
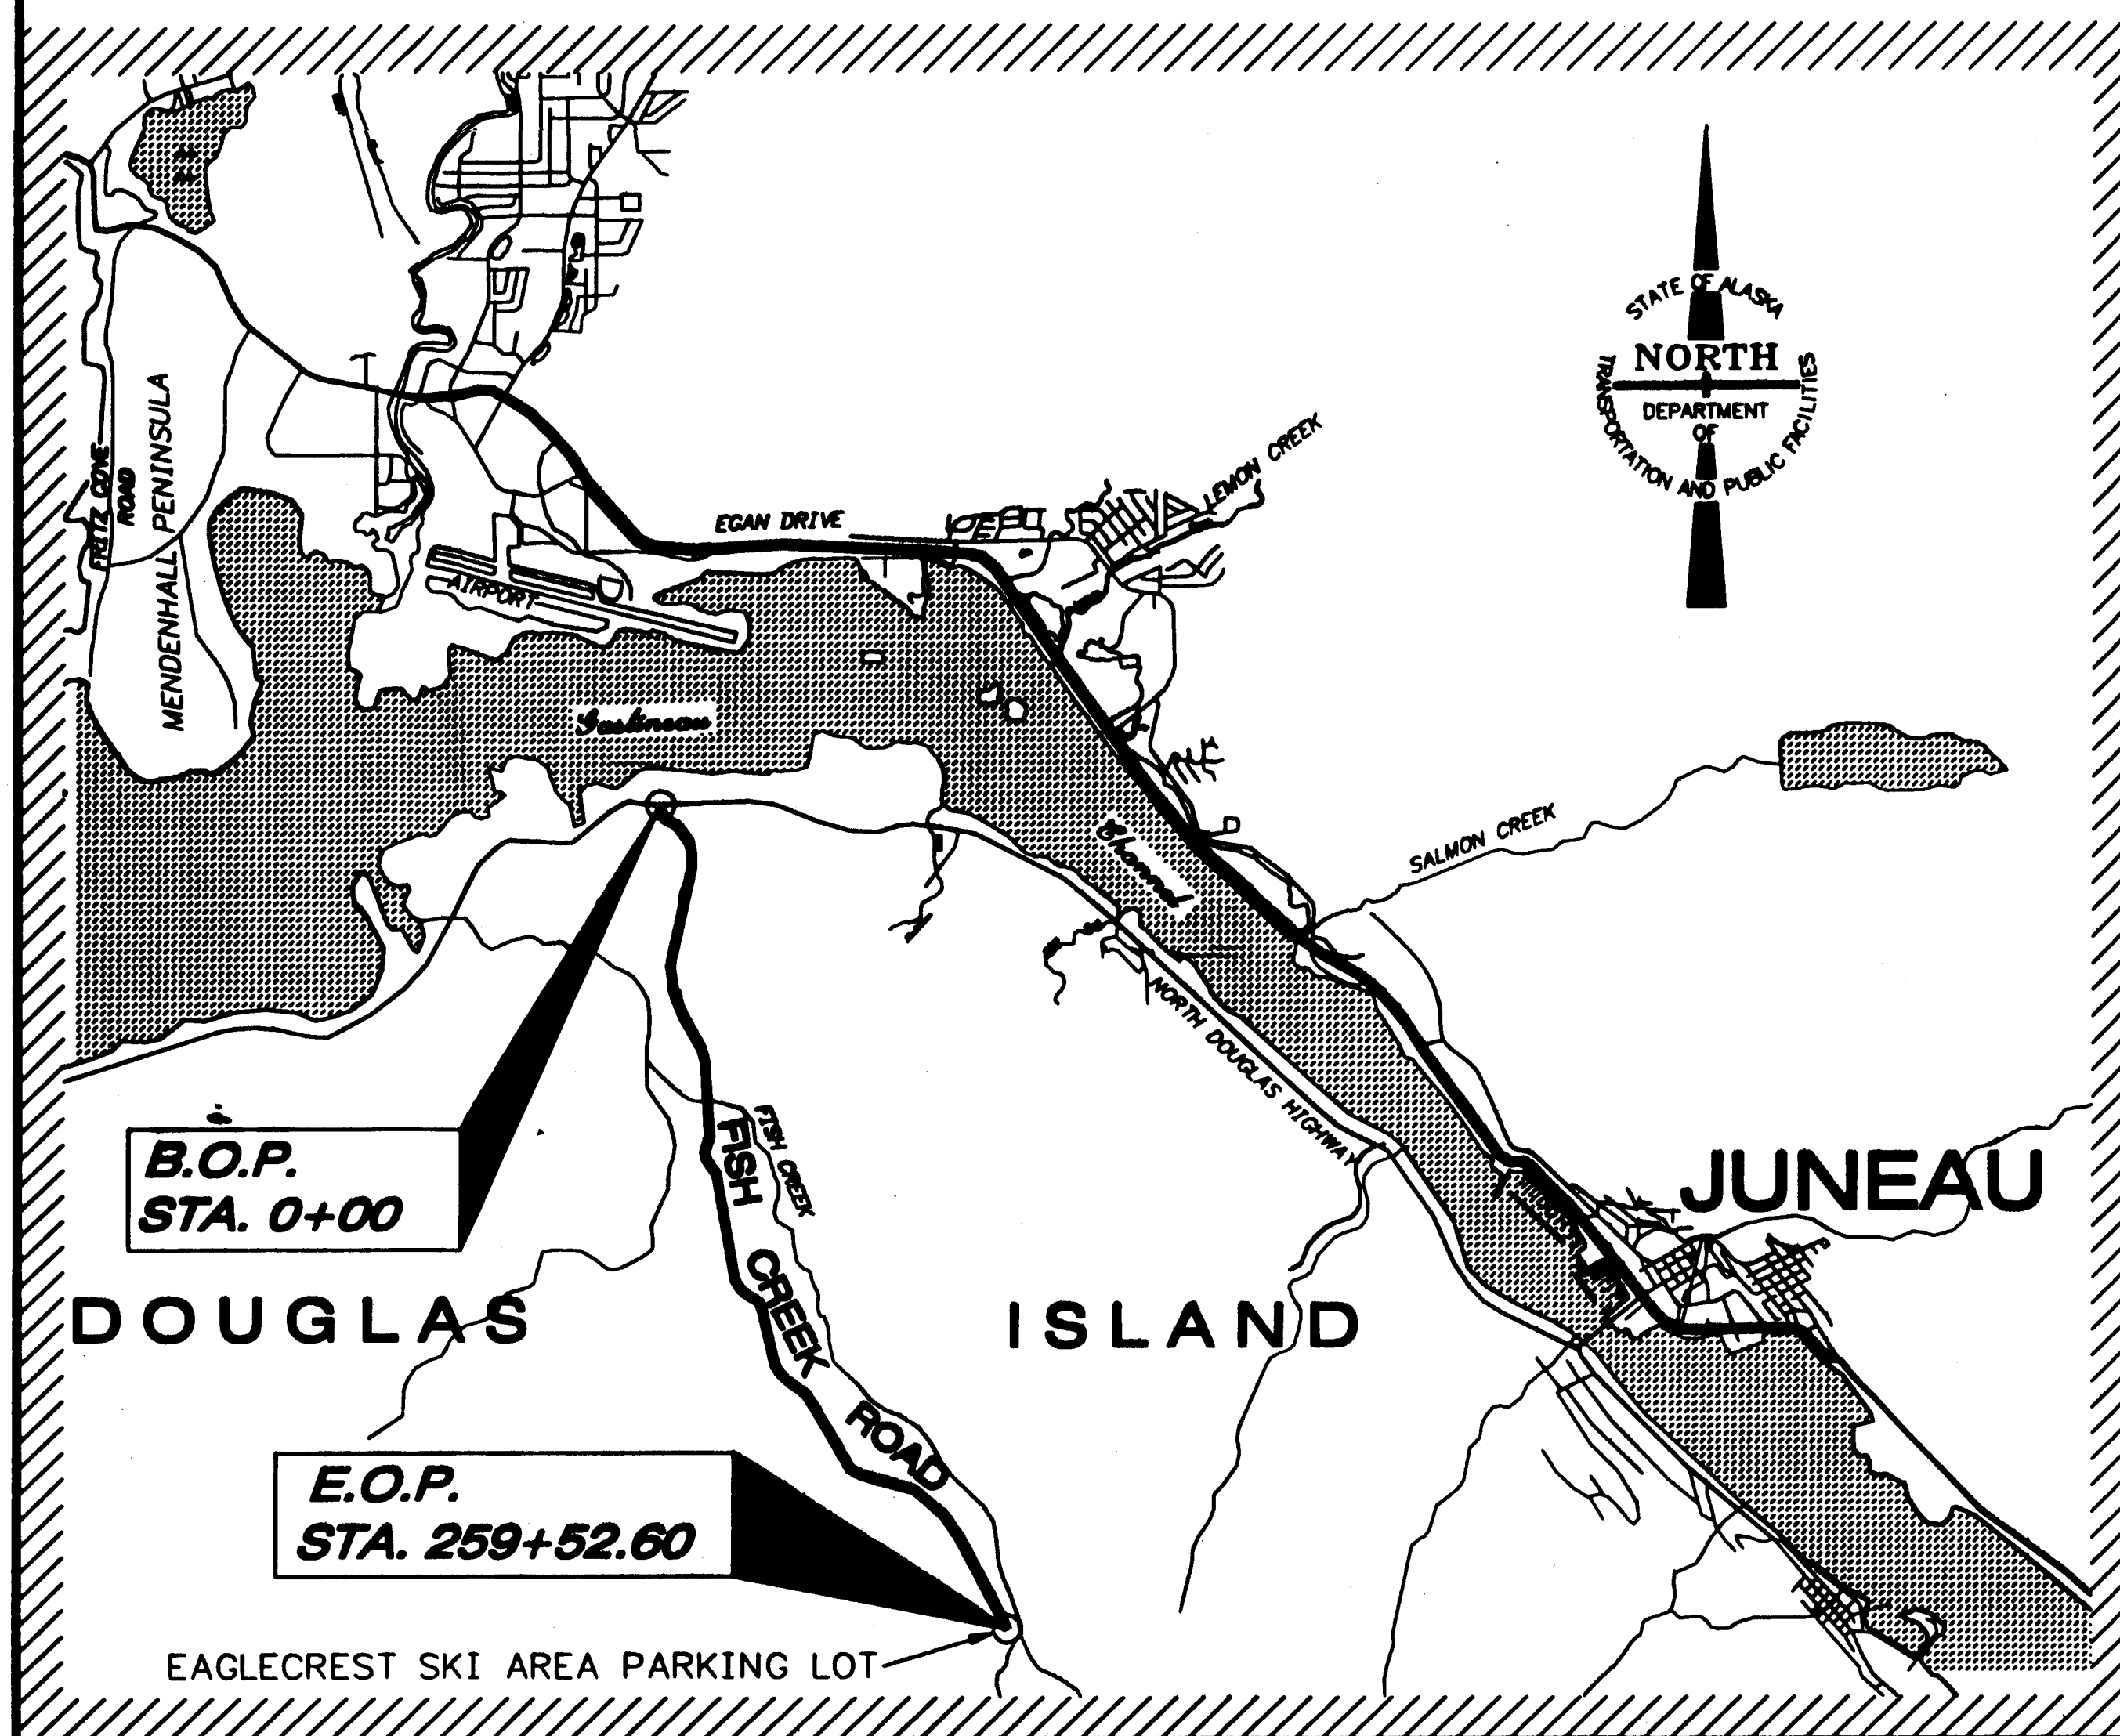


ACHRO-0953(4) - 68269

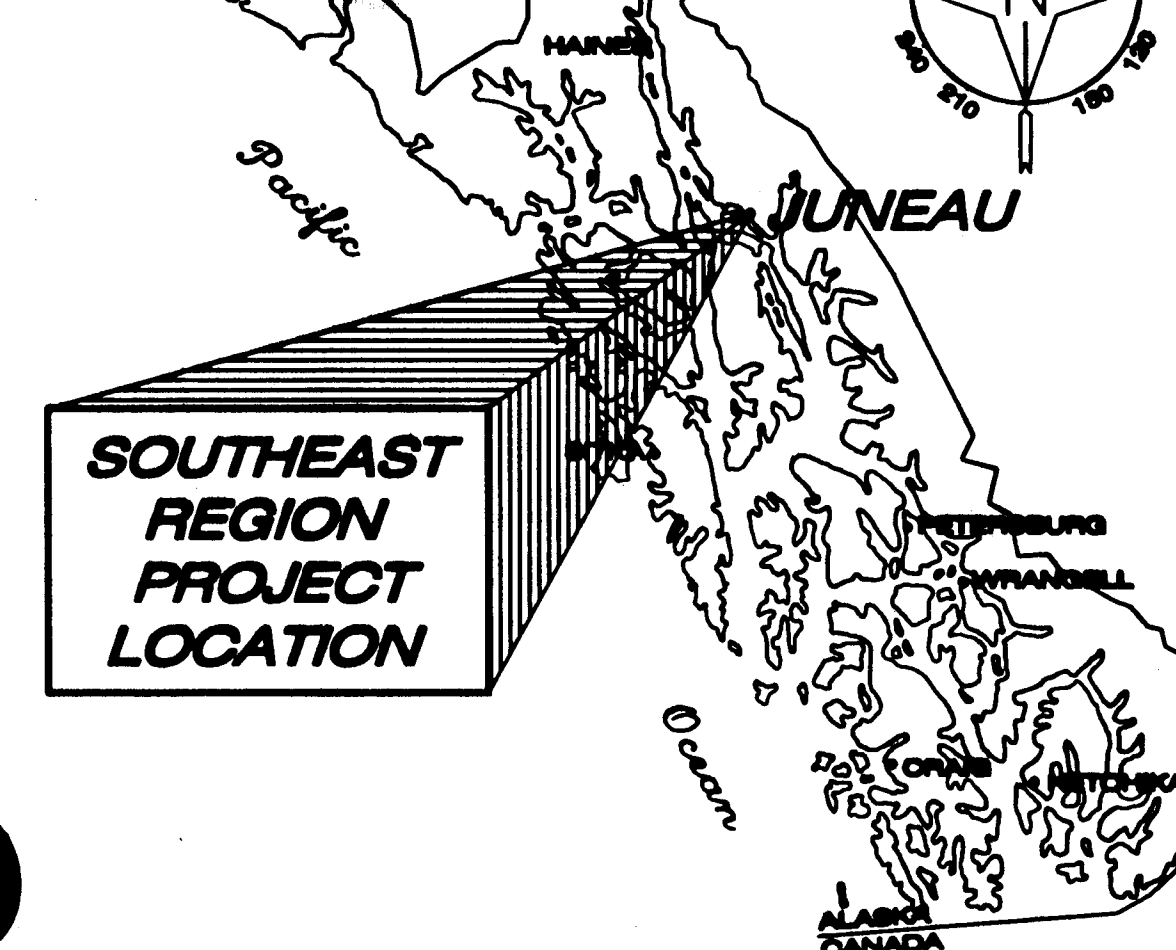


Proj. Engr Thad Hopper Date 7-22-03

G-00.01
G-04.06S
G-09.04S
G-10.01
G-20.00
G-29.03S

A1	TITLE SHEET
A2	CONTROL LAYOUT
A3	PROJECT LAYOUT PLAN
B1-B5	TYPICAL SECTIONS
C1	ESTIMATE OF QUANTITIES
C2	SUPERELEVATION TABLE
D1	CULVERT SUMMARY
E1-10	PLAN AND PROFILE
F1-F3	CULVERT INSTALLATION DETAILS
F4	GUARDRAIL PLAN VIEW
F5-F6	BRIDGE TRANSITION DETAILS
G1-G2	TRAFFIC CONTROL PLAN
H1-H2	EROSION AND SEDIMENT CONTROL
L1-L4	TRAFFIC LOOPS
M1-M5	NINEMILE CREEK FISH PASSAGE
M6	INTERPRETIVE SIGN SUPPORT

ROUTE: -	MILEPOINT: -
PATH: Q:\Jnu\68269\Planset\A_Tsht.dwg	
Tue, 15/Jan/02 02:12PM Kris	
PLOT: PSPACE OR MSPACE: 1000mm=1m(F)	TAB: TSHT

STATE OF ALASKA
DEPARTMENT OF TRANSPORTATION
& PUBLIC FACILITIES
STATEWIDE DESIGN & ENGINEERING SERVICES DIVISION

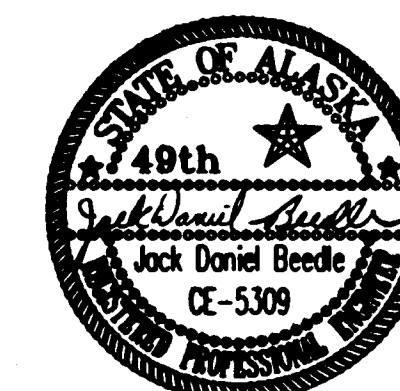

RECOMMENDED FOR APPROVAL:

PATRICK J. KEMP
REGIONAL PRE-CONSTRUCTION ENGINEER

APPROVED:


ROBERT DOLL
DIRECTOR, CONSTRUCTION & MAINTENANCE

CERTIFIED TRUE & CORRECT AS-BUILT OF ACTUAL FIELD CONDITION:

CONSTRUCTION PROJECT MANAGER

DATE _____

STATE	PROJECT DESIGNATION	YEAR	SHEET NO.	TOTAL SHEETS
ALASKA	ACHRO-0953(4)	2001	A1	41

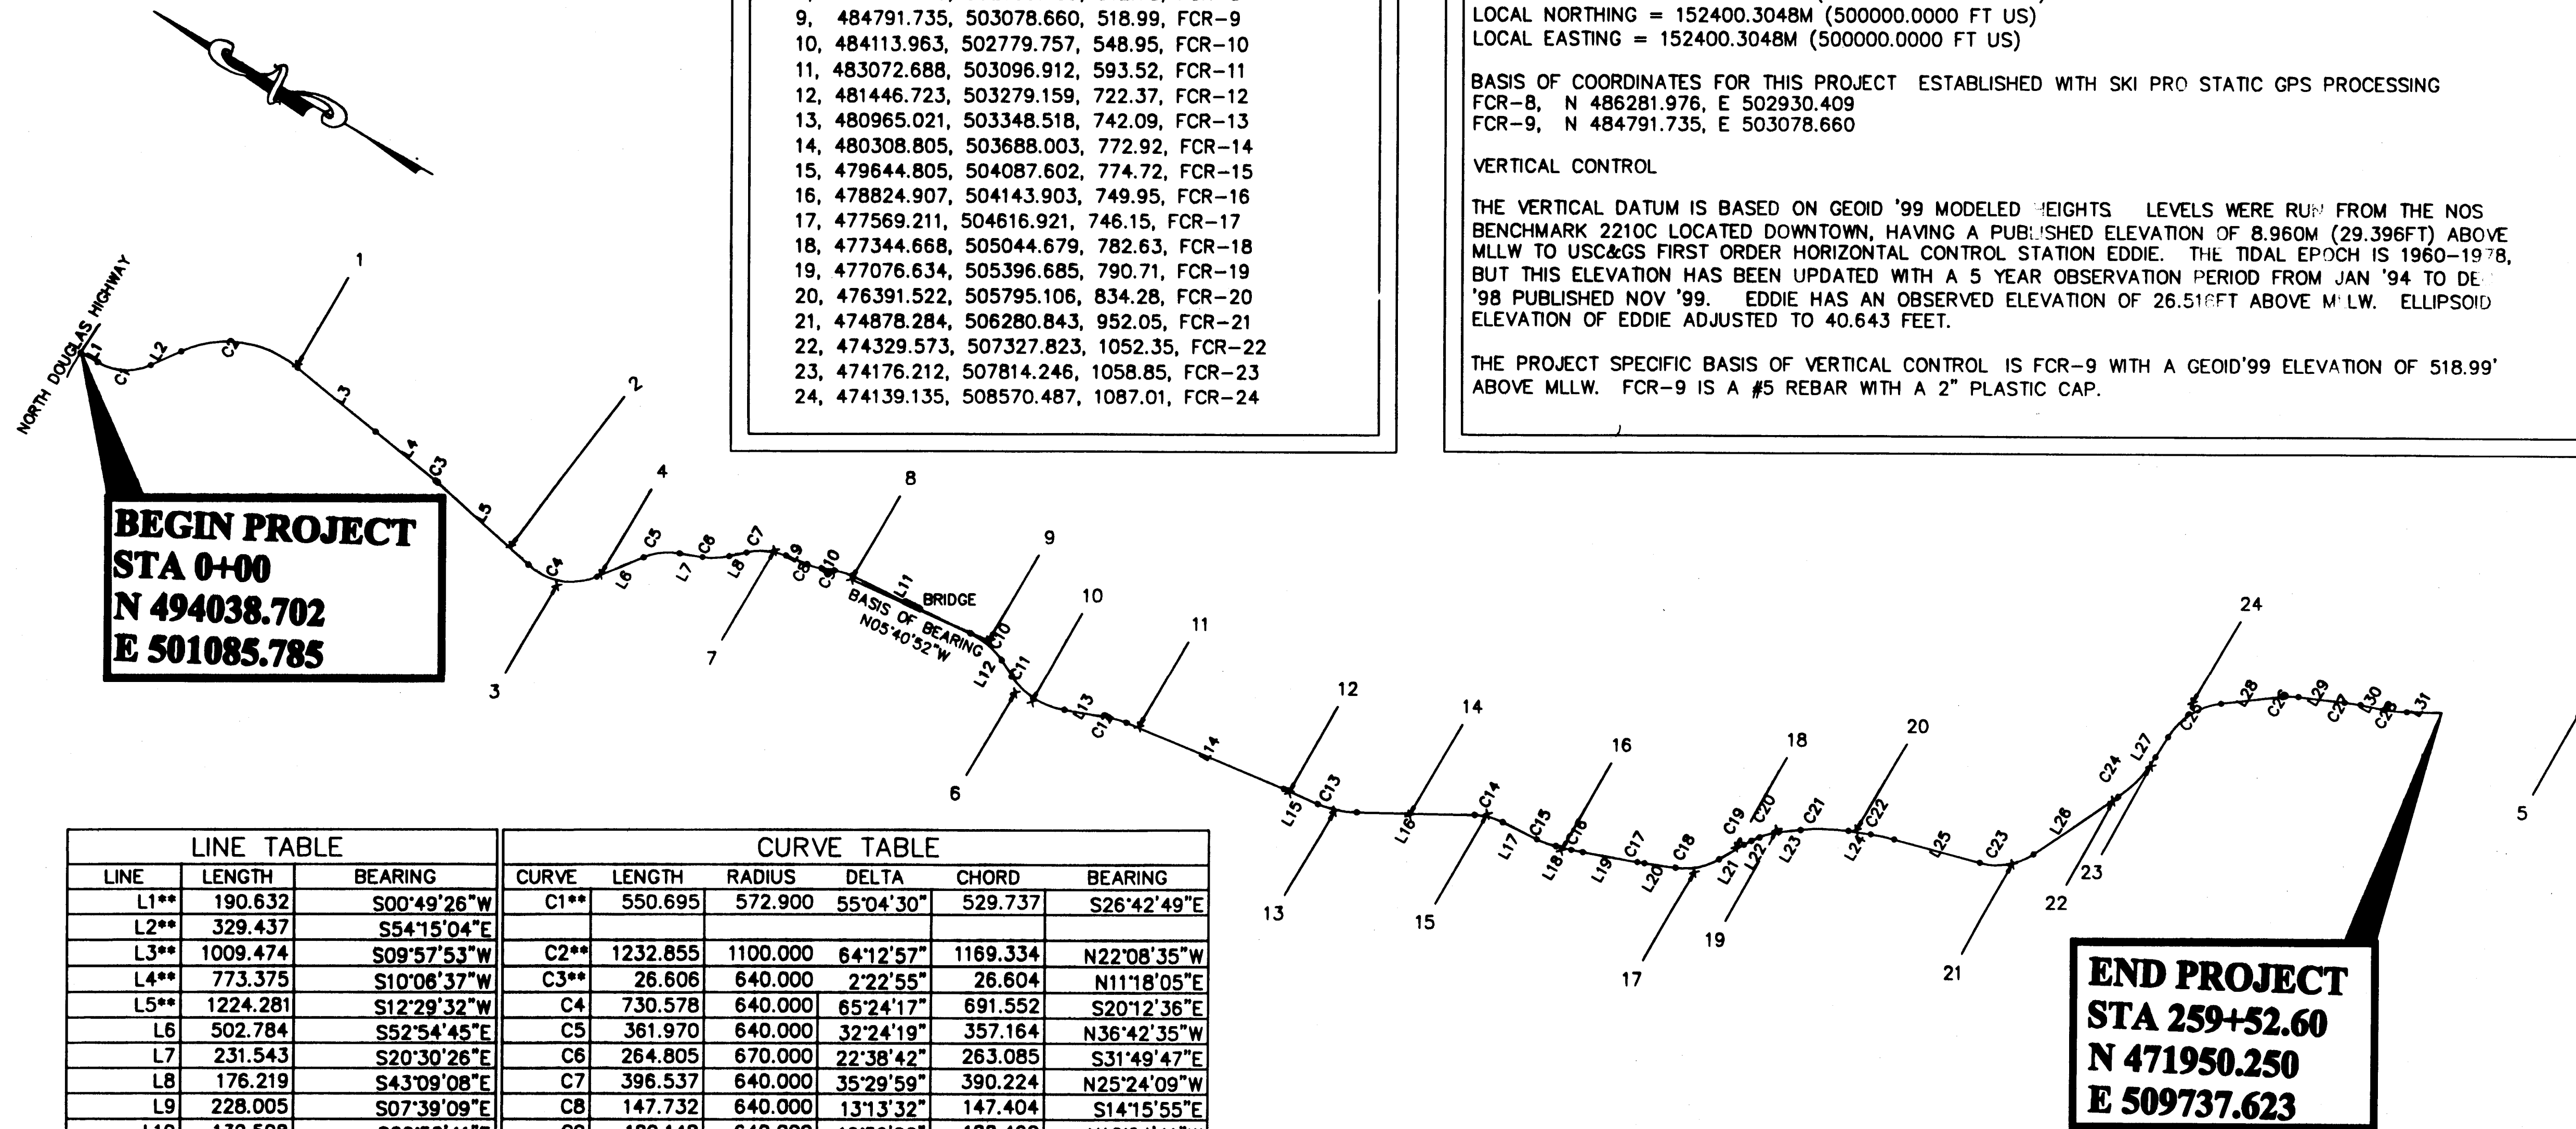

LINE TABLE			CURVE TABLE						
LINE	LENGTH	BEARING	CURVE	LENGTH	RADIUS	DELTA	CHORD	BEARING	
L1**	190.632	S00°49'26"W	C1**	550.695	572.900	55°04'30"	529.737	S26°42'49"E	
L2**	329.437	S54°15'04"E							
L3**	1009.474	S09°57'53"W	C2**	1232.855	1100.000	64°12'57"	1169.334	N22°08'35"W	
L4**	773.375	S10°08'37"W	C3**	26.606	640.000	2°22'55"	26.604	N11°18'05"E	
L5**	1224.281	S12°29'32"W	C4	730.578	640.000	65°24'17"	691.552	S20°12'36"E	
L6	502.784	S52°54'45"E	C5	361.970	640.000	32°24'19"	357.164	N36°42'35"W	
L7	231.543	S20°30'26"E	C6	264.805	670.000	22°38'42"	263.085	S31°49'47"E	
L8	176.219	S43°09'08"E	C7	396.537	640.000	35°29'59"	390.224	N25°24'09"W	
L9	228.005	S07°39'09"E	C8	147.732	640.000	13°13'32"	147.404	S14°15'55"E	
L10	132.508	S20°52'41"E	C9	189.148	640.000	16°56'00"	188.460	N12°24'41"W	
L11	1304.696	S03°56'41"E	C10	409.856	800.000	29°21'13"	405.388	N10°43'56"E	
L12	186.294	S25°24'32"W	C11	639.575	800.000	45°48'22"	622.678	S02°30'21"W	
L13	444.227	S20°23'50"E	C12	183.540	800.000	13°08'42"	183.138	N13°49'29"W	
L14**	1704.046	S07°15'08"E							
L15**	367.774	S06°36'29"E	C13**	392.353	1000.000	22°28'49"	389.841	S17°50'54"E	
L16**	1171.322	S29°05'18"E	C14	290.573	640.000	26°00'48"	288.083	N16°04'54"W	
L17	384.806	S03°04'30"E	C15	201.292	800.000	14°24'59"	200.761	S10°16'59"E	
L18	155.820	S17°29'29"E	C16	118.125	2864.790	2°21'45"	118.117	S18°40'22"E	
L19**	550.516	S19°51'14"E	C17**	71.412	2864.790	1°25'42"	71.410	S20°34'05"E	
L20**	313.944	S21°16'56"E	C18	447.721	640.000	40°04'55"	438.647	S41°19'23"E	
L21	285.585	S61°21'51"E	C19	84.223	640.000	7°32'24"	84.162	N57°35'39"W	
L22	88.609	S53°49'27"E	C20	196.923	640.000	17°37'46"	196.147	N45°00'34"W	
L23	220.640	S36°11'41"E	C21	478.616	1909.860	14°21'30"	477.364	N29°00'56"W	
L24	219.21	S21°50'10"E	C22	184.11	1900.000	5°33'07"	184.04	N19°03'37"W	
L25	1034.35	S16°17'04"E	C23	516.13	600.000	49°17'14"	500.37	S40°55'41"E	
L26	995.34	S65°34'18"E	C24	520.44	1300.000	22°56'15"	516.97	S77°02'25"E	
L27	236.57	S88°30'33"E	C25	647.173	716.200	51°46'25"	625.378	N62°37'21"W	
L28**	611.908	S36°44'08"E	C26**	161.229	700.000	13°11'48"	160.873	N30°08'14"W	
L29**	459.201	S23°32'20"E	C27**	161.351	1909.860	4°50'26"	161.303	N21°07'07"W	
L30**	237.839	S18°41'54"E	C28**	227.579	1200.000	10°51'58"	227.238	S24°07'53"E	
L31**	348.503	S29°33'52"E							

** APPROXIMATE ONLY, MATCH EXISTING ROADWAY CENTERLINE.

PROJECT CONTROL

PT NORTHING EASTING ELEV DESC

1, 492113.401, 502047.380, 153.58, FCR-1
2, 489370.703, 501522.729, 197.72, FCR-2
3, 488770.294, 501412.349, 248.78, FCR-3
4, 488452.696, 501729.970, 287.40, FCR-4
5, 470765.659, 510471.988, 1130.55, FCR-5
6, 484299.271, 502773.947, 541.20, FCR-6
7, 487084.877, 502800.028, 452.90, FCR-7
8, 486281.976, 502930.409, 512.78, FCR-8
9, 484791.735, 503078.660, 518.99, FCR-9
10, 484113.963, 502779.757, 548.95, FCR-10
11, 483072.688, 503096.912, 593.52, FCR-11
12, 481446.723, 503279.159, 722.37, FCR-12
13, 480965.021, 503348.518, 742.09, FCR-13
14, 480308.805, 503688.003, 772.92, FCR-14
15, 479644.805, 504087.602, 774.72, FCR-15
16, 478824.907, 504143.903, 749.95, FCR-16
17, 477569.211, 504616.921, 746.15, FCR-17
18, 477344.668, 505044.679, 782.63, FCR-18
19, 477076.634, 505396.685, 790.71, FCR-19
20, 476391.522, 505795.106, 834.28, FCR-20
21, 474878.284, 506280.843, 952.05, FCR-21
22, 474329.573, 507327.823, 1052.35, FCR-22
23, 474176.212, 507814.246, 1058.85, FCR-23
24, 474139.135, 508570.487, 1087.01, FCR-24

HORIZONTAL CONTROL

HORIZONTAL CONTROL FOR THIS PROJECT IS BASED ON THE DOT/PF 2000 JUNEAU GRID

THE DOT/PF 2000 JUNEAU GRID SYSTEM IS A LOCAL GROUND COORDINATE SYSTEM BASED AT USC&GS FIRST ORDER CONTROL STATION EDDIE (1992/2000GPS). IT RELATES TO AKSPC ZONE 1 NAD83 THROUGH THE FOLLOWING PARAMETERS:

ZONE = NAD83 AKSPC ZONE 1

GRID SCALE = 0.999928875

CONVERGENCE = -0°45'27.26"

TRANSLATION ABOUT USC&GS POINT EDDIE AS FOLLOWS:

AKSPC NORTHING = 726482.8570M (2383469.17310 FT US)

AKSPC EASTING = 765832.8870M (2512570.06318 FT US)

LOCAL NORTHING = 152400.3048M (500000.0000 FT US)

LOCAL EASTING = 152400.3048M (500000.0000 FT US)

BASIS OF COORDINATES FOR THIS PROJECT ESTABLISHED WITH SKI PRO STATIC GPS PROCESSING

FCR-8, N 486281.976, E 502930.409


FCR-9, N 484791.735, E 503078.660

VERTICAL CONTROL

THE VERTICAL DATUM IS BASED ON GEOID '99 MODELED HEIGHTS. LEVELS WERE RUN FROM THE NOS BENCHMARK 2210C LOCATED DOWNTOWN, HAVING A PUBLISHED ELEVATION OF 8.960M (29.396FT) ABOVE MLLW TO USC&GS FIRST ORDER HORIZONTAL CONTROL STATION EDDIE. THE TIDAL EPOCH IS 1960-1978, BUT THIS ELEVATION HAS BEEN UPDATED WITH A 5 YEAR OBSERVATION PERIOD FROM JAN '94 TO DEC '98 PUBLISHED NOV '99. EDDIE HAS AN OBSERVED ELEVATION OF 26.516FT ABOVE M.L.W. ELLIPSOID ELEVATION OF EDDIE ADJUSTED TO 40.643 FEET.

THE PROJECT SPECIFIC BASIS OF VERTICAL CONTROL IS FCR-9 WITH A GEOID'99 ELEVATION OF 518.99' ABOVE MLLW. FCR-9 IS A #5 REBAR WITH A 2" PLASTIC CAP.

GRAPHIC SCALE

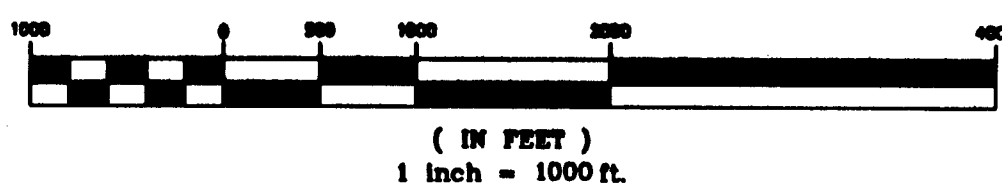

REALIGNMENT WORK

STATION	NORTHING	EASTING
51+50.00	489,305.26	501,489.33
87+86.95	486,197.96	502,970.54
99+15.00	485,072.76	503,048.13
120+00.00	483,069.66	503,086.93
154+92.63	479,759.77	504,011.57
166+65.00	478,620.87	504,241.38
174+25.00	477,907.67	504,503.83
239+15.00	473,751.30	508,809.54

PATH:
Q:\Jnu\68269\Planset\A2.dwg
Wed, 16/Jan/02 10:14AM Kris
PLOT:
PSPACE 1=1(F) OR MSPACE 1=1(F)
TAB: ESTIMATE

ADDENDUM NUMBER

ATTACHMENT NUMBER


RECORD OF REVISIONS

No.	DATE	DESCRIPTION

JNU-FISH CREEK ROAD
SAFETY IMPROVEMENTS
PROJECT NO. 68269

Control Layout

DESIGNED BY: G. McLean

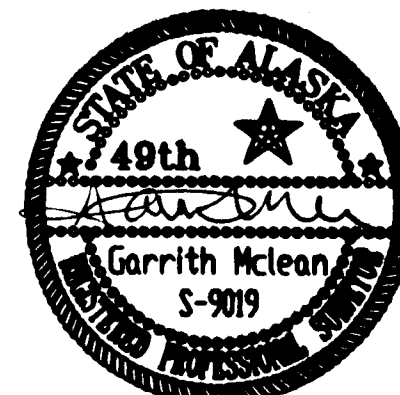

CHECKED BY: T. MOORE

DRAWN BY: G. McLean

STATE OF ALASKA
DEPARTMENT OF TRANSPORTATION
& PUBLIC FACILITIES
STATEWIDE DESIGN & ENGINEERING
SERVICES DIVISION


JNU-FISH CREEK ROAD
SAFETY IMPROVEMENTS
PROJECT NO. 68269

Control Layout

PROJECT DESIGNATION NUMBER

ACHRO-0953(4)

STATE	YEAR
ALASKA	2001
SHEET NUMBER	TOTAL SHEETS
A2	41

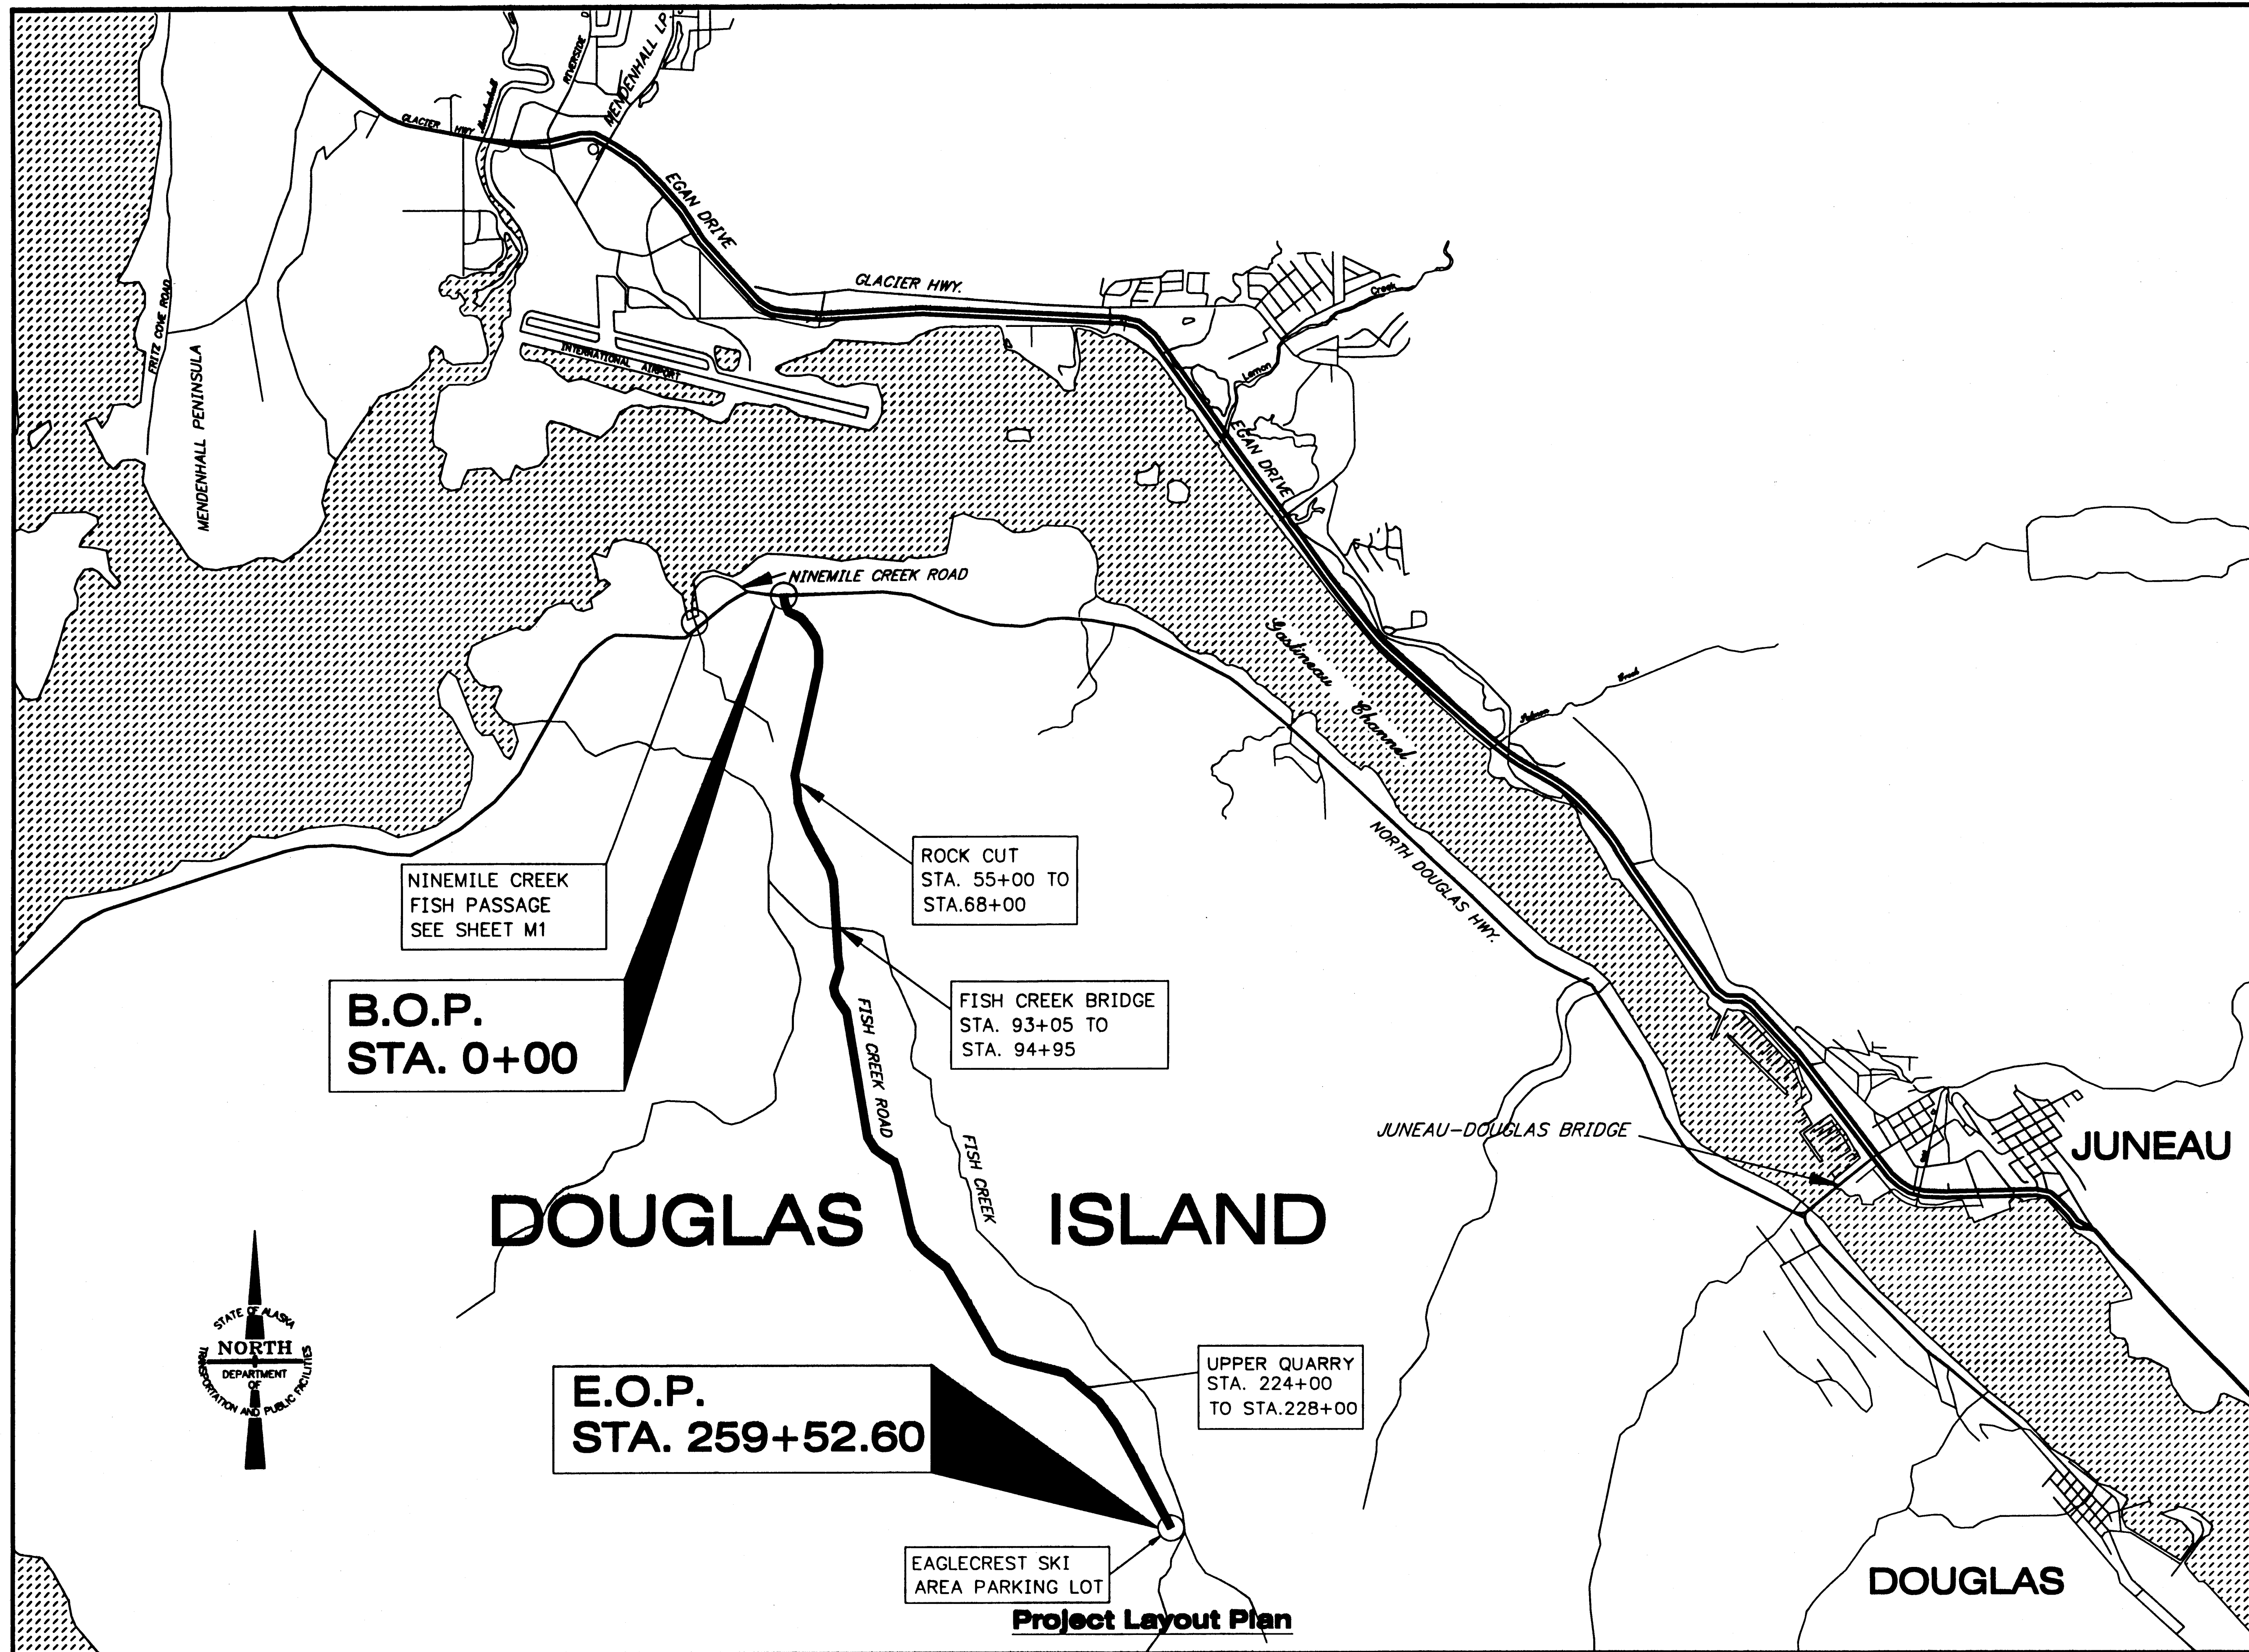

PATH:
Q:\jnu\68269\Planset\A_Layout.dwg
Wed, 09/Jan/02 09:51AM Kris
PLOT:
PSPACE 1=1(F) OR MSPACE 1=1(F)
TAB: PLAN

ADDENDUM NUMBER

ATTACHMENT NUMBER

RECORD OF REVISIONS

No.	DATE	DESCRIPTION

JNU-FISH CREEK ROAD
SAFETY IMPROVEMENTS
PROJECT NO. 68269

7/22/03

DESIGNED BY: M. LAVERING

1/6/02

CHECKED BY: T. MOORE
DRAWN BY: K.K.

STATE OF ALASKA
DEPARTMENT OF TRANSPORTATION
& PUBLIC FACILITIES
STATEWIDE DESIGN & ENGINEERING
SERVICES DIVISION

JNU-FISH CREEK ROAD
SAFETY IMPROVEMENTS
PROJECT NO. 68269

**Project Layout
Plan**

PROJECT DESIGNATION NUMBER

ACHRO-0953(4)

STATE	YEAR
ALASKA	2001

SHEET NUMBER	TOTAL SHEETS
A3	41

Project Layout Plan

Project Layout Plan


ADDENDUM NUMBER		
ATTACHMENT NUMBER		
Tue, 15/Jan/02 02:23PM		
RECORD OF REVISIONS		
No.	DATE	DESCRIPTION

JNU-FISH CREEK ROAD
SAFETY IMPROVEMENTS
PROJECT NO. 68269

Typical Sections

TH 7-22-03

DESIGNED BY: M. LAVERING

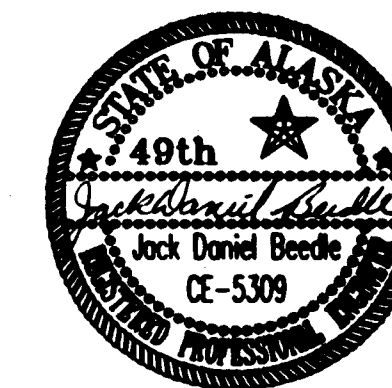

CHECKED BY: T. MOORE

DRAWN BY: R. SNYDER


STATE OF ALASKA
DEPARTMENT OF TRANSPORTATION
& PUBLIC FACILITIES
STATEWIDE DESIGN & ENGINEERING
SERVICES DIVISION
**JNU-FISH CREEK ROAD
SAFETY IMPROVEMENTS
PROJECT NO. 68269**

Typical
Sections

PROJECT DESIGNATION NUMBER


ACHRO-0953(4)

STATE	YEAR
ALASKA	2001
SHEET NUMBER	TOTAL SHEETS
B1	41

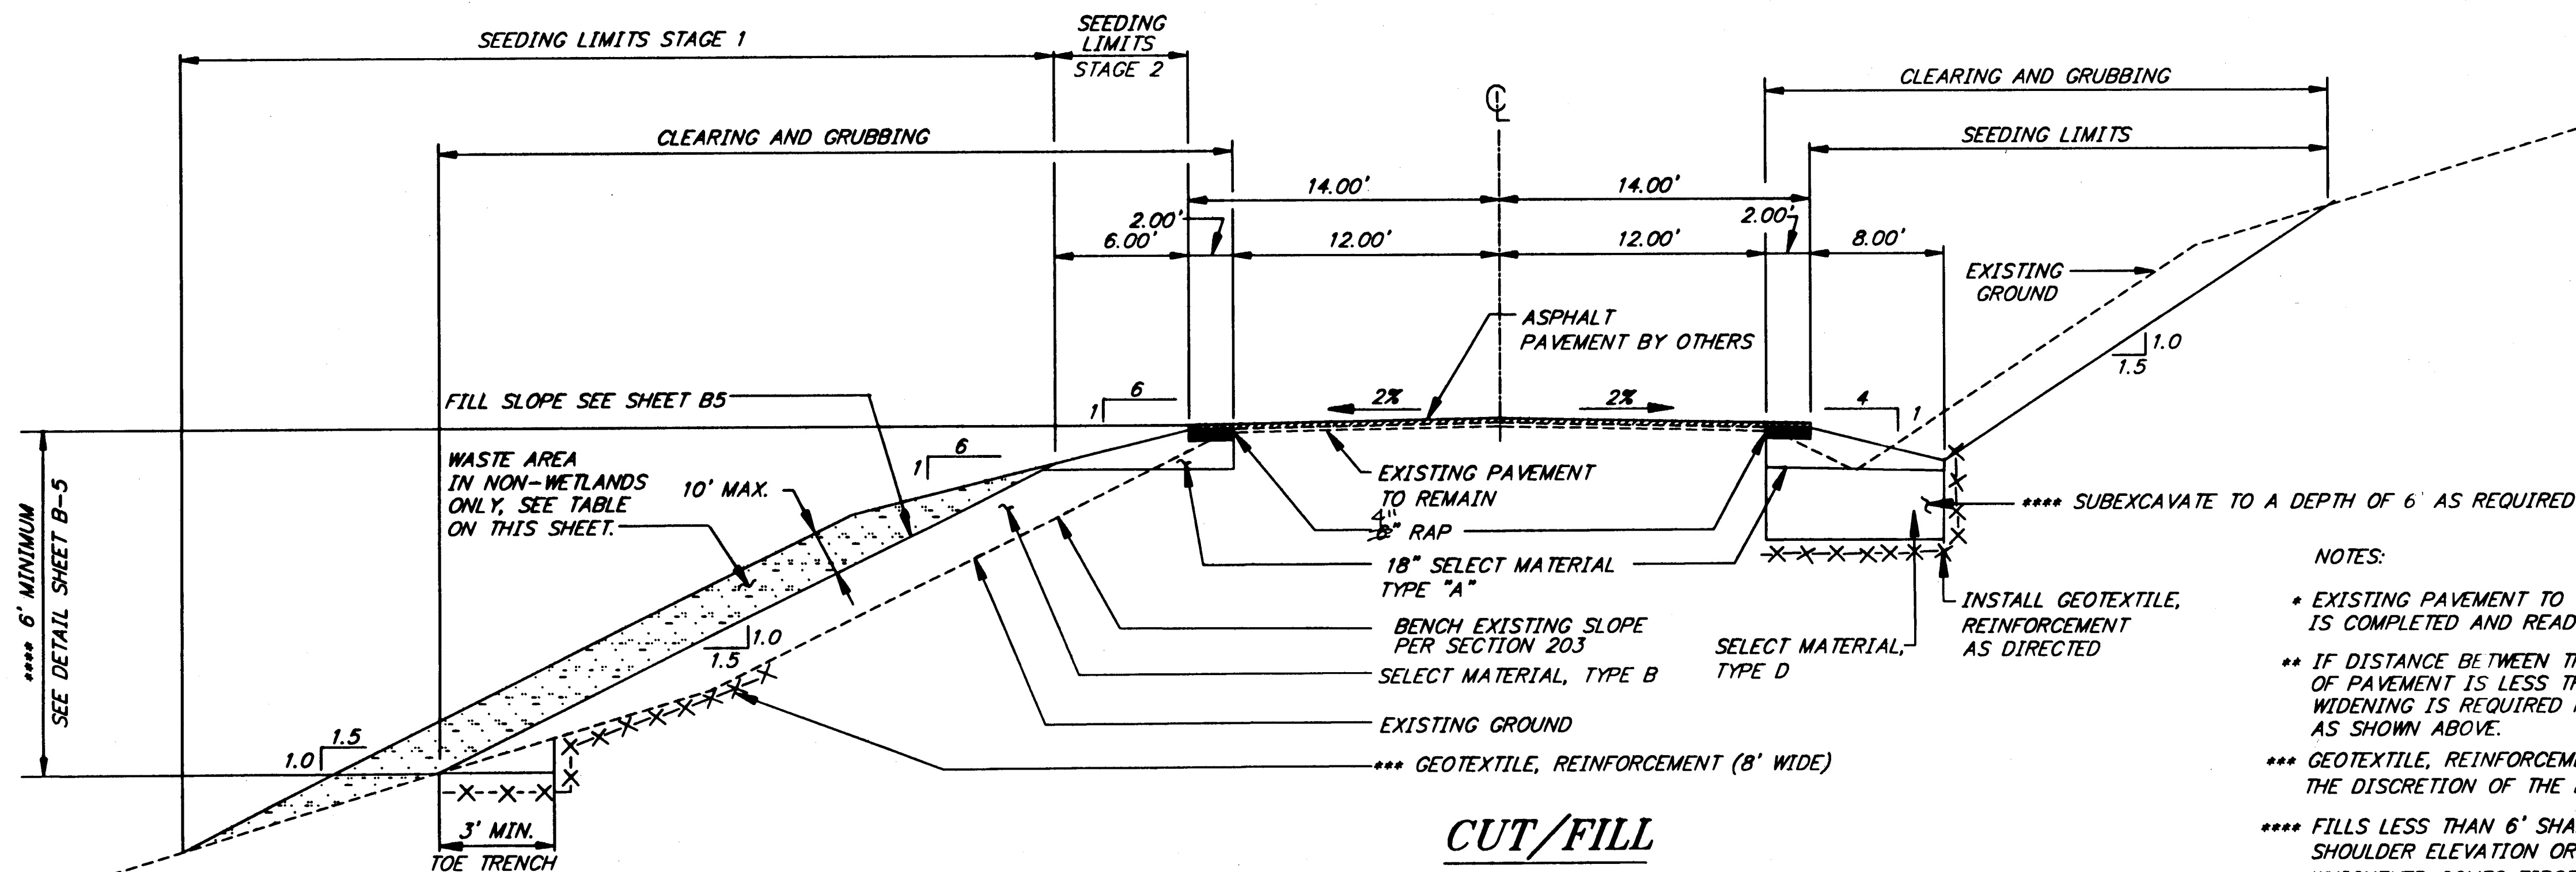

CUT/FILL TYPICAL SECTION

NOTE: PRIOR TO STAKING, SEE SPECIAL PROVISION 642-3.01

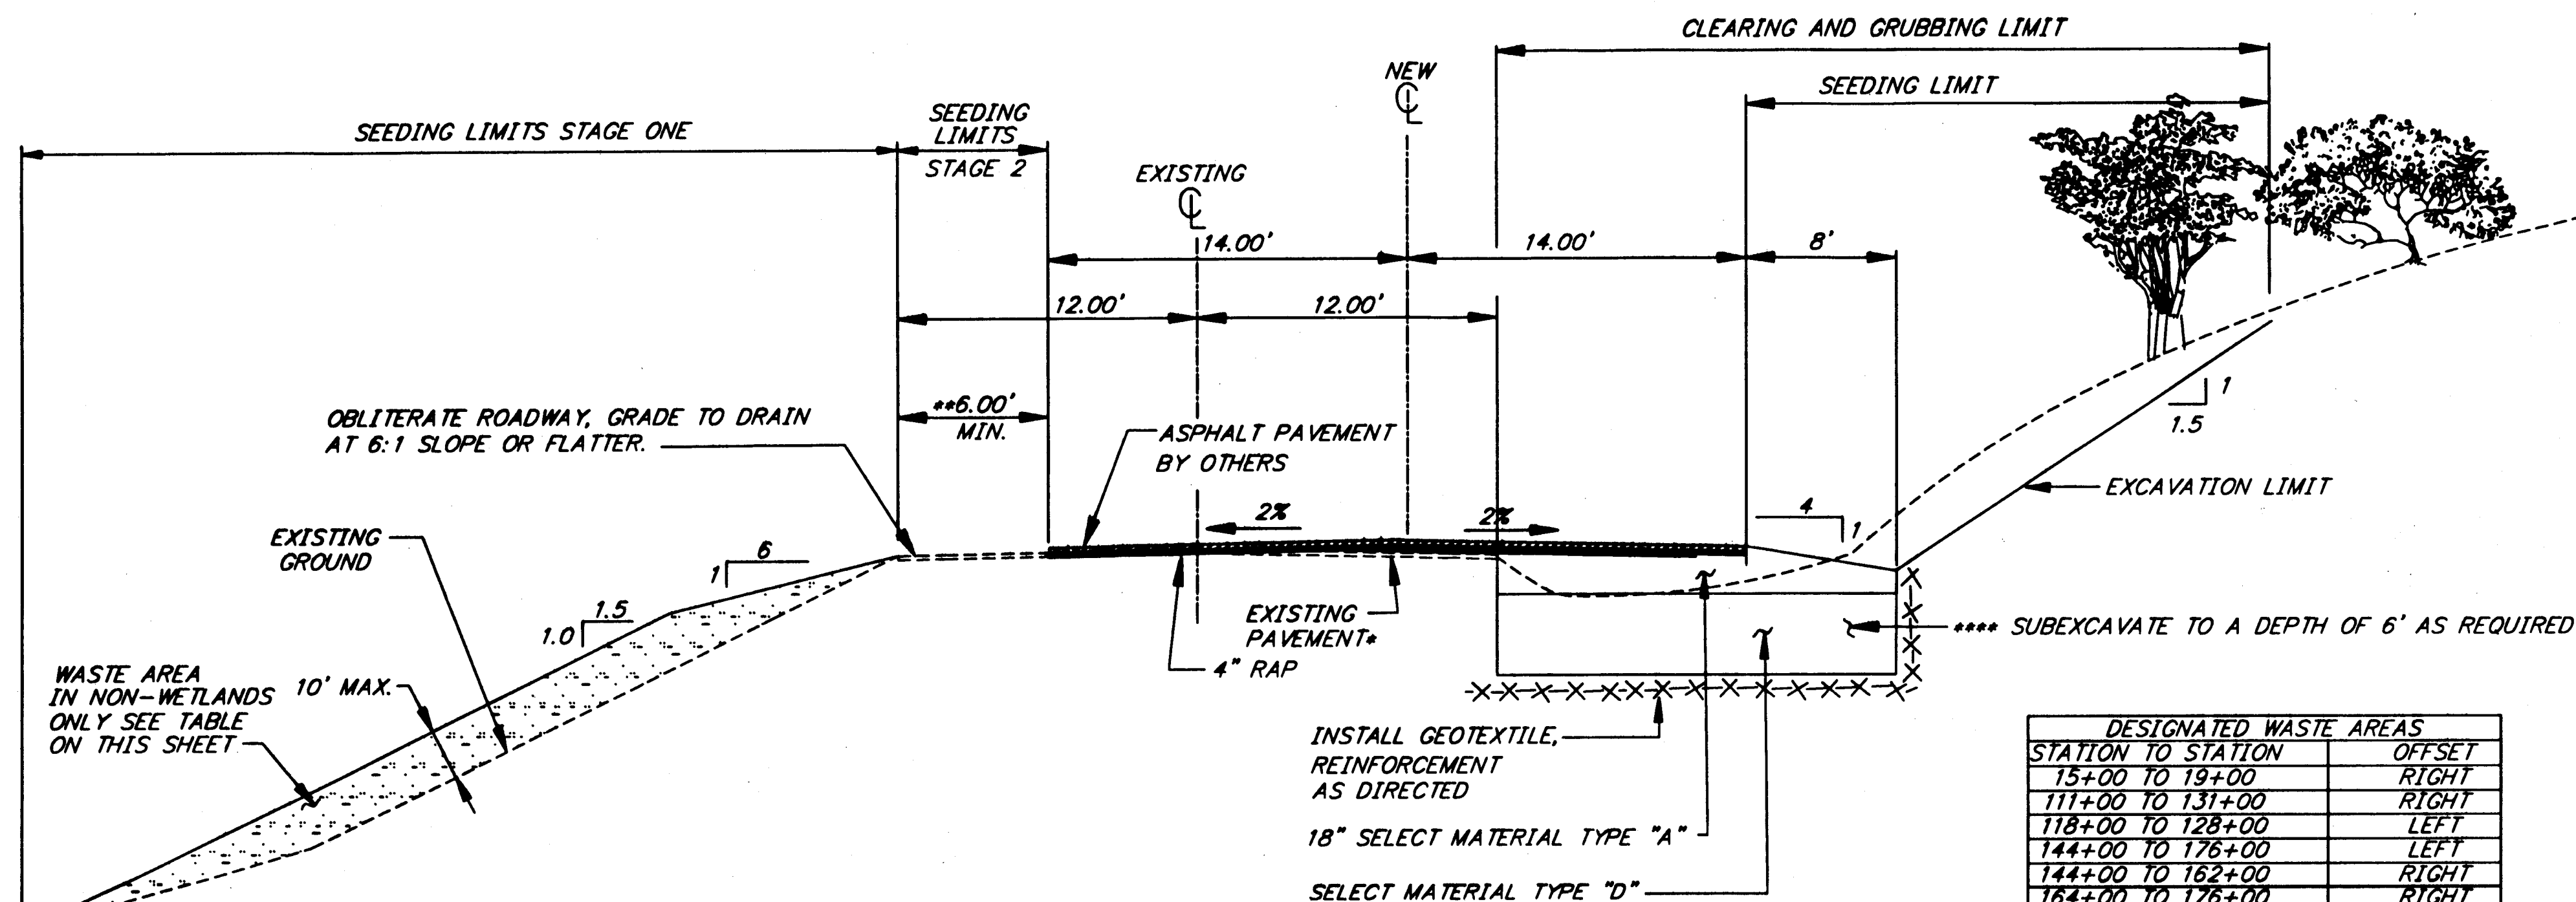



TYPICAL SECTION REALIGNMENT SECTION

NOTE: PRIOR TO STAKING, SEE SPECIAL PROVISION 642-3.01

DESIGNATED WASTE AREAS	
STATION TO STATION	OFFSET
15+00 TO 19+00	RIGHT
111+00 TO 131+00	RIGHT
118+00 TO 128+00	LEFT
144+00 TO 176+00	LEFT
144+00 TO 162+00	RIGHT
164+00 TO 176+00	RIGHT
183+00 TO 198+00	RIGHT
183+00 TO 230+00	LEFT

NOTES:

1. WASTE MATERIAL SHALL BE USED TO PROVIDE CURVE WIDENING, SEE SHEET B5.
2. ANY REMAINING WASTE MATERIAL SHALL BE DEPOSITED ADJACENT TO FILL SLOPES IN DESIGNATED AREAS SHOWN IN THE TABLE ABOVE.
3. PLACE NO WASTE WITHIN 25 FEET OF CULVERT PIPE ENDS.
4. WASTE AREAS CONSTRUCTED PRIOR TO MAY 1, 2002 SHALL BE SEEDDED BEFORE MAY 15, 2002. CUT AND FILL AND WASTE AREA CONSTRUCTED AFTER MAY 1, 2002 SHALL BE SEEDDED WITHIN 15-DAYS OF COMPLETION.

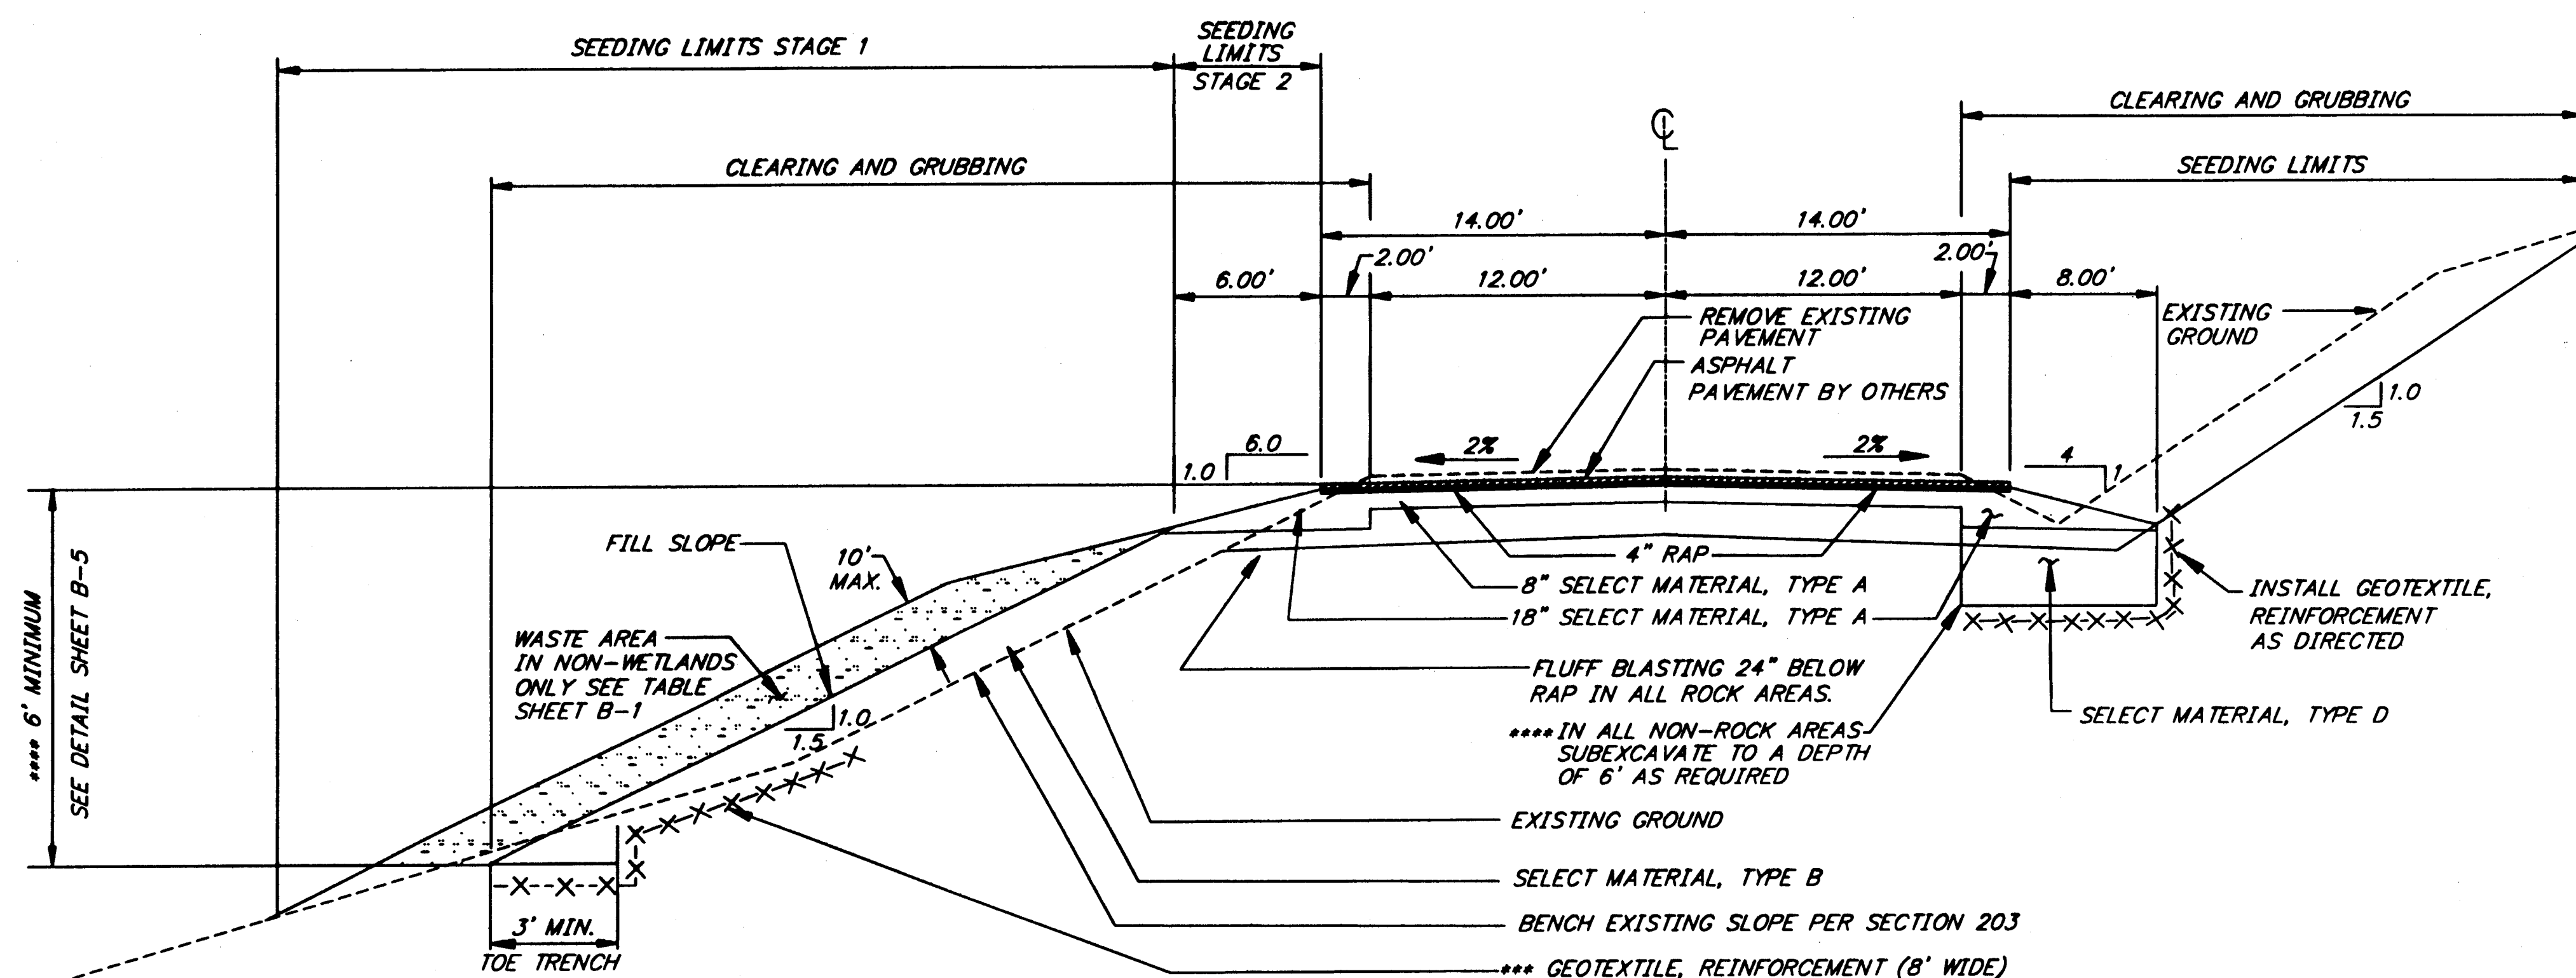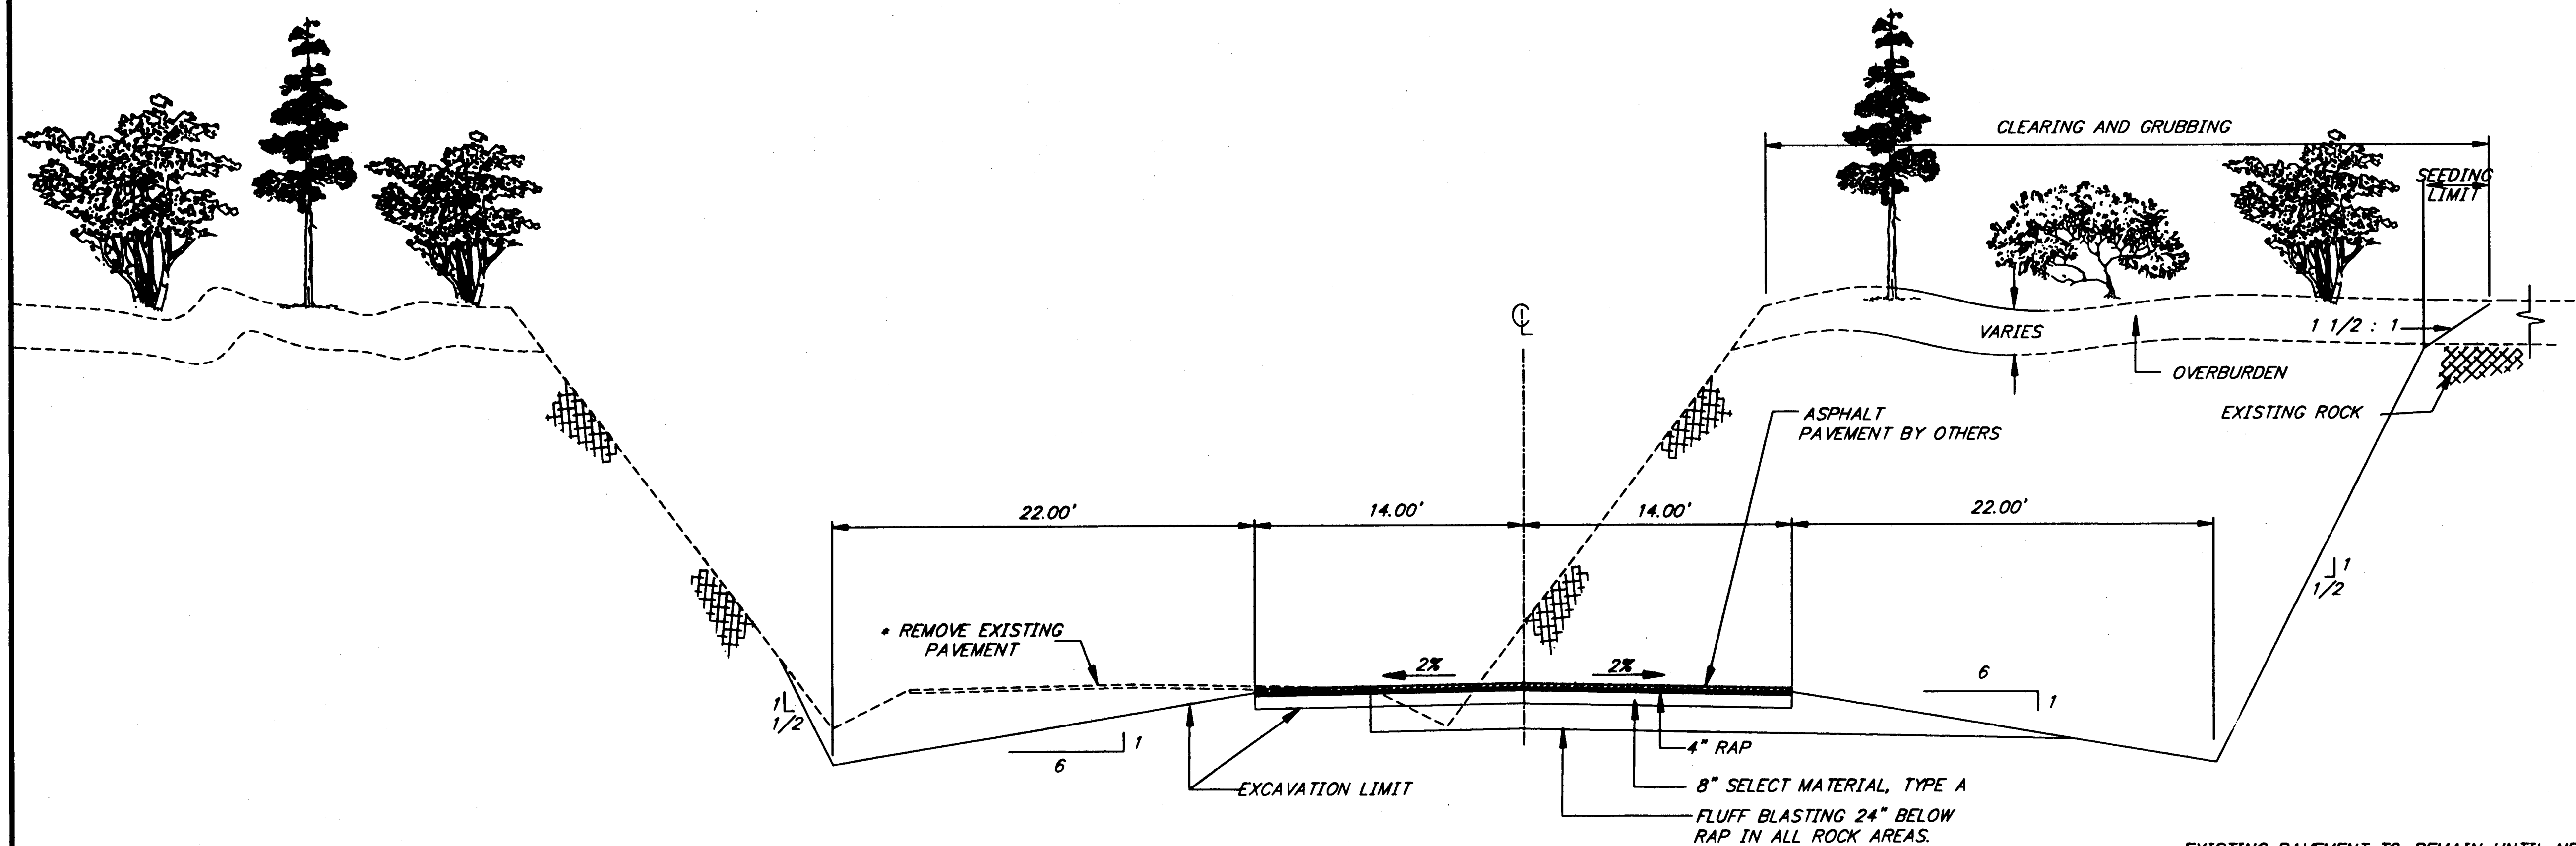

PATH:
Q:\Jnu\68269\Planset\B_Typsec.dwg
Tue, 15/Jan/02 02:24PM Kris
PLOT:
PSPACE 1=1(F) OR MSPACE 1=1(F)
TAB: SAFETY TYP

ADDENDUM NUMBER

ATTACHMENT NUMBER

Tue, 15/Jan/02 02:24PM

RECORD OF REVISIONS


No.	DATE	DESCRIPTION

**JNU-FISH CREEK ROAD
SAFETY IMPROVEMENTS
PROJECT NO. 68269**

Typical Sections

7-22-03 TH

DESIGNED BY: M. LAVERING

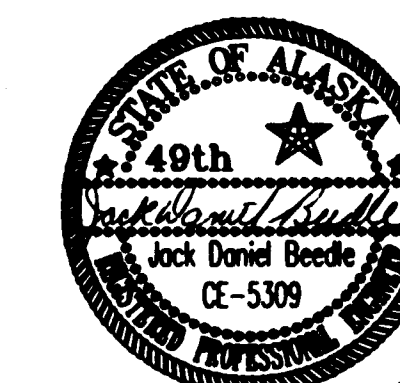

CHECKED BY: T. MOORE

DRAWN BY: R. SNYDER

STATE OF ALASKA
DEPARTMENT OF TRANSPORTATION
& PUBLIC FACILITIES
STATEWIDE DESIGN & ENGINEERING
SERVICES DIVISION

**JNU-FISH CREEK ROAD
SAFETY IMPROVEMENTS
PROJECT NO. 68269**

Typical Sections

PROJECT DESIGNATION NUMBER

ACHRO-0953(4)

STATE	YEAR
-------	------

STATE	YEAR
ALASKA	2001

SHEET NUMBER	TOTAL SHEET
--------------	-------------

B2	41
----	----

PATH:
Q:\Jnu\68269\Planset\B_Typsec.dwg
Tue, 15/Jan/02 02:24PM Kris
PLOT:
PSPACE 1=1(F) OR MSPACE 1=1(F)
TAB: SAFETY TYP

ADDENDUM NUMBER

ATTACHMENT NUMBER

Tue, 15/Jan/02 02:24PM

RECORD OF REVISIONS


No.	DATE	DESCRIPTION

JNU-FISH CREEK ROAD
SAFETY IMPROVEMENTS
PROJECT NO. 68269

Typical Sections

TX 7-22-03

DESIGNED BY: M. LAVERING

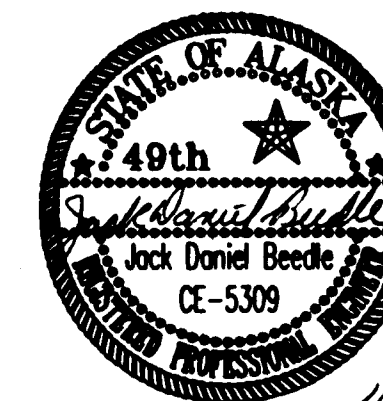

CHECKED BY: T. MOORE

DRAWN BY: R. SNYDER

STATE OF ALASKA
DEPARTMENT OF TRANSPORTATION
& PUBLIC FACILITIES
STATEWIDE DESIGN & ENGINEERING
SERVICES DIVISION

JNU-FISH CREEK ROAD
SAFETY IMPROVEMENTS
PROJECT NO. 68269

Typical
Sections

PROJECT DESIGNATION NUMBER


ACHRO-0953(4)

STATE YEAR

ALASKA 2001

SHEET NUMBER TOTAL SHEETS

B3 41

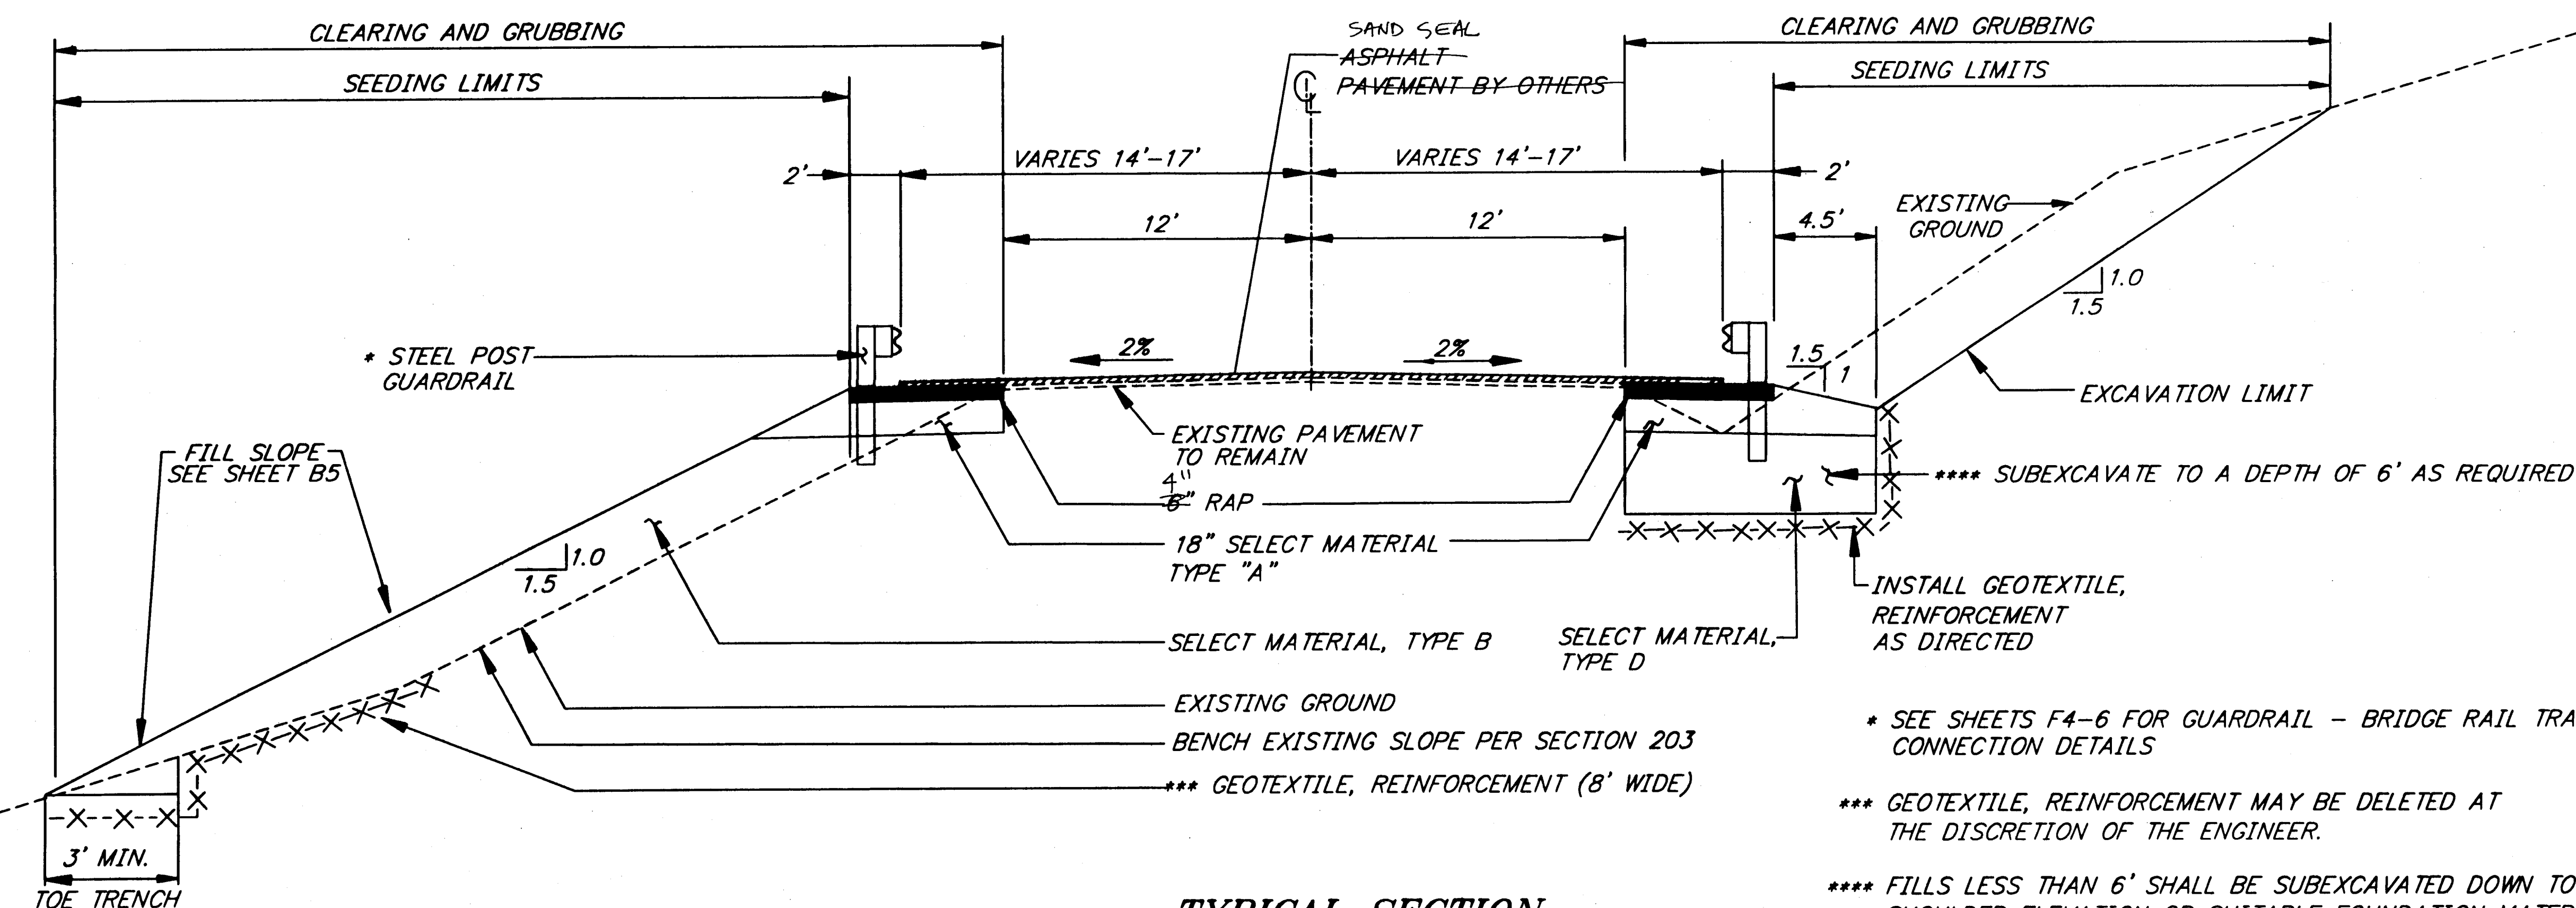

TYPICAL SECTION AT FISH CREEK BRIDGE APPROACH

NOTE: PRIOR TO STAKING, SEE SPECIAL PROVISION 642-3.01

* SEE SHEETS F4-6 FOR GUARDRAIL - BRIDGE RAIL TRANSITION AND CONNECTION DETAILS

*** GEOTEXTILE, REINFORCEMENT MAY BE DELETED AT THE DISCRETION OF THE ENGINEER.

**** FILLS LESS THAN 6' SHALL BE SUBEXCAVATED DOWN TO 6' BELOW SHOULDER ELEVATION OR SUITABLE FOUNDATION MATERIAL, WHICHEVER COMES FIRST.

**JUN-FISH CREEK ROAD
SAFETY IMPROVEMENTS
PROJECT NO. 68269**

1/16/62

SEAL OF THE STATE OF ALASKA
1958
JACK DONALD BEEDLE
CE-5309

DESIGNED BY: M. LAYERING

74-722-03

DRAWN BY: R. SNYDER
 STATE OF ALASKA
 DEPARTMENT OF TRANSPORTATION
 & PUBLIC UTILITIES
STATEWIDE DESIGN & ENGINEERING
 SERVICES DIVISION
 JUNI-SH CREEK ROAD
 SAFETY IMPROVEMENTS
 PROJECT NO. 68289
 Typical
 Sections



PROJECT DESIGNATION NUMBER	ACHRO-0953(4)
STATE	ALASKA
YEAR	2001
SHEET NUMBER	TOTAL SHEETS
B4	41


1. WHEN THE REMARKS ARE "MATCH EXISTING" CONSTRUCT THE RAP SHOULDERS PER THE "CUT/FILL" TYPICAL SECTION FOR THE
2. WHEN THE REMARKS ARE "MATCH SIGHT DISTANCE WORK" OR "MATCH REALIGNMENT WORK" THE TRANSITION BETWEEN THE TYPICAL SECTIONS IS ABRUPT. CONSTRUCT A TEMPORARY RAMP (10' MIN) UPON THE COMPLETION OF THE ADJACENT WORK, PER DETAIL SHEET F4.
3. WHEN THE REMARKS ARE "MATCH BRIDGE DECK" CONSTRUCT RAP SHOULDERS AND EMBANKMENT WIDTHS PER "APPROACH TO BRIDGE" TYPICAL.
4. WITHIN THIS SEGMENT "SIGHT DISTANCE WORK" IS ALSO SPECIFIED. CONSTRUCT THE SIGHT DISTANCE WORK AS SPECIFIED. STATE THE WORK FOR THE ADDITIONAL EMBANKMENT REQUIRED FOR "GRADE WORK BY OTHERS" TYPICAL.

GRADE WORK BY OTHERS												
SEGMENT NUMBER	NOTES	BEGIN TRANSITION	FULL DEPTH		END TRANSITION	NOTES						
			FROM	TO								
			REMARKS	STATION			REMARKS	STATION				
1	1	0+66	MATCH EXISTING	1+66	ADD 0.48	23+25	ADD 0.48	24+25	MATCH EXISTING	1		
2	1	39+50	MATCH EXISTING	40+50	ADD 0.48	41+25	ADD 0.48	42+25	MATCH EXISTING	1		
3	2	91+95	MATCH SIGHT DISTANCE WORK	91+95	ADD 0.48	TRANSITION TO			MATCH BRIDGE DECK	3		
4	3	94+95	MATCH BRIDGE DECK	95+95	ADD 0.48	99+00	ADD 0.48	99+00	MATCH REALIGNMENT	2		
5	1.4	138+25	MATCH EXISTING	139+25	ADD 0.48	148+00	ADD 0.48	149+00	MATCH EXISTING	1.4		
6	2	167+04	MATCH REALIGNMENT	167+04	ADD 0.48	174+25	ADD 0.48	174+25	MATCH REALIGNMENT	2		
7	2.4	239+15	MATCH REALIGNMENT	239+15	ADD 0.48	258+52	ADD 0.48	E.O.P.	MATCH EXISTING	1.4		


NOTE: PRIOR TO STAKING, SEE SPECIAL PROVISION 642-3.01

TYPICAL SECTION
GRADE WORK BY OTHERS

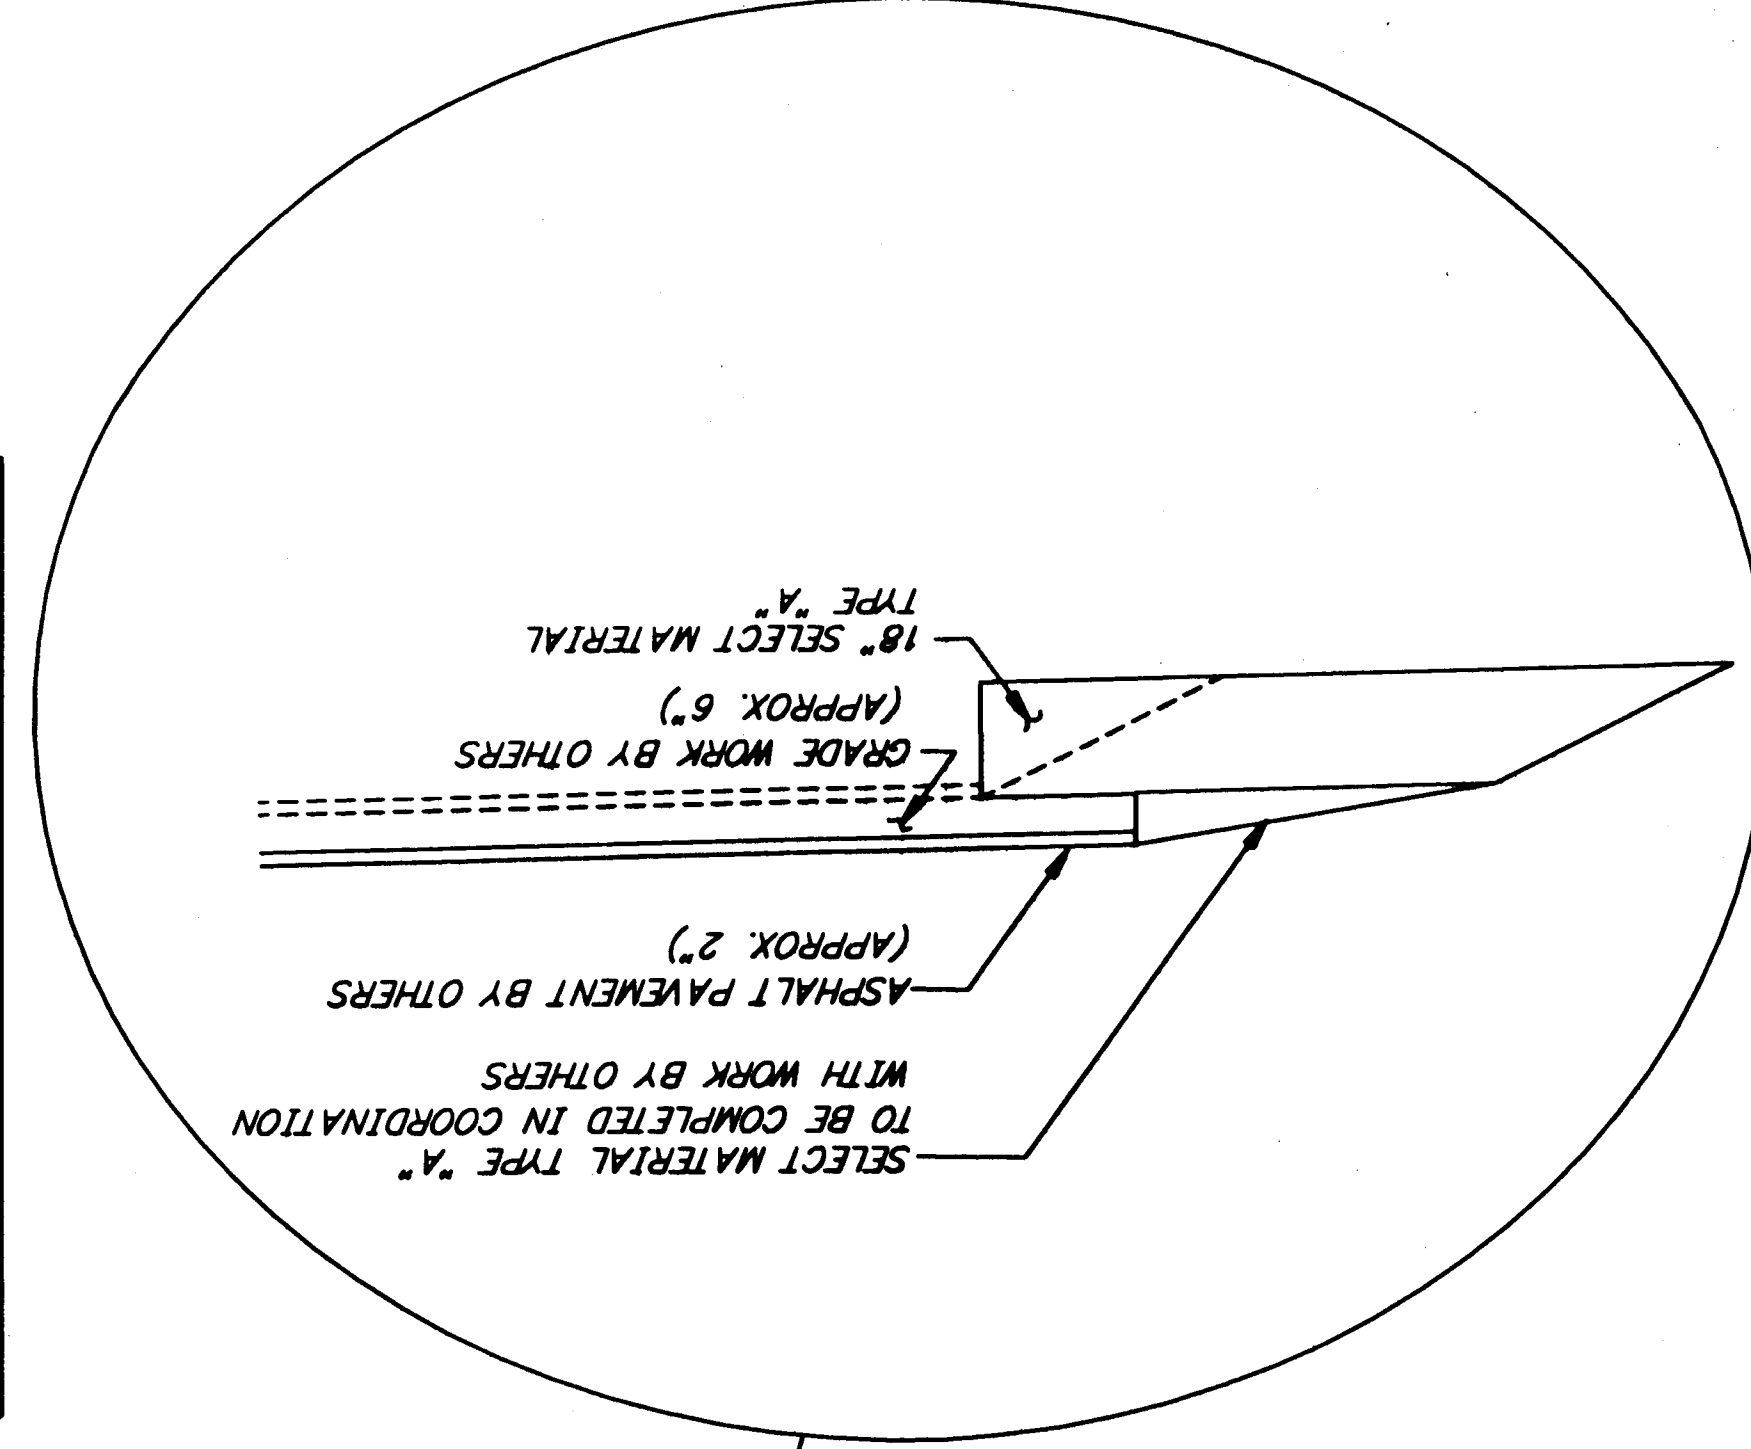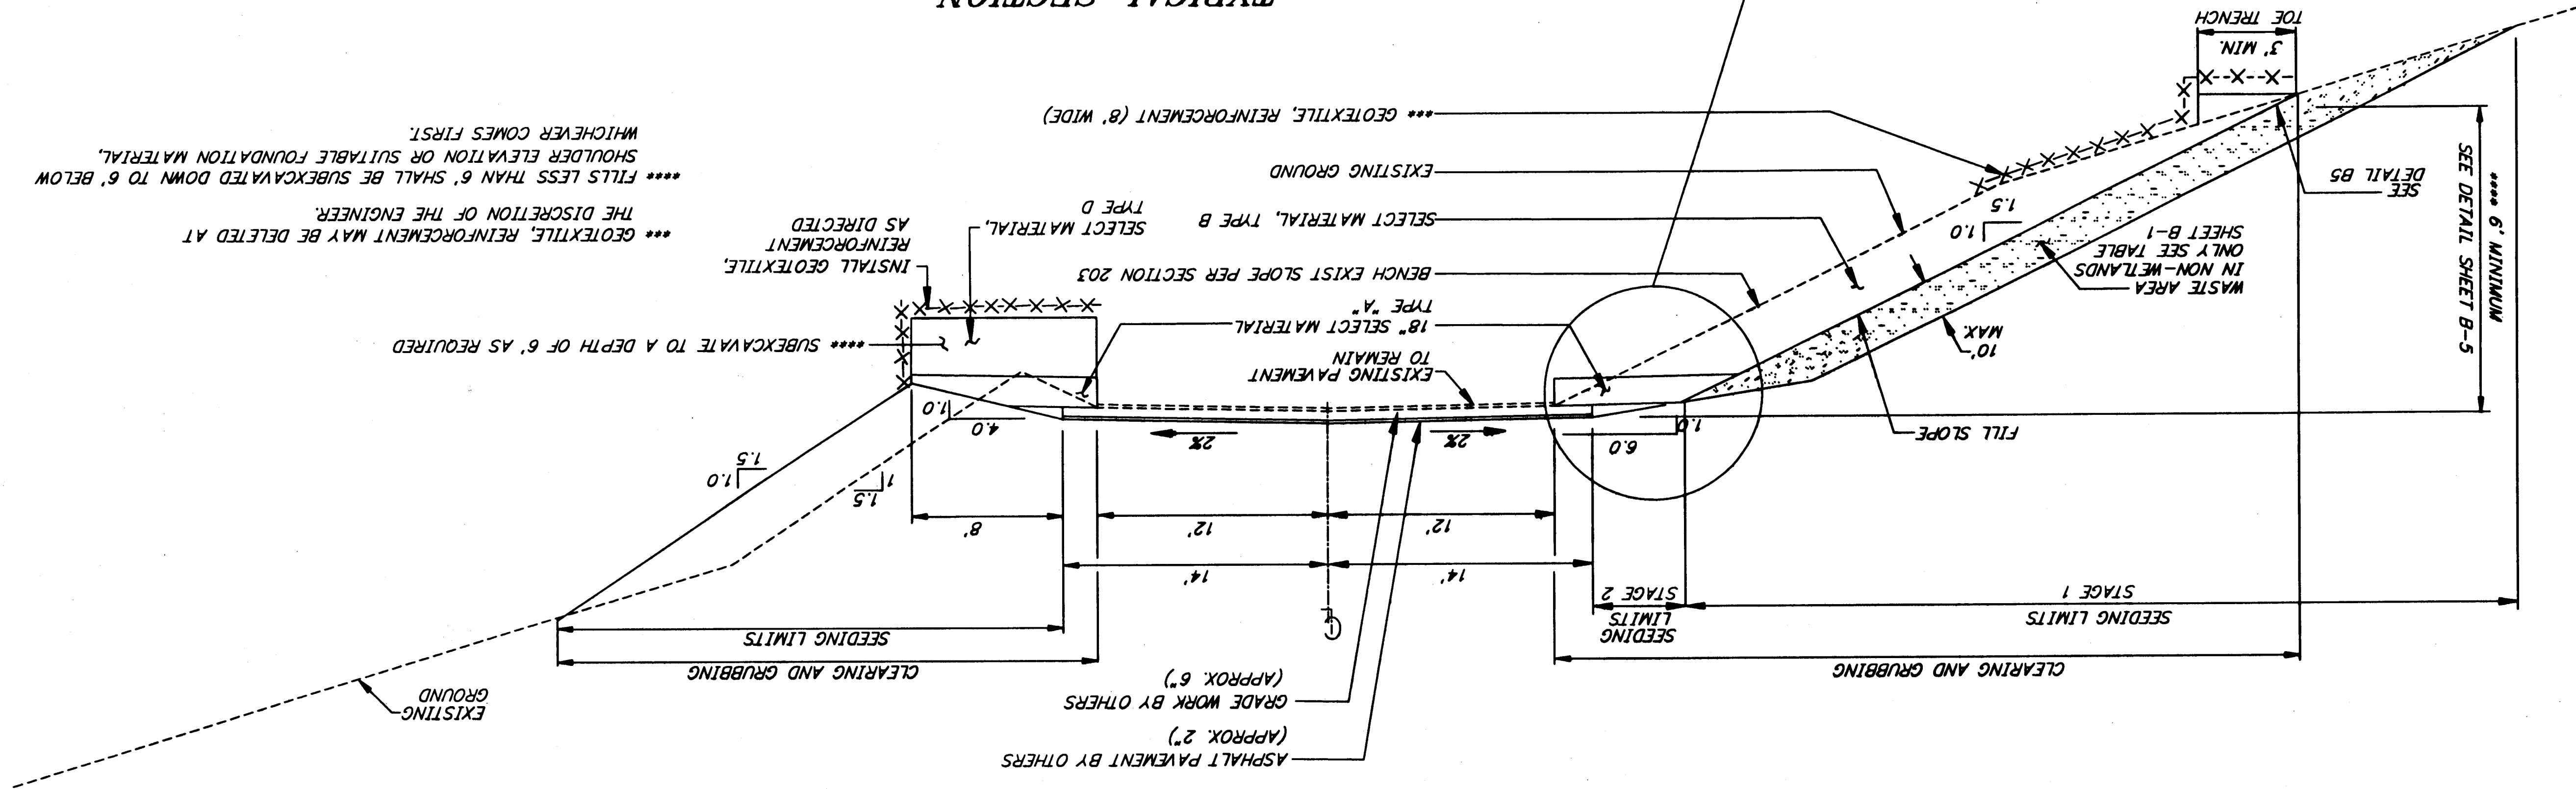

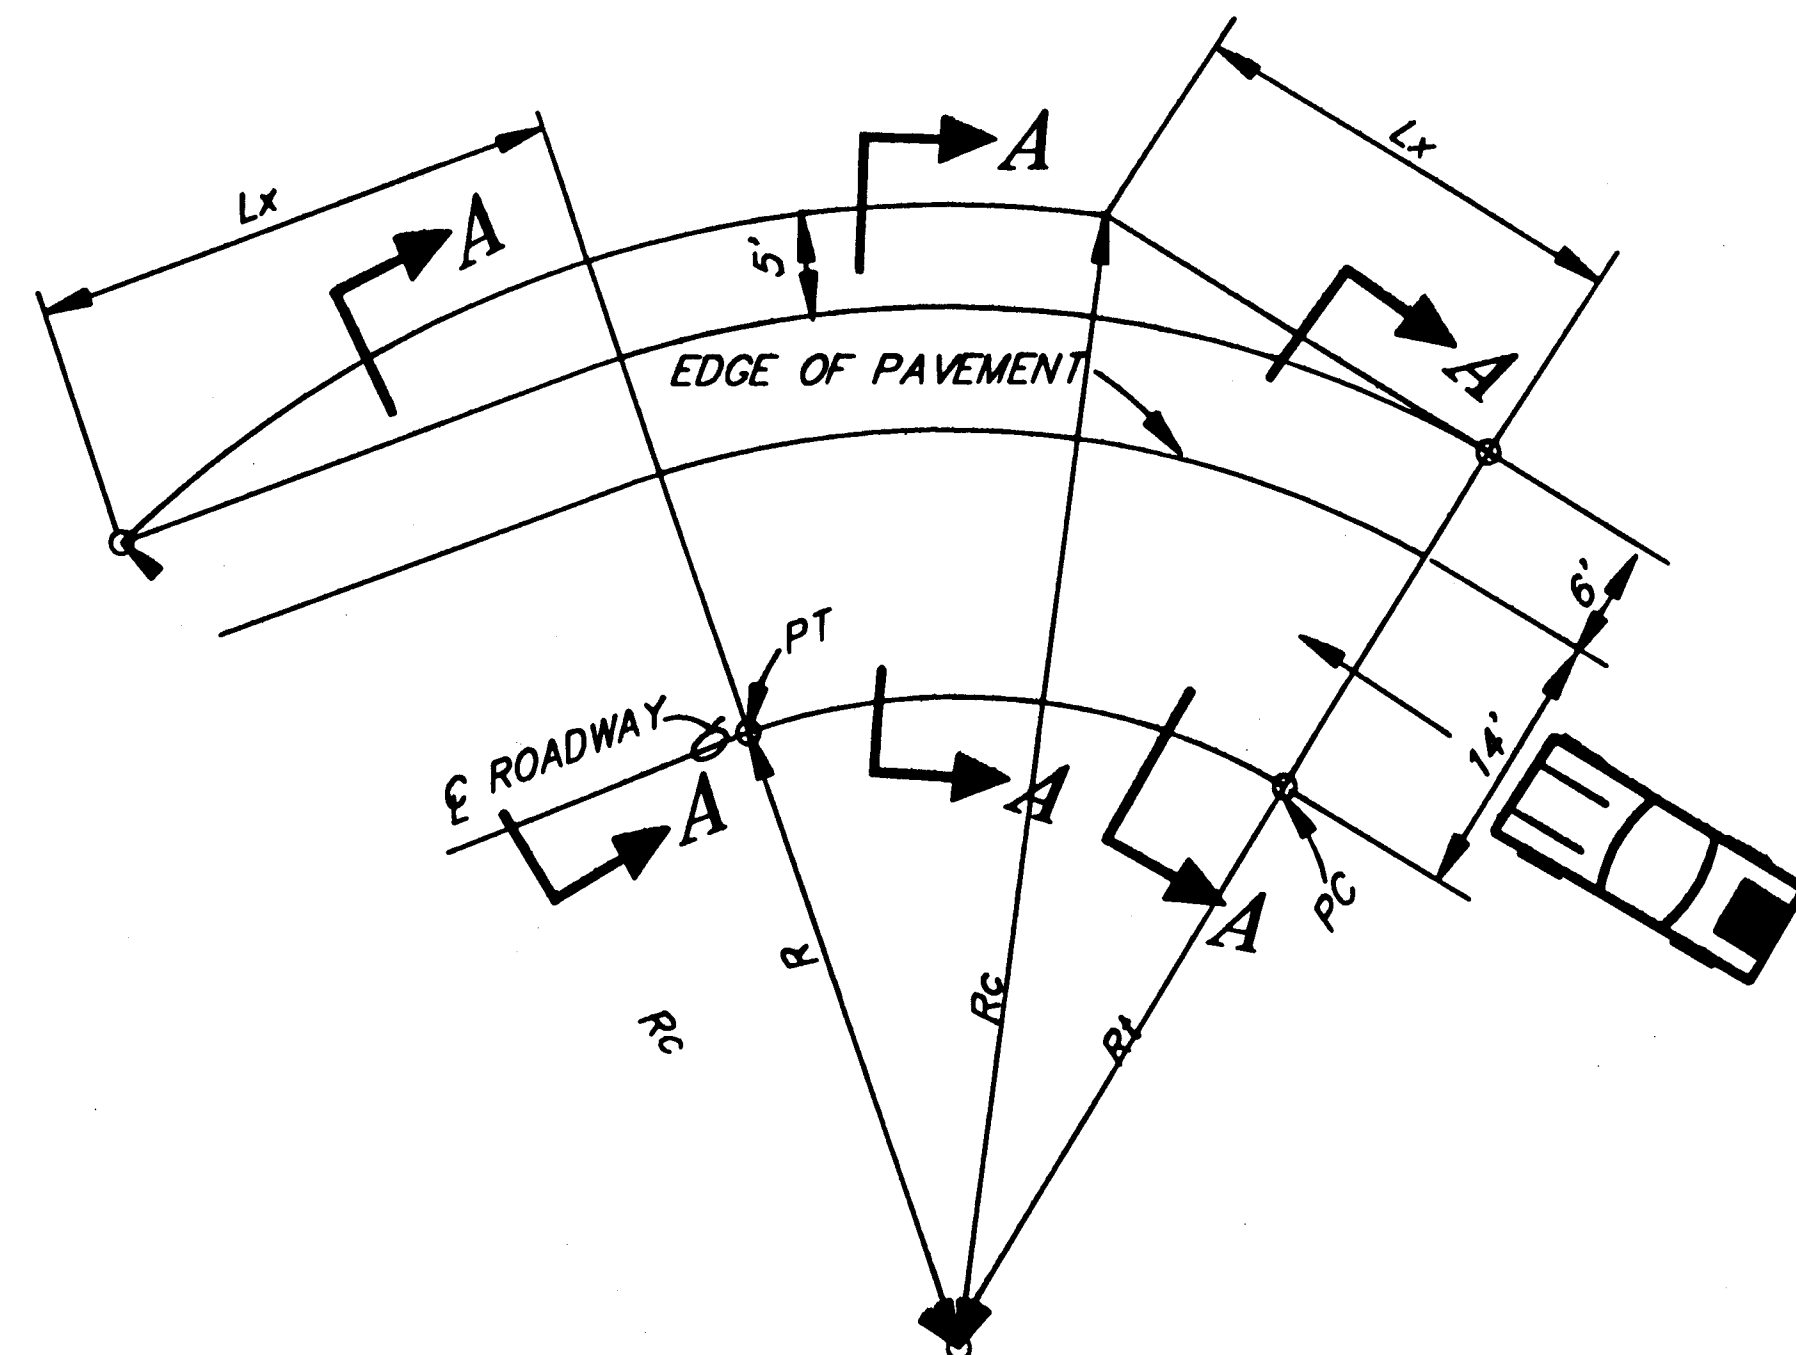


**HORIZONTAL CURVE WIDENING
N.T.S.**

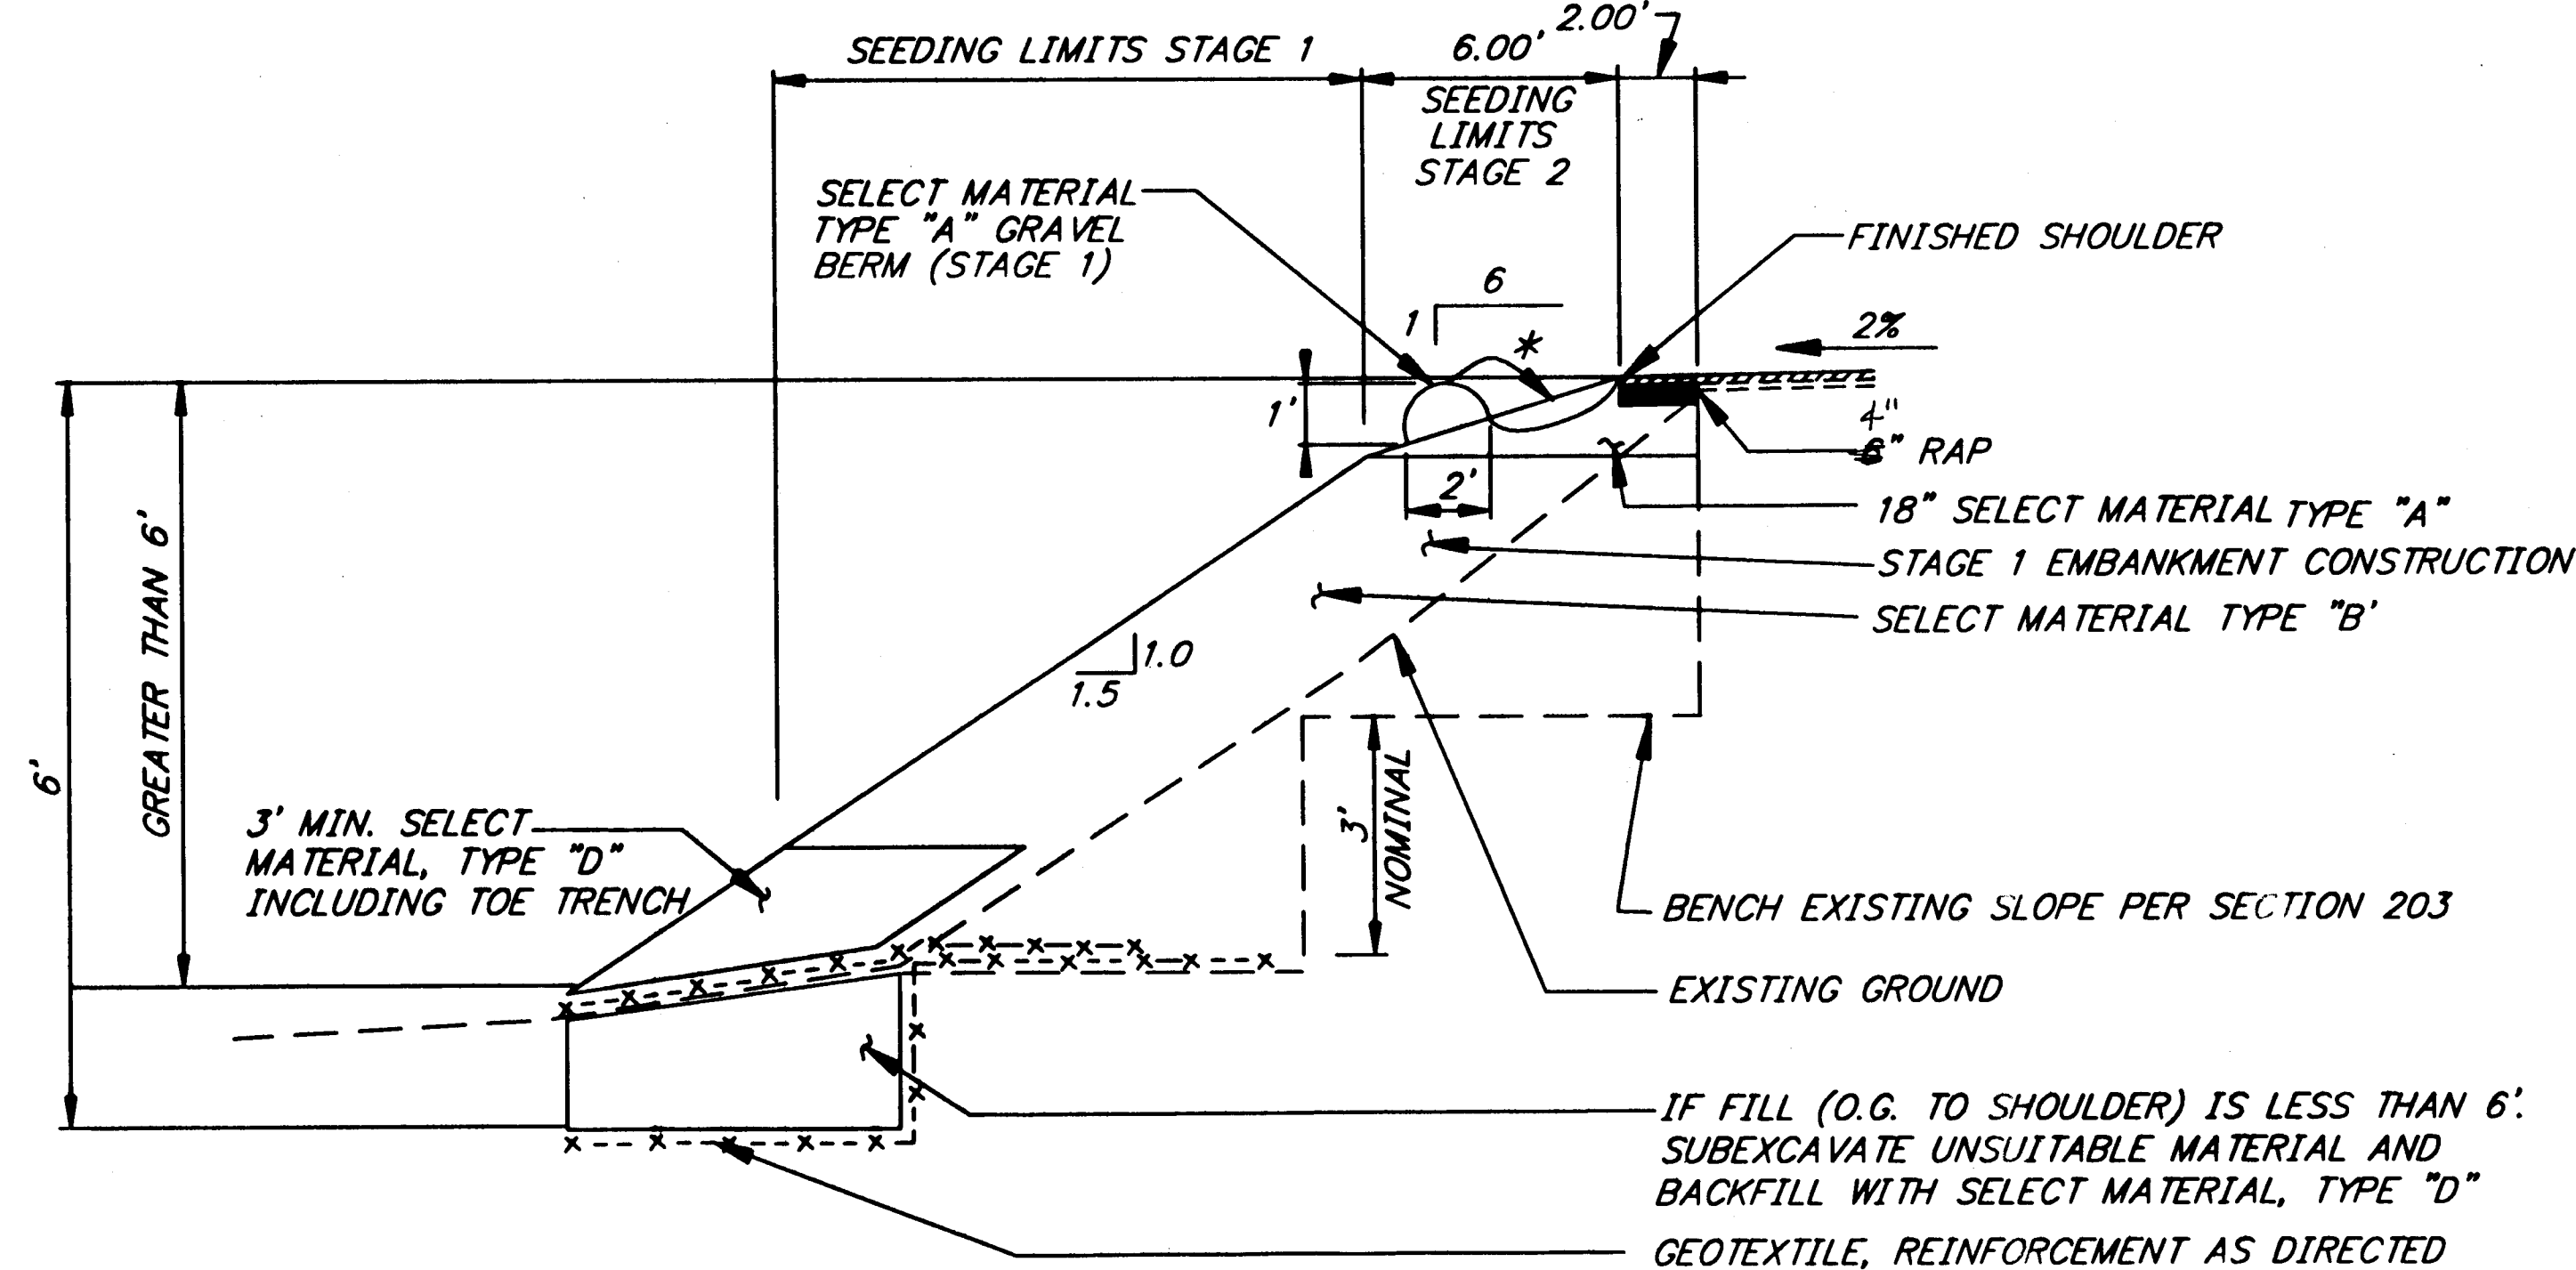

SUBEXCAVATION/EMBANKMENT CONSTRUCTION DETAIL

NOTES:

- * 1. WHEN STAGE 1 SEEDING IS SATISFACTORILY ESTABLISHED, BERM MAY BE GRADED INTO FINAL POSITION
2. BREAK BERM AT, AND DIRECT FLOW TO ROCK FLUME LOCATIONS SHOWN ON THE PLAN AND PROFILE SHEETS.
3. STAGE 1 SEEDING AND BERM ARE NOT REQUIRED IF STAGE 1 IS CONSTRUCTED WITH SELECT MATERIAL, TYPE "D"

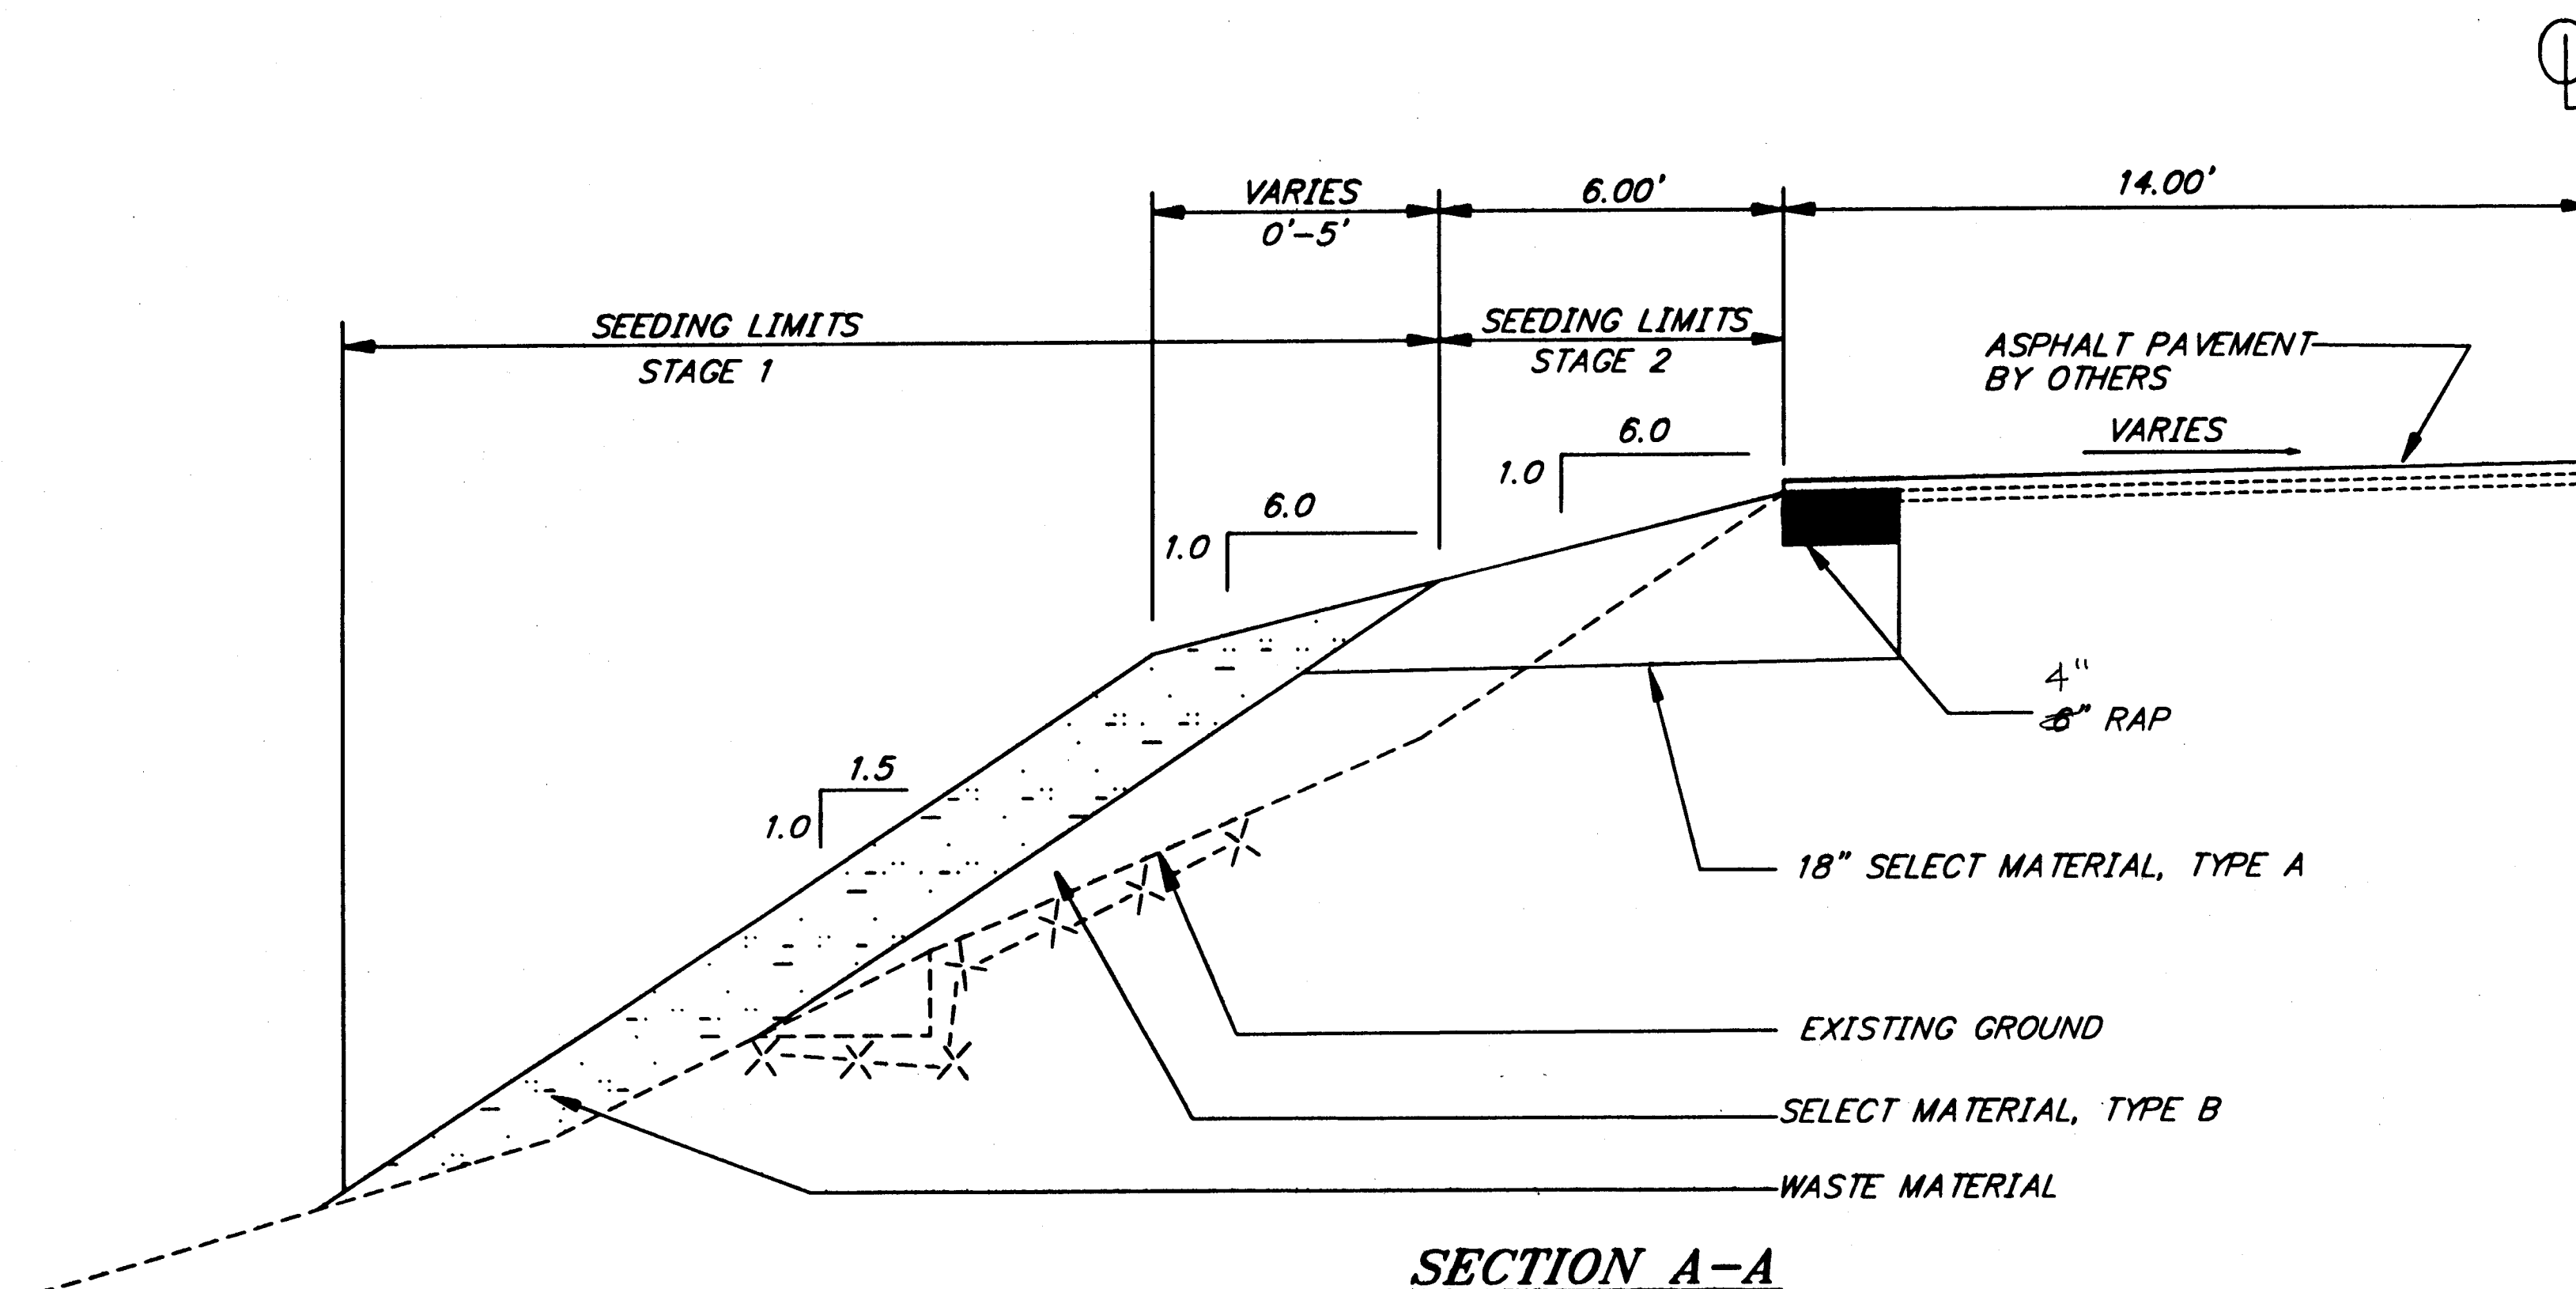

SECTION A-A

HORIZONTAL CURVE WIDENING SUMMARY				
CURVE P.I.	Rt DIMENSION	Rc DIMENSION	Lx DIMENSION	R RADIUS
57+48.27	660	665	80	640'
67+56.69	660	665	80	640'
102+13.41	820	825	90	800'
109+38.01	820	825	90	800'
156+50.70	660	665	80	640'
162+79.42	820	825	90	800'
178+22.81	660	665	80	640'
210+41.16	620	625	80	600'

PATH: Q:\Jnu\68269\Plan\B5_det.dwg
 Q:\Jnu\68269\Plan\B5_det.dwg
 Wed, 09/Jan/02 11:03AM Kris
 PLOT:
 PSPACE 1=1(F) OR MSPACE 1=1(F)
 TAB: ESTIMATE

ADDENDUM NUMBER

ATTACHMENT NUMBER

Wed, 09/Jan/02 11:03AM


RECORD OF REVISIONS

No.	DATE	DESCRIPTION

JNU-FISH CREEK ROAD
 SAFETY IMPROVEMENTS
 PROJECT NO. 68269

Typical Details

DESIGNED BY: M. LAVERING

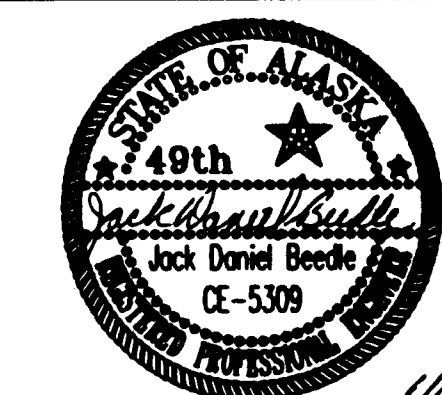

CHECKED BY: T. MOORE

DRAWN BY: K.K.

STATE OF ALASKA
 DEPARTMENT OF TRANSPORTATION
 & PUBLIC FACILITIES
 STATEWIDE DESIGN & ENGINEERING
 SERVICES DIVISION

JNU-FISH CREEK ROAD
 SAFETY IMPROVEMENTS
 PROJECT NO. 68269

Typical Details

PROJECT DESIGNATION NUMBER

ACHRO-0953(4)

STATE	YEAR
ALASKA	2001
SHEET NUMBER	TOTAL SHEETS
B5	41

ESTIMATE OF QUANTITIES			
ITEM No.	ITEM	UNIT	TOTAL
201 (3B)	Clearing And Grubbing	Lump Sum	All Required
201 (6)	Selective Tree Removal	Each	100
202 (13)	Removal and Disposal of Culvert Pipe	Lump Sum	All Required
203 (11)	Unclassified Excavation	Lump Sum	All Required
203 (12)	Embankment	Lump Sum	All Required
204 (2)	Culvert Subexcavation and Backfill	Contingent Sum	All Required
312(1)	Haulage & Placement Reprocessed Asphalt Pavement (RAP)	Cubic Yard	3548.93 5650
602 (2A)	Structural Plate Pipe-Arch, Span 8'2", Rise 6'2"	Linear Foot	20 40
602 (2B)	Structural Plate Pipe-Arch, Span 11'4", Rise 7'4"	Linear Foot	64
603 (9-24)	24" Corrugated Aluminum Pipe	Linear Foot	1603.5 948
603 (9-36)	36" Corrugated Aluminum Pipe	Linear Foot	0 28
603 (9-48)	48" Corrugated Aluminum Pipe	Linear Foot	93 70
603 (9-60)	60" Corrugated Aluminum Pipe	Linear Foot	107 48
603 (21-24)	24" Corrugated Polyethylene Pipe	Linear Foot	227 423
603 (11-24)	End Section for 24" Corrugated Aluminum Pipe	Each	0 33
606 (1)	W-Beam Guardrail	Linear Foot	500
606 (11)	ET-2000 End Section	Each	4
618 (1)	Seeding	Lump Sum	All Required
630 (2)	Geotextile, Reinforcement	Square Yard	23,584 24,000
640 (1)	Mobilization and Demobilization	Lump Sum	All Required
641 (1)	Erosion and Pollution Control Administration	Lump Sum	All Required
641 (2)	Erosion and Pollution Control	Contingent Sum	All Required
641 (3)	Erosion and Pollution Control Devices	Lump Sum	All Required
642 (1)	Construction Surveying	Lump Sum	All Required
642 (3)	Three Person Survey Party	Hour	0 5
643 (2)	Traffic Maintenance	Lump Sum	All Required
669 (1)	Permanent Traffic Recorder	Lump Sum	All Required
690 (1)	Nine Mile Fish Passage	Lump Sum	All Required

NOTES: 1. IT IS ANTICIPATED THAT ALL UNCLASSIFIED EXCAVATION WITH THE EXCEPTION OF ROCK AND THE EXISTING ROADWAY EMBANKMENT IS WASTE.

2 THE UNCLASSIFIED EXCAVATION QUANTITY, SHOWN ON THE PLAN SHEETS DO NOT INCLUDE AN ANTICIPATED 20,000 C.Y. OF SUBEXCAVATION.

CHANGE ORDER ITEMS		
201 (3C)	ADDITIONAL CLEARING & GRUBBING	L.S.
203 (11A)	ADDITIONAL EXCAVATION	L.S.
203 (12A)	ADDITIONAL EMBANKMENT	L.S.
203 (13)	ADDITIONAL CRUSHING	L.S.
203 (14)	CREEK REALIGNMENT	L.S.
203 (15)	ADDITIONAL GRADING	L.S.
203 (16)	ROADWAY SUB-EXCAVATION	L.S.
611 (3)	RIPRAP SLOPE STABILIZATION	L.S.
618 (1A)	ADDITIONAL SEEDING	L.S.
643 (2A)	ADDITIONAL TRAFFIC MAINTENANCE	L.S.
644 (8)	OFFICE SPACE RENT	MONTH
690 (1A)	ADDITIONAL FISH WEIR WORK	L.S.

PATH:
Q:\Jnu\68269\Planset\C_Est.dwg
Wed, 16/Jan/02 03:18PM Kris
PLOT:
PSPACE 1=1(F) OR MSPACE 1=1(F)
TAB: ESTIMATE

ADDENDUM NUMBER		
ATTACHMENT NUMBER		
RECORD OF REVISIONS		
No.	DATE	DESCRIPTION

JNU-FISH CREEK ROAD
SAFETY IMPROVEMENTS
PROJECT NO. 68269

Estimate of Quantities

TH 7-22-03	
DESIGNED BY: M. LAVERING	
 STATE OF ALASKA 49th Jack Daniel Beede CE-5309 REGISTERED PROFESSIONAL ENGINEER 1/16/02	
CHECKED BY: T. MOORE	
DRAWN BY: K.K.	
STATE OF ALASKA DEPARTMENT OF TRANSPORTATION & PUBLIC FACILITIES STATEWIDE DESIGN & ENGINEERING SERVICES DIVISION JNU-FISH CREEK ROAD SAFETY IMPROVEMENTS PROJECT NO. 68269 Estimate of Quantities	
PROJECT DESIGNATION NUMBER	
ACHRO-0953(4)	
STATE	YEAR
ALASKA	2001
SHEET NUMBER	TOTAL SHEETS
C1	41

CROSS SLOPE TABLE															
STATION	LEFT	RIGHT	REMARKS	STATION	LEFT	RIGHT	REMARKS	STATION	LEFT	RIGHT	REMARKS	STATION	LEFT	RIGHT	REMARKS
B.O.P.	-0.020	-0.020		80+54.45	0.000	-0.020		154+40.34	0.020	-0.020		194+14.71	0.020	-0.020	
0+66.46	-0.020	-0.020		80+87.36	-0.020	-0.020		155+02.87	0.058	-0.058	P.C.	194+47.62	0.000	-0.020	
0+97.50	-0.020	0.000		81+44.22	-0.020	-0.020		157+93.44	0.058	-0.058	P.T.	194+80.53	-0.020	-0.020	
1+28.55	-0.020	0.020		81+77.13	-0.020	0.000		158+55.97	0.020	-0.020		195+29.48	-0.020	-0.020	
1+90.63	-0.060	0.060	P.C.	82+10.04	-0.020	0.020		158+88.88	0.000	-0.020		195+62.39	0.000	-0.020	
7+41.33	-0.060	0.060	P.T.	82+29.79	-0.032	0.032	P.C.	159+21.80	-0.020	-0.020		195+95.30	0.020	-0.020	
8+03.41	-0.020	0.020		82+72.58	-0.058	0.058		160+97.06	-0.020	-0.020		196+18.34	0.034	-0.034	P.C.
8+34.46	-0.020	0.000		83+34.74	-0.058	0.058		161+29.97	-0.020	0.000		198+57.58	0.034	-0.034	P.T.
8+65.50	-0.020	-0.020		83+77.53	-0.032	0.032	P.T.	161+62.88	-0.020	0.020		198+80.62	0.020	-0.020	
9+60.50	-0.020	-0.020		83+97.28	-0.020	0.020		161+78.24	-0.029	0.029	P.C.	199+13.53	0.000	-0.020	
9+93.42	0.000	-0.020		84+24.46	-0.020	0.003		162+18.83	-0.054	0.054	P.T.	199+46.44	-0.020	-0.020	
10+26.33	0.020	-0.020		84+30.19	-0.017	0.000		163+38.95	-0.054	0.054		206+99.34	-0.020	-0.020	
10+70.76	0.047	-0.047	P.C.	84+43.78	-0.011	-0.011		163+79.54	-0.029	0.029		207+32.25	-0.020	0.000	
23+03.62	0.047	-0.047	P.T.	84+57.37	0.000	-0.017		163+94.90	-0.020	0.020		207+65.16	-0.020	0.020	
23+48.05	0.020	-0.020		84+63.10	0.003	-0.020		164+27.81	-0.020	0.000		208+29.34	-0.059	0.059	P.C.
23+80.96	0.000	-0.020		84+90.28	0.020	-0.020		164+60.72	-0.020	-0.020		213+45.47	-0.059	0.059	P.T.
24+13.88	-0.020	-0.020		85+10.03	0.032	-0.032	P.C.	164+84.89	-0.020	-0.020		2140+9.65	-0.020	0.020	
39+58.11	-0.020	-0.020		85+52.82	0.058	-0.058		165+17.81	-0.020	0.000		214+42.56	-0.020	0.000	
39+91.03	0.000	-0.020		86+56.39	0.058	-0.058		165+35.36	-0.017	0.017	P.C.	214+75.47	-0.020	-0.020	
40+23.94	0.020	-0.020		86+99.18	0.032	-0.032	P.T.	165+50.72	-0.020	0.020		222+37.14	-0.020	-0.020	
40+86.47	0.058	-0.058	P.C.	87+18.93	0.020	-0.020		165+60.59	-0.026	0.026		222+70.05	-0.020	0.000	
41+13.07	0.058	-0.058	P.T.	87+51.84	0.000	-0.020		166+28.25	-0.026	0.026		223+02.96	-0.020	0.020	
41+75.60	0.020	-0.020		87+84.75	-0.020	-0.020		166+38.12	-0.020	0.020		223+40.81	-0.043	0.043	P.C.
42+08.51	0.000	-0.020		99+22.70	-0.020	-0.020		166+53.48	-0.017	0.017	P.T.	228+61.25	-0.043	0.043	P.T.
42+41.43	-0.020	-0.020		99+55.61	0.000	-0.020		166+71.03	-0.020	0.000		228+99.10	-0.020	0.000	
52+09.00	-0.020	-0.020		99+88.52	0.020	-0.020		167+03.95	-0.020	-0.020		229+32.01	-0.020	0.020	
52+41.92	-0.020	0.000		100+03.88	0.029	-0.029	P.C.	171+28.30	-0.020	-0.020		229+64.92	-0.020	-0.020	
52+74.83	-0.020	0.020		100+44.47	0.054	-0.054		171+61.21	-0.020	0.000		229+71.11	-0.020	-0.020	
53+37.36	-0.058	0.058	P.C.	103+73.14	0.054	-0.054		171+94.13	-0.020	0.020		230+04.02	0.000	-0.020	
60+67.93	-0.058	0.058	P.T.	104+13.73	0.029	-0.029	P.T.	172+04.00	-0.026	0.026	P.C.	230+36.93	0.020	-0.020	
61+30.46	-0.020	0.020		104+29.09	0.020	-0.020		172+75.41	-0.026	0.026	P.T.	230+97.82	0.057	-0.057	P.C.
61+63.37	-0.020	0.000		104+62.00	0.000	-0.020		172+85.28	-0.020	0.020		237+44.99	0.057	-0.057	P.T.
61+96.29	-0.020	-0.020		104+94.91	-0.020	-0.020		173+18.20	-0.020	0.000		238+05.88	0.020	-0.020	
64+85.15	-0.020	-0.020		105+18.85	-0.020	-0.020		173+51.11	-0.020	-0.020		238+38.79	0.000	-0.020	
65+18.06	0.000	-0.020		105+51.76	-0.020	0.000		174+60.99	-0.020	-0.020		238+71.70	-0.020	-0.020	
65+50.97	0.020	-0.020		105+84.67	-0.020	0.020		174+93.91	-0.020	0.000		242+30.19	-0.020	-0.020	
65+70.72	0.032	-0.032	P.C.	106+00.03	-0.029	0.029	P.C.	175+26.82	-0.020	0.020		242+63.10	0.000	-0.020	
66+13.51	0.058	-0.058		106+40.62	-0.054	0.054		175+89.35	-0.058	0.058	P.C.	242+96.01	0.020	-0.020	
68+89.90	0.058	-0.058		111+99.01	-0.054	0.054		180+37.07	-0.058	0.058	P.T.	243+56.90	0.057	-0.057	P.C.
69+32.69	0.032	-0.032	P.T.	112+39.60	-0.029	0.029	P.T.	180+99.60	-0.020	0.020		245+18.13	0.057	-0.057	P.T.
69+52.44	0.020	-0.020		112+54.96	-0.020	0.020		181+32.51	-0.020	0.000		245+79.02	0.020	-0.020	
69+85.35	0.000	-0.020		112+87.87	-0.020	0.000		181+65.43	-0.020	-0.020		246+11.93	0.000	-0.020	
70+18.26	-0.020	-0.020		113+20.78	-0.020	-0.020		182+37.09	-0.020	-0.020		246+44.84	-0.020	-0.020	
70+78.66	-0.020	-0.020		115+62.06	-0.020	-0.020		182+70.00	0.000	-0.020		248+88.47	-0.020	-0.020	
71+11.57	-0.020	0.000		115+94.97	0.000	-0.020		183+02.91	0.020	-0.020		249+21.38	0.000	-0.020	
71+44.48	-0.020	0.020		116+27.88	0.020	-0.020		183+22.66	0.032	-0.032	P.C.	249+54.29	0.020	-0.020	
71+64.23	-0.032	0.032	P.C.	116+83.83	0.054	-0.054	P.C.	183+65.45	0.058	-0.058	P.T.	249+77.33	0.034	-0.034	P.C.
72+07.02	-0.058	0.058		118+67.37	0.054	-0.054	P.T.	183+64.09	0.058	-0.058		251+38.68	0.034	-0.034	P.T.
73+86.24	-0.058	0.058		119+23.32	0.020	-0.020		184+06.88	0.032	-0.032		251+61.72	0.020	-0.020	
74+29.03	-0.032	0.032	P.T.	119+56.23	0.000	-0.020		184+26.63	0.020	-0.020		251+94.63	0.000	-0.020	
74+48.78	-0.020	0.020		119+89.14	-0.020	-0.020		184+32.96	0.020	-0.020		252+27.54	-0.020	-0.020	
74+81.69	-0.020	0.000		138+25.64	-0.020	-0.020		184+95.49	0.058	-0.058	P.C.	252+69.56	-0.020	-0.020	
75+14.60	-0.020	-0.020		138+58.56	-0.020	0.000		186+92.41	0.058	-0.058	P.T.	253+02.47	-0.020	0.000	
75+19.68	-0.020	-0.020		138+91.47	-0.020	0.020		187+54.94	0.020	-0.020		253+35.38	-0.020	0.020	
75+52.59	0.000	-0.020		139+39.19	-0.049	0.049	P.C.	187+87.85	0.000	-0.020		253+76.52	-0.045	0.045	P.C.
75+85.50	0.020	-0.020		143+31.54	-0.049	0.049	P.T.	188+20.77	-0.020	-0.020		256+04.10	-0.045	0.045	P.T.
76+05.25	-0.032	0.032	P.C.	14379.26	-0.020	0.020		188+24.19	-0.020	-0.020		256+45.24	-0.020	0.020	
76+48.04	0.058	-0.058		144+12.17	-0.020	0.000		188+57.10	0.000	-0.020		256+78.15	-0.020	0.000	
79+59.00	0.058	-0.058		144+45.09	-0.020	-0.020		188+90.01	0.020	-0.020		257+11.06	-0.020	-0.020	
80+01.79	-0.032	0.032	P.T.	153+74.51	-0.020	-0.020		189+13.05	0.034	-0.034	P.C.	E.O.P.	-0.020	-0.020	
80+21.54	0.020	-0.020		154+07.43	0.000	-0.020		193+91.67	0.034	-0.034	P.T.				

PATH:
Q:\Jnu\68269\Planset\C_super elev.dwg
Wed, 09/Jan/02 11:53AM Kris
PLOT:
PSPACE 1=1(F) OR MSPACE 1=1(F)
TAB: ESTIMATE

ADDENDUM NUMBER

ATTACHMENT NUMBER


RECORD OF REVISIONS
No. DATE DESCRIPTION

JNU-FISH CREEK ROAD
SAFETY IMPROVEMENTS
PROJECT NO. 68269

Super Elevation Table

7-22-03 TJ

DESIGNED BY: M. LAYERING

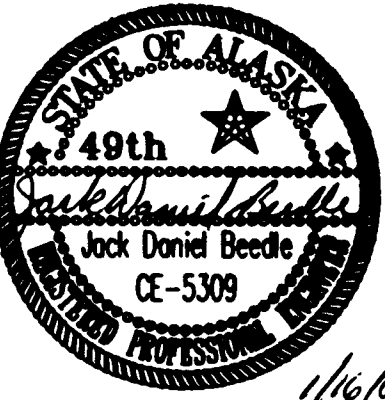
1/6/02

CHECKED BY: T. MOORE

DRAWN BY: M.L. / K.K.

STATE OF ALASKA
DEPARTMENT OF TRANSPORTATION
& PUBLIC FACILITIES
STATEWIDE DESIGN & ENGINEERING
SERVICES DIVISION
JNU-FISH CREEK ROAD
SAFETY IMPROVEMENTS
PROJECT NO. 68269
Super Elevation
Table

PROJECT DESIGNATION NUMBER

ACHRO-0953(4)

STATE YEAR
ALASKA 2001

SHEET NUMBER TOTAL SHEETS
C2 41

CULVERT SUMMARY					
STATION	TYPE	DIAMETER (IN.)	LENGTH (FT.)		REMARKS
			LT	RT	
15+00	CAP	24	46		REMOVE EXISTING AND REPLACE WITH NEW
25+40	CAP	24	10	10	EXTEND
41+75	CAP	24	20	20	2 CULVERTS/EXTEND
46+60	CAP	24	20	20	2 CULVERTS/EXTEND
54+50	CAP	24	17	6	EXTEND
68+35	CAP	24	84		REMOVE & REPLACE SKEW 30'± LEFT AHEAD
70+35	CAP	24	7	10	EXTEND
73+35	CAP	24	3	16	EXTEND
74+35	CAP	36	12	16	SKEW 45'± LEFT AHEAD/EXTEND
78+15	CAP	24	5	12	EXTEND
79+25	CAP	24	14	20	2 CULVERTS/EXTEND
79+75	CAP	24	13	10	SKEW 30'± LEFT AHEAD/EXTEND
82+85	CAP	24	12	12	SKEW 30'± LEFT AHEAD/EXTEND
84+85	CAP	24	12	12	SKEW 30'± RIGHT AHEAD/EXTEND
104+00	CAP	24	0	20	SKEW 30'± RIGHT AHEAD/EXTEND
109+60	CAP	24	23	0	SKEW 30'± RIGHT AHEAD/EXTEND
113+60	CAP	24	0	28	SKEW 45'± LEFT AHEAD/EXTEND
121+05	CAP	24	10	7	EXTEND
127+60	CAP	24	10	7	EXTEND
137+30	CAP	24	12	12	SKEW 30'± RIGHT AHEAD/EXTEND
142+90	CAP	24	66		REMOVE EXISTING AND REPLACE WITH NEW
147+20	CAP	24	82		REMOVE EXISTING AND REPLACE WITH NEW
162+25	CAP	24	17	6	EXTEND
166+75	CAP	24	48		REMOVE EXISTING AND REPLACE WITH NEW
168+60	CAP	24	14	6	EXTEND
171+90	CAP	60	10	10	EXTEND
176+30	CSP	11'4" X 7'4"	32	32	2 STRUCTURAL PLATE PIPE ARCHES, SEE SHEET F2 & F3
185+75	CAP	24	45		REMOVE EXISTING AND REPLACE
189+40	CAP	24	0	17	EXTEND
196+50	CAP	24	0	17	EXTEND
199+65	CAP	24	0	20	SKEW 30'± RIGHT AHEAD/EXTEND
203+00	CAP	24	0	17	EXTEND
206+35	CAP	24	0	17	EXTEND
208+45	CAP	24	0	32	EXTEND
210+40	CAP	24	0	32	EXTEND
210+70	CAP	24	34		REMOVE AND DISPOSE, SEE NOTE #4.
211+75	CAP	24	52		INSTALL NEW SKEW 30'± RIGHT AHEAD
212+45	CSP	8'2" x 6'2"	0	40	STRUCTURAL PLATE PIPE ARCH/EXTEND
213+45	CAP	48	0	42	SKEW 25'± RIGHT AHEAD/EXTEND
214+85	CAP	24	0	27	SKEW 30'± RIGHT AHEAD/EXTEND
222+30	CAP	60	0	28	SKEW 45'± RIGHT AHEAD/EXTEND
229+60	CAP	24	10	9	SKEW 20'± LEFT AHEAD/EXTEND
232+35	CAP	24	20	17	SKEW 60'± RIGHT AHEAD/EXTEND

CULVERT SUMMARY					
STATION	TYPE	DIAMETER (IN.)	LENGTH (FT.)		REMARKS
			LT	RT	
235+60	CAP	24	20	17	SKEW 60'± RIGHT AHEAD/EXTEND
236+25	CAP	24	14	11	SKEW 45'± LEFT AHEAD/EXTEND
242+85	CAP	24	10	7	EXTEND
245+00	CAP	24	12	9	SKEW 30'± RIGHT AHEAD/EXTEND
245+85	CAP	24	20	14	2 CULVERTS/EXTEND
250+95	CAP	24	10	7	EXTEND
252+25	CAP	24	12	9	SKEW 30'± RIGHT AHEAD/EXTEND
253+85	CAP	24	12	9	SKEW 30'± LEFT AHEAD/EXTEND
254+85	CAP	24	12	9	SKEW 30'± RIGHT AHEAD/EXTEND
256+15	CAP	24	10	7	EXTEND
257+35	CAP	24	10	7	EXTEND
258+55	CAP	24	10	7	EXTEND
259+40	CAP	48	14	14	SKEW 45'± LEFT AHEAD/EXTEND

NOTES:

1. Culverts scheduled for removal shall be replaced with new culverts in the same trench.
2. Culverts not shown in the summary but requiring replacement or extension shall be accomplished at the direction of the Engineer.
3. See sheets F1, F2 and F3 for culvert installation details.
4. The Contractor has the option of removing the culvert or filling the pipe w/ lean concrete mix and plugging the ends.

CAP = CORRUGATED ALUMINUM PIPE
 CPP = CORRUGATED POLYETHYLENE PIPE
 CSP = CORRUGATED STEEL PIPE

NOTE: SEE NEW CULVERT SUMMARY,
 SHEET D1A.

PATH:
 Q:\Jnu\68269\PlanSet\0_Sum.dwg
 Wed, 09/Jun/02 01:43PM Kris
 PLOT:
 PSPACE 1=1(F) OR MSPACE 1=1(F)
 TAB: ESTIMATE


ADDENDUM NUMBER		
ATTACHMENT NUMBER		
RECORD OF REVISIONS		
No.	DATE	DESCRIPTION

JNU-FISH CREEK ROAD
 SAFETY IMPROVEMENTS
 PROJECT NO. 68269

Culvert Summary

7/4 7-22-03

DESIGNED BY: M. LAVERING

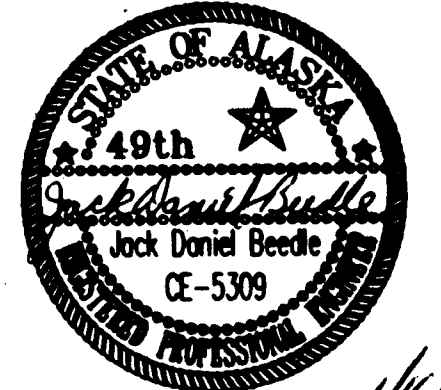

CHECKED BY: T. MOORE

DRAWN BY: M.L./ K.K.

STATE OF ALASKA
 DEPARTMENT OF TRANSPORTATION
 & PUBLIC FACILITIES
 STATEWIDE DESIGN & ENGINEERING
 SERVICES DIVISION
**JNU-FISH CREEK ROAD
 SAFETY IMPROVEMENTS
 PROJECT NO. 68269**

**Culvert
 Summary**

PROJECT DESIGNATION NUMBER

ACHRO-0953(4)

STATE	YEAR
ALASKA	2001
SHEET NUMBER	TOTAL SHEETS
D1	41

CULVERT SUMMARY					
STATION	TYPE	DIAMETER	LENGTH		REMARKS
		(IN.)	(FT.)		
			LT	RT	
25+50	CAP	24	13	0	
25+50	CAP	24	0	7	
33+00	CAP	24	20	0	2 PIPES
33+15	CAP	24	0	9.5	
37+50	CAP	24	0	22	2 PIPES
38+00	CAP	24	28	0	2 PIPES
41+35	CAP	24	30	0	2 PIPES
41+50	CAP	24	0	16	2 PIPES
46+50	CAP	24	23	19.5	2 PIPES
53+40	CAP	24	18	13.5	
69+75	CAP	24	0	10	
70+00	CAP	24	9	0	
71+25	CAP	24	0	17	
71+50	CAP	24	4	0	
72+50	CAP	24	0	30	
73+40	CAP	24	6	0	
73+75	CAP	24	0	20	
74+29	CAP	24	4	0	
76+00	CAP	24	0	8.5	
76+00	CAP	24	3	0	
77+50	CAP	24	0	16	
78+75	CAP	24	12	24	
84+15	CAP	24	18	8	
103+50	CAP	24	0	55	
109+00	CAP	24	40	0	
113+00	CPP	24	0	30.5	
113+00	CAP	24	17.5	0	
120+55	CAP	24	15	7	
126+92	CAP	24	17	5	
136+65	CAP	24	14	0	
136+70	CAP	24	0	11.5	
141+90	CAP	24	5	0	
142+10	CAP	24	0	8.5	
146+25	CAP	24	29	0	
147+15	CAP	24	0	20	
161+50	CAP	24	20	0	
167+60	CAP	24	11.5	11.5	
193+25	CAP	24	0	20	
195+50	CAP	24	0	17	
198+50	CAP	24	0	34	
201+83	CAP	24	0	29	
205+60	CAP	24	0	52	
207+20	CAP	24	0	44	
209+10	CAP	24	0	48	
210+25	CAP	24	0	76	

CULVERT SUMMARY					
STATION	TYPE	DIAMETER	LENGTH		REMARKS
		(IN.)	(FT.)		
			LT	RT	
213+00	CAP	24	0	48	
213+45	CAP	24	0	57	
217+80	CAP	24	0	36	
228+50	CAP	24	10	0	
228+67	CAP	24	0	12	
230+50	CAP	24	17	12	
233+50	CAP	24	73	43	2 PIPES
235+00	CAP	24	18	10	
241+50	CAP	24	21	17	2 PIPES
243+50	CAP	24	23	26	2 PIPES
248+50	CAP	24	12	24	2 PIPES
249+50	CAP	24	11	10	
250+60	CAP	24	8	10	
252+50	CAP	24	12	10	
253+25	CAP	24	22	0	2 PIPES
254+65	CAP	24	0	5	
254+75	CAP	24	10	0	
255+75	CAP	24	11	0	
257+00	CAP	24	0	8	
257+25	CAP	24	13	0	
212+00	CAP	48	0	70	
258+50	CAP	48	0	3	
258+75	CAP	48	20	0	
170+50	CAP	60	20.5	10.5	
220+50	CAP	60	76		CROSS-PIPE
15+00	CPP	24	52		CROSS-PIPE
68+00	CPP	24	60		CROSS-PIPE
184+50	CPP	24	55		CROSS-PIPE
188+40	CPP	24	60		CROSS-PIPE
NOTE: THERE WERE NO 36" CULVERTS INSTALLED ON THIS PROJECT					

NOTES:

1. Culverts scheduled for removal shall be replaced with new culverts in the same trench.
2. Culverts not shown in the summary but requiring replacement or extension shall be accomplished at the direction of the Engineer.
3. See sheets F1,F2 and F3 for culvert installation details.
4. The Contractor has the option of removing the culvert or filling the pipe w/ lean concrete mix and plugging the ends.

CAP = CORRUGATED ALUMINUM PIPE
CPP = CORRUGATED POLYETHYLENE PIPE
CSP = CORRUGATED STEEL PIPE


PATH:
Q:\Jnu\68269\Planset\D_Sum.dwg
Wed, 17/Sep/03 10:29AM kklemmetson
PLOT:
PSPACE 1=1(F) OR MSPACE 1=1(F)
TAB: ESTIMATE

ADDENDUM NUMBER		
ATTACHMENT NUMBER		
RECORD OF REVISIONS		
No.	DATE	DESCRIPTION

JNU-FISH CREEK ROAD
SAFETY IMPROVEMENTS
PROJECT NO. 68269

Culvert Summary

TH 9-18-03
DESIGNED BY: M. LAVERING

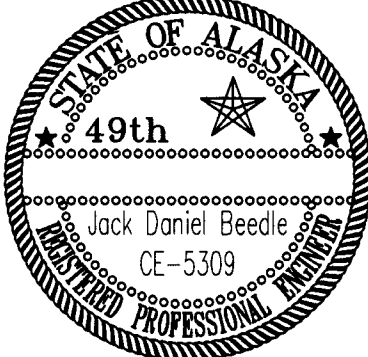


CHECKED BY: T. MOORE
DRAWN BY: M.L./ K.K.
STATE OF ALASKA
DEPARTMENT OF TRANSPORTATION & PUBLIC FACILITIES
STATEWIDE DESIGN & ENGINEERING SERVICES DIVISION
JNU-FISH CREEK ROAD
SAFETY IMPROVEMENTS
PROJECT NO. 68269
Culvert Summary

PROJECT DESIGNATION NUMBER
ACHRO-0953(4)

STATE	YEAR
ALASKA	2001
SHEET NUMBER	TOTAL SHEETS
D1 A	41


STATE	PROJECT DESIGNATION	YEAR	SHEET NO.	TOTAL SHEETS
ALASKA	ACHRO-0953(4)	2002	F5	41

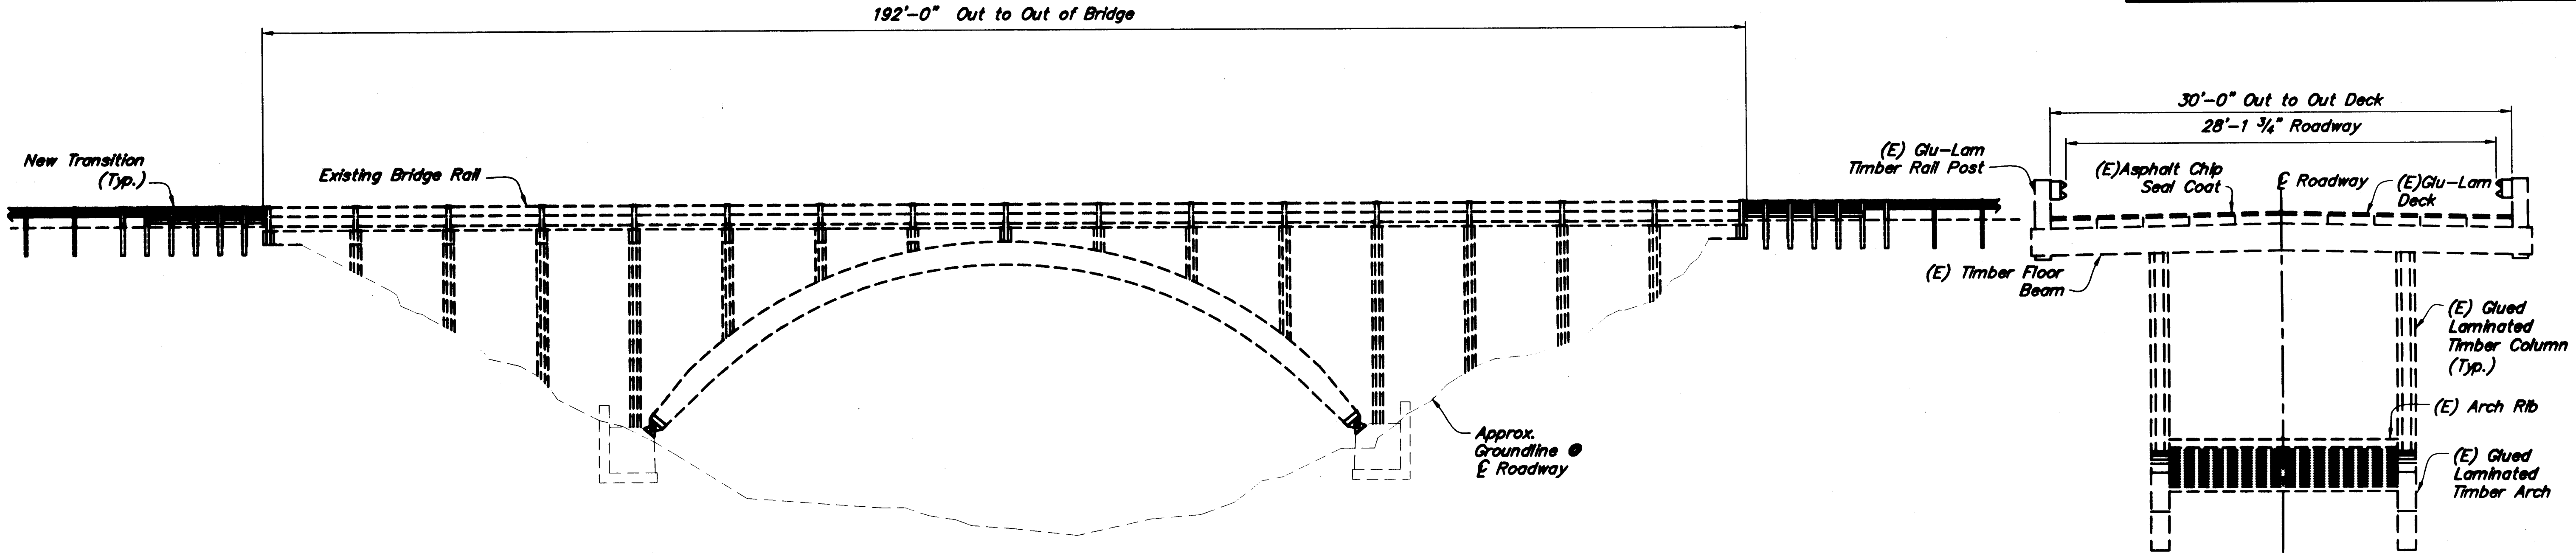

Elevation View



Typical Section

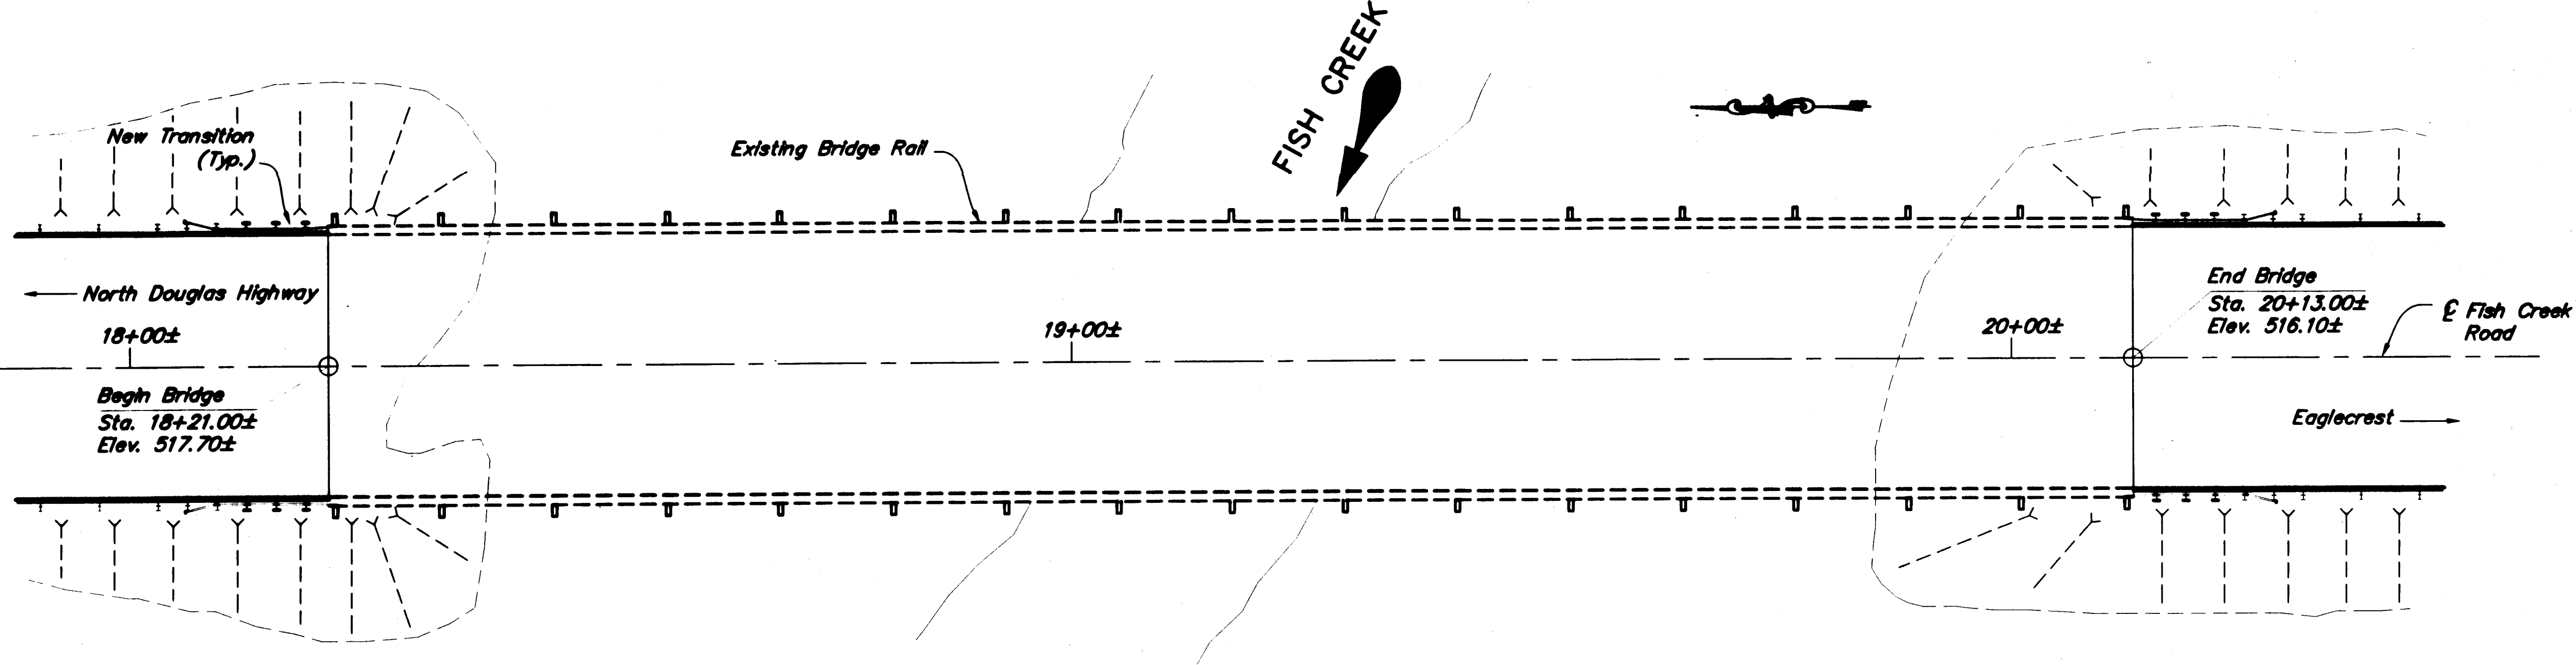

Plan View



- GENERAL NOTES:
1. Elevation, Bearings, and Dimensions are based on "As-Built" plans.
 2. Field verify all controlling dimensions before ordering or fabricating any material.

LEGEND		
SYMBOL	ABV.	DESCRIPTION
---	(E)	EXISTING
---	NEW	NEW CONSTRUCTION

ESTIMATE OF QUANTITIES					
ITEM NO.	ITEM	UNIT	SUBSTR.	SUPERSTR.	TOTAL
606(13)	Bridge Rail/Guardrail Connection	Each		4	4

DRAWING INDEX	
TITLE	DWG. NO.
General Layout	1
Bridge Transition Details	2

DESIGNED BY:
Mark Gyp

CHECKED BY:
Drew Sillback

LAYOUT BY:
Mark Gyp

CHECKED BY:
Drew Sillback

DRAWN BY:
L. Robertson

CHECKED BY:
Mark Gyp

SPECIFICATIONS BY:
Mark Gyp

PLANS & SPEC. COMPARED:
Drew Sillback

QUANTITIES BY:
Mark Gyp

CHECKED BY:
Mark Gyp

APPROVAL RECOMMENDED BY:
Mark Gyp


STATE OF ALASKA
DEPARTMENT OF TRANSPORTATION
AND PUBLIC FACILITIES
BRIDGE SECTION




FISH CREEK BRIDGE
FISH CREEK ROAD
GENERAL LAYOUT





BRIDGE NO. 1291
DWG NO. 1

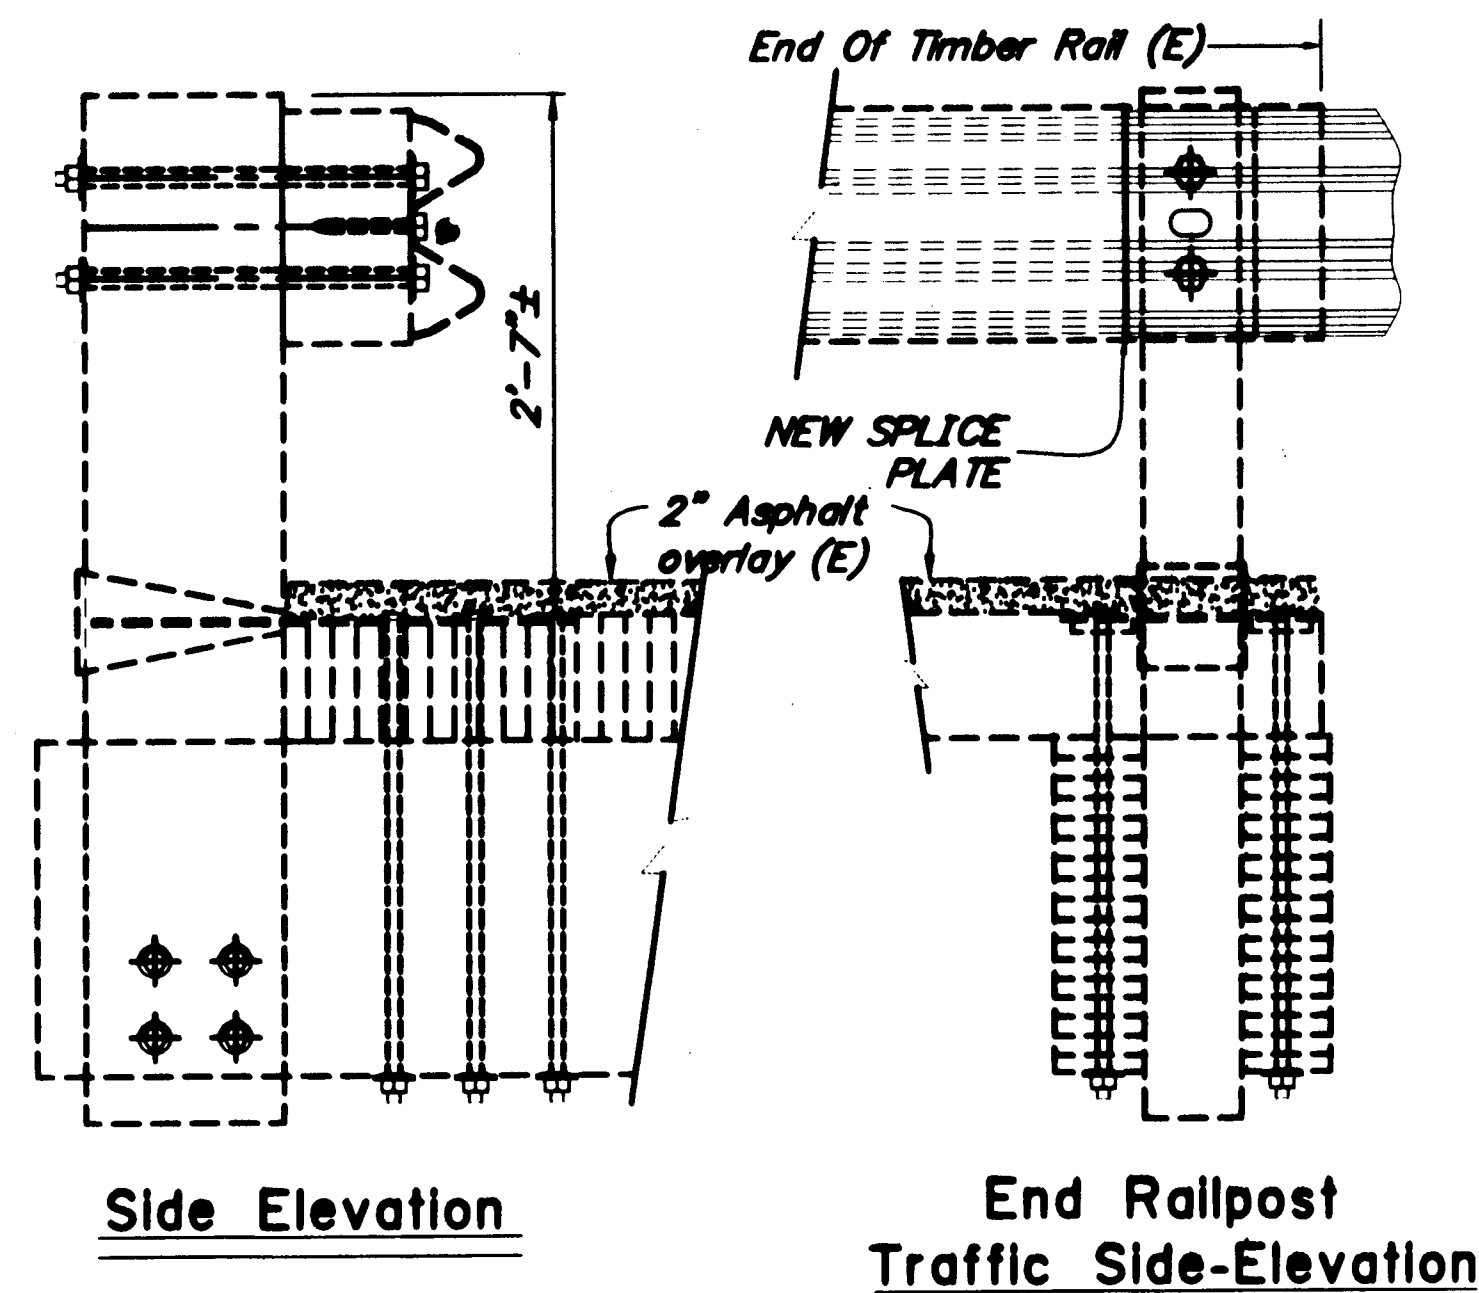


Railpost Details

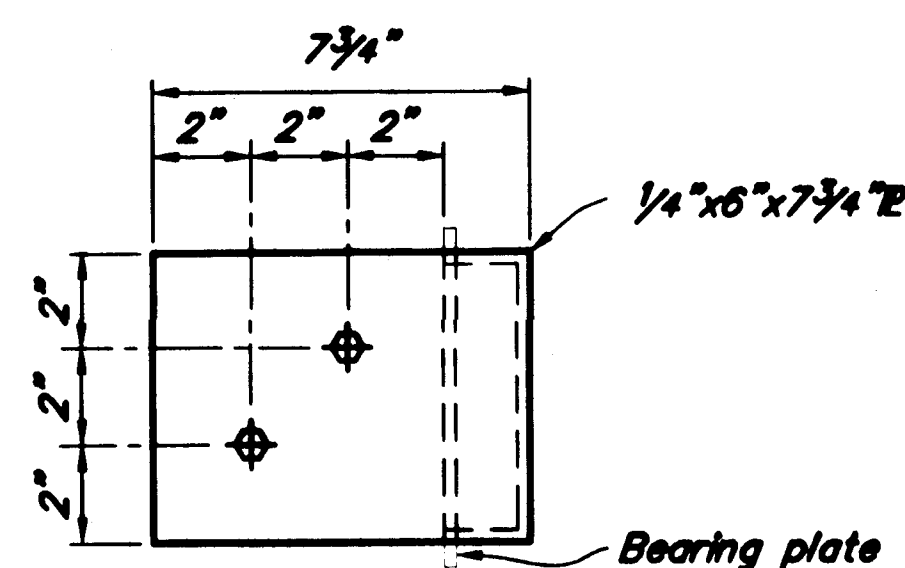



C6x8.2 Rubrail End Elevation

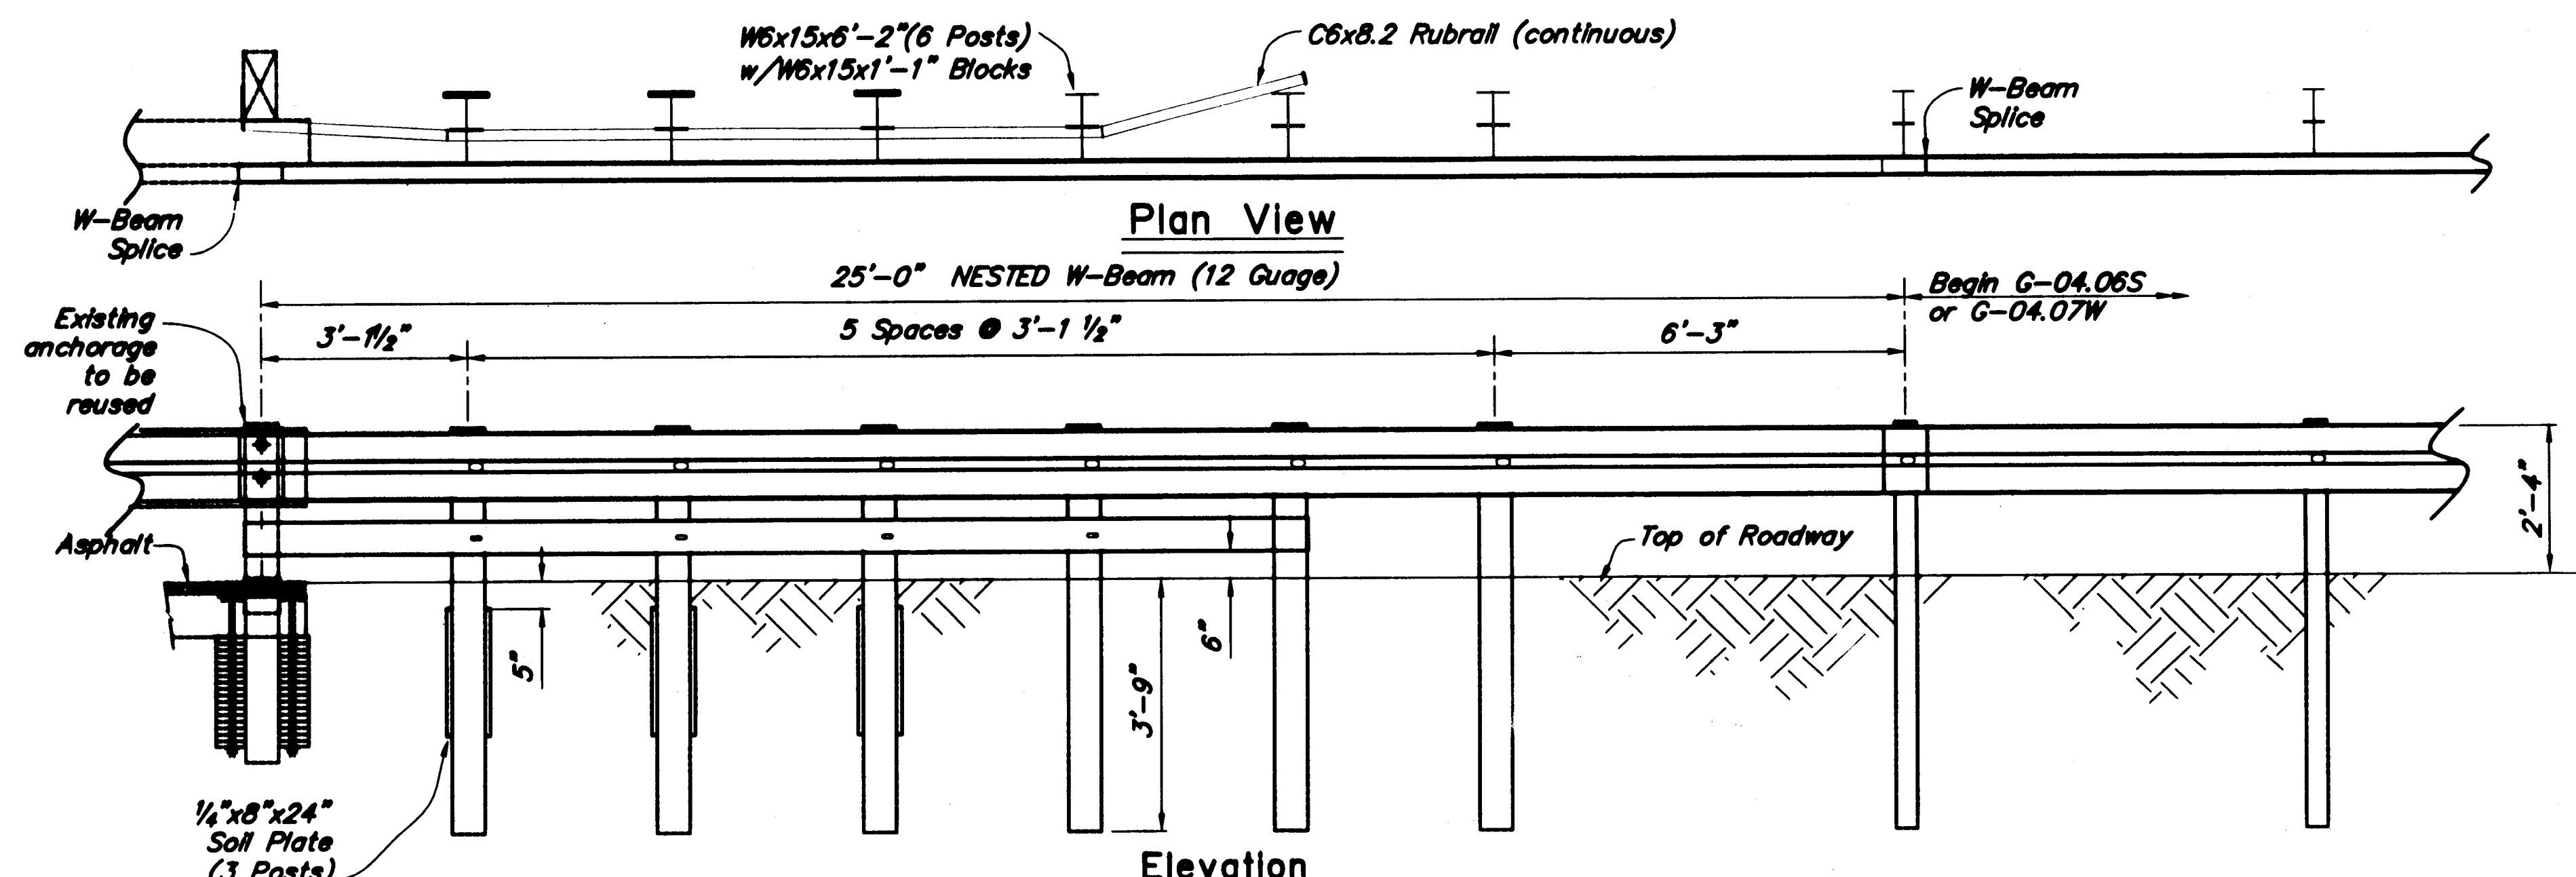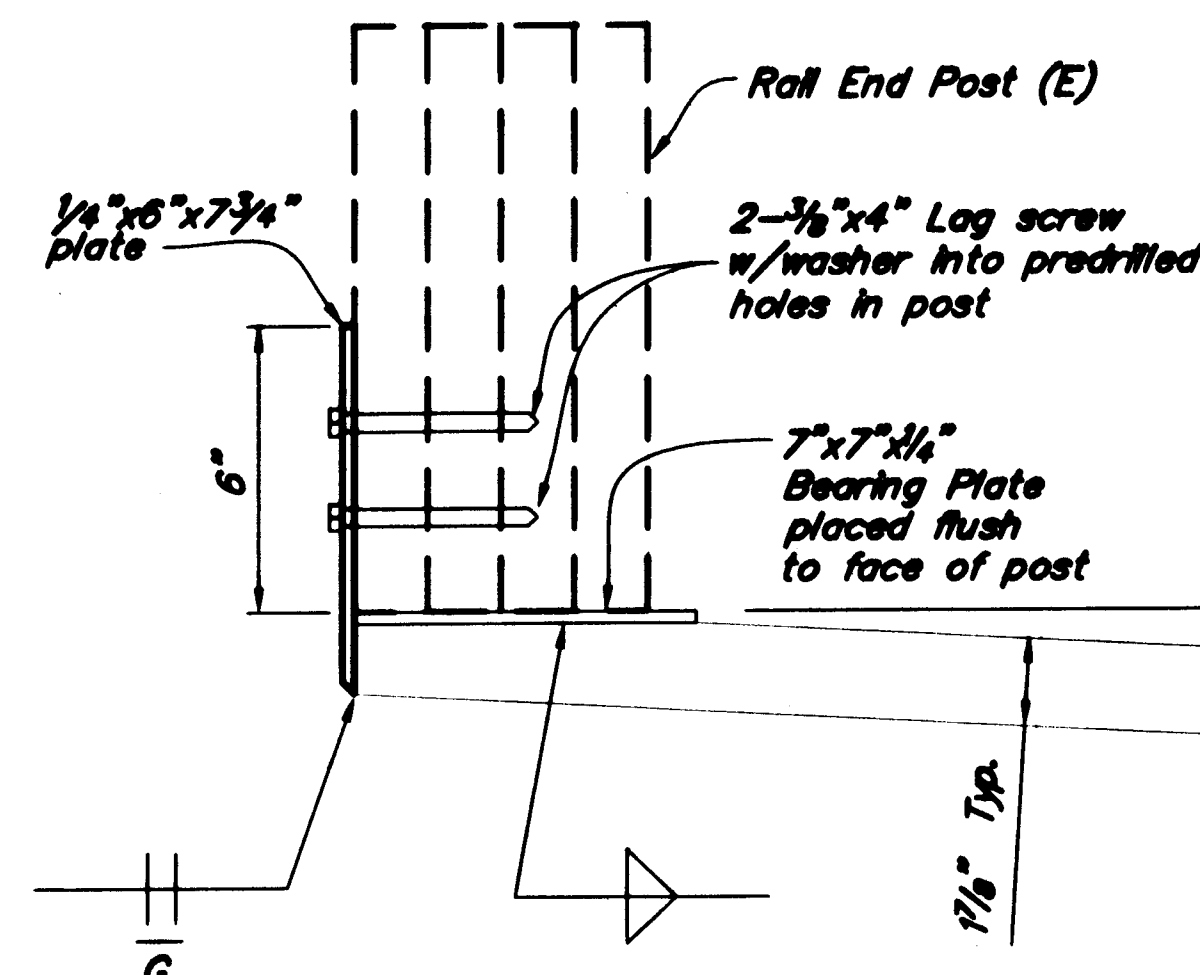

Transition Layout Plan

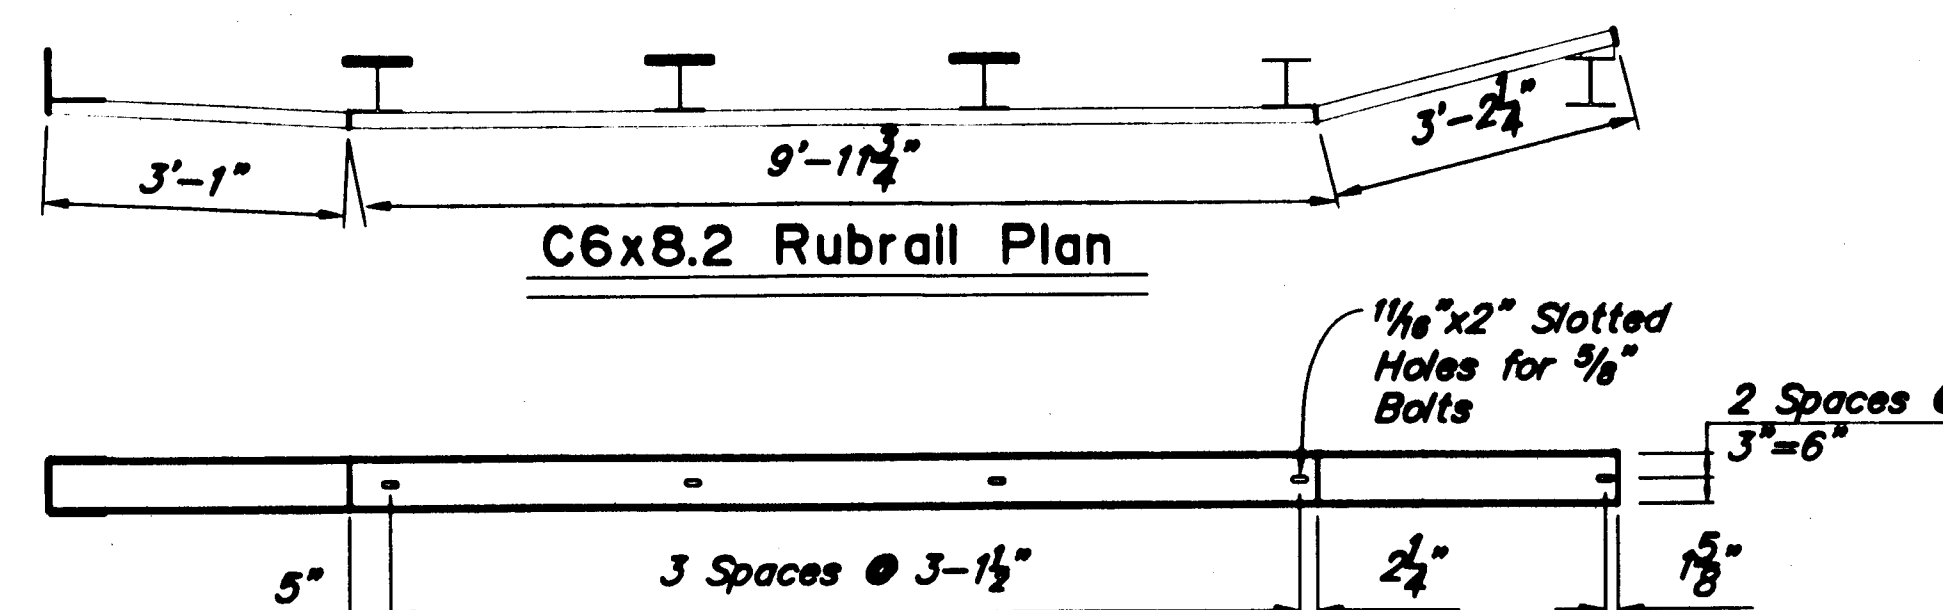

C6x8.2 Rubrail Elevation

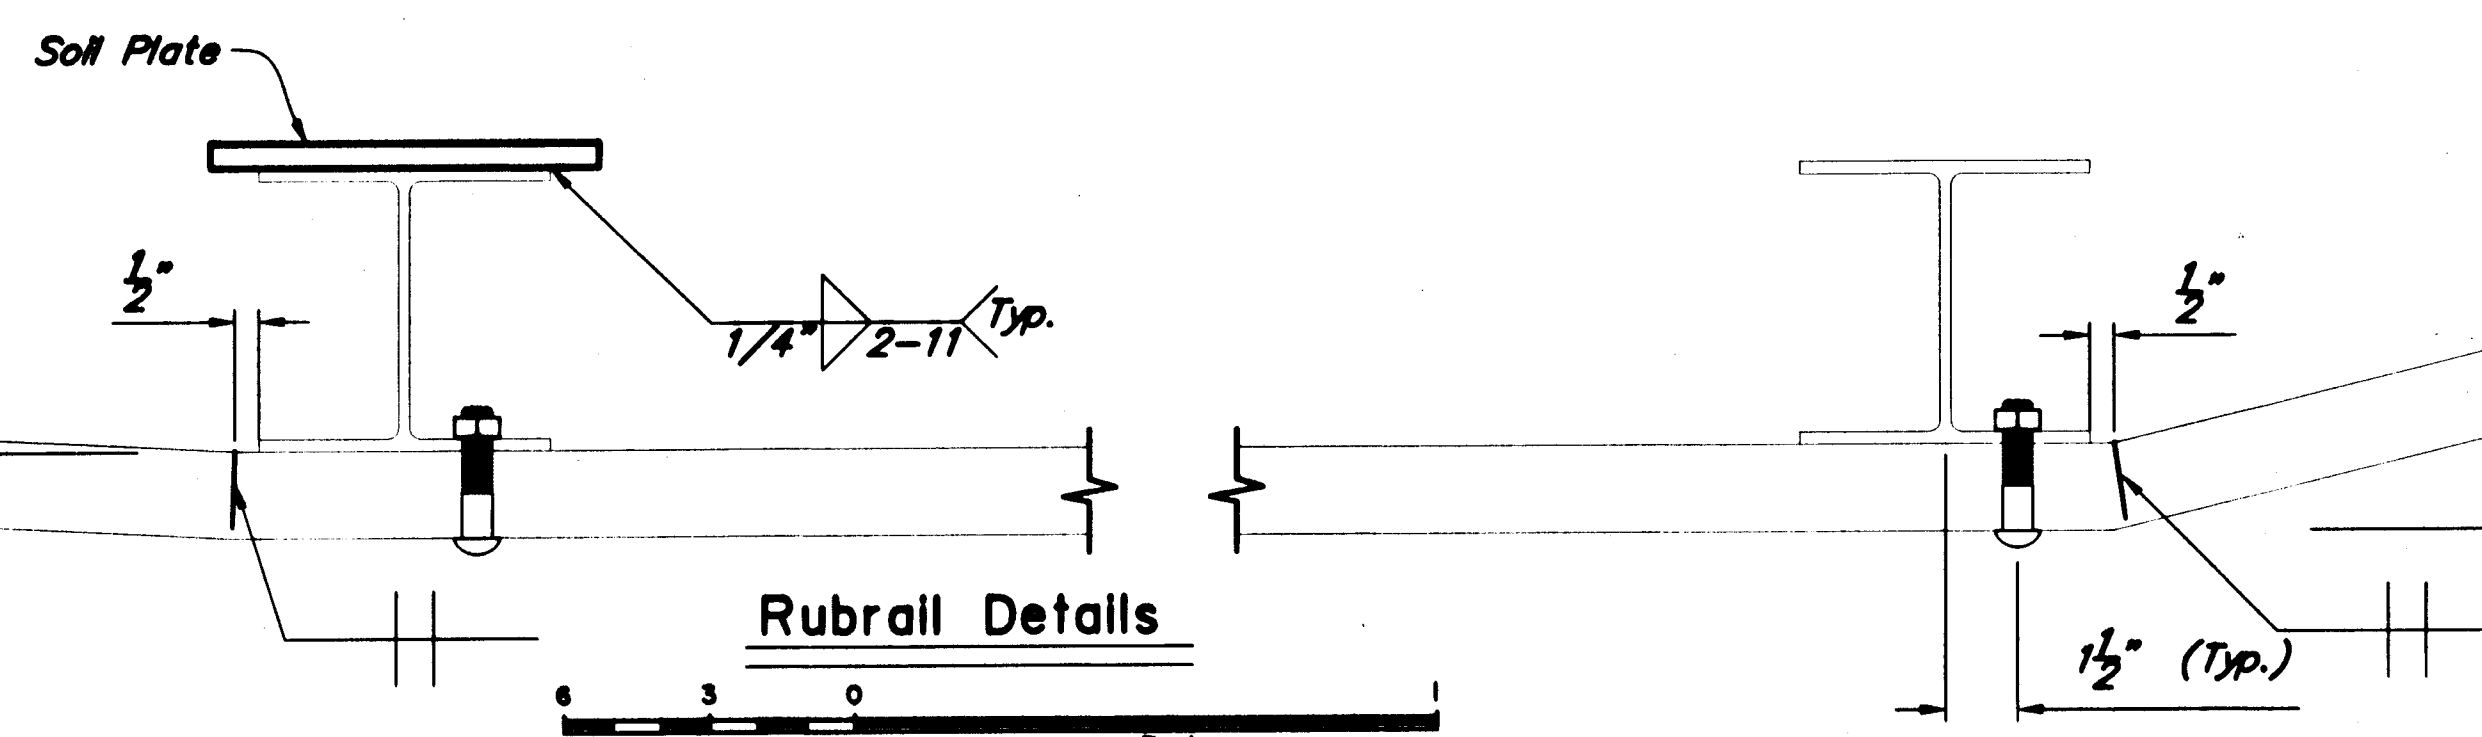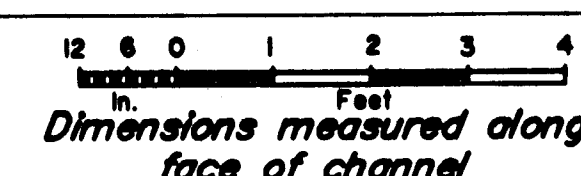

LEGEND		
SYMBOL	ABV.	DESCRIPTION
---	(E)	EXISTING
---	NEW	NEW CONSTRUCTION


NOTE:

1. Field verify all controlling dimensions before ordering or fabricating any material.

2x4x6 Timber Block Spacer (Cut To Fit)
 Standard square beveled, hardened steel, washer (ASTM F436) for 5/8" bolt

DESIGNED BY: <i>Mark J. [Signature]</i>	CHECKED: <i>Don Sillbach</i>
DRAWN BY: <i>L. Robertson</i>	CHECKED: <i>Mark J. [Signature]</i>
QUANTITIES BY: <i>Mark J. [Signature]</i>	CHECKED: <i>Don Sillbach</i>

STATE OF ALASKA
 DEPARTMENT OF TRANSPORTATION
 AND PUBLIC FACILITIES
 BRIDGE SECTION

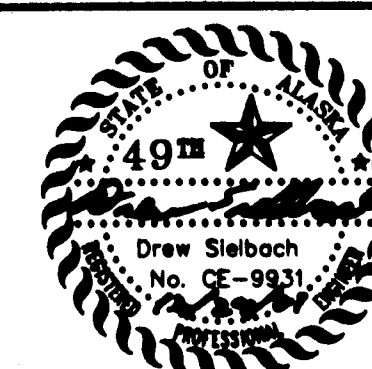

FISH CREEK BRIDGE
 FISH CREEK ROAD
 BRIDGE TRANSITION DETAILS



BRIDGE NO. 1291
 DWG. NO. 2

ADDENDUM NUMBER

ATTACHMENT NUMBER

RECORD OF REVISIONS


No.	DATE	DESCRIPTION

JNU-FISH CREEK ROAD
SAFETY IMPROVEMENTS
PROJECT NO. 68269

PLAN AND PROFILE
STA 0+00 TO STA 28+00

TH 7-22-03

DESIGNED BY: T. L. L. L.

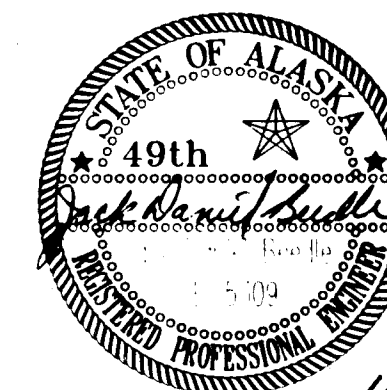

CHECKED BY: T. L. L. L.

DRAWN BY:

STATE OF ALASKA
DEPARTMENT OF TRANSPORTATION
& PUBLIC FACILITIES
STATEWIDE DESIGN & ENGINEERING
SERVICES DIVISION



JNU-FISH CREEK ROAD
SAFETY IMPROVEMENTS
PROJECT NO. 68269

PLAN AND
PROFILE



PROJECT DESIGNATION NUMBER

ACHRO-0953(4)

STATE	YEAR
ALASKA	2001
SHEET NUMBER	TOTAL SHEETS
E1	41

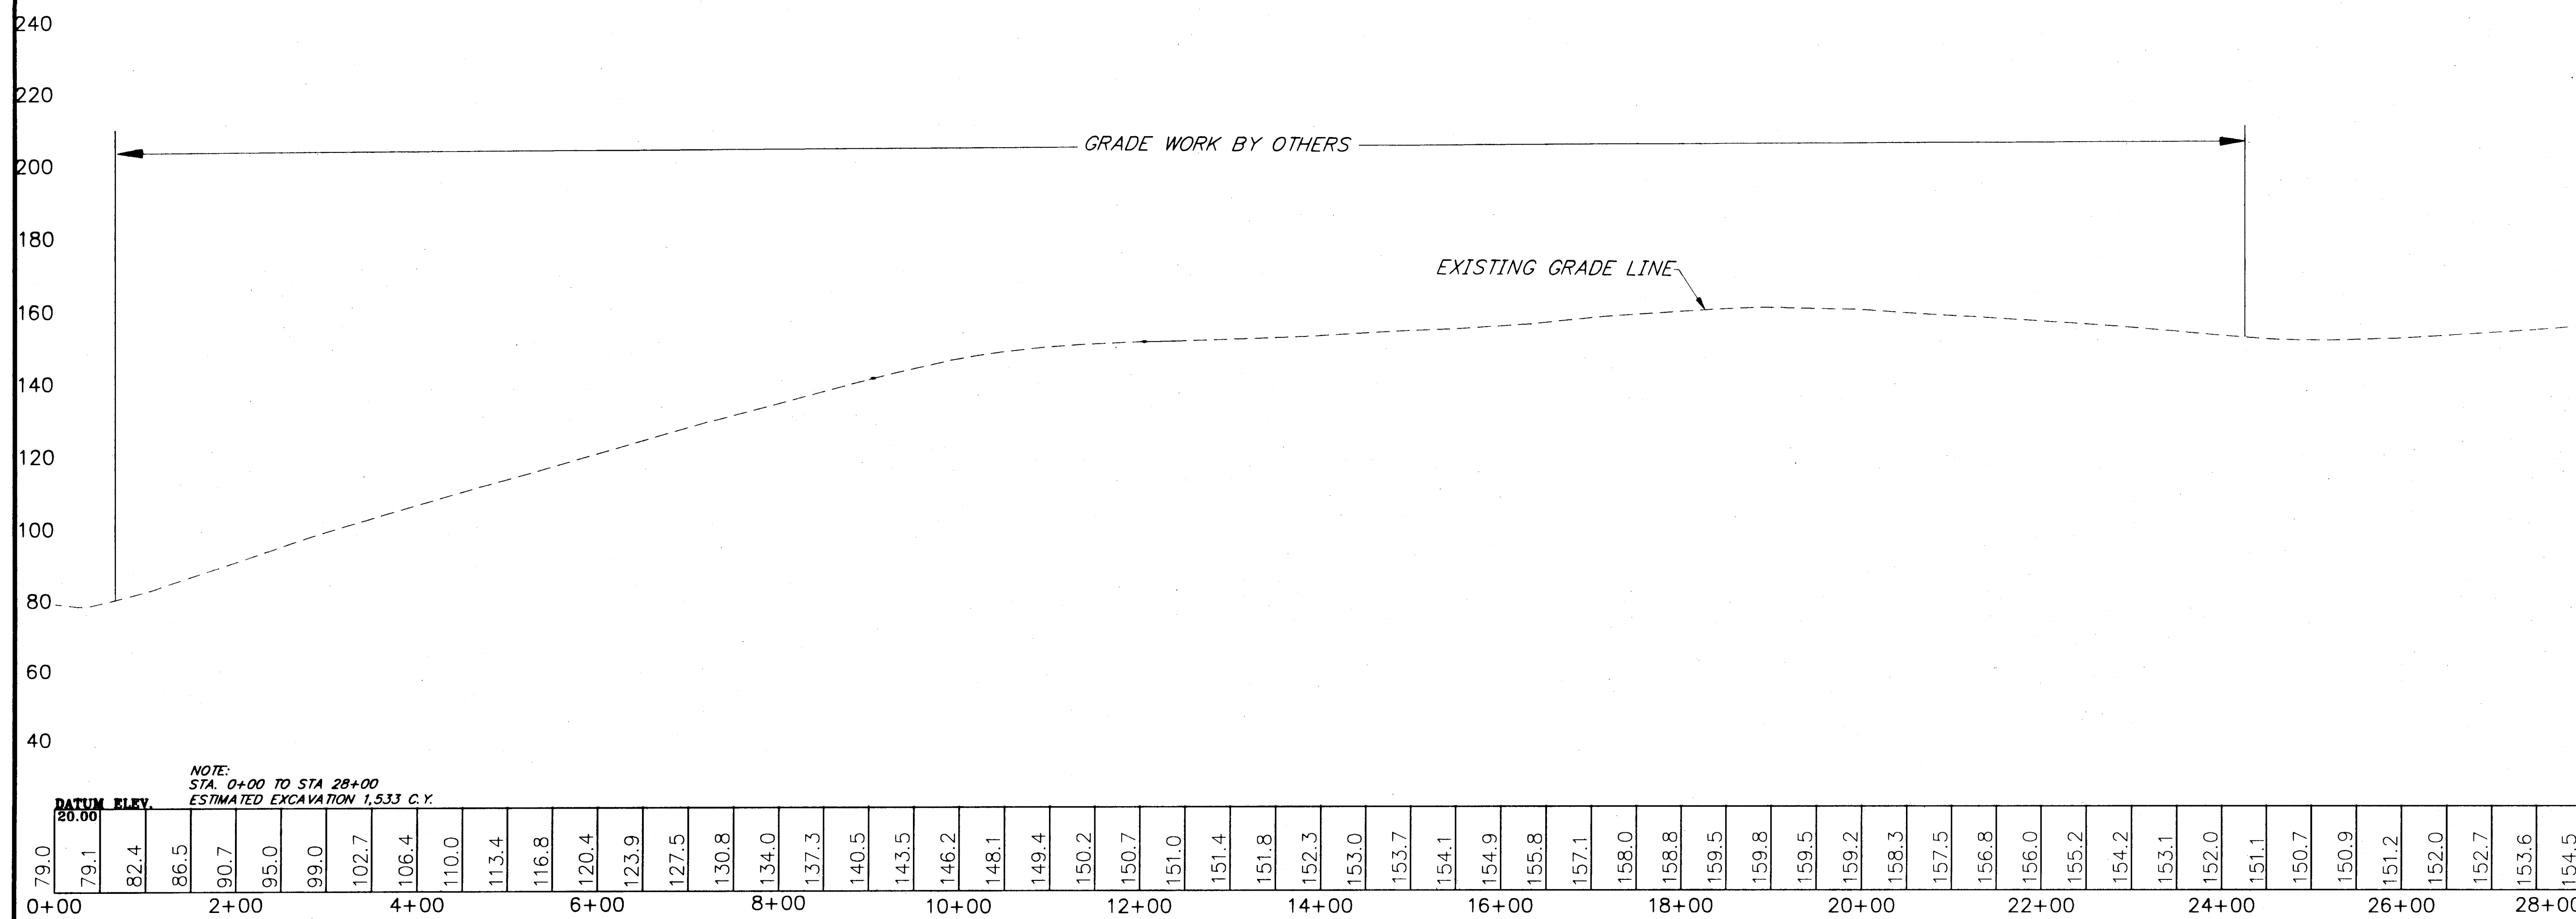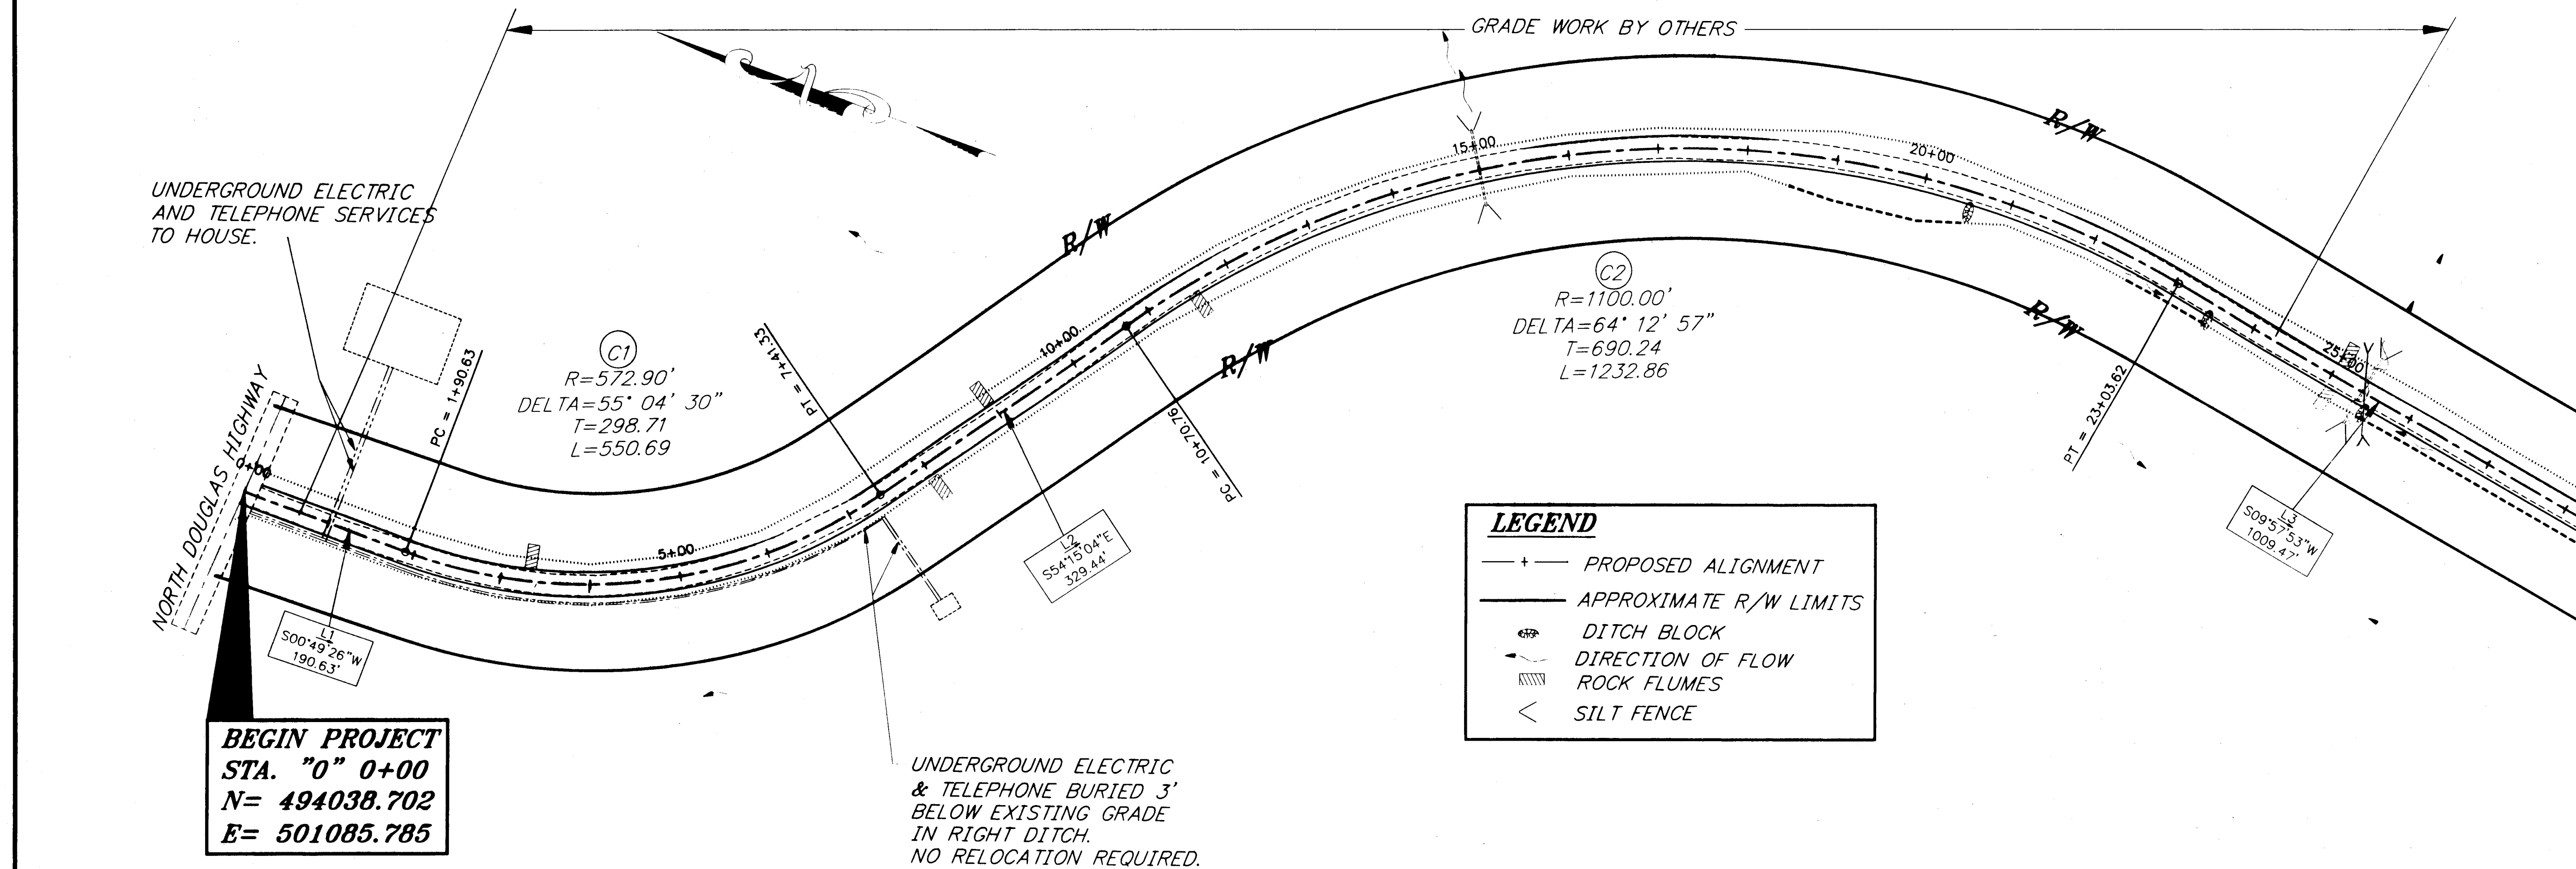

NOTE:
STA. 0+00 TO STA 28+00
ESTIMATED EXCAVATION 1,533 C.Y.

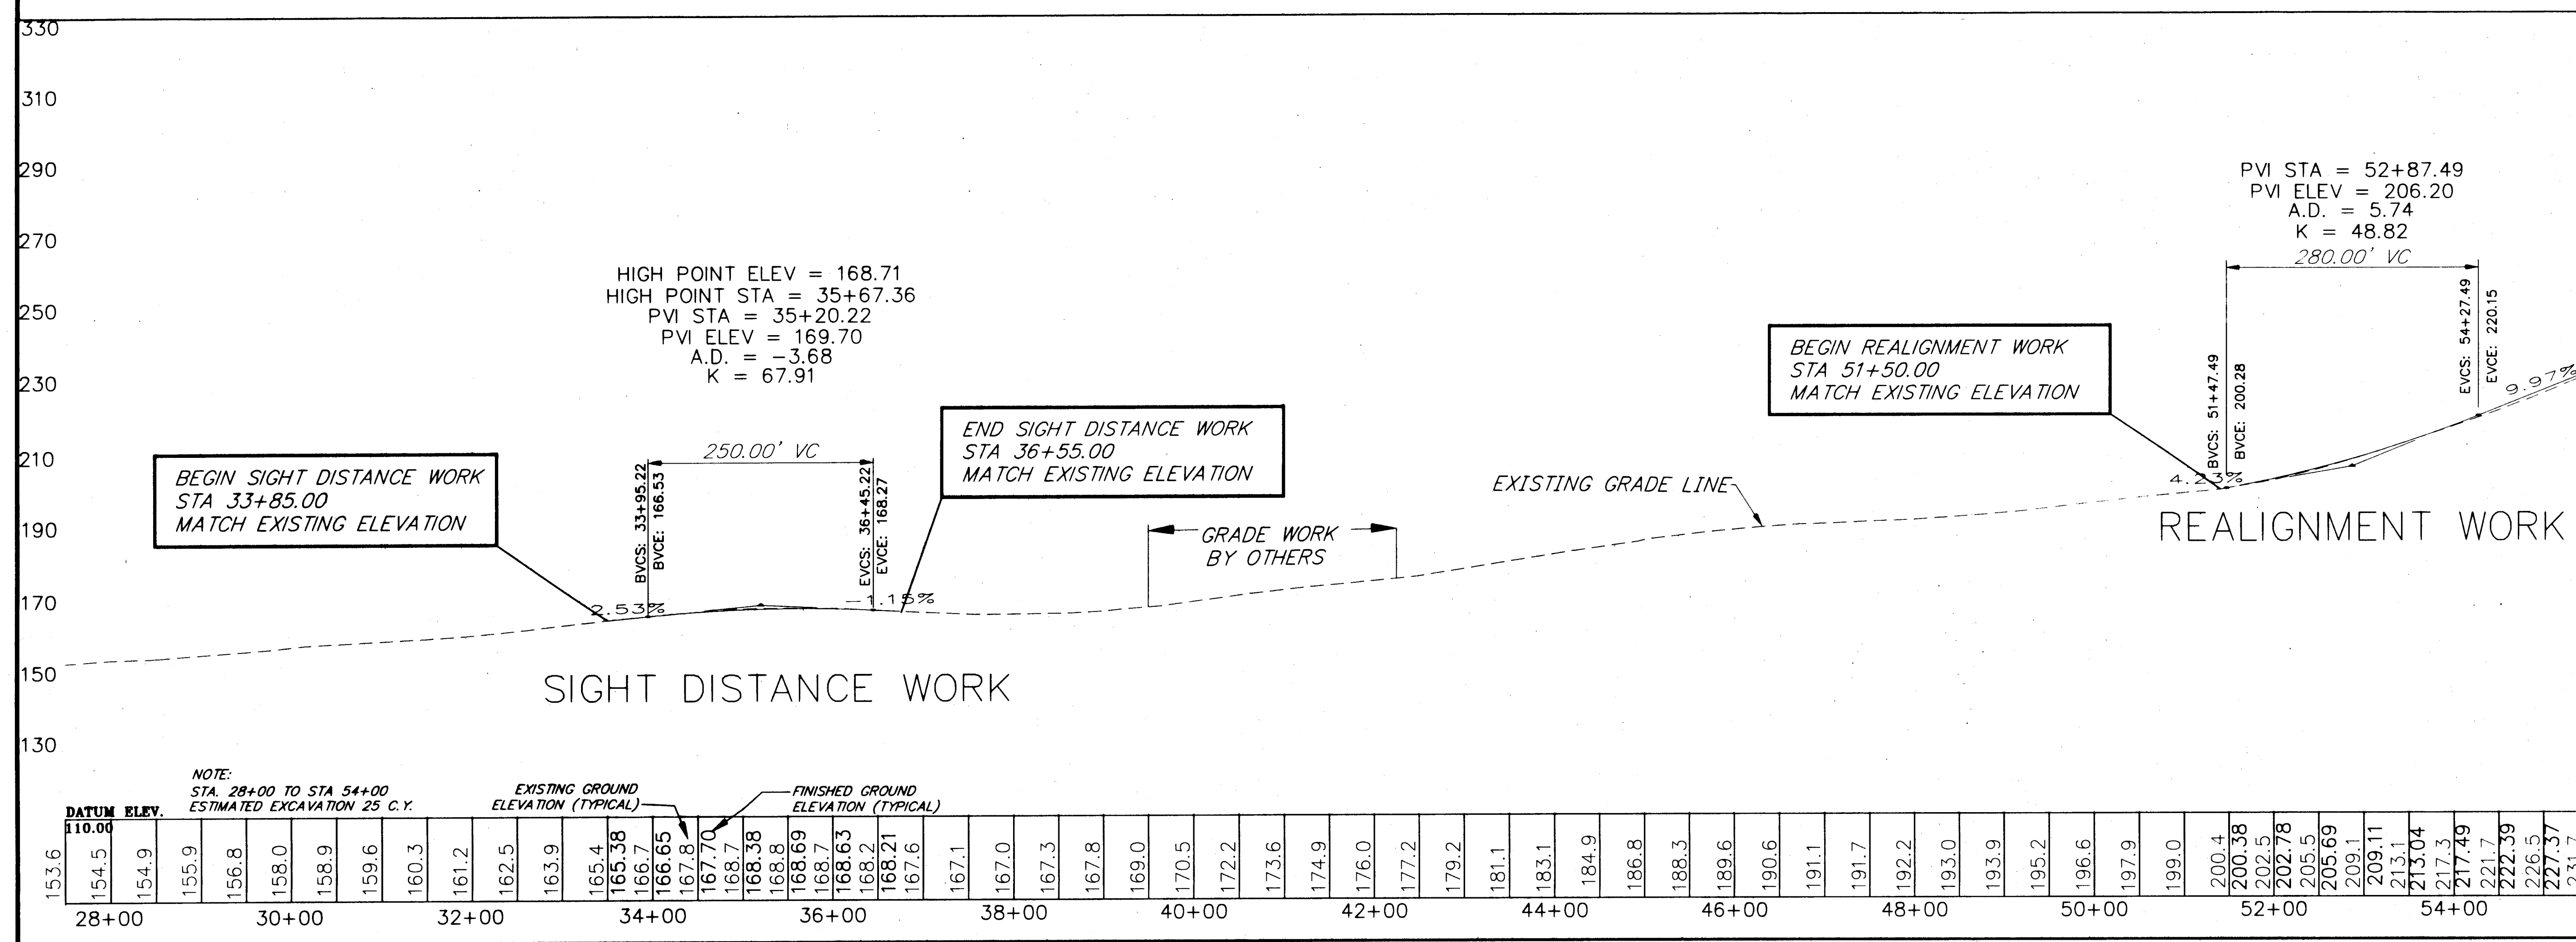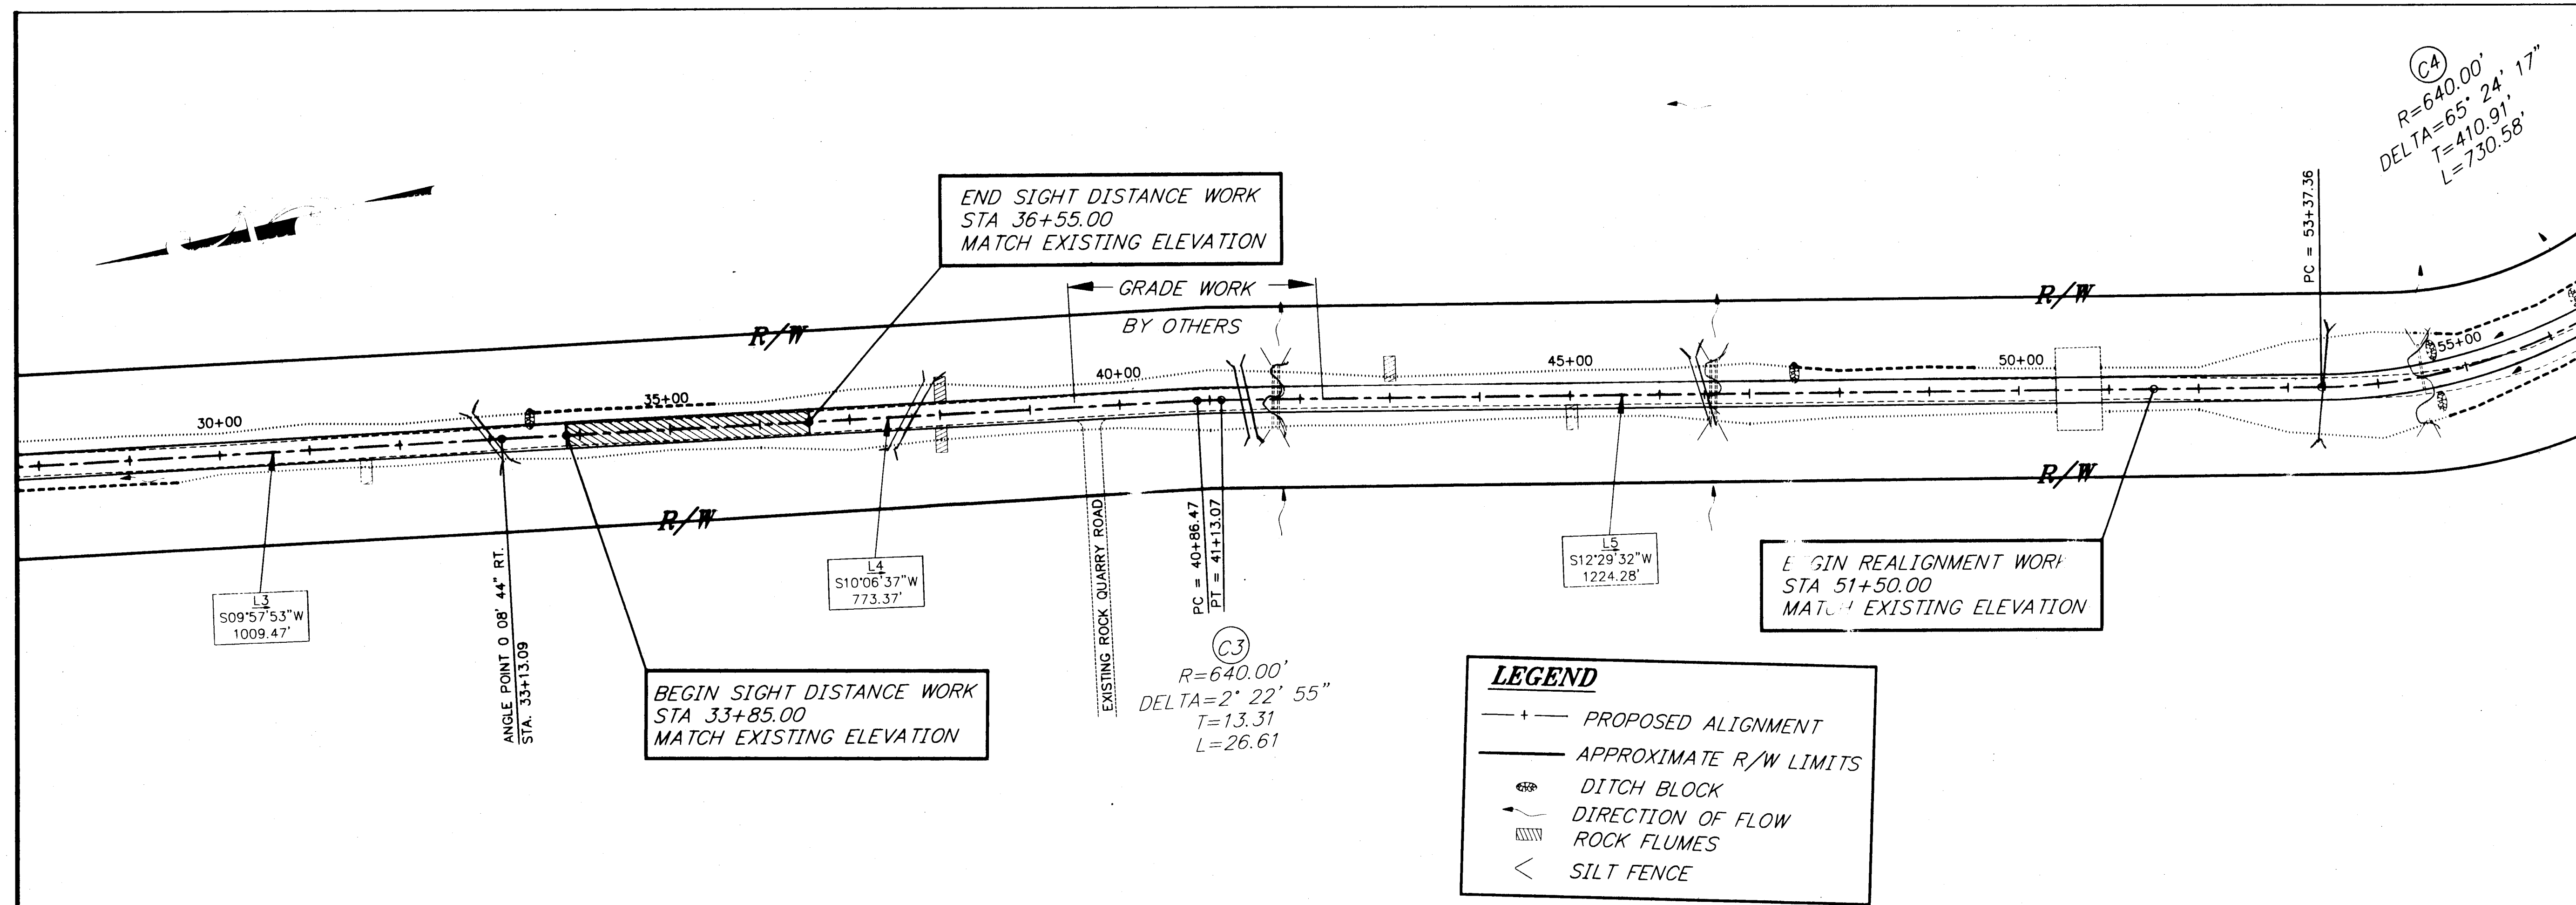

Q:\Jnu\68269_PlanSet\E_Plan&Profile.DWG Tue, 15/Jun/02 04:03PM Kris	
ADDENDUM NUMBER	
ATTACHMENT NUMBER	
RECORD OF REVISIONS	
No.	DATE DESCRIPTION
JNU-FISH CREEK ROAD SAFETY IMPROVEMENTS PROJECT NO. 68269	
DESIGNED BY: T. LAVERGNE 7-22-03	
CHECKED BY: M. KRIKORIAN DRAWN BY: M. KRIKORIAN	
STATE OF ALASKA DEPARTMENT OF TRANSPORTATION & PUBLIC FACILITIES STATEWIDE DESIGN & ENGINEERING SERVICES DIVISION JNU-FISH CREEK ROAD SAFETY IMPROVEMENTS PROJECT NO. 68269	
PLAN AND PROFILE	
PROJECT DESIGNATION NUMBER	
ACHRO-0953(4)	
STATE	YEAR
ALASKA	2001
SHEET NUMBER	TOTAL SHEETS
E2	41


PLAN AND PROFILE
STA 28+00 TO STA 54+00

ADDENDUM NUMBER		
ATTACHMENT NUMBER		
RECORD OF REVISIONS		
No.	DATE	DESCRIPTION

JNU-FISH CREEK ROAD
SAFETY IMPROVEMENTS
PROJECT NO. 68269

PLAN AND PROFILE STA 54+00 TO 77+00

7-22-03 JH
DESIGNED BY: L4/EPH

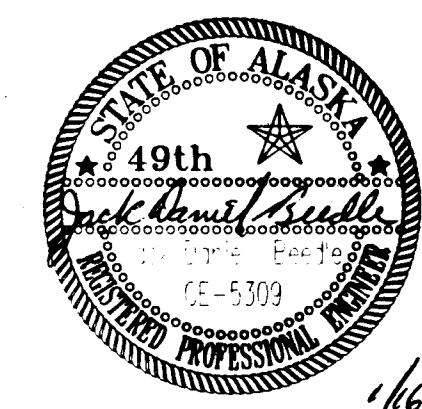

CHECKED BY: M. J. MOORE
DRAWN BY: J. L. MOORE

STATE OF ALASKA
DEPARTMENT OF TRANSPORTATION
& PUBLIC FACILITIES
STATEWIDE DESIGN & ENGINEERING
SERVICES DIVISION



JNU-FISH CREEK ROAD
SAFETY IMPROVEMENTS
PROJECT NO. 68269

PLAN AND PROFILE

PROJECT DESIGNATION NUMBER

ACHRO-0953(4)

STATE	YEAR
ALASKA	2001
SHEET NUMBER	TOTAL SHEETS
E3	41

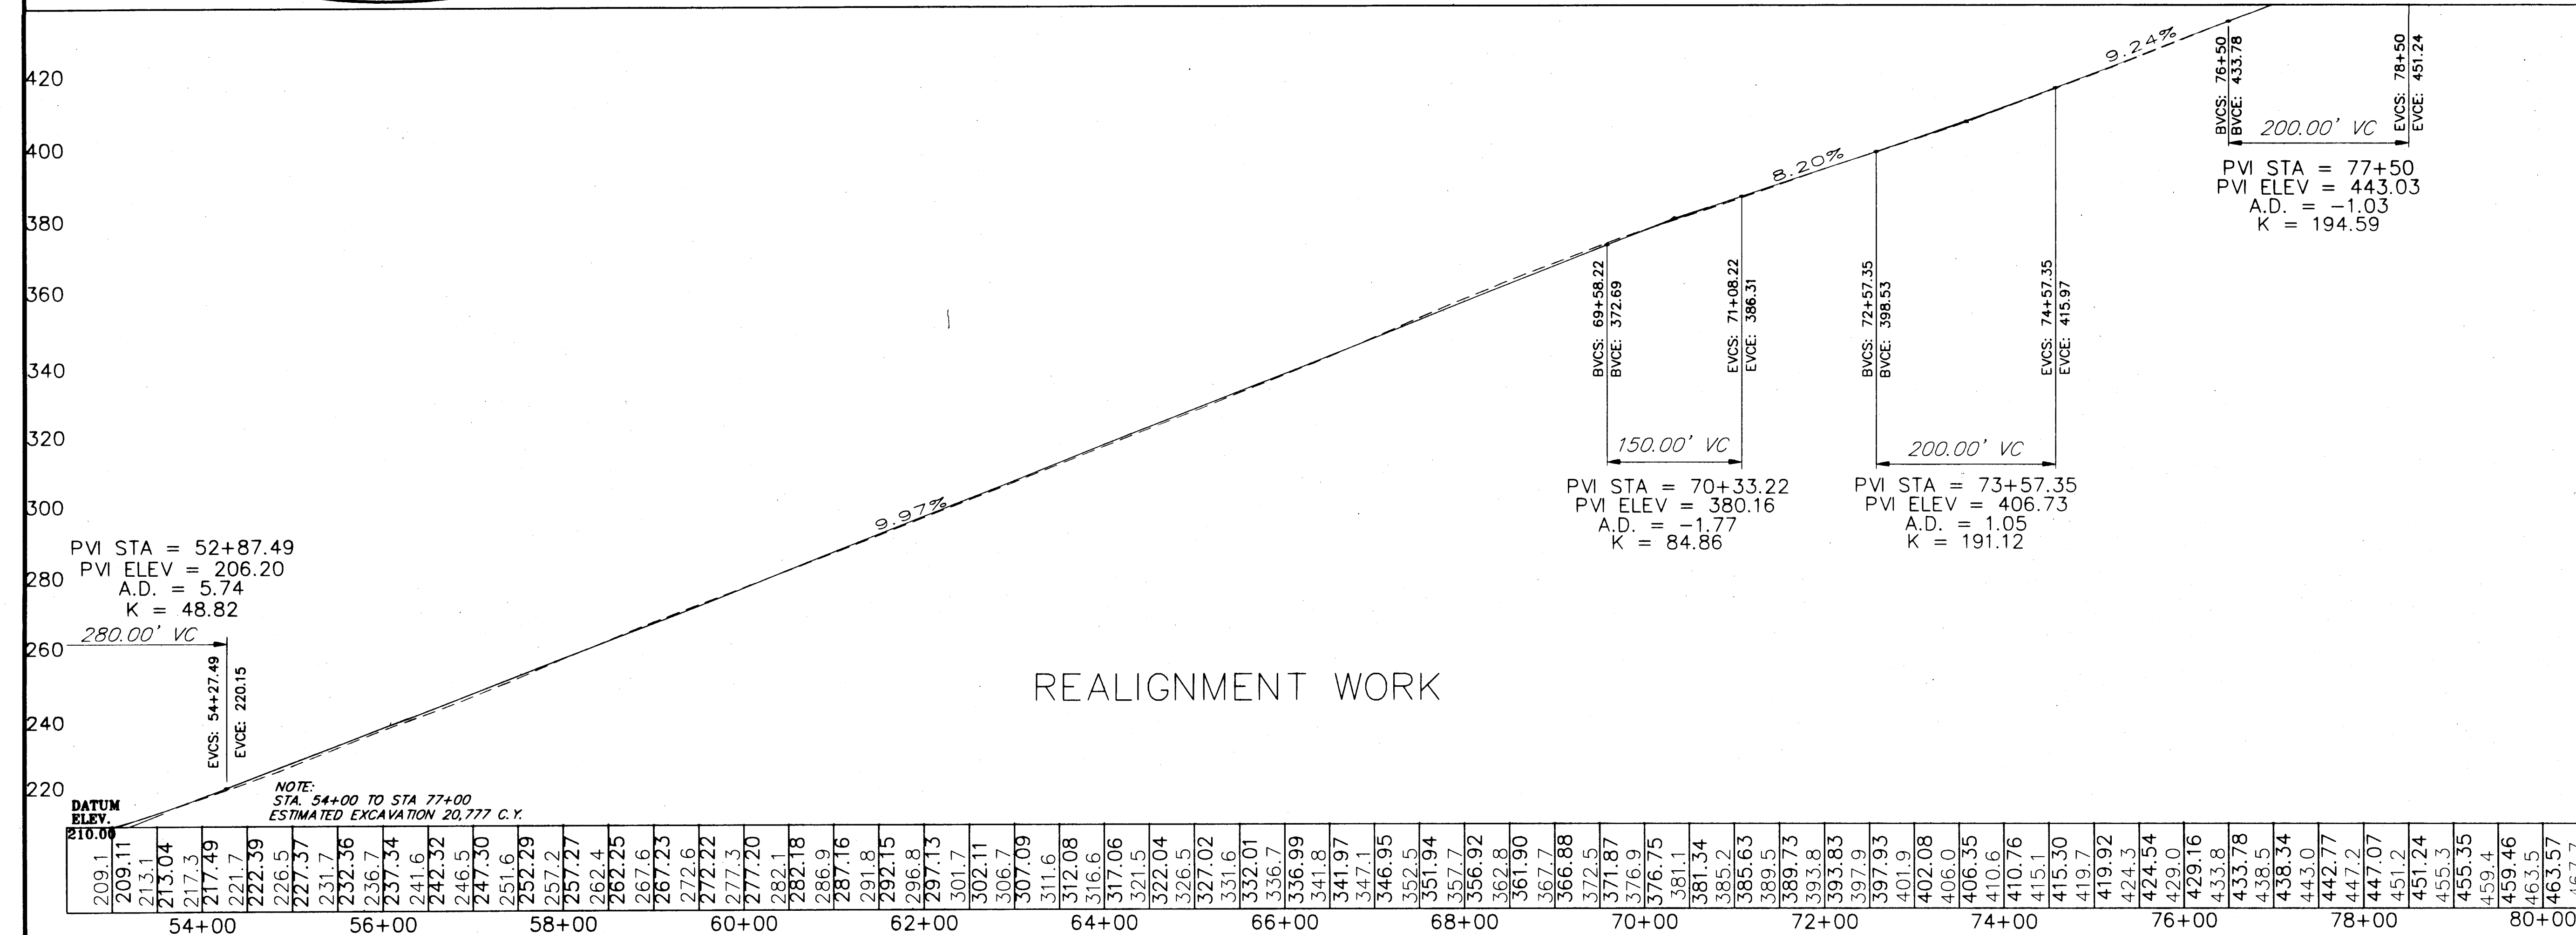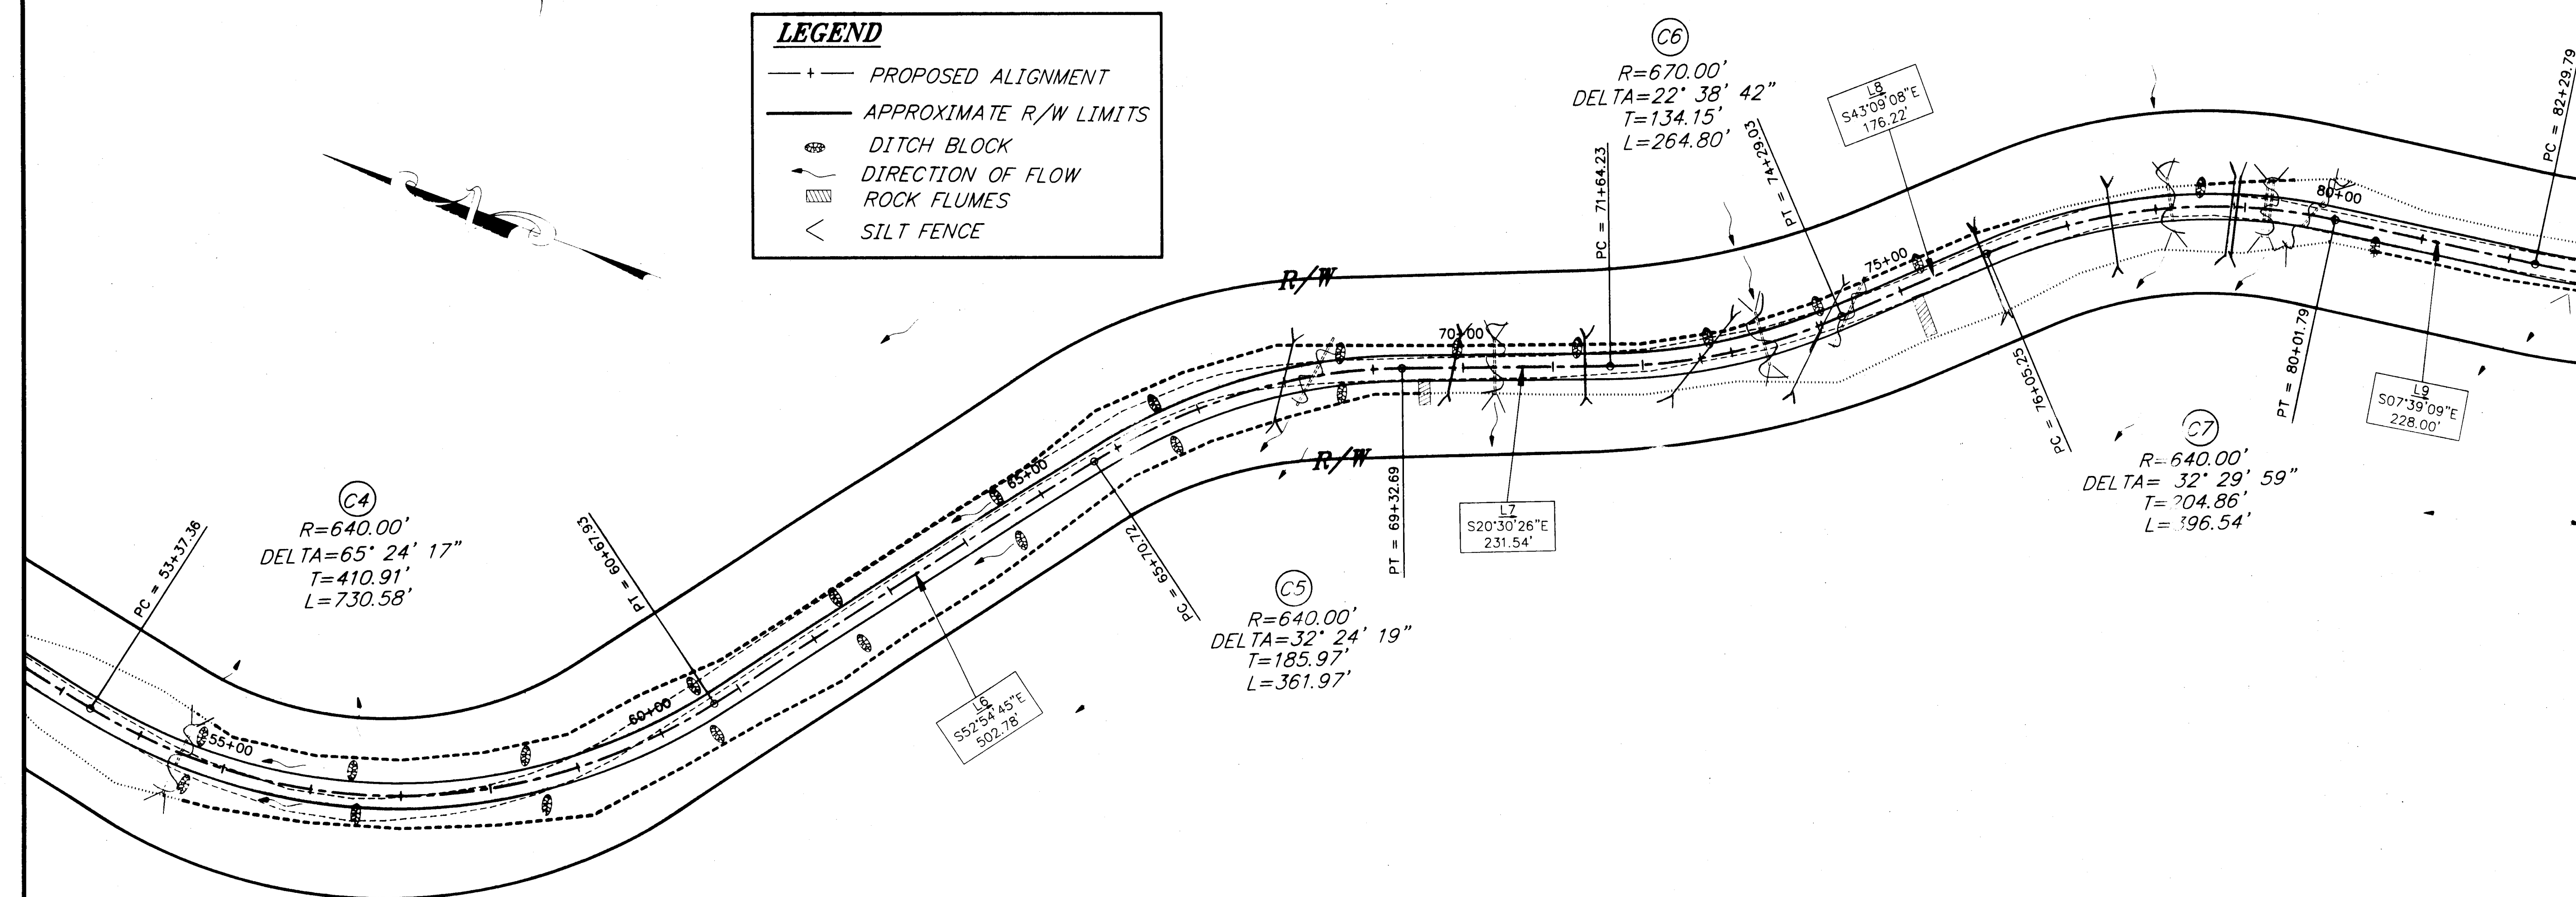


Q:\Jnu\68269\PlanSet\E_Plan&Profile.DWG
Tue, 15/Jan/02 04:04PM Kris

ADDENDUM NUMBER		
ATTACHMENT NUMBER		
RECORD OF REVISIONS		
No.	DATE	DESCRIPTION

JNU-FISH CREEK ROAD
SAFETY IMPROVEMENTS
PROJECT NO. 68269

PLAN AND PROFILE STA 77+00 TO STA 102+00

DESIGNED BY: J. LAURITSEN


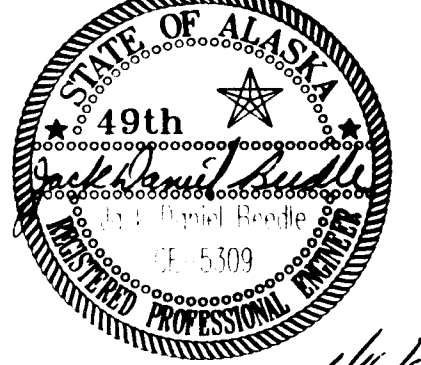


CHECKED BY: J. LAURITSEN
DRAWN BY: J. LAURITSEN

STATE OF ALASKA
DEPARTMENT OF TRANSPORTATION
& PUBLIC FACILITIES
STATEWIDE DESIGN & ENGINEERING
SERVICES DIVISION
**JNU-FISH CREEK ROAD
SAFETY IMPROVEMENTS
PROJECT NO. 68269**



PLAN AND PROFILE

PROJECT DESIGNATION NUMBER	
ACHRO-0953(4)	
STATE	YEAR
ALASKA	2001
SHEET NUMBER	TOTAL SHEETS
E4	41

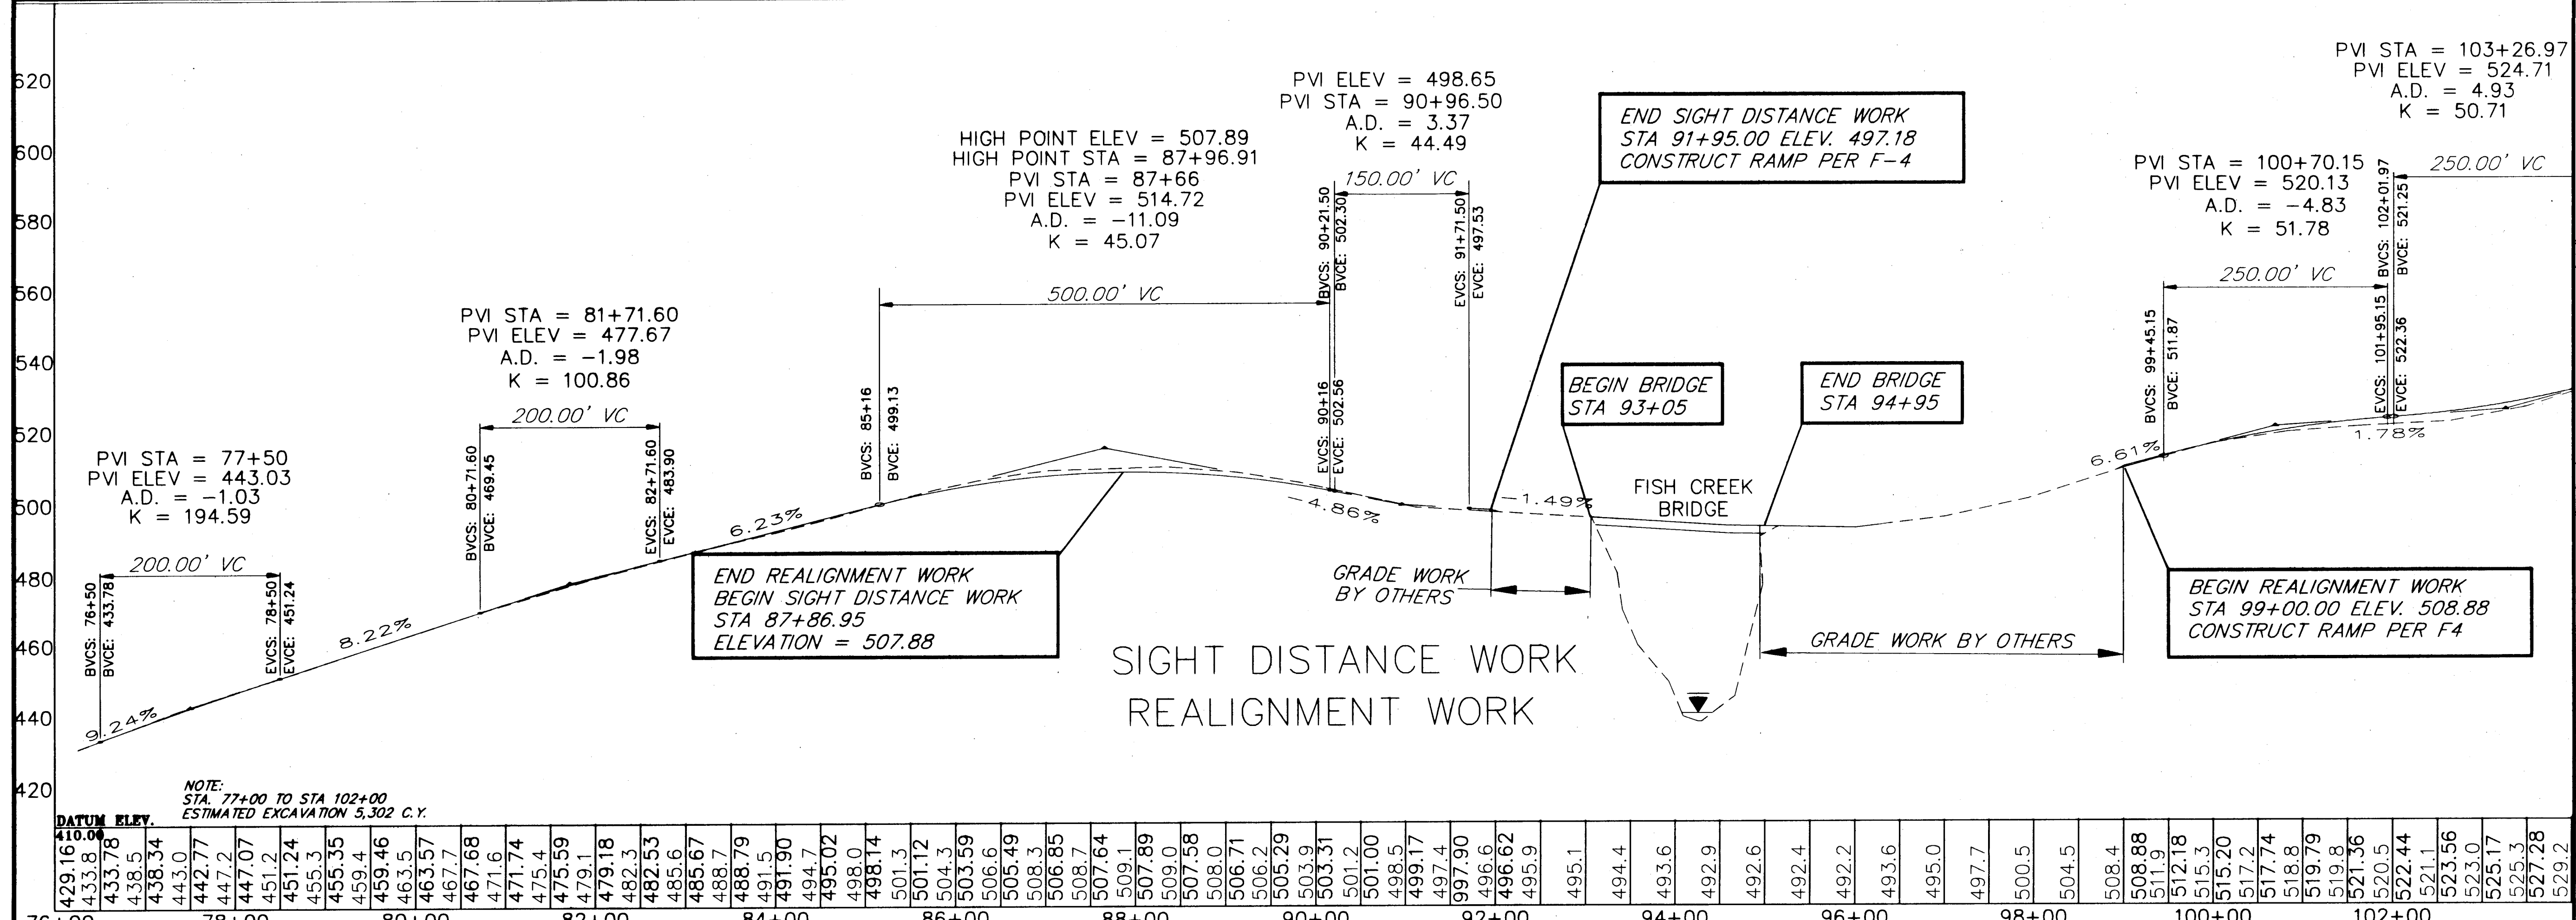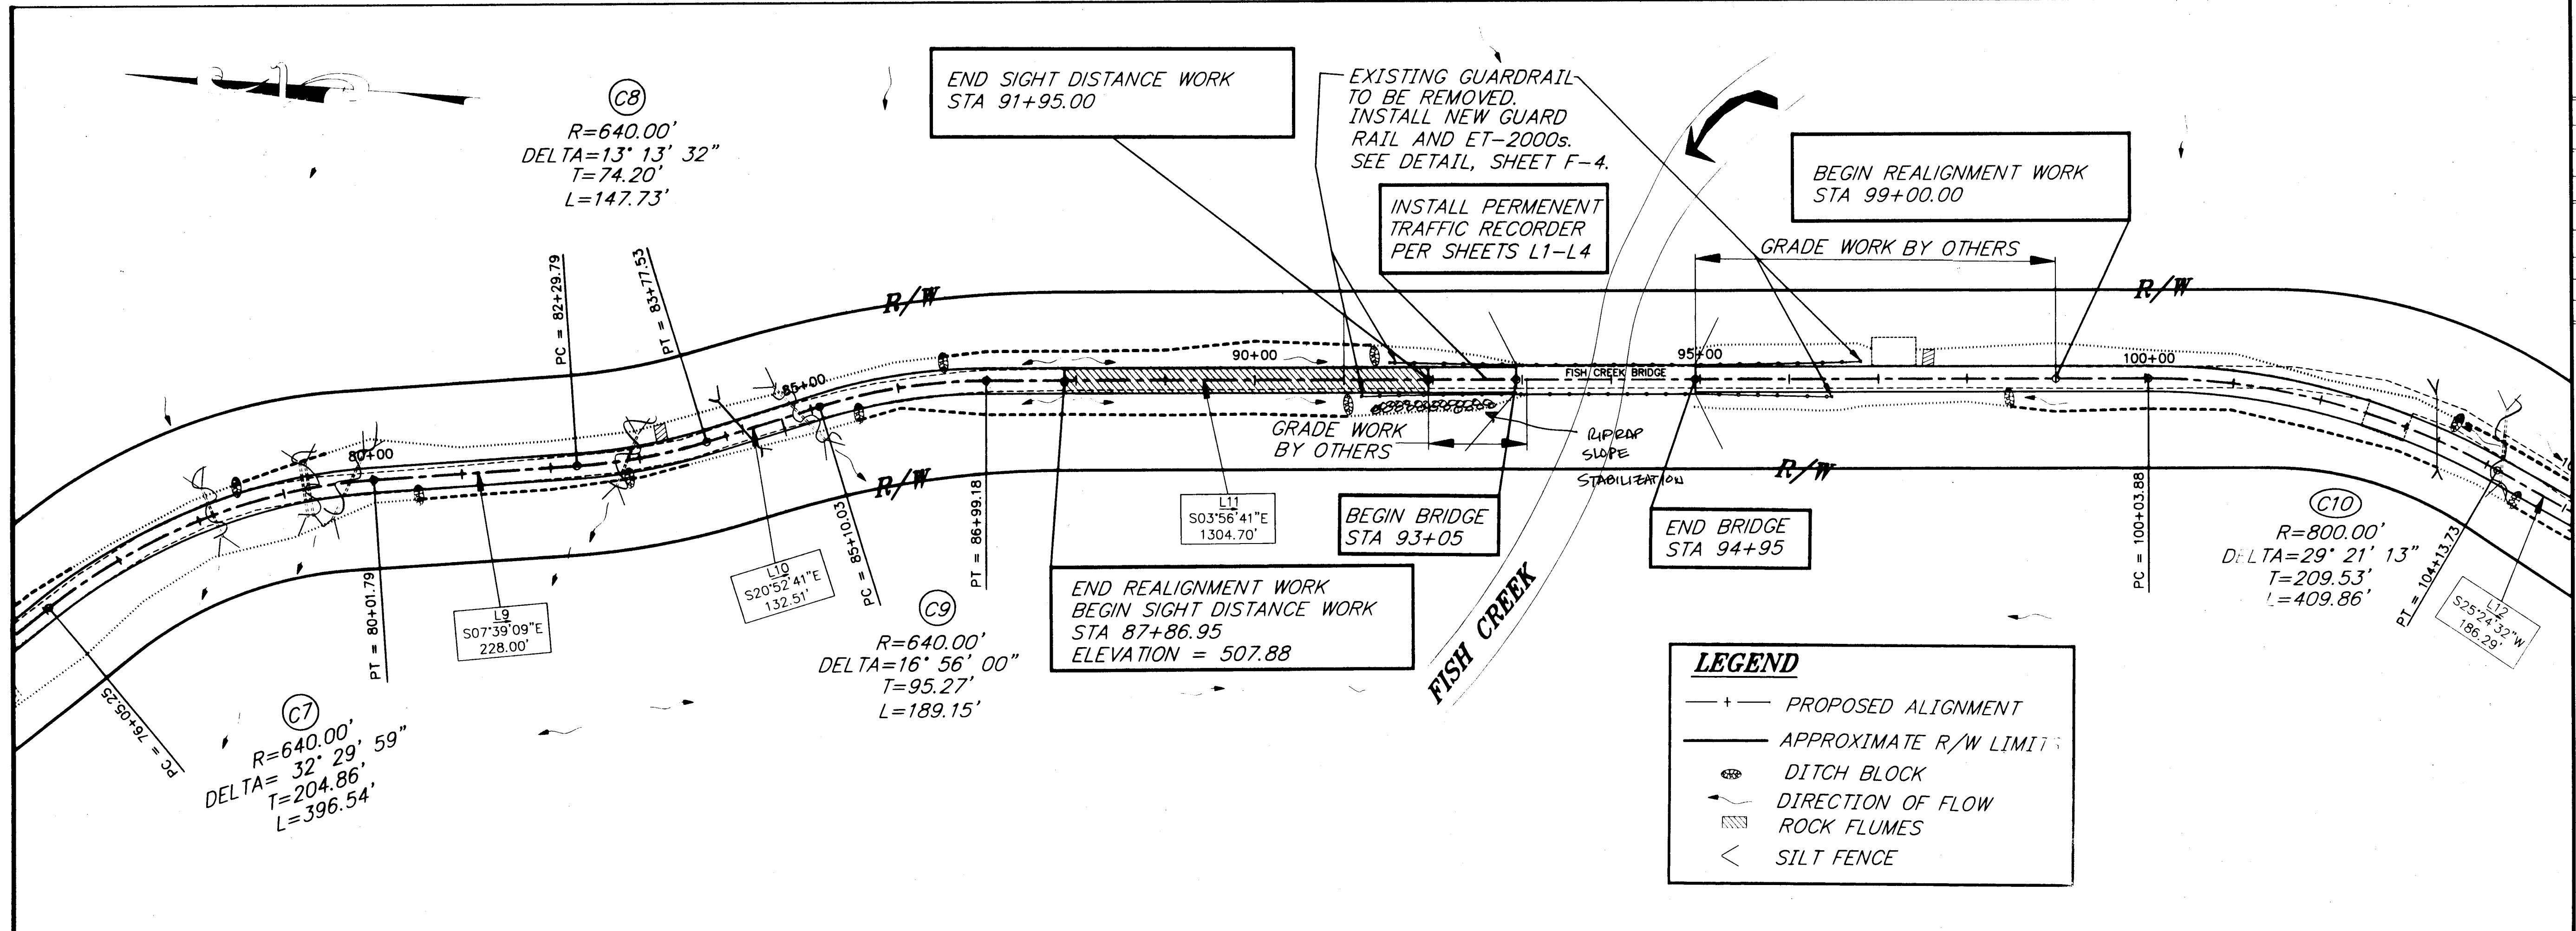

Q:\Jnu\68269\Plan\Profile.DWG
 Tue, 15/Jan/02 04:04PM Kris
 ELEV
 SCALE 1"=100' HORIZ. 1"=10'

ADDENDUM NUMBER		
ATTACHMENT NUMBER		
RECORD OF REVISIONS		
No.	DATE	DESCRIPTION

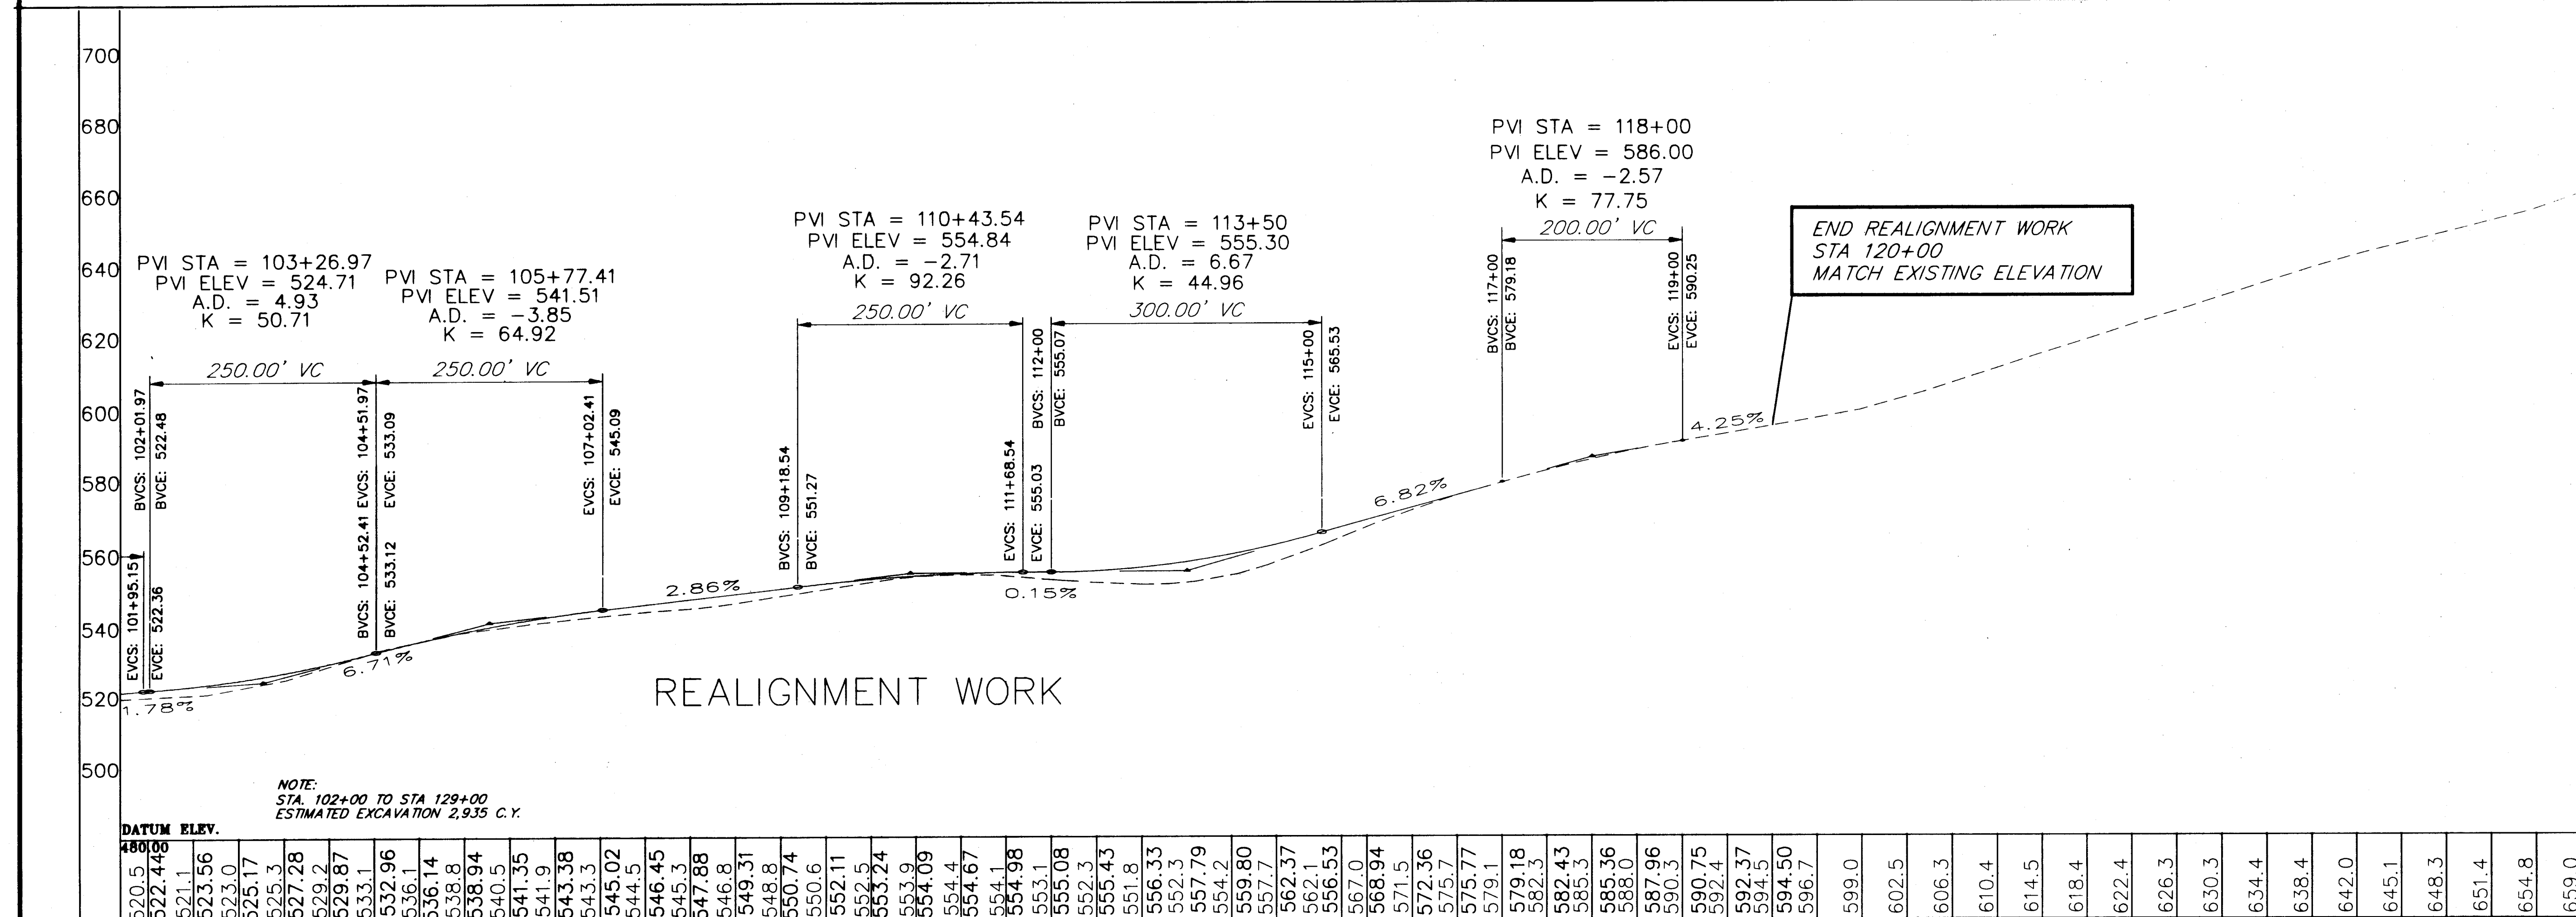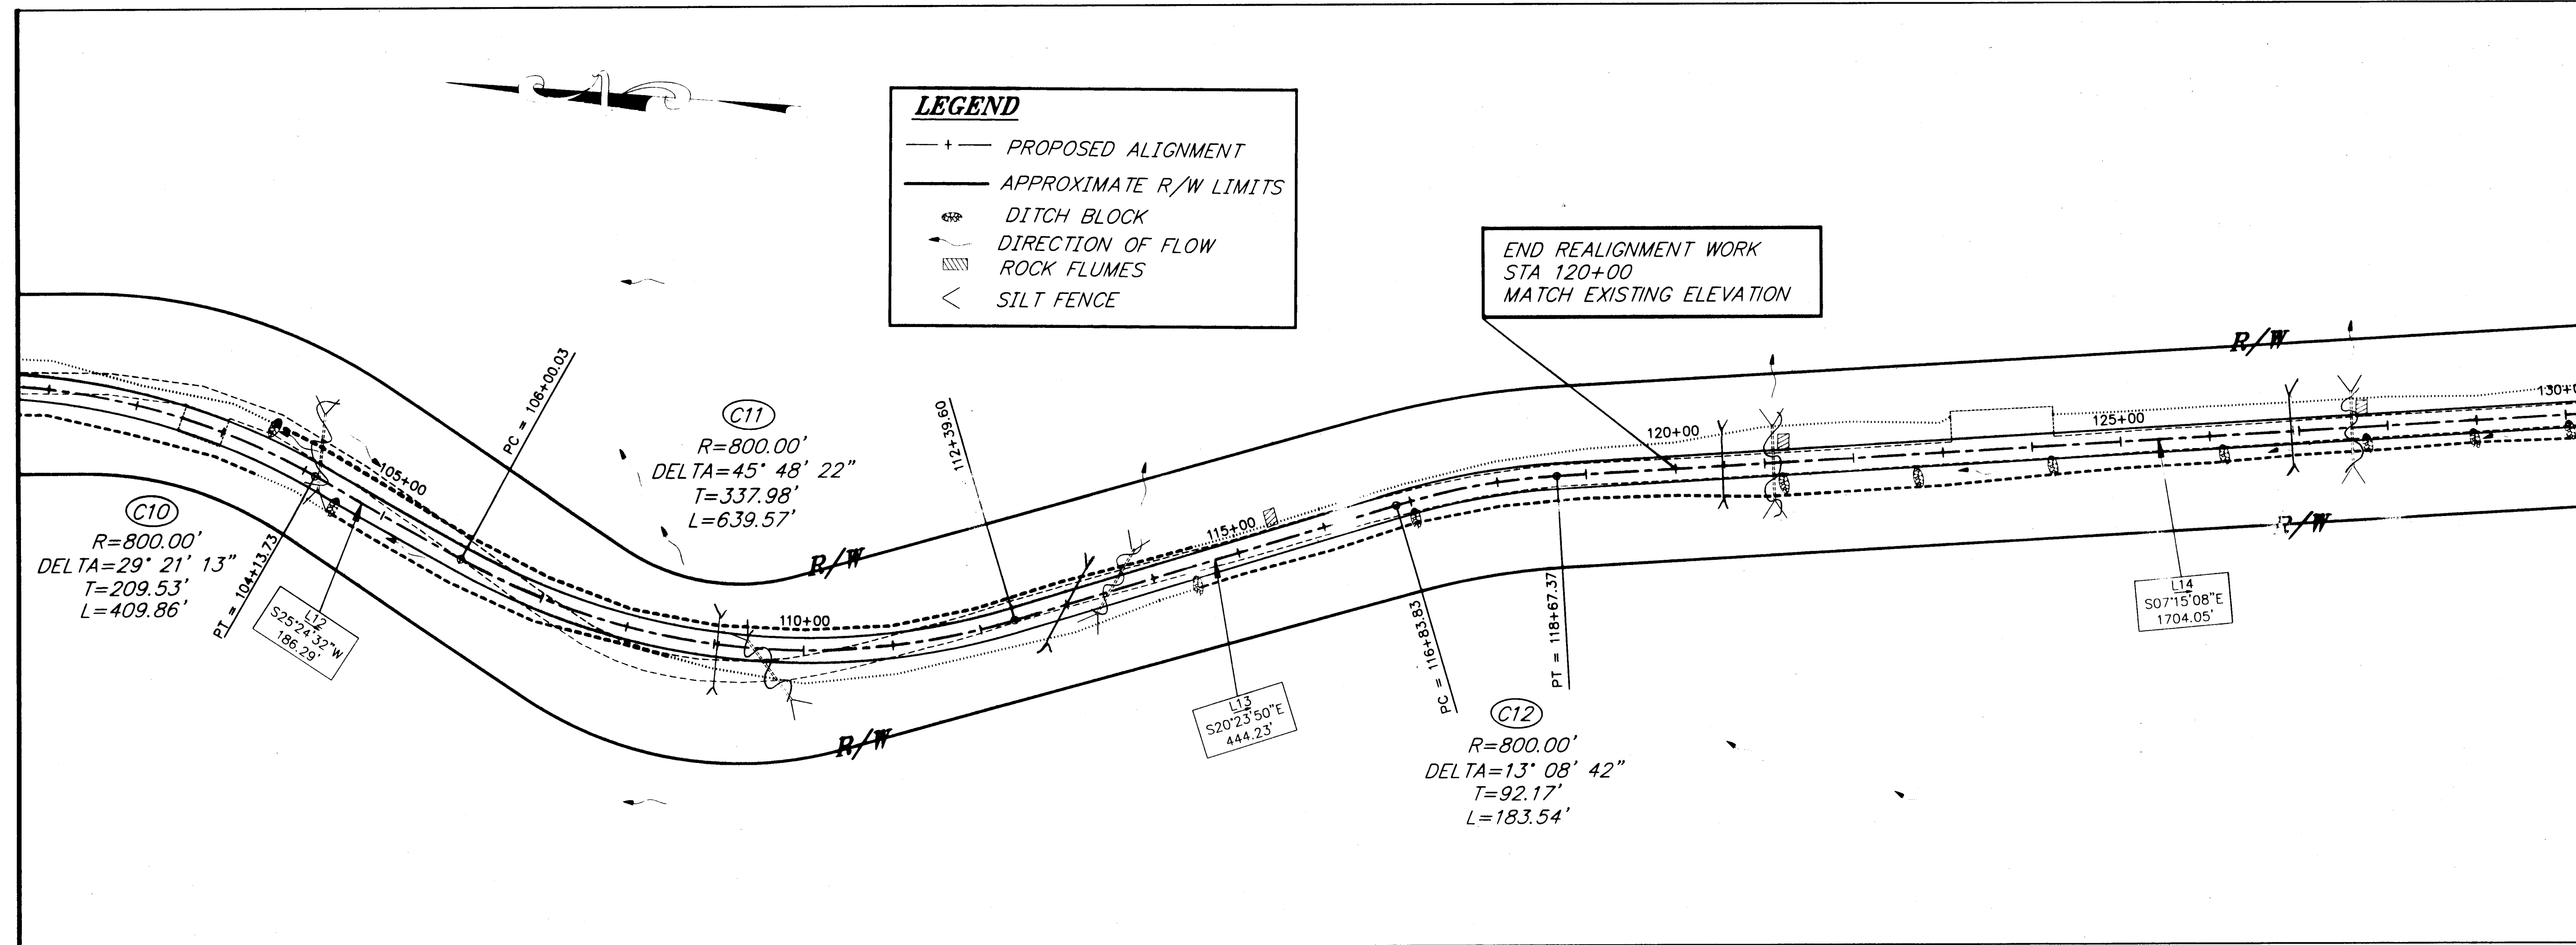

JNU-FISH CREEK ROAD
 SAFETY IMPROVEMENTS
 PROJECT NO. 68269

PLAN AND PROFILE
 STA 102+00 TO STA 129+00

DESIGNED BY: *TH 7-22-03*

CHECKED BY: *[Signature]*

DRAWN BY: *[Signature]*

STATE OF ALASKA
 DEPARTMENT OF TRANSPORTATION
 & PUBLIC FACILITIES
 STATEWIDE DESIGN & ENGINEERING
 SERVICES DIVISION

JNU-FISH CREEK ROAD
 SAFETY IMPROVEMENTS
 PROJECT NO. 68269

PLAN AND PROFILE



PROJECT DESIGNATION NUMBER
ACHRO-0953(4)

STATE	YEAR
ALASKA	2001

SHEET NUMBER	TOTAL SHEETS
E5	41

Q:\Jnu\68269\Plan\Set\Profile.DWG
Tue, 15 Jan 02 04:04PM Kris

ADDENDUM NUMBER		
ATTACHMENT NUMBER		
RECORD OF REVISIONS		
No.	DATE	DESCRIPTION

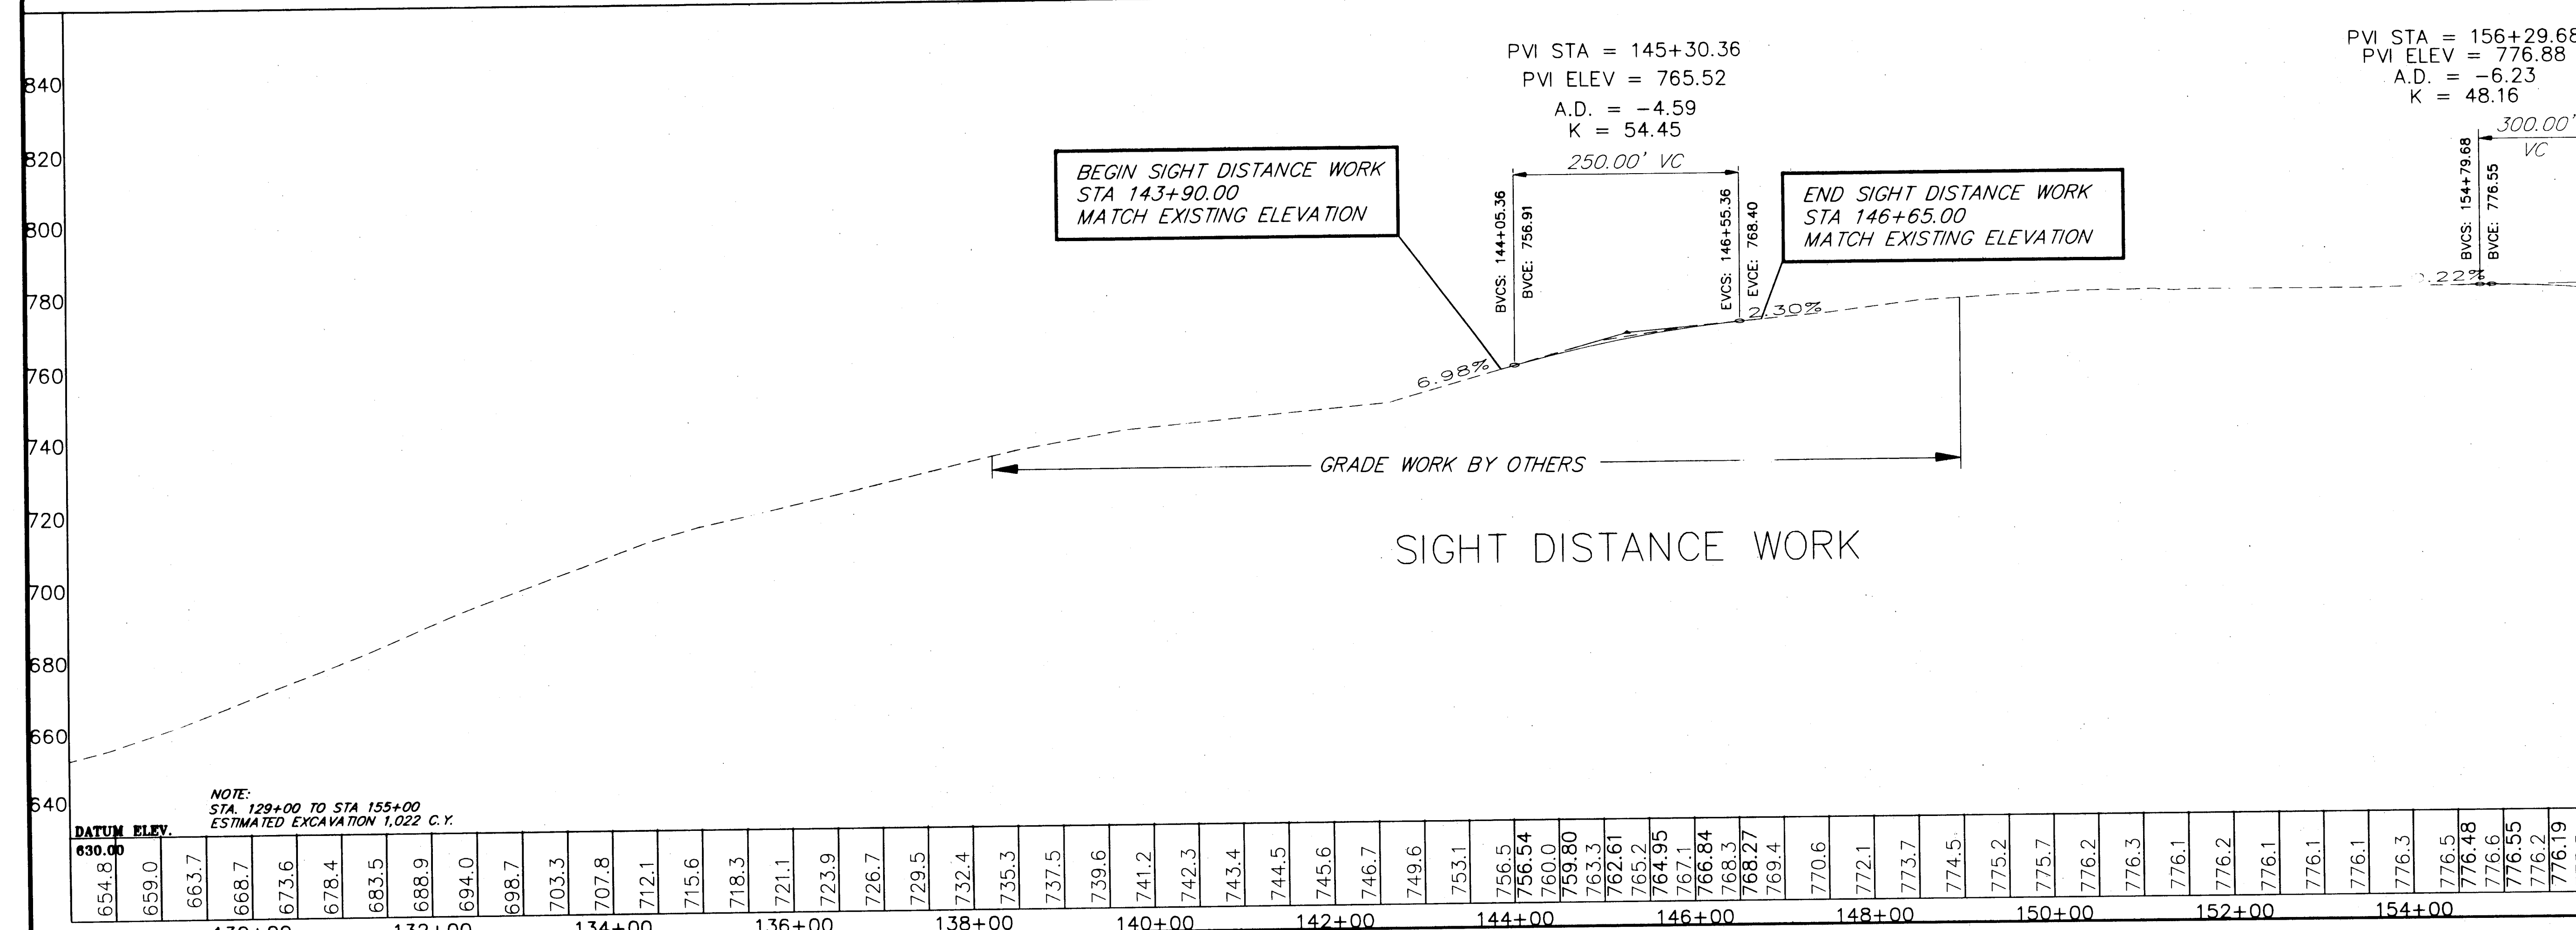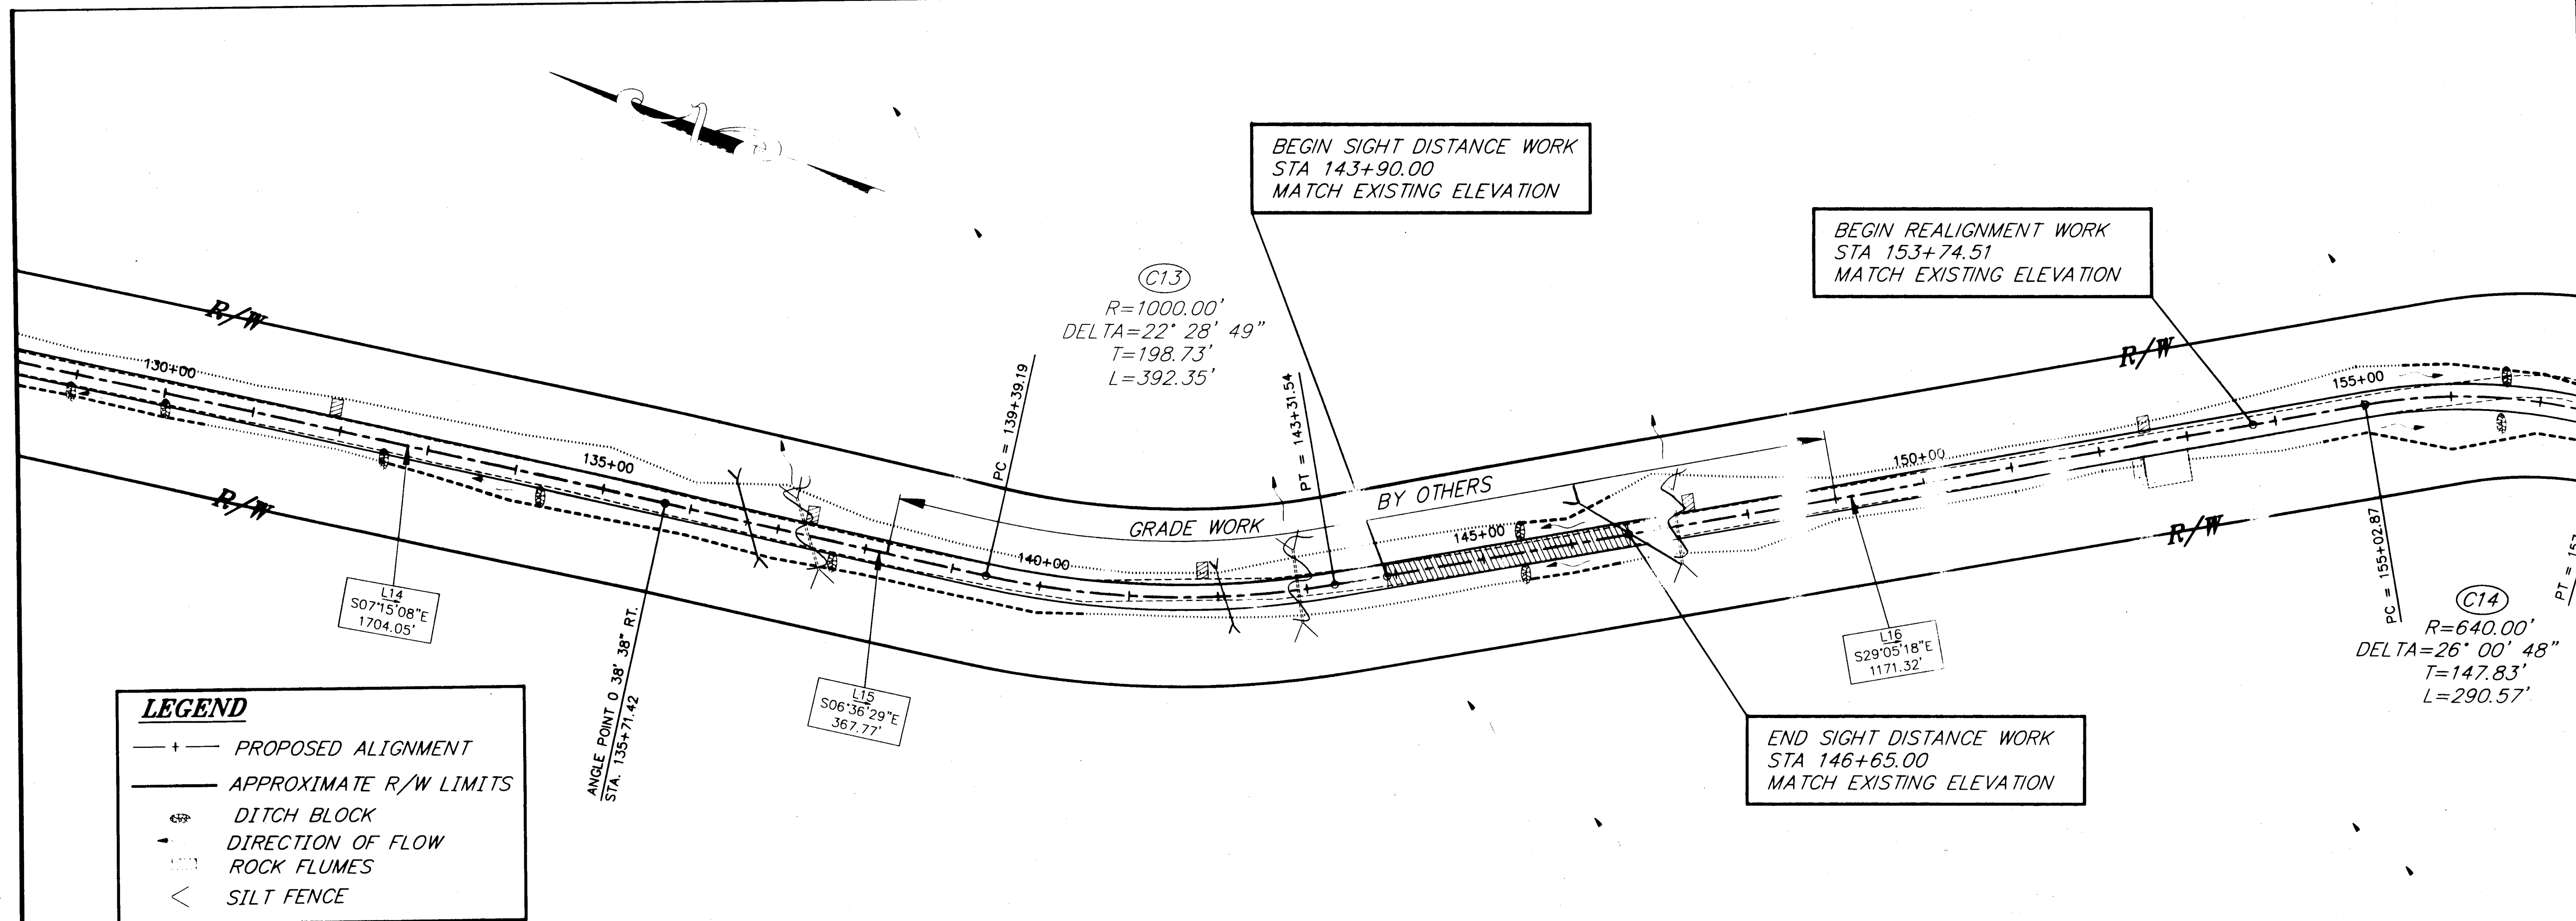

JNU-FISH CREEK ROAD
SAFETY IMPROVEMENTS
PROJECT NO. 68269

PLAN AND PROFILE
STA 129+00 TO STA 155+00

DESIGNED BY: M. LAVERGNE

CHECKED BY: T. MOORE
DRAWN BY: J. J.

STATE OF ALASKA
DEPARTMENT OF TRANSPORTATION & PUBLIC FACILITIES
STATEWIDE DESIGN & ENGINEERING SERVICES DIVISION

JNU-FISH CREEK ROAD
SAFETY IMPROVEMENTS
PROJECT NO. 68269

PLAN AND PROFILE

PROJECT DESIGNATION NUMBER
ACHRO-0953(4)

STATE	YEAR
ALASKA	2001
SHEET NUMBER	TOTAL SHEETS
E6	41

ADDENDUM NUMBER


ATTACHMENT NUMBER

RECORD OF REVISIONS

No.	DATE	DESCRIPTION


JNU-FISH CREEK ROAD
SAFETY IMPROVEMENTS
PROJECT NO. 68269

PLAN AND PROFILE STA 155 155+00 TO STA 179+00

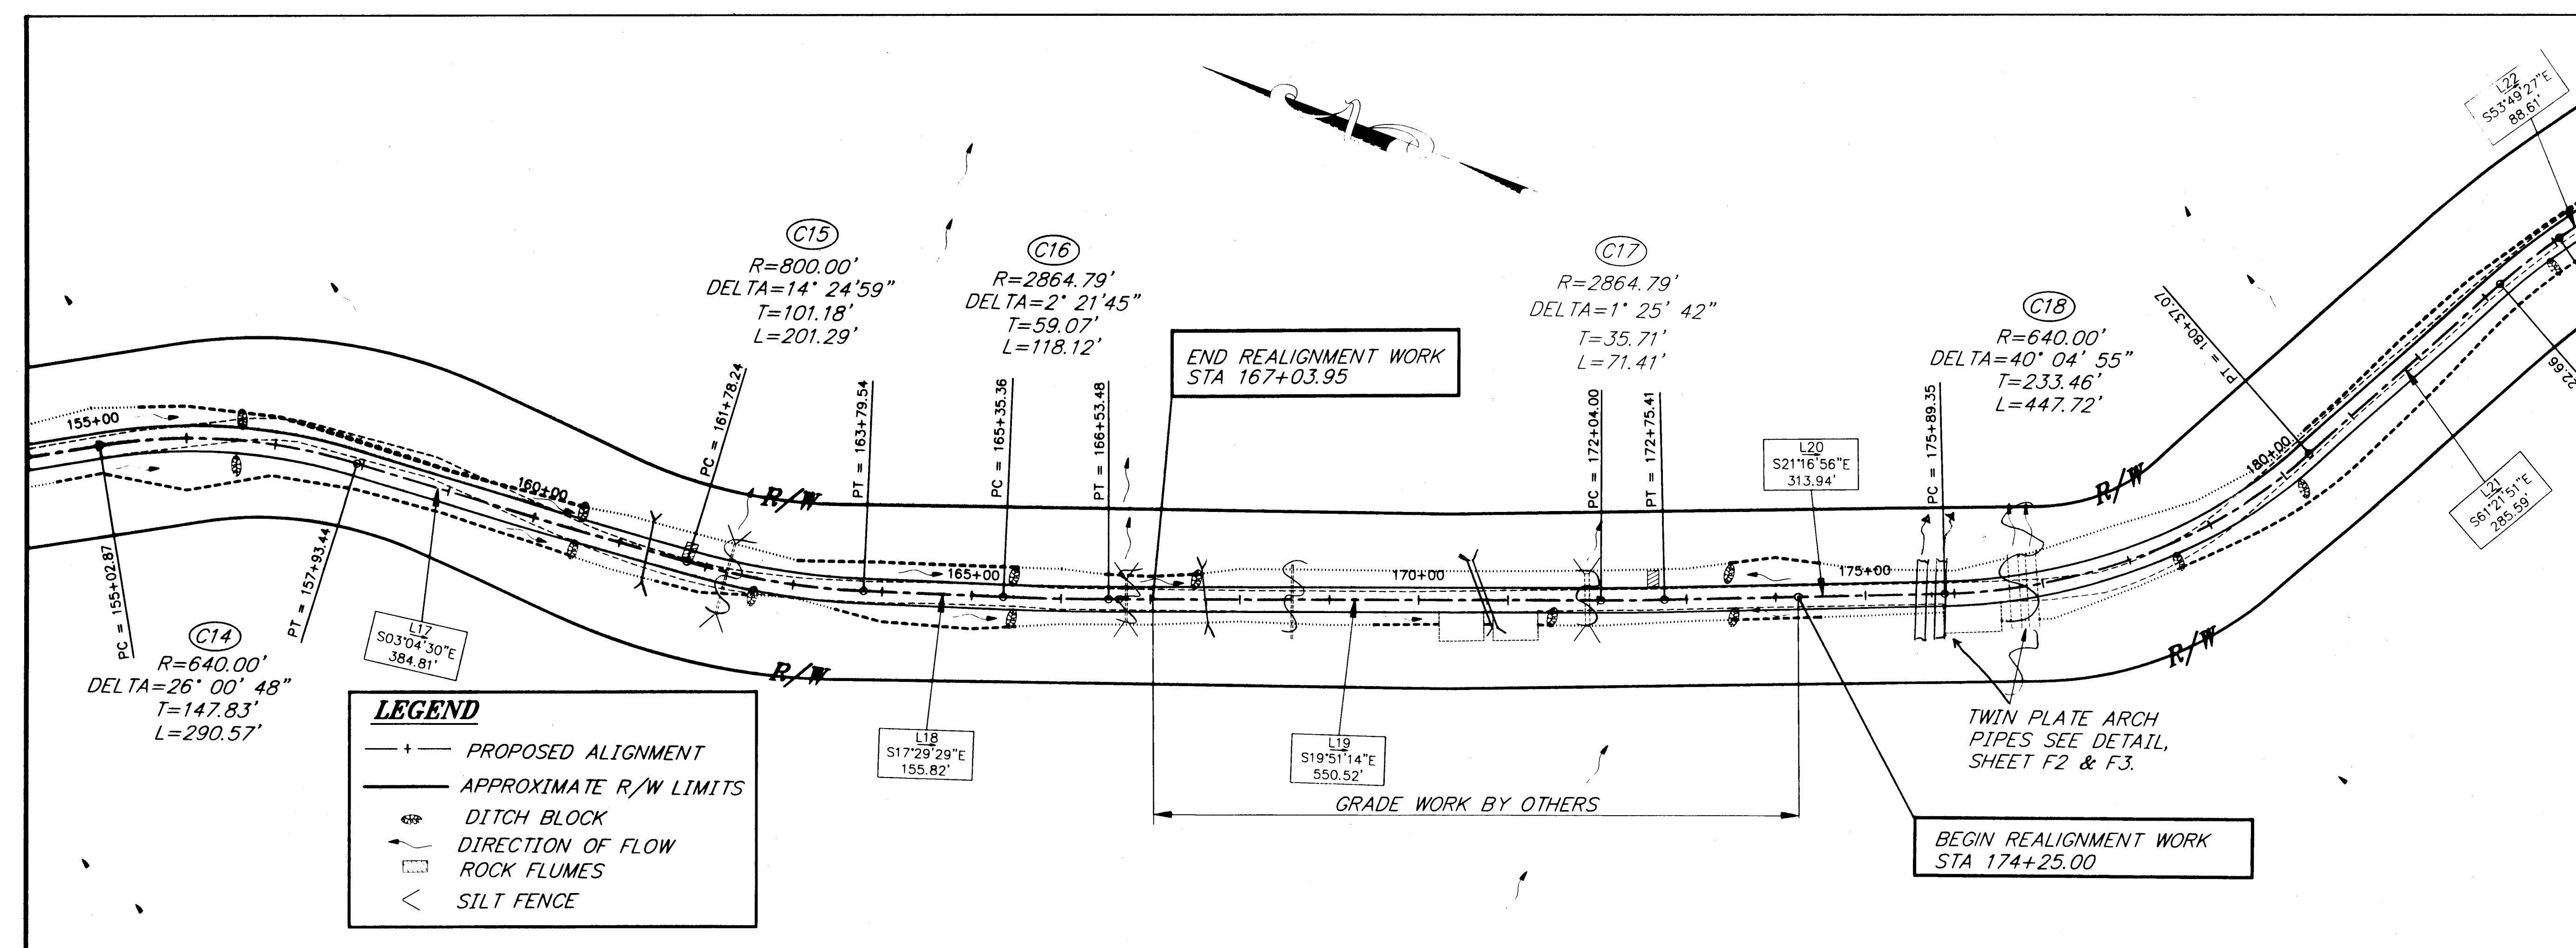

LEGEND

- +— PROPOSED ALIGNMENT
- APPROXIMATE R/W LIMITS
- DITCH BLOCK
- DIRECTION OF FLOW
- ROCK FLUMES
- < SILT FENCE

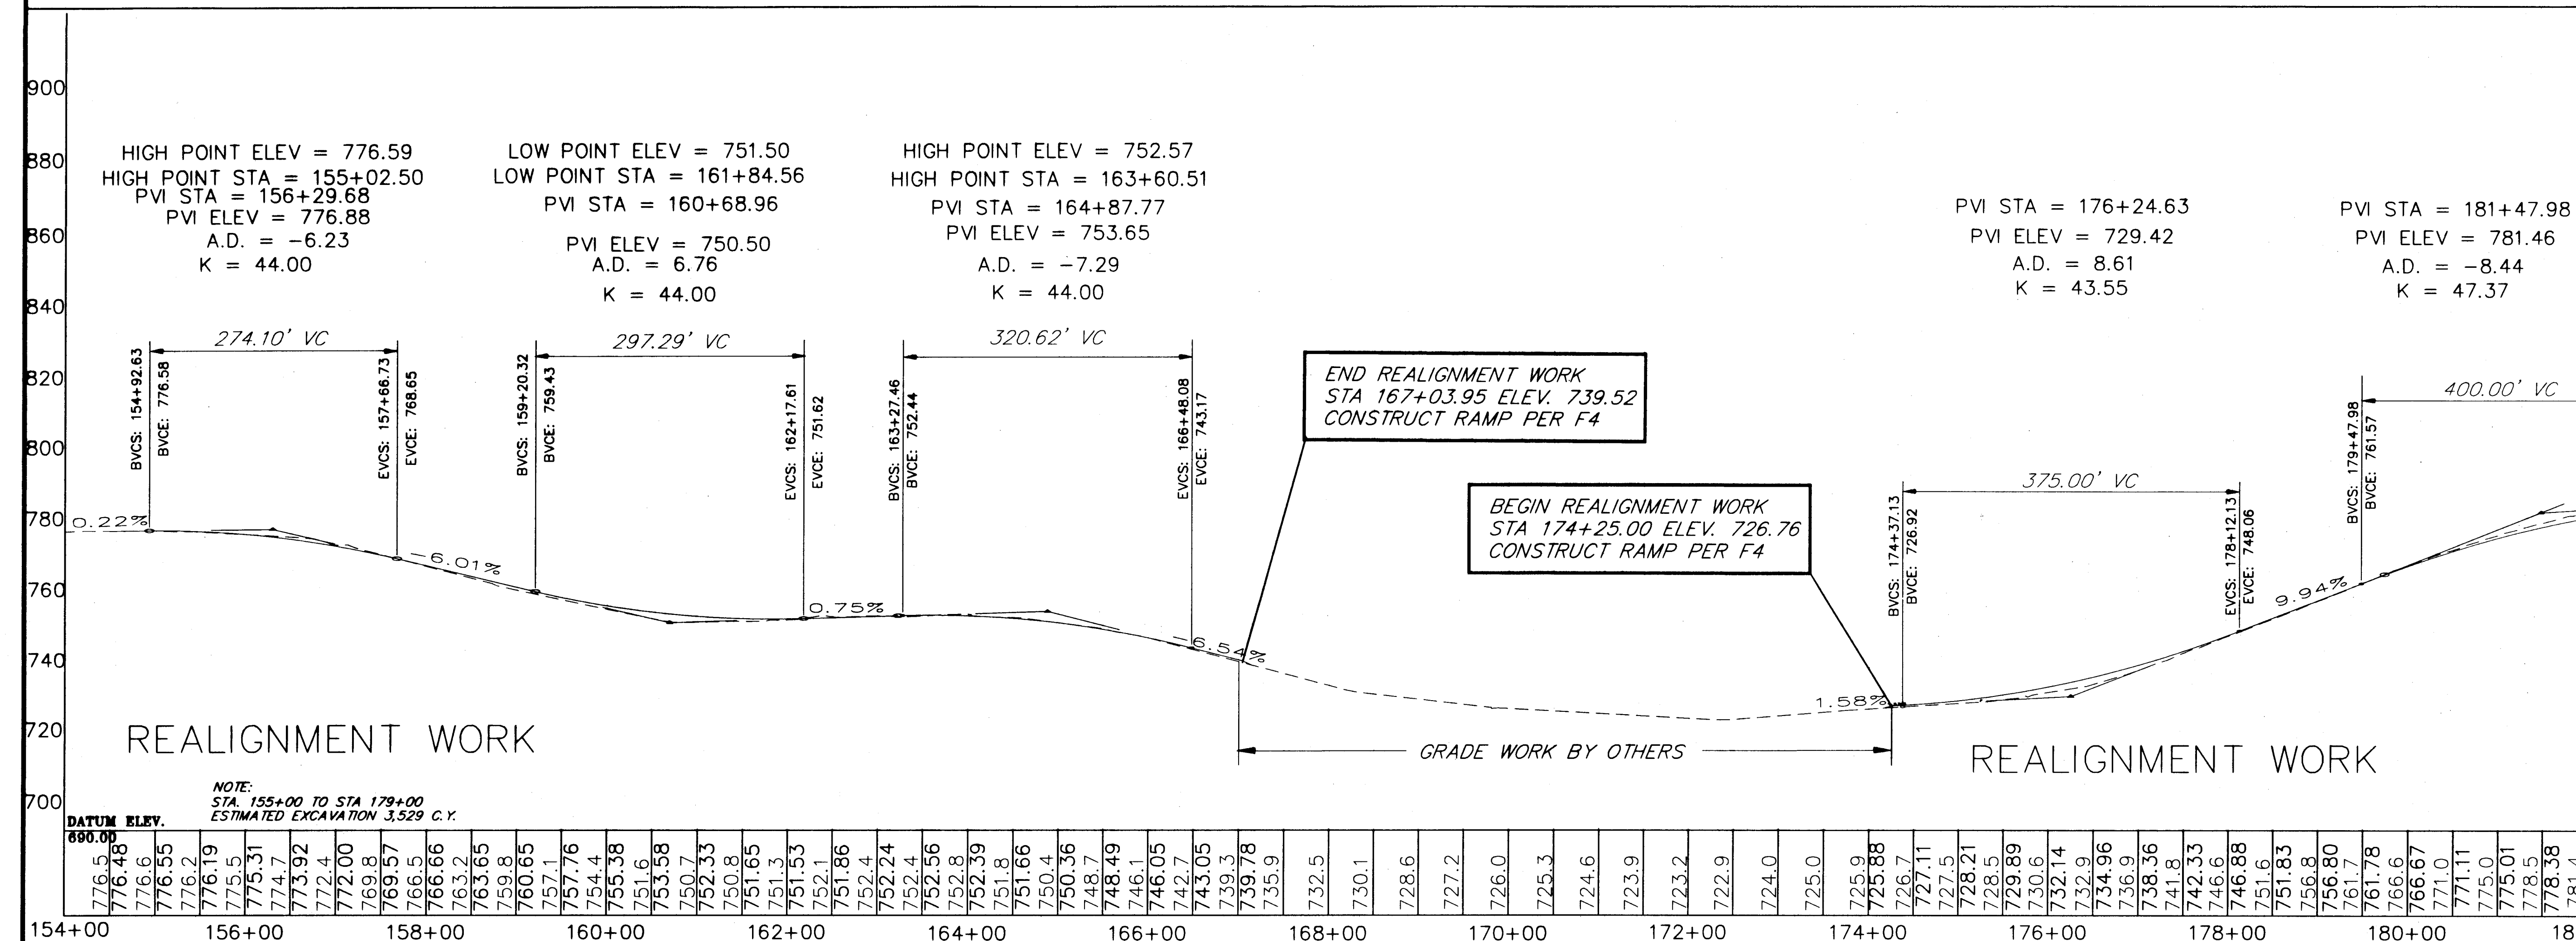

TH 7-22-03
DESIGNED BY: LAVERNE



CHECKED BY: MOORE
DRAWN BY:

STATE OF ALASKA
DEPARTMENT OF TRANSPORTATION
& PUBLIC FACILITIES
STATEWIDE DESIGN & ENGINEERING
SERVICES DIVISION

JNU-FISH CREEK ROAD
SAFETY IMPROVEMENTS
PROJECT NO. 68269



PLAN AND PROFILE

PROJECT DESIGNATION NUMBER

ACHRO-0953(4)

STATE YEAR
ALASKA 2001

SHEET NUMBER TOTAL SHEETS
E7 41

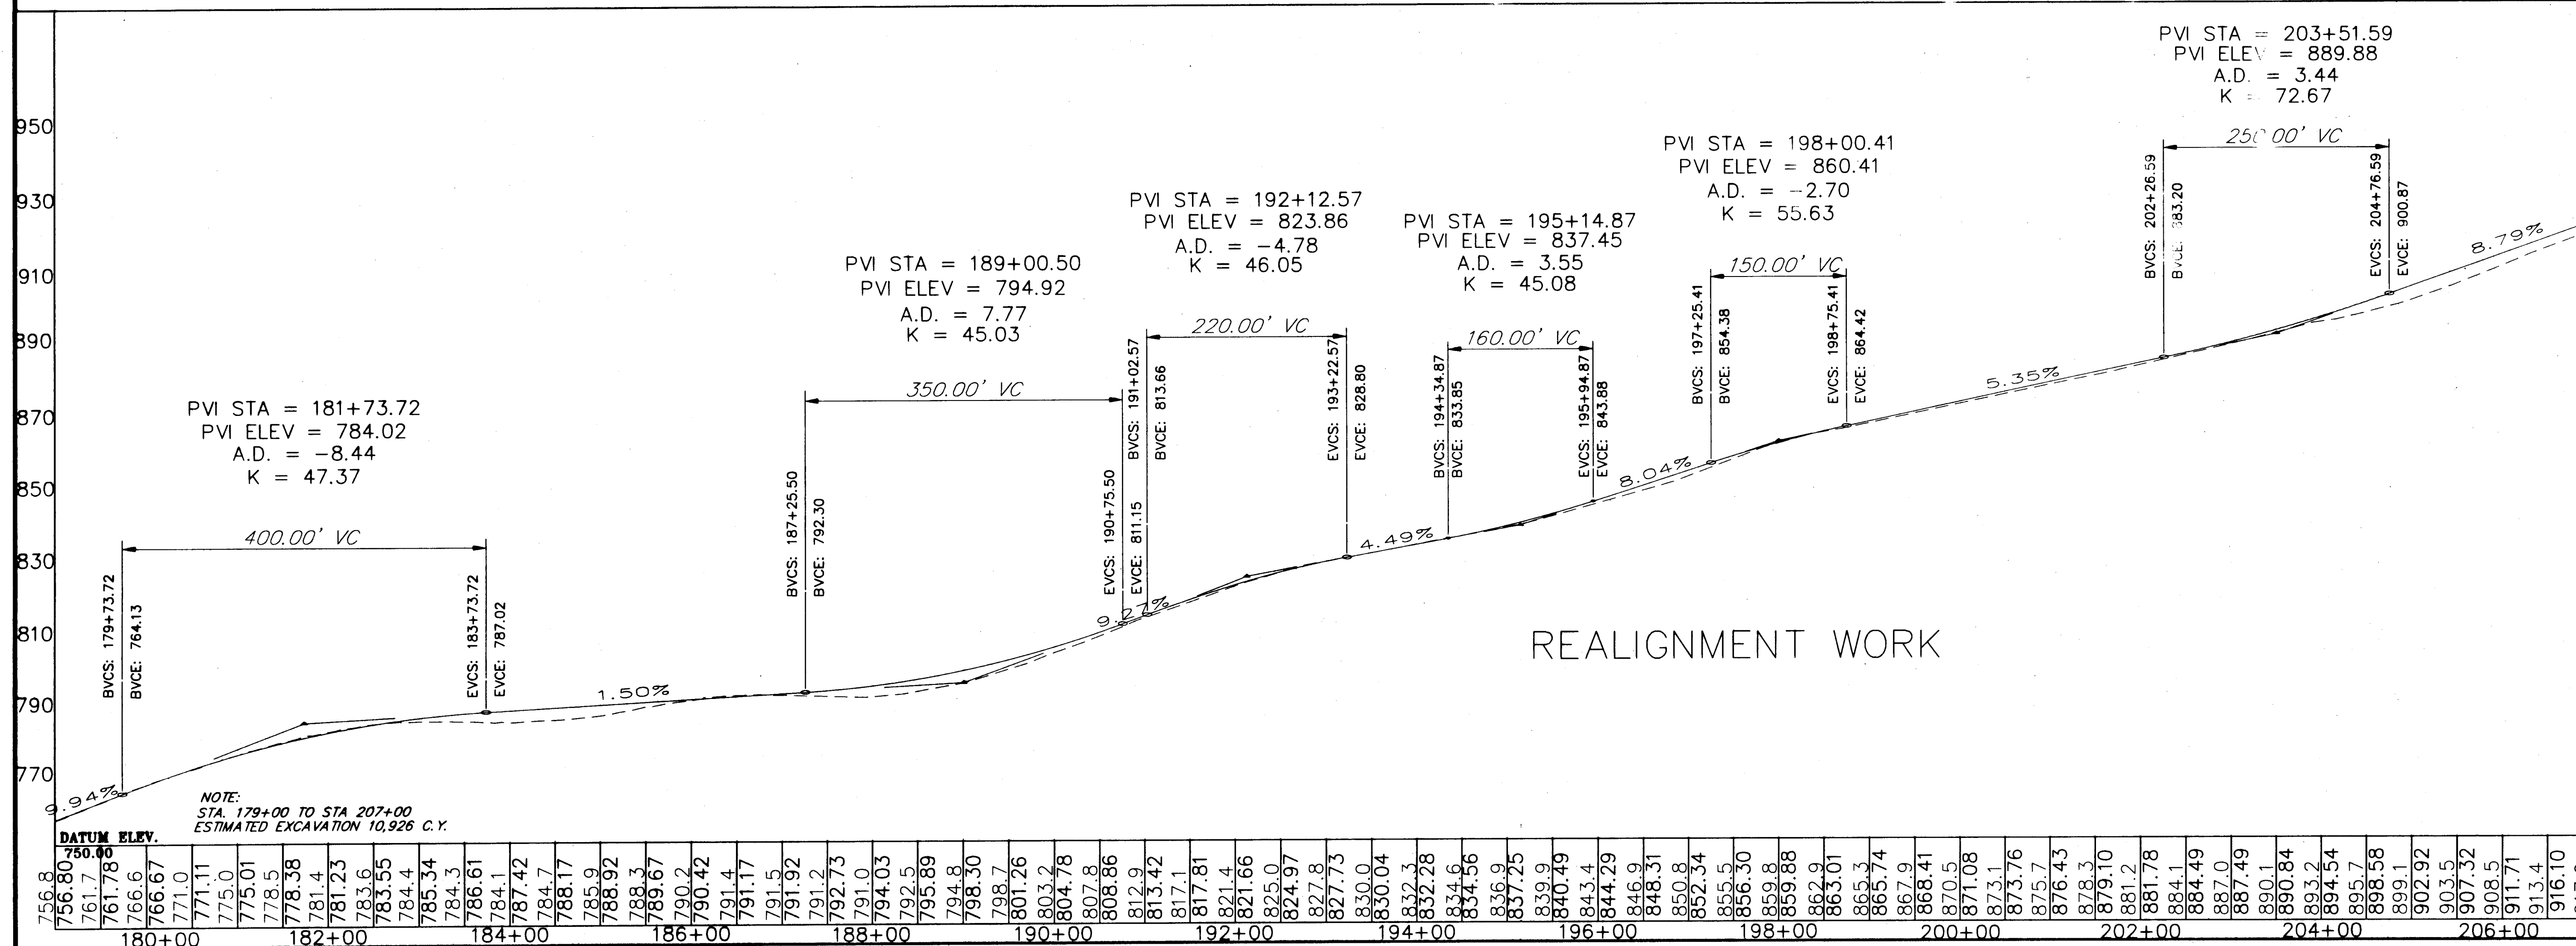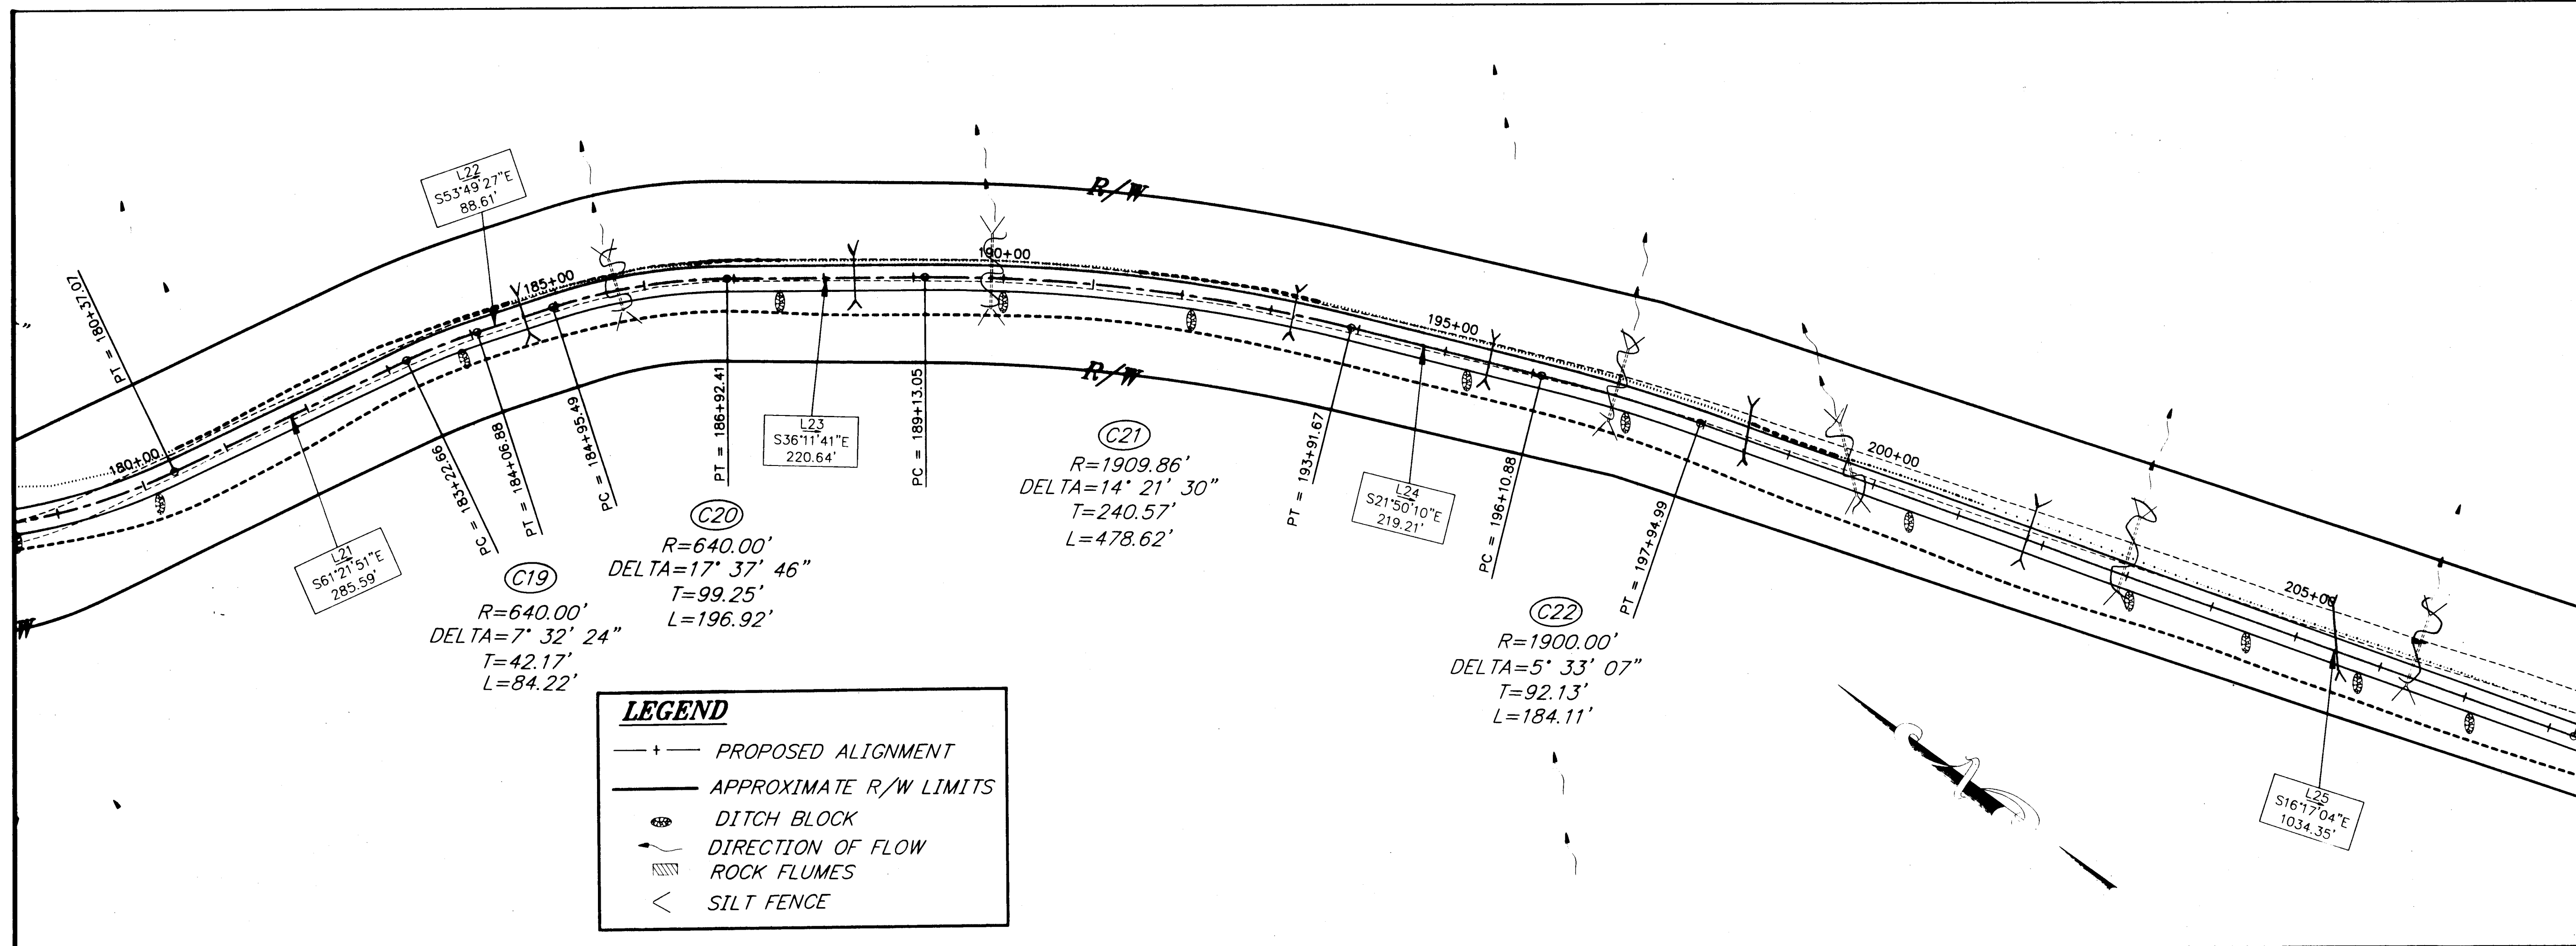

ADDENDUM NUMBER

ATTACHMENT NUMBER

RECORD OF REVISIONS

No.	DATE	DESCRIPTION

JNU-FISH CREEK ROAD

SAFETY IMPROVEMENTS

PROJECT NO. 68269

PLAN AND PROFILE

STA 179+00 TO STA 207+00

7/1/03

DESIGNED BY: [Signature]

STATE OF ALASKA

49th

[Signature]

REGISTERED PROFESSIONAL ENGINEER

CHECKED BY: [Signature]

DRAWN BY: [Signature]

STATE OF ALASKA

DEPARTMENT OF TRANSPORTATION & PUBLIC FACILITIES

STATEWIDE DESIGN & ENGINEERING SERVICES DIVISION

JNU-FISH CREEK ROAD

SAFETY IMPROVEMENTS

PROJECT NO. 68269

PLAN AND PROFILE

PROJECT DESIGNATION NUMBER

ACHRO-0953(4)

STATE

ALASKA

YEAR



2001

SHEET NUMBER

E8

TOTAL SHEETS

41

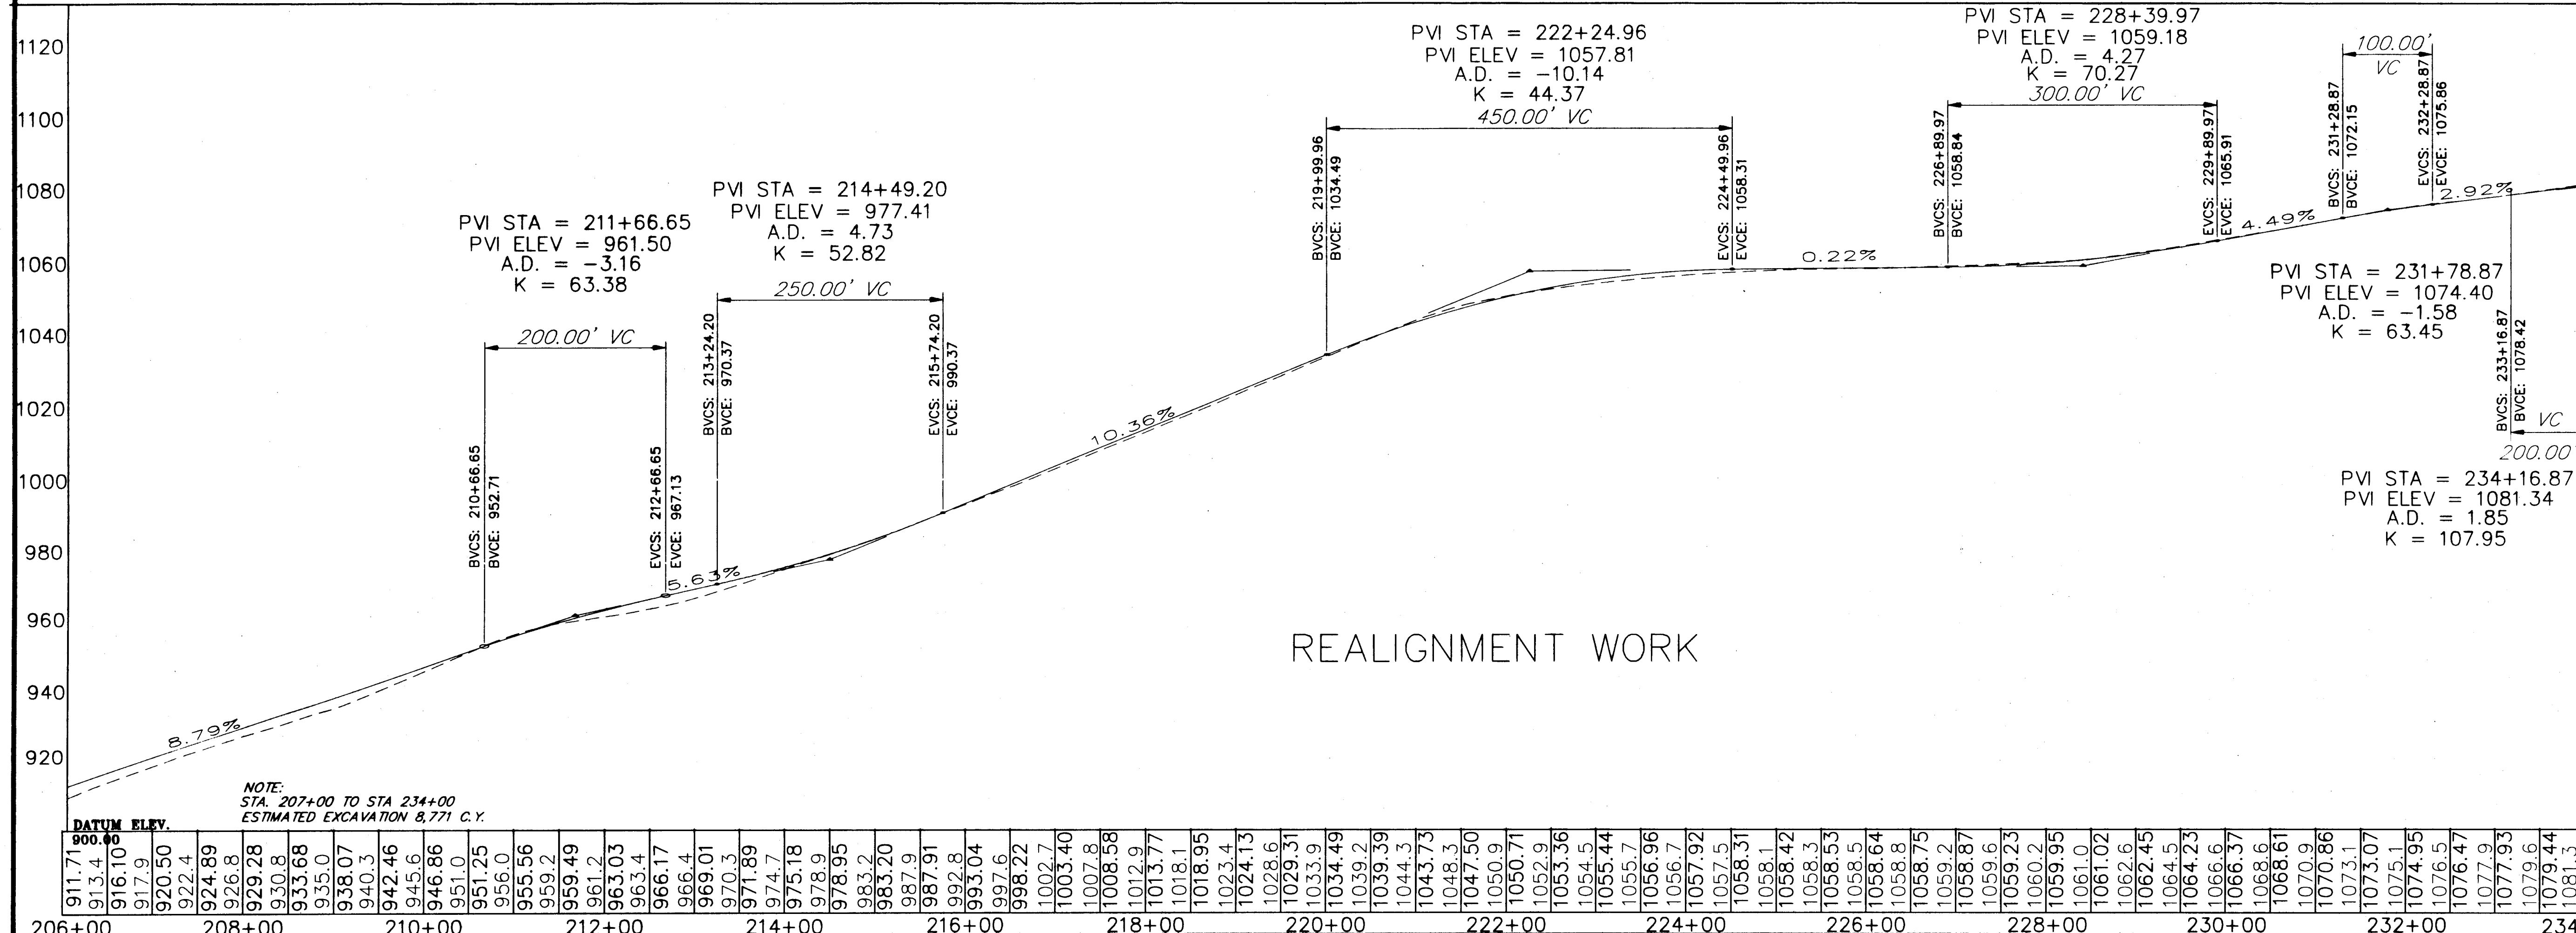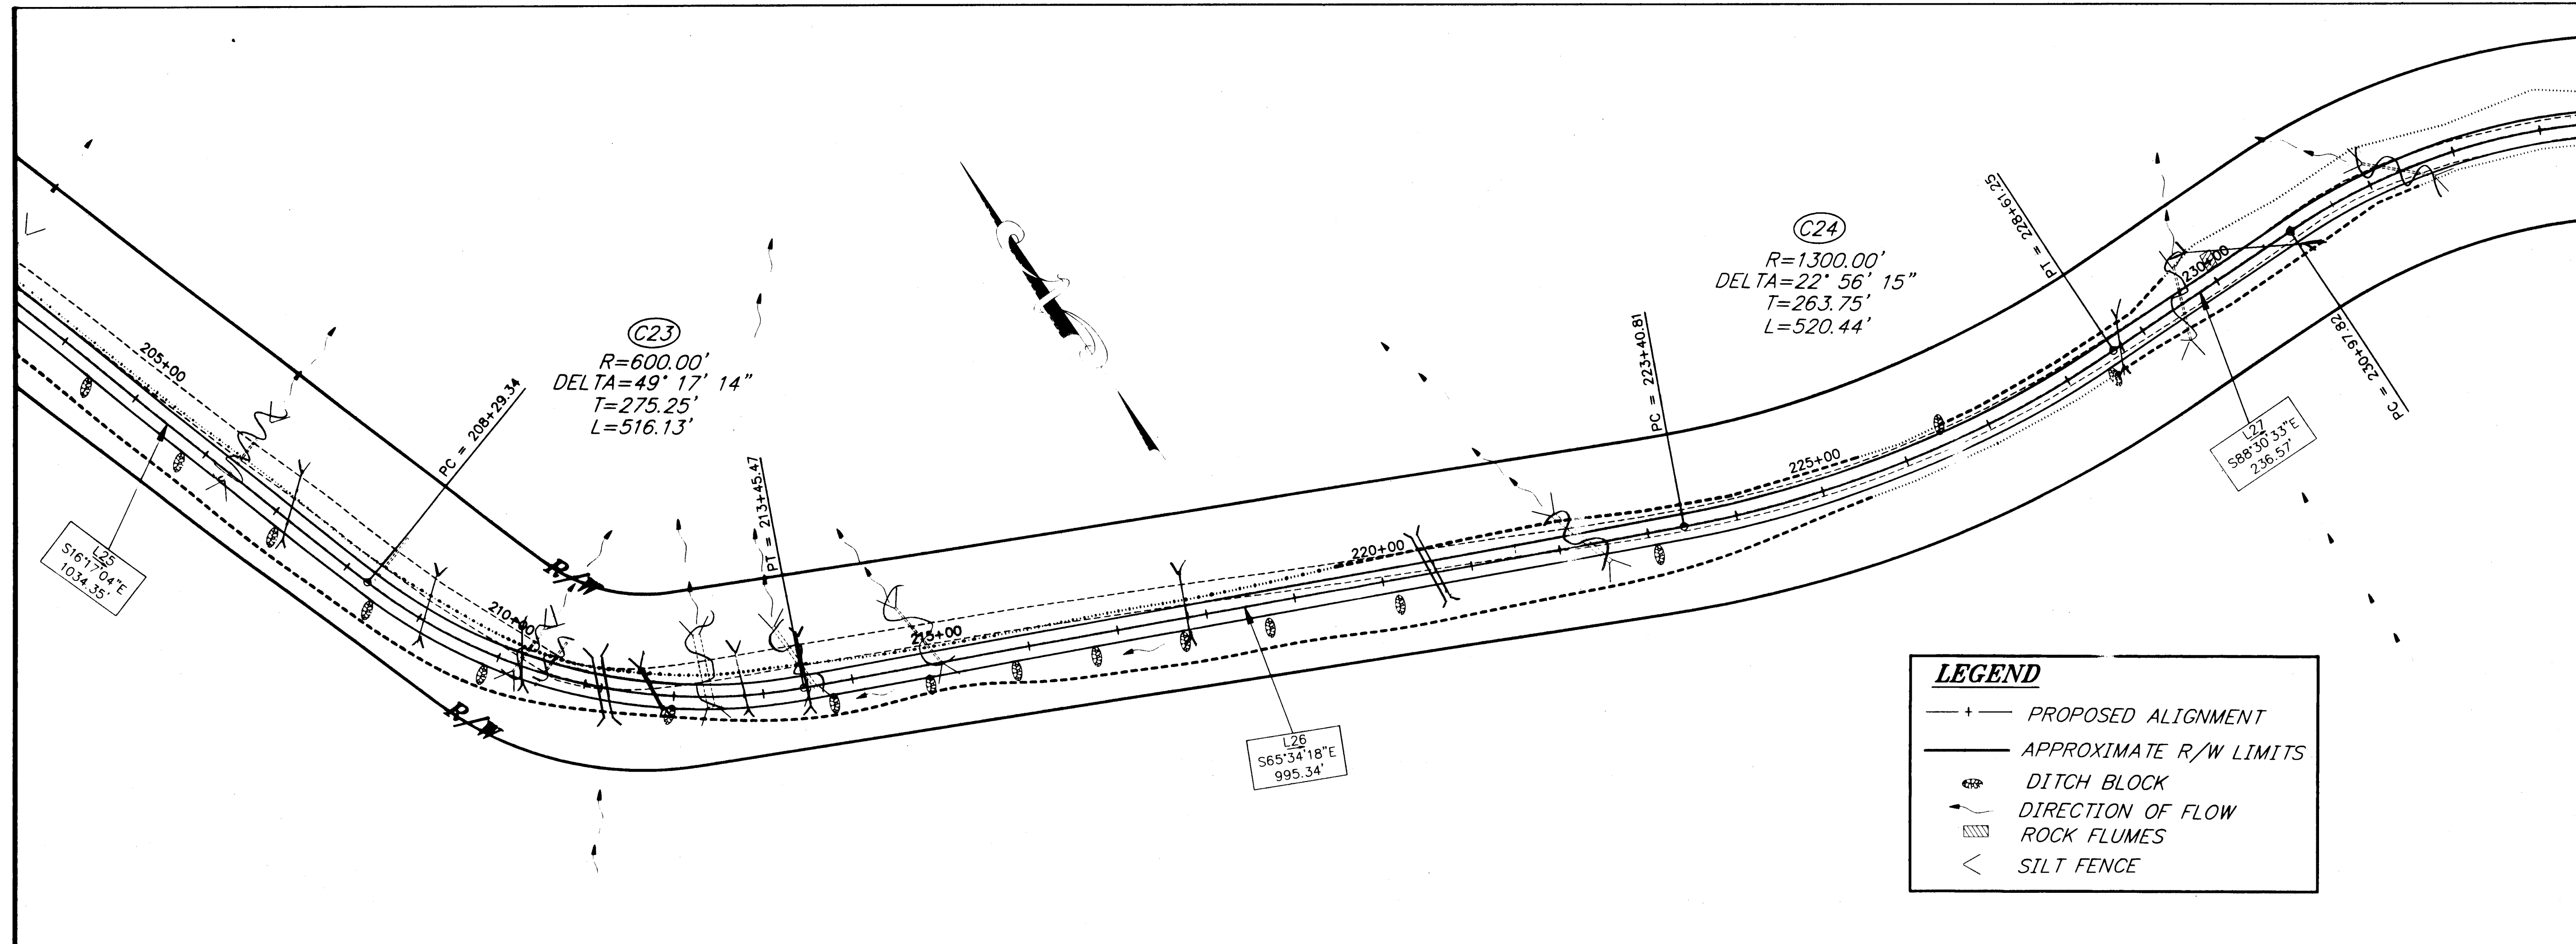

Q:\Jnu\68269\PlanSet\E_Plan&Profile.DWG
Wed, 16/Jun/02 07:42AM Kris

ADDENDUM NUMBER		
ATTACHMENT NUMBER		
RECORD OF REVISIONS		
No.	DATE	DESCRIPTION

JNU-FISH CREEK ROAD
SAFETY IMPROVEMENTS
PROJECT NO. 68269

PLAN AND PROFILE
STA 207+00 TO STA 234+00

DESIGNED BY: M. LAVERGNE

CHECKED BY: MOORE
DRAWN BY: F.K.

STATE OF ALASKA
DEPARTMENT OF TRANSPORTATION
& PUBLIC FACILITIES
STATEWIDE DESIGN & ENGINEERING
SERVICES DIVISION

JNU-FISH CREEK ROAD
SAFETY IMPROVEMENTS
PROJECT NO. 68269

**PLAN AND
PROFILE**

PROJECT DESIGNATION NUMBER
ACHRO-0953(4)

STATE	YEAR
ALASKA	2001

SHEET NUMBER	TOTAL SHEETS
E9	41


ADDENDUM NUMBER		
ATTACHMENT NUMBER		
RECORD OF REVISIONS		
No.	DATE	DESCRIPTION

JNU-FISH CREEK ROAD
SAFETY IMPROVEMENTS
PROJECT NO. 68269

PLAN AND PROFILE
STA 234+00 TO STA 260+00

7-22-03

DESIGNED BY: J. J. J. J.

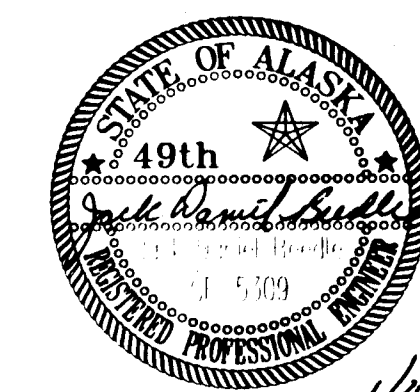

CHECKED BY: J. J. J. J.
DRAWN BY: J. J. J. J.

STATE OF ALASKA
DEPARTMENT OF TRANSPORTATION
& PUBLIC FACILITIES
STATEWIDE DESIGN & ENGINEERING
SERVICES DIVISION

JNU-FISH CREEK ROAD
SAFETY IMPROVEMENTS
PROJECT NO. 68269



PLAN AND
PROFILE

PROJECT DESIGNATION NUMBER

ACHRO-0953(4)


STATE YEAR
ALASKA 2001

SHEET NUMBER TOTAL SHEETS
E10 41

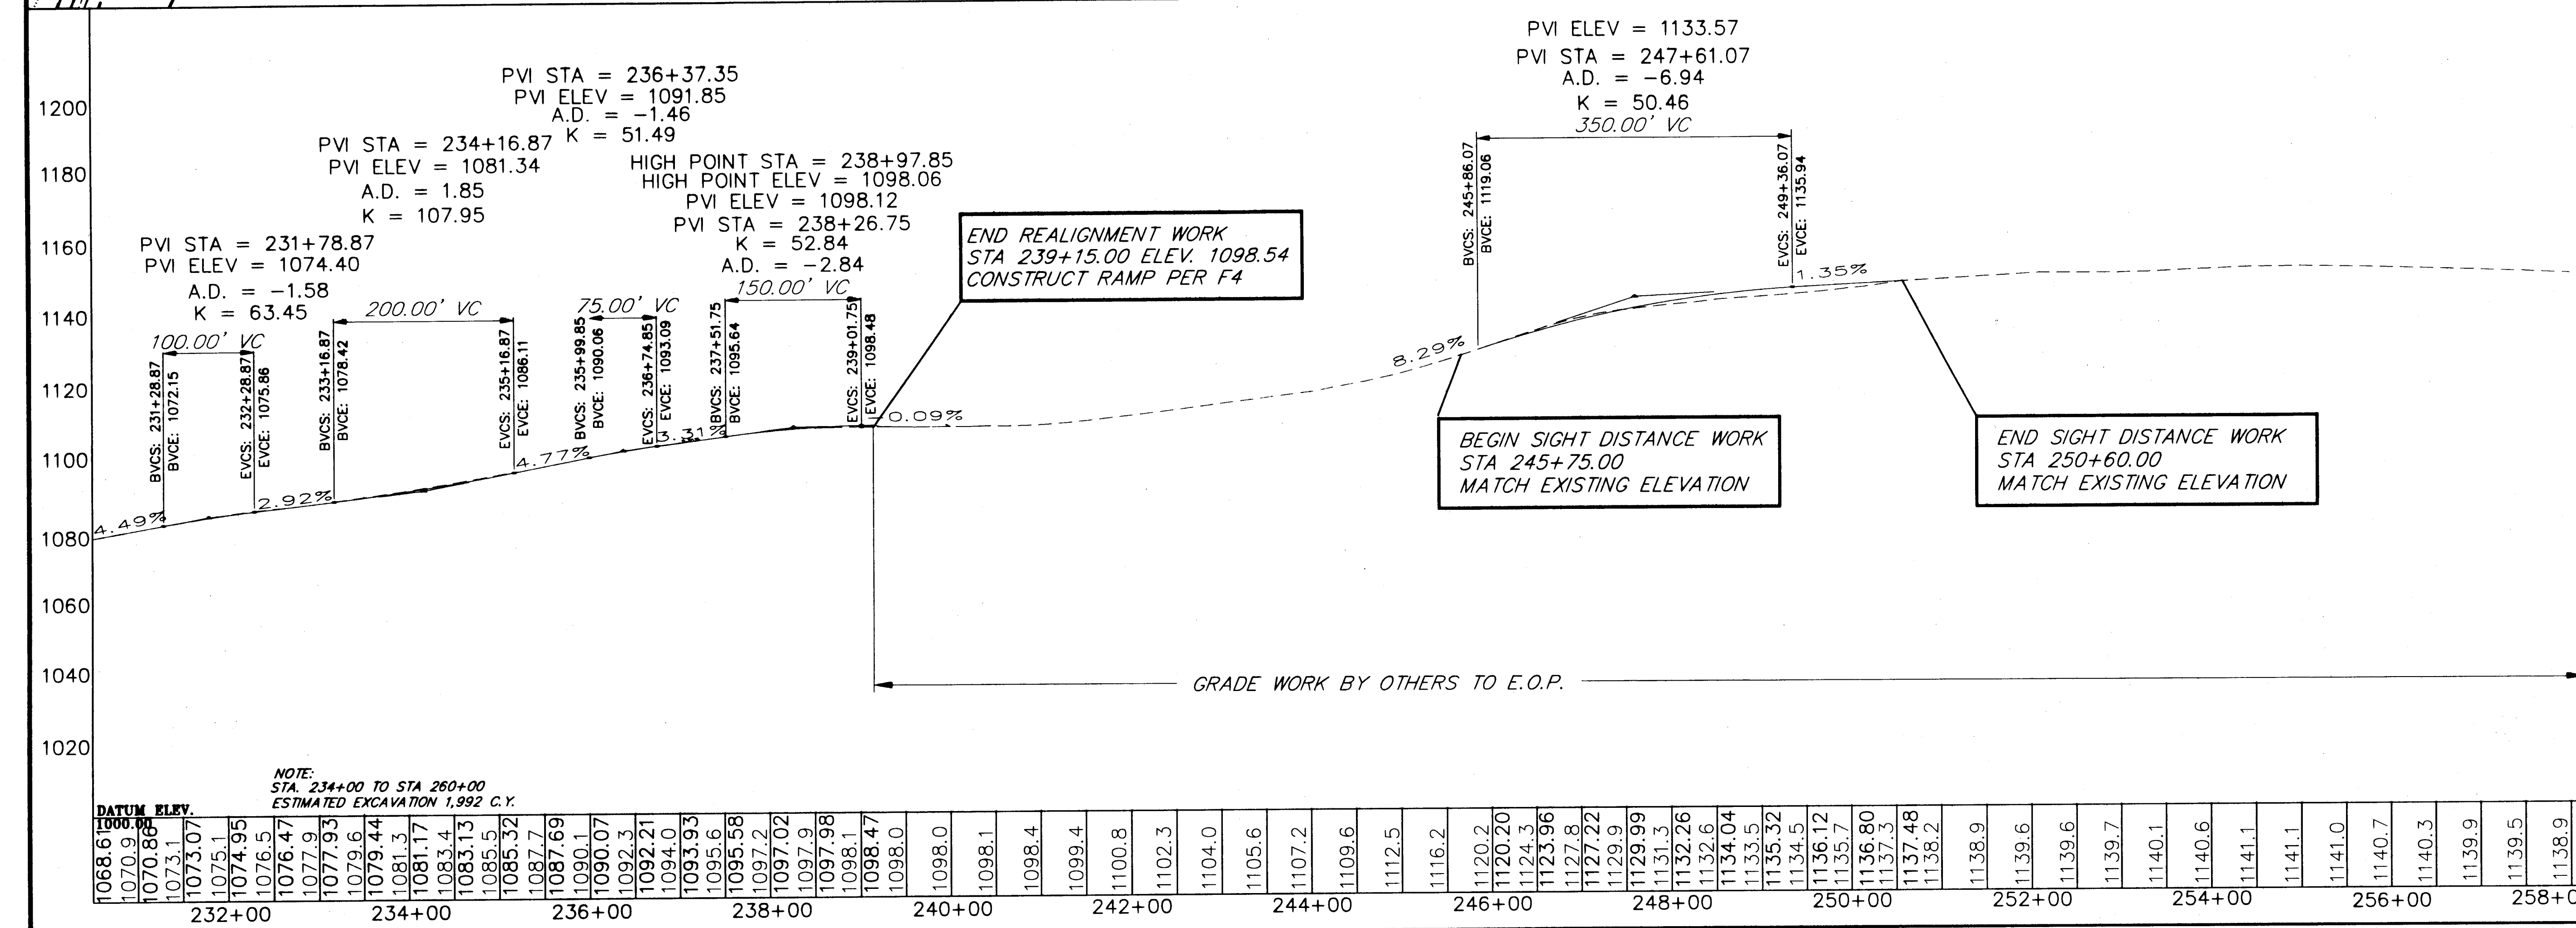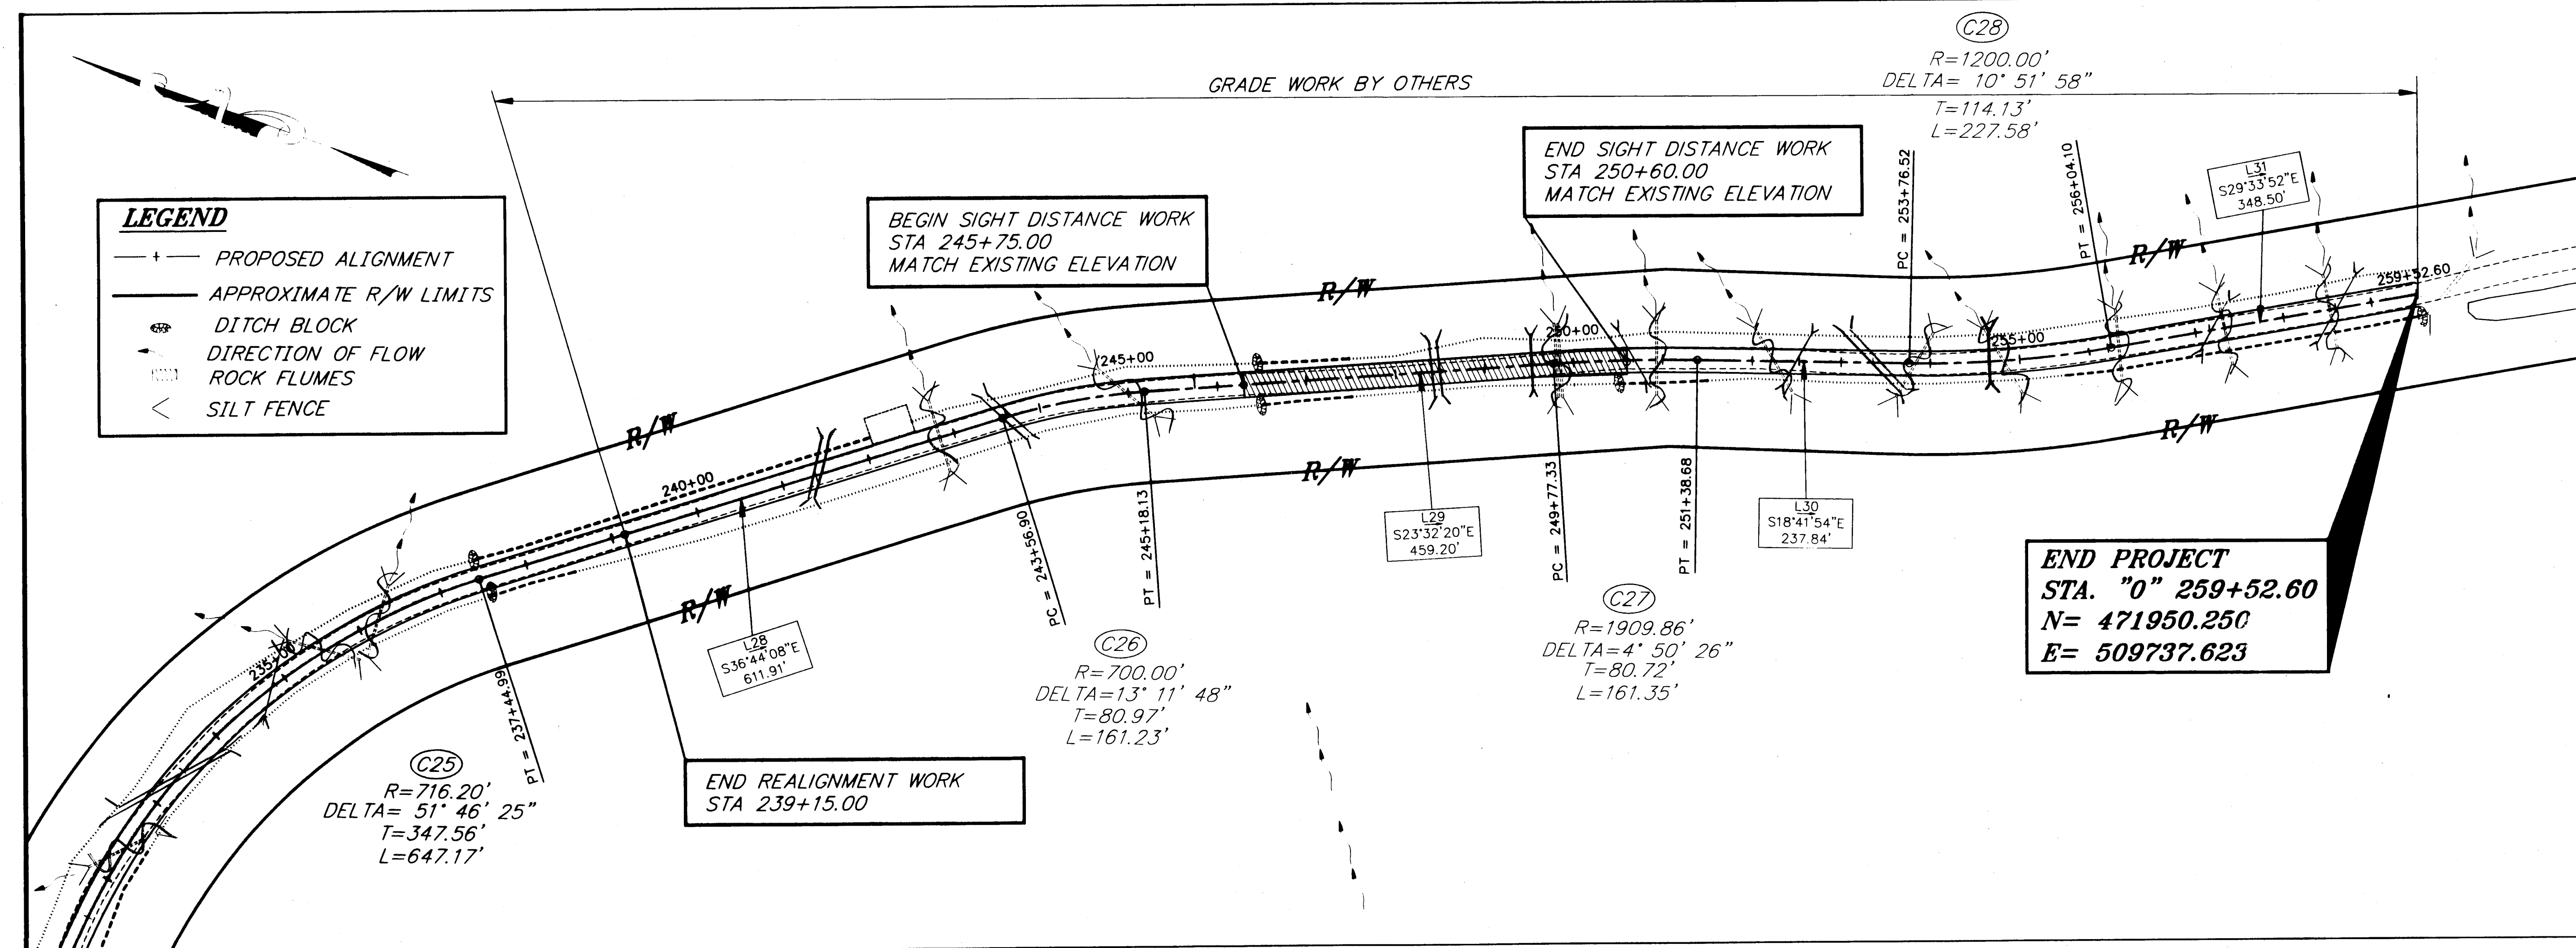


NOTE:
STA. 234+00 TO STA 260+00
ESTIMATED EXCAVATION 1,992 C.Y.

STATION	ELEVATION
232+00	1068.16
232+10	1070.9
232+20	1073.1
232+30	1075.1
232+40	1077.1
232+50	1079.1
232+60	1081.1
232+70	1083.1
232+80	1085.1
232+90	1087.1
233+00	1089.1
233+10	1091.1
233+20	1093.1
233+30	1095.1
233+40	1097.1
233+50	1099.1
233+60	1101.1
233+70	1103.1
233+80	1105.1
233+90	1107.1
234+00	1109.1
234+10	1111.1
234+20	1113.1
234+30	1115.1
234+40	1117.1
234+50	1119.1
234+60	1121.1
234+70	1123.1
234+80	1125.1
234+90	1127.1
235+00	1129.1
235+10	1131.1
235+20	1133.1
235+30	1135.1
235+40	1137.1
235+50	1139.1
235+60	1141.1
235+70	1143.1
235+80	1145.1
235+90	1147.1
236+00	1149.1
236+10	1151.1
236+20	1153.1
236+30	1155.1
236+40	1157.1
236+50	1159.1
236+60	1161.1
236+70	1163.1
236+80	1165.1
236+90	1167.1
237+00	1169.1
237+10	1171.1
237+20	1173.1
237+30	1175.1
237+40	1177.1
237+50	1179.1
237+60	1181.1
237+70	1183.1
237+80	1185.1
237+90	1187.1
238+00	1189.1
238+10	1191.1
238+20	1193.1
238+30	1195.1
238+40	1197.1
238+50	1199.1
238+60	1201.1
238+70	1203.1
238+80	1205.1
238+90	1207.1
239+00	1209.1
239+10	1211.1
239+20	1213.1
239+30	1215.1
239+40	1217.1
239+50	1219.1
239+60	1221.1
239+70	1223.1
239+80	1225.1
239+90	1227.1
240+00	1229.1
240+10	1231.1
240+20	1233.1
240+30	1235.1
240+40	1237.1
240+50	1239.1
240+60	1241.1
240+70	1243.1
240+80	1245.1
240+90	1247.1
241+00	1249.1
241+10	1251.1
241+20	1253.1
241+30	1255.1
241+40	1257.1
241+50	1259.1
241+60	1261.1
241+70	1263.1
241+80	1265.1
241+90	1267.1
242+00	1269.1
242+10	1271.1
242+20	1273.1
242+30	1275.1
242+40	1277.1
242+50	1279.1
242+60	1281.1
242+70	1283.1
242+80	1285.1
242+90	1287.1
243+00	1289.1
243+10	1291.1
243+20	1293.1
243+30	1295.1
243+40	1297.1
243+50	1299.1
243+60	1301.1
243+70	1303.1
243+80	1305.1
243+90	1307.1
244+00	1309.1
244+10	1311.1
244+20	1313.1
244+30	1315.1
244+40	1317.1
244+50	1319.1
244+60	1321.1
244+70	1323.1
244+80	1325.1
244+90	1327.1
245+00	1329.1
245+10	1331.1
245+20	1333.1
245+30	1335.1
245+40	1337.1
245+50	1339.1
245+60	1341.1
245+70	1343.1
245+80	1345.1
245+90	1347.1
246+00	1349.1
246+10	1351.1
246+20	1353.1
246+30	1355.1
246+40	1357.1
246+50	1359.1
246+60	1361.1
246+70	1363.1
246+80	1365.1
246+90	1367.1
247+00	1369.1
247+10	1371.1
247+20	1373.1
247+30	1375.1
247+40	1377.1
247+50	1379.1
247+60	1381.1
247+70	1383.1
247+80	1385.1
247+90	1387.1
248+00	1389.1
248+10	1391.1
248+20	1393.1
248+30	1395.1
248+40	1397.1
248+50	1399.1
248+60	1401.1
248+70	1403.1
248+80	1405.1
248+90	1407.1
249+00	1409.1
249+10	1411.1
249+20	1413.1
249+30	1415.1
249+40	1417.1
249+50	1419.1
249+60	1421.1
249+70	1423.1
249+80	1425.1
249+90	1427.1
250+00	1429.1
250+10	1431.1
250+20	1433.1
250+30	1435.1
250+40	1437.1
250+50	1439.1
250+60	1441.1
250+70	1443.1
250+80	1445.1
250+90	1447.1
251+00	1449.1
251+10	1451.1
251+20	1453.1
251+30	1455.1
251+40	1457.1
251+50	1459.1
251+60	1461.1
251+70	1463.1
251+80	1465.1
251+90	1467.1
252+00	1469.1
252+10	1471.1
252+20	1473.1
252+30	1475.1
252+40	1477.1
252+50	1479.1
252+60	1481.1
252+70	1483.1
252+80	1485.1
252+90	1487.1
253+00	1489.1
253+10	1491.1
253+20	1493.1
253+30	1495.1
253+40	1497.1
253+50	1499.1
253+60	1501.1
253+70	1503.1
253+80	1505.1
253+90	1507.1
254+00	1509.1
254+10	1511.1
254+20	1513.1
254+30	1515.1
254+40	1517.1
254+50	1519.1
254+60	1521.1
254+70	1523.1
254+80	1525.1
254+90	1527.1
255+00	1529.1
255+10	1531.1
255+20	1533.1
255+30	1535.1
255+40	1537.1
255+50	1539.1
255+60	1541.1
255+70	1543.1
255+80	1545.1
255+90	1547.1
256+00	1549.1
256+10	1551.1
256+20	1553.1
256+30	1555.1
256+40	1557.1
256+50	1559.1
256+60	1561.1
256+70	1563.1
256+80	1565.1
256+90	1567.1
257+00	1569.1
257+10	1571.1
257+20	1573.1
257+30	1575.1
257+40	1577.1
257+50	1579.1
257+60	1581.1
257+70	1583.1
257+80	1585.1
257+90	1587.1
258+00	1589.1

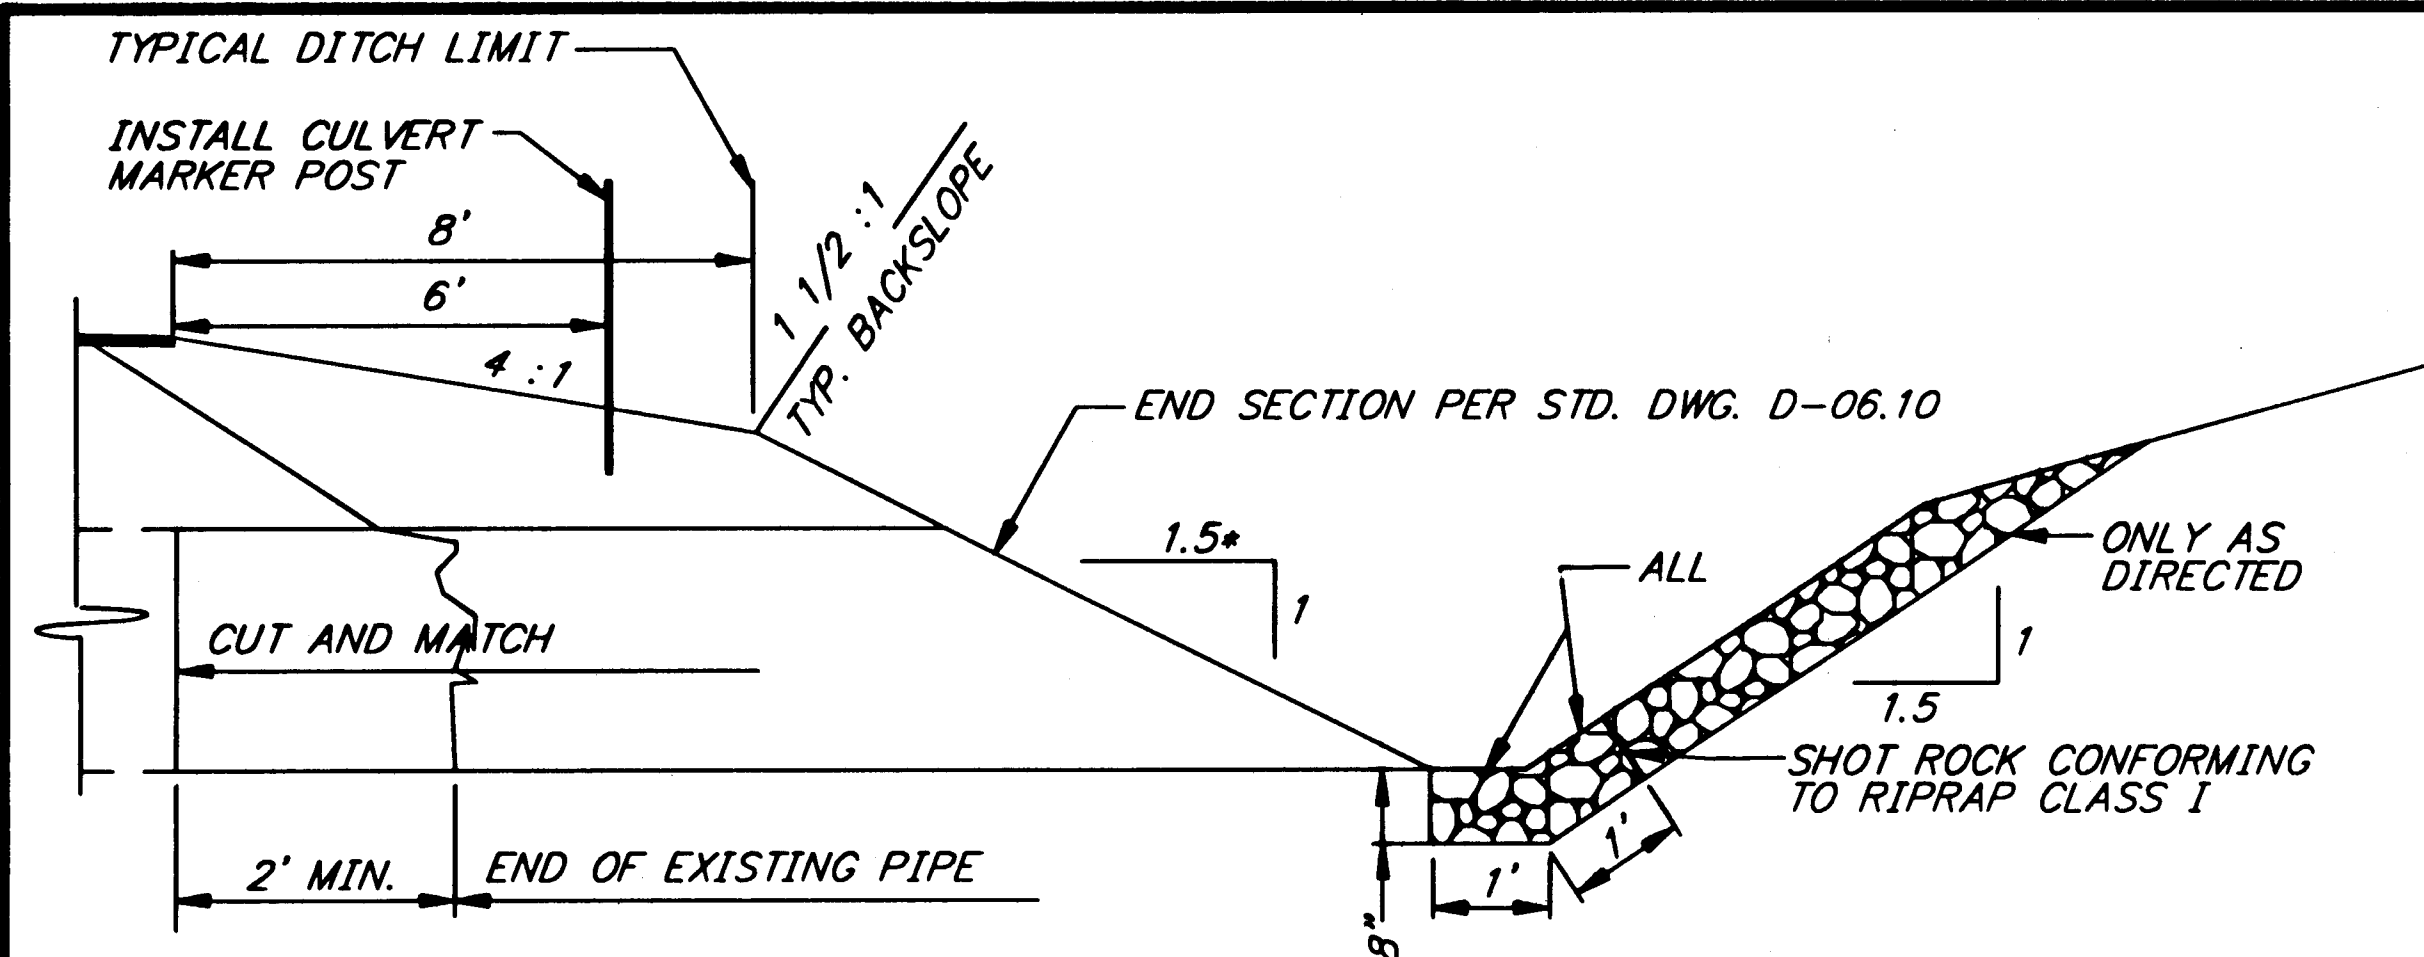


**INLET DETAIL
TYPICAL DITCH SECTION
SECTION VIEW**

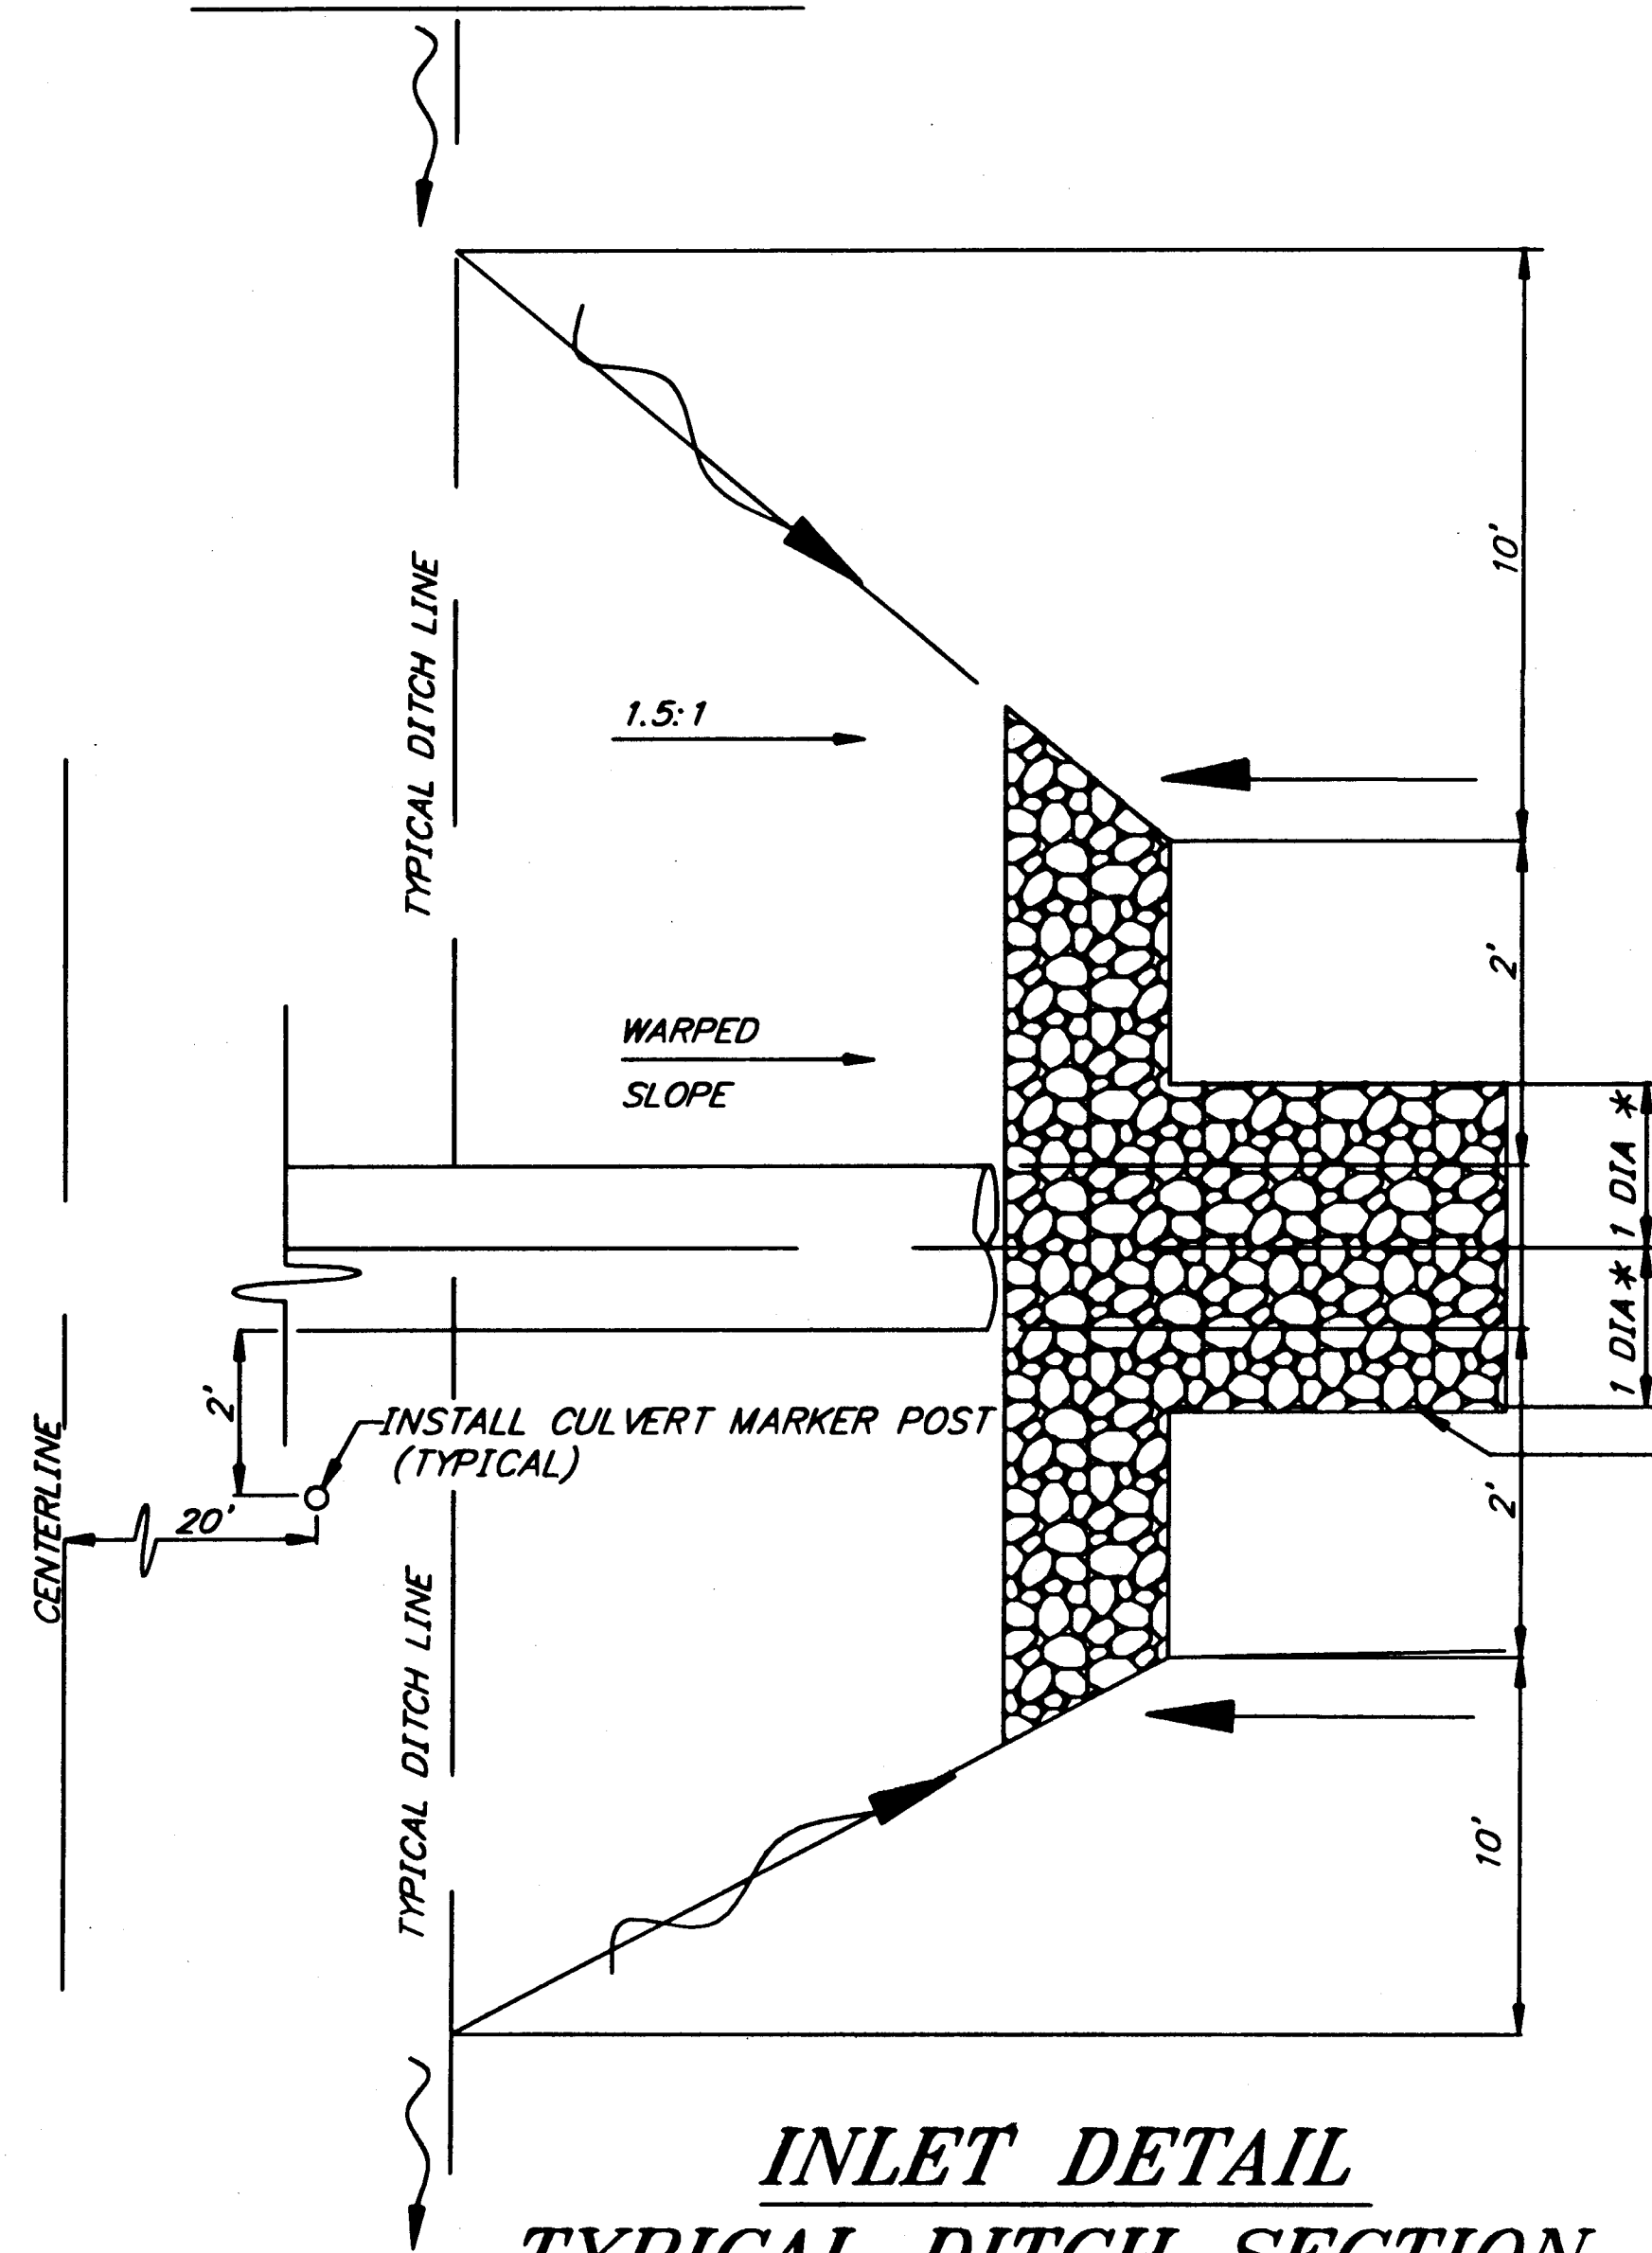


**INLET DETAIL
TYPICAL DITCH SECTION
PLAN VIEW**


* LINE BACK SLOPE TWO PIPE DIAMETERS WIDE IN CUT SECTIONS AS DIRECTED.

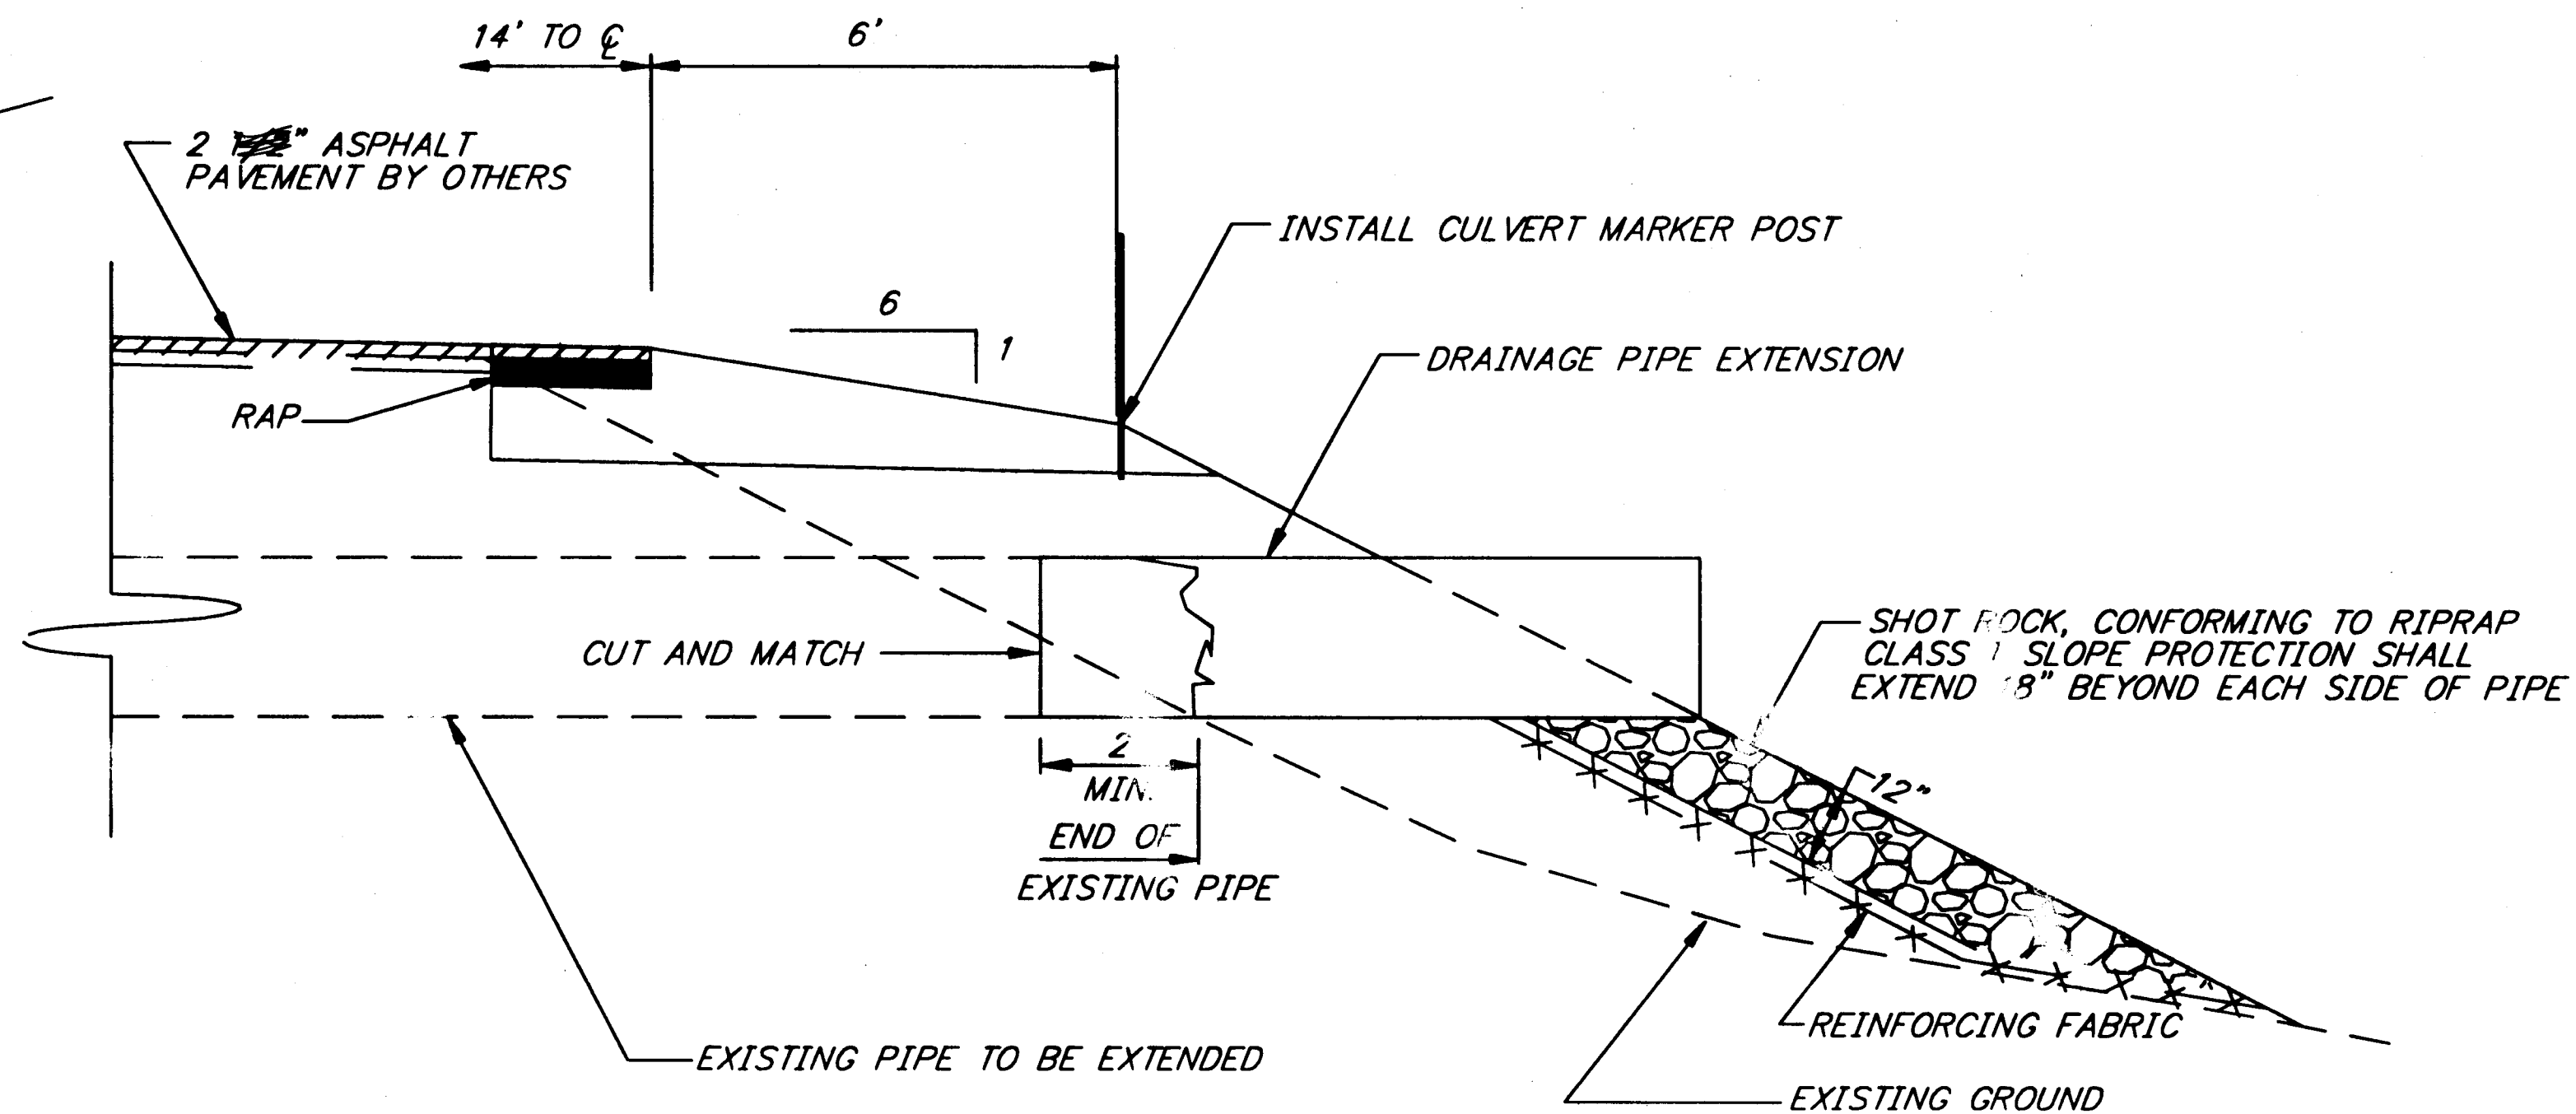

**PIPE EXTENSION DETAIL
OUTLET END**

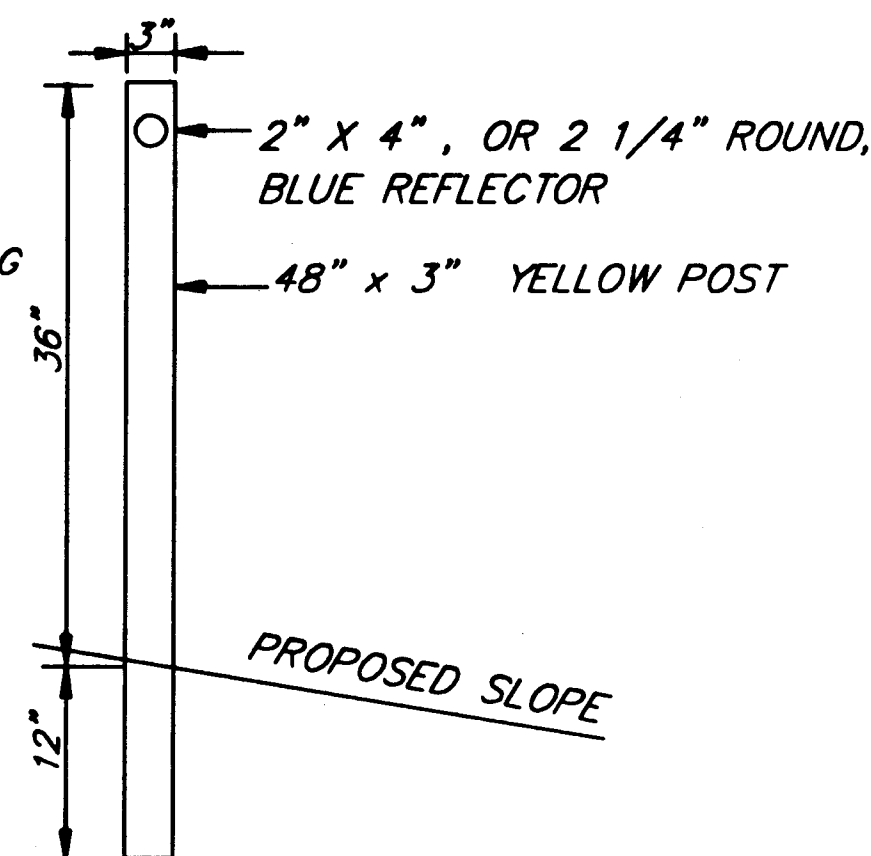

CULVERT MARKER DETAIL

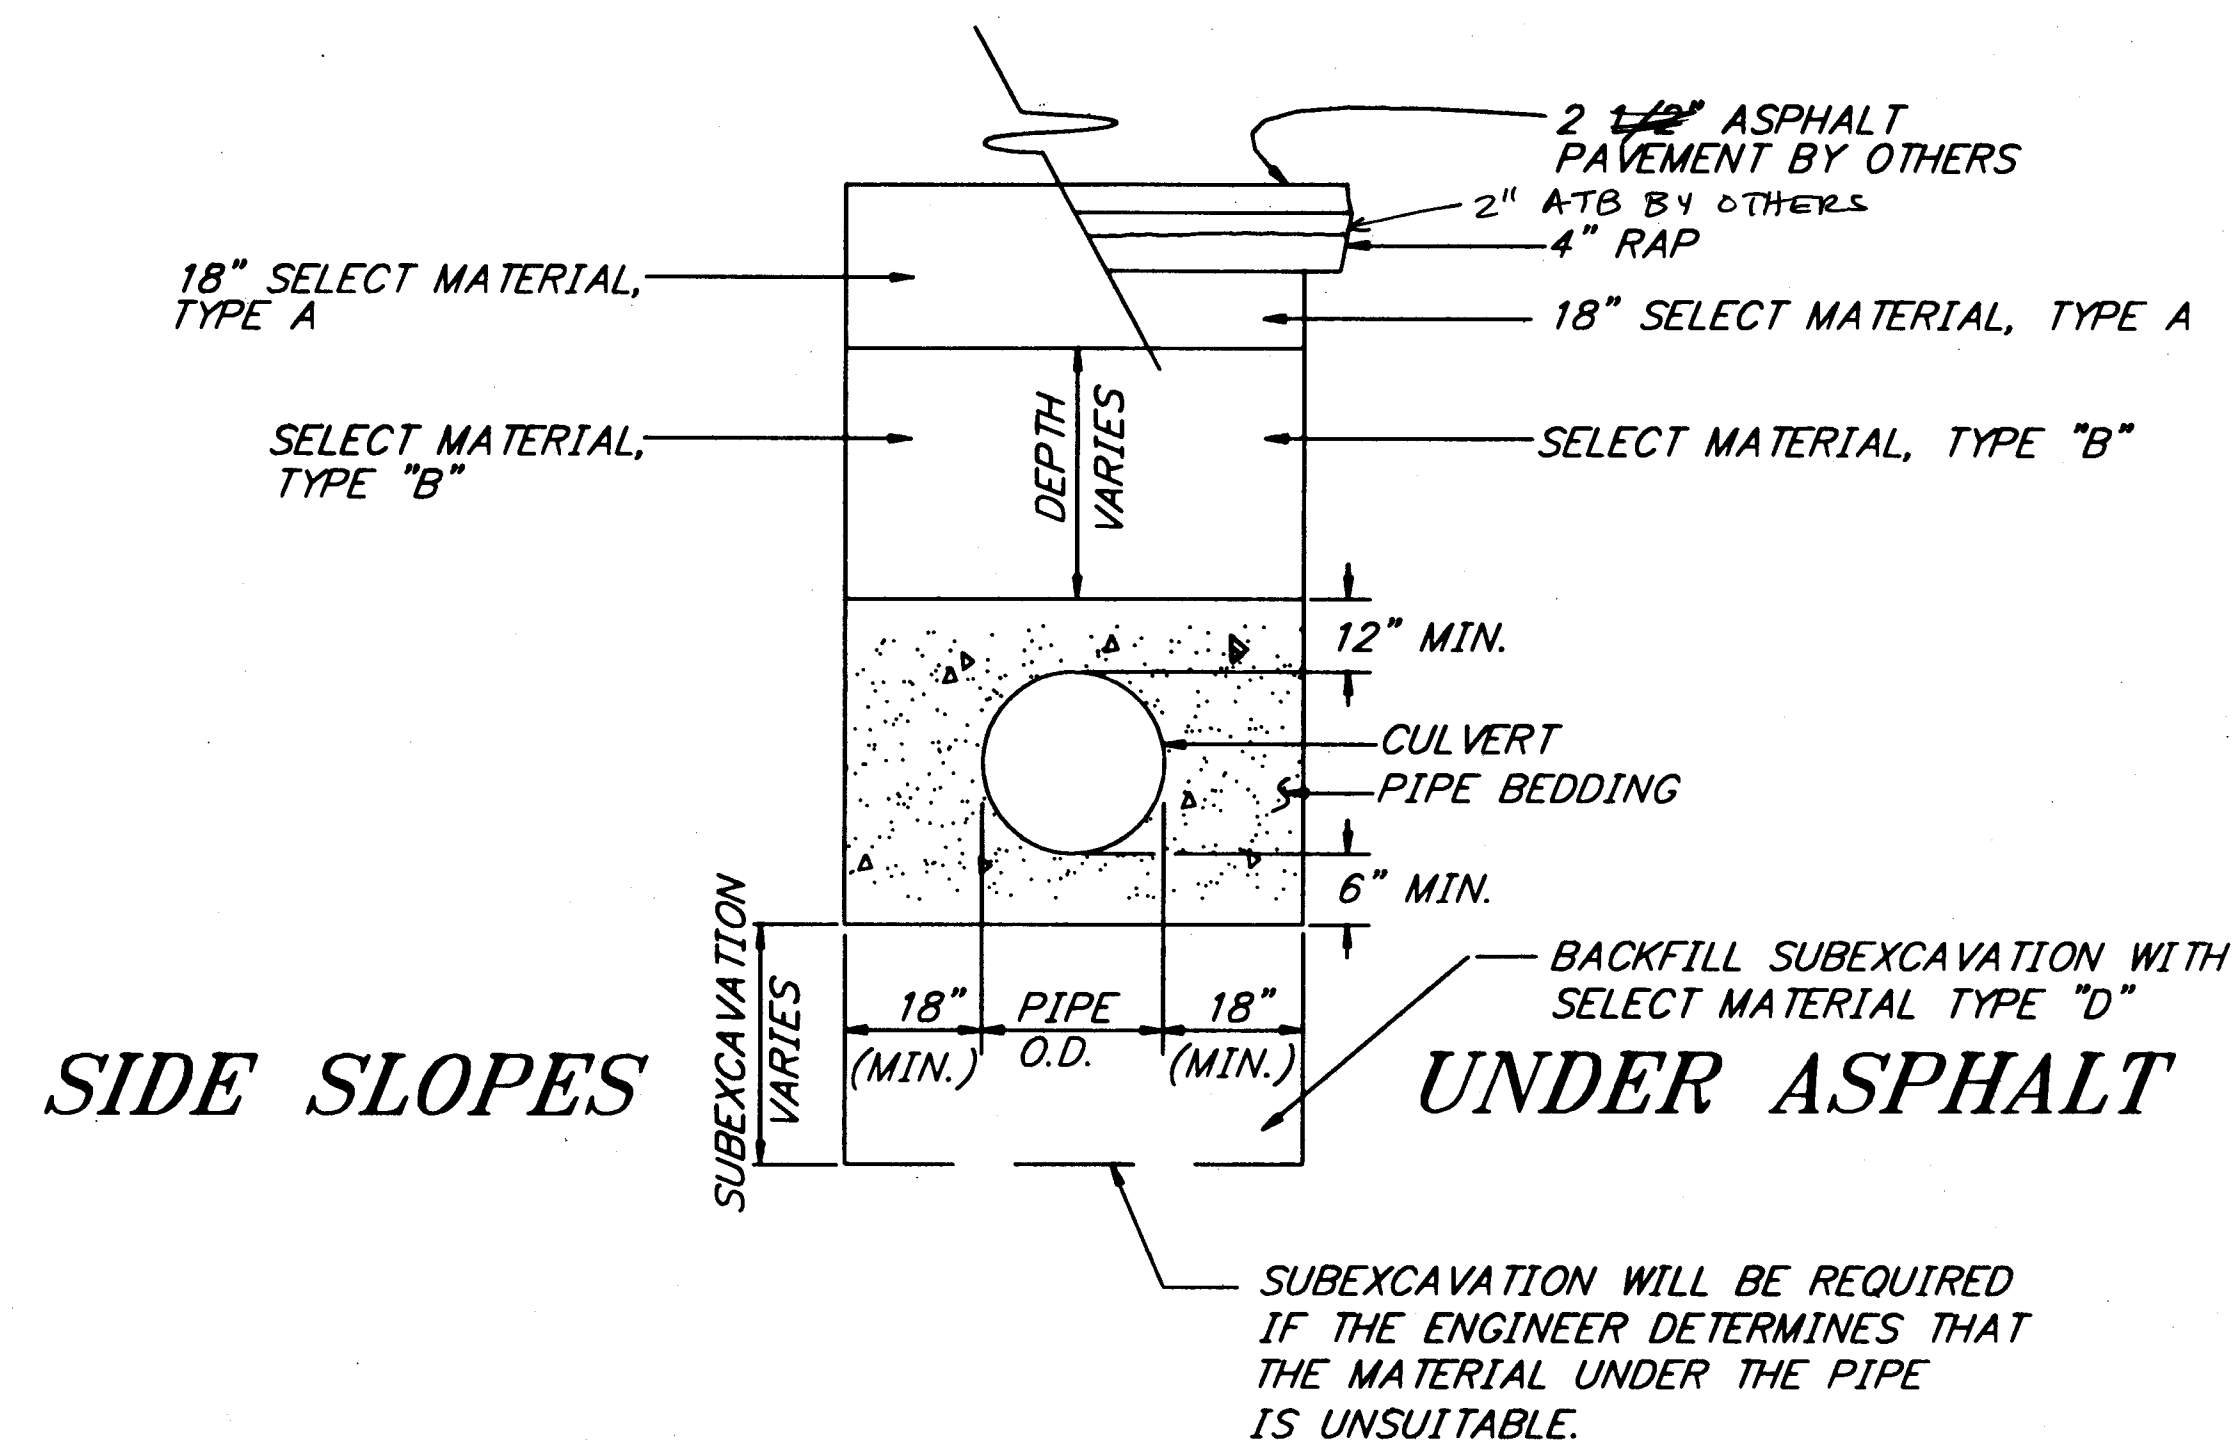

CULVERT BEDDING/BACKFILL DETAIL

N.T.S.

PATH:
Q:\Jnu\68269\Planset\F_det.dwg
Tue, 15/Jan/02 02:33PM Kris
PLOT:
PSPACE 1=1(F) OR MSPACE 1=1(F)
TAB: ESTIMATE

ADDENDUM NUMBER

ATTACHMENT NUMBER

RECORD OF REVISIONS


No.	DATE	DESCRIPTION

JNU-FISH CREEK ROAD
SAFETY IMPROVEMENTS
PROJECT NO. 68269

Culvert Installation Details

78 722.03

DESIGNED BY: M. LAVERING

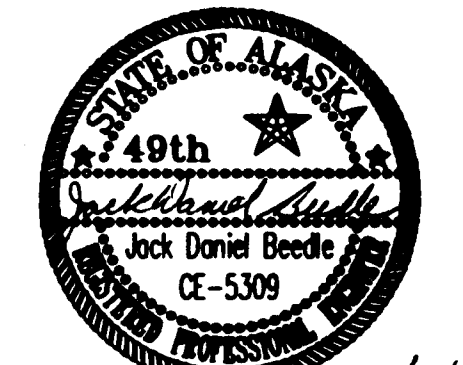

CHECKED BY: T. MOORE

DRAWN BY: K.K.

STATE OF ALASKA
DEPARTMENT OF TRANSPORTATION
& PUBLIC FACILITIES
STATEWIDE DESIGN & ENGINEERING
SERVICES DIVISION

JNU-FISH CREEK ROAD
SAFETY IMPROVEMENTS
PROJECT NO. 68269

**Culvert
Installation Details**

PROJECT DESIGNATION NUMBER

ACHRO-0953(4)

STATE	YEAR
ALASKA	2001
SHEET NUMBER	TOTAL SHEETS
F1	41


ADDENDUM NUMBER		
ATTACHMENT NUMBER		
RECORD OF REVISIONS		
No.	DATE	DESCRIPTION

JNU-FISH CREEK ROAD
SAFETY IMPROVEMENTS
PROJECT NO. 68269

Culvert Installation Details

7/4 7-22-03

DESIGNED BY: M. LAVERING

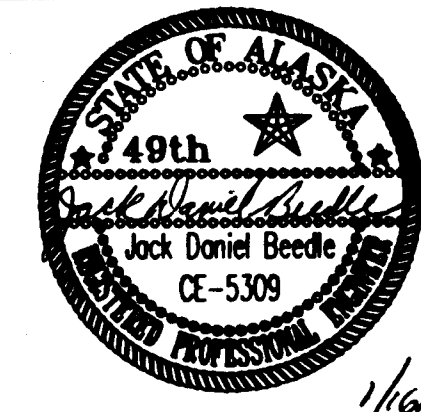

CHECKED BY: T. MOORE


DRAWN BY: K.K.

STATE OF ALASKA
DEPARTMENT OF TRANSPORTATION
& PUBLIC FACILITIES
STATEWIDE DESIGN & ENGINEERING
SERVICES DIVISION


JNU-FISH CREEK ROAD
SAFETY IMPROVEMENTS
PROJECT NO. 68269

Culvert Installation
Details

PROJECT DESIGNATION NUMBER	
ACHRO-0953(4)	
STATE	YEAR
ALASKA	2001
SHEET NUMBER	TOTAL SHEETS
F2	41

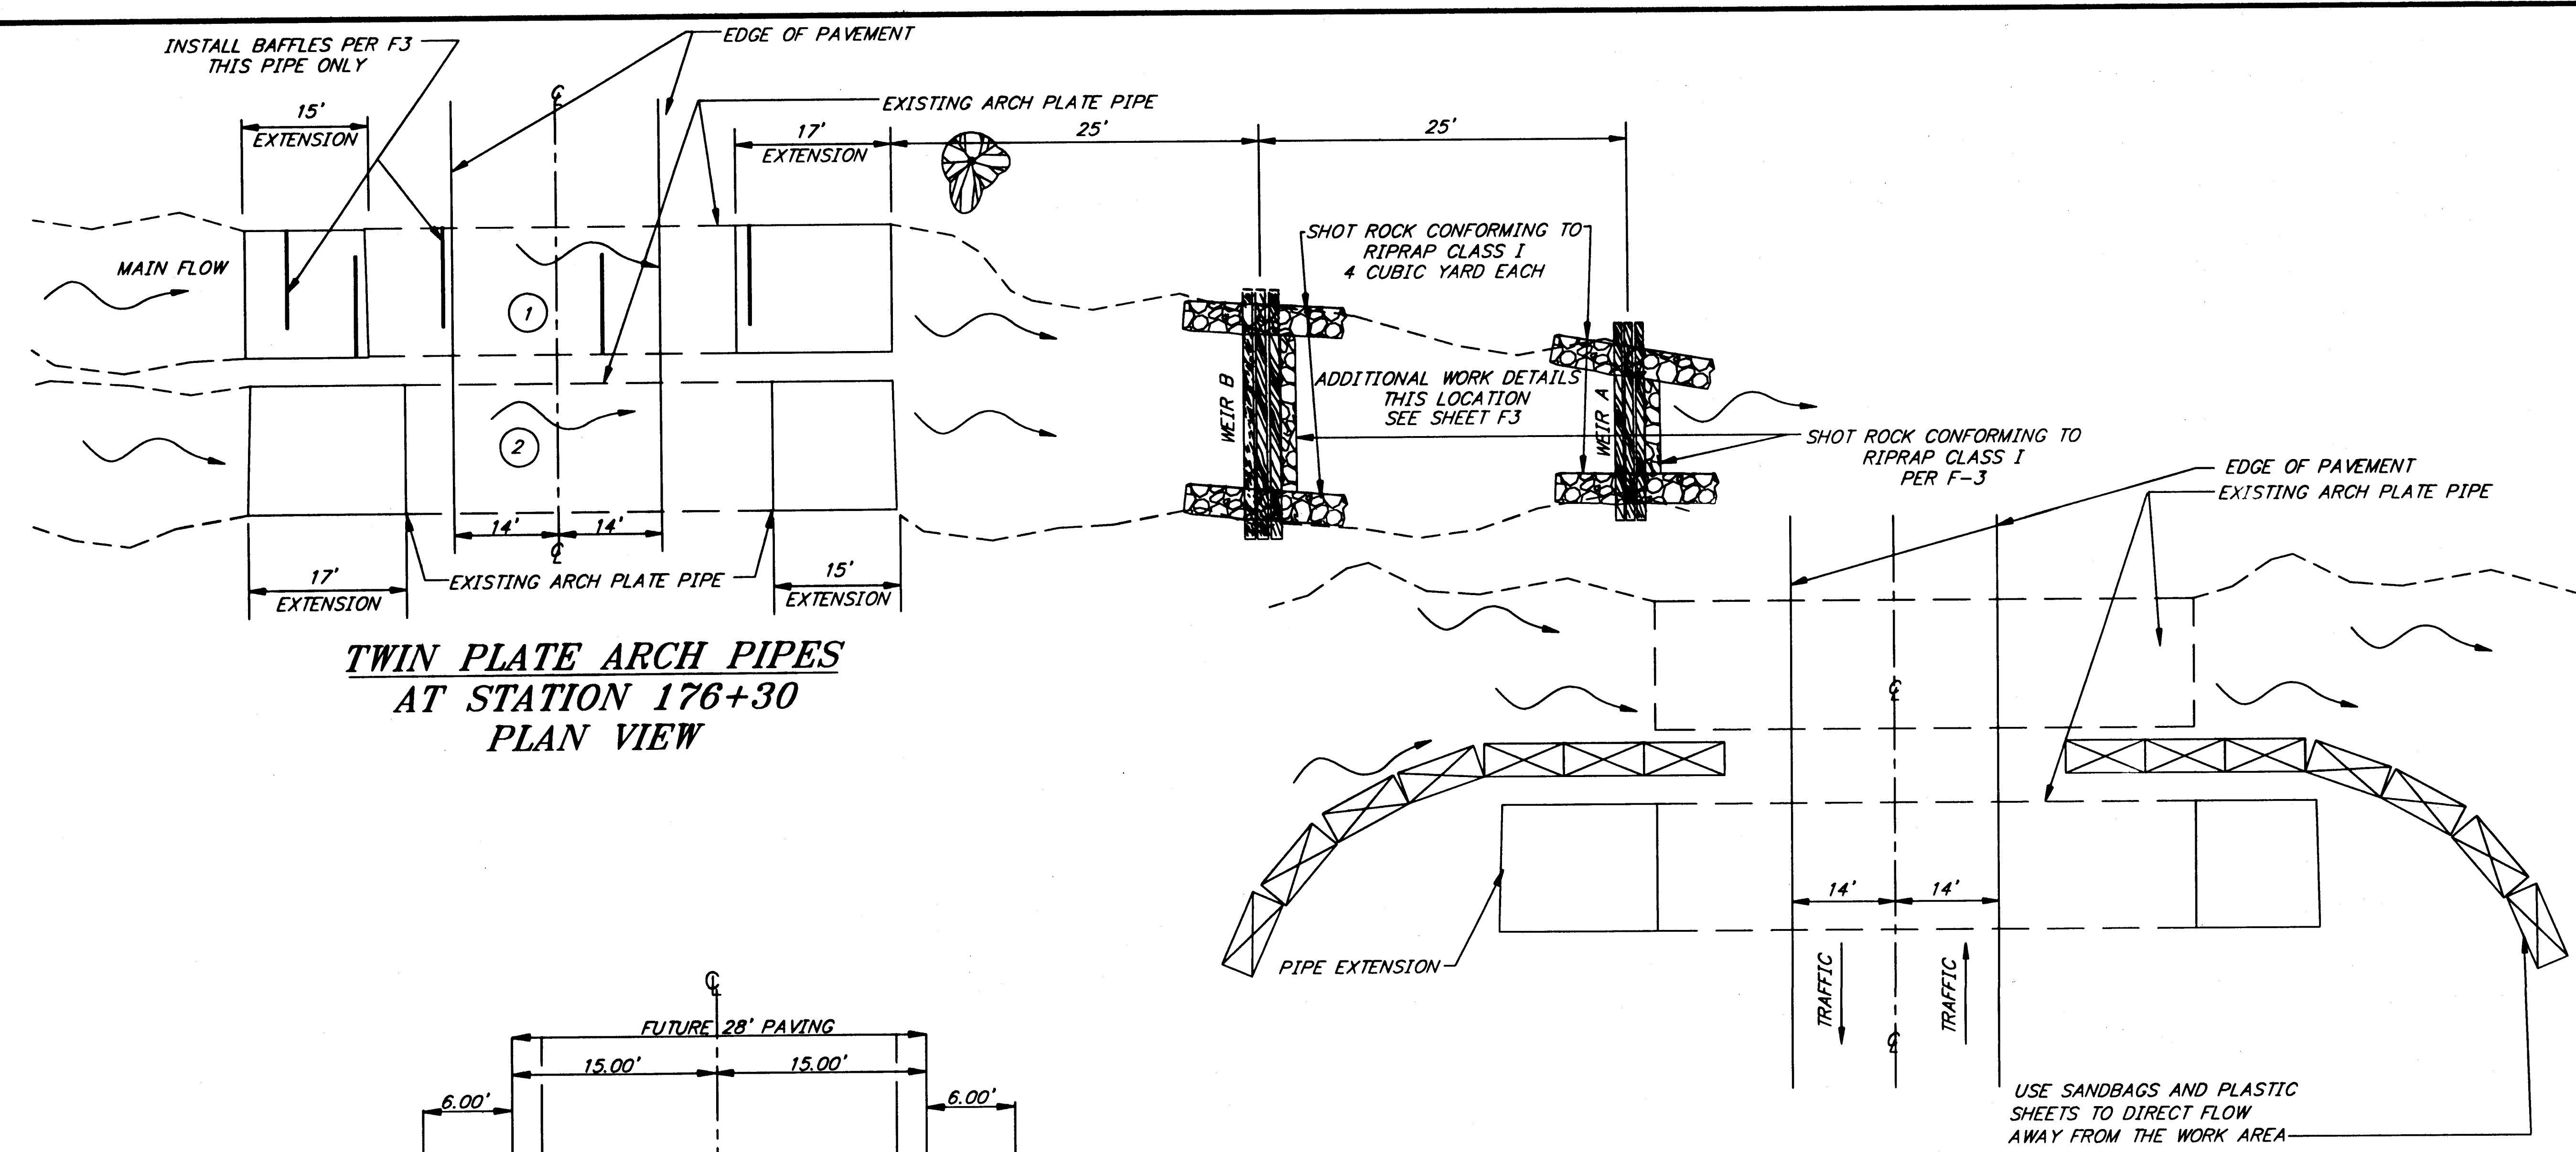

TWIN PLATE ARCH PIPES
AT STATION 176+30
PLAN VIEW

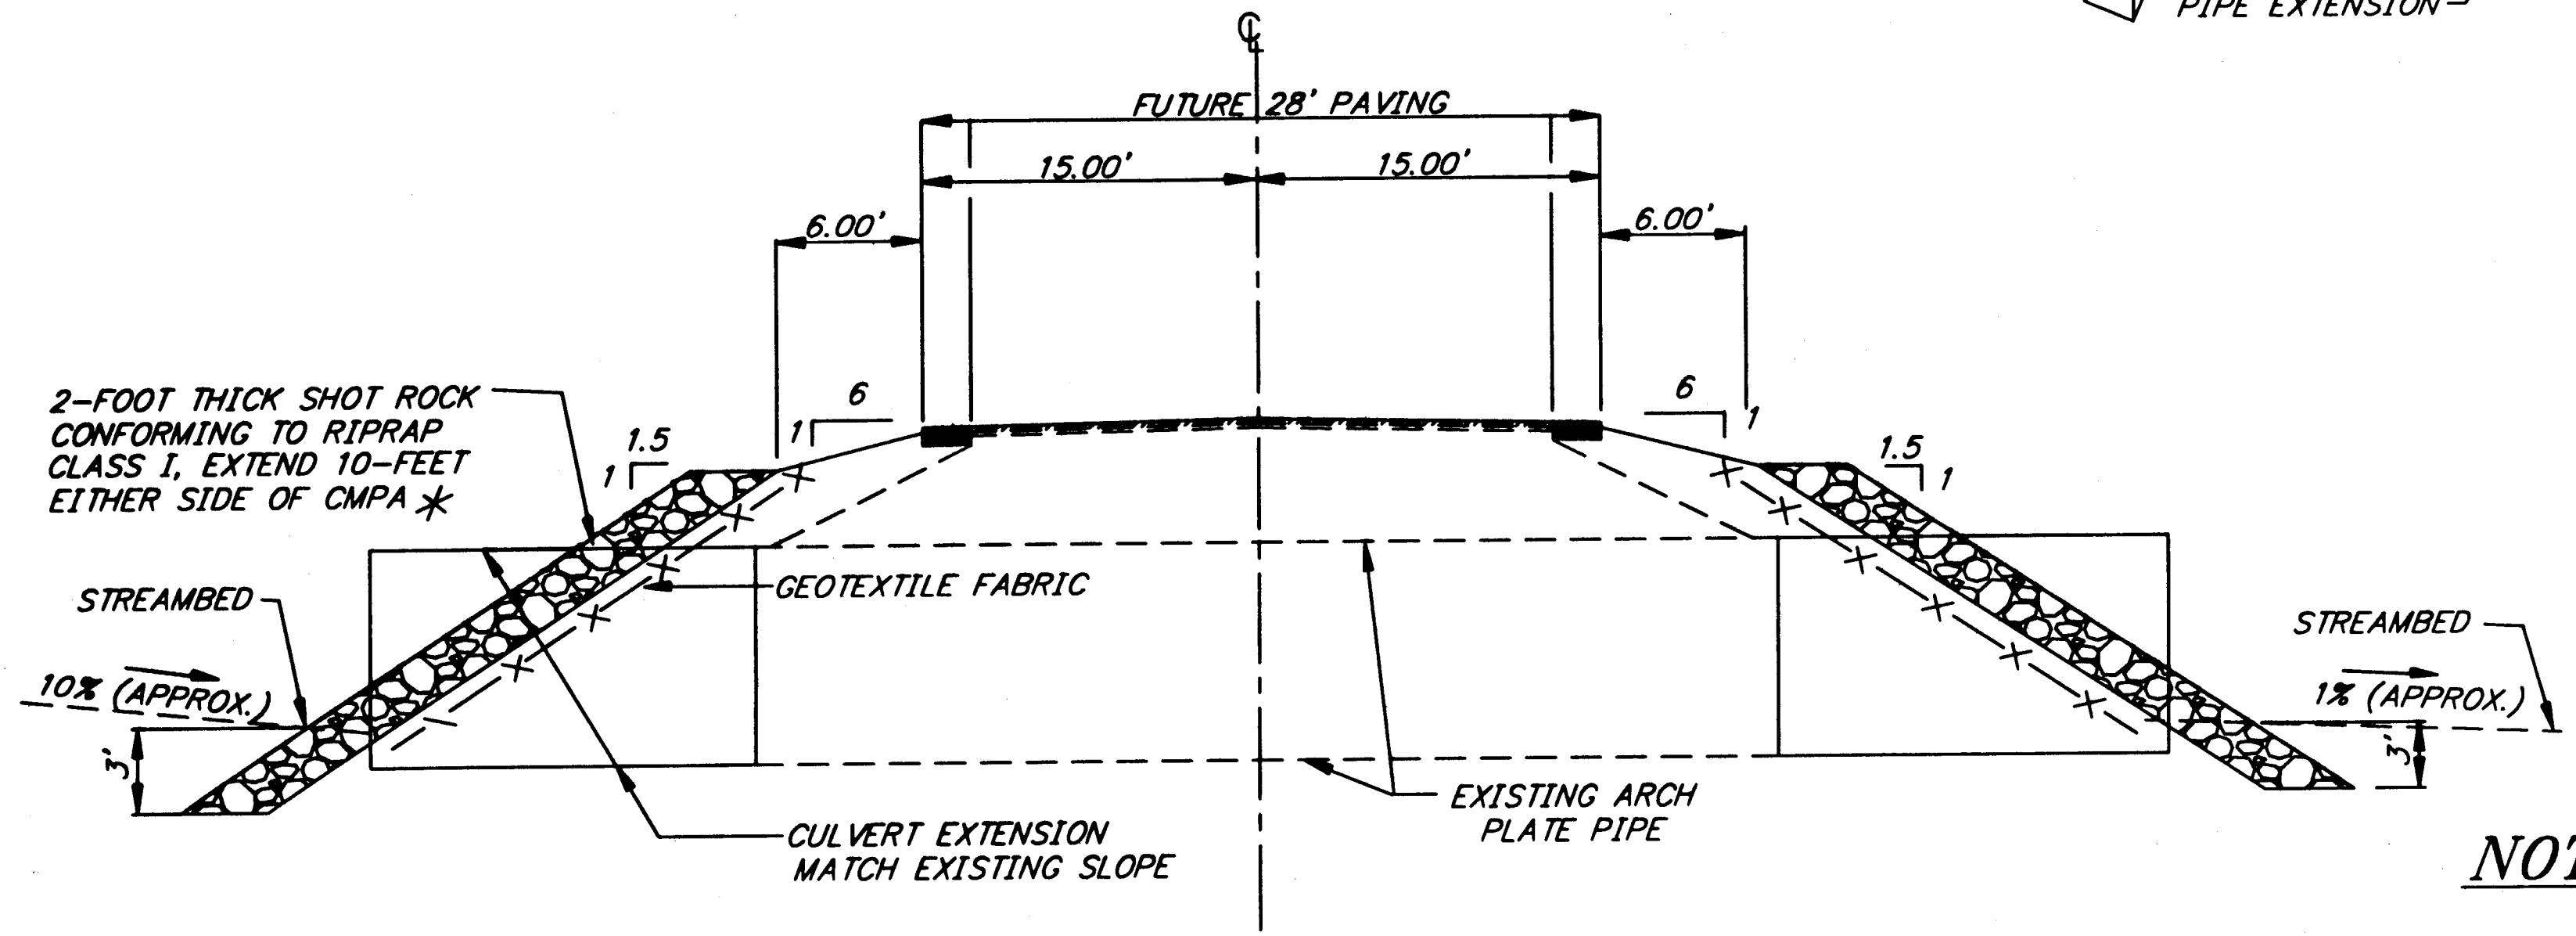


TWIN PLATE ARCH PIPES
AT STATION 176+30
PROFILE VIEW

* USE THESE DIMENSION FOR SHOT ROCK, CONFORMING TO RIPRAP CLASS I ON THE INLET END OF CMPA @ STATION 212+45


CONSTRUCTION WORK PLAN

NOTES:


1. A WORK PLAN BASED ON THESE DETAILS AND THE FISH AND GAME PERMIT (SEE APPENDIX B.) SHALL BE SUBMITTED FOR APPROVAL BEFORE WORKING IN THE STREAM. THE PLAN WILL INCLUDE WILLOW PLANTINGS ABOVE ORDINARY HIGH WATER AND NATIVE GRASS MIX IN ALL DISTURBED AREAS. THE STREAM FLOW SHALL BE DIVERTED TO ONE OF THE PIPES WHILE WORKING ON THE OTHER. A COMBINATION OF SILT FENCE, STRAW BALES, PLASTIC SHEETS, AND SANDBAGS SHALL BE USED TO MINIMIZE IMPACTS TO THE STREAM. SANDBAGS AND PLASTIC SHEETS SHALL BE USED TO DIRECT FLOW AWAY FROM THE WORK AREA.
2. IF PUMPING IS REQUIRED, DISCHARGE SHALL BE SITUATED A MINIMUM OF 50' FROM STREAMBED HIGHWATER LINE. THE 50' SEPARATION MUST BE VEGETATED; AND THE DISCARD END SHALL BE RELOCATED PERIODICALLY AS REQUIRED.
3. REVEGETATE STREAM BANKS AND ALL UPLAND AREAS DISTURBED BY CONSTRUCTION ACTIVITY PER SECTIONS 618 & 621.
4. NOTIFY THE ENGINEER AT LEAST 5 WORKING DAYS IN ADVANCE OF IN WATER WORK.

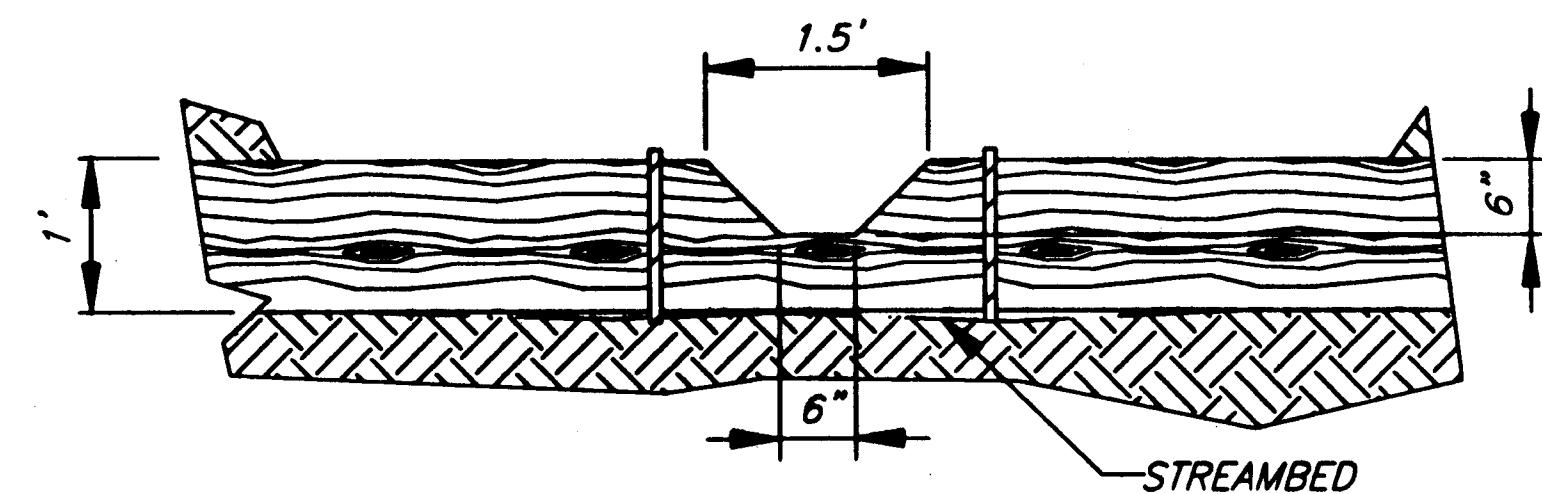

WEIR "A"

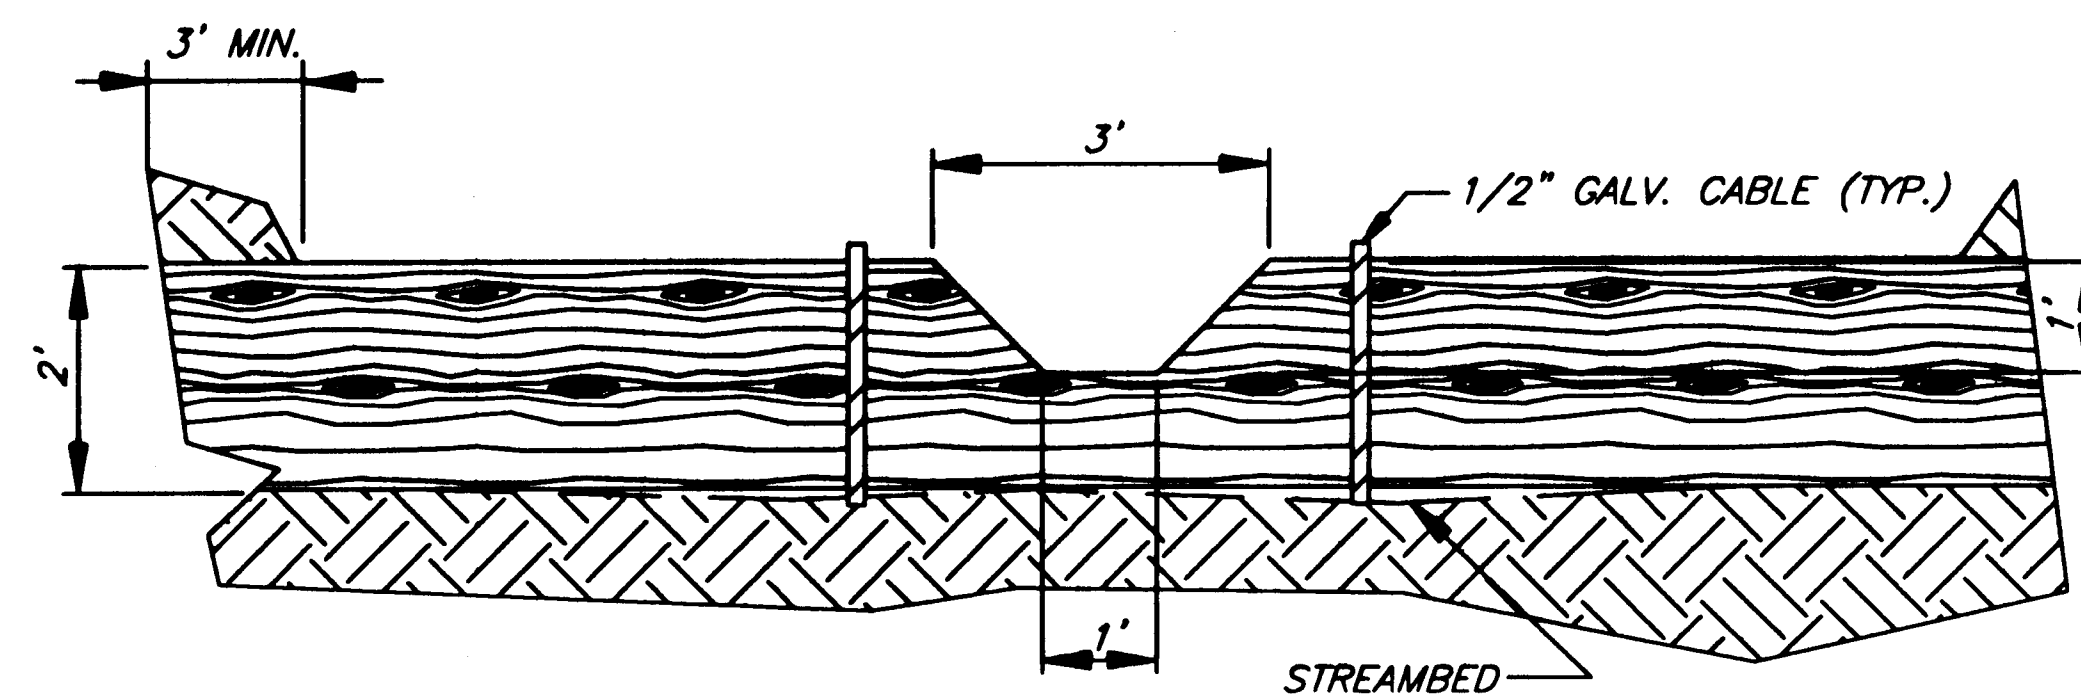


WEIR "B"

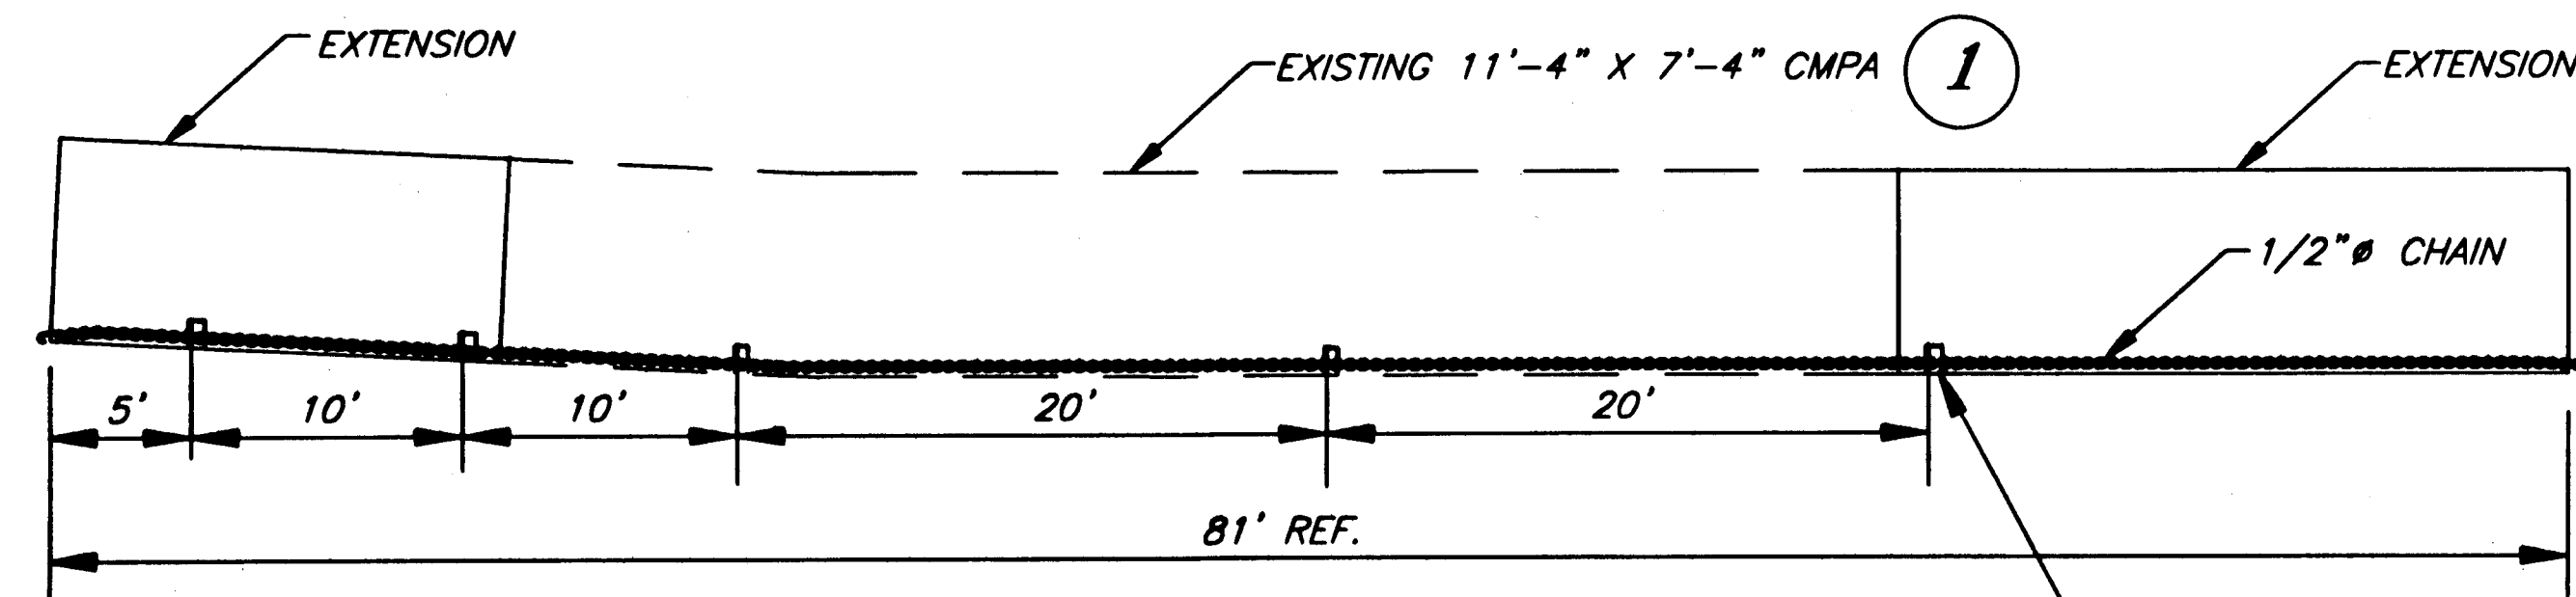


PROFILE VIEW

- NOTE:**
1. SEE SHEET M4 & M5, FOR ALL CONNECTION AND FABRICATION DETAIL NOT SHOWN HERE.
 2. BAFFLES TO BE INSTALLED IN CMPA ① ONLY.

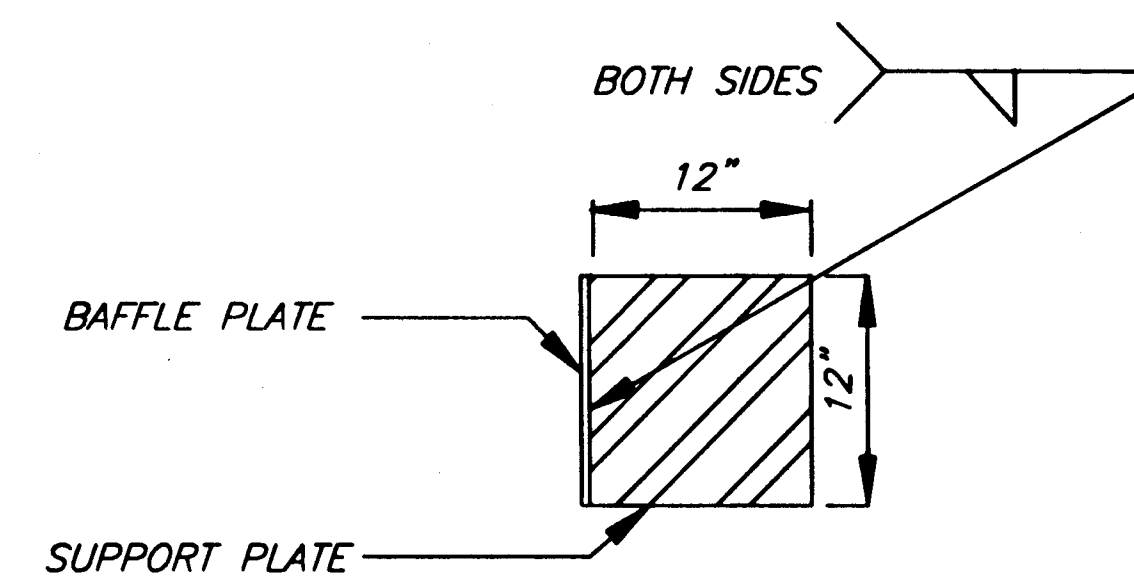


SUPPORT PLATE

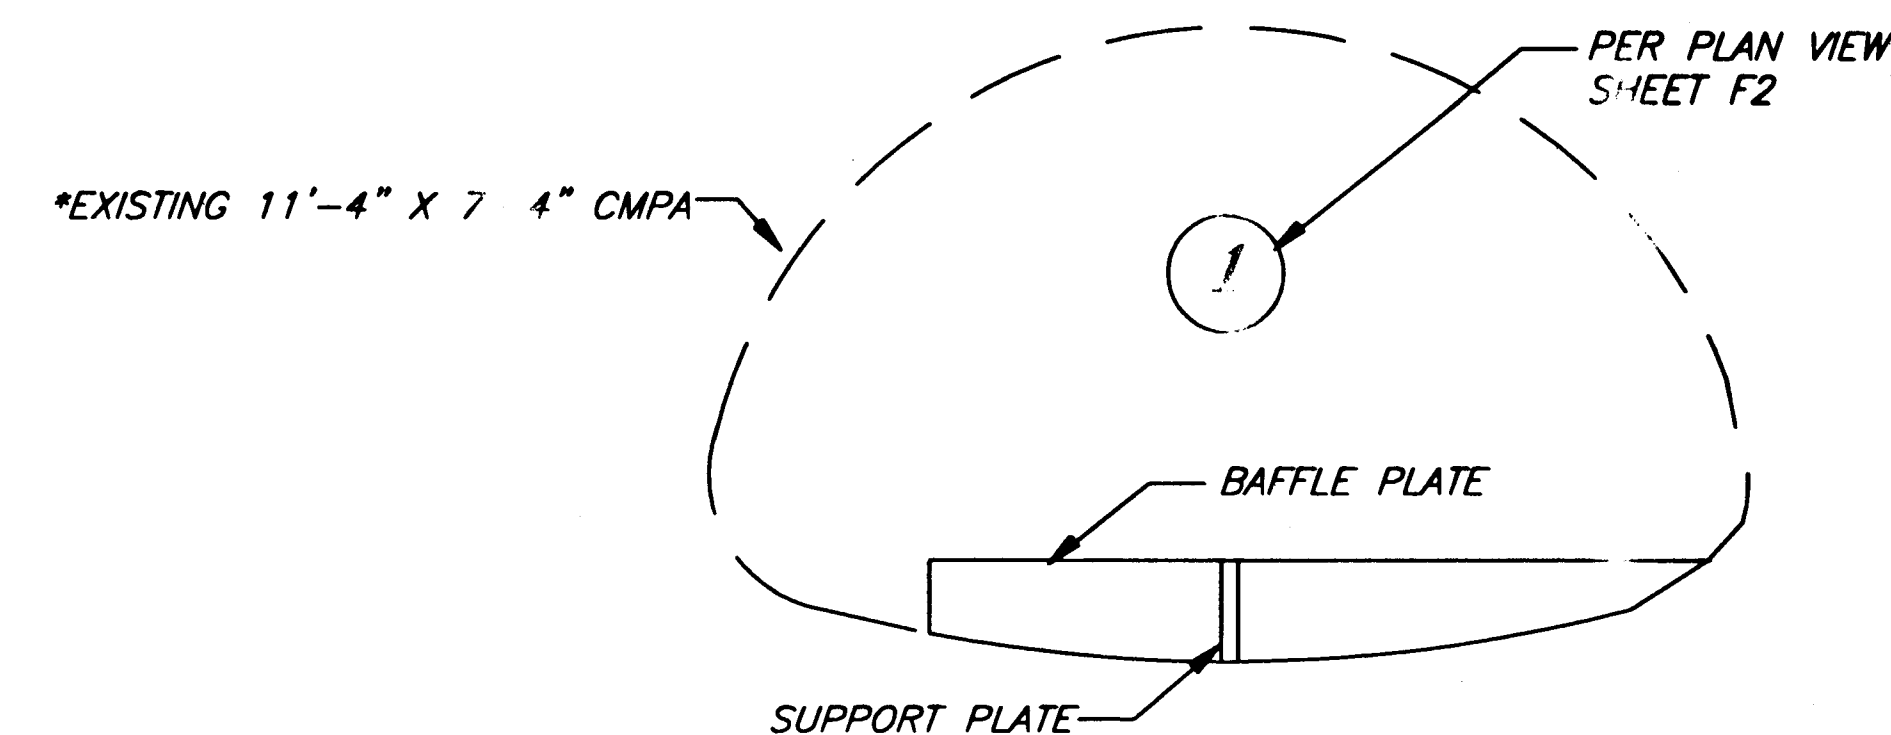


SECTION VIEW

* FIELD VERIFY PIPE DIMENSIONS BEFORE FABRICATION

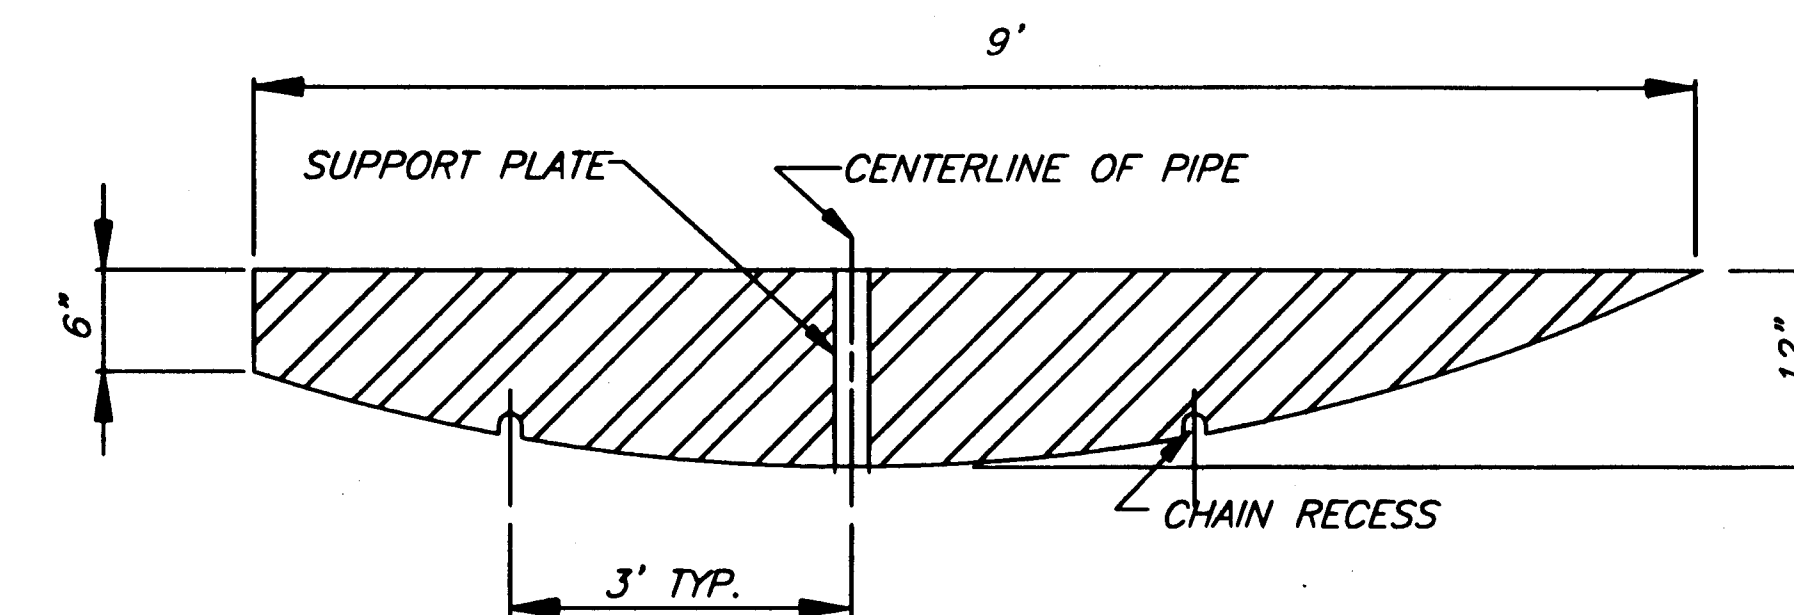

BAFFLE DETAILS

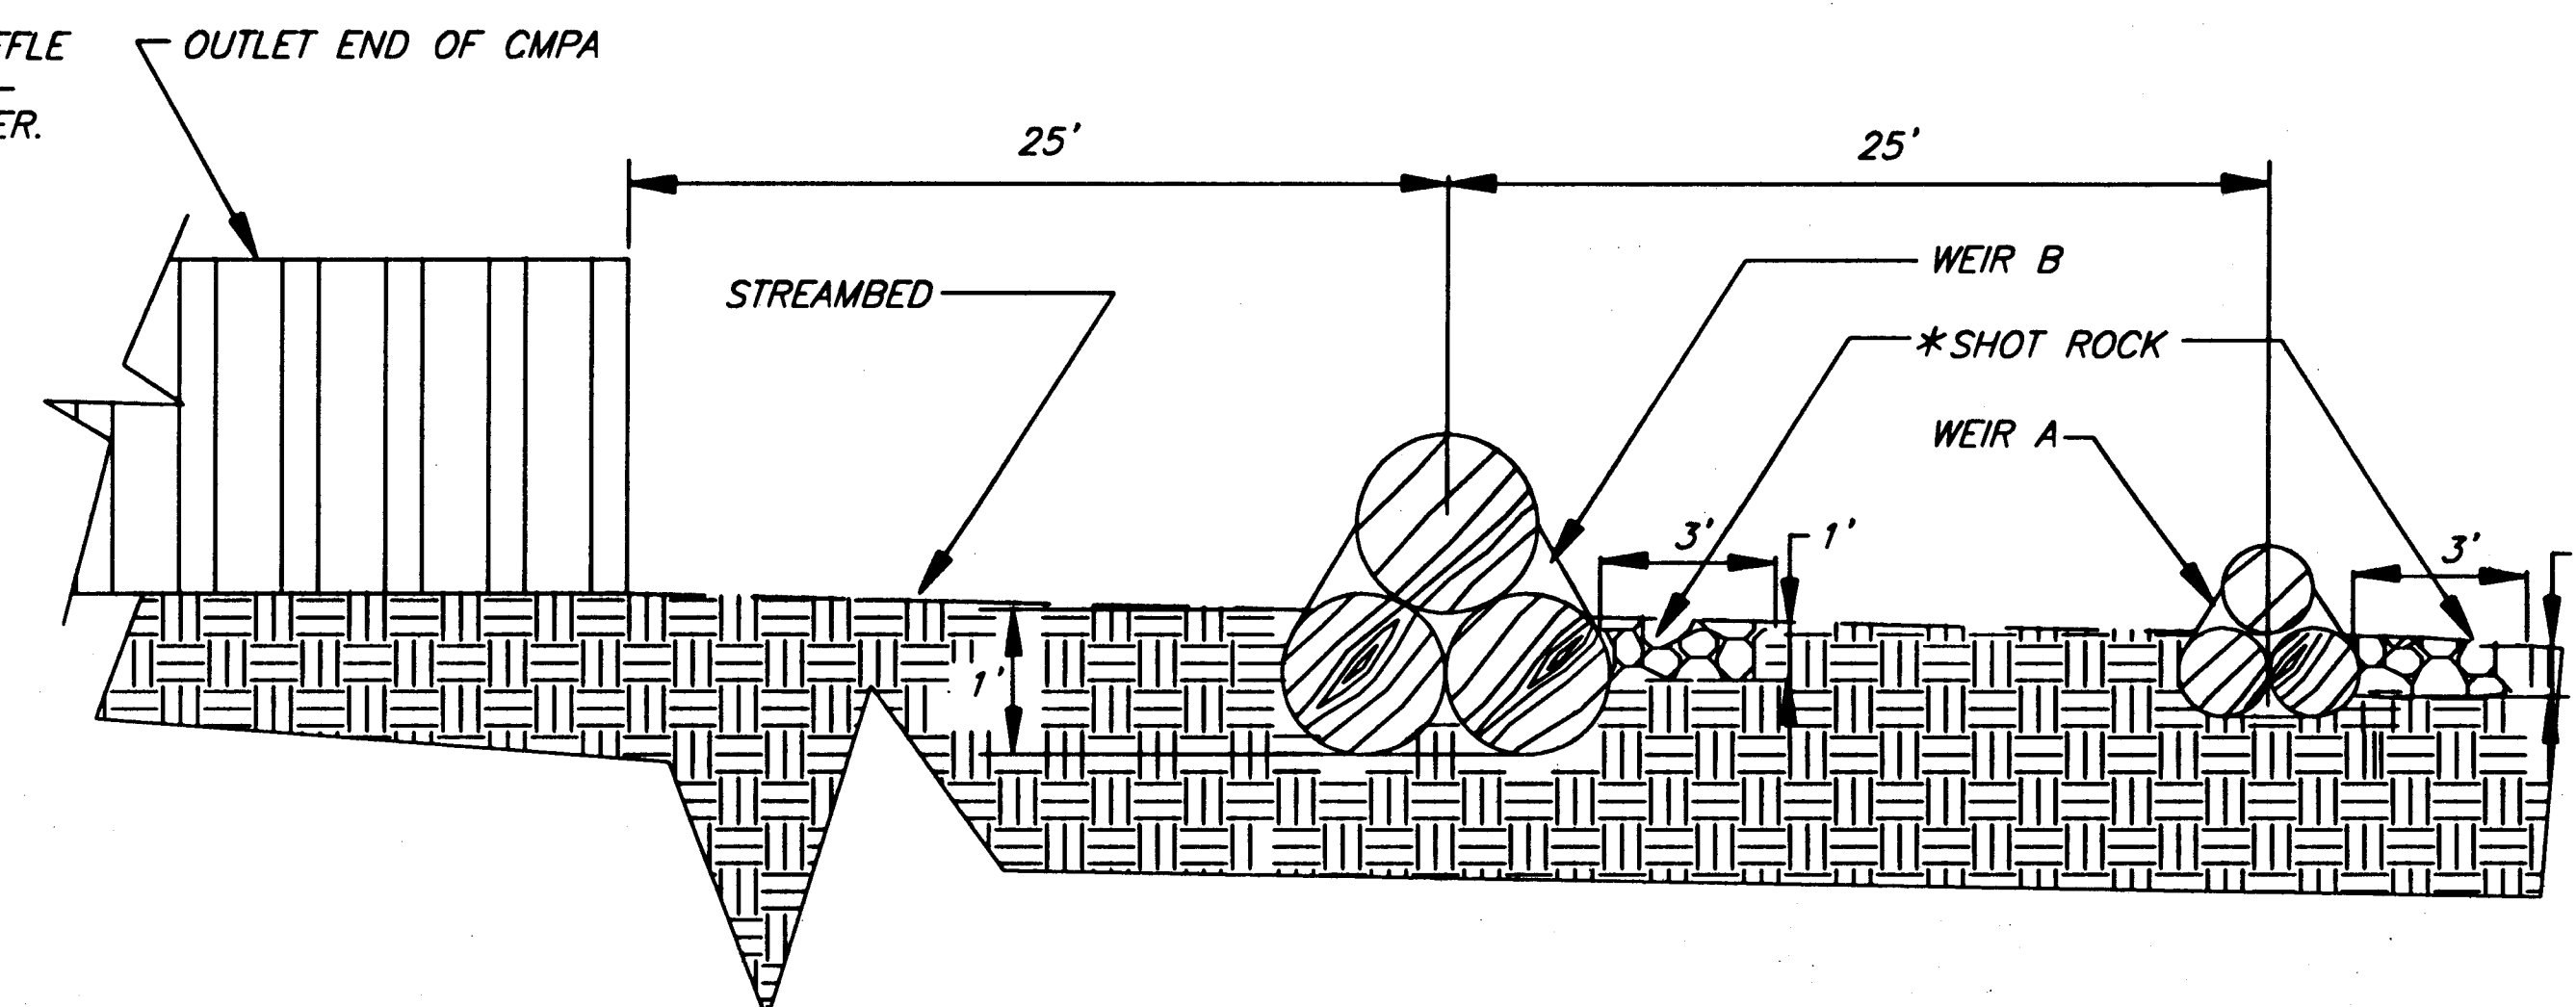

WEIR PLACEMENT DETAIL

* SHOT ROCK SHALL CONFORM TO RIPRAP, CLASS 1


PATH: Q:\Jnu\68269\PlanSet\F3det.dwg
Q: Jnu\68269\PlanSet\F3det.dwg
Wed, 09/Jan/02 02:32PM Kris
PLOT: PSPACE 1=1(F) OR MSPACE 1=1(F)
TAB: ESTIMATE

ADDENDUM NUMBER		
ATTACHMENT NUMBER		
Wed, 09/Jan/02 02:32PM		
RECORD OF REVISIONS		
No.	DATE	DESCRIPTION

JNU-FISH CREEK ROAD
SAFETY IMPROVEMENTS
PROJECT NO. 68269

Fish Pipe Station 176+30
Fish Passage Improvements
Culvert Details

DESIGNED BY: M. LAVERING

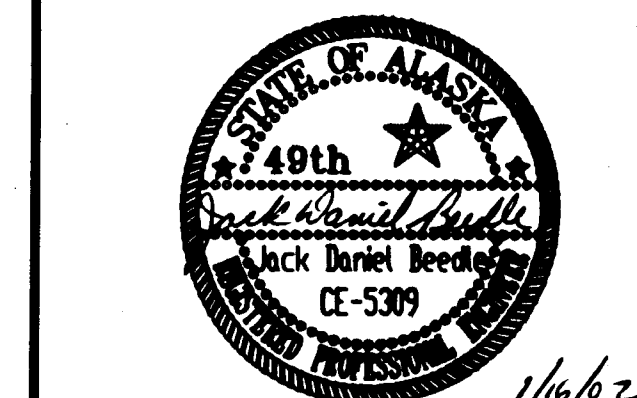

CHECKED BY: T. MOORE
DRAWN BY: K.K.

STATE OF ALASKA
DEPARTMENT OF TRANSPORTATION
& PUBLIC FACILITIES
STATEWIDE DESIGN & ENGINEERING
SERVICES DIVISION


JNU-FISH CREEK ROAD
SAFETY IMPROVEMENTS
PROJECT NO. 68269
Fish Pipe Station 177
Passage Improvements
Culvert Details

PROJECT DESIGNATION NUMBER
ACHRO-0953(4)


STATE YEAR
ALASKA 2001

SHEET NUMBER TOTAL SHEETS
F3 41

TRANSITION REALIGNMENT / SIGHT DISTANCE WORK
& GRADE WORK BY OTHERS

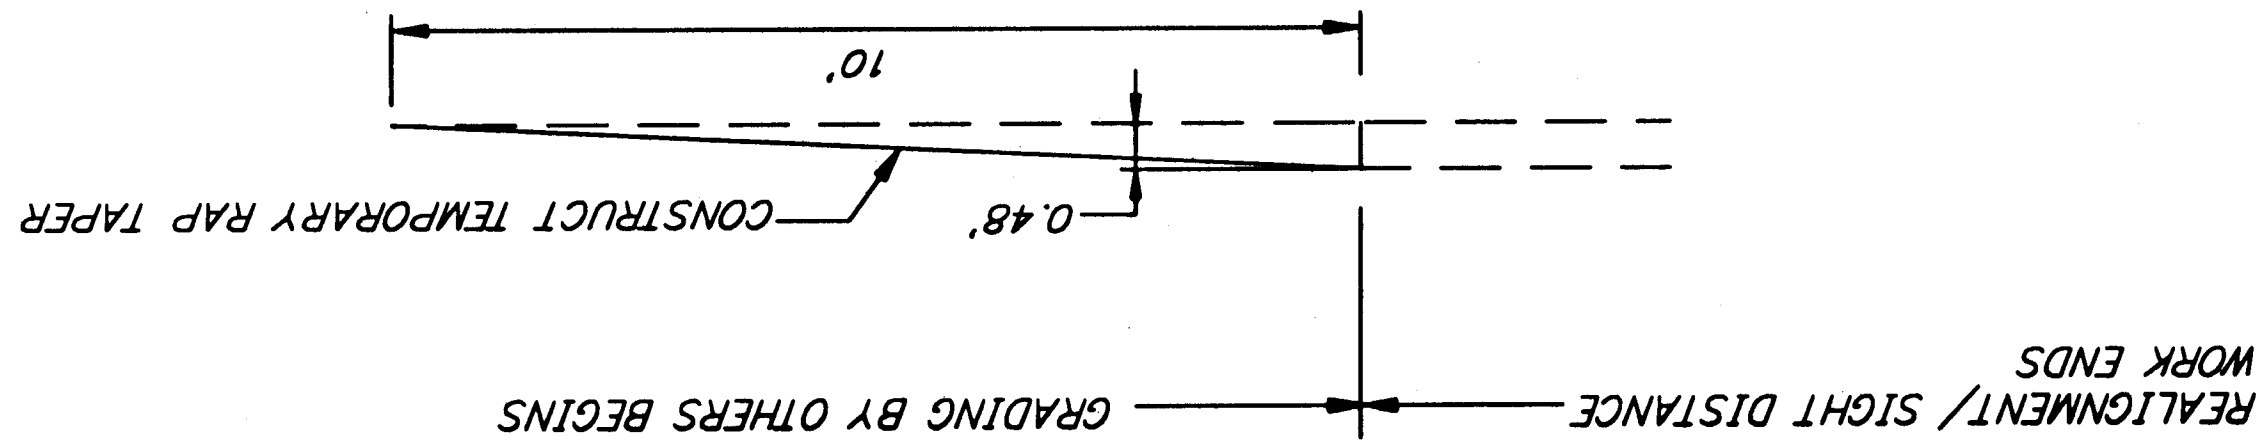

GUARDRAIL - BRIDGE RAIL TRANSITION
PLAN VIEW

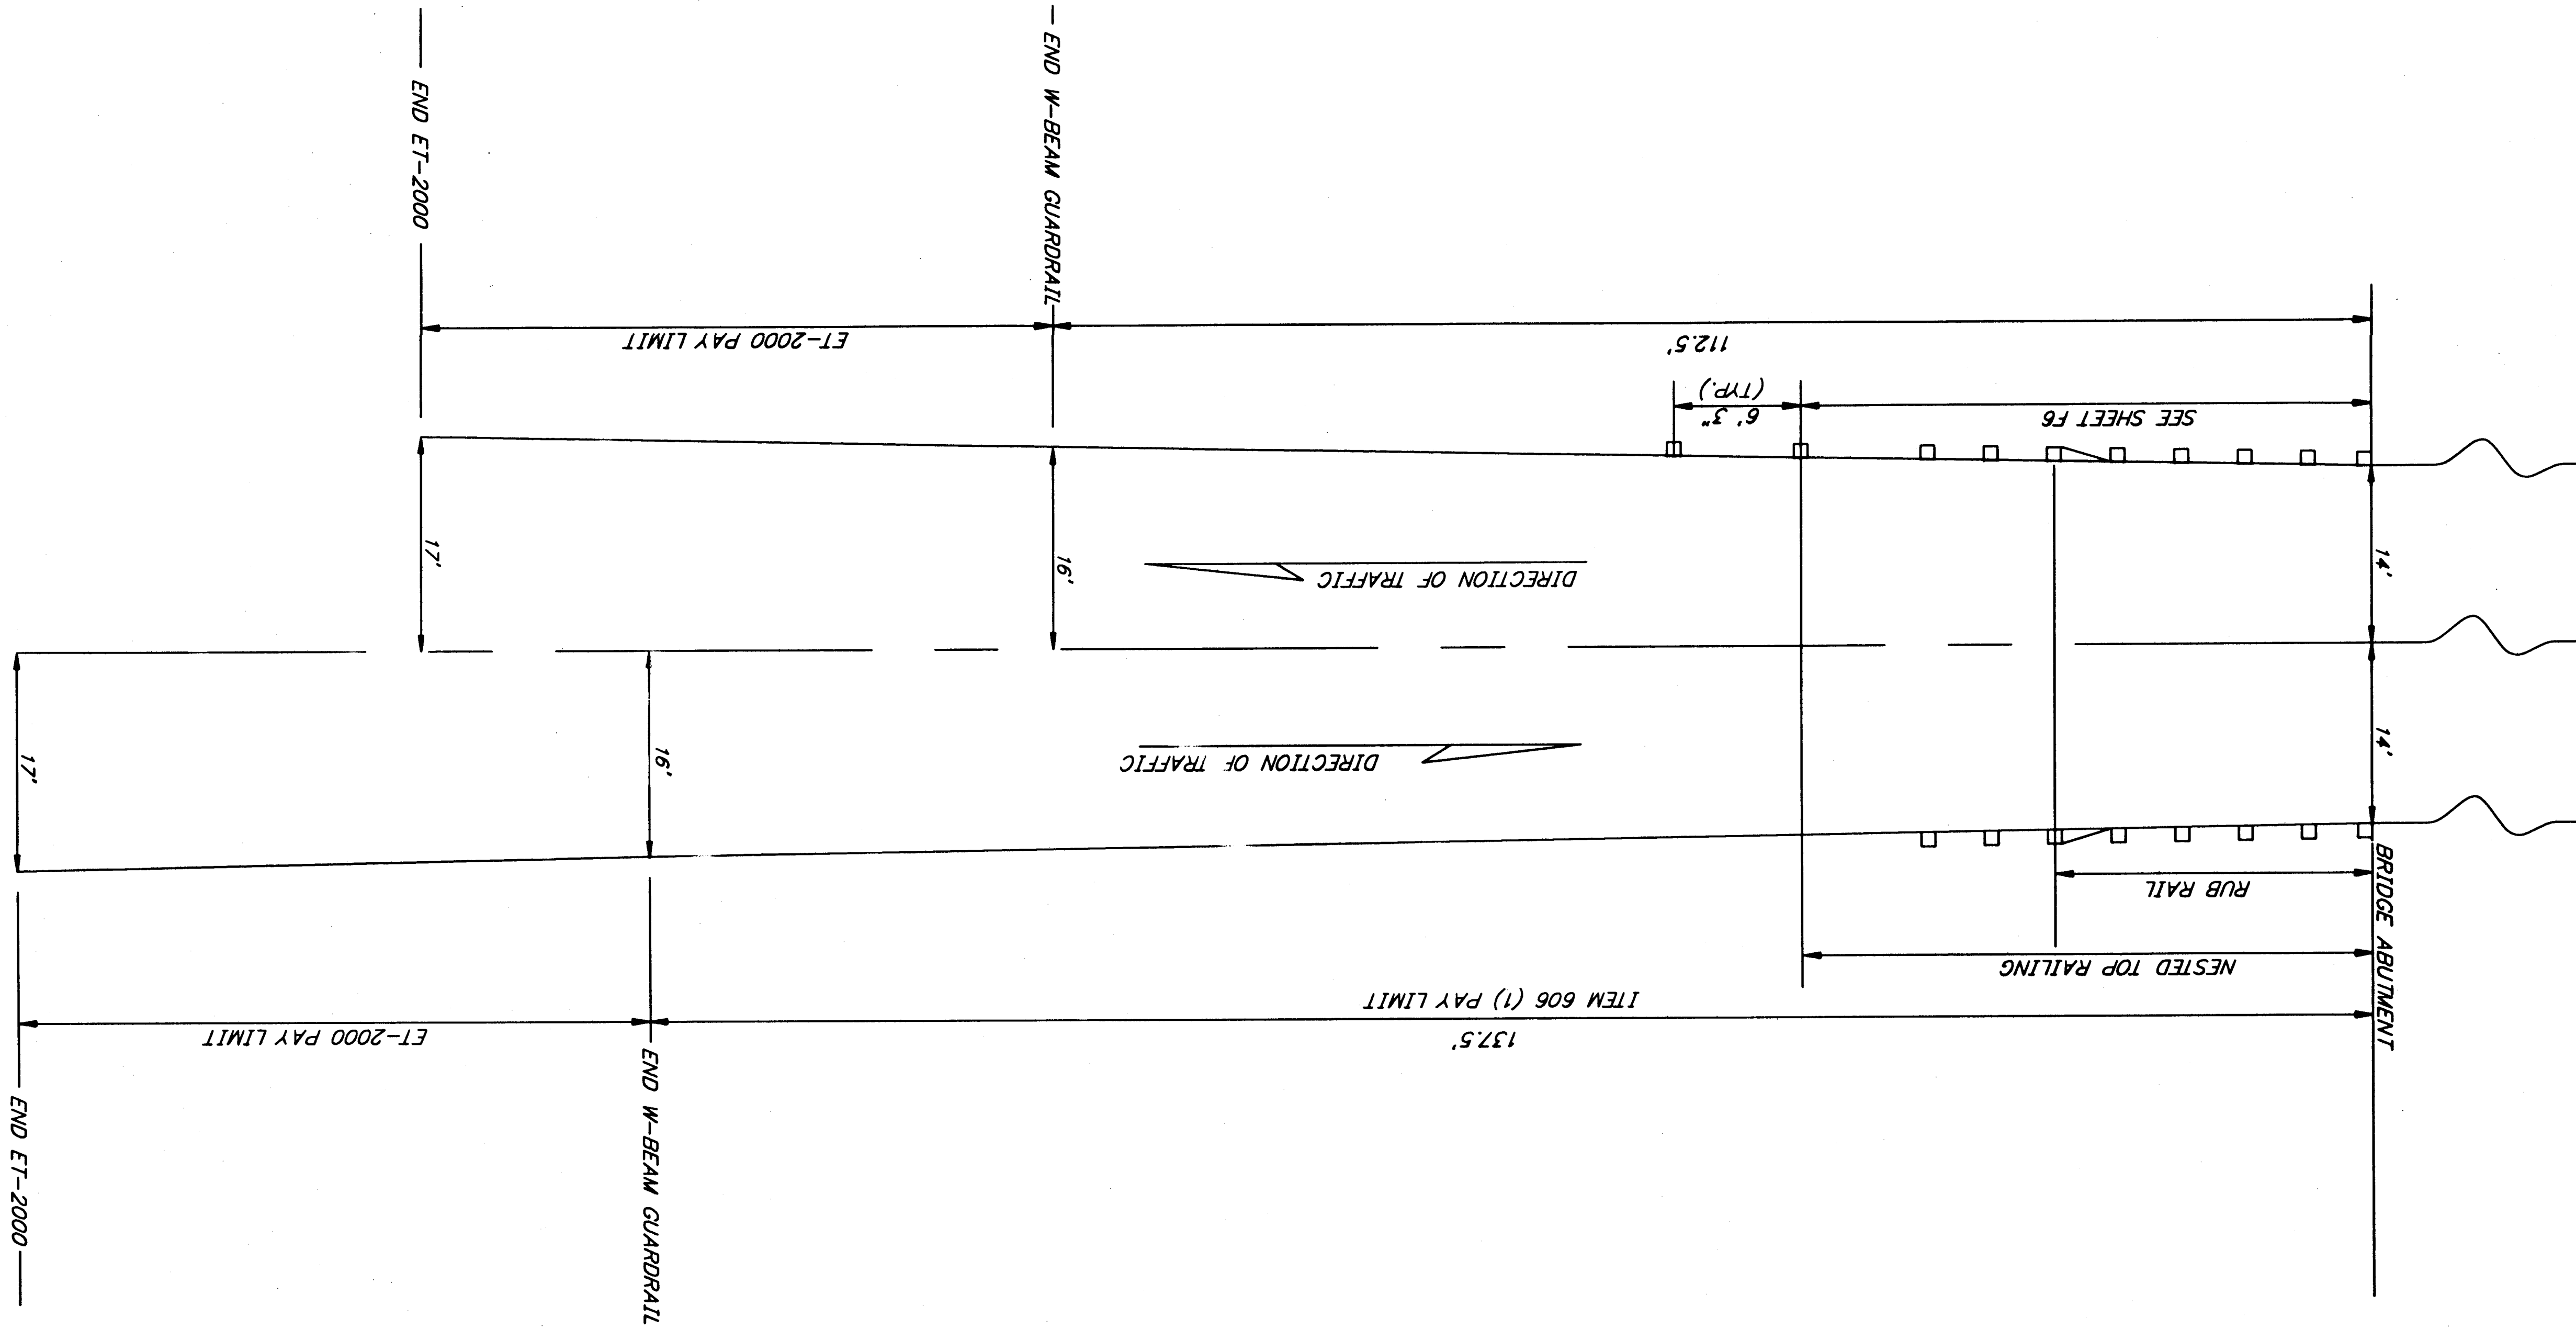

41

F4

SHEET NUMBER

TOTAL SHEETS

ALASKA

2001

STATE

YEAR

ACHRO-0953(4)

PROJECT DESIGNATION NUMBER

Guardrail

Plan View

JNU-FISH CREEK ROAD

SAFETY IMPROVEMENTS

PROJECT NO. 68269

STATEWIDE DESIGN & ENGINEERING

SERVICES DIVISION

DEPARTMENT OF TRANSPORTATION

STATE OF ALASKA

DRAWN BY: K.K.

CHECKED BY: T. MOORE

11/6/02

DESIGNED BY: M. LAVERING

7/22/03

19th

Jack David Beede

CE-5309

STATE OF ALASKA

JNU-FISH CREEK ROAD

SAFETY IMPROVEMENTS

PROJECT NO. 68269

Guardrail Plan View

ADDENDUM NUMBER

ATTACHMENT NUMBER

RECORD OF REVISIONS

No.

DATE

DESCRIPTION

0:\jnu\68269\Plan\et\F_.dwg

Wed, 09/Jun/02 02:25PM


Kris

PLT:


SPACE 1=1(F) OR MSPACE 1=1(F)

TAB: ESTIMATE

PATH:

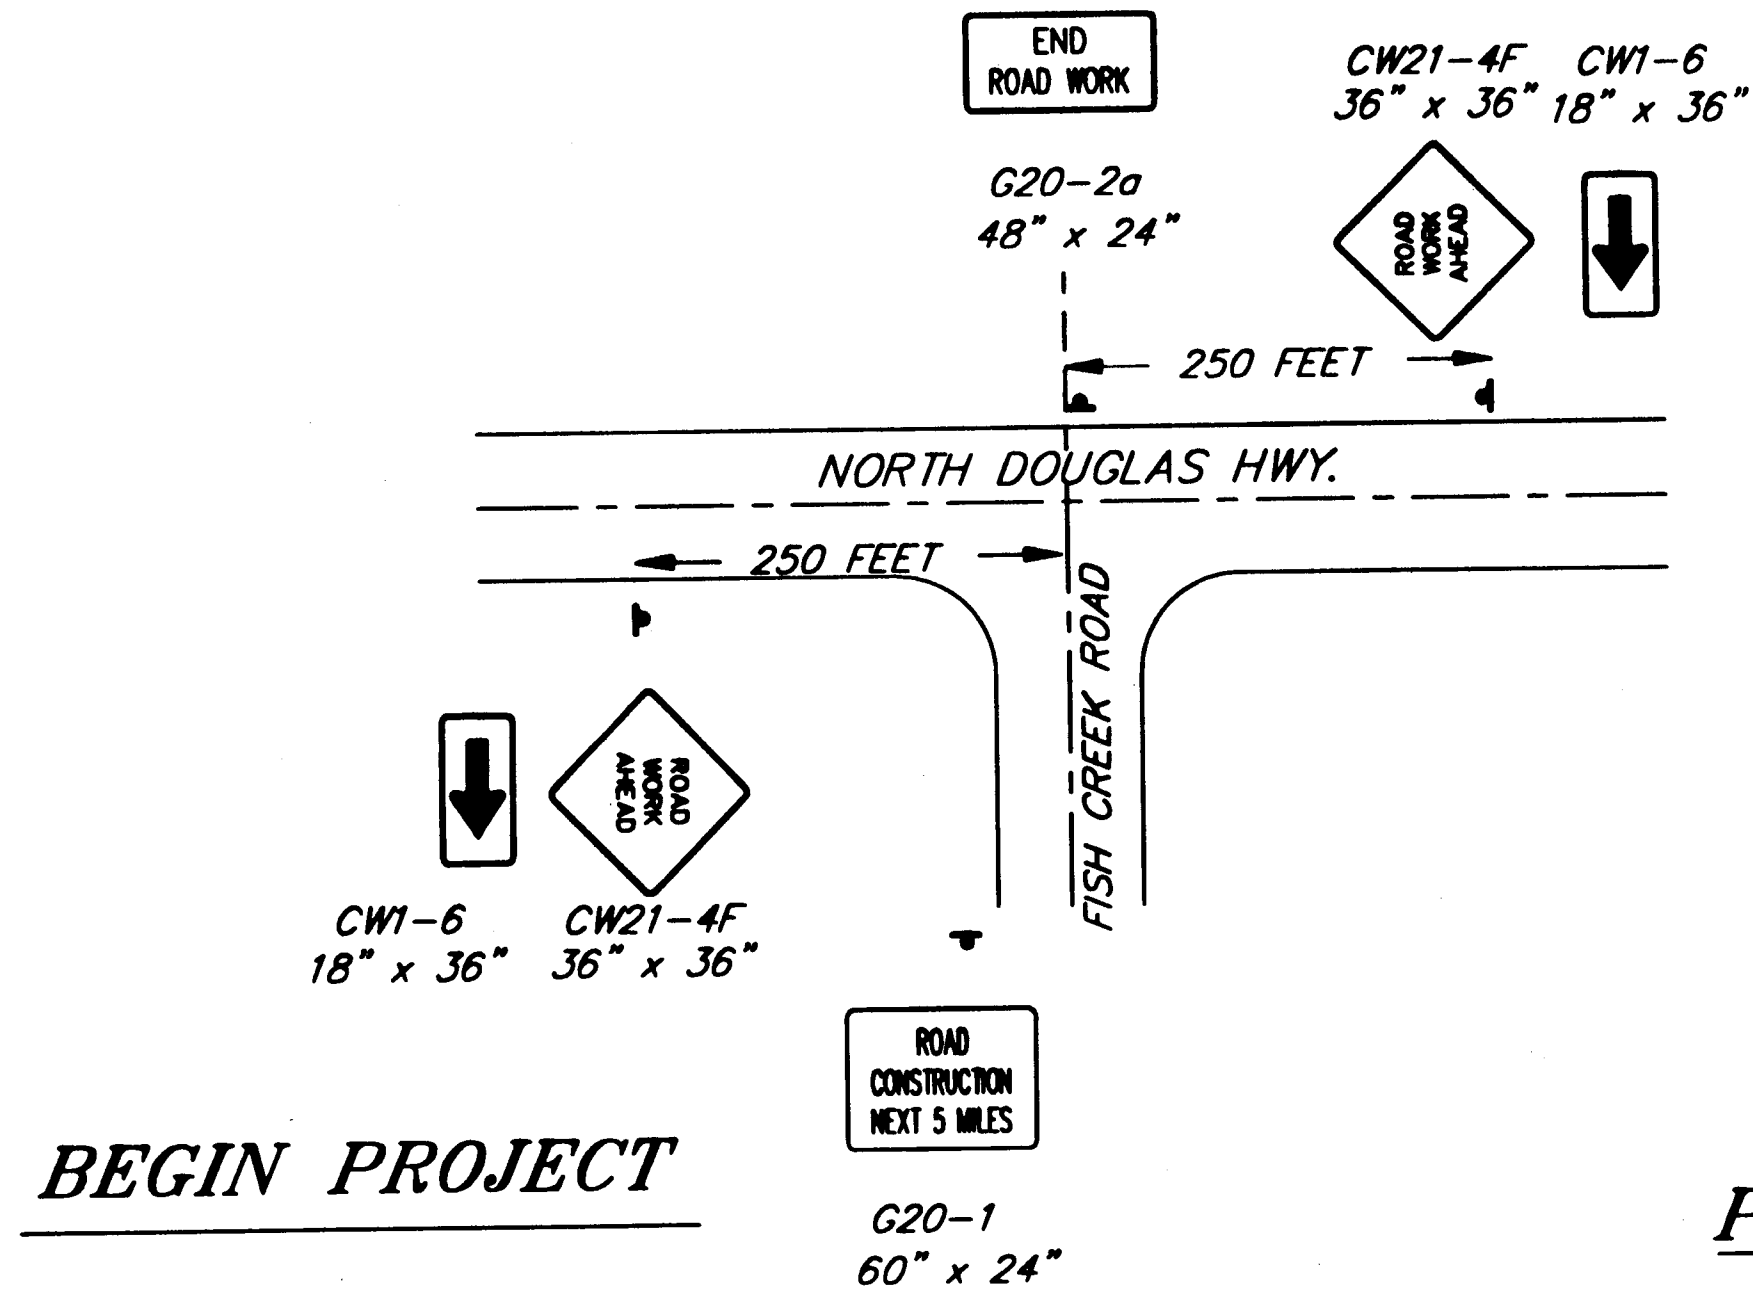

BEGIN PROJECT

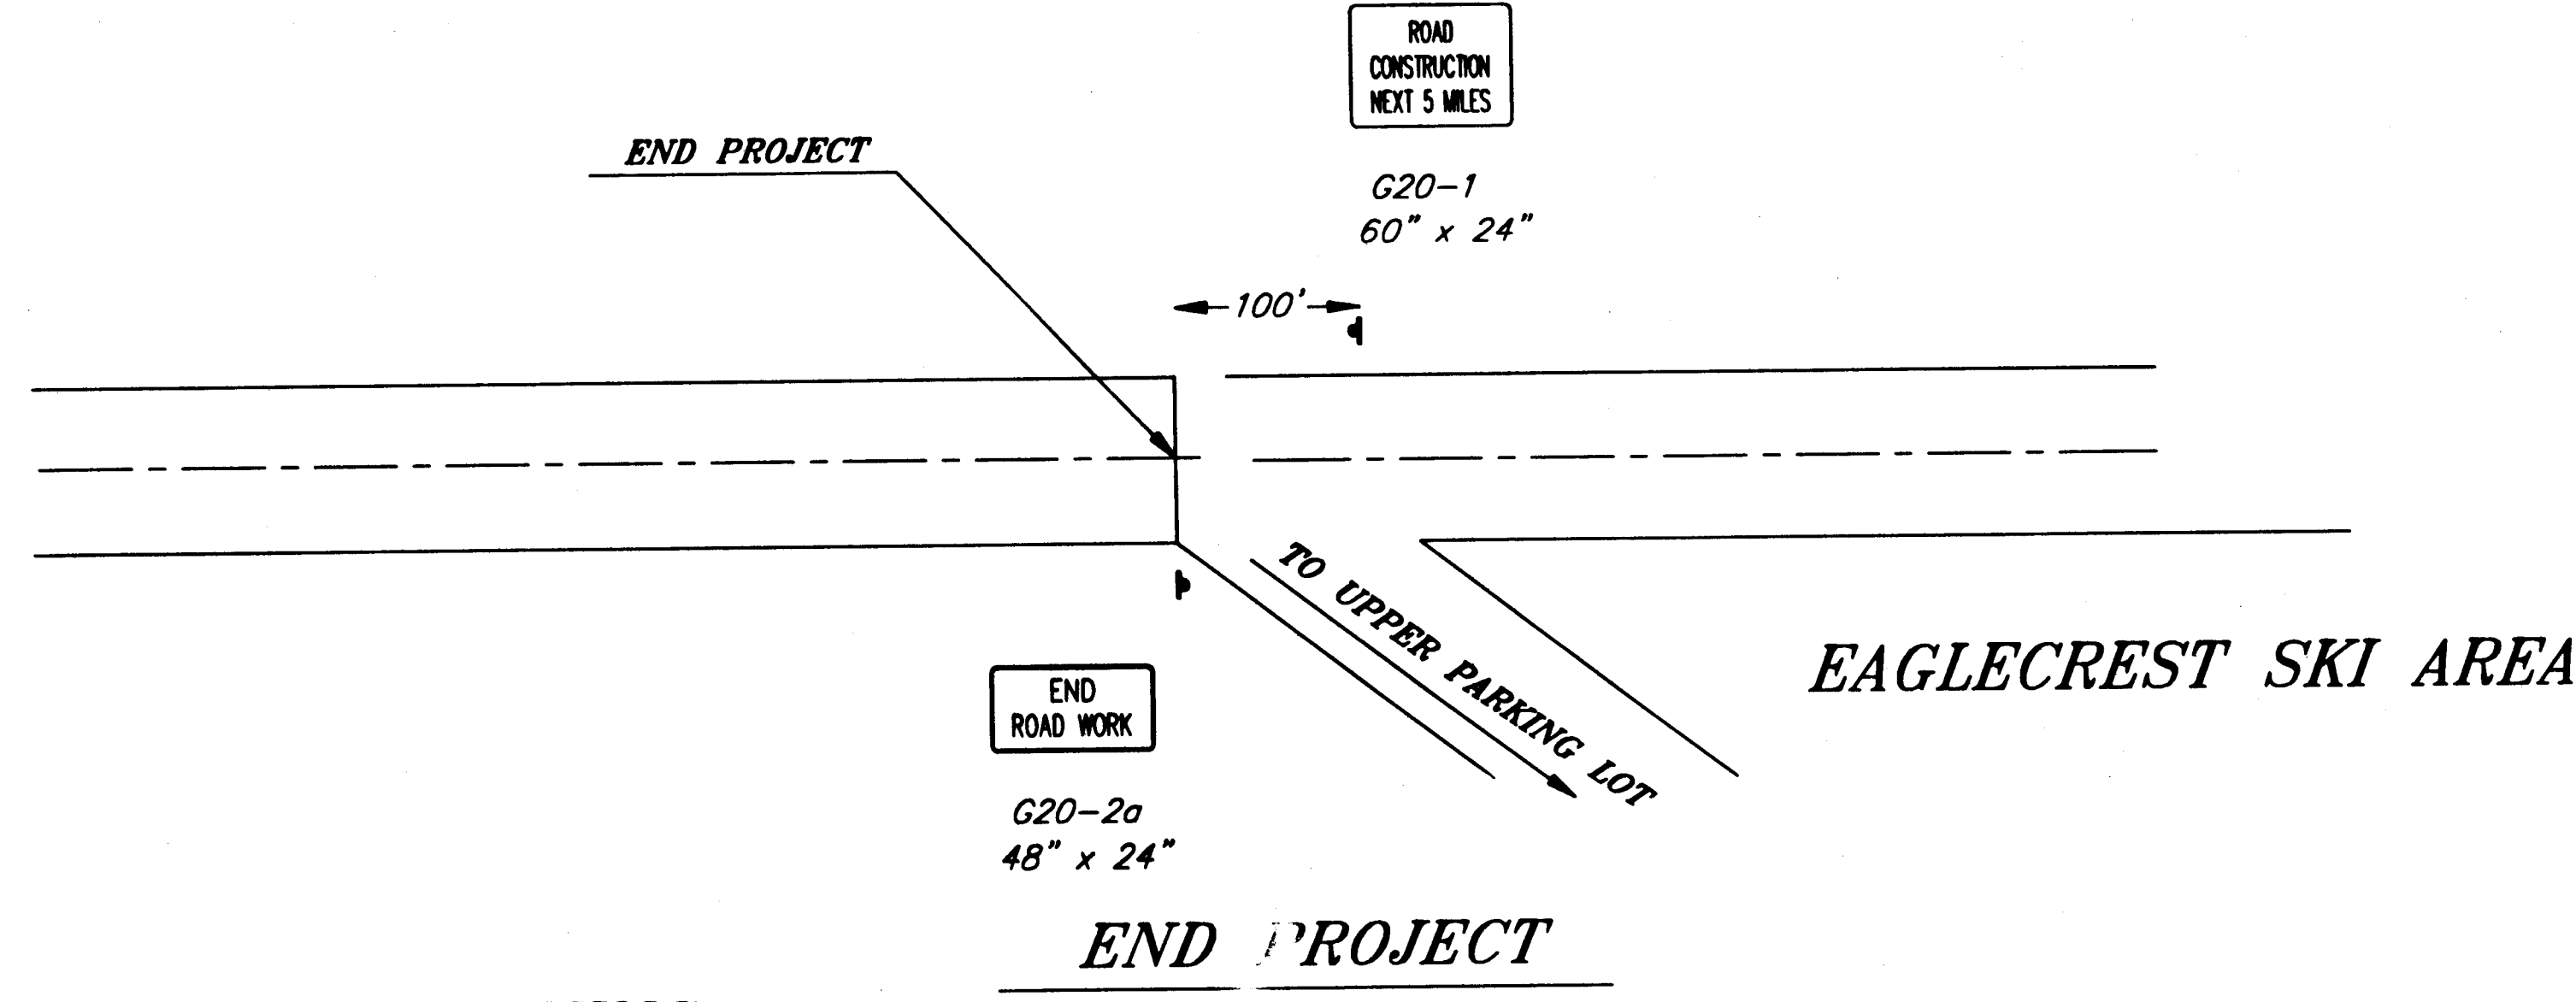

END PROJECT


PERMANENT CONSTRUCTION SIGNING

LIMITATION OF OPERATIONS

- TO MINIMIZE DISRUPTING THE SEASONAL OPERATIONS OF THE EAGLECREST SKI AREA, THE CONTRACTOR SHALL ABIDE TO THE STIPULATIONS LISTED BELOW FOR ANY CONSTRUCTION ACTIVITIES BETWEEN NOVEMBER 15, 2001 AND APRIL 14, 2002.
 - FRIDAY, SATURDAY, AND SUNDAY: TWO LANES OF TRAFFIC SHALL BE MAINTAINED BETWEEN 8:00 AM AND 5:00 PM AND ONE LANE OF TRAFFIC BETWEEN 5:00 PM AND 8:00 AM
 - MONDAY AND THURSDAY: TWO LANES OF TRAFFIC SHALL BE MAINTAINED BETWEEN 8:00 AM AND 10:00 AM AND ONE LANE OF TRAFFIC BETWEEN 10:00 AM AND 8:00 AM.
 - TUESDAY AND WEDNESDAY: ONE LANE OF TRAFFIC SHALL BE MAINTAINED.
 - SCHOOL BREAKS: TWO LANES OF TRAFFIC BETWEEN 8:00 AM AND 5:00 PM AND ONE LANE OF TRAFFIC BETWEEN 5:00 PM AND 8:00AM SHALL BE MAINTAINED. SCHOOL BREAKS START APPROXIMATELY DECEMBER 21, 2001 AND ENDS JANUARY 7, 2002 AND MARCH 21, 2002 AND ENDS MARCH 31, 2002. BLASTING DURING THIS TIME WILL NOT BE ALLOWED UNLESS THE SKI AREA IS NOT OPERATING..
 - BLASTING OPERATION SHALL BE ACCOMPLISHED ONLY ON TUESDAY AND WEDNESDAY, EXCEPT FOR THOSE WEEKS DESCRIBED IN PARAGRAPH NO. 1d. BLASTING MAY BE ALLOWED DURING DAYS THAT THE EAGLECREST SKI AREA IS NOT OPERATING.
 - THE ROADWAY MAY BE CLOSED A MAXIMUM OF 20-MINUTES DURING BLASTING OPERATIONS. PRIOR TO CLOSING THE ROADWAY FOR BLASTING OPERATIONS, THE EAGLECREST SKI AREA, LOCAL FIRE DEPARTMENT, JUNEAU FLIGHT SERVICE STATION AND LOCAL POLICE DEPARTMENT SHALL BE NOTIFIED AT LEAST 48-HOURS IN ADVANCE OF BLAST. ROADWAY CLOSURES SHALL ALSO BE PUBLISHED IN THE LOCAL NEWSPAPER AND ANNOUNCED THRU AT LEAST TWO RADIO STATIONS (1 AM AND 1 FM STATION).
 - TWO LANES OF TRAFFIC SHALL BE MAINTAINED DURING NON-WORKING HOURS.
- ROADWAY WORK INCLUDING BLASTING OPERATIONS AFTER APRIL 14, 2002 COULD BE ACCOMPLISHED ANY TIME DURING THE WEEK.
- THE CONTRACTOR'S WORK AREAS SHALL BE A MINIMUM OF 3,000-FEET APART AND LIMITED TO THREE WORK AREAS AT A GIVEN TIME. THE WORK ZONES SHALL NOT EXCEED 2,500-FEET EACH. A NEW WORK AREA WILL NOT BE ALLOWED UNTIL ONE OF THE PREVIOUS WORK AREAS IS COMPLETED AND READY TO RECIEVE RAP (CUT) OR IN CONFORMANCE WITH STAGE I DETAIL AS SHOWN ON SHEET B5 (FILL).
- THE CONTRACTOR SHALL MAINTAIN THE EXISTING ROADWAY IN THE REALIGNMENT AREAS UNTIL THE NEW ROADWAY IS READY TO ACCEPT VEHICLE TRAFFIC.

TRAFFIC CONTROL NOTES

- IT IS THE INTENT OF THIS TRAFFIC CONTROL PLAN (TCP) TO ILLUSTRATE SOME BUT NOT ALL OF THE TRAFFIC CONTROL CONFIGURATIONS THAT WILL BE REQUIRED BY THIS PROJECT. TRAFFIC CONTROL PLANS FOR CONFIGURATIONS NOT COVERED BY THIS TCP SHALL BE DEVELOPED BY THE CONTRACTOR AND SUBMITTED TO THE ENGINEER FOR APPROVAL PRIOR TO USE.
- TWO WAY TRAFFIC WILL BE MAINTAINED AT ALL TIMES. EXCEPT FOR WHEN THE ROAD IS CLOSED FOR BLASTING (SEE SECTION 108-1.04).
- TRAFFIC LANES SHALL BE A MINIMUM OF 10 FEET WIDE.
- THE CONTRACTOR SHALL KEEP THE PUBLIC INFORMED OF HIS CONSTRUCTION ACTIVITIES THROUGH THE USE OF THE LOCAL NEWS MEDIA. NEWS RELEASES SHALL BE APPROVED BY THE PROJECT ENGINEER PRIOR TO THEIR RELEASE. NEWS RELEASES WILL BE REQUIRED BUT NOT LIMITED TO, THE ONSET OF WORK, ROAD CLOSURES FOR BLASTING, AND CHANGES IN THE LANE CONFIGURATIONS.
- IF TRAFFIC DELAYS BECOME LONGER THAN 3 MINUTES AVERAGE PER VEHICLE, THE PROJECT ENGINEER MAY REQUIRE NIGHTTIME OPERATIONS.
- FLOOD LIGHTS SHALL BE PROVIDED FOR FLAGGER STATIONS DURING NIGHTTIME OPERATIONS.
- CHANNELIZATION DEVICES IF USED AT NIGHT SHALL BE LIT IN ACCORDANCE WITH THE ALASKA TRAFFIC MANUAL.
- TWO LANES SHALL BE MAINTAINED AT ALL TIMES IN NON-WORK AREAS AND DURING NON-WORKING HOURS. A MINIMUM OF ONE LANE SHALL BE MAINTAINED AT ALL TIMES THROUGH ALL WORK AREAS EXCEPT DURING BLASTING.

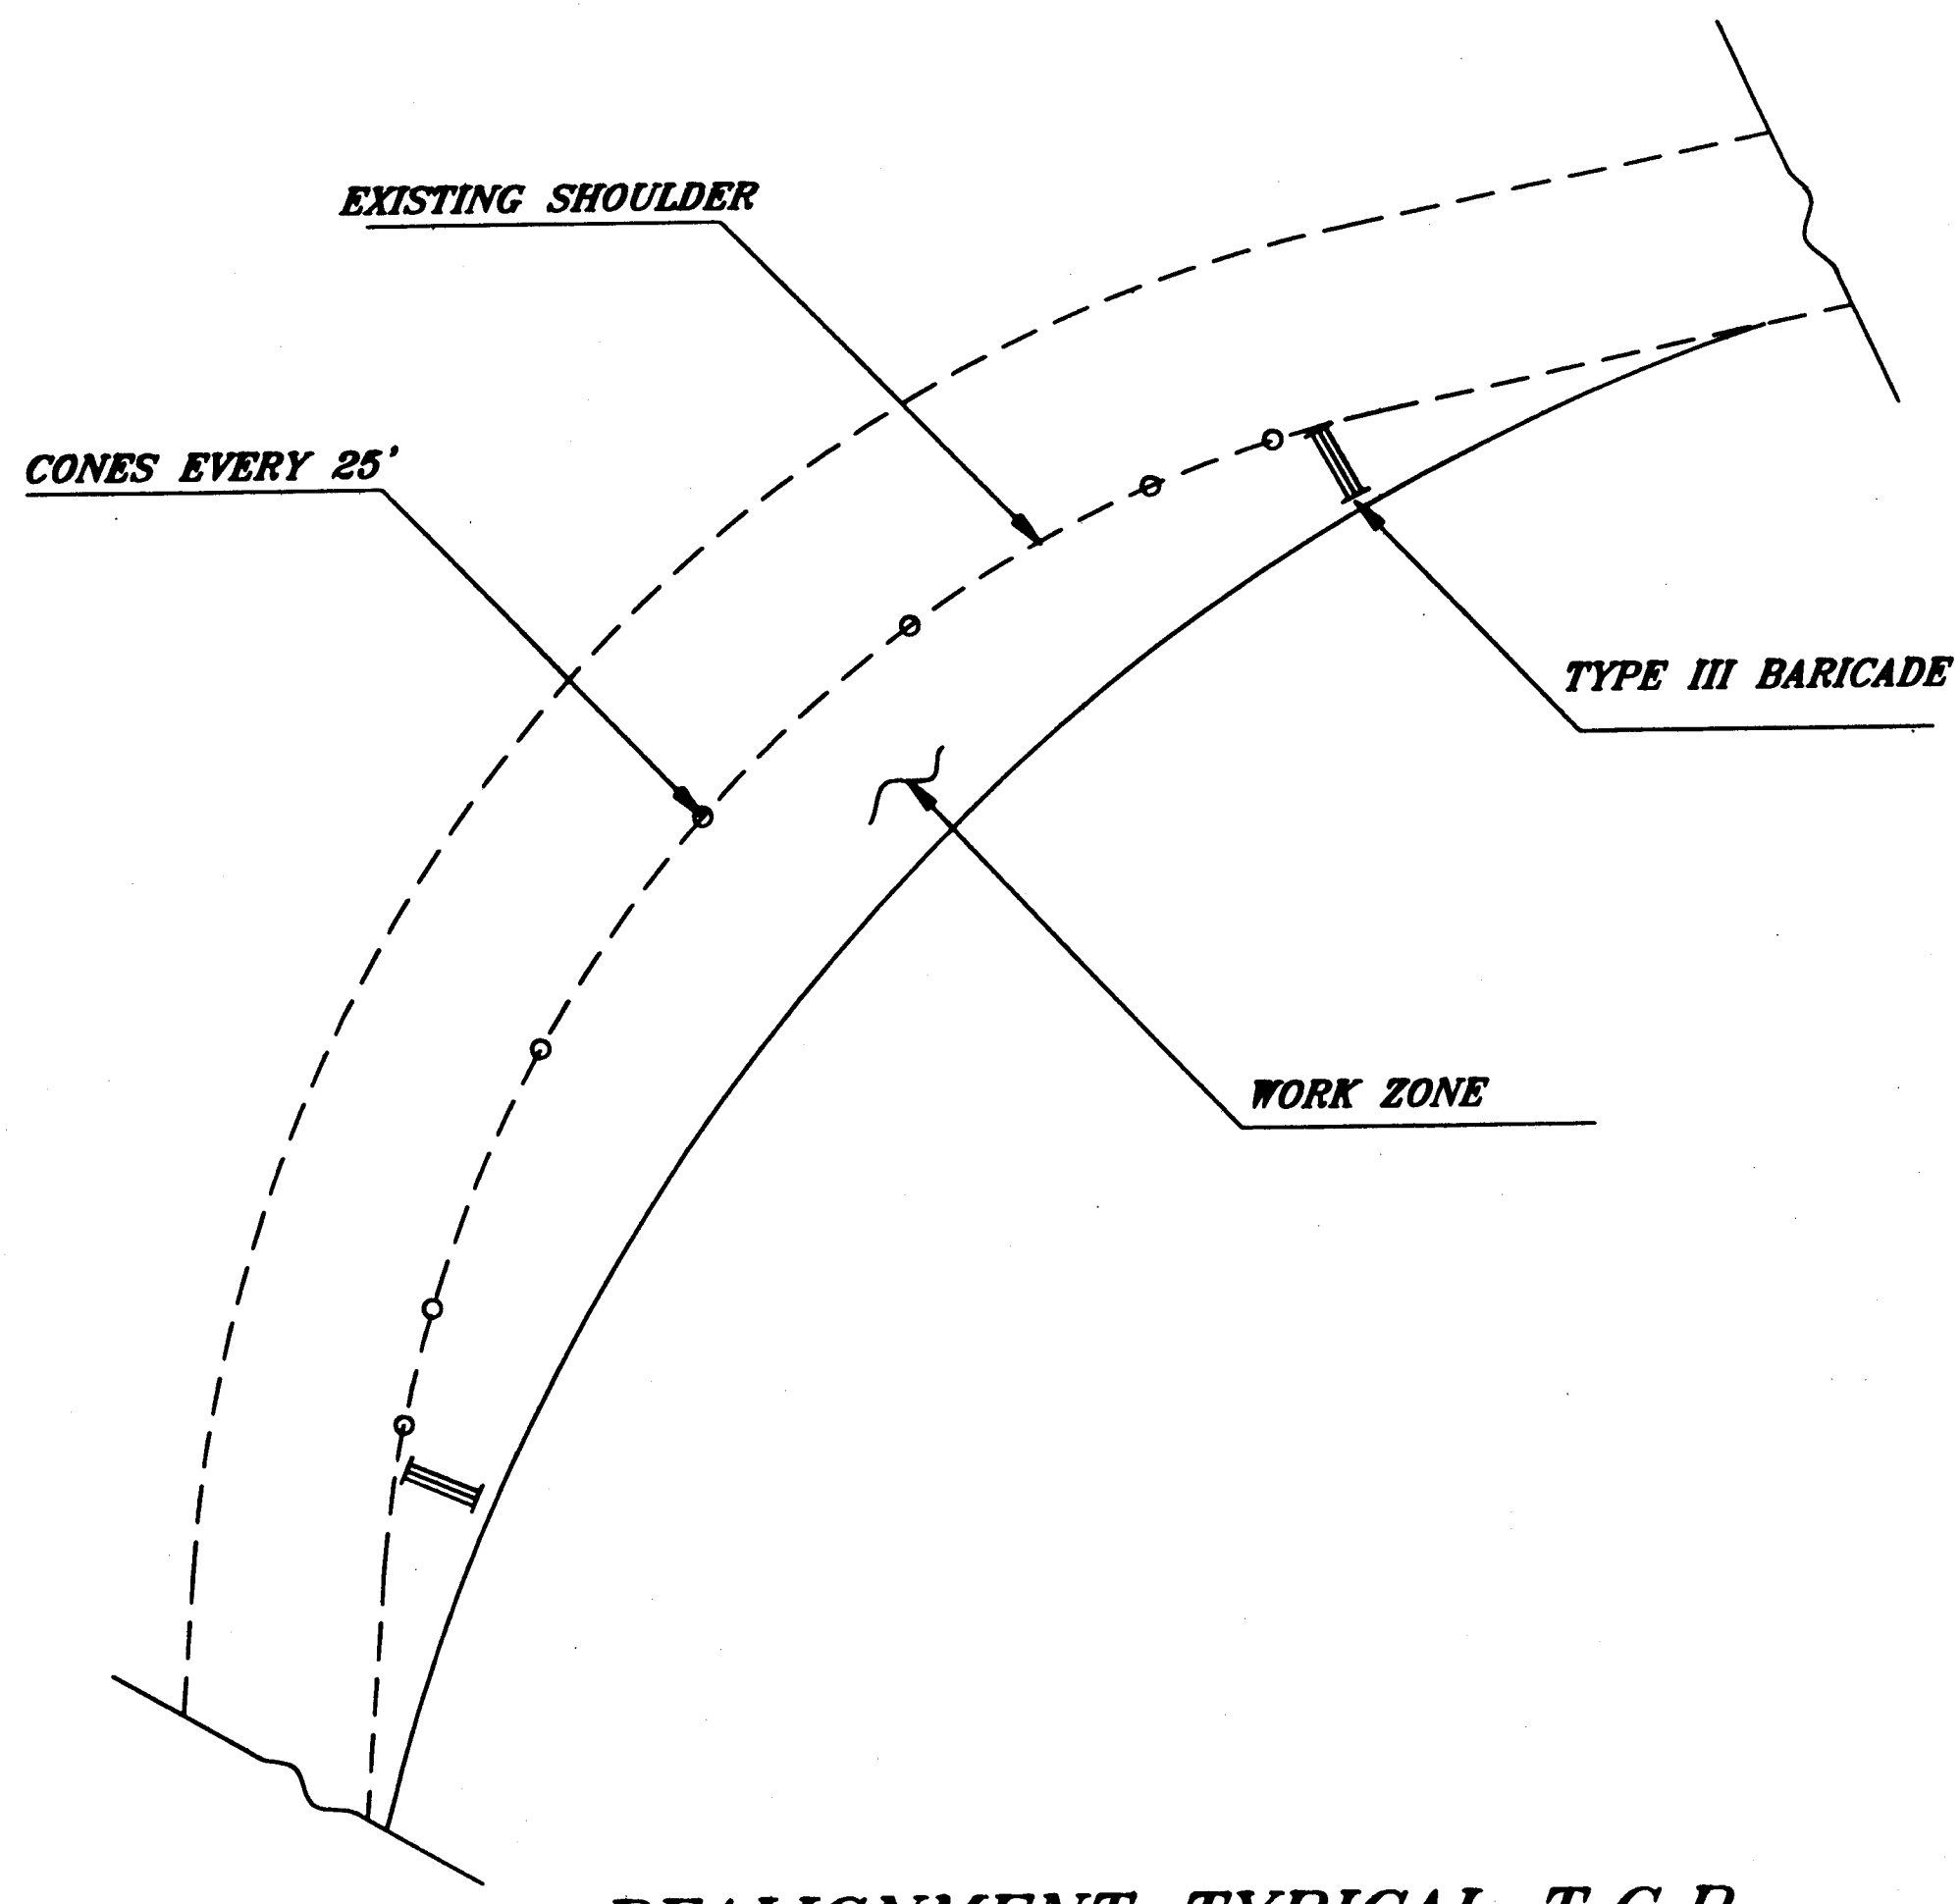

REALIGNMENT TYPICAL T.C.P.

Q:\Jnu\68269\Planset\G_Tcp1.dwg
Wed, 09/Jan/02 02:49PM Kris
PSPACE 1=1(F) OR MSPACE 1=1(F)
TAB: ESTIMATE

ADDENDUM NUMBER

ATTACHMENT NUMBER

Wed, 09/Jan/02 02:49PM

RECORD OF REVISIONS

No.	DATE	DESCRIPTION

JNU-FISH CREEK ROAD
SAFETY IMPROVEMENTS
PROJECT NO. 68269


7/1 7-22-03 7/1

DESIGNED BY: M. LAVERING

CHECKED BY: T. MOORE


DRAWN BY: K.K.

STATE OF ALASKA
DEPARTMENT OF TRANSPORTATION
& PUBLIC FACILITIES
STATEWIDE DESIGN & ENGINEERING
SERVICES DIVISION
JNU-FISH CREEK ROAD
SAFETY IMPROVEMENTS
PROJECT NO. 68269
**Traffic Control
Plan**
PROJECT DESIGNATION NUMBER
ACHRO-0953(4)
STATE YEAR
ALASKA 2001
SHEET NUMBER TOTAL SHEETS
G1 41

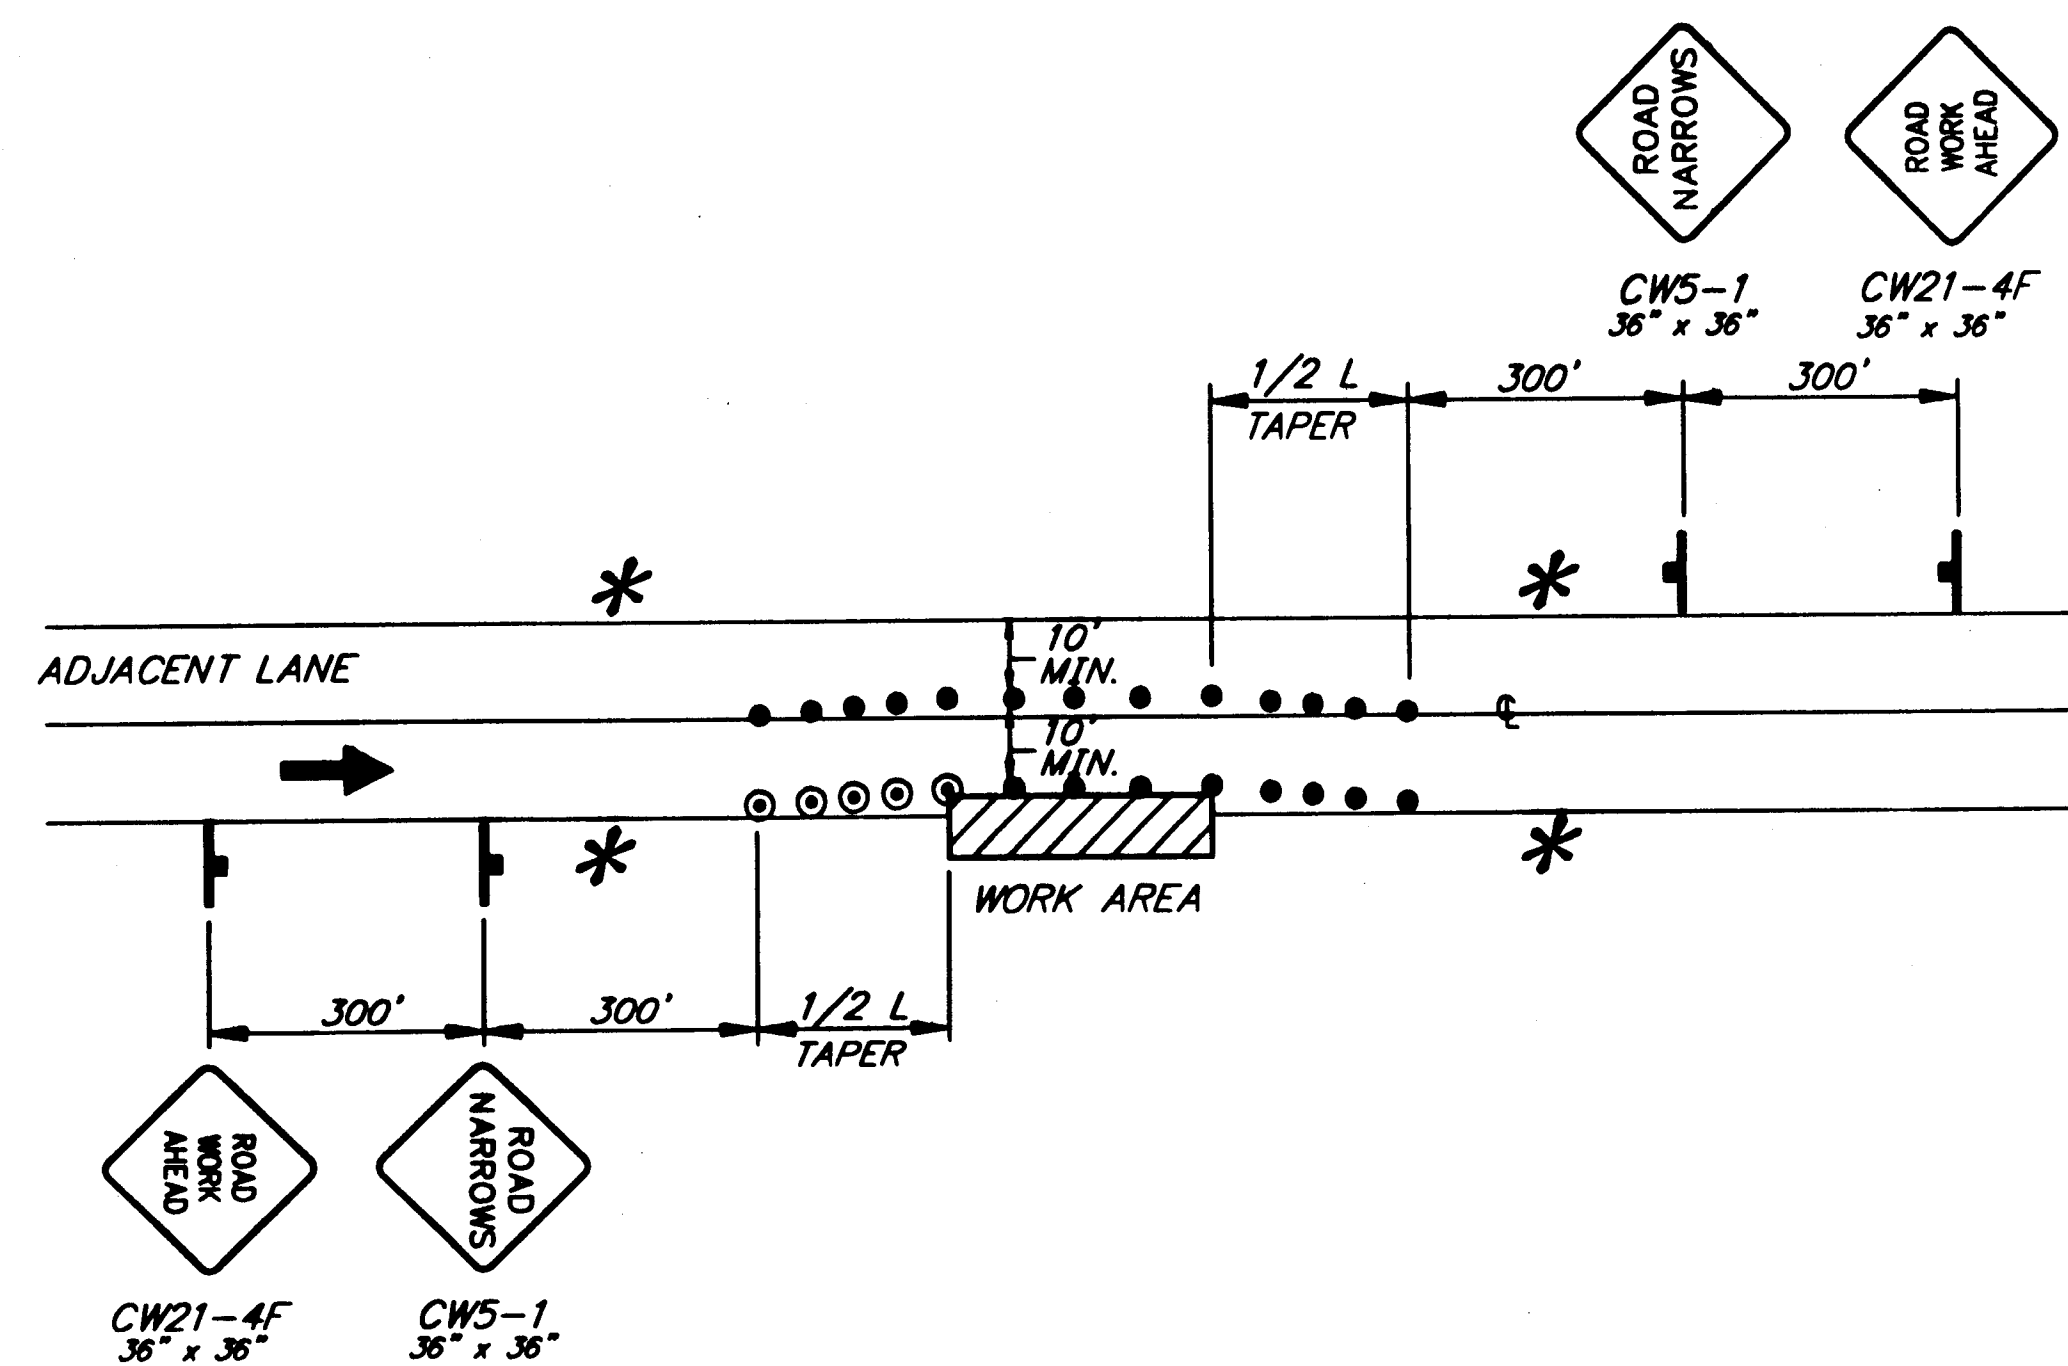


ROADWAY ENCROACHMENT

NOTE: IF ONLY ONE LANE IS EFFECTED BY ROAD WORK (THAT IS, THE CONES ALONG THE WORK AREA ARE NO CLOSER THAN 10' TO CENTERLINE) THE SIGNS AND CENTERLINE CONES FOR THE OPPOSING LANE MAY BE DELETED.

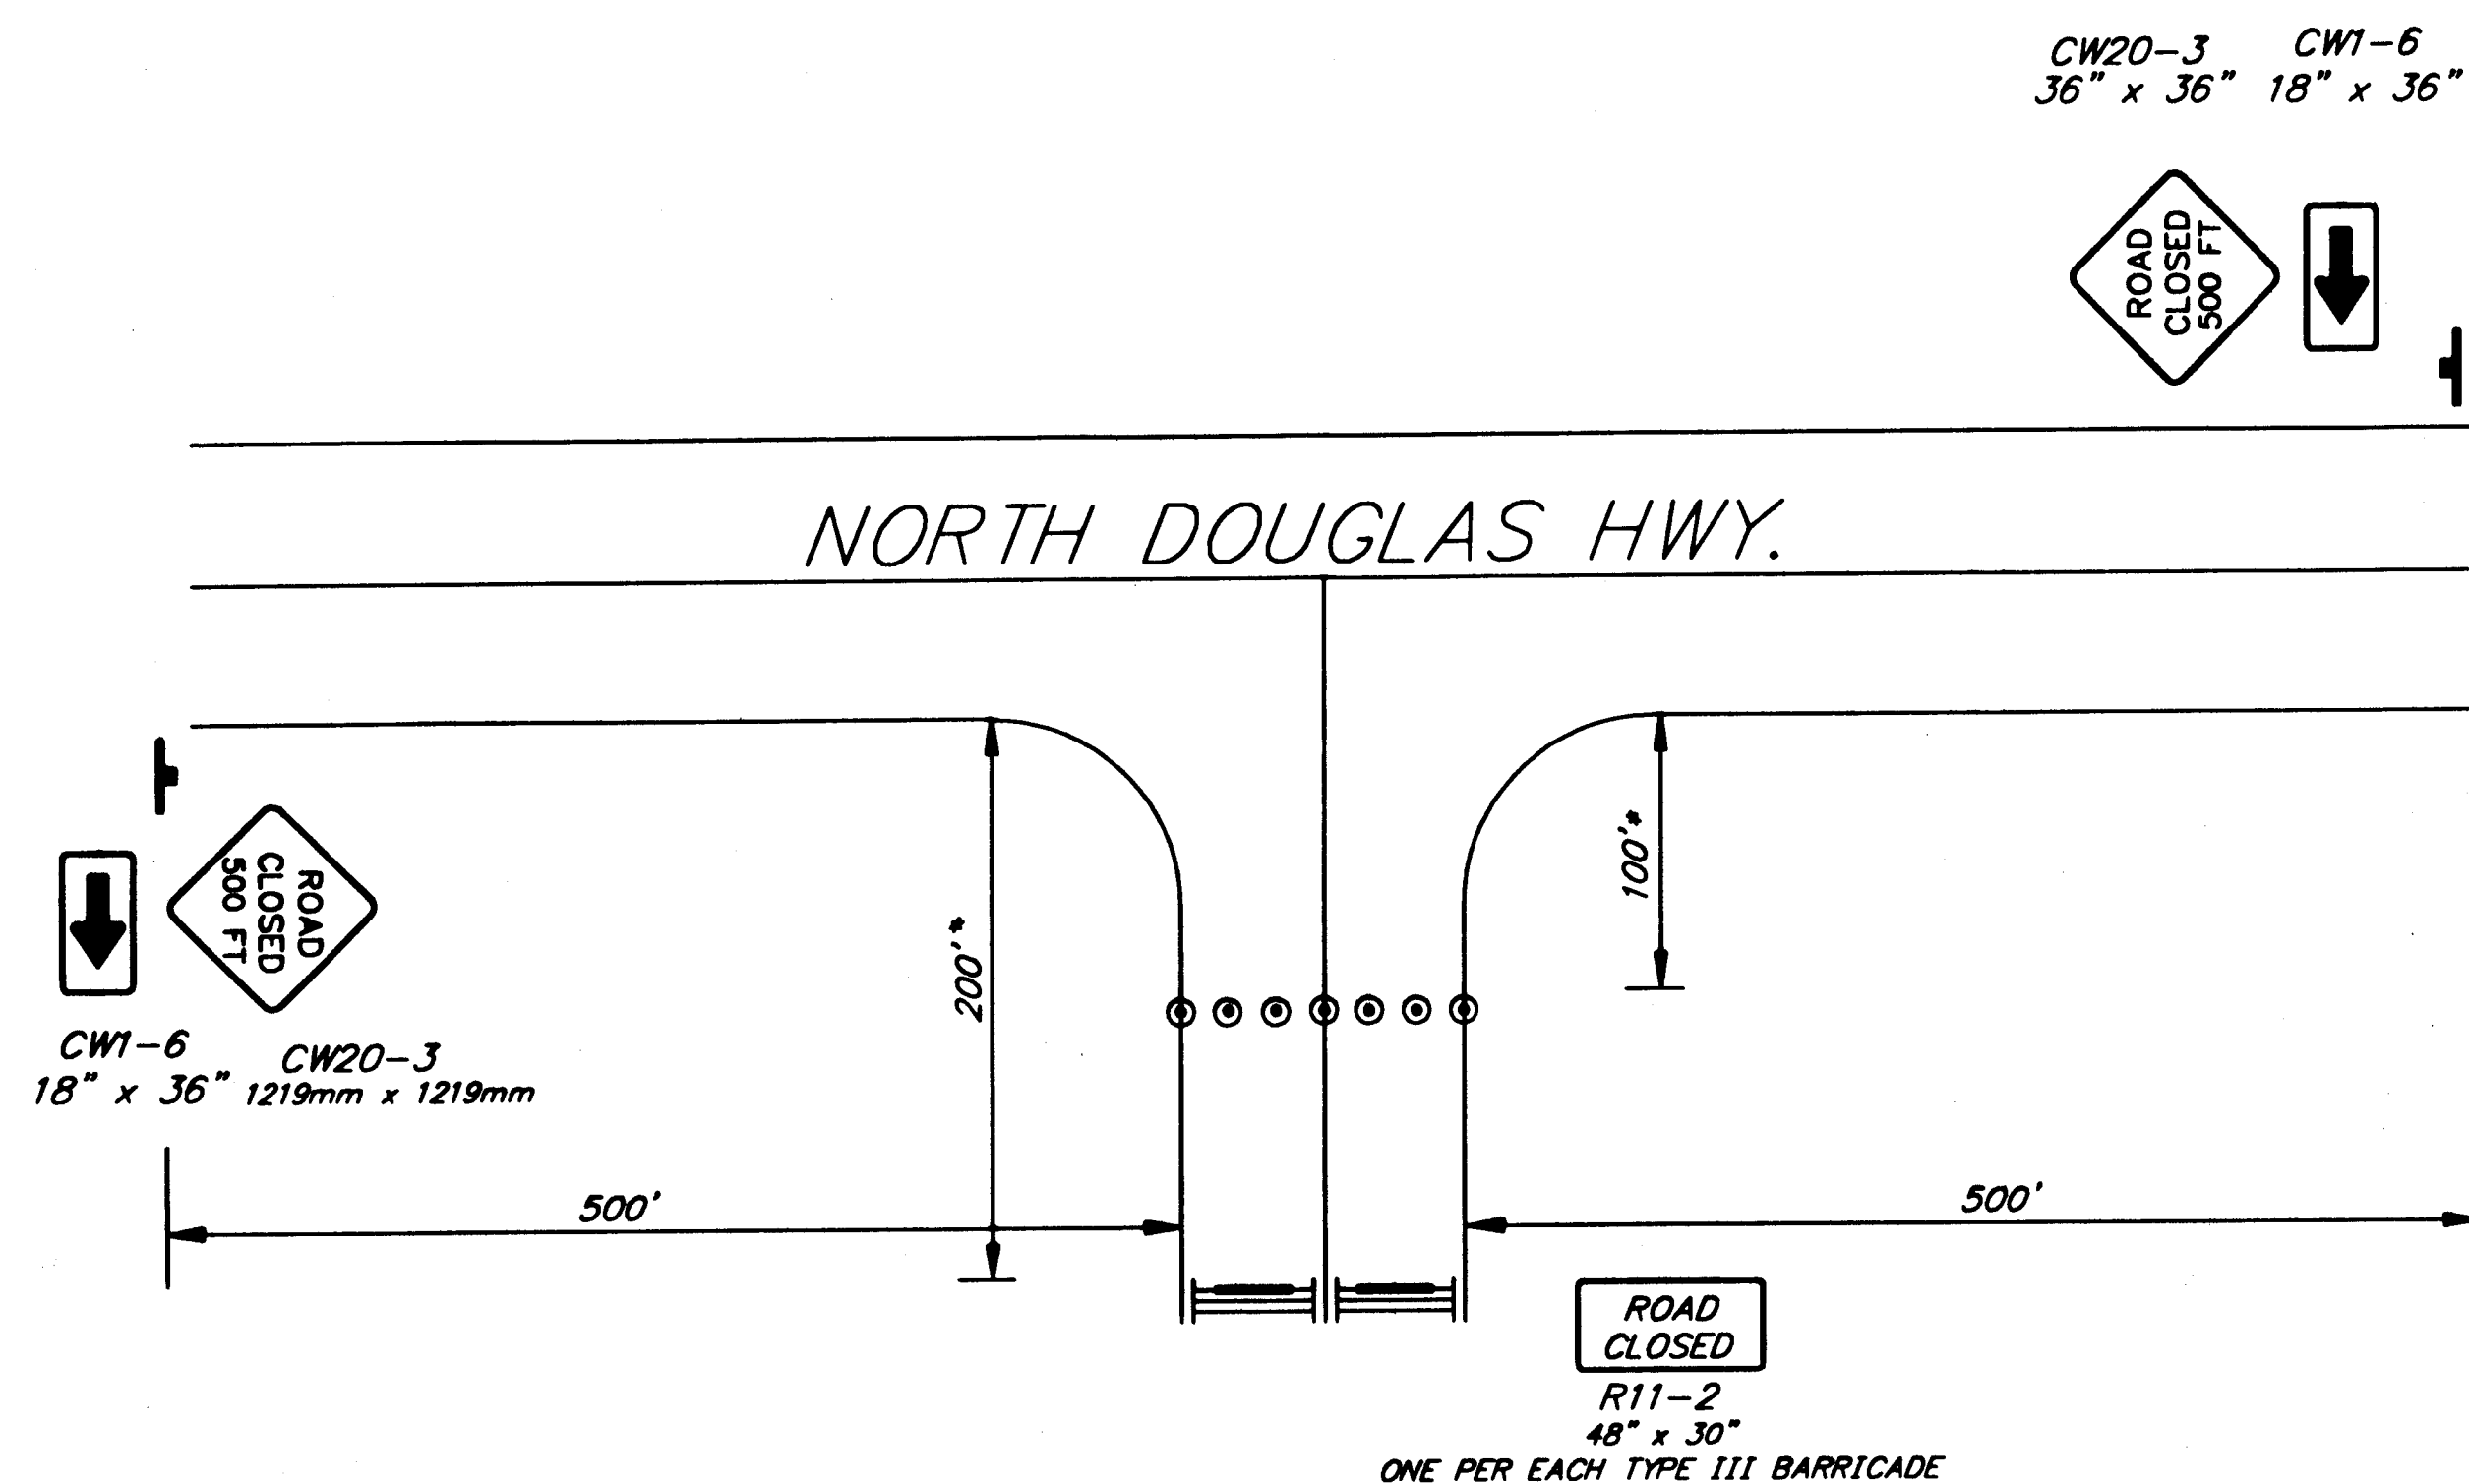

BLASTING TRAFFIC CONTROL PLAN

****A SINGLE FLAGGER MAY BE USED INSTEAD OF TWO FLAGGERS IF APPROVED BY THE ENGINEER.**

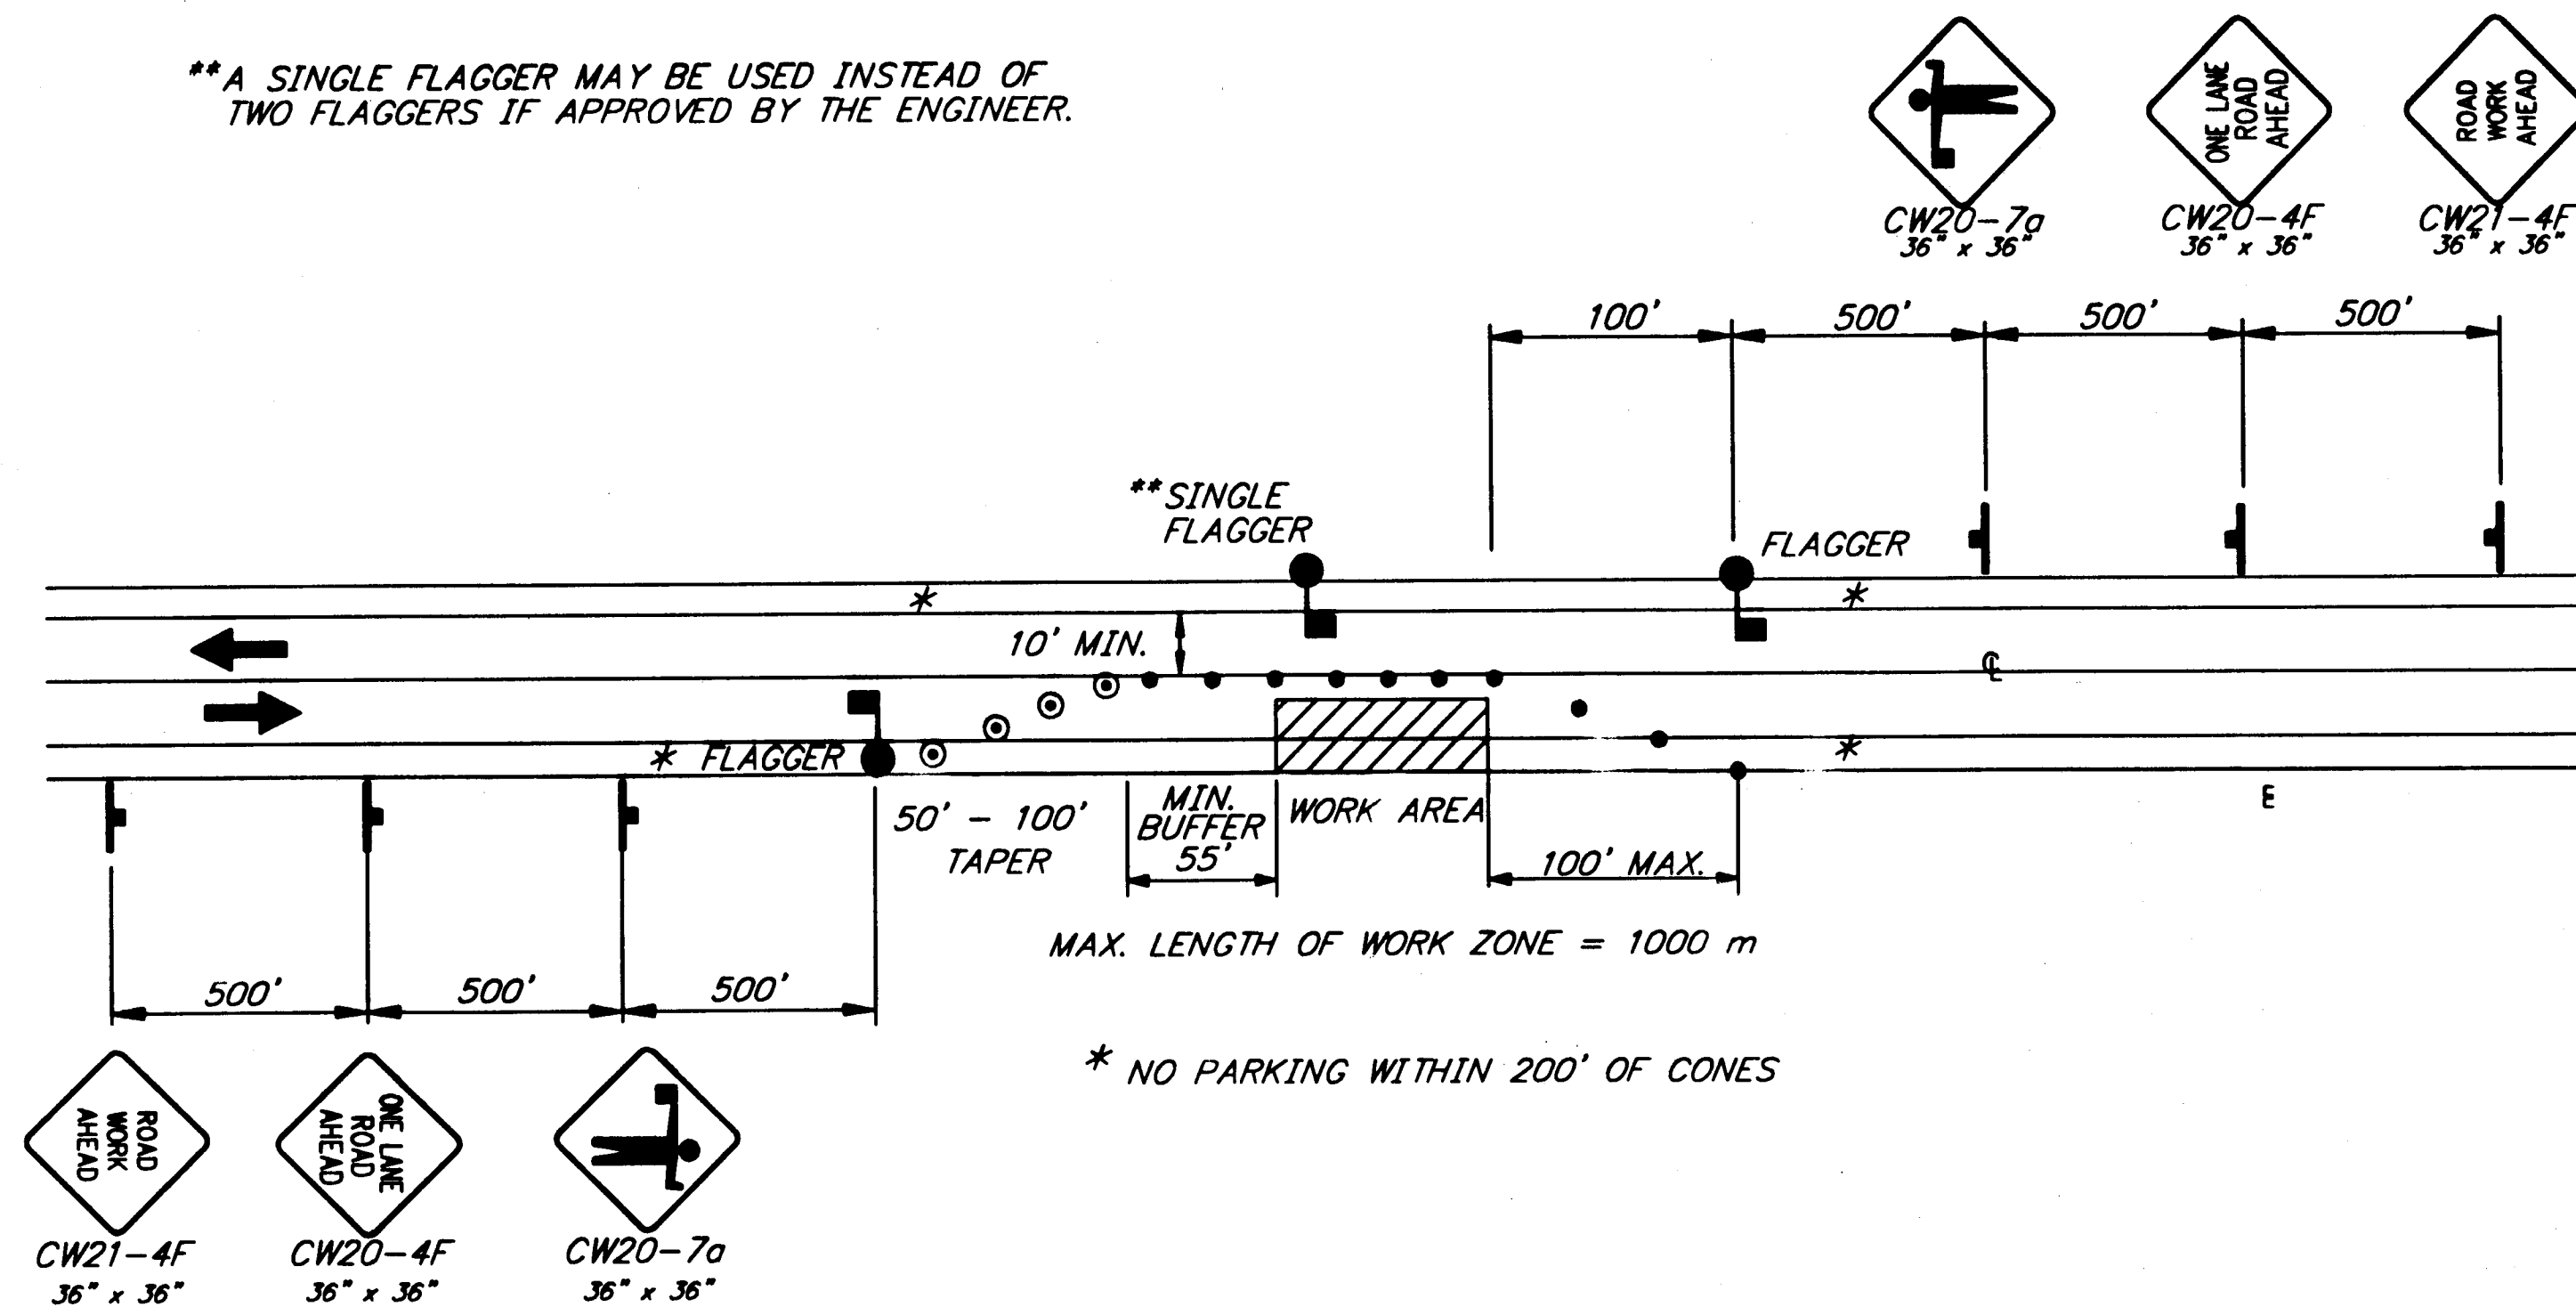

SINGLE LANE CLOSURE
TWO LANE ROAD


LEGEND

-  *SIGN*
-  *CONE*
-  *DRUM*
-  *TYPE III BARRICADE*
-  *FLAGGING STATION*
-  *HIGH-LEVEL WARNING DEVICE*

* NO PARKING WITHIN 200' OF CONES

$$L = W \times T$$

WHERE:
L= LENGTH OF TAPER
W= WIDTH OF OFFSET
T= TAPER FACTOR

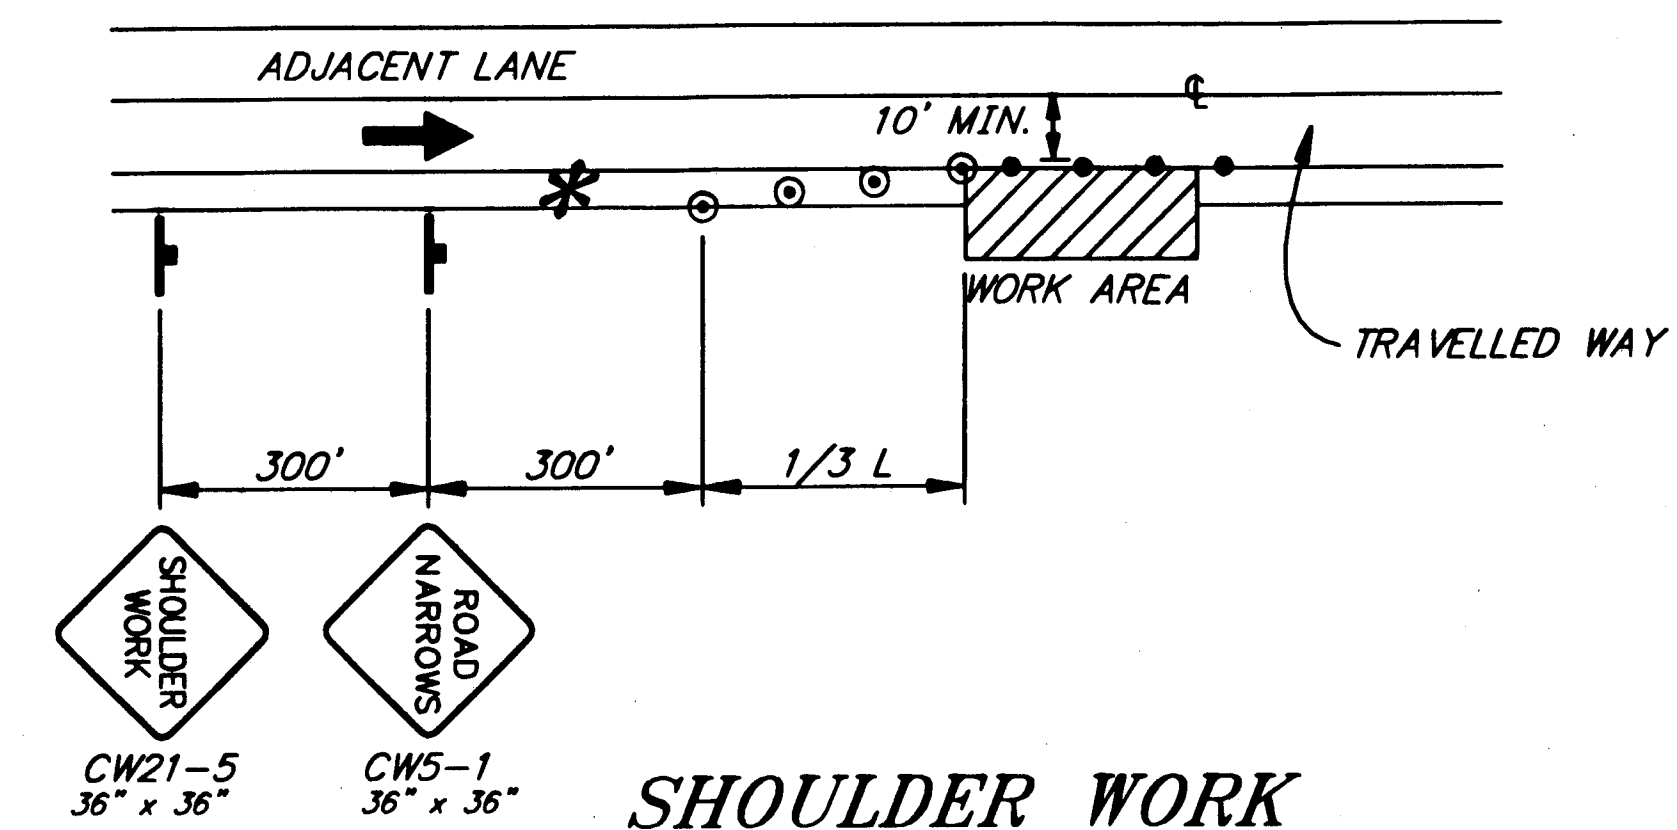[illegible]

SHOULDER WORK

ADDENDUM NUMBER

ATTACHMENT NUMBER

Wed, 09/Jan/02 02:51PM

RECORD OF REVISIONS


No.	DATE	DESCRIPTION

**JNU-FISH CREEK ROAD
SAFETY IMPROVEMENTS
PROJECT NO. 68269**

Traffic Control Plan

7/22.03

DESIGNED BY: M. LAVERING

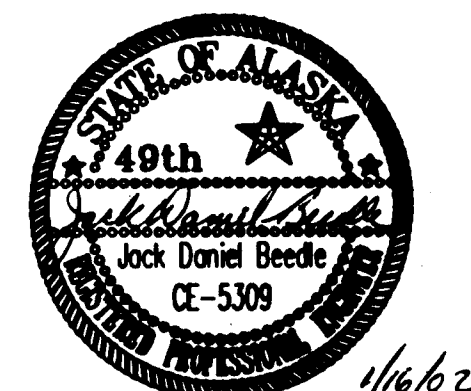

CHECKED BY: T. MOORE

DRAWN BY: K.K.

STATE OF ALASKA
DEPARTMENT OF TRANSPORTATION
& PUBLIC FACILITIES
STATEWIDE DESIGN & ENGINEERING
SERVICES DIVISION

**JNU-FISH CREEK ROAD
SAFETY IMPROVEMENTS
PROJECT NO. 68269**

Traffic Control Plan

PROJECT DESIGNATION NUMBER

ACHRO-0953(4)


STATE	YEAR
-------	------

STATE	YEAR
ALASKA	2001


SHEET NUMBER	TOTAL SHEETS
--------------	--------------

G2


41

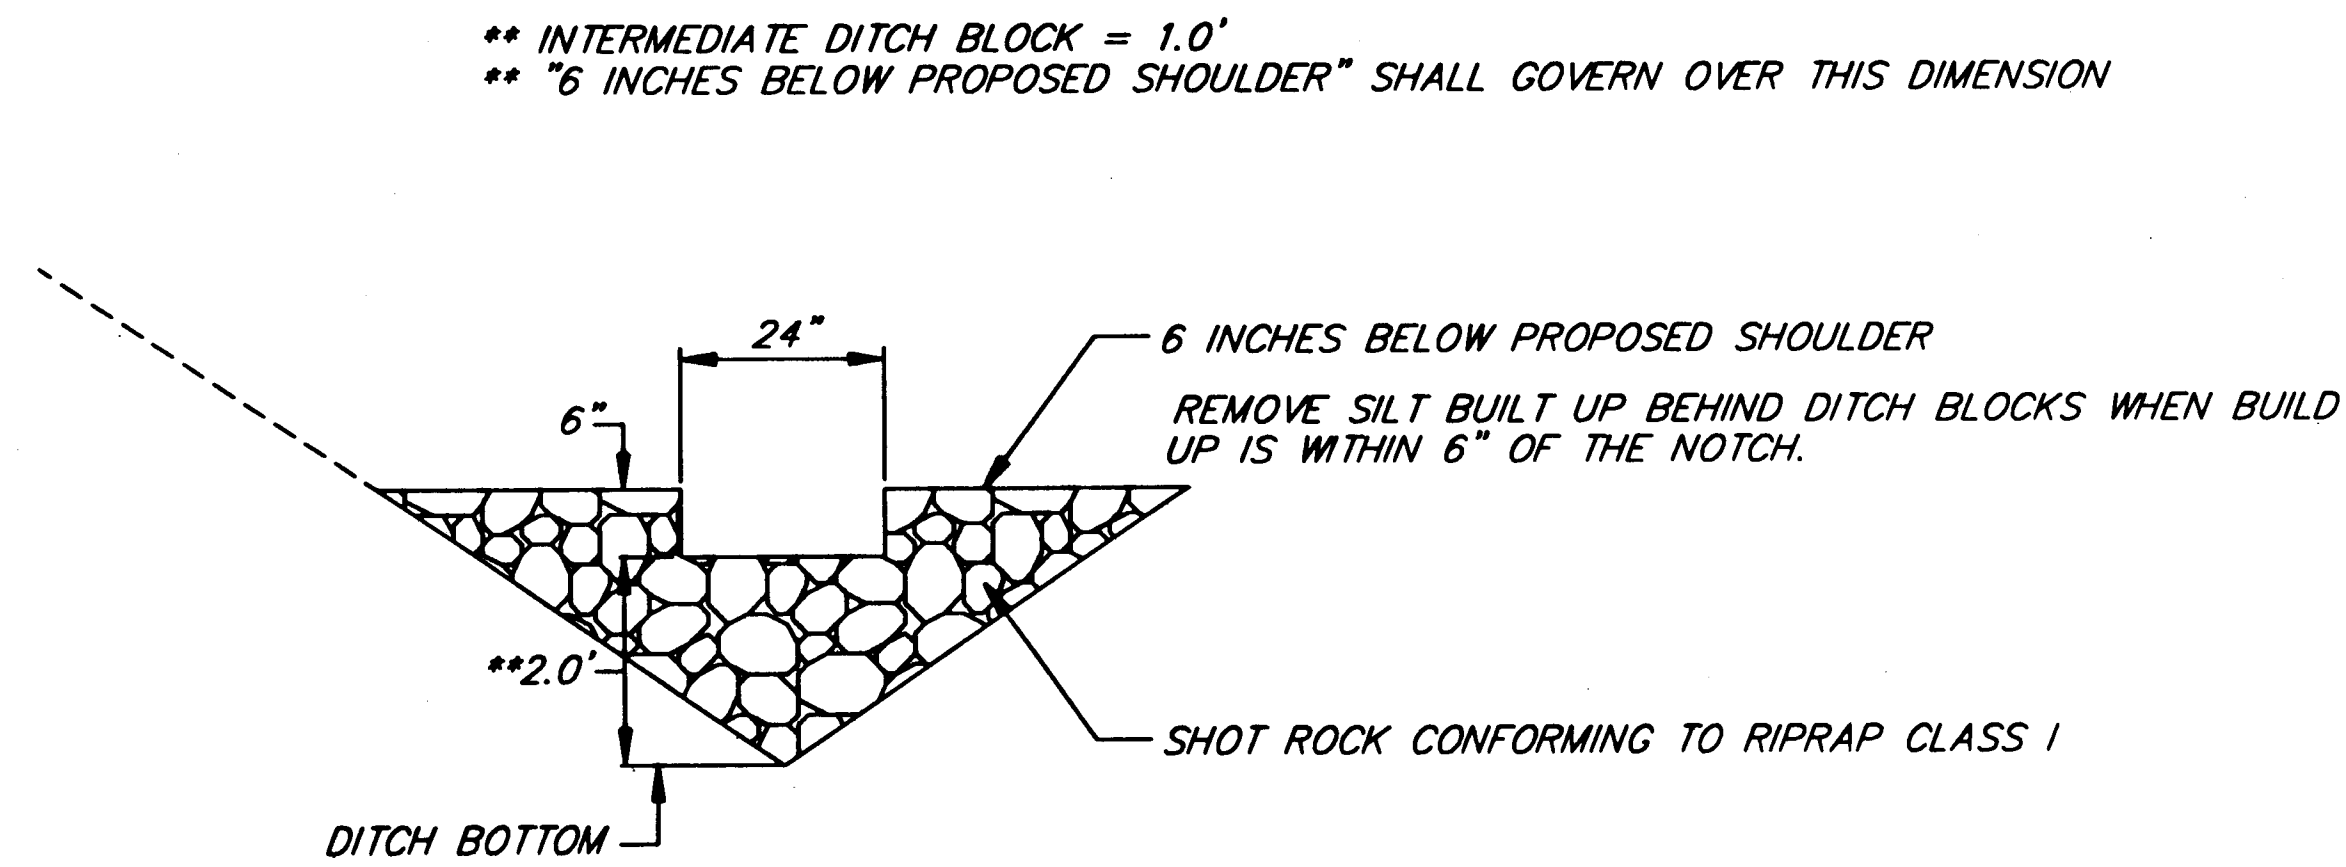

SECTION

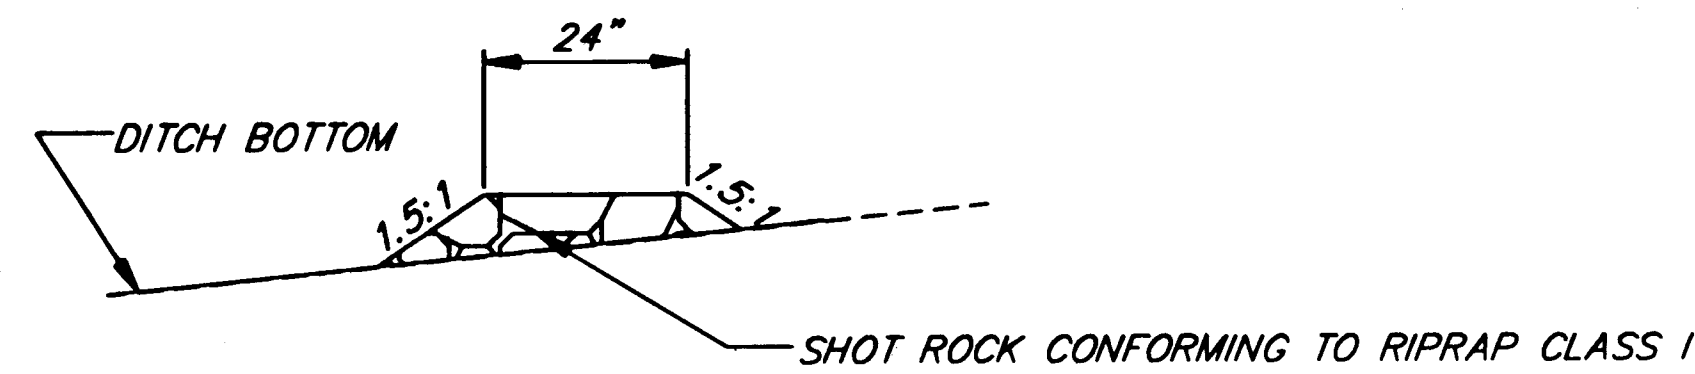

PROFILE

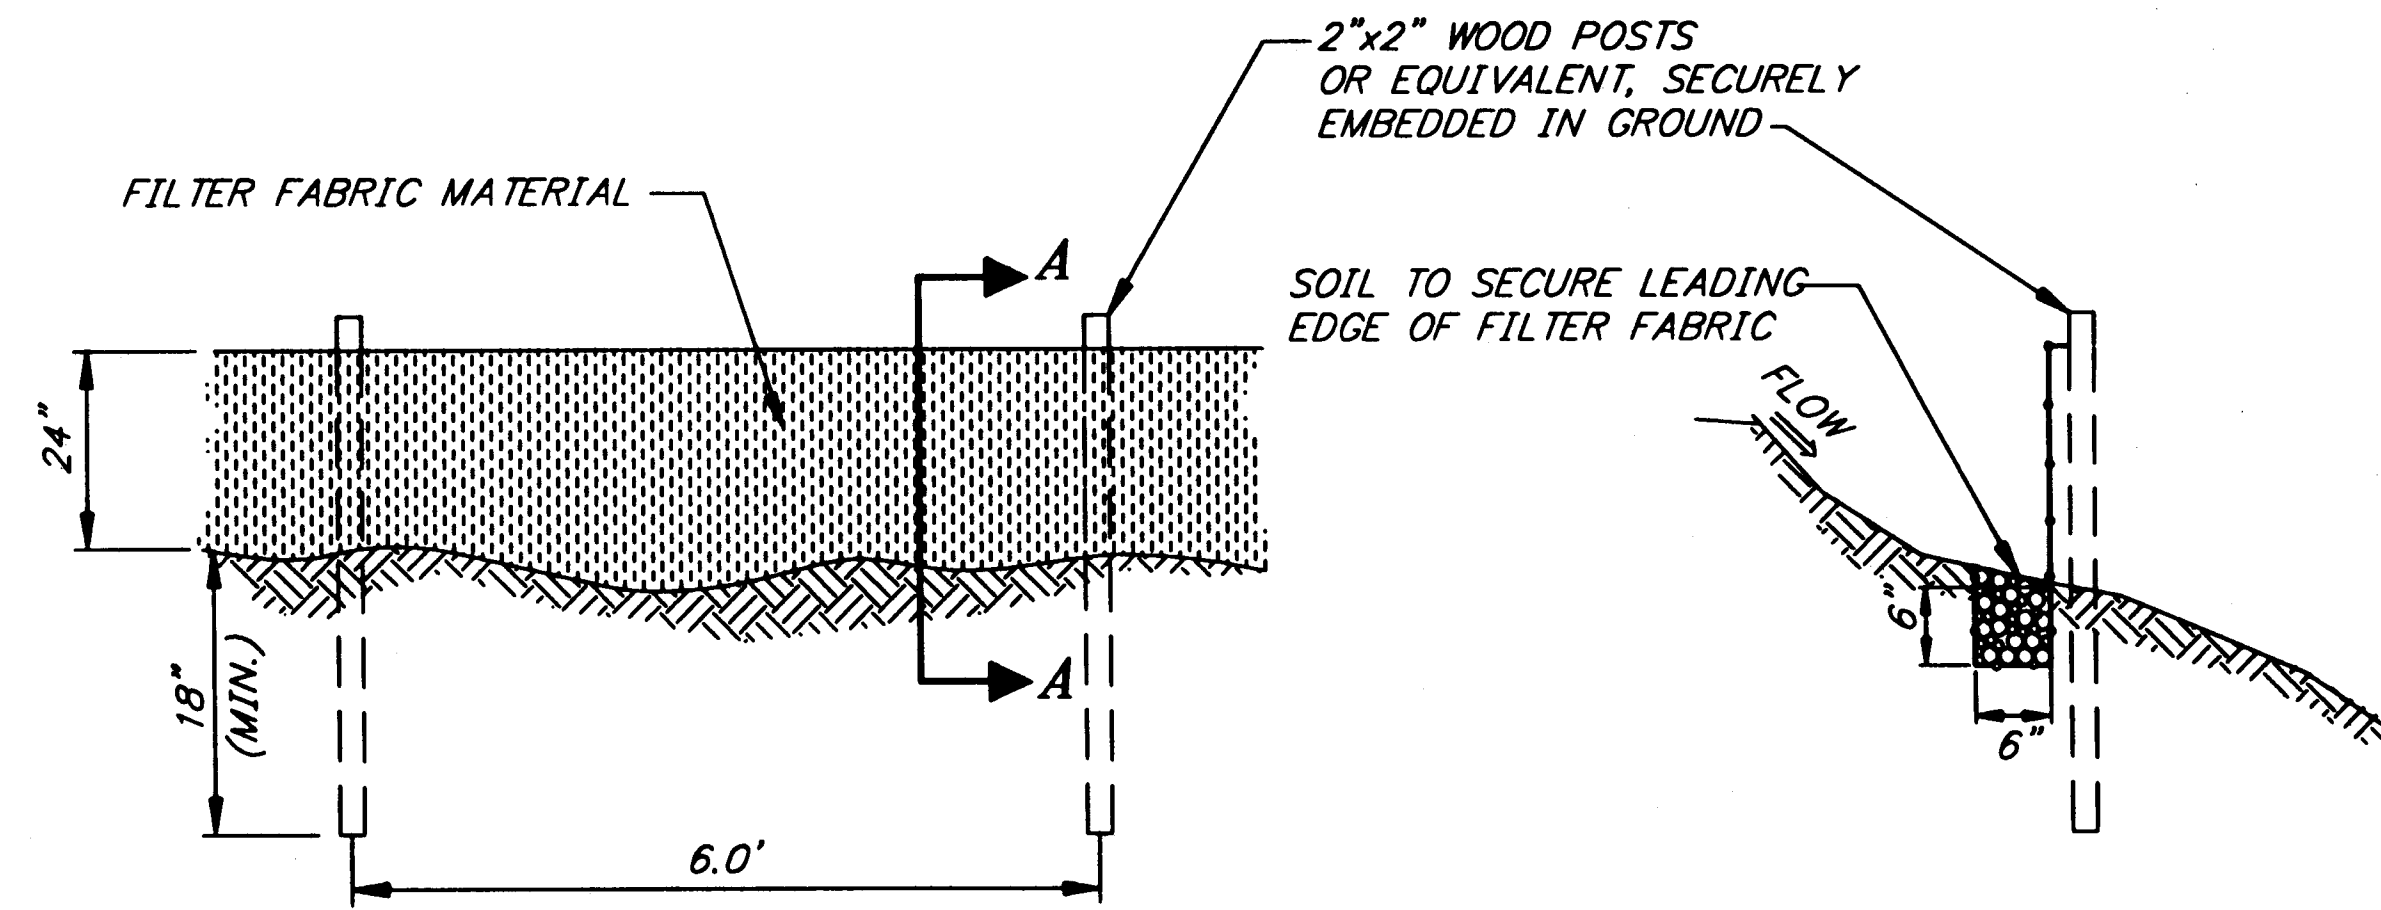

ELEVATION

SECTION A-A

SILT FENCE DETAILS

DITCH BLOCK LOCATION TABLE

STATION	RIGHT	LEFT	BLOCK TYPE	STATION	RIGHT	LEFT	SEE NOTE No.
20+50	X		INITIAL	137+26	X		*INTERMEDIATE
23+50	X		INITIAL	145+50	X	X	INITIAL
25+50	X		INITIAL	156+62	X	X	INTERMEDIATE
34+50		X	INITIAL	160+50	X	X	INITIAL
47+50		X	INITIAL	162+50	X		INITIAL
54+50	X	X	INITIAL	165+50	X	X	INITIAL
56+51	X	X	INTERMEDIATE	167+50		X	INITIAL
58+53	X	X	INTERMEDIATE	171+50	X		INITIAL
60+54	X	X	INTERMEDIATE	173+50	X	X	INITIAL
62+56	X	X	INTERMEDIATE	178+50	X		INITIAL
64+57	X	X	INTERMEDIATE	180+08	X		INTERMEDIATE
66+58	X	X	INTERMEDIATE	183+82	X		INTERMEDIATE
68+74	X	X	*INTERMEDIATE	187+50	X		*INTERMEDIATE
69+98		X	*INTERMEDIATE	190+04	X	X	*INTERMEDIATE
71+32		X	INTERMEDIATE	192+16	X		INTERMEDIATE
72+70		X	INTERMEDIATE	195+29	X		INTERMEDIATE
74+02		X	*INTERMEDIATE	197+34	X		*INTERMEDIATE
75+27	X		*INTERMEDIATE	200+42	X		*INTERMEDIATE
78+50		X	INITIAL	203+02	X		*INTERMEDIATE
80+50	X		INITIAL	204+49	X		INTERMEDIATE
82+64	X		*INTERMEDIATE	205+79	X		*INTERMEDIATE
85+50	X		INITIAL	207+08	X		INTERMEDIATE
86+50		X	INITIAL	208+38	X		*INTERMEDIATE
91+00	X		INITIAL	209+90	X		*INTERMEDIATE
91+50		X	INITIAL	211+89	X		*INTERMEDIATE
98+50	X		INITIAL	213+67	X		*INTERMEDIATE
103+50		X	INITIAL	214+86	X		*INTERMEDIATE
104+50	X		INITIAL	215+82	X		INTERMEDIATE
114+50	X		INITIAL	216+74	X		INTERMEDIATE
116+94	X		INTERMEDIATE	217+69	X		INTERMEDIATE
120+98	X		INTERMEDIATE	218+74	X		INTERMEDIATE
122+61	X		INTERMEDIATE	220+10	X		INTERMEDIATE
124+22	X		INTERMEDIATE	223+02	X		*INTERMEDIATE
126+12	X		INTERMEDIATE	226+50		X	INITIAL
127+86	X		*INTERMEDIATE	228+50	X		INITIAL
129+00	X		INTERMEDIATE	237+50	X	X	INITIAL
130+02	X		*INTERMEDIATE	246+50	X	X	INITIAL
132+50	X		INITIAL	250+50	X		INITIAL
134+29	X		INTERMEDIATE	259+50	X		INITIAL

* MAY REQUIRE "INITIAL" DITCH BLOCK PLACEMENT (SEE SHEET H2) AND DIMENSIONS, IF THE DITCH DAYLIGHTS UPHILL FROM THE CULVERT INLET.

PATH:
Q:\Jnu\68269\Planset\H_detail.dwg
Wed, 09/Jan/02 03:39PM Kris
PLOT:
PSPACE 1=1(F) OR MSPACE 1=1(F)
TAB: ESTIMATE

ADDENDUM NUMBER

ATTACHMENT NUMBER

Wed, 09/Jan/02 03:39PM

RECORD OF REVISIONS


No.	DATE	DESCRIPTION

JNU-FISH CREEK ROAD
SAFETY IMPROVEMENTS
PROJECT NO. 68269

**Erosion and Sediment
Control**

TB 7-22-03

DESIGNED BY: M. LAVERING

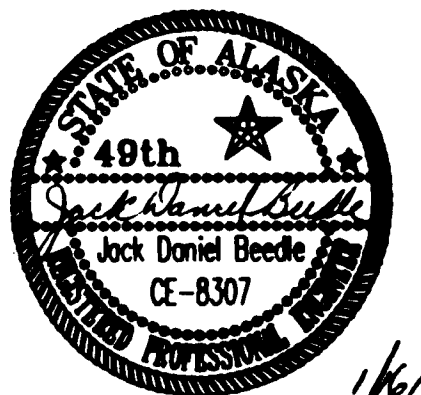

CHECKED BY: T. MOORE

DRAWN BY: K.K.

STATE OF ALASKA
DEPARTMENT OF TRANSPORTATION
& PUBLIC FACILITIES
STATEWIDE DESIGN & ENGINEERING
SERVICES DIVISION


JNU-FISH CREEK ROAD
SAFETY IMPROVEMENTS
PROJECT NO. 68269

**Erosion and
Sediment Control**

PROJECT DESIGNATION NUMBER

ACHRO-0953(4)

STATE	YEAR
ALASKA	2001
SHEET NUMBER	TOTAL SHEETS
H1	41

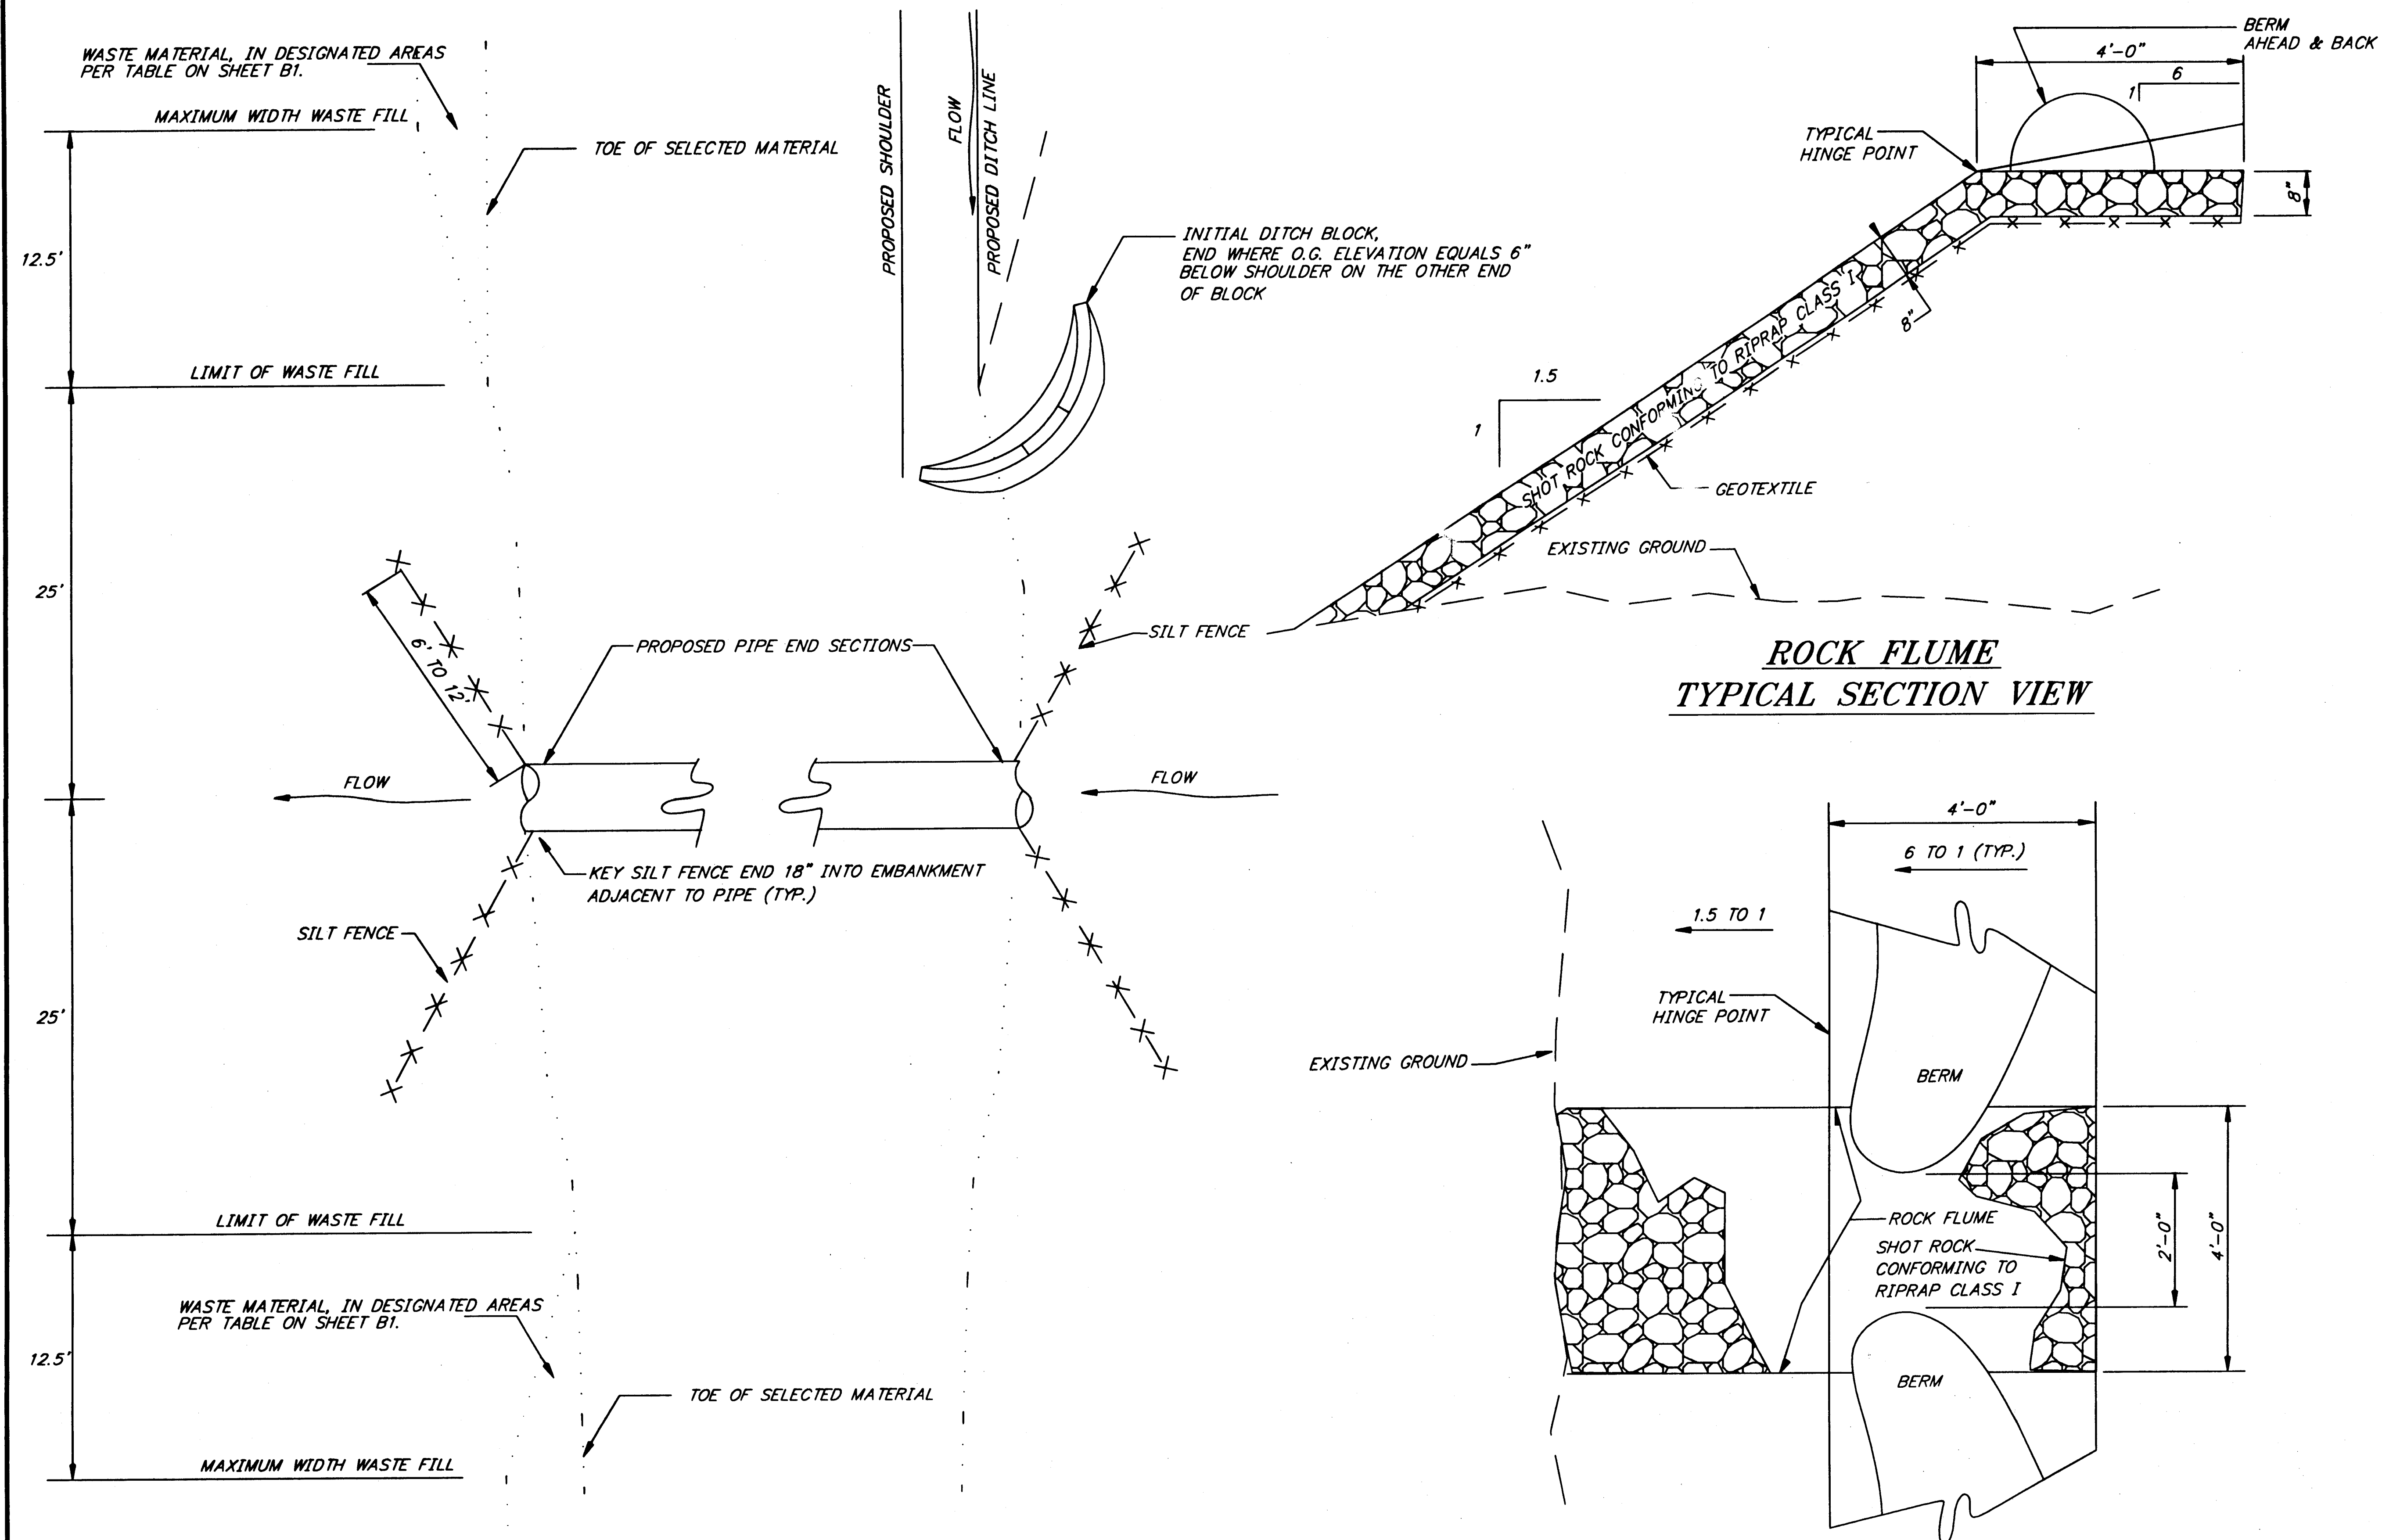

SILTATION / SEDIMENT CONTROL AT CULVERT

NOTE: SILT FENCE AND/OR ROCK FLUMES ARE NOT REQUIRED IF ADJACENT EMBANKMENT IS CONSTRUCTED OUT OF SELECT MATERIAL TYPE "D"

ROCK FLUME PLAN VIEW

PATH:
Q:\Jnu\68269\Planset\H_detail.dwg
Tue, 15/Jan/02 02:38PM Kris
PLOT:
PSPACE 1=1(F) OR MSPACE 1=1(F)
TAB: ESTIMATE

ADDENDUM NUMBER

ATTACHMENT NUMBER

Tue, 15/Jan/02 02:38PM

RECORD OF REVISIONS


No.	DATE	DESCRIPTION

JNU-FISH CREEK ROAD
SAFETY IMPROVEMENTS
PROJECT NO. 68269

Erosion and Sediment Control

78 7-22-03

DESIGNED BY: M. LAVERING

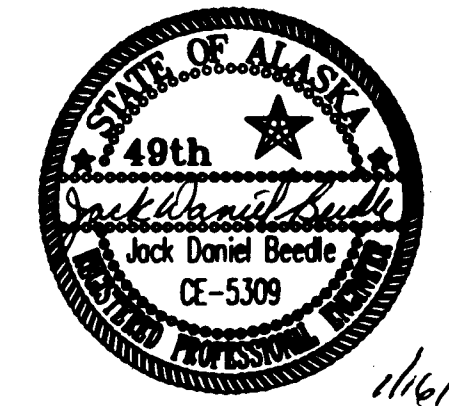

CHECKED BY: T. MOORE

DRAWN BY: K.K. / M.L.

STATE OF ALASKA
DEPARTMENT OF TRANSPORTATION
& PUBLIC FACILITIES
STATEWIDE DESIGN & ENGINEERING
SERVICES DIVISION


JNU-FISH CREEK ROAD
SAFETY IMPROVEMENTS
PROJECT NO. 68269

Erosion and
Sediment Control

PROJECT DESIGNATION NUMBER

ACHRO-0953(4)

STATE	YEAR
ALASKA	2001
SHEET NUMBER	TOTAL SHEETS
H2	41

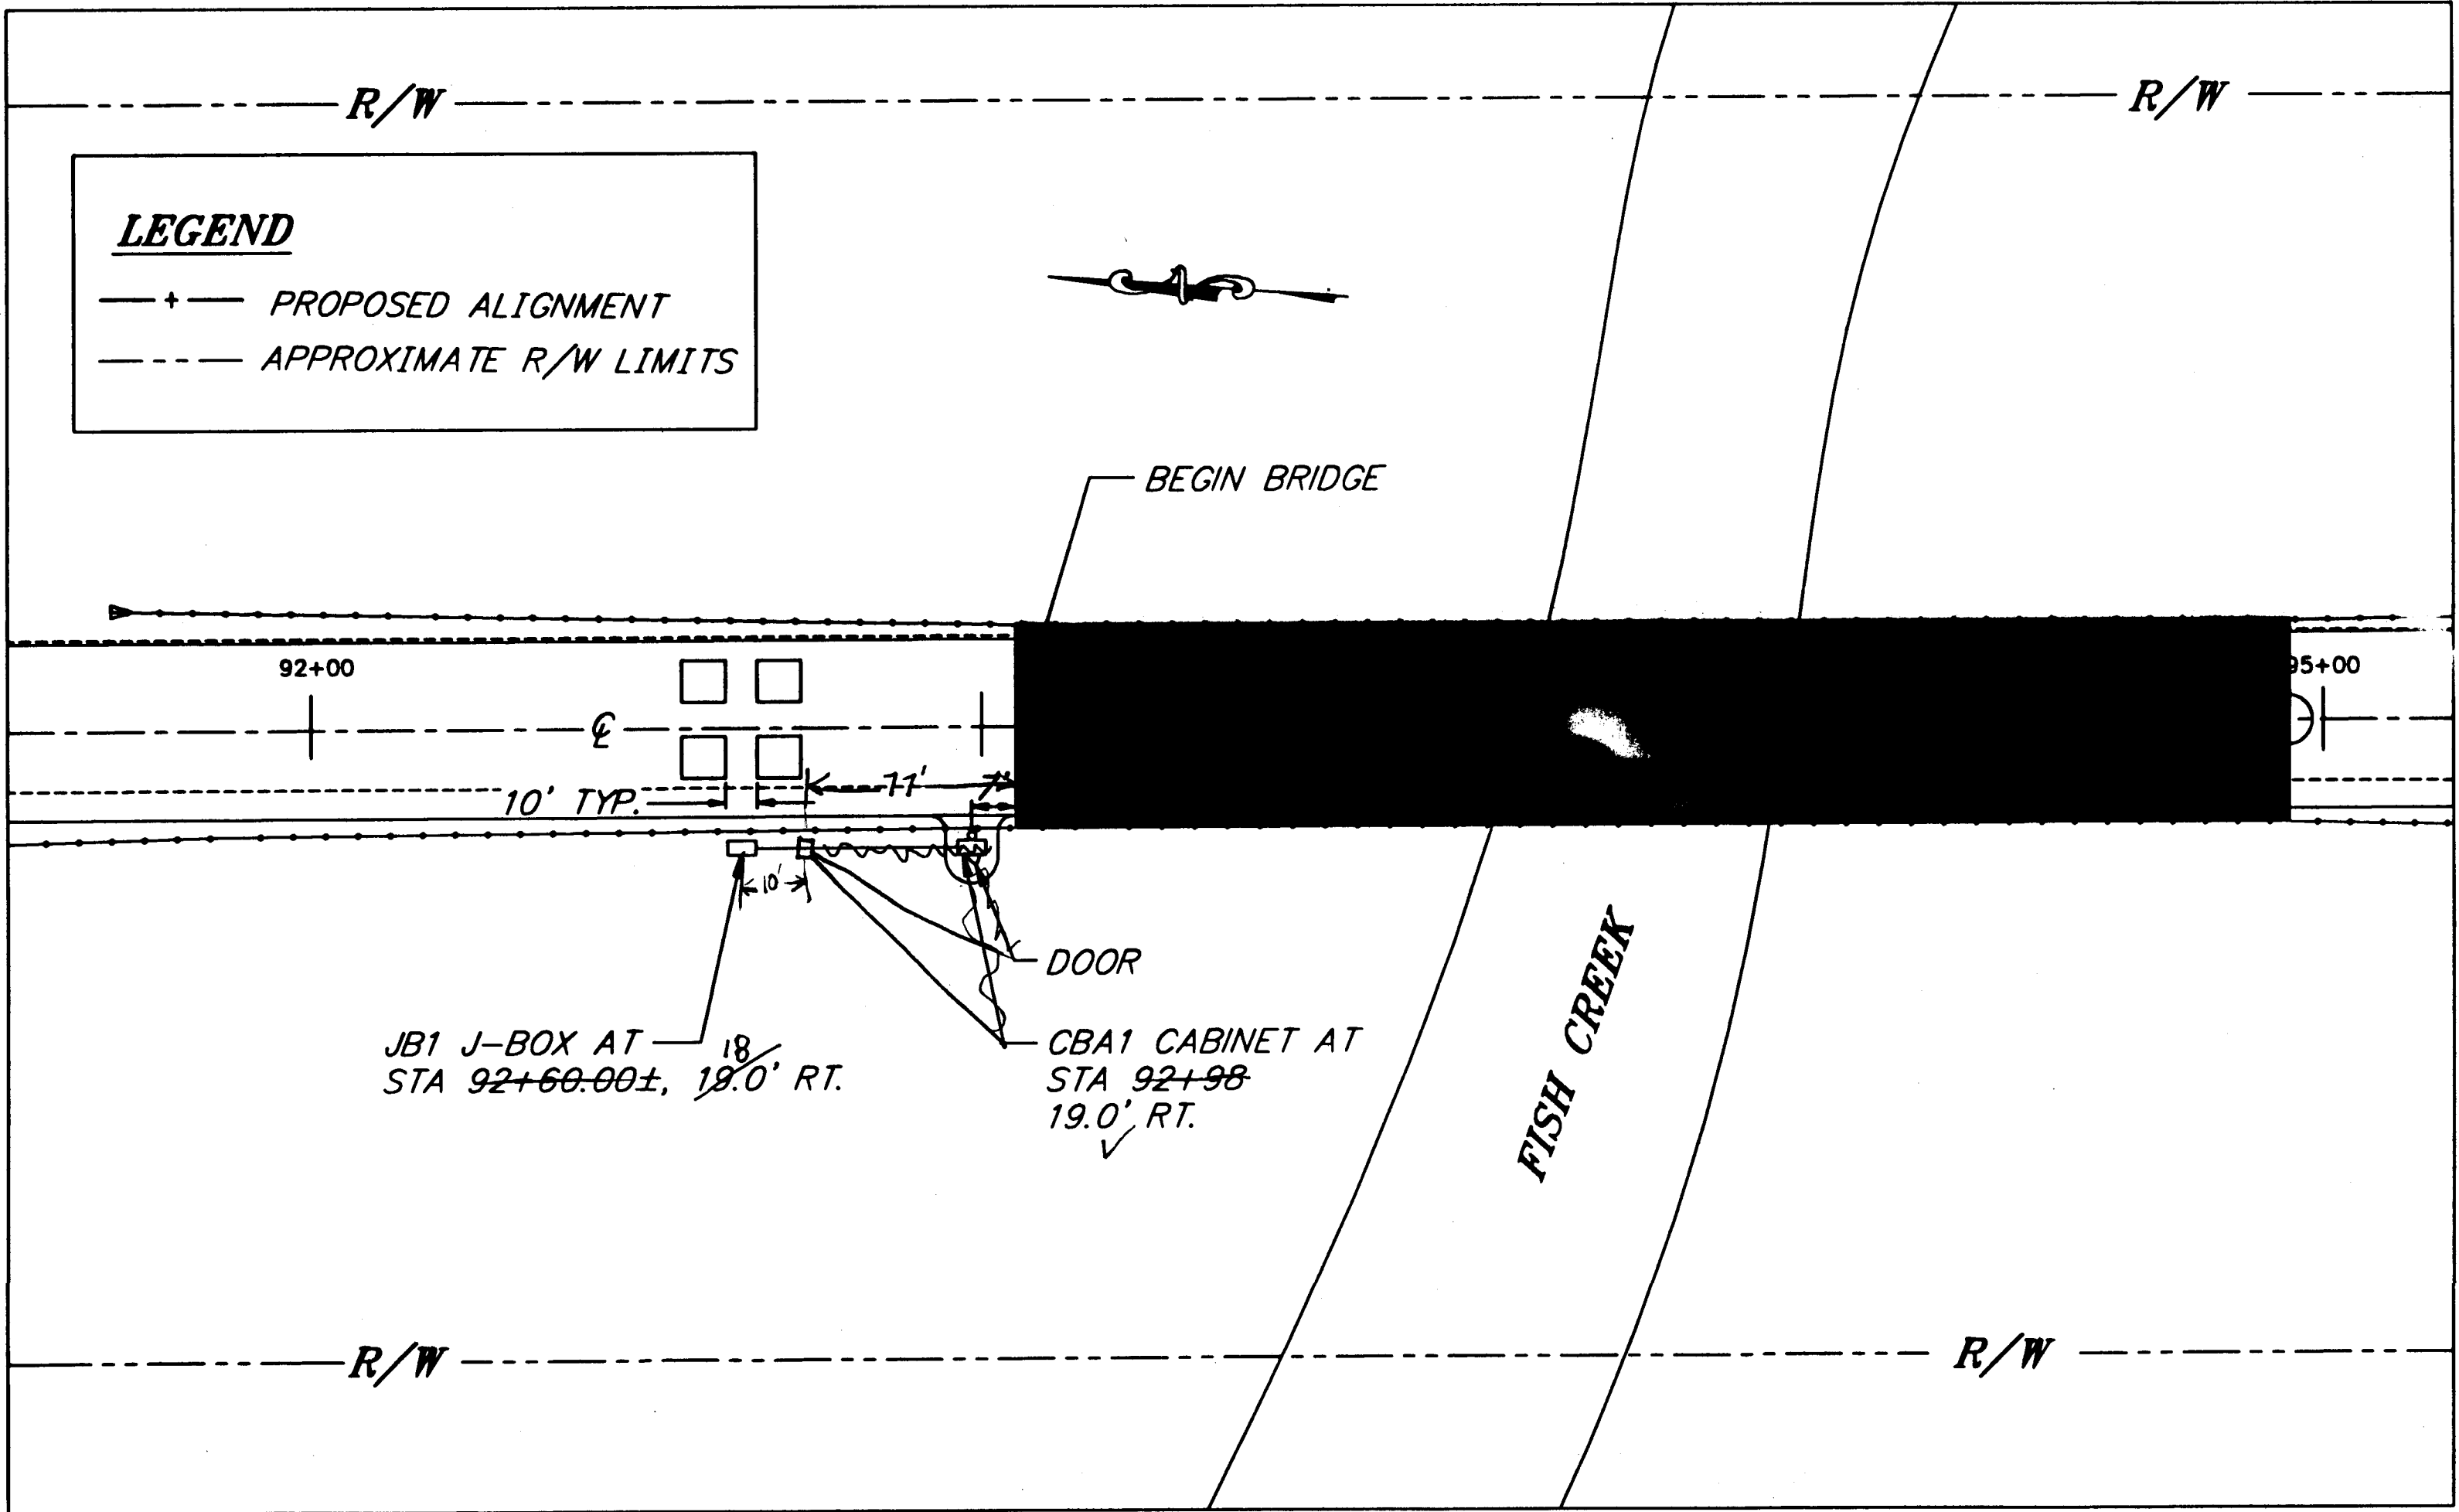

SITE PLAN
N.T.S.

Prime Contractor: Glacier State
Sub Contractor: Alaska Elec.
P.E. Thad Hopper

GENERAL NOTES:

1. INSTALLATION OF EQUIPMENT AND MATERIALS SHALL CONFORM TO ✓
APPLICABLE REQUIREMENTS OF THE CURRENT NEC, ALASKA DOT/PT
STANDARD SPECIFICATION FOR HIGHWAY CONSTRUCTION.
2. EVERY EFFORT HAS BEEN MADE TO MAKE THE INFORMATION ✓
CONTAINED IN THESE DOCUMENTS COMPLETE AND ACCURATE,
HOWEVER THE CONTRACTOR SHALL FIELD VERIFY ALL EXISTING
SITE CONDITIONS AND DIMENSIONS.
3. USE ONLY RMC CONDUIT. ✓
4. ALL CONSTRUCTION SHALL BE WITHIN STATE RIGHT-OF-WAY. ✓
5. ALL EXCAVATION SHALL BE WASTE AND HAULED TO APPROVED WASTE ✓
SITE PER THE ENGINEERS APPROVAL OF WHICH PAYMENT WILL BE
INCIDENTAL TO ITEM 669(1).
6. ALL REQUIRED RAP MATERIAL AND CLASS "A" CONCRETE
SHALL BE INCIDENTAL TO ITEM 669(1).

PAY ITEM	STATION	CABINET OFFSET	CABINET ASSEMBLY STYLE	INDUCTIVE LOOPS	WM SENSOR & TYPE	AVC SENSOR & TYPE	LOAD CENTER & TYPE	ELECTRICAL AND TELEPHONE SERVICE
669(1) ✓	AS SHOWN SITE PLANS ✓	19.0' ✓ RT.	CBA1 ✓	4 ✓	NONE ✓	NONE ✓	NONE ✓	NO ✓

CABINET OFFSET AS MEASURED FROM CENTERLINE, TO BE FIELD ADJUSTED, INSTALLATION NOT TO EXCEED

BASIS OF HORIZONTAL & VERTICLE CONTROL

1. HORIZONTAL AND VERTICAL CONTROL IS BASED ON THE EXISTING CENTERLINE OF ✓
FISH CREEK BRIDGE, AS SHOWN ON THE PLANS AND IS FOR INFORMATIONAL PURPOSES
ONLY AND SUBJECT TO CHANGE PER THE ENGINEER.

REFERENCE SPECIFICATIONS

ALL WIRING IN THIS SECTION SHALL BE CONSTRUCTED PER SPECIFICA-
TION SECTION 660 SIGNALS AND LIGHTING, EXCEPT WHERE NOTED ON
THE PLANS OR IN THE SPECIAL PROVISIONS. IN PARTICULAR, ALL
CONSTRUCTION SHALL CONFORM TO SPECIFICATION SECTIONS 660-2.05
CONDUIT, 660-2.06 JUNCTION BOXES, 660-2.08 CONDUCTORS, 660-2.09(A)
WIRING, 660-2.10 BONDING AND GROUNDING, AND 660-2.13 FIELD TESTS,
EXCEPT AS MODIFIED BY SECTION 669 PERMANENT TRAFFIC RECORDERS.

LABELS

ALL CABLES SHALL BE LABELED AT BOTH ENDS AND AT EVERY
JUNCTION BOX THROUGH WHICH THE CABLES PASS, PER SPECIFICATION
SECTION 660-209(a)

ALL WIRE PAIRS SHALL BE LABELED AT THE TERMINAL BLOCK
AND AT ANY LOOSE ENDS.

THE CONVENTIONS BELOW SHALL APPLY TO DESIGNATING AND
LABELING CABLES AND WIRE PAIRS:

LANES: TRAFFIC LANES AND THEIR RESPECTIVE LOOPS AND
SENSORS SHALL BE LABELED FROM THE OUTSIDE EDGE OF
THE ROAD TOWARD THE CENTER AS FOLLOWS:



TERMINAL BLOCKS: WIRES FROM SENSORS PLACED IN LANES
WHICH ARE CLOSEST TO THE CONTROL BOX SHALL BE PLACED
AT THE LEFT OR AT THE TOP OF THE TERMINAL BLOCK,
DEPENDENT ON ORIENTATION.

WIRES FOR INDUCTIVE LOOPS, SENSORS AND RESERVES SHALL BE
LABELED AS FOLLOWS:

WHERE: PnDlc

P IS THE PREFIX:

V = TRAFFIC VOLUME LOOP

H = VEHICLE CLASSIFICATION / SPEED LOOP

Co = AUTOMATIC VEHICLE CLASSIFICATION (AVC) SENSOR

D = PIEZO WEIGH-IN-MOTION (WIM) SENSOR

n NUMBER SUFFIX FOR MULTIPLE LOOPS

D DIRECTION (N, S, E, W)

Lc LANE DESIGNATION (A, B, C, D)

(X) CONDUIT REFERENCE NUMBER

(xx) NOTE REFERENCE NUMBER

ESTIMATE OF QUANTITIES

ITEM NO.	ITEM	UNIT	QUANTITY
669(1)	PERMANENT TRAFFIC RECORDER ✓	LUMP SUM	ALL REQ'D.

PATH:
Q:\Jnu\68269\Planset\L_LOOPS.DWG
Wed, 16/Jun/02 01:11PM Kris
PLOT:
PSPACE 1=1(F) OR MSPACE 1=1(F)
TAB: L1

ADDENDUM NUMBER

ATTACHMENT NUMBER

RECORD OF REVISIONS

No.	DATE	DESCRIPTION

EAGLECREST ROAD
PERMANENT TRAFFIC RECORDER
PROJECT NO. 68269

**SITE PLAN & ESTIMATE OF
QUANTITIES**

7/1 7-22-03

DESIGNED BY: P. JONES



CHECKED BY: K. MATTSON

DRAWN BY: D. STEVENS

STATE OF ALASKA
DEPARTMENT OF TRANSPORTATION
& PUBLIC FACILITIES
STATEWIDE DESIGN & ENGINEERING
SERVICES DIVISION

EAGLECREST ROAD
PERMANENT TRAFFIC
RECORDER


**SITE PLAN &
ESTIMATE OF
QUANTITIES**

PROJECT DESIGNATION NUMBER

ACHRO-0953(4)

STATE YEAR
ALASKA 2001

SHEET NUMBER TOTAL SHEETS
L1 41

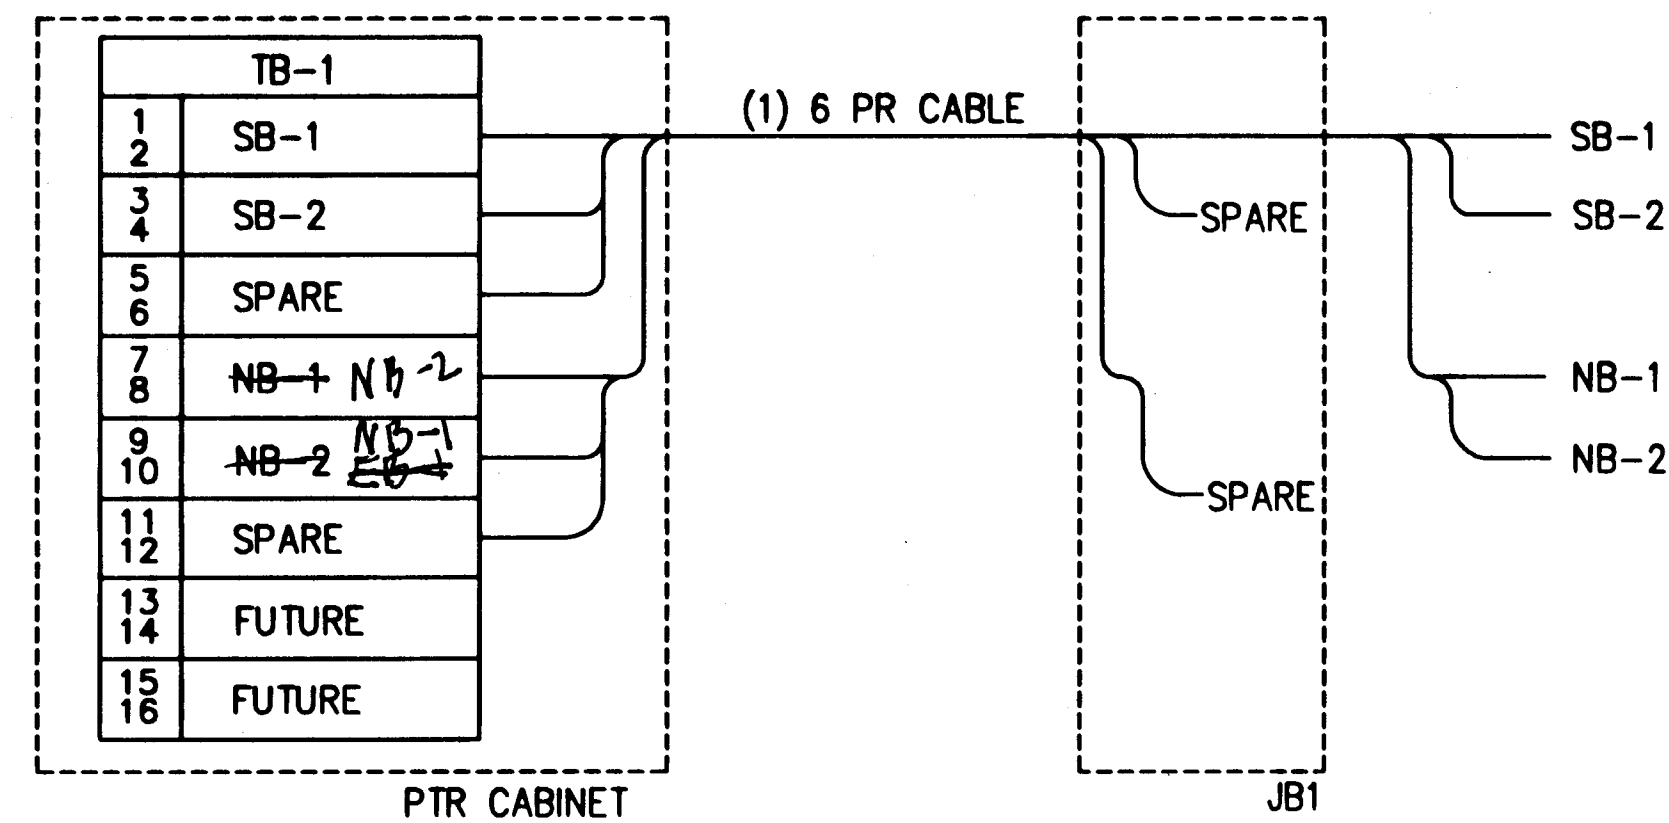

WIRING SCHEMATIC DETAIL


RMC CONDUIT NO.	SIZE	FROM	TO	CABLE QTY.	TYPE
1	2"	CBA1	JB1	1	6 PR CABLE
2	1"	JB1	SB-1	1	1PR No.12
3	1"	JB1	SB-2	1	1PR No.12
4	1"	JB1	NB-1	1	1PR No.12
5	1"	JB1	NB-2	1	1PR No.12

CONDUIT/CONDUCTOR SCHEDULE


SHEET NOTES

- JUNCTION BOX SHOWN HERE IS JB1 ON SITE PLAN.
- CONTROLLER CABINET DOORS TO OPEN AWAY FROM TRAFFIC.
- USE FACTORY 90° ELBOWS TO/FROM J-BOXES ON ALL CONDUITS LARGER THAN 1".
- ALL CONDUIT SHALL BE GALVANIZED STEEL UNLESS NOTED OTHERWISE.
- NOT ALL CONDUITS MAY BE SHOWN IN DETAIL. ADD OTHERS AS REQUIRED.
- PROVIDE SLIP BASE AND FOUNDATION PER DOT STD DETAIL S-34.00.
- PROVIDE CONDUIT DRAIN HOLES PER STANDARD SPECIFICATIONS SECTION 660-2.05.
- SEE TYPICAL SECTIONS FOR DIMENSIONS.
- INDUCTION LOOPS TO BE CENTERED IN TRAFFIC LANES.
- DIMENSIONS ARE TYPICAL FOR ALL LANES.
- CABINET TO BE EQUAL TO OR BETTER THAN HENNESEY PRODUCTS SINGLE DOOR ALUMINUM ENCLOSURE: CATALOG NUMBER SM201715 (20" X 17" X 16") WITH NEMA 3R RATING, CORBIN LOCK, EQUIPMENT MOUNTING PANEL AND ADJUSTING SHELF.
- 6 PR. CABLE SHALL TERMINATE IN A RE-ENTRYABLE SPLICE KIT.

NUMBER	TYPE
JB1	✓

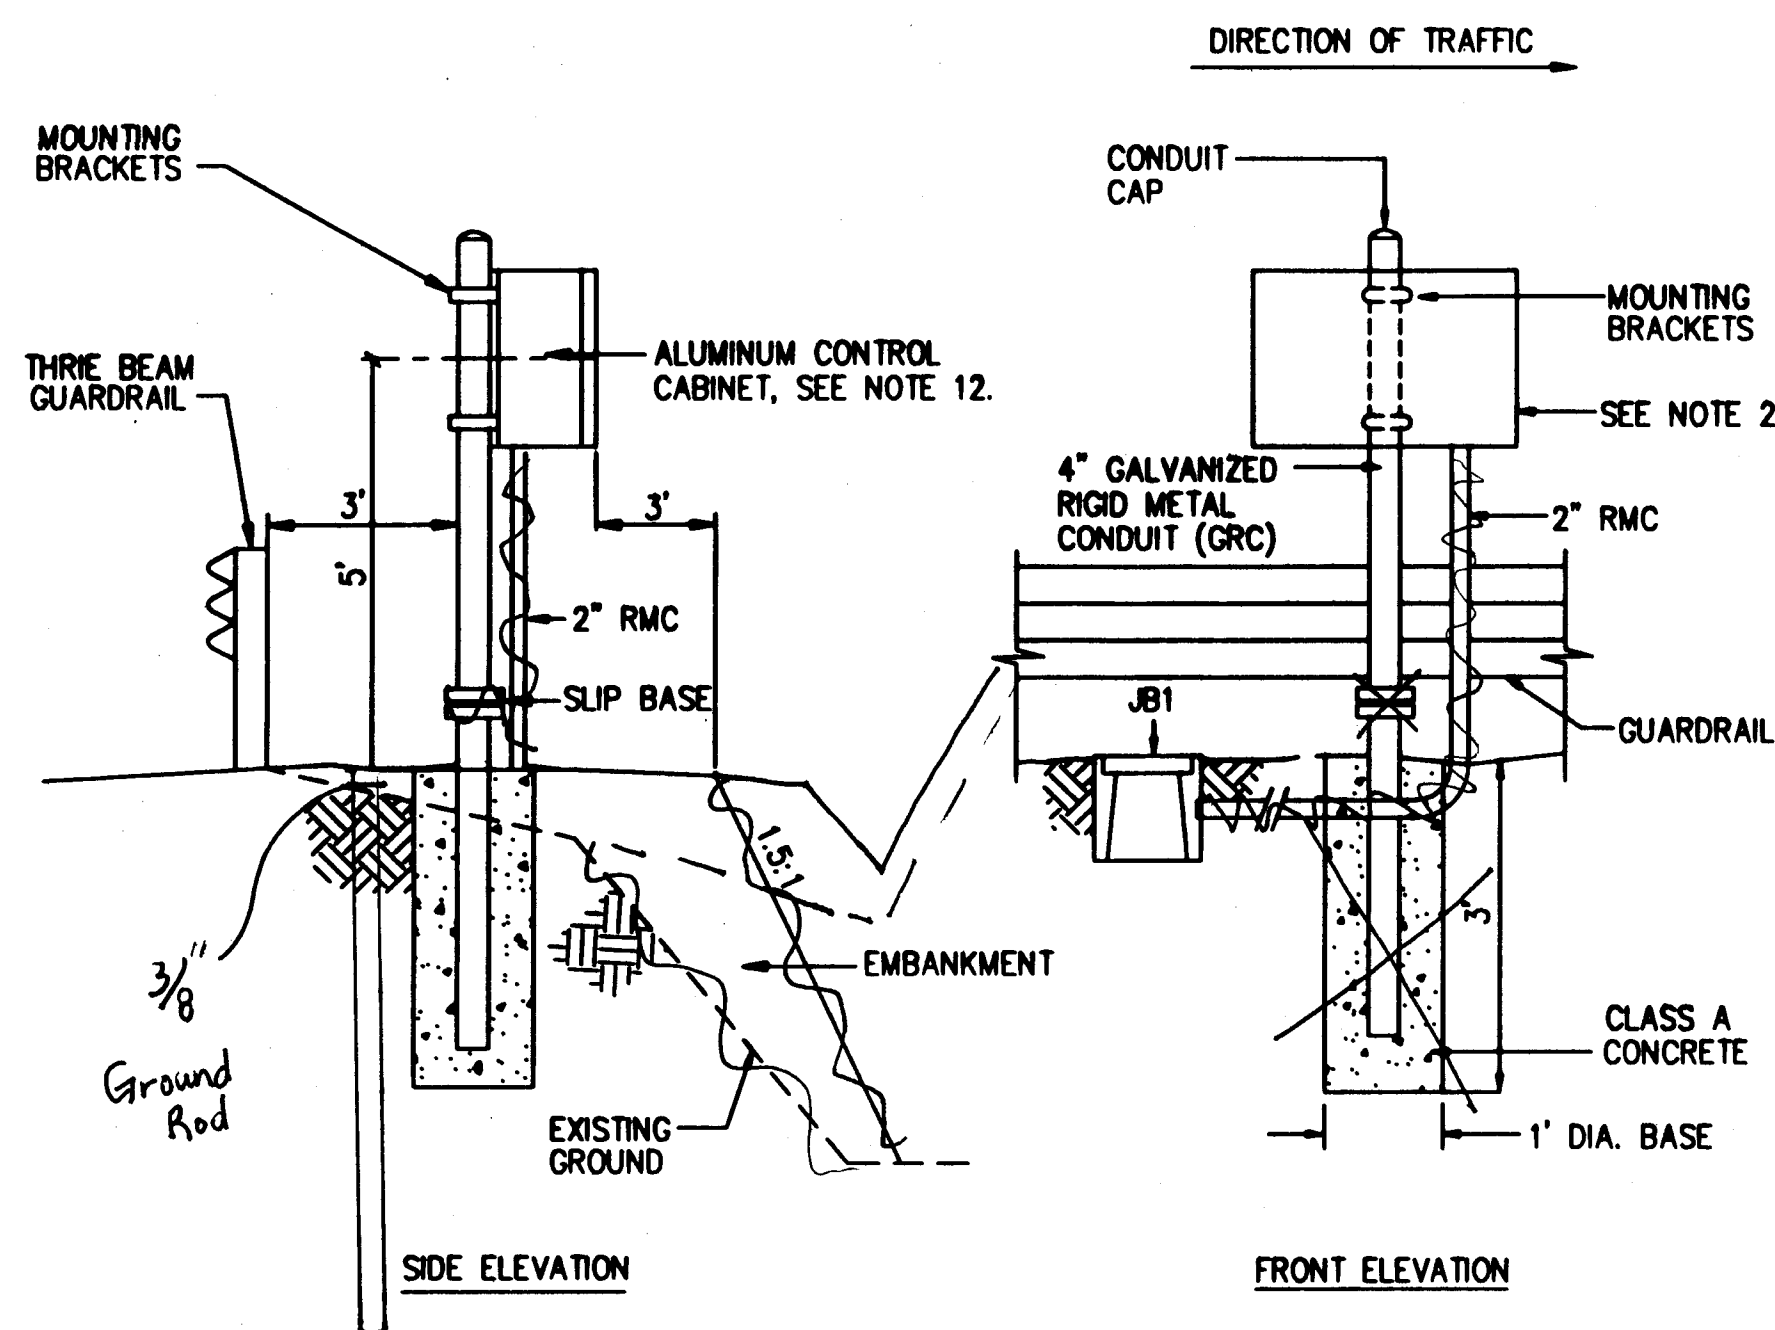

SECTION "A-A"
CABINET TYPE CBA1 DETAIL

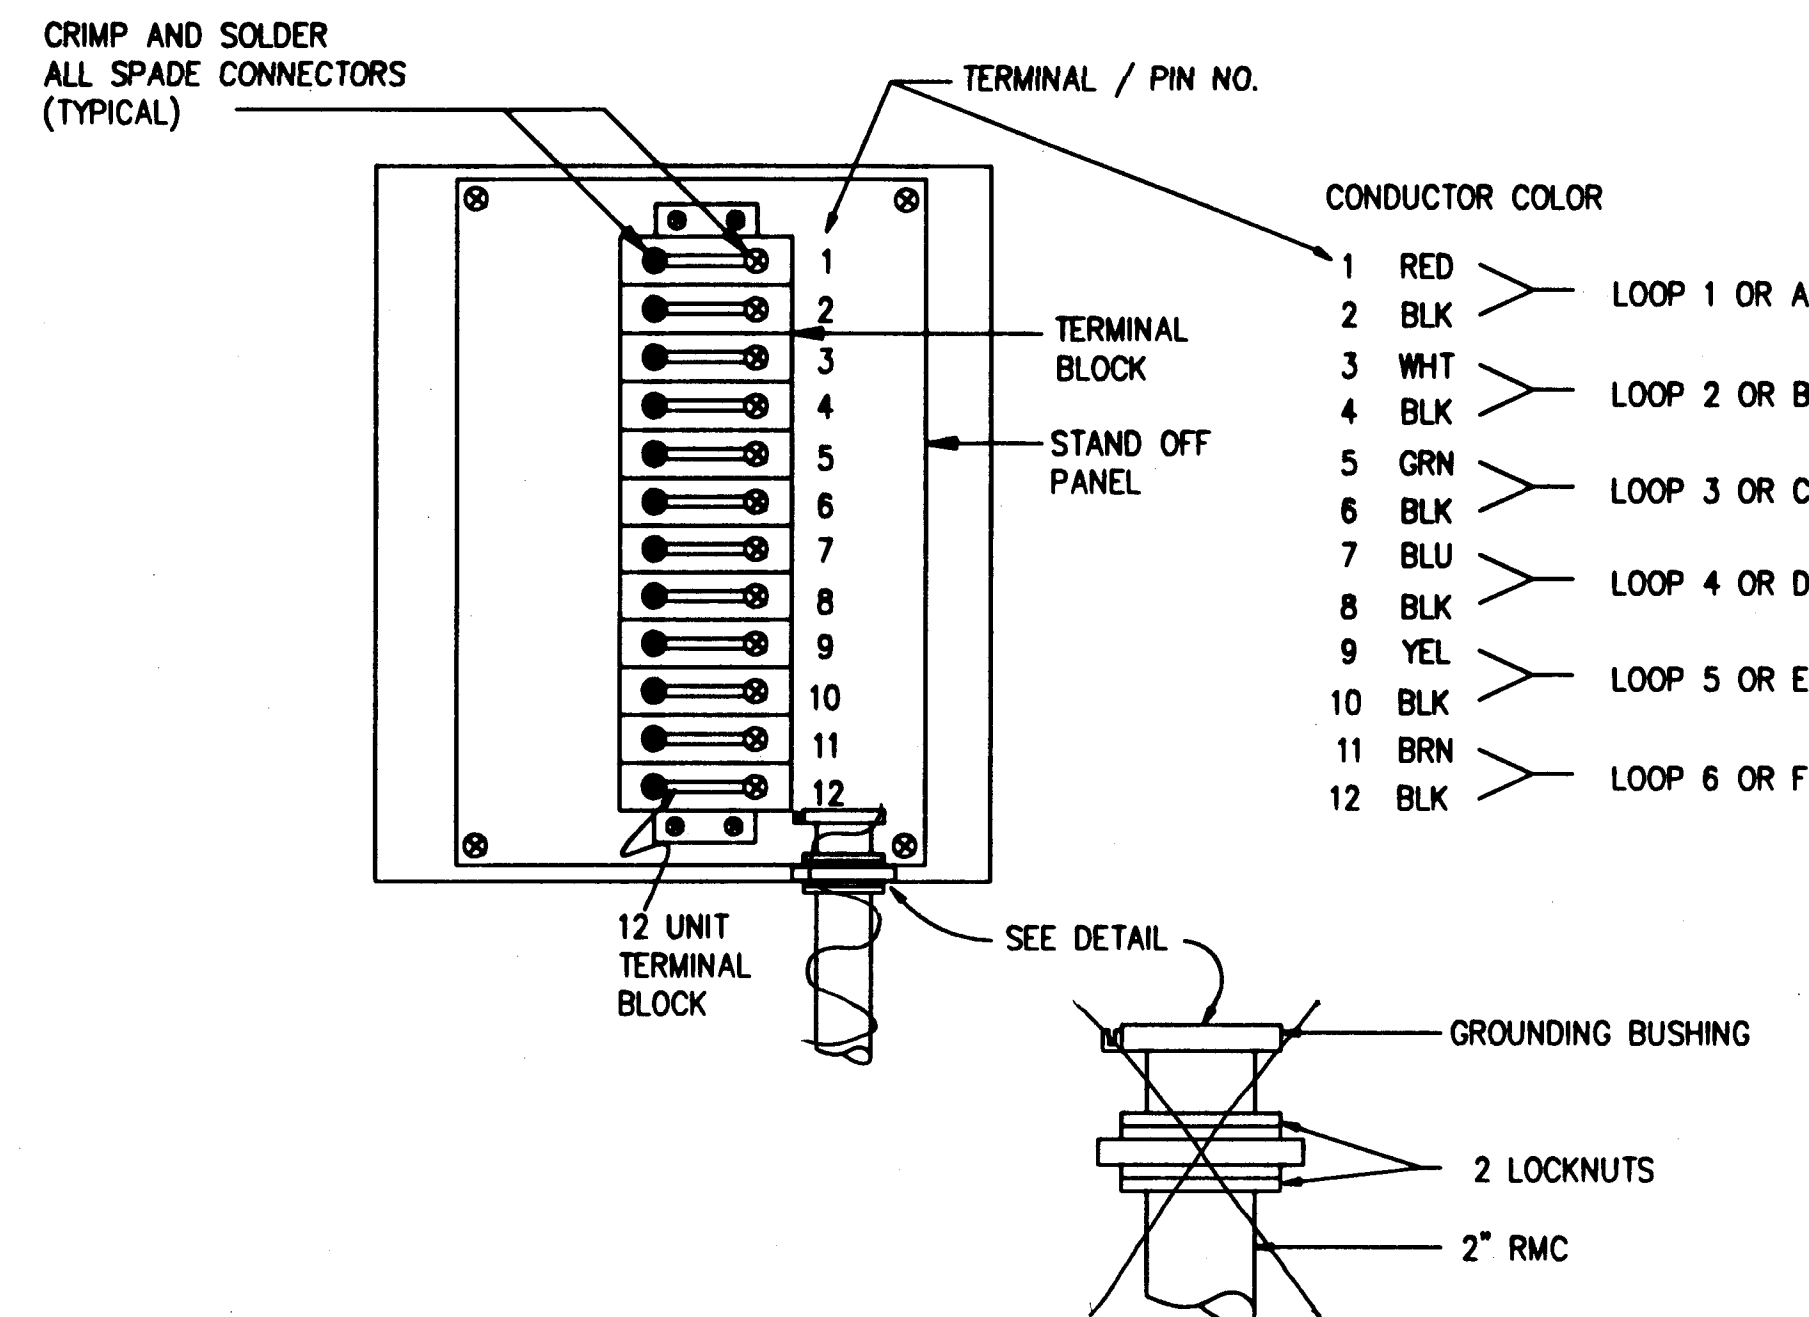

CABINET TYPE CBA1 DETAIL
FRONT VIEW, DOOR OPEN

NOT TO SCALE
USE DIMENSIONS

PATH:
Q:\Jnu\68269\Planset\L_LOOPS.DWG
Wed, 16/Jan/02 01:13PM Kris
PLOT:
PSPACE 1=1(F) OR MSPACE 1=1(F)
TAB: ESTIMATE

ADDENDUM NUMBER

ATTACHMENT NUMBER

RECORD OF REVISIONS

No.	DATE	DESCRIPTION

EAGLECREST ROAD
PERMANENT TRAFFIC RECORDER
PROJECT NO. 68269

MISCELLANEOUS DETAILS

TH 7-22-03

DESIGNED BY: P. JONES



CHECKED BY: K. MATTSON

DRAWN BY: D. STEVENS


STATE OF ALASKA
DEPARTMENT OF TRANSPORTATION
& PUBLIC FACILITIES
STATEWIDE DESIGN & ENGINEERING
SERVICES DIVISION
EAGLECREST ROAD
PERMANENT TRAFFIC
RECORDER

MISCELLANEOUS
DETAILS


PROJECT DESIGNATION NUMBER

ACHRO-0953(4)


STATE	YEAR
ALASKA	2001
SHEET NUMBER	TOTAL SHEETS
L2	41

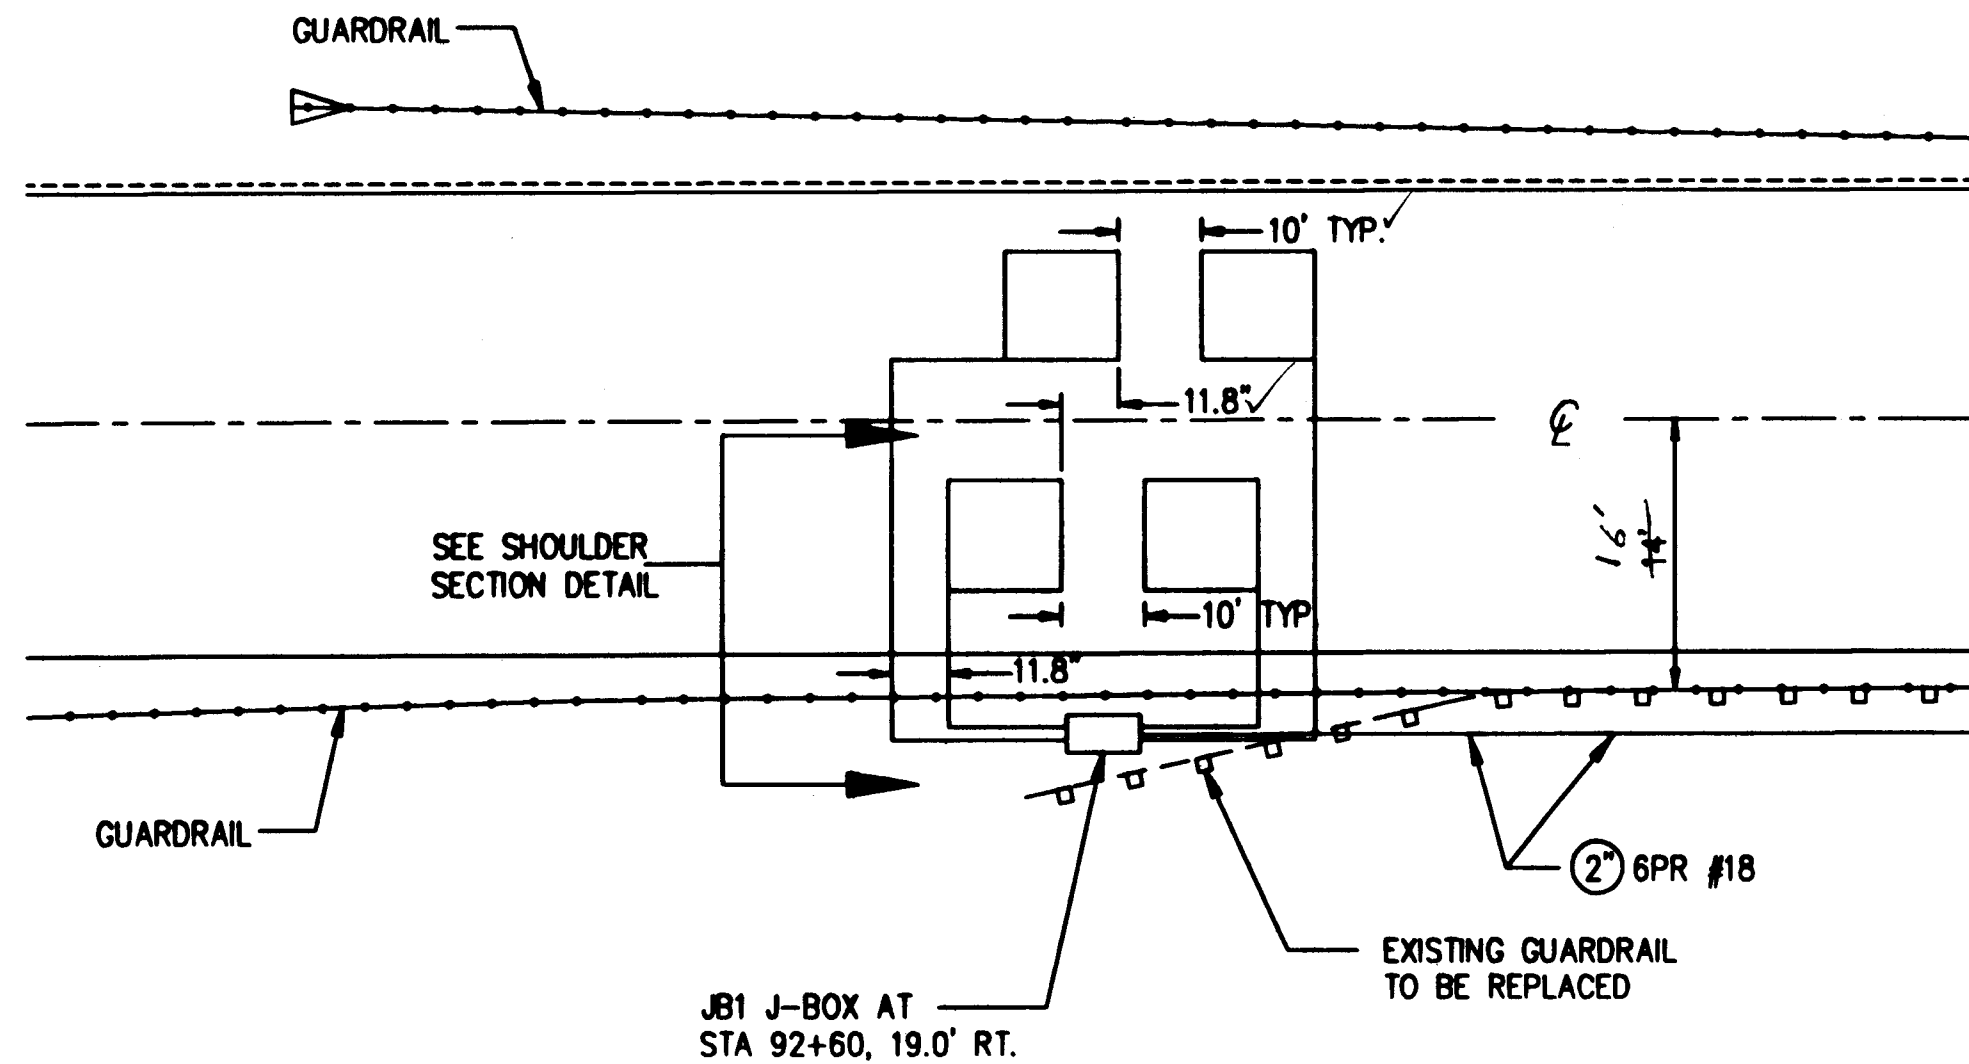


LOOP INSTALLATION DETAIL
NTS

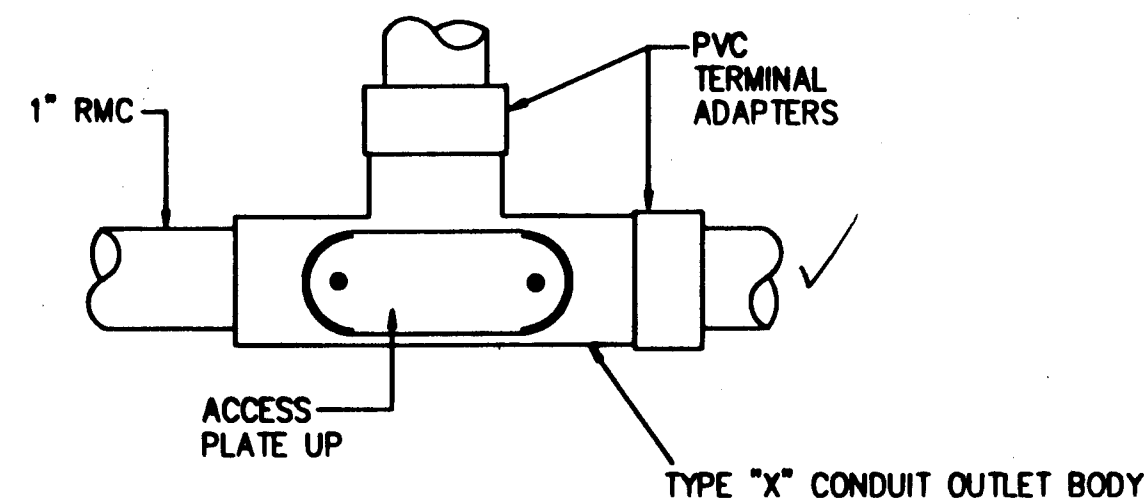


TYPE "X" CONDUIT DETAIL

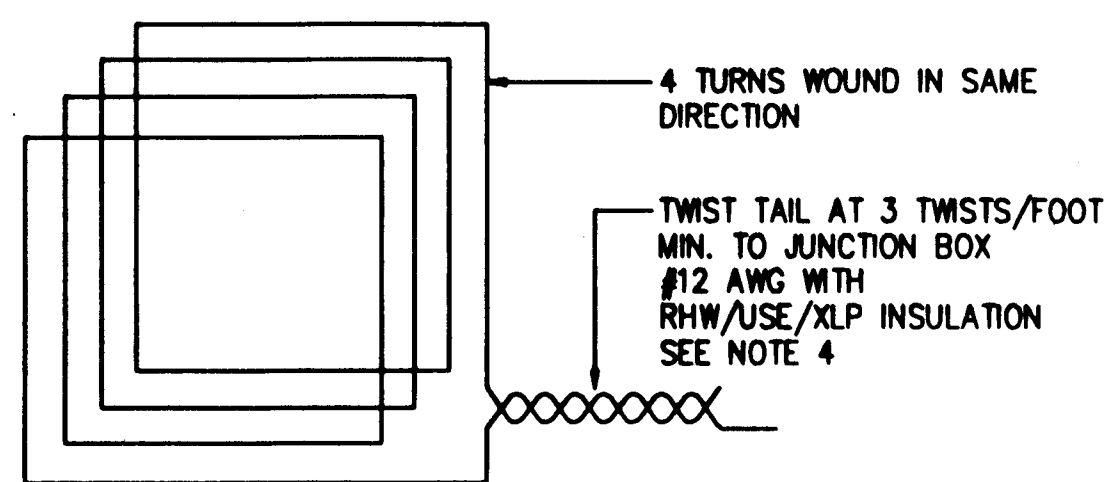


LOOP WIRING DETAIL

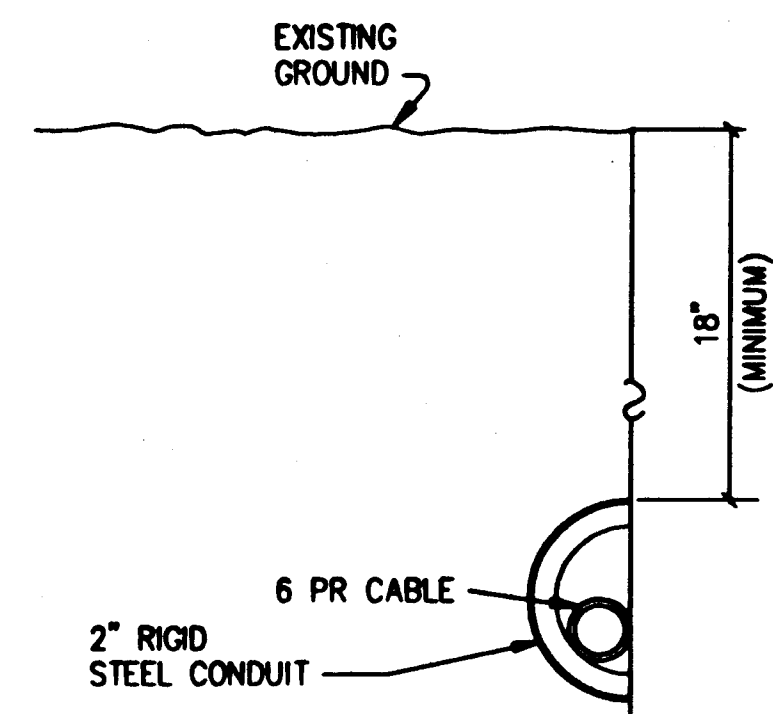


2" RIGID METAL CONDUIT INSTALLATION DETAIL
N.T.S.

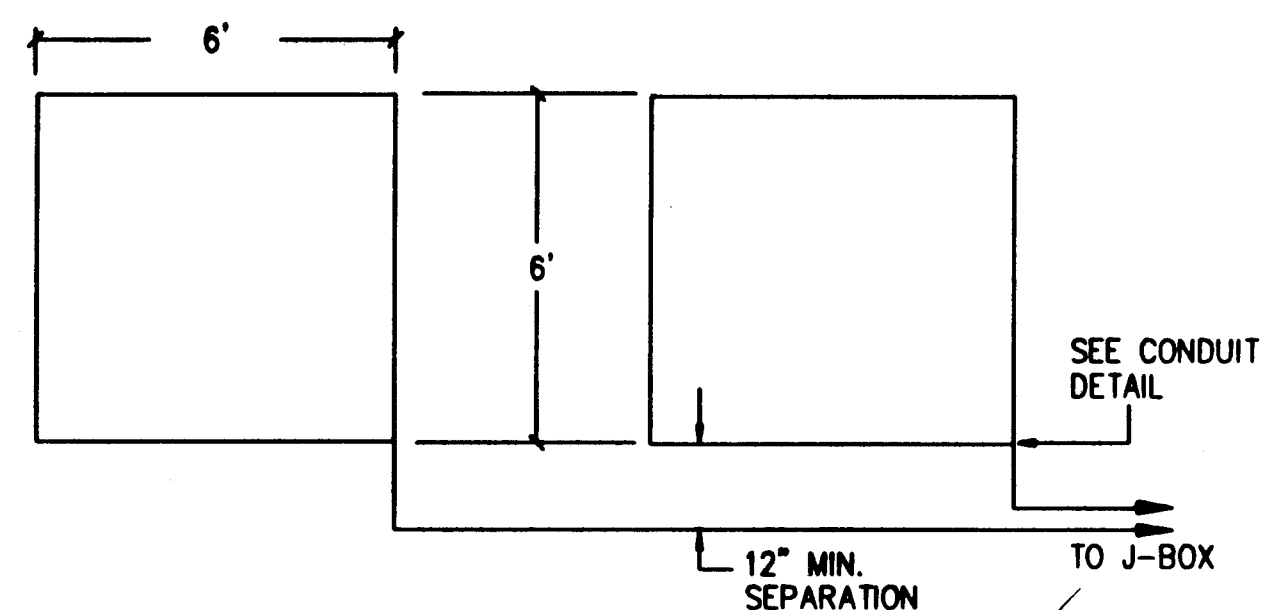

LOOP INSTALLATION PLAN

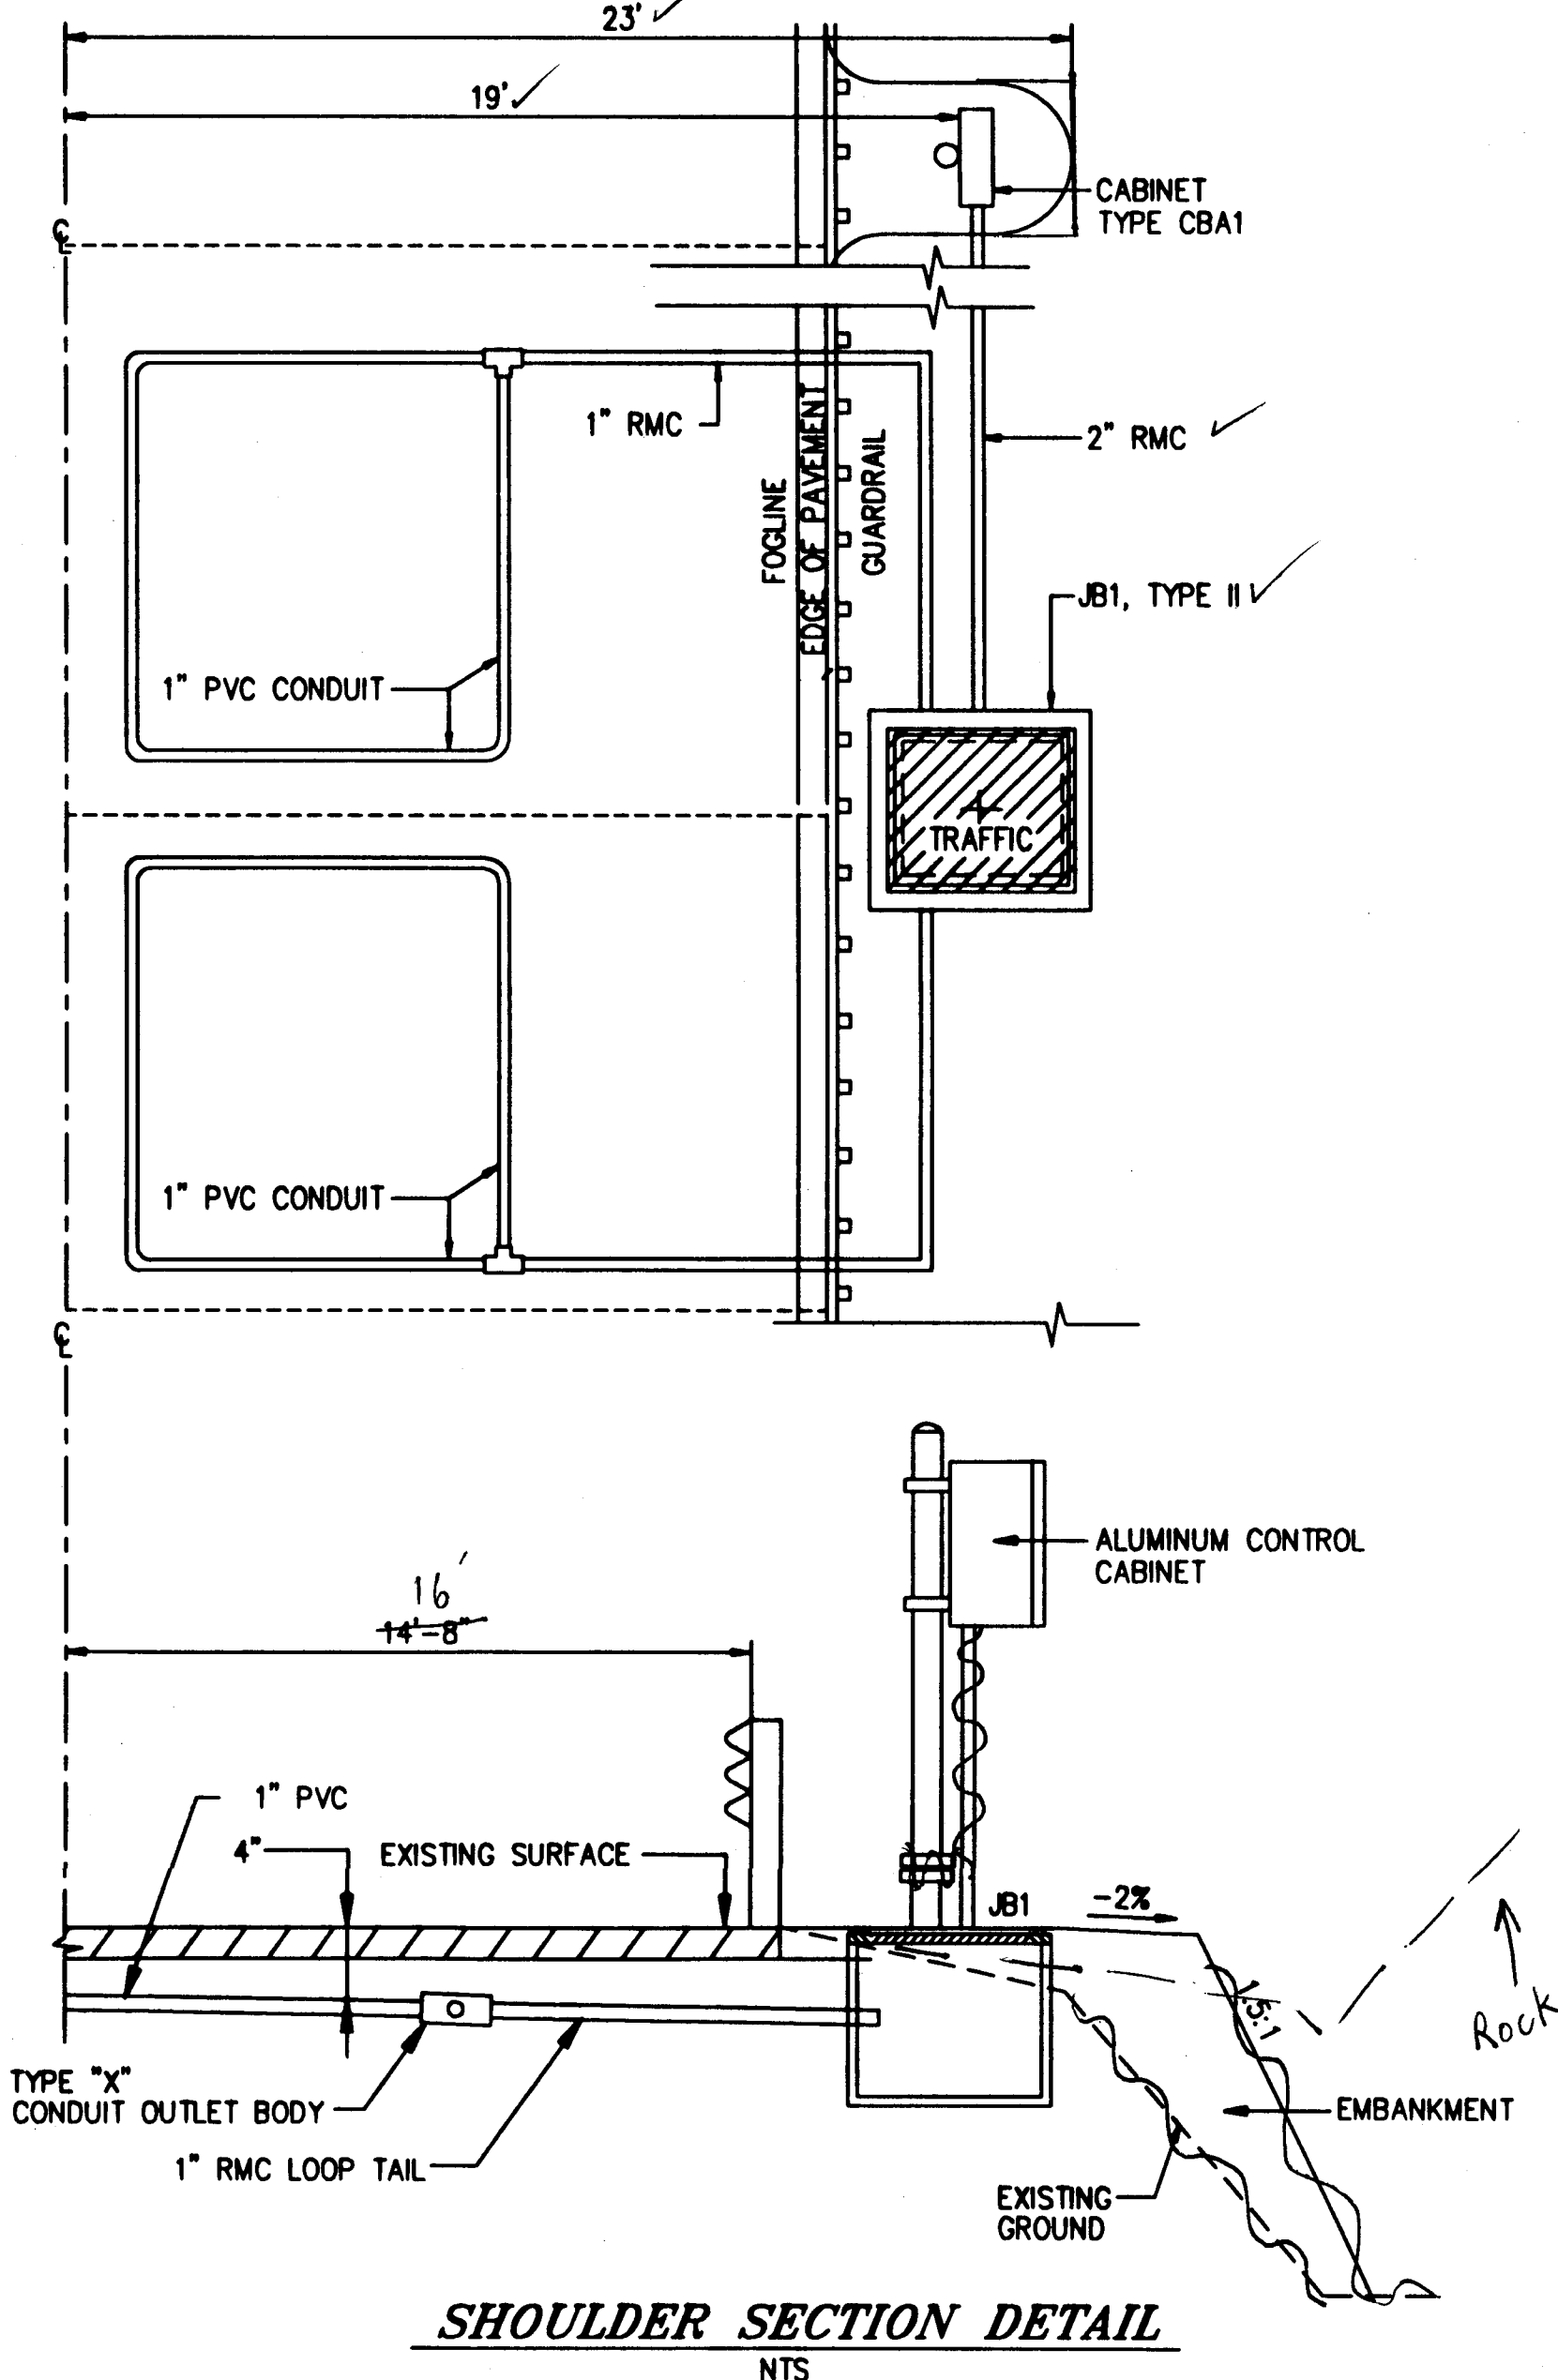

SHOULDER SECTION DETAIL
NTS

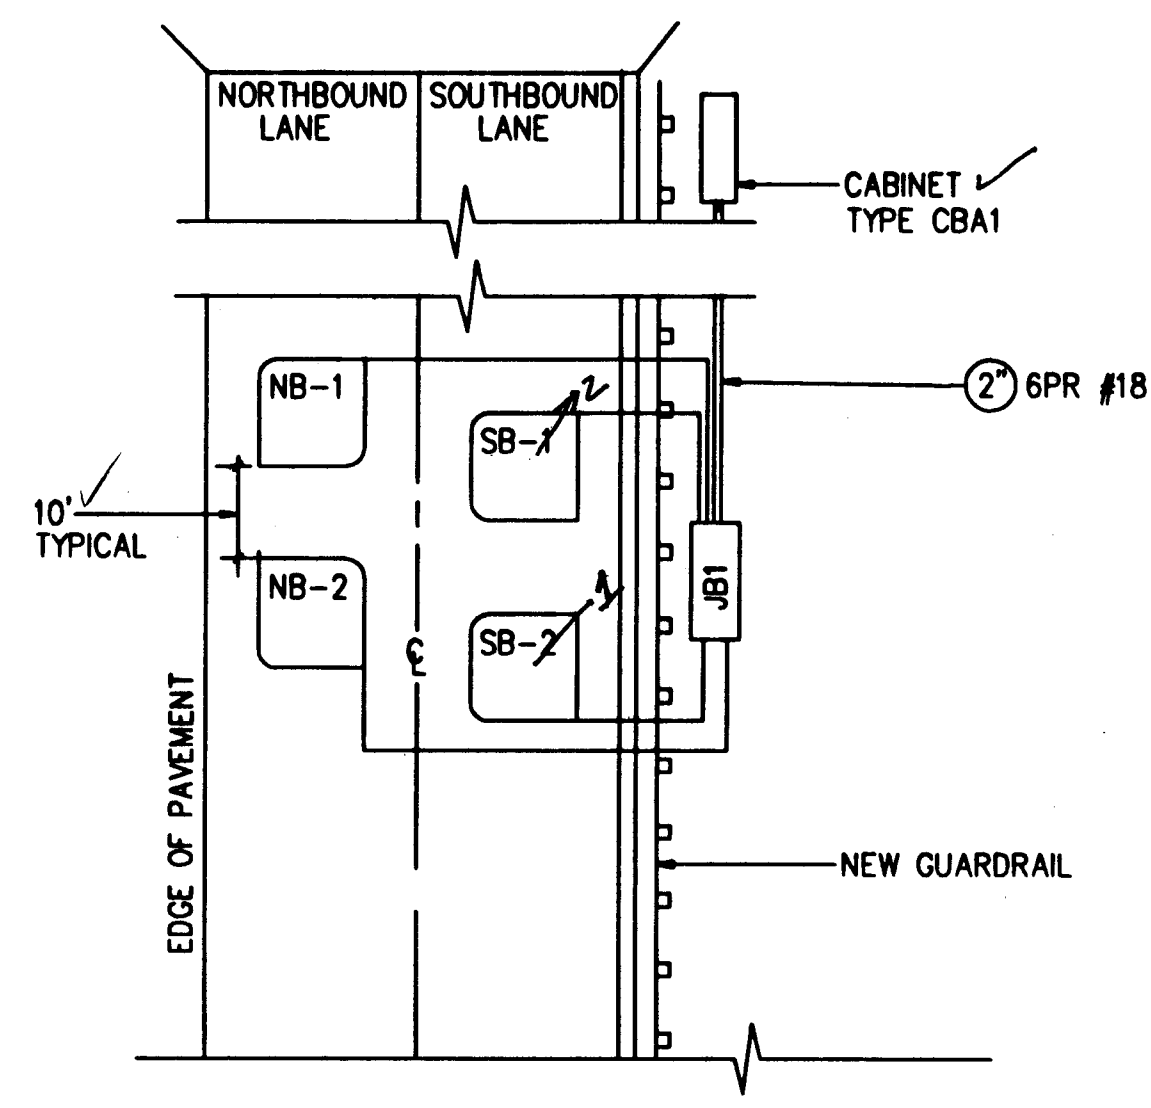

TRAFFIC COUNTER TYPICAL
CENTER LOOPS IN THE LANES

SHEET NOTES

1. WHEN NEW ASPHALT PAVEMENT IS BEING INSTALLED, COMPLETE LOOP INSTALLATIONS PRIOR TO PAVING.
2. PRIOR TO FINAL ACCEPTANCE OF THE PROJECT, EACH LOOP SHALL BE CHECKED FOR CONTINUITY AND CONDUCTOR INSULATION INTEGRITY IN ACCORDANCE WITH SECTION 660-2.14 OF THE SPECIFICATIONS.
3. SPlicing OF THE LOOP TAIL WIRES TO THE LEAD-IN CABLE SHALL CONFORM TO SECTION 660-2.09(A) OF THE SPECIFICATIONS.
4. LABEL ALL LOOP TAILS AND LEAD-IN CABLE IN ACCORDANCE WITH SECTION 660-2.08 AND TABLE 660(4) OF THE SPECIFICATIONS.
5. ALL DETECTOR LOOPS SHALL BE 6' WIDE BY 6' LONG, UNLESS DIMENSIONED OTHERWISE IN THE PLANS.
6. LEAD IN WIRES FOR EACH LOOP SHALL BE IN SEPARATE CONDUITS TO THE FIRST JUNCTION BOX WITH A MINIMUM SEPARATION BETWEEN CONDUITS OF 12".
7. INDUCTIVE LOOPS SHALL BE INSTALLED IMMEDIATELY PRIOR TO PAVING. FINAL LIFT ASPHALT PAVEMENT SHALL BE SMOOTH OVER ALL INDUCTIVE LOOPS AND WITHOUT TRANSVERSE SEAMS, JOINTS, OR ROUGHNESS WITHIN 50' OF LOOPS.
8. ALL PVC CONDUIT COUPLINGS, ELBOWS AND ADAPTERS SHALL BE 1" SCHED. 80.
9. ALL PVC JOINTS SHALL BE SOLVENT WELDED AND WATERTIGHT.
10. INSTALL 1/2" PREFORMED BITUMINOUS JOINT MATERIAL AROUND ALL JUNCTION BOXES WHEN LOCATED IN A SIDEWALK.
11. PROVIDE GROUNDING BUSHINGS ON ALL CONDUITS. GROUND WITH MIN. No. 4 BARE CU.
12. ALL JUNCTION BOX COVERS SHALL BE BONDED WITH COPPER BRAID OF #8 AWG CROSS SECTION. FOR TYPES I & I-A THE LENGTH SHALL BE 3', AND 5' FOR TYPES II & III.
13. J-BOX TO BE LOCATED 2' BEHIND UTILWALK OR SIDEWALK WHEN PRESENT.
14. JUNCTION BOXES SHALL BE SET FLUSH WITH THE SURROUNDING SURFACE EXCEPT IN AN UNPAVED SHOULDER, WHEN THEY SHALL BE LOCATED 2" BELOW GRADE.
15. JUNCTION BOX COVERS TO BE EMBOSSED WITH "TRAFFIC".
16. PROVIDE CONDUIT DRAIN HOLES PER STANDARD SPECIFICATIONS SECTION 660-2.05.
17. ALL OPEN END CONDUIT INSIDE THE JUNCTION BOX SHALL BE DUCK SEALED.
18. J-BOX SHALL BE MARKED WITH A 4" ORANGE EMS (ELECTRONIC MARKING SYSTEM) BALL. THE BALL SHALL BE 3m SCOTCHMARK OR EQUAL.

LEGEND

(X) = X" DIAMETER RMC CONDUIT.

LOCATION SUMMARY

NUMBER	TYPE	STATION	OFFSET
JB1	J-BOX	92+50	18' RT.
CBA1	CABINET	92+84	18' RT.

8

NOT TO SCALE
USE DIMENSIONS

PATH: Q:\Jnu\68269\PlanSet\L_LOOPS.DWG
Wed, 16/Jun/02 01:14PM Kris
PLOT: PSPACE 1=1(F) OR MSPACE 1=1(F)
TAB: L3

ADDENDUM NUMBER

ATTACHMENT NUMBER

RECORD OF REVISIONS

No.	DATE	DESCRIPTION

**EAGLECREST ROAD
PERMANENT TRAFFIC RECORDER
PROJECT NO. 68269**

MISCELLANEOUS DETAILS

78 722-03

DESIGNED BY: P. JONES



CHECKED BY: K. MATTSO

DRAWN BY: D. STEVENS


STATE OF ALASKA
DEPARTMENT OF TRANSPORTATION
& PUBLIC FACILITIES
STATEWIDE DESIGN & ENGINEERING
SERVICES DIVISION
**EAGLECREST ROAD
PERMANENT TRAFFIC
RECORDER**

**MISCELLANEOUS
DETAILS**

PROJECT DESIGNATION NUMBER


ACHRO-0953(4)

STATE	YEAR
ALASKA	2001
SHEET NUMBER	TOTAL SHEETS
L3	41

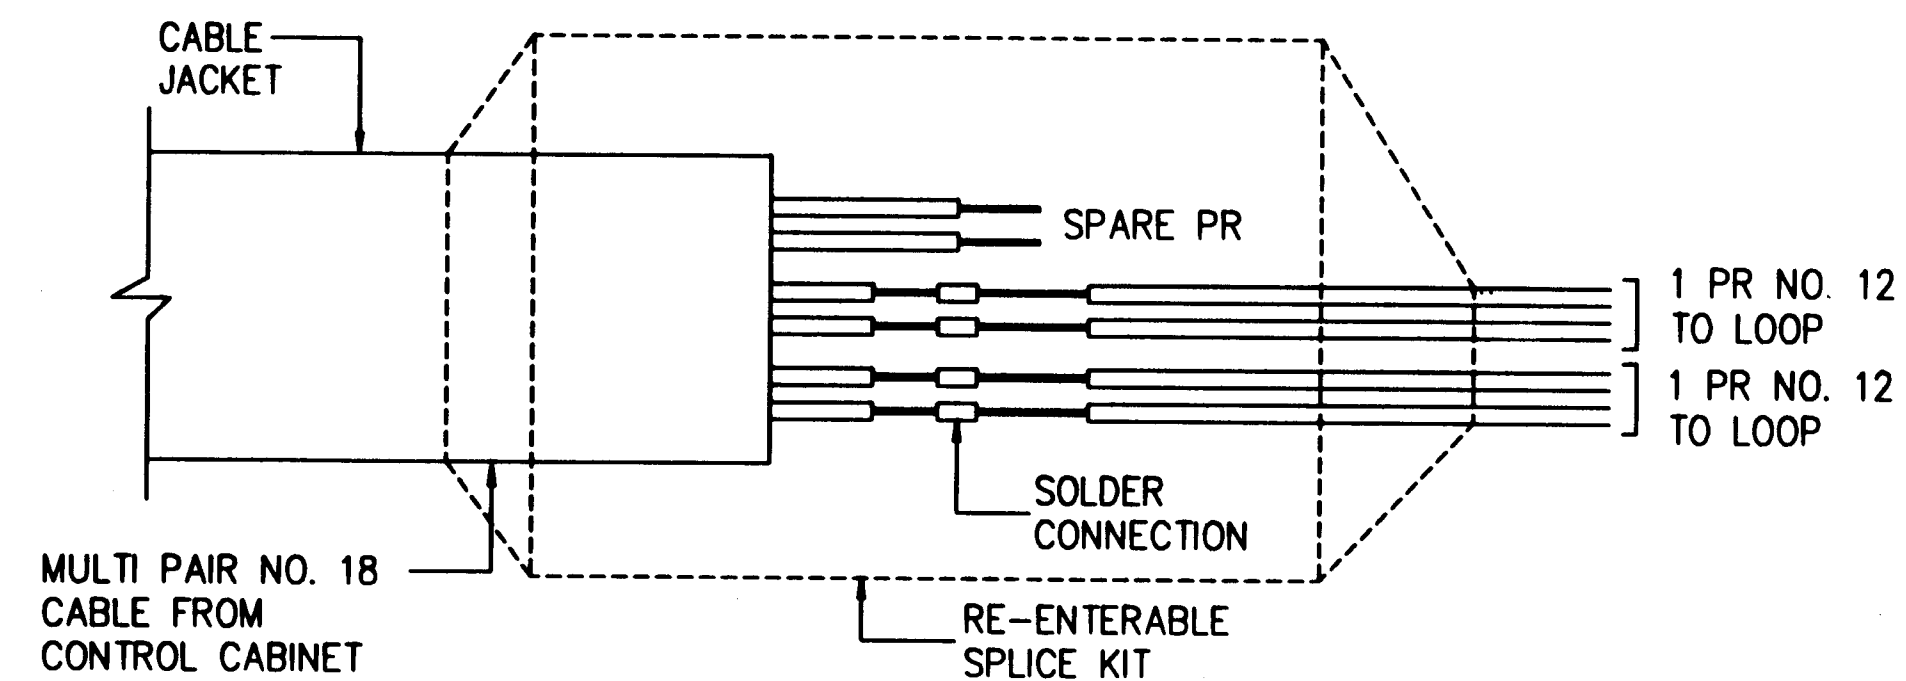


TYPICAL SPLICE DETAILS

- NOTES:
1. SCHEMATIC SKETCH SHOWS AN EXAMPLE OF TWO PAIRS USED WITH ONE SPARE
 2. TERMINATE ALL SPARES WITHIN THE SPLICE BODY.
 3. SPLICE BODY TO ENCLOSE ALL CABLE JACKETS.
 4. SOLDER CONNECTIONS. DO NOT USE COMPRESSION CONNECTORS WRAP EACH CONDUCTOR OVER OTHER CONDUCTOR BEFORE SOLDERING.
 5. USE COMMERCIAL SPLICE KITS SIMILAR OR EQUAL TO 3M PRODUCTS, TYPE 82-F1.

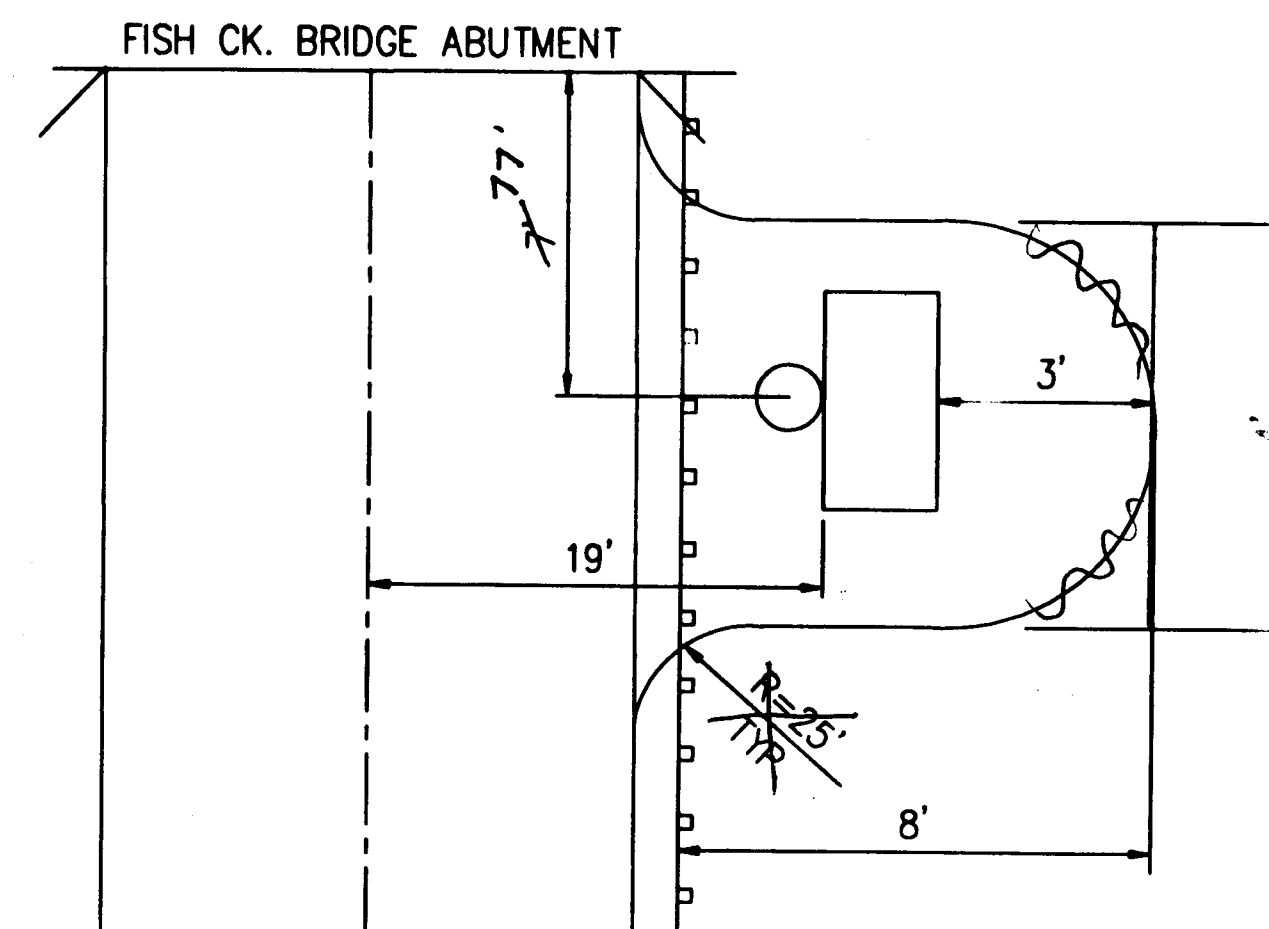

PAD TYPICAL

OR AS DIRECTED BY THE ENGINEER

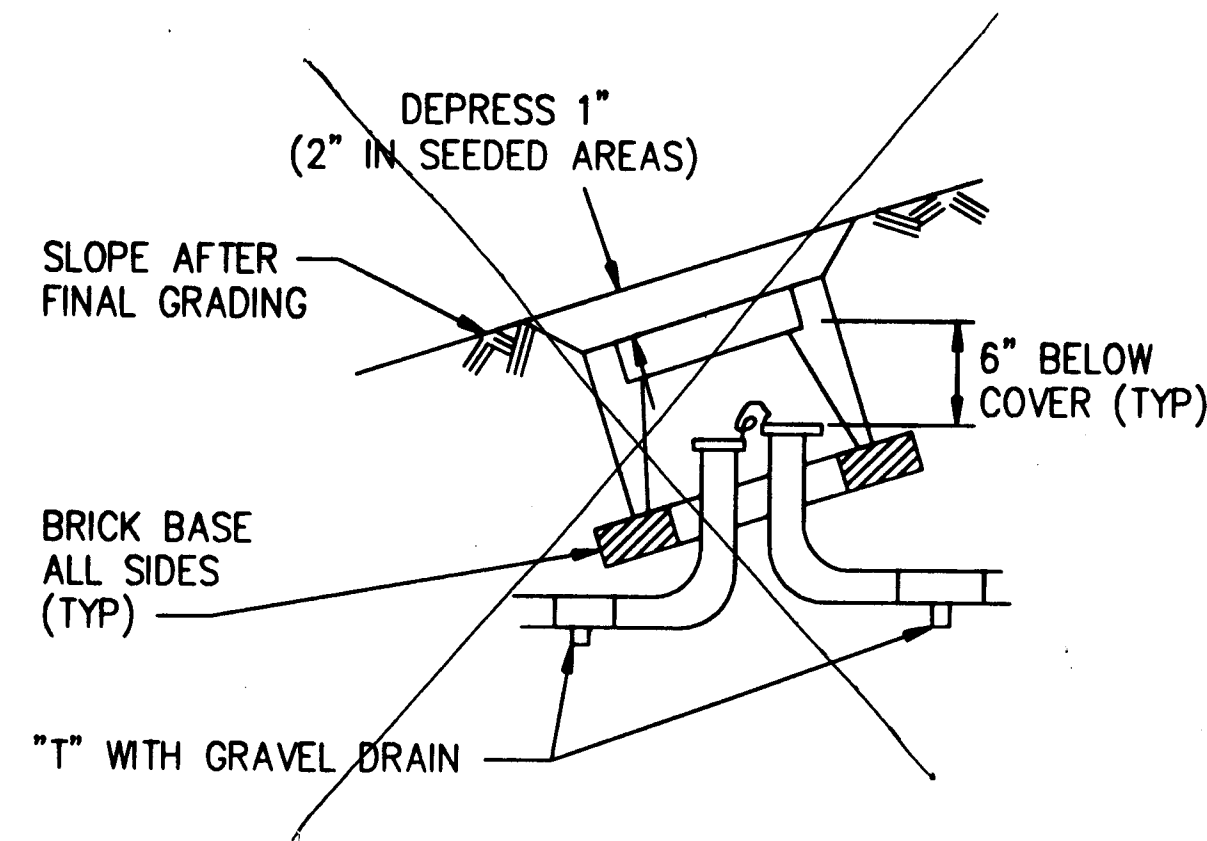

TYPE IA J-BOX INSTALLATION ON SLOPE

NOT TO SCALE
USE DIMENSIONS

PATH:
D:\Jnu\68269\PlanSet\L_LOOPS.DWG
Wed, 16/Jun/02 01:19PM Kris
PLOT:
PSPACE 1=1(F) OR MSPACE 1=1(F)
TAB: L4

ADDENDUM NUMBER

ATTACHMENT NUMBER

RECORD OF REVISIONS


No.	DATE	DESCRIPTION

**EAGLECREST ROAD
PERMANENT TRAFFIC RECORDER
PROJECT NO. 68269**

MISCELLANEOUS DETAILS

7/7-22-03

DESIGNED BY: P. JONES

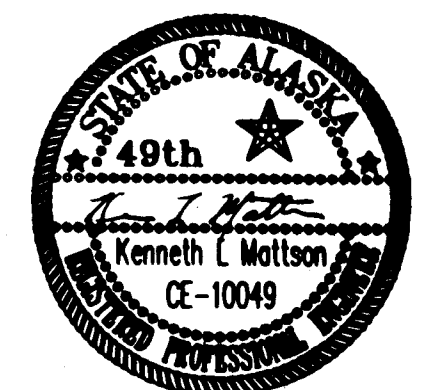

CHECKED BY: K. MATTSON

DRAWN BY: D. STEVENS

STATE OF ALASKA
DEPARTMENT OF TRANSPORTATION
& PUBLIC FACILITIES
STATEWIDE DESIGN & ENGINEERING
SERVICES DIVISION
**EAGLECREST ROAD
PERMANENT TRAFFIC
RECORDER**

**MISCELLANEOUS
DETAILS**

PROJECT DESIGNATION NUMBER

ACHRO-0953(4)

STATE	YEAR
ALASKA	2001
SHEET NUMBER	TOTAL SHEETS
L4	41

ADDENDUM NUMBER

ATTACHMENT NUMBER

Thu, 10/Jan/02 08:24AM

RECORD OF REVISIONS


No.	DATE	DESCRIPTION

JNU-FISH CREEK ROAD
SAFETY IMPROVEMENTS
PROJECT NO. 68269

Ninemile Creek Fish Passage Improvements Access Plan

7/1 7.22-03

DESIGNED BY: M. LAVERING

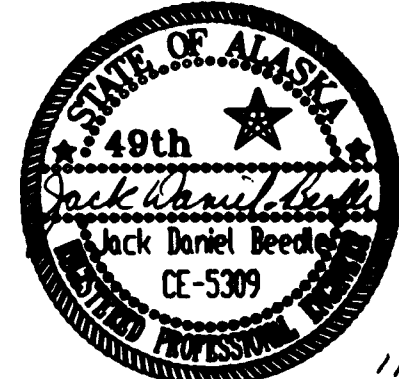

CHECKED BY: T. MORRE

DRAWN BY: K.K.

STATE OF ALASKA
DEPARTMENT OF TRANSPORTATION
& PUBLIC FACILITIES
STATEWIDE DESIGN & ENGINEERING
SERVICES DIVISION

JNU-FISH CREEK ROAD
SAFETY IMPROVEMENTS
PROJECT NO. 68269
Ninemile Ck. Fish
Passage Improvements
Access Plan

PROJECT DESIGNATION NUMBER

ACHRO-0953(4)


STATE	YEAR
ALASKA	2001
SHEET NUMBER	TOTAL SHEETS
M1	41

ACCESS NOTES

WORK SITE SHALL BE ACCESSED DIRECTLY FROM THE NORTH DOUGLAS HIGHWAY RIGHT OF WAY. TRAFFIC CONTROL SHALL BE CONSIDERED SUBSIDIARY.

TIMBER MATS AS DEPICTED BELOW, OR EQUAL WILL BE REQUIRED TO PROTECT WETLANDS AND PROVIDE SUPPORT TO EQUIPMENT BELOW ELEVATION 24.


UPON COMPLETION OF SITE WORK, REMOVE TIMBER MATS, APPLY A SINGLE APPLICATION OF FERTILIZER AS SPECIFIED IN SECTION 618 TO ALL VEGETATED AREAS PREVIOUSLY COVERED BY THE MATS. IF THE SOIL IS DISTURBED THEN ALSO SEED WITH NATIVE GRASS MIX (SEE SECTION 618).

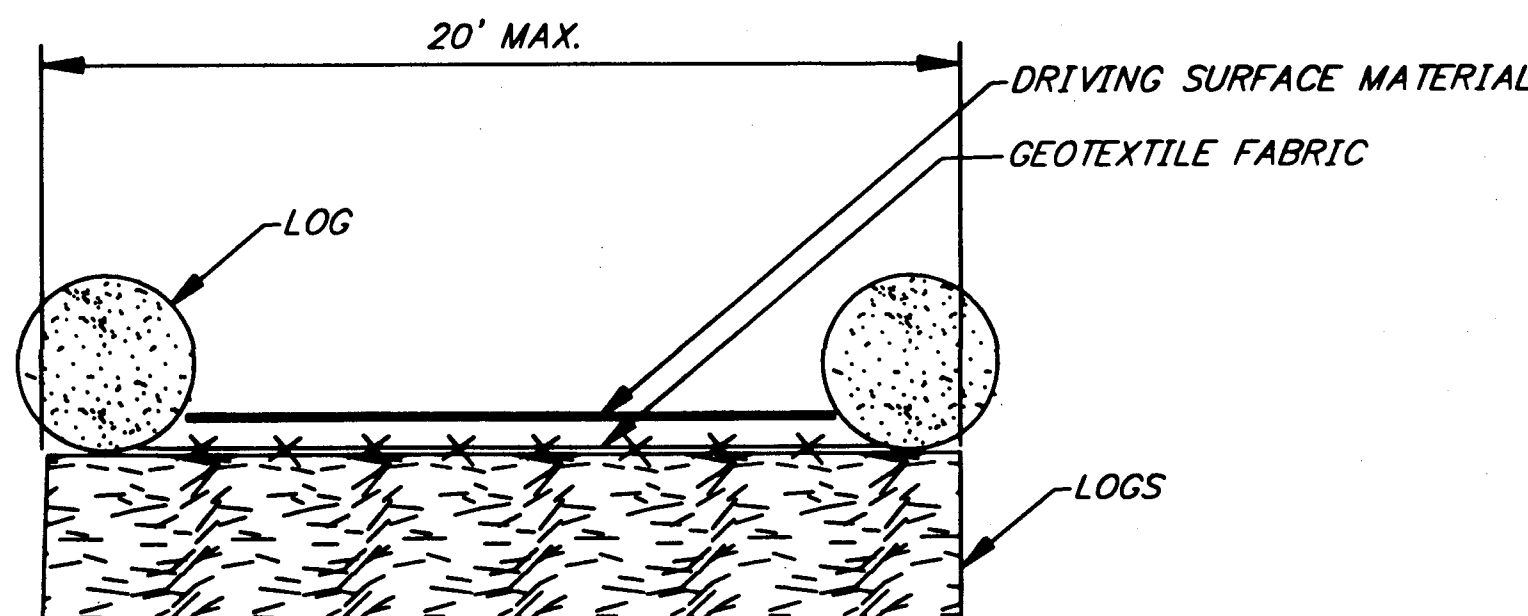

TIMBER MAT USE BELOW ELEVATION +24'

GENERAL NOTES:

1. NOTIFY THE ENGINEER AT LEAST 5 WORKING DAYS IN ADVANCE OF IN-WATER WORK.
2. FROM CULVERT OUTLET DOWNSTREAM, ANY REMOVED HEMLOCK AND SPRUCE TREES SHALL BE REPLACED WITH LIVE, ROOTED HEMLOCK AND SPRUCE, RESPECTIVELY, 2 TO 4 FEET TALL. ALL DISTURBED AREAS SHALL BE SEED WITH NATIVE GRASS MIX (SECTION 618). WILLOWS (SECTION 621) SHALL BE PLANTED IN DISTURBED AREAS ABOVE BOTH THE ORDINARY HIGH WATER LINE IN THE STREAM AND THE HIGH TIDE LINE (ELEVATION 20.8 FEET).
3. COMPLY WITH THE FISH AND GAME PERMIT (SEE APPENDIX B).

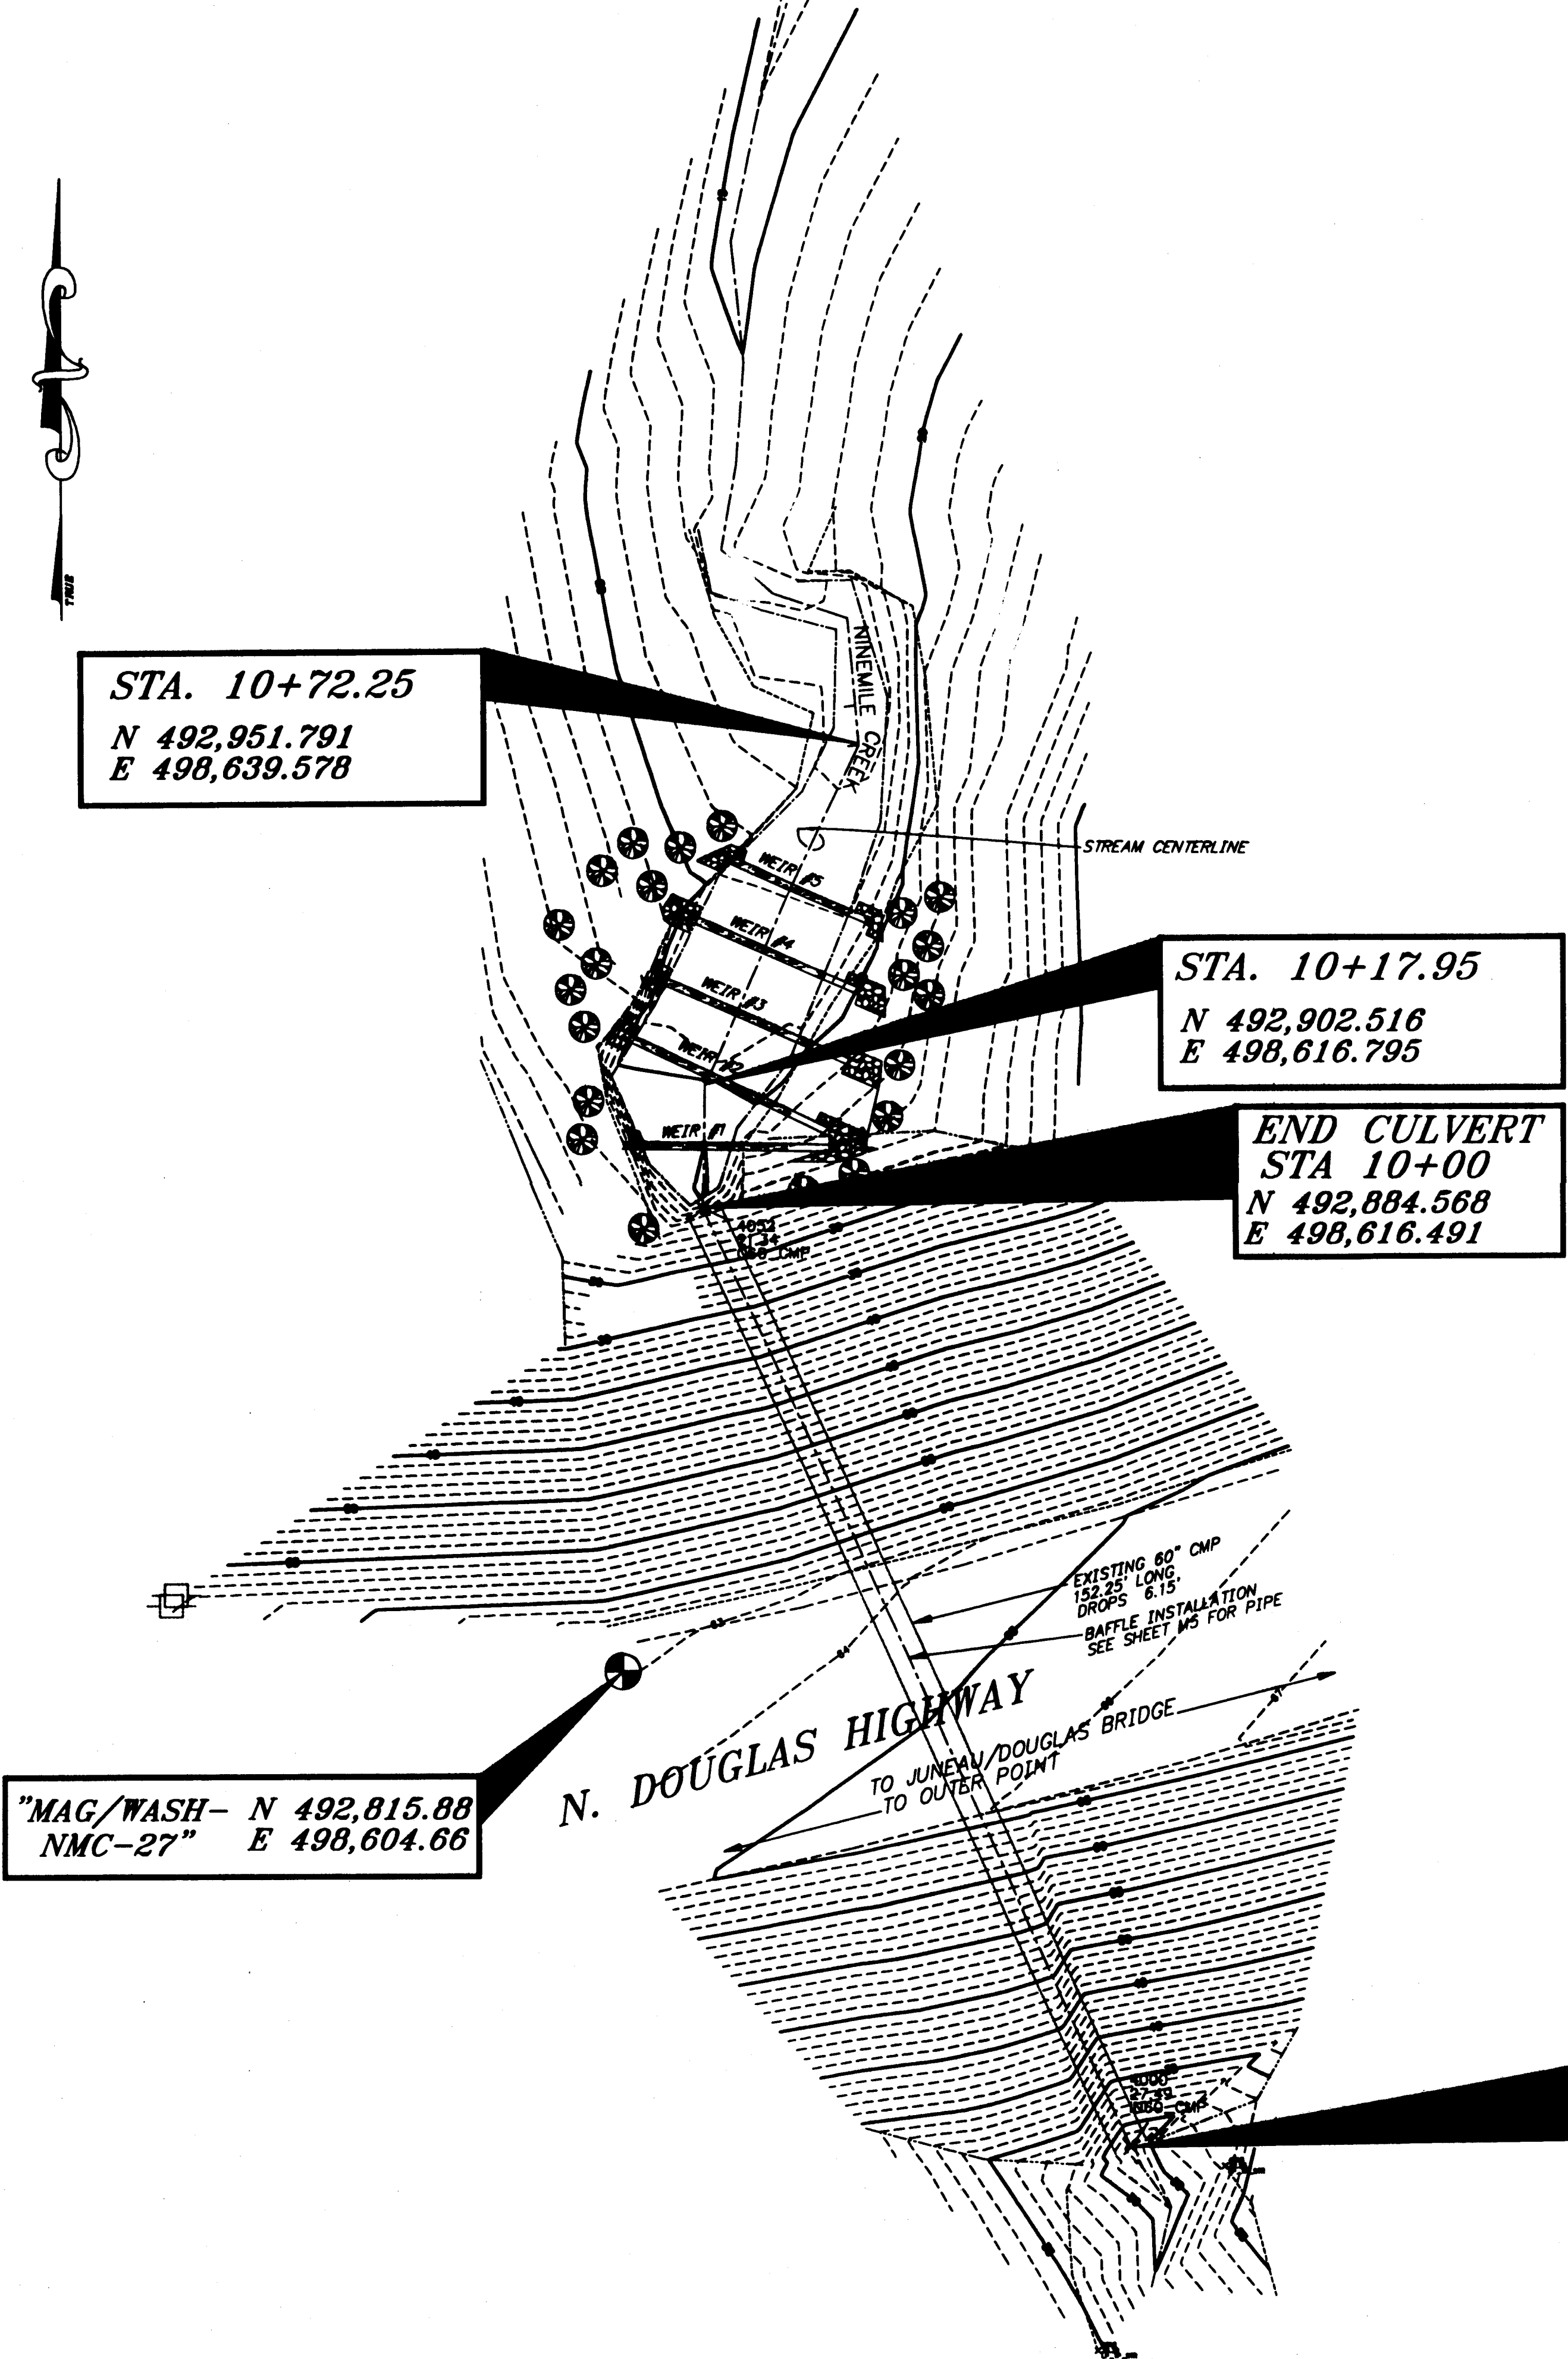


STA. 10+72.25
N 492,951.791
E 498,639.578

STA. 10+17.95
N 492,902.516
E 498,616.795

END CULVERT
STA 10+00
N 492,884.568
E 498,616.491

"MAG/WASH- N 492,815.88
NMC-27" E 498,604.66

BEGIN CULVERT
STA 8+47.75
N 492,745.641
E 498,678.765

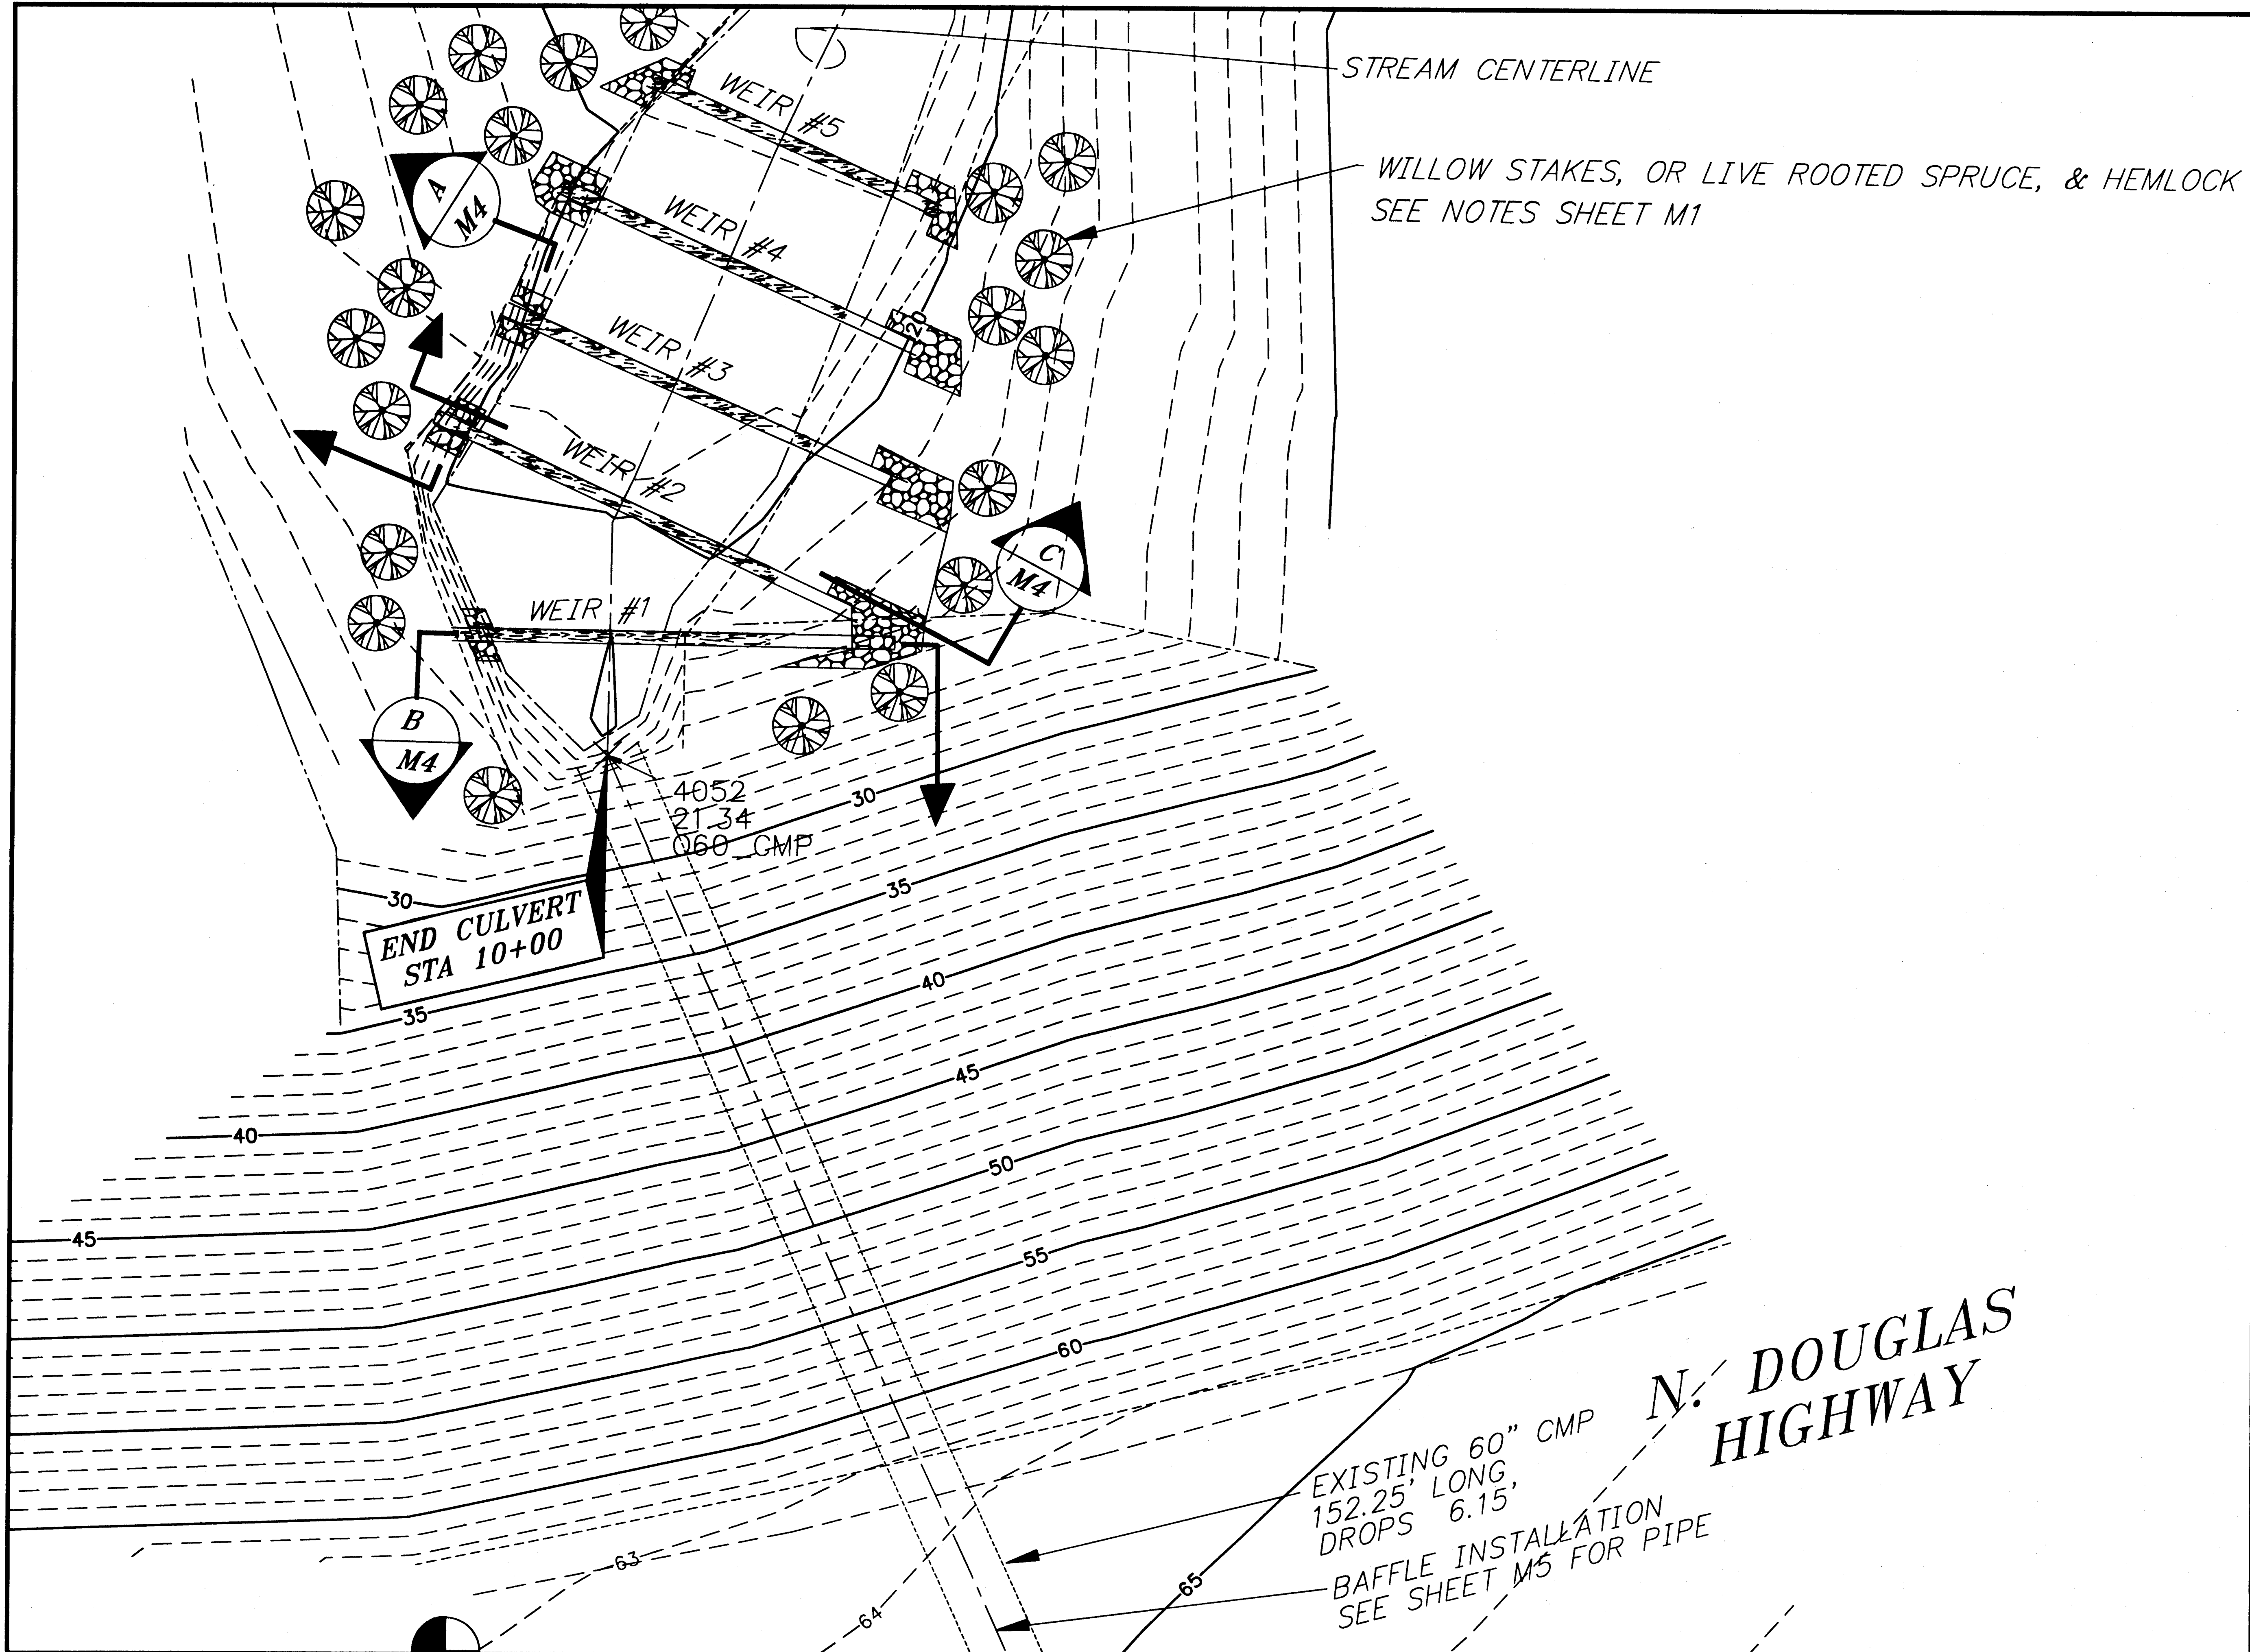

PATH:
Q:\Jnu\68269\Planset\M2-9-mile.dwg
Thu, 10/Jan/02 08:30AM Kris
PLOT:
PSPACE 1=1(F) OR MSPACE 1=1(F)
TABplan2

ADDENDUM NUMBER

ATTACHMENT NUMBER
Thu, 10/Jan/02 08:30AM

RECORD OF REVISIONS
No. DATE DESCRIPTION

JNU-FISH CREEK ROAD
SAFETY IMPROVEMENTS
PROJECT NO. 68269

Ninemile Creek
Fish Passage Improvements
Mitigation Plan Detail

7/22-03

DESIGNED BY: M. LAVERING

STATE OF ALASKA
49th
Jack Daniel Beedle
Professional Engineer
CE-5307
1/6/02

CHECKED BY: T. MOORE


DRAWN BY: K.K.

STATE OF ALASKA
DEPARTMENT OF TRANSPORTATION
& PUBLIC FACILITIES
STATEWIDE DESIGN & ENGINEERING
SERVICES DIVISION
JNU-FISH CREEK ROAD
SAFETY IMPROVEMENTS
PROJECT NO. 68269
Ninemile Ck. Fish
Passage Improvements
Mitigation Plan Detail

PROJECT DESIGNATION NUMBER
ACHRO-0953(4)

STATE YEAR
ALASKA 2001

SHEET NUMBER TOTAL SHEETS
M2 41

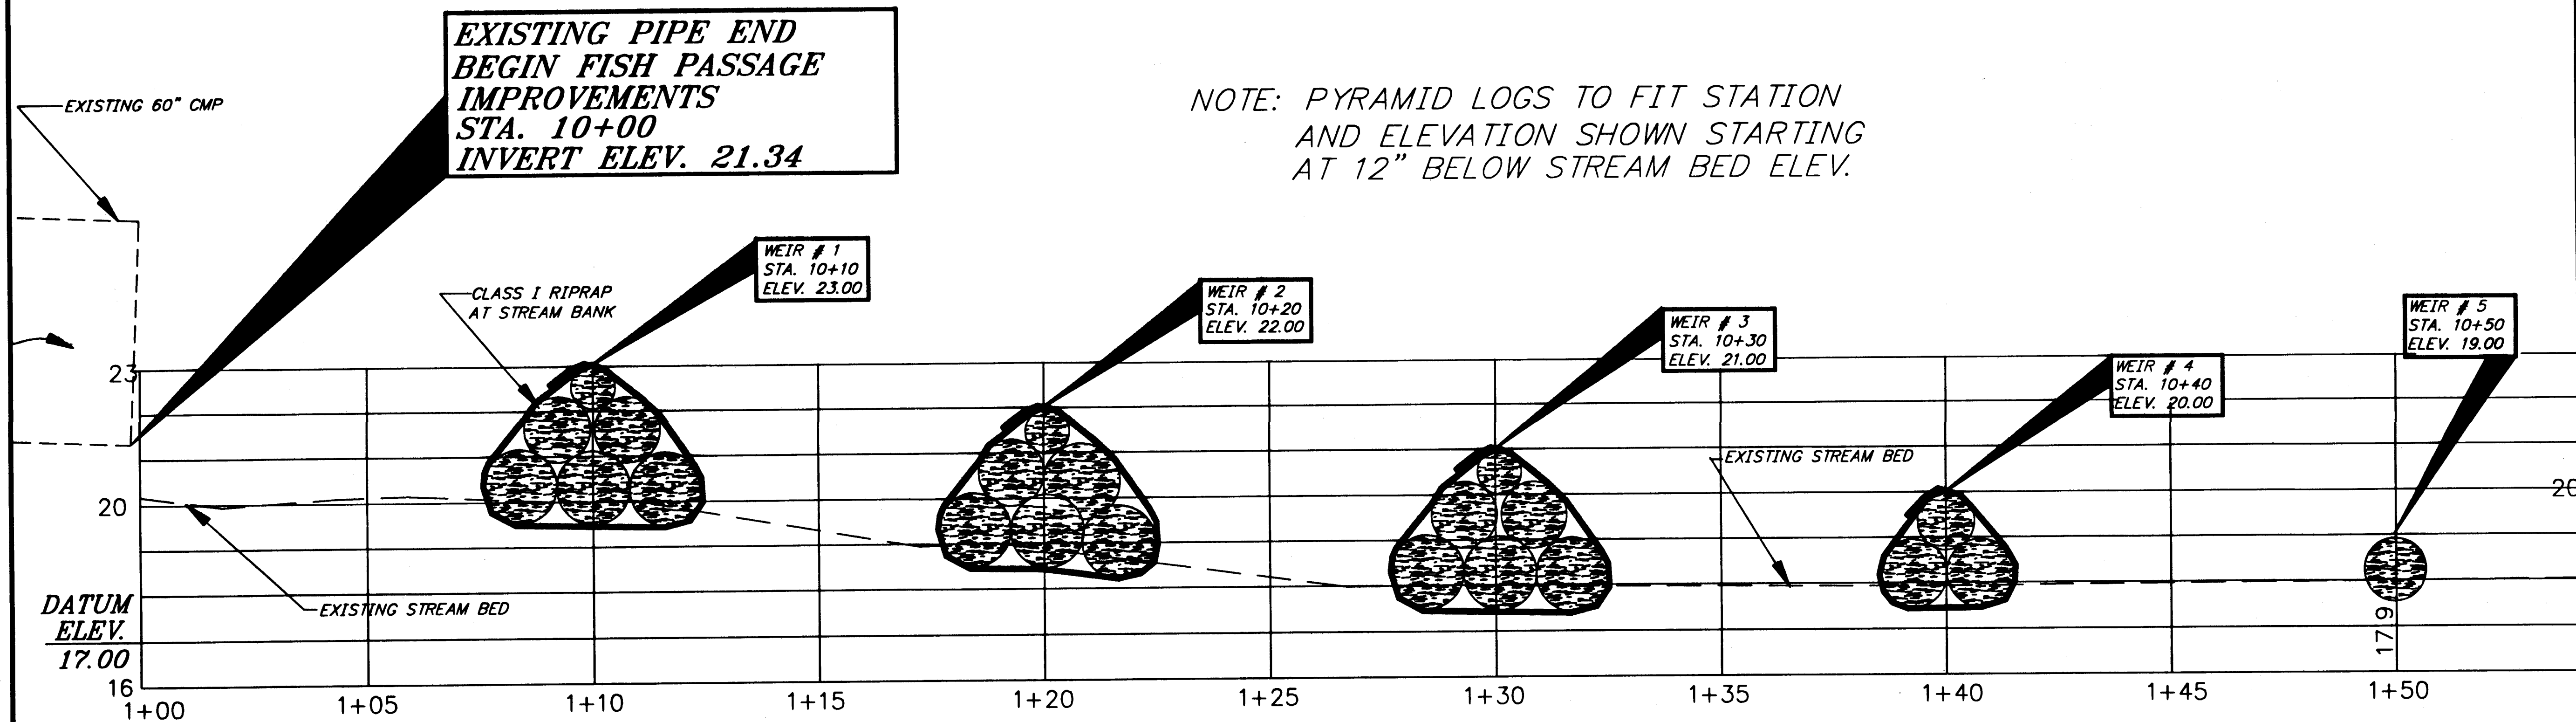

PROFILE

NOTE: LOGS SHOWN ABOVE ARE NOT DRAWN TO SCALE BUT MERELY DEPICT THE PYRAMIDING THAT IS REQUIRED.

PATH:
Q:\Jnu\68269\Plan\set\A2-9-mile.dwg
Wed, 09/Jan/02 04:14PM Kris
PLOT:
PSPACE 1=1(F) OR MSPACE 1=1(F)
TAB: profile

ADDENDUM NUMBER

ATTACHMENT NUMBER

Wed, 09/Jan/02 04:14PM

RECORD OF REVISIONS


No.	DATE	DESCRIPTION

JNU-FISH CREEK ROAD
SAFETY IMPROVEMENTS
PROJECT NO. 68269

Ninemile Creek Fish Passage Improvements Profile

TH 722-03

DESIGNED BY: M. LAVERING

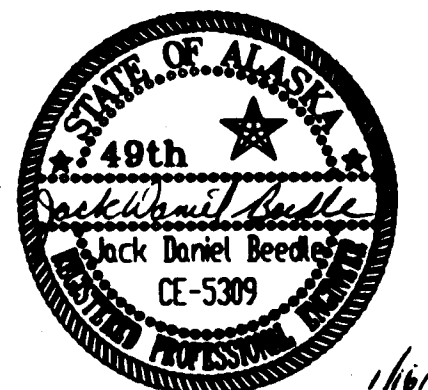

CHECKED BY: T. MOORE

DRAWN BY: K.K.


STATE OF ALASKA
DEPARTMENT OF TRANSPORTATION
& PUBLIC FACILITIES
STATEWIDE DESIGN & ENGINEERING
SERVICES DIVISION

JNU-FISH CREEK ROAD
SAFETY IMPROVEMENTS
PROJECT NO. 68269
**Ninemile Ck. Fish
Passage Improvements
Profile Plan**

PROJECT DESIGNATION NUMBER


ACHRO-0953(4)

STATE	YEAR
ALASKA	2001
SHEET NUMBER	TOTAL SHEETS
M3	41

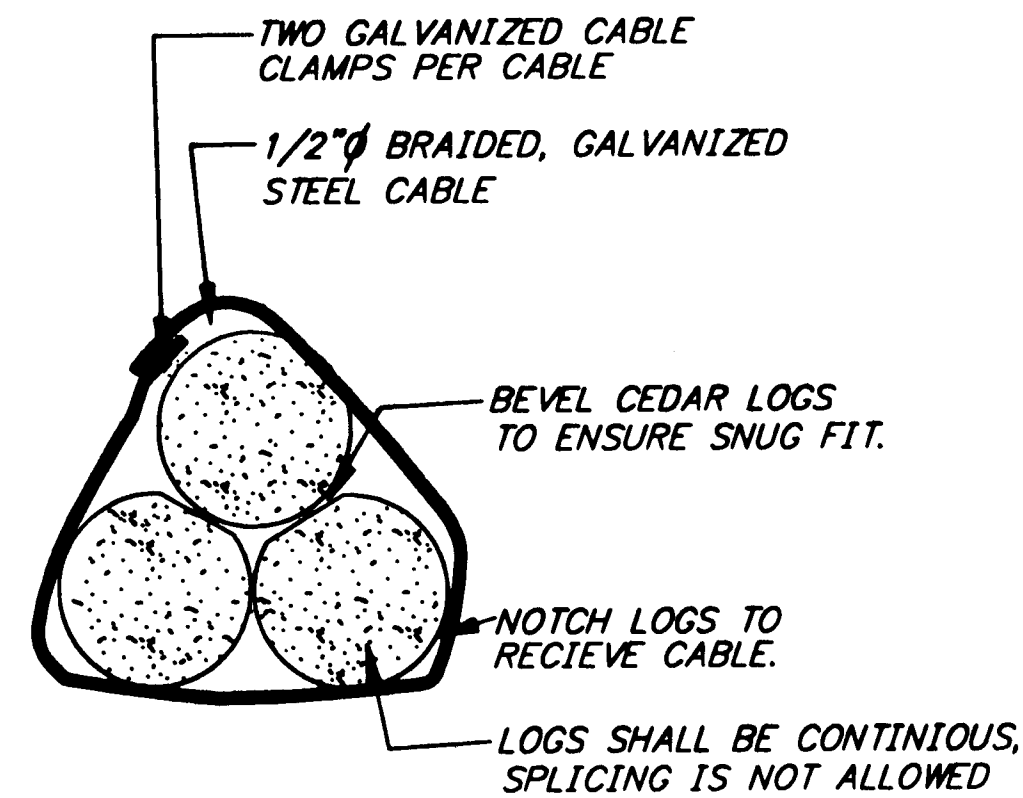


CEDAR LOG DETAIL


NOTE: LOGS SHALL BE BARK FREE CEDAR~~?~~ HEMLOCK WEIR SHALL BE INSTALLED PERPENDICULAR TO STREAM CENTERLINE.

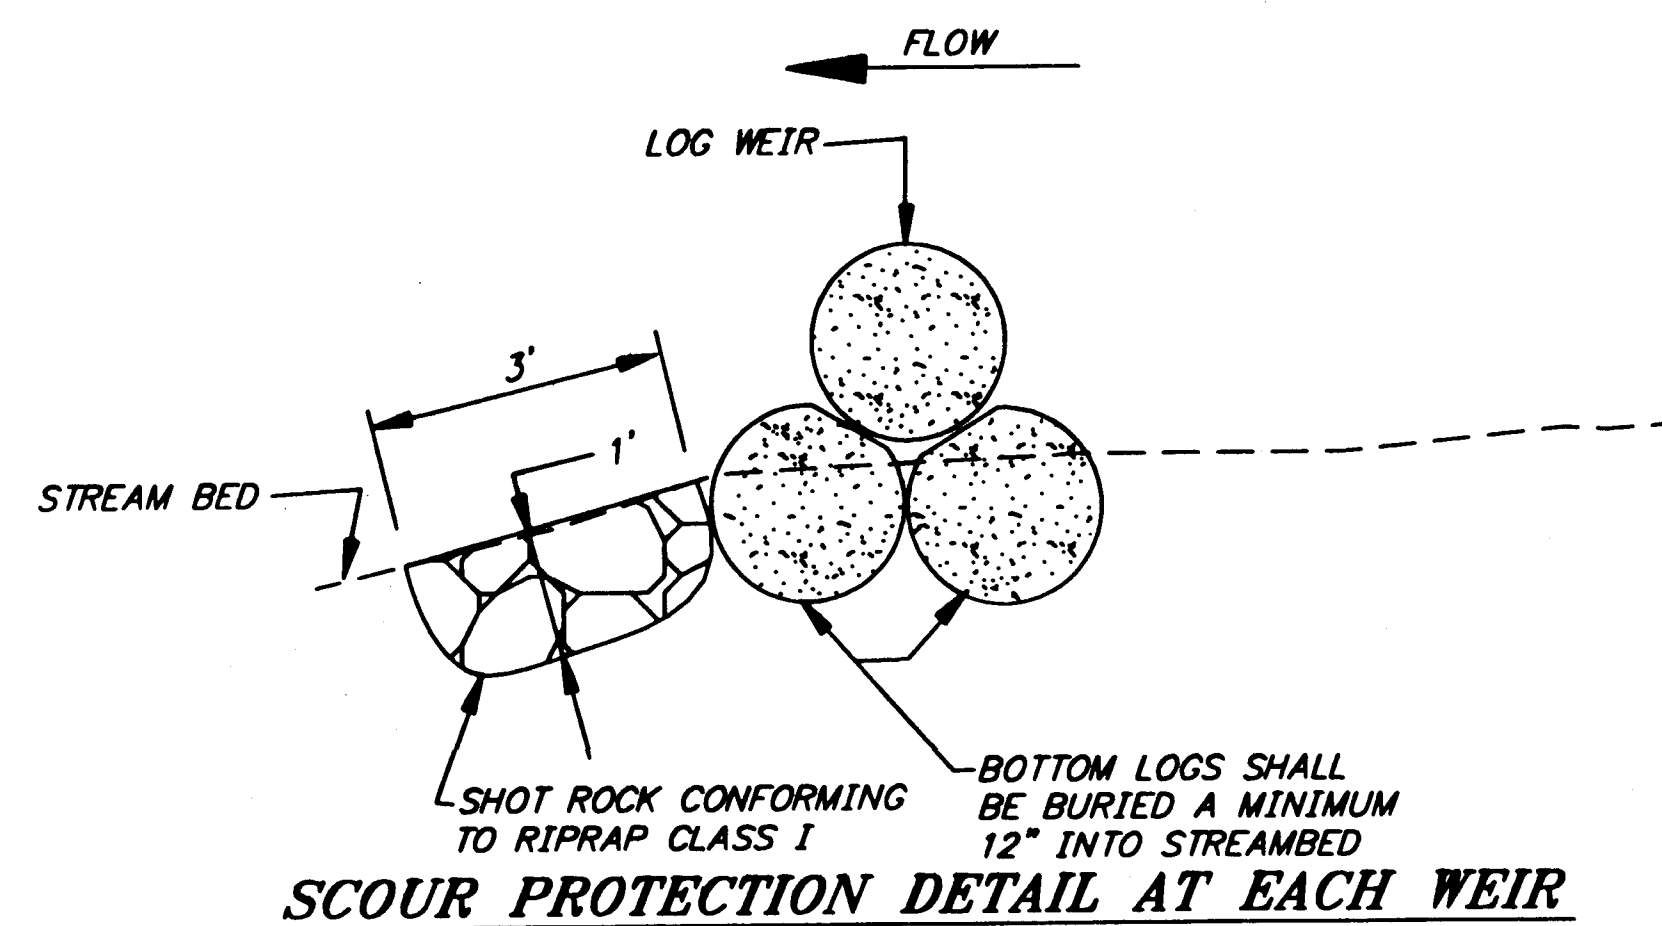

SCOUR PROTECTION DETAIL AT EACH WEIR

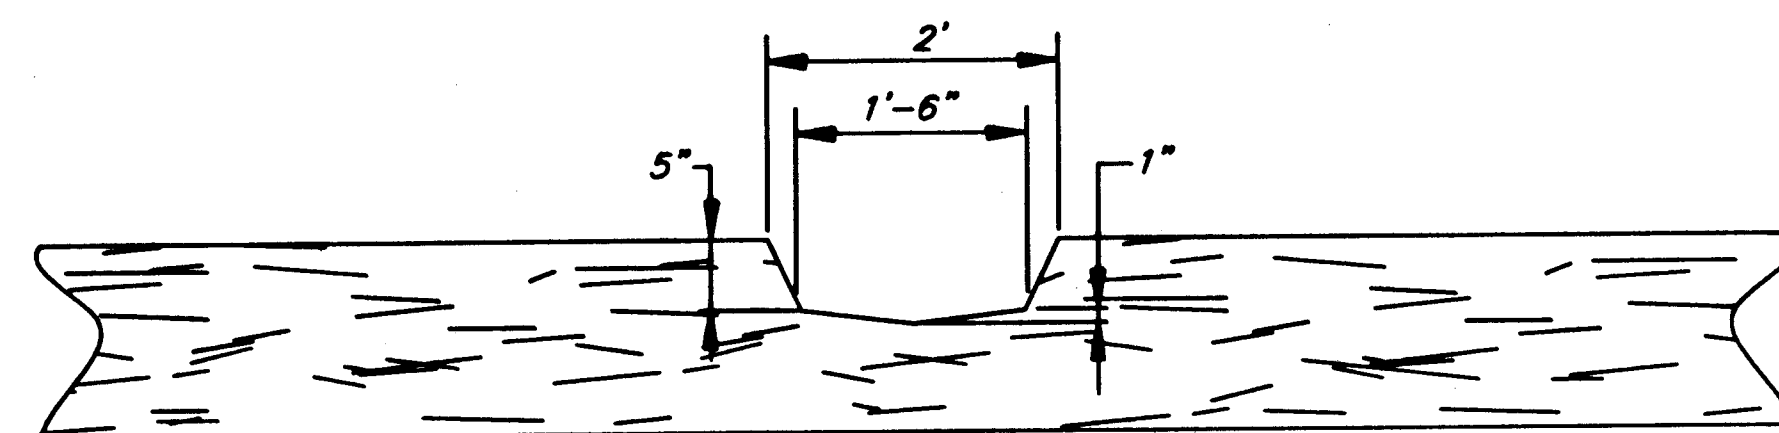


DOWNSTREAM VIEW NOTCH DETAIL

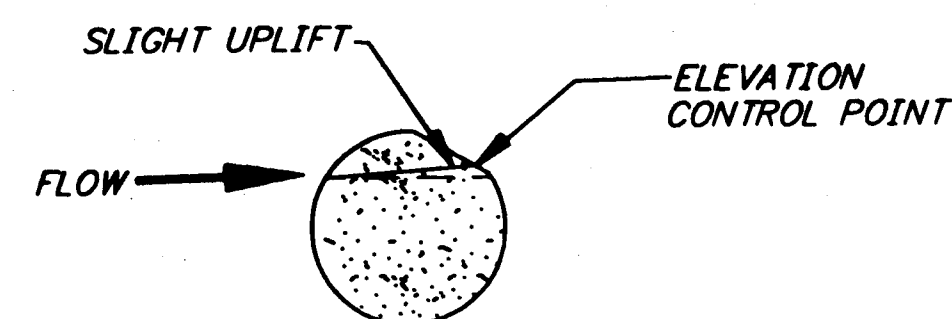


END VIEW

LOW FLOW DETAILS

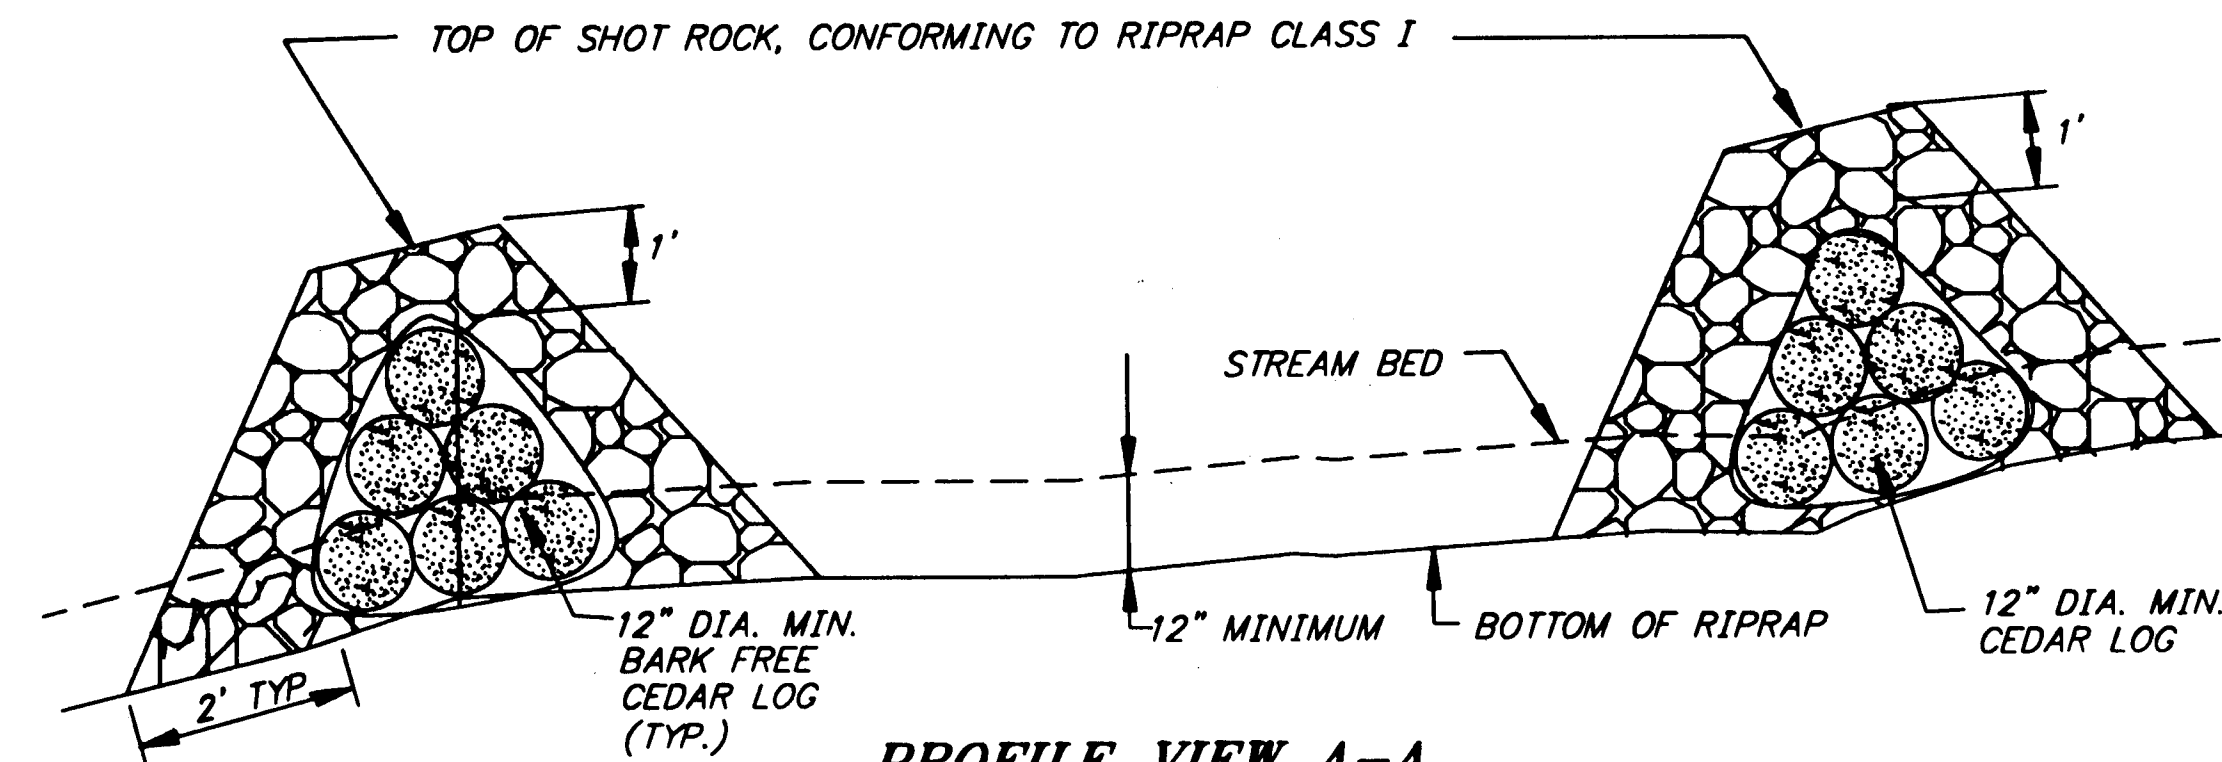


PROFILE VIEW A-A

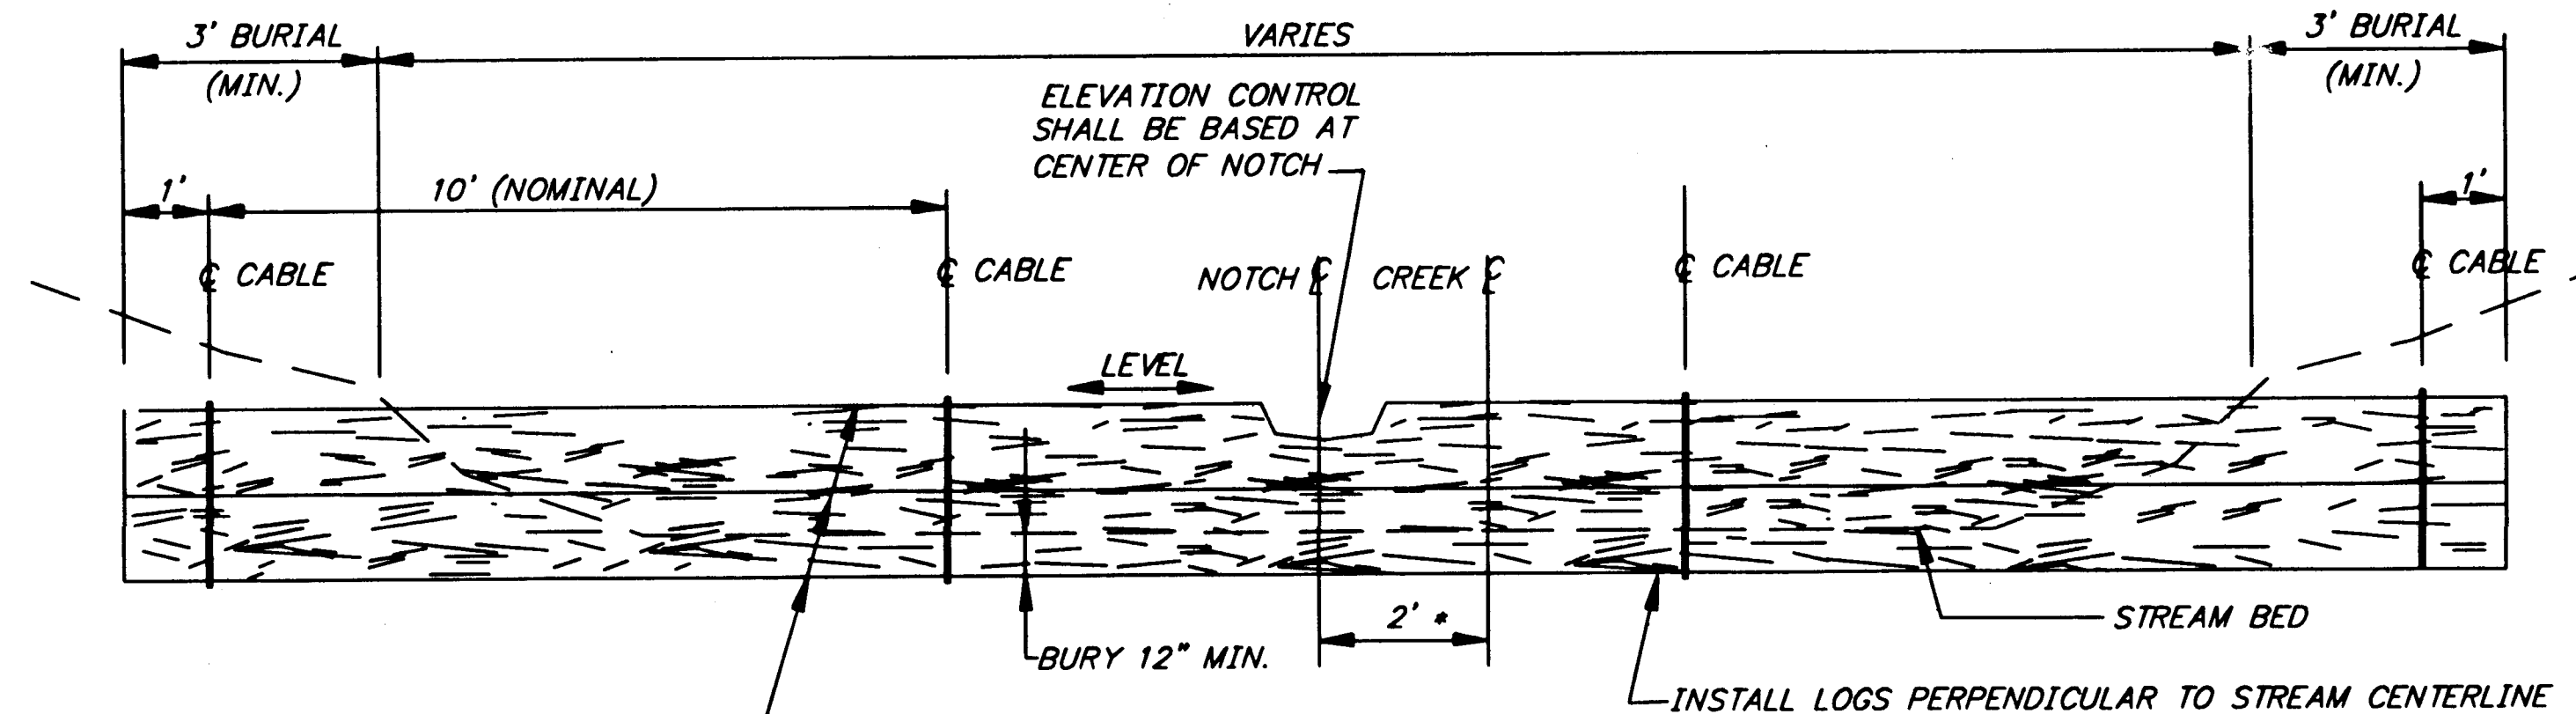

SECTION VIEW B-B

* LOCATE THE NOTCH IN WEIRS 1,3 AND 5 TO THE LEFT OF CREEK CENTERLINE AND FOR WEIRS 2 AND 4 TO THE RIGHT OF CREEK CENTERLINE.

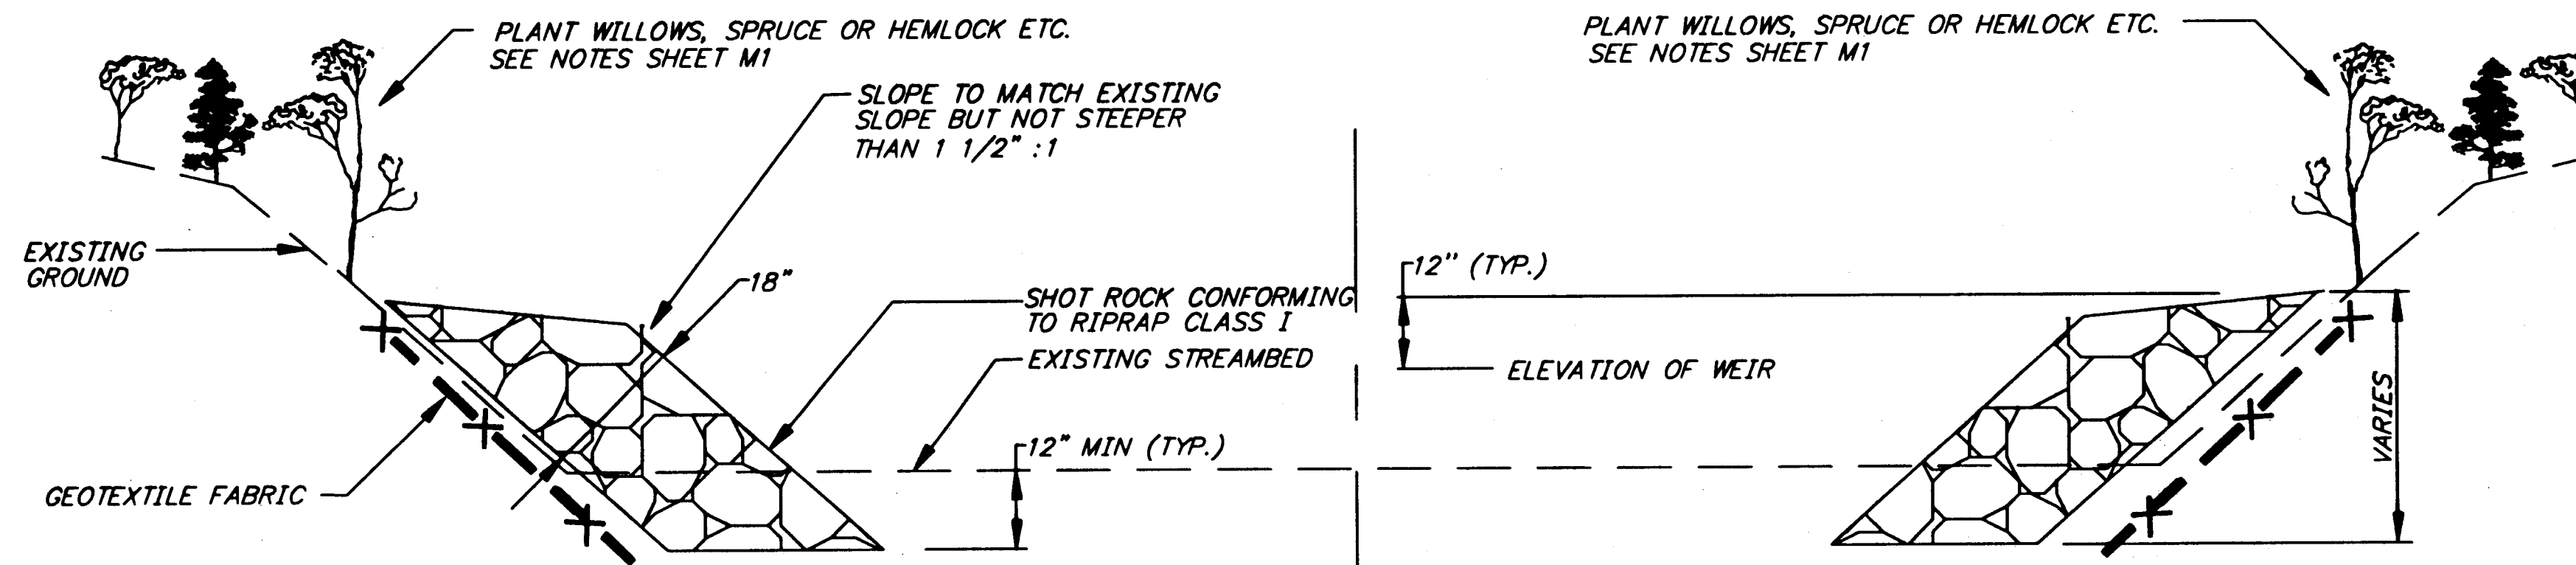

SECTION VIEW C-C

PATH: Q:\Jnu\68269\Plans\A2-9-mile.dwg
Tue, 15/Jun/02 02:41PM Kris
PLOT: PSPACE 1=1(F) OR MSPACE 1=1(F)
TAB: details

ADDENDUM NUMBER

ATTACHMENT NUMBER

Tue, 15/Jun/02 02:41PM

RECORD OF REVISIONS


No.	DATE	DESCRIPTION

JNU-FISH CREEK ROAD
SAFETY IMPROVEMENTS
PROJECT NO. 68269

Ninemile Creek Fish Passage Improvements Details

TJH 7-22-03

DESIGNED BY: M. LAVERING

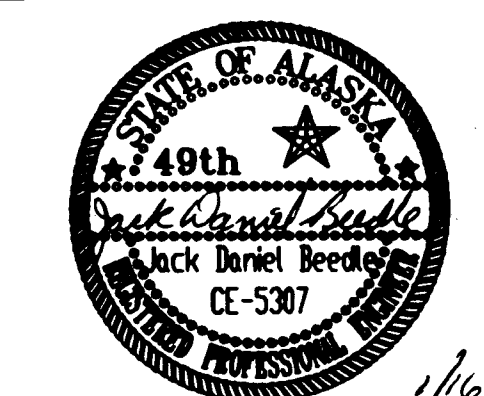

CHECKED BY: T. MOORE

DRAWN BY: K.K.

STATE OF ALASKA
DEPARTMENT OF TRANSPORTATION
& PUBLIC FACILITIES
STATEWIDE DESIGN & ENGINEERING
SERVICES DIVISION


JNU-FISH CREEK ROAD
SAFETY IMPROVEMENTS
PROJECT NO. 68269
**Ninemile Ck. Fish
Passage Improvements
Details**

PROJECT DESIGNATION NUMBER


ACHRO-0953(4)

STATE	YEAR
ALASKA	2001
SHEET NUMBER	TOTAL SHEETS
M4	41


NOTE: THESE DETAILS ARE INTENDED TO BE USED IN CONJUNCTION WITH THE STIPULATIONS IN THE CORRESPONDING FISH AND GAME PERMITS AND THE PROJECT ENVIRONMENTAL COMMITMENTS.

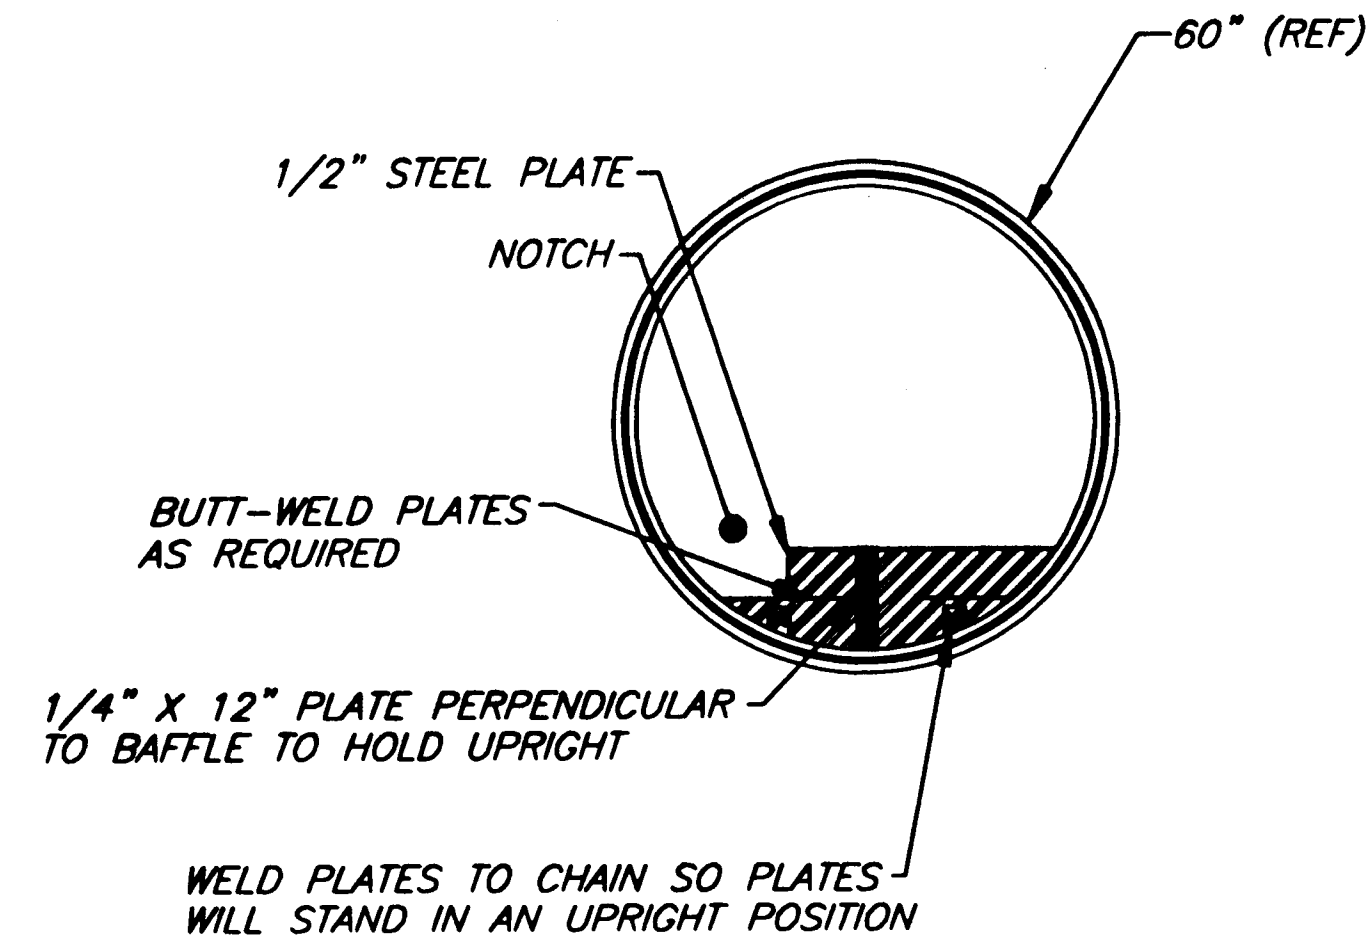

SECTION A-A

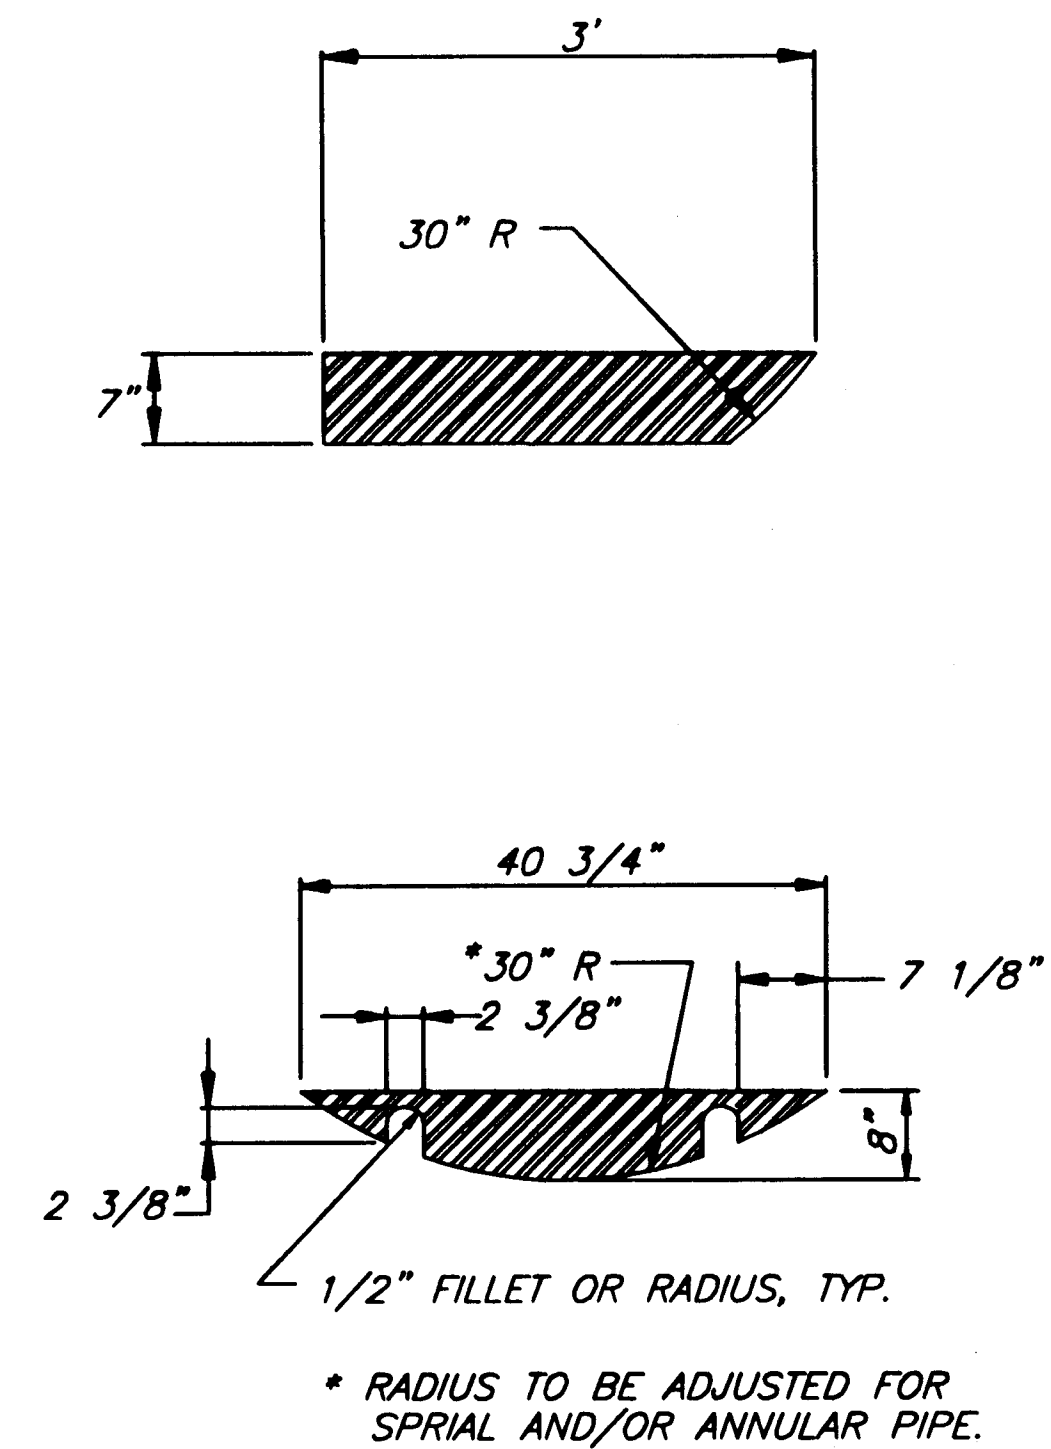

BAFFLE DETAILS

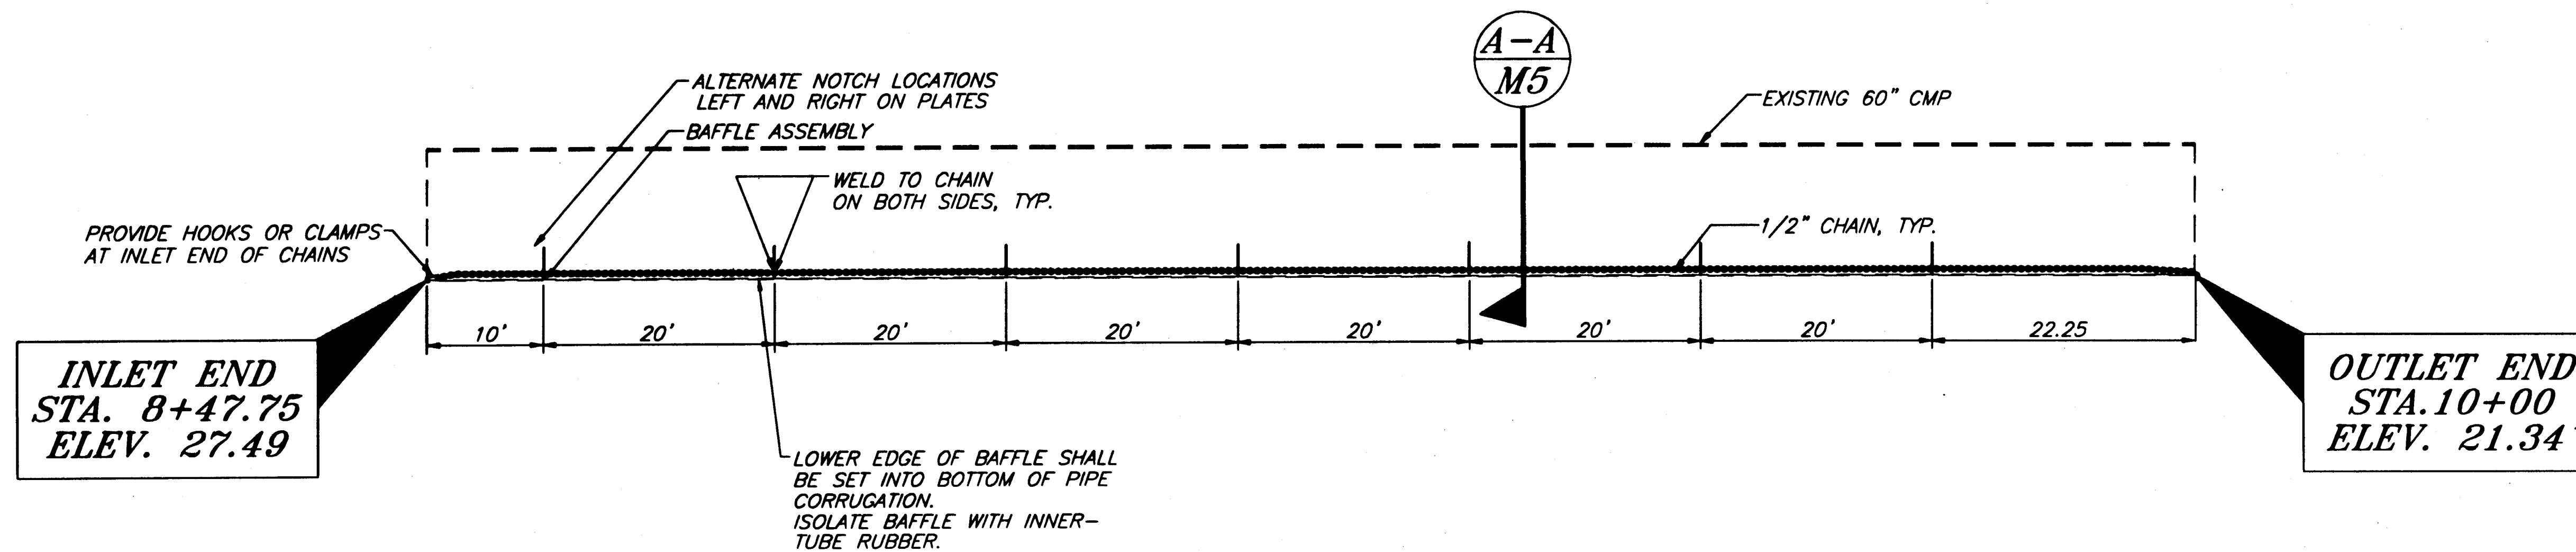

CULVERT SECTION

PATH: O:\jnu\68269\PlanSet\W5del2.dwg
Tue, 15/Jan/02 02:43PM Kris
PLOT: PSPACE 1=1(F) OR MSPACE 1=1(F)
TAB: ESTIMATE

ADDENDUM NUMBER

ATTACHMENT NUMBER

Tue, 15/Jan/02 02:43PM

RECORD OF REVISIONS


No.	DATE	DESCRIPTION

JNU-FISH CREEK ROAD
SAFETY IMPROVEMENTS
PROJECT NO. 68269

Ninemile Creek Fish Passage Improvements Culvert Details

TH 7-22-03

DESIGNED BY: M. LAVERING

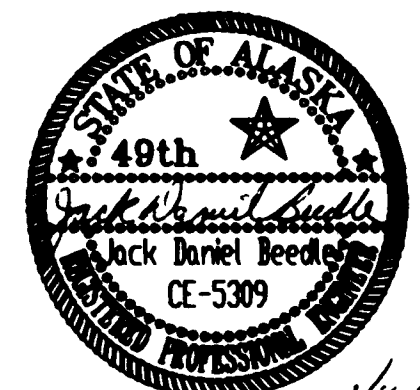

CHECKED BY: T. MOORE

DRAWN BY: K.K.

STATE OF ALASKA
DEPARTMENT OF TRANSPORTATION
& PUBLIC FACILITIES
STATEWIDE DESIGN & ENGINEERING
SERVICES DIVISION

JNU-FISH CREEK ROAD
SAFETY IMPROVEMENTS
PROJECT NO. 68269
**Ninemile Ck. Fish
Passage Improvements
Culvert Details**

PROJECT DESIGNATION NUMBER


ACHRO-0953(4)

STATE YEAR


ALASKA 2001

SHEET NUMBER TOTAL SHEETS

M5 41

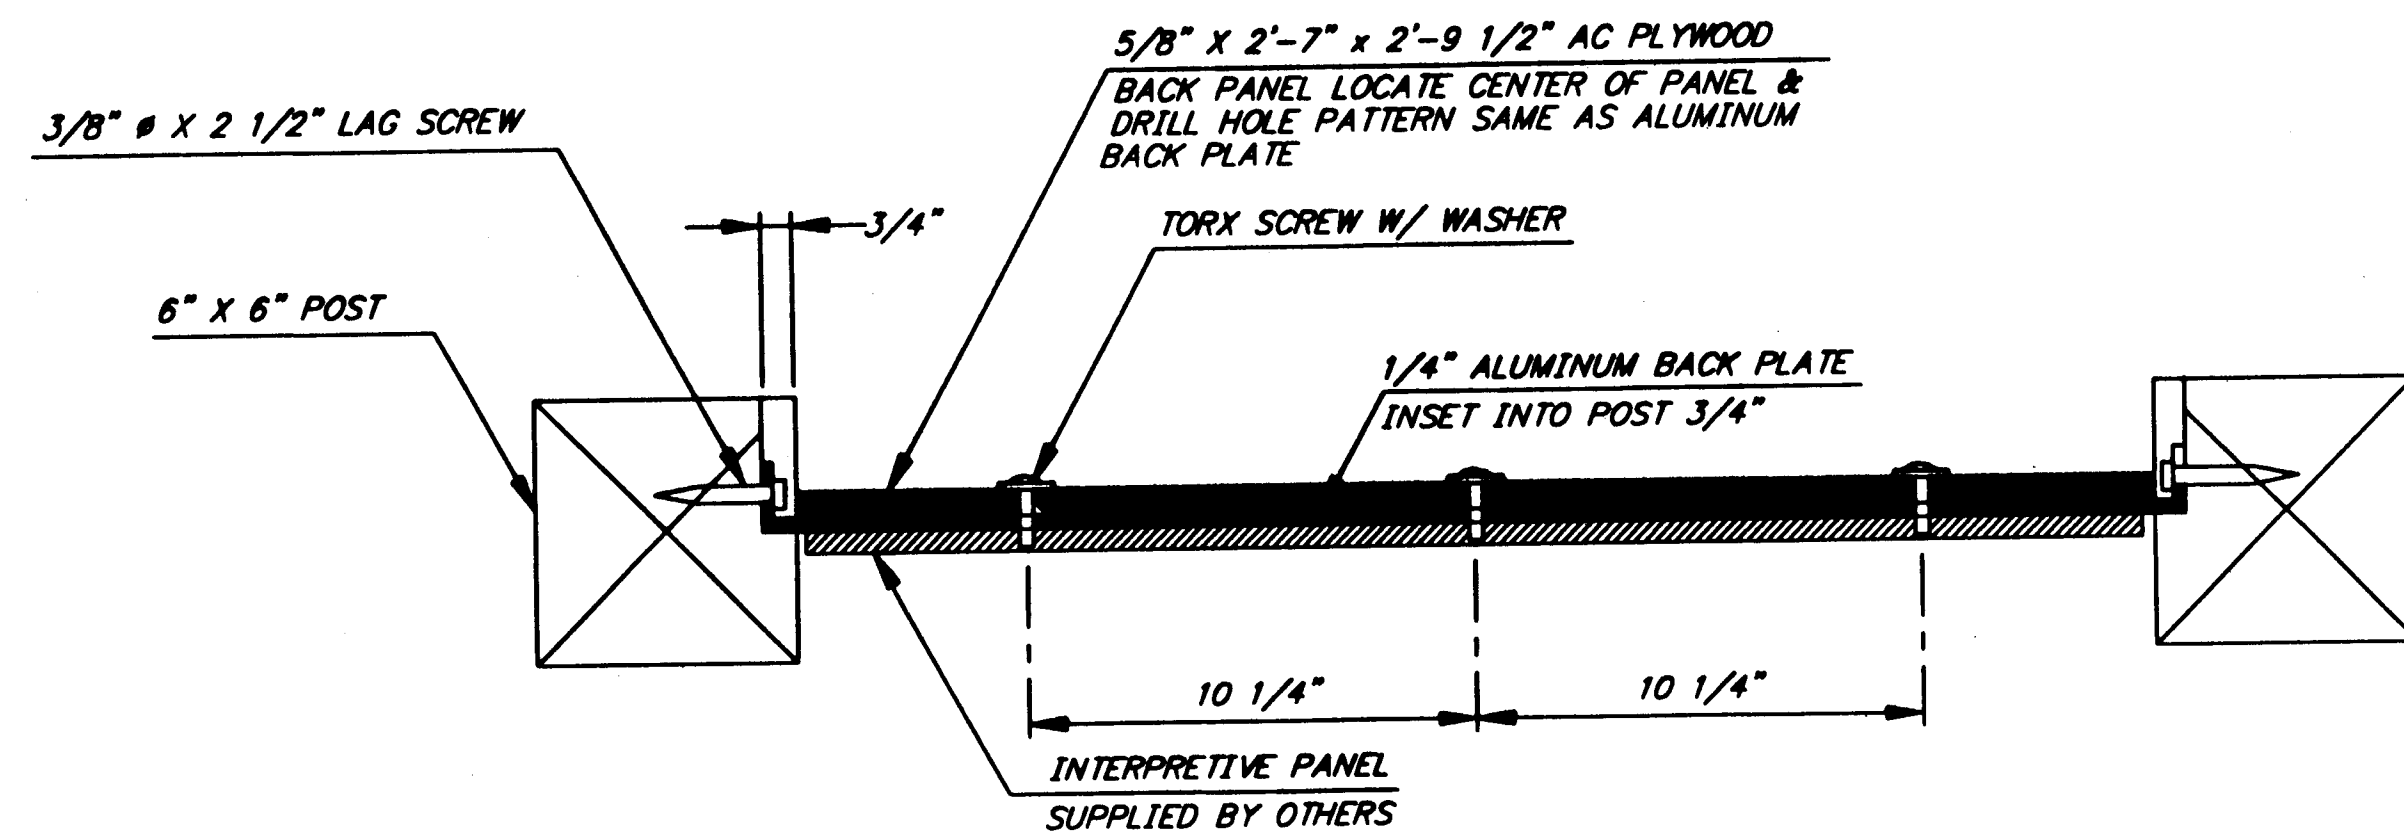


1 SECTION
1

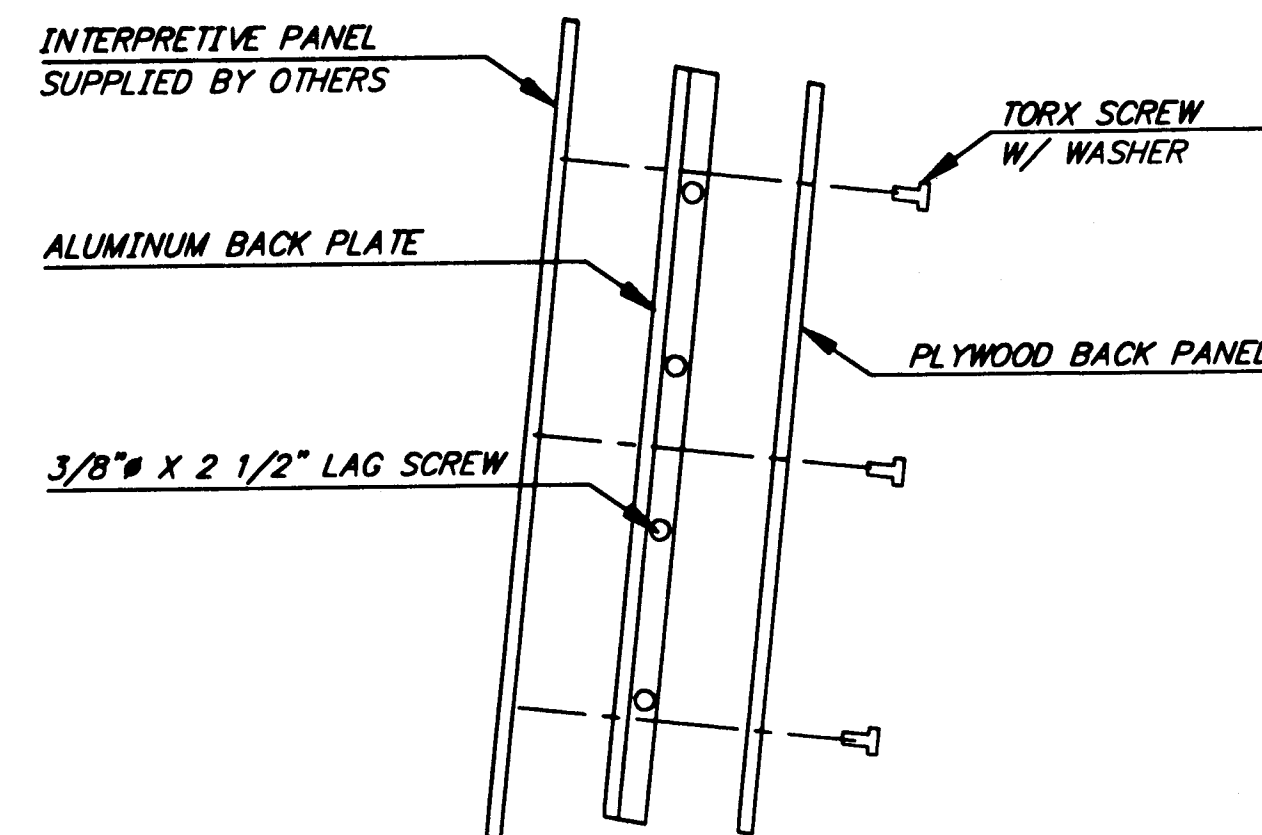


2 EXPLODED VIEW
1 INTERPRETIVE PANEL ASSEMBLY

- NOTES:**
1. INTERPRETIVE PANEL SUPPLIED BY OTHERS MEASURES 1/2" X 2'-6 1/2" X 3'-0 1/2".
 2. 1/4"-20 X 1 1/4" BUTTON HEAD "PIN IN HEAD" TORX TAMPER RESISTANT STAINLESS STEEL SCREWS WITH FINISHING WASHERS SHALL BE USED TO ATTACH THE INTERPRETIVE PANEL & THE PLYWOOD BACK PANEL TO THE ALUMINUM BACK PLATE.

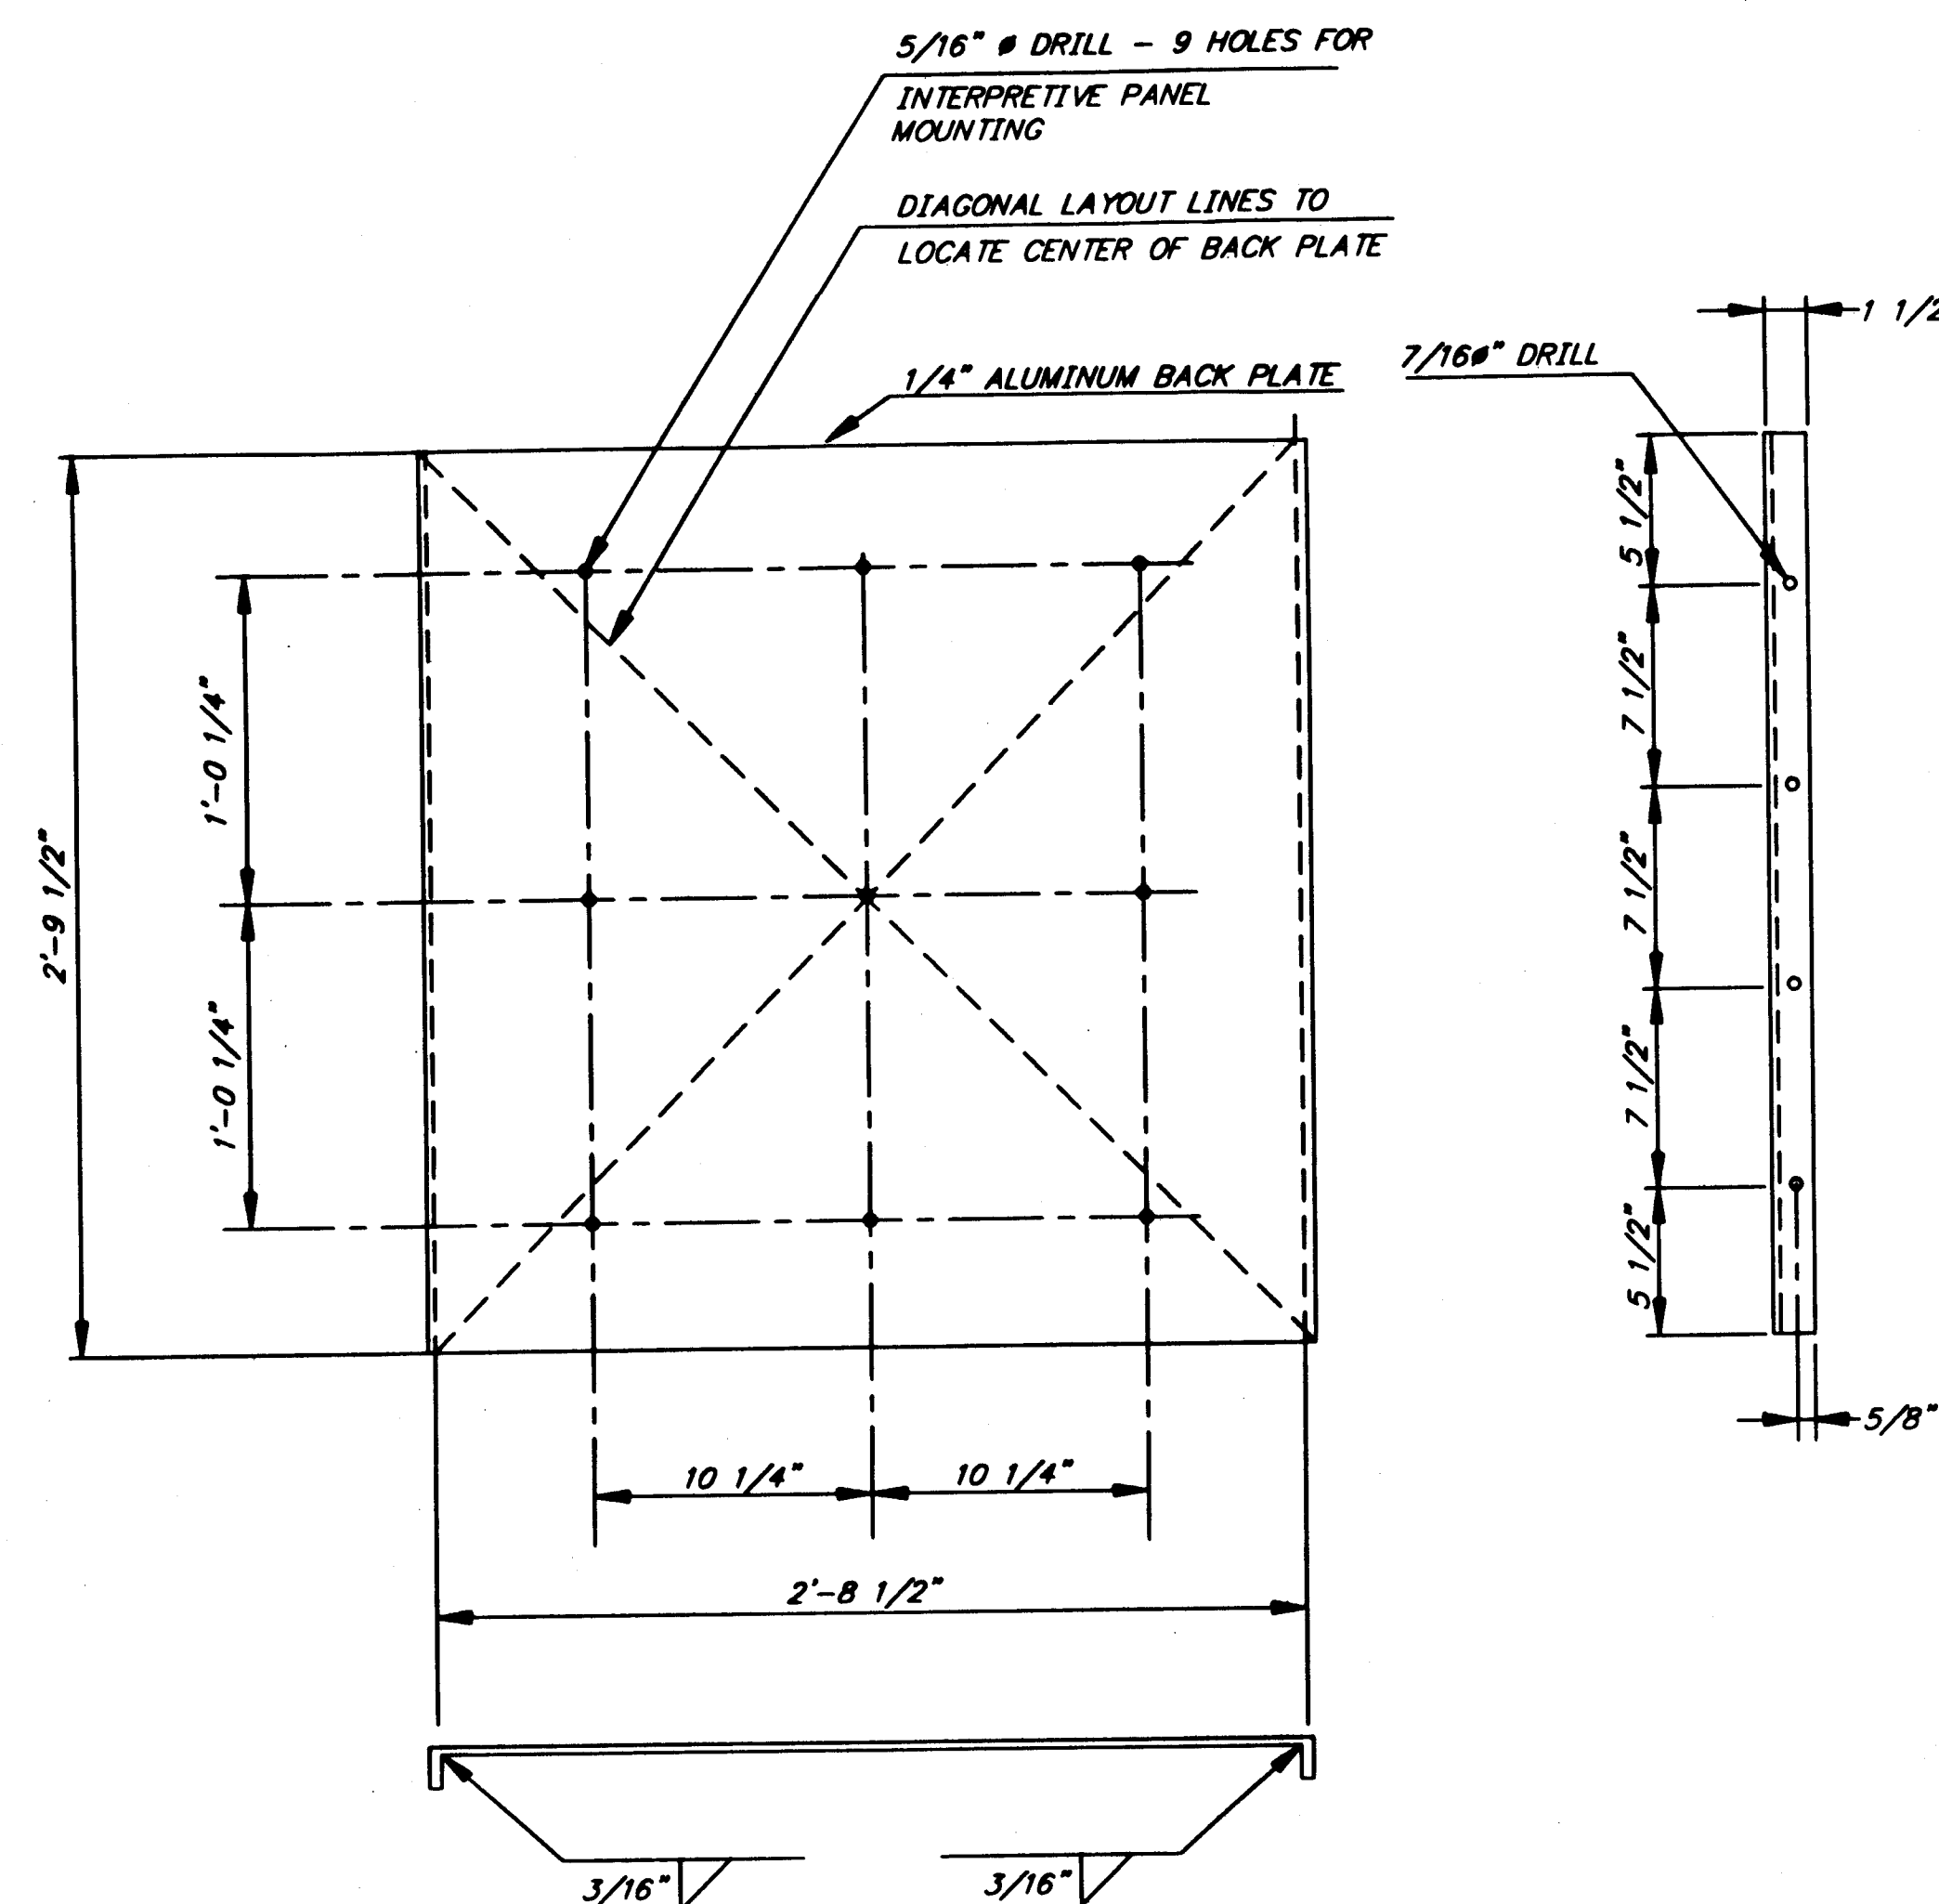

3 ALUMINUM BACK PLATE
1

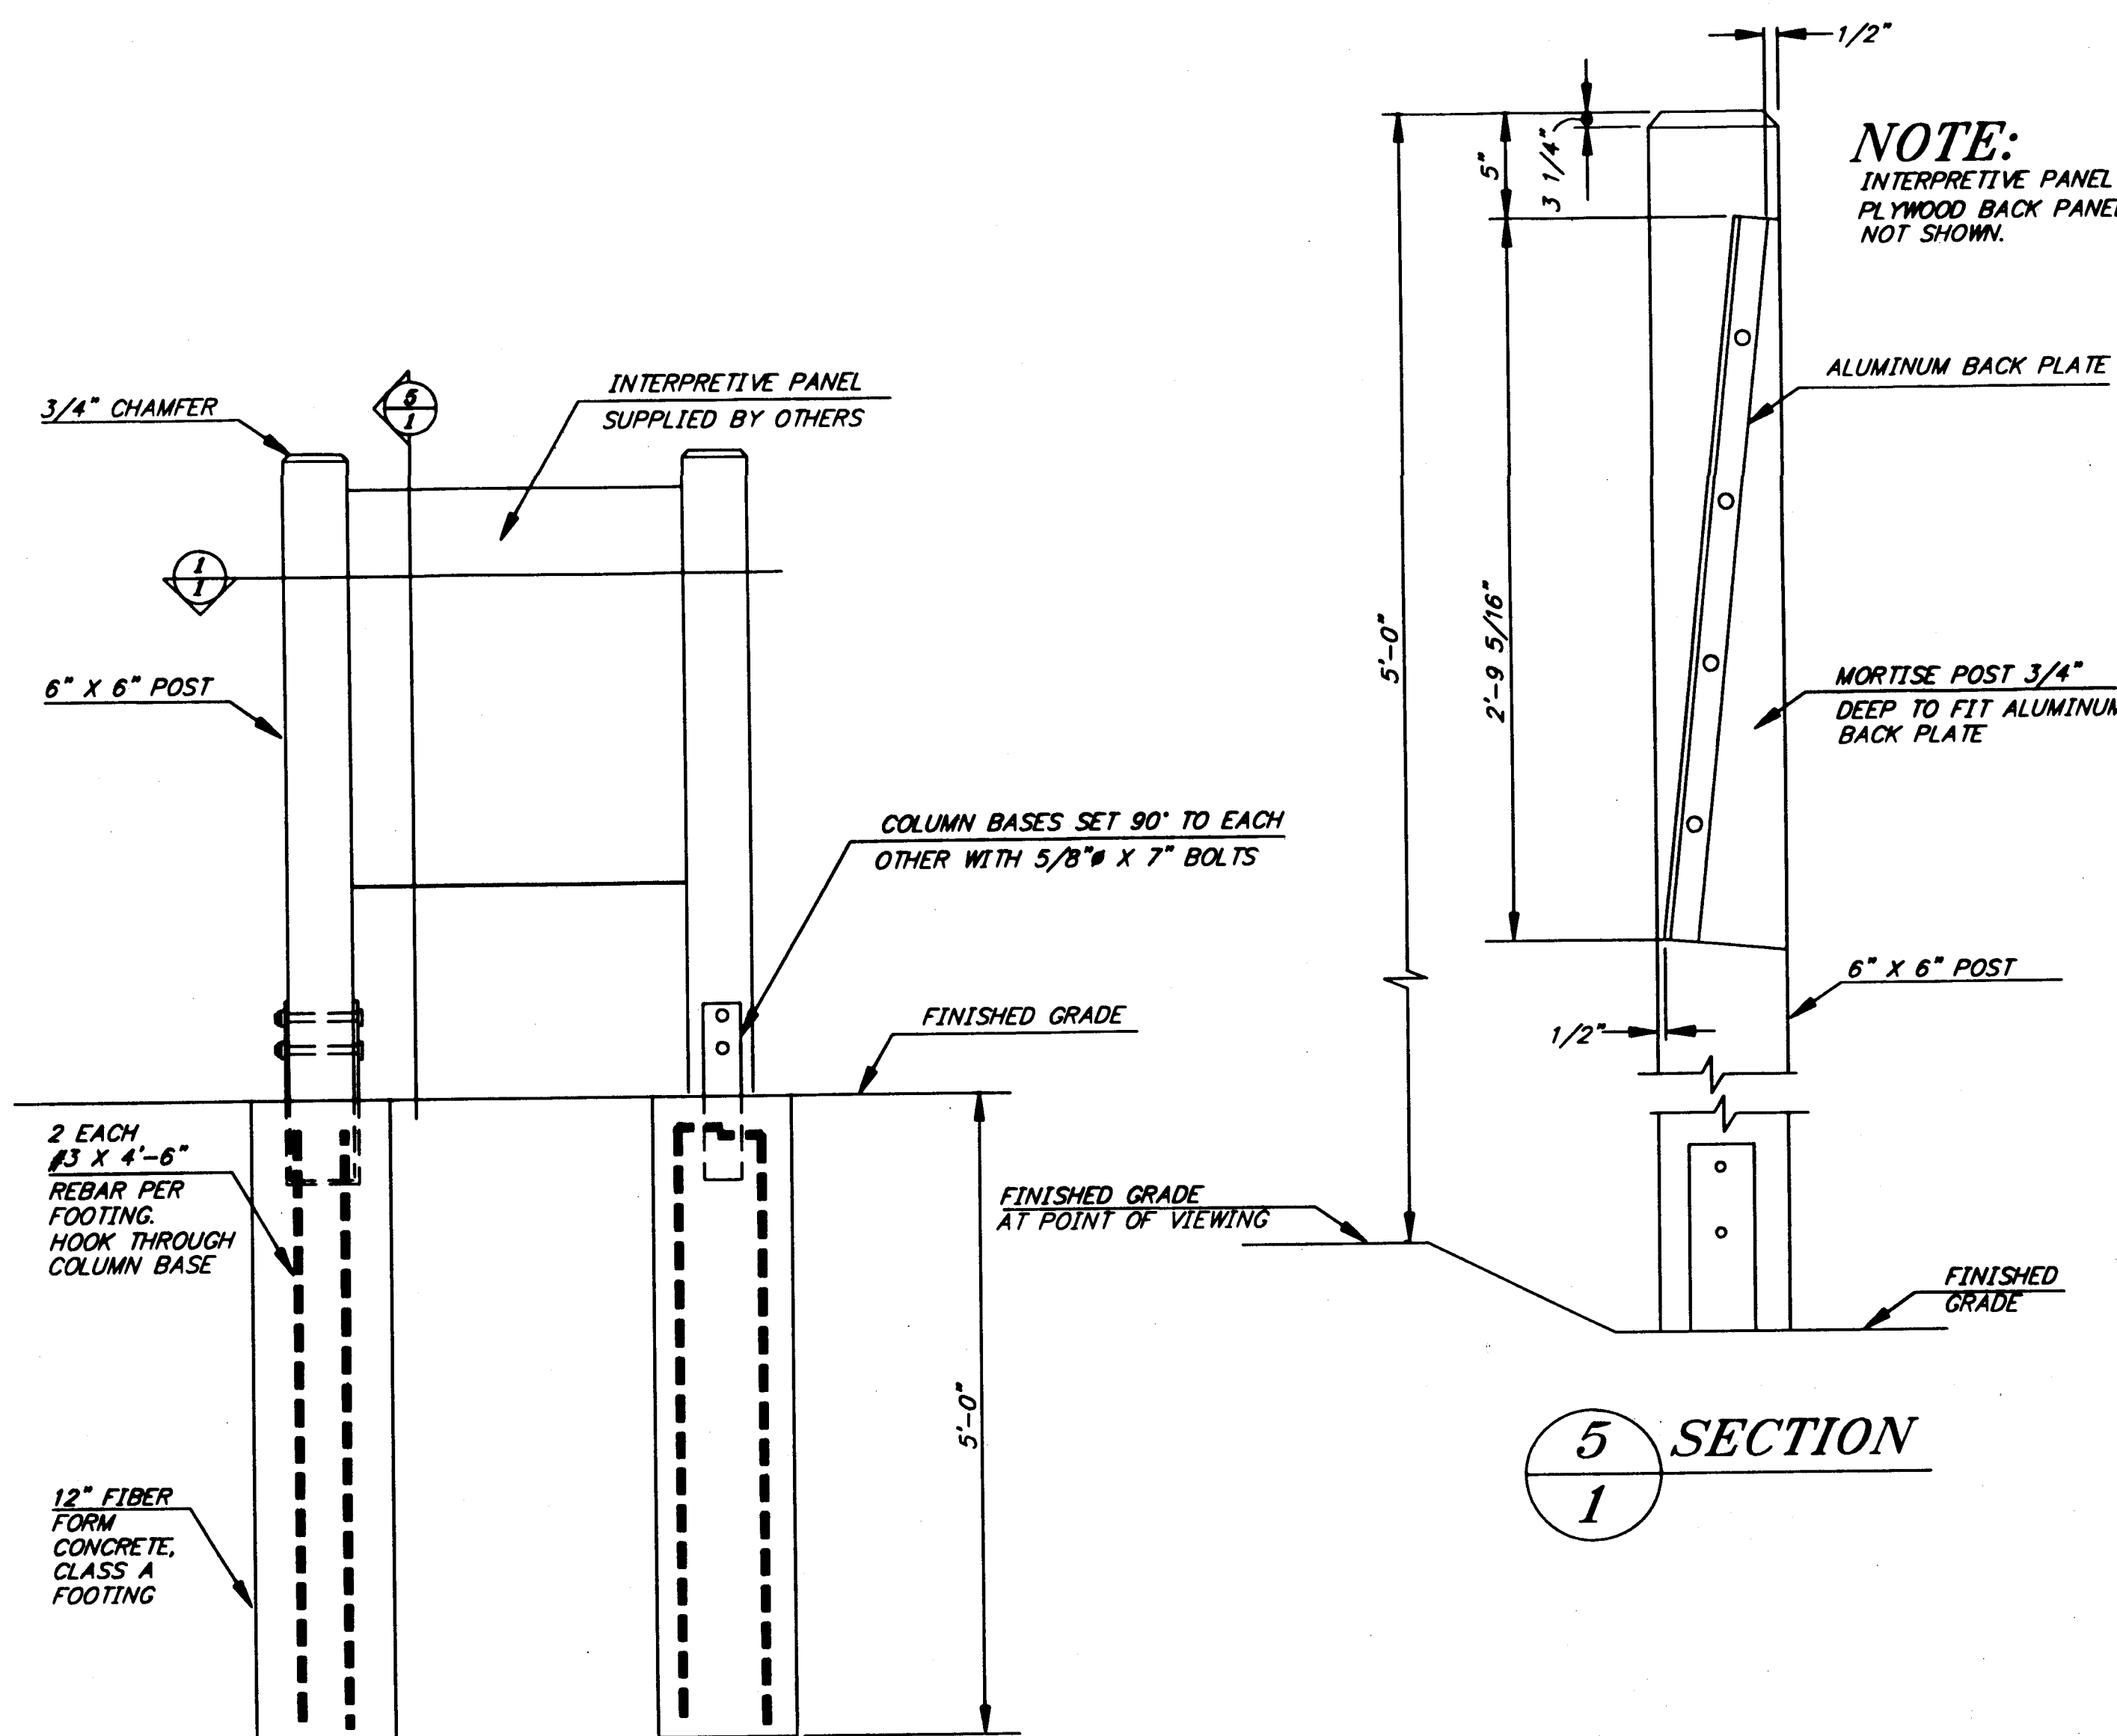

4 FRONT ELEVATION
1

5 SECTION
1

Q:\Jnu\68269\PlanSet\M_Det5.DWG
Tue, 15/Jan/02 02:44PM Kris
PSPACE 1=1(F) OR MSPACE 1=1(F)
TAB: ESTIMATE


ADDENDUM NUMBER		
ATTACHMENT NUMBER		
Tue, 15/Jan/02 02:44PM		
RECORD OF REVISIONS		
No.	DATE	DESCRIPTION

JNU-FISH CREEK ROAD
SAFETY IMPROVEMENTS
PROJECT NO. 68269

Interpretive Sign Support

7/22-03

DESIGNED BY: M. LAVERING

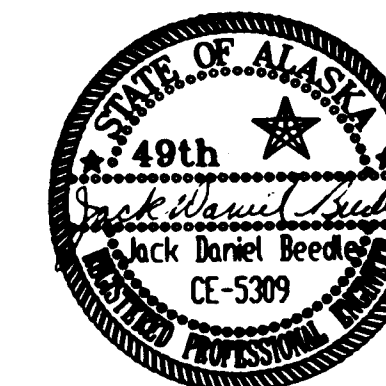

CHECKED BY: T. MOORE

DRAWN BY: K.K.

STATE OF ALASKA
DEPARTMENT OF TRANSPORTATION
& PUBLIC FACILITIES
STATEWIDE DESIGN & ENGINEERING
SERVICES DIVISION

JNU-FISH CREEK ROAD
SAFETY IMPROVEMENTS
PROJECT NO. 68269

Interpretive Sign Support

PROJECT DESIGNATION NUMBER

ACHRO-0953(4)

STATE YEAR

ALASKA 2001

SHEET NUMBER TOTAL SHEETS

M6 41