

STATE OF ALASKA


DEPARTMENT OF TRANSPORTATION
AND PUBLIC FACILITIES
SOUTHCOAST REGION

JUNEAU, ALASKA

JNU: MENDENHALL VALLEY ADAPTIVE
TRAFFIC SIGNAL CONTROL SYSTEM
PROJECT NO. Z685840000 ~ 0003184


The undersigned hereby certifies that this duplicated document is an exact and true copy of the original.

Cody Smith

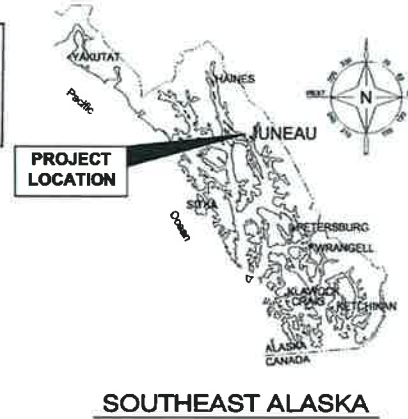

SOUTHEAST ALASKA

INDEX	
SHEET NO.	DESCRIPTION
A1	TITLE SHEET
A2	LEGEND
C1	TRAFFIC SIGNAL ESTIMATE OF QUANTITIES
F1-F2	GLACIER AND EGAN DRIVE (MCNUGGET)
F3-F4	GLACIER AND JORDAN
F5-F6	GLACIER AND SHELL SIMMONS
F7-F8	LOOP ROAD AND EGAN DRIVE
F9-F10	RIVERSIDE AND EGAN DRIVE
F11-F12	LOOP ROAD AND MALL ROAD
F13-F15	RIVERSIDE AND MALL ROAD
F16-F17	LOOP ROAD AND STEPHEN RICHARDS
F18-F19	LOOP ROAD AND VALLEY BOULEVARD
F20-F21	RIVERSIDE AND RIVERWOOD
F22-F25	SOUTHCOAST REGION OFFICE PLAN SHEET
S1	TRAFFIC CONTROL NOTES

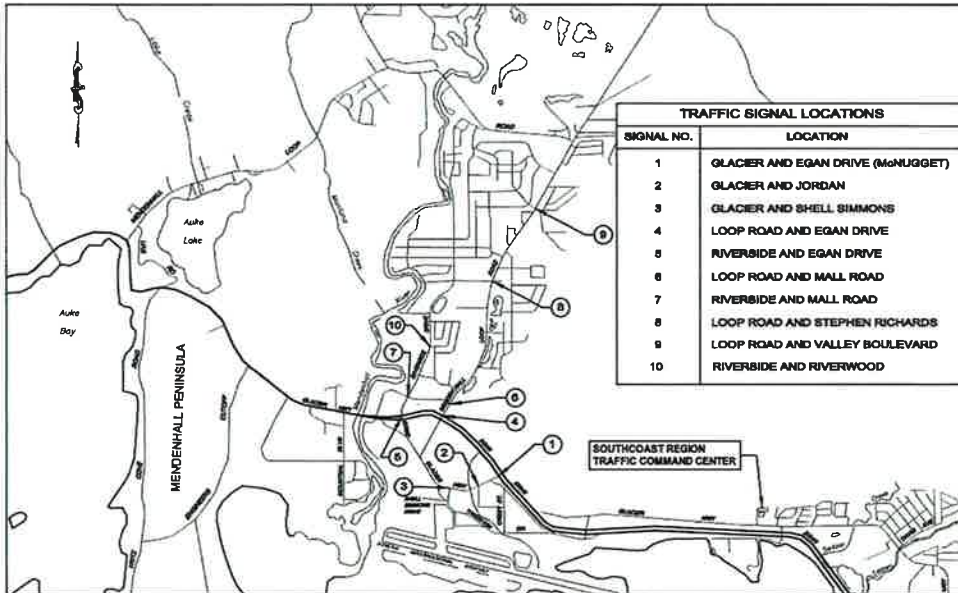

VICINITY MAP

TRAFFIC SIGNAL LOCATIONS	
SIGNAL NO.	LOCATION
1	GLACIER AND EGAN DRIVE (MCNUGGET)
2	GLACIER AND JORDAN
3	GLACIER AND SHELL SIMMONS
4	LOOP ROAD AND EGAN DRIVE
5	RIVERSIDE AND EGAN DRIVE
6	LOOP ROAD AND MALL ROAD
7	RIVERSIDE AND MALL ROAD
8	LOOP ROAD AND STEPHEN RICHARDS
9	LOOP ROAD AND VALLEY BOULEVARD
10	RIVERSIDE AND RIVERWOOD

As-Built

CONTRACTOR: Ever Electric
PE: Micheal Hills
Begin Date: 7-8-2016
END Date: 1-16-2017

THE FOLLOWING STANDARD DRAWINGS APPLY TO THIS PROJECT:

T-30-11

Record Drawings have been reviewed by the Project Engineer, and represent to the best of my knowledge, the project as constructed.

PE MWH Date 5-9-17

PATH: Q:\nuh\68584\Planee\68584_A1_Title Sheet.dwg

STATE OF ALASKA
DEPARTMENT OF TRANSPORTATION
& PUBLIC FACILITIES
SOUTHCOAST REGION



APPROVED: *Pat Carroll* *edolis*
L. PAT CARROLL, P.E.
PRECONSTRUCTION ENGINEER, SOUTHCOAST REGION DATE

APPROVED: *Chuck Correa* *8/20/15*
CHUCK CORREA, P.E.
DIRECTOR OF DESIGN AND CONSTRUCTION, SOUTHCOAST REGION DATE

CERTIFIED TRUE & CORRECT AS-BUILT OF ACTUAL FIELD CONDITION:

CONSTRUCTION PROJECT MANAGER		DATE		
STATE	PROJECT DESIGNATION	YEAR	SHEET NO.	TOTAL SHEETS
ALASKA	Z685840000~0003184	2015	A1	29

	RECOVERED	SET		EXISTING	PROPOSED		EXISTING	PROPOSED		EXISTING	PROPOSED
BLM MONUMENT			SANITARY SEWER (FLOW DIRECTION →)			ROADWAY/PAVEMENT EDGE			JUNCTION BOX, TYPE IA		
GLO MONUMENT			FUEL LINE			FENCE			JUNCTION BOX, TYPE II		
US&GS MONUMENT			GAS LINE			CURB AND GUTTER			JUNCTION BOX, TYPE III		
PRIMARY MONUMENT			WATER LINE			DETECTABLE WARNINGS			SIGNAL FACE, VEHICULAR		
CENTERLINE MONUMENT IN CASING			METER, VALVE, FIRE HYDRANT			GUARDRAIL			SIGNAL FACE, BACKPLATE		
PRIMARY R.O.W. MONUMENT			EXISTING STORM DRAIN (FLOW DIRECTION →)			CULVERT PIPE			SIGNAL FACE, LEFT TURN, BACKPLATE		
BEARING OBJECT			PROPOSED STORM DRAIN			SIGN			SIGNAL FACE, PEDESTRIAN		
MISCELLANEOUS MONUMENT			FIBER OPTIC LINE			MAILBOX			LOOP DETECTOR		
LINE OF SIGHT MONUMENT			DIRECT BURIAL TELEPHONE CABLE			RAILROAD TRACKS			VIDEO DETECTOR		
CONCRETE R.O.W. MONUMENT			DIRECT BURIAL ELECTRIC CABLE			RAILROAD DEVICES			RADAR DETECTOR		
BENCHMARK			ELECTRIC LINE (OVERHEAD)			TREE LINE			OPTICOM DETECTOR		
REBAR AND CAP			POWER POLE LINE			WATER BOUNDARY			PTZ CAMERA		
REBAR			JOINT USE POWER & TELEPHONE			ORDINARY HIGH WATER LINE			PEDESTRIAN PUSH BUTTON		
IRON PIPE			TELEPHONE POLE LINE			FLOW CENTERLINE			SIGNAL POST W/O MAST ARM		
PK NAIL			POLE ANCHOR			FLOW DIRECTION			SIGNAL POLE W/MAST ARM		
SPIKE			STUB POLE (POWER OR TELEPHONE)			WETLANDS			SIGNAL CONTROLLER		
HUB AND TACK			TELEPHONE DUCT			EXISTING BUILDINGS			LOAD CENTER		
CONSTRUCTION CENTERLINE			TELEPHONE PEDESTAL			POST OR BOLLARD			LUMINAIRE		
MISCELLANEOUS CENTERLINE			BURIED CABLE MARKER			WELL OR MONITORING WELL			ROID METAL CONDUIT		
STATION EQUATION			PIPELINE MARKER OR VALVE			SEPTIC PIPE					
PROJECT RIGHT-OF-WAY LINE			CATCH BASIN OR DROP INLET			FUEL TANK FILL PIPE/VENT					
EXISTING RIGHT-OF-WAY LINE			MANHOLE			SATELLITE DISH					
EXISTING PROPERTY LINE			SANITARY SEWER CLEAN OUT			TEST HOLE					
CONTROLLED ACCESS LINE						CONIFER TREE					
EXISTING EASEMENT LINE						DECIDUOUS TREE					
PROPOSED EASEMENT LINE						GRAVE					
PROPOSED CUT SLOPE LIMIT						THERMOSIPHON					
PROPOSED FILL SLOPE LIMIT						PARKING METER					
SECTION LINE						VEHICLE PLUG-IN					
1/4 SECTION LINE						DELINEATOR/GUIDE MARKER					
1/16 SECTION LINE											
TOWNSHIP & RANGE LINE											
MEANDER LINE											

Record Drawings have been reviewed by the Project Engineer, and represent to the best of my knowledge, the project as constructed.

PE MWH Date 5.9.17

DO NOT SCALE FROM THESE DRAWINGS USE DIMENSIONS

CHECKED BY: D. STEVENS

STATE OF ALASKA
DEPARTMENT OF TRANSPORTATION
& PUBLIC FACILITIES
SOUTHCOAST REGION

JNU-MENDENHALL VALLEY
ADAPTIVE TRAFFIC SIGNAL
CONTROL SYSTEM

LEGEND

DESIGNED BY: J. MAPLE
DRAWN BY: D. STEVENS

DATE: 8.19.15

PATH: G:\JNU\2015\4\PLANSET\2015\4\LEGEND.DWG
TAB: A2 Monday, August 17, 2015 8:31:51 AM

PROJECT DESIGNATION: STEVENS, DAVID A (DOT)

NO.	DATE	DESCRIPTION	YEAR	SHEET NO.	TOTAL SHEETS
				A2	29

This page was replaced with a new sheet C1 in Change Order #1.

ESTIMATE OF QUANTITIES			
ITEM NUMBER	ITEM DESCRIPTION	PAY UNIT	QUANTITY
640(1)	MOBILIZATION AND DEMOBILIZATION	LUMP SUM	ALL REQUIRED
643(2)	TRAFFIC MAINTENANCE	LUMP SUM	ALL REQUIRED
643(15)	FLAGGING	LUMP SUM	ALL REQUIRED
643(23)	TRAFFIC PRICE ADJUSTMENT	CONTINGENT SUM	ALL REQUIRED
643(25)	TRAFFIC CONTROL	CONTINGENT SUM	ALL REQUIRED
660(14)	SIGNAL NO. 1, GLACIER AND EGAN DRIVE (MCNUGGET) TRAFFIC SIGNAL MODIFICATION COMPLETE	LUMP SUM	ALL REQUIRED
660(15)	SIGNAL NO. 2, GLACIER AND JORDAN TRAFFIC SIGNAL MODIFICATION COMPLETE	LUMP SUM	ALL REQUIRED
660(16)	SIGNAL NO. 3, GLACIER AND SHELL SIMMONS TRAFFIC SIGNAL MODIFICATION COMPLETE	LUMP SUM	ALL REQUIRED
660(17)	SIGNAL NO. 4, LOOP ROAD AND EGAN DRIVE TRAFFIC SIGNAL MODIFICATION COMPLETE	LUMP SUM	ALL REQUIRED
660(18)	SIGNAL NO. 5, RIVERSIDE AND EGAN DRIVE TRAFFIC SIGNAL MODIFICATION COMPLETE	LUMP SUM	ALL REQUIRED
660(19)	SIGNAL NO. 6, LOOP ROAD AND MALL ROAD TRAFFIC SIGNAL MODIFICATION COMPLETE	LUMP SUM	ALL REQUIRED
660(20)	SIGNAL NO. 7, RIVERSIDE AND MALL ROAD TRAFFIC SIGNAL MODIFICATION COMPLETE	LUMP SUM	ALL REQUIRED
660(21)	SIGNAL NO. 8, LOOP ROAD AND STEPHEN RICHARDS TRAFFIC SIGNAL MODIFICATION COMPLETE	LUMP SUM	ALL REQUIRED
660(22)	SIGNAL NO. 9, LOOP ROAD AND VALLEY BOULEVARD TRAFFIC SIGNAL MODIFICATION COMPLETE	LUMP SUM	ALL REQUIRED
660(23)	SIGNAL NO. 10, RIVERSIDE AND RIVERWOOD TRAFFIC SIGNAL MODIFICATION COMPLETE	LUMP SUM	ALL REQUIRED
660(24)	SOUTHCOAST REGION TRAFFIC COMMAND CENTER COMPLETE	LUMP SUM	ALL REQUIRED

SIGNAL HEAD BASIS OF ESTIMATE		
ITEM NUMBER	ITEM DESCRIPTION	ESTIMATING FACTORS
660(14)	SIGNAL NO. 1, GLACIER AND EGAN DRIVE (MCNUGGET) TRAFFIC SIGNAL MODIFICATION COMPLETE	5 R-Y-G, 2 RLA-YLA-GLA, 3 MATRIX, 2 ADVANCE, 1 PTZ
660(15)	SIGNAL NO. 2, GLACIER AND JORDAN TRAFFIC SIGNAL MODIFICATION COMPLETE	5 R-Y-G, 4 MATRIX, 1 PTZ
660(16)	SIGNAL NO. 3, GLACIER AND SHELL SIMMONS TRAFFIC SIGNAL MODIFICATION COMPLETE	4 R-Y-G, 4 MATRIX, 1 PTZ
660(17)	SIGNAL NO. 4, LOOP ROAD AND EGAN DRIVE TRAFFIC SIGNAL MODIFICATION COMPLETE	8 R-Y-G, 6 RLA-YLA-GLA, 3 R-Y-G-GLA, 4 MATRIX, 2 ADVANCE, 1 PTZ
660(18)	SIGNAL NO. 5, RIVERSIDE AND EGAN DRIVE TRAFFIC SIGNAL MODIFICATION COMPLETE	3 R-Y-G, 4 RLA-YLA-GLA, 2 RRA-YRA-GRA, 1 R-Y-G-YRA-GRA, 1 PTZ
660(19)	SIGNAL NO. 6, LOOP ROAD AND MALL ROAD TRAFFIC SIGNAL MODIFICATION COMPLETE	8 R-Y-G, 4 RLA-YLA-GLA, 4 MATRIX, 1 PTZ
660(20)	SIGNAL NO. 7, RIVERSIDE AND MALL ROAD TRAFFIC SIGNAL MODIFICATION COMPLETE	1 R-Y-G, 1 PTZ
660(21)	SIGNAL NO. 8, LOOP ROAD AND STEPHEN RICHARDS TRAFFIC SIGNAL MODIFICATION COMPLETE	1 PTZ
660(22)	SIGNAL NO. 9, LOOP ROAD AND VALLEY BOULEVARD TRAFFIC SIGNAL MODIFICATION COMPLETE	4 MATRIX, 1 PTZ
660(23)	SIGNAL NO. 10, RIVERSIDE AND RIVERWOOD TRAFFIC SIGNAL MODIFICATION COMPLETE	4 MATRIX, 1 PTZ

ITEM NO. 660(24), SOUTHCOAST REGION TRAFFIC COMMAND CENTER COMPLETE BASIS OF ESTIMATE	
ITEM DESCRIPTION	QUANTITY REQUIRED IN CONTRACT
LOCKABLE DOOR AND ASSOCIATED FRAMING	1
DESKS	2
GUEST CHAIRS	4
TRAFFIC COMMAND CENTER WORK STATION CABINET	1
SERVER	1
TRAFFIC COMMAND CENTER WORK STATION	1
MONITORS, WALL-MOUNTED, 85 INCH LCD	2
TRAFFIC COMMAND CENTER WORK STATION MONITOR	1
TRAFFIC COMMAND CENTER SOFTWARE	1

Record Drawings have been reviewed by the Project Engineer, and represent to the best of my knowledge, the project as constructed.

PE MWH Date 5-9-17


PATH: C:\Users\j65584\Documents\65584_01_Summary.dwg
 Title: 18-Aug-15 09:45:04
 PLOT: PSPACE 1+1 (P) OR MSPACE 1+1 (P)
 TAB: TYPICAL

ADDENDUM NUMBER
 ATTACHMENT NUMBER

RECORD OF REVISIONS
 No. DATE DESCRIPTION

MENDENHALL VALLEY ADAPTIVE TRAFFIC SIGNAL CONTROL SYSTEM
 2685840000 - 0003184

TRAFFIC SIGNAL ESTIMATE OF QUANTITIES



DESIGNED BY: D. EPSTEIN
 DRAWN BY: D. STEVENS

STATE OF ALASKA
 DEPARTMENT OF TRANSPORTATION & PUBLIC FACILITIES
 SOUTHCOAST REGION
 MENDENHALL VALLEY ADAPTIVE TRAFFIC SIGNAL CONTROL SYSTEM

TRAFFIC SIGNAL ESTIMATE OF QUANTITIES

PROJECT DESIGNATION NUMBER
 2685840000 - 0003184

STATE	YEAR
ALASKA	2015
SHEET NUMBER	TOTAL SHEETS
C1	29

New sheet C1 - Issued in change Order # 1

ESTIMATE OF QUANTITIES			
ITEM NUMBER	ITEM DESCRIPTION	PAY UNIT	QUANTITY
640(1)	MOBILIZATION AND DEMOBILIZATION	LUMP SUM	ALL REQUIRED
643(2)	TRAFFIC MAINTENANCE	LUMP SUM	ALL REQUIRED
643(15)	FLAGGING	LUMP SUM	ALL REQUIRED
643(23)	TRAFFIC PRICE ADJUSTMENT	CONTINGENT SUM	ALL REQUIRED
643(25)	TRAFFIC CONTROL	CONTINGENT SUM	ALL REQUIRED
660(14)	SIGNAL NO. 1, GLACIER AND EGAN DRIVE (MONUGGET) TRAFFIC SIGNAL MODIFICATION COMPLETE	LUMP SUM	ALL REQUIRED
660(15)	SIGNAL NO. 2, GLACIER AND JORDAN TRAFFIC SIGNAL MODIFICATION COMPLETE	LUMP SUM	ALL REQUIRED
660(16)	SIGNAL NO. 3, GLACIER AND SHELL SIMMONS TRAFFIC SIGNAL MODIFICATION COMPLETE	LUMP SUM	ALL REQUIRED
660(17)	SIGNAL NO. 4, LOOP ROAD AND EGAN DRIVE TRAFFIC SIGNAL MODIFICATION COMPLETE	LUMP SUM	ALL REQUIRED
660(18)	SIGNAL NO. 5, RIVERSIDE AND EGAN DRIVE TRAFFIC SIGNAL MODIFICATION COMPLETE	LUMP SUM	ALL REQUIRED
660(19)	SIGNAL NO. 6, LOOP ROAD AND MALL ROAD TRAFFIC SIGNAL MODIFICATION COMPLETE	LUMP SUM	ALL REQUIRED
660(20)	SIGNAL NO. 7, RIVERSIDE AND MALL ROAD TRAFFIC SIGNAL MODIFICATION COMPLETE	LUMP SUM	ALL REQUIRED
660(21)	SIGNAL NO. 8, LOOP ROAD AND STEPHEN RICHARDS TRAFFIC SIGNAL MODIFICATION COMPLETE	LUMP SUM	ALL REQUIRED
660(22)	SIGNAL NO. 9, LOOP ROAD AND VALLEY BOULEVARD TRAFFIC SIGNAL MODIFICATION COMPLETE	LUMP SUM	ALL REQUIRED
660(23)	SIGNAL NO. 10, RIVERSIDE AND RIVERWOOD TRAFFIC SIGNAL MODIFICATION COMPLETE	LUMP SUM	ALL REQUIRED
660(24)	SOUTHCOAST REGION TRAFFIC COMMAND CENTER COMPLETE	LUMP SUM	ALL REQUIRED

SIGNAL HEAD BASIS OF ESTIMATE		
ITEM NUMBER	ITEM DESCRIPTION	ESTIMATING FACTORS
660(14)	SIGNAL NO. 1, GLACIER AND EGAN DRIVE (MONUGGET) TRAFFIC SIGNAL MODIFICATION COMPLETE	5 R-Y-G, 2 RLA-YLA-GLA, 3 MATRIX, 3 ADVANCE, 1 PTZ
660(15)	SIGNAL NO. 2, GLACIER AND JORDAN TRAFFIC SIGNAL MODIFICATION COMPLETE	5 R-Y-G, 4 MATRIX, 1 PTZ
660(16)	SIGNAL NO. 3, GLACIER AND SHELL SIMMONS TRAFFIC SIGNAL MODIFICATION COMPLETE	4 R-Y-G, 4 MATRIX, 1 PTZ
660(17)	SIGNAL NO. 4, LOOP ROAD AND EGAN DRIVE TRAFFIC SIGNAL MODIFICATION COMPLETE	8 R-Y-G, 6 RLA-YLA-GLA, 3 R-Y-G-GLA, 4 MATRIX, 4 ADVANCE, 1 PTZ
660(18)	SIGNAL NO. 5, RIVERSIDE AND EGAN DRIVE TRAFFIC SIGNAL MODIFICATION COMPLETE	3 R-Y-G, 4 RLA-YLA-GLA, 2 RRA-YRA-GRA, 1 R-Y-G-YRA-GRA, 1 PTZ, 1 ADVANCE
660(19)	SIGNAL NO. 6, LOOP ROAD AND MALL ROAD TRAFFIC SIGNAL MODIFICATION COMPLETE	8 R-Y-G, 4 RLA-YLA-GLA, 4 MATRIX, 1 PTZ, 2 ADVANCE
660(20)	SIGNAL NO. 7, RIVERSIDE AND MALL ROAD TRAFFIC SIGNAL MODIFICATION COMPLETE	1 R-Y-G, 1 PTZ, 1 ADVANCE (PROVIDED BY DEPARTMENT)
660(21)	SIGNAL NO. 8, LOOP ROAD AND STEPHEN RICHARDS TRAFFIC SIGNAL MODIFICATION COMPLETE	1 PTZ
660(22)	SIGNAL NO. 9, LOOP ROAD AND VALLEY BOULEVARD TRAFFIC SIGNAL MODIFICATION COMPLETE	4 MATRIX, 1 PTZ
660(23)	SIGNAL NO. 10, RIVERSIDE AND RIVERWOOD TRAFFIC SIGNAL MODIFICATION COMPLETE	4 MATRIX, 1 PTZ

ITEM NO. 660(24), SOUTHCOAST REGION TRAFFIC COMMAND CENTER COMPLETE BASIS OF ESTIMATE	
ITEM DESCRIPTION	QUANTITY REQUIRED IN CONTRACT
LOCKABLE DOOR AND ASSOCIATED FRAMING	1
DESKS	2
GUEST CHAIRS	4
TRAFFIC COMMAND CENTER WORK STATION CABINET	1
SERVER	1
TRAFFIC COMMAND CENTER WORK STATION	1
MONITORS, WALL-MOUNTED, 65 INCH LCD	2
TRAFFIC COMMAND CENTER WORK STATION MONITOR	1
TRAFFIC COMMAND CENTER SOFTWARE	1

Record Drawings have been reviewed by the Project Engineer, and represent to the best of my knowledge, the project as constructed.

PE MWH Date 5.9.17

PATH: G:\m\16551\Project\65584_D1_South.dwg Date: 15/Aug/16 08:33AM PLOT: PSPACE 1x1 (7) OR MSPACE 1x1 (7) TAB: TYPICALS		
ADDENDUM NUMBER		
ATTACHMENT NUMBER		
RECORD OF REVISIONS		
No.	DATE	DESCRIPTION


MENDENHALL VALLEY ADAPTIVE
TRAFFIC SIGNAL CONTROL SYSTEM
Z685840000 ~ 0003184

**TRAFFIC SIGNAL
ESTIMATE OF QUANTITIES**



DESIGNED BY:	D. EPSTEIN
DRAWN BY:	D. STEVENS
STATE OF ALASKA DEPARTMENT OF TRANSPORTATION & PUBLIC FACILITIES SOUTHCOAST REGION MENDENHALL VALLEY ADAPTIVE TRAFFIC SIGNAL CONTROL SYSTEM	
TRAFFIC SIGNAL ESTIMATE OF QUANTITIES	
PROJECT DESIGNATION NUMBER	
Z685840000 ~ 0003184	
STATE	YEAR
ALASKA	2015
SHEET NUMBER	TOTAL SHEETS
C1	36

1

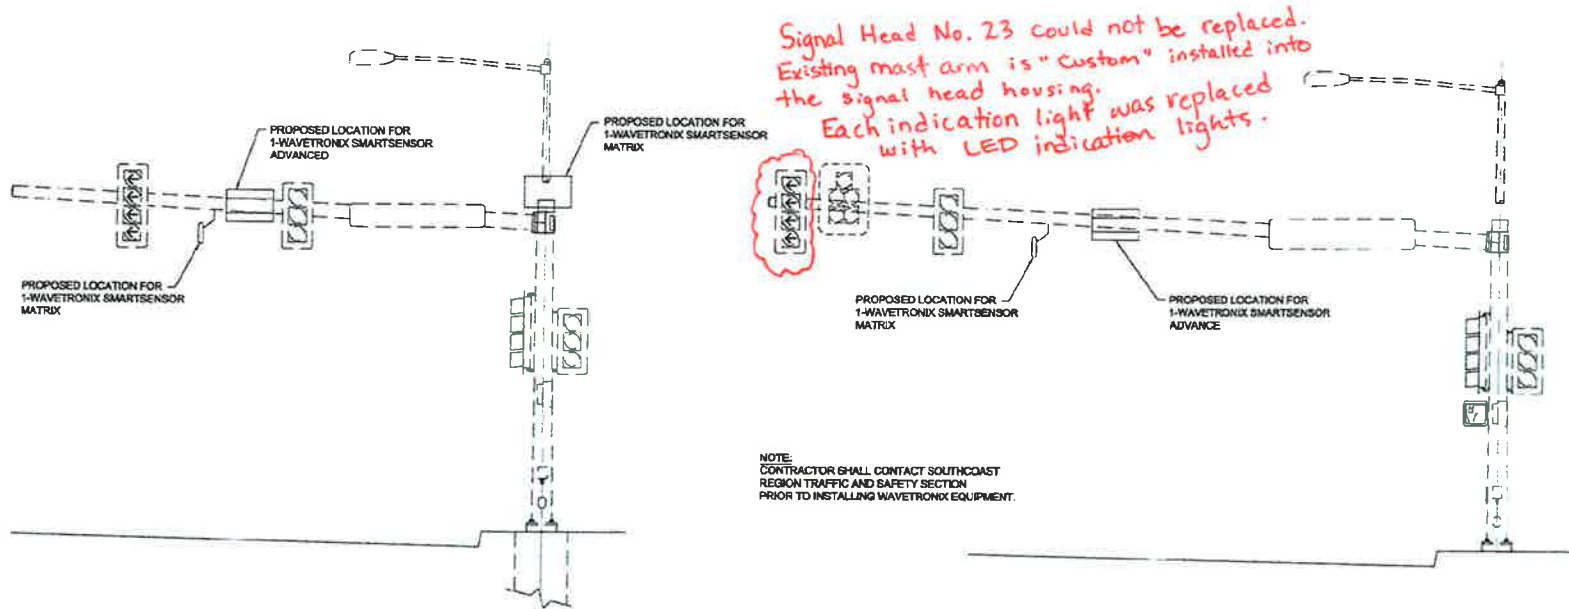

SIGNAL POLE NO. 3 DETAIL

SIGNAL POLE NO. 2 DETAIL

NOTE:
CONTRACTOR SHALL CONTACT SOUTHCOAST
REGION TRAFFIC AND SAFETY SECTION
PRIOR TO INSTALLING WAVETRONIX EQUIPMENT.

- Change Order No. 1
1 additional - Wavetronix Smartsensor Advanced was installed on Signal Pole No. 1
(see page F1)


Record Drawings have been reviewed by the Project Engineer, and represent to the best of my knowledge, the project as constructed.

PE MWH Date 5.9.17

DO NOT SCALE FROM THESE DRAWINGS USE DIMENSIONS

CHECKED BY: D. EPSTEIN 		STATE OF ALASKA DEPARTMENT OF TRANSPORTATION & PUBLIC FACILITIES SOUTH COAST REGION	
DESIGNED BY: J. MARBLE DRAWN BY: D. STEVENS DATE: 10.13.15		JNU-MENDENHALL VALLEY ADAPTIVE TRAFFIC SIGNAL CONTROL SYSTEM SIGNAL POLE DETAILS GLACIER AND EGAN DRIVE (MCNUGGET)	
PATH: C:\JNU\M64\PLANSET\M64_E1 SIGNAL POLE DETAILS.DWG TAB: E1 Monday, October 12, 2015 8:58:47 AM STEVENS, DAVID A (DOT)			
NO.	DATE	REVISION	PROJECT DESIGNATION
			Z685840000-0003184
			YEAR
			2015
			SHEET NO
			E1
			TOTAL SHEETS
			36

2

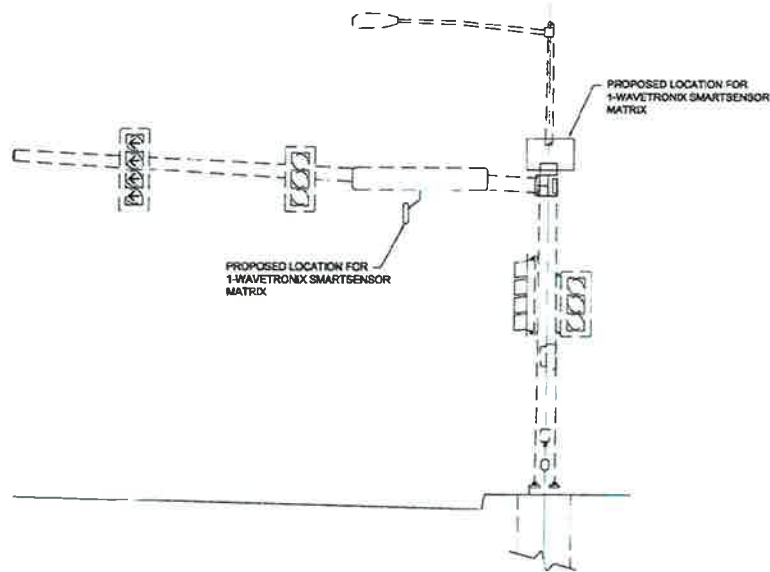

SIGNAL POLE NO. 2 DETAIL

Record Drawings have been reviewed by the Project Engineer, and represent to the best of my knowledge, the project as constructed.


PE MWH Date 5-9-17

NOTE:
CONTRACTOR SHALL CONTACT SOUTHCOAST
REGION TRAFFIC AND SAFETY SECTION
PRIOR TO INSTALLING WAVETRONIX EQUIPMENT.


DO NOT SCALE FROM THESE DRAWINGS USE DIMENSIONS

		STATE OF ALASKA DEPARTMENT OF TRANSPORTATION & PUBLIC FACILITIES SOUTH-COAST REGION			
CHECKED BY: D. REITEN 10-13-15		JNU-MENDENHALL VALLEY ADAPTIVE TRAFFIC SIGNAL CONTROL SYSTEM			
DESIGNED BY: J. SWALE DRAWN BY: D. STEVENS		SIGNAL POLE DETAILS GLACIER AND JORDAN			
PATH: Q:\UNAMSH\PLAN\ETMSM E1 SIGNAL POLE DETAILS.DWG T.A.D: ED Tuesday, October 13, 2015 1:10:43 PM STEVENS, DAVID A (DOT)					
REVISIONS		PROJECT DESIGNATION	YEAR	SHEET NO	TOTAL SHEETS
NO	DATE	DESCRIPTION	Z685840000-0003184	2015	E2 36

3

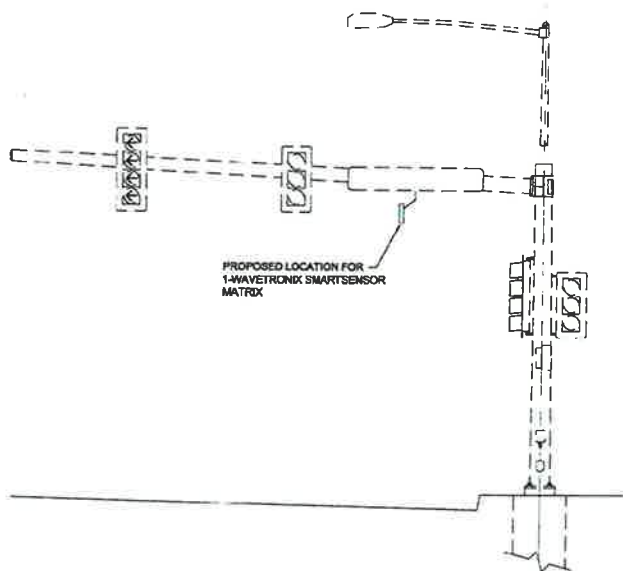

SIGNAL POLE NO. 4 AND NO. 5 DETAIL

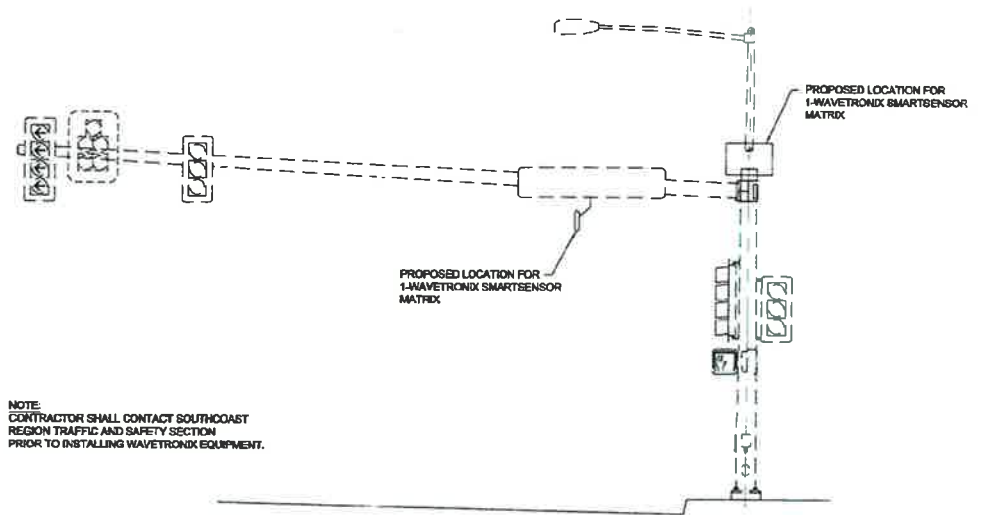

NOTE:
CONTRACTOR SHALL CONTACT SOUTHOAST
REGION TRAFFIC AND SAFETY SECTION
PRIOR TO INSTALLING WAVETRONIX EQUIPMENT.


SIGNAL POLE NO. 1 DETAIL

Record Drawings have been reviewed by the Project Engineer, and represent to the best of my knowledge, the project as constructed.
PE MWH Date 5.9.17

DO NOT SCALE FROM THESE DRAWINGS USE DIMENSIONS

	STATE OF ALASKA DEPARTMENT OF TRANSPORTATION & PUBLIC FACILITIES SOUTHOAST REGION		
	JNU-MENDENHALL VALLEY ADAPTIVE TRAFFIC SIGNAL CONTROL SYSTEM		
SIGNAL POLE DETAILS GLACIER AND SHELL SIMMONS			
CHECKED BY: D. EPSTEIN DESIGNED BY: J. MARLE DRAWN BY: D. EPSTEIN DATE: 10.13.15	PATH: Q:\ALASKA\PLAN\SET\05054_E1 SIGNAL_POLE_DETAILS.DWG TAB: E3 Monday, October 12, 2015 9:57:46 AM STEVENS, DAVID A. (DOT)		
REVISIONS NO. DATE DESCRIPTION	PROJECT DESIGNATION Z685840000-0003184	YEAR 2015	SHEET NO. E3
			TOTAL SHEETS 36


4

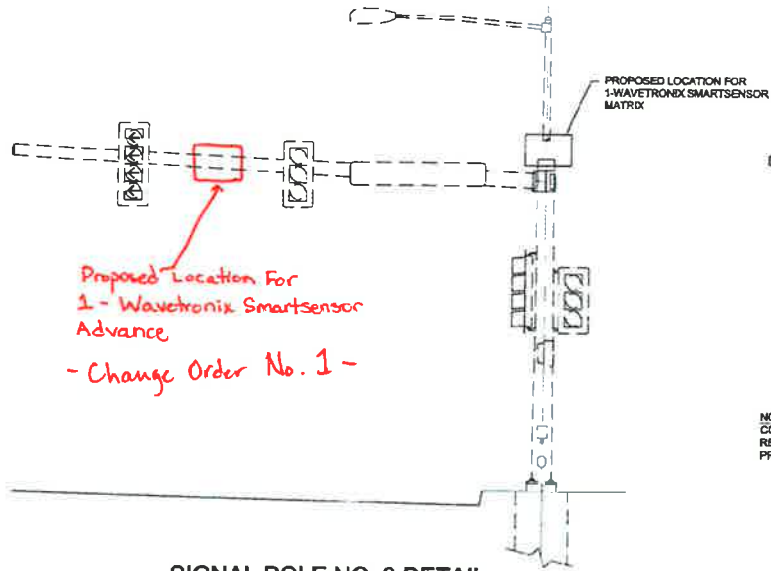


Proposed Location For
1 - Wavetronix SmartSensor
Advance
- Change Order No. 1 -

SIGNAL POLE NO. 3 DETAIL

NOTE:
CONTRACTOR SHALL CONTACT SOUTHCOAST
REGION TRAFFIC AND SAFETY SECTION
PRIOR TO INSTALLING WAVETRONIX EQUIPMENT.

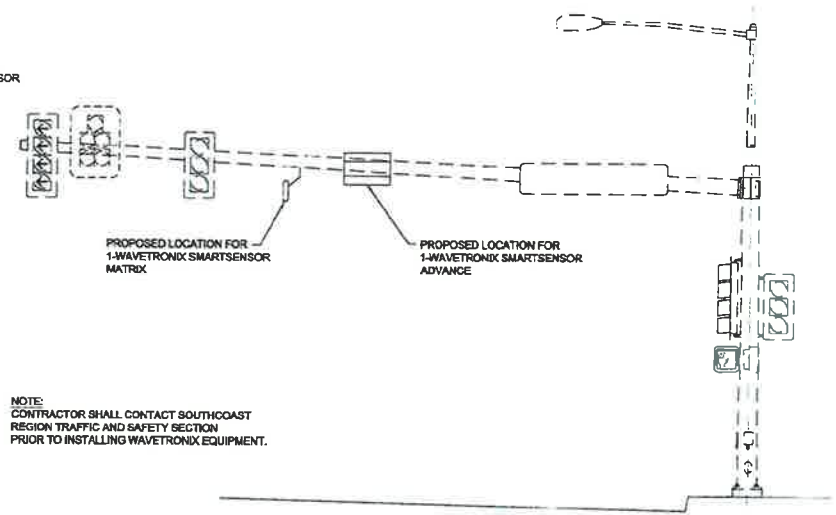

SIGNAL POLE NO. 2 AND NO. 4 DETAIL

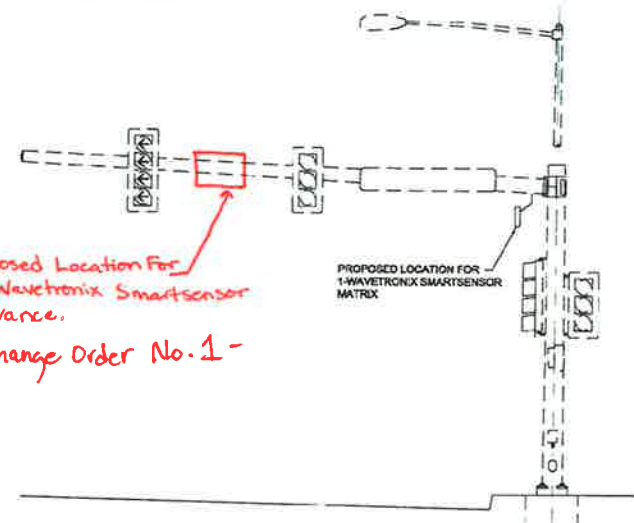


Proposed Location For
1 - Wavetronix SmartSensor
Advance.
- Change Order No. 1 -

SIGNAL POLE NO. 1 DETAIL


Record Drawings have been reviewed by the Project Engineer, and represent to the best of my knowledge, the project as constructed.

PE MWH Date 5-9-17

DO NOT SCALE FROM THESE DRAWINGS USE DIMENSIONS

CHECKED BY: J. EPSTEIN  STATE OF ALASKA DEPARTMENT OF TRANSPORTATION & PUBLIC FACILITIES SOUTHCOAST REGION		JNU-MENDENHALL VALLEY ADAPTIVE TRAFFIC SIGNAL CONTROL SYSTEM							
DESIGNED BY: J. MAPLE DRAWN BY: D. STEVENS 10-13-15		SIGNAL POLE DETAILS LOOP ROAD AND EGAN DRIVE							
PATH: O:\UT\B&S\PLANS\BTR\SSM\ E1 SIGNAL POLE DETAILS.DWG T.A.B. Monday, October 12, 2015 9:07 AM		STEVENS, DAVID A. (DOT)							
<table border="1"> <thead> <tr> <th>NO.</th> <th>DATE</th> <th>DESCRIPTION</th> </tr> </thead> <tbody> <tr> <td> </td> <td> </td> <td> </td> </tr> </tbody> </table>		NO.	DATE	DESCRIPTION				PROJECT DESIGNATION Z685840000-0003184	YEAR 2015
NO.	DATE	DESCRIPTION							
SHEET NO E4		TOTAL SHEETS 36							

6

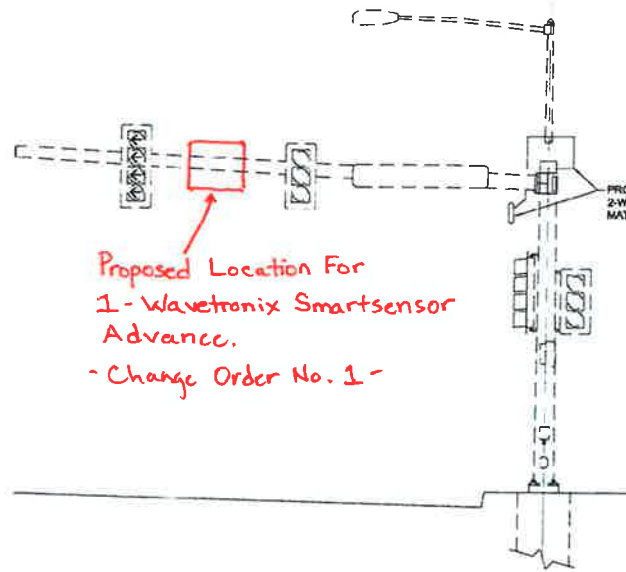


SIGNAL POLE NO. 4 DETAIL

NOTE:
CONTRACTOR SHALL CONTACT SOUTHCOAST
REGION TRAFFIC AND SAFETY SECTION
PRIOR TO INSTALLING WAVETRONIX EQUIPMENT.

Record Drawings have been reviewed
by the Project Engineer, and represent
to the best of my knowledge, the
project as constructed.

PE MWH Date 5-9-17

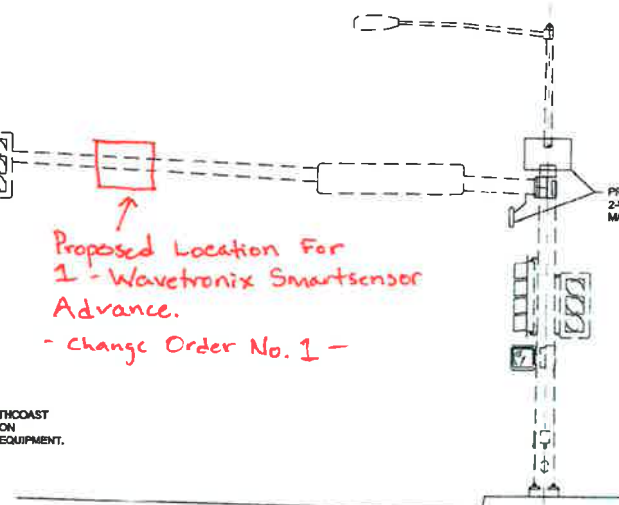


SIGNAL POLE NO. 2 DETAIL


DO NOT SCALE FROM THESE DRAWINGS USE DIMENSIONS

	STATE OF ALASKA DEPARTMENT OF TRANSPORTATION & PUBLIC FACILITIES SOUTHWEST REGION	
	JNU-MENDENHALL VALLEY ADAPTIVE TRAFFIC SIGNAL CONTROL SYSTEM	
SIGNAL POLE DETAILS LOOP ROAD AND MALL ROAD		
CHECKED BY: D. SPSTEN DESIGNED BY: J. SANCHEZ DRAWN BY: D. STEVENSON	PROJECT DESIGNATION: Z685840000-0003184	YEAR: 2015 SHEET NO: E5 TOTAL SHEETS: 36
PATH: Q:\UNLAKM\PLANSET\2015AL_E5 SIGNAL POLE DETAILS.DWG TAB: E5 Monday, October 12, 2015 8:58:05 AM STEVENS, DAVID A (DVT)	REVISIONS:	
NO. DATE DESCRIPTION	NO. DATE DESCRIPTION	

9

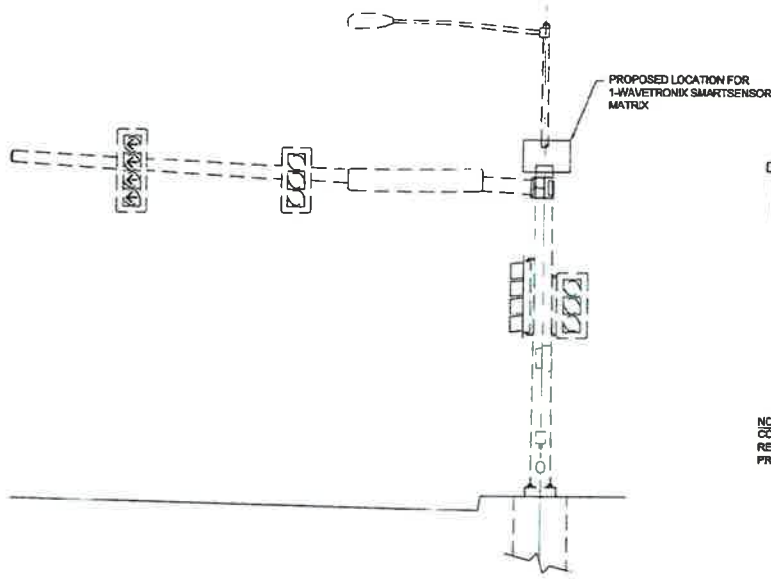

SIGNAL POLE NO. 4 DETAIL

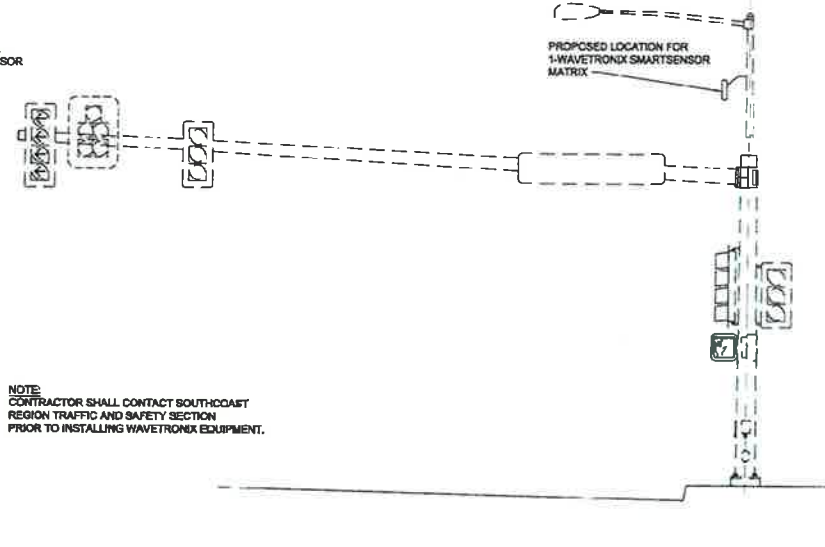


SIGNAL POLE NO. 1, NO. 2, NO. 3 AND NO. 4 DETAIL

NOTE:
CONTRACTOR SHALL CONTACT SOUTHEAST
REGION TRAFFIC AND SAFETY SECTION
PRIOR TO INSTALLING WAVETRONIX EQUIPMENT.


Record Drawings have been reviewed by the Project Engineer, and represent to the best of my knowledge, the project as constructed.

PE MWH Date 5-9-17

DO NOT SCALE FROM THESE DRAWINGS USE DIMENSIONS


		STATE OF ALASKA DEPARTMENT OF TRANSPORTATION & PUBLIC FACILITIES SOUTHEAST REGION	
CHECKED BY: D. EPSTEIN DESIGNED BY: J. MAWLE DRAWN BY: D. STEVENS DATE: 10-13-15		JNU-MENDENHALL VALLEY ADAPTIVE TRAFFIC SIGNAL CONTROL SYSTEM SIGNAL POLE DETAILS LOOP ROAD AND VALLEY BOULEVARD	
PATH: C:\JNU\MS&P\LANSET\JNSM_E1_SIGNAL_POLE_DETAILS.DWG TAB: BE		PROJECT DESIGNATION: STEVENS, DAVID A (DOT) DATE: Monday, October 13, 2015 8:58:11 AM	
NO.	DATE	DESCRIPTION	REVISIONS
PROJECT DESIGNATION		YEAR	SHEET NO
Z685840000-0003184		2015	E6
TOTAL SHEETS		36	

10

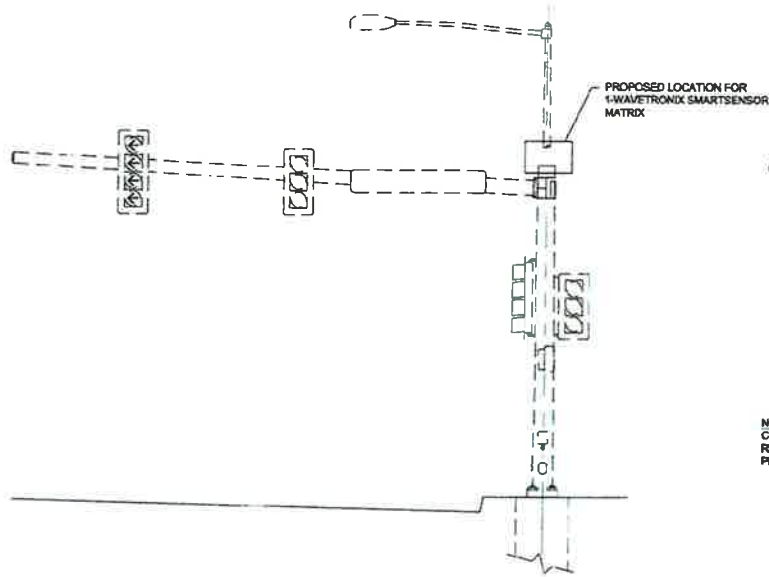

SIGNAL POLE NO. 4 DETAIL

NOTE:
CONTRACTOR SHALL CONTACT SOUTHCOAST
REGION TRAFFIC AND SAFETY SECTION
PRIOR TO INSTALLING WAVETRONIX EQUIPMENT.

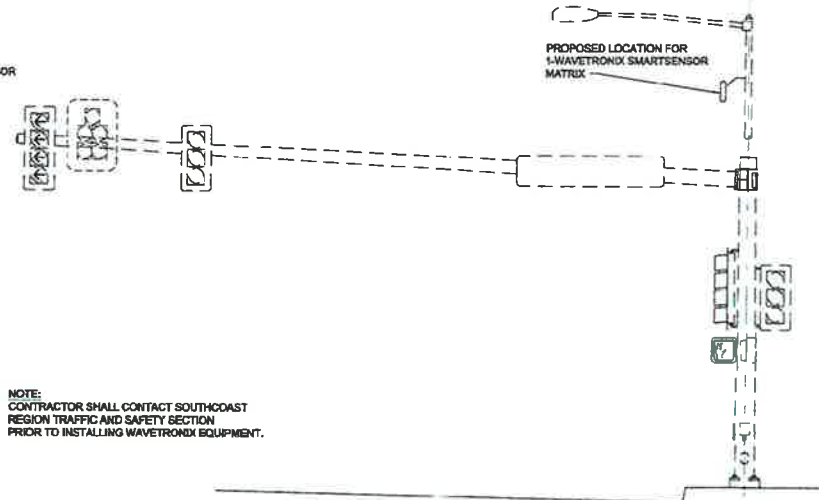

SIGNAL POLE NO. 2 DETAIL

Record Drawings have been reviewed by the Project Engineer, and represent to the best of my knowledge, the project as constructed.
PE MWH Date 5-9-17

DO NOT SCALE FROM THESE DRAWINGS USE DIMENSIONS

CHECKED BY: D. EPSTEIN 		STATE OF ALASKA DEPARTMENT OF TRANSPORTATION & PUBLIC FACILITIES SOUTHCOAST REGION	
DESIGNED BY: J. MARLE DRAWN BY: D. EPSTEIN DATE: 01-13-15		JNU-MENDENHALL VALLEY ADAPTIVE TRAFFIC SIGNAL CONTROL SYSTEM	
PATH: Q:\JNU\MAS-PLAN\BETHOOD_E1\SIGNAL_POLE_DETAILS.DWG TAB: E7 Monday, October 13, 2016 8:58:18 AM		SIGNAL POLE DETAILS RIVERSIDE AND RIVERWOOD	
REVISIONS NO. DATE DESCRIPTION		PROJECT DESIGNATION: Z685840000-0003184	YEAR: 2016 SHEET NO: E7 TOTAL SHEETS: 36

1



MAJOR WORK ITEMS AT THIS INTERSECTION

1. REPLACE ALL SIGNAL HEADS.
2. INSTALL PTZ CAMERA TO SIGNAL POLE 1.
3. INSTALL RADAR DETECTORS AS SHOWN.

SIGNAL HEAD / WAVETRONIX / PTZ CAMERA SUMMARY TABLE

Signal No. 1, Glacier and Egan Drive ("McNuggett")

Pole No.	Signal Head No.	Mounting Type	Indication	Wavetronix Matrix Unit Detector Number and mounting location	Wavetronix Advance Unit Number and mounting location	PTZ Camera Number and mounting location
1	11	Side-mounted S-1	RLA-YLA-GRA			
1	12	See Note 3	RLA-YLA-GRA			
1					6, mast arm	1, mast arm
2	21	Side-mounted S-1	R-Y-G			
2	22	See Note 3	R-Y-G			
2	23	See Note 3	RLA-YLA-GLA			
2				4, mast arm		
2					1, mast arm	
3	31	Side-mounted S-1	R-Y-G			
3	32	See Note 3	R-Y-G			
3	33	See Note 3	R-Y-G			
3				2, mast arm		
3					5, mast arm	
3				3, signal pole		
4	52	Post-mounted T-1	RLA-YLA-GLA			

Could not be replaced - Replaced indications w/ LED's

*EGAN DRIVE
Could not be replaced. Existing mast arm is "custom" installed into the signal head housing.*

- NOTES:
1. SIGNAL NUMBER CORRESPONDS WITH SHEET A1.
 2. SEE STANDARD DRAWING T-30.11 FOR MOUNTING TYPE.
 3. ASTROBRAC STELLAR STAINLESS 3 SECTION 96" CABLE MOUNT AS-Ø125-3-96 FOR 3 SECTION HEAD.
 4. ASTROBRAC STELLAR STAINLESS 4 SECTION 96" CABLE MOUNT AS-Ø125-4-96 FOR 4 SECTION HEAD.
 5. ASTROBRAC STELLAR STAINLESS 5 SECTION 96" CABLE MOUNT AS-Ø125-5-96 FOR 5 SECTION HEAD.

SIGNAL HEAD CODE LEGEND

Indication Code	Translation
R	Red ball
Y	Yellow ball
G	Green ball
RLA	Red left arrow
YLA	Yellow left arrow
GLA	Green left arrow
RRA	Red right arrow
YRA	Yellow right arrow
GRA	Green right arrow

Record Drawings have been reviewed by the Project Engineer, and represent to the best of my knowledge the project as constructed.

PE MWH Date 5.3.17

PATH:
G:\m\168584\Plan\168584_Glacier & Egan
Mod: 12/Aug/15 10:30AM
PLOT:
PSPACE 1=1 (F) OR MSPACE 1=1 (F)
TAL: TYPICAL

ADDENDUM NUMBER
ATTACHMENT NUMBER

RECORD OF REVISIONS
No. DATE DESCRIPTION

MENDELHALL VALLEY ADAPTIVE TRAFFIC SIGNAL CONTROL SYSTEM
Z685840000 - 0003184

SIGNAL NO. 1
GLACIER AND EGAN DRIVE
(MCNUGGETT)



DESIGNED BY: D. EPSTEIN
DRAWN BY: D. STEVENS

STATE OF ALASKA
DEPARTMENT OF TRANSPORTATION & PUBLIC FACILITIES
SOUTHEAST REGION

MENDELHALL VALLEY ADAPTIVE TRAFFIC SIGNAL CONTROL SYSTEM

SIGNAL NO. 1
GLACIER AND EGAN DRIVE
(MCNUGGETT)

PROJECT DESIGNATION NUMBER
Z685840000 - 0003184


STATE	YEAR
ALASKA	2015
SHEET NUMBER	TOTAL SHEETS
F1	29

2

- NOTES:**
1. SIGNAL NUMBER CORRESPONDS WITH SHEET A1.
 2. SEE STANDARD DRAWING T-30.11 FOR MOUNTING TYPE.
 3. ASTROBRAC STELLAR STAINLESS 3 SECTION 96" CABLE MOUNT AS-Ø125-3-96 FOR 3 SECTION HEAD.
 4. ASTROBRAC STELLAR STAINLESS 4 SECTION 96" CABLE MOUNT AS-Ø125-4-96 FOR 4 SECTION HEAD.
 5. ASTROBRAC STELLAR STAINLESS 5 SECTION 96" CABLE MOUNT AS-Ø125-5-96 FOR 5 SECTION HEAD.

SIGNAL HEAD CODE LEGEND	
Indication Code	Translation
R	Red ball
Y	Yellow ball
G	Green ball
RLA	Red left arrow
YLA	Yellow left arrow
GLA	Green left arrow
RRA	Red right arrow
YRA	Yellow right arrow
GRA	Green right arrow

FIRST NATIONAL BANK OF ANCHORAGE

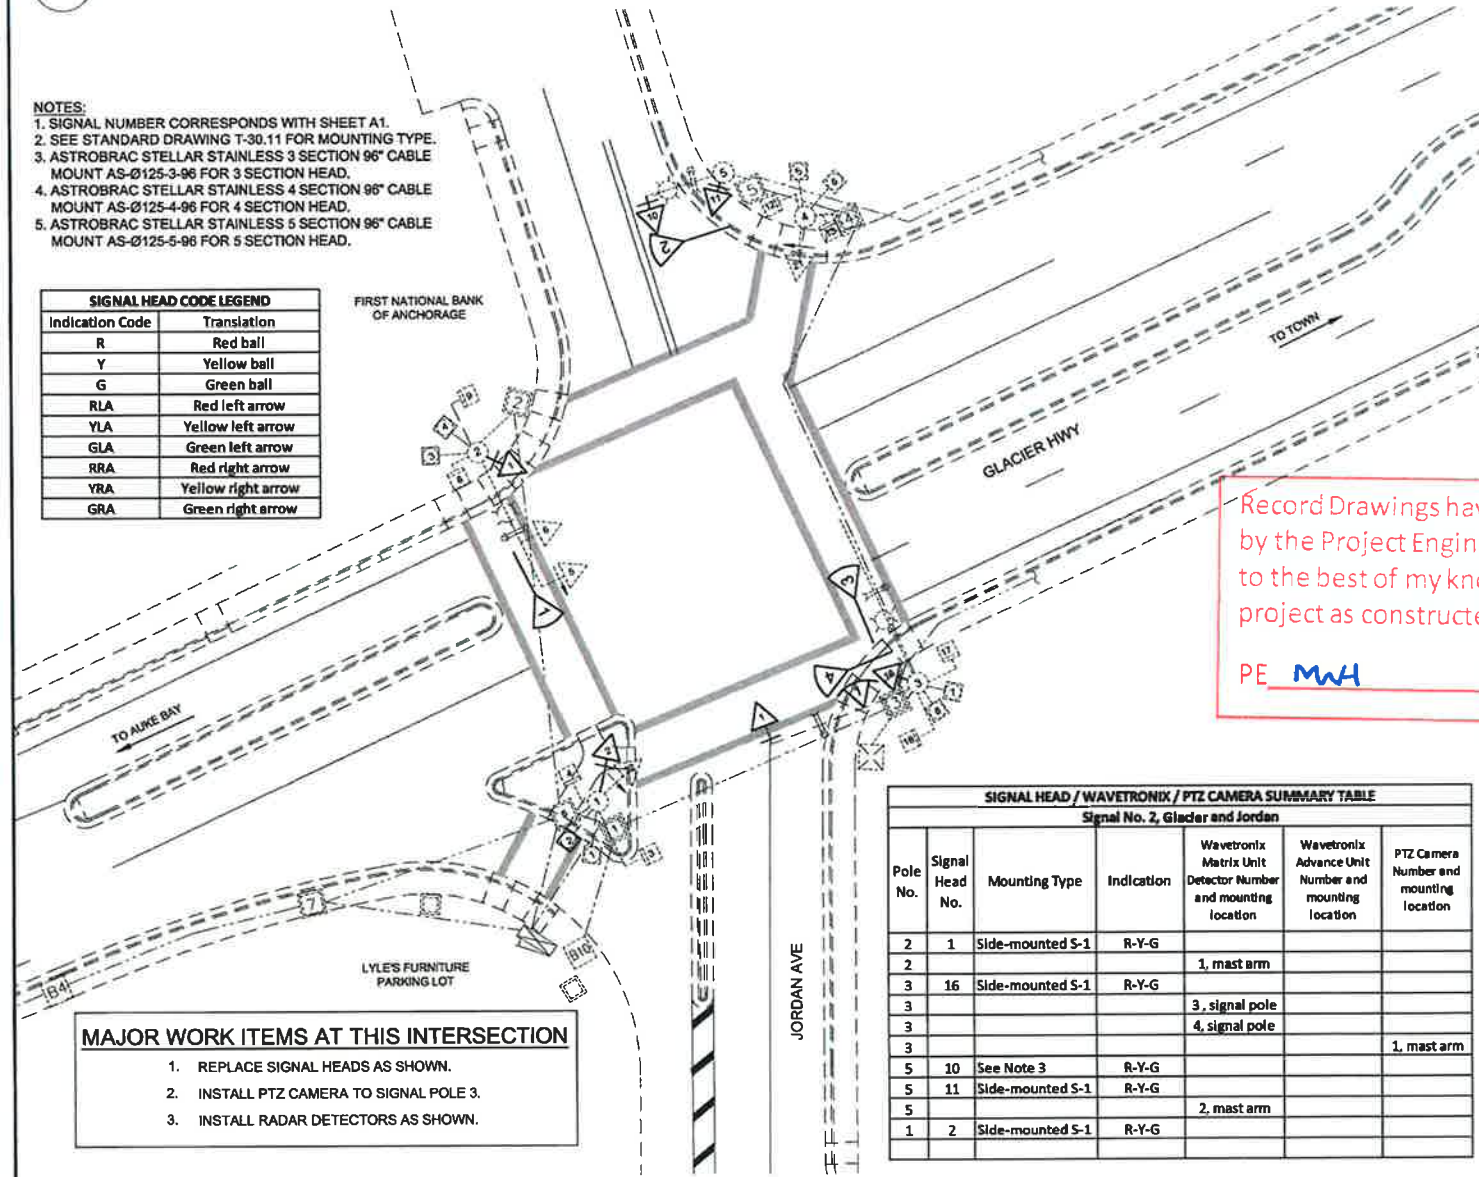

Record Drawings have been reviewed by the Project Engineer, and represent to the best of my knowledge, the project as constructed.

PE MWH Date 5-9-17

- MAJOR WORK ITEMS AT THIS INTERSECTION**
1. REPLACE SIGNAL HEADS AS SHOWN.
 2. INSTALL PTZ CAMERA TO SIGNAL POLE 3.
 3. INSTALL RADAR DETECTORS AS SHOWN.

SIGNAL HEAD / WAVETRONIX / PTZ CAMERA SUMMARY TABLE						
Signal No. 2, Glacier and Jordan						
Pole No.	Signal Head No.	Mounting Type	Indication	Wavetronix Matrix Unit Detector Number and mounting location	Wavetronix Advance Unit Number and mounting location	PTZ Camera Number and mounting location
2	1	Side-mounted S-1	R-Y-G			
2				1, mast arm		
3	16	Side-mounted S-1	R-Y-G			
3				3, signal pole		
3				4, signal pole		
3						1, mast arm
5	10	See Note 3	R-Y-G			
5	11	Side-mounted S-1	R-Y-G			
5				2, mast arm		
1	2	Side-mounted S-1	R-Y-G			

PATH: C:\pva\88584\Planent\88584_Glacier & Jordan Mon, 17/Aug/15 11:18AM
 PLOT: F:\SPACE 1\1 (7) OR MSPACE 1\1 (7)
 TAB: TYPICALS

ADDENDUM NUMBER		
ATTACHMENT NUMBER		
RECORD OF REVISIONS		
No.	DATE	DESCRIPTION

MENDENHALL VALLEY ADAPTIVE TRAFFIC SIGNAL CONTROL SYSTEM
 Z885840000 - 0003184

SIGNAL NO. 2
 GLACIER AND JORDAN



DESIGNED BY: D. EPSTEIN
 DRAWN BY: D. STEVENS


STATE OF ALASKA
 DEPARTMENT OF TRANSPORTATION & PUBLIC FACILITIES
 SOUTHCOAST REGION

MENDENHALL VALLEY ADAPTIVE TRAFFIC SIGNAL CONTROL SYSTEM

SIGNAL NO. 2
 GLACIER AND JORDAN

PROJECT DESIGNATION NUMBER:
 Z885840000 - 0003184

STATE	YEAR
ALASKA	2015
SHEET NUMBER	TOTAL SHEETS
F3	29

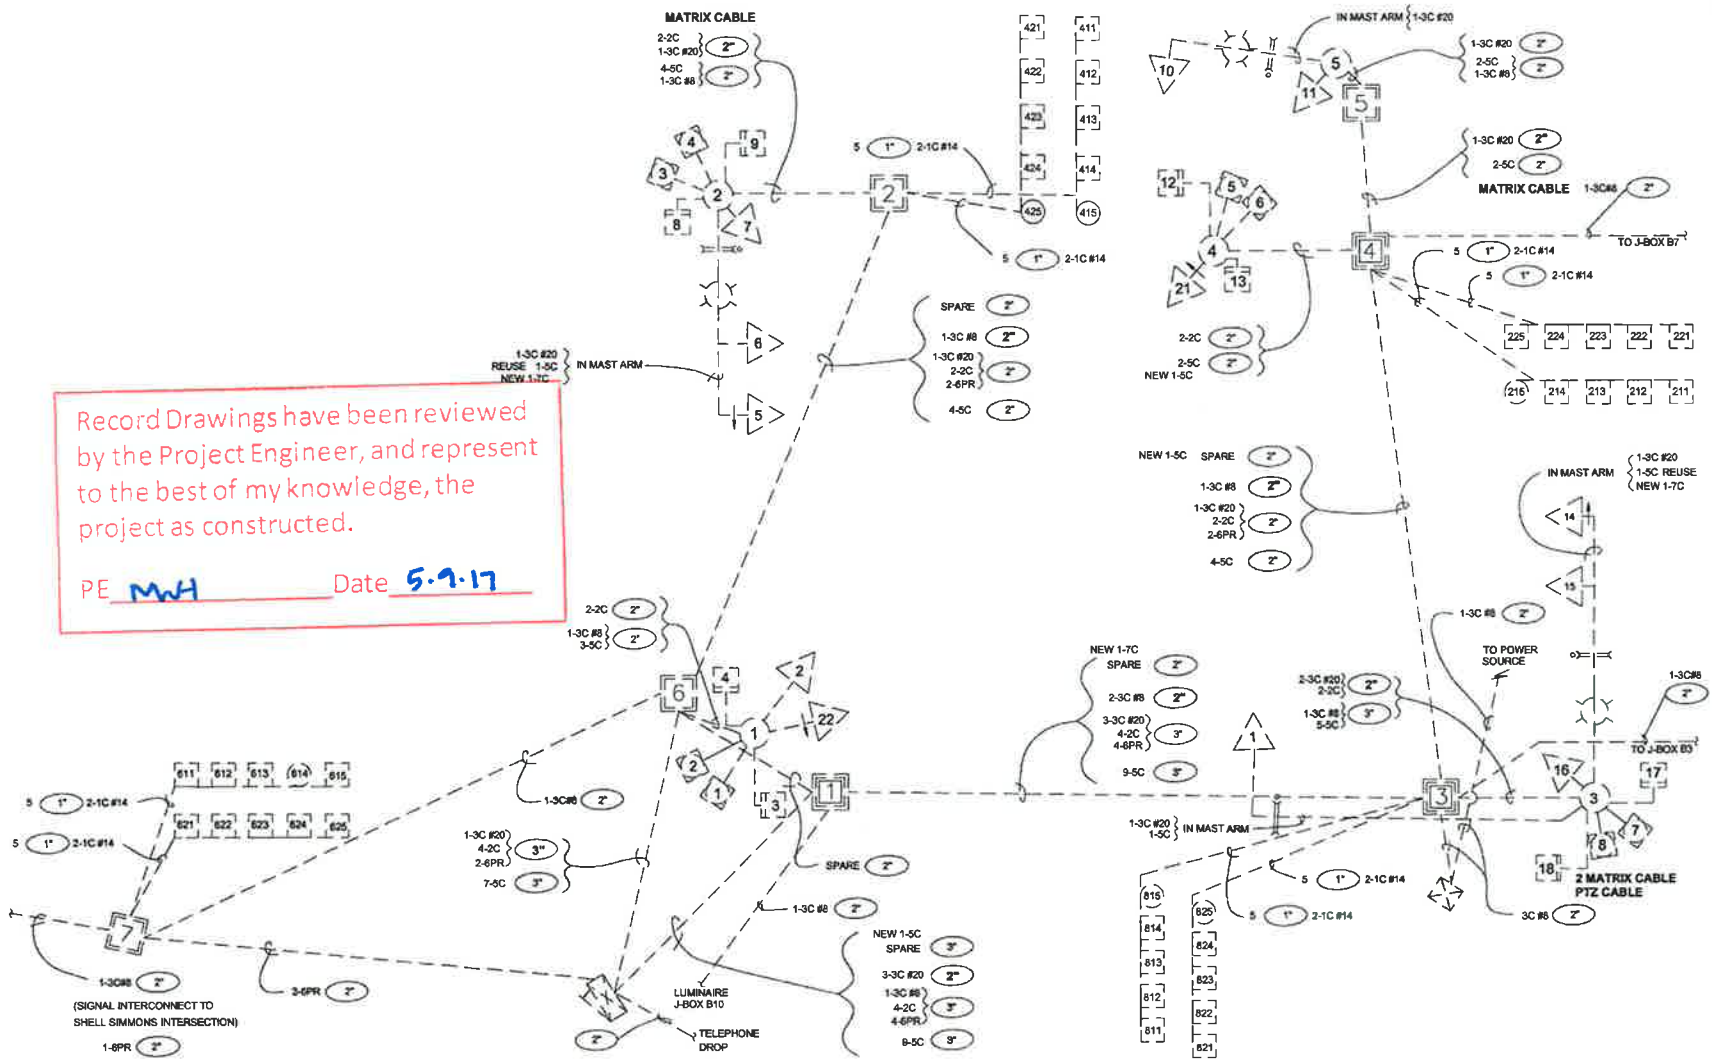

Record Drawings have been reviewed by the Project Engineer, and represent to the best of my knowledge, the project as constructed.
 PE MWH Date 5.7.17

PATH
 C:\p\m\88584\Drawings\05164_Glacier & Jordan
 Date: 18/Aug/15 02:52PM
 PLOT:
 PBPAGE 1 of 1 (F) OR MSPAGE 1 of 1 (F)
 TAB TYPICALS

RECORD OF REVISIONS		
No.	DATE	DESCRIPTION

MENDENHALL VALLEY ADAPTIVE
 TRAFFIC SIGNAL CONTROL SYSTEM
 Z885840000 ~ 0003184


SIGNAL NO. 2
 GLACIAR AND JORDAN
 WIRING DIAGRAM



DESIGNED BY: D. EPSTEIN	DATE: 5-19-15
DRAWN BY: D. STEVENS	
STATE OF ALASKA DEPARTMENT OF TRANSPORTATION & PUBLIC FACILITIES SOUTHCOST REGION MENDENHALL VALLEY ADAPTIVE TRAFFIC SIGNAL CONTROL SYSTEM SIGNAL NO. 2 GLACIAR AND JORDAN WIRING DIAGRAM	
PROJECT DESIGNATION NUMBER Z885840000 ~ 0003184	
STATE	YEAR
ALASKA	2015
SHEET NUMBER	TOTAL SHEETS
F4	29

3

- NOTES:
1. SIGNAL NUMBER CORRESPONDS WITH SHEET A1.
 2. SEE STANDARD DRAWING T-30.11 FOR MOUNTING TYPE.
 3. ASTROBRAC STELLAR STAINLESS 3 SECTION 96" CABLE MOUNT AS-Ø125-3-96 FOR 3 SECTION HEAD.
 4. ASTROBRAC STELLAR STAINLESS 4 SECTION 96" CABLE MOUNT AS-Ø125-4-96 FOR 4 SECTION HEAD.
 5. ASTROBRAC STELLAR STAINLESS 5 SECTION 96" CABLE MOUNT AS-Ø125-5-96 FOR 5 SECTION HEAD.

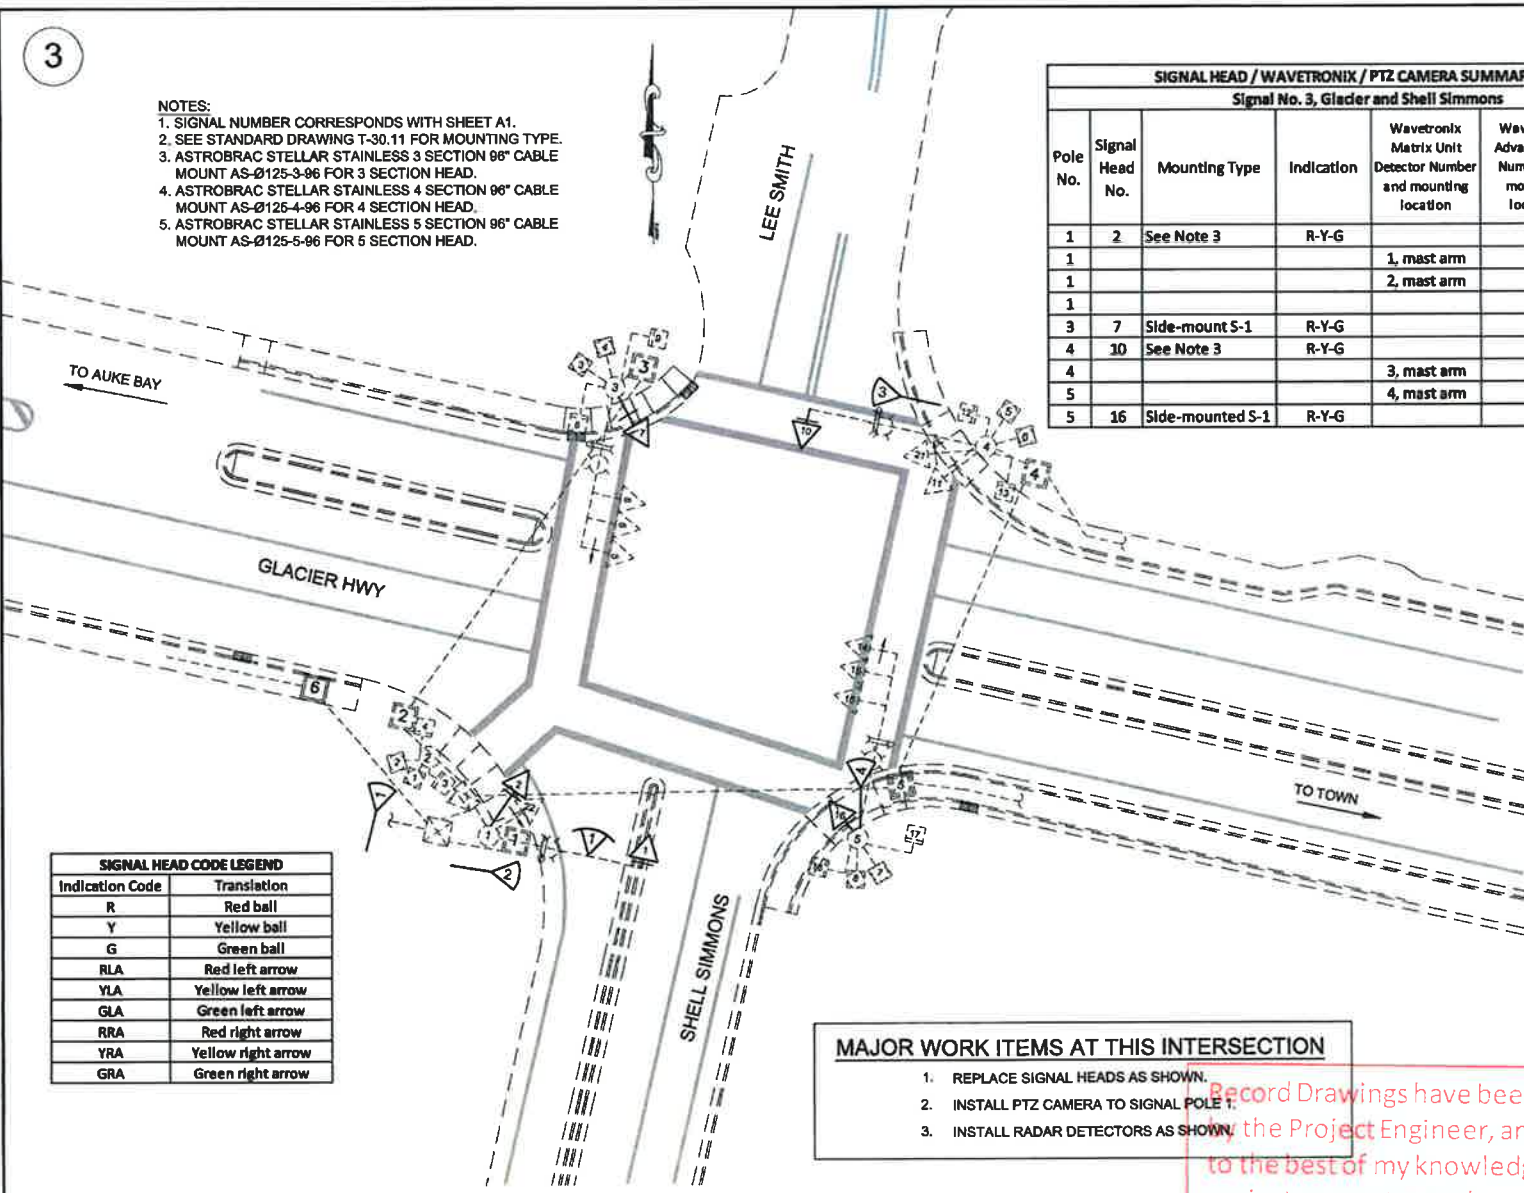

SIGNAL HEAD CODE LEGEND	
Indication Code	Translation
R	Red ball
Y	Yellow ball
G	Green ball
RLA	Red left arrow
YLA	Yellow left arrow
GLA	Green left arrow
RRA	Red right arrow
YRA	Yellow right arrow
GRA	Green right arrow

SIGNAL HEAD / WAVETRONIX / PTZ CAMERA SUMMARY TABLE						
Signal No. 3, Glacier and Shell Simmons						
Pole No.	Signal Head No.	Mounting Type	Indication	Wavetronix Matrix Unit Detector Number and mounting location	Wavetronix Advance Unit Number and mounting location	PTZ Camera Number and mounting location
1	2	See Note 3	R-Y-G			
1				1, mast arm		
1				2, mast arm		
1						1, mast arm
3	7	Side-mount S-1	R-Y-G			
4	10	See Note 3	R-Y-G			
4				3, mast arm		
5				4, mast arm		
5	16	Side-mounted S-1	R-Y-G			

- MAJOR WORK ITEMS AT THIS INTERSECTION**
1. REPLACE SIGNAL HEADS AS SHOWN.
 2. INSTALL PTZ CAMERA TO SIGNAL POLE 1.
 3. INSTALL RADAR DETECTORS AS SHOWN.

Record Drawings have been reviewed by the Project Engineer, and represent to the best of my knowledge, the project as constructed.

PE *MWH* Date *5-9-17*

PATH: C:\pwworkspace\Projects\0264_Glacier & Shell Simm... 17/Nov/15 11:53AM
 PLOT: PSPACE 1x1 (P) OR MSPACE 1x1 (P)
 TAB: TYPICAL

ADDENDUM NUMBER

ATTACHMENT NUMBER

RECORD OF REVISIONS

No.	DATE	DESCRIPTION

MENDENHALL VALLEY ADAPTIVE TRAFFIC SIGNAL CONTROL SYSTEM
 Z685840000 - 0003184

SIGNAL NO. 3
 GLACIER AND SHELL SIMMONS



DESIGNED BY: D. EPSTEIN
 DRAWN BY: D. STEVENS

STATE OF ALASKA
 DEPARTMENT OF TRANSPORTATION & PUBLIC FACILITIES
 SOUTHWEST REGION

MENDENHALL VALLEY ADAPTIVE TRAFFIC SIGNAL CONTROL SYSTEM

SIGNAL NO. 3
 GLACIER AND SHELL SIMMONS


PROJECT DESIGNATION NUMBER
 Z685840000 - 0003184

STATE	YEAR
ALASKA	2015

SHEET NUMBER	TOTAL SHEETS
F5	29

Record Drawings have been reviewed by the Project Engineer, and represent to the best of my knowledge, the project as constructed.

PE MWH Date 5.9.17

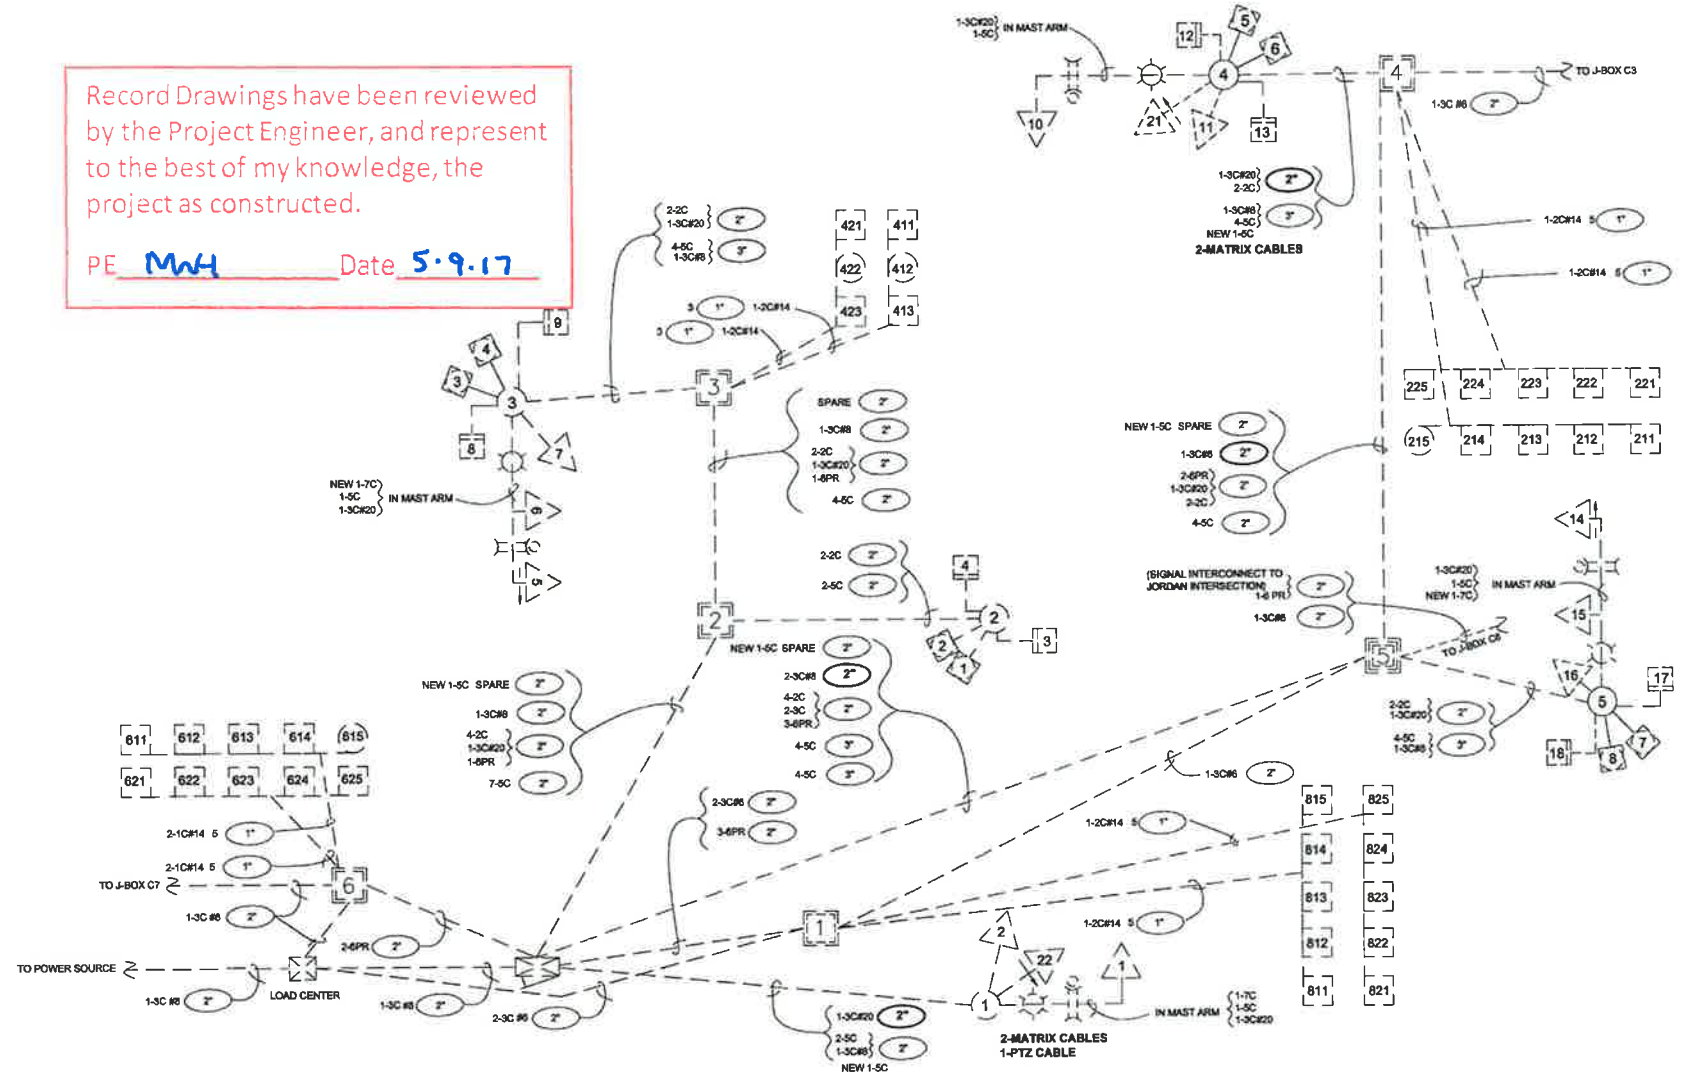

PATH:
 G:\Info\88584\PlanSet\88584_01.dwg & Sheet
 Tue, 18/Aug/15 03:53PM
 PLOT:
 PSPACE 1=1 (F) OR MSPACE 1=1 (F)
 TAB: TYPICAL

ADDENDUM NUMBER

ATTACHMENT NUMBER

RECORD OF REVISIONS

No.	DATE	DESCRIPTION

Mendenhall Valley Adaptive
 Traffic Signal Control System
 Z865840000 - 0003184

SIGNAL NO. 3
 GLACIER AND SHELL SIMMONS
 WIRING DIAGRAM



DESIGNED BY: D. EPSTEIN
 DRAWN BY: D. STEVENS

STATE OF ALASKA
 DEPARTMENT OF TRANSPORTATION
 & PUBLIC FACILITIES
 BOOTHCAFT REGION
 Mendenhall Valley Adaptive Traffic Signal
 Control System
 SIGNAL NO. 3
 GLACIER AND
 SHELL SIMMONS
 WIRING DIAGRAM

PROJECT DESIGNATION NUMBER
 Z865840000 - 0003184


STATE	YEAR
ALASKA	2015

SHEET NUMBER	TOTAL SHEETS
F6	29

SIGNAL HEAD / WAVETRONIX / PTZ CAMERA SUMMARY TABLE						
Signal No. 4, Loop Road and Egan Drive						
Pole No.	Signal Head No.	Mounting Type	Indication	Wavetronix Matrix Unit Detector Number and mounting location	Wavetronix Advance Unit Number and mounting location	PTZ Camera Number and mounting location
1	3	Side-mounted S-2	RLA-YLA-GLA			
1	4	Share with Signal No. 3	R-Y-G			
1	1	See Note 3	RLA-YLA-GLA			
1	2	See Note 4	R-Y-G-GLA			
1					6, mast arm	1, mast arm
1				1, mast arm		
2	10	Side-mounted S-1	R-Y-G			
2	7	See Note 3	R-Y-G			
2	8	See Note 3	RLA-YLA-GLA			
2				2, mast arm		
2					4, mast arm	
2					3, mast arm	
3	12	Side-mount S-1	RLA-YLA-GLA			
3	9	Side-mount S-1	R-Y-G-GLA			
3	13	See Note 4	R-Y-G-GLA			
3				5, mast arm	7, Mast arm	
4	18	Side-mounted S-2	RLA-YLA-GLA			
4	19	Share with Signal No. 18	R-Y-G			
4	14	See Note 3	RLA-YLA-GLA			
4	16	See Note 3	R-Y-G			
4				4, mast arm		
5	17	Post-mounted T-1	R-Y-G			
8	26	Post-mounted T-2	R-Y-G			
8	27	Share with Signal No. 26	RLA-YLA-GLA			

MAJOR WORK ITEMS AT THIS INTERSECTION

1. REPLACE ALL SIGNAL HEADS.
2. INSTALL PTZ CAMERA TO SIGNAL POLE 1.
3. INSTALL RADAR DETECTORS AS SHOWN.
4. REPLACE EXISTING SIGNAL CABINET WITH NEW TS-2, TYPE 2 SIGNAL CABINET.

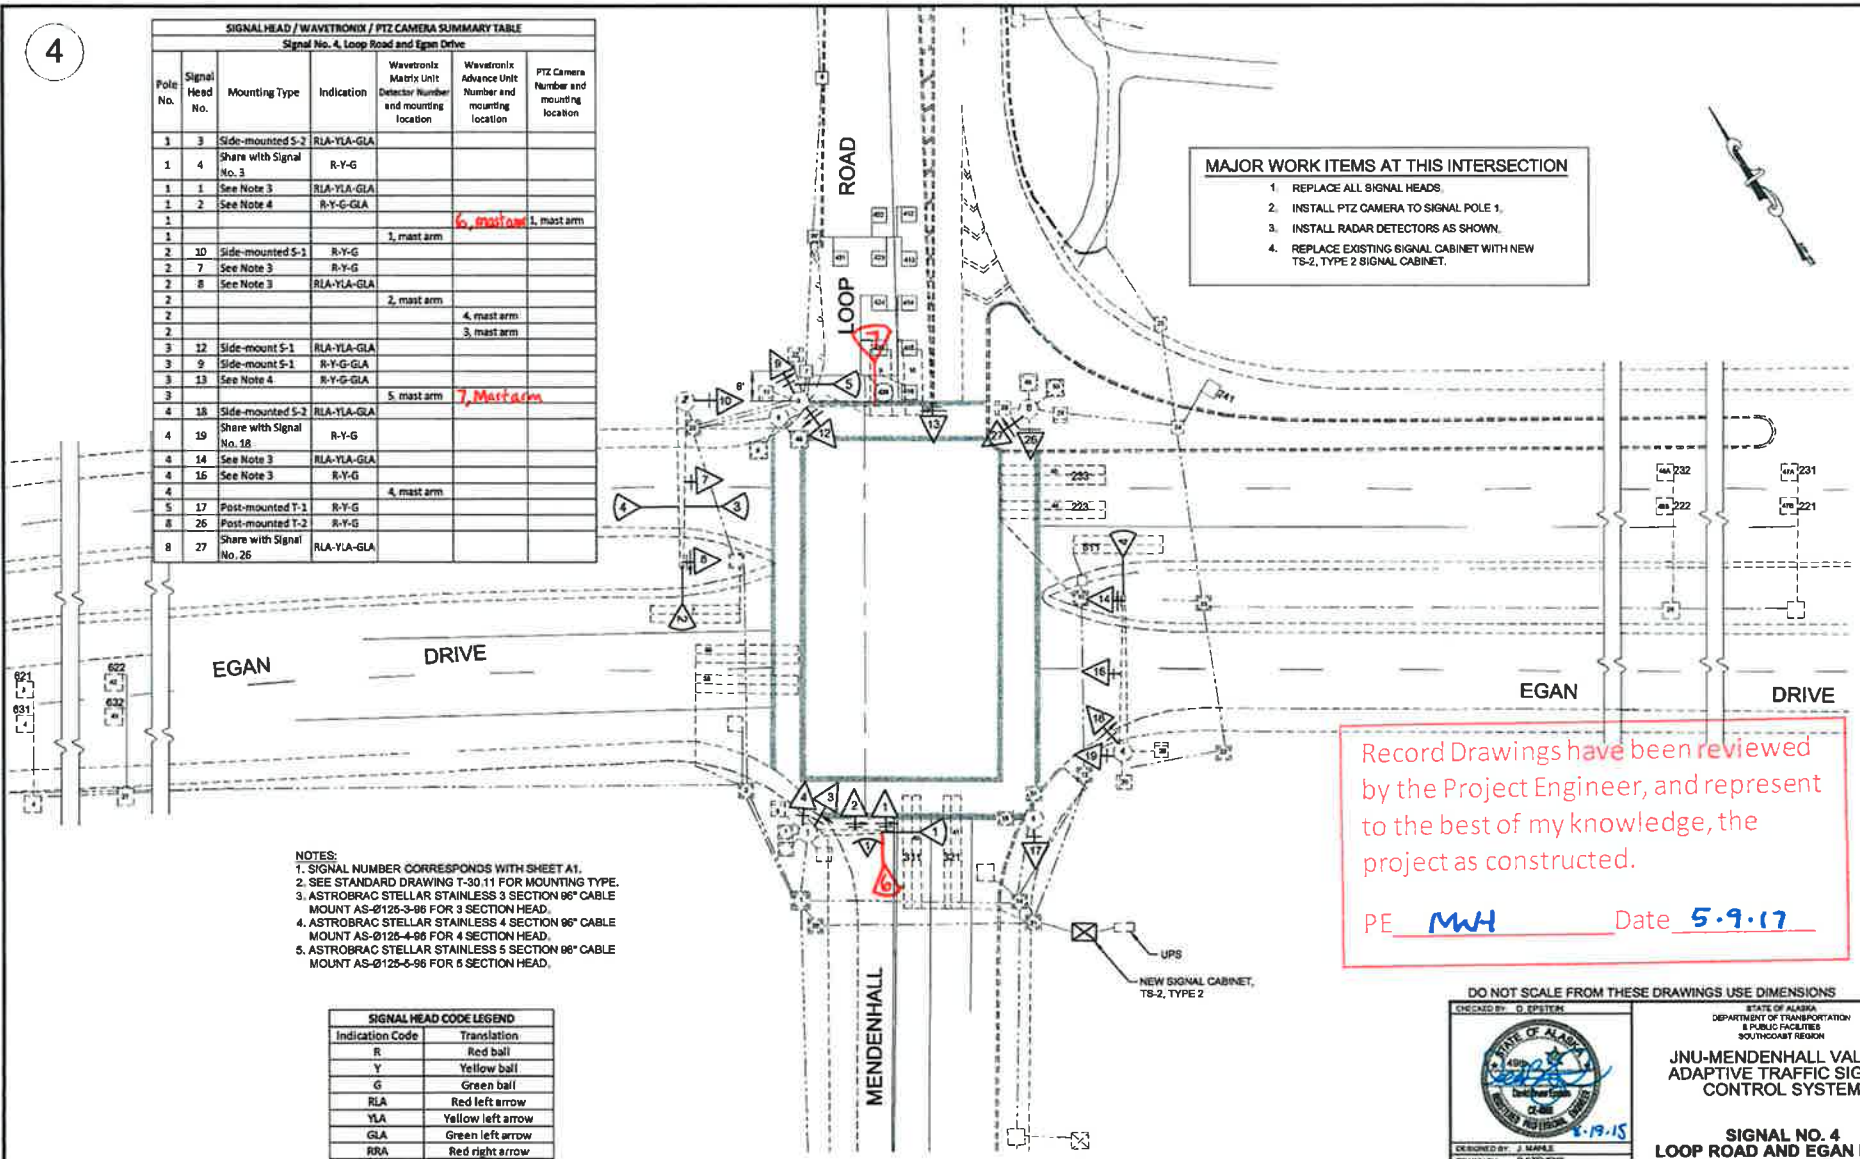

NOTES:
 1. SIGNAL NUMBER CORRESPONDS WITH SHEET A1.
 2. SEE STANDARD DRAWING T-30.11 FOR MOUNTING TYPE.
 3. ASTROBRAC STELLAR STAINLESS 3 SECTION 96" CABLE MOUNT AS-Ø125-3-96 FOR 3 SECTION HEAD.
 4. ASTROBRAC STELLAR STAINLESS 4 SECTION 96" CABLE MOUNT AS-Ø125-4-96 FOR 4 SECTION HEAD.
 5. ASTROBRAC STELLAR STAINLESS 5 SECTION 96" CABLE MOUNT AS-Ø125-5-96 FOR 5 SECTION HEAD.

SIGNAL HEAD CODE LEGEND	
Indication Code	Translation
R	Red ball
Y	Yellow ball
G	Green ball
RLA	Red left arrow
YLA	Yellow left arrow
GLA	Green left arrow
RRA	Red right arrow
YRA	Yellow right arrow
GRA	Green right arrow

Record Drawings have been reviewed by the Project Engineer, and represent to the best of my knowledge, the project as constructed.

PE MWH Date 5.9.17

DO NOT SCALE FROM THESE DRAWINGS USE DIMENSIONS

CHECKED BY: G. EPSTEIN

STATE OF ALASKA
 DEPARTMENT OF TRANSPORTATION
 & PUBLIC FACILITIES
 SOUTHCENTRAL REGION

JNU-MENDENHALL VALLEY
 ADAPTIVE TRAFFIC SIGNAL
 CONTROL SYSTEM

SIGNAL NO. 4
 LOOP ROAD AND EGAN DRIVE


DESIGNED BY: J. MARLE
 DRAWN BY: G. STEVENS

DATE: 5.19.15

PATH: C:\JNU\B04\PLAN\B04_LOOP RD & EGAN DRIVE.DWG
 TAB: MODEL: Wednesday, August 16, 2018 7:42:19 AM STEVENS, DAVID A (DOT)

NO.	DATE	REVISIONS	DESCRIPTION	PROJECT DESIGNATION	YEAR	SHEET NO.	TOTAL SHEETS
				Z685840000-0003184	2015	F7	29

4

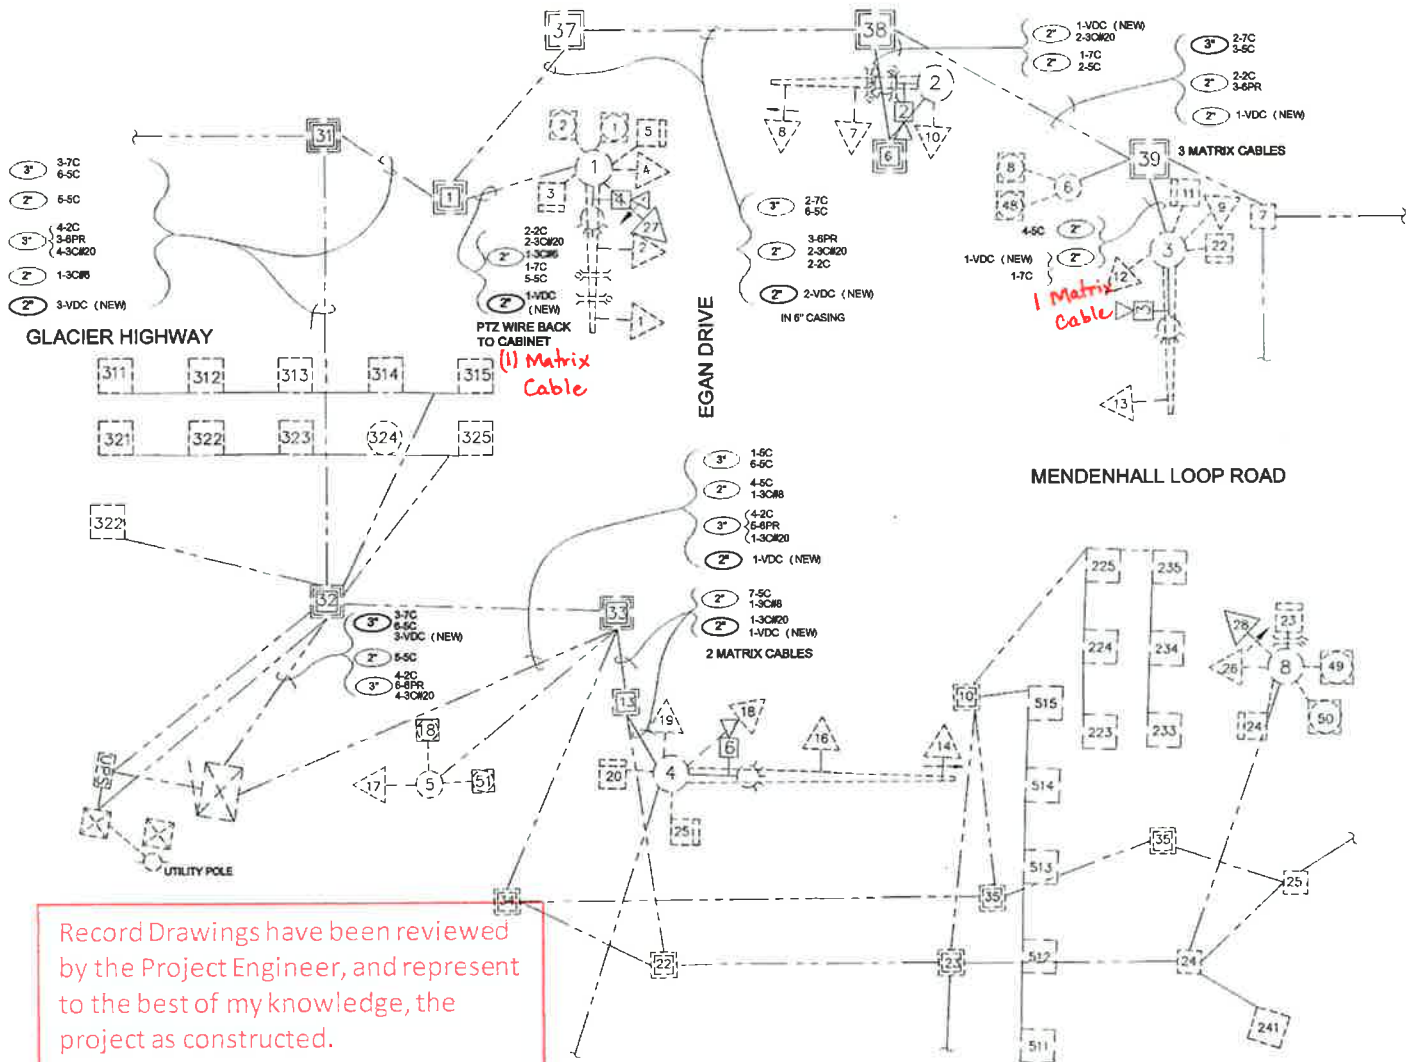

Record Drawings have been reviewed by the Project Engineer, and represent to the best of my knowledge, the project as constructed.
 PE MWH Date 5.9.17

PATH: Q:\no\68584\Planets\68584_Loop & Egan
 Title: 15/Aug/15 02:54PM
 PLOT: P:\PAGE 1+1 (F) OR MBPAGE 1+1 (F)
 TAB: TYPICAL

ADDENDUM NUMBER		
ATTACHMENT NUMBER		
RECORD OF REVISIONS:		
No	DATE	DESCRIPTION

MENDENHALL VALLEY ADAPTIVE TRAFFIC SIGNAL CONTROL SYSTEM
 Z685840000 - 0003184

SIGNAL NO. 4
 LOOP ROAD AND EGAN DRIVE
 WIRING DIAGRAM



DESIGNED BY: D. EPSTEIN
 DRAWN BY: D. STEVENS


STATE OF ALASKA
 DEPARTMENT OF TRANSPORTATION & PUBLIC FACILITIES
 SOUTHEAST REGION
 MENDENHALL VALLEY
 ADAPTIVE TRAFFIC SIGNAL CONTROL SYSTEM

SIGNAL NO. 4 LOOP ROAD AND EGAN DRIVE WIRING DIAGRAM	
PROJECT DESIGNATION NUMBER Z685840000 - 0003184	
STATE	YEAR
ALASKA	2015
SHEET NUMBER	TOTAL SHEETS
F8	29

5

MAJOR WORK ITEMS AT THIS INTERSECTION

1. REPLACE ALL SIGNAL HEADS.
2. INSTALL PTZ CAMERA TO SIGNAL POLE 2.
3. INSTALL RADAR DETECTORS AS SHOWN.
4. REPLACE EXISTING SIGNAL CABINET WITH NEW TS-2, TYPE 2 CABINET.

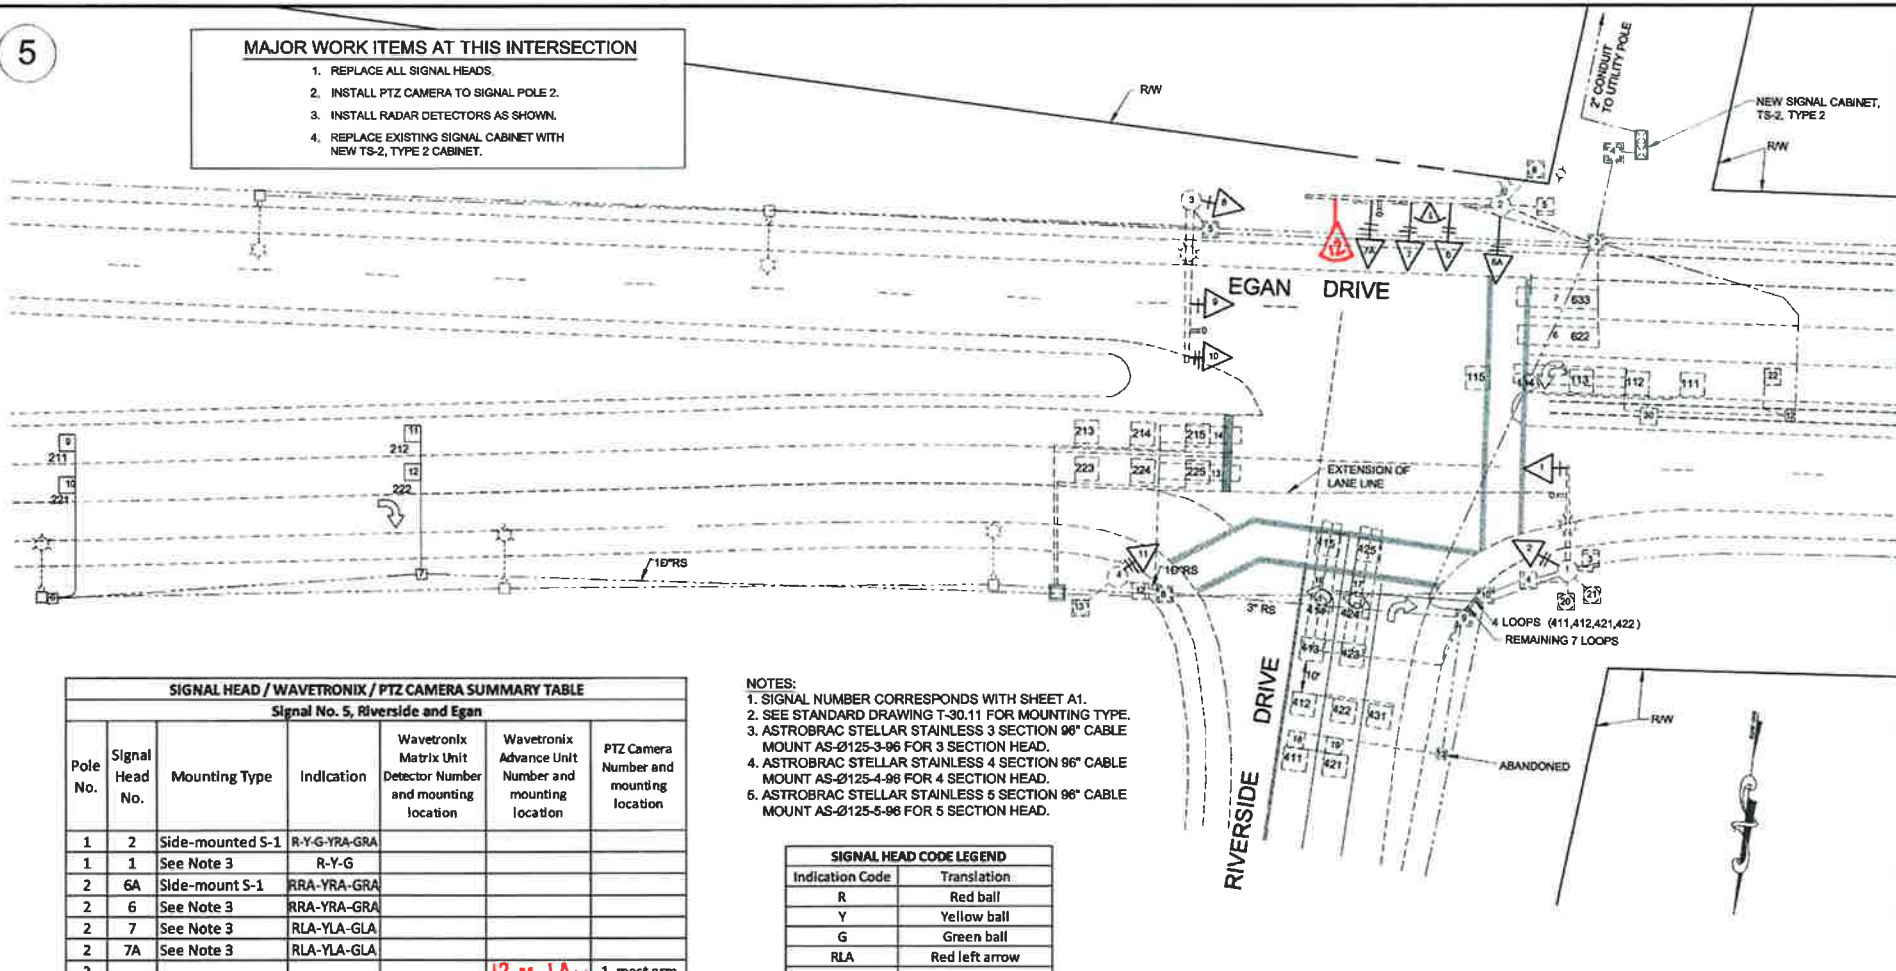

SIGNAL HEAD / WAVETRONIX / PTZ CAMERA SUMMARY TABLE

Signal No. 5, Riverside and Egan

Pole No.	Signal Head No.	Mounting Type	Indication	Wavetronix Matrix Unit Detector Number and mounting location	Wavetronix Advance Unit Number and mounting location	PTZ Camera Number and mounting location
1	2	Side-mounted S-1	R-Y-G-YRA-GRA			
1	1	See Note 3	R-Y-G			
2	6A	Side-mount S-1	RRA-YRA-GRA			
2	6	See Note 3	RRA-YRA-GRA			
2	7	See Note 3	RLA-YLA-GLA			
2	7A	See Note 3	RLA-YLA-GLA			
2					12, Mast Arm	1, mast arm
3	8	Side-mounted S-1	R-Y-G			
3	9	See Note 3	R-Y-G			
3	10	See Note 3	RLA-YLA-GLA			
4	11	Side-mounted S-1	RLA-YLA-GLA			

NOTES:

1. SIGNAL NUMBER CORRESPONDS WITH SHEET A1.
2. SEE STANDARD DRAWING T-30.11 FOR MOUNTING TYPE.
3. ASTROBRAC STELLAR STAINLESS 3 SECTION 96" CABLE MOUNT AS-0125-3-96 FOR 3 SECTION HEAD.
4. ASTROBRAC STELLAR STAINLESS 4 SECTION 96" CABLE MOUNT AS-0125-4-96 FOR 4 SECTION HEAD.
5. ASTROBRAC STELLAR STAINLESS 5 SECTION 96" CABLE MOUNT AS-0125-5-96 FOR 5 SECTION HEAD.

SIGNAL HEAD CODE LEGEND

Indication Code	Translation
R	Red ball
Y	Yellow ball
G	Green ball
RLA	Red left arrow
YLA	Yellow left arrow
GLA	Green left arrow
RRA	Red right arrow
YRA	Yellow right arrow
GRA	Green right arrow


Record Drawings have been reviewed by the Project Engineer, and represent to the best of my knowledge, the project as constructed.

PE MWH Date 5-9-17

DO NOT SCALE FROM THESE DRAWINGS USE DIMENSIONS

CHECKED BY: D. EPSTEIN
 STATE OF ALABAMA
 DEPARTMENT OF TRANSPORTATION & PUBLIC FACILITIES
 SOUTHCOAST REGION
 JNU-MENDENHALL VALLEY ADAPTIVE TRAFFIC SIGNAL CONTROL SYSTEM
 SIGNAL NO. 5
 RIVERSIDE AND EGAN DRIVE
 DESIGNED BY: J. MAHLE
 DRAWN BY: D. STEVENS
 DATE: 8-19-15
 PAT#: G:\IN\85564\PLAN\SET\0000_RIVERSIDE & EGAN.DWG
 TAB: PD Monday, August 17, 2015 1:30:02 PM STEVENS, DAVID A (DOT)
 PROJECT DESIGNATION: Z685840000-0003184
 YEAR: 2015
 SHEET NO: F9
 TOTAL SHEETS: 29

NOTES:
 1. ALL EXISTING ELECTRICAL SHOWN IS TO REMAIN UNLESS OTHERWISE NOTED.

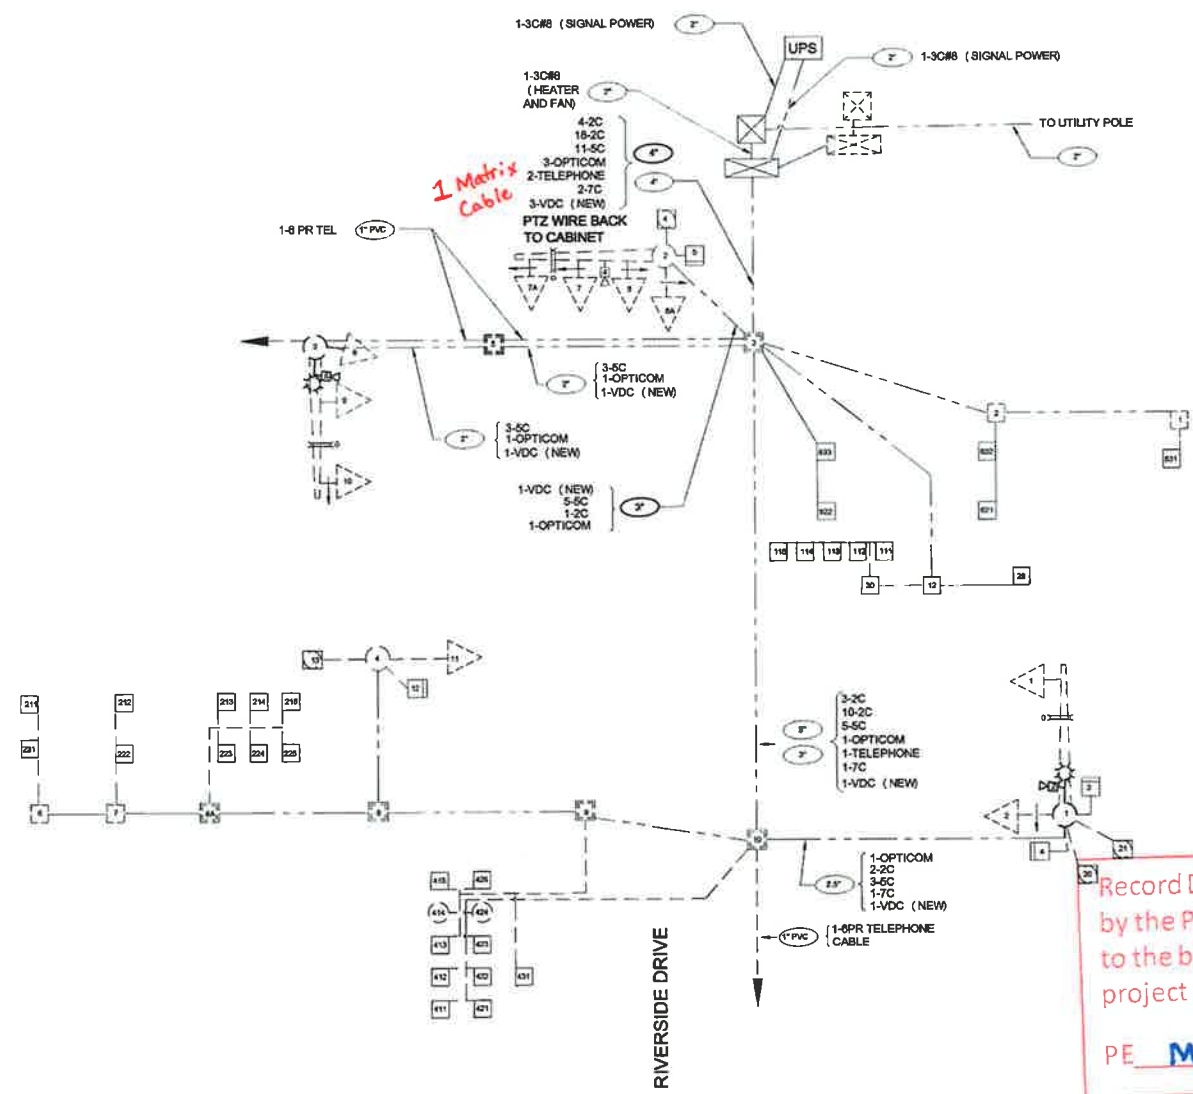

Record Drawings have been reviewed by the Project Engineer, and represent to the best of my knowledge, the project as constructed.
 PE MWH Date 5-9-17

PATH: Q:\m\68584\Plan\68584_Riverside & Egan
 Title: 18/Aug/15 02:55PM
 PLOT: PREPAGE 1st (F) OR MSPAGE 1st (F)
 TAB: TYPICALS

ADDENDUM NUMBER		
ATTACHMENT NUMBER		
RECORD OF REVISIONS		
No.	DATE	DESCRIPTION

MENDENHALL VALLEY ADAPTIVE TRAFFIC SIGNAL CONTROL SYSTEM
 Z885840000 - 0003184

SIGNAL NO. 5
 RIVERSIDE AND EGAN DRIVE
 WIRING DIAGRAM



DESIGNED BY: D. EPSTEIN
 DRAWN BY: D. STEVENS

STATE OF ALASKA
 DEPARTMENT OF TRANSPORTATION & PUBLIC FACILITIES
 SOUTHCOST REGION
 MENDENHALL VALLEY ADAPTIVE TRAFFIC SIGNAL CONTROL SYSTEM

SIGNAL NO. 5
 RIVERSIDE AND EGAN DRIVE
 WIRING DIAGRAM


PROJECT DESIGNATION NUMBER	Z885840000 - 0003184
STATE	ALASKA
YEAR	2015
SHEET NUMBER	F10
TOTAL SHEETS	29

SIGNAL HEAD / WAVETRONIX / PTZ CAMERA SUMMARY TABLE						
Signal No. 6, Loop Road and Mall Road						
Pole No.	Signal Head No.	Mounting Type	Indication	Wavetronix Matrix Unit Detector Number and mounting location	Wavetronix Advance Unit Number and mounting location	PTZ Camera Number and mounting location
1	3	Side-mounted S-2	RLA-YLA-GLA			
1	4	Share with Signal No. 3	R-Y-G			
1	2	See Note 3	R-Y-G			
2	8	Side-mounted S-1	R-Y-G			
2	5	See Note 3	RLA-YLA-GLA			
2	6	See Note 3	R-Y-G			
2				3, mast arm	17, Mast Arm	
2				4, mast arm		
3	11	Side-mounted S-2	RLA-YLA-GLA			
3	12	Share with Signal No. 11	R-Y-G			
3	10	See Note 3	R-Y-G			
3						1, mast arm
4	15	Side-mounted S-1	R-Y-G			
4	14	See Note 3	R-Y-G			
4	13	See Note 3	RLA-YLA-GLA			
4				1, mast arm	16, Mast Arm	
4				2, mast arm		

- MAJOR WORK ITEMS AT THIS INTERSECTION**
1. REPLACE ALL SIGNAL HEADS.
 2. INSTALL PTZ CAMERA TO SIGNAL POLE 3
 3. INSTALL RADAR DETECTORS AS SHOWN.

- NOTES:**
1. SIGNAL NUMBER CORRESPONDS WITH SHEET A1
 2. SEE STANDARD DRAWING T-30.11 FOR MOUNTING TYPE.
 3. ASTROBRAC STELLAR STAINLESS 3 SECTION 90° CABLE MOUNT AS-0125-3-00 FOR 3 SECTION HEAD.
 4. ASTROBRAC STELLAR STAINLESS 4 SECTION 90° CABLE MOUNT AS-0125-4-00 FOR 4 SECTION HEAD.
 5. ASTROBRAC STELLAR STAINLESS 5 SECTION 90° CABLE MOUNT AS-0125-5-00 FOR 5 SECTION HEAD.

SIGNAL HEAD CODE LEGEND	
Indication Code	Translation
R	Red ball
Y	Yellow ball
G	Green ball
RLA	Red left arrow
YLA	Yellow left arrow
GLA	Green left arrow
RRA	Red right arrow
YRA	Yellow right arrow
GRA	Green right arrow

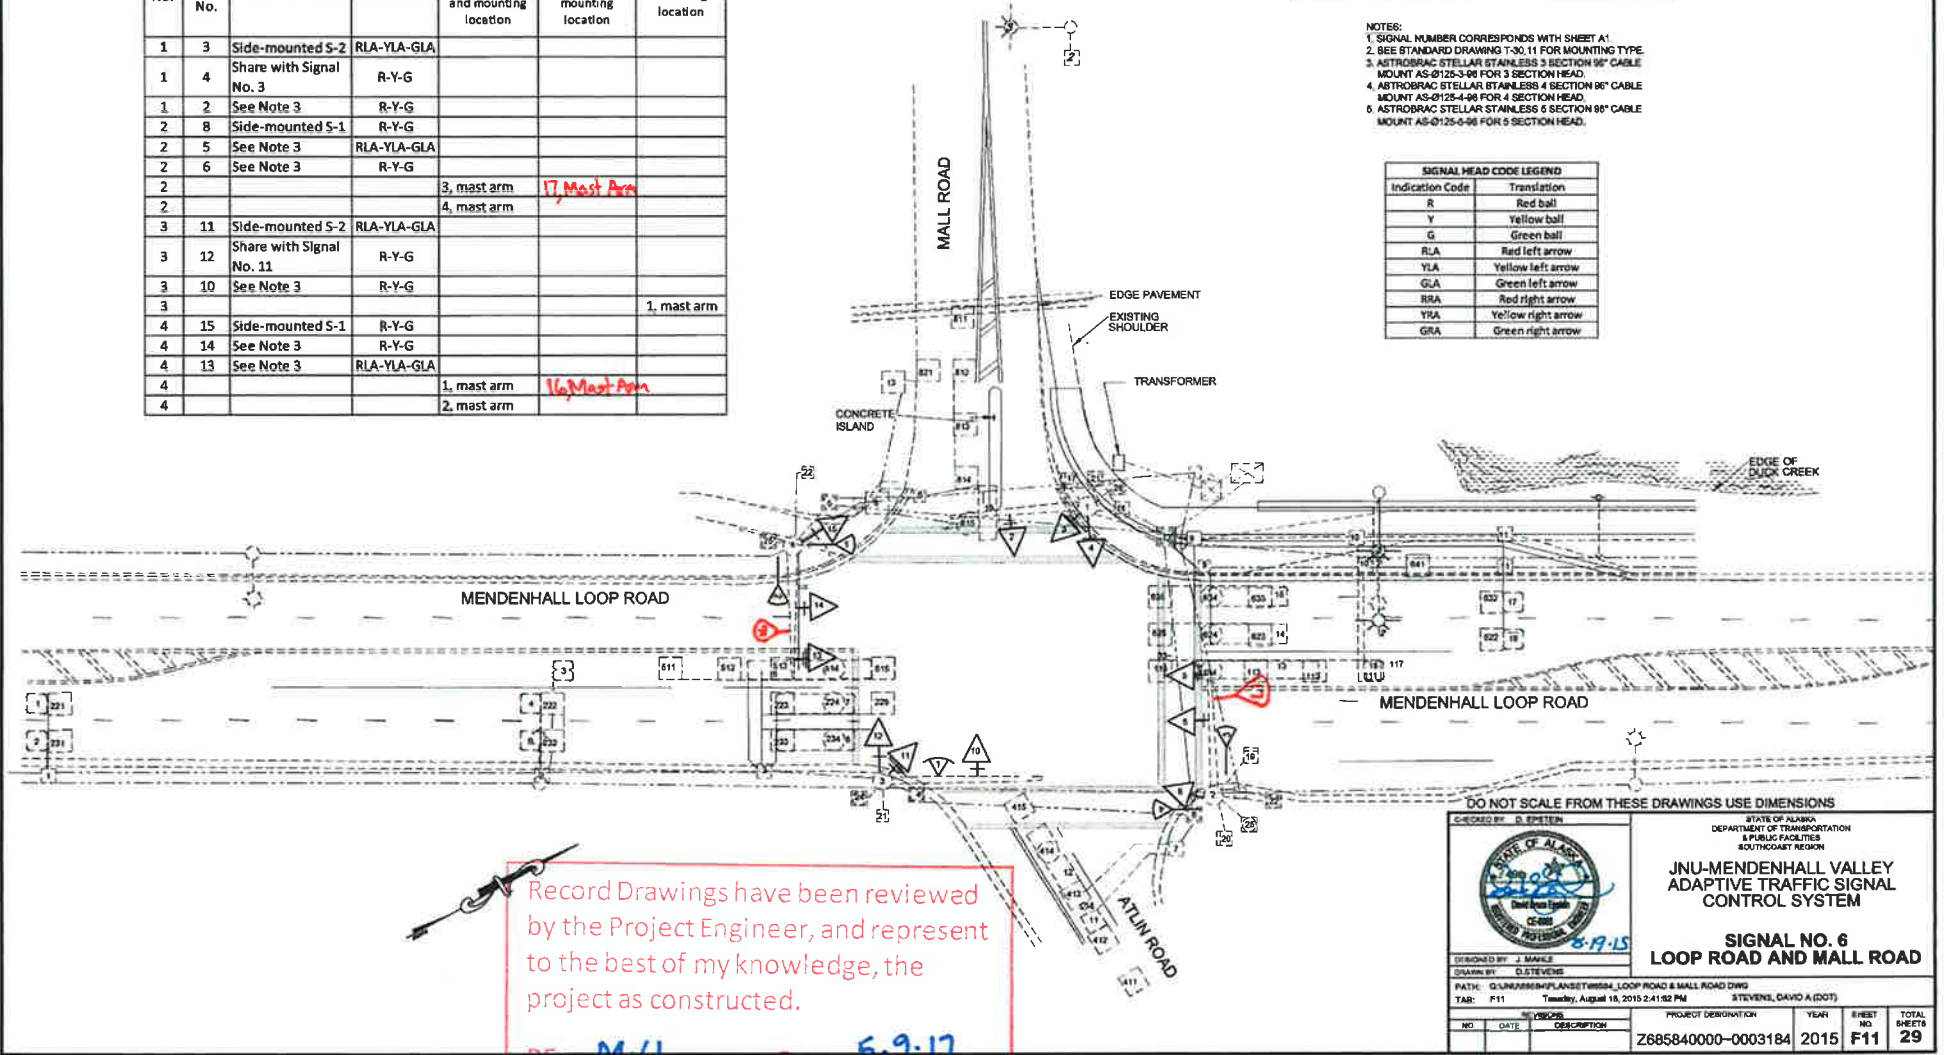

Record Drawings have been reviewed by the Project Engineer, and represent to the best of my knowledge, the project as constructed.

PE MWJ Date 5-9-17

DO NOT SCALE FROM THESE DRAWINGS USE DIMENSIONS

CHECKED BY: D. STEVENS

DESIGNED BY: J. MAHLE
DRAWN BY: D. STEVENS


STATE OF ALABAMA
DEPARTMENT OF TRANSPORTATION
& PUBLIC FACILITIES
SOUTHEAST REGION

**JNU-MENDENHALL VALLEY
ADAPTIVE TRAFFIC SIGNAL
CONTROL SYSTEM**

**SIGNAL NO. 6
LOOP ROAD AND MALL ROAD**

PATH: G:\UNRESERVED\PLANS\SET\ISSUE_LOOP ROAD & MALL ROAD.DWG
TAB: F11 Tuesday, August 16, 2015 2:41:02 PM STEVENS, DAVID A (DOT)

NO.	DATE	DESCRIPTION	PROJECT DESIGNATION	YEAR	SHEET NO.	TOTAL SHEETS
			Z685840000-0003184	2015	F11	29

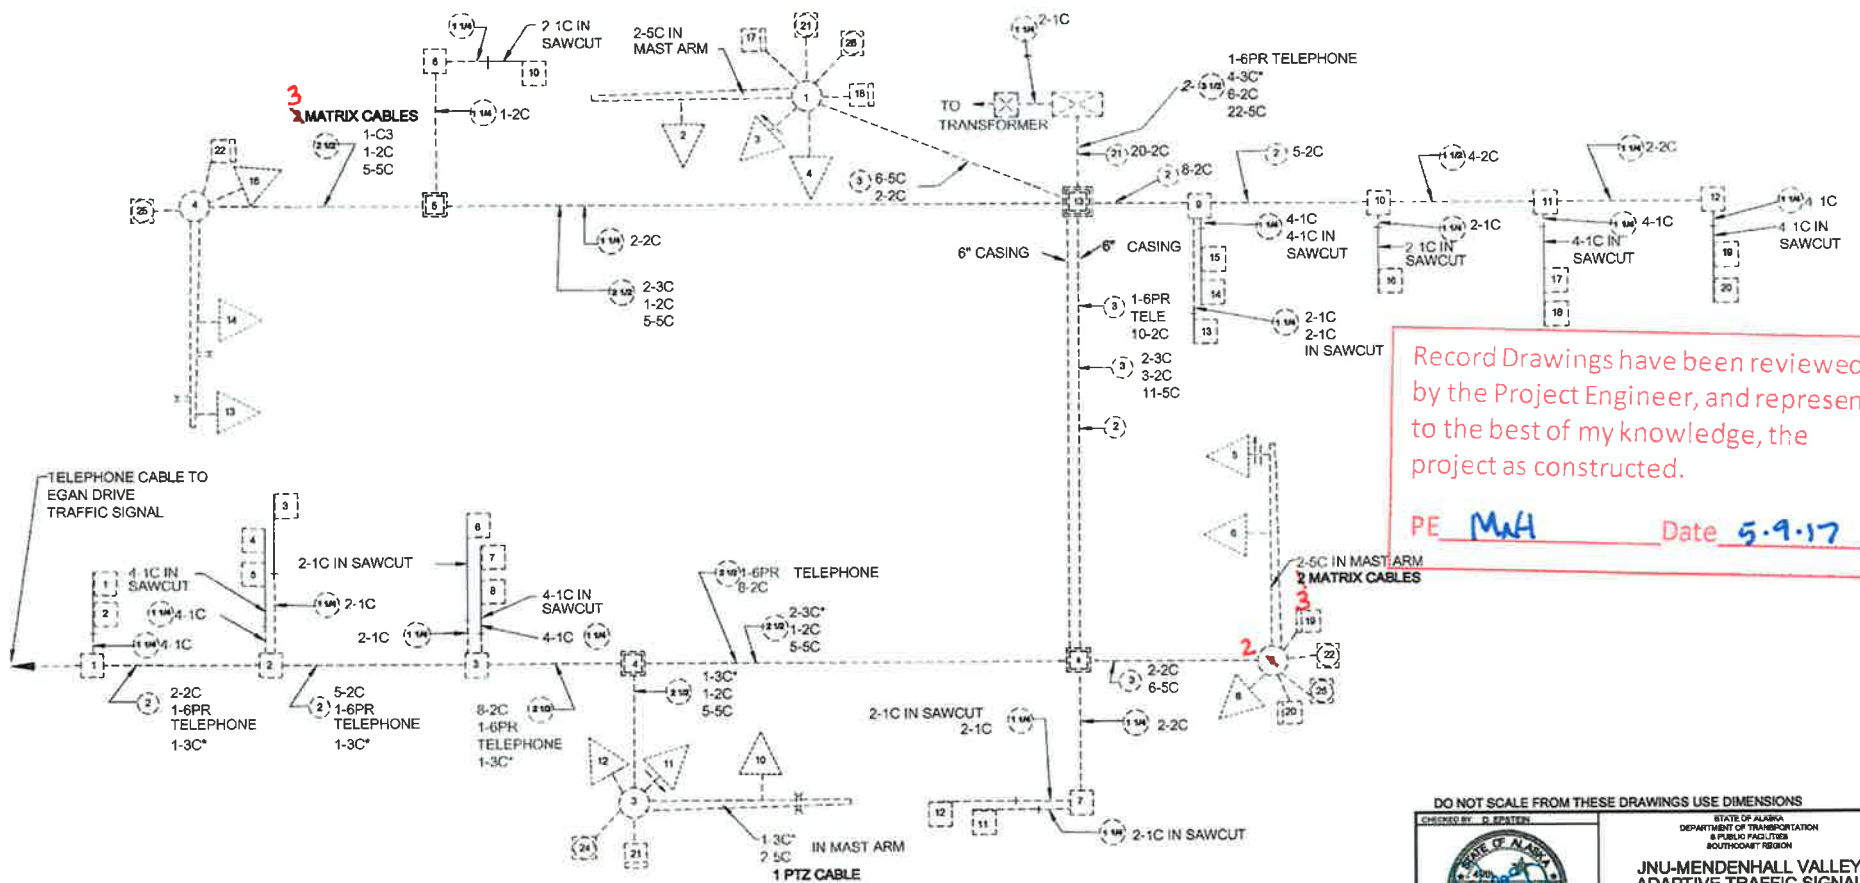

Record Drawings have been reviewed by the Project Engineer, and represent to the best of my knowledge, the project as constructed.

PE MJA Date 5-9-17

DO NOT SCALE FROM THESE DRAWINGS USE DIMENSIONS



STATE OF ALABAMA
DEPARTMENT OF TRANSPORTATION
& PUBLIC FACILITIES
BIRMINGHAM REGION
**JNU-MENDENHALL VALLEY
ADAPTIVE TRAFFIC SIGNAL
CONTROL SYSTEM**
SIGNAL NO. 6
LOOP ROAD AND MALL ROAD
WIRING DIAGRAM

DESIGNED BY: J. MAHLE		PROJECT ORIGINATOR		YEAR	SHEET NO.	TOTAL SHEETS
DRAWN BY: D. STEVENS		STEVENS, DAVID A. (DOT)		2015	F12	29
PATH: G:\UNIFORM\PLANS\BAMA_LOOP RD & MALL RD WIRING.DWG						
TAB: F12 Tuesday, August 18, 2015 11:12:10 AM						
REVISIONS						
NO.	DATE	DESCRIPTION				

7

POST OFFICE

SIGNAL HEAD CODE LEGEND	
Indication Code	Translation
R	Red ball
Y	Yellow ball
G	Green ball
RLA	Red left arrow
YLA	Yellow left arrow
GLA	Green left arrow
RRA	Red right arrow
YRA	Yellow right arrow
GRA	Green right arrow

- NOTES:
1. SIGNAL NUMBER CORRESPONDS WITH SHEET A1.
 2. SEE STANDARD DRAWING T-30.11 FOR MOUNTING TYPE.
 3. ASTROBRAC STELLAR STAINLESS 3 SECTION 96" CABLE MOUNT AS-Ø125-3-96 FOR 3 SECTION HEAD.
 4. ASTROBRAC STELLAR STAINLESS 4 SECTION 96" CABLE MOUNT AS-Ø125-4-96 FOR 4 SECTION HEAD.
 5. ASTROBRAC STELLAR STAINLESS 5 SECTION 96" CABLE MOUNT AS-Ø125-5-96 FOR 5 SECTION HEAD.

See Sheet F14

EXISTING CONTROL CABINET AND FOUNDATION

EXISTING LOAD CENTER

SAFEGWAY

- MAJOR WORK ITEMS AT THIS INTERSECTION**
1. REPLACE SIGNAL HEAD AS SHOWN.
 2. REPLACE POLE 7 AND PEDESTRIAN HARDWARE.
 3. INSTALL PTZ CAMERA ON SIGNAL POLE 1.

SIGNAL HEAD / WAVETRONIX / PTZ CAMERA SUMMARY TABLE						
Signal No. 7, Riverside Drive and Mall Road						
Pole No.	Signal Head No.	Mounting Type	Indication	Wavetronix Matrix Unit Detector Number and mounting location	Wavetronix Advance Unit Number and mounting location	PTZ Camera Number and mounting location
1					2, Mast Arm	1, signal pole
7	19	Post-mounted T-1	R-Y-G			

Record Drawings have been reviewed by the Project Engineer, and represent to the best of my knowledge, the project as constructed.

PE MWJ Date 5-9-17

PATH:
G:\mhu\86584\F\Drawn\86584_Riverside.dwg
Date: 17/Aug/16 02:36PM
PLOT:
PSPACE 1st (P) OR MSPACE 1st (P)
TAB: TYPICALS

ADDENDUM NUMBER

ATTACHMENT NUMBER

RECORD OF REVISIONS

No.	DATE	DESCRIPTION

MENDENHALL VALLEY ADAPTIVE TRAFFIC SIGNAL CONTROL SYSTEM
2886840000 - 0003184

SIGNAL NO. 7
RIVERSIDE AND MALL ROAD



DESIGNED BY: D. EPSTEIN
DRAWN BY: D. STEVENS

STATE OF ALASKA
DEPARTMENT OF TRANSPORTATION & PUBLIC FACILITIES
SOUTHCOST REGION
MENDENHALL VALLEY
ADAPTIVE TRAFFIC SIGNAL CONTROL SYSTEM

SIGNAL NO. 7
RIVERSIDE AND MALL ROAD

PROJECT DESIGNATION NUMBER
2886840000 - 0003184

STATE	YEAR
ALASKA	2015

SHEET NUMBER	TOTAL SHEETS
F13	29

PATH:
 C:\msd\05584\Plan\05584_Riverside & Mall Signal
 Mon, 17/Aug/15 02:41PM
 PLOT:
 P:\SPACE 1-1 (F) OR MSPACE 1-1 (F)
 TAE: TYPICAL.B

ADDENDUM NUMBER		
ATTACHMENT NUMBER		
RECORD OF REVISIONS		
No.	DATE	DESCRIPTION

MENDENHALL VALLEY ADAPTIVE
 TRAFFIC SIGNAL CONTROL SYSTEM
 Z885840000 - 0003184
 SIGNAL NO. 7
 RIVERSIDE AND MALL ROAD



DESIGNED BY: D. EPSTEIN
 DRAWN BY: D. STEVENS




STATE OF ALASKA
 DEPARTMENT OF TRANSPORTATION
 & PUBLIC FACILITIES
 SOUTHCOAST REGION
 MENDENHALL VALLEY
 ADAPTIVE TRAFFIC SIGNAL
 CONTROL SYSTEM

SIGNAL NO. 7
 RIVERSIDE AND
 MALL ROAD

PROJECT DESIGNATION NUMBER
 Z885840000 - 0003184

STATE	YEAR
ALASKA	2015

SHEET NUMBER	TOTAL SHEETS
F14	29

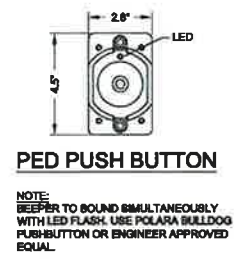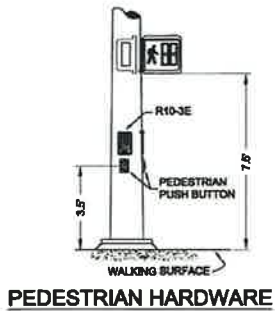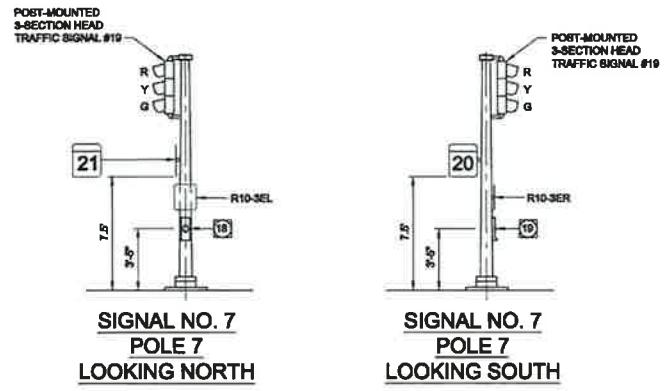

NOTE:
 REFER TO SOUND SIMULTANEOUSLY
 WITH LED FLASH. USE POLARA BULLDOG
 PUSH-BUTTON OR ENGINEER APPROVED
 EQUAL.

Record Drawings have been reviewed by the Project Engineer, and represent to the best of my knowledge, the project as constructed.
 PE MWH Date 5-9-17

Signal Pole No.7 → Was not replaced. The design was not what was in the field. The designer of record decided not to install Pole No.7.

7

PATH:
D:\JHA\08554\Project\08554_Riverside & Mall
Top: 18/Aug/15 02:30PM
PLT:
PSPACE 1=1 (F) OR MSPACE 1=1 (F)
TAB: TYPICALS

ADDENDUM NUMBER
ATTACHMENT NUMBER

RECORD OF REVISIONS		
No.	DATE	DESCRIPTION

MENDENHALL VALLEY ADAPTIVE
TRAFFIC SIGNAL CONTROL SYSTEM
2885840000 - 0003184

SIGNAL NO. 7
RIVERSIDE AND MALL ROAD
WIRING DIAGRAM




DESIGNED BY: D. EPSTEIN
DRAWN BY: D. STEVENS

STATE OF ALASKA
DEPARTMENT OF TRANSPORTATION
& PUBLIC FACILITIES
SOUTHCOST REGION
MENDENHALL VALLEY
ADAPTIVE TRAFFIC SIGNAL
CONTROL SYSTEM
SIGNAL NO. 7
RIVERSIDE AND
MALL ROAD
WIRING DIAGRAM

PROJECT DESIGNATION NUMBER
2885840000 - 0003184

STATE	YEAR
ALASKA	2015
SHEET NUMBER	TOTAL SHEETS
F15	29

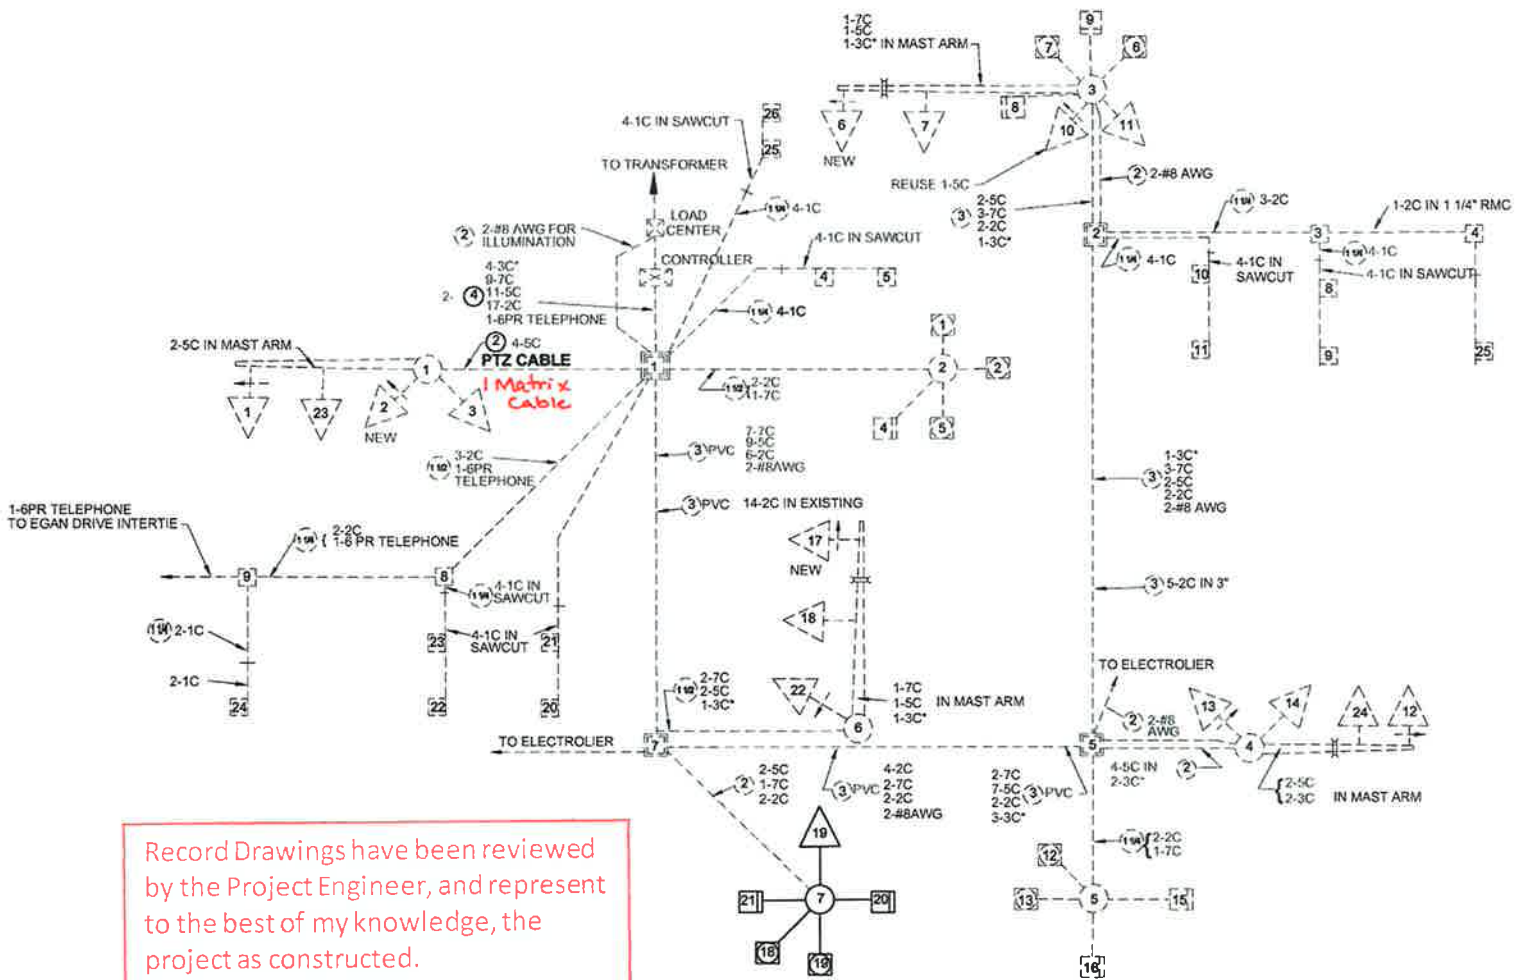


Record Drawings have been reviewed by the Project Engineer, and represent to the best of my knowledge, the project as constructed.

PE MWH Date 5-9-17

SIGNAL HEAD / WAVETRONIX / PTZ CAMERA SUMMARY TABLE

Signal No. 8, Loop Road and Stephen Richards

Pole No.	Signal Head No.	Mounting Type	Indication	Wavetronix Matrix Unit Detector Number and mounting location	Wavetronix Advance Unit Number and mounting location	PTZ Camera Number and mounting location
3						1, mast arm

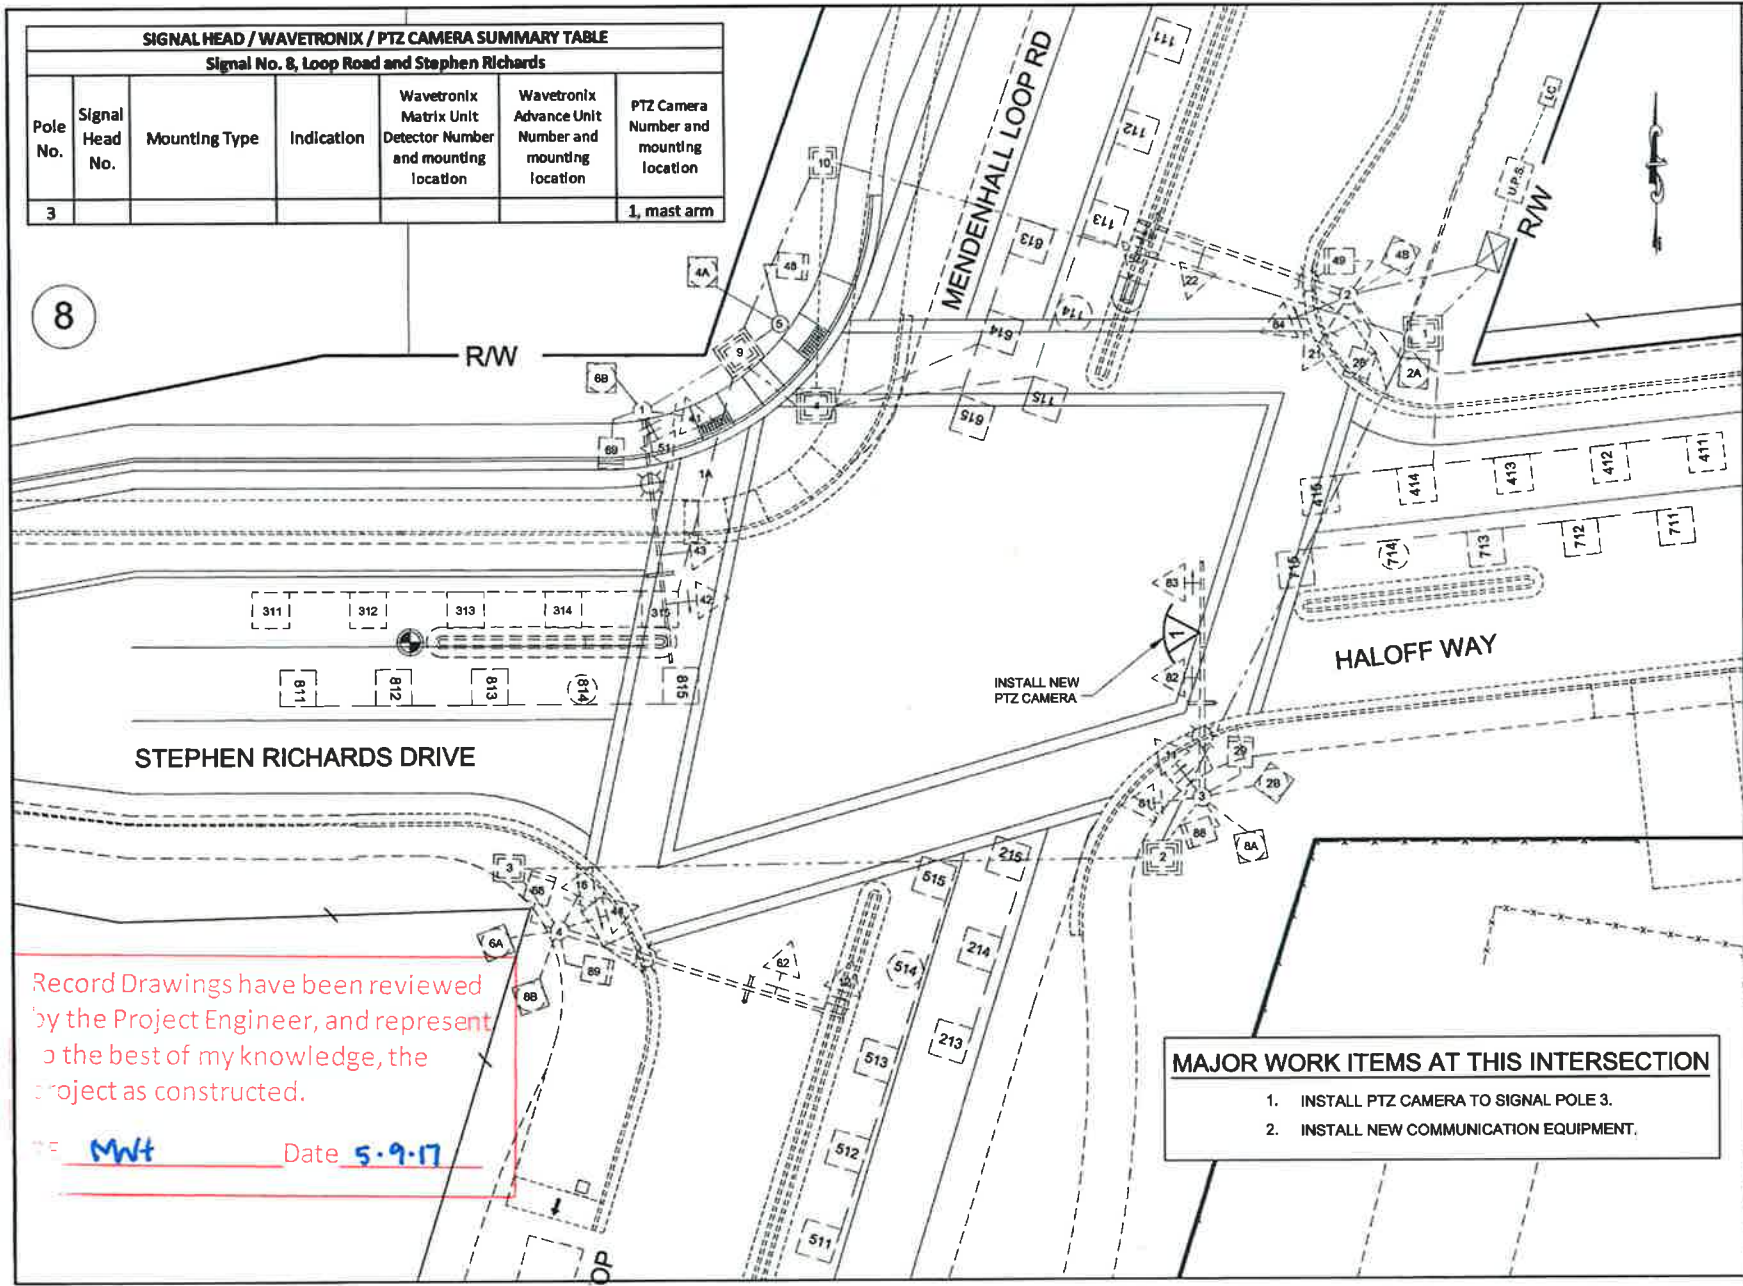

- MAJOR WORK ITEMS AT THIS INTERSECTION**
1. INSTALL PTZ CAMERA TO SIGNAL POLE 3.
 2. INSTALL NEW COMMUNICATION EQUIPMENT.

Record Drawings have been reviewed by the Project Engineer, and represent to the best of my knowledge, the project as constructed.

MWT Date 5-9-17

PATH: D:\proj\60554\Plan\60554_Loop Rd & Stephen Richards\15 02:57PM
 FILE: PSPACE 141 (P) OR MSPACE 141 (P)
 TAB: TYPICALS

ADDENDUM NUMBER		
ATTACHMENT NUMBER		
RECORD OF REVISIONS		
No.	DATE	DESCRIPTION

MENDENHALL VALLEY ADAPTIVE
 TRAFFIC SIGNAL CONTROL SYSTEM
 Z685840000 ~ 0003184

SIGNAL NO. 8
 LOOP ROAD AND
 STEPHEN RICHARDS



DESIGNED BY: D. EPSTEIN
 DRAWN BY: D. STEVENS


STATE OF ALASKA
 DEPARTMENT OF TRANSPORTATION
 & PUBLIC FACILITIES
 SOUTHEAST REGION
 MENDENHALL VALLEY
 ADAPTIVE TRAFFIC SIGNAL
 CONTROL SYSTEM

SIGNAL NO. 8
 LOOP ROAD AND
 STEPHEN RICHARDS

PROJECT DESIGNATION NUMBER	
Z685840000 - 0003184	
STATE	YEAR
ALASKA	2015
SHEET NUMBER	TOTAL SHEETS
F16	29

Record Drawings have been reviewed by the Project Engineer, and represent to the best of my knowledge, the project as constructed.

PE *MWH* Date *5-9-17*

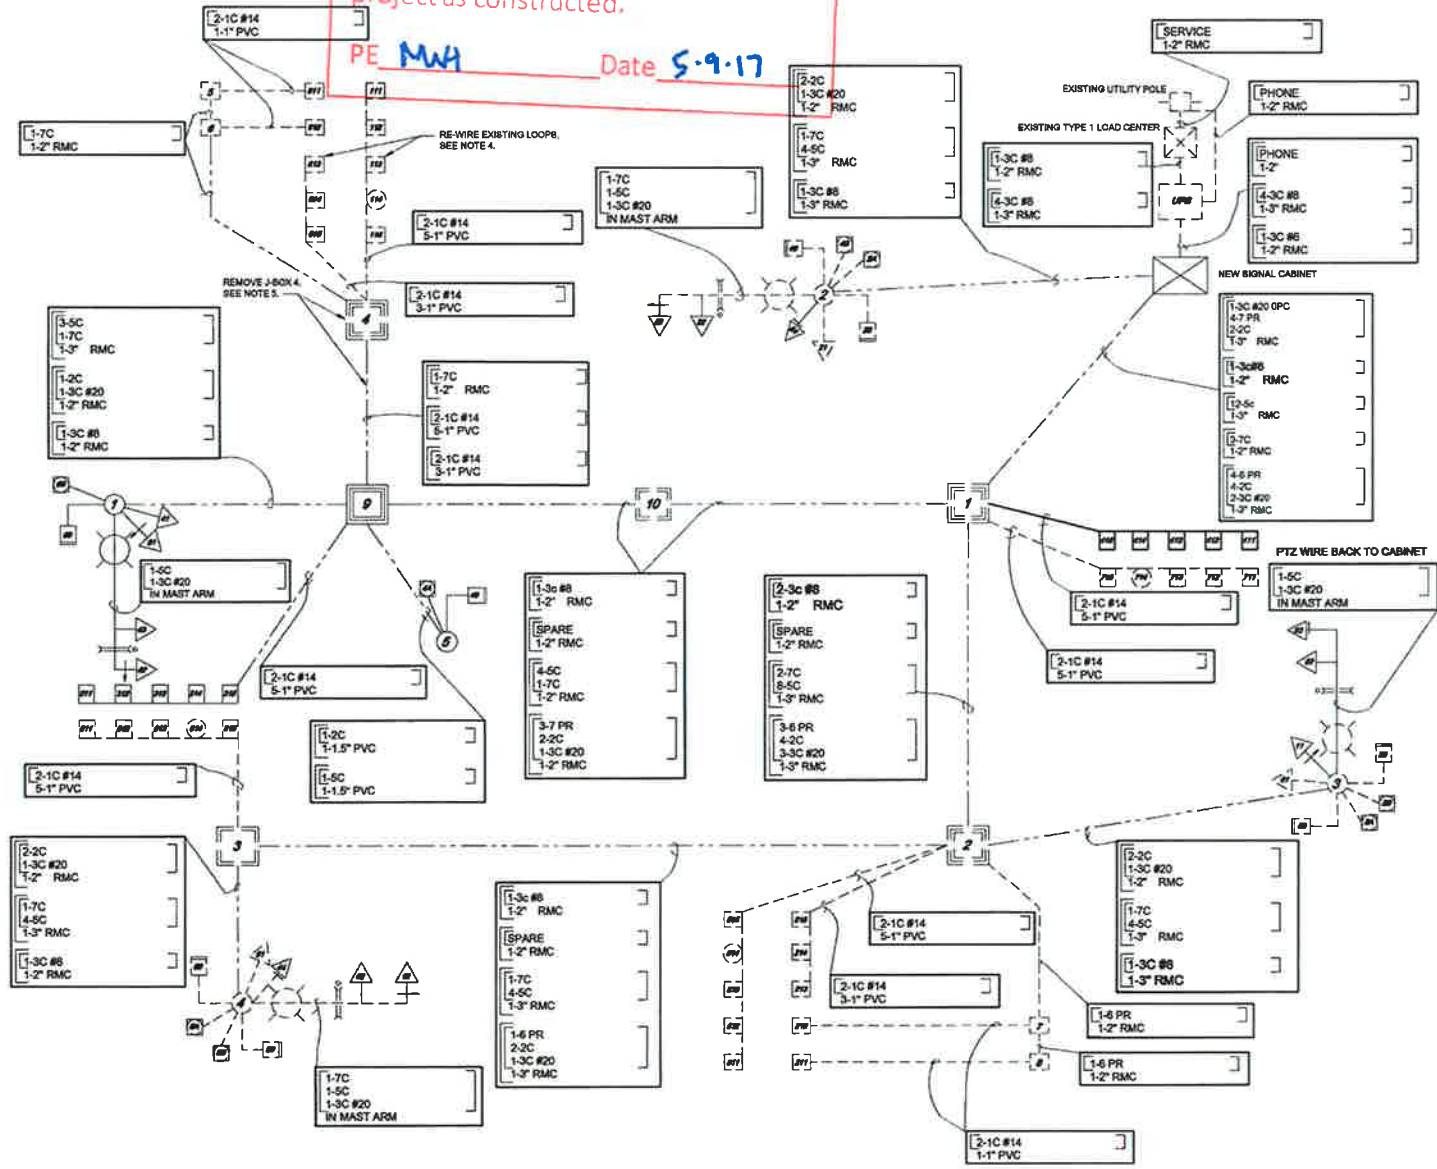

PATH:
D:\m\68584\Plan\68584_Loop rd & Step
Title: 18/Aug/15 02:58PM
PLT:
PSFACE 1=1 (R) OR MSPACE 1=1 (F)
TAB TYPICALS

ADDENDUM NUMBER		
ATTACHMENT NUMBER		
RECORD OF REVISIONS		
No.	DATE	DESCRIPTION

MENDENHALL VALLEY ADAPTIVE
TRAFFIC SIGNAL CONTROL SYSTEM
Z685840000 - 0003184

SIGNAL NO. 8
LOOP ROAD AND STEPHEN RICHARDS
WIRING DIAGRAM




DESIGNED BY: D. EPSTEIN
DRAWN BY: D. STEVENS

STATE OF ALASKA
DEPARTMENT OF TRANSPORTATION
& PUBLIC FACILITIES
SOUTH CENTRAL REGION
MENDENHALL VALLEY
ADAPTIVE TRAFFIC SIGNAL
CONTROL SYSTEM
SIGNAL NO. 8
LOOP ROAD AND
STEPHEN RICHARDS
WIRING DIAGRAM

PROJECT DESIGNATION NUMBER
Z685840000 - 0003184


STATE	YEAR
ALASKA	2015
SHEET NUMBER	TOTAL SHEETS
F17	29

9

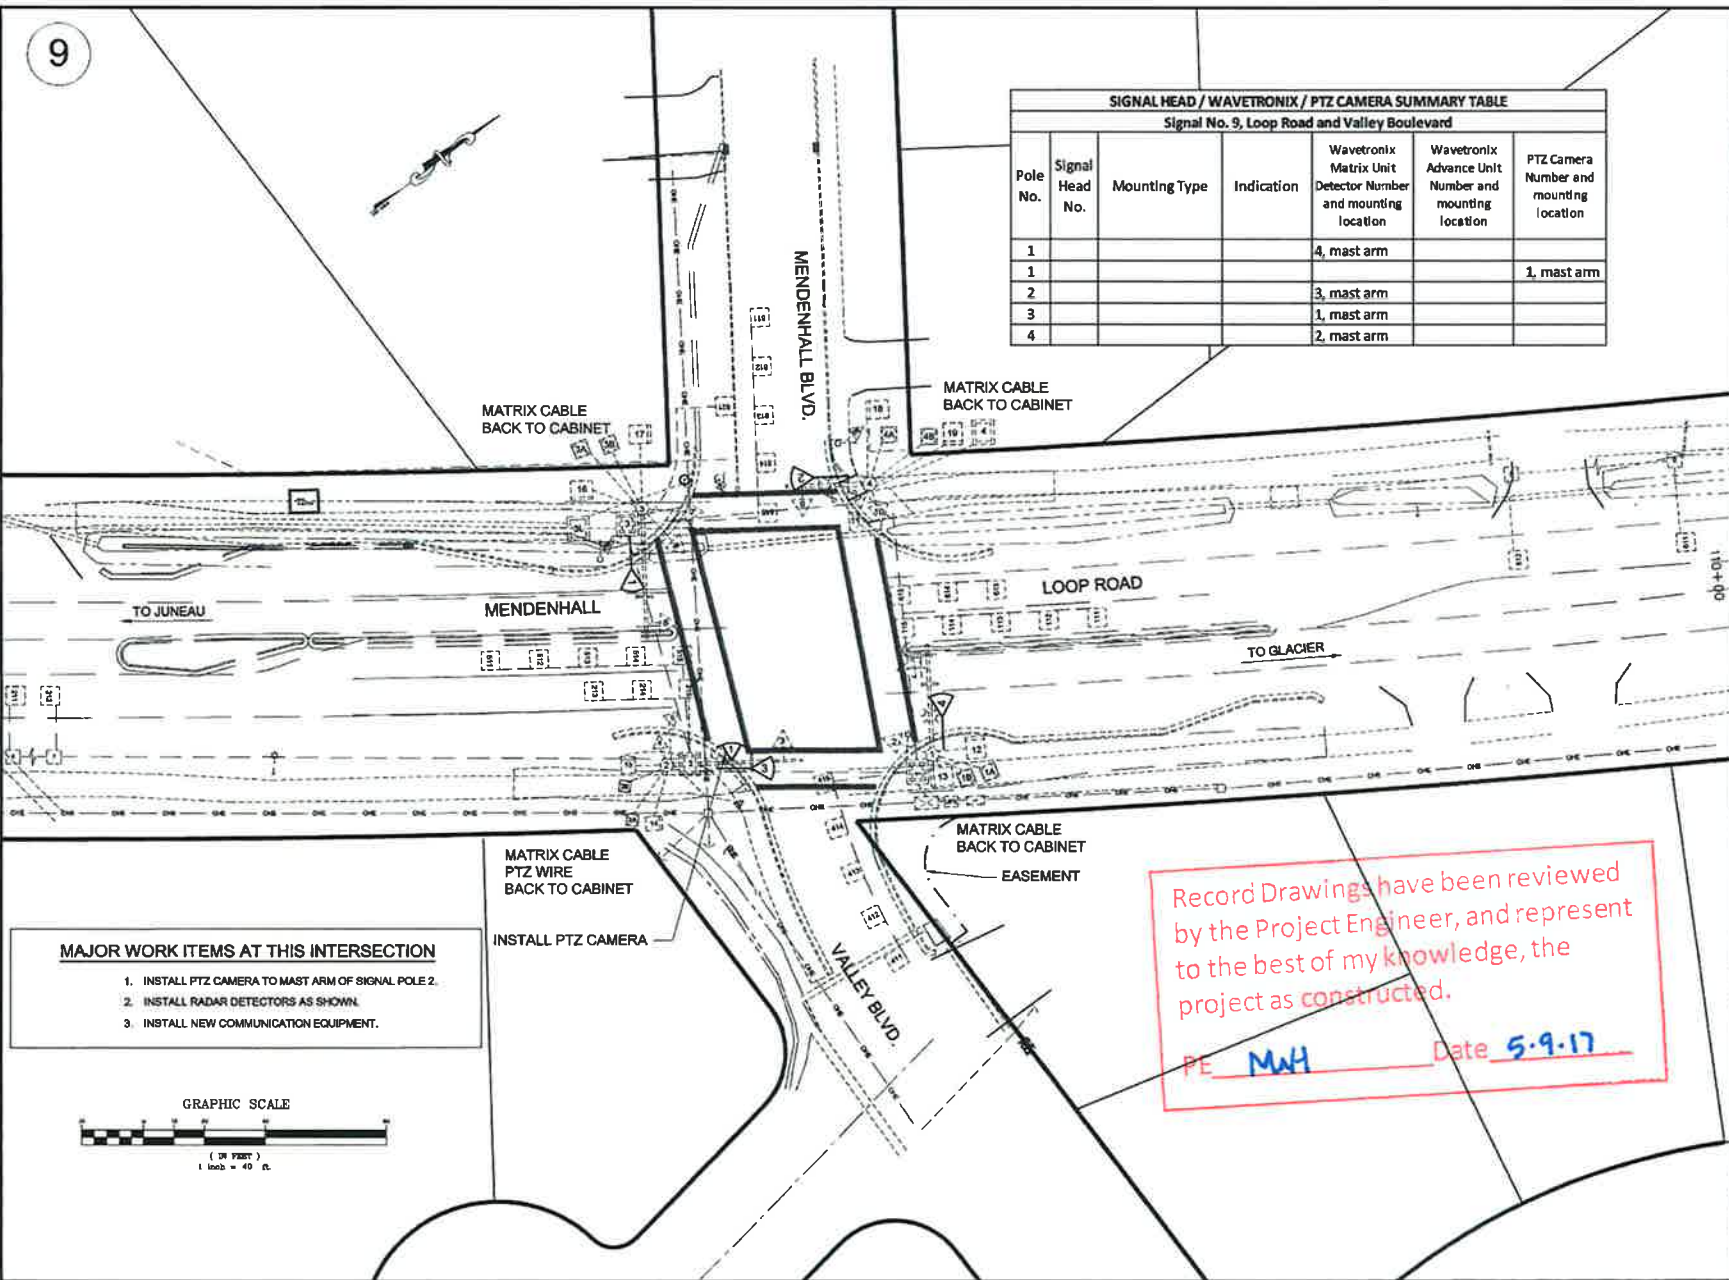

SIGNAL HEAD / WAVETRONIX / PTZ CAMERA SUMMARY TABLE						
Signal No. 9, Loop Road and Valley Boulevard						
Pole No.	Signal Head No.	Mounting Type	Indication	Wavetronix Matrix Unit Detector Number and mounting location	Wavetronix Advance Unit Number and mounting location	PTZ Camera Number and mounting location
1				4, mast arm		
1						1, mast arm
2				3, mast arm		
3				1, mast arm		
4				2, mast arm		

- MAJOR WORK ITEMS AT THIS INTERSECTION**
1. INSTALL PTZ CAMERA TO MAST ARM OF SIGNAL POLE 2.
 2. INSTALL RADAR DETECTORS AS SHOWN.
 3. INSTALL NEW COMMUNICATION EQUIPMENT.

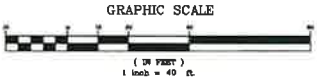

PATH: Q:\proj\88584\Planee\88584_Loop Road & V...
 Title: 18/Aug/15 09:12AM
 PLOT: PSPACE 1=1 (F) OR MSFACE 1=1 (F)
 TAB: TYPICALS

ADDENDUM NUMBER		
ATTACHMENT NUMBER		
RECORD OF REVISIONS		
No.	DATE	DESCRIPTION

MENDENHALL VALLEY ADAPTIVE TRAFFIC SIGNAL CONTROL SYSTEM
 Z885840000 - 0003184

SIGNAL NO. 9
 LOOP ROAD AND VALLEY BOULEVARD




DESIGNED BY: D. EPSTEIN
 DRAWN BY: D. STEVENS

STATE OF ALASKA
 DEPARTMENT OF TRANSPORTATION & PUBLIC FACILITIES
 SOUTHCOAST REGION

MENDENHALL VALLEY ADAPTIVE TRAFFIC SIGNAL CONTROL SYSTEM

SIGNAL NO. 9
 LOOP ROAD AND VALLEY BOULEVARD

PROJECT DESIGNATION NUMBER	
Z885840000 - 0003184	
STATE	YEAR
ALASKA	2015
SHEET NUMBER	TOTAL SHEETS
F18	29

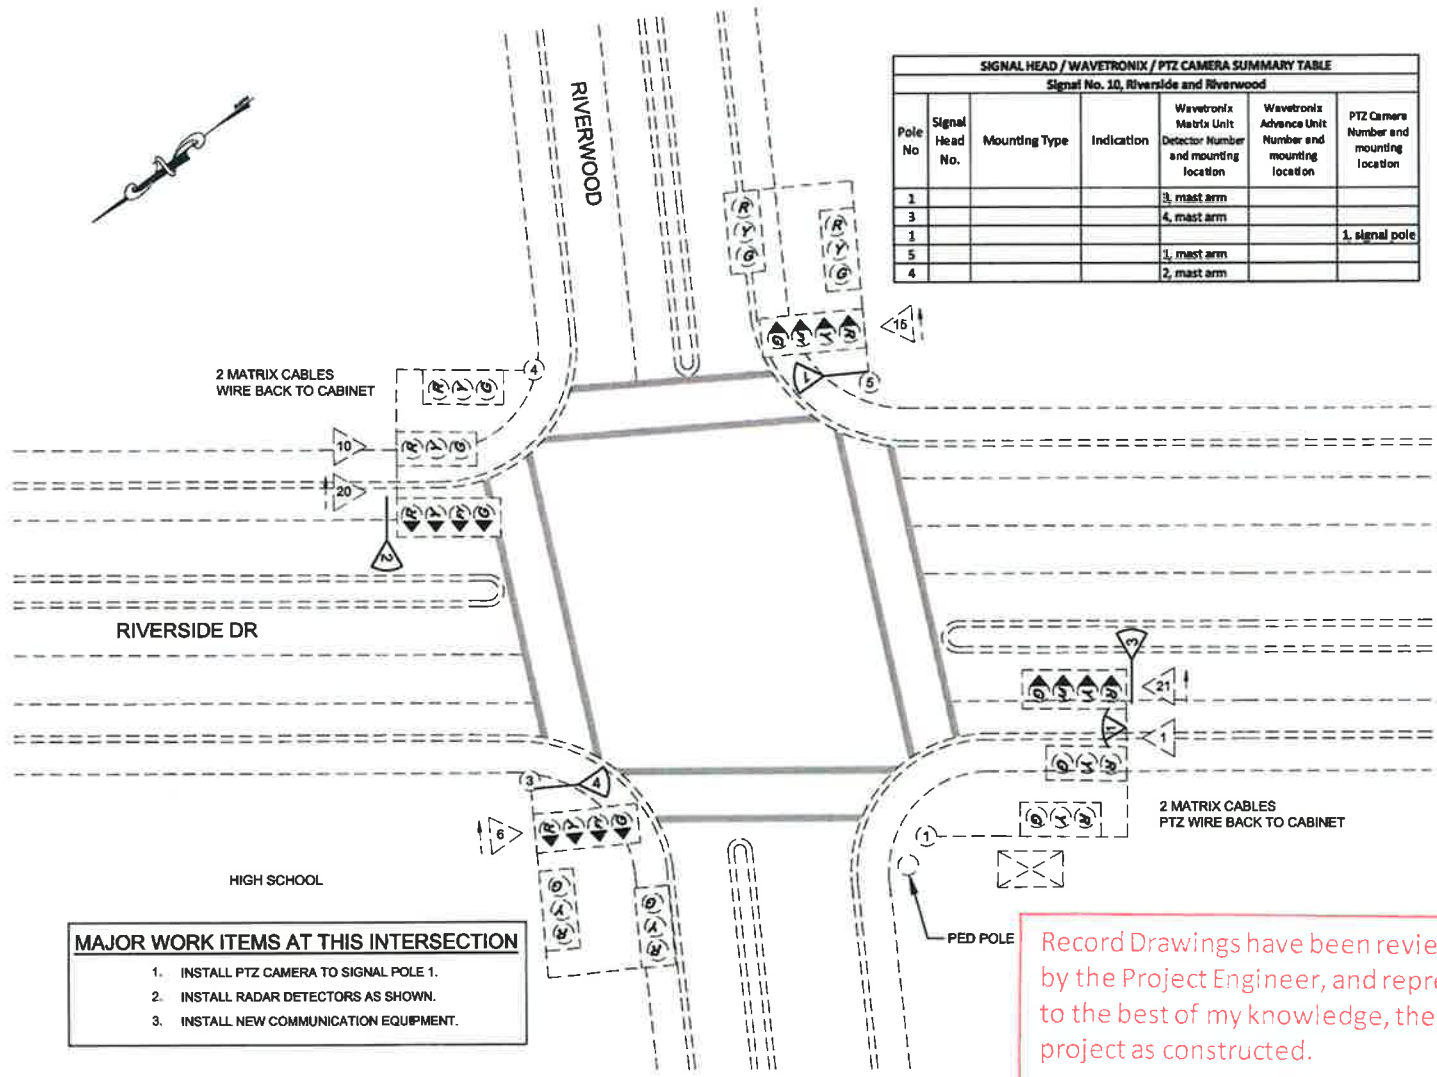

SIGNAL HEAD / WAVETRONIX / PTZ CAMERA SUMMARY TABLE						
Signal No. 10, Riverside and Riverwood						
Pole No	Signal Head No.	Mounting Type	Indication	Wavetronix Matrix Unit Detector Number and mounting location	Wavetronix Advance Unit Number and mounting location	PTZ Camera Number and mounting location
1				3, mast arm		
3				4, mast arm		
1						1, signal pole
5				1, mast arm		
4				2, mast arm		

- MAJOR WORK ITEMS AT THIS INTERSECTION**
1. INSTALL PTZ CAMERA TO SIGNAL POLE 1.
 2. INSTALL RADAR DETECTORS AS SHOWN.
 3. INSTALL NEW COMMUNICATION EQUIPMENT.

Record Drawings have been reviewed by the Project Engineer, and represent to the best of my knowledge, the project as constructed.

PE MWH Date 5.9.17

PATH:
 O:\2014\68584\Planm\68584_RiverSide.dwg
 Thu, 18/Aug/15 02:26PM
 RCT
 PSPACE 1x1 (F) OR MSPACE 1x1 (F)
 TAB: TYPICALS

ADDENDUM NUMBER		
ATTACHMENT NUMBER		
RECORD OF REVISIONS		
No.	DATE	DESCRIPTION

MENDENHALL VALLEY ADAPTIVE
 TRAFFIC SIGNAL CONTROL SYSTEM
 Z885840000 - 0003184

SIGNAL NO. 10
 RIVERSIDE AND RIVERWOOD



DESIGNED BY: D. EPSTEIN
 DRAWN BY: D. STEVENS

STATE OF ALASKA
 DEPARTMENT OF TRANSPORTATION
 & PUBLIC FACILITIES
 SOUTH-COAST REGION
 MENDENHALL VALLEY
 ADAPTIVE TRAFFIC SIGNAL
 CONTROL SYSTEM


SIGNAL NO. 10
 RIVERSIDE AND
 RIVERWOOD

PROJECT DESIGNATION NUMBER
 Z885840000 - 0003184

STATE	YEAR
ALASKA	2015

SHEET NUMBER	TOTAL SHEETS
F20	29

10

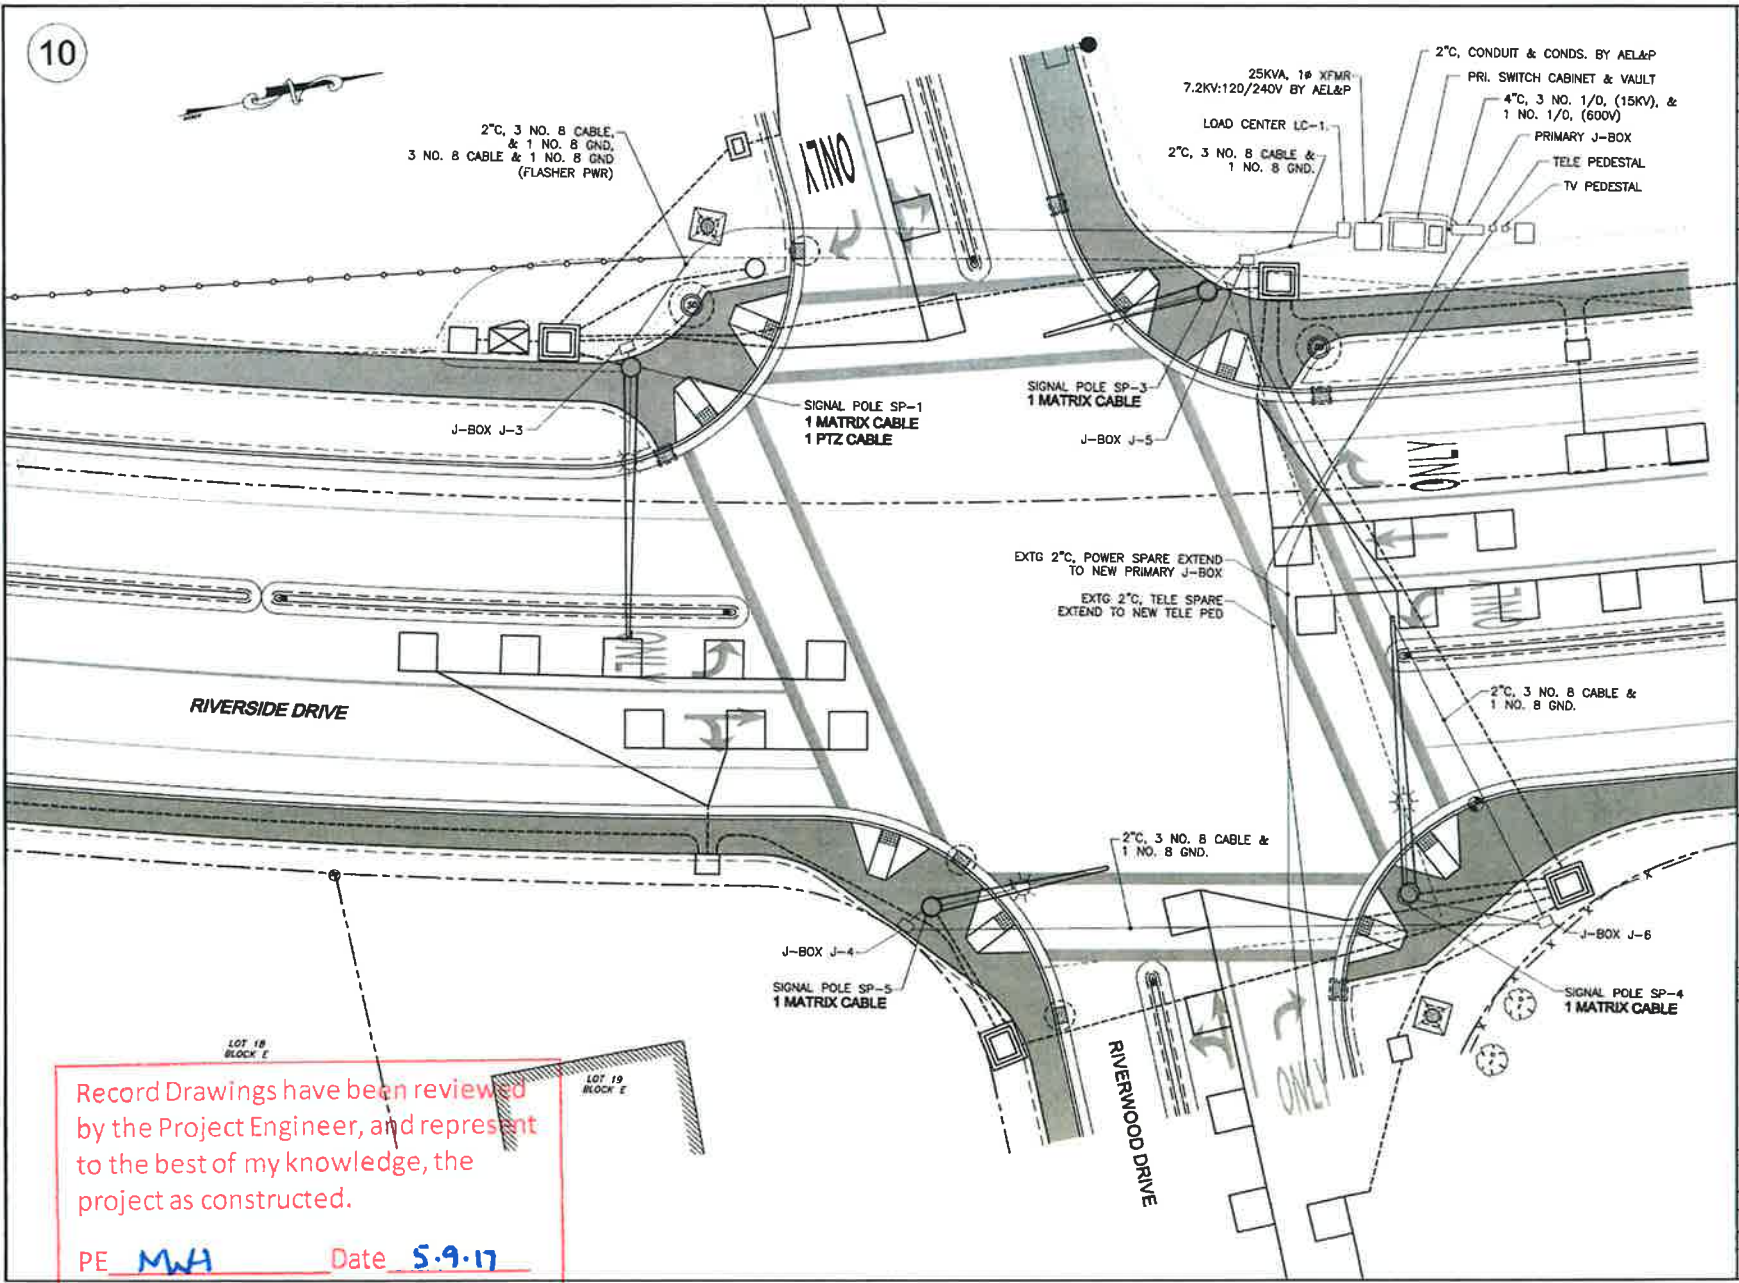

PATH: C:\proj\68584\Project\68584_Riverside & Riv
 Rev: 15/Aug/15 09:05AM
 PLOT: RSPACE #11 (F) OR RSPACE #11 (F)
 TAE: TYPICALS

ADDENDUM NUMBER	

ATTACHMENT NUMBER	

RECORD OF REVISIONS		
No.	DATE	DESCRIPTION

MENDENHALL VALLEY ADAPTIVE TRAFFIC SIGNAL CONTROL SYSTEM
 2685840000 ~ 0003184

SIGNAL NO. 10 RIVERSIDE AND RIVERWOOD WIRING DIAGRAM




DESIGNED BY: D. EPSTEIN
 DRAWN BY: D. STEVENS
 STATE OF ALASKA
 DEPARTMENT OF TRANSPORTATION & PUBLIC FACILITIES
 SOUTHWEST REGION
MENDENHALL VALLEY ADAPTIVE TRAFFIC SIGNAL CONTROL SYSTEM
SIGNAL NO. 10 RIVERSIDE AND RIVERWOOD WIRING DIAGRAM

PROJECT DESIGNATION NUMBER	
2685840000 ~ 0003184	
STATE	YEAR
ALASKA	2015
SHEET NUMBER	TOTAL SHEETS
F21	29

Record Drawings have been reviewed by the Project Engineer, and represent to the best of my knowledge, the project as constructed.

PE MWH Date 5-9-17

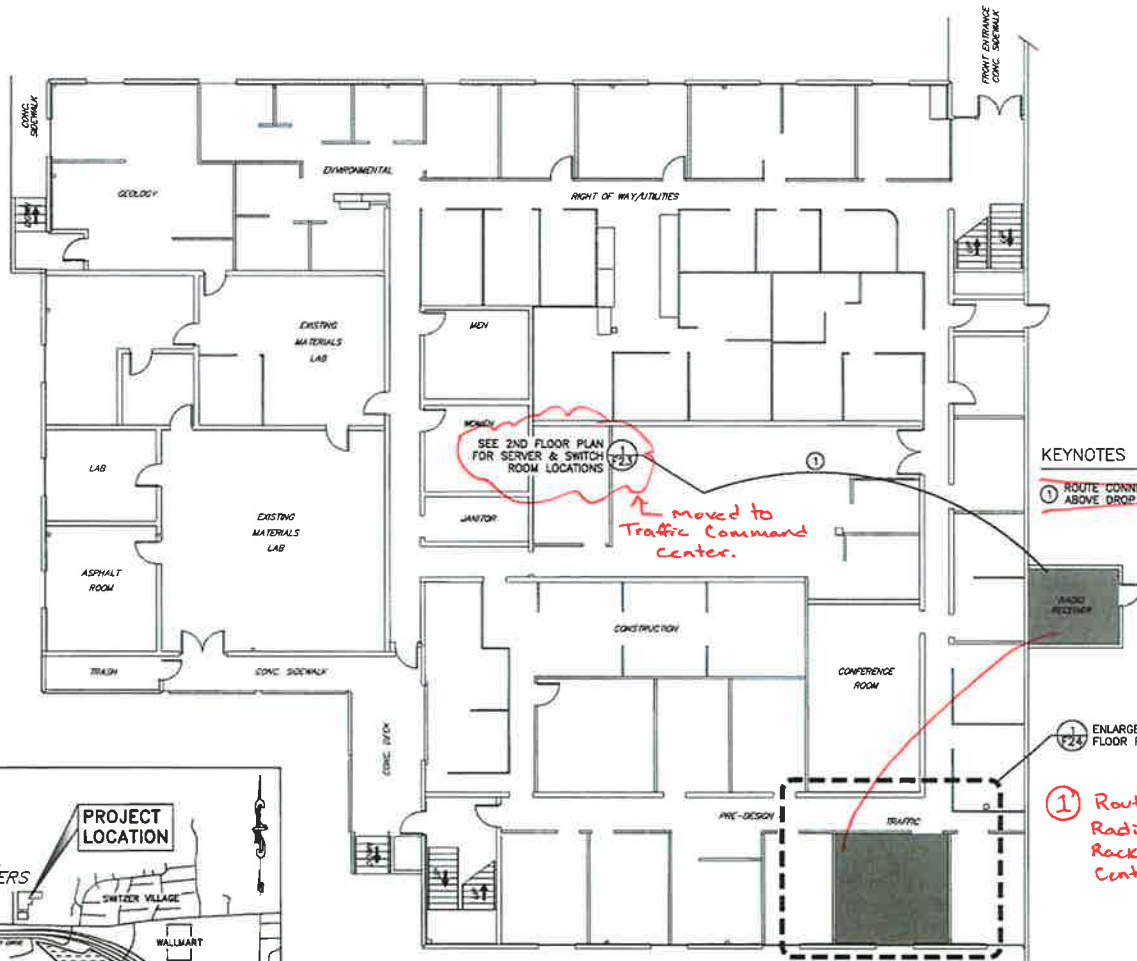


KEYNOTES

① ROUTE CONNECTION FROM RADIO RECEIVER TO SWITCH RACK ABOVE DROP CEILING, 1-CAT 6.

② ENLARGED FLOOR PLAN

① Route Connection From Radio Receiver to Switch Rack in Traffic Command Center.

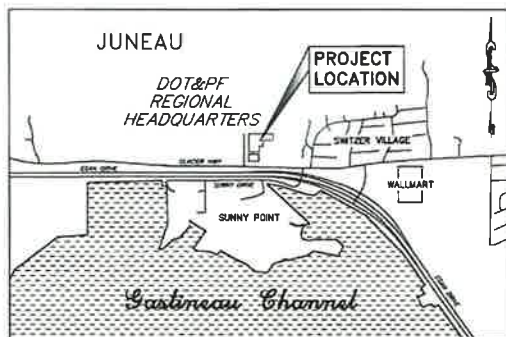

VICINITY MAP

① 1ST FLOOR PLAN
SCALE: 1/8" = 1'-0"



SOUTHCOAST REGION HEADQUARTERS - 1ST FLOOR PLAN

Rev. 17/Aug/15 10:46AM
 FLOT
 PSPACE 1+1 (F) OR MSPACE 1+1 (F)
 TAB TYPICALS

ADDENDUM NUMBER		
ATTACHMENT NUMBER		
RECORD OF REVISIONS		
No.	DATE	DESCRIPTION

MENDENHALL VALLEY ADAPTIVE
 TRAFFIC SIGNAL CONTROL SYSTEM
 0003184 - 2685840000
 SOUTHCOAST REGION HEADQUARTERS - 1ST FLOOR PLAN




DEVELOPED BY: KENNEY ENGINEERING, LLC
 DESIGNED BY: W. WEBB
 DRAWN BY: B. PADDOCK
 STATE OF ALASKA
 DEPARTMENT OF TRANSPORTATION
 & PUBLIC FACILITIES
 SOUTHCOAST REGION
 MENDENHALL VALLEY ADAPTIVE
 TRAFFIC SIGNAL CONTROL SYSTEM
 SOUTHCOAST REGION
 TRAFFIC COMMAND CENTER

PROJECT DESIGNATION NUMBER	
0003184-2685840000	
STATE	YEAR
ALASKA	2015
SHEET NUMBER	TOTAL SHEETS
F22	29

Record Drawings have been reviewed by the Project Engineer, and represent to the best of my knowledge, the project as constructed.
 PE MWH Date 5-9-17

PATH: C:\PROJECTS\2015\184_05_Traffic Command Center\DWG\F22.dwg

Date: 17/AUG/15 10:45AM
 PLOT: PSPACE 1=1 (7) OR MSPACE 1=1 (9)
 TAB: TYPICALS
 ADDENDUM NUMBER:
 ATTACHMENT NUMBER:
 RECORD OF REVISIONS:
 No. DATE DESCRIPTION

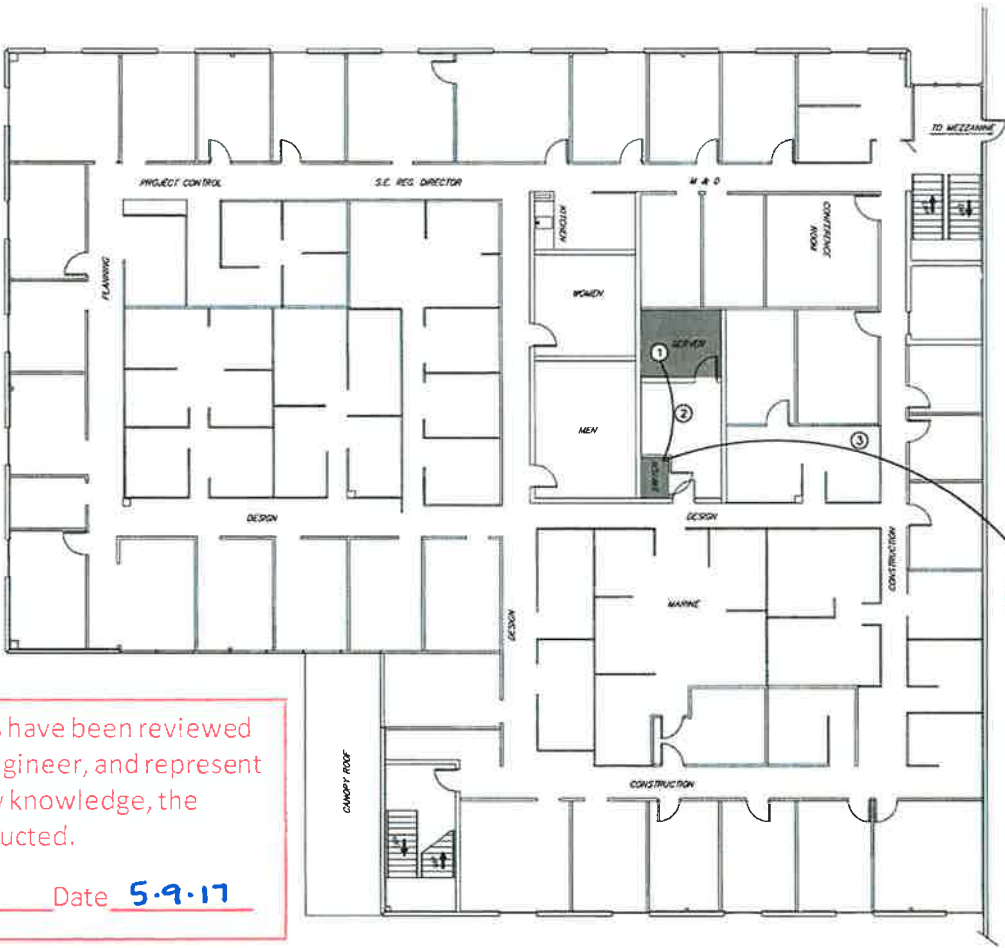

- KEYNOTES
- ~~1~~ INSTALL NEW SERVER IN EXISTING RACK
 - ~~2~~ ROUTE CONNECTION FROM SERVER TO SWITCH PANEL, 2-CAT6
 - ~~3~~ ROUTE CONNECTION FROM RADIO RECEIVER TO SERVER ABOVE DROP CEILING
 - ~~SEE 1ST FLOOR PLAN FOR RADIO RECEIVER ROOM LOCATION~~

No equipment was located in the server building. All equipment was re-located to the Traffic command center on 1st Floor.

Record Drawings have been reviewed by the Project Engineer, and represent to the best of my knowledge, the project as constructed.

PE MWH Date 5.9.17

1 2ND FLOORPLAN
F23 SCALE: 1/8" = 1'-0"



SOUTHCOAST REGION HEADQUARTERS - 2ND FLOOR PLAN



MENDENHALL VALLEY ADAPTIVE
 TRAFFIC SIGNAL CONTROL SYSTEM
 0003184 - Z685840000
 SOUTHCOAST REGION HEADQUARTERS - 2ND FLOOR PLAN



DEVELOPED BY: JIMMY ENGINEERING, LLC
 DESIGNED BY: W. WEBB
 DRAWN BY: S. PADDOCK
 STATE OF ALASKA
 DEPARTMENT OF TRANSPORTATION
 & PUBLIC FACILITIES
 SOUTHCOAST REGION
 MENDENHALL VALLEY
 ADAPTIVE TRAFFIC SIGNAL
 CONTROL SYSTEM
 SOUTHCOAST REGION
 TRAFFIC COMMAND CENTER

PROJECT DESIGNATION NUMBER	
0003184-Z685840000	
STATE	YEAR
ALASKA	2015
SHEET NUMBER	TOTAL SHEETS
F23	29

PATH: C:\PROJECTS\DOTM\300_14 traffic command center\WORKS\1\Sheet\F23.dwg

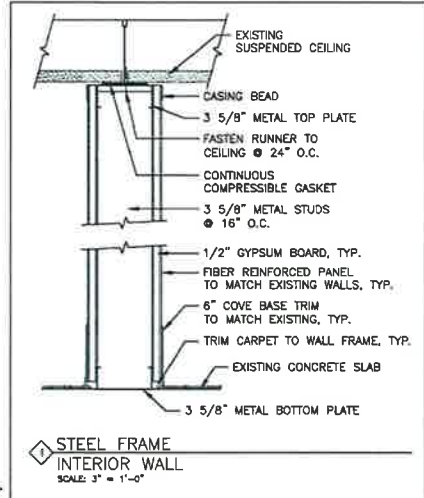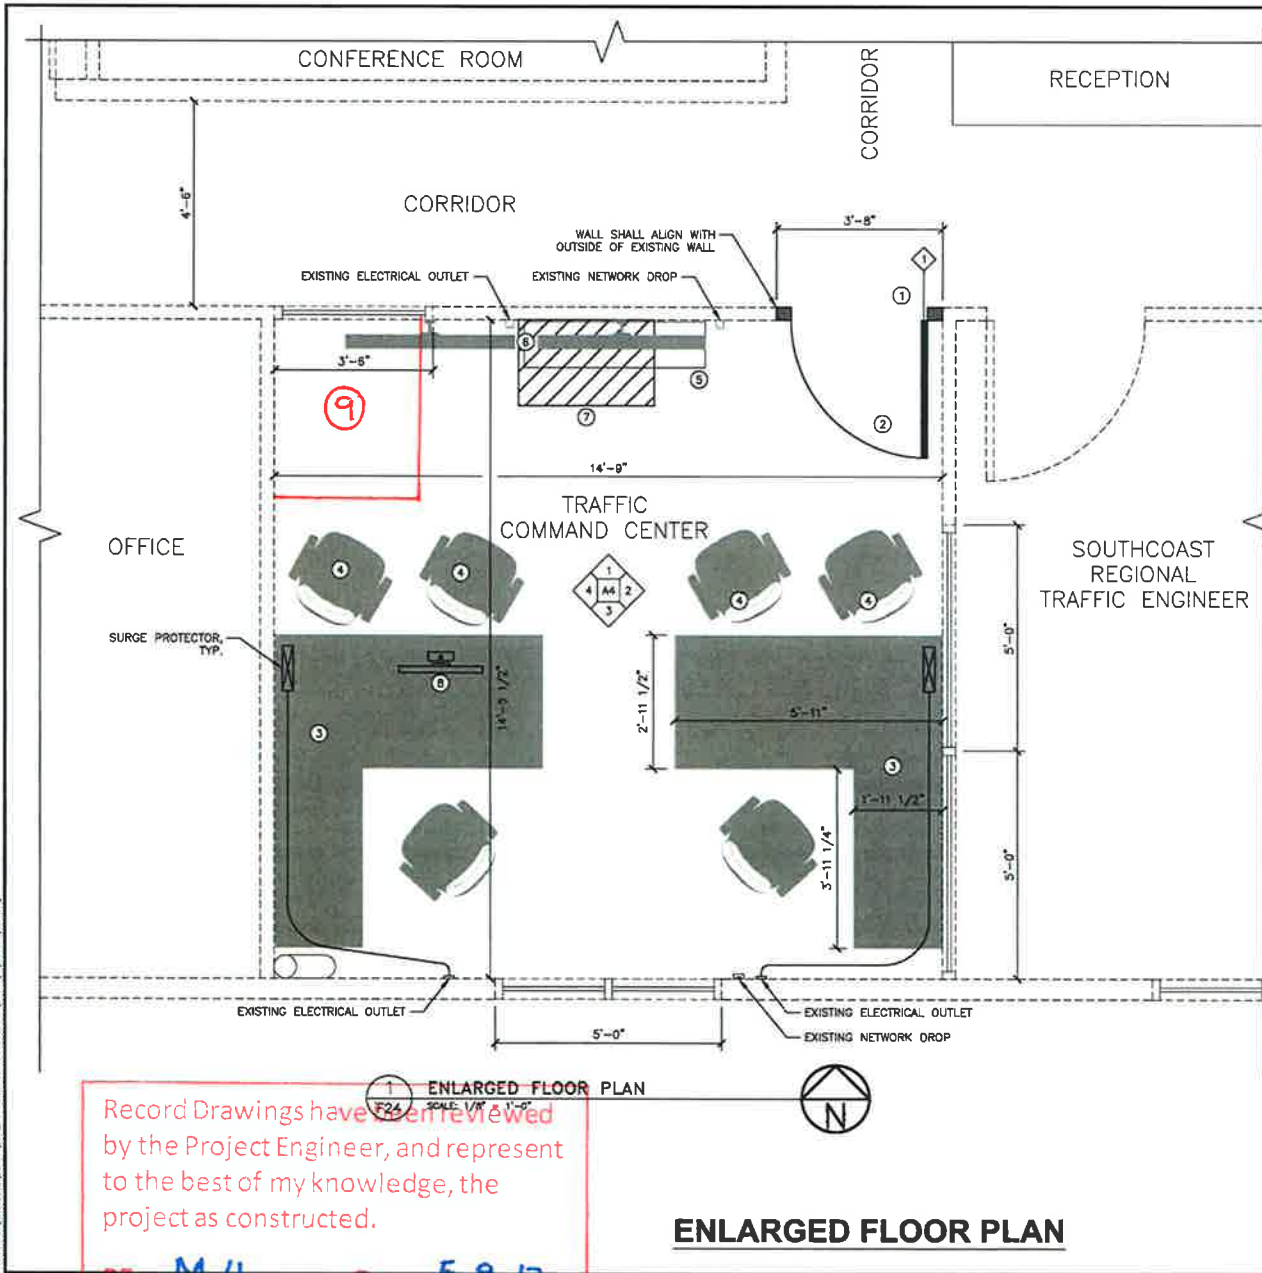

KEYNOTES

- ① NEW WALL AND HEADER
- ② NEW DOOR (SEE SCHEDULE ON SHEET F25)
- ③ NEW DESK
- ④ NEW CHAIR
- ⑤ REMOVE EXISTING WALL MOUNTED SHELVING
- ⑥ NEW 55" MONITORS
- ⑦ NEW CABINET HOUSING TCC WORKSTATION
- ⑧ TCC WORKSTATION MONITOR
- ⑨ *New Servers installed on shelf*

NOTES:

- 1. PROVIDE SURGE PROTECTORS UNDER EACH DESK AND MOUNTED ON THE INSIDE OF THE NEW CABINET. CORD LENGTHS TO BE: 2 AT 12' AND 1 AT 6'.
- 2. PROVIDE CAT 6 PATCH CABLES FOR EACH DESK AND FOR NEW CABINET. CORD LENGTHS TO BE: 2 AT 16' AND 1 AT 8'.
- 3. PROVIDE 26' CABLE FOR TCC WORKSTATION MONITOR.
- 4. CONTRACTOR TO VERIFY ALL CORD LENGTHS PRIOR TO PURCHASING.
- 5. DESK DIMENSIONS ARE TYPICAL AND APPROXIMATE.
- 6. EXISTING DUAL MONITOR COMPUTER WORKSTATIONS TO BE INSTALLED ON DESKS BY DOT STAFF.

Rev: 17/Aug/15 10:53AM
 PLOT: PSPACE 1=1 (F) OR MSPAGE 1=1 (F)
 TAB: TYPICALS

ADDENDUM NUMBER		
ATTACHMENT NUMBER		
RECORD OF REVISIONS		
No.	DATE	DESCRIPTION

MENDENHALL VALLEY ADAPTIVE
 TRAFFIC SIGNAL CONTROL SYSTEM
 0003184 - 2689840000
 ENLARGED FLOOR PLAN



DEVELOPED BY: KINNEY ENGINEERING, LLC
 DESIGNED BY: W. WEBB
 DRAWN BY: B. PADDOCK

STATE OF ALASKA
 DEPARTMENT OF TRANSPORTATION
 & PUBLIC FACILITIES
 SOUTHCOAST REGION

MENDENHALL VALLEY
 ADAPTIVE TRAFFIC SIGNAL
 CONTROL SYSTEM
 SOUTHCOAST REGION
 TRAFFIC COMMAND CENTER

PROJECT DESIGNATION NUMBER	
0003184-2689840000	
STATE	YEAR
ALASKA	2015
SHEET NUMBER	TOTAL SHEETS
F24	29

Record Drawings have been reviewed
 by the Project Engineer, and represent
 to the best of my knowledge, the
 project as constructed.
 PE MWH Date 5-9-17

ENLARGED FLOOR PLAN

PATH: C:\PROJ\003184\0001\F24.dwg traffic command center\0001\F24.dwg

TRAFFIC CONTROL NOTES:

1. A MINIMUM OF ONE 10 FOOT LANE SHALL BE MAINTAINED AT ALL TIMES, THROUGH ALL WORK AREAS.
2. TWO LANES SHALL BE MAINTAINED AT ALL TIMES IN NON-WORK AREAS AND DURING NON-WORK HOURS.
3. TEMPORARY DRIVING LANES SHALL HAVE A MINIMUM WIDTH OF 10'-0".
4. THE LENGTH OF WORK AREA SHALL BE MINIMIZED TO AVOID EXCESSIVE TRAFFIC DELAYS AS DIRECTED BY THE ENGINEER.
5. WORK SHALL BE DONE BETWEEN 9:00 PM AND 5:00AM.
6. WHEN WORKING ON EGAN DRIVE SHOULDERS, THE CONTRACTOR SHALL CLOSE THE RIGHT LANE.
7. TRAFFIC CONTROL PLANS SHALL BE CREATED BY THE CONTRACTOR AND SUBMITTED TO THE ENGINEER FOR APPROVAL. WHERE APPROPRIATE, THEY SHALL INCORPORATE APPLICABLE PORTIONS OF DETAILS ON THESE SHEETS. TRAFFIC CONTROL SHALL CONFORM TO THE ALASKA TRAFFIC MANUAL. WORK ON A SIGNAL SHALL NOT BEGIN UNTIL THE TCP IS APPROVED.
8. THE CONTRACTOR MAY NOT WORK ON BOTH CARRIAGEWAYS OF EGAN DRIVE AT THE SAME TIME.
9. ACTIVE TRAFFIC LANE (S) SHALL BE CLOSED WHEN WORK IS BEING PERFORMED ABOVE THEM.
10. NO FLAGGERS ARE ALLOWED ON EGAN DRIVE/GLACIER HIGHWAY.
11. 72 HOURS PRIOR TO PERFORMING ANY WORK THAT REQUIRES SHUTTING OFF SIGNALS AND/OR COVERING SIGNAL HEADS, THE CONTRACTOR SHALL NOTIFY THE SOUTHCOAST REGION TRAFFIC AND SAFETY SECTION (JOSH MAHLE, 465-8945) .

Record Drawings have been reviewed by the Project Engineer, and represent to the best of my knowledge, the project as constructed.

PE MMH Date 5-9-17

PATH:
D:\jms\88584\Planets\88584_TCP_Notes.dwg
Tue, 18/Aug/15 02:15PM
PLOT:
PPRAGE 1 of 1 (F) OR MPRAGE 1 of 1 (F)
TAB: TYPICALS

ADDENDUM NUMBER		
ATTACHMENT NUMBER		
RECORD OF REVISIONS		
No.	DATE	DESCRIPTION

MENDENHALL VALLEY ADAPTIVE
 TRAFFIC SIGNAL CONTROL SYSTEM
 Z685840000 - 0003184

TRAFFIC CONTROL NOTES



DESIGNED BY: D. EPSTEIN
DRAWN BY: D. STEVENS



STATE OF ALASKA
 DEPARTMENT OF TRANSPORTATION
 & PUBLIC FACILITIES
 SOUTHCOAST REGION
 MENDENHALL VALLEY
 ADAPTIVE TRAFFIC SIGNAL
 CONTROL SYSTEM

TRAFFIC CONTROL NOTES	
PROJECT DESIGNATION NUMBER	
Z685840000 - 0003184	
STATE	YEAR
ALASKA	2015
SHEET NUMBER	TOTAL SHEETS
S1	29


Record Drawings have been reviewed by the Project Engineer, and represent to the best of my knowledge, the project as constructed.

PE MWH Date 5-9-17


T-30.11

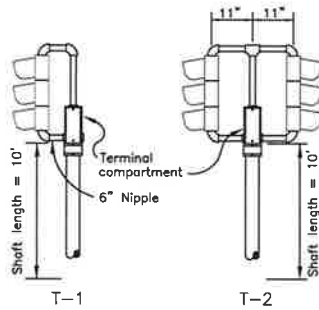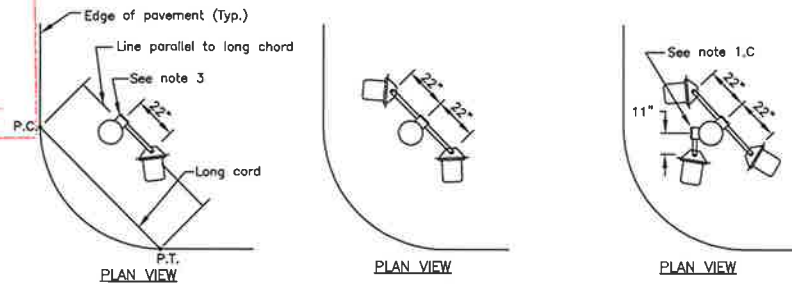


POST MOUNTED SIGNALS
(Shown without backplate)

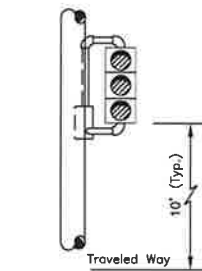

Use a one way, L.O.D. frame for installing one face

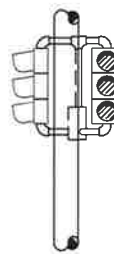


Use a two way frame for installing two faces

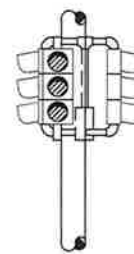


Use two frames for installing three faces: a two way and a one way R.O.D.


SIDE MOUNTED SIGNAL FRAMES WITH VEHICULAR SIGNALS
(Shown without backplates)

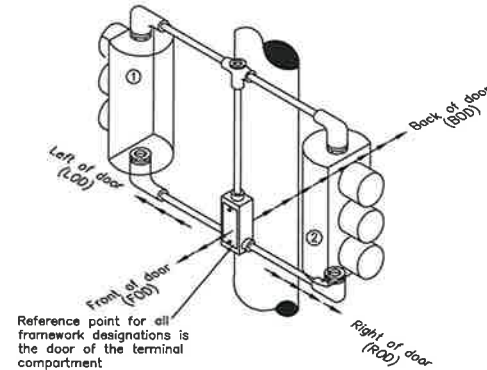


FRAMEWORK DESCRIPTION
Head no. ① offset L.O.D.
Head no. ② offset R.O.D.

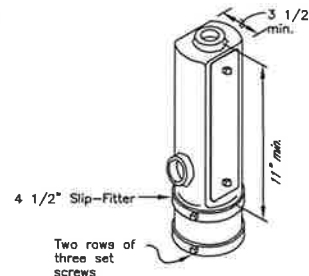

TERMINAL COMPARTMENT WITH SLIP FITTER
(See notes 1.C. and 2)

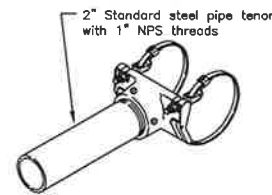

CLAMP ASSEMBLY FOR FIELD INSTALLED PLUMBIZER MOUNT
(See notes 4 and 8)

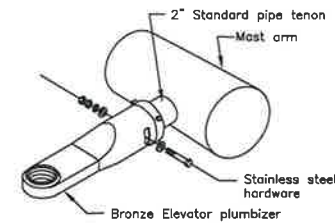

ELEVATOR PLUMBIZER
(See note 1.A.)

GENERAL NOTES

- Install the signal faces in the plans as detailed on this sheet.
 - Use elevator plumbizers to install faces on mast arms and whenever 2" pipe tenons are specified. Install the plumbizer between the red and yellow signal indications.
 - Use signal frames to install signal faces on the sides of poles and on the tops of posts.
 - Use a second signal frame to install the third face when three side mounted signal faces are shown.
- Furnish all signal frames with terminal compartments.
- Install one terminal compartment on the side of the pole opposite the midpoint of the radius. Position the terminal compartment at the location where a line parallel to the long chord (P.C. to P.T.) of the radius is tangent to the pole.
- Field drill the holes needed for attaching all signal hardware. Remove burrs after drilling. Treat the bare steel surfaces in accordance with AASHTO M36.
- Provide back plates sized for the number of signal sections and mounting type, so that no light is visible between the back plate and the signal face.
- Attach all back plates using stainless steel rivets with large flange button heads. Install 3/16" diameter by 9/16" long stainless steel rivets that provide at least 535 lb. and 675 lb. shear and tensile strengths, respectively. Bore out the mounting hole in the back plates and signal heads to the diameter recommended by the rivet manufacturer.
- Before installing the machine screws that secure the visors, coat the threads with an anti-seizing compound.
- Furnish clamp assemblies for field-installed plumbizer mounts with stainless steel hardware, AB-3007-L as manufactured by Pelco Products, Inc., or approved equivalent. The tenon shall be a 6" length of 2" rigid metal conduit with 1" tapered threads on one end. Drill the tenon to accept the plumbizer through bolt and debur all openings. Coat the tenon threads with Z.R.C. Galvite, Crown-Gold Galvanizing Compound, or approved equivalent.

REVISIONS		
Date	Description	By

Sheet 1 of 2

State of Alaska
Department of Transportation
& Public Facilities

**TRAFFIC SIGNAL
HARDWARE**

APPROVED

5/21/12

Date










Record Drawings have been reviewed by the Project Engineer, and represent to the best of my knowledge, the project as constructed.

PE MWH Date 5-9-17

T-30.11

GENERAL NOTES

1. Install the signal faces in the plans as detailed on this sheet.
2. Use slip fitters to install pedestrian signals on the top of posts.
3. Use clamshell brackets to install all pedestrian signals except those that are post-top mounted.
4. Install pedestrian signals on the side of poles away from traffic, unless indicated otherwise in the plans.
5. Drill and tap the pole for all mounting holes for sign and pedestrian push button housing.
6. Install R10-3E if a push button is installed. Install R10-101 if no push button is installed.
7. Apply caint-seize compound to cap screws tapped directly into pole.

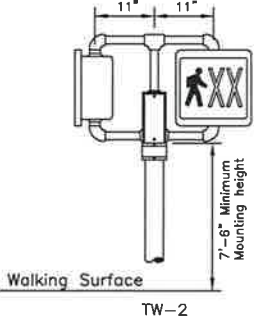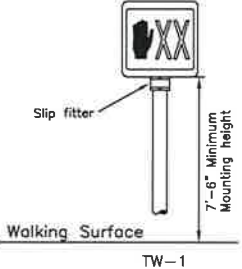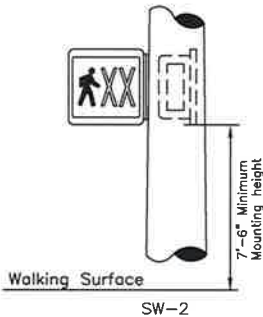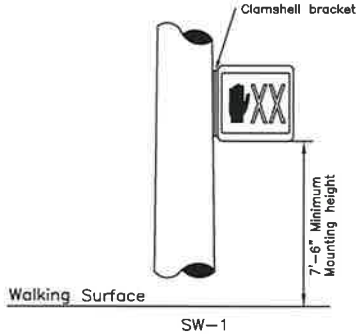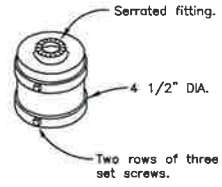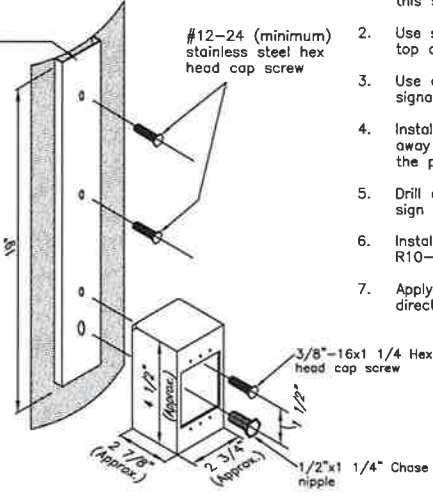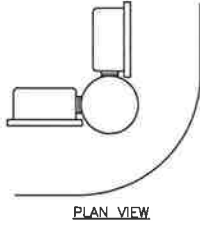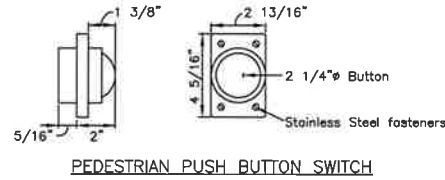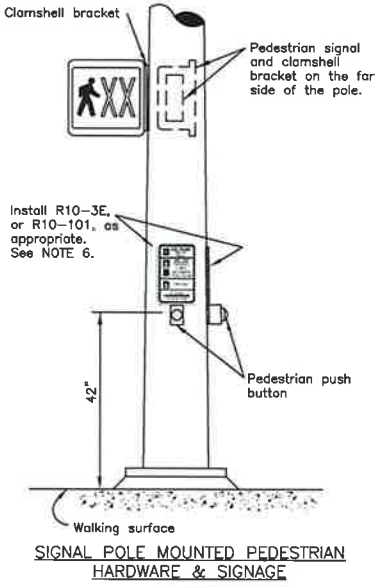

SIDE MOUNTED SIGNALS

POST MOUNTED SIGNALS

REVISIONS		
Date	Description	By
4/28/10	Notes, signal, signage	KIS

Sheet 2 of 2

State of Alaska
Department of Transportation
& Public Facilities
**TRAFFIC SIGNAL
HARDWARE**



Date 5/31/12