

**KEY MAP**

**STATE OF ALASKA  
DEPARTMENT OF TRANSPORTATION  
&  
PUBLIC FACILITIES**

**PLAN AND PROFILE  
PROPOSED HIGHWAY PROJECT**

*JUNEAU MENDENHALL LOOP/MALL/JAMES  
BLVD. SIGNAL AND LEFT TURN LANE  
HES-M-966(14) 69058*

STATE	PROJECT	SHEET NO.	TOTAL SHEETS
ALASKA	HES-M-966(14)	1	28

INDEX OF SHEETS	
SHEET NO.	DESCRIPTION
1	TITLE SHEET
2	ESTIMATE OF QUANTITIES
3	TYPICAL SECTIONS
4	TYPICAL SECTIONS & PROFILE - ATLIN DRIVE
5 & 6	PLAN LAYOUT
7 & 8	INTERSECTION & BUS TURNOUT LAYOUT
9 & 10	STRIPING & SIGNING LAYOUT
11	ISLAND & BIKEPATH RECONSTRUCTION LAYOUT
12	TRAFFIC CONTROL PLAN
13-17	STORM DRAIN DETAILS
18	SLOTTED DRAIN AND ELBOW CONNECTION DETAILS
19	PETROLEUM SEPARATOR DETAILS
20	CURB & GUTTER AND MISCELLANEOUS DETAILS
21	LUMINAIRE FOUNDATION EXTENSION DETAIL
22 & 23	MENDENHALL MALL, ATLIN DR. & LOOP ROAD SIGNALIZATION AND TABLES
24 & 25	EGAN DRIVE & LOOP RD. SIGNALIZATION AND TABLES
26	MASTER TRAFFIC SIGNAL SYSTEM INTERCONNECT
27	ILLUMINATION PLAN
28	THAW WIRE INSTALLATION DETAIL


**DESIGN DESIGNATION**

ADT (1987)	17,831
ADT (2008)	19,701
DHV	2,364
% T	5
T.I.	9.5
V(mph)	40

**PROJECT SUMMARY**

LENGTH OF PROJECT - 3,491.04 FEET (0.66 MILE).  
ADD CURB & GUTTER, BUS TURNOUTS, STRIPING AND DRAINAGE FACILITIES TO EXISTING ROADWAY; AND SIGNALIZE THE INTERSECTION AT MENDENHALL LOOP ROAD AND ATLIN DRIVE.  
LENGTH OF 3/4" ASPHALT CONCRETE OVERLAY = 3,376 FEET.

The following Standard Drawings apply to this project:  
A-1, C-01.02, C-02.00, C-03.01, C-05.00, D-01.00, D-04.10, D-05.10, D-20.01, D-23.00, D-26.01, D-27.01, G-04.03W, L-10.01, L-23.00, L-30.01, M-20.10, M-23.10, S-00.00, S-05.00, S-30.01, T-20.00, T-21.01, T-22.01, T-30.00, T-31.00, T-32.00, T-33.00, T-33.01, T-34.00, T-52.01, G-04.035.

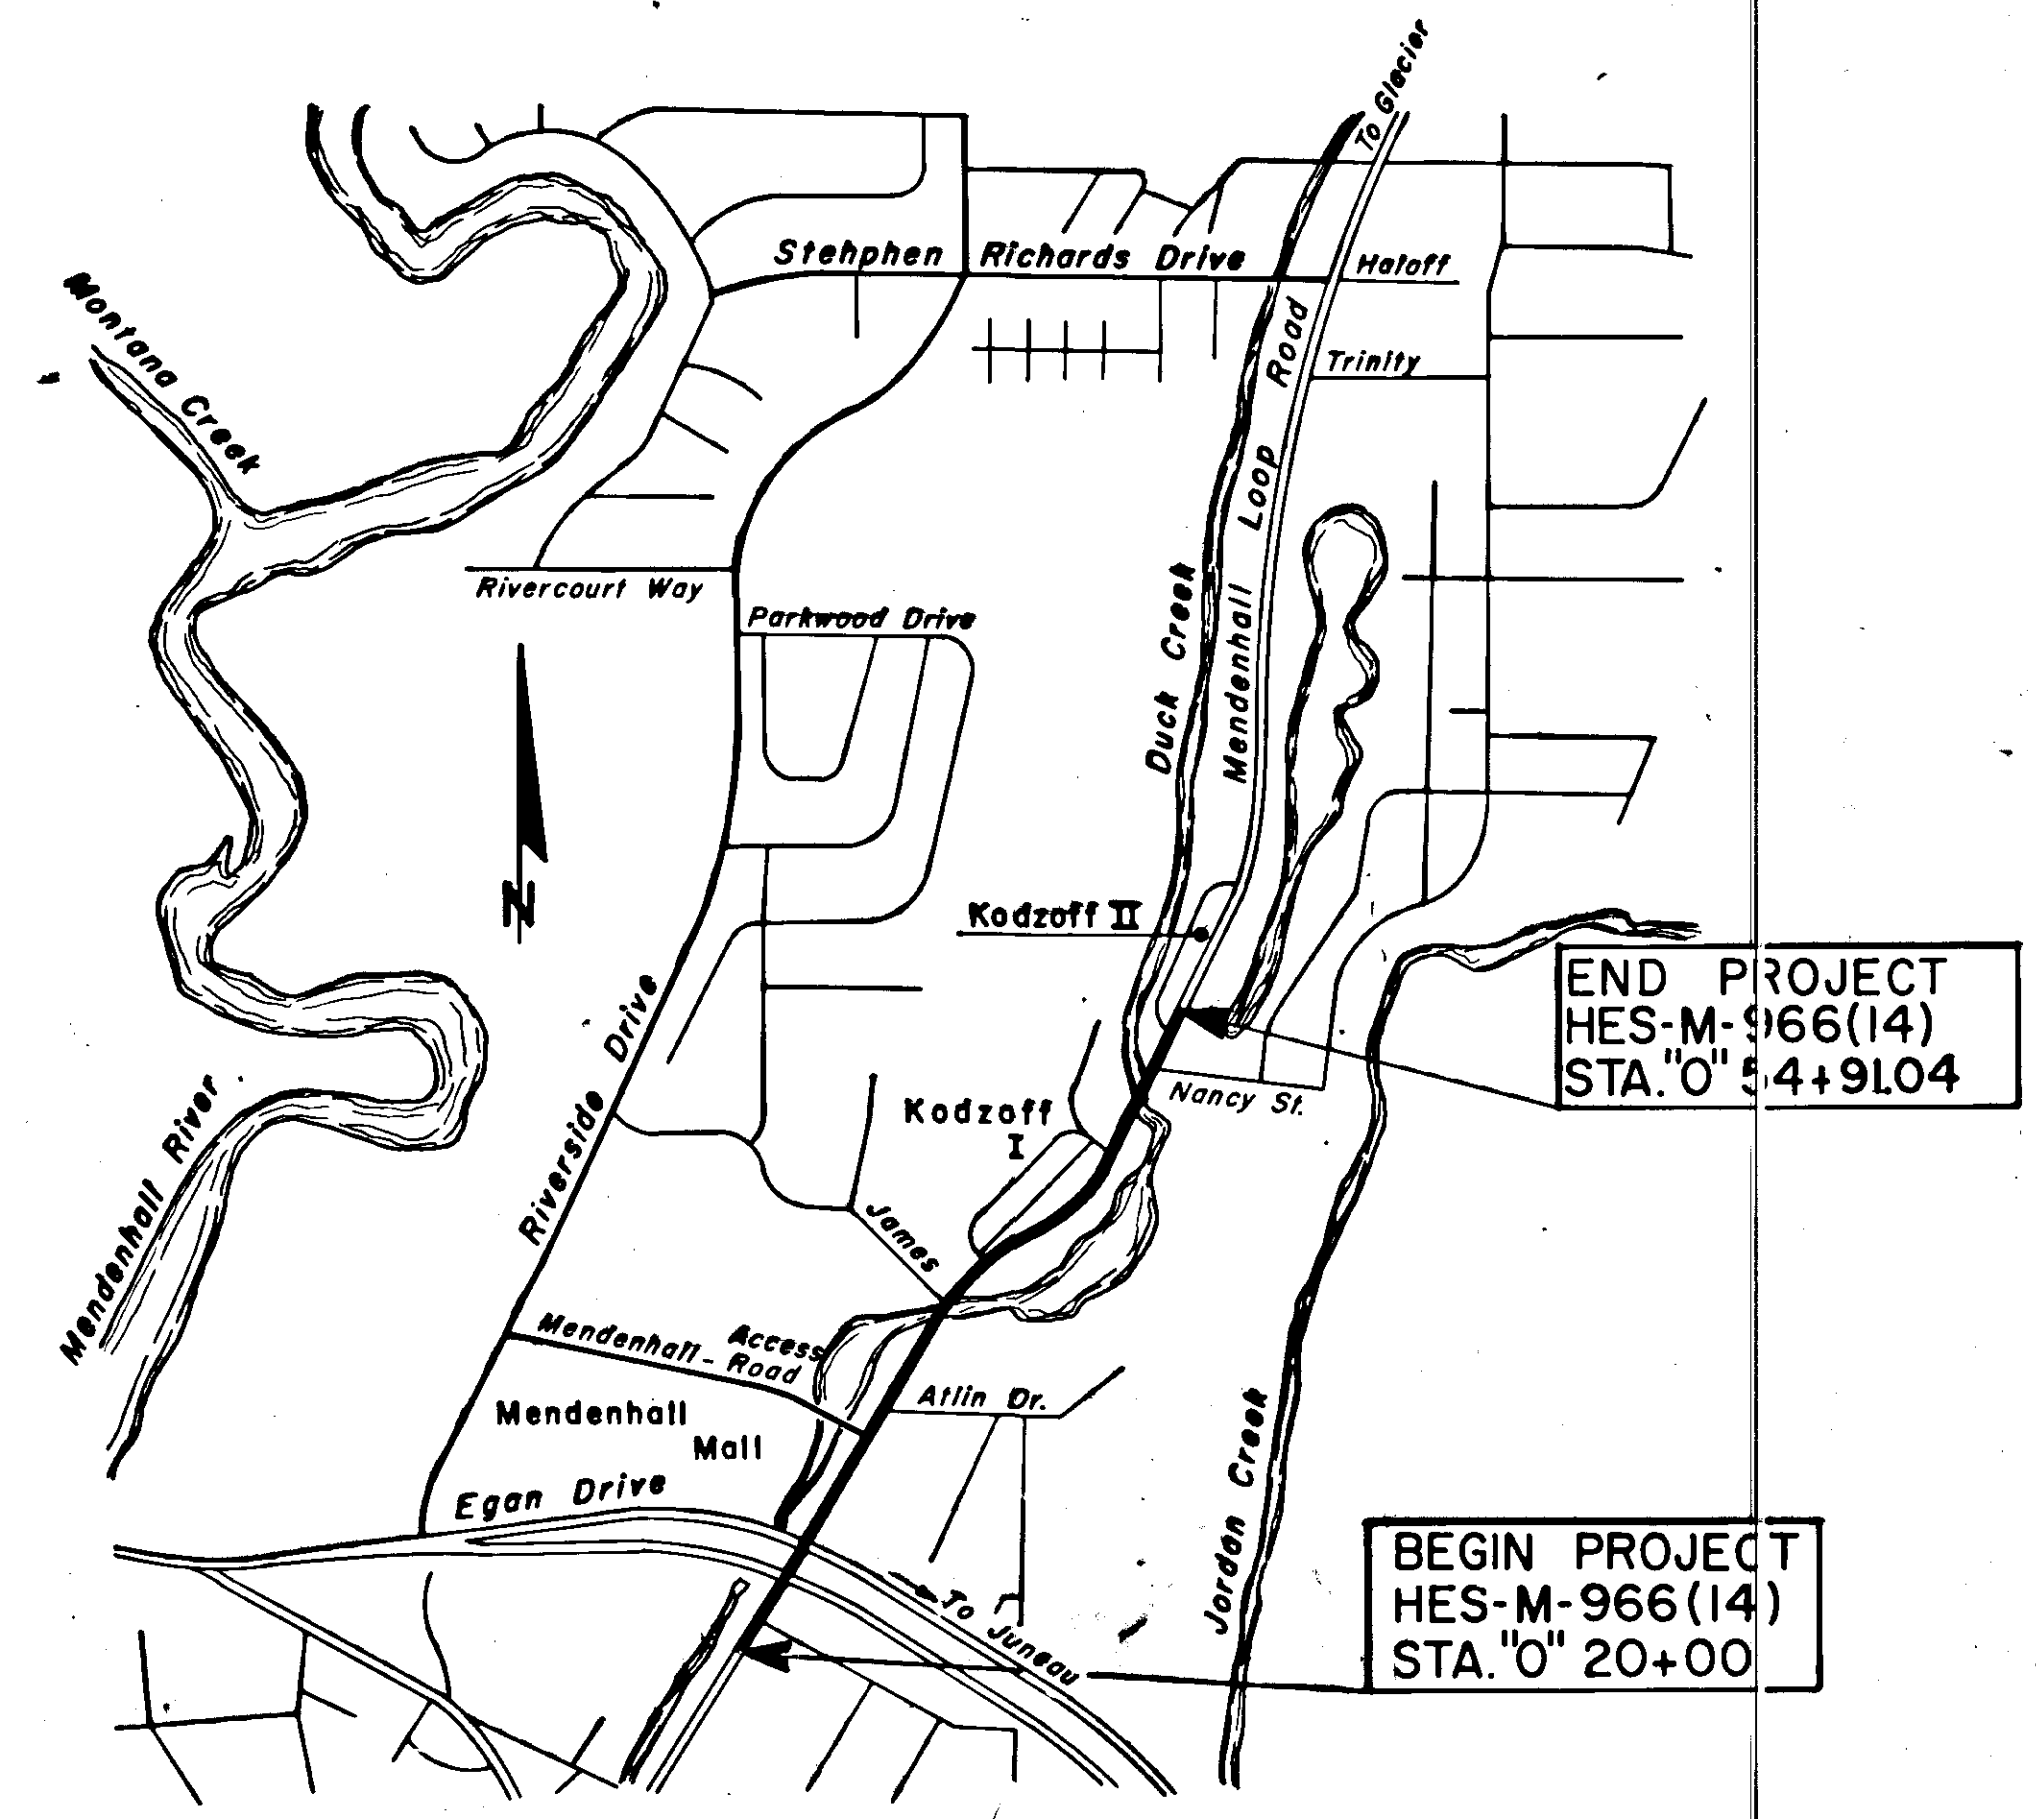

*"As-Built Plans"*

**CONTRACTOR: ASSOCIATED SAND & GRAVEL**  
**PROJ. ENG.: SOC KREUZENSTEIN**  
**DATE BEGAN: APRIL 17, 1989**  
**DATE COMPLETED: AUGUST 7, 1989**

STATE OF ALASKA  
DEPARTMENT OF TRANSPORTATION  
AND  
PUBLIC FACILITIES  
SOUTHEASTERN REGION DESIGN SECTION

APPROVED  
*[Signature]* Date 6-22-88  
S.E. Region Design Chief

APPROVED  
*[Signature]* Date 6-22-88  
Director, S.E. Region Design & Construction

ESTIMATE OF QUANTITIES

Item No.	Item	Unit	Total
109 (2)	DBE and WBE Adjustments	C.S.	All Req'd.
110 (1)	Mobilization and Demobilization	Lump Sum	All Req'd.
111 (1)	Temporary Erosion and Pollution Control	C.S.	All Req'd.
114 (1)	Construction Surveying by the Contractor	Lump Sum	All Req'd.
115 (1)	Traffic Maintenance	Lump Sum	All Req'd.
115 (2)	Traffic Control	Lump Sum	All Req'd.
115 (3)	Permanent Construction Signing	Lump Sum	All Req'd.
115 (4)	Traffic Control Devices	C.S.	All Req'd.
115 (5)	Flagging	Man-Hours	487
116 (1)	Furnishing and Maintaining Field Office	Lump Sum	All Req'd.
116 (2)	Furnishing and Maintaining Field Laboratory	Lump Sum	All Req'd.
201 (2B)	Clearing and Grubbing	Lump Sum	All Req'd.
202 (2)	Removal of Pavement	Square Yard	1,936
202 (4)	Removal of Culvert Pipe	Linear Foot	136
202 (11)	Relocate and Install Mailboxes	Lump Sum	All Req'd.
202 (12)	Removal of Curb	Linear Foot	605
203 (3)	Unclassified Excavation (Approx. 450 C.Y.)	Lump Sum	All Req'd.
301 (1)	Crushed Aggregate Base Course	Ton	1,073.9
304 (1)	Subbase, Grading "E"	Ton	1,501
401 (1A)	Asphalt Concrete, Type II	Ton	4067
401 (1B)	Asphalt Concrete, Type III	Ton	1,173.4
401 (2)	Asphalt Cement, AC-5	Ton	100.02
402 (1)	CSS-1 Asphalt for Tack Coat	Ton	5.6
603 (1-12)	12 Inch Corrugated Steel Pipe	Linear Foot	108.8
603 (1-18)	18 Inch Corrugated Steel Pipe	Linear Foot	20
603 (13-12)	12 Inch Corrugated Aluminum Pipe	Linear Foot	106
603 (13-18)	18 Inch Corrugated Aluminum Pipe	Linear Foot	122.5
603 (30)	Slotted Drain Pipe	Linear Foot	800.8
604 (3)	Reconstruct existing manholes	Each	1
604 (4)	Adjust existing Manholes	Each	3
604 (5A)	Inlet, Type "A"	Each	18
604 (5B)	Inlet, Type "A" with Petroleum Separator	"	7
606 (1)	Beam Type Guardrail, Type I Post	Linear Foot	75
604 (3A)	Reconstruct Existing Manhole	Each	1
609 (2)	Curb and Gutter	Linear Foot	607.0
610 (1)	Ditch Line	Linear Foot	1046
615 (1)	Standard Sign	Square Foot	98.5
615 (2)	Remove and Relocate Existing Signs	Each	9
618 (1)	Seeding	MSF	60.6
660 (1B)	Miscellaneous Electrical Work	Lump Sum	All Req'd.
660 (1A)	Additional Opticom	Lump Sum	All Req'd.
660 (1)	Traffic Signal System Complete	Lump Sum	All Req'd.
660 (10)	Master Traffic Signal Control System	Lump Sum	All Req'd.
660 (11)	Master Traffic Signal System Interconnect	Lump Sum	All Req'd.
660 (9)	Adjustment of Existing Electroliers	Lump Sum	All Req'd.
670 (1)	Painted Traffic Markings	Lump Sum	All Req'd.
670 (8)	Preformed Pavement Markings	Lump Sum	All Req'd.

BASIS OF ESTIMATE


Item No.	Estimating Factor
301 (1)	1.96 Tons per Cubic Yard
304 (1)	1.87 Tons per Cubic Yard
401 (1)	116 Pounds per Square Yard per Inch Depth
401 (2)	6% of Item 401 (1)
402 (2)	0.04 Gallons per Square Yard, 256 Gallons per Ton @ 60° F.

STATE	PROJECT DESIGNATION	YEAR	SHEET NO.	TOT SHEETS
ALASKA	HES-M-966(4)	'88	2	28

STANDARD SIGN SCHEDULE A

NO.	STATION	OFFSET		CODE NO.	LEGEND	SIGN PANEL			POST			FACING TRAFFIC		
		Left	Right			CLASS	THICKNESS	AREA-SF	No. of Post	Type	Size		Length	Imbedment
1	"0" 26+07.5	6.0'	0	R3-5L	ONLY	T	0.080	7.5	1			N.E. Bound		
2	"0" 26+07.5	6.0'		R3-6R		T	0.080	7.5	1			N.E. Bound		
3	"0" 33+81		52.0'	R7-101	NO PARKING ANYTIME	T	0.080	1.5	1	P.S.T.	2"x2"	14.0'	3.5'	N.E. Bound
4	"0" 39+85	35.0'		R7-101	NO PARKING ANYTIME	T	0.080	1.5	1	P.S.T.	2"x2"	14.0'	3.5'	N.E. Bound
5	"0" 47+75		32.0'	W4-2		T	0.080	9.0	1	P.S.T.	2"x2"	15.0'	3.5'	N. Bound
6	"0" 49+94	55.0'		R7-101	NO PARKING ANYTIME	T	0.080	1.5	1	P.S.T.	2"x2"	14.0'	3.5'	N.E. Bound
7	"0" 50+28		48.0'	R7-101	NO PARKING ANYTIME	T	0.080	1.5	1	P.S.T.	2"x2"	14.0'	3.5'	N.E. Bound
8	"0" 31+98	48.0'		RI-1	"STOP"	Bike	0.080	2.25	1	P.S.T.	2"x2"	10.0'	3.5'	N.E. Bound
9	"0" 32+24		49.0'	RI-1	"STOP"	Bike	0.080	2.25	1	P.S.T.	2"x2"	10.0'	3.5'	N.E. Bound
10	"0" 33+12		53.0'	RI-1	"STOP"	Bike	0.080	2.25	1	P.S.T.	2"x2"	10.0'	3.5'	S.W. Bound
11	"0" 37+21	56.0'		RI-1	"STOP"	Bike	0.080	2.25	1	P.S.T.	2"x2"	10.0'	3.5'	N.E. Bound
12	"J" 10+75		22.0'	RI-1	"STOP"	Bike	0.080	2.25	1	P.S.T.	2"x2"	10.0'	3.5'	S.E. Bound
13	"0" 44+43	56.0'		RI-1	"STOP"	Bike	0.080	2.25	1	P.S.T.	2"x2"	10.0'	3.5'	S.W. Bound
14	"0" 49+13		51.0'	RI-1	"STOP"	Bike	0.080	2.25	1	P.S.T.	2"x2"	10.0'	3.5'	N.E. Bound
15	"0" 49+80		51.0'	RI-1	"STOP"	Bike	0.080	2.25	1	P.S.T.	2"x2"	10.0'	3.5'	S.W. Bound
16	"0" 50+69	54.0'		RI-1	"STOP"	Bike	0.080	2.25	1	P.S.T.	2"x2"	10.0'	3.5'	N.E. Bound
17	"0" 51+29	54.0'		RI-1	"STOP"	Bike	0.080	2.25	1	P.S.T.	2"x2"	10.0'	3.5'	S.W. Bound
18	"0" 32+51	52.0'		R3-6 SL		T	0.080	7.5	1					N.W. Bound
19	"0" 32+39	52.0'		R3-5R	ONLY	T	0.080	7.5	1					N.W. Bound
20	"0" 32+35		38.0'	R3-5R	ONLY	T	0.080	7.5	1					E. Bound
21	"0" 32+47		38.0'	R3-6 SL		T	0.080	7.5	1					E. Bound
22	"0" 45+25				LEFT LANE ENDS MERGE RIGHT			16						N. Bound

- ▲ New sign shall be mounted on the mast arm of existing signal pole. Existing signs mounted on the mast arm shall be removed.
- ▲ Shall be facing toward the roadway centerline.
- ▲ Lengths shown are only approximate for estimating purposes.
- ▲ Stations and offsets are approximate and can be adjusted to better fit field conditions and in conformance with the Engineer.
- ▲ These signs shall be mounted below the Bus stop signs. These existing Bus stop signs are to be removed and relocated from their existing location along Mendenhall Loop Road.
- ▲ From Alaska Sign Design Specification.
- ▲ Stop sign for pedestrian traffic shall be 18" x 18"
- ▲ All existing signs to be removed shall be the property of the State to be delivered by the Contractor to the DOT / PF Building at 7 mile Glacier Hwy., Juneau Ak.
- ▲ New sign shall be mounted on the mast arm of proposed signal pole no. 1, see sheet no. 21 for location.
- ▲ New sign shall be mounted on the mast arm of proposed signal pole no. 3, see sheet no. 21 for location.

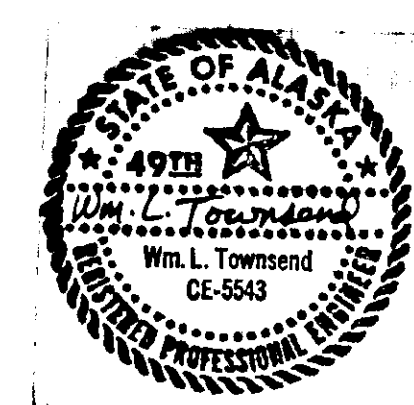


EXISTING SIGN

EXIST. Station	EXIST. Offset	PROPOSED Station	PROPOSED Offset	LEGEND	FACING TRAFFIC	NOTES
	left right		left right			
"0" 30+94		-		"LANE ENDS MERGE RIGHT"		Remove existing sign mounted on luminaire pole.
"0" 32+12	48.0'	-		"STOP"		Remove existing sign.
"0" 32+38		50.0'		"YIELD"		Remove existing sign.
"0" 32+75		39.0'		"STOP"		Remove existing sign.
"0" 32+83	57.0'	-		"STOP" & "NO BURNING"		Existing sign to remain in place.
"0" 36+17		37.0'		"STOP"		Removed existing sign mounted on luminaire pole.
"0" 37+28	42.0'	"0" 37+24	42.0'	"STOP"	S.E. Bound	Existing sign to be relocated, James Boulevard.
"0" 38+48	53.0'	-		"STOP"		Existing pedestrian stop sign to remain in place.
"0" 38+55	49.0'	-		"STOP"		Existing sign to remain in place.
"0" 39+04	59.0'	-		"STOP"		Existing pedestrian stop sign to remain in place.
"0" 40+23		37.0'	"0" 39+59	"BUS"		Existing sign on luminaire pole to be relocated on the same post as sign no. (4)
"0" 43+89	36.0'	"0" 43+80	39.0'	"STOP"	S.E. Bound	Existing sign to be relocated.
"0" 43+96	54.0'	"0" 43+80	66.0'	"STOP"	N.E. Bound	Existing pedestrian stop sign to be relocated.
"0" 49+60		54.0'	"N" 10+72	"STOP"	West Bound	Existing sign to be relocated.
"0" 49+58	37.0'	"0" 50+11.5	55.0'	"BUS"		Existing sign on luminaire pole to be relocated on the same post as sign no. (6)
"0" 50+00		37.0'	"0" 50+59	"BUS"	N.E. Bound	Existing sign to be relocated on existing luminaire pole.
"0" 50+59		38.0'	"0" 50+28	"BUS"		Existing sign mounted on luminaire pole to be relocated on the same post as sign no. (7)
"0" 50+76	38.0'	"0" 50+70	40.0'	"STOP"	S.E. Bound	Existing sign to be relocated.
"0" 52+62		37.0'	-	"BEGIN CENTER LANE"		Existing sign to remain in place.
"0" 39+05	37.0'	"0" 33+68	52.0'	"BUS"		Existing sign on luminaire pole to be relocated on same post as sign no. (3)




**NOTES**

- Roadway widths transition from 56'-0" to 60'-0" between Sta. "O" 20+14.5 to Sta. "O" 24+96.
- Dimensions in parenthesis corresponds to stations in parenthesis.
- Overlay not required between Sta. "O" 24+82 to Sta. "O" 25+93.

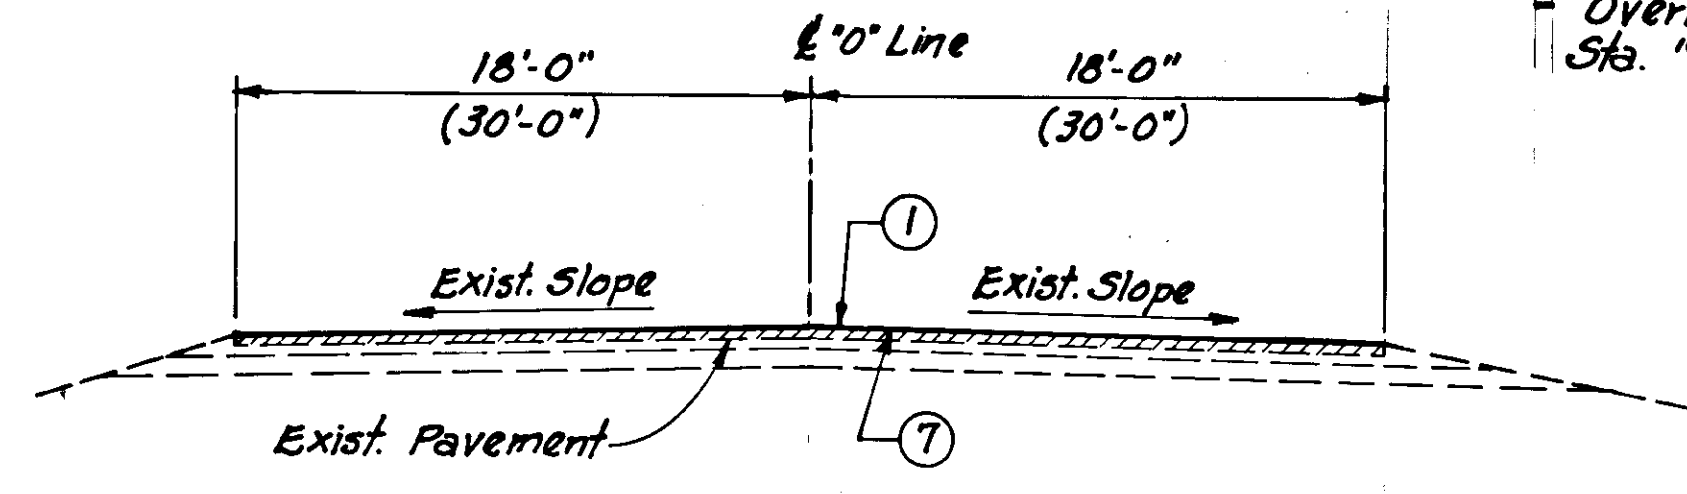


**Typical Section**  
 Sta. "O" 20+00 to Sta. "O" 24+96  
 (Sta. "O" 24+96 to Sta. "O" 26+00)

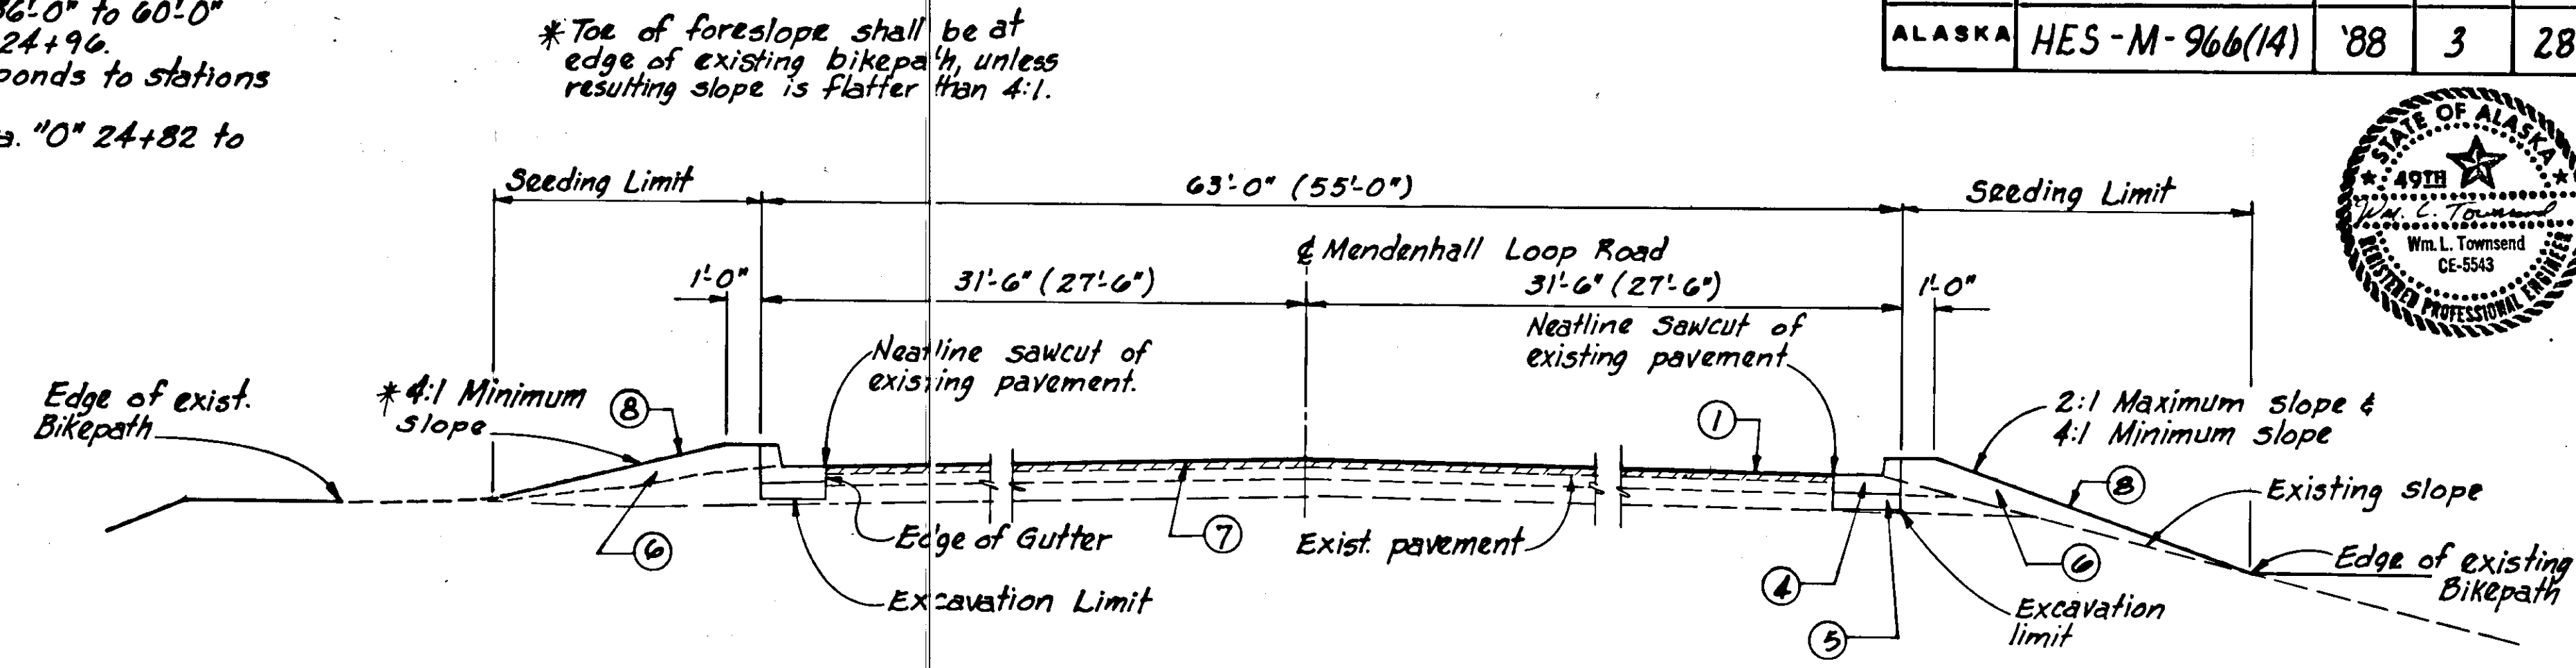


**Typical Section**  
 Sta. "O" 26+50 to Sta. "O" 41+00  
 (Sta. "O" 41+00 to Sta. "O" 54+00)

**Note:**


- Dimensions in parenthesis corresponds to stations in parenthesis.
- Roadway width transition from 63'-0" to 55'-0" between Sta. "O" 39+00 to 41+00.
- 3/4" overlay shall end at Sta. "O" 54+91.04
- Curb & Gutter shall end at Sta. "O" 54+00.

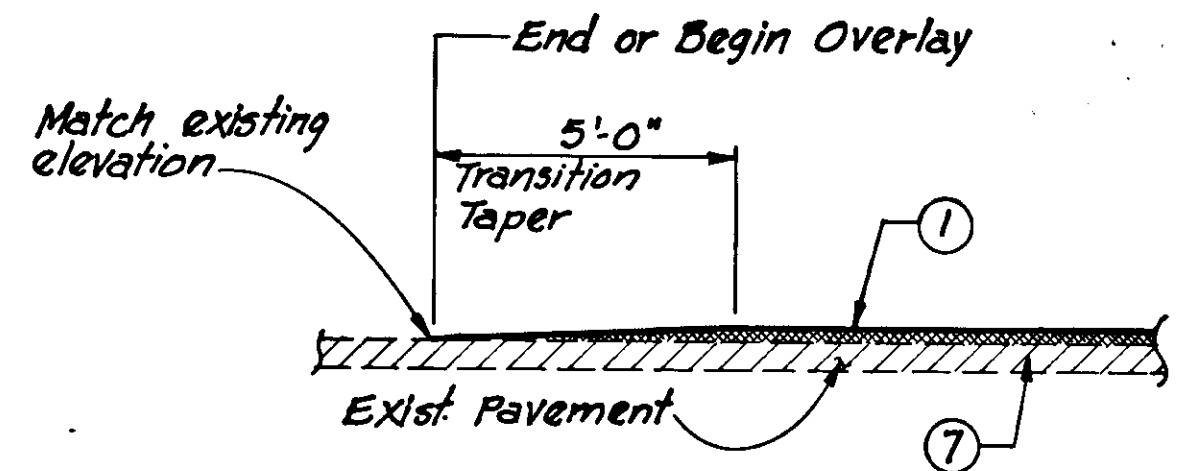

**Overlay Taper Detail**

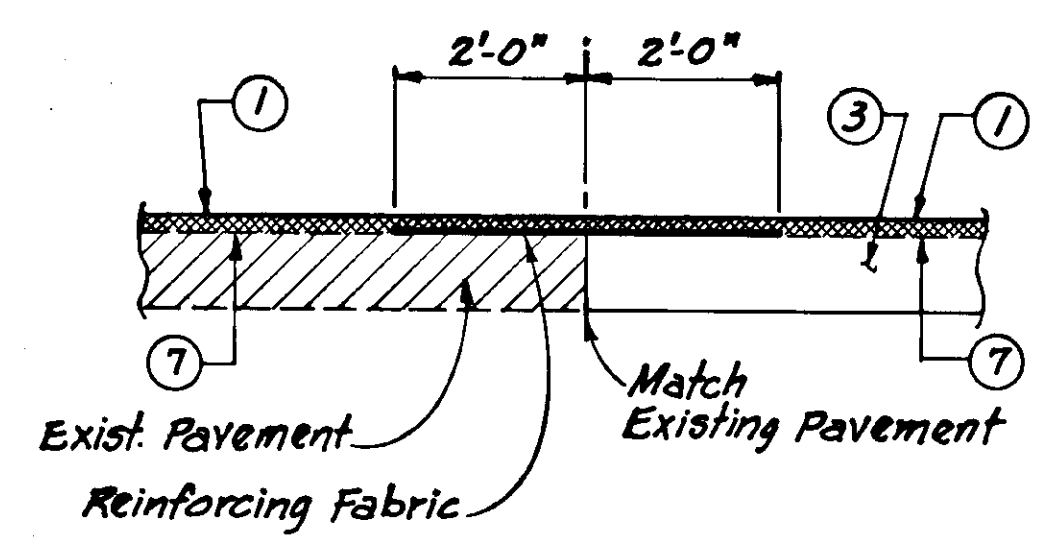

**Pavement Joint Detail**

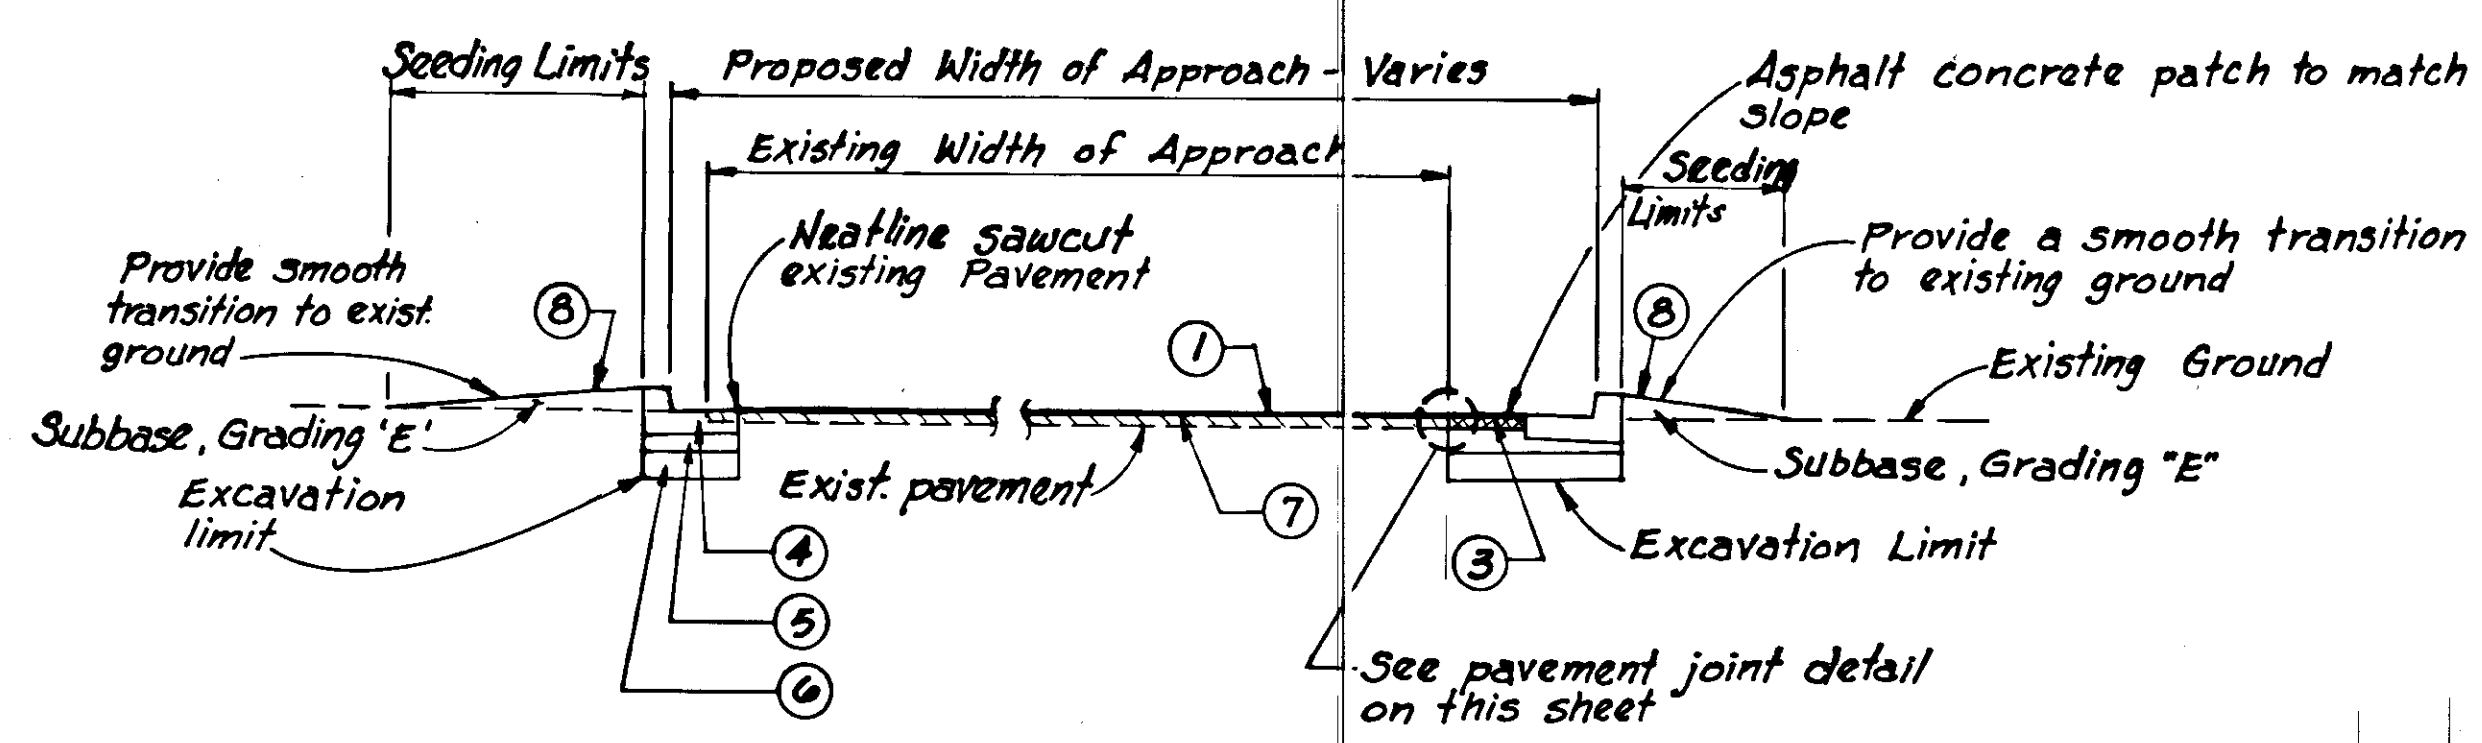


**Approaches**

**General Notes**


- All types of pavement removal (bikepath, patching, roadway, island, etc.) shall be paid under pay item 202 (2), Removal of Pavement.
- Curb & Gutter, Type I shall be used if existing slope drains toward the proposed curb and Type II shall be used if existing slope drains away from the proposed curb.
- Reinforcing fabric shall be considered incidental to pay item 401 (1A), Asphalt Concrete, Type II.
- Localized low spots on existing pavement shall be pre-level with asphalt concrete, Type III to match surrounding pavement prior to overlay.
- Existing slopes that are disturbed shall be seeded, see Special Provisions, Section 618.
- Tack Coat shall be applied to edge of gutter prior to paving.
- Existing topsoil shall be stockpiled and applied to all fill slopes with a minimum thickness of one (1) inch, see Section 618 of the Special Provision.

**Labeling Index**


- 3/4" Asphalt Concrete, Type III overlay
- 1 1/2" Asphalt Concrete, Type II
- 3" Asphalt Concrete, Type II
- Concrete Curb & Gutter (See General Notes #2)
- 4" Crushed Aggregate Base Course
- 6" Subbase, Grading "E"
- CSS-1 Asphalt for Tack Coat
- Seeding
- Useable Unclassified Excavation or Subbase Grading (E) (See Special Provisions)

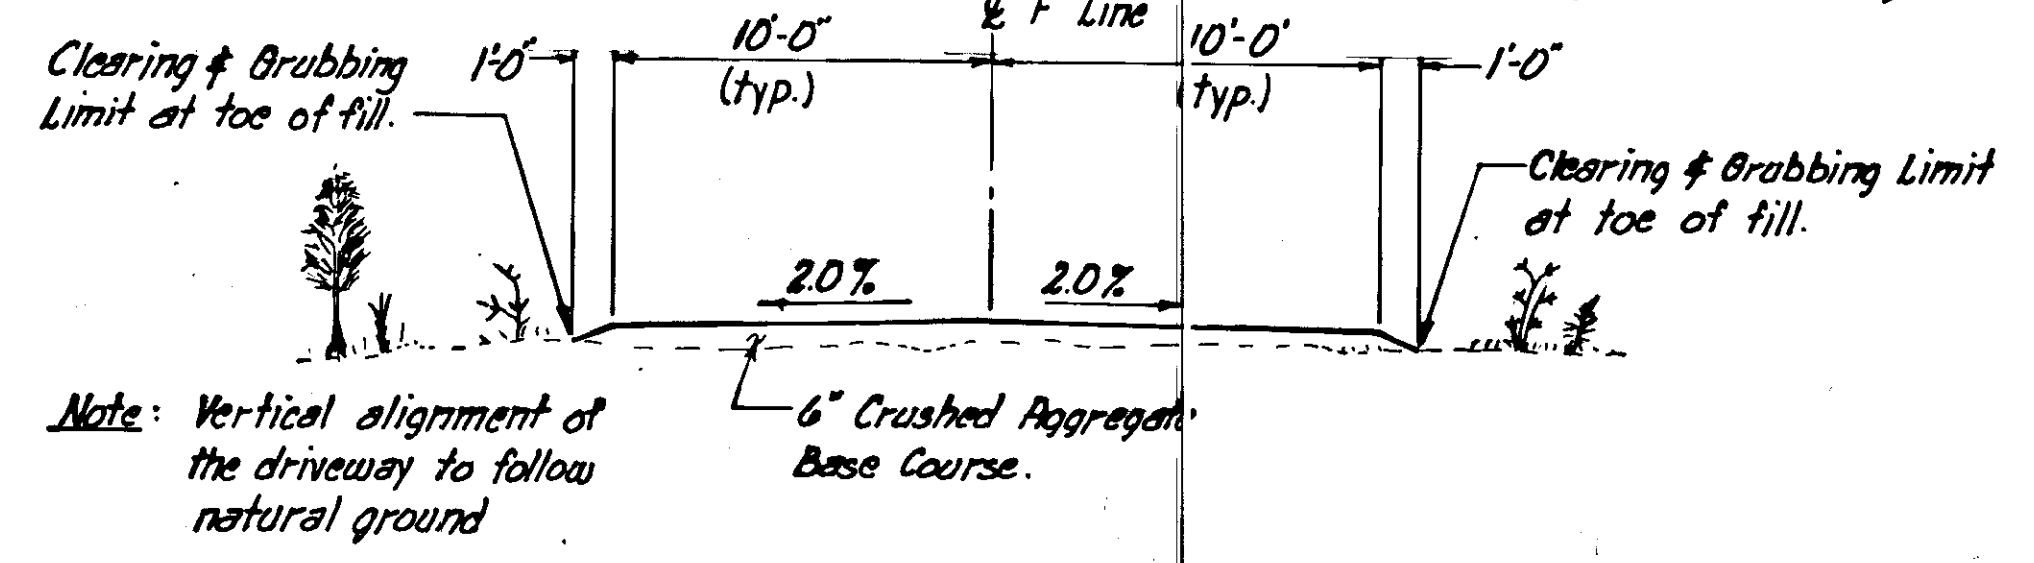


**Typical Section - Forest Service Driveway**  
 Sta. "F" 10+13 to Sta. "F" 12+10

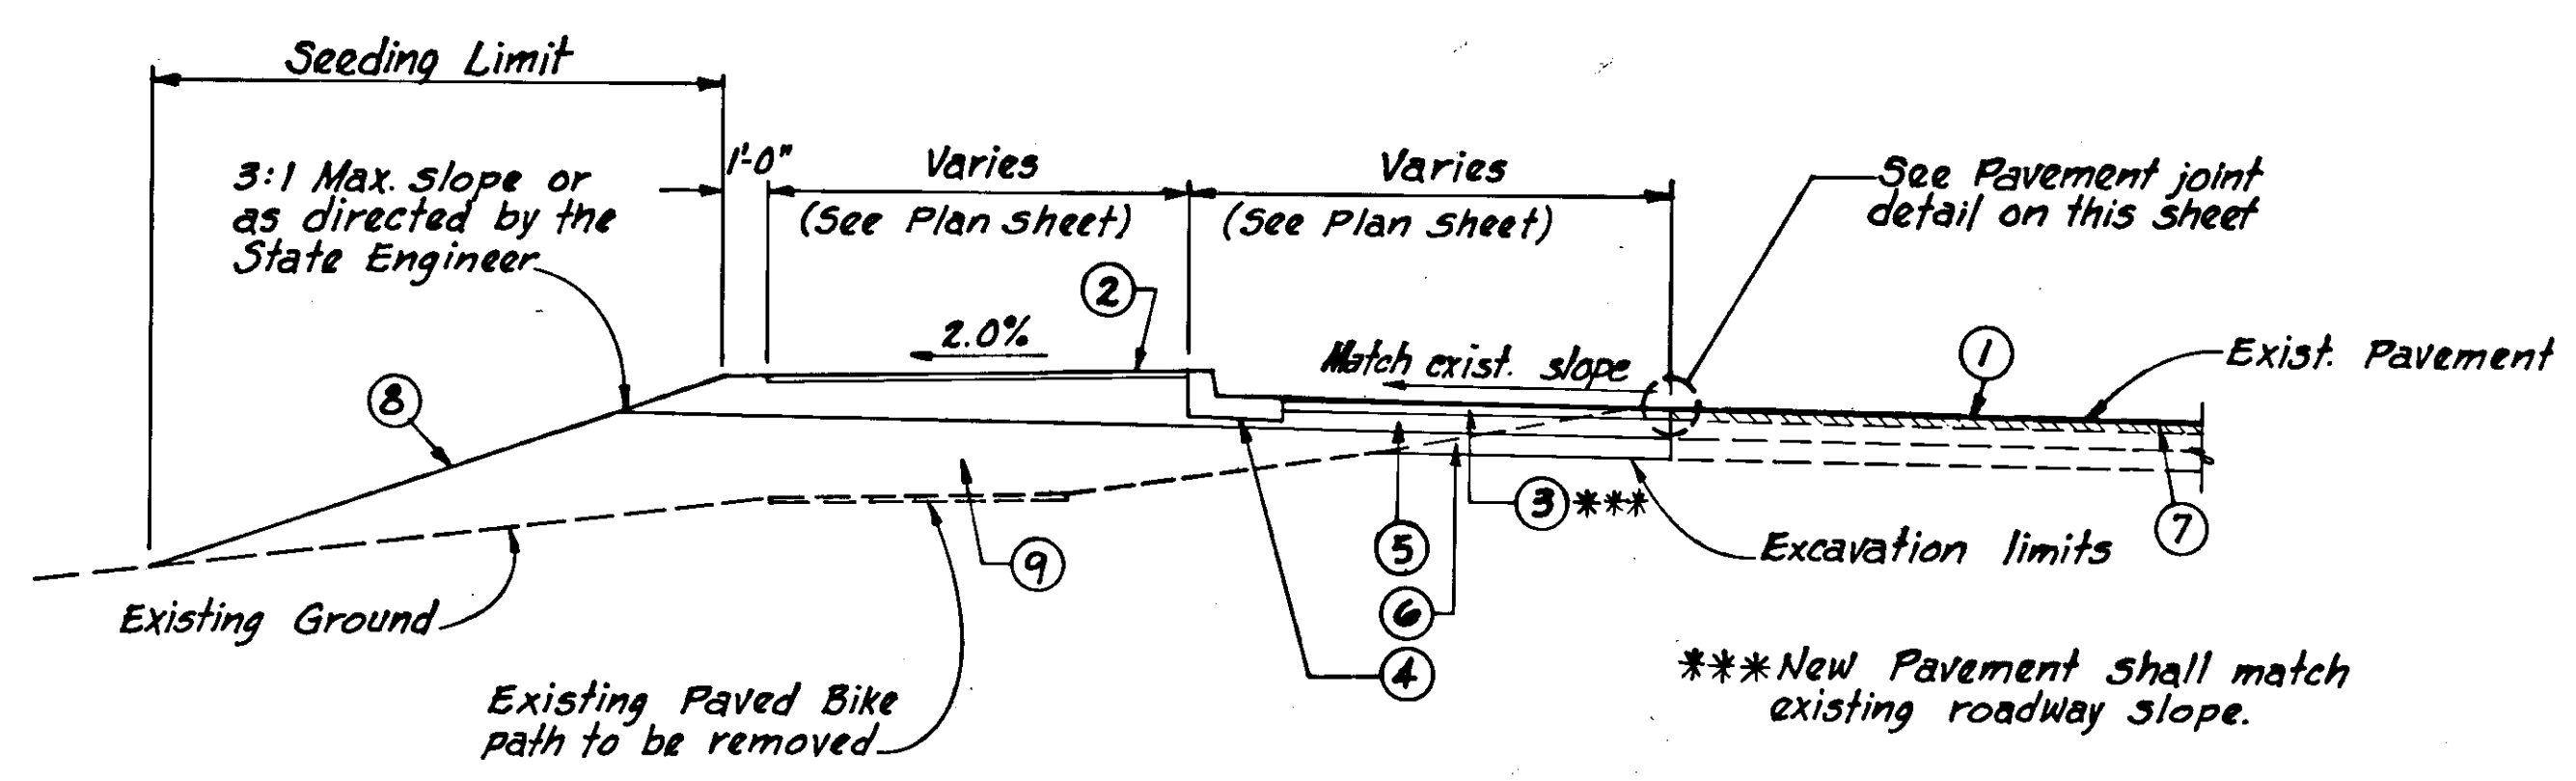

**Section A-A**  
 WIDENING FOR BUS TURNOUT

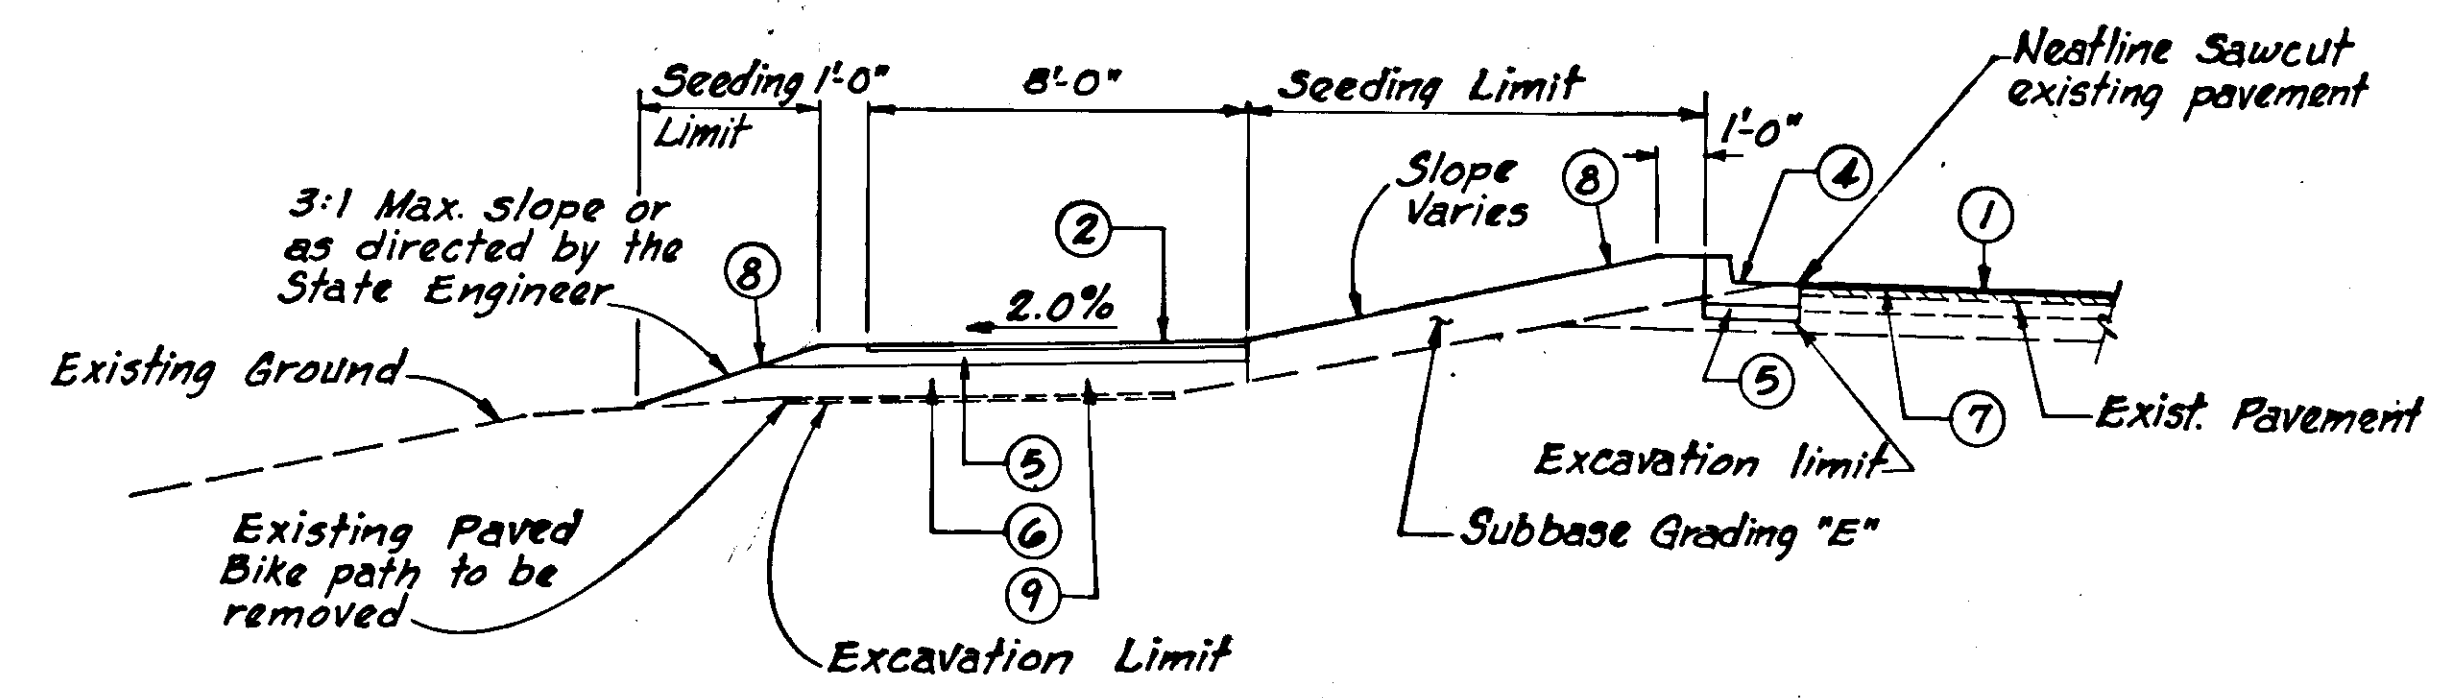


**Section B-B**  
 Bikepath at Bus Turnout

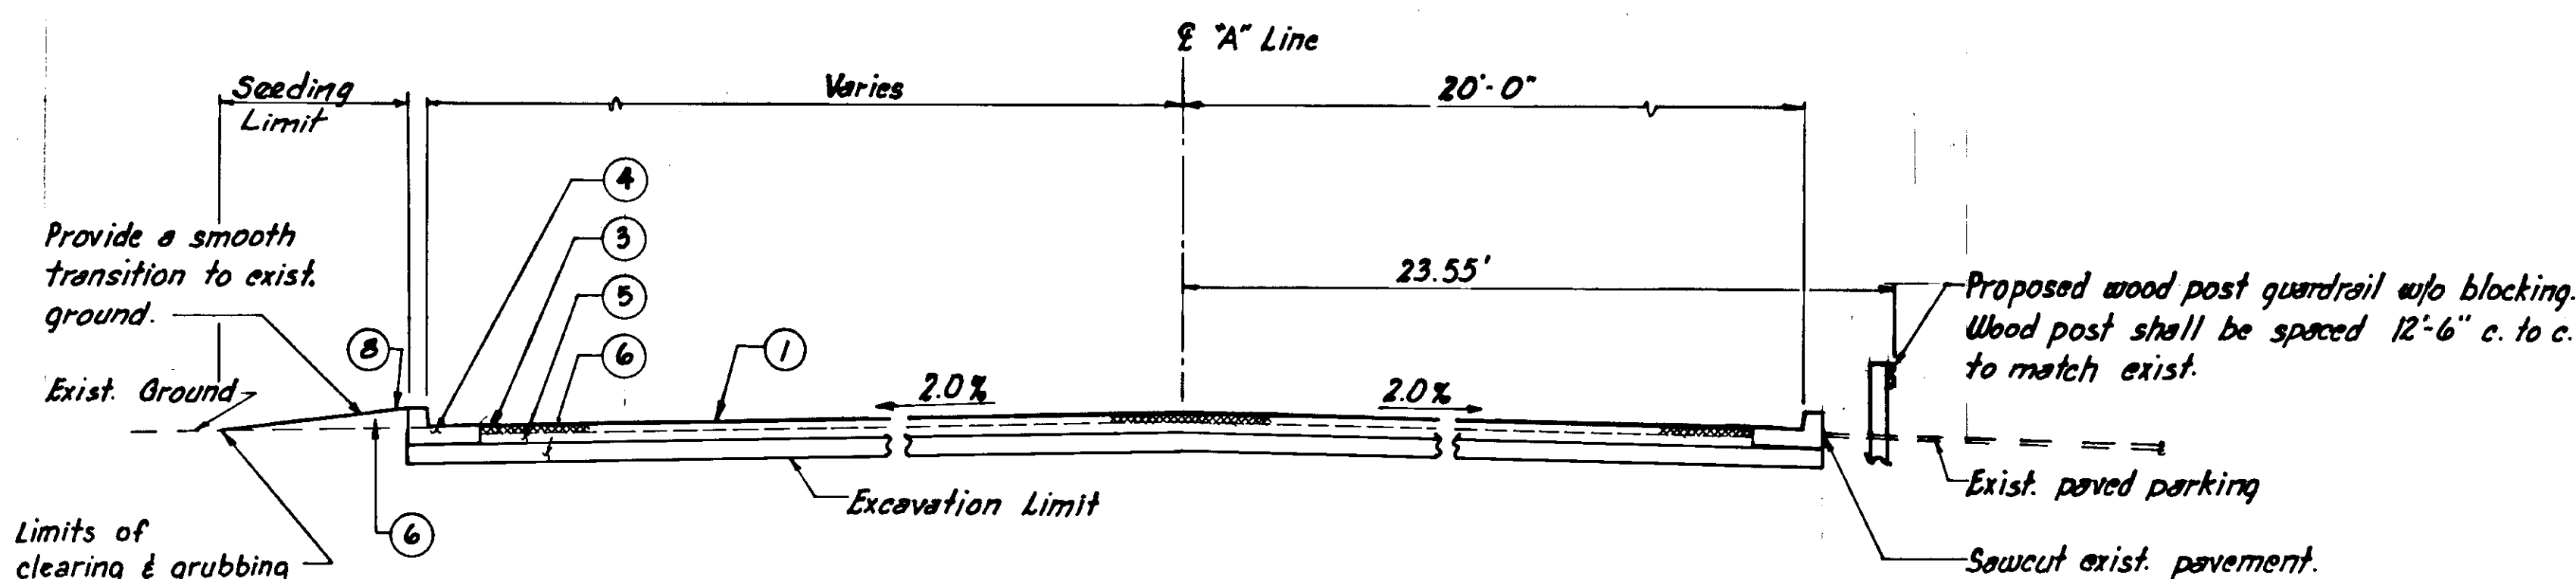


**ATLIN DRIVE**  
STA. "A" 10+35 TO STA. "A" 11+14

**Labeling Index**

- ① 3/4" Asphalt Concrete, Type III, Overlay
- ③ 3" Asphalt Concrete, Type II
- ④ Concrete Curb and Butter
- ⑤ 4" Crushed Aggregate Base Course
- ⑥ 6" Subbase, Grading "E"
- ⑧ Seeding

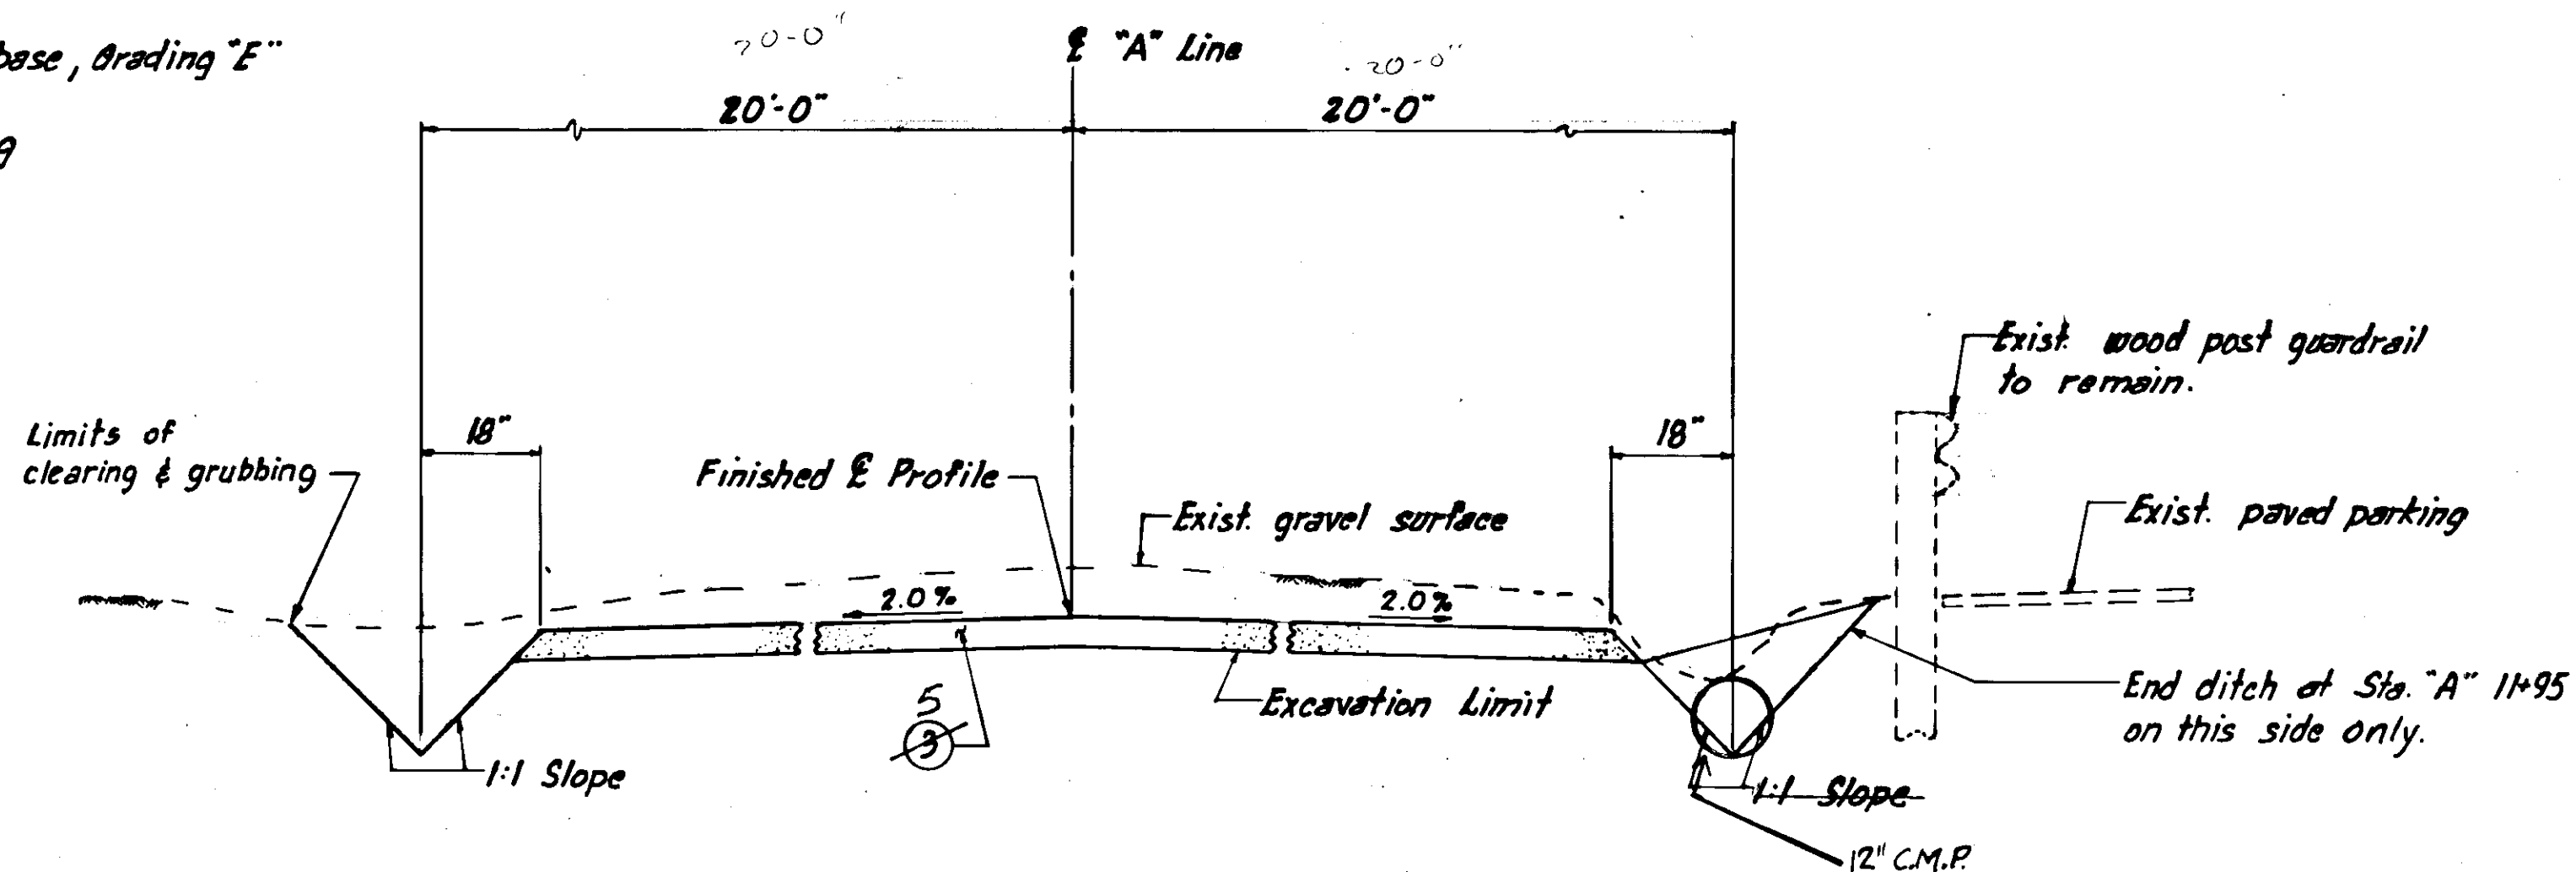


**ATLIN DRIVE**  
STA. "A" 11+14 TO STA. "A" 12+00

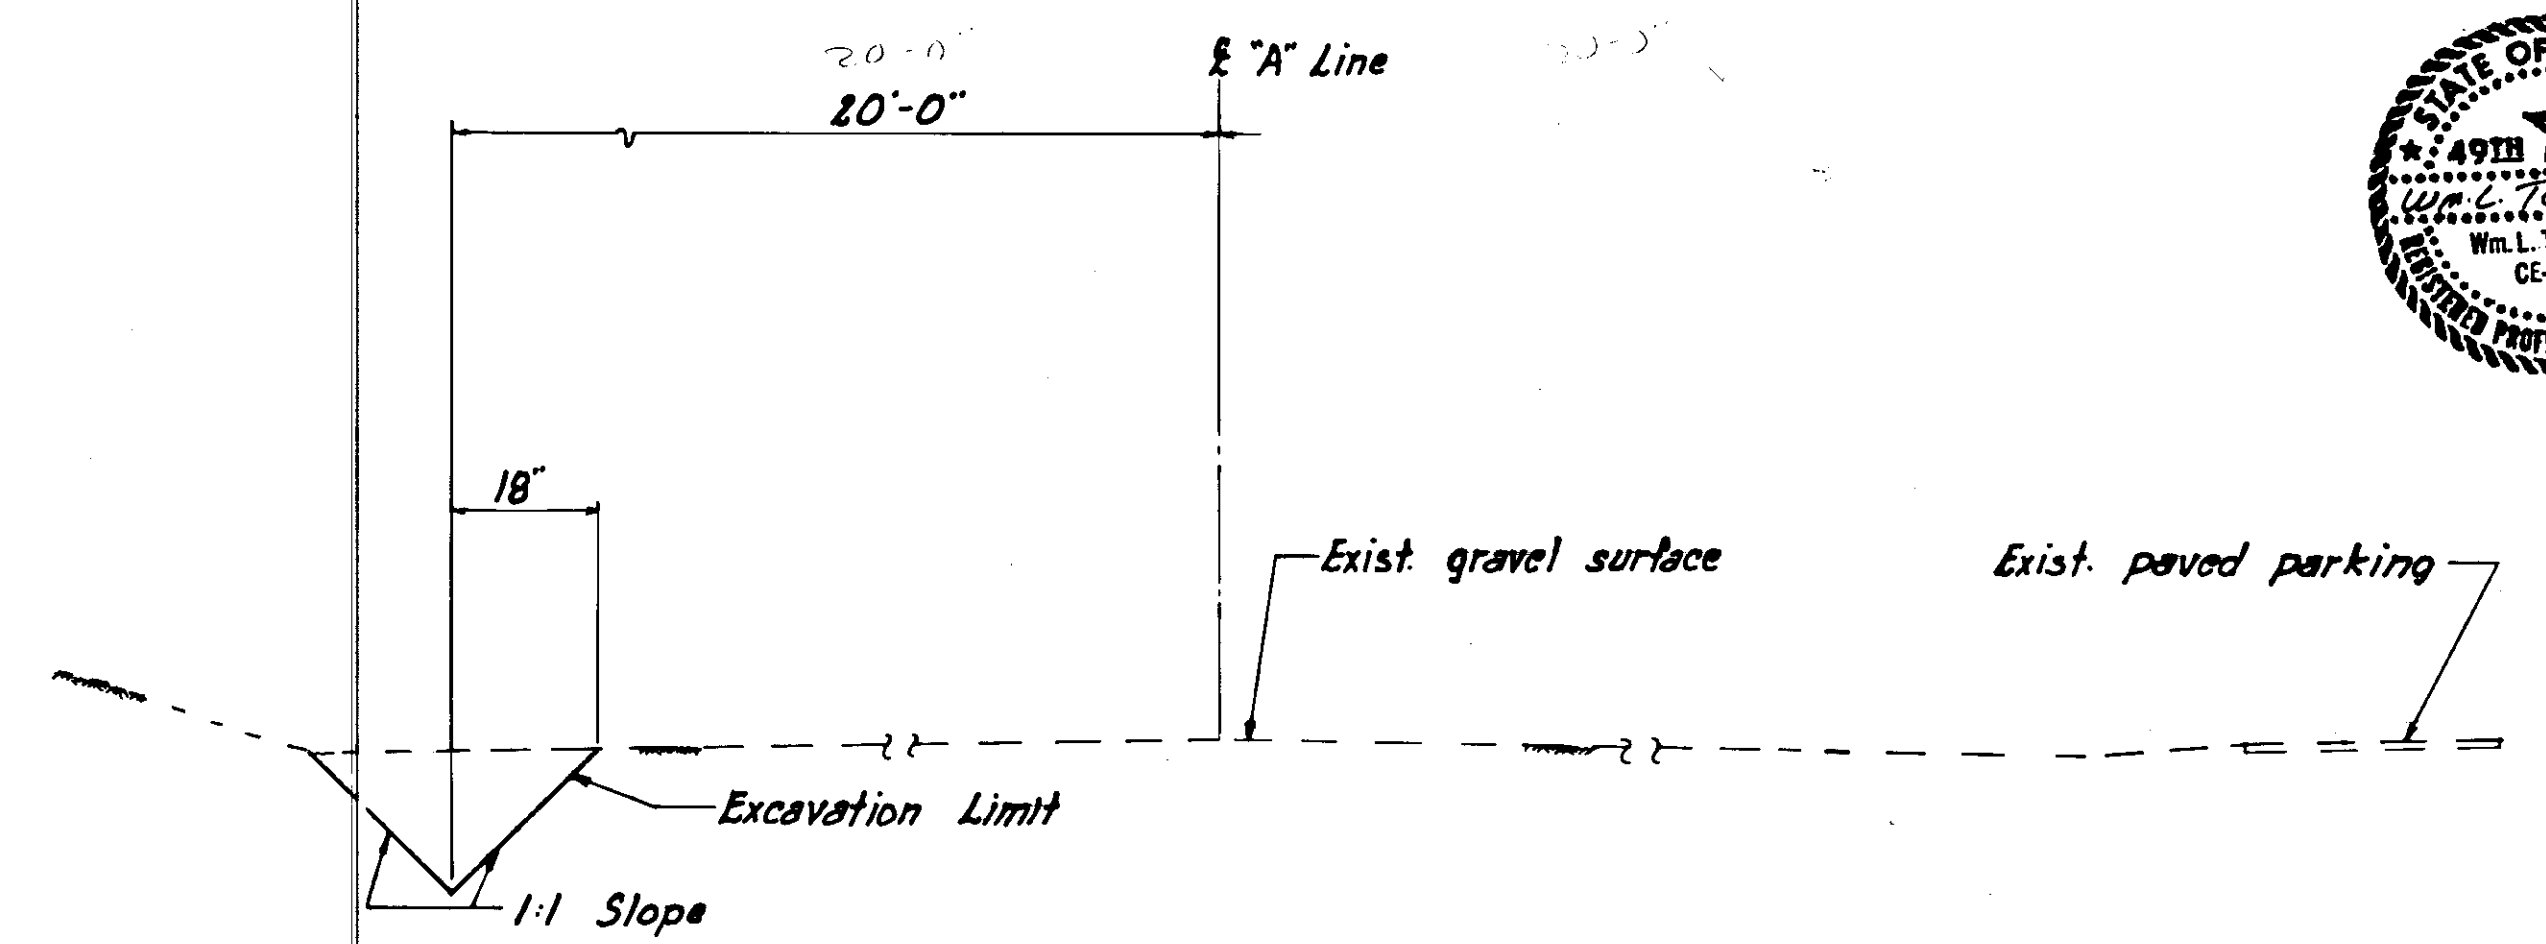

**ATLIN DRIVE**  
STA. "A" 12+00 TO STA. "A" 12+50


**GENERAL NOTES**

- Roadway shall match exist. pavement at Sta. "A" 10+35 and transition to a 2.0% typical cross section at Sta. 10+89. The edge of pavement shall rotate about the proposed centerline profile in the transition area.
- Curb and Butter type I shall be used if exist. or proposed grade drains toward the proposed curb and type II shall be used if exist. or proposed grade drains away from the proposed curb.

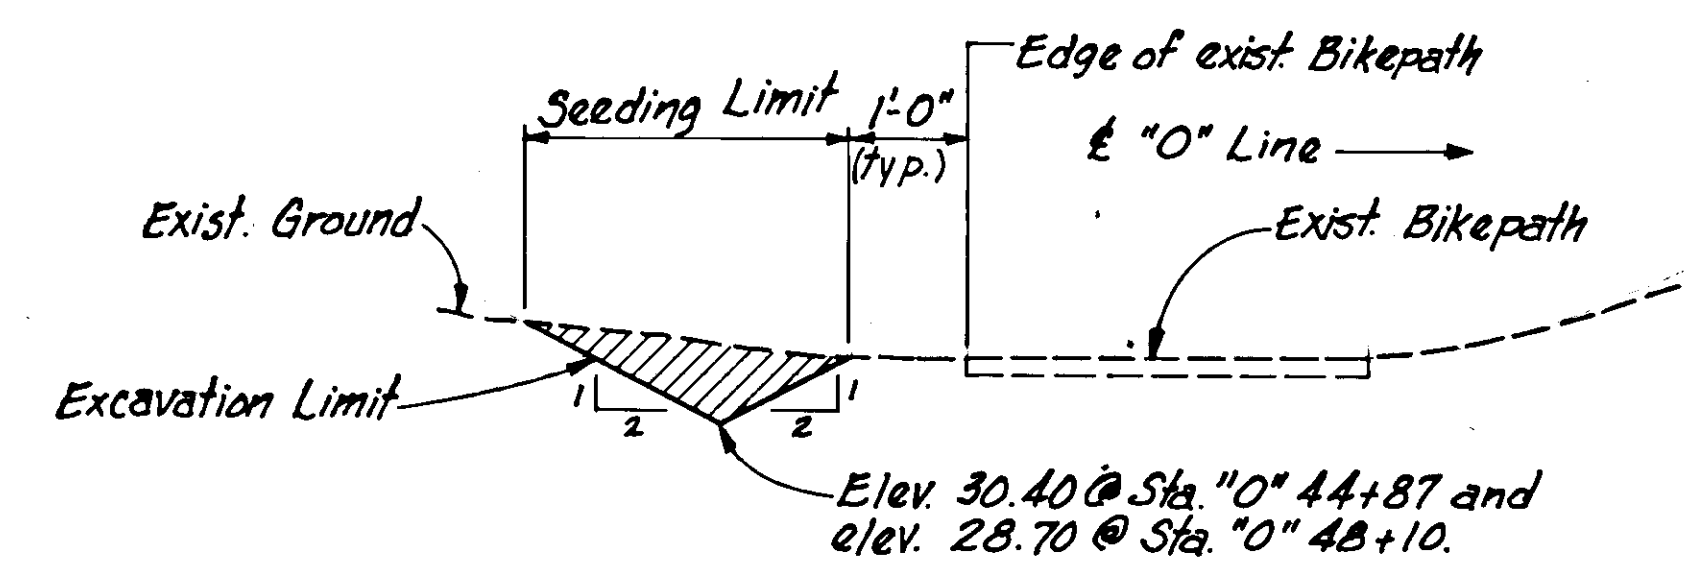


**Ditch Line**

Sta. "O" 44+87, Lt. to Sta. "O" 48+10, Lt.

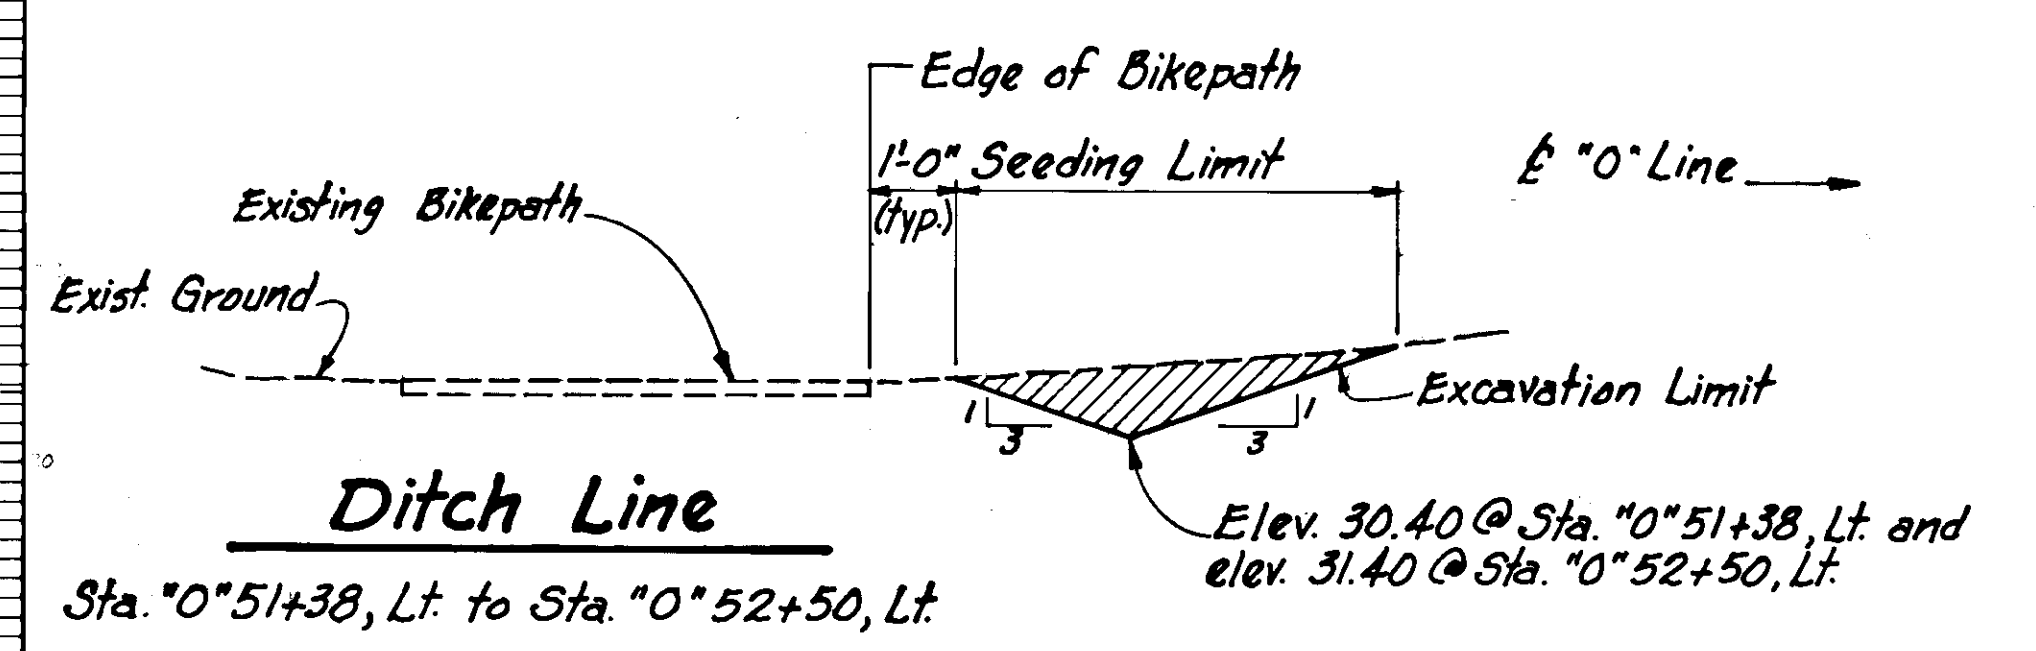

**Ditch Line**

Sta. "O" 51+38, Lt. to Sta. "O" 52+50, Lt.

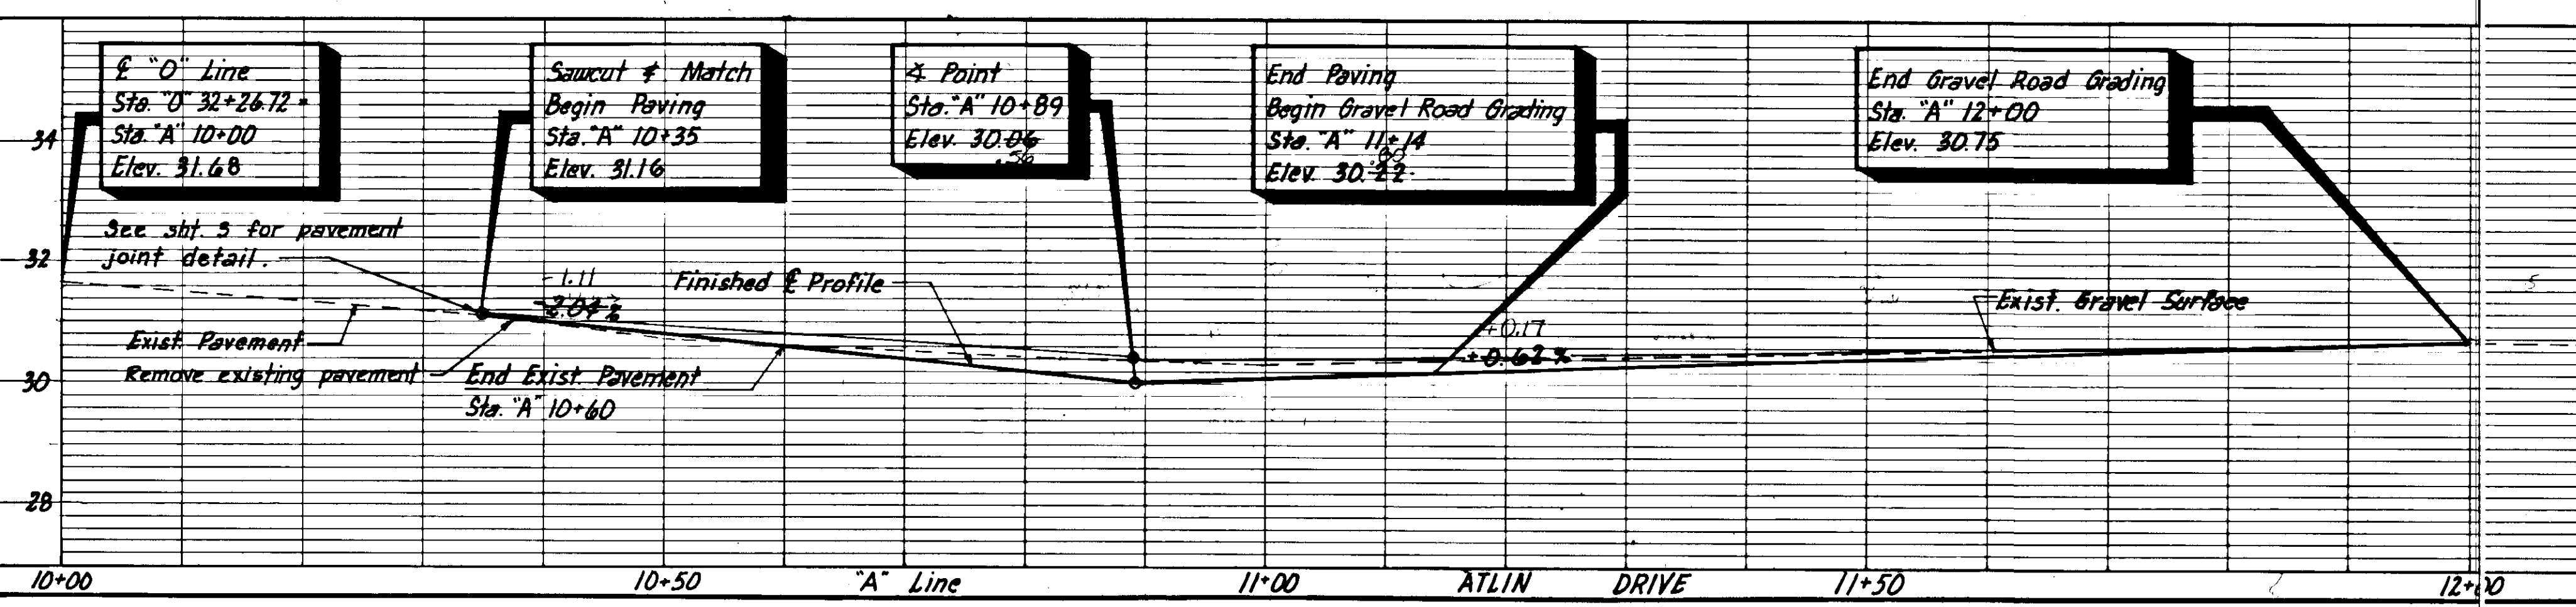


NOTE: See Sheet 10 for work items between Sta. 0+20+00 to Sta. 0+25+48.11


**GUARDRAIL NOTES**

1. Relocation of exist. guardrail shall be paid under pay item 606(1), Beam Type Guardrail, Type I Post.
2. Steel post blocking to be added shall be considered incidental to pay item 606(1).
3. Any other work necessary to complete the guardrail relocation and addition of post blocking to exist. guardrail posts shall be considered incidental to pay item 606(1).

STATE	PROJECT DESIGNATION	YEAR	SHEET NO.	TOTAL SHEETS
ALASKA	HES-M-966 (14)	'88	5	28

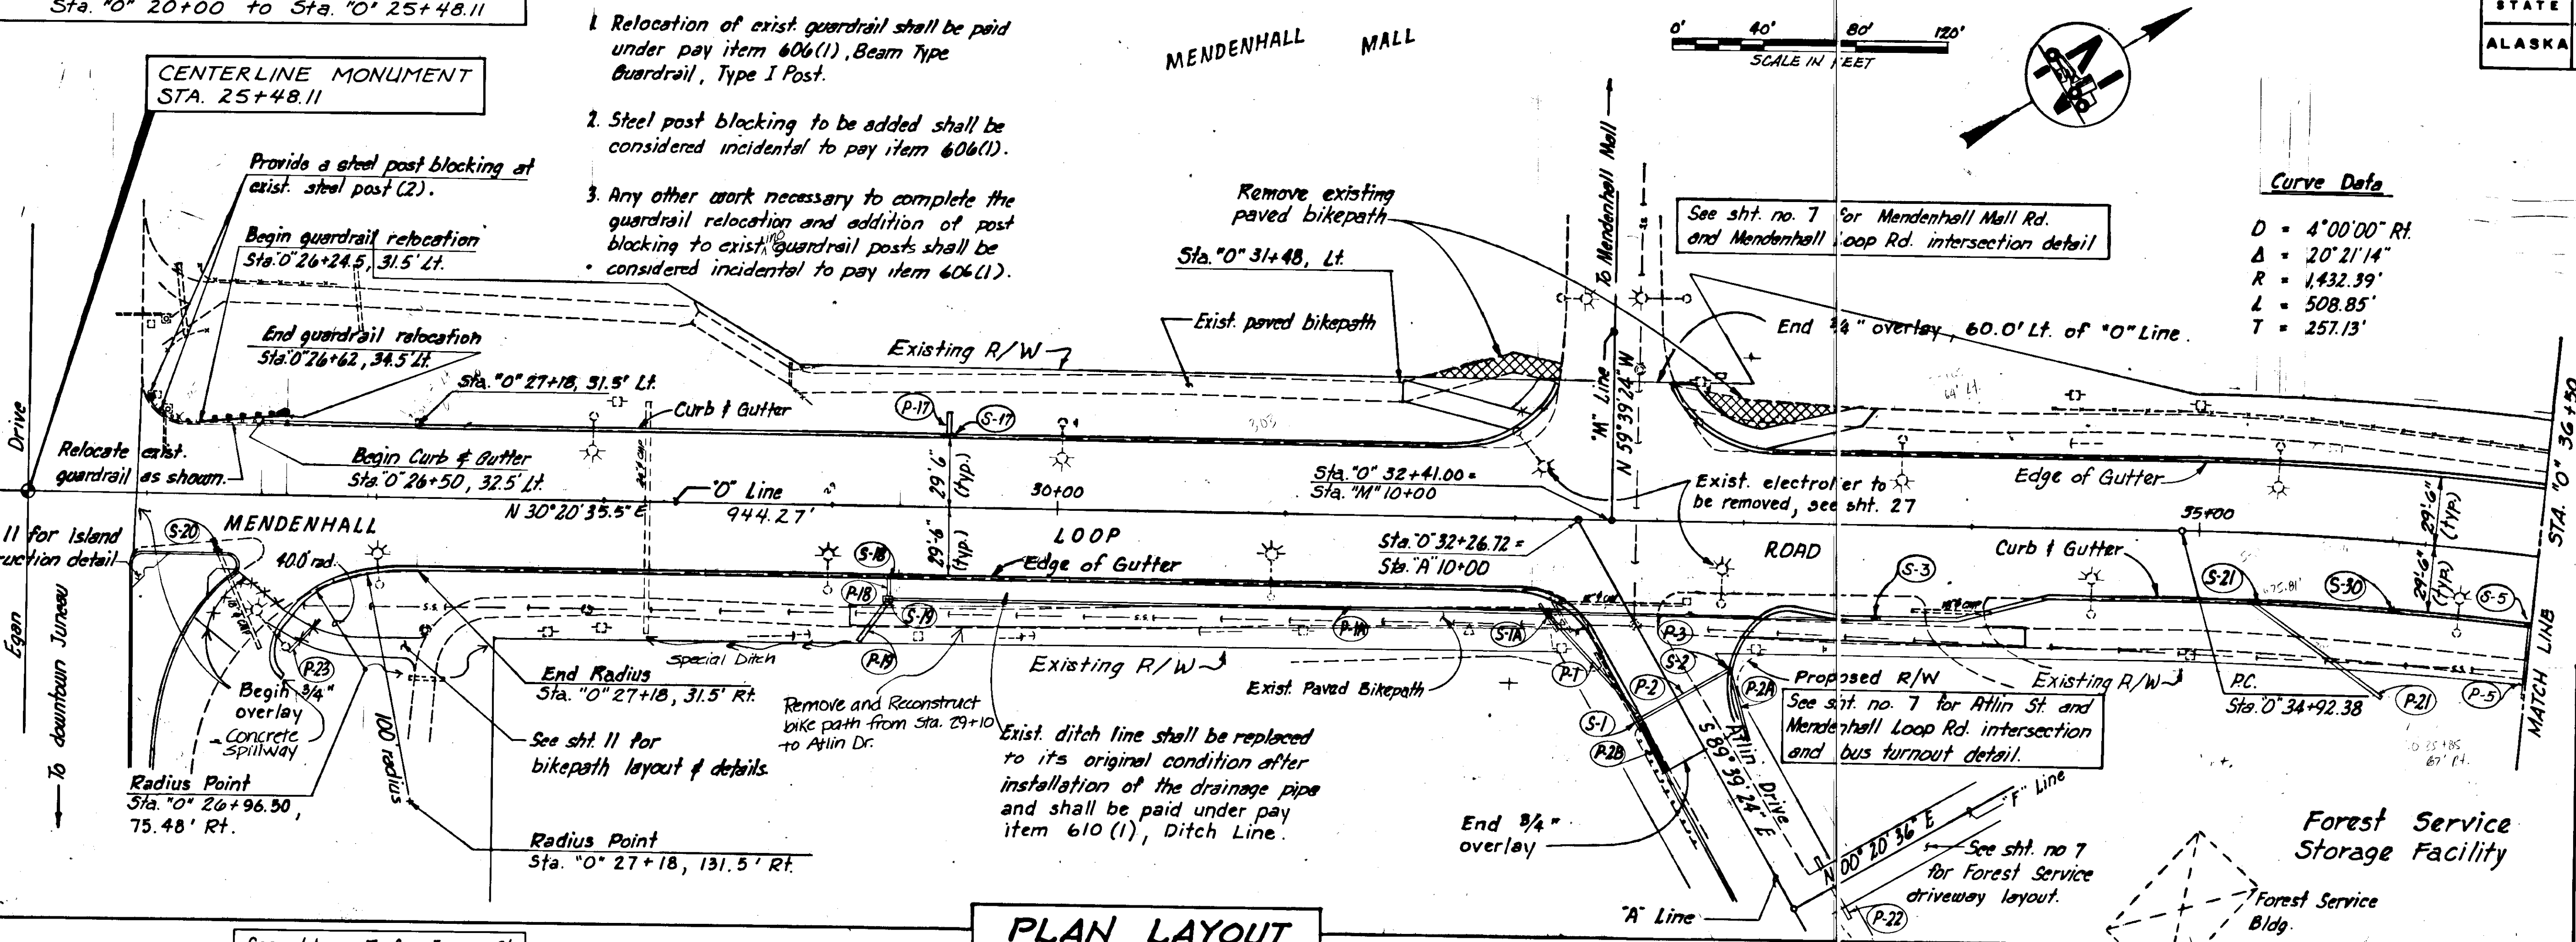

**PLAN LAYOUT**

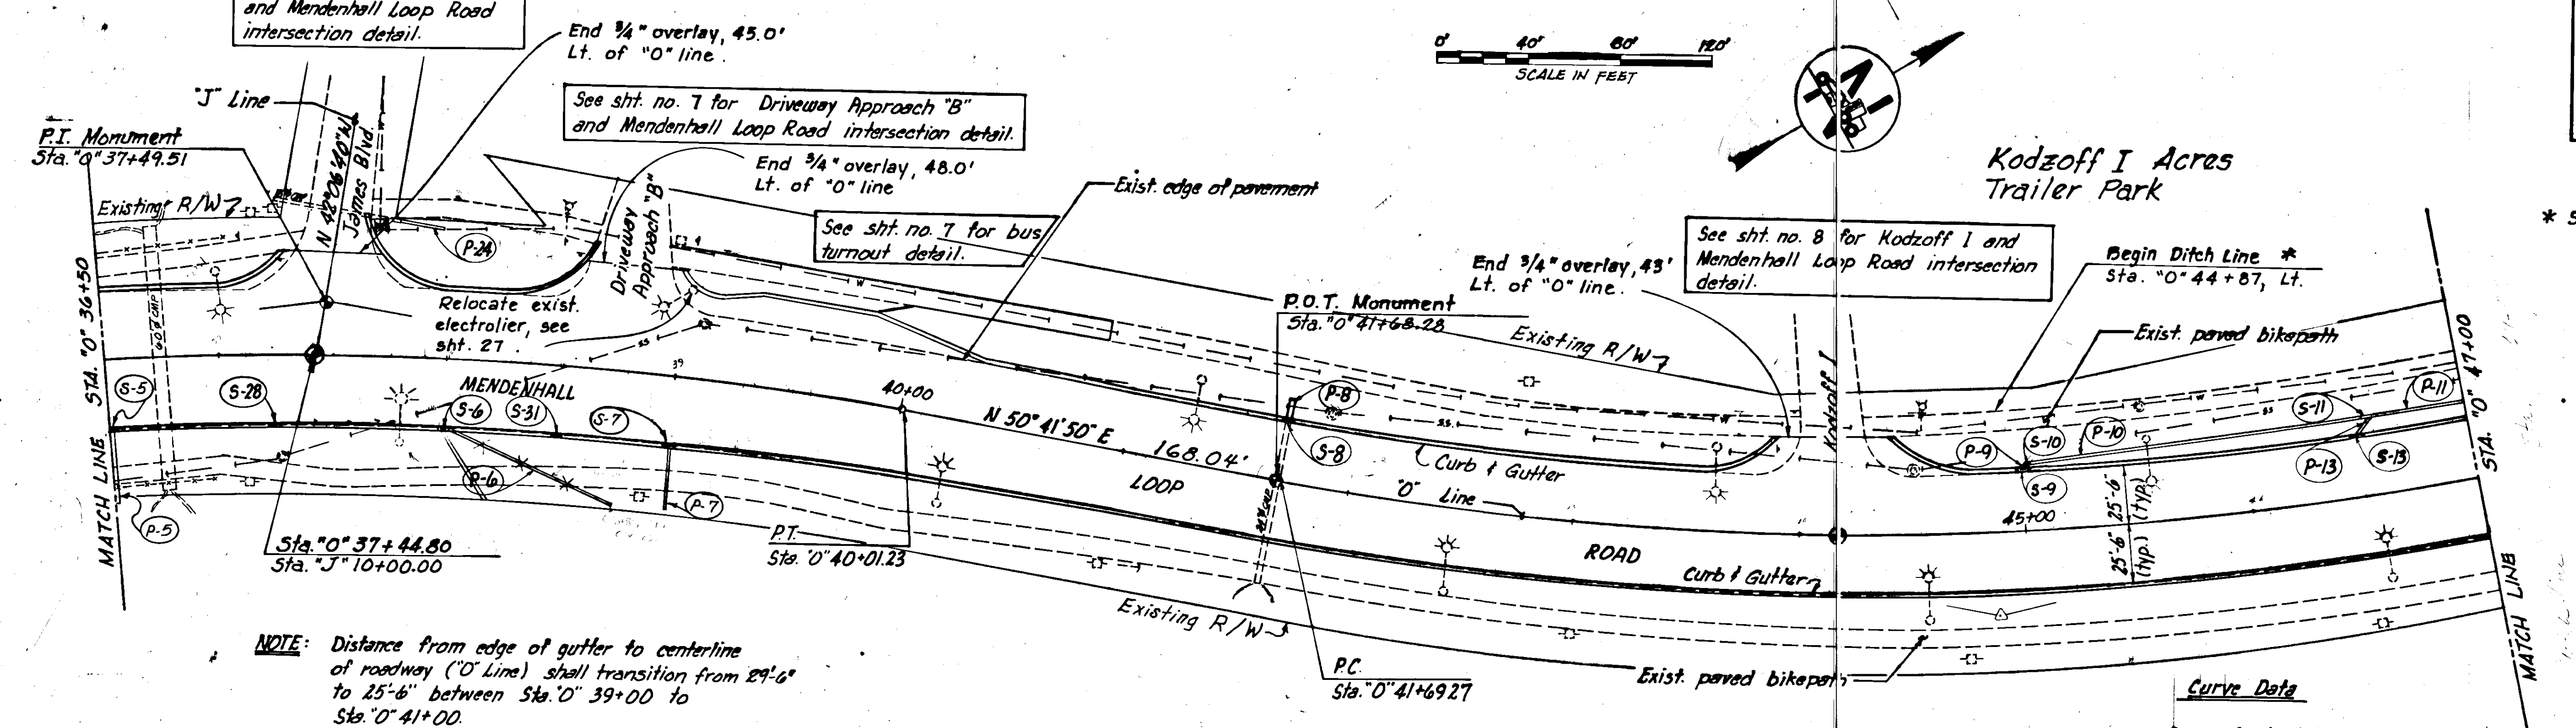

**BASIS OF CONTROL**

**Basis of Horizontal Control**  
 The basis of bearing for this project is the line of sight between the Loop Road monument, station "O" 17+45.83 P.I., and the intersection monument of Loop Road and Egan Drive, Egan Drive stationing of "L" 393+81.12 P.O.T., with a bearing of N30° 02' 03" E.

The basis of coordinates for this project is the intersection monument, at Loop Road and Egan Drive with project coordinates of N. 89036.025 E. 29383.933

**Basis of Vertical Control**  
 The basis of vertical control is the top of the monument at the intersection of Loop Road and Egan Drive with an accepted elevation of 29.92 feet above MLLW.


NOTE: Distance from edge of gutter to centerline of roadway ('O' Line) shall transition from 29'-6" to 25'-6" between Sta. 0+39+00 to Sta. 0+41+00.

NOTE: Existing conduits for the existing electroliers are assumed to run directly between poles and are buried 30' below existing ground. See Special Provisions Section 107-1.16

\* See sht. 4 for details.



\* See sht. 4 for details.

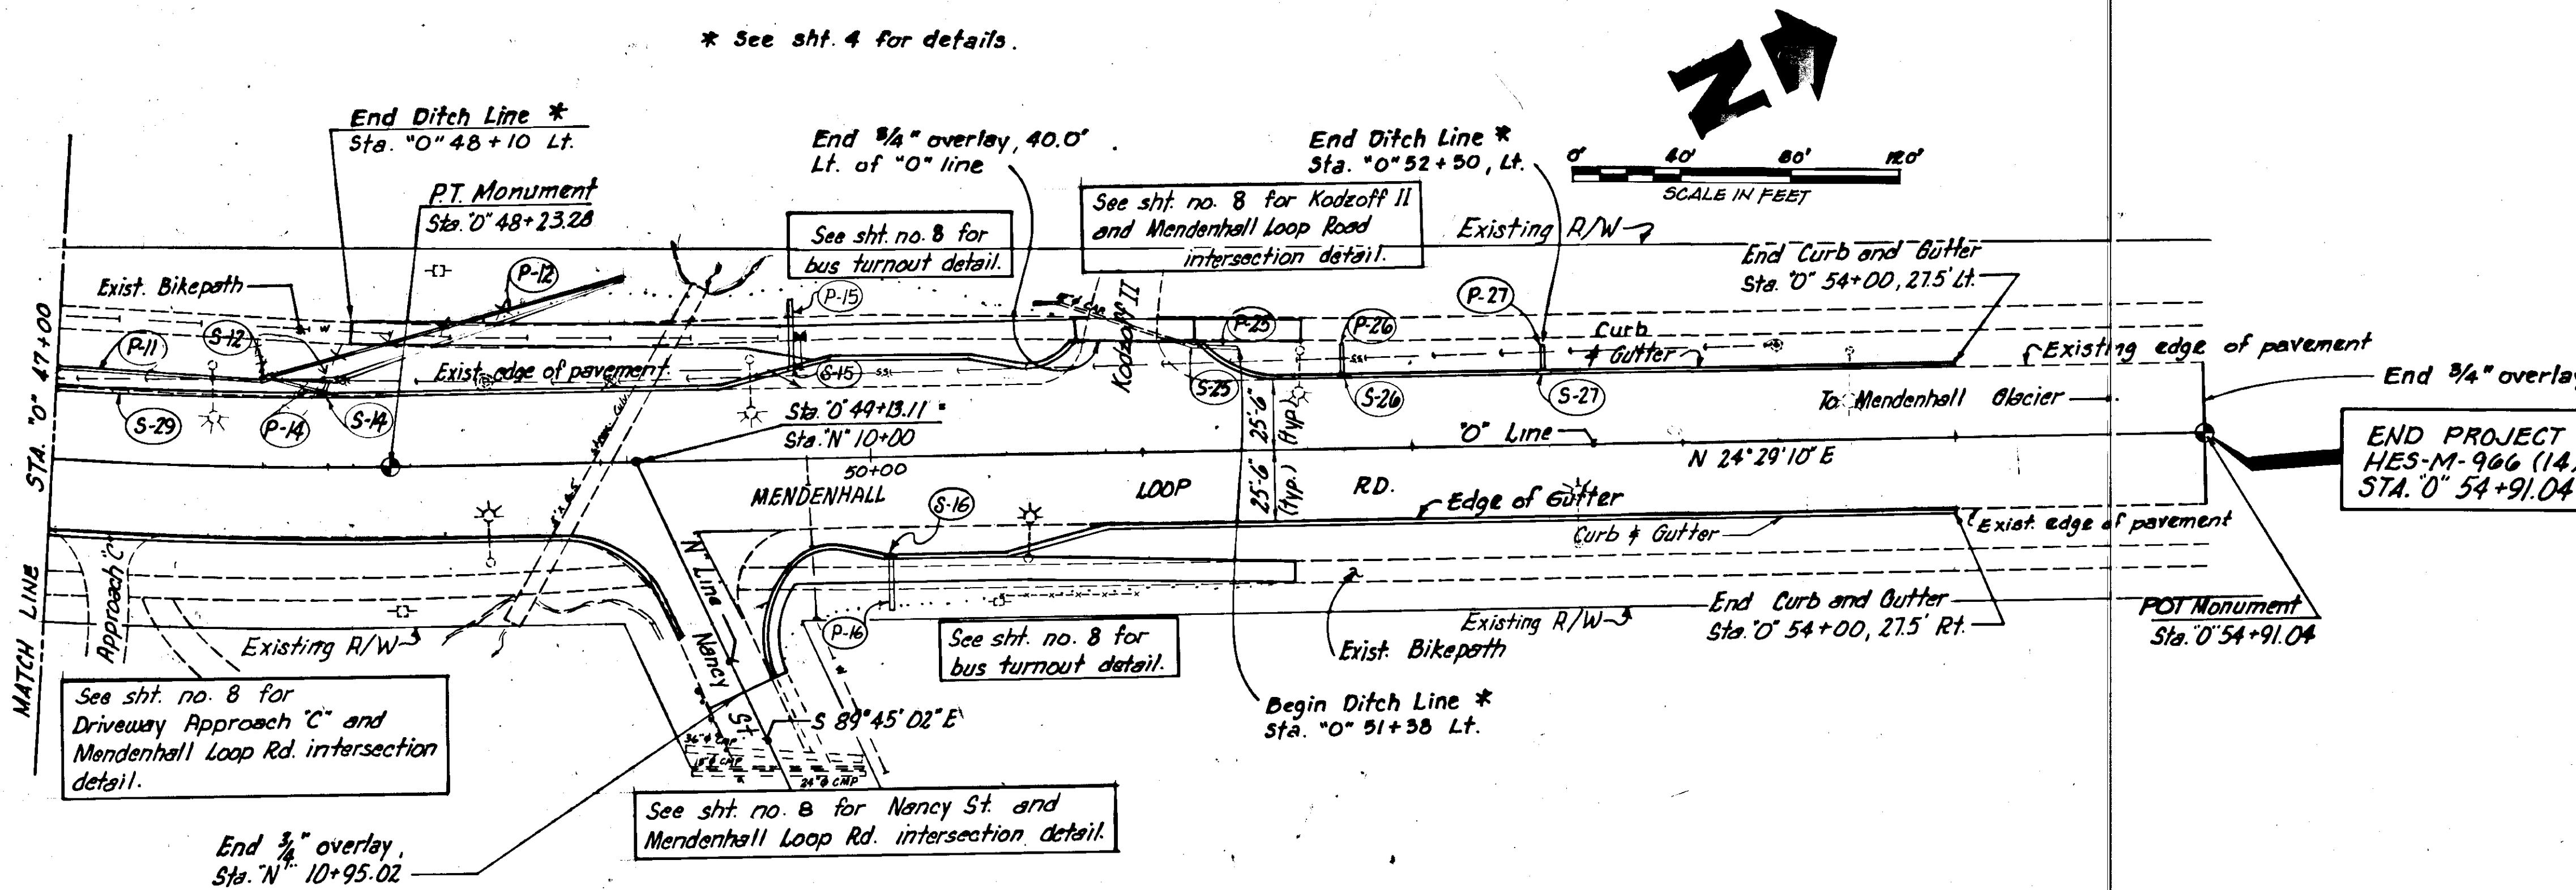


**PLAN LAYOUT**

**EXISTING MONUMENT TABLE \***





STATION "0"	NORTH	EAST
25+48.11	89036.025	29383.933
37+49.51	90072.854	29990.856
41+68.28	90341.541	30319.095
48+23.28	90855.884	30715.357
54+91.04	91463.591	30992.127

\* Existing monument coordinates are for reference only. See sheet no. 5 for basis of control.

# INTERSECTION AND BUS TURNOUT DETAIL


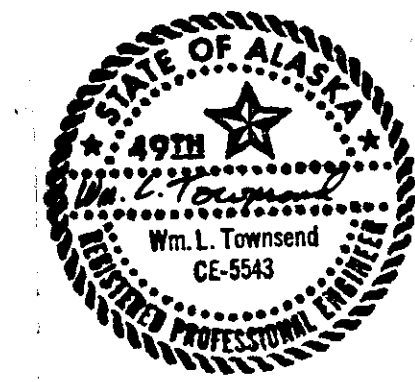


STATE	PROJECT DESIGNATION	YEAR	SHEET NO.	TOTAL SHEETS
ALASKA	HES-M-966 (14)	'88	7	28

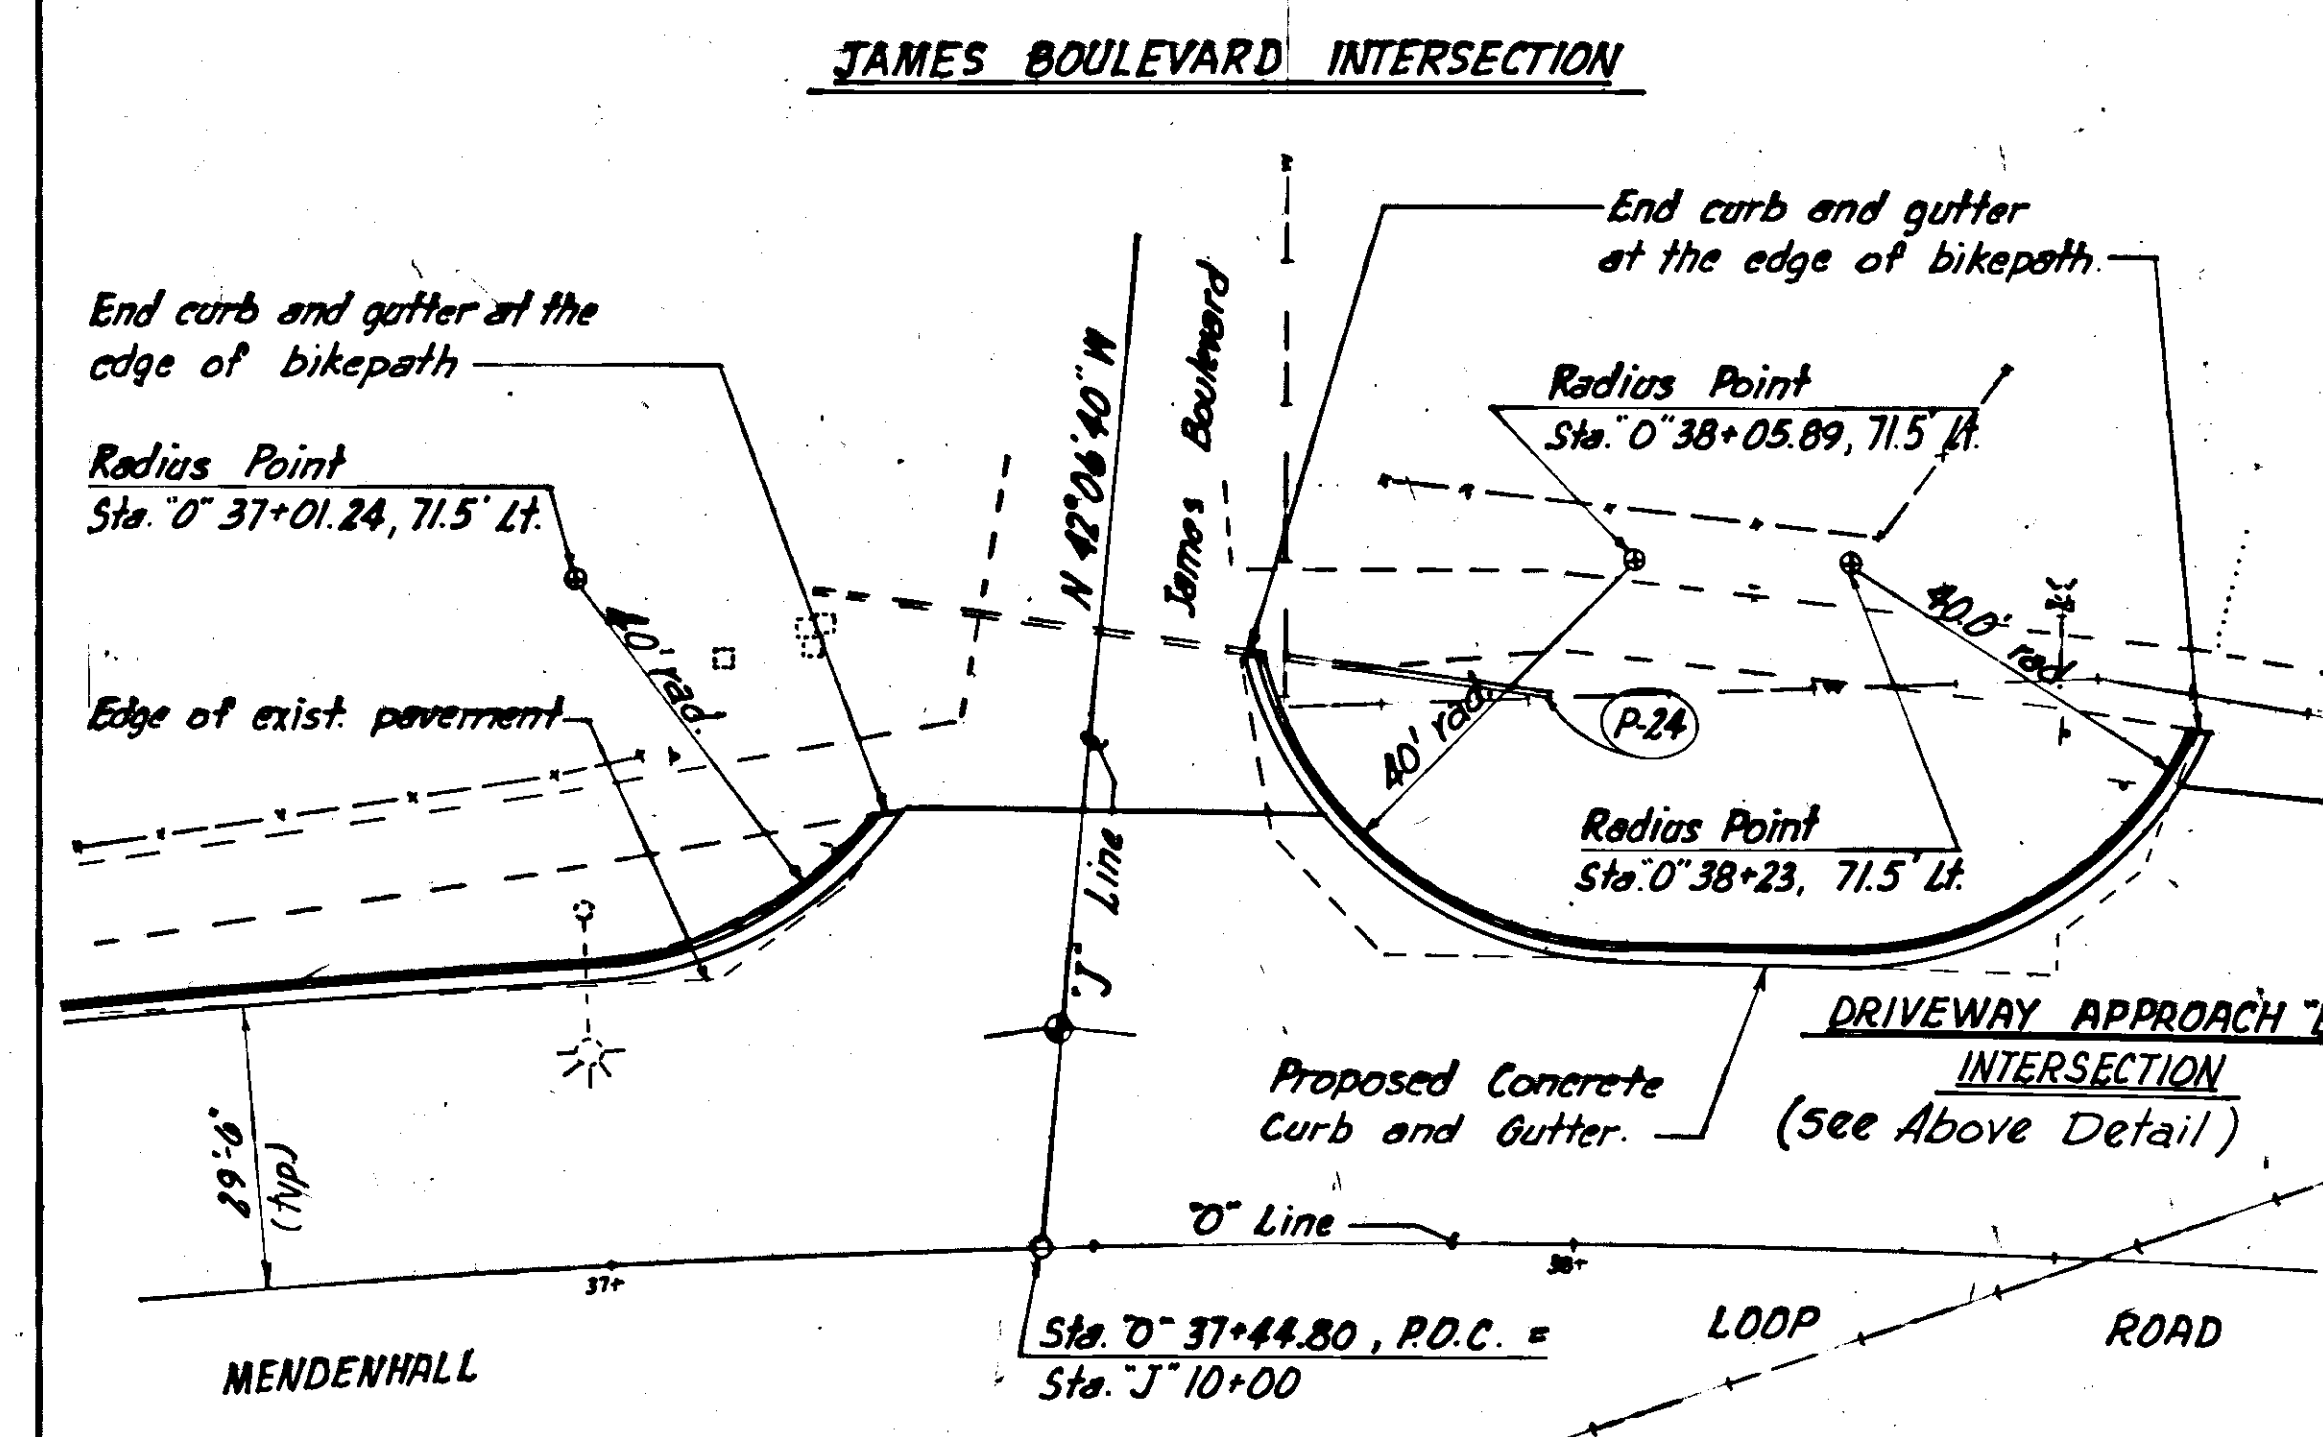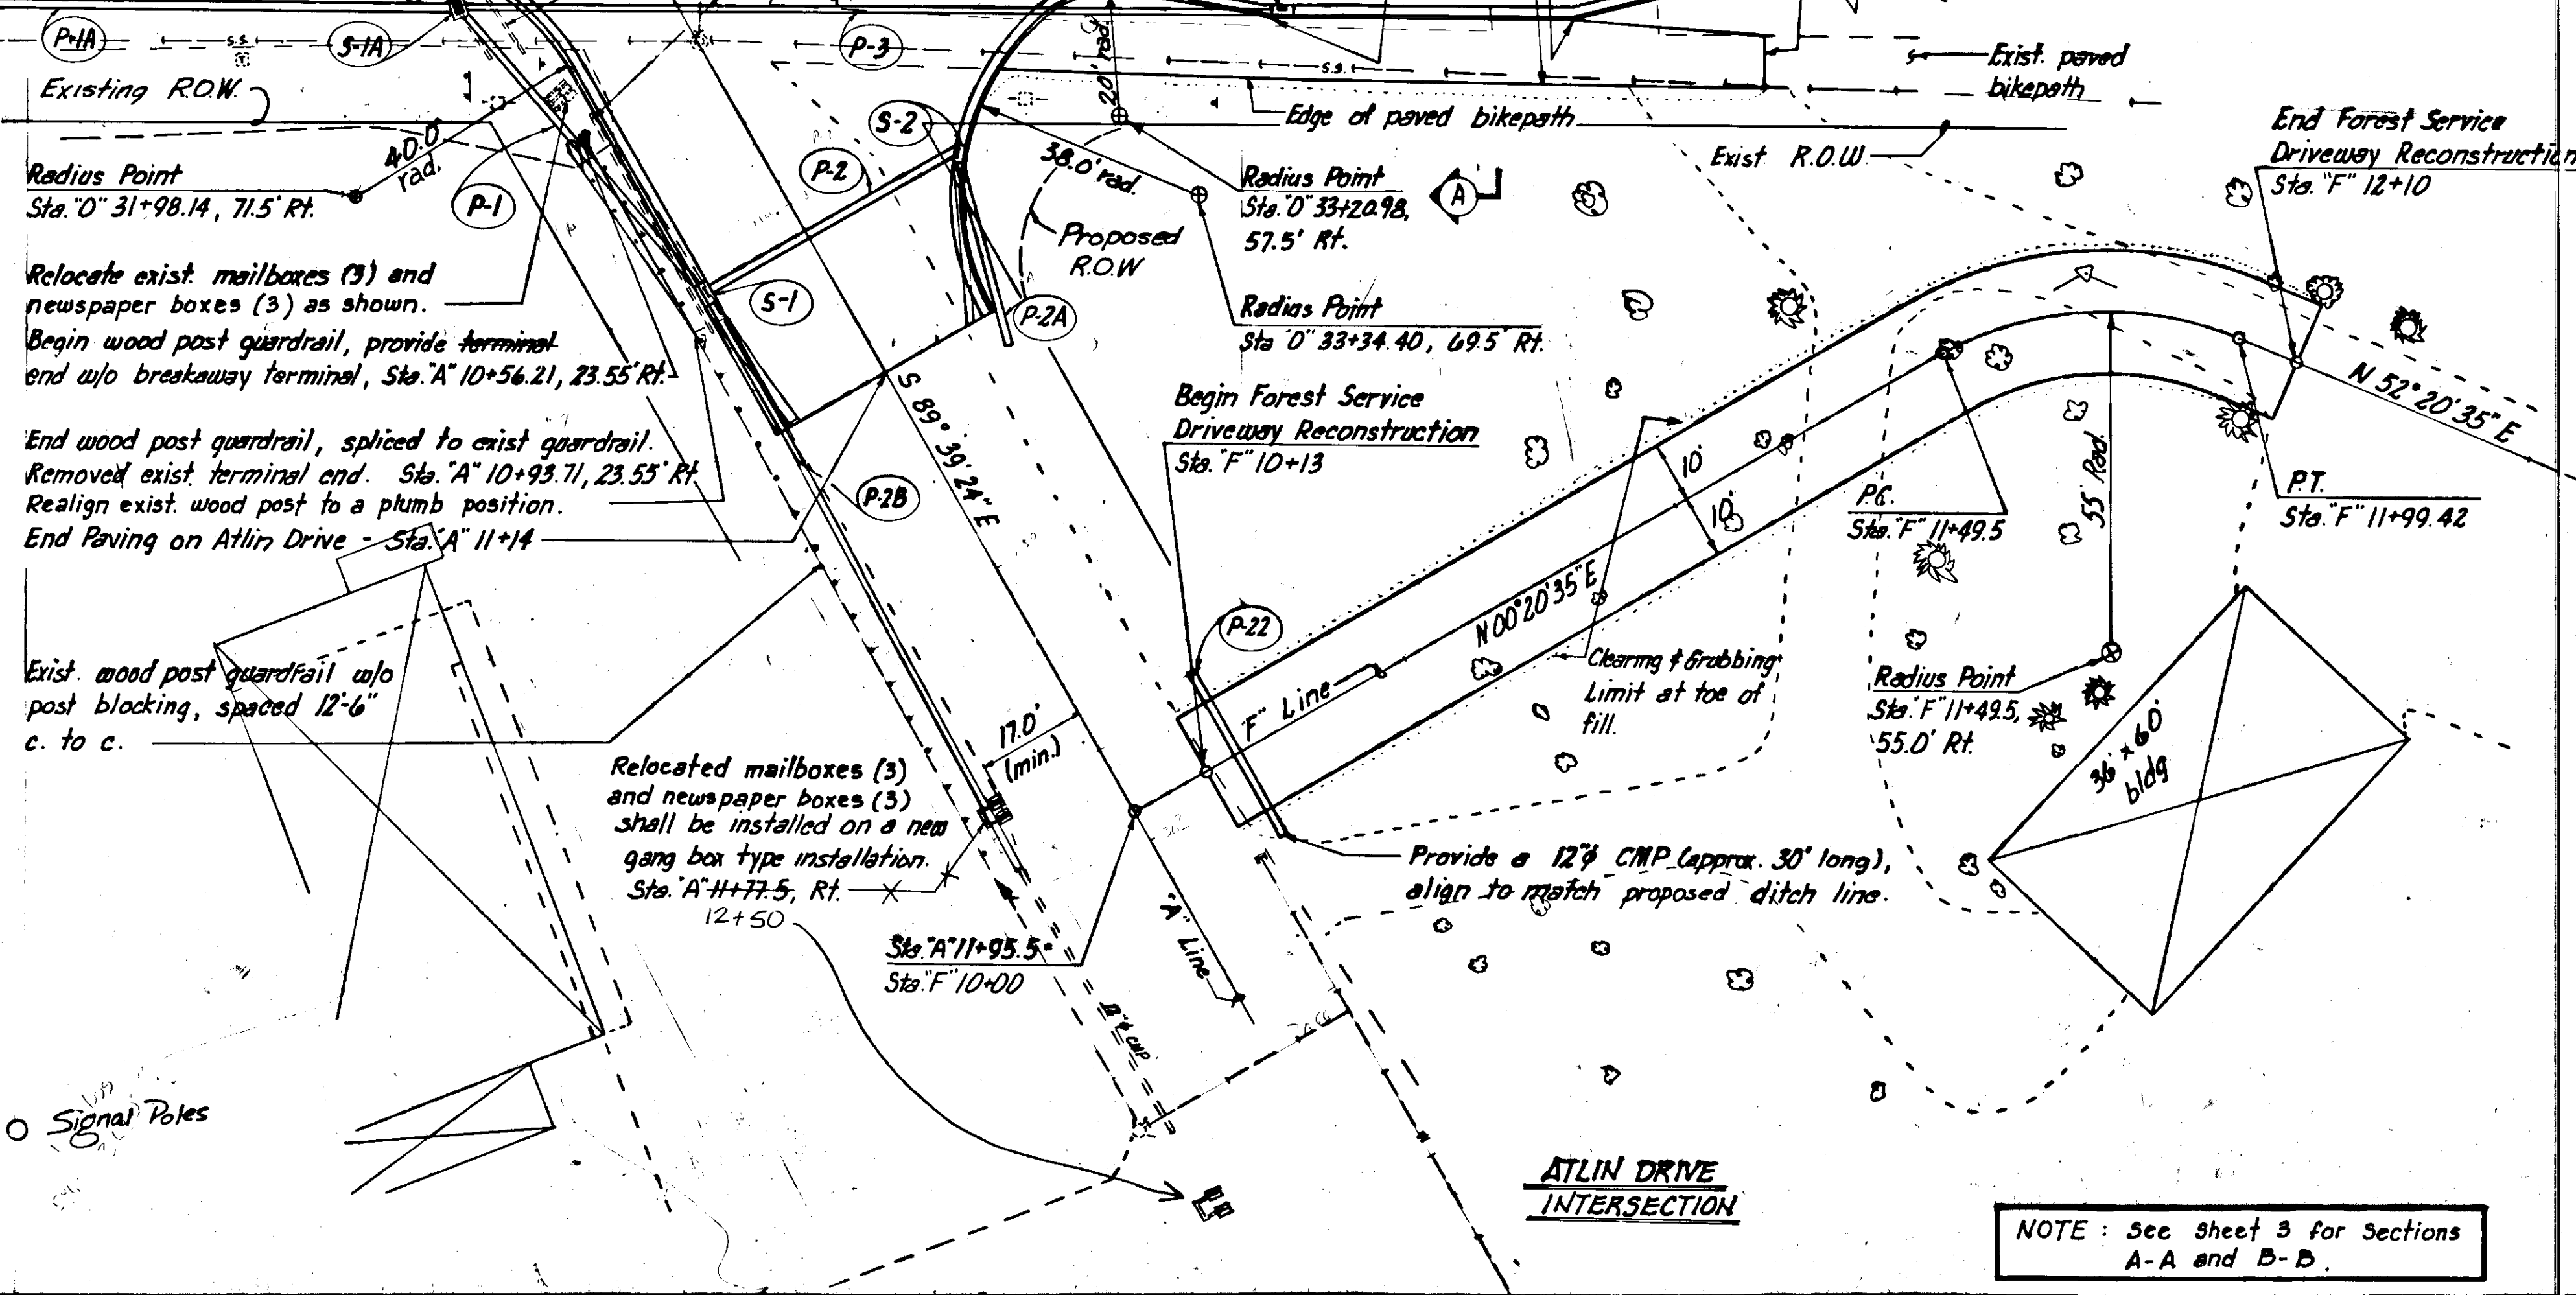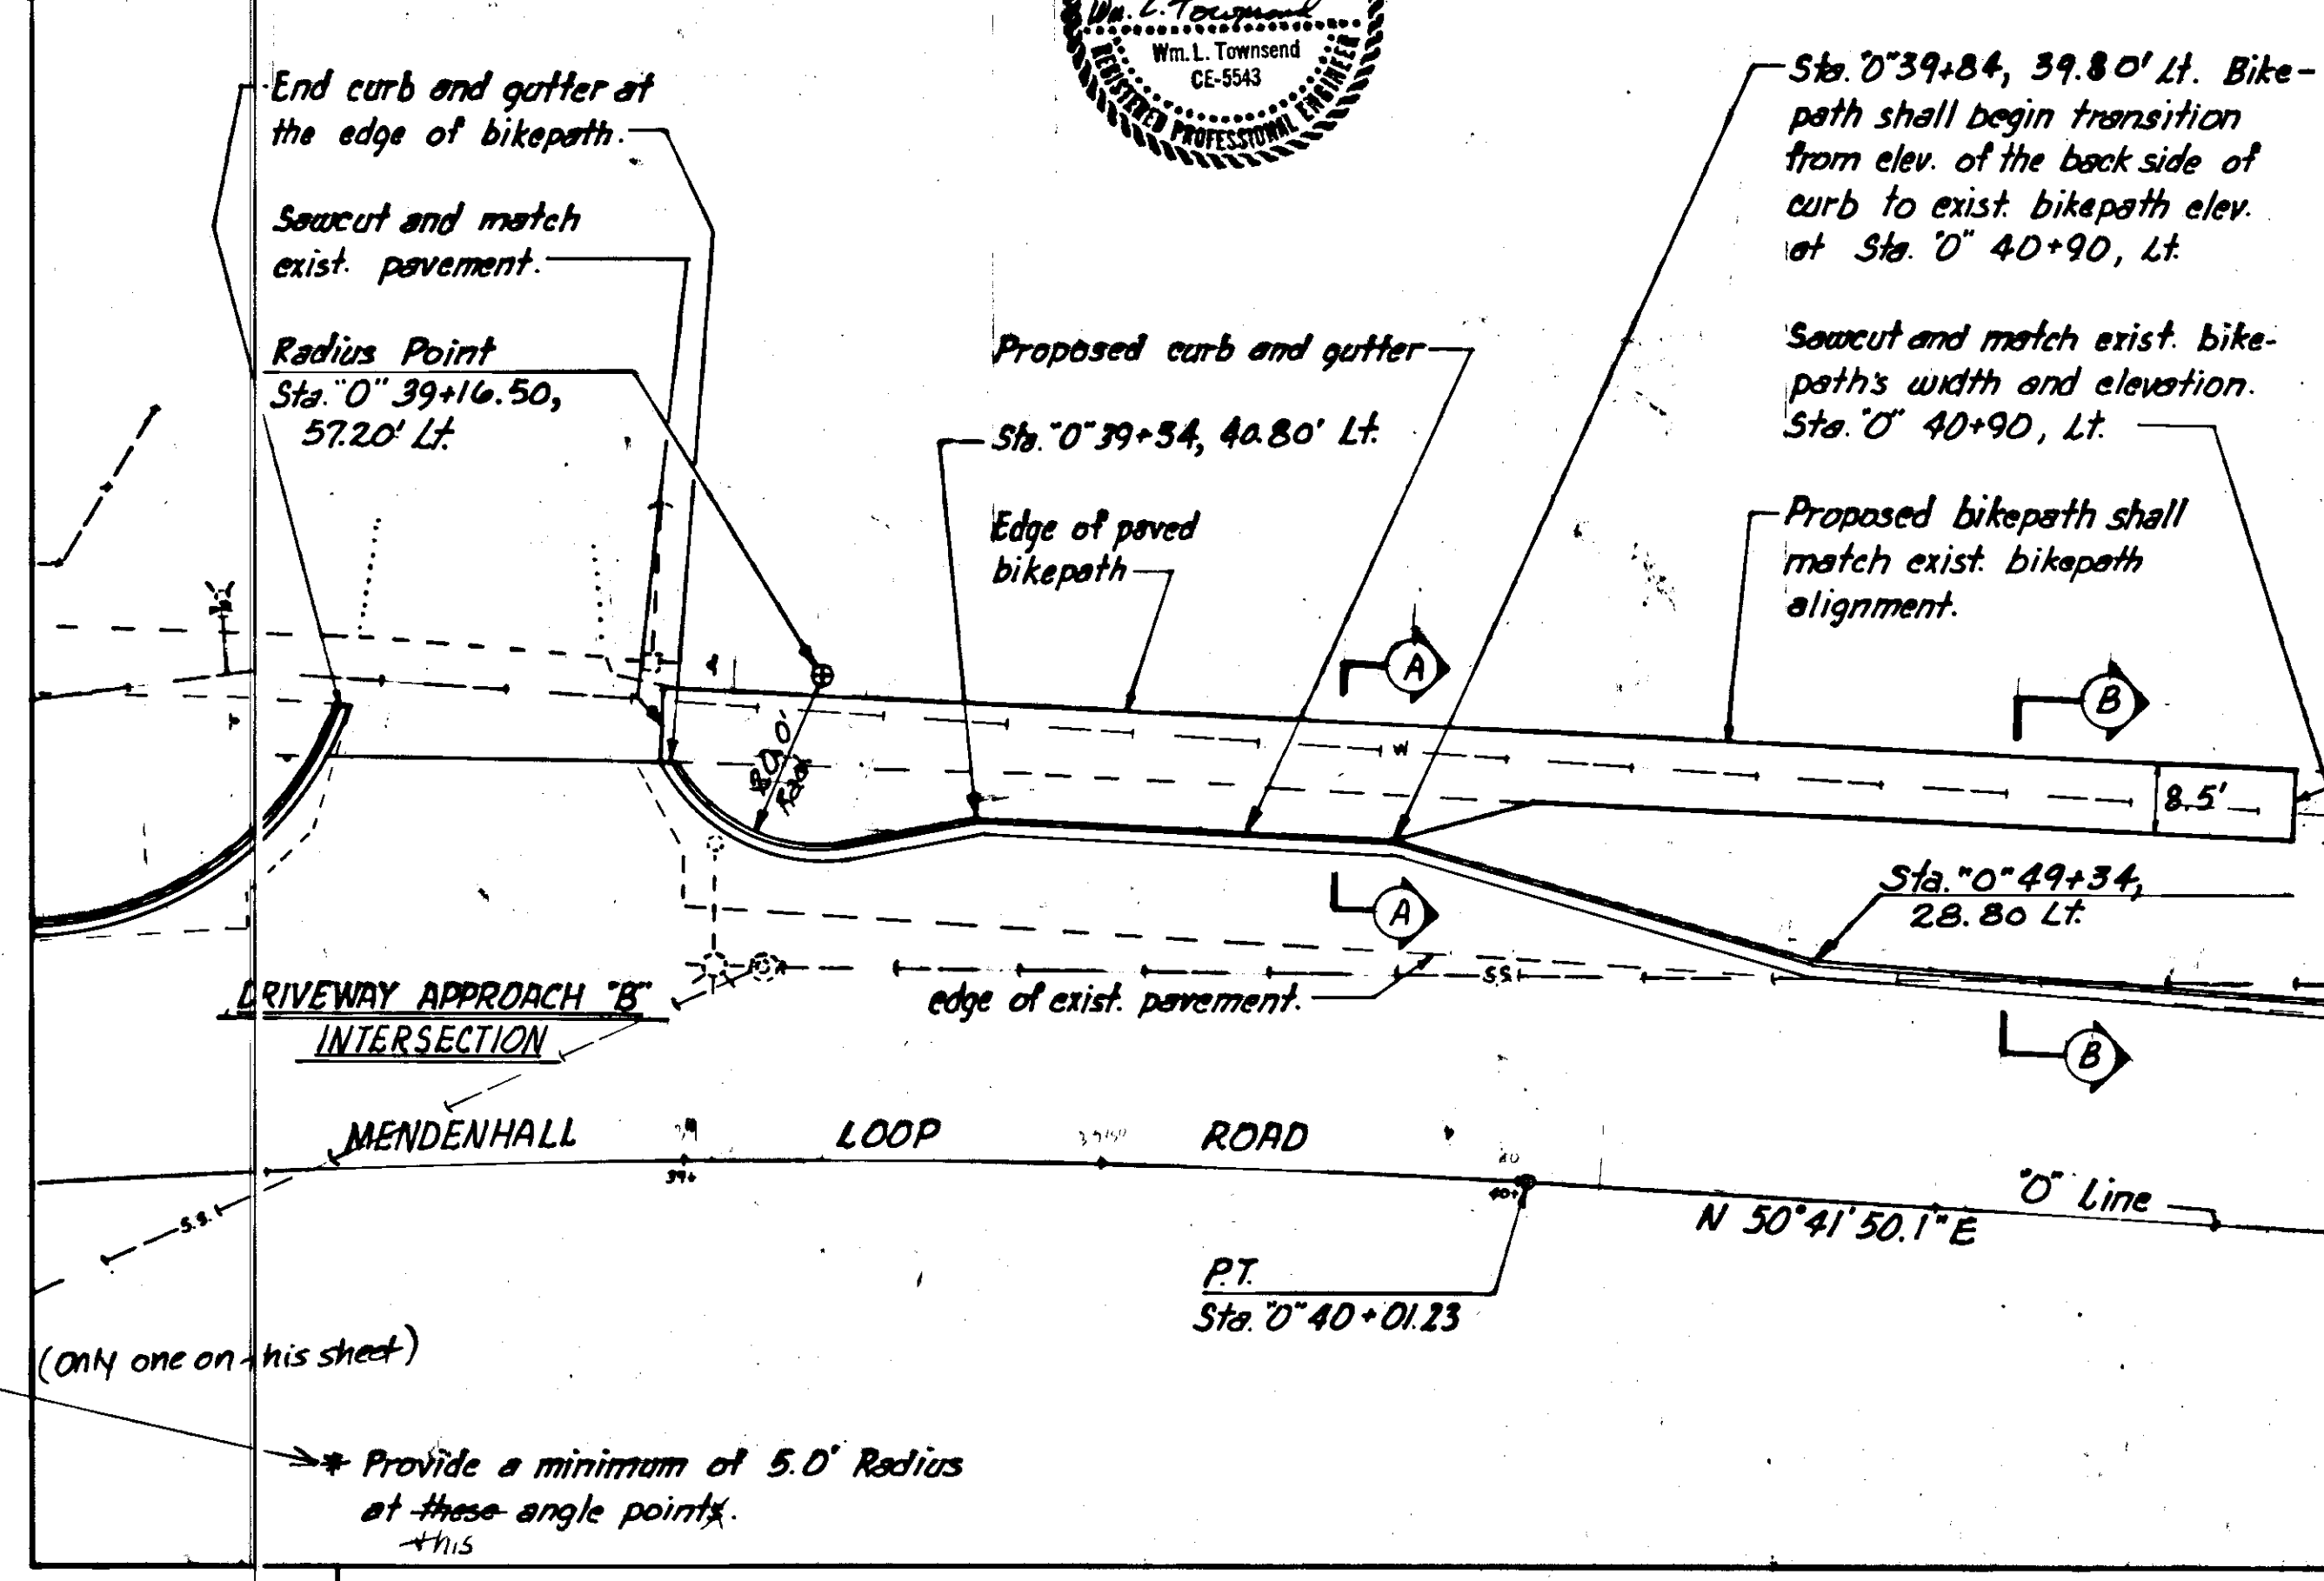
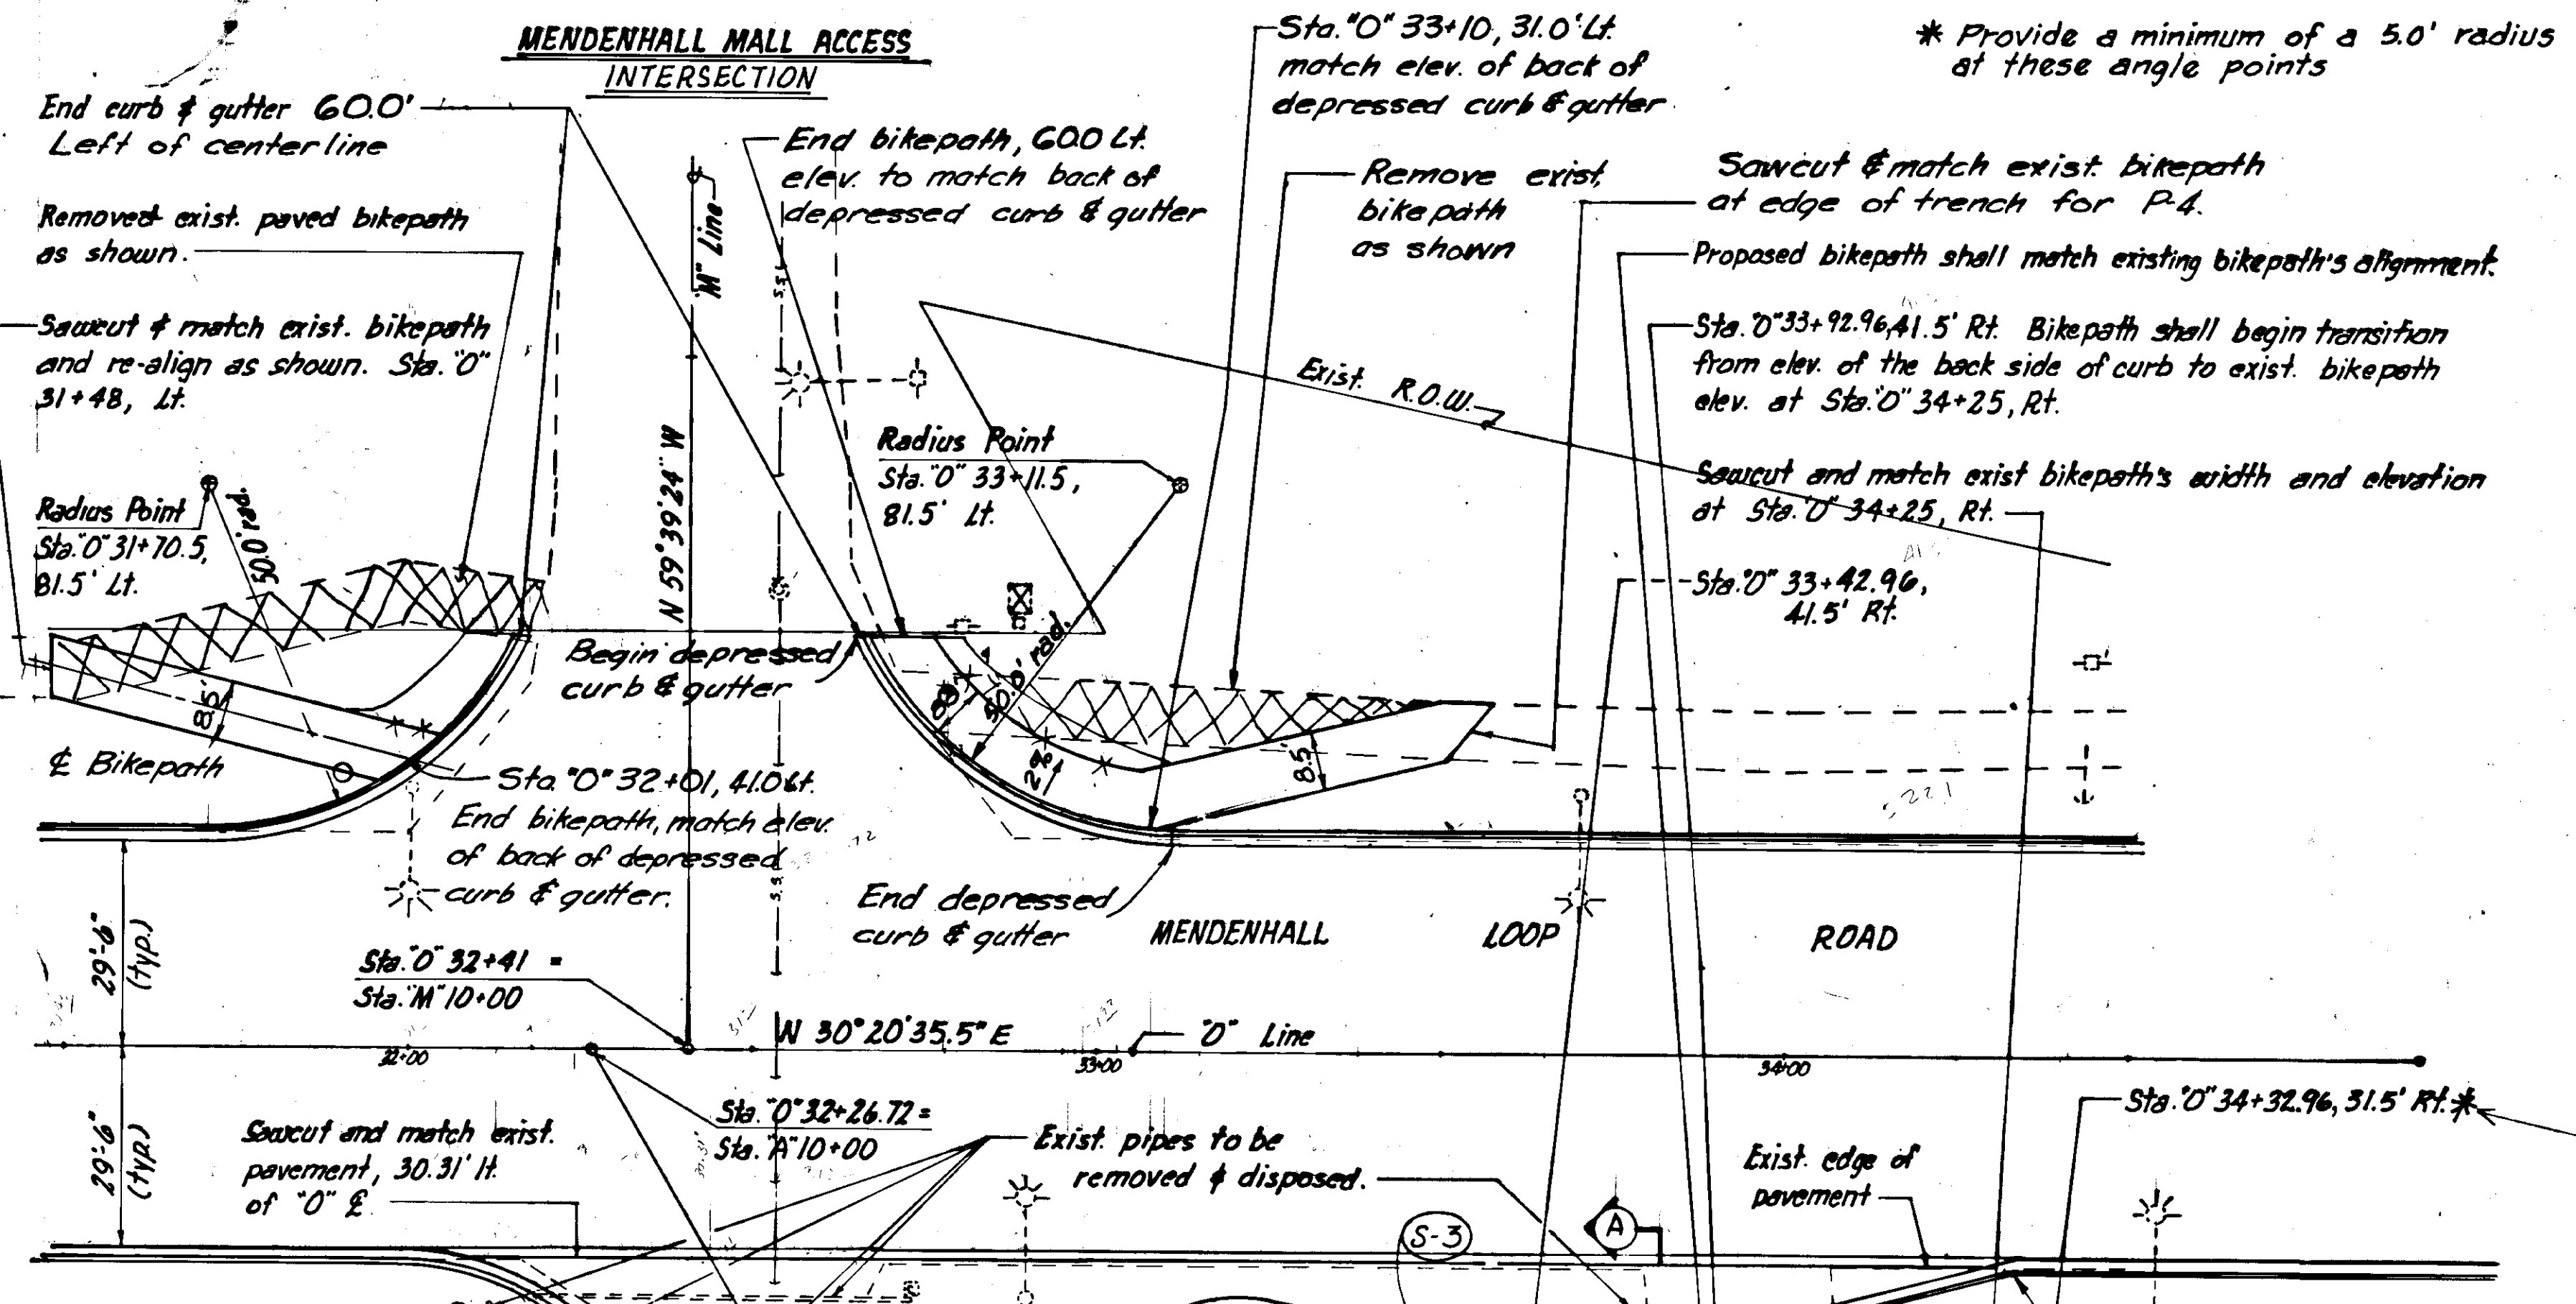


NOTE: See sheet 3 for Sections A-A and B-B.

STATE	PROJECT DESIGNATION	YEAR	SHEET NO.	TOTAL SHEETS
ALASKA	HES-M-966(14)	'88	8	28

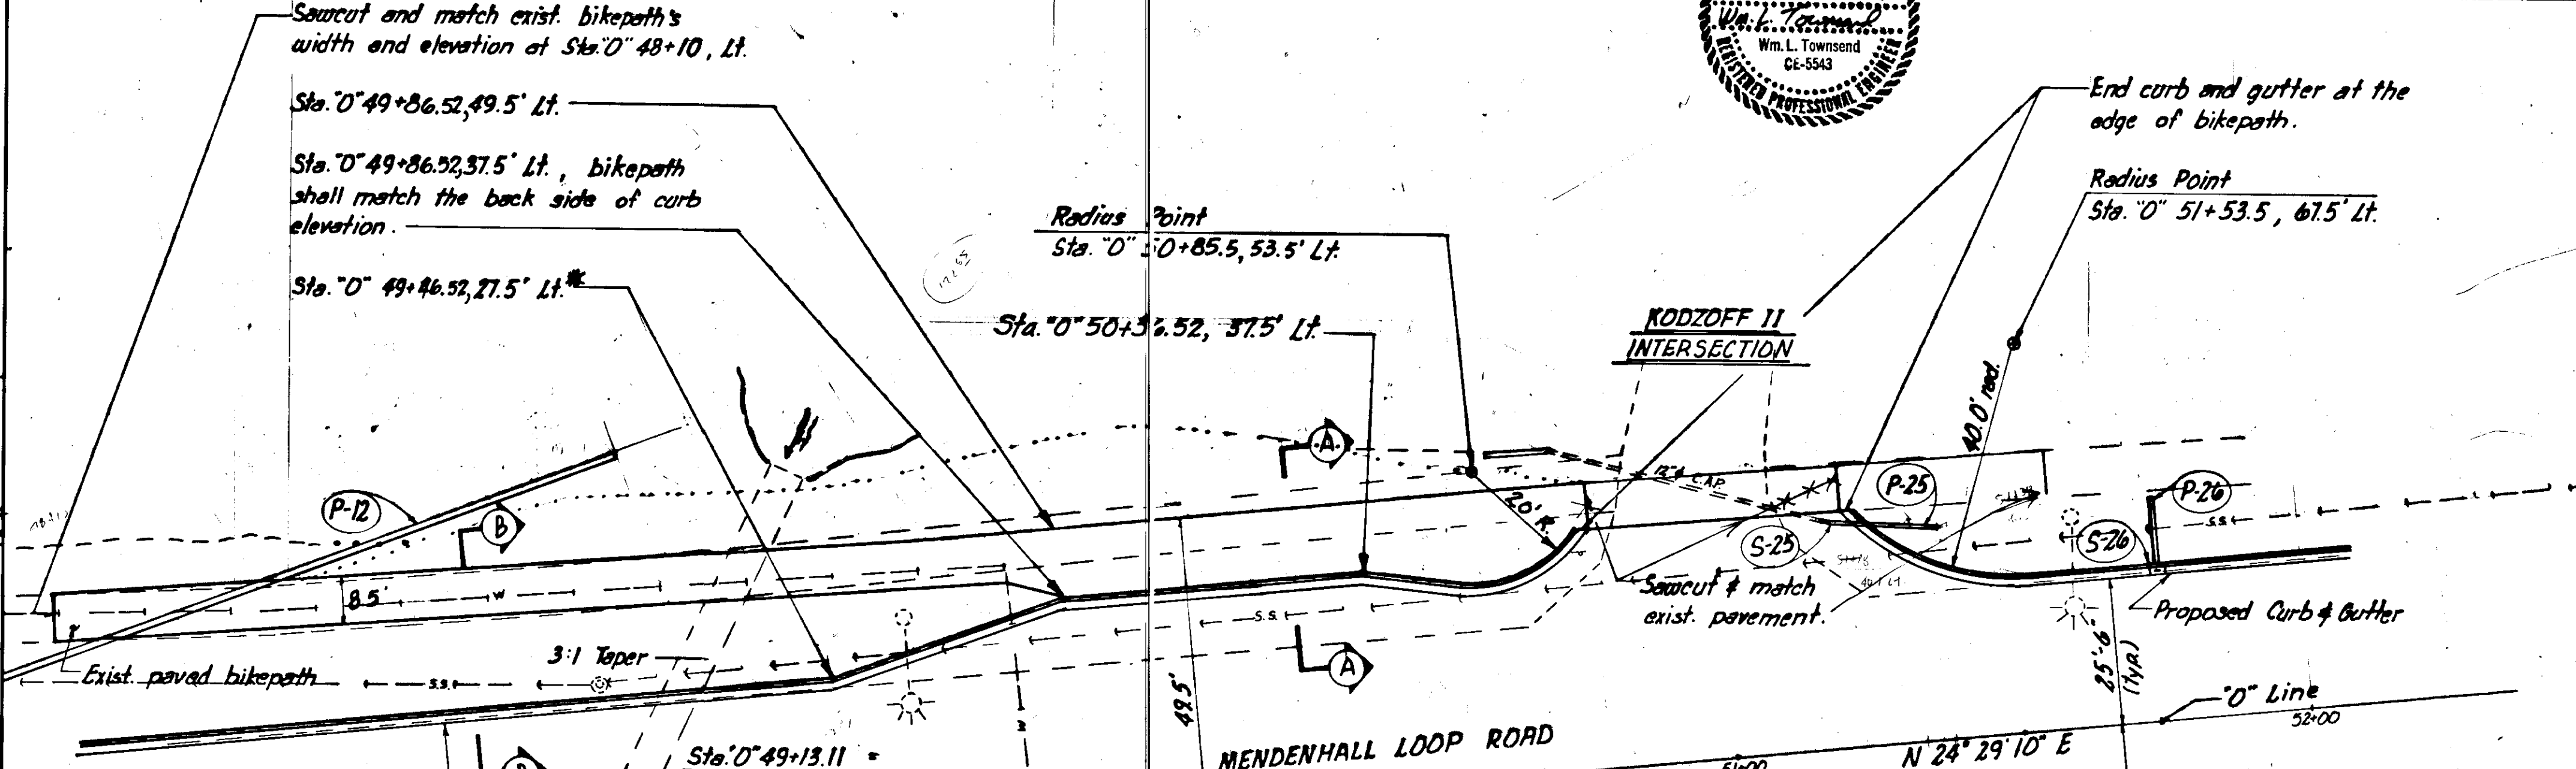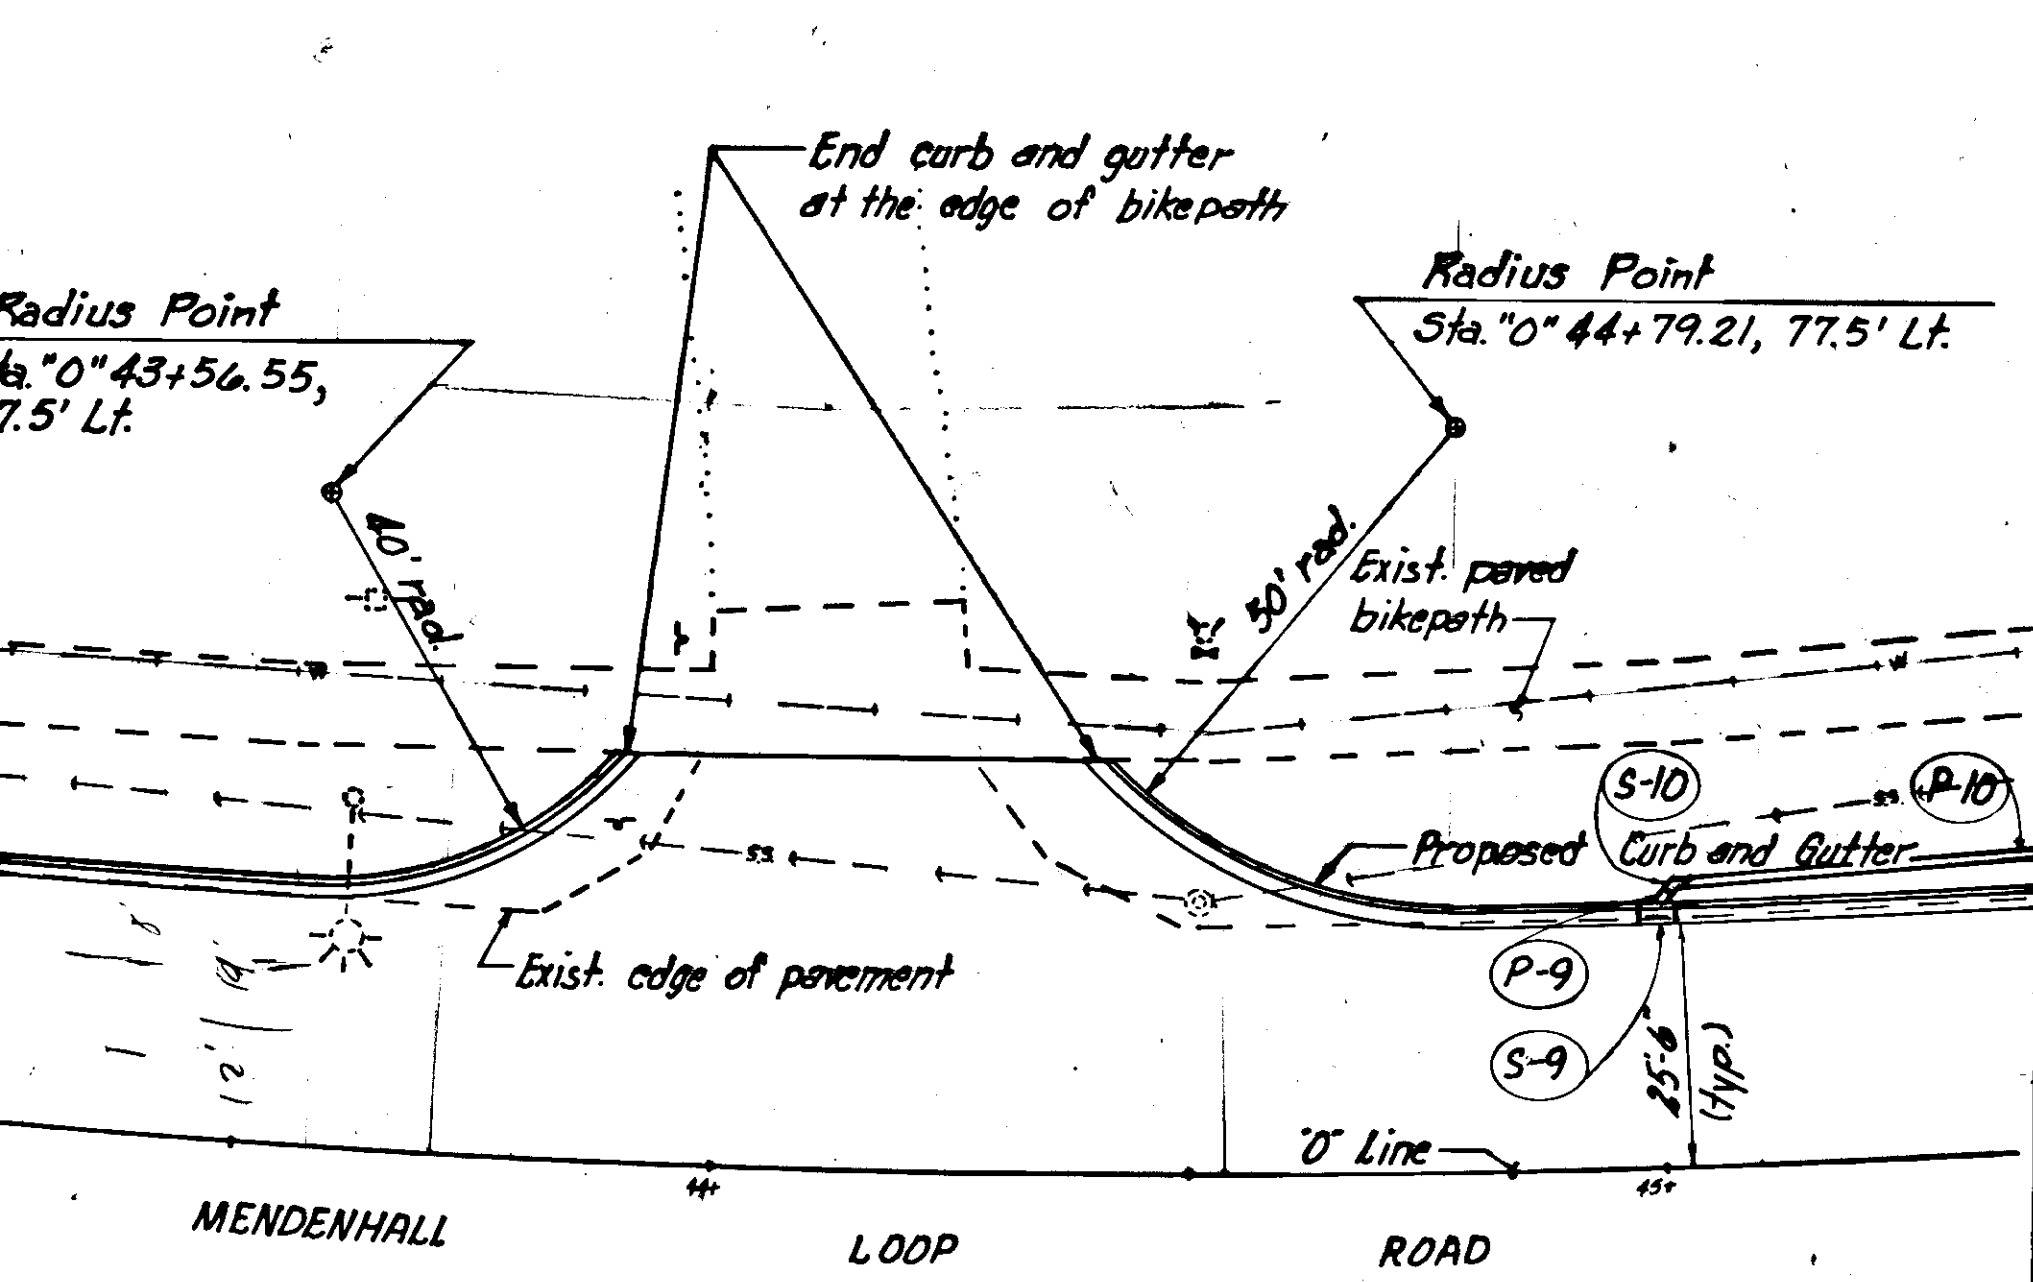

**KODZOFF I INTERSECTION**

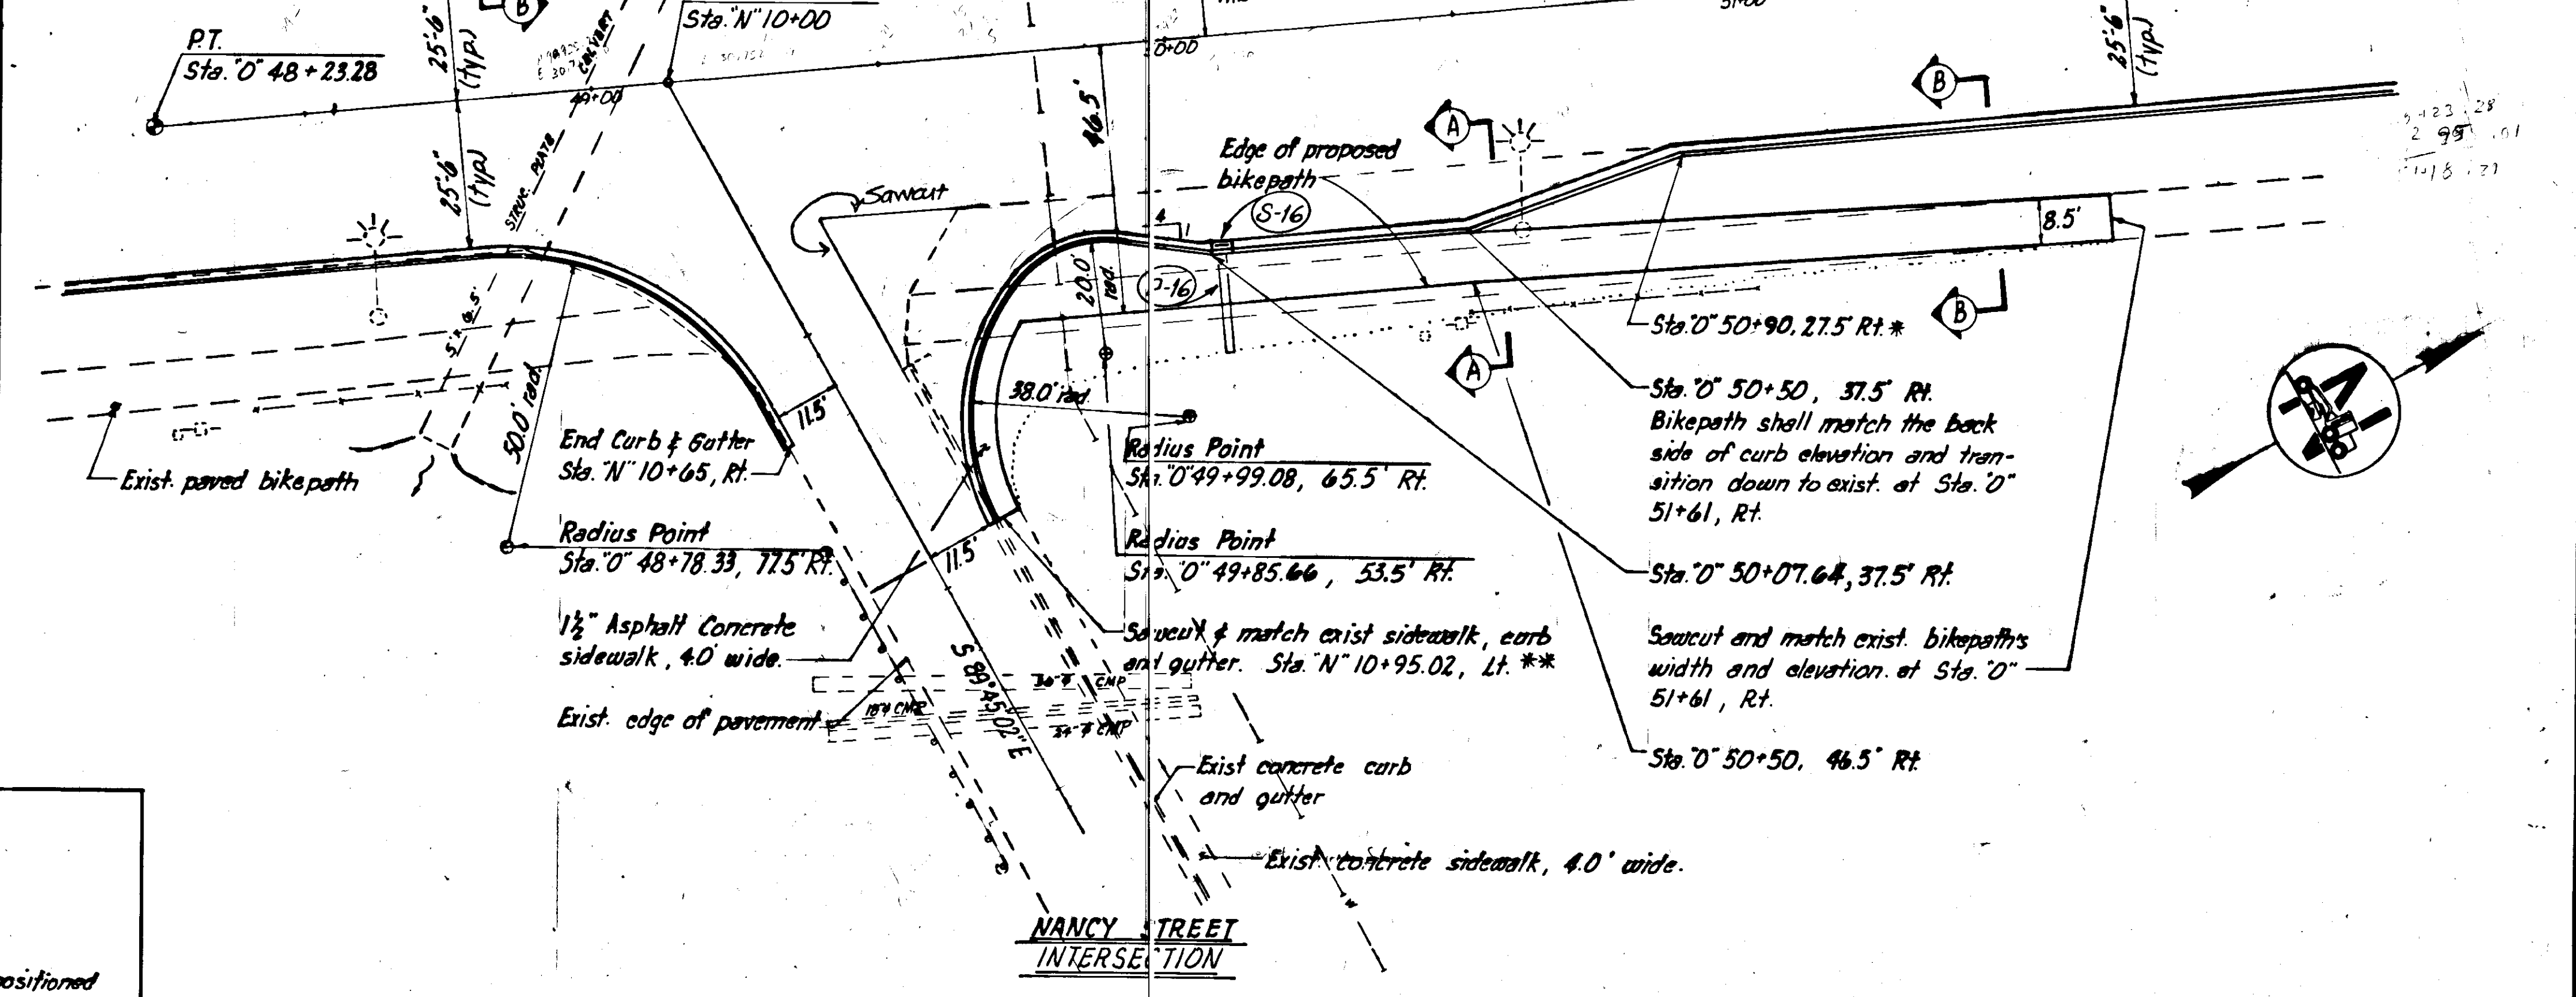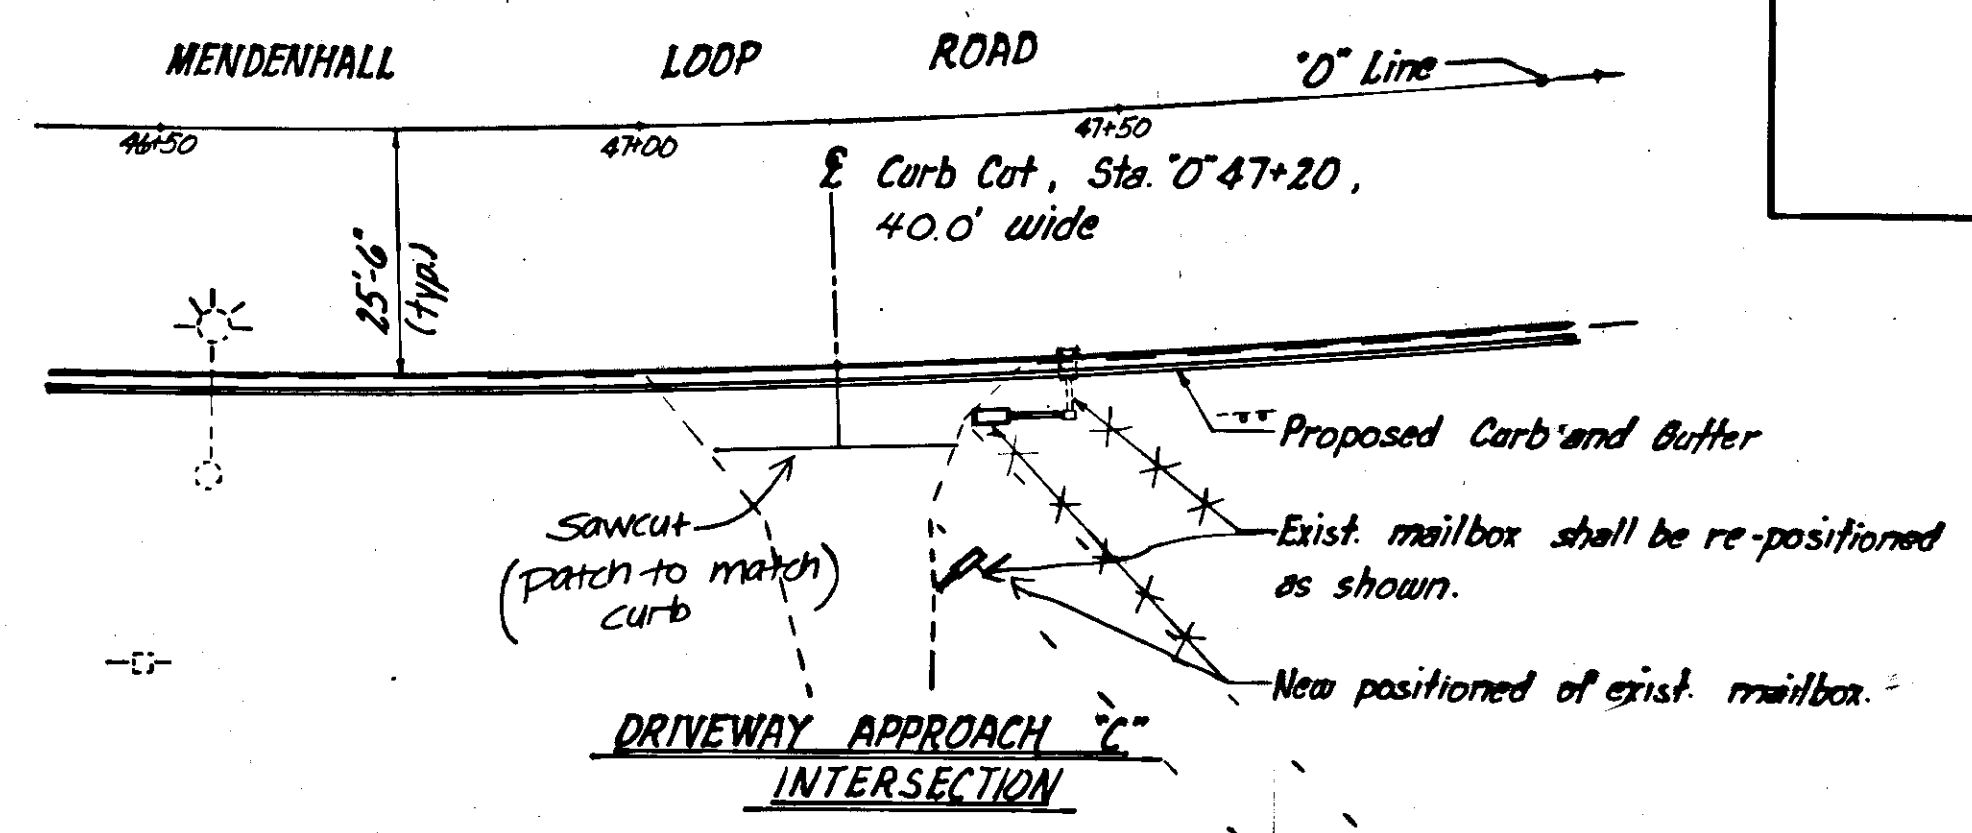

NOTE: See Sheet 3 for Sections A-A and B-B

- \* Provide a minimum of 5.0' radius at these angle points.
- \*\* Proposed sidewalk shall transition to match exist. sidewalk at 12:1 slope.




**GENERAL NOTES**

1. Dimensioning of striping is to the centerline of striping.
2. Install arrows and the word "ONE" as shown.
3. Exist. signs to be removed or re-located are not shown. See table on sht. 2 for locations of signs.
4. See sht. 10 for additional Striping and Signing Layout of Egan Drive and Mendenhall Loop Road intersection.




See sht. 10 for additional striping detail. (PAINTED)

Remove exist directional signs on the most arm of exist signal pole and replace with signs no. 1 and 2.

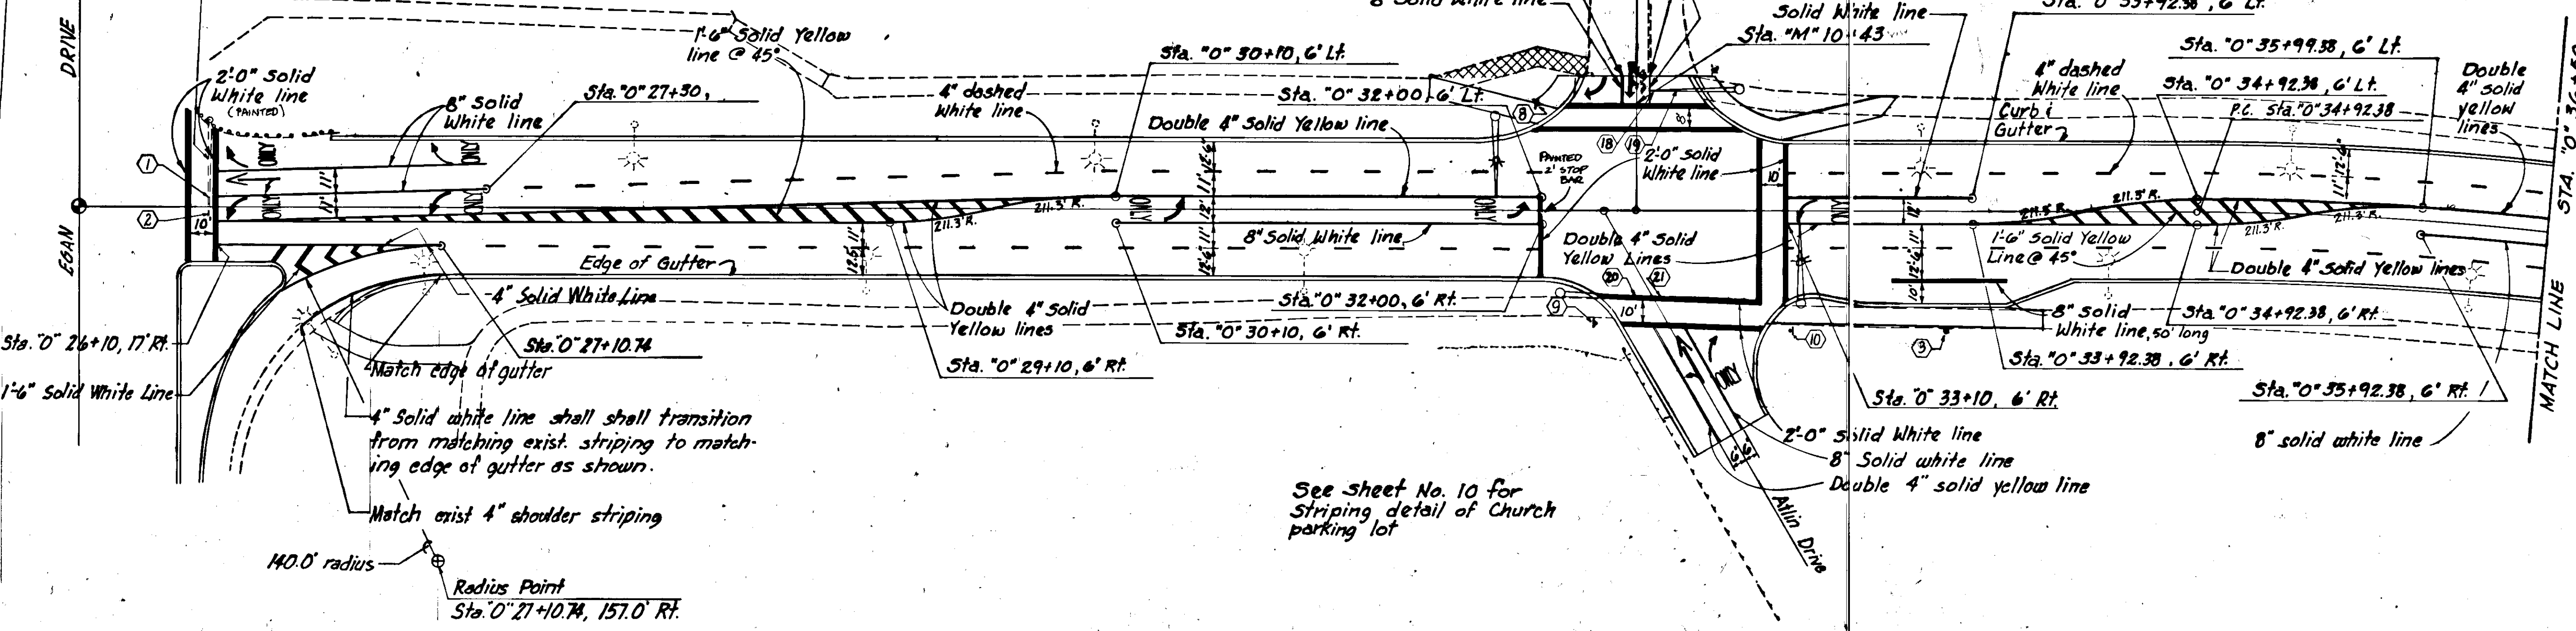

See sheet No. 10 for striping detail of Church parking lot




**STRIPING AND SIGNING LAYOUT**

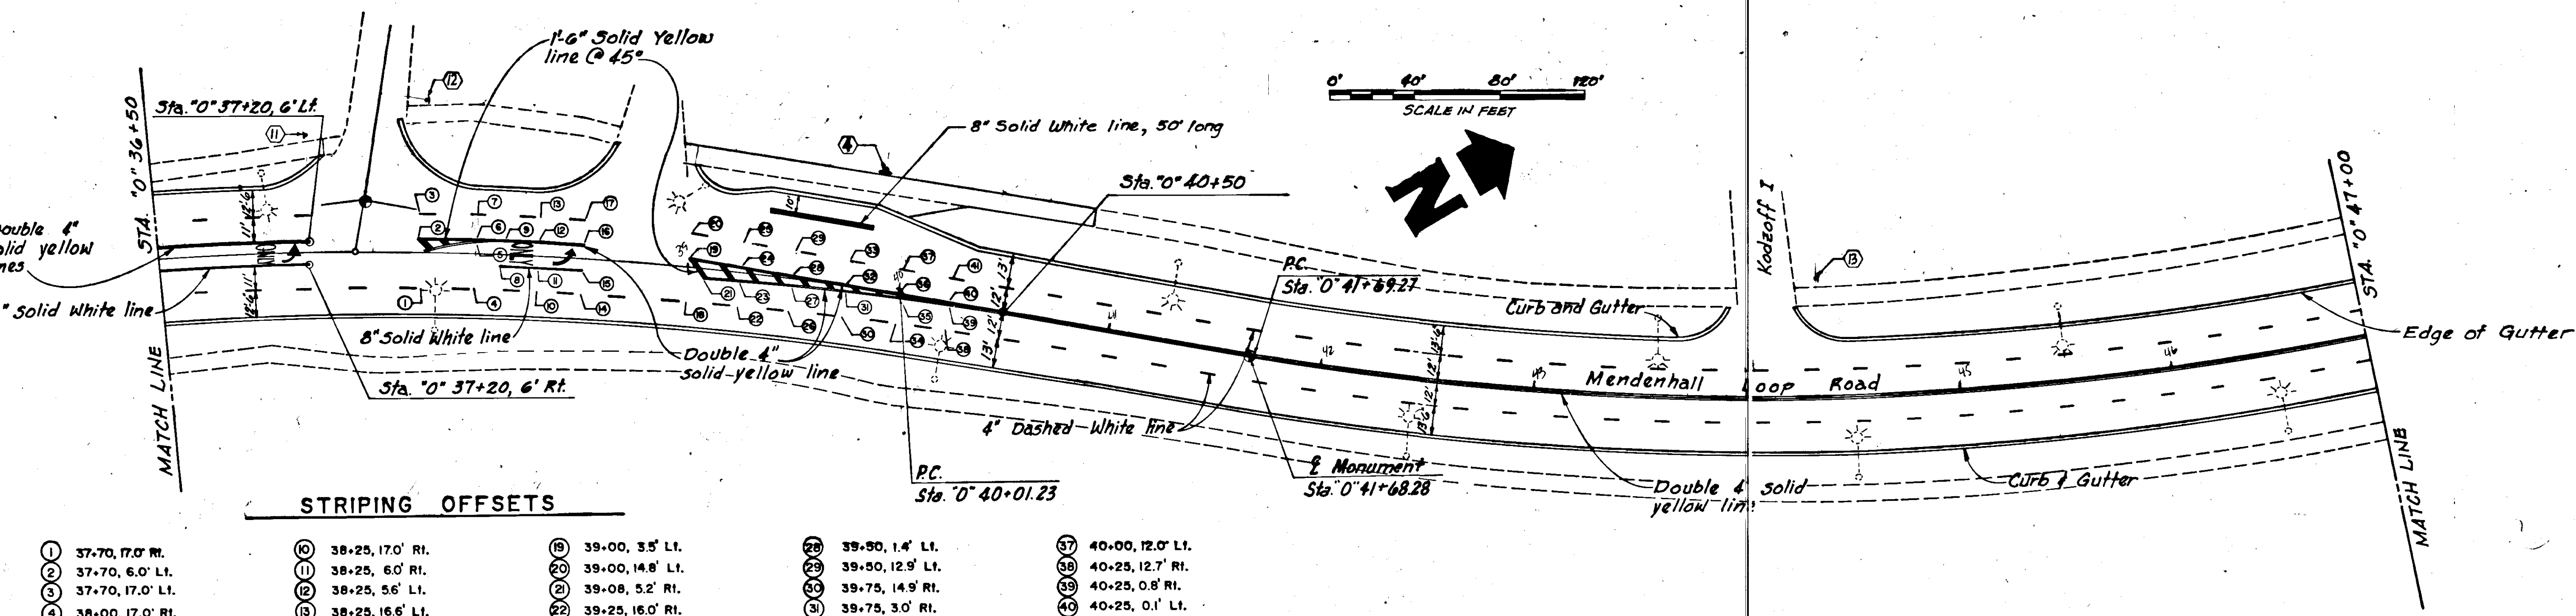




**STRIPING OFFSETS**

1 37+70, 17.0' Rl.	10 38+25, 17.0' Rl.	19 39+00, 3.5' Lt.	28 39+50, 1.4' Lt.	37 40+00, 12.0' Lt.
2 37+70, 6.0' Lt.	11 38+25, 6.0' Rl.	20 39+00, 14.8' Lt.	29 39+50, 12.9' Lt.	38 40+25, 12.7' Rl.
3 37+70, 17.0' Lt.	12 38+25, 5.6' Lt.	21 39+08, 5.2' Rl.	30 39+75, 14.9' Rl.	39 40+25, 0.8' Rl.
4 38+00, 17.0' Rl.	13 38+25, 16.6' Lt.	22 39+25, 16.0' Rl.	31 39+75, 3.0' Rl.	40 40+25, 0.1' Lt.
5 38+00, 5.0' Lt.	14 38+50, 17.0' Rl.	23 39+25, 4.6' Rl.	32 39+75, 0.9' Lt.	41 40+25, 12.0' Lt.
6 38+00, 5.9' Rl.	15 38+50, 6.0' Rl.	24 39+25, 2.5' Lt.	33 39+75, 12.2' Lt.	
7 38+00, 16.9' Lt.	16 38+50, 5.2' Lt.	25 39+25, 13.9' Lt.	34 40+00, 13.7' Rl.	
8 38+10, 6.0' Rl.	17 38+50, 16.2' Lt.	26 39+50, 15.4' Rl.	35 40+00, 2.0' Rl.	
9 38+10, 6.0' Lt.	18 39+00, 16.6' Rl.	27 39+50, 3.9' Rl.	36 40+00, 0.3' Lt.	

STATE	PROJECT DESIGNATION	YEAR	SHEET NO.	TOTAL SHEETS
ALASKA	HES-M-966 (14)	'88	10	28

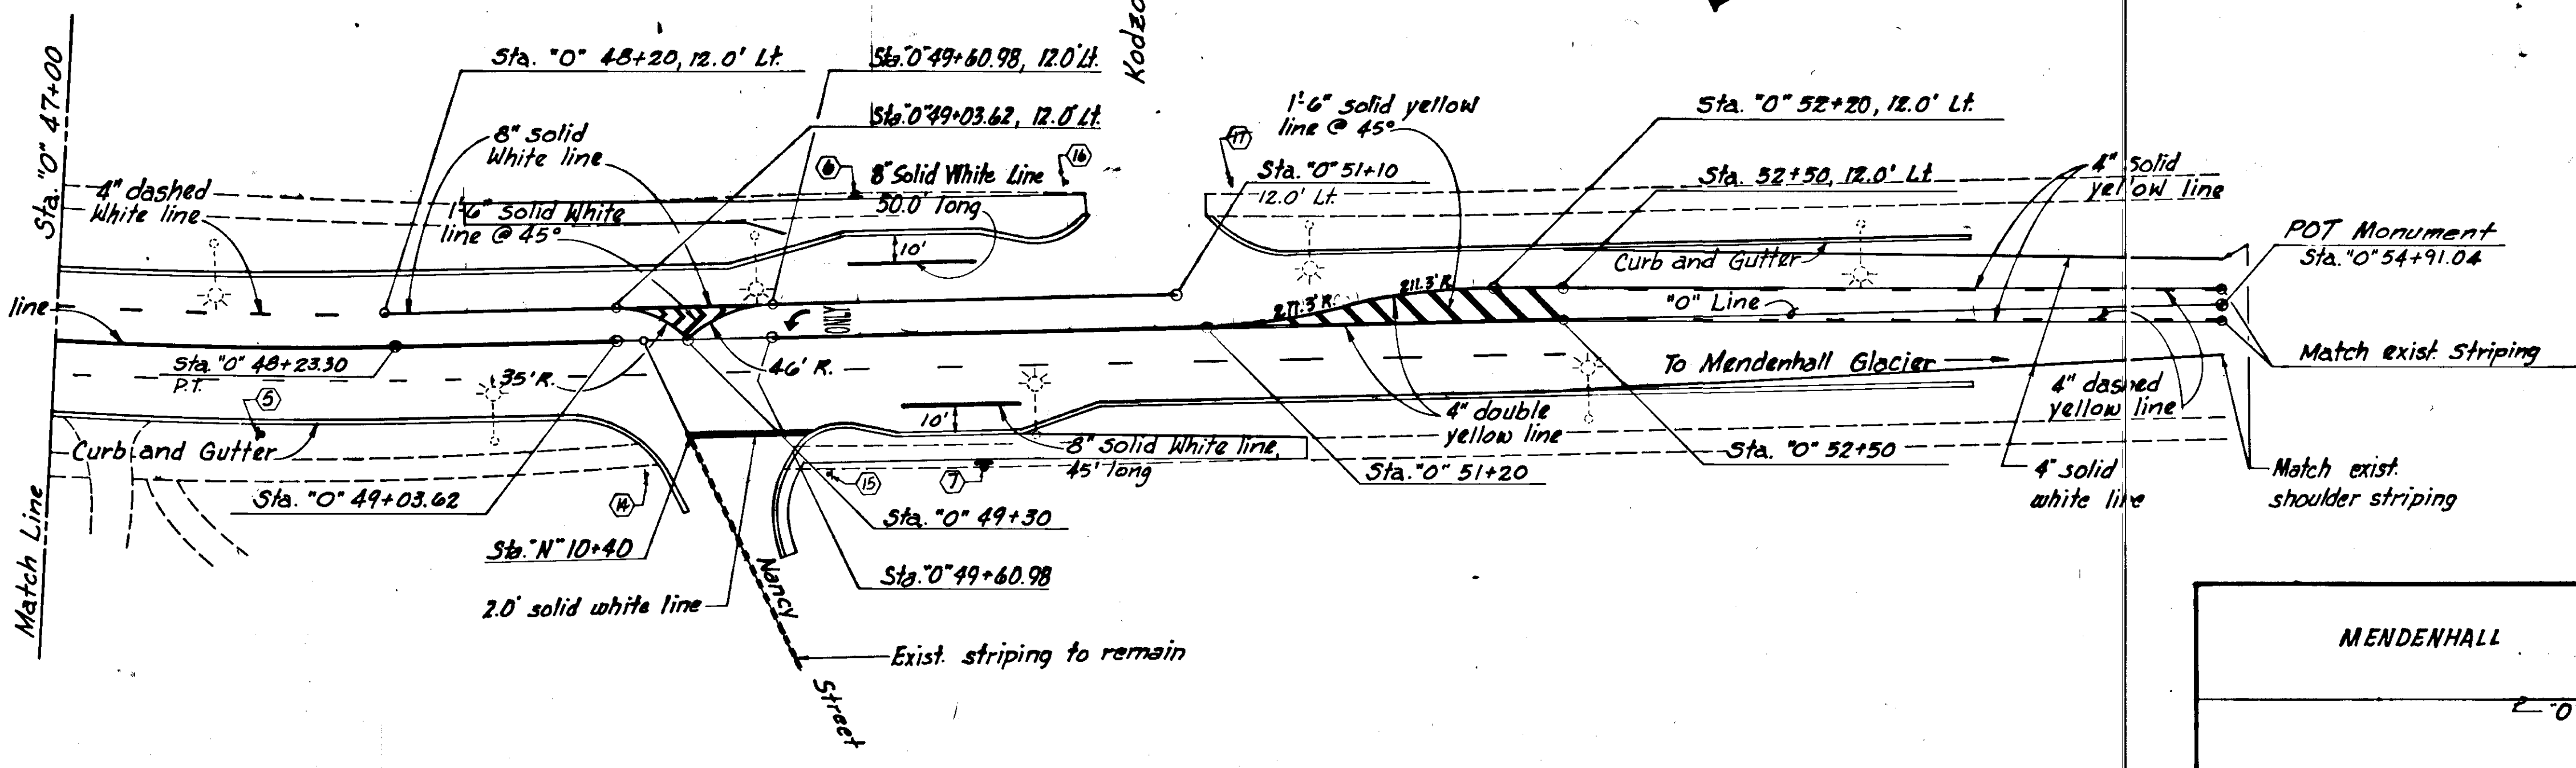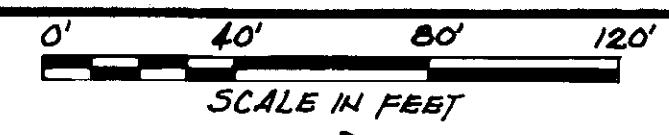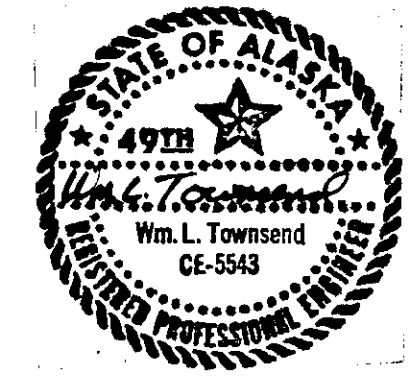


**SIGNING AND STRIPING LAYOUT**

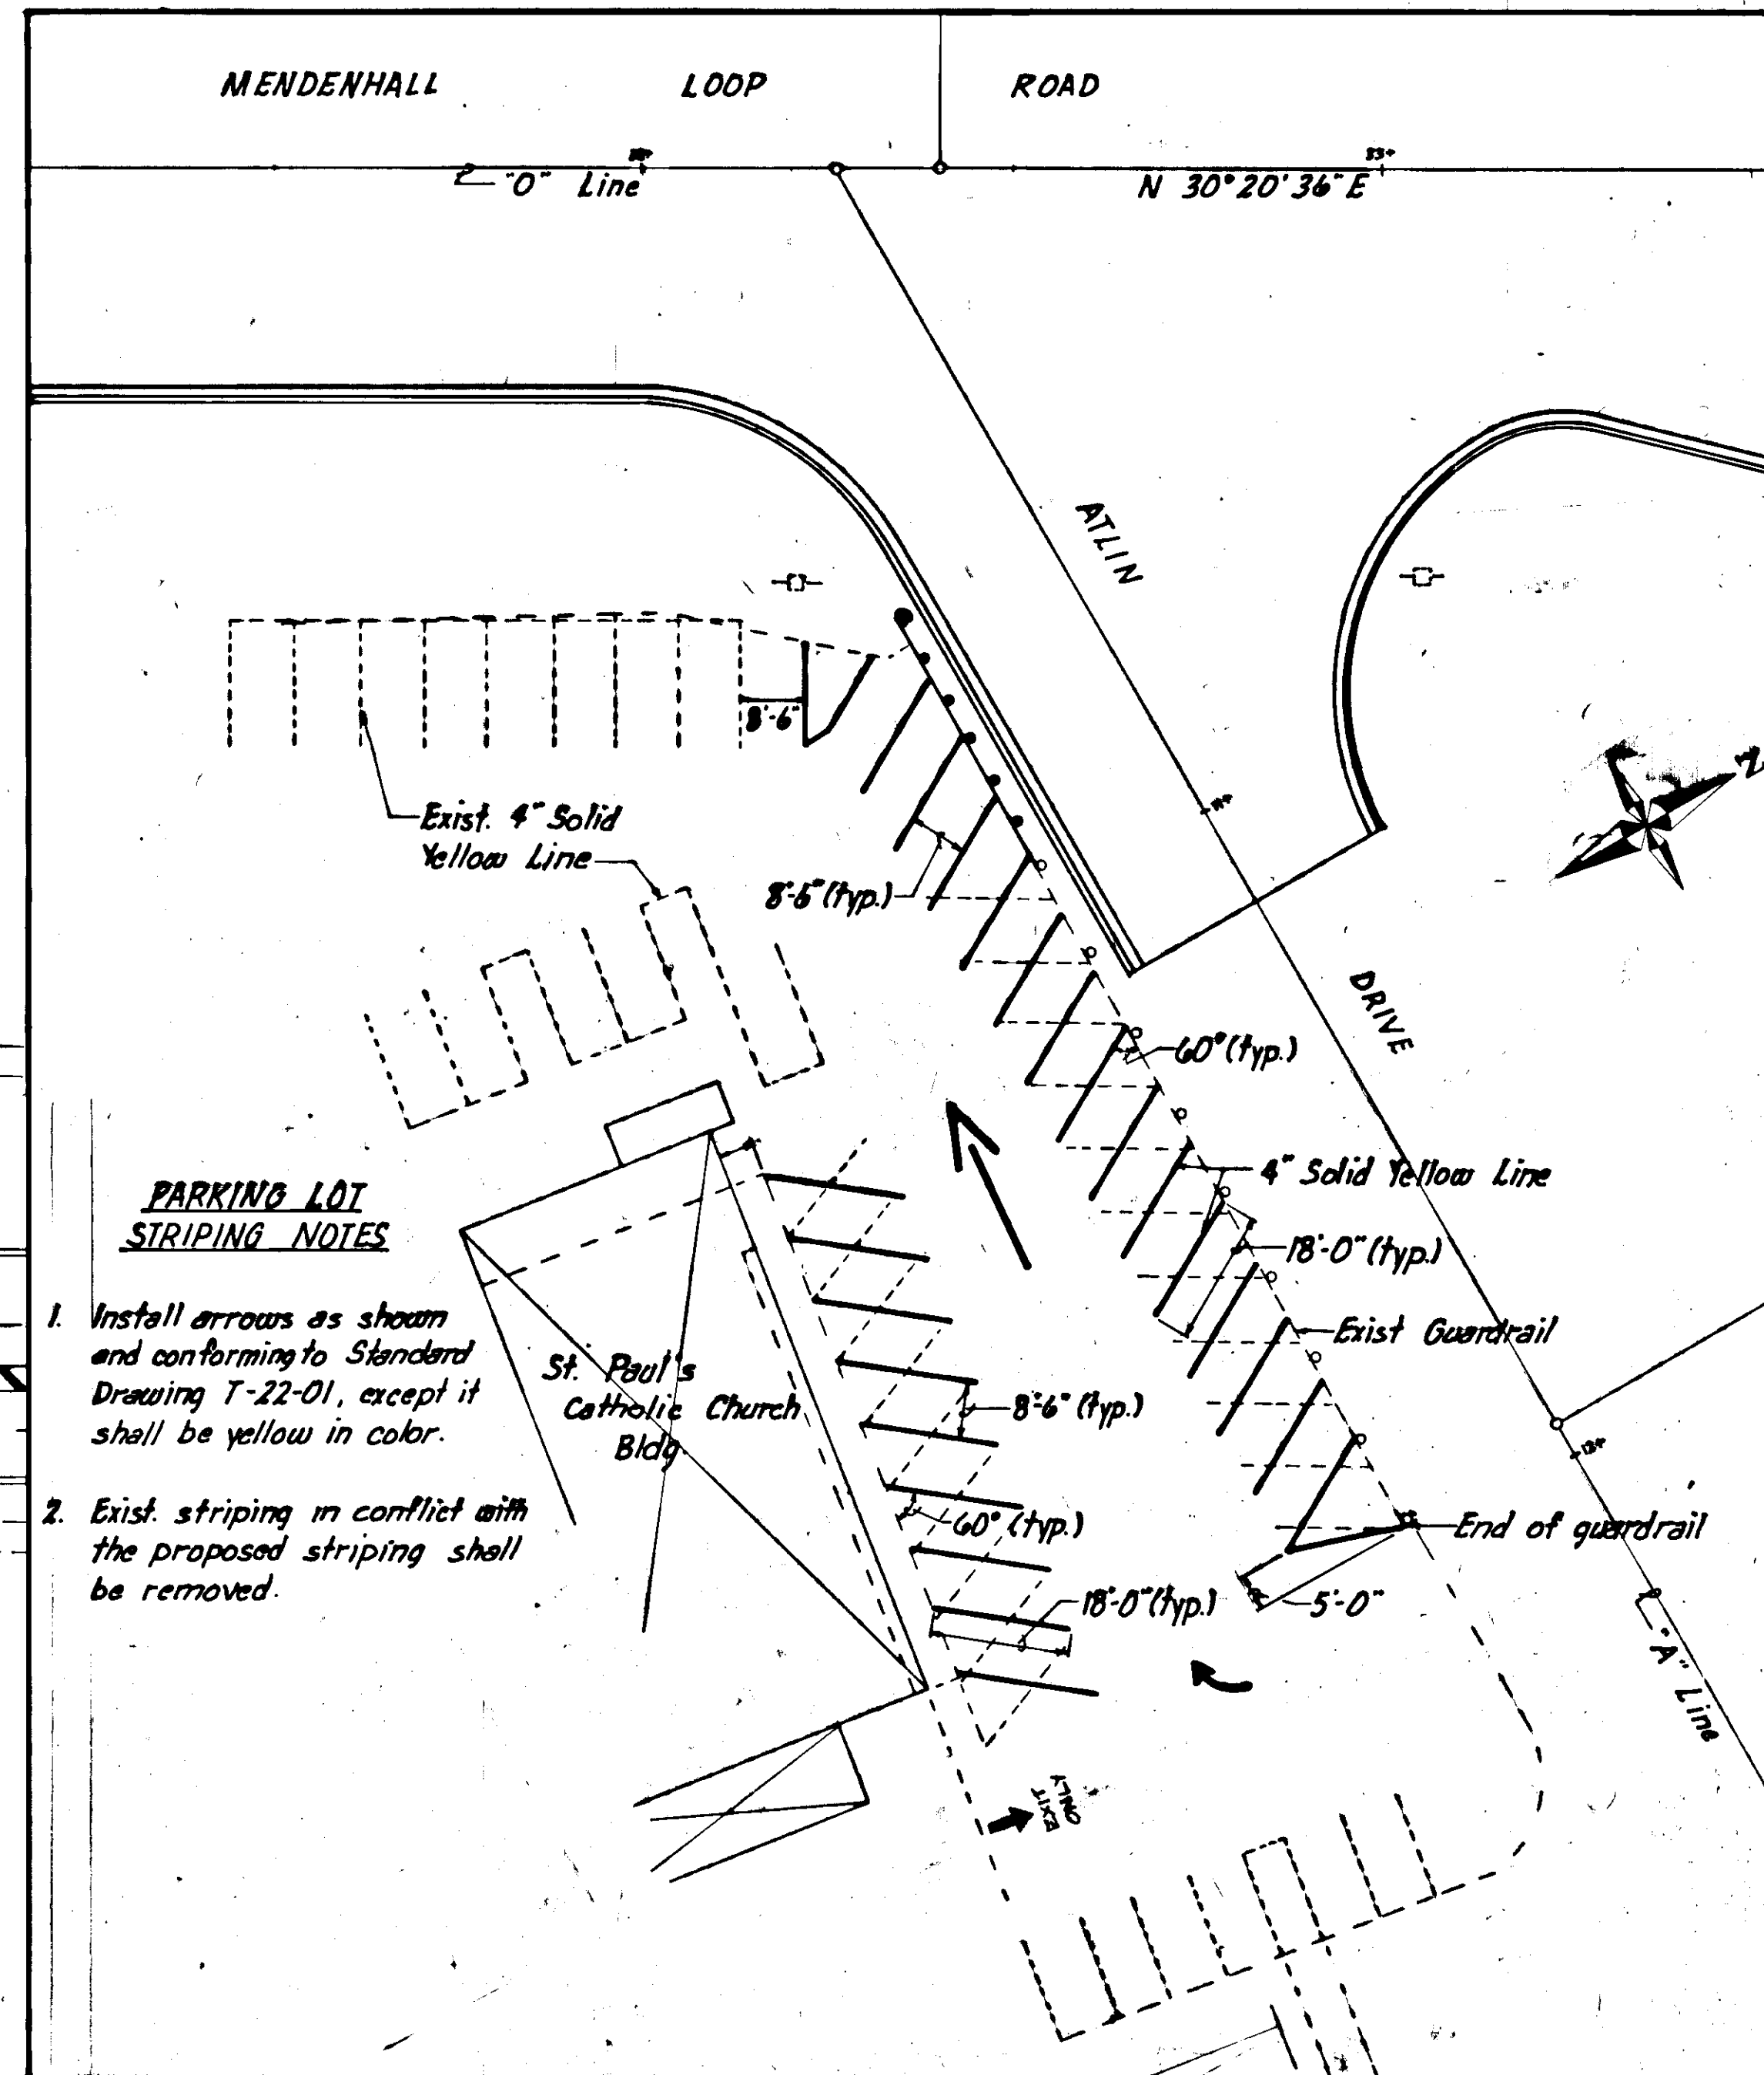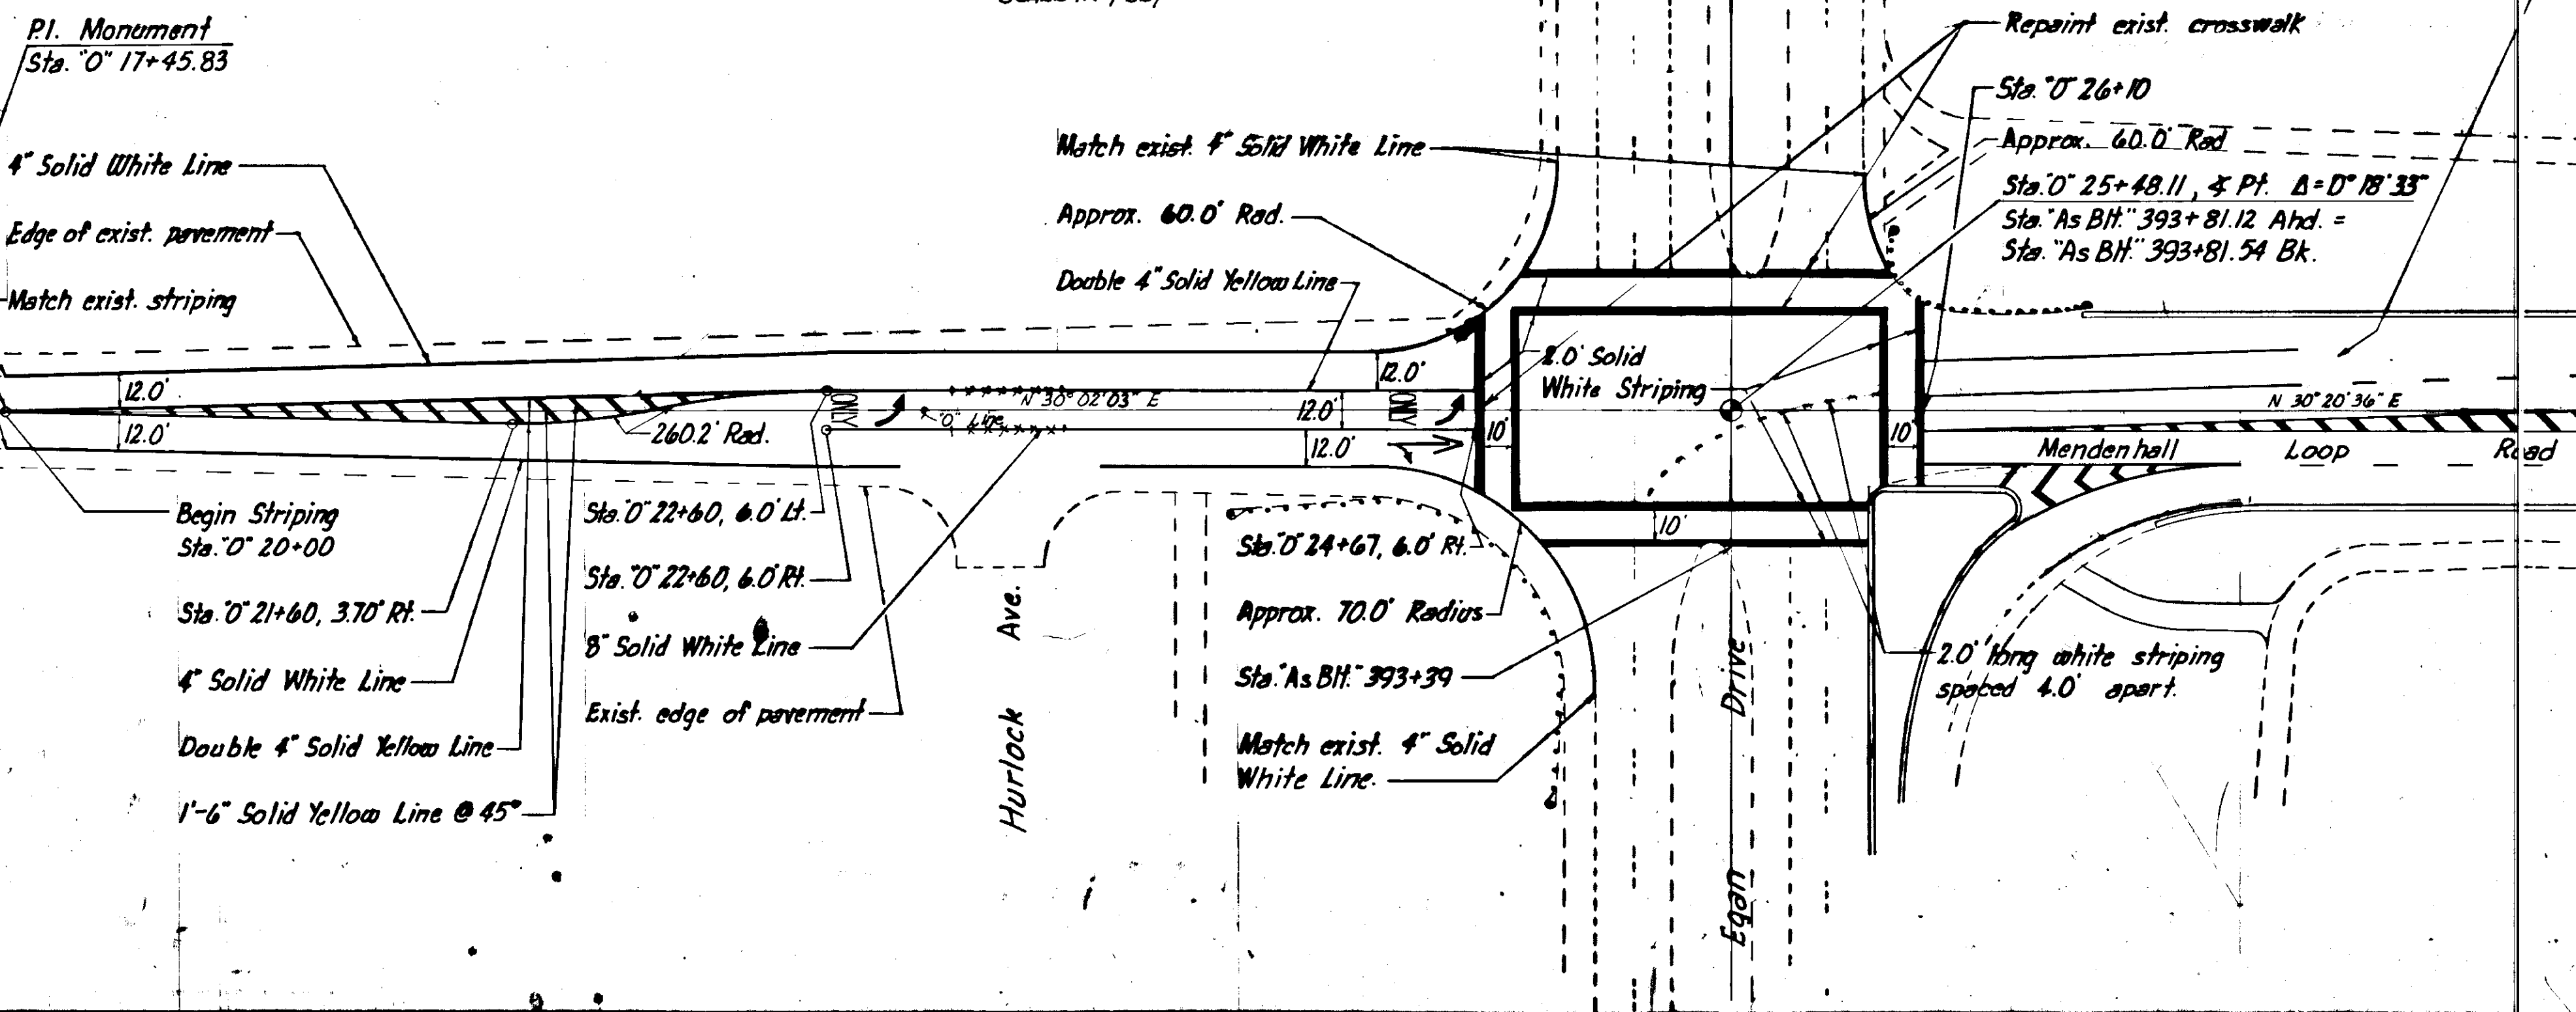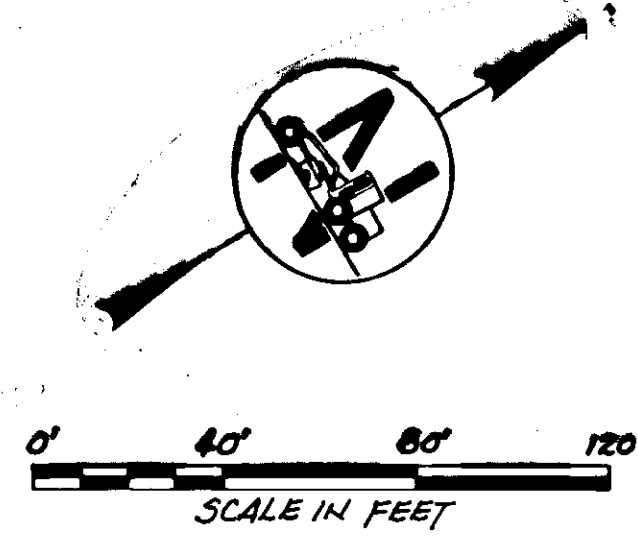




### Traffic Control Plan Notes

- Two (2) Southwest bound lanes and one (1) Northeast bound lane shall be maintained between Egan Drive and Nancy Street from 6:30 A.M. to 8:30 A.M., from Monday thru Friday.
- Two (2) Northeast bound lanes and one (1) Southwest bound lane shall be maintained between Egan Drive and James Blvd. and one (1) Northeast bound lane and one (1) Southwest bound lane shall be maintained between James Blvd. and Nancy Street from 4:00 P.M. to 6:00 P.M., from Monday thru Friday.
- Two (2) directional traffic (minimum of one lane for each direction) shall be maintained at all times except as outlined in note #1 & 2 above.
- Closures and Detours will not be allowed.
- Additional speed advisory signs may be required adjacent to work area and will be paid under pay item 115 (3), Permanent Construction Signing.
- Construction debris shall be removed from the paved bikepath prior to the end of each shift.
- Continuous access to Mendenhall Mall, James Blvd., Nancy Street, Kodzoff I and Kodzoff II Trailer Parks shall be provided at all times. Closure to their access will not be allowed.
- Bicycle/Pedestrian access shall be provided on both sides of the roadway at all times. Minimum width of the bicycle/pedestrian access shall be 40' wide. Plan for the temporary access shall be submitted to the Engineer for approval.

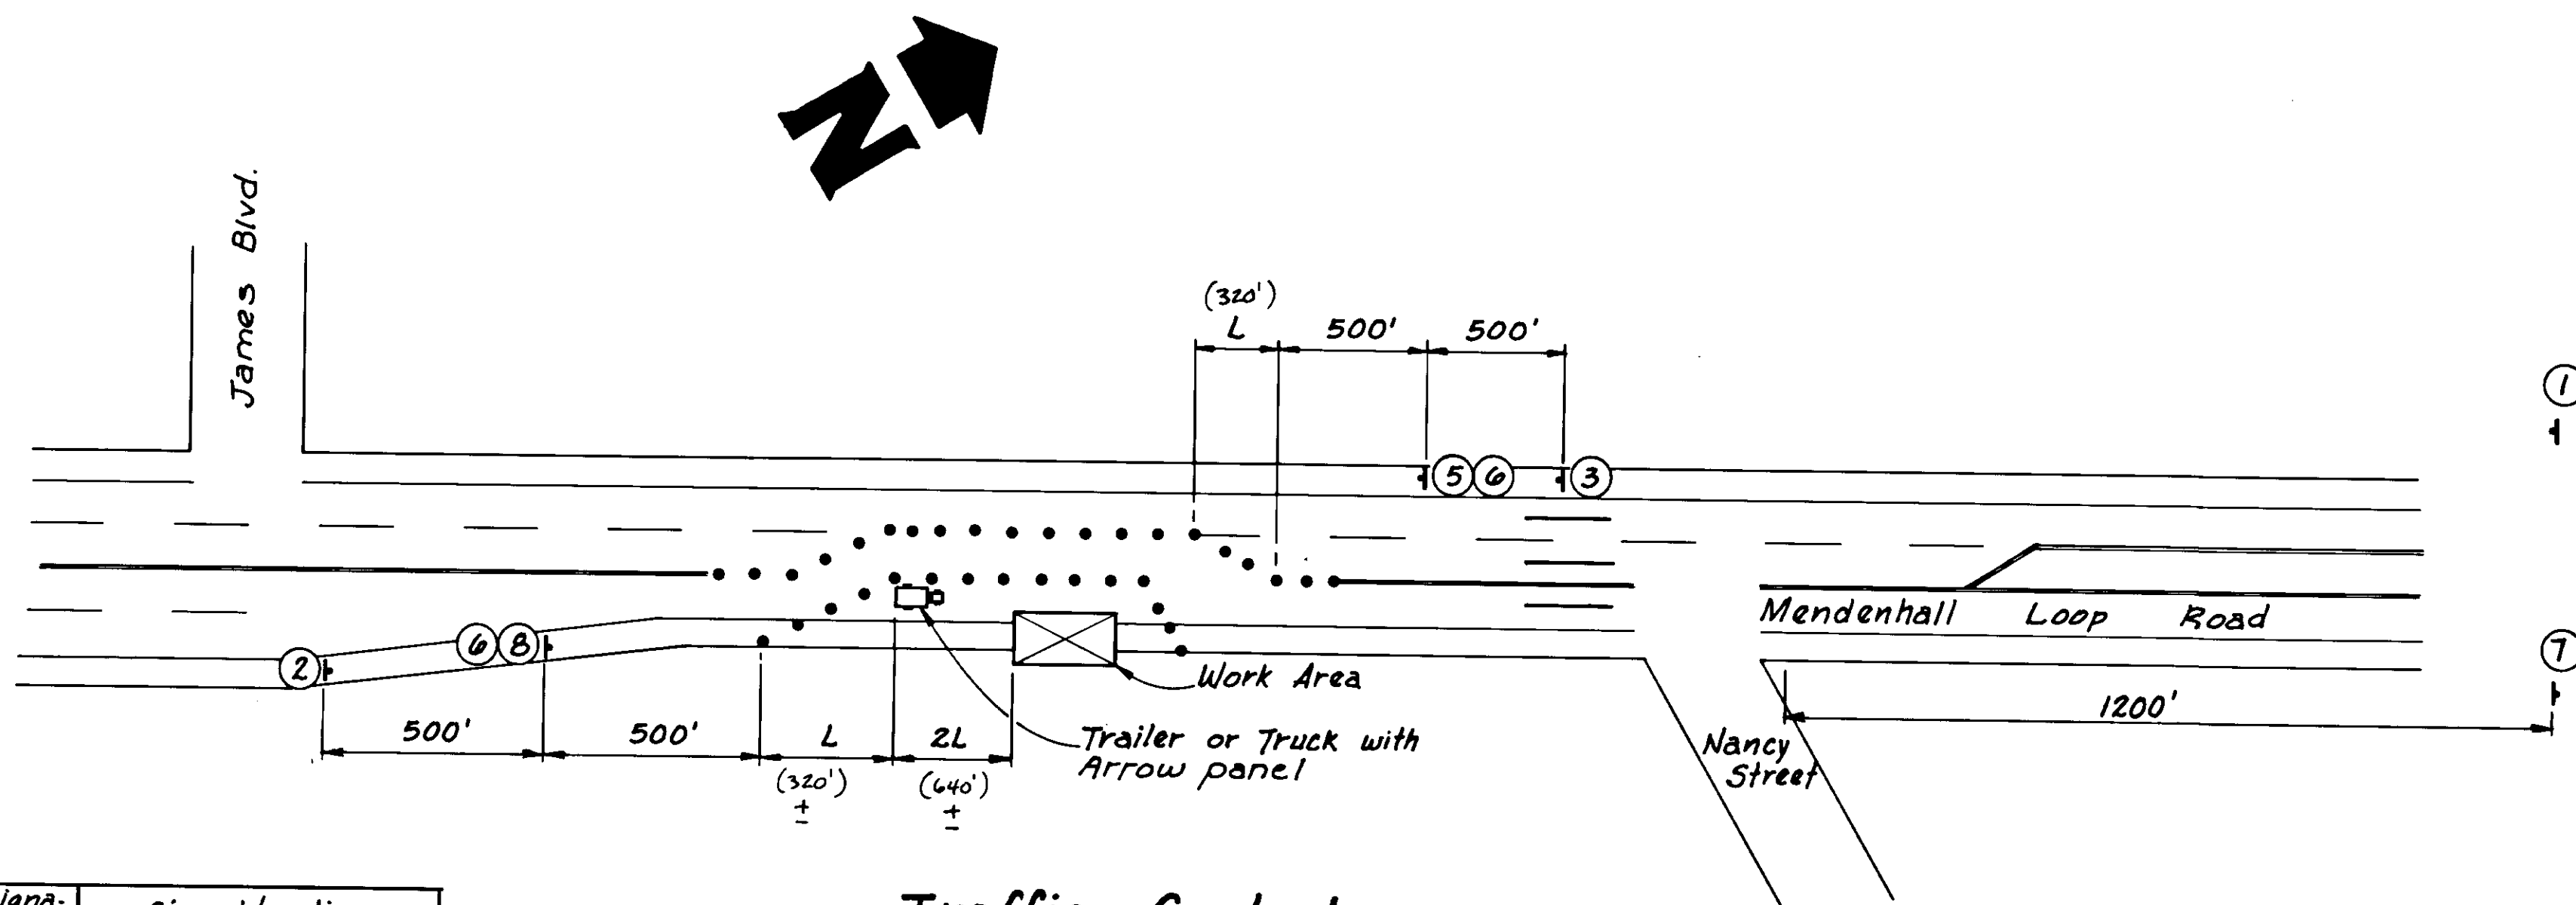

**Traffic Control**  
James Blvd. to EOP

Size	Designation	Sign Wording
48"x48"	CW 20-1F	"Road Construction Ahead"
48"x48"	CW 20-5RF	"Right Lane Closed Ahead"
48"x48"	CW 20-5LF	"Left Lane Closed Ahead"
48"x48"	WA-2R	
48"x48"	WA-2L	
24"x24"	CW 13-1	"20 MPH"
60"x24"	G20-2	"End Construction"
30"x30"	CW 1-3L	

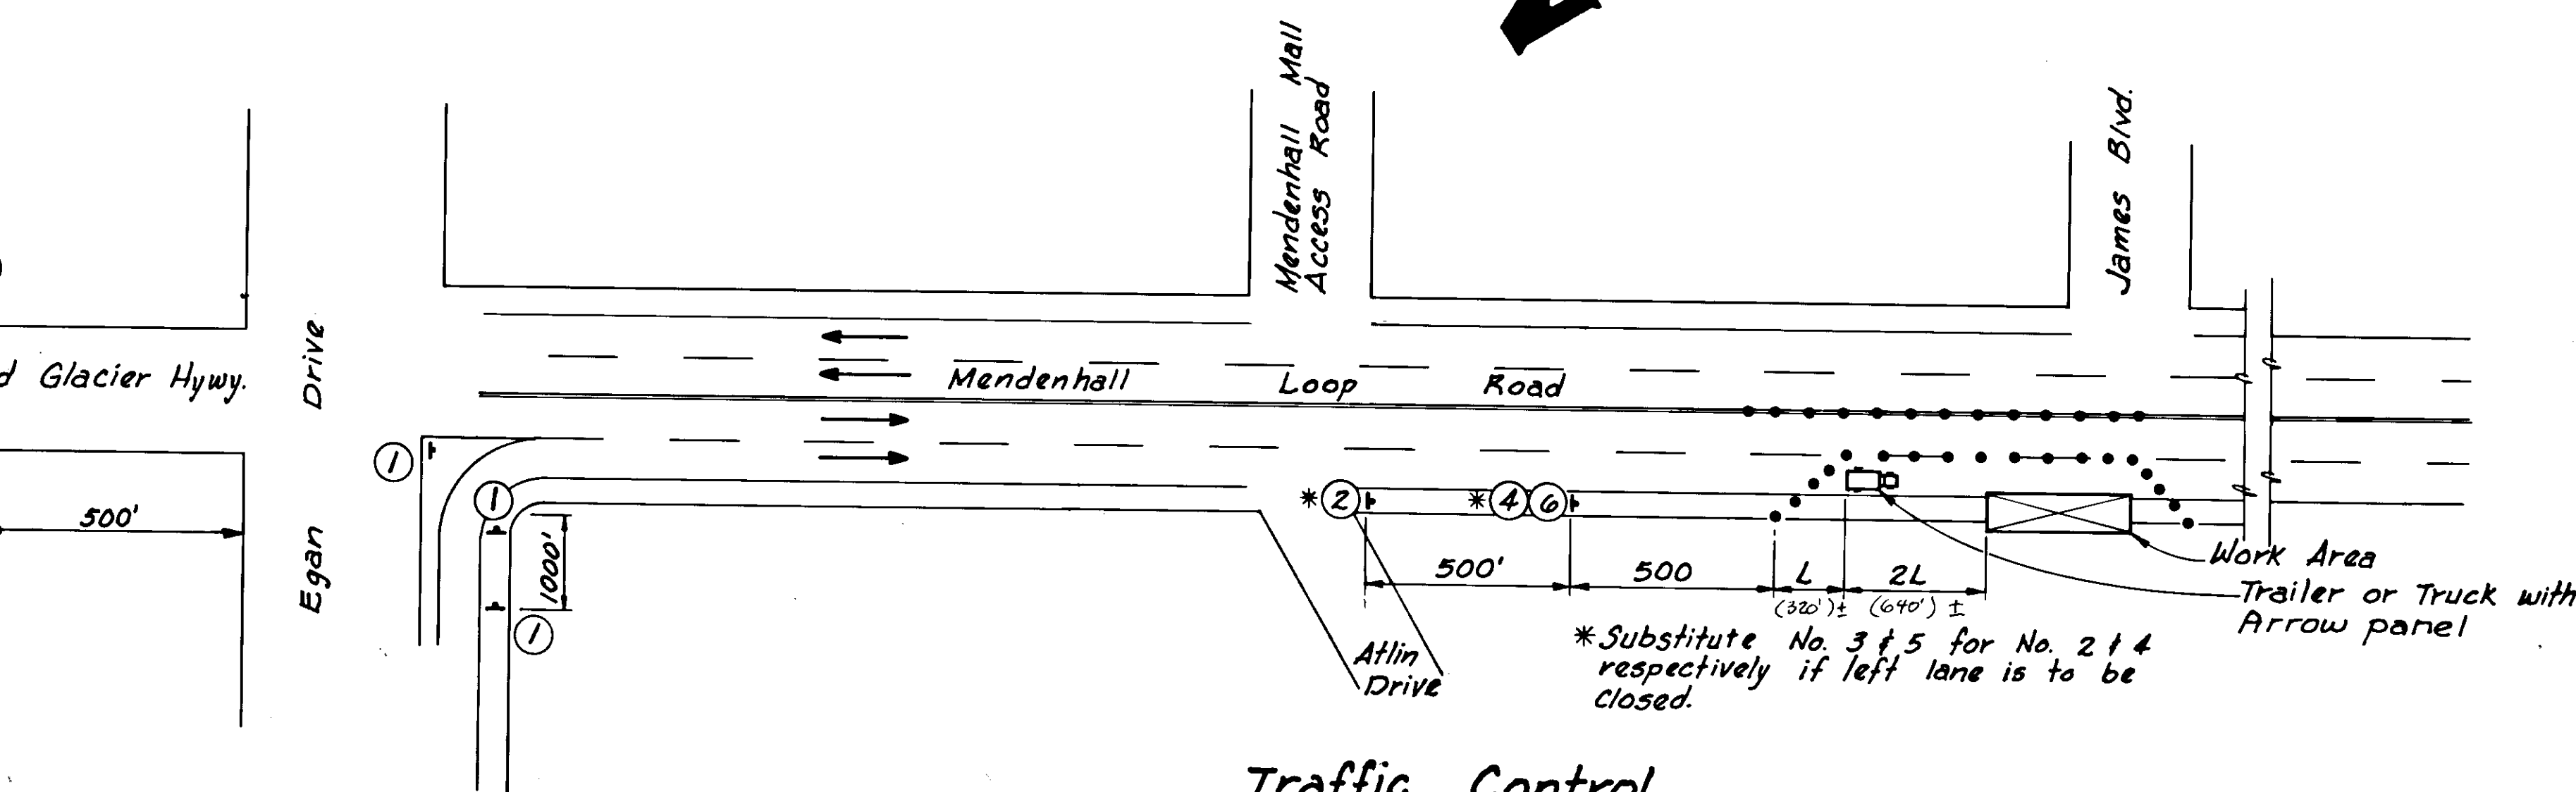

**Traffic Control**  
Egan Drive to James Blvd.

### Taper Formula Notes


$L = WS^2/40$  Minimum length of taper = 320 Ft in feet

- S = Numerical value of posted  $\pm$  speed limit.
- W = Width of offset in feet.  $\pm 12$


- Maximum spacing between channelizing devices in taper should be approximately equal in feet to the speed limit.

• Cones or Tubular Markers



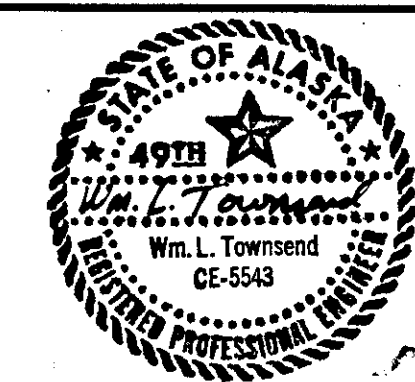


STATE	PROJECT DESIGNATION	YEAR	SHEET NO.	TOTAL SHEETS
ALASKA	HES-M-966(14)	88	13	28

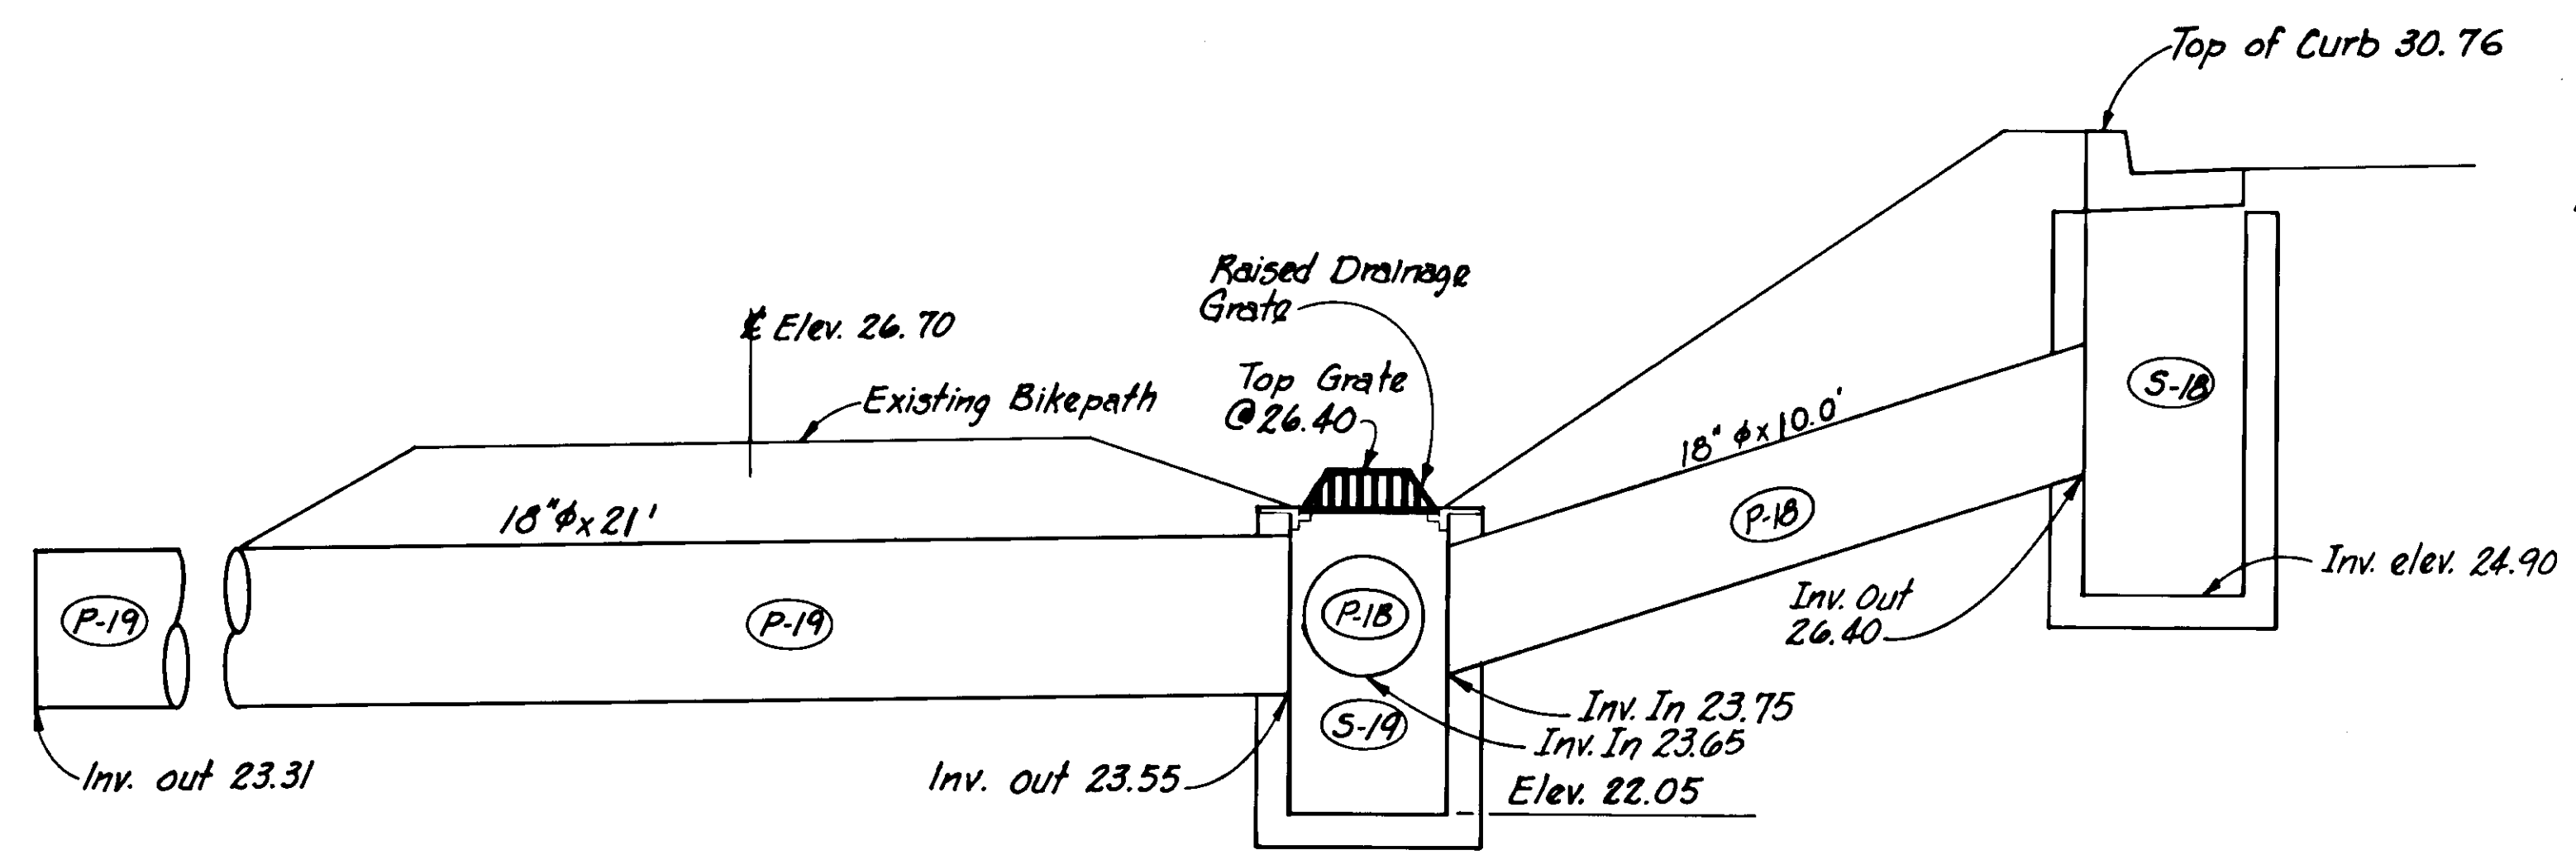


Sta. "0" 29+12, 58.5' Rt.

Sta. "0" 29+23, 40.5' Rt.


Sta. "0" 29+23, 31' Rt.

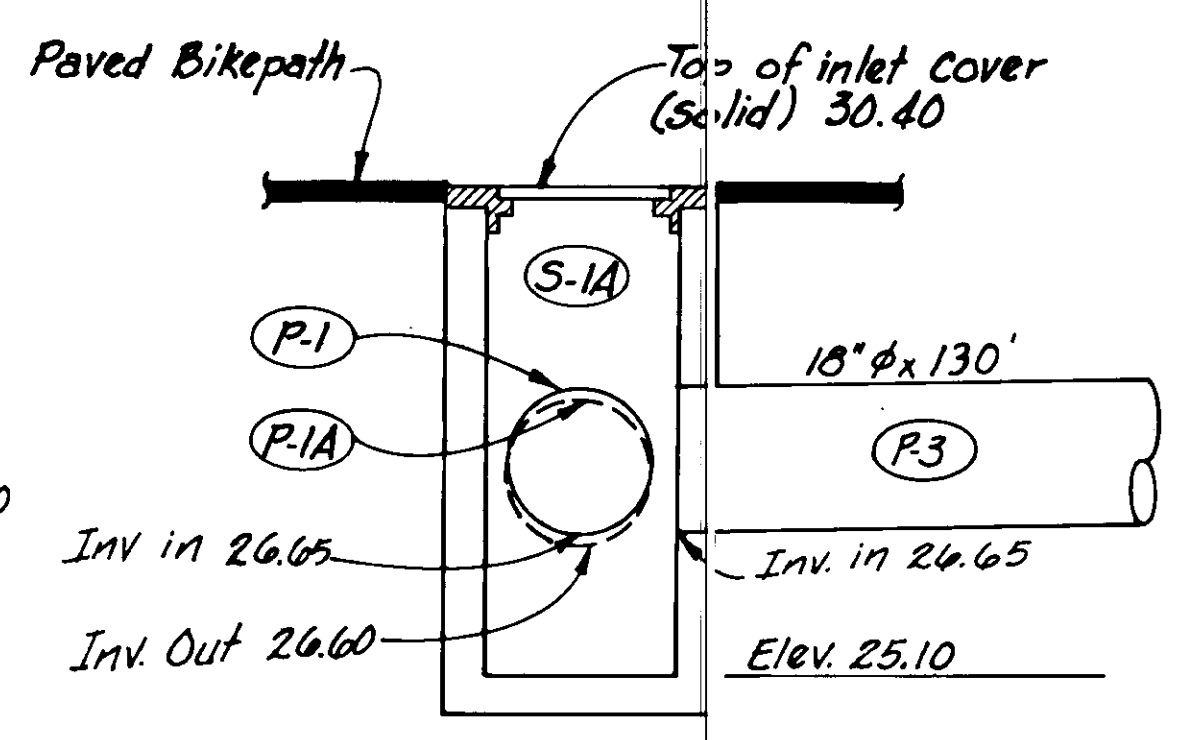

Sta. "0" 32+15, 41.0' Rt.

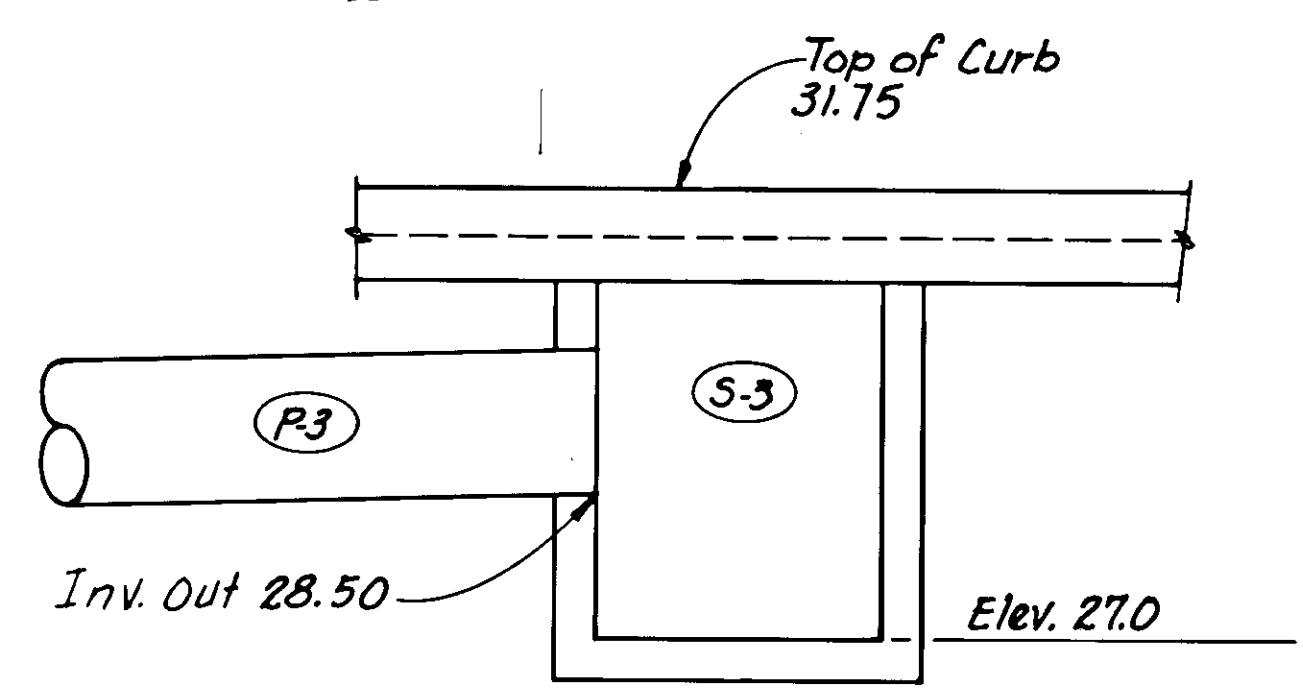


Sta. "0" 33+45, 41.0' Rt.

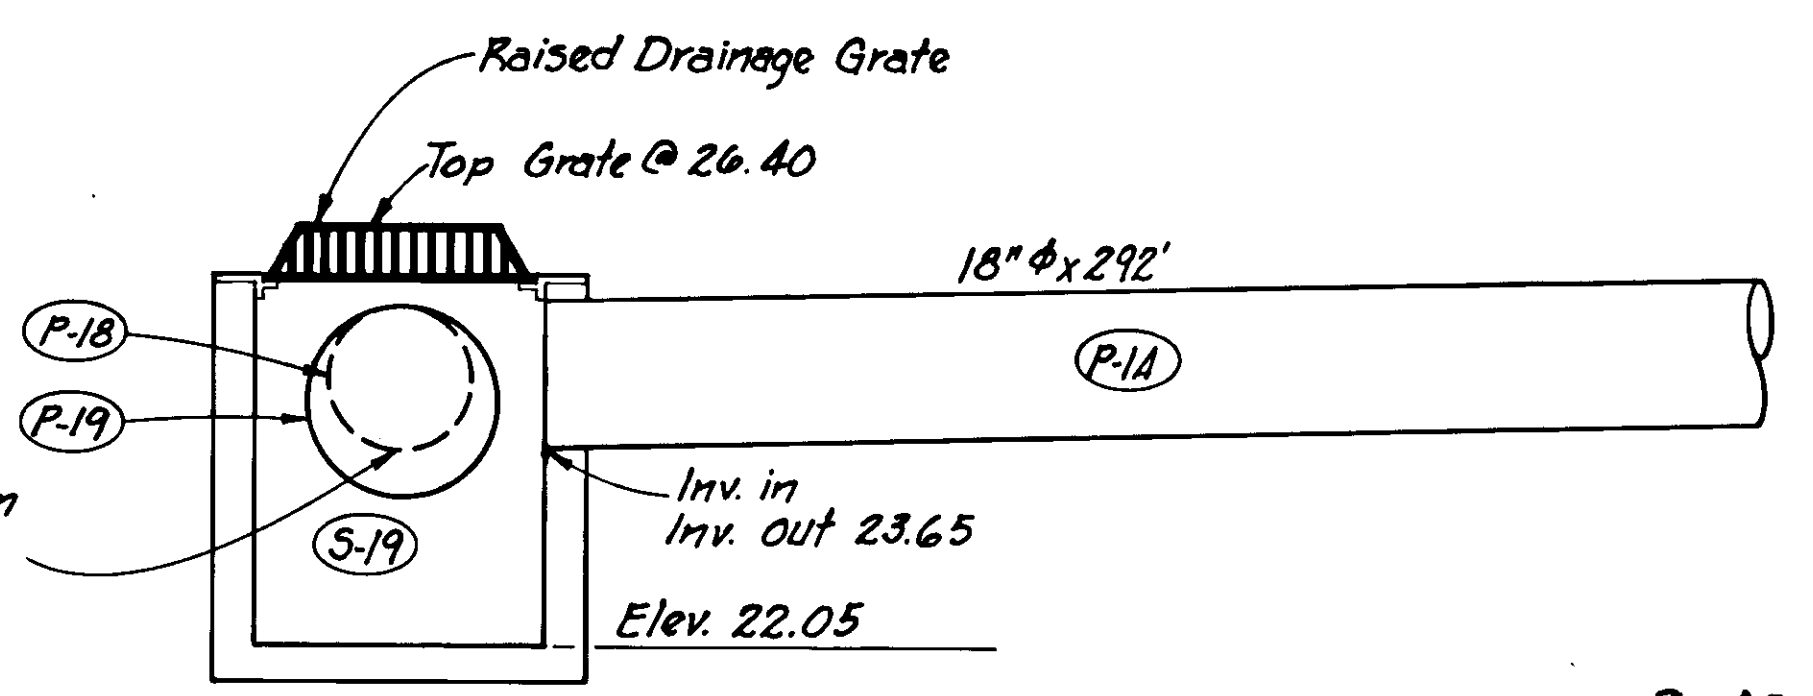

Sta. "0" 29+23, 40.5' Rt.


Concrete Cradle Class "W" concrete shall be continuous from S1 to S2. Concrete and reinforcing steel shall be incidental to 603 (13-18), 18 inch corrugated aluminum pipe.

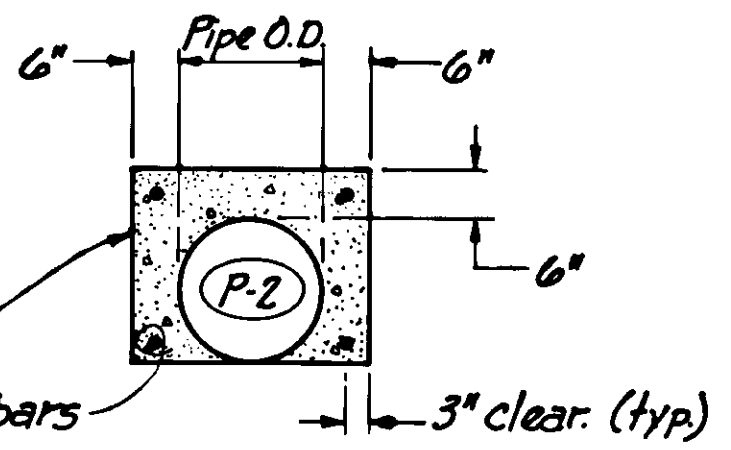


Concrete Pipe Cradle Detail

**Inlet Frame and Cover Notes**

1. Drainage grate for S-19 shall be a maximum of six (6) and a minimum of five (5) inches in height. All four sides and the top shall have open grates.
2. Inlet cover for S-1A shall be solid and rated to handle HS-20 loading.
3. Inlet frame for both S-1A & S-19 shall fit around the inlet perimeter as shown. Inlet frame shall conform to Section 604.
4. Minimum weight for the inlet frame & grate for S-18 and the inlet frame & cover for S-1A shall be 350 lbs.
5. Inlet cover for S-1A shall be set 1/4" below the paved bikepath elevation.

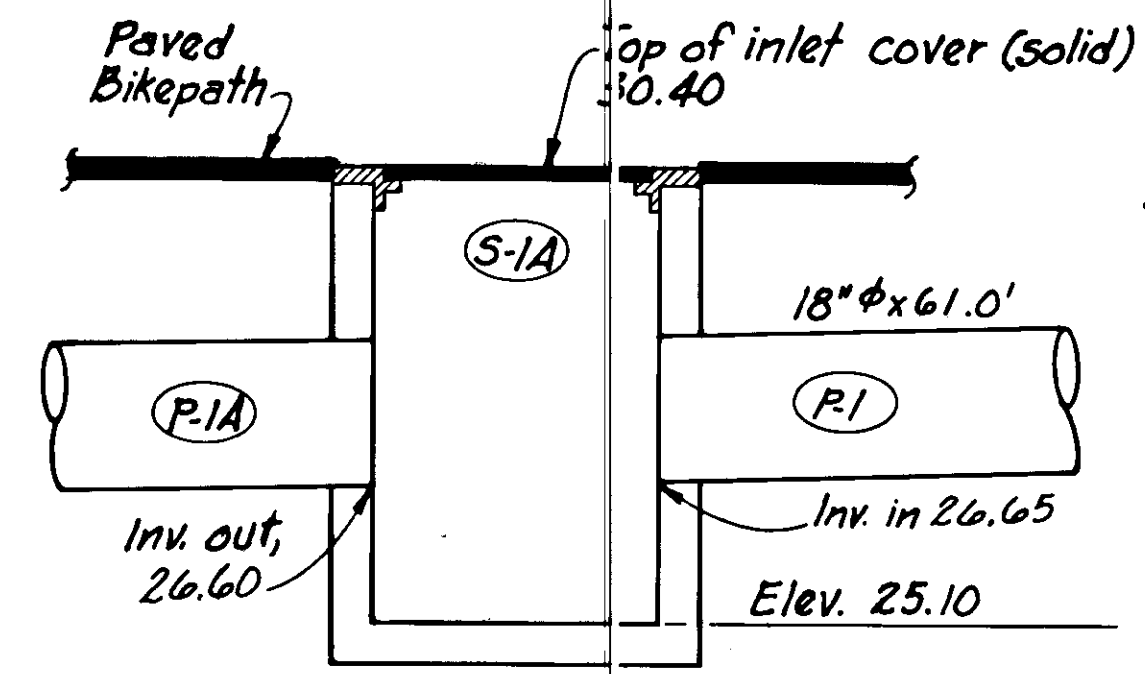

Sta. "0" 32+15, 41.0' Rt.

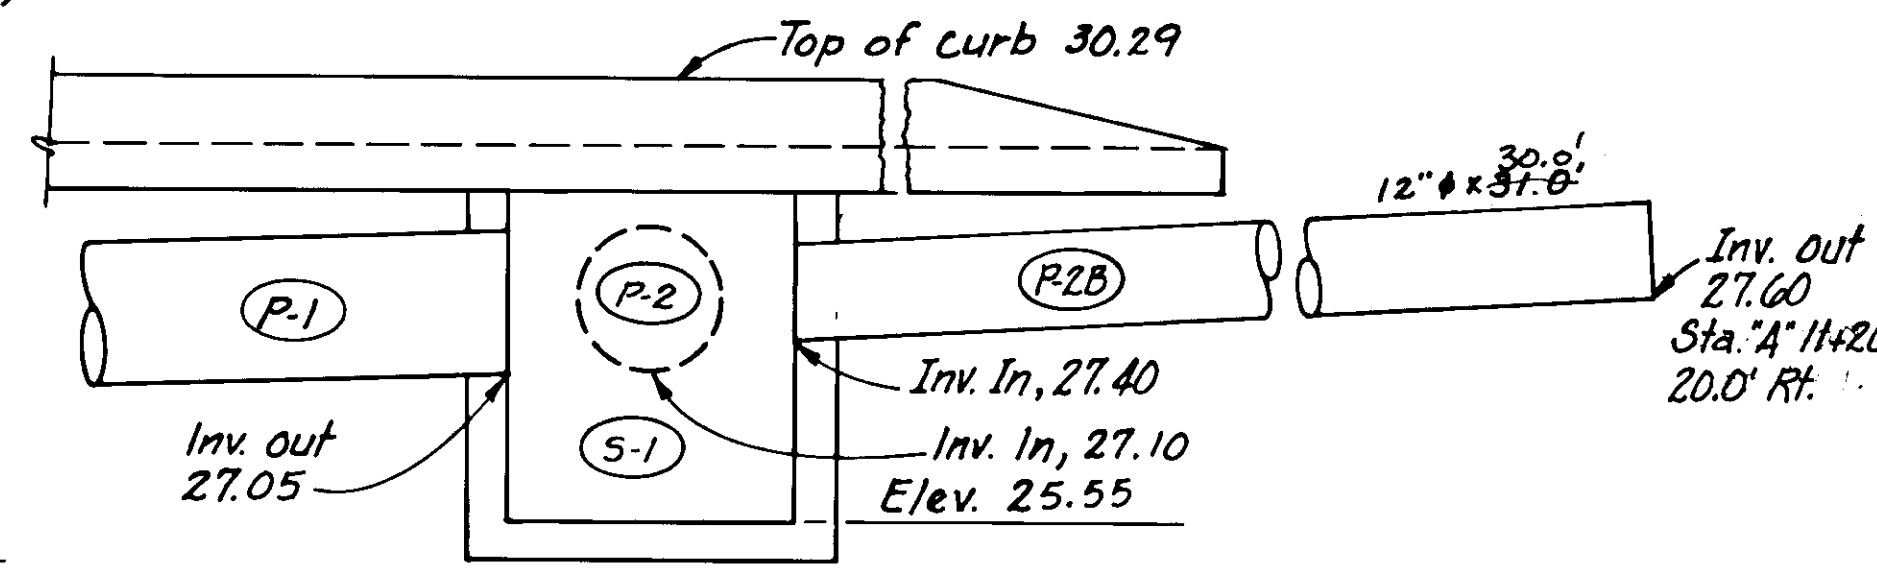

Sta. "A" 10+89, 20.0' Rt.


**INLET SUMMARY**

Structure	Type	Location	Offset		Top Curb Elev.	Invert Elev.
			Left	Right		
S-1	"A"	"A" 10+89		20.0'	30.29	25.55
S-1A	"A"	"0" 32+15		41.0'	30.40*	25.10
S-2	"A"	"A" 10+89	29.25		30.10	25.80
S-3	"A"	"0" 33+45		41.0'	31.75	27.00
S-18	"A"	"0" 29+23		31.0'	30.76	24.90
S-19	"A"	"0" 29+23		40.5'	25.90**	22.05


\* Elevation at the top of the inlet's cover.  
\*\* Elevation at the top of the inlet's grate.

**PIPE SUMMARY**

Pipe	Diameter	Length	From		To	
			Struct./Station	Elev.	Struct./Station	Elev.
P-1	18"	61.0'	S-1	27.11	S-1A	26.65
P-1A	18"	292'	S-1A	26.60	S-19	23.65
P-2	18"	48.5'	S-2	27.30	S-1	27.10
P-2A	12"	32'-0" 3/4"	"A" 11+06.5, 19.0' Lt.	27.60	S-2	27.40
P-2B	12"	31'-0" 3/8"	"A" 11+06.5, 19.0' Rt.	27.60	S-1	27.40
P-18	18"	10.0'	S-18	26.40	S-19	23.70
P-19	18"	21.0'	S-19	23.55	"0" 29+12, 58.5' Rt.	23.31
P-3	18"	130.0'	S-3	28.50	S-1A	26.65
P-2C	12"	74.8'	"A" 11+20 RT		"A" 11+94 RT	

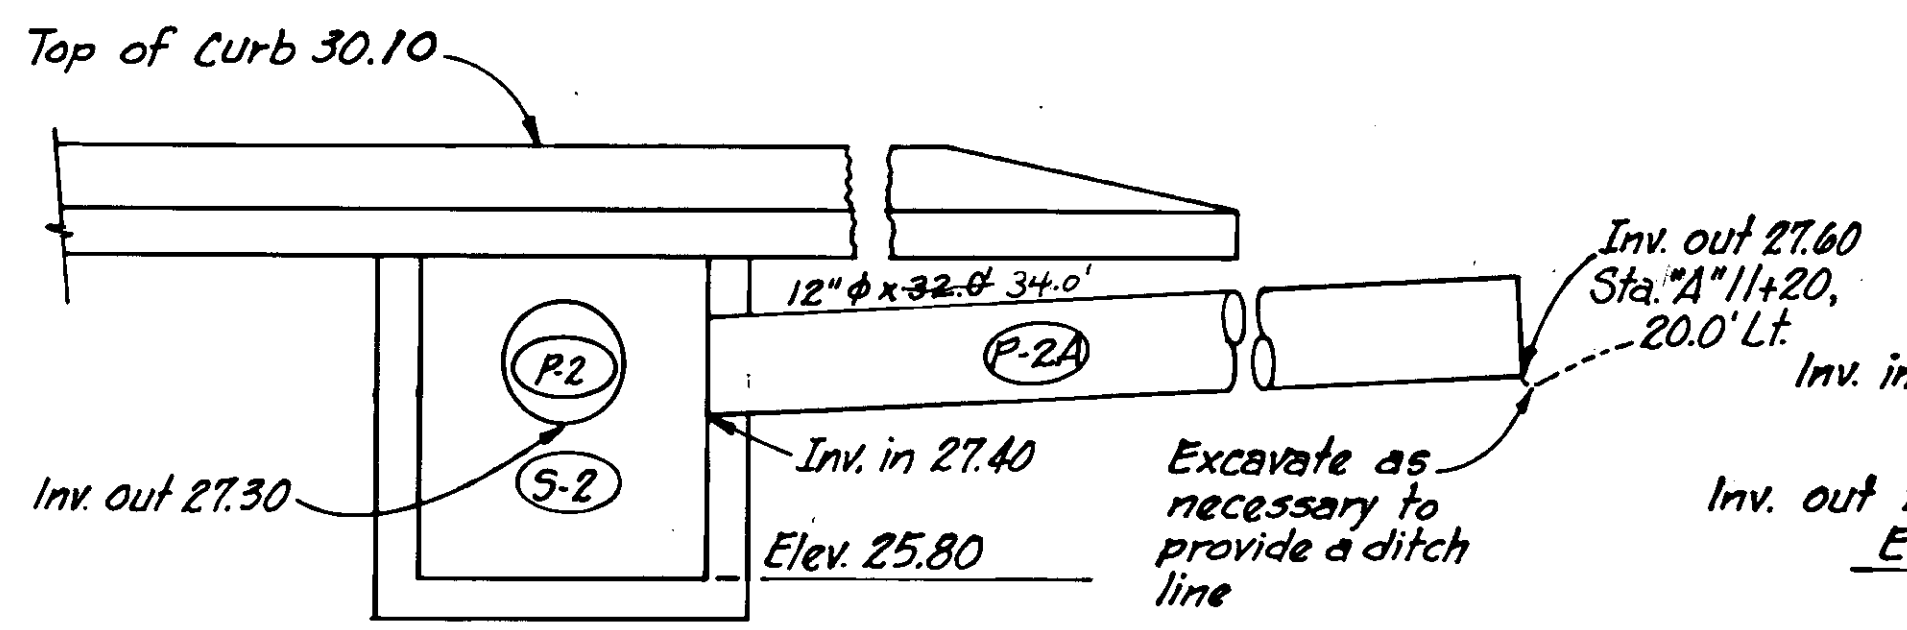

Sta. "A" 10+89, 29.25 Lt.

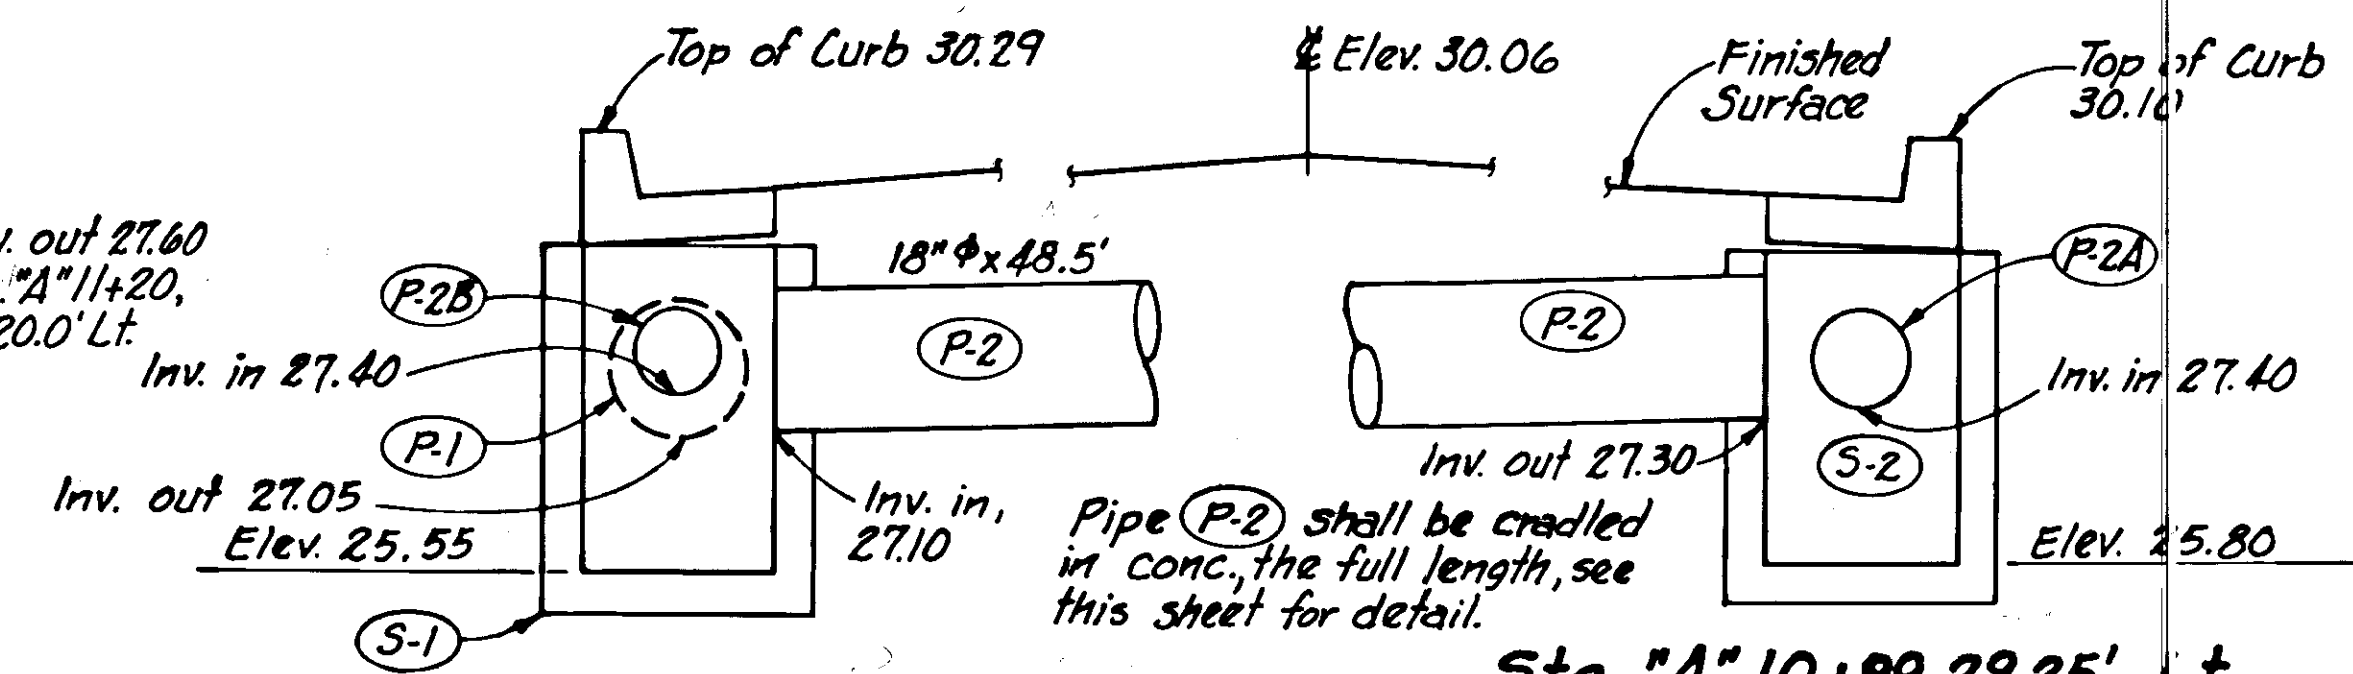


Sta. "A" 10+89, 20.0' Rt.

Sta. "A" 10+89, 29.25' Lt.

Excavate as necessary to provide a ditch line

Pipe P-2 shall be cradled in conc. the full length, see this sheet for detail.

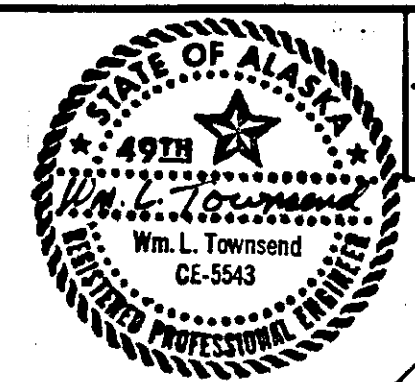

STATE	PROJECT DESIGNATION	YEAR	SHEET NO.	TOTAL SHEETS
ALASKA	HES-M-966 (14)	'88	14	28


### INLET SUMMARY

STRUCT.	TYPE	LOCATION	OFFSET		TOP OF CURB ELEV.	INVERT ELEV.
			LEFT	RIGHT		
S-5	"A"	"0" 36+50		31.0'	32.59	27.30
S-6	"A"	"0" 38+00		31.0'	32.66	26.68
S-7	"A"	"0" 39+00		31.0'	32.81	26.50
S-8	"A"	"0" 41+69	27.0'		33.06	27.68
S-21	"A"	"0" 35+25		31.0'	32.73	27.00


### PIPE SUMMARY

PIPE	DIA.	LENGTH	FROM		TO	
			STRUCT./STA.	INV. EL.	STRUCT./STA.	INV. EL.
P-5	18"	31.5'	S-5	28.80	0"36+50,62.0' Rt.	25.50
P-6	18"	85.0' 36'	S-6	28.18	0"38+80, 59' Rt.	25.00
P-7	18"	29.0' 24'	S-7	28.00	0"39+00,59.5' Rt.	26.50
P-8	18"	41.0' 12'	0"41+69,37.5' Lt.	29.40	S-8	29.30
P-21	18"	70.5' 72'	S-21	28.50	0"35+85,67.0' Rt.	25.80


- GENERAL DRAINAGE NOTES :**
- Curb inlet offsets are shown to face of curb.
  - Standard curb inlet grates shall conform to design pattern G3R or G3L as shown on the Standard Drawing D-23.00.
  - Curb inlet locations may be field adjusted if required as approved by the Engineer.
  - See sheet 18 for listing of inlets with Petroleum separator.
  - All pipes except the slotted drain pipes shall be a minimum thickness of 0.064" for the galvanized steel and 0.060 for the aluminum pipe.
  - Pipe lengths and inverts can be adjusted to better fit field conditions as approved by the Engineer.
  - All pipe shall be aluminum except as noted.

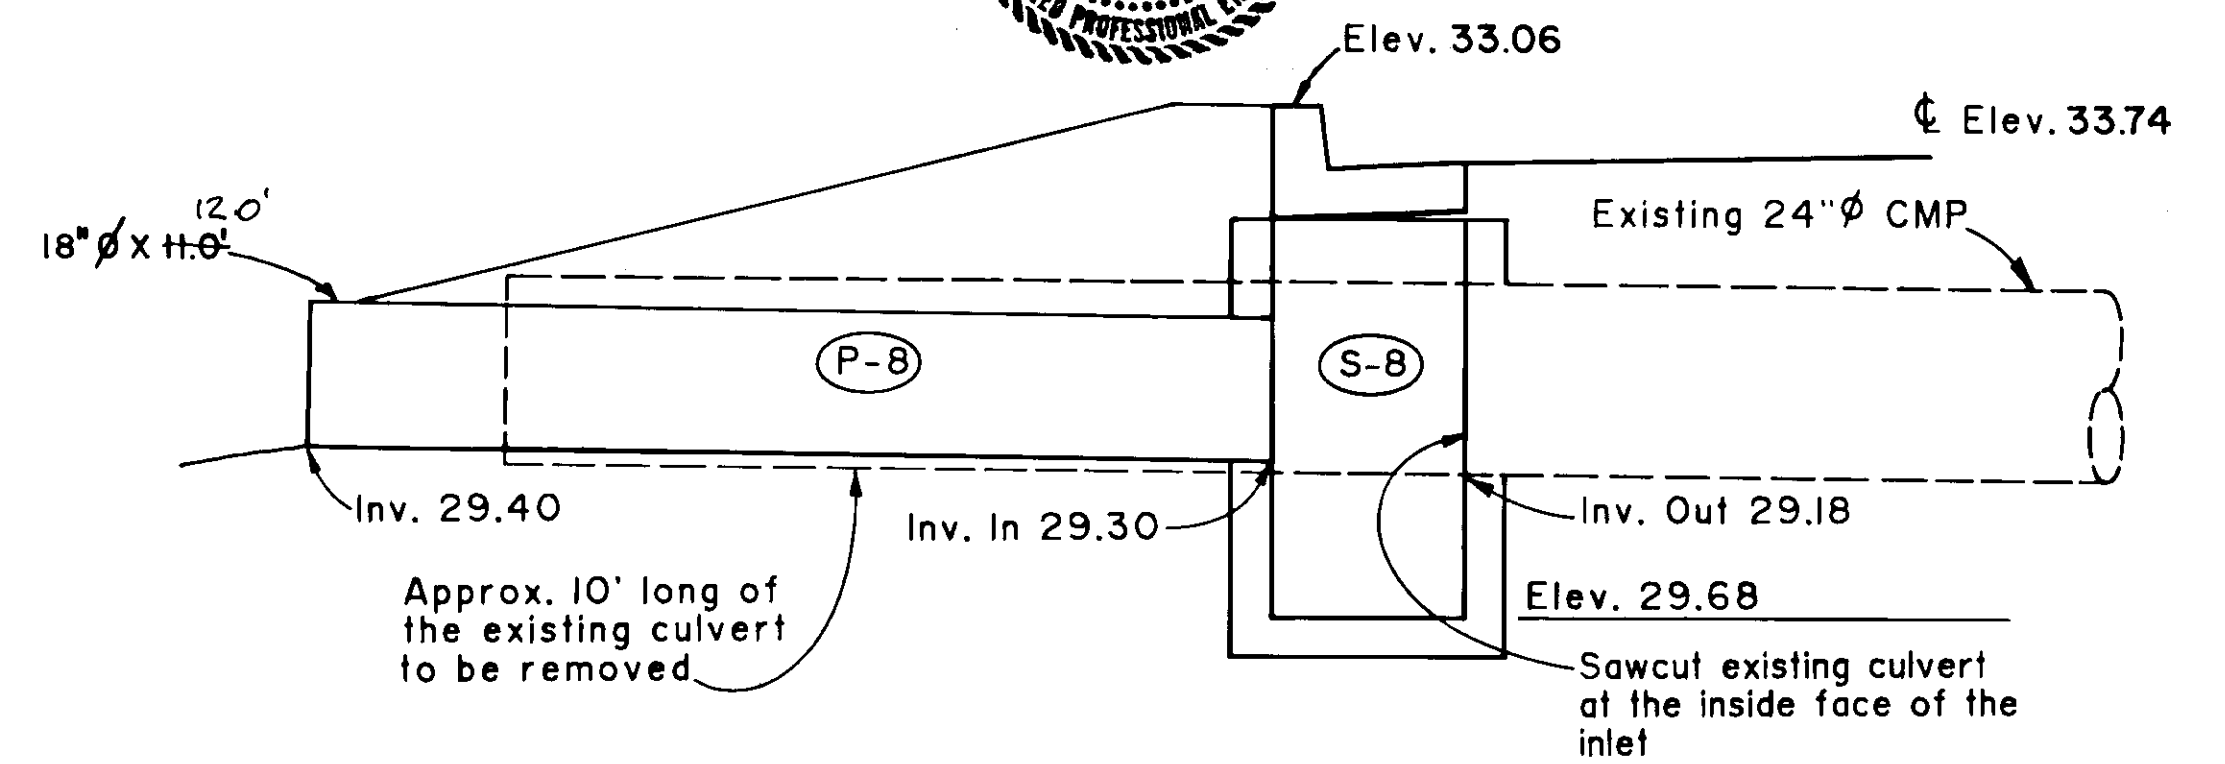


**STA. "A" 41+69, 27' Lt.**

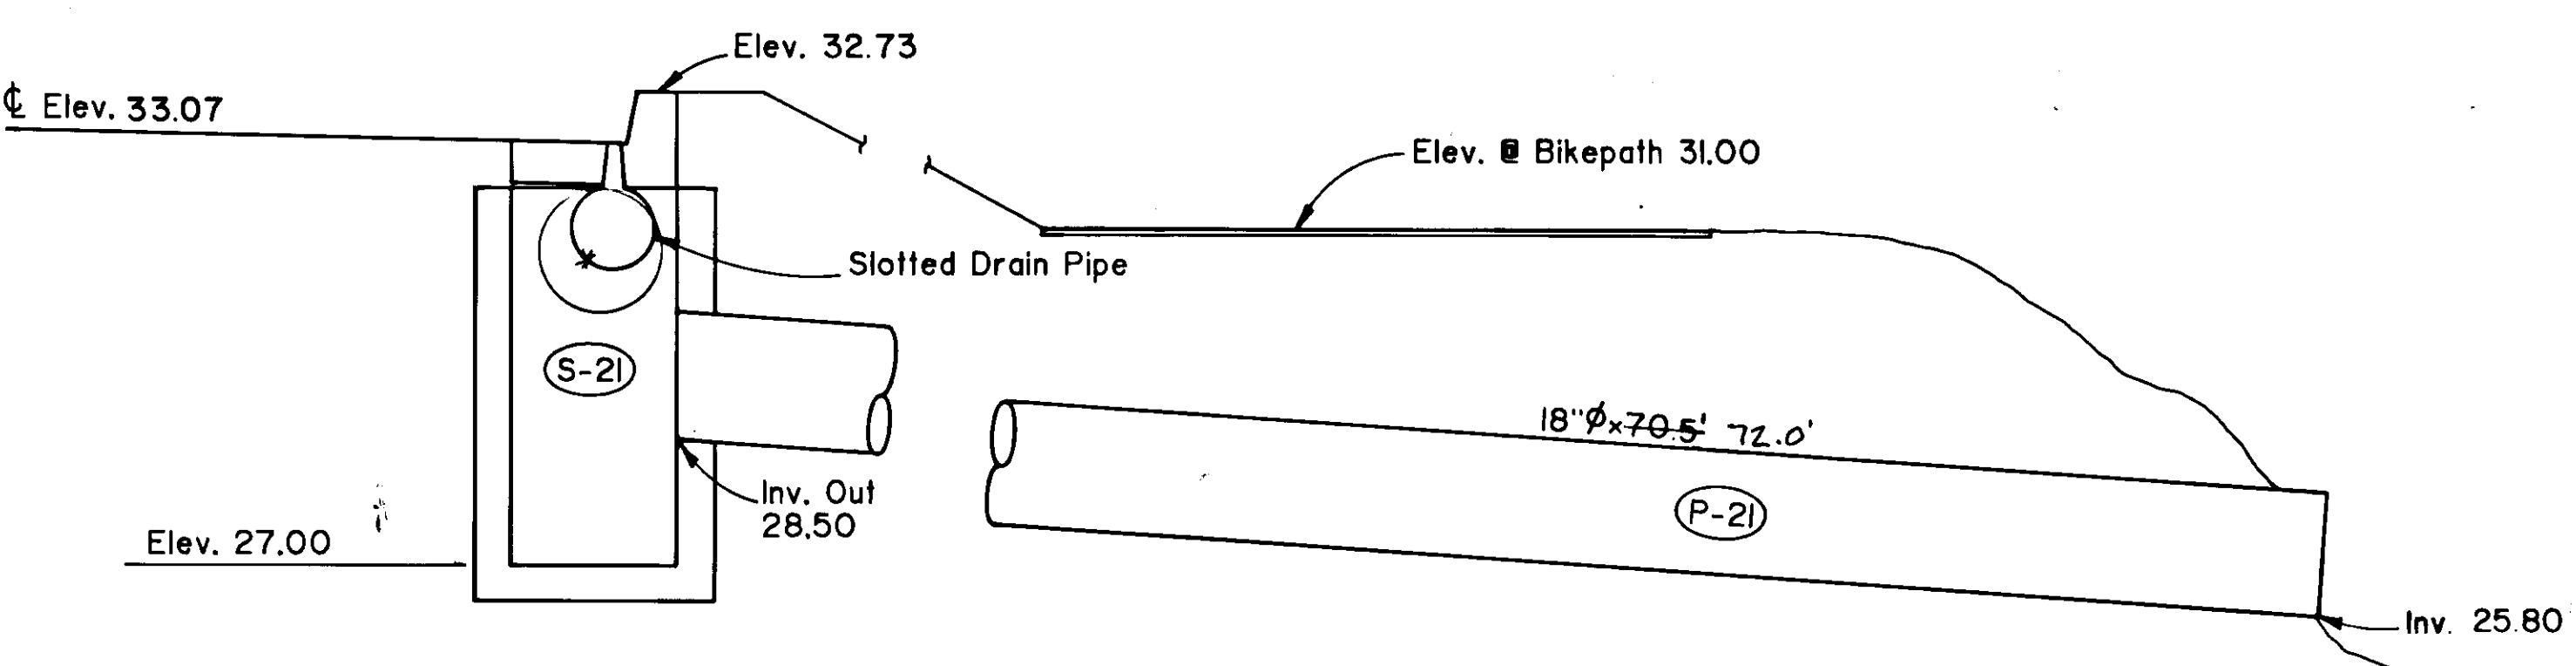


**STA. "A" 35+25, 31' Rt.**

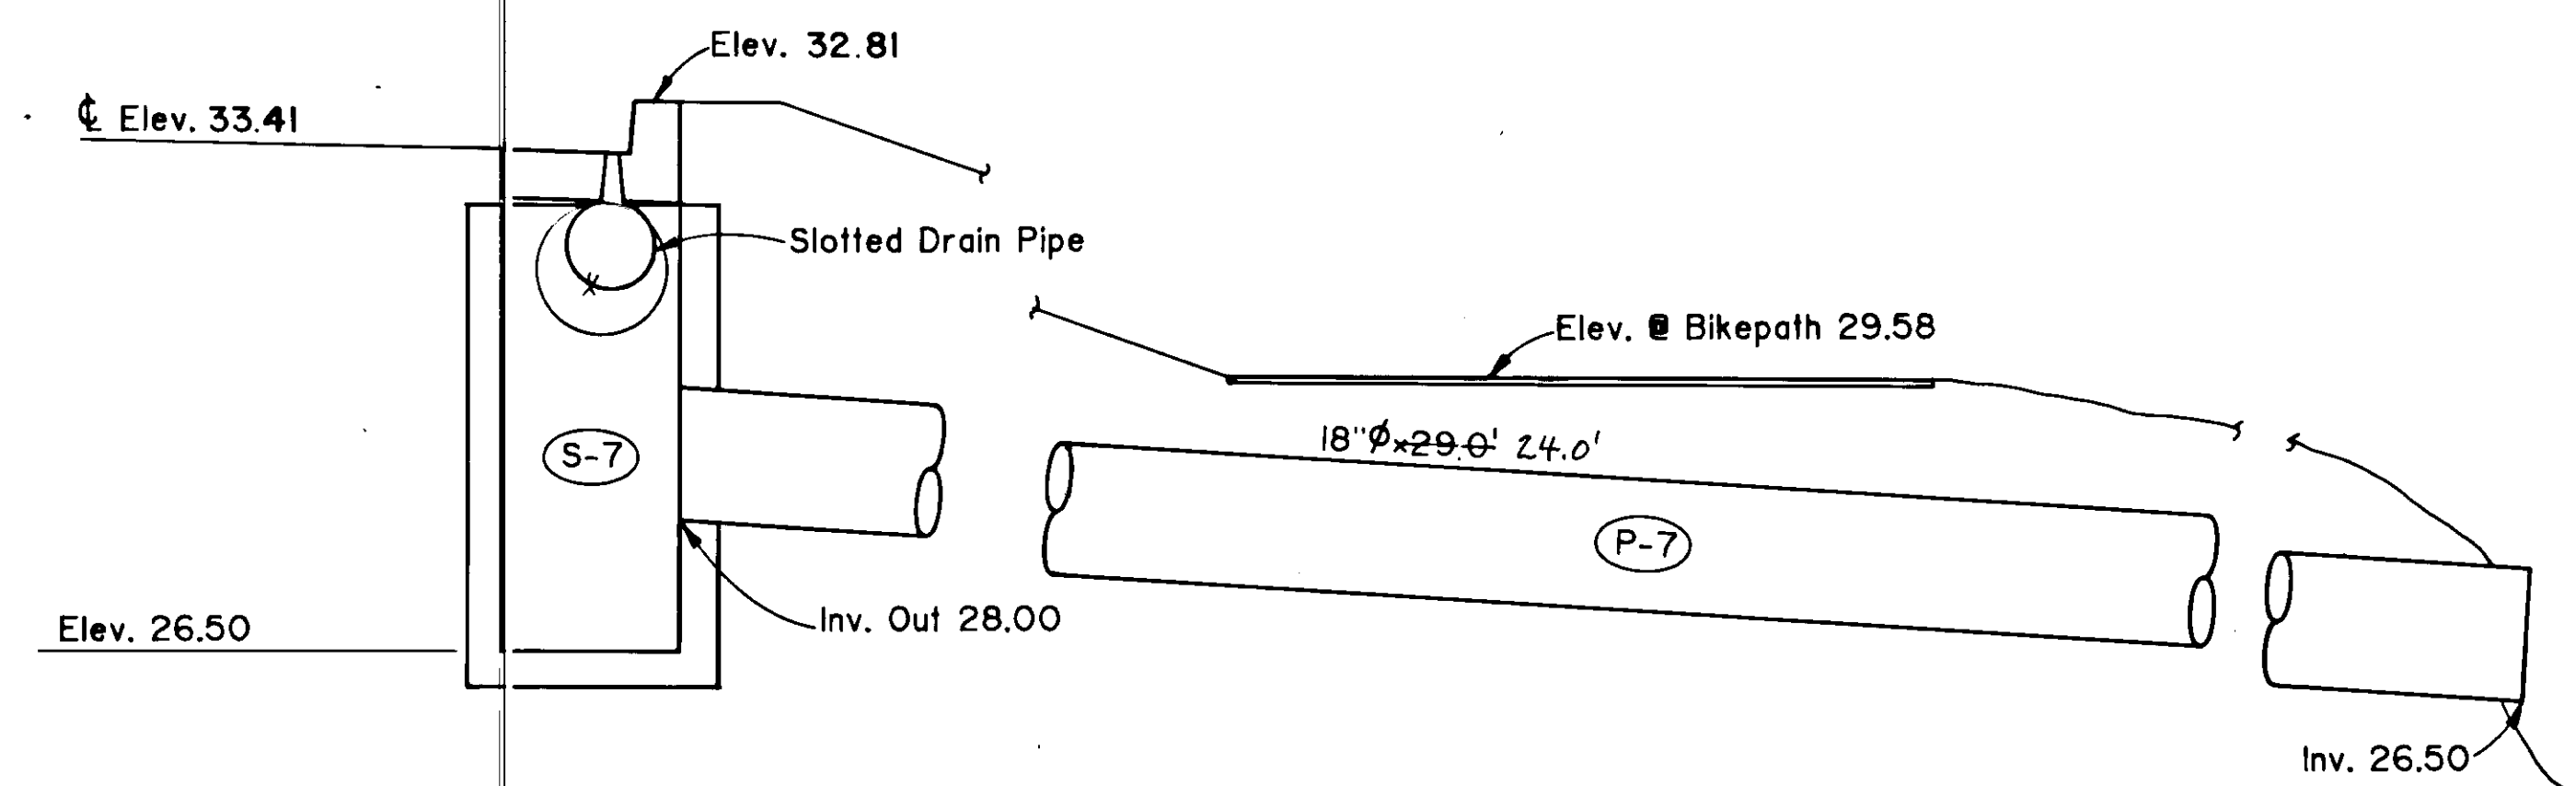

**STA. "A" 39+00, 31' Rt.**

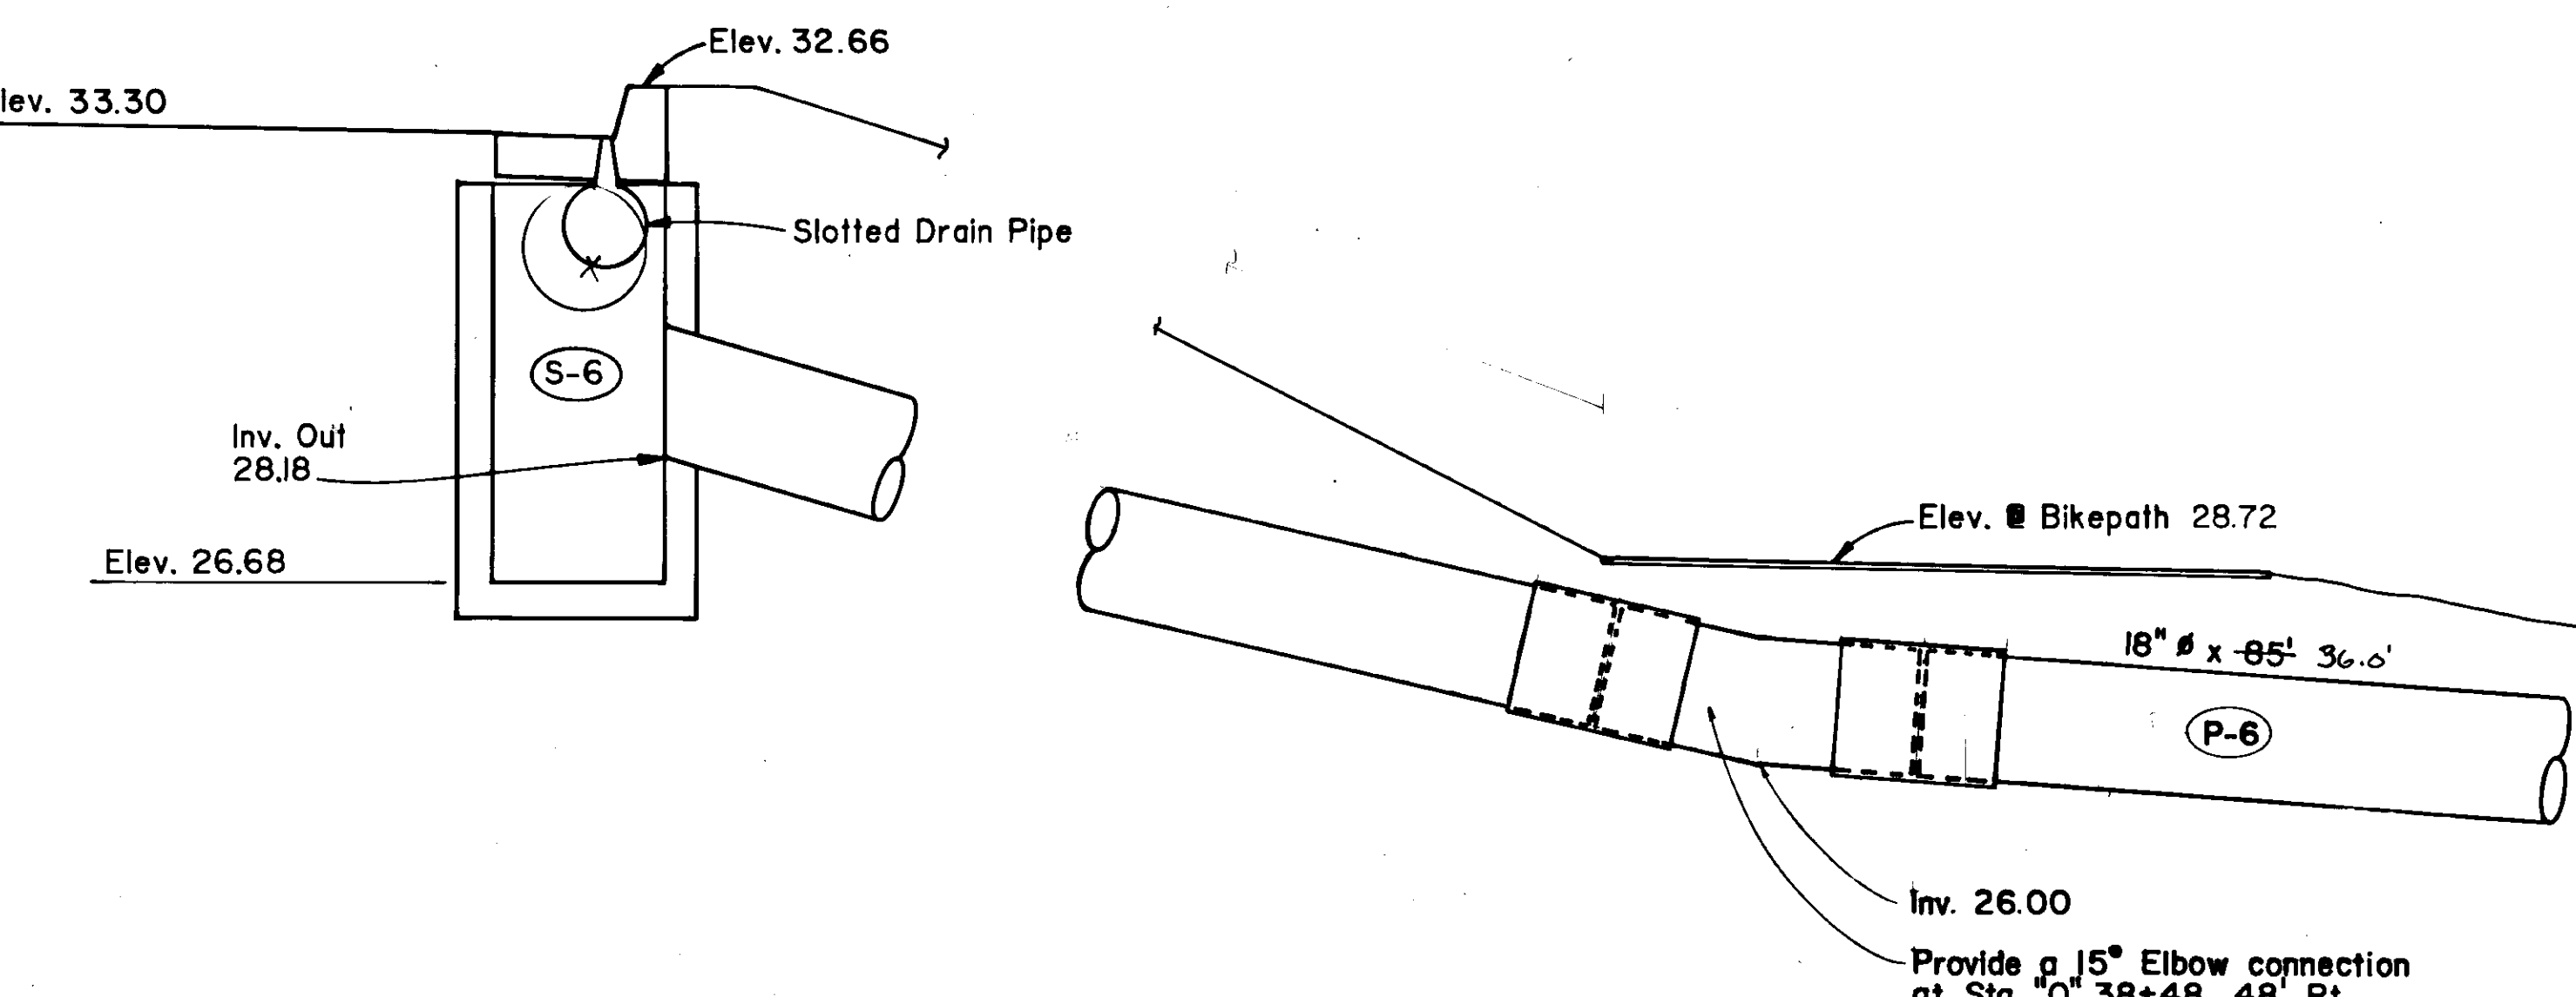


**STA. "A" 38+00, 31' Rt.**

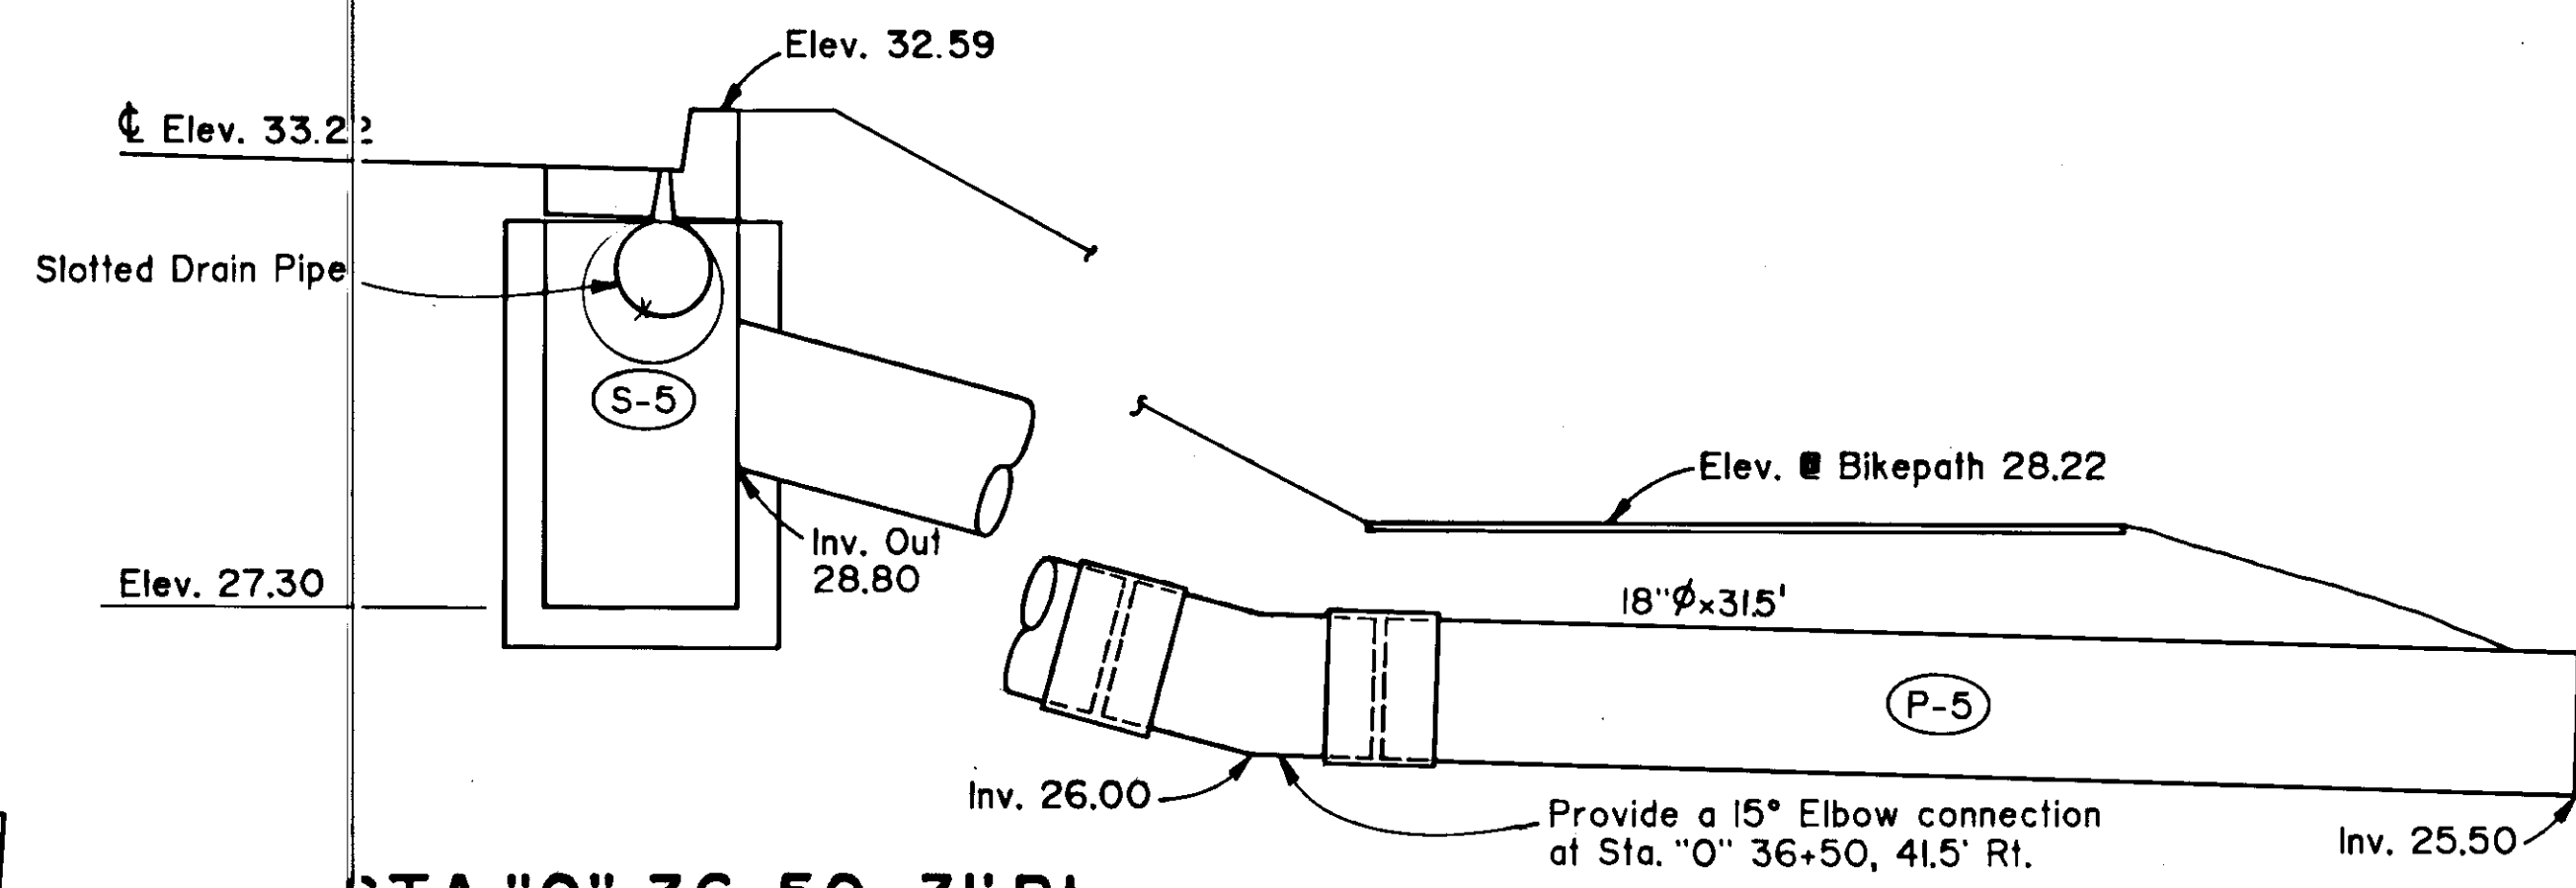

**STA. "0" 36+50, 31' Rt.**

**STA. "A" 38+80, 59' Rt.**

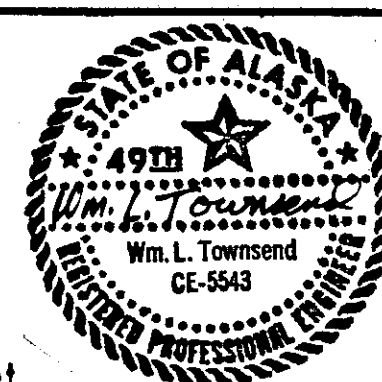

STATE	PROJECT DESIGNATION	YEAR	SHEET NO.	TOTAL SHEETS
ALASKA	HES-M-966(14)	'88	15	28









### Inlet Summary

Structure	Type	Location	Offset		Top Curb Elev.	Invert Elev.
			Left	Right		
S-9	"A"	"0" 45+00	27.0'		33.80	29.10
S-10	45° Elbow *	"0" 45+02	28.5'			30.50
S-11	45° Lateral *	"0" 46+59	35.5'			29.23
S-12	"A" **	"0" 47+73	32.0'		33.60	26.75
S-13	"A"	"0" 46+50	27.0'		34.20	29.30
S-14	"A"	"0" 48+00	27.0'		34.36	29.50
S-15	"A"	"0" 49+70	37.0'		34.49	29.50
S-16	"A"	"0" 50+10		37.0'	35.22	30.24

### Pipe Summary

Pipe	Diameter	Length	From		To	
			Struct./Station	Elev.	Struct./Station	Elev.
P-9	18"	3.0' 5"	S-9	30.60	S-10	30.50
P-10	18"	152.0' 13"	S-10	30.50	S-11	29.23
P-11	18"	13.0' 13 1/2"	S-11	29.23	S-12	28.30
P-12	18"	140.0' 11 1/4"	S-12	28.25	"0" 49+10, 68' Lt.	27.10
P-13	18"	13.0' 10"	S-13	30.80	S-11	29.23
P-14	18"	27.0' 5 1/2"	S-14	31.00	S-12	28.30
P-15	18"	25.0' 2 1/4"	S-15	31.00	"0" 49+70, 61' Lt.	30.50
P-16	18"	22.0' 16"	S-16	31.74	"0" 50+10, 59' Rt.	31.30

\* See sheet #17 for details.  
 \*\* Inlet Type "A" with frame and cover.

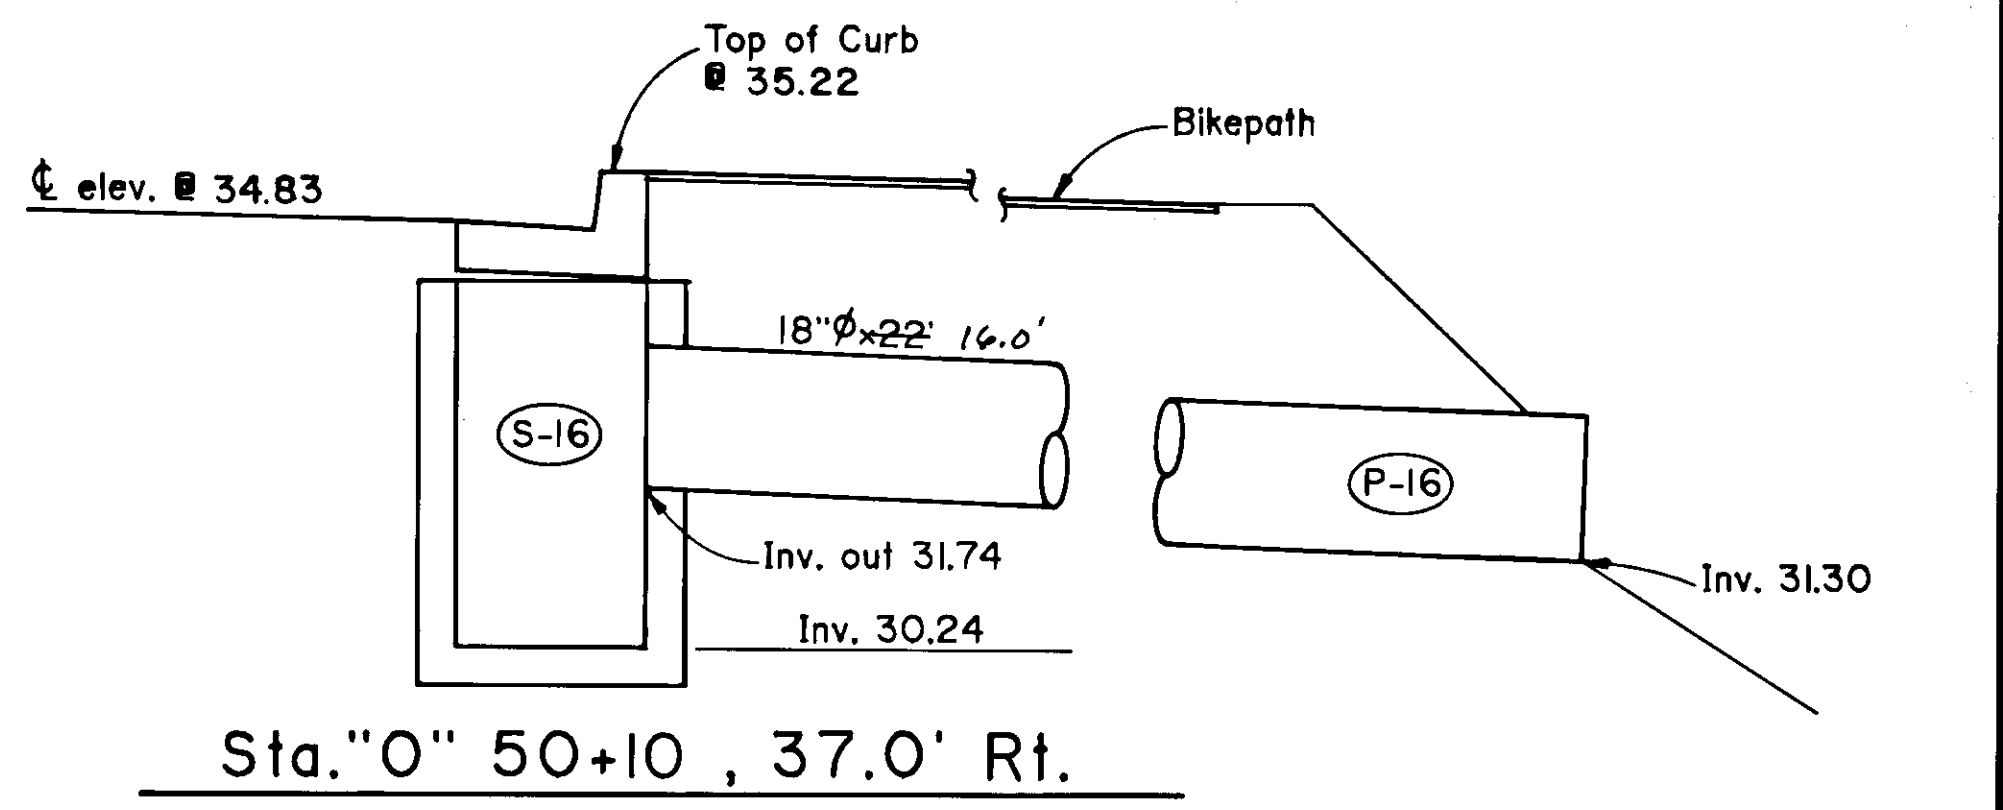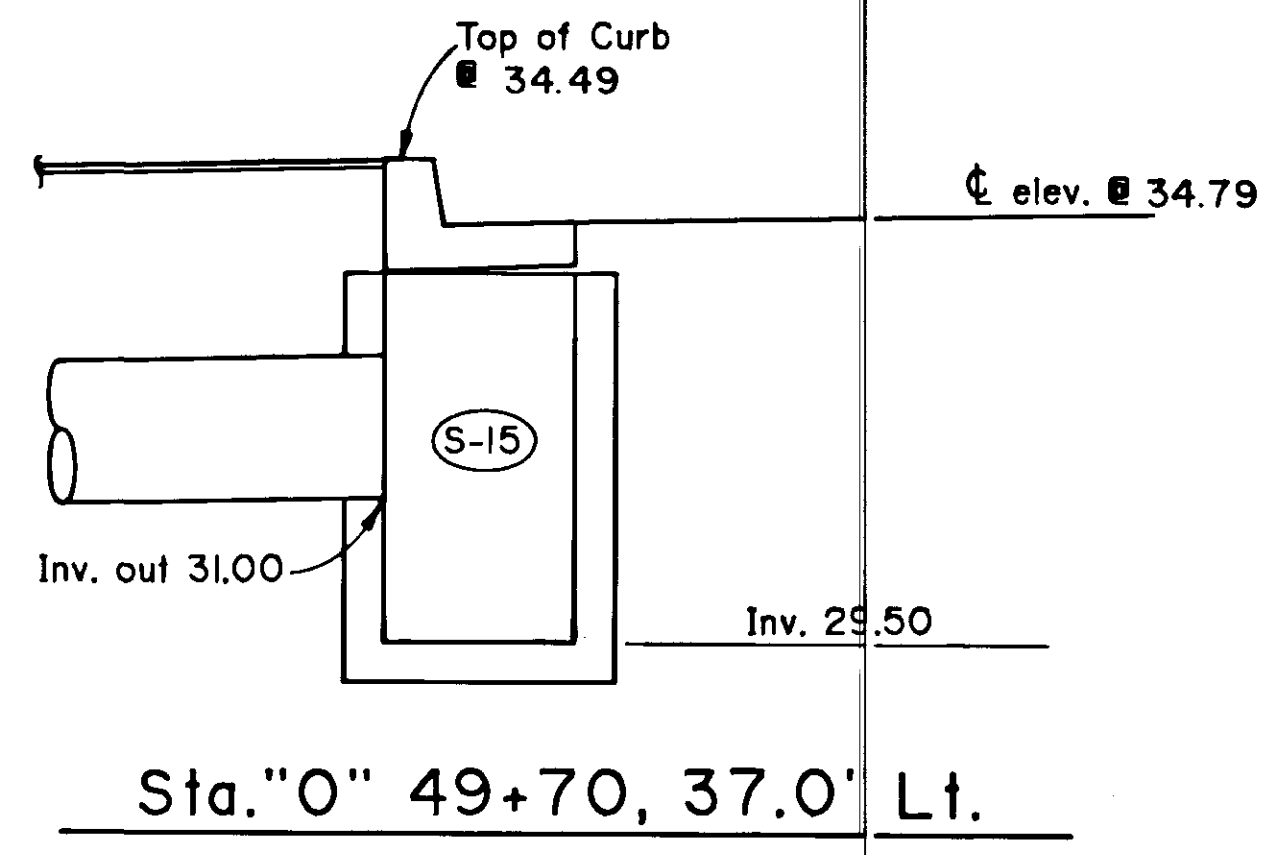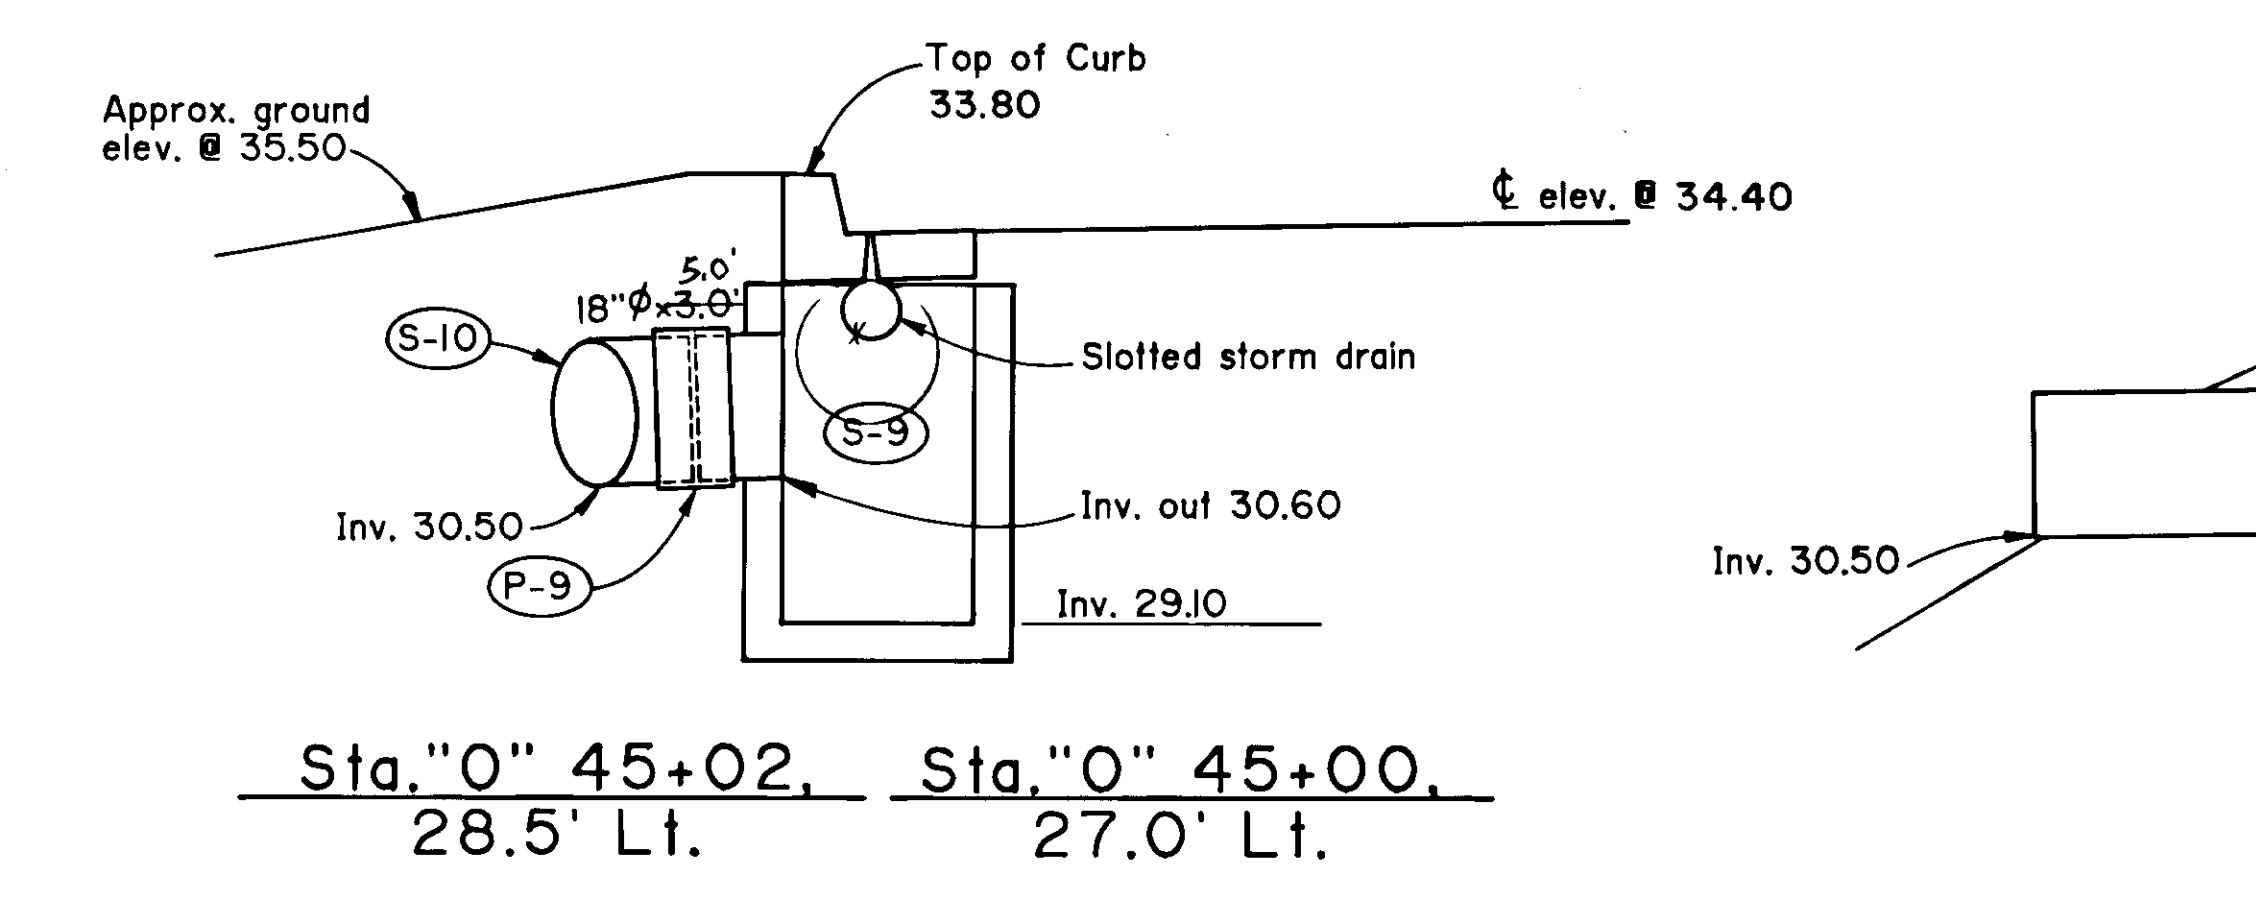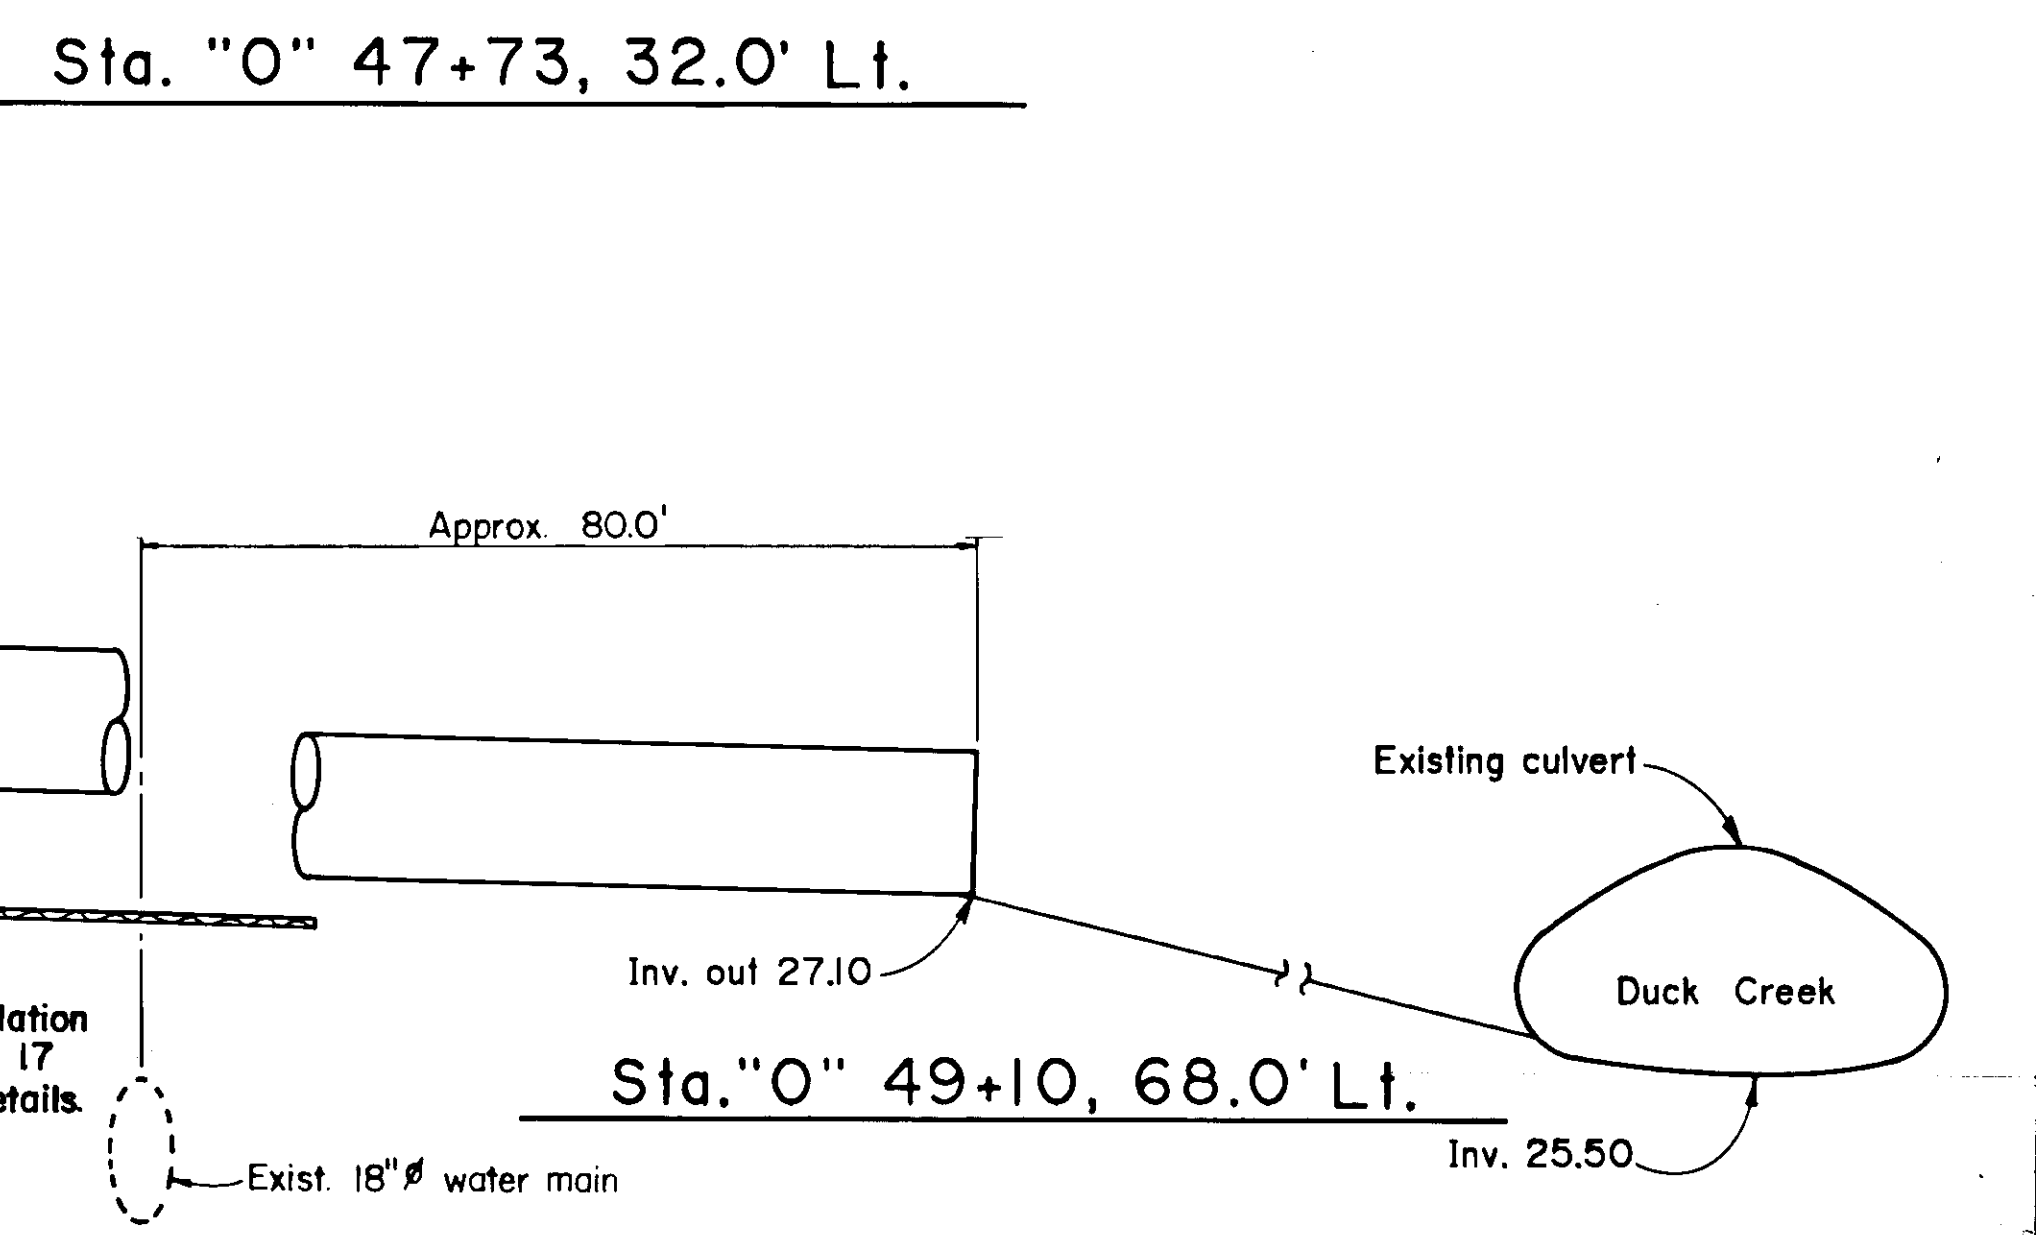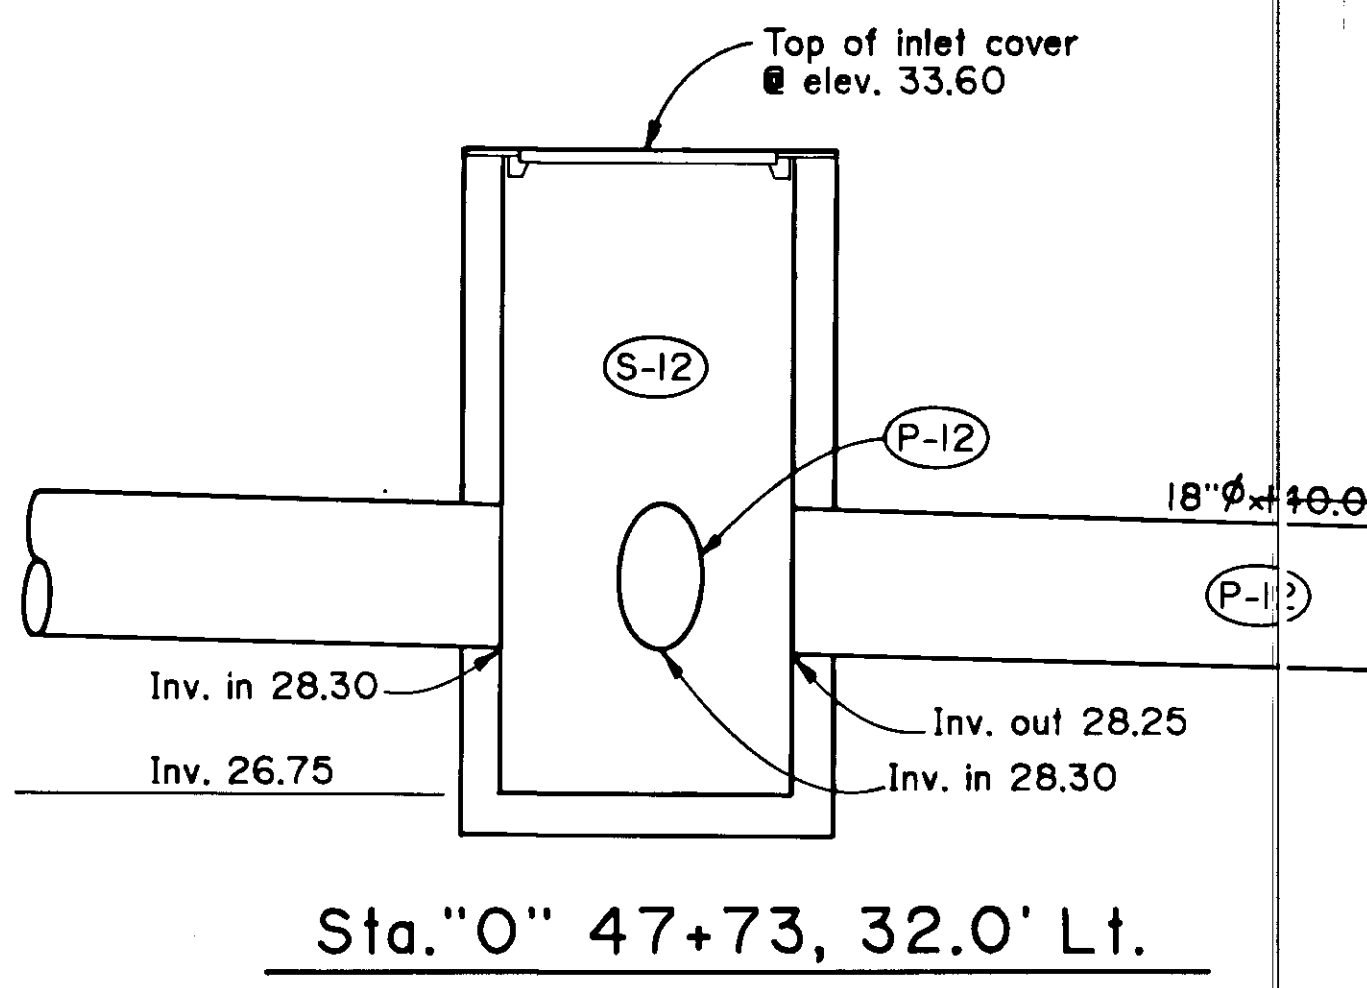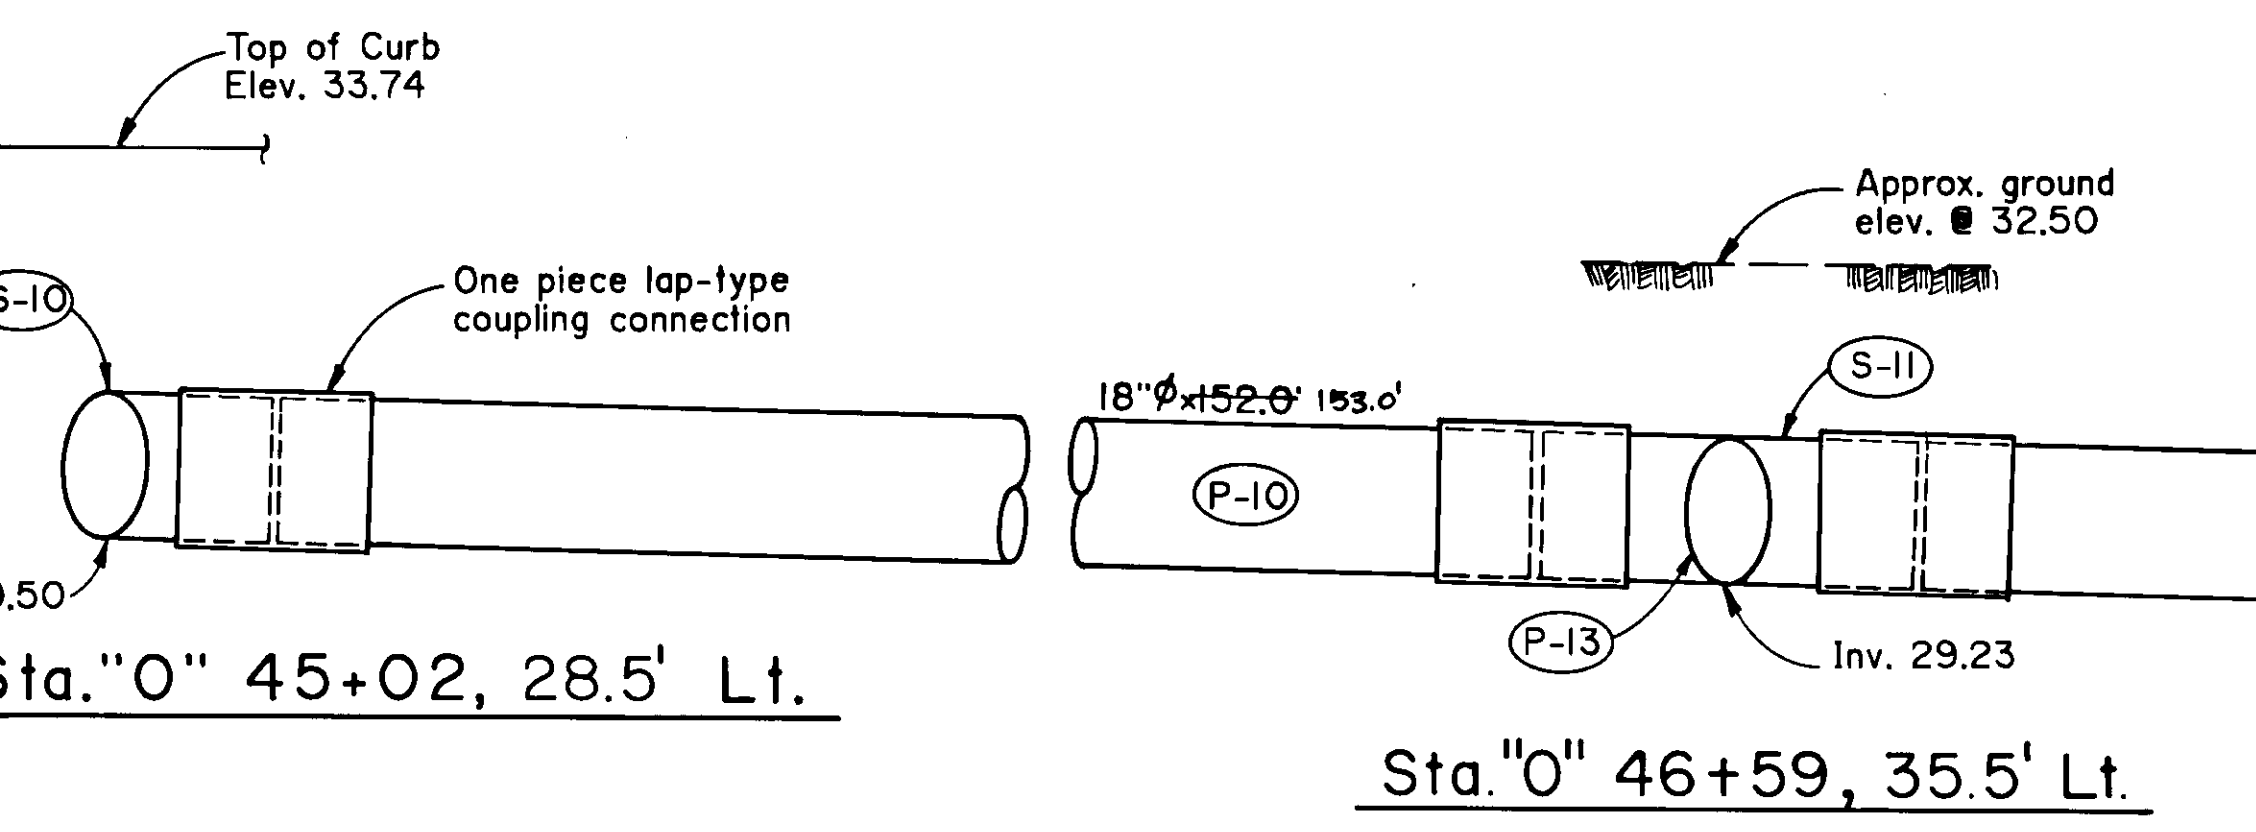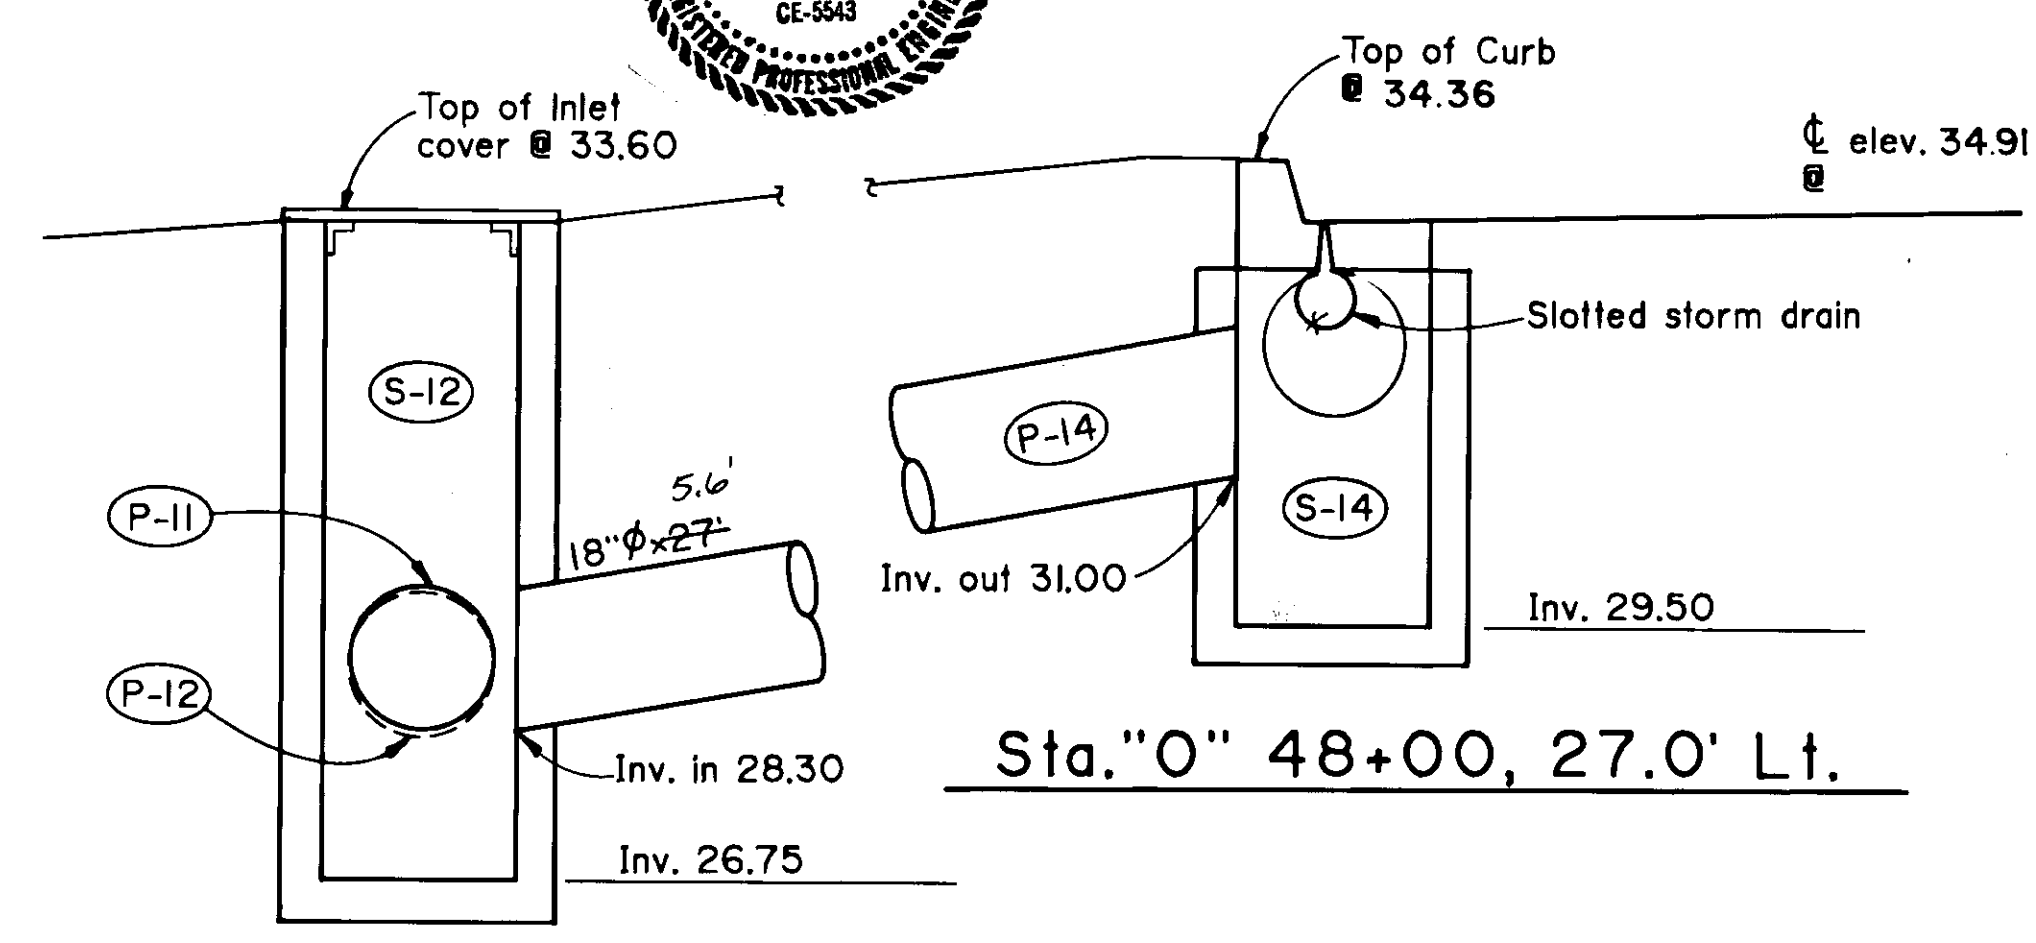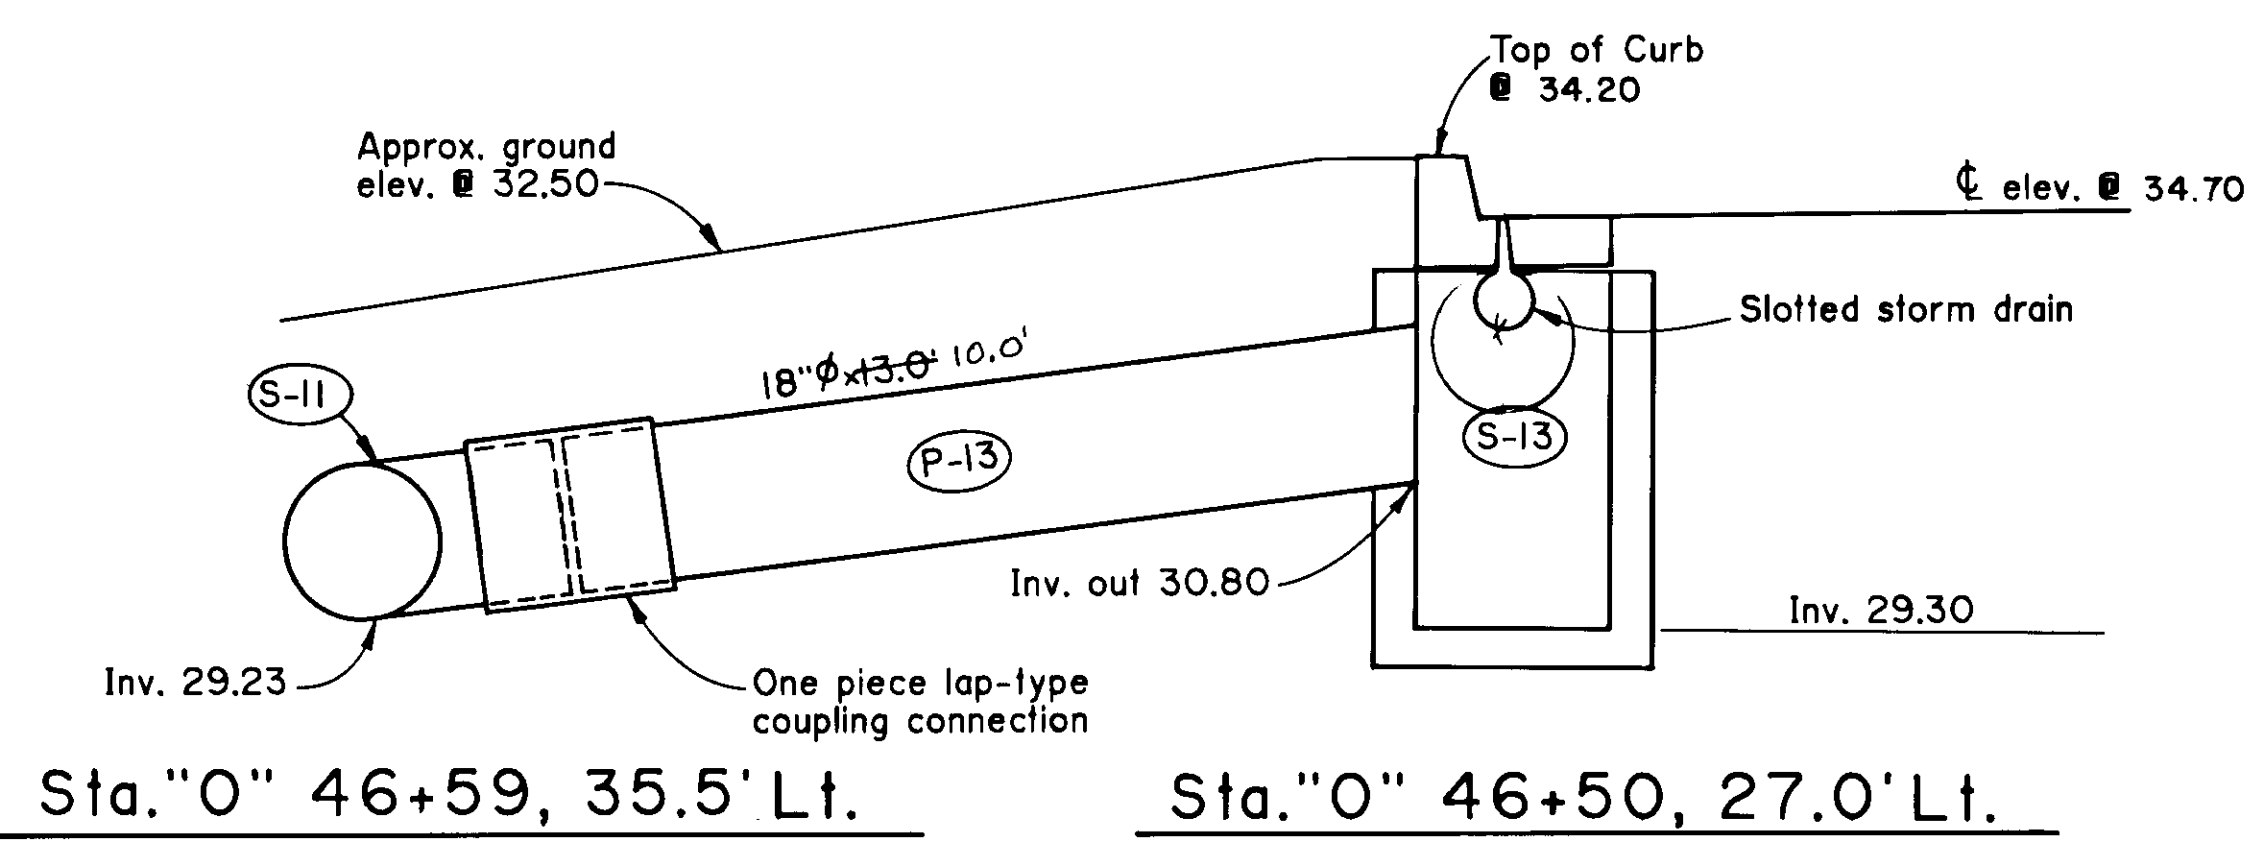

\* See sheet #17 for details.  
 \*\* Inlet Type "A" with frame and cover.



### INLET SUMMARY

Struct.	Type	Location	Offset		Top Curb Elev.	Invert Elev.
			Left	Right		
S-20	"A"	"0" 26+32.83		26.0'	29.78	24.43
S-25	15° Elbow	"0" 51+18	40.1'		-	30.34
S-17	"A"	"0" 29+50	31'		30.87	25.87




### PIPE SUMMARY

Pipe	Diameter	Length	From		To	
			Struct./Station	Elev.	Struct./Station	Elev.
P-17	18"	10'	S-17	27.39	29+50, 40' Lt.	27.19
P-23	18"	30'	"0" 26+81.50' Rt.	26.00	"0" 26+59.72' Rt.	25.50
P-24	18"	20'	"0" 37+68.5, 56.5' Rt.	28.96	"0" 37+68.5, 59' Rt.	28.68
P-25	12"	20' 22	"0" 51+38, 40.1' Lt.	30.50	25	30.34
P-25A	12"	12'	"0" 50+70 LT			


NOT NEEDED

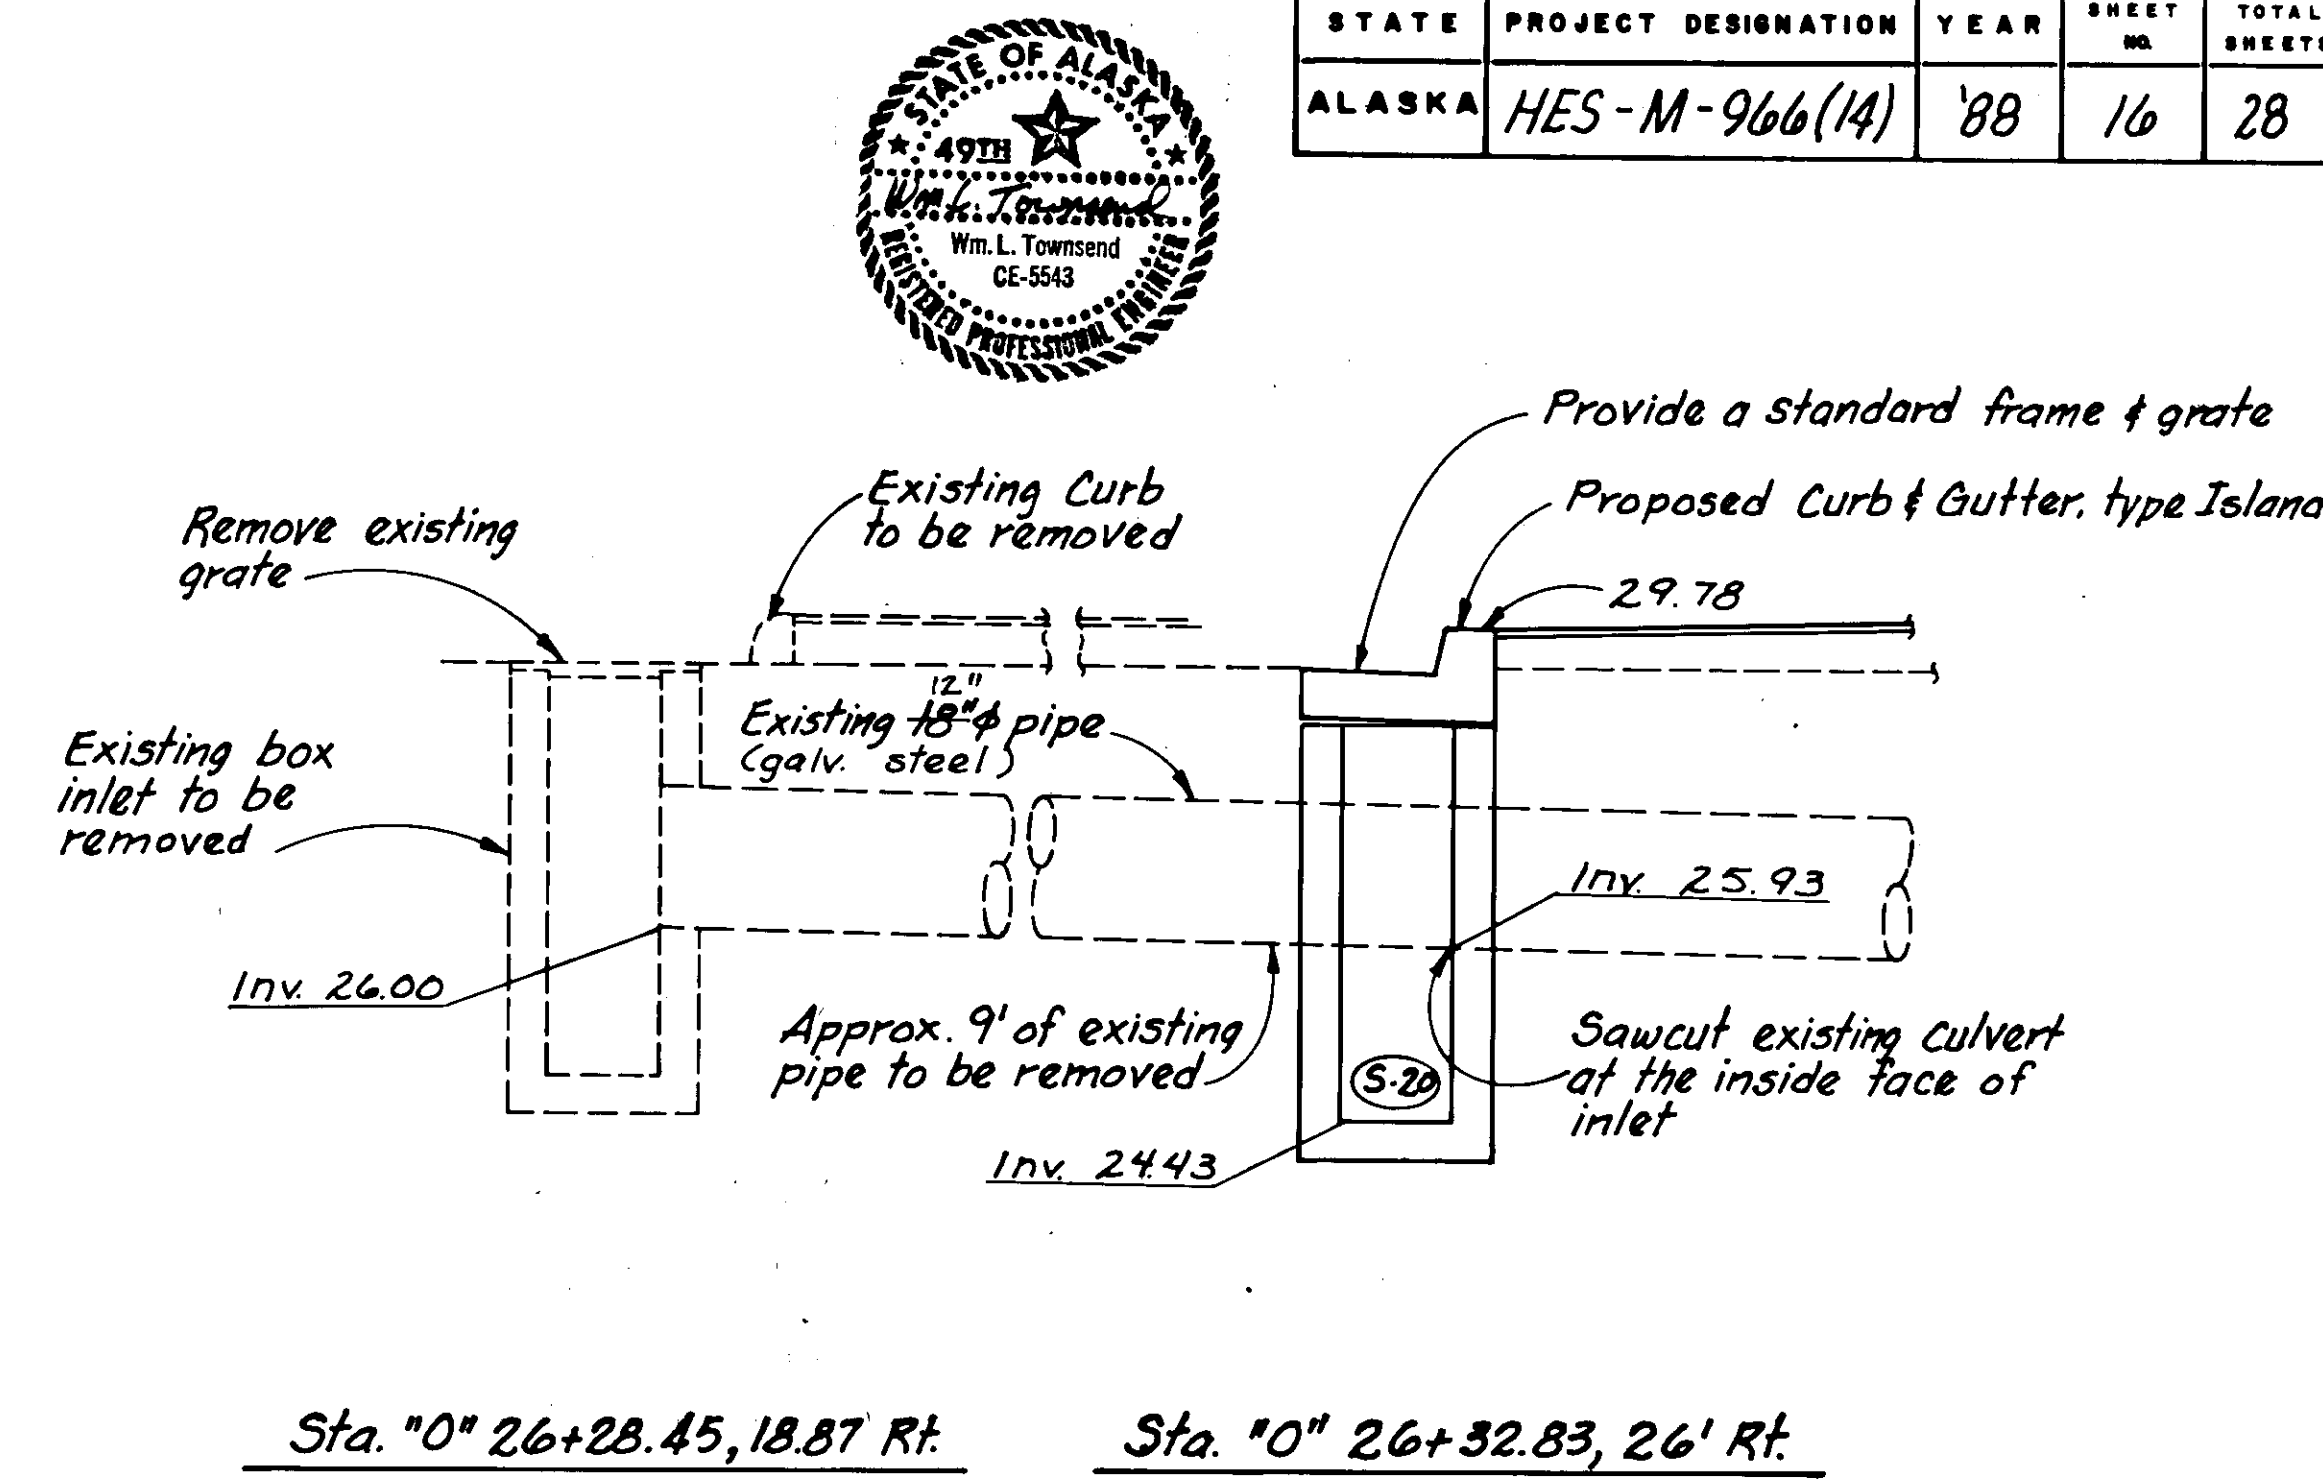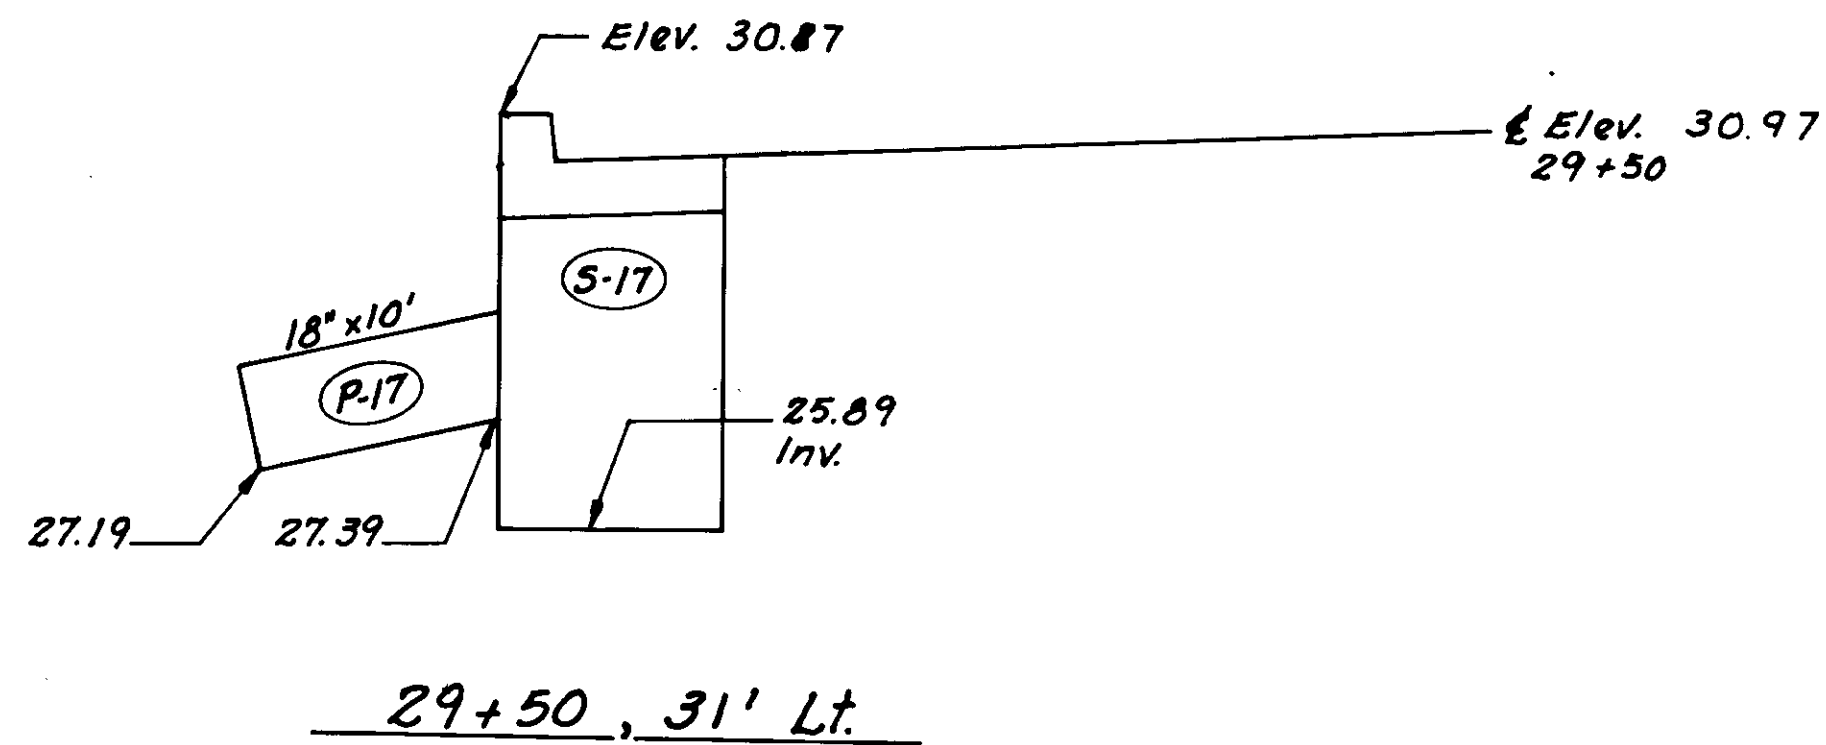

STATE	PROJECT DESIGNATION	YEAR	SHEET NO.	TOTAL SHEETS
ALASKA	HES-M-966(14)	'88	16	28

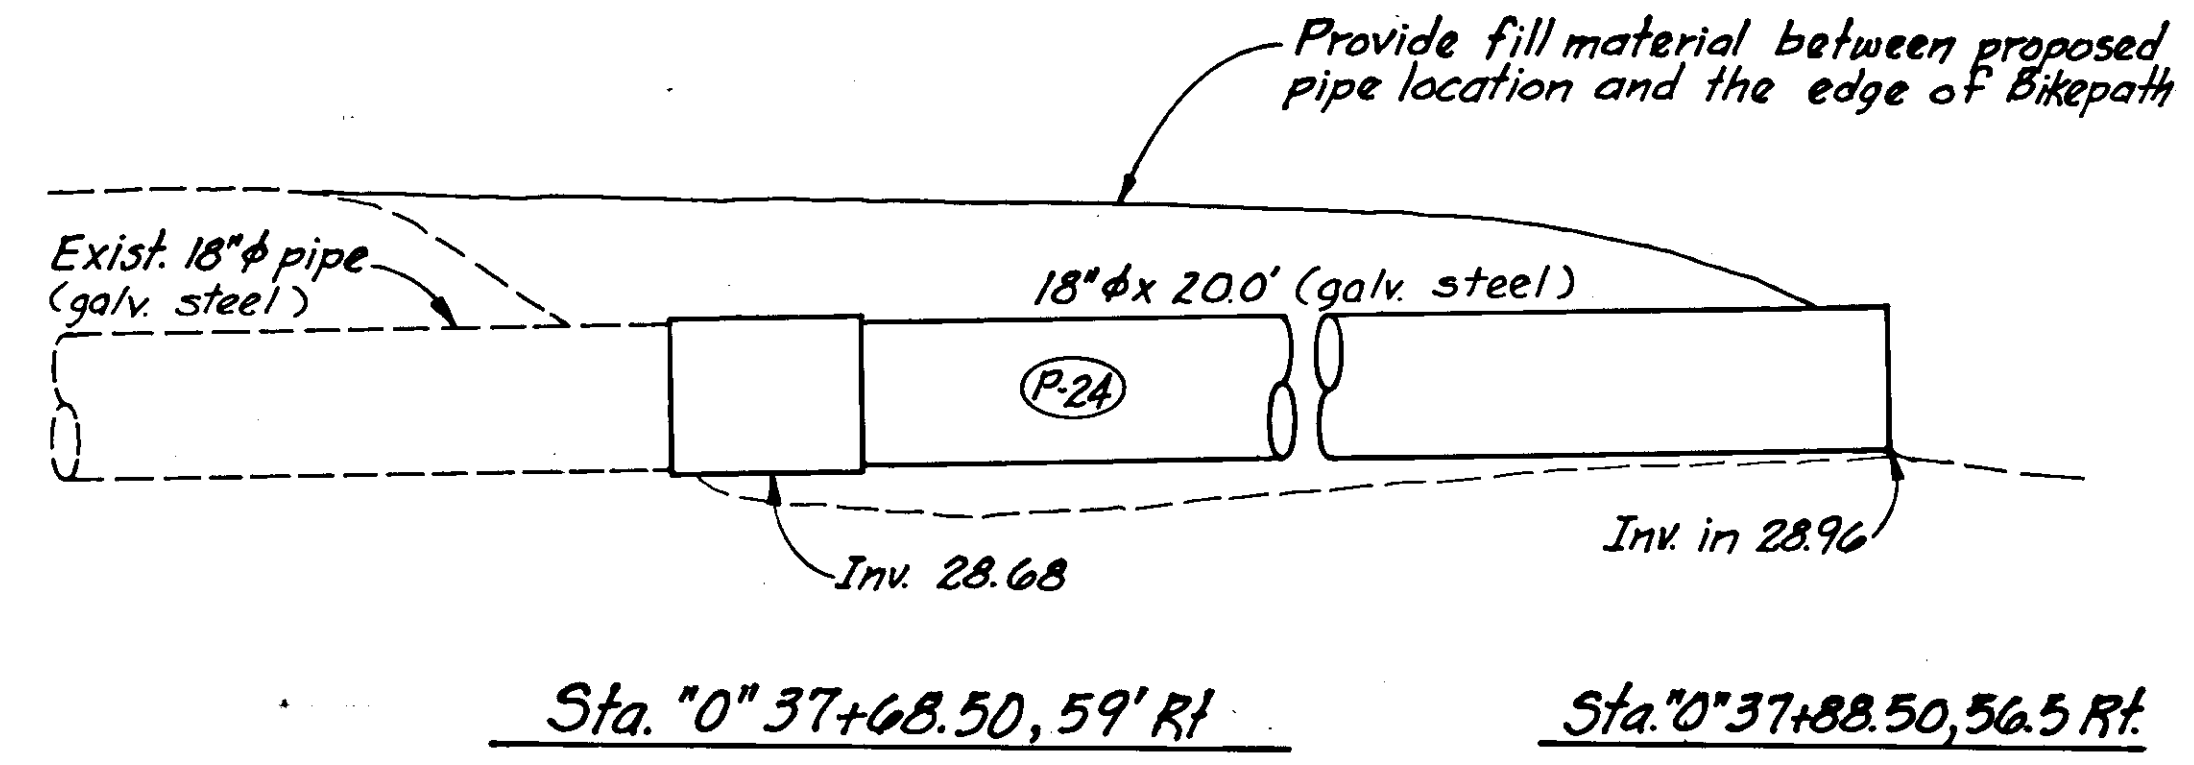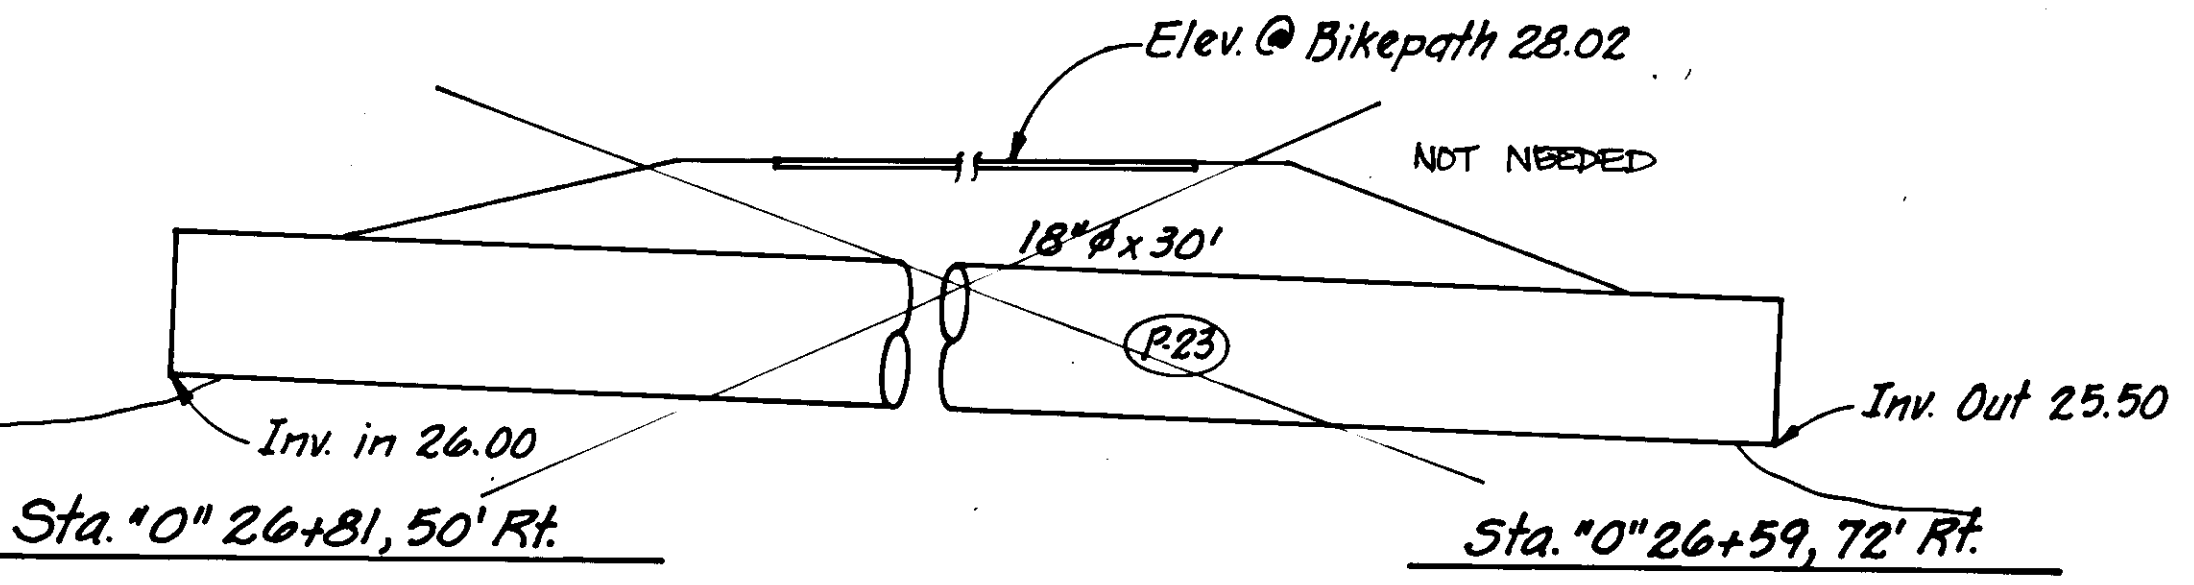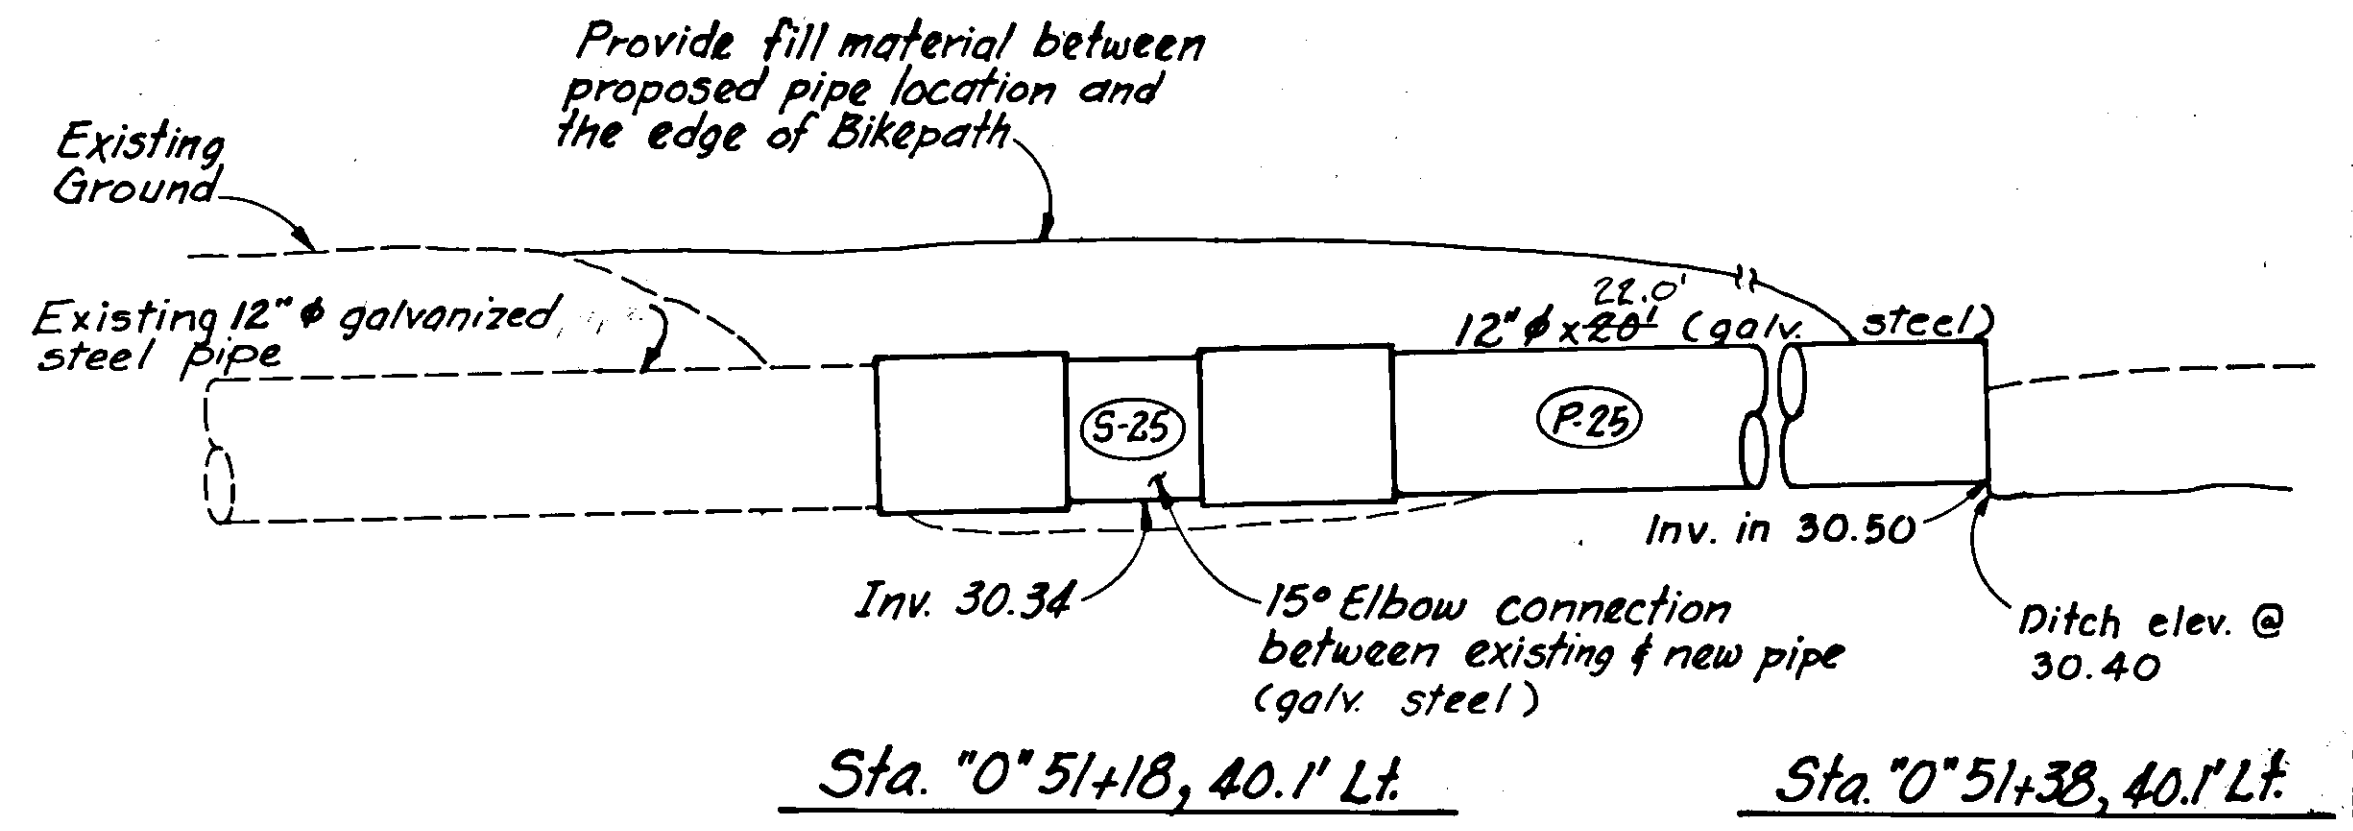

STATE	PROJECT DESIGNATION	YEAR	SHEET NO.	TOTAL SHEETS
ALASKA	HES-M-966(14)	'88	17	28

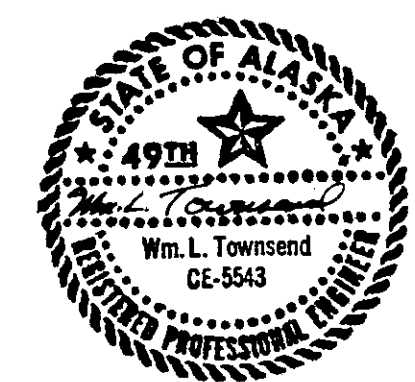

### INLET SUMMARY




STRUCT.	TYPE	LOCATION	OFFSET		TOP CURB ELEV.	INVERT ELEV.
			LEFT	RIGHT		
S-26	"A"	"0" 51+75	27'		35.05'	30.13'
S-27	"A"	"0" 52+50	27'		35.11'	30.19'
S-28	"A"	"0" 37+25		31'	32.67'	28.50'
S-29	"A"	"0" 47+25	27'		34.32'	30.15'
S-30	"A"	"0" 35+87.5		31'	32.75'	28.58'
S-31	"A"	"0" 38+50		31'	32.73'	28.56'

### SLOTTED DRAIN PIPE SUMMARY

PIPE	DIAMETER	LENGTH	FROM		TO	
			STRUCT./STA.	ELEV.	STRUCT./STA.	ELEV.
P-32	18"	62.5' 61.2'	S-21		S-30	
P-33	18"	75' 74.5'	S-5		S-28	
P-34	18"	75' 73.2'	S-28		S-6	
P-35	18"	50' 49.0'	S-6		S-31	
P-36	18"	50' 21.5'	44+50, 27' LT.		S-9	
P-37	18"	50' 48.5'	46+00, 27' LT.		S-13	
P-38	18"	75' 73.5'	S-13		S-29	
P-39	18"	75' 74.0'	S-29		S-14	
P-40	18"	50' 47.5'	S-14		48+50, 27' LT.	
P-41	18"	75'	S-26		S-27	
P-42	18"	50' 47.2'	S-27		53+00, 27' LT.	
P-43	18"	25' 24.5'	35+00, 31' RT.		S-21	
P-44	18"	62.5' 61.2'	S-30		S-5	
P-45	18"	50' 48.5'	S-31		S-7	
P-46	18"	20' 21.5'	51+55, 27' LT.		S-26	

### PIPE SUMMARY




PIPE	DIAMETER	LENGTH	FROM		TO	
			STRUCT./STA.	ELEV.	STRUCT./STA.	ELEV.
P-26	18"	13' 12.0'	S-26	31.63	"0" 51+75, 39.5' LT.	30.72'
P-27	12"	16' 12.0'	S-27	31.69	"0" 52+50, 42.5' LT.	31.40'

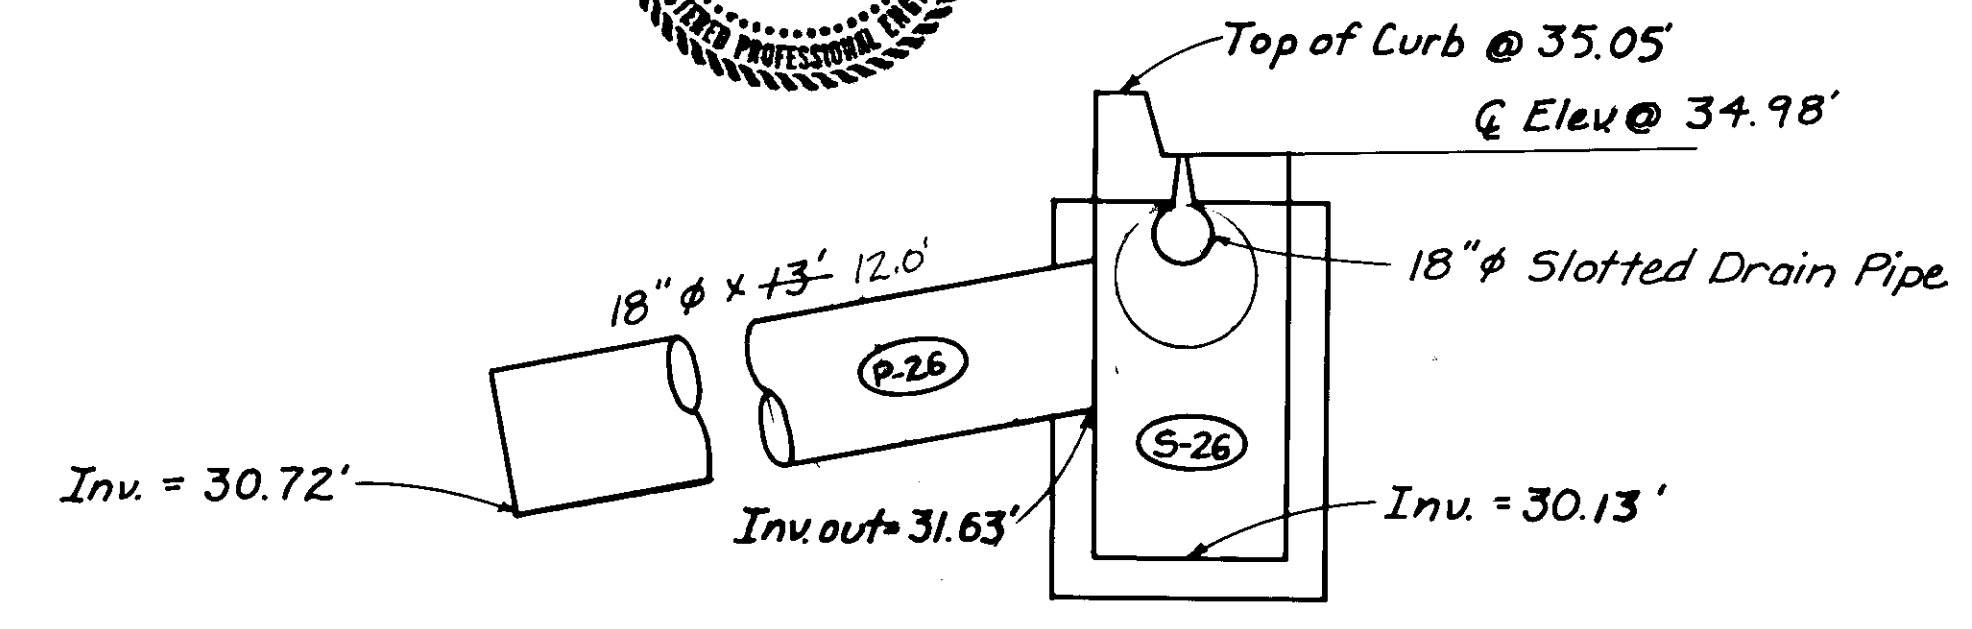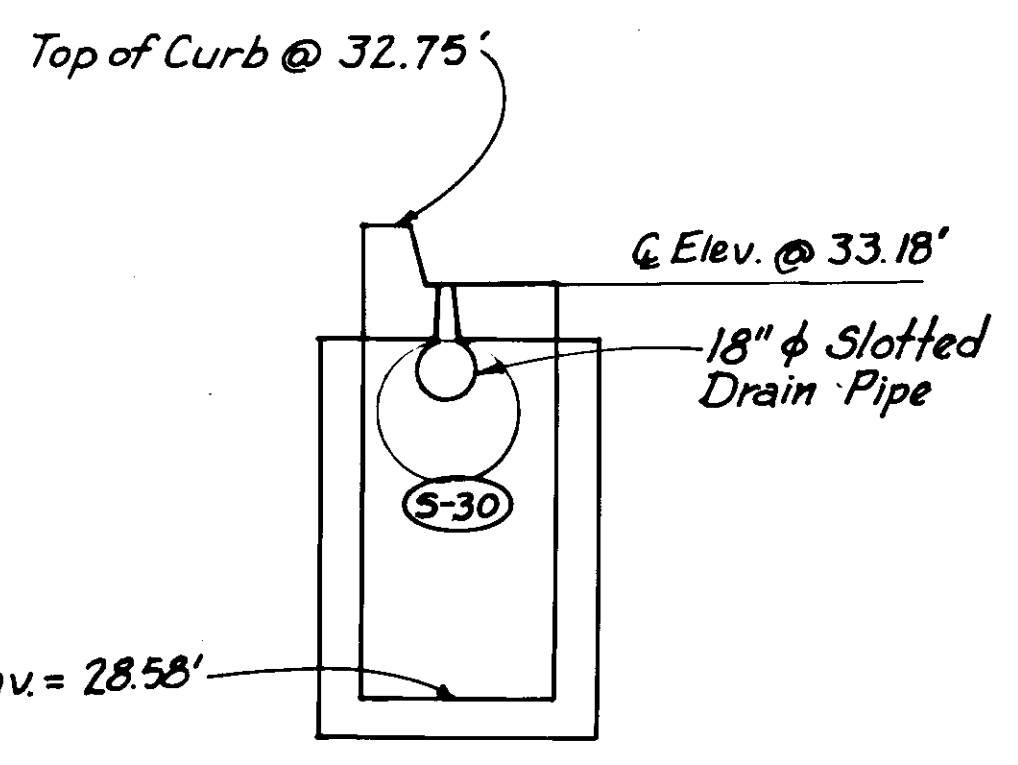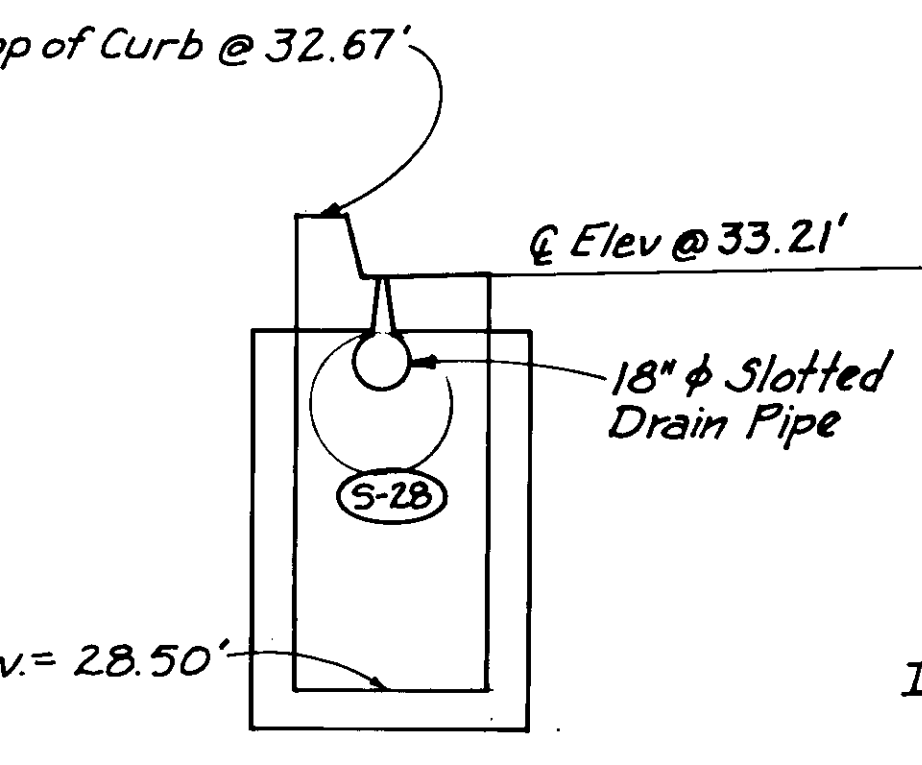

STA. "0" 37+25, 31' RT.

STA. "0" 35+87.5, 31' RT.








STA. "0" 51+75, 27' LT.

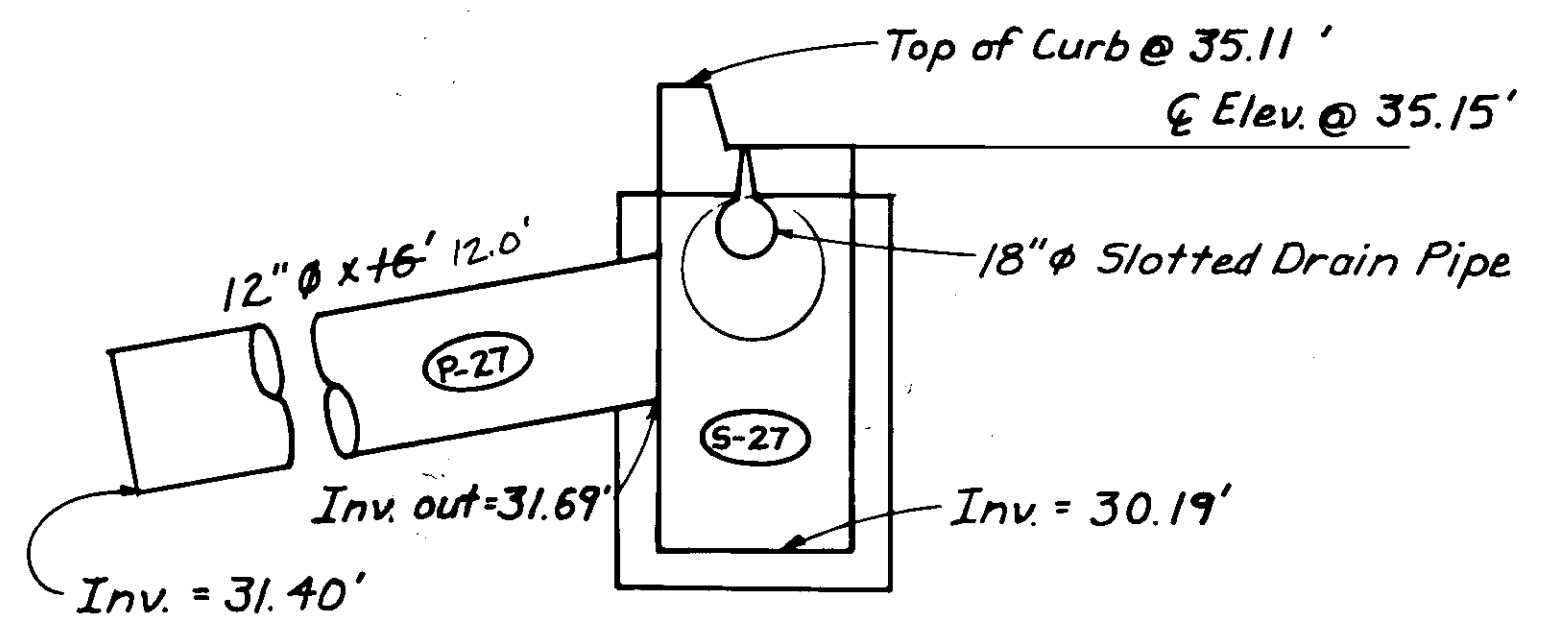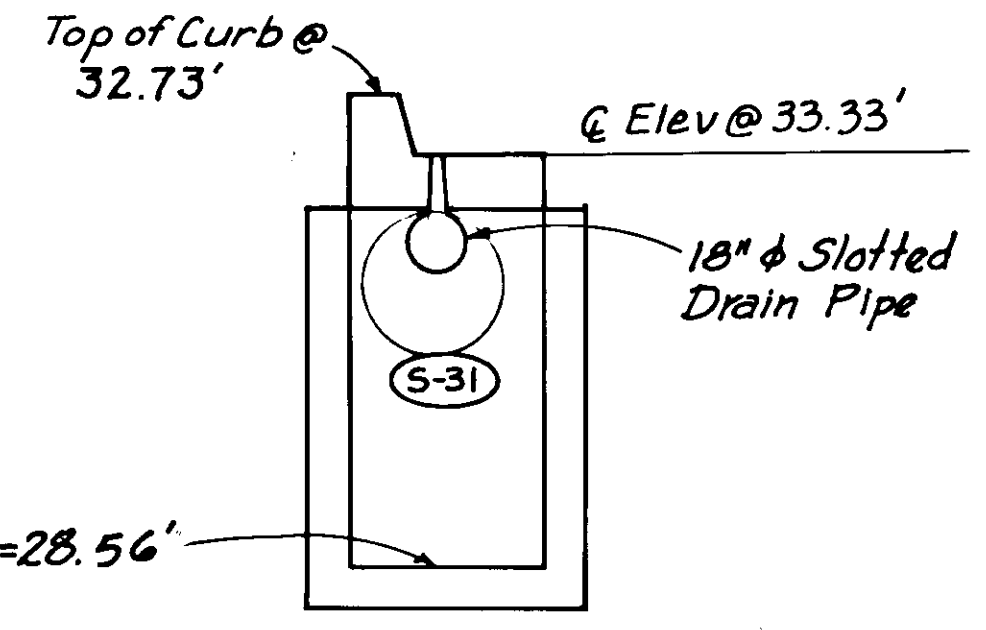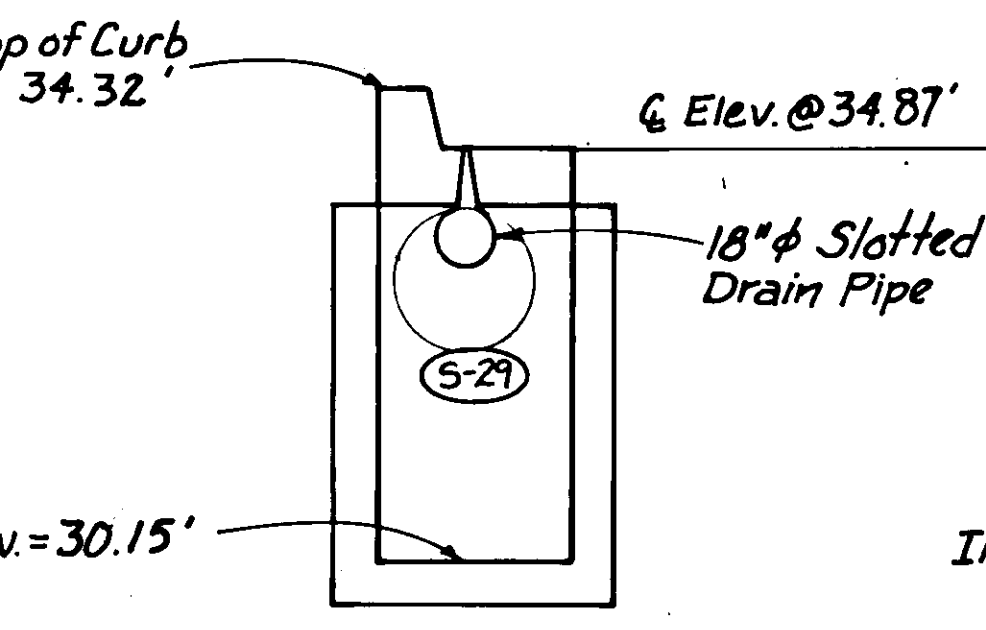

STA. "0" 47+25, 27' LT.

STA. "0" 38+50, 31' RT.

STA. "0" 52+50, 27' LT.

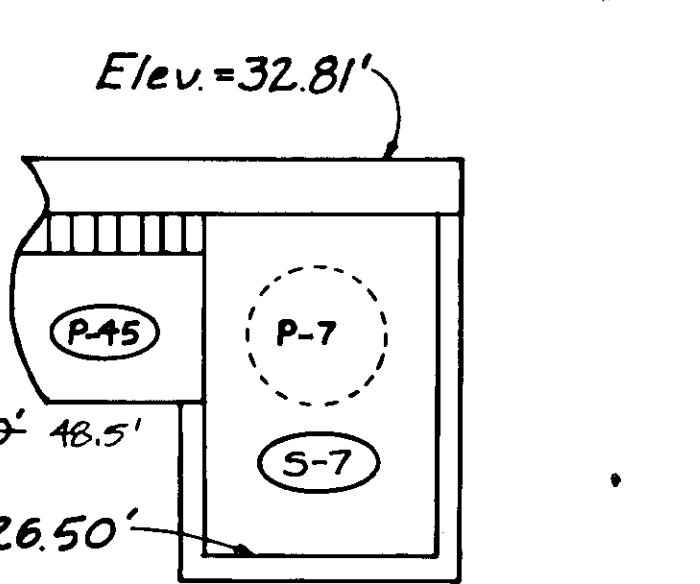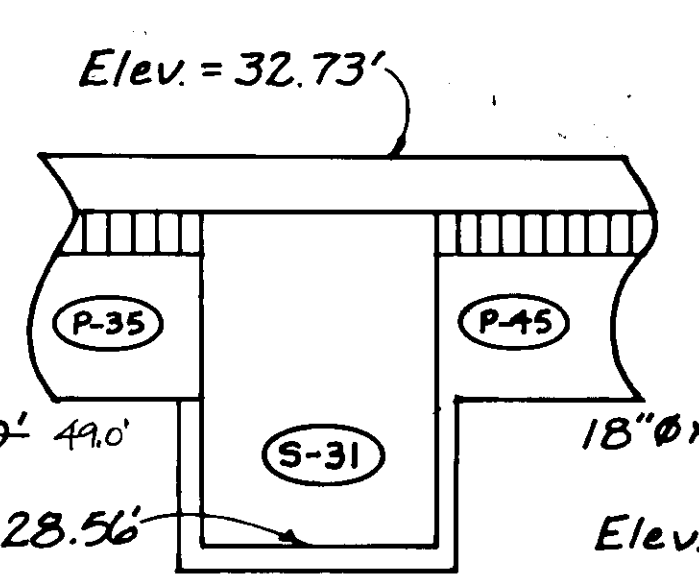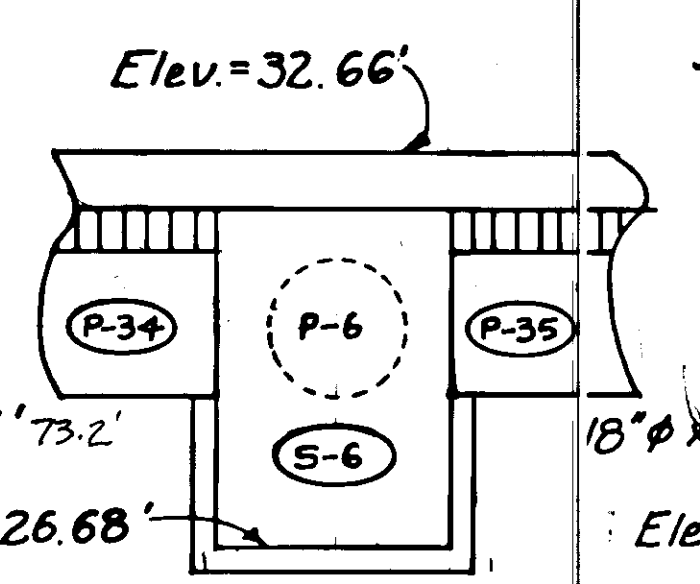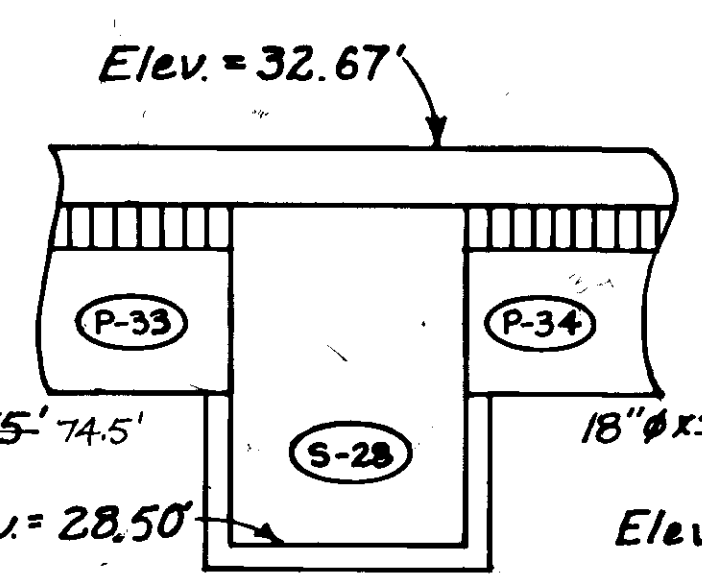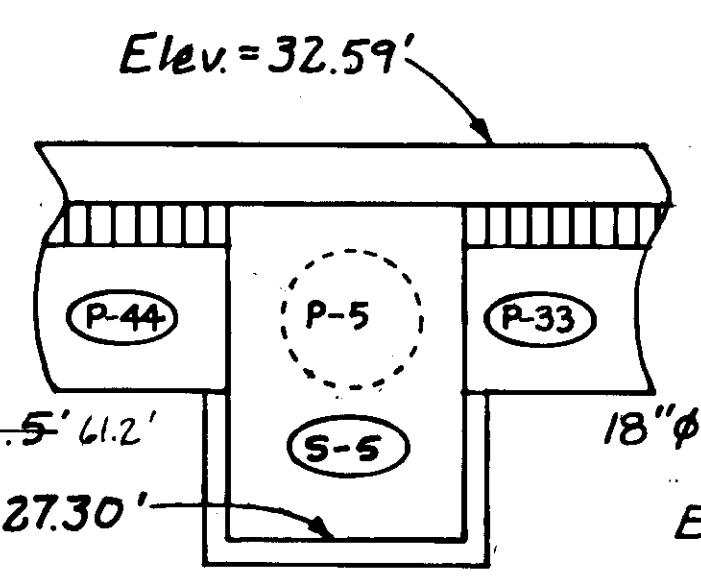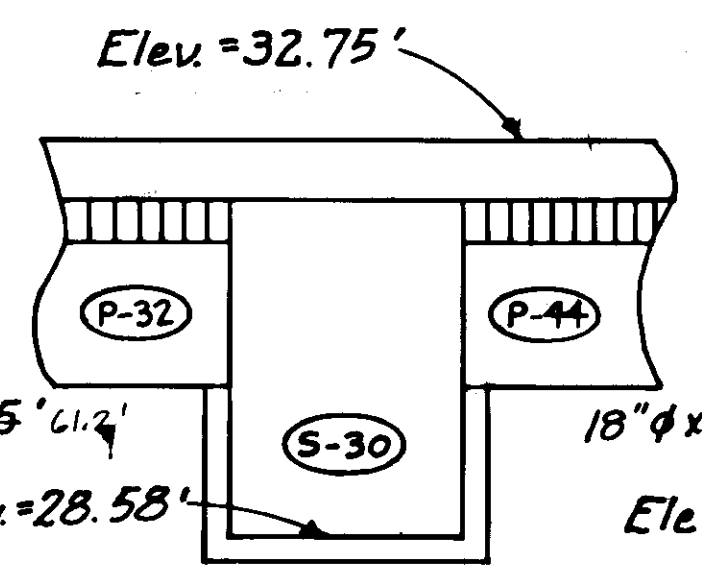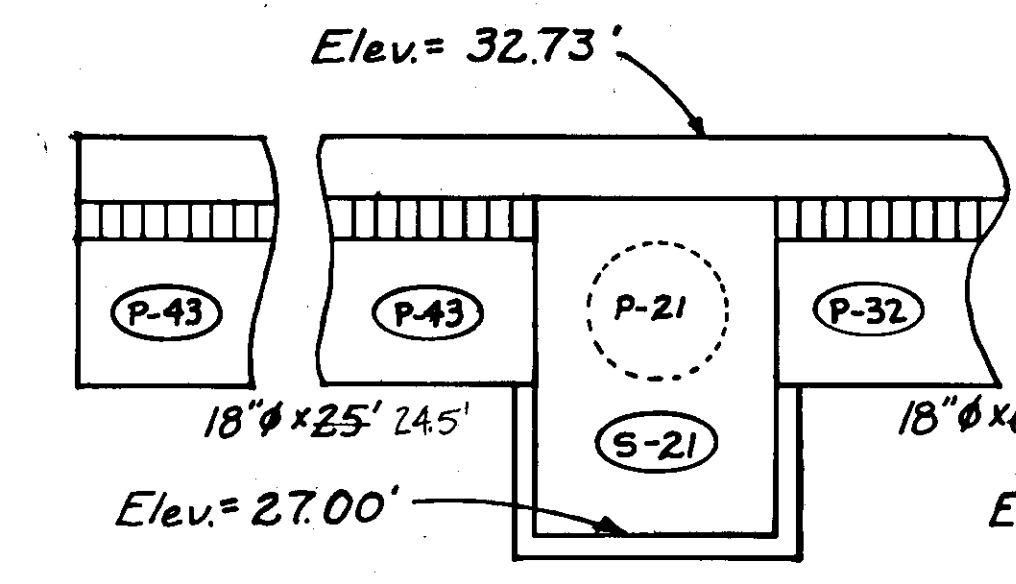

STA. 35+25, 31' RT.

STA. 35+87.5, 31' RT.







STA. 36+50, 31' RT.

STA. 37+25, 31' RT.

STA. 38+00, 31' RT.

STA. 38+50, 31' RT.

STA. 39+00, 31' RT.

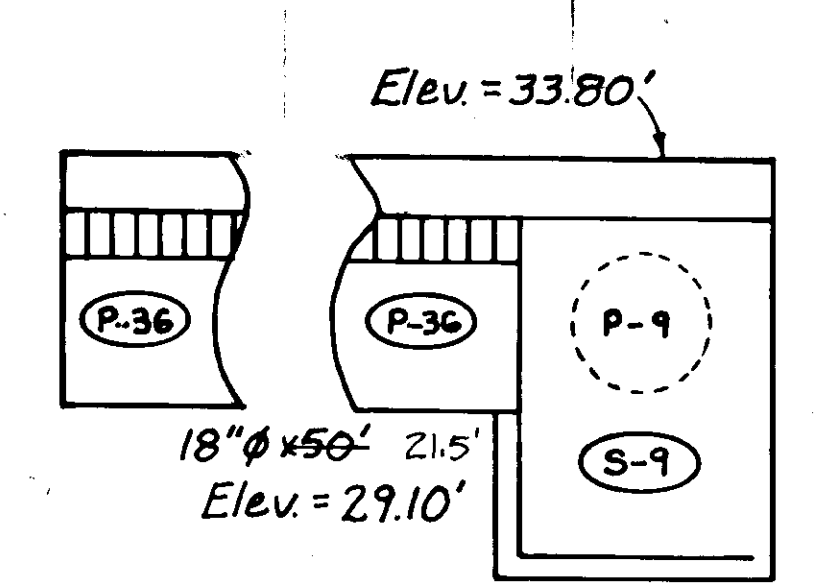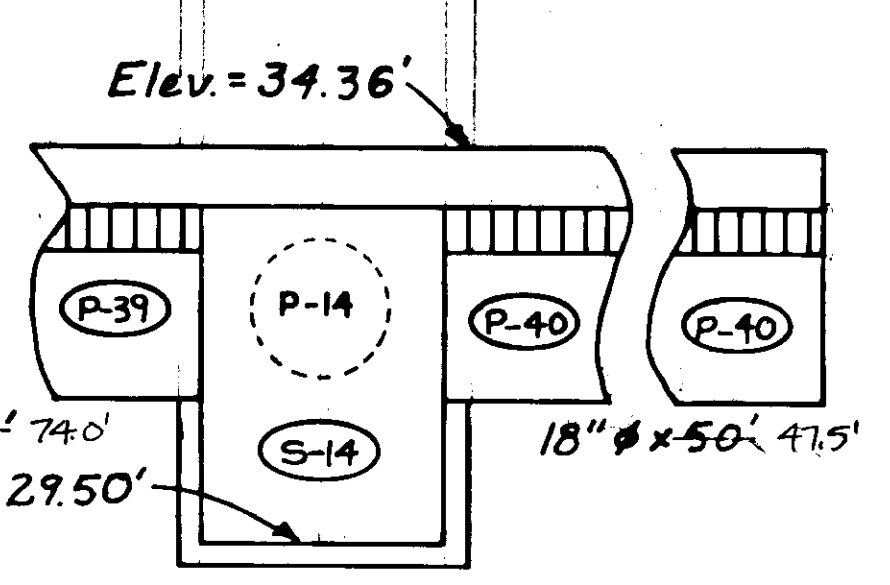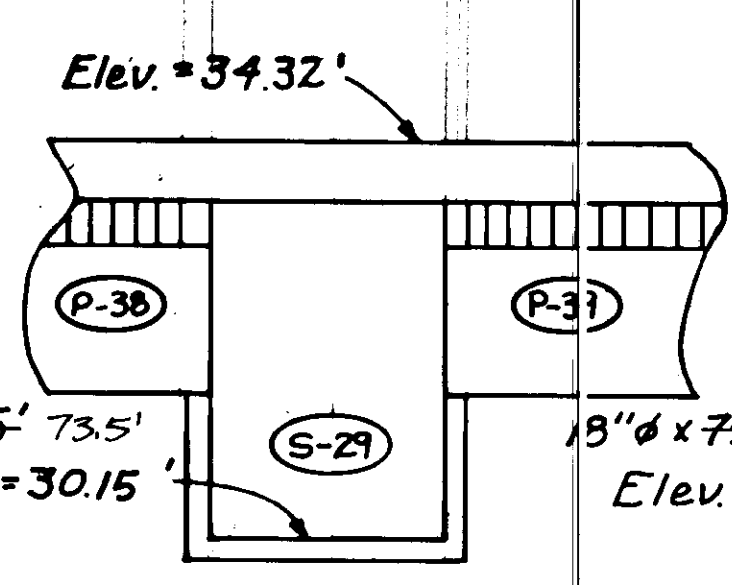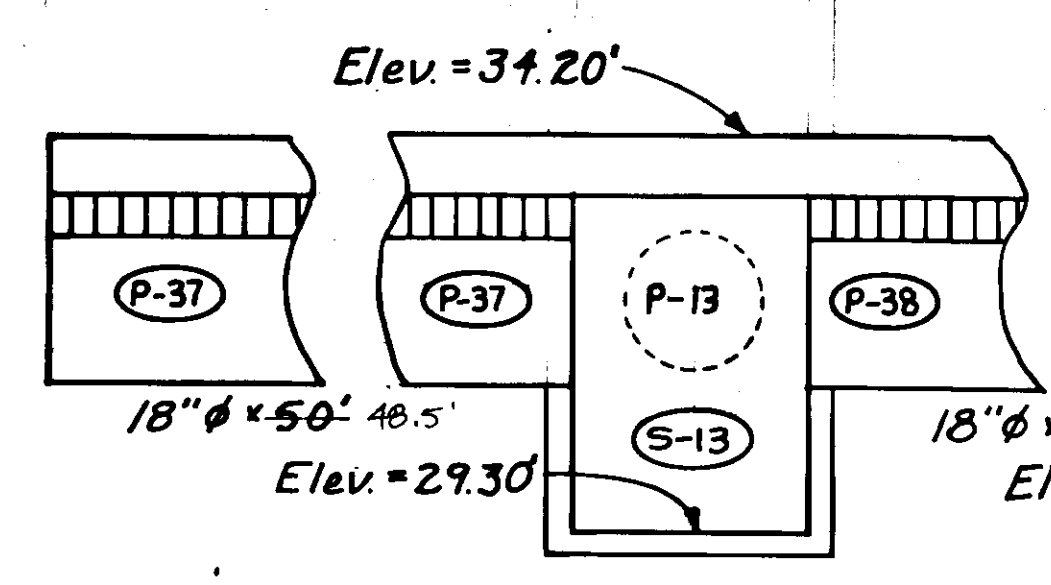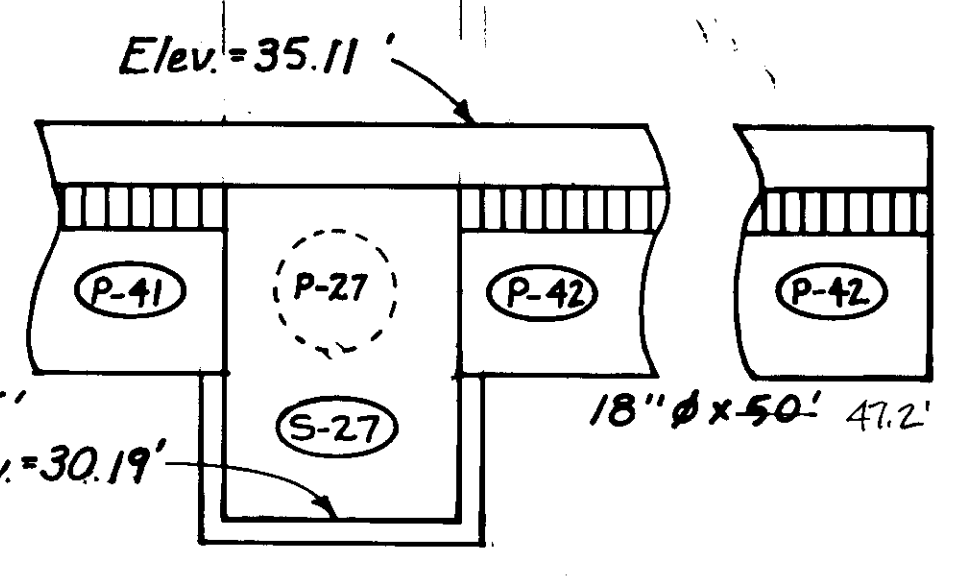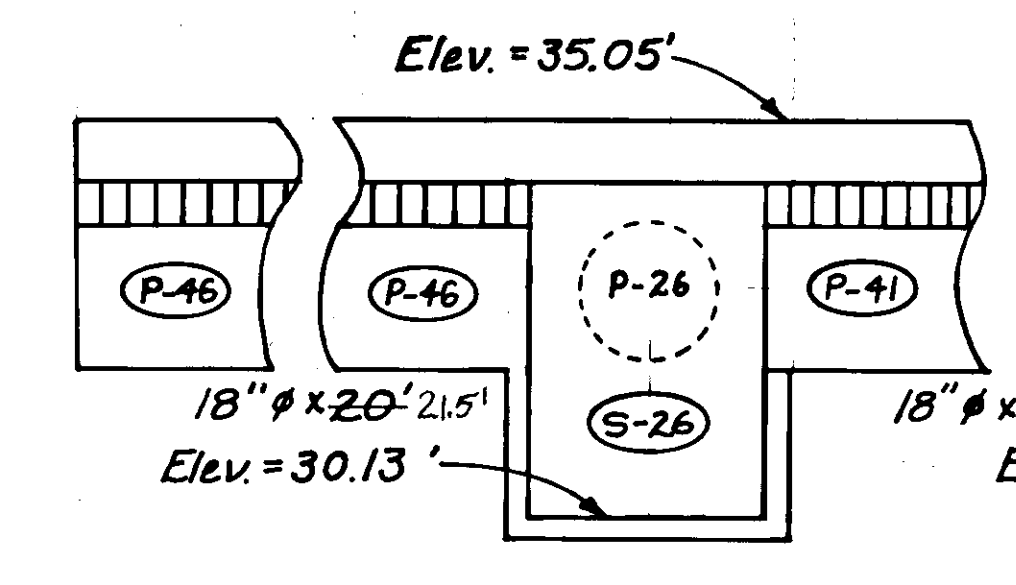

STA. 51+75, 27' LT.

STA. 52+50, 27' LT.


STA. 46+50, 27' LT.

STA. 47+25, 27' LT.


STA. 48+00, 27' LT.

STA. 45+00, 27' LT.


STATE	PROJECT DESIGNATION	YEAR	SHEET NO.	TOTAL SHEETS
ALASKA	HES-M-966 (14)	'88	18	28

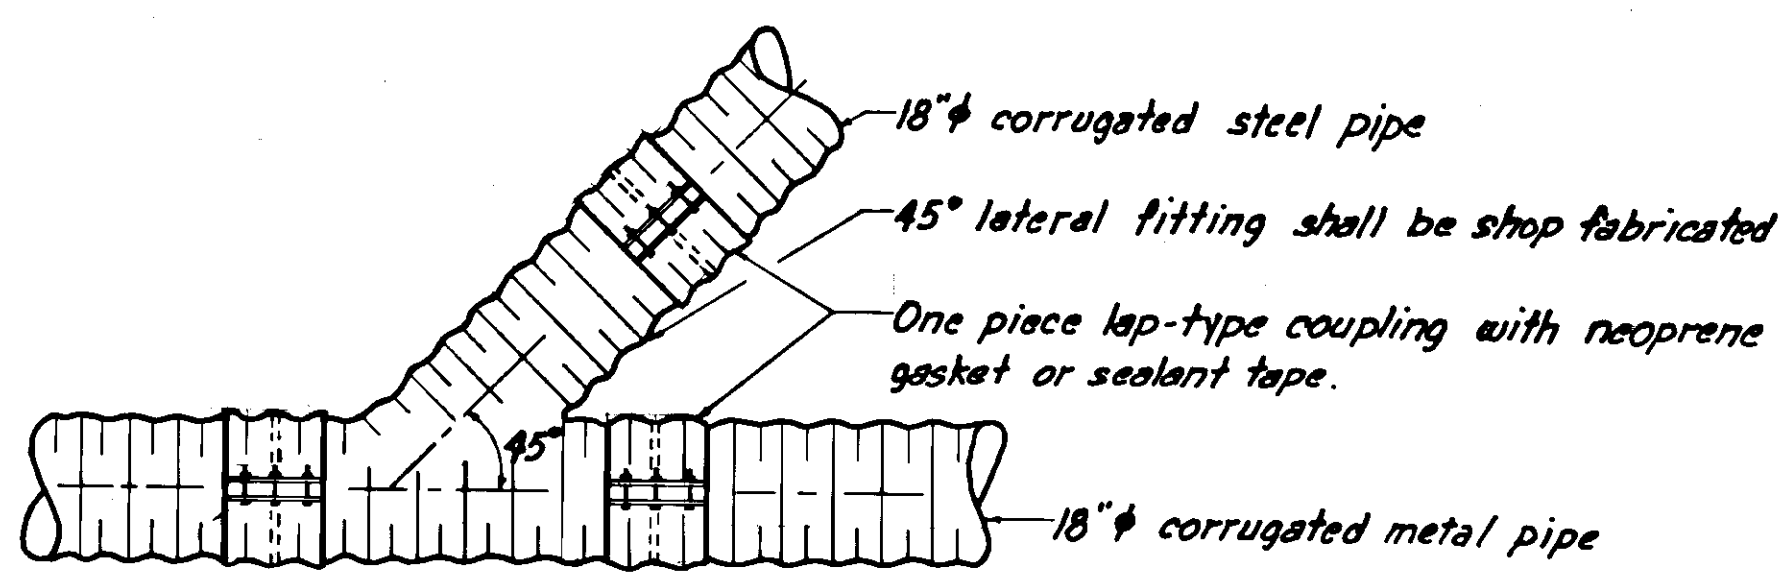


**45° LATERAL CONNECTION DETAIL**

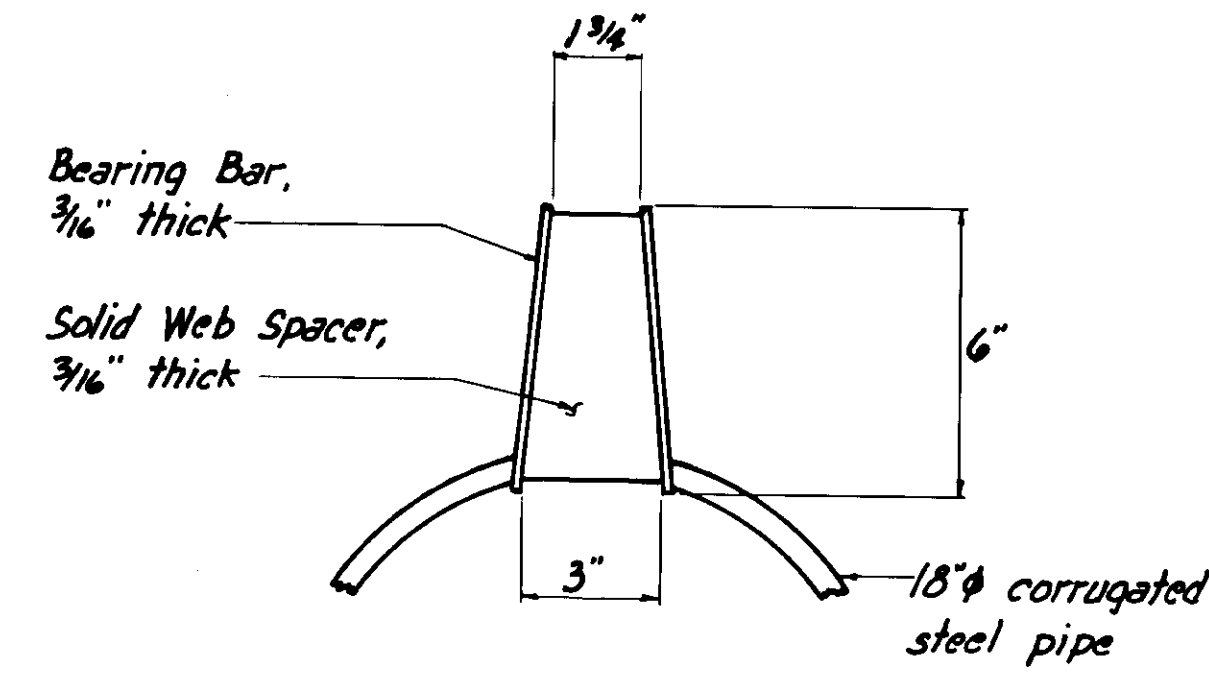


**SECTION-A-A  
STANDARD GRATE DETAIL**

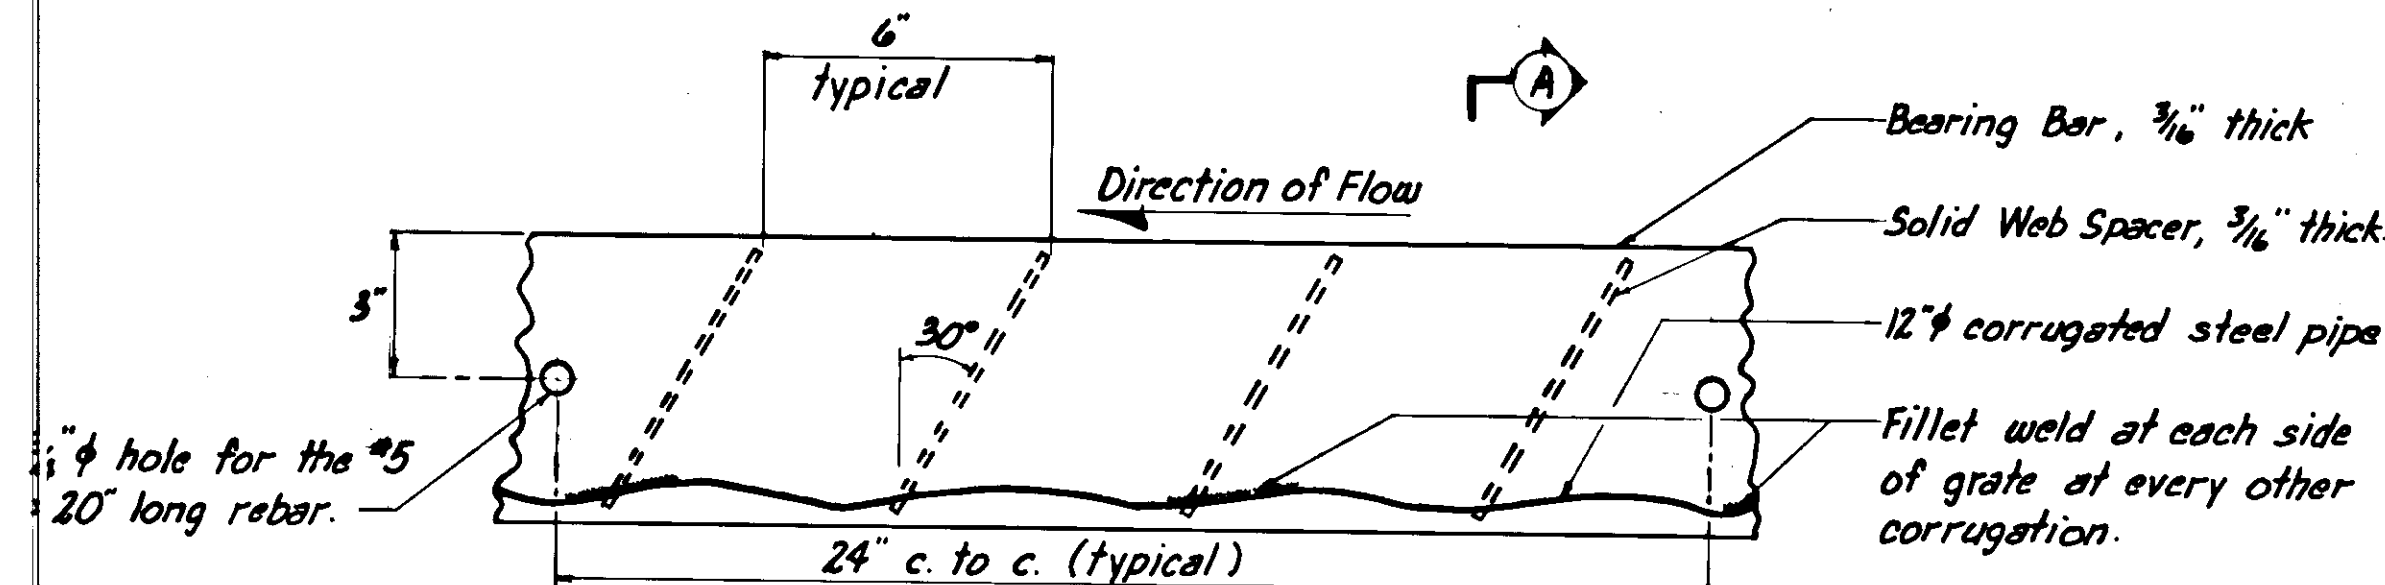


**GRATE WELDING DETAIL**

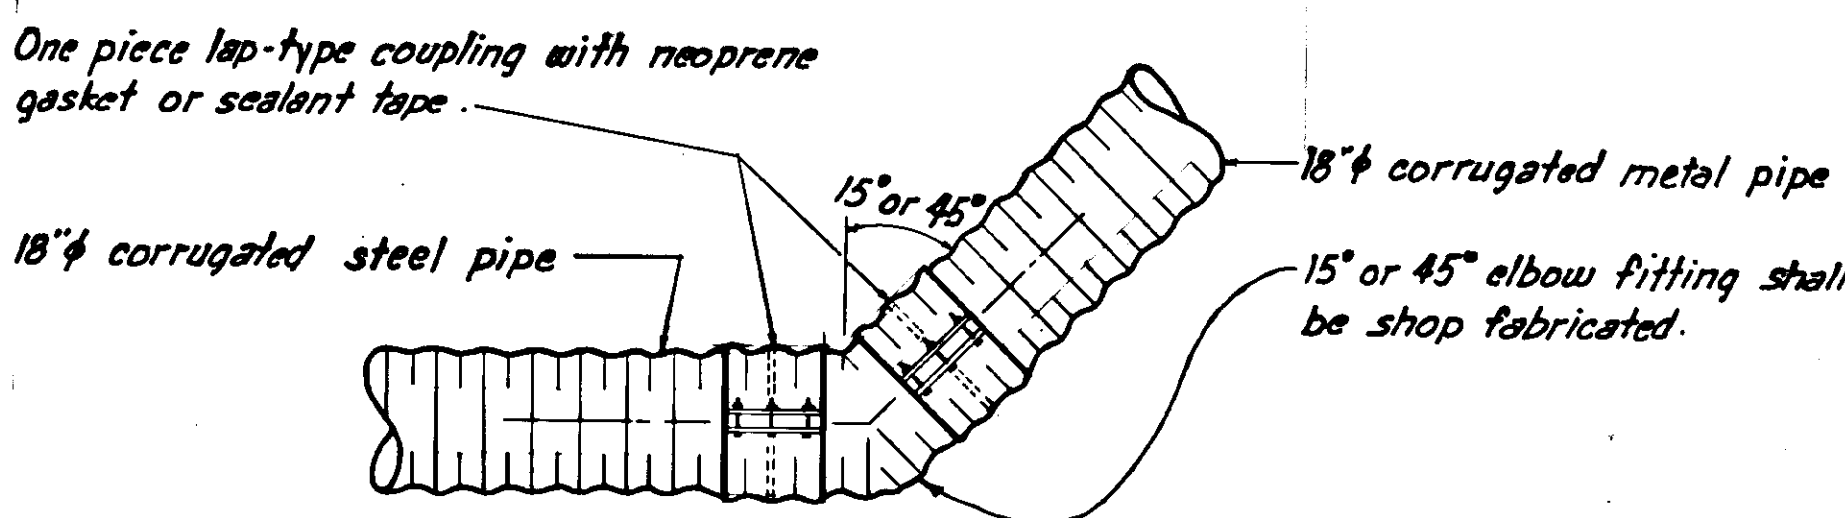


**ELBOW CONNECTION DETAIL**

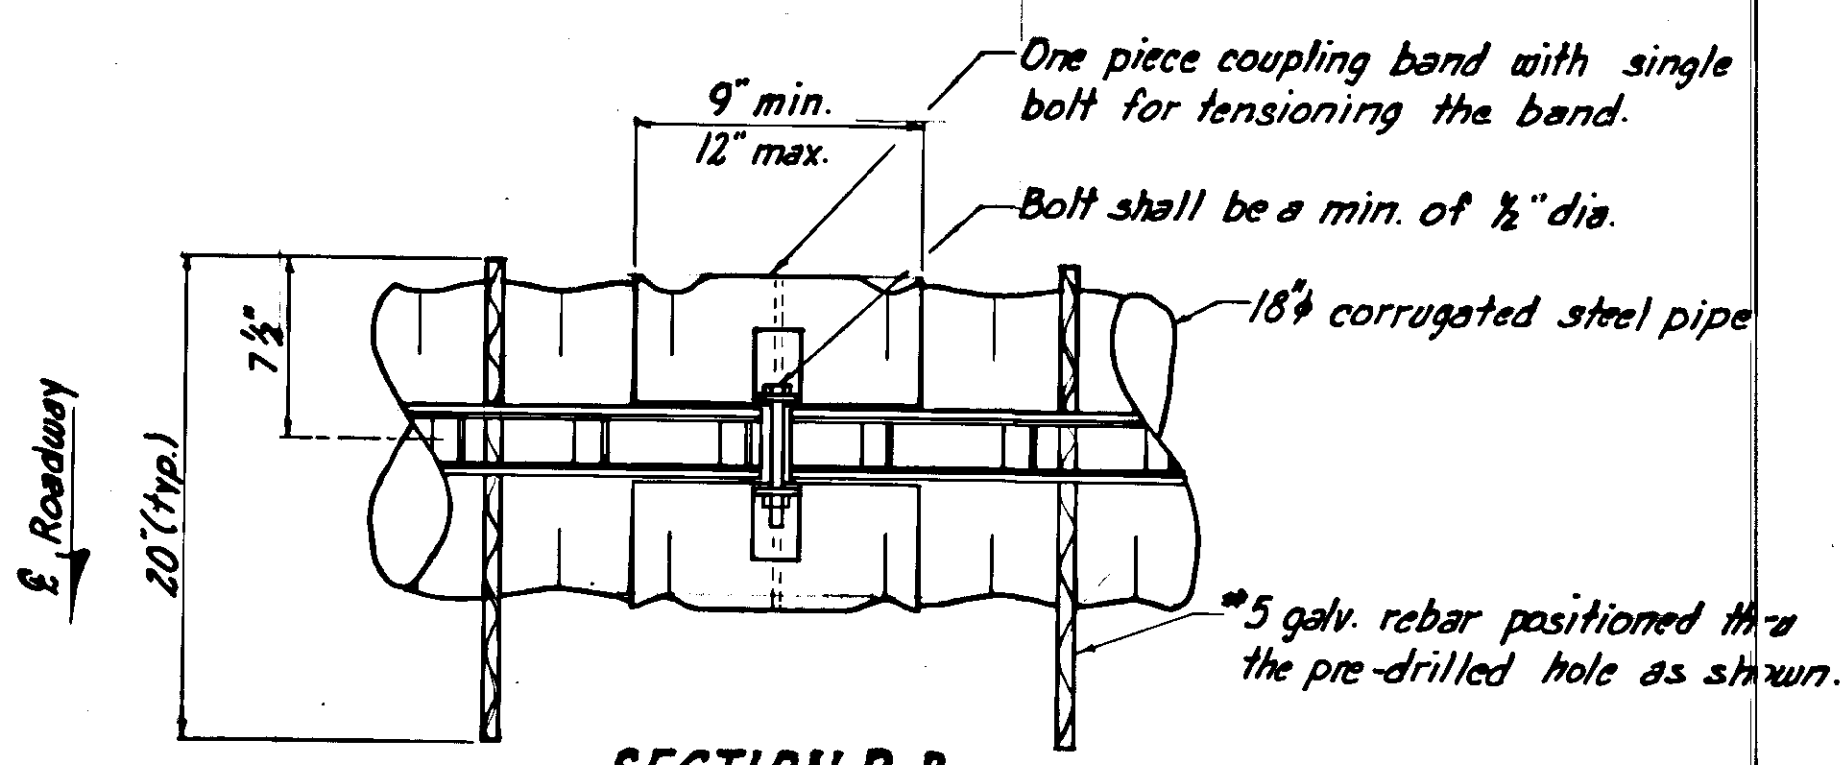


**SECTION B-B  
SLOTTED DRAIN JOINT DETAIL**

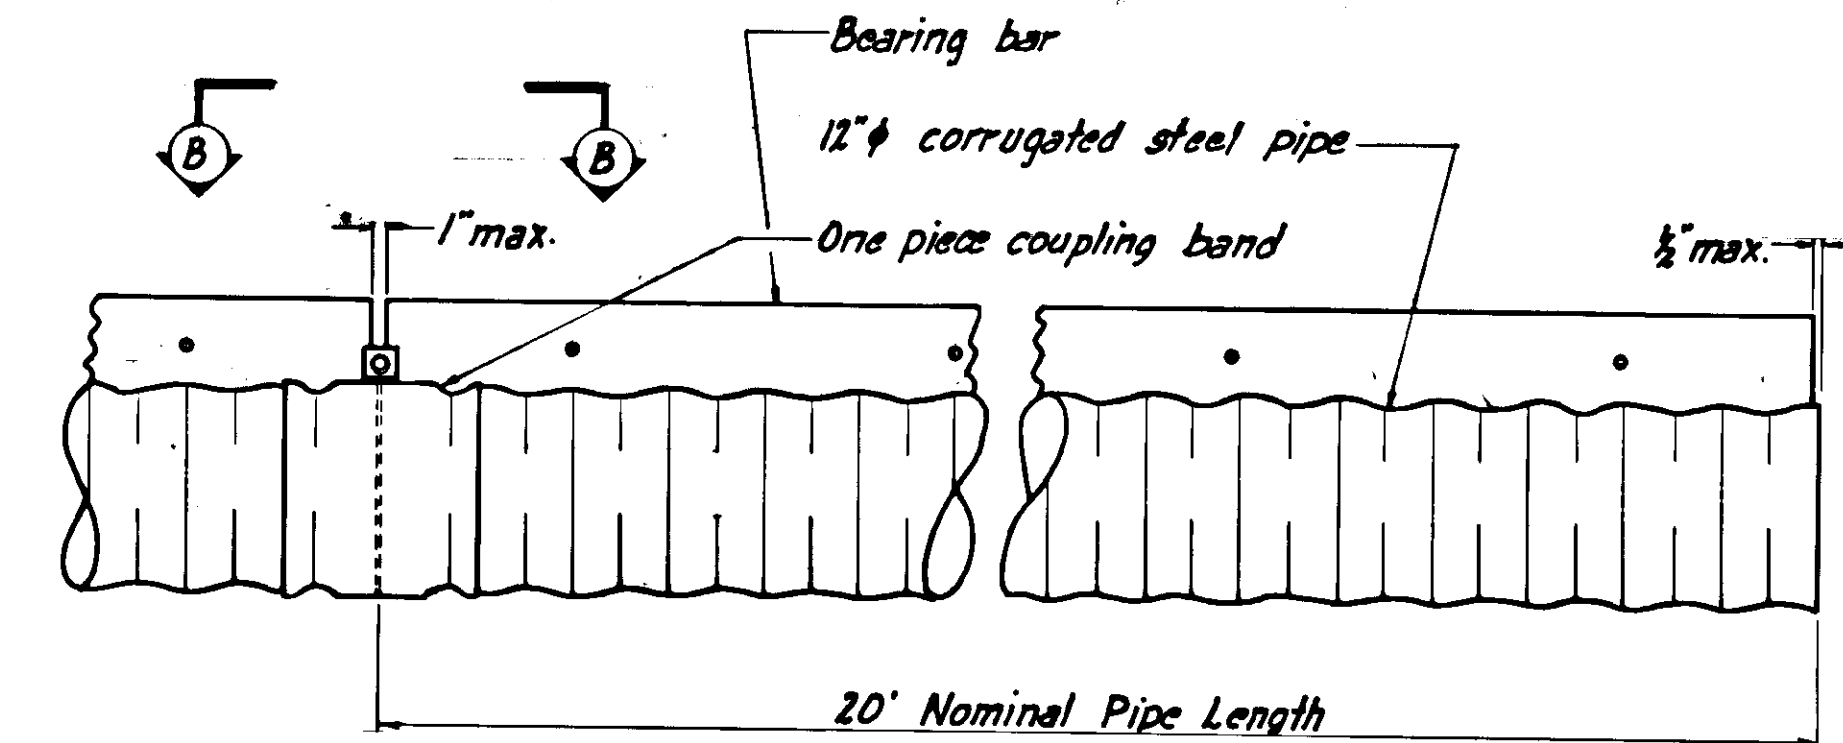

**TYPICAL SLOTTED DRAIN  
PIPE SECTION**

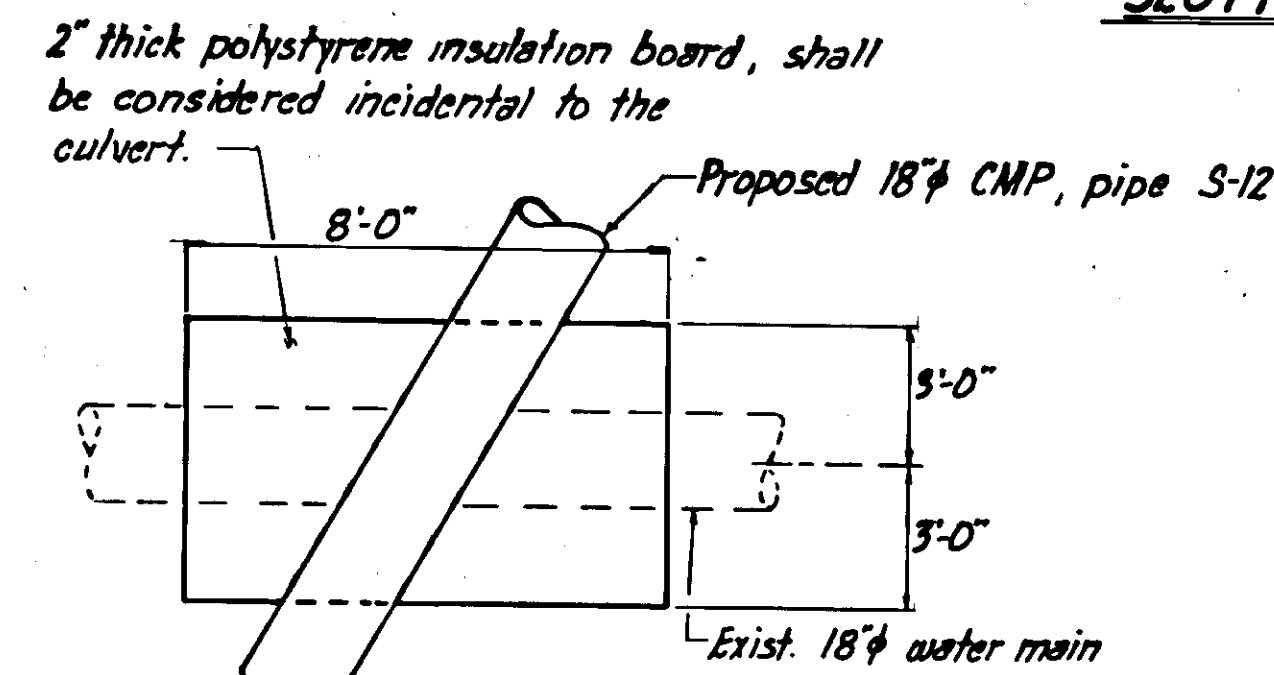


**PLAN VIEW  
WATER MAIN CROSSING**

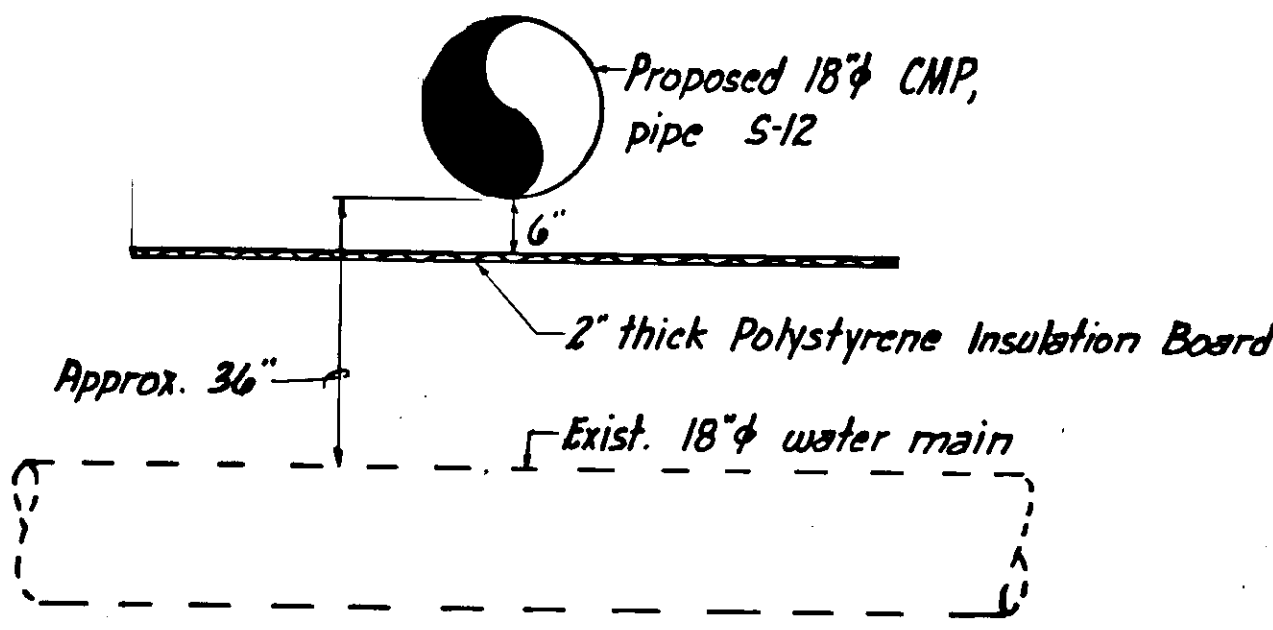


**ELEVATION VIEW  
WATER MAIN CROSSING**

**SLOTTED DRAIN PIPE NOTE**



1. Slotted drain pipe shall be galvanized 18" nominal diameter and min. thickness of 0.079"
2. The grate assemblies shall be hot dip galvanized after fabrication to meet the requirements of ASTM A-123.
3. Web spacers shall be joined to the bearing bars in such a manner that the 6" deep grating shall provide 15,000 lbs. of tension across the slot.
4. One piece coupling band shall be used for connection between pipes. A single bolt, 1/2" min. diameter, for tensioning the coupling band is required.
5. Coupling band shall be the same base metal and galvanized as the pipe.
6. Class W concrete for securing the slotted drain pipe shall be considered incidental to part item 603 (30), Slotted Storm Drain.

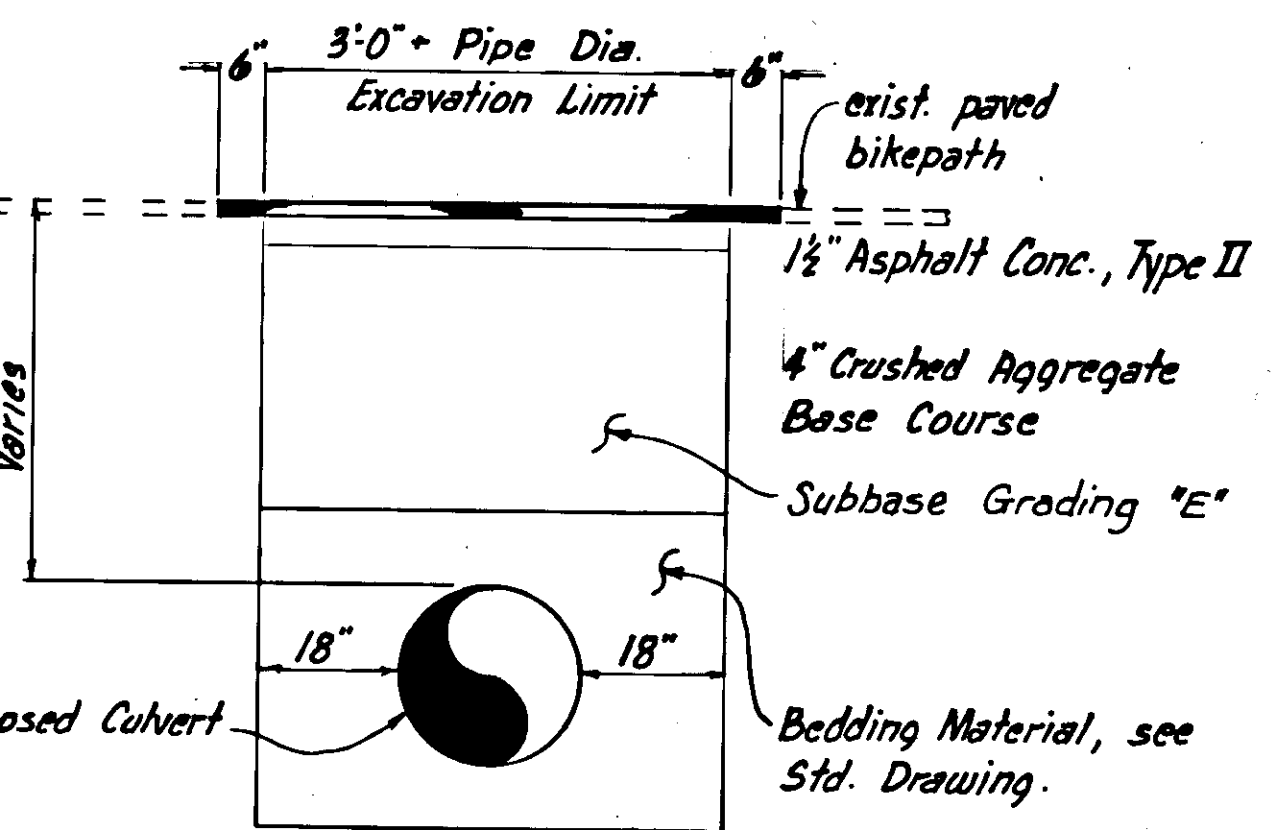


**CULVERT CROSSING DETAIL  
AT BIKEPATH**

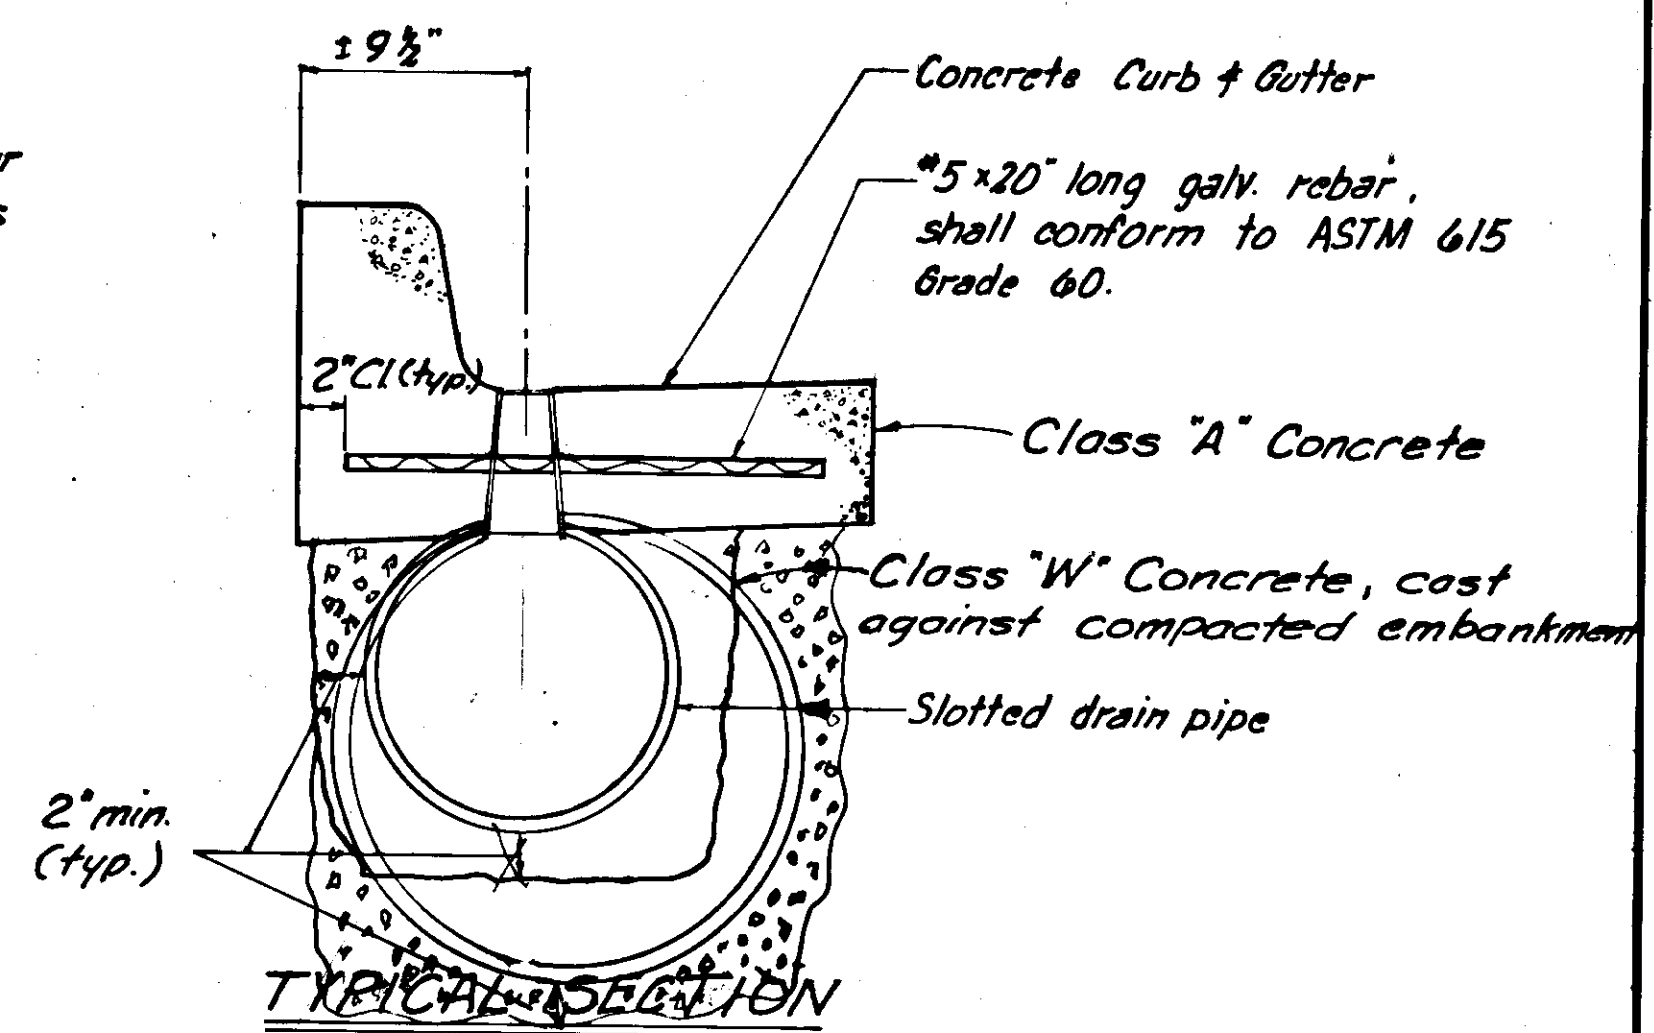


**TYPICAL SECTION**

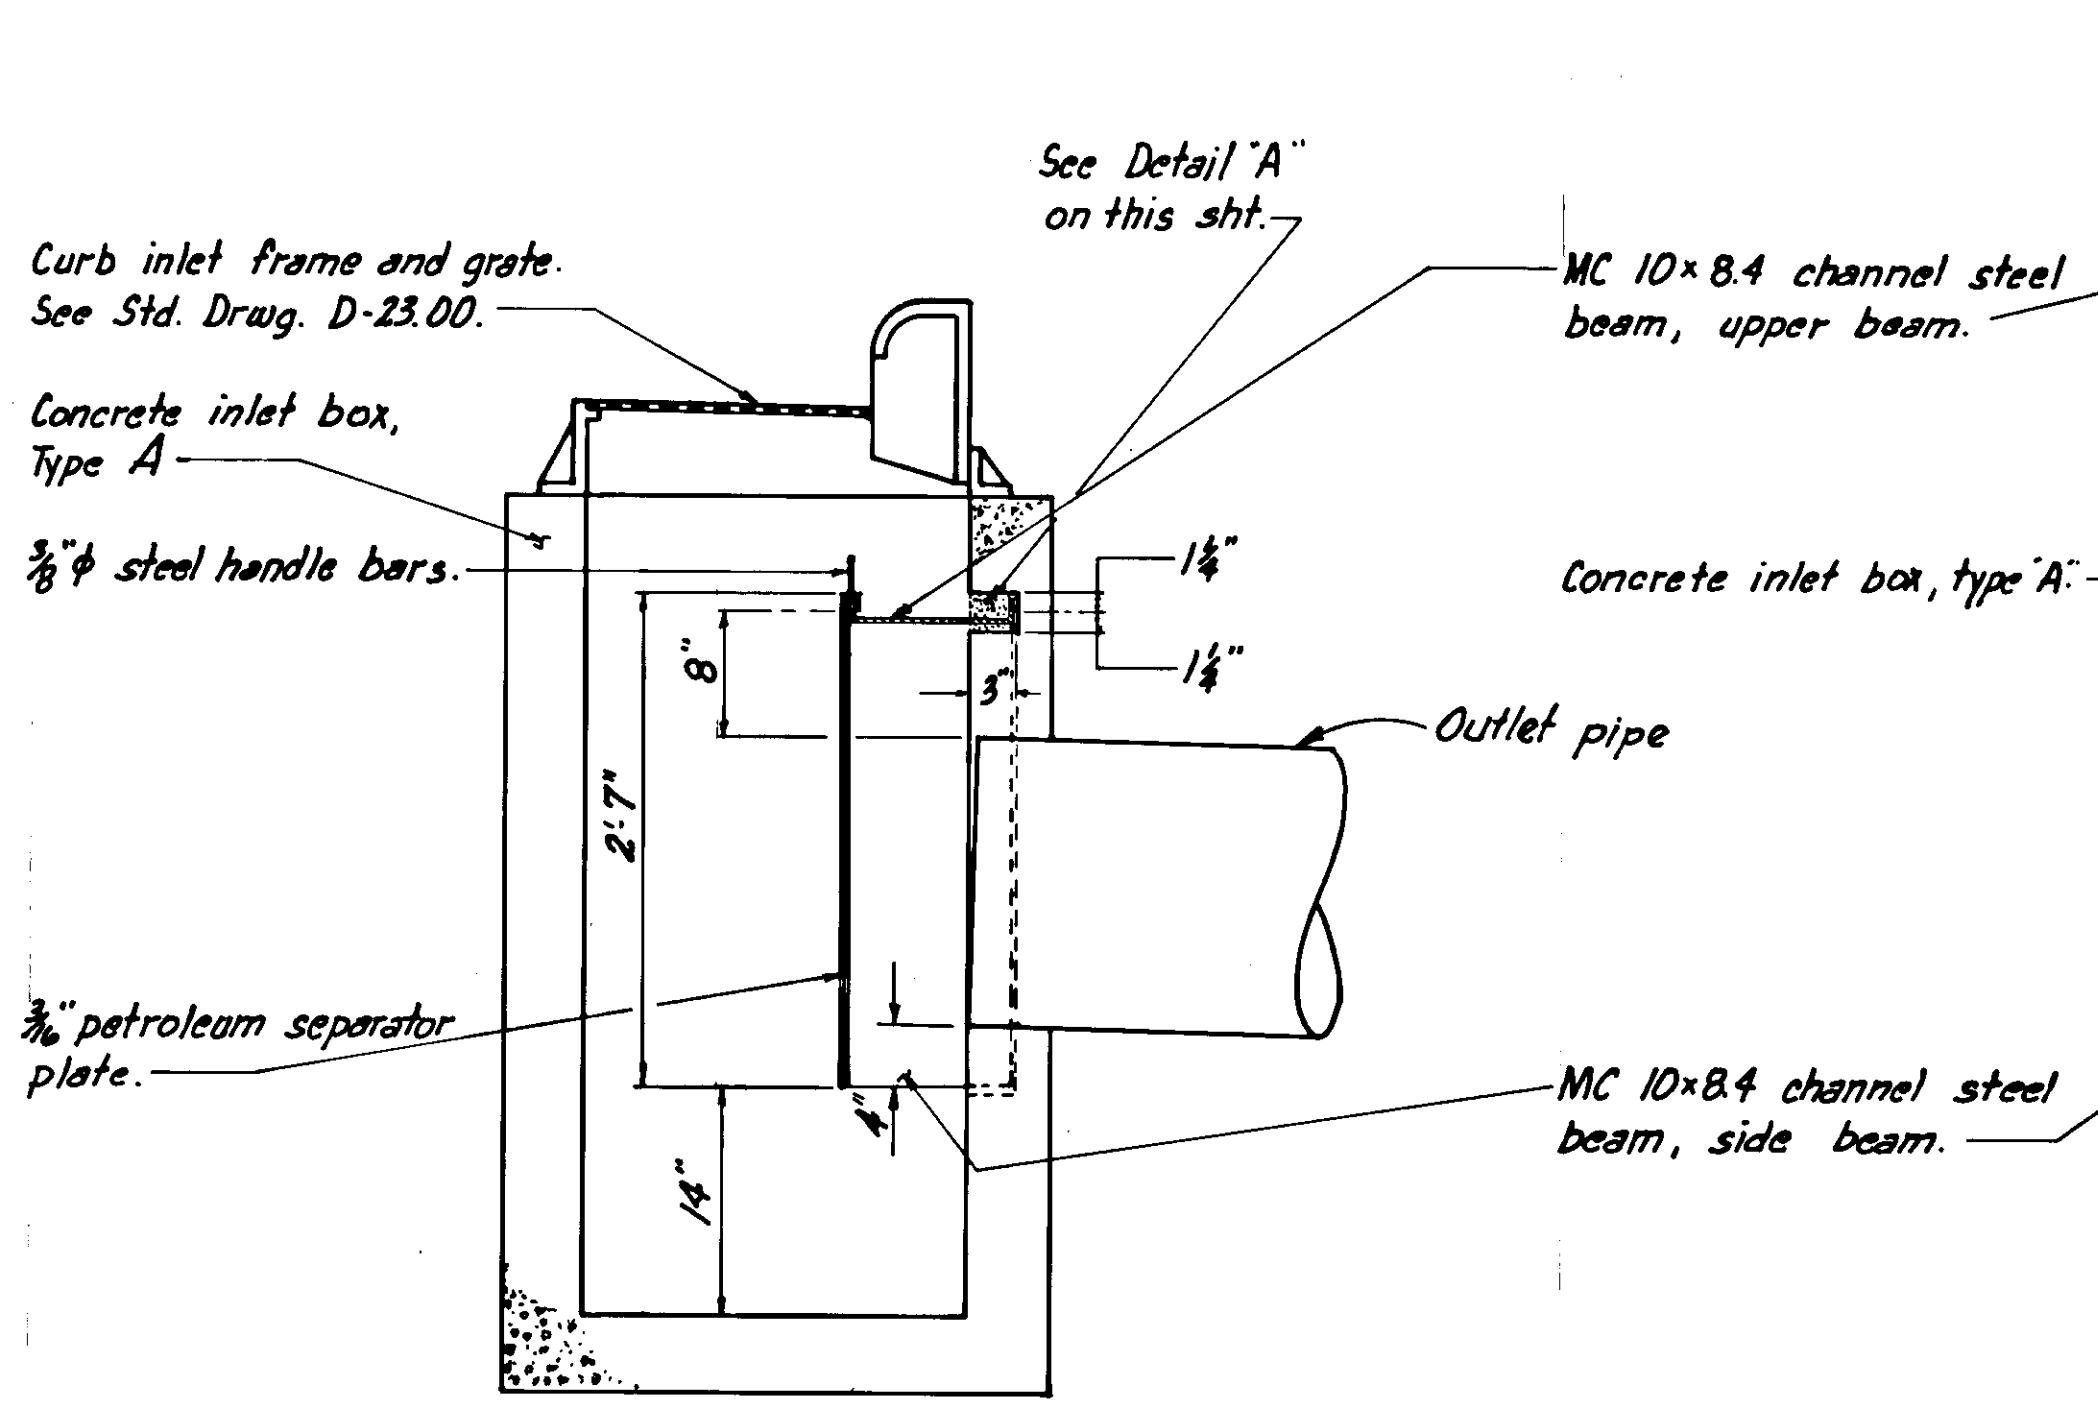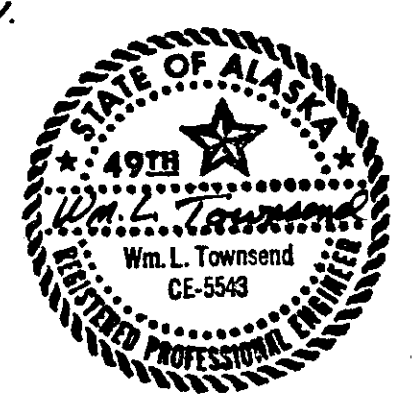


**SECTION A-A**

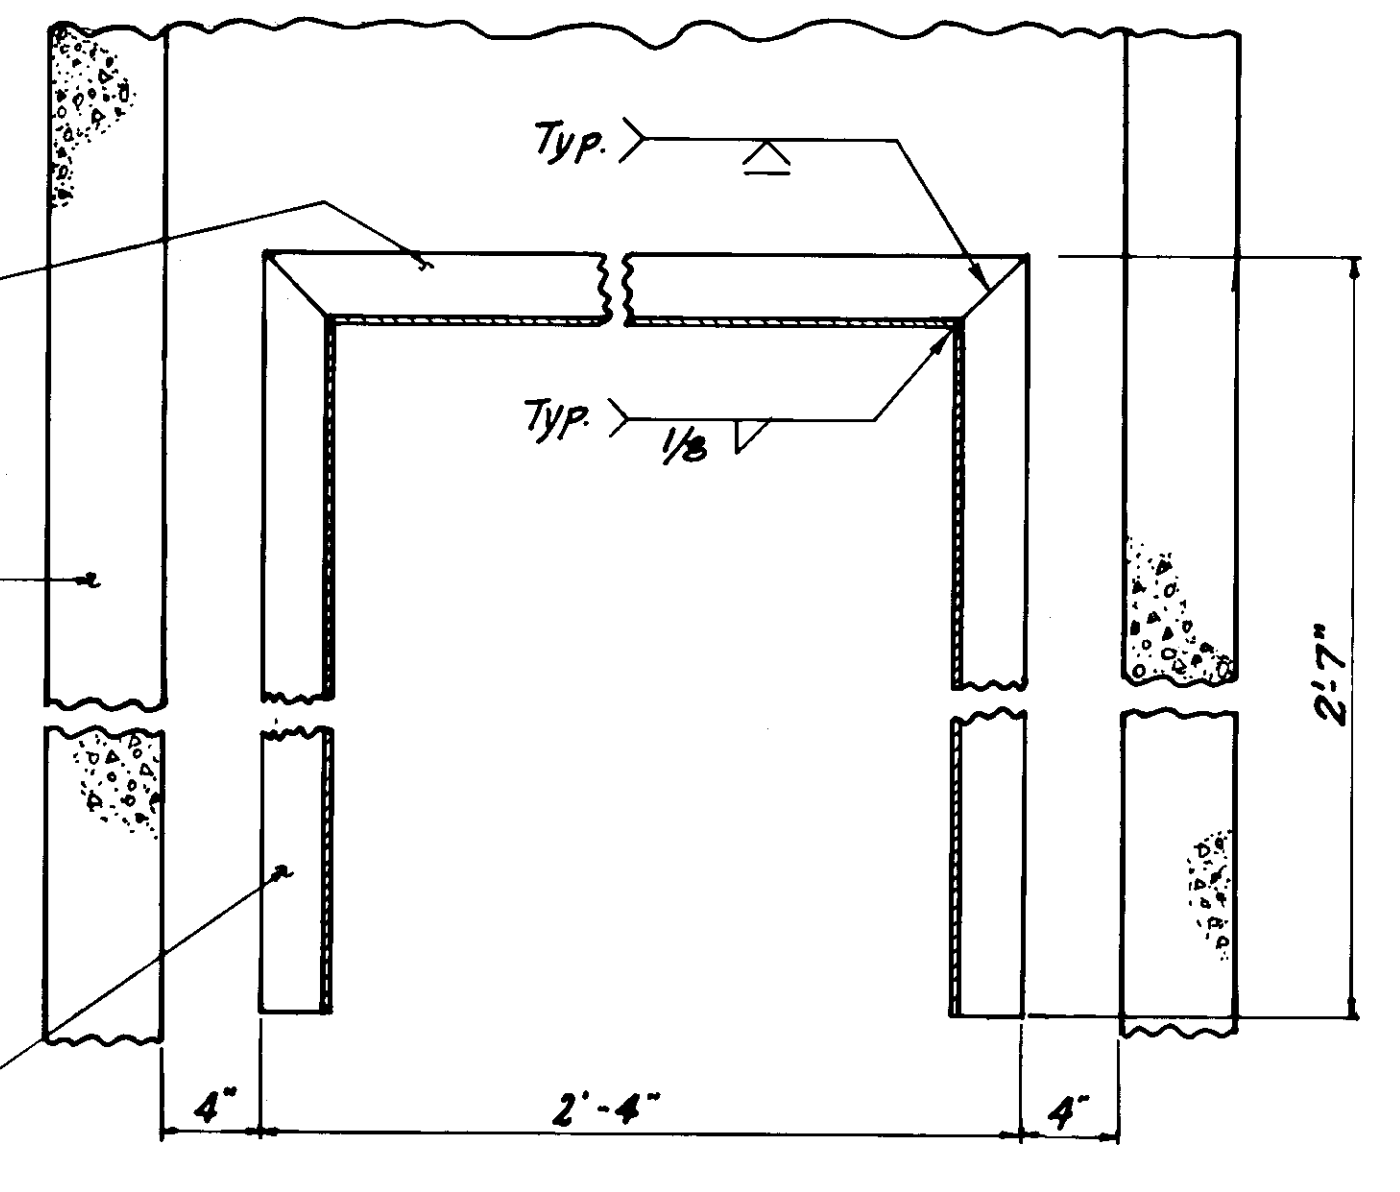


**SECTION B-B**

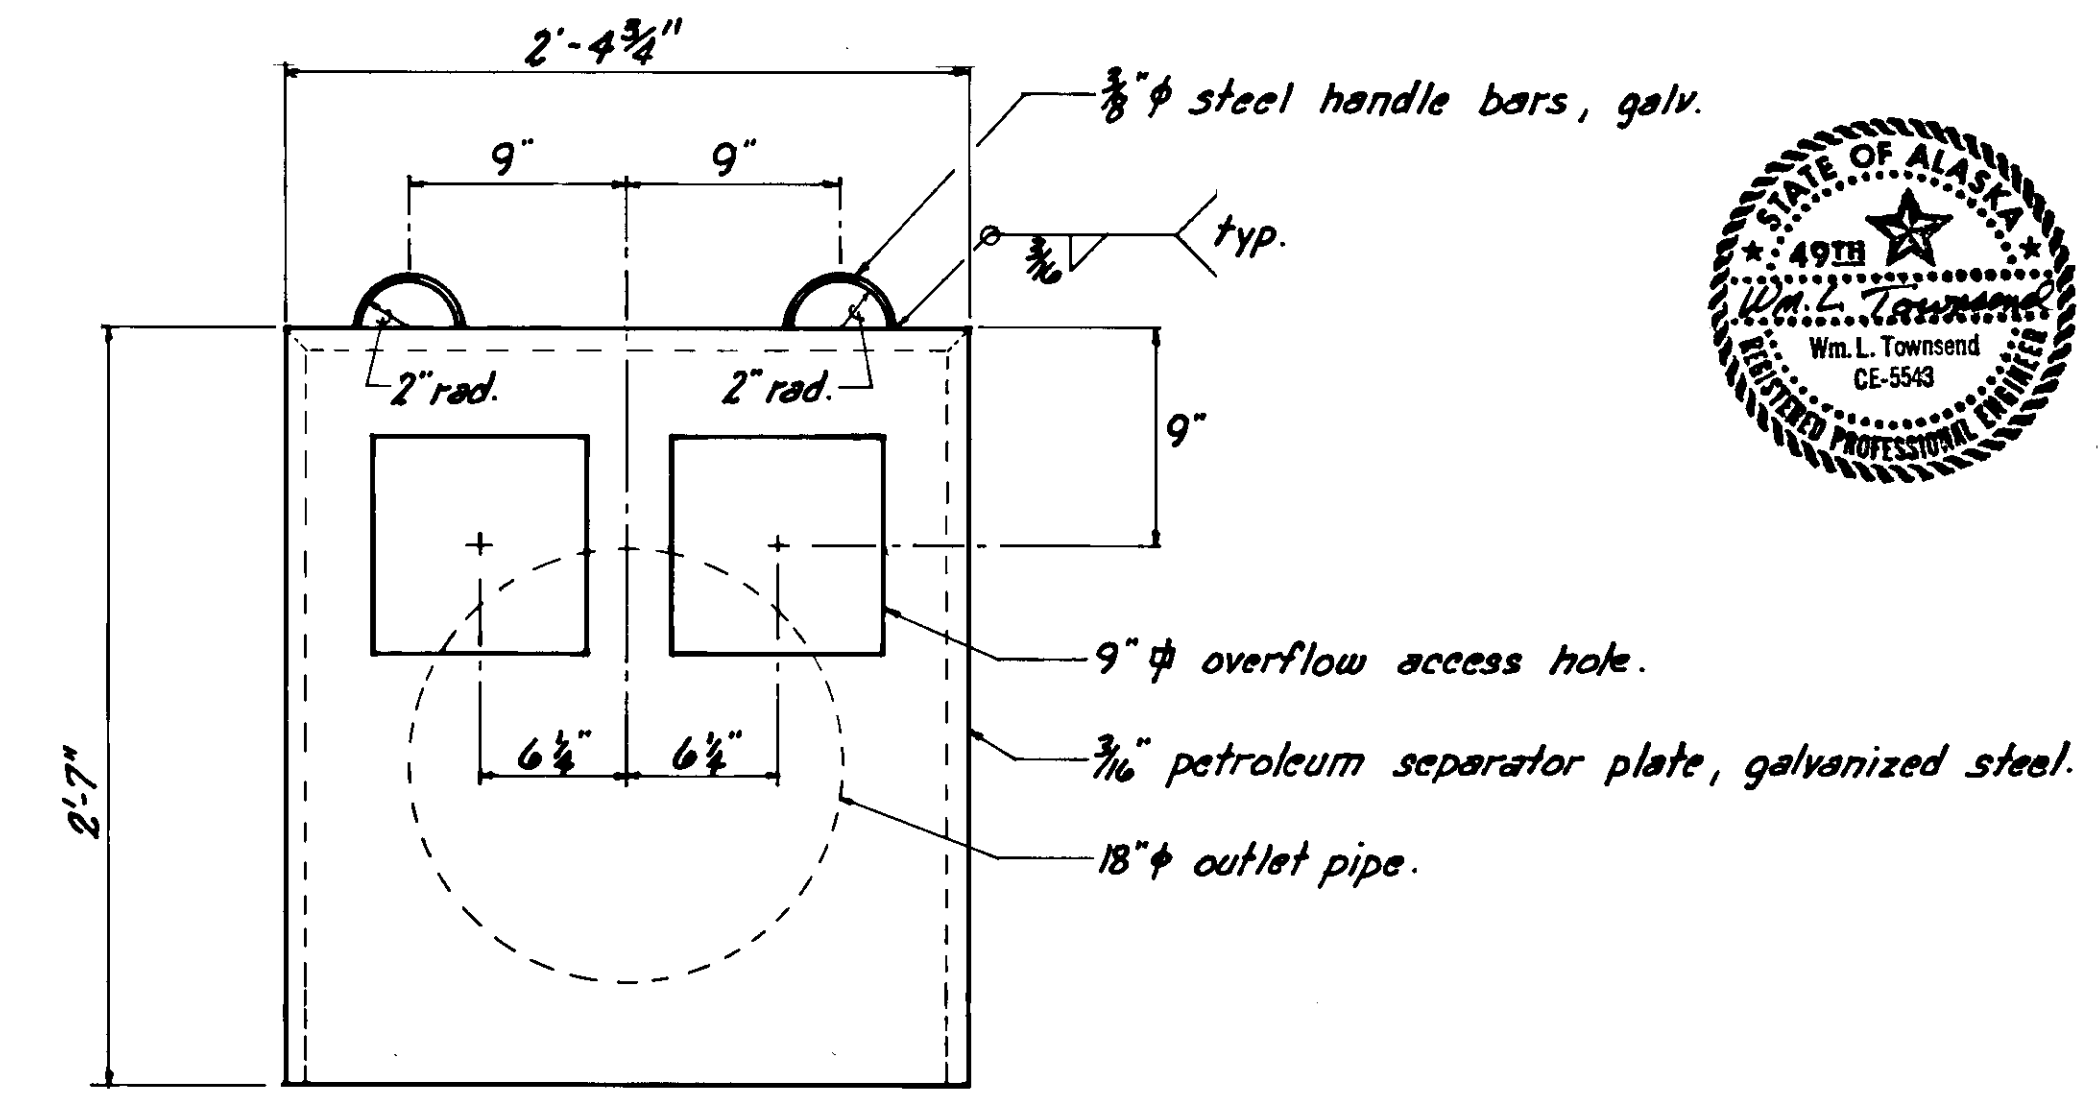

**PETROLEUM SEPARATOR PLATE DETAIL**

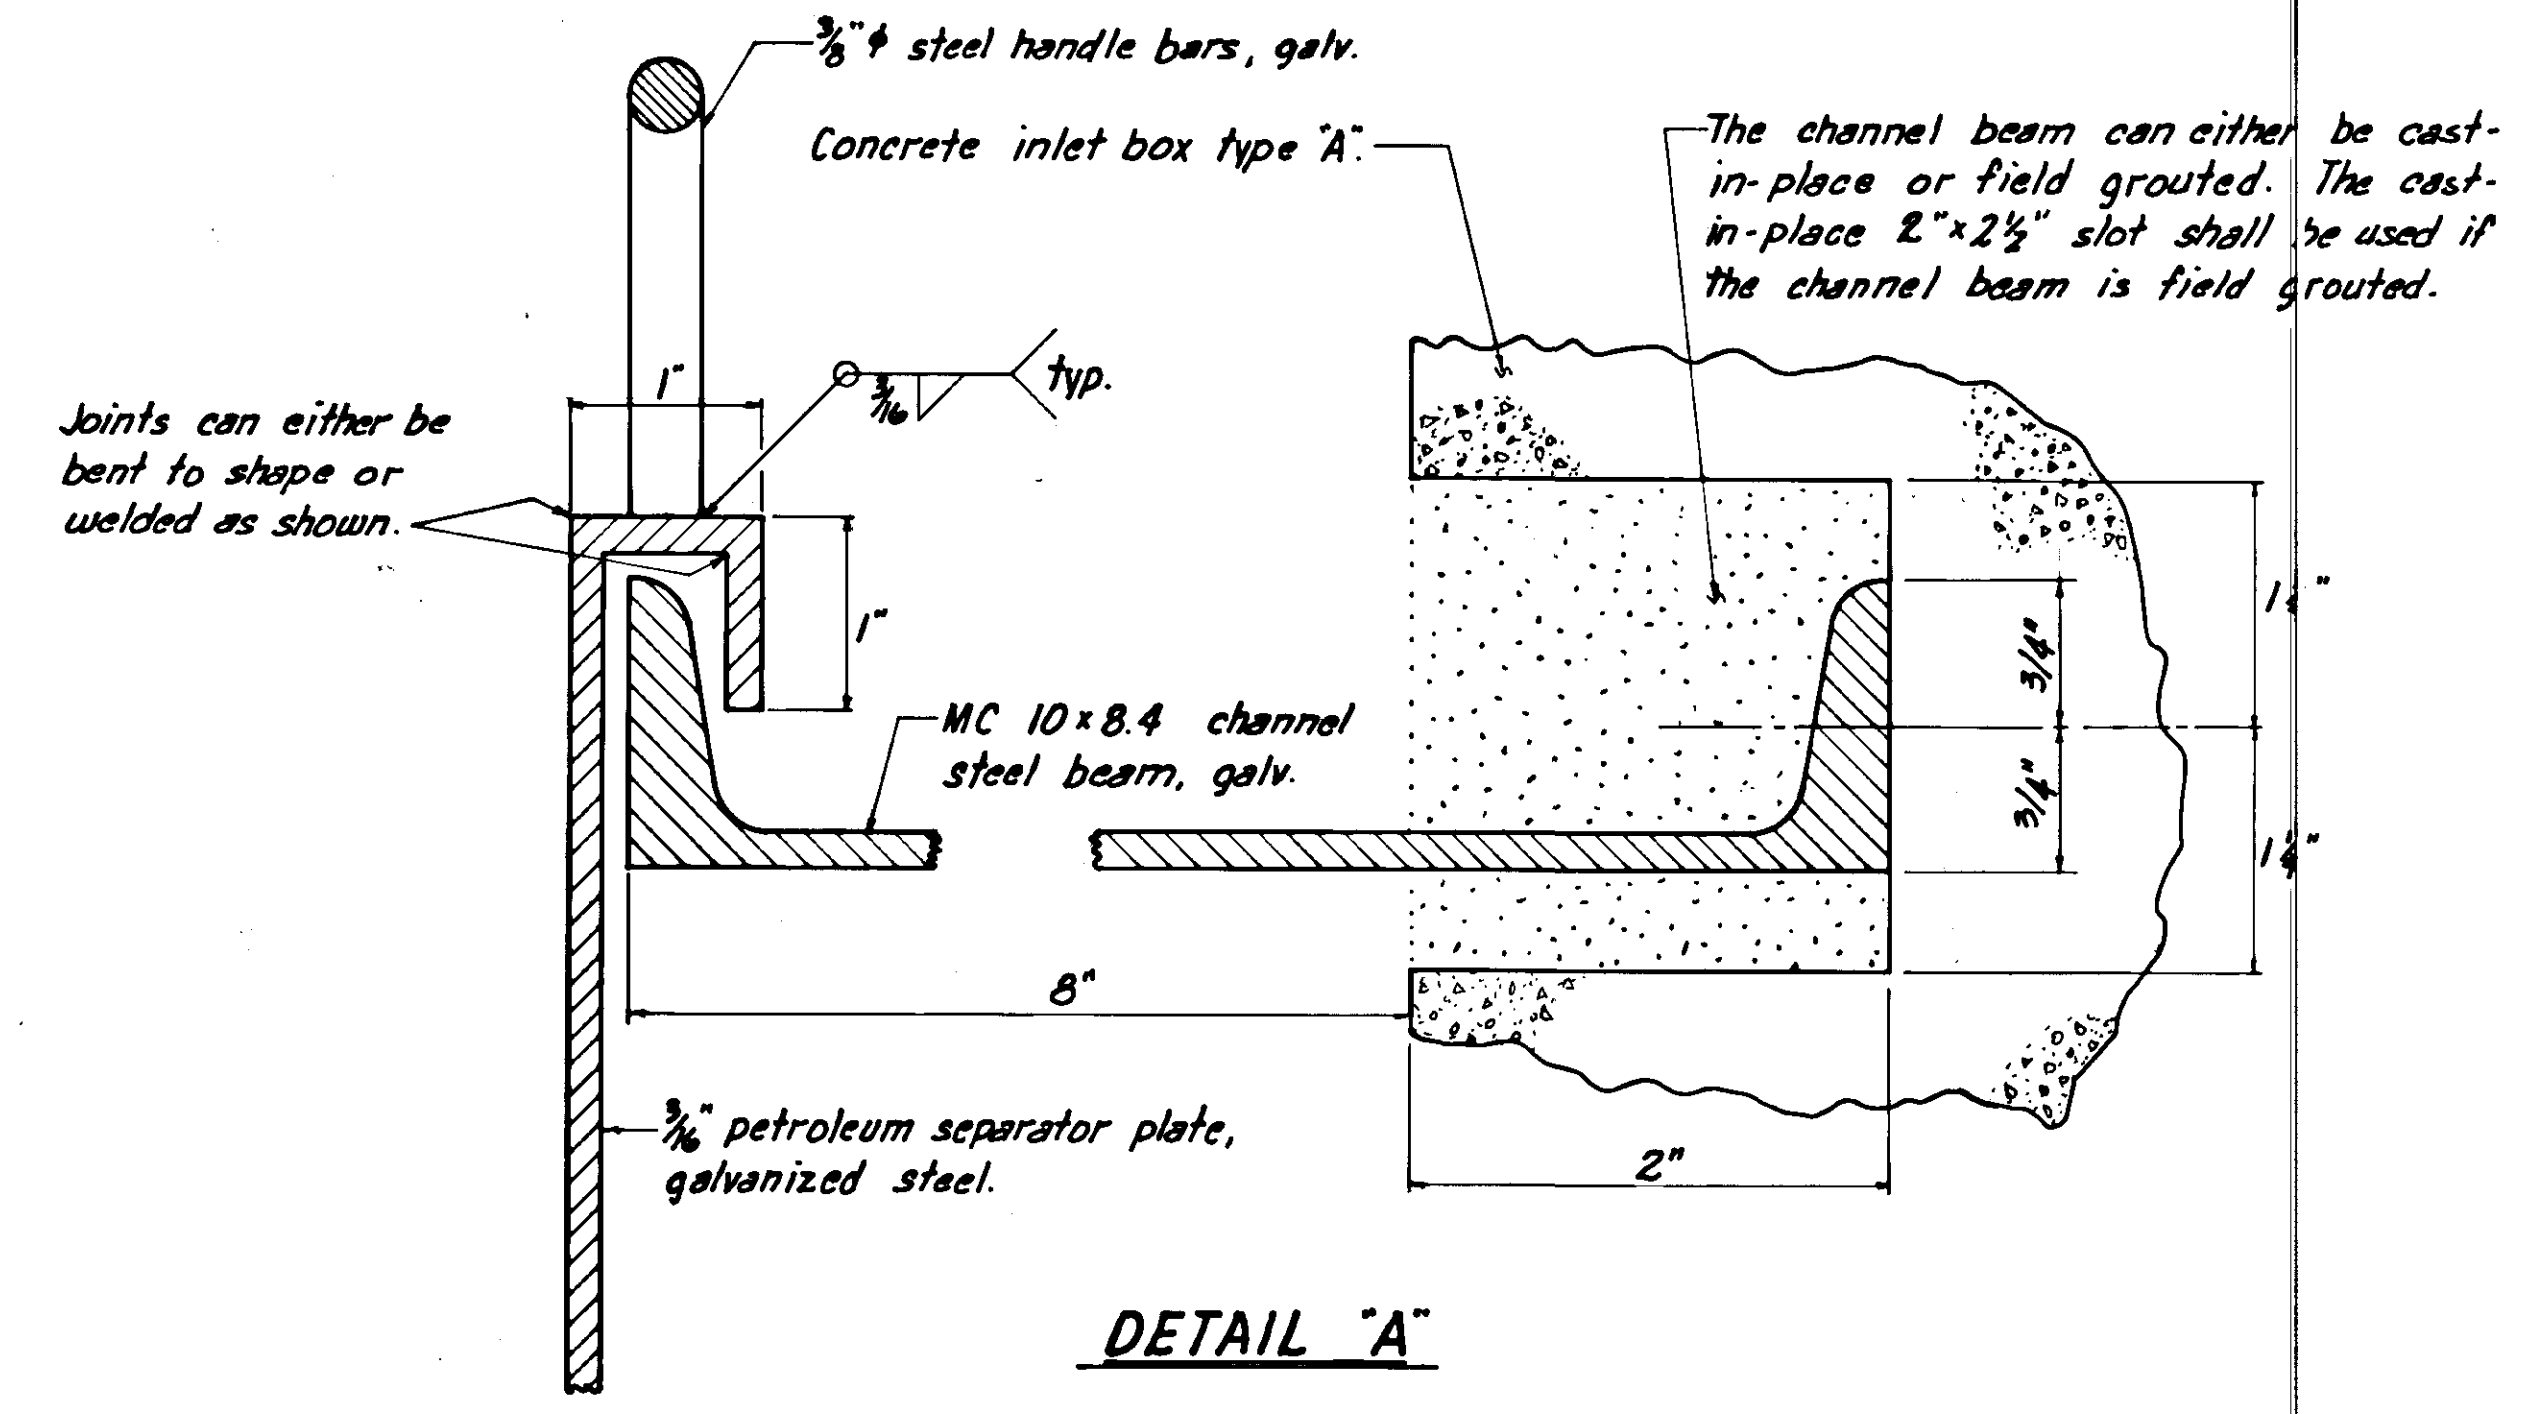



**DETAIL 'A'**

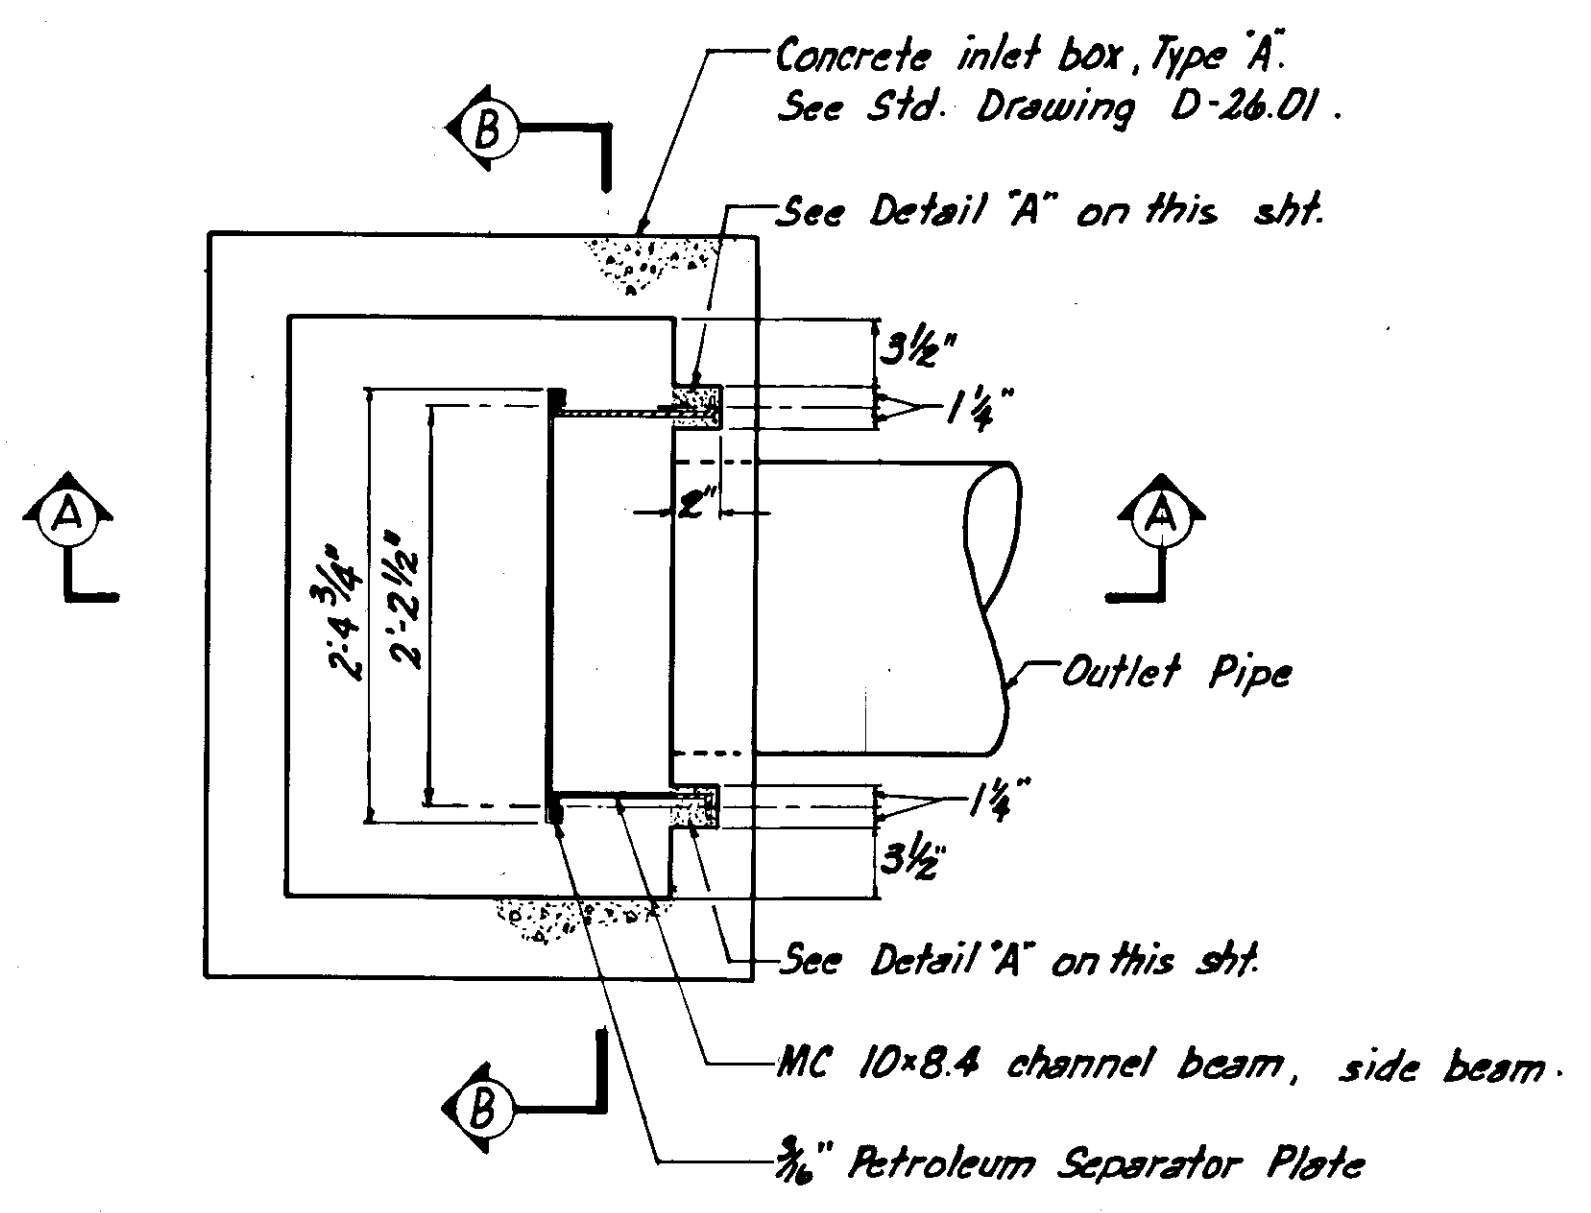

**PLAN VIEW  
PETROLEUM SEPARATOR**

**PETROLEUM SEPARATOR NOTES**






1. Petroleum separator plate shall be installed on inlets S-5, S-6, S-7, S-12, S-15, S-16 & S-18.
2. All fabrication shall be made in the shop and galvanized after fabrication.
3. Inlets with petroleum separator assembly shall be paid under pay item 604(5B), Inlet, Type 'A' w/Petroleum Separator.

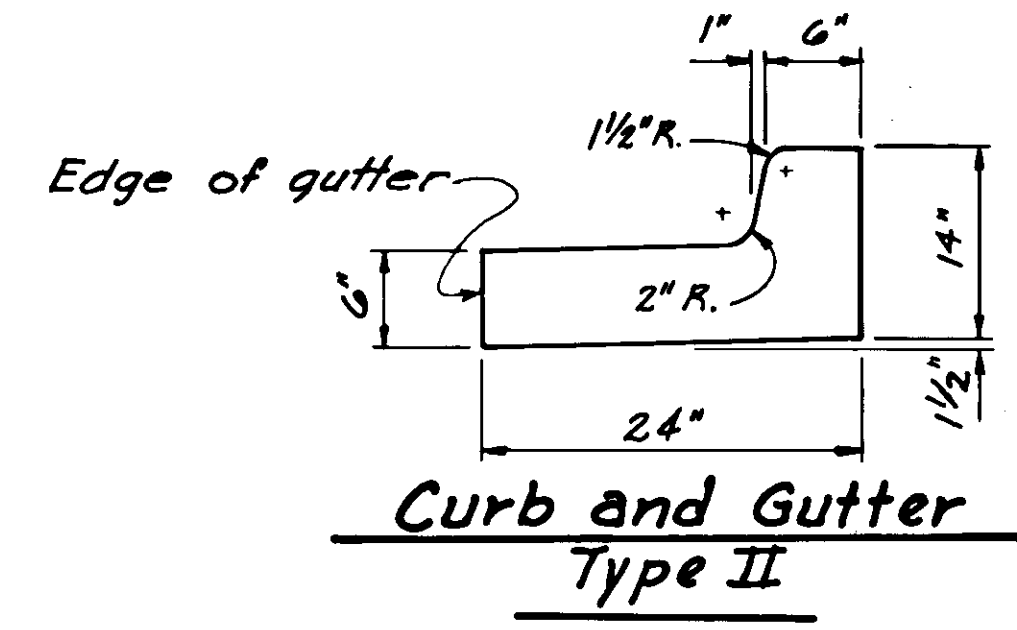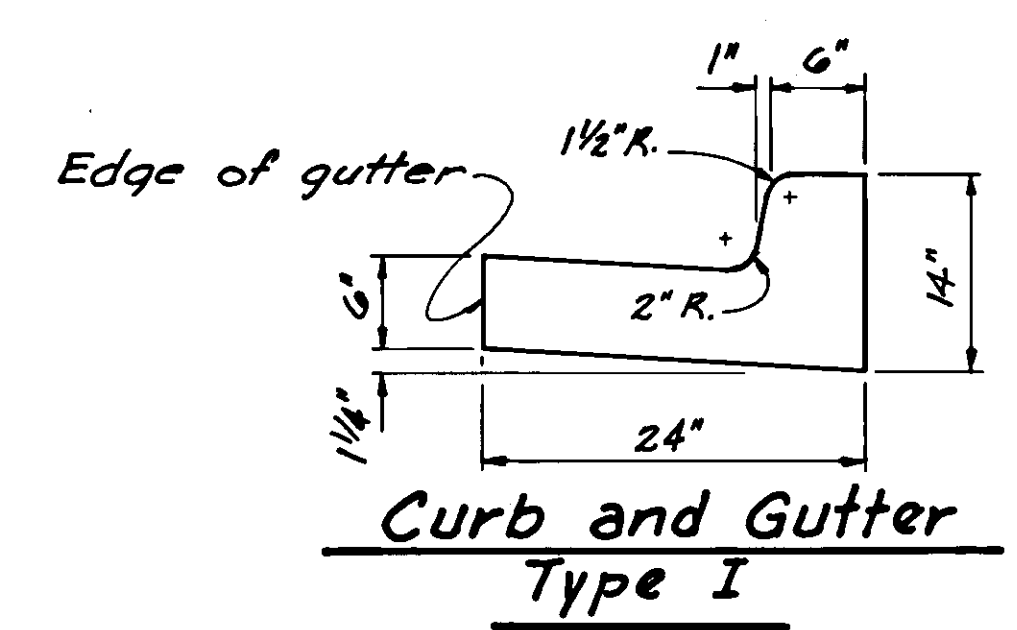

STATION	OFFSET		REMARKS
	Left	Right	
0+32+53.5		45.5'	RECONSTRUCT Adjust exist. sewer manhole
0+39+10	23.0'		" " " "
0+44+51	28.0'		" " " "
0+49+64 48+54	30.0'		RECONSTRUCT exist. sewer manhole ADJUST


**Curb and Gutter Notes**

- Premolded expansion joint filler and Polymer joint sealer shall be considered incidental to item 609 (2).
- Curb and Gutter expansion joints shall be at each end of the curb returns and immediately preceding and following curb cuts. Thereafter they shall be placed at 30'-0" (max.) intervals except where shorter sections are needed for closure.
- All curb and gutters shall be Class "A" concrete with minimum 28 day compressive strength of  $f_c = 3000$  p.s.i.
- Curb cuts shall be provided at all pedestrian cross-walks, bike paths and as shown on the intersection details. Curb cut width shall match the width of the pedestrian cross-walk, bike path or as shown on the intersection details.
- Curb and Gutter, Type I, shall be used if existing roadway cross slope drains toward the curb. Curb and Gutter, Type II, shall be used if existing roadway cross slope drains away from the curb.
- Curb and Gutter Type I and Type II shall be paid under pay item 609(2) Curb and Gutter
- Depression depth at the flow line for the inlet grate as shown on D-23.00 of the Standard Drawing shall be changed from  $1\frac{1}{2}$ " to  $\frac{3}{4}$ ".

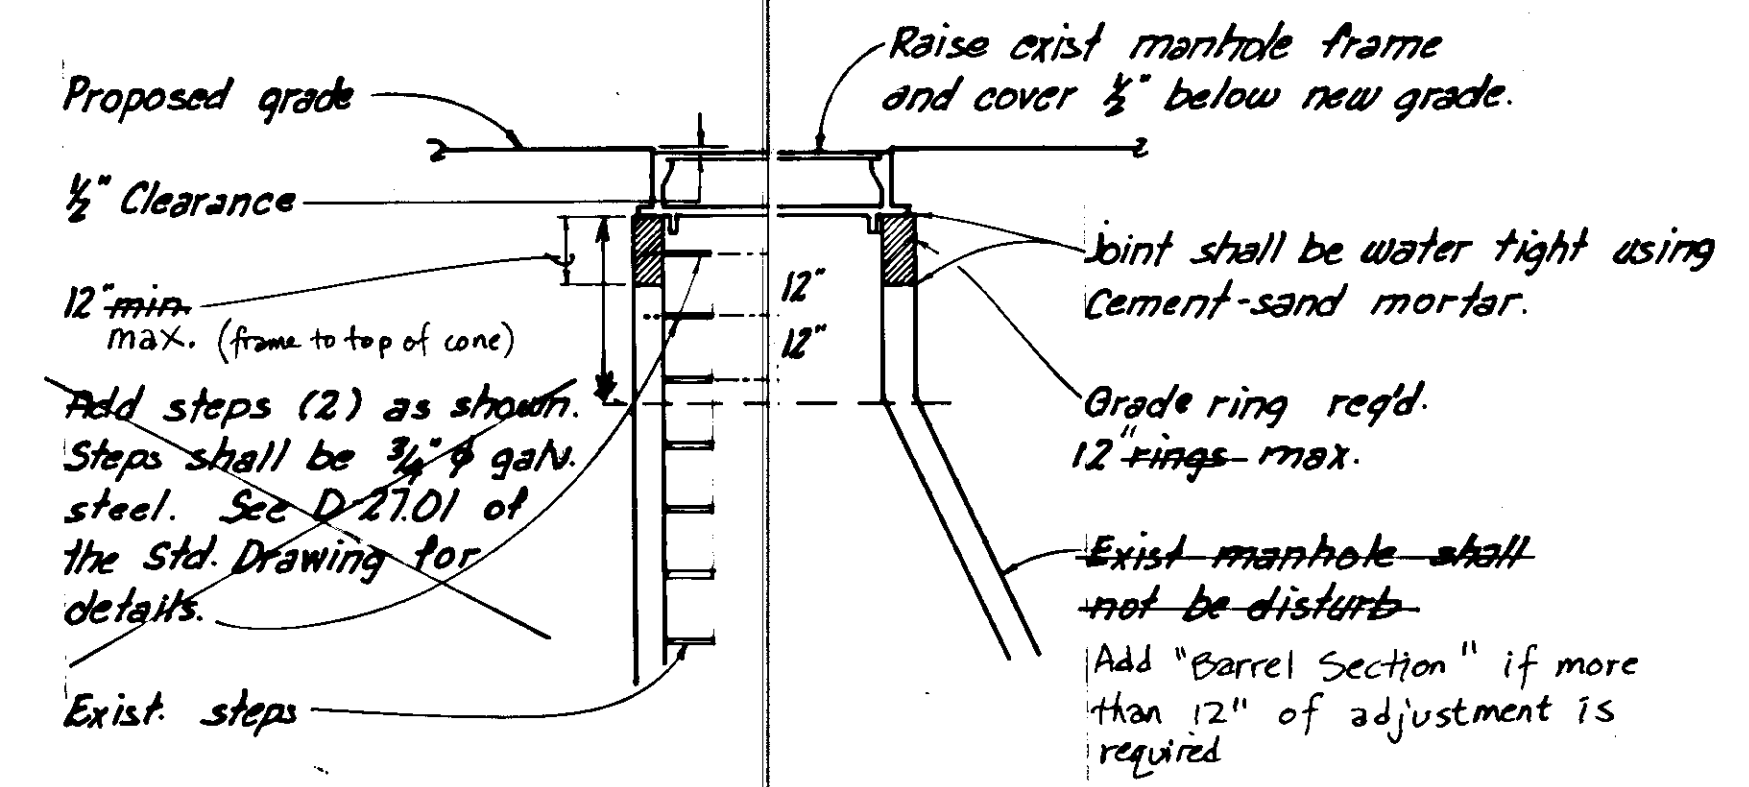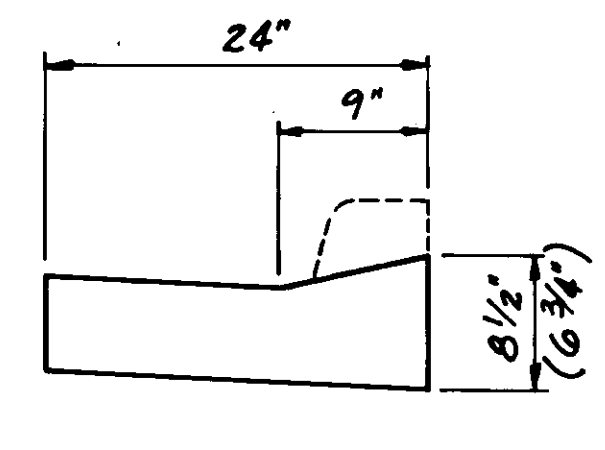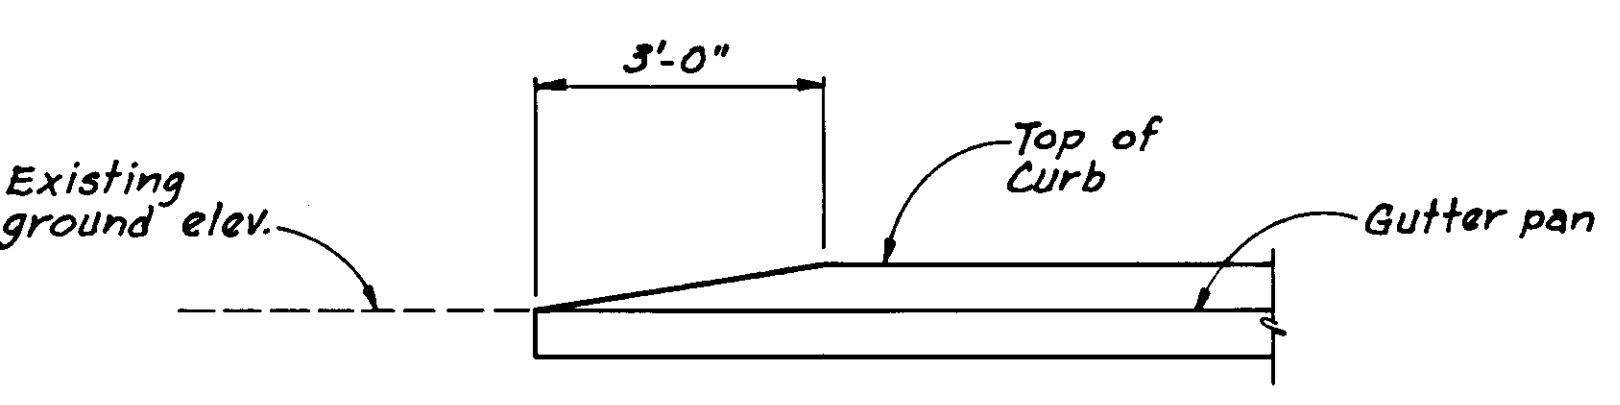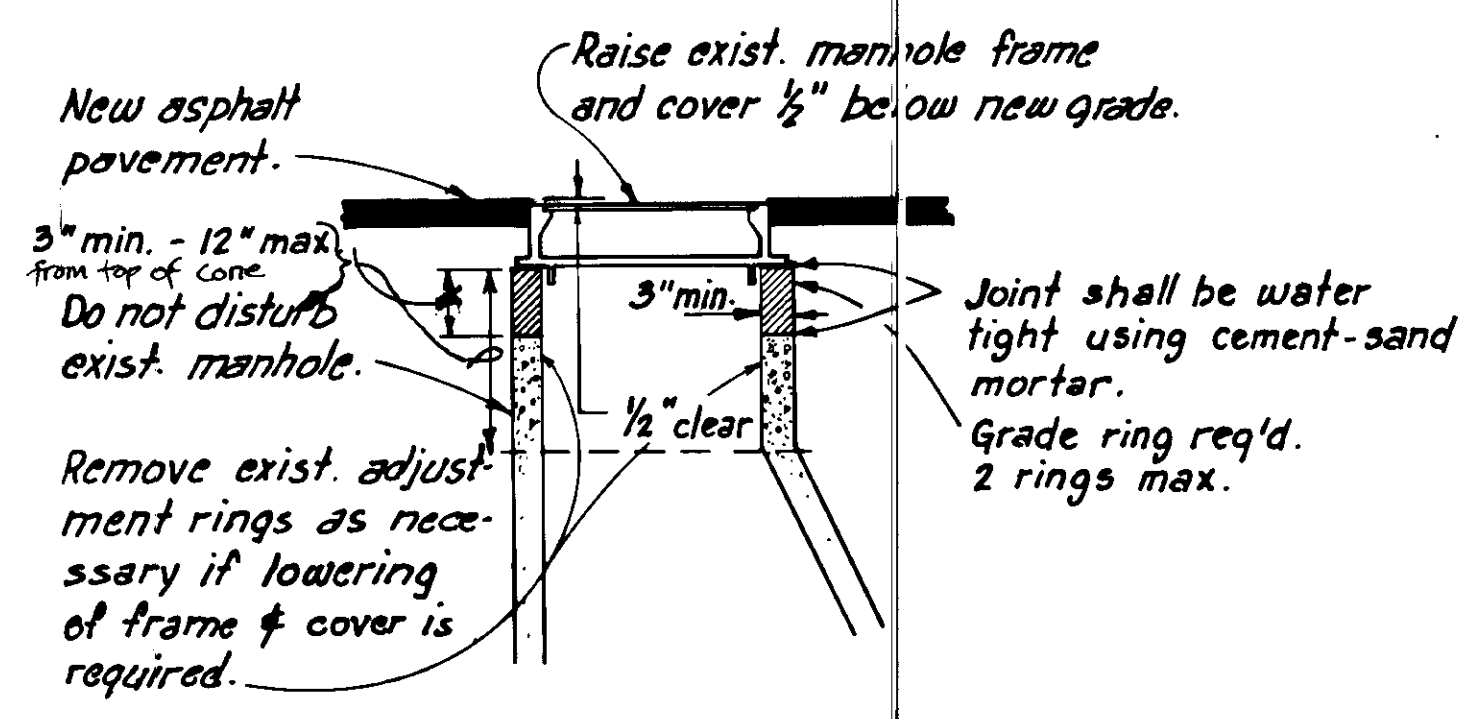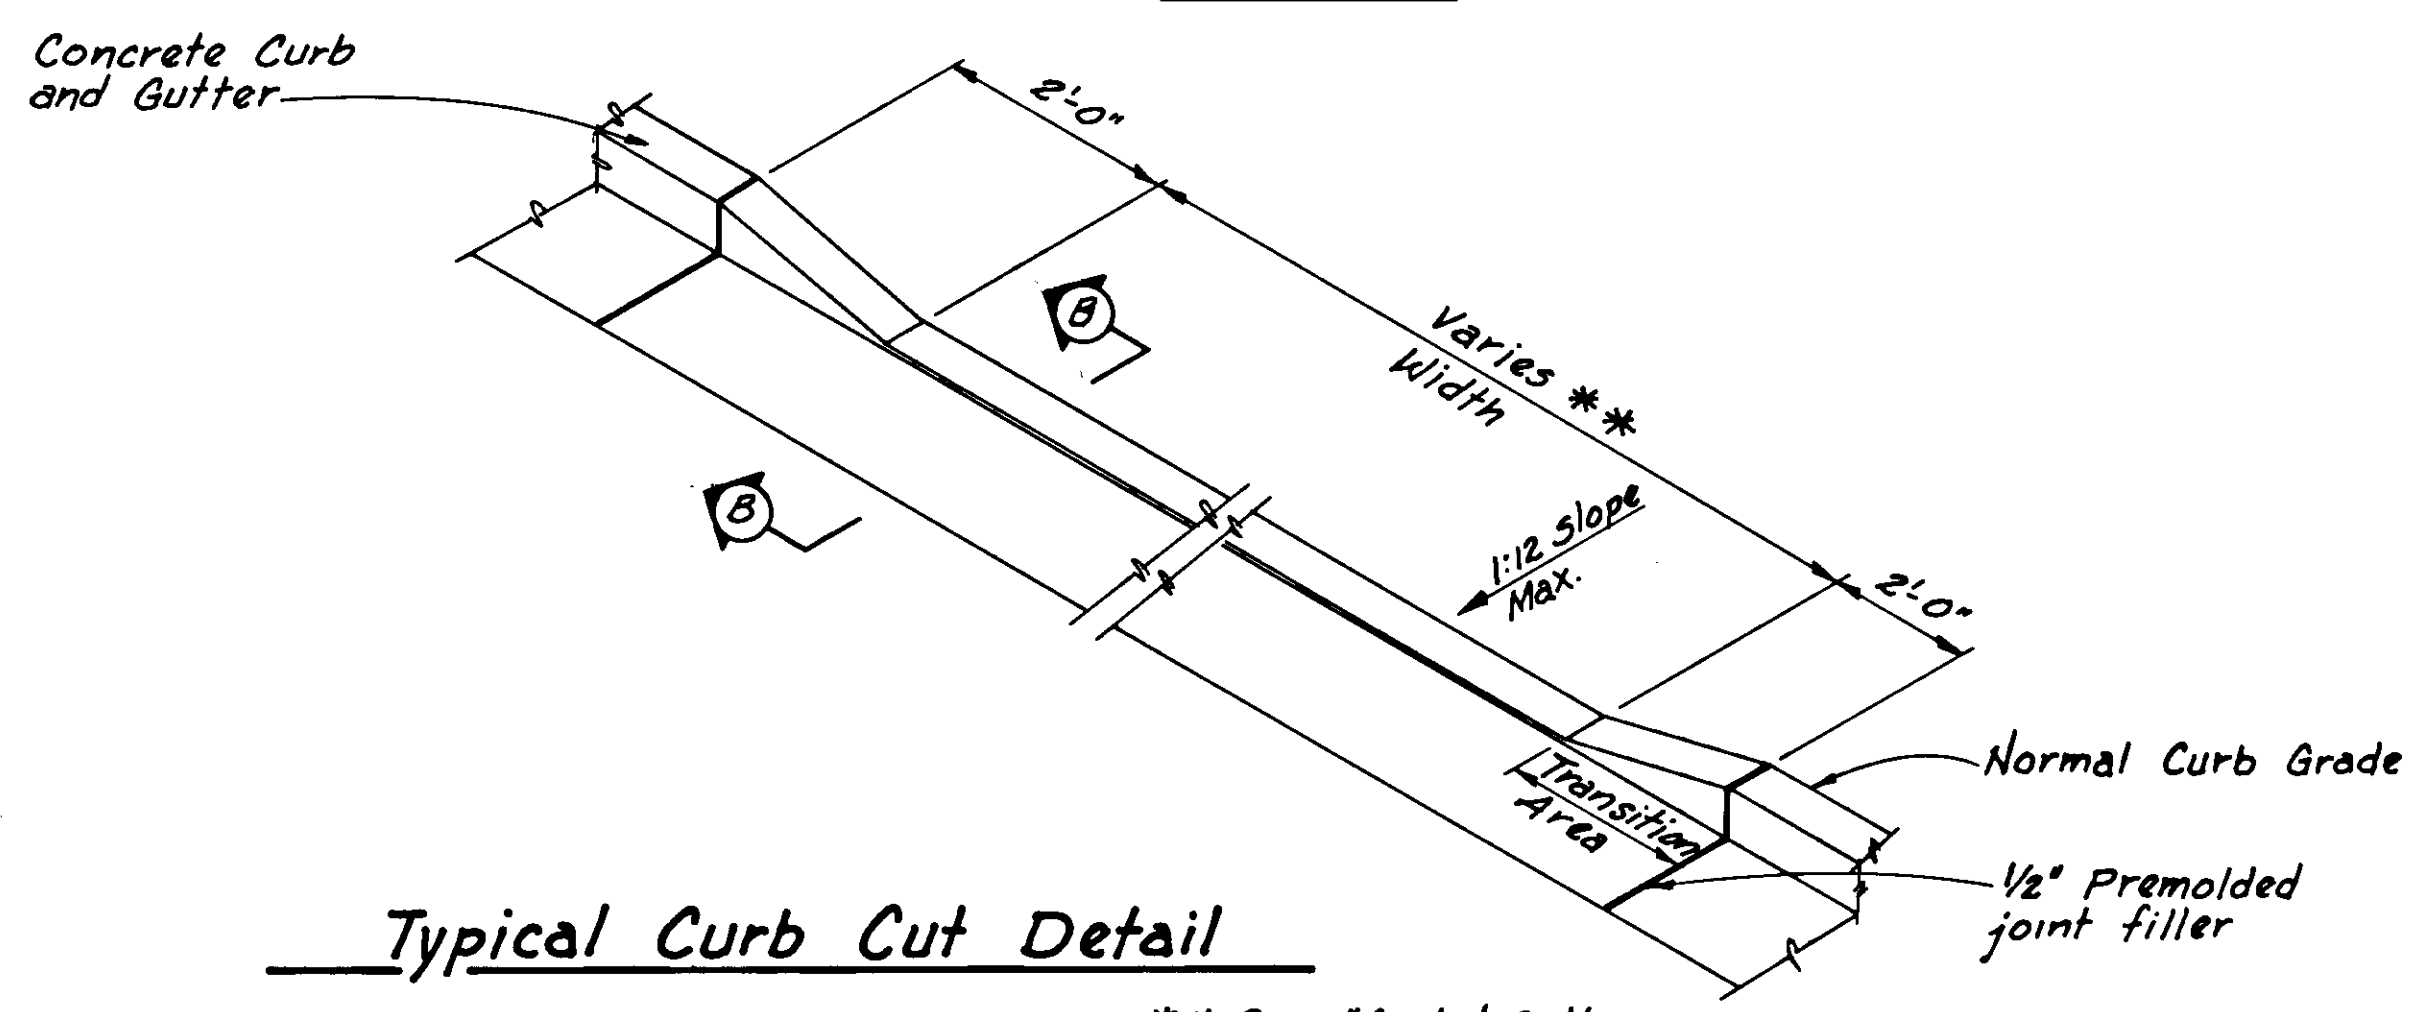

**Manhole Adjustment Notes**


- Grade rings shall be reset in full bed of mortar. Design and strength requirements for the grade rings shall conform to ASTM Designation C-478.
- The Contractor can use bricks & mortar combination to raise manhole frame & cover to new grade if adjustment is less than three (3) inches.
- Manhole located at Sta 0+49+64, 30.0' Lt. shall be <sup>adjusted</sup> reconstructed as shown on this sheet. The two (2) steps to be added shall be considered incidental to pay item 604(3), Reconstruct Existing Manholes.

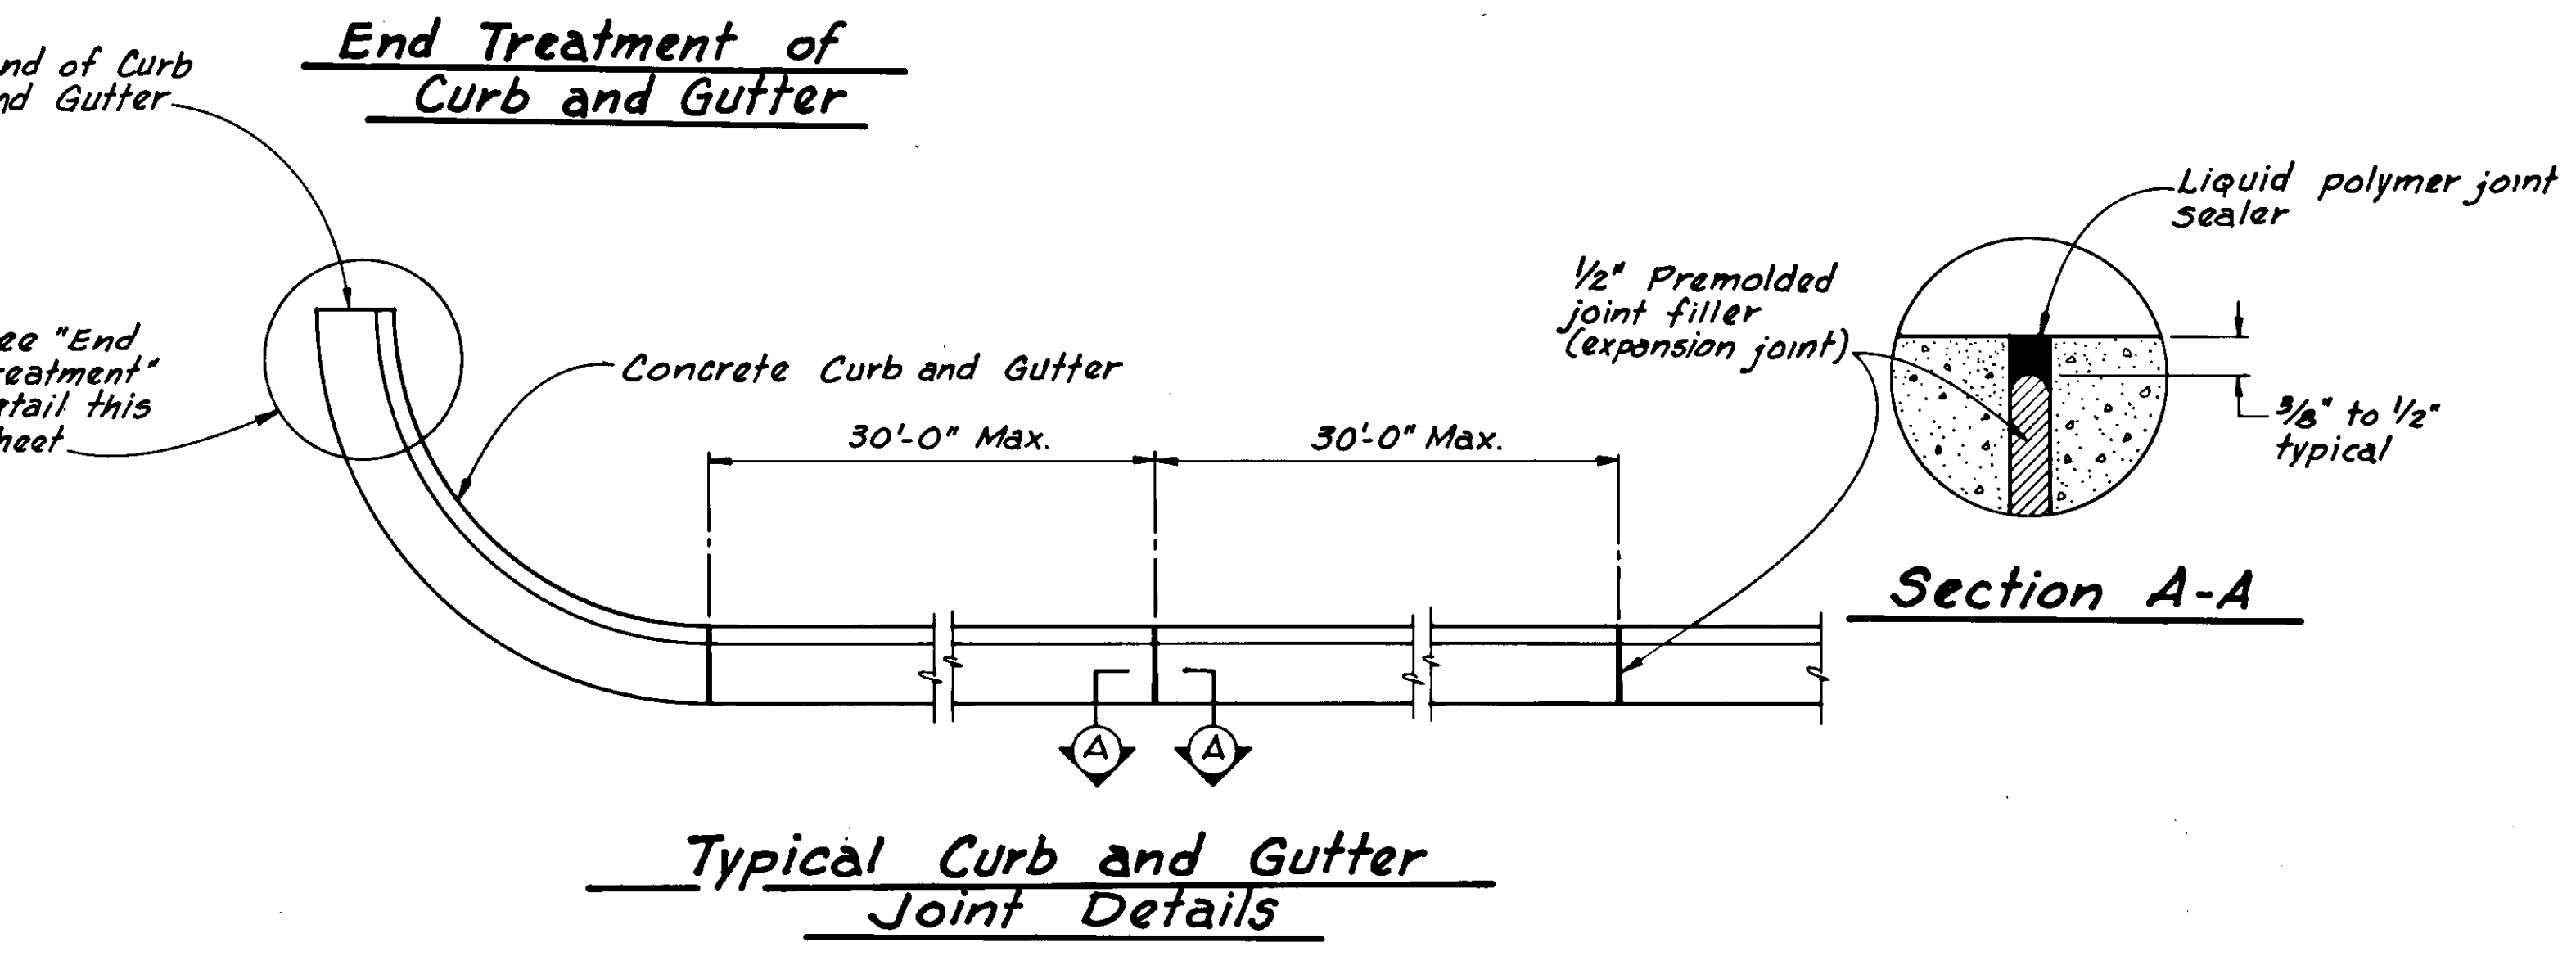



### LUMINAIRE FOUNDATION NOTES


1. Wrench tighten the lower slip base bolts. There is no torque requirement.
2. A liquid tight conduit coupling shall be used for splicing an extension of the exist. conduit. The length of the extension shall be field determined.
3. Bolts, nuts, washer shall conform to ASTM A325 and galvanized in accordance with ASTM A153.
4. Luminaire footing shall be constructed using Class "A" concrete with minimum 28 day compressive strength of  $f'_c = 3,000$  p.s.i.
5. Grout shall be 2" min to 3" max. in thickness. Grout mix shall be 3 parts sand to 1 part cement with only enough water to permit placing and packing.
6. The lower slip base bolt shall be  $\frac{1}{8}" \phi$  - 9NC x 7" long with nuts and washer.
7. The exist. upper slip base does not have to be separated from the lower slip base during construction. If the upper slip base bolt does get unbolted a new bolt, nut and washer shall be provided and torque to 1800 in-lbs.
8. New conductors will be required if there is not enough slack in existing conductor.

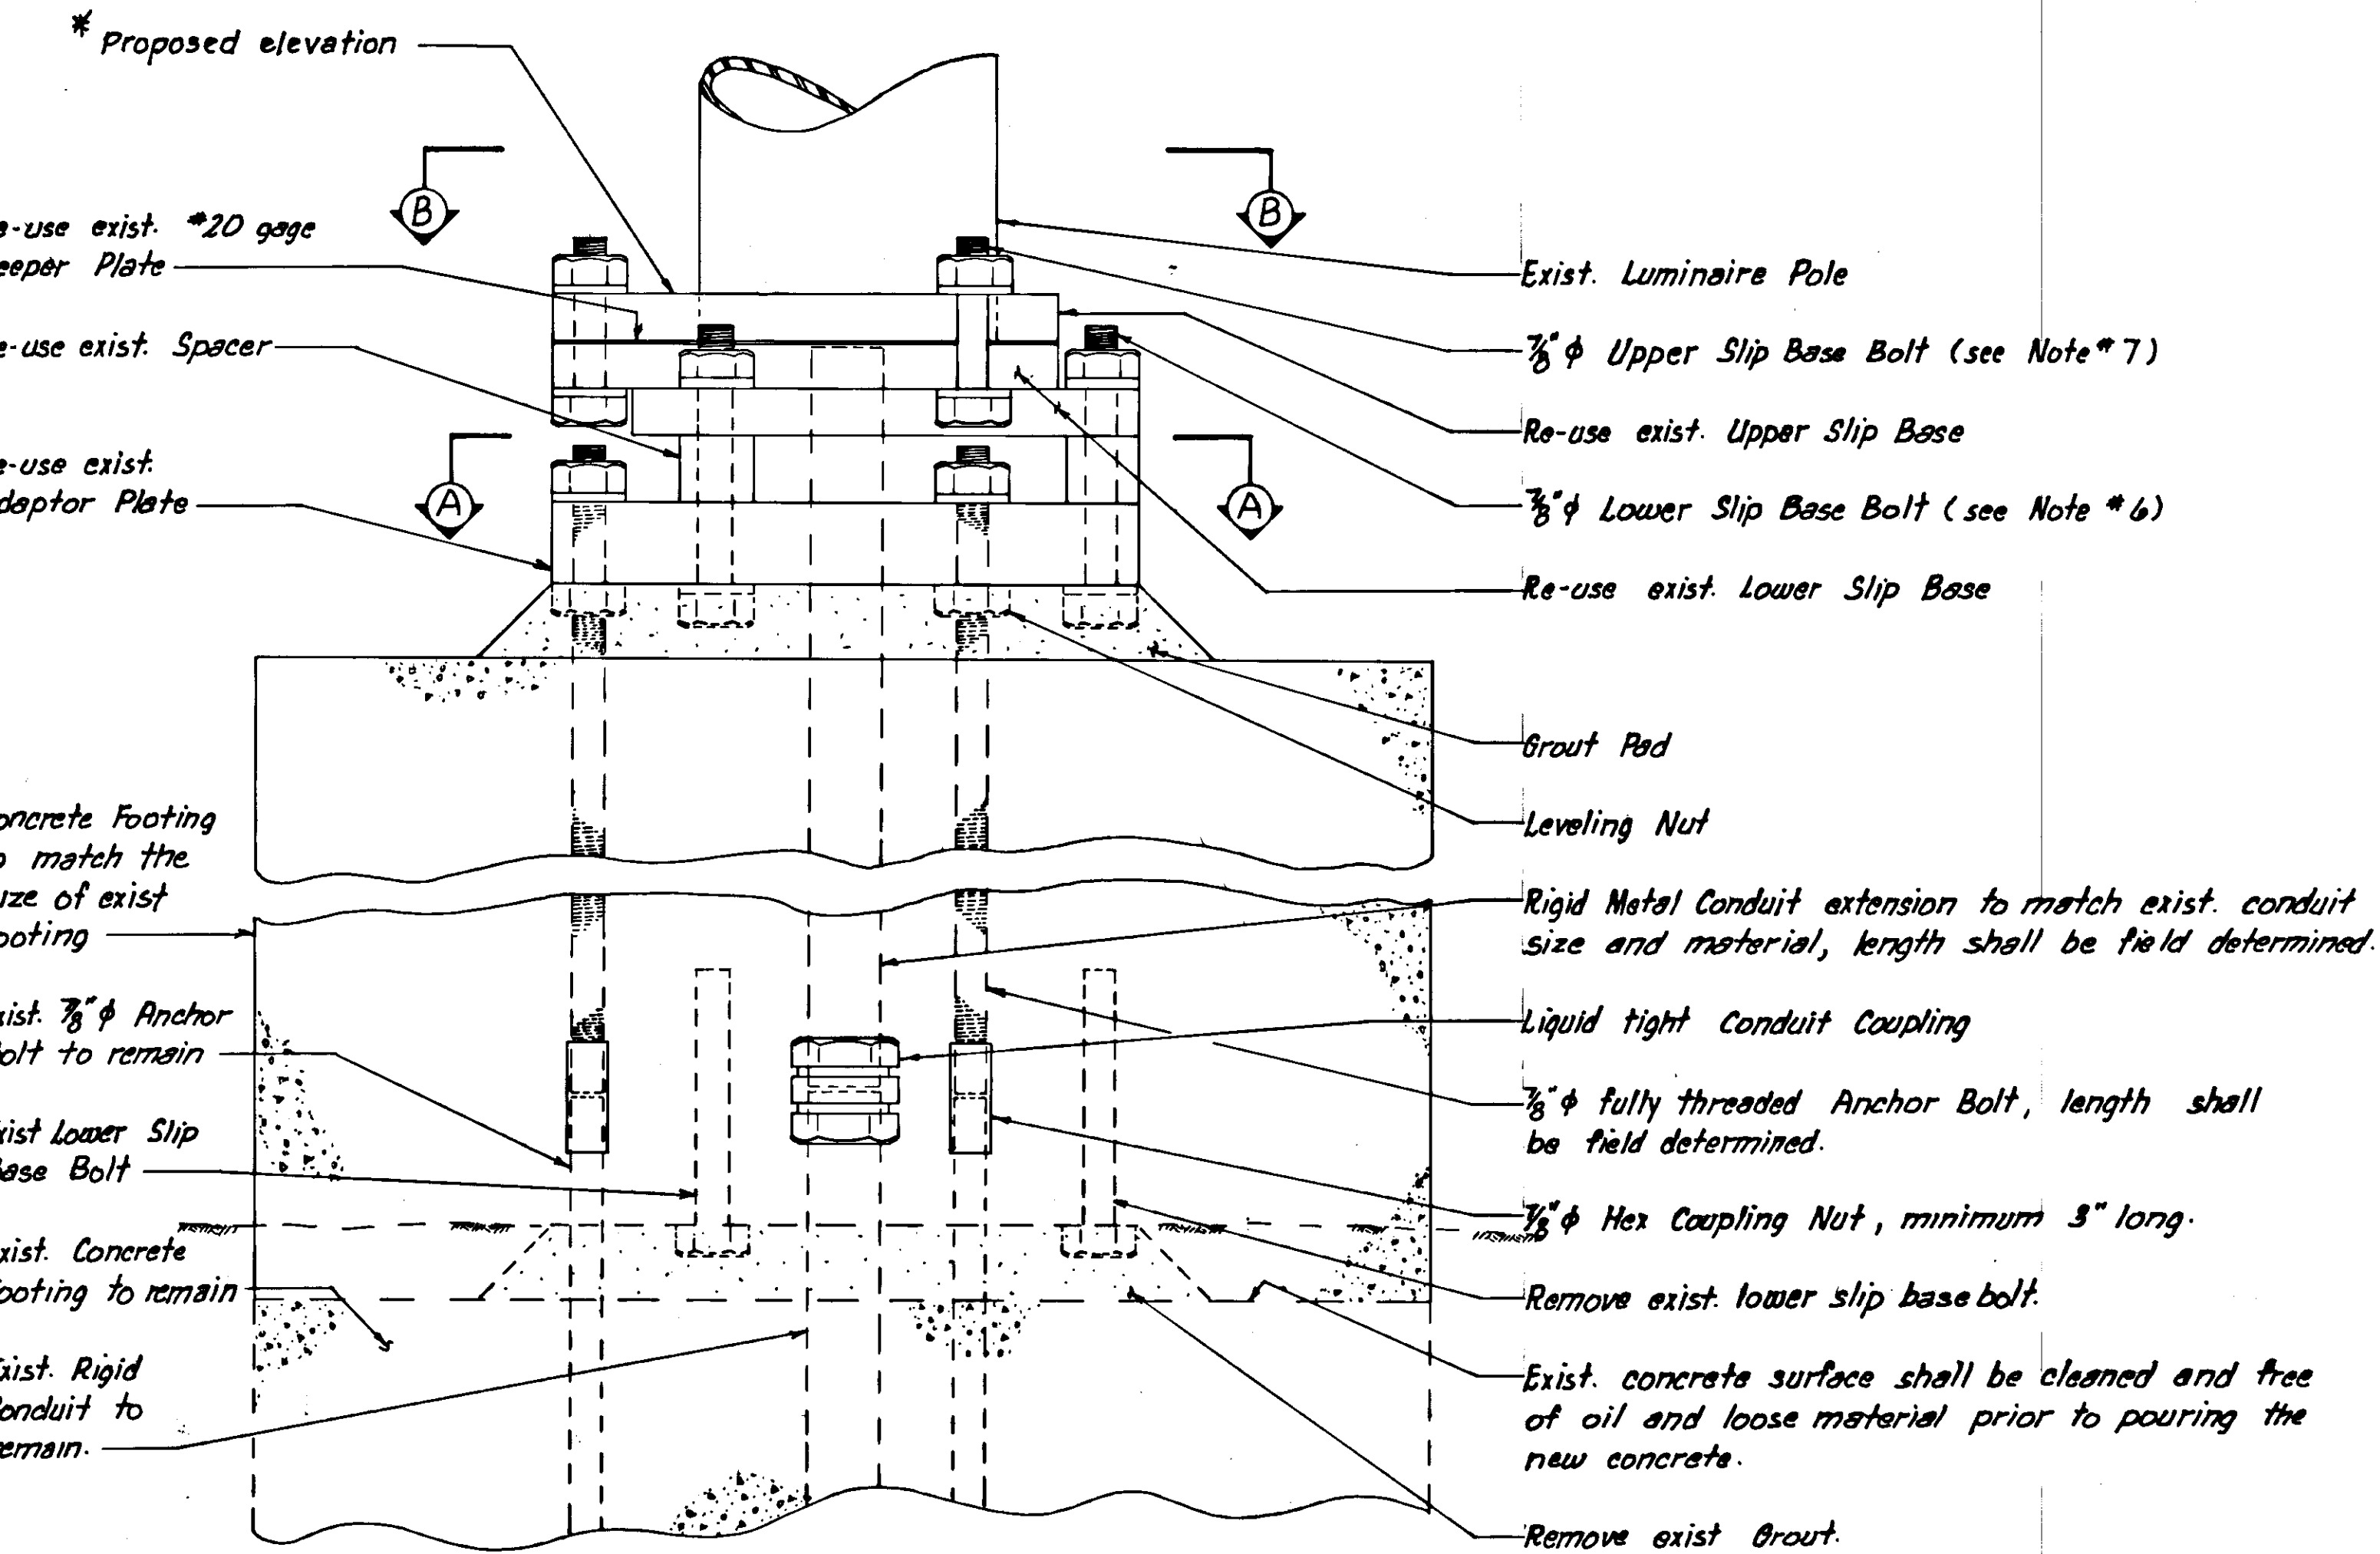

**LUMINAIRE FOUNDATION  
EXTENSION DETAIL**

STATION	OFFSET		EXIST. ELEVATION	PROPOSED ELEVATION*
	LEFT	RIGHT		
49 "0" 47+56.5	37.0		32.24	33.77
50 "0" 50+59	38.0	38.0	34.02	35.50

\*Proposed elevation can be adjusted to better fit field conditions.


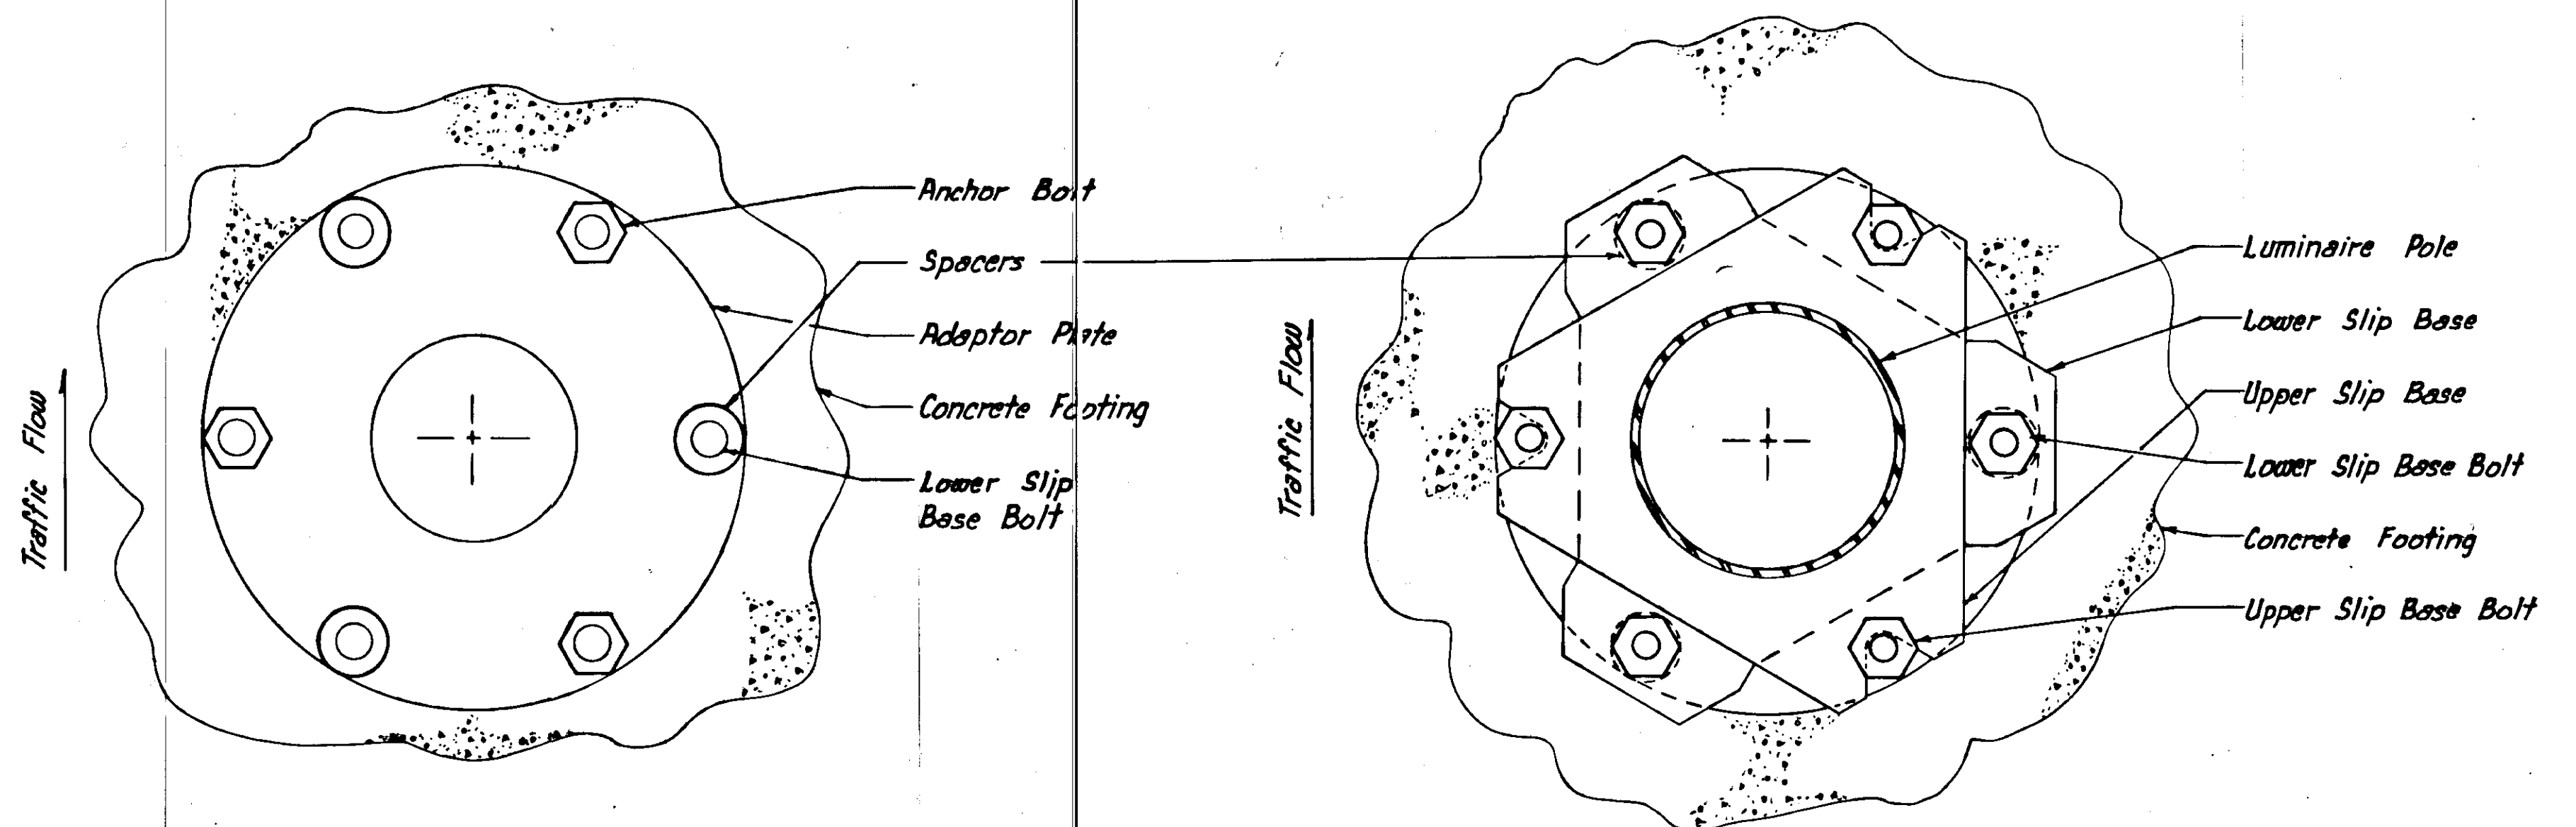


**SECTION A-A**


**SECTION B-B**

# Mendenhall Mall

STATE	PROJECT DESIGNATION	YEAR	SHEET NO.	TOTAL SHEETS
ALASKA	HES-M-966 (14)	'88	22	28

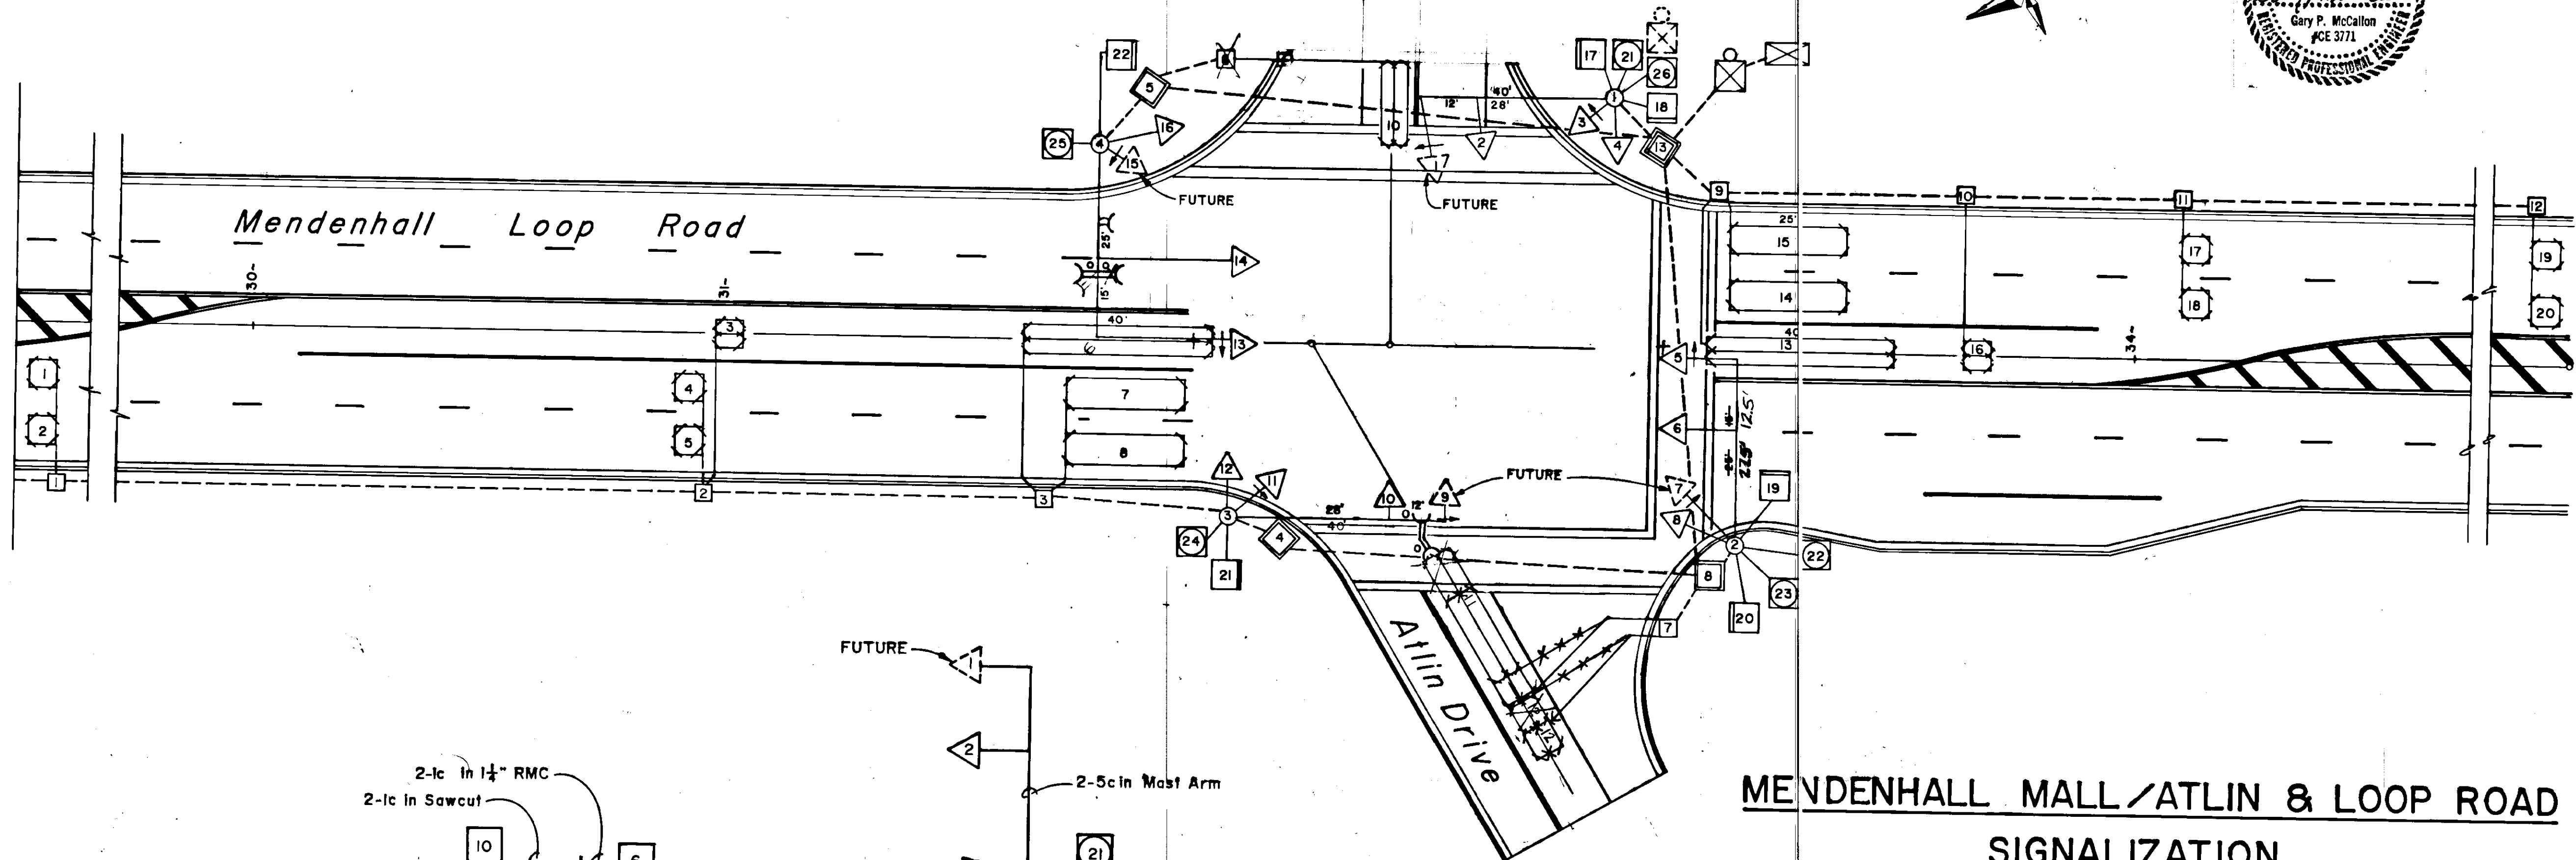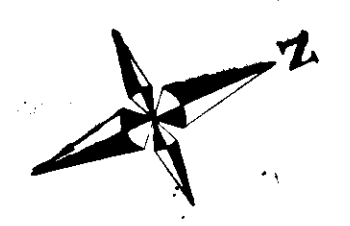

## MENDENHALL MALL / ATLIN & LOOP ROAD SIGNALIZATION

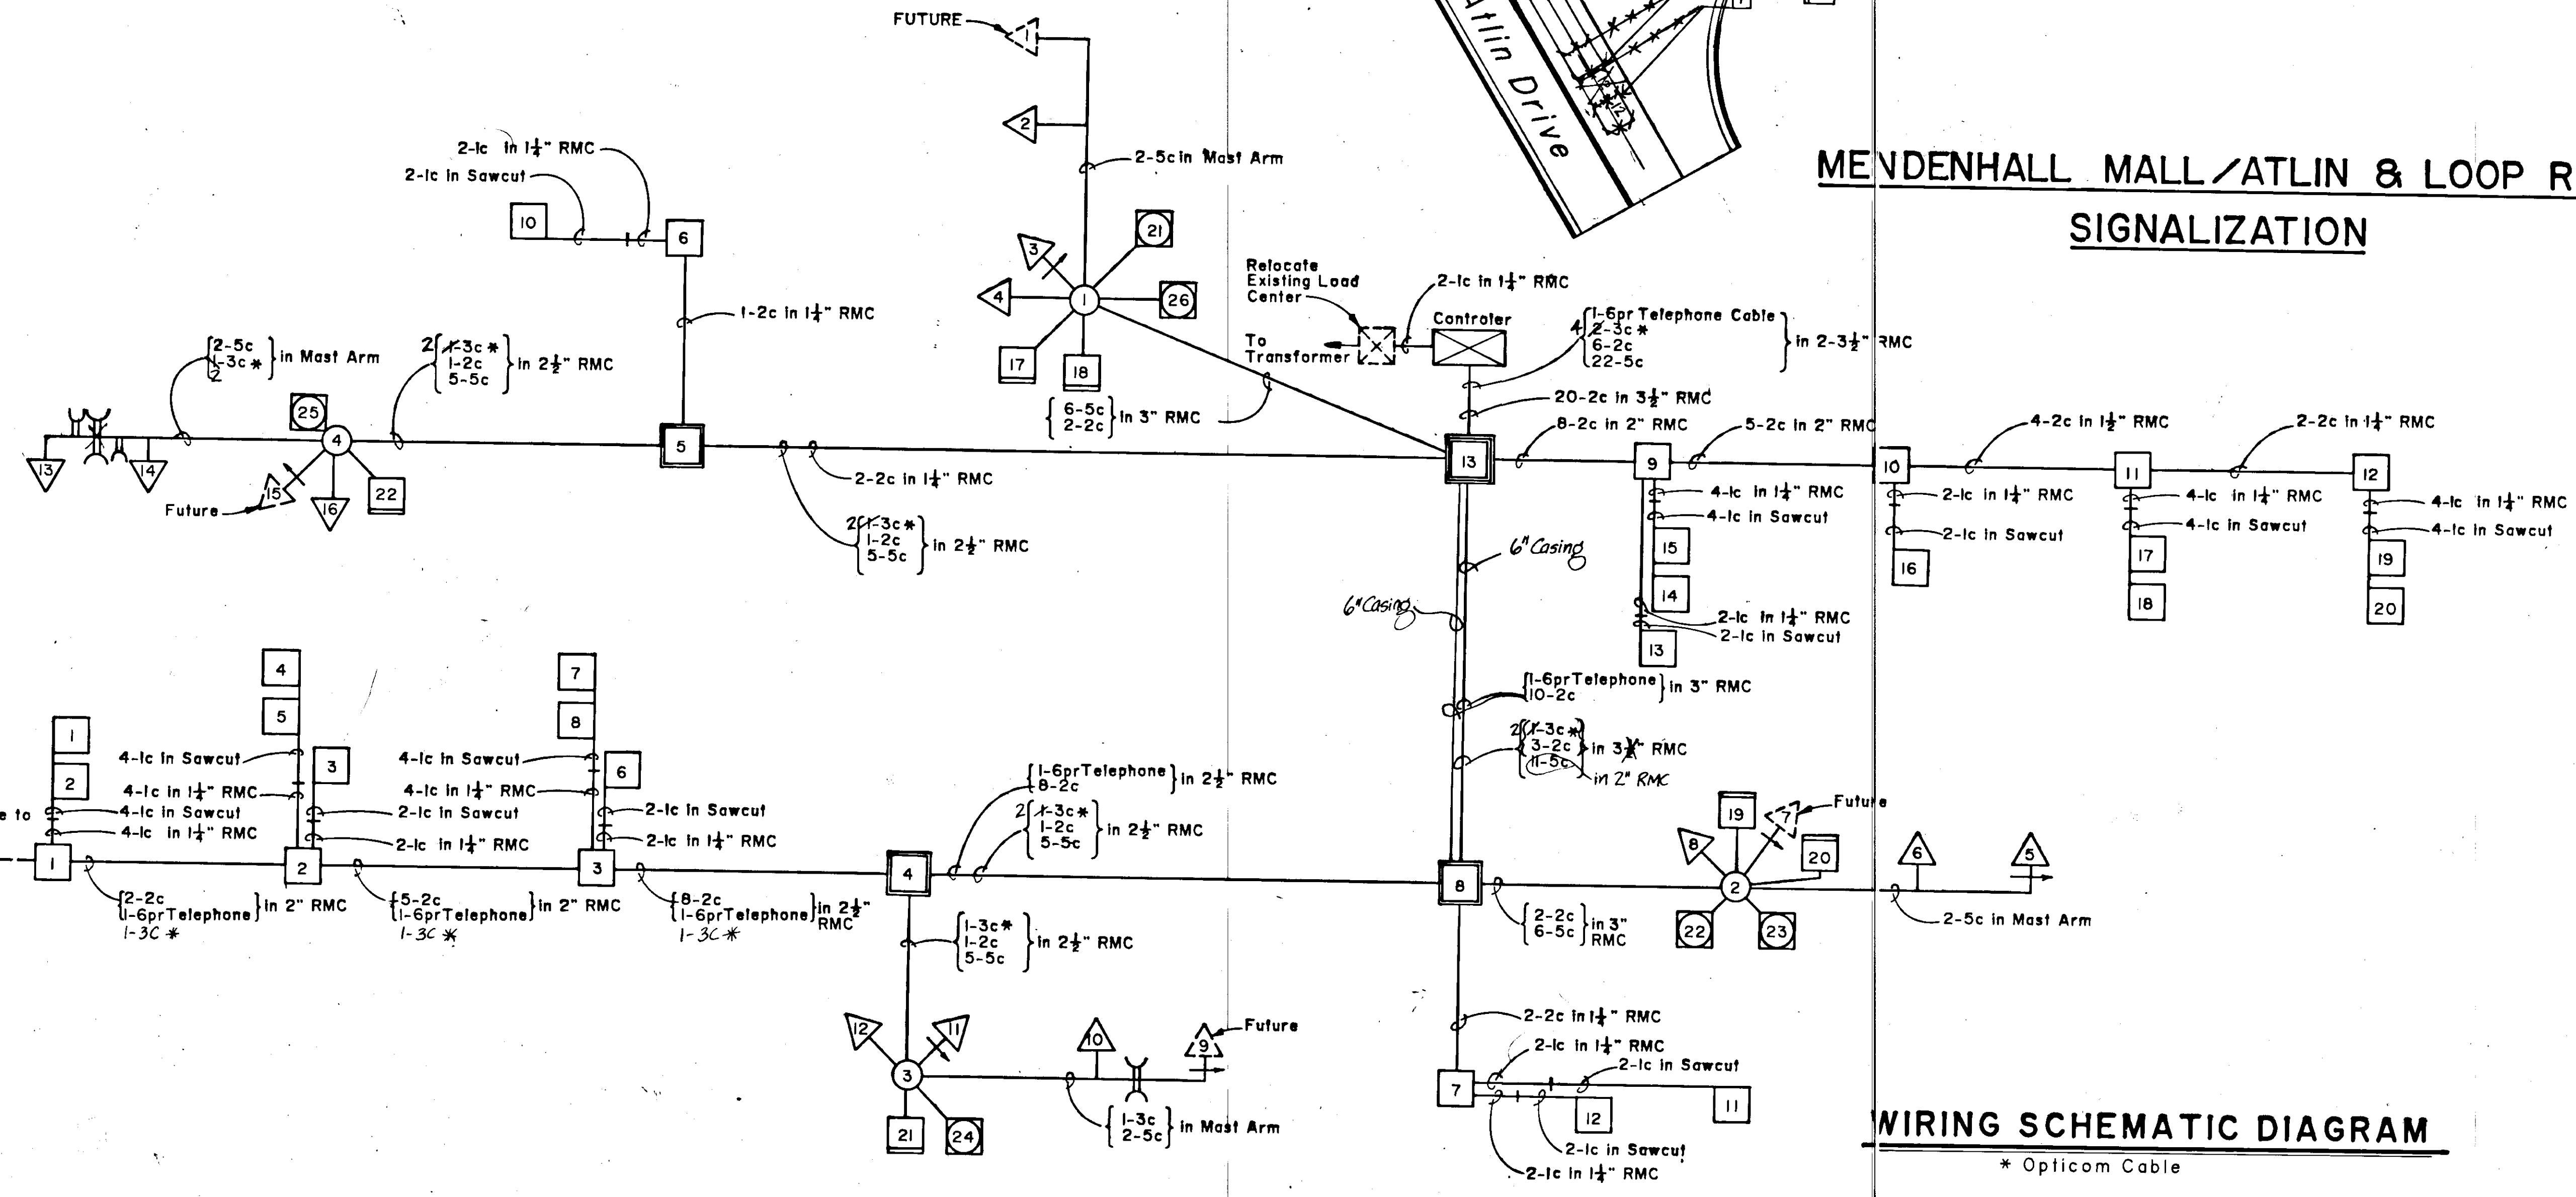

## WIRING SCHEMATIC DIAGRAM

\* Opticom Cable

# Mendenhall Mall / Atlin & Loop Road Signalization Tables

STATE	PROJECT DESIGNATION	YEAR	SHEET NO.	TOTAL SHEETS
ALASKA	HES-M-966(14)	88	23	28

## Detector Summary

Number	Station	Offset		Type	Phase	Remarks
		Lt.	Rt.			
1	"O" 29+45		11'	6'x6' Loop	2	3 Turns
2	"O" 29+45		23'	6'x6' Loop	2	3 Turns
3	"O" 31+01	0'		6'x6' Loop	5	2-4-2 Quadrapole
4	"O" 30+92		11'	6'x6' Loop	2	3 Turns
5	"O" 30+92		23'	6'x6' Loop	2	3 Turns
6	"O" 31+84+76	0'		6'x40' Loop	5	2-4-2 Quadrapole
7	"O" 31+95+90		11'	6'x25' Loop	2	2 Turns
8	"O" 31+95+90		23'	6'x25' Loop	2	2 Turns
10	"O" 32+41	50'		6'x20' Loop	8	2-4-2 Quadrapole
11	"O" A10+67+73	0'		6'x30' Loop	4	2-4-2 Quadrapole
12	"O" A10+90+94	0'		6'x6' Loop	4	2-4-2 Quadrapole
13	"O" 33+22+30	0'		6'x40' Loop	1	2-4-2 Quadrapole
14	"O" 33+18.5+25	11'		6'x25' Loop	6	2 Turns
15	"O" 33+18.5+25	23'		6'x25' Loop	6	2 Turns
16	"O" 33+67	0'		6'x6' Loop	1	2-4-2 Quadrapole
17	"O" 34+13	23'		6'x6' Loop	6	3 Turns
18	"O" 34+13	11'		6'x6' Loop	6	3 Turns
19	"O" 35+58	23'		6'x6' Loop	6	3 Turns
20	"O" 35+58	11'		6'x6' Loop	6	3 Turns
21	"O" 32+73	52'		Ped. Pushbutton	8	Install RIO-4B(L)
22	"O" 33+01		41'	Ped. Pushbutton	4	Install RIO-4B(L)
23	"O" 33+01		41'	Ped. Pushbutton	2	Install RIO-4B(R)
24	"O" 32+02		41'	Ped. Pushbutton	2	Install RIO-4B(R)
25	"O" 32+02	40'		Ped. Pushbutton	6	Install RIO-4B(R)
26	"O" 32+73	52'		Ped. Pushbutton	6	Install RIO-4B(L)

### Detector Summary Notes :

- Signs are incidental to Item 660(i), Traffic Signal System complete.
- Loop Detector wire shall have it's own PVC ducting. The wire shall be #14 A.W.G. stranded T.H.H.N.(U.L.) 600V. The ducting shall be ULFR-1 rated 105°C, wall thickness 0.031", inner diameter nominal 0.186" moisture, chemical and oil resistant.

## Signal Pole Summary (State Furnished)

Number	Station	Offset		Type	Signal Mast Arm			Foundation	Luminaire Mast Arm Length
		Lt.	Rt.		K	M	N		
1	"O" 32+78	52'		Standard	35'	12'	23'	Optional	
2	"O" 33+16		43'	Combination	40'	15'	25'	Optional	8'
3	"O" 32+08		38'	Standard	40'	12'	28'	Optional	
4	"O" 31+90	40'		Combination	40'	15'	25'	Optional	8'

### Signal Pole Summary Notes :

- All 4 poles shall have a R9-4 decal placed 5' above the ground level of the pole facing the crossing.

## Signal Head Summary

Signal Head Number	Phase	Pole Number	Indication	Lens Size	Mounting Type	Remarks
1	7	1	LR-LY-LG	12"	Plumbizer	Future
2	4	1	R-Y-G	12"	Plumbizer	
3	5	1	LR-LY-LG	12"	S-2	
4	4	1	R-Y-G	12"	S-2	
5	5	2	LR-LY-LG	12"	Plumbizer	
6	2	2	R-Y-G	12"	Plumbizer	
7	3	2	LR-LY-LG	12"	S-2	Future
8	2	2	R-Y-G	12"	S-2	
9	3	3	LR-LY-LG	12"	Plumbizer	Future
10	8	3	R-Y-G	12"	Plumbizer	
11	1	3	LR-LY-LG	12"	S-2	
12	8	3	R-Y-G	12"	S-2	
13	1	4	LR-LY-LG	12"	Plumbizer	
14	6	4	R-Y-G	12"	Plumbizer	
15	7	4	LR-LY-LG	12"	S-2	Future
16	6	4	R-Y-G	12"	S-2	
17	6	1	Ped. Symbol	Neon	SW-2	
18	4	1	Ped. Symbol	Neon	SW-2	
19	4	2	Ped. Symbol	Neon	SW-2	
20	2	2	Ped. Symbol	Neon	SW-2	
21	2	3	Ped. Symbol	Neon	SW-1	
22	6	4	Ped. Symbol	Neon	SW-1	

## J-Box & Cabinet Base Summary


Number	Station	Offset		Type	Remarks
		Lt.	Rt.		
1	"O" 29+48		33'	1	
2	"O" 31+00		33'	1	
3	"O" 31+68		33'	1	
4	"O" 32+24		46'	2	
5	"O" 32+07		53'	2	
6	"O" 32+16		54'	1	
7	"O" 32+88		60'	1	
8	"O" 33+10		47'	2	
9	"O" 33+02		32'	1	
10	"O" 33+62		32'	1	
11	"O" 34+03		32'	1	
12	"O" 35+55		32'	1	
13	"O" 32+90		40'	3	
-	"O" 33+17		65'	Controller Cabinet	See notes

### J-Box & Cabinet Base Summary Notes :

- The Contractor shall supply 4- $\frac{3}{4}$ "x16" anchor bolts for the Traffic Signal Controller Cabinet.
- Contractor shall install a 50 AMP 120V Traffic Signal breaker in existing load center Cabinet.
- Existing load center shall be relocated to a new pole at Sta. "O" 33+10, 65' Lt.

## General Signalization Notes


- All poles shall be field drilled for mounting hardware.
- All signal heads shall have backplates.
- Signal hardware shall be mounted as per Standard Drawing T-30.00 and T-52.01.
- Each vehicle signal head shall have it's own "home run" cable.
- All conduits shall be sloped to drain to a "T" drain.
- The contractor shall locate all existing underground utilities, pipes, and culverts.
- Conduit locations as shown on the signalization plan are schematic only and may be adjusted to suit field conditions.
- J-Box locations may be adjusted to suit field conditions.
- The State of Alaska shall furnish to the Contractor, as State furnished materials, the traffic signal poles (including mast arms and anchor bolts), and the controller cabinet, complete with all components. The Contractor shall furnish all other required material.
- The signal poles and controller cabinet will be available at the DOT & PF Maintenance Station at 7 mile Glacier Highway.
- Loop detector sawcuts shall be hydroblasted and blown dry.
- Loop detector wire shall be held down at 2 foot intervals with pieces of  $\frac{1}{2}$ " diameter foam or wedging clamps.
- Sawcuts for loop detectors shall be  $\frac{3}{8}$ " wide.
- In lieu of 45° sawcuts on loop corners, 2- $\frac{1}{2}$ " diameter holes may be bored in the pavement or the pavement may be chipped out to allow for a wire bending radius of no less than 1 inch.
- The signal shall be equipped with an approved brand Opticom Emergency Vehicle Pre-emptor. All detectors and wire shall be supplied by the Contractor and wired to the State furnished controller cabinet. 4 detectors and 2 discriminator boards are required. The detectors shall be mounted on the mast arms over the roadway. The State furnished cabinet will have provisions for the Contractor to install the two Opticom Discriminator Boards.
- Conduits shall be jacked or augered under pavement on Egan Drive and Mendenhall Loop Road.
- Cables for future signal heads on poles shall be terminated at controller box and on mast arms at the signal head locations.
- "C" = Conductor, "RMC" = Rigid Metal Conduit.
- The existing signal at Egan Drive is equipped with a Opticom Emergency Vehicle pre-emptor. The Contractor shall supply and install two new discriminator boards for the State furnished new Signal Cabinet.

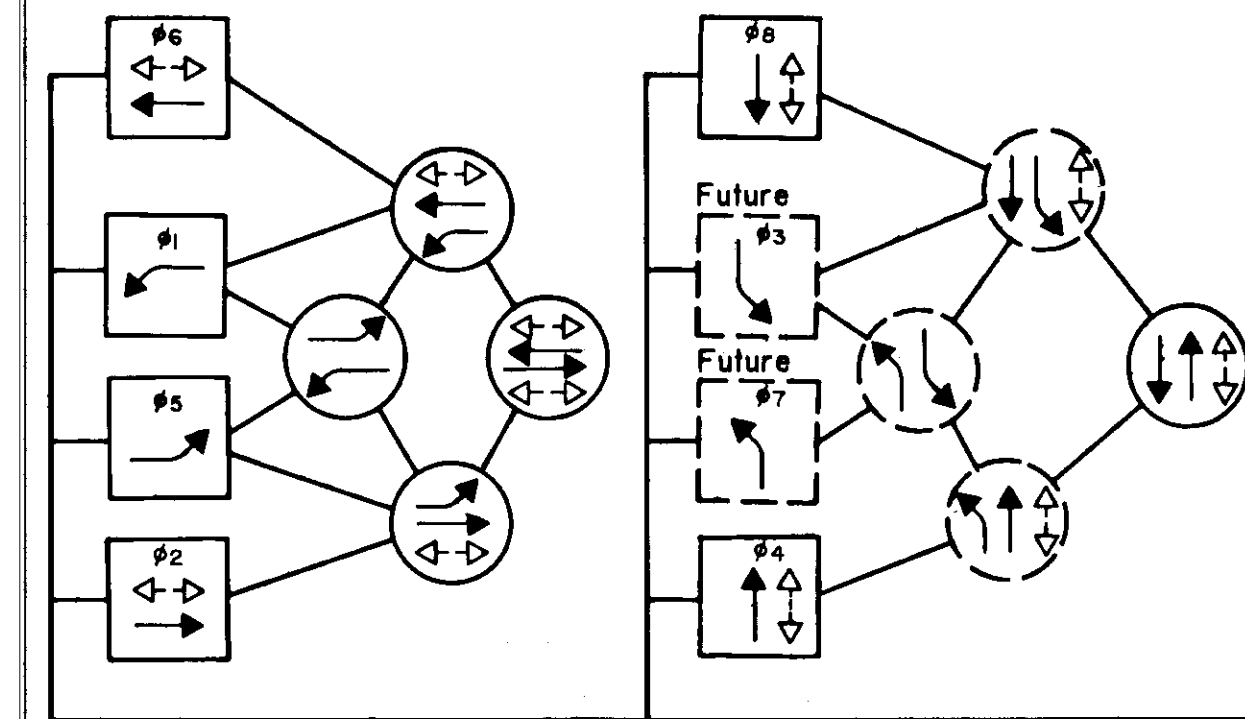

Phase Diagram



STATE	PROJECT DESIGNATION	YEAR	SHEET NO.	TOTAL SHEETS
ALASKA	HES-M-966(14)	88	24	28

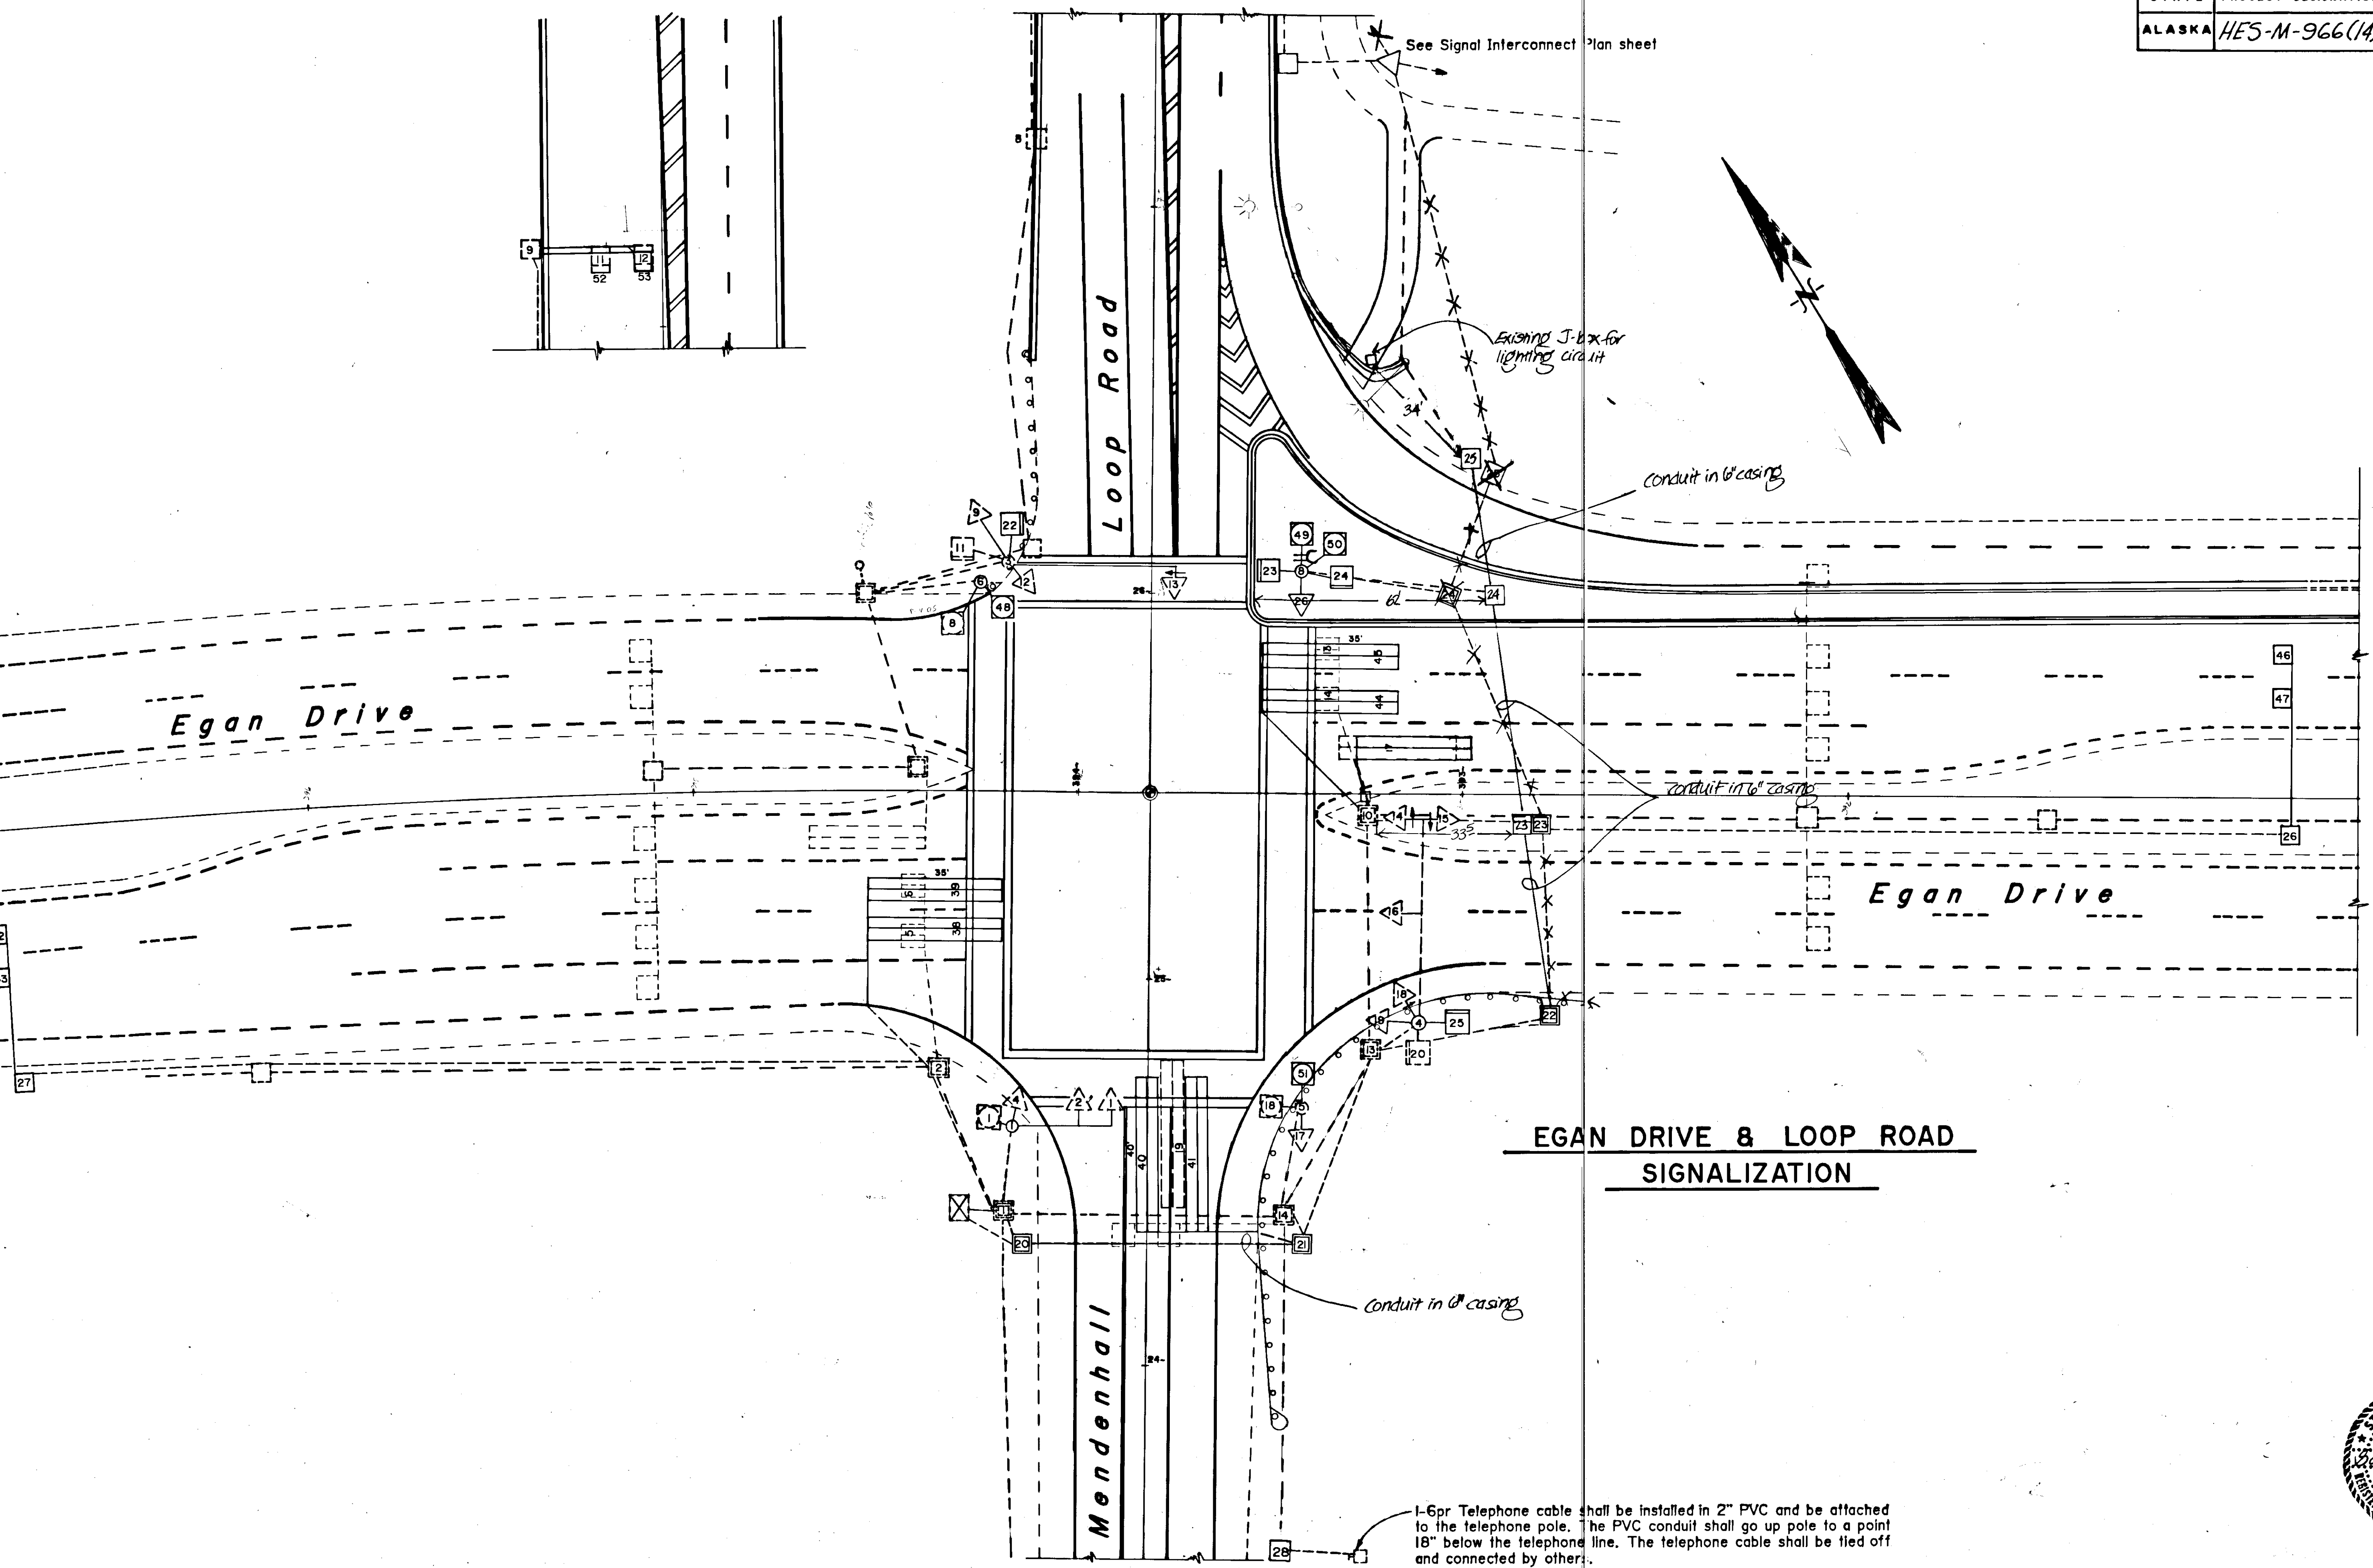

**EGAN DRIVE & LOOP ROAD  
SIGNALIZATION**

1-6pr Telephone cable shall be installed in 2" PVC and be attached to the telephone pole. The PVC conduit shall go up pole to a point 18" below the telephone line. The telephone cable shall be tied off and connected by others.



# EGAN DRIVE & LOOP ROAD SIGNALIZATION TABLES

STATE	PROJECT DESIGNATION	YEAR	SHEET NO.	TOTAL SHEETS
ALASKA	HES-M-966(14)	88	25	28

## SIGNALIZATION TABLES Egan Drive & Mendenhall Loop Rd.

### Detector Summary

Number	Station	Offset		Type	Phase	Remarks
		Lt.	Rt.			
5	"E" 394+43	36'		Quadrupole		Abandon in place
6	"E" 394+43	25'		Quadrupole		Abandon in place
13	"E" 393+35		37'	Quadrupole		Abandon in place
14	"E" 393+35		25'	Quadrupole		Abandon in place
19	"E" 393+74		85'	Quadrupole		Abandon in place
38	"E" 394+35	36'		35'x6' Quadrupole	4	2-4-2
39	"E" 394+35	25'		35'x6' Quadrupole	4	2-4-2
40	"E" 393+81	94'		40'x6' Quadrupole	1	2-4-2
41	"E" 393+68	94'		40'x6' Quadrupole	1	2-4-2
42	"E" 396+83	26'		6'x6' Loop	4	3 Turns
43	"E" 396+83	37'		6'x6' Loop	4	3 Turns
44	"E" 393+34		25'	35'x6' Quadrupole	8	2-4-2
45	"E" 393+34		37'	35'x6' Quadrupole	8	2-4-2
46	"E" 390+88		37'	6'x6' Loop	8	3 Turns
47	"E" 390+88		25'	6'x6' Loop	8	3 Turns
48	"E" 394+24		54'	Ped. Pushbutton	8	Install RIO-4B(R)(see note #1)
49	"E" 393+42		52'	Ped. Pushbutton	8	Install RIO-4B(L)(see note #1)
50	"E" 393+42		52'	Ped. Pushbutton	1	Install RIO-4B(R)(see note #1)
51	"E" 393+42		82'	Ped. Pushbutton	1	Install RIO-4B(L)(see note #1)
11	"O" 28+18	17'		6'x6' Loop	2	Abandon in place
12	"O" 28+18	6'		6'x6' Loop	2	Abandon in place
52	"O" 28+17	17'		6'x6' Loop	2	
53	"O" 28+17	6'		6'x6' Loop	2	
1	"O" 24+62	35'		Ped. Pushbutton	4	See note 4
18	"O" 24+66	40'		Ped. Pushbutton	4	See note 4

#### Detector Summary Notes:

- Signs are incidental to Item 660(I), Traffic Signal System-Complete.
- Loop detector wire shall have it's own P.V.C. ducting. The wire shall be #14 A.W.G. stranded T.H.H.N. (U.L.) 600V. The ducting shall be ULFR-I rated 105° C., wall thickness is 0.031", inner diameter nominal 0.186", moisture, chemical and oil resistant.
- "E" = Egan Drive stations; "O" = Mendenhall Loop Road stations, this sheet.
- Change complete pedestrian pushbutton assembly. Remove or tape all wire ends except 24V DC and common.

### Signal Pole Summary

Number	Station	Offset		Type	Remarks
		Lt.	Rt.		
6	"E" 394+24		54'	Optional	Replace or modify to accommodate two Pedestrian pushbuttons.
8	"E" 393+42		52'	Optional	Pole shall be installed with 1" Frangible anchor bolts. See detail at right.

### Signal Head Summary

Signal Head Number	Phase	Pole Number	Indication	Lens Size	Mounting Type	Remarks
22	8	3	Ped. Symbol	Neon	SW-1	Use existing spare wires
23	8	8	Ped. Symbol	Neon	TW-2	
24	1	8	Ped. Symbol	Neon	TW-2	
25	1	4	Ped. Symbol	Neon	SW-1	
9	2	3	R-Y-G-LG	12"-8"	Plumbizer	Remove-LG
13	1	3	R-Y-G	12"	Plumbizer	Install-LG from 9
4	2	1	R-Y-G-LG	12"-8"	S-1	Remove-LG
26	1	8	R-Y-G	12"	T-1	
12	1	3	R-Y-G			Remove

#### Signal Head Summary Notes:


- Spare signal head will be property of DOT & PF.

### J-Box & Cabinet Base Summary


Number	Station	Offset		Type	Remarks
		Lt.	Rt.		
20	"O" 24+30	35'		II	
21	"O" 24+30		40'	II	
22	"E" 392+65	55'		II	
23	"E" 392+65	10'		II	
24	"E" 392+95		50'	II	
25	"E" 392+85		80'	I	
-	"O" 24+40	45'		Cabinet	Install new cabinet
26	"E" 390+88	10'		I	
27	"E" 396+83	65'		I	
8	"O" 27+17	31'		I	Relocate J-Box, abandon loops.
9	"O" 28+18	31'		I	Relocate J-Box
28	"O" 23+50		36'	I	See note #1.

#### J-Box & Cabinet Base Summary Notes:


- Locate existing RMC and cut conduit to J-Box.

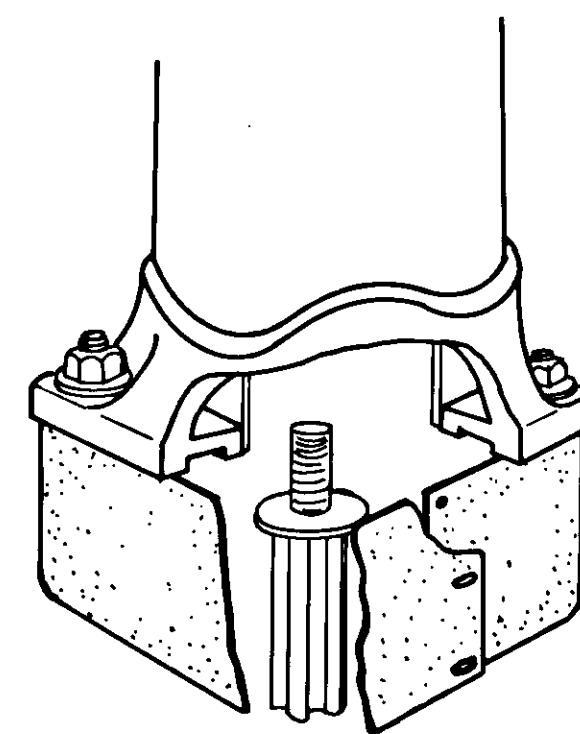


Frangible Anchor Bolt Detail

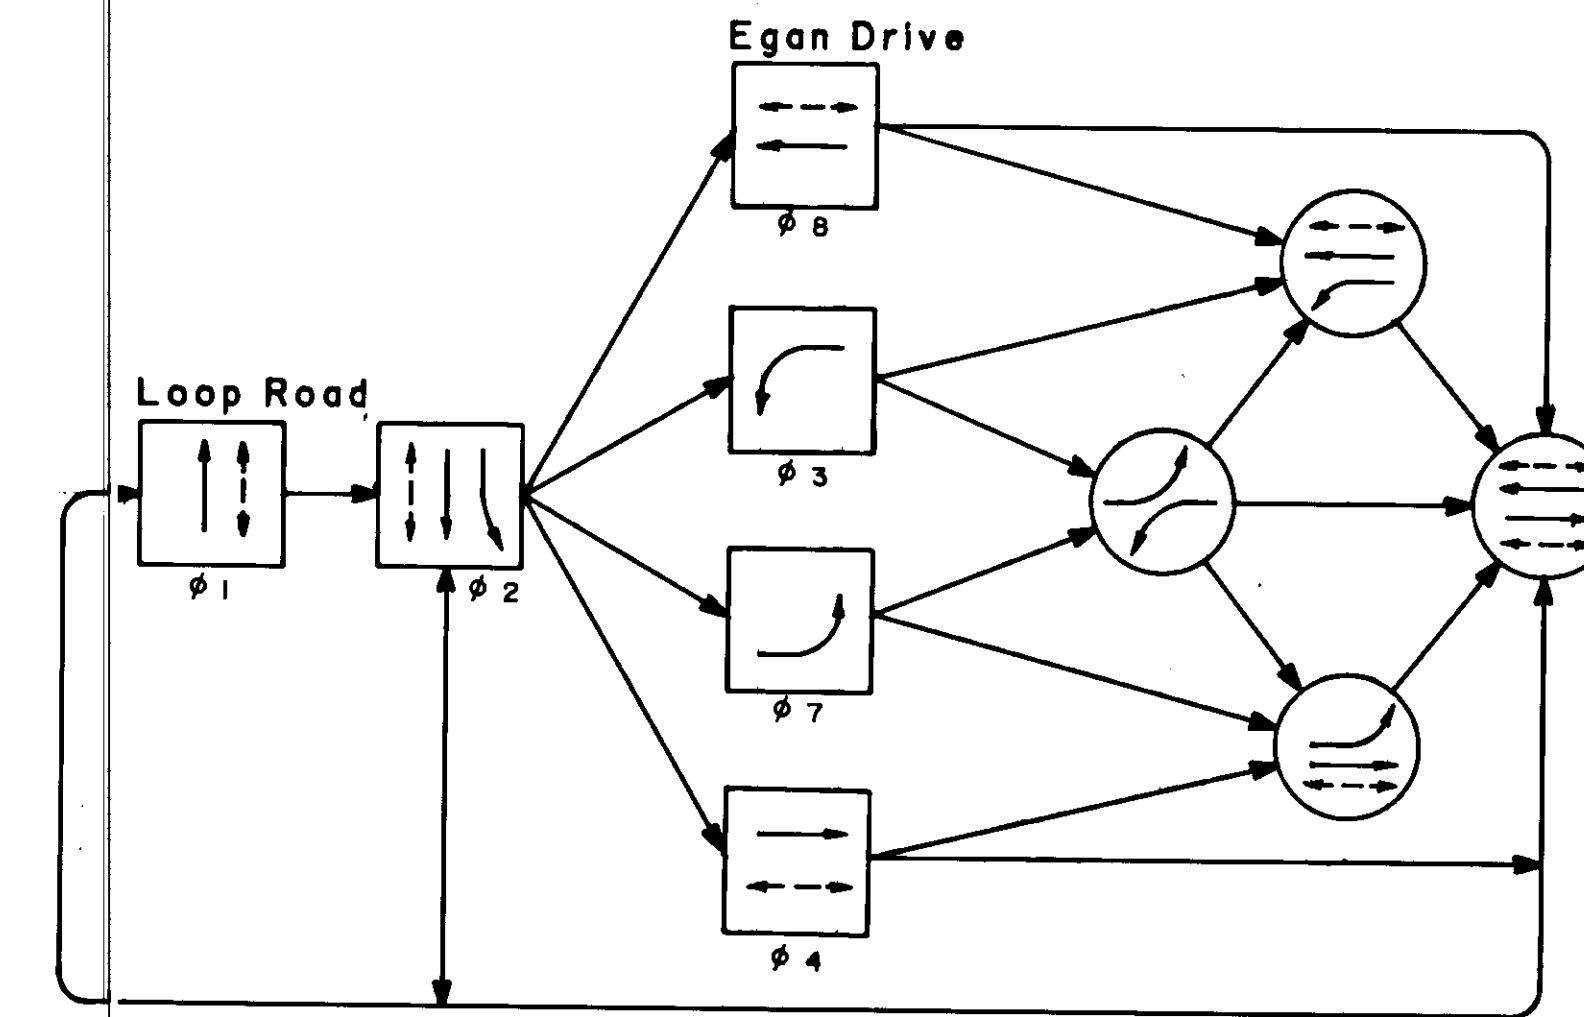

6φ Signal Diagram


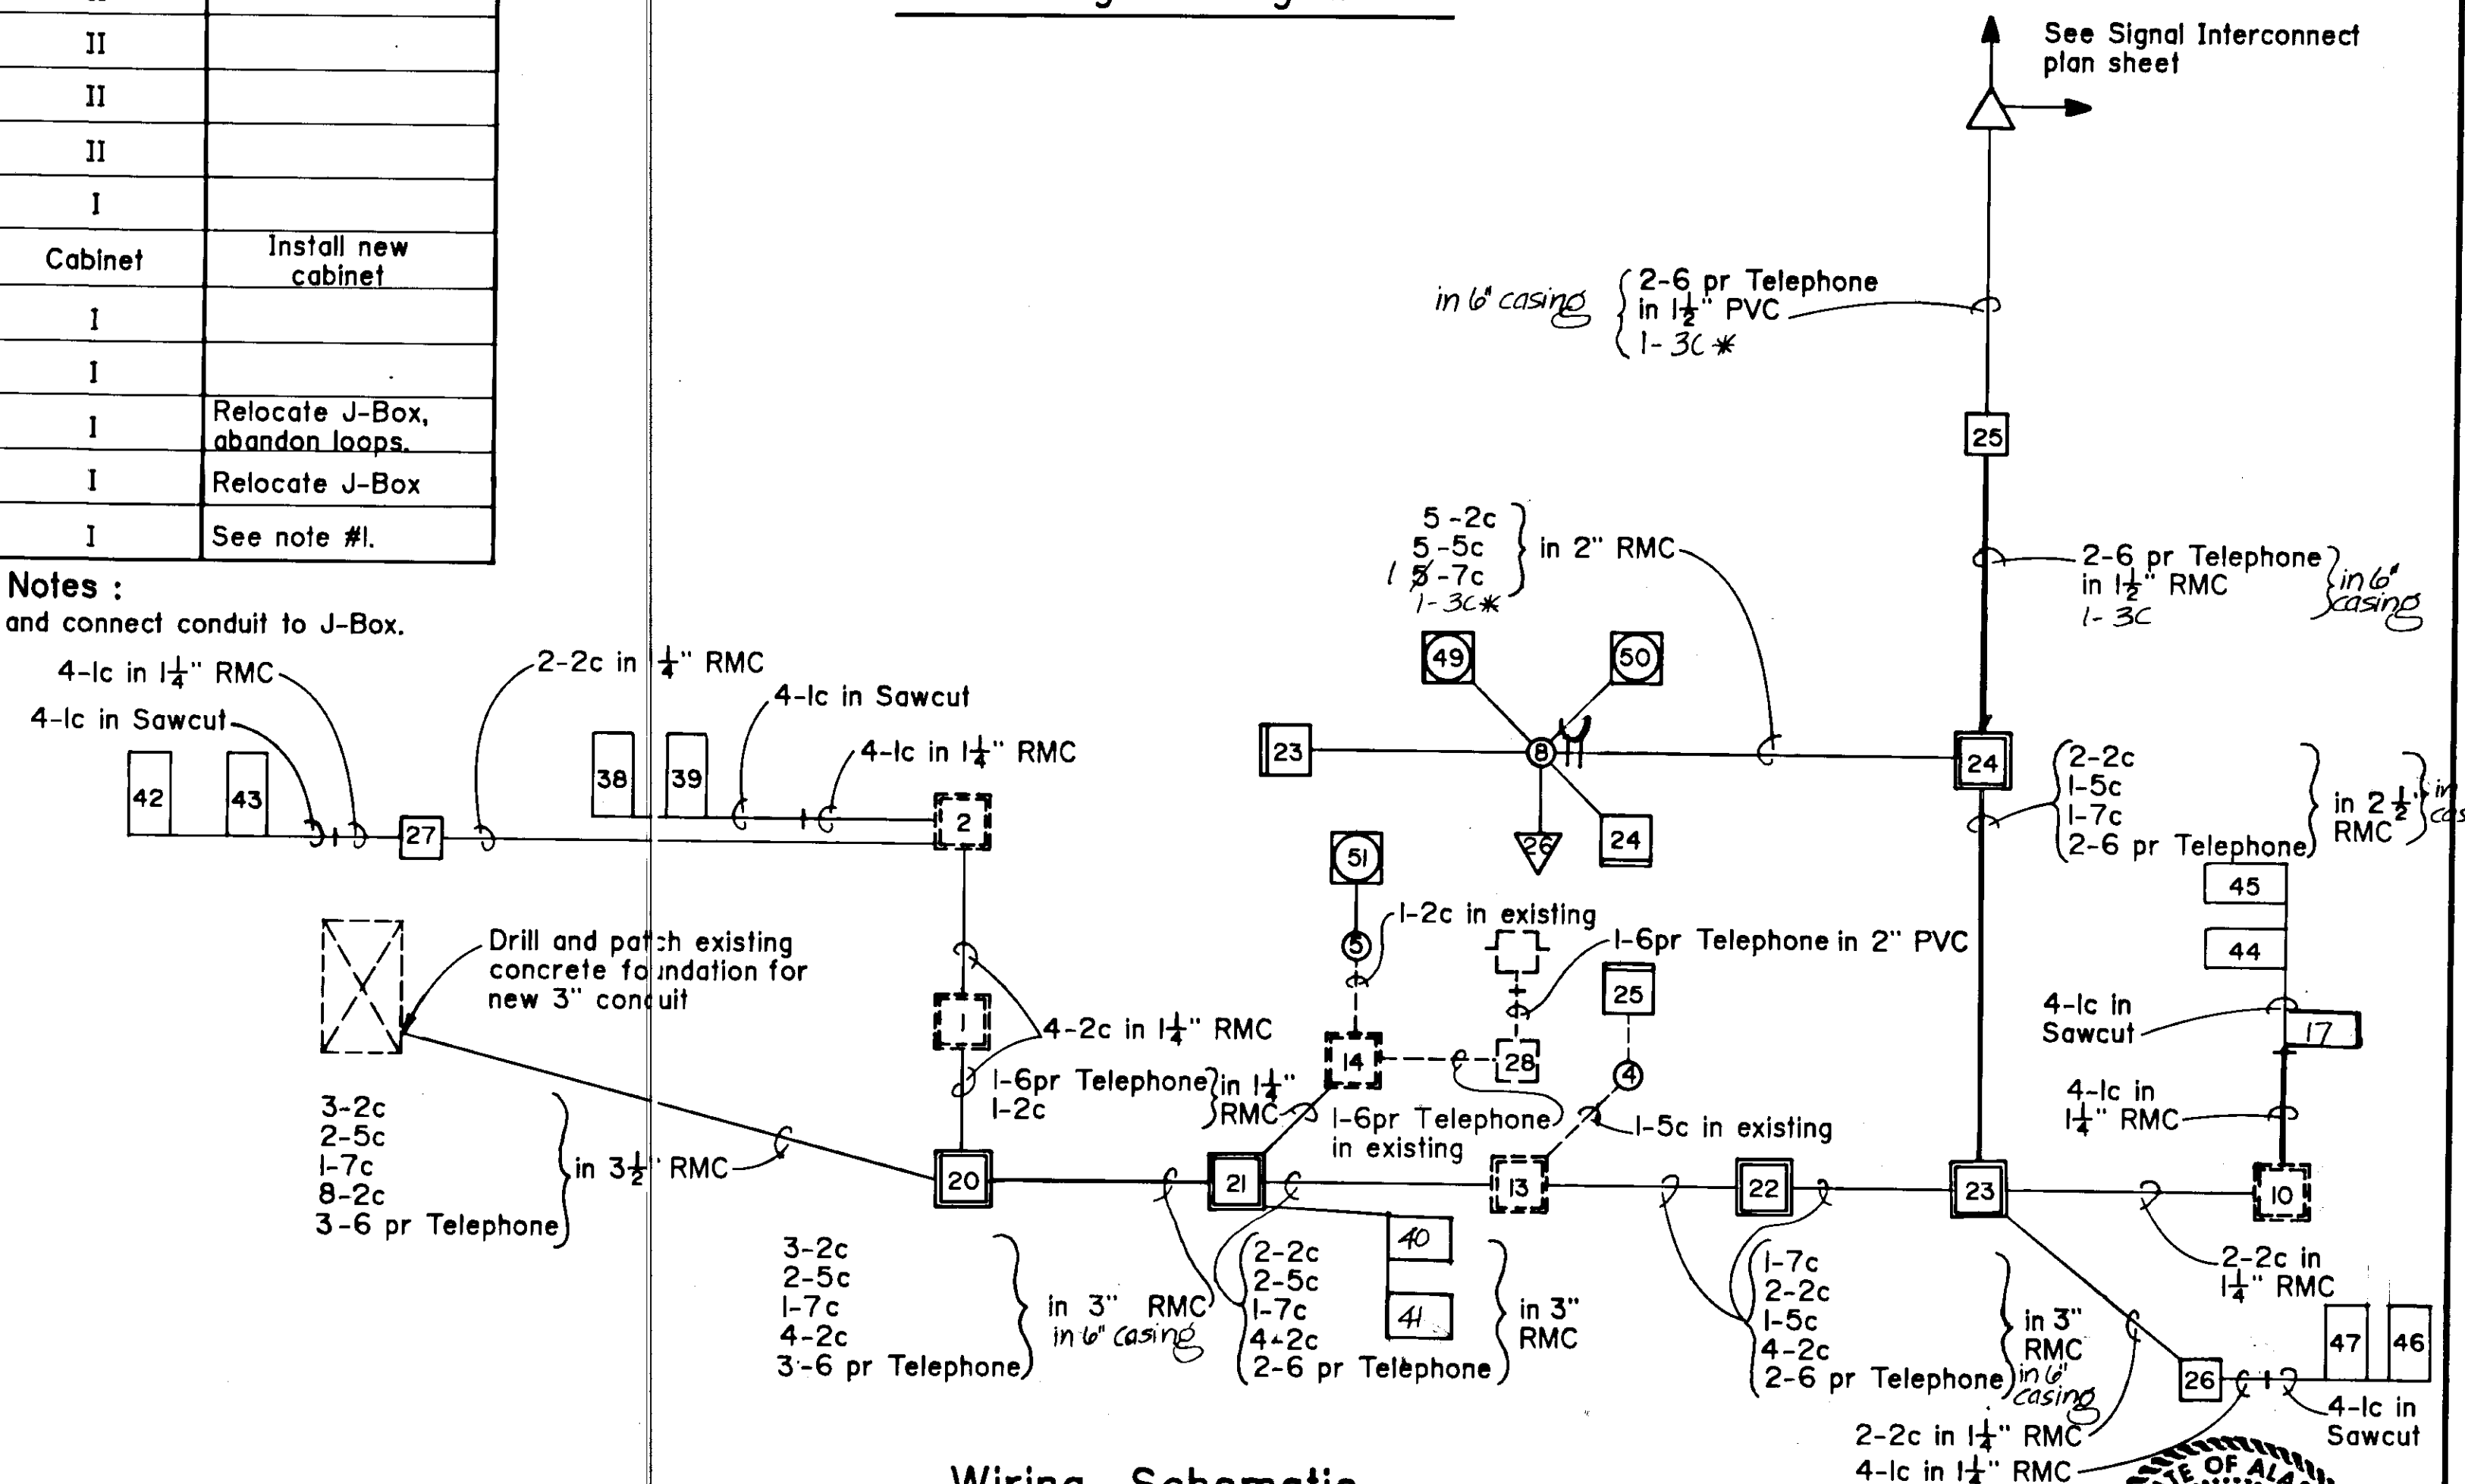


Wiring Schematic

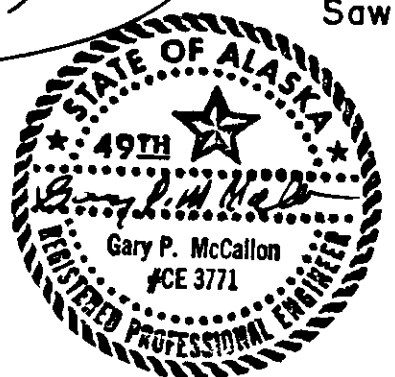

### Signal Interconnect General Notes

- Telephone pedestals shall be above ground "Commercial Plant Housing" type ( $\pm 34"$  above ground junction box), and contain the following components:
  - Terminal Strip
  - Fiberglass Housing
  - Lockable Door or Cover.
- Telephone pedestals are to be installed on the far outside right edge of the sidewalk with a maximum spacing of 600' at the approximate stations shown.
- Any pavement repair necessary because of conduit or J-box pedestal installation shall be incidental to Item 660(II), Master Traffic Signal System Interconnect.
- 1" P.V.C. conduit shall be installed between the fence and the edge of sidewalk along Egan Drive.
- Conduit across Jordan Creek shall be 1" R.M.C. and be attached to the outside of the pedestrian bridge as shown.
- Conduit to be installed under Egan Drive and Loop Road and shall be jacked or augered. No pavement cuts will be allowed.
- The Contractor shall verify the location of all utilities and coordinate conflicts with the utility company before any work begins.
- No cutting of pavement is allowed except at sidewalks and the Super Bear Mall entrance. Patching and repairing of pavement cuts will be incidental to Item 660(II).
- Conduit, pedestal and J-box locations are schematic in nature and the final location of all installations shall be approved by the Engineer.
- All J-box lids in the signal circuit shall be marked "TRAFFIC".
- The Contractor shall repair and bear the expense of any damage that results from boring or trenching activities.
- Interconnect cable shall be 6 pair, Telephone type 19 AWG copper, polyethylene insulated, twisted pairs, flooded with a water blocking compound, core wrapped, shielded with corrugated copper shield with a outer jacket of polyethylene conforming to type TEL CU WT.
- $\Delta$  = symbol for telephone pedestal.

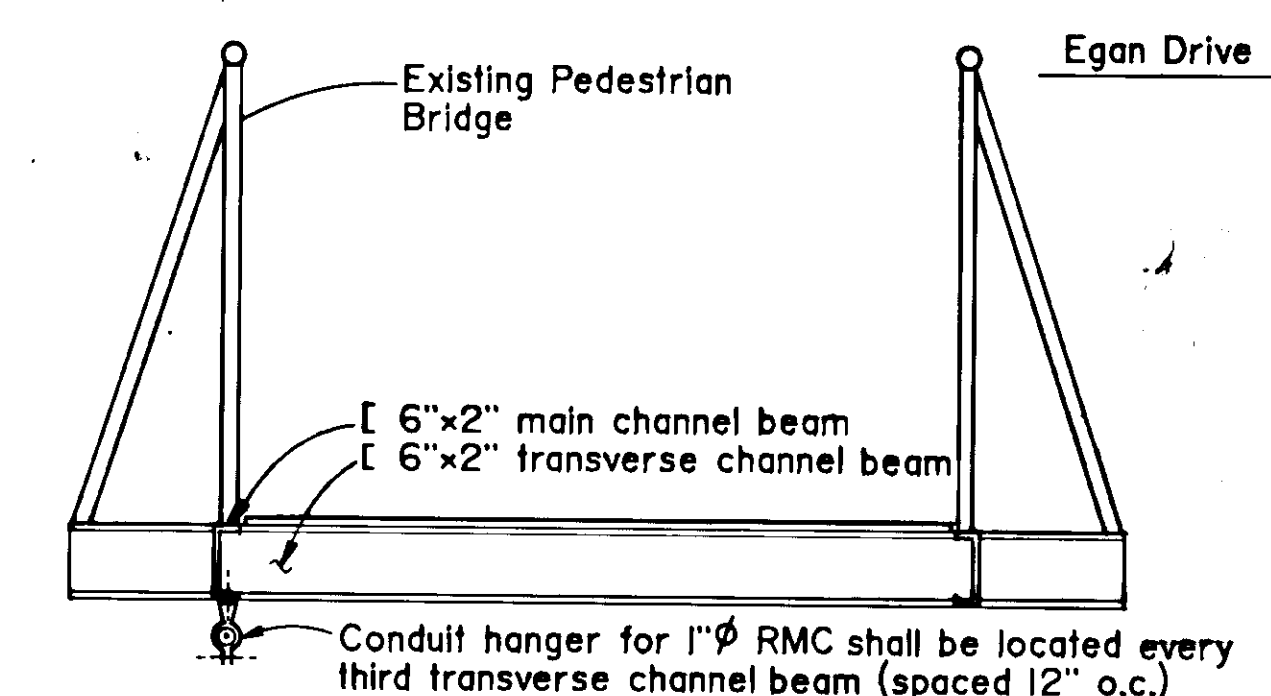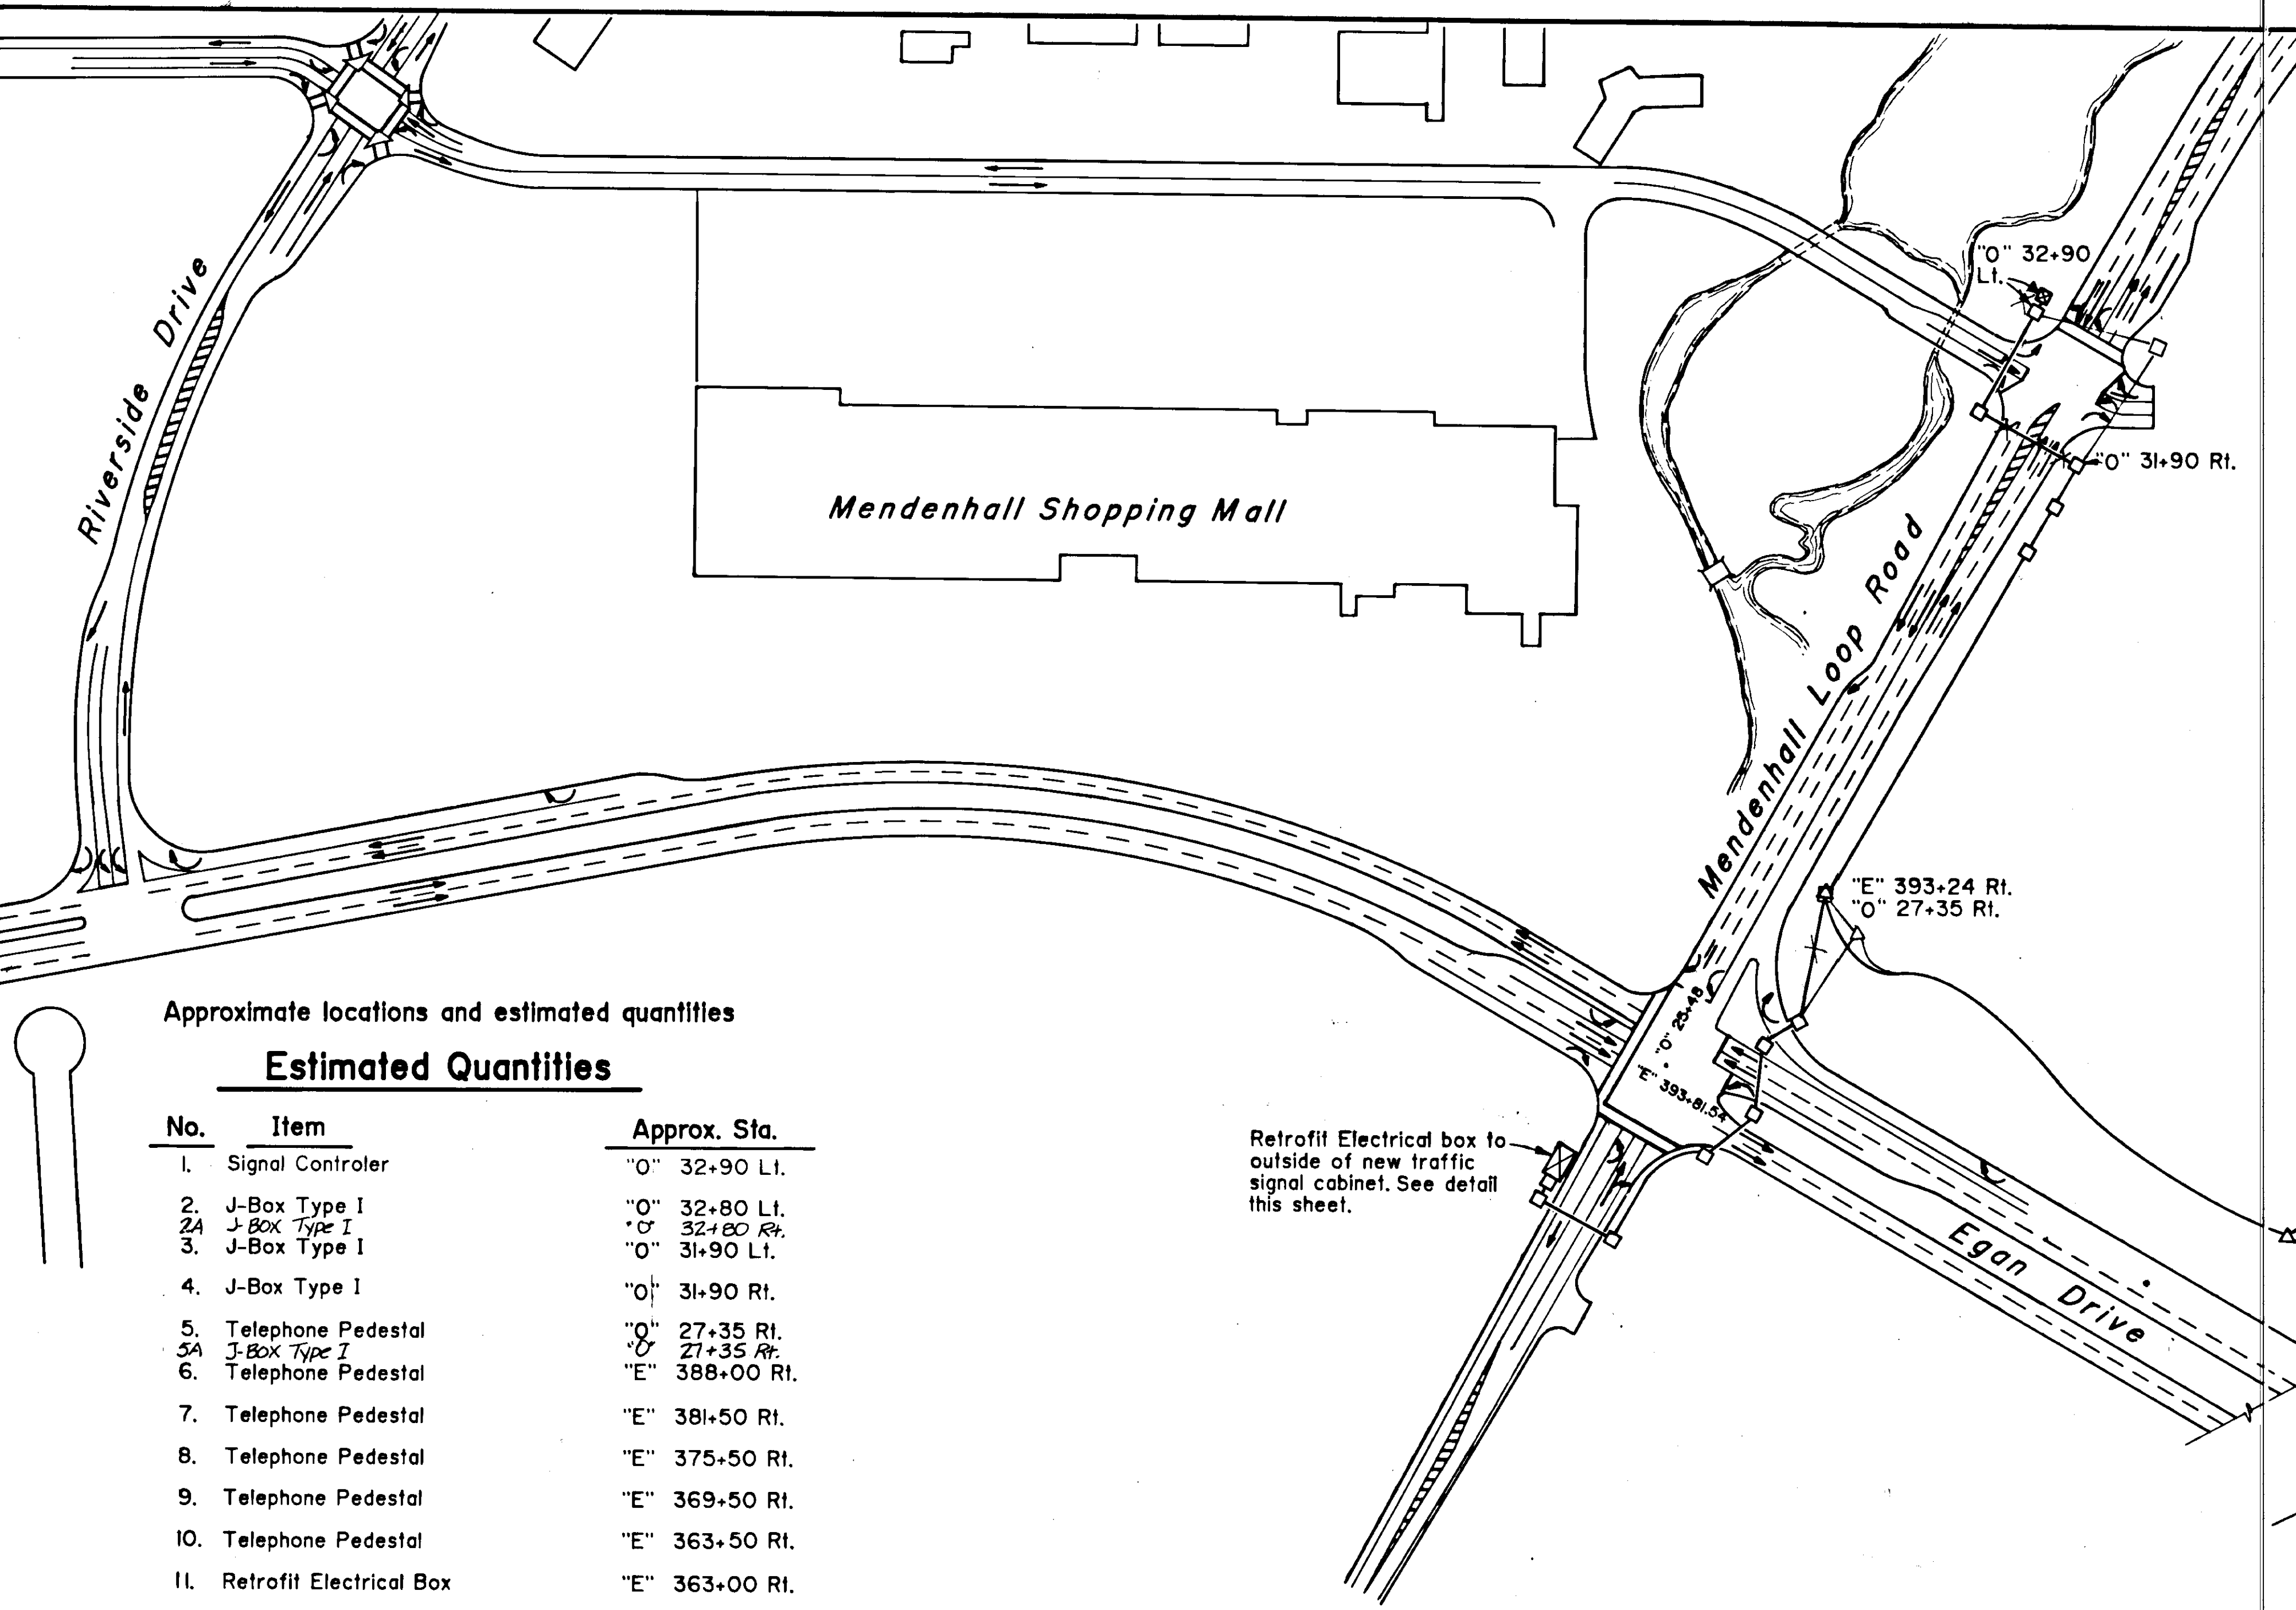

#### Conduit Hanger Detail Conduit Hanger Notes

- Conduit hanger, nuts, bolts and washer shall be galvanized steel.
- Hanger bolts shall be a minimum of  $\frac{1}{4}$ "  $\phi$ .
- Conduit hanger shall be fastened securely with a bolt as shown on the detail.
- Contractor shall submit the type of conduit hanger to be used for the Engineer's approval.


#### Approximate locations and estimated quantities

#### Estimated Quantities

No.	Item	Approx. Sta.
1.	Signal Controller	"O" 32+90 Lt.
2.	J-Box Type I	"O" 32+80 Lt.
2A	J-Box Type I	"O" 32+80 Rt.
3.	J-Box Type I	"O" 31+90 Lt.
4.	J-Box Type I	"O" 31+90 Rt.
5.	Telephone Pedestal	"O" 27+35 Rt.
5A	J-Box Type I	"O" 27+35 Rt.
6.	Telephone Pedestal	"E" 388+00 Rt.
7.	Telephone Pedestal	"E" 381+50 Rt.
8.	Telephone Pedestal	"E" 375+50 Rt.
9.	Telephone Pedestal	"E" 369+50 Rt.
10.	Telephone Pedestal	"E" 363+50 Rt.
11.	Retrofit Electrical Box	"E" 363+00 Rt.
12.	J-Box Type I	"O" 25+95 Rt.
13.	J-Box Type I	"E" 393+90 Centerline
14.	J-Box Type I	"E" 394+00 Lt.
15.	J-Box Type I	"O" 23+88 Rt.
16.	J-Box Type I	"O" 23+88 Lt.
17.	Retrofit Electrical Box	"O" 23+90 Lt.
18.	55 feet of 1" R.M.C.	(Jordan Creek Bridge)
19.	450 feet of 2" R.M.C.	(Roadway crossings)
20.	3,780 feet of 1" P.V.C. conduit	
21.	4,700 feet of 6 pair Telephone Interconnect cable	

"O" = Mendenhall Loop Road and "E" = Egan Drive on this sheet only.

Retrofit Electrical box to outside of new traffic signal cabinet. See detail this sheet.

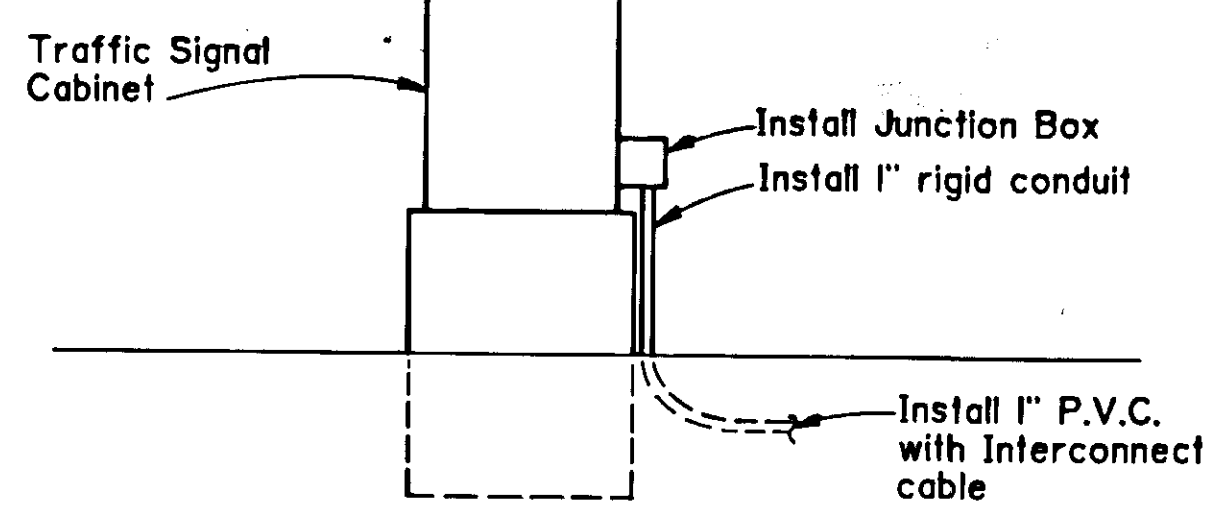

#### J-Box Retrofit Detail

"E" 388+00 Rt.  
"E" 381+50 Rt.  
"E" 375+50 Rt.  
"E" 372+63 Rt. } Jordan Creek pedestrian bridge, see detail this sheet for conduit hanger.  
"E" 372+08 Rt.

Install 1" P.V.C. with Interconnect cable

"E" 363+50 Rt.


"E" 363+00 Rt.

Retrofit Electrical box to outside of existing traffic signal cabinet. See detail this sheet.

STATE OF ALASKA  
DEPARTMENT OF TRANSPORTATION & PUBLIC FACILITIES  
SOUTHEAST REGION DESIGN & CONSTRUCTION


### MASTER TRAFFIC SIGNAL SYSTEM INTERCONNECT

APPROVED BY:	DESIGNED BY:	SCALE:
RECOMMENDED BY:	DRAWN BY:	DATE:
PREPARED BY:	CHECKED BY:	SHEET 26 OF 28

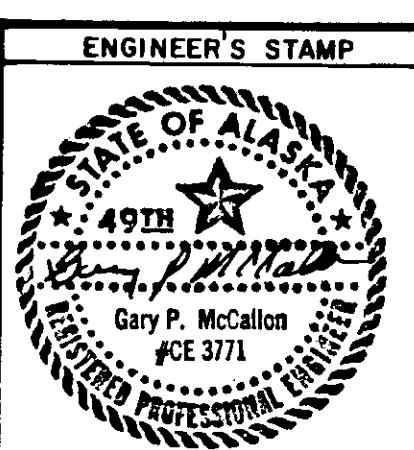

DATE	DESCRIPTION OF CHANGE

STATE	PROJECT DESIGNATION	YEAR	SHEET NO.	TOTAL SHEETS
ALASKA	HES-M-966(1A)	88	27	28

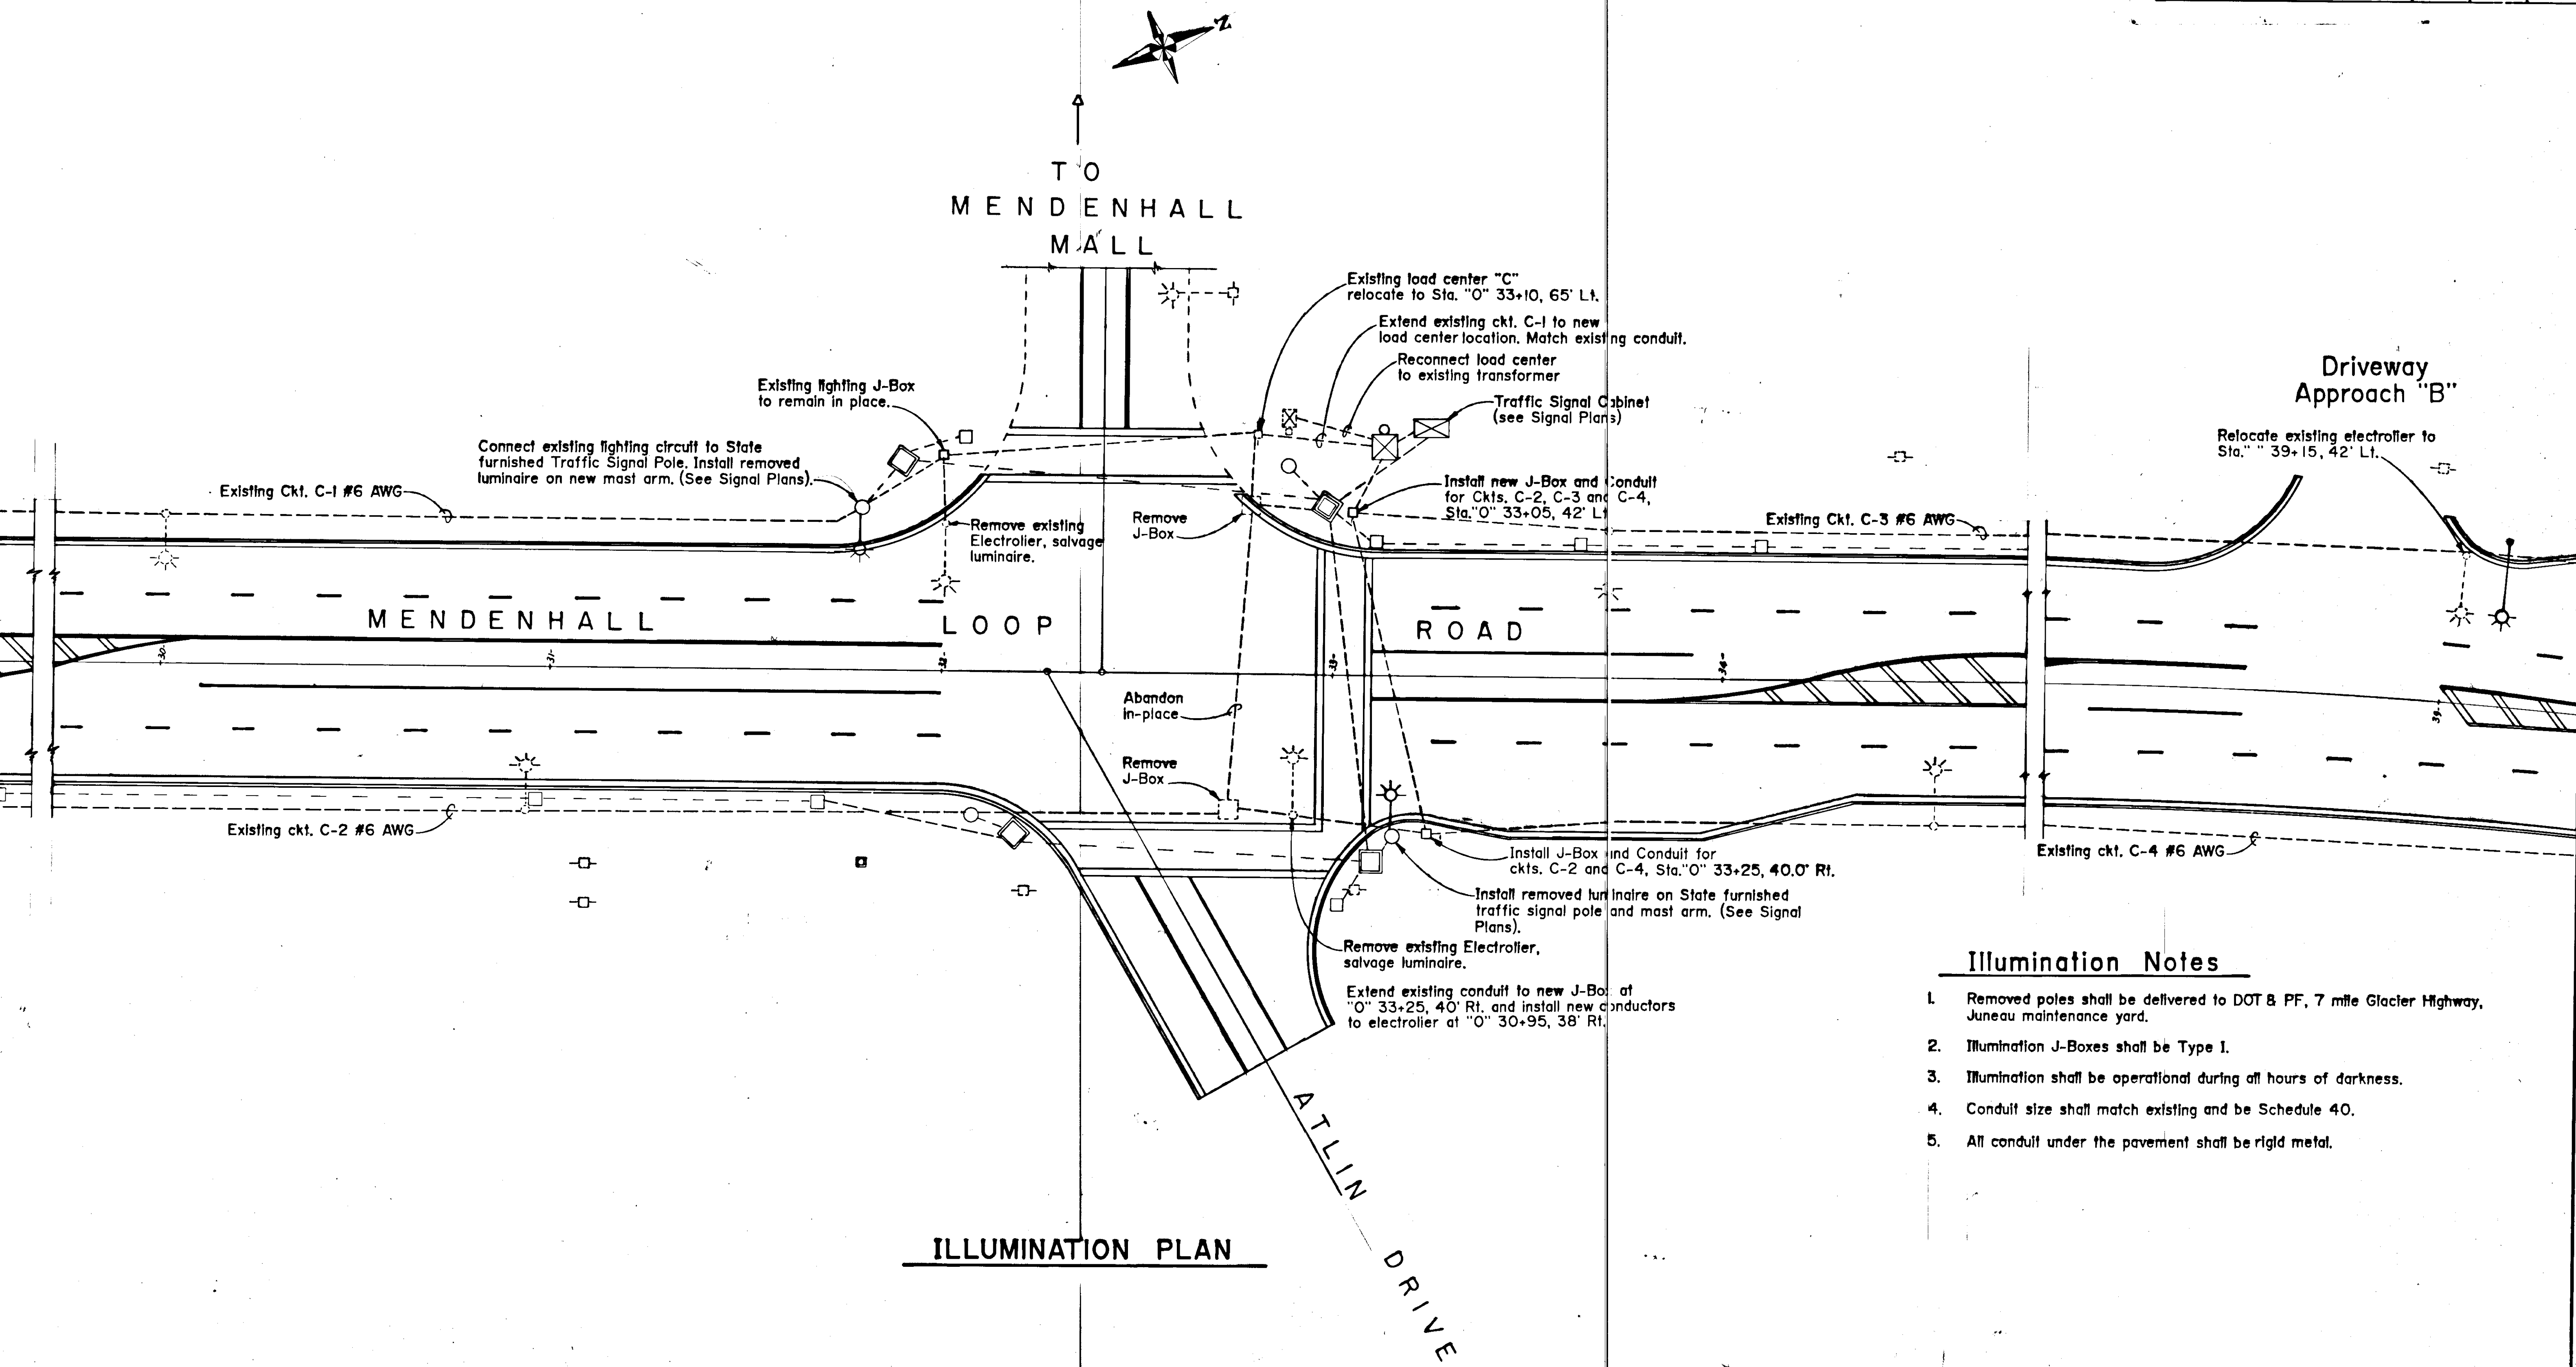


ILLUMINATION PLAN

Illumination Notes


1. Removed poles shall be delivered to DOT & PF, 7 mile Glacier Highway, Juneau maintenance yard.
2. Illumination J-Boxes shall be Type 1.
3. Illumination shall be operational during all hours of darkness.
4. Conduit size shall match existing and be Schedule 40.
5. All conduit under the pavement shall be rigid metal.



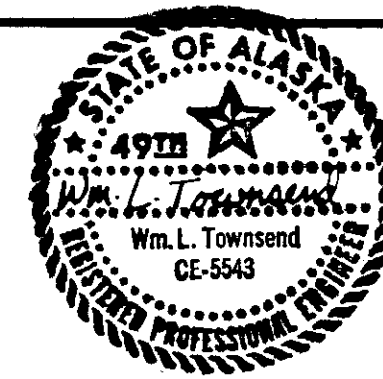


STATE	PROJECT DESIGNATION	YEAR	SHEET NO.	TOTAL SHEETS
ALASKA	HES-M-966(14)	'88	28	28

## Thaw Wire for Slotted Drain Pipe Layout and Details

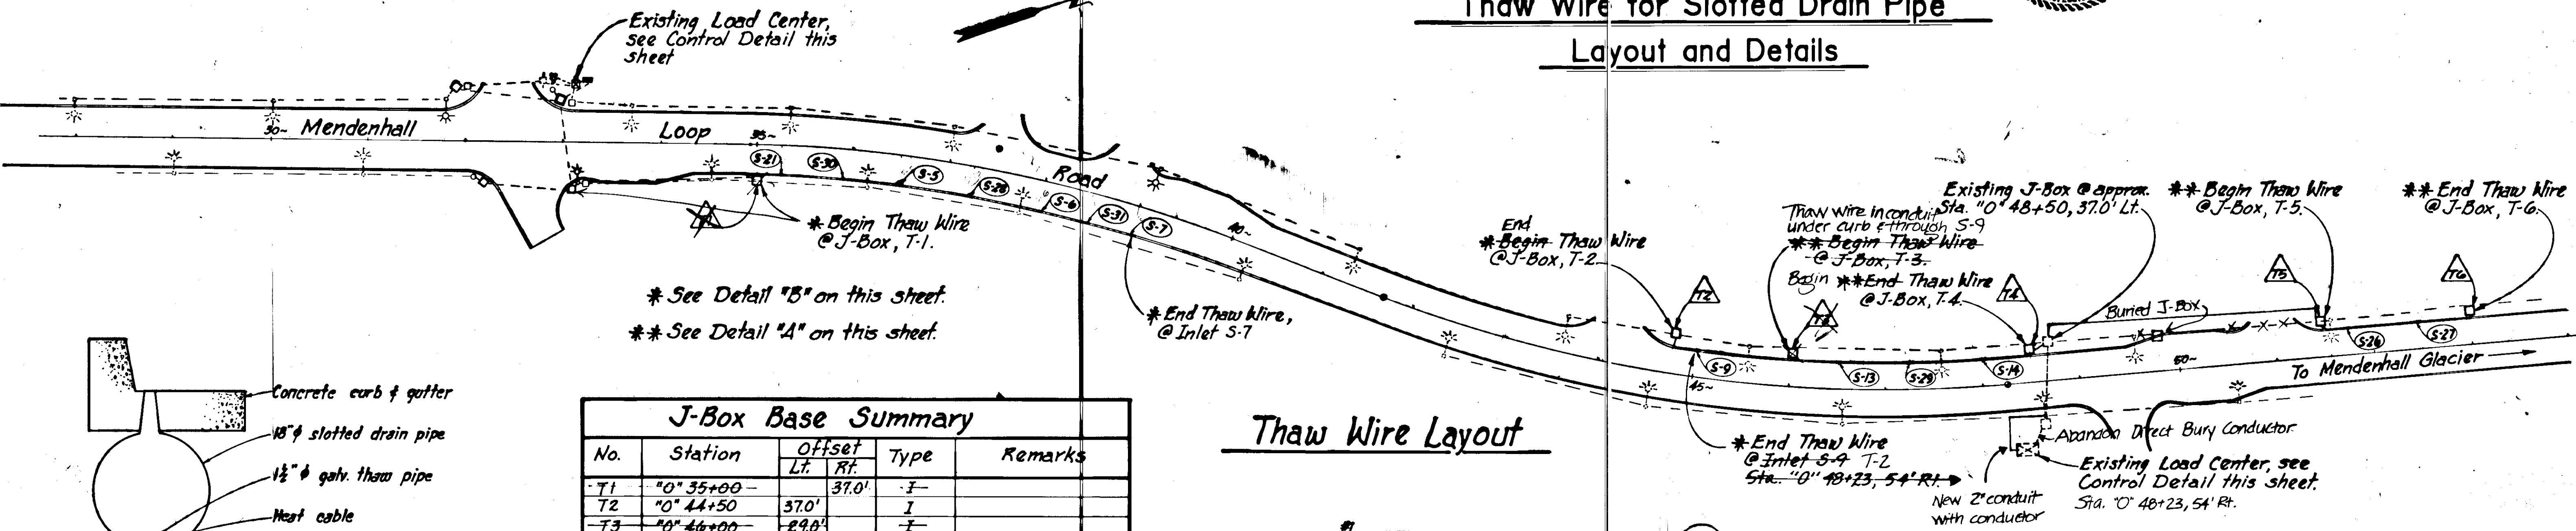

No.	Station	Offset		Type	Remarks
		Lt.	Rt.		
T-1	"0" 35+00		37.0'	I	
T-2	"0" 44+50	37.0'		I	
T-3	"0" 46+00	29.0'		I	
T-4	"0" 48+50	29.0'		I	
T-5	"0" 51+50	37.0'		I	
T-6	"0" 53+00	29.0'		I	

### Thaw Wire Layout

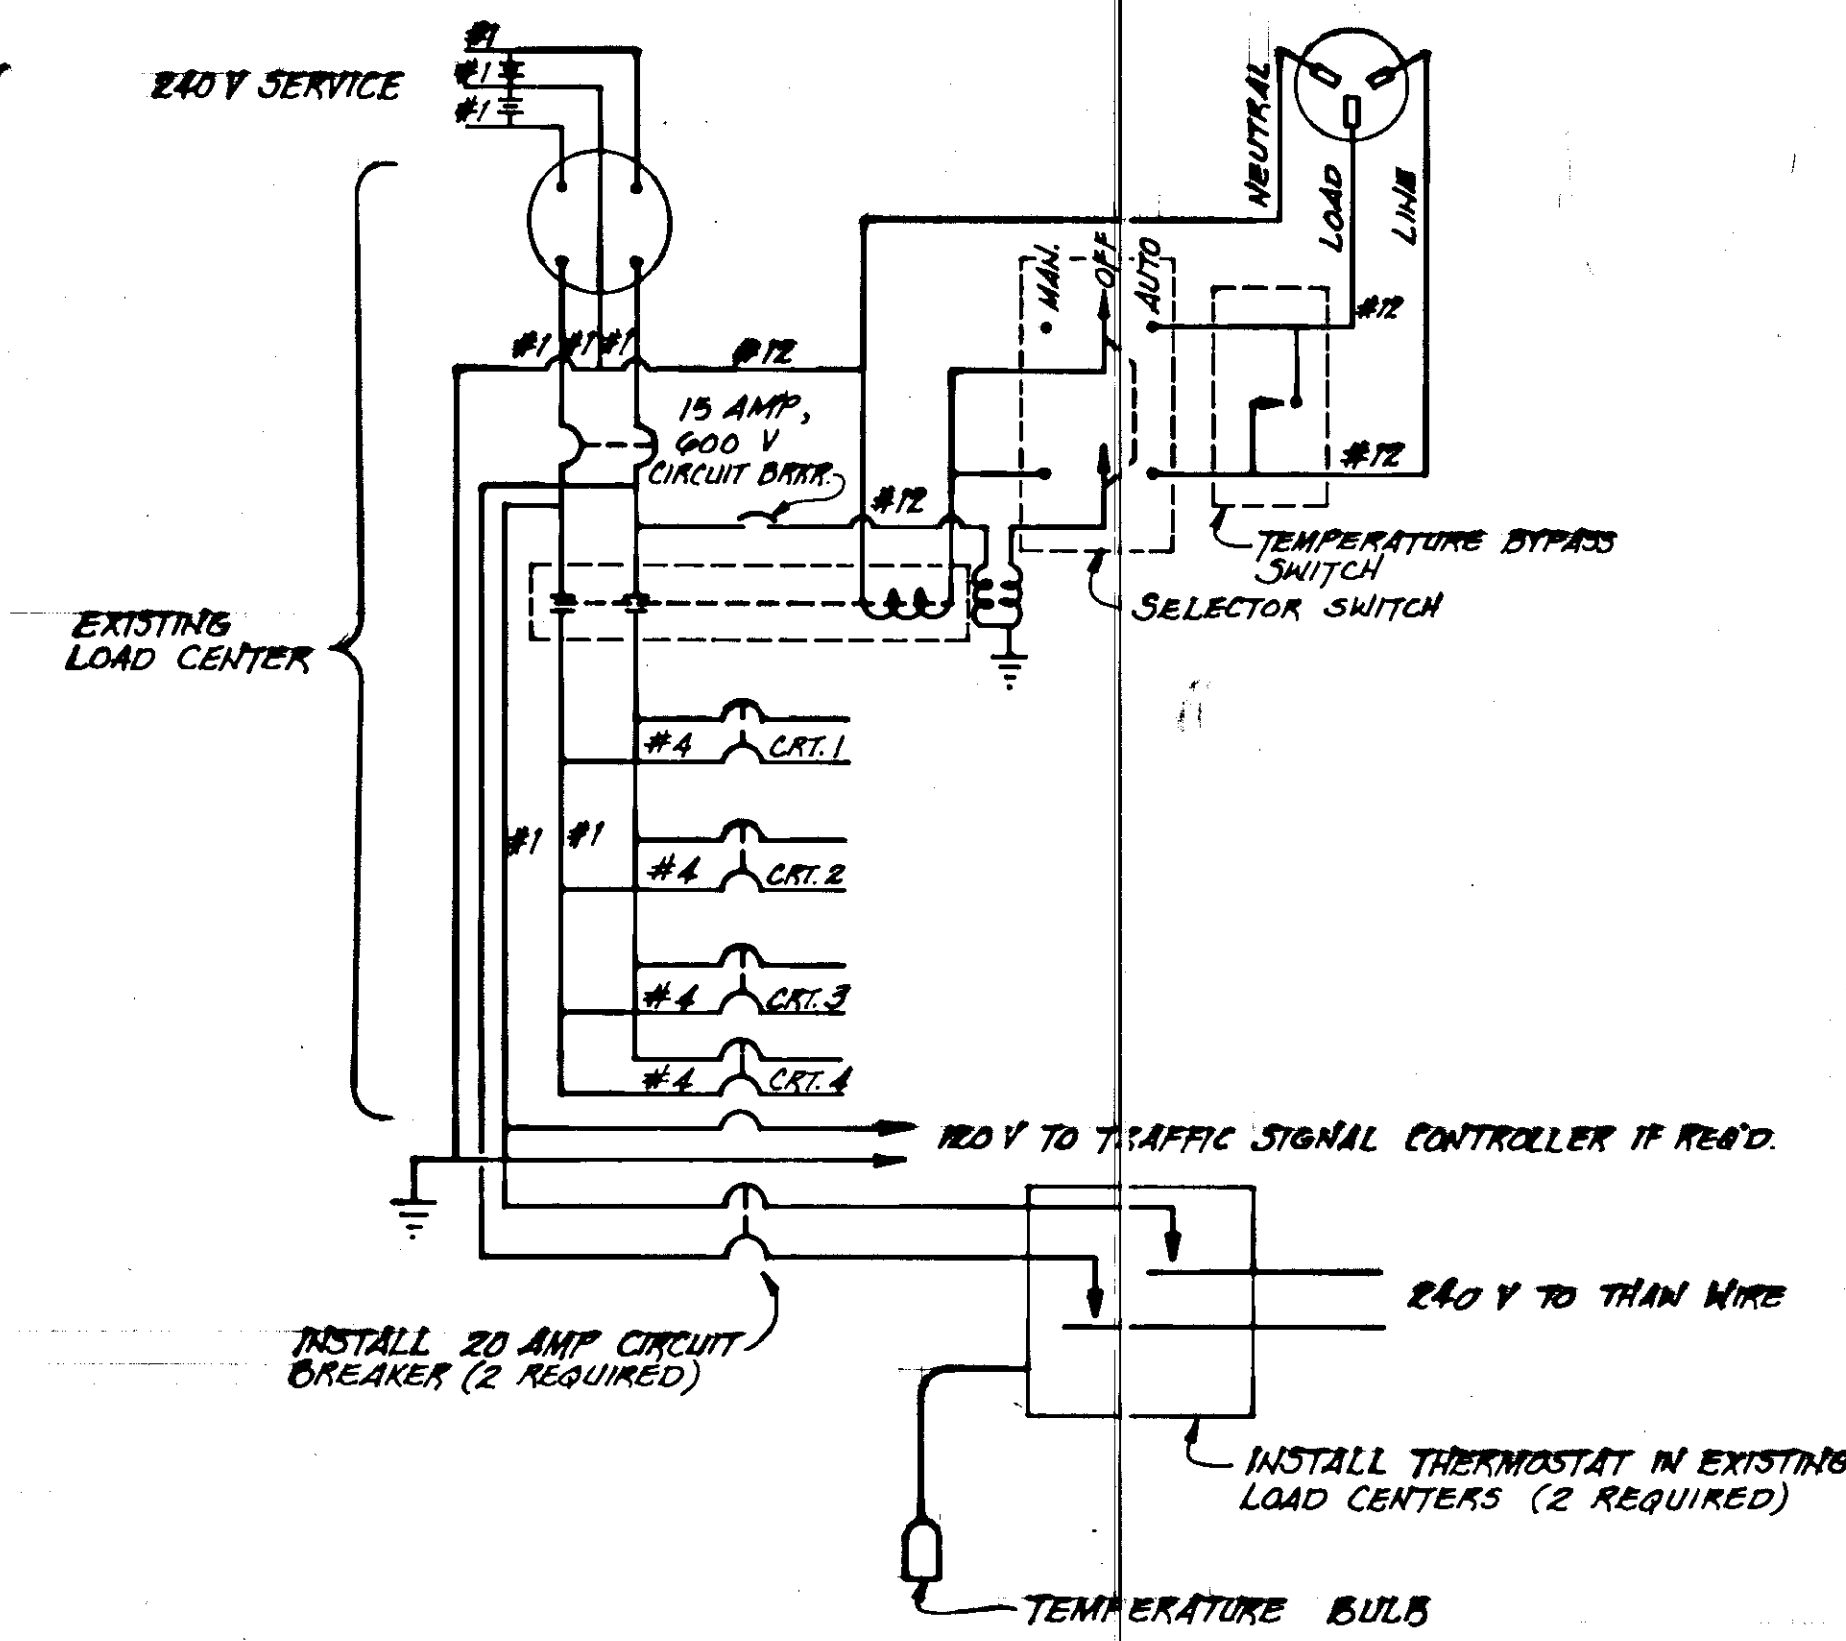


### Thaw Wire Notes


1. Thermostats shall be 2 poles, 35amp with a temperature range of 0-100° F.
2. Thermostat bulb shall be installed in a 3/4" conduit housing as shown on Standard Drawing T-33.01.
3. Existing Illumination wires shall be removed from conduit and pulled back in with new cold conductor thaw wire cables. Cables shall be XHHW, AWG #12.
4. All splices shall be sealed with waterproof epoxy splice kits.
5. Approximately 890 feet total of thaw wire required.
6. Thaw pipe shall be 1 1/2" diameter Standard galvanized pipe.
7. Heat Cable output shall be a minimum of 4 watt per foot (240 operating voltage).

### Control Detail

### Typical Section Thaw Wire Installation

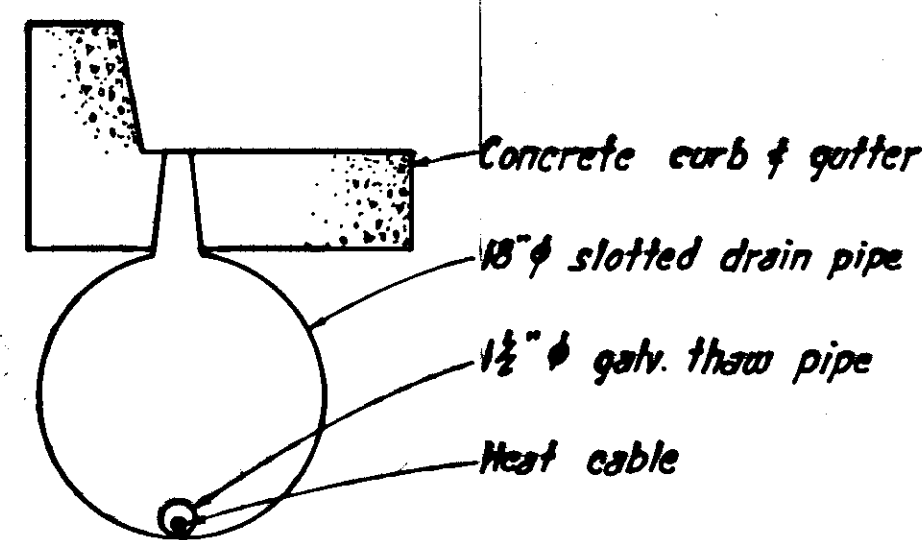

### Thaw Wire Installation Detail "B"

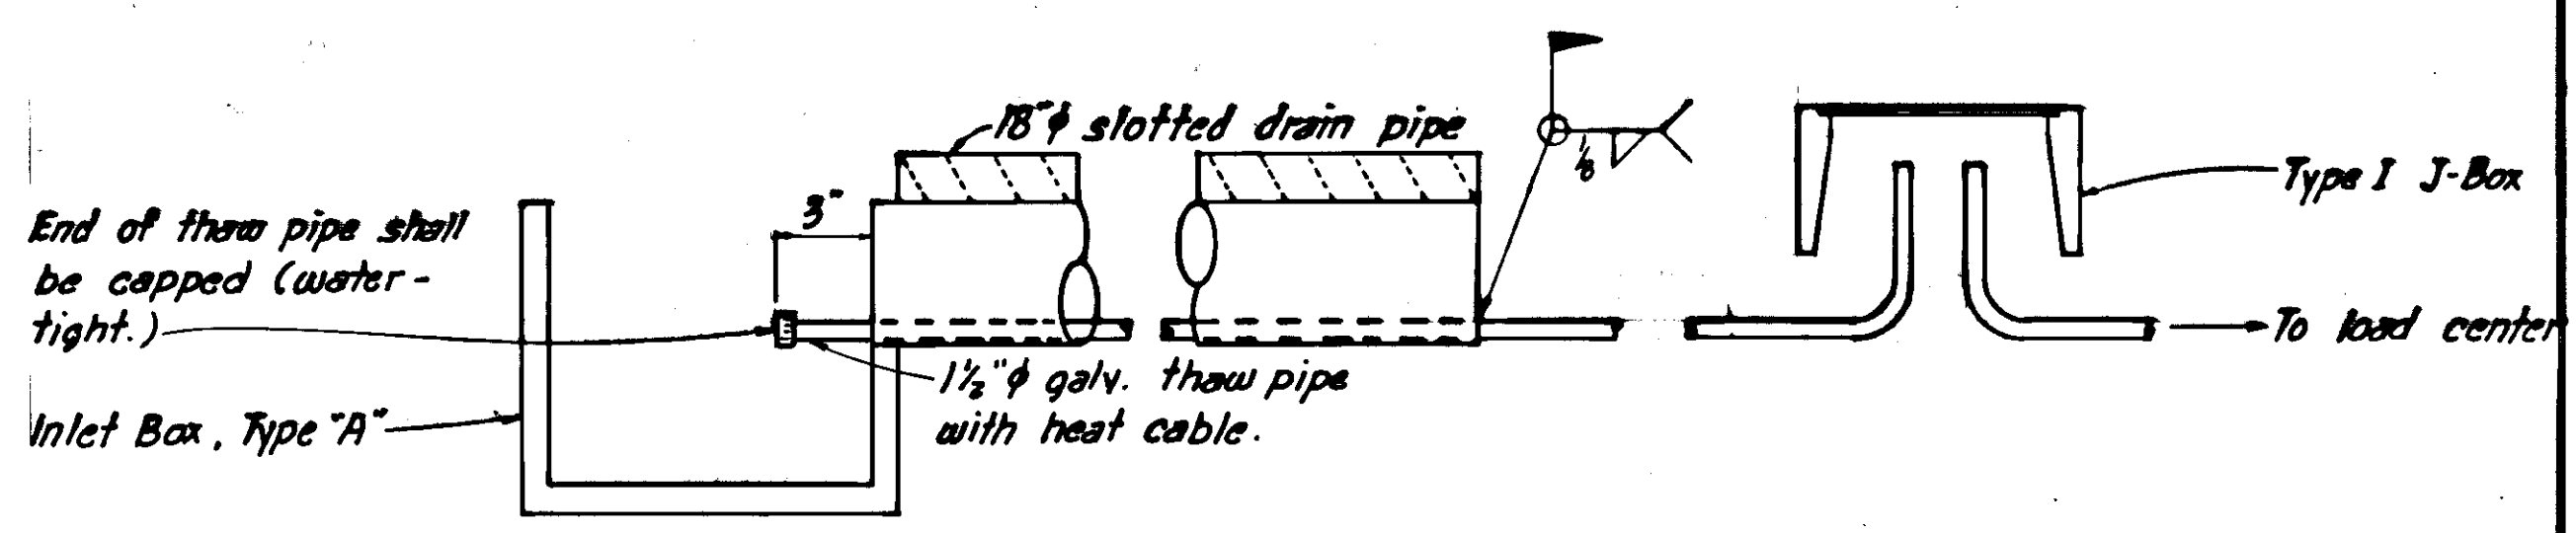

### Thaw Wire Installation Detail "A"

