

State of Alaska

Department of Transportation
and Public Facilities
Southcoast Region


JNU: GLACIER HWY MULTI-USE SEPARATED PATH TO UAS

PROJECT No. 0933037 ~ 69500


The undersigned hereby
certifies that this duplicated
document is an exact and
true copy of the original.

Cody Sutter

September 30, 2015

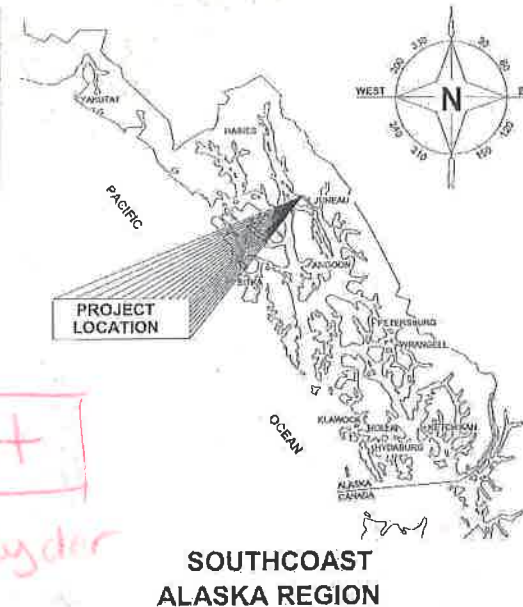

Project Engineer: Danielle Ryder
Contractor: SECON
Begin Work: 10-12-15
End Work: 10-27-16

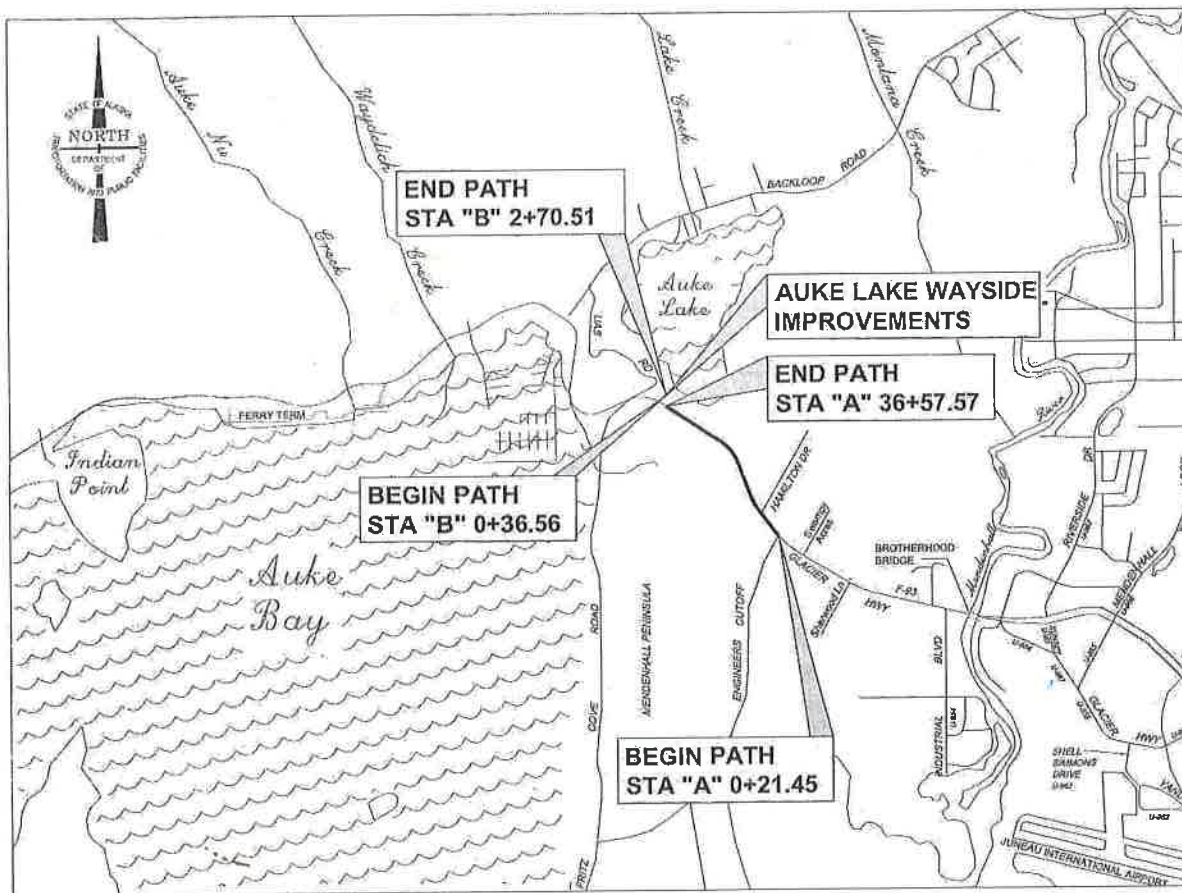

VICINITY MAP

DESIGN DESIGNATION ENGINEERS CUTOFF TO AUKE LAKE

DESIGN CRITERIA	=	MULTI-USE PATH
FACILITY TYPE	=	B & C
DESIGN SPEED	=	20 M.P.H.

PROJECT SUMMARY

LENGTH OF PATH	=	0.73 MILES
WIDTH OF PATH	=	10 FT
GLACIER HIGHWAY		
FUNCTIONAL CLASSIFICATION	=	URBAN PRINCIPAL ARTERIAL
A.D.T. 2010	=	8180
POSTED SPEED	=	40/50 M.P.H.
DIRECTIONAL DISTRIBUTION	=	55/45
TRUCKS (%)	=	5.7%

THE FOLLOWING STANDARD DRAWINGS APPLY TO THIS PROJECT:

A-1	G-00.02	I-20.14	S-00.11
D-04.21	G-04.10S	L-03.10	S-01.00
D-22.01	G-20.11	L-30.10	S-05.01
D-26.02	G-46.11	M-23.12	S-20.10
E-13.00			S-30.03

THE FOLLOWING CITY AND BOROUGH OF JUNEAU STANDARD DETAILS APPLY TO THIS PROJECT:

203	304A	403	405
206A	310	404	406A

INDEX

SHEET NO.	DESCRIPTION
A1	TITLE SHEET
A2-A3	SURVEY CONTROL
A4	LAYOUT PLAN
B1-B2	TYPICAL SECTIONS
C1	ESTIMATE OF QUANTITIES
D1-D2	MISCELLANEOUS SUMMARIES
E1-E6	DETAILS
F1-F10	PLAN AND PROFILES
G1-G2	DRIVEWAY PLAN & PROFILE
H1-H5	SIGNING & STRIPING
J1	WAYSIDE GRADING & DRAINAGE
L1	WAYSIDE LANDSCAPING PLAN
L2-L3	WAYSIDE HABITAT BENCH PLAN
M1	MSE RETAINING WALL
P1-P6	EROSION AND SEDIMENT CONTROL PLAN
Q1-Q4	ILLUMINATION
R1-R4	RIGHT OF WAY PLAN
T1-T3	TRAFFIC CONTROL PLAN

PATH: Q:\JNU\69500\PLANS\69500_A1.DWG TAB:A1

Thursday, June 05, 2014 3:21:46 PM

PLOT: PSPACE OR MSPACE: 1=1(F)

STATE OF ALASKA
DEPARTMENT OF TRANSPORTATION
& PUBLIC FACILITIES
SOUTHCOAST REGION



APPROVED:

REGIONAL PRE-CONSTRUCTION ENGINEER
L. PAT CARROLL, P.E.

APPROVED:

DIRECTOR OF DESIGN & CONSTRUCTION
CHUCK CORREA, P.E.

CERTIFIED TRUE & CORRECT AS-BUILT OF ACTUAL FIELD
CONDITION:

CONSTRUCTION PROJECT MANAGER

DATE

STATE	PROJECT DESIGNATION	YEAR	SHEET NO.	TOTAL SHEETS
ALASKA	0933037 ~ 69500	2015	A1	54

ADDENDUM NUMBER		
ATTACHMENT NUMBER		
RECORD OF REVISIONS		
No.	DATE	DESCRIPTION

MONUMENT NOTES:
1. If any pair of control points disagrees from published value by more than 1:10,000 horizontally or vertically then a third network point must be tied to ascertain which point is in error or has been disturbed.

2. Whether listed or not, all monuments, property markers, or accessories that will be disturbed or buried shall be referenced prior to being disturbed, and re-established in their original position and a record of monument form in accordance with A.S.34.65.040 shall be submitted to the construction engineer for review prior to recording. Coordinate values listed are for informational purposes and should be used to reset monuments only as a last resort.

CHECKED BY: DJIGNOTOV



DESIGNED BY: J.PAPOI
DRAWN BY: J.PAPOI

STATE OF ALASKA
DEPARTMENT OF TRANSPORTATION & PUBLIC FACILITIES
DESIGN & ENGINEERING SERVICES
DIVISION-SOUTHCOST REGION
JNU:GLACIER HIGHWAY MULTI-USE SEPARATED PATH TO UAS PROJECT# 69500

SURVEY CONTROL


PROJECT DESIGNATION	
0933037~69500	
STATE	YEAR
ALASKA	2014
SHEET NUMBER	TOTAL SHEETS
A2	54

Existing Survey Control						
Point #	Northing	Easting	Elevation	Description	Station	Offset
2	509441.22	487413.07	85.86	GPS_ALCTRL2*_FCF-2	36+71.66	12.17L
19	509621.62	486921.10	96.51	ALCTRL2*_FCF-19	N\A	N\A
339	509443.36	486960.67	92.21	BC3*_TBM-108	N\A	N\A

All **SURVEY CONTROL** monuments in this table are provided strictly for survey control. Should any of them be destroyed during construction they **shall NOT** be replaced.

Existing Centerline Monuments						
Point #	Northing	Easting	ELEVATION	Description	Station	Offset
13	505708.39	491390.68	32.22	GPS_SH_MON_DOH	N\A	N\A
14	506601.04	489874.75	71.13	SH_MON/BC2.5*_DOH	0+06.01	70.44L
15	507419.22	489230.50	117.20	SH_MON/BC2.5*_DOH	10+32.25	51.25L
16	506343.53	490312.31	64.00	CL_MON/BC2.5*_DOH	N\A	N\A
1111	508075.30	488976.36	130.73	CL_MON/BC2.5*_DOH	17+28.58	31.87L
1112	508392.82	488830.35	124.89	CL_MON/BC2.5*_DOH	20+85.17	30.45L
1113	508587.84	488670.93	114.55	CL_MON/BC2.5*_DOH	23+44.46	30.44L
1114	508794.00	488388.80	94.48	CL_MON/BC2.5*_DOH	27+01.12	31.47L
1115	509374.54	487482.87	84.33	CL_MON/BC2.5*_DOH	37+76.86	30.36L
1116	509519.16	487220.57	87.54	CL_MON/BC2.5*_DOH	N\A	N\A
1117	509569.45	486955.08	90.22	CL_MON_DOH	N\A	N\A

All **CENTERLINE** monuments in the **existing centerline** table shall be **preserved** and **referenced** prior to disturbance and replaced at their original horizontal position.

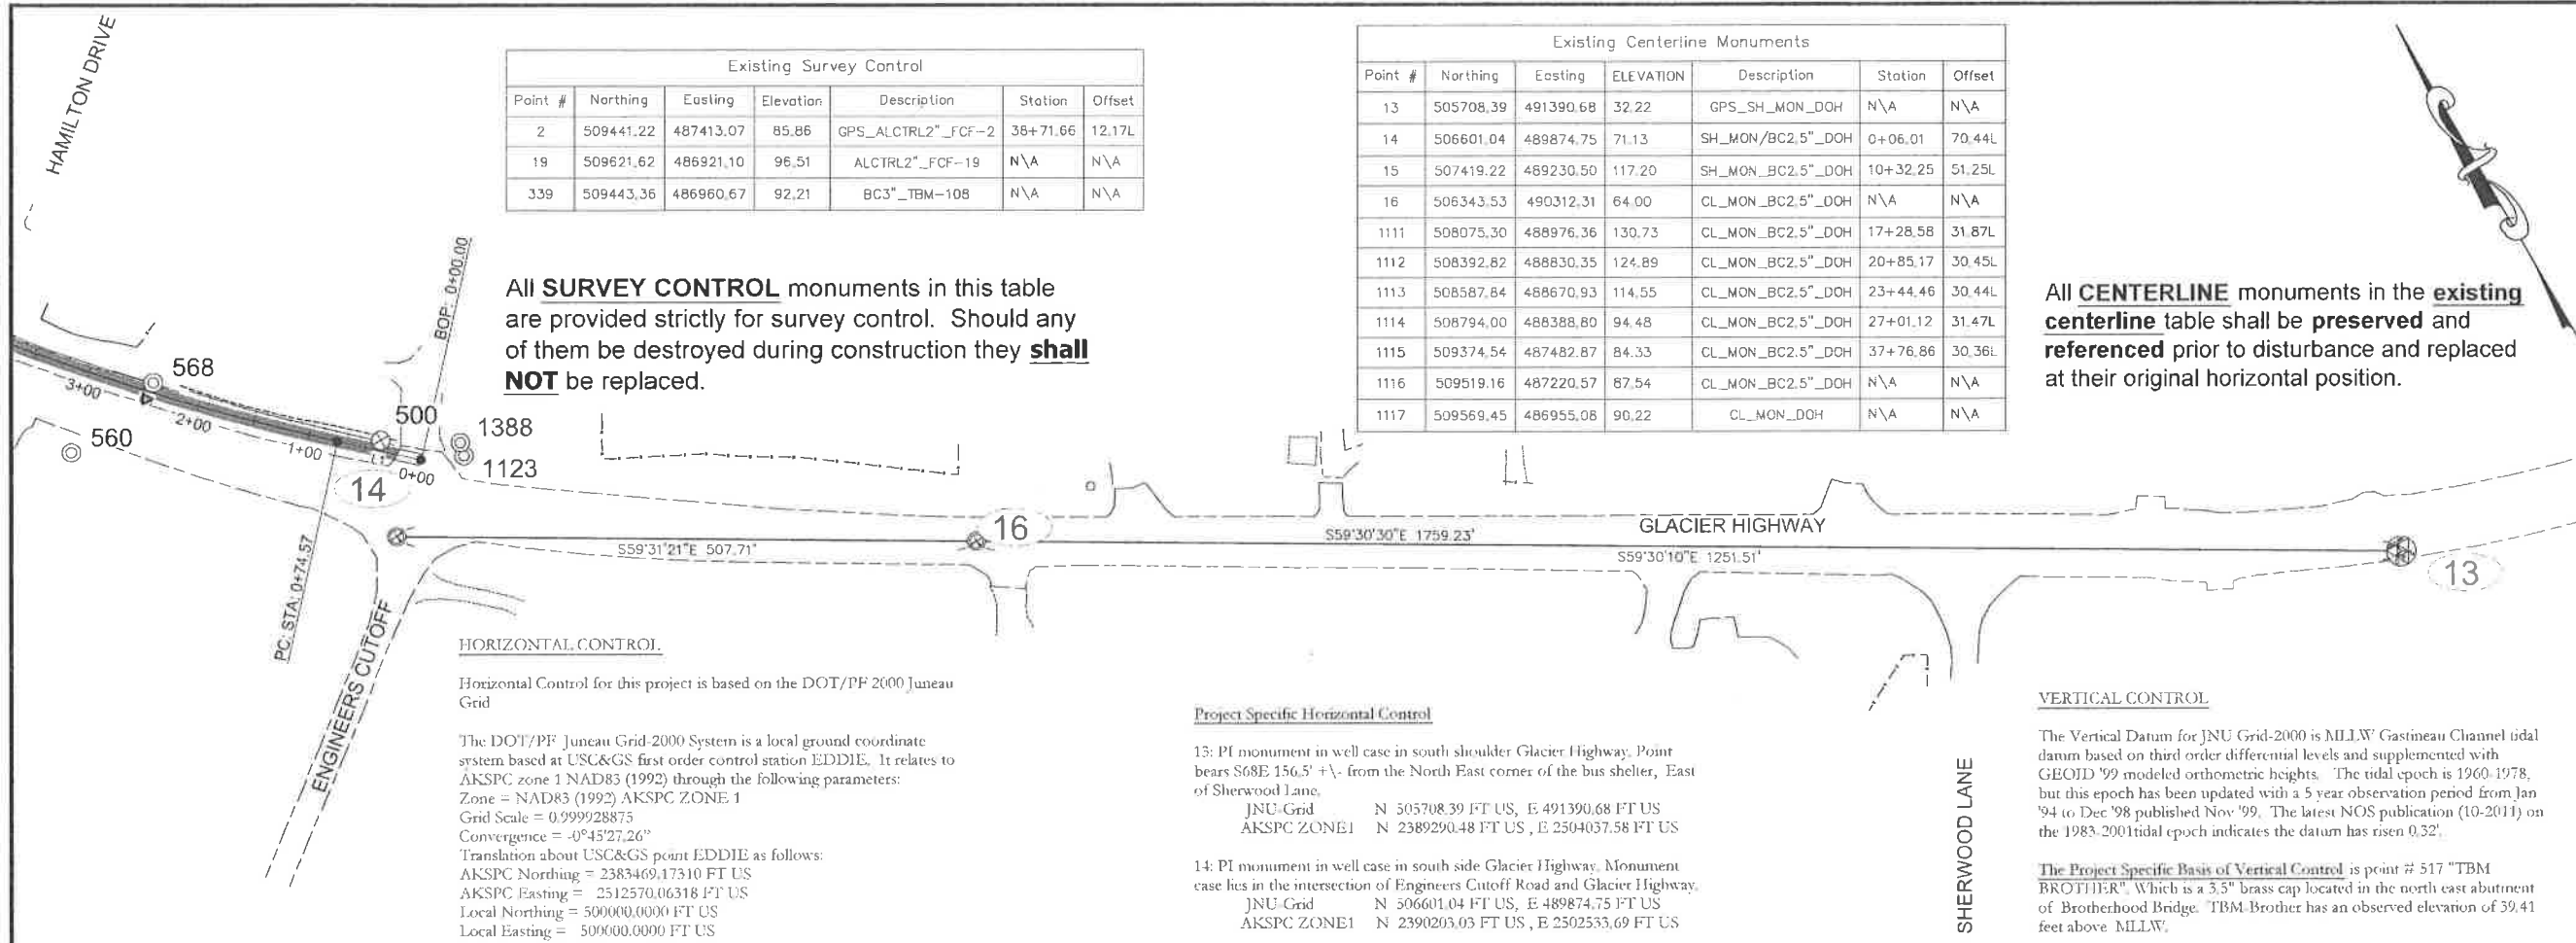

HORIZONTAL CONTROL

Horizontal Control for this project is based on the DOT/PP 2000 Juneau Grid

The DOT/PP Juneau Grid-2000 System is a local ground coordinate system based at US&GS first order control station EDDIE. It relates to AKSPC zone 1 NAD83 (1992) through the following parameters:
Zone = NAD83 (1992) AKSPC ZONE 1
Grid Scale = 0.999928875
Convergence = -0°45'27.26"
Translation about US&GS point EDDIE as follows:
AKSPC Northing = 2383469.17310 FT US
AKSPC Easting = 2512570.06318 FT US
Local Northing = 500000.0000 FT US
Local Easting = 500000.0000 FT US

Project Specific Horizontal Control

13: PI monument in well case in south shoulder Glacier Highway. Point bears S68°15'6" +\ - from the North East corner of the bus shelter, East of Sherwood Lane.
JNU Grid N 505708.39 FT US, E 491390.68 FT US
AKSPC ZONE1 N 2389290.48 FT US, E 2504037.58 FT US

14: PI monument in well case in south side Glacier Highway. Monument case lies in the intersection of Engineers Cutoff Road and Glacier Highway.
JNU Grid N 506601.04 FT US, E 489874.75 FT US
AKSPC ZONE1 N 2390203.03 FT US, E 2502533.69 FT US

VERTICAL CONTROL

The Vertical Datum for JNU Grid-2000 is MLLW Gastineau Channel tidal datum based on third order differential levels and supplemented with GEOID '99 modeled orthometric heights. The tidal epoch is 1960-1978, but this epoch has been updated with a 5 year observation period from Jan '94 to Dec '98 published Nov '99. The latest NOS publication (10-2011) on the 1983-2001 tidal epoch indicates the datum has risen 0.32'.



The Project Specific Basis of Vertical Control is point # 517 "TBM BROTHER". Which is a 3.5" brass cap located in the north east abutment of Brotherhood Bridge. TBM-Brother has an observed elevation of 39.41 feet above MLLW.

BIKE PATH ALIGNMENT TABLE

SEGMENT	STATION	NORTHING	EASTING	DISTANCE	BEARING	STATION	RADIUS	LENGTH	DELTA
L1	0+00.00	506648.84	489926.85	74.57	N47° 24' 28"W	0+74.57			
C1	0+74.57	506699.31	489871.95			4+15.67	2102.13	341.10	9°17'49"
L2	4+15.67	506949.47	489640.62	302.49	N38° 06' 39"W	7+18.16			
C2	7+18.16	507187.48	489453.93			8+47.28	2990.59	129.12	2°28'26"
L3	8+47.28	507290.76	489376.45	60.17	N35° 38' 14"W	9+07.45			
C3	9+07.45	507339.66	489341.40			10+00.00	1000.00	92.54	5°18'08"
L4	10+00.00	507417.26	489291.03	46.55	N30° 20' 05"W	10+46.55			
C4	10+46.55	507457.44	489267.52			11+69.05	1000.00	122.51	7°01'09"
L5	11+69.05	507566.69	489212.27	79.53	N23° 18' 57"W	12+48.58			
C5	12+48.58	507639.73	489180.79			13+44.11	2500.00	95.53	2°11'22"
L6	13+44.11	507728.15	489144.67	506.64	N21° 07' 35"W	18+50.75			
C6	18+50.75	508200.74	488962.06			25+83.32	1150.00	732.57	36°29'54"
L7	25+83.32	508757.50	488505.13	391.02	N57° 37' 29"W	29+74.34			
L8	29+74.34	508966.87	488174.90	713.87	N57° 21' 06"W	36+88.21			
L9	36+88.21	509351.99	487573.82	204.68	N57° 10' 12"W	38+92.88			

A2 Existing Property						
Point #	Northing	Easting	Description	Station	Offset	
500	506681.30	489904.83	BC3.25*_S2386_LA/C4_L9/C1_L10_S3260	0+38.18	9.00R	
560	506806.38	489665.76	IP_1.5"	2+91.75	72.31L	
568	506824.26	489758.42	PLASCAP_BEAN	2+43.57	8.40R	
570	507095.68	489535.54	PLASCAP_BEAN	5+95.57	7.56R	
571	507156.46	489395.72	GLO_BC2.5*_C3_L6/C4_LH/S2386	7+29.44	64.96L	
572	507383.81	489321.15	BPR_BC3*_L3B/L4C/S2386	9+55.54	8.12R	
573	507501.94	489157.84	GLO_BC2.5*_C3_LF/C4_L6/S2386	11+33.81	76.28L	
574	507734.92	489175.22	GLO_BC2.5*_C3_LC/C4_LD_S2386	13+39.35	30.93R	
575	507887.84	489006.09	BPR_BC3*_L4F/L3F/ROW_S2386	15+43.01	71.71L	
576	508070.06	489031.90	BPR_BC3*_C15_S3406/ROW_S2386	17+03.68	18.04R	
577	507975.24	488970.97	PLASCAP	16+37.20	72.96L	
579	508052.16	488939.32	PLASCAP	17+20.35	74.76L	
580	508171.26	488869.80	PLASCAP	18+57.03	96.67L	
581	508532.58	488657.35	PLASCAP_BEAN	23+13.48	79.10L	
582	508550.42	488637.85	PLASCAP_BEAN	23+41.85	80.33L	
583	508592.73	488590.94	PLASCAP_BEAN	24+09.78	81.06L	
584	508711.90	488427.11	GLO_BC2.5*_C3_LK/C4_LJ_S2386	26+24.81	80.29L	
585	508782.17	488308.25	BC2.5*_PAR1/PAR2/ROW_WVH	27+62.82	84.58L	
586	508858.55	488178.24	GLO_BC2.5*_C3_L-L/C4_L-K_S2386	29+13.52	89.69L	
593	507160.01	489630.97	PLASCAP_BEAN	5+87.28	122.35R	
1123	506633.17	489961.02	ALSEC2*_63505_RESET_7712S	N\A	N\A	
1388	506644.80	489964.05	ALCAP2*_ROW/L-7/L510811	N\A	N\A	

All **PROPERTY** monuments in the **existing property** table shall be **preserved** and **referenced** prior to disturbance and replaced at their original horizontal position.

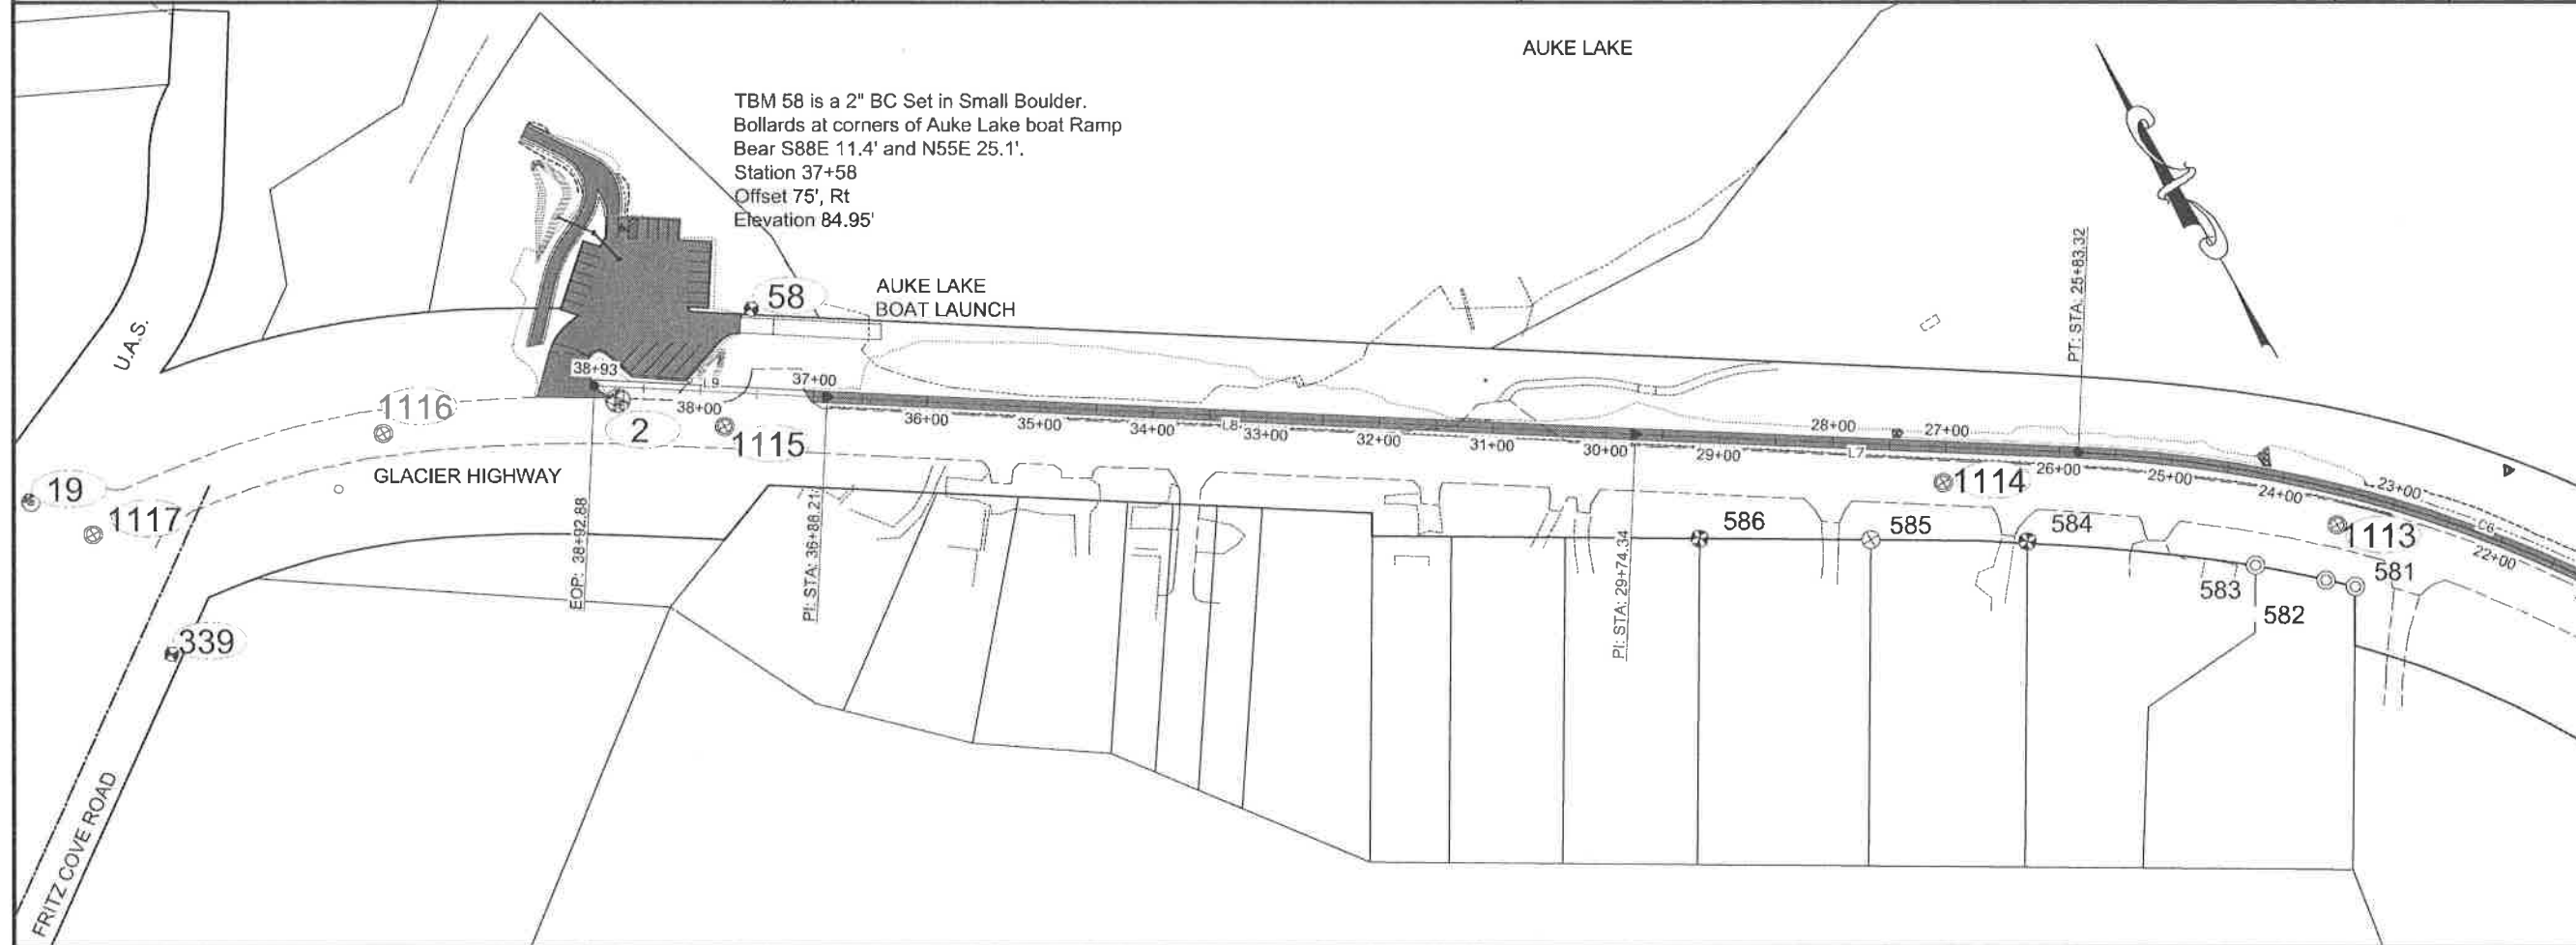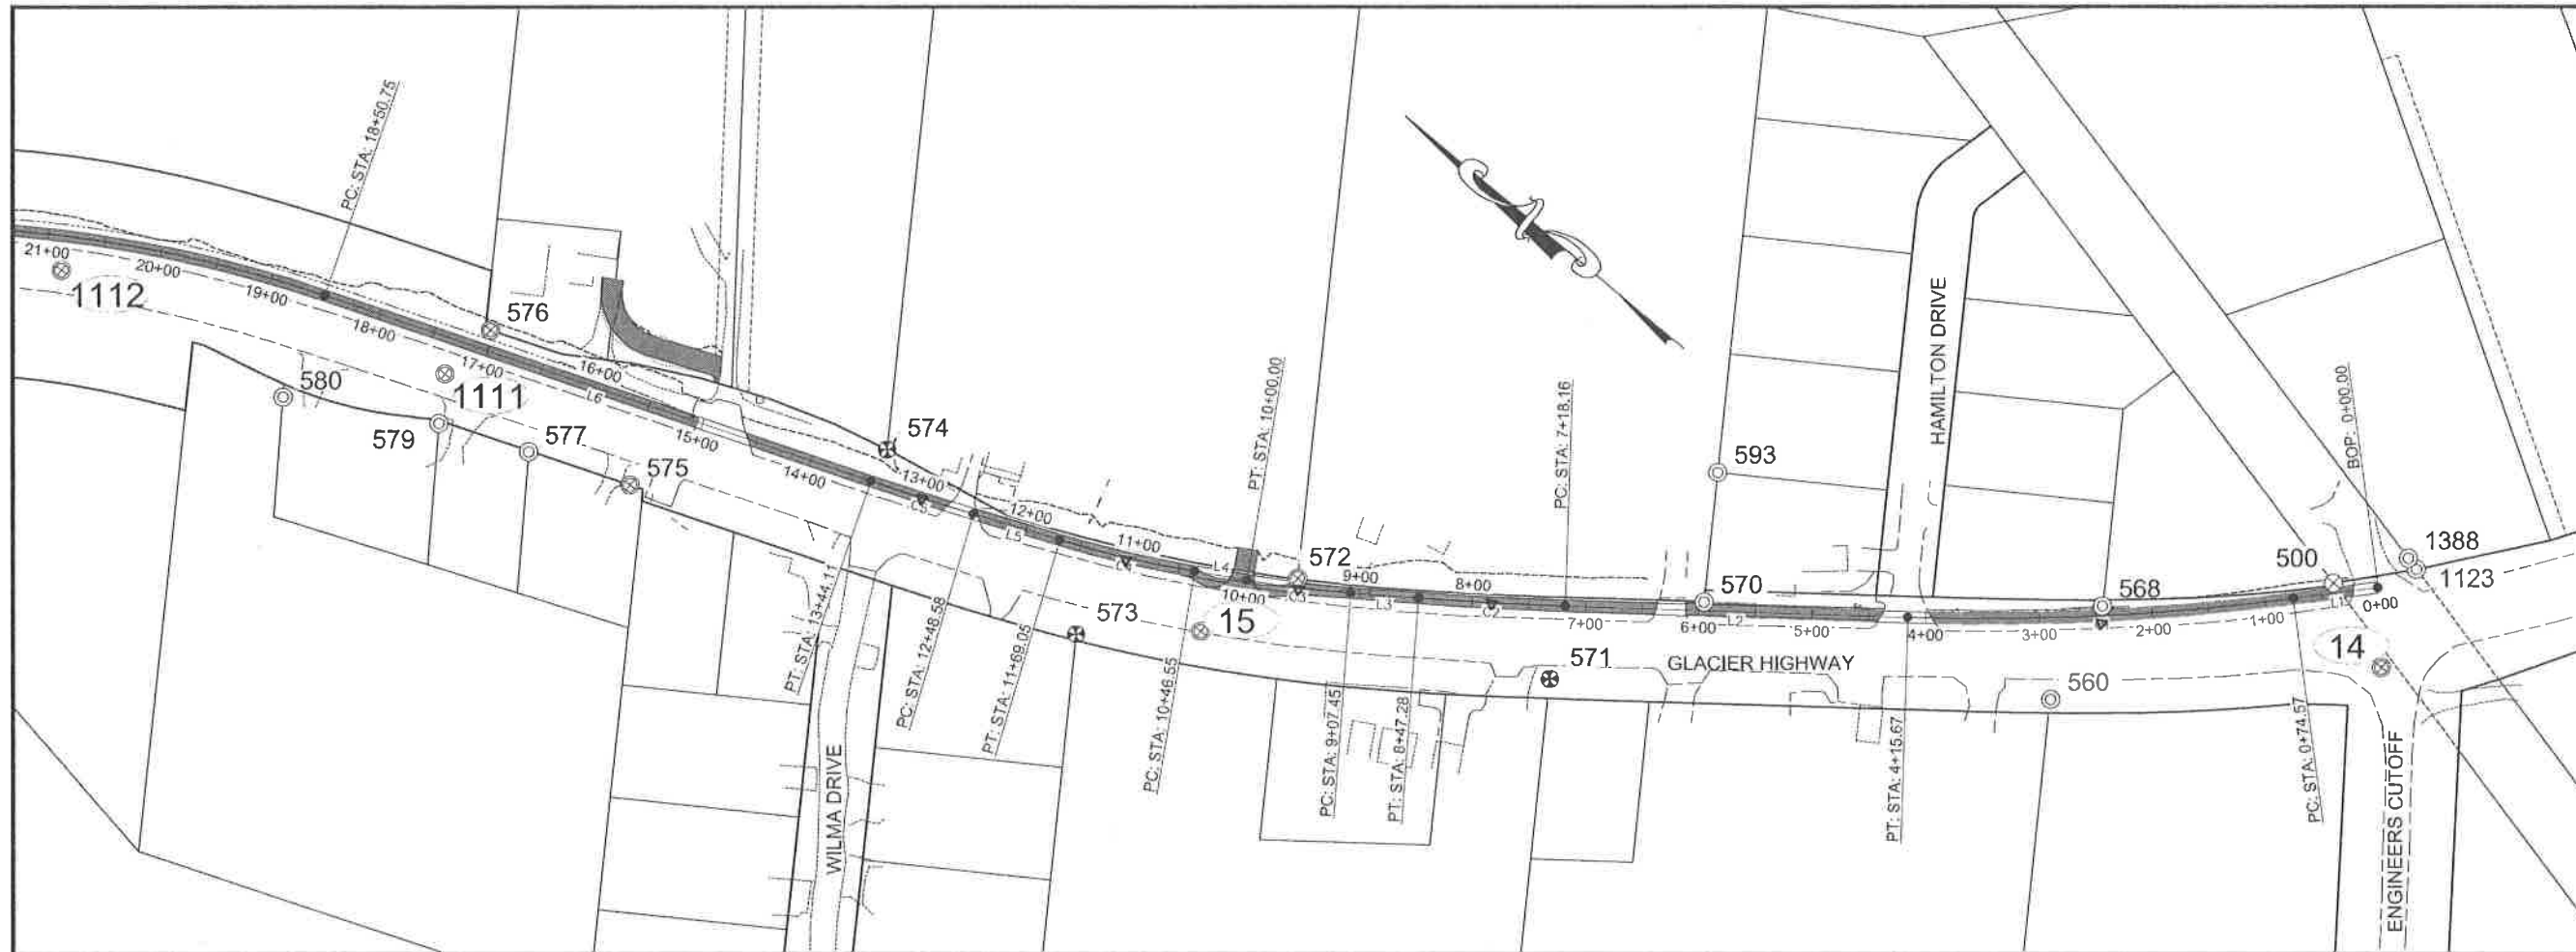

TBM 58 is a 2" BC Set in Small Boulder.
 Bollards at corners of Auke Lake boat Ramp
 Bear S88E 11.4' and N55E 25.1'.
 Station 37+58
 Offset 75', Rt
 Elevation 84.95'

PATH: Q:\JNU\69500\PLANSET\69500_A2-A3 CONTROL.DWG

CHAMBERS, LUCAS M (DOT)
 TAB: A3 Friday, August 14, 2015 4:55:54 PM

RECORD OF REVISIONS		
No.	DATE	DESCRIPTION

MONUMENT NOTES:

1. If any pair of control points disagrees from published value by more than 1:10,000 horizontally or vertically then a third network point must be tied to ascertain which point is in error or has been disturbed.
2. Whether listed or not, all monuments, property markers, or accessories that will be disturbed or buried shall be referenced prior to being disturbed, and re-established in their original position and a record of monument form in accordance with A.S.34.65.040 shall be submitted to the construction engineer for review prior to recording. Coordinate values listed are for informational purposes and should be used to reset monuments only as a last resort.

CHECKED BY: D.IGNOTOV


DESIGNED BY: J.PAPOI
 DRAWN BY: J.PAPOI

STATE OF ALASKA
 DEPARTMENT OF TRANSPORTATION & PUBLIC FACILITIES
 DESIGN & ENGINEERING SERVICES
 DIVISION-SOUTHCOST REGION


JNU:GLACIER HIGHWAY MULTI-USE SEPERATED PATH TO UAS
 PROJECT# 69500

SURVEY CONTROL

PROJECT DESIGNATION	
0933037~69500	
STATE	YEAR
ALASKA	2014
SHEET NUMBER	TOTAL SHEETS
A3	54

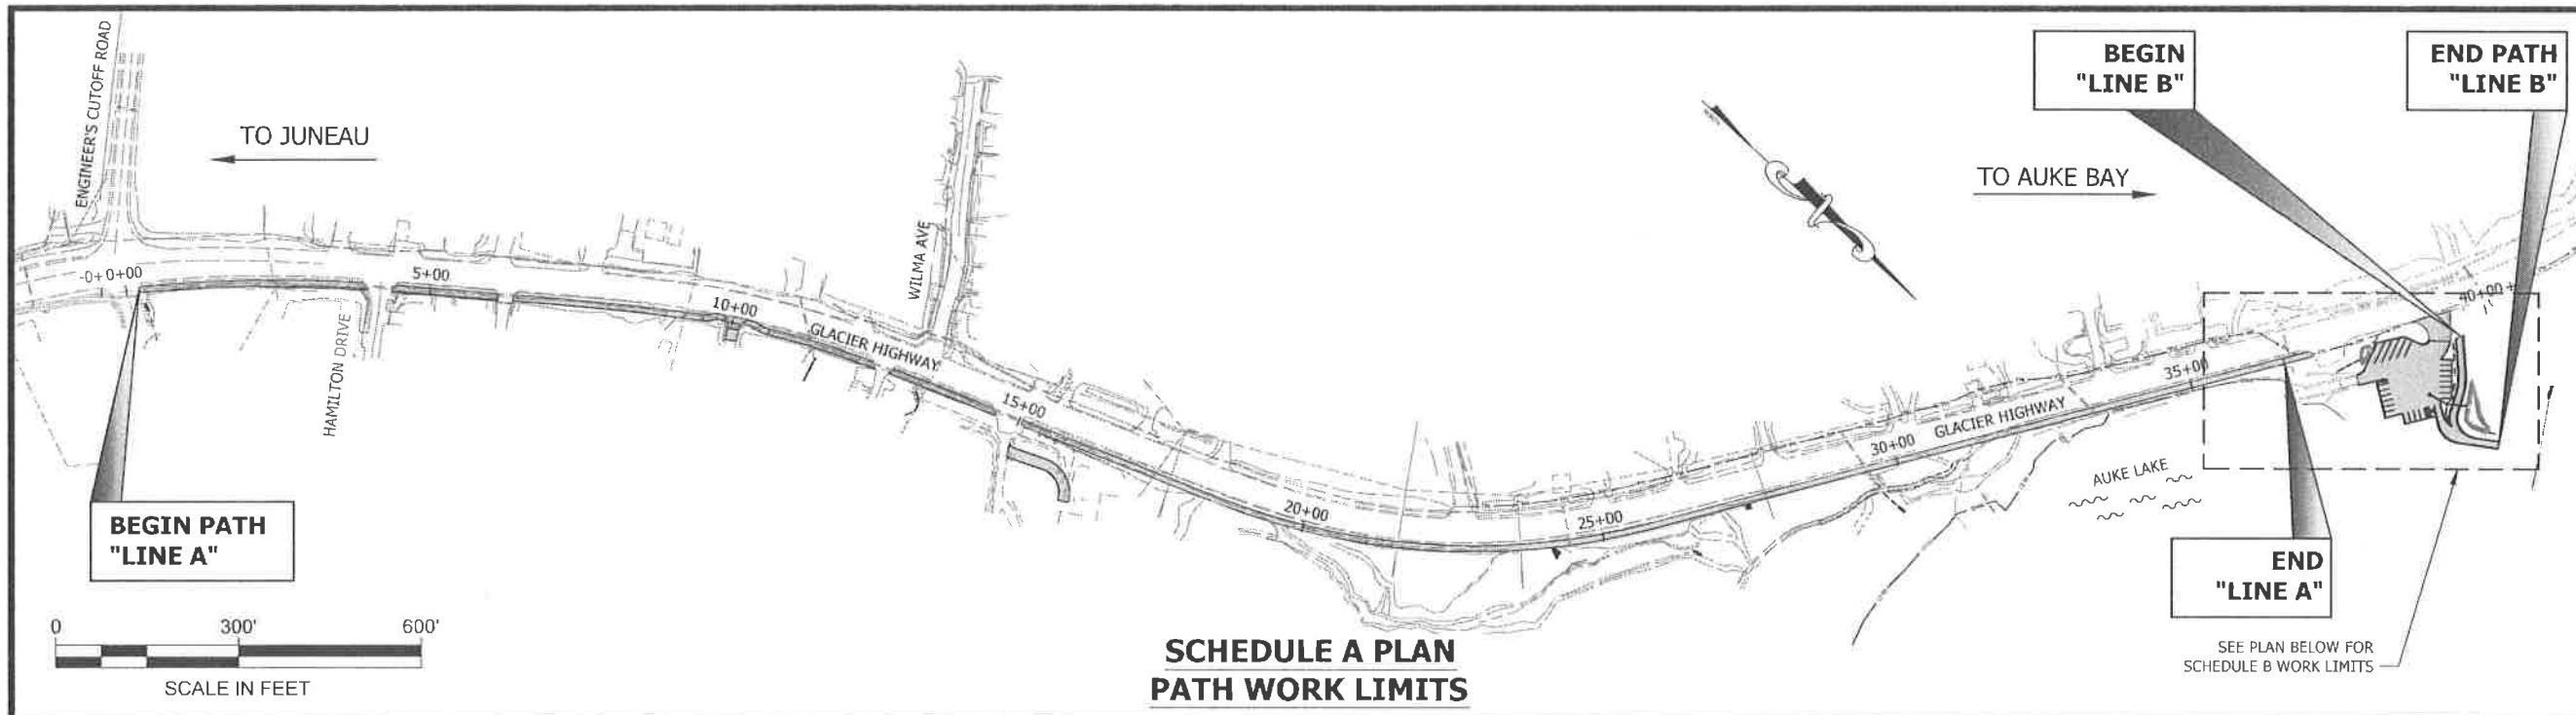

**SCHEDULE A PLAN
PATH WORK LIMITS**

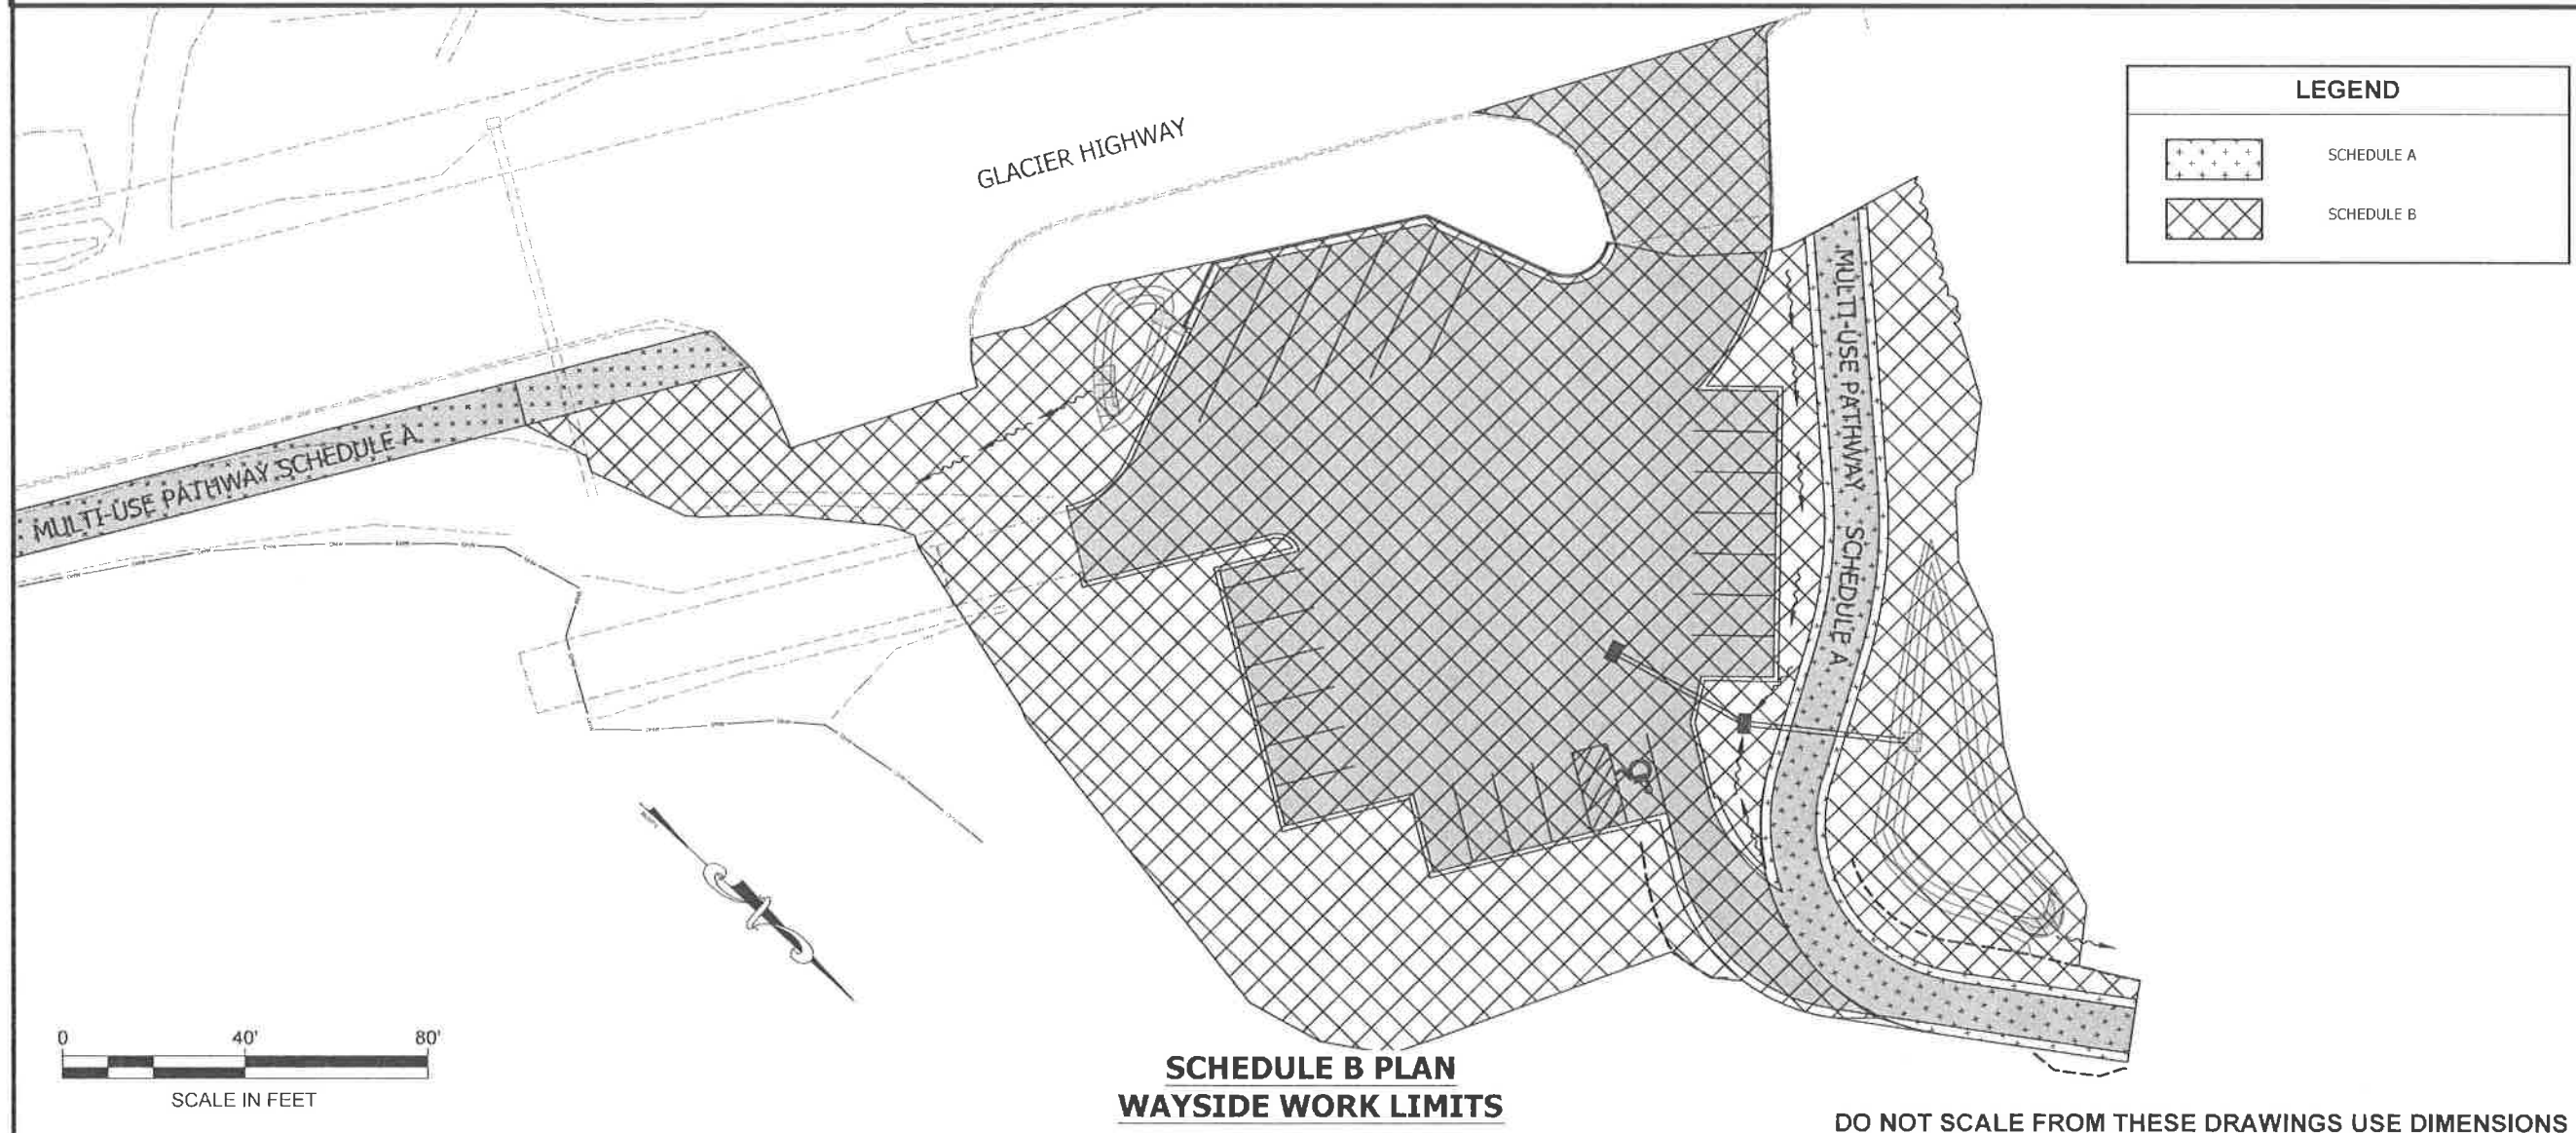


**SCHEDULE B PLAN
WAYSIDE WORK LIMITS**

DO NOT SCALE FROM THESE DRAWINGS USE DIMENSIONS

PATH: Q:\JNU\69500\PLANSET\69500_A4_LAYOUT.DWG
 GRANHAM, RICK L (DOT)
 TAB: A4 Monday, July 20, 2015 12:06:04 PM

ADDENDUM NUMBER		
ATTACHMENT NUMBER		
RECORD OF REVISIONS		
No.	DATE	DESCRIPTION

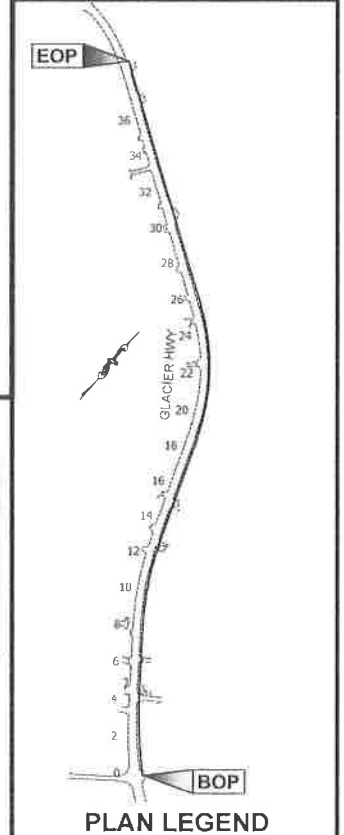

CHECKED BY: J. BROWN



DESIGNED BY: J. BROWN
 DRAWN BY: R. GRANHAM

STATE OF ALASKA
 DEPARTMENT OF TRANSPORTATION
 & PUBLIC FACILITIES
 SOUTHOAST REGION



JNU: GLACIER HWY MULTI-USE
 SEPARATED PATH TO UAS
 PROJECT NO. 69500

LAYOUT PLAN

PROJECT DESIGNATION
0933037 ~ 69500

STATE	YEAR
ALASKA	2015
SHEET NUMBER	TOTAL SHEETS
A4	54

RECORD OF REVISIONS		
No.	DATE	DESCRIPTION
1	01/04/16	MATERIAL TYPE MODS.

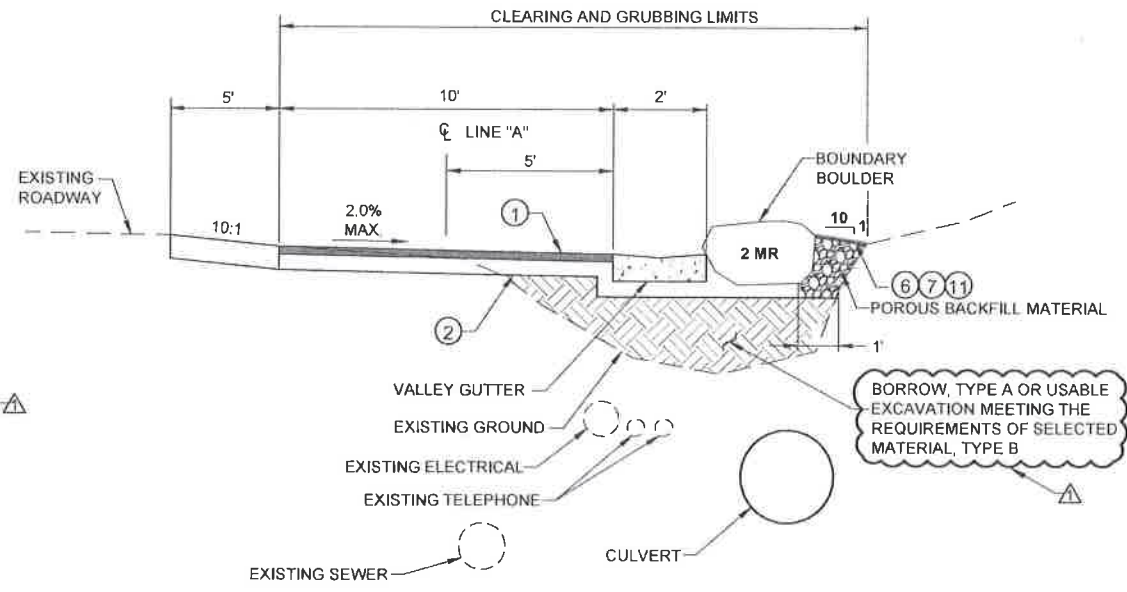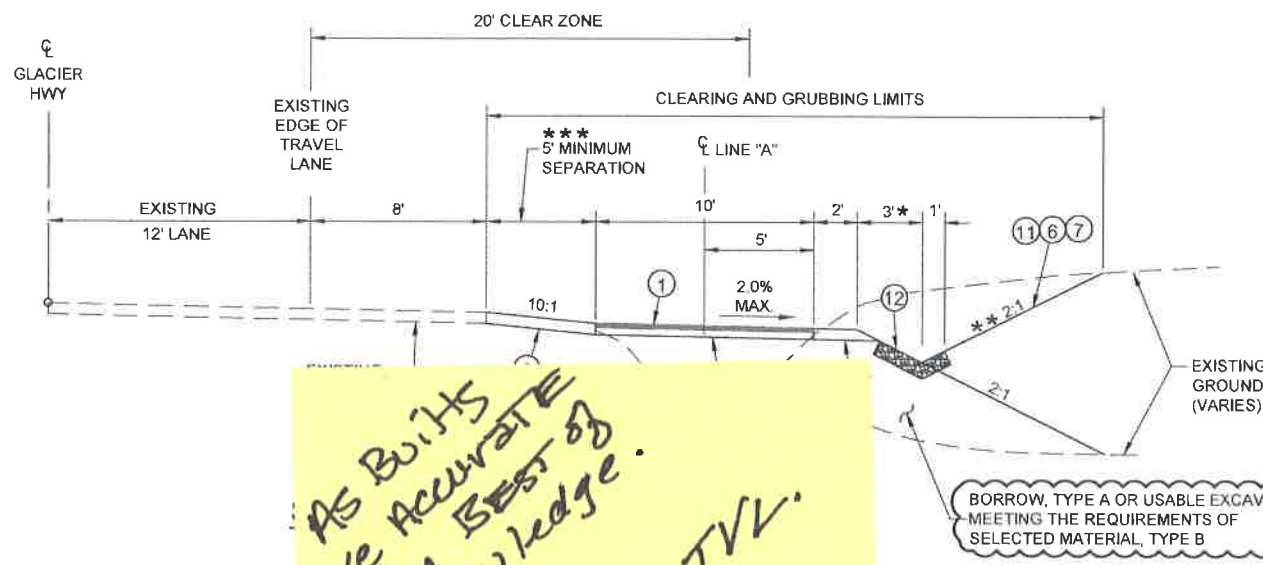

AS BUILT
ave accurate
to the best of
my knowledge.
4/2/19
Reviewed By: TVL
@ AK DOT.

SEE REVERSE SIDE
FOR CHANGE ORDER
#20 Price Reduct. for D-1.

VALLEY GUTTER / BOUNDARY BOULDER SECTION

STA. 2+20 TO STA. 6+10
LINE "A"

BOUNDARY BOULDER NOTES:

- BOUNDARY BOULDER LOCATION & OFFSETS SHALL BE APPROVED BY THE PROJECT ENGINEER. SEE F SHEETS AND SUMMARY TABLE FOR BOULDER LOCATIONS.
- LONG DIMENSION OF ROCKS SHALL EXTEND BACK TOWARDS THE CUT OR FILL FACE.
- THE SIZE CATEGORY FOR ROCK SHALL BE AS FOLLOWS:

SIZE	APPROXIMATE WEIGHT	DIMENSIONS
2MR	150 TO 250 LBS	12-18 INCHES

GENERAL NOTES:

THE 10:1 SLOPE FROM THE EXISTING ROADWAY IS APPROXIMATE CONSTRUCT PATH ACCORDING TO PROFILE.

PLAN LEGEND

CHECKED BY: J. BROWN



DESIGNED BY: J. BROWN, L. CHAMBERS

DRAWN BY: R. GRANTHAM

STATE OF ALASKA
DEPARTMENT OF TRANSPORTATION
& PUBLIC FACILITIES
SOUTHCOST REGION


JNU: GLACIER HWY MULTI-USE
SEPARATED PATH TO UAS
PROJECT NO. 69500

TYPICAL SECTIONS

PROJECT DESIGNATION

0933037 ~ 69500

STATE	YEAR
ALASKA	2015
SHEET NUMBER	TOTAL SHEETS
B1	56

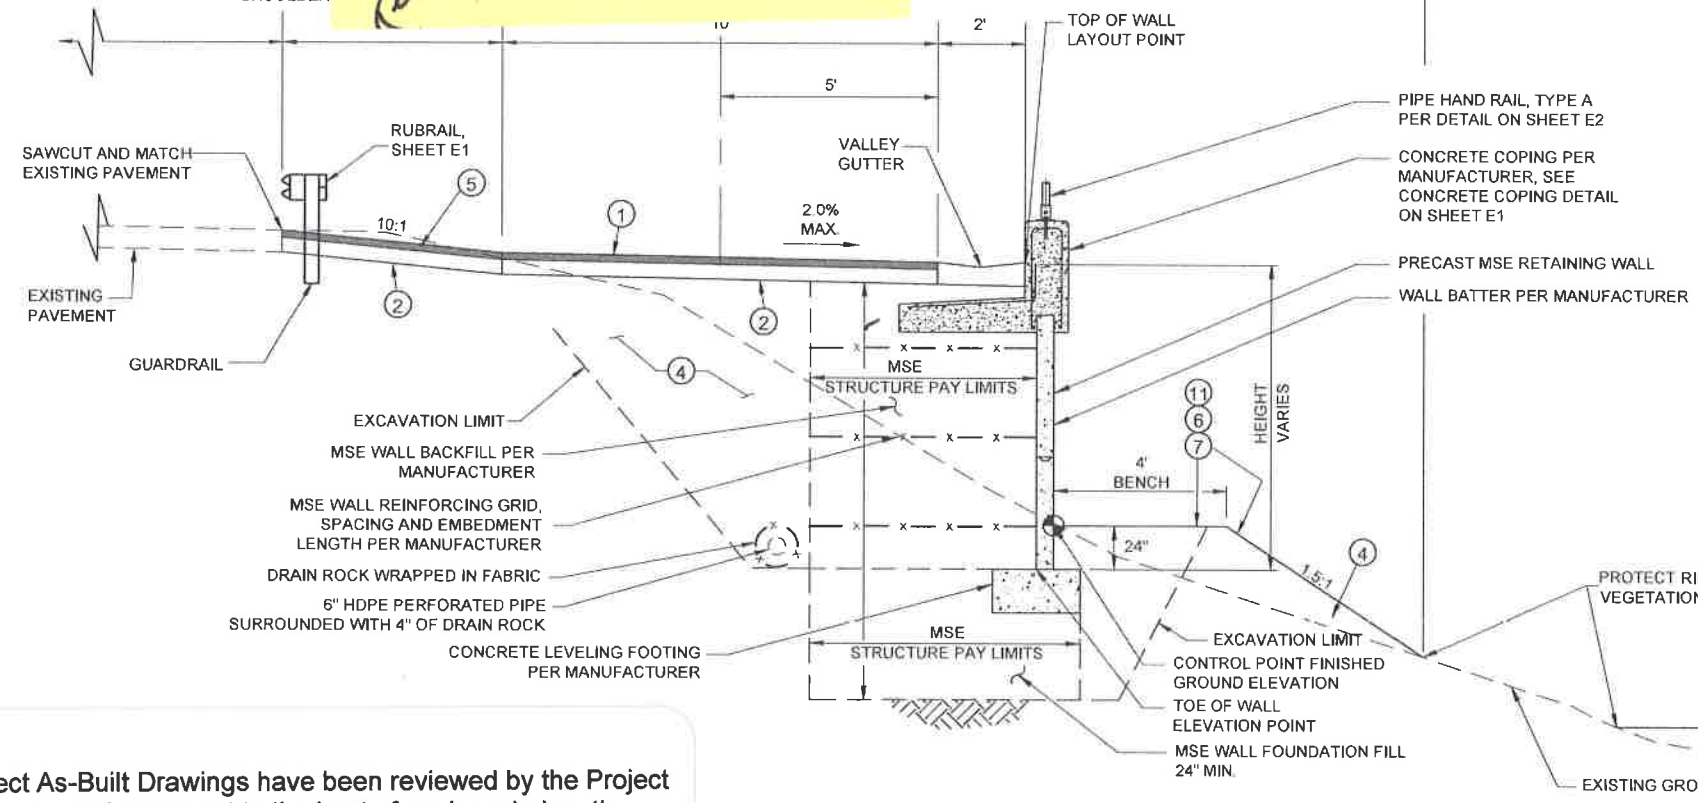

MSE WALL TYPICAL

STA. 24+20 TO STA. 27+40
LINE "A"

Project As-Built Drawings have been reviewed by the Project Engineer, and represent to the best of my knowledge, the project as constructed.
PE *[Signature]* Date 2/7/2018

DO NOT SCALE FROM THESE DRAWINGS USE DIMENSIONS



STATE OF ALASKA
DEPARTMENT OF TRANSPORTATION
AND PUBLIC FACILITIES
SOUTHCOST REGION

Change Order

Project No.: 69500/0933037 Change Order No. 20

Project Name: JNU-Glacier Highway Multi-Use Path to UAS

Contractor:	Secon, Inc.	Change Order Summary:	
Address:	P.O. Box 32159	Calendar Days (+ / -):	N/A
	Juneau, AK 99803	New Completion Date:	N/A
		Amount of Change Order:	-\$4,868.40

Recommended By: Date: 5 Dec 2017

Title: Project Engineer

Approved By: Date: 5 Dec 17

Title: Project Manager

This change order constitutes agreement to terms, conditions and prices stated below.

Accepted By: _____ Date: _____

Contractor's Representative


Acknowledgement indicates only receipt of Change Order and not mutual agreement for basis of payment or time allowance. If a the matter cannot be resolved within 7 days from signature date, an Intent to Claim form must be submitted to the engineer within 14 days.

Acknowledged By: Date: 5-31-18

Contractor's Representative

Permission for previously submitted subcontractor(s) to perform all or portions of the work described herein is as checked: Yes No N/A

Seal of Alaskan Professional Engineer
(if required)

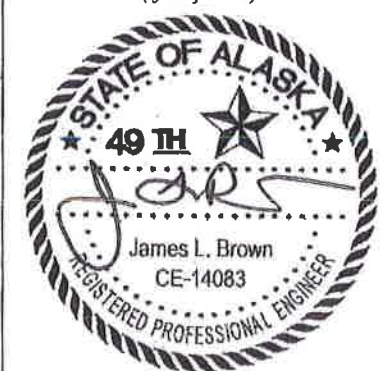

The following change(s) in the above Contract are hereby made in accordance with the terms of the Contract and under the terms and conditions stated below. Price adjustments resulting from inaccurate cost and pricing data are subject to the provisions of AS 36.30.400(c). This document shall become an amendment to the Contract and all provisions of the Contract will be applicable.

DESCRIPTION OF CHANGE (Use Continuation Sheet 25D-065 as Required)

In accordance with Subsection 104-1.02 of the Standard Specifications, the following changes are hereby made:

Establish New Item 301(1A) Aggregate Base Course, Grading D-1 Price Reduction

Description: This item authorizes 1,167.11 tons of non-conforming Aggregate Base Course, grading D-1 from Item 301(1)A Aggregate Base Course Grading D-1 material on Bid Schedule A, for the main path, to remain in place with a price reduction in accordance with Subsection 105-1.03.

Materials: See new Table 703-2 for tolerance changes.

Construction Requirements: No changes.

Method of Measurement: This item is Lump Sum and in accordance with Subsection 109-1.01 is not measured for



STATE OF ALASKA
DEPARTMENT OF TRANSPORTATION
AND PUBLIC FACILITIES
SOUTHCOST REGION

Change Order

Project No.: 69500/0933037 Change Order No. 21

Project Name: JNU-Glacier Highway Multi-Use Path to UAS

Contractor:	Secon, Inc.	Change Order Summary:	
Address:	P.O. Box 32159	Calendar Days (+ / -):	N/A
	Juneau, AK 99803	New Completion Date:	N/A
		Amount of Change Order:	-\$2,418.12

Recommended By: Date: 2/2/2018

Title: Project Engineer

Approved By: Date: 2/2/18

Title: Project Manager

This change order constitutes agreement to terms, conditions and prices stated below.

Accepted By: Date: 2/2/18

Contractor's Representative

Acknowledgement indicates only receipt of Change Order and not mutual agreement for basis of payment or time allowance. If a the matter cannot be resolved within 7 days from signature date, an Intent to Claim form must be submitted to the engineer within 14 days.

Acknowledged By: _____ Date: _____

Contractor's Representative

Permission for previously submitted subcontractor(s) to perform all or portions of the work described herein is as checked: Yes No N/A

Seal of Alaskan Professional Engineer
(if required)



The following change(s) in the above Contract are hereby made in accordance with the terms of the Contract and under the terms and conditions stated below. Price adjustments resulting from inaccurate cost and pricing data are subject to the provisions of AS 36.30.400(c). This document shall become an amendment to the Contract and all provisions of the Contract will be applicable.

DESCRIPTION OF CHANGE (Use Continuation Sheet 25D-065 as Required)

In accordance with Subsection 104-1.02 of the Standard Specifications, the following changes are hereby made:


Reduce Existing Item 630(1)A Geotextile, Separation by 2,259 square yards.

Establish New Item 630(3)A Geotextile, Separation (200)



Description: This item is for geotextile separation fabric meeting the requirements of 200 lb grab tensile strength (Class 3), but not the Class 1+ specifications required for Item 630(1)A Geotextile, Separation on Bid Schedule A, for the main path.

Materials: *Modify as follows:*

729-2.01 GEOTEXTILE, SEPARATION AND STABILIZATION

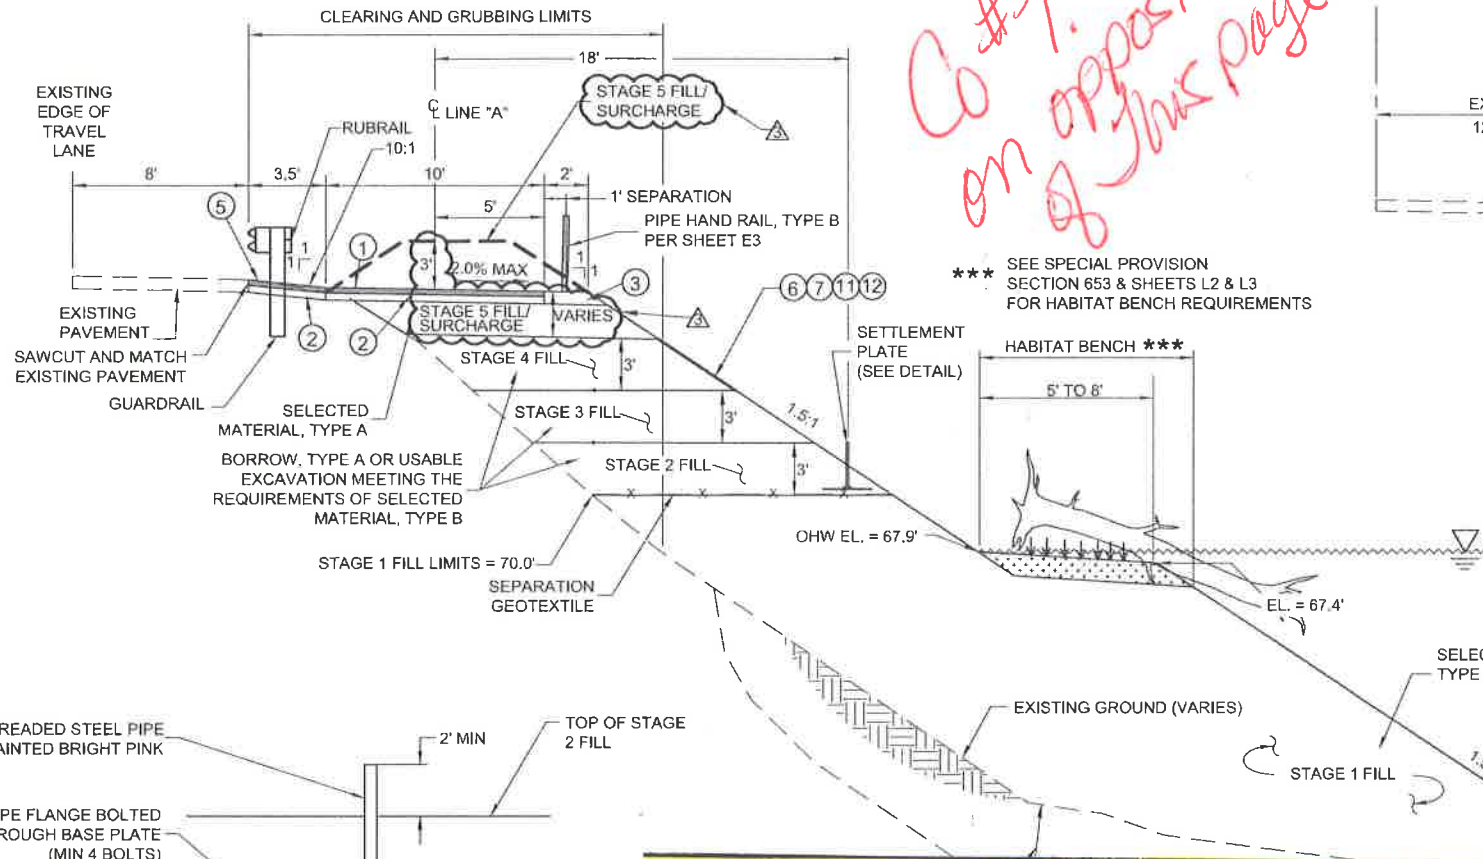

Co #1. on opposite side of this page.

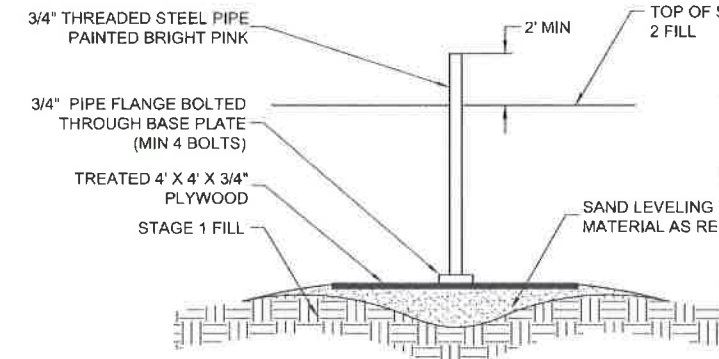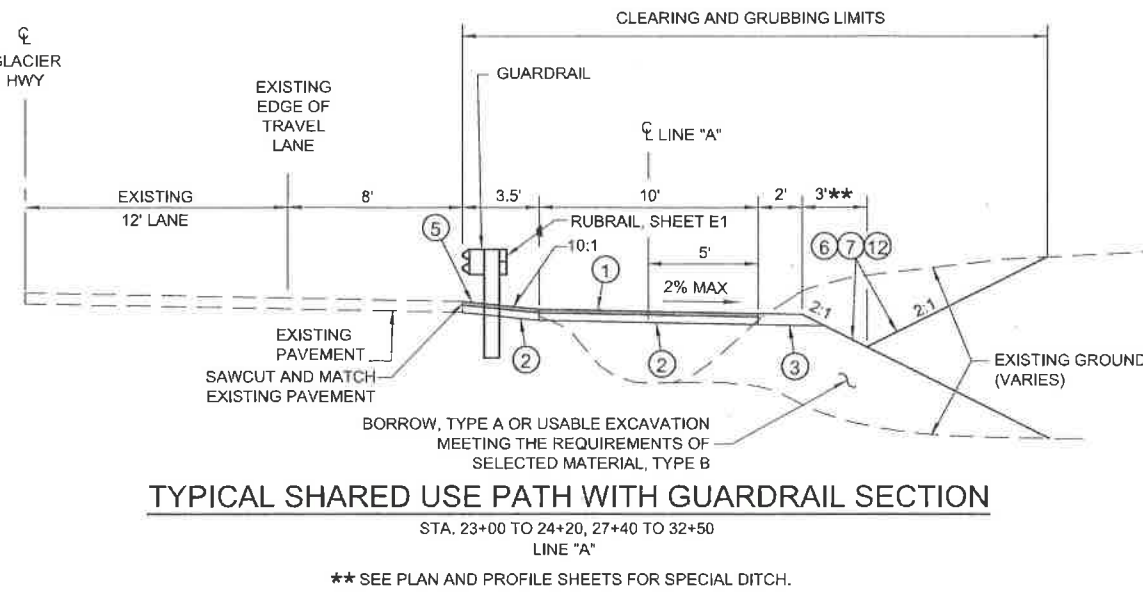

SETTLEMENT PLATE DETAIL

- SETTLEMENT PLATFORM NOTES**
1. INSTALL SETTLEMENT PLATFORM PRIOR TO PLACEMENT OF STAGE
 2. 3/4" STEEL SHALL NOT EXTEND MORE THAN 3' ABOVE THE FILL SURF ANY TIME.
 3. SETTLEMENT PLATFORMS SHALL BE PROTECTED FROM CONSTRUCTION EQUIPMENT.

- LEGEND:**
- ① 2" ASPHALT SIDEWALK
 - ② 4" BED COURSE MATERIAL, GRADING D-1
 - ③ 6" BED COURSE MATERIAL, GRADING D-1
 - ④ SELECT MATERIAL, TYPE A
 - ⑤ GUARDRAIL PAVING
 - ⑥ 2" TOPSOIL
 - ⑦ SEEDING
 - ⑧ 3" ASPHALT CONCRETE, TYPE II, CLASS B
 - ⑨ 6" AGGREGATE BASE COURSE, GRADING D-1
 - ⑩ SELECTED MATERIAL, TYPE A
 - ⑪ MATTING
 - ⑫ BONDED FIBER MATRIX (BFM)

DESCRIPTION OF CHANGE (Use Continuation Sheet 25D-065 as Required)

In accordance with Subsection 104-1.02 of the Standard Specifications, the following changes are hereby made:

Reason for Change Order
 This is a material change to a major bid item. The original MSE Wall design had to be completely replaced to accommodate a new typical section and avoid conflict with the adjacent fish stream. The new section increases the depth, increases the block quantities, requires additional excavation, shoring, sheeting, a stepped footing, larger blocks, additional engineering, and additional ESCP control.


Replace Sheet B3 and M1 with the attached Sheet B3 and M1.

Delete Item 511(1A)a MSE Concrete Wall - Pattern Finish

Form 25D-068 (Revised 04/12)


C.O. No. 8

Page 1 of 4

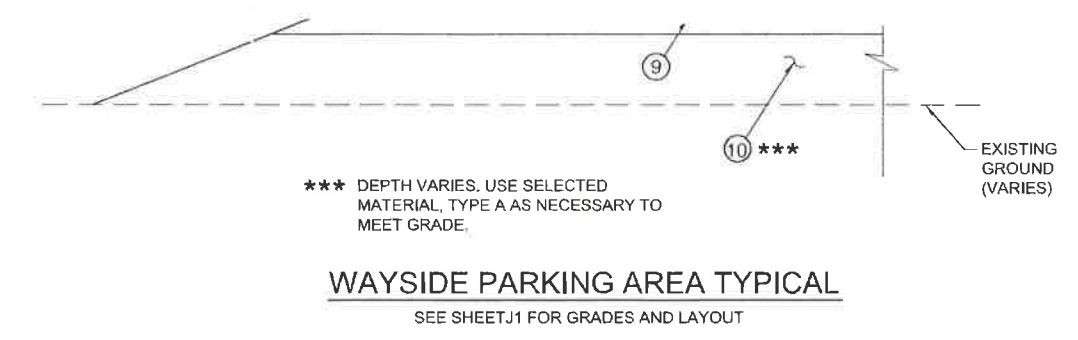

WAYSIDE PARKING AREA TYPICAL
 SEE SHEET J1 FOR GRADES AND LAYOUT

Project As-Built Drawings have been reviewed by the Project Engineer, and represent to the best of my knowledge, the project as constructed.
 PE *[Signature]* Date 2/7/2018

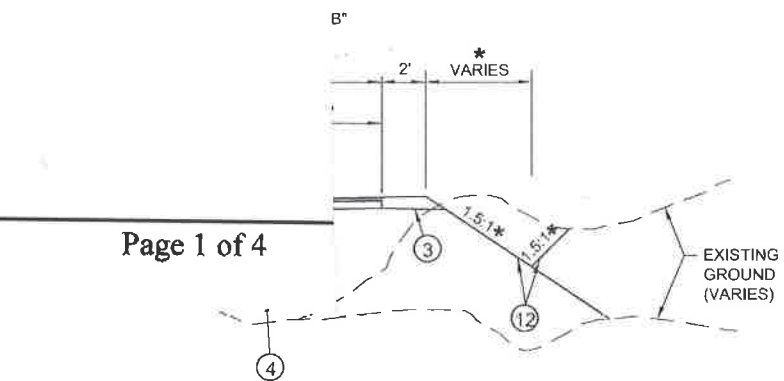

LINE "B" PATH TYPICAL SECTION
 STA. 0+36.56 TO STA. 2+70.51
 LINE "B"

* DITCH SLOPE AND WIDTH VARIES. SEE SHEET F10 FOR LAYOUT. USE 3' WIDTH AND 1.5:1 SLOPE WHEN NOT SPECIFIED ON F10 LAYOUT. SEE SHEET L1 FOR LANDSCAPING.


DO NOT SCALE FROM THESE DRAWINGS USE DIMENSIONS

PATH: Q:\JNU\69500\PLA\ SEC.DWG
 CHAMBERS, TAB: B2 Wednesday
 ADDI
 ATTA
 RECO
 No. DATE
 01/04/11
 01/11/11
 01/27/11

Summary of Quantities

ITEM	UNIT	PRICE	QUANTITY	AMOUNT
MSE Concrete Wall-Pattern Finish	S.F.	\$100.00	-2,216.0	-\$221,600.00
MSE Concrete Wall-Pattern Finish	S.F.	\$124.00	+3,490.0	+\$432,760.00
TOTAL THIS CHANGE ORDER				+\$211,160.00

Change Order
 Change Order No. 8

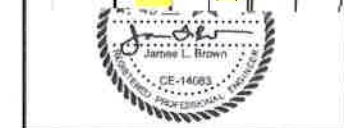

DESIGNED BY: J. BROWN, L. CHAMBERS
 DRAWN BY: R. GRANTHAM
 STATE OF ALASKA
 DEPARTMENT OF TRANSPORTATION & PUBLIC FACILITIES
 SOUTHCOST REGION
 JNU: GLACIER HWY MULTI-USE SEPARATED PATH TO UAS
 PROJECT NO. 69500

TYPICAL SECTIONS

PROJECT DESIGNATION: 0933037 ~ 69500

STATE	YEAR
ALASKA	2015
SHEET NUMBER	TOTAL SHEETS
B2	56



Change Order

Change Order No. 7

DESCRIPTION OF CHANGE (Use Continuation Sheet 25D-065 as Required)

In accordance with Subsection 104-1.02 of the Standard Specifications, the following changes are hereby made:

Reason for Change Order

The elevations shown in Section 203 and on the Typical Section Sheet B2 vary from the profile elevations. This change modifies the plans and specifications to provide a three foot surcharge on the fill during Stage 5 and eliminates the need for the Stage 6 surcharge.

Delete Item 203(19)a Stage 6 Temporary Surcharge

Replace Sheet B2 with the attached Sheet B2.

Subsection 203-3.03; Stage 2 through 5: Above OHW Embankment Construction, modify as follows:

Form 25D-068 (Revised 04/12)

C.O. No. 7

Page 1 of 3

Summary of Quantities

ITEM NO.	ITEM	UNIT	PRICE	QUANTITY (+ or -)	AMOUNT (+ or -)
203(19)a	Stage 6 Temporary Surcharge	Ton	\$20.00	-1,226	-\$24,520.00
TOTAL THIS CHANGE ORDER					-\$24,520.00

This Change Order decreases the Contract Amount by \$24,520.00.

The Contract Completion Date is not affected by this Change Order.

PLEASE INDICATE YOUR ACCEPTANCE OR ACKNOWLEDGEMENT BY SIGNING AND DATING THE APPROPRIATE SIGNATURE LINE, AND THEN RETURN THE ORIGINAL DOCUMENT TO THIS OFFICE.



Change Order

Change Order No. 9

DESCRIPTION OF CHANGE (Use Continuation Sheet 25D-065 as Required)

In accordance with Subsection 104-1.02 of the Standard Specifications, the following changes are hereby made:

Reason for Change Order

The Department performed test pit investigation to determine the quantity of useable excavation within the excavation limits for use as fill.

Establish New Item 203(21)a Test Pit Investigation

Description: Provide test pits in the existing ground where unclassified excavation is called for on the plans at a frequency of 300 feet or as designated by the Engineer. Test pits will be used to sample the existing material and evaluate the amount of useable excavation within project limits.

Materials: None.

Form 25D-068 (Revised 04/12)

C.O. No. 9


Page 1 of 2

Summary of Quantities


ITEM NO.	ITEM	UNIT	PRICE	QUANTITY (+ or -)	AMOUNT (+ or -)
203(21)a	Test Pit Investigation	L.S.	\$1,593.41	+1.0	+\$1,593.41
TOTAL THIS CHANGE ORDER					+\$1,593.41

Project As-Built Drawings have been reviewed by the Project Engineer, and represent to the best of my knowledge, the project as constructed.
 PE Rick L. Grantham Date 2/7/2018

ADDENDUM NUMBER		
ATTACHMENT NUMBER		
RECORD OF REVISIONS		
No.	DATE	DESCRIPTION
1	11/23/15	RETAINING WALL MODS

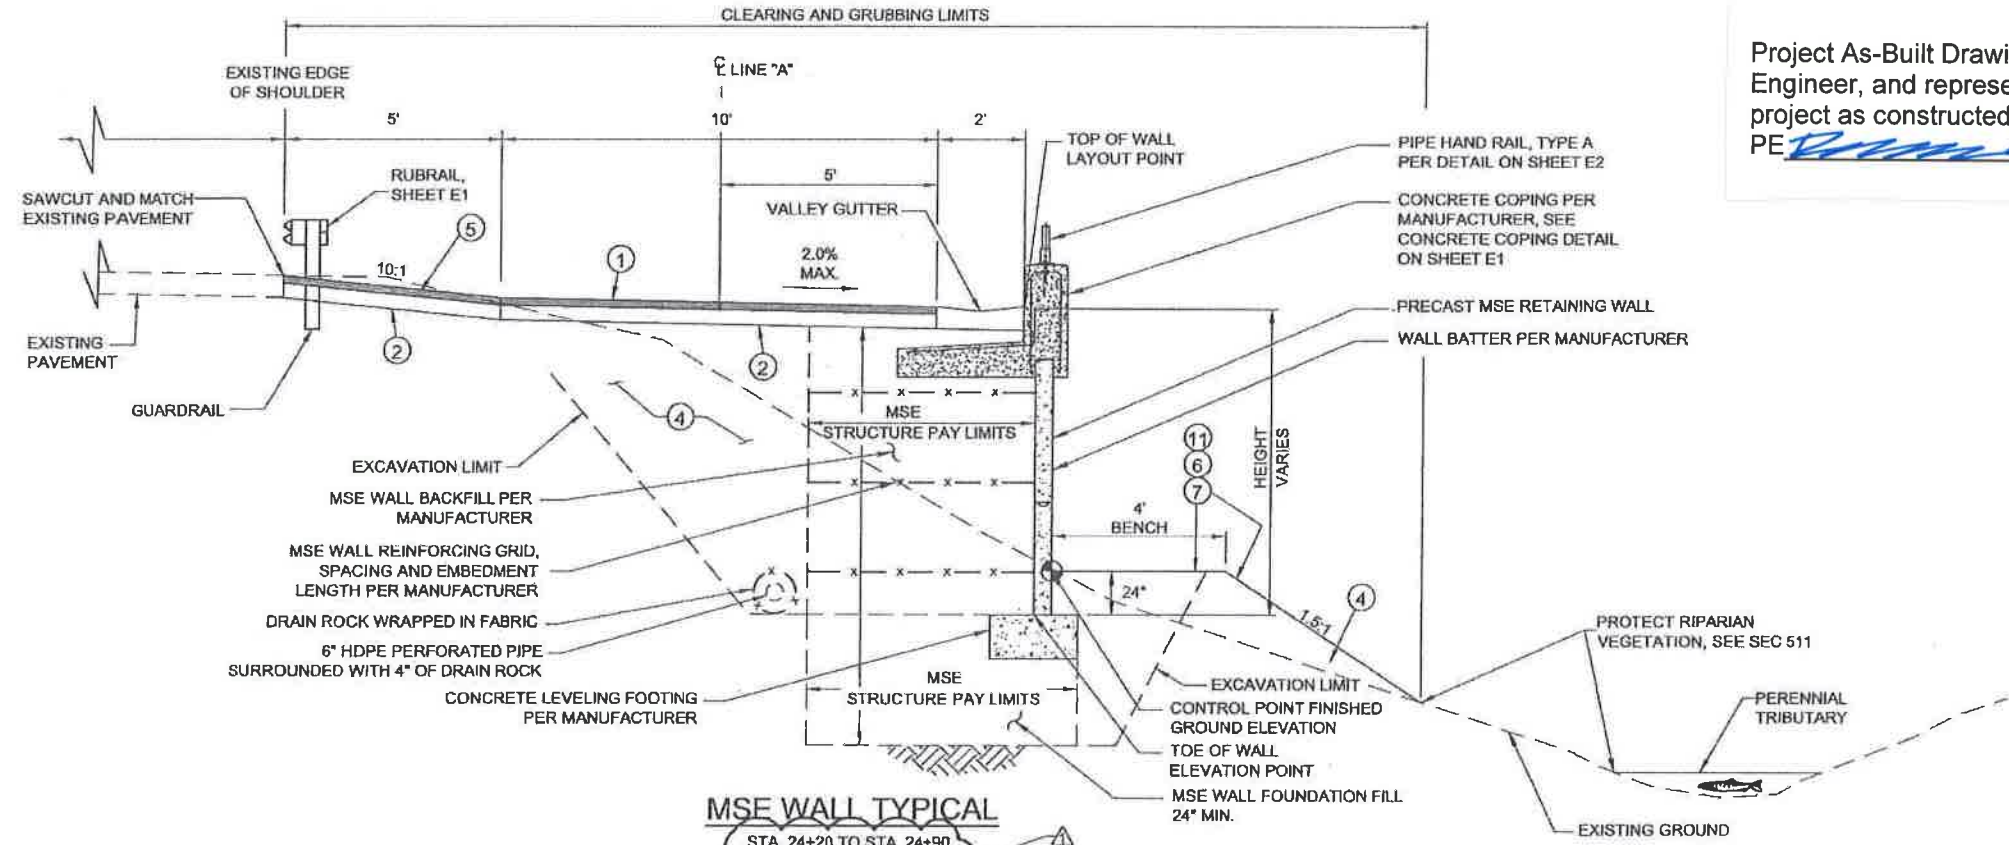

MSE WALL TYPICAL
 STA. 24+20 TO STA. 24+90
 STA. 26+15 TO STA. 27+40
 LINE "A"

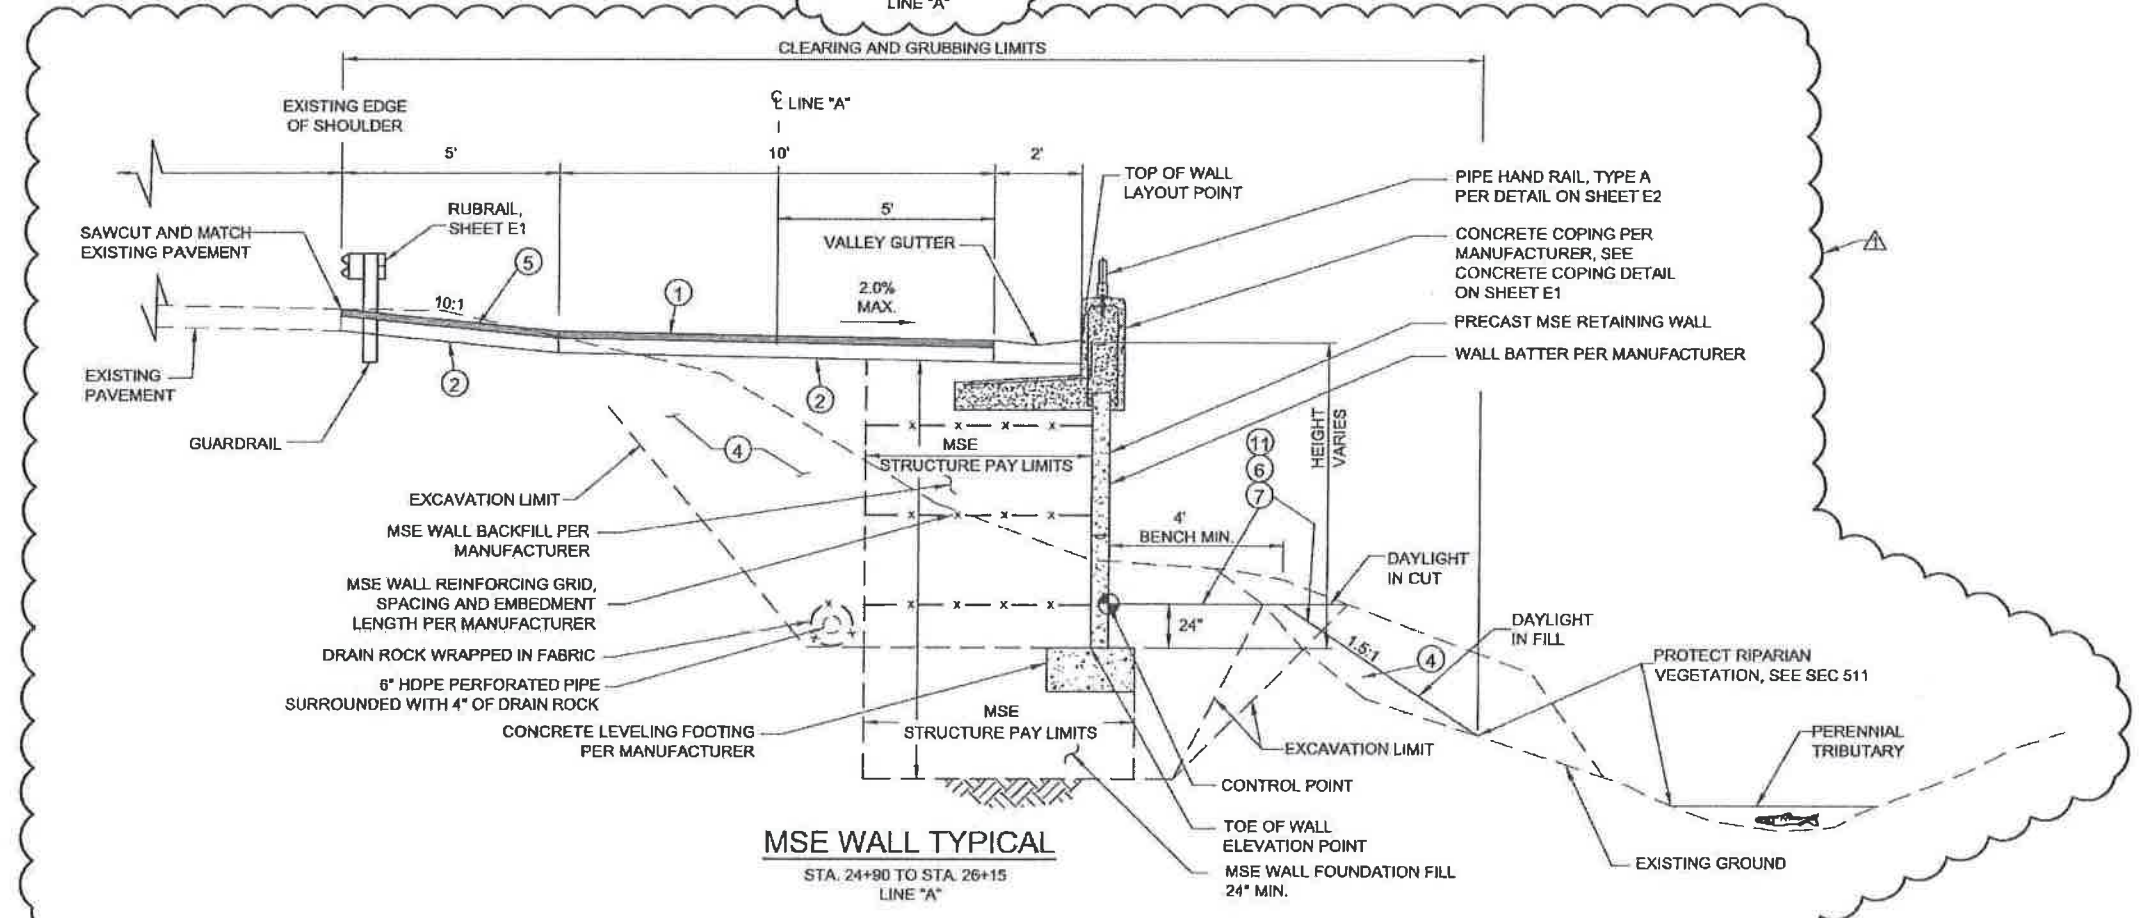

MSE WALL TYPICAL
 STA. 24+90 TO STA. 26+15
 LINE "A"

- LEGEND:**
- ① 2" ASPHALT SIDEWALK
 - ② 4" BED COURSE MATERIAL, GRADING D-1
 - ③ 6" BED COURSE MATERIAL, GRADING D-1
 - ④ SELECT MATERIAL, TYPE A
 - ⑤ GUARDRAIL PAVING
 - ⑥ 2" TOPSOIL
 - ⑦ SEEDING
 - ⑧ 3" ASPHALT CONCRETE, TYPE II, CLASS B
 - ⑨ 6" AGGREGATE BASE COURSE, GRADING D-1
 - ⑩ 15" SELECTED MATERIAL, TYPE A
 - ⑪ BONDED FIBER MATRIX (BFM)
 - ⑫ 8" DITCH LINING

DO NOT SCALE FROM THESE DRAWINGS USE DIMENSIONS

PLAN LEGEND

CHECKED BY: J. BROWN



DESIGNED BY: J. BROWN, L. CHAMBERS

DRAWN BY: R. GRANHAM

STATE OF ALASKA
 DEPARTMENT OF TRANSPORTATION
 & PUBLIC FACILITIES
 SOUTHCOAST REGION

JNU: GLACIER HWY MULTI-USE
 SEPARATED PATH TO UAS
 PROJECT NO. 69500

TYPICAL SECTIONS

PROJECT DESIGNATION

0933037 ~ 69500

STATE	YEAR
ALASKA	2015

SHEET NUMBER	TOTAL SHEETS
B3	54



**STATE OF ALASKA
DEPARTMENT OF TRANSPORTATION
AND PUBLIC FACILITIES
SOUTHCOAST REGION**

Change Order

Project No.: 69500/0933037

Change Order No. 22

Project Name: JNU-Glacier Highway Multi-Use Path to UAS

Contractor:	Secon, Inc.	Change Order Summary:	
Address:	P.O. Box 32159 Juneau, AK 99803	Calendar Days (+ / -):	N/A
		New Completion Date:	N/A
		Amount of Change Order:	+\$13,394.21

Recommended By: *Russell Gao* Date: 8/1/2018

Title: Project Engineer

Approved By: _____ Date: _____

Title: Project Manager

This change order constitutes agreement to terms, conditions and prices stated below.

Accepted By: _____ Date: _____
Contractor's Representative

Acknowledgement indicates only receipt of Change Order and not mutual agreement for basis of payment or time allowance. If a the matter cannot be resolved within 7 days from signature date, an Intent to Claim form must be submitted to the engineer within 14 days.

Acknowledged By: _____ Date: _____
Contractor's Representative

Permission for previously submitted subcontractor(s) to perform all or portions of the work described herein is as checked: Yes No N/A

The following change(s) in the above Contract are hereby made in accordance with the terms of the Contract and under the terms and conditions stated below. Price adjustments resulting from inaccurate cost and pricing data are subject to the provisions of AS 36.30.400(c). This document shall become an amendment to the Contract and all provisions of the Contract will be applicable.

DESCRIPTION OF CHANGE (Use Continuation Sheet 25D-065 as Required)

In accordance with Subsection 104-1.02 of the Standard Specifications, the following changes are hereby made:

Establish New Item 641(8)A Drainage and Slope Stability Improvements

Description: This item improved drainage and slope stability throughout the project where erosion issues were prevalent. The work was initiated under Item 641(5)A Temporary Erosion and Pollution Control By Directive, but the work became permanent repairs and improvements. This item includes these permanent erosion and pollution control work items.

Materials: Comply with all applicable material sections for the installed material.

Construction Requirements:

Install the following for the provided plans and directives:



Change Order

Change Order No. 4

PATH:
Q:\UNU\69500\PLANSET\69500_B1-B4_TYP
SEC.DWG
CHAMBERS, LUCAS M (DOT)
TAB: B4 Monday, January 04, 2016 1:57:49 PM

REVISIONS
DESCRIPTION
DELETED NEW SHEET
MATERIAL TYPE MODS.

DESCRIPTION OF CHANGE (Use Continuation Sheet 25D-065 as Required)

In accordance with Subsection 104-1.02 of the Standard Specifications, the following changes are hereby made:

Reason for Change Order


Additional locations for useable excavation were identified in the plans to avoid safety risks during winter excavation.

SHEET B1, B2 and B4. Delete and replace with the attached SHEET B1, B2, and B4.



This Change Order does not affect the Contract Amount.

The Contract Completion Date is not affected by this Change Order.

PLEASE INDICATE YOUR ACCEPTANCE OR ACKNOWLEDGEMENT BY SIGNING AND DATING THE APPROPRIATE SIGNATURE LINE, AND THEN RETURN THE ORIGINAL DOCUMENT TO THIS OFFICE.

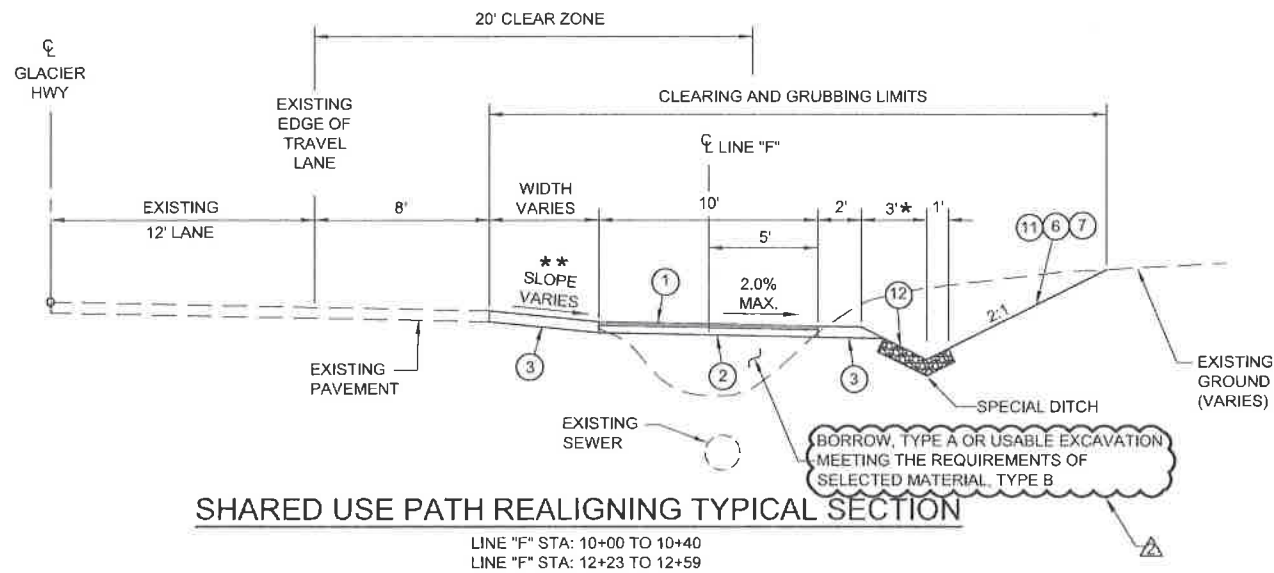

- * SEE SHEET G1 FOR SPECIAL DITCH PROFILE.
- ** CONSTRUCT PATH ACCORDING TO PROFILE. IF NECESSARY ADJUST CROSS SLOPE TO 1.0% MIN. OR LOWER PROFILE TO AVOID CREATING A BERM WITH OUTSIDE EDGE OF PATH.

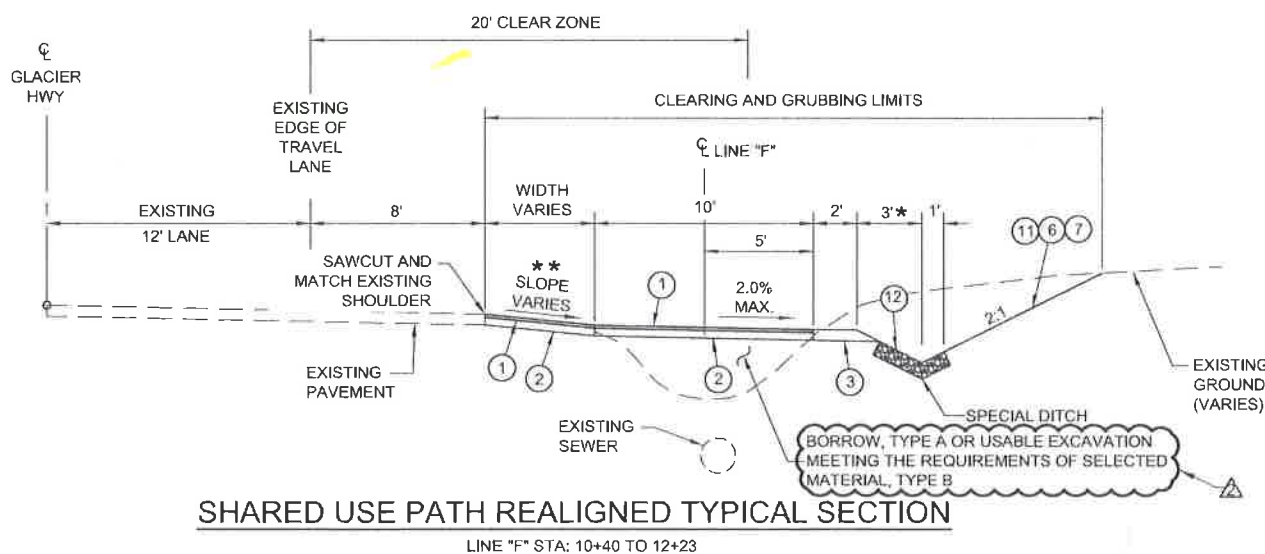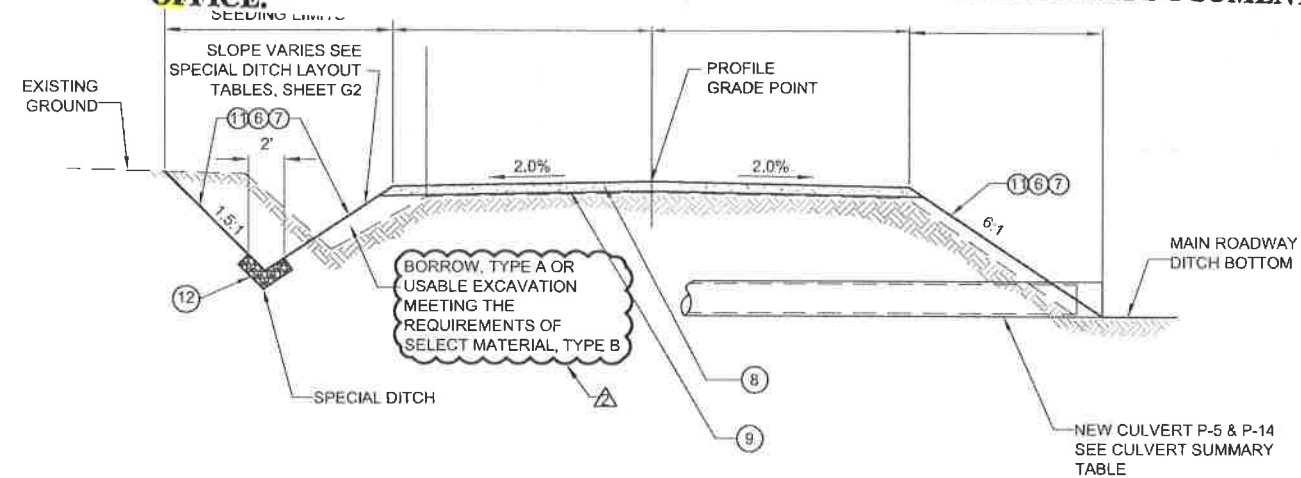

- * SEE SHEET G1 FOR SPECIAL DITCH PROFILE.
- ** CONSTRUCT PATH ACCORDING TO PROFILE. IF NECESSARY ADJUST CROSS SLOPE TO 1.0% MIN. OR LOWER PROFILE TO AVOID CREATING A BERM WITH OUTSIDE EDGE OF PATH.

PLAN LEGEND

CHECKED BY: J. BROWN



DESIGNED BY: J. BROWN, L. CHAMBERS

DRAWN BY: R. GRANTHAM

STATE OF ALASKA
DEPARTMENT OF TRANSPORTATION
& PUBLIC FACILITIES
SOUTHCOST REGION

JNU: GLACIER HWY MULTI-USE
SEPARATED PATH TO UAS
PROJECT NO. 69500

TYPICAL SECTIONS

PROJECT DESIGNATION

0933037 ~ 69500

STATE	YEAR
ALASKA	2015
SHEET NUMBER	TOTAL SHEETS
B4	56

LEGEND:

- 1 2" ASPHALT SIDEWALK
- 2 4" BED COURSE MATERIAL, GRADING D-1
- 3 6" BED COURSE MATERIAL, GRADING D-1
- 4 SELECT MATERIAL, TYPE A
- 5 GUARDRAIL PAVING
- 6 2" TOPSOIL
- 7 SEEDING
- 8 3" ASPHALT CONCRETE, TYPE II, CLASS B
- 9 6" AGGREGATE BASE COURSE, GRADING D-1
- 10 15" SELECTED MATERIAL, TYPE A
- 11 BONDED FIBER MATRIX (BFM)
- 12 8" DITCH LINING

Project As-Built Drawings have been reviewed by the Project Engineer, and represent to the best of my knowledge, the project as constructed.

PE [Signature] Date 2/7/2018

DO NOT SCALE FROM THESE DRAWINGS USE DIMENSIONS

69500 REVIEWED BY
T.M. 3-29-18. SOD.

ESTIMATE OF QUANTITIES - SCHEDULE A

ITEM NO	ITEM DESCRIPTION	PAY UNIT	QUANTITY
201(3A)a	CLEARING AND GRUBBING	ACRE	3.8 2.439
201(7)a	INVASIVE SPECIES CONTROL, REMOVAL AND DISPOSAL	SQUARE YARD	2,684 3,414.95
202(2)a	REMOVAL OF PAVEMENT	SQUARE YARD	1,107 868.00
202(4)a	REMOVAL OF CULVERT PIPE	LINEAR FOOT	305 Actual: 336.5 L.F.
202(10)a	SINGLE MAILBOX INSTALLATION	EACH	2
202(12)a	DOUBLE MAILBOX INSTALLATION	EACH	1
203(3)a	UNCLASSIFIED EXCAVATION	CUBIC YARD	4,460
203(6A)a	BORROW, SELECTED MATERIAL, TYPE A	TON	5,151 Actual: 14,492.70
203(6B)a	BORROW, SELECTED MATERIAL, TYPE B	TON	200
203(6D)a	BORROW, SELECTED MATERIAL, TYPE D	TON	6,842 Actual: 7,285.57
203(19)a	STAGE 6 TEMPORARY SURCHARGE	TON	1,226
203(20)a	GAUGES AND MONITORING DEVICES	LUMP SUM	ALL REQD 1 ✓
301(1)a	AGGREGATE BASE COURSE, GRADING D-1	TON	2,110 Actual: 2,534.20
511(1)a	MECHANICALLY STABILIZED EARTH WALL	SQUARE FOOT	2,216
514(1)a	BOUNDARY BOULDERS	LINEAR FOOT	110
603(1)-18a	18 INCH CORRUGATED STEEL PIPE	LINEAR FOOT	6
603(1)-24a	24 INCH CORRUGATED STEEL PIPE	LINEAR FOOT	59
603(21)-18a	18 INCH CORRUGATED POLYETHYLENE PIPE	LINEAR FOOT	130
603(21)-24a	24 INCH CORRUGATED POLYETHYLENE PIPE	LINEAR FOOT	438 66' L.F.
604(3)a	RECONSTRUCT EXISTING MANHOLE	EACH	4
604(4)a	ADJUST EXISTING MANHOLE	EACH	1 Actual: 3 ADJUSTED
604(5)a	INLET, TYPE A	EACH	1
606(1)a	W-BEAM GUARDRAIL	LINEAR FOOT	1,285
606(6)a	REMOVING AND DISPOSING OF GUARDRAIL	LINEAR FOOT	1,285 Actual: 1,351.00 L.F.
606(13)a	PARALLEL GUARDRAIL TERMINAL	EACH	2 Actual = 3 P.G.T.S.
608(3)a	ASPHALT SIDEWALK	SQUARE YARD	4,350 Actual: 5,239.3
609(2)a	CURB AND GUTTER, TYPE 1	LINEAR FOOT	420 609.36'
610(3)a	DITCH LINING	STATION	17.2 Actual: 16.6 STATION
611(2)a	RIPRAP, CLASS II	TON	1,881 Actual: 2,381.43
615(1)a	STANDARD SIGN	SQUARE FOOT	57 59
618(2)a	SEEDING	POUND	175 Actual: 111.50 Pounds.
619(2)a	MATTING	SQUARE YARD	1,117
619(3)a	BONDED FIBER MATRIX (BFM)	POUND	4,630 Actual 3,200.0 LBS.
620(1)a	TOPSOIL	SQUARE YARD	5,090 Actual 195 YARDS.
625(1)a	PIPE HAND RAIL, TYPE A	LINEAR FOOT	325
625(2)a	PIPE HAND RAIL, TYPE B	LINEAR FOOT	410
627(10)a	ADJUSTMENT OF VALVE BOX	EACH	3
627(11)a	SHUT-OFF VALVE RELOCATION	LUMP SUM	ALL REQD
629(1)a	GUARDRAIL PAVING	LINEAR FOOT	1,385 Actual: 1,358.30 L.F.
630(1)a	GEOTEXTILE, SEPARATION	SQUARE YARD	752 Actual: 3,006.70
635(2)a	INSULATION BOARD	CONTINGENT SUM	ALL REQD
639(1)a	RESIDENCE DRIVEWAY	EACH	2 7
640(1)a	MOBILIZATION AND DEMOBILIZATION	LUMP SUM	ALL REQD
641(1)a	EROSION, SEDIMENT AND POLLUTION CONTROL ADMINISTRATION	LUMP SUM	ALL REQD
641(3)a	TEMPORARY EROSION, SEDIMENT AND POLLUTION CONTROL	LUMP SUM	ALL REQD
641(5)a	TEMPORARY EROSION, SEDIMENT AND POLLUTION CONTROL BY DIRECTIVE	CONTINGENT SUM	ALL REQD
641(6)a	WITHHOLDING	CONTINGENT SUM	ALL REQD
641(7)a	SWPPP MANAGER	LUMP SUM	ALL REQD
642(1)a	CONSTRUCTION SURVEYING	LUMP SUM	ALL REQD
642(4)a	SET PRIMARY MONUMENT	EACH	4
642(9)a	REFERENCE EXISTING MONUMENT	EACH	1 5
643(2)a	TRAFFIC MAINTENANCE	LUMP SUM	ALL REQD
643(3)a	PERMANENT CONSTRUCTION SIGNS	LUMP SUM	ALL REQD
643(12)a	PORTABLE BARRIER	LINEAR FOOT	50 Actual: 51.3 L.F.
643(15)a	FLAGGING	CONTINGENT SUM	ALL REQD
643(23)a	TRAFFIC PRICE ADJUSTMENT	CONTINGENT SUM	ALL REQD
643(25)a	TRAFFIC CONTROL	CONTINGENT SUM	ALL REQD
643(24)a	PORTABLE CHANGEABLE MESSAGE BOARD SIGN	DAY	30
646(1)a	CPM SCHEDULING	LUMP SUM	ALL REQD
653(1)a	HABITAT BENCH	LUMP SUM	ALL REQD
654(1)a	LANDSCAPE SUPERINTENDENT	LUMP SUM	ALL REQD
660(3)a	HIGHWAY LIGHTING SYSTEM COMPLETE	LUMP SUM	ALL REQD
661(3)a	LOAD CENTER, TYPE 2	EACH	1

ESTIMATE OF QUANTITIES - SCHEDULE B

ITEM NO	ITEM DESCRIPTION	PAY UNIT	QUANTITY
201(3A)b	CLEARING AND GRUBBING	ACRE	0.4
201(7)b	INVASIVE SPECIES CONTROL, REMOVAL AND DISPOSAL	SQUARE YARD	176
203(3)b	UNCLASSIFIED EXCAVATION	CUBIC YARD	1172
203(6A)b	BORROW, SELECTED MATERIAL, TYPE A	TON	100
301(1)b	AGGREGATE BASE COURSE, GRADING D-1	TON	650
401(1)b	HMA, TYPE II; CLASS B	TON	320
401(4)b	ASPHALT BINDER, GRADE 58-28	TON	20
402(1)b	STE-1 ASPHALT FOR TACK COAT	TON	0.5
603(1)-12b	12 INCH CORRUGATED STEEL PIPE	LINEAR FOOT	73
604(5)b	INLET, TYPE A	EACH	2
607(7)b	WAYSIDE WOOD FENCE	LINEAR FOOT	105
609(2)b	CURB AND GUTTER, TYPE I	LINEAR FOOT	109
620(1)b	TOPSOIL	SQUARE YARD	1695
621(1)b	EXTERIOR PLANTS	LUMP SUM	ALL REQD
621(2)b	WAYSIDE BOULDERS	EACH	13
630(1)b	GEOTEXTILE, SEPARATION	SQUARE YARD	25
640(1)b	MOBILIZATION AND DEMOBILIZATION	LUMP SUM	ALL REQD
641(1)b	EROSION, SEDIMENT AND POLLUTION CONTROL ADMINISTRATION	LUMP SUM	ALL REQD
641(3)b	TEMPORARY EROSION, SEDIMENT AND POLLUTION CONTROL	LUMP SUM	ALL REQD
641(5)b	TEMPORARY EROSION, SEDIMENT AND POLLUTION CONTROL BY DIRECTIVE	CONTINGENT SUM	ALL REQD
641(6)b	WITHHOLDING	CONTINGENT SUM	ALL REQD
641(7)b	SWPPP MANAGER	LUMP SUM	ALL REQD
642(1)b	CONSTRUCTION SURVEYING	LUMP SUM	ALL REQD
643(2)b	TRAFFIC MAINTENANCE	LUMP SUM	ALL REQD
643(23)b	TRAFFIC PRICE ADJUSTMENT	CONTINGENT SUM	ALL REQD
643(25)b	TRAFFIC CONTROL	CONTINGENT SUM	ALL REQD
646(1)b	CPM SCHEDULING	LUMP SUM	ALL REQD
654(1)b	LANDSCAPE SUPERINTENDENT	LUMP SUM	ALL REQD
670(1)b	PAINTED TRAFFIC MARKINGS	LUMP SUM	ALL REQD

BASIS OF ESTIMATE

ITEM NO.	ITEM	ESTIMATING FACTOR/QUANTITY
203(6A)	BORROW, SELECTED MATERIAL, TYPE A	1.81 TONS/CY
203(6B)	BORROW, SELECTED MATERIAL, TYPE B	1.81 TONS/CY
203(6D)	BORROW, SELECTED MATERIAL, TYPE D	1.81 TONS/CY
203(19)	STAGE 6 TEMPORARY SURCHARGE	1.81 TONS/CY
301(1)	AGGREGATE BASE COURSE, GRADING D-1	1.95 TON/CY
401(1)	HMA, TYPE II; CLASS B	120 LBS/SY/IN
401(2)	ASPHALT BINDER, GRADE 58-28	6% OF ITEM 401(1)
402(1)	STE-1 ASPHALT FOR TACK COAT	0.1 GAL/SY, 243 GAL/TON
611(2)	RIPRAP, CLASS II	1.41 TONS/CY
618(2)	SEEDING	50 LBS/ACRE
619(3)	BONDED FIBER MATRIX	4000 LB/ACRE
621(1)	EXTERIOR PLANTS	0.3 ACRES OF WAYSIDE SEEDING, 216 PLANTS
653(1)	HABITAT BENCH	410 LINEAR FOOT

PLEASE SEE REVERSE
SIDE FOR
SUMMARY OF QTY'S
AND SUMMARY OF
CHANGE ORDERS.

DO NOT SCALE FROM THESE DRAWINGS USE DIMENSIONS

PATH:
Q:\JNU\69500\PLANSET\69500_C1_EST
QTY.DWG
CHAMBERS, LUCAS M (DOT)
TAB: C1 Tuesday, July 28, 2015 11:34:58 AM
ADDENDUM NUMBER
ATTACHMENT NUMBER
RECORD OF REVISIONS
No. DATE DESCRIPTION

PLAN LEGEND

CHECKED BY: J. BROWN



DESIGNED BY: J. BROWN

DRAWN BY: R. GRANTHAM

STATE OF ALASKA
DEPARTMENT OF TRANSPORTATION
& PUBLIC FACILITIES
SOUTHCOST REGION

JNU: GLACIER HWY MULTI-USE
SEPARATED PATH TO UAS
PROJECT NO. 69500

ESTIMATE OF
QUANTITIES

PROJECT DESIGNATION

0933037 ~ 69500

STATE	YEAR
ALASKA	2015
SHEET NUMBER	TOTAL SHEETS
C1	54

FINAL ESTIMATE SUMMARY OF QUANTITIES

Projec 69500/0933037 JNU Glacier Hwy Multi-Use Path to UAS

Table with columns: FA ACT., ITEM NO., CODE CODE, ITEM, UNIT, UNIT PRICE, QUANTITY, ANITICIPATED AMOUNT. Contains detailed item list from 201(3A)a to 643(15)a.

643(23)a 28 450 TRAFFIC PRICE ADJUSTMENT CONT \$

Summary table for items 643(25)a to 661(3)a, including TOTAL ORIGINAL SCHEDULE "A" BID ITEMS with a total of \$ 1,636,275.59.

CHANGE ORDER ITEMS

Table of change order items from 201(6)a to 653(2)a, including descriptions and costs.

TOTAL CHANGE ORDER ITEMS \$ 685,395.22 and TOTAL SCHEDULE "A" ITEMS \$ 2,321,670.81

Prepared by: _____ Date: _____ Checked By: _____ Date: _____

Item 607

Item 607 (1/2) Cedar Rivet Service @ 147.3' LF. As' over planned qty.

Change Order

Summary of Quantities

Project No.: 69500/0933037

ITEM NO.	ITEM	UNIT	PRICE	QUANTITY (+ or -)	AMOUNT (+ or -)
203(6B)a	Borrow, Selected Material, Type B	Ton	\$30.00	-200	-\$6,000.00
NET CHANGE THIS ORDER					-\$6,000.00

Change Order No. 3

202(2) REMOVAL OF PAVEMENT - SCHEDULE A

BEGIN			END			REMARKS
TATION	LINE	OFFSET	STATION	LINE	OFFSET	
38+85	A	10.0' LT & RT	39+40	A	10' LT & RT	REMOVE EXISTING DRIVEWAY APPROACH

202(2) REMOVAL OF PAVEMENT 868 54.

202 (4) REMOVAL OF CULVERT PIPE - SCHEDULE A

TATION	LINE	OFFSET		DIAMETER (IN)	LENGTH (FT)	REMARKS
		LEFT	RIGHT			
0+00	A		10	24	50	HAMILTON STREET
3+85	A	1		24	60	HAMILTON STREET
5+05	A		1	6	20	<i>58.5' LF</i>
5+39	A		2	4	3	
8+06	A	4		18	40	<i>Below</i>
8+66	A	5		18	60	
9+89	A	3		18	30	<i>PLANNED QTY.</i>
12+32	A	3		18	52	
14+46	A	4		18	80	

*PLANNED LENGTH OF REMOVAL: 395' LF.
ACTUAL LENGTH: 336.5' LF.*

202(10) SINGLE MAILBOX INSTALLATION - SCHEDULE A

STATION	LINE	OFFSET	REMARKS
6+46	A	7.7' LT	MAILBOX FOR HOUSE # 10650
12+80	A	7.2' LT	

202(12) DOUBLE MAILBOX INSTALLATION - SCHEDULE A

STATION	LINE	OFFSET	REMARKS
15+09	A	7' LT	MAILBOX FOR HOUSE # 10670 AND 10691

511(1) MECHANICALLY STABILIZED EARTH WALL - SCHEDULE A

WALL NO.	START STATION	LINE	OFFSET	END STATION	LINE	OFFSET	MSE AREA (SQ. FT.)	REMARKS
1	24+20	A	7.0' RT	27+40	A	7.0' RT	2537	

COB

ACTUAL FOR 511(1) → 3503.77 SF.

514(1) BOUNDARY BOULDERS - SCHEDULE A

START STATION	LINE	OFFSET	END STATION	LINE	OFFSET	LENGTH (FT)	REMARKS
2+30	A	RT	2+80	A	RT	50	
5+50	A	RT	6+10	A	RT	60	

603 CULVERT INSTALLATION SUMMARY

IPE	INLET				OUTLET				LENGTH (FT)	SIZE (IN.)	MATERIAL	APPROX. GRADE	REMARKS	
	STA	LINE	OFFSET	INVERT	STA	LINE	OFFSET	INVERT						
P-2	S-1	A	RT	81.1	2+11.8	A	10.5	RT	70.8	239	24	CPP	4.31%	BID SCHEDULE A. SEE DRAINAGE DETAIL, SHEET E6
P-3	06+46.8	A	RT	81.8	S-1	A		RT	81.1	195	24	CPP	5.50%	
P-4	04+48.5	A	RT	MATCH EXISTING	S-1	A		RT	83.0	6	18	CSP	0.00%	
P-5	10+25.4	A	RT	112.7	9+68.9	A	12.5	RT	109.8	57	18	CPP	-5.13%	
P-6	12+80.2	A	RT	122.0	12+40.2	A	11.8	RT	120.7	40	18	CPP	3.26%	
P-7	15+20.2	A	RT	127.6	14+80.2	A	11.7	RT	127.1	60	18	CPP	-0.85%	
P-8	11+30.9	A	LT	116.5	11+41.4	A	11.0	RT	117.2	20	24	CSP	-3.73%	
P-9	24+43.3	A	RT	102.1	24+43.5	A	8.0	RT	102.0	4	24	CPP	2.00%	
P-10	29+52.2	A	RT	73.5	29+56.7	A	25.0	RT	73.2	13	24	CSP	2.00%	
P-11	33+37.0	A	RT	66.9	33+50.2	A	30.8	RT	66.4	28	24	CSP	2.00%	
P-12	S-2	B	RT	78.9	S-3	B		RT	77.3	37	12	CPP	5.06%	
P-13	S-3	B	RT	77.0	1+47.9	B	20.5	LT	76.6	36	12	CPP	1.11%	
P-14	09+19.8	A	RT	107.2	08+47.8	A	12.1	RT	103.5	72	18	CPP	-5.07%	

PLANNED / ACTUAL
24" CPP 497' LF. 429' LF.
18" CPP 235' LF. 277' LF.
12" CPP 73.0' LF. NO CO. FOUND.

604 (3) RECONSTRUCT EXISTING MANHOLE SCHEDULE A

STATION	LINE	OFFSET	TYPE	REMARKS
1+89	A	1.8' LT	SSMH	<i>4 INSTALLED</i>
7+50	A	1.8' LT	SSMH	
10+94	A	3.7' LT	SSMH	
13+32	A	2.8' LT	SSMH	

3/14/19

604 (4) ADJUST EXISTING MANHOLE - SCHEDULE A

STATION	LINE	OFFSET	TYPE	REMARKS
17+29	A	2.5' RT	SSMH	

604(4) ACTUAL M/H. Adj. = 3 total. 3/14/19.

604 (5) DRAINAGE STRUCTURE SUMMARY

STRUCT. NO.	STATION	LINE	OFFSET	INSERTION RIM ELEVATION	STRUCT. TYPE	REMARKS
S-1	4+51.70	A	6.1' RT	86.1	INLET, TYPE A	INTERCEPT EXISTING OUTLET PIPE, SCHEDULE A
S-2	1+47.9	B	47.0' RT	81.9	INLET, TYPE A	SCHEDULE B
S-3	1+55.00	B	15.0' RT	79.5	INLET, TYPE A	SCHEDULE B

STATION AND OFFSET TAKEN TO CENTER OF STRUCTURE
ALL TYPE A INLET BOXES SHALL HAVE 18" MIN. SUMP

604(5) DRAIN STRUCTURE Actual Count = 1.

Reviewed By TVL @ AK DOT. 3-29-19

DO NOT SCALE FROM THESE DRAWINGS USE DIMENSIONS

PATH: Q:\HUBS\SS SUMS.DWG
CHAM: TAB-D1.W

Summary of Quantities

Change Order

Change Order No. 2

ITEM NO.	ITEM	UNIT	PRICE	QUANTITY (+ or -)	AMOUNT (+ or -)
202(13)	Removal of Existing Floats	Lump Sum	\$1,811.25	+1.0	+\$1,811.25
NET CHANGE THIS ORDER					+\$1,811.25

DESIGNED BY:
DRAWN BY:
CHECKED BY:
JNU: C
SEP
F



SUMMARIES

PROJECT DESIGNATION	
0933037 ~ 69500	
STATE	YEAR
ALASKA	2015
SHEET NUMBER	TOTAL SHEETS
D1	56





STATE OF ALASKA
DEPARTMENT OF TRANSPORTATION
AND PUBLIC FACILITIES
SOUTHCOAST REGION

Change Order

Project No.: 69500/0933037 Change Order No. 5

Project Name: JNU-Glacier Highway Multi-Use Path to UAS

Contractor:	Secon, Inc.	Change Order Summary:	
Address:	P.O. Box 32159	Calendar Days (+/-):	N/A
	Juneau, AK 99803	New Completion Date:	N/A
		Amount of Change Order:	+\$2,705.00

Recommended By: [Signature] Date: 11 Jan 2016

Title: Project Engineer

Approved By: [Signature] Date: 11 Jan 2016

Title: Project Manager

This change order constitutes agreement to terms, conditions and prices stated below.

Accepted By: _____ Date: _____
Contractor's Representative

Seal of Alaskan Professional Engineer
(if required)

N/A

Acknowledgement indicates only receipt of Change Order and not mutual agreement for basis of payment or time allowance. If a the matter cannot be resolved within 7 days from signature date, an Intent to Claim form must be submitted to the engineer within 14 days.

Acknowledged By: _____ Date: _____
Contractor's Representative

Permission for previously submitted subcontractor(s) to perform all or portions of the work described herein is as checked: Yes No N/A

The following change(s) in the above Contract are hereby made in accordance with the terms of the Contract and under the terms and conditions stated below. Price adjustments resulting from inaccurate cost and pricing data are subject to the provisions of AS 36.30.400(c). This document shall become an amendment to the Contract and all provisions of the Contract will be applicable.

DESCRIPTION OF CHANGE (Use Continuation Sheet 25D-065 as Required)

In accordance with Subsection 104-1.02 of the Standard Specifications, the following changes are hereby made:

Reason for Change Order

The piezometer conduits required backfill to protect them from equipment damage after they were relocated. This change order provides that cover.

Establish New Item 203(22)a Piezometer Backfill

Description: Provide backfill to protect both piezometers installed in the fill.

Materials: Provide bedding material meeting the requirements of Subsection 204-2.01 for corrugated polyethylene pipe. Provide backfill material meeting the requirements of Borrow Type B with 100% passing the 3 inch sieve.

STATE OF ALASKA
DEPARTMENT OF TRANSPORTATION AND PUBLIC FACILITIES

Project No.: 69500/0933037 JNU-Glacier Hwy. Multi-Use
Path to UAS
Change Order No. 5

Continuation Sheet

Construction Requirements: Provide one foot of bedding material around the conduits. Provide two feet of cover four feet wide over the two installed piezometer conduits running horizontally over the fill. Ramp the backfill material from the top of the backfill to the Stage 1 fill, providing a six foot long ramp. Conform to Subsection 203-3.05 for compaction of bedding and backfill.

Method of Measurement: This a lump sum and in accordance with Subsection 109-1.01 is not measured for payment.

Basis of Payment: This item is paid at the agreed upon amount of \$2,705.00 and includes the resources required to provide bedding and backfill cover for the installed piezometer conduits. This item includes the bedding 1 foot around the conduit and backfill required to complete the work. Full compensation is made in accordance with Subsection 109-1.03.

Payment will be made under:

Pay Item	Pay Unit
203(22)a Piezometer Backfill	Lump Sum

Summary of Quantities					
ITEM NO.	ITEM	UNIT	PRICE	QUANTITY (+ or -)	AMOUNT (+ or -)
203(22)a	Piezometer Backfill	Lump Sum	\$2,705.00	+1.0	+2,705.00
NET CHANGE THIS ORDER					+2,705.00

This Change Order increases the Contract Amount by \$2,705.00.

The Contract Completion Date is not affected by this Change Order.

PLEASE INDICATE YOUR ACCEPTANCE OR ACKNOWLEDGEMENT BY SIGNING AND DATING THE APPROPRIATE SIGNATURE LINE, AND THEN RETURN THE ORIGINAL DOCUMENT TO THIS OFFICE.

Reviewed By So2.DOT
TVL 3-29-18

✓ By Jh. 3/14/19.

✓ By Jh. 3/14/19.

606 (1) W-BEAM GUARDRAIL INSTALLATION - SCHEDULE A						
FROM	LINE	TO	LINE	OFFSET	LENGTH	REMARKS
23+50	A	36+35	A	LEFT	1,285	Actual Length: 1,304.10'

606 (13) PARALLEL GUARDRAIL TERMINAL - SCHEDULE A			
STATION	LINE	OFFSET	REMARKS
23+00	A	LT	50' LENGTH, 0' END OFFSET
36+85	A	LT	50' LENGTH, 0' END OFFSET

Actual Count Installed = 3
606 (13) P.E.T. ✓ By Jh. 3/14/19.

609 (2) CURB AND GUTTER, TYPE 1					
FROM	TO	LENGTH	REMARKS		
2+20	A	6+10	A	420	VALLEY, SCHEDULE A
		PARKING LOT		109	STANDARD, SCHEDULE B

Actual Count Installed
609.30 LF. ✓ Jh. 3/14/19.

610(3) DITCH LINING - SCHEDULE A					
FROM	TO	LENGTH (FT)	REMARKS		
10+30	A	2+12	A	182	Actual Length
6+46	A	9+90	A	344	By Stationing:
10+20	A	11+35	A	115	60 Stations
11+41	A	12+40	A	99	3/14/19.

OK ✓ By TVL.
OK ✓ By TVL.
3-14-19.

Actual = 5
Referenced
Monuments

642(9) REFERENCE EXISTING MONUMENT - SCHEDULE A				
STATION	LINE	OFFSET	REMARKS	
0+38.2	A	9.0' RT	BC3.25' S2386 LA/C4 L9/C1 L10 S3260	
9+55.5	A	8.1' RT	BPR_BC3' L3B/L4C/S2386	
13+39.4	A	30.9' RT	GLO_BC2.5' C3 LC/C4 LD_S2386	
17+03.7	A	18.0' RT	BPR_BC3' C15 S3406/ROW_S2386	

643(30) DELINEATE REMOVED GUARDRAIL - SCHEDULE A							
START			END			LENGTH (FT)	REMARKS
STA.	LINE	OFFSET	STA.	LINE	OFFSET		
15+09.0	LINE A	RIGHT	16+37.0	LINE A	RIGHT	128	
22+98.9	LINE A	LEFT	27+91.3	LINE A	LEFT	493	
31+34.3	LINE A	LEFT	37+10.3	LINE A	LEFT	591	
36+91.5	LINE A	RIGHT	37+65.7	LINE A	RIGHT	71	

627 (10) ADJUSTMENT OF VALVE BOX - SCHEDULE A			
STATION	LINE	OFFSET	REMARKS
8+89.3	A	7.4' RT	3:3
12+99.9	A	9.5' RT	
15+47.9	A	0.4' RT	

639 (3) DRIVEWAY			
LINE "A"		DRIVEWAY	REMARKS
STATION	OFFSET	WIDTH	
10+02.4	11.9'	18'	SEE G-SHEETS FOR DETAILS
15+00.8	52.7'	18'	SEE G-SHEETS FOR DETAILS

639 (3) 36' LF.
DRIVEWAYS. ACTUAL
INSTALLATIONS: 7.0
✓ Jh. 3/14/19.

SEE REVERSE
For Change Order # 18.

DO NOT SCALE FROM THESE DRAWINGS USE DIMENSIONS

PATH		
Q:\JNU\69500\PLANSET\69500_D1-D2		
SUMS.DWG		
GRANTHAM, RICK L (DOT)		
TAB: D2 Monday, July 20, 2015 12:13:37 PM		
ADDENDUM NUMBER		
ATTACHMENT NUMBER		
RECORD OF REVISIONS		
No.	DATE	DESCRIPTION

OK ✓ By TVL.
OK ✓ By TVL.
3-14-19.

Actual = 5
Referenced
Monuments

PLAN LEGEND



CHECKED BY: J. BROWN
DESIGNED BY: J. BROWN
DRAWN BY: R. GRANTHAM
STATE OF ALASKA
DEPARTMENT OF TRANSPORTATION
& PUBLIC FACILITIES
SOUTHCOST REGION
JNU: GLACIER HWY MULTI-USE
SEPARATED PATH TO UAS
PROJECT NO. 69500

SUMMARIES

PROJECT DESIGNATION	
0933037 ~ 69500	
STATE	YEAR
ALASKA	2015
SHEET NUMBER	TOTAL SHEETS
D2	54



STATE OF ALASKA
DEPARTMENT OF TRANSPORTATION
AND PUBLIC FACILITIES
SOUTHCOST REGION

Change Order

Project No.: 69500/0933037 Change Order No. 1

Project Name: JNU-Glacier Highway Multi-Use Path to UAS

Construction Requirements: Comply with Section 642.
Method of Measurement: Conforms to Section 642-4.01.

Basis of Payment: This item includes the resources required to provide a survey required on the project in addition to what is shown on the plans. This item will be authorized by the Engineer. Full compensation for Item 642(3) is made in accordance with Section 109-1.03.

This item does not affect other lump sum items.

Payment will be made under:

Pay Item	Pay Unit
642(3) Three Person Survey Party	Hour

NO	DESCRIPTION	UNIT	QUANTITY	RATE	AMOUNT	EST. NO.	EST. DATE	EST. BY	EST. CHECKED
9	NO PARKING ANY TIME <->	30+31	A	RT	R7P-101	12	18	1.50	PST SW
10	SPEED ZONE AHEAD	33+07	A	PT	R2-5C	30	36	7.50	PST E
11	635-5.01 Basis of Payment, Add the following:				7P-101	12	18	1.50	PST S
12					P-101R	12			
13	635(2)a Insulation Board								
14	JUNEAU 11 (BICYCLE SYMBOL) AIRPORT	38+76	A	RT	D1-2	24	18	3.00	PST W
15	UAS (BICYCLE SYMBOL) ->	00+38	B	LT	D1-1B	24	6	1.00	PST SW

OK ✓ By TVL.
OK ✓ By TVL.
3-14-19.

NOTE: EXISTING SIGNS IN PATH SHALL BE REMOVED.

COMMENTS
6" UC / 4" LC B FONT
MOUNT BELOW SIGN 2
MOUNT BELOW SIGN 5



STATE OF ALASKA
DEPARTMENT OF TRANSPORTATION
AND PUBLIC FACILITIES
SOUTHCOAST REGION

Change Order

Project No.: 69500/0933037 Change Order No. 18

Project Name: JNU-Glacier Highway Multi-Use Path to UAS

Contractor:	Secon, Inc.	Change Order Summary:	
Address:	P.O. Box 32159 Juneau, AK 99803	Calendar Days (+ / -):	N/A
		New Completion Date:	N/A
		Amount of Change Order:	-\$3,604.00

Recommended By: [Signature] Date: 7/12/2017

Approved By: [Signature] Title: Project Engineer Date: 12 Jul 2017

Title: Project Manager

This change order constitutes agreement to terms, conditions and prices stated below.

Accepted By: _____ Date: _____
Contractor's Representative

Acknowledged By: _____ Date: _____
Contractor's Representative

Seal of Alaskan Professional Engineer (if required) N/A

Permit for previously submitted subcontractor(s) to perform all or portions of the work described herein is as checked: Yes No N/A

The following change(s) in the above Contract are hereby made in accordance with the terms of the Contract and under the terms and conditions stated below. Price adjustments resulting from inaccurate cost and pricing data are subject to the provisions of AS 36.30.400(c). This document shall become an amendment to the Contract and all provisions of the Contract will be applicable.

DESCRIPTION OF CHANGE (Use Continuation Sheet 25D-065 as Required)

In accordance with Subsection 104-1.02 of the Standard Specifications, the following changes are hereby made:


Delete Item 203(3)a Unclassified Excavation

Establish New Item: 203(3a) Unclassified Excavation
DESCRIPTION: This item replaces Item 203(3)a Unclassified Excavation.

MATERIALS REQUIREMENTS: No material changes are required for this item.

CONSTRUCTION REQUIREMENTS: No construction requirement changes are required for this item.

METHOD OF MEASUREMENT: This item is a lump sum item and in accordance with Section 109-1.01 is

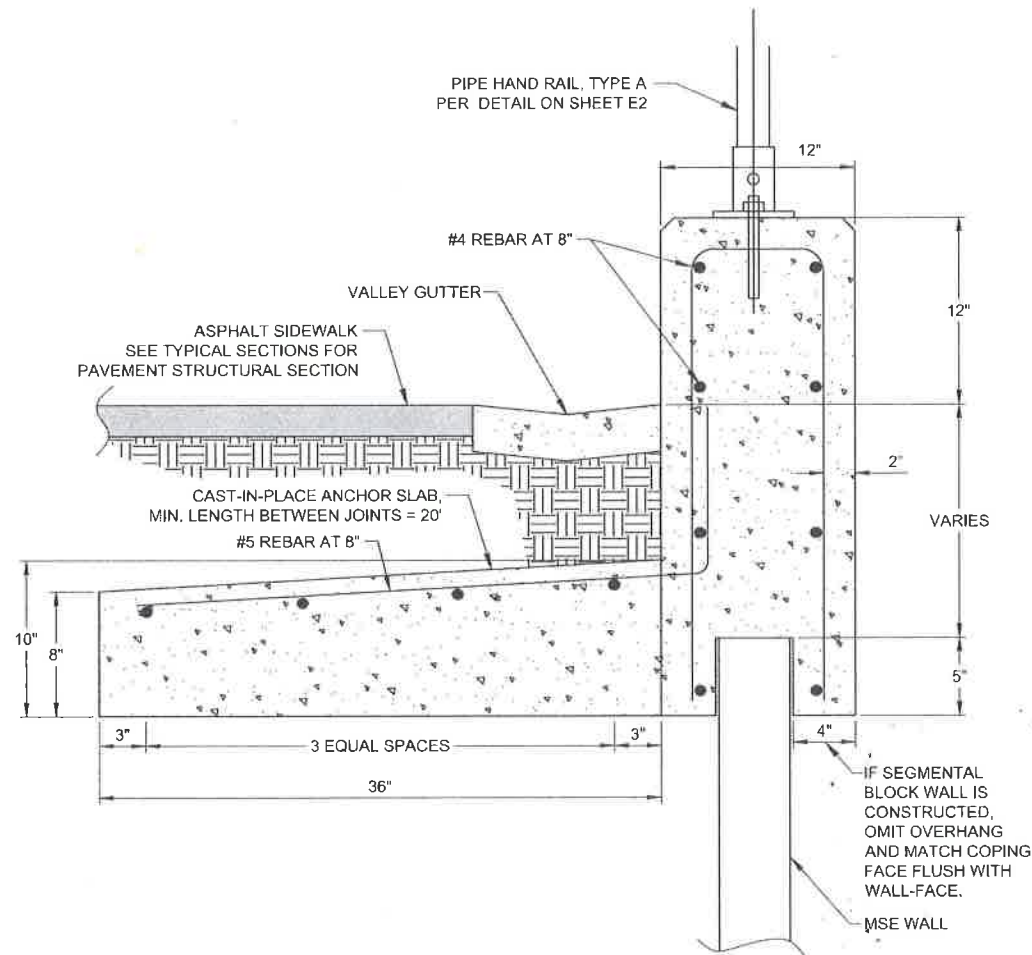

CONCRETE COPING DETAIL


N.T.S.

GENERAL NOTES:

1. MSE WALL AND COPING DETAILS SHOWN ARE FOR CONCEPTUAL PURPOSES ONLY. DEVELOP SPECIFIC COPING DETAILS FOR THE CONTRACTOR SELECTED WALL SYSTEM. SHOP DRAWINGS SHALL BE SUBMITTED TO THE ENGINEER IN ACCORDANCE WITH 511-2.01.4.
2. DETAILS ON THIS SHEET ARE CONCEPTUAL AND TO BE USED IN DEVELOPMENT OF SPECIFIC DETAILS FOR MOUNTING PIPE HAND RAIL ON MSE WALLS. SEE SHEET E2 FOR PIPE HAND RAIL DETAILS.
3. PRECASTING OF THE COPING WILL BE ALLOWED. THE ANCHOR SLAB SHALL BE CAST-IN-PLACE.

CAST IN-PLACE COPING NOTES:

1. CASTING OF THE COPING DIRECTLY AGAINST THE PRECAST PANEL SIDES WILL NOT BE PERMITTED, AS THIS MAY RESULT IN PANEL CRACKING. THE CONTRACTOR SHALL USE A 1/4" (MIN.) COMPRESSIBLE MATERIAL ON BOTH SIDES OF THE PANEL TO ISOLATE THE COPING FROM THE PRECAST PANEL.
2. COPING JOINTS SHALL BE PROVIDED AT 33' MAXIMUM SPACING AND SHALL BE PLACED TO COINCIDE WITH PRECAST PANEL JOINTS.
3. PRECAST COPING SHALL BE PROVIDED IN 10' MINIMUM LENGTHS.

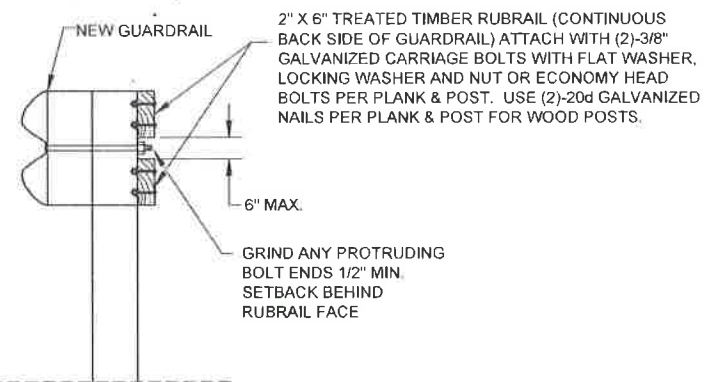

RUBRAIL DETAILS

RUBRAIL NOTES:

1. TREATED TIMBER MAY BE ROUGH SAWN HEM-FIR OR LARCH, ACZA PRESERVATIVE OR EQUIVALENT TREATED 0.4 PCF RETENTION BY ASSAY IN ACCORDANCE WITH AWPA-C2 STANDARDS MINIMUM BOARD ALLOWABLE STRESS f_b 1200 PSI.
2. 45° BEVEL LEADING AND TRAILING EXPOSED EDGES.
3. RUBRAIL IS TO BE INSTALLED ON ALL GUARDRAIL WITH THE EXCEPTION OF PARALLEL GUARDRAIL TERMINALS.

Project As-Built Drawings have been reviewed by the Project Engineer, and represent to the best of my knowledge, the project as constructed.
 PE *[Signature]* Date 2/7/18

DO NOT SCALE FROM THESE DRAWINGS USE DIMENSIONS

PATH
 Q:\JNU\69500\PLANSET\69500_E1-E7_DETAILS.DWG

GRANTHAM, RICK L (DOT)
 TAB: E1 Monday, July 20, 2015 12:14:18 PM

ADDENDUM NUMBER


ATTACHMENT NUMBER

RECORD OF REVISIONS

No.	DATE	DESCRIPTION

PLAN LEGEND

CHECKED BY: J. BROWN

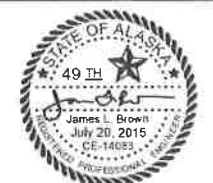

DESIGNED BY: J. BROWN

DRAWN BY: R. GRANTHAM


STATE OF ALASKA
 DEPARTMENT OF TRANSPORTATION
 & PUBLIC FACILITIES
 SOUTHCOAST REGION

JNU: GLACIER HWY MULTI-USE
 SEPARATED PATH TO UAS
 PROJECT NO. 69500

COPING DETAIL


PROJECT DESIGNATION
0933037 ~ 69500

STATE	YEAR
ALASKA	2015
SHEET NUMBER	TOTAL SHEETS
E1	54

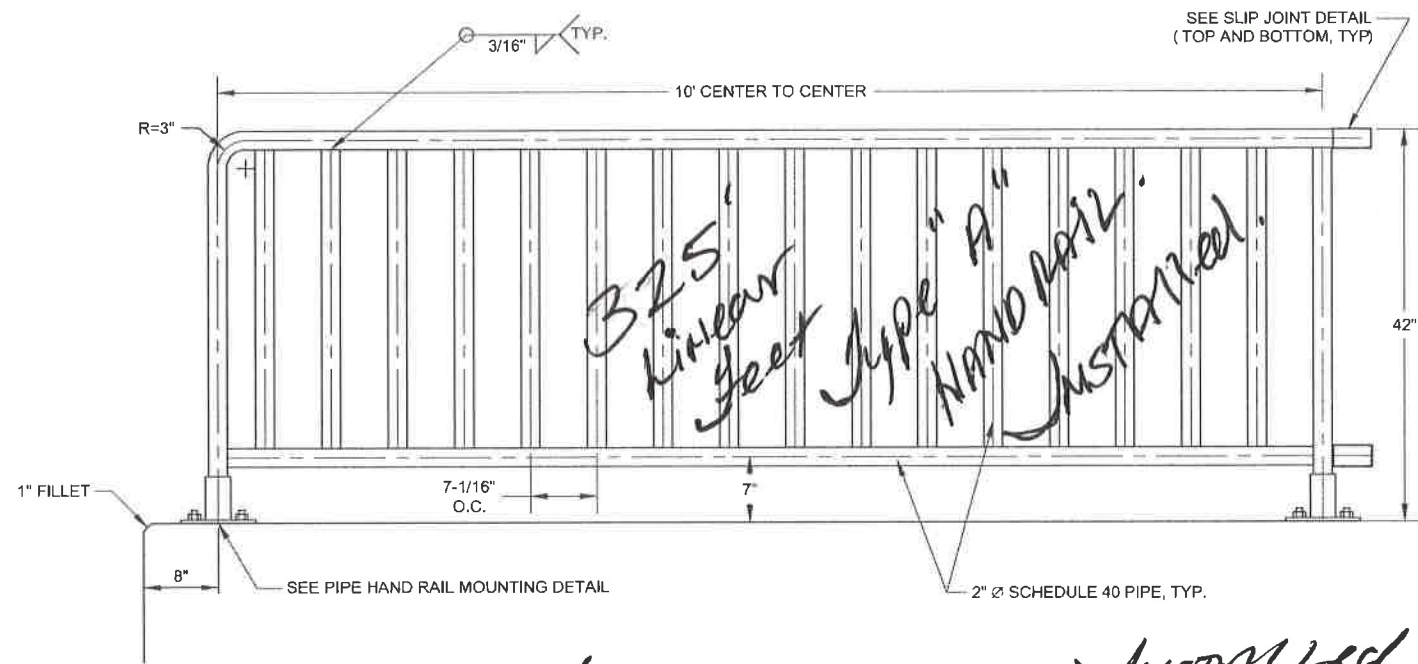


325' PIPE HAND RAIL, TYPE A
ELEVATION VIEW
 N.T.S.


*Installed over
 "Key-stone MSE-WALL"*

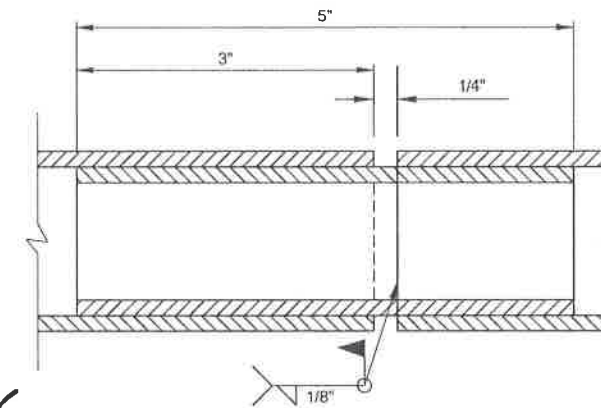

SLIP JOINT DETAIL
 N.T.S.

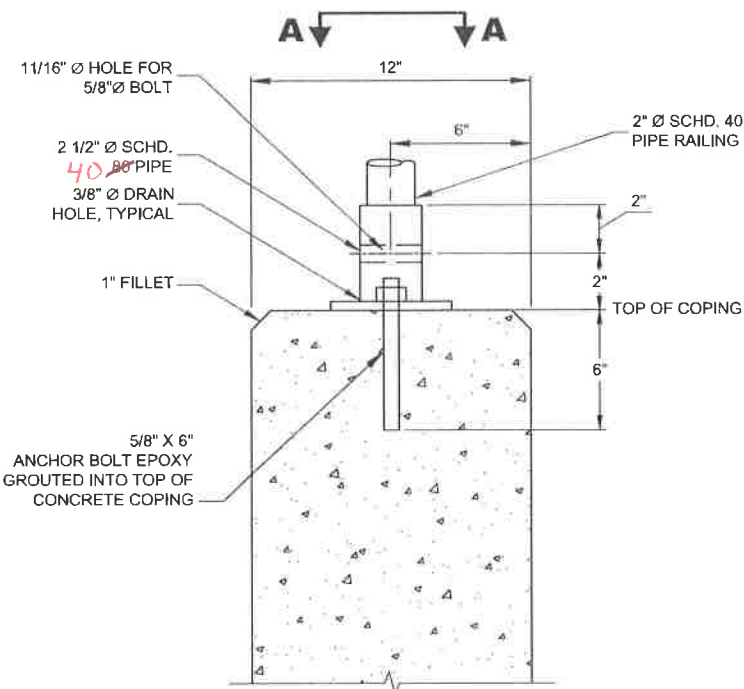

PIPE HAND RAIL, TYPE A MOUNTING DETAIL
 N.T.S.

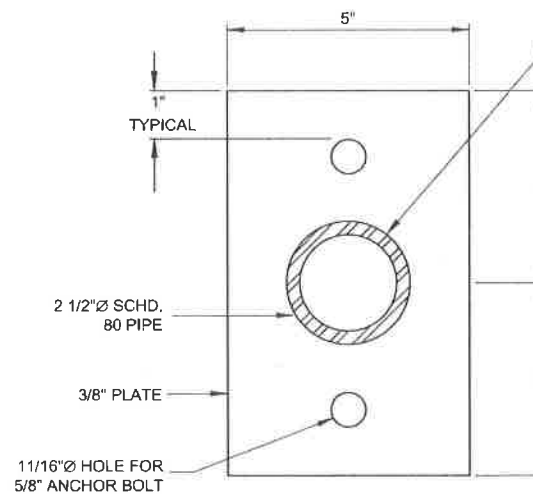

SECTION A-A
 N.T.S.

Project As-Built Drawings have been reviewed by the Project Engineer, and represent to the best of my knowledge, the project as constructed.
 PE *[Signature]* Date *2/7/2018*

PIPE HANDRAIL NOTES:

1. CONTRACTOR SHALL PROVIDE SHOP DRAWINGS OF ALL PIPE HAND RAIL PRIOR TO FABRICATION FOR THE ENGINEER'S REVIEW AND APPROVAL.
2. ASSURE VERTICAL RAILING IS PLUMB.
3. RAILING PANELS SHALL BE SPLICED USING SLIP JOINT TO PROVIDE CONTINUOUS RAILING. SEE DETAIL.
4. OVERALL LENGTH OF RAILING SEGMENT MAY BE LIMITED DUE TO CONFIGURATION OF WALL. SEE SHEET M1 FOR MSE WALL PLANS.
5. ALL RAILING MEMBERS AND ASSOCIATED HARDWARE SHALL BE GALVANIZED.
6. RAILING SHALL BE CENTERED IN TOP OF COPING.
7. ALL VERTICAL MEMBERS SHALL BE SPACED TO MAINTAIN A UNIFORM GAP.
8. VERIFY ALL CONTROLLING DIMENSIONS IN THE FIELD BEFORE ORDERING OR FABRICATING ANY MATERIAL.

PATH
 Q:\JNU\69500\PLANSET\69500_E1-ET_DETAILS.DWG

GRANTHAM, RICK L (DOT)
 TAB: E2 Monday, July 20, 2015 12:14:22 PM

ADDENDUM NUMBER

ATTACHMENT NUMBER

RECORD OF REVISIONS

No.	DATE	DESCRIPTION

PLAN LEGEND

CHECKED BY: J. BROWN



DESIGNED BY: J. BROWN

DRAWN BY: R. GRANTHAM

STATE OF ALASKA
 DEPARTMENT OF TRANSPORTATION
 & PUBLIC FACILITIES
 SOUTHCOAST REGION

JNU: GLACIER HWY MULTI-USE
 SEPARATED PATH TO UAS
 PROJECT NO. 69500


**PIPE HAND RAIL,
 TYPE A DETAILS**

PROJECT DESIGNATION
0933037 ~ 69500

STATE	YEAR
ALASKA	2015


SHEET NUMBER	TOTAL SHEETS
E2	54

DO NOT SCALE FROM THESE DRAWINGS USE DIMENSIONS

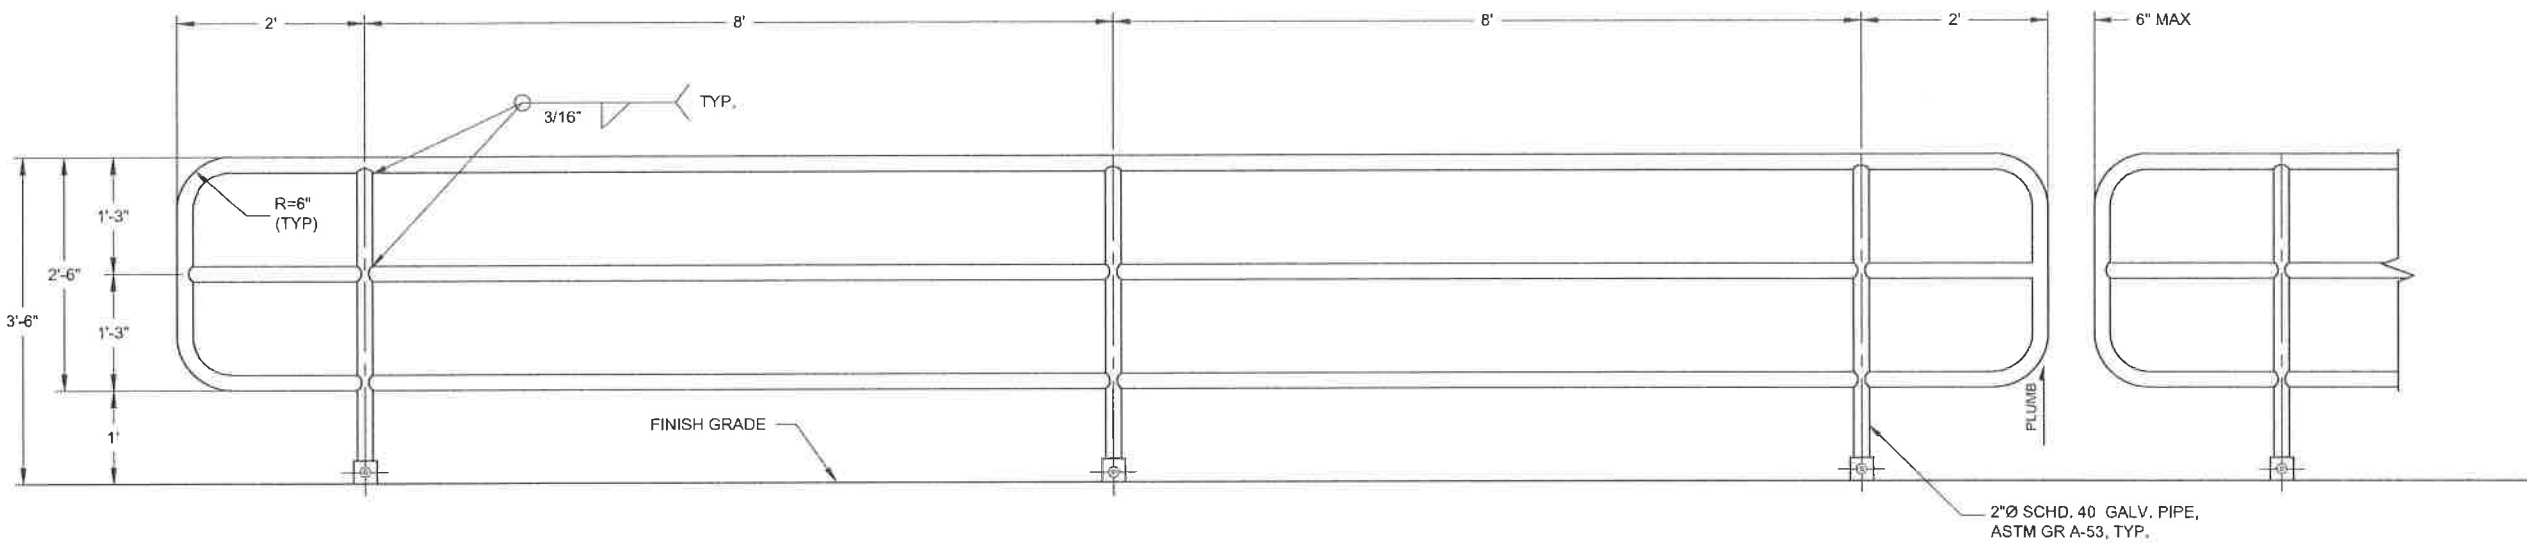


410' FT. PIPE HAND RAIL, TYPE B ELEVATION VIEW
Installed.

Installed on portion of
Multi-use path that's
parallel to Anuk Lake.

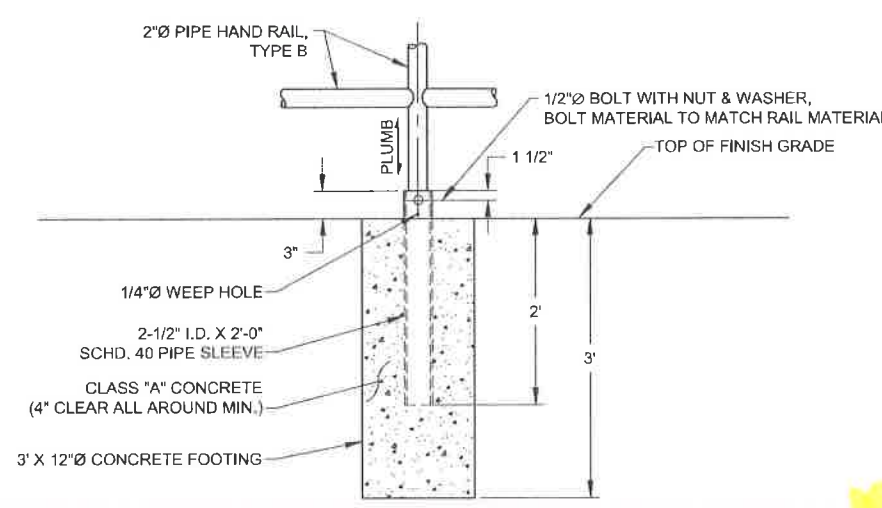

PIPE SLEEVE AND FOOTING DETAIL
 N.T.S.

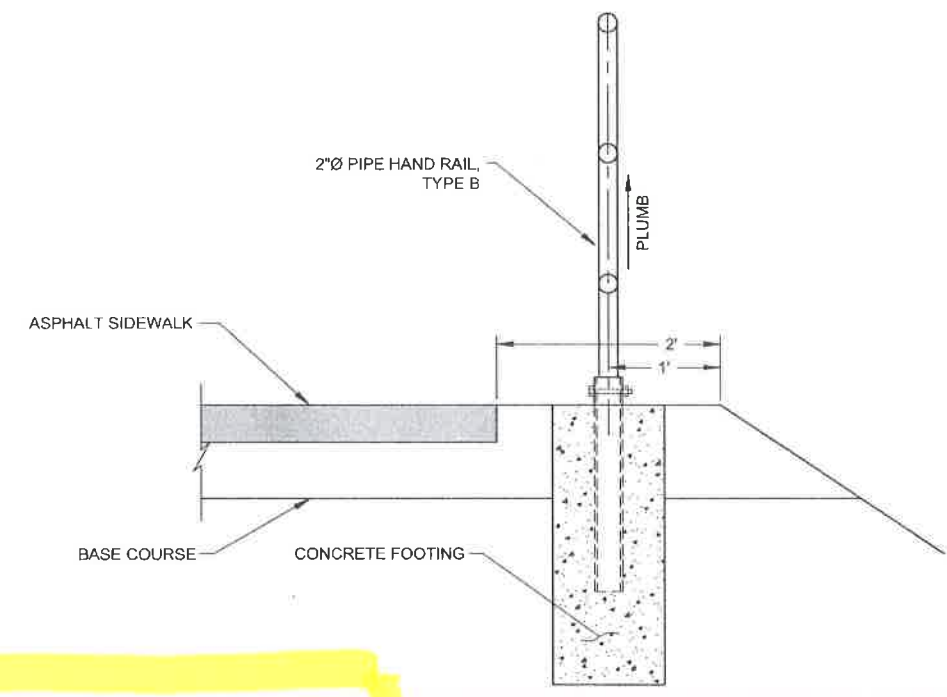

LAYOUT DETAIL
 N.T.S.

Project As-Built Drawings have been reviewed by the Project Engineer, and represent to the best of my knowledge, the project as constructed.
 PE *[Signature]* Date *2/7/2018*

PATH:
 Q:\JUNU69500\PLANSET\69500_E1-E7_DETAILS.DWG

GRANTHAM, RICK L (DOT)
 TAB: E3 Monday, July 20, 2015 12:14:26 PM

ADDENDUM NUMBER

ATTACHMENT NUMBER

RECORD OF REVISIONS

No.	DATE	DESCRIPTION

PLAN LEGEND

CHECKED BY: J. BROWN

DESIGNED BY: J. BROWN

DRAWN BY: R. GRANTHAM

STATE OF ALASKA
 DEPARTMENT OF TRANSPORTATION
 & PUBLIC FACILITIES
 SOUTHCOAST REGION

JNU: GLACIER HWY MULTI-USE
 SEPARATED PATH TO UAS
 PROJECT NO. 69500


**PIPE HAND RAIL,
 TYPE B DETAILS**

PROJECT DESIGNATION
0933037 ~ 69500


STATE	YEAR
ALASKA	2015

SHEET NUMBER	TOTAL SHEETS
E3	54

DO NOT SCALE FROM THESE DRAWINGS USE DIMENSIONS

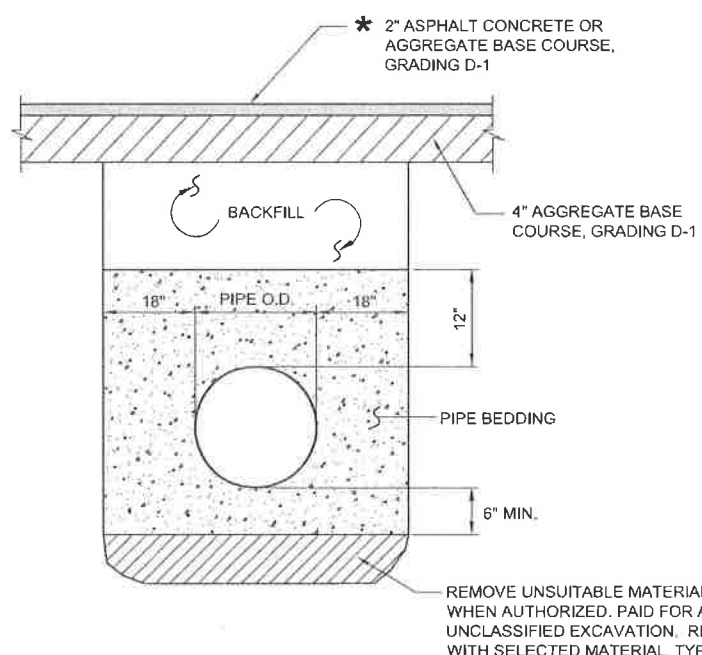


CULVERT BEDDING/BACKFILL DETAIL
 N.T.S.

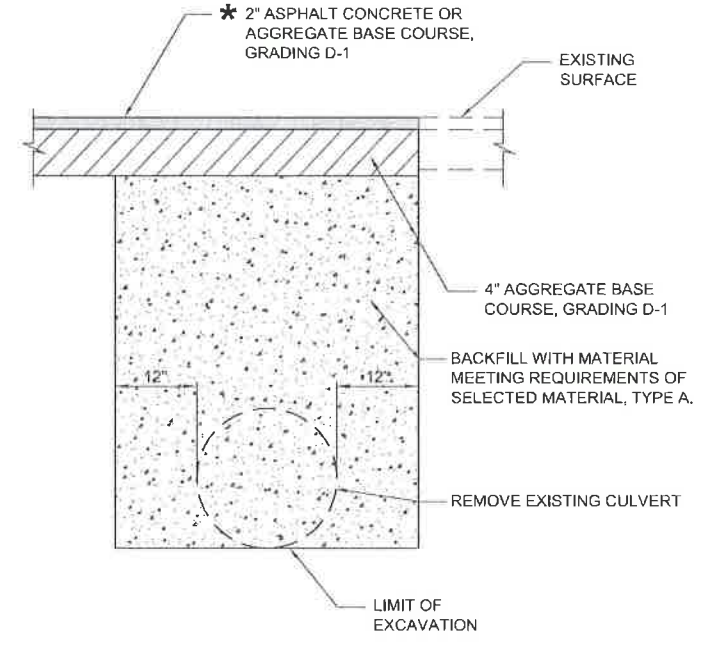

DRIVEWAY CULVERT REMOVAL & PATCH DETAIL
 N.T.S.

* REPLACE IN KIND WITH EXISTING DRIVE MATERIAL.


* REPLACE IN KIND WITH EXISTING DRIVE MATERIAL.

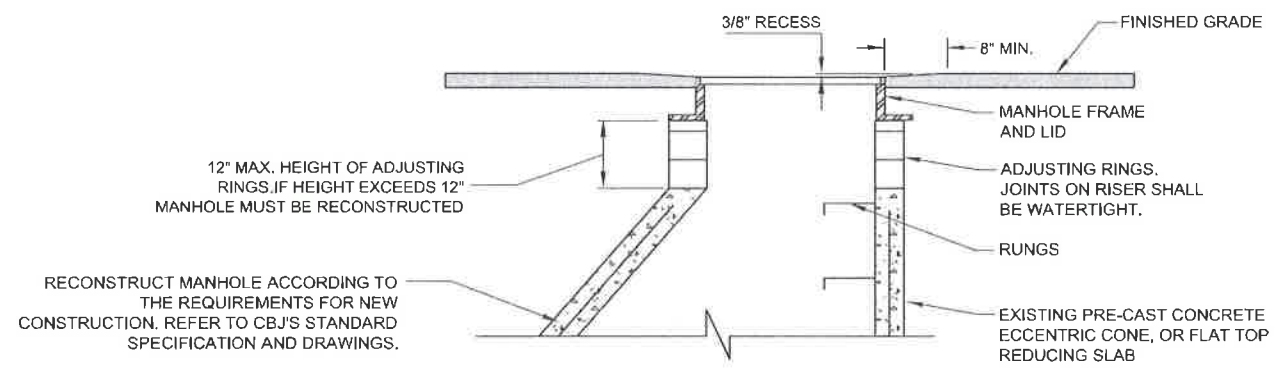

MANHOLE ADJUSTMENT / RECONSTRUCT DETAIL
 N.T.S.

MANHOLE ADJUST/RECONSTRUCT NOTES:


1. INSTALL INVERT COVER PRIOR TO ADJUSTING/ RECONSTRUCTING MANHOLE, SEE DETAIL THIS SHEET. MAINTAIN INVERT COVER DURING ADJUSTMENT/ RECONSTRUCTION TO PREVENT MATERIAL AND DEBRIS FROM ENTERING THE SEWER SYSTEM.
2. ENSURE MANHOLES REMAIN ACCESSIBLE DURING CONSTRUCTION.
3. RAISE, LOWER, OR RECONSTRUCT MANHOLES AS REQUIRED IN ACCORDANCE WITH SECTION 604 OF THE SPECIFICATIONS AND SECTION 02402 OF THE CITY AND BOROUGH OF JUNEAU'S (CBJ) STANDARD SPECIFICATIONS AND DRAWINGS. INSTALL STEEL PLATE OVER MANHOLE OPENING AS A TEMPORARY MEASURE WHEN THE LID AND FRAME ARE REMOVED.
4. COORDINATE WITH CBJ FOR REPLACEMENT OF FRAMES AND LIDS. REUSE EXISTING FRAME AND LID IF NOT DAMAGED.
5. ADJUSTING RINGS SHALL BE REPLACED IN ACCORDANCE TO EACH MANHOLE INVESTIGATION, CONDUCTED BY THE PROJECT ENGINEER.
6. MANHOLE CASTING SHALL BE ADJUSTED TO CONFORM WITH SLOPE AND GRADE OF PROPOSED PAVEMENT.
7. ADJUSTING RINGS SHALL BE PROPERLY SIZED FOR THE EXISTING CONE OR FLAT TOP OPENING, AND INSTALLED PER MANUFACTURER'S RECOMMENDATIONS.
8. INSTALLATION OF FRAME, LID, AND ADJUSTMENT RINGS, ONTO THE EXISTING STRUCTURE SHALL BE WATER-TIGHT.
9. MANHOLE RUNGS ARE TO BE PLACED 12" O.C. FROM UNOBSTRUCTED SIDE OF MANHOLE. LAST RUNG PLACED 18" MAX. FROM BOTTOM OF MANHOLE, OVER SMALLEST PIPE.
10. AFTER MANHOLE ADJUSTMENT/ RECONSTRUCTION IS COMPLETE REMOVE INVERT COVER. REMOVE MATERIAL COLLECTED ON TOP OF INVERT COVER PRIOR TO ITS REMOVAL. REMOVE ANY MATERIAL THAT HAS FALLEN INTO THE MANHOLE AS A RESULT OF MANHOLE ADJUSTMENT/ RECONSTRUCTION.

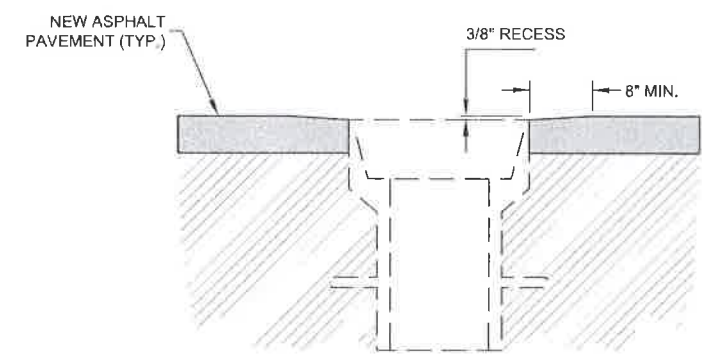

VALVE BOX ADJUSTMENT DETAIL


WHERE VALVE BOX ADJUSTMENT IS REQUIRED IN AN UNPAVED AREA RECESS VALVE BOX 6" BELOW FINISHED GRADE.

Project As-Built Drawings have been reviewed by the Project Engineer, and represent to the best of my knowledge, the project as constructed.
 PE *[Signature]* Date 2/7/2018

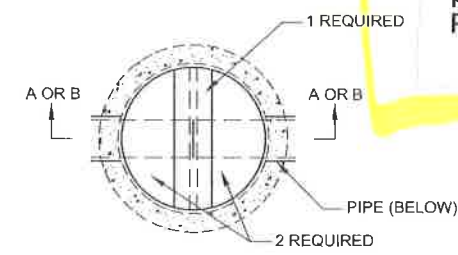

INVERT COVER PLAN

(INVERT COVER IN PLACE)

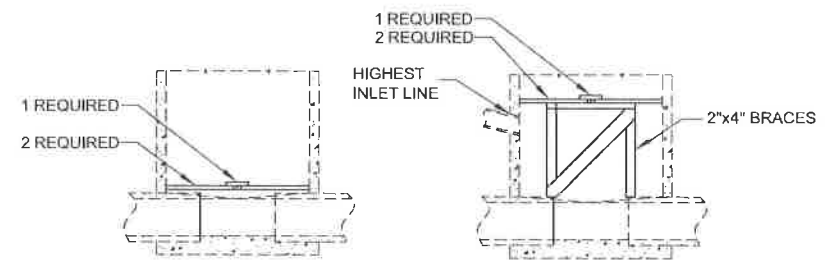


SECTION A-A


OPTION 1

SECTION B-B

OPTION 2

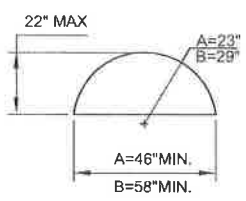

2 REQUIRED

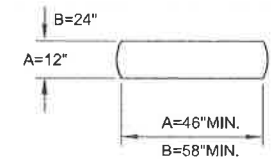

1 REQUIRED

USE DIMENSION A FOR 48" MANHOLES
 USE DIMENSION B FOR 60" MANHOLES

DO NOT SCALE FROM THESE DRAWINGS USE DIMENSIONS

PLAN LEGEND

CHECKED BY: J. BROWN



DESIGNED BY: J. BROWN

DRAWN BY: R. GRANTHAM

STATE OF ALASKA
 DEPARTMENT OF TRANSPORTATION
 & PUBLIC FACILITIES
 SOUTHWEST REGION


JNU: GLACIER HWY MULTI-USE
 SEPARATED PATH TO UAS
 PROJECT NO. 69500

MISCELLANEOUS DETAILS

PROJECT DESIGNATION

0933037 ~ 69500


STATE	YEAR
ALASKA	2015
SHEET NUMBER	TOTAL SHEETS
E4	54

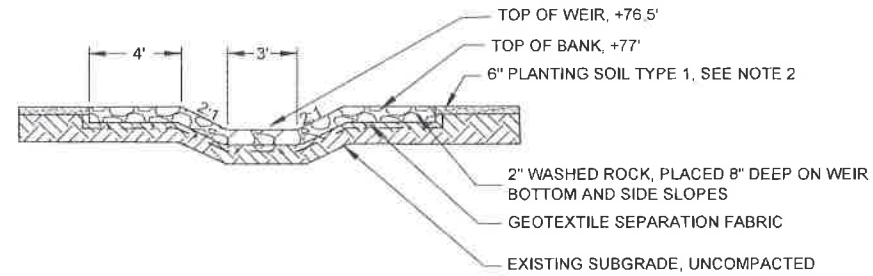


STORMWATER WETPOND 'A' WEIR ELEVATION
NTS

WETPOND NOTES:

1. WETPONDS MAY BE USED AS A TEMPORARY SEDIMENT TRAP DURING CONSTRUCTION, EITHER WITH VEGETATION ESTABLISHED PRIOR TO THE COMMENCEMENT OF CONSTRUCTION ACTIVITIES OR WITH FILTER FABRIC UNDER WASHED GRAVEL AND COARSE AGGREGATE. IF THE PONDS ARE USED AS CONSTRUCTION BMPs, THE TRAP MUST BE CLEANED OUT PRIOR TO USE AS A PERMANENT WETPOND. POND SEEDING EFFORTS SHALL BE SUPPLEMENTED WITH THE SPECIFIED SEDGE PLANTINGS FROM SECTION 621. 70% PLANT COVERAGE MUST BE OBTAINED PRIOR TO USE OF FINAL WETPONDS. PLANTING OF SAGES DOES NOT GUARANTEE 70% COVERAGE.
2. WETPOND 'B' IS A SIMILAR SECTION WITH ELEVATIONS SHOWN ON SITE PLAN.
3. THE CULVERT PIPE OUTLET IN WETPOND 'A' SHALL BE PROTECTED WITH 2" WASHED ROCK.
4. SHRUBS AND GROUND COVER PLANTS SHALL BE PLANTED ABOVE THE MAX WATER LEVEL OF THE PONDS, SEDGES SHALL BE PLANTED BELOW THE MAX WATER LEVEL OF THE PONDS.
5. THE SUBGRADE OF THE WETPONDS SHALL NOT BE COMPACTED. EQUIPMENT, MACHINERY, AND MATERIALS SHALL NOT BE PLACED IN THIS AREA PRIOR TO OR DURING CONSTRUCTION. IF THE SUBGRADE IS FOUND TO BE COMPACTED DURING CONSTRUCTION OF THE WETPONDS, BREAK UP AND LOOSEN THE SOIL TO A DEPTH OF 24" TO ALLOW FOR MAXIMUM INFILTRATION.
6. ALL SEEDING SHALL BE PERFORMED AS SHOWN ON THE PLANS.

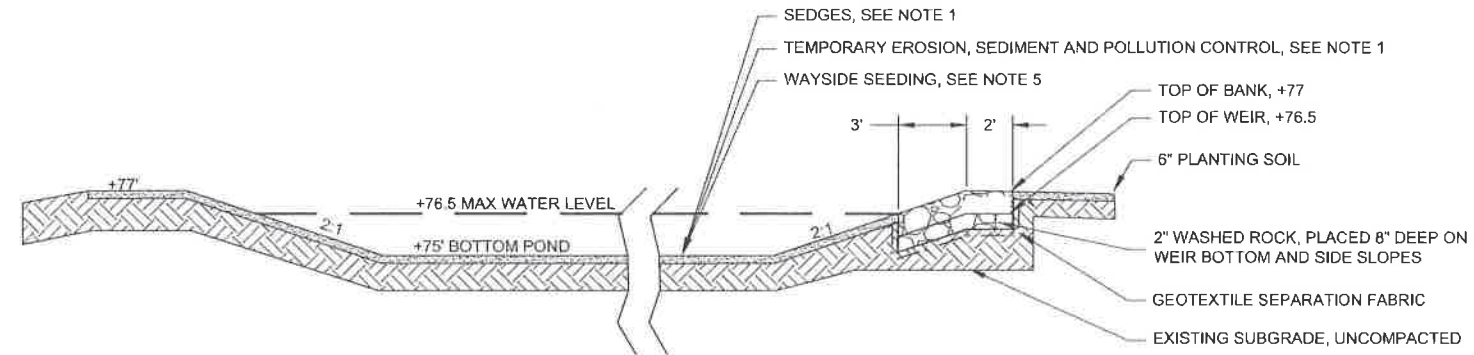


STORMWATER WETPOND 'A' TYPICAL SECTION
NTS

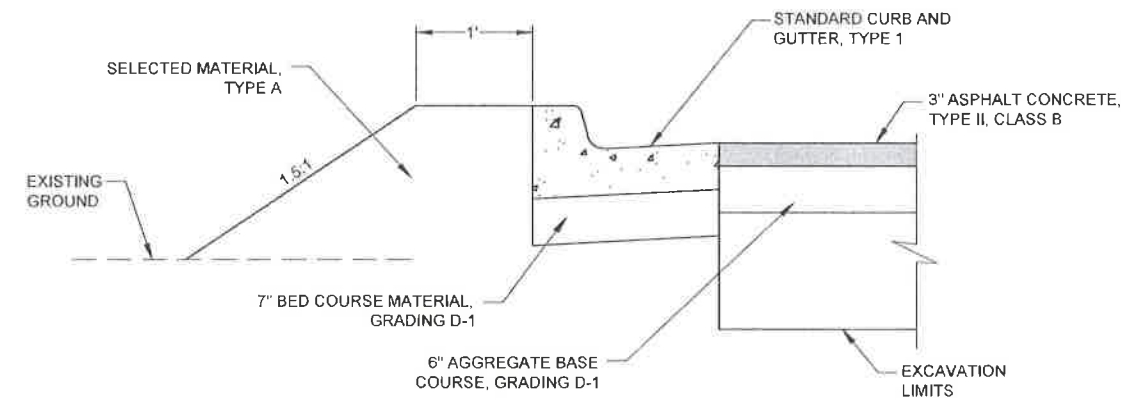

WAYSIDE CURB AND GUTTER DETAIL
N.T.S.


installed sh.

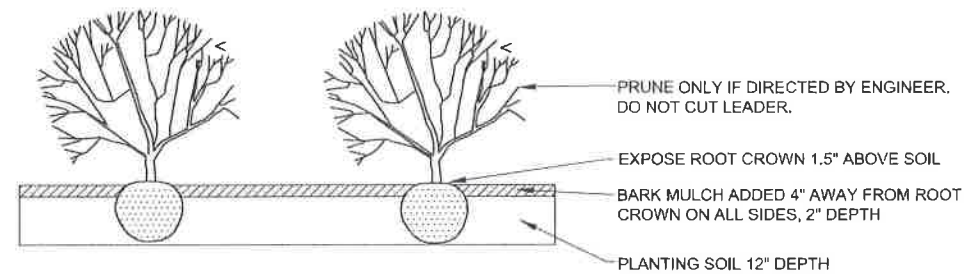

WAYSIDE PLANTING DETAIL
NTS

PLANTING NOTES:

1. REMOVE AND DISPOSE OF ALL METAL, PLASTIC, AND NON BIODEGRADABLE MATERIALS COMPLETELY FROM ROOTBALL.
2. LOOSEN AND SCARIFY SOIL GENTLY ON SURFACE OF ROOTBALL WITHOUT DAMAGING ROOTS. AFTER PLACING THE ROOTBALL IN THE SOIL, STRIP AWAY BURLAP OR OTHER BIODEGRADABLE COVERING TO EXPOSE ALL SIDES OF ROOTBALL TO SOIL.
3. SCARIFY/LOOSEN SOIL TO A DEPTH OF 24" IN SHRUB BEDS. REMOVE 12" OF EXISTING FILL AND REPLACE WITH 12" OF PLANTING SOIL.
4. BARK MULCH ADDED TO SHRUB BEDS ONLY. DO NOT ADD BARK MULCH TO WET PONDS.

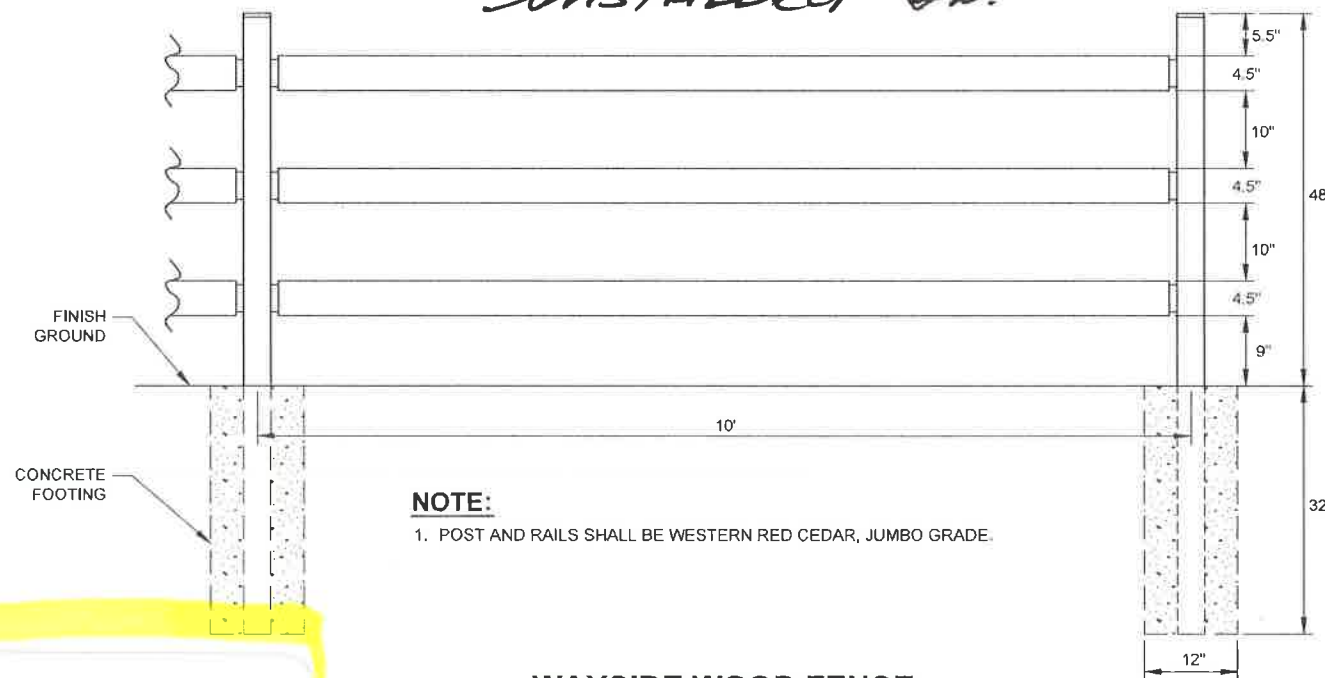

WAYSIDE WOOD FENCE
NTS

DO NOT SCALE FROM THESE DRAWINGS USE DIMENSIONS

Project As-Built Drawings have been reviewed by the Project Engineer, and represent to the best of my knowledge, the project as constructed.
PE *[Signature]* Date 2/7/2018

PATH
Q:\JUNU69500\PLANSET\69500_E1-ET_DETAILS.DWG

GRANTHAM, RICK L (DOT)
TAB E5 Monday, July 20, 2015 12:14:35 PM

ADDENDUM NUMBER

ATTACHMENT NUMBER

RECORD OF REVISIONS

No	DATE	DESCRIPTION

PLAN LEGEND

CHECKED BY: J. BROWN

DESIGNED BY: J. BROWN
DRAWN BY: R. GRANTHAM

STATE OF ALASKA
DEPARTMENT OF TRANSPORTATION & PUBLIC FACILITIES
SOUTHEAST REGION


JNU: GLACIER HWY MULTI-USE
SEPARATED PATH TO UAS
PROJECT NO. 69500

WAYSIDE DETAILS


PROJECT DESIGNATION

0933037 ~ 69500

STATE	YEAR
ALASKA	2015
SHEET NUMBER	TOTAL SHEETS
E5	54

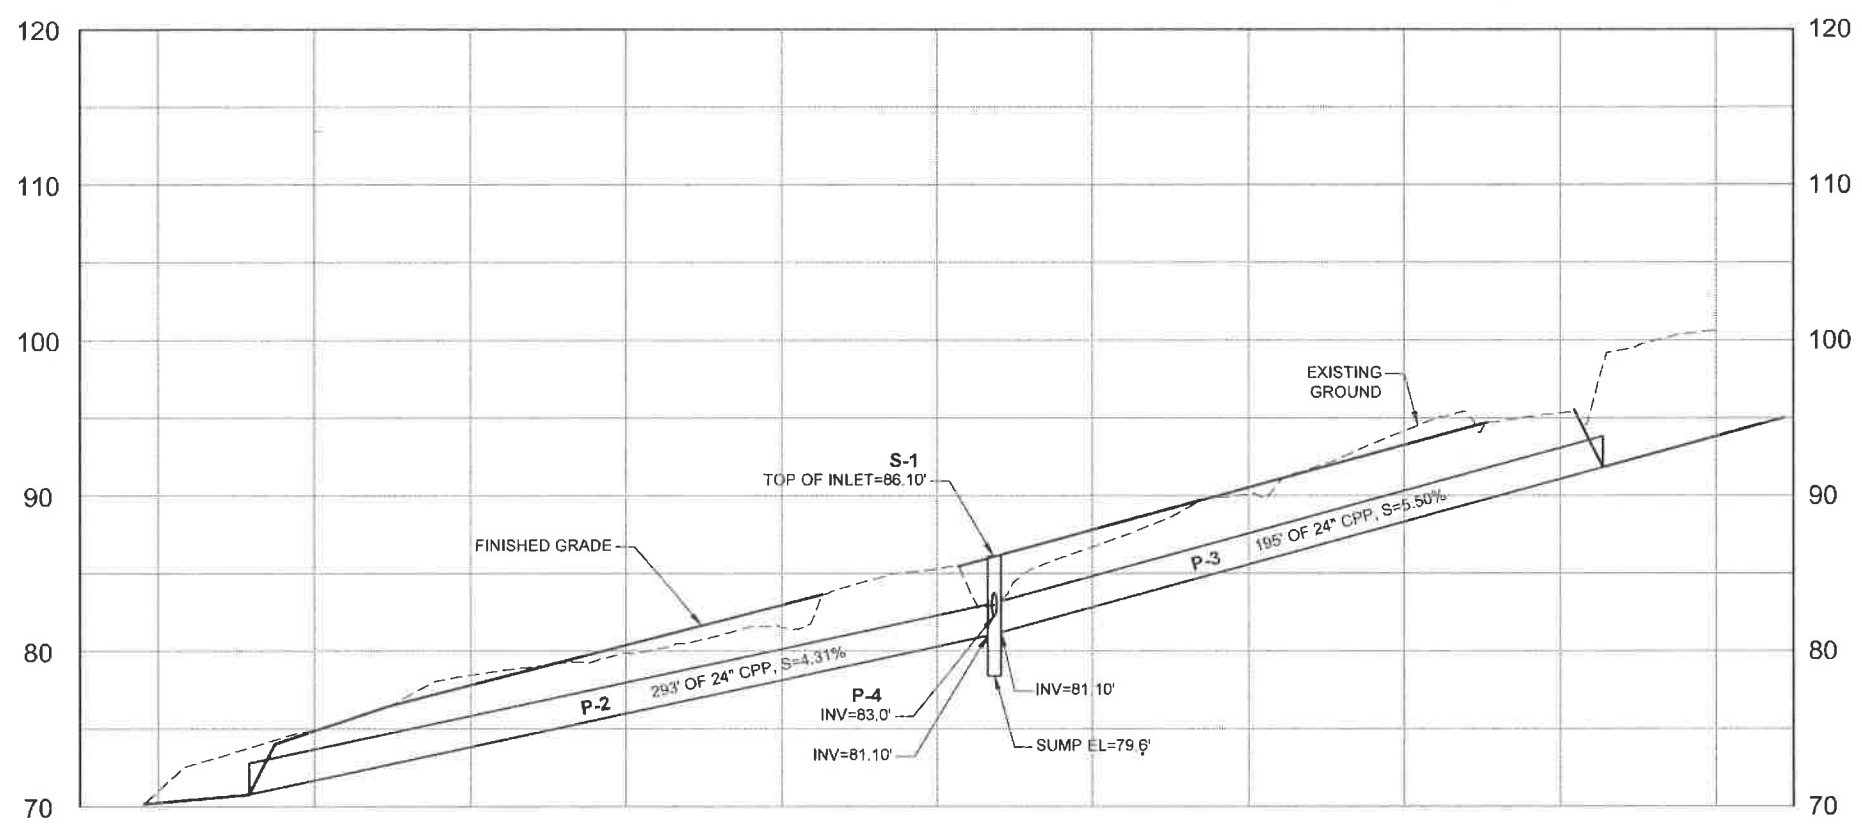

DRAINAGE DETAIL
 N.T.S.

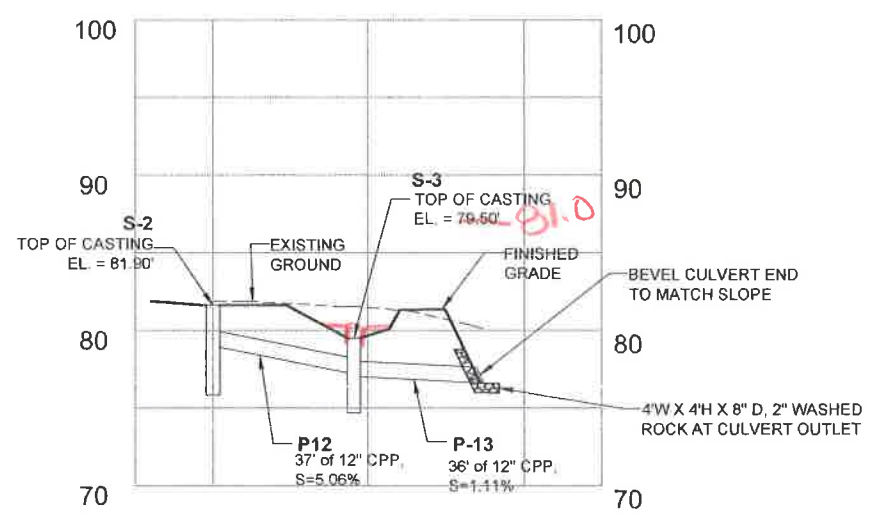

WAYSIDE DRAINAGE DETAIL
 N.T.S.

Project As-Built Drawings have been reviewed by the Project Engineer, and represent to the best of my knowledge, the project as constructed.
 PE *[Signature]* Date 2/2/2018

PLAN LEGEND

CHECKED BY: J. BROWN



DESIGNED BY: J. BROWN

DRAWN BY: R. GRANHAM

STATE OF ALASKA
 DEPARTMENT OF TRANSPORTATION
 & PUBLIC FACILITIES
 SOUTHCOST REGION
 JNU: GLACIER HWY MULTI-USE
 SEPARATED PATH TO UAS
 PROJECT NO. 69500


DRAINAGE DETAILS

PROJECT DESIGNATION
 0933037 ~ 69500


STATE	YEAR
ALASKA	2015
SHEET NUMBER	TOTAL SHEETS
E6	54

DO NOT SCALE FROM THESE DRAWINGS USE DIMENSIONS


Building gutter spillway @ Sta 2+20 RT

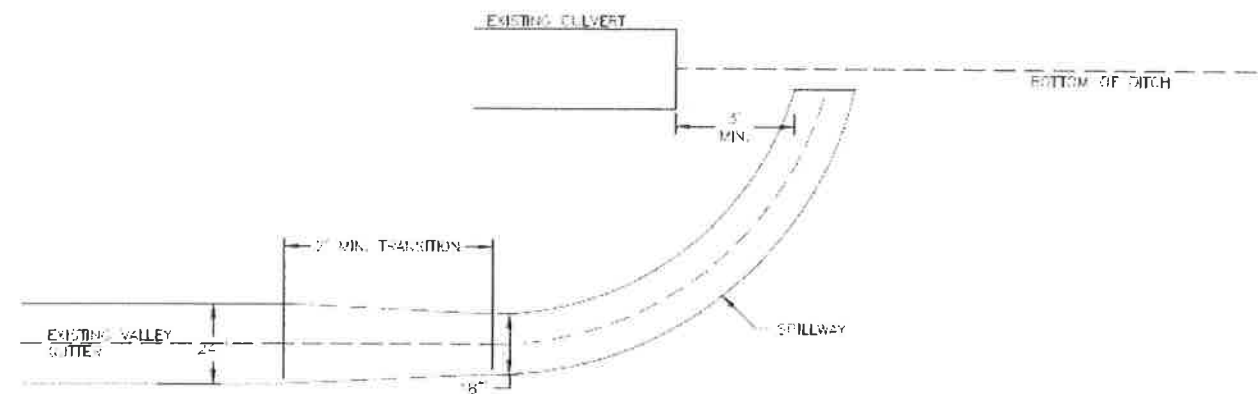

PLAN
NTS.

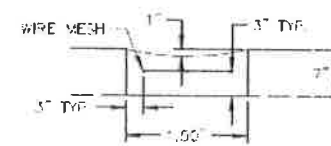

SECTION A-A
NTS.

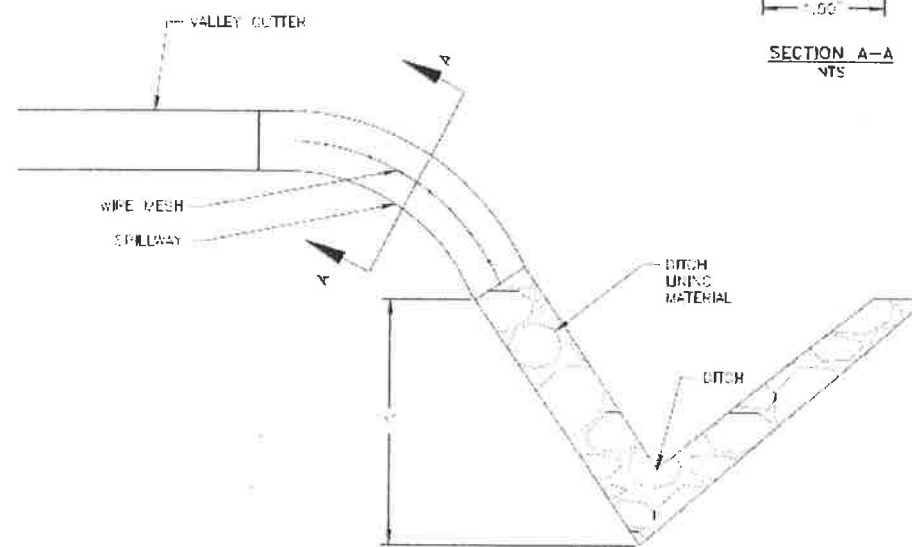

PROFILE
NTS.

EC-1



STATE OF ALASKA
DEPARTMENT OF TRANSPORTATION
AND PUBLIC FACILITIES
SOUTHCOST REGION

Change Order

Project No.: 69500/0933037

Change Order No. 15

Project Name: JNU-Glacier Highway Multi-Use Path to UAS

Contractor:	Secon, Inc.	Change Order Summary:	
Address:	P.O. Box 32159 Juneau, AK 99803	Calendar Days (+ / -):	N/A
		New Completion Date:	N/A
		Amount of Change Order:	+\$4,030.55

Recommended By: [Signature] Date: 27 Dec 2016

Approved By: [Signature] Title: Project Engineer
Date: 30 Dec 2016
Title: Project Manager

Accepted By: [Signature] Date: 1/4/2017
Contractor's Representative

Seal of Alaskan Professional Engineer
(if required)
N/A

Acknowledgement indicates only receipt of Change Order and not mutual agreement for basis of payment or time allowance. If a the matter cannot be resolved within 7 days from signature date, an Intent to Claim form must be submitted to the engineer within 14 days.

Acknowledged By: _____ Date: _____
Contractor's Representative

Permission for previously submitted subcontractor(s) to perform all or portions of the work described herein is as checked: Yes No N/A


The following change(s) in the above Contract are hereby made in accordance with the terms of the Contract and under the terms and conditions stated below. Price adjustments resulting from inaccurate cost and pricing data are subject to the provisions of AS 36.30.400(c). This document shall become an amendment to the Contract and all provisions of the Contract will be applicable.

DESCRIPTION OF CHANGE (Use Continuation Sheet 25D-065 as Required)

Reason for Change Order The following is a brief description of the rationale for this change order:


- Existing utilities were encountered from Station 16+75 to 17+45. This change order is required to excavate around the existing utilities from Station 16+75 to 17+45 to the grades shown on the plans.
- A buried electrical ground line was uncovered during excavation of the existing Wayside Parking Lot and additional resources were required to work around the buried electrical line during excavation efforts.
- The boundary boulders from Station 2+20 to 2+80 and from Station 5+50 to 6+10 were replaced with material to allow drainage to the valley gutter and shaping around the utility pole and load center. This work provides for a backfilled slope at these locations instead of the boundary boulders.
- During excavation two existing underdrains were uncovered within the fill area of the path. The existing underdrains were extended to provide drainage underneath the new multi-use pathway into the new ditch line.

In accordance with Subsection 104-1.02 of the Standard Specifications, the following changes are hereby made:

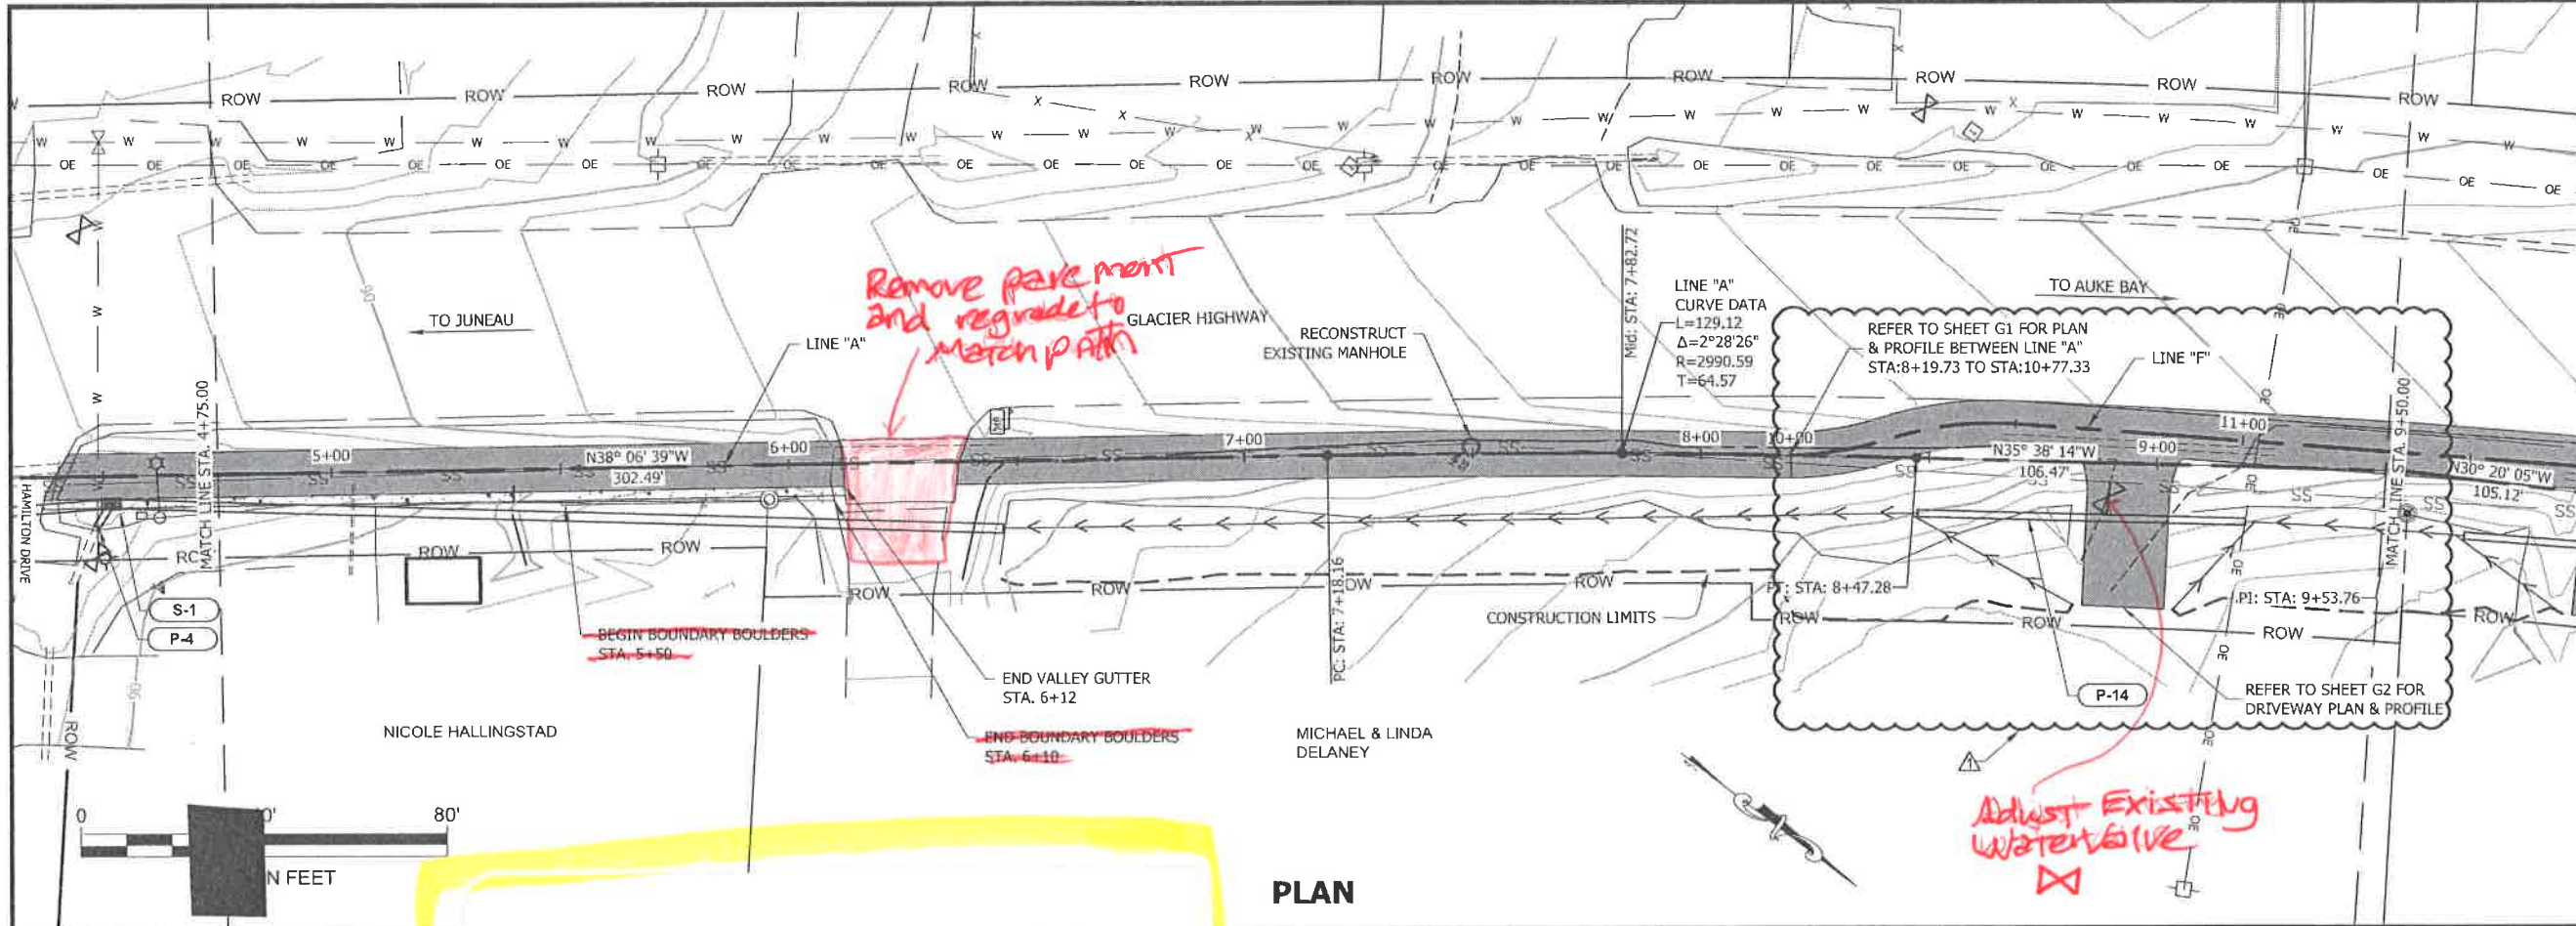

PLAN

Project As-Built Drawings have been reviewed by the Project Engineer, and represent to the best of my knowledge, the project as constructed.
 PE R. Grant Date 2/19/2019

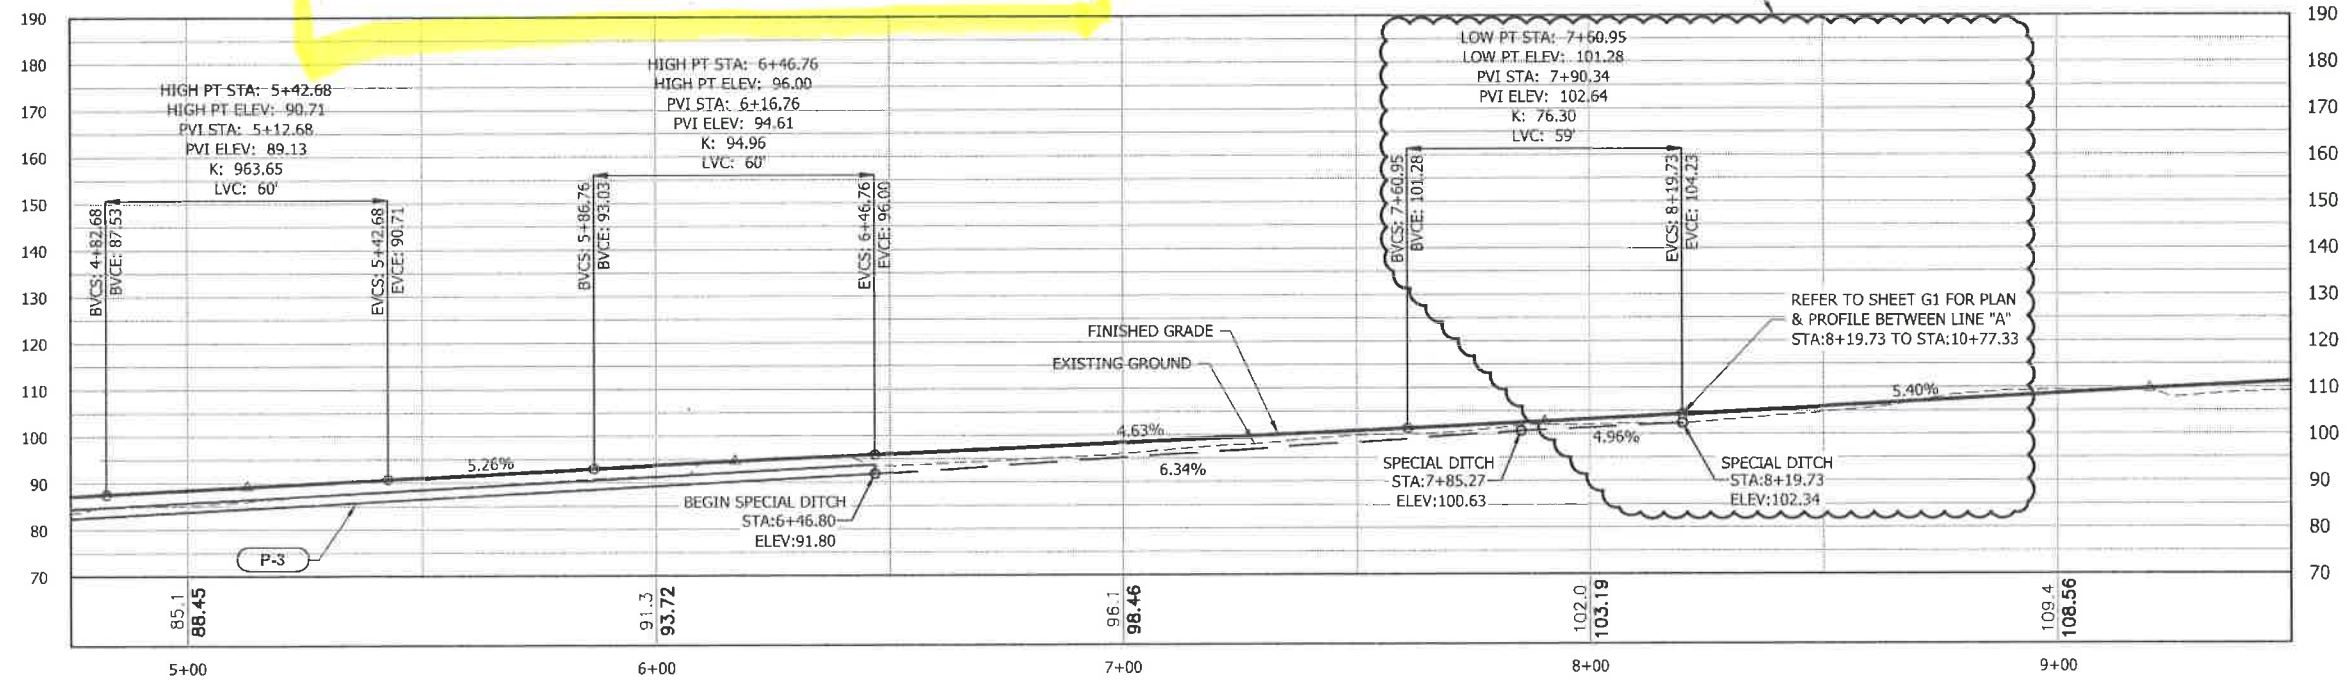


LINE "A" PROFILE

DO NOT SCALE FROM THESE DRAWINGS USE DIMENSIONS

PATH: Q:\JNU\69500\PLANSET\69500_F1-F9_P-P.DWG
 CHAMBERS, LUCAS M (DOT)
 TAB: F2 Wednesday, January 27, 2016 9:34:53 A

RECORD OF REVISIONS		
No	DATE	DESCRIPTION
1	01/27/16	REALIGNMENT FOR DRIVES

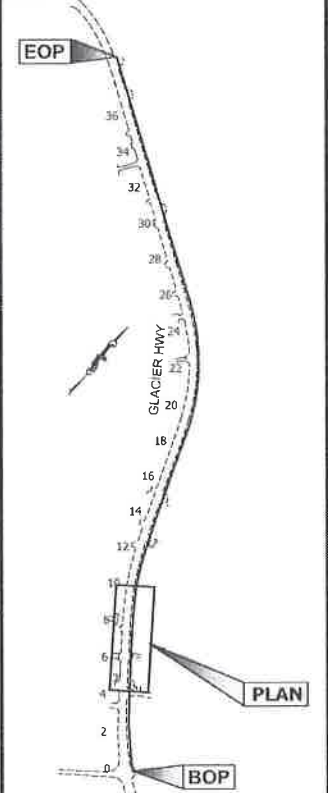

PLAN LEGEND


CHECKED BY: J. BROWN

DESIGNED BY: J. BROWN, L. CHAMBERS
 DRAWN BY: R. GRANTHAM
 STATE OF ALASKA
 DEPARTMENT OF TRANSPORTATION & PUBLIC FACILITIES
 SOUTHCOST REGION

JNU: GLACIER HWY MULTI-USE SEPARATED PATH TO UAS PROJECT NO. 69500


PLAN & PROFILE

PROJECT DESIGNATION	
0933037 ~ 69500	
STATE	YEAR
ALASKA	2015
SHEET NUMBER	TOTAL SHEETS
F2	54

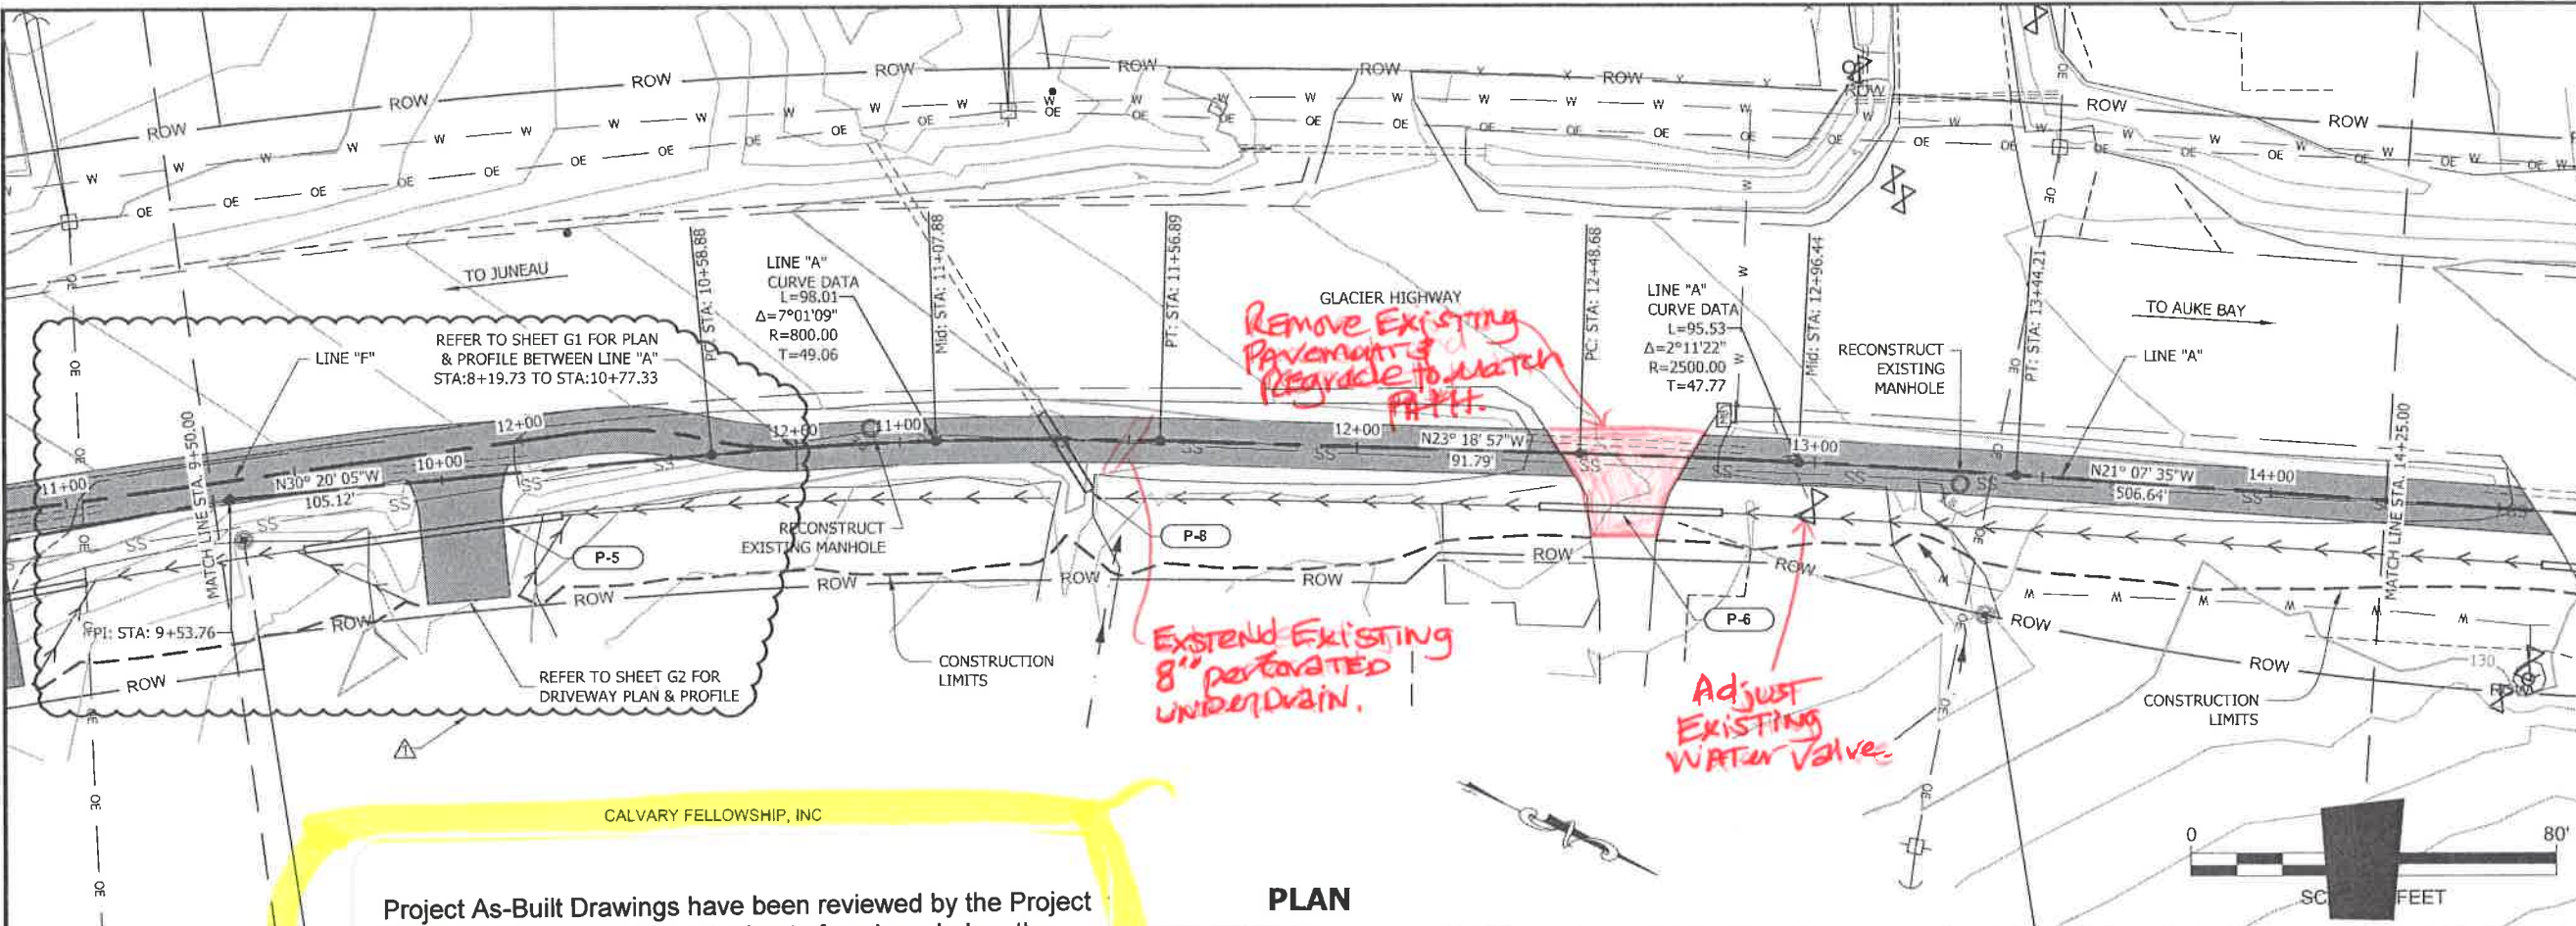


Project As-Built Drawings have been reviewed by the Project Engineer, and represent to the best of my knowledge, the project as constructed.
 PE [Signature] Date 2/19/2019

PLAN

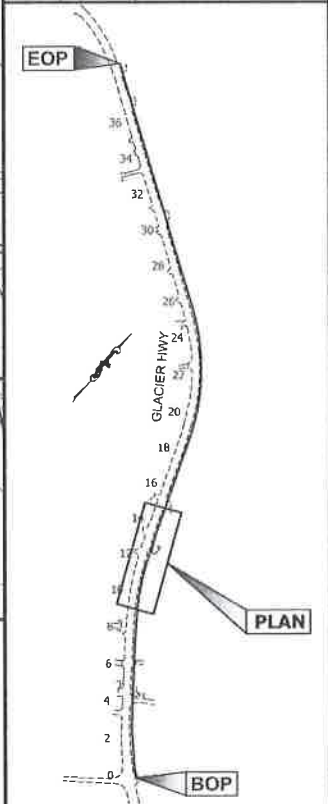


PLAN LEGEND

CHECKED BY: J. BROWN

 DESIGNED BY: J. BROWN, L. CHAMBERS
 DRAWN BY: R. GRANTHAM
 STATE OF ALASKA
 DEPARTMENT OF TRANSPORTATION & PUBLIC FACILITIES
 SOUTHCOAST REGION
 JNU: GLACIER HWY MULTI-USE SEPARATED PATH TO UAS
 PROJECT NO. 69500

PLAN & PROFILE


PROJECT DESIGNATION
0933037 ~ 69500

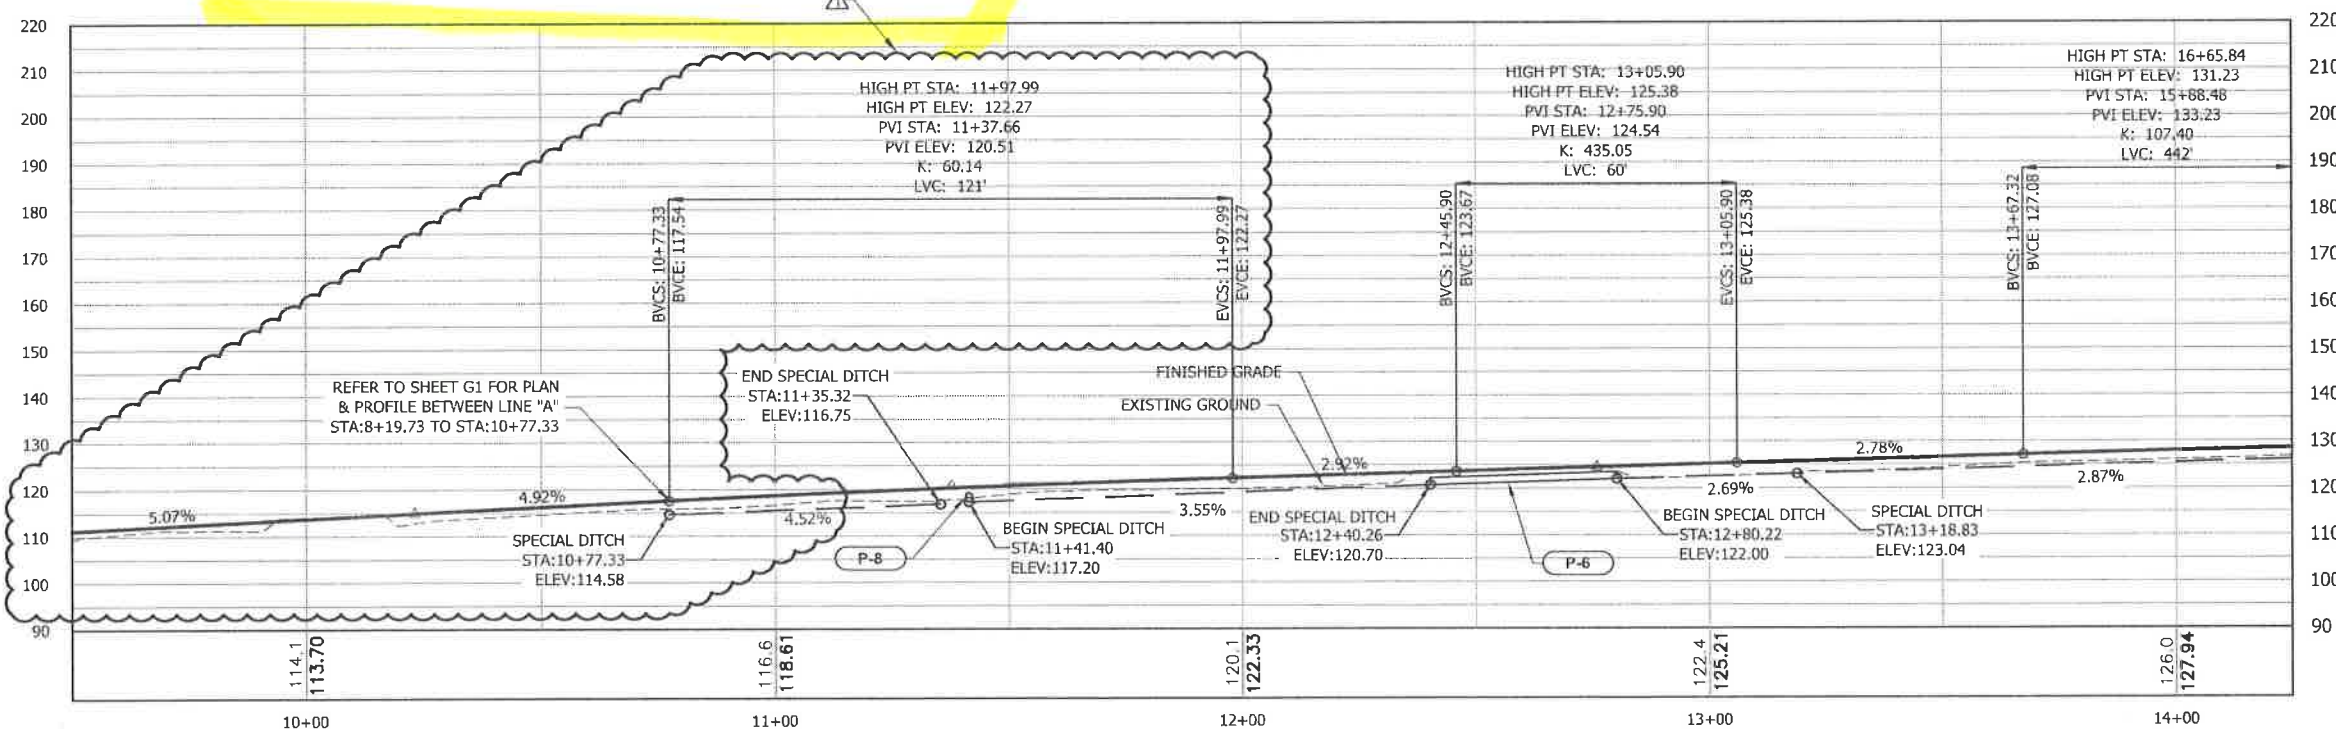STATE	YEAR
ALASKA	2015
SHEET NUMBER	TOTAL SHEETS
F3	54



LINE "A" PROFILE

DO NOT SCALE FROM THESE DRAWINGS USE DIMENSIONS

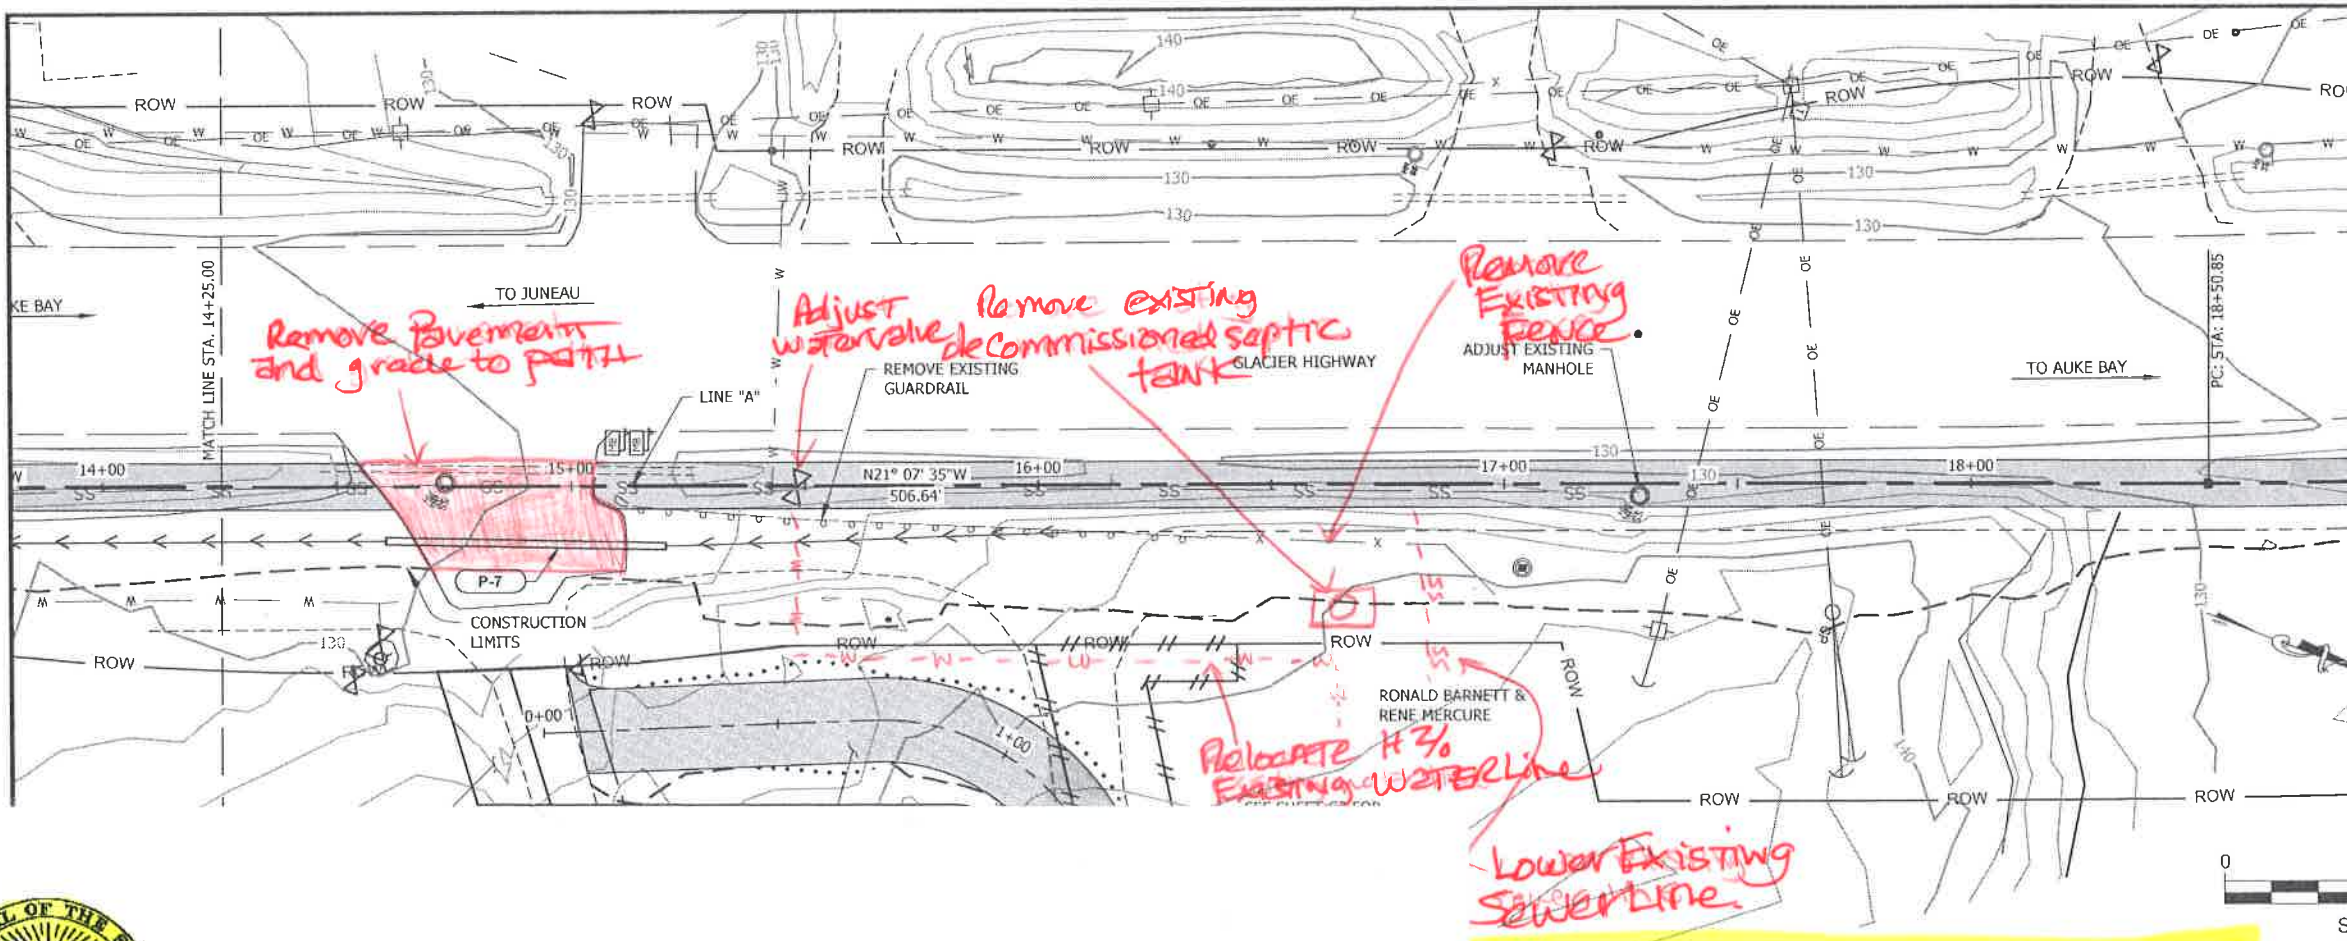

STATE OF ALASKA
DEPARTMENT OF TRANSPORTATION
AND PUBLIC FACILITIES
SOUTHCOST REGION

Change Order

Project No.: 69500/0933037

Change Order No. 19

Project Name: JNU-Glacier Highway Multi-Use Path to UAS

		Change Order Summary:	
Contractor:	Secon, Inc.	Calendar Days (+ / -):	N/A
Address:	P.O. Box 32159 Juneau, AK 99803	New Completion Date:	N/A
		Amount of Change Order:	+\$22,453.84

Project As-Built Drawings have been reviewed by the Project Engineer, and represent to the best of my knowledge, the project as constructed.

PE *[Signature]* Date 2/19/2019

DESCRIPTION OF CHANGE (Use Continuation Sheet 25D-065 as Required)

In accordance with Subsection 104-1.02 of the Standard Specifications, the following changes are hereby made:


Establish New Item 202(15)a Removal of Existing Septic Tank

Description: Remove and dispose of the existing decommissioned septic tank at Station 16+75 RT to lay the slope back to the planned slope.

Materials: Conform to Section 202 and as approved by the Engineer.

Construction Requirements: Conform to Section 202 and as directed by the Engineer.

Method of Measurement: This item is lump sum and in accordance with Subsection 109-1.01 is not measured for payment.

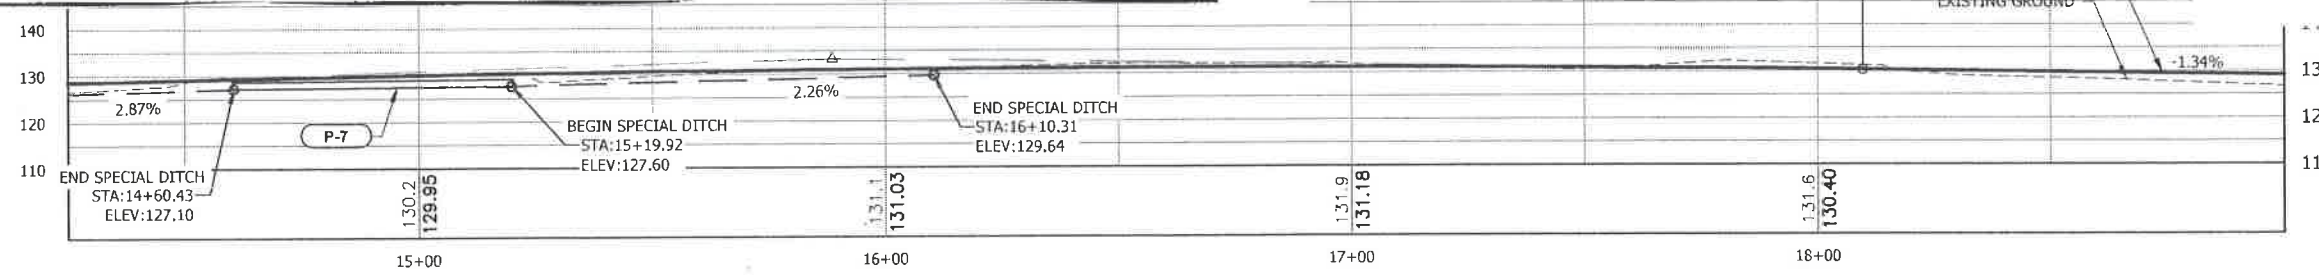

LINE "A" PROFILE

DO NOT SCALE FROM THESE DRAWINGS USE DIMENSIONS

see Co. # 15 opposite side.
REGARDING Buried UTILITIES.

SEPARATED PATH TO UAS
PROJECT NO. 69500

PLAN & PROFILE

PROJECT DESIGNATION	
0933037 ~ 69500	
STATE	YEAR
ALASKA	2015
SHEET NUMBER	TOTAL SHEETS
F4	54



STATE OF ALASKA
DEPARTMENT OF TRANSPORTATION
AND PUBLIC FACILITIES
SOUTHCOAST REGION

Change Order

Project No.: 69500/0933037 Change Order No. 15

Project Name: JNU-Glacier Highway Multi-Use Path to UAS

Contractor:	Secon, Inc.	Change Order Summary:	
Address:	P.O. Box 32159	Calendar Days (+/-):	N/A
	Juneau, AK 99803	New Completion Date:	N/A
		Amount of Change Order:	+\$4,030.55

Recommended By: [Signature] Date: 27 Dec 2016

Title: Project Engineer

Approved By: [Signature] Date: 30 Dec 2016

Title: Project Manager

This change order constitutes agreement to terms, conditions and prices stated below.

Accepted By: [Signature] Date: 1/4/2017
Contractor's Representative

Seal of Alaskan Professional Engineer
(if required)

N/A

Acknowledgement indicates only receipt of Change Order and not mutual agreement for basis of payment or time allowance. If a the matter cannot be resolved within 7 days from signature date, an Intent to Claim form must be submitted to the engineer within 14 days.

Acknowledged By: _____ Date: _____
Contractor's Representative

Permission for previously submitted subcontractor(s) to perform all or portions of the work described herein is as checked: Yes No N/A

The following change(s) in the above Contract are hereby made in accordance with the terms of the Contract and under the terms and conditions stated below. Price adjustments resulting from inaccurate cost and pricing data are subject to the provisions of AS 36.30.400(c). This document shall become an amendment to the Contract and all provisions of the Contract will be applicable.

DESCRIPTION OF CHANGE (Use Continuation Sheet 25D-065 as Required)

Reason for Change Order The following is a brief description of the rationale for this change order:

- Existing utilities were encountered from Station 16+75 to 17+45. This change order is required to excavate around the existing utilities from Station 16+75 to 17+45 to the grades shown on the plans.
- A buried electrical ground line was uncovered during excavation of the existing Wayside Parking Lot and additional resources were required to work around the buried electrical line during excavation efforts.
- The boundary boulders from Station 2+20 to 2+80 and from Station 5+50 to 6+10 were replaced with material to allow drainage to the valley gutter and shaping around the utility pole and load center. This work provides for a backfilled slope at these locations instead of the boundary boulders.
- During excavation two existing underdrains were uncovered within the fill area of the path. The existing underdrains were extended to provide drainage underneath the new multi-use pathway into the new ditch line.

In accordance with Subsection 104-1.02 of the Standard Specifications, the following changes are hereby made:



STATE OF ALASKA
DEPARTMENT OF TRANSPORTATION
AND PUBLIC FACILITIES
SOUTHCOAST REGION

Change Order

Project No.: 69500/0933037 Change Order No. 19

Project Name: JNU-Glacier Highway Multi-Use Path to UAS

Contractor:	Secon, Inc.	Change Order Summary:	
Address:	P.O. Box 32159	Calendar Days (+/-):	N/A
	Juneau, AK 99803	New Completion Date:	N/A
		Amount of Change Order:	+\$22,453.84

Recommended By: [Signature] Date: 8/4/2017

Title: Project Engineer

Approved By: [Signature] Date: 4 Aug 2017

Title: Project Manager

This change order constitutes agreement to terms, conditions and prices stated below.

Accepted By: [Signature] Date: 8/14/2017
Contractor's Representative

Seal of Alaskan Professional Engineer
(if required)

N/A

Acknowledgement indicates only receipt of Change Order and not mutual agreement for basis of payment or time allowance. If a the matter cannot be resolved within 7 days from signature date, an Intent to Claim form must be submitted to the engineer within 14 days.

Acknowledged By: _____ Date: _____
Contractor's Representative

Permission for previously submitted subcontractor(s) to perform all or portions of the work described herein is as checked: Yes No N/A

The following change(s) in the above Contract are hereby made in accordance with the terms of the Contract and under the terms and conditions stated below. Price adjustments resulting from inaccurate cost and pricing data are subject to the provisions of AS 36.30.400(c). This document shall become an amendment to the Contract and all provisions of the Contract will be applicable.

DESCRIPTION OF CHANGE (Use Continuation Sheet 25D-065 as Required)

In accordance with Subsection 104-1.02 of the Standard Specifications, the following changes are hereby made:


Establish New Item 202(15)a Removal of Existing Septic Tank

Description: Remove and dispose of the existing decommissioned septic tank at Station 16+75 RT to lay the slope back to the planned slope.

Materials: Conform to Section 202 and as approved by the Engineer.

Construction Requirements: Conform to Section 202 and as directed by the Engineer.

Method of Measurement: This item is lump Sum and in accordance with Subsection 109-1.01 is not measured for payment.

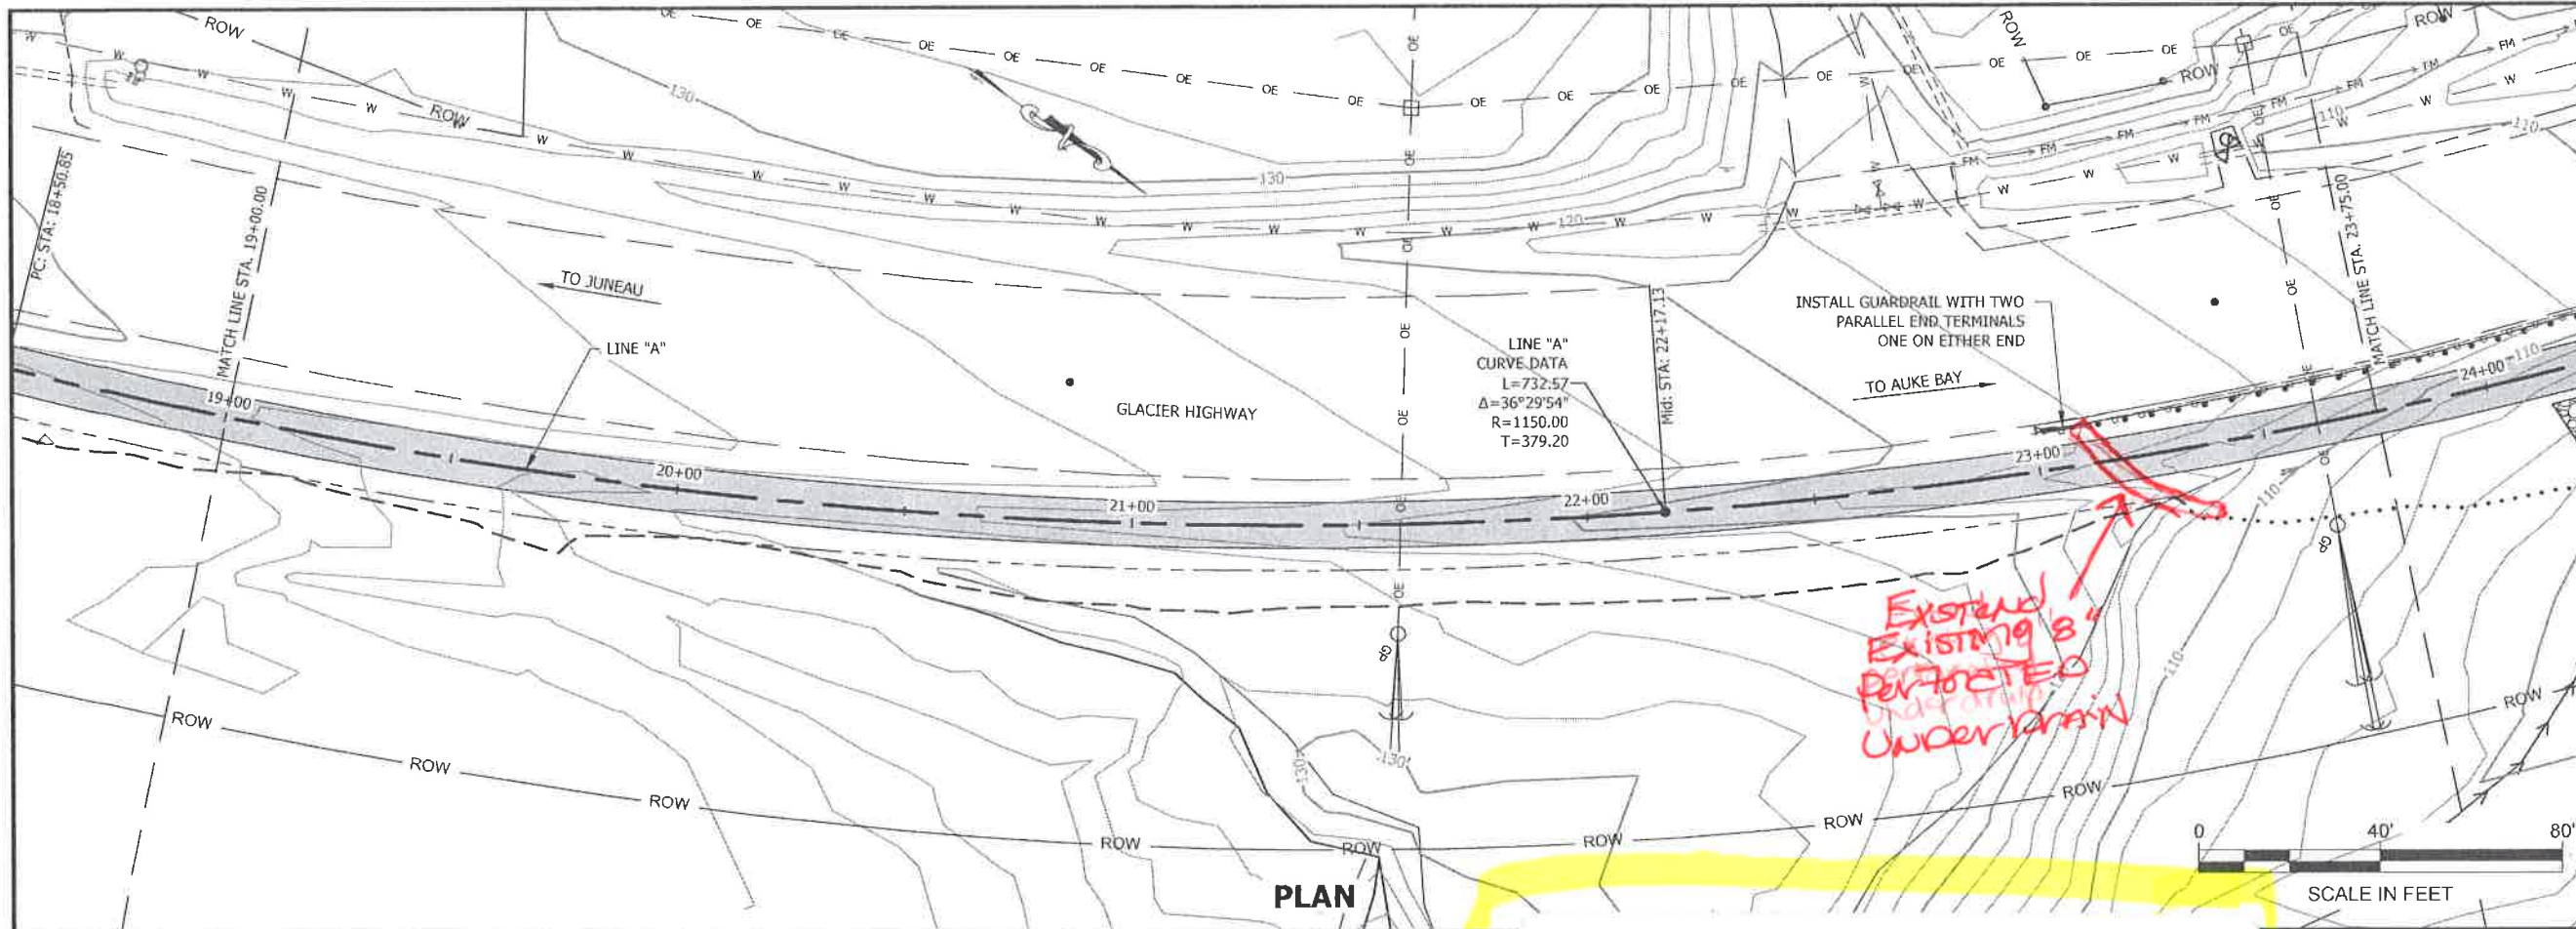

PATH: Q:\JNU\69500\PLANSET\69500_F1-F9_P-P.DWG

GRANTHAM, RICK L (DOT)


TAB: F5 Monday, July 20, 2015 12:34:24 PM

ADDENDUM NUMBER



ATTACHMENT NUMBER

RECORD OF REVISIONS

No.	DATE	DESCRIPTION

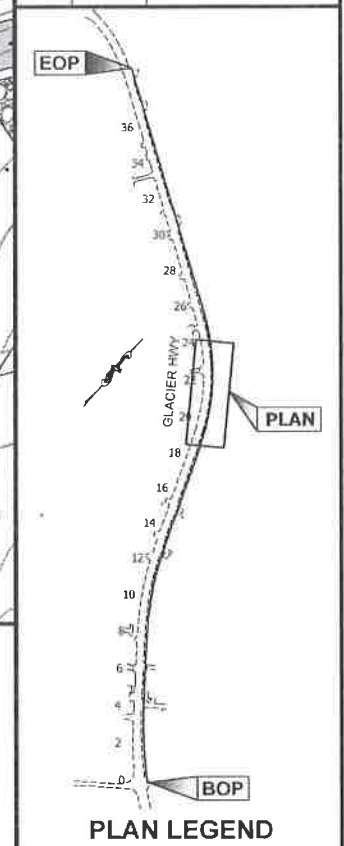

Project As-Built Drawings have been reviewed by the Project Engineer, and represent to the best of my knowledge, the project as constructed.
 PE *J. Brown* Date *2/19/2019*
 SEE OPPOSITE SIDE FOR CHANGE ORDER # 15.

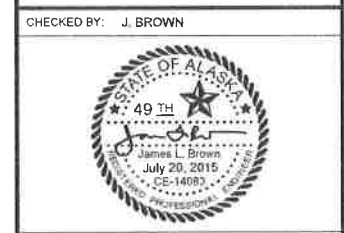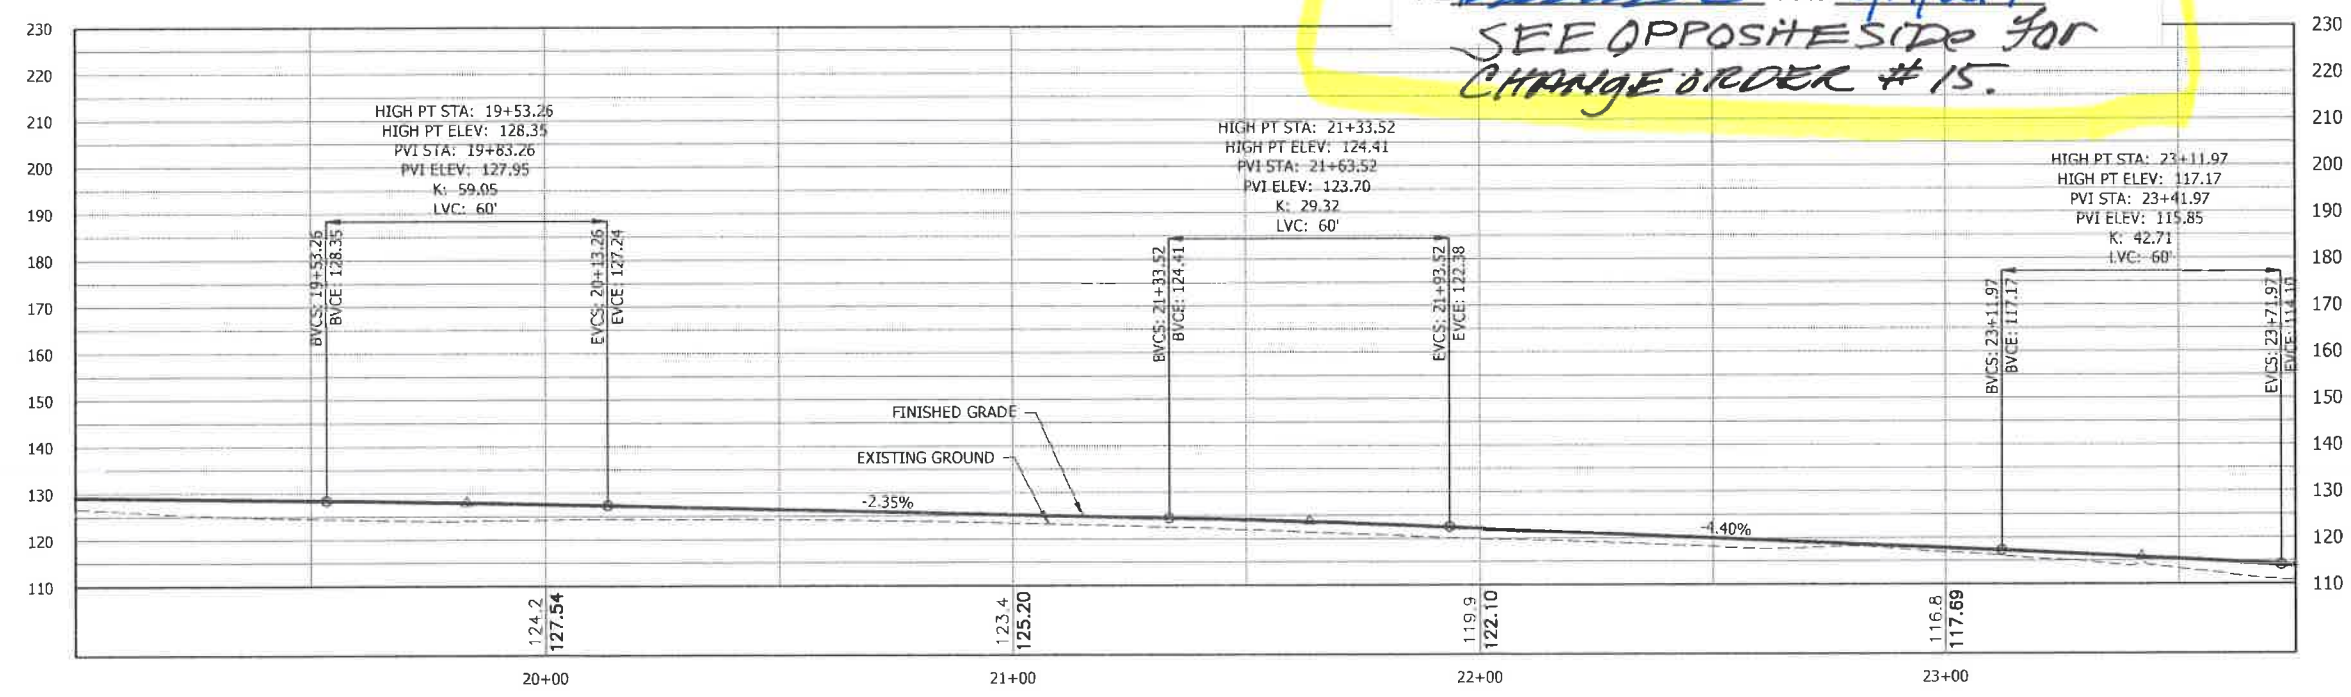

DESIGNED BY: J. BROWN

DRAWN BY: R. GRANTHAM

STATE OF ALASKA
 DEPARTMENT OF TRANSPORTATION & PUBLIC FACILITIES
 SOUTHCOST REGION

JNU: GLACIER HWY MULTI-USE SEPARATED PATH TO UAS
 PROJECT NO. 69500

PLAN & PROFILE

PROJECT DESIGNATION

0933037 ~ 69500

STATE	YEAR
ALASKA	2015

SHEET NUMBER	TOTAL SHEETS
F5	54

DO NOT SCALE FROM THESE DRAWINGS USE DIMENSIONS



STATE OF ALASKA
DEPARTMENT OF TRANSPORTATION
AND PUBLIC FACILITIES
SOUTHCOST REGION

Change Order

Project No.: 69500/0933037

Change Order No. 15

Project Name: JNU-Glacier Highway Multi-Use Path to UAS

Contractor:	Secon, Inc.	Change Order Summary:	
Address:	P.O. Box 32159 Juneau, AK 99803	Calendar Days (+ / -):	N/A
		New Completion Date:	N/A
		Amount of Change Order:	+\$4,030.55

Recommended By: [Signature] Date: 27 Dec 2016

Approved By: [Signature] Title: Project Engineer Date: 30 Dec 2016

[Signature] Title: Project Manager

This change order constitutes agreement to terms, conditions and prices stated below.

Accepted By: [Signature] Date: 1/4/2017 Seal of Alaskan Professional Engineer (if required) N/A

Acknowledgement indicates only receipt of Change Order and not mutual agreement for basis of payment or time allowance. If a the matter cannot be resolved within 7 days from signature date, an Intent to Claim form must be submitted to the engineer within 14 days.

Acknowledged By: _____ Date: _____ Contractor's Representative

Permission for previously submitted subcontractor(s) to perform all or portions of the work described herein is as checked: Yes No N/A

The following change(s) in the above Contract are hereby made in accordance with the terms of the Contract and under the terms and conditions stated below. Price adjustments resulting from inaccurate cost and pricing data are subject to the provisions of AS 36.30.400(c). This document shall become an amendment to the Contract and all provisions of the Contract will be applicable.

DESCRIPTION OF CHANGE (Use Continuation Sheet 25D-065 as Required)

Reason for Change Order The following is a brief description of the rationale for this change order:

- Existing utilities were encountered from Station 16+75 to 17+45. This change order is required to excavate around the existing utilities from Station 16+75 to 17+45 to the grades shown on the plans.
- A buried electrical ground line was uncovered during excavation of the existing Wayside Parking Lot and additional resources were required to work around the buried electrical line during excavation efforts.
- The boundary boulders from Station 2+20 to 2+80 and from Station 5+50 to 6+10 were replaced with material to allow drainage to the valley gutter and shaping around the utility pole and load center. This work provides for a backfilled slope at these locations instead of the boundary boulders.
- During excavation two existing underdrains were uncovered within the fill area of the path. The existing underdrains were extended to provide drainage underneath the new multi-use pathway into the new ditch line.

In accordance with Subsection 104-1.02 of the Standard Specifications, the following changes are hereby made:

Change Order

Change Order No. 11

PATH: Q:\JNU169500\PLANSET\69500_F1-F9_P-P.DWG
 CHAMBERS, LUCAS M (DOT)
 TAB: F6 Friday, August 14, 2015 2:57:32 PM
 ADDENDUM NUMBER
 ATTACHMENT NUMBER

DESCRIPTION OF CHANGE (Use Continuation Sheet 25D-065 as Required)

In accordance with Subsection 104-1.02 of the Standard Specifications, the following changes are hereby made:

Reason for Change:

The inlet in the Auke Lake Parking Lot was much lower than the rest of the grade. The drainage system was installed per plan, but the inlet elevation for S-3 required adjustment to avoid a hazardous drop off. This change order adjusts the inlet to provide proper drainage while eliminating a potential hazard.

Establish New Item 604(8)b Adjust Inlet

Description: Provide resources to adjust Inlet S-3 from Elevation 79.5 to Elevation 81.0.

Reason for Change:

The MSE Wall was changed in design significantly from the initial design. This change order accounts for the additional survey for the new MSE Wall.

Delete Item 642(1)a Construction Surveying

Establish New Item 642(1)a Construction Surveying

PLAN

Pay item Description

620(1A)a Topsoil


Pay Unit

Square Yard

REASON: "ARMOR WAS NOT INCLUDED IN PLANS"


Project As-Built Drawings have been reviewed by the Project Engineer, and represent to the best of my knowledge, the project as constructed.

PE R. GRANTHAM Date 2/19/2019

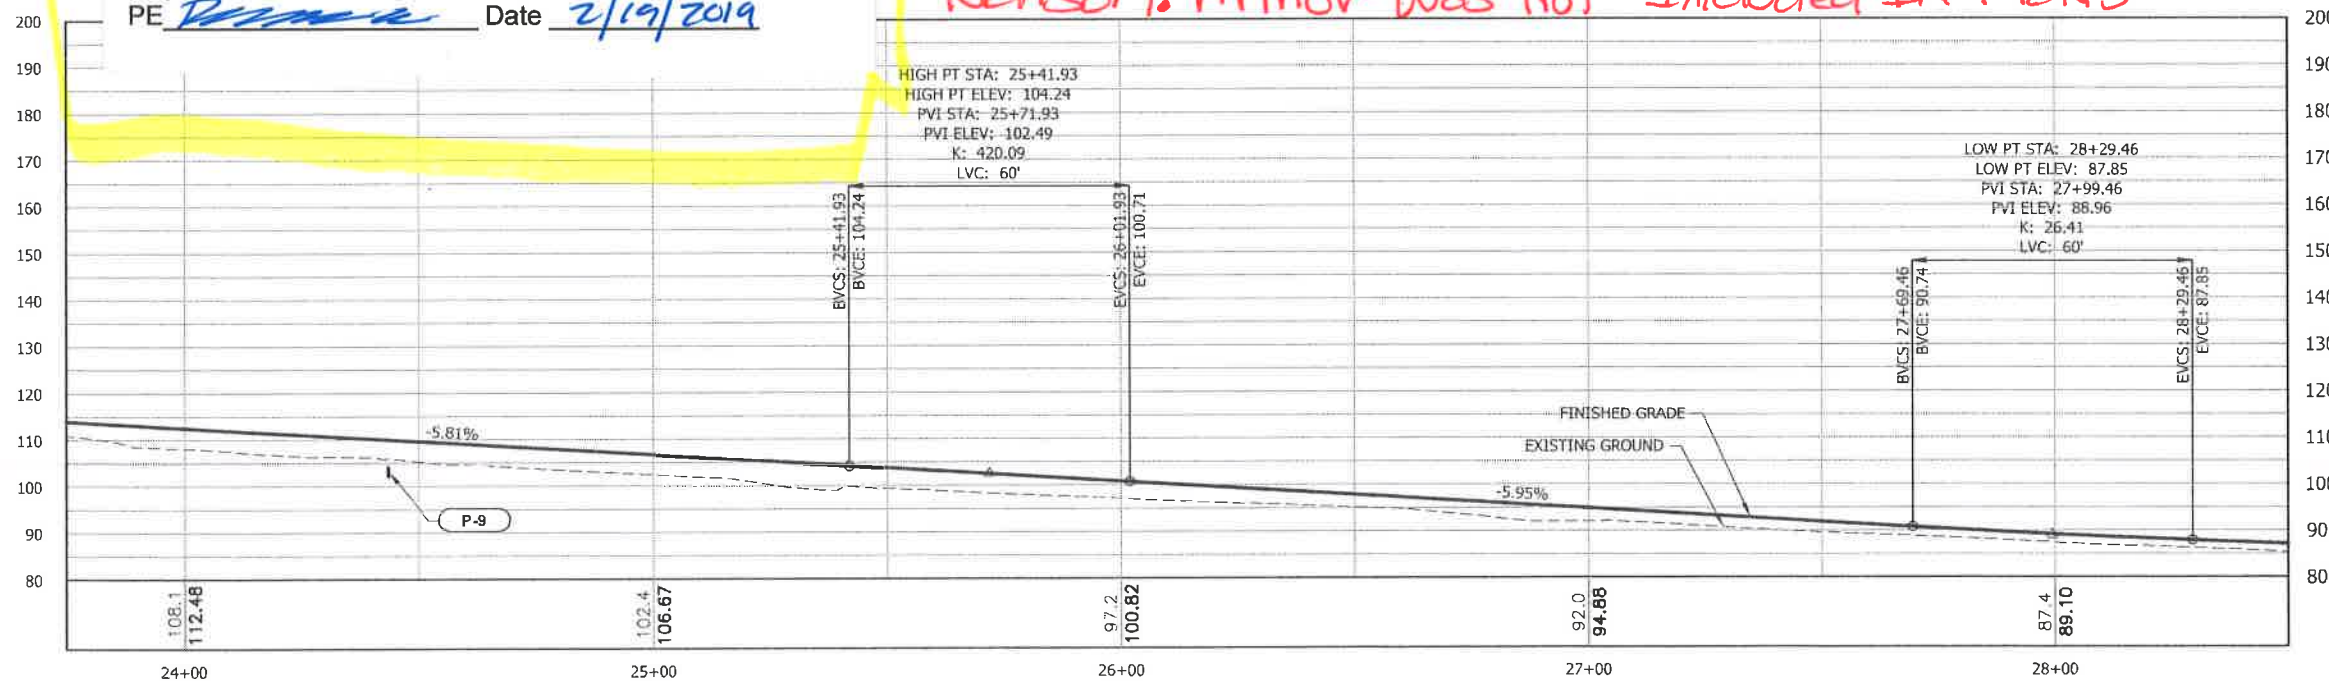


LINE "A" PROFILE

DO NOT SCALE FROM THESE DRAWINGS USE DIMENSIONS

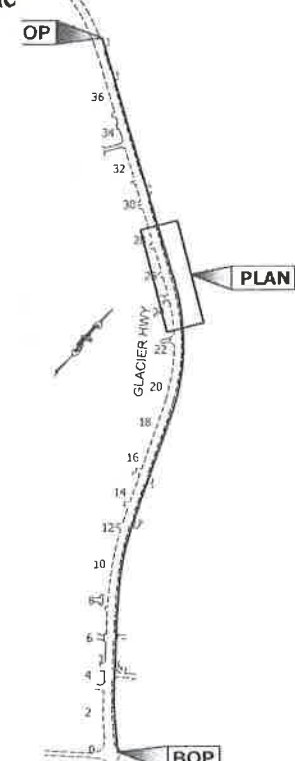

PLAN LEGEND

CHECKED BY: J. BROWN

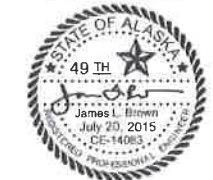

DESIGNED BY: J. BROWN

DRAWN BY: R. GRANTHAM

STATE OF ALASKA
 DEPARTMENT OF TRANSPORTATION
 & PUBLIC FACILITIES
 SOUTHCOAST REGION

JNU: GLACIER HWY MULTI-USE
 SEPARATED PATH TO UAS
 PROJECT NO. 69500

PLAN & PROFILE

PROJECT DESIGNATION
 0933037 ~ 69500

STATE	YEAR
ALASKA	2015

SHEET NUMBER	TOTAL SHEETS
F6	54

See REVERSE for CO #12.



NOTE: # 12 Co. WAS MISS LABELED AS # 11.
ON THE "Q" DRIVE.

STATE OF ALASKA
DEPARTMENT OF TRANSPORTATION
AND PUBLIC FACILITIES
SOUTHCOAST REGION

#12.
Change Order

Project No.: 69500/0933037
Project Name: JNU-Glacier Highway Multi-Use Path to UAS
Change Order No. 11

Contractor:	Secor, Inc.	Change Order Summary:	
Address:	P.O. Box 32159	Calendar Days (+ / -):	N/A
	Juneau, AK 99803	New Completion Date:	July 15, 2016
		Amount of Change Order:	+\$0.00

Recommended By: T. J. [Signature] Date: 6/30/16
Title: Construction Group Chief
Approved By: Vita Wain Date: 6/30/16
Title: Regional Construction Engineer

This change order constitutes agreement to terms, conditions and prices stated below.

Accepted By: _____ Date: _____
Contractor's Representative

Acknowledged By: _____ Date: _____
Contractor's Representative

Permission for previously submitted subcontractor(s) to perform all or portions of the work described herein is as checked: Yes No N/A

Seal of Alaskan Professional Engineer (if required)
N/A

Acknowledgement indicates only receipt of Change Order and not mutual agreement for basis of payment or time allowance. If a matter cannot be resolved within 7 days from signature date, an Intent to Claim form must be submitted to the engineer within 14 days.

The following change(s) in the above Contract are hereby made in accordance with the terms of the Contract and under the terms and conditions stated below. Price adjustments resulting from inaccurate cost and pricing data are subject to the provisions of AS 36.30.400(c). This document shall become an amendment to the Contract and all provisions of the Contract will be applicable.

DESCRIPTION OF CHANGE (Use Continuation Sheet 25D-065 as Required)

In accordance with Subsection 104-1.02 of the Standard Specifications, the following changes are hereby made:


Reason for Change Order
During the Final Inspection new items of work were proposed. This change order provides time for Department and Contractor negotiations on the new work.

Construction Contract (Form 25D-7). Change the Completion Date from June 30, 2016 to July 15, 2016.

The Contract Amount is not affected by this Change Order.

The Contract Completion Date is extended to **July 15, 2016**.

PLEASE INDICATE YOUR ACCEPTANCE OR ACKNOWLEDGEMENT BY SIGNING AND DATING THE APPROPRIATE SIGNATURE LINE, AND THEN RETURN THE ORIGINAL DOCUMENT TO THIS OFFICE.

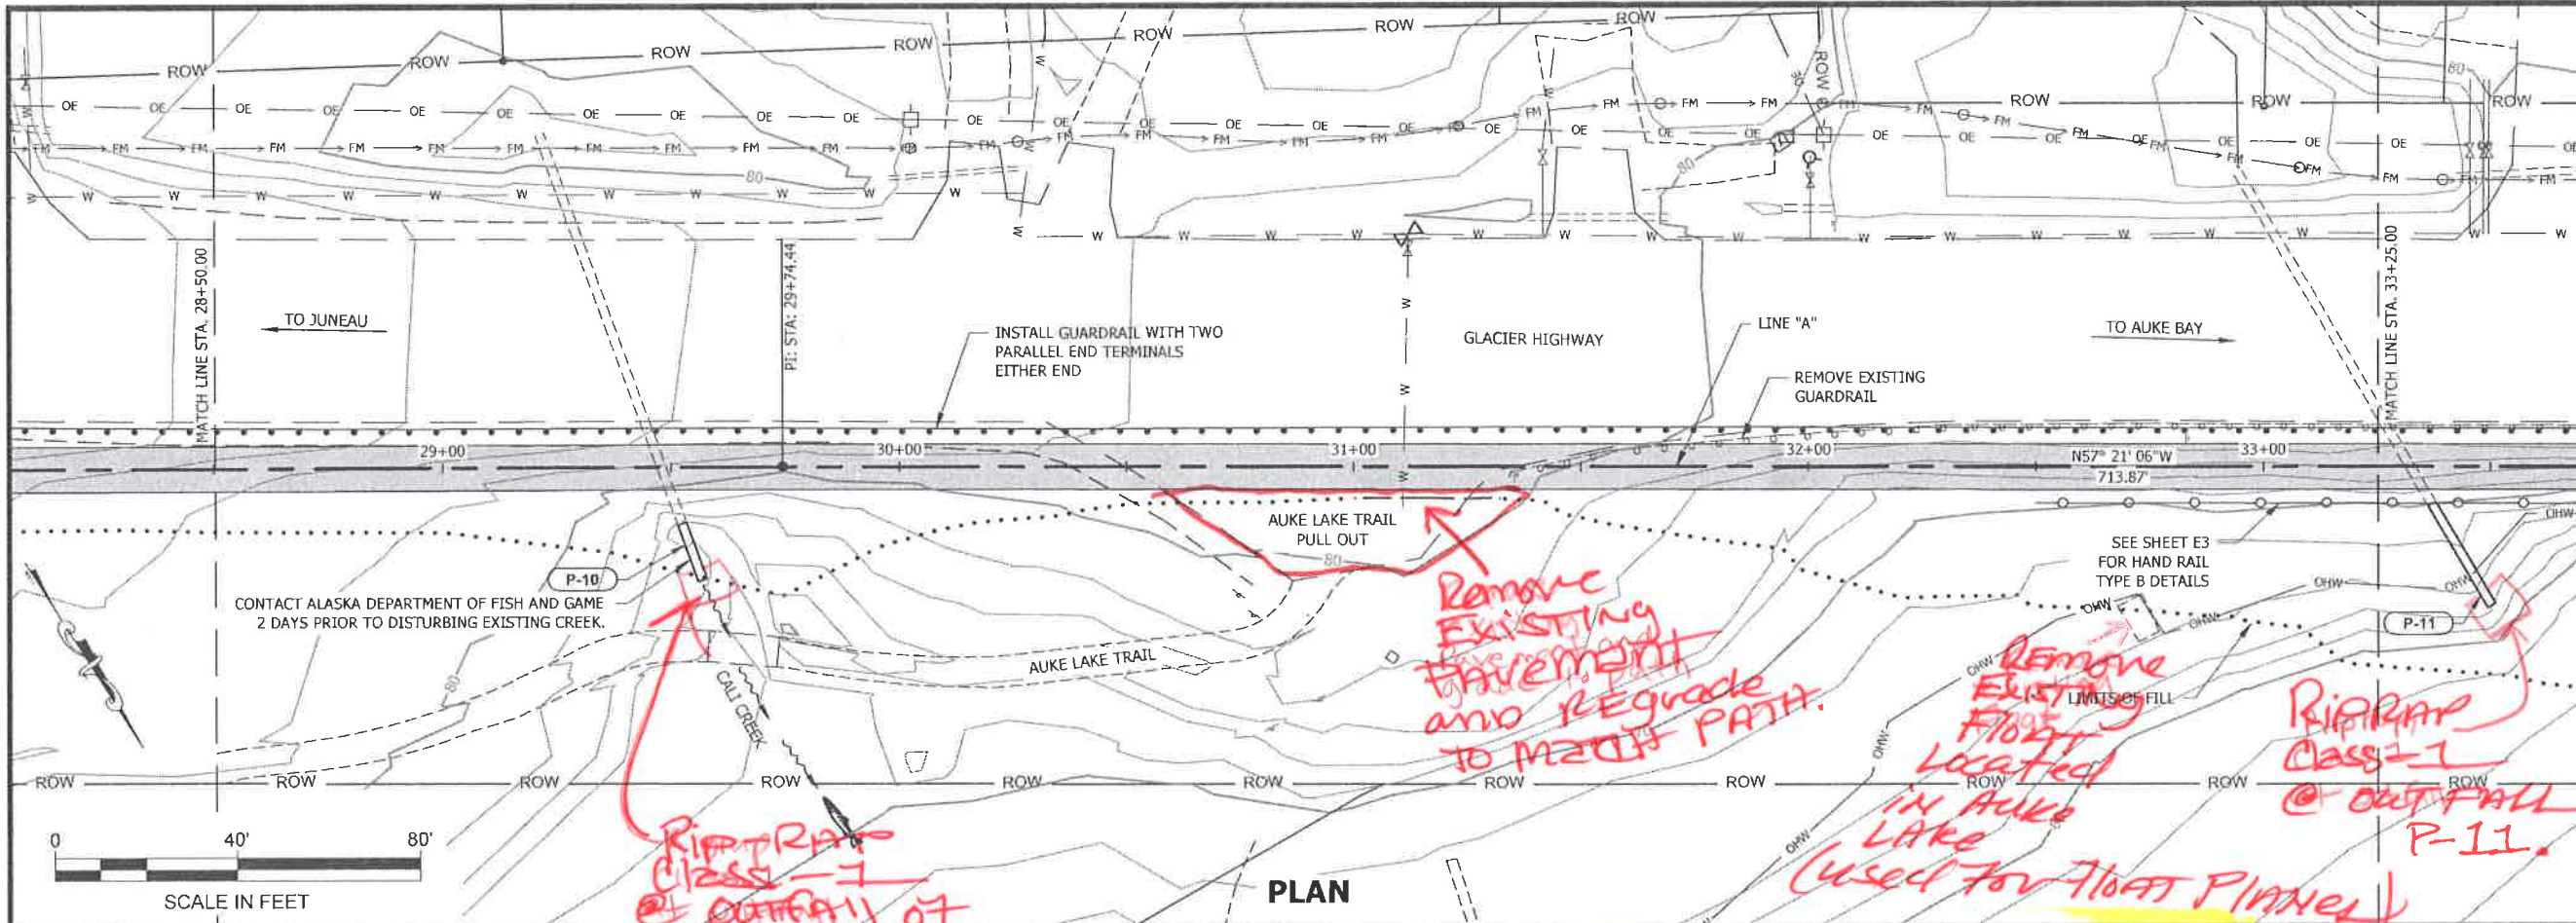

PATH:
Q:\JNU\69500\PLANSET\69500_F1-F9_P-P.DWG


GRANTHAM, RICK L (DOT)
TAB F7 Monday, July 20, 2015 12:34:52 PM

ADDENDUM NUMBER


ATTACHMENT NUMBER

RECORD OF REVISIONS

No.	DATE	DESCRIPTION

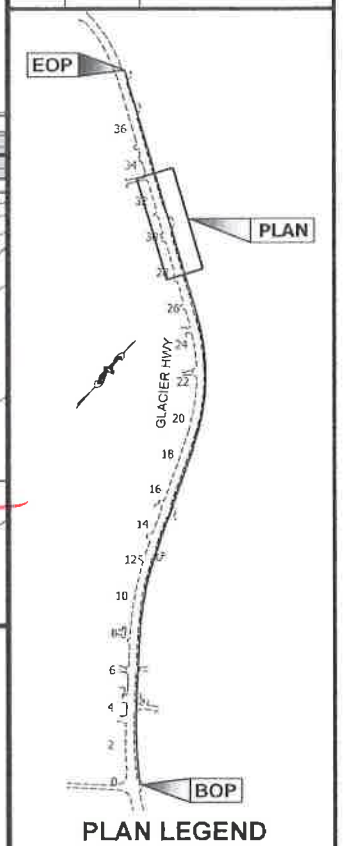

Project As-Built Drawings have been reviewed by the Project Engineer, and represent to the best of my knowledge, the project as constructed.
PE *[Signature]* Date 2/19/2019

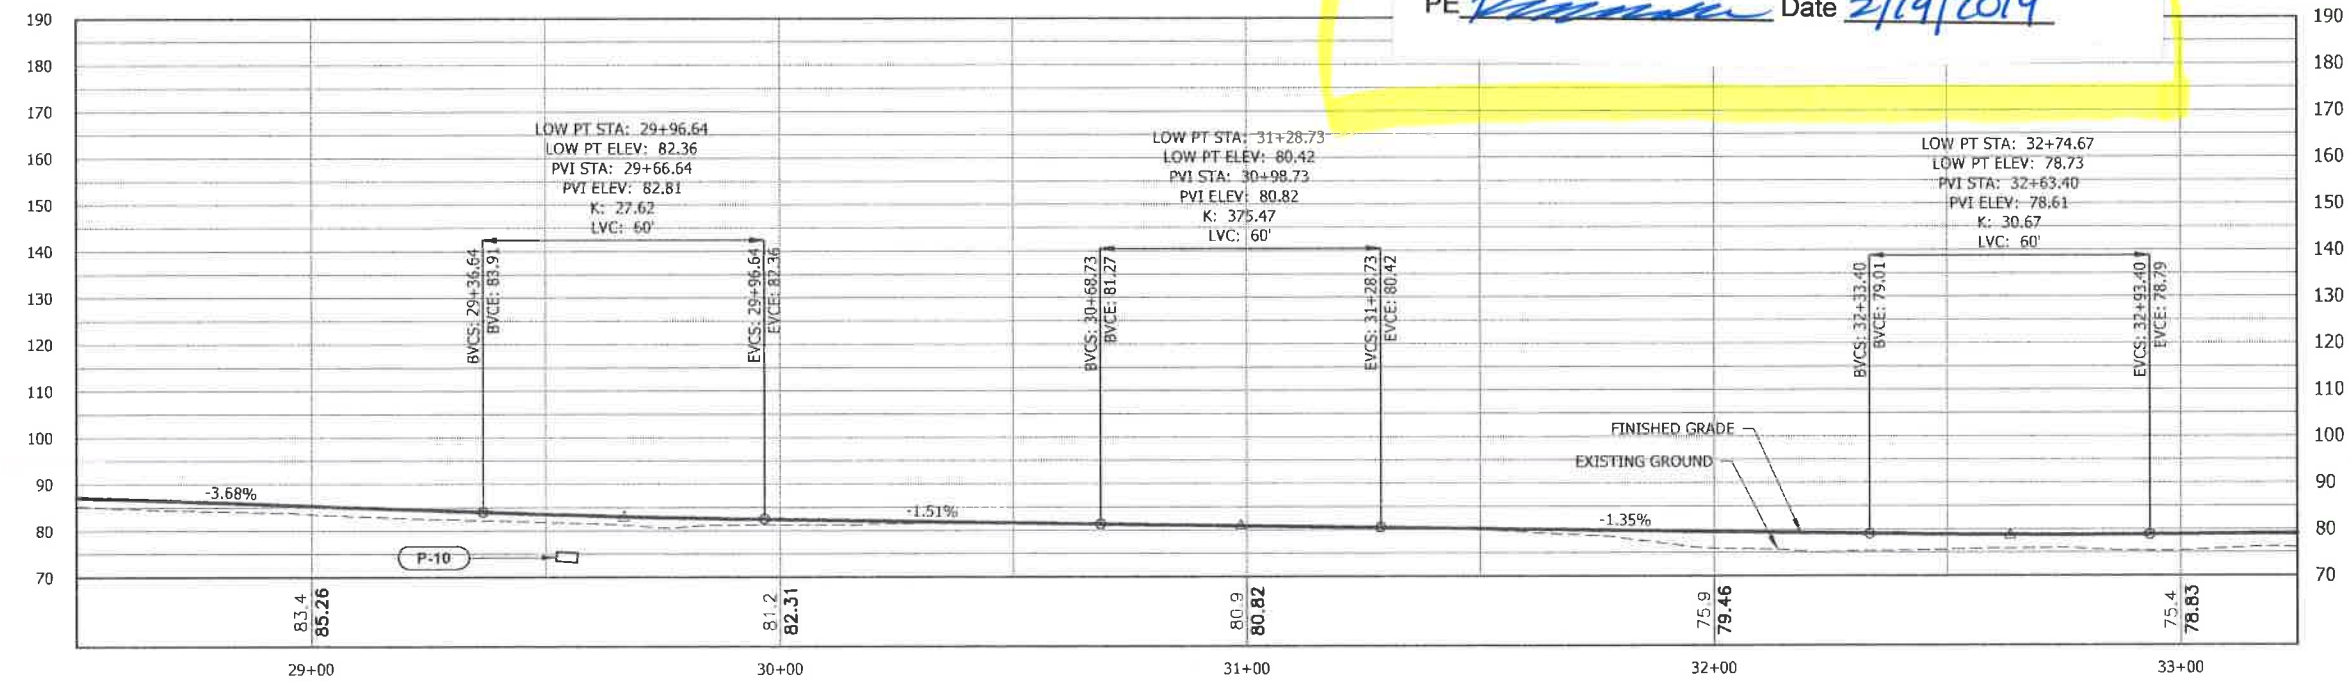

LINE "A" PROFILE

DO NOT SCALE FROM THESE DRAWINGS USE DIMENSIONS

CHECKED BY: J. BROWN

DESIGNED BY: J. BROWN

DRAWN BY: R. GRANTHAM

STATE OF ALASKA
DEPARTMENT OF TRANSPORTATION & PUBLIC FACILITIES
SOUTHCOST REGION


JNU: GLACIER HWY MULTI-USE SEPARATED PATH TO UAS
PROJECT NO. 69500

PLAN & PROFILE

PROJECT DESIGNATION
0933037 ~ 69500

STATE	YEAR
ALASKA	2015

SHEET NUMBER	TOTAL SHEETS
F7	54

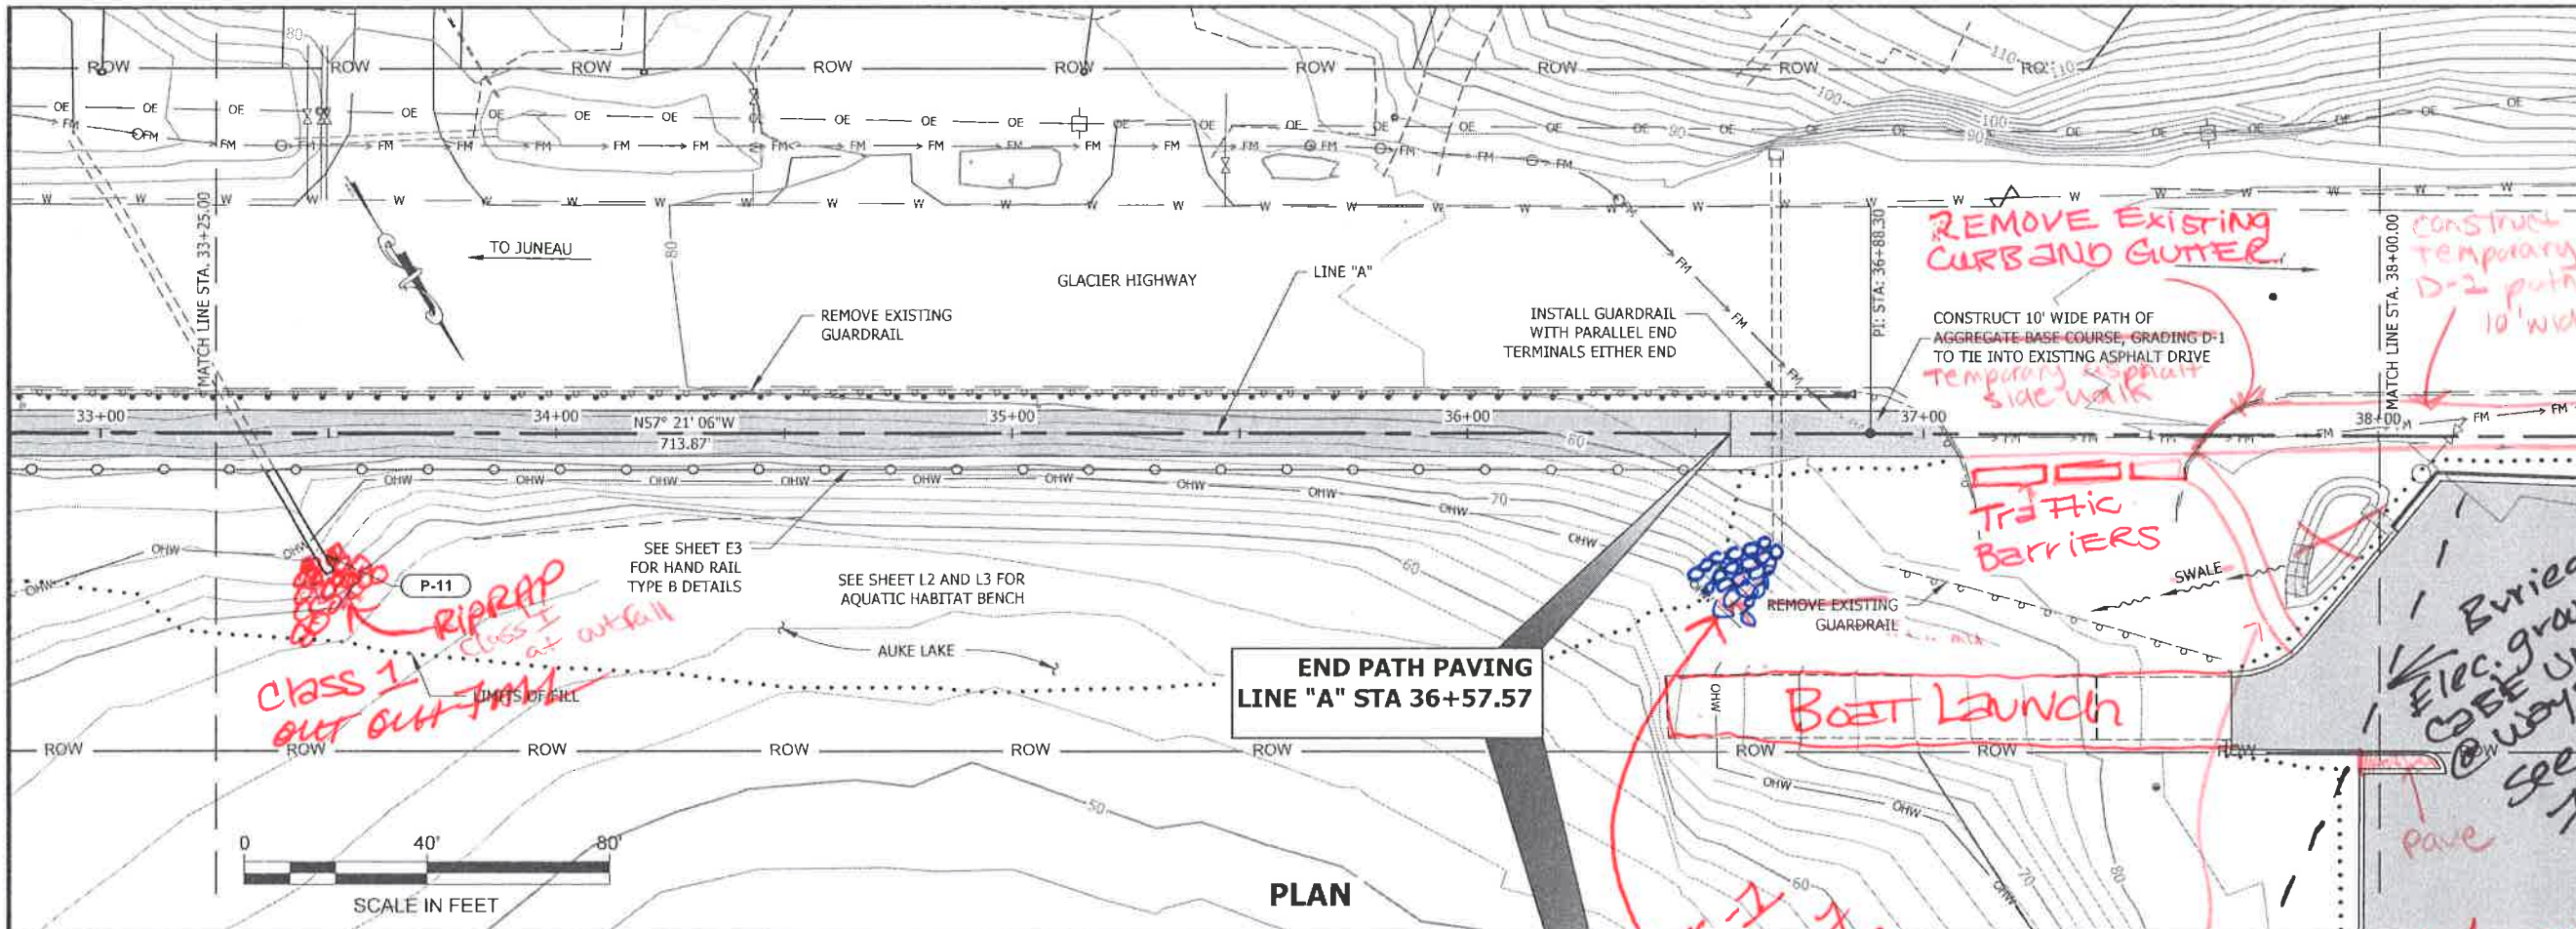

**END PATH PAVING
LINE "A" STA 36+57.57**


*CLASS 1 RIPRAP
OUT AT FALL*

*CLASS 1
R.R. @
out span of
cross pipe
to
Auks Lake*

*Foot PATH added
to way-side parking
area by C.B.J.*

*construct
Temporary
D-2 path
10' wide*

*Buried
Elec. ground
cable uncovered
@ way-side parking
see REVERSE SIDE
FOR CHANGE ORDER
15*

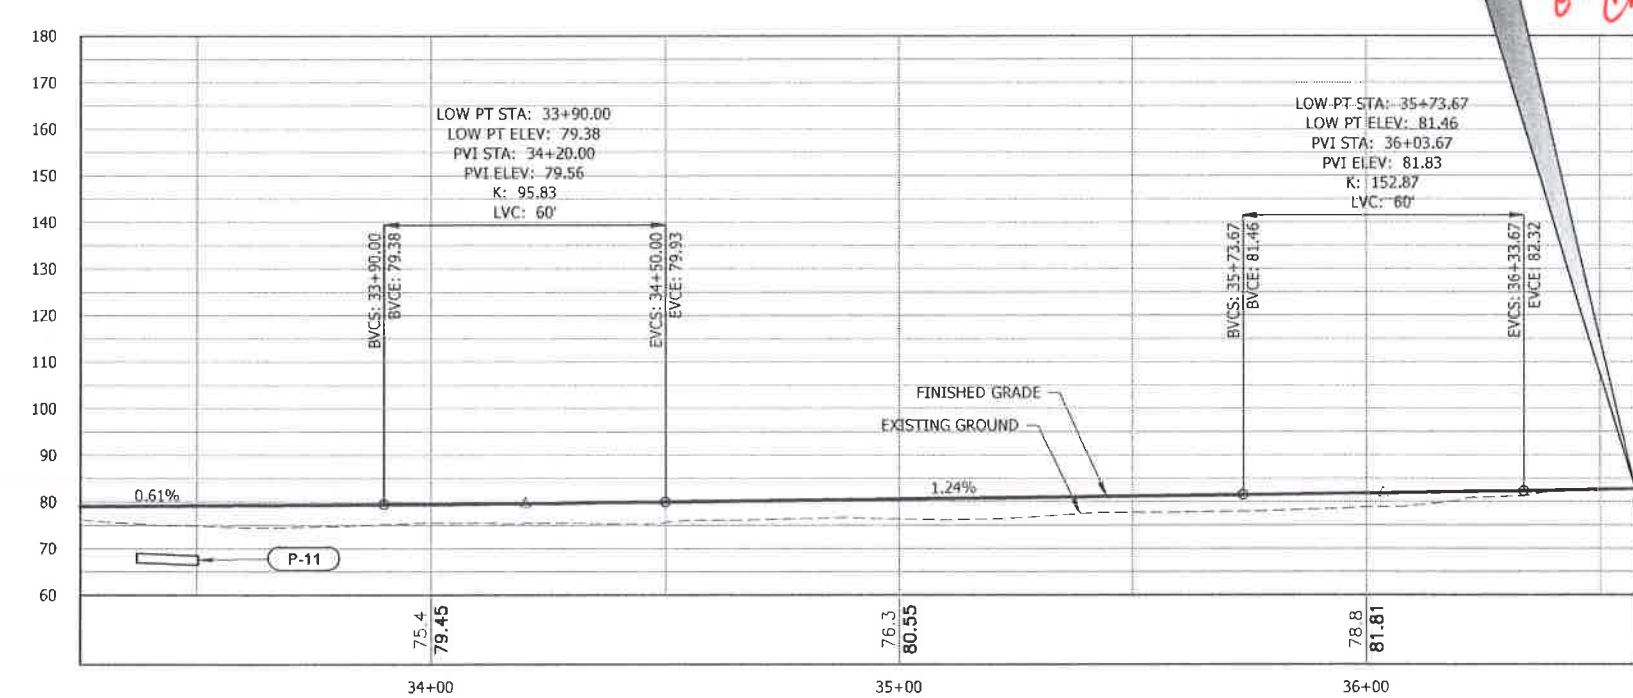

LINE "A" PROFILE

Project As-Built Drawings have been reviewed by the Project Engineer, and represent to the best of my knowledge, the project as constructed.
PE *[Signature]* Date *2/19/2019*

PATH
Q:\JNU\69500\PLANSET\69500_F1-F9_P.P.DWG

GRANTHAM, RICK L (DOT)
TAB: F8 Monday, July 20, 2015 12:35:05 PM

ADDENDUM NUMBER

ATTACHMENT NUMBER

RECORD OF REVISIONS

No.	DATE	DESCRIPTION

EOP

PLAN

BOP

PLAN LEGEND

CHECKED BY: J. BROWN

DESIGNED BY: J. BROWN

DRAWN BY: R. GRANTHAM

STATE OF ALASKA
DEPARTMENT OF TRANSPORTATION
& PUBLIC FACILITIES
SOUTHCOST REGION

JNU: GLACIER HWY MULTI-USE
SEPARATED PATH TO UAS
PROJECT NO. 69500

PLAN & PROFILE

PROJECT DESIGNATION
0933037 ~ 69500

STATE	YEAR
ALASKA	2015

SHEET NUMBER	TOTAL SHEETS
F8	54

DO NOT SCALE FROM THESE DRAWINGS USE DIMENSIONS

No. 09330337
 JNU-Glacier Highway Multi-Use Path to UAS
 Project Name
 69500/09330337
 Project No.



STATE OF ALASKA
DEPARTMENT OF TRANSPORTATION
AND PUBLIC FACILITIES
SOUTHCOAST REGION

Change Order

Project No.: 69500/09330337 Change Order No. 15
 Project Name: JNU-Glacier Highway Multi-Use Path to UAS

Contractor:	Seccon, Inc.	Change Order Summary:
Address:	P.O. Box 32159 Juneau, AK 99803	Calendar Days (+ / -): <u>N/A</u>
		New Completion Date: <u>N/A</u>
		Amount of Change Order: <u>+\$4,030.55</u>

Recommended By: [Signature] Date: 27 Dec 2016
 Title: Project Engineer
 Approved By: [Signature] Date: 30 Dec 2016
 Title: Project Manager

This change order constitutes agreement to terms, conditions and prices stated below.

Accepted By: [Signature] Date: 1/4/2017
 Contractor's Representative

Acknowledged By: _____ Date: _____
 Contractor's Representative

Permission for previously submitted subcontractor(s) to perform all or portions of the work described herein is as checked: Yes No N/A


Seal of Alaskan Professional Engineer (if required) N/A

The following change(s) in the above Contract are hereby made in accordance with the terms of the Contract and under the terms and conditions stated below. Price adjustments resulting from inaccurate cost and pricing data are subject to the provisions of AS 36.30.400(c). This document shall become an amendment to the Contract and all provisions of the Contract will be applicable.

DESCRIPTION OF CHANGE (Use Continuation Sheet 25D-065 as Required)

- Reason for Change Order** The following is a brief description of the rationale for this change order:
- 1) Existing utilities were encountered from Station 16+75 to 17+45. This change order is required to excavate around the existing utilities from Station 16+75 to 17+45 to the grades shown on the plans.
 - 2) A buried electrical ground line was uncovered during excavation of the existing Wayside Parking Lot and additional resources were required to work around the buried electrical line during excavation efforts.
 - 3) The boundary boulders from Station 2+20 to 2+80 and from Station 5+50 to 6+10 were replaced with material to allow drainage to the valley gutter and shaping around the utility pole and load center. This work provides for a backfilled slope at these locations instead of the boundary boulders.
 - 4) During excavation two existing underdrains were uncovered within the fill area of the path. The existing underdrains were extended to provide drainage underneath the new multi-use pathway into the new ditch line.

In accordance with Subsection 104-1.02 of the Standard Specifications, the following changes are hereby made:

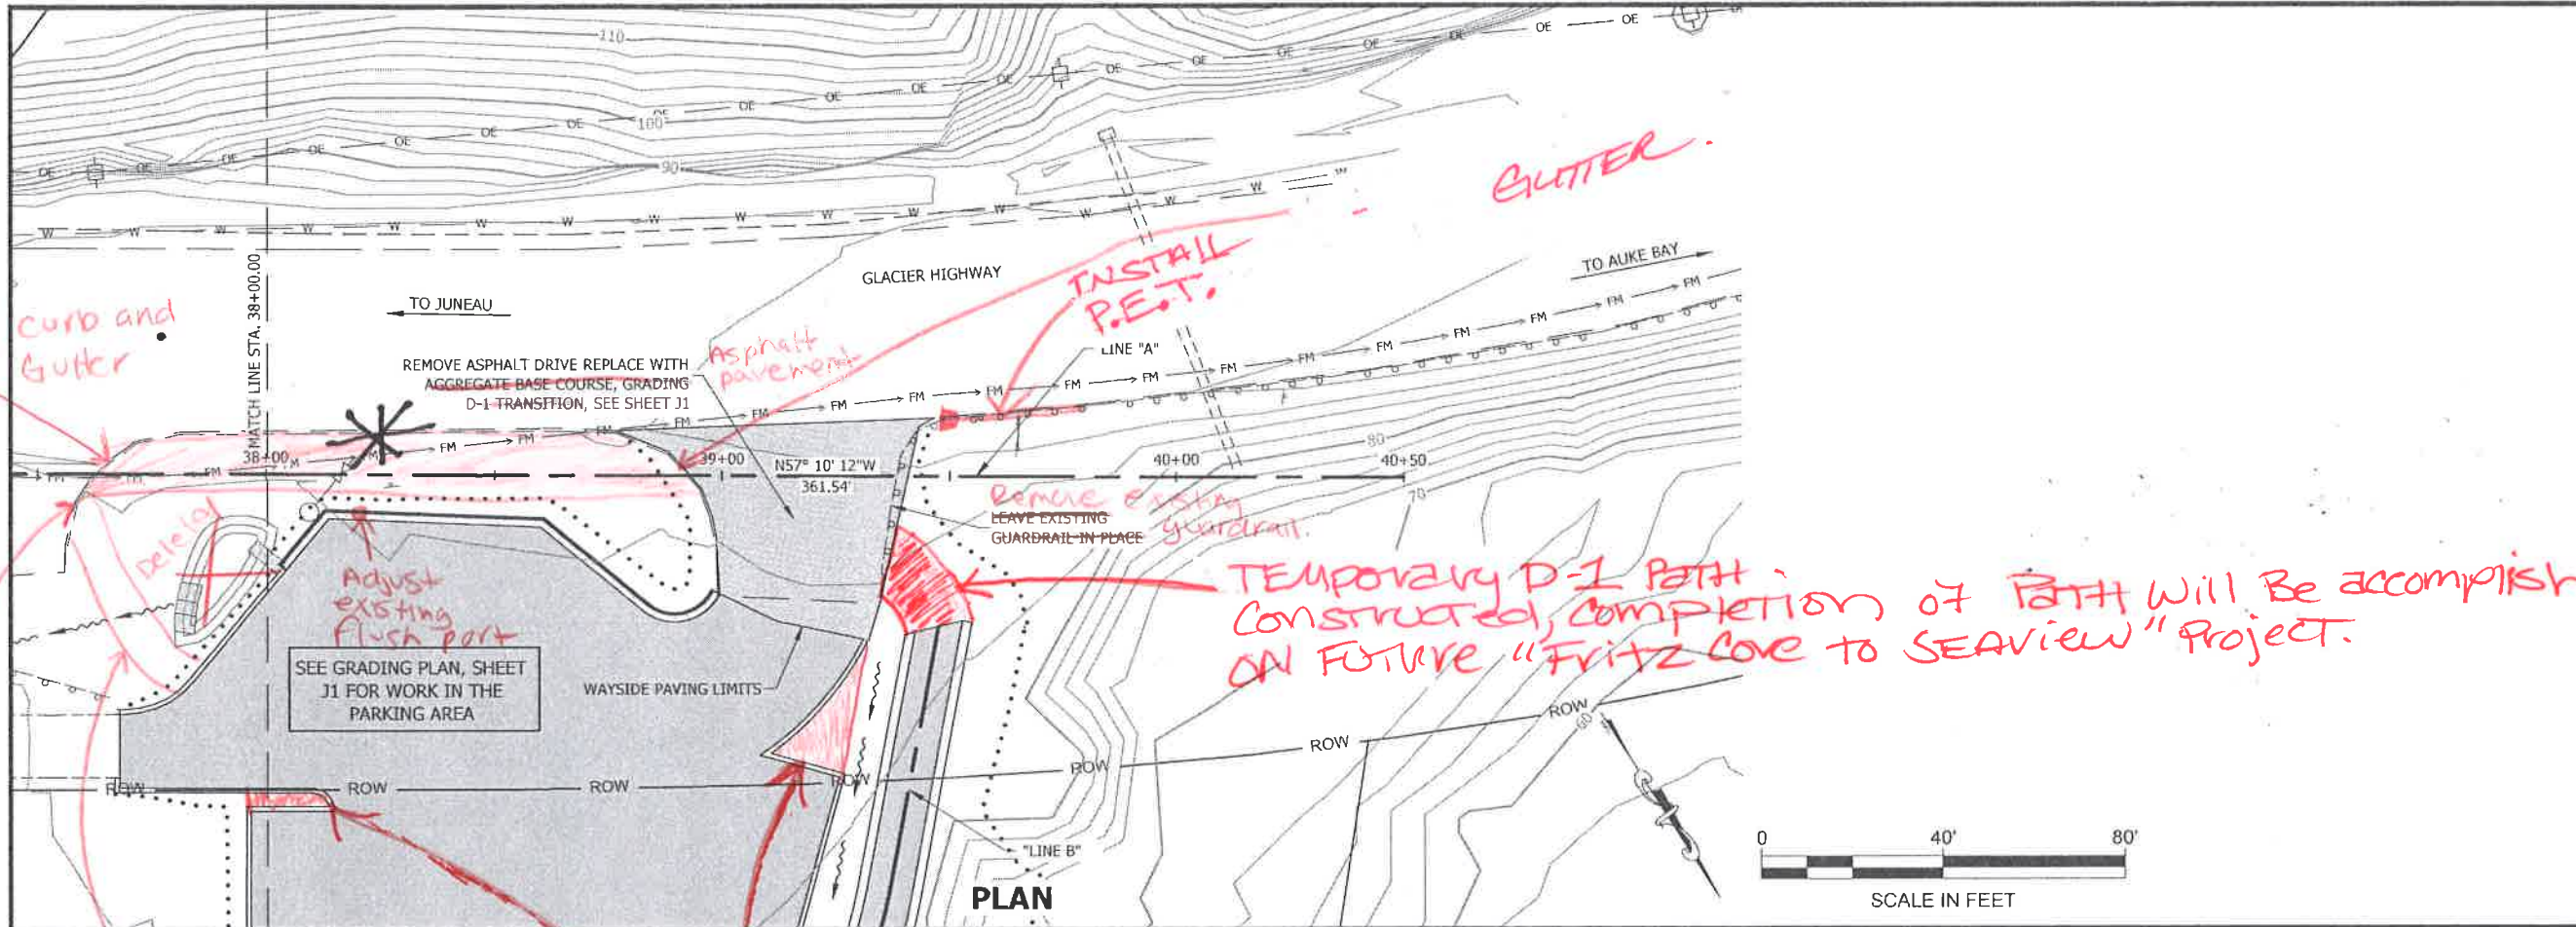

Remove Existing curb and Gutter

GUTTER

INSTALL P.E.T.

REMOVE ASPHALT DRIVE REPLACE WITH AGGREGATE BASE COURSE, GRADING D-1 TRANSITION, SEE SHEET J1

Asphalt pavement

REMOVE existing GUARDRAIL IN PLACE

TEMPORARY D-1 PATH. CONSTRUCTED, COMPLETION OF PATH WILL BE ACCOMPLISHED ON FUTURE "FRITZ COVE TO SEAVIEW" PROJECT.

SEE GRADING PLAN, SHEET J1 FOR WORK IN THE PARKING AREA

WAYSIDE PAVING LIMITS

PLAN



Foot path added by CBJ.
Add temporary D-1 10" wide path for foot traffic.

THESE LANDS WERE DELETED FROM PLAN AND PAVED OVER INSTEAD.

See REVERSE for Co. #13 REGARDING Pedestrian Path on THIS plan SHEET. SEE * ABOVE.

Project As-Built Drawings have been reviewed by the Project Engineer, and represent to the best of my knowledge, the project as constructed.
PE D. Brown Date 2/19/2019

DO NOT SCALE FROM THESE DRAWINGS USE DIMENSIONS

PATH
Q:\JUNU69500\PLANSET\69500_F1-F9_P-P.DWG


GRANTHAM, RICK L (DOT)
TAB F9 Monday, July 20, 2015 12:35:17 PM

ADDENDUM NUMBER

ATTACHMENT NUMBER

RECORD OF REVISIONS

No.	DATE	DESCRIPTION

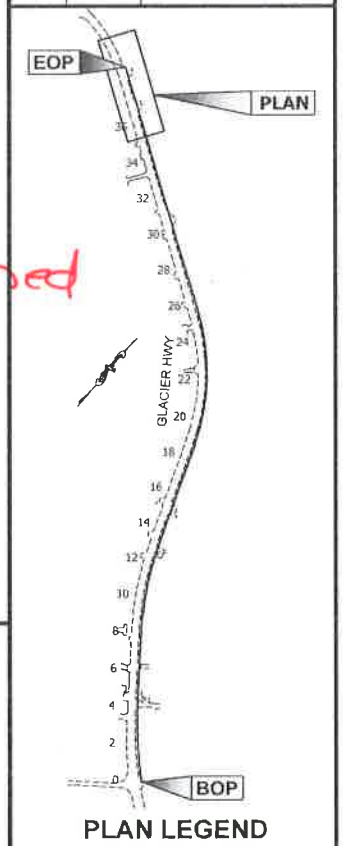

CHECKED BY: J. BROWN

DESIGNED BY: J. BROWN
DRAWN BY: R. GRANTHAM

STATE OF ALASKA
DEPARTMENT OF TRANSPORTATION & PUBLIC FACILITIES
SOUTHCOST REGION

JNU: GLACIER HWY MULTI-USE SEPARATED PATH TO UAS
PROJECT NO. 69500

PLAN & PROFILE

PROJECT DESIGNATION
0933037 ~ 69500

STATE	YEAR
ALASKA	2015
SHEET NUMBER	TOTAL SHEETS
F9	54



STATE OF ALASKA
DEPARTMENT OF TRANSPORTATION
AND PUBLIC FACILITIES
SOUTHCOAST REGION

Change Order

Project No.: 69500/0933037 Change Order No. 13

Project Name: JNU-Glacier Highway Multi-Use Path to UAS

Contractor:	Secon, Inc.	Change Order Summary:	
Address:	P.O. Box 32159	Calendar Days (+ / -):	N/A
	Juneau, AK 99803	New Completion Date:	August 12, 2016
		Amount of Change Order:	+\$4,741.50

Recommended By: [Signature] Date: 7-11-16

Title: Construction Group Chief

Approved By: [Signature] Date: 7-11-16

Title: Regional Construction Engineer

This change order constitutes agreement to terms, conditions and prices stated below.

Accepted By: [Signature] Date: 7-12-16
Contractor's Representative

Seal of Alaskan Professional Engineer
(if required)
N/A

Payment will be made under:

Pay item Description	Pay Unit
608(7)a Temporary Asphalt Sidewalk	Square Yard

Payment will be made under:

Pay item Description	Pay Unit
609(7)a Concrete Spillway	Lump Sum

Form 25D-065 (Revised 4/12)

Page 2 of 4

SEE * ITEMS *
LISTED ON THIS DRAWING
REGARDING POSITION

STATE OF ALASKA
DEPARTMENT OF TRANSPORTATION AND PUBLIC FACILITIES
Continuation Sheet

Project No.: 69500/0933037 JNU-Glacier Hwy. Multi-Use
Path to UAS
Change Order No. 13

Summary of Quantities				
ITEM NO.	ITEM	UNIT	PRICE	AMOUNT
608(7)a	Temporary Asphalt Sidewalk	S.Y.	\$40.00	(+ or -) +\$2,200.00
609(7)a	Concrete Spillway	L.S.	\$2,541.50	+1.0 +\$2,541.50
TOTAL THIS CHANGE ORDER				+\$4,741.50

This Change Order increases the Contract Amount by \$4,741.50.

The Contract Completion Date is extended to August 12, 2016.

PLEASE INDICATE YOUR ACCEPTANCE OR ACKNOWLEDGEMENT BY SIGNING AND DATING THE APPROPRIATE SIGNATURE LINE, AND THEN RETURN THE ORIGINAL DOCUMENT TO THIS OFFICE.

No.	DATE	DESCRIPTION

*606 (9/2)
REMOVAL of
Guard Rail*

*Removal of
CURB & GUTTER
2021/9/2*

*NEW END
Terminal
and
P1*

*Remove
existing
guardrail*

*Regrade
existing
curb and
gutter*

*Adjust existing
flush port*

*Deleted
Ditch SWALE*

**BEGIN PATH LINE "B"
MATCH TO PJ# 68471
SIDEWALK
LINE "B" STA 0+36.56 =
LINE "A" STA. 39+48.21, OFF: 29.73' RT**

**END PATH
LINE "B"
STA 2+70.51
TIE INTO EXISTING
PAVEMENT**

GRADE BORROW TO
EXISTING GROUND. PJ# 68471
WILL TIE INTO PATH LINE "B"
IN THE FUTURE.

SEE I SHEETS FOR
WAYSIDE LANDSCAPING

SEE GRADING PLAN, SHEET
J1 FOR WORK IN THE
PARKING AREA

PLAN



PLAN LEGEND

CHECKED BY: J. BROWN



DESIGNED BY: J. BROWN

DRAWN BY: G. AMUNDSEN

STATE OF ALASKA
DEPARTMENT OF TRANSPORTATION
& PUBLIC FACILITIES
SOUTHCOST REGION

JNU: GLACIER HWY MULTI-USE
SPARATED PATH TO UAS
PROJECT NO. 69500

**LINE "B"
PLAN & PROFILE**

PROJECT DESIGNATION


0933037-69500

STATE YEAR
ALASKA 2015

SHEET NUMBER TOTAL SHEETS




F10 54

Project As-Built Drawings have been reviewed by the Project Engineer, and represent to the best of my knowledge, the project as constructed.
PE *[Signature]* Date *2/19/2019*

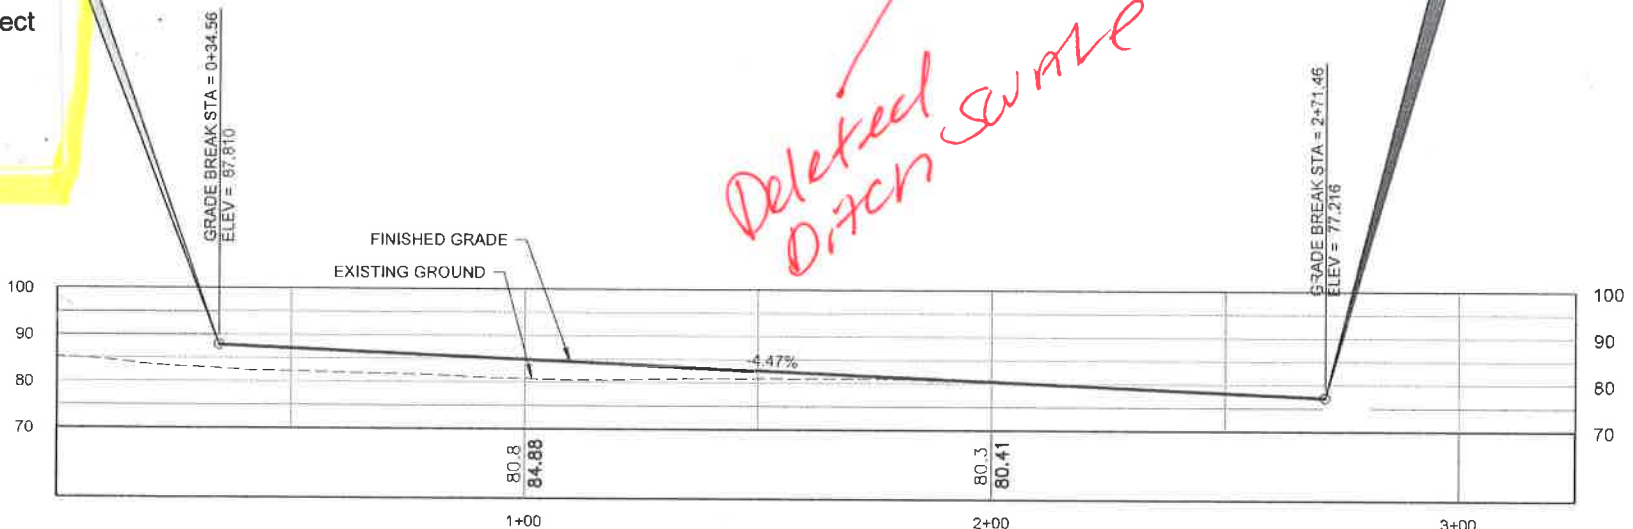

LINE "B" PROFILE

DO NOT SCALE FROM THESE DRAWINGS USE DIMENSIONS

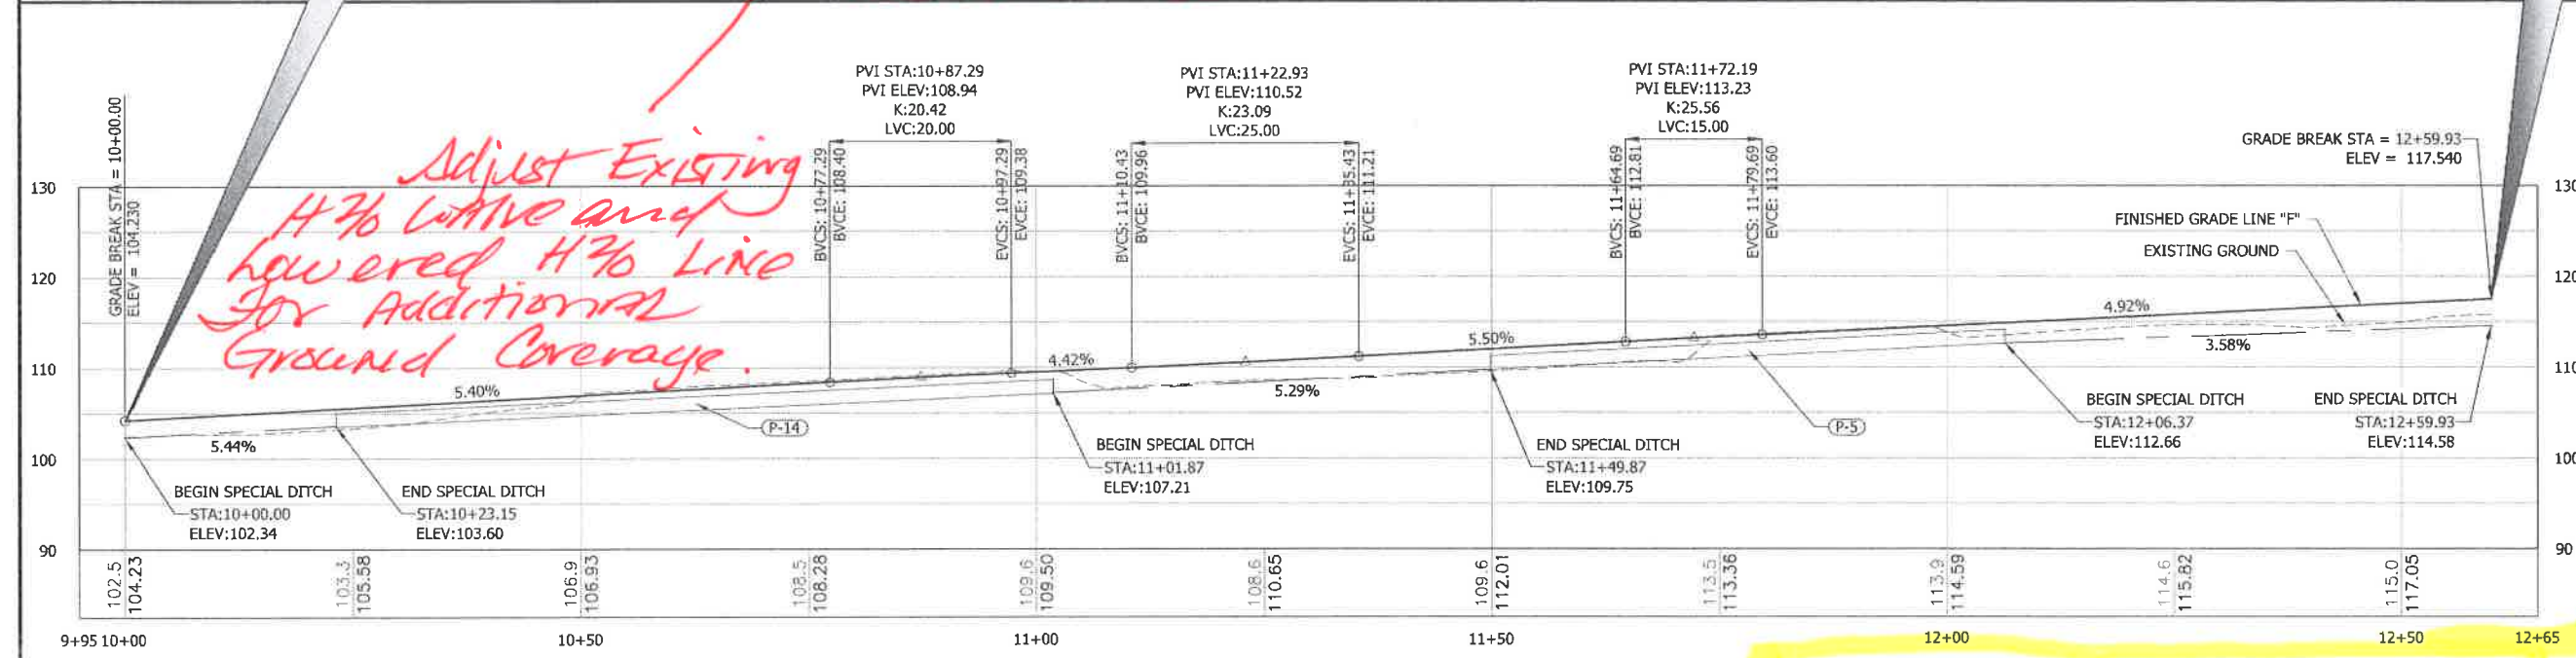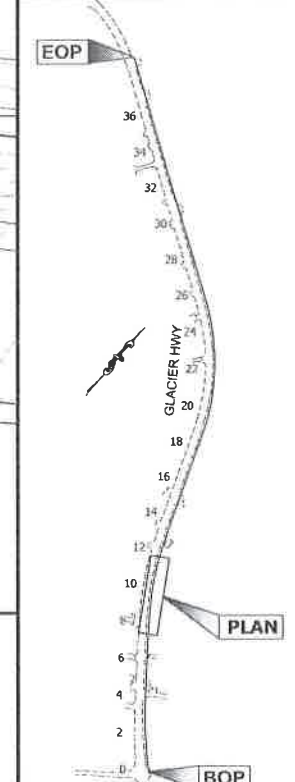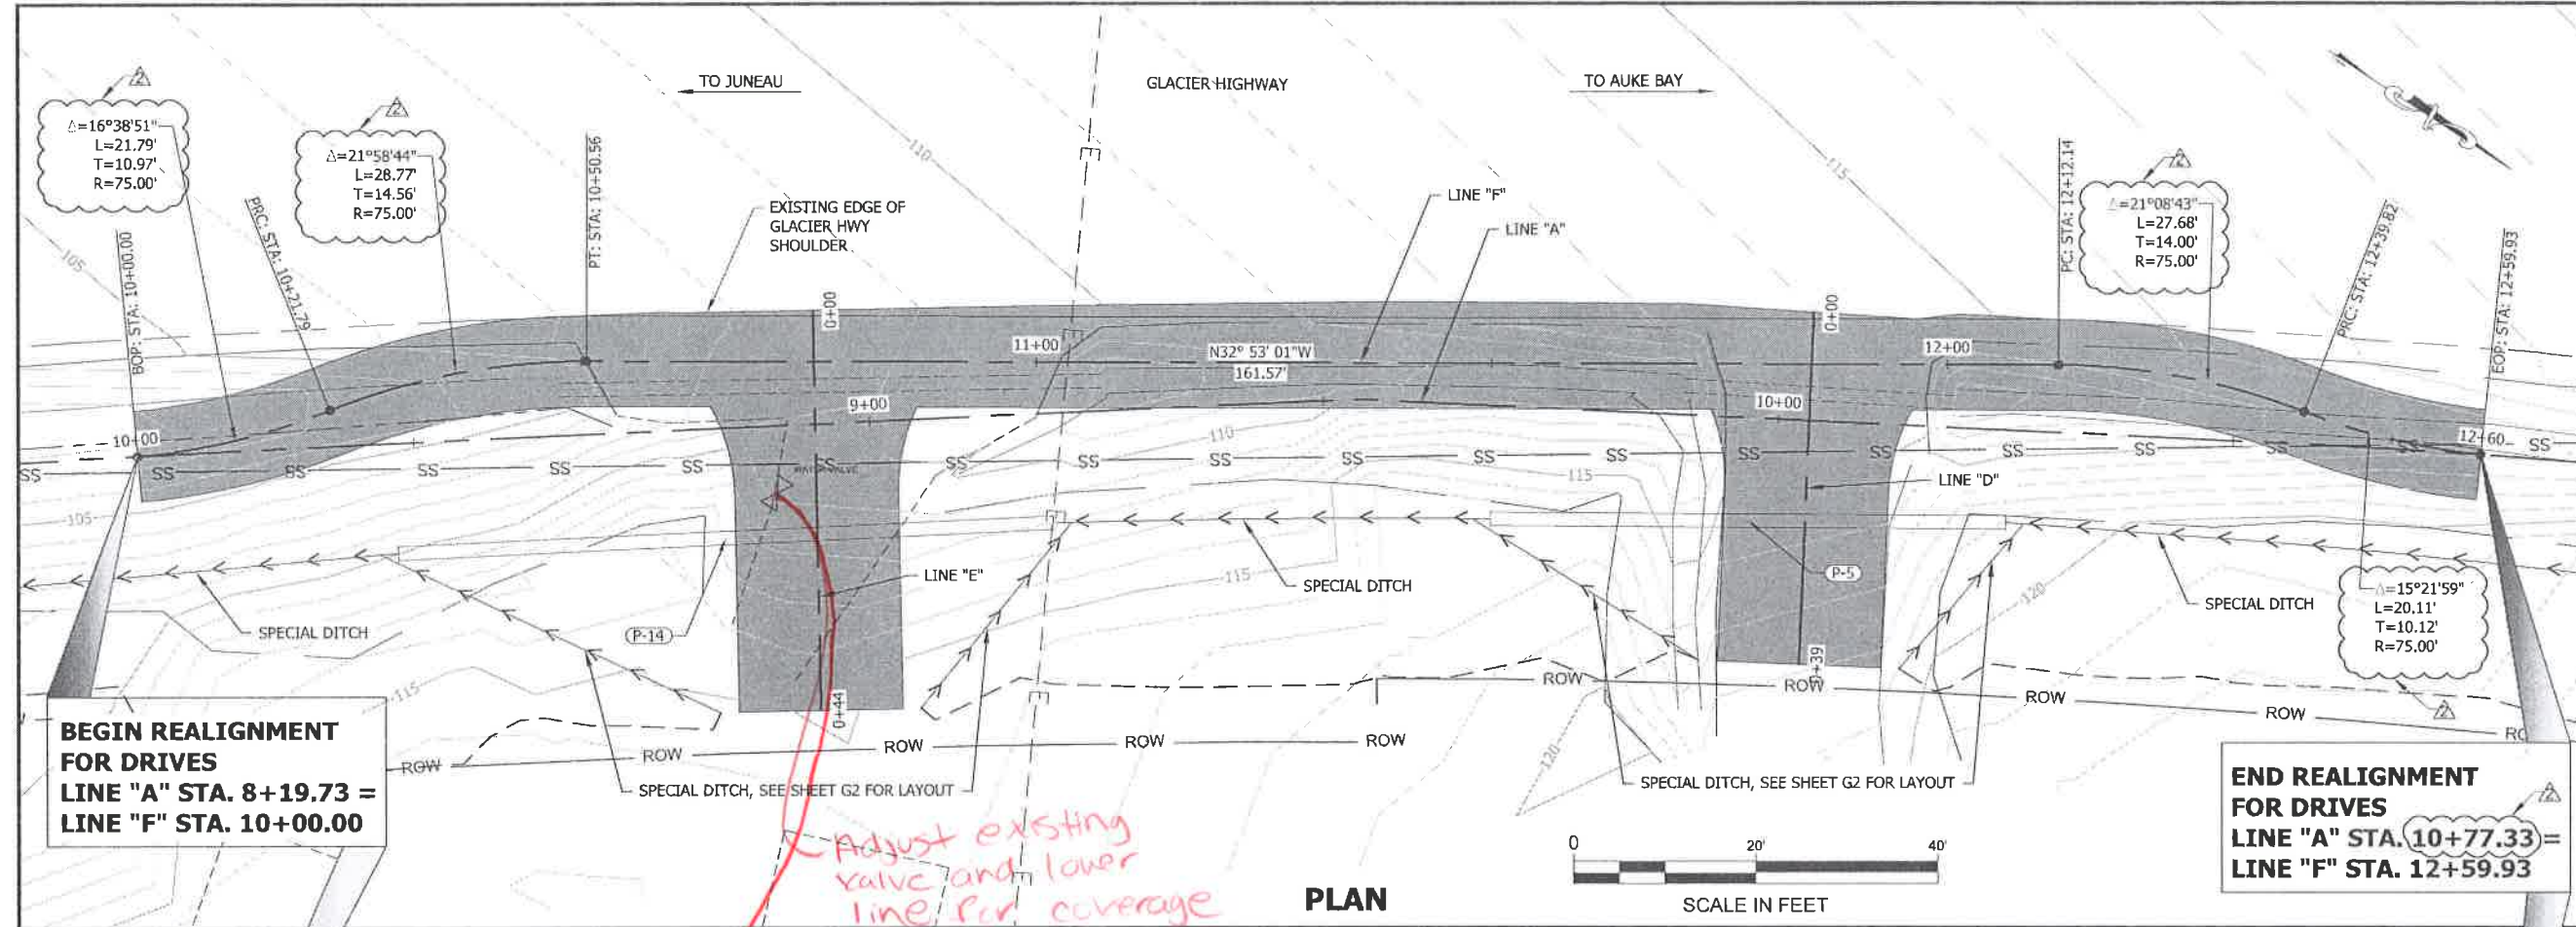

CHECKED BY: J. BROWN

DESIGNED BY: L. CHAMBERS

DRAWN BY: R. GRANTHAM, L. CHAMBERS

STATE OF ALASKA
DEPARTMENT OF TRANSPORTATION & PUBLIC FACILITIES
SOUTHCOST REGION

JNU: GLACIER HWY MULTI-USE
SEPARATED PATH TO UAS
PROJECT NO. 69500


PLAN & PROFILE

PROJECT DESIGNATION	
0933037 ~ 69500	
STATE	YEAR
ALASKA	2015
SHEET NUMBER	TOTAL SHEETS
G1	56

Project As-Built Drawings have been reviewed by the Project Engineer, and represent to the best of my knowledge, the project as constructed.


PE *[Signature]* Date 2/19/2019

DO NOT SCALE FROM THESE DRAWINGS USE DIMENSIONS

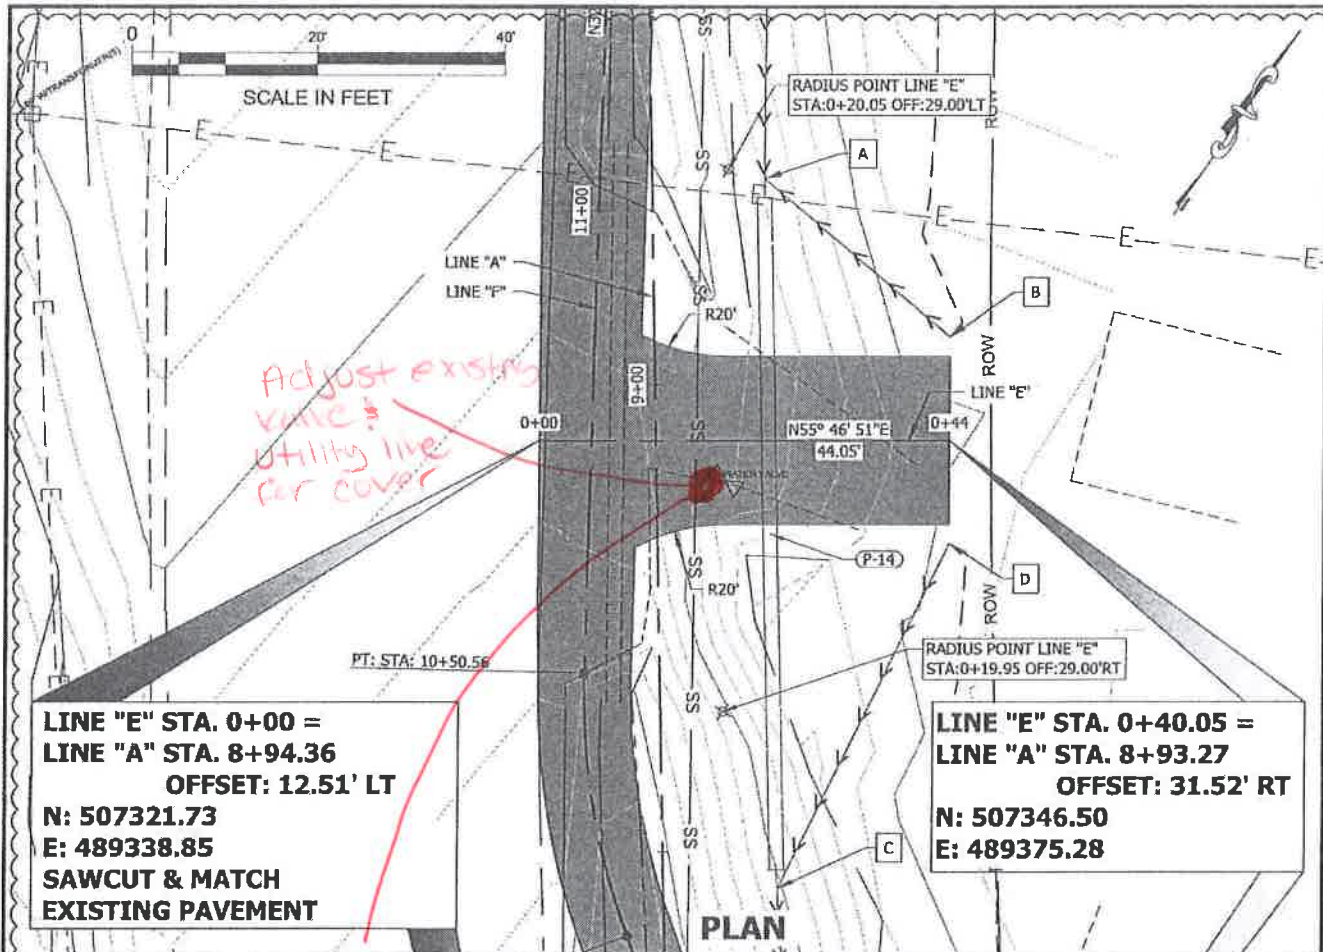



LINE "E" STA. 0+00 =
 LINE "A" STA. 8+94.36
 OFFSET: 12.51' LT
 N: 507321.73
 E: 489338.85
 SAWCUT & MATCH
 EXISTING PAVEMENT

LINE "E" STA. 0+40.05 =
 LINE "A" STA. 8+93.27
 OFFSET: 31.52' RT
 N: 507346.50
 E: 489375.28

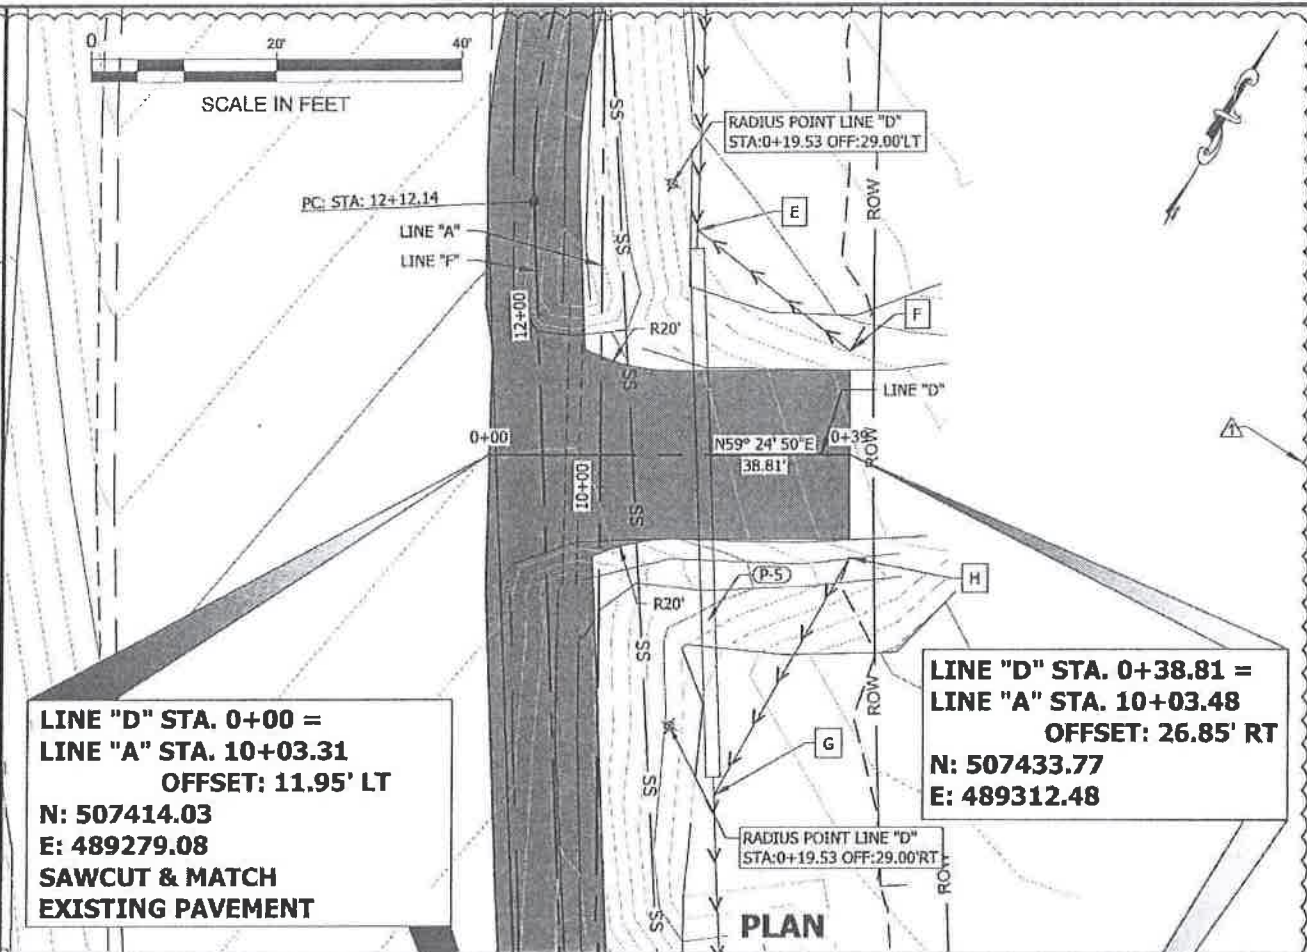

LINE "D" STA. 0+00 =
 LINE "A" STA. 10+03.31
 OFFSET: 11.95' LT
 N: 507414.03
 E: 489279.08
 SAWCUT & MATCH
 EXISTING PAVEMENT

LINE "D" STA. 0+38.81 =
 LINE "A" STA. 10+03.48
 OFFSET: 26.85' RT
 N: 507433.77
 E: 489312.48

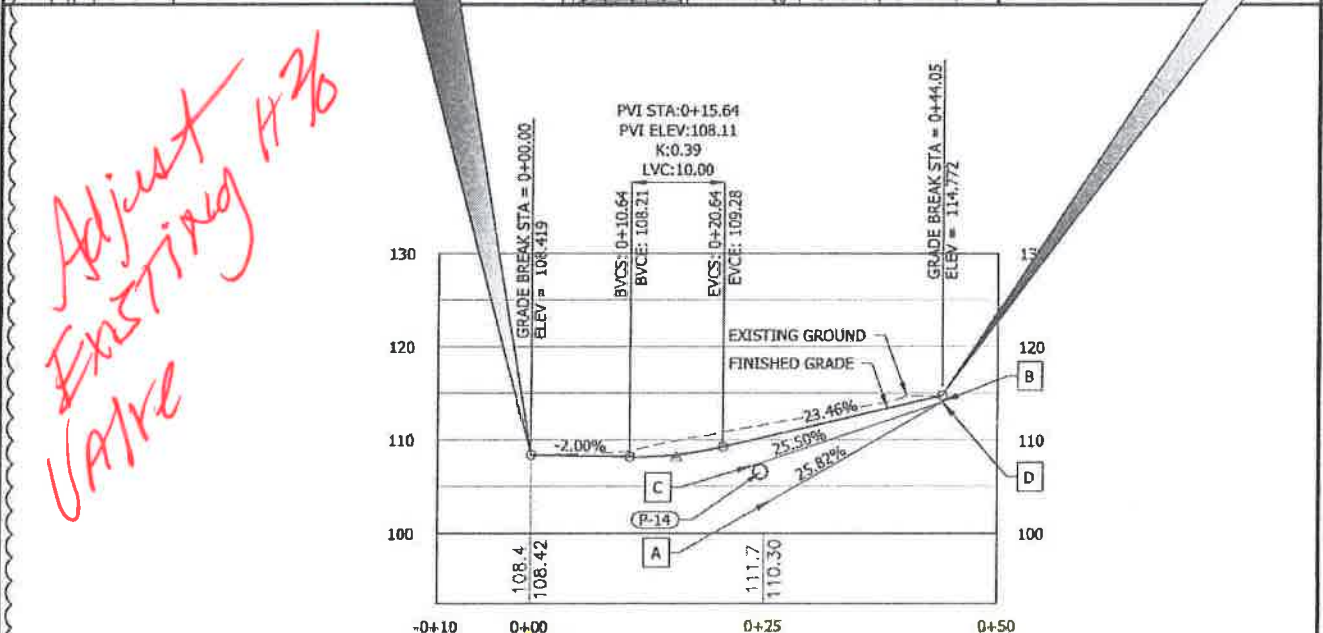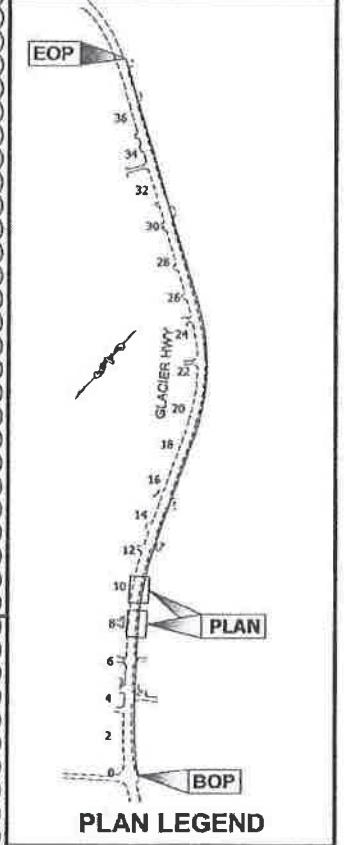


SPECIAL DITCH LAYOUT TABLE

LINE "E" STA	OFFSET (FT)	ELEV. (FT)	
A	0+23.9	48.0 RT	103.6
B	0+44.1	11.0 RT	114.1
C	0+23.9	28.0 LT	107.3
D	0+44.1	11.0 LT	114.1

LINE "E" PROFILE

Project As-Built Drawings have been reviewed by the Project Engineer, and represent to the best of my knowledge, the project as constructed.
 PE *[Signature]* Date 2/17/2019

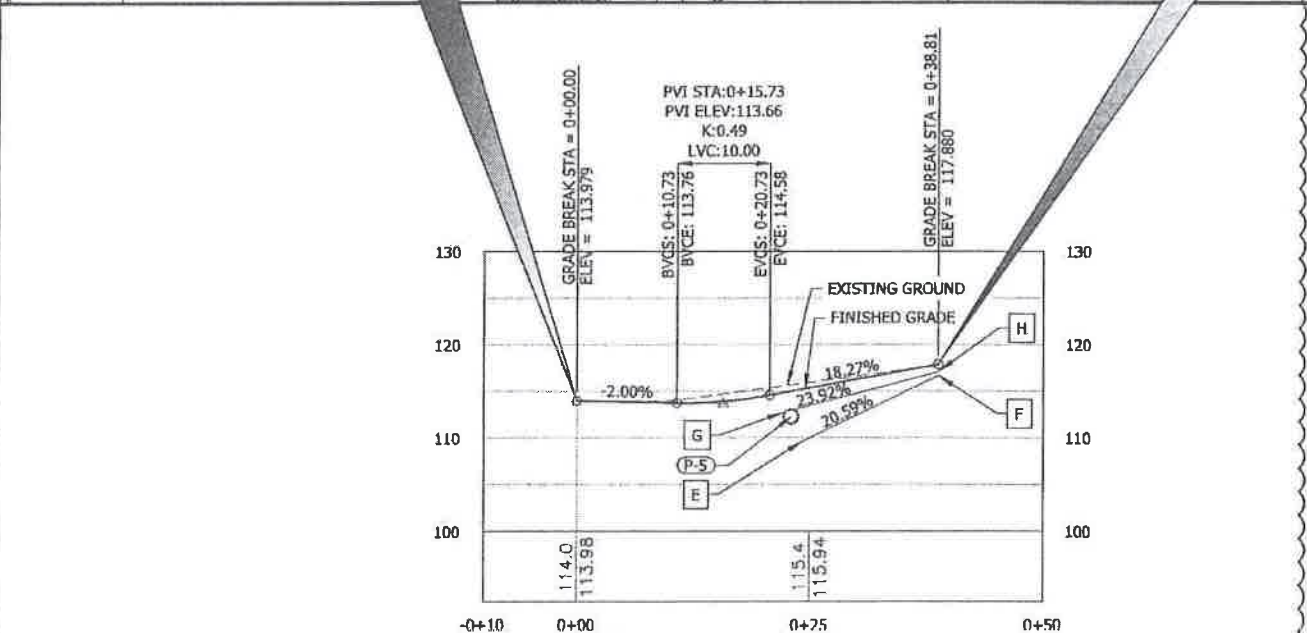

SPECIAL DITCH LAYOUT TABLE

LINE "D" STA	OFFSET (FT)	ELEV. (FT)	
E	0+24.3	36.5 RT	109.7
F	0+38.8	11.0 RT	116.7
G	0+22.3	24.0 LT	112.7
H	0+38.8	11.0 LT	117.1

LINE "D" PROFILE

DO NOT SCALE FROM THESE DRAWINGS USE DIMENSIONS

CHECKED BY: J. BROWN

DESIGNED BY: L. CHAMBERS
 DRAWN BY: R. GRANTHAM, L. CHAMBERS

STATE OF ALASKA
 DEPARTMENT OF TRANSPORTATION & PUBLIC FACILITIES
 SOUTHCOST REGION


JNU: GLACIER HWY MULTI-USE
 SEPARATED PATH TO UAS
 PROJECT NO. 69500

DRIVEWAY PLAN & PROFILE

PROJECT DESIGNATION
 0933037 ~ 69500

STATE	YEAR
ALASKA	2015


SHEET NUMBER	TOTAL SHEETS
G2	56

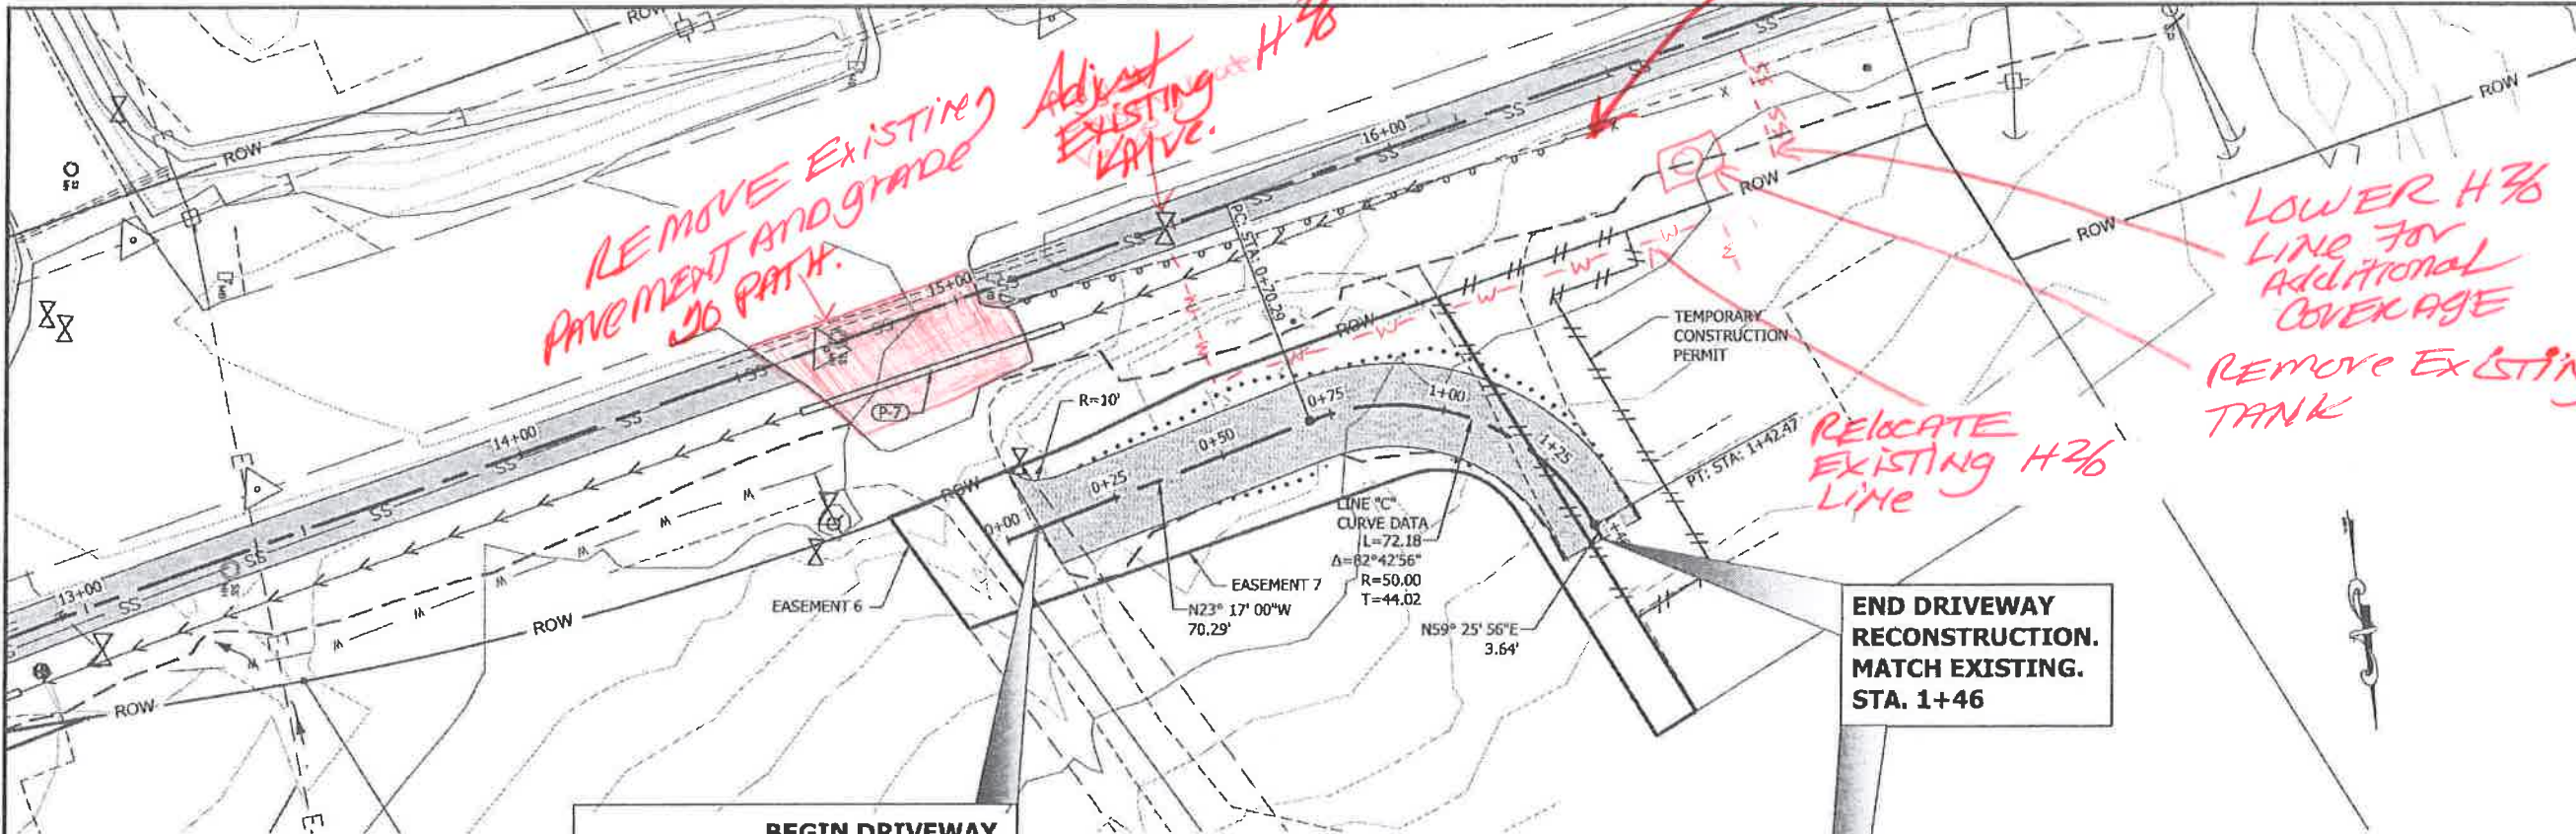


BEGIN DRIVEWAY RECONSTRUCTION. MATCH EXISTING
 LINE "C" STA 0+06.75 =
 LINE "A" STA. 15+00.8, OFF: 52.72' RT

END DRIVEWAY RECONSTRUCTION. MATCH EXISTING.
 STA. 1+46

PLAN

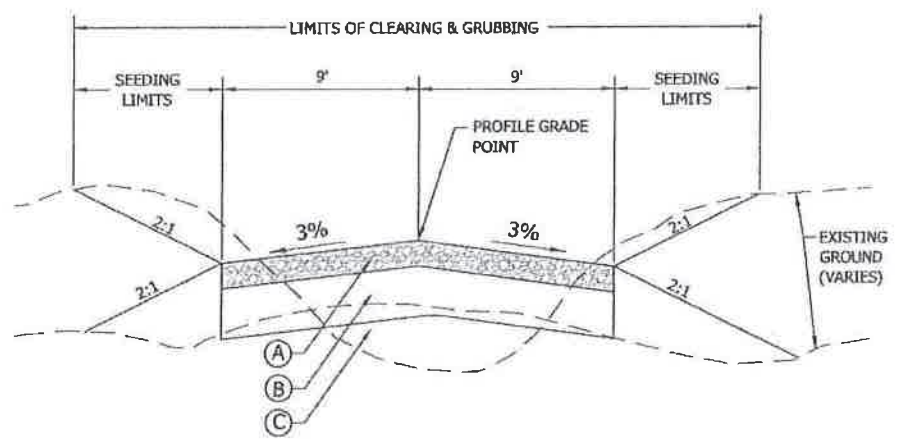

RECONSTRUCTED DRIVEWAY TYPICAL SECTION
 LINE "C", STA. 0+06.76 TO STA. 1+46.10

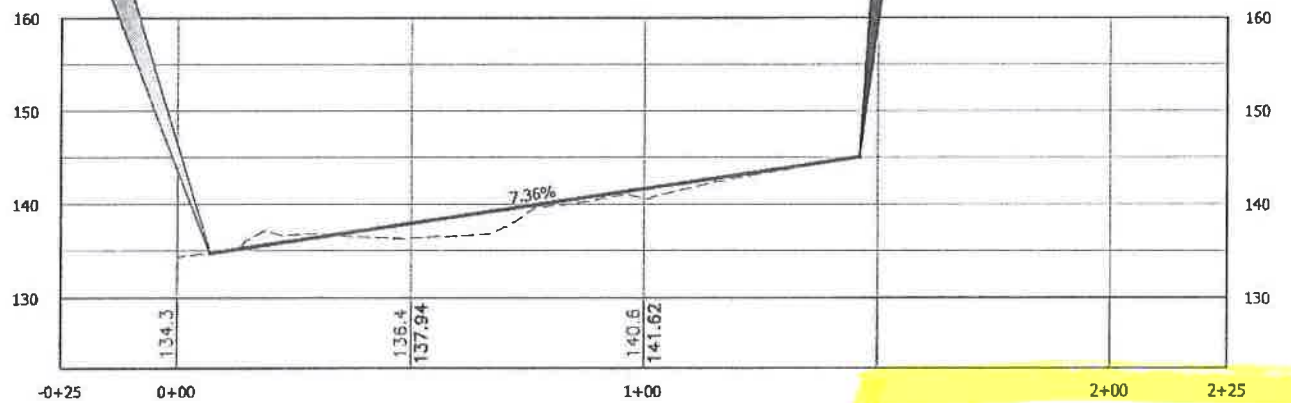

LINE "C" PROFILE

- LEGEND:**
- (A) 6" AGGREGATE BASE COURSE, GRADING D-1
 - (B) 12" SELECT MATERIAL, TYPE A
 - (C) SELECT MATERIAL, TYPE A *
 - * AS NECESSARY

Project As-Built Drawings have been reviewed by the Project Engineer, and represent to the best of my knowledge, the project as constructed.
 PE *[Signature]* Date *2/19/2019*

DO NOT SCALE FROM THESE DRAWINGS USE DIMENSIONS

PATH: Q:\UNL09500\PLANSET\09500_G3_APPROACH.DWG
 CHAMBERS, LUCAS M (DOT)
 TAB: G3 Wednesday, December 09, 2015 3:58:59 PM

RECORD OF REVISIONS		
No.	DATE	DESCRIPTION
1	12/9/15	RENUMBERED SHEET FROM G2 TO G3

PLAN LEGEND

CHECKED BY: J. BROWN




DESIGNED BY: J. BROWN, L. CHAMBERS
 DRAWN BY: R. GRANTHAM


STATE OF ALASKA
 DEPARTMENT OF TRANSPORTATION & PUBLIC FACILITIES
 SOUTHEAST REGION

JNU: GLACIER HWY MULTI-USE
 SEPARATED PATH TO UAS
 PROJECT NO. 69500

DRIVEWAY PLAN & PROFILE

PROJECT DESIGNATION	
0933037 ~ 69500	
STATE	YEAR
ALASKA	2015
SHEET NUMBER	TOTAL SHEETS
G3	56

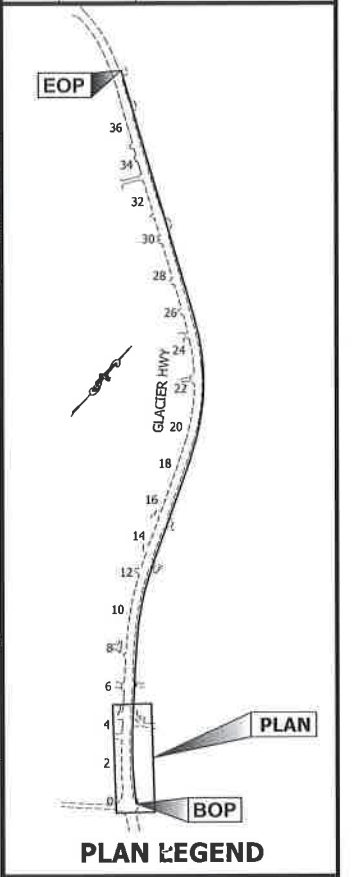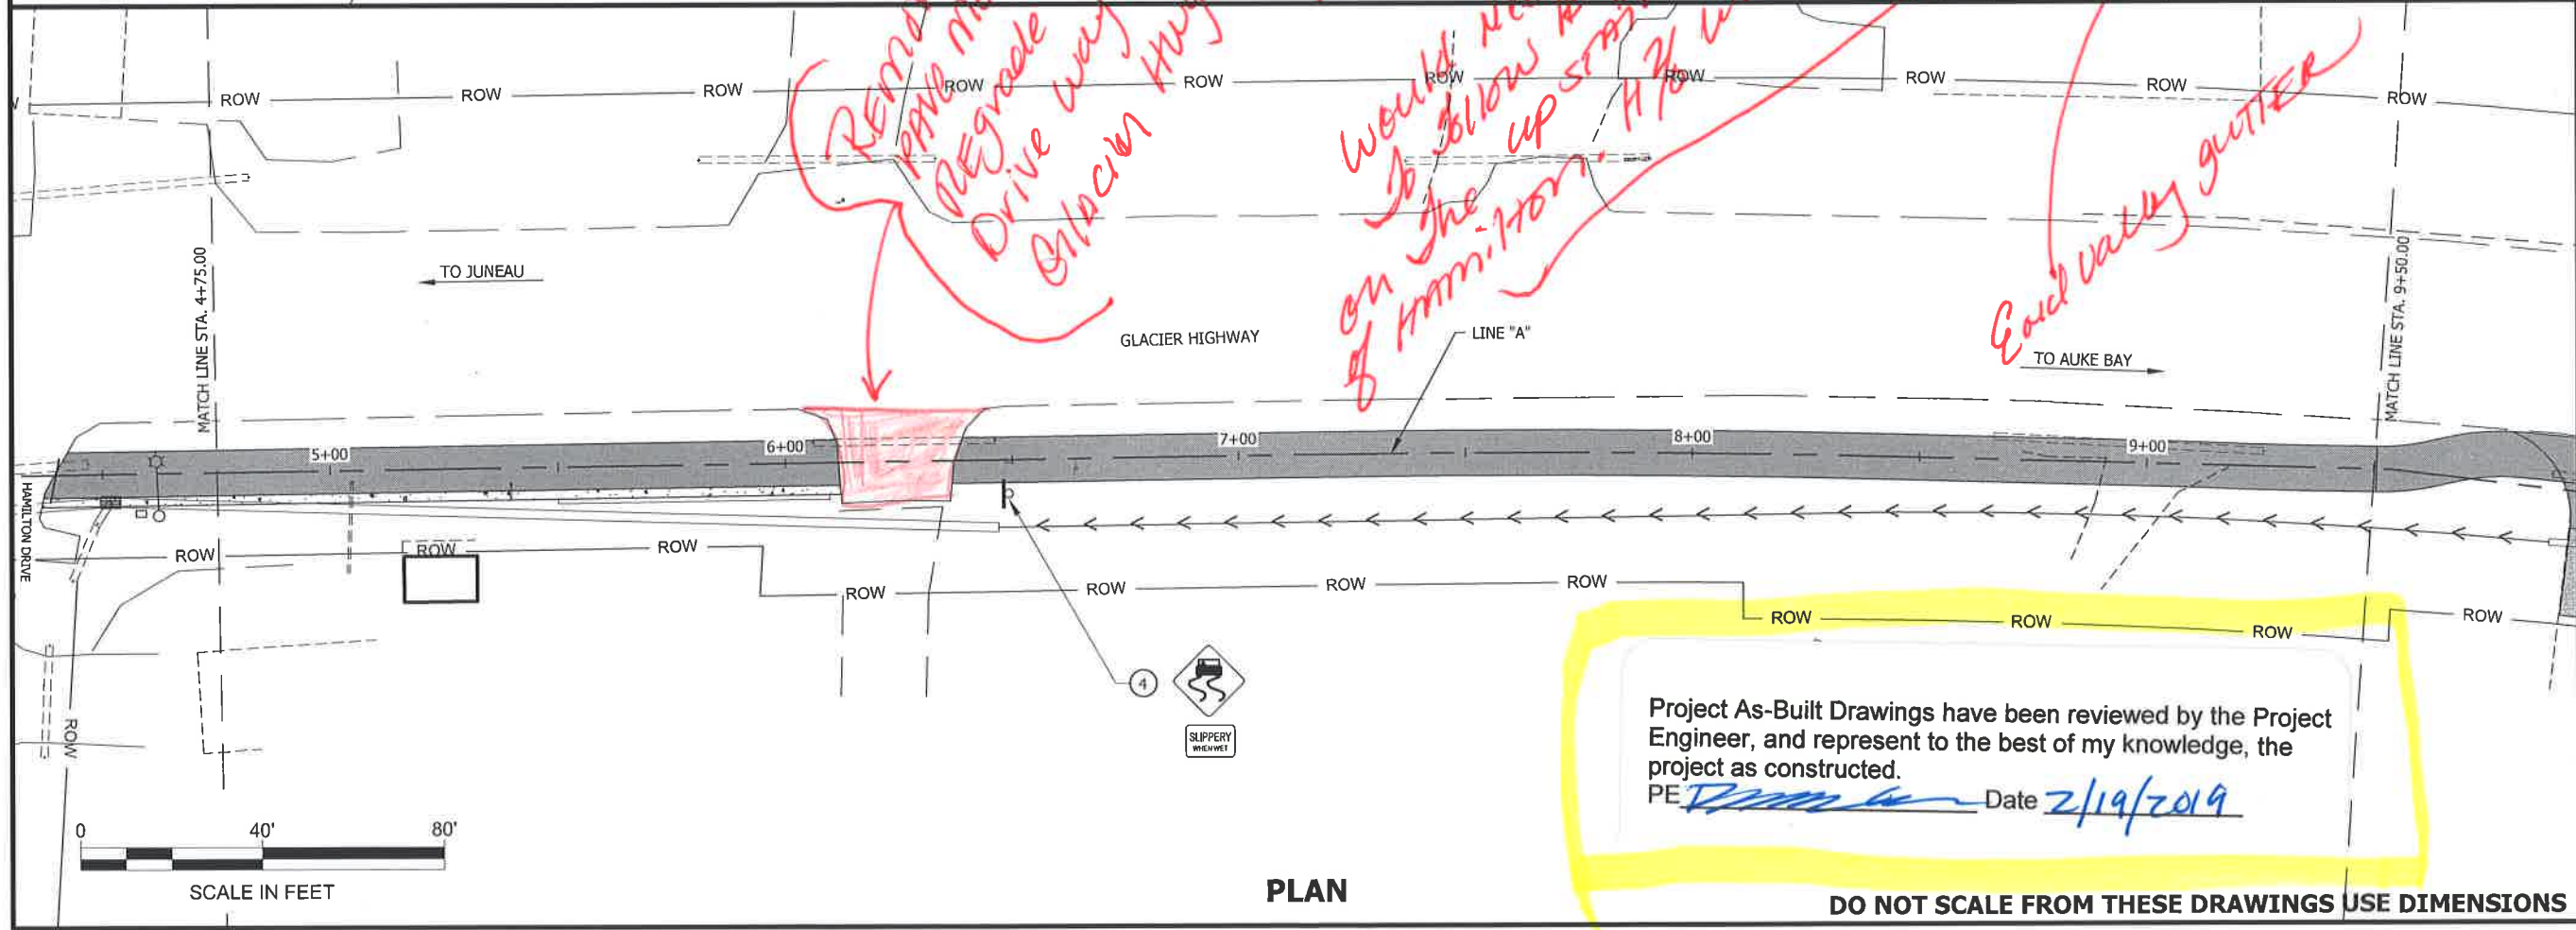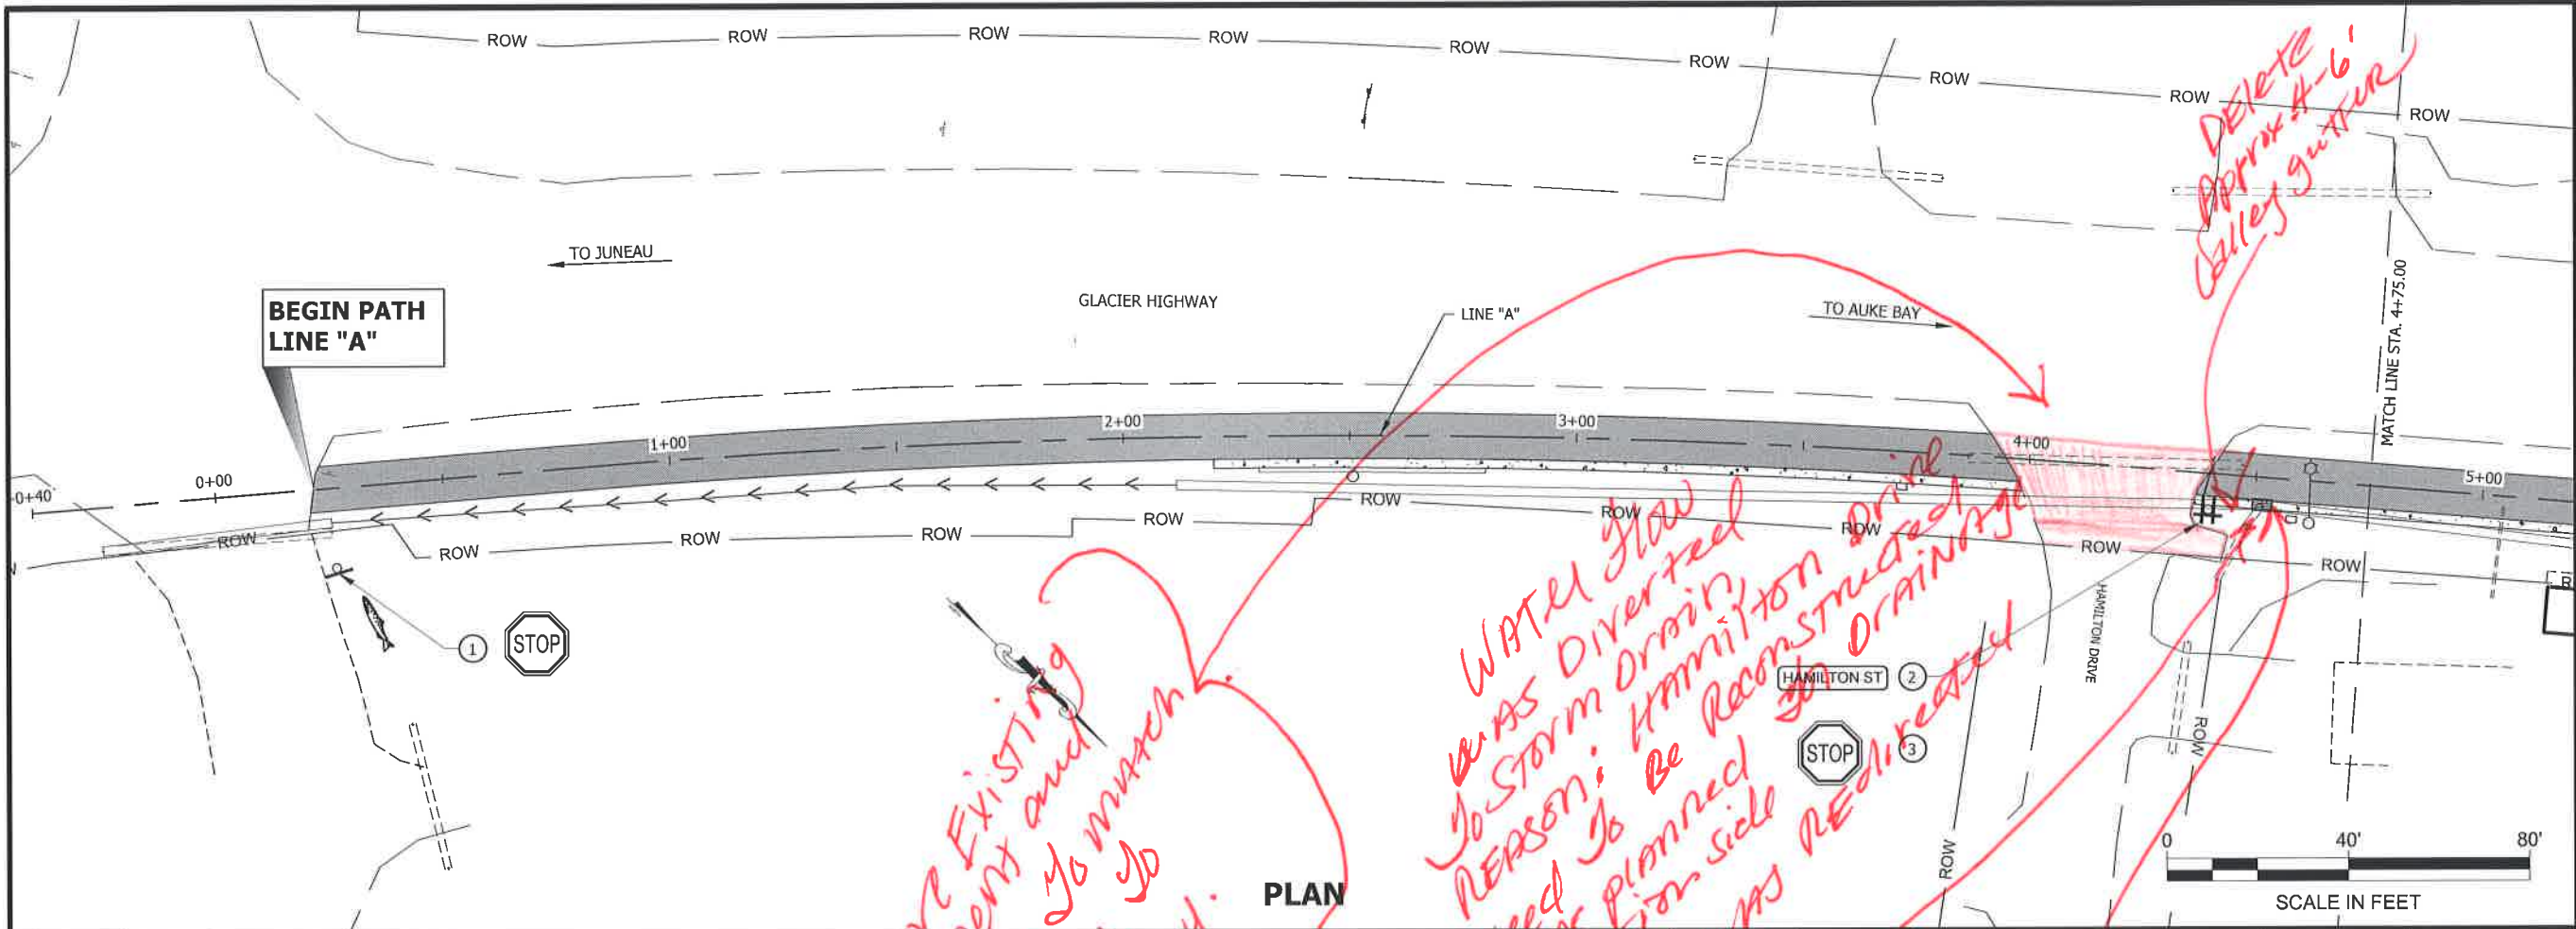

CHECKED BY: D. EPSTEIN


DESIGNED BY: J. BROWN
 DRAWN BY: R. GRANHAM
 STATE OF ALASKA
 DEPARTMENT OF TRANSPORTATION
 & PUBLIC FACILITIES
 SOUTHEAST REGION
 JNU: GLACIER HWY MULTI-USE
 SEPARATED PATH TO UAS
 PROJECT NO. 69500

SIGNING & STRIPING

PROJECT DESIGNATION
0933037 ~ 69500

STATE	YEAR
ALASKA	2015
SHEET NUMBER	TOTAL SHEETS
H1	54

Project As-Built Drawings have been reviewed by the Project Engineer, and represent to the best of my knowledge, the project as constructed.
 PE [Signature] Date 2/19/2019

DO NOT SCALE FROM THESE DRAWINGS USE DIMENSIONS



Change Order

Change Order No. 6

DESCRIPTION OF CHANGE (Use Continuation Sheet 25D-065 as Required)

In accordance with Subsection 104-1.02 of the Standard Specifications, the following changes are hereby made:

Reason for Change Order

An existing fence at station 16+50 RT required removal as it was within the project cut limits.

Establish New Item 202(14)a Removal of Existing Fence



Description: This item is for the removal and disposal of the existing fence at Station 16+50 RT.

Materials: None.

Construction Requirements: Comply with Section 202.

Project As-Built Drawings have been reviewed by the Project Engineer, and represent to the best of my knowledge, the project as constructed.
 PE *[Signature]* Date 2/19/2019

- 5 ADOPT A HIGHWAY
- 6 PARENTS FAMILIES AND FRIENDS OF LESBIANS AND GAYS

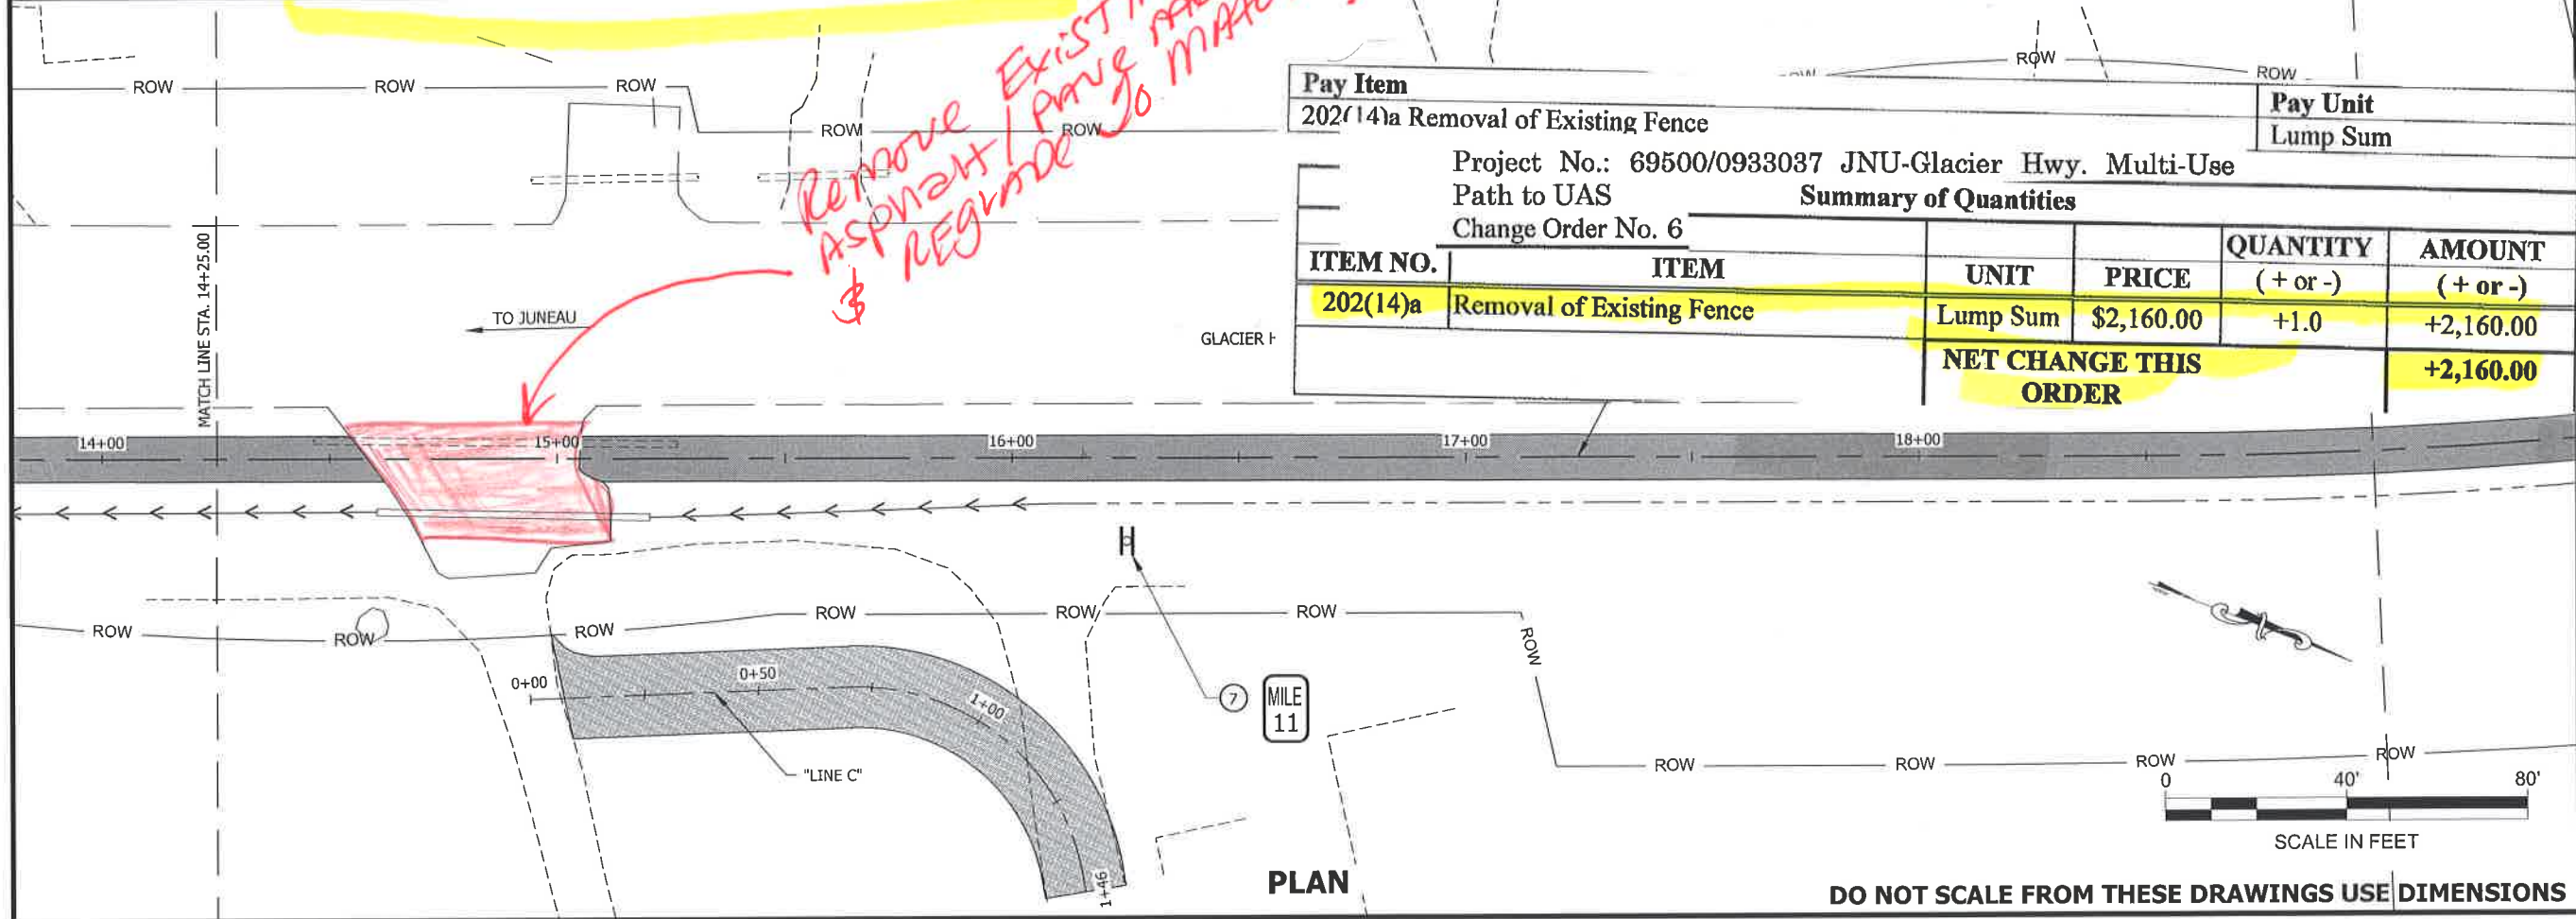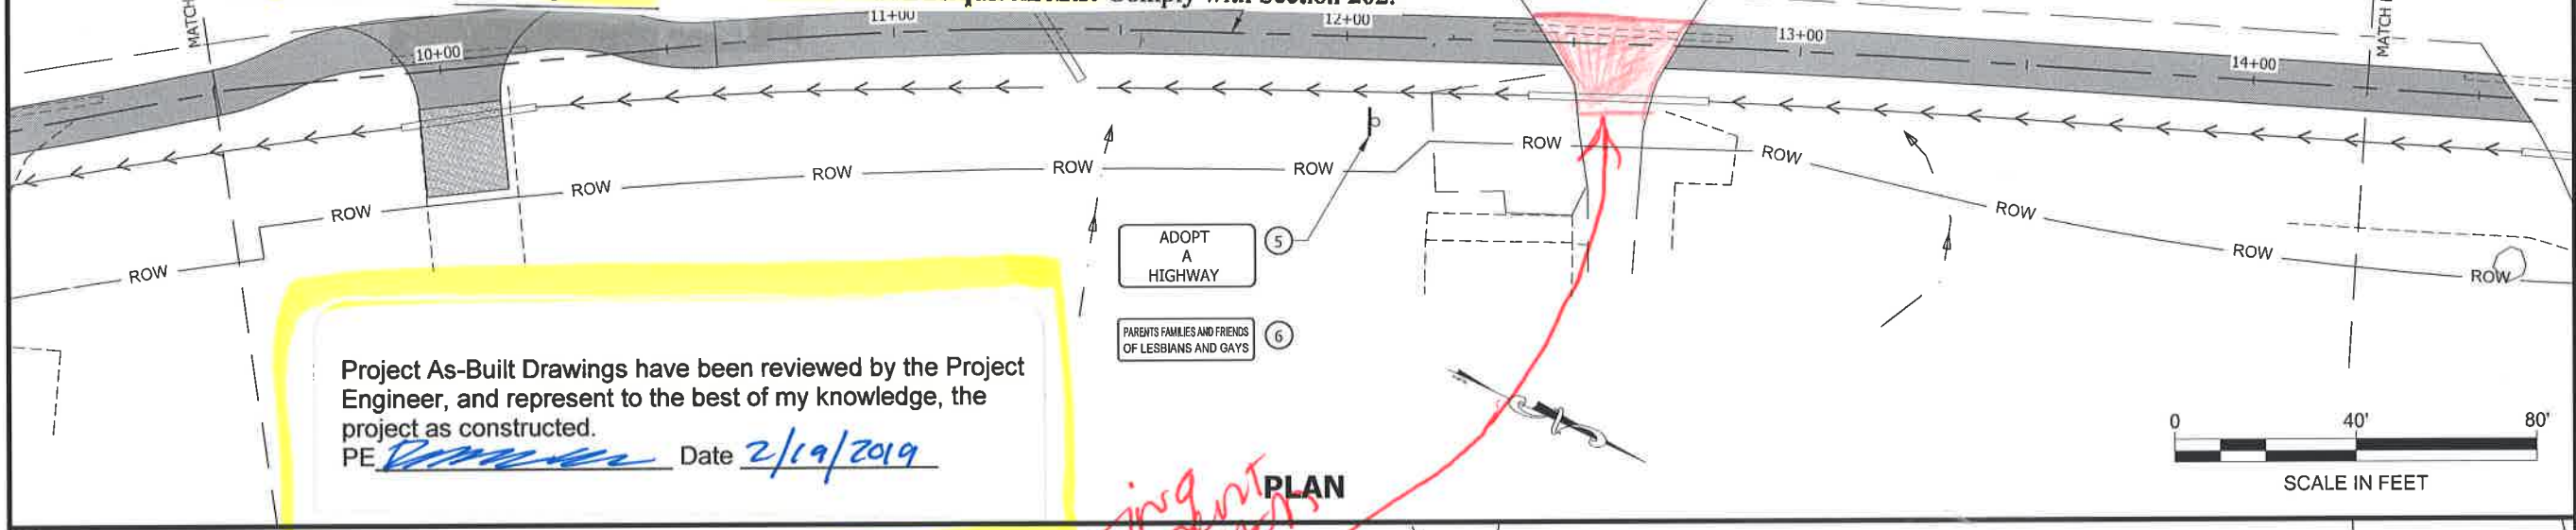


Remove Existing ASPHALT / PAINT REGRADE TO MATCH

Pay Item		Pay Unit			
202(14)a	Removal of Existing Fence	Lump Sum	Lump Sum		
Project No.: 69500/0933037 JNU-Glacier Hwy. Multi-Use Path to UAS					
Change Order No. 6					
Summary of Quantities					
ITEM NO.	ITEM	UNIT	PRICE	QUANTITY (+ or -)	AMOUNT (+ or -)
202(14)a	Removal of Existing Fence	Lump Sum	\$2,160.00	+1.0	+2,160.00
NET CHANGE THIS ORDER					+2,160.00

PATH: Q:\JNU\69500\PLANSET\69500_H1-H5_SIGN.DWG
 GRANHAM, RICK L (DOT)
 TAB: H2 Monday, July 20, 2015 12:45:08 PM

RECORD OF REVISIONS		
No.	DATE	DESCRIPTION

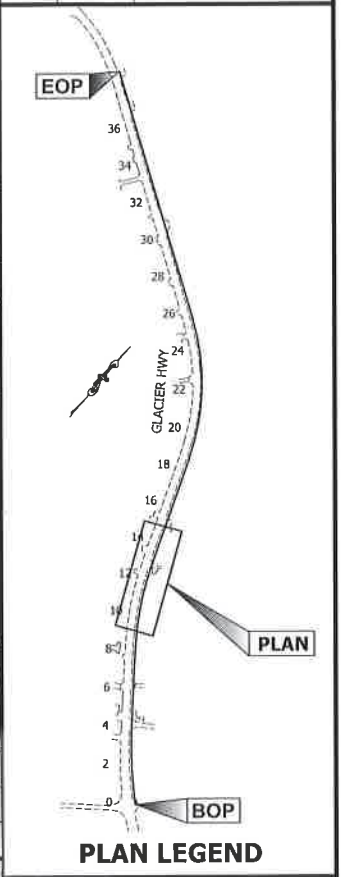

CHECKED BY: D. EPSTEIN

DESIGNED BY: J. BROWN
 DRAWN BY: R. GRANTHAM

STATE OF ALASKA
 DEPARTMENT OF TRANSPORTATION & PUBLIC FACILITIES
 SOUTHCOST REGION

JNU: GLACIER HWY MULTI-USE SEPARATED PATH TO UAS PROJECT NO. 69500

SIGNING & STRIPING

PROJECT DESIGNATION
0933037 ~ 69500

STATE	YEAR
ALASKA	2015
SHEET NUMBER	TOTAL SHEETS
H2	54

DO NOT SCALE FROM THESE DRAWINGS USE DIMENSIONS

DESCRIPTION OF CHANGE (Use Continuation Sheet 25D-065 as Required)

In accordance with Subsection 104-1.02 of the Standard Specifications, the following changes are hereby made:

Reason for Change Order:


The SKT parallel end terminal lower hinge post height exceeded 4 inches in relation to surrounding ground surface. New Item 606(17)a Parallel Guardrail Terminal Grading corrects this safety issue. The Department and Contractor mutually agreed to extend the Contract Completion Date in order to add extra work to the Contract and research solutions to the issue.

Extension of Contract Completion Date:

Construction Contract (Form 25D-7). Change the Completion Date from August 12, 2016 to October 31, 2016.

Form 25D-068 (Revised 04/12)

C.O. No. 14

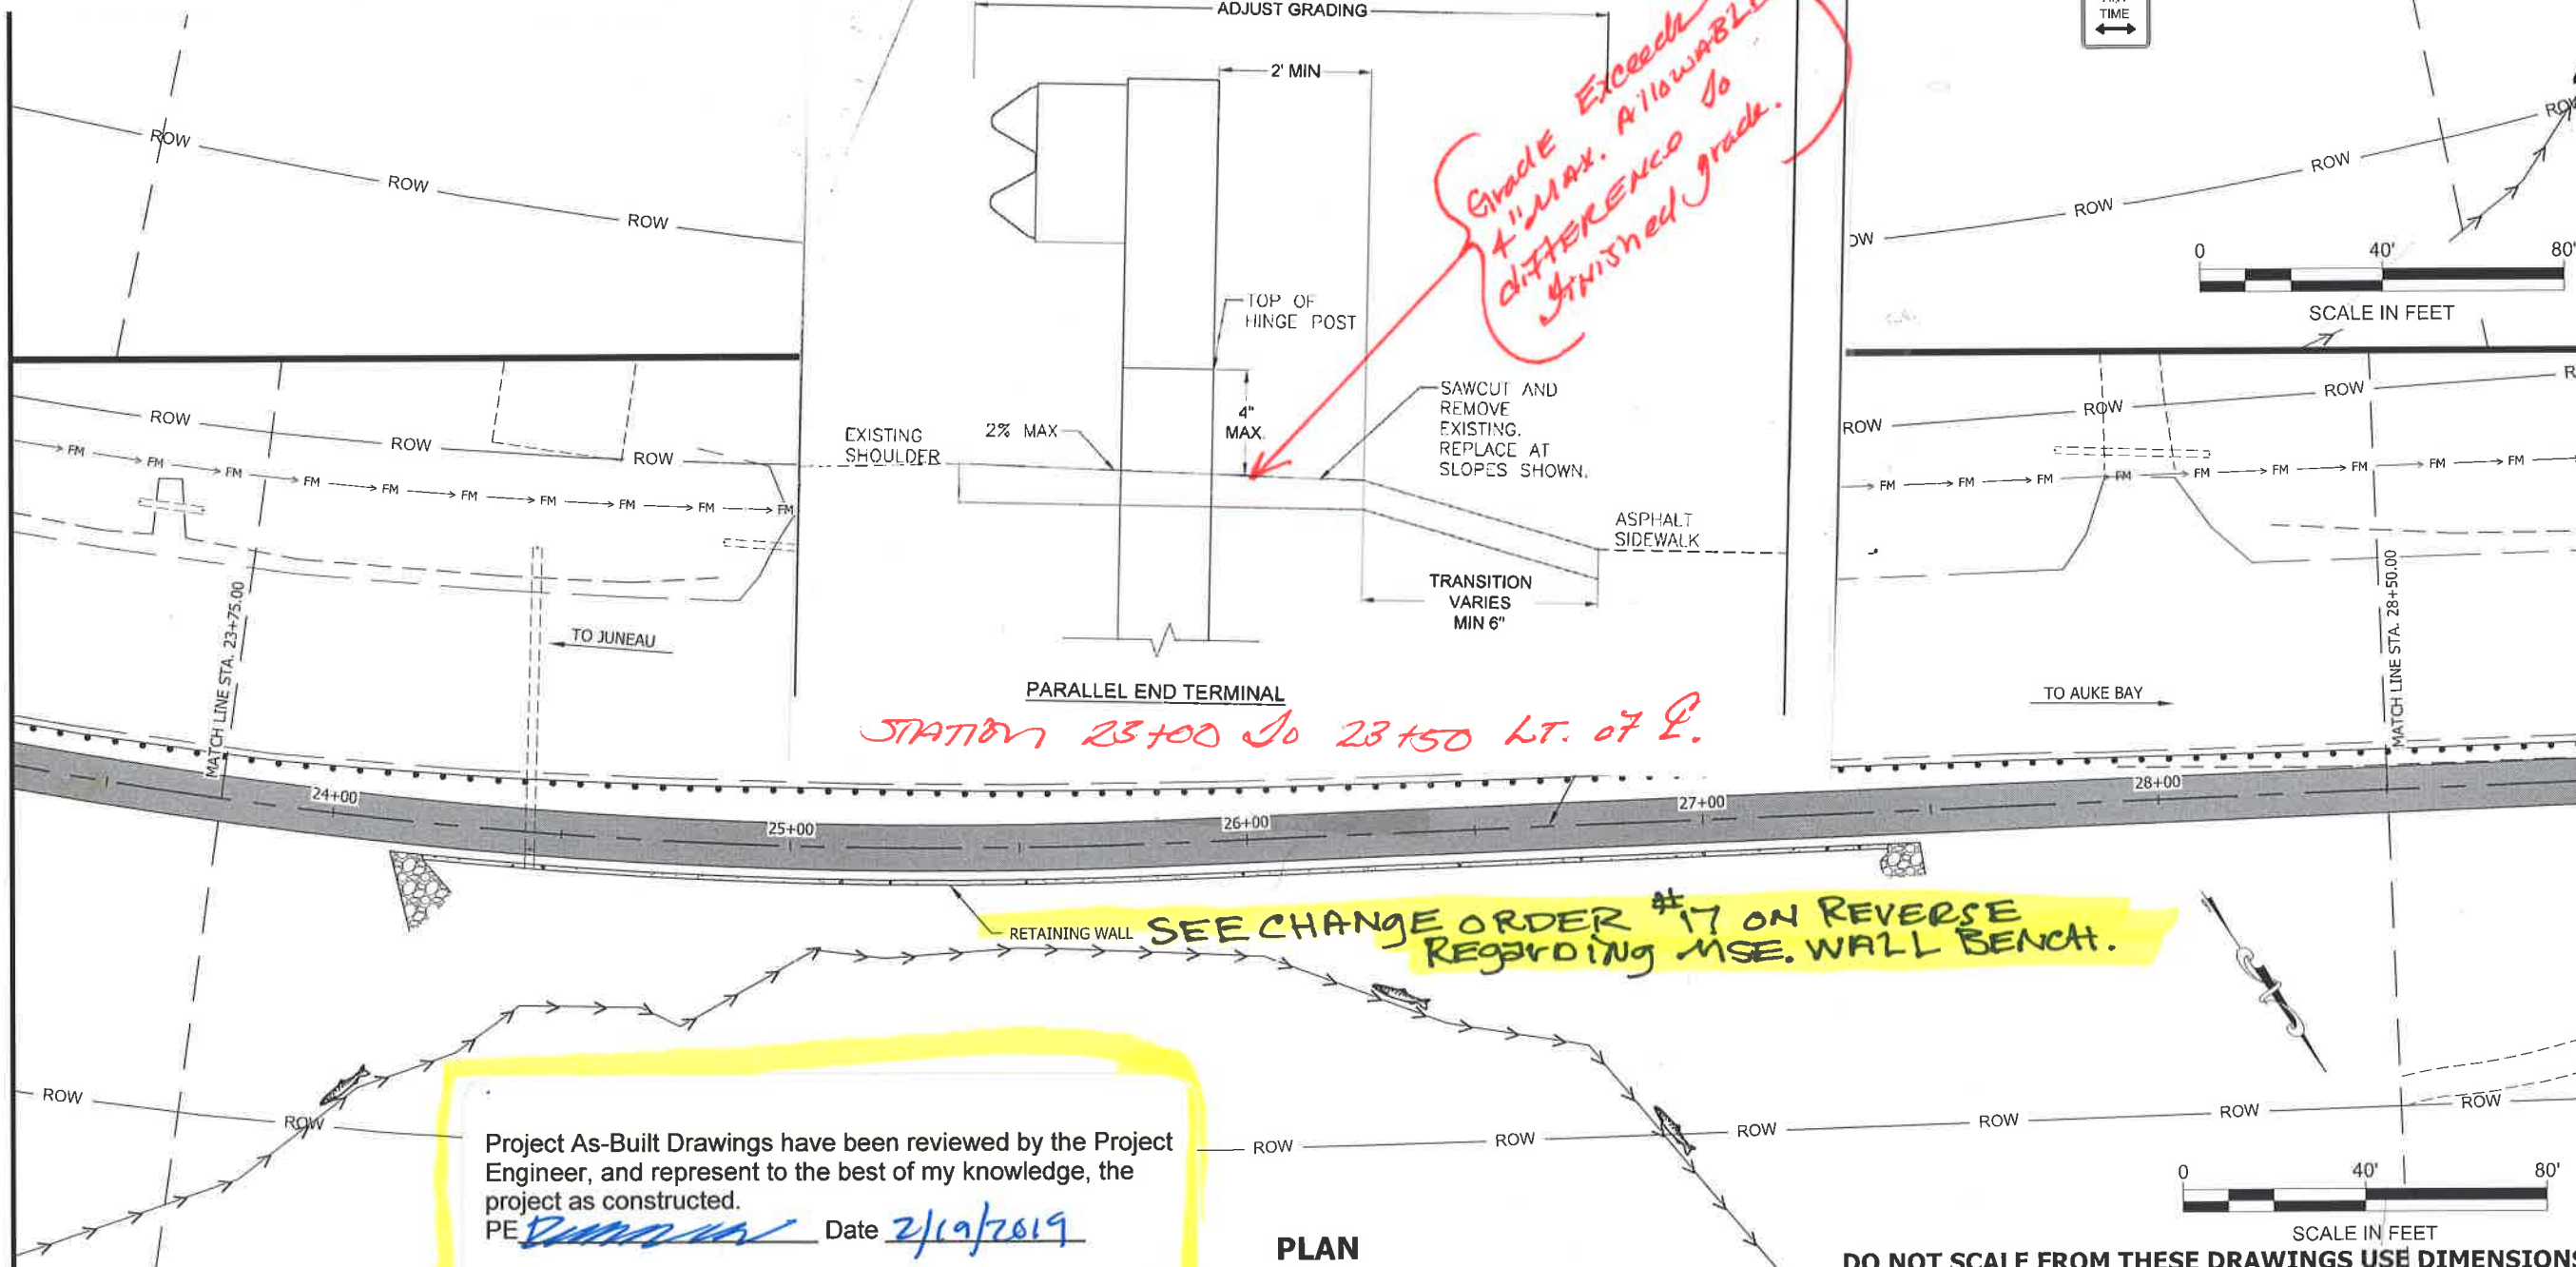

STATION 23+00 TO 23+50 LT. OF R.

SEE CHANGE ORDER #17 ON REVERSE REGARDING MSE WALL BENCH.

Project As-Built Drawings have been reviewed by the Project Engineer, and represent to the best of my knowledge, the project as constructed.
 PE *[Signature]* Date *2/19/2019*


PLAN

DO NOT SCALE FROM THESE DRAWINGS USE DIMENSIONS

Grade Exceeds 4" Max. Allowable Difference to Finished grade.

PATH: Q:\JNU\69500\PLANSET\69500_H1-H5_SIGN.DWG
 CHAMBERS, LUCAS M (DOT)
 TAB: H3 Tuesday, July 28, 2015 11:46:12 AM

RECORD OF REVISIONS		
No.	DATE	DESCRIPTION

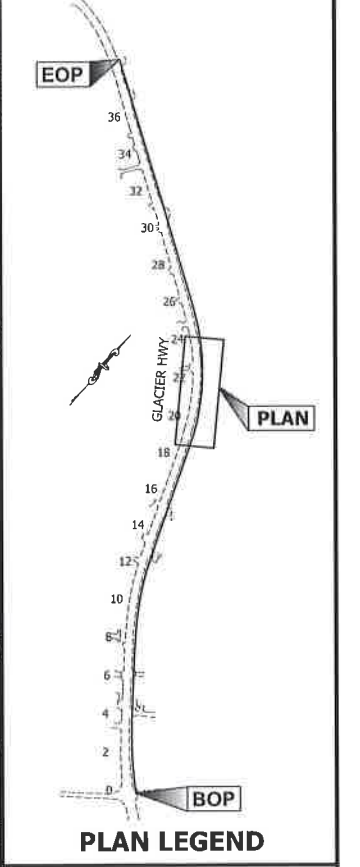

CHECKED BY: D. EPSTEIN

DESIGNED BY: J. BROWN
 DRAWN BY: R. GRANTHAM
 STATE OF ALASKA
 DEPARTMENT OF TRANSPORTATION & PUBLIC FACILITIES
 SOUTHCOAST REGION
 JNU: GLACIER HWY MULTI-USE SEPARATED PATH TO UAS
 PROJECT NO. 69500

SIGNING & STRIPING

PROJECT DESIGNATION
0933037 ~ 69500

STATE	YEAR
ALASKA	2015
SHEET NUMBER	TOTAL SHEETS
H3	54



**STATE OF ALASKA
DEPARTMENT OF TRANSPORTATION
AND PUBLIC FACILITIES
SOUTHCOAST REGION**

Change Order

Project No.: 69500/0933037 Change Order No. 17
Project Name: JNU-Glacier Highway Multi-Use Path to UAS

Contractor:		Change Order Summary:	
Second, Inc.		Calendar Days (+ / -):	N/A
P.O. Box 32159		New Completion Date:	N/A
Juneau, AK 99803		Amount of Change Order:	+\$7,672.52

Recommended By: [Signature] Date: 3 January 2017
Approved By: [Signature] Title: Project Engineer Date: 3 Jan. 2017
Title: Project Manager

This change order constitutes agreement to terms, conditions and prices stated below.

Accepted By: [Signature] Date: 14 Jan 2017
Contractor's Representative

Acknowledged By: _____ Date: _____
Contractor's Representative

Seal of Alaskan Professional Engineer (if required) N/A

Permission for previously submitted subcontractor(s) to perform all or portions of the work described herein is as checked: Yes No N/A

The following change(s) in the above Contract are hereby made in accordance with the terms of the Contract and under the terms and conditions stated below. Price adjustments resulting from inaccurate cost and pricing data are subject to the provisions of AS 36.30.400(c). This document shall become an amendment to the Contract and all provisions of the Contract will be applicable.



DESCRIPTION OF CHANGE (Use Continuation Sheet 25D-065 as Required)


In accordance with Subsection 104-1.02 of the Standard Specifications, the following changes are hereby made:

Reason for Change Order Items:

- Selective Tree Removal was required to reduce safety hazards with undermined trees throughout the project.
- Material was needed for the bench in front of the MSE Wall. Material was taken from the MSE Wall during excavation operations and placed in front of the MSE Wall to fill in the bench in front of the MSE Wall in lieu of bringing in new material.
- Modification was required to the new inlet to accommodate the planned 24 inch culvert.
- A conflict between a planned culvert and a force water main was encountered and this change order compensates the Contractor for standby time while adjustments were made.

ADDENDUM NUMBER		
ATTACHMENT NUMBER		
RECORD OF REVISIONS		
No.	DATE	DESCRIPTION

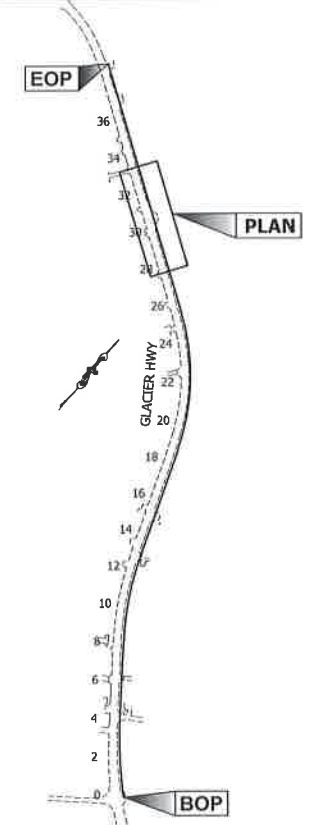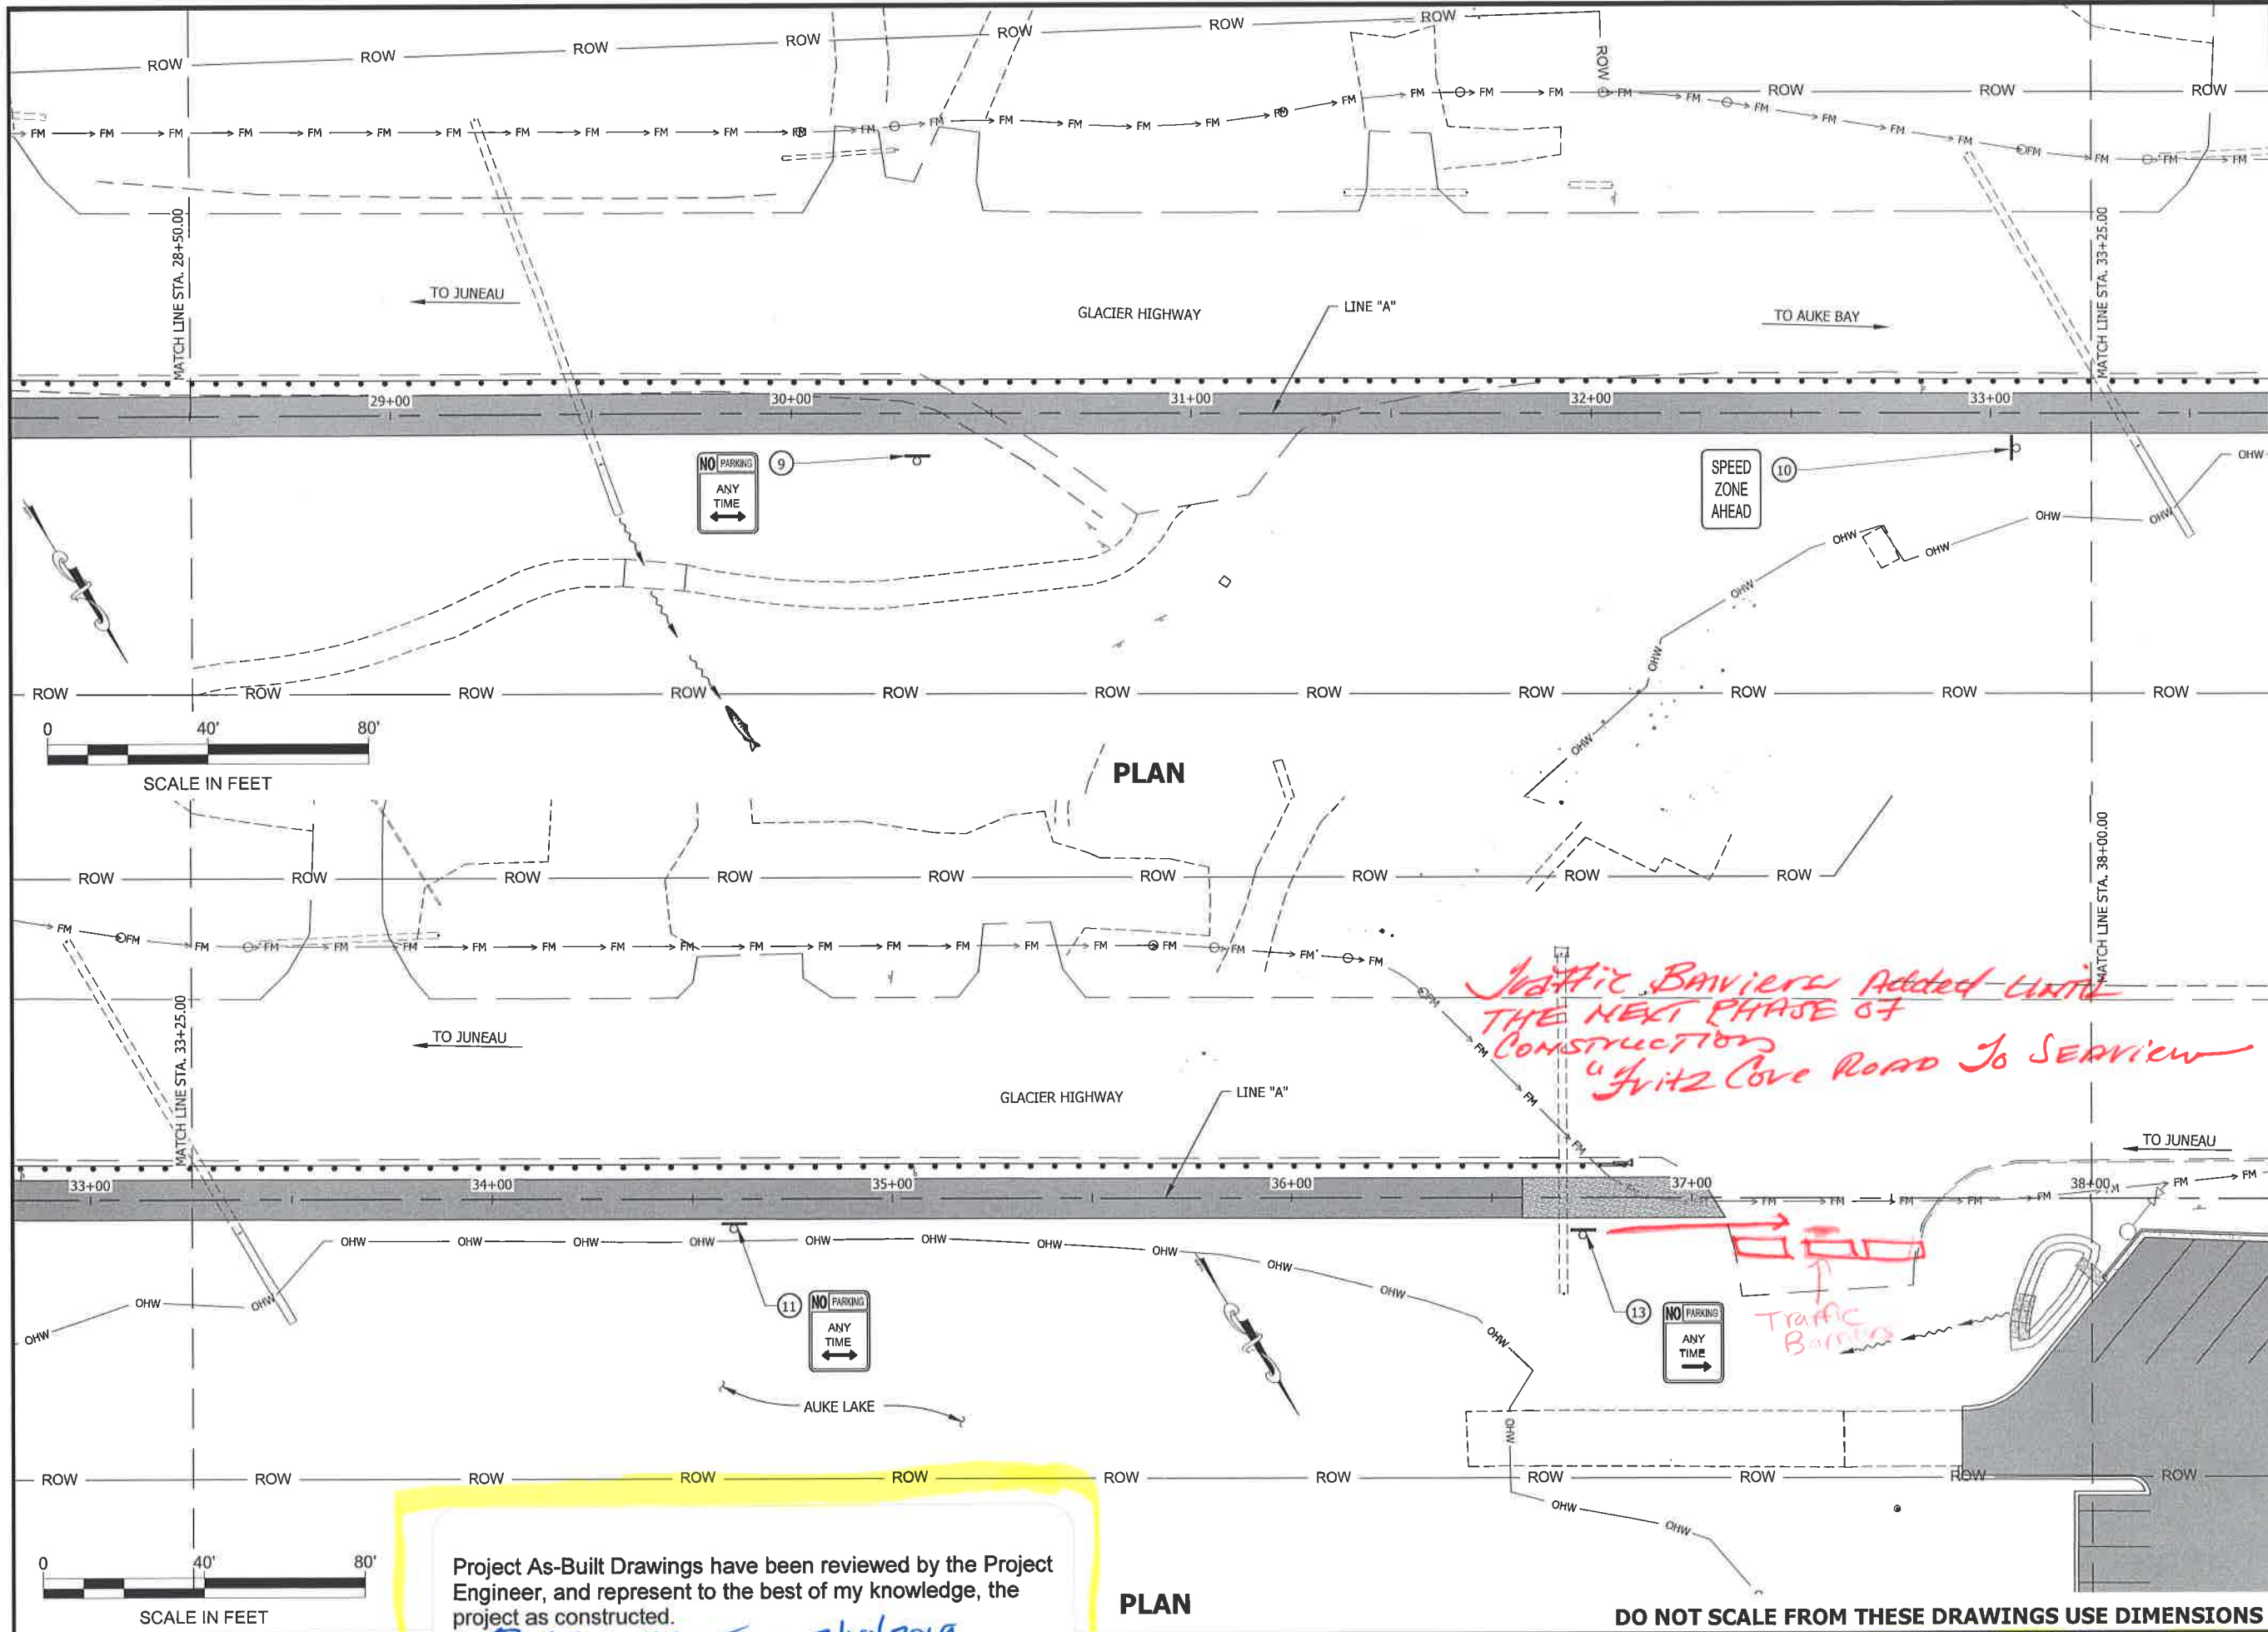

CHECKED BY: D. EPSTEIN


DESIGNED BY: J. BROWN
 DRAWN BY: R. GRANHAM
 STATE OF ALASKA
 DEPARTMENT OF TRANSPORTATION & PUBLIC FACILITIES
 SOUTHCOST REGION
 JNU: GLACIER HWY MULTI-USE SEPARATED PATH TO UAS
 PROJECT NO. 69500

SIGNING & STRIPING	
PROJECT DESIGNATION	
0933037 ~ 69500	
STATE	YEAR
ALASKA	2015
SHEET NUMBER	TOTAL SHEETS
H4	54

Project As-Built Drawings have been reviewed by the Project Engineer, and represent to the best of my knowledge, the project as constructed.
 PE *[Signature]* Date 2/19/2019

Traffic Barriers Added Until THE NEXT PHASE OF CONSTRUCTION "Fritz Cove Road To Service"

Traffic Barriers

DO NOT SCALE FROM THESE DRAWINGS USE DIMENSIONS

SEE CHANGE ORDER # 17 ON REVERSE FOR SELECTIVE TREE REMOVAL.



**STATE OF ALASKA
DEPARTMENT OF TRANSPORTATION
AND PUBLIC FACILITIES
SOUTHCOAST REGION**

Change Order

Project No.: 69500/0933037

Change Order No. 17

Project Name: JNU-Glacier Highway Multi-Use Path to UAS

Contractor:	Secon, Inc.	Change Order Summary:	
Address:	P.O. Box 32159	Calendar Days (+ / -):	N/A
	Juneau, AK 99803	New Completion Date:	N/A
		Amount of Change Order:	+\$7,672.52

Recommended By: [Signature] Date: 3 January 2017

Title: Project Engineer

Approved By: [Signature] Date: 3 Jan 2017

Title: Project Manager

This change order constitutes agreement to terms, conditions and prices stated below.

Accepted By: Margaret A. Hansen Date: 1/4/2017
Contractor's Representative

Seal of Alaskan Professional Engineer
(if required)

N/A

Acknowledgement indicates only receipt of Change Order and not mutual agreement for basis of payment or time allowance. If a the matter cannot be resolved within 7 days from signature date, an Intent to Claim form must be submitted to the engineer within 14 days.

Acknowledged By: _____ Date: _____
Contractor's Representative

Permission for previously submitted subcontractor(s) to perform all or portions of the work described herein is as checked: Yes No N/A

The following change(s) in the above Contract are hereby made in accordance with the terms of the Contract and under the terms and conditions stated below. Price adjustments resulting from inaccurate cost and pricing data are subject to the provisions of AS 36.30.400(c). This document shall become an amendment to the Contract and all provisions of the Contract will be applicable.


DESCRIPTION OF CHANGE (Use Continuation Sheet 25D-065 as Required)

In accordance with Subsection 104-1.02 of the Standard Specifications, the following changes are hereby made:

Reason for Change Order Items:


1. Selective Tree Removal was required to reduce safety hazards with undermined trees throughout the project.
2. Material was needed for the bench in front of the MSE Wall. Material was taken from the MSE Wall during excavation operations and placed in front of the MSE Wall to fill in the bench in front the MSE Wall in lieu of bringing in new material.
3. Modification was required to the new inlet to accommodate the planned 24 inch culvert.
4. A conflict between a planned culvert and a force water main was encountered and this change order compensates the Contractor for standby time while adjustments were made.

REMOVED FOR RECORDS LESS FORMER...
ON THE CHANGE ORDER # 17

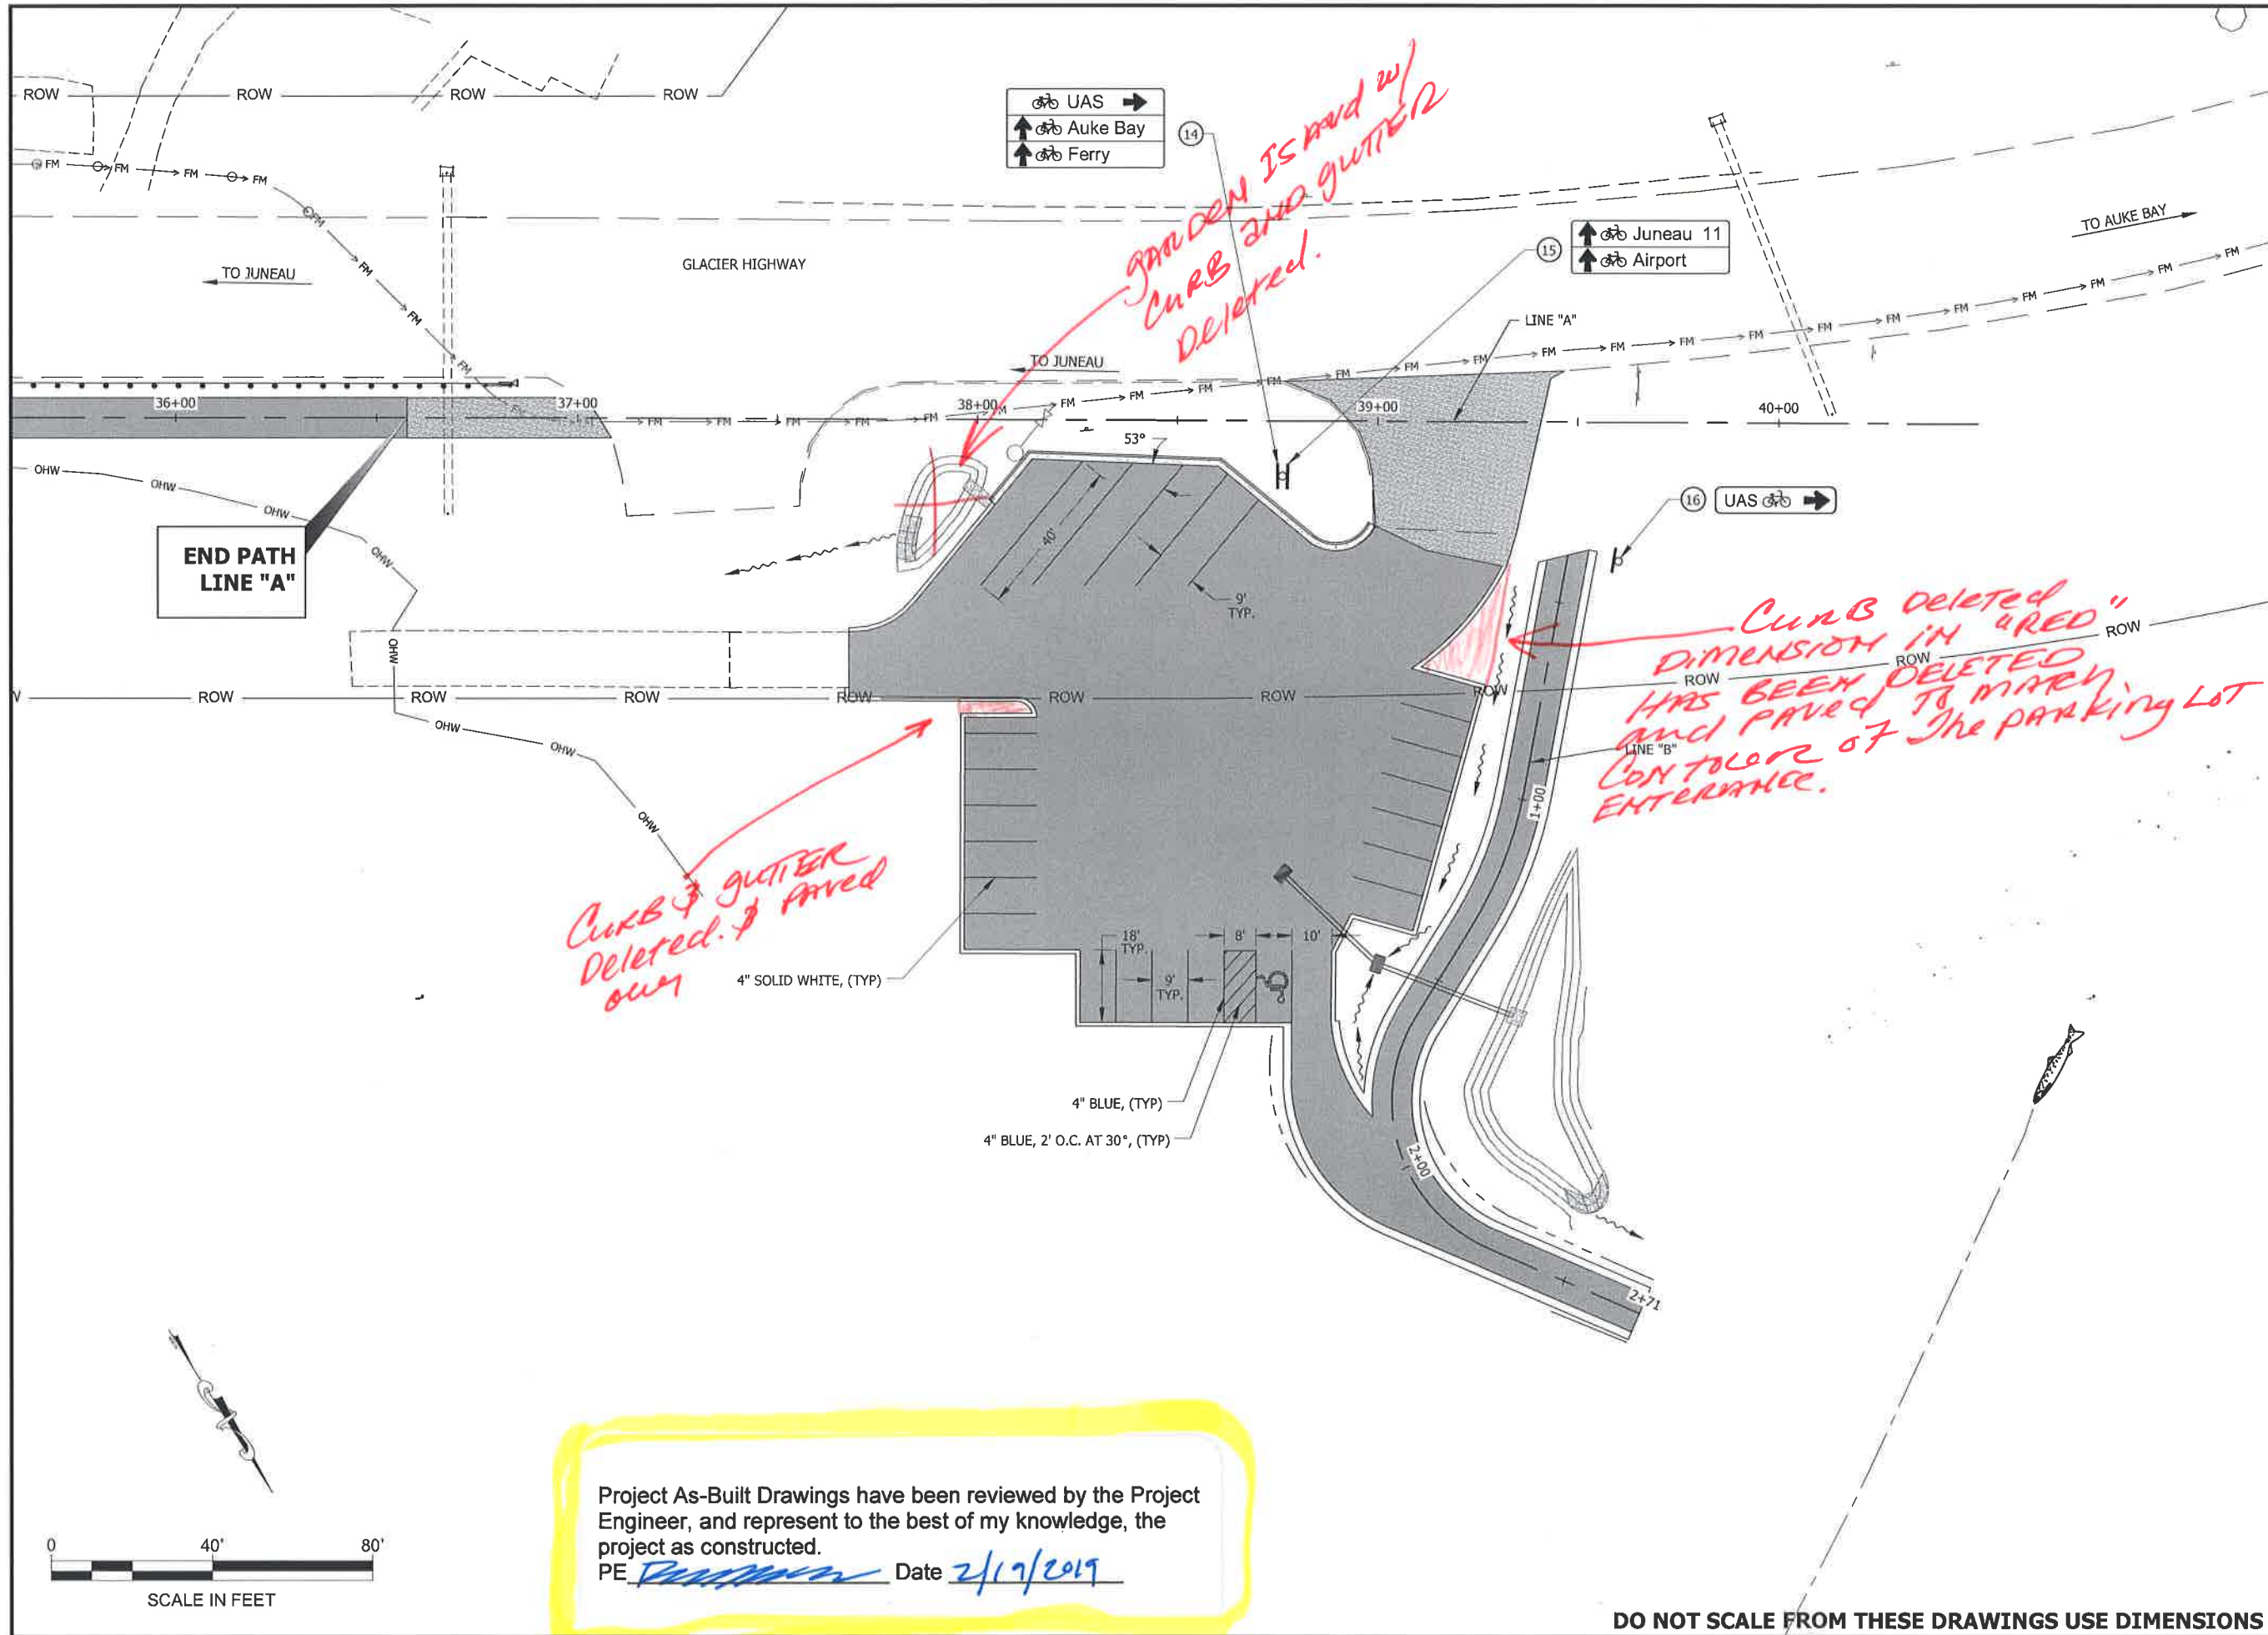

PATH:
Q:\JNU\69500\PLANSET\69500_H1-H5_SIGN.DWG
GRANTHAM, RICK L (DOT)
TAB: H5 Monday, July 20, 2015 12:45:41 PM

RECORD OF REVISIONS		
No.	DATE	DESCRIPTION

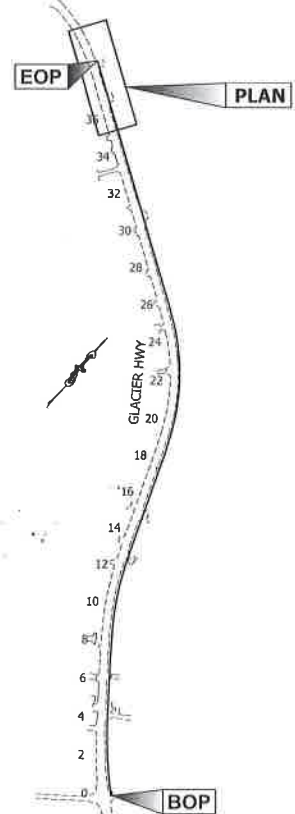

CHECKED BY: D. EPSTEIN

DESIGNED BY: J. BROWN
DRAWN BY: R. GRANTHAM

STATE OF ALASKA
DEPARTMENT OF TRANSPORTATION
& PUBLIC FACILITIES
SOUTHCOST REGION

JNU: GLACIER HWY MULTI-USE
SEPARATED PATH TO UAS
PROJECT NO. 69500


**WAYSIDE SIGNING
& STRIPING**

PROJECT DESIGNATION
0933037 ~ 69500

STATE	YEAR
ALASKA	2015

SHEET NUMBER	TOTAL SHEETS
H5	54

Project As-Built Drawings have been reviewed by the Project Engineer, and represent to the best of my knowledge, the project as constructed.
PE *[Signature]* Date *2/17/2019*

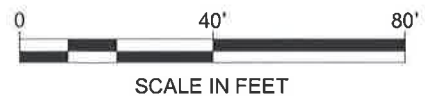

DO NOT SCALE FROM THESE DRAWINGS USE DIMENSIONS

NOTE: CONTACT CBJ MAINTENANCE SUPERVISOR, COLBY SHIBLER FOR RELOCATION OF OF EXISTING TRASH BINS.

PATH
Q:\JUNU69500\PLANSET\69500_J1_WAYSIDE_G-D.DWG


GRANTHAM, RICK L [DOT]
TAB: J1 Monday, July 20, 2015 12:46:57 PM

ADDENDUM NUMBER

ATTACHMENT NUMBER

RECORD OF REVISIONS

No.	DATE	DESCRIPTION

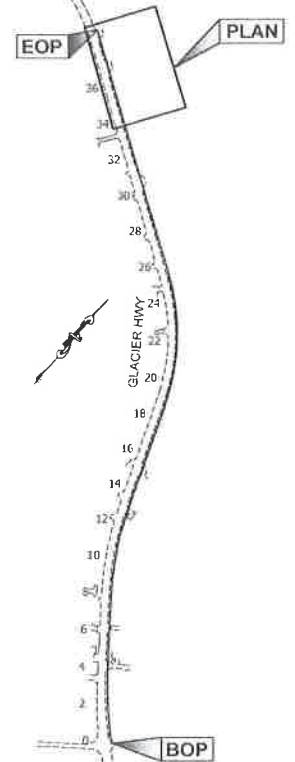

CHECKED BY: J. BROWN



DESIGNED BY: J. BROWN, L. CHAMBERS

DRAWN BY: R. GRANTHAM


STATE OF ALASKA
DEPARTMENT OF TRANSPORTATION
& PUBLIC FACILITIES
SOUTHCOST REGION

JNU: GLACIER HWY MULTI-USE
SEPARATED PATH TO UAS
PROJECT NO. 69500

WAYSIDE GRADING & DRAINAGE

PROJECT DESIGNATION
0933037 ~ 69500

STATE	YEAR
ALASKA	2015
SHEET NUMBER	TOTAL SHEETS
J1	54

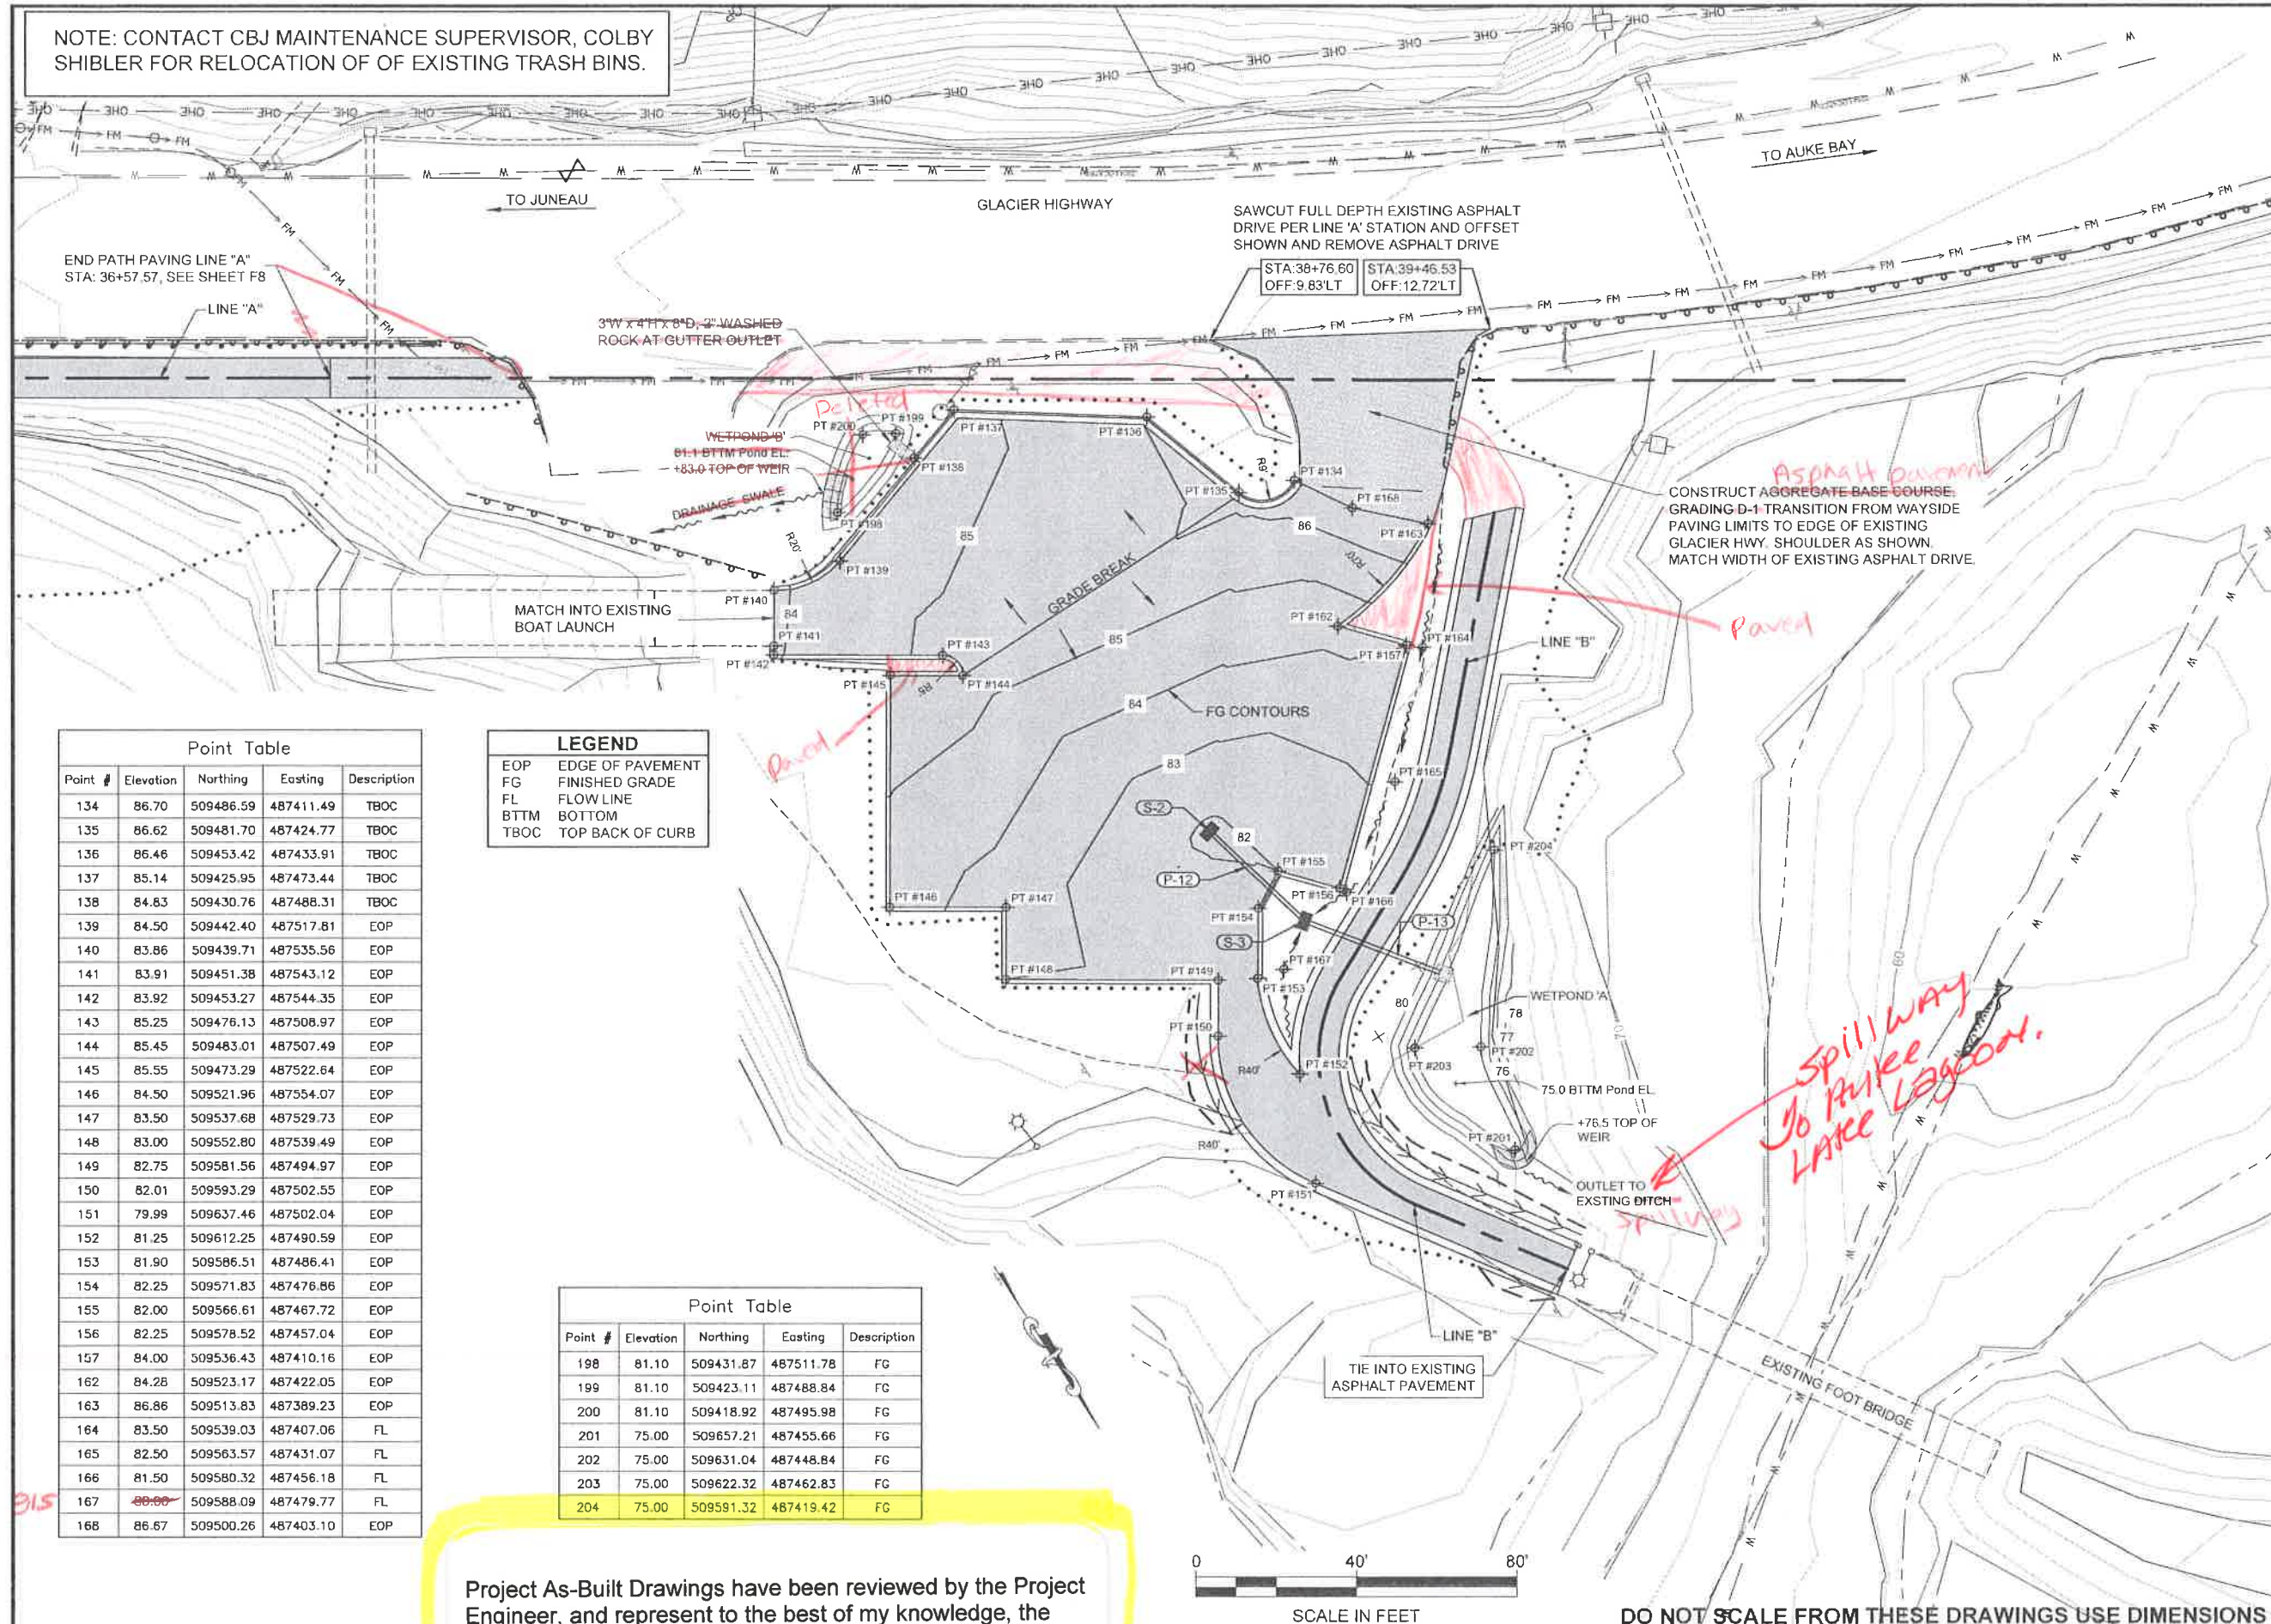


Point #	Elevation	Northing	Easting	Description
134	86.70	509486.59	487411.49	TBOC
135	86.62	509481.70	487424.77	TBOC
136	86.46	509453.42	487433.91	TBOC
137	85.14	509425.95	487473.44	TBOC
138	84.83	509430.76	487488.31	TBOC
139	84.50	509442.40	487517.81	EOP
140	83.86	509439.71	487535.56	EOP
141	83.91	509451.38	487543.12	EOP
142	83.92	509453.27	487544.35	EOP
143	85.25	509476.13	487508.97	EOP
144	85.45	509483.01	487507.49	EOP
145	85.55	509473.29	487522.64	EOP
146	84.50	509521.96	487554.07	EOP
147	83.50	509537.68	487529.73	EOP
148	83.00	509552.80	487539.49	EOP
149	82.75	509581.56	487494.97	EOP
150	82.01	509593.29	487502.55	EOP
151	79.99	509637.46	487502.04	EOP
152	81.25	509612.25	487490.59	EOP
153	81.90	509586.51	487486.41	EOP
154	82.25	509571.83	487476.86	EOP
155	82.00	509566.61	487467.72	EOP
156	82.25	509578.52	487457.04	EOP
157	84.00	509536.43	487410.16	EOP
162	84.28	509523.17	487422.05	EOP
163	86.86	509513.83	487389.23	EOP
164	83.50	509539.03	487407.06	FL
165	82.50	509563.57	487431.07	FL
166	81.50	509580.32	487456.18	FL
167	80.00	509588.09	487479.77	FL
168	86.67	509500.26	487403.10	EOP


Symbol	Description
EOP	EDGE OF PAVEMENT
FG	FINISHED GRADE
FL	FLOW LINE
BTTM	BOTTOM
TBOC	TOP BACK OF CURB

Point #	Elevation	Northing	Easting	Description
198	81.10	509431.87	487511.78	FG
199	81.10	509423.11	487488.84	FG
200	81.10	509418.92	487495.98	FG
201	75.00	509657.21	487455.66	FG
202	75.00	509631.04	487448.84	FG
203	75.00	509622.32	487462.83	FG
204	75.00	509591.32	487419.42	FG

Project As-Built Drawings have been reviewed by the Project Engineer, and represent to the best of my knowledge, the project as constructed.
PE R. Grantam Date 2/19/2017

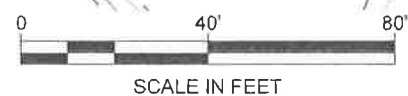

DO NOT SCALE FROM THESE DRAWINGS USE DIMENSIONS

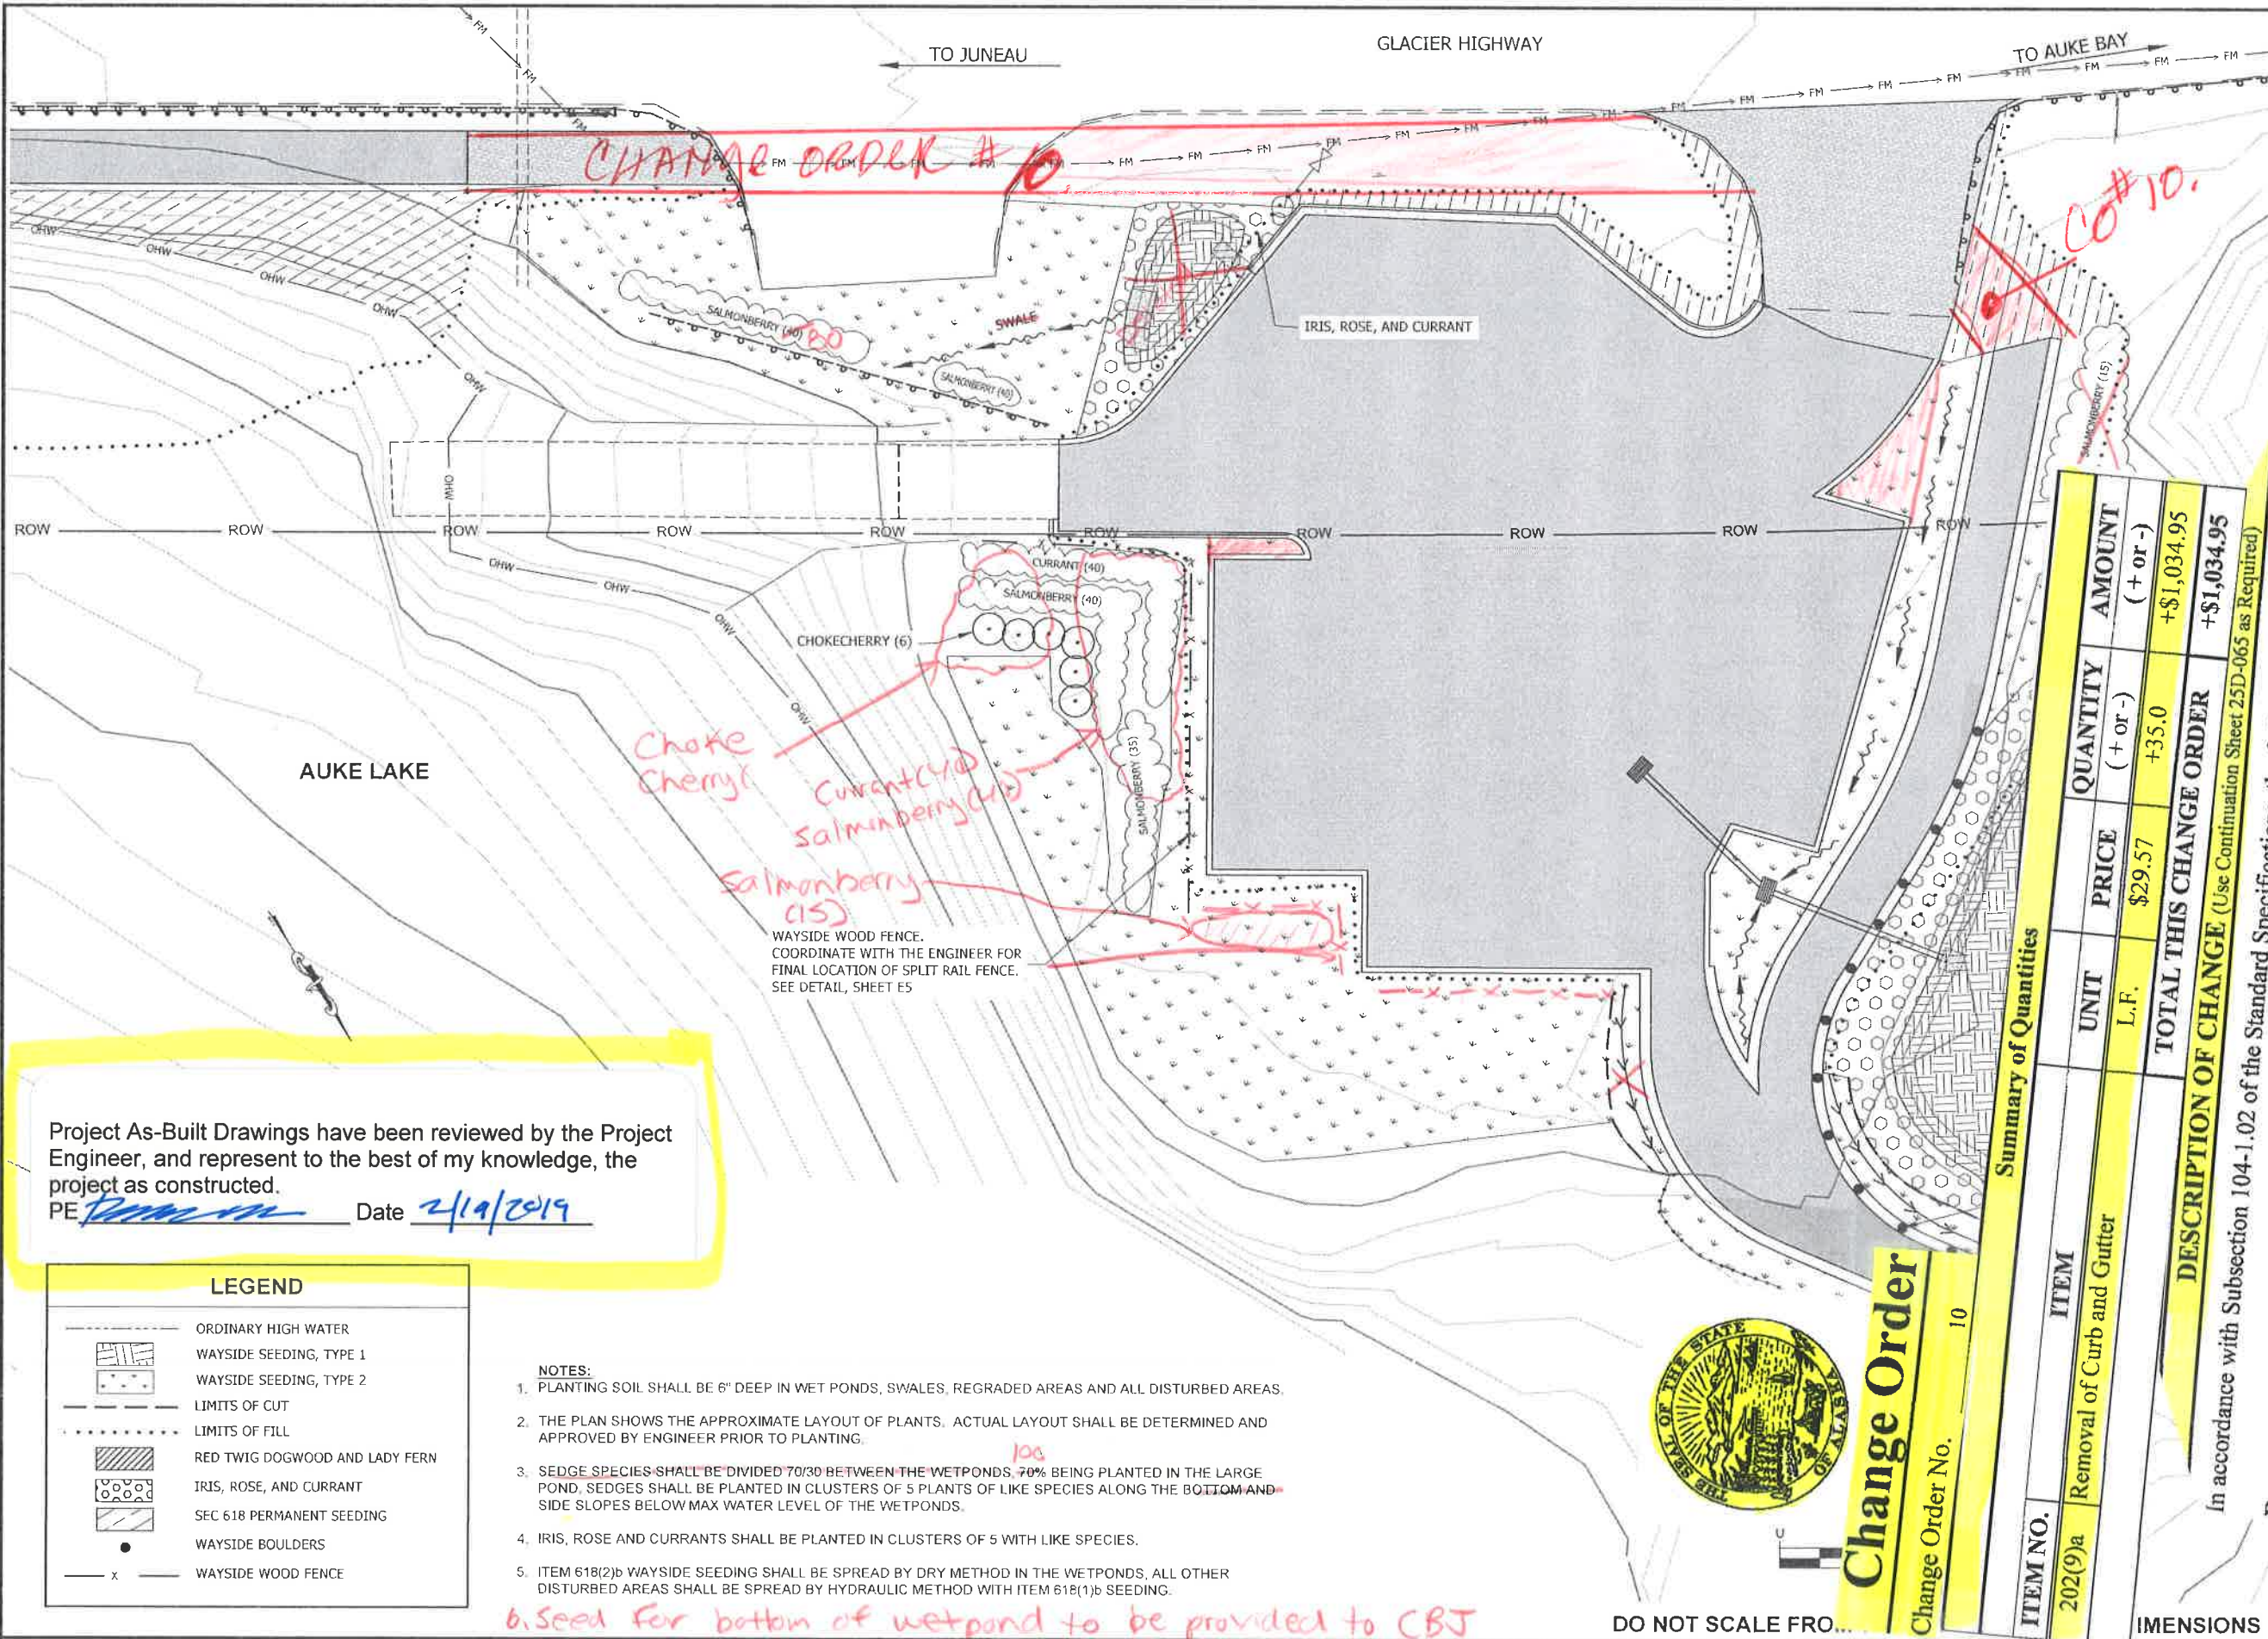

PATH:
Q:\JUN1695001\PLANSET\69500_L1_LSCP.DWG

GRANTHAM, RICK L (DOT)
Thursday, July 23, 2015 8:45:05 AM

ADDDUM NUMBER

ATTACHMENT NUMBER

RECORD OF REVISIONS

No.	DATE	DESCRIPTION

Project As-Built Drawings have been reviewed by the Project Engineer, and represent to the best of my knowledge, the project as constructed.
 PE *[Signature]* Date 2/19/2019

LEGEND

	ORDINARY HIGH WATER
	WAYSIDE SEEDING, TYPE 1
	WAYSIDE SEEDING, TYPE 2
	LIMITS OF CUT
	LIMITS OF FILL
	RED TWIG DOGWOOD AND LADY FERN
	IRIS, ROSE, AND CURRANT
	SEC 618 PERMANENT SEEDING
	WAYSIDE BOULDERS
	WAYSIDE WOOD FENCE

- NOTES:**
- PLANTING SOIL SHALL BE 6" DEEP IN WET PONDS, SWALES, REGRADED AREAS AND ALL DISTURBED AREAS.
 - THE PLAN SHOWS THE APPROXIMATE LAYOUT OF PLANTS. ACTUAL LAYOUT SHALL BE DETERMINED AND APPROVED BY ENGINEER PRIOR TO PLANTING.
 - SEDGE SPECIES SHALL BE DIVIDED 70/30 BETWEEN THE WETPONDS, 70% BEING PLANTED IN THE LARGE POND. SEDGES SHALL BE PLANTED IN CLUSTERS OF 5 PLANTS OF LIKE SPECIES ALONG THE BOTTOM AND SIDE SLOPES BELOW MAX WATER LEVEL OF THE WETPONDS.
 - IRIS, ROSE AND CURRANTS SHALL BE PLANTED IN CLUSTERS OF 5 WITH LIKE SPECIES.
 - ITEM 618(2)b WAYSIDE SEEDING SHALL BE SPREAD BY DRY METHOD IN THE WETPONDS, ALL OTHER DISTURBED AREAS SHALL BE SPREAD BY HYDRAULIC METHOD WITH ITEM 618(1)b SEEDING.

6. Seed for bottom of wetpond to be provided to CBJ



Change Order
 Change Order No. 10

STATE	ALASKA	2015
SHEET NUMBER	L1	TOTAL SHEETS 54


Reason for Change Order
 Due to delays on an adjacent project the connection in the Wayside parking lot was not established. This change order removes the curb and gutter in the existing driveways to allow for a connection to be established and provide a useable path from the beginning of the project to the end of the project.

Establish New Item 202(9)a Removal of Curb and Gutter
Description: Provide resources to remove the existing curb from approximate Station 38+76.60 LT to Station 37+70 LT. and approximate Station 37+60 RT to Station 37+70 LT.


Materials: Comply with the plans and Section 202.

In accordance with Subsection 104-1.02 of the Standard Specifications, the following changes are hereby made:

DO NOT SCALE FROM...

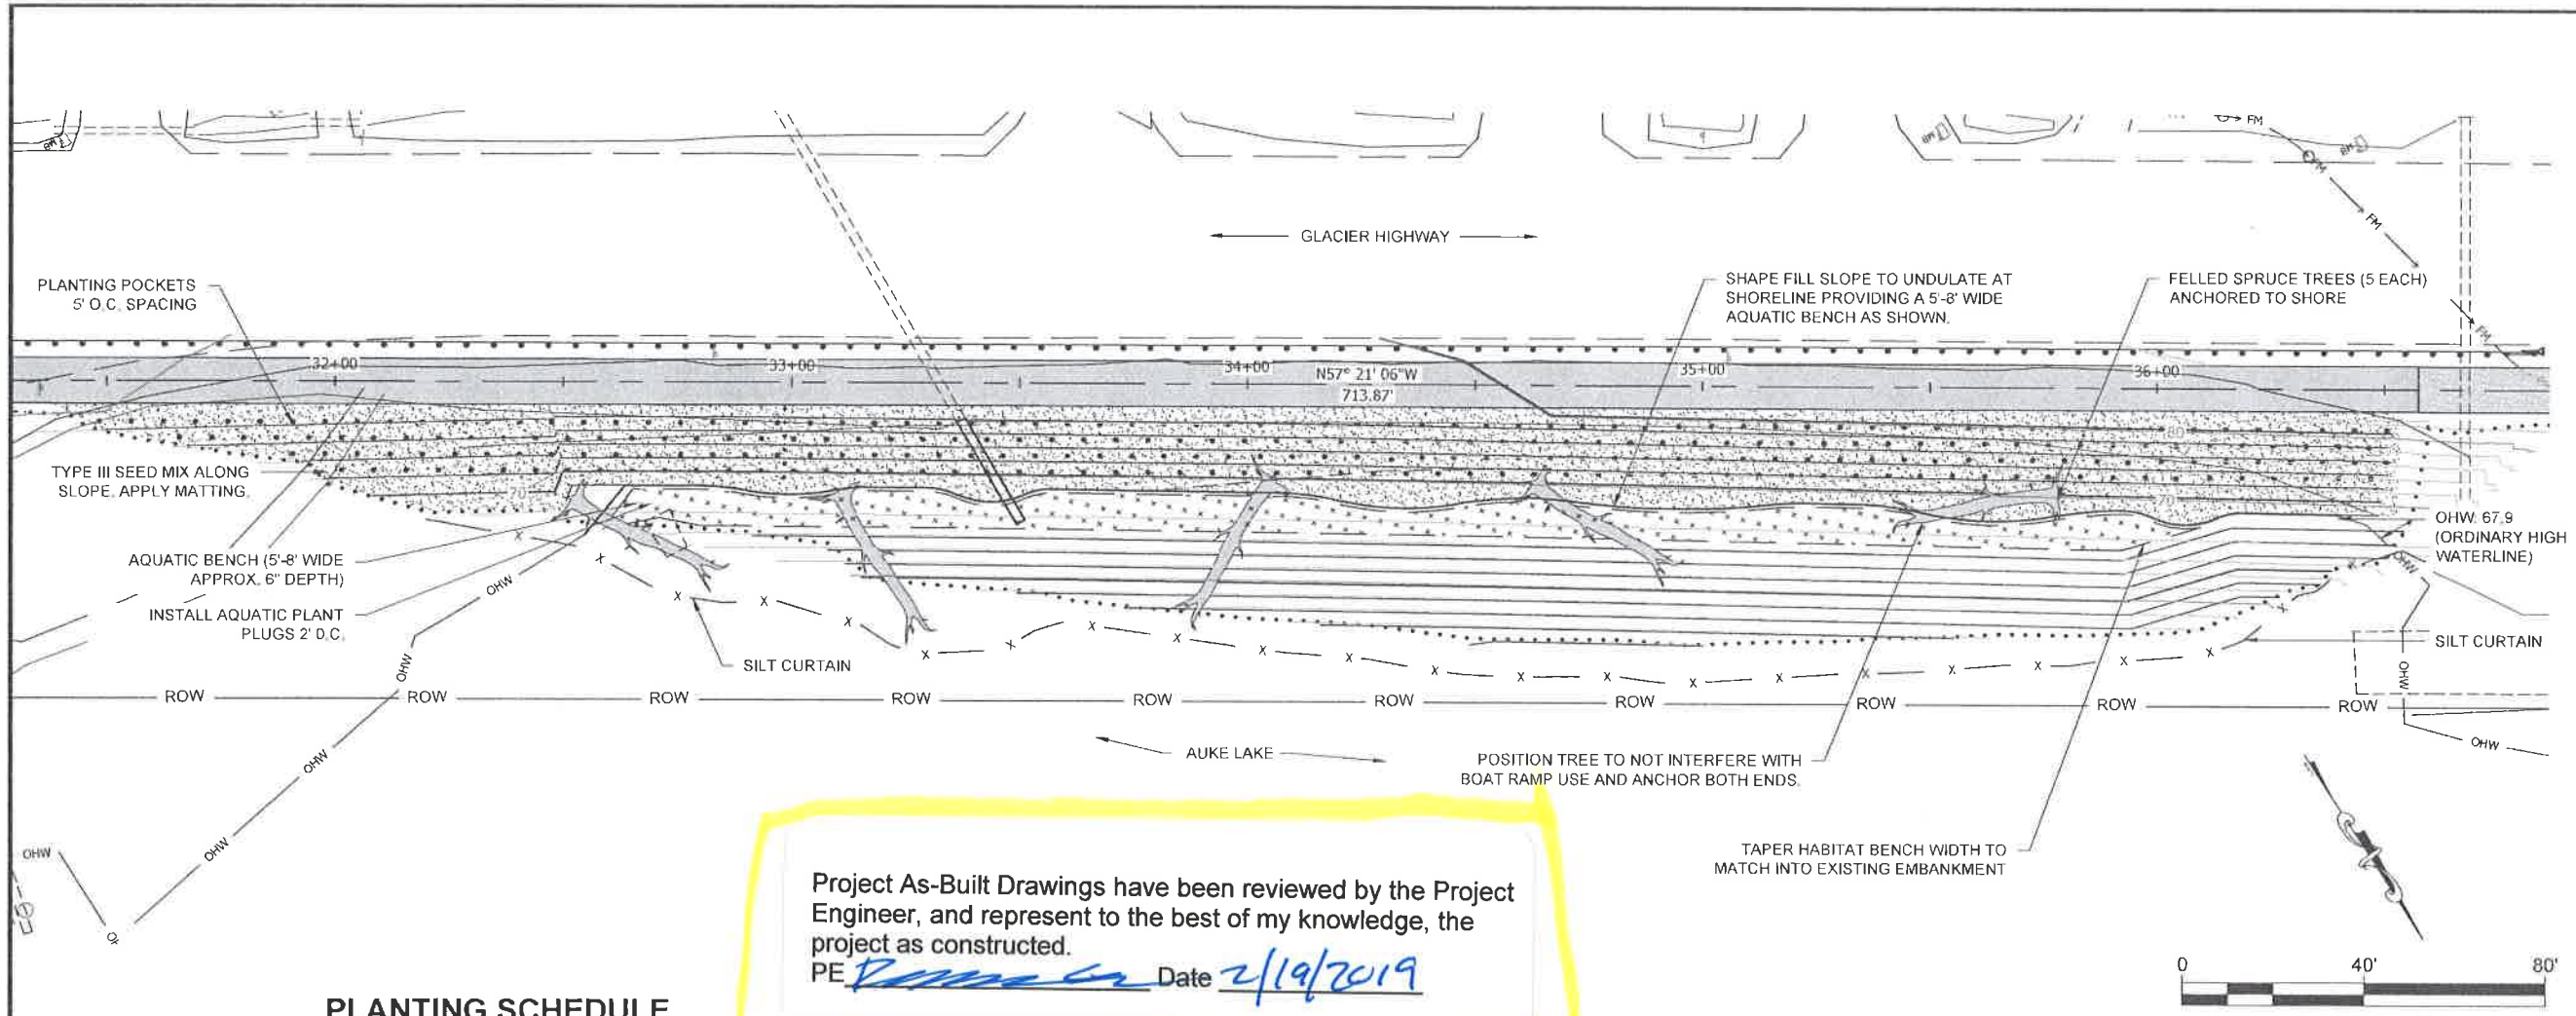

Project As-Built Drawings have been reviewed by the Project Engineer, and represent to the best of my knowledge, the project as constructed.
 PE *[Signature]* Date *2/19/2019*

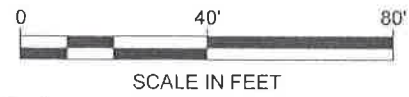

PLANTING SCHEDULE

WOODY PLANTS FOR PLANT POCKETS ALONG SLOPE						
SYMBOL	BOTANICAL NAME	COMMON NAME	NOTES	SIZE	SPACING	QTY
*	ALNUS VIRIDIS	SITKA ALDER	SALVAGED LOCALLY	24"-36"	60"	25%
	ARUNCUS SYLVESTER	GOAT'S BEARD	SALVAGED LOCALLY	PLUGS	60"	30%
	CORNUS STOLONIFERA	RED TWIG DOGWOOD	PURCHASED	18"	60"	20%
	PICEA SITCHENSIS	SITKA SPRUCE	SALVAGED LOCALLY	SAPLING	60"	5%
	SALIX SITCHENSIS	SITKA WILLOW	PURCHASED	18"	60"	20%
INTERMIX PLANTS IN PLANTING POCKETS ALONG SLOPE. 275 POCKETS AT 5' O.C. SPACING.						

AQUATIC PLUGS FOR BENCH				
SYMBOL	BOTANICAL NAME	COMMON NAME	DESCRIPTION	SOURCE LOCATION
[Symbol]	EQUISETUM FLUVIATILE	SWAMP HORSETAIL	PLUG PLANTING	ROW*
	CARIX SITCHENSIS	SITKA SEDGE	PLUG PLANTING	ROW
	CALTHA PALUSTRIS	MARSH MARIGOLD	PLUG PLANTING	ROW
	SCIRPUS MICROCARPUS	SMALL LEAVED BULLRUSH	PLUG PLANTING	ROW
INTERMIX 775 PLANTING PLUGS ALONG AQUATIC BENCH AT 2' O.C. SPACING. PLANT OVER 2,675 SQ.FT. OF 12" DEPTH PEAT TOPSOIL.				

TYPE III SEED MIX FOR SLOPE ABOVE WATER LINE				
SYMBOL	BOTANICAL NAME	COMMON NAME	PROPORTION BY WEIGHT	APPLICATION RATE
[Symbol]	CALAMAGROSTIS CANADENSIS	BLUEJOINT REEDGRASS	20%	3 LBS. PER 1000 S.F.
	DESCHAMPSIA CESPITOSA	TUFTED HAIRGRASS	20%	
	BECKMANNIA SYZIGACHNE	AMERICAN SLOUGHGRASS	10%	
	LOLIUM MULTIFLORUM	ANNUAL RYE	10%	
	FESTUCA RUBRA	RED FESCUE	40%	
SEED AND COVER SLOPE WITH JUTE MESH. FILL SLOPE ABOVE THE OHW LINE IS APPROXIMATELY 10350 SQ.FT.				

LEGEND			
SYMBOL	NOTES	DESCRIPTION	QTY
[Symbol]	SILT CURTAIN	SEE DETAIL & SPECS	480 LF.

NOTES

SPRUCE TREES ARE AVAILABLE ON SITE WITHIN THE AREA OF CLEARING AND GRUBBING.

*DONOR SITE FOR PLANT PLUGS IS LOCATE WITHIN THE RIGHT OF WAY AT THE SOUTHEAST END OF THE AQUATIC BENCH.

DO NOT SCALE FROM THESE DRAWINGS USE DIMENSIONS

PATH
 Q:\JNU\69500\PLANSET\69500_L2-L3_HABITAT BENCH.DWG
 GRANHAM, RICK L (DOT)
 TAB: L2 AUGUST 2014
 ADDENDUM NUMBER
 ATTACHMENT NUMBER
 RECORD OF REVISIONS
 No. DATE DESCRIPTION

PLAN LEGEND

CHECKED BY: J. BROWN

DESIGNED BY: J. BROWN
 DRAWN BY: G. AMUNDSEN

STATE OF ALASKA
 DEPARTMENT OF TRANSPORTATION & PUBLIC FACILITIES
 SOUTHCOAST REGION

JNU: GLACIER HWY MULTI-USE SEPARATED PATH TO UAS
 PROJECT NO. 69500

AUKE LAKE FILL AND PLANTINGS

PROJECT DESIGNATION
0933037 ~ 69500

STATE	YEAR
ALASKA	2015
SHEET NUMBER	TOTAL SHEETS
L2	54


PATH:
 Q:\JNU\69500\PLANSET\69500_L2-L3_HABITAT
 BENCH.DWG
 GRANHAM, RICK L (DOT)
 TAB: L3 AUGUST 2014

ADDENDUM NUMBER

ATTACHMENT NUMBER

RECORD OF REVISIONS

No.	DATE	DESCRIPTION

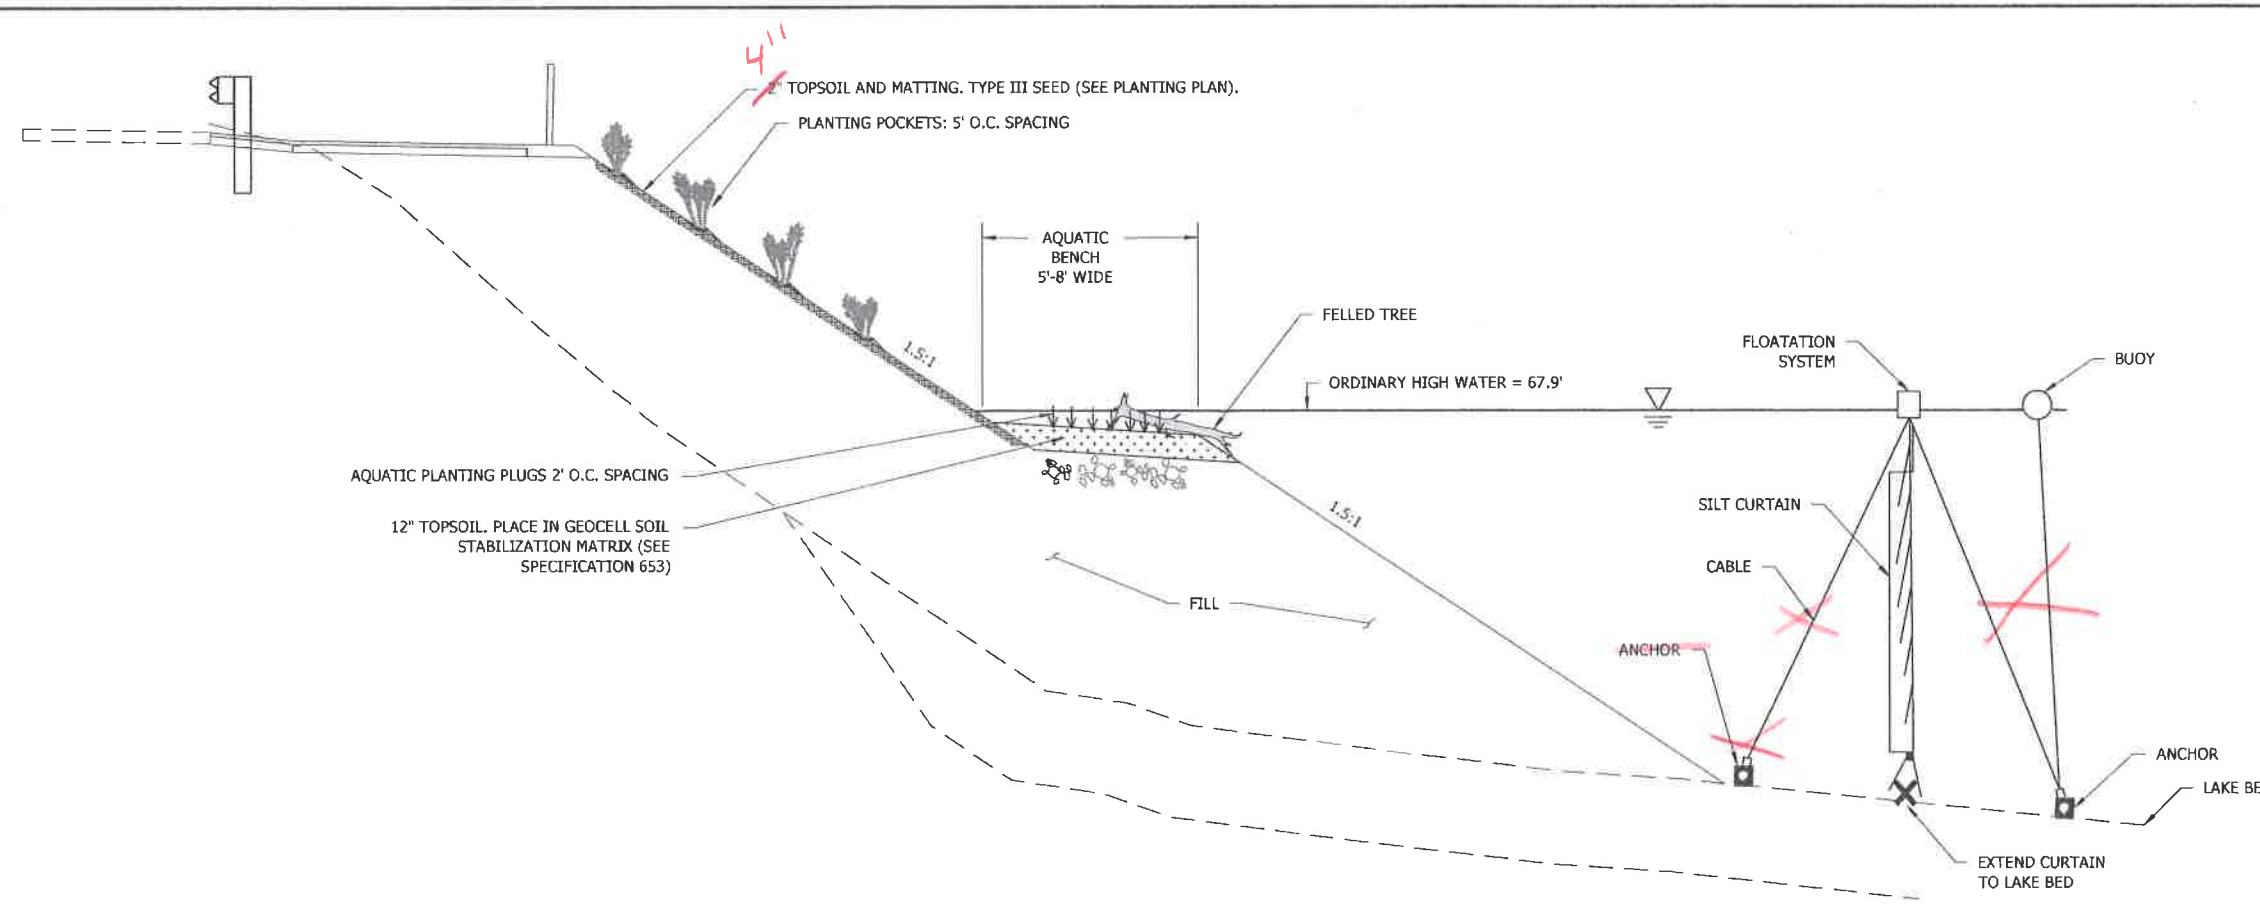

PLAN LEGEND

CHECKED BY: T.S.



DESIGNED BY: T.S.
 DRAWN BY: B.K.

STATE OF ALASKA
 DEPARTMENT OF TRANSPORTATION
 & PUBLIC FACILITIES
 SOUTHEAST REGION

JNU: GLACIER HWY MULTI-USE
 SEPARATED PATH TO UAS
 PROJECT NO. 69500

AQUATIC BENCH

PROJECT DESIGNATION	
0933037 ~ 69500	
STATE	YEAR
ALASKA	2015
SHEET NUMBER	TOTAL SHEETS
L3	54

SEE REVERSE FOR C.O.# 16.
 Project As-Built Drawings have been reviewed by the Project Engineer, and represent to the best of my knowledge, the project as constructed.
 PE *[Signature]* Date 2/19/2019

DO NOT SCALE FROM THESE DRAWINGS USE DIMENSIONS



**STATE OF ALASKA
DEPARTMENT OF TRANSPORTATION
AND PUBLIC FACILITIES
SOUTHCOST REGION**

Change Order

Change Order No. 16

Project No.: 69500/0933037
Project Name: JNU-Glacier Highway Multi-Use Path to UAS

Contractor:	Seccon, Inc.	Change Order Summary:	
Address:	P.O. Box 32159 Juneau, AK 99803	Calendar Days (+ / -):	N/A
		New Completion Date:	N/A
		Amount of Change Order:	+\$20,780.56

Recommended By: [Signature] Date: 27 Dec 2016

Title: Project Engineer
Approved By: [Signature] Date: 27 Dec 2016

Title: Project Manager

This change order constitutes agreement: to terms, conditions and prices stated below.
Accepted By: [Signature] Date: 1/4/2017
Contractor's Representative

Seal of Alaskan Professional Engineer
(if required)
N/A

Acknowledgement indicates only receipt of Change Order and not mutual agreement for basis of payment or time allowance. If a the matter cannot be resolved within 7 days from signature date, an Intent to Claim form must be submitted to the engineer within 14 days.

Acknowledged By: _____ Date: _____
Contractor's Representative

Permission for previously submitted subcontractor(s) to perform all or portions of the work described herein is as checked: Yes No N/A

The following change(s) in the above Contract are hereby made in accordance with the terms of the Contract and under the terms and conditions stated below. Price adjustments resulting from inaccurate cost and pricing data are subject to the provisions of AS 36.30.400(c). This document shall become an amendment to the Contract and all provisions of the Contract will be applicable.

DESCRIPTION OF CHANGE (Use Continuation Sheet 25D-065 as Required)


In accordance with Subsection 104-1.02 of the Standard Specifications, the following changes are hereby made:

Reason for Change Order

- 1) The Contractor and the Department discussed the use of permanent signs rather than daily traffic signs and agreed to delete the permanent construction signs and pay for the signs per day. This change order deletes the lump sum item for permanent signs.
- 2) The geocell on the habitat bench was installed per plan, but the face of the geocell was plastic and there were environmental concerns about the long term effects on the fish habitat. This change order makes adjustments to the habitat bench in order to create suitable fish habitat.


Delete Item 643(2)a Permanent Construction Signs.

Establish New Item 653(2)a Habitat Bench Adjustment

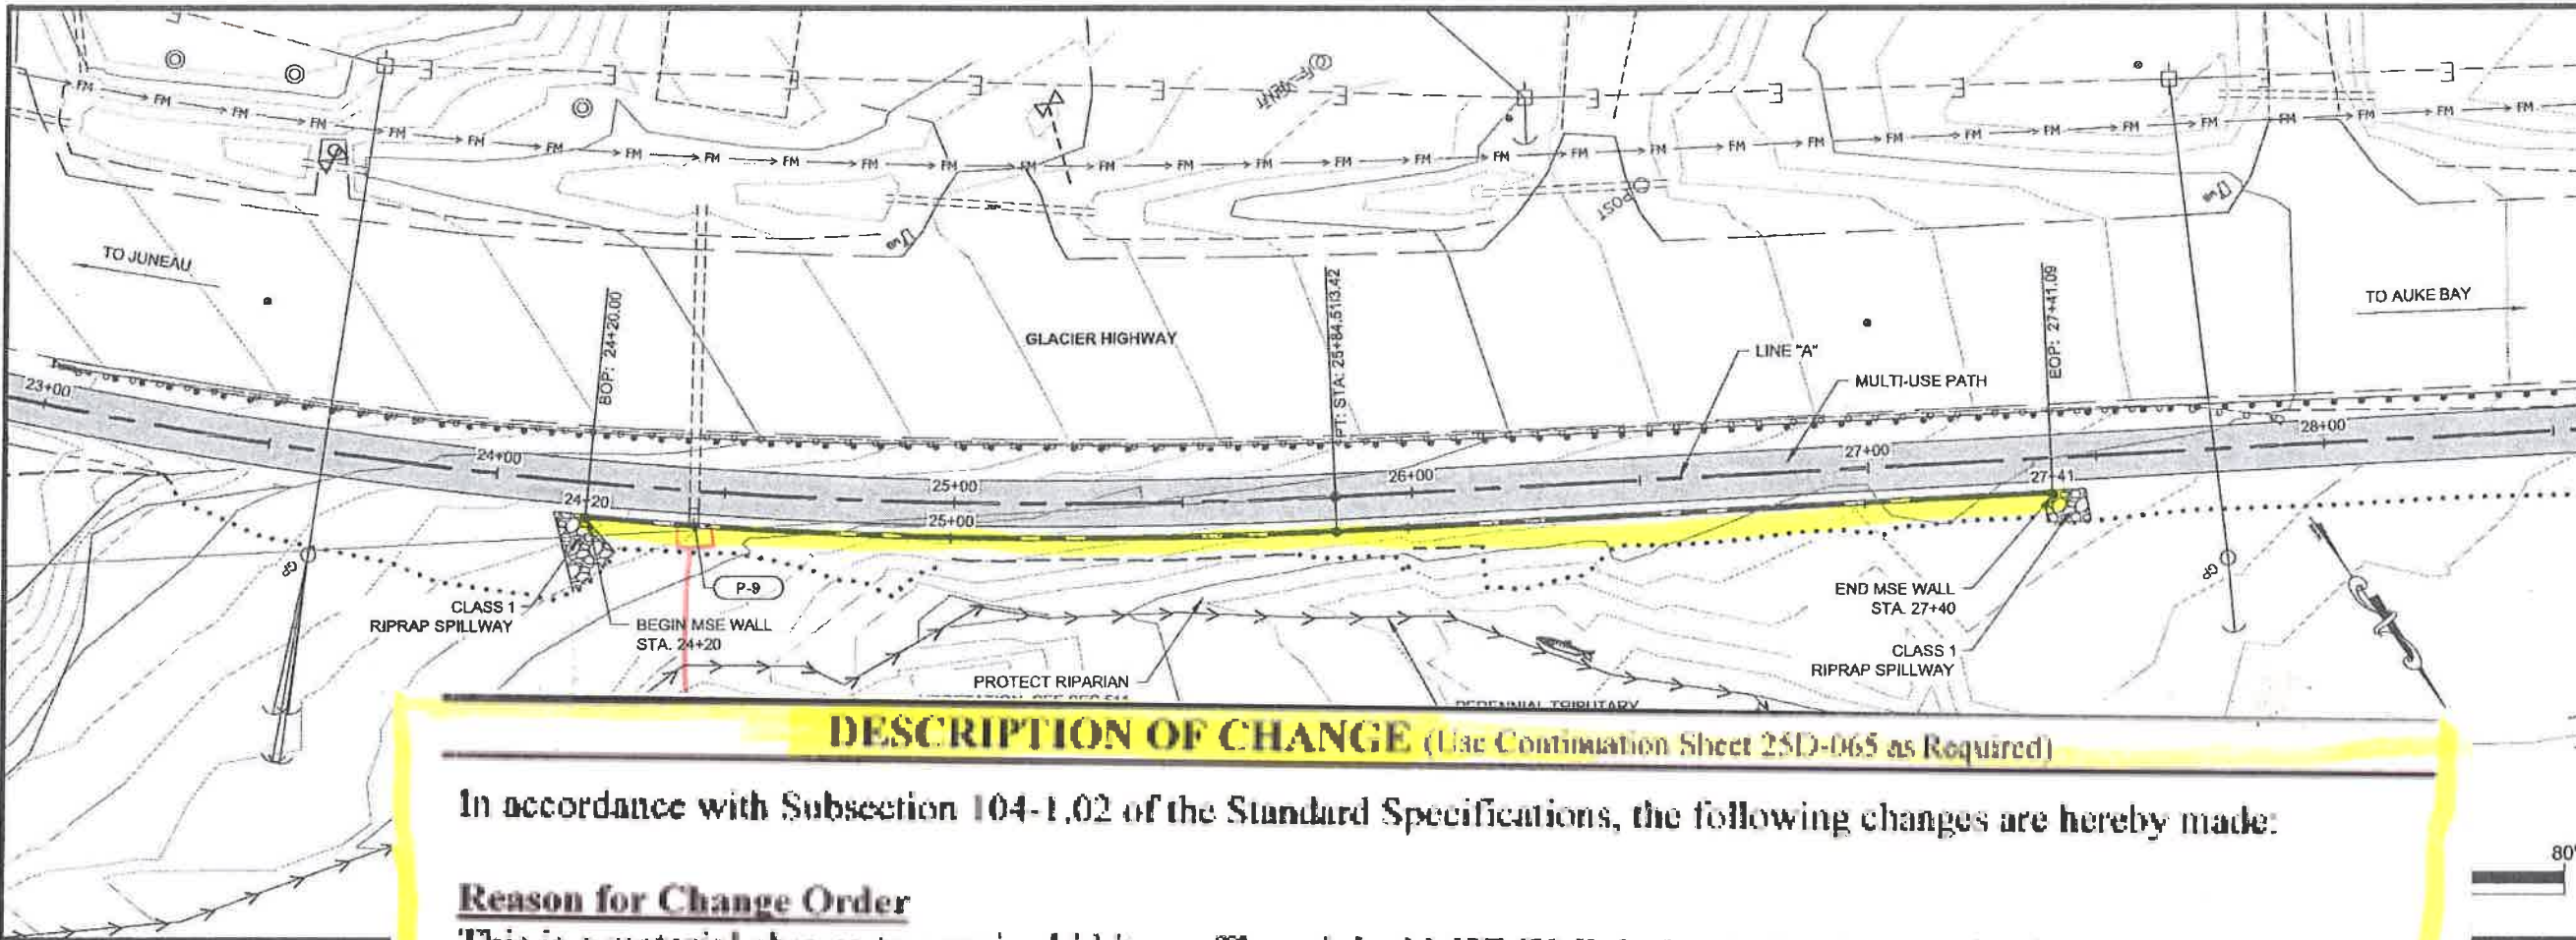

PATH: Q:\JNU189500\PLANSET189500_M1_RETAINING WALL.DWG
 GRANHAM, RICK L (DOT)
 TAB: M1 Monday, November 23, 2015 1:09:10 PM

ADDENDUM NUMBER		
ATTACHMENT NUMBER		
RECORD OF REVISIONS		
No.	DATE	DESCRIPTION
1	11/23/15	CONTROL POINT MOD

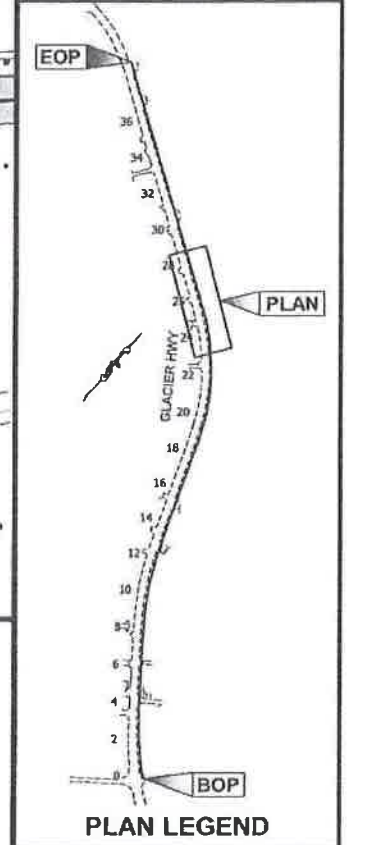

DESCRIPTION OF CHANGE (Use Continuation Sheet 25D-065 as Required)


In accordance with Subsection 104-1.02 of the Standard Specifications, the following changes are hereby made:

Reason for Change Order
 This is a material change to a major bid item. The original MSE Wall design had to be completely replaced to accommodate a new typical section and avoid conflict with the adjacent fish stream. The new section increases the depth, increases the block quantities, requires additional excavation, shoring, sheeting, a stepped footing, larger blocks, additional engineering, and additional ESCP control.

Replace Sheet B3 and M1 with the attached Sheet B3 and M1.

Delete Item 511(1A)a MSE Concrete Wall – Pattern Finish

Form 25D-068 (Revised 04/12) C.O. No. 8 Page 1 of 4

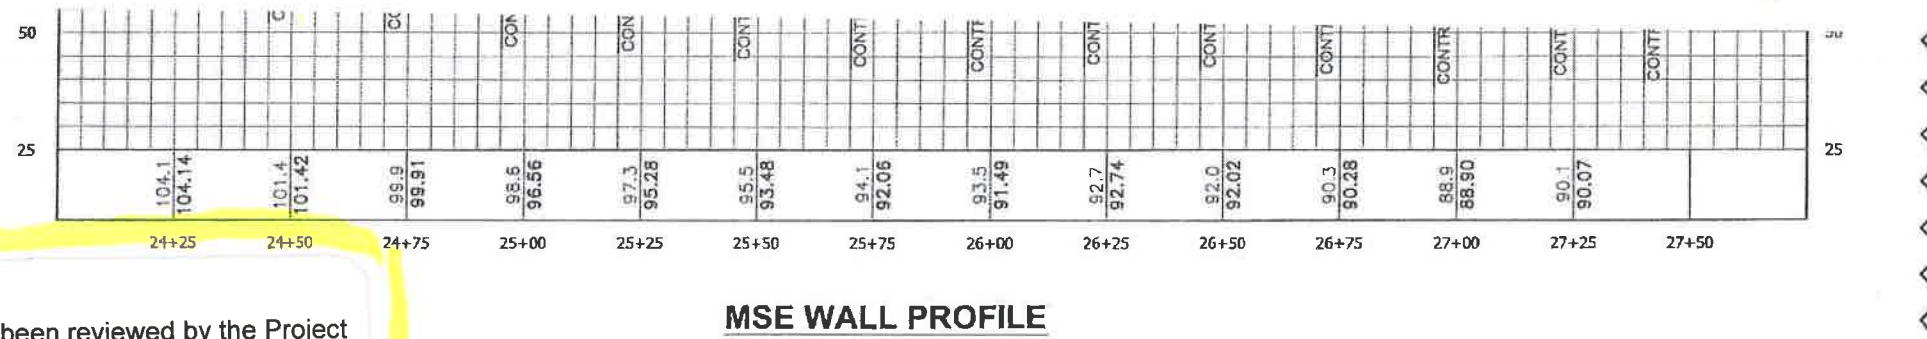

MSE WALL PROFILE

DO NOT SCALE FROM THESE DRAWINGS USE DIMENSIONS

Project As-Built Drawings have been reviewed by the Project Engineer, and represent to the best of my knowledge, the project as constructed.
 PE [Signature] Date 2/19/2019

CHECKED BY: J. BROWN

DESIGNED BY: J. BROWN, L. CHAMBERS
 DRAWN BY: R. GRANHAM



STATE OF ALASKA
 DEPARTMENT OF TRANSPORTATION & PUBLIC FACILITIES
 SOUTHCOST REGION

JNU: GLACIER HWY MULTI-USE SEPARATED PATH TO UAS
 PROJECT NO. 69500

MSE RETAINING WALL


PROJECT DESIGNATION
0933037 ~ 69500

STATE	YEAR
ALASKA	2015
SHEET NUMBER	TOTAL SHEETS
M1	54

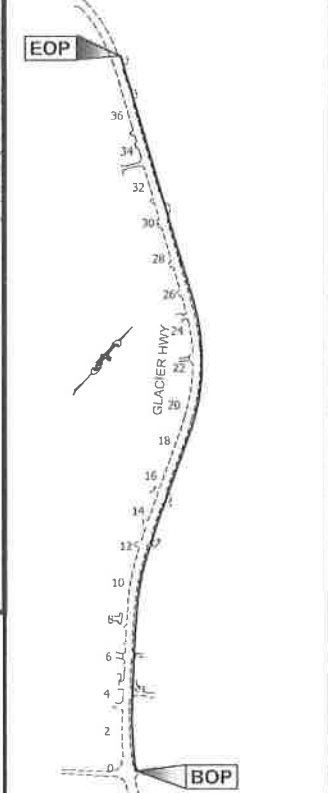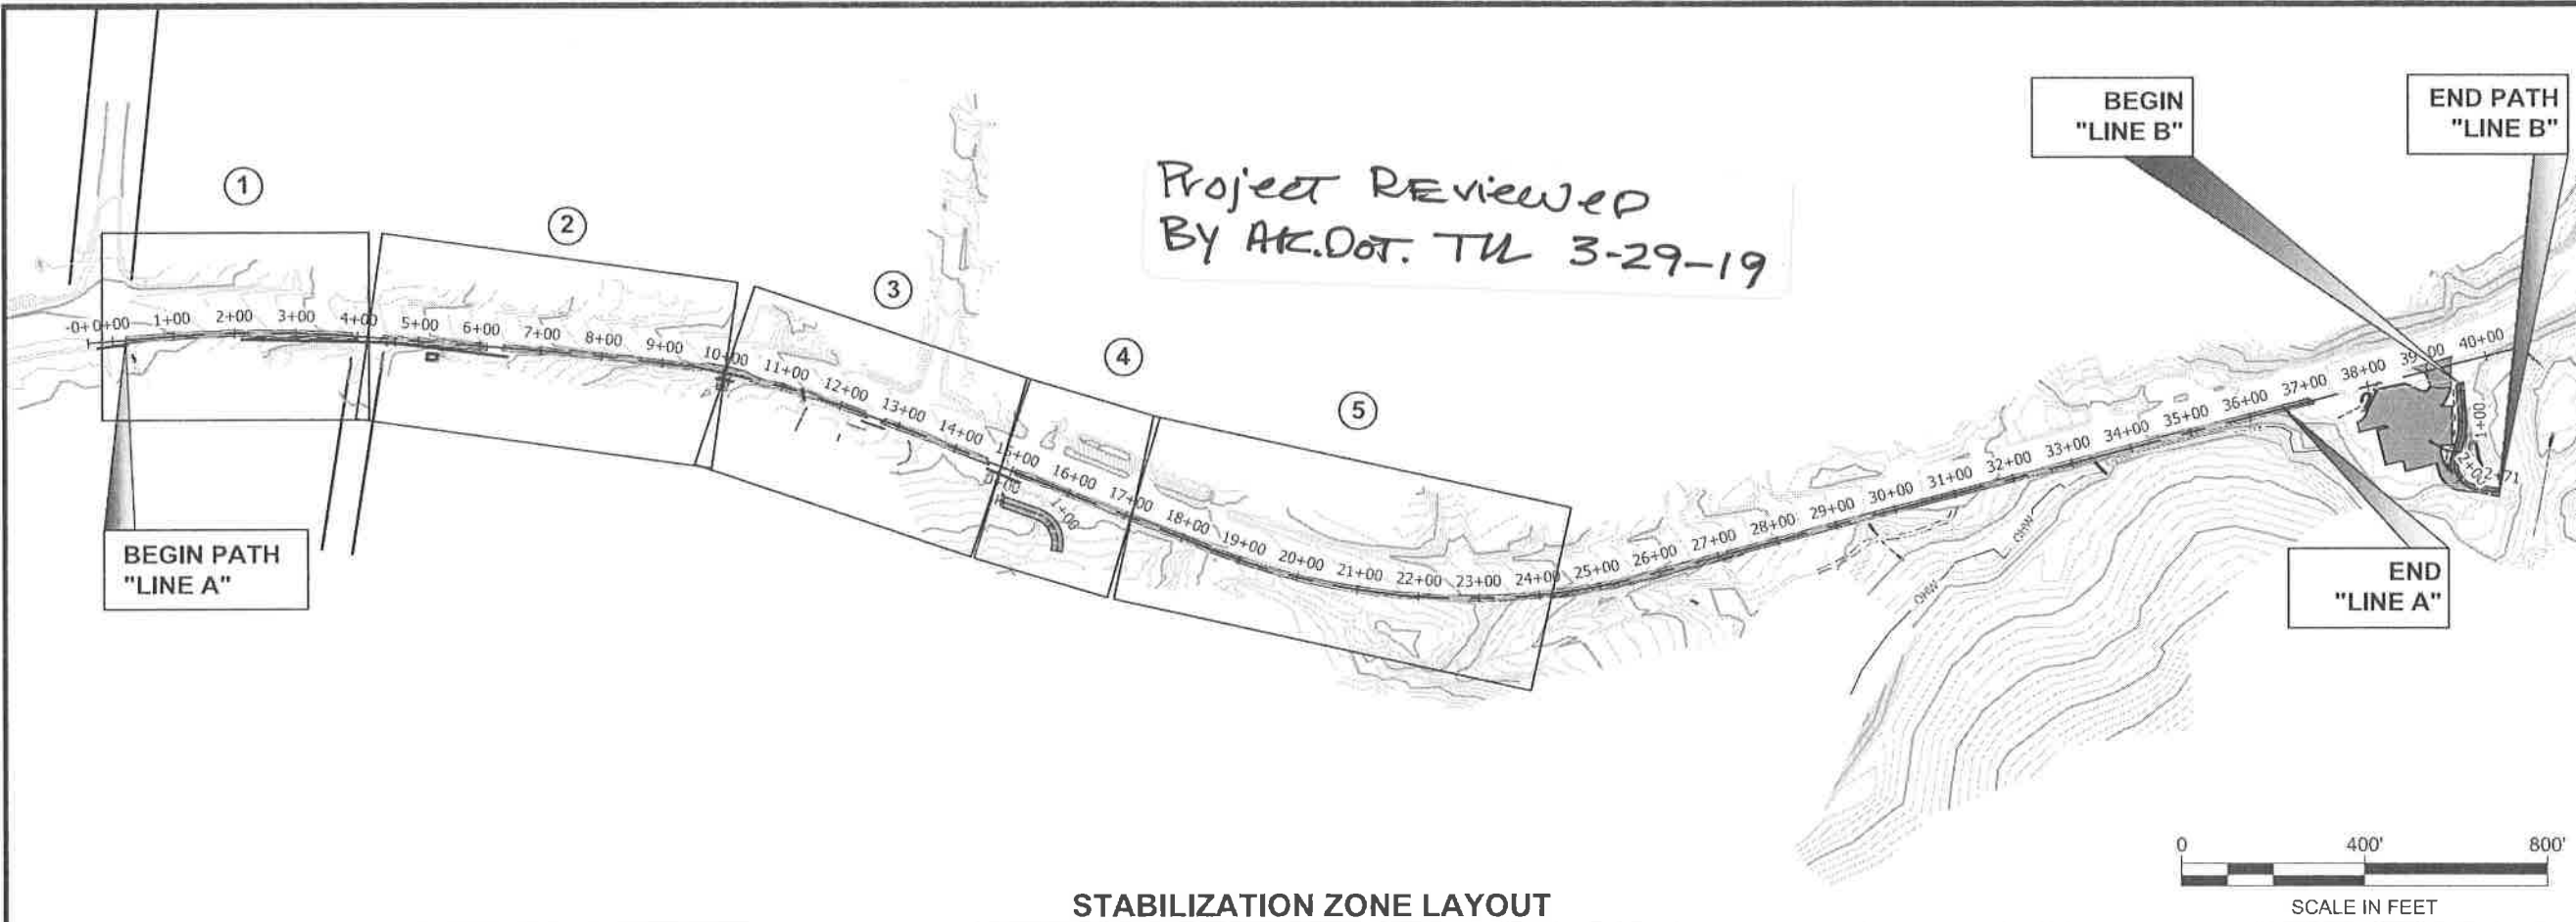

STABILIZATION ZONE LAYOUT

SCALE IN FEET

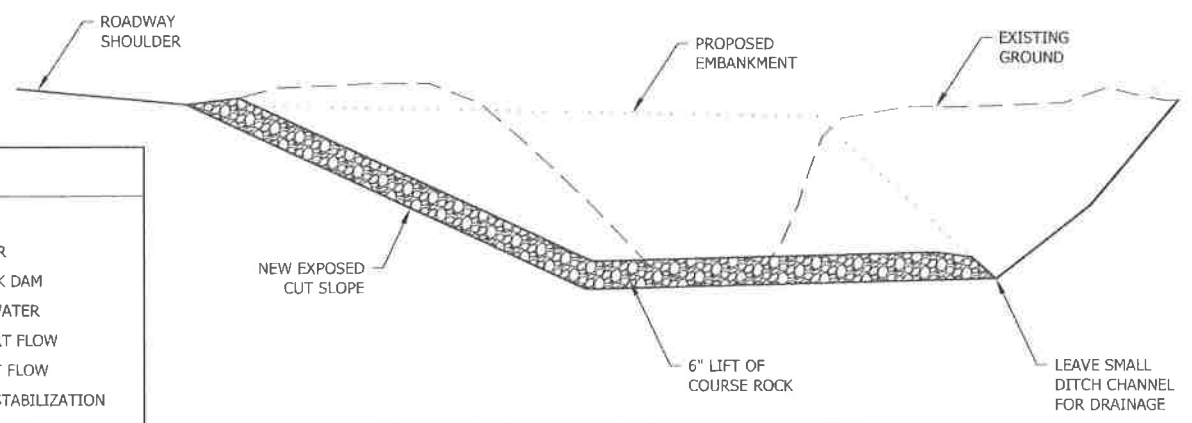

**ASPHALT SIDEWALK CONSTRUCTION
TEMPORARY STABILIZATION DETAIL**

1. DURING ASPHALT SIDEWALK CONSTRUCTION ONCE AREA HAS BEEN CLEARED GRUBBED AND EXCAVATED TO GRADE TEMPORARILY STABILIZE EXPOSED CUTS WITH COURSE ROCK TO PREVENT EROSION OF EXPOSED GROUND.
2. COURSE ROCK SHALL BE 1" TO 6" SIZED STONES WITH 5% OR LESS FINES.
3. THE 6" COURSE ROCK LIFT MAY BE INCORPORATED INTO THE FINAL EMBANKMENT.
4. CONTRACTOR SHALL STABILIZE DOWN STREAM STABILIZATION ZONES WITH COURSE ROCK PRIOR TO DISTURBING THE SUBSEQUENT UPSTREAM ZONE.
5. ASPHALT SIDEWALK CONSTRUCTION TEMPORARY STABILIZATION SHALL BE PAID FOR UNDER ITEM 641(3)a.

INVASIVE PLANT SUMMARY				INVASIVE PLANT SUMMARY			
SITE	TYPE	AREA (SQ FT)	SCHEDULE	SITE	TYPE	AREA (SQ FT)	SCHEDULE
NT1	REED CANARY GRASS	8000	A	NT24	REED CANARY GRASS	65	A
NT2	CANADA THISTLE	2	A	NT25	REED CANARY GRASS	100	A
NT3	ORANGE HAWK WEED	0.25	A	NT26	REED CANARY GRASS	9	A
NT4	REED CANARY GRASS	1125	A	NT27	REED CANARY GRASS	275	A
NT5	REED CANARY GRASS	80	A	NT28	OXEYE DAISY	9	A
NT6	REED CANARY GRASS	6000	A	NT29	REED CANARY GRASS	40	A
NT7	OXEYE DAISY, ORANGE HAWK WEED	16	A	NT30	REED CANARY GRASS	2	A
NT8	ORANGE HAWK WEED	3	A	NT31	OXEYE DAISY	125	A
NT9	REED CANARY GRASS	4	A	NT32	REED CANARY GRASS	30	A
NT10	REED CANARY GRASS	4	A	NT33	OXEYE DAISY	3	A
NT11	REED CANARY GRASS	4000	A	NT34	OXEYE DAISY	1	A
NT12	JAPANESE KNOT WEED	20	A	NT35	REED CANARY GRASS	150	A
NT13	JAPANESE KNOT WEED	200	A	NT36	OXEYE DAISY	1	A
NT14	JAPANESE KNOT WEED	250	A	NT37	OXEYE DAISY	0.25	A
NT15	REED CANARY GRASS	2000	A	NT38	OXEYE DAISY	0.5	A
NT16	OXEYE DAISY, ORANGE HAWK WEED	1	A	NT39	OXEYE DAISY	40	A
NT17	REED CANARY GRASS	600	A	NT40	REED CANARY GRASS	28	A
NT18	JAPANESE KNOT WEED	6	A	NT41	OXEYE DAISY	1290	B
NT19	OXEYE DAISY	9	A	NT42	REED CANARY GRASS	4	B
NT20	REED CANARY GRASS	120	A	NT43	OXEYE DAISY	240	B
NT21	REED CANARY GRASS	50	A	NT44	OXEYE DAISY	25	B
NT22	REED CANARY GRASS	8	A	NT45	REED CANARY GRASS	25	B
NT23	OXEYE DAISY	600	A	NT46	REED CANARY GRASS	2	B

LEGEND

	PROFILE FLOW
	SEDIMENT BARRIER
	TEMPORARY CHECK DAM
	ORDINARY HIGH WATER
	PROPOSED CULVERT FLOW
	EXISTING CULVERT FLOW
	SLOPE/SPILLWAY STABILIZATION
	PERMANENT SEEDING
	LIMITS OF FILL
	LIMITS OF CUT
	DITCH CENTERLINE
	SILT/TURBIDITY CURTAIN
	INLET PROTECTION
	SURFACE FLOW
	WATERS OF THE U.S.
	WETLAND
	IDENTIFIED INVASIVE PLANT SITE
	WAYSIDE SEEDING

PLAN LEGEND

CHECKED BY: J. BROWN

ESCP NOT SEALED IN ACCORDANCE WITH ALASKA HIGHWAY PRECONSTRUCTION MANUAL SECTION 1120.7.3 DATED NOVEMBER 15, 2013


DESIGNED BY: G. AMUNDSEN
DRAWN BY: G. AMUNDSEN

STATE OF ALASKA
DEPARTMENT OF TRANSPORTATION & PUBLIC FACILITIES
SOUTHCOST REGION
JNU: GLACIER HWY MULTI-USE SEPARATED PATH TO UAS
PROJECT NO. 69500


ESCP PLAN

PROJECT DESIGNATION	
0933037 ~ 69500	
STATE	YEAR
ALASKA	2015
SHEET NUMBER	TOTAL SHEETS
P1	54

DO NOT SCALE FROM THESE DRAWINGS USE DIMENSIONS

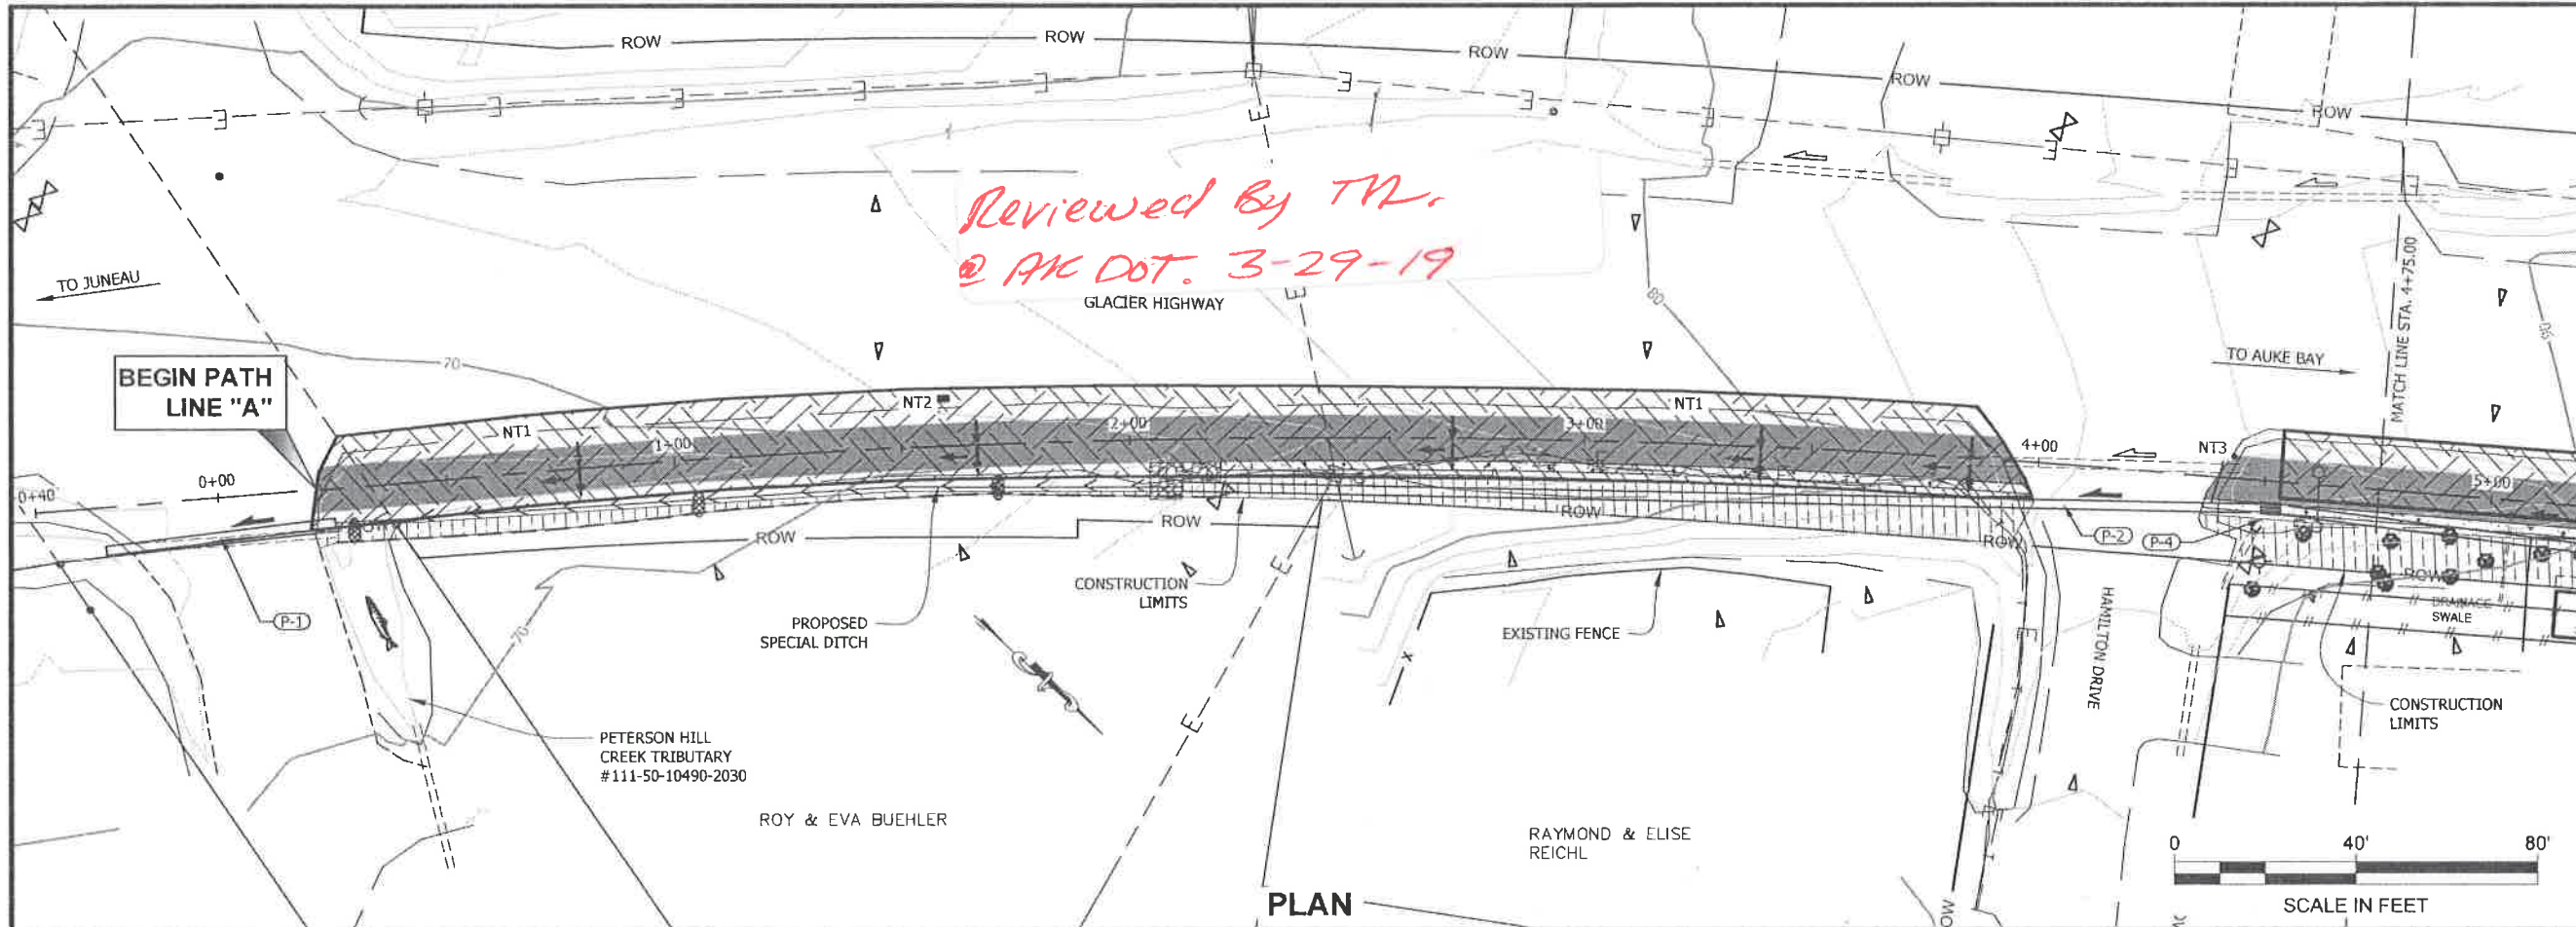

PLAN

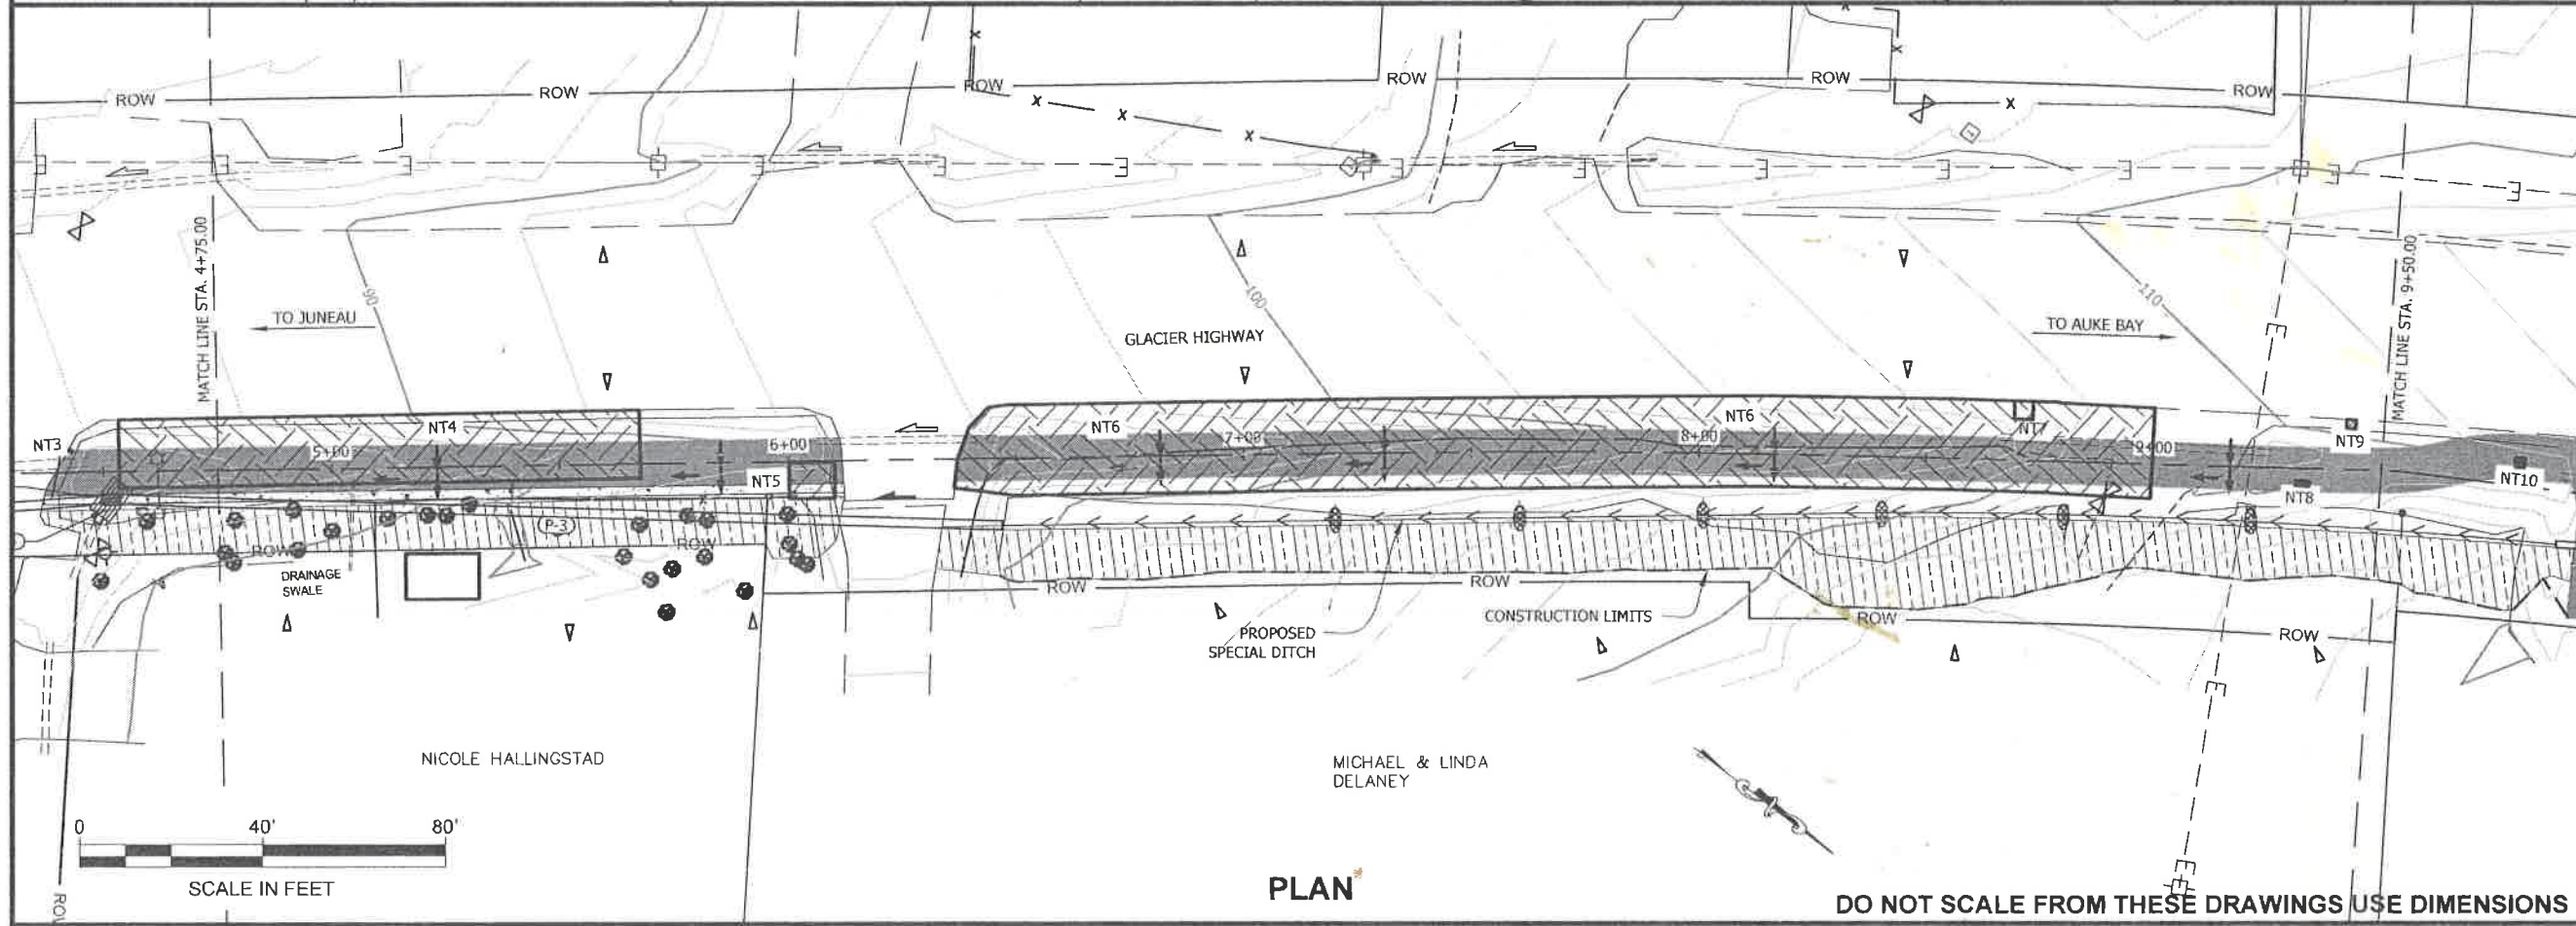

PLAN

DO NOT SCALE FROM THESE DRAWINGS USE DIMENSIONS

PATH:
Q:\JNU\69500\PLANSET\69500_P2-P6_ESCP.DWG


GRANTHAM, RICK L (DOT)
TAB: P2 Monday, July 20, 2015 12:52:26 PM

ADDENDUM NUMBER

ATTACHMENT NUMBER

RECORD OF REVISIONS

No.	DATE	DESCRIPTION

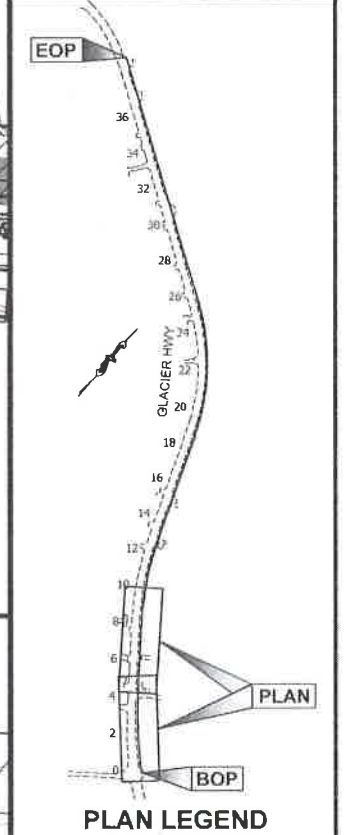

PLAN LEGEND

CHECKED BY: J. BROWN

ESCP NOT SEALED IN ACCORDANCE WITH ALASKA HIGHWAY PRECONSTRUCTION MANUAL SECTION 1120.7.3 DATED NOVEMBER 15, 2013

DESIGNED BY: G. AMUNDSEN
DRAWN BY: G. AMUNDSEN

STATE OF ALASKA
DEPARTMENT OF TRANSPORTATION & PUBLIC FACILITIES
SOUTHCOST REGION


JNU: GLACIER HWY MULTI-USE SEPARATED PATH TO UAS
PROJECT NO. 69500

ESCP PLAN


PROJECT DESIGNATION
0933037 ~ 69500

STATE	YEAR
ALASKA	2015
SHEET NUMBER	TOTAL SHEETS
P2	54

Handwritten signature

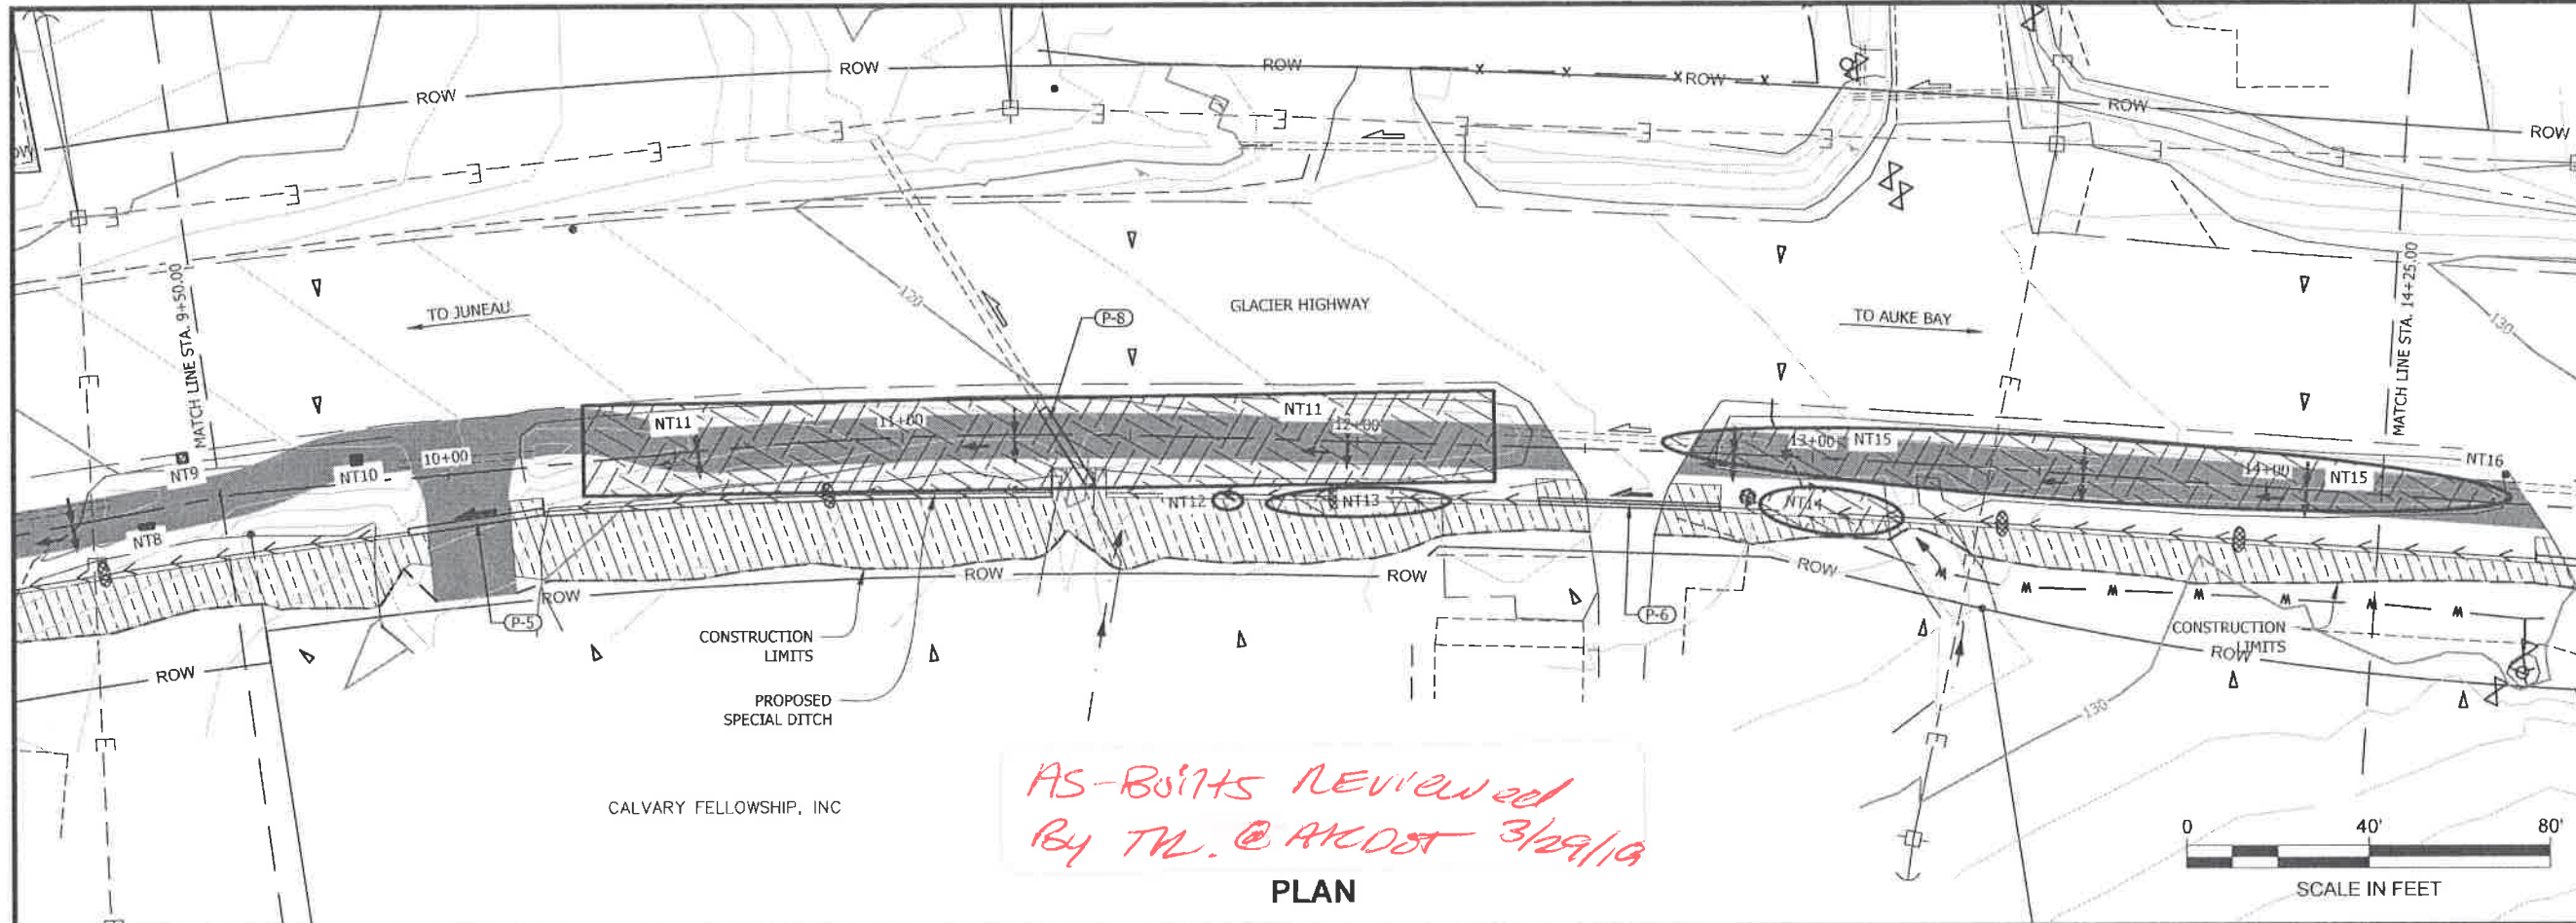

PLAN

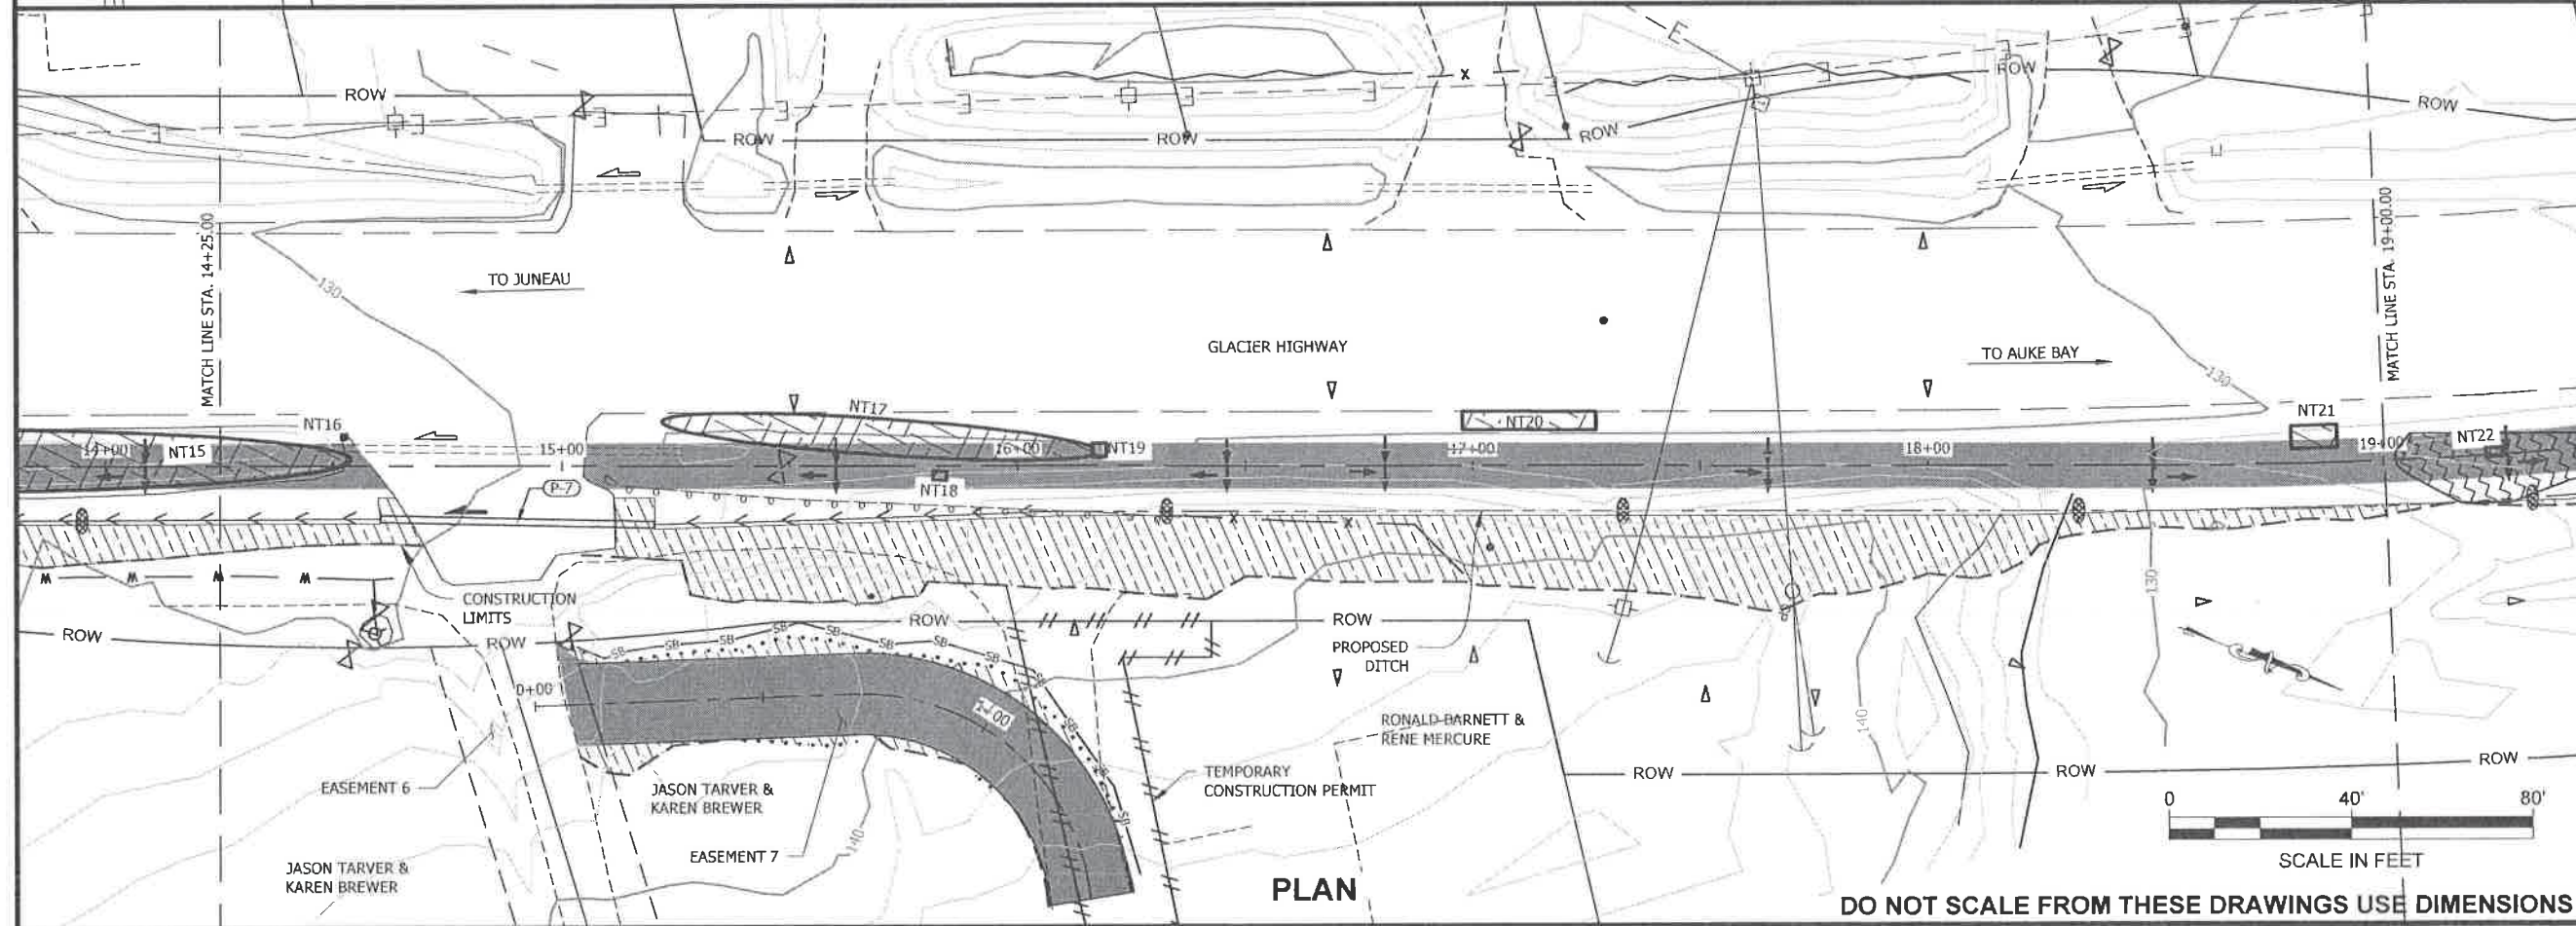


PLAN

DO NOT SCALE FROM THESE DRAWINGS USE DIMENSIONS

PATH:
Q:\JNU\69500\PLANSET\69500_P2-P6_ESCP.DWG

GRANTHAM, RICK L (DOT)
TAB: P3 Monday, July 20, 2015 12:52:45 PM

ADDENDUM NUMBER		
ATTACHMENT NUMBER		
RECORD OF REVISIONS		
No.	DATE	DESCRIPTION

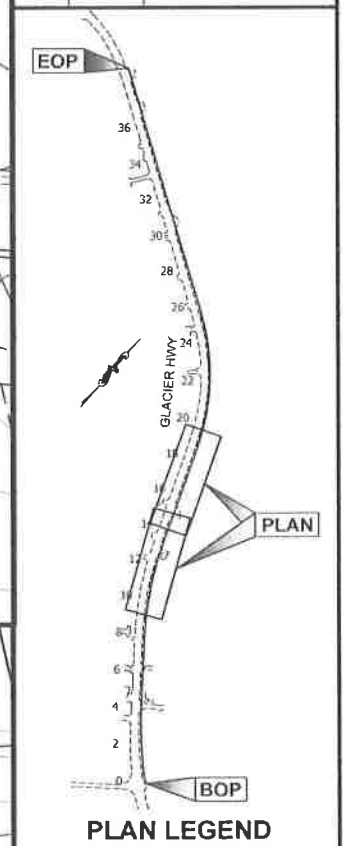

CHECKED BY: J. BROWN

ESCP NOT SEALED IN ACCORDANCE WITH ALASKA HIGHWAY RECONSTRUCTION MANUAL SECTION 1120.7.3 DATED NOVEMBER 15, 2013

DESIGNED BY: G. AMUNDSEN
DRAWN BY: G. AMUNDSEN


STATE OF ALASKA
DEPARTMENT OF TRANSPORTATION
PUBLIC FACILITIES
SOUTHCOST REGION

JNU: GLACIER HWY MULTI-USE SEPARATED PATH TO UAS
PROJECT NO. 69500


ESCP PLAN

PROJECT DESIGNATION	
0933037 ~ 69500	
STATE	YEAR
ALASKA	2015
SHEET NUMBER	TOTAL SHEETS
P3	54

As Builts Reviewed By
DOT. 3-29-19 By TM.

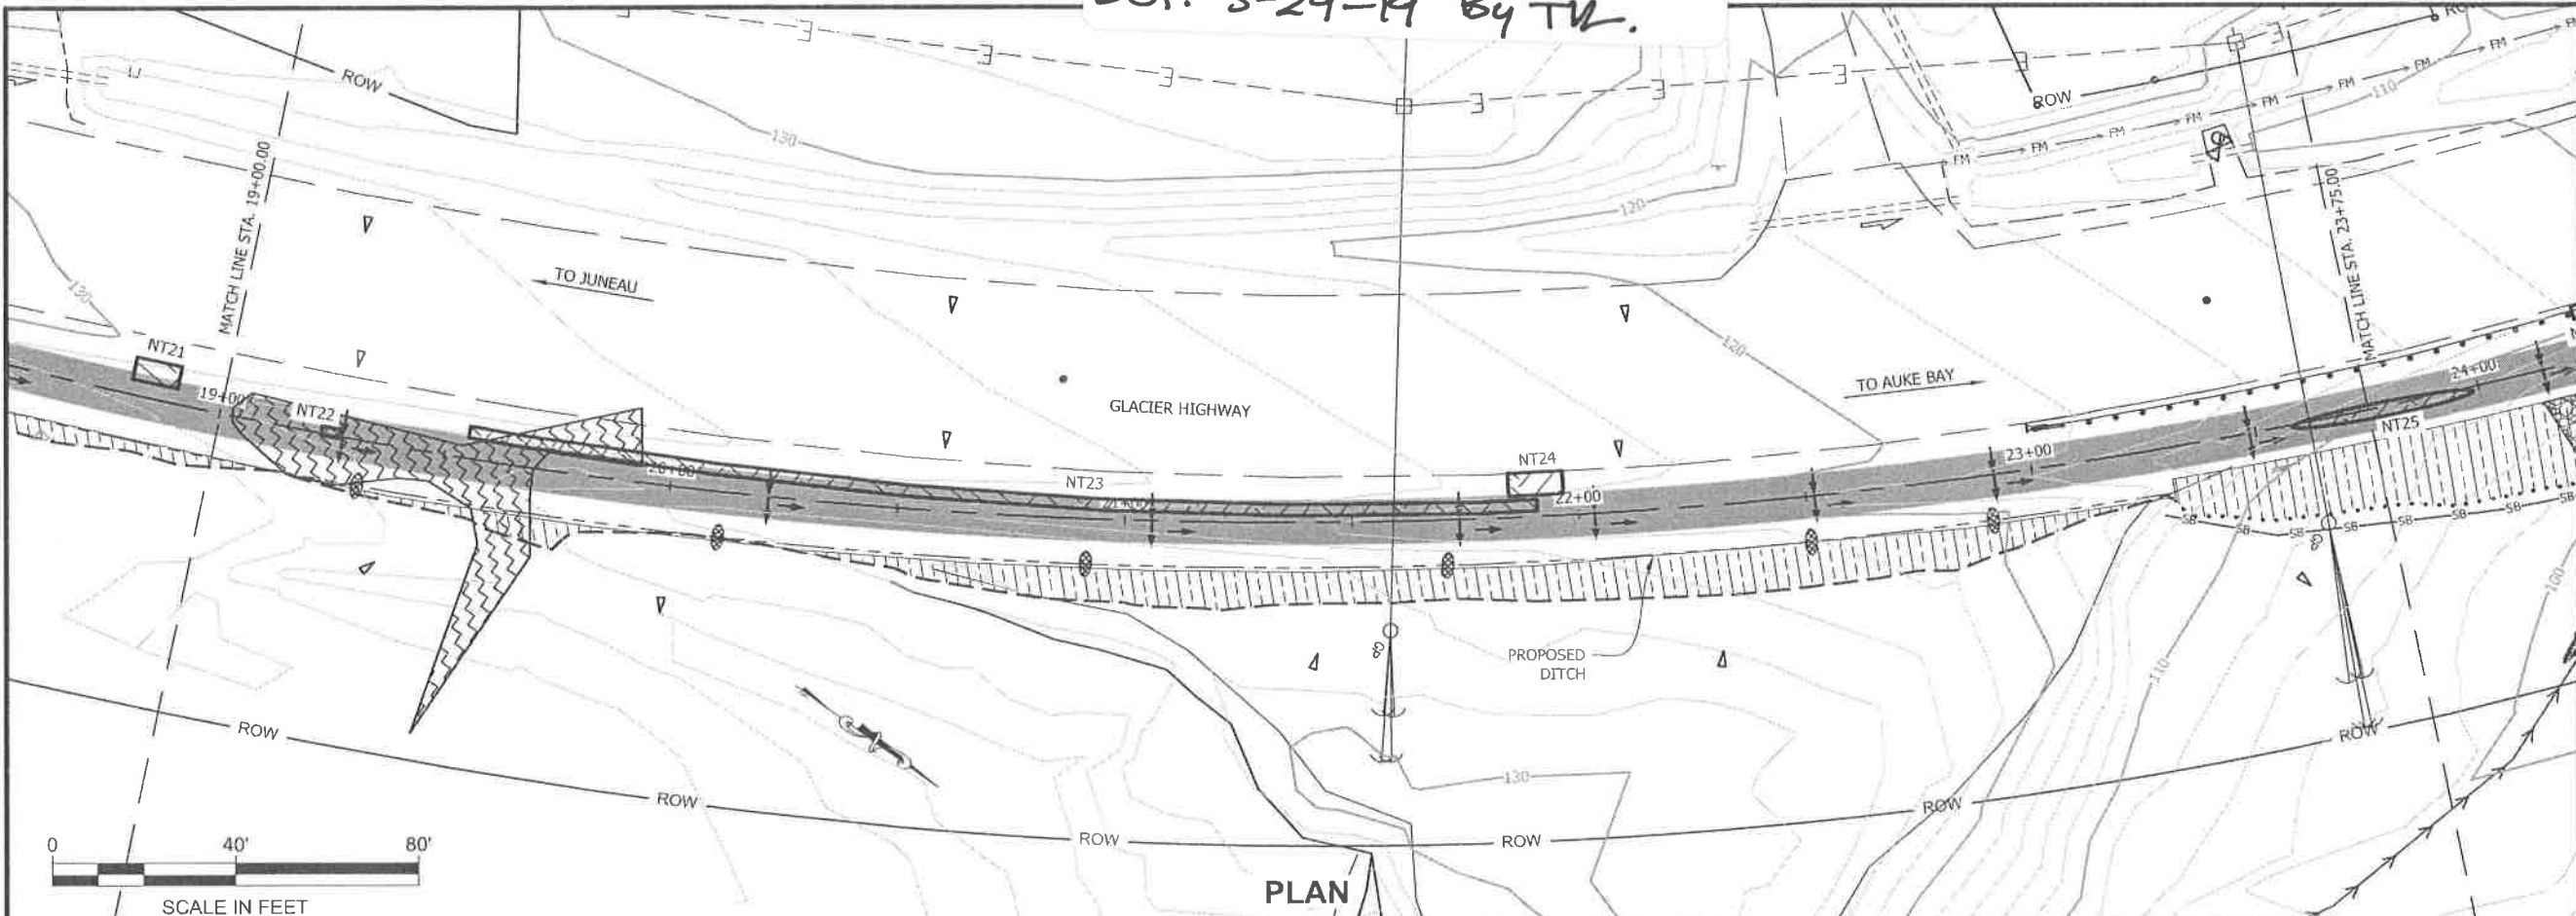

PLAN

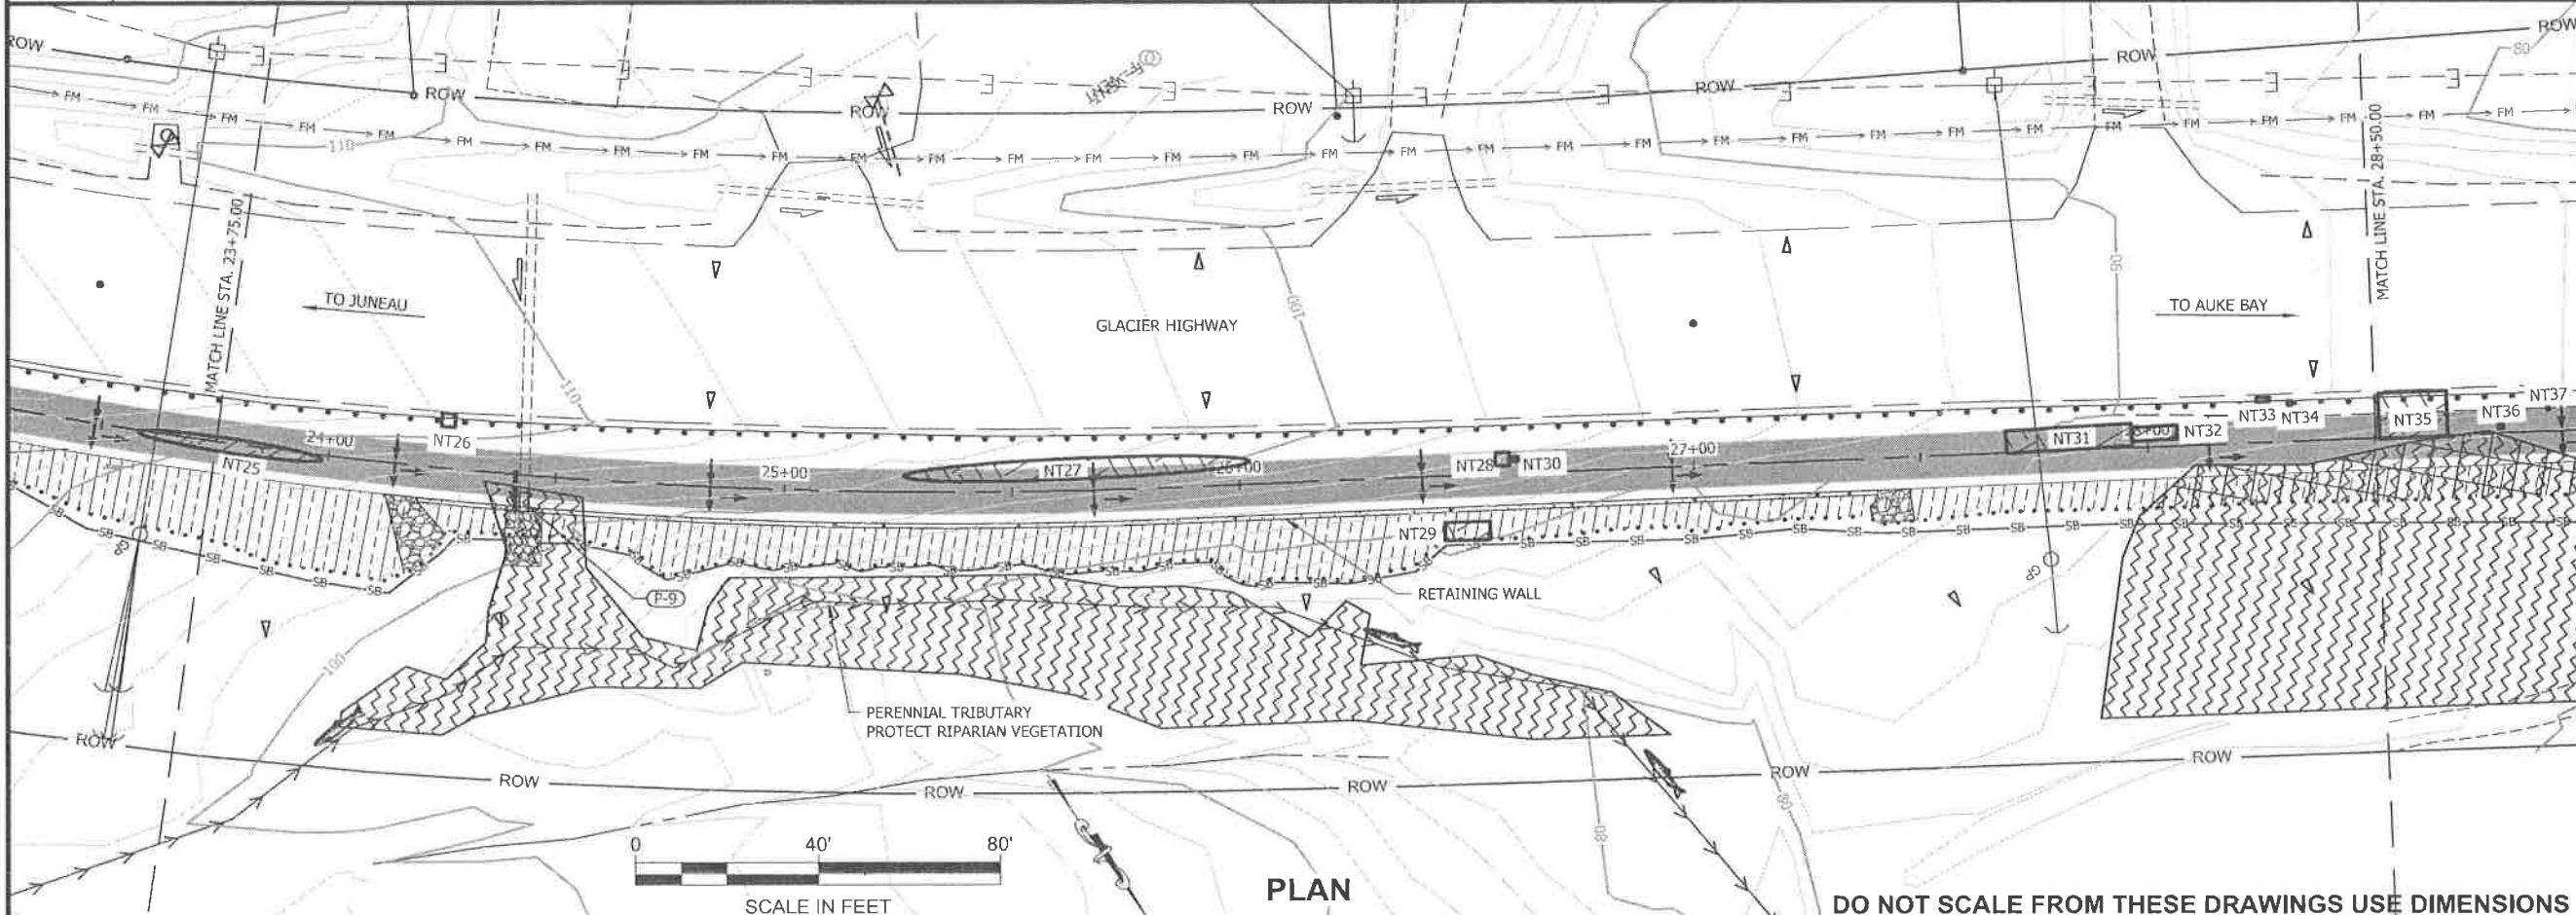

PLAN



DO NOT SCALE FROM THESE DRAWINGS USE DIMENSIONS

PATH:
Q:\JNU\69500\PLANSET\69500_P2-P6_ESCP.DWG


CHAMBERS, LUCAS M (DOT)
TAB: P4 Friday, August 14, 2015 2:59:18 PM

ADDENDUM NUMBER

ATTACHMENT NUMBER

RECORD OF REVISIONS

No	DATE	DESCRIPTION

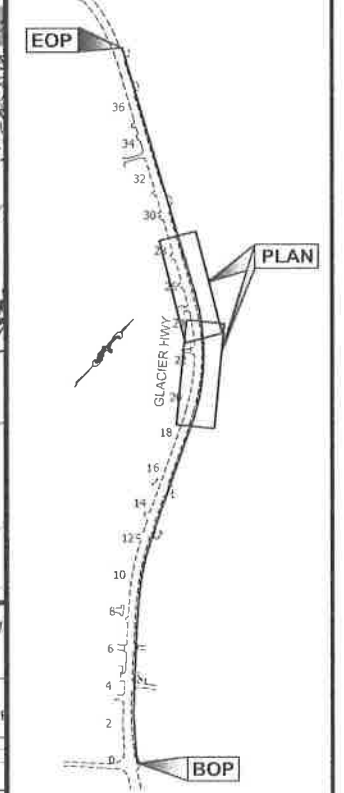

CHECKED BY: J. BROWN

ESCP NOT SEALED IN ACCORDANCE WITH ALASKA HIGHWAY PRECONSTRUCTION MANUAL SECTION 1120.7.3 DATED NOVEMBER 15, 2013

DESIGNED BY: G. AMUNDSEN
DRAWN BY: G. AMUNDSEN

STATE OF ALASKA
DEPARTMENT OF TRANSPORTATION & PUBLIC FACILITIES
SOUTHCOST REGION

JNU: GLACIER HWY MULTI-USE SEPARATED PATH TO UAS
PROJECT NO. 69500

ESCP PLAN


PROJECT DESIGNATION

0933037 ~ 69500

STATE	YEAR
ALASKA	2015

SHEET NUMBER	TOTAL SHEETS
P4	54

AS BUILTS REVIEWED BY
TL. @ AK DOT. 3-29-19.

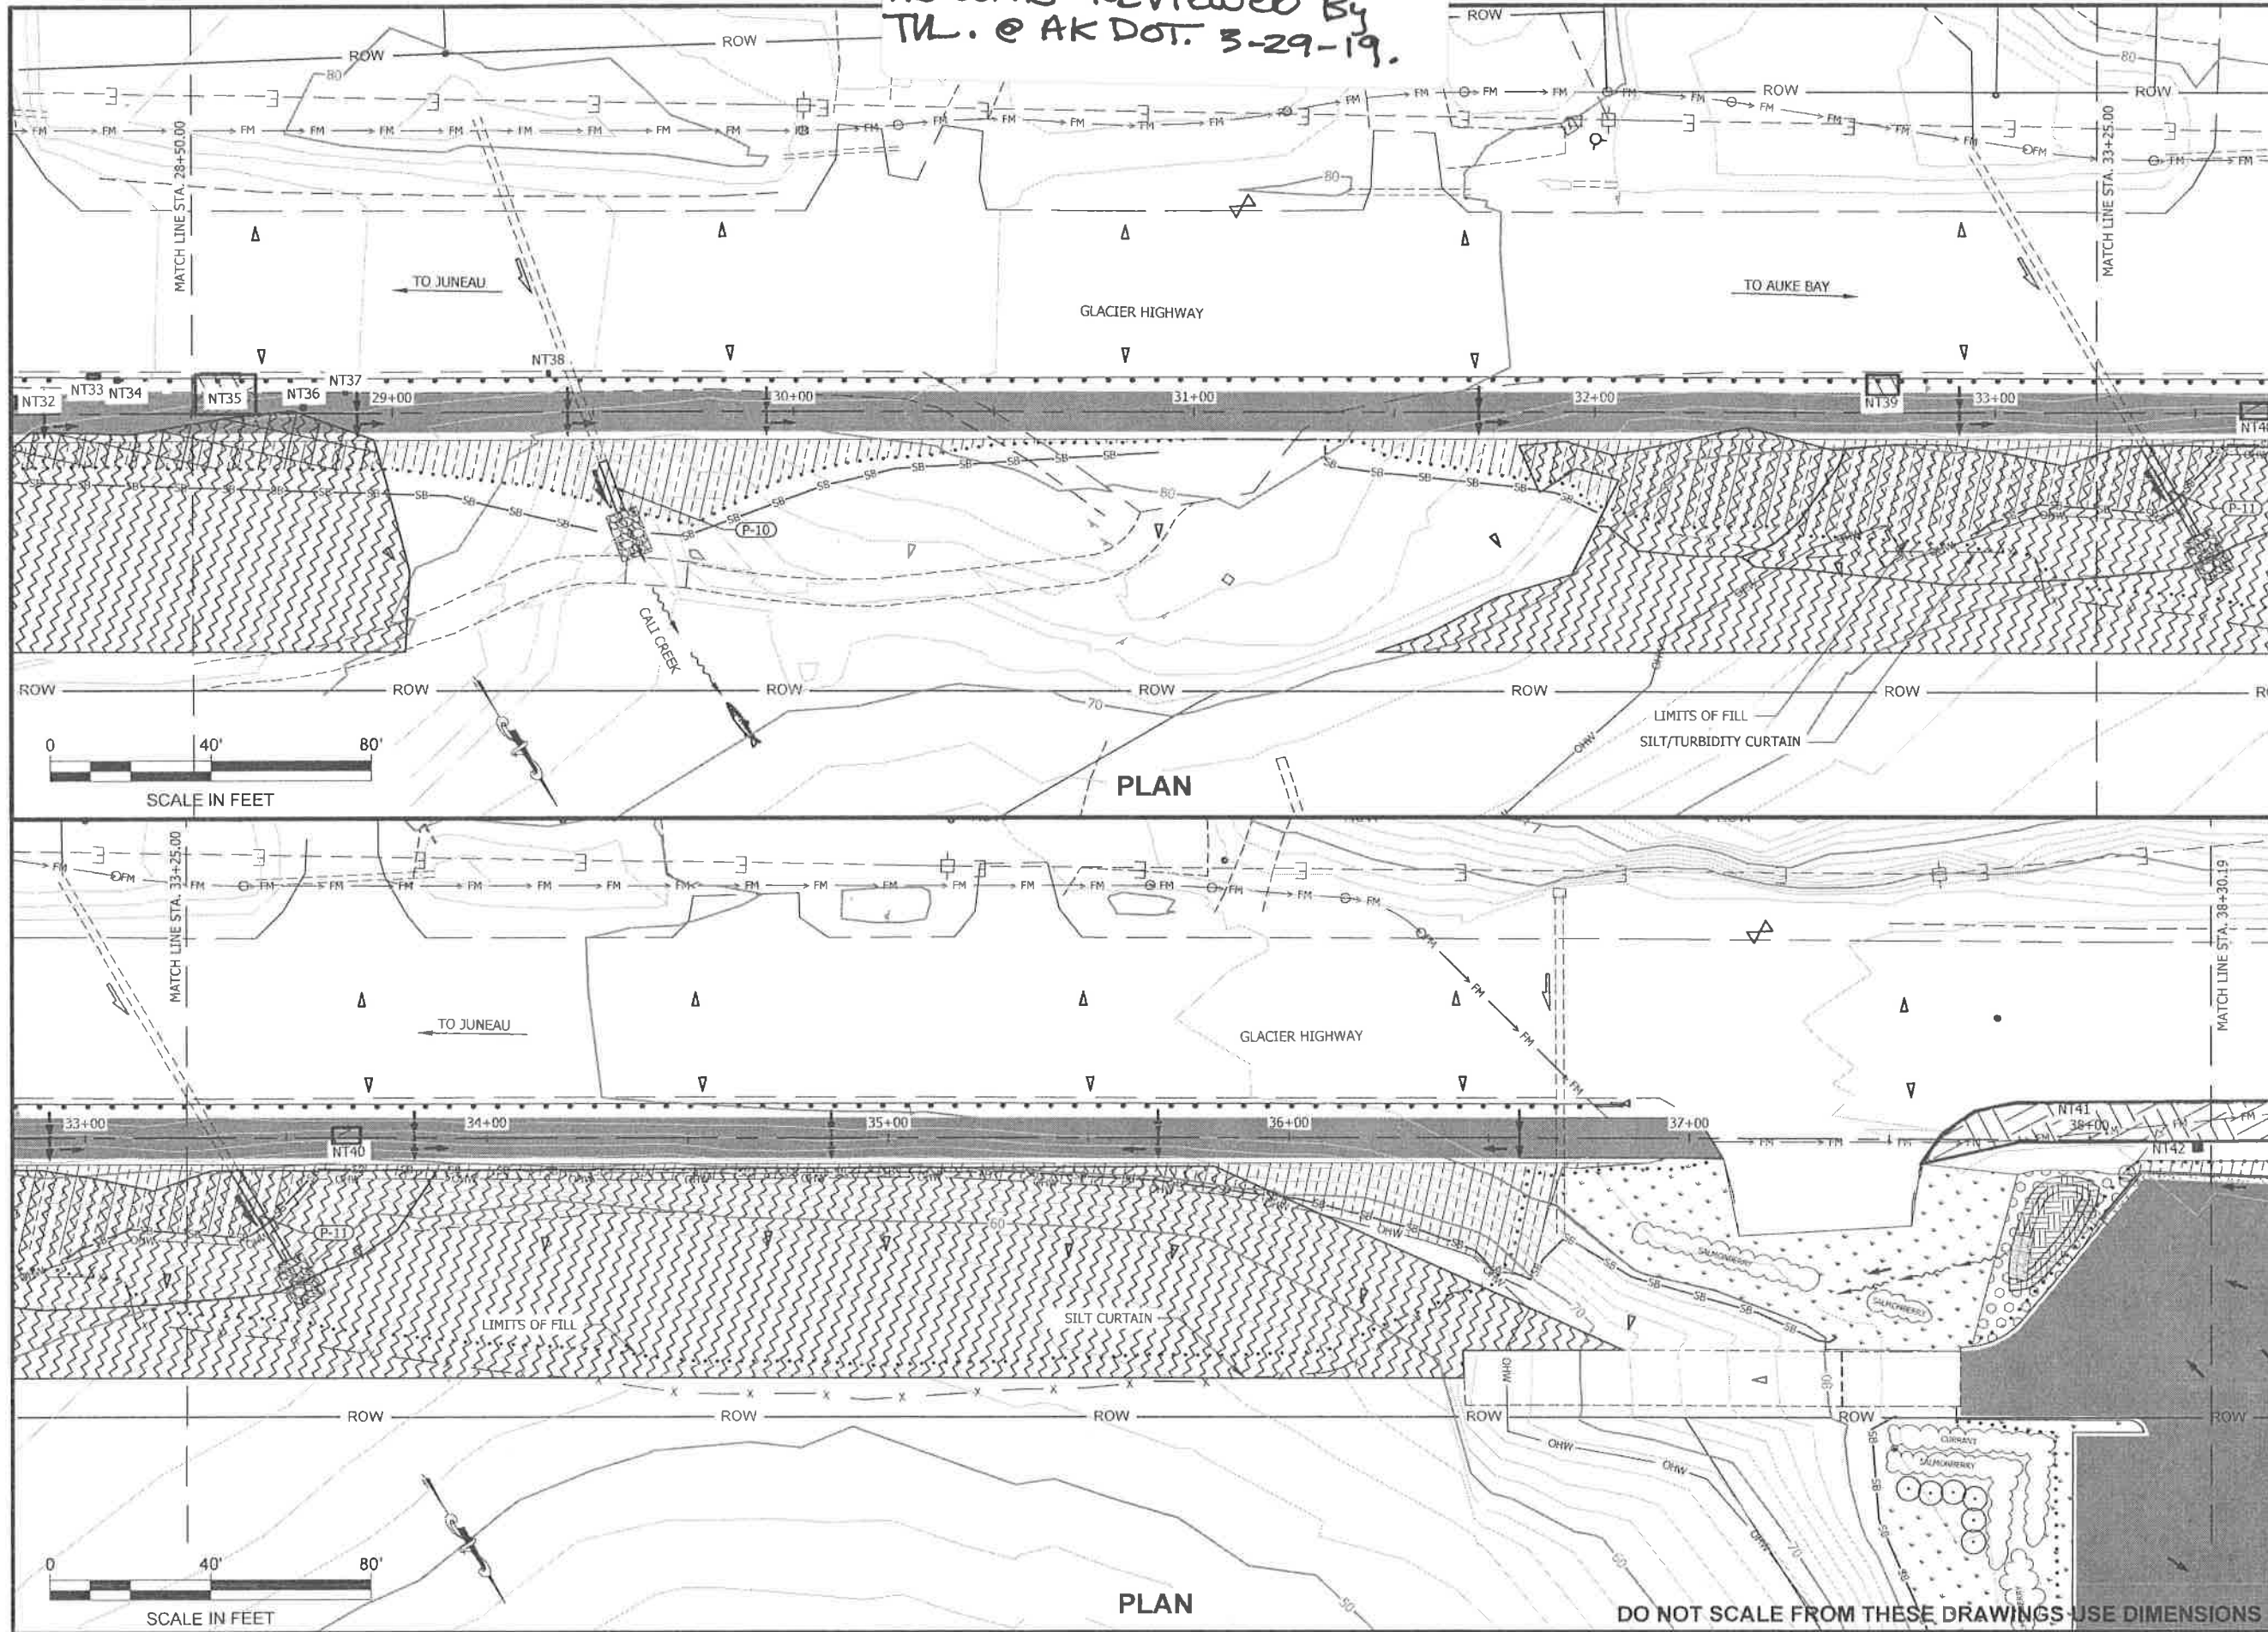

PATH:
Q:\JNU\69500\PLANSET\69500_P2-P6_ESCP.DWG

GRANTHAM, RICK L (DOT)
Monday, July 20, 2015 12:53:22 PM


TAB: P5

ADDENDUM NUMBER

ATTACHMENT NUMBER

RECORD OF REVISIONS

No.	DATE	DESCRIPTION

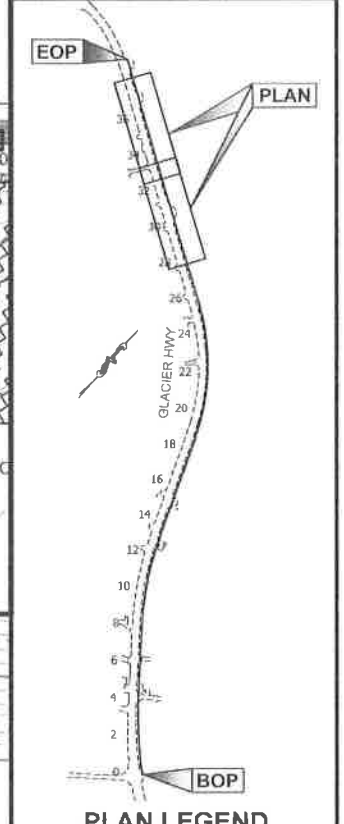

CHECKED BY: J. BROWN

ESCP NOT SEALED IN ACCORDANCE WITH ALASKA HIGHWAY PRECONSTRUCTION MANUAL SECTION 1120.7.3 DATED NOVEMBER 15, 2013

DESIGNED BY: G. AMUNDSEN
DRAWN BY: G. AMUNDSEN
STATE OF ALASKA
DEPARTMENT OF TRANSPORTATION & PUBLIC FACILITIES
SOUTHCOST REGION

JNU: GLACIER HWY MULTI-USE SEPARATED PATH TO UAS
PROJECT NO. 69500

ESCP PLAN

PROJECT DESIGNATION

0933037 ~ 69500

STATE	YEAR
ALASKA	2015
SHEET NUMBER	TOTAL SHEETS
P5	54



DO NOT SCALE FROM THESE DRAWINGS USE DIMENSIONS

AS BUILTS REVIEWED BY: TM
@ AK DOT 3-29-19.

PATH:
Q:\JNU\69500\PLANSET\69500_P2-P6_ESCP.DWG


GRANTHAM, RICK L (DOT)
TAB: P6 Monday, July 20, 2015 12:53:34 PM

ADDENDUM NUMBER		
ATTACHMENT NUMBER		
RECORD OF REVISIONS		
No.	DATE	DESCRIPTION

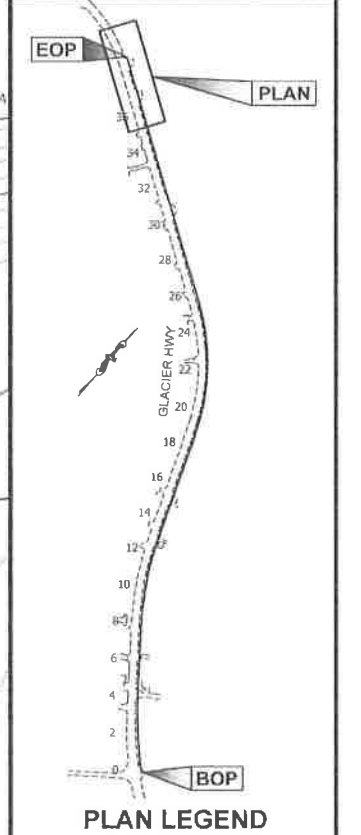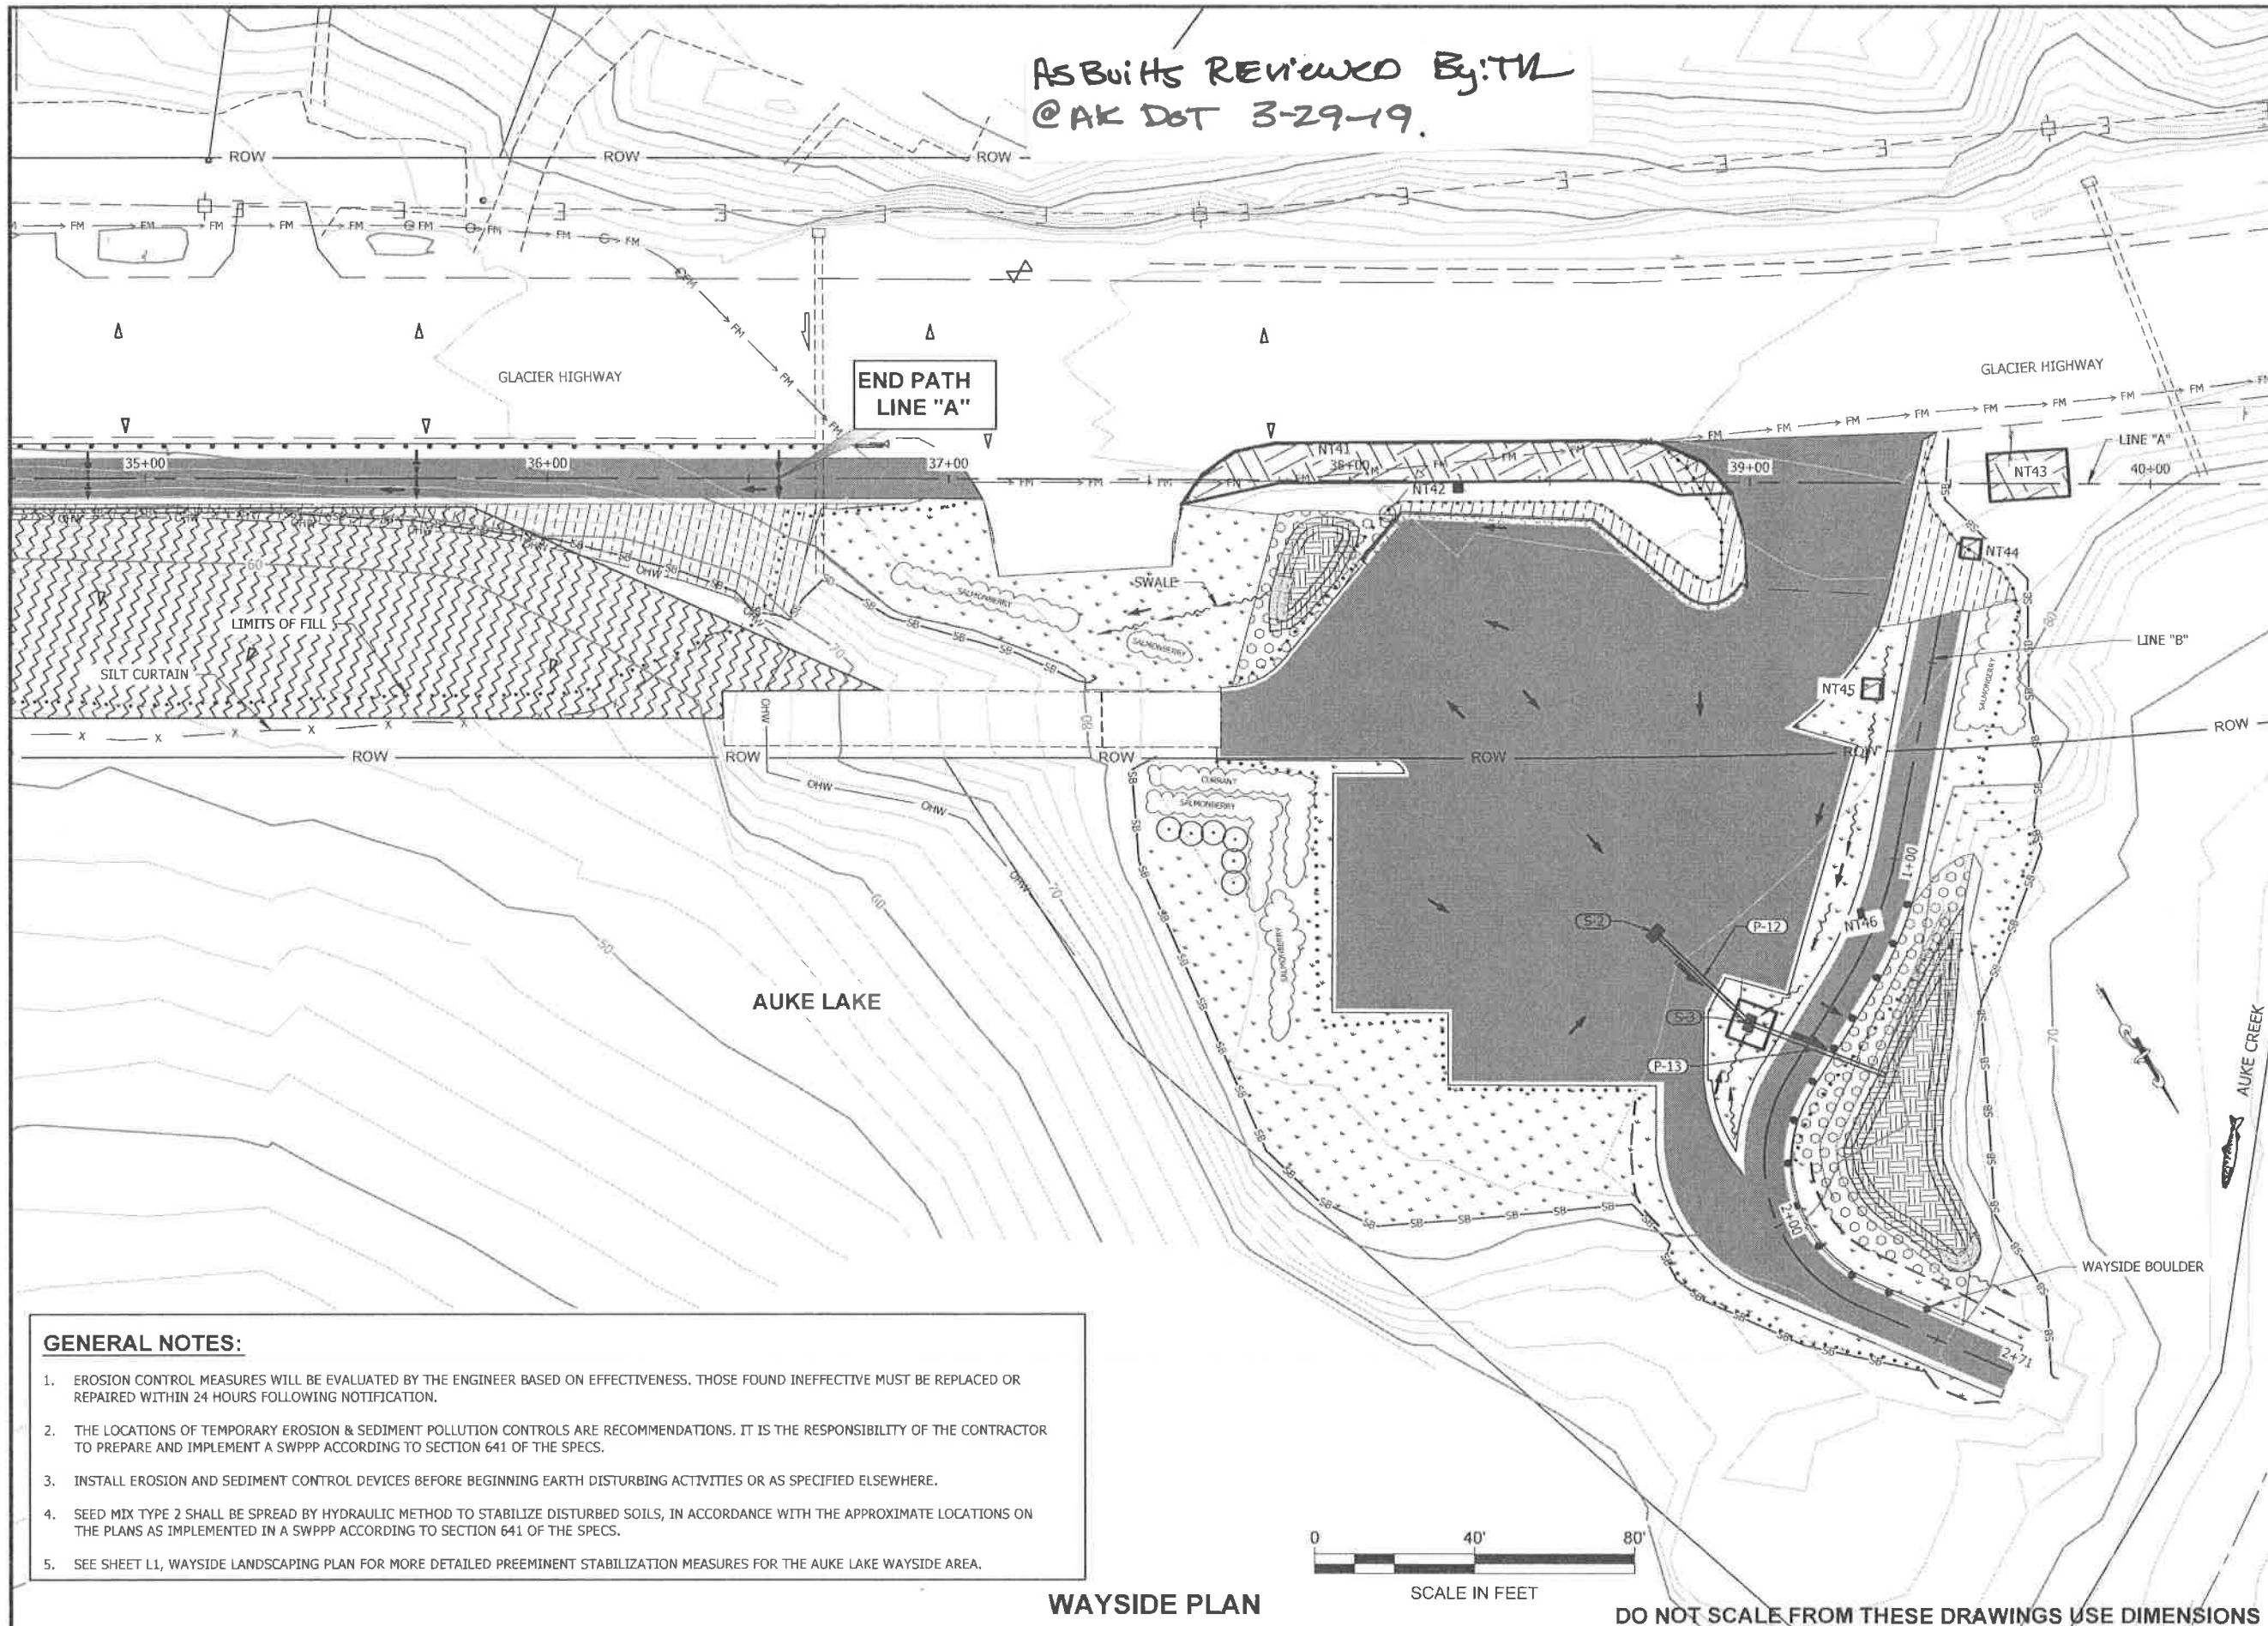

- GENERAL NOTES:**
1. EROSION CONTROL MEASURES WILL BE EVALUATED BY THE ENGINEER BASED ON EFFECTIVENESS. THOSE FOUND INEFFECTIVE MUST BE REPLACED OR REPAIRED WITHIN 24 HOURS FOLLOWING NOTIFICATION.
 2. THE LOCATIONS OF TEMPORARY EROSION & SEDIMENT POLLUTION CONTROLS ARE RECOMMENDATIONS. IT IS THE RESPONSIBILITY OF THE CONTRACTOR TO PREPARE AND IMPLEMENT A SWPPP ACCORDING TO SECTION 641 OF THE SPECS.
 3. INSTALL EROSION AND SEDIMENT CONTROL DEVICES BEFORE BEGINNING EARTH DISTURBING ACTIVITIES OR AS SPECIFIED ELSEWHERE.
 4. SEED MIX TYPE 2 SHALL BE SPREAD BY HYDRAULIC METHOD TO STABILIZE DISTURBED SOILS, IN ACCORDANCE WITH THE APPROXIMATE LOCATIONS ON THE PLANS AS IMPLEMENTED IN A SWPPP ACCORDING TO SECTION 641 OF THE SPECS.
 5. SEE SHEET L1, WAYSIDE LANDSCAPING PLAN FOR MORE DETAILED PREEMINENT STABILIZATION MEASURES FOR THE AUKE LAKE WAYSIDE AREA.

WAYSIDE PLAN

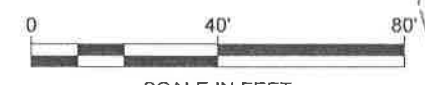

DO NOT SCALE FROM THESE DRAWINGS USE DIMENSIONS

CHECKED BY: J. BROWN

ESCP NOT SEALED IN ACCORDANCE WITH ALASKA HIGHWAY PRECONSTRUCTION MANUAL SECTION 1120.7.3 DATED NOVEMBER 15, 2013

DESIGNED BY: G. AMUNDSEN
DRAWN BY: G. AMUNDSEN

STATE OF ALASKA
DEPARTMENT OF TRANSPORTATION & PUBLIC FACILITIES
SOUTHCOST REGION

JNU: GLACIER HWY MULTI-USE SEPARATED PATH TO UAS
PROJECT NO. 69500

ESCP PLAN



PROJECT DESIGNATION
0933037 ~ 69500

STATE	YEAR
ALASKA	2015
SHEET NUMBER	TOTAL SHEETS
P6	54

SHEET NOTES:

- ① USE TWO CONDUCTORS FOR POWER AND ONE AS A SPARE. MAINTAIN CONDUIT SEPARATION PER TRENCH DETAIL.
- ② COORDINATE WITH ALASKA ELECTRIC LIGHT & POWER TO PROVIDE NEW ELECTRICAL SERVICES TO LOAD CENTER.
- ③ PROVIDE NEW ELECTROLIER AS SHOWN IN PLANS, AND ORIENT ELECTROLIER PERPENDICULAR TO TRAVELED WAY.
- ④ PROVIDE NEW LOAD CENTER WHERE SHOWN. ADJUST LOCATION IF CONFLICTS ARE DISCOVERED WHEN VERIFYING ACTUAL LOCATIONS OF EXISTING UNDERGROUND UTILITIES. DO NOT GO OUTSIDE OF RIGHT OF WAY WHICH IS APPROXIMATELY 14' FROM PATH CENTERLINE. SEE RIGHT OF WAY SHEETS FOR EXACT LOCATION.

SYMBOL LEGEND:

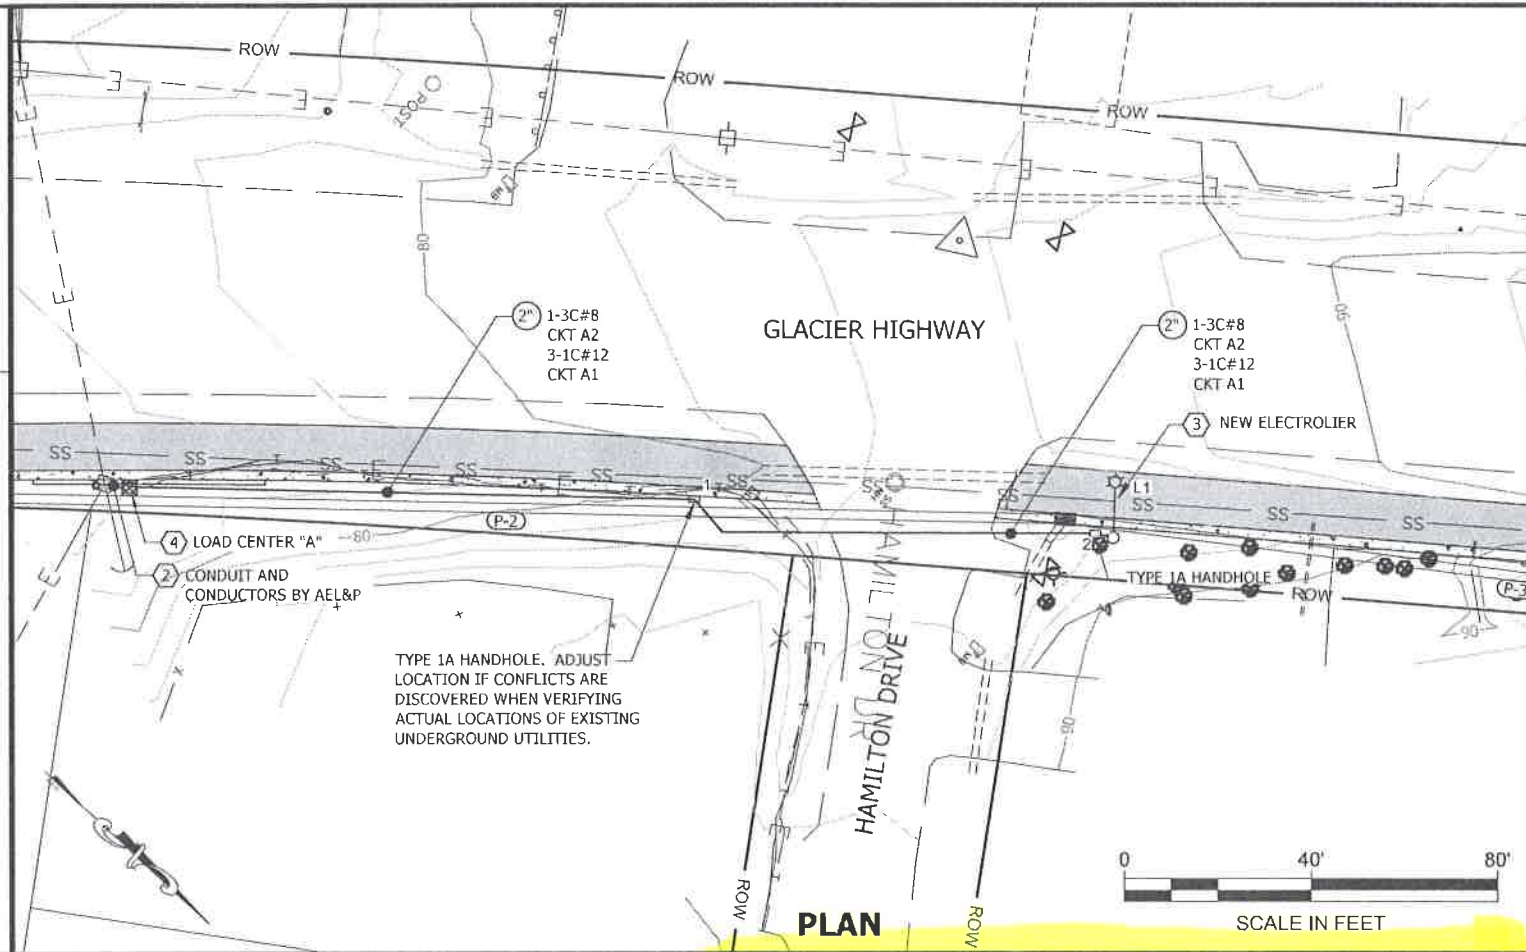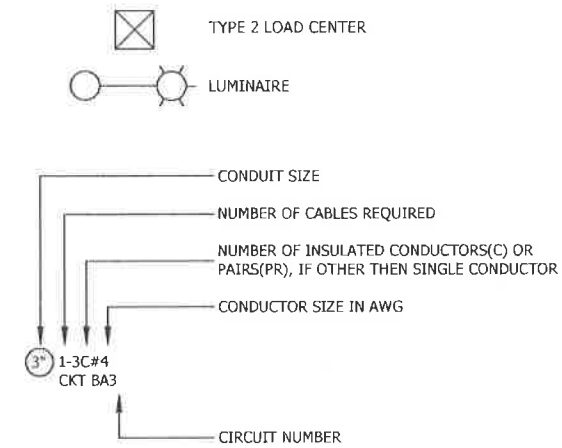

PATH:
Q:\JNU\69500\PLANSET\69500_Q1-Q4_ELECTRICAL.DWG


GRANTHAM, RICK L (DOT)
TAB: Q1 Monday, July 20, 2015 12:54:42 PM

ADDENDUM NUMBER


ATTACHMENT NUMBER

RECORD OF REVISIONS


No.	DATE	DESCRIPTION

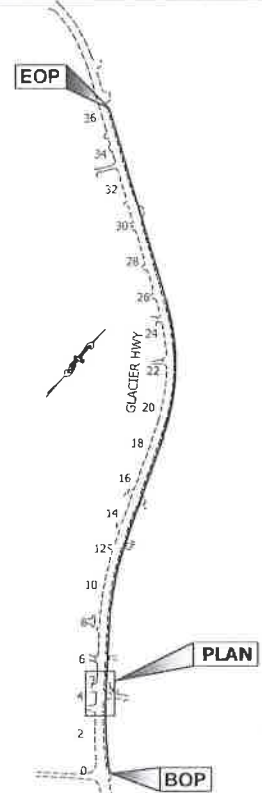

Project As-Built Drawings have been reviewed by the Project Engineer, and represent to the best of my knowledge, the project as constructed.
 PE *[Signature]* Date 2/19/2019

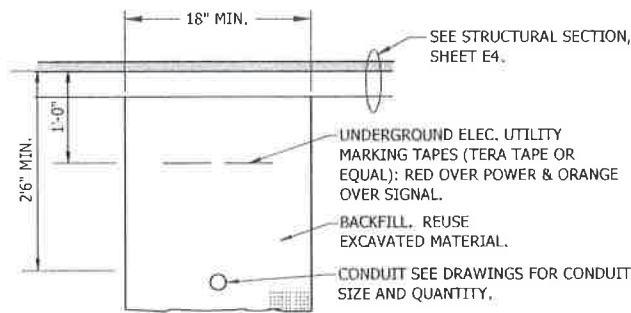

ROADWAY/SIDEWALK AREAS
NTS

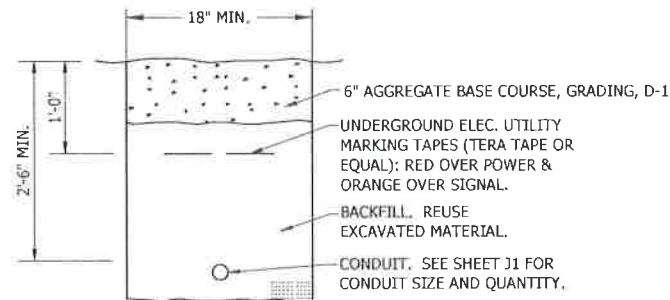

NON-PAVED AREAS
NTS

CONDUIT TRENCH DETAIL

NOTES:

1. SEE SHEET B1 FOR TYPICAL SECTION UNDER ROADWAY/SIDEWALK AREAS. PROVIDE BACKFILL PER SECTION 204 OF THE SPECIAL PROVISIONS.
2. THE LOCATION OF ALL EXISTING PIPING, CONDUIT, ETC MAY NOT BE WHERE SHOWN AND MAY NOT BE SHOWN. ALL LOCATIONS THAT ARE SHOWN ARE APPROXIMATE AND SHOULD BE FIELD VERIFIED. OBTAIN UTILITY LOCATES PRIOR TO DIGGING. DIG WITH CAUTION. AVOID WATER, SEWER, DRAINAGE PIPES AND OTHER CONFLICTS.
3. MAINTAIN 12 INCHES MINIMUM SEPARATION (ALL DIRECTIONS) BETWEEN POWER AND OTHER EXISTING CONDUITS, PIPES, ETC.
4. SAWCUT EXISTING ASPHALT BACK 18" ON EACH SIDE OF TRENCH. LEAVE 18" UNDISTURBED SOIL BETWEEN EDGE OF SAWCUT AND EXCAVATION LIMITS. REPAVE SAWCUT AREAS PER PAVING SPECIFICATION.

NO.	*STATION	*OFFSET (FT)	**ELEV. (FT)	LUMINAIRE	REMARKS
L1	4+62.3	9.3 LT	86.0	GE. NO M-250A3, CATALOG NUMBER M2AC25S0M2GMC3 OR APPROVED EQUAL	12' MAST ARM & 35' POLE SHAFT LENGTH. PROVIDE HOUSE SIDE SHIELD. MOUNT PHOTO CELL ON TOP LUMINAIRE.

*STATION AND OFFSET GIVEN TO CENTER OF ELECTROLIER FOUNDATION
 ** ELEVATIONS GIVEN TO TOP OF ELECTROLIER FOUNDATION

NO.	*STATION	*OFFSET (FT)	TYPE	REMARKS
1	3+72.1	8.0' RT	1A	INSTALL AT SAME ELEV. AS LIP OF VALLEY GUTTER
2	4+58.4	8.7' RT	1A	INSTALL AT SAME ELEVATION AS ELECTROLIER BASE

*STATION AND OFFSET ARE APPROXIMATE FIELD ADJUST AS REQUIRED. ALL ADJUSTMENTS SHALL BE APPROVED BY THE ENGINEER AND BE WITHIN RIGHT-OF-WAY.

DO NOT SCALE FROM THESE DRAWINGS USE DIMENSIONS

CHECKED BY: J. BROWN



DESIGNED BY: J. BROWN

DRAWN BY: R. GRANTHAM


STATE OF ALASKA
 DEPARTMENT OF TRANSPORTATION
 & PUBLIC FACILITIES
 SOUTHCOST REGION

JNU: GLACIER HWY MULTI-USE
 SEPARATED PATH TO UAS
 PROJECT NO. 69500
**HIGHWAY
 ILLUMINATION
 PLAN**


PROJECT DESIGNATION
0933037 ~ 69500

STATE	YEAR
ALASKA	2015
SHEET NUMBER	TOTAL SHEETS
Q1	54

ASBUILTS REVIEWED BY: TVL.
@ AK DOT. 5-29-19.

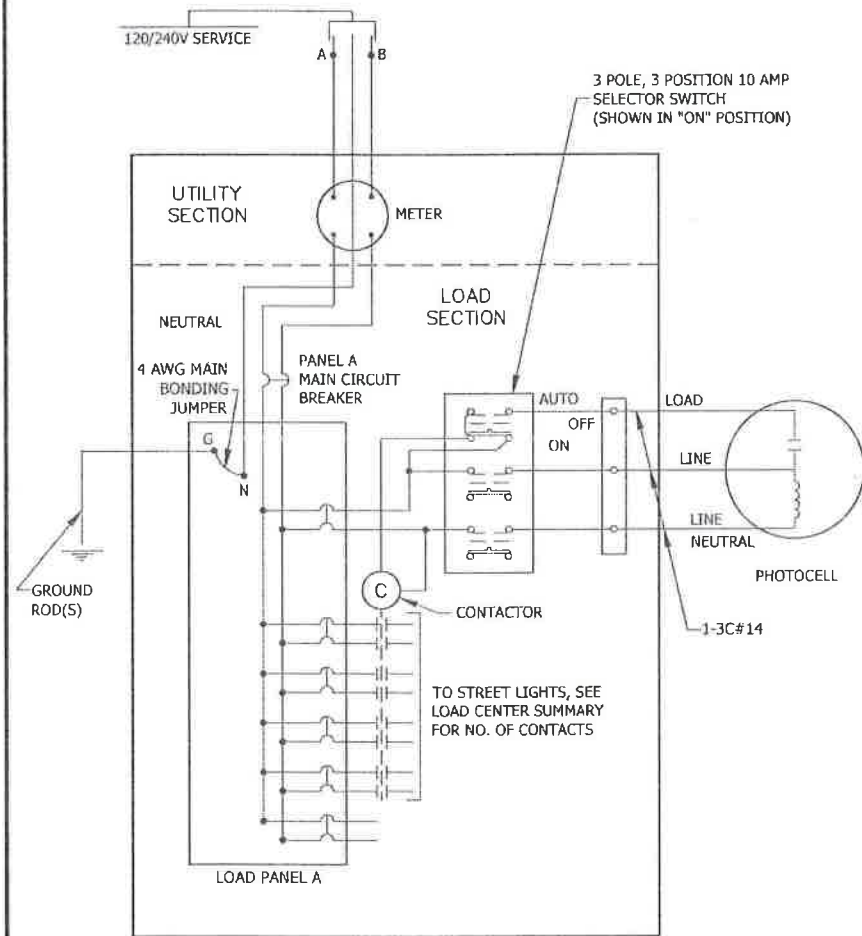

LOAD CENTER ONE LINE DIAGRAM AND SELECTOR SWITCH WIRING

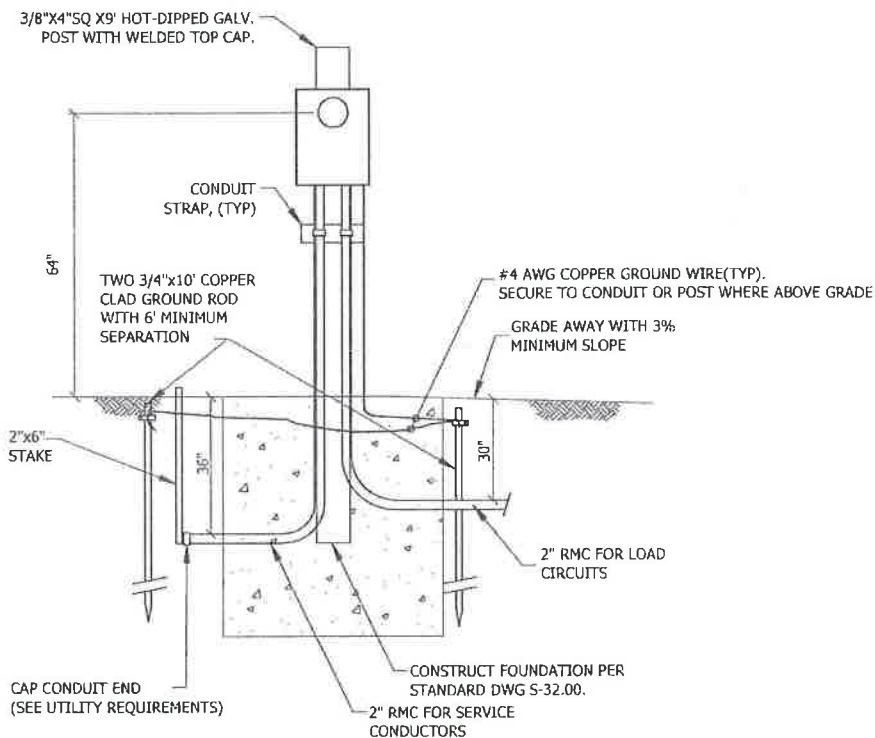

TYPE 2 LOAD CENTER

SUMMARY OF LOAD CENTER A			
LOAD CENTER TYPE:	TYPE 2		
SERVICING UTILITY:	AEL&P		
SERVICE CONDUIT TYPE:	RIGID METAL CONDUIT		
LOCATION DATA			
LOAD CENTER:	8.7 FEET RIGHT OF STATION 2+50.7		
POWER SOURCE:	UTILITY POLE ADJACENT LOAD CENTER		
PHOTOELECTRIC CONTROL:	TOP OF LUMINAIRE, L1		
SERVICE VOLTAGE:	1 PHASE, 3 WIRE, 120/240 VOLTS AC WITH GROUNDED NEUTRAL		
PROVIDE METER SOCKET?	YES	SERVICE AMPS: 100A	
MAIN BREAKER A:	240 VOLT, 2 POLE, 100 AMPERES		
CONTACTOR:	600 VOLT, 4 POLE, 30 AMPERES		
AIC RATING OF CIRCUIT BKRS:	10,000 AMPS		
PANEL A			
CIRCUIT NUMBER	DESCRIPTION	KVA LOAD	BREAKER AMPS POLES
A1	P. E. CELL	0.1	15 2
A2*	LUMINAIRE L1	0.3	20 2
A3	SPARE	0.0	20 2
A4	SPACE	0.0	---
TOTAL CONNECTED KVA LOAD		0.4	1.7
TOTAL DEMAND KVA LOAD (@125%)		0.5	2.1

* CIRCUIT THROUGH CONTACTOR

LOAD CENTER NOTES:

1. PROVIDE FAULT CURRENT LABEL ON LOAD CENTER DEAD-FRONT: "AVAILABLE FAULT CURRENT = 3677A, CALCULATED ON 18 AUG 2014."
2. CALCULATED FAULT CURRENT IS BASED ON LOAD CENTER BEING SERVED FROM A 15 KVA UTILITY TRANSFORMER. FIELD VERIFY CONDITIONS AND NOTIFY ENGINEER IF DIFFERENT PRIOR TO PRINTING FAULT CURRENT LABEL.
3. THE LIGHTING CONTACTOR SHALL BE CONTROLLED BY THE P.E. CELL WHEN THE HOA SWITCH IS IN "AUTOMATIC".

WIRING NOTES:

1. FURNISH ALL EQUIPMENT NOTED IN THE LOAD CENTER SUMMARY. SEE SUMMARIES FOR LOAD PANEL VOLTAGES, CURRENT RATINGS, SHORT CIRCUIT INTERRUPTING RATINGS, AND THE NAME OF THE SERVING UTILITY.
2. SIZE THE TYPE 2 LOAD CENTER CABINETS TO HOLD THE EQUIPMENT SHOWN IN THE WIRING DIAGRAM AND DETAILED IN EACH LOAD CENTER SUMMARY, ALLOWING SPACE FOR WIRING PER THE NATIONAL ELECTRICAL CODE. INSTALLING A METER BASE AND MAIN BREAKER IN A SEPARATE ENCLOSURE IS ALLOWABLE. HOWEVER IN THIS CASE, FURNISH A BREAKER PANEL WITH A MAIN BREAKER.
3. THE VOLTAGE FOR THE PHOTOELECTRIC CONTROL EQUIPMENT SHALL BE 240-VOLT, DERIVED FROM THE SERVICE VOLTAGE.
4. LABEL ALL CIRCUIT BREAKERS AS TO FUNCTION AND POSITION. LABEL THE SELECTOR SWITCH "LIGHTING" AND ITS POSITIONS "ON-OFF-AUTO".
5. STORE A SCHEMATIC DIAGRAM, A CIRCUIT DIRECTORY, AND A MATERIALS LIST INCLUDING THE MANUFACTURERS' NAMES AND PART/CATALOG NUMBERS, ALL LAMINATED IN PLASTIC, IN A METAL POCKET ATTACHED TO THE INSIDE OF THE LOAD CENTER.

UTILITY REQUIREMENTS:







1. INSTALL A PULL ROPE IN THE SERVICE CONDUIT AND A CAP ON THE BURIED END. MARK THE BURIED END WITH A 2"x6" STAKE.

Project As-Built Drawings have been reviewed by the Project Engineer, and represent to the best of my knowledge, the project as constructed.

PE *[Signature]* Date 2/19/2019

DO NOT SCALE FROM THESE DRAWINGS USE DIMENSIONS

CHECKED BY: EE 	STATE OF ALASKA DEPARTMENT OF TRANSPORTATION & PUBLIC FACILITIES SOUTHCOAST REGION									
	JNU: GLACIER HWY MULTI-USE SEPARATED PATH TO UAS PROJECT #69500 LOAD CENTER SUMMARY & DETAILS									
DESIGNED BY: N. GEARY DRAWN BY: N. GEARY	PATH: Q:\JUN69500\PLANSET\69500_Q1-Q4_ELECTRICAL.DWG TAB: Q2			GRANHAM, RICK L (DOT)						
<table border="1"> <thead> <tr> <th>NO</th> <th>DATE</th> <th>DESCRIPTION</th> </tr> </thead> <tbody> <tr> <td> </td> <td> </td> <td> </td> </tr> </tbody> </table>	NO	DATE	DESCRIPTION				PROJECT DESIGNATION 0933037 ~ 69500	YEAR 2015	SHEET NO. Q2	TOTAL SHEETS 54
NO	DATE	DESCRIPTION								

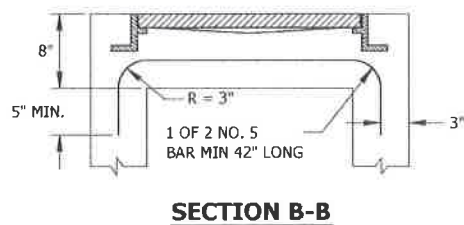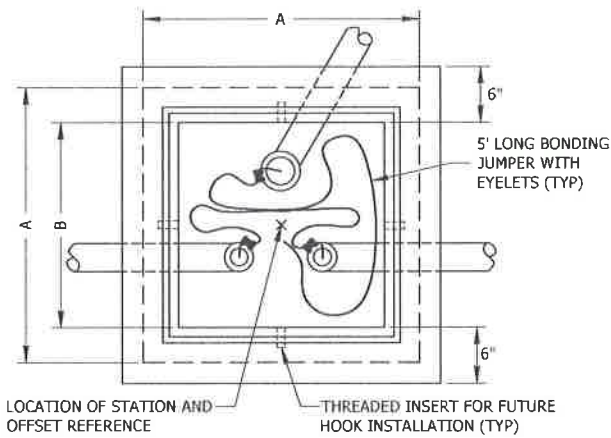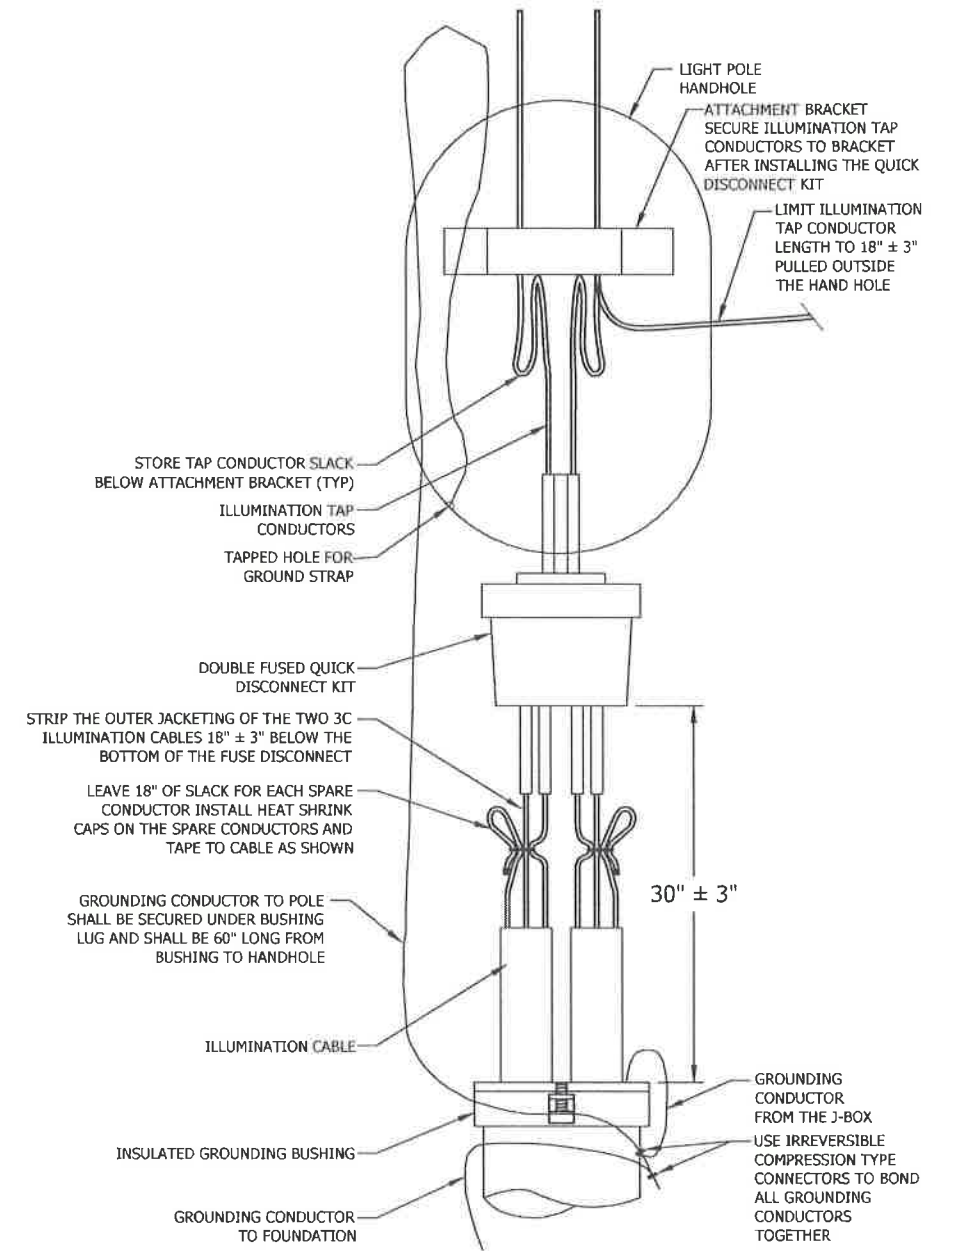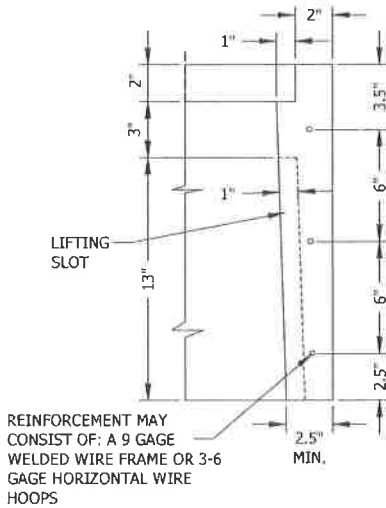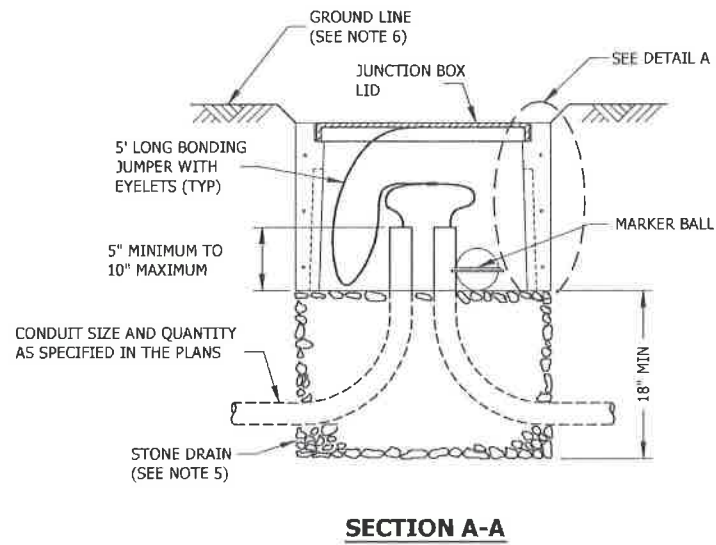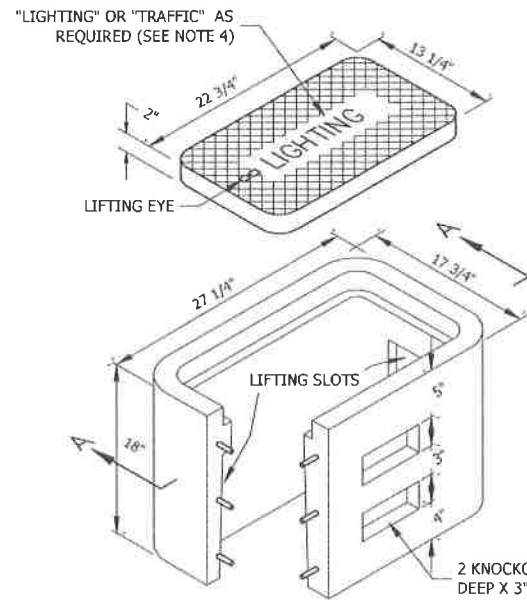

TYPE IA JUNCTION BOX

NOTES:

1. AVOID INSTALLING TYPE IA JUNCTION BOXES IN DRIVEWAYS OR IN LOCATIONS SUBJECT TO USE BY HEAVY TRUCKS. INSTALL JUNCTION BOXES ONLY AT THE LATERAL LOCATIONS ALLOWED IN SUBSECTION 660-3.04.
2. FURNISH TYPE IA JUNCTION BOXES WITH CAST IRON LIDS THAT WEIGH A MINIMUM OF 50 POUNDS.
3. CONSTRUCT JUNCTION BOXES ACCORDING TO SECTION 501 USING CLASS A CONCRETE. REINFORCE TYPE IA JUNCTION BOXES AS SHOWN. SYNTHETIC STRUCTURAL FIBER-REINFORCED CONCRETE THAT MEETS ASTM C 1116 AND CONTAINS FIBER IN PROPORTIONS AS RECOMMENDED BY THE FIBER MANUFACTURER MAY BE ADDED FOR STRENGTH.
4. FOR JUNCTION BOXES THAT CONTAIN ILLUMINATION CONDUCTORS EXCLUSIVELY, FURNISH LIDS WITH THE WORD "LIGHTING" INSCRIBED INTO THEM. FOR OTHER JUNCTION BOXES, FURNISH LIDS WITH THE WORD "TRAFFIC" INSCRIBED INTO THEM.
5. UNDER JUNCTION BOXES, INSTALL STONE DRAINS THAT CONSIST OF POROUS BACKFILL MATERIAL CONFORMING TO SUBSECTION 703-2.10.
6. SET THE TOPS OF JUNCTION BOXES WITH THE FOLLOWING DIMENSIONS BELOW THE FINISHED SURROUNDING SURFACE:
 1" IN PAVED MEDIANS AND ADJACENT TO PEDESTRIAN FACILITIES
 1/4" IN PEDESTRIAN FACILITIES AND ROADWAY
 2" IN ALL OTHER AREAS
7. BOND JUNCTION BOX LIDS TO THE SYSTEM OF EQUIPMENT GROUNDING CONDUCTORS ACCORDING TO SUBSECTION 660-3.06. ATTACH BONDING JUMPERS TO THE JUNCTION BOX LIDS WITH BRASS OR STAINLESS STEEL HARDWARE.
8. INSTALL LOOP DETECTOR TAILS THROUGH ONE OF THE KNOCKOUTS OF TYPE IA JUNCTION BOXES. AFTER SETTING THE BOXES TO GRADE, INSTALL GROUT IN THE GAPS THAT REMAIN IN THE KNOCKOUT.
9. INSTALL A 1/2" THICK PREFORMED BITUMINOUS JOINT MATERIAL AROUND JUNCTION BOXES INSTALLED IN PORTLAND CEMENT CONCRETE WALKWAYS.
10. INSTALL AN ELECTRONIC MARKER BALL IN ALL JUNCTION BOXES PER SUBSECTION 660-3.04.

LIGHT POLE HANDHOLE WIRING DETAIL

DO NOT SCALE FROM THESE DRAWINGS USE DIMENSIONS

CHECKED BY: N. GEARY 		STATE OF ALASKA DEPARTMENT OF TRANSPORTATION & PUBLIC FACILITIES SOUTHCOAST REGION JNU: GLACIER HWY MULTI-USE SEPARATED PATH TO UAS PROJECT #69500	
DESIGNED BY: N. GEARY DRAWN BY: N. GEARY		JUNCTION BOX DETAILS	
PATH: Q:\JNU\69500\PLANSET\69500_Q1-Q4_ELECTRICAL.DWG TAB: Q3 Monday, July 20, 2015 12:54:56 PM GRANHAM, RICK L (DOT)		PROJECT DESIGNATION: 0933037 ~ 69500 YEAR: 2015 SHEET NO: Q3 TOTAL SHEETS: 54	
REVISIONS NO. DATE DESCRIPTION			

Project As-Built Drawings have been reviewed by the Project Engineer, and represent to the best of my knowledge, the project as constructed.
 PE *[Signature]* Date 2/19/2019

STATE	PROJECT DESIGNATION	YEAR	SHEET NO.	TOTAL SHEETS
ALASKA		2015	04	54

GENERAL NOTES

FRANGIBLE COUPLING DATA

Use frangible Coupling Breakaway System, meeting NCHRP 350 test level 3 criteria, designed for impacts from any direction and having no specific torque requirements. Install components of the Frangible Coupling System in accordance with the manufacturer's written instructions.

Use this drawing when frangible couplings have the following properties:

Ultimate Shear Capacity = $V_u = 5.5$ kips
 Ultimate Tensile Capacity = $T_u = 49.8$ kips

Foundation Design based on 120% of coupling ultimate capacities.

MATERIALS

CONCRETE.....Class **DS** f'c = 4,000 psi.

PIPE PILE.....API 5L X52, $F_y = 52,000$ psi or ASTM A709, GR 50, $F_y = 50,000$ psi.

POLE DATA



Pole Height = 50' maximum
 Mast Arm Length = 22' maximum
 Luminaire = 50 lbs. maximum
 Luminaire Projected Area = 2 square feet maximum
 Pole, Arm and Luminaire Dead load ≤ 950 lbs.

INSTALLATION


Pre-drilling required.

Grout annular space between casing and soil with DS grout if not in direct contact.

Submit grounding wire details for approval.

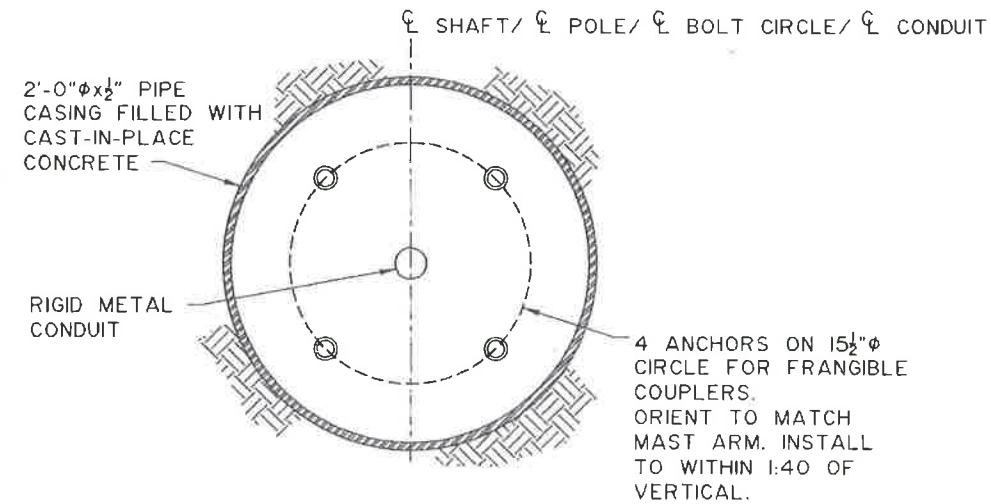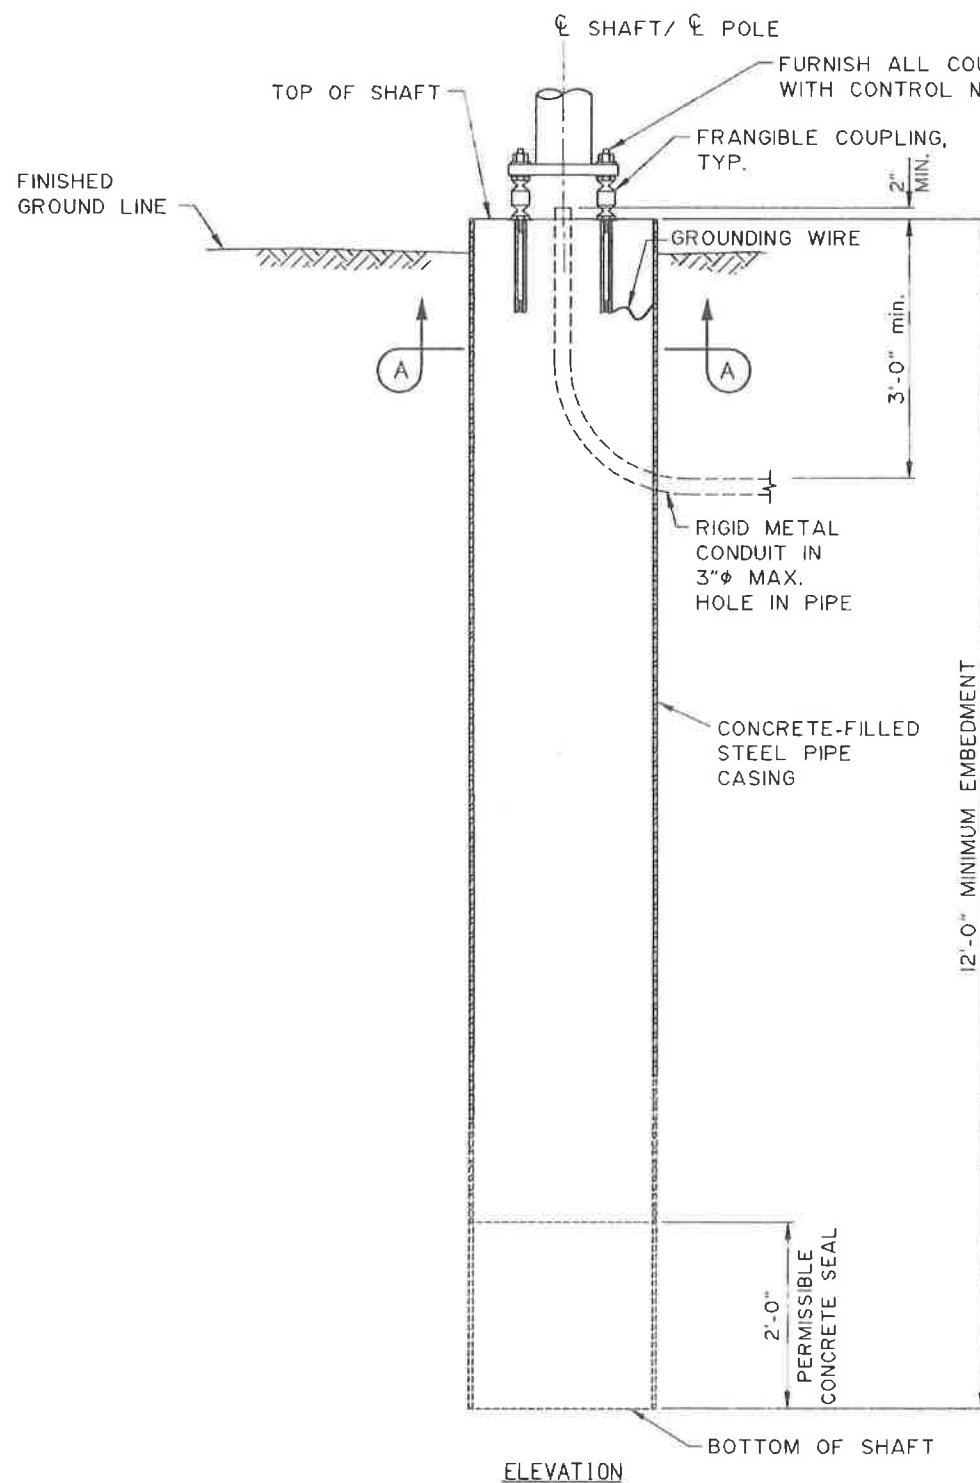

SECTION A-A

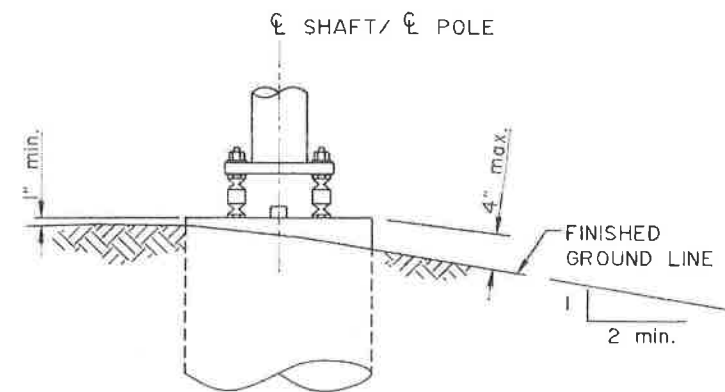

SOIL CLEARANCE DETAIL (SKIRT NOT SHOWN)

CONCRETE-FILLED STEEL PIPE CASING WITH FRANGIBLE COUPLINGS (SKIRT NOT SHOWN)

Project As-Built Drawings have been reviewed by the Project Engineer, and represent to the best of my knowledge, the project as constructed.
 PE *[Signature]* Date 2/19/2019

DESIGNED BY: Elmer Marx	CHECKED: Mary McFoe
DRAWN BY: Sam Soltie	CHECKED: Elmer Marx
QUANTITIES BY: Elmer Marx	CHECKED: Mary McFoe

STATE OF ALASKA
 DEPARTMENT OF TRANSPORTATION
 AND PUBLIC FACILITIES
 BRIDGE SECTION




HAMILTON STREET LIGHT
 HAMILTON STREET
 POLE FOUNDATION



BRIDGE NO. NA
 DWG. NO. 04

AS BUILT Reviewed 3-29-19
By AK. DOT. TL. Insp.

PROJECT DESIGNATION	SHEET NO.	TOTAL SHEETS
69500	R2	54

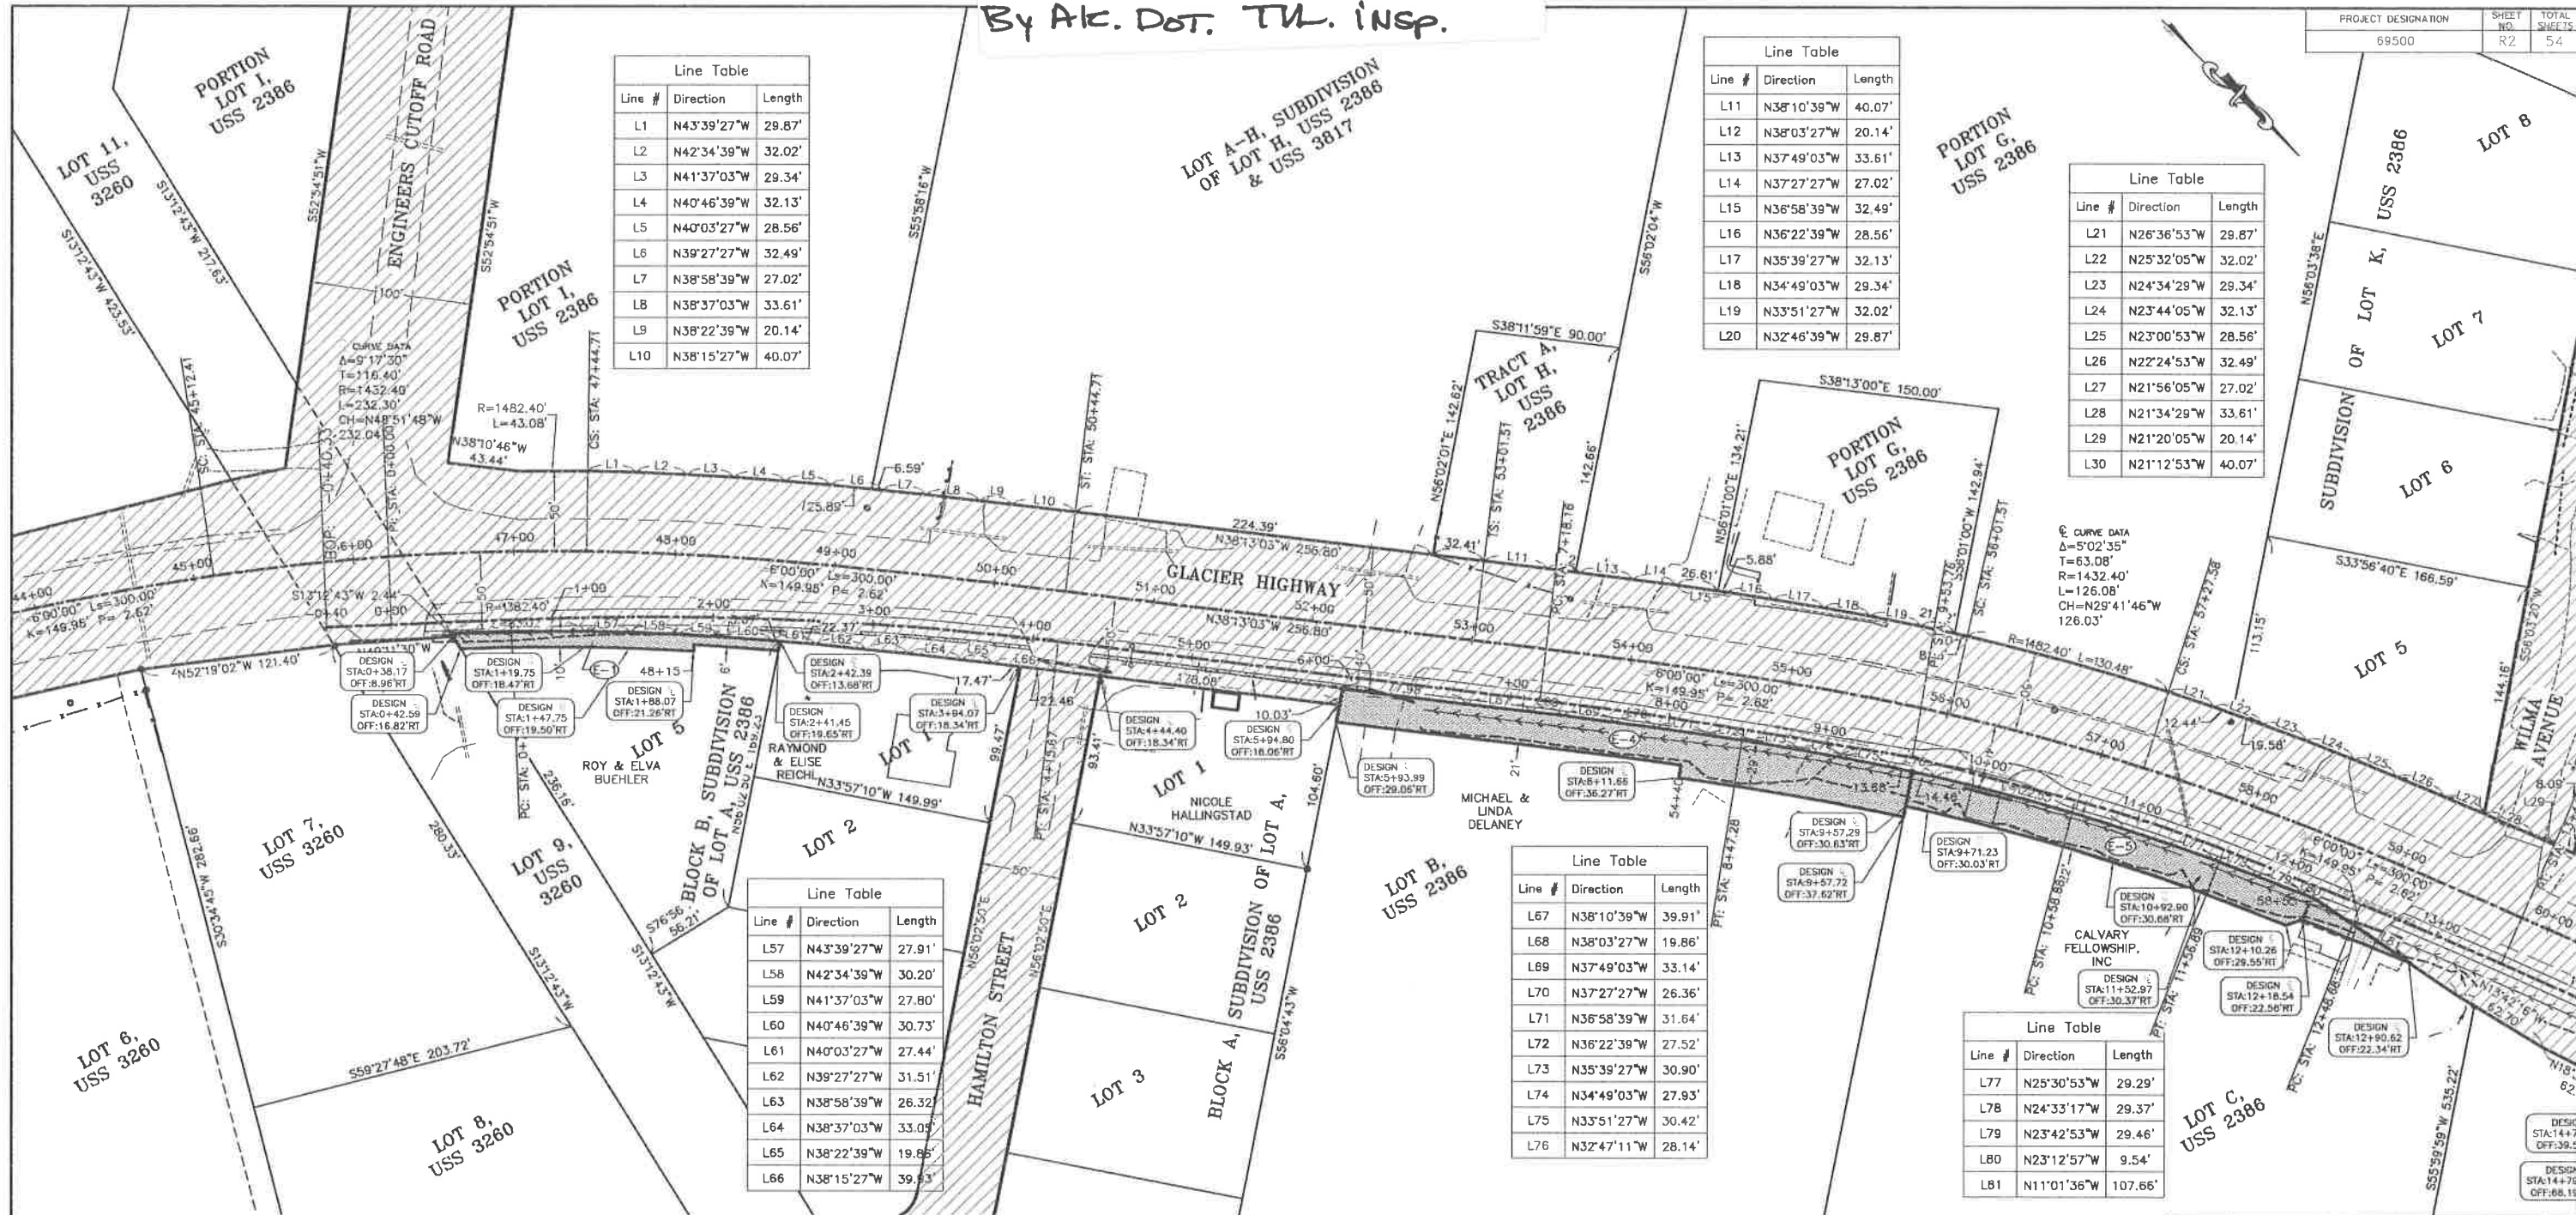

Line #	Direction	Length
L1	N43°39'27"W	29.87'
L2	N42°34'39"W	32.02'
L3	N41°37'03"W	29.34'
L4	N40°46'39"W	32.13'
L5	N40°03'27"W	28.56'
L6	N39°27'27"W	32.49'
L7	N38°58'39"W	27.02'
L8	N38°37'03"W	33.61'
L9	N38°22'39"W	20.14'
L10	N38°15'27"W	40.07'

Line #	Direction	Length
L11	N38°10'39"W	40.07'
L12	N38°03'27"W	20.14'
L13	N37°49'03"W	33.61'
L14	N37°27'27"W	27.02'
L15	N36°58'39"W	32.49'
L16	N36°22'39"W	28.56'
L17	N35°39'27"W	32.13'
L18	N34°49'03"W	29.34'
L19	N33°51'27"W	32.02'
L20	N32°46'39"W	29.87'

Line #	Direction	Length
L21	N26°36'53"W	29.87'
L22	N25°32'05"W	32.02'
L23	N24°34'29"W	29.34'
L24	N23°44'05"W	32.13'
L25	N23°00'53"W	28.56'
L26	N22°24'53"W	32.49'
L27	N21°56'05"W	27.02'
L28	N21°34'29"W	33.61'
L29	N21°20'05"W	20.14'
L30	N21°12'53"W	40.07'

Line #	Direction	Length
L57	N43°39'27"W	27.91'
L58	N42°34'39"W	30.20'
L59	N41°37'03"W	27.80'
L60	N40°46'39"W	30.73'
L61	N40°03'27"W	27.44'
L62	N39°27'27"W	31.51'
L63	N38°58'39"W	26.32'
L64	N38°37'03"W	33.09'
L65	N38°22'39"W	19.85'
L66	N38°15'27"W	39.93'

Line #	Direction	Length
L67	N38°10'39"W	39.91'
L68	N38°03'27"W	19.86'
L69	N37°49'03"W	33.14'
L70	N37°27'27"W	26.36'
L71	N36°58'39"W	31.64'
L72	N36°22'39"W	27.52'
L73	N35°39'27"W	30.90'
L74	N34°49'03"W	27.93'
L75	N33°51'27"W	30.42'
L76	N32°47'11"W	28.14'

Line #	Direction	Length
L77	N25°30'53"W	29.29'
L78	N24°33'17"W	29.37'
L79	N23°42'53"W	29.46'
L80	N23°12'57"W	9.54'
L81	N11°01'36"W	107.66'

EASEMENT	OWNER	AREA	PURPOSE	RECORDING DATA
E-1	Roy & Elva Buehler	1797 SF	Ditch & Slope Maint.	
E-4	Michael V. & Linda M. Delaney	8684 SF	Ditch & Slope Maint.	
E-5	Calvary Fellowship, Inc.	6251 SF	Ditch & Slope Maint.	

DATE	REVISIONS	BY
4-1-14	Edit Esmts. - Des. Changes, add parcels 7&8	RJG
3-12-14	Edit E-5	RJG


STATE OF ALASKA
DEPARTMENT OF TRANSPORTATION
&
PUBLIC FACILITIES
RIGHT OF WAY MAP
ALASKA PROJECT
0933037 / 69500
JNU GLACIER HWY MULTI-USE SEPERATED PATH TO UAS

DRAWN	RJG	DATE	08/23/2013	SCALE	1" = 50'
CHECKED		DATE		SHEET	R2 OF 54

G:\JNU\69500\RW\CD\14\SOURCE DWGS\BASEMAP\69500_ROW_PLANSSET.DWG

AS-BUILTS REVIEWED
 By: T.VL @ AKDOT.
 3-29-19

PROJECT DESIGNATION	SHEET NO.	TOTAL SHEETS
69500	P.3	54

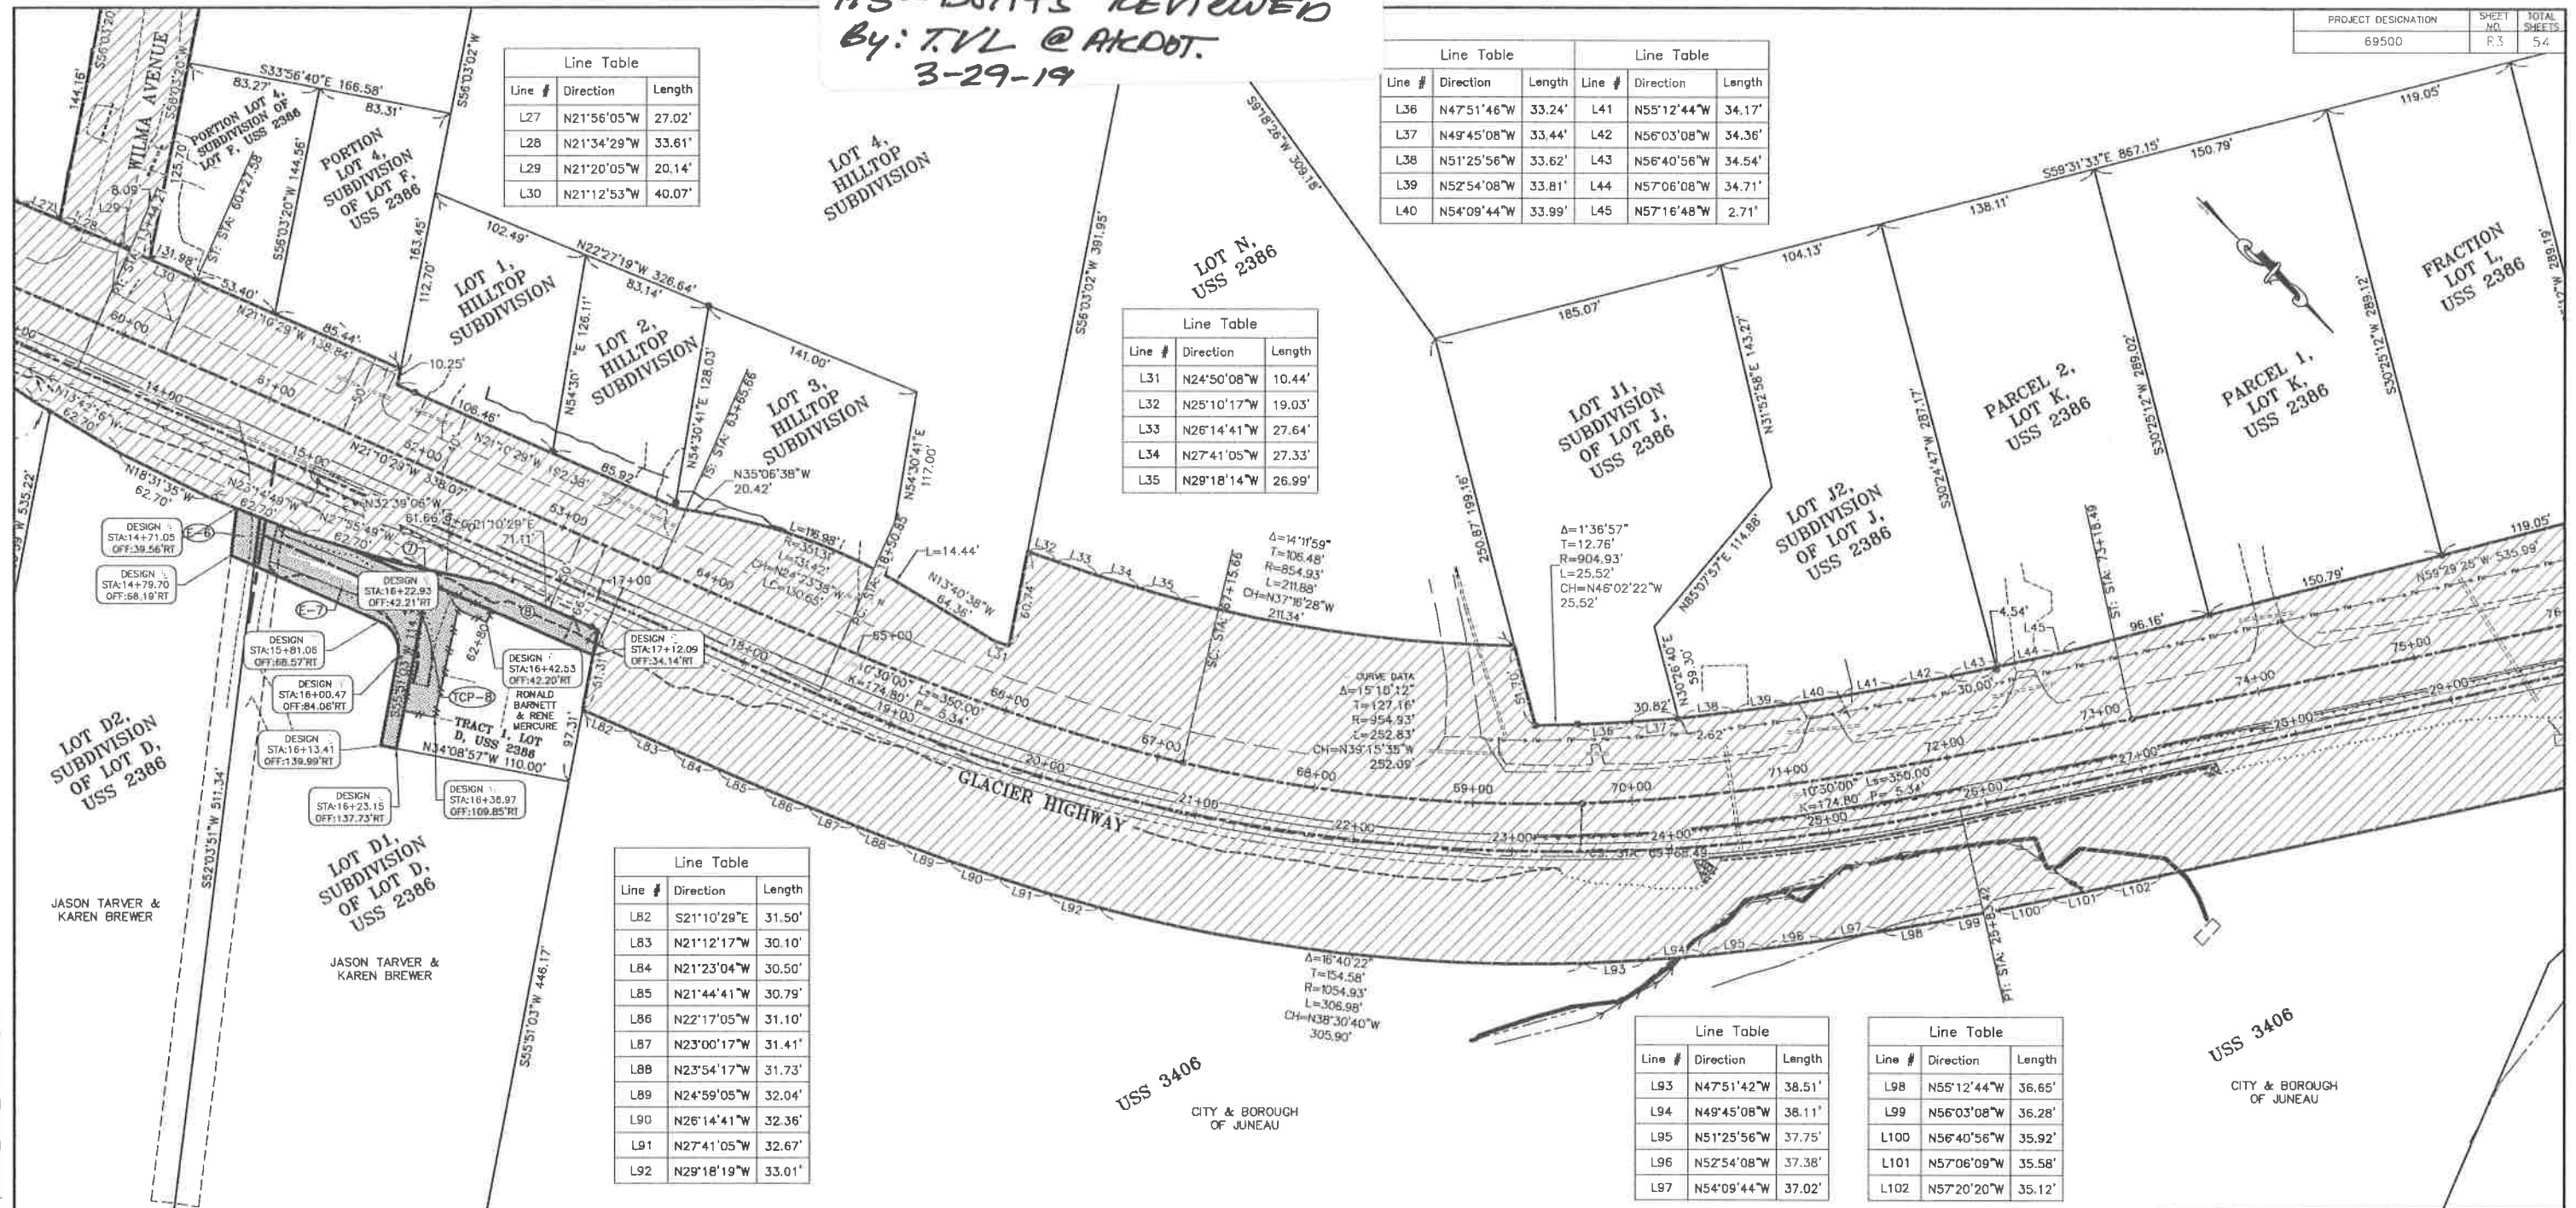

Line #	Direction	Length
L27	N21°56'05"W	27.02'
L28	N21°34'29"W	33.61'
L29	N21°20'05"W	20.14'
L30	N21°12'53"W	40.07'

Line #	Direction	Length	Line #	Direction	Length
L36	N47°51'46"W	33.24'	L41	N55°12'44"W	34.17'
L37	N49°45'08"W	33.44'	L42	N56°03'08"W	34.36'
L38	N51°25'56"W	33.62'	L43	N56°40'56"W	34.54'
L39	N52°54'08"W	33.81'	L44	N57°06'08"W	34.71'
L40	N54°09'44"W	33.99'	L45	N57°16'48"W	2.71'

Line #	Direction	Length
L31	N24°50'08"W	10.44'
L32	N25°10'17"W	19.03'
L33	N26°14'41"W	27.64'
L34	N27°41'05"W	27.33'
L35	N29°18'14"W	26.99'

Line #	Direction	Length
L82	S21°10'29"E	31.50'
L83	N21°12'17"W	30.10'
L84	N21°23'04"W	30.50'
L85	N21°44'41"W	30.79'
L86	N22°17'05"W	31.10'
L87	N23°00'17"W	31.41'
L88	N23°54'17"W	31.73'
L89	N24°59'05"W	32.04'
L90	N26°14'41"W	32.36'
L91	N27°41'05"W	32.67'
L92	N29°18'19"W	33.01'

Line #	Direction	Length
L93	N47°51'42"W	38.51'
L94	N49°45'08"W	38.11'
L95	N51°25'56"W	37.75'
L96	N52°54'08"W	37.38'
L97	N54°09'44"W	37.02'

Line #	Direction	Length
L98	N55°12'44"W	36.65'
L99	N56°03'08"W	36.28'
L100	N56°40'56"W	35.92'
L101	N57°06'08"W	35.58'
L102	N57°20'20"W	35.12'

EASEMENT	OWNER	AREA	PURPOSE	RECORDING DATA
E-6	Jason B Tarver & Karen Jane Brewer Tarver	448 SF	Access Easement for Ptn Lot D	
E-7	Jason B Tarver & Karen Jane Brewer Tarver	4444 SF	Access Easement for Ptn Lot D	

TCP NO.	OWNER	AREA	PURPOSE
TCP-8	Ronald A Barnett & Rene Mercure	1809 SF	Driveway Reconstruction

PARCEL	OWNER	AREA	REMAIN	RECORDING DATA
7	Jason B Tarver & Karen Jane Brewer	186 SF		
8	Ronald A Barnett & Rene Mercure	1638 SF		


DATE	REVISIONS	BY
4-1-14	Edit Esmts. - Des. Changes, add parcels 7&8	RJG
3-12-14	Add E-6 thru E-8, TCP-8	RJG

STATE OF ALASKA
 DEPARTMENT OF TRANSPORTATION
 &
 PUBLIC FACILITIES
 RIGHT OF WAY MAP
 ALASKA PROJECT
 0933037 / 69500
 JNU GLACIER HWY MULTI-USE SEPARATED PATH TO UAS

DRAWN	RJG	DATE	08/23/2013	SCALE	1"=50'
CHECKED		DATE		SHEET	R3 OF 54

C:\JNU\69500\RW\C3D14\SOURCE DWGS\BASEMAP\69500_ROW_PLANSET.DWG

G:\JNU\69500\RW\CSD14\SOURCE DWGS\BASEMAP\69500_ROW_PLANS\SET.DWG

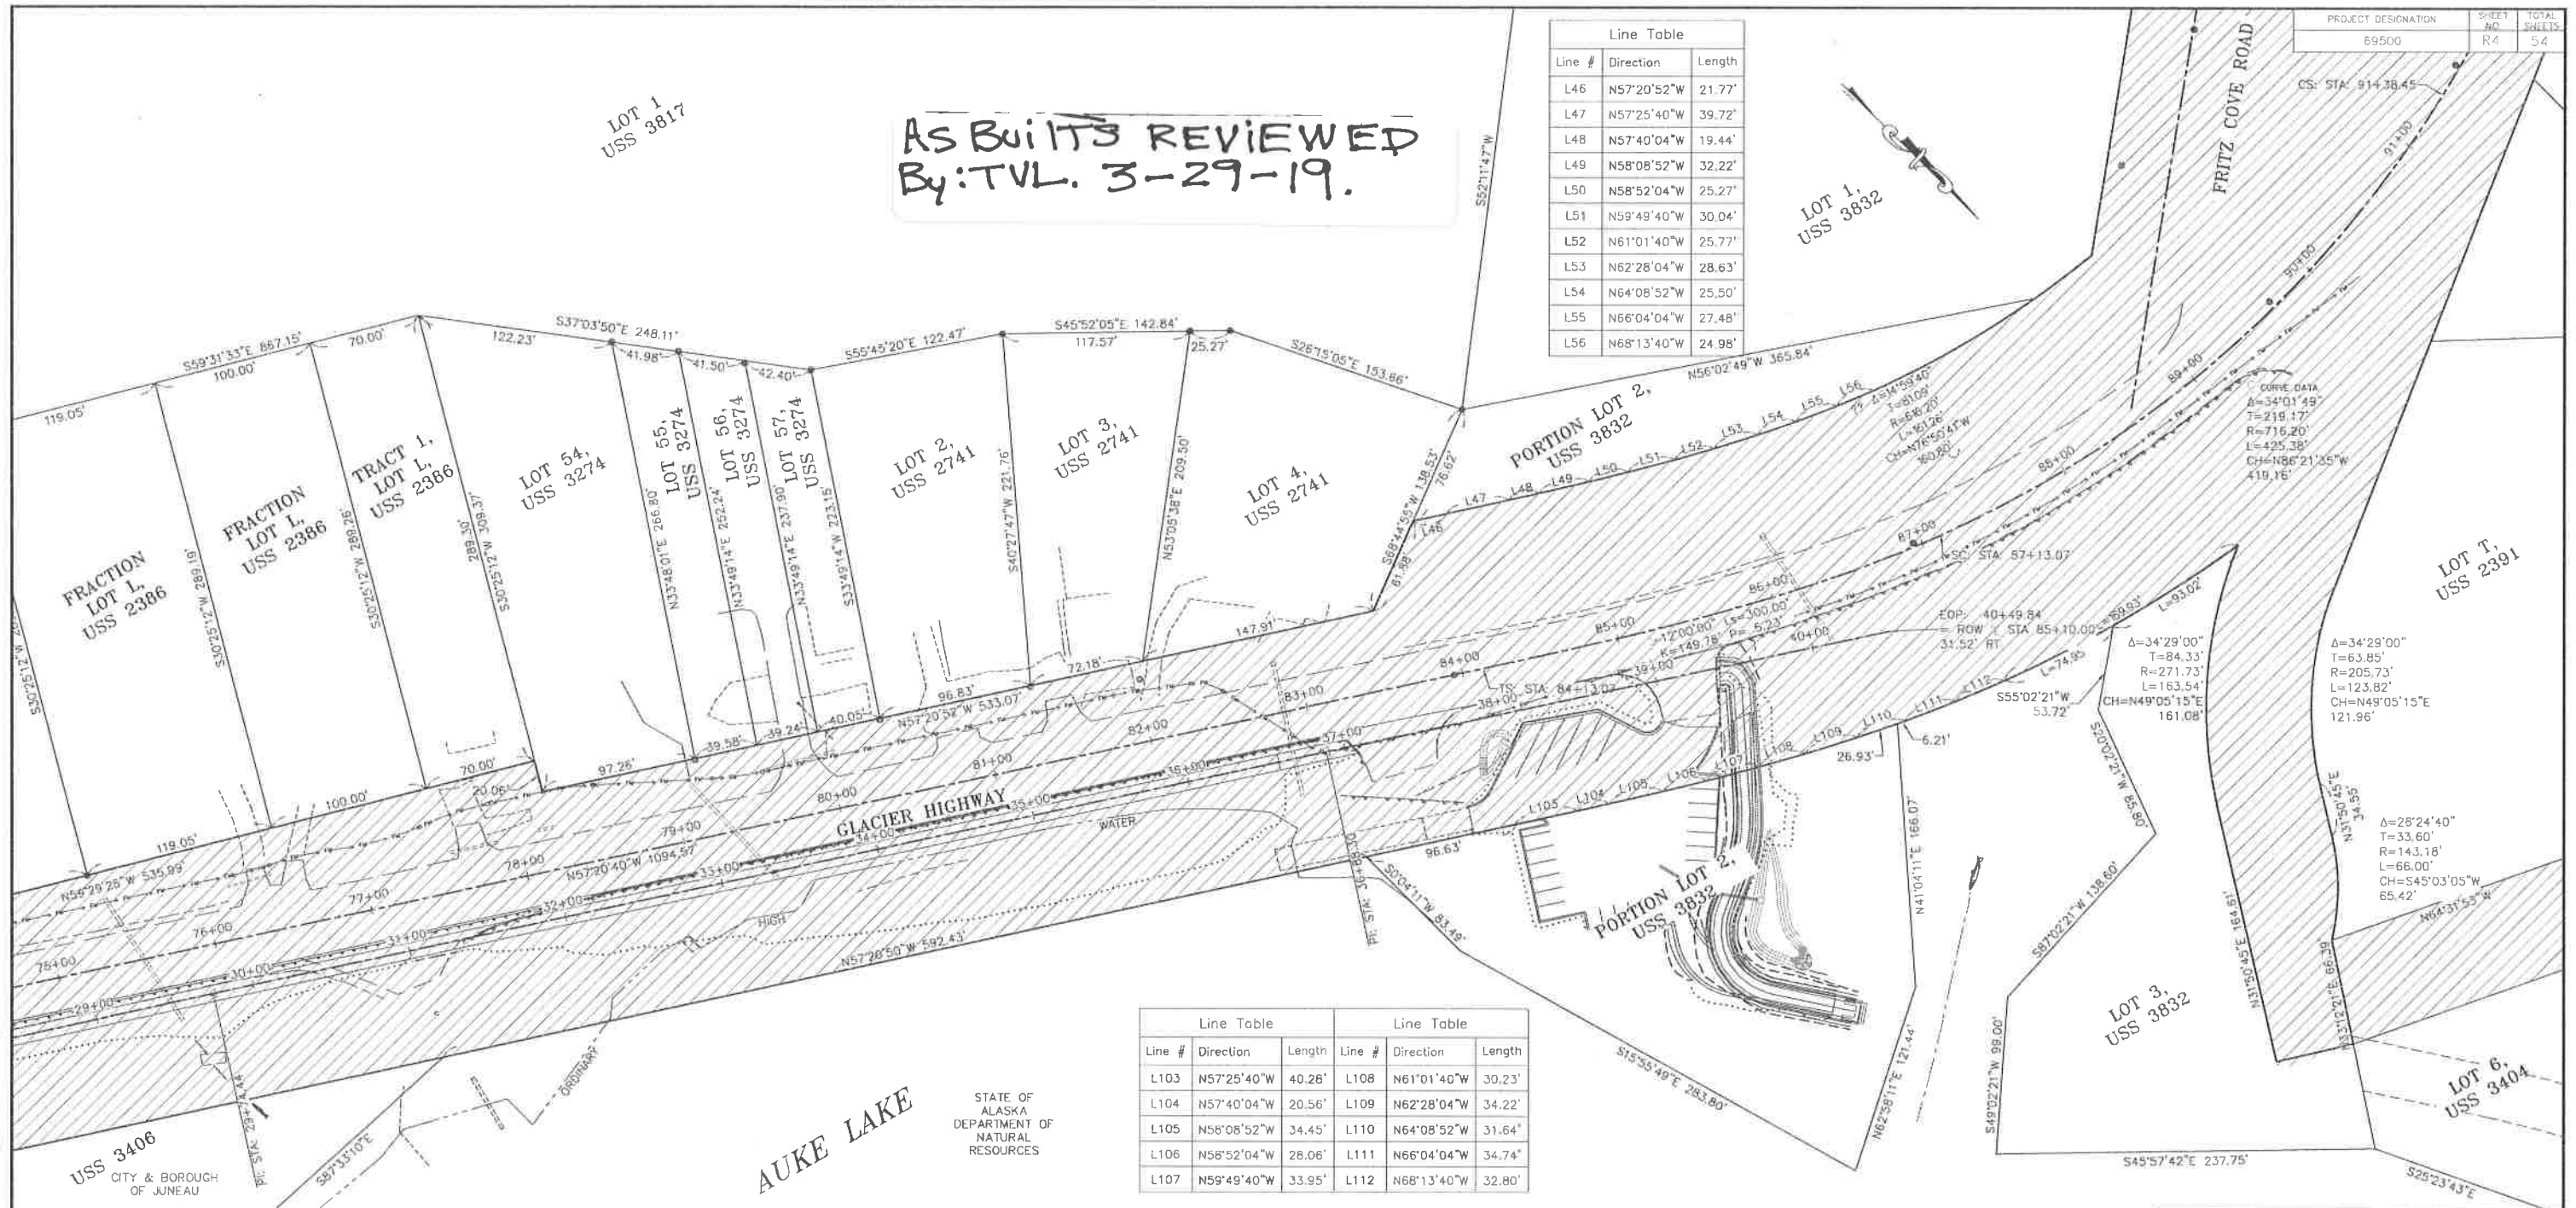

AS BUILT'S REVIEWED
By: TVL. 3-29-19.

Line Table		
Line #	Direction	Length
L46	N57°20'52"W	21.77'
L47	N57°25'40"W	39.72'
L48	N57°40'04"W	19.44'
L49	N58°08'52"W	32.22'
L50	N58°52'04"W	25.27'
L51	N59°49'40"W	30.04'
L52	N61°01'40"W	25.77'
L53	N62°28'04"W	28.63'
L54	N64°08'52"W	25.50'
L55	N66°04'04"W	27.48'
L56	N68°13'40"W	24.98'

Line Table			Line Table		
Line #	Direction	Length	Line #	Direction	Length
L103	N57°25'40"W	40.26'	L108	N61°01'40"W	30.23'
L104	N57°40'04"W	20.56'	L109	N62°28'04"W	34.22'
L105	N58°08'52"W	34.45'	L110	N64°08'52"W	31.64'
L106	N58°52'04"W	28.06'	L111	N66°04'04"W	34.74'
L107	N59°49'40"W	33.95'	L112	N68°13'40"W	32.80'


STATE OF ALASKA
DEPARTMENT OF
NATURAL RESOURCES

EASEMENT	OWNER	AREA	PURPOSE	RECORDING DATA


DATE	REVISIONS	BY
6-6-14	Delete E-9	RJG
4-1-14	Edit Esmts. - Des. Changes, add parcels 7&8	RJG
3-12-14	Edit E-9	RJG

STATE OF ALASKA
DEPARTMENT OF TRANSPORTATION
&
PUBLIC FACILITIES
RIGHT OF WAY MAP
ALASKA PROJECT
0933037 / 69500
JNU GLACIER HWY MULTI-USE SEPARATED PATH TO UAS


DRAWN	RJG	DATE	08/23/2013	SCALE	1" = 50'
CHECKED		DATE		SHEET	R4 OF 54

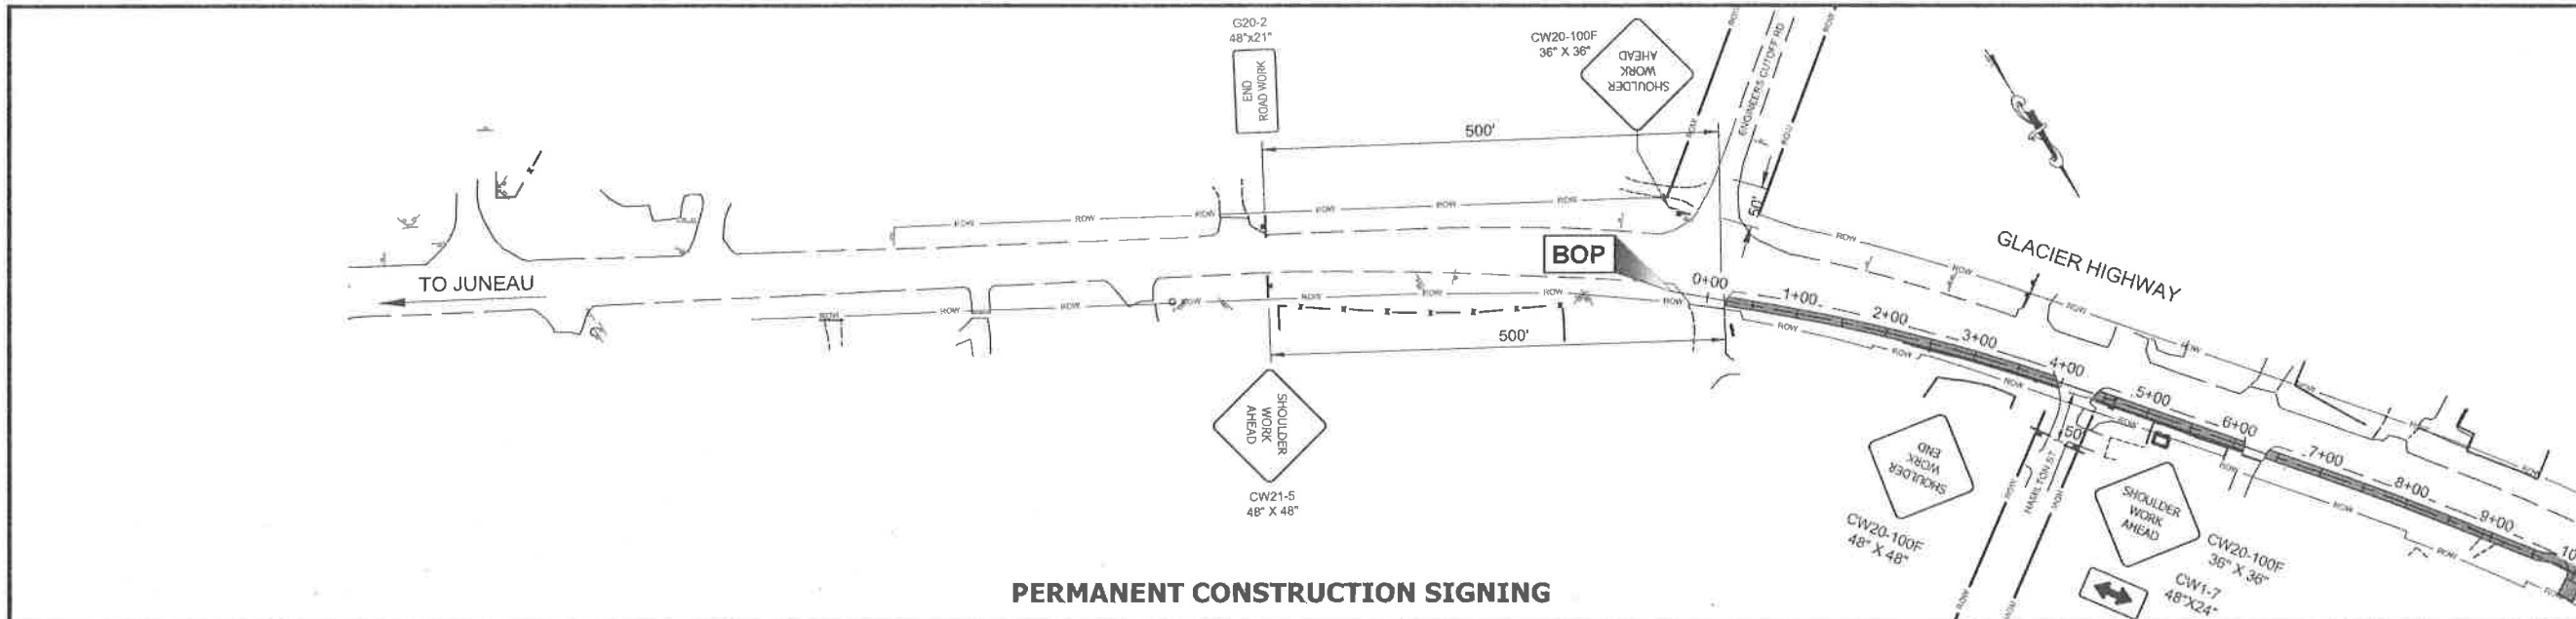


PERMANENT CONSTRUCTION SIGNING

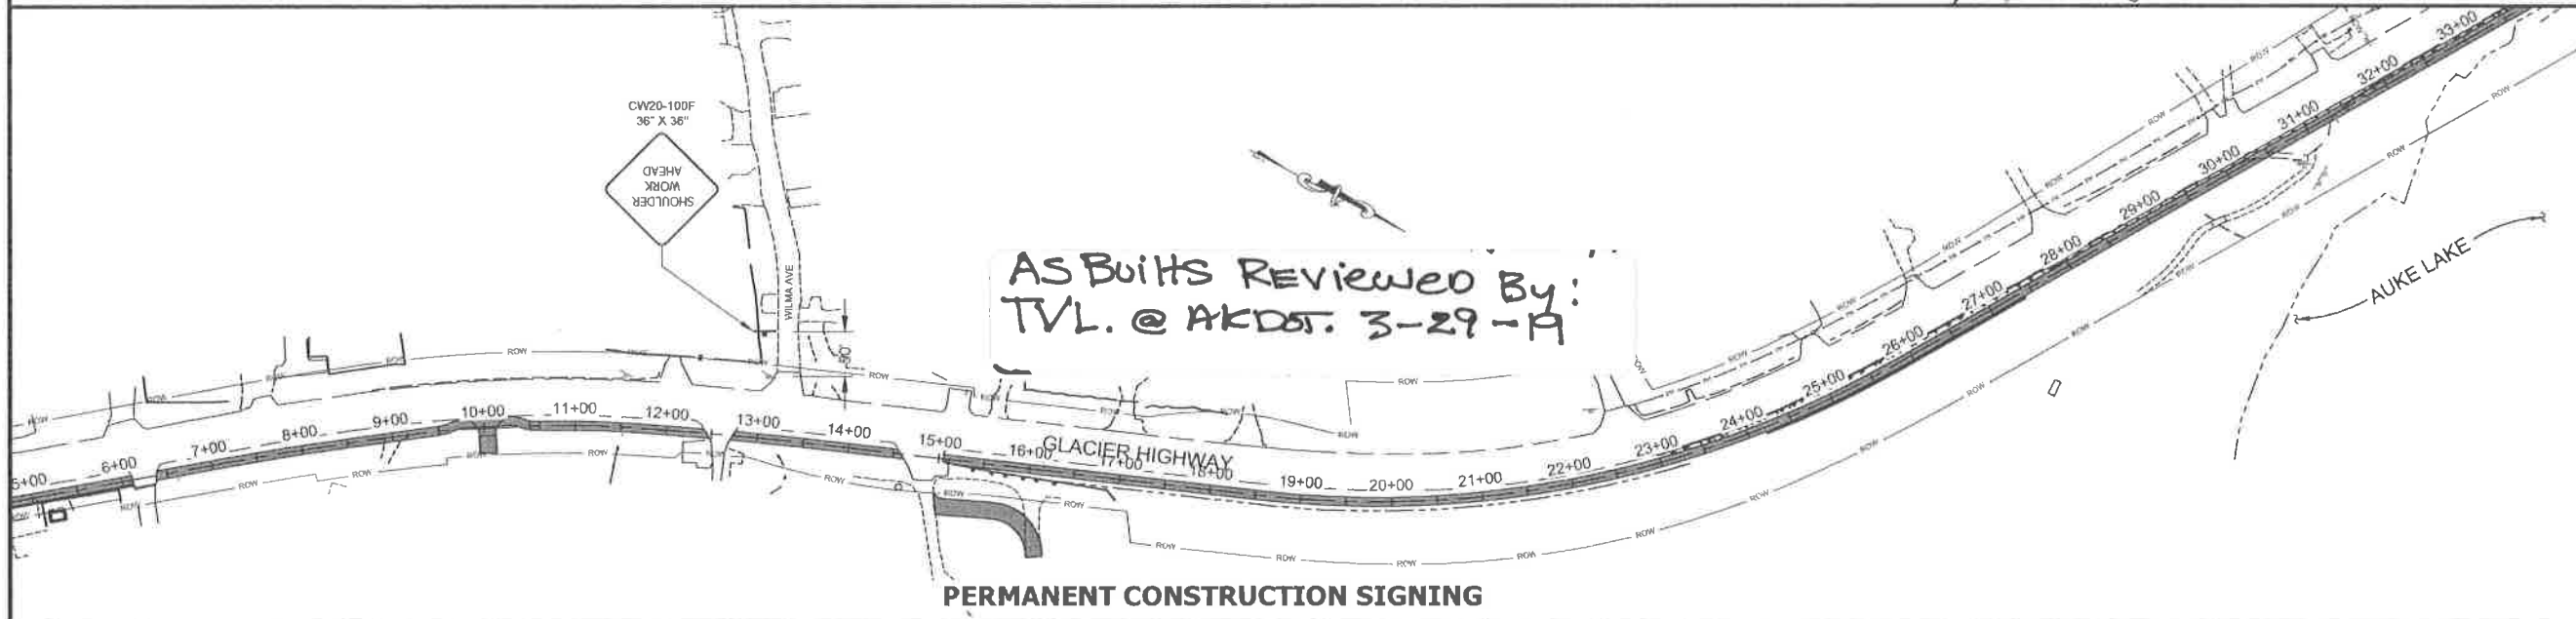

PERMANENT CONSTRUCTION SIGNING

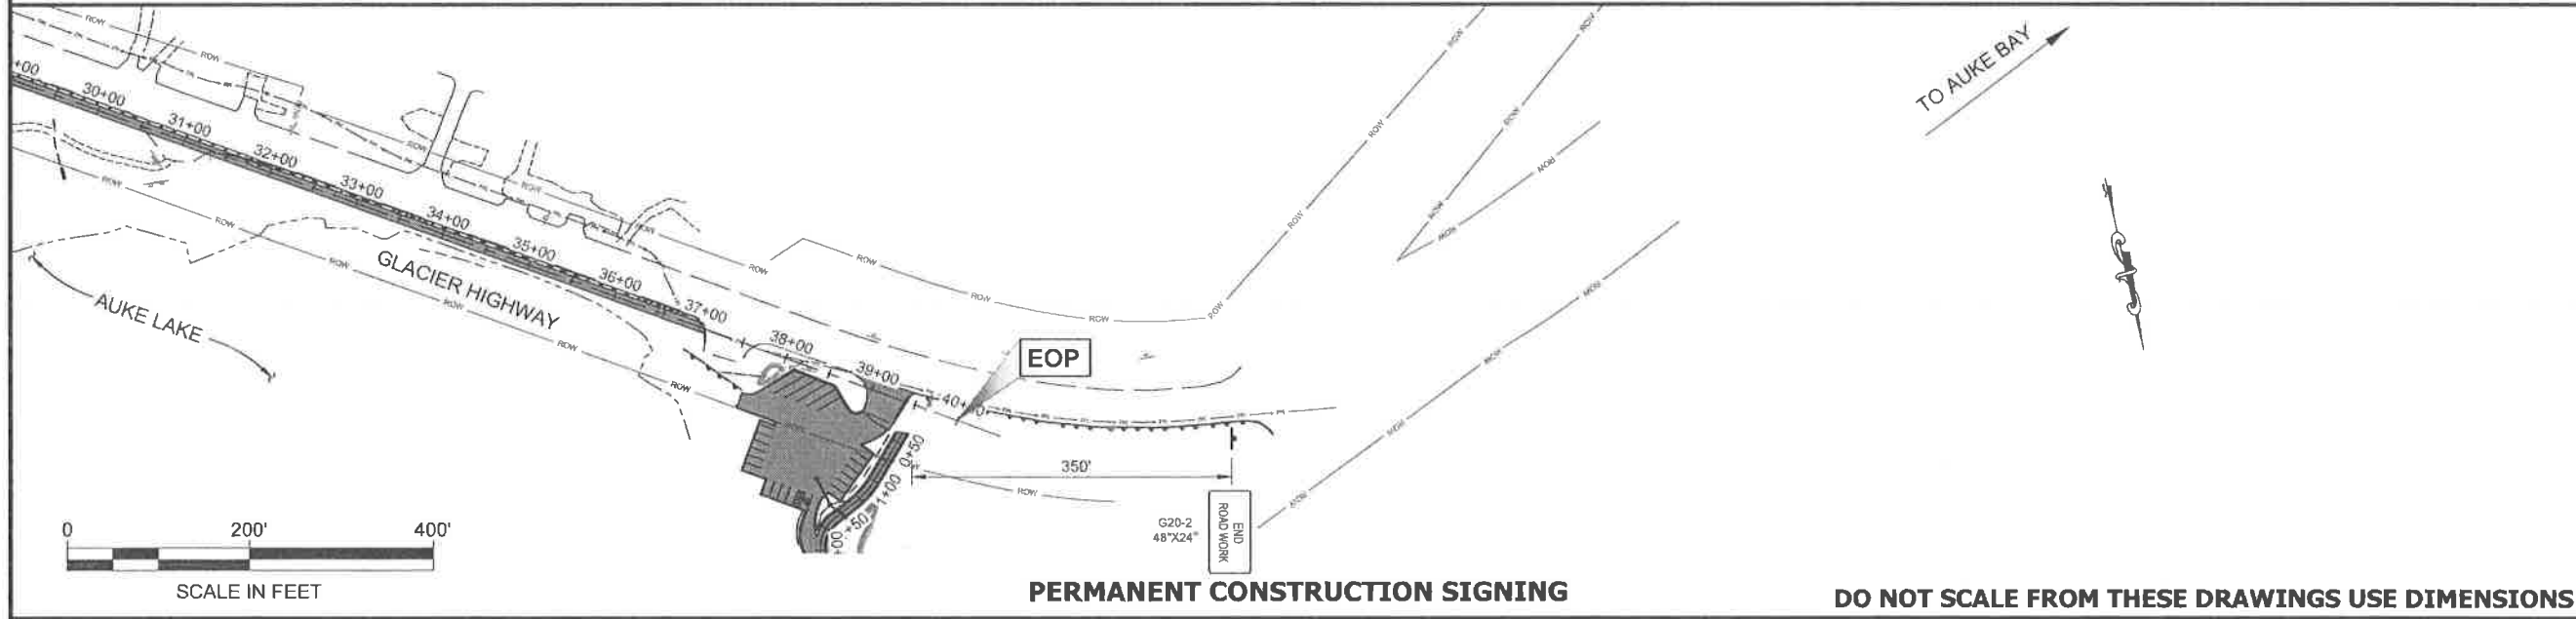

PERMANENT CONSTRUCTION SIGNING

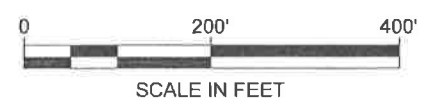

DO NOT SCALE FROM THESE DRAWINGS USE DIMENSIONS

PATH:
Q:\JNU\69500\PLANSET\69500_T1-T3_TRAFF-CNTL.DWG

GRANTHAM, RICK L (DOT)
TAB: T1 Monday, July 20, 2015 12:55:58 PM

ADDENDUM NUMBER

ATTACHMENT NUMBER

RECORD OF REVISIONS

No.	DATE	DESCRIPTION

PLAN LEGEND

CHECKED BY: D. EPSTEIN

TCP NOT SEALED IN ACCORDANCE WITH ALASKA HIGHWAY PRECONSTRUCTION MANUAL SECTION 1400.3.5 DATED JANUARY 30, 2012.

DESIGNED BY: J. BROWN

DRAWN BY: R. GRANTHAM

STATE OF ALASKA
DEPARTMENT OF TRANSPORTATION & PUBLIC FACILITIES
SOUTHCOST REGION

JNU: GLACIER HWY MULTI-USE SEPARATED PATH TO UAS
PROJECT NO. 69500

TRAFFIC CONTROL PLAN

PROJECT DESIGNATION
0933037 ~ 69500

STATE	YEAR
ALASKA	2015

SHEET NUMBER	TOTAL SHEETS
T1	54

SPEED (MPH)	MIN MERGING TAPER LENGTH (L) IN FEET WIDTH OF OFFSET (W) IN			MIN NUMBER OF DEVICES WIDTH OF OFFSET (W) IN FEET			MAX DEVICE SPACING IN FEET		BUFFER SPACE (FT)	BUFFER SPACE PER THE ATTTSA GUIDE (FT)
	10'	11'	12'	10'	11'	12'	ALONG TAPER	ALONG TANGENT		
25 OR BELOW	105	115	125	6	6	6	25	50	155	55
30	150	165	180	6	7	7	30	60	200	85
35	205	225	245	7	8	8	35	70	250	120
40	270	295	320	8	9	9	40	80	305	170
45	450	495	520	11	12	13	45	90	360	220

PLAN LEGEND

CHECKED BY: D. EPSTEIN

TCP NOT SEALED IN ACCORDANCE WITH ALASKA HIGHWAY PRECONSTRUCTION MANUAL SECTION 1400.3.5 DATED JANUARY 30, 2012.

DESIGNED BY: J. BROWN
DRAWN BY: R. GRANTHAM

STATE OF ALASKA
DEPARTMENT OF TRANSPORTATION & PUBLIC FACILITIES
SOUTHCOST REGION


JNU: GLACIER HWY MULTI-USE SEPARATED PATH TO UAS PROJECT NO. 69500

TRAFFIC CONTROL PLAN

PROJECT DESIGNATION
0933037 ~ 69500


STATE	YEAR
ALASKA	2015

SHEET NUMBER	TOTAL SHEETS
T2	54

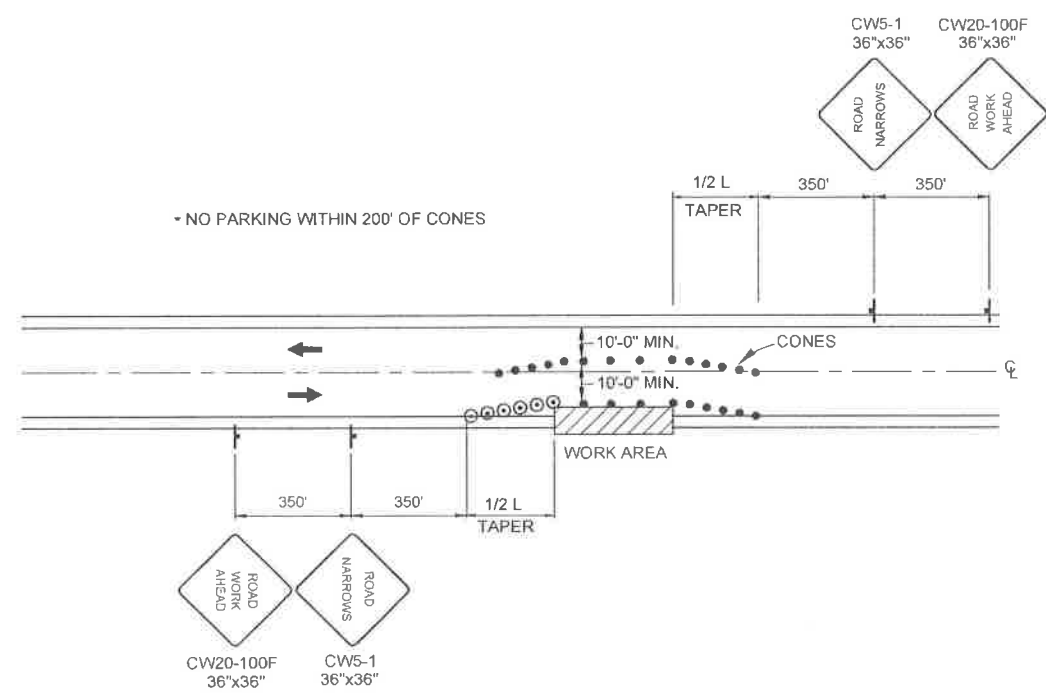


ROADWAY ENCROACHMENT


- NOTES:
- IF ONLY ONE LANE IS AFFECTED BY ROAD WORK (THAT IS, THE CONES ALONG THE WORK AREA ARE NO CLOSER THAN 10' TO CENTERLINE) THE CENTERLINE CONES FOR THE OPPOSING LANE MAY BE DELETED.

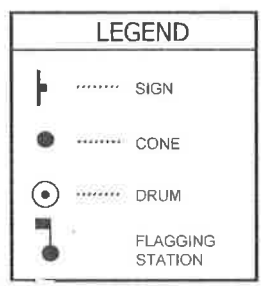

TCPs Reviewed By T.VL @ AK DOT. ON 3-29-19


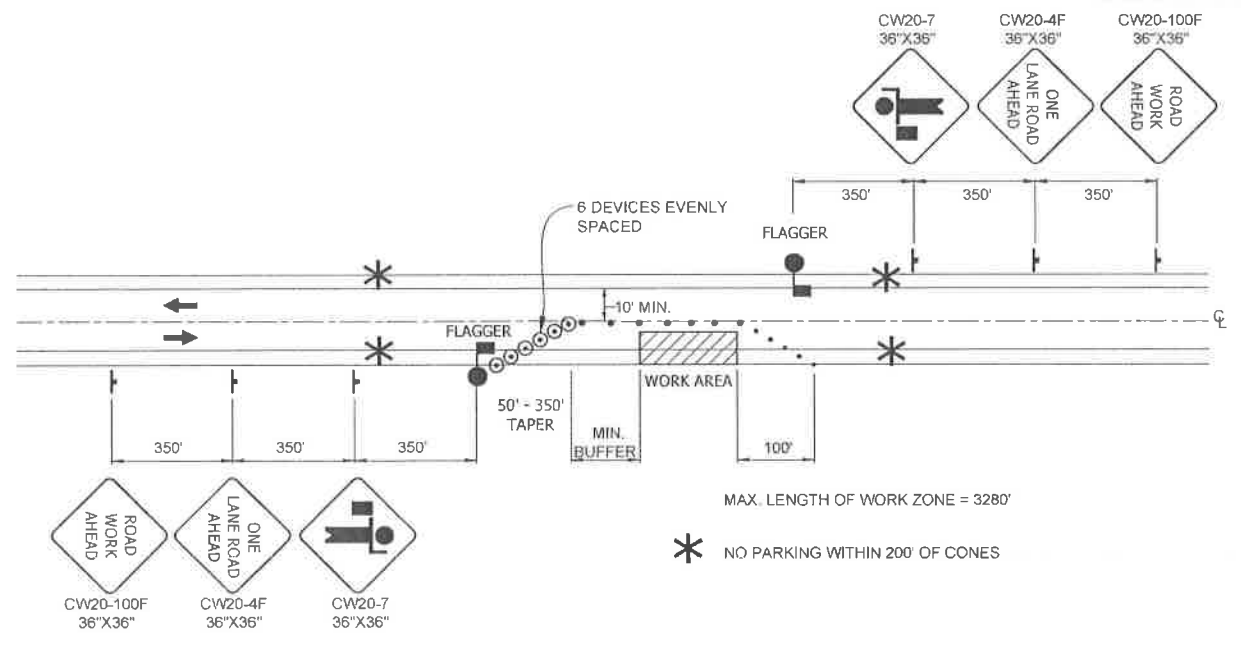


SINGLE LANE CLOSURE TWO LANE ROAD

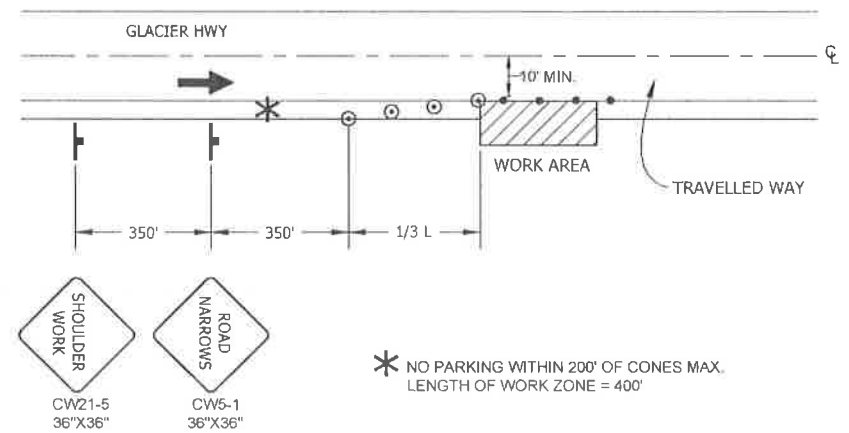


SHOULDER WORK


DO NOT SCALE FROM THESE DRAWINGS USE DIMENSIONS

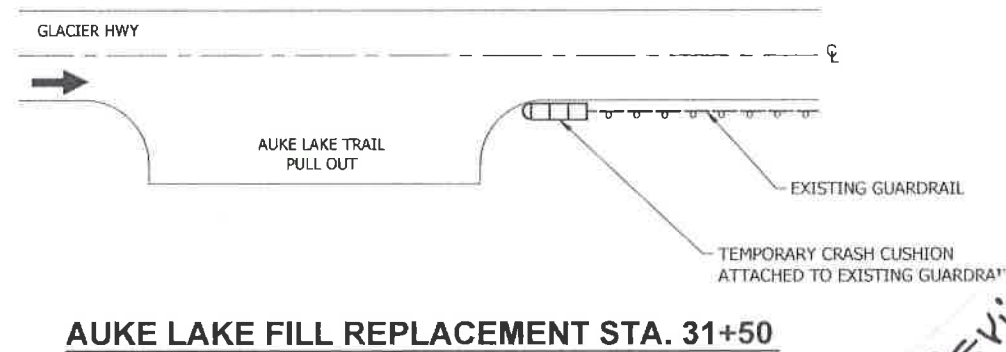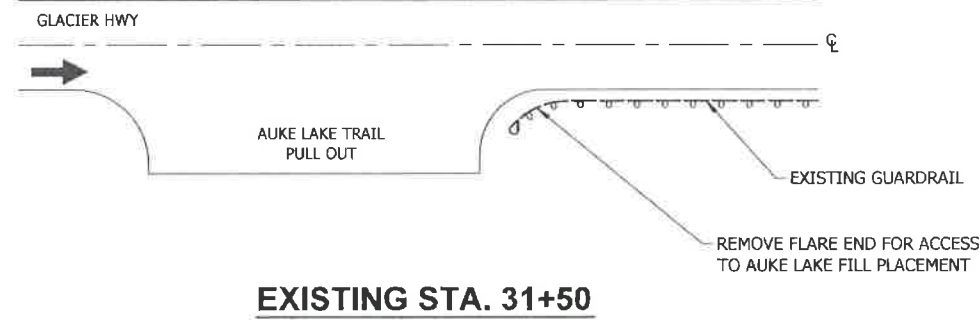

AS-BUILT REVIEWED BY TVL @ AK DOT. 3-29-19

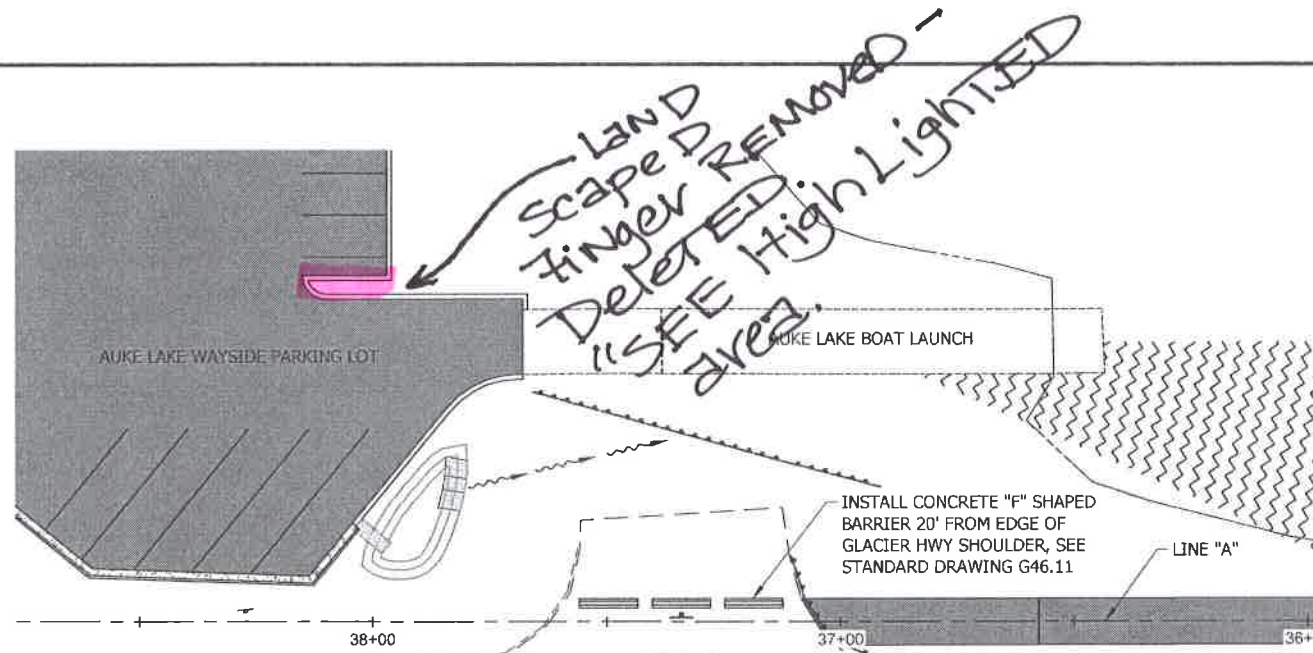

AUKE LAKE DRIVE PERMANENT CLOSURE

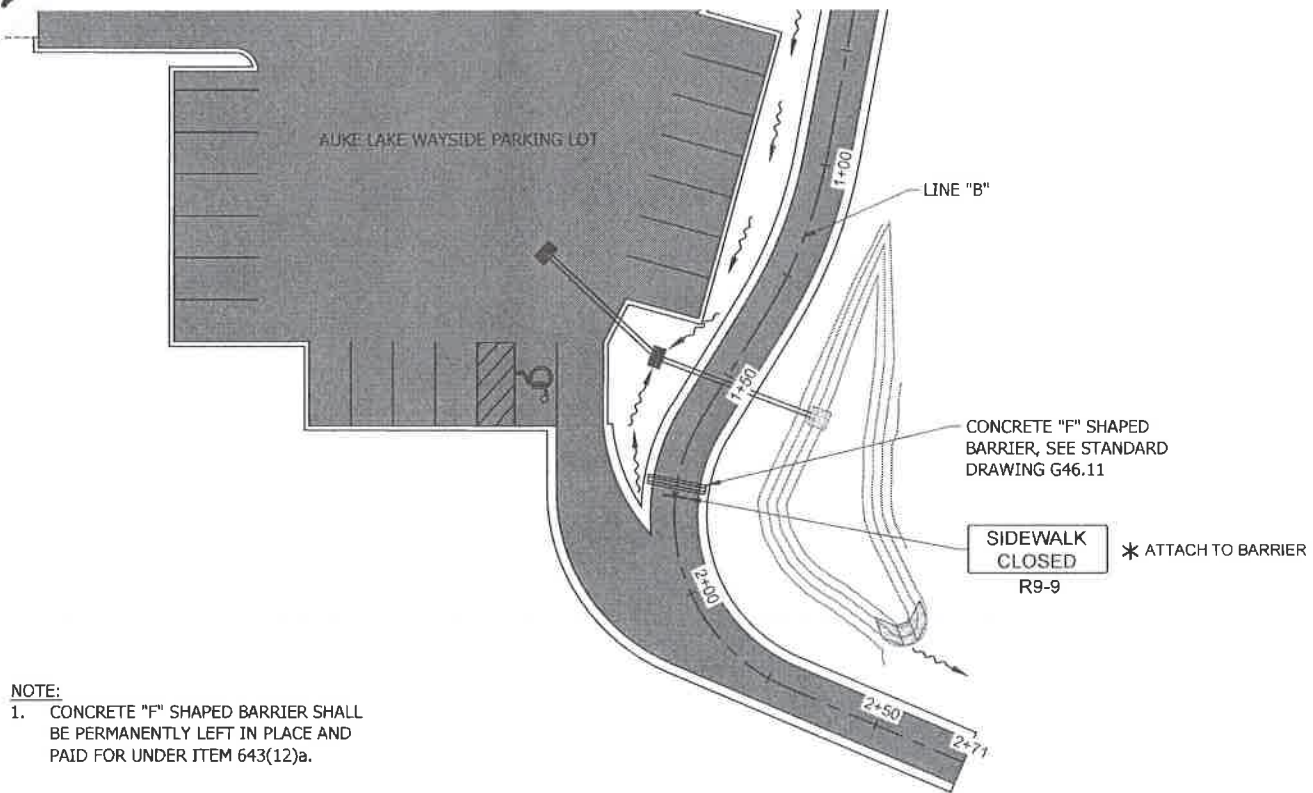

NOTE: 1. CONCRETE "F" SHAPED BARRIER SHALL BE PERMANENTLY LEFT IN PLACE AND PAID FOR UNDER ITEM 643(12)a.

UAS PATH LINE "B" PERMANENT CLOSURE

DO NOT SCALE FROM THESE DRAWINGS USE DIMENSIONS

PATH: Q:\JNU\69500\PLANSET\69500_T1-T3_TRAFF-CNTL.DWG

GRANTHAM, RICK L (DOT)

TAB: T3 Monday, July 20, 2015 12:56:13 PM

ADDENDUM NUMBER		
ATTACHMENT NUMBER		
RECORD OF REVISIONS		
No.	DATE	DESCRIPTION

PLAN LEGEND

CHECKED BY: D. EPSTEIN

TCP NOT SEALED IN ACCORDANCE WITH ALASKA HIGHWAY PRECONSTRUCTION MANUAL SECTION 1400.3.5 DATED JANUARY 30, 2012.

DESIGNED BY: J. BROWN






DRAWN BY: R. GRANTHAM

STATE OF ALASKA
DEPARTMENT OF TRANSPORTATION & PUBLIC FACILITIES
SOUTHCOST REGION

JNU: GLACIER HWY MULTI-USE SEPARATED PATH TO UAS
PROJECT NO. 69500

TRAFFIC CONTROL PLAN

PROJECT DESIGNATION	
0933037 ~ 69500	
STATE	YEAR
ALASKA	2015
SHEET NUMBER	TOTAL SHEETS
T3	54

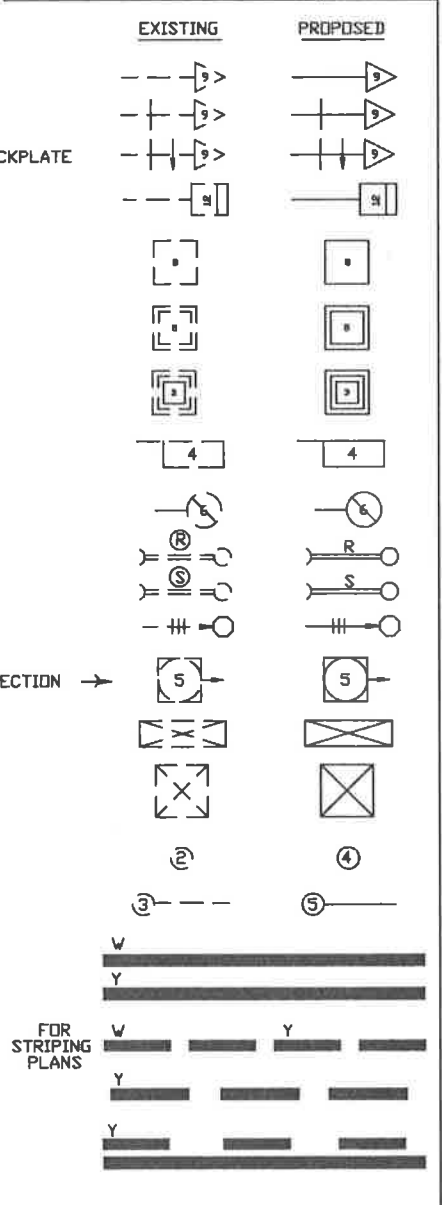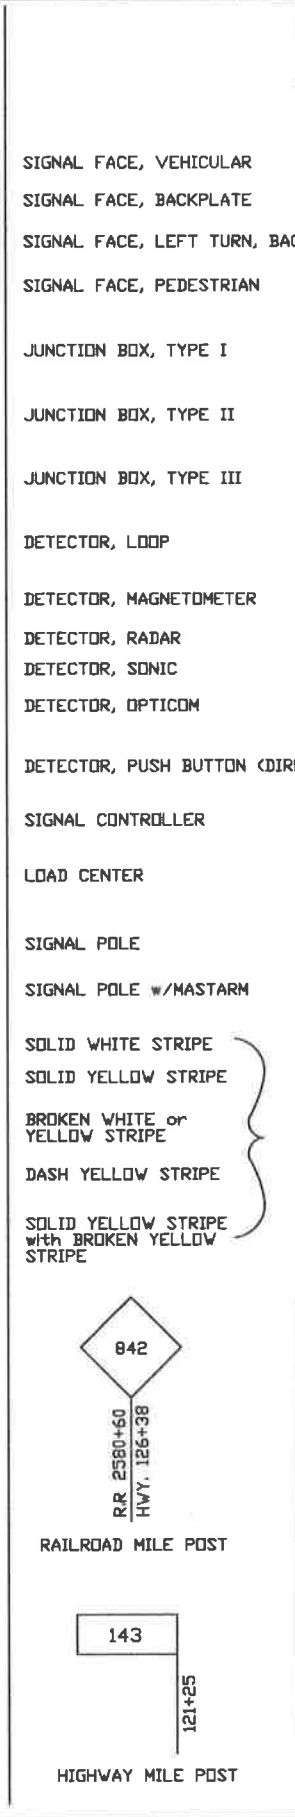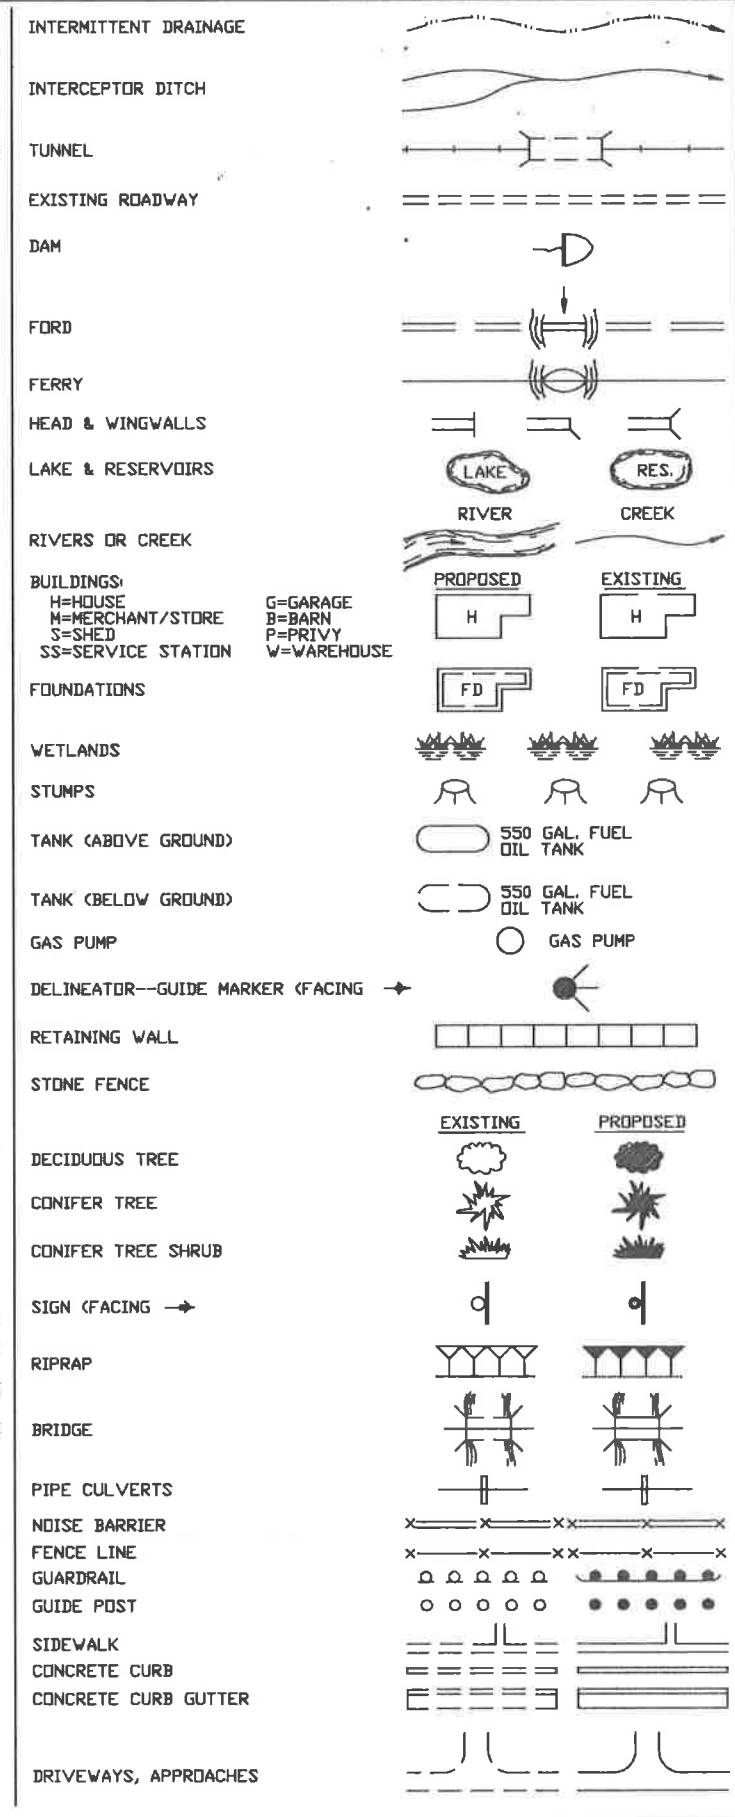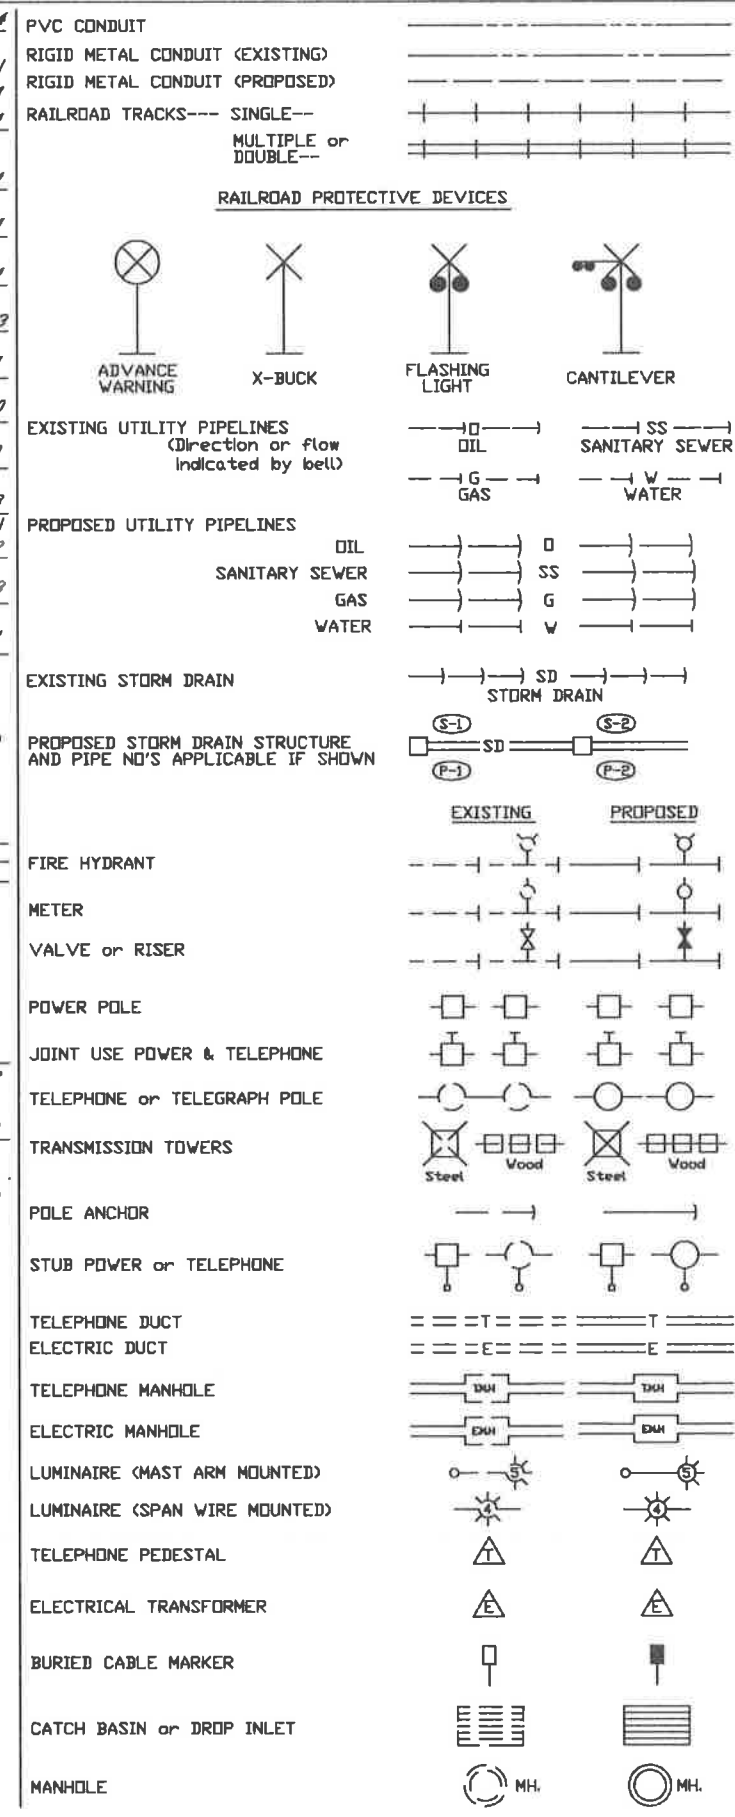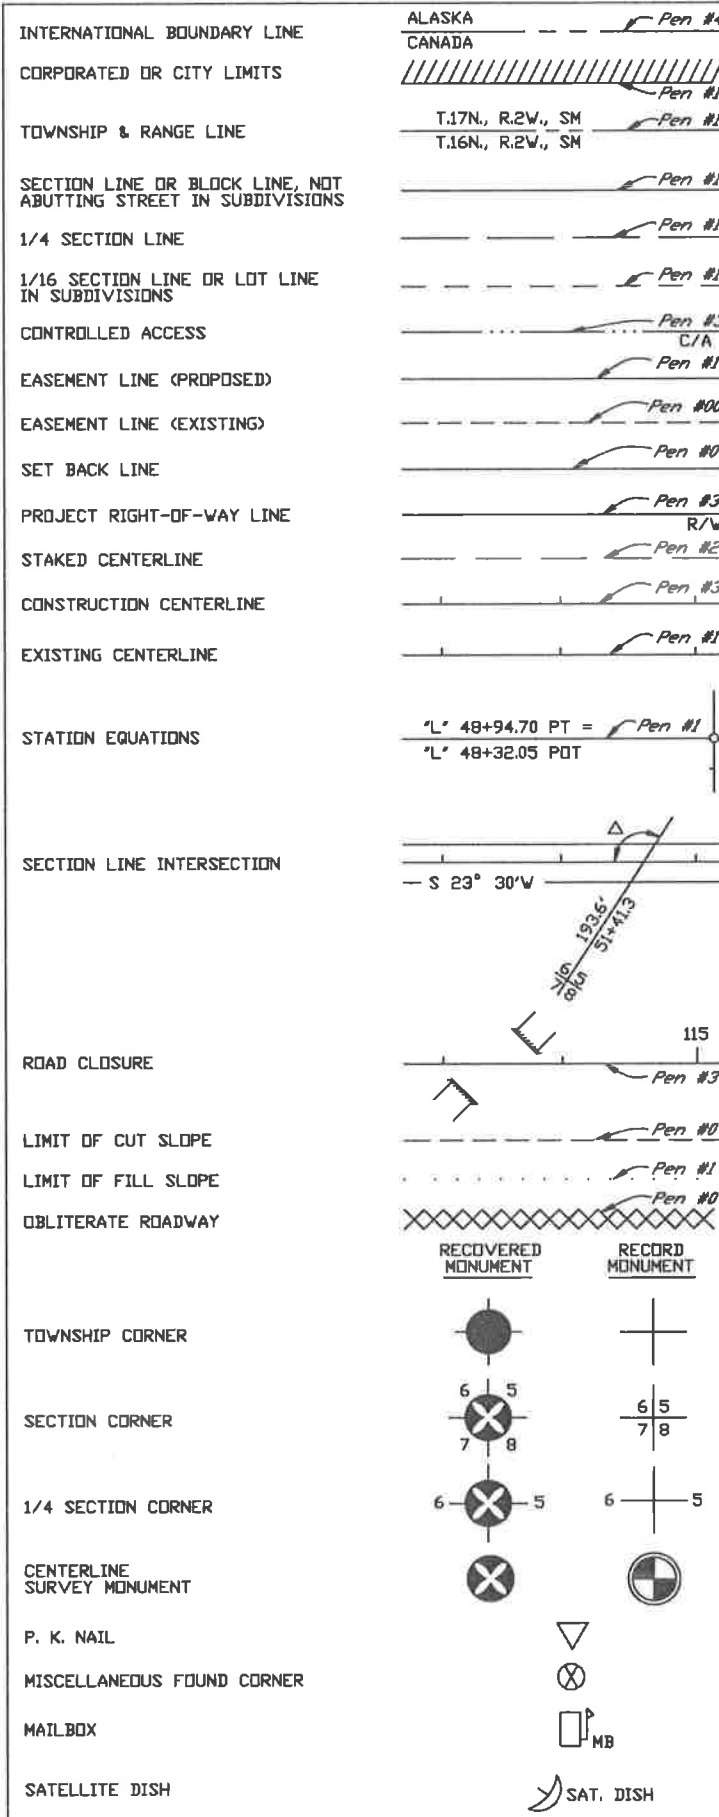

REVISIONS		
Date	Description	By

State of Alaska
 Department of Transportation
 & Public Facilities

SYMBOLS

APPROVED

Date

D-04.21

GENERAL NOTES:

- All material and workmanship shall be in accordance with the State of Alaska, Standard Specifications for Highway Construction.
- The contractor shall select only pipes that meet specific height of cover criteria shown on the plans or in the special provisions.
- No more than one type of pipe may be used on any single installation or installation grouping.
- All structural plate pipes shall be placed on a pre-shaped foundation conforming to the depth of the bottom plates with clearance for assembling to the adjacent plates allowed.
- See Standard Drawing "Culvert Pipe & Arch Installation Details" for foundation and structural backfill details.
- Minimum cover shall be measured from the top of pipe to the top of rigid pavement or to the top of flexible pavement subgrade. In all cases, the minimum cover shall not be less than 12". Minimum cover during construction shall be that required to protect the pipe from damage or deflection.
- These tables have been developed for an H-20 live load and for compacted soil weighing 120 lbs. per cubic foot or less. If compacted soil cover exceeds 120 lbs. per cubic foot, the contractor shall use the depth of cover shown in the plans for the specific pipe. Where compacted soil cover exceeds 120 lbs. per cubic foot and no specific cover requirements are provided in the plans, the contractor shall determine the required minimum pipe cover in accordance with Section 12 of the 2000 AASHTO "LRFD Bridge Design Specifications".


GAGE	0.060"		0.075"		0.105"		0.135"		0.164"	
	Min. (In)	Max. (Ft)	Min. (In)	Max. (Ft)	Min. (In)	Max. (Ft)	Min. (In)	Max. (Ft)	Min. (In)	Max. (Ft)
12	12	100+	12	100+	12	100+	12	100+	12	100+
15	12	94	12	100+	12	100+	12	100+	12	100+
18	12	75	12	94	12	100+	12	100+	12	100+
21	12	65	12	82	12	100+	12	100+	12	100+
24	12	56	12	71	12	99	12	100+	12	100+
27	12	48	12	63	12	89	12	100+	12	100+
30			12	56	12	79	12	100+	12	100+
36			12	47	12	66	12	85	12	100+
42			12	55	12	56	12	73	12	100+
48			12	47	12	49	12	63	12	78
54			15	43	15	56	15	69		
60					15	50	15	62		
66					18	44	18	56		
72							18	45		

GAGE	0.060"		0.075"		0.105"	
	Min. (In)	Max. (Ft)	Min. (In)	Max. (Ft)	Min. (In)	Max. (Ft)
30	12	52	12	65		
36	12	43	12	54	12	
42	12	36	12	46	12	
48	12	32	12	40	12	
54	15	28	15	35	15	
60	15	25	15	32	15	
66	18	23	18	28	18	
72	18	21	18	25	18	
78			21	24	21	
84					21	
90					24	
96					24	
102						
108						
114					24	37
120					24	35

Burial DEPTHS for Culverts Reviewed by: TW @ AKDOT. 3-29-19.

Dia. (In)	0.150"		0.175"		0.200"		0.225"		0.250"	
	Min. (In)	Max. (Ft)	Min. (In)	Max. (Ft)	Min. (In)	Max. (Ft)	Min. (In)	Max. (Ft)	Min. (In)	Max. (Ft)
12	12	49	12	58	12	58	12	58	12	58
15	12	60	12	70	12	81	12	92	12	100+
18	12	44	12	53	12	53	12	53	12	53
21	12	54	12	64	12	74	12	84	12	94
24	12	41	12	48	12	48	12	48	12	48
27	12	50	12	58	12	67	12	77	12	86
30	12	37	12	45	12	45	12	45	12	45
33	12	46	12	54	12	62	12	71	12	79
36	12	35	12	41	12	41	12	41	12	41
39	12	42	12	50	12	58	12	66	12	73
42	12	32	12	39	12	39	12	39	12	39
45	12	40	12	47	12	54	12	61	12	68
48	12	30	12	36	12	36	12	36	12	36
51	12	37	12	44	12	50	12	57	12	64
54	12	29	12	34	12	34	12	34	12	34
57	12	35	12	41	12	47	12	54	12	60
60	12	27	12	32	12	32	12	32	12	32
63	12	33	12	39	12	45	12	51	12	57
66	12	25	12	30	12	30	12	30	12	30
69	12	31	12	37	12	42	12	48	12	54
72	12	24	12	29	12	29	12	29	12	29
75	12	30	12	35	12	40	12	46	12	51
78	12	23	12	27	12	27	12	27	12	27
81	12	28	12	33	12	38	12	44	12	49
84	12	22	12	26	12	26	12	26	12	26
87	12	27	12	32	12	37	12	42	12	47
90	12	21	12	25	12	25	12	25	12	25
93	12	26	12	30	12	35	12	40	12	44
96	12	20	12	24	12	24	12	24	12	24
99	12	25	12	29	12	33	12	38	12	43
102	12	15	12	18	12	18	12	18	12	18
105	12	19	12	23	12	23	12	23	12	23
108	12	18	12	21	12	21	12	21	12	21
111	12	23	12	28	12	32	12	36	12	41
114	12	14	12	17	12	17	12	17	12	17
117	12	24	12	28	12	32	12	36	12	41
120	12	17	12	20	12	20	12	20	12	20
123	12	21	12	25	12	29	12	33	12	37
126	12	17	12	20	12	20	12	20	12	20
129	12	20	12	23	12	27	12	31	12	35
132	12	14	12	17	12	17	12	17	12	17
135	12	19	12	22	12	26	12	30	12	34
138	12	13	12	16	12	16	12	16	12	16
141	12	18	12	21	12	25	12	29	12	33
144	12	12	12	15	12	15	12	15	12	15
147	12	16	12	19	12	23	12	27	12	31
150	12	11	12	14	12	14	12	14	12	14
153	12	15	12	18	12	22	12	26	12	30
156	12	10	12	13	12	13	12	13	12	13
159	12	14	12	17	12	21	12	25	12	29
162	12	9	12	12	12	12	12	12	12	12
165	12	13	12	16	12	20	12	24	12	28
168	12	8	12	11	12	11	12	11	12	11
171	12	12	12	15	12	19	12	23	12	27
174	12	7	12	10	12	10	12	10	12	10
177	12	11	12	14	12	18	12	22	12	26
180	12	6	12	9	12	9	12	9	12	9

*Longitudinal seams use (5 1/3) 3/4" dia. bolts per foot.

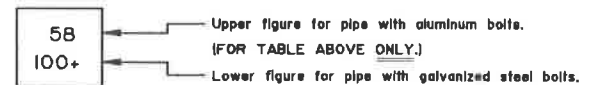

CORRUGATED CIRCULAR ALUMINUM PIPE

CORRUGATED ALUMINUM PIPE-ARCH

Span x Rise (In. x In.)	Corner Radius (In)	Minimum Gage (In)	Min. Cover (In)	Max. Cover (Ft)	
				2 Tons Corner Bearing Pressure	3 Tons Corner Bearing Pressure
17 x 13	3	0.060	12	13	20
21 x 15	3	0.060	12	12	19
24 x 18	3	0.060	12	11	16
28 x 20	3	0.075	12	10	16
35 x 24	3	0.075	12	9	14
42 x 29	3 1/2	0.105	12	7	13
49 x 33	4	0.105	15	6	12
57 x 38	5	0.135	15	6	12
64 x 43	6	0.135	18	6	12
71 x 47	7	0.164	18	6	12

Span x Rise (In. x In.)	Corner Radius (In)	Minimum Gage (In)	Min. Cover (In)	Max. Cover (Ft)	
				2 Tons Corner Bearing Pressure	3 Tons Corner Bearing Pressure
40 x 31	5	0.075	30	8	12
46 x 36	6	0.075	24	8	13
53 x 41	7	0.075	24	8	13
60 x 46	8	0.075	24	13	20
66 x 51	9	0.075	18	13	20
73 x 56	12	0.075	18	16	24
81 x 59	14	0.105	18	14	22
87 x 63	14	0.105	18	13	20
95 x 67	16	0.105	18	12	18
103 x 71	16	0.135	24	11	17
112 x 75	18	0.164	24	10	16
117 x 79	18	0.164	24	10	15

Span x Rise (Ft-In x Ft-In)	Corner Radius (In)	Minimum Gage (In)	Min. Cover (Ft)	Max. Cover In Feet For Soil Bearing Capacity of:	
				2 Tons/ft ²	3 Tons/ft ²
5 - 11 x 5 - 5	31.8	0.100	2	24**	24**
6 - 11 x 5 - 9	31.8	0.100	2	22**	22**
7 - 3 x 5 - 11	31.8	0.100	2	20**	20**
7 - 9 x 6 - 0	31.8	0.100	2	28**	18**
8 - 5 x 6 - 3	31.8	0.100	2	17**	17**
9 - 3 x 6 - 5	31.8	0.100	2	15**	15**
10 - 3 x 6 - 9	31.8	0.100	2	14**	14**
10 - 9 x 6 - 10	31.8	0.100	2	13**	13**
11 - 5 x 7 - 1	31.8	0.100	2	12**	12**
12 - 7 x 7 - 5	31.8	0.125	2	14	16**
12 - 11 x 7 - 6	31.8	0.150	2	13	14**
13 - 1 x 8 - 2	31.8	0.150	2	13	18**
13 - 11 x 8 - 5	31.8	0.150	2	12	17**
14 - 8 x 9 - 8	31.8	0.175	2	12	18
15 - 4 x 10 - 0	31.8	0.175	2	11	17
16 - 1 x 10 - 4	31.8	0.200	2	10	16
16 - 9 x 10 - 8	31.8	0.200	2.17	10	15
17 - 3 x 11 - 0	31.8	0.225	2.25	10	15
18 - 0 x 11 - 4	31.8	0.255	2.25	9	14
18 - 8 x 11 - 8	31.8	0.250	2.33	9	14

*Longitudinal seams use (5 1/3) 3/4" dia. bolts per foot.
 **Fill limited by the seam strength of the bolts. 3/4" dia. bolts per foot.

ALUMINUM	GAGE NO. (For Info Only)
0.060	16
0.075	14
0.105	12
0.135	10
0.164	8

*This column shall not be used unless specified on the plans or approved by the Regional Geotechnical Engineer.

Date	Description	By
8/10/00	Pipe Tables & G. Notes.	DFD
10/31/03	Pipe Table Updates & New Sheet 4	LRG

Sheet 1 of 4

State of Alaska
 Department of Transportation
 & Public Facilities

PIPE AND ARCH TABLES



Date 10/31/03

D-04.21

D-04.21

GENERAL NOTES

- All material and workmanship shall be in accordance with the State of Alaska, Standard Specifications for Highway Construction.
- The contractor shall select only pipes that meet specific height of cover criteria shown on the plans or in the special provisions.
- No more than one type of pipe may be used on any single installation or installation grouping.
- All structural plate pipes shall be placed on a pre-shaped foundation conforming to the depth of the bottom plates with clearance for assembling to the adjacent plates allowed.
- See Standard Drawing "Culvert Pipe & Arch Installation Details" for foundation and structural backfill details.
- Minimum cover shall be measured from the top of pipe to the top of rigid pavement or to the top of flexible pavement subgrade. In all cases, the minimum cover shall not be less than 12". Minimum cover during construction shall be that required to protect the pipe from damage or deflection.
- These tables have been developed for an H-20 live load and for compacted soil weighing 120 lbs. per cubic foot or less. If compacted soil cover exceeds 120 lbs. per cubic foot, the contractor shall use the depth of cover shown in the plans for the specific pipe. Where compacted soil cover exceeds 120 lbs. per cubic foot and no specific cover requirements are provided in the plans, the contractor shall determine the required minimum pipe cover in accordance with Section 12 of the 2000 AASHTO "LRFD Bridge Design Specifications".

GAGE	0.064"		0.079"		0.109"		0.138"		0.168"	
	Min. (in)	Max. (ft)	Min. (in)	Max. (ft)	Min. (in)	Max. (ft)	Min. (in)	Max. (ft)	Min. (in)	Max. (ft)
12	12	100+	12	100+	12	100+	12	100+	12	100+
15	12	100+	12	100+	12	100+	12	100+	12	100+
18	12	100+	12	100+	12	100+	12	100+	12	100+
21	12	100+	12	100+	12	100+	12	100+	12	100+
24	12	100+	12	100+	12	100+	12	100+	12	100+
27	12	100+	12	100+	12	100+	12	100+	12	100+
30	12	99	12	100+	12	100+	12	100+	12	100+
36	12	83	12	100+	12	100+	12	100+	12	100+
42	12	71	12	88	12	100+	12	100+	12	100+
48	12	62	12	77	12	100+	12	100+	12	100+
54			12	66	12	93	12	100+	12	100+
60			12	79	12	100+	12	100+	12	100+
66			12	68	12	88	12	100+	12	100+
72					12	75	12	93		
78							12	79		
84								12	66	

GAGE	0.064"		0.079"		0.109"		0.138"		0.168"	
	Min. (in)	Max. (ft)	Min. (in)	Max. (ft)	Min. (in)	Max. (ft)	Min. (in)	Max. (ft)	Min. (in)	Max. (ft)
36	12		12		12	100+	12	100+	12	100+
42	12		12		12	100+	12	100+	12	100+
48	12		12	76	12	100+	12	100+	12	100+
54	12	63	12	79	12	100+	12	100+	12	100+
60	12	56	12	71	12	99	12	100+	12	100+
66	12	52	12	64	12	90	12	100+	12	100+
72	12	47	12	59	12	82	12	100+	12	100+
78	12	44	12	54	12	77	12	98	12	100+
84	12	41	12	51	12	71	12	92	12	100+
90	12	37	12	47	12	67	12	86	12	100+
96	12	35	12	44	12	62	12	80	12	98
102	18	33	18	42	18	59	18	76	18	93
108			18	40	18	55	18	71	18	87
114			18	36	18	51	18	66	18	80
120			18	34	18	46	18	61	18	75
126			18	44	18	56	18	70		
132			18	41	18	53	18	64		
138			18	37	18	49	18	60		
144					18	44	18	55		
150							18	52		

GAGE	0.064"		0.079"		0.109"		0.138"		0.168"	
	Min. (in)	Max. (ft)	Min. (in)	Max. (ft)	Min. (in)	Max. (ft)	Min. (in)	Max. (ft)	Min. (in)	Max. (ft)
36	12	81	12	90	12	100+	12	100+	12	100+
42	12	71	12	77	12	100+	12	100+	12	100+
48	12	62	12	68	12	100+	12	100+	12	100+
54	12	56	12	70	12	98	12	100+	12	100+
60	12	50	12	63	12	88	12	100+	12	100+
66	12	46	12	57	12	80	12	100+	12	100+
72	12	42	12	52	12	73	12	95	12	100+
78	12	39	12	48	12	68	12	87	12	100+
84	12	36	12	45	12	63	12	81	12	99
90	12	33	12	42	12	59	12	76	12	93
96	12	31	12	39	12	55	12	71	12	87
102	18	29	18	37	18	52	18	67	18	82
108			18	35	18	48	18	63	18	77
114										
120										
126										
132										
138										
144										
150										

Required Burial Depth for Culvert Installation Reviewed 3-29-19 for STATE of Alaska.

GAGE	ALL	0.111"		0.140"		0.170"		0.188"		0.218"		0.249"		0.280"	
		Min. (in)	Max. (ft)	Min. (in)	Max. (ft)	Min. (in)	Max. (ft)	Min. (in)	Max. (ft)	Min. (in)	Max. (ft)	Min. (in)	Max. (ft)	Min. (in)	Max. (ft)
60	12	46	68	90	100+	100+	100+	100+	100+	100+	100+	100+	100+	100+	100+
66	12	42	62	81	93	100+	100+	100+	100+	100+	100+	100+	100+	100+	100+
72	12	38	57	75	86	100+	100+	100+	100+	100+	100+	100+	100+	100+	100+
78	12	35	52	69	79	95	100+	100+	100+	100+	100+	100+	100+	100+	100+
84	12	33	49	64	73	88	100+	100+	100+	100+	100+	100+	100+	100+	100+
90	12	31	45	60	68	82	97	100+	100+	100+	100+	100+	100+	100+	100+
96	12	29	43	56	64	77	91	100+	100+	100+	100+	100+	100+	100+	100+
102	18	27	40	52	60	73	86	94	100+	100+	100+	100+	100+	100+	100+
108	18	25	38	50	57	69	81	88	100+	100+	100+	100+	100+	100+	100+
114	18	24	36	47	54	65	77	84	100+	100+	100+	100+	100+	100+	100+
120	18	23	34	45	51	62	73	80	100+	100+	100+	100+	100+	100+	100+
126	18	22	32	42	49	59	69	76	100+	100+	100+	100+	100+	100+	100+
132		21	31	40	46	56	66	72	100+	100+	100+	100+	100+	100+	100+
138		20	29	39	44	54	63	69	100+	100+	100+	100+	100+	100+	100+
144		19	28	37	43	51	61	66	100+	100+	100+	100+	100+	100+	100+
150		18	27	36	41	49	58	64	100+	100+	100+	100+	100+	100+	100+
		17	26	34	39	47	56	61	100+	100+	100+	100+	100+	100+	100+
		17	25	33	38	46	54	59	100+	100+	100+	100+	100+	100+	100+
		16	24	32	36	44	52	57	100+	100+	100+	100+	100+	100+	100+
		16	23	31	35	42	50	55	100+	100+	100+	100+	100+	100+	100+
		15	22	30	34	41	48	53	100+	100+	100+	100+	100+	100+	100+
		15	22	29	33	40	47	51	100+	100+	100+	100+	100+	100+	100+
		21	28	32	38	45	50	55	100+	100+	100+	100+	100+	100+	100+
		20	27	31	37	44	48	53	100+	100+	100+	100+	100+	100+	100+
		20	26	30	36	43	47	51	100+	100+	100+	100+	100+	100+	100+
		19	25	29	35	41	45	49	100+	100+	100+	100+	100+	100+	100+
		25	28	34	40	44	48	52	100+	100+	100+	100+	100+	100+	100+
		24	27	33	39	43	47	51	100+	100+	100+	100+	100+	100+	100+
		23	27	32	38	42	46	50	100+	100+	100+	100+	100+	100+	100+
		23	26	31	37	41	45	49	100+	100+	100+	100+	100+	100+	100+
		25	25	31	36	40	44	48	100+	100+	100+	100+	100+	100+	100+
3-29-19
By: Jh.
Reviewed

Maximum Cover for Type S
Corrugated Polyethelene Pipe

Size (in.)	Max. Cover (ft.)
12	30.0
15	30.0
18	30.0
24	30.0
30	30.0
36	30.0
40	20.0
48	20.0

GENERAL NOTES

1. All materials and workmanship shall be in accordance with the State of Alaska Standard Specifications for Highway Construction.
2. For foundation and structural backfill details see Standard Drawing "Culvert Pipe & Arch Installation Details".
3. Pipe cover height is measured from top of the pipe to top of rigid pavement, or to the top of subgrade for flexible pavement. In all cases the minimum cover shall be no less than 2 ft. Where loads traverse the culvert during construction minimum cover shall be no less than 4 ft.

REVISIONS		
Date	Description	By
10/31/03	New Sheet 4.	LRG

Sheet 3 of 4

State of Alaska
Department of Transportation
& Public Facilities

PIPE AND ARCH TABLES



Date 10/31/03

D-04.21

GENERAL NOTES

- All material and workmanship shall be in accordance with the State of Alaska, Standard Specifications for Highway Construction.
- The contractor shall select only pipes that meet specific height of cover criteria shown on the plans or in the special provisions.
- No more than one type of pipe may be used on any single installation or installation grouping.
- All structural plate pipes shall be placed on a pre-shaped foundation conforming to the depth of the bottom plates with clearance for assembling to the adjacent plates allowed.
- See Standard Drawing "Culvert Pipe & Arch Installation Details" for foundation and structural backfill details.
- Minimum cover shall be measured from the top of pipe to the top of rigid pavement or to the top of flexible pavement subgrade. In all cases, the minimum cover shall not be less than 12". Minimum cover during construction shall be that required to protect the pipe from damage or deflection.
- These tables have been developed for an H-20 live load and for compacted soil weighing 120 lbs. per cubic foot or less. If compacted soil cover exceeds 120 lbs. per cubic foot, the contractor shall use the depth of cover shown in the plans for the specific pipe. Where compacted soil cover exceeds 120 lbs. per cubic foot and no specific cover requirements are provided in the plans, the contractor shall determine the required minimum pipe cover in accordance with Section 12 of the 2000 AASHTO "LRFD Bridge Design Specifications".

GAGE	0.060"		0.075"		0.105"	
	Min. (in)	Max. (ft)	Min. (in)	Max. (ft)	Min. (in)	Max. (ft)
12	24	35	24	50		
18	24	34	24	49		
24	24	25	24	36	24	63
30	24	19	24	28	24	50
36	24	15	24	24	24	41
42			24	19	24	35
48			24	17	24	30
54			24	14	24	27
60			24	12	24	24

* $\frac{3}{8}$ x $\frac{3}{8}$ x $\frac{7}{8}$ in. or $\frac{3}{4}$ x 1 x $1\frac{1}{2}$ in.

AKDST.
Reviewed
3-29-19
By: TVL.
AS BUILTS are to THE
BEST OF KNOWLEDGE
are TRUE &
CORRECT.

Span x Rise (in. x in.)	Min. Cover (in.)	Soil Corner Bearing Capacity of 2 Tons/ s.f.		
		0.060"		
		Max. Cover (ft.)	0.075"	0.105"
	12	13		
	12	14		
	12	13		
	12	13		
	12	13		
	12	14		
	18		13	
	18		20	
	18		21	
	18			21
	18			17
	18			17
	18			17

* $\frac{3}{8}$ x $\frac{3}{8}$ x $\frac{7}{8}$ in. or $\frac{3}{4}$ x 1 x $1\frac{1}{2}$ in. Corrugations

ALUMINUM SPIRAL RIB PIPE

STEEL SPIRAL RIB PIPE

GAGE	0.064"		0.079"		0.109"		0.138" **	
	Min. (in)	Max. (ft)	Min. (in)	Max. (ft)	Min. (in)	Max. (ft)	Min. (in)	Max. (ft)
18	12							
24	12	51	12	72	12	121		
30	12	41	12	58	12	97		
36	12	34	12	48	12	81		
42	12	29	12	41	12	69		
48	12	26	12	36	12	61		
54	18	23	18	32	18	54		
60	18	21	18	29	18	49	18	73
66	18	19	18	26	18	44	18	65
72			18	24	18	40	18	59
78			24	22	24	37	24	55
84			24	21	24	35	24	52
90					24	32	24	47
96					24	30	24	44
102					30	29	30	43
108					30	27	30	41

* $\frac{3}{8}$ x $\frac{3}{8}$ x $\frac{7}{8}$ in. or $\frac{3}{4}$ x 1 x $1\frac{1}{2}$ in. Corrugations
 ** $\frac{3}{8}$ x $\frac{3}{8}$ x $\frac{7}{8}$ in. Corrugations Only.

Span x Rise (in. x in.)	Min. Cover (in.)	Soil Corner Bearing Capacity of 2 Tons/ s.f.		
		0.064"		
		Max. Cover (ft.)	0.079"	0.109"
20 x 15	12	13		
23 x 19	12	14		
27 x 21	12	13		
33 x 26	12	13		
40 x 31	12	13		
46 x 36	12	14		
53 x 41	18		13	
60 x 46	18		20	
66 x 51	18		21	
73 x 55	18			21
81 x 59	18			17
87 x 63	18			17
95 x 67	18			17

* $\frac{3}{8}$ x $\frac{3}{8}$ x $\frac{7}{8}$ in. or $\frac{3}{4}$ x 1 x $1\frac{1}{2}$ in. Corrugations

Date	Description	By
8/10/00	Pipe Tables & G. Notes.	DFD
10/31/03	New Sheet 4.	LRG

Sheet 4 of 4


State of Alaska
Department of Transportation
& Public Facilities

PIPE AND ARCH TABLES




Date 10/31/03

D-04.21

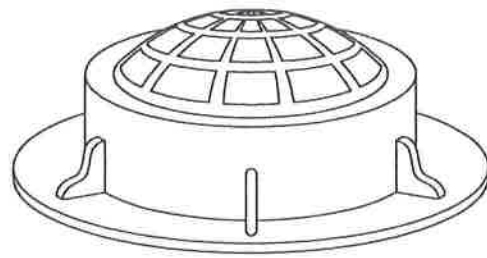


Surround field inlets with a 24" wide rock rubble collar 10" deep, 3" maximum size rock.

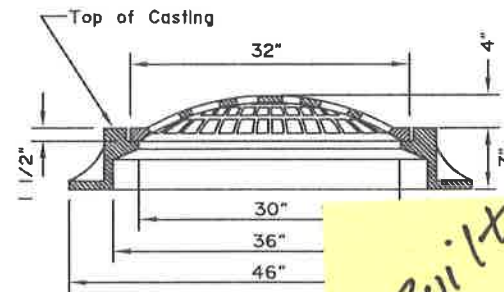

FIELD INLET FRAME

To be supplied for storm where field inlets are specified. Field inlet frame and grate a minimum total weight of 725 lb.

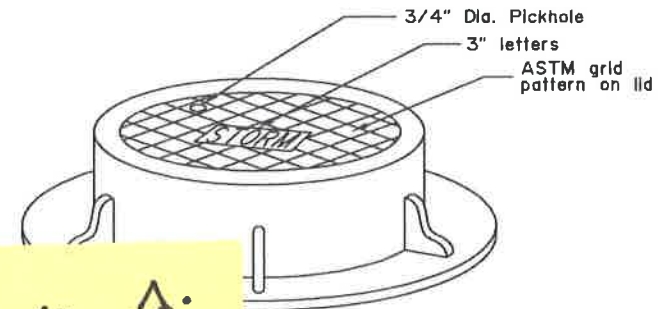


MANHOLE FRAME AND GRATE

*AS BUILT
STANDARD
PROJECT 69500
REVIEWED 3/29/19 BY
JAMES VANJEMEN & S.O.J.
FOR DANIELLE RYDER.*


NOTES:

- Details shown are to indicate general design only. Dimensions and design may vary among the manufacturers, except that inlet grate shall be within $\frac{1}{4}$ " of dimensions shown on this drawing.
- Manhole lids shall be 32" in diameter and may be used with field inlet frames.
- Type A field inlet frame inside dimensions shall be 24" x 36". Lugs will not protrude outside the concrete surface of the inlet box.
- Grates shall be bicycle safe. Where high capacity grates are called for on the plans, they shall conform to Std. Dwg. D-25.
- Frame and grate casting types are identified by the following abbreviations:
C.I. = Curb Inlet
F.I. = Field Inlet
M.H. = Manhole
- Flowline depression shall conform to Std. Dwg. D-23 for an on grade or sag point conditions.
- These are the default frames and grates to be used unless shown otherwise on the drainage plans or drainage structure summary.

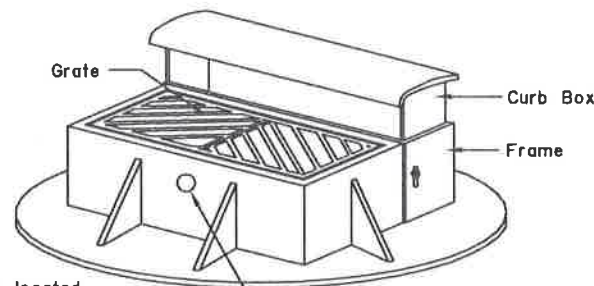


Pickhole located 3" from the top of frame

NOTE: Curb Box, Grate and frame shall have a minimum total weight of 725 lb.

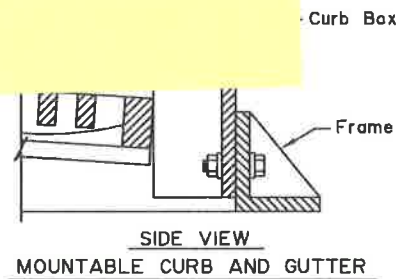

SIDE VIEW MOUNTABLE CURB AND GUTTER


REQUIRED FRAME AND GRATES (See Note 7)			
STRUCTURE	INLET TYPE	CURB TYPE	TYPE FRAME AND GRATE
INLET BOX, TYPE A	Curb	Mountable	Standard Curb Inlet
	Curb	Expressway	Mountable Curb Inlet
	Curb	Rolled Curb	Depressed Inlet
	Field	-----	Field Inlet
STORM DRAIN MANHOLES, TYPE I, II AND III	Curb	Mountable	Mountable Curb Inlet
	Curb	Expressway	Expressway Curb Inlet
	Curb	Rolled Curb	Depressed Inlet
	Field	-----	Field Inlet
	Manhole Lids	-----	Field Inlet Frame, Solid MH. Lid

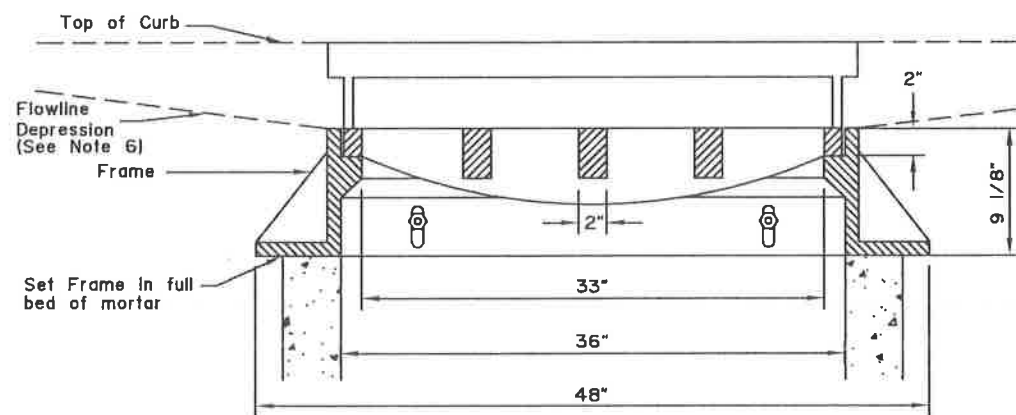

FRONT VIEW

CURB INLET FRAME AND GRATE

To be supplied for storm drain manholes Type I, Type II and Type III where curb inlets are specified.

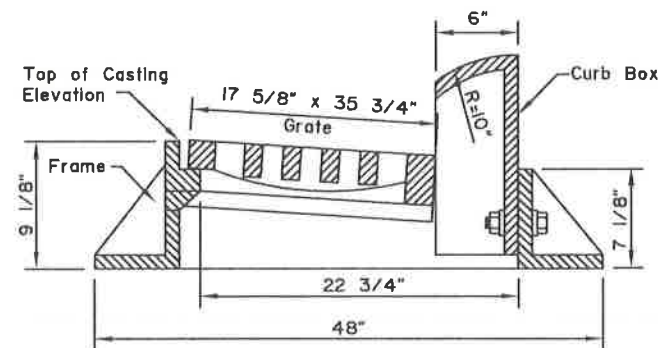

SIDE VIEW EXPRESSWAY CURB AND GUTTER

REVISIONS		
Date	Description	By
10/31/03	Misc. Revisions/ Corrections	LRG

Sheet 1 of 1









State of Alaska
Department of Transportation
& Public Facilities
**STORMDRAIN MANHOLE
FRAME AND GRATE
DETAILS**



NOT TO SCALE Date 10/31/03

GENERAL NOTES:

1. Cast in Place Concrete Inlet Box shall be Class "W" Concrete.
2. Concrete Inlet Box depth and location shall be shown on the plans, or as directed by the Engineer.
3. Shape floors to drain.
4. Concrete Inlet Box shall be parallel to roadway centerline unless directed otherwise by the Engineer.
5. Shall be specified on plans when inlets require a sump.

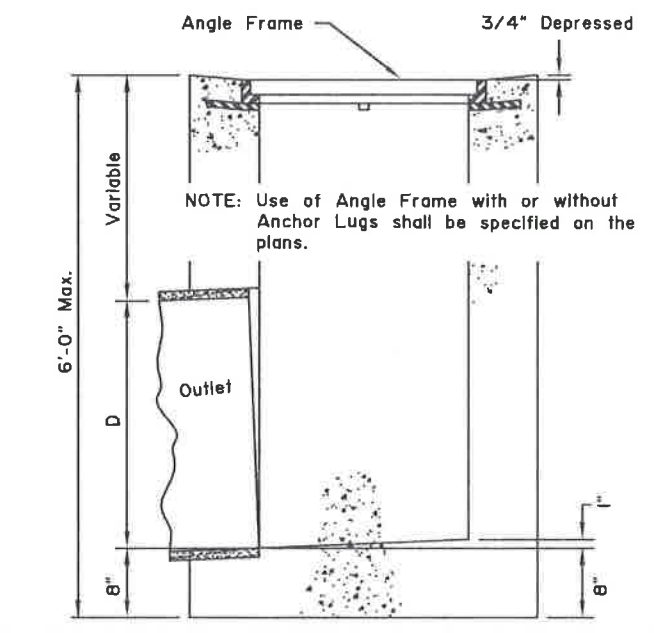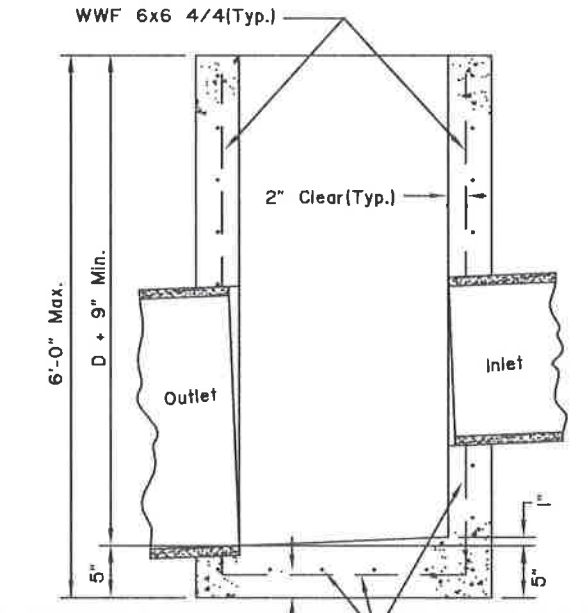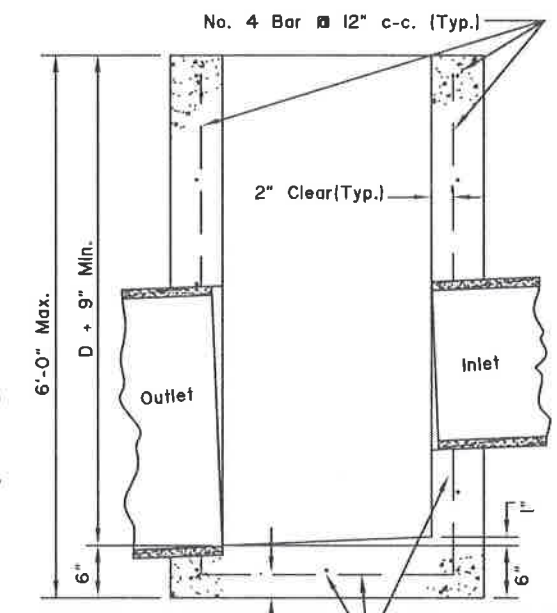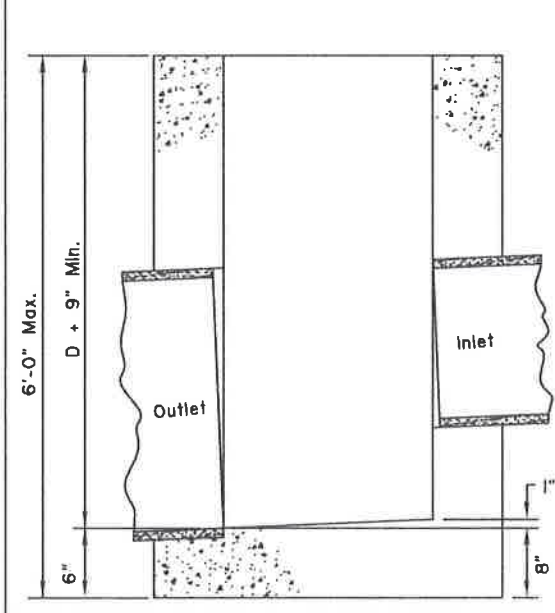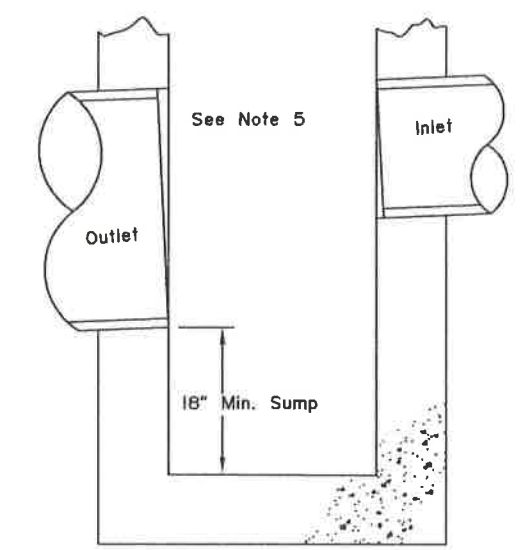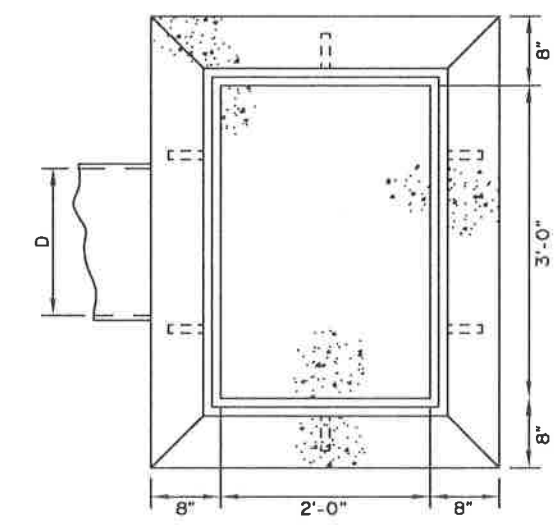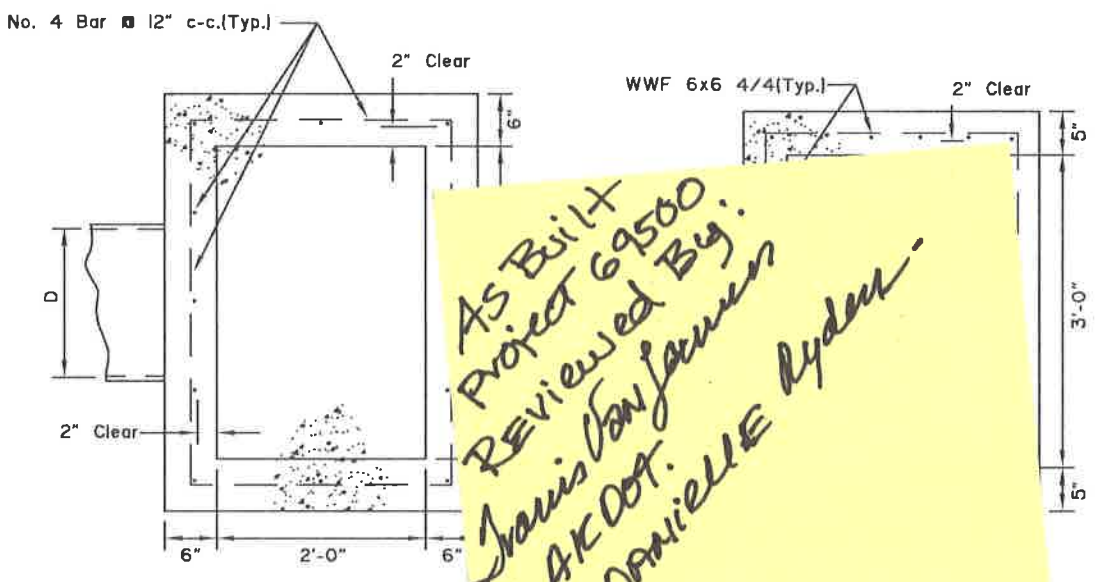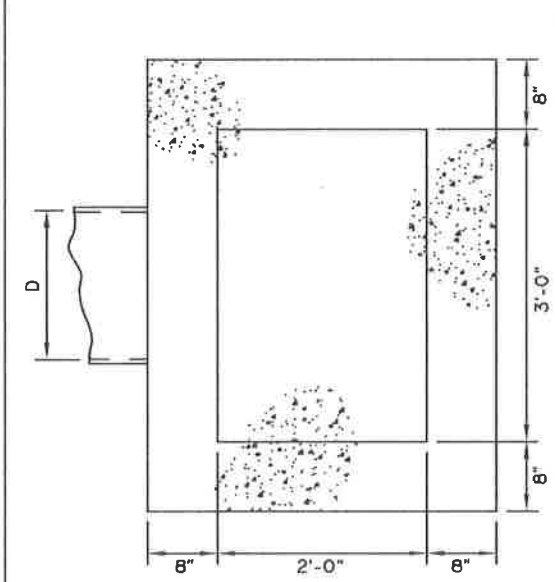

AS BUILT
Project 69500
Reviewed By:
Javis Van Jaamen
@ AK DOT.
for DANIELLE Ryden.

CAST IN PLACE

REINFORCED
CAST IN PLACE

PRECAST

FIELD INLET BOX
CAST* IN PLACE

TYPE "A" CONCRETE INLET BOXES

* May be Precast or Reinforced Cast-In-Place Box.

REVISIONS		
Date	Description	By
3/1/83	Gen. Note Revision	WJF/HK
1/1/96	Add 6'-0" Box Ht.	Gdo

State of Alaska
Department of Transportation
& Public Facilities


TYPE "A"
INLET BOXES





Date 7/15/82

GENERAL NOTES:



1. Silt Fence Supports shall be 2-inch PVC pipe reinforced with iron pipe or No. 6 rebar, wood posts, or as approved.
2. For Water Installations, secure the ends of the silt fence to the stream bank by staking.
3. Use approved Wire Support Mesh to keep filter fabric in place in water installations.
4. For Land Installations, fence shall be placed at the toe of embankment or excavation areas, or as directed.
5. Fence anchored in standing water shall have the bottom anchored with sandbags or equivalent to prevent gaps.
6. Installation and application shall be in accordance with the practices as outlined in the Erosion and Sediment Control Plan.
7. Filter fabric shall be overlapped 6 inches at fence supports.
8. Filter fabric shall be hung taut, not loose or folded.

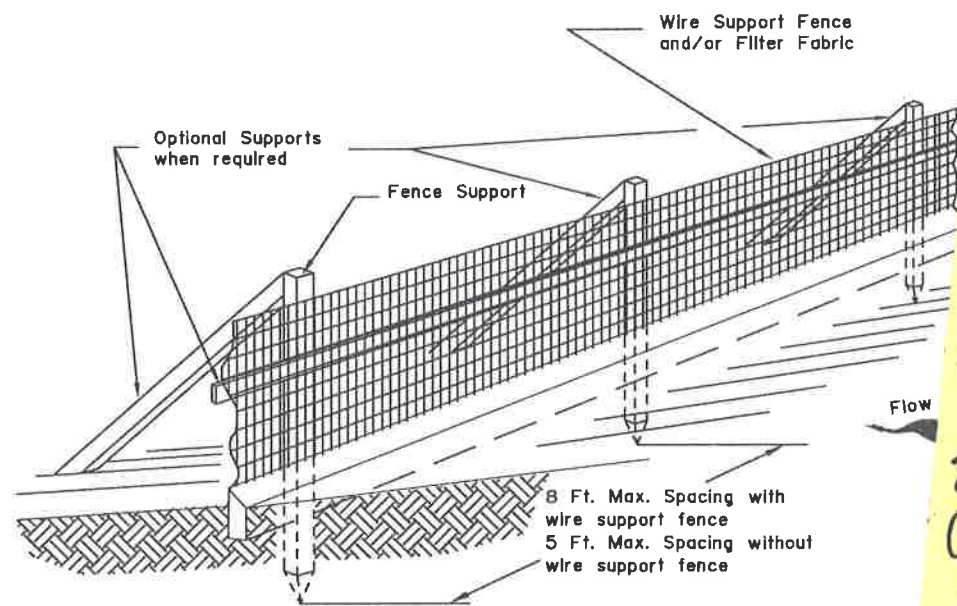

AS BUILT
 Project #69500
 Are Accurate & Correct to the Best of my knowledge & Reviewal By Jayis Conjourney
 3-29-19.

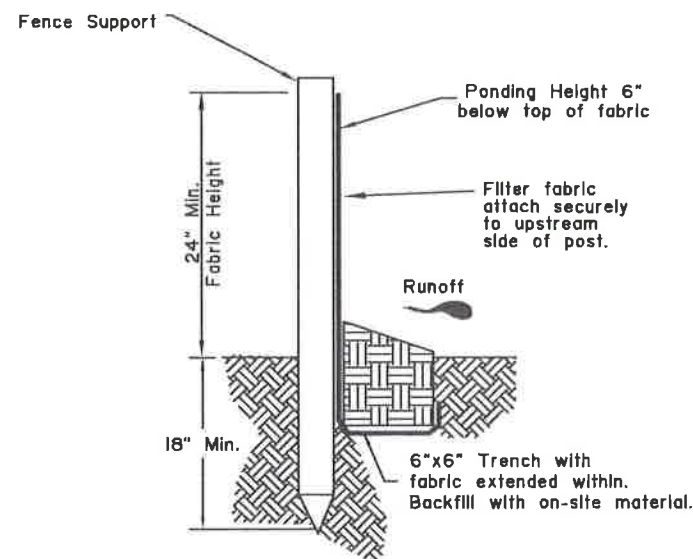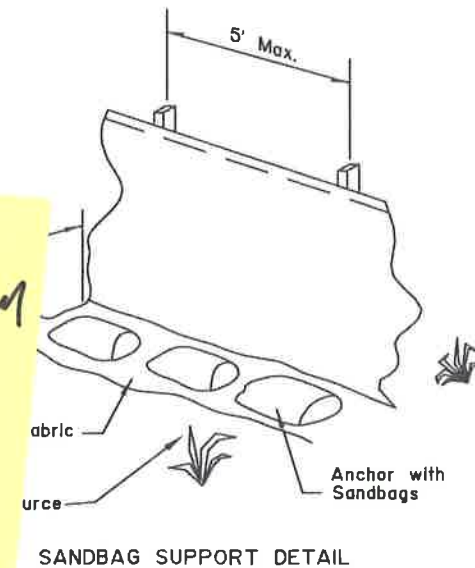

TRENCH SUPPORT DETAIL
TYPICAL LAND INSTALLATION

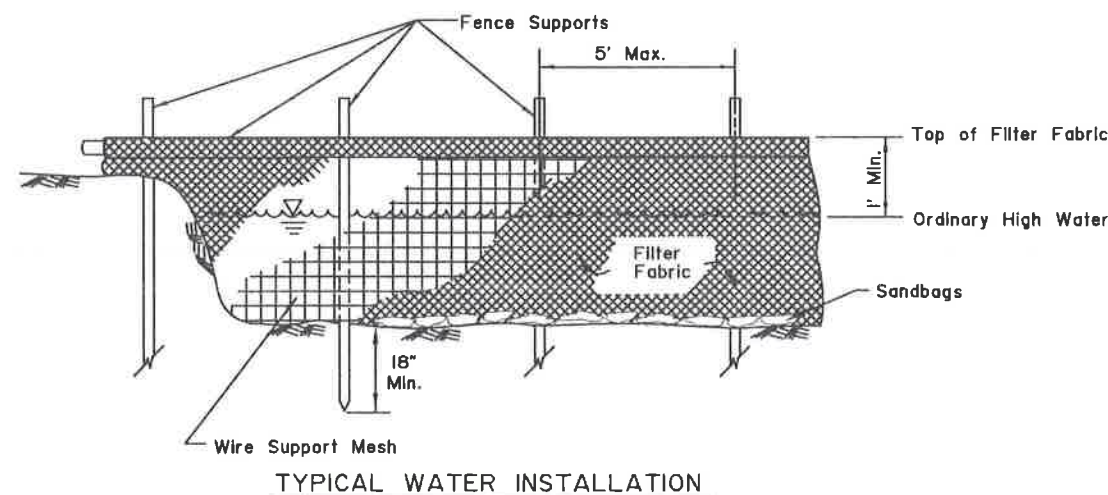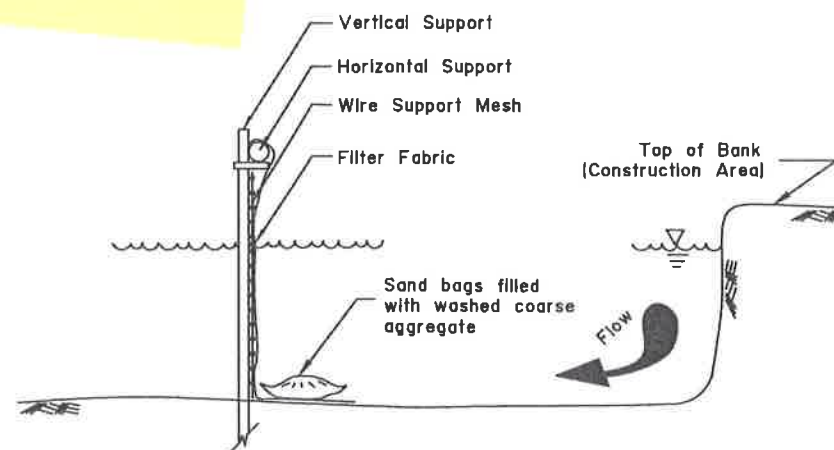

REVISIONS		
Date	Description	By


State of Alaska
 Department of Transportation
 & Public Facilities
**SEDIMENT CONTROL
 SYSTEM
 (SILT FENCE)**



Date 1/1/96


GENERAL NOTES:

- All covered hardware shall comply with the AASHTO/AGC/ARTBA "A Guide to Standardized Highway Barrier Hardware", latest edition.

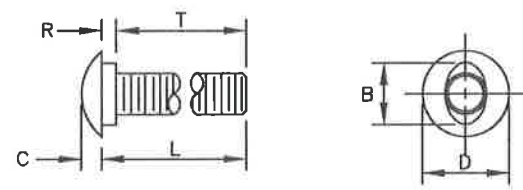


B	C	D	L (Length)	R	T (Thread Length)
15/16"	5/16"	1 5/16" or 1 7/16"	As Required	7/32"	As Required

5/8" BUTTONHEAD BOLT

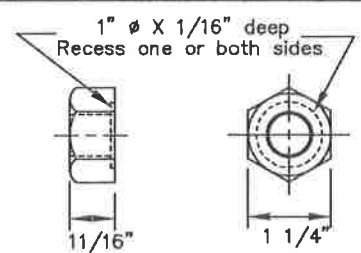


5/8" Dia. RECESSED HEX NUT

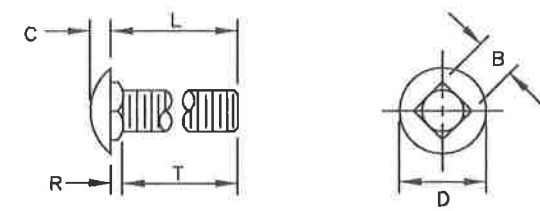


B	C	D	L (Length)	R	T (Thread Length)
5/8"	5/16"	1 5/16"	As Required	3/16"	As Required

5/8" Dia. CARRIAGE BOLT

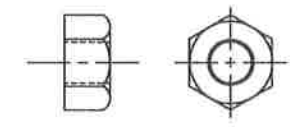

STANDARD HEX NUT

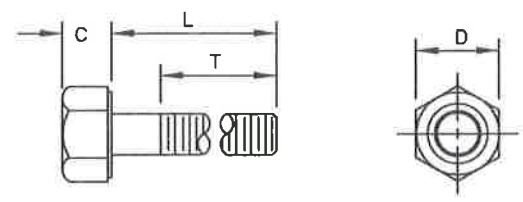


Bolt Size	C	D	L (Length)	T (Thread Length)
5/16"	—	—	1 1/2"	7/8"
5/16"	—	—	1"	1"
3/8"	—	—	7 1/2"	1 1/2"
1/2"	—	—	1 1/2"	1 1/2"
1/2"	—	—	1 1/4"	1 1/4"
5/8" H.S.	5/16"	7/8"	8"	1 1/2"
5/8"-11	—	—	1 1/2"	1 1/2"
3/4"	—	—	1 1/2"	1 1/2"
3/4"	—	—	As Required	2"
3/4" H.S.	15/32"	1 1/4"	2"	1 1/2"

STANDARD HEX BOLTS


*Guard rails
as built
are as true and
accurate as the best
of my ability
J.W. AK. DOT.
3-29-19.*

For	1	2	3/4"
1	1 1/16"	1 1/4"	1 3/4"
3/4"	1 1/16"	1 1/4"	1 3/4"


STANDARD STEEL WASHERS

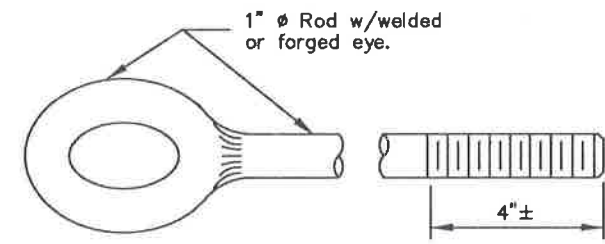


EYE BOLT

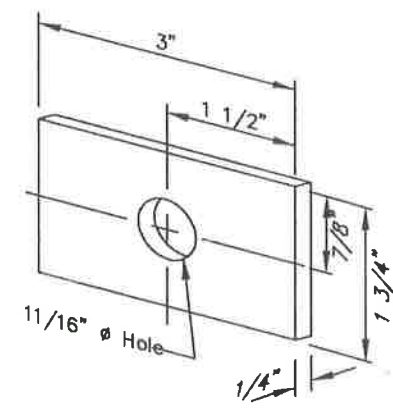

FLAT PLATE WASHER

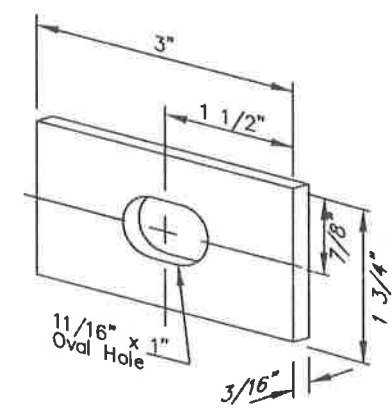

RECTANGULAR POST BOLT WASHER

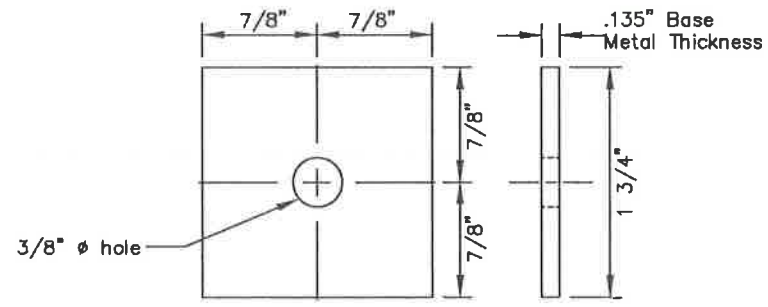

SQUARE STEEL WASHER

REVISIONS		
Date	Description	By
3/15/99	Delete BCT Hardware	KJS









State of Alaska
Department of Transportation
& Public Facilities
**STANDARD GUARDRAIL
HARDWARE
(NUTS, BOLTS, WASHERS)**



APPROVED
Date 5/31/12

GENERAL NOTES:

1. Provide hardware compliant with the AASHTO/AGC/ARTBA "A Guide to Standardized Highway Barrier Hardware, latest edition.
2. Install back-up plates between blockouts and w-beam or thrie-beam rail at intermediate (non-splice) posts when steel blockouts are used but not with wood, rubber, plastic, or other approved blockouts.
3. Provide Thrie beam and W-beam compliant with AASHTO M180A. Use 12 gauge (0.105") thick steel for both.

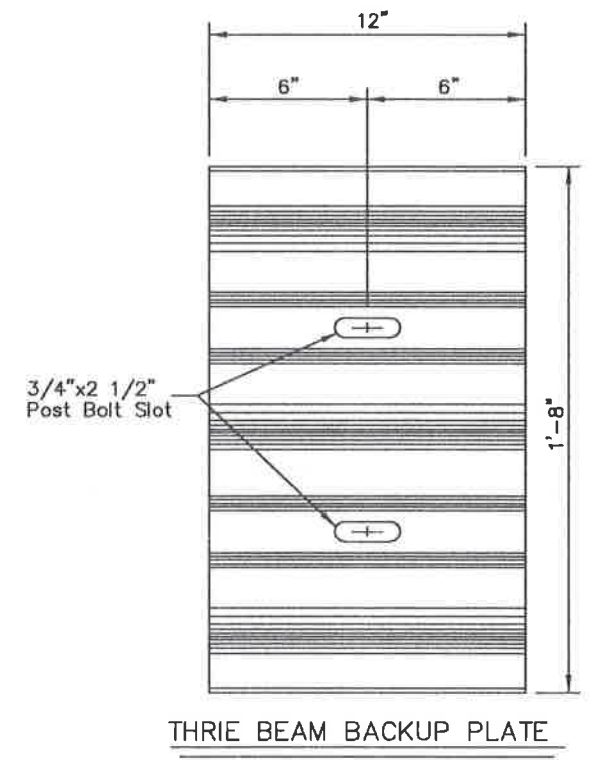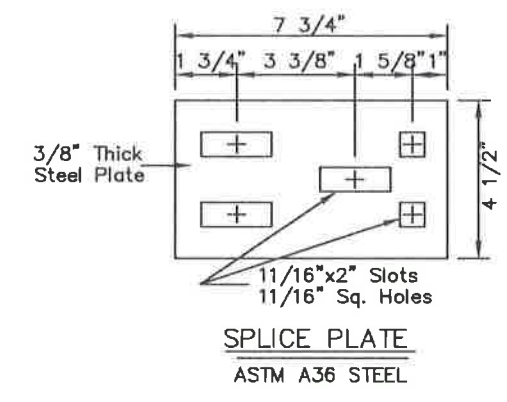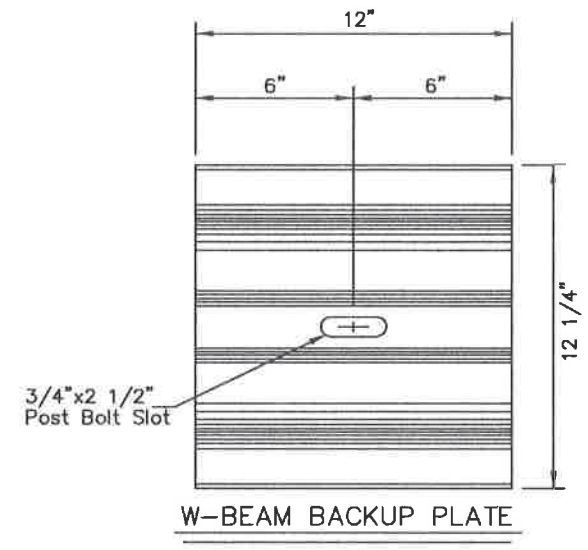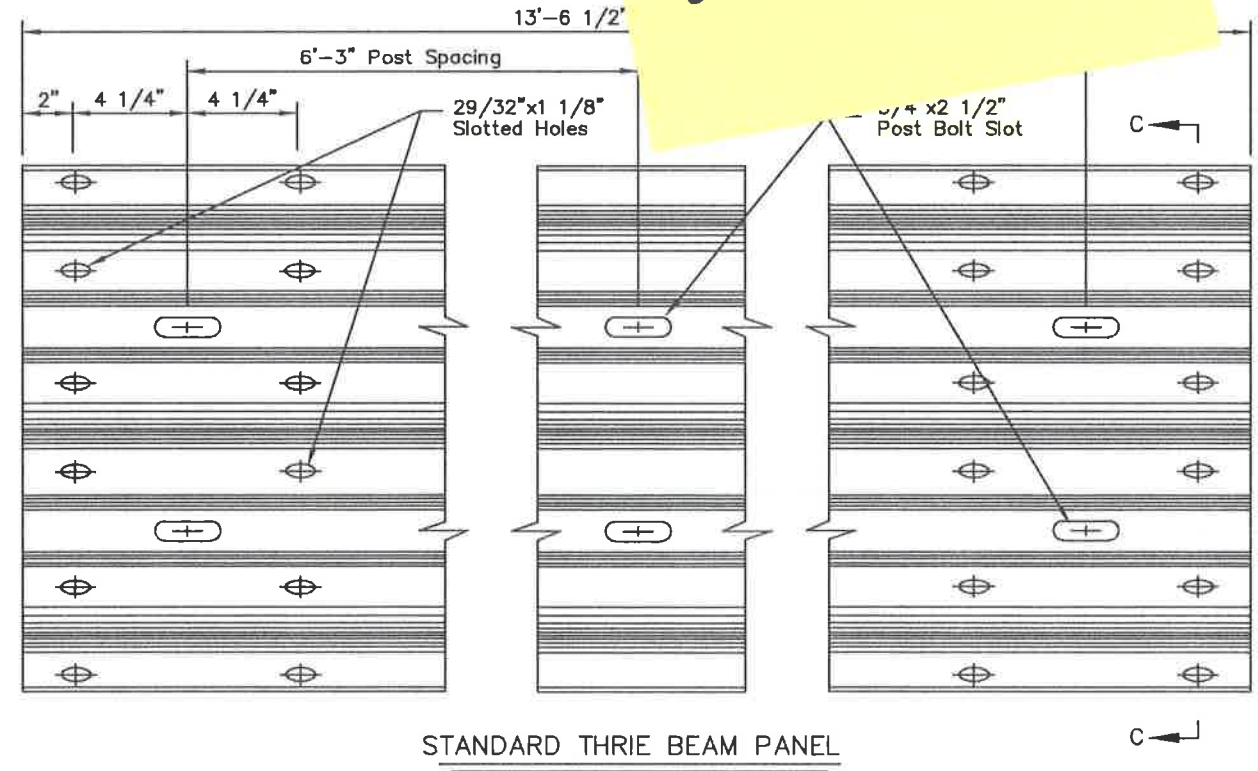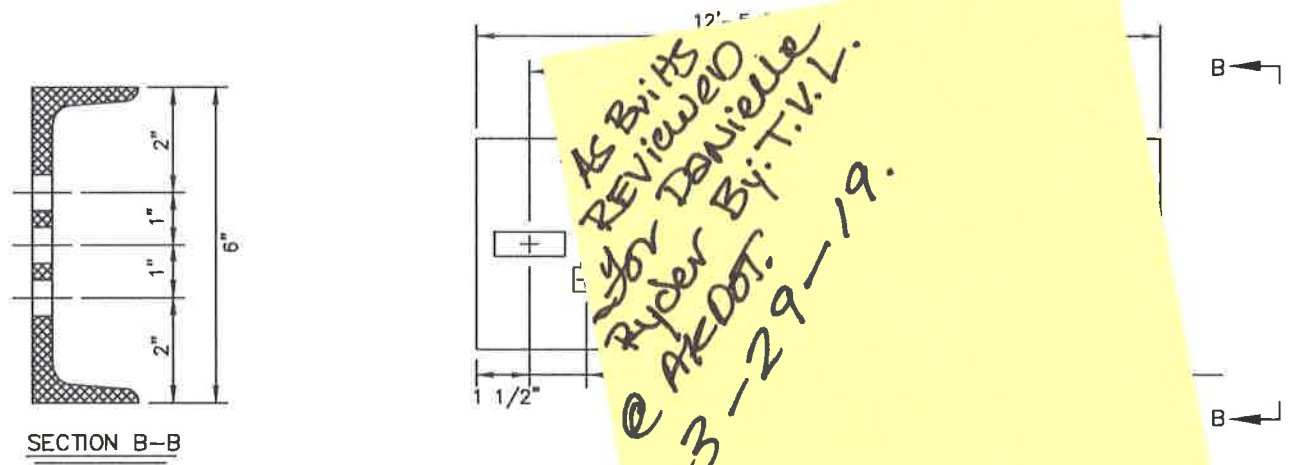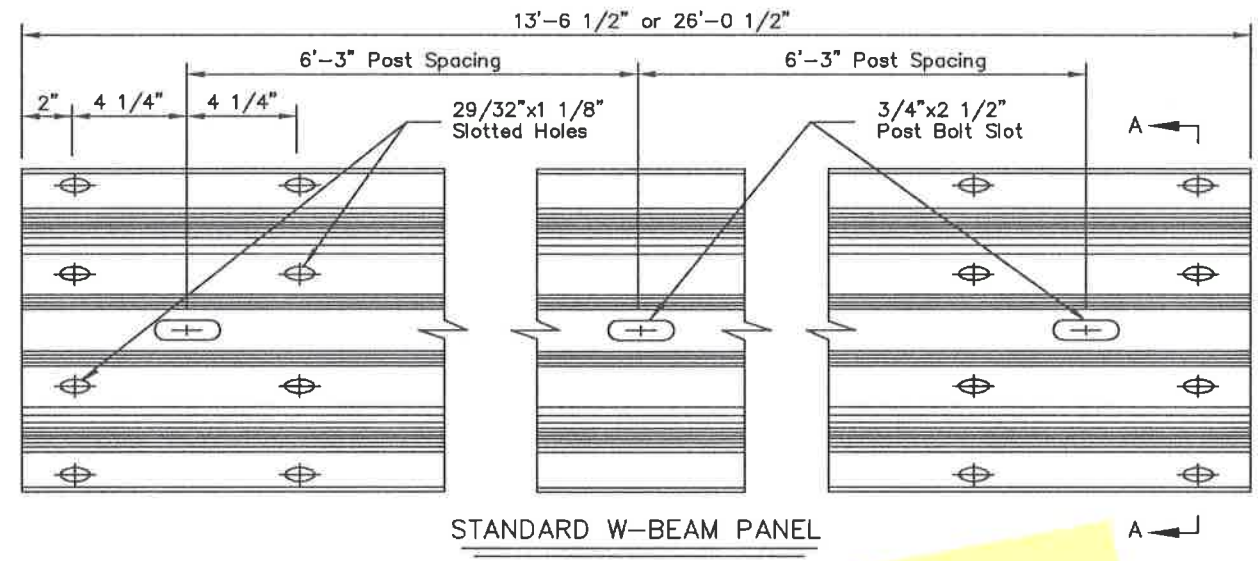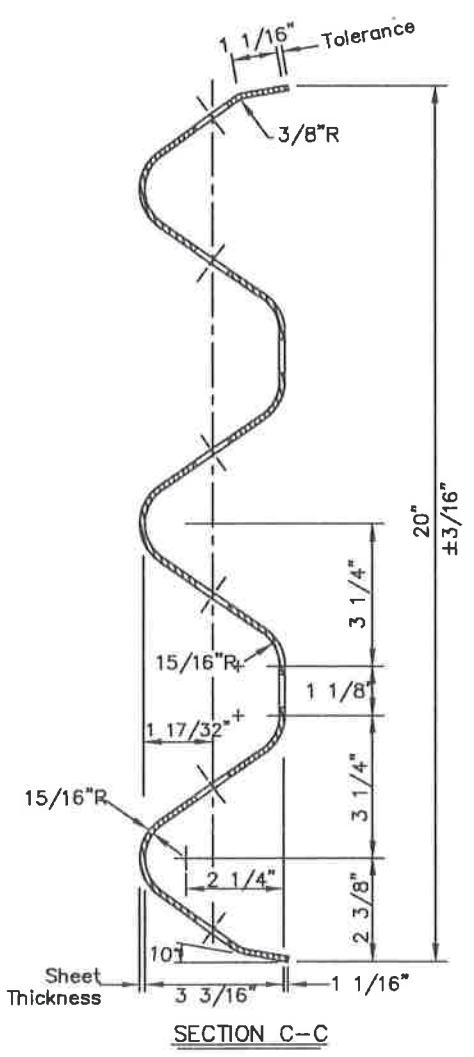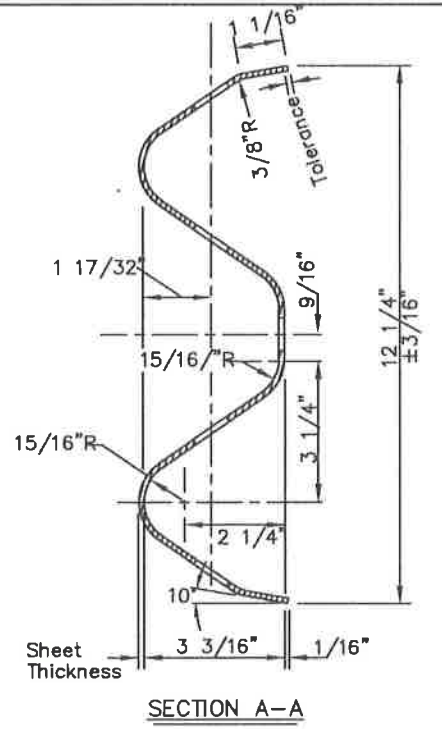

REVISIONS		
Date	Description	By
4/28/10	Revise General Notes	KJS

State of Alaska
Department of Transportation
& Public Facilities



**STANDARD GUARDRAIL
HARDWARE
(RAILS AND SPLICES)**

APPROVED


Date 5/31/12

GENERAL NOTES:


1. W-Beam and Thrie Beam Terminal Connectors shall conform to AASHTO M180, Class B, Type 2.
2. W-Beam end sections shall conform to AASHTO M180, Class A, Type 2.
3. All covered hardware shall comply with the AASHTO/AGC/ARTBA "A Guide to Standardized Highway Barrier Hardware", latest edition.

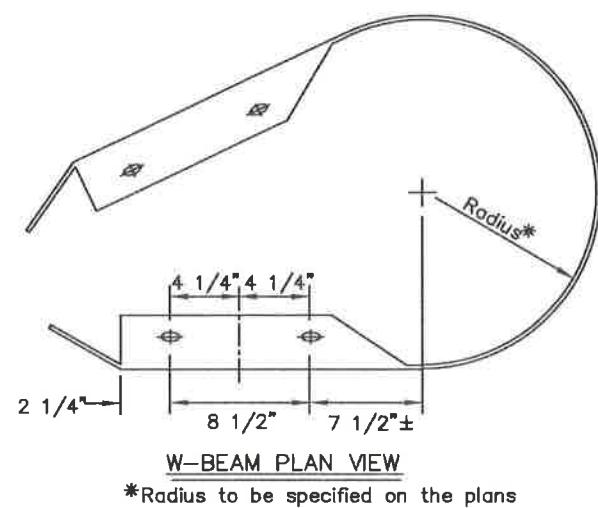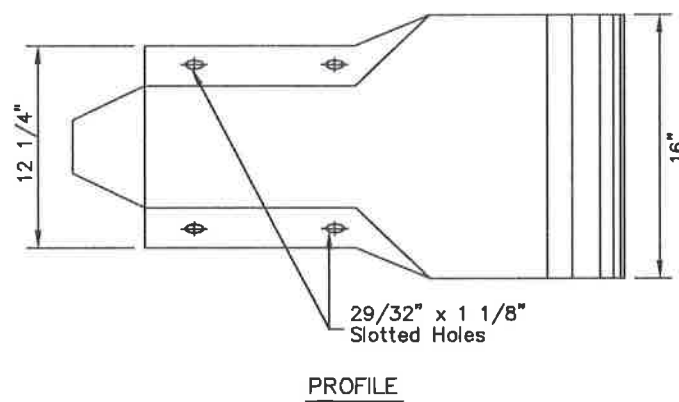

STANDARD W-BEAM END SECTION

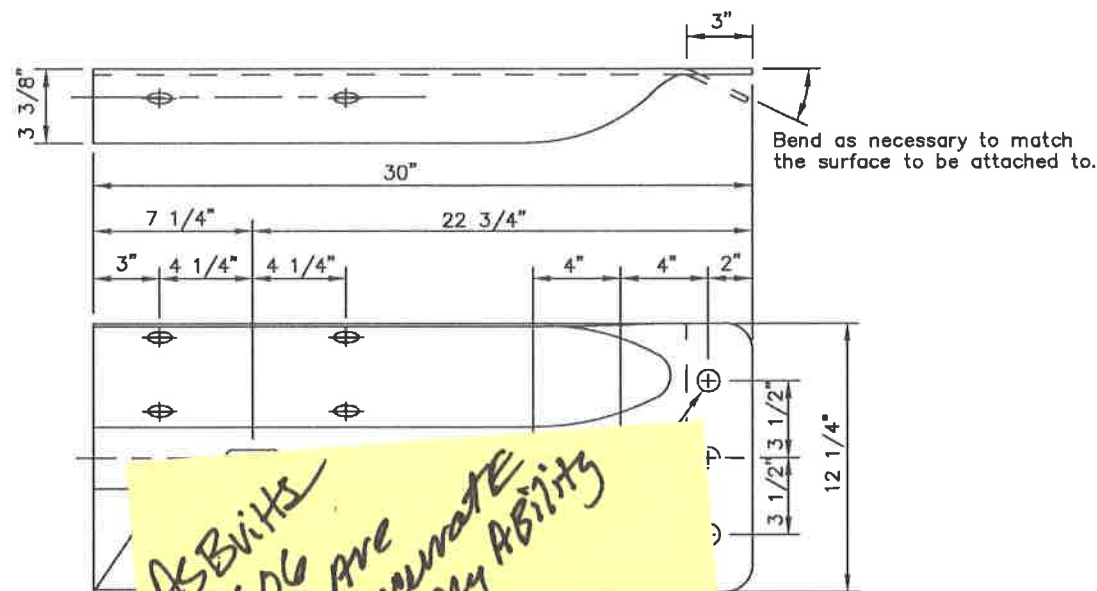

AS BUILT FOR 606 frame. ARE TRUE AND ACCURATE to the best of my ability Reviewed By: Gran Vanjaunen & Ak Ost. 3-29-19

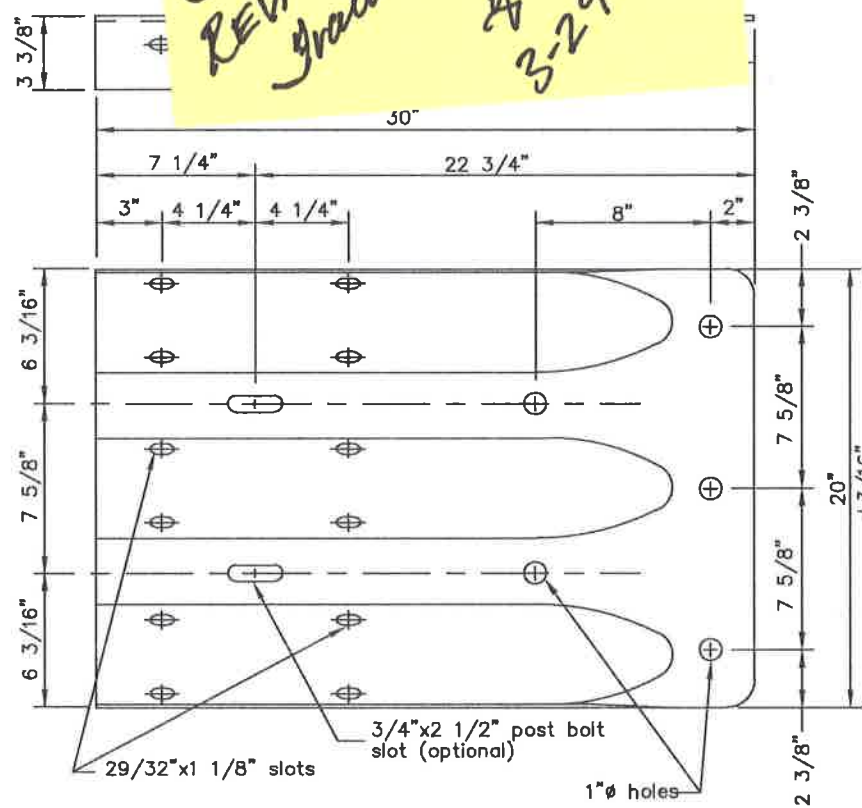


STANDARD THRIE BEAM TERMINAL CONNECTOR

REVISIONS		
Date	Description	By
3/15/99	Delete Thrie End Sect.	KJS

State of Alaska
Department of Transportation
& Public Facilities
**STANDARD GUARDRAIL
HARDWARE
(TERMINAL CONNECTORS)**




APPROVED
Date 5/31/12

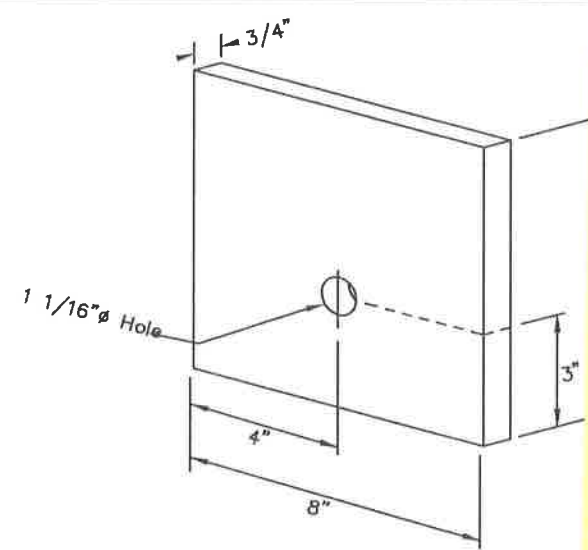


BEARING PLATE for CRT TERMINAL ANCHOR


AS BUILTS
IN ITEM -
606.
ARE ACCURATE and
COMPLETE TO THE BEST
OF MY ABILITY.
T.V.L. 3-29-19

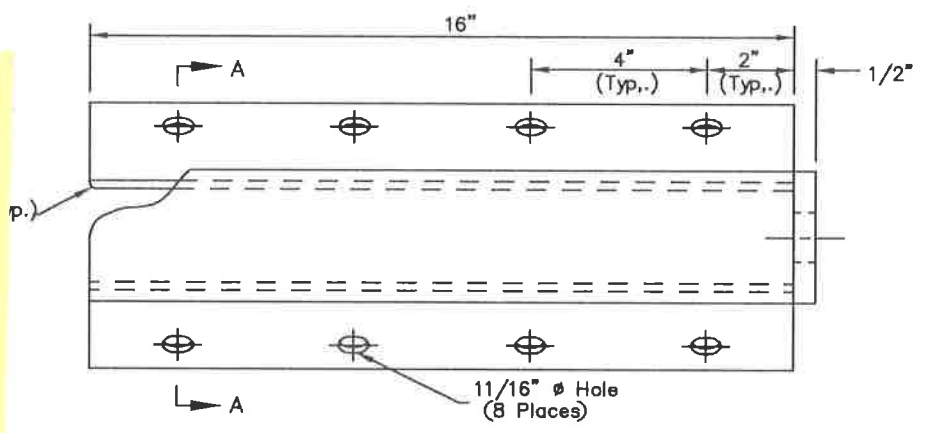


CABLE ANCHOR PLATE

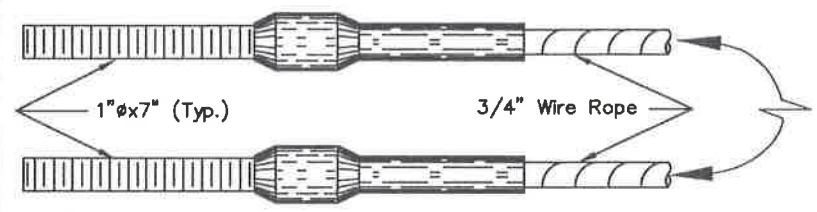

SWAGED FITTING DETAIL

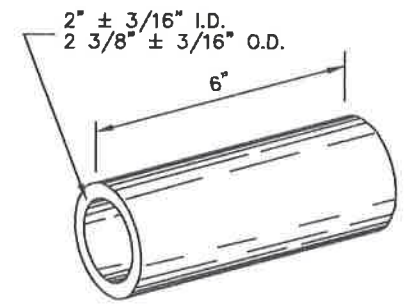


SLEEVE DETAIL

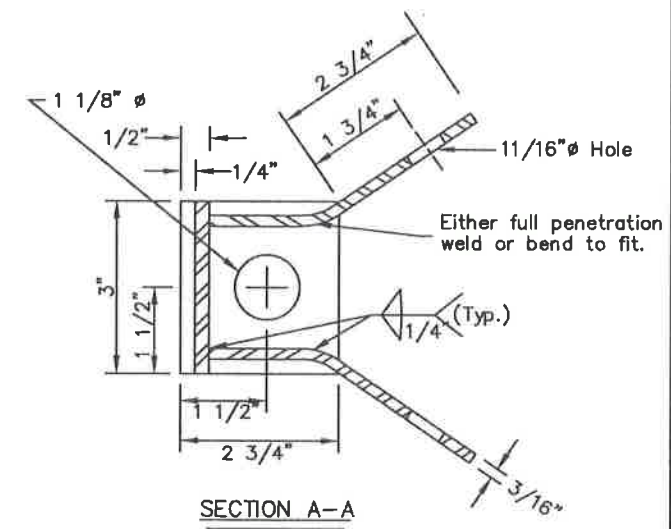


SECTION A-A


CONTROLLED RELEASE TERMINAL HARDWARE DETAILS

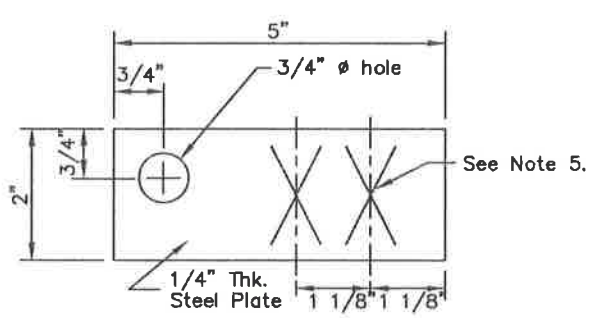

RADIUS I.D. PLATE

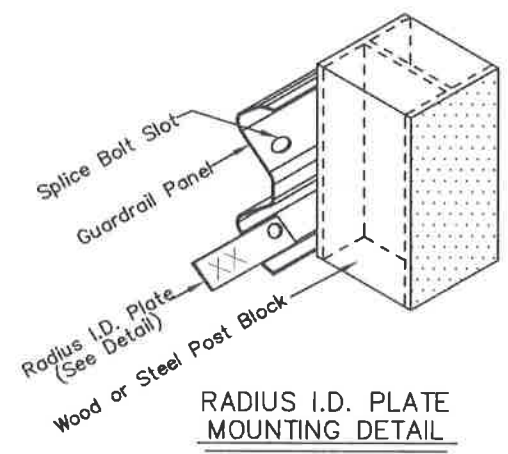

RADIUS I.D. PLATE MOUNTING DETAIL

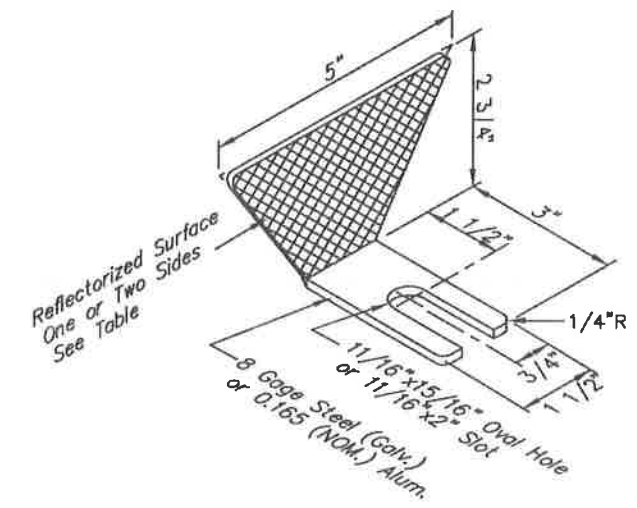

GUARDRAIL REFLECTOR

Type	Guardrail Reflectors Color	Reflectorized
A	White	Front & Rear
B	White	Front
C	Yellow	Front
D	Yellow	Front & Rear

- GENERAL NOTES:
- Cable Anchor Plate may be formed in single unit or welded fabrication.
 - Anchor Cable Assembly shall conform to AASHTO M-30 with Type II Wire Rope.
 - Sleeve for Wood Posts shall conform to the requirements of ASTM A120 and shall be of 2-inch galvanized standard pipe. Sleeve shall be a tight, pressed fit in post.
 - Bolts, nuts and washers shall conform to ASTM A-325 and galvanized in accordance with ASTM A-153.
 - Radius ID plates shall be attached to all shop-bent guardrail sections. They shall be bolted to the back side of the guardrail panel with the lower splice bolt nearest the P.C. of the radius.
 - Rail bend radius in feet shall be shown as "XX" on the radius ID plate. Digits shall be etched or stamped and have a min. height of 1 1/2" and a max. width of 3/4". The plate shall be galvanized after digits are marked.
 - All covered hardware shall comply with the AASHTO/AGC/ARTBA "A Guide to Standardized Highway Barrier Hardware", latest edition.


REVISIONS		
Date	Description	By
3/15/99	Delete BCT Hardware	KJS

State of Alaska
Department of Transportation
& Public Facilities


**STANDARD GUARDRAIL
HARDWARE
(MISCELLANEOUS)**

APPROVED


Date 5/31/12

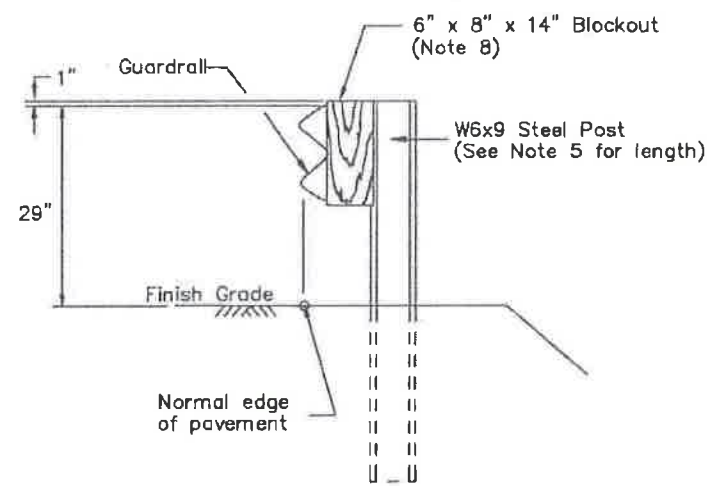

TYPE I POST INSTALLATION

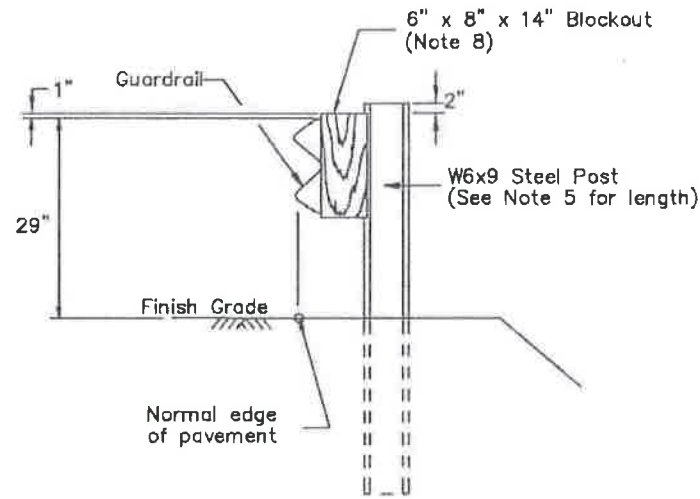

TYPE II POST INSTALLATION

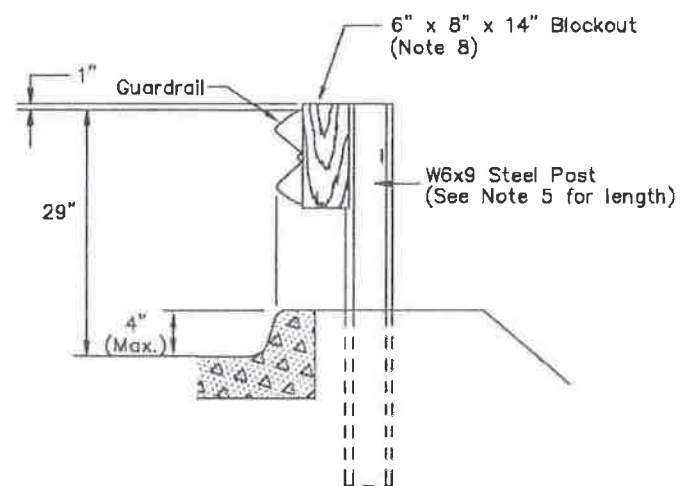


CURB DETAIL

TYPE III POST INSTALLATION

NOTE: Curb should not be installed with guardrail when the speed limit exceeds 40 mph.


GENERAL NOTES:

1. Attach guardrail reflectors at 50' centers beginning with the first post. Use Type A reflectors unless specified otherwise.
2. Provide hardware compliant with the AASHTO/AGC/ARTBA "A Guide to Standardized Highway Barrier Hardware," latest edition.
3. See Standard Drawing G-00 for hardware details.
4. Mount rail to block with bolt on approaching traffic side of block web.
5. See Standard Drawing G-10 for post lengths corresponding to different combinations of slope and behind-post embankment width.
6. Typical post spacing is 6'-3" center to center.
7. This barrier is acceptable under NCHRP 350, TL-3.
8. Use wood, rubber, plastic, or other NCHRP 350 or MASH approved blockouts designed to be used with steel posts.
9. Use 25 linear foot transition to match height of existing or new rail elements and end treatments.
10. W6x8.5 steel post may be substituted for W6x9 steel post.

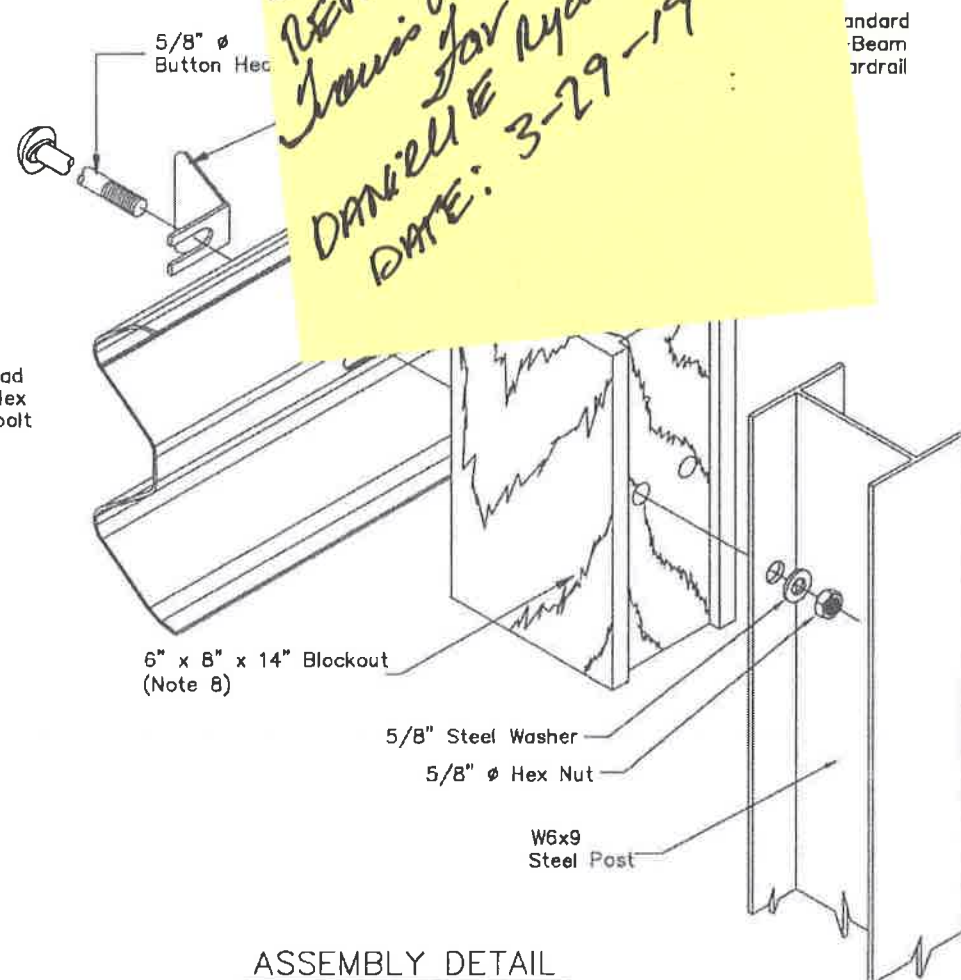


ASSEMBLY DETAIL

(Type I post shown)

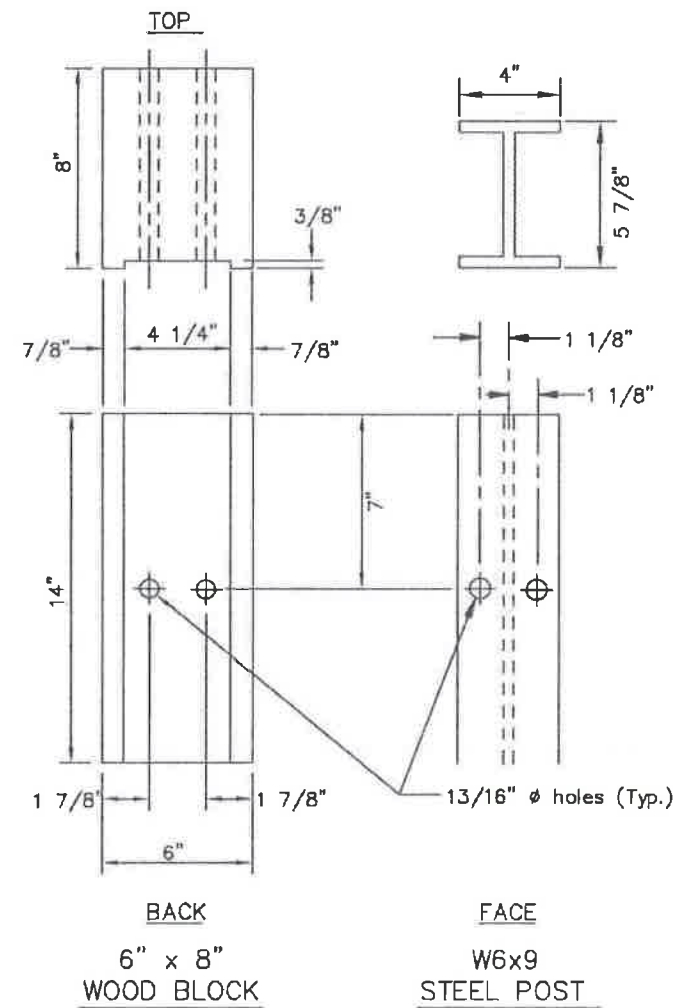

BACK
6" x 8"
WOOD BLOCK

FACE
W6x9
STEEL POST

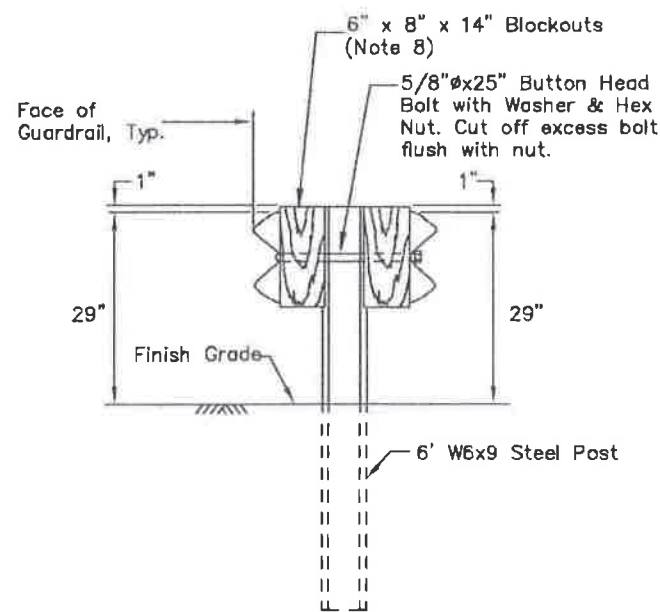

TYPE IV DOUBLE SIDED INSTALLATION

AS BUILT
FOR 606 ITEM
REVIEWED BY:
Louis Van Jansen
for Ryan
DANIEL E RYDER
DATE: 3-29-19

REVISIONS		
Date	Description	By
3/1/83	Revised gen. notes	Gdo
1/1/86	Revised hanger detail	Gdo
3/15/99	Block and post length	KJS
4/1/13	Add double-sided detail and increase g.r. height	JCJ

State of Alaska
Department of Transportation
& Public Facilities

STEEL POST
W-BEAM GUARDRAIL




Date 05/15/13

G-20.11


GENERAL NOTES:

- The standard detail applies to all approved guardrail terminals, including those with parabolic flares. The alternate detail may only be used with straight terminals. The terminal details shown are for illustration only - see manufacturer's drawings for actual post, rail, etc. drawings.
- Use the standard detail for all terminals except when upgrading existing non-NCHRP 350 or MASH compliant terminals to NCHRP 350 or MASH compliant terminals where site conditions make the use of the standard detail infeasible. In that case, use the alternate detail.
- Construct the hatched areas to match the slope of the adjacent shoulder to a maximum slope of 10:1. Maintain 10:1 for steeper shoulders. Match the slope when the shoulder slopes toward the road as well as away from the road.
- On paved roads, the hatched areas shall be paved. On gravel roads, surface the hatched areas with the same materials used to surface the travel lanes.
- From point (Y) to point (Z) make the side slope match the approaching side slope except where it is flatter than 4:1. In that case, the slope may be steepened to 4:1.
- Attach a flexible marker to the first point (where the flare begins) and the end post of each terminal.
- The maximum allowable height for foundation tubes or other steel components of terminal post breakaway systems is 4 inches above the surrounding grade.
- The details on this sheet do not apply to Controlled Release Terminals (G-25) or Downstream End Anchors (G-13).
- On two-way undivided roads, the details on this sheet do apply to NCHRP 350 or MASH compliant guardrail terminals on both the approach and downstream ends.

AS BUILT'S
 FOR 606 PAD
 ARE ACCURATE &
 CORRECT TO THE BEST
 OF MY KNOWLEDGE.
 TM @ AK DOT.
 3-29-19



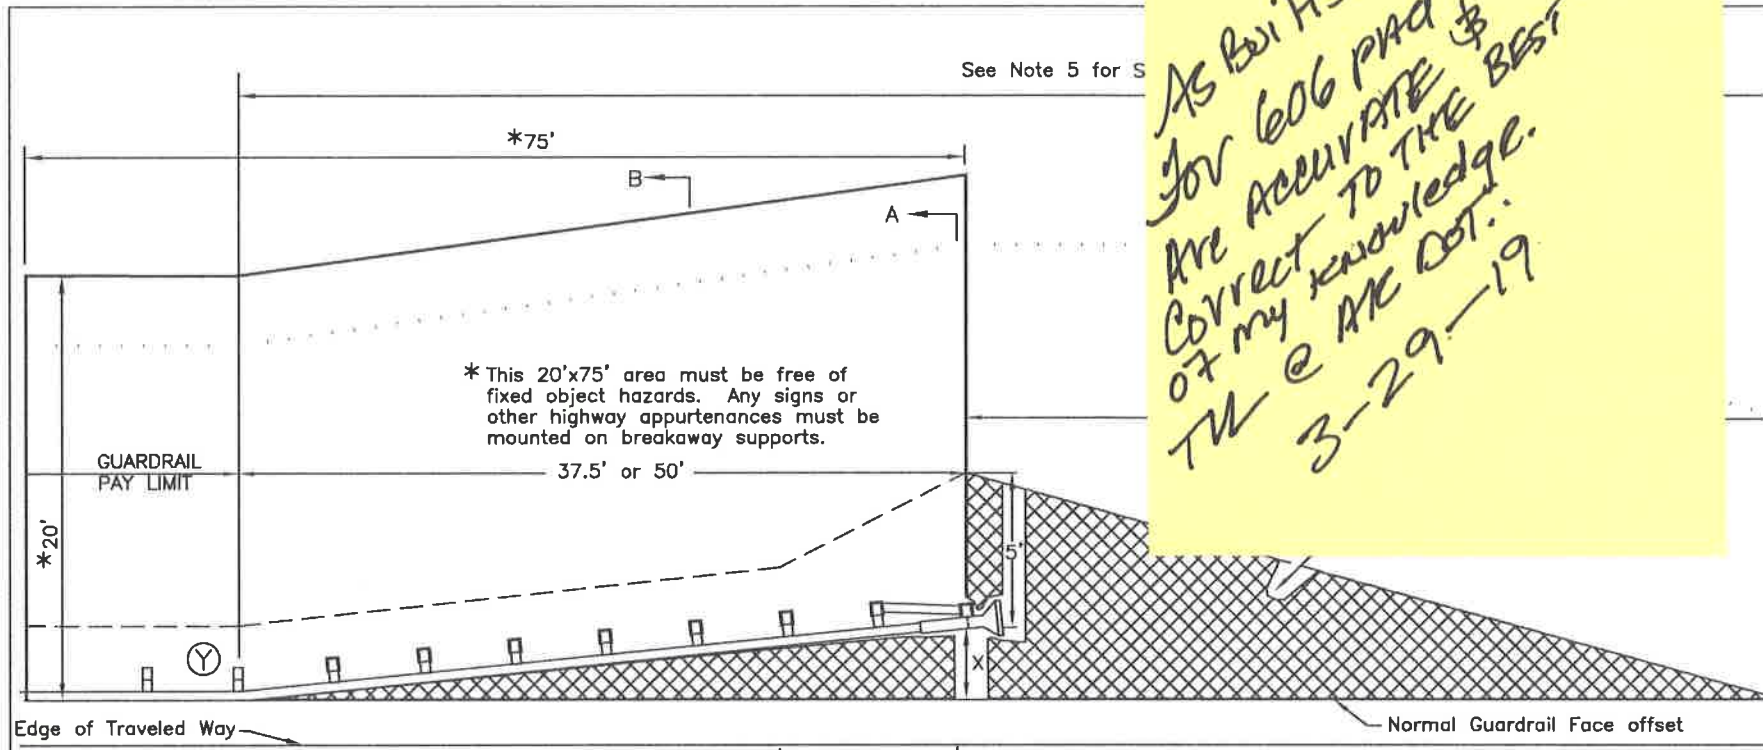


STANDARD GUARDRAIL TERMINAL WIDENING DETAIL

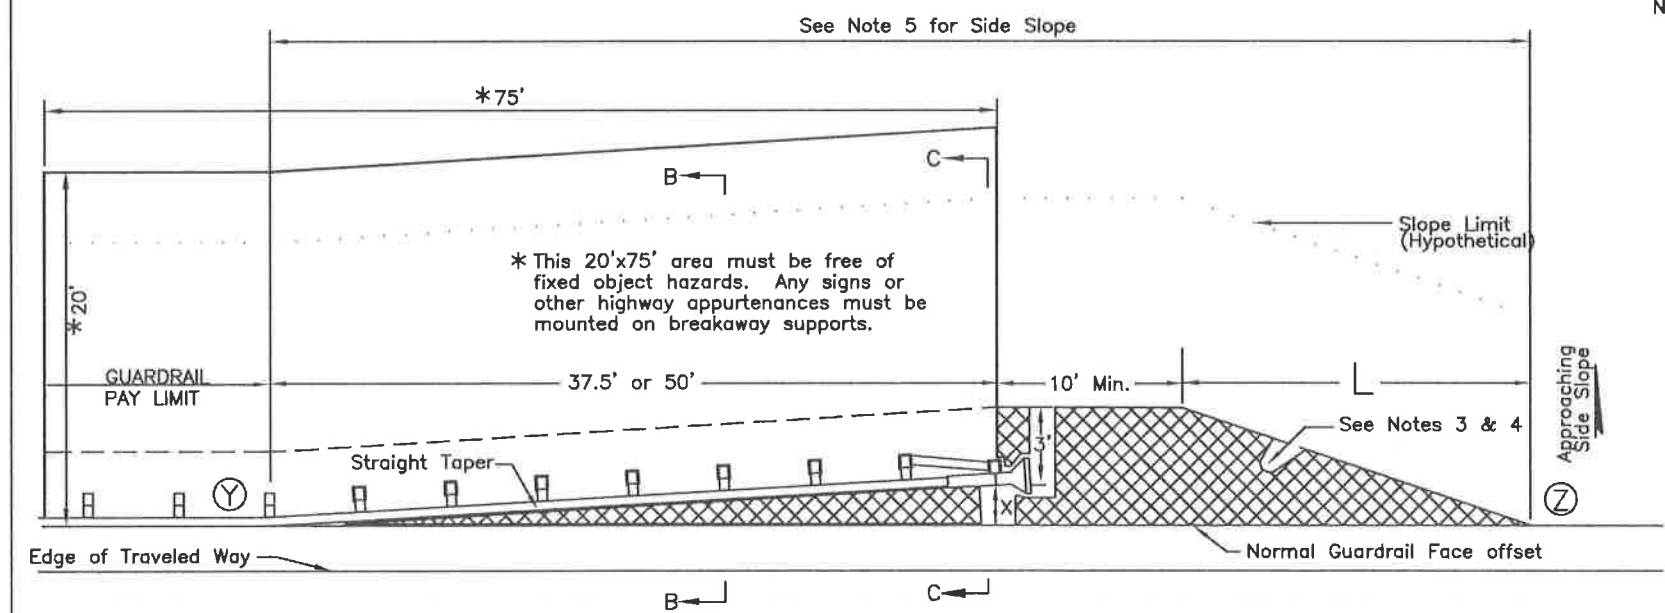

ALTERNATE GUARDRAIL TERMINAL WIDENING DETAIL

X: End offset. See manufacturer's information for the range of acceptable (NCHRP 350 or MASH compliant) end offsets for each terminal.

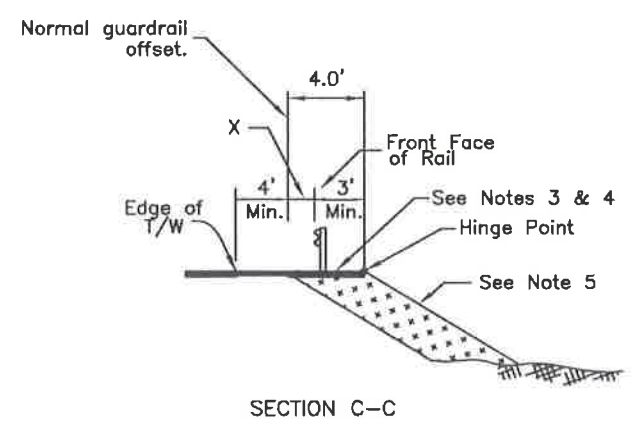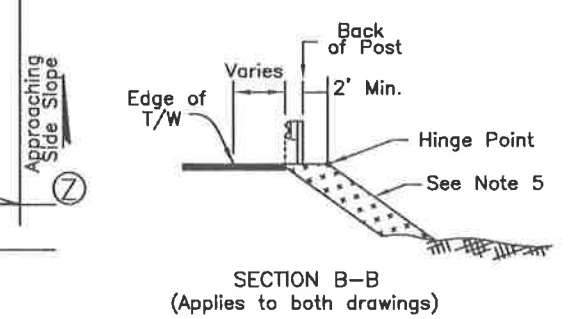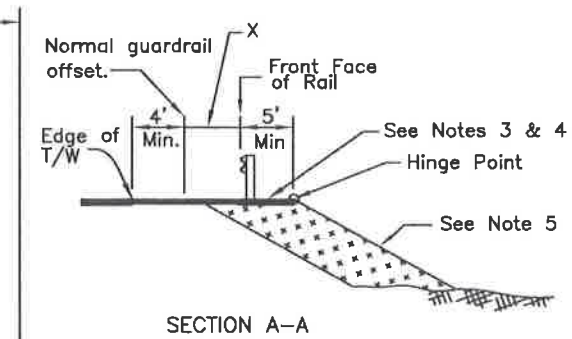

Taper Lengths (L) for Common End Offsets (X)		
End Offset	Standard Detail	Alternate Detail
0'	15.0'	10.0'
1'	17.0'	10.0'
1.5'	20.0'	15.0'
2'	22.0'	15.0'
2.5'	25.0'	15.0'
4'	30.0'	20.0'

Interpolate if the end offset falls between table values

REVISIONS		
Date	Description	By
3/6/02	Change ET Offset	KJS
2/28/03	Major Revisions	KJS
4/28/10	Revise General Notes	KJS

Sheet 1 of 1

State of Alaska
 Department of Transportation
 & Public Facilities

**WIDENING FOR GUARDRAIL
 END TERMINALS**



Date 5/31/12

G-20.11

G-46.11

GENERAL NOTES

- Use tapered end sections only where:
 - Barriers terminate outside the clear zone, or
 - The regulatory speed limit is 25 MPH or below, or 30 MPH if the Engineer determines NCHRP 350 or MASH compliant end treatments are unfeasible.
- Use air entrained concrete with minimum compressive strength of 3,000 p.s.i.
- Provide a minimum of two inches clear cover for reinforcing steel bars except as shown otherwise.
- Galvanize all exposed hardware in accordance with AASHTO M 232.
- Provide reinforcing steel bars conforming to AASHTO M 31-86, grade 60.
- Provide anchor pins conforming to AASHTO M 183 steel.
- Provide connecting pins conforming to AASHTO M 164-86.
- Provide four anchor pins per unit.






REVISIONS		
Date	Description	By
4/28/10	Correct dimensioning	KJS

Sheet 2 of 2


State of Alaska
Department of Transportation
& Public Facilities
**PRECAST CONCRETE
"F" SHAPE BARRIER
TAPERED END SECTION**




APPROVED
Date 5/31/12

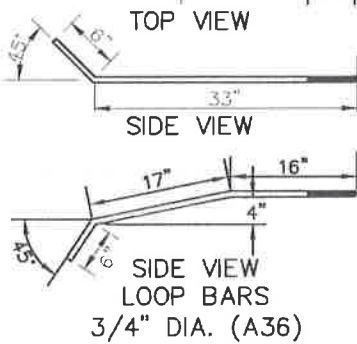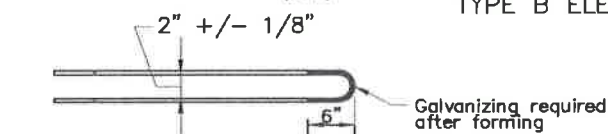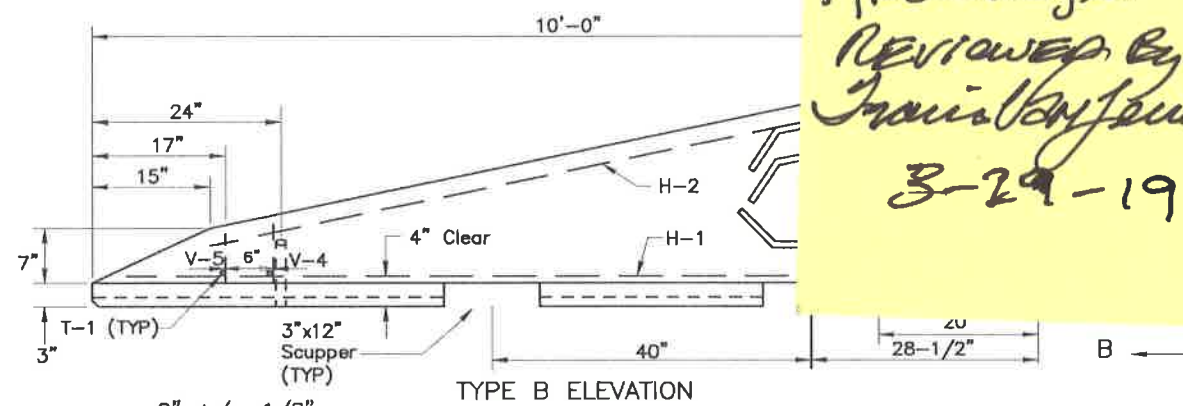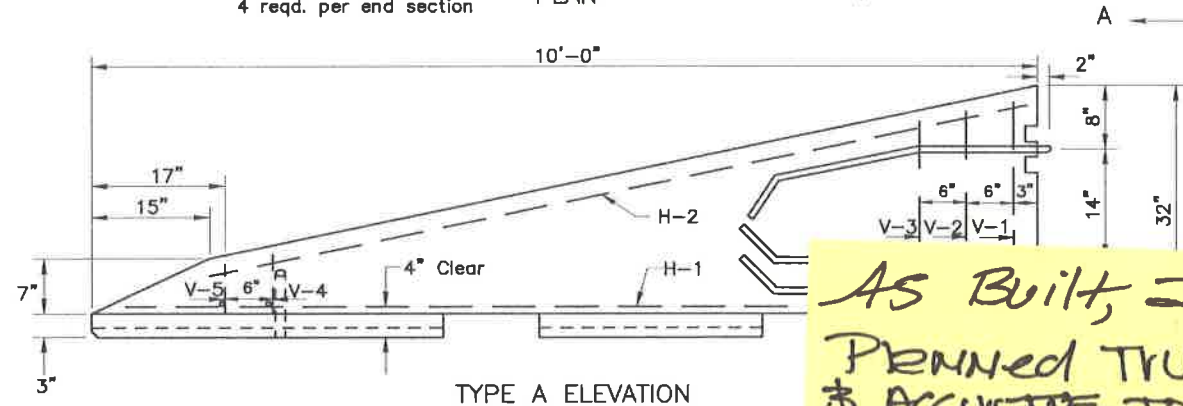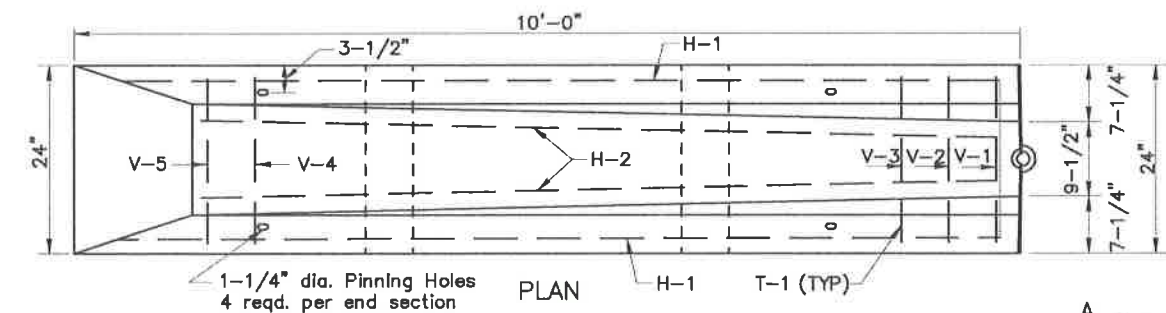


REINFORCEMENT DETAIL

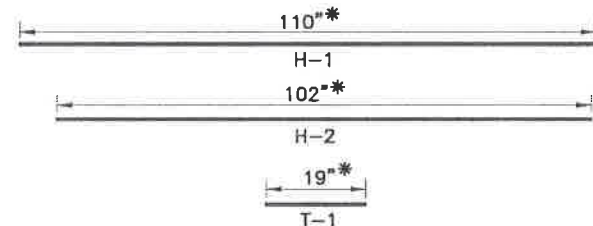


* Dimensions marked thus are to the intersection point of the barrier slopes.

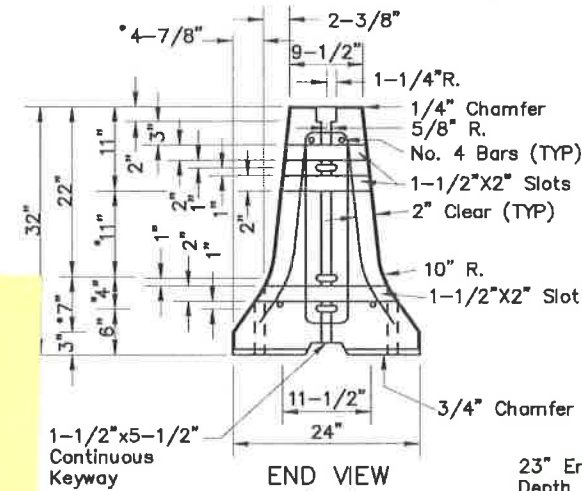


END VIEW

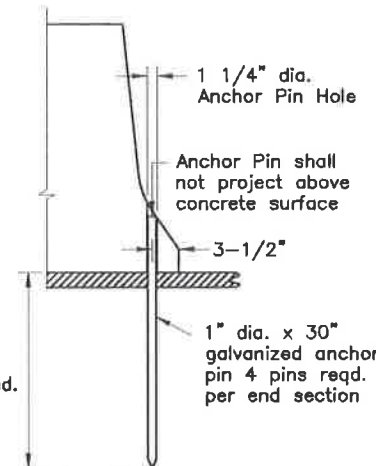

ANCHOR PIN PLACEMENT DETAIL

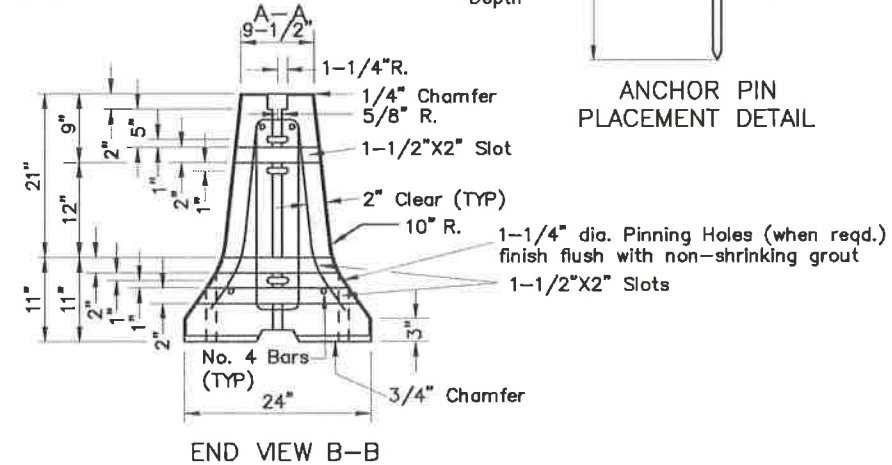






END VIEW B-B

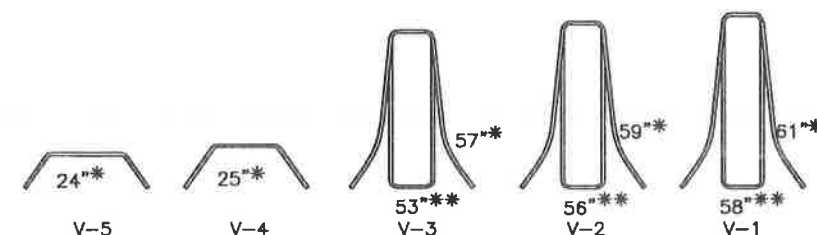



*Length of No. 4 Rebar **Length of No. 4 Rebar (Inner Core)
REINFORCING STEEL

*AS BUILT, IS
PENNED TRUE
& ACCURATE TO THE
BEST of MY
KNOWLEDGE.
Reviewed by
Trainor Jensen
3-29-19*



G-46.11 Sheet 2 of 2

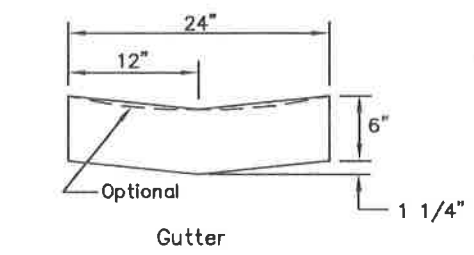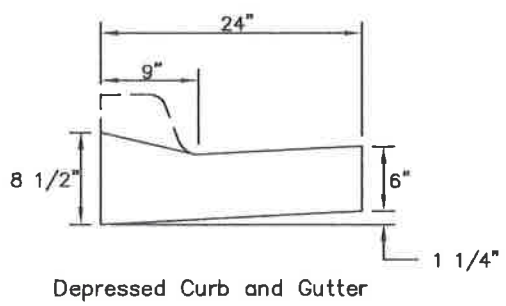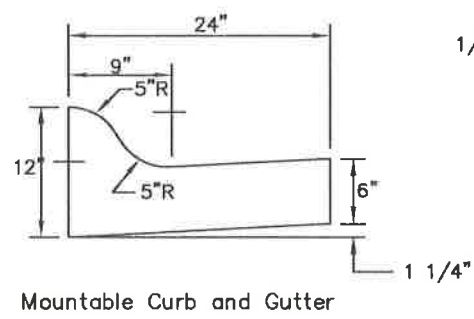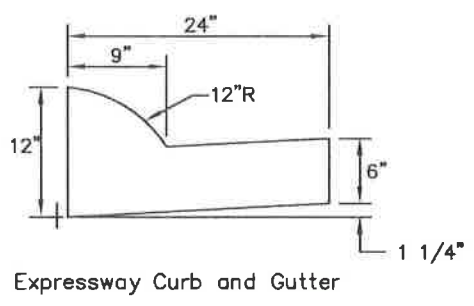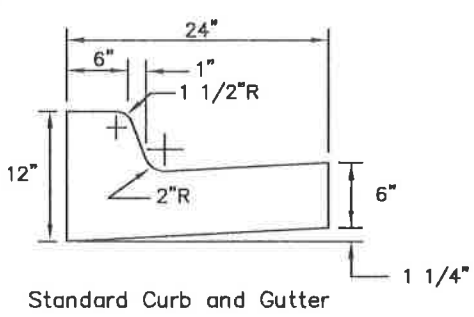


CURB and GUTTER DETAILS

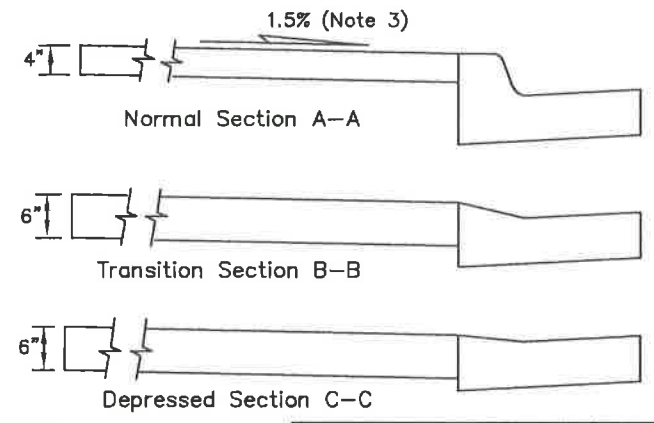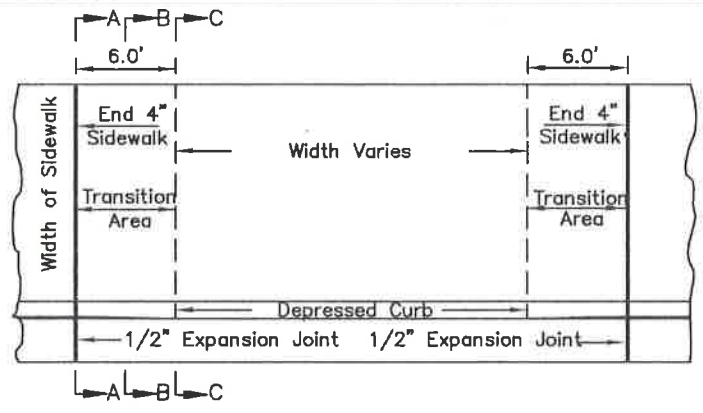

VEHICULAR CURB CUT DETAILS

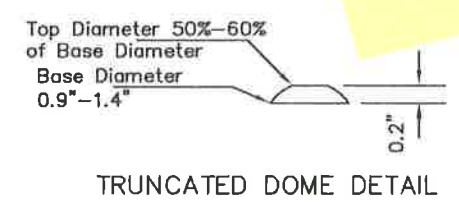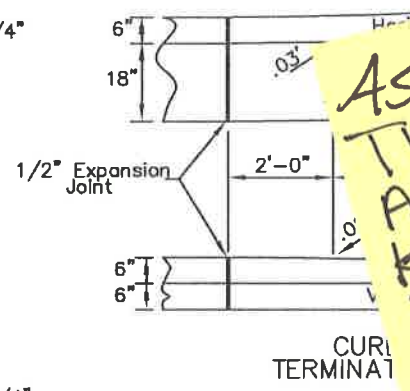


TRUNCATED DOME DETAIL

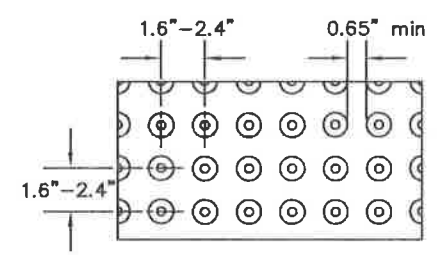



TEXTURE PATTERN DETAIL

AS BUILT ARE TRUE AND ACCURATE TO MY KNOWLEDGE REVIEWED BY TL @ AK DOT 3-29-19

Truncated dome surface see note 9

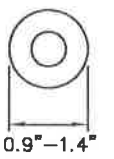


Snow plow taper on downstream side of curb ramp: 6" thick concrete poured monolithically with curb and gutter.

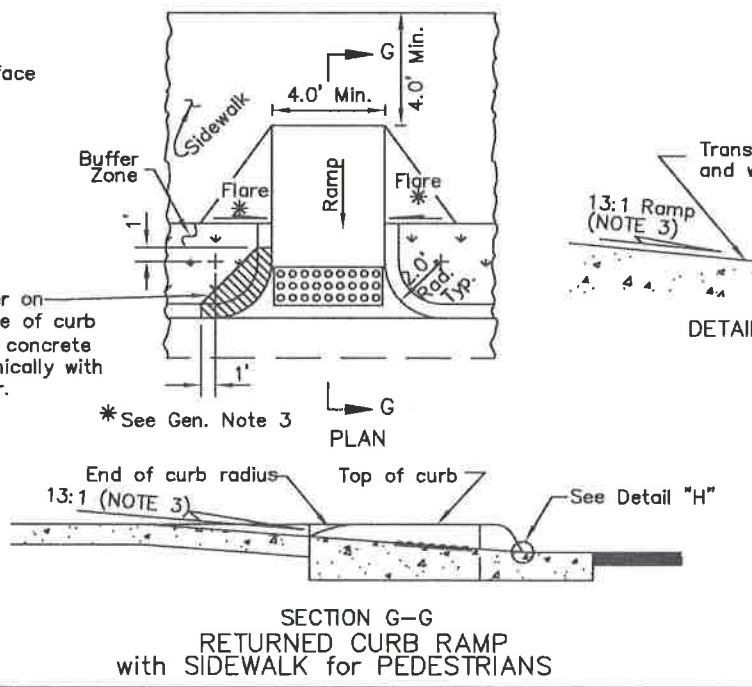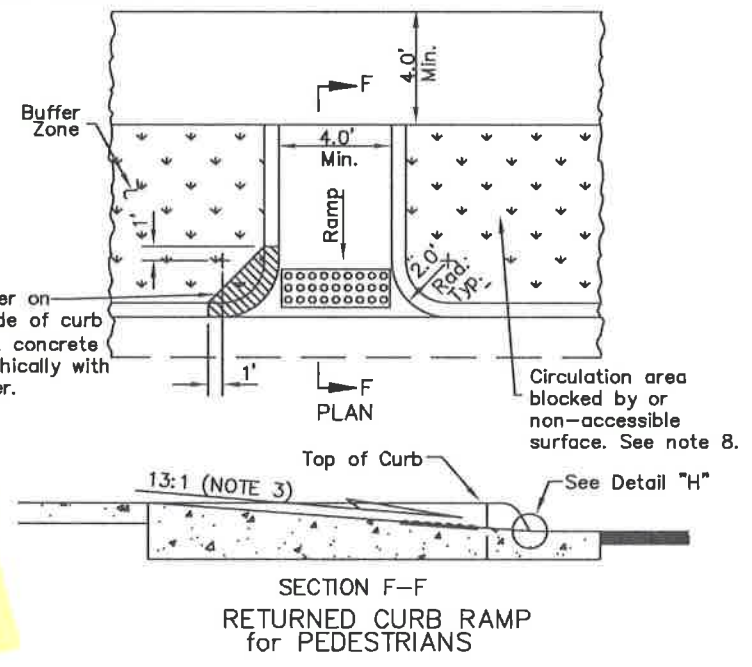

GENERAL NOTES:

- Use the type of curb and/or gutter specified on the plans.
- Use Mountable or Expressway curbs on medians and traffic islands.
- Construct ramp runs and landings of concrete, regardless of whether the sidewalk is asphalt or concrete.
- Construct ramp slopes 13:1 or flatter, flare slopes 12:1 or flatter, and sidewalk cross slopes 1.5% or flatter. If conditions require, the Engineer may increase ramp slopes to 12:1 maximum. Construct grade breaks perpendicular to ramp runs.
- Do not construct flare slopes steeper than 10:1 measured parallel to the curb line, ramp slopes steeper than 12:1, or sidewalk cross slopes steeper than 2% (50:1), except as provided under Note 6. These are the steepest slopes allowed by law.
- Where sidewalk slope makes it necessary to lengthen a ramp run to avoid exceeding the allowable ramp slope, do not exceed a ramp length of 15 feet. The slope resulting from that run length is acceptable, even if it exceeds the maximum slope shown.
- Provide a coarse broomed finish on ramp runs perpendicular to the ramp slope.
- When approved by the Engineer, curb returns may be replaced with flares at locations where access to the side of a ramp run is free of poles, utility boxes, other obstructions, or non-accessible surfaces such as a dirt planter strips. See Standard Drawing I-22 for details.
- Install 24" detectable warning tiles for the full width of the ramp. Domes shall be in a square pattern. Align truncated dome pattern in the predominant direction of wheelchair travel to permit wheels to roll between domes.
- Construct curb ramps and detectable warning tiles in accordance with requirements for the American with Disabilities Act (ADA).

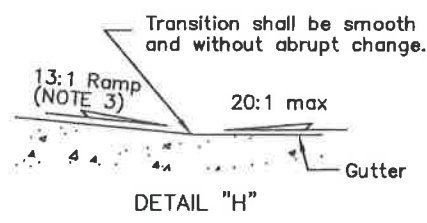

REVISIONS		
Date	Description	By
5/15/89	Added Curb Ramps	Gdo
4/1/93	Revised Detail "H"	Gdo
1/1/96	Gen. Note 3	Gdo
12/1/99	Delete Flared Ramp	KJS
5/31/12	ADA Updates	JCJ

State of Alaska
Department of Transportation & Public Facilities

CURB CUT, CURB & GUTTER AND CURB RAMP DETAILS




APPROVED

Date 5/31/12


L-03.10

GENERAL NOTES

- Design and fabricate all shafts to support a mast arm 22' long with luminaire. Assume each offset fixture weighs 60 lbs. and has an effective projected area of 2.8 SF. Assume each Cobra head weighs 55 lbs. and has an effective projected area of 1.2 square feet. With this dead load, limit the angular rotation of the pole top to 1° 40' maximum.
- Weld size to be determined by manufacturer.
- Mounting height, if specified in the plans, refers to the height of luminaire above the roadway. Adjust each pole's shaft length to maintain this difference in elevation whenever slope and/or offset varies.
- Minimum outside diameter at the top of pole equals 3-7/8". Pole diameter shall taper uniformly from the top of pole to the base plate, with a maximum taper rate of 0.15" per foot.
- Mast arm rise may vary ±0.5ft from the values listed in the table.
- Locate the handhole at 90 degrees to the mast arm on the side of pole downstream from traffic flow.
- Furnish all poles with a J-hook to support the illumination top conductors. Furnish all mast arm poles with a removable raintight cap.
- Frangible couplings shall be NCHRP 350, Test Level 3 compliant and have no measured torque requirement.
- Frangible couplings shall be installed into flush mounted female anchors so that no fixed hardware extends above the foundation top.
- Install all components of the breakaway support system in accordance with the manufacturer's written instructions.
- Fabricate the skirt from four pieces of 0.06" thick 3003 h-14 aluminum sheet. Bend each plate to provide corners with a 3/4" radius. Assemble the skirt with E10 x 3/8" self tapping stainless screws or pop rivets. The assembled skirt measures about 12-7/8" square.

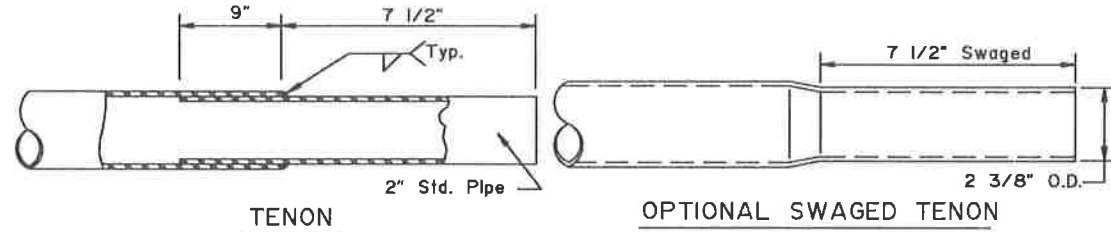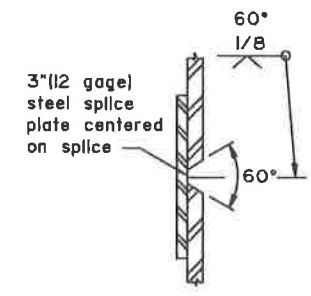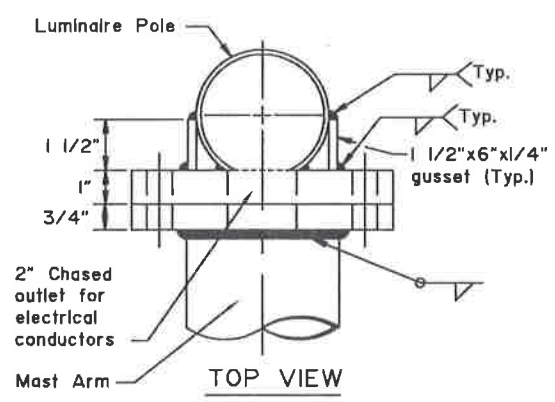


END OF MAST ARM DETAIL

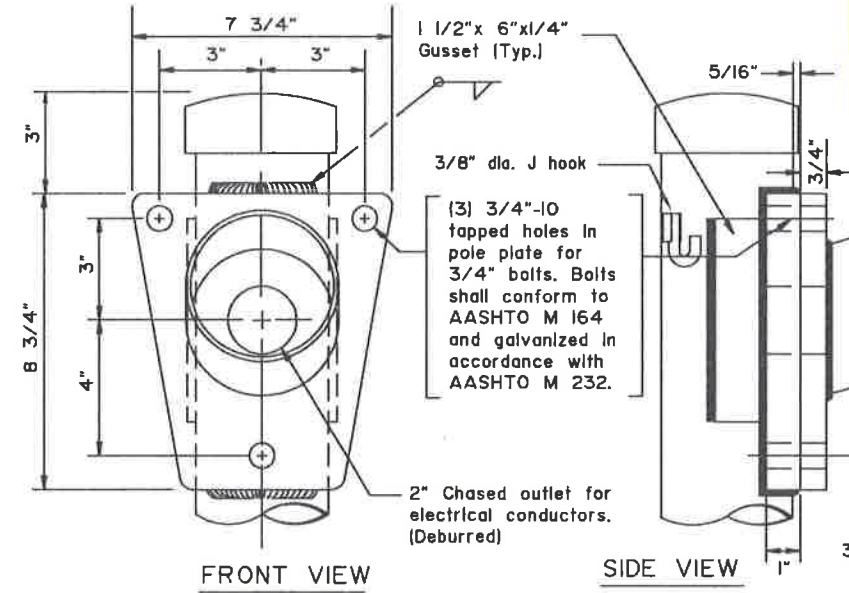


MAST ARM CONNECTION DETAIL

As Built for Lighting are true & accurate to the best of my knowledge. TVL. @ AKDOT. 3-29-19

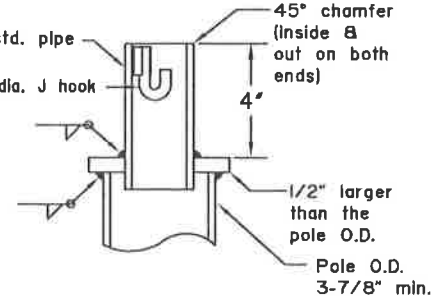


OFFSET LIGHTING STANDARD POLE TOP DETAIL (CUTAWAY FOR CLARITY)

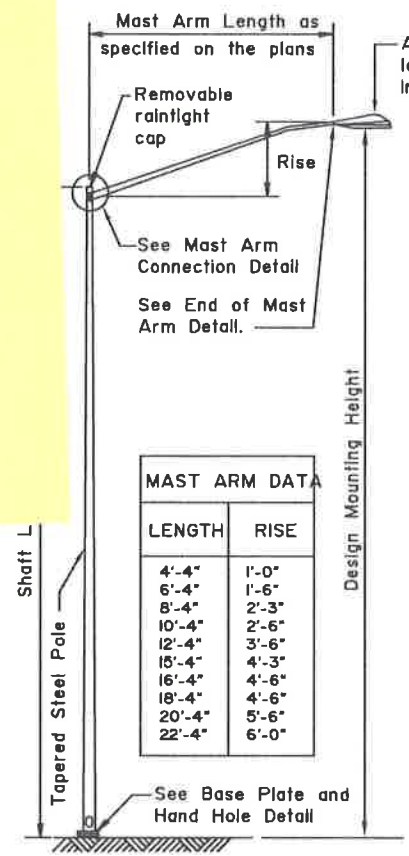


ELECTROLIER ELEVATION COBRA HEAD


MAST ARM DATA	
LENGTH	RISE
4'-4"	1'-0"
6'-4"	1'-6"
8'-4"	2'-3"
10'-4"	2'-6"
12'-4"	3'-6"
15'-4"	4'-3"
16'-4"	4'-6"
18'-4"	4'-6"
20'-4"	5'-6"
22'-4"	6'-0"

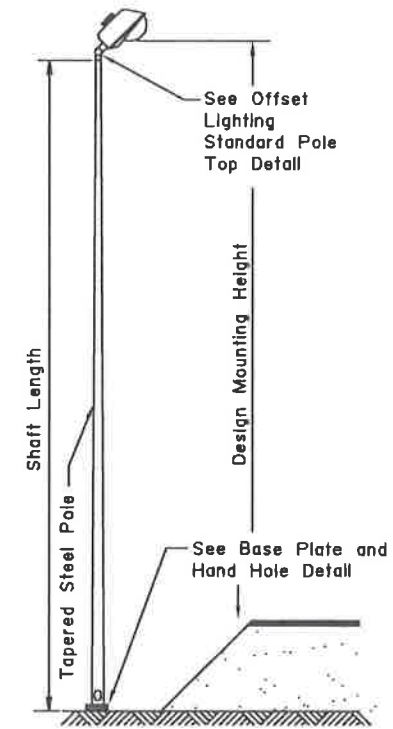


ELECTROLIER ELEVATION OFFSET

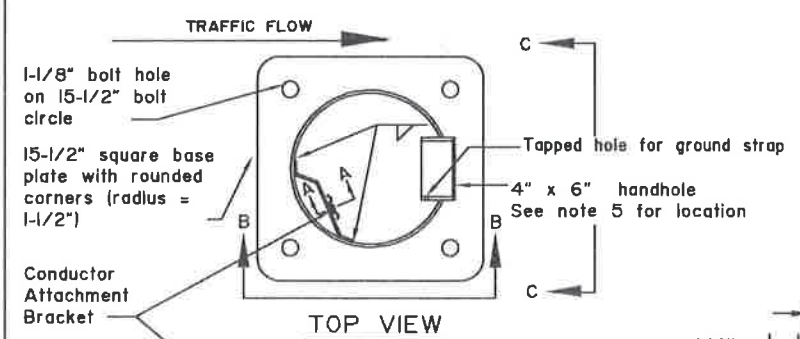


BASE PLATE AND HAND HOLE DETAIL

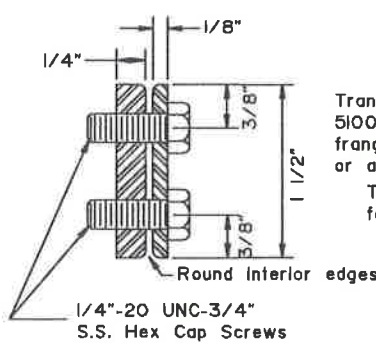


SECTION A-A

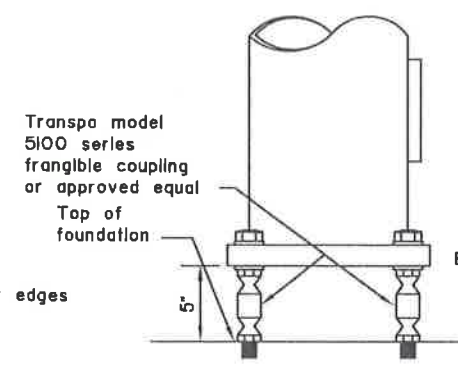

VIEW B-B

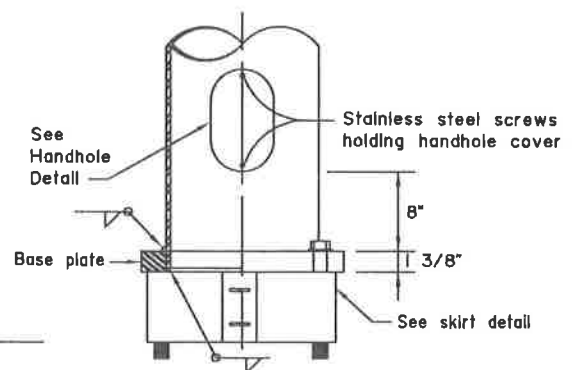

VIEW C-C

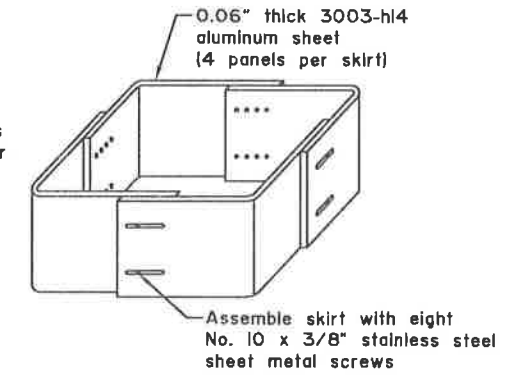

SKIRT DETAIL

REVISIONS		
Date	Description	By

Sheet 1 of 1

State of Alaska
 Department of Transportation & Public Facilities
LIGHTING STANDARD



Date

L-03.10

DESIGN NOTES:

Design Standard: 2001 Standard Specifications for Structural Supports for Highway Signs, Luminaires and Traffic Signals with 2006 interim.

Design Load: 1,000 lbs axial, 2,000 lbs shear, 50,000 ft-lbs moment.

Construction Standard: Latest edition of the State Of Alaska Standard Specifications for Highway Construction with Special Provisions.

NOTES:

- This foundation is approved for electrolier and breakaway traffic signal applications in cohesionless soils with an N1-60 value of 10 or greater per AASHTO T-206, "Standard Penetration Test" (SPT). This foundation shall not be used if any of the following are encountered; water table above the bottom of foundation, very loose soils, organic soils, cohesive soils (clay), or soils susceptible to frost jacking. If any of these conditions are encountered, stop foundation work and contact the Engineer.
- Place foundation in drilled or excavated hole with centerline of foundation located at the station, offset, and elevation specified in plans. Set foundation to satisfy the conditions depicted in clearance detail.
- Form the foundation in corrugated metal pipe conforming to Subsection 707-2.01 of the Specifications.
- Provide 1.5 extra turns at each end of the spiral reinforcing steel. Reinforcing steel shall not be spliced. Tie vertical reinforcing steel to each intersection of the spiral reinforcing steel.
- Connect ground wire near the top of spiral reinforcing steel with two irreversible connectors as shown. Fasten connectors according to the manufacturers' recommendations including the use of manufacturer specified tools. The ground wire may be bare solid, stranded, or braided copper. Protect ground wire with protective sleeve as shown and fill with silicon sealant.
- Complete all concrete work in conformance with Sections 501, 503, and 660 of the Specifications. Use a tube with a hopper head or other approved device when dropping concrete more than 5 feet per Subsection 501-3.08. Vibrate concrete during placement by mechanical vibration per Subsection 501-3.08. Ensure anchor threads are protected from contact with concrete during pour.
- Backfill and compact according to Section 205, and Subsections 203-3.04 and 660-3.01 of the Specifications. Use select material, Type A or sand slurry as backfill material. Ensure area below foundation meets compaction requirements and is free of loose material and debris prior to concrete work.
- Install all anchors according to the manufacturer's written installation instructions. Anchors shall be installed plumb. Anchors greater than 1:40 out-of-plumb will result in foundation rejection.
- When used for electrolier reduce the foundation depth 1 foot when there is no luminaire arm or the luminaire arm is less than or equal to 12 feet.
- Grade in depth table refers to fill slopes. If foundation is in a cut slope assume flat grade in table. To determine grade in fill slopes, use the most severe grade found within an 8 foot radius of the center of the foundation. Slopes steeper than 1.5:1 require engineered depth calculation.


MATERIAL REQUIREMENTS		
Concrete	Class A	$f'c = 4000$ psi
CMP	AASHTO M218	14 ga.
Vertical Reinforcing Steel	AASHTO M31 #11	GR 60
Spiral Reinforcing Steel	AASHTO M31 #5	GR 60
Ground Wire		#4 awg
Frangible Coupling	NCHRP 350 TL3 Frangible Coupling	$V_u = 5.5$ kips $T_u = 43.2$ kips
Anchor	NCHRP 350 TL3 Frangible Coupling Anchor	
Conduit	Sch 40	RMC
Protective Sleeve	Sch 40	PVC

GRADE	FOUNDATION DEPTH BY APPLICATION (ft.)	
	ELECTROLIER * SEE NOTE 9	BREAKAWAY TRAFFIC SIGNAL
Flat to 6:1	8	6
>=6:1 to 3:1	9	7
>=3:1 to 1.5:1	10	8



SAND SLURRY MIX DESIGN		
ITEM	BATCHING QUANTITIES PER CYD BATCH (lbs.)	APPLICABLE SPECS.
Portland Cement Concrete	188	701-2.01
Water (52.1 gal.)	435	712-2.01
Fine Aggregate SSD	3041	703-2.01
Admixture: Microair	2.0 oz.	711-2.02
Total	3664	

BOLT CIRCLE	
REGION	DIAMETER
Northern Region Projects	14.5"
Central Region Projects	15.5"
Southeast Region Projects	15.5"

AS BUILT FOR LIGHTING BASE, IS ACCURATE TO THE BEST OF MY KNOWLEDGE. T.V.L. @ AKDOT. 3-29-19.

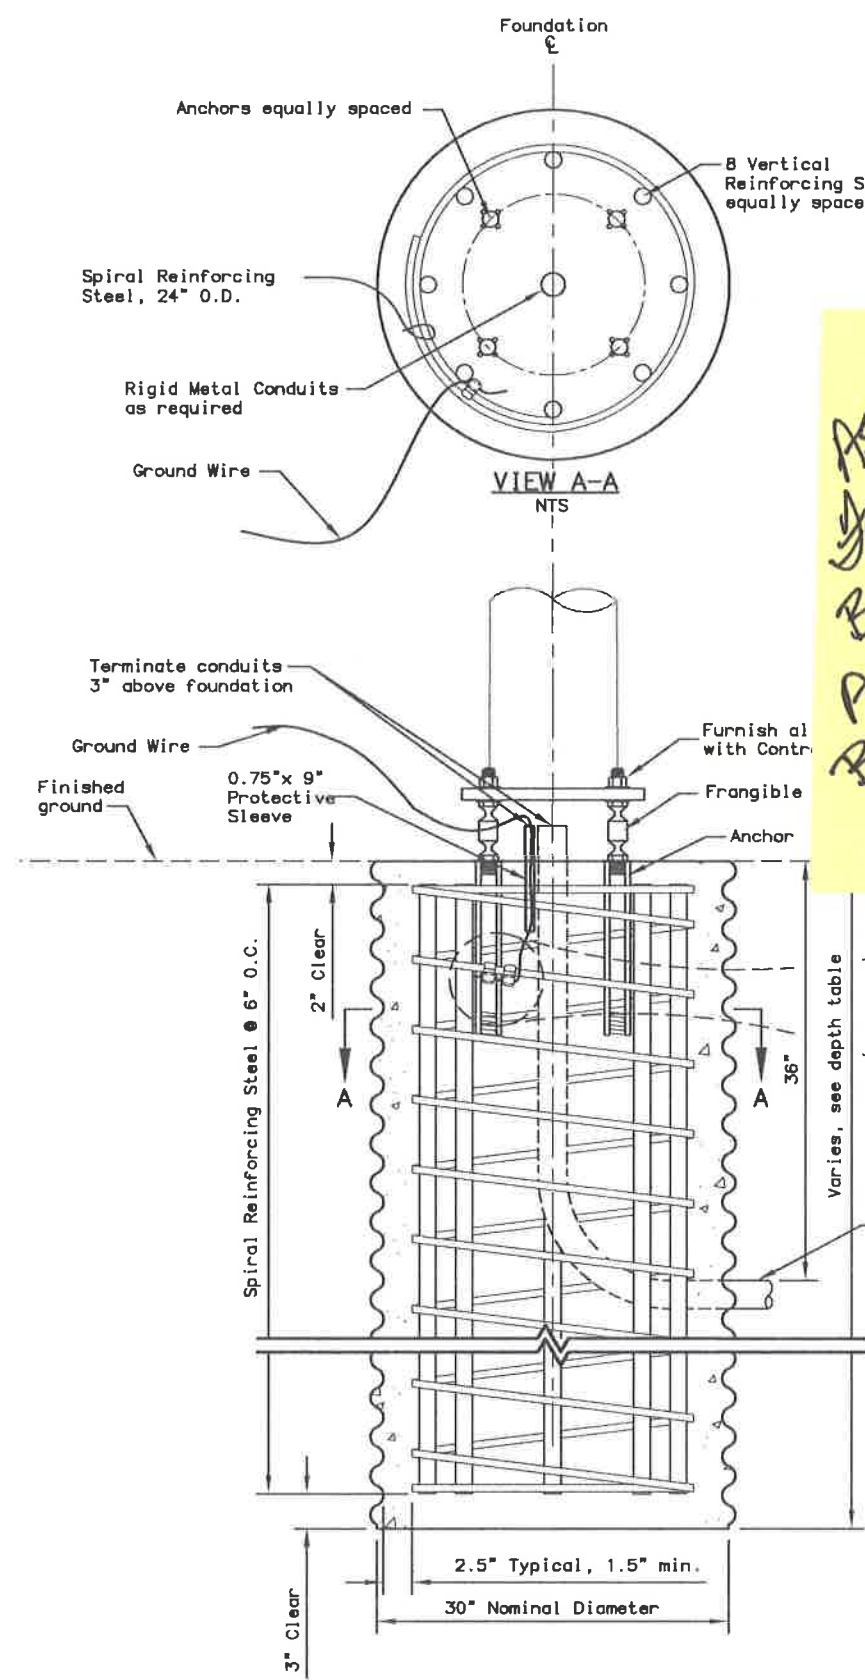

FOUNDATION DETAILS
NTS
(Skirt omitted for clarity)

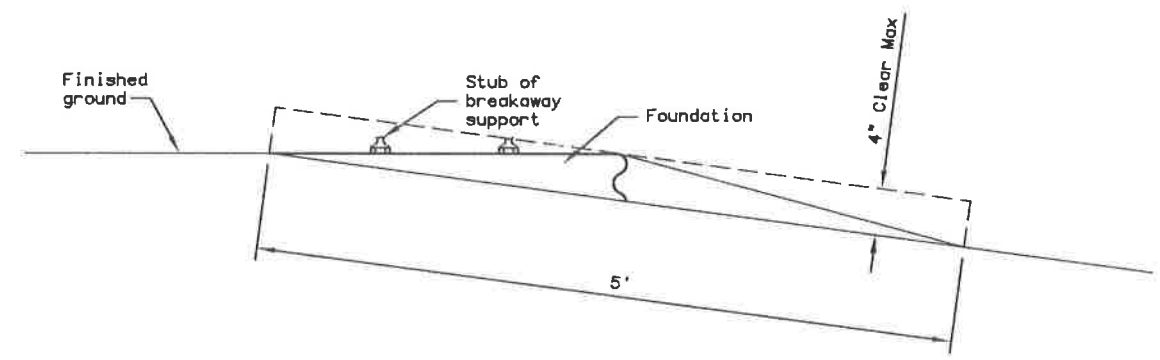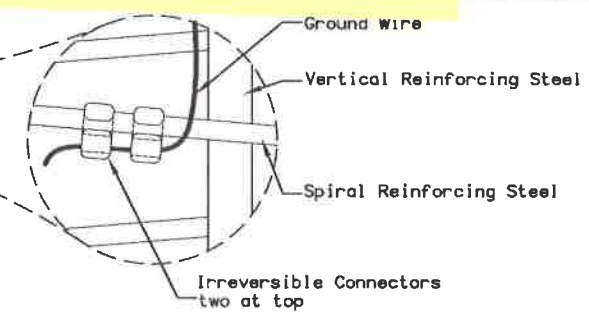

CLEARANCE DETAIL
NTS

REVISIONS		
Date	Description	By

SHEET 1 OF 1

State of Alaska
Department of Transportation
& Public Facilities
**CONCRETE STREET LIGHT
POLE FOUNDATION**




Date 05/31/12


GENERAL NOTES:

1. See Standard Drawing, 'Mailbox Location', for locating posts and boxes along roadway.
2. Posts shall be 6"x6" Treated Wood Post S4S or 2" (Max.) Standard Weight Steel Pipe.
3. Each support structure shall not accommodate more than two mailboxes unless the support structure conforms to the requirements of the U.S. Postal Service and is approved by the Engineer.
4. Other steel or aluminum structural sections may be used except, the stiffness properties equivalent to the 2" dia. standard weight steel pipe shall not be exceeded.
5. Reflectors shall have a minimum area of 4.5 sq. in.


*MAIL BOXES AS-BUILTS ARE ACCURATE & TRUE TO THE BEST OF MY KNOWLEDGE
J.W. @ AKDOT.
3-29-19.*

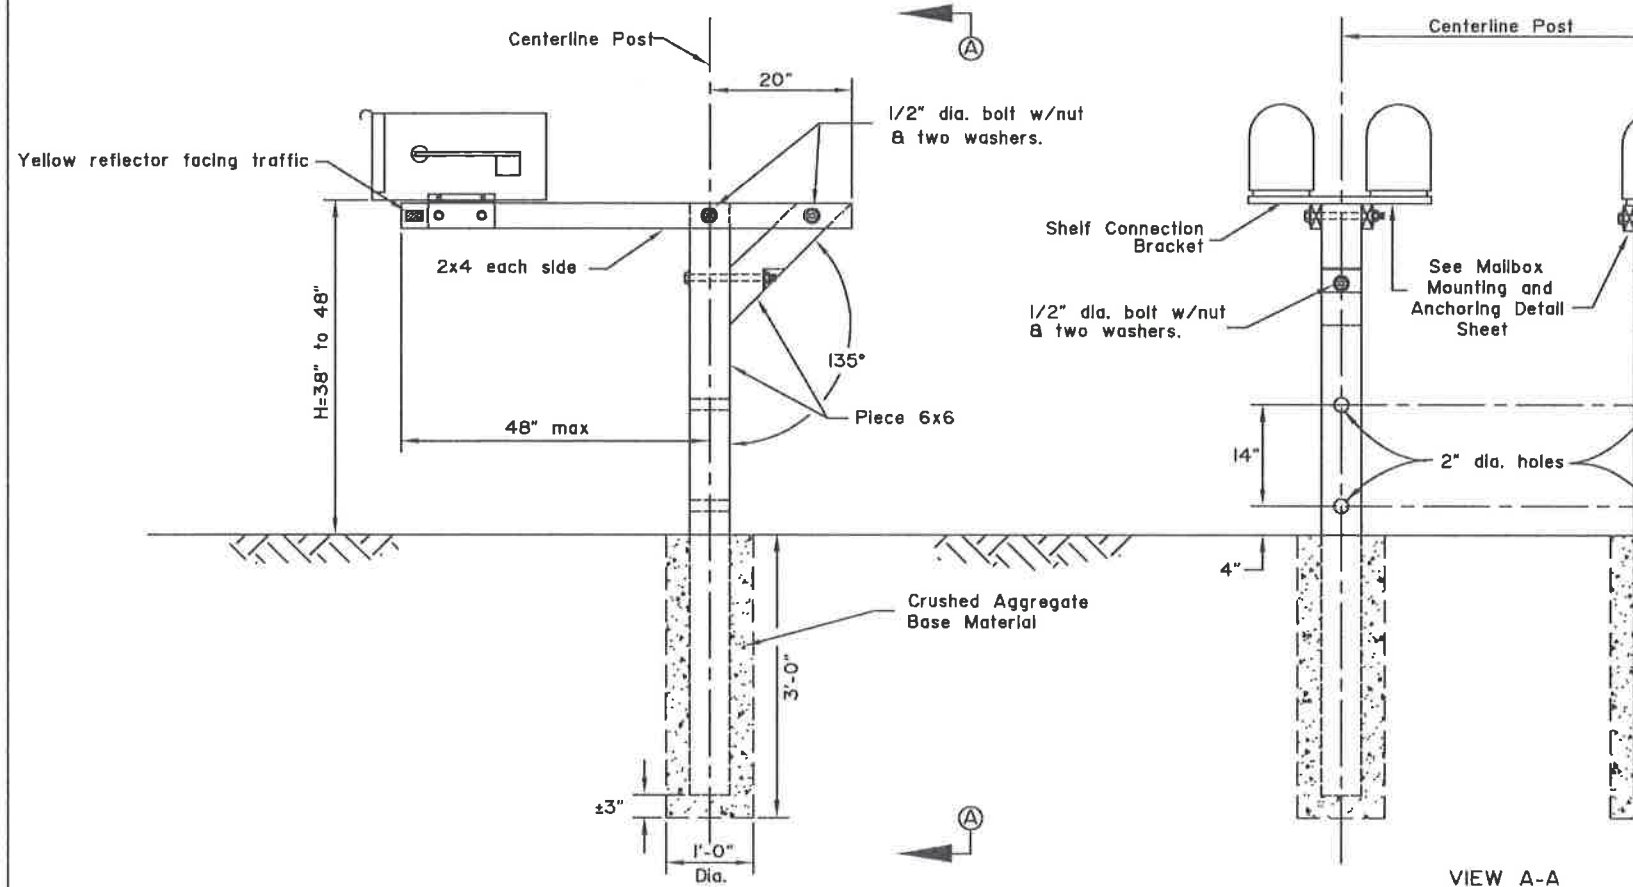


TYPICAL WOOD CANTILEVER INSTALLATION

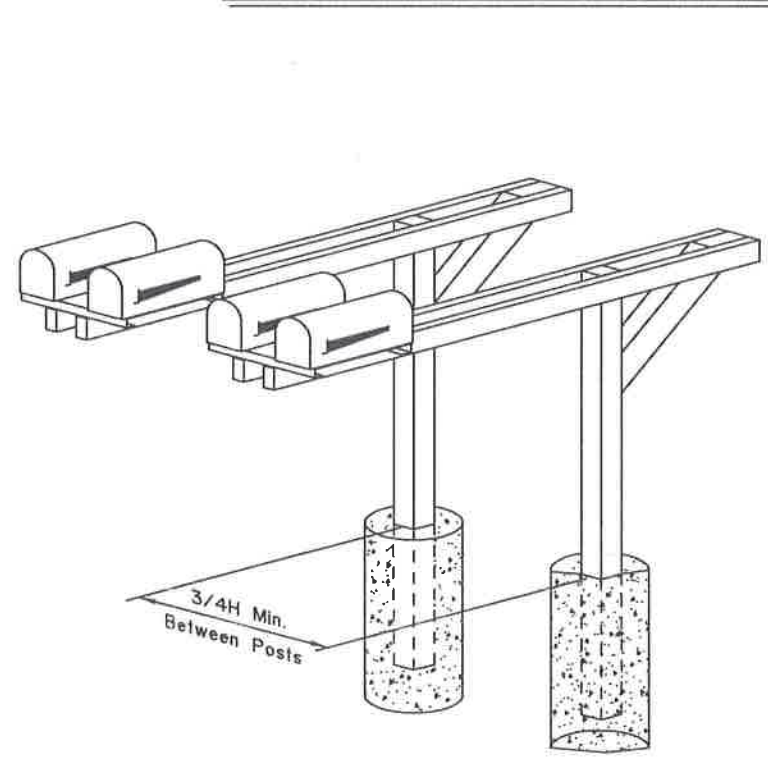

TYPICAL GANG BOX INSTALLATION

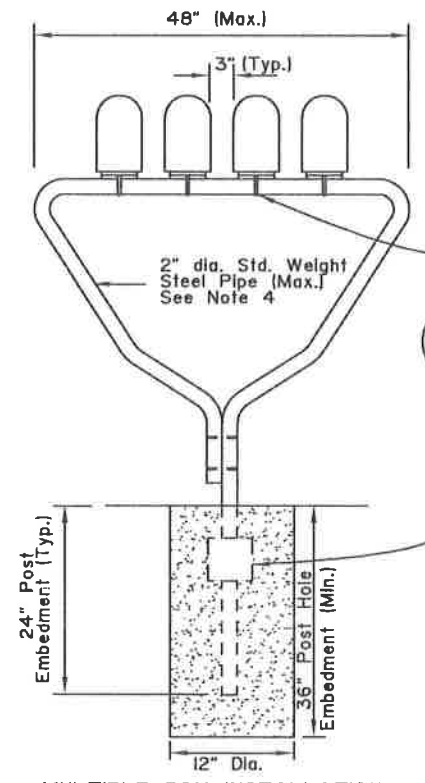

MULTIPLE BOX INSTALLATION (U.S.P.S. Approved)

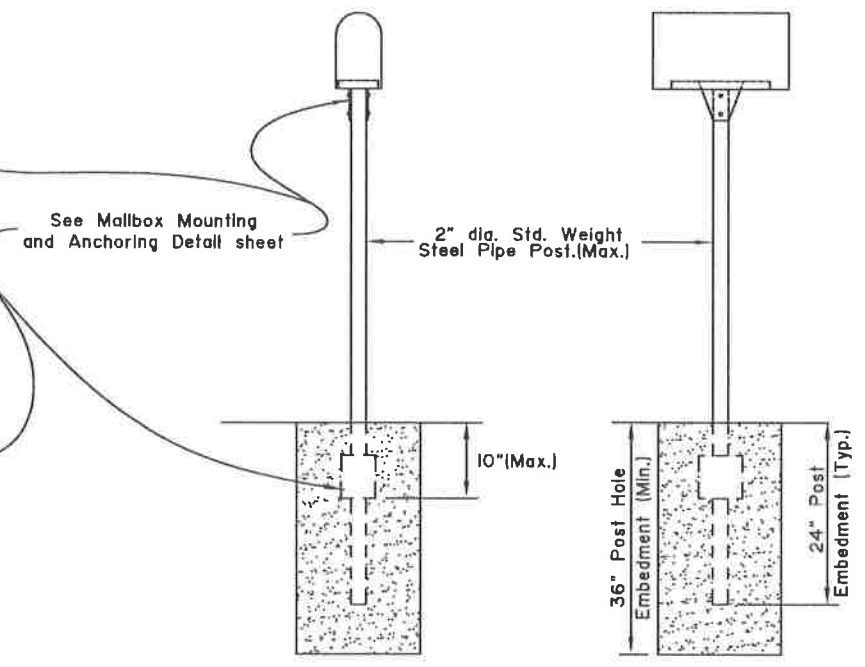

METAL POST SUPPORTS (URBAN ONLY)


REVISIONS		
Date	Description	By
9/15/91	Mod w/USPS specs.	Gdo
4/1/93	Revise Embedment Depth	Gdo
1/1/96	Del. Specs./Min. Height	Gdo

State of Alaska
Department of Transportation
& Public Facilities


MAILBOX
INSTALLATION




Date 12/1/87

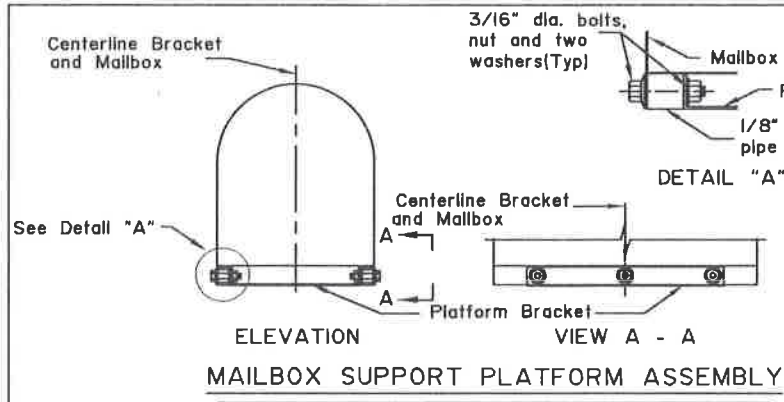


MAILBOX SUPPORT PLATFORM ASSEMBLY

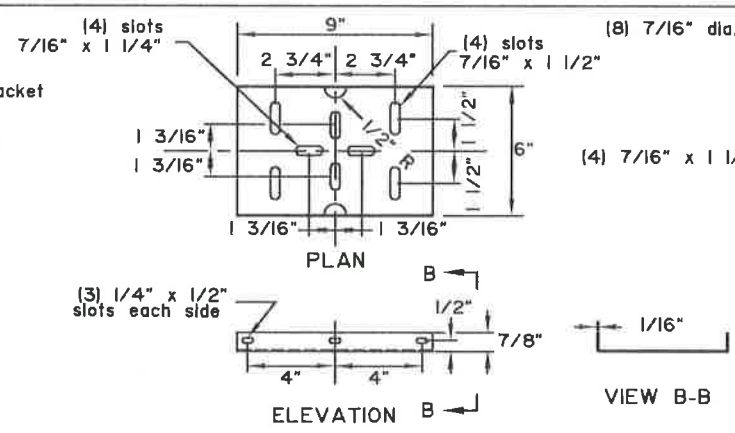


STEEL PLATFORM BRACKET

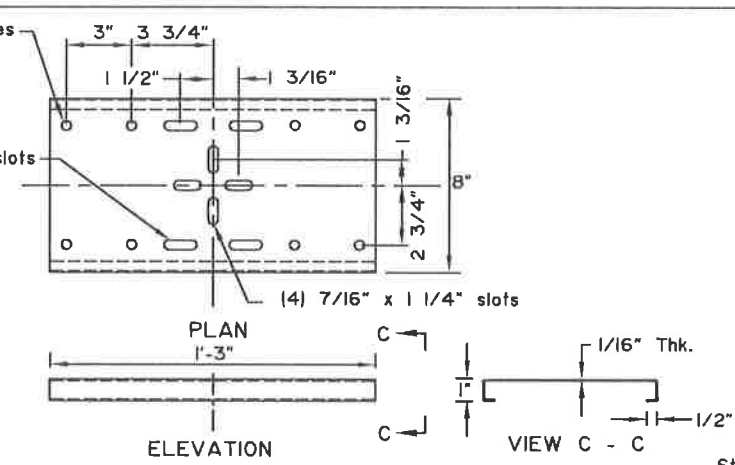

STEEL SHELF BRACKET

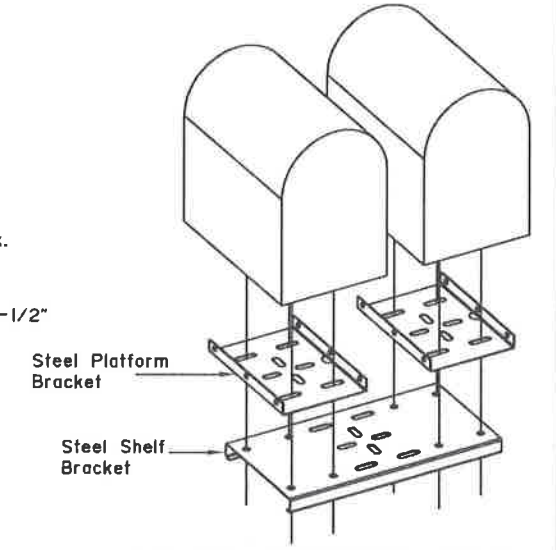


MAILBOX CONNECTION DETAIL

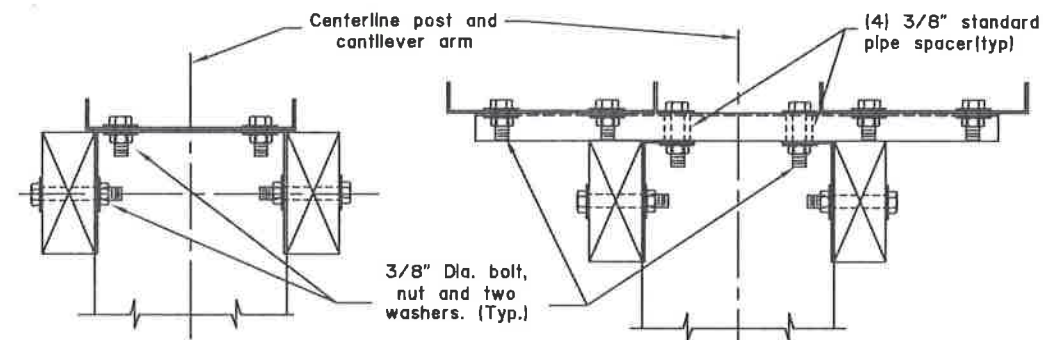


WOOD CANTILEVER ARM PLATFORM CONNECTION

WOOD CANTILEVER ARM SHELF CONNECTION


MAN
BOX AS BUILT
ARE ACCURATE
TO THE BEST OF
MY KNOWLEDGE.
Reviewed by Jhu
3-29-19.

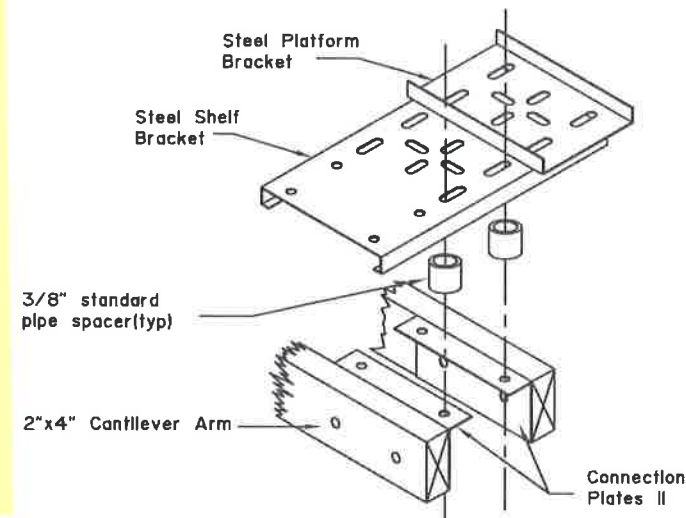


SHELF BRACKET CONNECTION DETAIL

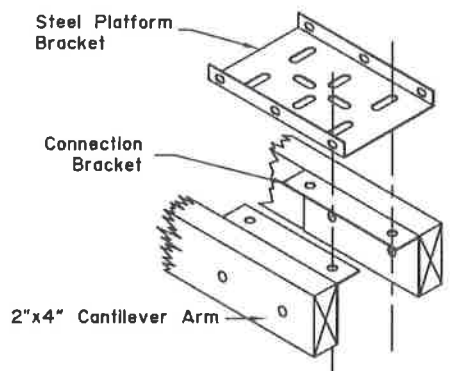


PLATFORM BRACKET CONNECTION DETAIL

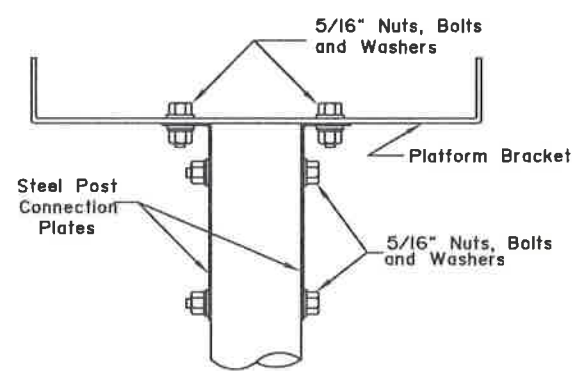


BRACKET ASSEMBLY DETAIL

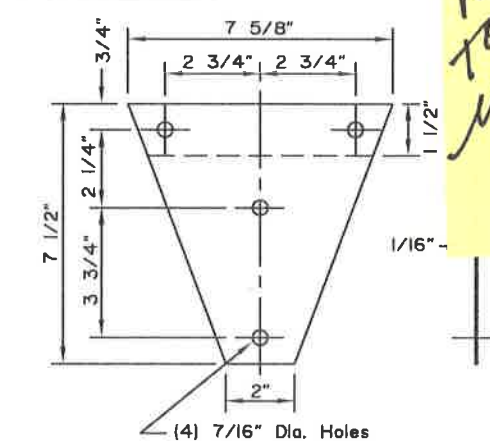


STEEL POST CONNECTION PLATES for STEEL PIPE POST

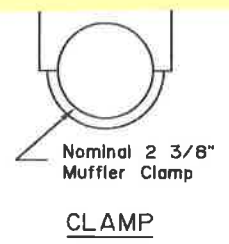


CLAMP

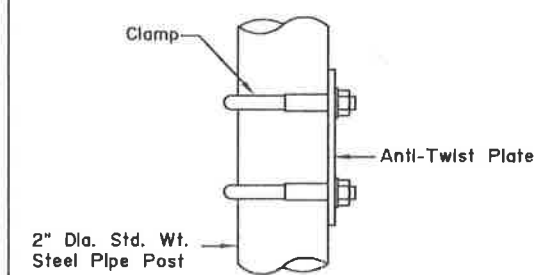


ANTI-TWIST PLATE ASSEMBLY DETAIL

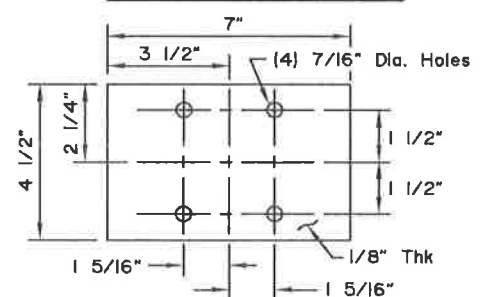

ANTI-TWIST PLATE for STEEL PIPE POST

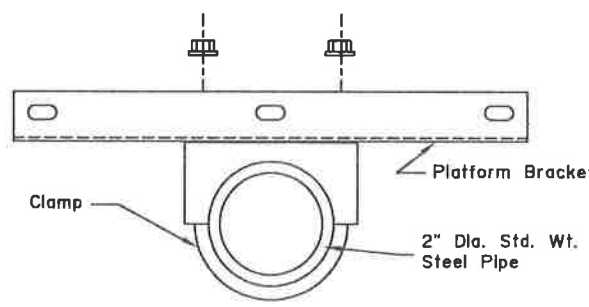

MULTIPLE BOX CLAMP ASSEMBLY DETAIL

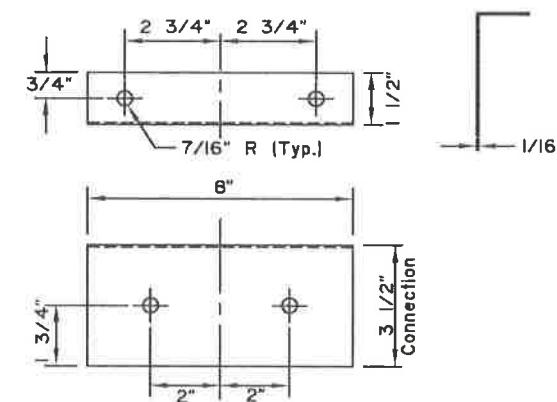

CONNECTION PLATES for WOOD CANTILEVER ARM

REVISIONS		
Date	Description	By

State of Alaska
Department of Transportation
& Public Facilities
**MAILBOX MOUNTING
AND ANCHORING DETAILS**



Date 4/1/93

GENERAL NOTES



- See the standard specifications for the aluminum alloys that you may use for sign sheeting and wind framing members.
- Fabricate all signs from 0.125" thick aluminum sheeting.
- Sign fabricators may use alternates to the zee shaped framing member with approval of the engineer, if the frame manufacturer certifies their design equals or exceeds the strength of the zee shaped design.
- Install one piece wind framing members on all signs up to 23.5' wide. Use one splice in each wind frame on all signs wider than 23.5'. Locate splices at least 18" from all posts and panel edges. Stagger splices in adjacent framing members at least 8.0' apart.
- Attach wind framing members with rivets or with an engineer approved, double sided, high strength, adhesive tape. Clean and handle sheeting and framing members and apply tape in accordance with the tape manufacturer's written instructions. Install two rivets in both ends of each framing member.
- Use 3/16" diameter rivets conforming to aluminum alloy 6061-T6 for cold driven rivets, or aluminum alloy 6061-T43 for hot driven rivets.
- Sign fabricators may use sign panels extruded with integral framing with approval of the engineer, if the manufacturer certifies their design equals or exceeds the strength of the 0.125" thick panel with framing attached to it.
- Frame all signs taller than 8.0' with five wind framing members located $(H-0.15)/4$ spaces. If needed, make a horizontal splice at the middle wind frame.
- Do not use round pipes for sign supports.

TUBE SIGN POST SPACING								
Sign Width (feet)	No. of Posts	Distance Between Posts	Sign Overhang	Post Type				Notes
				P.S.T.	Wood	Steel Tube	W-Shape	
0.5 to 4.0	1	-	0.5W	X	X	X		See Note 2.
4.5 to 10.0	2	0.6W	0.2W	X	X	X		See Note 3.
10.5 to 11.0	2	6	Varies	X	X	X		See Note 3.
11.5 to 13.0	2	8	Varies				X	
13.5 to 20.0	2	0.6W	0.2W				X	
20.5 to 22.5	3	8	Varies				X	
23.0 to 29.5	3	0.35W	0.15W				X	
30.0 to 31.5	4	8	Varies				X	
32.0 to 40.0	4	0.25W	0.125W				X	

SIGN POST SPACING NOTES:

- Install sign support in accordance with the table above, unless otherwise required by plans or specifications.
- Exceptions:
 - Use one post for all E5-1 gore signs, regardless of width.
 - Use one 2.5" P.S.T. for all STOP signs, with or without street name signs.
- Supports placed within 7' of each other must be acceptable for that use. See Standard Drawing S-30 for the sizes of wood posts and P.S.T.s that may be used. See manufacturer's documentation for breakaway couplings and foundations.


SIGN POST Spacing AB-BUILTS are accurate to the best of my knowledge. Reviewed By: T.V.L. 3-29-19

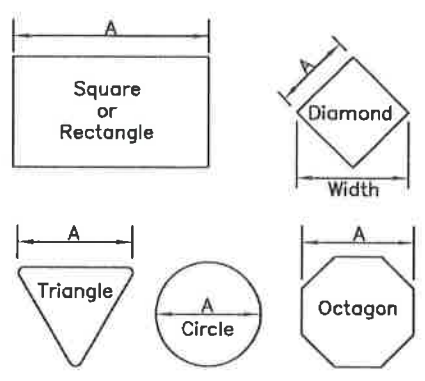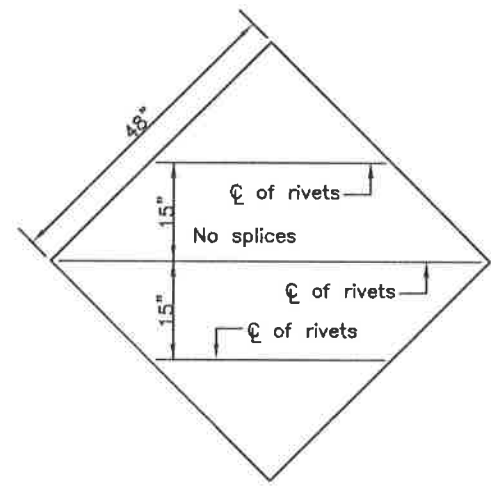


Maximum size unframed signs using 0.125" thick aluminum sheeting.	
Sign Shape	A
Squares, Shields, and Route Markers	48"
Rectangles	48"
Diamonds	48"
Triangles	48"
Rounds and Octagons	48"

Install wind framing on all signs that exceed the dimensions listed.


LIGHT SIGNS

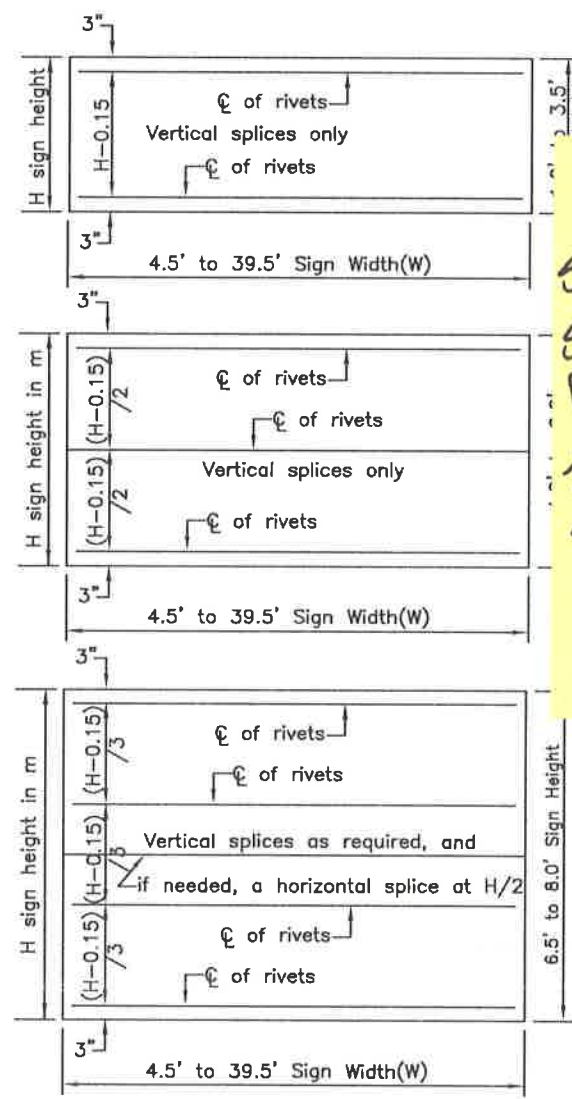

WIND FRAMING LOCATIONS

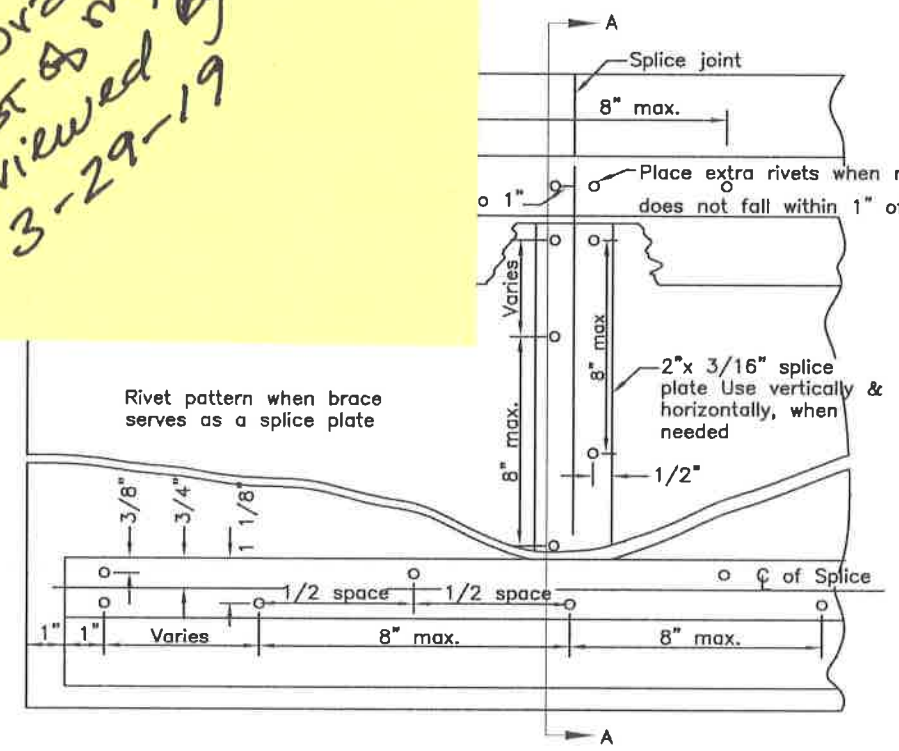

RIVET DETAIL FOR ZEE SHAPED WIND FRAMING & SPLICE PLATE

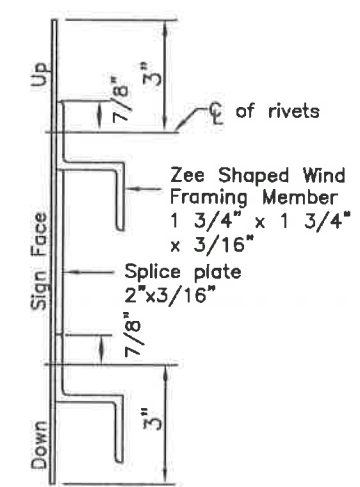

SECTION A-A

REVISIONS		
Date	Description	By
4/28/10	Delete pipe, rev notes	KJS

Sheet 1 of 1

State of Alaska
Department of Transportation
& Public Facilities

**SIGN FRAMING AND
POST SPACING**

APPROVED

49th

4/28/10

Date 5/31/12

SEE REVERSE SIDE FOR CO. # 16.

2015 for 04/12
2015 RECEIVED



STATE OF ALASKA
DEPARTMENT OF TRANSPORTATION
AND PUBLIC FACILITIES
SOUTHCOST REGION

Change Order

Change Order No. 16

Project No.: 69500/0933037
Project Name: JNU-Glacier Highway Multi-Use Path to UAS

Contractor:	Secon, Inc.	Change Order Summary:	
Address:	P.O. Box 32159 Juneau, AK 99803	Calendar Days (+ / -):	N/A
		New Completion Date:	N/A
		Amount of Change Order:	+\$20,780.56

Recommended By: [Signature] Date: 27 Dec 2016

Title: Project Engineer
Approved By: [Signature] Date: 27 Dec 2016
Title: Project Manager

This change order constitutes agreement to terms, conditions and prices stated below.
Accepted By: [Signature] Date: 1/4/2017
Contractor's Representative

Acknowledged By: _____ Date: _____
Contractor's Representative
Permission for previously submitted subcontractor(s) to perform all or portions of the work described herein is as checked: Yes No N/A

The following change(s) in the above Contract are hereby made in accordance with the terms of the Contract and under the terms and conditions stated below. Price adjustments resulting from inaccurate cost and pricing data are subject to the provisions of AS 36.30.400(c). This document shall become an amendment to the Contract and all provisions of the Contract will be applicable.




DESCRIPTION OF CHANGE (Use Continuation Sheet 25D-065 as Required)

In accordance with Subsection 104-1.02 of the Standard Specifications, the following changes are hereby made:

- Reason for Change Order**
- 1) The Contractor and the Department discussed the use of permanent signs rather than daily traffic signs and agreed to delete the permanent construction signs and pay for the signs per day. This change order deletes the lump sum item for permanent signs.
 - 2) The geocell on the habitat bench was installed per plan, but the face of the geocell was plastic and there were environmental concerns about the long term effects on the fish habitat. This change order makes adjustments to the habitat bench in order to create suitable fish habitat.

Delete Item 643(2)a Permanent Construction Signs.




Establish New Item 653(2)a Habitat Bench Adjustment

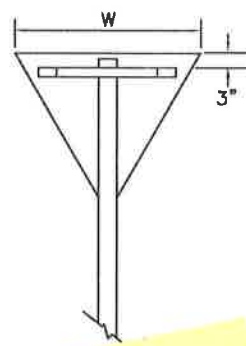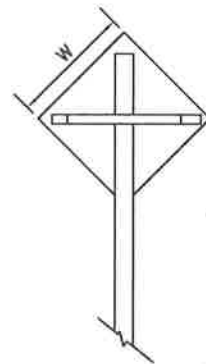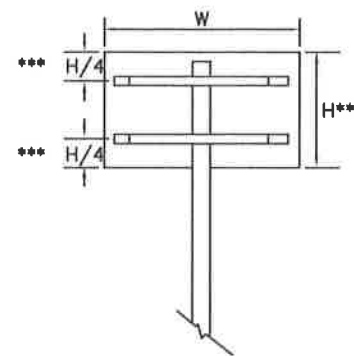


*** Use one brace when
Use two
Use
** Posi
Pred

*SIGN POST
AS BUILDS
ARE TRUE &
ACCURATE TO THE
BEST OF MY KNOWLEDGE.*


SIG

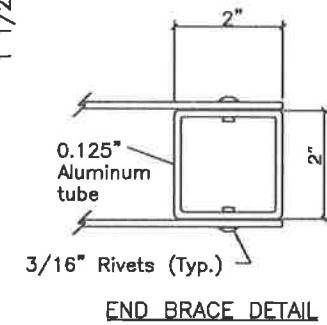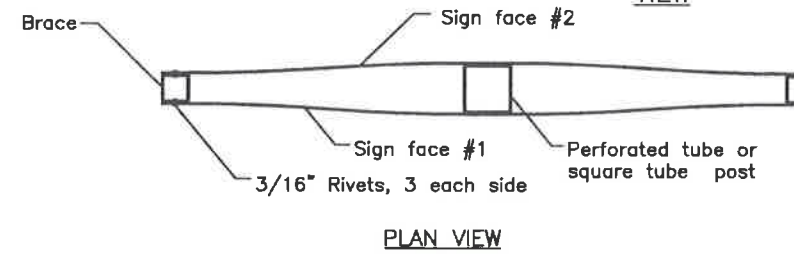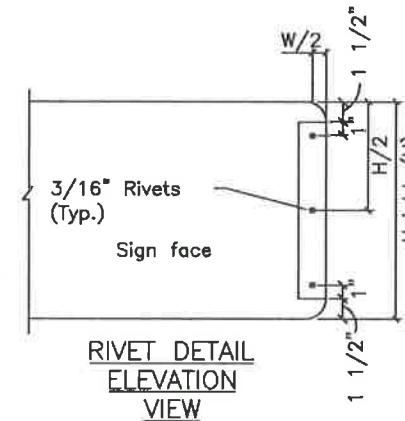

SMALL STREET NAME SIGN (D3-1, D3-1A, D3-1D) BRACING DETAILS

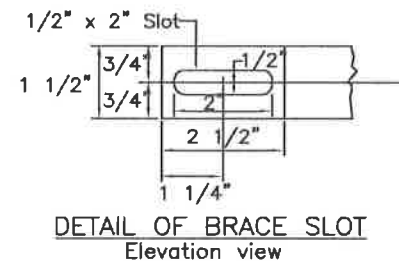

DETAIL OF BRACE SLOT
Elevation view

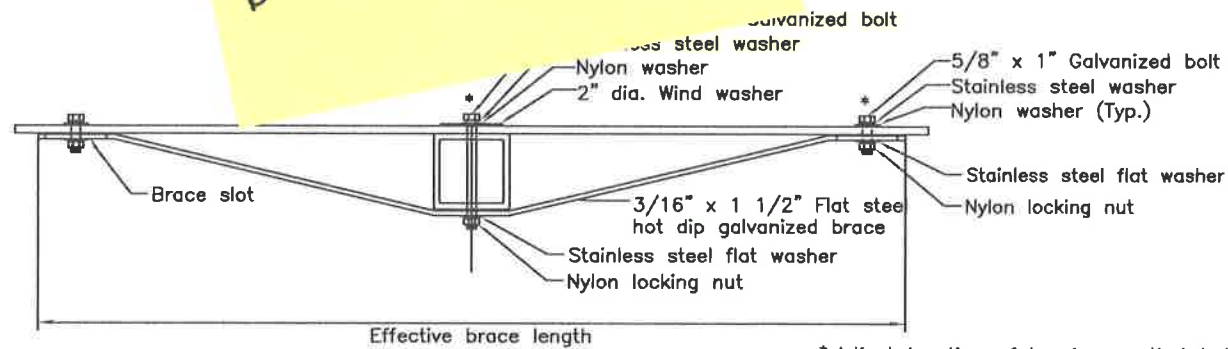

TUBE POST SIGN BRACING
Plan view

* Adjust location of bracing so that bolts and washers will miss the sign legend

SIGN WIDTH(W)	EFFECTIVE BRACE LENGTH		
	WARNING	YIELD	OTHER
30"	36"	24"	24"
36"	42"	30"	30"
42"	48"	-	36"
48"	TWO POSTS	36"	42"

< 30" No bracing required and use square tube

REVISIONS		
Date	Description	By

Sheet 1 of 1

State of Alaska
Department of Transportation
& Public Facilities
**BRACING FOR SIGNS
MOUNTED ON SINGLE POST**




APPROVED




Date 2/28/03

GENERAL NOTES


1. Unless shown otherwise on the plans, the standard sign offset is 12'. The minimum is 6'.
2. If signs extend over sidewalks, the minimum vertical clearance is 7'-0".
3. Add 6" to mounting height on unpaved roads.
4. If signs extend over bike paths, the minimum vertical clearance is 8' 0".
5. When signs are placed 30' or more from the edge of traveled way, mount them with the bottom of the sign at least 5' above the road surface at the near edge of the road.
6. When multiple hinged sign supports are used, mount hinges at least 7' above the ground.

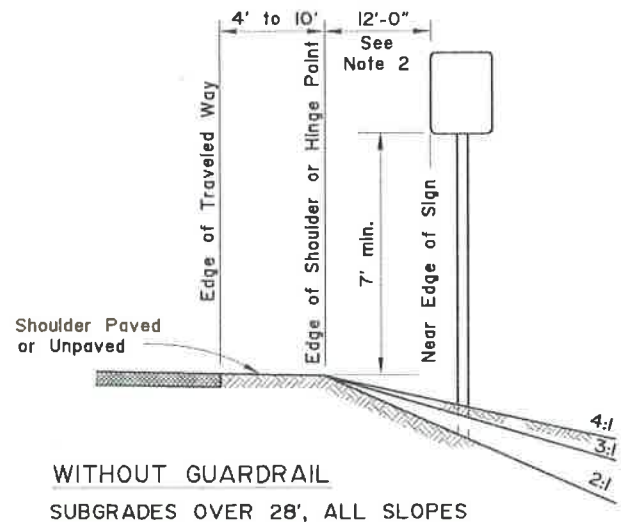


WITHOUT GUARDRAIL
SUBGRADES OVER 28', ALL SLOPES

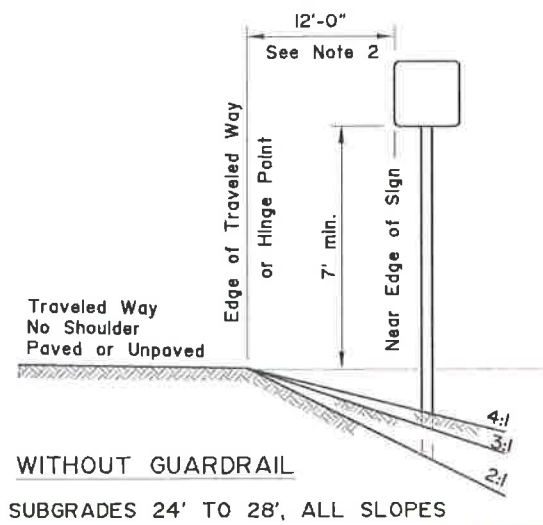


WITHOUT GUARDRAIL
SUBGRADES 24' TO 28', ALL SLOPES

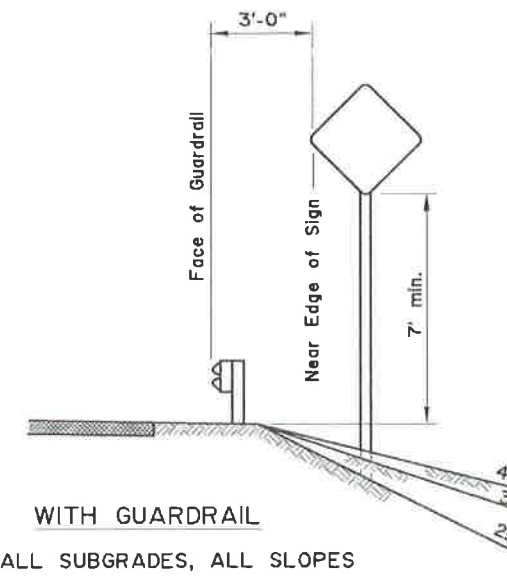


WITH GUARDRAIL
ALL SUBGRADES, ALL SLOPES

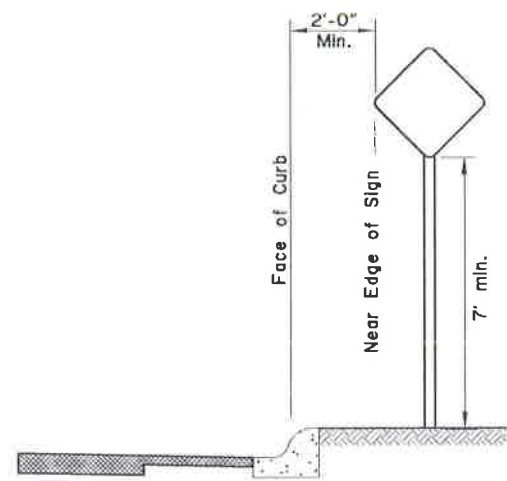


CURB WITHOUT SIDEWALK

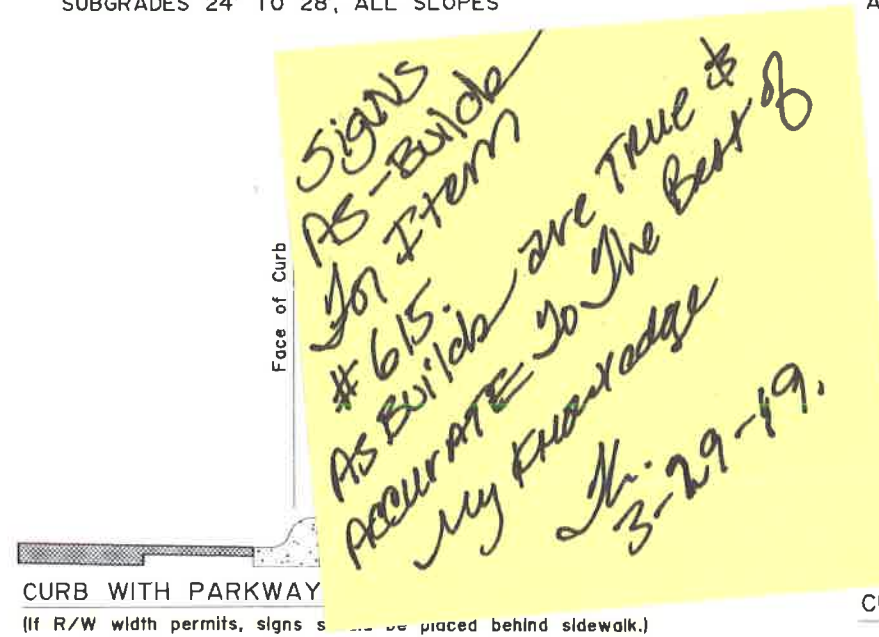


CURB WITH PARKWAY
(If R/W width permits, signs should be placed behind sidewalk.)

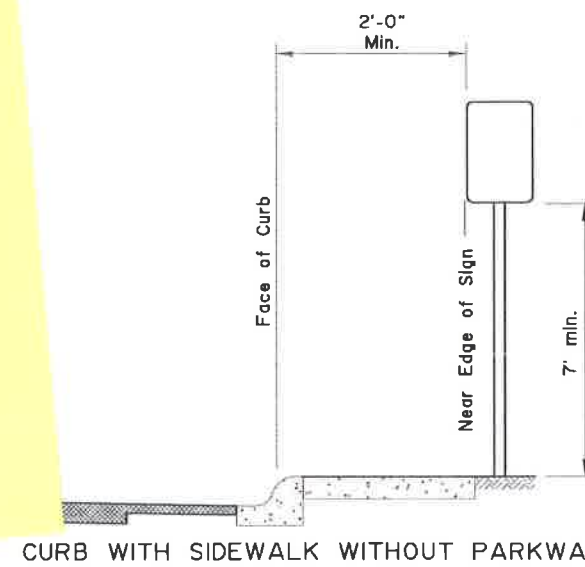


CURB WITH SIDEWALK WITHOUT PARKWAY

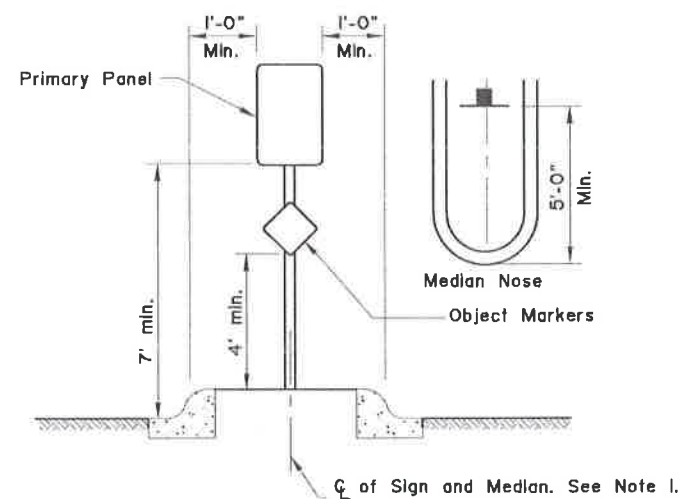

RAISED MEDIANS
Minimum 4' Width for Signing

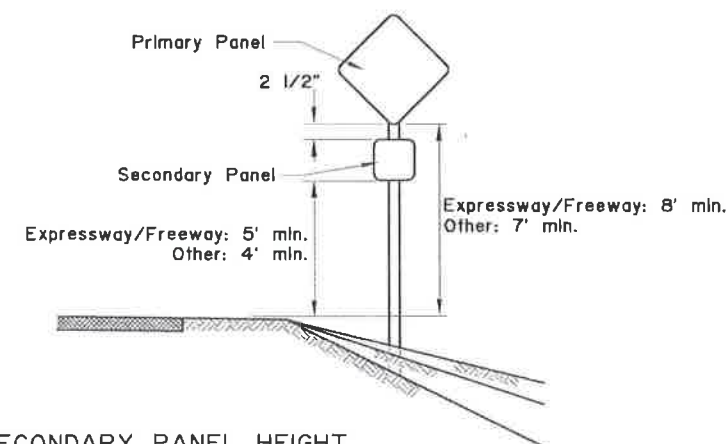

SECONDARY PANEL HEIGHT
ALL TWO PANEL MOUNTING

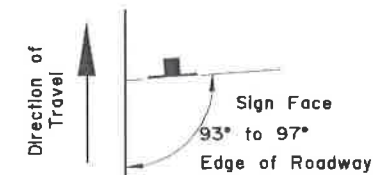

SIGN POSITIONING

REVISIONS		
Date	Description	By
4/3/01	Revised Sign Heights	KJS

Sheet 1 of 1

State of Alaska
Department of Transportation
& Public Facilities

POST MOUNTED SIGN
OFFSET AND HEIGHT




APPROVED
Date 7/15/82

S-20.10

GENERAL NOTES

1. Details shown indicate general design only. Dimensions and design may vary among the manufacturers.
2. Install weather tight caps on all pipe and tube post (except perforated tubing).
3. Protect sign posts installed using driving methods with drive caps during installation.
4. Bolt braces to posts at each point where they cross posts.
5. Install signs with top of post, mounting brackets, etc. with a minimum of 3" below top of sign.
6. Paint all sign mounting fasteners on sign face a color closely matching the sign face.
7. Attach all signs, zees and braces mounted to the posts with 5/16" bolts.
8. Furnish all aluminum nuts, bolts and washers with anodized finish.

FASTENER SPECIFICATION TABLE				
FASTENERS		ALUMINUM	STEEL	STAINLESS STEEL
BOLTS	MACHINE CARRIAGE "U"	2024-T4	A-307	A-276
NUTS	REGULAR	6061-T6	A-307	A-276
	LOCK	2017-T4		
WASHERS		2024-T4	A-36	A-276
POST CLIP		356-T6		

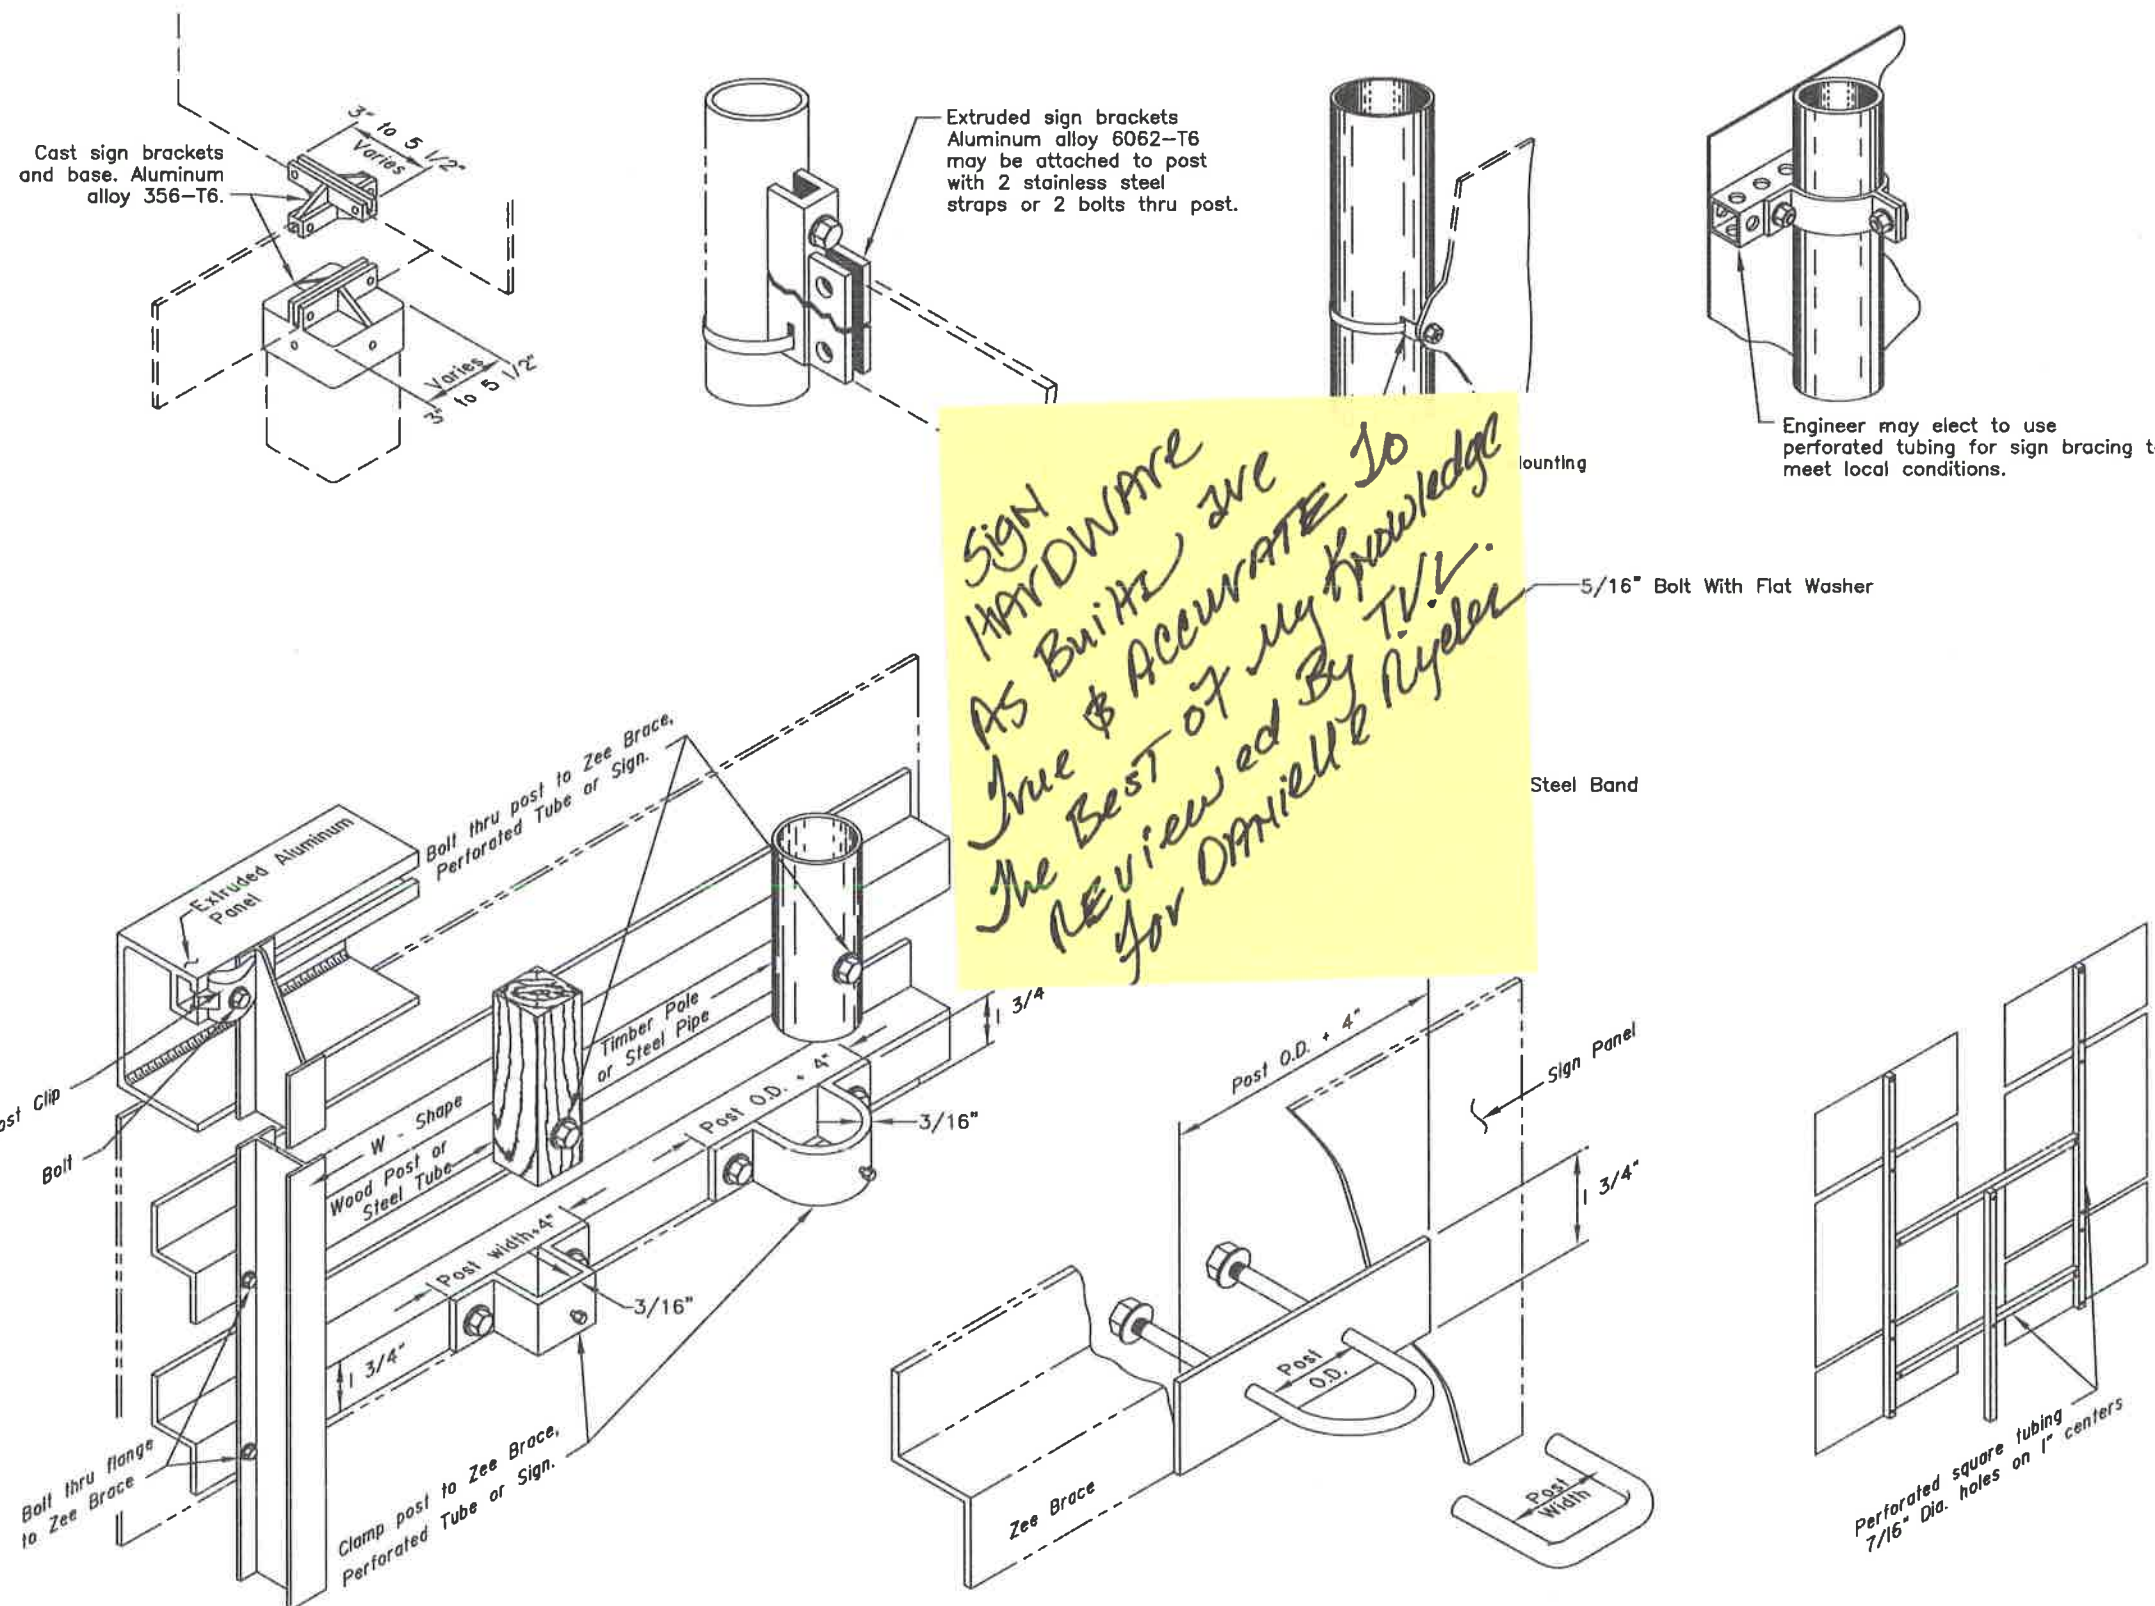

SIGN HARDWARE AS BUILT, IVE Done & ACCURATE TO THE BEST OF MY KNOWLEDGE REVIEWED BY T.V.L. FOR OMIK & RYLER

REVISIONS		
Date	Description	By

Sheet 1 of 1

State of Alaska
Department of Transportation & Public Facilities

SIGN TO SIGN POST CONNECTIONS


APPROVED

Date 2/28/03

S-20.10

GENERAL NOTES:

1. Refer to Standard Drawing "Sheet Aluminum Sign and Framing" for light sign details.
2. See plans for type of post, size and embedment type.
3. To maintain crashworthiness, install no more than the number of P.S.T.s or wood posts specified in the tables within 7' of each other.
4. Do not install wood posts larger than 6"x8".
5. Use larger posts than shown on this sheet, with hinges, for multiple support signs where the supports are separated by more than 7 feet.

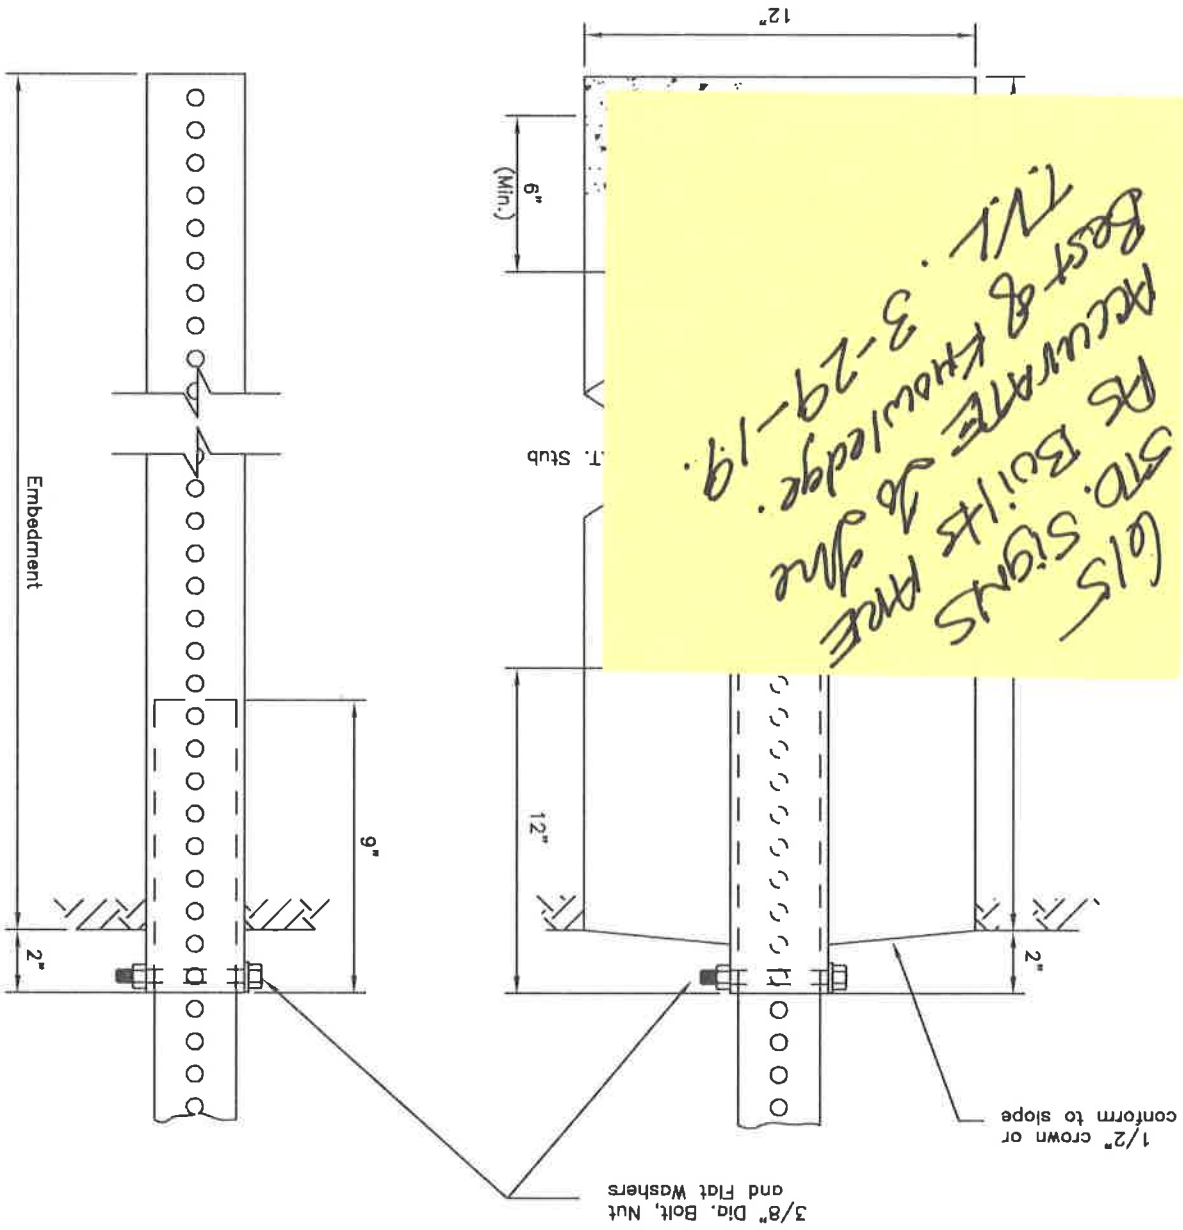

SLEEVE TYPE - SOIL EMBEDMENT *
CONCRETE FOUNDATION - SLEEVE TYPE

PERFORATED STEEL TUBES (P.S.T.) (12 ga. - .105" Wall Thickness)

POST SIZE (inch)	Embedment No. of P.S.T.s permitted within 7 ft path	Depth (inch)
1 1/2" x 1 1/2"	3'-0"	2
1 3/4" x 1 3/4"	3'-0"	2
2" x 2"	3'-6"	2
2 1/4" x 2 1/4"	4'-0"	1
2 1/2" x 2 1/2"	4'-6"	1


* Use 3"x3"x3/16" Stub for 2 1/2"x2 1/2" PST Applications.

WOOD POSTS

SIZE	HOLE DIA.	EMBEDMENT	NUMBER OF POSTS WITHIN 7 FT. PATH
4"x4"	NONE	36"	2
4"x6"	1 1/2"	36"	2
6"x6"	1 1/2"	40"	1
6"x8"	3"	48"	1

* Embedment depth applies in both strong and weak soil.

Note: If holes are field drilled after post has been treated, the holes shall be thoroughly swabbed with a 5% solution of pentachlorophenol and mineral spirits.

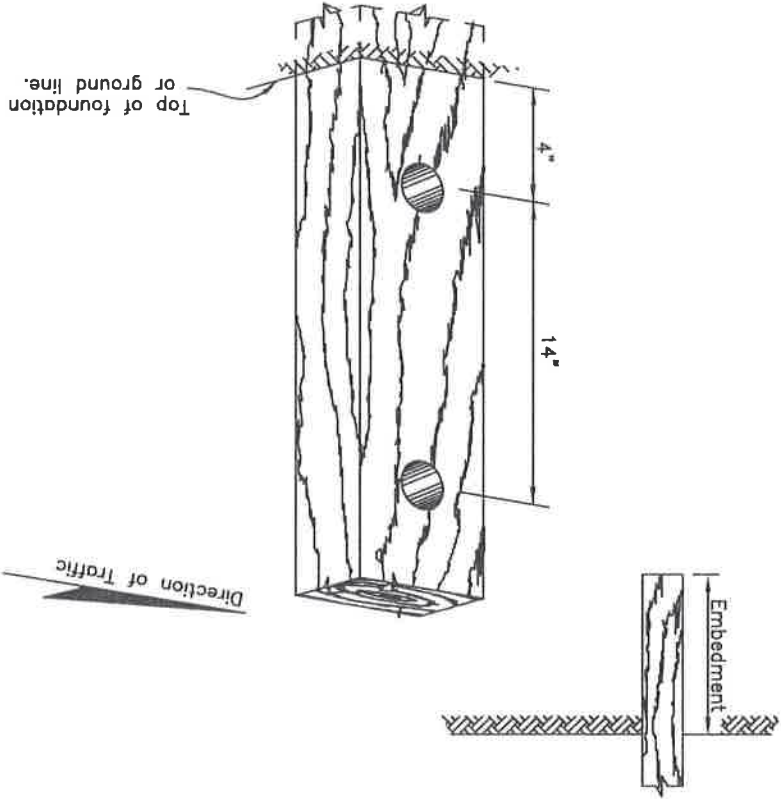

REVISIONS

Date	Description	By
1/1/85	Redraft-Delete Post	Gdo
4/2/01	Revised PST table	Kjs
2/12/02	Revised Wood Posts	Kjs


Added note 3

Sheet 1 of 1

State of Alaska
Department of Transportation
& Public Facilities
LIGHT SIGN
STRUCTURE POST
EMBEDMENT




Date 7/15/82

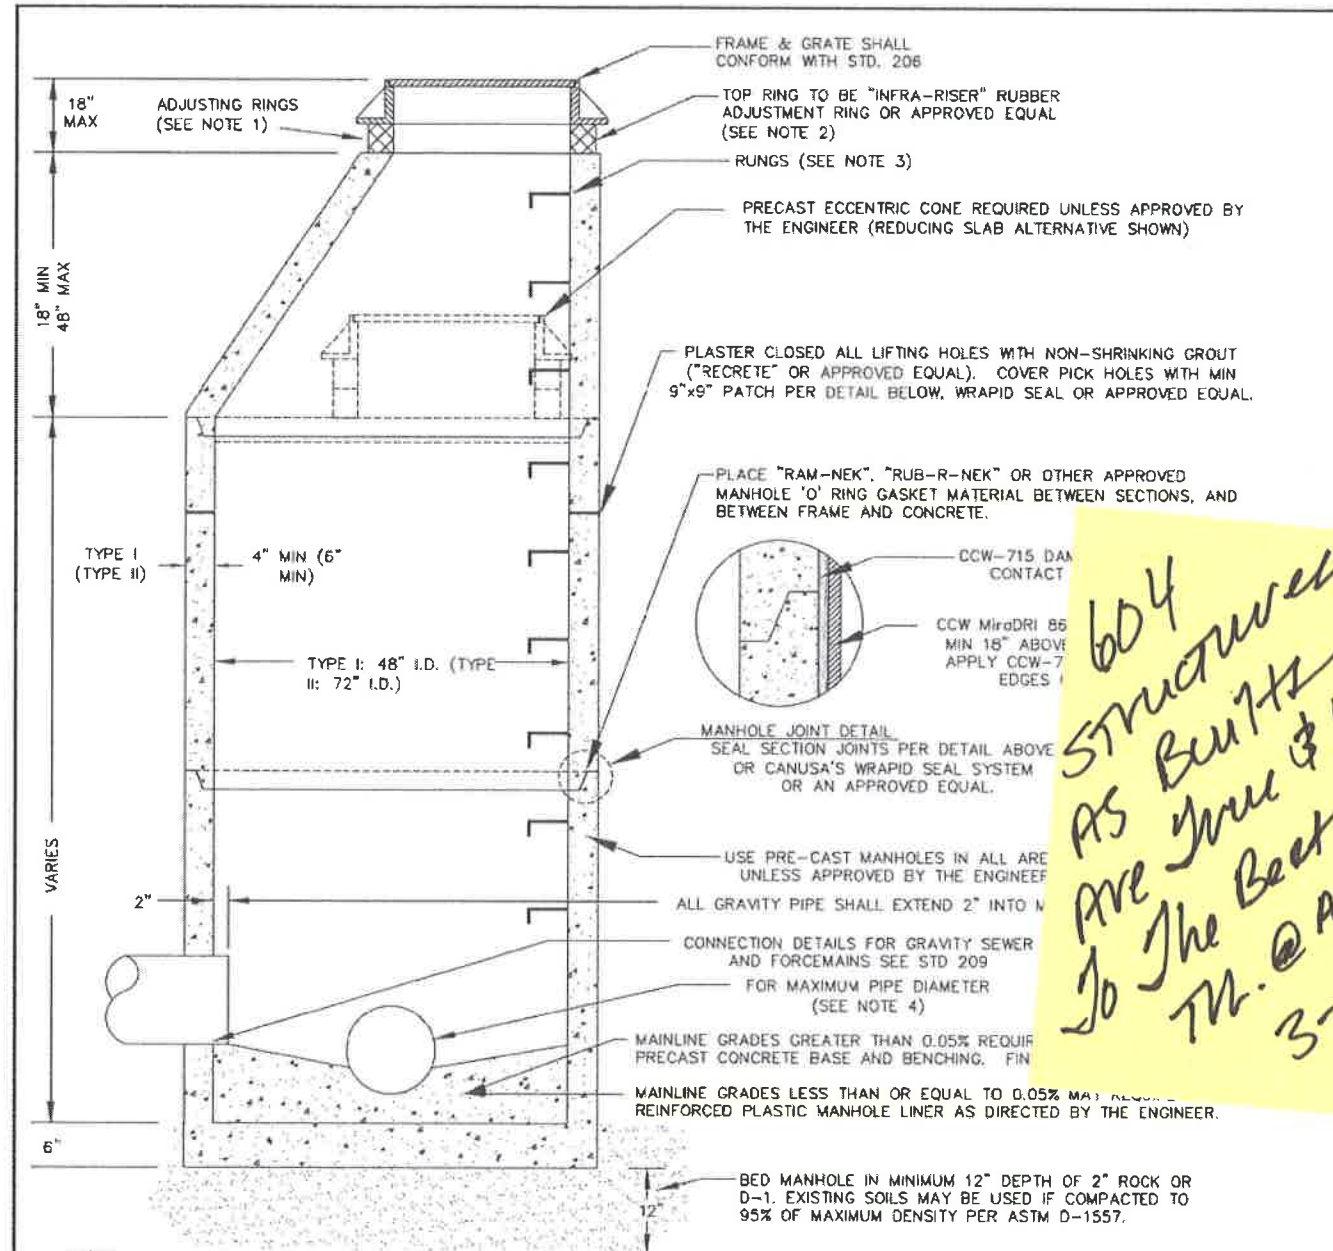

*604
STRUCTURES
AS BUILT
ARE TRUE & ACCURATE
TO THE BEST OF KNOWLEDGE
TM. @ AK DOT.
3-29-19.*


- NOTES**
1. USE NO MORE THAN ONE 4" ADJUSTING RING FOR NEW CONSTRUCTION OR UNPAVED ROADS. USE NO MORE THAN THREE 4" RINGS FOR RECONSTRUCTION OF PAVED OR CHIPSEAL ROADS. TOP ADJUSTING RINGS SHALL BE AN "INFRA-RISER" RUBBER ADJUSTING RING OR APPROVED EQUAL. MATCH FINAL GRADE PER TABLE CBJ STANDARD 205.
 2. USE "PL POLYURETHANE SELF-LEVELING CONCRETE CRACK SEALANT" OR APPROVED EQUAL FOR "INFRA-RISER" INSTALLATION.
 3. RUNGS TO BE PLACED 12" O.C. ON UNOBSTRUCTED SIDE OF MANHOLE. LAST RUNG SHALL BE 18" MAX FROM BOTTOM OF MANHOLE, AND TOP RUNG SHALL BE 6" MAXIMUM FROM TOP OF CONE. IF UNOBSTRUCTED SIDE NOT AVAILABLE, LAST RUNG SHALL BE PLACED 6" OVER SMALLEST PIPE. RUNGS SHALL BE LANE POLYETHYLENE 14" LADDER STEPS OR AN APPROVED EQUAL.
 4. MAXIMUM PIPE DIAMETER SHALL BE 20" FOR A TYPE I MANHOLE. FOR LARGER PIPES, USE A TYPE II MANHOLE. MANHOLES INTERSECTED BY MORE THAN 2 PIPES, 15" DIAMETER OR LARGER, USE A TYPE II MANHOLE. MINIMUM MAINLINE DIAMETER SHALL BE 8".
 5. REFER TO A.S.T.M. C-478 FOR DESIGN REQUIREMENTS AND C-478-69 FOR MINIMUM STEEL FOR BARREL AND BASE. BLOCKOUTS SHALL BE FORMED.
 6. IF MANHOLE IS WITHIN A ROADWAY, COMPACTION TESTS MUST BE TAKEN ON BACKFILL EVERY 3'. DENSITY SHALL BE 95% OF MAXIMUM PROCTOR DENSITY.
 7. MANHOLE FRAMES MAY BE RAISED TO ACCOMMODATE PAVEMENT OVERLAYS PROVIDED THE DISTANCE FROM THE TOP OF THE FRAME TO THE FIRST RUNG IS LESS THAN 36".

SCALE: NTS	DATE: 10/16/96	CITY AND BOROUGH OF JUNEAU, ALASKA SANITARY SEWER MANHOLE TYPES I & II
DRAWN BY: DRW	CHECKED BY: STAFF	
APPROVED BY: <i>DRW</i>	REVISED: 8/14/2011	STANDARD 203

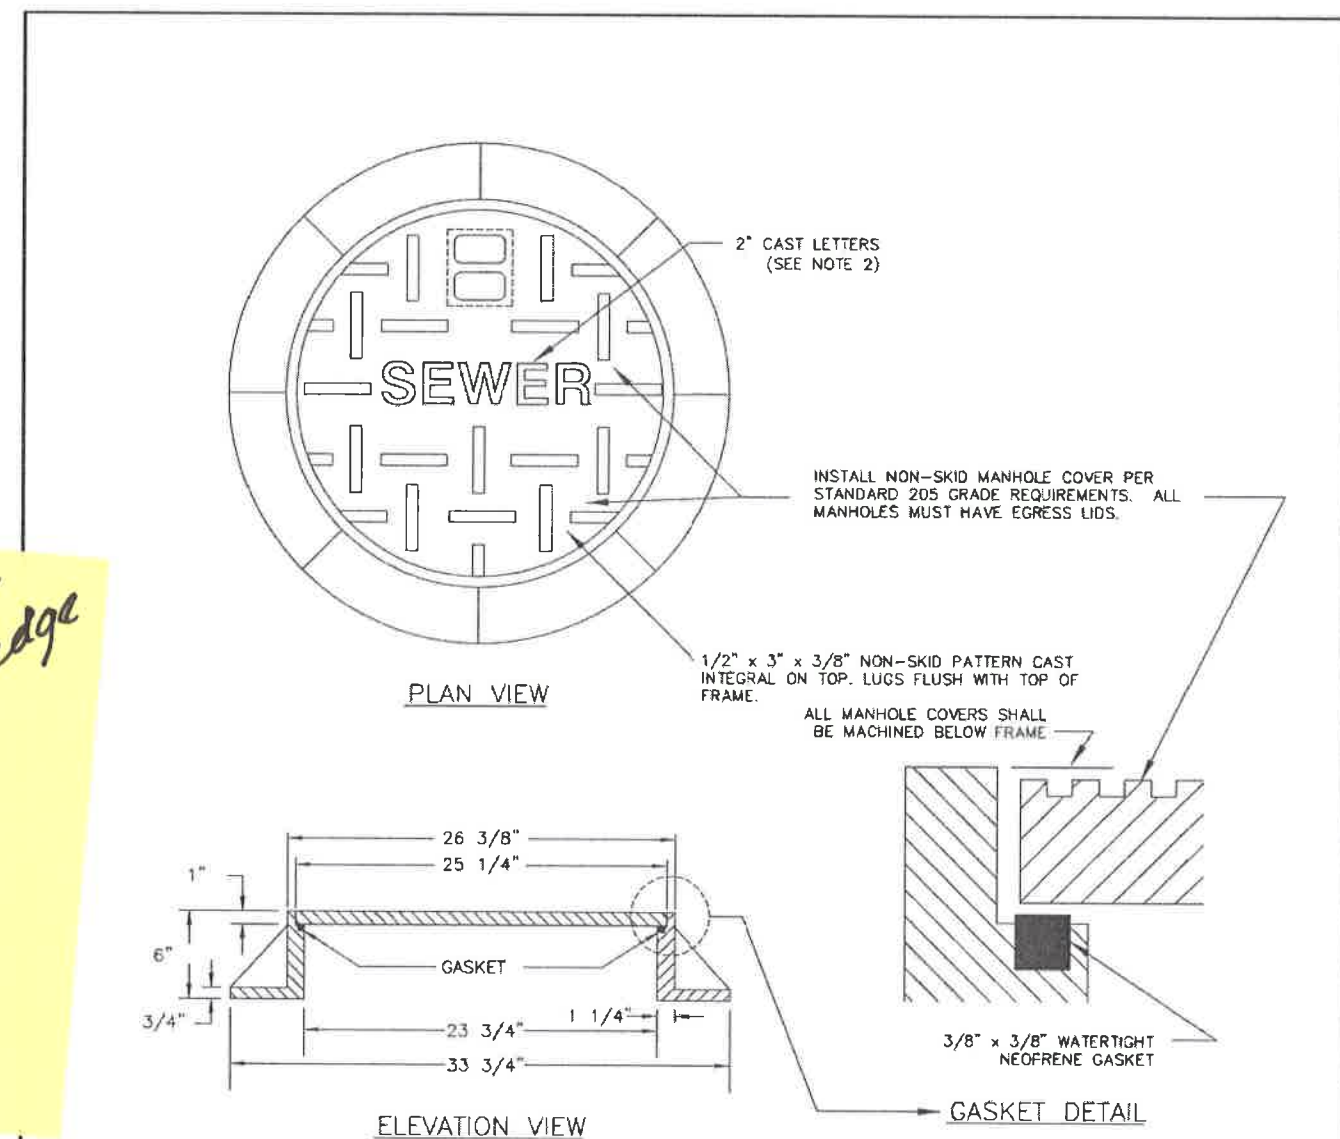


- NOTES:**
1. FRAME MUST BE MACHINED TO FIT WATERTIGHT NEOPRENE GASKET.
 2. MANHOLE COVER SHALL BE WATER TIGHT WITH NO HOLES, SHALL HAVE THE WORD "SEWER", "WATER" OR "STORM DRAIN" CAST IN COVER AND SHALL BE PROVIDED WITH AN INTEGRAL POCKET LIFT HANDLE.
 3. FRAME AND MANHOLE COVER DIMENSIONS SHALL BE IN ACCORDANCE WITH OLYMPIC CONSTRUCTION CASTINGS NO. MH30A WITH EGRESS LID, OR AN APPROVED EQUAL.
 4. FRAME AND MANHOLE COVER SHALL BE DUCTILE OR CAST IRON AND A TYPE THAT WILL NOT CREATE A HAZARD FOR BICYCLE TRAFFIC.
 5. IF MAINLINE IS 20" OR GREATER, PROVIDE MANHOLE WITH 30" OPENING IN COVER & FRAME.
 6. ALL MANHOLE COVERS SHALL BE MACHINED BELOW FRAME AS SHOWN IN GASKET DETAIL ABOVE.

SCALE: NTS	DATE: 2/28/98	CITY AND BOROUGH OF JUNEAU, ALASKA STANDARD MANHOLE COVER & FRAME
DRAWN BY: DRW	CHECKED BY: STAFF	
APPROVED BY: <i>DRW</i>	REVISED: 8/14/2011	STANDARD 206A

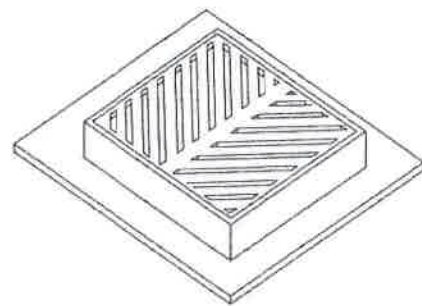


FRAME & GRATE

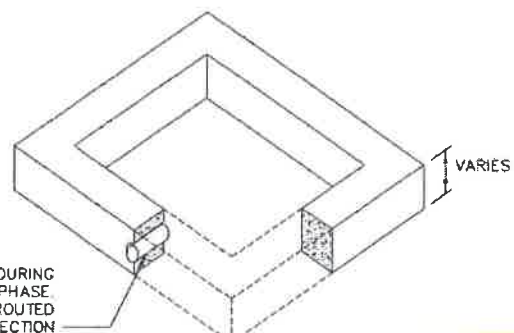

1" PVC PERMITTED DURING CONSTRUCTION PHASE. PLUGGED AND GROUTED PRIOR TO FINAL INSPECTION

CONCRETE SECTION

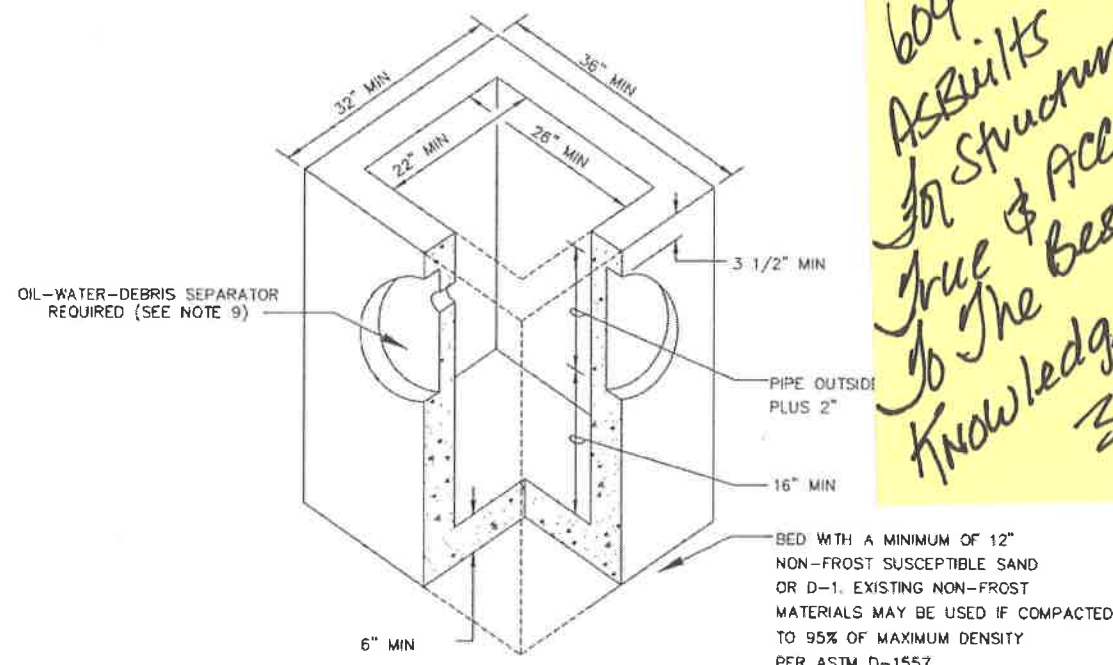


CATCH BASIN

NOTES


1. FOR USE WITH TWO INLET/OUTLET PIPES OF DIAMETER 12" OR SMALLER. FOR LARGER AND/OR MORE INLET/OUTLET PIPES OR IF CATCH BASIN IS DEEPER THAN 4' FROM FINISH GRADE TO SUMP, INSTALL A TYPE I OR TYPE II STORM DRAIN MANHOLE (SEE STANDARD 303).
2. ENTIRE KNOCKOUT IS TO BE REMOVED AND SEALED SHUT AROUND PIPE. ALL PIPES ARE TO EXTEND MIN 1" AND MAX 3" INTO CATCH BASIN. GROUT INTERIOR AND EXTERIOR BETWEEN FRAME, SECTIONS, AND CATCH BASIN.
3. FRAME AND GRATE SHALL BE DUCTILE IRON. FRAME MAY BE CAST INTO THE TOP UNIT OR PLACED OVER THE OPENING AS APPROVED BY THE ENGINEER. FRAME AND GRATE SHALL BE OF A TYPE THAT WILL NOT CREATE A HAZARD FOR BICYCLE TRAFFIC.
4. CATCH BASIN SHALL MEET HIGHWAY STANDARD-20 LOAD REQUIREMENTS.
5. MINIMUM STEEL SHALL BE SPECIFIED BY ASTM C-478-69.
6. MINIMUM SUMP DEPTH SHALL BE 16".
7. ADJUSTING RING SHALL BE THE SAME SIZE AS THE CATCH BASIN.
8. THE AREA BETWEEN THE TOP OF THE CATCH BASIN AND THE FRAME SHALL BE FORMED AND FILLED WITH CONCRETE MEETING THE REQUIREMENTS OF CBJ SPECIFICATION 03302 - CONCRETE STRUCTURES. NO BRCKS, WOOD OR OTHER MATERIALS PERMITTED FOR ADJUSTING GRADE.
9. ALL CATCH BASINS THAT EMPTY INTO AN OPEN DRAINAGE SHALL BE FITTED WITH AN OIL-WATER-DEBRIS SEPARATOR DEVICE AS DIRECTED BY THE ENGINEER.

*boy
As built
for structures
true & accurate
to the best of my
knowledge. TKL.
3-29-19.*

SCALE: NTS	DATE: 12/6/96	CITY AND BOROUGH OF JUNEAU, ALASKA	
DRAWN BY: DRW	CHECKED BY: STAFF	TYPE III CATCH BASIN	
APPROVED BY: <i>DRW</i>	REVISED: 8/14/2011	STANDARD 304A	

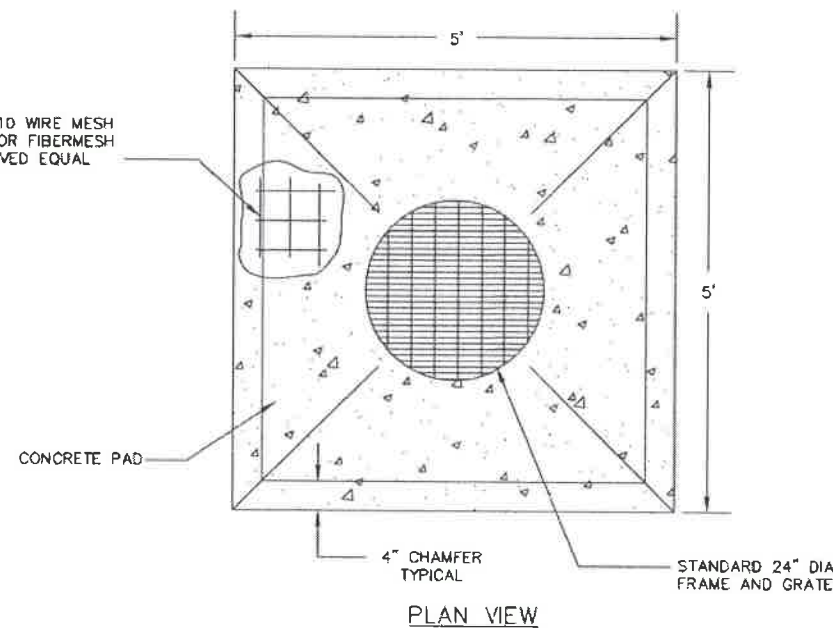

PLAN VIEW

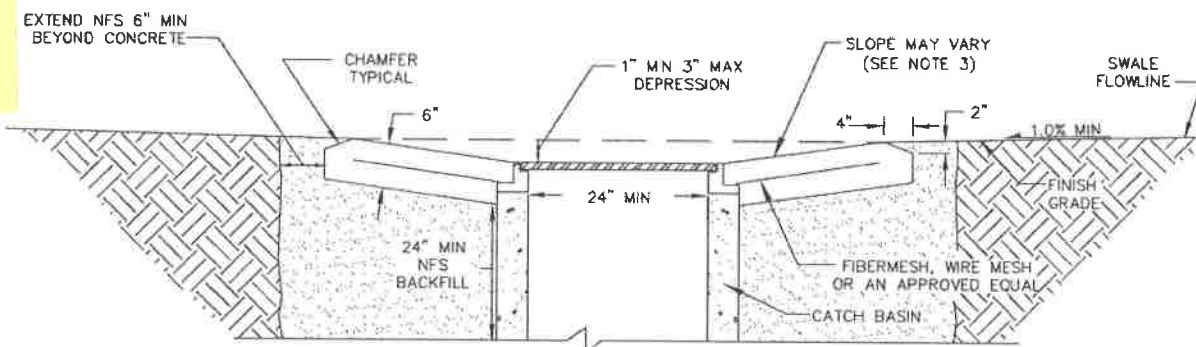


ELEVATION VIEW

NOTES:

1. FRAME AND GRATE TO BE DUCTILE IRON AND A TYPE THAT WILL NOT CREATE A HAZARD FOR A BICYCLE TRAFFIC.
2. COMPACT NON FROST SUSCEPTIBLE (NFS) BACKFILL TO 95% OF MAXIMUM DENSITY.
3. SLOPE MAY VARY TO MATCH SWALE FLOWLINE. FINAL GRADE AS DIRECTED BY THE ENGINEER.

SCALE: NTS	DATE: 12/12/96	CITY AND BOROUGH OF JUNEAU, ALASKA	
DRAWN BY: DRW	CHECKED BY: STAFF	AREA DRAIN DETAIL	
APPROVED BY: <i>DRW</i>	REVISED: 8/14/2011	STANDARD 310	

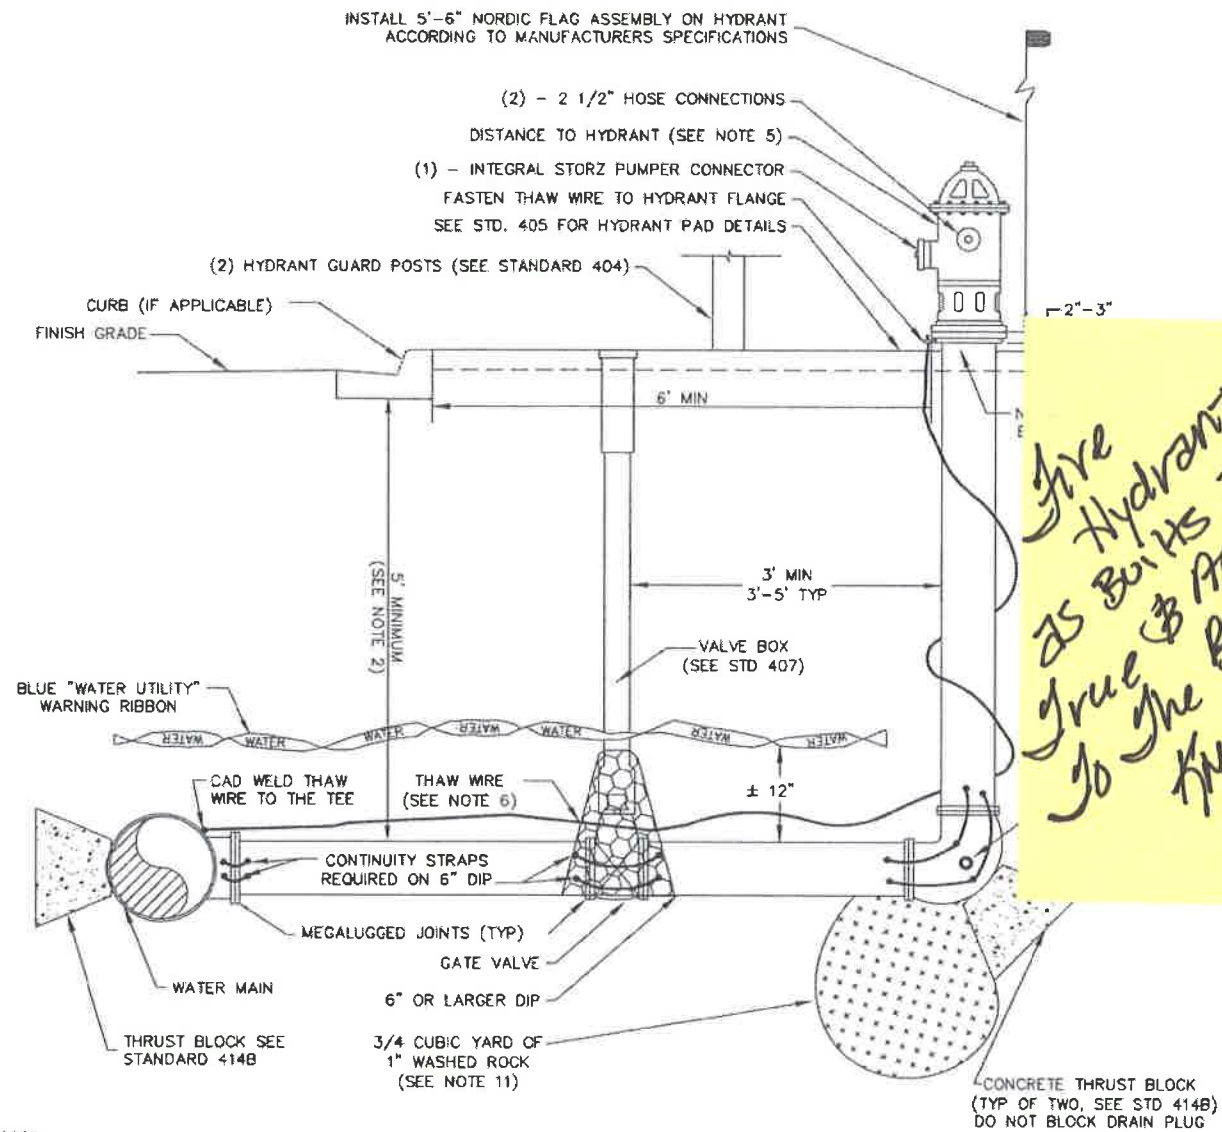


NOTES

1. HYDRANT BARREL AND VALVE BOX SHALL BE PLUMB.
2. GROUND COVER SHALL BE 5" MINIMUM. ADDITIONAL COVER (MORE THAN 5") MAY BE REQUIRED BY THE ENGINEER.
3. WATER PIPE SHALL BE 6" MIN. D.I.P. AND ALL CONNECTIONS SHALL BE MEGALUGGED OR CONNECTED WITH LOCKING FIELD GASKETS.
4. BENDS BETWEEN THE HYDRANT AND THE MAIN SHALL NOT EXCEED 11 1/4" UNLESS APPROVED BY ENGINEER.
5. ALL HYDRANTS SHALL BE PAINTED CATERPILLAR YELLOW, AND THE NUMBER OF FEET TO VALVE SHALL BE PRINTED IN BLACK 1/2" BLOCK LETTERS JUST BELOW TOP BONNET. PORT CAPS SHALL BE COLOR CODED PER NFPA STANDARD 291 AS DIRECTED BY THE CBJ WATER UTILITIES DEPARTMENT.
6. THAW WIRE SHALL BE #2 COPPER WITH TYPE THW INSULATION. THAW WIRE SHALL BE BOLTED OR CAD WELDED TO THE TEE AT THE MAIN. CONTINUITY STRAPS ARE REQUIRED ON 6" DIP. CONTINUITY AND ARRANGEMENT FOR TESTING BY CBJ WATER UTILITIES IS THE RESPONSIBILITY OF THE INSTALLER/CONTRACTOR.
7. INSTALL A PAVED HYDRANT PAD PER STANDARD 405 AND GUARD POSTS PER STANDARD 404.
8. HYDRANT SHALL BE MUELLER CENTURION 200 OR 250 WITH INTEGRAL STORZ PUMPER CONNECTION OR APPROVED EQUAL. CLOW F2500 SERIES HYDRANTS ARE NO LONGER ACCEPTED BY CBJ.
9. THIS STANDARD TO BE USED FOR ALL HYDRANTS AND BLOW-OFFS. ALTERNATE BLOW-OFF TYPE HYDRANTS ARE NO LONGER ACCEPTED BY CBJ.
10. FIRE HYDRANT TO THE VALVE SHALL BE TESTED TO A MINIMUM OF 200 PSI FOR TWO (2) HOURS PER STANDARD SPECIFICATION SECTION 02601 ARTICLE 3.5 PARAGRAPH B 2.
11. CBJ WATER UTILITIES DEPARTMENT SHALL DETERMINE FOR EACH HYDRANT INSTALLATION IF HYDRANT PLUGS SHALL BE REMOVED FOR SELF DRAINING. DO NOT BLOCK PLUG WITH THE THRUST BLOCK.

Fire Hydrant
 as built I've
 done & accurate
 to the best of my
 knowledge.
 J/W
 3-29-19.

SCALE:	NTS	DATE:	11/20/96	CITY AND BOROUGH OF JUNEAU, ALASKA
DRAWN BY:	DRW	CHECKED BY:	STAFF	FIRE HYDRANT
APPROVED BY:	<i>DRW</i>		REVISED:	STANDARD 403
			8/14/2011	

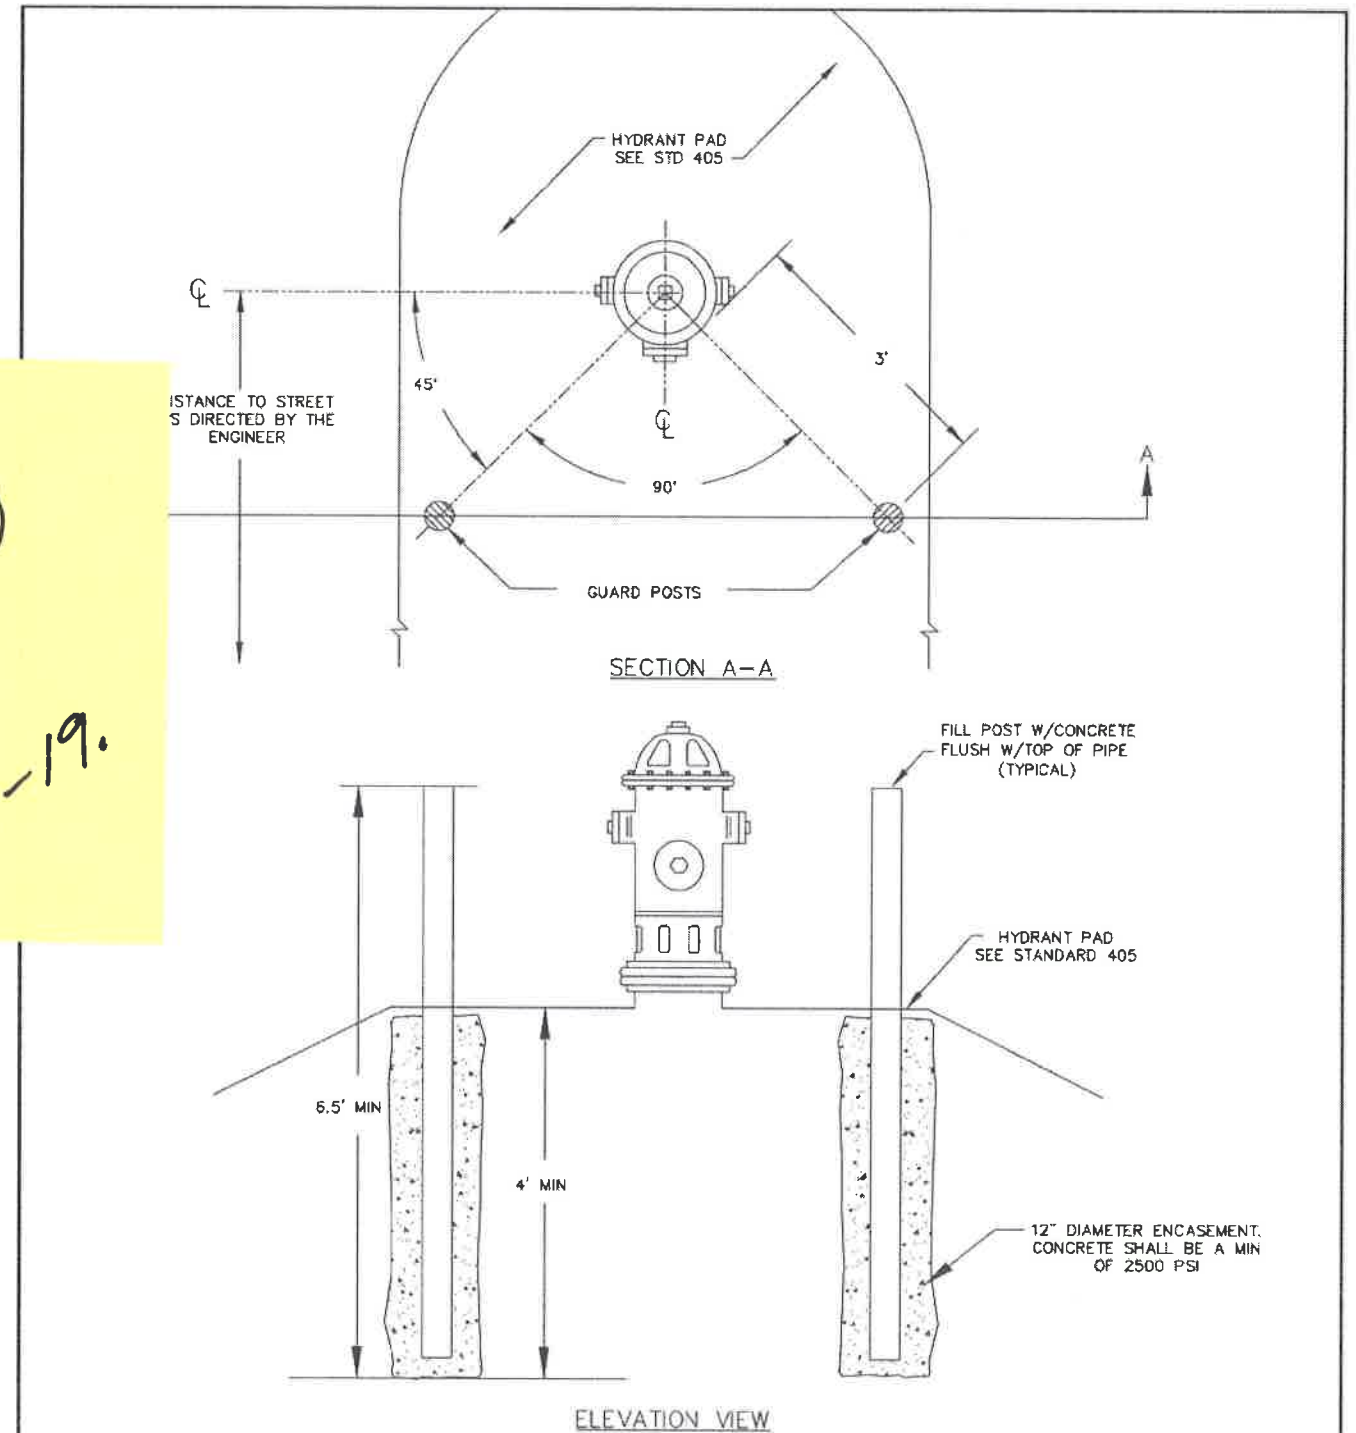

NOTES

1. GUARD POST ARE REQUIRED ON ALL HYDRANTS EXCEPT THOSE IN SIDEWALKS, ALONG STATE HIGHWAYS OR AS DIRECTED BY THE ENGINEER.
2. GUARD POST SHALL BE 4" DIAMETER, SCHEDULE 40 STEEL PIPE WITH A MINIMUM 4 FEET OF BURIAL AND 2-1/2 FEET OF EXPOSURE.
3. POSTS SHALL BE FILLED FLUSH WITH CONCRETE AND PAINTED WITH 4C-184 CATERPILLAR YELLOW ENAMEL AFTER INSTALLATION.
4. POSTS SHALL NOT BLOCK OPERATION OF VALVE.

SCALE:	NTS	DATE:	11/20/96	CITY AND BOROUGH OF JUNEAU, ALASKA
DRAWN BY:	DRW	CHECKED BY:	STAFF	HYDRANT GUARD POSTS
APPROVED BY:	<i>DRW</i>		REVISED:	STANDARD 404
			8/14/2011	

PROJECT No. 69500

Multi Use Path
Findings Summary

ADMIN FILES FINDINGS

A02 – Subcontracts is Complete-(First Tier).

(Sub Contractor – “Trucano” is Second Tier and is not listed in the Specs Book or anywhere else)

A04 - Labor Compliance Interviews – is Complete (3 prime and 5 subs)

A05 - Certified Payrolls is ordered by Dates – No in order by CPRs number.

A08 - Directives are 32. #32 needs Sub signature

A09 - RFP total: 18

A10 - IWA total: 9

A16 – Scales certs are not available

B07 – Safety Meetings is incomplete

Change of Orders –

- COs Summary Audit page is Incomplete

- #16 have a \$\$\$ difference of 0.56

- **CO#8, #09, #10, #20 needs Contractor Signatures (not signatures in digital form).**

- Back-up files is Incomplete.

-CO Labeled as #12, in the filed form appears as #11. **In CO#12 Final Date is extended to July 15 2016**

-CO#22 appears in the Q Drive, but is not filed in the Admin Files folder box. Needs Signatures also.

Note:

bundle with multiple (3) “COs #11” and Directives 5 and 7 shown conflictive Numbers in COs existing list.

PAY ITEMS FINDINGS

- Estimate #18 is divided in two (2) sections: - “Line A” Multi Use Path (pages 1 to 4 in a total of 7pages)

-“Line B” Auke Lake Parking Lot (pages 5 to 6 in a total of 7pages)

- Item “# 203(3)a” and “# 203(3)b” are in conflict in CO# 18.

- Item “# 203(25)B” or “CO # 15” is not listed in the present Estimate #18.

- Item “# 604(8)a”, Dollar Value \$93.82, related to “CO # 17” is not listed in the present Estimate #18.

- Item “# 630(3)b”, Item Created by CO #21 is not included in the present Estimate #18.