

Basis of Horizontal Control:

Horizontal Control is defined by "Eldred Grid" a custom projection developed specifically for this project and controlled by static GPS measurements. Datum is NAD83 (96) holding NGS mounuments "Eddy" and "HNS-D" fixed.

Basis of Vertical Control:

Vertical Control is Mean Lower Low Water based on static GPS ties to NOS benchmarks in tidal series 9452434 at Tiayasanka Harbor, published 11/9/2000. Geoid '99 used for orthometric height corrections.

Definition of Eldred Grid:



ELDRED GRID 2003
DATUM: NAD83 AK,CAN, CON-US (1996 Adjustment)
ELLIPSOID: GRS80
UNITS : SURVEY FEET
TRANSVERSE MERCATOR PROJECTION
CM @ -135°07' LON
ORIGIN LAT 58°
FALSE N = 0.0 FT US
FALSE E = 200,000.0 FT US
SCALE REDUCTION = 1.000003

CONTROL MONUMENT NOTES:

- 1. If any pair of control points disagrees from published value by more than 1:10,000 horizontally or vertically then a third network point must be tied to ascertain which point is in error or has been disturbed.
- 2. TBM/RP tags (points 691-705) consist of a PK nail driven through yellow plastic tag. They are intended as an elevation check for horizontal control points 171-185. Elevation listed is at center of PK nail.
- 3. Install new monuments in accordance with 624(4) and standard drawing M-16.01. Approximate positions of monuments to be set can be found in a table on sheet D2.

Primary Control

POINT	STATION	OFFSET	NORTHING	EASTING	ELEVATION	DESCRIPTION
51	65+20.11	22.08' L	242067.2275	240554.4790	123.58	GPS_ALCAP/REBAR_SM-22
171	74+60.38	34.54' L	242965.4059	240277.4587	186.48	ALCTRL2.5"_BB-171
691	74+87.78	39.62' L	242991.3038	240267.1520	189.44	TBM_RP-TAG
172	86+46.56	37.08' R	244148.6378	240128.7900	230.25	ALCTRL2.5"_BB-172
692	86+50.45	46.88' R	244155.8362	240136.5955	235.56	TBM_RP-TAG
173	97+13.01	23.73' L	245037.5653	239523.8660	197.41	ALCTRL2.5"_BB-173
693	97+62.71	37.81' L	245079.8813	239489.6817	198.01	TBM_RP-TAG
694	112+43.25	48.91' L	246539.4601	239225.0178	222.67	TBM_RP-TAG
174	112+46.93	18.45' L	246549.6009	239253.9774	223.63	GPS_ALCTRL2"_BB-174
175	121+24.17	6.52' R	247420.9418	239183.6428	241.63	ALCTRL2.5"_BB-175
695	121+25.15	27.55' R	247427.3402	239203.6933	248.28	TBM_RP-TAG
176	132+00.60	18.80' R	248443.6409	238845.0581	262.00	ALCTRL2.5"_BB-176
696	132+10.26	37.82' R	248461.4599	238856.9698	268.18	TBM_RP-TAG
177	149+81.05	4.24' L	249859.2253	237768.1627	251.40	ALCTRL2.5"_BB-177
697	150+40.73	23.72' L	249896.9162	237718.8731	254.04	TBM_RP-TAG
698	162+27.84	45.36' L	250813.5596	236969.9901	254.05	TBM_RP-TAG
178	162+38.48	10.91' L	250844.0510	236989.2298	251.99	ALCTRL2.5"_BB

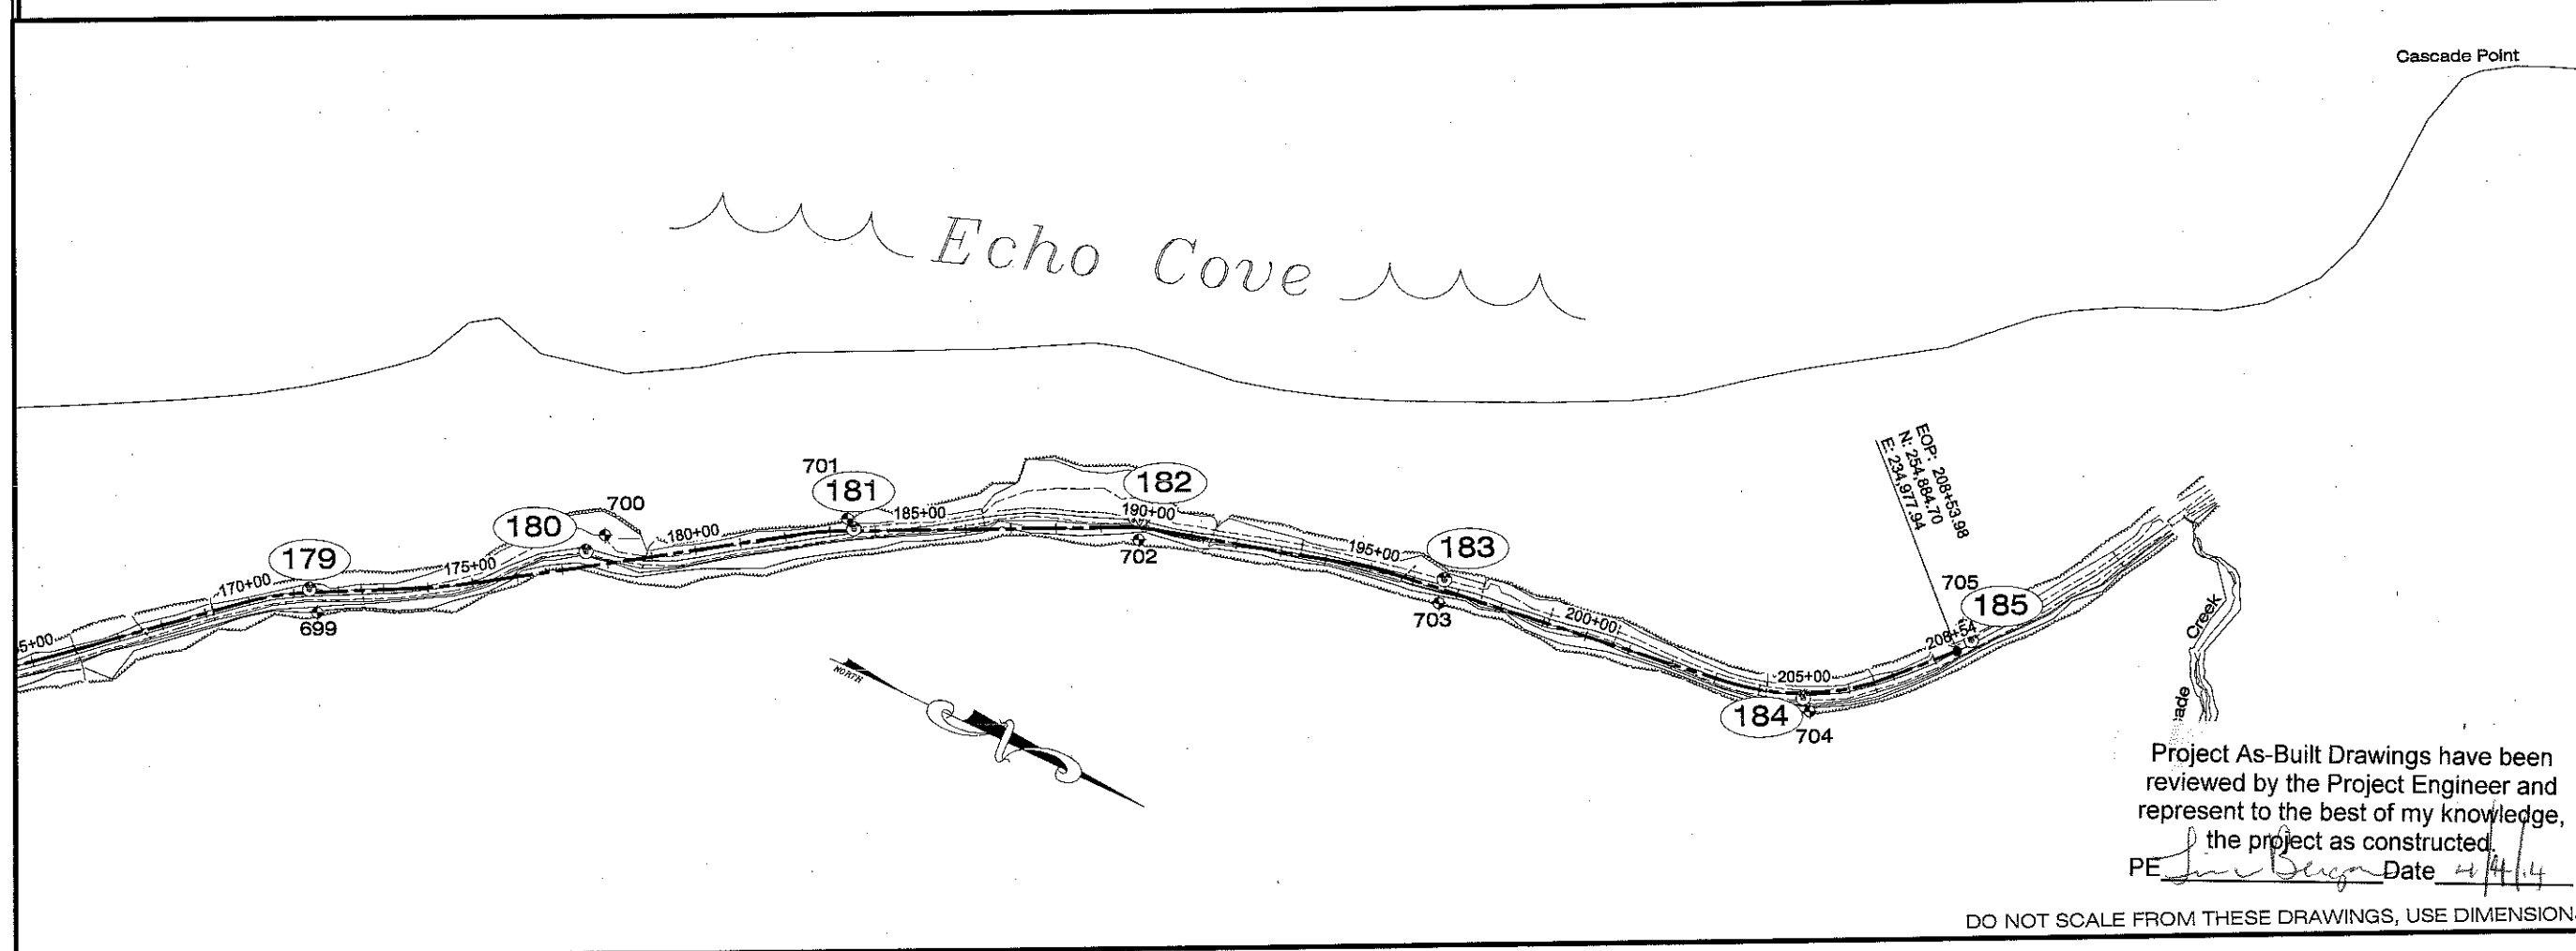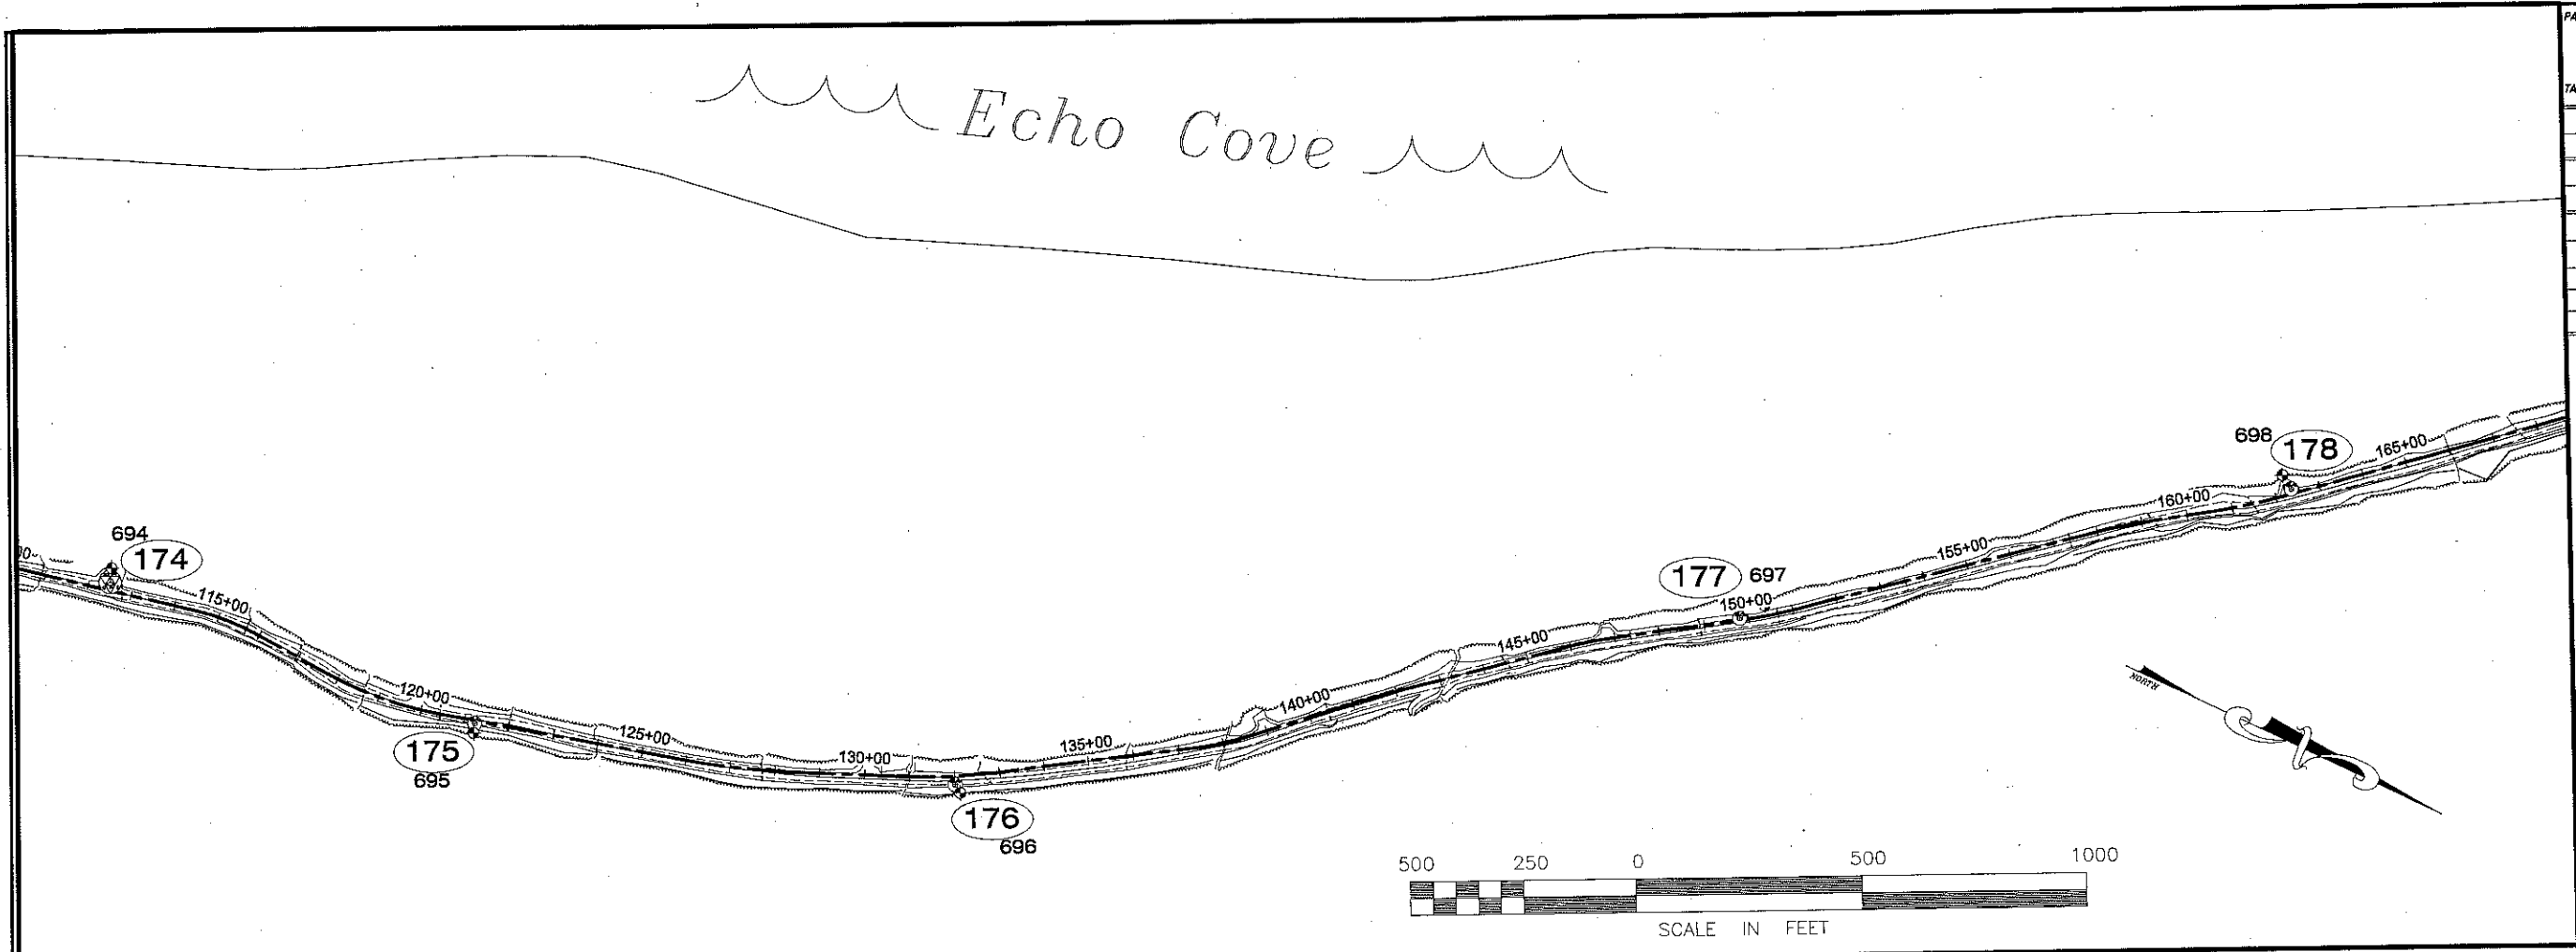

Project As-Built Drawings have been reviewed by the Project Engineer and represent to the best of my knowledge, the project as constructed.

PE Jim Berger Date 4/4/11

DO NOT SCALE FROM THESE DRAWINGS, USE DIMENSIONS

PATH: H:\2010\101309\Autocad Drawings\A2_Control.dwg

TAB: A3 March 23, 2011 at: 7:05am

ADDENDUM NUMBER

ATTACHMENT NUMBER

RECORD OF REVISIONS

No.	DATE	DESCRIPTION

GLACIER HIGHWAY EXTENSION

Survey Data

DESIGNED BY: T. REED

CHECKED BY: R. Davis

DRAWN BY: T. REED/ N. PURVES

STATE OF ALASKA
49 TH
Timothy Reed
No. 10613
REGISTERED PROFESSIONAL LAND SURVEYOR

3-23-11

STATE OF ALASKA
DEPARTMENT OF TRANSPORTATION & PUBLIC FACILITIES
SOUTHEAST REGION
GLACIER HIGHWAY EXTENSION
DOT&PF PROJECT # 69583

Survey Data

PROJECT DESIGNATION NUMBER
69583

STATE	YEAR
ALASKA	2011

SHEET NUMBER	TOTAL SHEETS
A3	52

LT. TRAVERSABLE SLOPE TRANSITION	
STATION	WIDTH
74+50	15'
75+00	8'
77+50	8'
78+00	15'
106+50	15'
107+00	8'
114+00	8'
114+50	15'
116+50	15'
117+00	8'
124+00	8'
124+50	15'
125+50	15'
126+00	8'
146+00	8'
146+50	15'
148+00	15'
148+50	8'
157+06.35	8'
157+96.35	15'

LT. TRAVERSABLE SLOPE TRANSITION	
STATION	WIDTH
168+00	15'
168+50	8'
171+50	8'
172+00	15'
181+50	15'
182+00	8'
188+00	8'
188+50	15'
193+00	15'
193+50	8'
196+00	8'
196+50	15'
197+00	15'
198+00	8'
200+00	8'
201+00	15'
203+50	15'
204+00	8'
205+00	8'
205+50	15'

TYPICAL SECTION NOTES:

1. IN AREAS OF GRADE RAISE AND/OR REALIGNMENT, CONSTRUCT SUB GRADE WITH 18" OF SELECTED MATERIAL, TYPE A FULL WIDTH.
2. ALL SOIL CONSTRUCTION SLOPES SHALL BE SEEDED AND MULCHED. ALL SLOPES 4:1 (H:V) OR STEEPER WILL BE EVALUATED BY THE ENGINEER FOR SLOPE STABILIZATION MEASURES.
3. SUPERELEVATIONS ROTATE ABOUT THE CENTERLINE, THE RATES OF SUPERELEVATION AND THE SUPERELEVATION TRANSITION REGIONS ARE GIVEN ON THE PLAN AND PROFILE SHEETS. REFER TO CASE 1 OF STANDARD DRAWING I-81.00 FOR TRANSITION DETAILS.
4. MAINTAIN POSITIVE DRAINAGE AWAY FROM ROAD.
5. BENCH ACCORDING TO SUBSECTION 203 IN THE STANDARD SPECIFICATIONS FOR HIGHWAY CONSTRUCTION
6. FROM STATION 176+00 TO 178+00 ADD A 3' FLAT BOTTOM DITCH PER DETAIL BELOW.
7. WHEN WAQTC FOP FOR AASHTO T 27/T 11 IS SPECIFIED, METHOD A OR B WILL BE PERFORMED ON ALL CRUSHED AGGREGATE AND ON MATERIAL CONTAINING 3/4" NOMINAL MAXIMUM SIZE AGGREGATE OR LESS.
8. WHEN WAQTC FOP FOR AASHTO T 180 IS SPECIFIED, METHOD D WILL BE PERFORMED UNLESS OTHERWISE STATED.

RT. CUT SLOPE TRANSITION	
STATION	SLOPE
173+00	1.5:1
173+25	0.75:1
179+25	0.75:1
179+50	1.5:1
186+50	1.5:1
186+75	0.75:1
189+25	0.75:1
189+50	1.5:1
191+50	1.5:1
191+75	0.75:1
193+75	0.75:1
194+00	1.5:1
195+50	1.5:1
195+75	0.75:1
201+75	0.75:1
202+00	1.5:1

PATH: I:\2010\101309\Autocad Drawings\Typical Sections.dwg

TAB:B1 March 23, 2011 at 10:02am

ADDEND

ADDENDUM NUMBER

ATTACHMENT NUMBER

RECORD OF REVISIONS

No.	DATE	DESCRIPTION

GLACIER HIGHWAY EXTENSION

TYPICAL SECTIONS

PREPARED BY: R&M ENGINEERING, INC.

R&M PROJECT #: 101309

DESIGNED BY: M. STORY



CHECKED BY: M. JOHNSON

DRAWN BY: N. PURVES

STATE OF ALASKA
DEPARTMENT OF TRANSPORTATION
& PUBLIC FACILITIES
SOUTHEAST REGION

GLACIER HIGHWAY EXTENSION
DOT&PF PROJECT # 69583

TYPICAL SECTIONS

PROJECT DESIGNATION NUMBER


69583

STATE YEAR


ALASKA 2011

SHEET NUMBER TOTAL SHEETS

B2 52

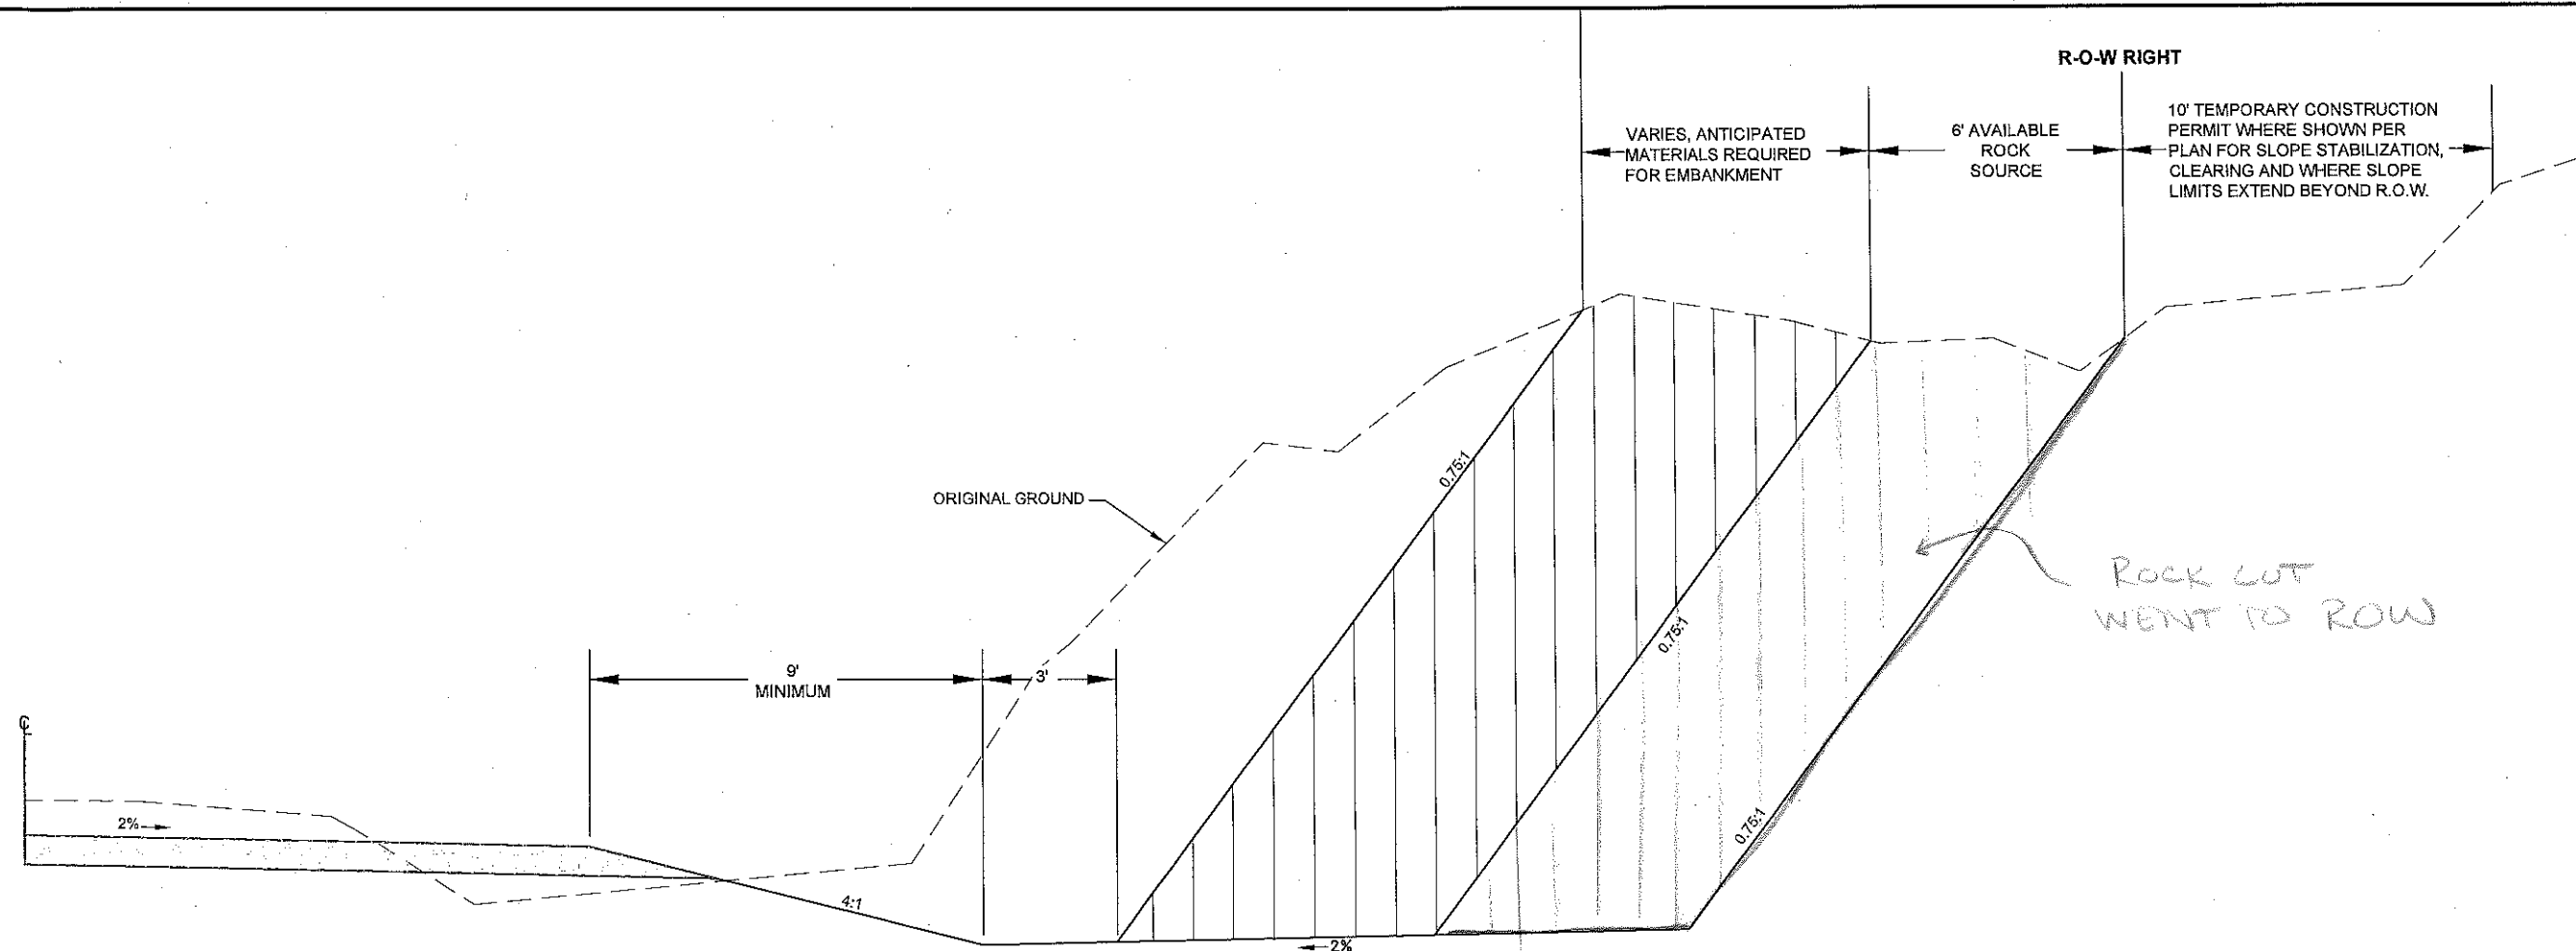



ROCK CUT SECTION TYPICAL, STA 184+50 TO 194+00

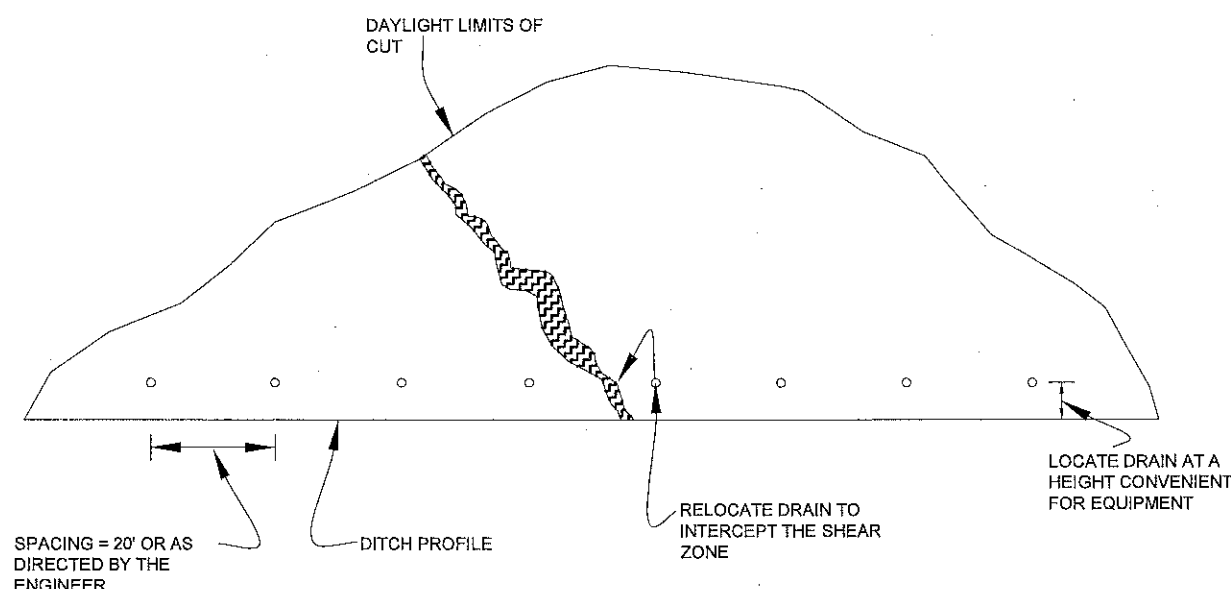


DRAIN HOLE LAYOUT
(ELEVATION VIEW)

DRAIN HOLES REQUIRED IN ROCK CUT SECTIONS WITHOUT A 3' OR GREATER FLAT BOTTOM DITCH

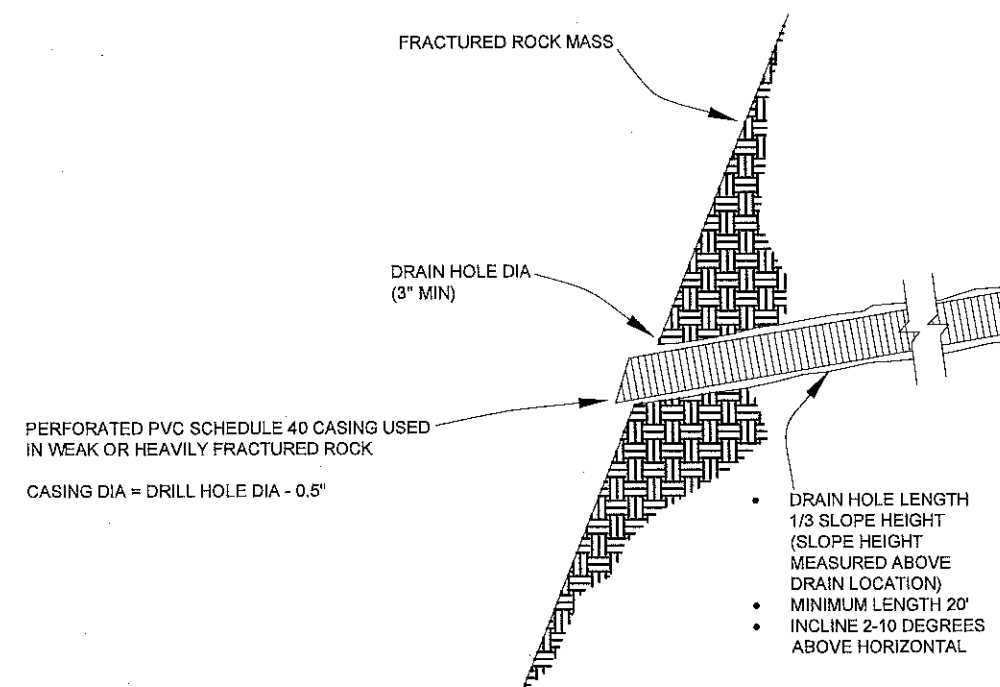


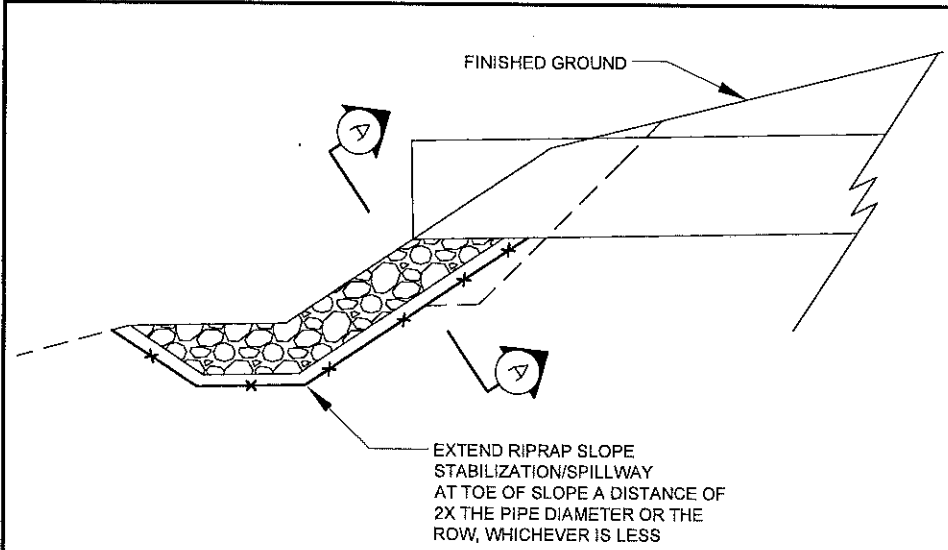

ROADWAY SECTION

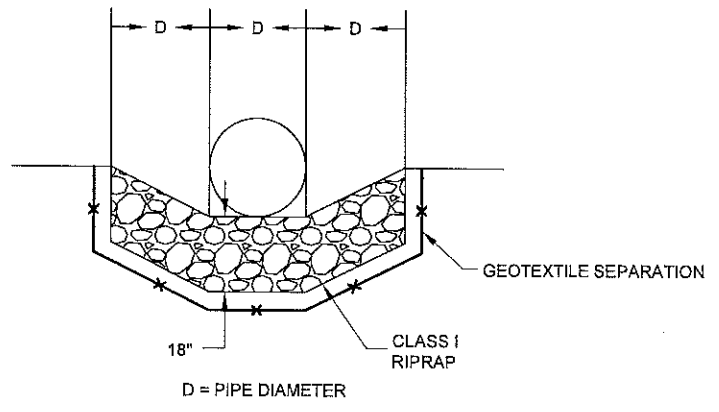


SECTION "A-A"

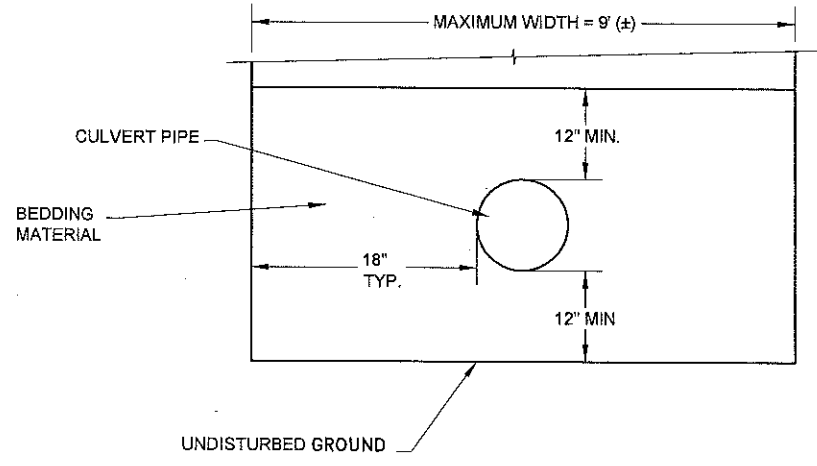

CULVERT BEDDING TYPICAL

CULVERT OUTLET PROTECTION AS DIRECTED

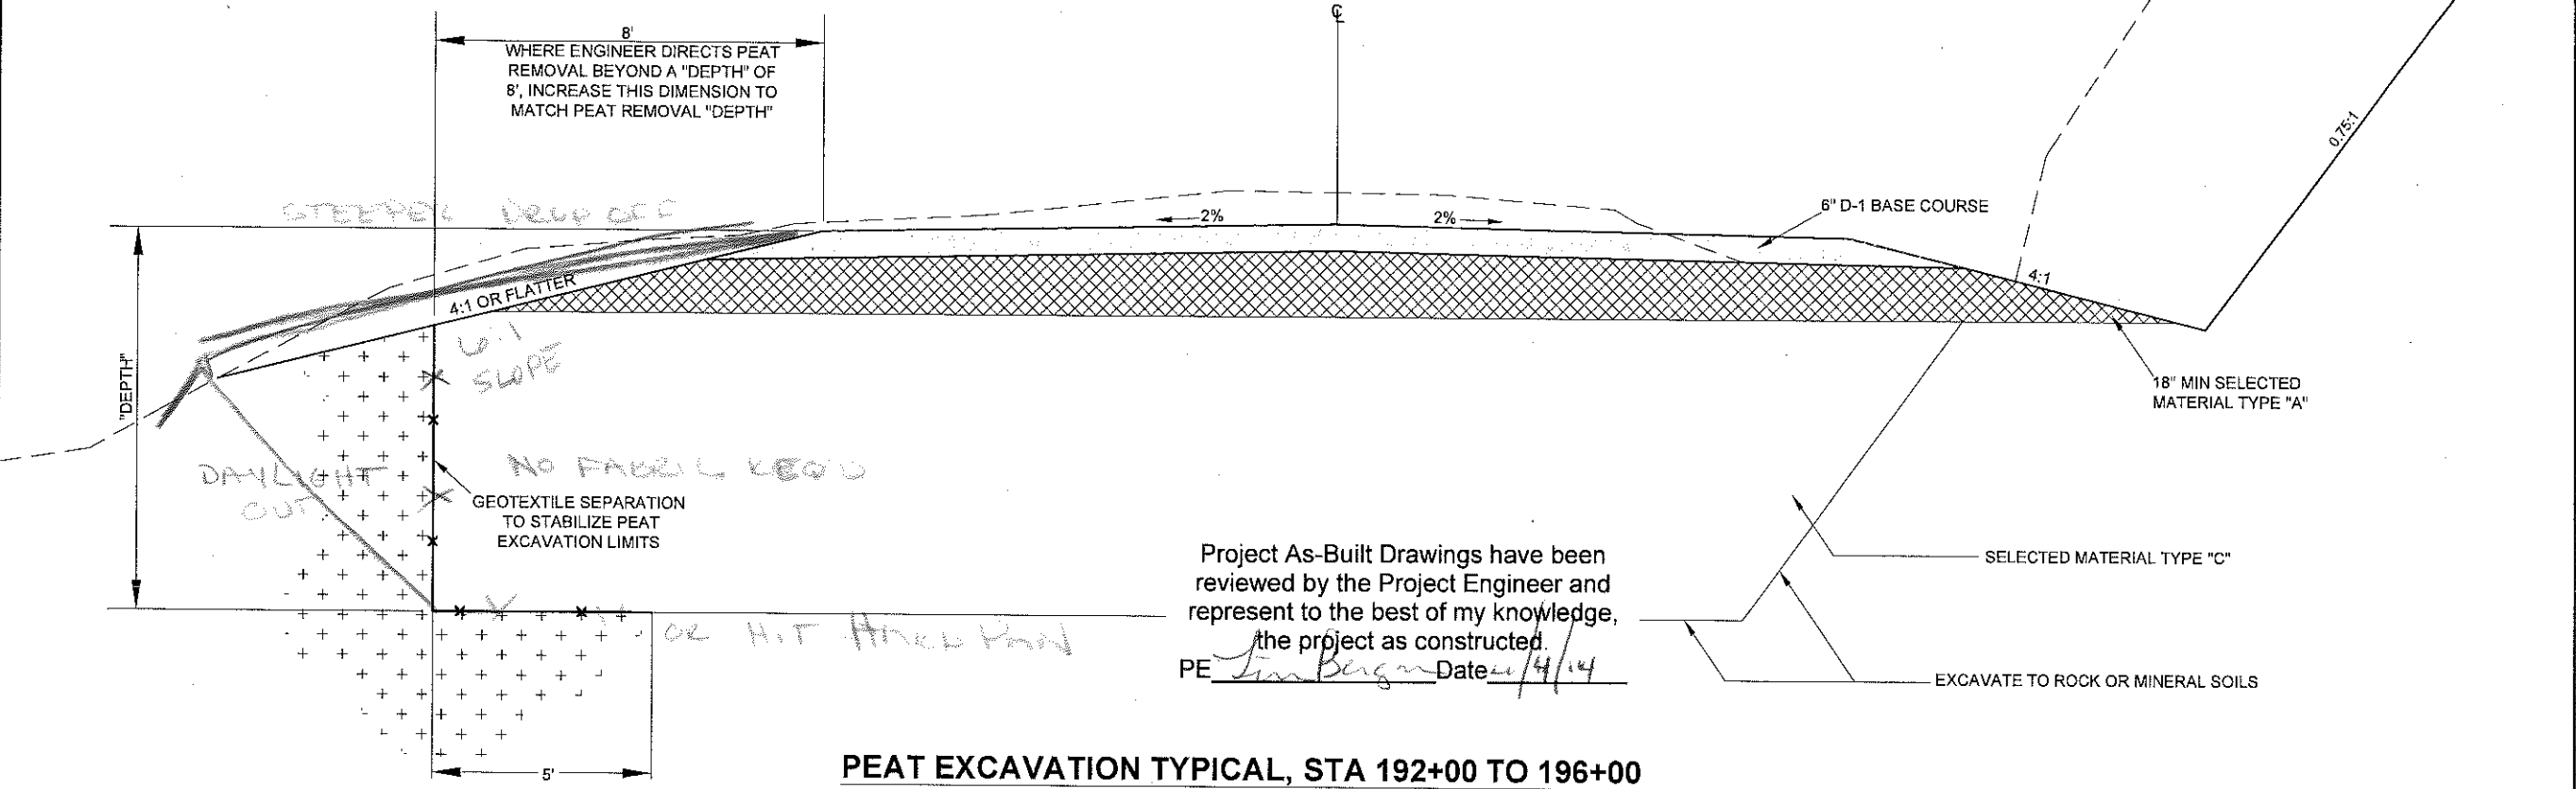

PEAT EXCAVATION TYPICAL, STA 192+00 TO 196+00

Project As-Built Drawings have been reviewed by the Project Engineer and represent to the best of my knowledge, the project as constructed.

PE Tim Berger Date 4/4/14

PATH: I:\2010\101309\Autocad Drawings\DATA SHEETS.dwg

TAB: B3 March 23, 2011 at: 9:36am

ADDENDUM NUMBER

ATTACHMENT NUMBER

RECORD OF REVISIONS

No.	DATE	DESCRIPTION

GLACIER HIGHWAY EXTENSION

TYPICAL SECTIONS

PREPARED BY: R&M ENGINEERING, INC.
R&M PROJECT #: 101309

DESIGNED BY: M. STORY

A:\2010\101309\Autocad Drawings\DATA SHEETS.dwg PLOT: March 22, 2011 at: 4:58pm nate

ESTIMATE OF QUANTITIES			
Item No.	Item	Pay Unit	QTY.
201 (1A)	Clearing	Acre	7.18
201 (3A)	Clearing and Grubbing	Acre	15.20
201 (6)	Selective Tree Removal	Each	15
202 (1)	Removal of Structures and Obstructions	Lump Sum	All required
202 (2)	Removal of Pavement	Square Yard	155.54
202 (4)	Removal of Culvert Pipe	Linear Foot	1716.5
203 (3)	Unclassified Excavation	Cubic Yard	415,000
203 (9)	Obliteration of Roadway	Square Yard	150
203 (10)	Controlled Blasting	Linear Foot	4585
203 (12)	Drain Holes	Linear Foot	1200
301 (1)	Aggregate Base Course, Grading D-1	Ton	40,000
603 (22-24)	24 inch DOT Furnished CSP	Linear Foot	2,897
603 (22-36)	36 inch DOT Furnished CSP	Linear Foot	376
603 (22-48)	48 inch DOT Furnished CSP	Linear Foot	139
603 (22-72)	72 inch DOT Furnished CSP	Linear Foot	113
611 (1)	Riprap, Class I	Cubic Yard	100
615 (1)	Standard Sign	Square Foot	100
615 (2)	Remove and Relocate Existing Sign	Each	10
615 (6)	Salvage Sign	Each	8
618 (1)	Seeding	Acre	15
619 (3)	Flexible Growth Medium	Square Yard	30,000
630 (1)	Geotextile, Separation	Square Yard	1,800
633 (2)	Sediment Barrier	Linear Foot	6,000
640 (1)	Mobilization and Demobilization	Lump Sum	All required
641 (1)	Erosion, Sediment And Pollution Control Administration	Lump Sum	All required
641 (2)	Temporary Erosion, Sediment And Pollution Control	Contingent Sum	All required
641 (6)	Withholding	Contingent Sum	All required
641 (8)	Temporary Check Dam	Each	220
641 (9)	Temporary Gravel Construction Entrance/Exit	Lump Sum	All required
642 (1)	Construction Surveying	Lump Sum	All required
642 (4)	Set Primary Monument	Each	16
643 (2)	Traffic Maintenance	Lump Sum	All required

ADDENDUM NUMBER

ATTACHMENT NUMBER

RECORD OF REVISIONS

No.	DATE	DESCRIPTION

GLACIER HIGHWAY EXTENSION

TYPICAL SECTIONS

PREPARED BY: R&M ENGINEERING, INC.

R&M PROJECT #: 101309

DESIGNED BY: M. STORY



CHECKED BY: M. JOHNSON

DRAWN BY: N. PURVES

STATE OF ALASKA
DEPARTMENT OF TRANSPORTATION
& PUBLIC FACILITIES
SOUTHEAST REGION
GLACIER HIGHWAY EXTENSION
DOT&PF PROJECT # 69583

TYPICAL SECTIONS

PROJECT DESIGNATION NUMBER


69583

STATE YEAR

ALASKA 2011

SHEET NUMBER TOTAL SHEETS


B4 52

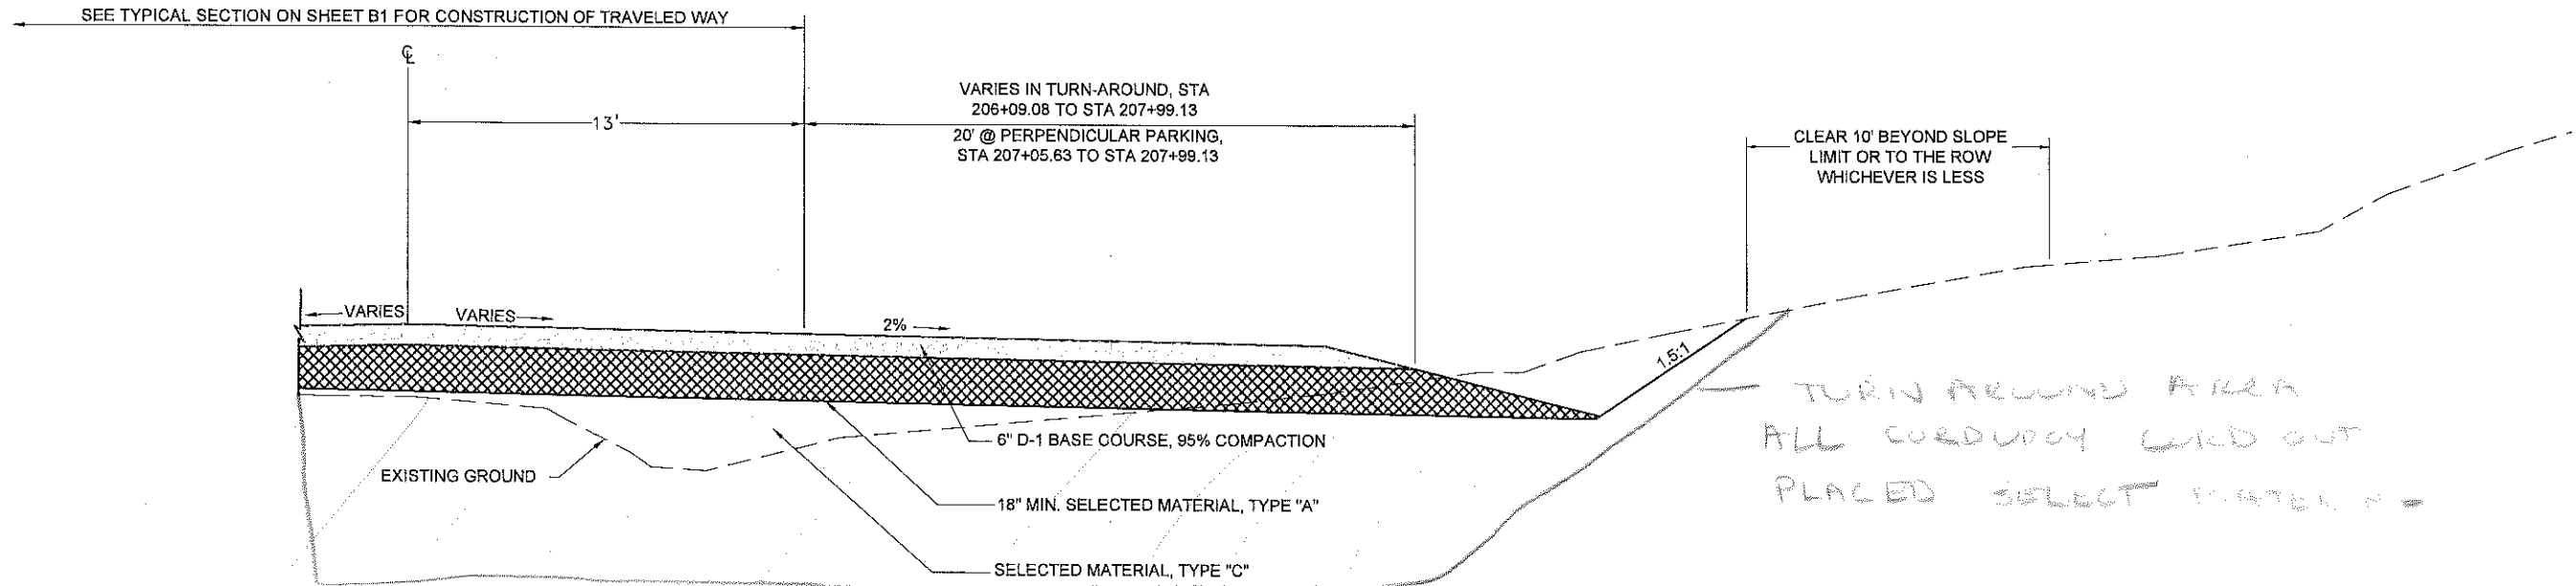

E:\2010\101309\Autocad Drawings\DATA SHEETS.dwg PLOT: March 22, 2011 at: 10:08am note


615 (1) & 615 (2) STANDARD SIGN SUMMARY									
NUMBER	"O" STATION	OFF.	DESCRIPTION	ASDS CODE	ORIENTATION	DIM. (HXV)	AREA (SF)	POST SIZE	REMARKS
1	59+10	LT	STOP	R1-1	W.B.	30X30	NA	2.5	REMOVE & RELOCATE
2	61+00	RT	SPEED LIMIT 35	R2-1	N.B.	24X24	4	2.5	
3	104+10	RT	ENTERING NATIONAL FOREST	NFL-E	N.B.	18X18	NA	2.5	REMOVE & RELOCATE
4	104+10	LT	LEAVING NATIONAL FOREST	NFL-L	S.B.	18X18	NA	2.5	REMOVE & RELOCATE
5	112+12	LT	ENTERING NATIONAL FOREST	NFL-E	S.B.	18X18	NA	2.5	REMOVE & RELOCATE
6	123+46	RT	LEAVING NATIONAL FOREST	NFL-L	N.B.	18X18	NA	2.5	REMOVE & RELOCATE
7	130+89	RT	ENTERING NATIONAL FOREST	NFL-E	N.B.	18X18	NA	2.5	REMOVE & RELOCATE
8	131+31	LT	LEAVING NATIONAL FOREST	NFL-L	S.B.	18X18	NA	2.5	REMOVE & RELOCATE
9	163+84	LT	ENTERING NATIONAL FOREST	NFL-E	S.B.	18X18	NA	2.5	REMOVE & RELOCATE
10	164+81	RT	LEAVING NATIONAL FOREST	NFL-L	N.B.	18X18	NA	2.5	REMOVE & RELOCATE
11	198+39	RT	END ROAD 1000 FT	W14-101	N.B.	36X36	9	2.5	
12	204+00	LT	SPEED LIMIT 35	R2-1	S.B.	24X24	4	2.5	
13	206+13	RT	NO PARKING ANY TIME	R7S-10L	N.B.	18X9	1.13	2.5	ARROW POINTS LEFT
14	207+11	RT	NO PARKING ANY TIME	R7S-10R	N.B.	18X9	1.13	2.5	ARROW POINTS RIGHT
15									

A:\2010\101309\Autocad Drawings\DATA SHEETS.dwg PLOT: March 16, 2011 at: 6:42pm


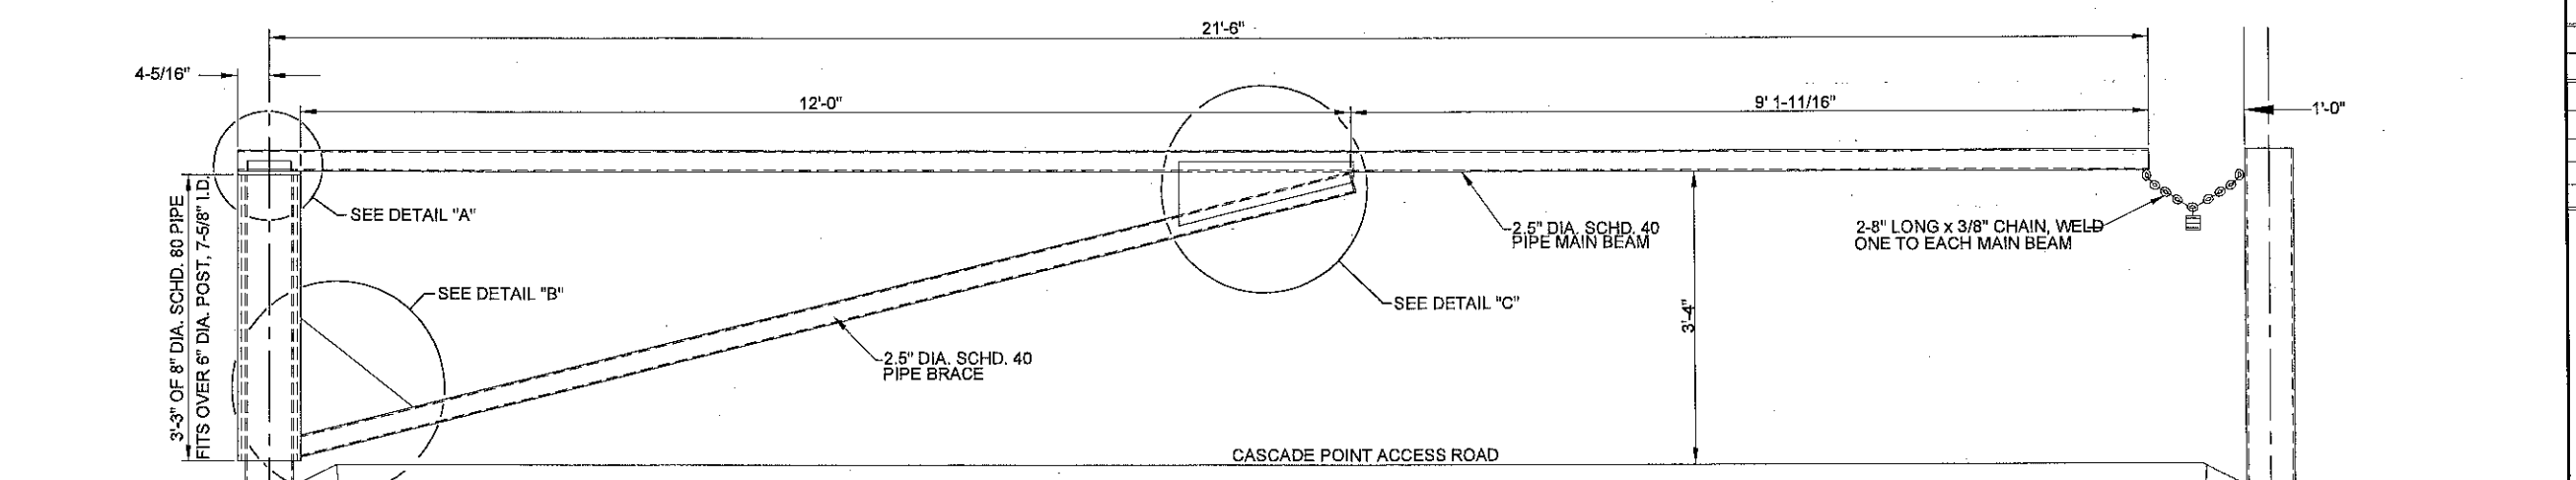


GATE DETAIL


NOTE: AS BUILT OF GATE FOR INFORMATIONAL PURPOSES

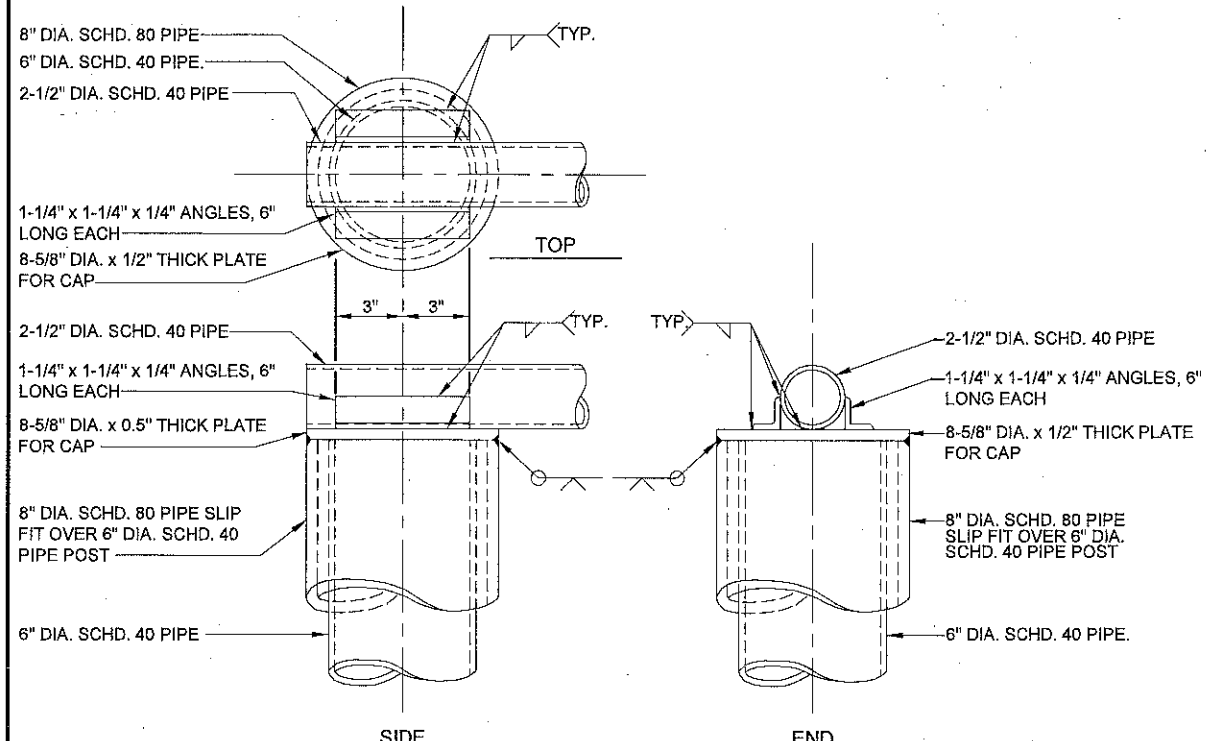


DETAIL "A"

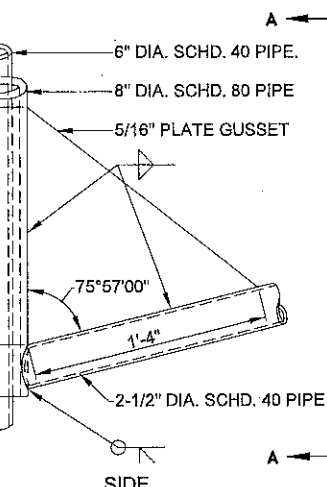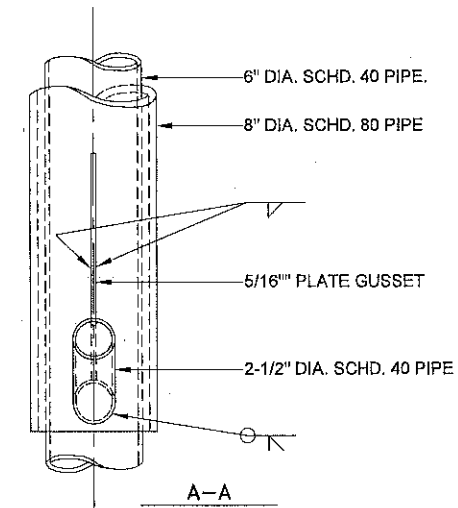


DETAIL "B"

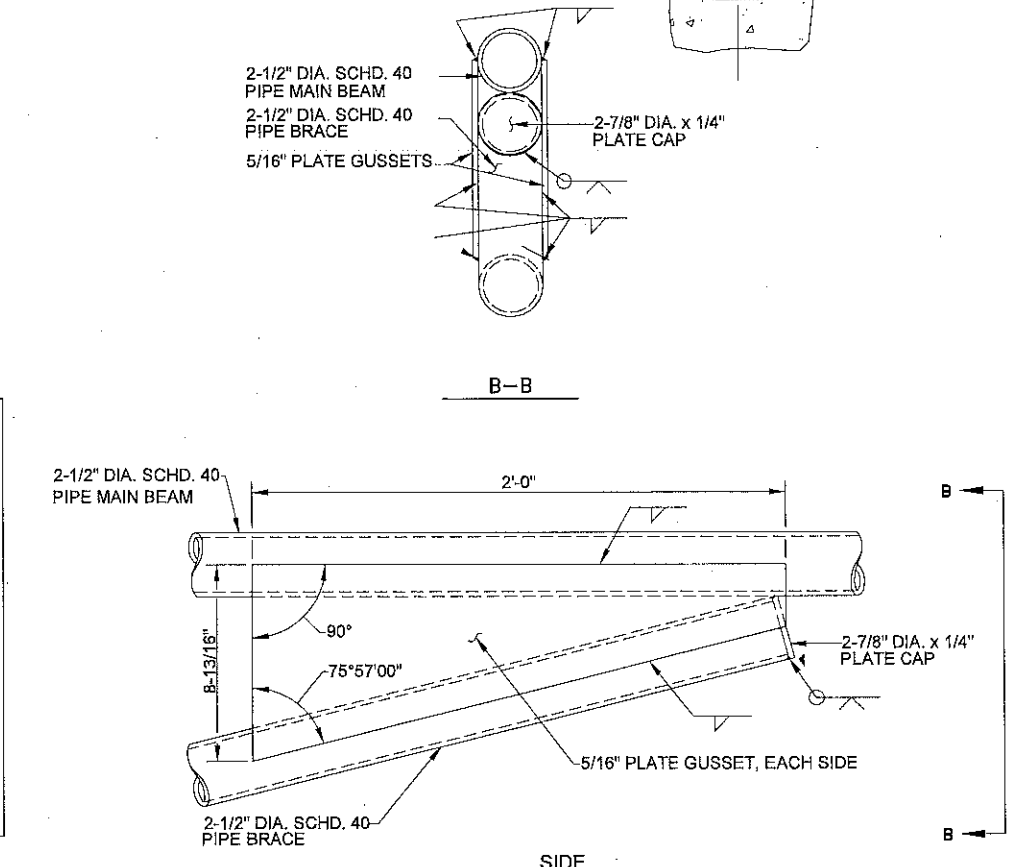

DO NOT SCALE FROM THESE DRAWINGS. USE DIMENSIONS

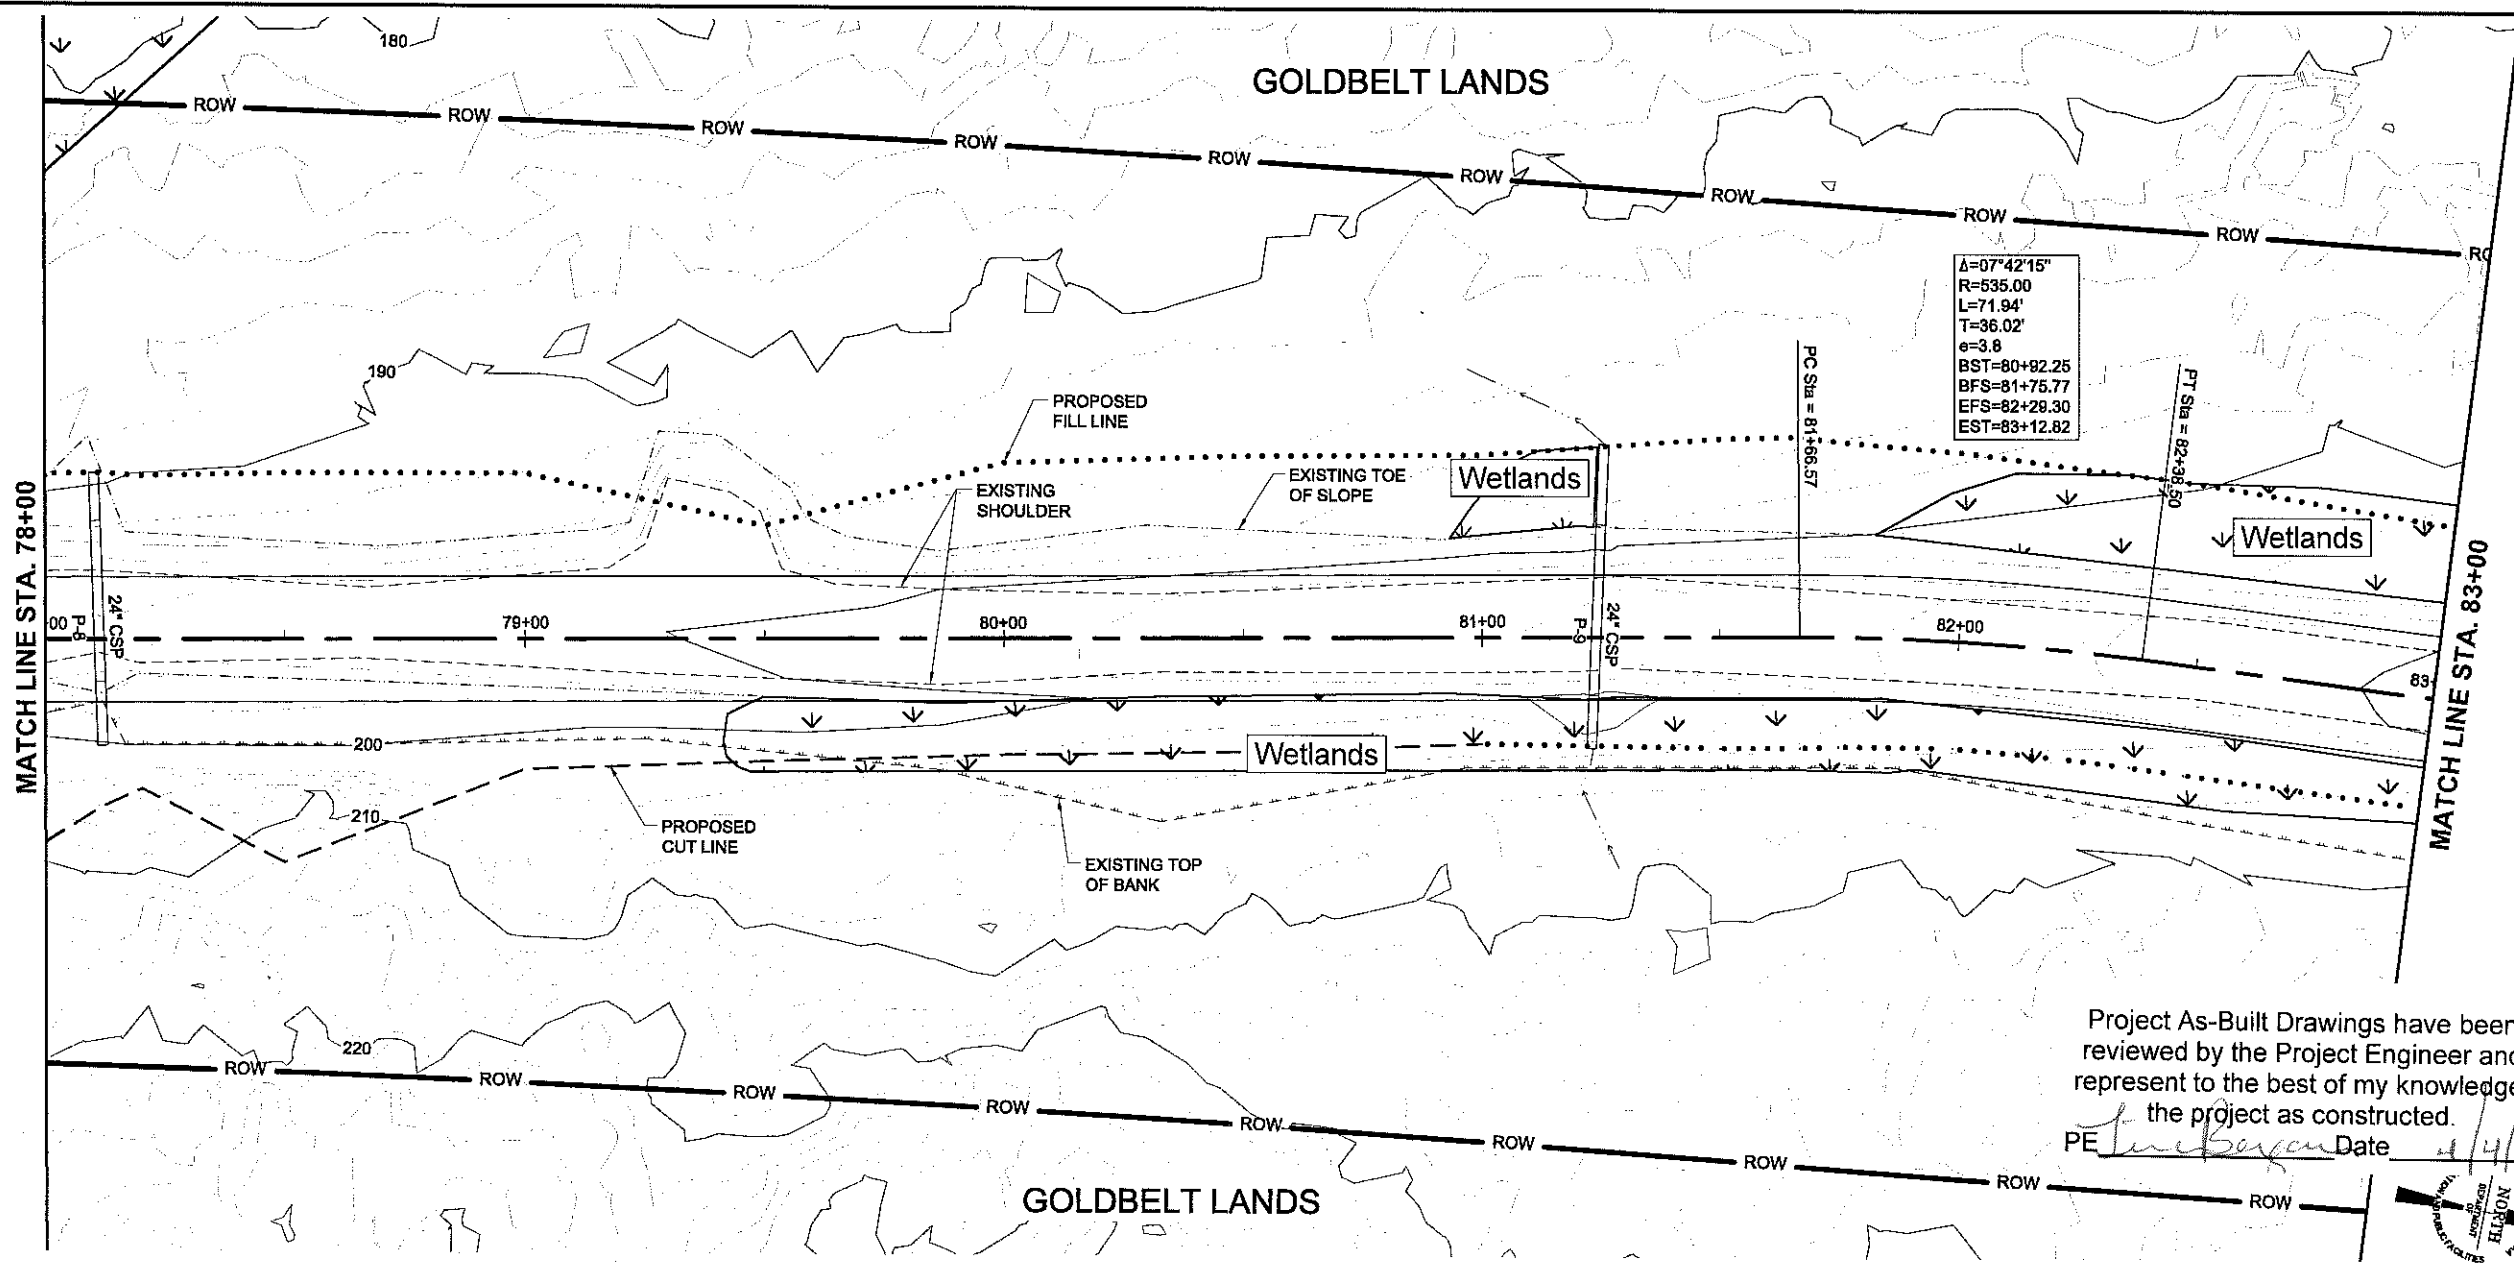

Project As-Built Drawings have been reviewed by the Project Engineer and represent to the best of my knowledge, the project as constructed.
PE *[Signature]* Date *4/14*

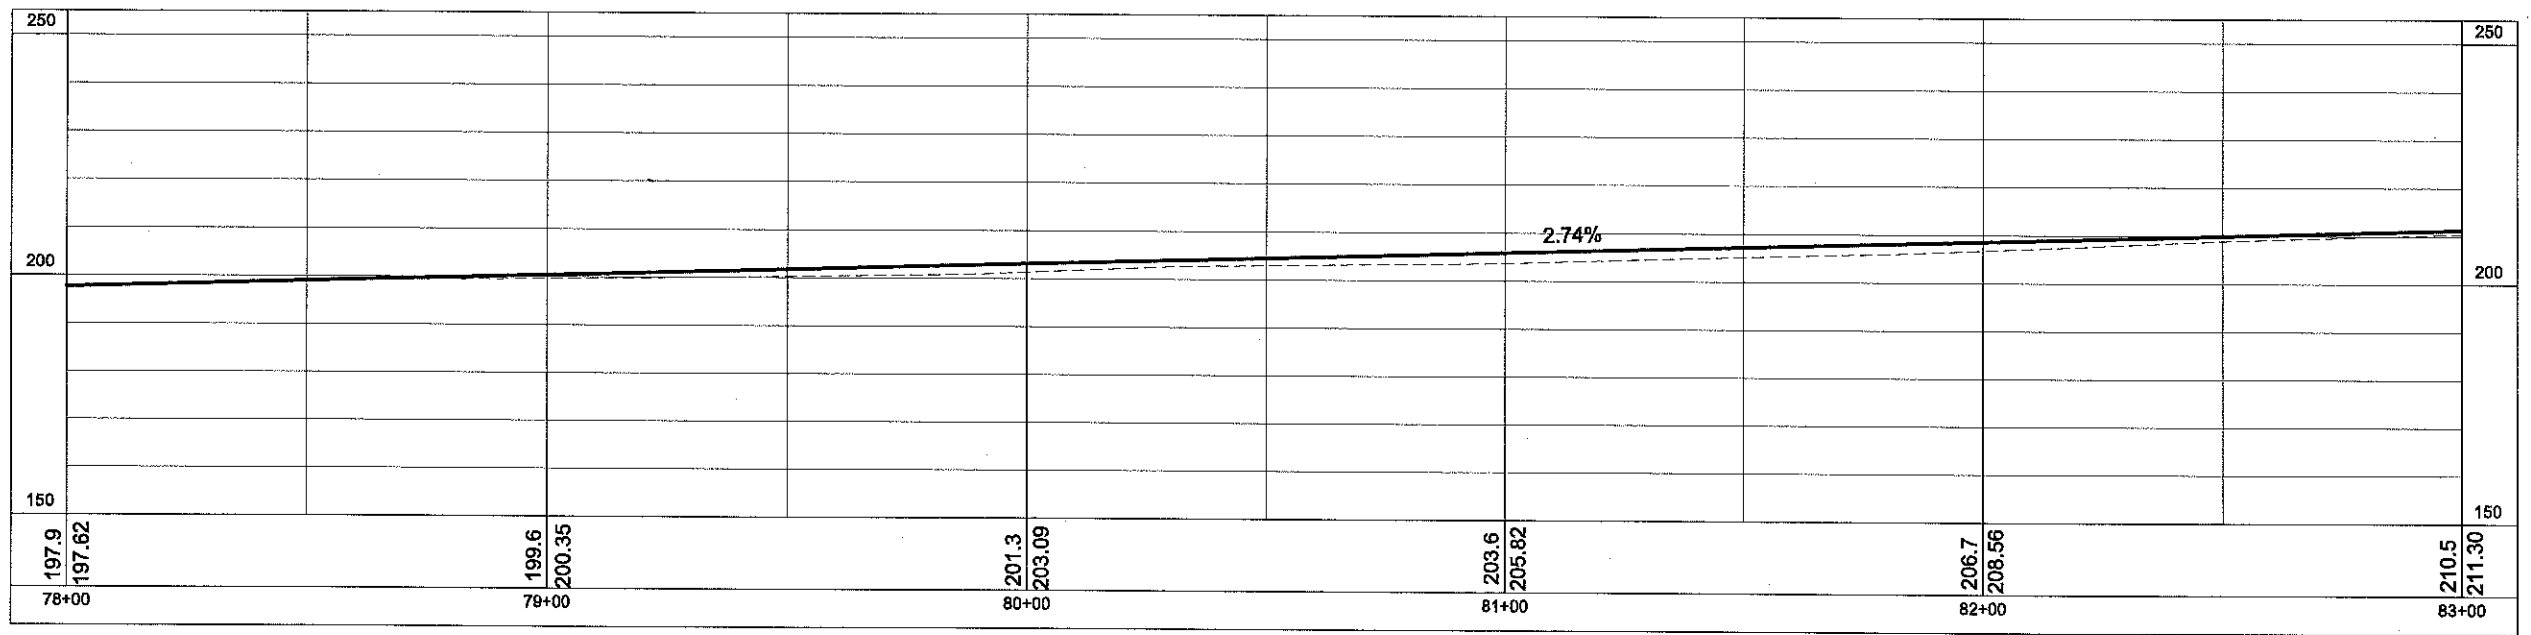

PATH: H:\2010\101309\Autocad Drawings\EP\101309w.dwg

TAB: F5 March 22, 2011 at 3:22pm

ADDENDUM NUMBER

ATTACHMENT NUMBER

RECORD OF REVISIONS

No.	DATE	DESCRIPTION
-----	------	-------------

KEY MAP

E.O.P.

200+00

190+00

180+00

PLAN

STATE OF ALASKA
DEPARTMENT OF
TRANSPORTATION & PUBLIC FACILITIES

PREPARED BY: R&M ENGINEERING, INC.
R&M PROJECT #: 101309

DESIGNED BY: M. STORY

CHECKED BY: M. JOHNSON

DRAWN BY: N. PURVES

STATE OF ALASKA
DEPARTMENT OF TRANSPORTATION & PUBLIC FACILITIES
SOUTHEAST REGION
GLACIER HIGHWAY EXTENSION
DOT&PF PROJECT # 69583


PLAN & PROFILE

PROJECT DESIGNATION NUMBER

69583

STATE

DO NOT SCALE FROM THESE DRAWINGS. USE DIMENSIONS

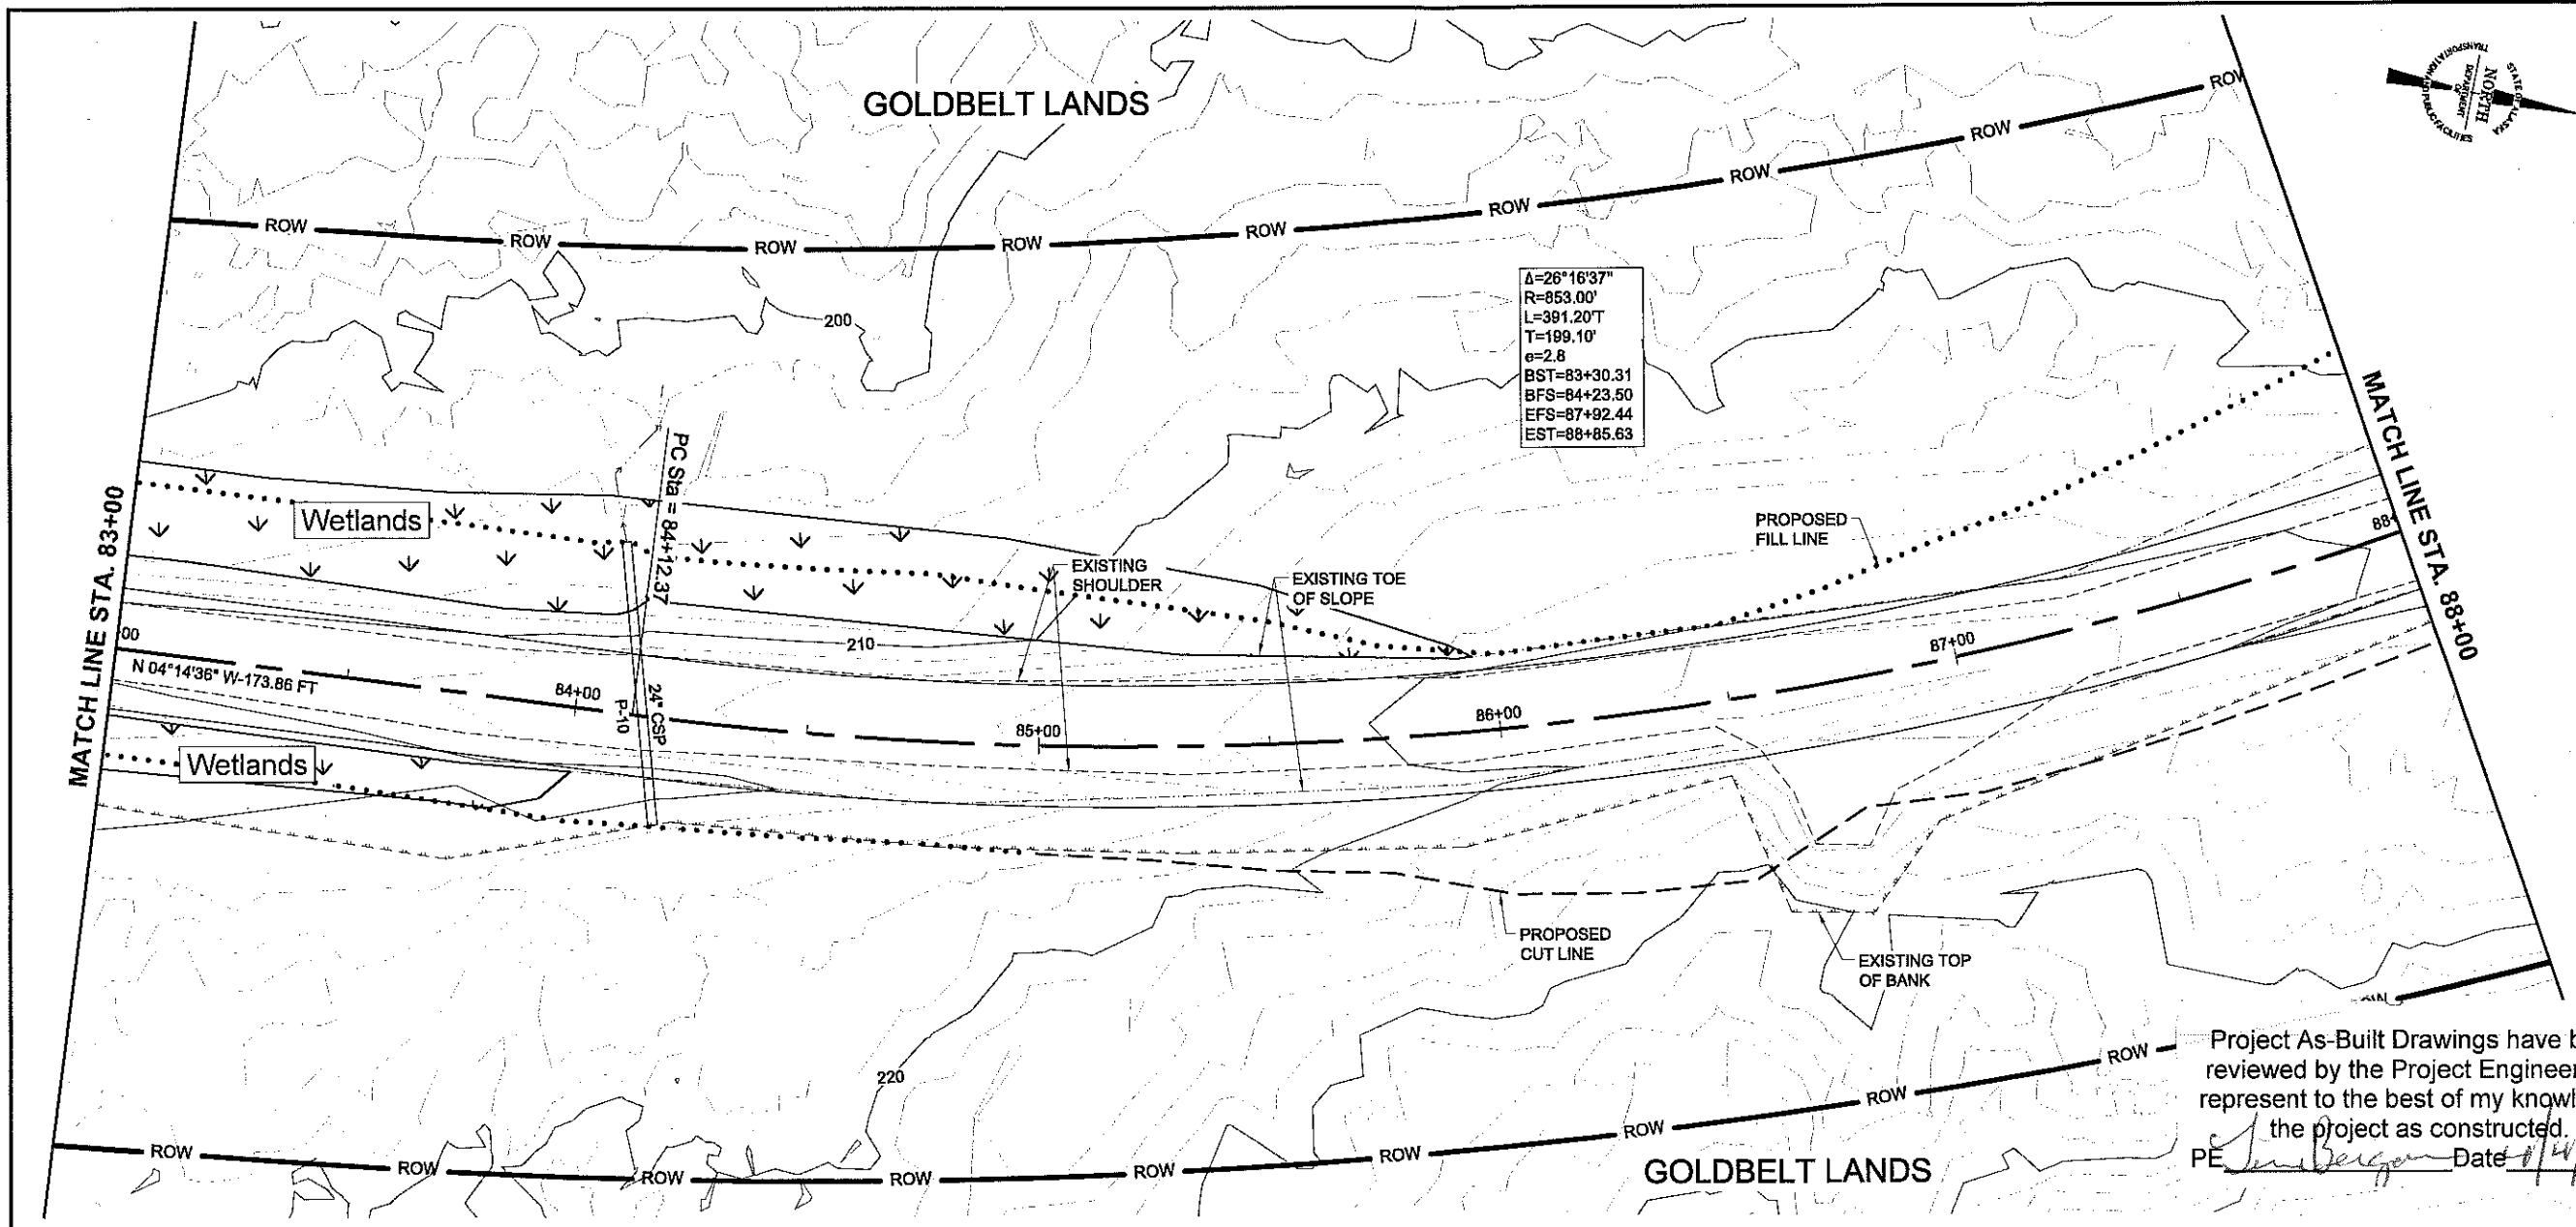

Project As-Built Drawings have been reviewed by the Project Engineer and represent to the best of my knowledge, the project as constructed.
PE *[Signature]* Date *8/24/11*

PATH: I:\2010\101309\Autocad Drawings\EP\101309wk.dwg

TAB:F6 March 23, 2011 at: 7:55am

ADDENDUM NUMBER

ATTACHMENT NUMBER

RECORD OF REVISIONS

No.	DATE	DESCRIPTION
-----	------	-------------

KEY MAP

E.O.P.

200+00

180+00

160+00

140+00

120+00

100+00

90+00

80+00

70+00

60+00

50+00

40+00

30+00

20+00

10+00

0+00

PLAN

PREPARED BY: R&M ENGINEERING, INC.
R&M PROJECT #: 101309

DESIGNED BY: M. STORY

CHECKED BY: M. JOHNSON
DRAWN BY: N. PURVES


STATE OF ALASKA
DEPARTMENT OF TRANSPORTATION & PUBLIC FACILITIES
SOUTHEAST REGION
GLACIER HIGHWAY EXTENSION
DOT&PF PROJECT # 69583

PLAN & PROFILE



PROJECT DESIGNATION NUMBER
69583

STATE	YEAR
ALASKA	2011

SHEET NUMBER	TOTAL SHEETS
F6	52

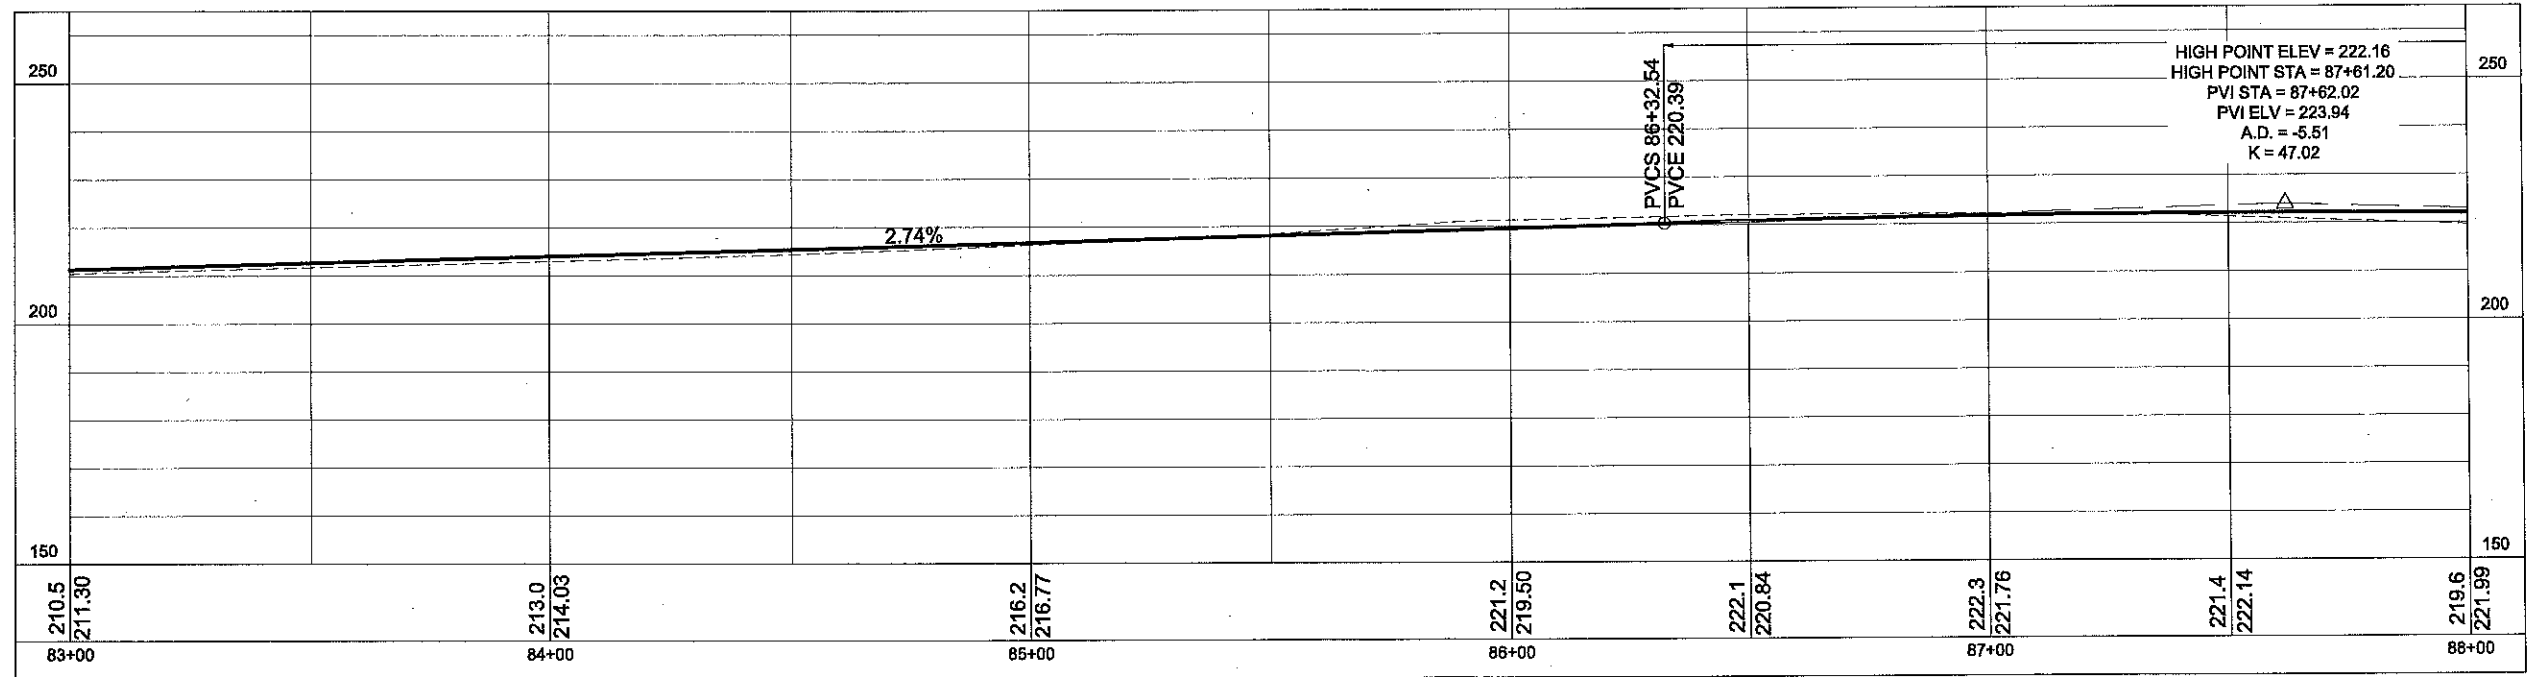

DO NOT SCALE FROM THESE DRAWINGS. USE DIMENSIONS

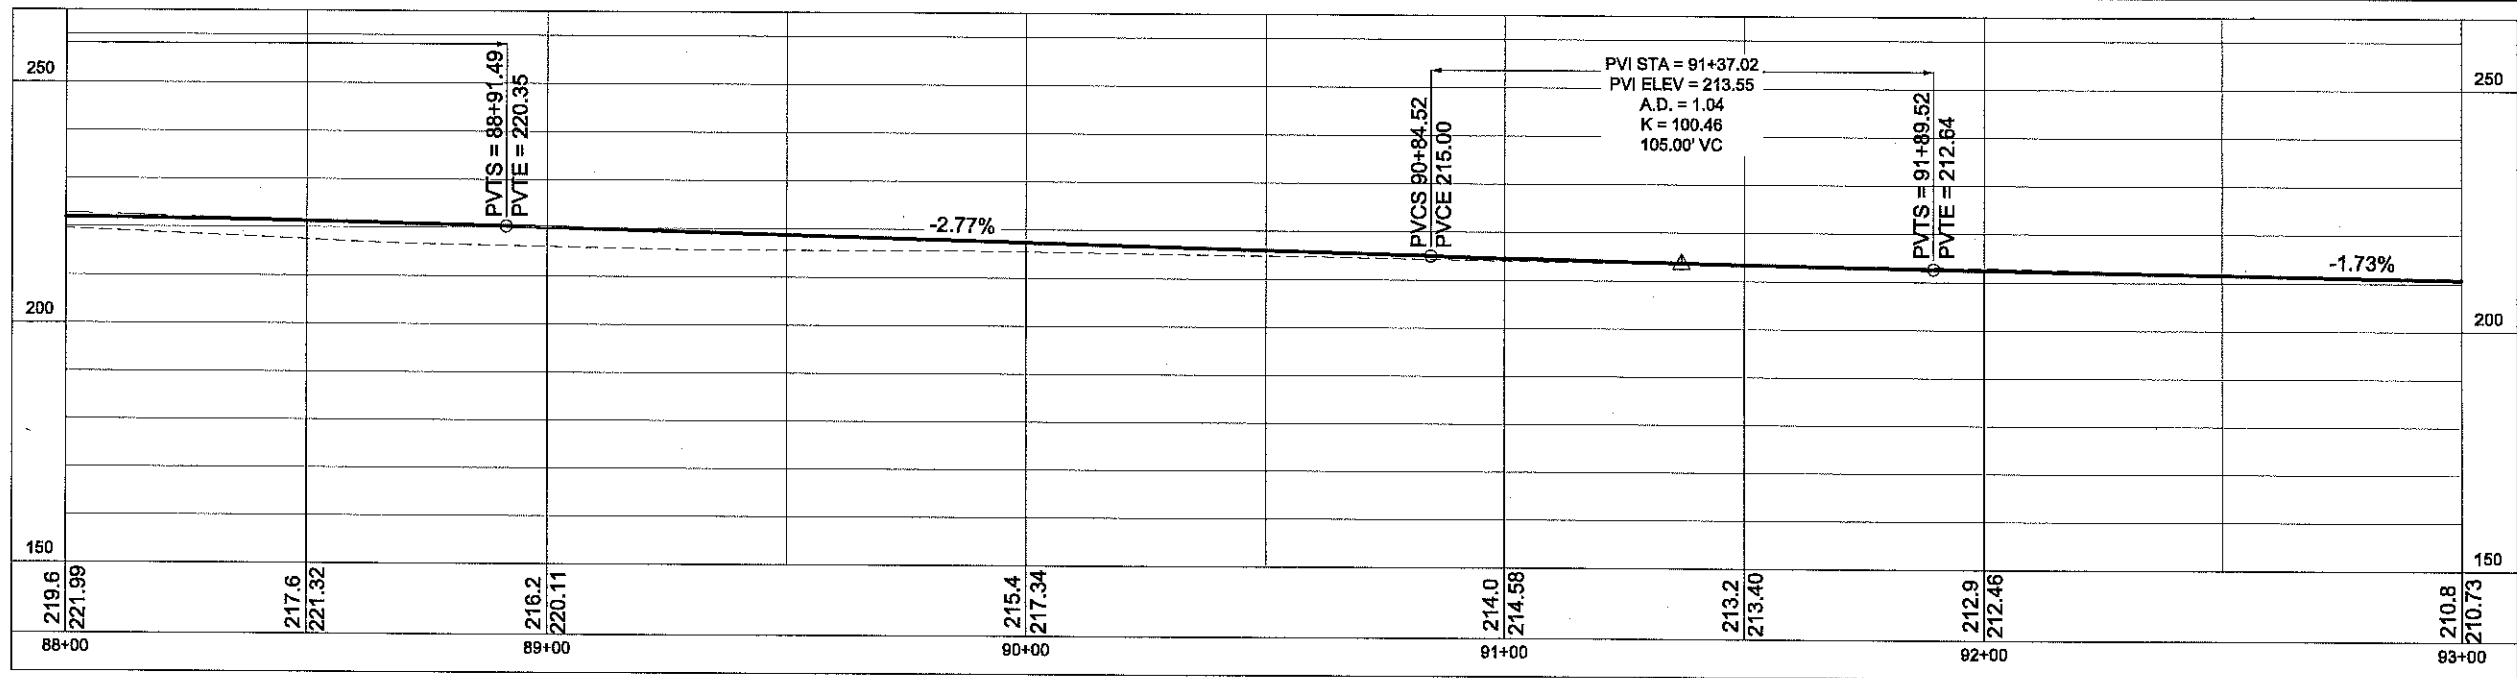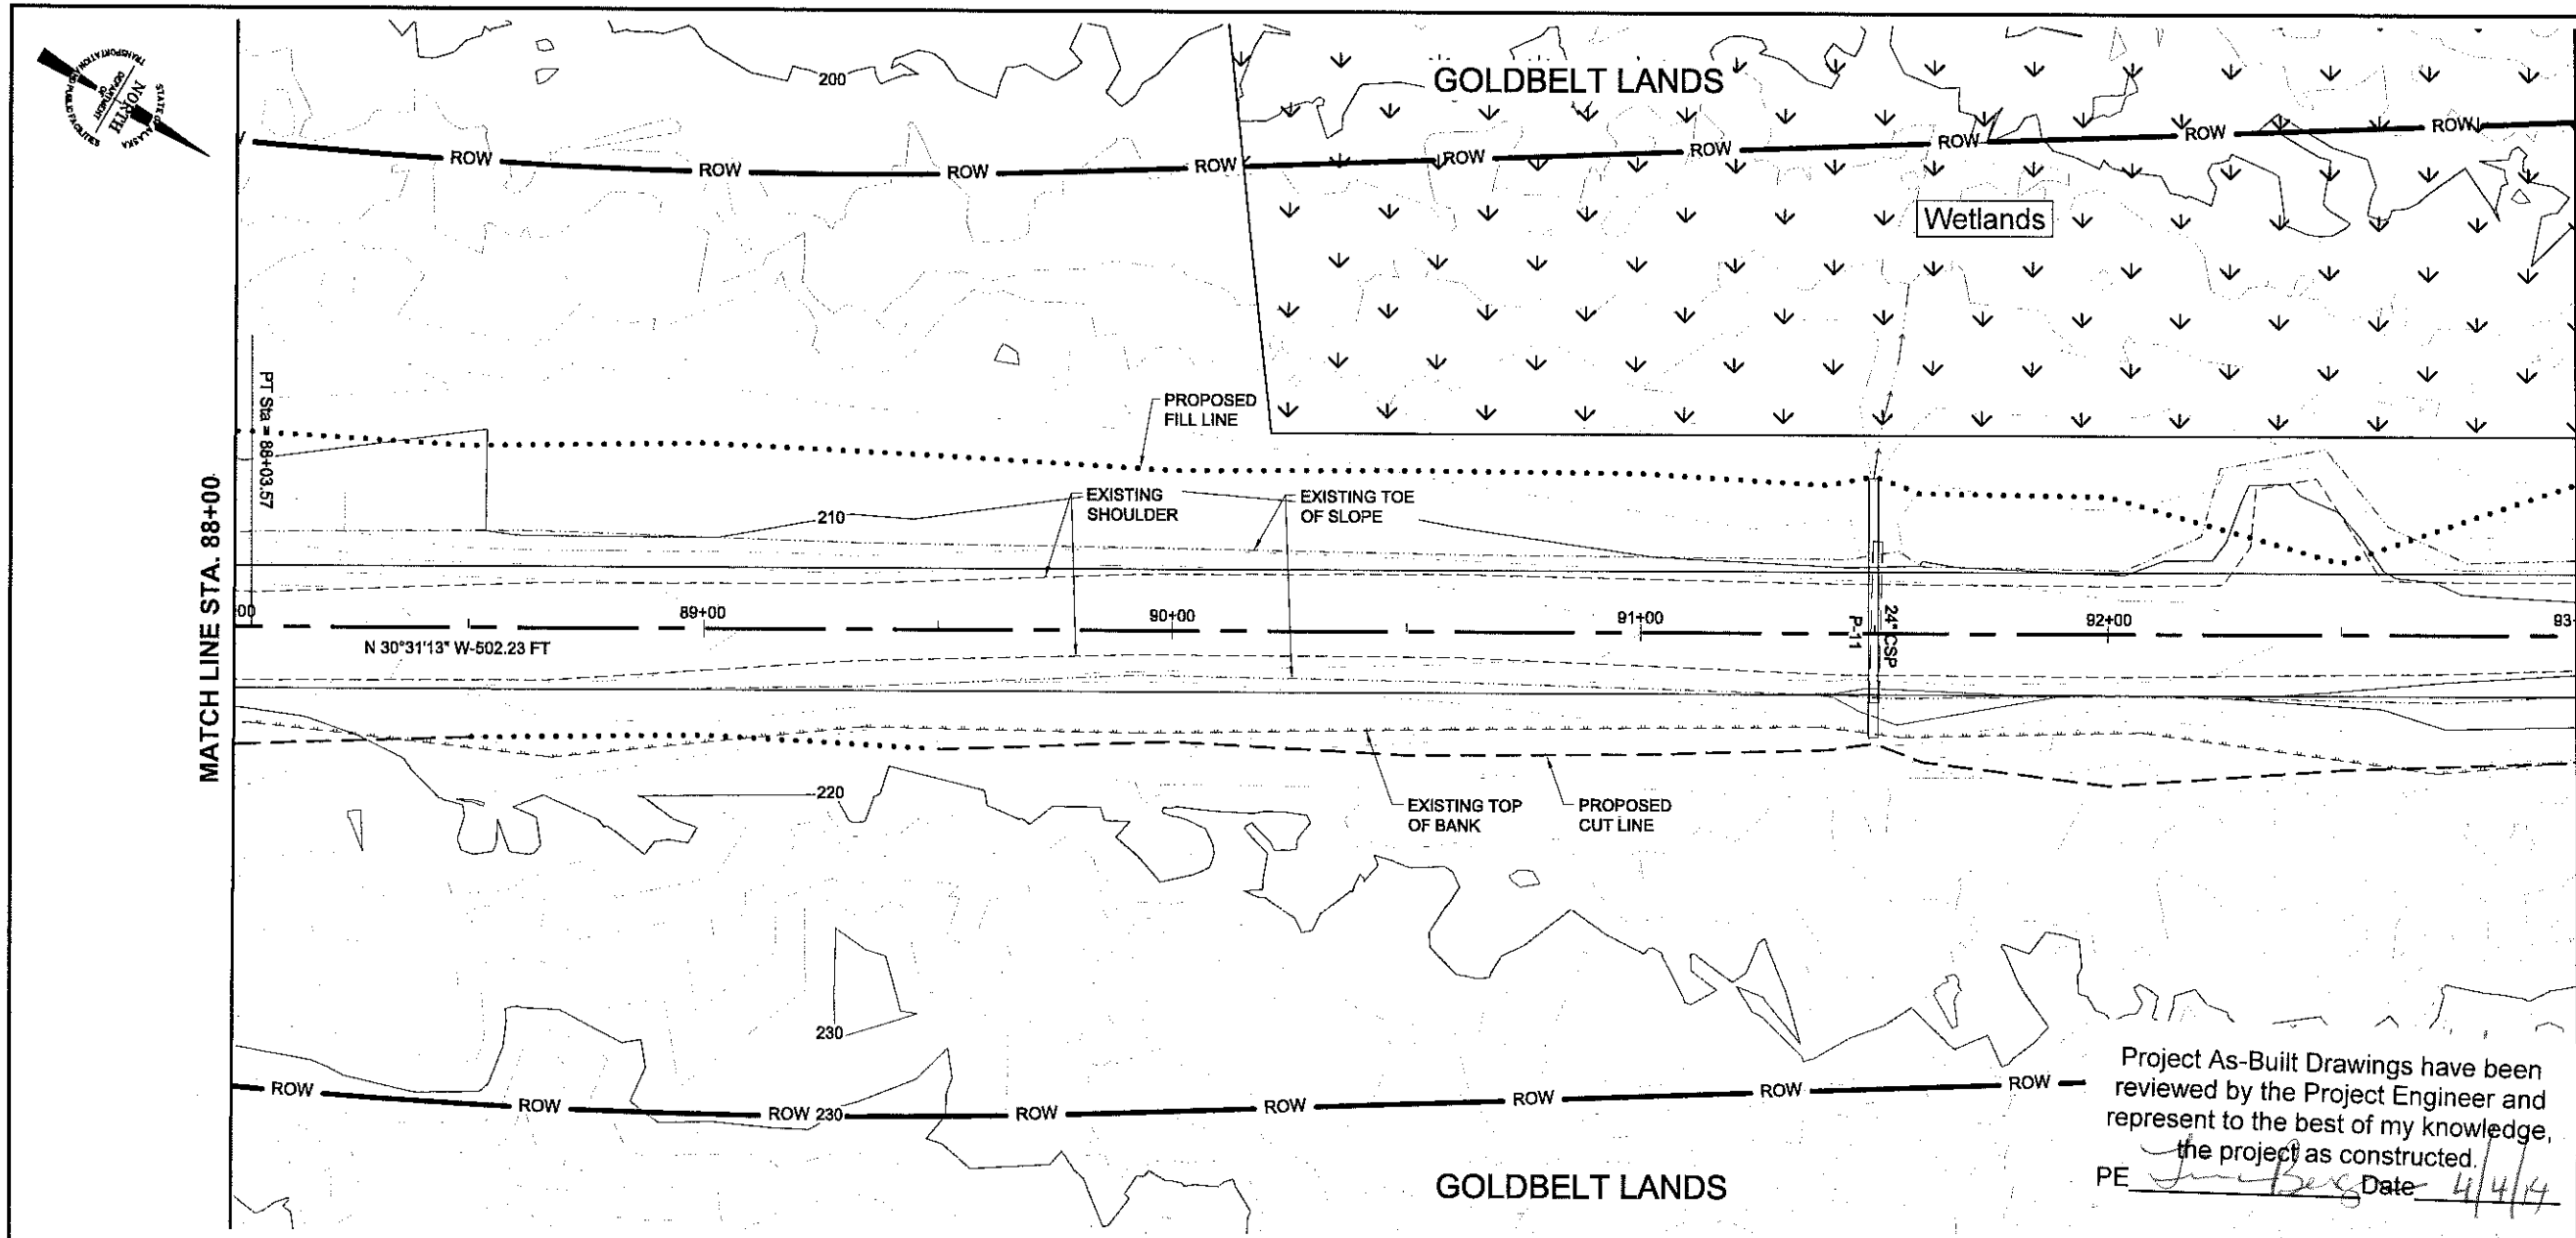

PATH: I:\2010\101309\Autocad Drawings\EP\101309wk.dwg

TAB:F7 March 23, 2011 at 7:55am


ADDENDUM NUMBER

ATTACHMENT NUMBER

RECORD OF REVISIONS

No.	DATE	DESCRIPTION

KEY MAP

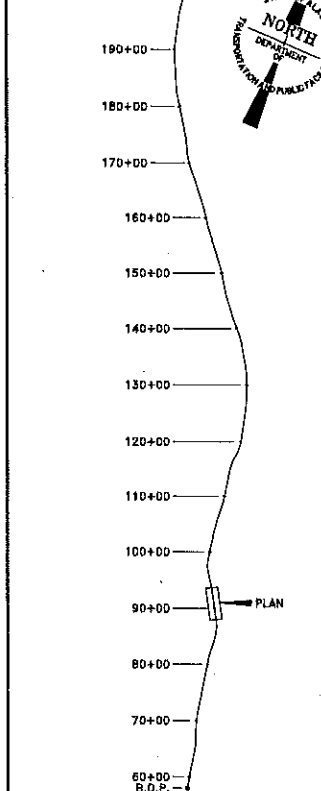

PREPARED BY: R&M ENGINEERING, INC.
R&M PROJECT #: 101309

DESIGNED BY: M. STORY



