

KEY MAP

STATE OF ALASKA
DEPARTMENT OF TRANSPORTATION
&
PUBLIC FACILITIES

PLAN AND PROFILE
PROPOSED HIGHWAY PROJECT

GLACIER HIGHWAY SAFETY IMPROVEMENTS
1985

GLACIER HIGHWAY,
INDUSTRIAL BLVD. INTERSECTION

HES-RS-093-2(16) [E-90052]

MENDENHALL PENINSULA ROAD

LANE WIDENING

HES-RS-093-2(18) [E-30112]

| STATE | PROJECT | SHEET NO. | TOTAL SHEETS |
|--------|---------|-----------|--------------|
| ALASKA | | 1 | 11 |

| INDEX OF SHEETS | |
|-----------------|---------------------------------------------------|
| SHEET NO. | DESCRIPTION |
| 1 | TITLE SHEET |
| 2-3 | TYPICAL SECTIONS |
| 4 | ESTIMATE OF QUANTITIES SUMMARY TABLES |
| 5-7 | PLAN AND PROFILE SHEETS |
| 8-10 | SIGNING, STRIPING, RPM, TCP & ILLUMINATION SHEETS |
| 11 | DRIVEWAY DETAILS |

THE FOLLOWING STANDARD DRAWINGS ARE INCLUDED IN THIS PROJECT

- A-1, C-01.01, C-02.00, C-03.01, C-04.00, D-01.00, D-05.01, F-01.01, F-03.01, I-40.00, L-03.00, L-10.00, L-14.00, L-20.00, L-23.00, L-30.00, M-20.01, M-23.00, S-00.00, S-05.00, S-20.00, S-30.01, T-03.01, T-05.00, T-20.00, T-21.00, T-22.00


PROJECT SUMMARY
GLACIER HIGHWAY AT INDUSTRIAL BLVD.
WIDTH OF WIDENING = 0'-6" LT. & RT.
LENGTH OF PROJECT = 732.00' = 0.139 MI.

DESIGN DESIGNATION
GLACIER HIGHWAY
ADT (1983) = 8,705
ADT (2004) = 14,264
DMV (13%) = 1,854
T. = 10%
T.I. = 9.5
V = 50

PROJECT SUMMARY
INDUSTRIAL BLVD.
WIDTH OF PROJECT = 32' - 44'
LENGTH OF PAVEMENT = 388.73' = 0.074 MI.
LENGTH OF GRADING = 438.73' = 0.083 MI.
LENGTH OF PROJECT = 450.00' = 0.085 MI.
LENGTH OF TEMPORARY = 50.00'
CONNECTION

PROJECT SUMMARY
MENDENHALL PENINSULA ROAD -LANE WIDENING
WIDTH OF WIDENING = 0'-15'
LENGTH OF PROJECT = 850.00' = 0.161 MI.

'AS-BUILT' PLANS
Contractor: ASSOCIATED SAND & GRAVEL CO., INC.
Proj. Engr.: S. KREUZENSTEIN
Begin: JULY 19, 1985
Completion: SEPT. 27, 1985
(ITEM 660(3)): NOV. 15, 1985

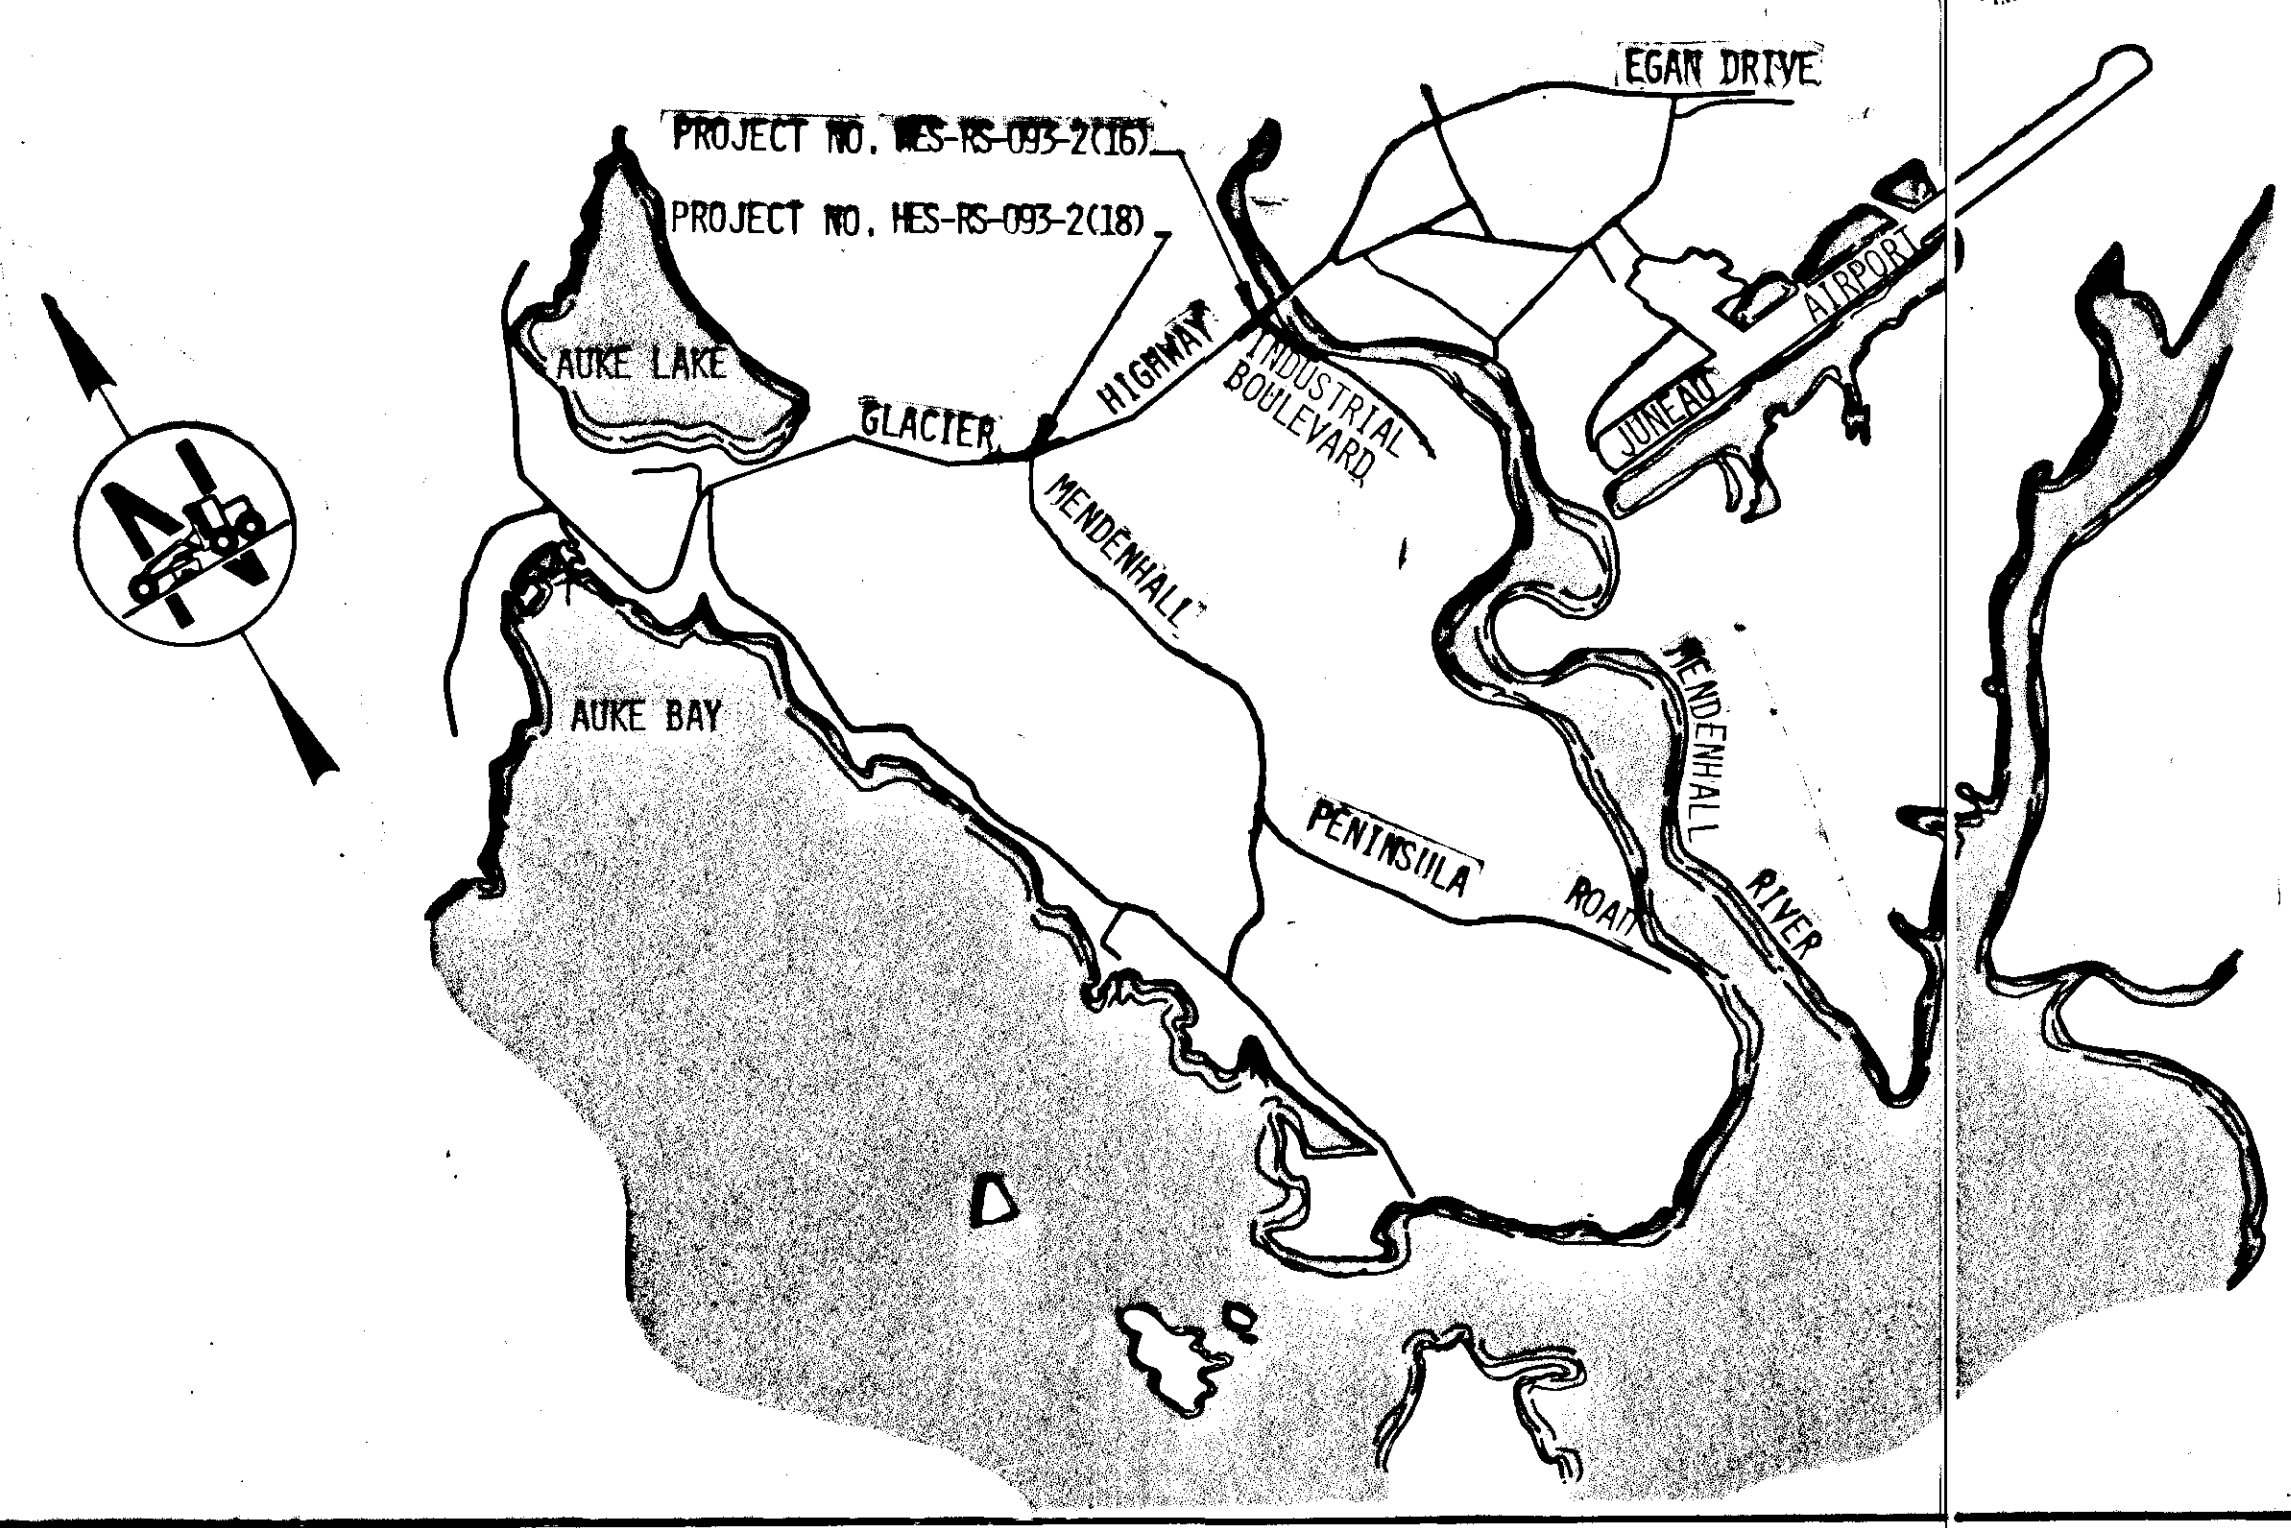

STATE OF ALASKA
DEPARTMENT OF TRANSPORTATION
AND
PUBLIC FACILITIES
APPROVED BY: *Wilbur K. Williams* DATE: 4/10/85
Southeast Region
Design Engineer

STATE OF ALASKA
DEPARTMENT OF TRANSPORTATION
AND
PUBLIC FACILITIES
APPROVED BY: *S. E. Design and Construction* DATE: 4/10/85
DIRECTOR
S. E. Design and Construction





TYPICAL SECTIONS OF IMPROVEMENT

GLACIER HWY./INDUSTRIAL BLVD. INTERSECTION

GENERAL NOTES

HES-RS-093-2 (16) & HES-RS-093-2 (18)


- Alignments and Grades shown on the Plans are subject to minor revisions.
- Pipe Conduit lengths and locations are approximate only and are subject to field adjustments.
- All waste material shall be disposed of outside of the R/W limits at a location selected by the Contractor and approved by the Engineer. Also, the Contractor may be required to obtain a Corp. Permit if he chooses to waste the materials in the waters of the U.S. (i.e. Muckey).
- The Contractor will be required to design intersection grades to match existing grades. Existing pavement cross slope grades shall be extended through the shoulder of the new Asphalt.
- Clearing and Grubbing Limits shall be 10' beyond the slope limits in cut areas and 5' beyond the slope limits in fill areas or to the R/W line, Easement Line or Permit Line as directed by the Engineer.
- Any Special Ditching required by the Engineer will be minor and will be paid for as Unclassified Excavation under Section 203 and no additional payment will be made therefore.
- All existing recessed pavement markers within the project limits shall be removed by the Contractor and the holes patched with Tack Coat and Patched with Asphalt Concrete. The removal of the recessed pavement markers and the patching of the holes shall be considered incidental to other items of work.
- All removed asphalt pavement shall be stockpiled in the yard at the intersection of Egan Drive and the Mendenhall Loop Road.
- The Contractor shall maintain continuous vehicular access to the Emmanuel Baptist Church during the construction of this project.

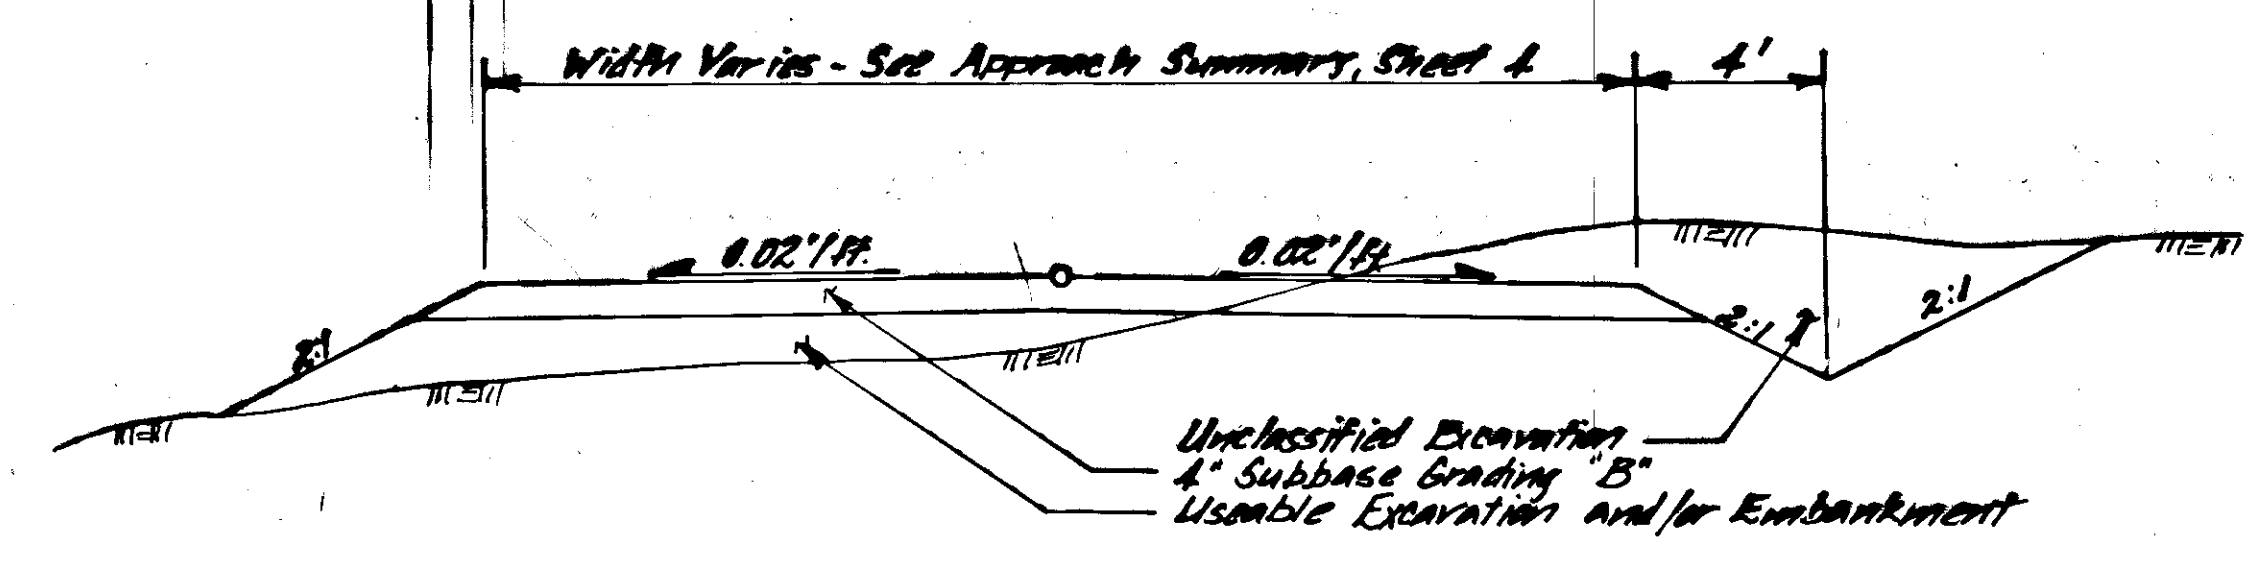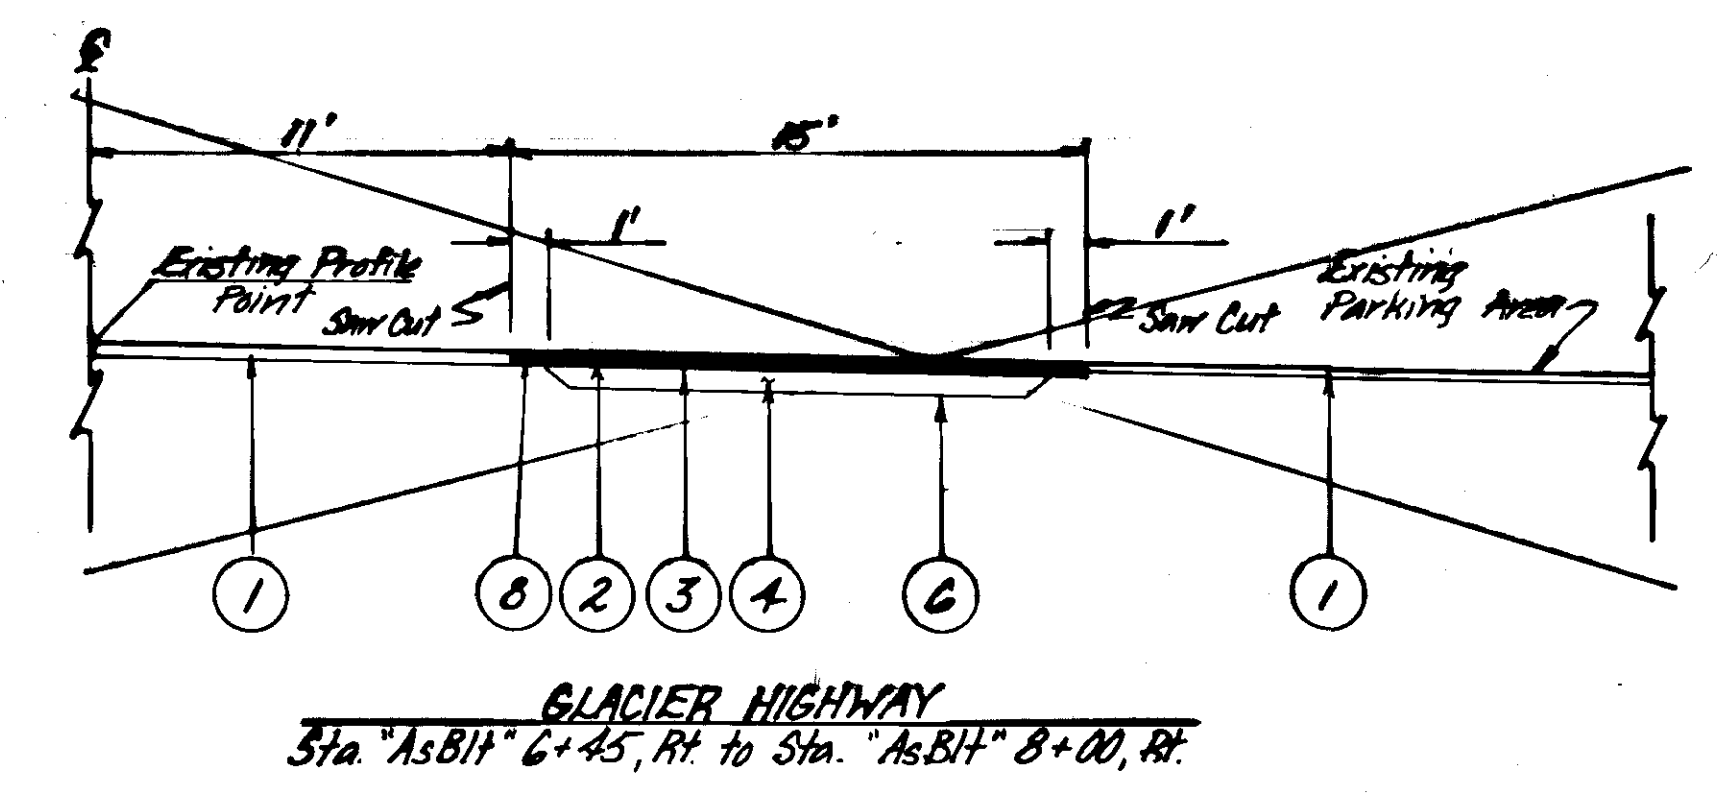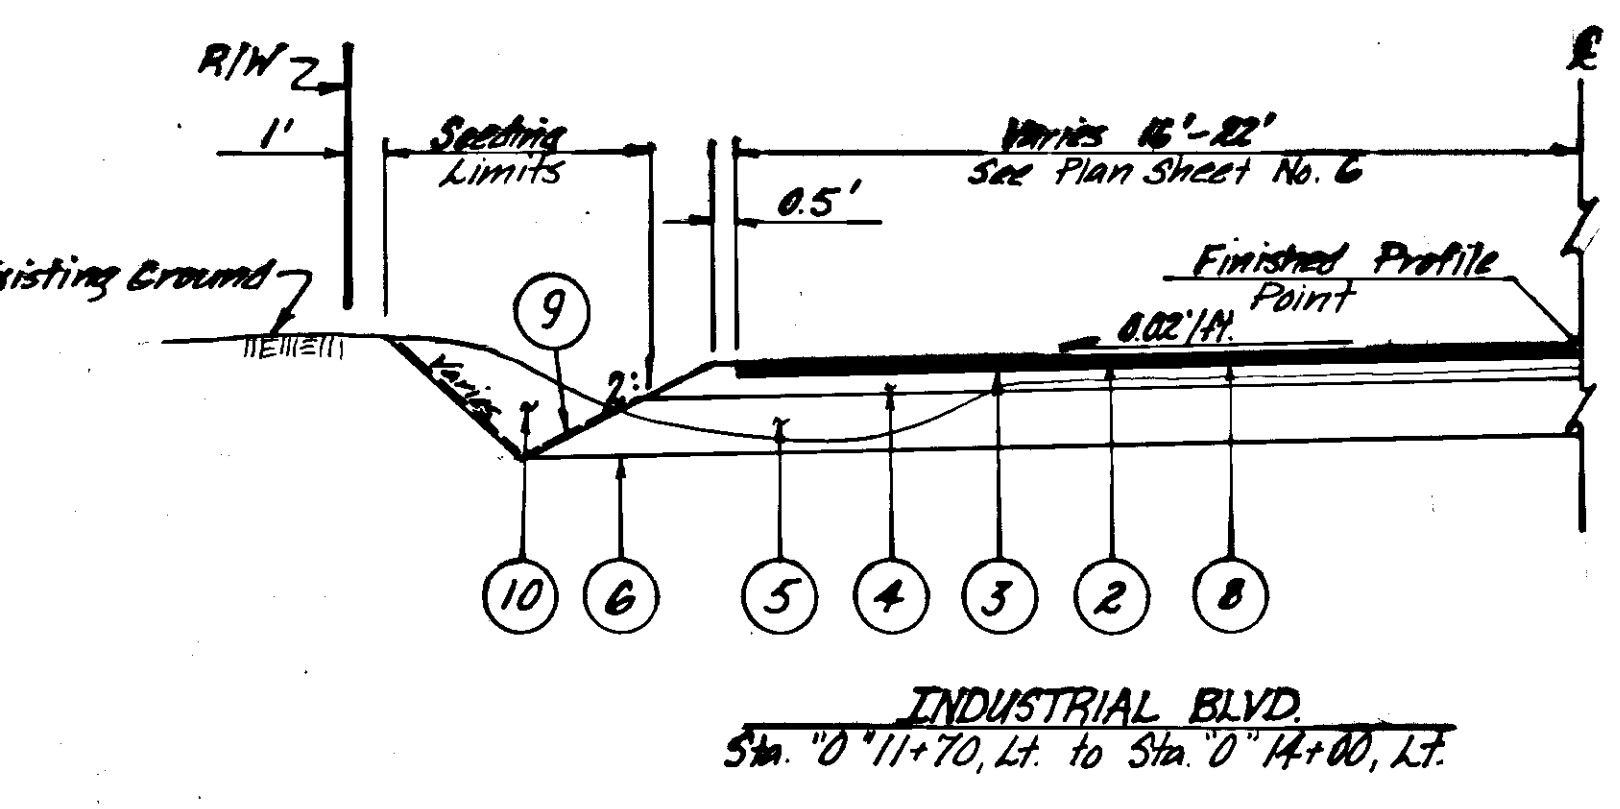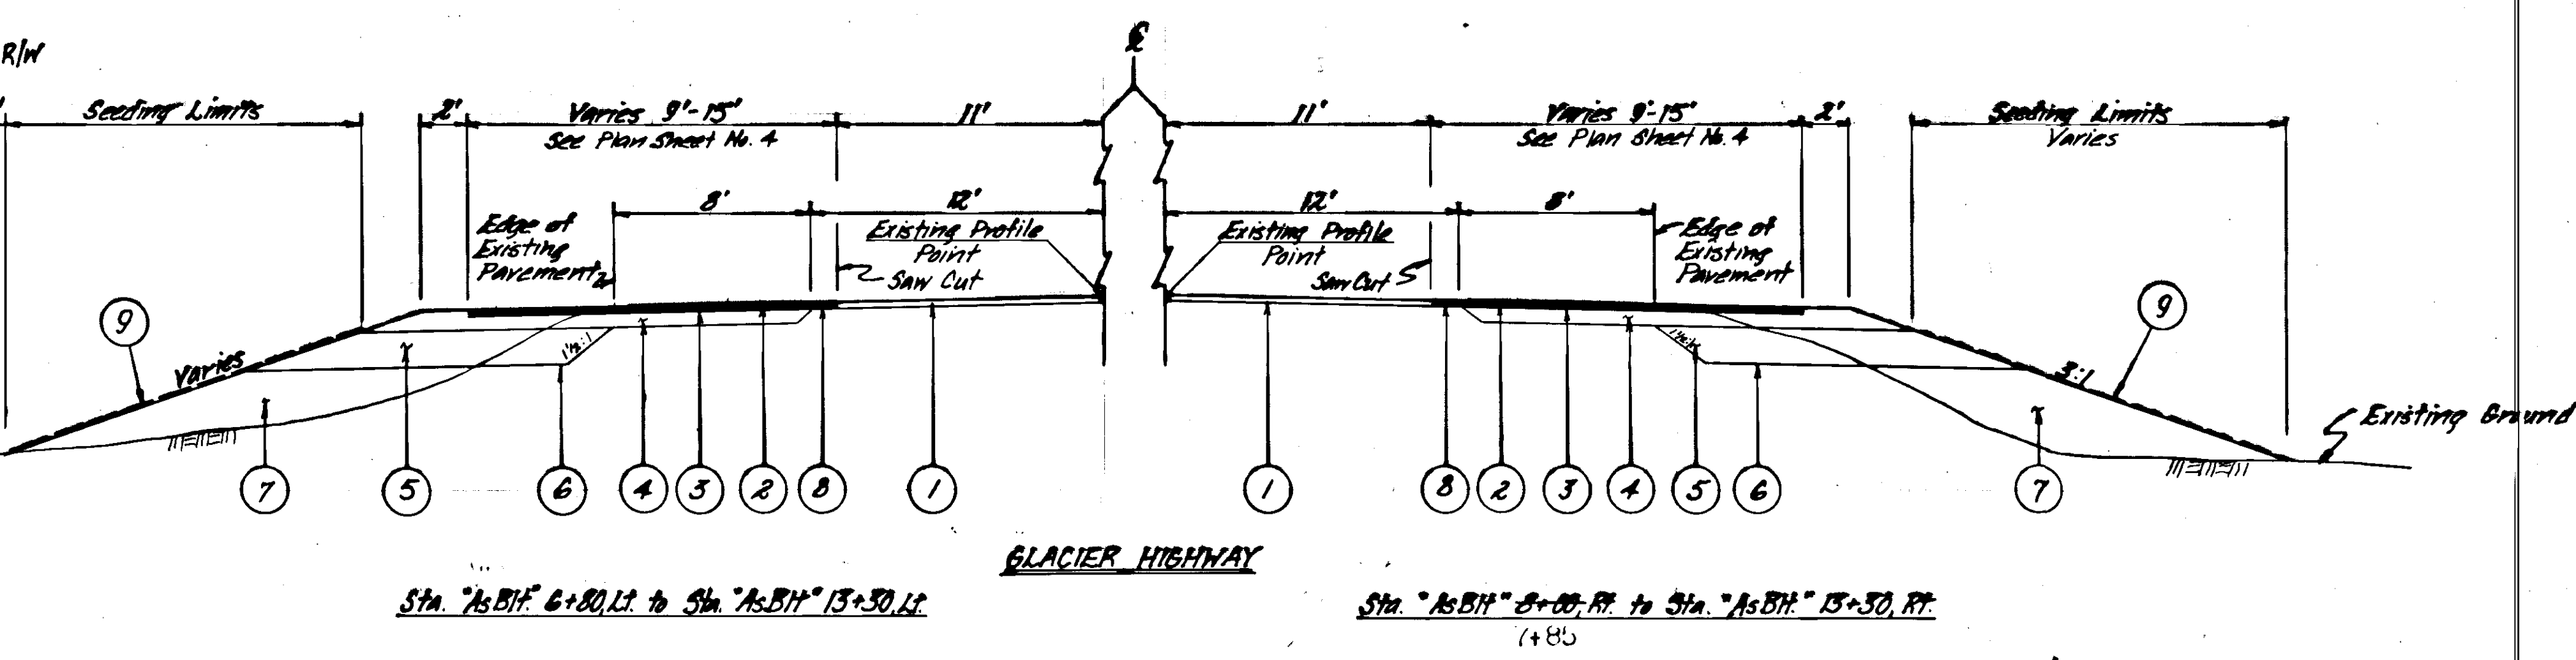

APPROACH ROAD DETAILS

"A" & "B" Lines

- Approaches shall be constructed with the same structural section as Industrial Blvd, except that beyond the paving limits the above detail shall be used.
- All work involved in forming, shaping and construction shall be considered incidental to the Bid Items involved. Materials required shall be paid for at contract bid prices.

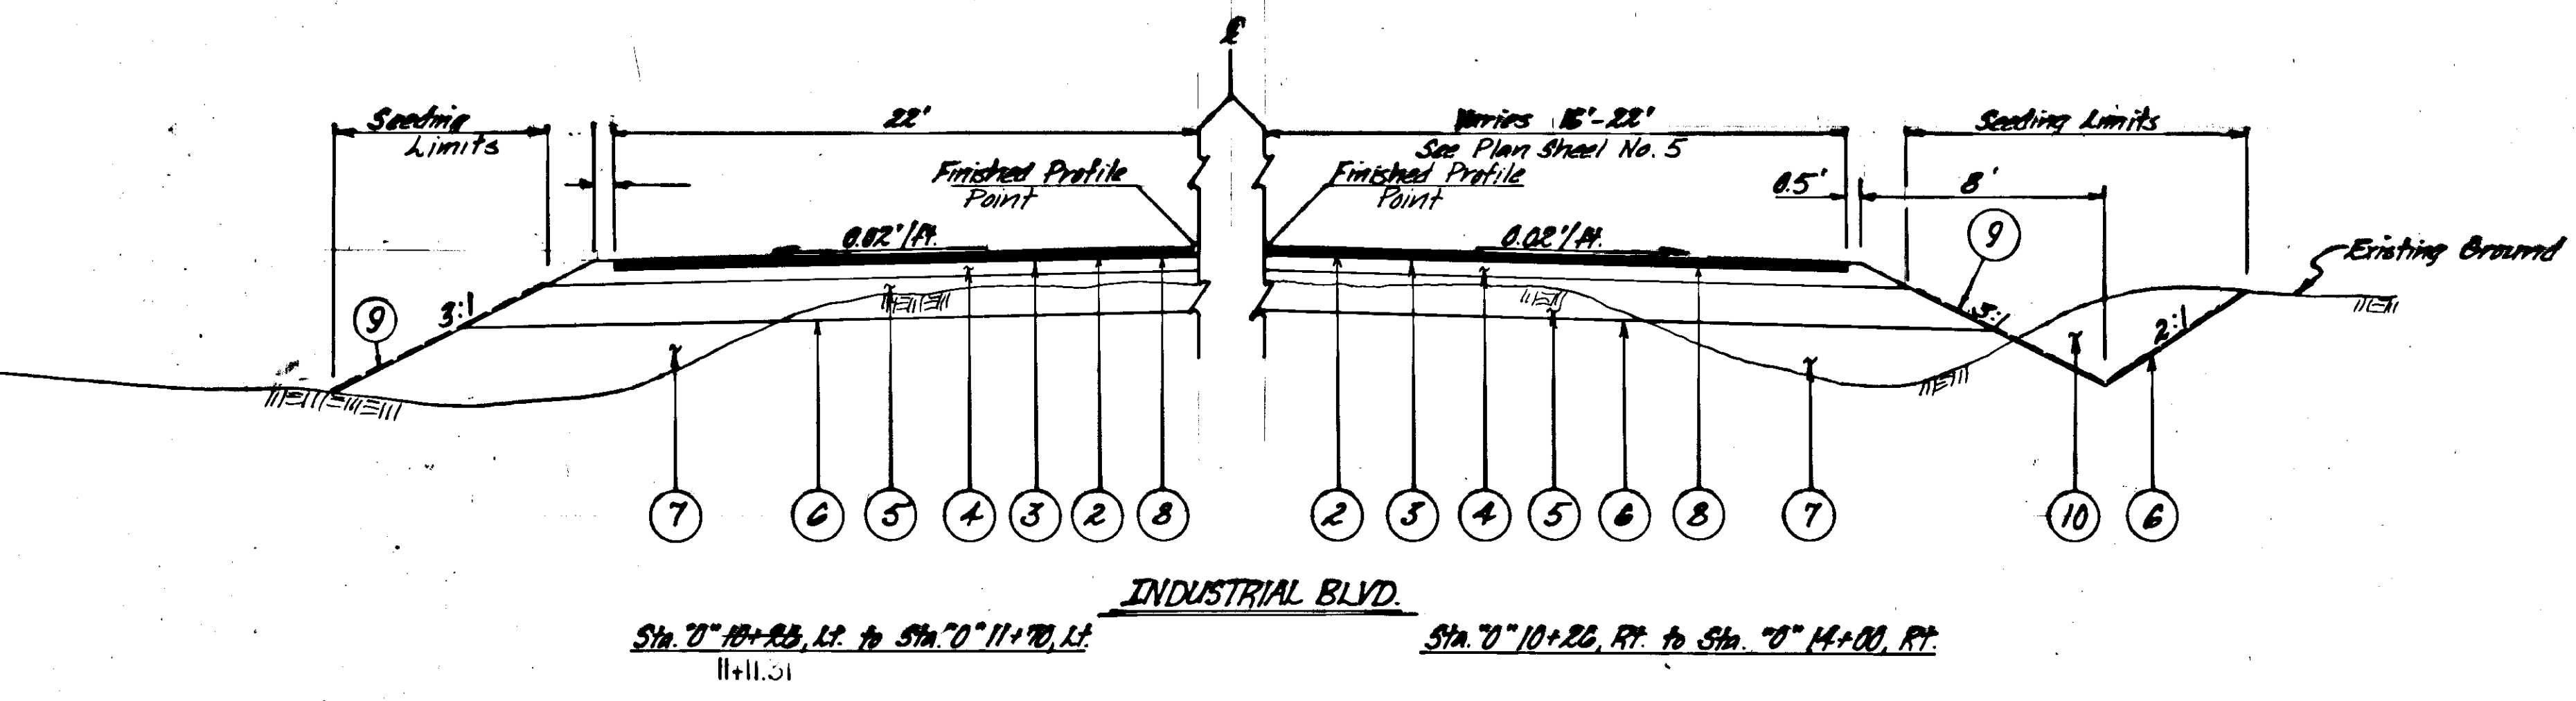


| LABELING INDEX | |
|----------------|-------------------------------------------------------|
| ① | Existing Asphalt Pavement |
| ② | 3 1/2" Asphalt Concrete Type II (Two Lifts) |
| ③ | MC-30 Liquid Asphalt for Prime Coat DELETED by EWO. 3 |
| ④ | 6" Crushed Aggregate Base Course, G-1, D-1 C.O. 1 |
| ⑤ | 18" Subbase Grading "B" "A" C.O. 1 |
| ⑥ | Limits of Unclassified Excavation |
| ⑦ | Embankment and/or Usable Unclassified Excavation |
| ⑧ | CSS-1 Asphalt for Tack Coat (Between Lifts) |
| ⑨ | 3" Topsoil and Hydro-seeding |
| ⑩ | Unclassified Excavation |

TYPICAL SECTIONS OF IMPROVEMENT


MENDENHALL PENINSULA ROAD LANE WIDENING

| STATE | PROJECT DESIGNATION | YEAR | SHEET NO. | TOTAL SHEETS |
|--------|---------------------|------|-----------|--------------|
| ALASKA | HES-RS-093-2(18) | 1985 | 3 | 11 |

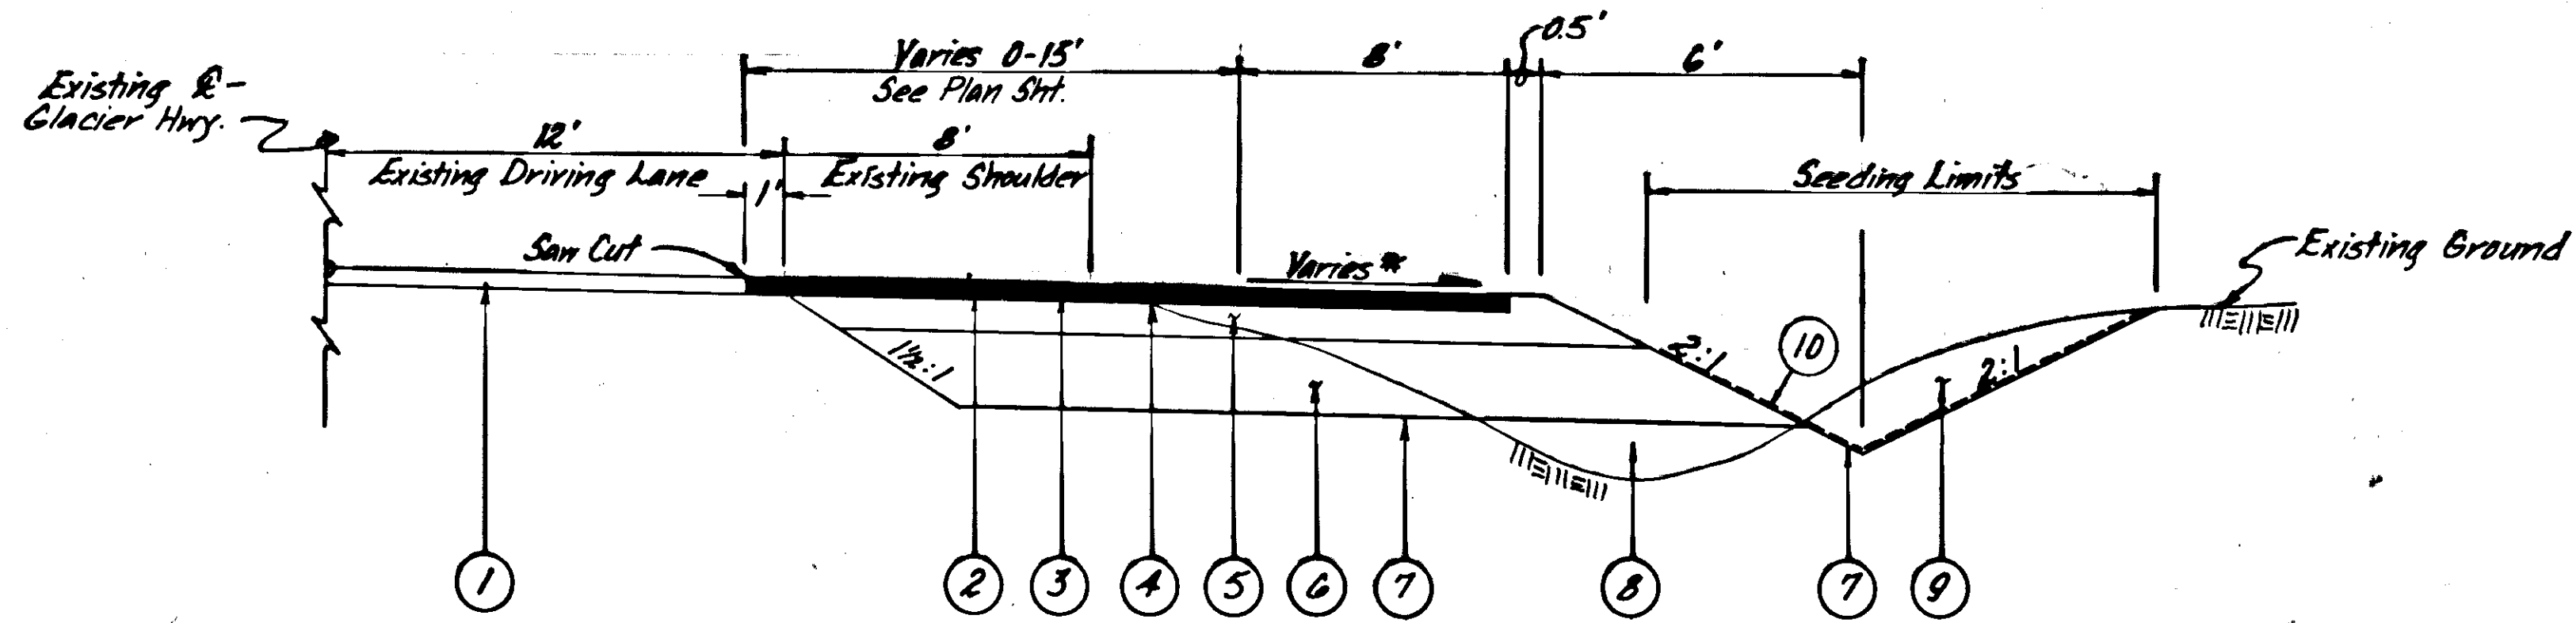


TYPICAL CUT SECTION
Sta. "AsBt" 43+00.00 to Sta. "AsBt" 50+00.00

* Extend existing Cross Slope

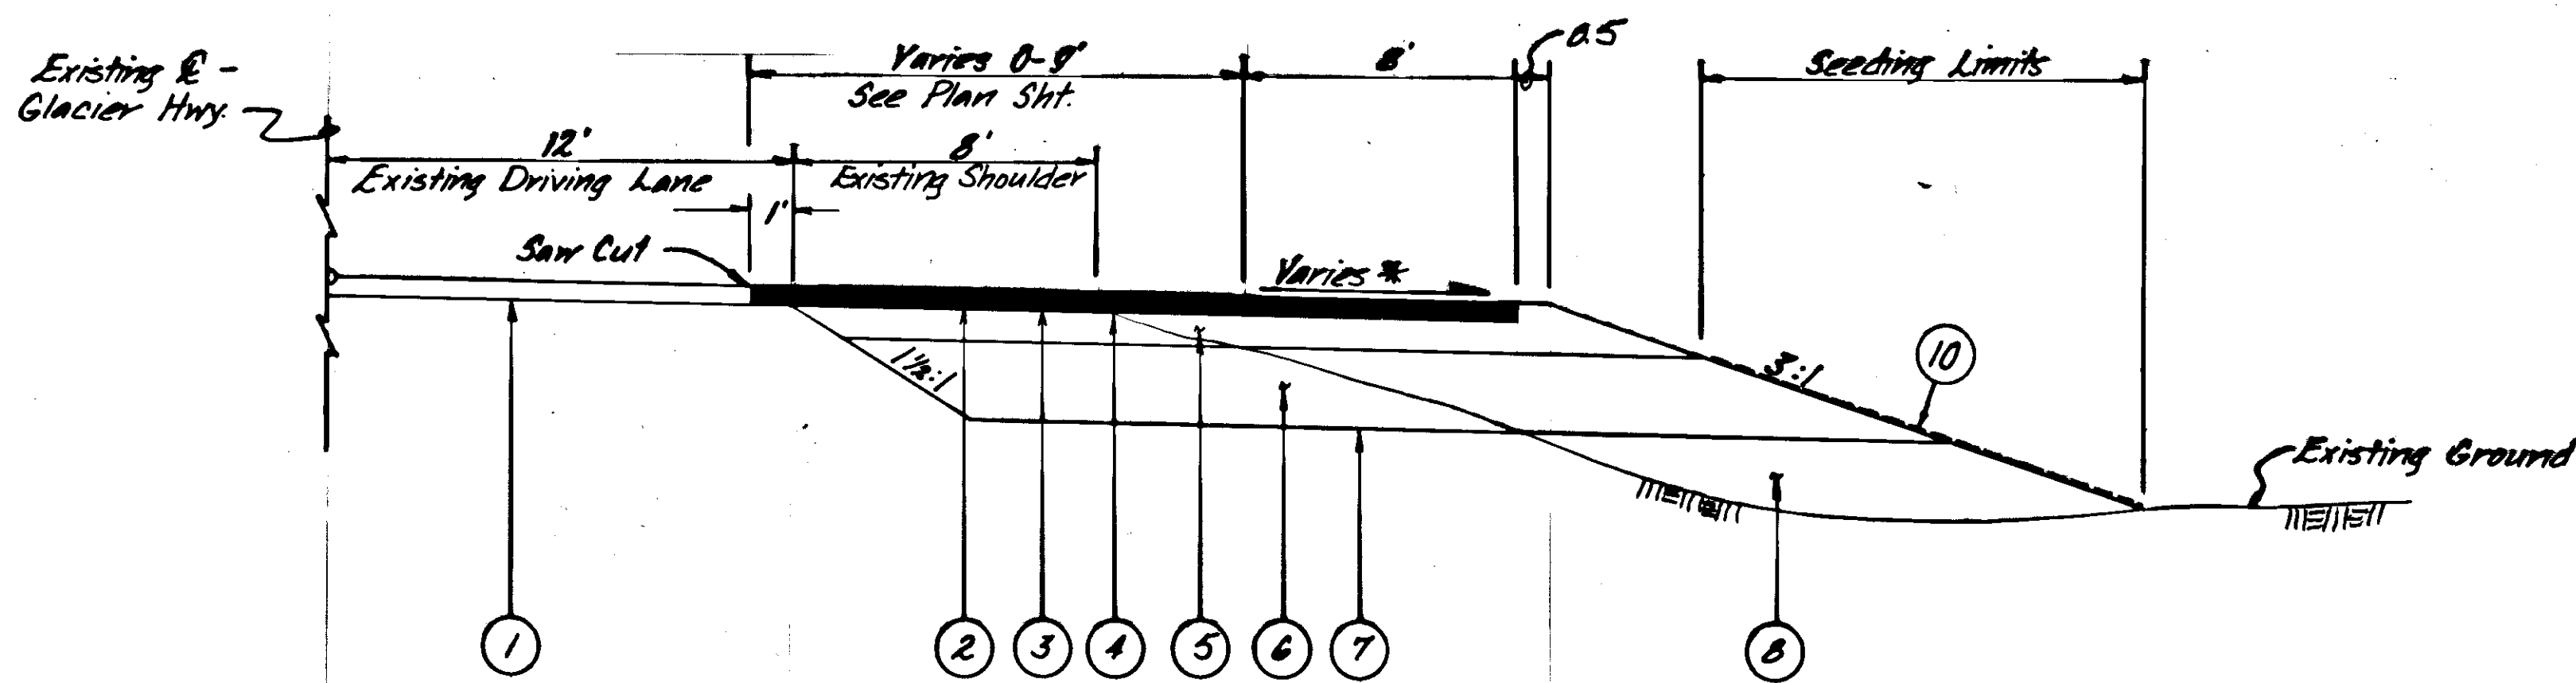

TYPICAL FILL SECTION
Sta. "AsBt" 41+50.00 to Sta. "AsBt" 43+00.00

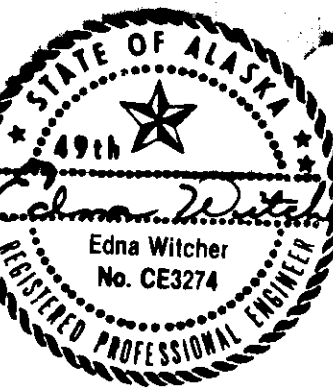

LABELING INDEX

| | |
|---|-----------------------------------------------------------|
| ① | Existing Asphalt Pavement |
| ② | 3 1/2" Asphalt Concrete Type II (2-Lifts) |
| ③ | CSS-1 Asphalt for Tack Coat (Between Lifts) |
| ④ | MC-30 Liquid Asphalt for Prime Coat - DELETED by E.W.O. 3 |
| ⑤ | 6" Crushed Aggregate Base Course B+ D-1 |
| ⑥ | 18" Subbase Grading "B" "A" |
| ⑦ | Limits of Unclassified Excavation |
| ⑧ | Useable Unclassified Excavation and/or Embankment |
| ⑨ | Unclassified Excavation |
| ⑩ | 3" Topsoil and Hydro-seeding |
| ○ | |
| ○ | |

ESTIMATE OF QUANTITIES & SUMMARY TABLES

| ESTIMATE OF QUANTITIES | | | GLACIER HWY INDUSTRIAL BLVD HES-RS-093-2(16) | MENDENHALL PENINSULA RD LANE WIDENING HES-RS-093-2(18) | GRAND TOTAL |
|------------------------|------------------------------------------|--------|-------------------------------------------------|-----------------------------------------------------------|--------------|
| NO. | ITEM | UNIT | | | |
| 109(2) | DBE and MBE Adjustments | C.S. | All Required | All Required | All Required |
| 110(2) | Mobilization and Demobilization | L.S. | All Required | All Required | All Required |
| 111(1) | Temporary Erosion and Pollution Control | C.S. | All Required | All Required | All Required |
| 114(1) | Construction Surveying by the Contractor | L.S. | All Required | All Required | All Required |
| 115(1) | Traffic Maintenance | L.S. | All Required | All Required | All Required |
| 201(2B) | Clearing and Grubbing | L.S. | All Required | All Required | All Required |
| 202(2) | Removal of Pavement | S.Y. | 1289.8 | 1585 | 2874.8 |
| 202(4) | Removal of Culvert Pipe | L.F. | 0 | 82 | 82 |
| 202(9) | Single Mail Box Installation | Each | 0 | + | + |
| 203(3) | Unclassified Excavation | C.Y. | 549.7 | 1212 | 1761.7 |
| 203(8) | Embankment | C.Y. | 262.8 | 2038 | 2300.8 |
| 203(A) | UNCLASSIFIED EXCAVATION | EWO. 4 | 0 | 511.8 | 511.8 |
| 301(1)(A) | Crushed Aggregate Base Course 6-1 D-1 | C.O.1 | 1566.1 | 1486 | 3052.1 |
| 304(1)(A) | Subbase Grading "B" "A" | C.O.1 | 3003 | 1748.3 | 4751.3 |
| 401(1) | Asphalt Concrete, Type II | Ton | 733.4 | 755 | 1488.4 |
| 401(2) | Asphalt Cement, AC-5 | Ton | 48.8 | 42 | 90.8 |
| 402(2) | CSS-1 Asphalt for Tack Coat | L.S. | All Required | All Required | All Required |
| 403(2) | MC-30 Liquid Asphalt for Prime Coat | EWO. 3 | 0 | 5.3 | 5.3 |
| 603(1-18) | 18-Inch Corrugated Steel Pipe | L.F. | 80 | 77 | 157 |
| 603(1-24) | 24-Inch Corrugated Steel Pipe | L.F. | 0 | 58 | 58 |
| 607(7) | Reconstructed Fence | L.S. | All Required | 0 | All Required |
| 628(5) | ADJUST FIRE HYDRANT | EWO. 7 | 1 | N/A | 1 |
| 615(1) | Standard Signs | S.F. | 46.25 | 19.0 | 65.25 |
| 615(5) | Guide Markers | Each | 10 | 0 | 10 |
| 618(1) | Seeding | M.S.F. | 35.2 | 5.1 | 40.3 |
| 628(11) | Adjustment of Valve Box | Each | 2 | 0 | 2 |
| 628(12) | RECONSTRUCT MANHOLE | EWO. 5 | 1 | N/A | 1 |
| 660(3) | Highway Lighting System, Complete | L.S. | All Required | All Required | All Required |
| 670(1) | Painted Traffic Markings | L.S. | All Required | All Required | All Required |
| 670(7) | Raised Pavement Markers | Each | 37 | 46 | 83 |


| ILLUMINATION SUMMARY | | | REMARKS |
|----------------------|---------|-------------|-----------------------------------------------------------------------|
| STATION | OFFSET | ITEM | |
| *AsBH 5+98 | 27' Lt. | J-Box | CUT 1 RUN EXISTING & NEW CONDUIT INTO J-Box. SPUR TO EXISTING CIRCUIT |
| *AsBH 7+91 | 33' Lt. | J-Box | |
| *AsBH 8+13 | 32' Rt. | Electrolier | Slip Base with Footing & 12' Mast Arm |
| *AsBH 9+59 | 39' Lt. | J-Box | |
| *AsBH 9+58 | 30' Rt. | J-Box | |
| *AsBH 9+62 | 39' Lt. | Electrolier | Slip Base with Footing & 12' Mast Arm |
| *AsBH 10+85 | 35' Rt. | Electrolier | Slip Base with Footing & 12' Mast Arm |
| *AsBH 13+45 | 35' Rt. | Electrolier | Slip Base with Footing & 12' Mast Arm |
| *AsBH 13+50 | 32' Rt. | J-Box | |
| *AsBH 15+45 | 24' Lt. | Electrolier | Slip Base with Footing & 10' Mast Arm |
| *AsBH 15+52 | 35' Rt. | J-Box | |
| *AsBH 15+52 | 22' Lt. | J-Box | |
| *AsBH 15+83 | 72' Lt. | Load Center | See Illumination Notes, Sheet 10 |
| *AsBH 16+80 | 34' Rt. | J-Box | |
| *AsBH 16+85 | 37' Rt. | Electrolier | Slip Base with Footing & 12' Mast Arm |

| APPROACH SUMMARY | | | |
|------------------|-------|--------|-------------------------|
| STATION | WIDTH | RADIUS | REMARKS |
| *AsBH 8+59, Rt. | 14' | 15' | |
| 0+11+79, Rt. | 14' | 10' | |
| 0+12+75, Lt. | 22' | 15' | Match Existing Pavement |
| 4L+91 Mt. | 20' | | |
| *AsBH 16+21, Rt. | 24' | | 20' R. Lt., 50' R. Rt. |

| SIGNING SCHEDULE | | | | | | | | | | | | | | |
|------------------|-----------------|--------|-----|---------|--------------------------|------------|-----------|--------------|------|-------|--------|----------------|---------|----------------------------------------|
| NO. | STATION | OFFSET | | CODE | LEGEND | SIGN PANEL | | POST | | | | FACING TRAFFIC | REMARKS | |
| | | Lt. | Rt. | | | SIZE | AREA S.F. | No. of Posts | TYPE | SIZE | LENGTH | | | EMBED |
| 1 | *AsBH 6+00 | | 22' | M10-2 | 10 | 6"x12" | 0.5 | 1 | PST | 2"x2" | 11' | 3' | WB | |
| 2 | *AsBH 6+00 | | 22' | M10-2 | 10 | 6"x12" | 0.5 | | | | | | EB | Mount on same post as #1 |
| 3 | *AsBH 9+08 8+62 | | 32' | D3-2(L) | ← Industrial Blvd. | 18"x112" | 14.00 | 2 | PST | 2"x2" | 12' | 3' | WB | Framed, 0.125" thick |
| 4 | *AsBH 9+62 | 35' | 31' | R7-101 | No Parking Any Time | 12"x18" | 1.50 | | | | | | EB | Mount on Electrolier Pole |
| 5 | 0+10+62 | | 40' | R1-1 | STOP | 30"x30" | 6.25 | 1 | PST | 2"x2" | 11' | 3' | NB | |
| 6 | 0+10+62 | | 40' | D3-1 | Industrial Blvd. | 8"x36" | 2.00 | | | | | | EB-WB | USE SERIES "B" LETTERS. MOUNT ABOVE #6 |
| 7 | *AsBH 12+50 | | 28' | D3-2(R) | Industrial Blvd. → | 18"x112" | 14.00 | 2 | PST | 2"x2" | 12' | 3' | EB | Framed, 0.125" thick |
| 8 | *AsBH 10+85 | | 33' | R2-1 | SPEED LIMIT 50 | 30"x36" | 7.50 | 1 | PST | 2"x2" | 12' | 3' | WB | Mount on Electrolier Pole |
| 9 | *AsBH 12+00 | | 34' | D1-2L | ← Engineer's Cut-off Rd. | 24"x90" | 15.00 | 2 | PST | 2"x2" | 14' | 3' | WB | Framed, 0.125" thick |
| 10 | *AsBH 16+47 | | 47' | R1-1 | STOP | 24"x24" | 4.00 | 1 | PST | 2"x2" | 12' | 3' | SB | |

| BASIS OF ESTIMATE | | |
|-------------------|-------------------------------------|--------------------------------------|
| NO. | ITEM | FACTOR |
| 301(1)(A) | Crushed Aggregate Base Course 6-1 | 1.96 Tons/Cu. Yd. |
| 304(1)(A) | Subbase, Grading "B" "A" | 1.90 Tons/Cu. Yd. |
| | | 114.0 |
| 401(1) | Asphalt Concrete, Type II | 114.4 lbs/S.Y.-Inch |
| 401(2) | AC-5, Asphalt Cement | 6% of Item 401(1). |
| 402(1) | CSS-1, Asphalt for Tack Coat | 0.04 Gal/S.Y.-(Residual) 240 Gal/Ton |
| | | Application Rate = 0.10 Gal./S.Y. |
| 403(2) | MC-30 Liquid Asphalt for Prime Coat | 0.25 Gal./S.Y., 256 Gal./Ton. |

TYPICAL RPM PLACEMENT DETAIL

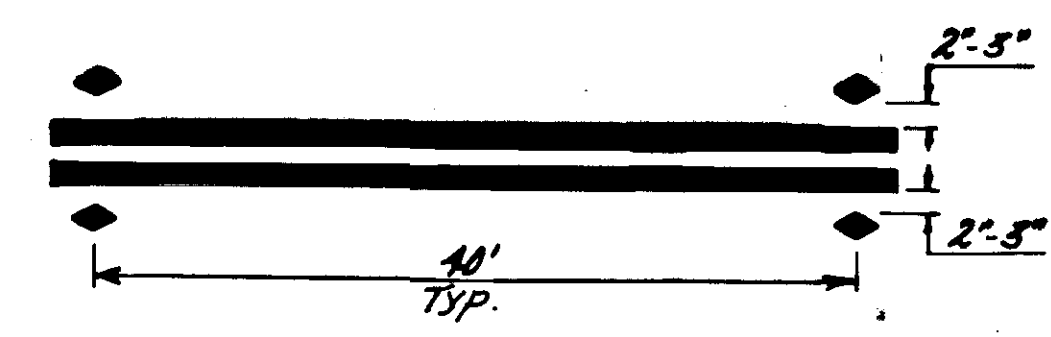

| CULVERT SUMMARY | | | | |
|--------------------|-------------|-----|-----|----------------------|
| STATION | PIPE LENGTH | | | REMARKS |
| | 18" | 24" | 36" | |
| 0+11+79.3 Rt. | 36' | | | |
| 0+12+75.25 Lt. | 44' | | | |
| AsBH 4+63.35 Rt. | | 8' | | Extend existing pipe |
| AsBH 16+21.54 Rt. | | 50' | | |
| 0+12+28 | 37' | | | |
| AsBH 12+90, 36 Rt. | 40' | | | |

| CULVERT REMOVAL SUMMARY | | | |
|-------------------------|--------|--------------------|--------|
| STATION | LENGTH | STATION | LENGTH |
| 0+11+47, 22 Rt. | 20' | AsBH 44+84, 32 Rt. | 40' |
| 0+11+79, 25 Lt. | 40' | | |
| AsBH 44+37, 32 Rt. | 42' | | |


| RECONSTRUCTED FENCE SUMMARY | | |
|-----------------------------|--------|-------------------------------------------------------------------------------------------------------------|
| STATION TO STATION | LENGTH | REMARKS |
| AsBH 8+40, Lt. | - | Chain existing gates shut |
| 0+10+77 to 0+12+00 Lt. | 125' | Remove existing chain-link fabric, posts and gate and install new posts and chain-link fabric. See sheet 6. |
| 0+12+62 to 0+12+86, Lt. | 24' | Remove existing chain-link fabric and posts. Install new gate posts and salvaged gate swings. See sheet 6. |



| STATE | PROJECT DESIGNATION | YEAR | SHEET NO. | TOTAL SHEETS |
|--------|---------------------|------|-----------|--------------|
| ALASKA | HES-RS-093-2 (16) | 1985 | 5 | 11 |

PLAN-GLACIER HWY./INDUSTRIAL BLVD. INTERSECTION


"AsBt" 8+30, 37' Rt. Remove and save existing sign and chain, and remove & dispose existing 8"x8" posts. At 44' Rt., install new 8"x8" posts centered about the approach & and at 16' C.C. Installed height of posts shall be 4'0". Install salvaged sign and chains on new posts. All work and materials shall be considered incidental to Item 607(7), Reconstructed Fence.

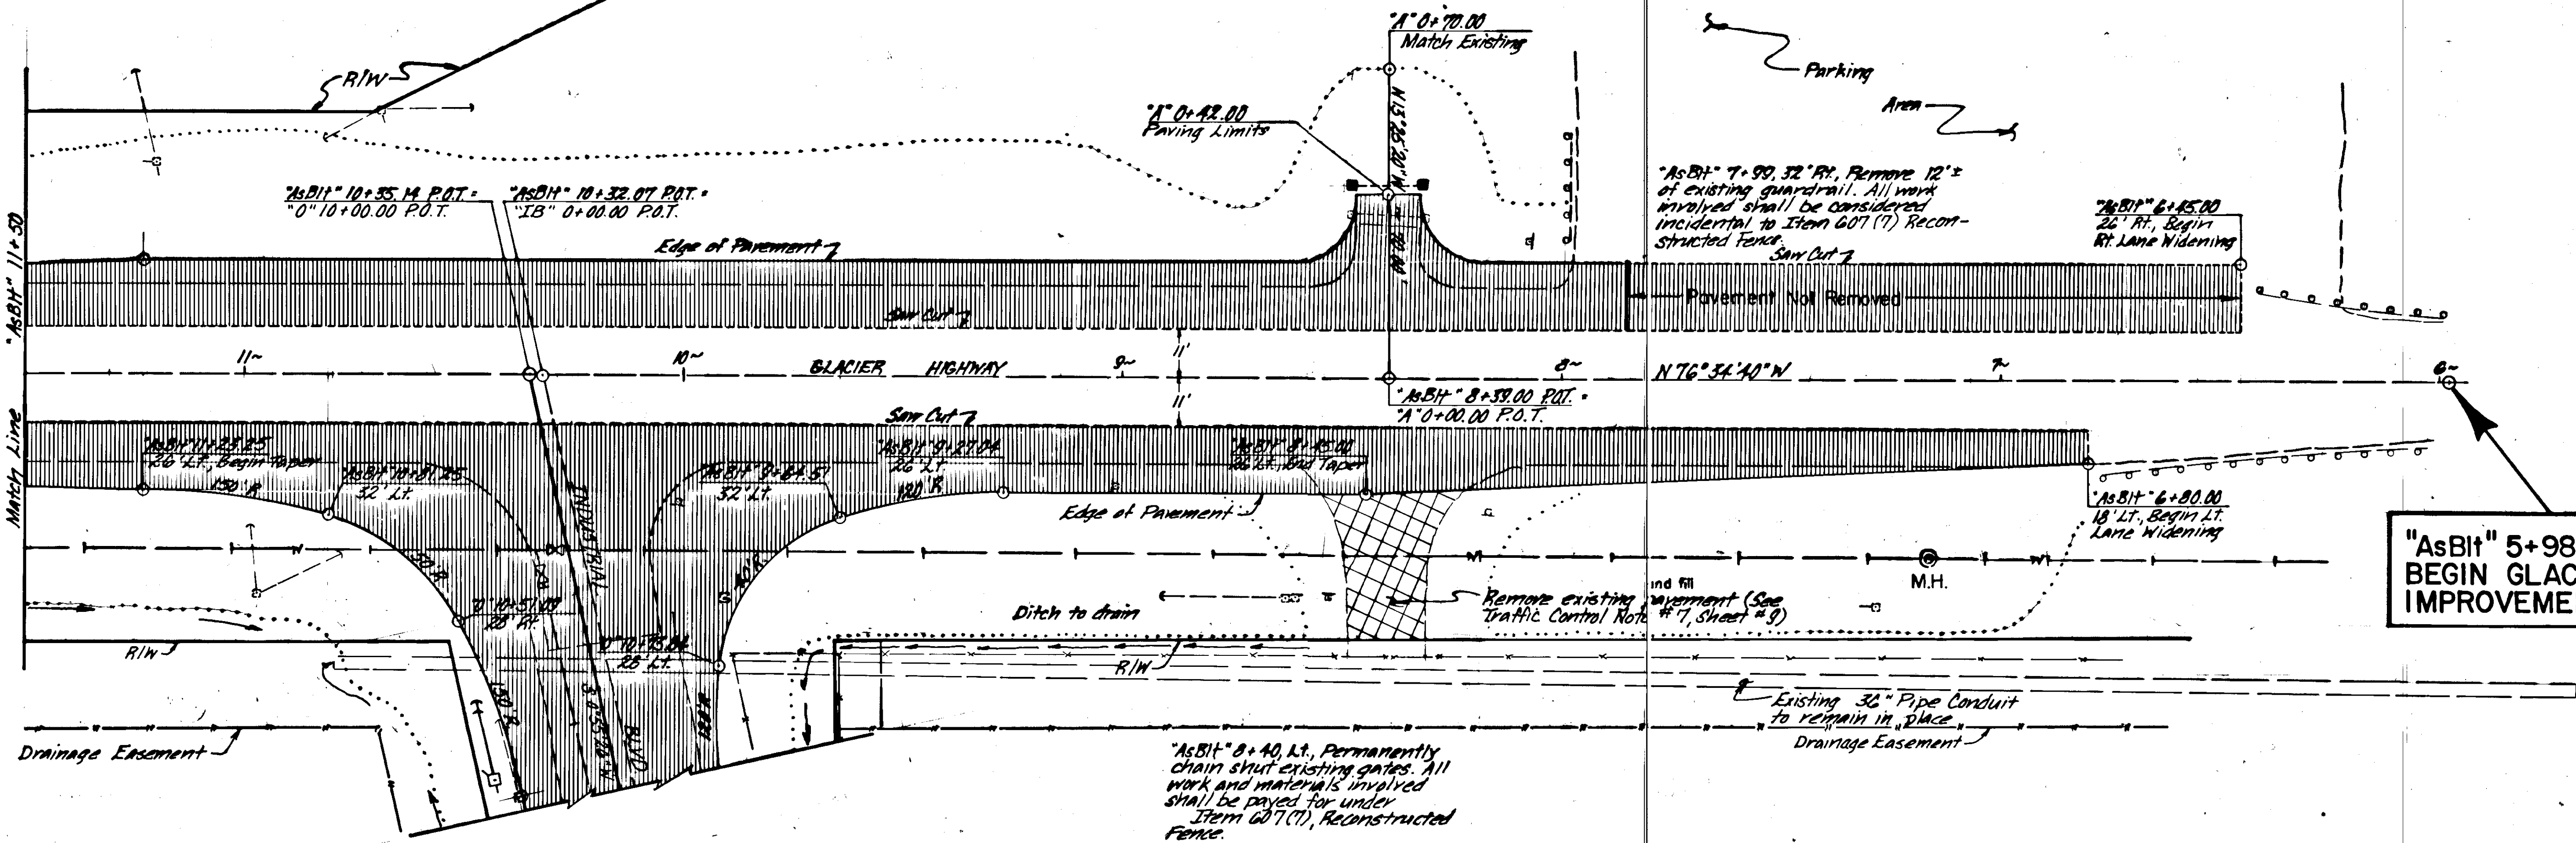

**"AsBt" 5+98.00
BEGIN GLACIER HWY.
IMPROVEMENTS**

**"AsBt" 13+30.00
END GLACIER HWY.
IMPROVEMENTS**


10+10+40, 3' Rt.
Adjust Valve Box
10+10+45, 7' Rt.
Adjust Valve Box

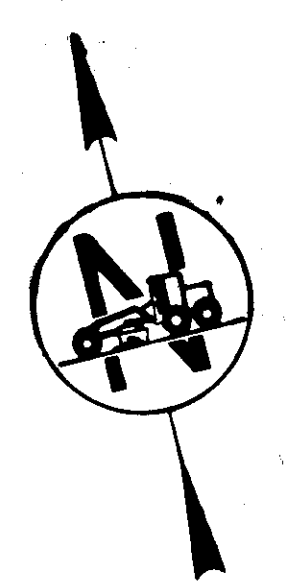

Indicates New Pavement Construction under this Contract

HORIZONTAL CONTROL
Horizontal Control for this project was the "AsBt" 6 for project F-093-2(8), Brotherhood Bridge to Auk Bay, the bearing given as N. 76° 34' 40" W.


VERTICAL CONTROL
The basis of Vertical Control for this project was TBM #2, a nail in the top of a R/W post 60' Rt. of Glacier Highway Sta. "L" 20+03, Elev. 25.39.

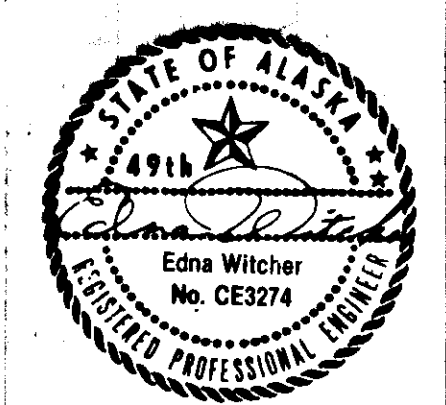

| STATE | PROJECT DESIGNATION | YEAR | SHEET NO. | TOTAL SHEETS |
|--------|---------------------|------|-----------|--------------|
| ALASKA | HES-RS-093-2(16) | 1985 | 6 | 11 |

PLAN-GLACIER HWY./INDUSTRIAL BLVD. INTERSECTION

Don Abel Lumber Company


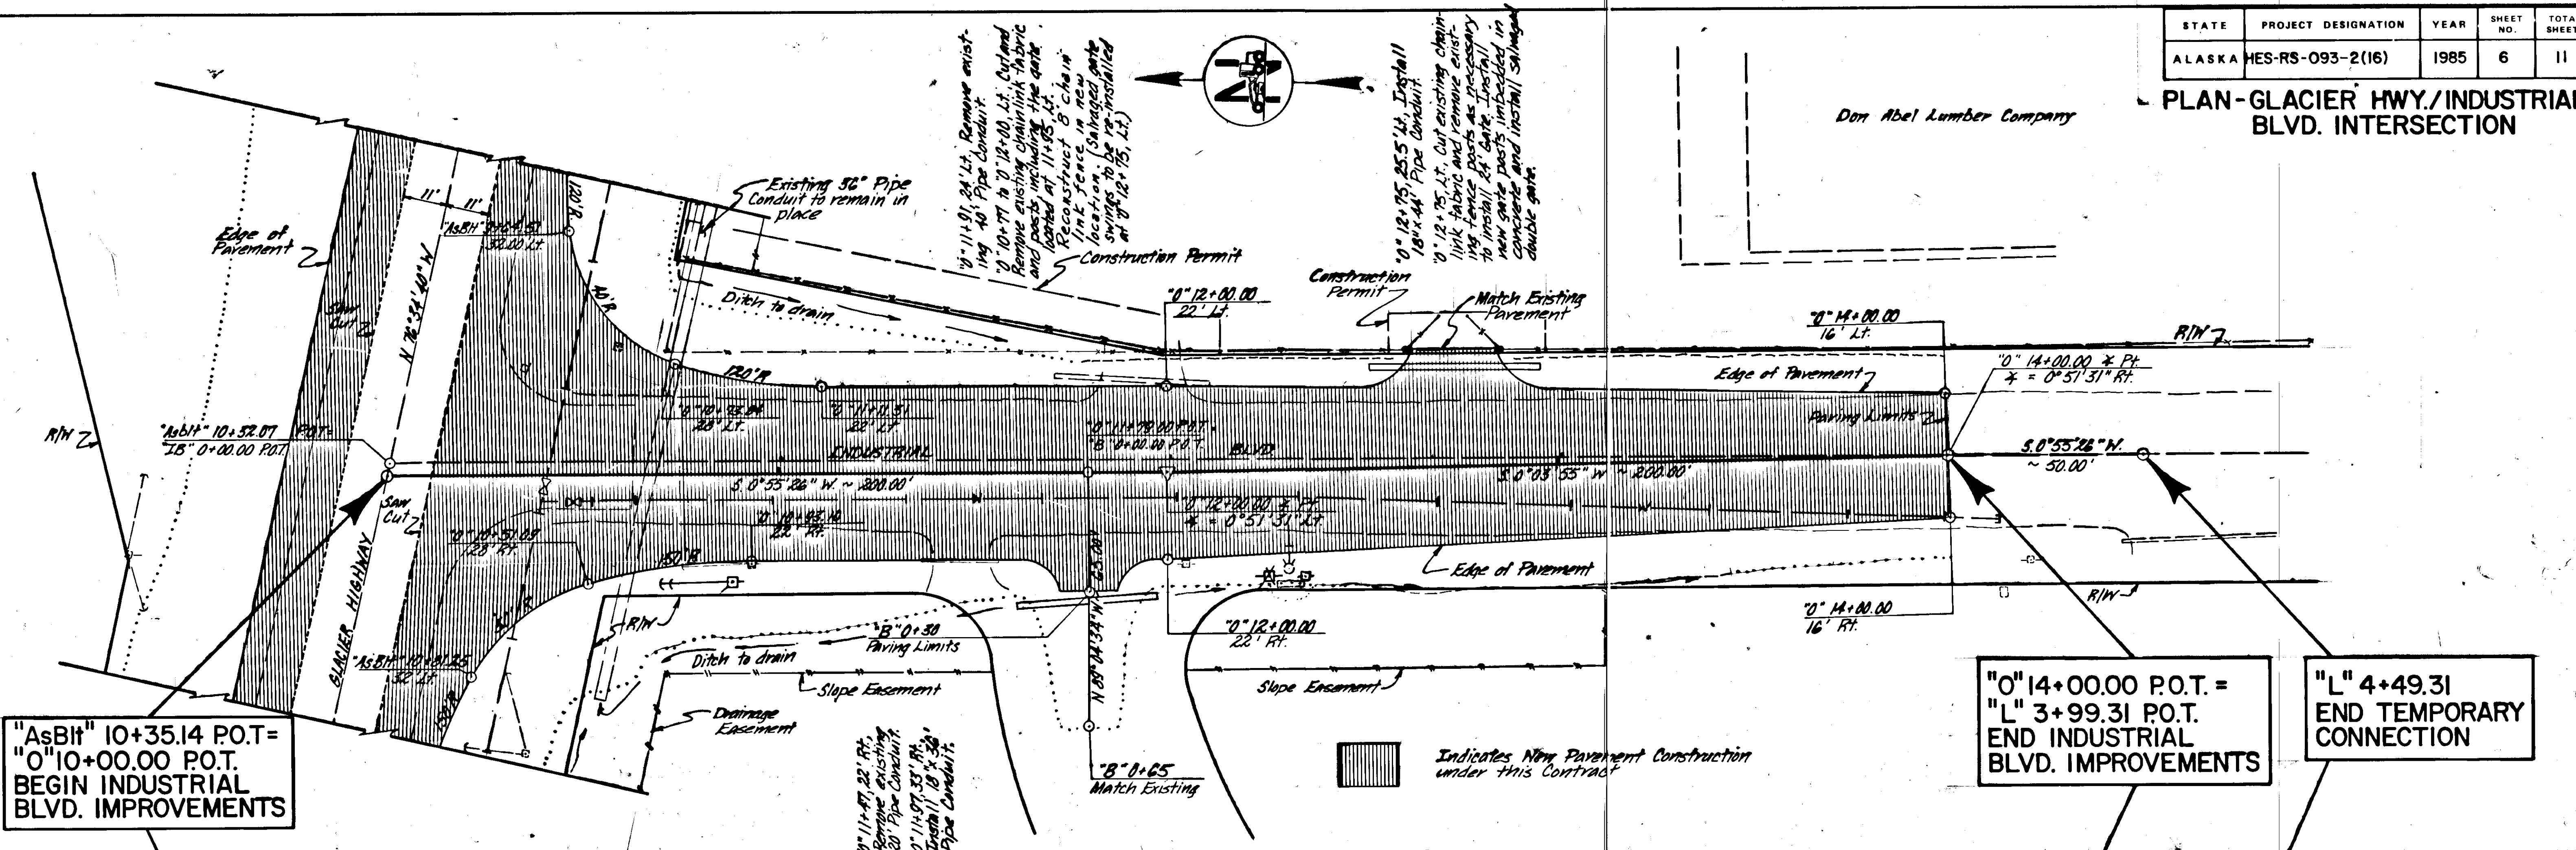


"AsBlt" 10+35.14 P.O.T. =
"0" 10+00.00 P.O.T.
BEGIN INDUSTRIAL
BLVD. IMPROVEMENTS

"0" 14+00.00 P.O.T. =
"L" 3+99.31 P.O.T.
END INDUSTRIAL
BLVD. IMPROVEMENTS


"L" 4+49.31
END TEMPORARY
CONNECTION

Indicates New Pavement Construction
under this Contract

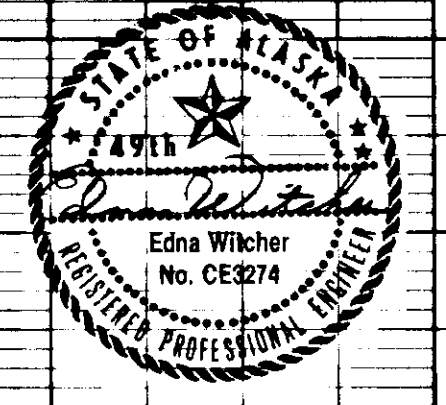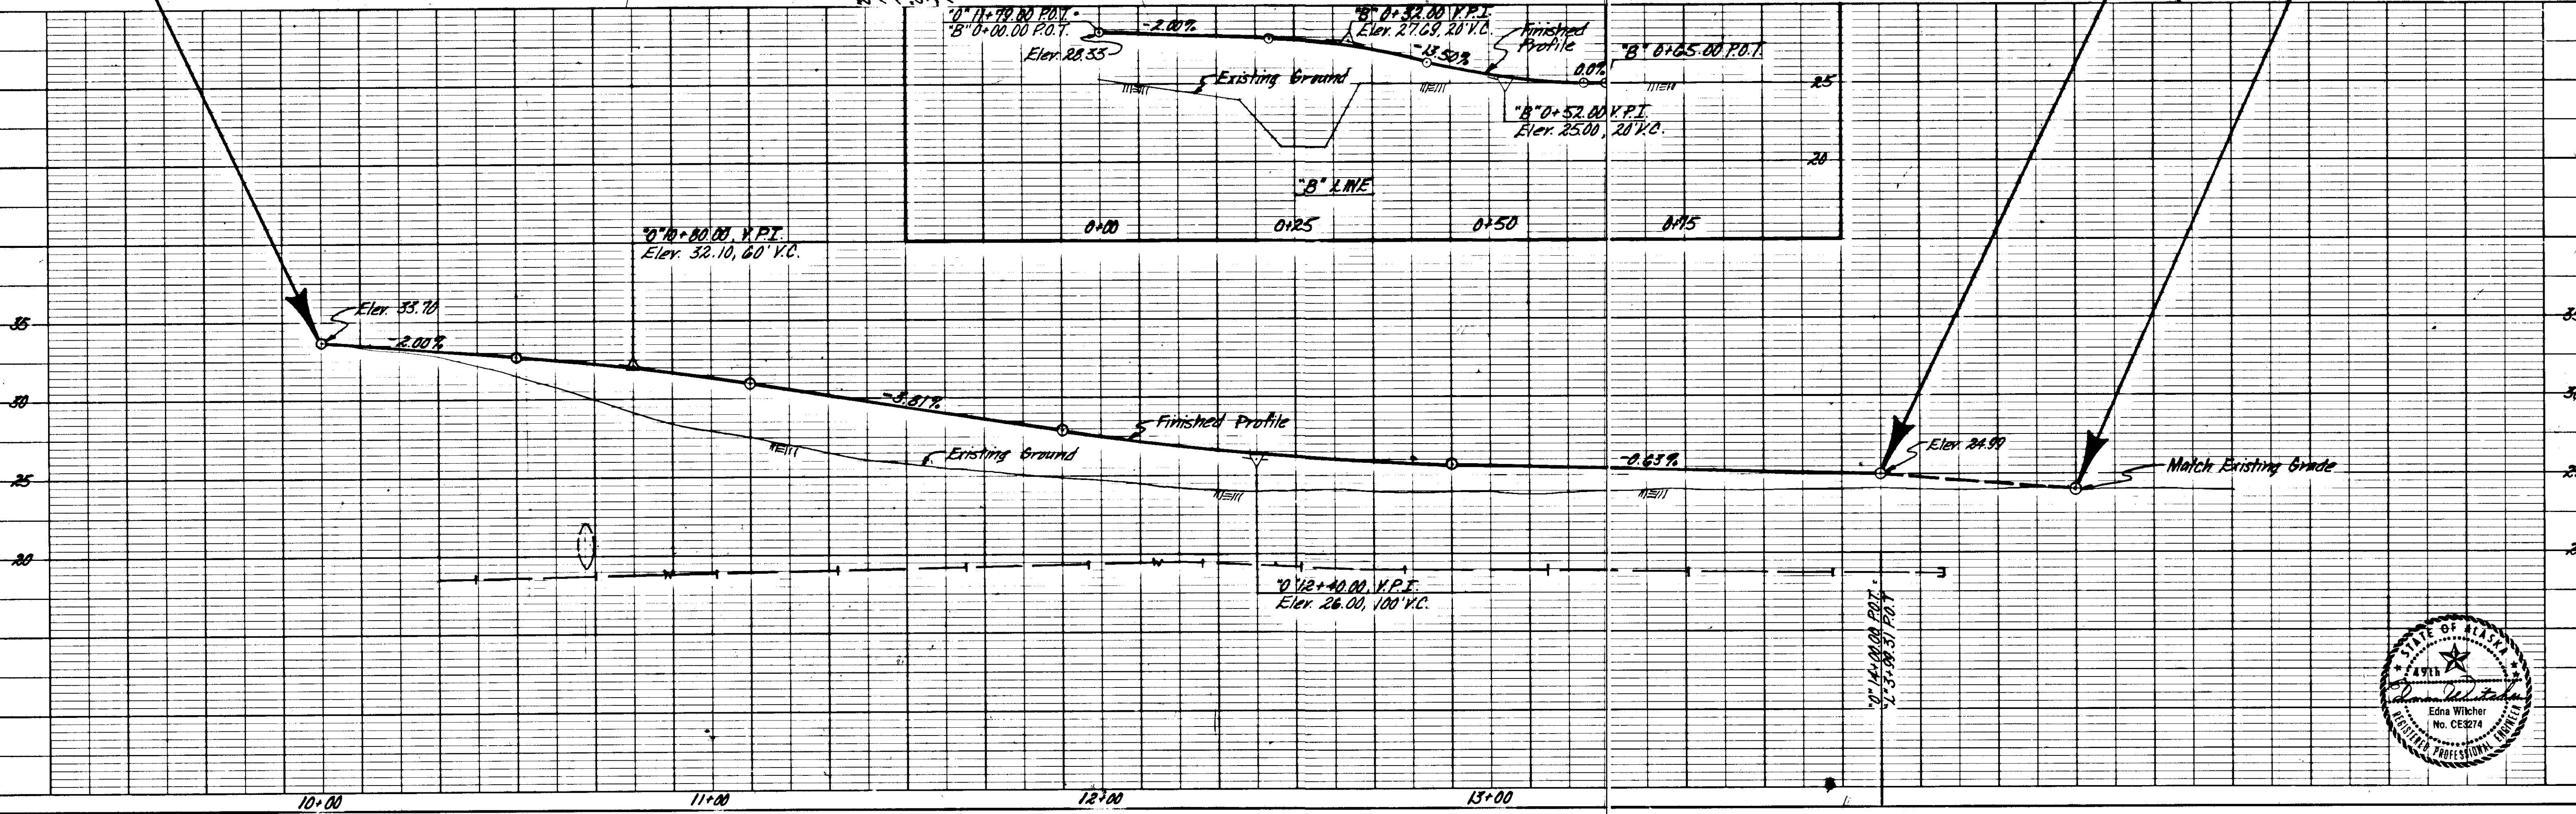

| STATE | PROJECT DESIGNATION | YEAR | SHEET NO. | TOTAL SHEETS |
|--------|---------------------|------|-----------|--------------|
| ALASKA | HES-RS-093-2(18) | 1985 | 7 | 11 |

PLAN - MENDENHALL PENINSULA ROAD LANE WIDENING

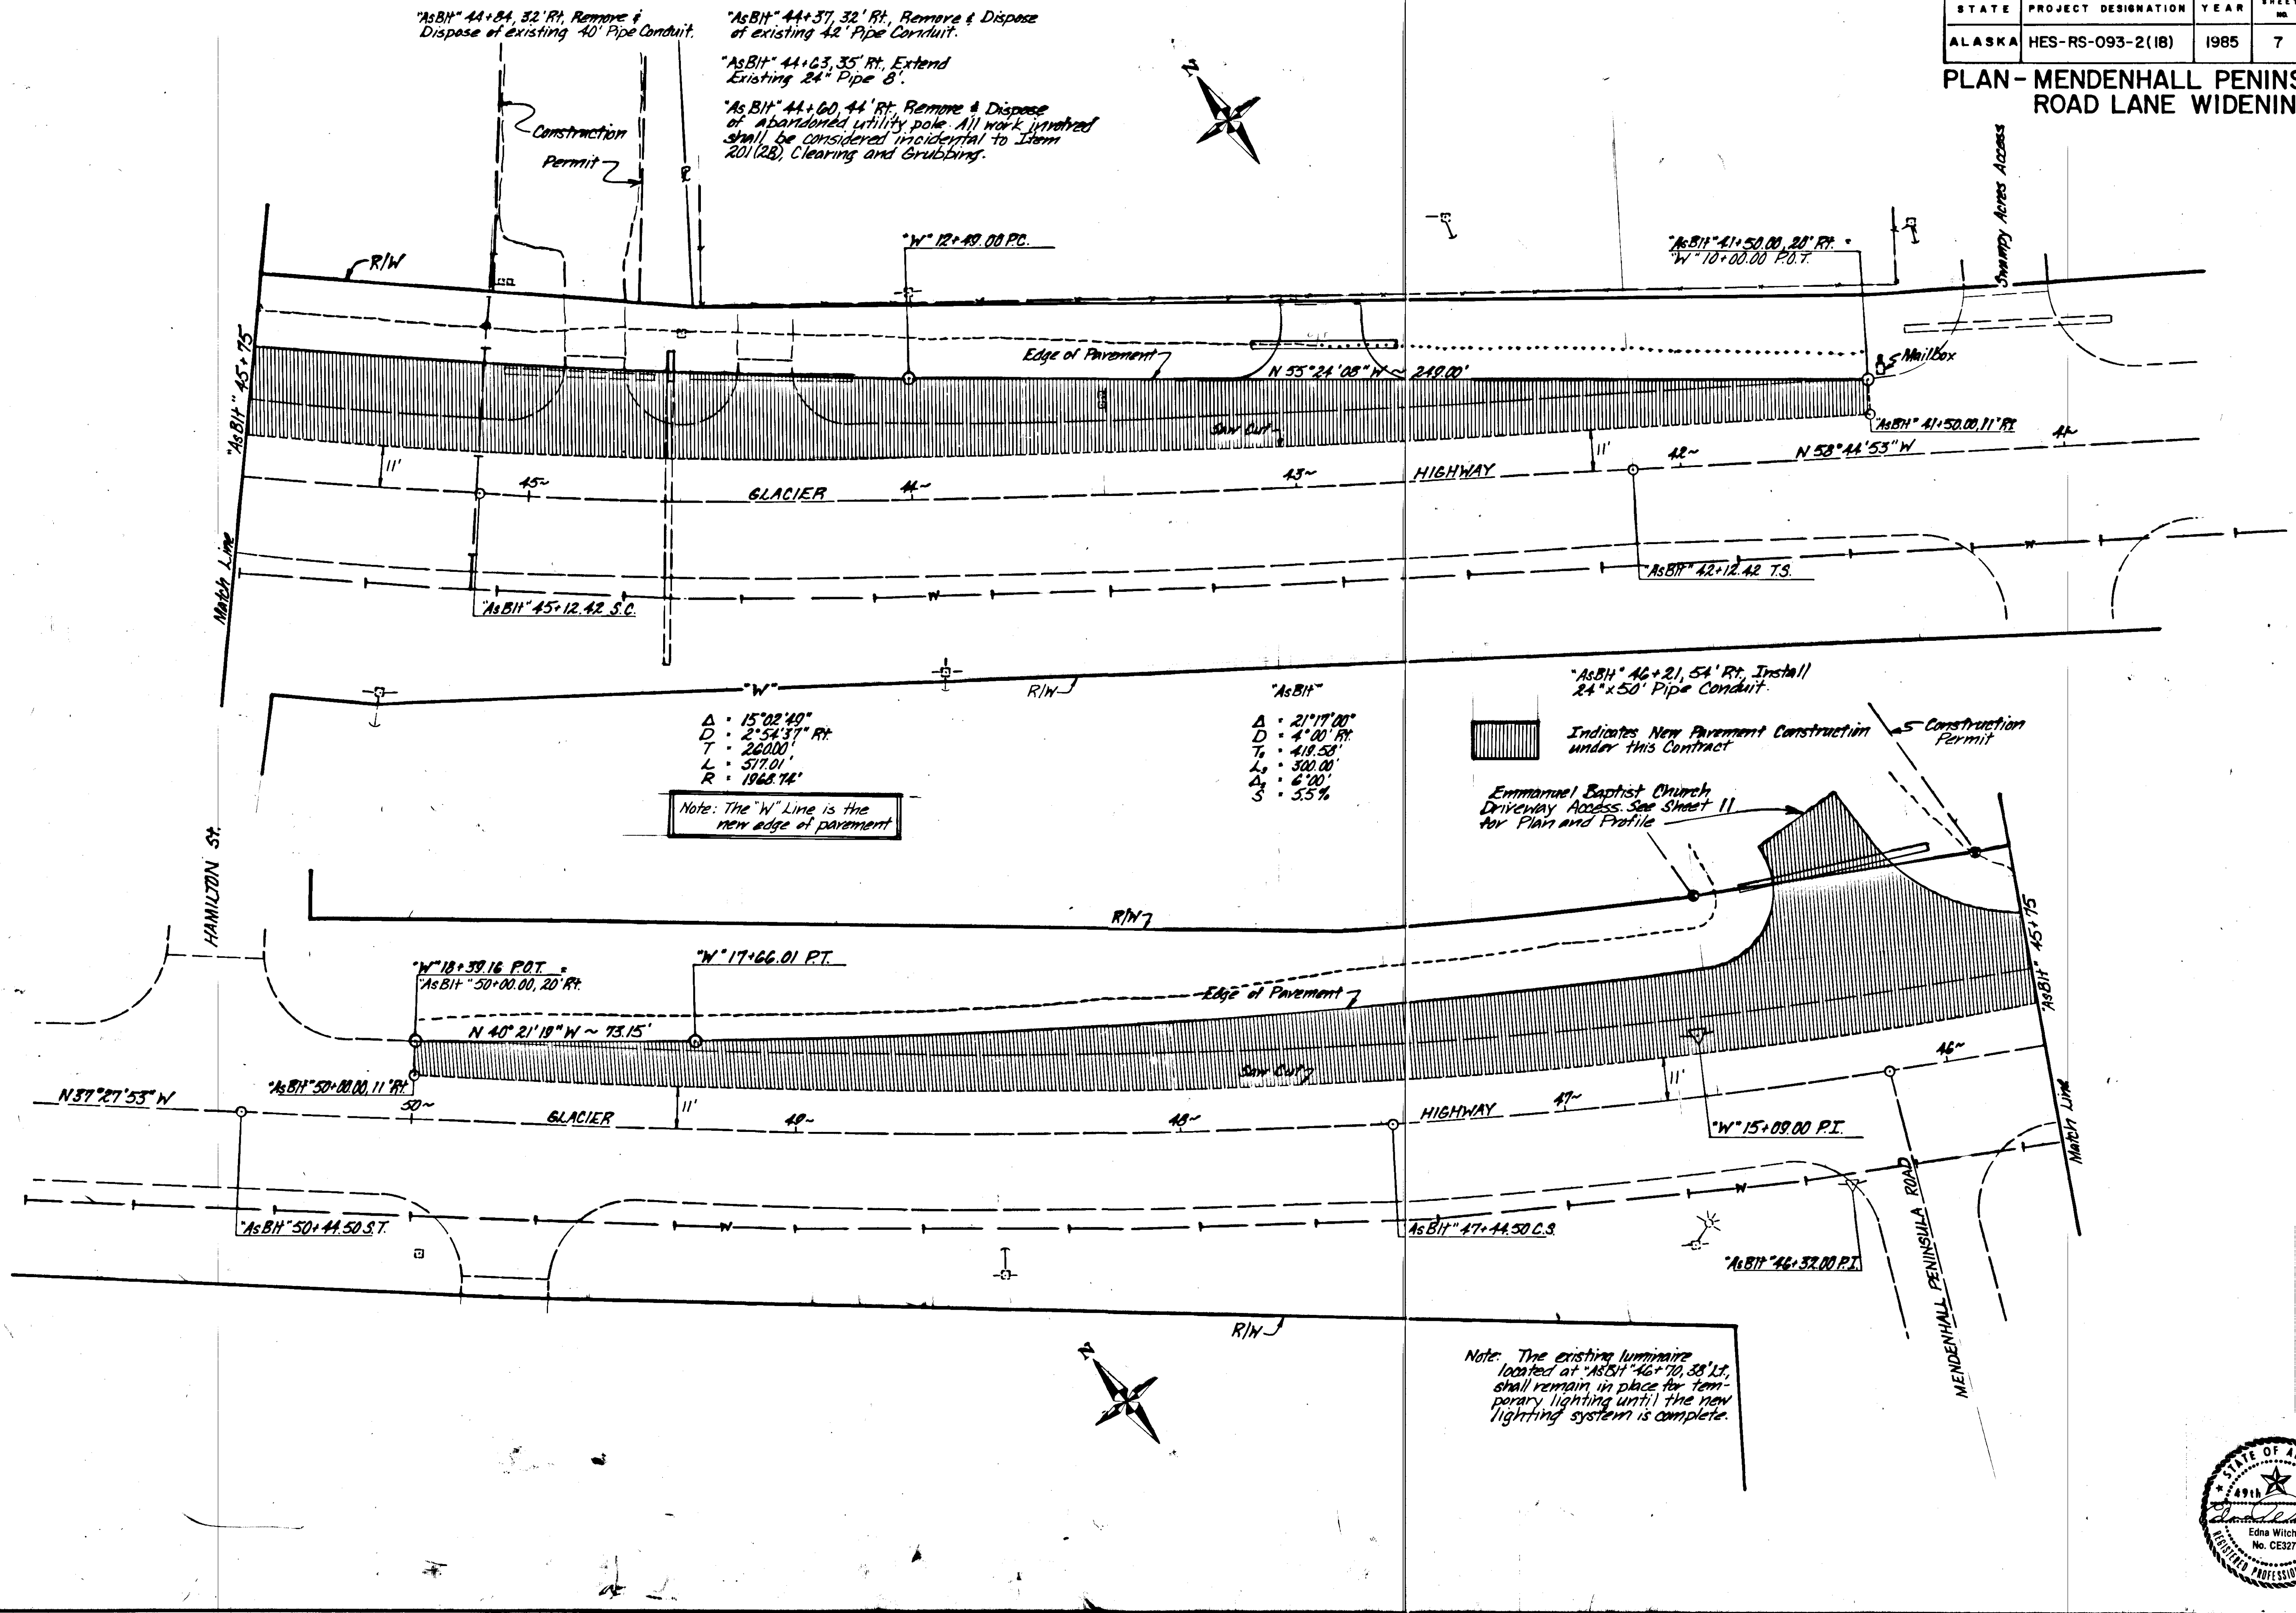

"AsBH" 44+84, 32' Rt. Remove & Dispose of existing 40' Pipe Conduit.

"AsBH" 44+37, 32' Rt. Remove & Dispose of existing 42' Pipe Conduit.

"AsBH" 44+03, 35' Rt. Extend Existing 24" Pipe 8'.

"AsBH" 44+60, 44' Rt. Remove & Dispose of abandoned utility pole. All work involved shall be considered incidental to Item 201(2B), Clearing and Grubbing.


"AsBH" 46+21, 54' Rt. Install 24" x 50' Pipe Conduit.

Note: The "W" Line is the new edge of pavement


Indicates New Pavement Construction under this Contract

Emmanuel Baptist Church Driveway Access. See Sheet 11 for Plan and Profile

Note: The existing luminaire located at "AsBH" 46+70, 38' Lt. shall remain in place for temporary lighting until the new lighting system is complete.

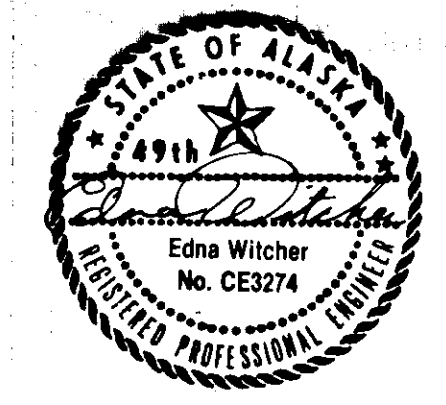


SIGNING, STRIPING AND ILLUMINATION PLAN - GLACIER HWY./INDUSTRIAL BLVD. INTERSECTION

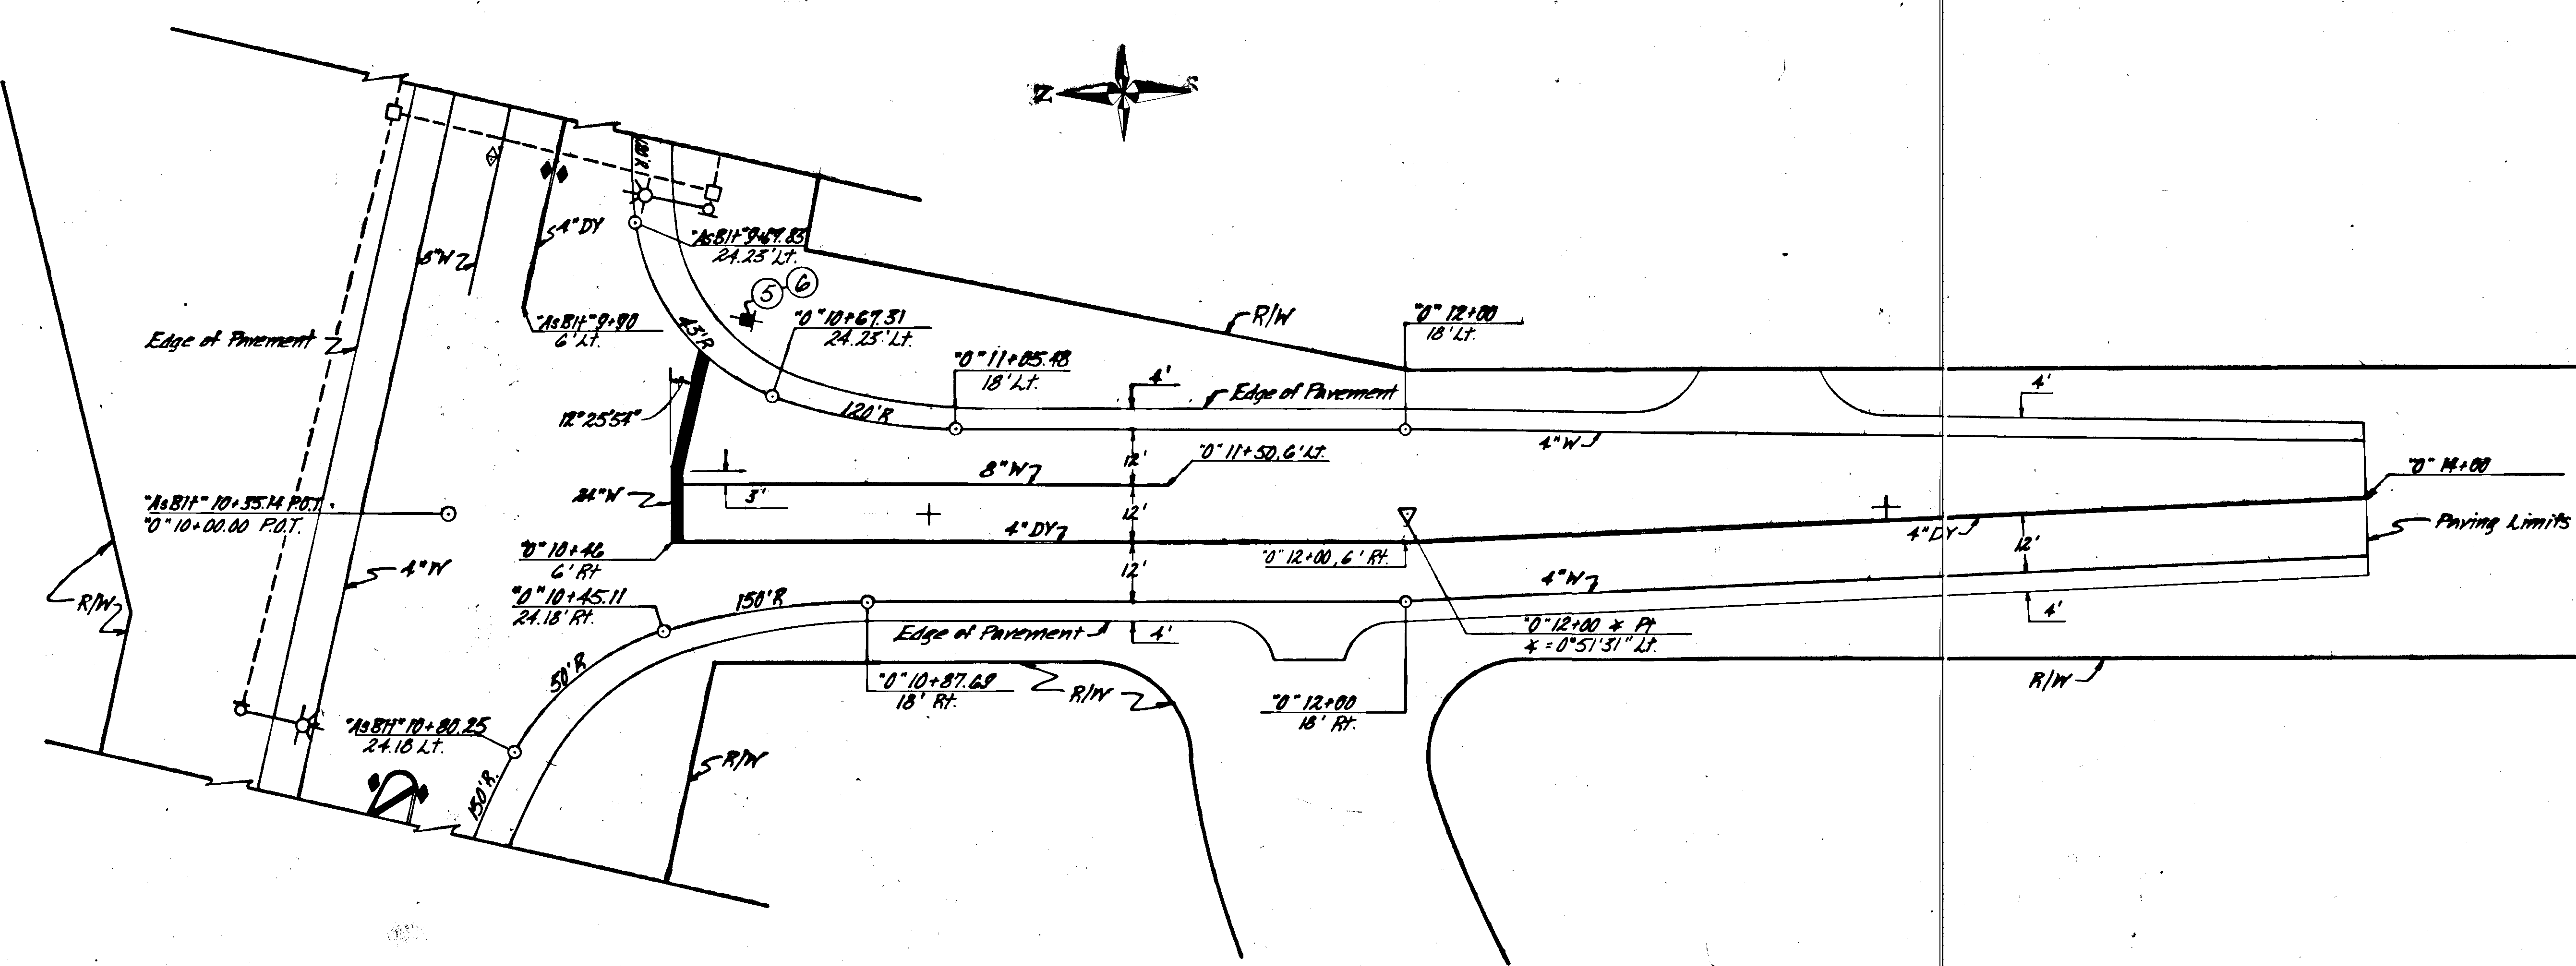

TRAFFIC CONTROL NOTES

HES-RS-093-2 (16) & HES-RS-093-2 (18)

1. The Contractor shall submit a Traffic Control Plan (TCP) for approval by the Engineer. The TCP shall conform to the standards set forth by the Manual on Uniform Traffic Control Devices with the Alaska Supplement, Work Zone Traffic Control, the Standard Drawings and the Standard and Special Provisions.
2. Glacier Highway shall be open to two-way traffic weekdays between the hours of 7-9 A.M. and 4-6 P.M.
3. Flagmen shall be provided during other times that two-way traffic cannot be maintained. Any flagging required shall be considered incidental to Item 115(C), Traffic Maintenance.
4. During the hours of darkness, Type C, Steadyburn Yellow lights shall be used to delineate the traveled way for transitions, continuums, obstructions or pavement drop-offs. Flashing yellow lights on barricades shall be used to warn of obstructions in the roadway.
5. The Contractor may close Industrial Blvd. and detour traffic to a side street during the Contractor's normal working hours provided the following conditions are met:
 - a) The Closure and Detour Route Proposals are coordinated with the City and Borough of Juneau before closing Industrial Blvd.
 - b) The Public is advised of the closure and detour through the use of the local news media.
 - c) During the Contractor's non-working hours, Industrial Blvd. shall be in a safe, traversable condition, free of rutting or washboarding.
6. The maximum dropoff at the edge of the work area during the Contractor's non-working hours shall be 2-Inches.
7. The driveway located at "ASB" 8+40, Lt. shall remain open to traffic until the new driveway located at "0" 12+75, Lt. is operational.
8. The Contractor shall designate one of his employees whose responsibility shall be the installation and maintenance of all required traffic control devices. All traffic control elements shall be maintained 24 hours a day.


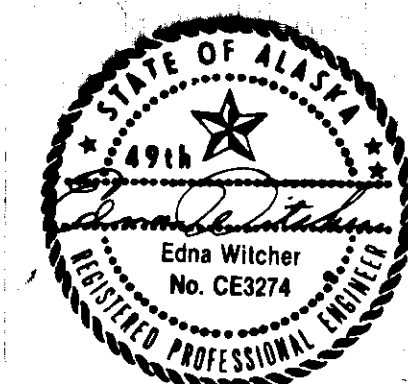


| STATE | PROJECT DESIGNATION | YEAR | SHEET NO. | TOTAL SHEETS |
|--------|---------------------|------|-----------|--------------|
| ALASKA | HES-RS-093-2(18) | 1985 | 10 | 11 |

SIGNING, STRIPING AND ILLUMINATION
MENDENHALL PENINSULA ROAD LANE WIDENING

"As Bt" 45+52, 35' Ft., Install
Type I J-Box

"As Bt" 43+45, 35' Ft., Install
Electroliner with 12' mast arm
and base
"As Bt" 43+50, 32' Ft., Install
Type I J-Box

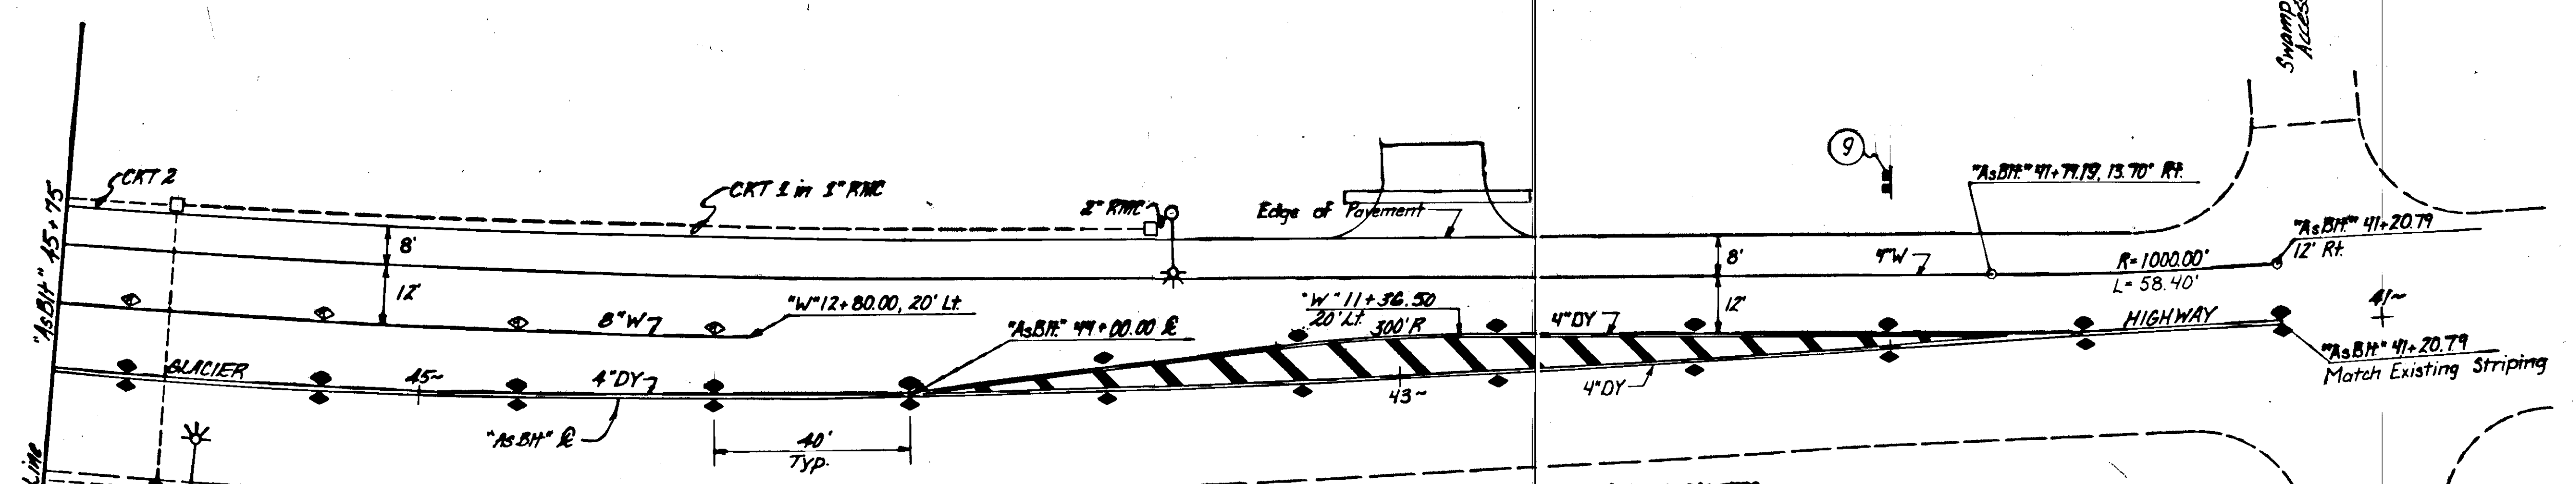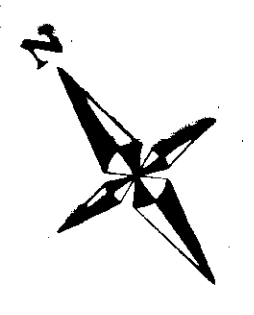

"As Bt" 45+52, 22' Lt.,
Install Type I J-Box
"As Bt" 45+45, 24' Lt., Install
Electroliner with 10 foot mast
arm and base.


- LEGEND**
- ◊ Red-White Raised Pavement Markers
 - ◆ Two-Way Yellow Raised Pavement Markers

GENERAL ILLUMINATION NOTES
HES-RS-093-2(18)


1. The Load Center shall be installed as shown on standard Drawing L-20.00. The Contractor shall supply all materials, including pressure treated pole.
2. The Load Center and Circuits shall be 240 volts, single phase. The main breaker shall be 50 amps, circuits 1 & 2 shall be 15 amps and the contractor shall be rated at 100 amps.
3. All conduits shall be Rigid Metal. All wiring shall be in conduit.
4. The conduit shall be jacked under the pavement.
5. All luminaire poles shall have slip bases.
6. Pole and Mast Arm Design shall be able to withstand 120 mph wind.
7. All J-Boxes shall be Type I as per Standard Drawing L-25.00.
8. All interconnecting conductors shall be #8 A.W.G.
9. All luminaires shall be 240 V, 250 W, High Pressure Sodium, Type II, medium, semi-cutoff, mounted at 35 feet above the roadway.
10. Underground utilities (cable, telephone, water, etc) exist and their locations shall be verified before excavation.
11. The existing roadway foreslope rate shall be maintained around electroliner bases as shown in the Standard Drawings. Additional fill material shall be payed for as Item 304(1), Subbase Grading 'B'.

Hamilton Street
Match Existing Striping
"As Bt" 50+00.00
Match Existing Striping


"As Bt" 46+80, 54' Ft., Install
Type I J-Box.
"As Bt" 46+85, 37' Ft., Install
Electroliner with 12' Mast arm
and base

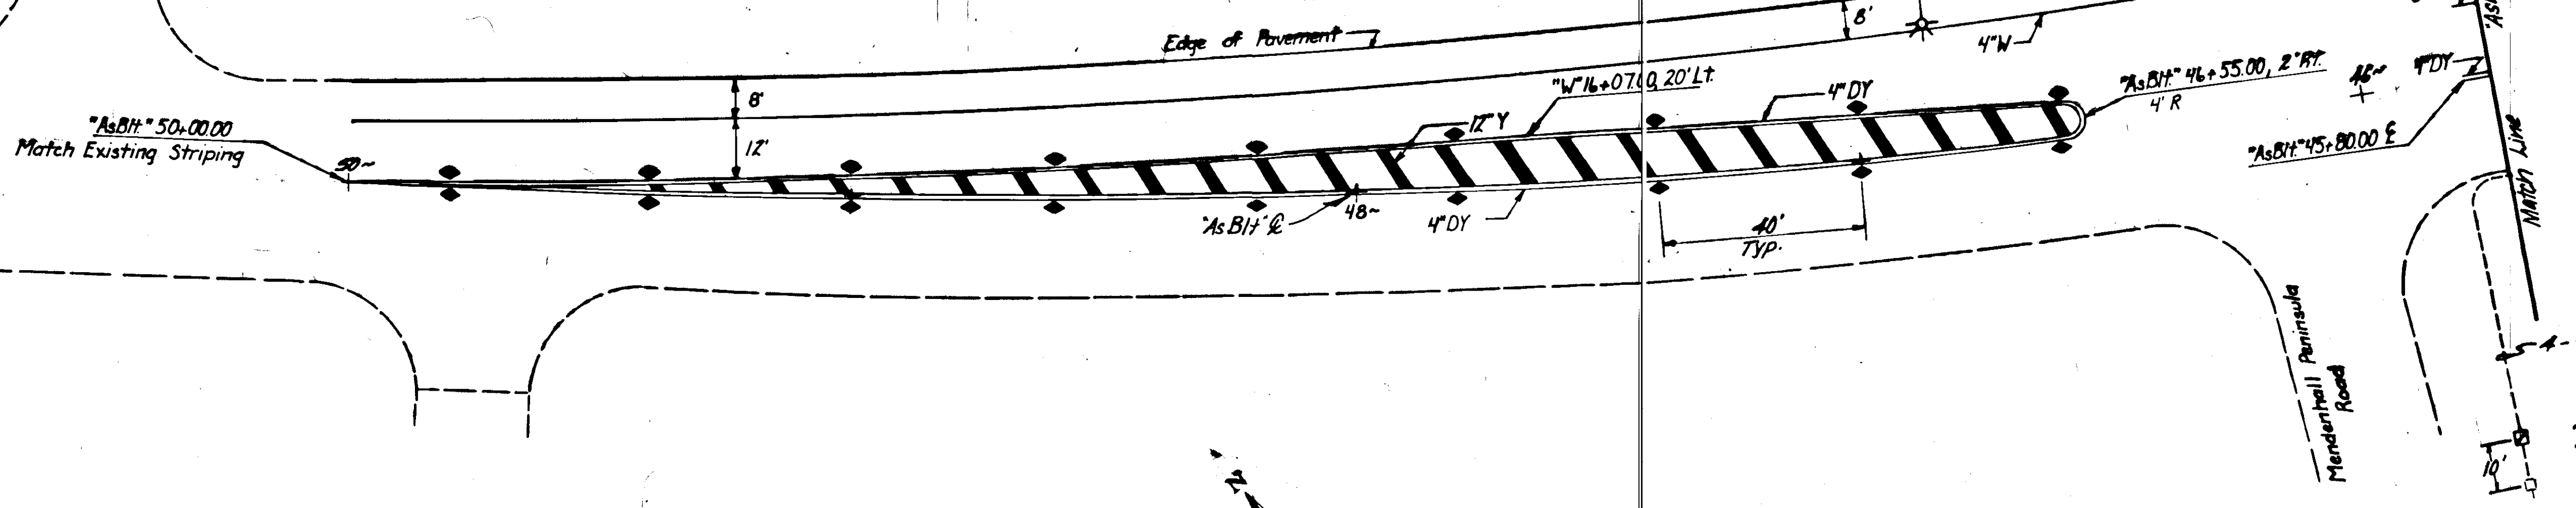

4-#8 AWG, CRTs L & R in 1 1/2\" RMC.
"As Bt" 45+83, Lt. Install
Load Center 10' from existing
utility pole. See notes this
sheet.

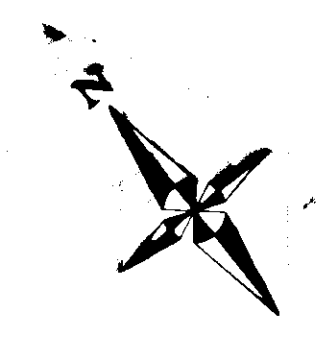


| STATE | PROJECT DESIGNATION | YEAR | SHEET NO. | TOTAL SHEETS |
|--------|---------------------|------|-----------|--------------|
| ALASKA | HES-RS-093-2 (18) | 1985 | 11 | 11 |

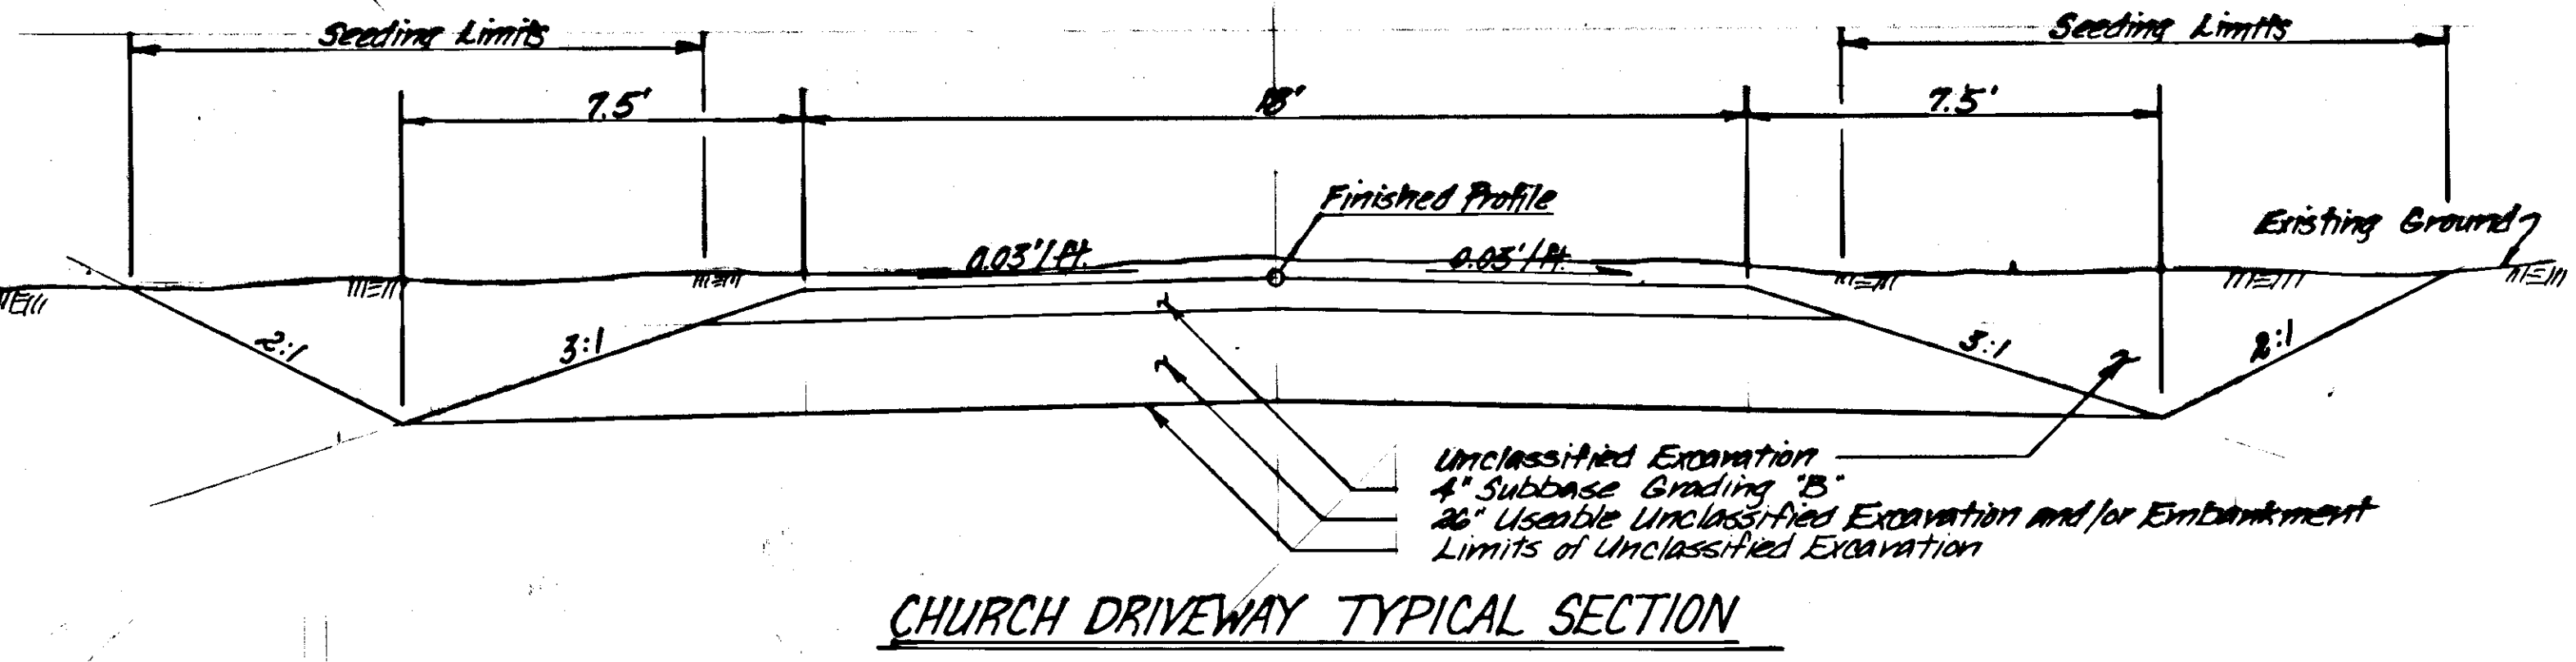

CHURCH DRIVEWAY TYPICAL SECTION

- NOTES:**
- The paved portion of the driveway shall be constructed with the same structural section as the Mendenhall Peninsula Road Lane Widening. Beyond the paving limits, the above detail shall be used.
 - All work involved in forming, shaping and construction shall be considered incidental to the Bid Items involved. Materials required shall be paid for at contract bid prices.
 - From Sta. "C" 10+70 to Sta. "C" 11+20, the driveway width shall transition smoothly from 24' to 18'.
 - The Contractor shall maintain continuous vehicular access to the Emmanuel Baptist Church during the construction of this project.

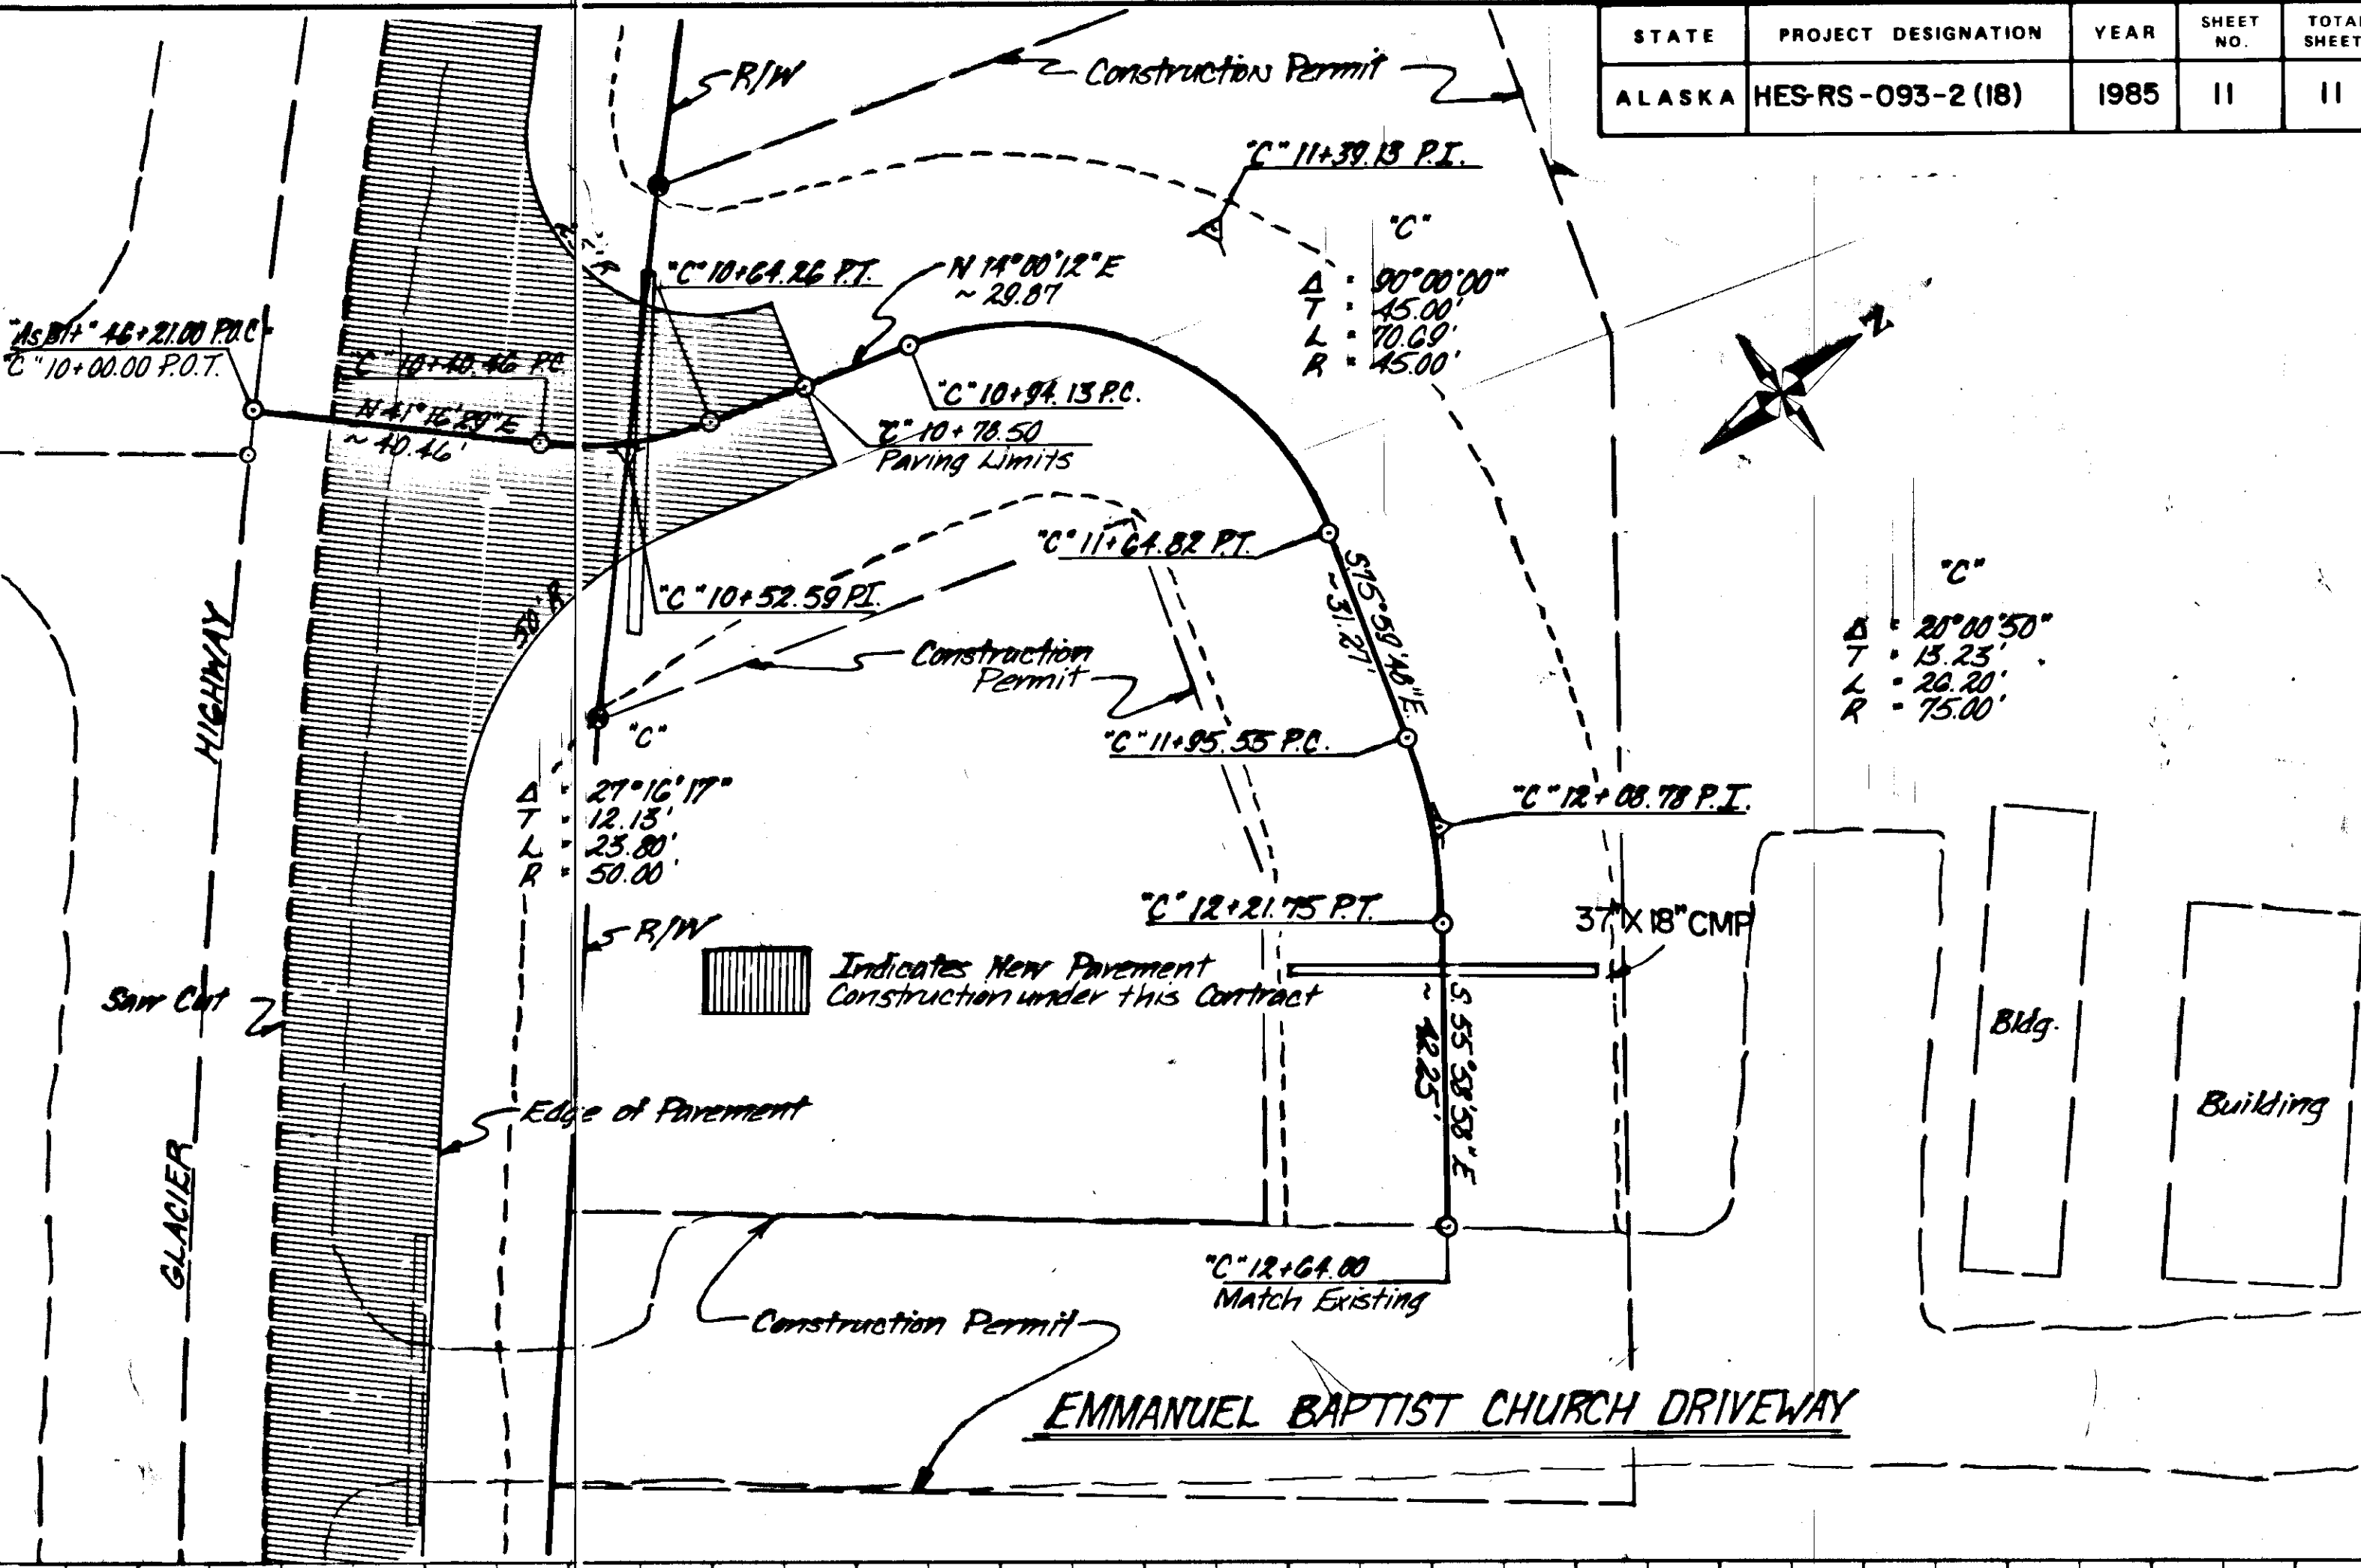

EMMANUEL BAPTIST CHURCH DRIVEWAY

