

STATE OF ALASKA DEPARTMENT OF TRANSPORTATION & PUBLIC FACILITIES

PLAN AND PROFILE PROPOSED HIGHWAY PROJECT INTERSECTION OF ADMIRAL WAY & SOUTH FRANKLIN ST. F-093-2(5) GRADING, DRAINAGE, PAVING, ILLUMINATION, AND UTILITIES

INDEX OF SHEETS	
1	TITLE SHEET
2	TYPICAL SECTION
3	ESTIMATE & SUMMARIES
4-5	PLAN & PROFILE
6-8	UTILITIES
9	INTERSECTION DETAIL
10-11	DRAINAGE DETAILS
12-15	SIGNING, STRIPING & ILLUMINATION
16	TRAFFIC CONTROL PLAN


THE FOLLOWING STANDARD DRAWINGS SHALL APPLY TO THIS PROJECT:
A-1, C-00.04, C-10.04, C-11.04, D-01.00, D-04.00, D-20.10, D-23.02,
D-26.03, I-20.01, L-03.12, L-10.13, L-23.03, L-30.01, M-16.03, S-00.11,
S-05.00, S-20.10, S-30.12, S-41.00, T-20.03, T-21.03, T-22.00, T-30.00,
T-32.01, T-52.01, & U-03.00

DESIGN DESIGNATION

ADT 1980	=	4,400
ADT 2000	=	7,000
DHV 13 %	=	910
D	=	60-40
%T	=	13%
T.I.	=	8%
V.	=	20

PROJECT SUMMARY

WIDTH OF ROADBED	=	VARIABLES, 38' to 48'
WIDTH OF PAVEMENT	=	VARIABLES, 24' to 34'
LENGTH OF GRADING	=	994.53' = 0.188 mi.
LENGTH OF PAVING	=	1,019.53' = 0.193 mi.
LENGTH OF PROJECT	=	730.67' = 0.138 mi.

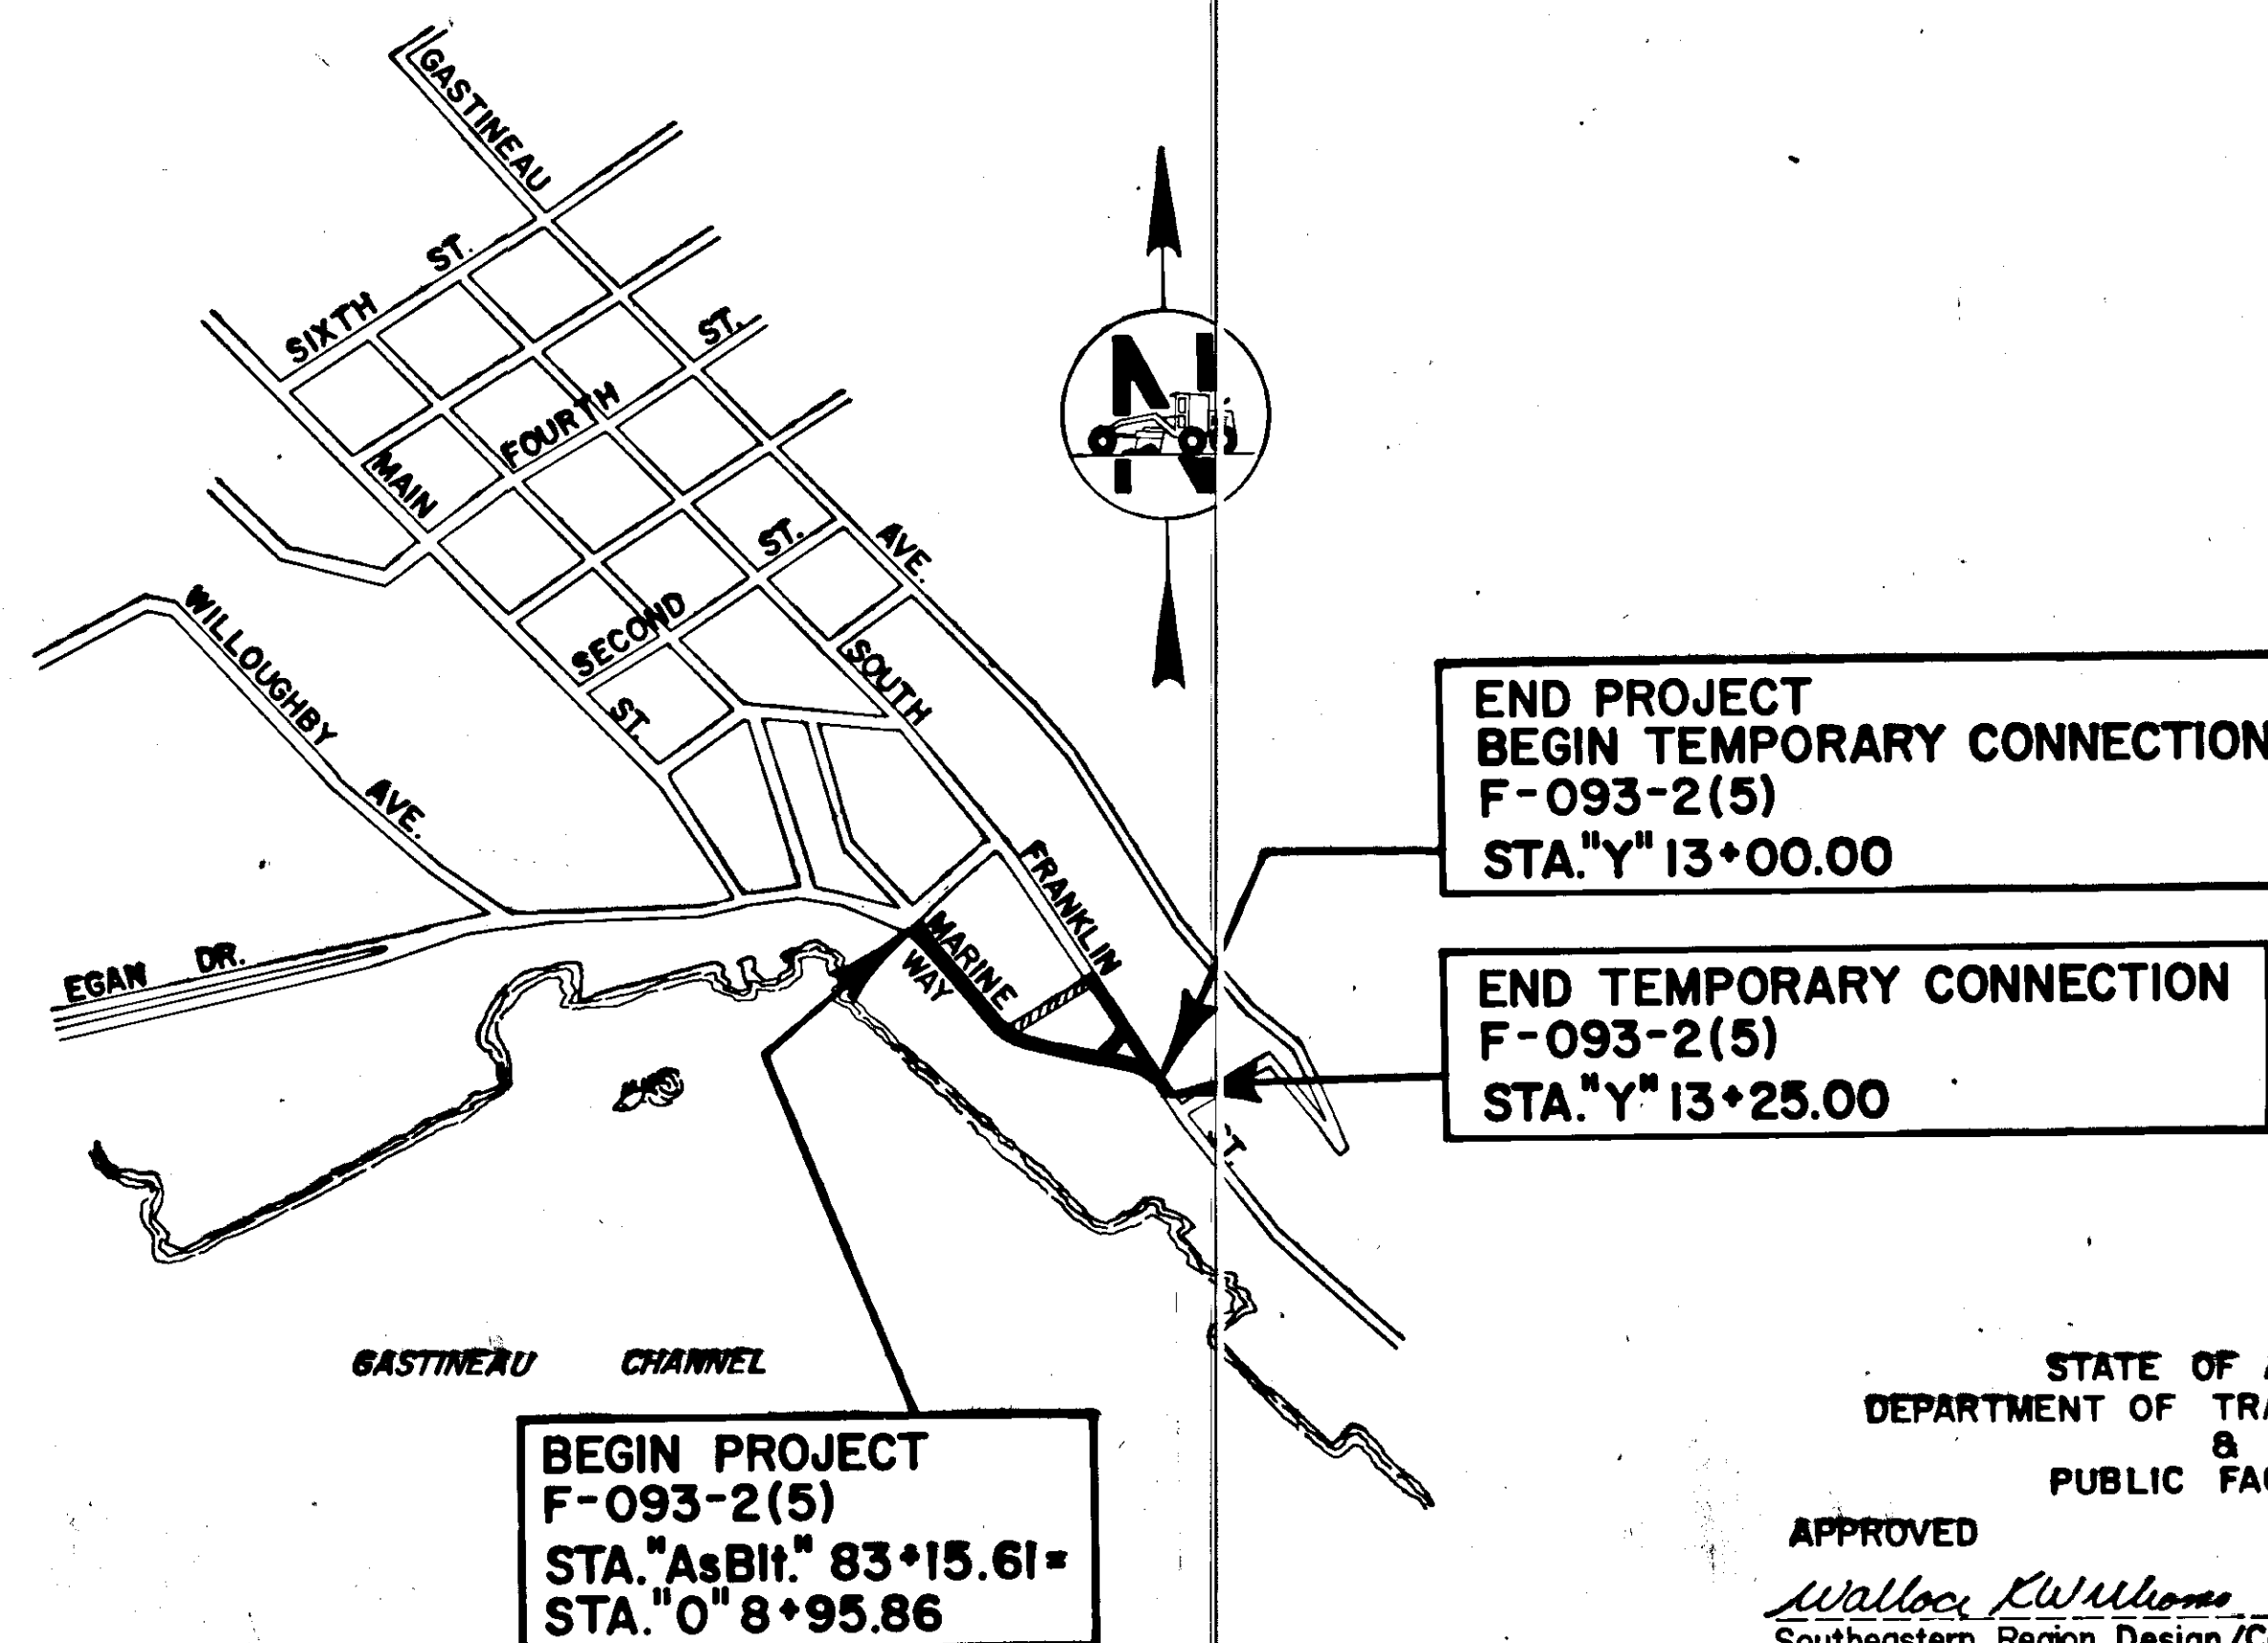

"AS BUILT" PLAN

PROJECT ENGINEER: PHIL SPEER
CONTRACTOR: RED SAMM CONSTRUCTION
BEGINNING DATE: APRIL 22, 1982
ENDING DATE: JULY 23, 1982

STATE OF ALASKA
DEPARTMENT OF TRANSPORTATION
&
PUBLIC FACILITIES

APPROVED *Wallace Williams* DATE 5/22/82
Southeastern Region Design/Construction Engineer

STATE OF ALASKA
DEPARTMENT OF TRANSPORTATION
&
PUBLIC FACILITIES


APPROVED *Henry Kelly* DATE 7/17/82
Director, Highway Design/Construction

STATE	PROJECT DESIGNATION	YEAR	SHEET NO.	TOTAL SHEETS
ALASKA	F-093-2(5)	1981	2	16

TYPICAL SECTIONS

TYPICAL SECTION


STA. "0" 12+48 to "0" 14+53

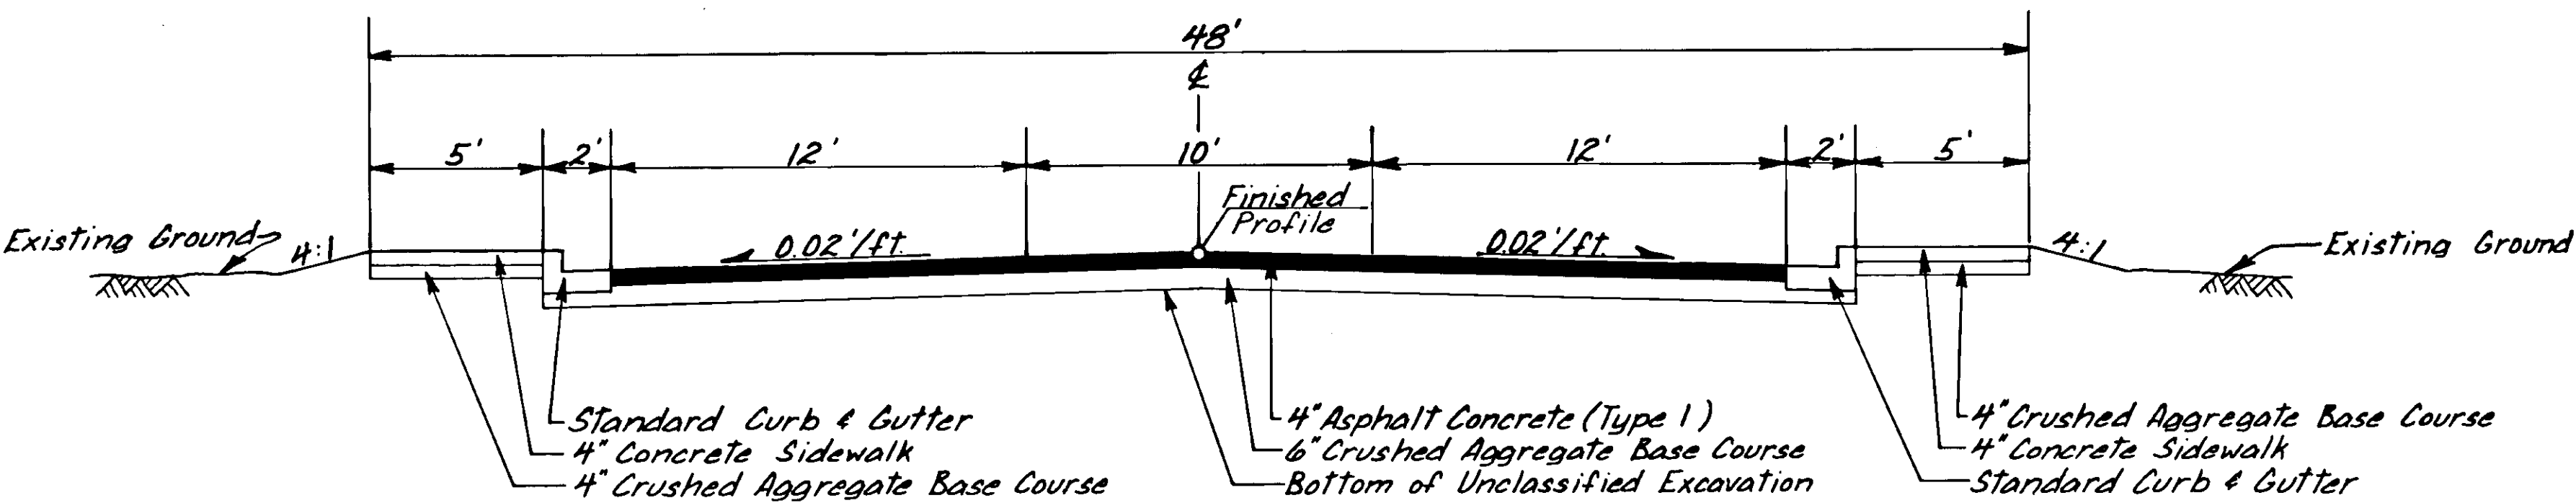


GENERAL NOTES

1. Grades & alignment shown on the plans are subject to minor revisions.
2. Curb inlets & culvert lengths & locations are subject to minor revisions.
3. All existing piling encountered within the project limits shall be either removed or cut off 1' below the proposed subgrade. Payment shall be made under Item 202(1) Removal of Structures & Obstructions.
4. Asphalt pavement removal shall be paid for as unclassified excavation.
5. Where the proposed sidewalk abuts existing asphalt that asphalt shall be patched in a workmanlike manner. This work shall be considered incidental to Item 401(1A) Asphalt Pavement Type 1 & no separate payment shall be made therefore.

TYPICAL CURB & SIDEWALK JOINT DETAILS

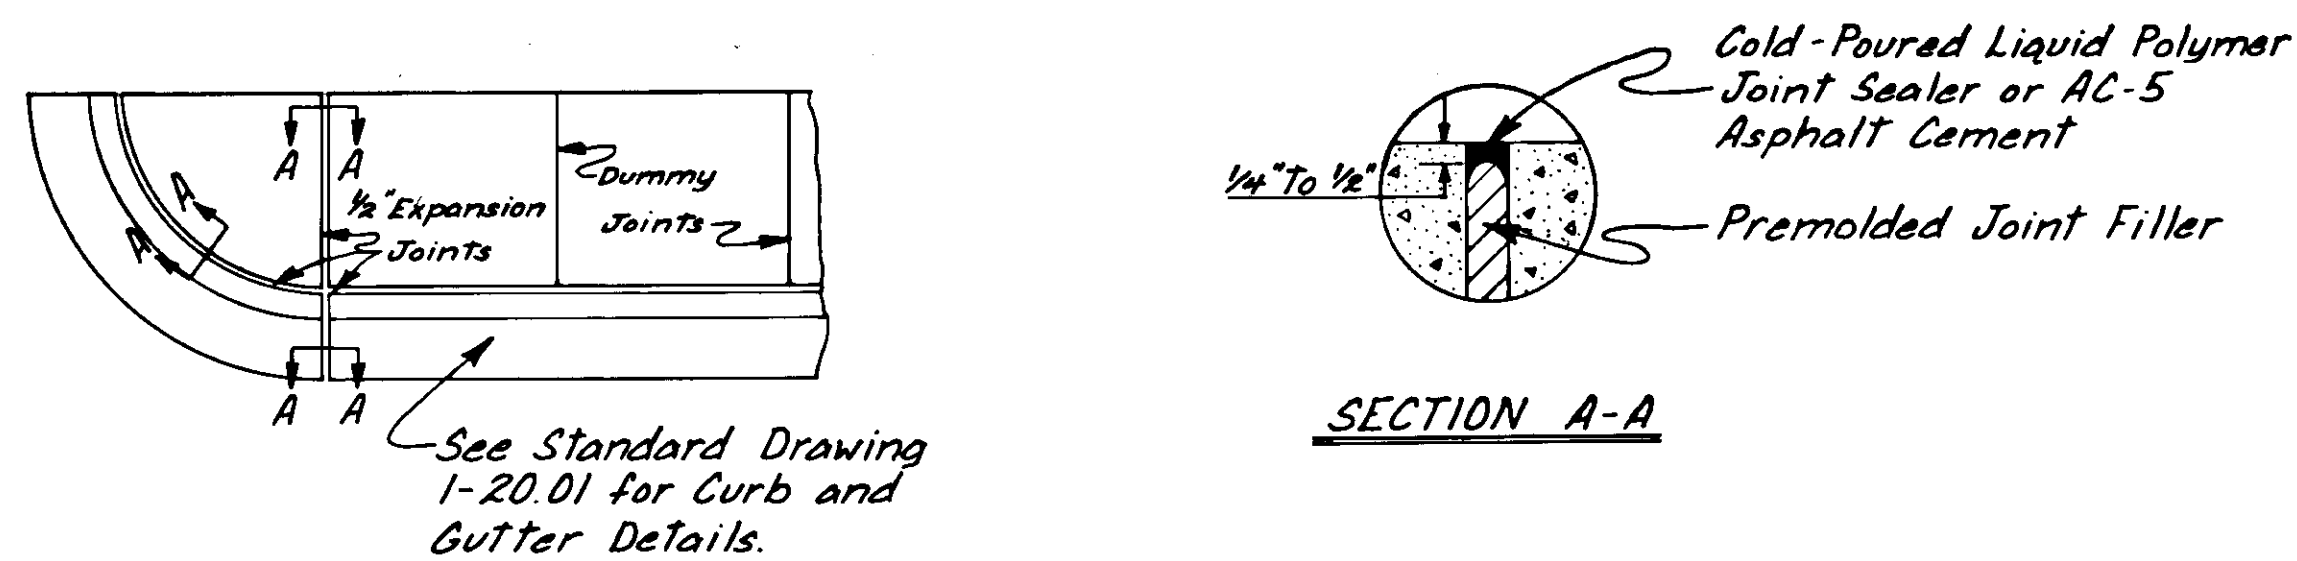

WHEELCHAIR RAMP DETAILS

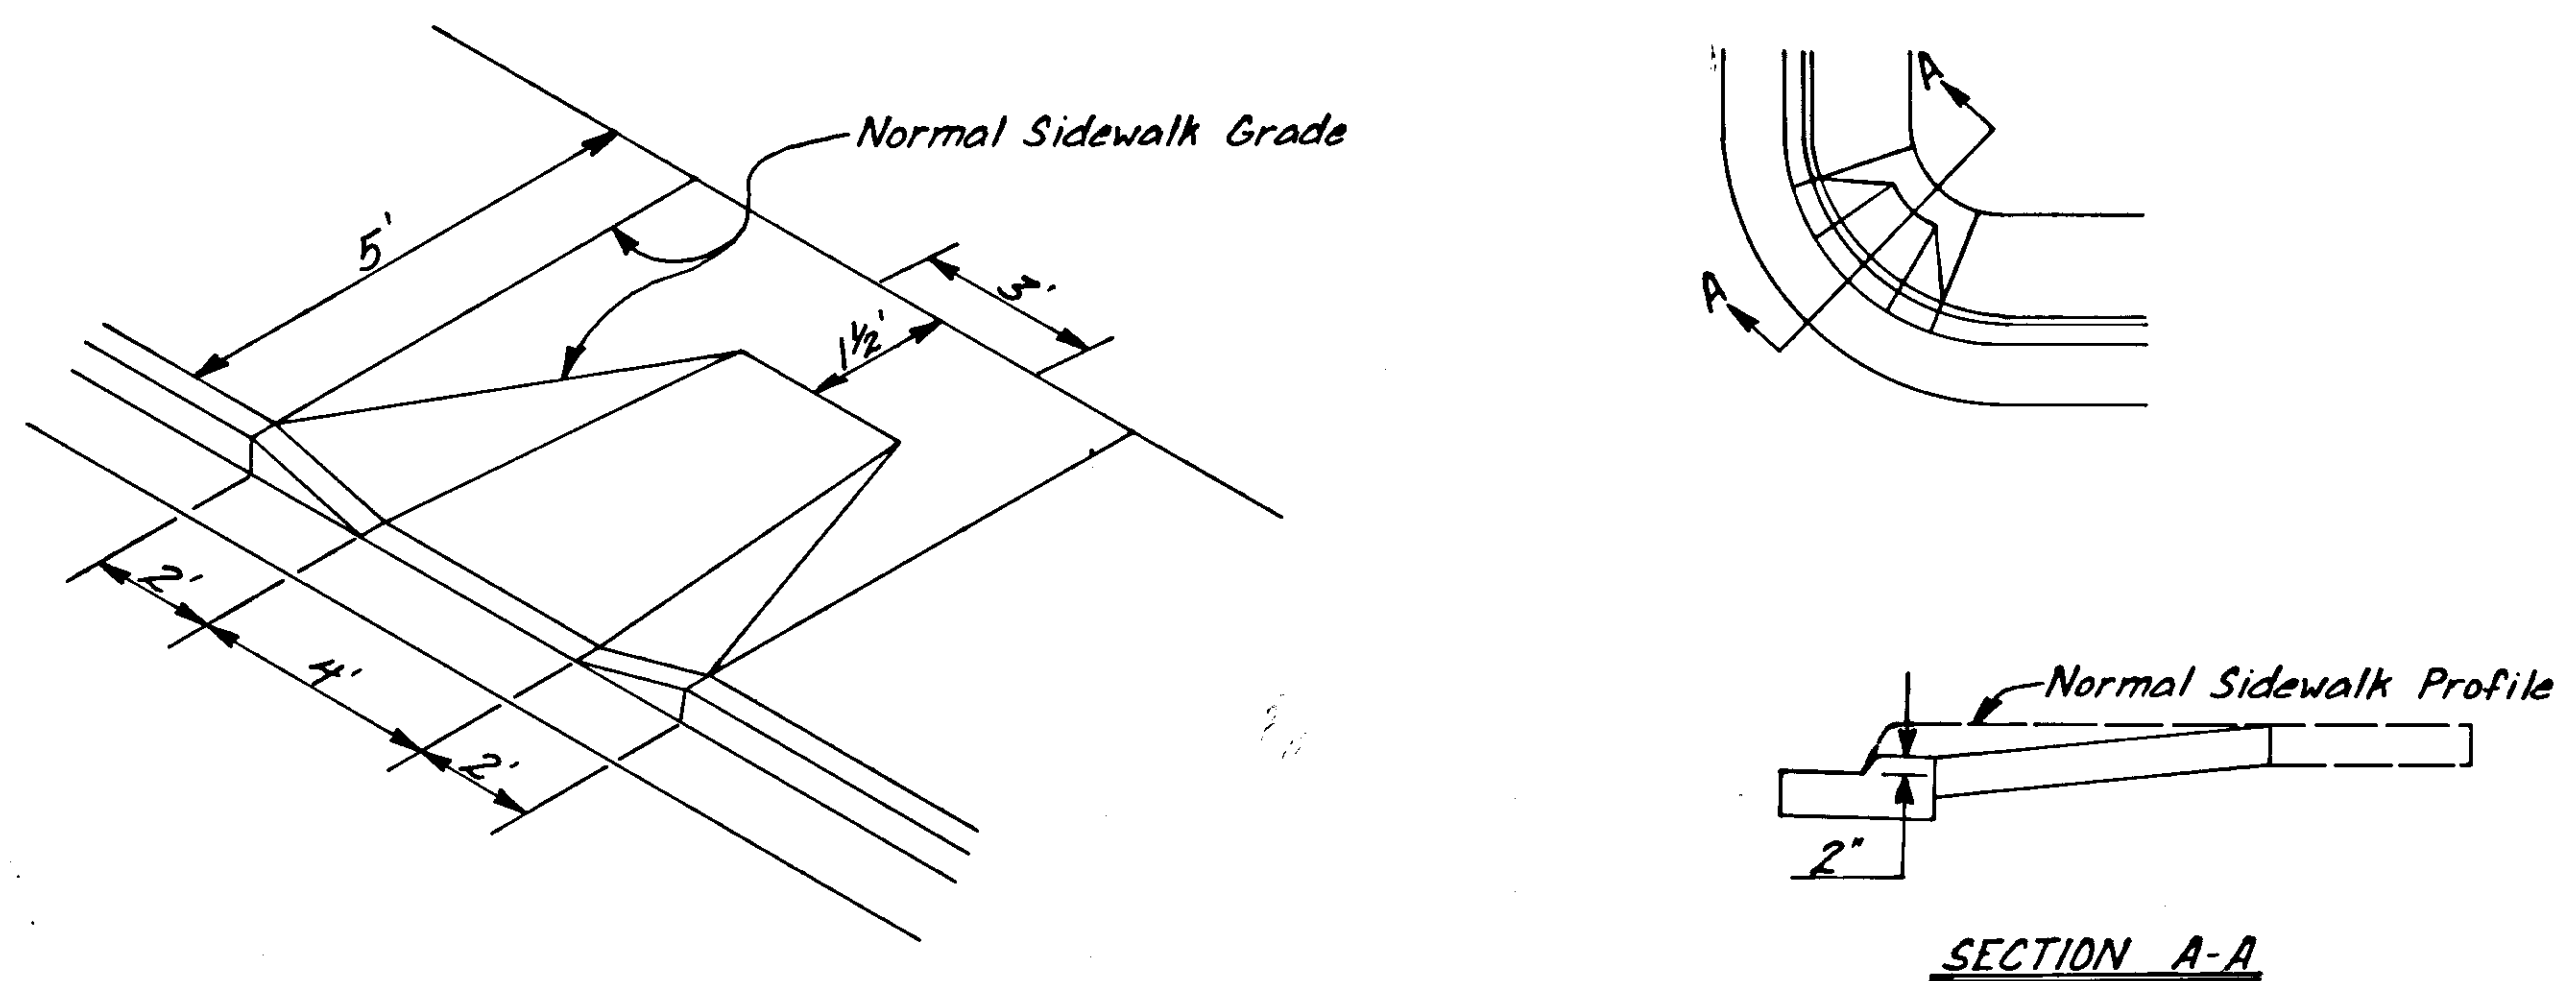

SIDEWALK NOTES

1. Premolded expansion joint filler & liquid polymer joint sealer (see specs) or AC-5 asphalt cement shall be considered incidental to Items 608(1-4) & 608(1-6) Concrete Sidewalk. No separate payment shall be made therefore.
2. Curb & gutter expansion joints shall be at each end of the curb returns & immediately preceding and following all curb cuts. Thereafter they shall be placed at intervals of 30' except where shorter sections are needed for closure.
3. Sidewalk expansion joints shall be opposite expansion joints in adjoining curb & gutter. Dummy joints shall be equally spaced between expansion joints; spacing shall not exceed 5'.
4. Wheelchair ramps shall be constructed as detailed on this sheet & shall be constructed at locations designated by a ★ on the plan sheets.
5. Wheelchair ramps shall have a wood float finish or rougher finish & shall have a small curb face of 2".

STATE	PROJECT DESIGNATION	YEAR	SHEET NO.	TOTAL SHEETS
ALASKA	F-093-2(5)	1981	3	16

ESTIMATE OF QUANTITIES AND SUMMARY TABLES

See page 32, book No. 10

NOTES
1. Water main appurtenances shall not be paid for directly but shall be considered incidental to Item 628(2) 8" Ductile Iron Water Conduit.

ESTIMATE OF QUANTITIES				
ITEM NO.	ITEM	UNIT	QUANTITY	
109(1)	Petroleum Escalation NOT USED	C.S.	All Req'd.	
110(1)	Mobilization	L.S.	All Req'd.	
111(1)	Temporary Erosion & Pollution Control NOT USED	L.S.	"	
113(1)	Flagging	M.H.	140	
114(1)	Construction Surveying by the Contractor	L.S.	All Req'd.	
115(1)	Traffic Maintenance	L.S.	"	
116(1)	Furnishing & Maintaining Field Office	L.S.	"	
116(2)	Furnishing & Maintaining Field Laboratory	L.S.	"	
202(1)	Removal of Structures and Obstructions	L.S.	"	
202(2)	Removal of Pavement	S.Y.	20833	
202(3)	Removal of Sidewalk	S.Y.	337	
202(5)	Removal of Manholes	EA.	1	
202(7)	Removal of Inlets	EA.	109	
202(8)	Removal of Curb and Gutter	L.F.	693	
203(3A)	Unclassified Excavation	L.S.	All Req'd.	
301(1A)	Crushed Aggregate Base Course	L.S.	"	
401(1A)	Asphalt Concrete (Type 1)	L.S.	"	
401(2A)	AC-5 Asphalt Cement	L.S.	"	
402(2)	CSS-1 Asphalt for Tack Coat NOT USED	L.S.	"	
604(5A)	Special Inlet Drainage	L.S.	All Req'd.	
603(2A)	MC-30 Liquid Asphalt for Prime Coat	L.F.	208 517	
603(13-12)	12" Corrugated Aluminum Pipe	L.F.	254 356	
603(13-18)	18" Corrugated Aluminum Pipe	EA.	1	
604(1)	Storm Sewer Manhole	EA.	6	
604(4)	Adjust Existing Manholes	EA.	10	
604(5)	Inlets	S.Y.	389	
608(1-4)	Concrete Sidewalk, 4" Depth	S.Y.	228.2	
608(1-6)	Concrete Sidewalk, 6" Depth	L.F.	1659	
609(2)	Curb & Gutter, Type Standard	EA.	4	
614(1)	Survey Monuments	EA.	5	
614(2)	Monument Cases	EA.	21	
614(3A)	Adjust Existing Monuments	S.F.	159.4	
615(1)	Standard Sign	L.F.	216	
626(2)	15" P.V.C. Sewer Conduit	L.F.	316	
628(2)	8" Ductile Iron Water Conduit	EA.	2	
628(7)	Fire Hydrant Relocation	EA.	98	
628(11)	Adjustment of Valve Boxes	L.S.	All Req'd.	
660(3)	Highway Lighting System, Complete	L.S.	"	
670(6)	Thermoplastic Pavement Markings	L.S.	"	
681(1)	Electrical Power System	L.S.	"	

INLET REMOVAL SUMMARY			
STATION	OFFSET		REMARKS
	LEFT	RIGHT	
"0" 9+74		15'	
"0" 10+65	19'		
"0" 10+95	19'		Deleted-See book No.4, pg 35
"0" 11+04		12'	
"0" 11+55	18'		
"Y" 9+78		15'	
"Y" 9+90	15'		
"Y" 10+27		18'	
"Y" 11+65		15'	
"Y" 11+89	16'		
"0" 14+07	19'		See Book No.4, Page 39

CURB CUT SUMMARY			
STATION	WIDTH		REMARKS
	LEFT	RIGHT	
"0" 10+12	74'		
"0" 10+51		50'	
"0" 11+23	17'		
"0" 11+64	30'		
"0" 11+79 to "0" 12+34	97'		Depressed Curb Mountable Curb w/6" Sidewalk
"0" 13+55		32'	
"0" 13+60	24'		
"Y" 10+20.50		24'	
"Y" 11+78	10'		
"Y" 12+93	18'		Match Existing

MANHOLE ADJUSTMENT SUMMARY			
STATION	OFFSET		REMARKS
	LEFT	RIGHT	
"0" 9+05	2'		
"0" 12+24		21'	
"0" 12+27		24'	
"X" 12+97			
"X" 14+18	3'		
"Y" 9+96	13'		

MANHOLE REMOVAL SUMMARY			
STATION	OFFSET		REMARKS
	LEFT	RIGHT	
"0" 12+11		19'	Remove after new water line is installed.

SEWER MAIN INSTALLATION SUMMARY				
STATION TO STATION	LENGTH	OFFSET	DIA.	REMARKS
M.H. "A" to M.H. "B"	95'		15"	P.V.C.
M.H. "B" to M.H. "C"	121'		15"	P.V.C.

FIRE HYDRANT RELOCATION SUMMARY			
STATION	EXISTING LOCATION	PROPOSED LOCATION	REMARKS
"0" 10+75	17' Lt.	20' Lt.	
"0" 12+05	19.5' Rt.	22' Rt.	21' Rt.

WATER MAIN INSTALLATION SUMMARY				
STATION TO STATION	LENGTH	OFFSET	DIA.	REMARKS *
"0" 9+03 to "0" 12+24	316'	Varies	8" D.I.	
"0" 10+75		11' Rt.	8" x 8" x 6"	Tee
"0" 12+06		9'	8" x 8" x 6"	Tee
"0" 12+15		5' Rt.	8"	Gate Valve & Valve Box
"0" 12+21		9' Rt.	8" x 10"	Reducer
"0" 12+23		10' Rt.	10"	90° Elbow

MONUMENT SUMMARY				
STATION	LOCATION	REMARKS	MON.	CASE
"0" 8+95.86	E	P.D.T.	X	X
"0" 11+37.28	E	P.C.	X	X
"0" 12+20.00	W	Deleted Adjust		
"0" 12+36.78	E	P.T.	X	X
"0" 14+30.00	E	P.D.T.	X	X
"X" 14+09.00	14' Lt.	Adjust		

VALVE ADJUSTMENT SUMMARY			
STATION	OFFSET		REMARKS
	LEFT	RIGHT	
"0" 9+02.50	11'		
"0" 9+06.50	7'		
"0" 9+08.50	11'		
"0" 15+44	21'		
"0" 12+32		4'	
"Y" 9+92	6'		
"Y" 9+92	9'		
"X" 13+01	9.5'		New Valve Box

ELECTRICAL POWER SYSTEM SUMMARY			
DESCRIPTION	UNIT	QUANT.	
Class "A" Concrete	C.Y.	80	
4" Polyvinyl Chloride Pipe	L.F.	1900	
5" Polyvinyl Chloride Pipe	L.F.	1050	
2" Polyvinyl Chloride Pipe	L.F.	200	
350 KCM XLP Wire	L.F.	1985	
750 KCM XLP Wire	L.F.	1335	
1/0 XLP Wire	L.F.	350	
2/0 XLP Wire	L.F.	665	
3/0 XLP Wire	L.F.	700	
4/0 XLP Wire	L.F.	445	
4" Rigid Steel Conduit	L.F.	32	

ESTIMATE OF ROADWAY QUANTITIES				
ITEM NO.	ITEM	UNIT	QUANTITY	
203(3A)	Unclassified Excavation	C.Y.	1,050	
301(1A)	Crushed Aggregate Base Course	Ton	1,484	
401(1A)	Asphalt Concrete (Type 1)	Ton	914	
401(2A)	AC-5 Asphalt Cement	Ton	55	
402(2)	CSS-1 Asphalt for Tack Coat	Ton	1.8	
403(2A)	MC-30 Liquid Asphalt for Prime Coat	Ton	4.5	
670(6)	See sht 13			


BASIS OF ESTIMATE		
ITEM NO.	ITEM	ESTIMATING FACTOR
301(1A)	Crushed Aggregate Base Course	190 Tons/Cu. Yd.
401(1A)	Asphalt Concrete (Type 1)	114.4 lbs./Sq. Yd./Inch Depth
401(2A)	AC-5 Asphalt Cement	6% of Item 401(1A)
402(2)	CSS-1 Asphalt for Tack Coat	*0.10 Gal./Sq. Yd. - 253 Gal./Ton
403(2A)	MC-30 Liquid Asphalt for Prime Coat	0.25 Gal./Sq. Yd. - 256 Gal./Ton @ 60%

* Diluted

* See Notes on this Sheet.

ELECTRICAL CONNECTIONS SCHEDULE									
NO.	FROM	TO	WIRE SIZE	DISTANCE	TOTAL LENGTH	SERVICE TYPE	CONDUIT		REMARKS
							SIZE	LENGTH	
1.	Switch "X" 8+50.60	Transformer	3# 250 KCM	445	1335	15 KV	5"	425	
		"0" 12+12.25 Rt.	# 4/0 XLP	445	445	600V			
2.	Transformer "0" 12+12.25 Lt.	Service	3# 350 KCM	290	870	1# 3# 600V	4"	270	
		"0" 9+95.25 Lt.	# 2/0 XLP	290	290	600V			
3.	Transformer "0" 12+12.25 Lt.	Service	3# 350 KCM	195	585	1# 3# 600V	4"	175	
		"0" 11-56.73 Lt.	# 2/0 XLP	195	195	600V			
4.	Transformer "0" 12+12.25 Lt.	Service	3# 350 KCM	170	510	1# 3# 600V	4"	150	Through Vault at Sta. "X" 13+31.13' Lt.
		"X" 13+31.27 Lt.	# 2/0 XLP	170	170	600V			
5.	Transformer "0" 12+12.25 Lt.	Service	2# 3/0 XLP	180	360	1# 600V	4"	160	Through Vault at Sta. "X" 13+31.13' Lt.
		"X" 13+33.20 Lt.	# 1/0 XLP	180	180	600V			

STATE	PROJECT DESIGNATION	YEAR	SHEET NO.	TOTAL SHEETS
ALASKA	F-093-2(5)	1981	5	16

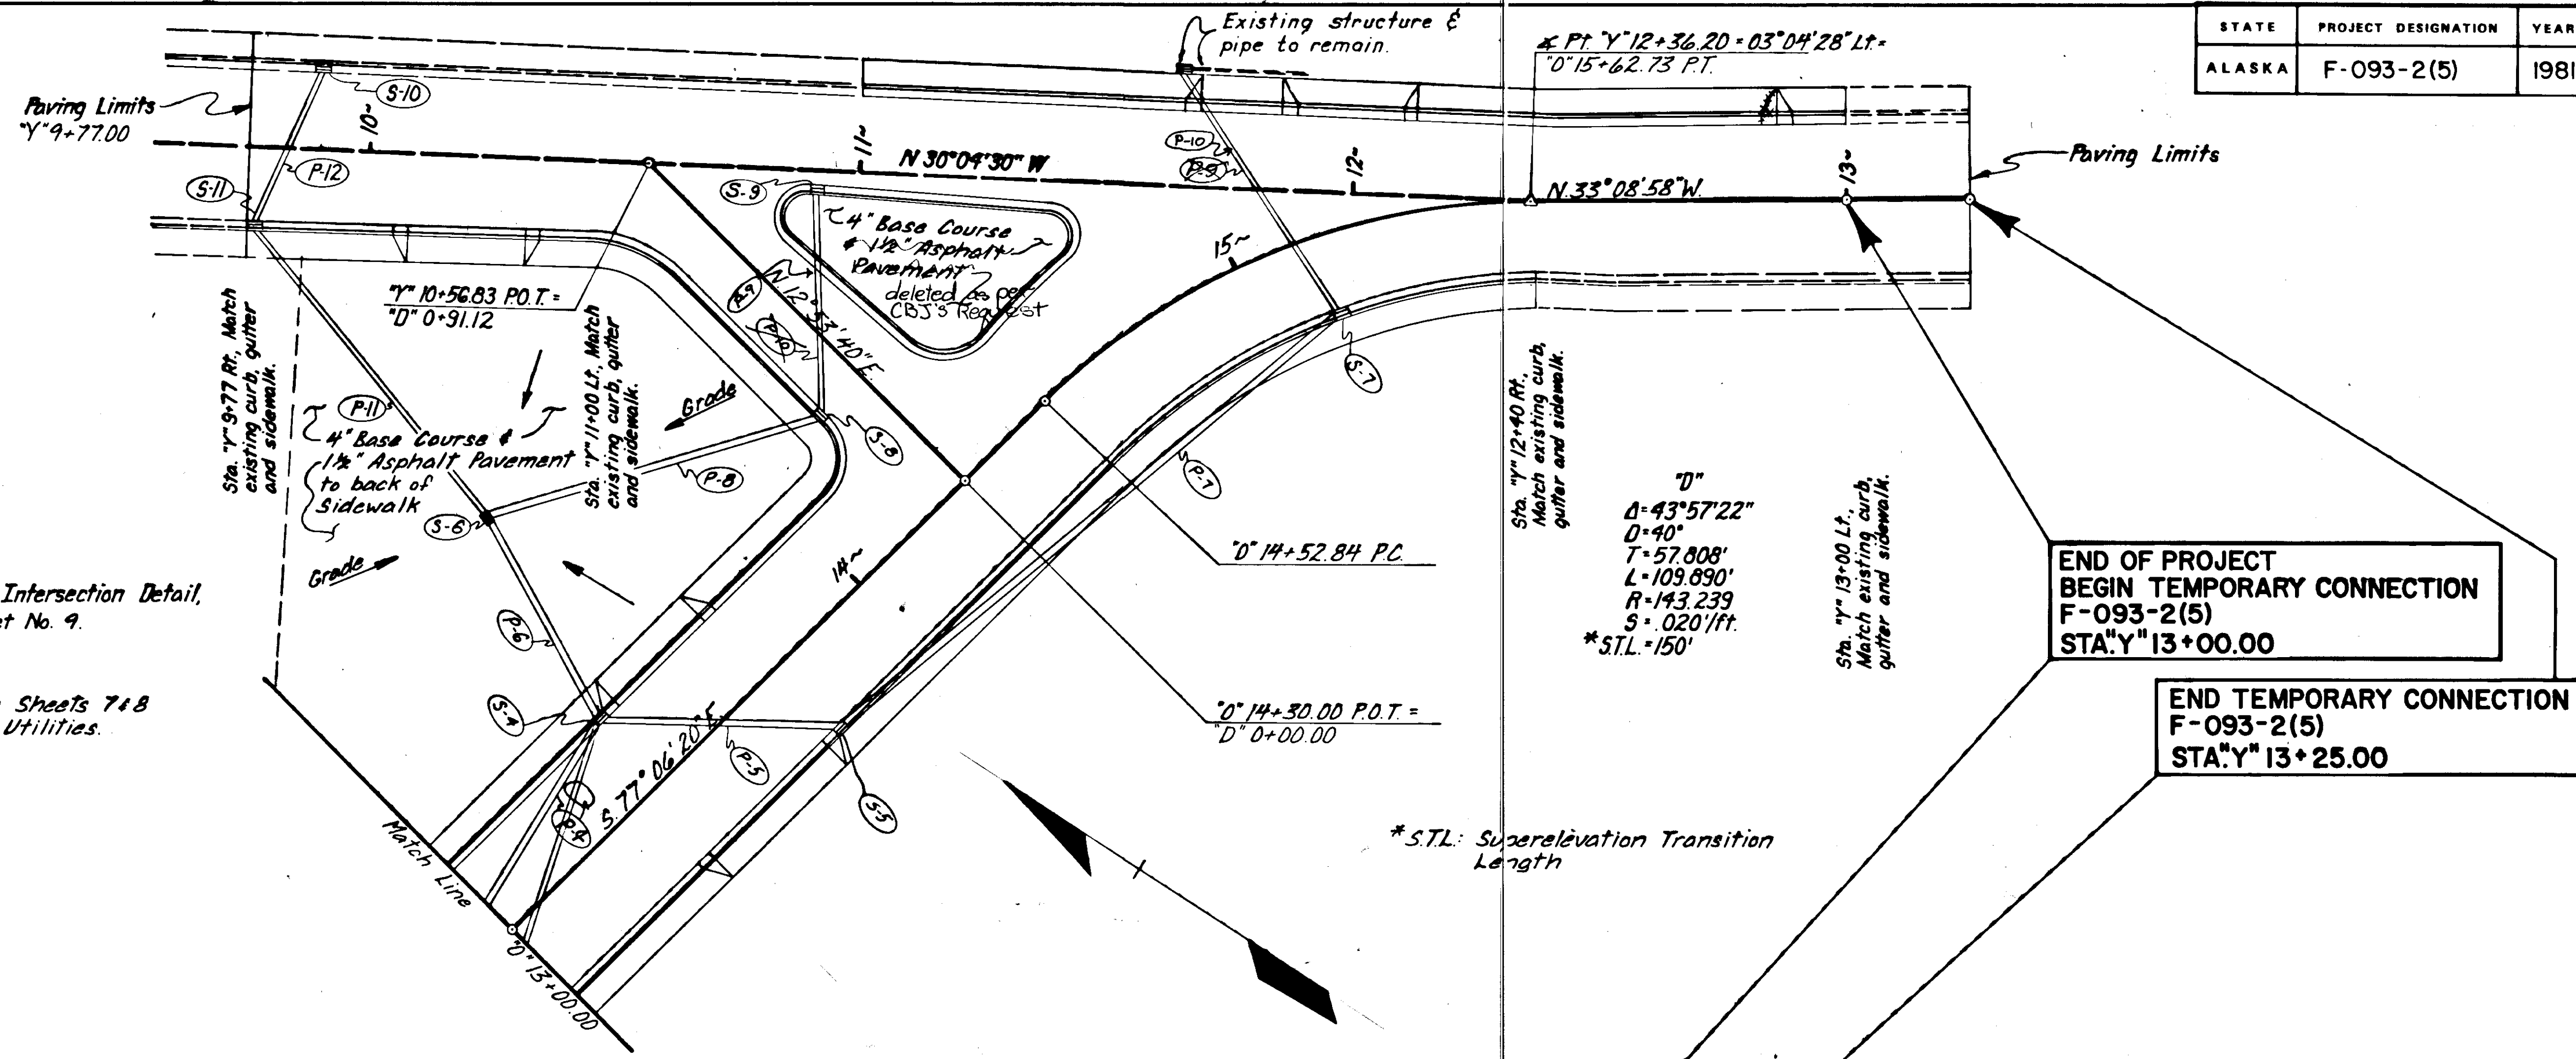


Note: See Intersection Detail, Sheet No. 9.

NOTE: See Sheets 7 & 8 for Utilities.

END OF PROJECT
BEGIN TEMPORARY CONNECTION
F-093-2(5)
STA "Y" 13+00.00

END TEMPORARY CONNECTION
F-093-2(5)
STA "Y" 13+25.00


*STL: Superelevation Transition Length

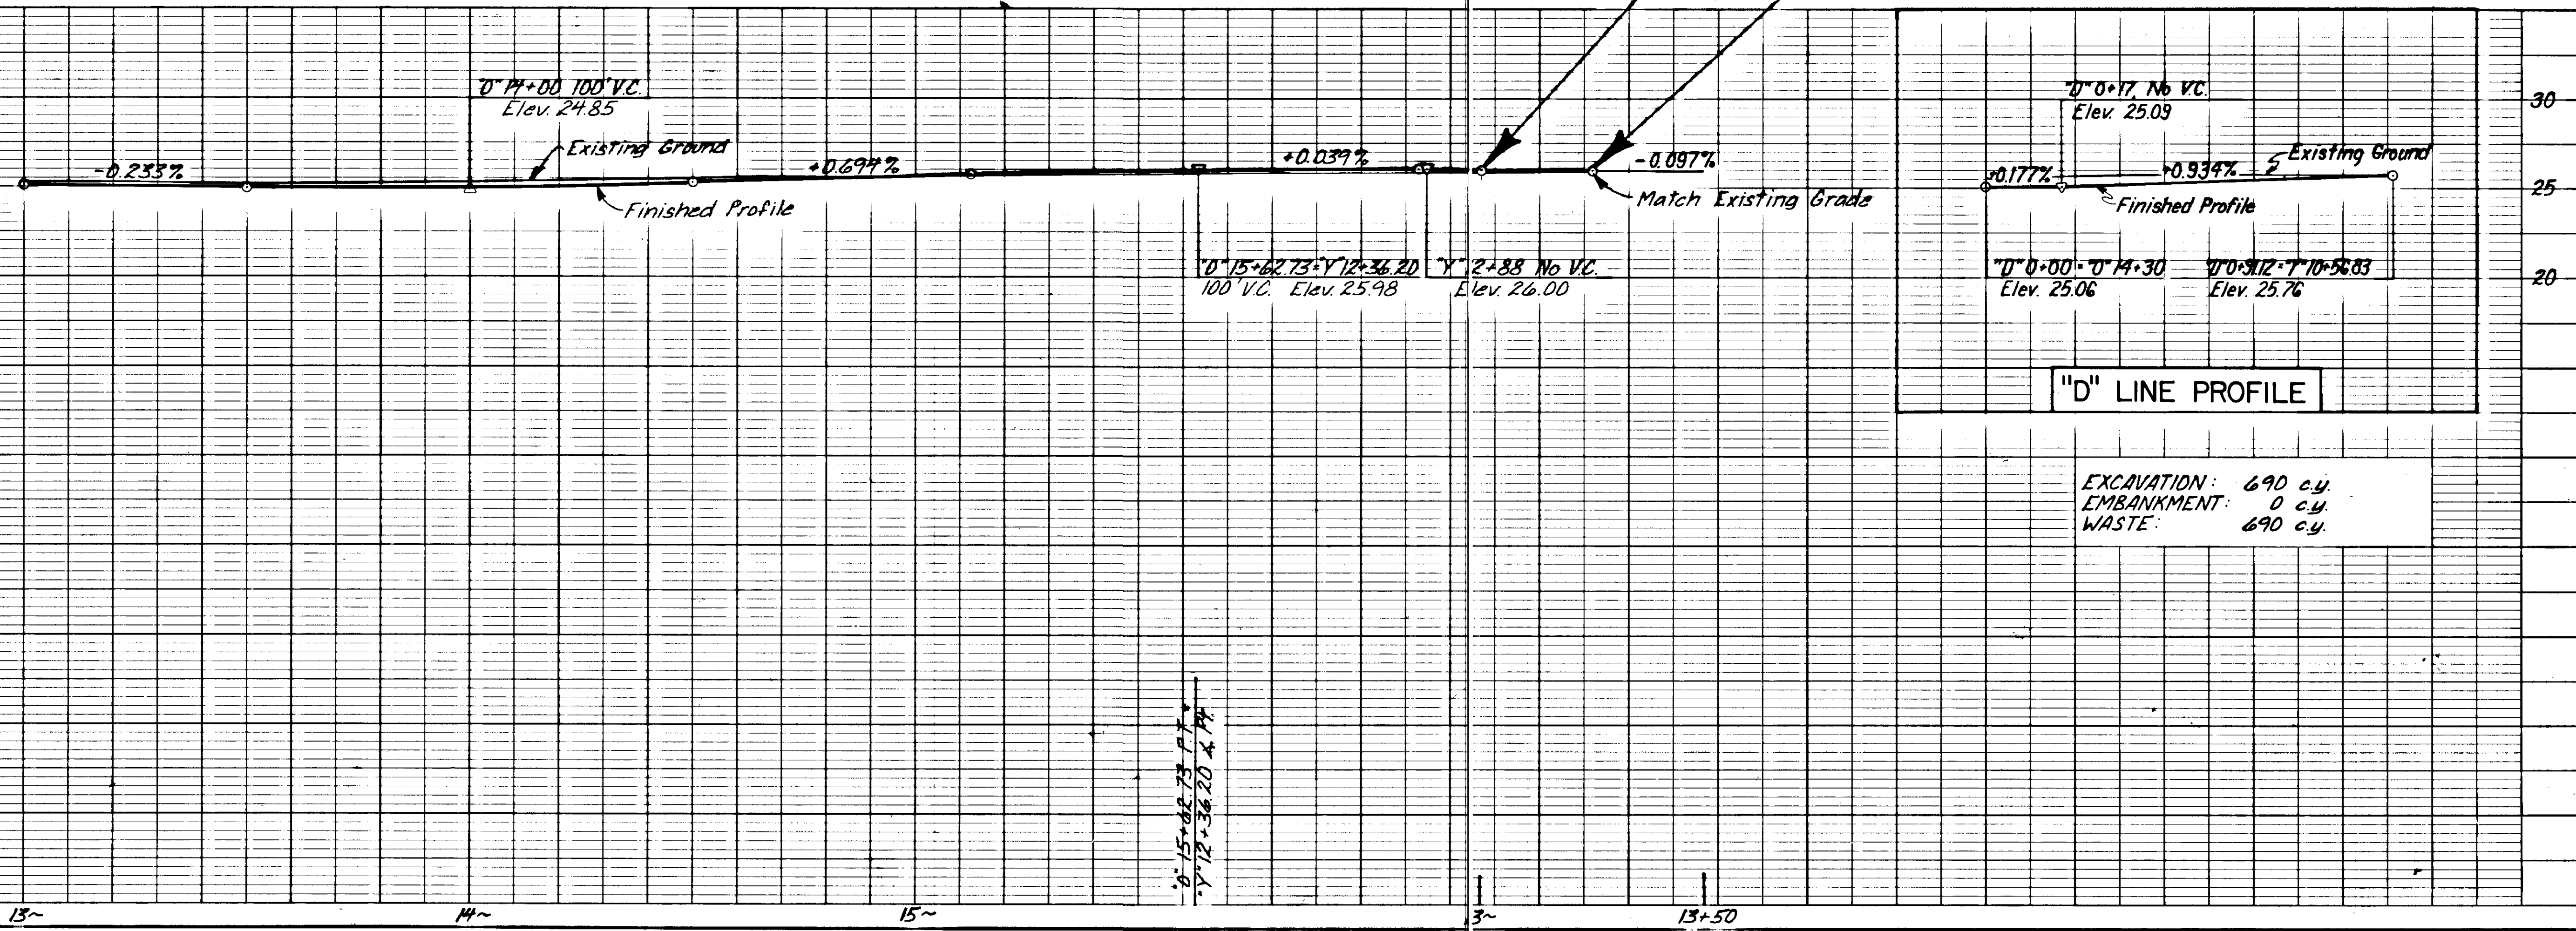


EXCAVATION: 690 c.y.
EMBANKMENT: 0 c.y.
WASTE: 690 c.y.

STATE	PROJECT DESIGNATION	YEAR	SHEET NO.	TOTAL SHEETS
ALASKA	F-093-2(5)	1981	6	16


UTILITIES DETAIL

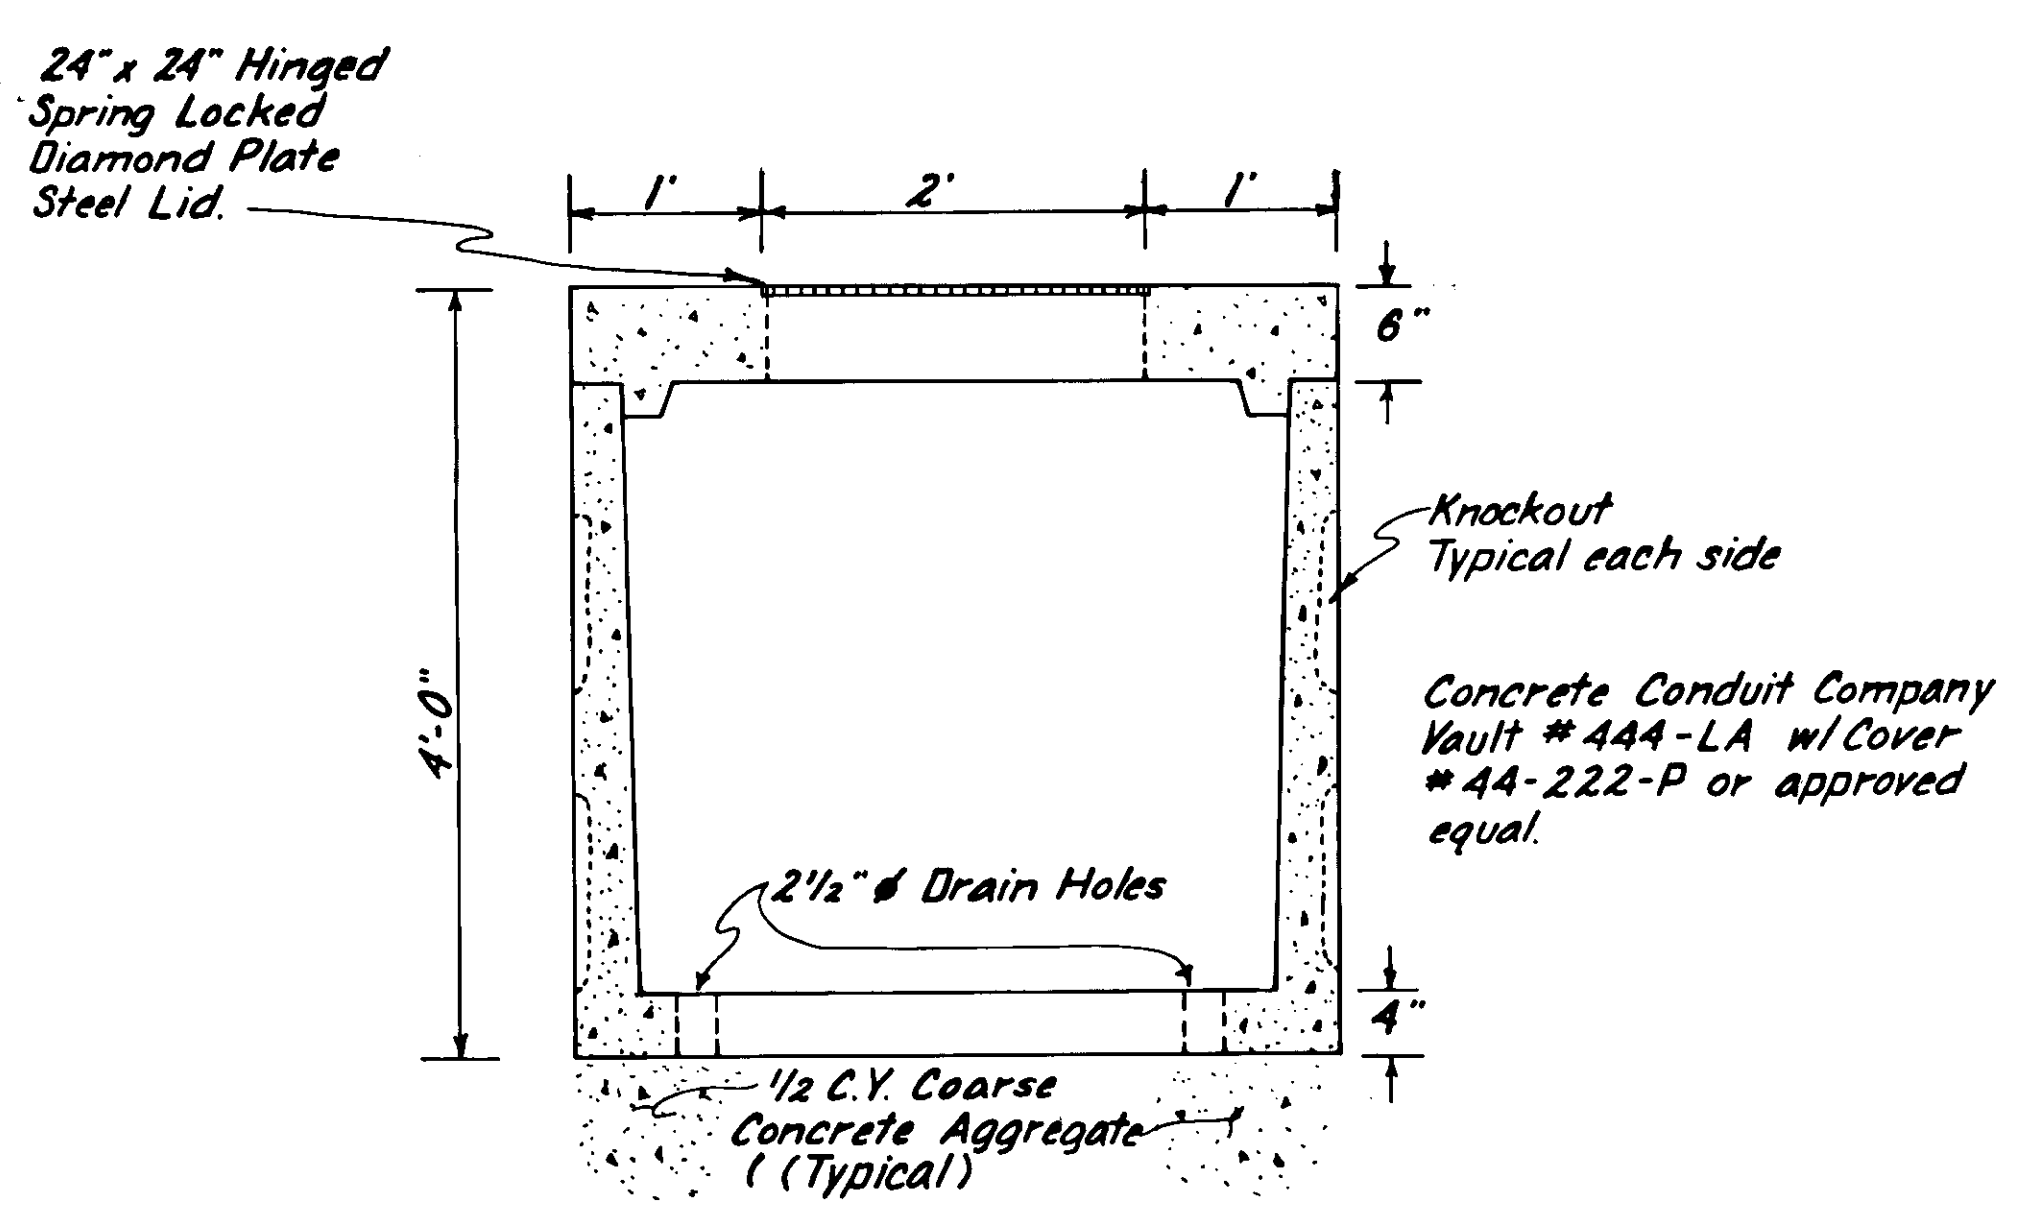

HAND HOLE DETAIL
Sta. "X" 13+31, 13' Lt.

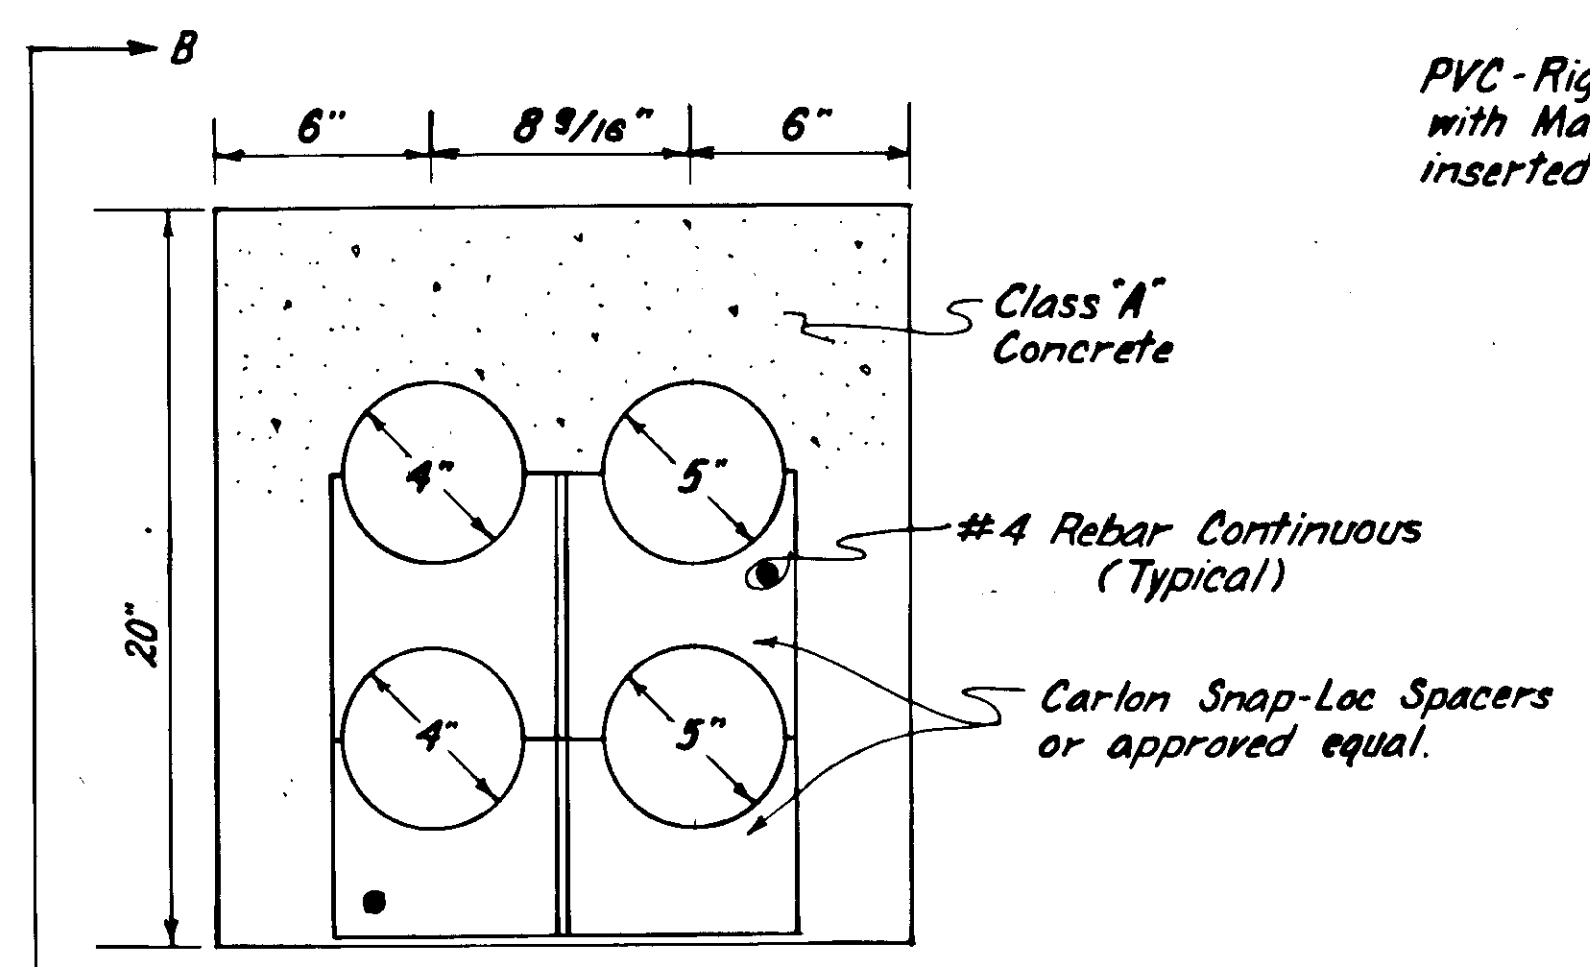


UTILITY DUCT CONCRETE ENCLOSURE
Sta. "O" 12+12 to Sta. "X" 14+45

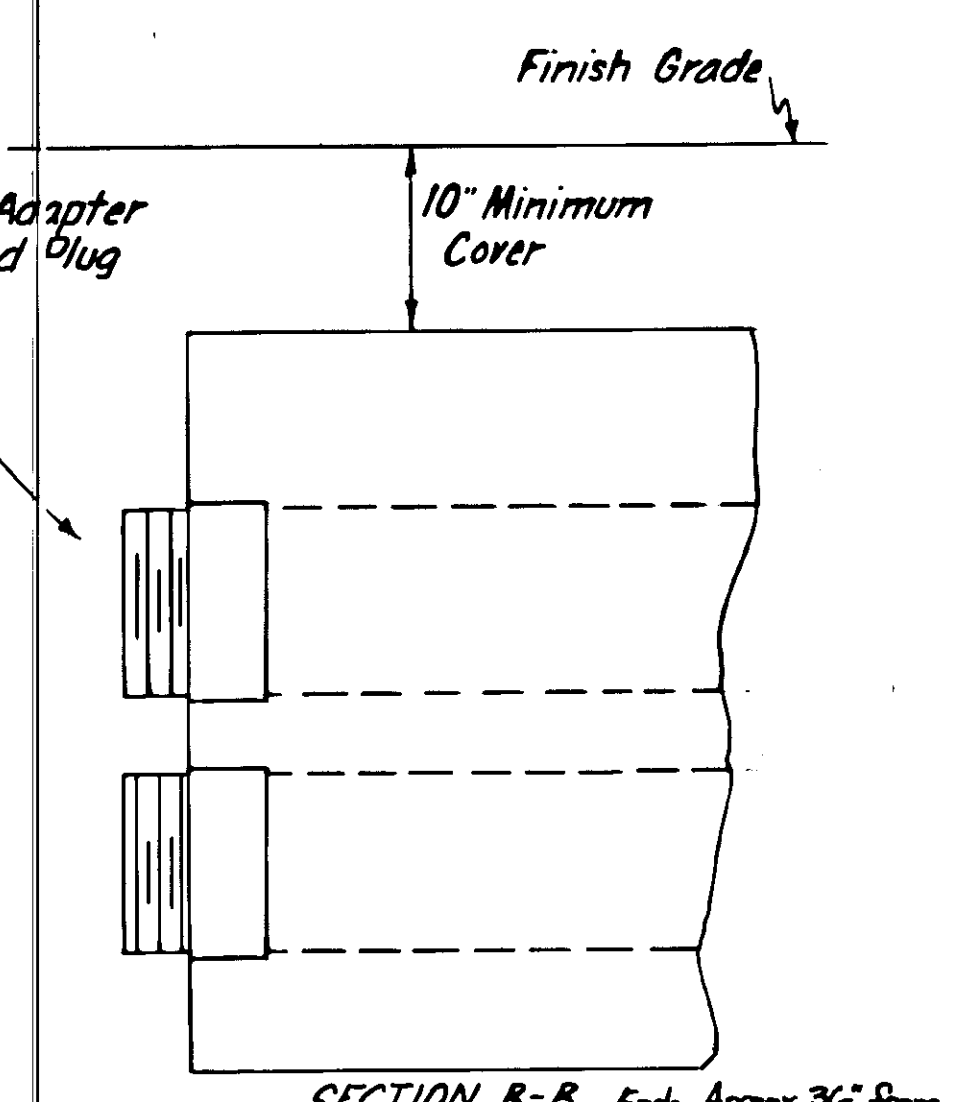


SECTION B-B Ends Approx. 36" from base of pipe.
END DETAIL
"X" 14+45, 17' Lt. & "O" 12+90, 74' Rt.


- UTILITY GENERAL NOTES**
- The 8" D.I. water line shall be installed at a depth of five (5) feet below the finish grade elevation. Minor adjustments may be permitted as approved by the engineer.
 - Existing storm drainage pipes that connect curb inlets to the sanitary sewer shall be capped and abandoned as directed by the engineer.
 - The contractor shall submit shop drawings showing the forming and tie down details for the construction of the Utility Ducts. The shop drawings shall be approved by the engineer prior to the placement of Class W Concrete.
 - Excavation, Bedding and Backfill for the conduit systems shall conform to Sections 203 and 205 and shall be considered incidental to Item 681 Electrical Power System Lump Sum.
 - The existing 18" A.C. sewer conduit is to be removed for placement of new 15" P.V.C. sewer conduit between manholes 'A' & 'C'.

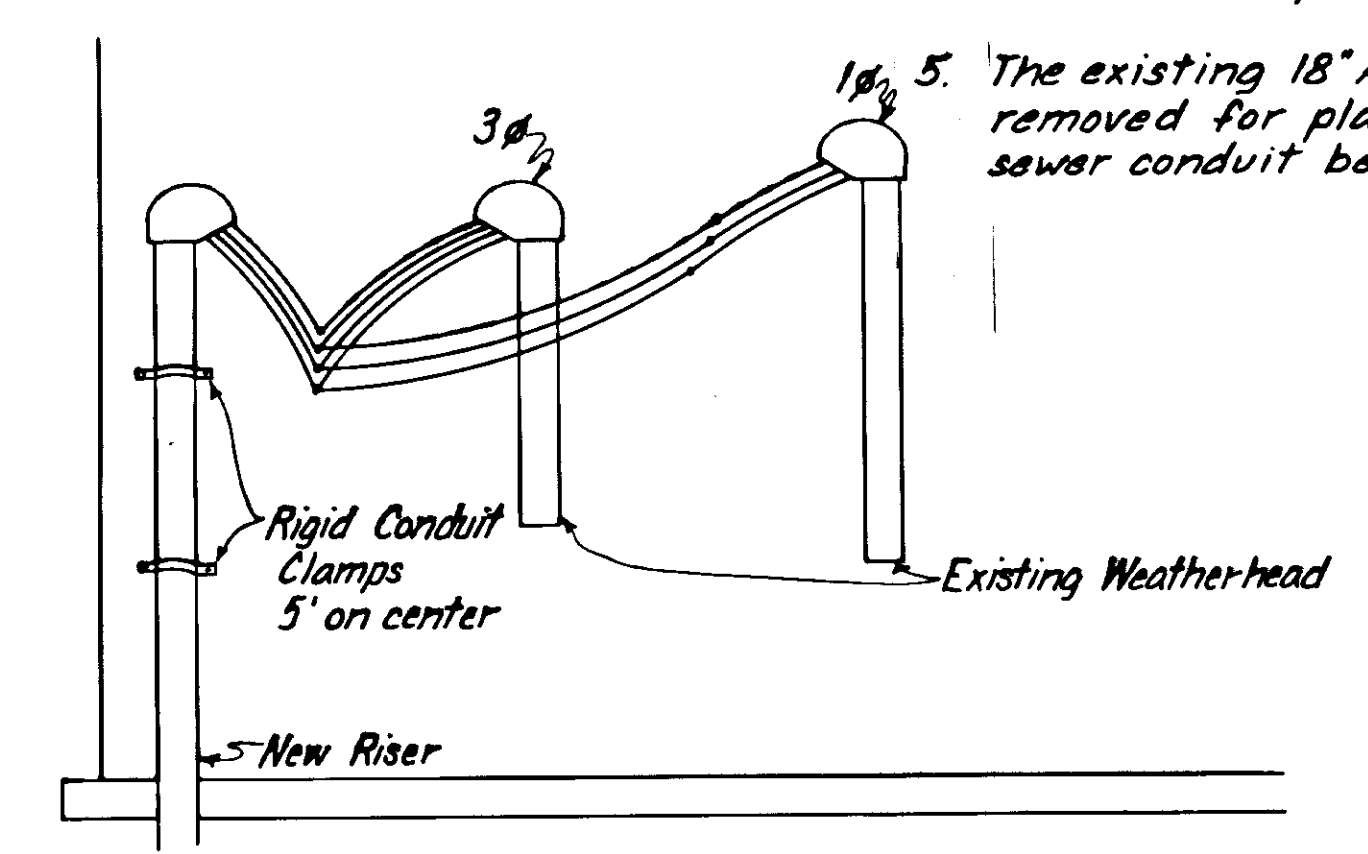


POWER RISER & TERMINATION

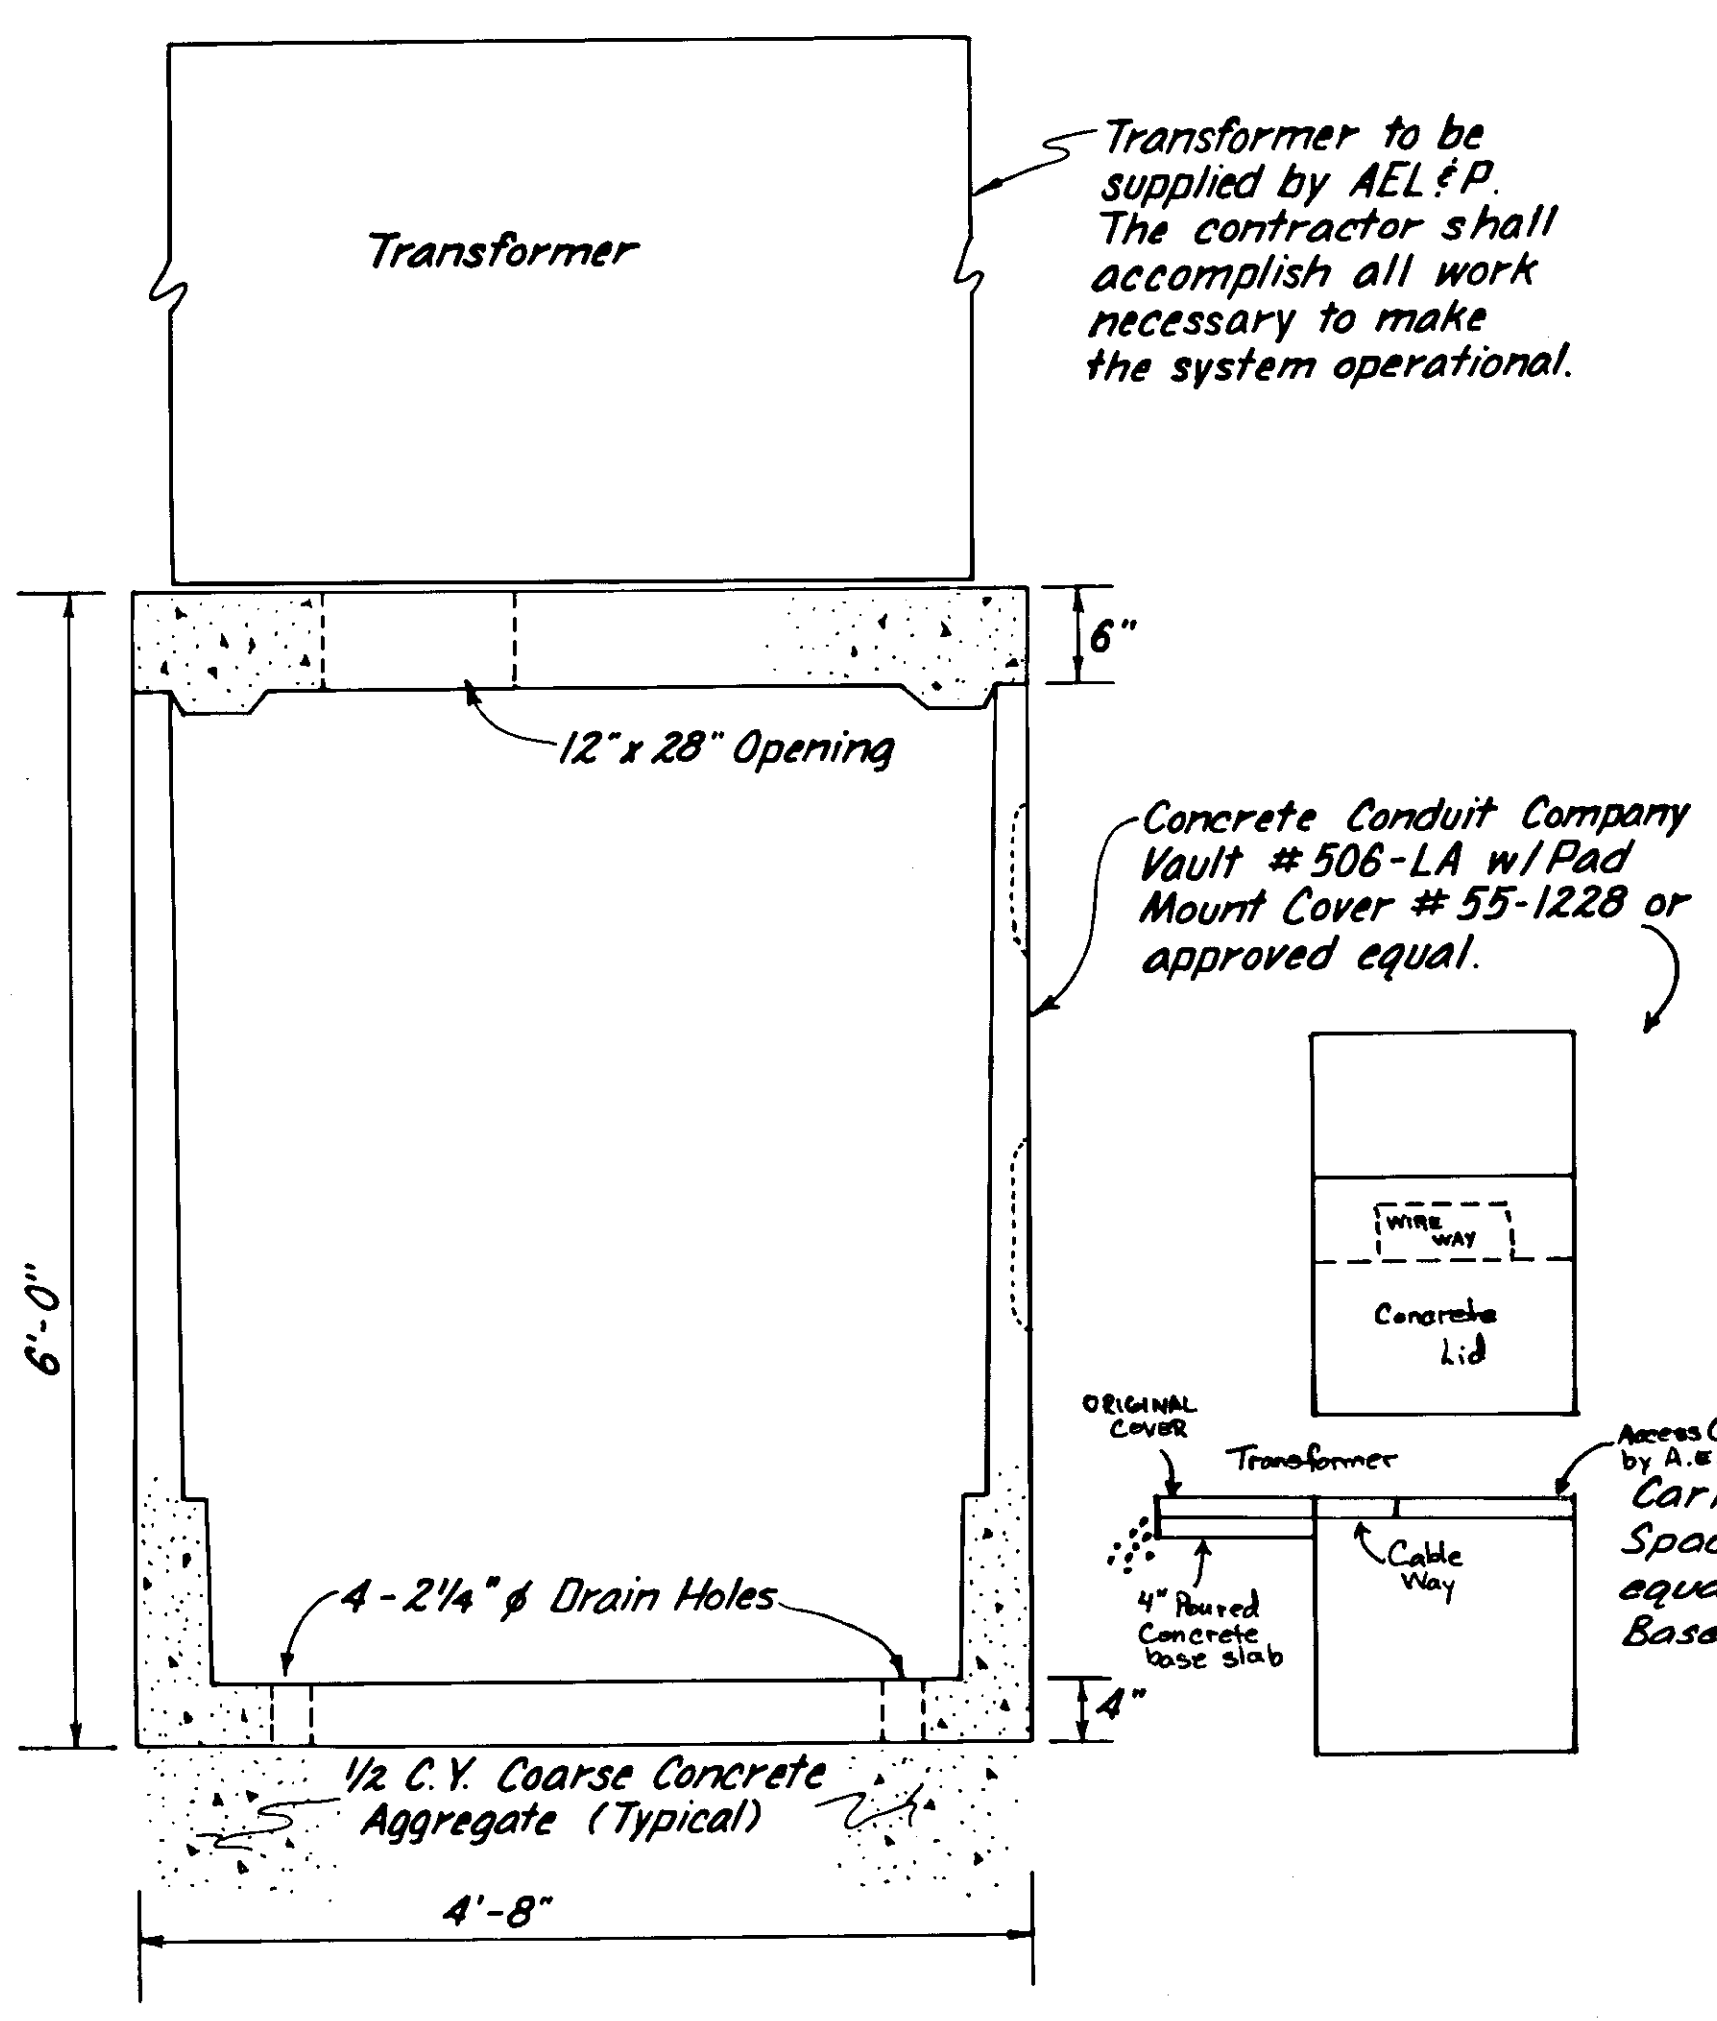


VAULT DETAIL
Sta. "O" 12+12, 25' Rt.

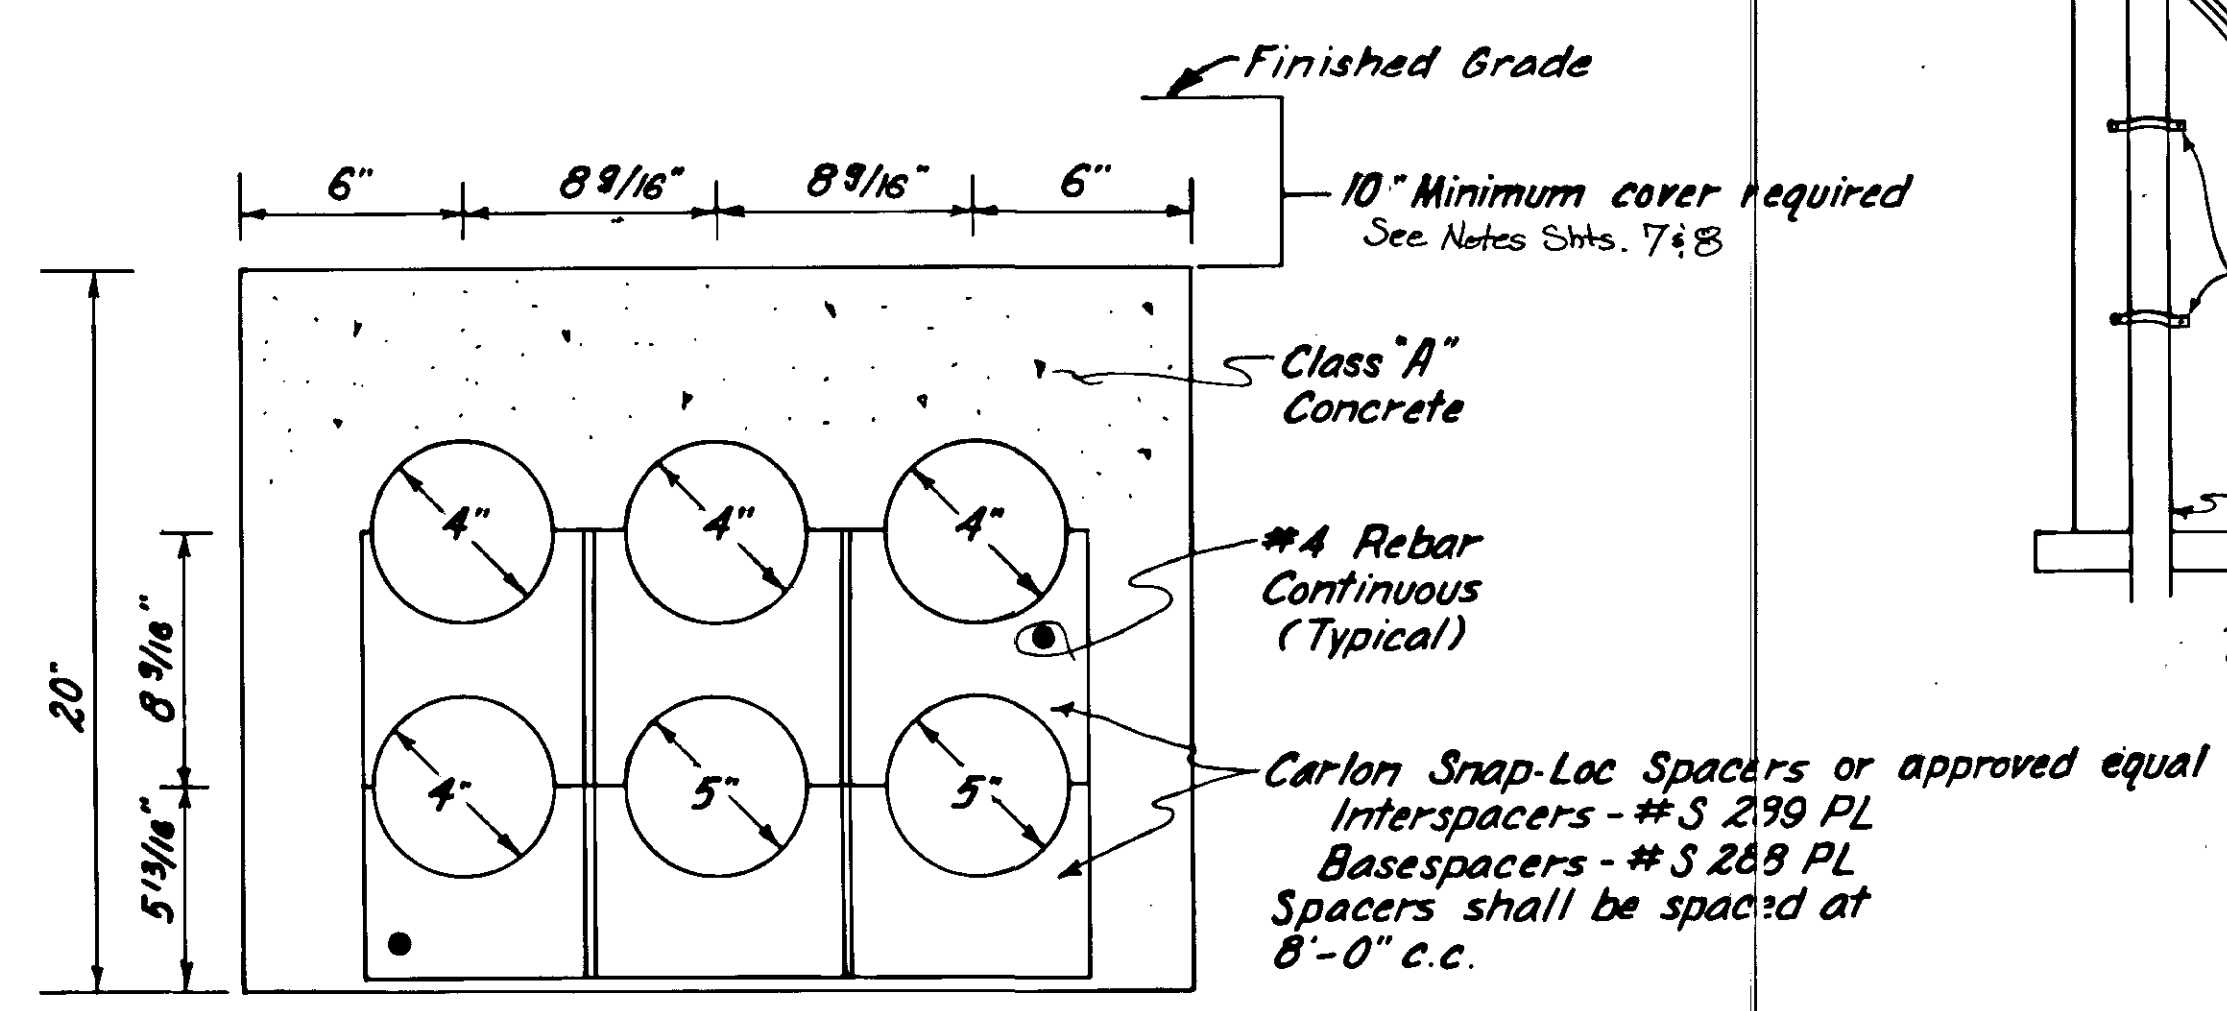

UTILITY DUCT CONCRETE ENCLOSURES
Sta. "O" 9+50 to Sta. "O" 12+12

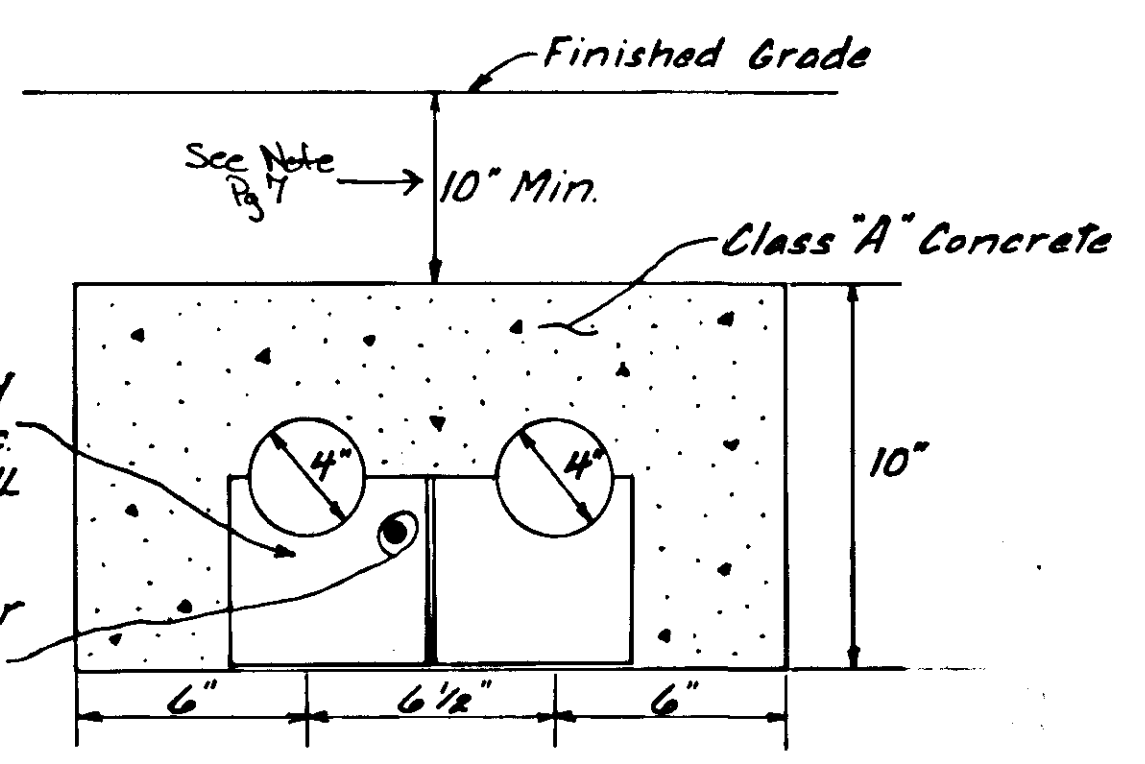


SECTION A-A
SERVICE DUCT CONCRETE ENCLOSURE

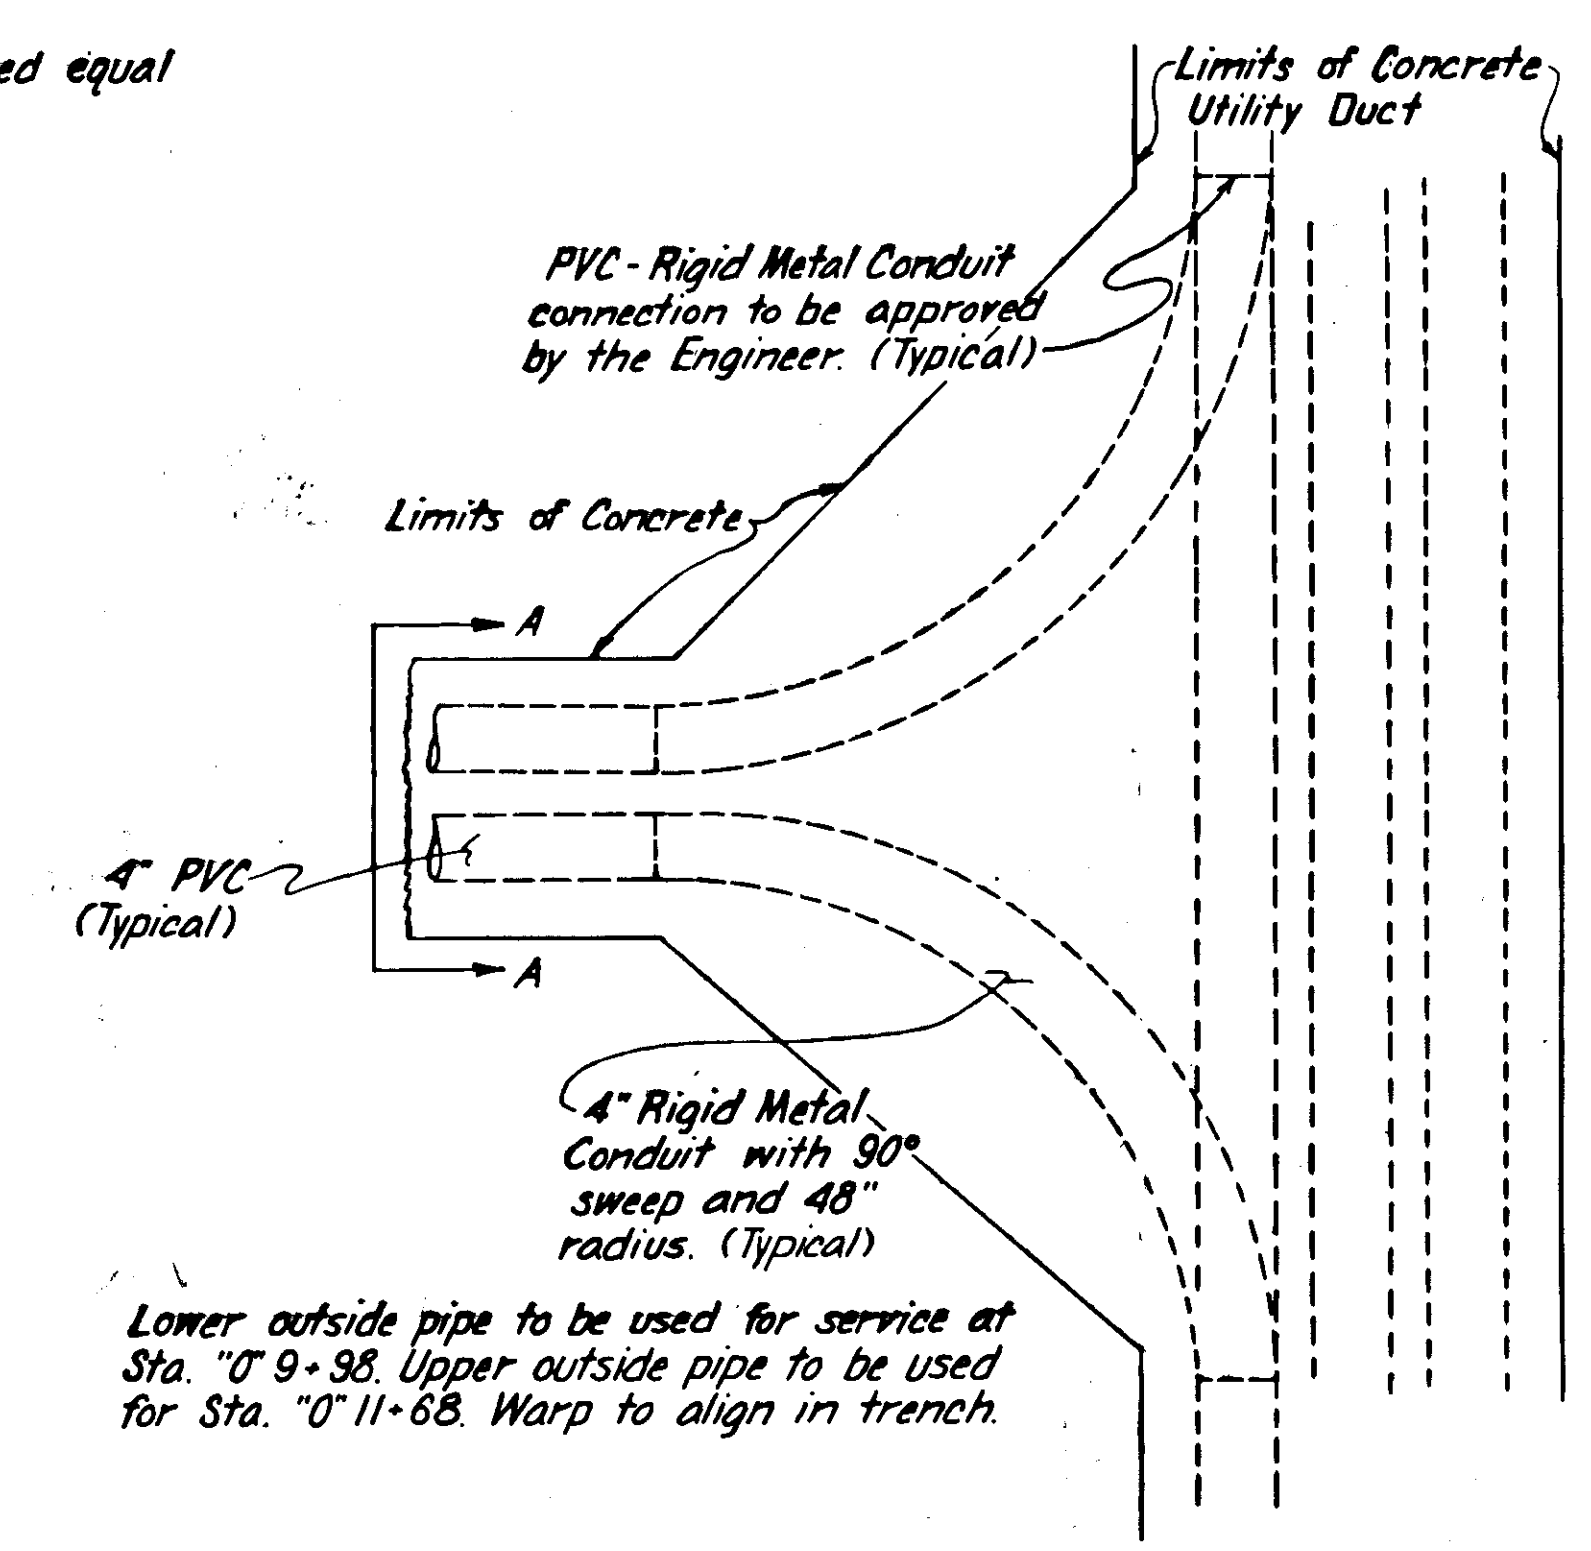



Lower outside pipe to be used for service at Sta. "O" 9+98. Upper outside pipe to be used for Sta. "O" 11+68. Warp to align in trench.

UTILITIES

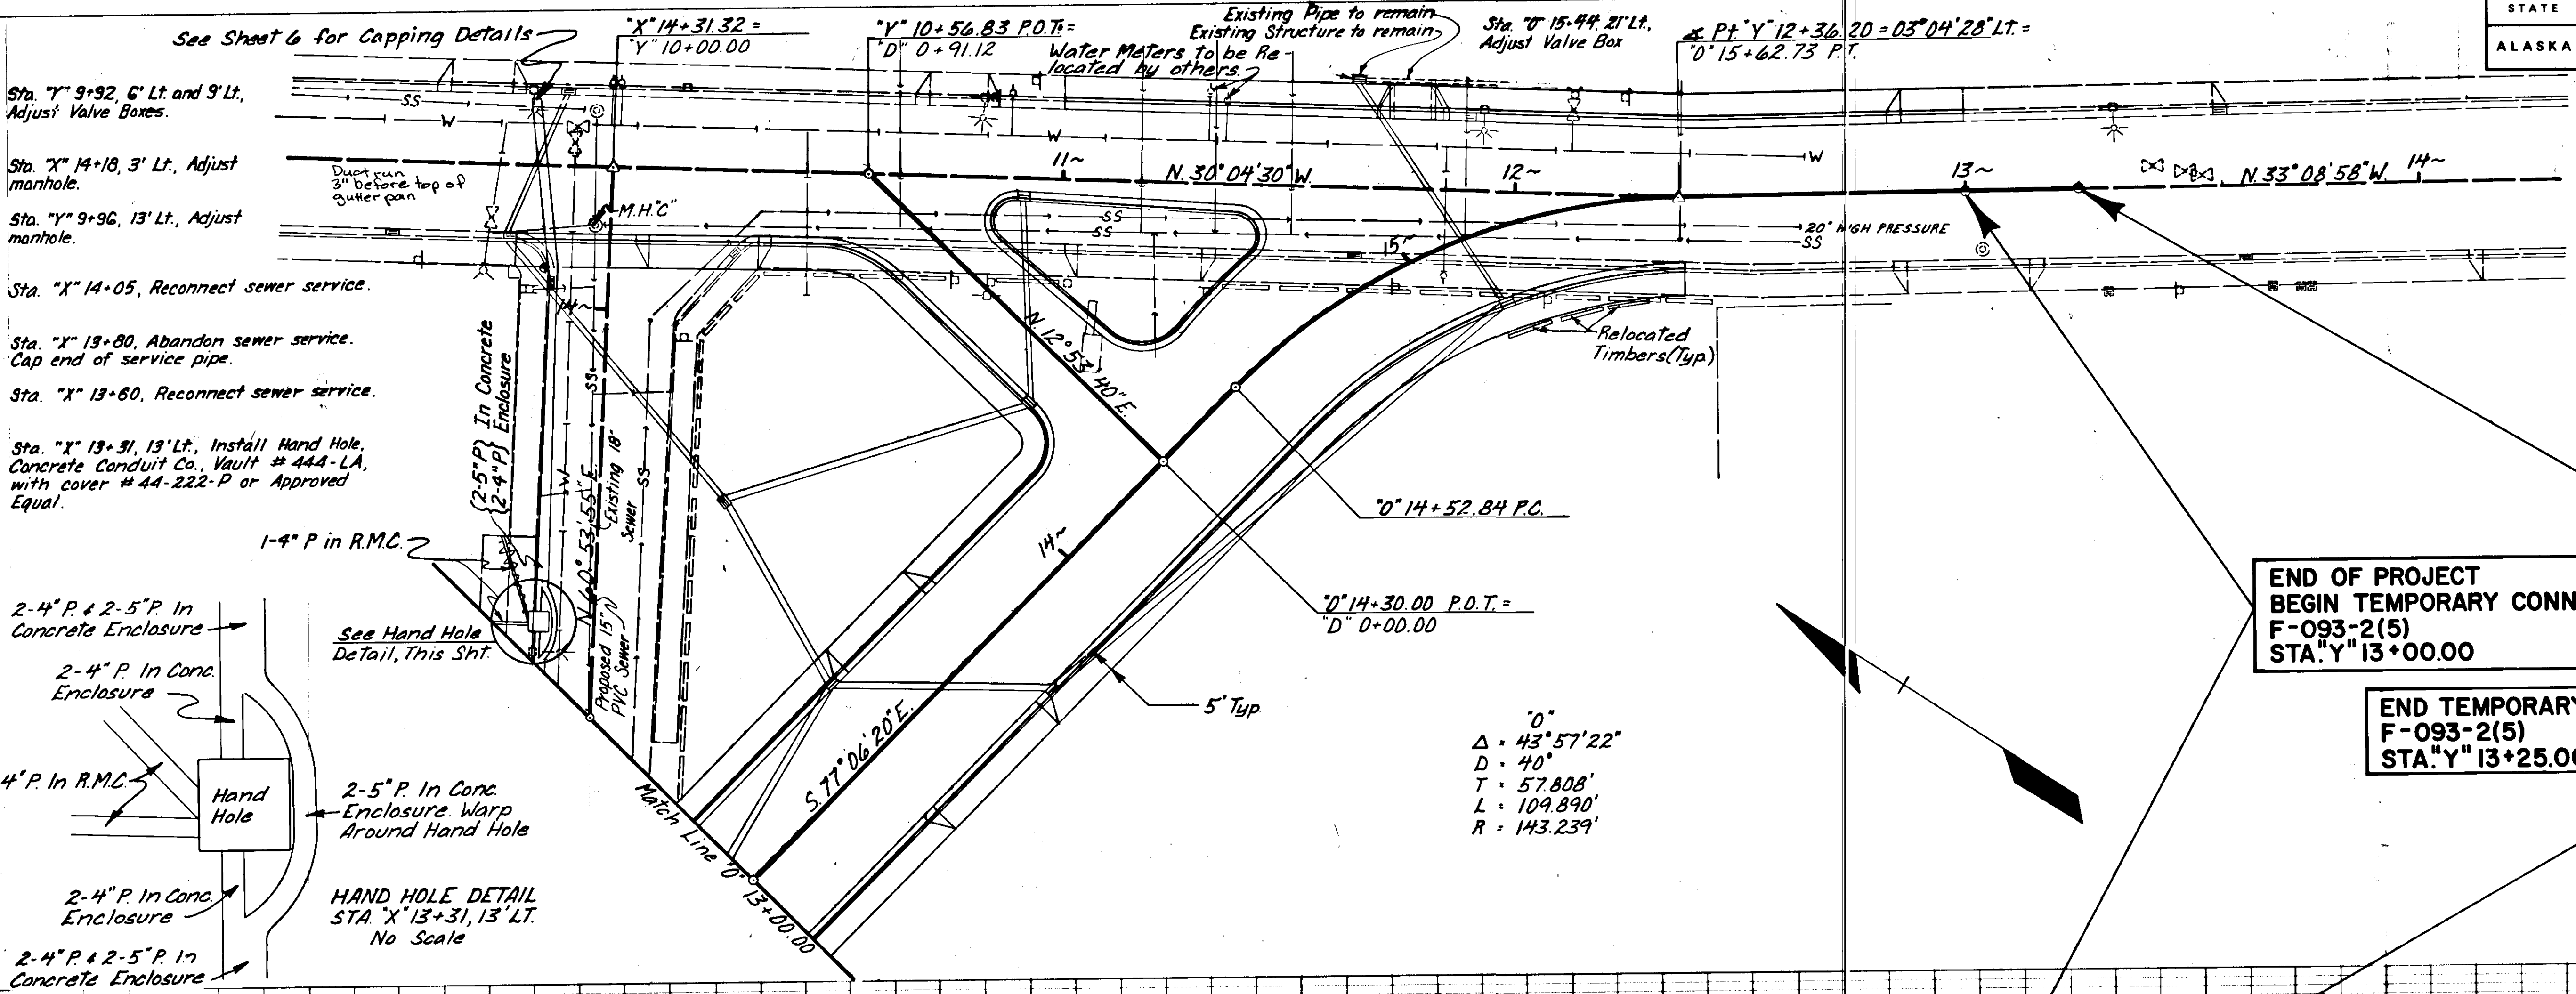


END OF PROJECT
 BEGIN TEMPORARY CONNECTION
 F-093-2(5)
 STA. "Y" 13+00.00

END TEMPORARY CONNECTION
 F-093-2(5)
 STA. "Y" 13+25.00

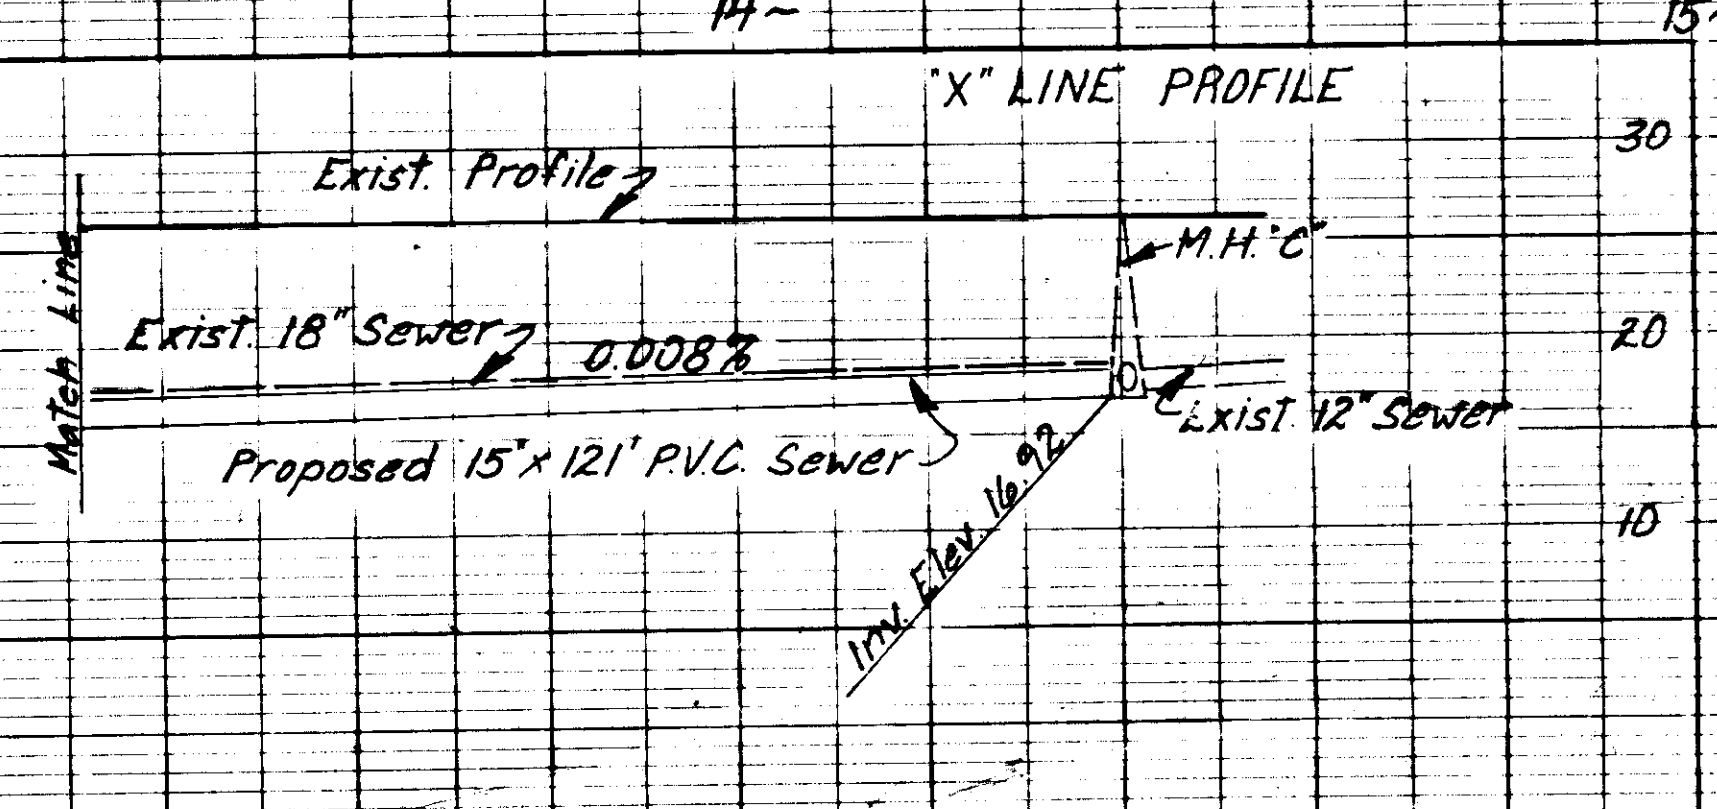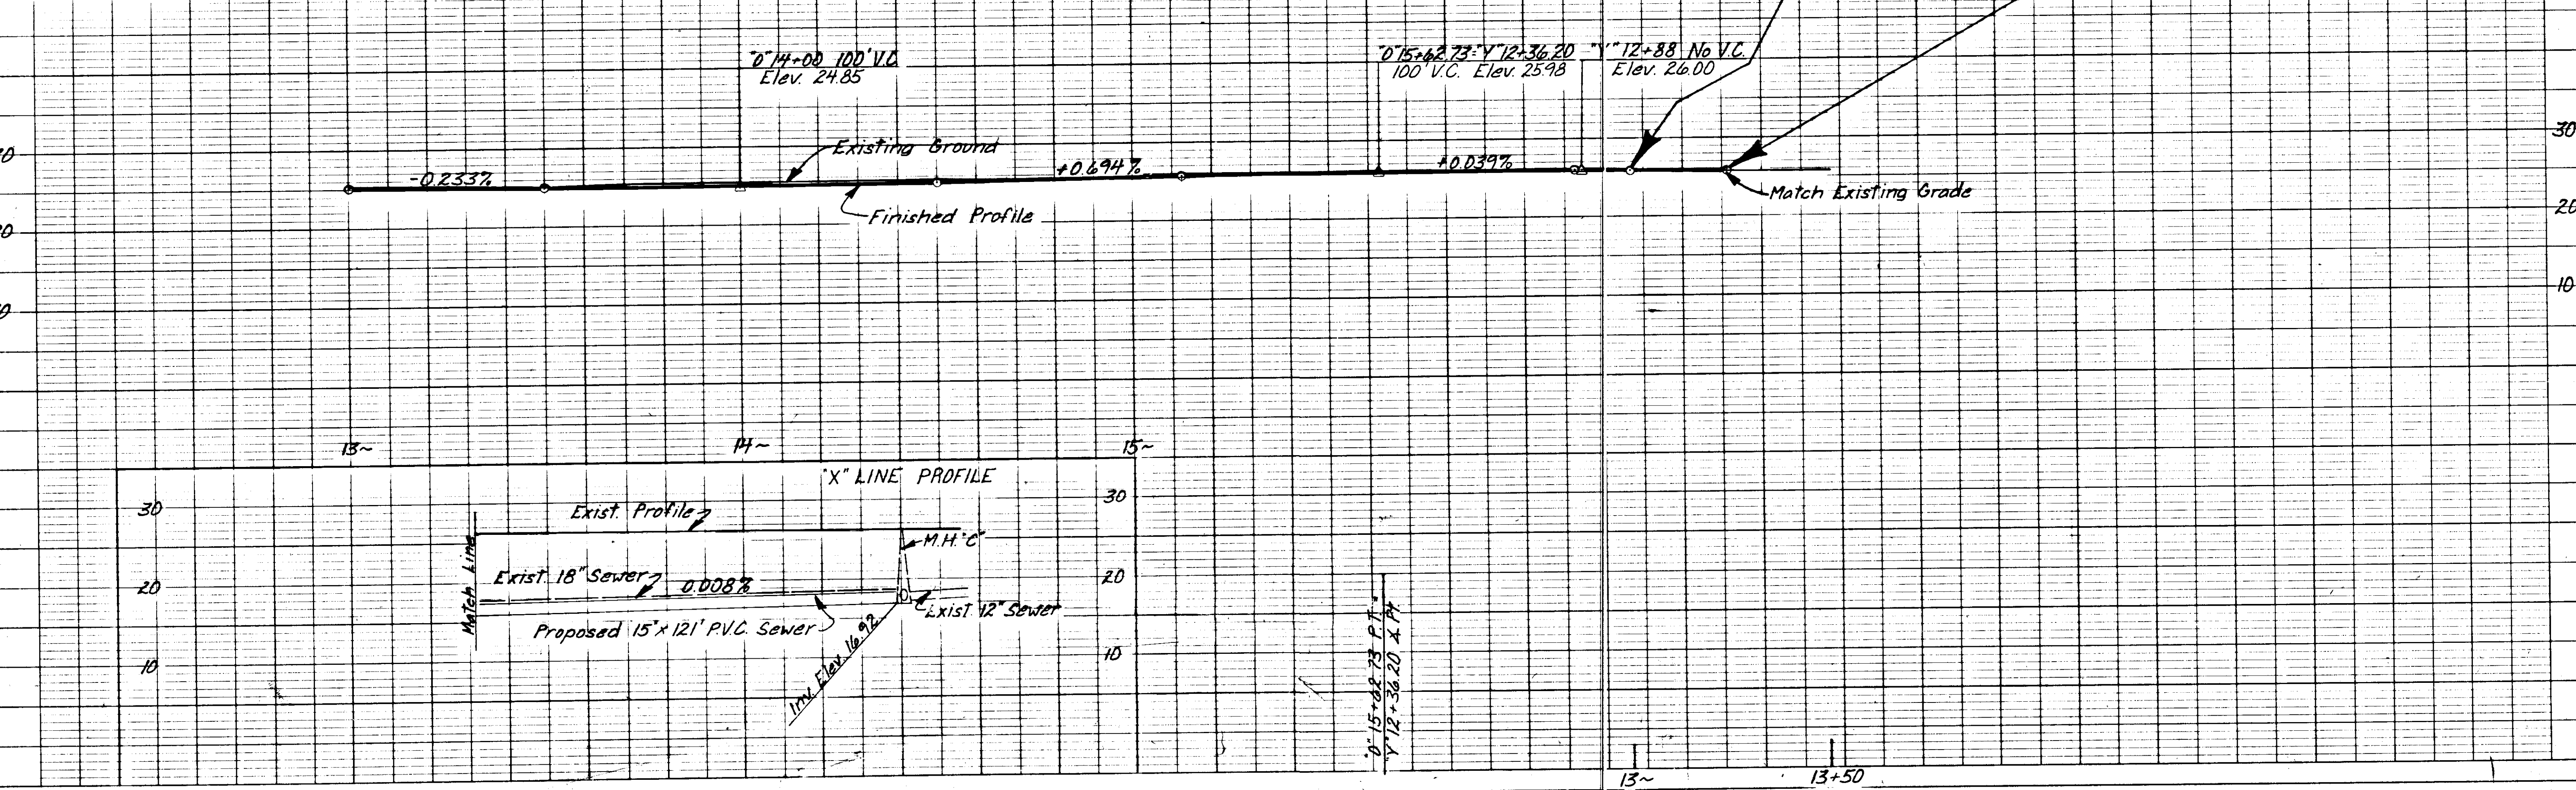

STATE	PROJECT DESIGNATION	YEAR	SHEET NO.	TOTAL SHEETS
ALASKA	F-093-2(5)	1981	9	16

INTERSECTION DETAIL

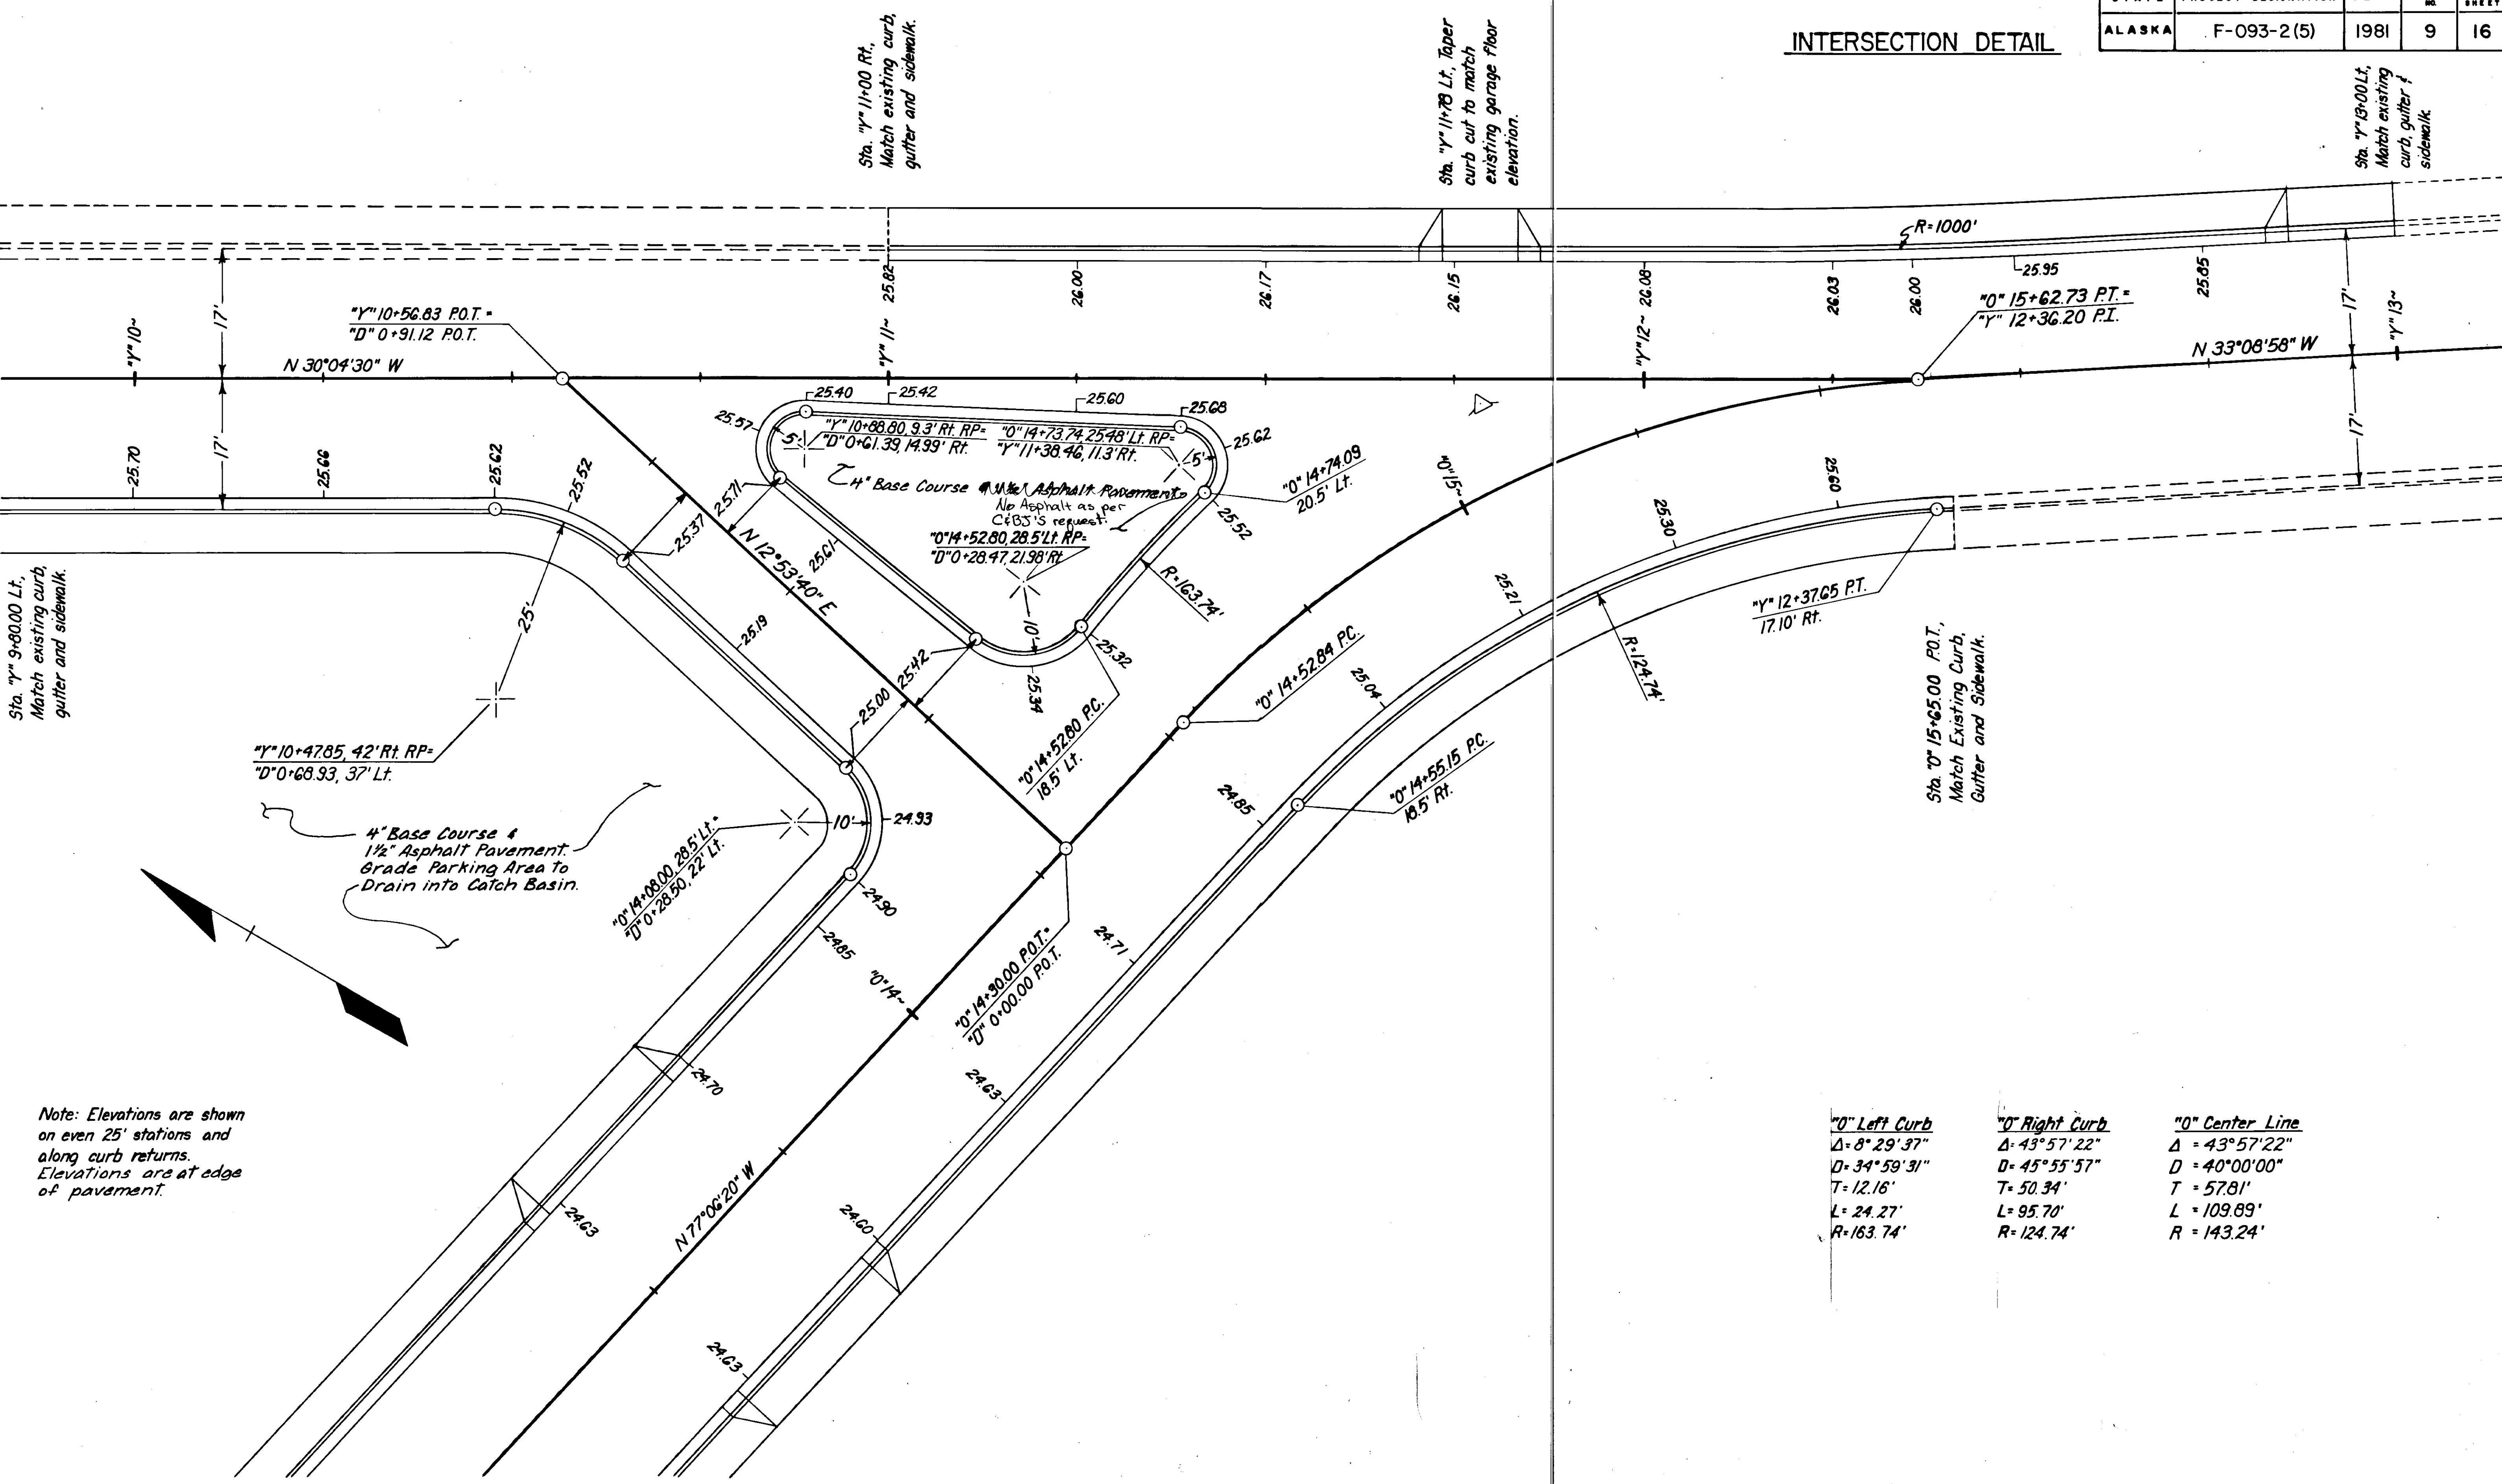

Sta. 11+00 Rt.
Match existing curb,
gutter and sidewalk.

Sta. 11+78 Lt. Taper
curb cut to match
existing garage floor
elevation.

Sta. 13+00 Lt.
Match existing
curb, gutter &
sidewalk.


Sta. 9+80.00 Lt.
Match existing curb,
gutter and sidewalk.

Sta. 15+65.00 P.O.T.
Match Existing Curb,
Gutter and Sidewalk.

Note: Elevations are shown
on even 25' stations and
along curb returns.
Elevations are at edge
of pavement.

"O" Left Curb	"O" Right Curb	"O" Center Line
$\Delta = 8^{\circ}29'37''$	$\Delta = 43^{\circ}57'22''$	$\Delta = 43^{\circ}57'22''$
$D = 34^{\circ}59'31''$	$D = 45^{\circ}55'57''$	$D = 40^{\circ}00'00''$
$T = 12.16'$	$T = 50.34'$	$T = 57.81'$
$L = 24.27'$	$L = 95.70'$	$L = 109.89'$
$R = 163.74'$	$R = 124.74'$	$R = 143.24'$






DRAINAGE DETAILS

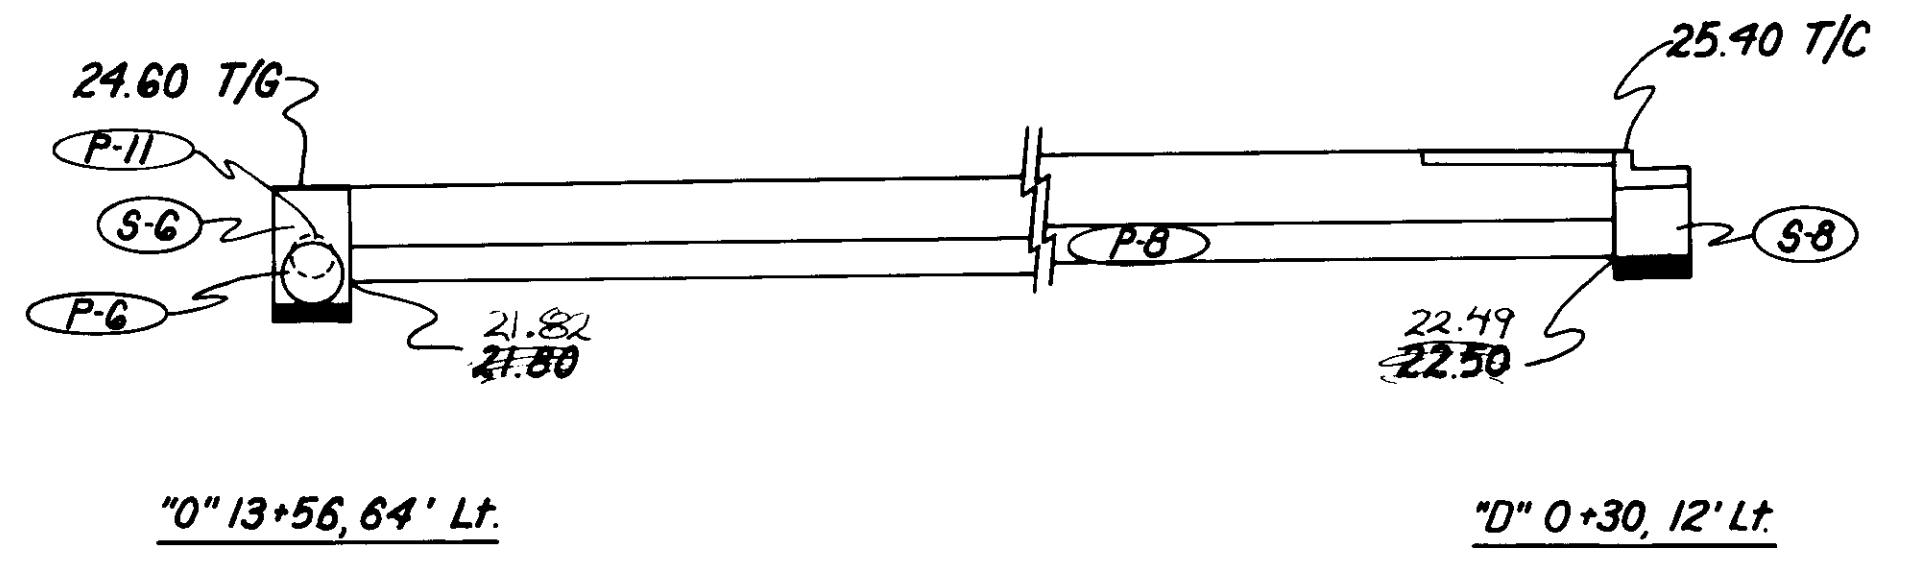

Structure	Type	Location	Offset		Top Curb Elev.	Invert Elev.
			Left	Right		
S-7	"A" Curb	"0" 15+15		17.65'	25.72	22.90
S-8	"A" Curb	"0" 0+30	12'		25.40	22.50
S-9	"A" Curb	"Y" 10+92	4'		25.80	22.65
S-10	"A" Curb	"Y" 9+90	15.5'		26.24	22.60
S-11	"A" Curb	"Y" 9+79		15.5'	25.73	22.30

Pipe	Dia.	Length	From		To	
			Struc./Sta.	Elev.	Struc./Sta.	Elev.
P-7	18"	132'	S-7	22.90	S-5	22.20
P-8	12"	70' 78'	S-8	22.50	S-6	21.80
P-9	12"	60' 46'	S-9	22.90	S-8	22.65
P-10	12"	76' 59'	"Y" 11+66, 24' Lt.*	23.50	S-7	22.90
P-11	12"	74' 81'	S-11	22.10	S-6	21.60
P-12	12"	34'	S-10	22.60	S-11	22.30

* Existing Structure

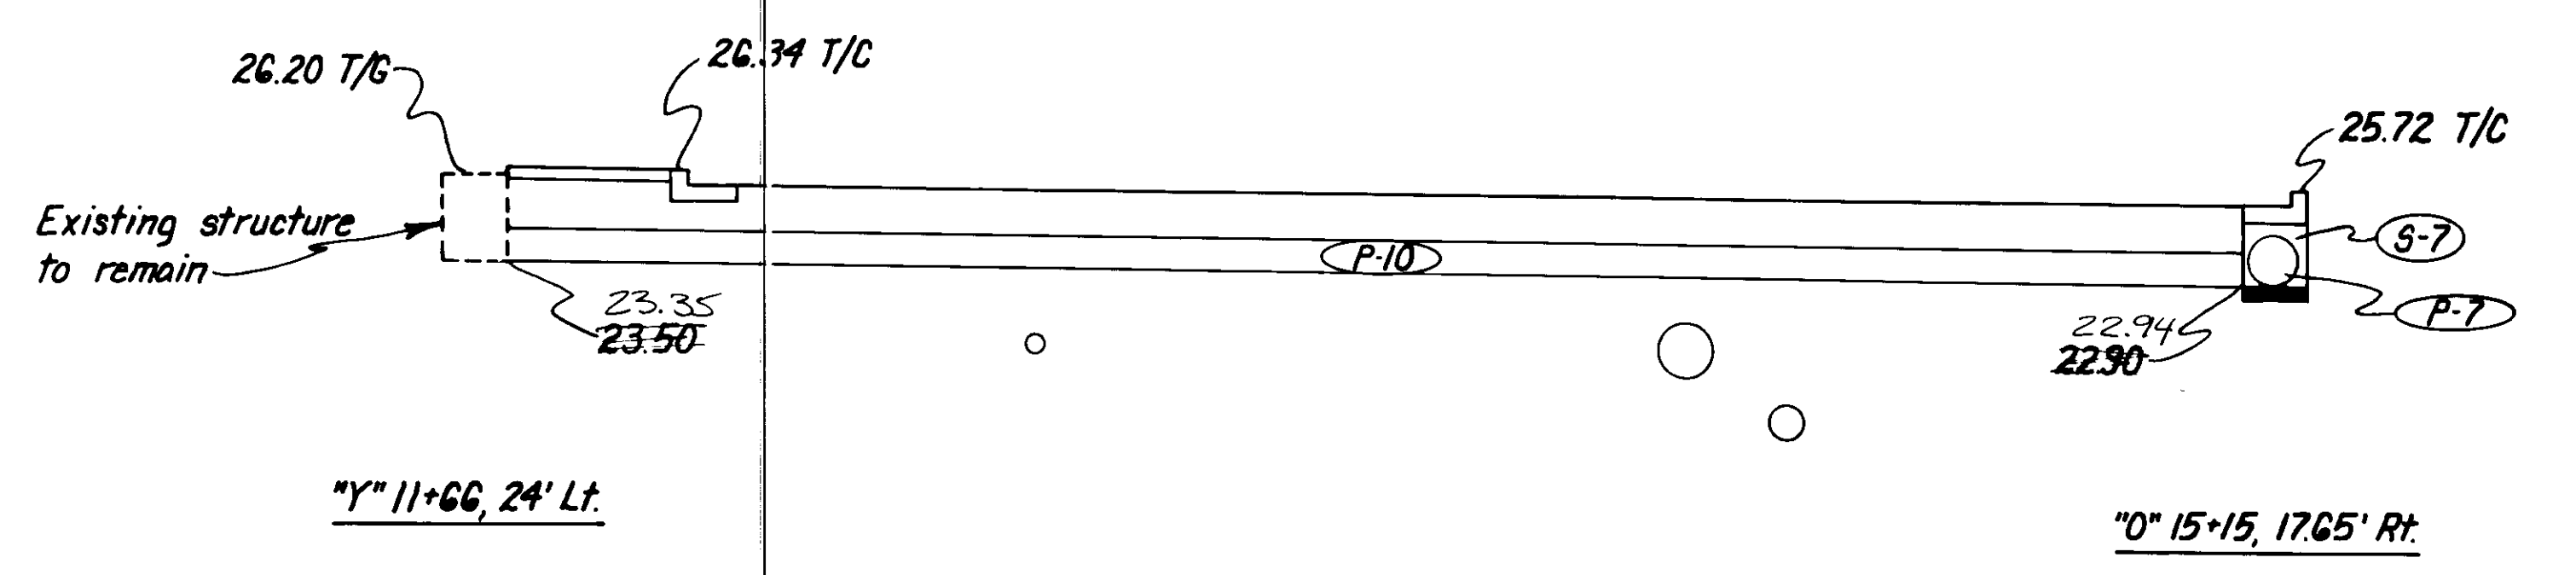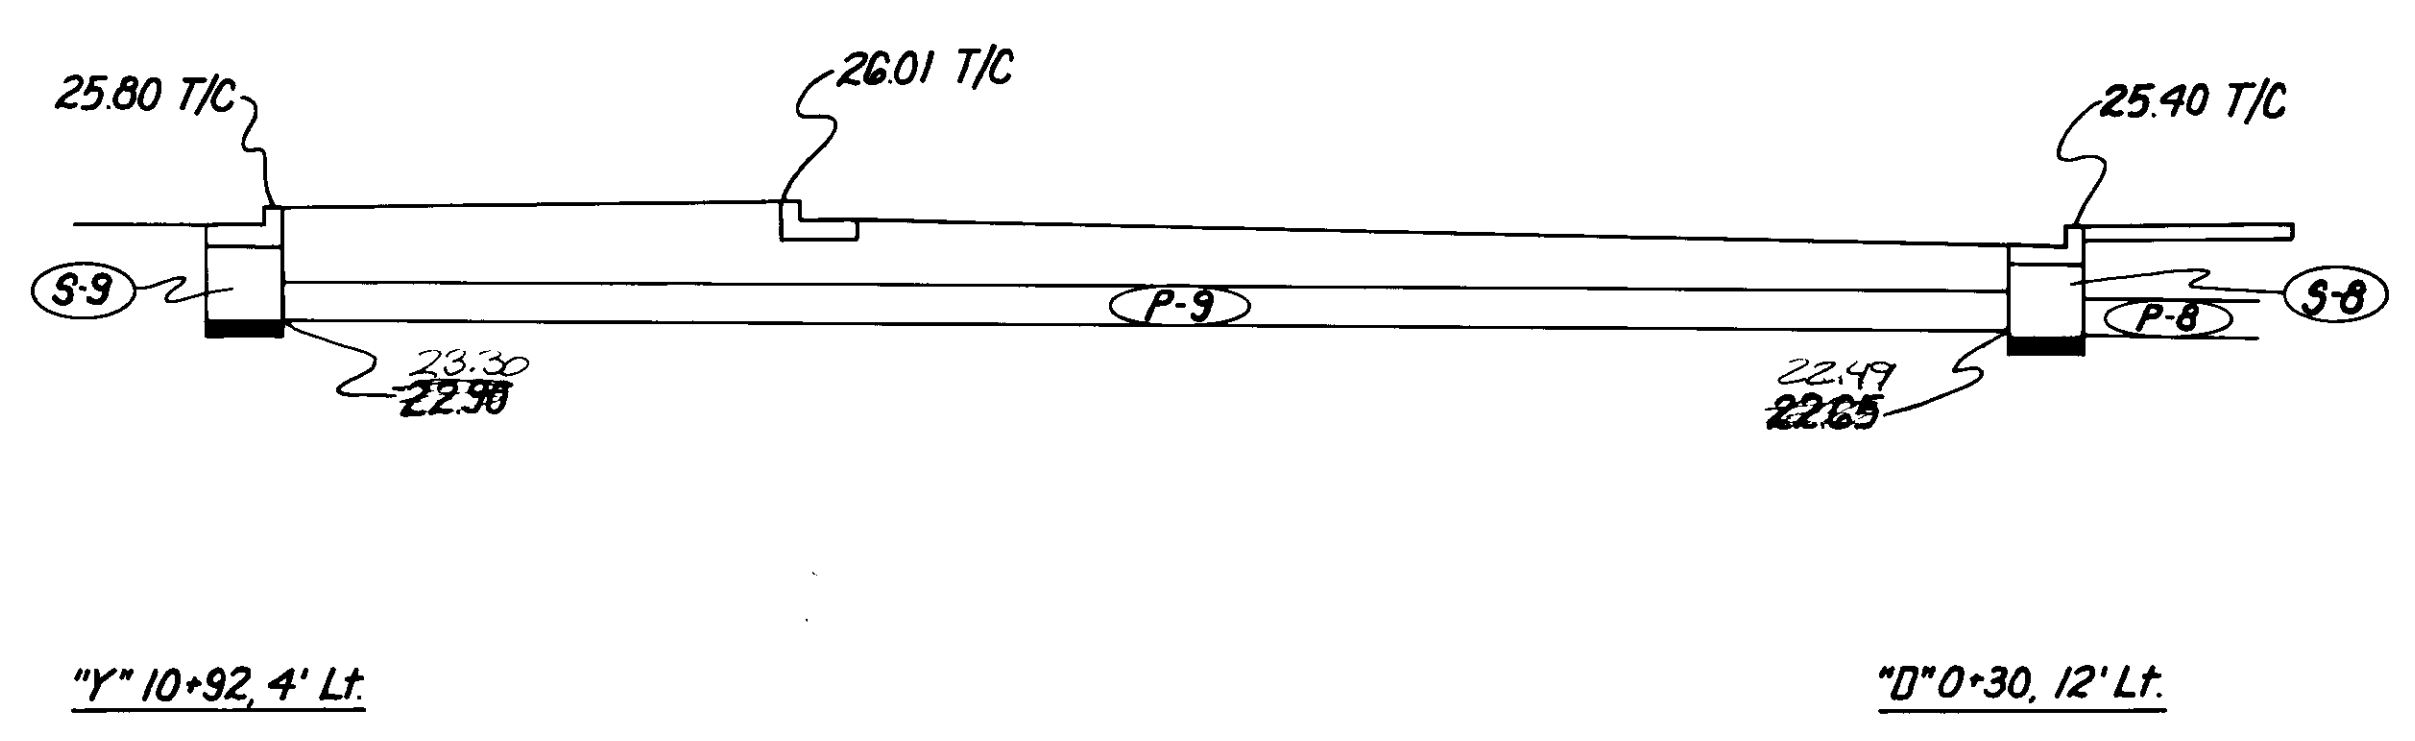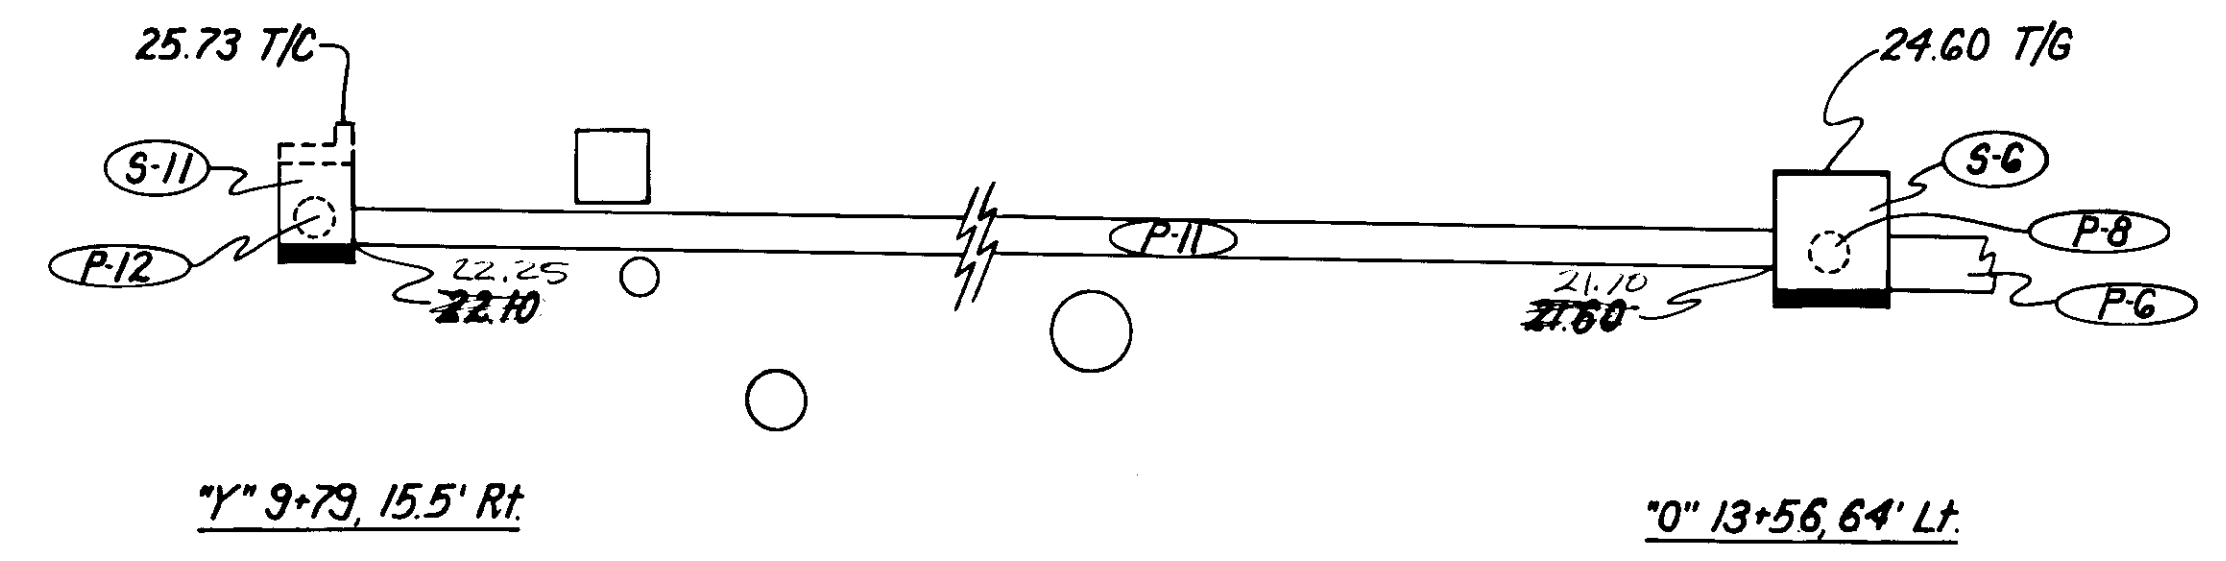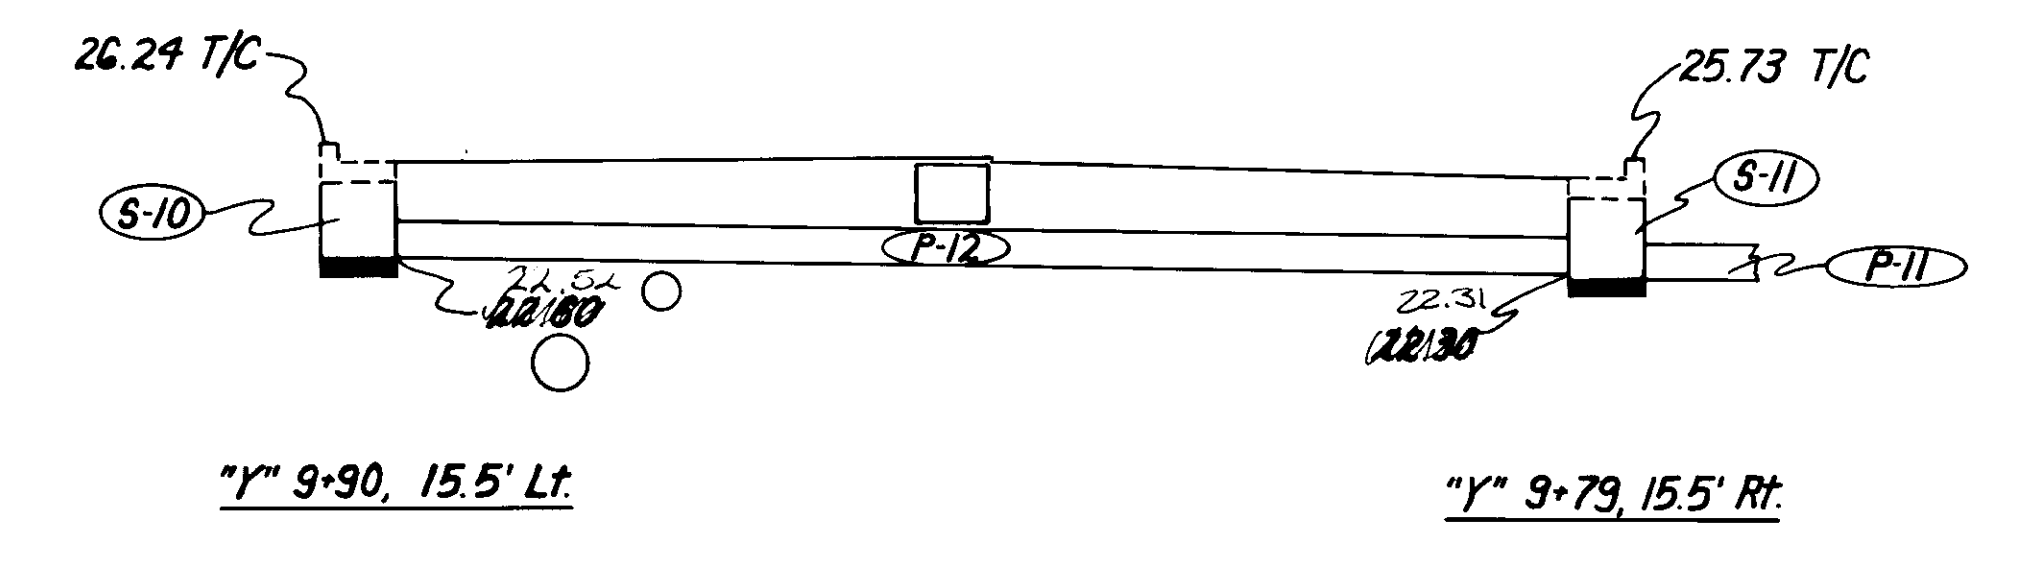
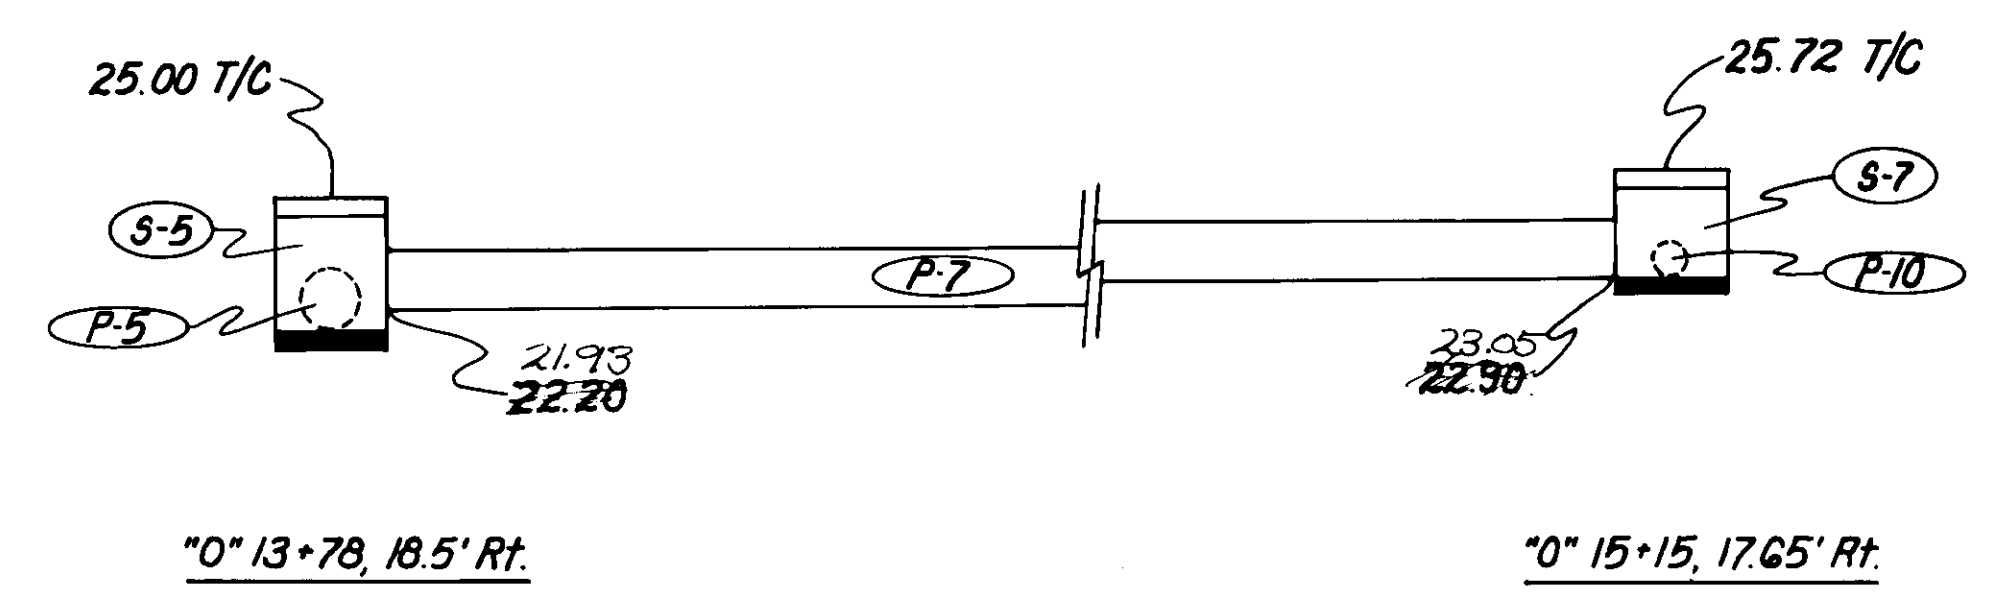


SIGNING, STRIPING AND ILLUMINATION

STATE	PROJECT DESIGNATION	YEAR	SHEET NO.	TOTAL SHEETS
ALASKA	F-093-2(5)	1981	12	16


DETAIL SHEET

- Notes:
1. Salvage the existing Mast Arms, Luminaires & interconnecting wires and transfer to the new poles.
 2. All work and materials involved in installing and reconnecting the new Luminaire Poles shall be considered incidental to illumination system and no separate payment will be made therefore.
 3. New Luminaire poles shall be installed coincidental to the location of the existing poles.

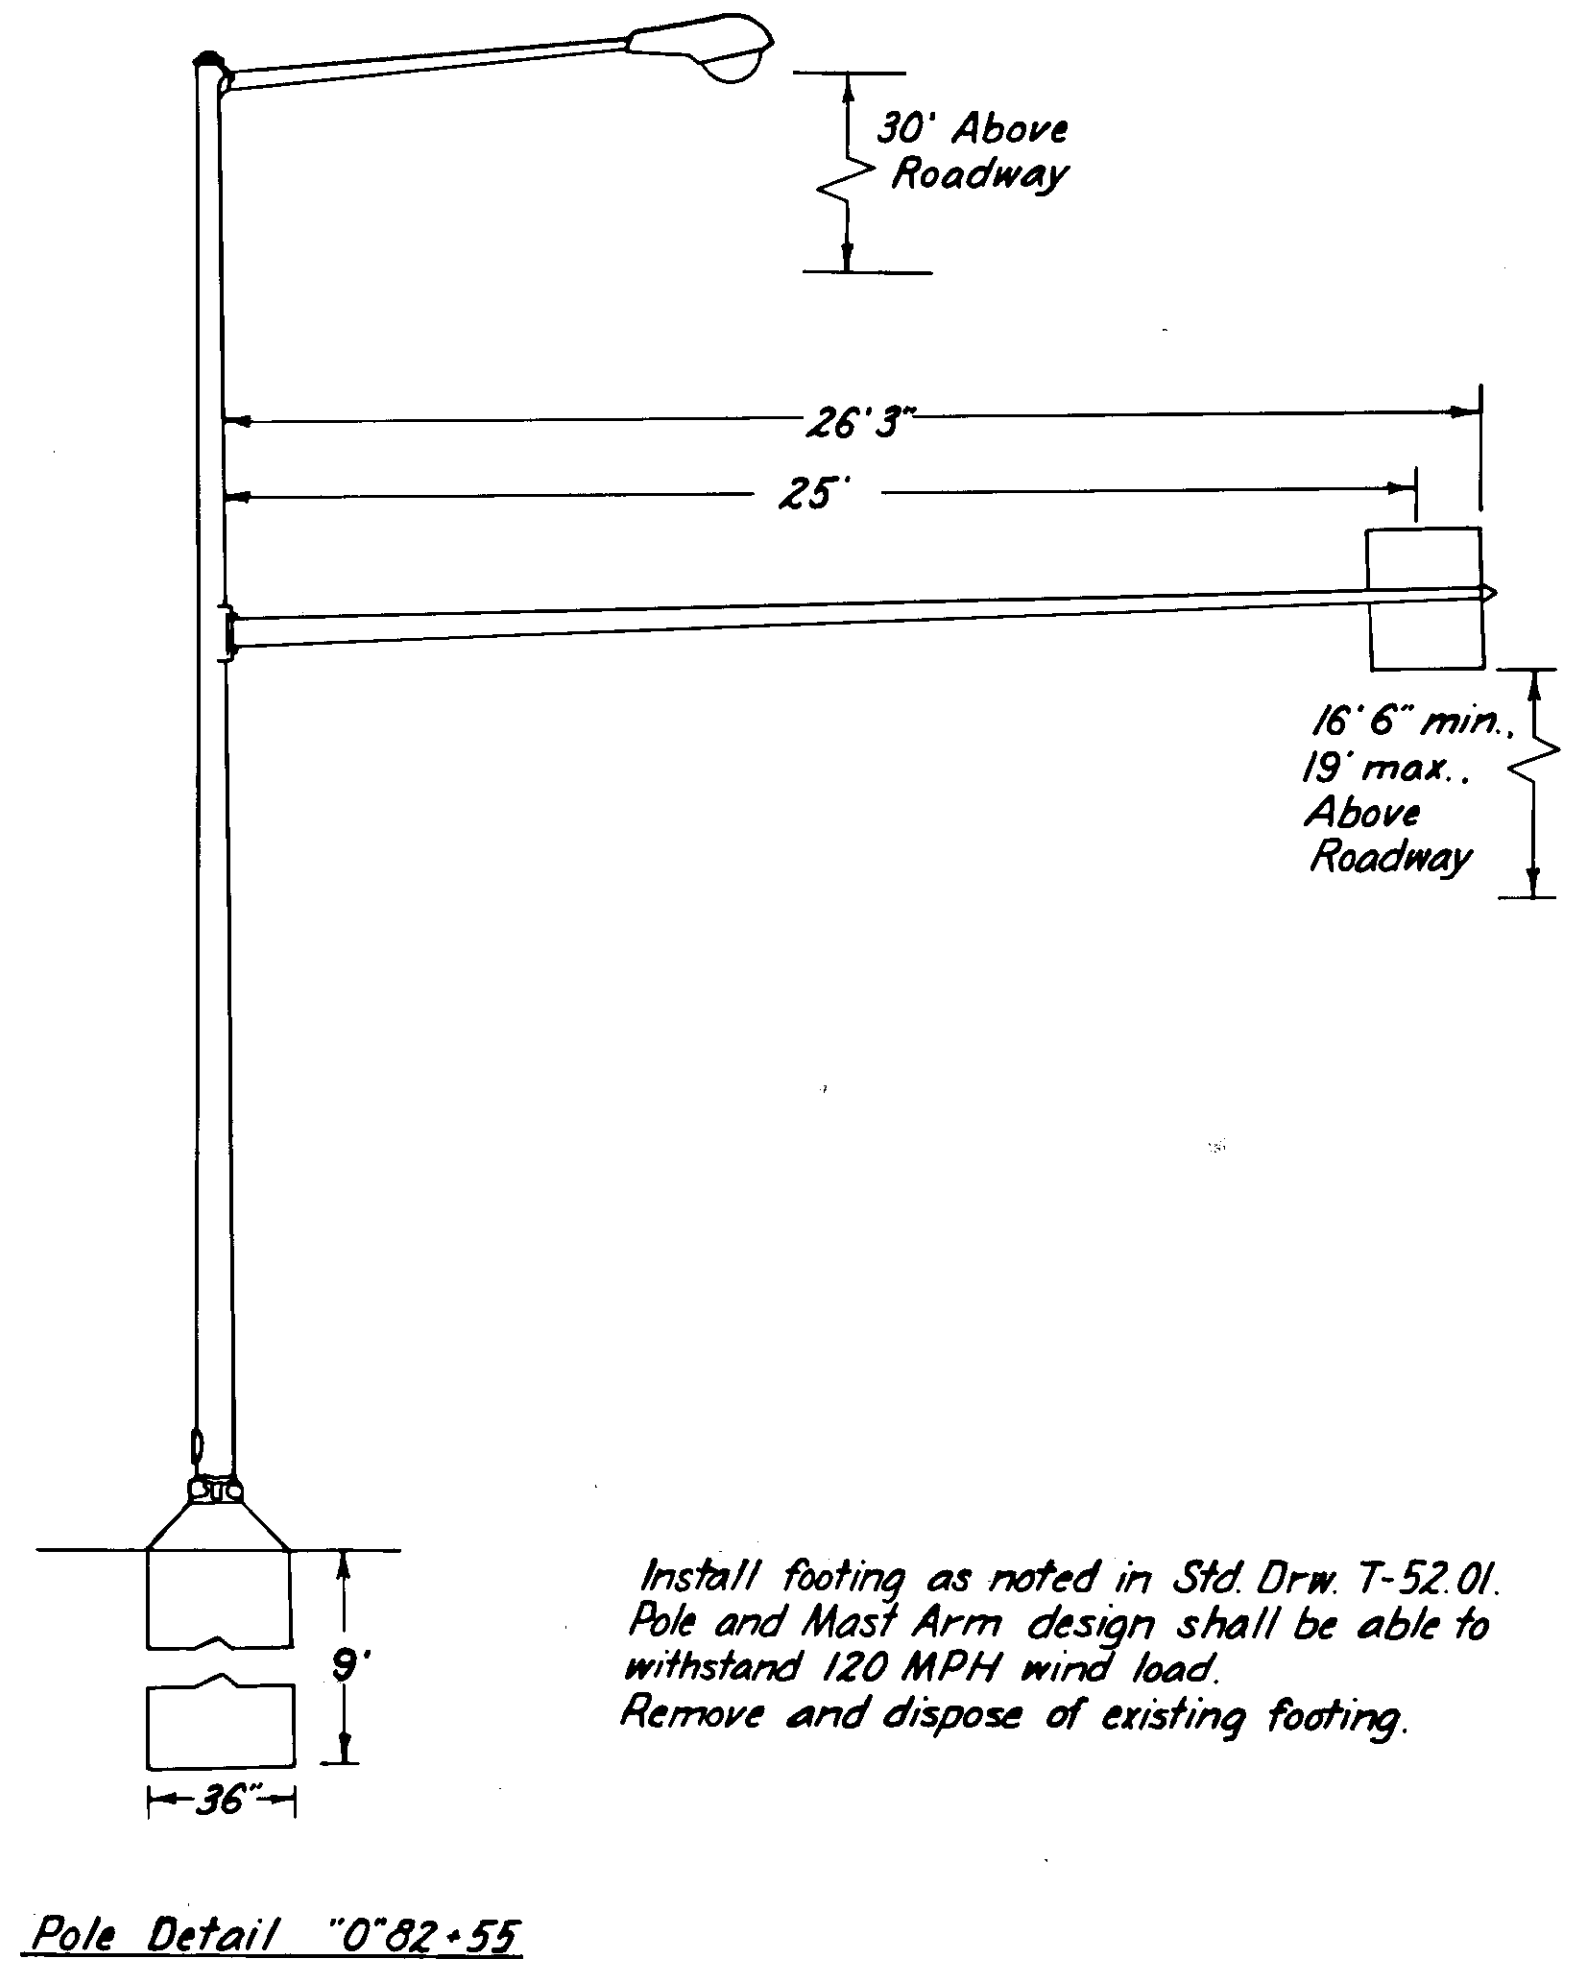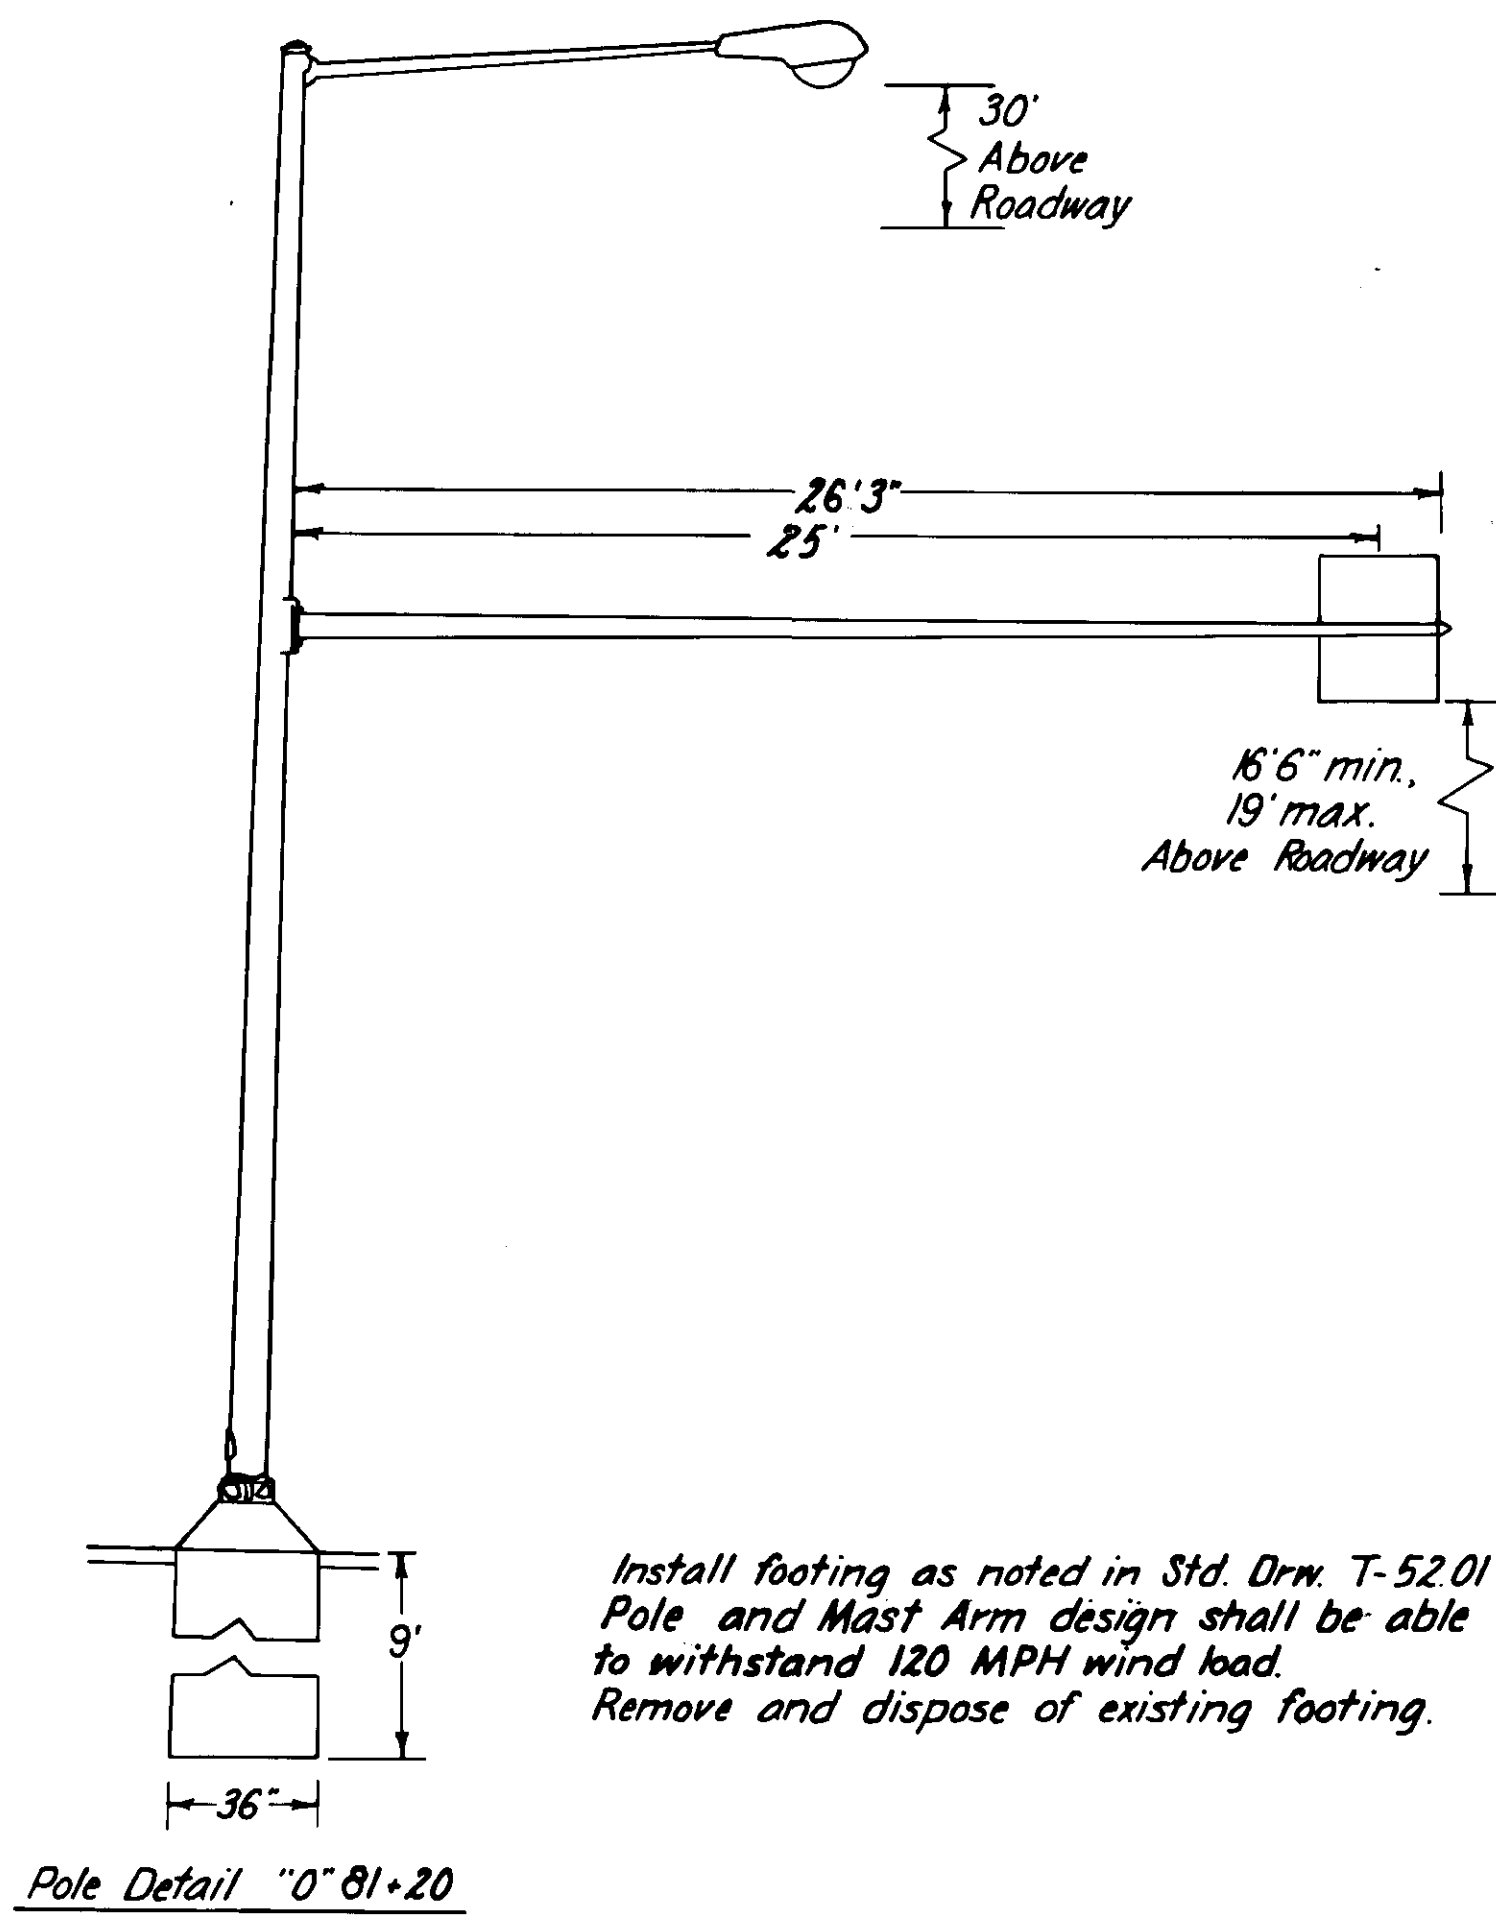

SIGNING, STRIPING AND ILLUMINATION

STATE	PROJECT DESIGNATION	YEAR	SHEET NO.	TOTAL SHEETS
ALASKA	F-093-2(5)	1981	13	16

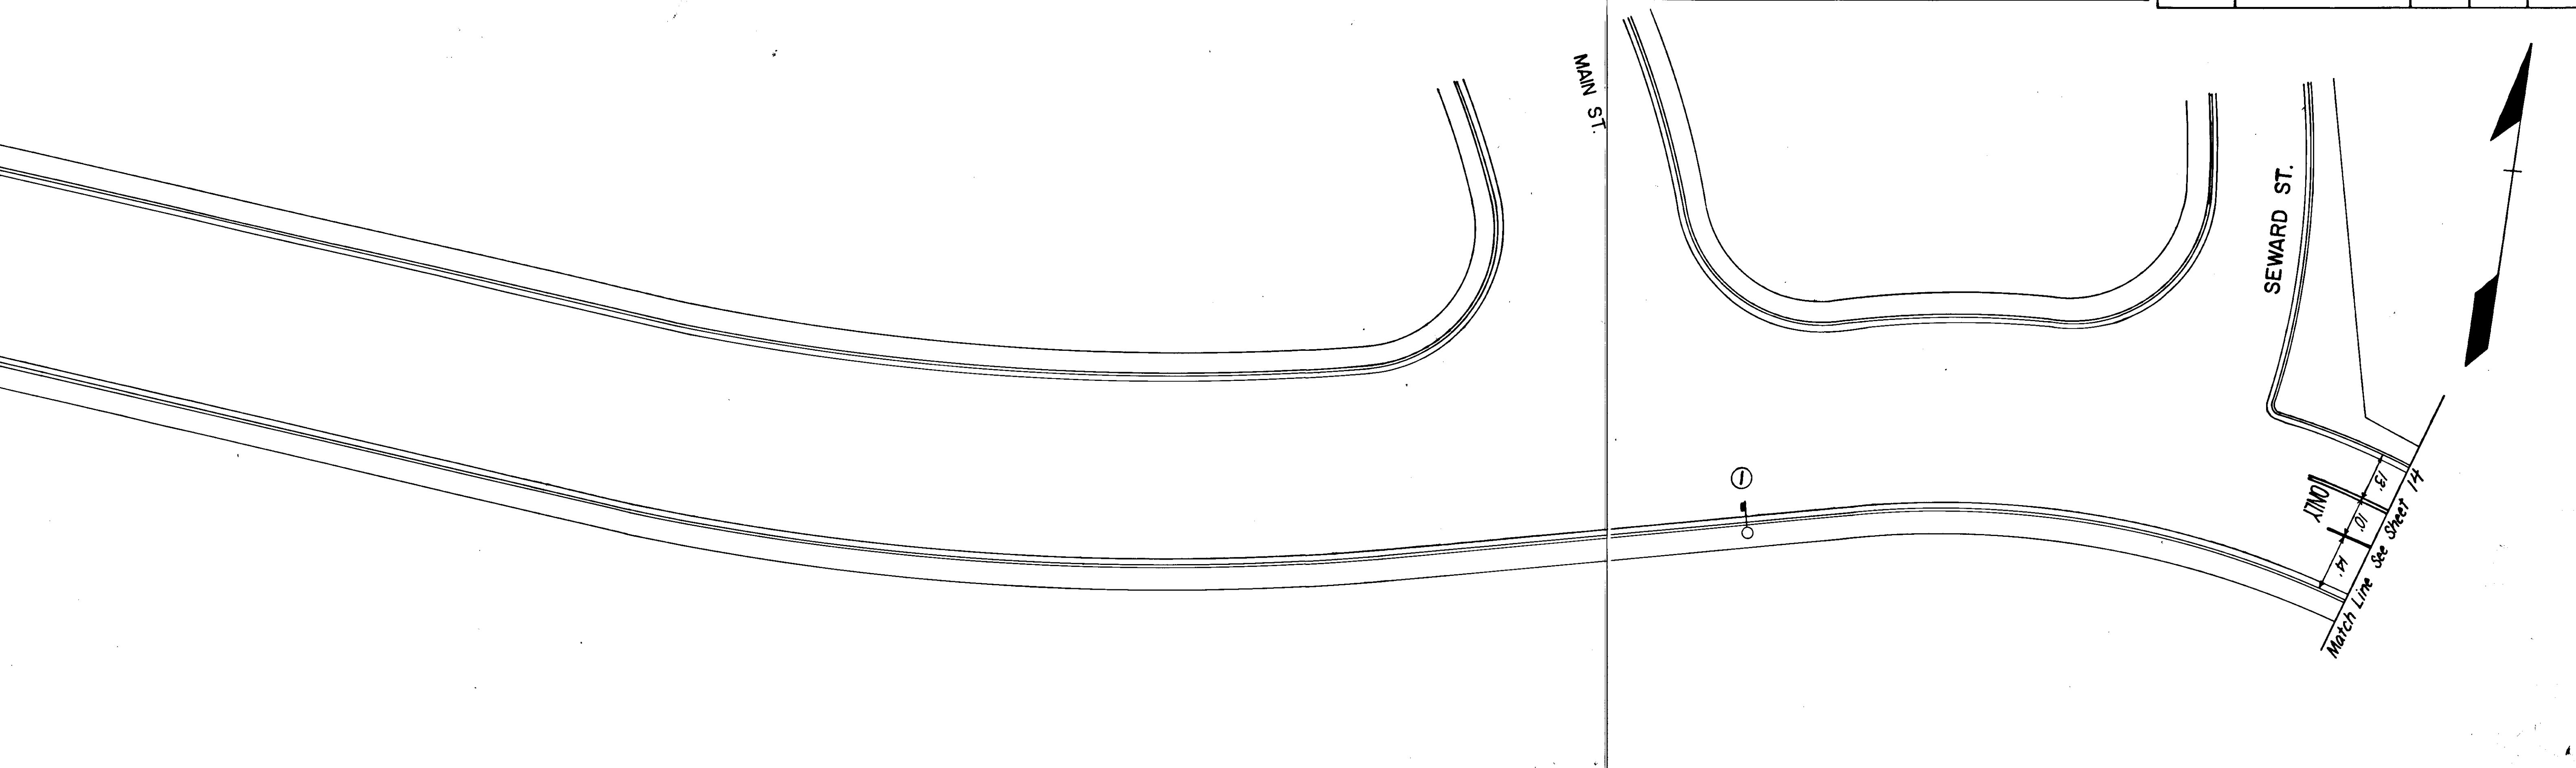

SIGNING SCHEDULE

No.	Station	Dist. from C		Code No.	Legend	Sign Panel Thickness			Post			Facing Traffic	Remarks
		Lt.	Rt.			Size	Unframed	Framed	Area S.F.	No. of Posts	Type		
1	79+42			D3-1C	Main	24x8	.080	1.33				SB	Mount on Signal Arm
2	81+20			R3-5L	← ONLY	30x36	.080	7.5				SB	See special detail
3	81+85			D1-3	Thane-Ferry Terminal ↑ ← City Center	110x54	.100	41.3				SB	See Illumination note #10
4	82+55			R3-5L	← ONLY	30x36	.080	7.5				SB	See special detail
5	83+19	40		R6-1L	ONE WAY	36x12	.080	3.0	1	Tube	9	NB	
6	83+25	37		R6-1R	ONE WAY	36x12	.080	3.0	1	Tube	9	SB	
7	83+23		31	R6-1R	ONE WAY	36x12	.080	3.0	1	Tube	9	SB	
8	83+23		31	R6-1R	ONE WAY	36x12	.080	3.0	1	Tube	9	NB	Mount on same post as #7
9													OMITTED
10	12+20		26	D9-R	Arrow Rt	6x24	.080	1.0					Installed, then removed
11	11+36		20	R7-1	No Parking Anytime	12x18	.080	1.5	1	Tube	9.5	SB	
12	11+39		22	R7-1	No Parking Anytime	12x18	.080	1.5	1	Tube	9.5	NB	
13	13+28		31	R7-1	No Parking Anytime	12x18	.080	1.5	1	Tube	9.5	SB	
14	13+78		21	R7-1	No Parking Anytime	12x18	.080	1.5	1	Tube	9.5	NB	
15	14+48		21	R6-1L	ONE WAY	36x12	.080	3.0	1	Tube	9	SB	
16	14+74		20	D1-3	← Auke Bay Douglas City Center →	110x54	.125	41.3	2	Tube	11		
17	15+67		24	R7-1	No Parking Anytime	12x18	.080	1.5	1	Tube	9.5	SB	
18	85+33		30	R1-1	STOP	30x30	.080	6.25	1	Tube	12	EB	
19	85+33		30	R6-1L	ONE WAY	36x12	.080	3.0				EB	Mount on same post as #18
20	85+32		36	R1-1	STOP	30x30	.080	6.25	1	Tube	9	EB	
21	85+36		34	R6-1R	ONE WAY	36x12	.080	3.0	1	Tube	12	NB	
22	85+36		34	R3-2	No Left Turn	30x30	.080	9.25				NB	Mount on same post as #21
23	*			R6-1R	ONE WAY	36x12	.080	3.0	1	Tube	9	NB	
24	*			R6-1L	ONE WAY	36x12	.080	3.0	1	Tube	12	EB	
25	*			R3-1	No Right Turn	30x30	.080	9.25				EB	Mount on same post as #23

* See approximate location on plans. Place as directed by Project Engineer.

ILLUMINATION NOTES

- Luminaires shall be high pressure sodium, 250 watts- 240 volts, ANSI TYPE II, medium-semi cutoff unless otherwise noted on the plans.
- Luminaires shall have a 35' mounting height unless otherwise noted on the plans.
- All interconnecting conductors shall be #6 AWG.
- All luminaire base footings shall be TYPE III, 6' deep x 3' diameter as shown on Std. Drw. L-30.01, unless otherwise noted on the plans.
- Conduit and cable routing as shown on the plans are schematic only and may be modified in the field as necessary to complete the illumination system. Any modification shall be approved by the Engineer.
- All junction boxes shall be TYPE I as shown on the Std. Drw. L-23.03.
- The new illumination system shall connect into existing junction box #14, Lt. Sta. 9+07. All work and materials involved shall be considered incidental to the illumination system.
- Pole and Mast Arm design shall be able to withstand 120 MPH wind load.
- Existing Luminaire poles at Stations 81+85 and 82+55 shall be removed and taken to the DOT/PF Maintenance yard at 6 1/2 mile Glacier Hwy.
- Luminaire at Station 81+20 shall be moved to 81+85 and new overhead sign mounted to Mast Arm.

SIGNING NOTES

- Sign locations are approximate and are subject to minor revisions.
- All sign posts shall be telescoping perforated galvanized steel posts; the 2" size shall be used above ground, and the 2 1/4" shall be used below ground. All materials shall be 12 gauge.
- Overhead sign mounted at 81+20 shall be removed from luminaire and taken to DOT/PF at 6 1/2 mile Glacier Hwy.
- Mast Arms for the overhead signs shall be considered incidental to standard signs and no separate payment will be made therefore.
- Relocate existing Juneau Police sign to Sta. 0+12+65 ft. This work shall be considered incidental to Item 615(1) Standard Signs & no separate payment shall be made therefore. Deleted as per City and Borough of Juneau.
- Relocate existing signs in Borough Parking Area to behind proposed sidewalk. Sta. 0+11+00 To 0+12+00 ft. This work shall be considered incidental to Item 615(1) Standard Signs & no separate payment shall be made therefore.
- All signing shall be in compliance with the Alaska Traffic Manual (A.T.M.)

PAVEMENT MARKING NOTES


- All pavement markings on Ferry Way shall be removed by any means, approved by the Project Engineer, without damaging the pavement.
- All markings shall be thermoplastic.
- Thermoplastic "ONLY" and Right Turn arrow, in southbound right hand lane, between Seward and Shattuck Way, shall be removed.
- Thermoplastic shall be installed as per manufacturer's recommendation; both cold overlay method, and hot, inlaid method.
- All pavement markings shall be in compliance with the Alaska Traffic Manual (A.T.M.)

Thermoplastic Pavement Markings Quantities

- 4" Solid Yellow & ————— 2,411 L.F.
- 18" " " Diagonal Bars — 122 L.F.
- 4" Dashed White Lane Markers — 36 L.F.
- 4" Solid White Lane Markers — 63 L.F.
- 8" " " Island Markers — 102 L.F.
- 18" " " Diagonal Bars — 53 L.F.
- 24" " " Crosswalk Lines — 294 L.F.
- 8" " " "ONLY" Marking — 3 ea.
- 6'-11" Left Turn Arrows (White) — 3 ea.
- 8" Solid White Lane Markers — 113 L.F.
- 8" Solid White "YIELD" Marking — 1 ea.

STATE	PROJECT DESIGNATION	YEAR	SHEET NO.	TOTAL SHEETS
ALASKA	F-093-2(5)	1981	14	16

SIGNING, STRIPING AND ILLUMINATION

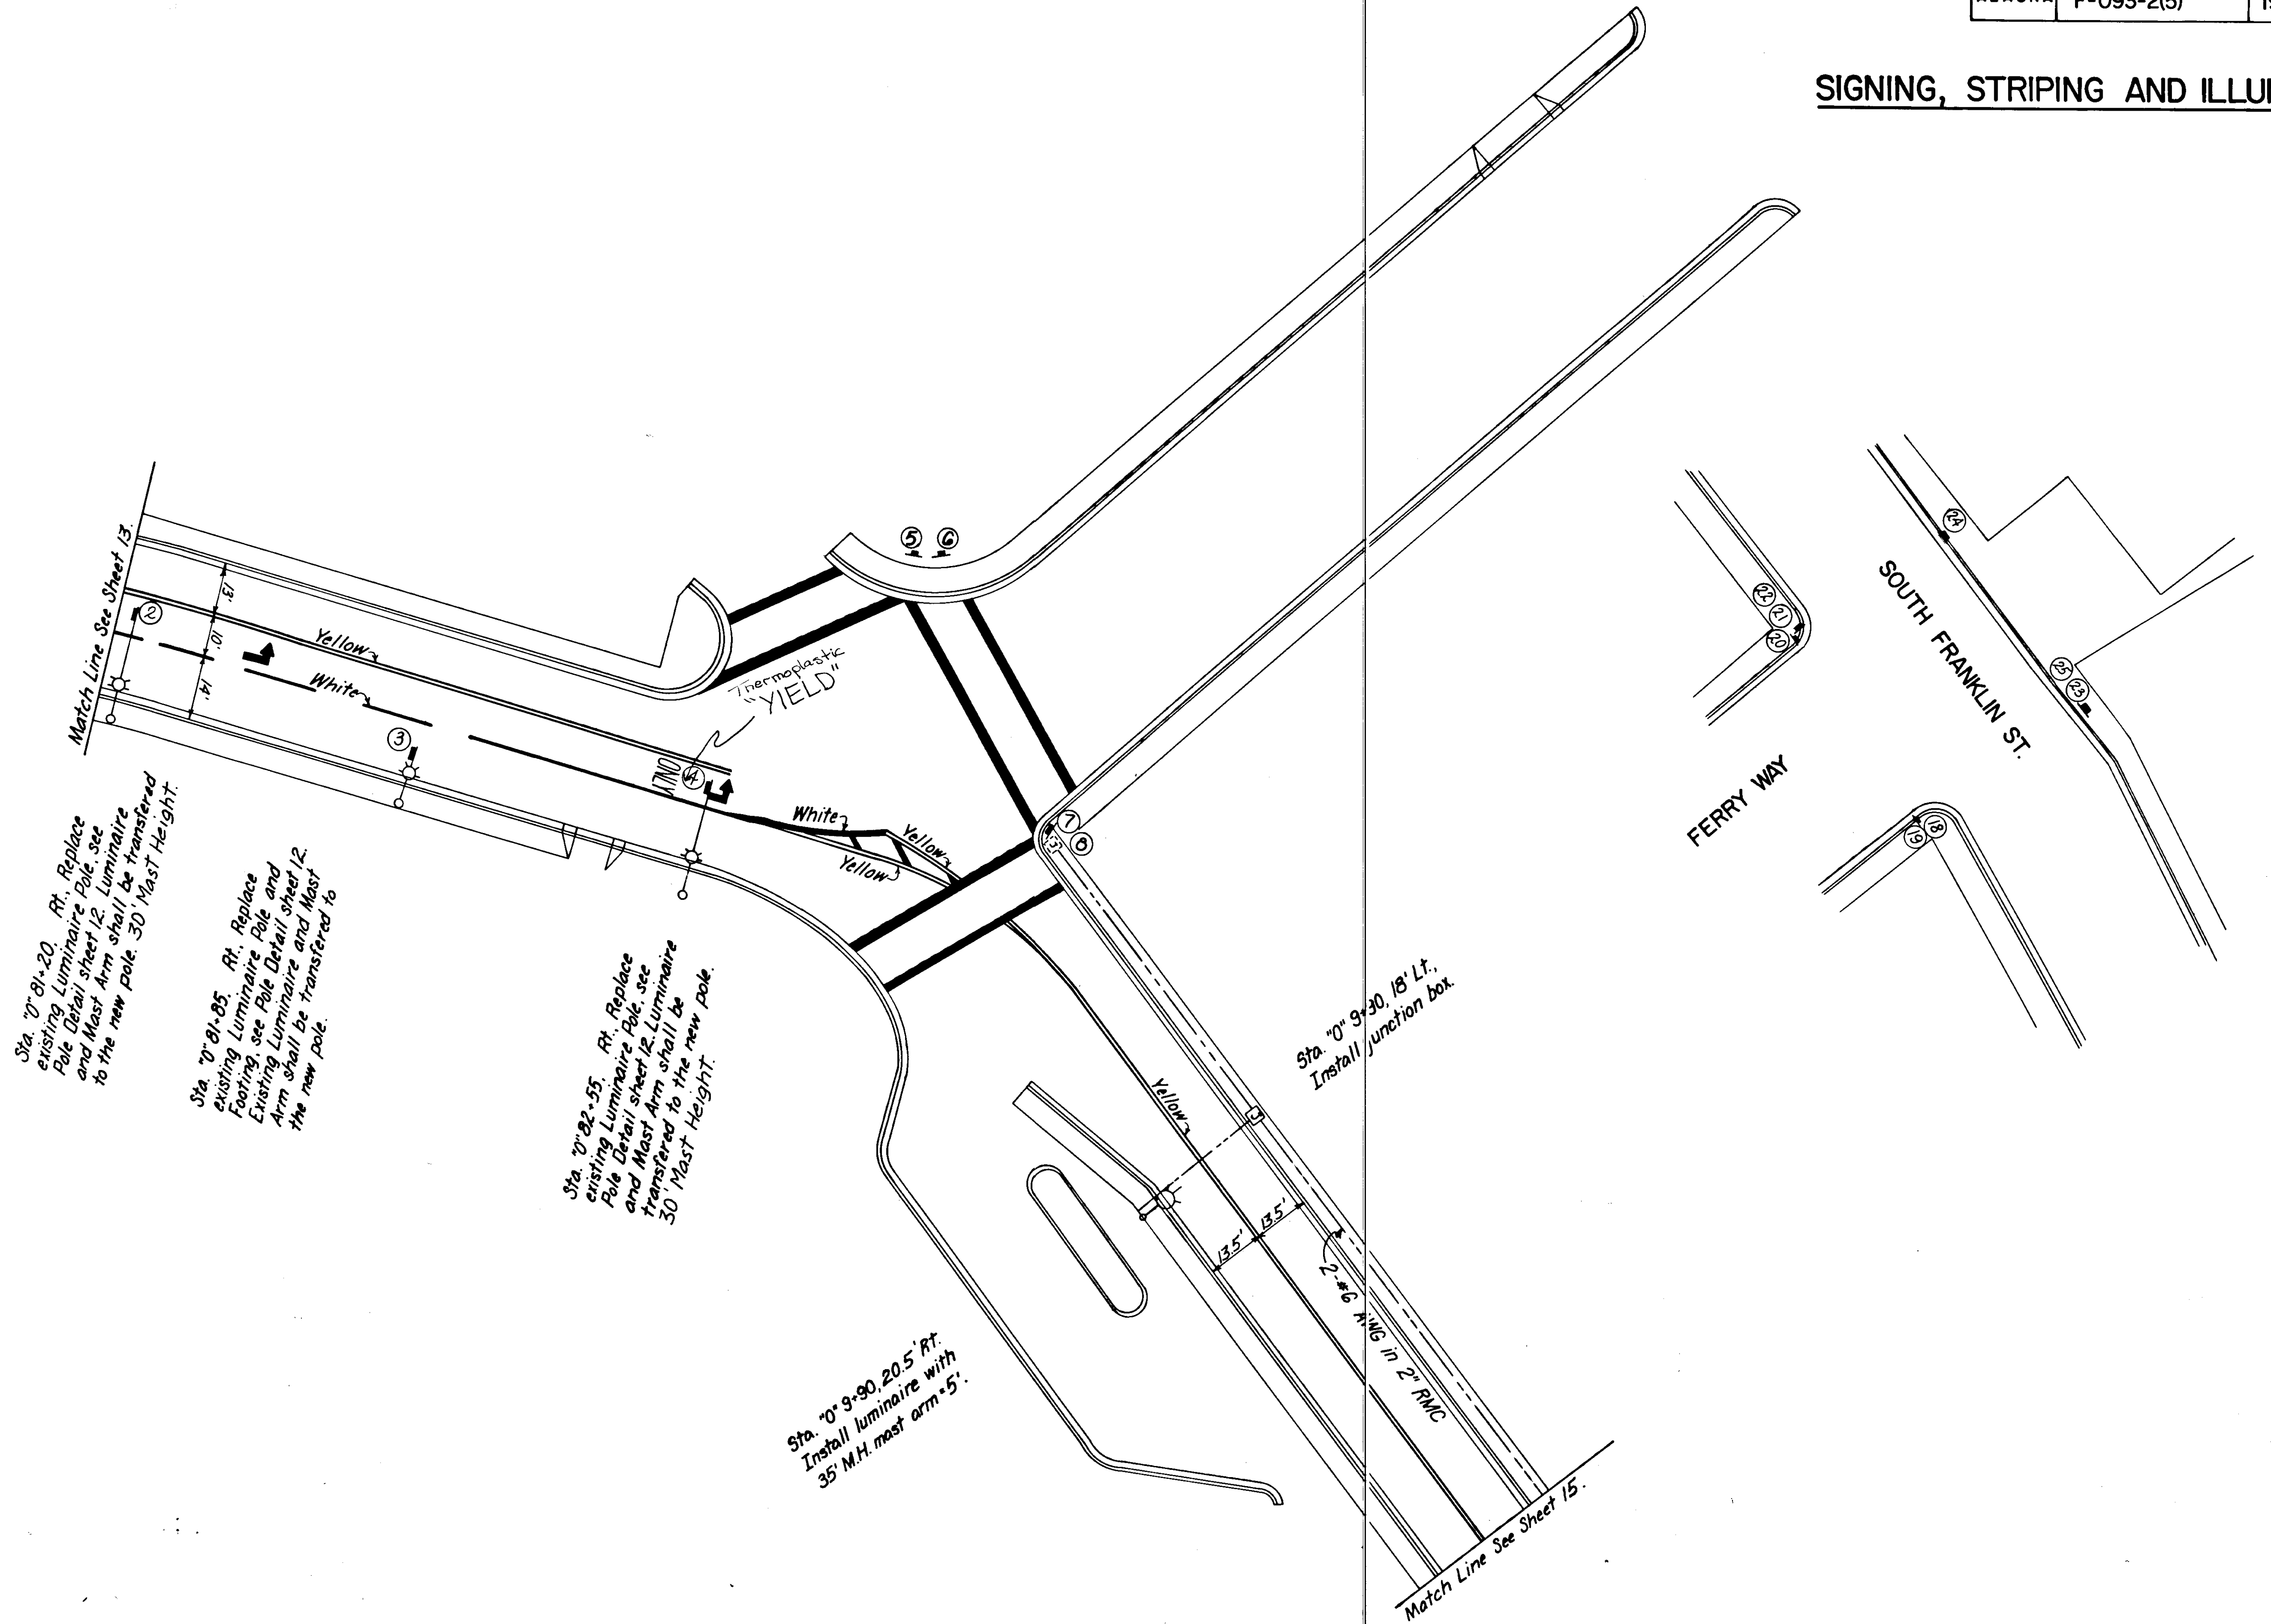

Sta. 0+81+20. Rt. Replace existing Luminaire Pole, see Pole Detail sheet 12. Luminaire and Mast Arm shall be transferred to the new pole. 30' Mast Height.


Sta. 0+81+85. Rt. Replace existing Luminaire Pole and Footing, see Pole Detail sheet 12. Existing Luminaire and Mast Arm shall be transferred to the new pole.

Sta. 0+82+55. Rt. Replace existing Luminaire Pole, see Pole Detail sheet 12. Luminaire and Mast Arm shall be transferred to the new pole. 30' Mast Height.

Sta. 0+9+90. 20.5' Rt. Install luminaire with 35' M.H. mast arm = 5'.


Sta. 0+9+30. 18' Lt. Install junction box.

Match Line See Sheet 15.

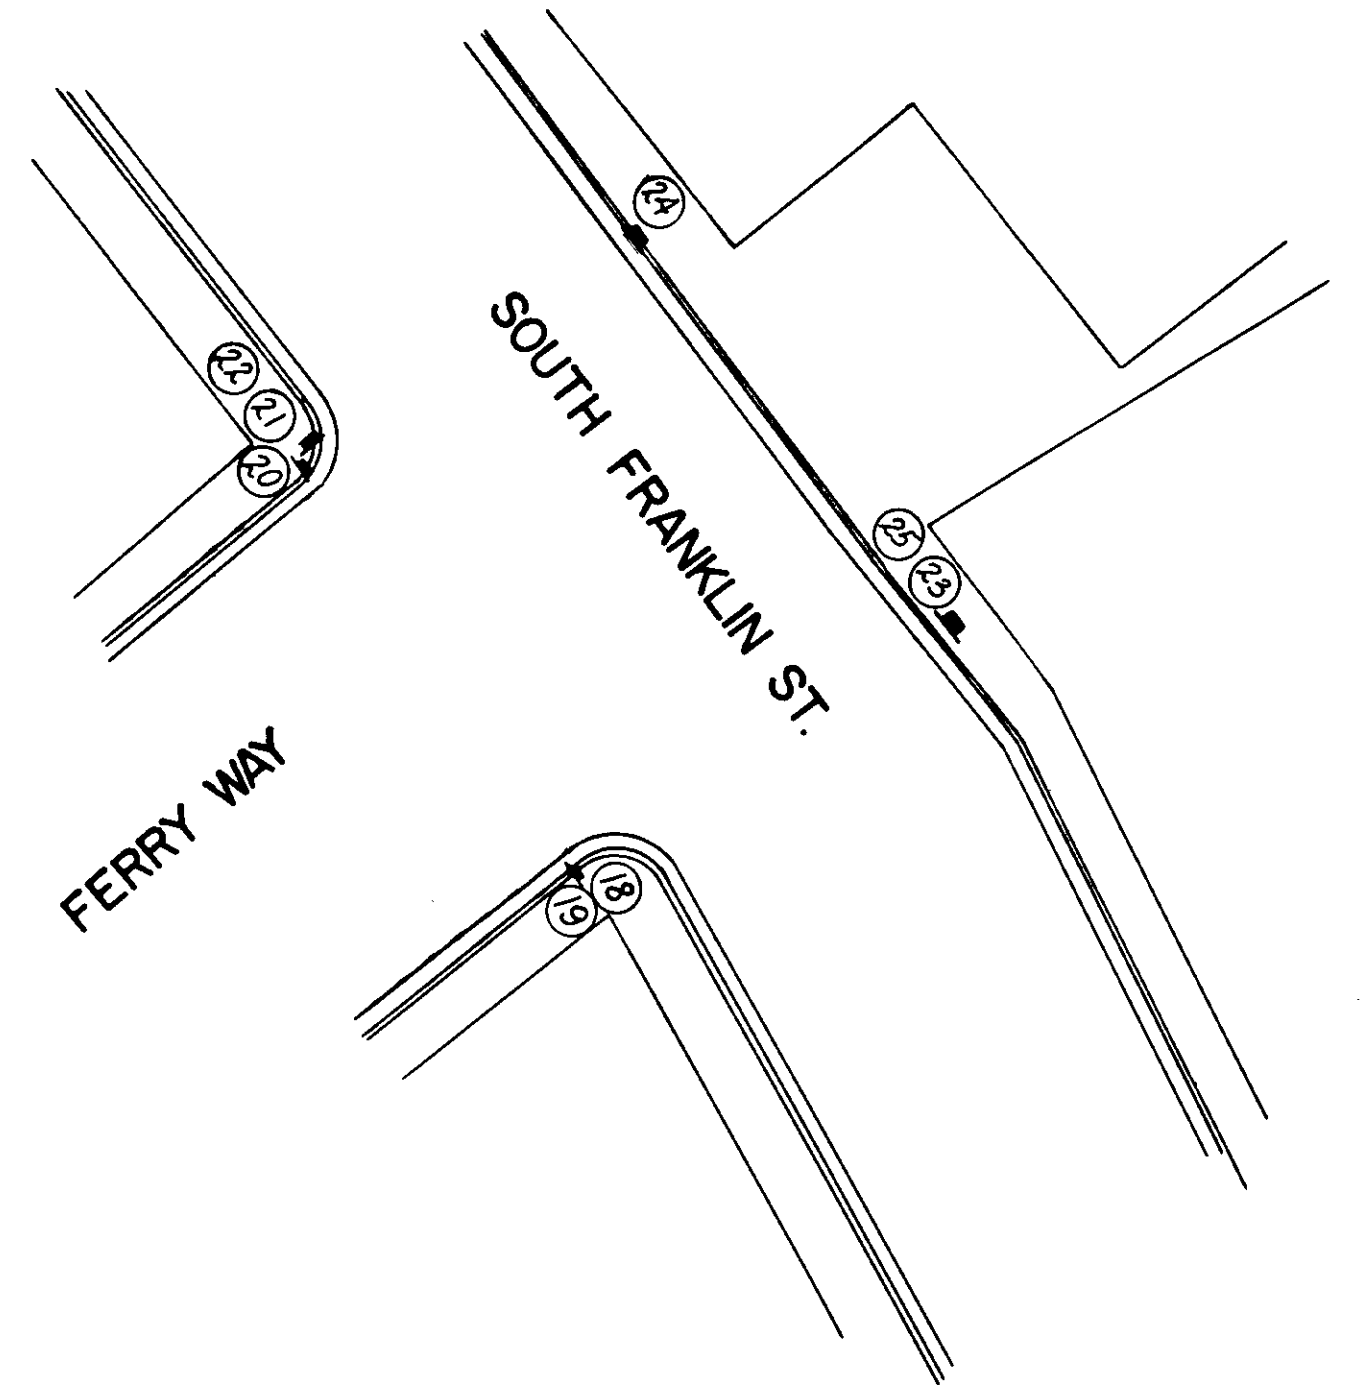



STATE	PROJECT DESIGNATION	YEAR	SHEET NO.	TOTAL SHEETS
ALASKA	F-093-2(5)	1981	15	16


SIGNING, STRIPING AND ILLUMINATION

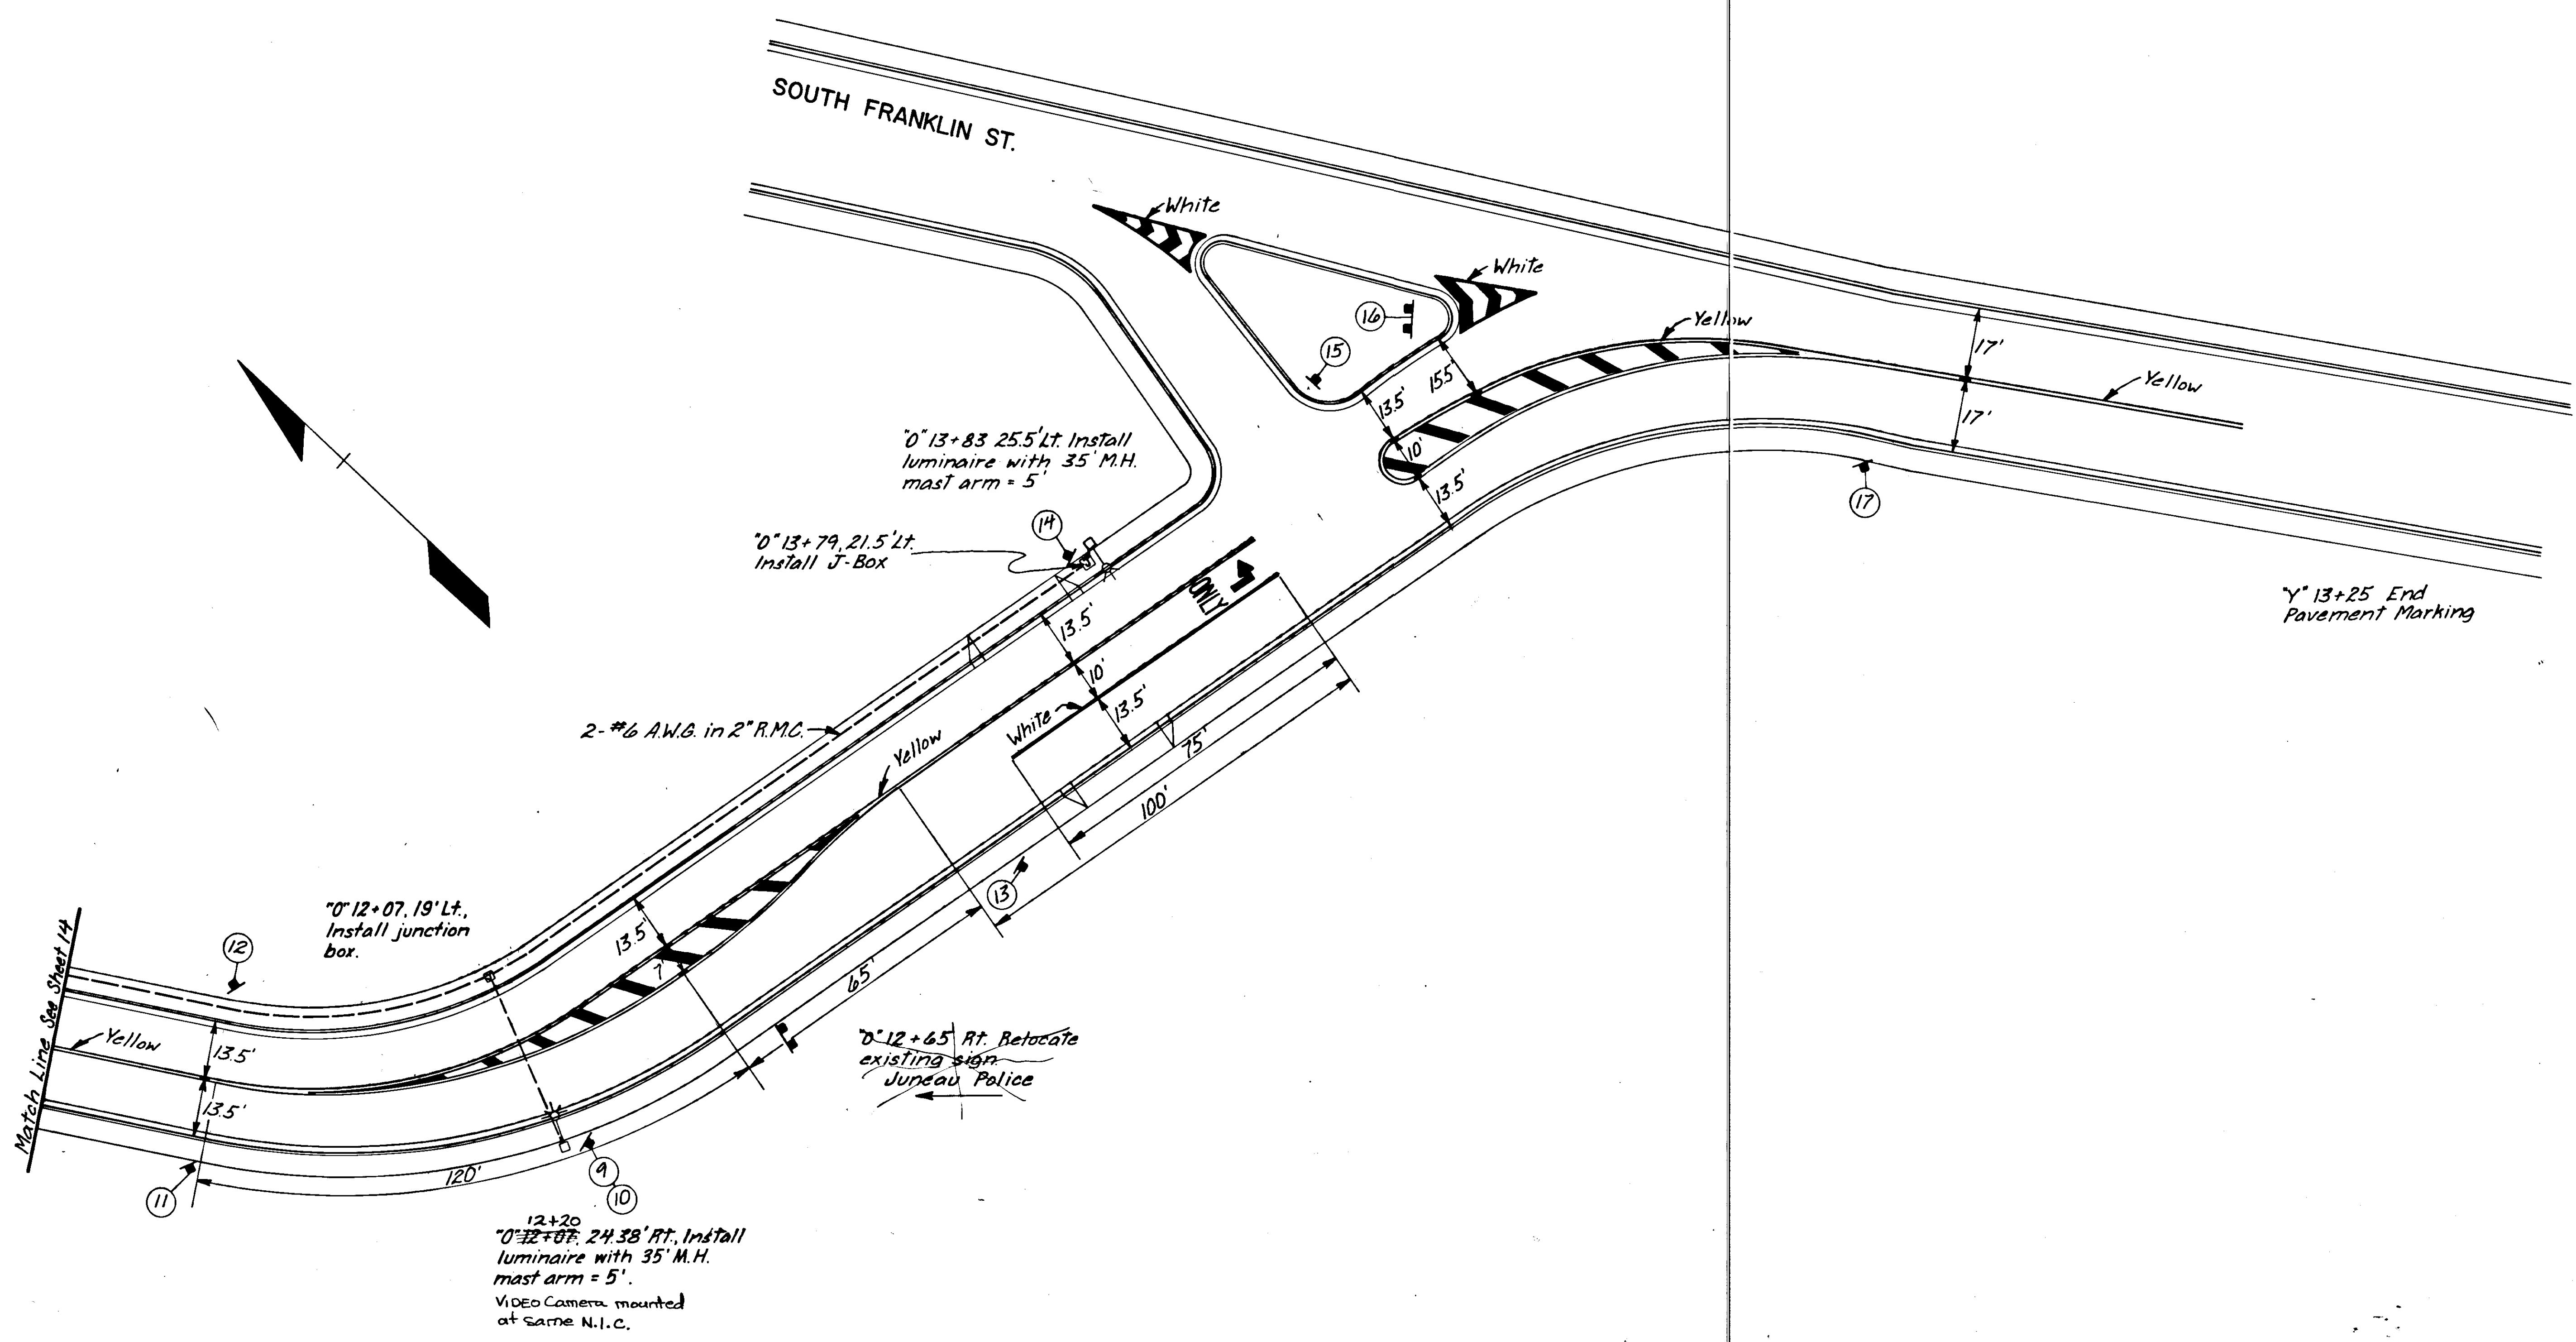

STATE	PROJECT DESIGNATION	YEAR	SHEET NO.	TOTAL SHEETS
ALASKA	F-093-2(5)	1981	16	16

TRAFFIC CONTROL PLAN

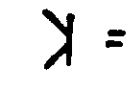LEGEND:  = Barricade with orange flag or warning lights.
 = Work Area

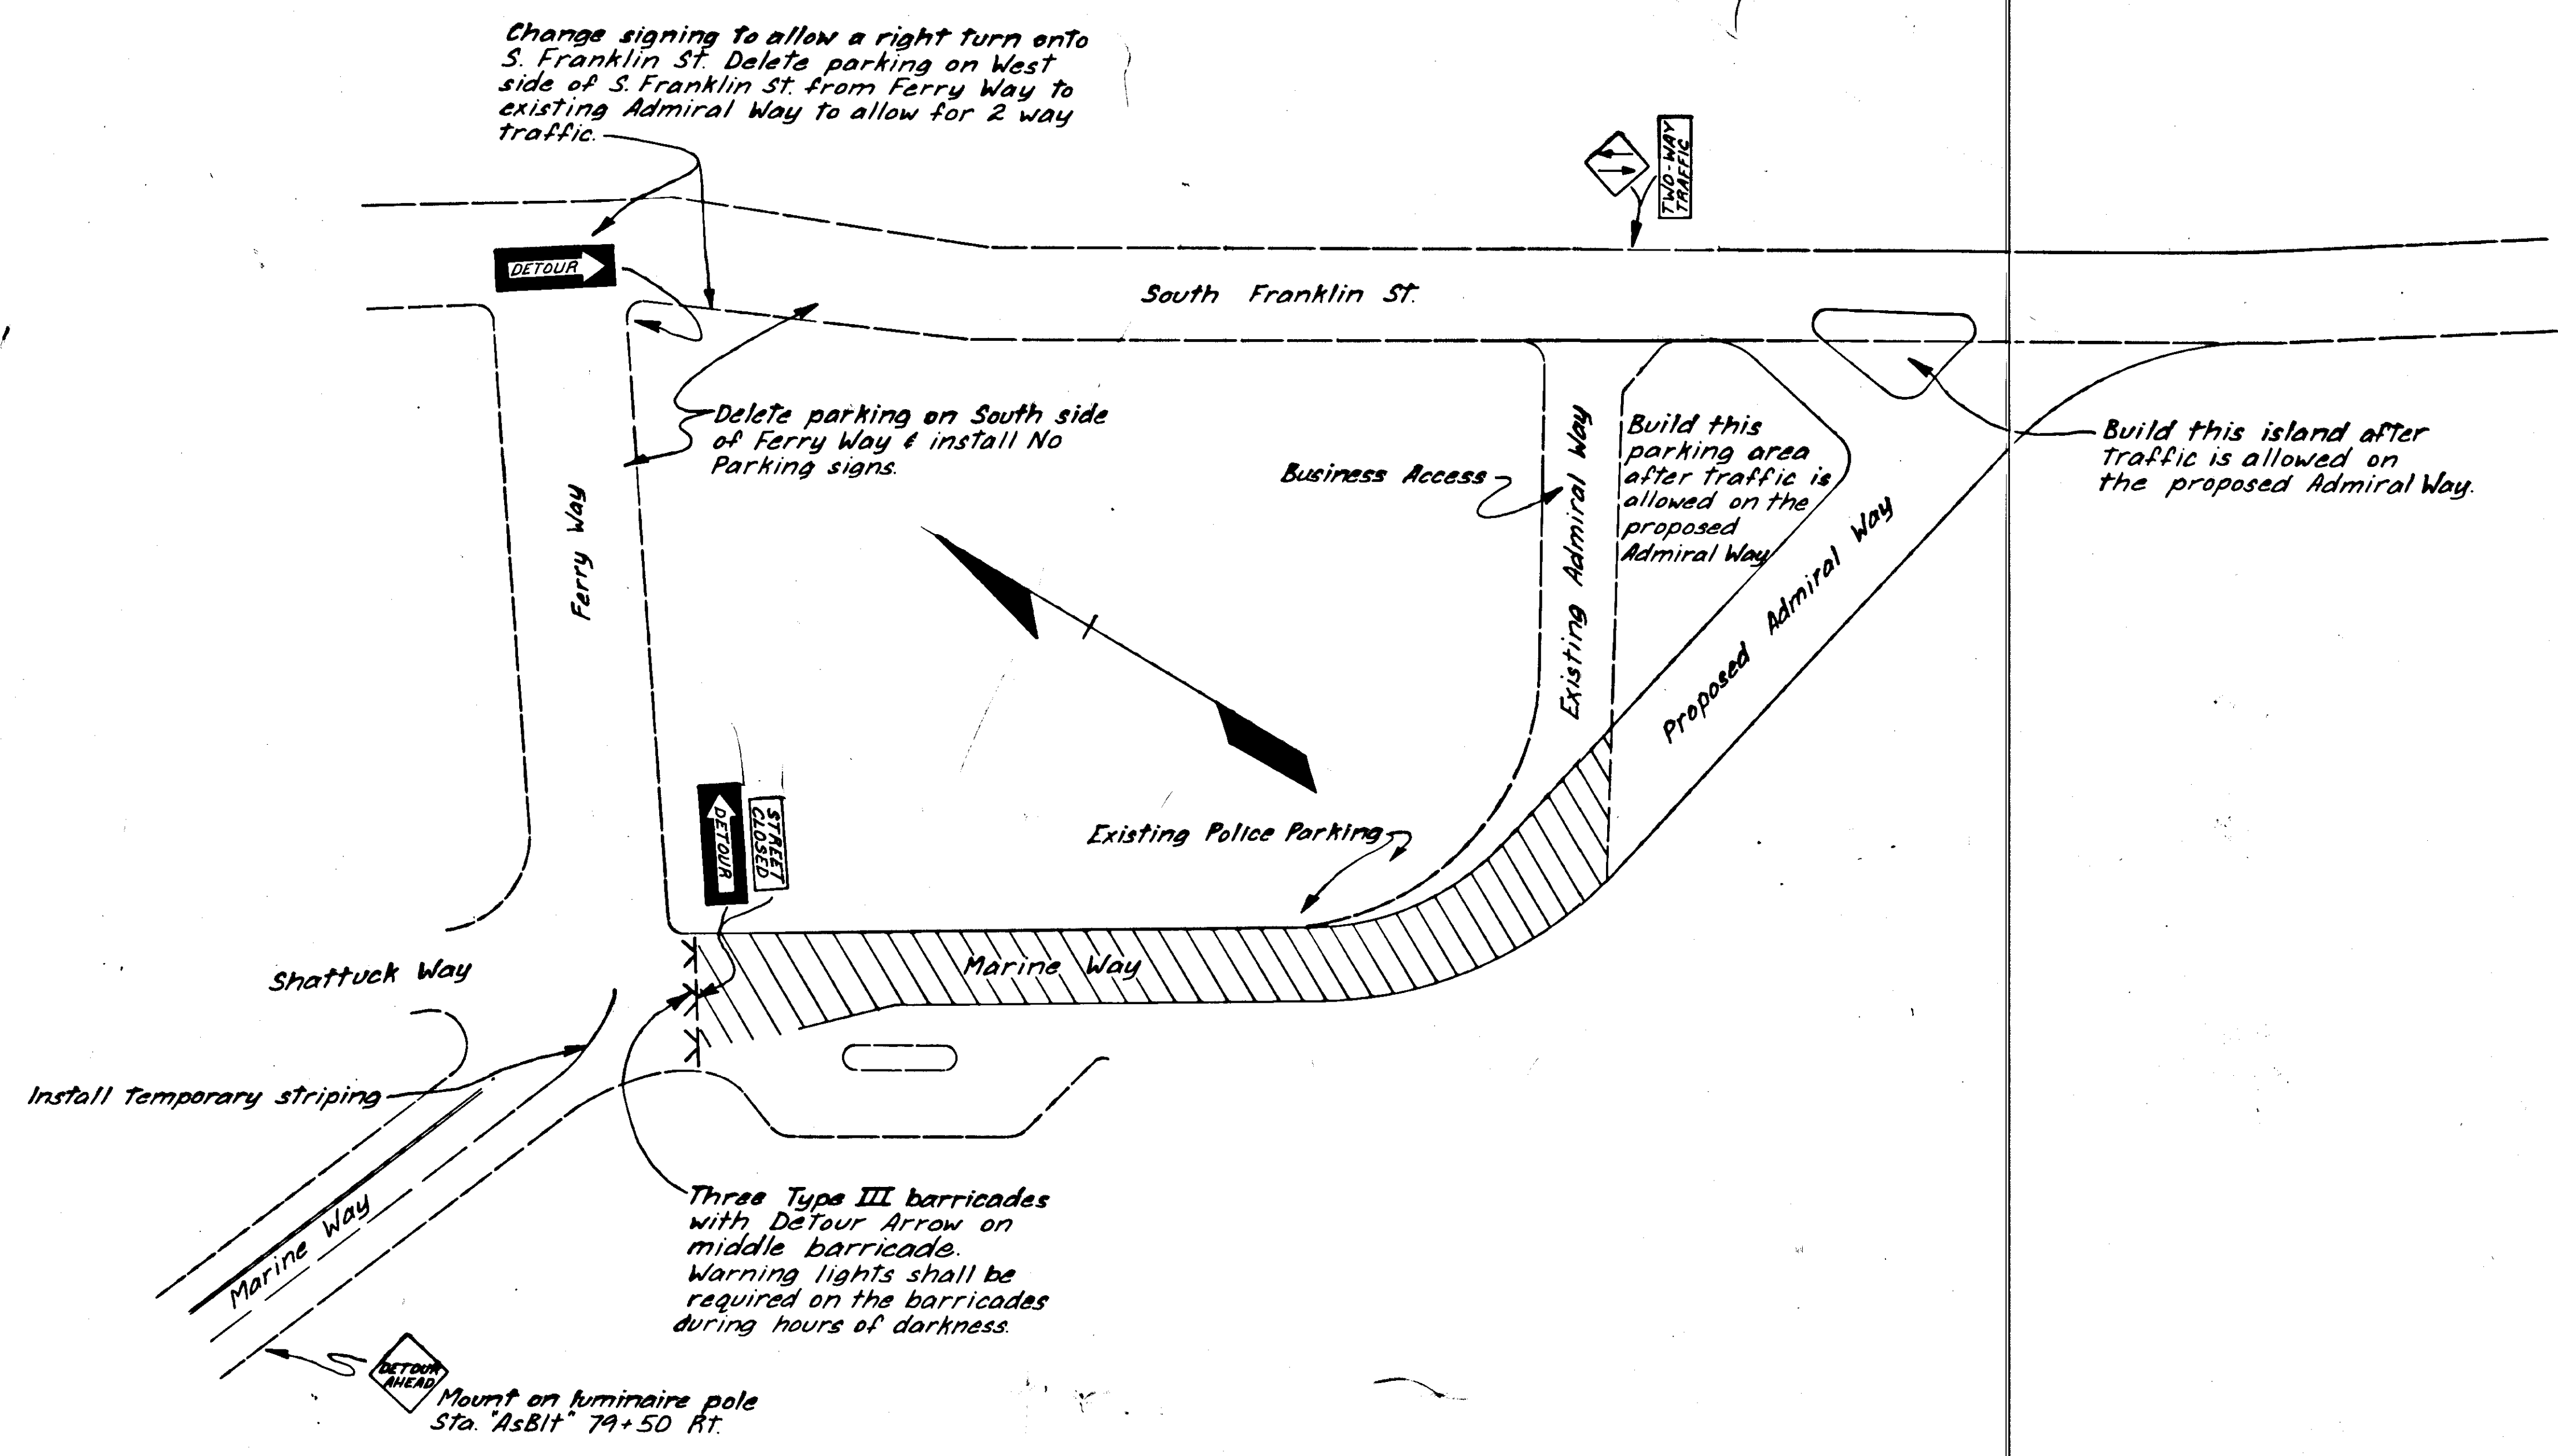

TRAFFIC CONTROL NOTES

1. The contractor shall designate at least one of his employees to maintain & continuously monitor the condition & placement of all traffic control devices during road-way work operations.
2. The contractor shall publish in the local newspaper for 3 consecutive days prior to commencement of work, a map showing the revised traffic pattern for the area, along with the date that the work will begin.
3. The contractor shall be responsible for the installation of the temporary striping & the necessary changes in signing to accomplish the changes in the traffic pattern.
4. The contractor shall be responsible for maintaining access to the parking lot south of the proposed Admiral Way for tour buses.
5. The contractor shall cooperate with the local businesses by giving them access on the existing Admiral Way from South Franklin St.
6. The contractor shall keep the police & fire departments informed of any changes in the traffic pattern & shall provide alternate parking for police vehicles within close proximity of the police station while working in the area.
7. Barricades shall be provided at the east end of the proposed Admiral Way.