

STATE OF ALASKA DEPARTMENT OF TRANSPORTATION & PUBLIC FACILITIES

PLAN AND PROFILE PROPOSED HIGHWAY PROJECT F-093-2(9) EGAN EXPRESSWAY INTERSECTION IMPROVEMENTS GRADING, PAVING, DRAINAGE, ILLUMINATION, SIGNALIZATION, BRIDGE, & PEDESTRIAN ACCESS

STATE	PROJECT	SHEET NO.	TOTAL SHEETS
ALASKA	F-093-2(9)	1	31

SHT. NO.	INDEX OF SHEETS
1	TITLE SHEET
2,3	TYPICAL SECTIONS
4	ESTIMATE OF QUANTITIES, MISC. SUMMARIES, & MISC. DETAILS
5-11	PLAN SHEETS
12-17	SIGNING, STRIPING, & ILLUMINATION
18-21	SIGNALIZATION
22	TRAFFIC CONTROL PLAN *
23-24	PEDESTRIAN ACCESS
25-29	BRIDGE PLANS
30-31	BORING LOG

Sheet 11 revised 7/1/82

The following standard drawings shall apply to this project:
 A-1, C-00.04, C-10.04, C-11.04, D-01.00, D-04.00, D-05.00,
 F-01.21, G-04.15, G-14.08, G-45.00, I-80.00, L-23.03,
 L-30.01, M-16.03, S-00.11, S-05.00, S-30.12, T-20.03, T-21.03,
 T-22.00, T-30.00, T-31.01, T-32.01, T-33.03, T-34.03, T-52.01


DESIGN DESIGNATION

SALMON CREEK INTER.	VANDERBILT HILL INTER.	SUNNY POINT INTER.
ADT 1980 = 2492	ADT 1980 = 4100	ADT 1980 = 4564
ADT 2000 = 4959	ADT 2000 = 8813	ADT 2000 = 9081
DHV 15% = 744	DHV 15% = 1322	DHV 15% = 1362
D. = 60-40	D. = 60-40	D. = 55-45
T. = 4%	T. = 3%	T. = 7%
T.I. = 7.5	T.I. = 7.5	T.I. = 8.5

AIRPORT ACCESS INTER.	NUGGET MALL INTER.
ADT 1980 = 3,581	ADT 1980 = 4,644
ADT 2000 = 7,697	ADT 2000 = 9,241
DHV 15% = 1,155	DHV 15% = 1,386
D. = 40-60	D. = 45-55
T. = 4%	T. = 4%
T.I. = 8.0	T.I. = 8.0

PROJECT SUMMARY

WIDTH OF PAVING = Varies
 LENGTH OF GRADING = 11,400' = 2.159 mi.
 LENGTH OF PAVING = 11,400' = 2.159 mi.
 LENGTH OF PROJECT = 11,400' = 2.159 mi.

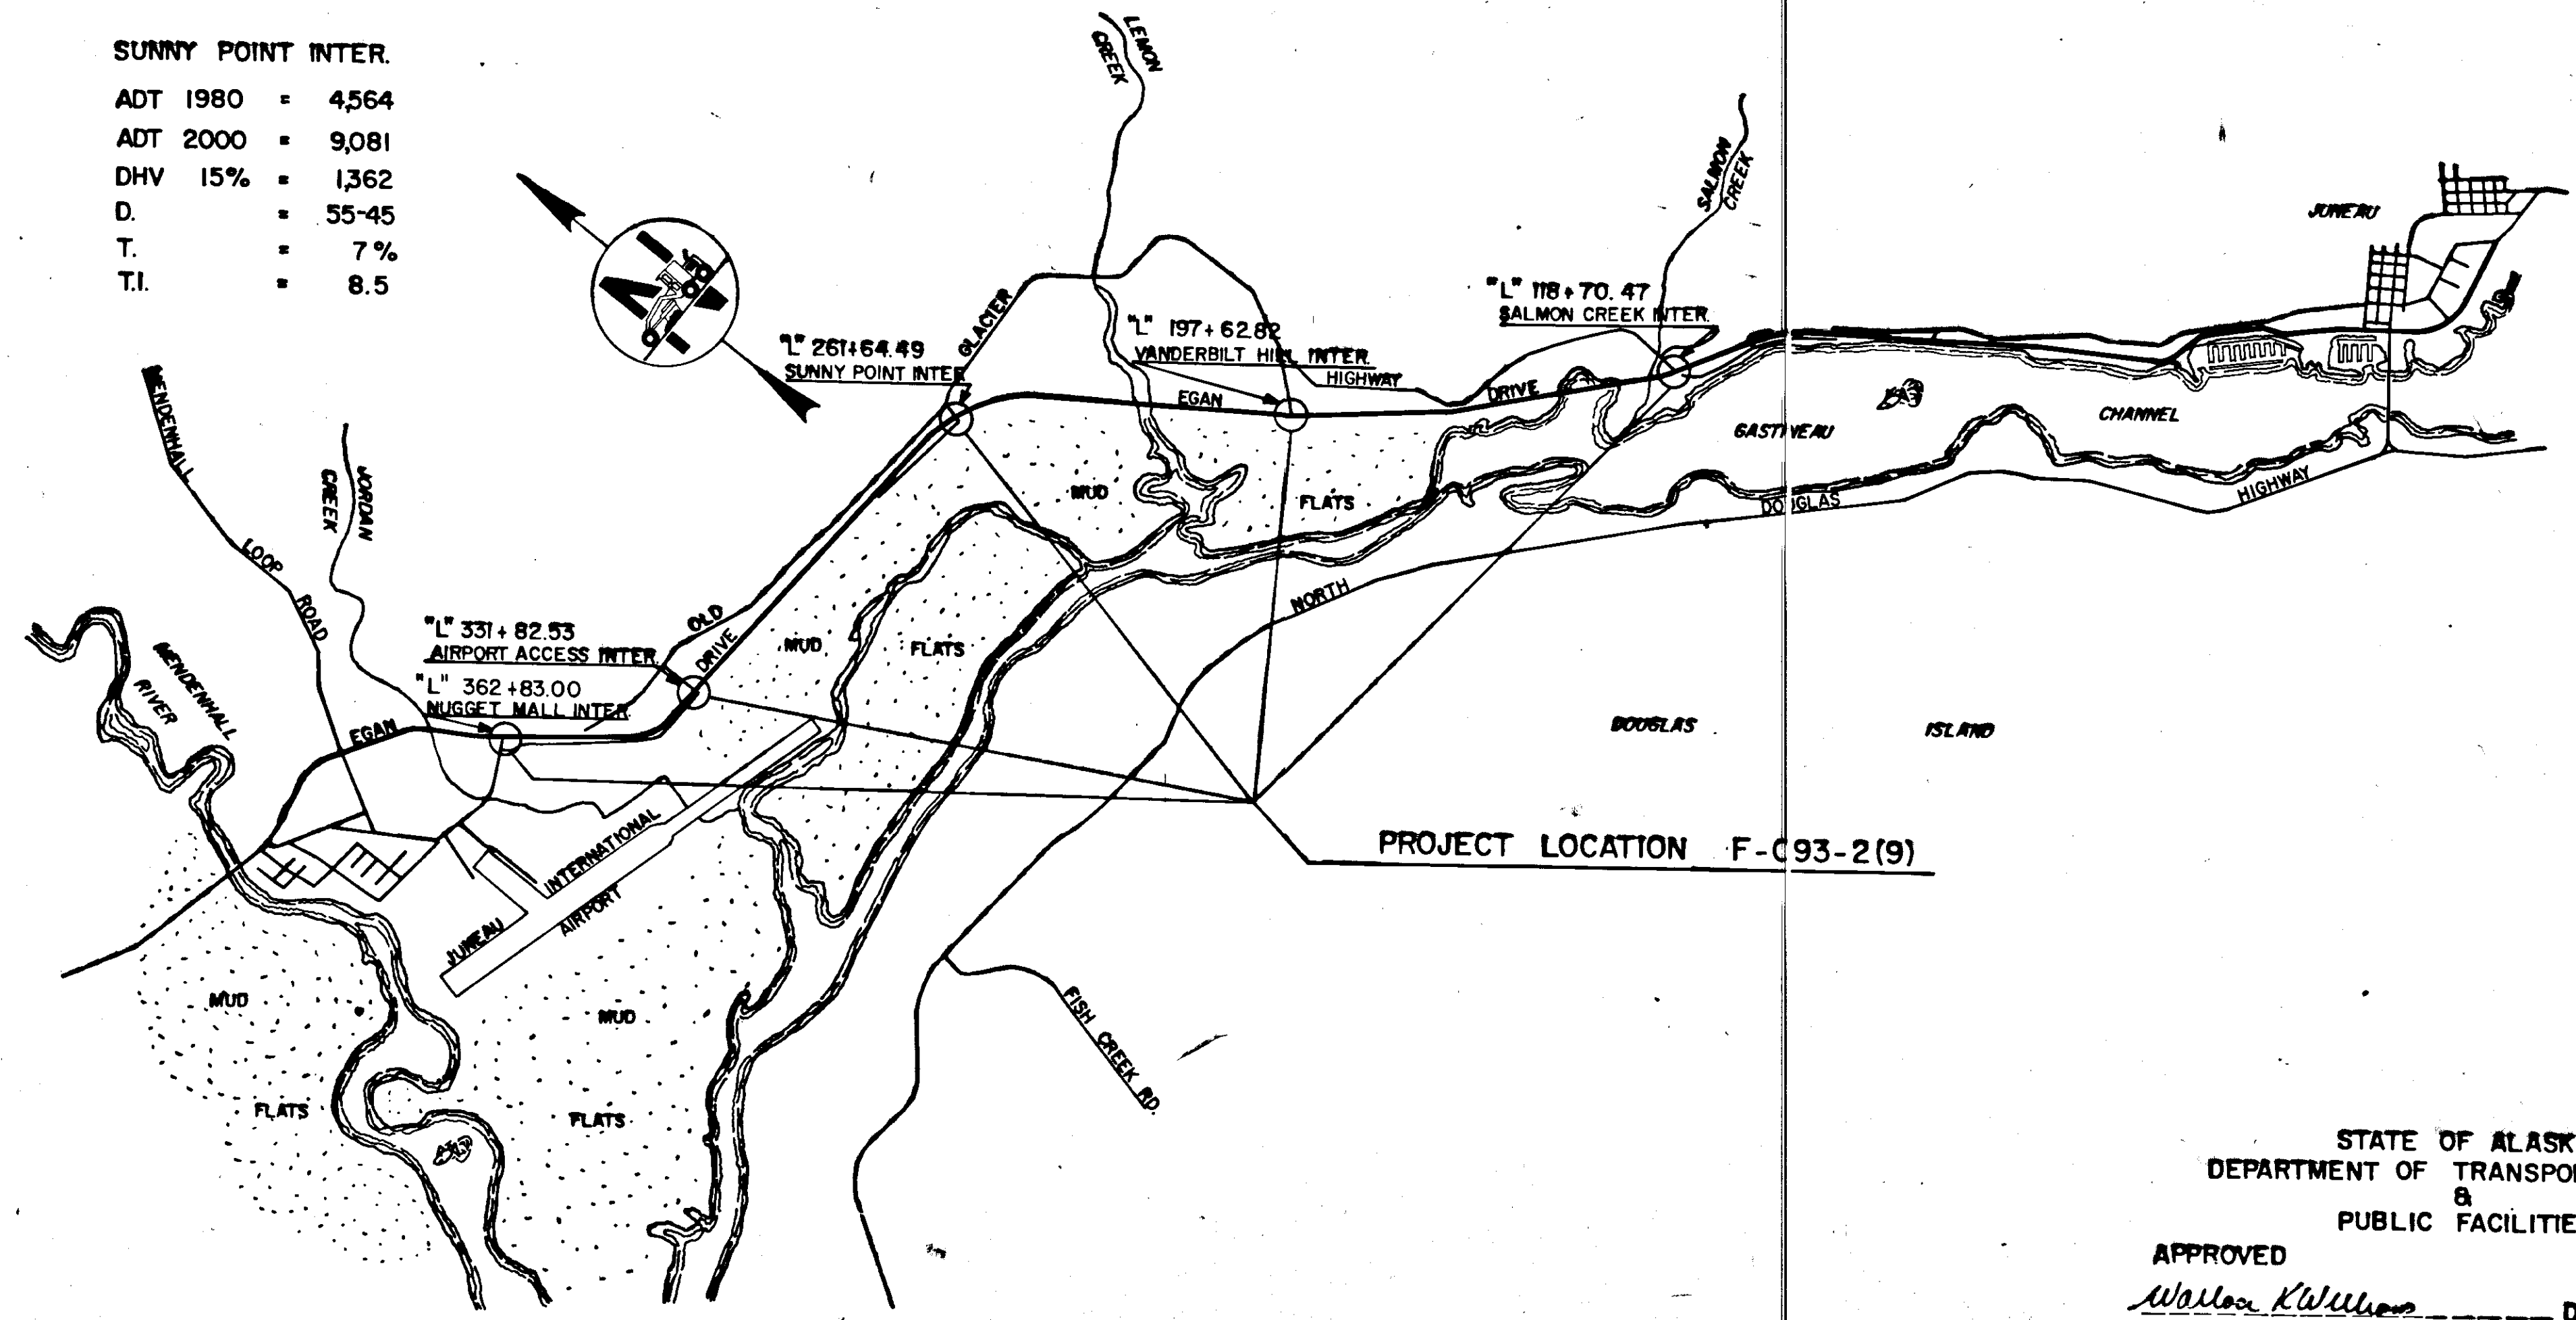

"As Built"

Project Engineer: Phil Speer
 Contractor: Red Somm Construction Co.
 Begin Work: June 1, 1982
 Completion: July 25, 1983

STATE OF ALASKA
 DEPARTMENT OF TRANSPORTATION
 &
 PUBLIC FACILITIES

APPROVED
Wallace K. Williams
 Southeastern Region Design/Const. Engineer

STATE OF ALASKA
 DEPARTMENT OF TRANSPORTATION
 &
 PUBLIC FACILITIES


APPROVED
Charles E. Matlock
 Director, Highway Design/Construction

DATE 12-21-81

DATE 12-21-81

TYPICAL SECTIONS OF IMPROVEMENT

STATE	PROJECT DESIGNATION	YEAR	SHEET NO.	TOTAL SHEETS
ALASKA	F-093-2(9)	1981	2	31

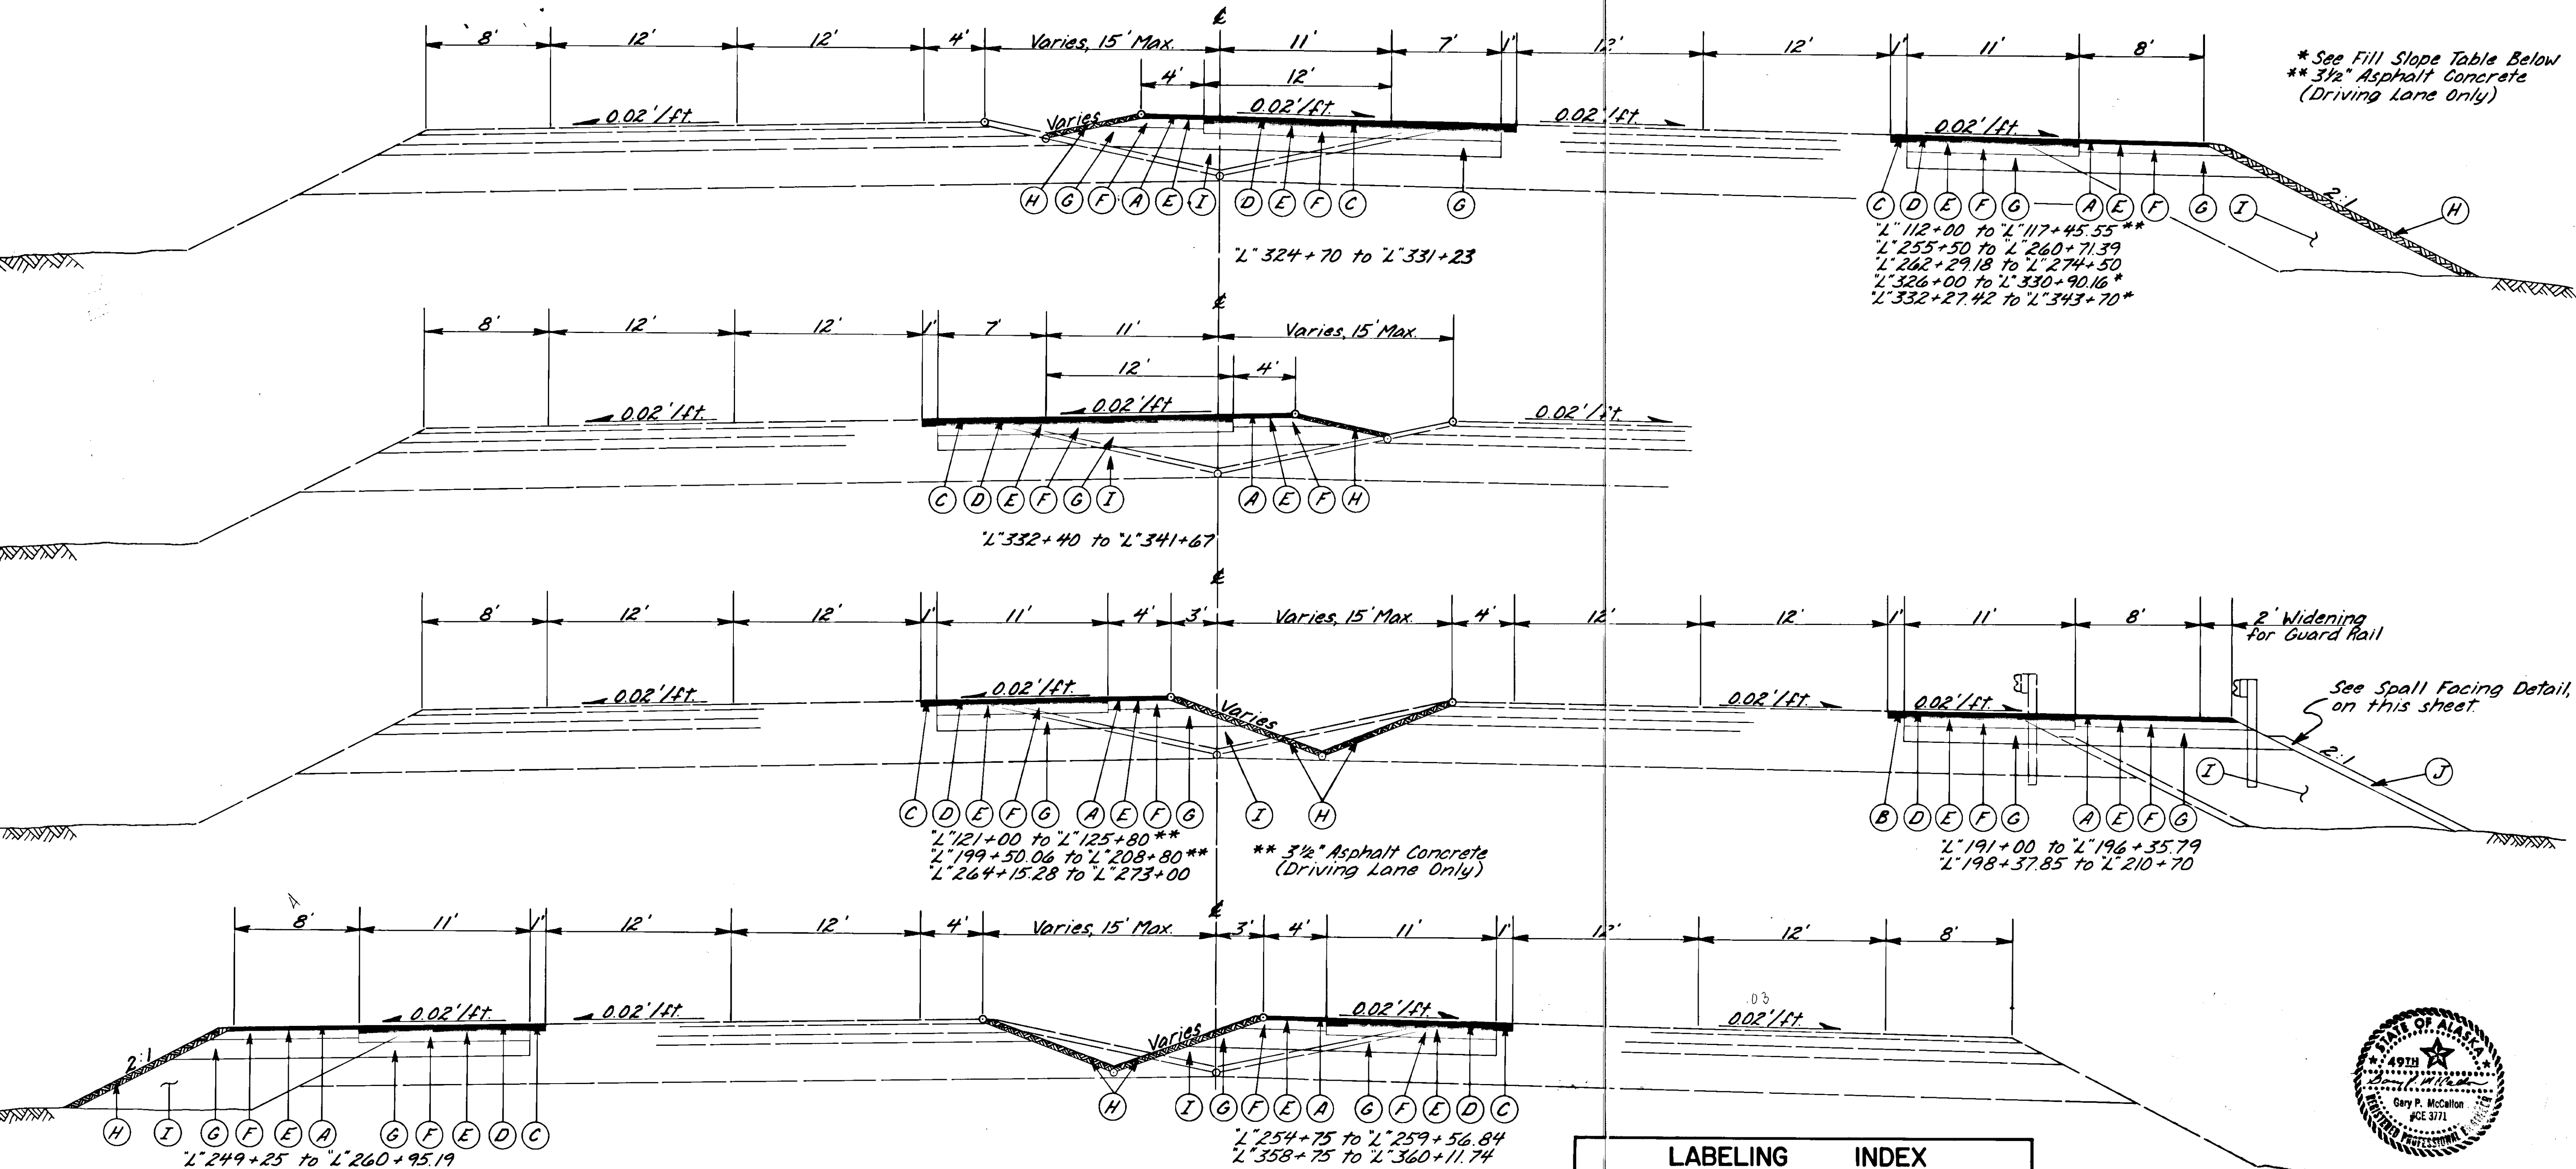


* See Fill Slope Table Below
 ** 3 1/2" Asphalt Concrete (Driving Lane Only)

2' Widening for Guard Rail


See Spall Facing Detail, on this sheet.

* See Fill Slope Table on this sheet.

L' 249+25 to L' 260+95.19
 L' 262+43.81 to L' 267+75
 L' 317+00 to L' 325+00*
 L' 332+73.64 to L' 338+30
 L' 359+25 to L' 362+47.71*
 L' 363+86.12 to L' 369+25*

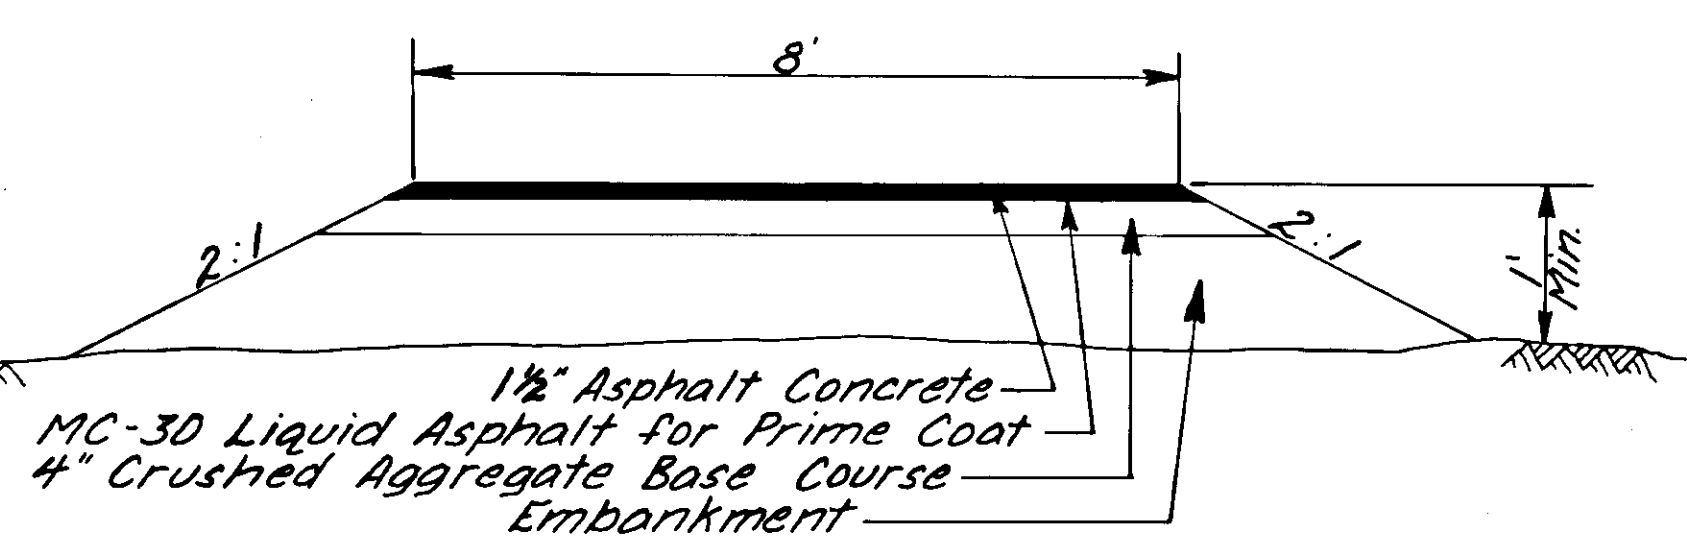

BIKEPATH TYPICAL SECTION

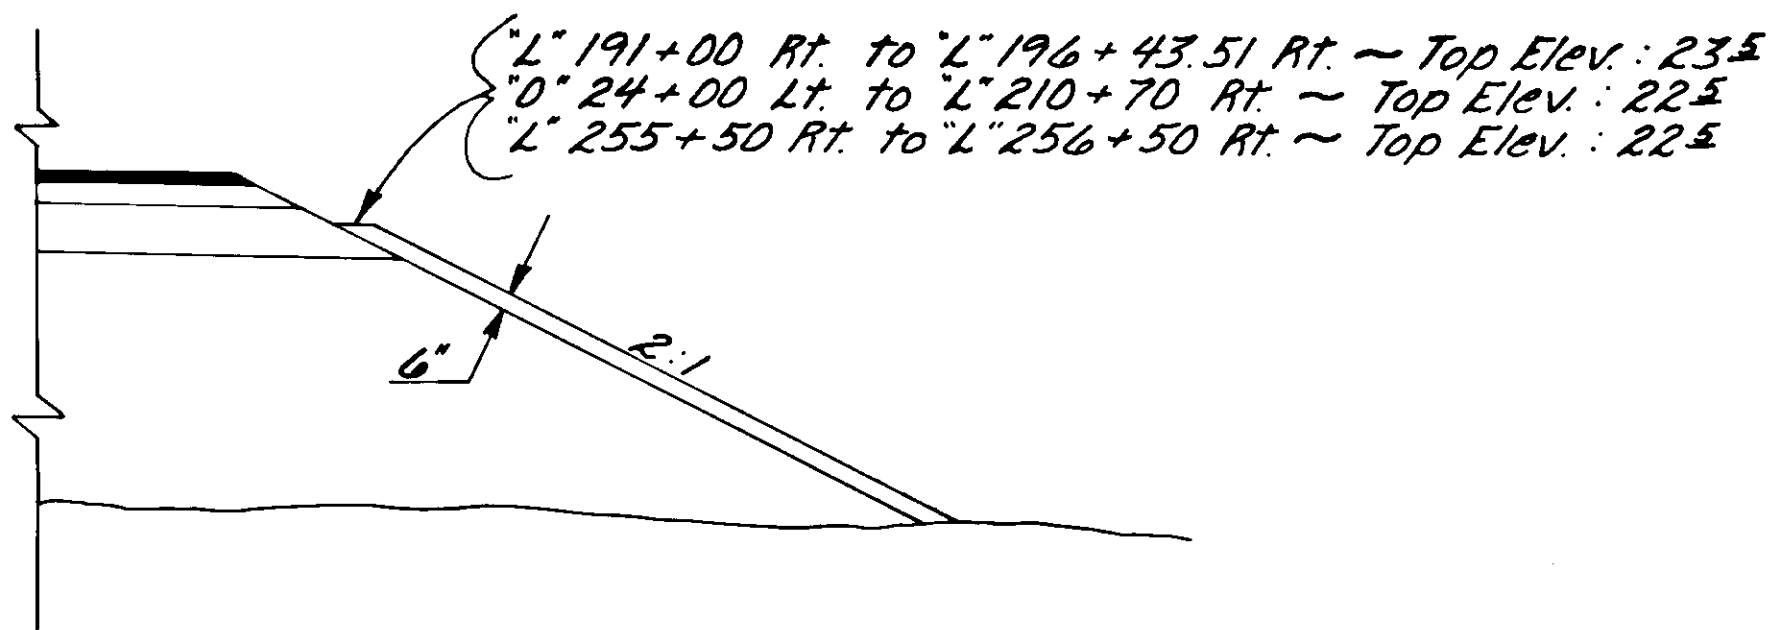

SPALL FACING DETAIL

LABELING INDEX	
(A)	1 1/2" Asphalt Concrete (Type I)
(B)	3 1/2" Asphalt Concrete (Type I)
(C)	4" Asphalt Concrete (Type I)
(D)	CSS-1 Asphalt for Tack Coat
(E)	MC-30 Liquid Asphalt for Prime Coat
(F)	6" Crushed Aggregate Base Course
(G)	10" Minimum, Subbase Grading "E"
(H)	4" Topsoil & Hydro-Seeding
(I)	Useable Excavation and/or Borrow
(J)	6" Spall Facing <i>don't need</i>






FILL SLOPE TABLE			
STATION TO	STATION	OFFSET	SLOPE
L' 317+00	to L' 325+00	Lt.	4:1
L' 325+00	to L' 330+90.16	Rt.	4:1
L' 332+27.42	to L' 343+70	Rt.	4:1
L' 359+25	to L' 362+47.71	Lt.	3:1
L' 363+86.12	to L' 369+25	Lt.	3:1



TYPICAL SECTIONS APPROACH ROADS

STATE	PROJECT DESIGNATION	YEAR	SHEET NO.	TOTAL SHEETS
ALASKA	F-093-2(9)	1981	3	31

LABELING INDEX	
(A)	1 1/2" Asphalt Concrete (Type 1)
(B)	3 1/2" Asphalt Concrete (Type 1)
(C)	4" Asphalt Concrete (Type 1)
(D)	GSS-1 Asphalt for Tack Coat
(E)	MC-30 Liquid Asphalt for Prime Coat
(F)	6" Crushed Aggregate Base Course
(G)	10" Minimum, Subbase Grading "E"
(H)	4" Topsoil & Hydro-Seeding
(I)	Useable Excavation and/or Borrow
()	
()	

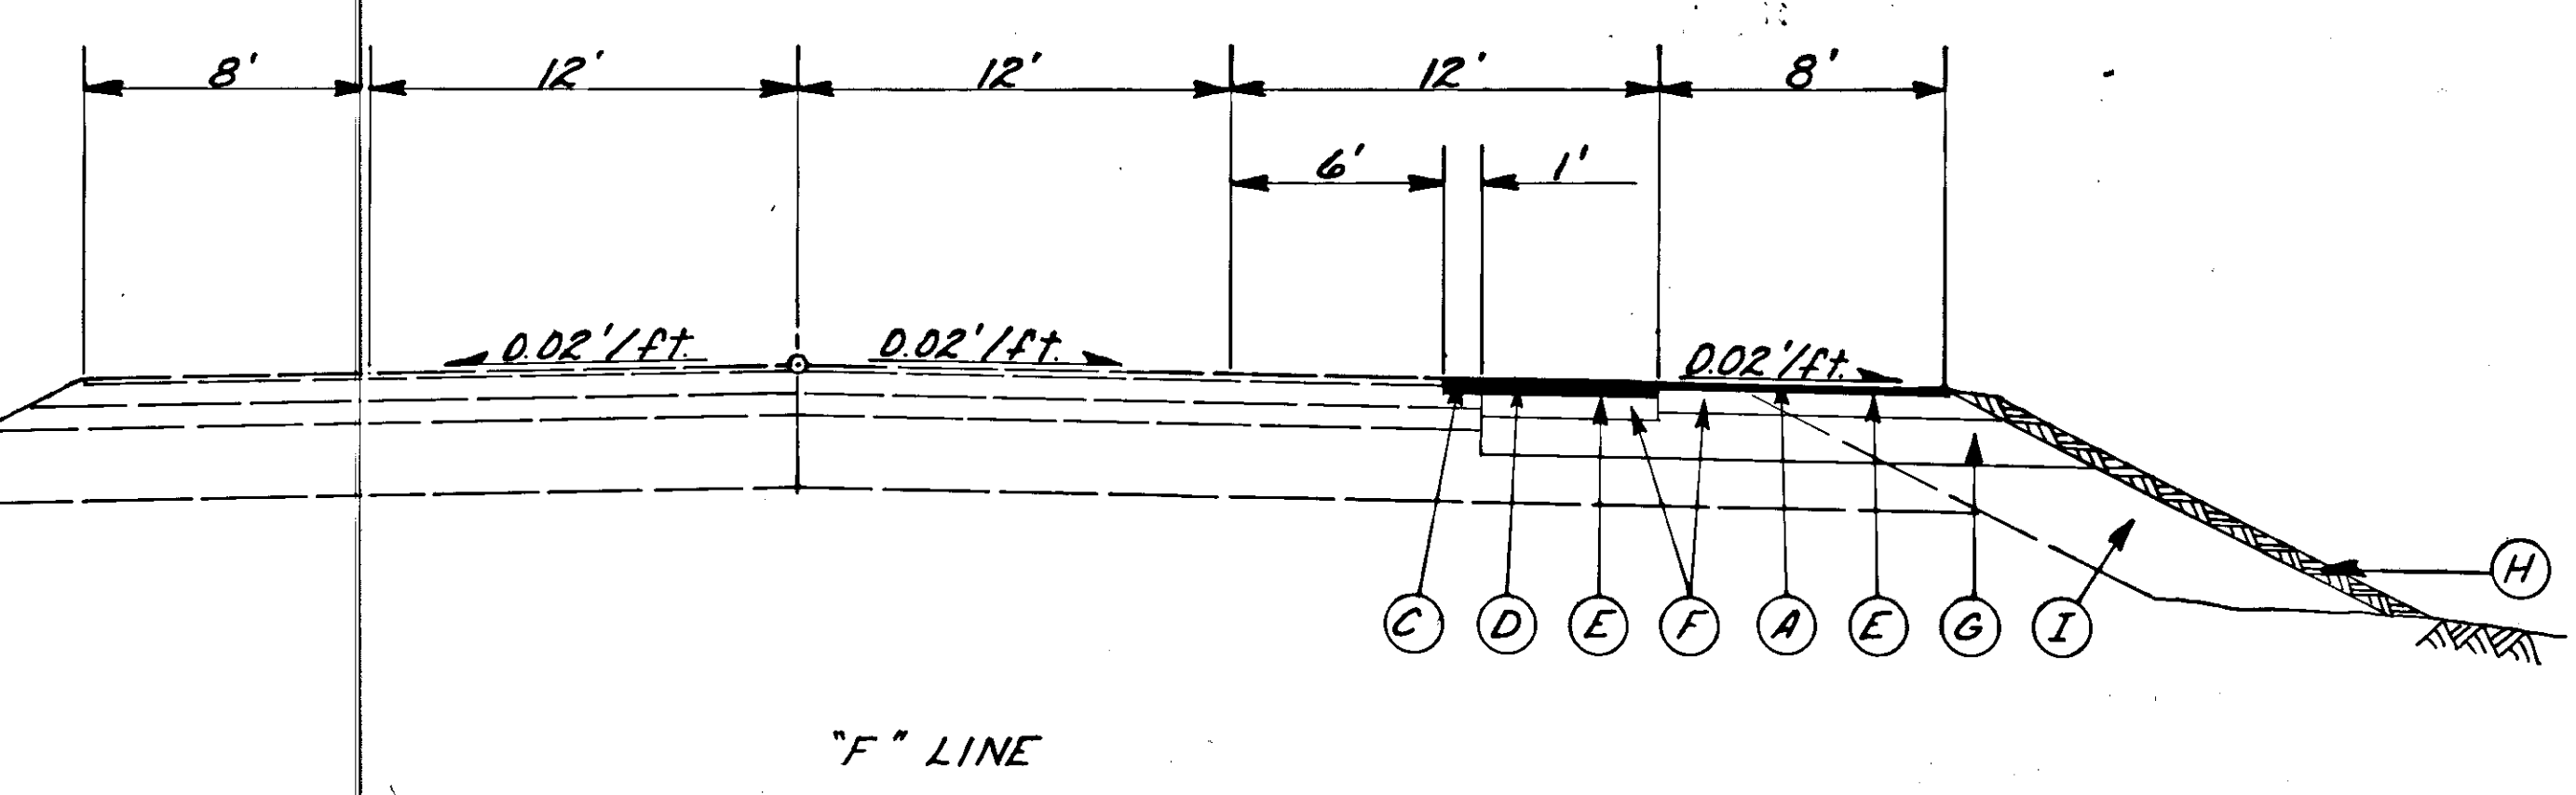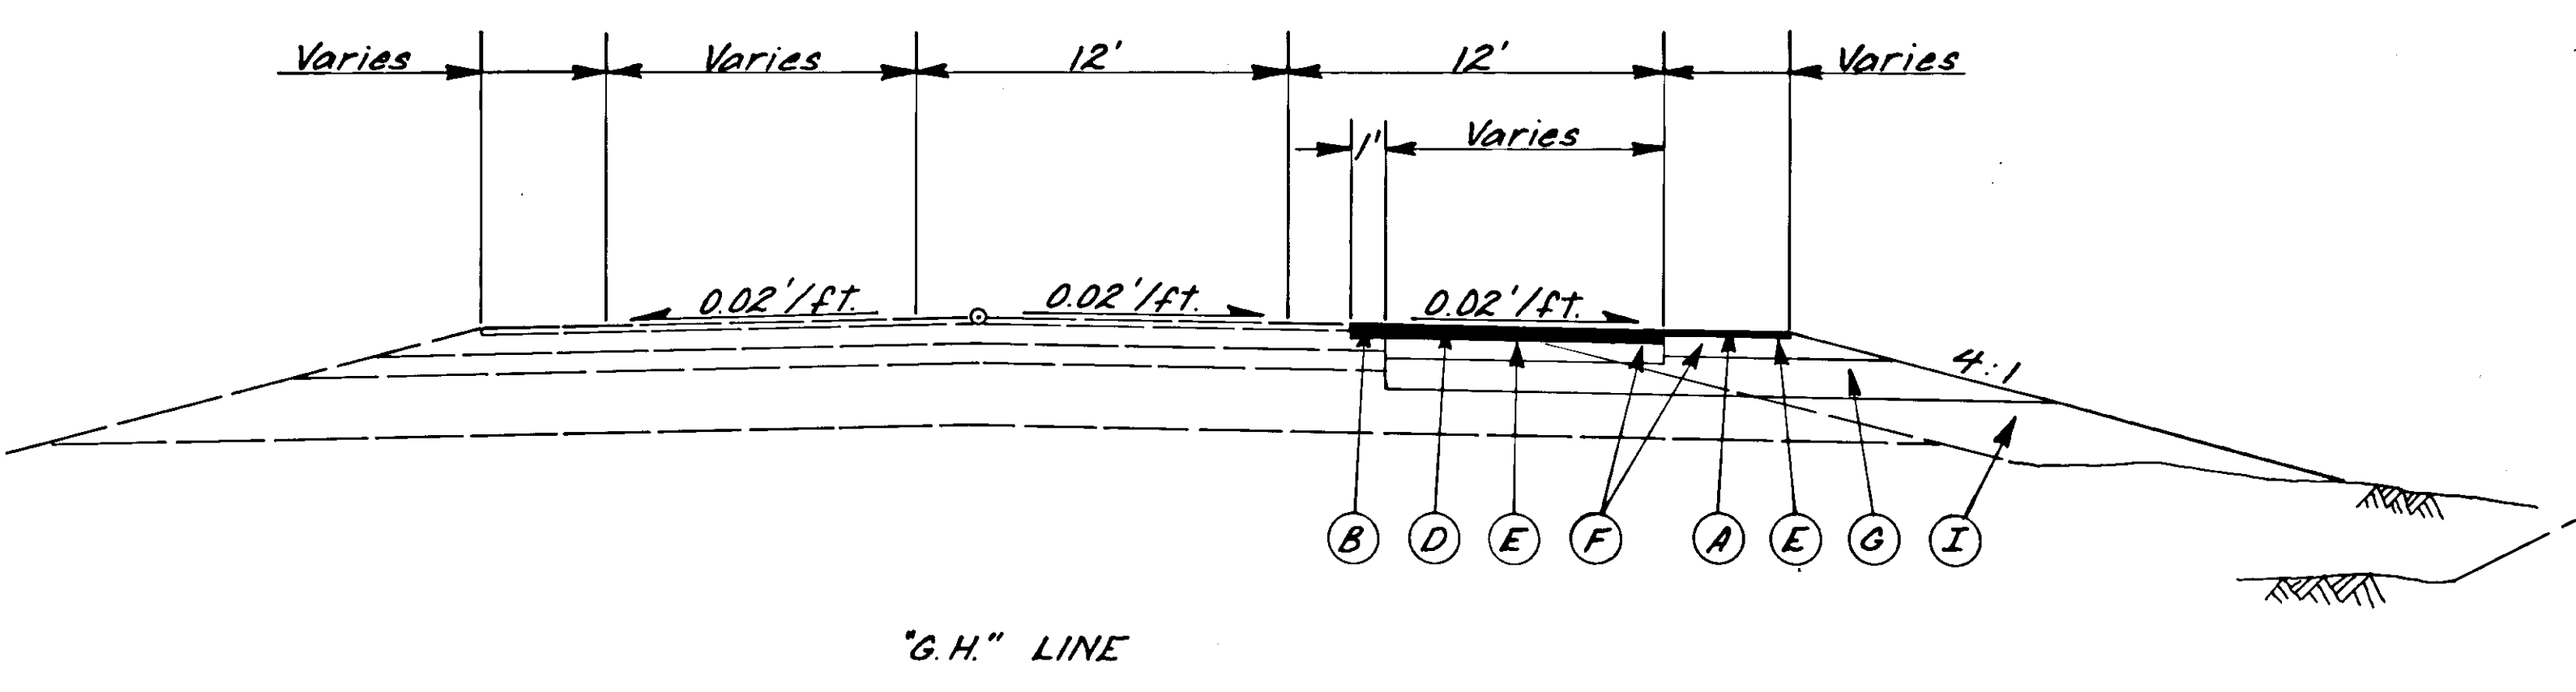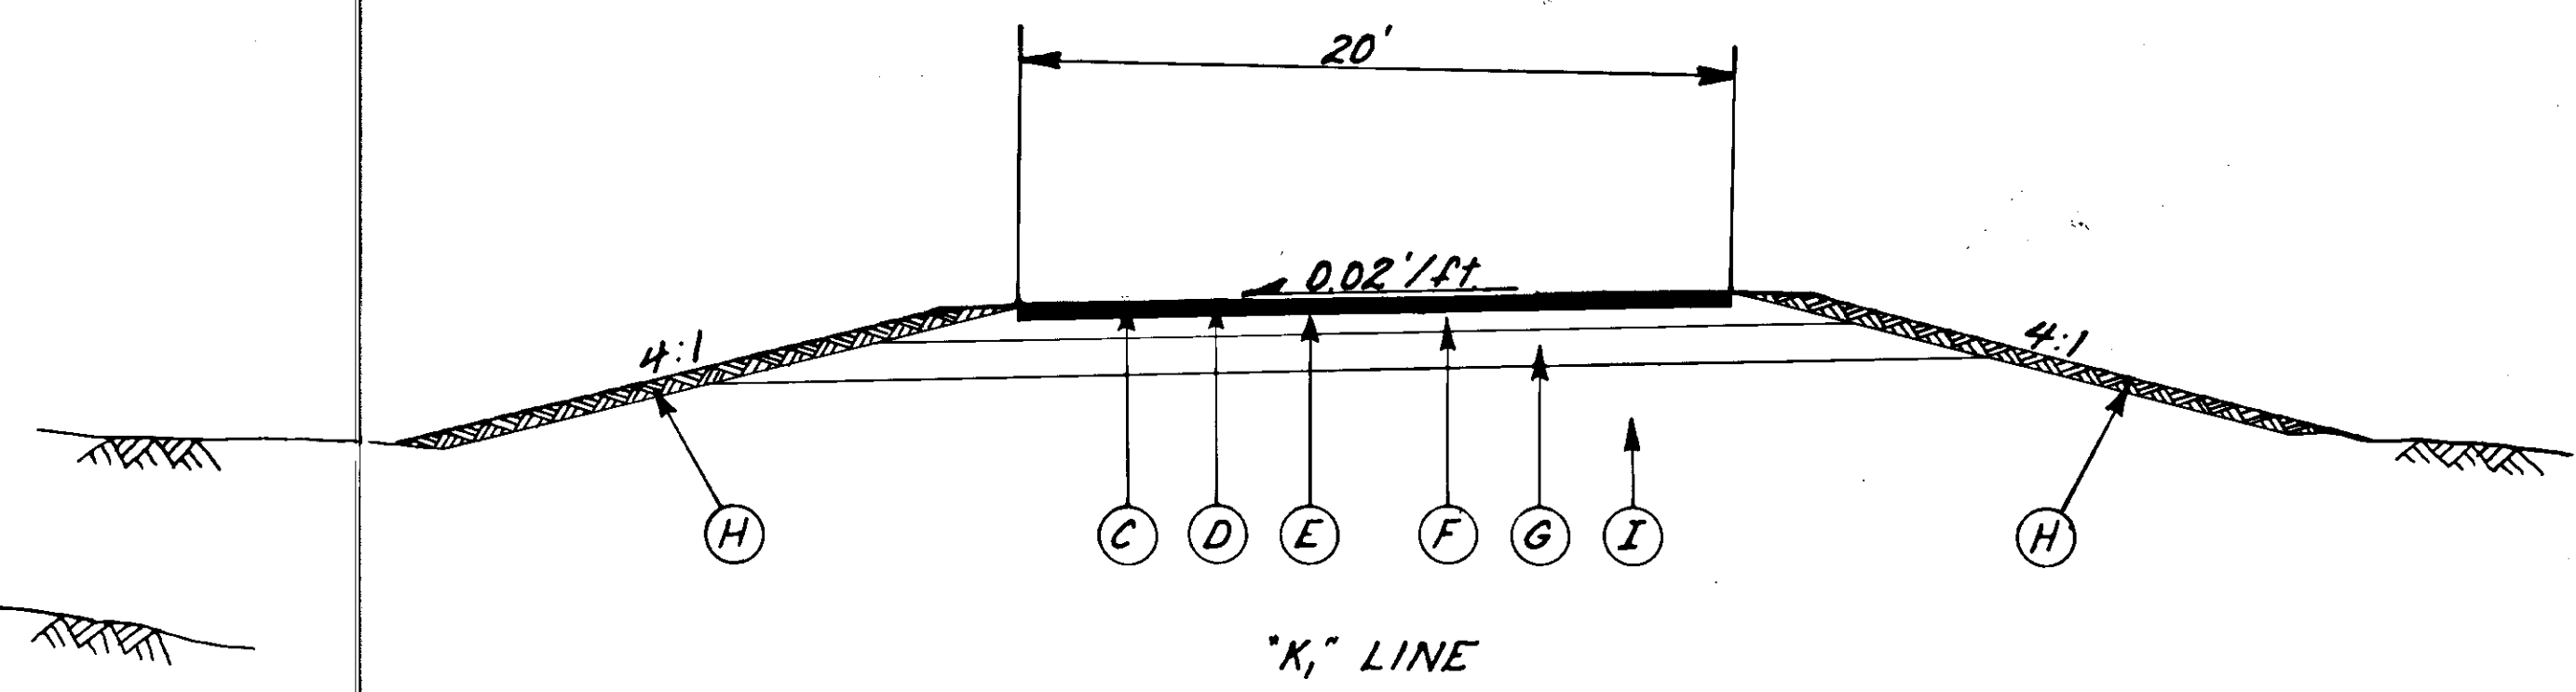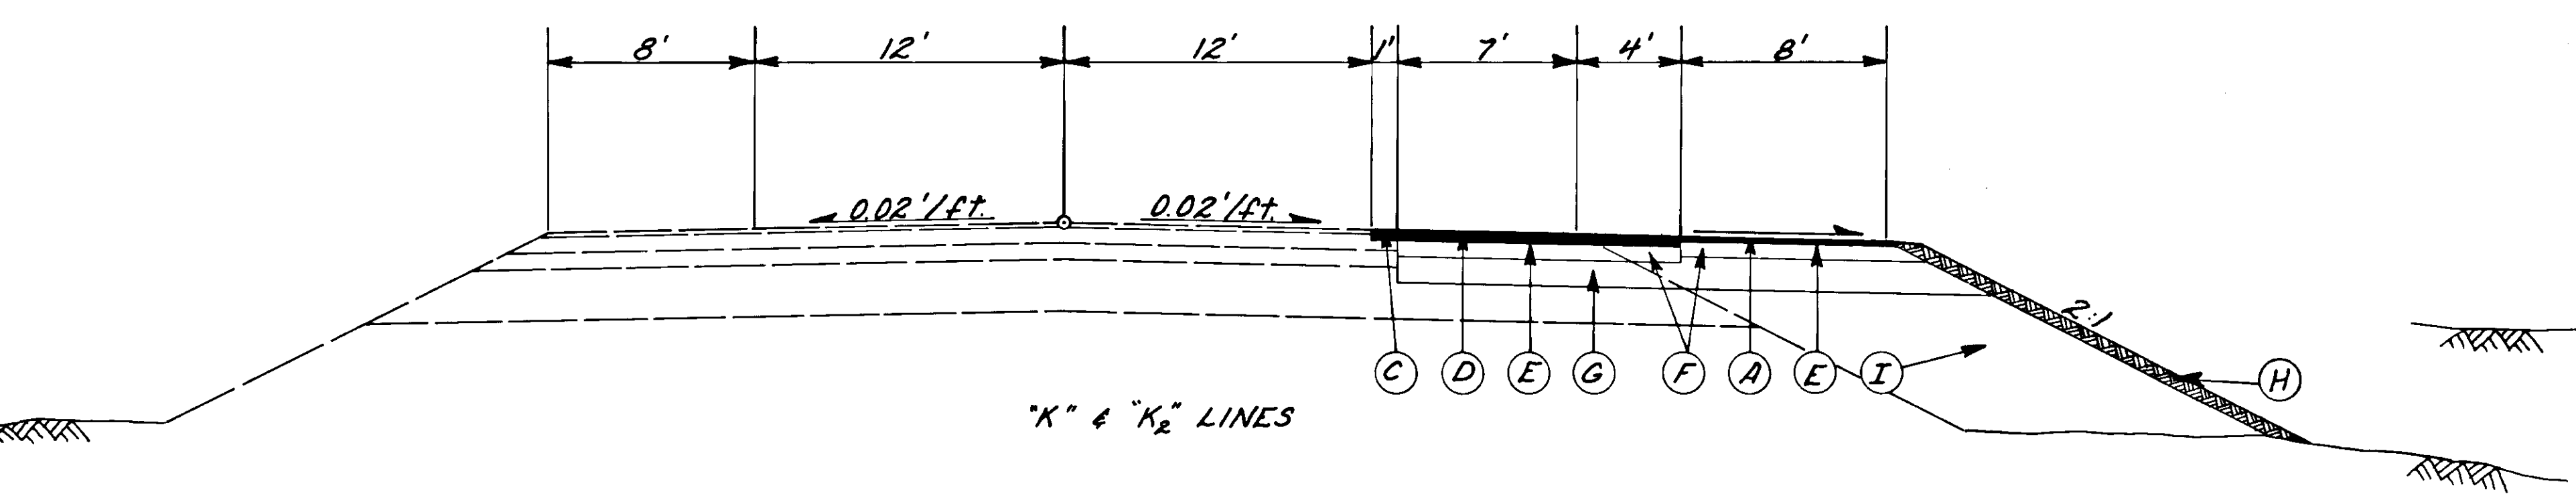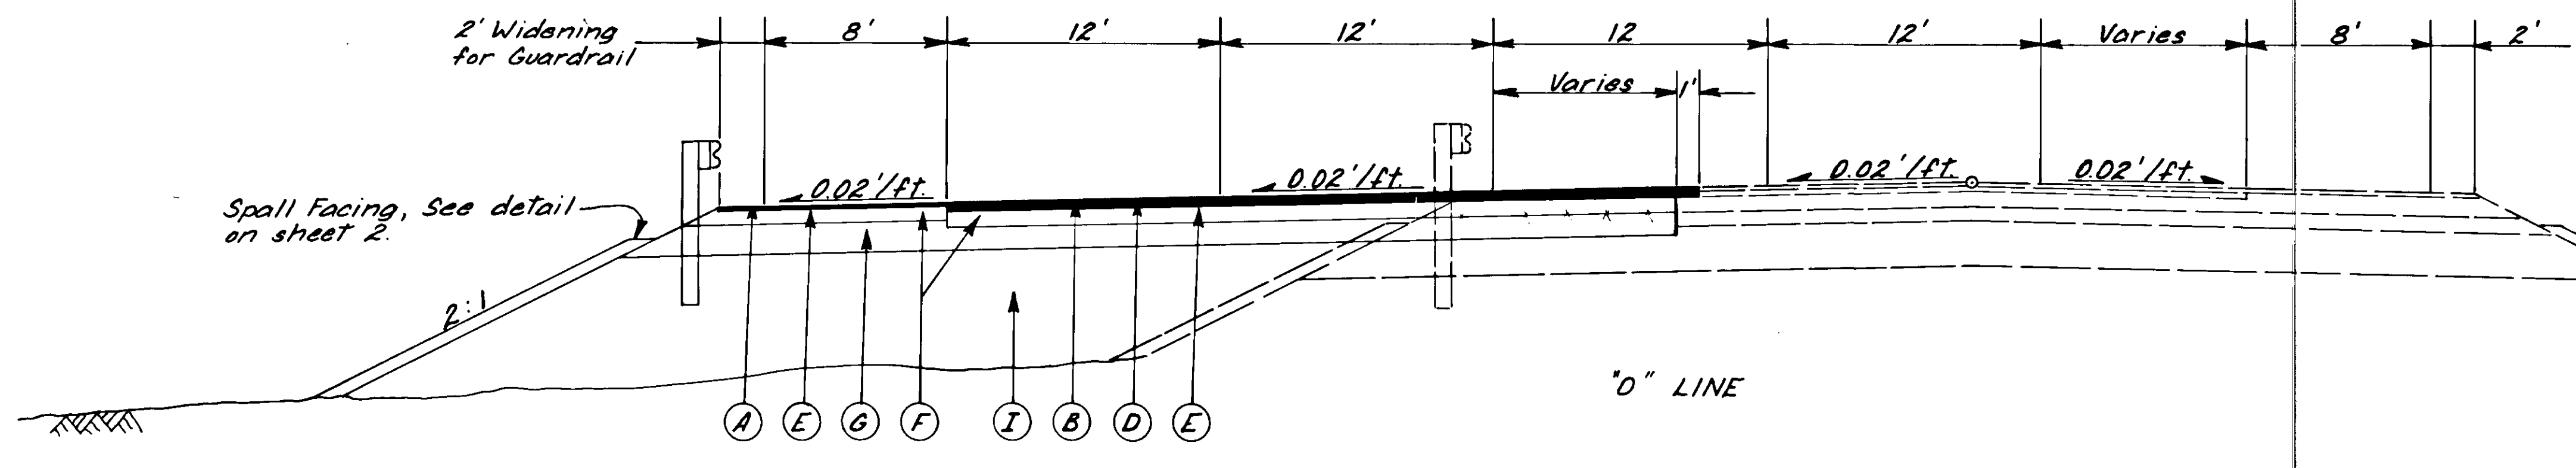

ESTIMATE OF QUANTITIES

ITEM NO.	ITEM	UNIT	PAGE TOTALS								TOTAL
			5	6	7	8	9	10	11		
109(1)	Petroleum Escalation	C.S.								All Req'd.	
110(1)	Mobilization	L.S.								All Req'd.	
111(1)	Temporary Erosion & Pollution Control	C.S.								All Req'd.	
114(1)	Construction Surveying by the Contractor	L.S.								All Req'd.	
115(1)	Traffic Maintenance	L.S.								All Req'd.	
116(1)	Furnishing & Maintaining Field Office	L.S.								All Req'd.	
116(2)	Furnishing & Maintaining Field Laboratory	L.S.								All Req'd.	
202(11)	Removal of Portions of Bridge No. 1188	L.S.								All Req'd.	
203(3)	Unclassified Excavation	C.Y.	793	1,842	870	1,951	3,218		4,910	10,584	
203(5B)	Borrow, Type "A"	Ton	1,240	9,074	7,942	1,049	5,069		4,335	24,331	
301(1)	Crushed Aggregate Base Course	Ton	679	2,381	1,038	1,839	3,661		1,696	11,294	
304(1)	Subbase, Grading "E"	Ton	1,211	3,249	2,289	3,197	7,033	E.W.D. #2	3,121	20,100	
401(1)	Asphalt Concrete, Type 1	Ton	368	973	817	1,073	2,290		995	6,516	
401(2)	AC-5 Asphalt Cement	Ton	22	58	49	64	138		60	391	
402(1)	CSS-1 Asphalt for Tack Coat	Ton	86	15	14	15	35		14	99	
403(2)	MC-30 Liquid Asphalt for Prime Coat	Ton	23	62	48	60	119		56	368	
501(1)	Class "A" Concrete	L.S.								All Req'd.	
501(2)	Class "A-A" Concrete	L.S.								All Req'd.	
502(1)	Prestressed Concrete Struct. Members (59' 2" Girders)	Ea.								6	
503(1)	Reinforcing Steel	L.S.								All Req'd.	
505(7)	Cast-In-Place Concrete Pile - Furnished	L.F.						See E.W.D. #1		480	
505(8)	Cast-In-Place Concrete Pile - Driven	Ea.								9	
509(1)	Deck Protection	L.S.								All Req'd.	
513(1)	Spall Facing	Ton		1,479	646	4		see C.O. #6		2,129	
535(1)	Contractor Designed Pedestrian Access Path	L.S.								All Req'd.	
602(2)	Structural Plate Pipe Arch, 0.175" Thick, 13'-1" x 8'-5"	L.F.		24						24	
603(9-11)	36" Asb. Bonded, Bit. Coated, Corr. Steel Pipe	L.F.	6		52					114	
603(9-13)	60" Asb. Bonded, Bit. Coated, Corr. Steel Pipe	L.F.		18						18	
603(10-6)	43" x 27" Asb. Bonded, Bit. Coated, Corr. Steel Pipe Arch	L.F.					34			34	
603(10-9)	65" x 40" Asb. Bonded, Bit. Coated, Corr. Steel Pipe Arch	L.F.					10			10	
603(10-10)	72" x 44" Asb. Bonded, Bit. Coated, Corr. Steel Pipe Arch	L.F.				8				8	
603(22-5)	18" Pipe	L.F.	420				13	10	12	442	
603(22-7)	24" Pipe	L.F.					12	12	6	24	
603(22-11)	48" Pipe	L.F.					5	12		12	
604(5C)	24" Pipe Conduit Inlet	Ea.	1	1			2	2	2	8	
604(5D)	36" Pipe Conduit Inlet	Ea.	1							1	
606(4)	Removal & Reconstruction of Guardrail	L.F.		1,961	935	50		see C.O. #3		2,946	
606(5)	Removal & Disposal of Guardrail	L.F.	398							398	
607(4)	Reconstructed Fence	L.F.	75			40				115	
615(1)	Standard Signs	S.F.						see C.O. #1 and #7		496	
618(1)	Seeding	L.S.								All Req'd.	
660(1)	Traffic Signal System, Complete	L.S.								All Req'd.	
660(3)	Highway Lighting System, Complete	L.S.								All Req'd.	
670(1)	Painted Traffic Markings	L.S.								All Req'd.	
670(6)	Thermoplastic Pavement Markings	L.S.								All Req'd.	

BASIS OF ESTIMATE

ITEM NO.	ITEM	ESTIMATING FACTOR
203(5B)	Borrow, Type "A"	1.80 Tons/C.Y.
301(1)	Crushed Aggregate Base Course	1.90 Tons/C.Y.
304(1)	Subbase, Grading "E"	1.80 Tons/C.Y.
401(1)	Asphalt Concrete, Type 1	114.4 Lbs./Sq. Yd./In. Depth
401(2)	AC-5 Asphalt Cement	6.0% of item 401(1)
402(1)	CSS-1 Asphalt for Tack Coat	0.10 Gal./Sq. Yd. - 253 Gal./Ton
403(2)	MC-30 Liquid Asphalt for Prime Coat	0.25 Gal./Sq. Yd. - 256 Gal./Ton @ 60%
513(1)	Spall Facing	1.82 Tons/C.Y.
618(1)	Seeding	Approx. 157 M.S.F. *Diluted Mixture



REMOVE & RECONSTRUCT GUARDRAIL

STATION TO STATION	EXIST. OFFSET	PROP. OFFSET	REMARKS
"L" 191+00	"L" 196+50	RT.	RT.
"O" 12+00	"O" 21+35	LT.	LT.
"O" 12+00	"L" 210+70	RT.	RT.
"L" 255+50	"L" 256+00	RT.	RT.

RECONSTRUCTED FENCE SUMMARY

STATION TO STATION	EXIST. OFFSET	PROP. OFFSET	REMARKS
"L" 118+38	"G.H." 135+30	RT.	RT.
"L" 263+60	"L" 263+90	RT.	RT.

REMOVAL & DISPOSAL OF GUARDRAIL

FROM STATION	OFFSET	TO STATION	OFFSET
"L" 120+88	RT.	"L" 121+84	RT.
"L" 120+88	RT.	"L" 122+00	LT.
"L" 123+25	LT.	"L" 124+85	LT.
"L" 121+84	RT.	"L" 122+00	LT.


ESTIMATED PEDESTRIAN ACCESS PATH QUANTITIES

Borrow	3816 Tons
Crushed Agg. Base Course	547 Tons
Asphalt Concrete, Type 1	241 Tons
AC-5 Asphalt Cement	14.5 Tons
MC-30 Liquid Asph. for Prime Coat	2.7 Tons
Chain Link Fence, 48" high	4468 L.F.
36" Pipe	16 L.F.
18" Pipe	32 L.F.
Structure (Clear Span)	75 L.F.

* Quantity dependent on Contractor Design.

- ### GENERAL NOTES
- Grades & alignment as shown on these plans are subject to minor revisions.
 - Culvert lengths & locations are approximate only & are subject to minor revisions.
 - Instream activity in Vanderbilt Creek at approx. sta. "L" 199+55 & the creek at approx. sta. "L" 263+67 shall be limited to the period between June 15th & August 30th.
 - Removal & reinstallation of existing culvert end-sections shall not be paid for directly but shall be considered incidental to other items of work.
 - Existing culvert mitered ends shall be cut off a minimum of 2' from the end of the culvert (measured along the top) & removed in a neat & workmanlike manner. The barrel extension shall then be attached to the existing culvert & the mitered end reinstalled to complete the extension. This additional work of removing & reinstalling the mitered ends shall not be paid for directly but shall be considered incidental to other items of work.
 - Instream activity in Salmon Creek shall be limited to the period between May 15th & July 15th, and in Jordan Creek between June 15th & Sept. 15th.
 - It shall be the contractor's responsibility to begin only that amount of work which can be completed by the end of the shift. There shall be no drop-off at the edge of existing pavement during non-working hours.





MEDIAN DRAINAGE SADDLE CONNECTION DETAIL
24" PIPE CONDUIT INLET

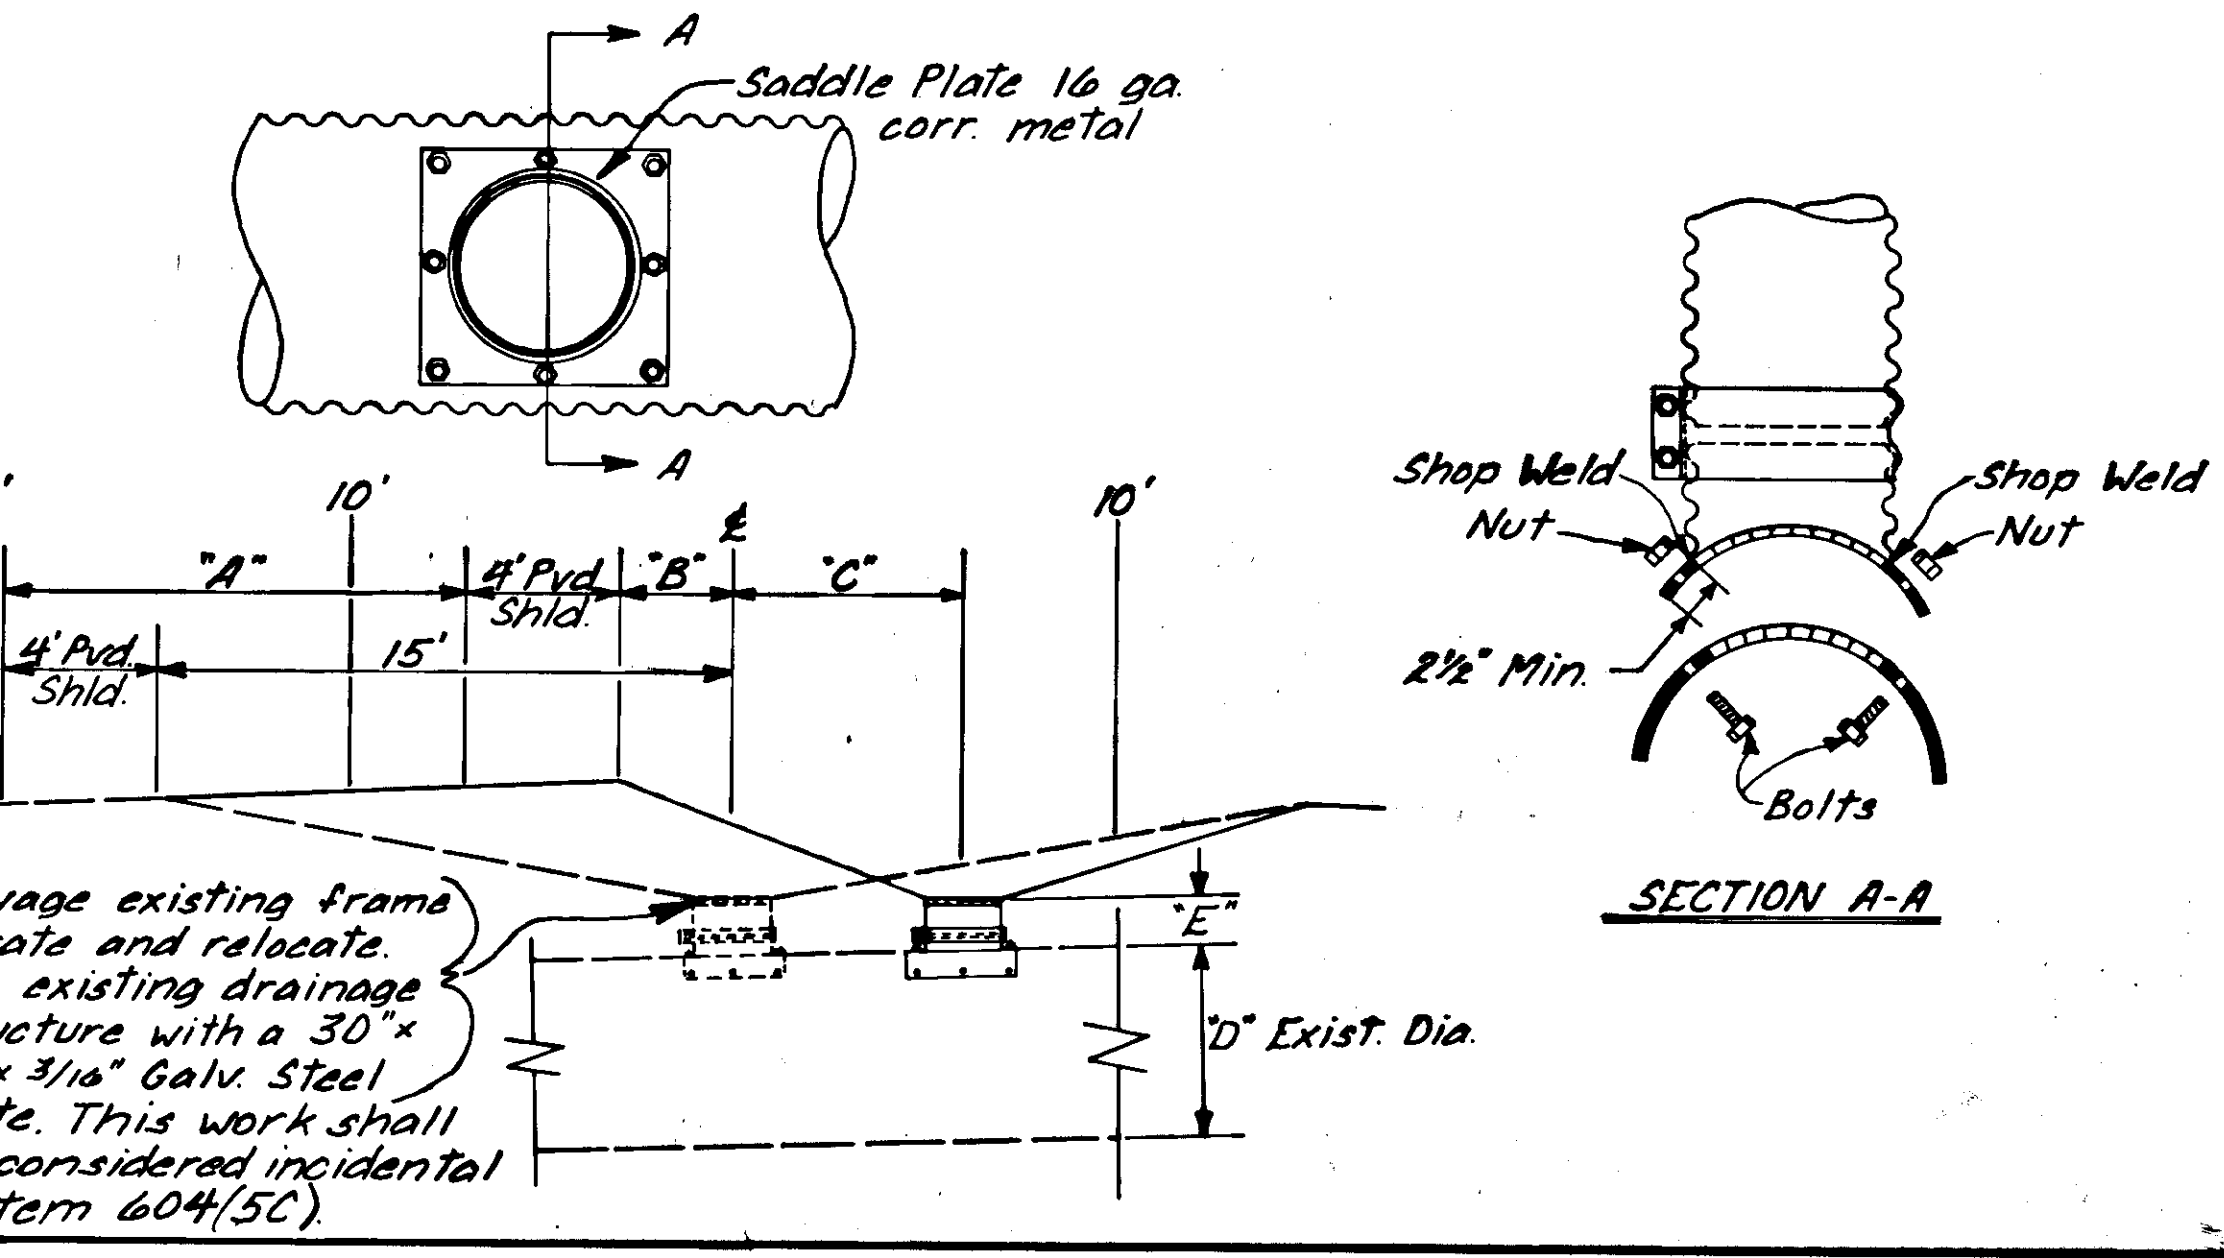

MEDIAN DRAINAGE

STATION	"A"	"B"	"C"		"D"	"E"	REMARKS
			LT.	RT.			
"L" 203+00	12'	3'	8.6'	60"	7.2'		
"L" 255+71	11.4'	3.6'	5.7'	48"	1.4'		
"L" 268+57	12'	3'	5.6'	48"	2.8'		
"L" 328+12.5	20'	-5'	10.5'	36"	1.8'		
"L" 336+98.5	20'	-5'	10.5'	18"	1.8'	*	
"L" 353+69	12'	3'	6.5'	24"	1.8'	*	
"L" 359+19	12'	3'	6'	18"	0.5'	*	

* NOTE: Salvage & relocate existing C.M.P. inlets. Payment shall be made under Item 604(5C) 24" Pipe Conduit Inlet.

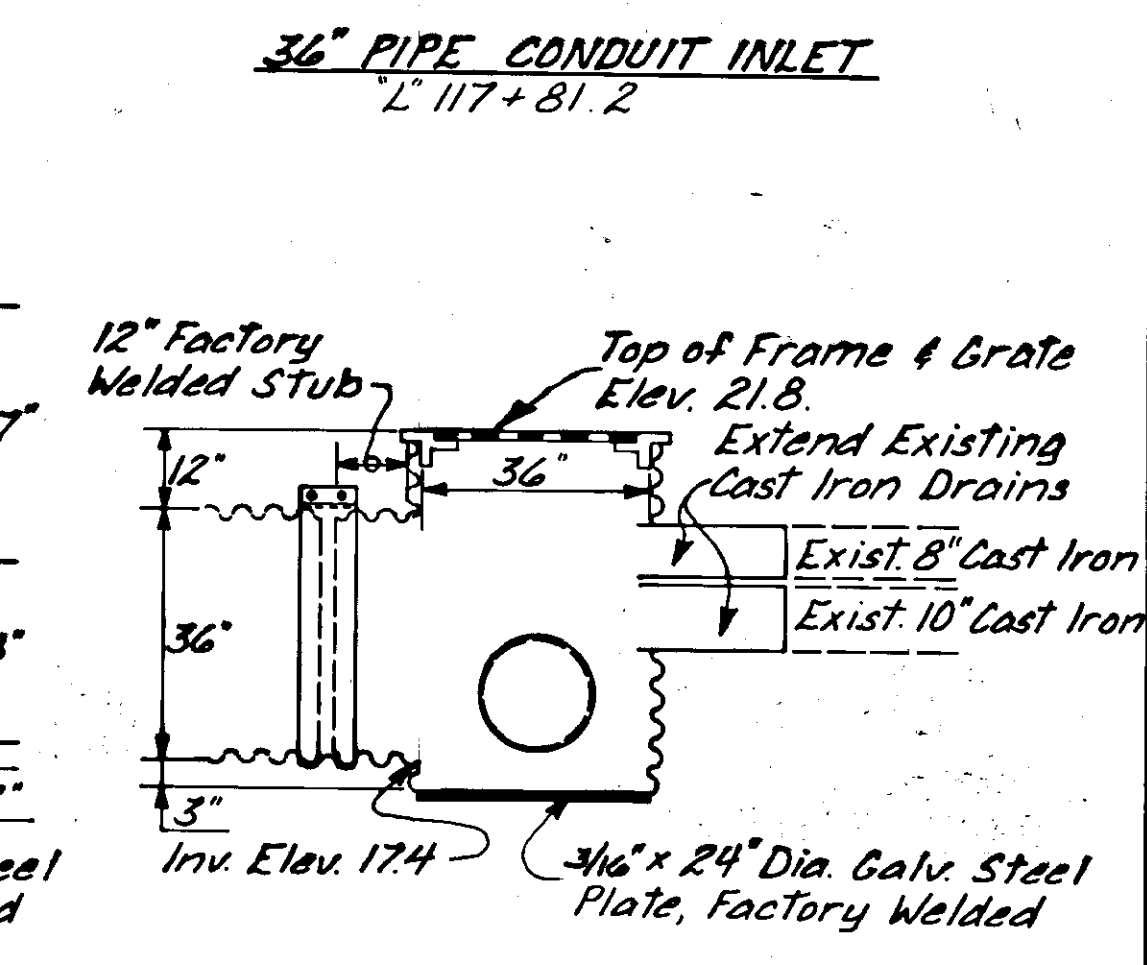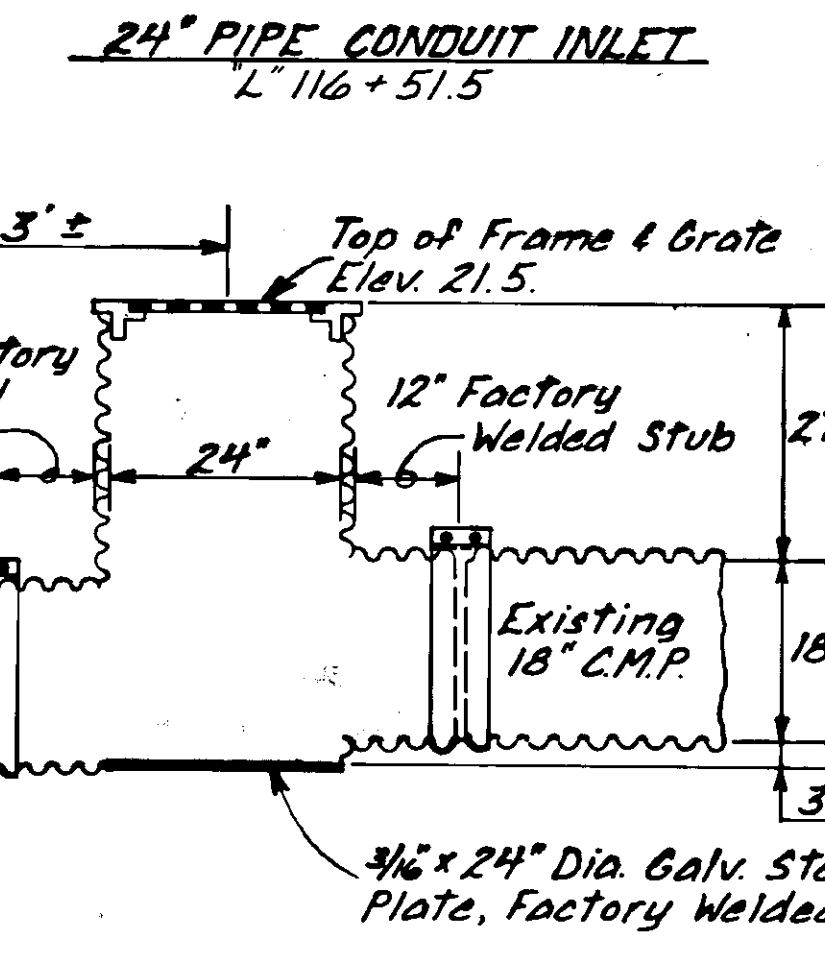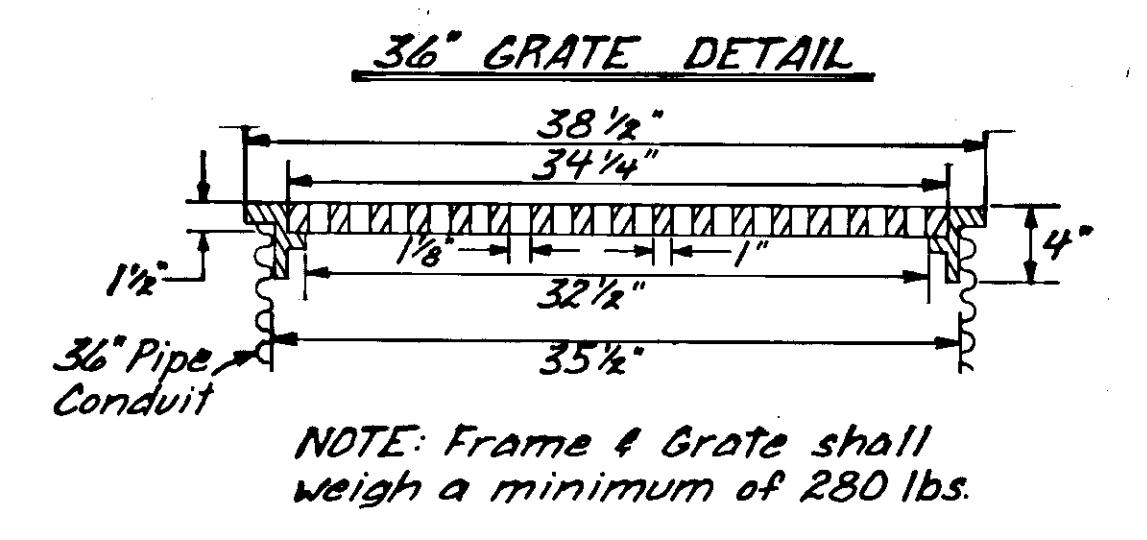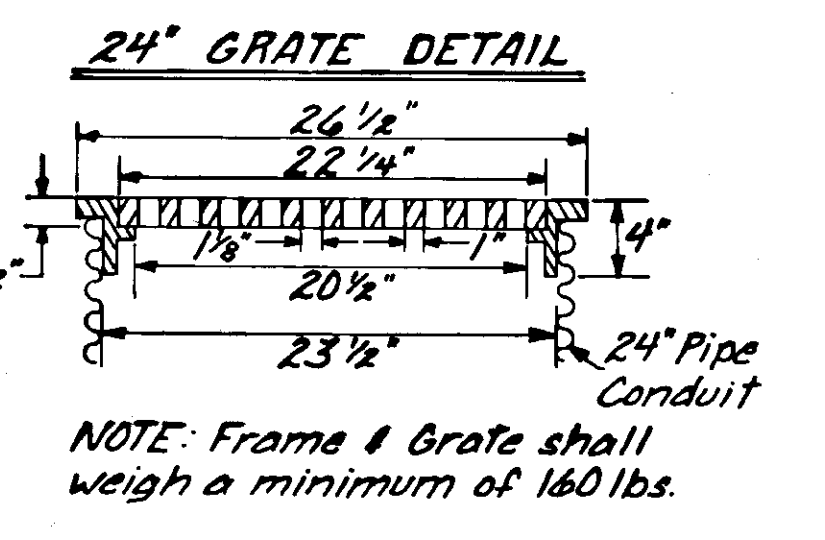


STATE	PROJECT DESIGNATION	YEAR	SHEET NO.	TOTAL SHEETS
ALASKA	F-093-2(9)	1981	5	31

SALMON CREEK INTERSECTION

VERTICAL CONTROL: Tidal bench mark 15 set in a concrete block on the S.E. corner of a foundation 17.5' N.E. of the National Guard Building, Elev. 24.75 M.L.L.W.


HORIZONTAL CONTROL: Triangulation net based on the U.S.G.S. Monuments "Salmon" & "Creek" with state plane coordinates;
 SALMON: N. 2,371,754.406 - E. 2,529,435.315
 CREEK: N. 2,373,678.922 - E. 2,531,058.937
 A scale factor of 0.9999323 was used to convert grid distances to ground distances.

EARTHWORK EQUATION: Borrow = Embankment - Unclassified Excavation.

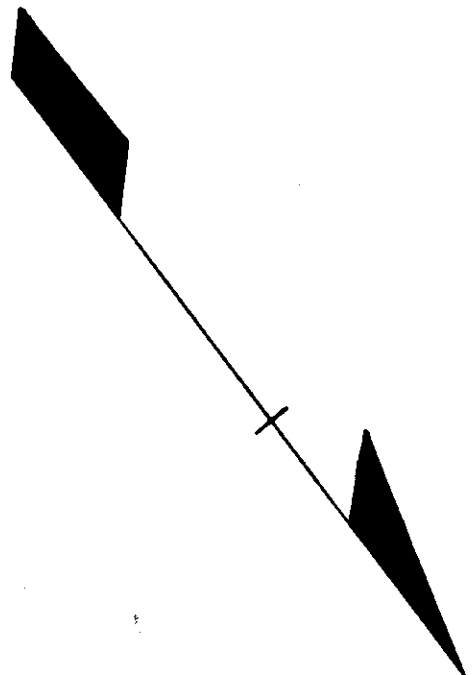

L' 117+75
 Existing 36" x 168' Bit.
 Coated, Asb. Bonded, Galv.
 Corr., Steel Pipe Skewed 10° Rt.
 Connect to 36" C.M.P. Inlet.
 6' extension added

Sta L' 122+00 Right
 18" Pipe Relocation. E.W.O. #5
 Elevation Lowered on existing
 Pipe and 6' extension added, in
 Order to Install new Portion of
 Bridge Abutment.

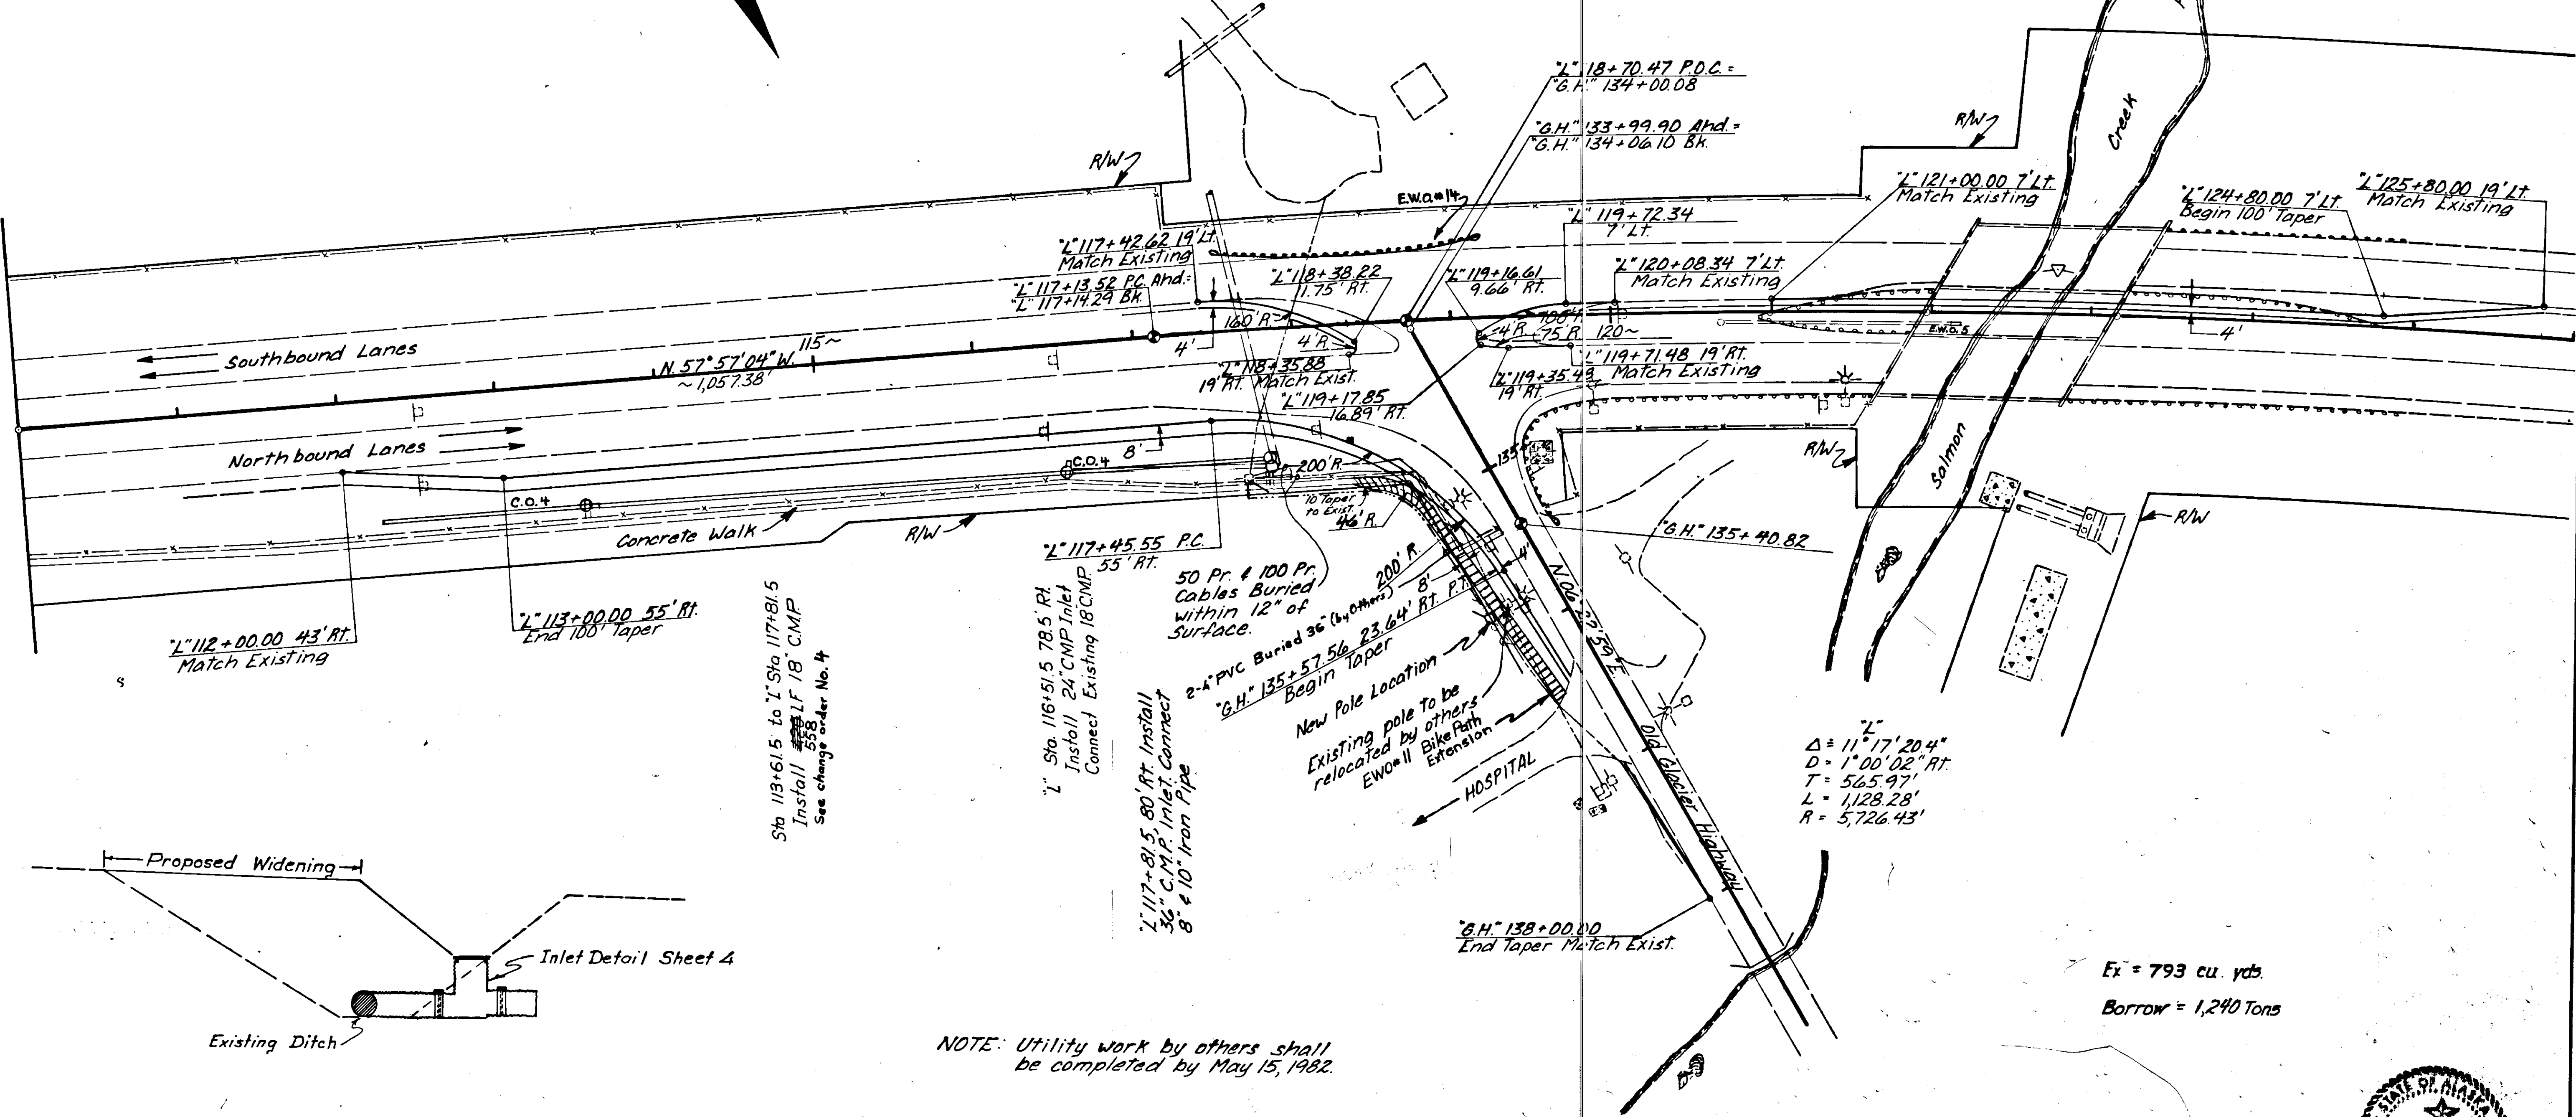

Sta 113+61.5 to L' Sta 117+81.5
 Install 18" LF 18" C.M.P.
 558
 See change order No. 4

L' 117+45.55 P.C.
 55' RT.
 50 Pr. & 100 Pr.
 Cables Buried
 within 12" of
 Surface.
 2-4" PVC Buried 36" (w/anchors)
 23.64' RT. P.T.
 Begin Taper
 "G.H." 135+57.56
 New Pole Location
 Existing pole to be
 relocated by others
 E.W.O. #11
 Bike Path
 Extension

L'
 $\Delta = 11^\circ 17' 20.4"$
 $D = 1' 00' 02" RT.$
 $T = 565.97'$
 $L = 1,128.28'$
 $R = 5,726.43'$


Ex = 793 cu. yds.
 Borrow = 1,240 Tons

NOTE: Utility work by others shall
 be completed by May 15, 1982.



STATE	PROJECT DESIGNATION	YEAR	SHEET NO.	TOTAL SHEETS
ALASKA	F-093-2(9)	1981	6	31

VANDERBILT HILL INTERSECTION

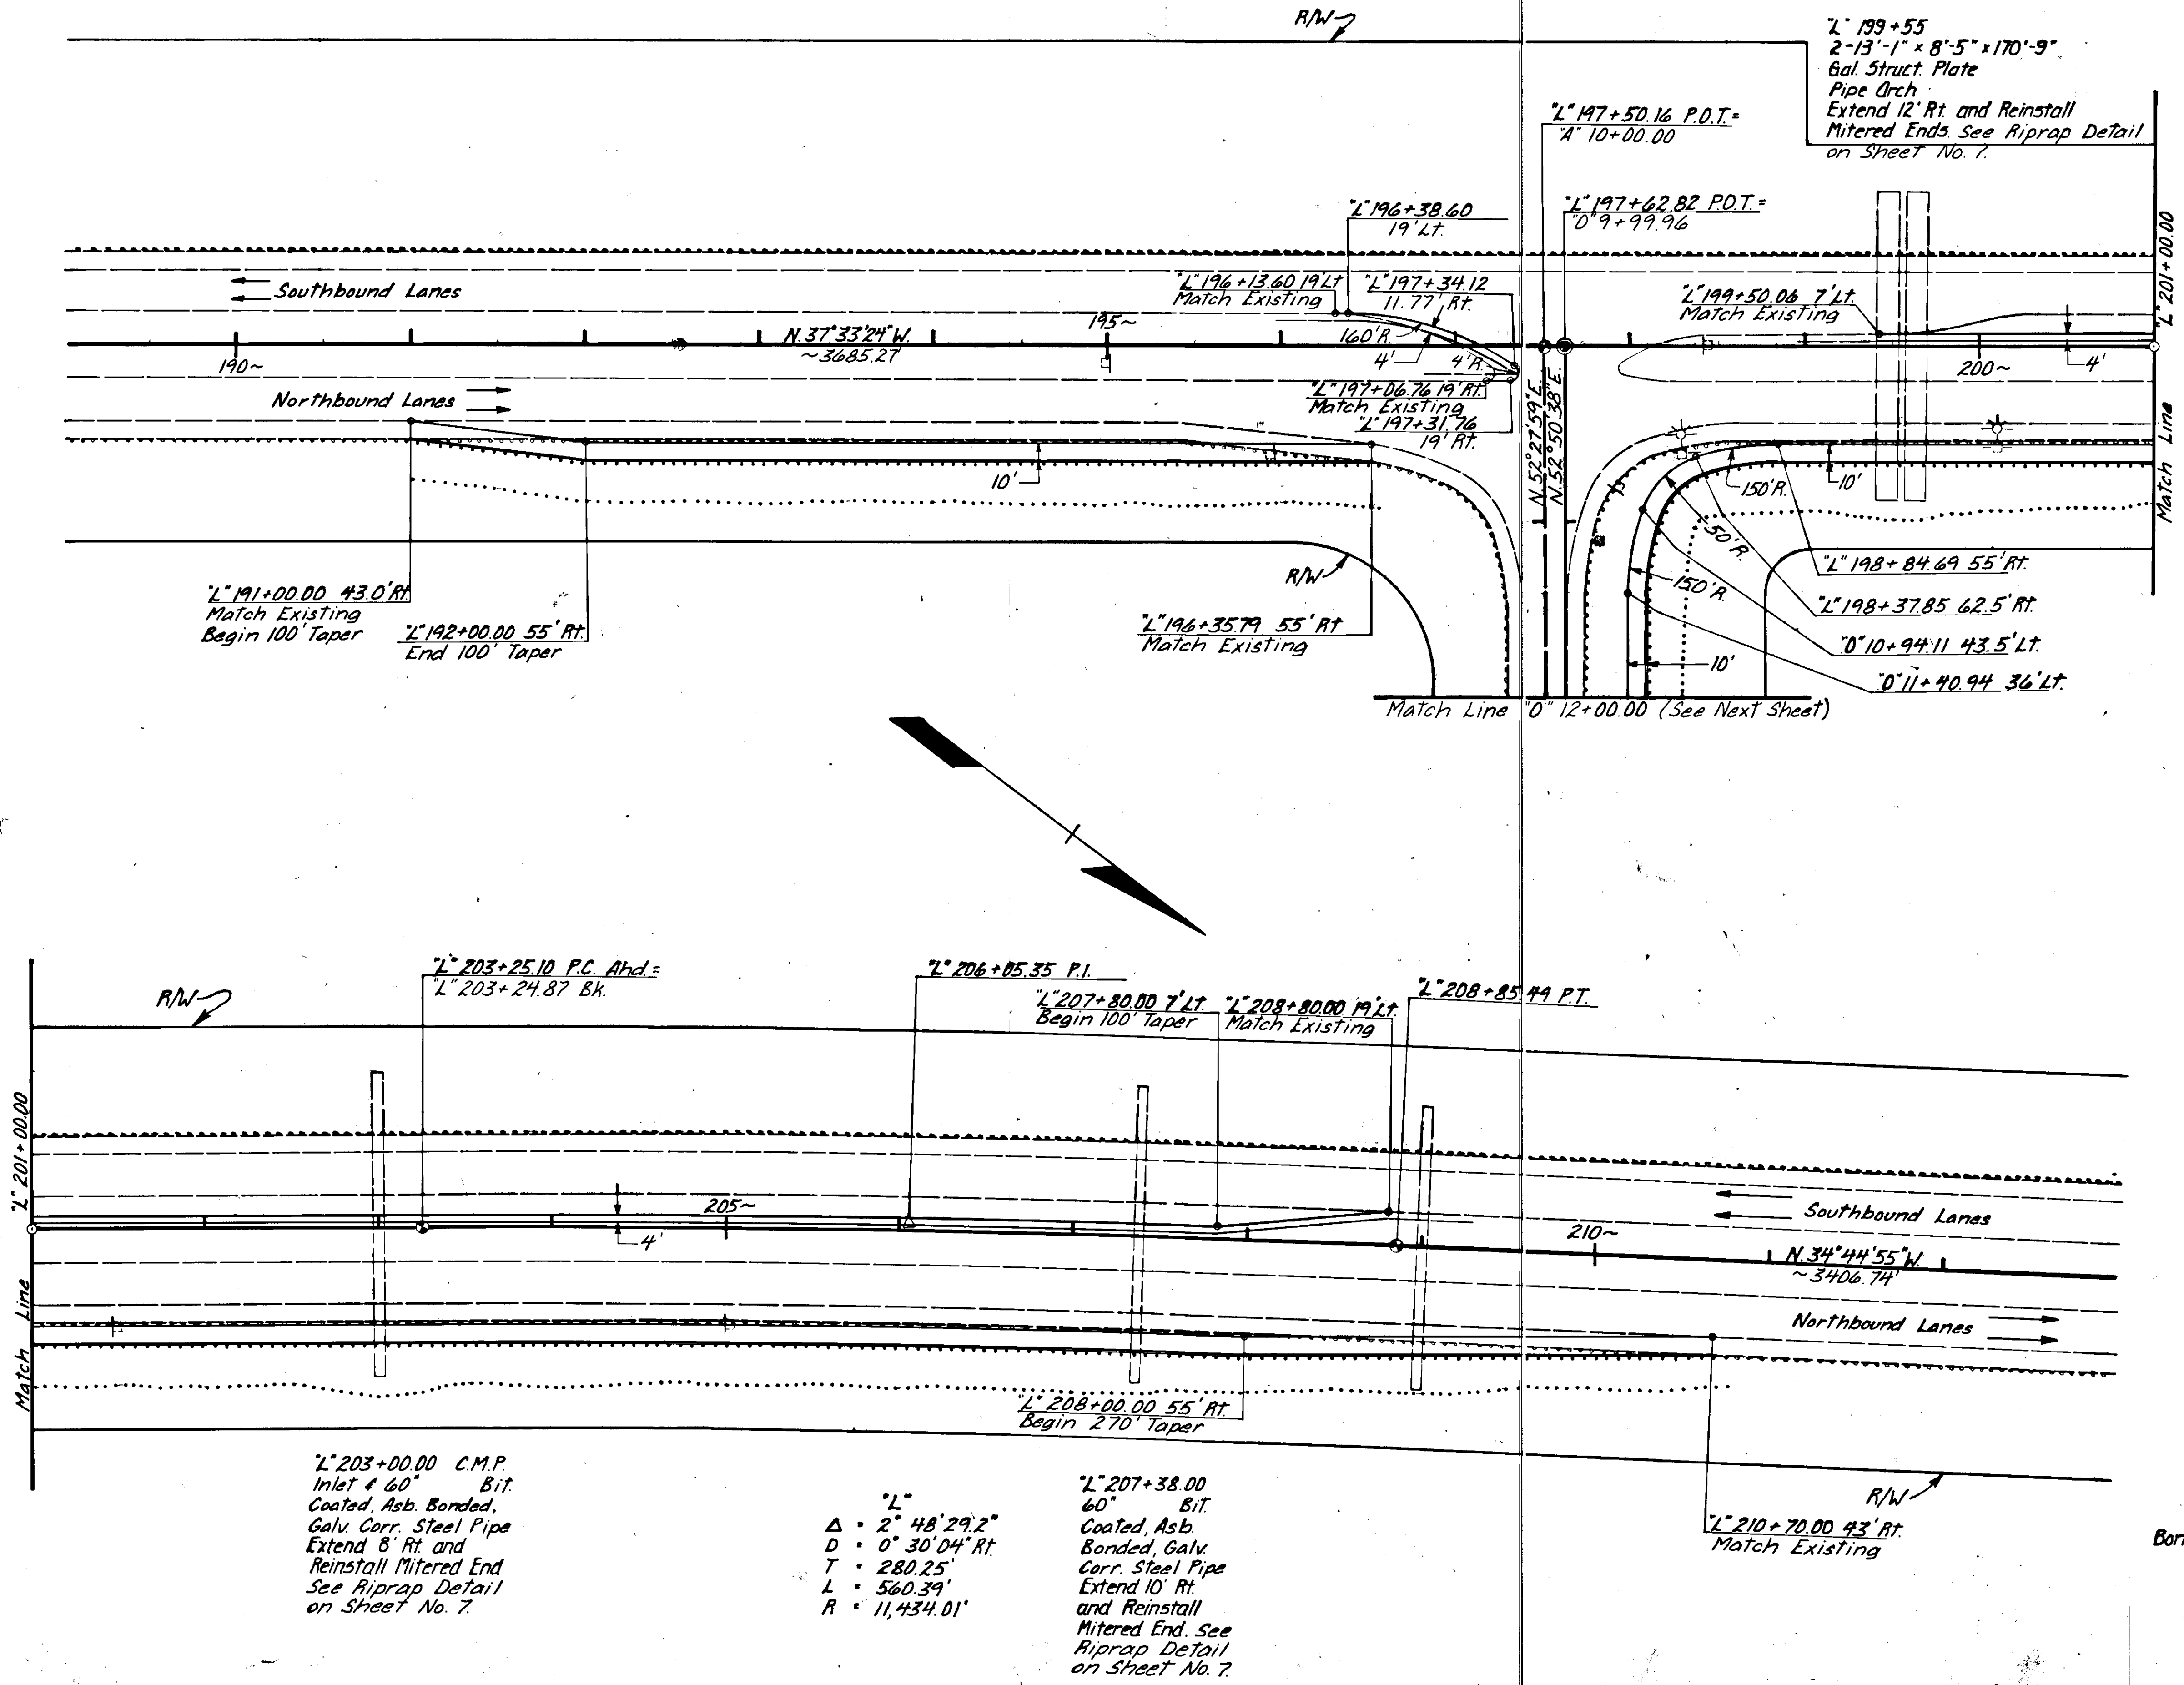



Ex = 1842 cu. yds.
Borrow = 9,074 Tons




STATE	PROJECT DESIGNATION	YEAR	SHEET NO.	TOTAL SHEETS
ALASKA	F-093-2(9)	1981	7	31

VANDERBILT HILL INTERSECTION

$\Delta = 27^{\circ} 20' 17''$
 $D = 4' LT$
 $T = 683.45'$
 $L = 1,432.39'$
 $R = 348.37'$

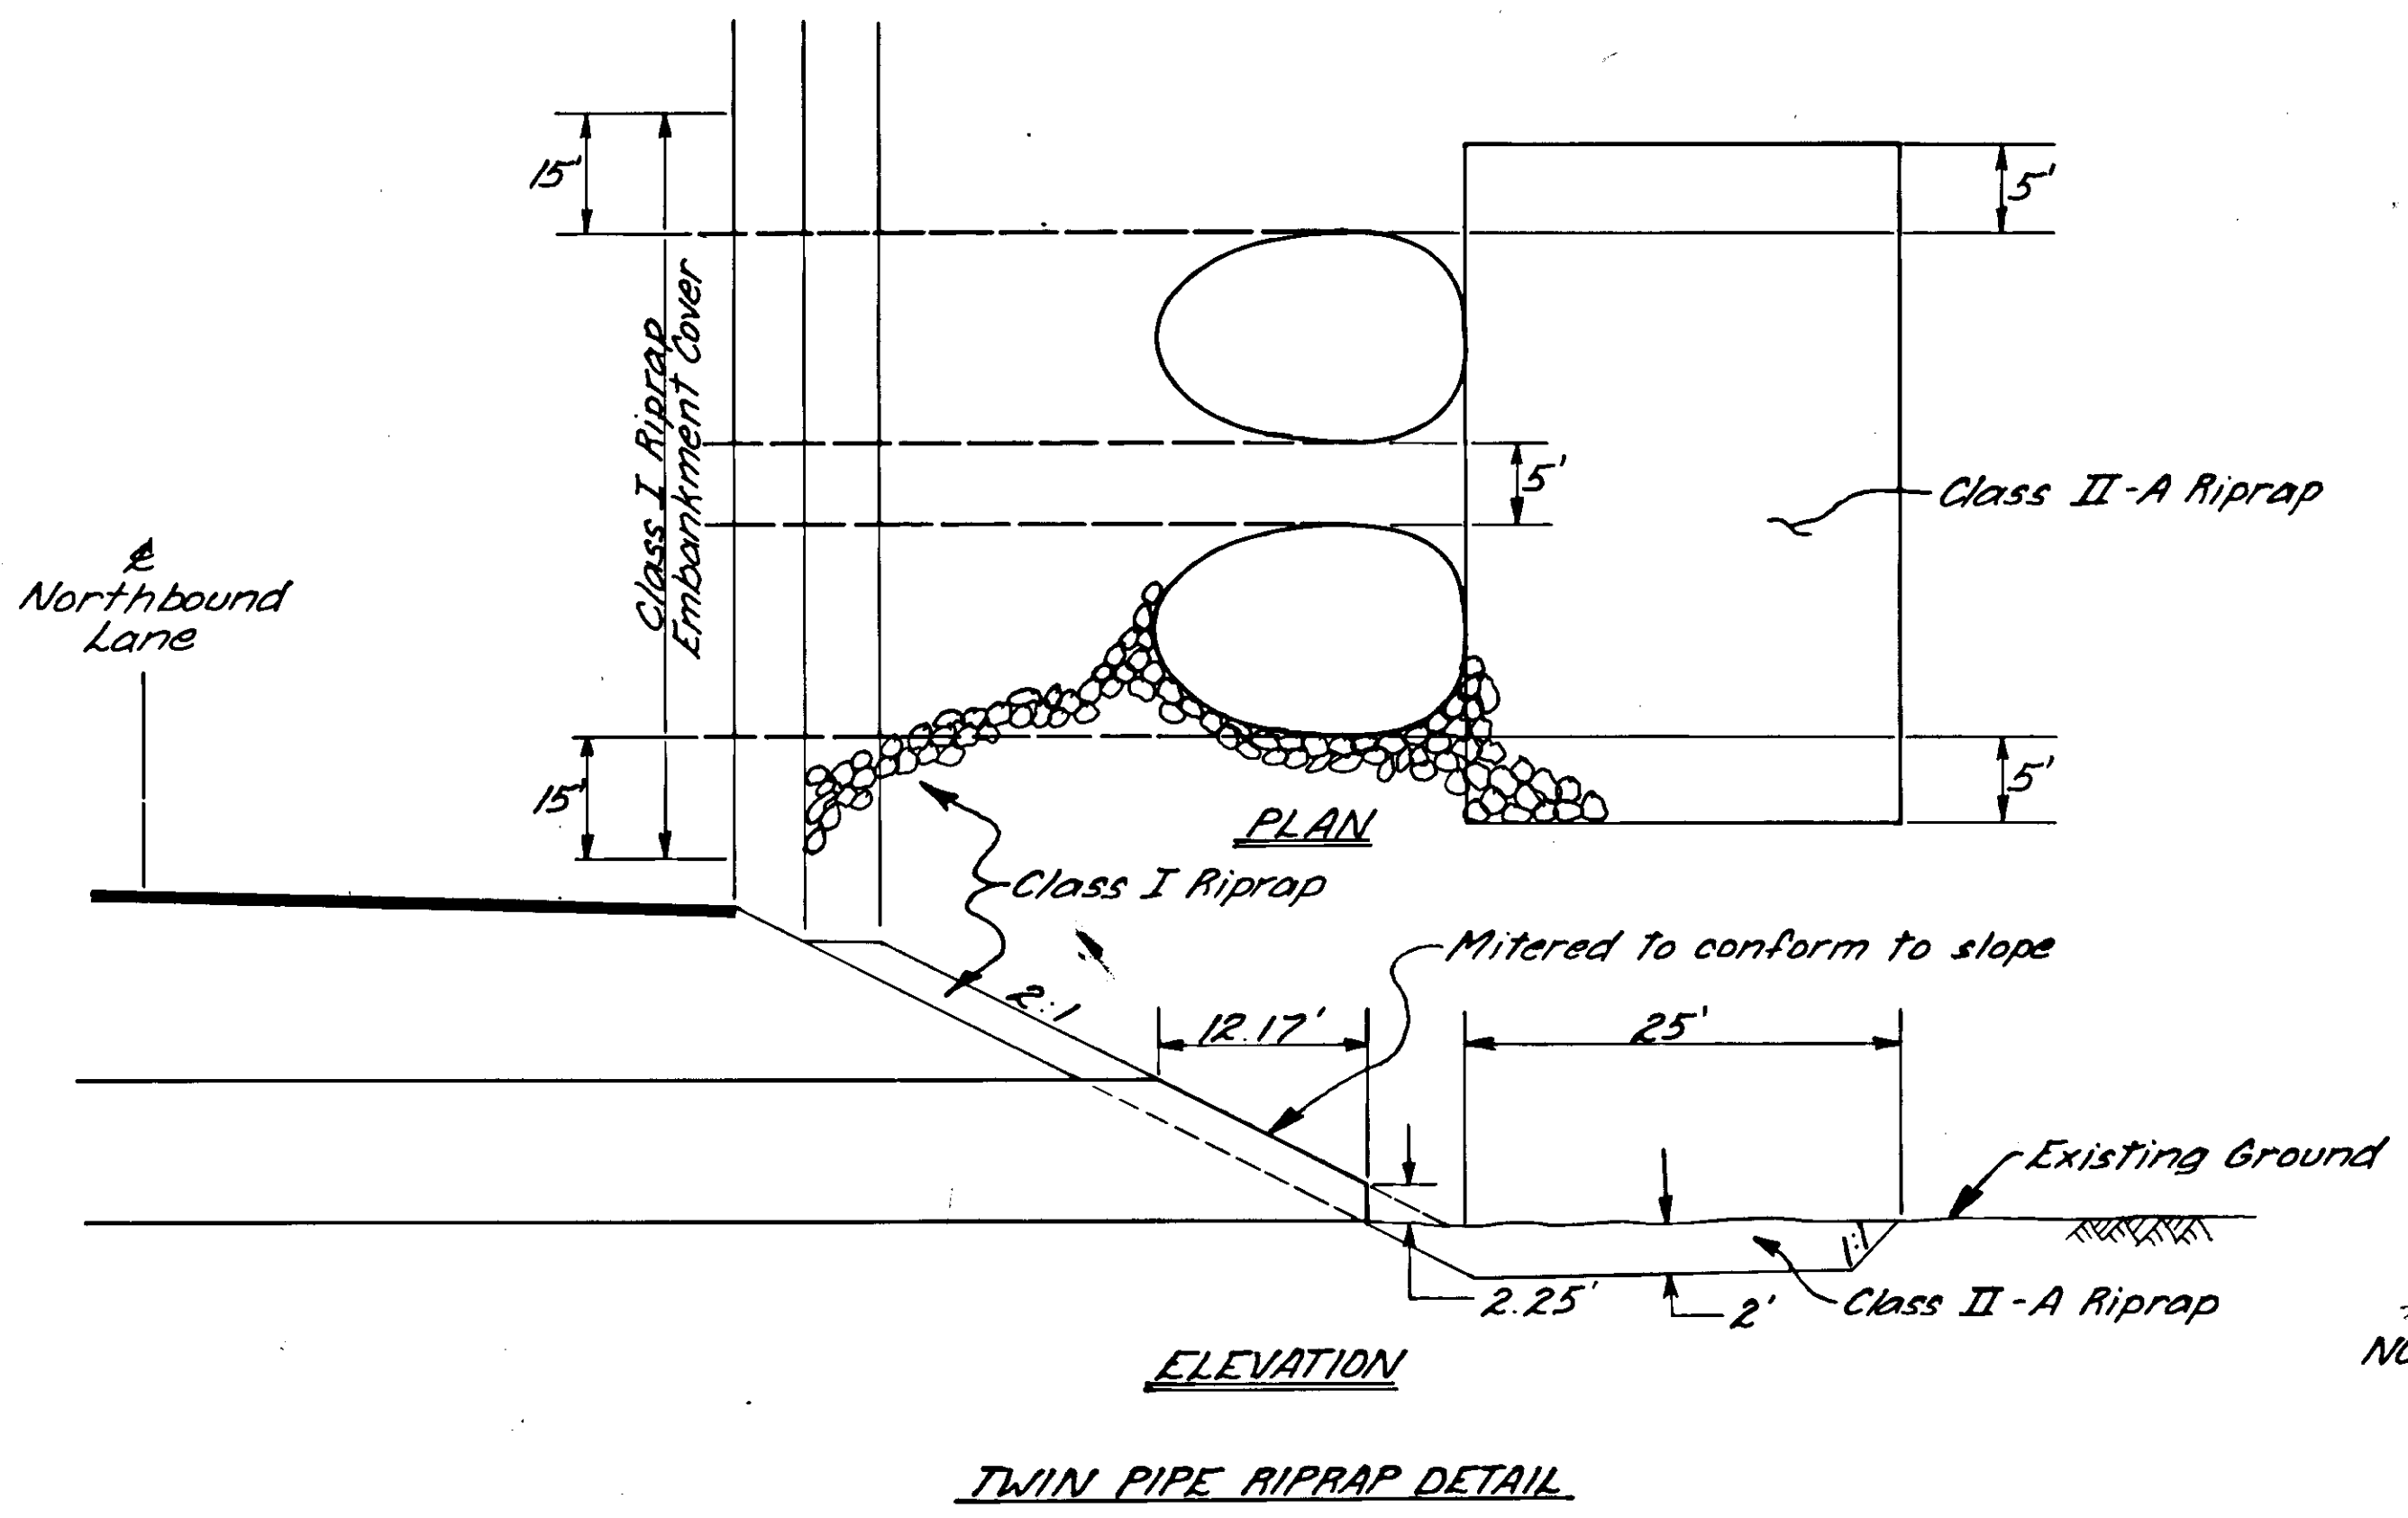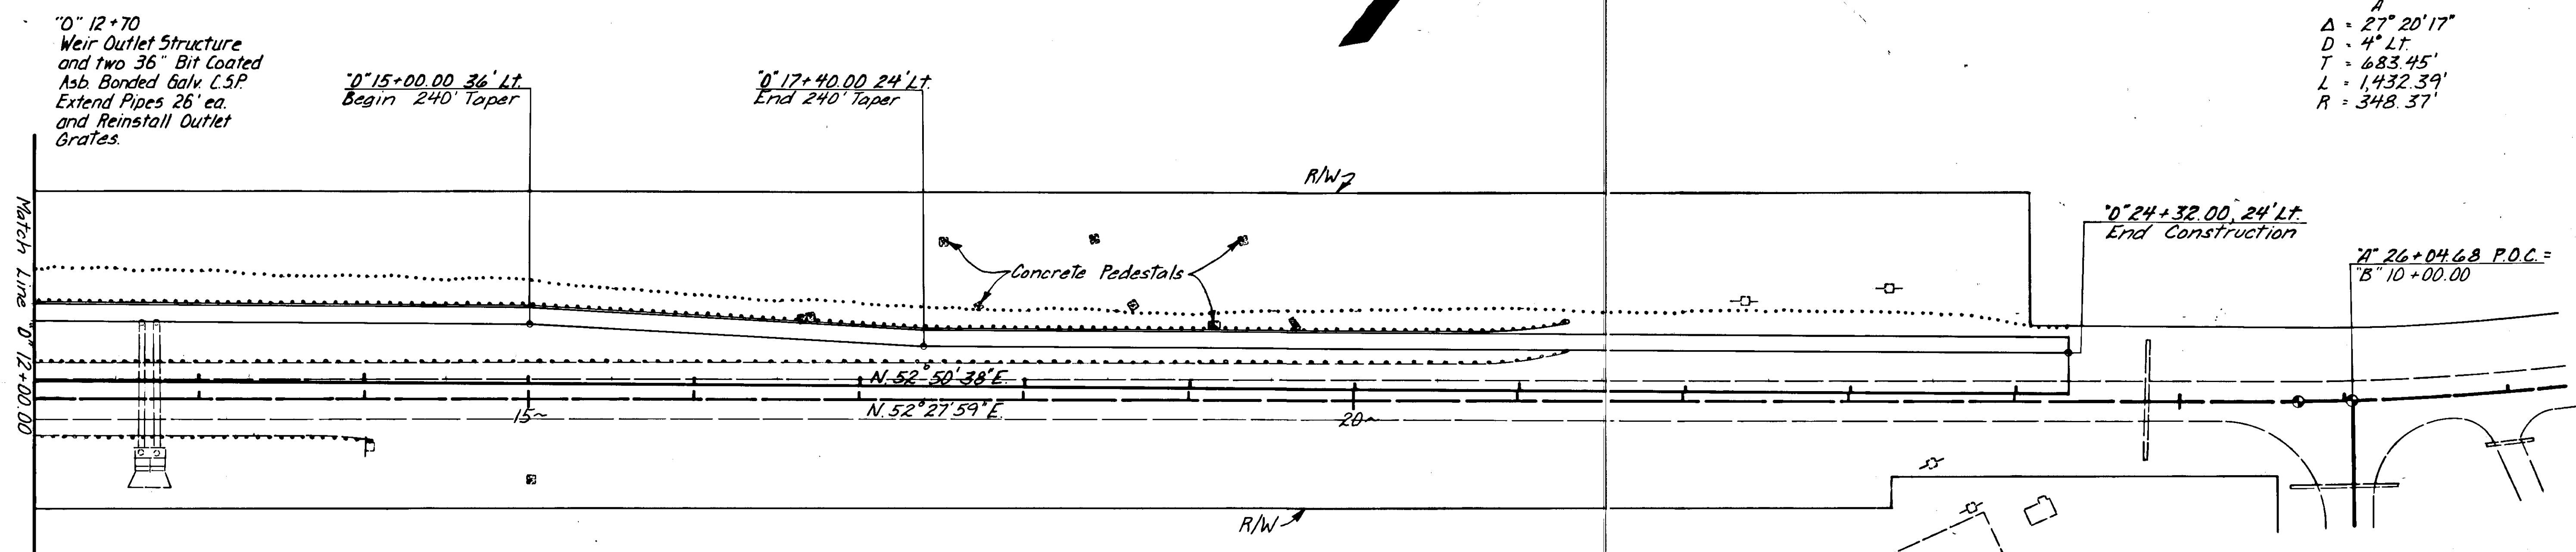

NOTE: Riprap and the installation thereof shall not be measured for pay but shall be considered incidental to other items of work & no separate payment shall be made therefore.

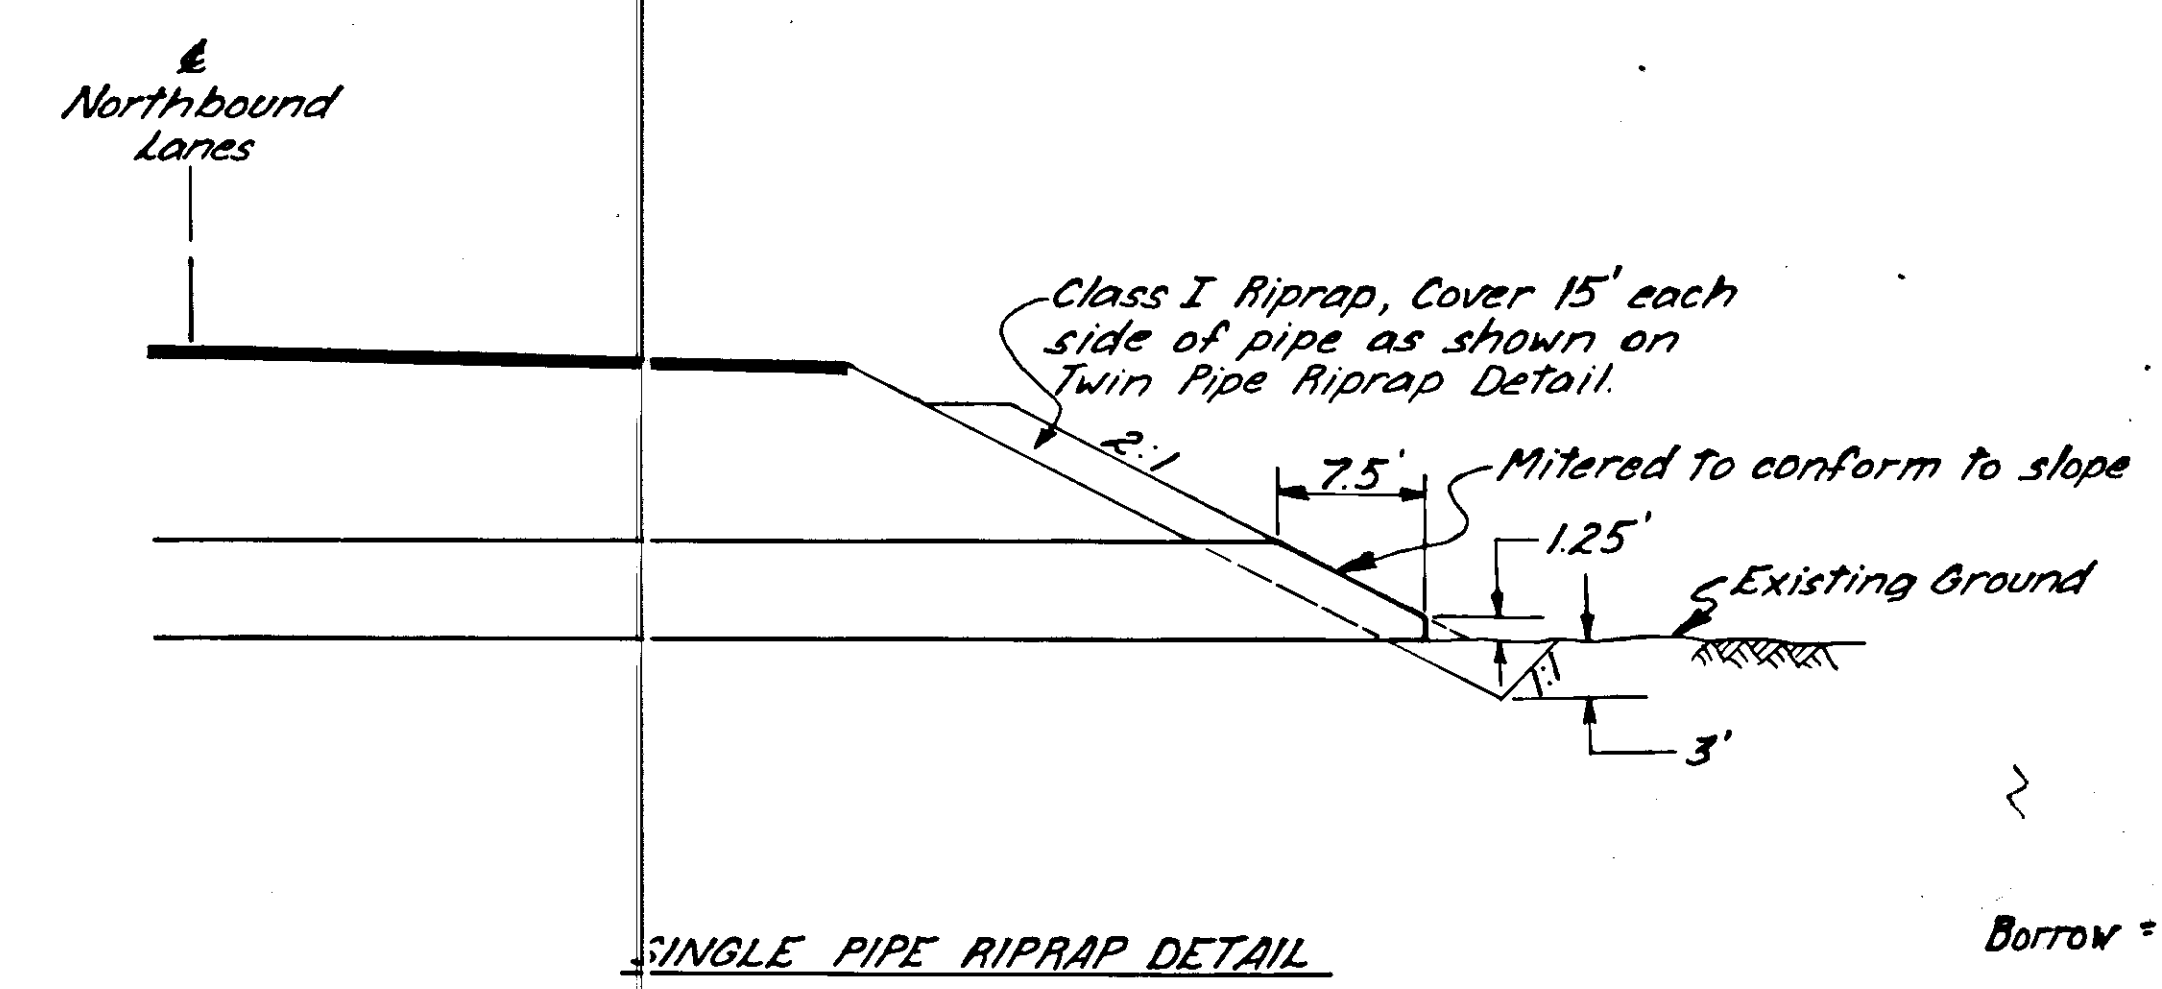

Ex = 870 cu. yds.
 Bottom = 7,949 Tons



STATE	PROJECT DESIGNATION	YEAR	SHEET NO.	TOTAL SHEETS
ALASKA	F-093-2(9)	1981	10	31

AIRPORT ACCESS INTERSECTION

L' 317+00.00 43' LT
Match Existing

K₁
 $\Delta = 17^{\circ} 23' 13.3''$
 $D = 5^{\circ} 30'$
 $T = 159.2882'$
 $L = 316.1278'$
 $R = 1,041.7415'$

K₁ 4+34.81 P.C. 5'110' LT
of L' 325+04.84 P.O.T.

K₁ 7+50.94 P.T.

K₂
 $\Delta = 31^{\circ} 00' 00''$
 $D = 11^{\circ} 30'$
 $T = 138.1697'$
 $L = 269.5652'$
 $R = 498.224'$




K₂ 12+43.31 6' LT of
K₂ 12+43.31 P.T.

K₂ 12+41.48 P.T.

K₃ 11+27.11 P.C.
K₃ 11+12.19 P.C. =
K₃ 11+17.19 P.O.T.


K₃
 $\Delta = 92^{\circ} 28' 02''$
 $D = 81^{\circ} 51' 04''$
 $T = 73.08'$
 $L = 112.97'$
 $R = 70.00'$

L' 331+82.53 P.O.T. =
K₃ 10+00.00 P.O.T.

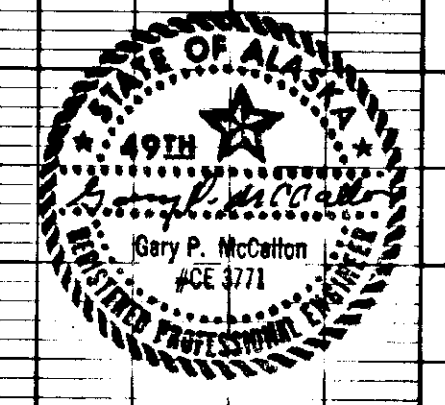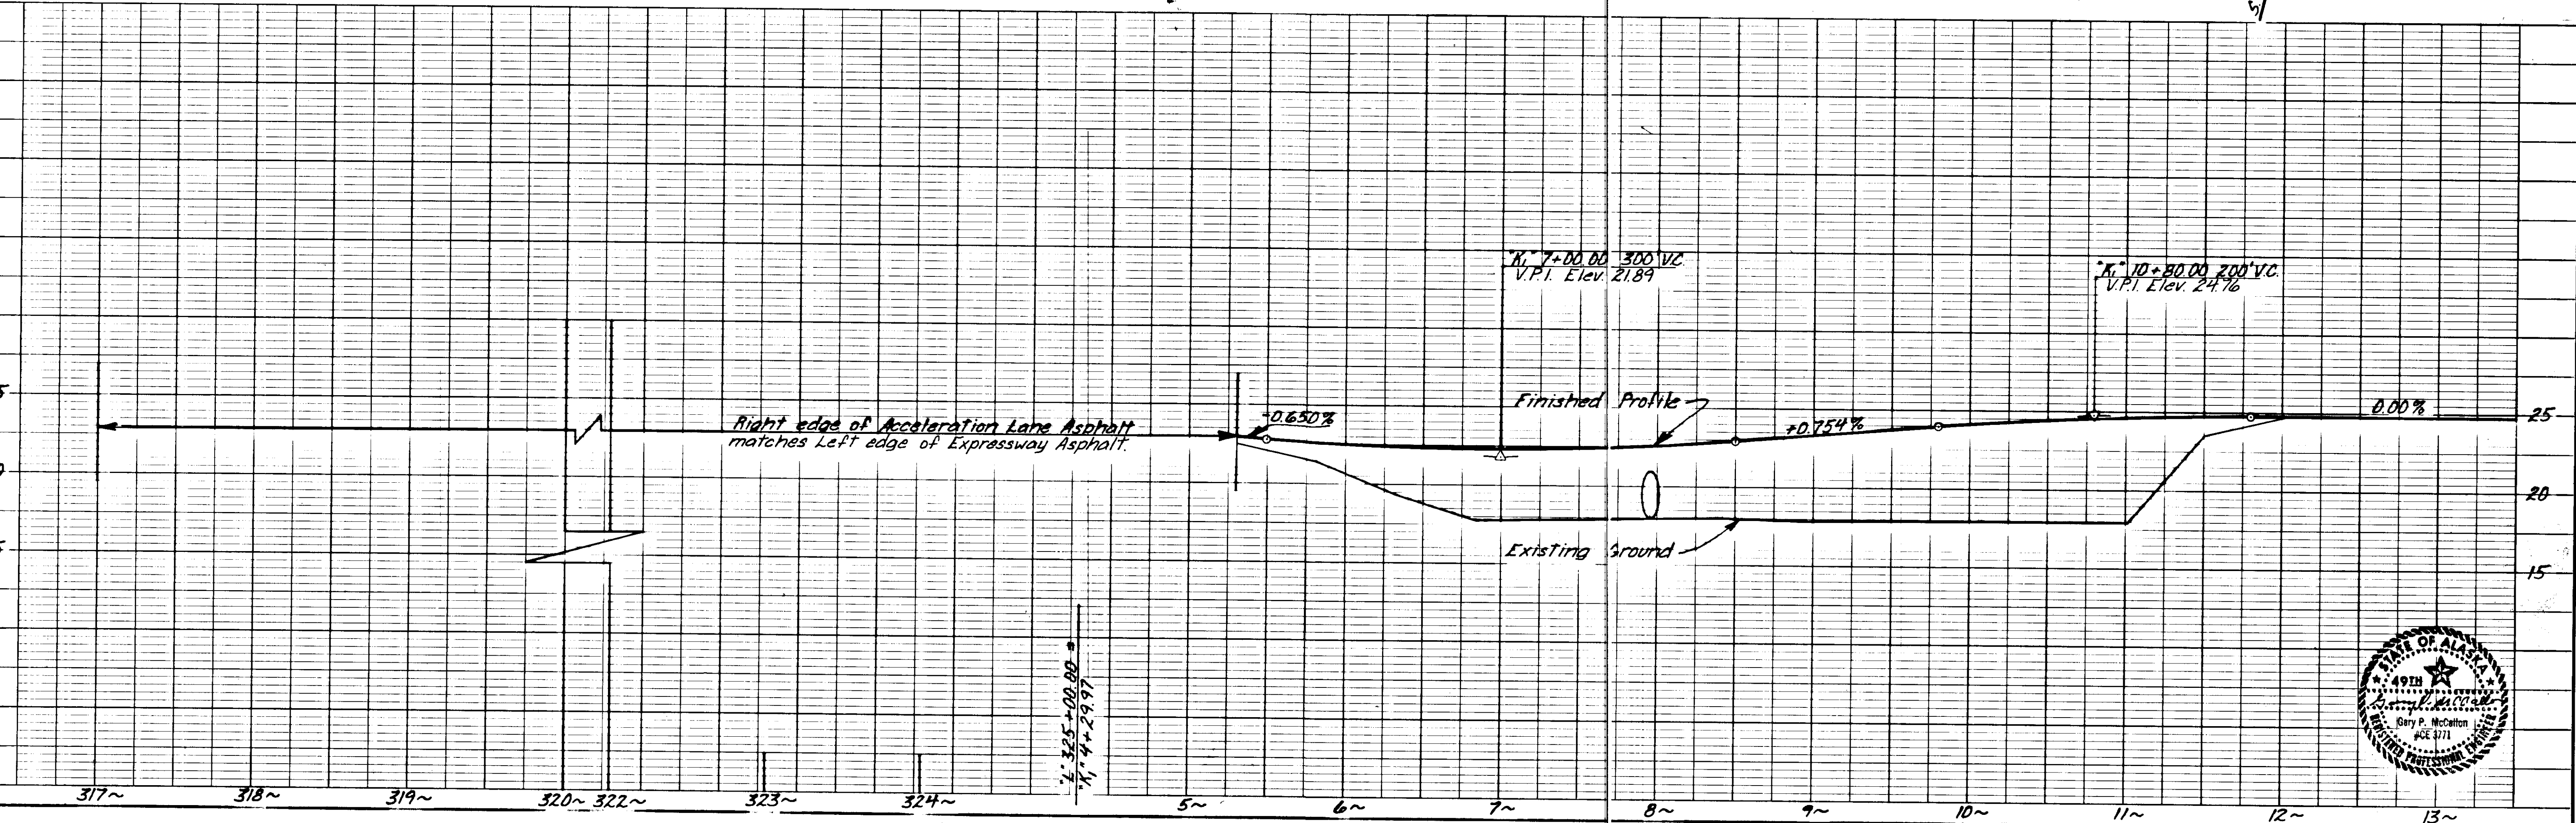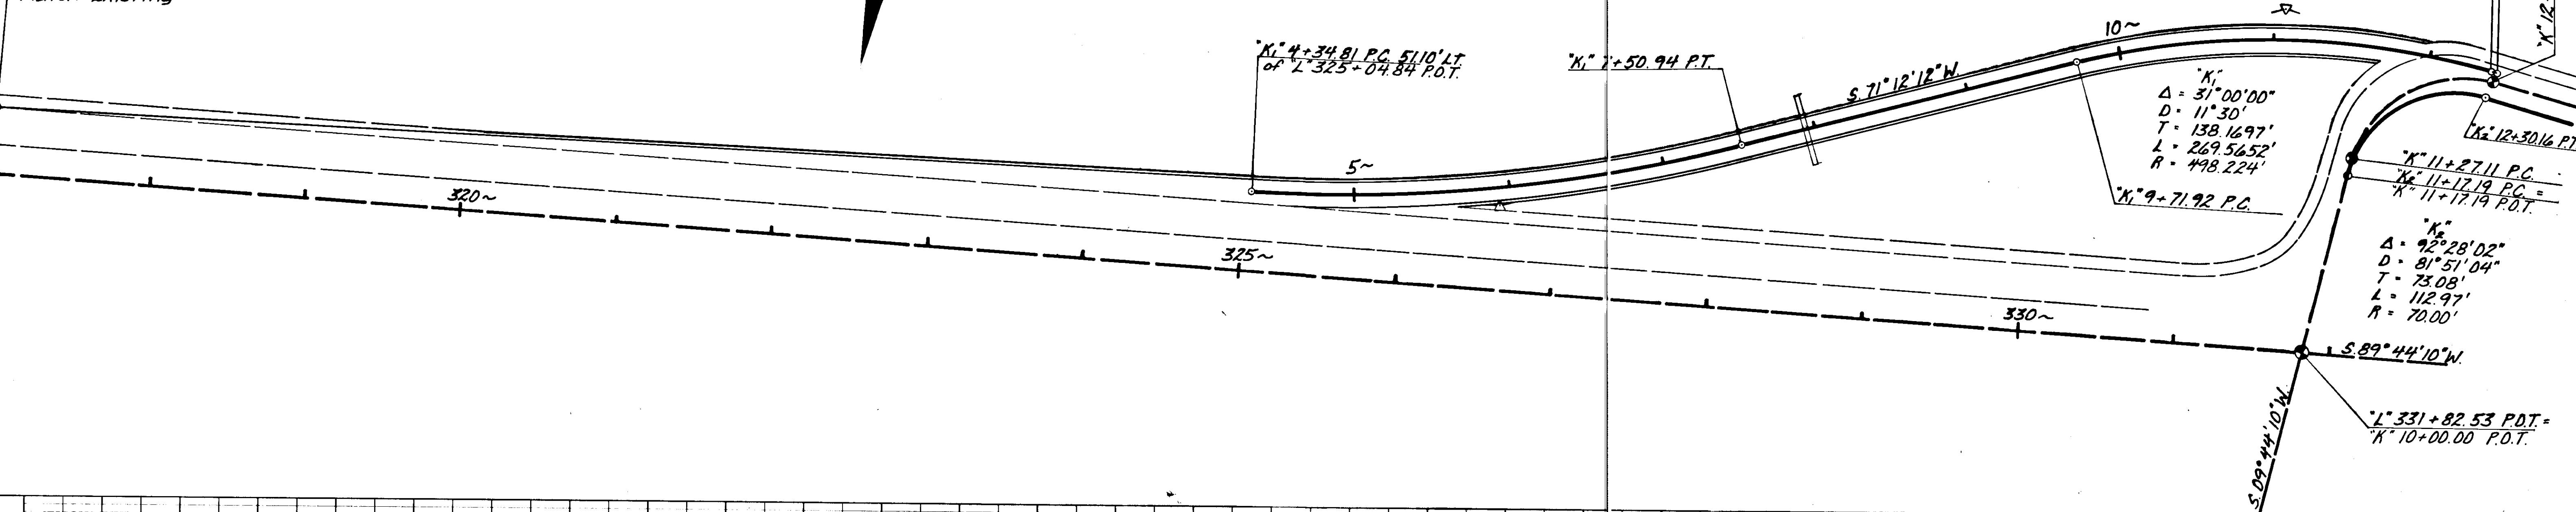


STATE	PROJECT DESIGNATION	YEAR	SHEET NO.	TOTAL SHEETS
ALASKA	F-093-2(9)	1981	11	31

NUGGET MALL INTERSECTION

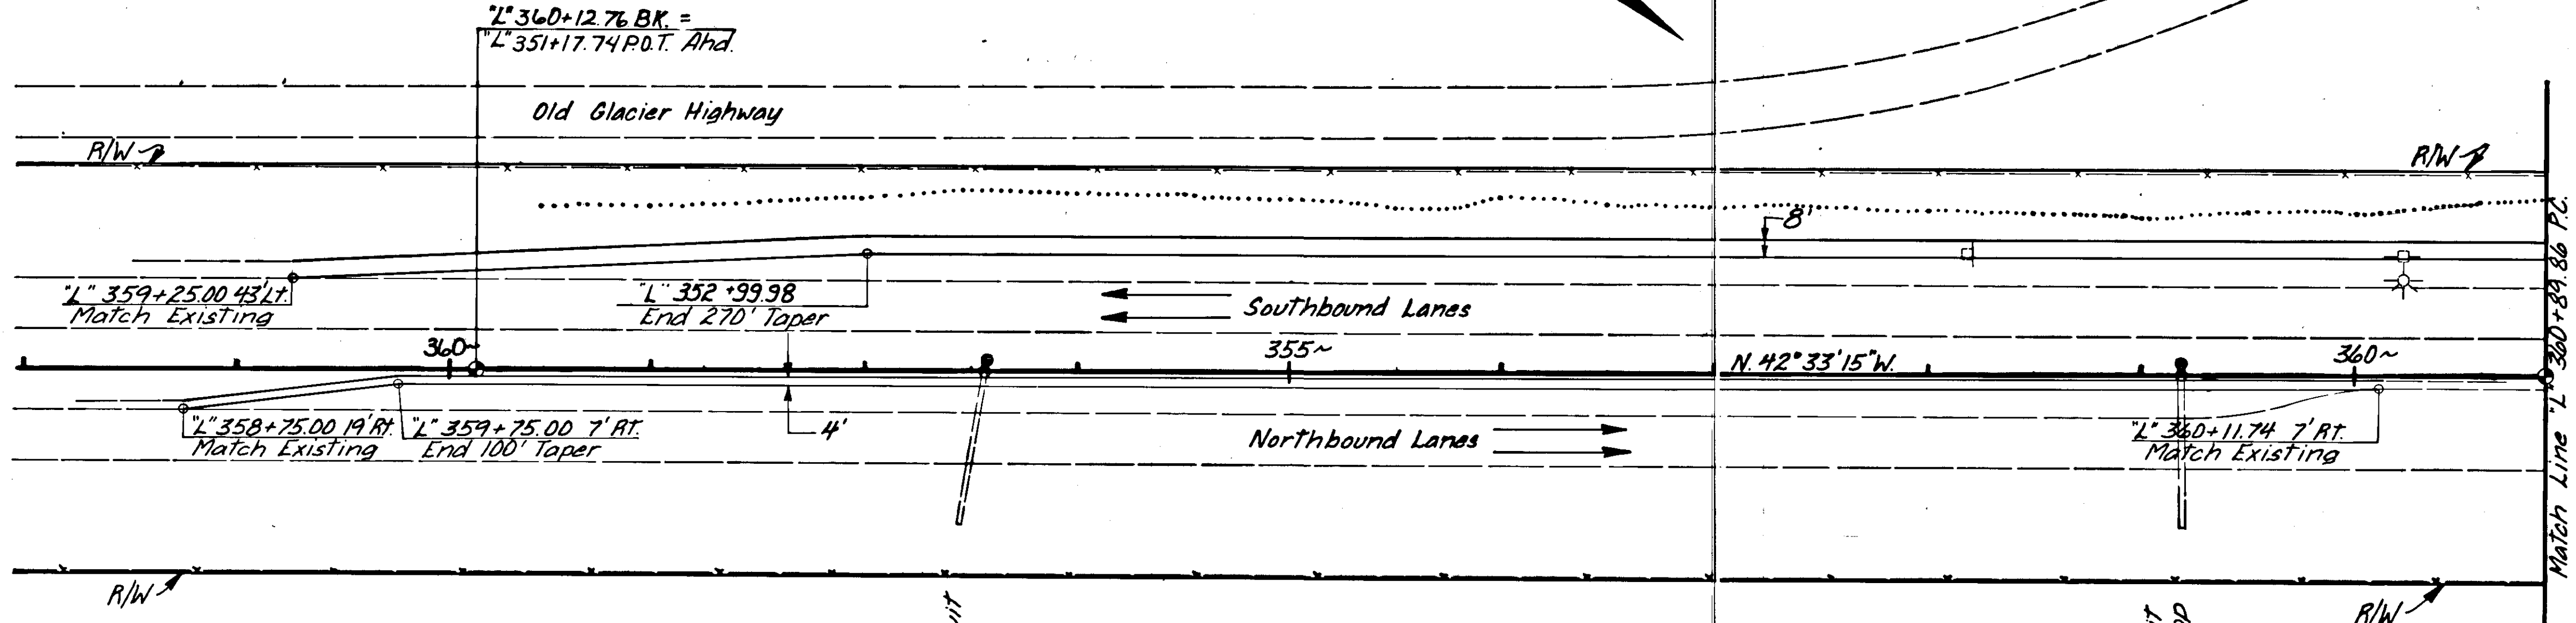

"L" 353+69 Existing Drop Inlet & 24" x 72" Pipe Conduit Extend 6' Lt. & Reinstall Drop Inlet.

"L" 359+19 Existing Drop Inlet & 18" x 72" Pipe Conduit Extend 6' Lt. & Reinstall Drop Inlet.

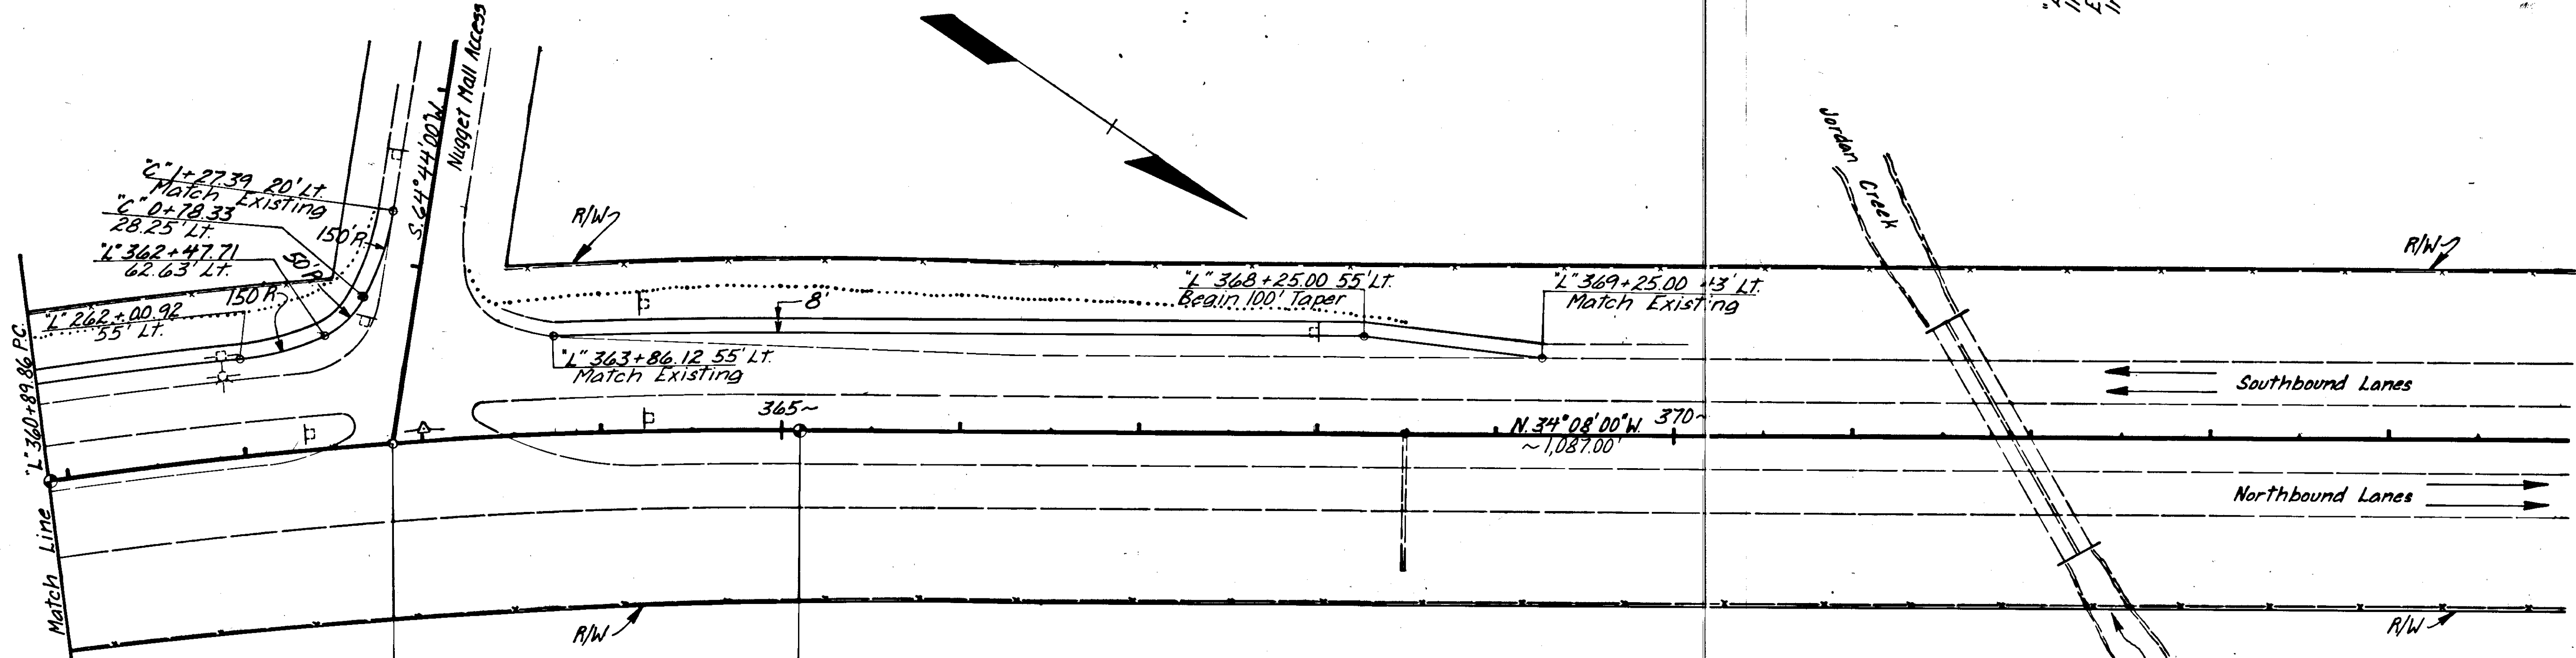

"L"
 $\Delta = 8^{\circ} 25' 15''$
 $D = 2^{\circ} 00' 00''$
 $T = 210.90'$
 $L = 421.04'$
 $R = 2,864.79'$

"L" 362+83.00 P.O.C. =
 "C" 0+00.00

"L" 365+10.90 P.T.

Ex = 1910 cu. yds. (466 cu. yds. Excess) to Sheet 9.



STATE	PROJECT DESIGNATION	YEAR	SHEET NO.	TOTAL SHEETS
ALASKA	F-093-2(9)	1981	12	31

SALMON CREEK INTERSECTION SIGNING, STRIPING, & ILLUMINATION


ADDENDUM I, ATTACHMENT I

SIGNING NOTES

1. Sign locations & post lengths are approximate only & are subject to minor revisions.
2. All sign posts shall be telescoping, perforated, & galvanized steel posts; the 2" size shall be used above ground & the 2 1/4" size shall be used below ground for the sleeve.
3. All posts shall be installed with the sleeve type embedment in accordance with Standard Drawing 5-30.12, except that the 2 1/4" size shall be used for the entire embedment depth.
4. All signs shall be unframed except signs no. 7, 13, 15 and 25.
5. All signs shall be .063" thick.
6. All existing signs shall be removed by the contractor & shall be returned to the State of Alaska, D.O.T. & P.F. Maintenance Yard, as directed by the engineer. This work shall be considered incidental to other items of work & no separate payment shall be made therefor.

ILLUMINATION NOTES

1. All interconnecting conductors shall be #6 AWG.
2. Conduit & cable routing as shown on the plans are schematic only & may be modified in the field as necessary to complete the illumination system. Any modifications shall be approved by the engineer.
3. All junction boxes shall be Type I as per Standard Drawing L-23.03.
4. All new wiring shall be in conduit.
5. Unused poles shall be delivered to DOT/P.F. at 7 mile Glacier Hwy.

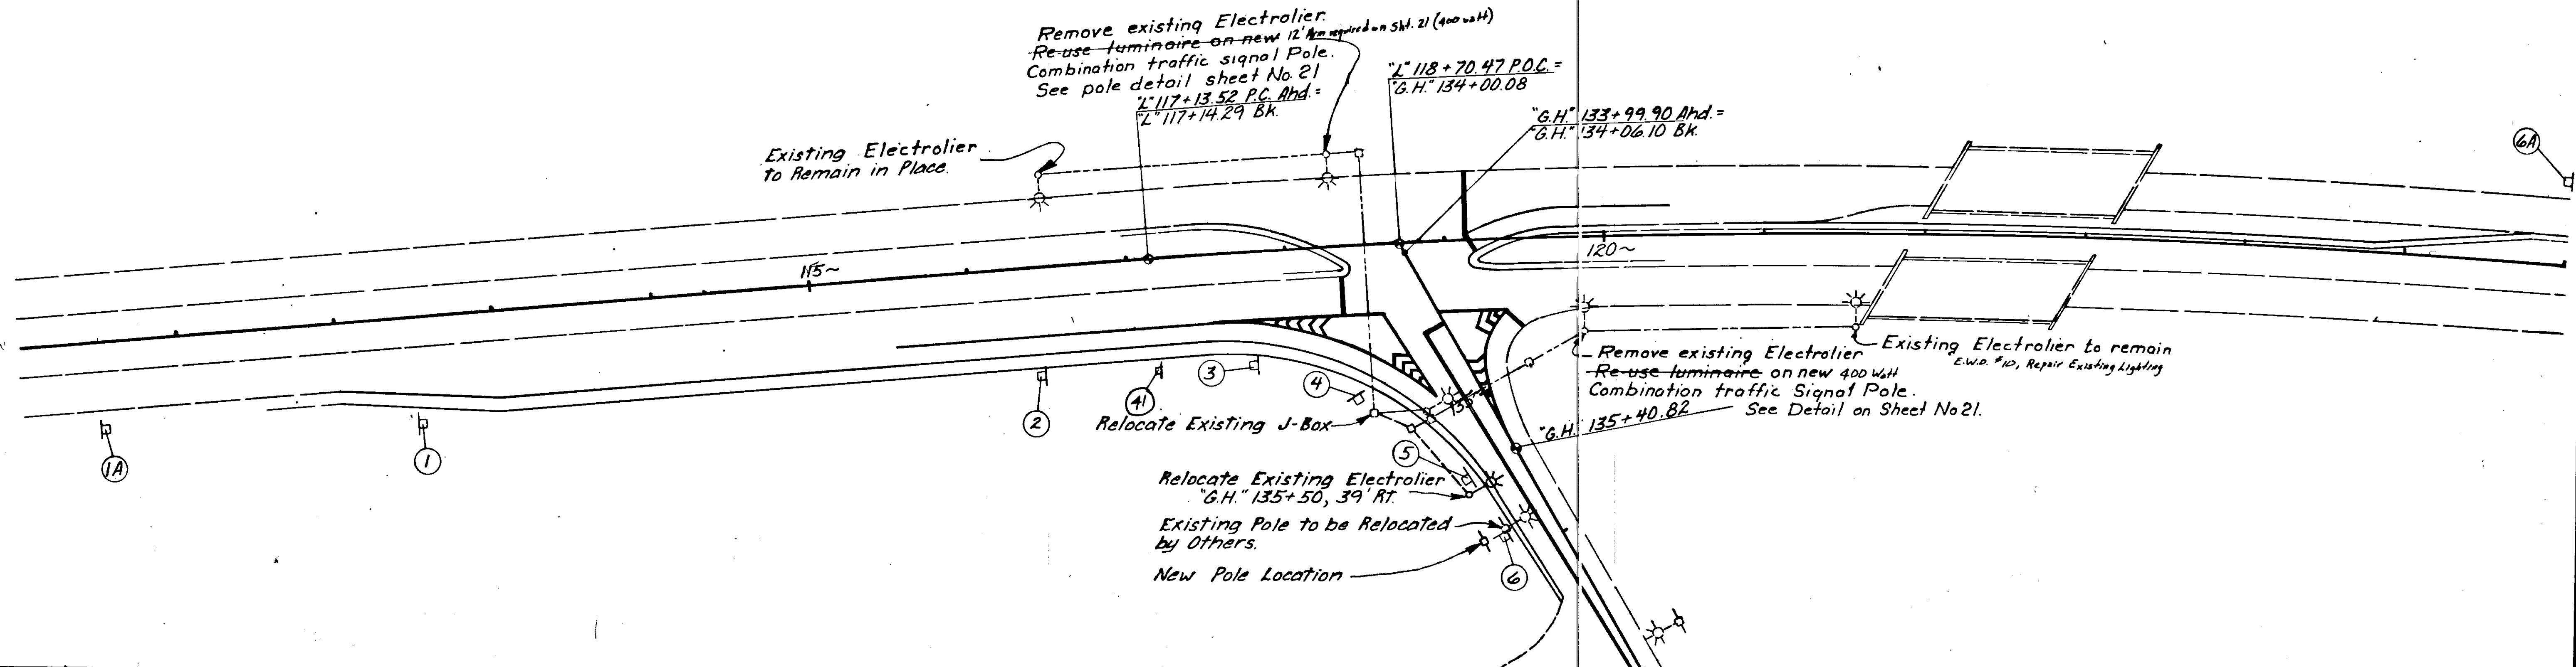


SIGNING SCHEDULE

SIGN NO.	STATION	POST LENGTH		CODE NO.	LEGEND	SIGN PANEL		FACING	REMARKS
		LEFT	RIGHT			SIZE	AREA		
1	"L" 112+50		20'	D9-2	SYMBOL HOSPITAL	30"x30" 24"x6"	6.25 1.0		Mount on Same Post
1A	"L" 110+50		20'	W3-3	SYMBOL	36"x36" 48"x48"	9.0 16.0	N.B.	Mount on 2 Posts (c.o.#7)
2	"L" 116+41		18'	R5-10C	Pedestrians Prohibited	24"x12"	2.0	S.B.	
3	"L" 117+75		21'	R5-1	DO NOT ENTER	48"x48"	16.0	S.B.	Mount on 2 Posts
4	"G.H." 134+65		14'	R1-2	YIELD	36"x36"	3.9	N.B.	
5	"G.H." 135+43		12'	D11-1	BIKE ROUTE	30"x24"	5.0	S.B.	
6	"G.H." 135+86		15'	D9-2	SYMBOL HOSPITAL	30"x30" 24"x6"	6.25 1.0	E.B.	Mount on Same Post
6A	"L" 126+00		20'	W3-3	SYMBOL	36"x36" 48"x48"	9.0 16.0	S.B.	Mount on 2 Posts (c.o.#7)
41	"L" 117+10		21'	R3-11-30	Rt. turn Permitted w.o. stopping	24"x30"	5.0	N.B.	(c.o.#8)



STATE	PROJECT DESIGNATION	YEAR	SHEET NO.	TOTAL SHEETS
ALASKA	F-093-2(9)	1981	13	31

VANDERBILT HILL INTERSECTION SIGNING, STRIPING, & ILLUMINATION

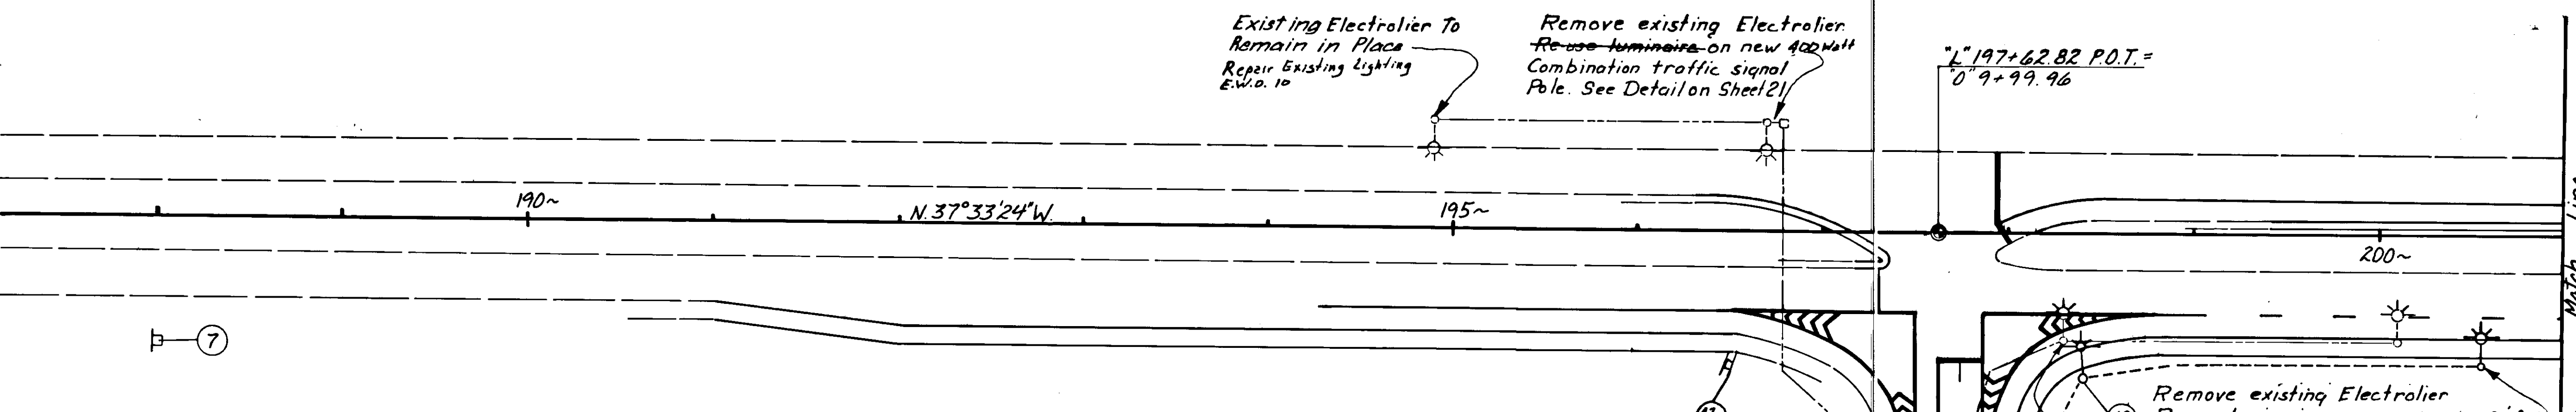

Existing Electrolier To Remain in Place Repair Existing Lighting E.W.O. 10

Remove existing Electrolier Re-use luminaire on new 400 Watt Combination traffic signal Pole. See Detail on Sheet 21

"L" 197+62.82 P.O.T. =
"O" 9+99.96


Remove existing Electrolier Re-use luminaire on new 400w. 20' Arm Combination traffic signal pole See Detail on Sheet No 21 Remove existing J-Box

Relocate existing Electrolier "L" 200+55.70' Rt.

Install new wire and conduit in shoulder of road to existing load center at "A" 26+33.140' Rt.

Match Line "O" 12+00 See Sheet 14

SIGN NO.	STATION	POST LENGTH		CODE NO.	LEGEND	SIGN PANEL		FAC-ING	REMARKS
		LT.	RT.			SIZE	AREA		
7	"L" 188+00		19'	D3-2R	Vanderbilt Hill Rd. →	24" x 156"	26.0	N.B.	Mount on 2 Posts
8	"O" 11+25		38'	R5-1	DO NOT ENTER	48" x 48"	16.0	S.B.	Mount on Same 2 Posts
9		R5-10B		Pedestrians & Bicycles Prohibited	30" x 18"	3.75			
10	"L" 198+75			R5-10B	Pedestrians & Bicycles Prohibited	30" x 18"	3.75	N.B.	Mount on Luminaire Std.
11	"L" 201+49		17'	R2-1	Speed Limit 55	36" x 48"	12.0	N.B.	
12	"L" 205+03		16'	R8-4	Emergency Parking Only	30" x 24"	5.0	N.B.	
13	"L" 212+00		16'	D3-2L	← Vanderbilt Hill Rd.	24" x 156"	26.0	S.B.	Mount on 2 Posts
1A	"L" 203+00		17'	W4-1	↑	30" x 30"	6.25	N.B.	
12	"L" 196+80		21'	R-3-N-30	Rt. Turn Permitted with out Stopping	24" x 30"	5.0	N.B.	C.O.#B
13	"L" 198+70		30'	R-3-N-30	Rt. Turn Permitted with out Stopping	24" x 30"	5.0	N.B.	C.O.#B

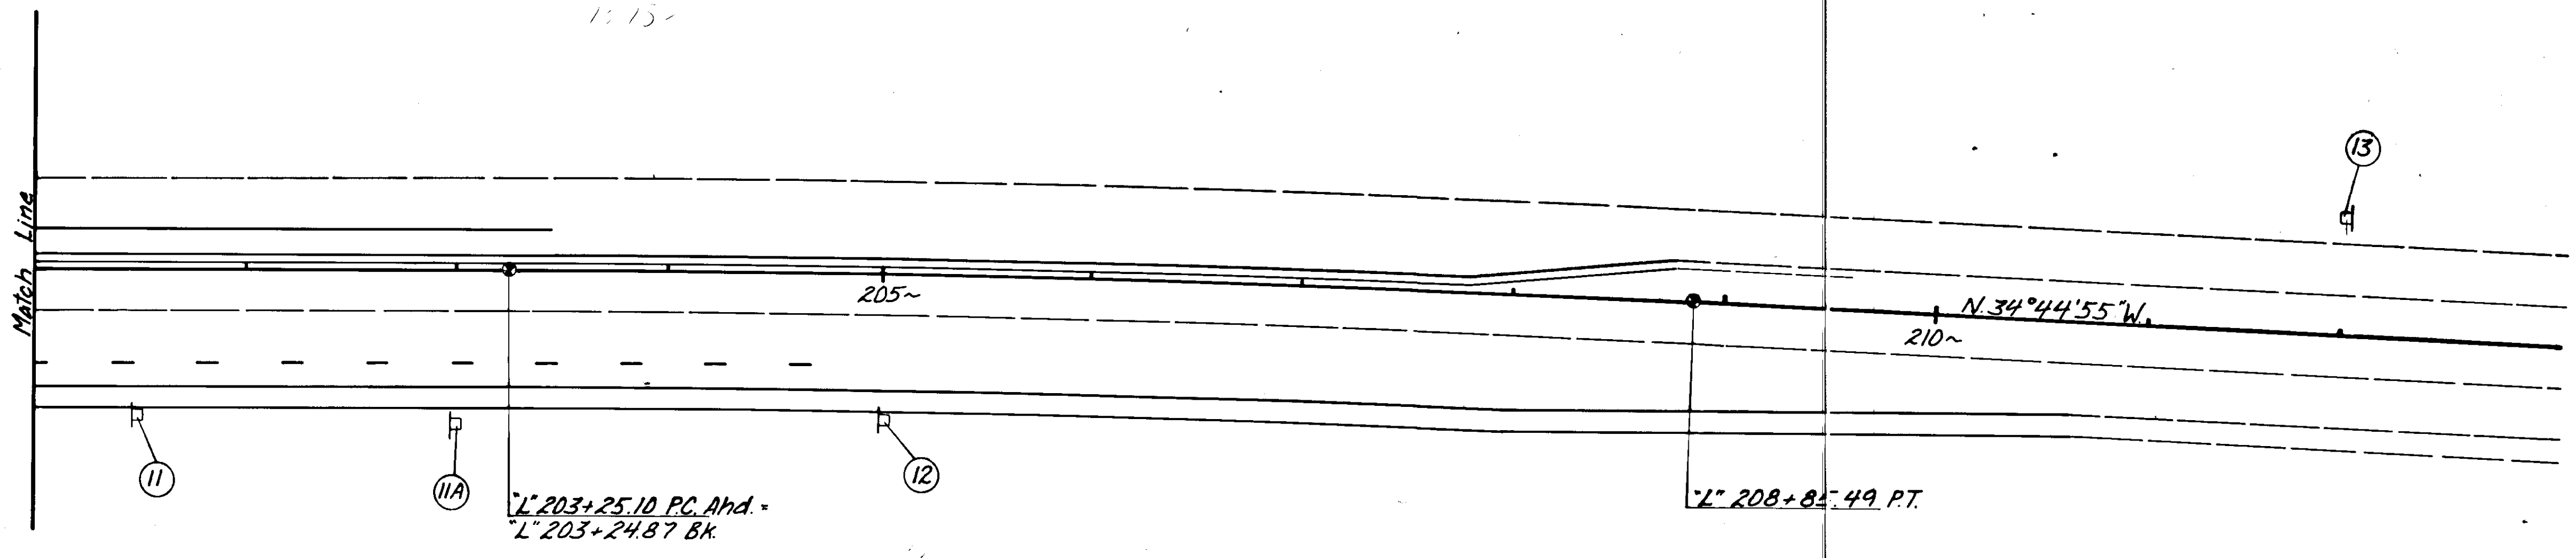




"L" 203+25.10 P.C. Ahd. =
"L" 203+24.87 Bk.

"L" 208+82.49 P.T.




STATE	PROJECT DESIGNATION	YEAR	SHEET NO.	TOTAL SHEETS
ALASKA	F-093-2(9)	1981	14	31

VANDERBILT HILL INTERSECTION SIGNING, STRIPING, & ILLUMINATION

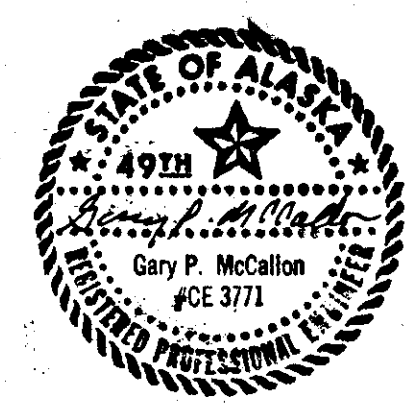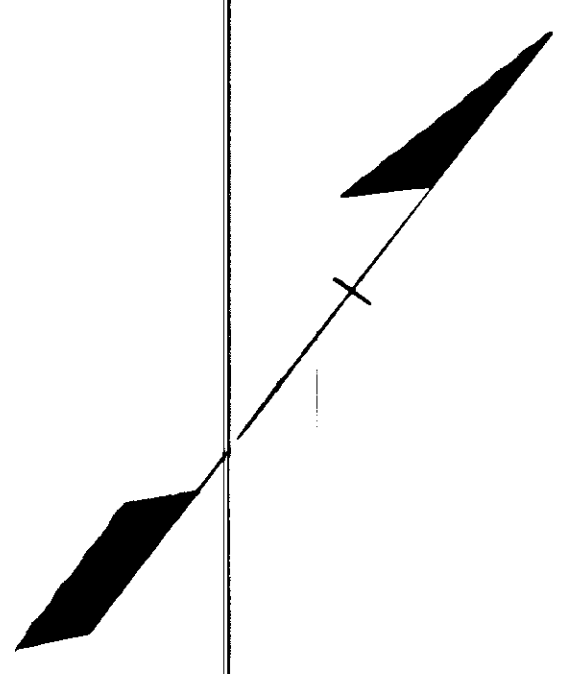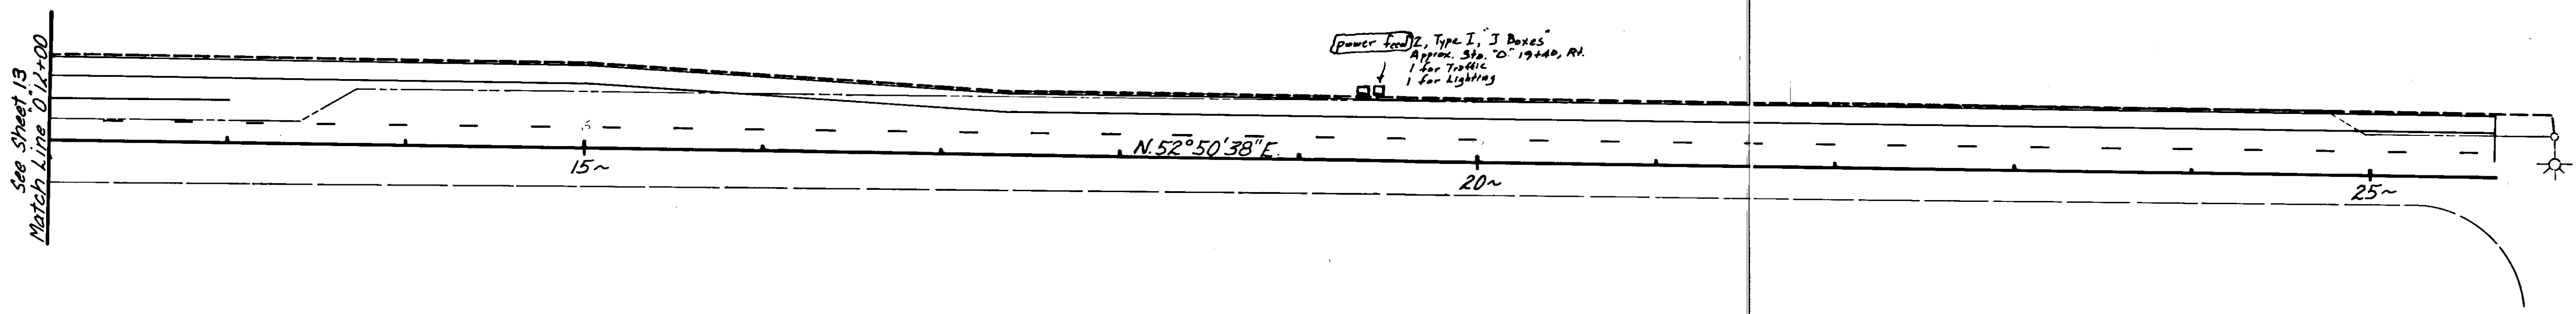


SUNNY POINT INTERSECTION SIGNING, STRIPING, & ILLUMINATION

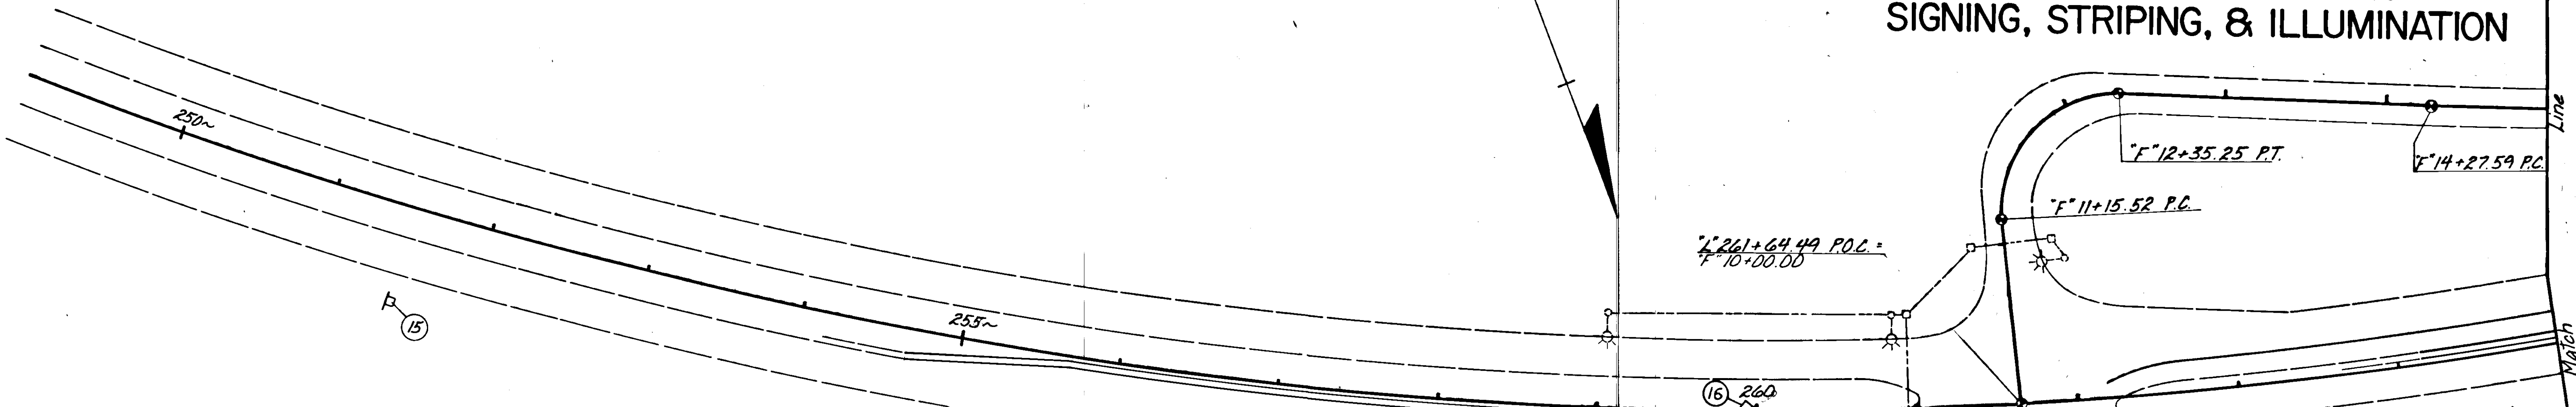

SIGNING SCHEDULE

STATION	POLE LENGTH		CODE NO.	LEGEND	SIGN PANEL		FAC-ING	REMARKS
	LT.	RT.			SIZE	AREA		
"L" 251+50		18'	DI-2	← Sunny Dr. - Glacier Hwy. →	42" x 114"	33.25	N.B.	Mount on 2 Posts
"L" 259+95		16'	R5-1	DO NOT ENTER	48" x 48"	16.0	S.B.	"
"L" 260+30		10'	R3-11-30	Rt. Turn Permitted with out Stopping	24" x 30"	5.0	N.B.	c.o. #B
"L" 260+70		18'	R5-1	DO NOT ENTER	48" x 48"	16.0	S.B.	"
"L" 262+86			R5-10B	Pedestrians & Bicycles Prohibited	30" x 18"	3.75	N.B.	Mount on Luminaire Std.
"F" 9+00		20'	R3-11-30	Rt. Turn Permitted with out Stopping	24" x 30"	5.0	N.B.	c.o. #B
"F" 9+20		20'	R1-1	STOP	36" x 36"	9.0	W.B.	"
"L" 264+66			R2-1	SPEED LIMIT 55	36" x 48"	12.0	S.B.	Mount on Lum. Std.
"L" 276+00	16'		DI-2	← Sunny Dr. - Glacier Hwy. →	42" x 114"	33.25	S.B.	Mount on 2 Posts
"L" 264+50		19'	W4-1		30" x 30"	6.25	N.B.	Merge Sign

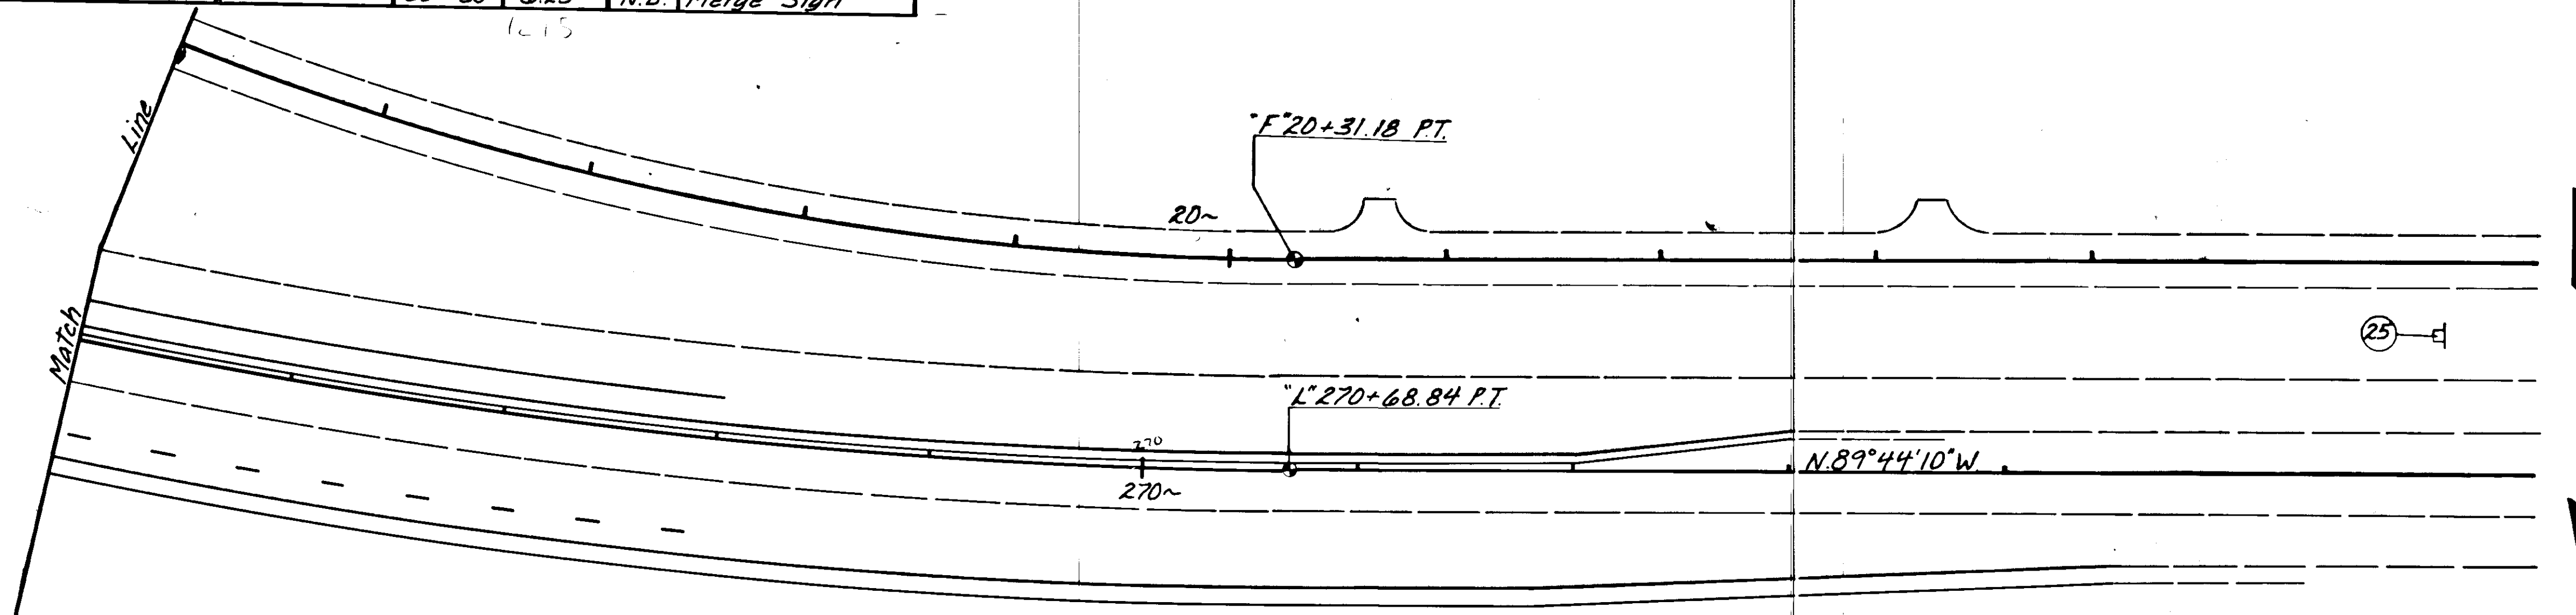

Existing Electrolier & J-Box To Remain in Place

Relocate Existing Electrolier "L" 262+86, 70' RT

Relocate Existing Electrolier "L" 264+86, 70' RT

Relocate Existing Junction Box

Load Center "C"

Power Source from Existing Pole @ "G.H." 314+44, 30' RT. - 480V. Service To Load Center "C"

"F" 7+53.39 = "G.H." 314+08.80

S.15°23'37"W


N.89°09'20"E



AIRPORT ACCESS INTERSECTION SIGNING, STRIPING, & ILLUMINATION

STATE	PROJECT DESIGNATION	YEAR	SHEET NO.	TOTAL SHEETS
ALASKA	F-093-2(9)	1981	16	31

ADDENDUM 1, ATTACHMENT 2

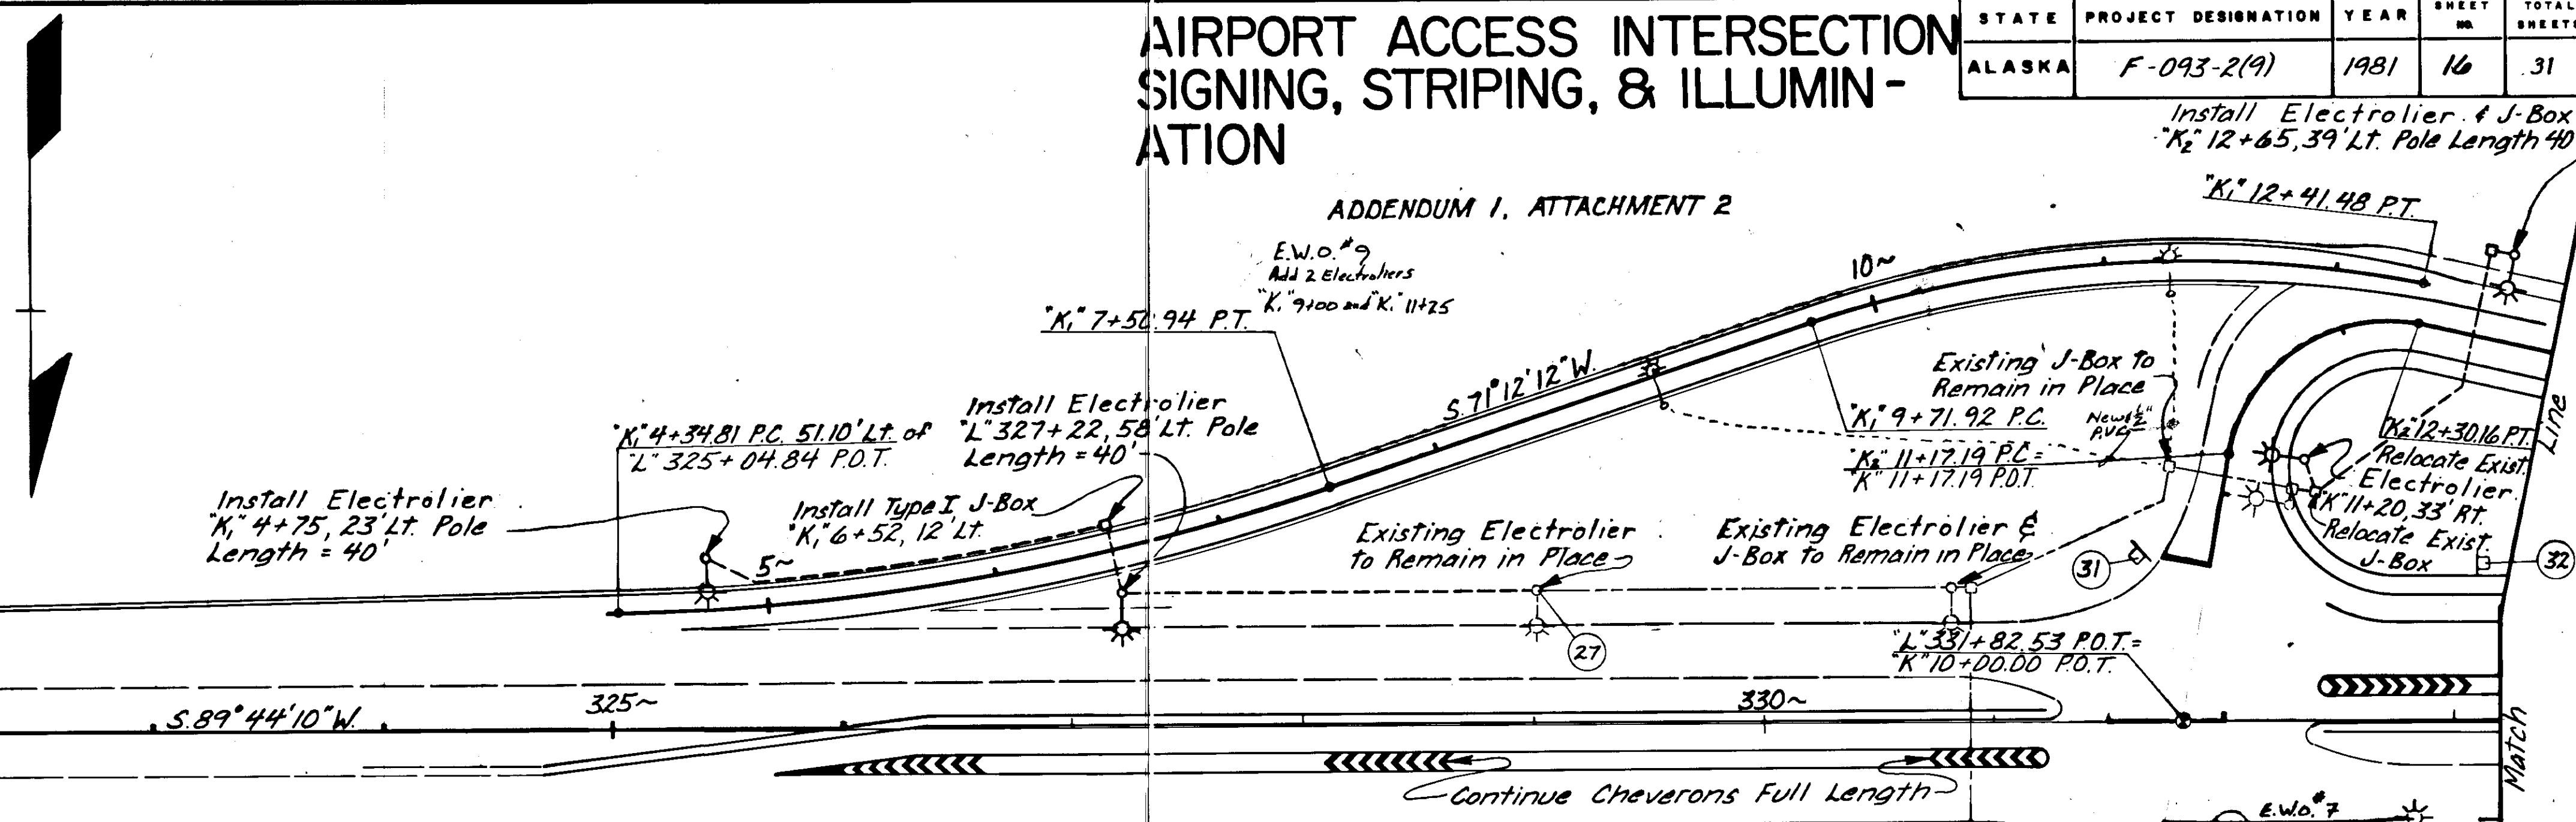


SIGNING SCHEDULE


STATION	POST LENGTH		CODE NO	LEGEND	SIGN SIZE	PANEL AREA	FACING TRAFFIC	REMARKS
	LT.	RT.						
"L" 322+00		15' 17'	D1-3 IS-L	SYMBOL - YANDUKIN AIRPORT Drive	30" x 30" 6" x 24" 6" x 24"	6.25 1.0 1.0	S.B.	Mount on Same Post C.O.#1
"L" 329+00	16'		W4-1		30" x 30"	6.25	S.B.	Mount on Lum. Std.
"L" 330+10	15'		R-3-11-30	Rt. Turn Permitted without Stopping	24" x 30"	5.0	N.B.	C.O.#B
"L" 330+50	15'		R5-10B	Pedestrians & Bicycles Prohibited	30" x 18"	3.75	S.B.	
"L" 330+95	17'		R5-1	DO NOT ENTER	48" x 48"	16.0	S.B.	2 Posts - Face 45° Lt.
"K" 9+30	17'		R1-1	STOP	36" x 36"	9.0	W.B.	
"K" 10+65	18'		R3-1 R1-1	NO RIGHT TURN STOP	36" x 36" 36" x 36"	9.0 9.0	E.B.	Mount on Same Post
"L" 333+14	16'		R5-10B	Pedestrians & Bicycles Prohibited	30" x 18"	3.75	N.B.	
"L" 334+62		17'	R2-1	SPEED LIMIT 55	36" x 48"	12.0	N.B.	Mount on Lum. Std.
"K" 9+20		17'	R-3-11-30	Rt. Turn Permitted without Stopping	24" x 30"	5.0	N.B.	C.O.#B
"K" 13+83		17'	R2-1	SPEED LIMIT 50	36" x 48"	12.0	N.B.	
"L" 341+30	19'		IS-R	SYMBOL - YANDUKIN AIRPORT Drive	36" x 36" 6" x 24" 6" x 24"	9.0 1.0 1.0	S.B.	Mount on Same Post C.O.#1
"L" 335+00	16'		W4-1		30" x 30"	6.25	N.B.	Merge Sign

NOTES: Luminaires "L" 327+22, "K" 4+75, & "K" 12+65 shall be high pressure sodium, 250 watt, 480 volt, U.S.A.S.I. Type II, medium semi-cutoff.


Existing Transformer is located at approximate station "K" 4+90, 70 feet Rt.

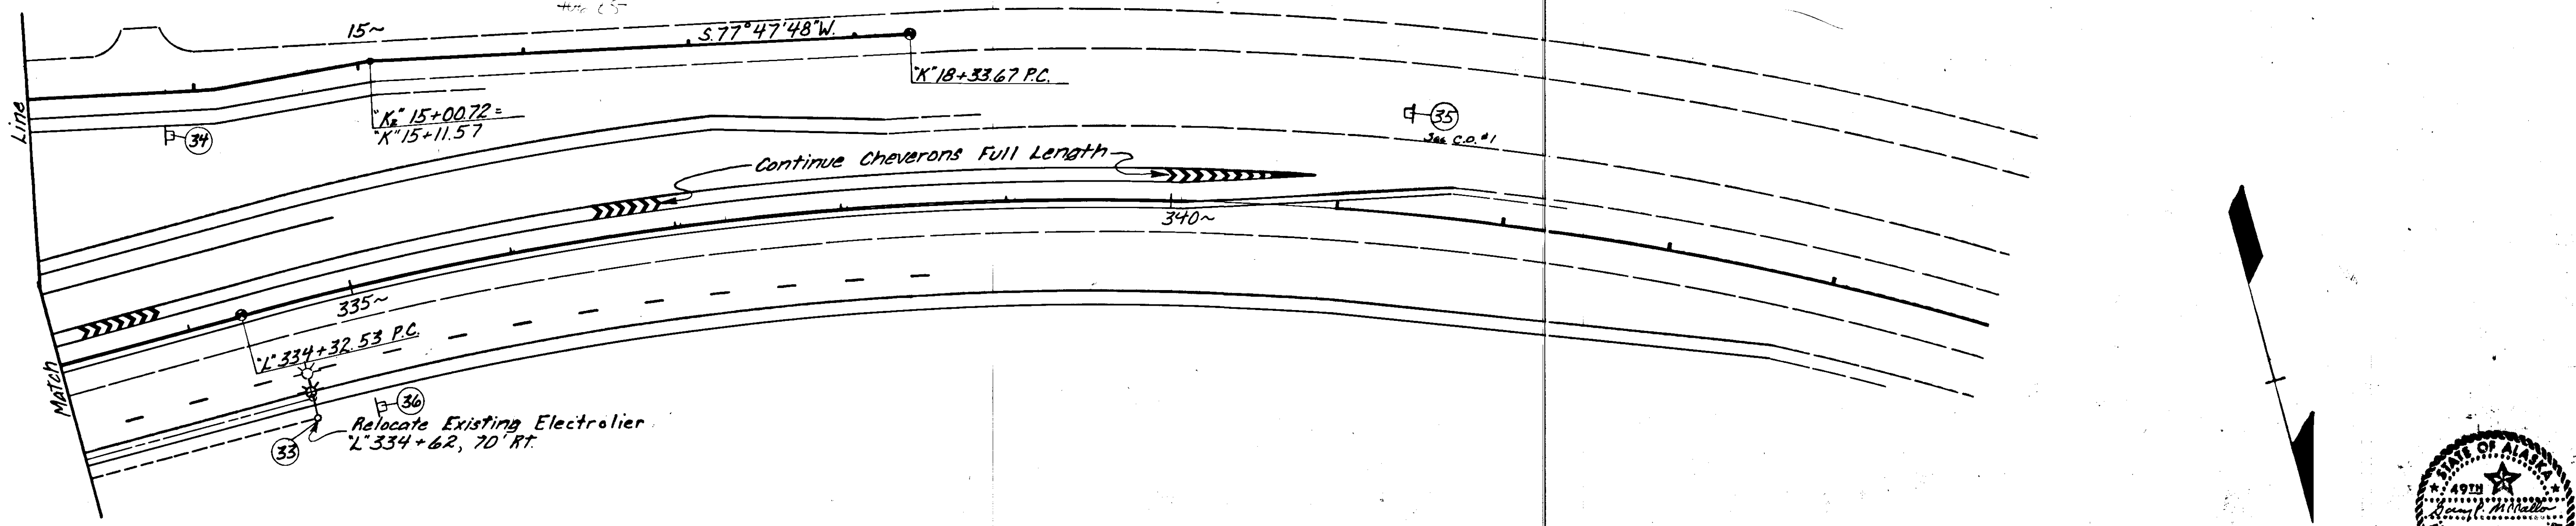

NUGGET MALL INTERSECTION SIGNING, STRIPING, & ILLUMINATION



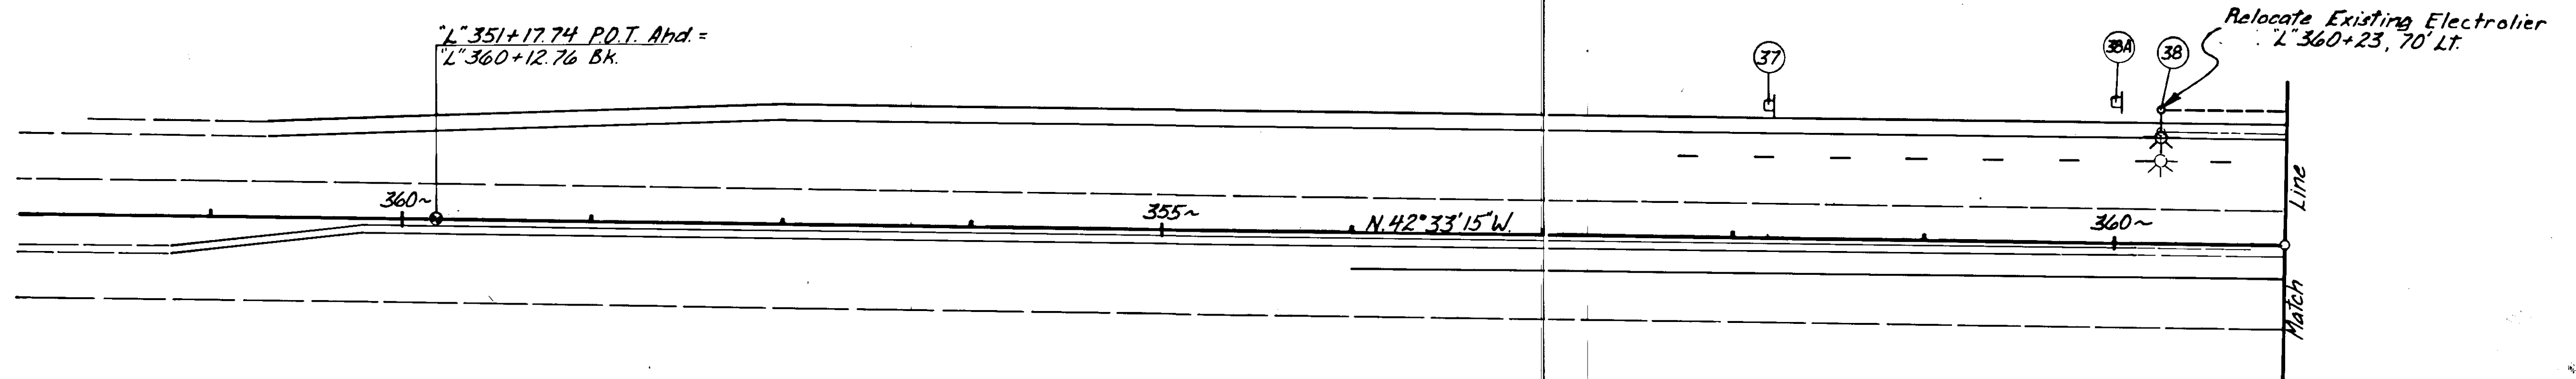


SIGN NO.	STATION	POST LENGTH		CODE NO.	LEGEND	SIGN PANEL		FACING TRAFFIC	REMARKS
		LT.	RT.			SIZE	AREA		
37	"L" 358+18	18'			Keep Our State Clean Please Don't Litter	36" x 72"	18.0	S.B.	Mount on 2 Posts
38	"L" 360+23			R2-1	SPEED LIMIT 55	36" x 48"	12.0	S.B.	Mount On Luminaire
39	"L" 361+93			R5-5	Pedestrians & Bicycles Prohibited	30" x 18"	3.75	S.B.	Mount On Luminaire Pole
39A	"L" 363+00		15'	R5-6	SYMBOL	36" x 36"	9.0	E.B.	
40	"C" 0+75.50	18'-12"		R1-1	STOP	36" x 36"	9.0	E.B.	
41	"L" 372+00	16"			State Troopers Commercial Area	18" x 78"	9.75	S.B.	Mount on Same 2 Posts
38A	"L" 360+00	18'		W4-1		30" x 30"	6.25	S.B.	Merge Sign
40A	"C" 0+75	20'		R5-6	SYMBOL	36" x 36"	9.0	W.B.	10' Lt of Sign #40
40B	"C" 0+90		16'	R5-6	SYMBOL	36" x 36"	9.0	W.B.	
48	"C" 0+95	16'		R-3-11-30	Rt. turn Permitted without Stopping	24" x 30"	5.0	E.B.	C.O. #8
49	"C" 364+00		16'	R-3-11-30	Rt. turn Permitted without Stopping	24" x 30"	5.0	S.B.	C.O. #8

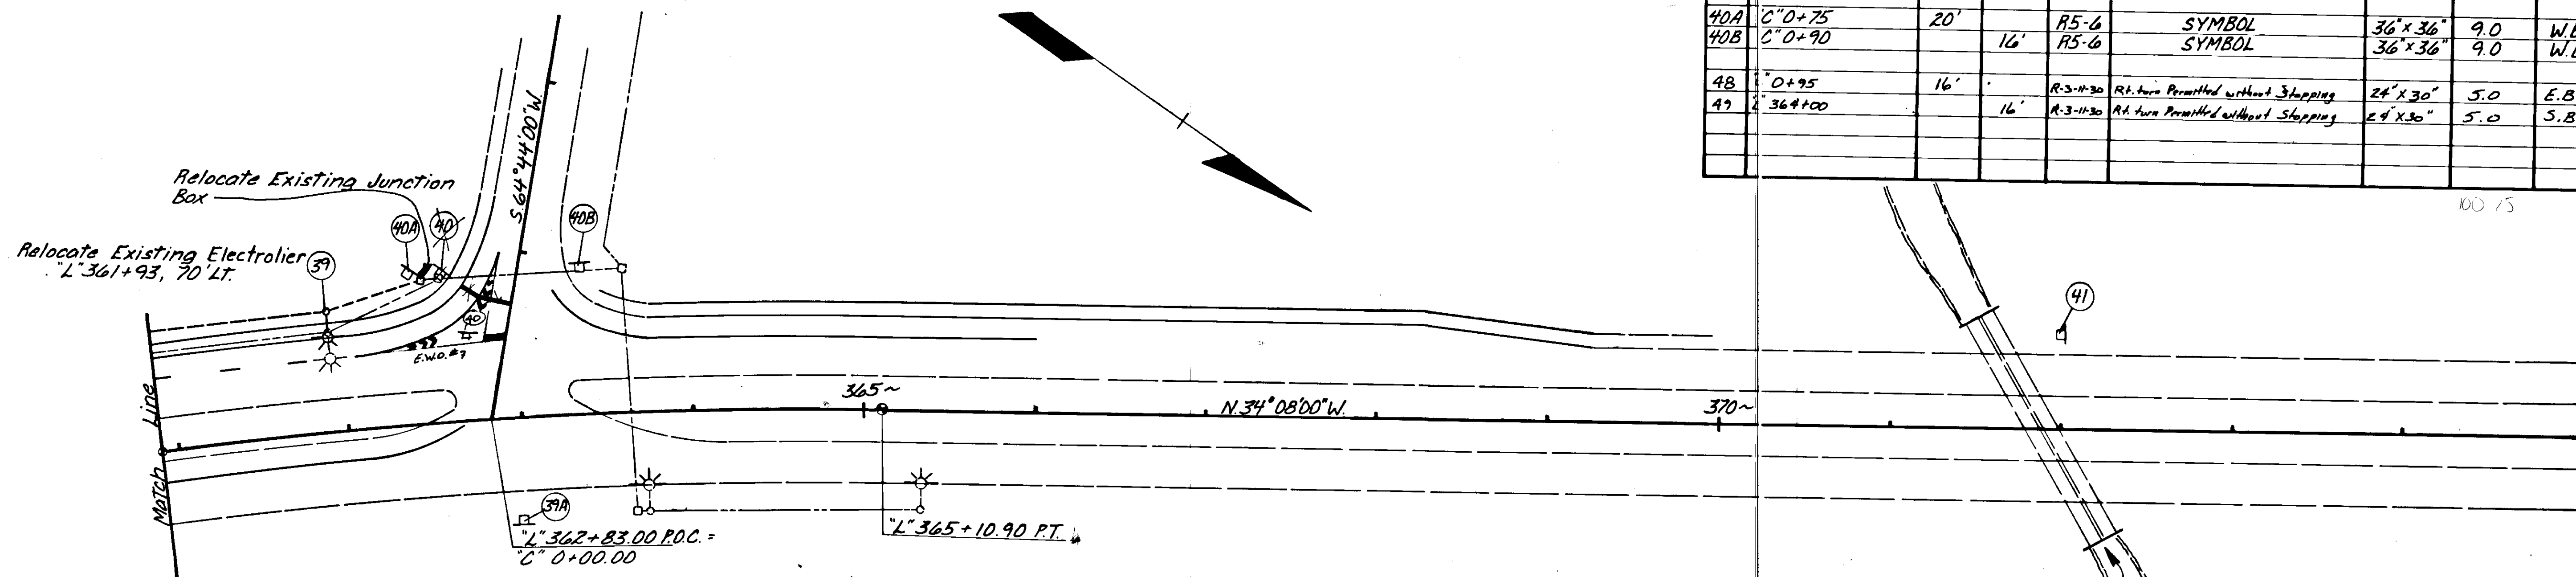

STATE	PROJECT DESIGNATION	YEAR	SHEET NO.	TOTAL SHEETS
ALASKA	F-093-2(9)	1981	18	31


SALMON CREEK INTERSECTION SIGNALIZATION DETAILS

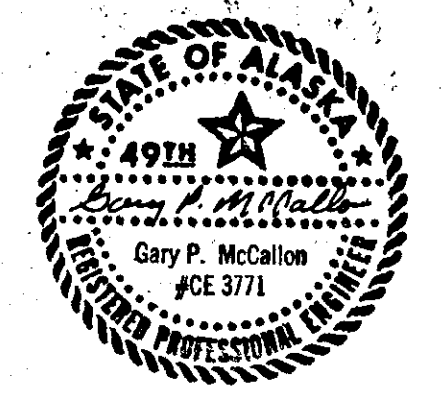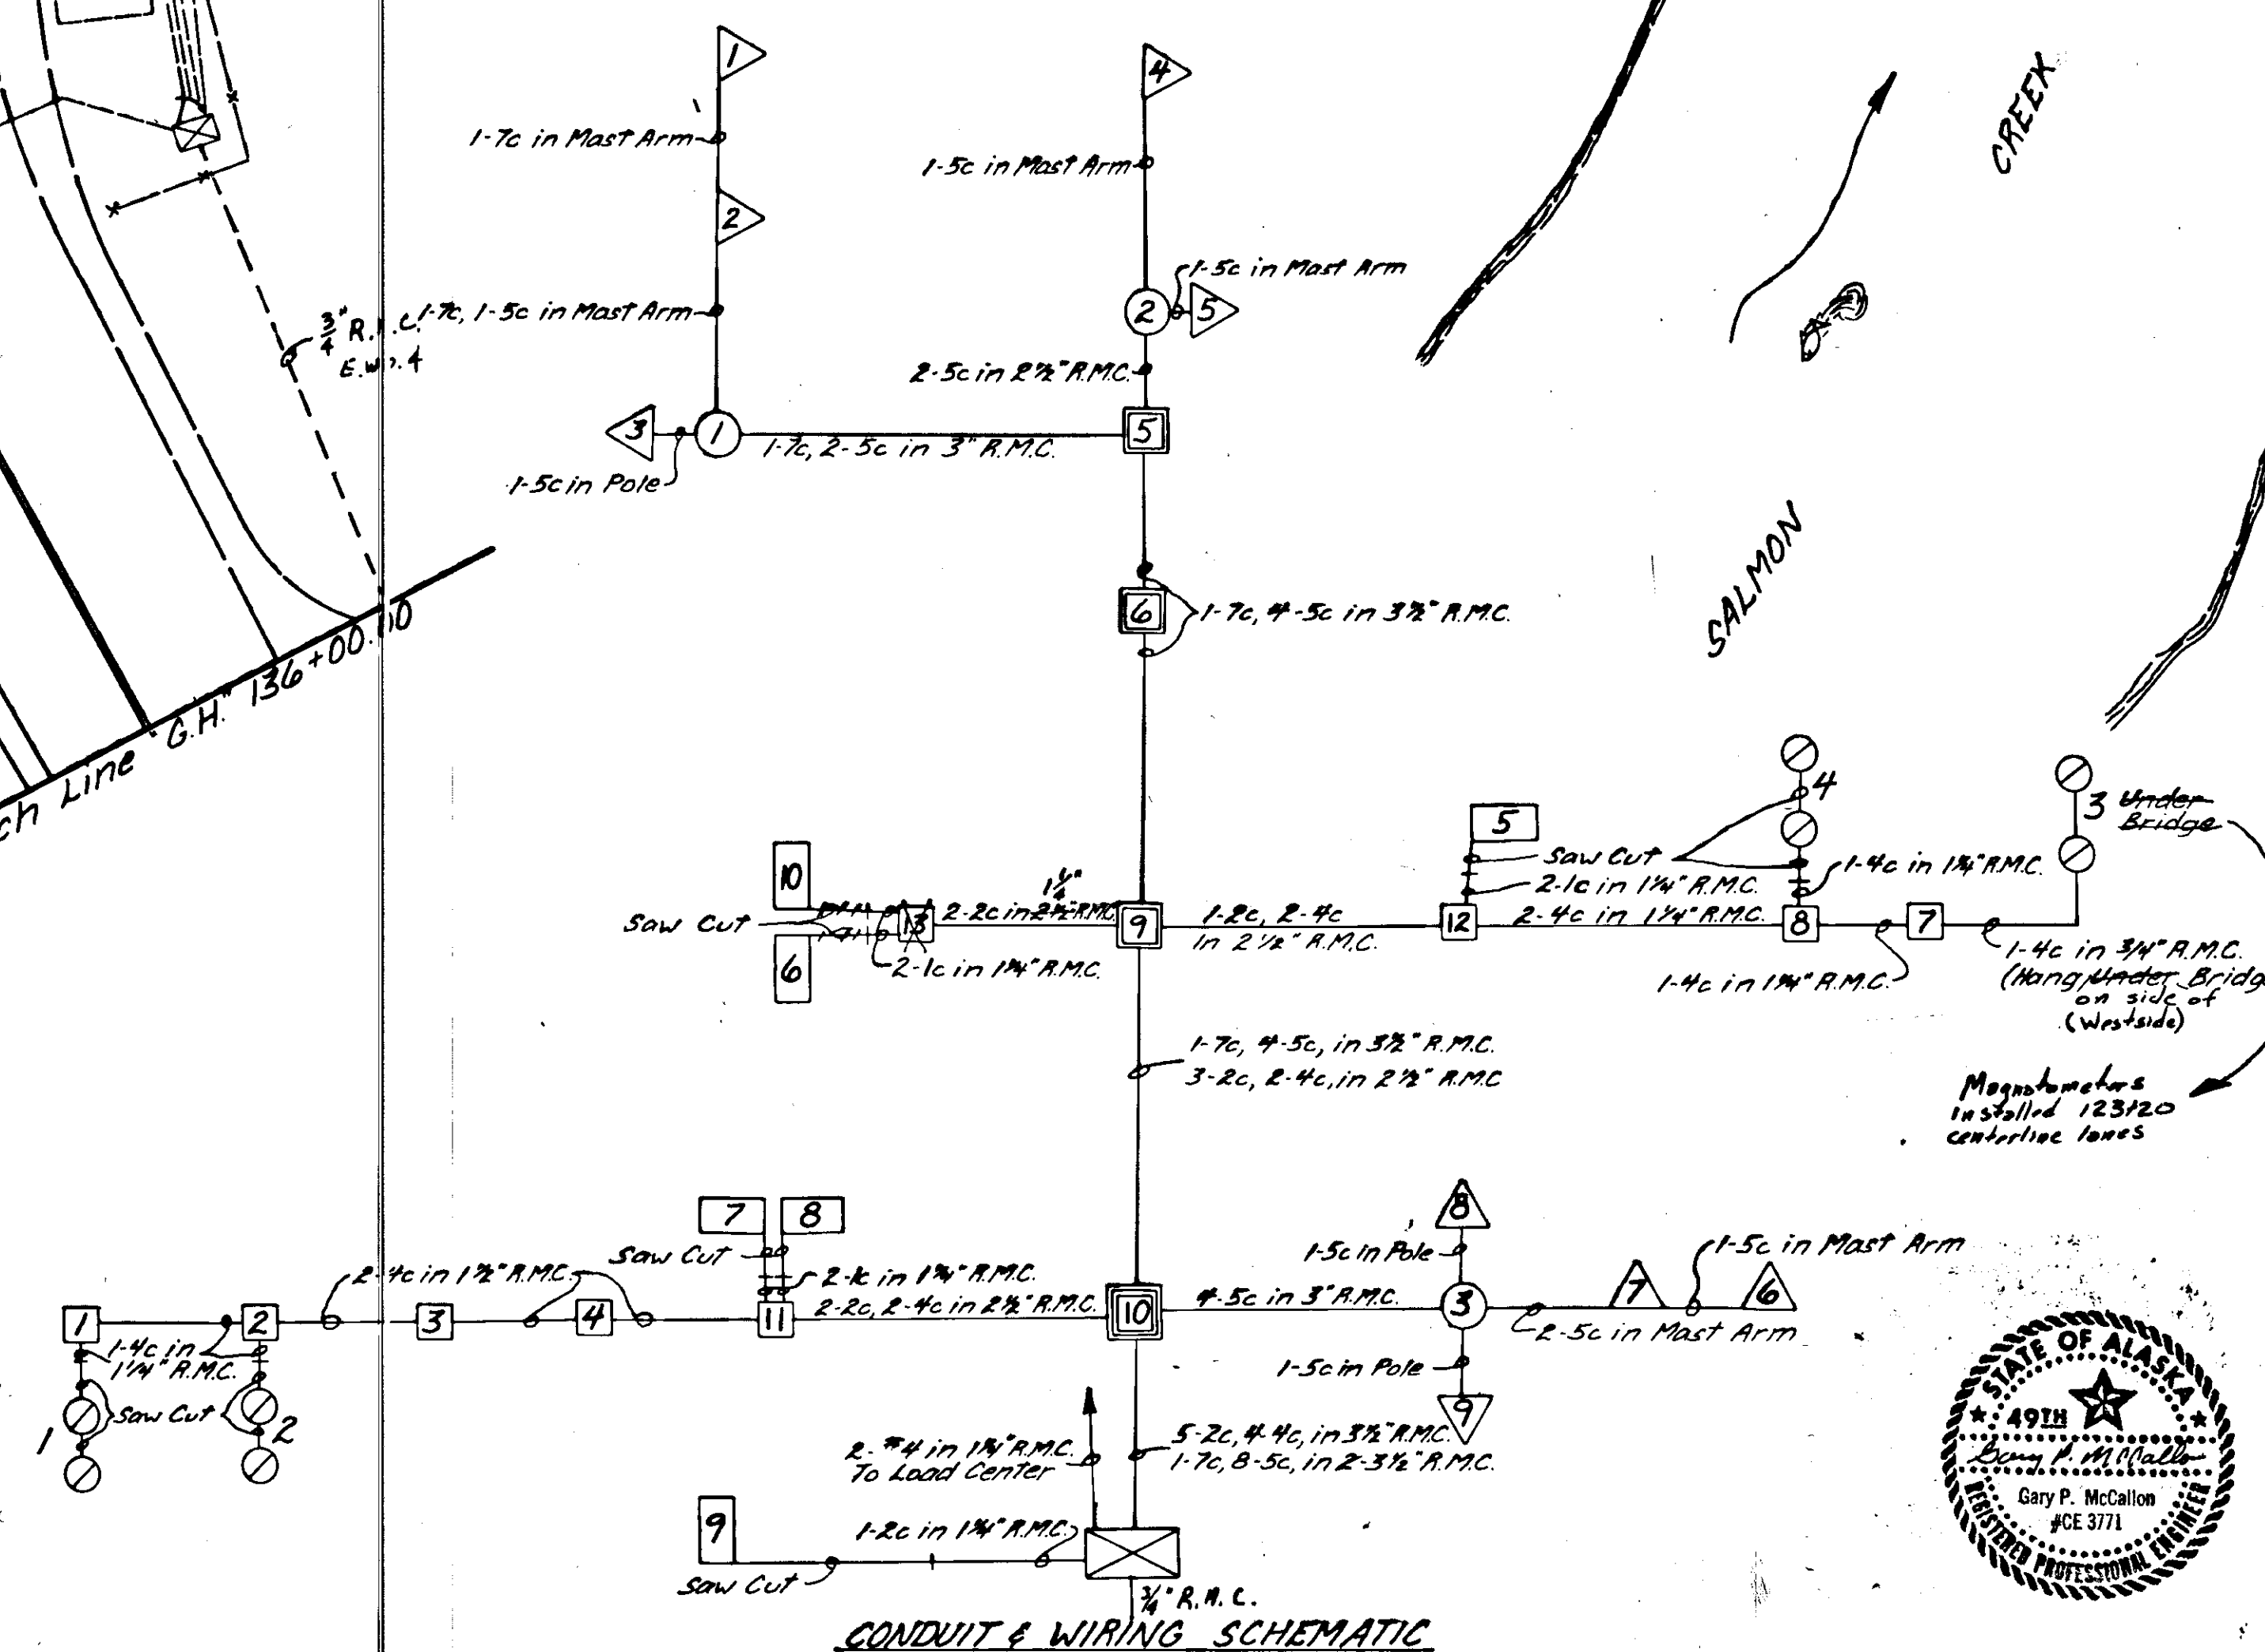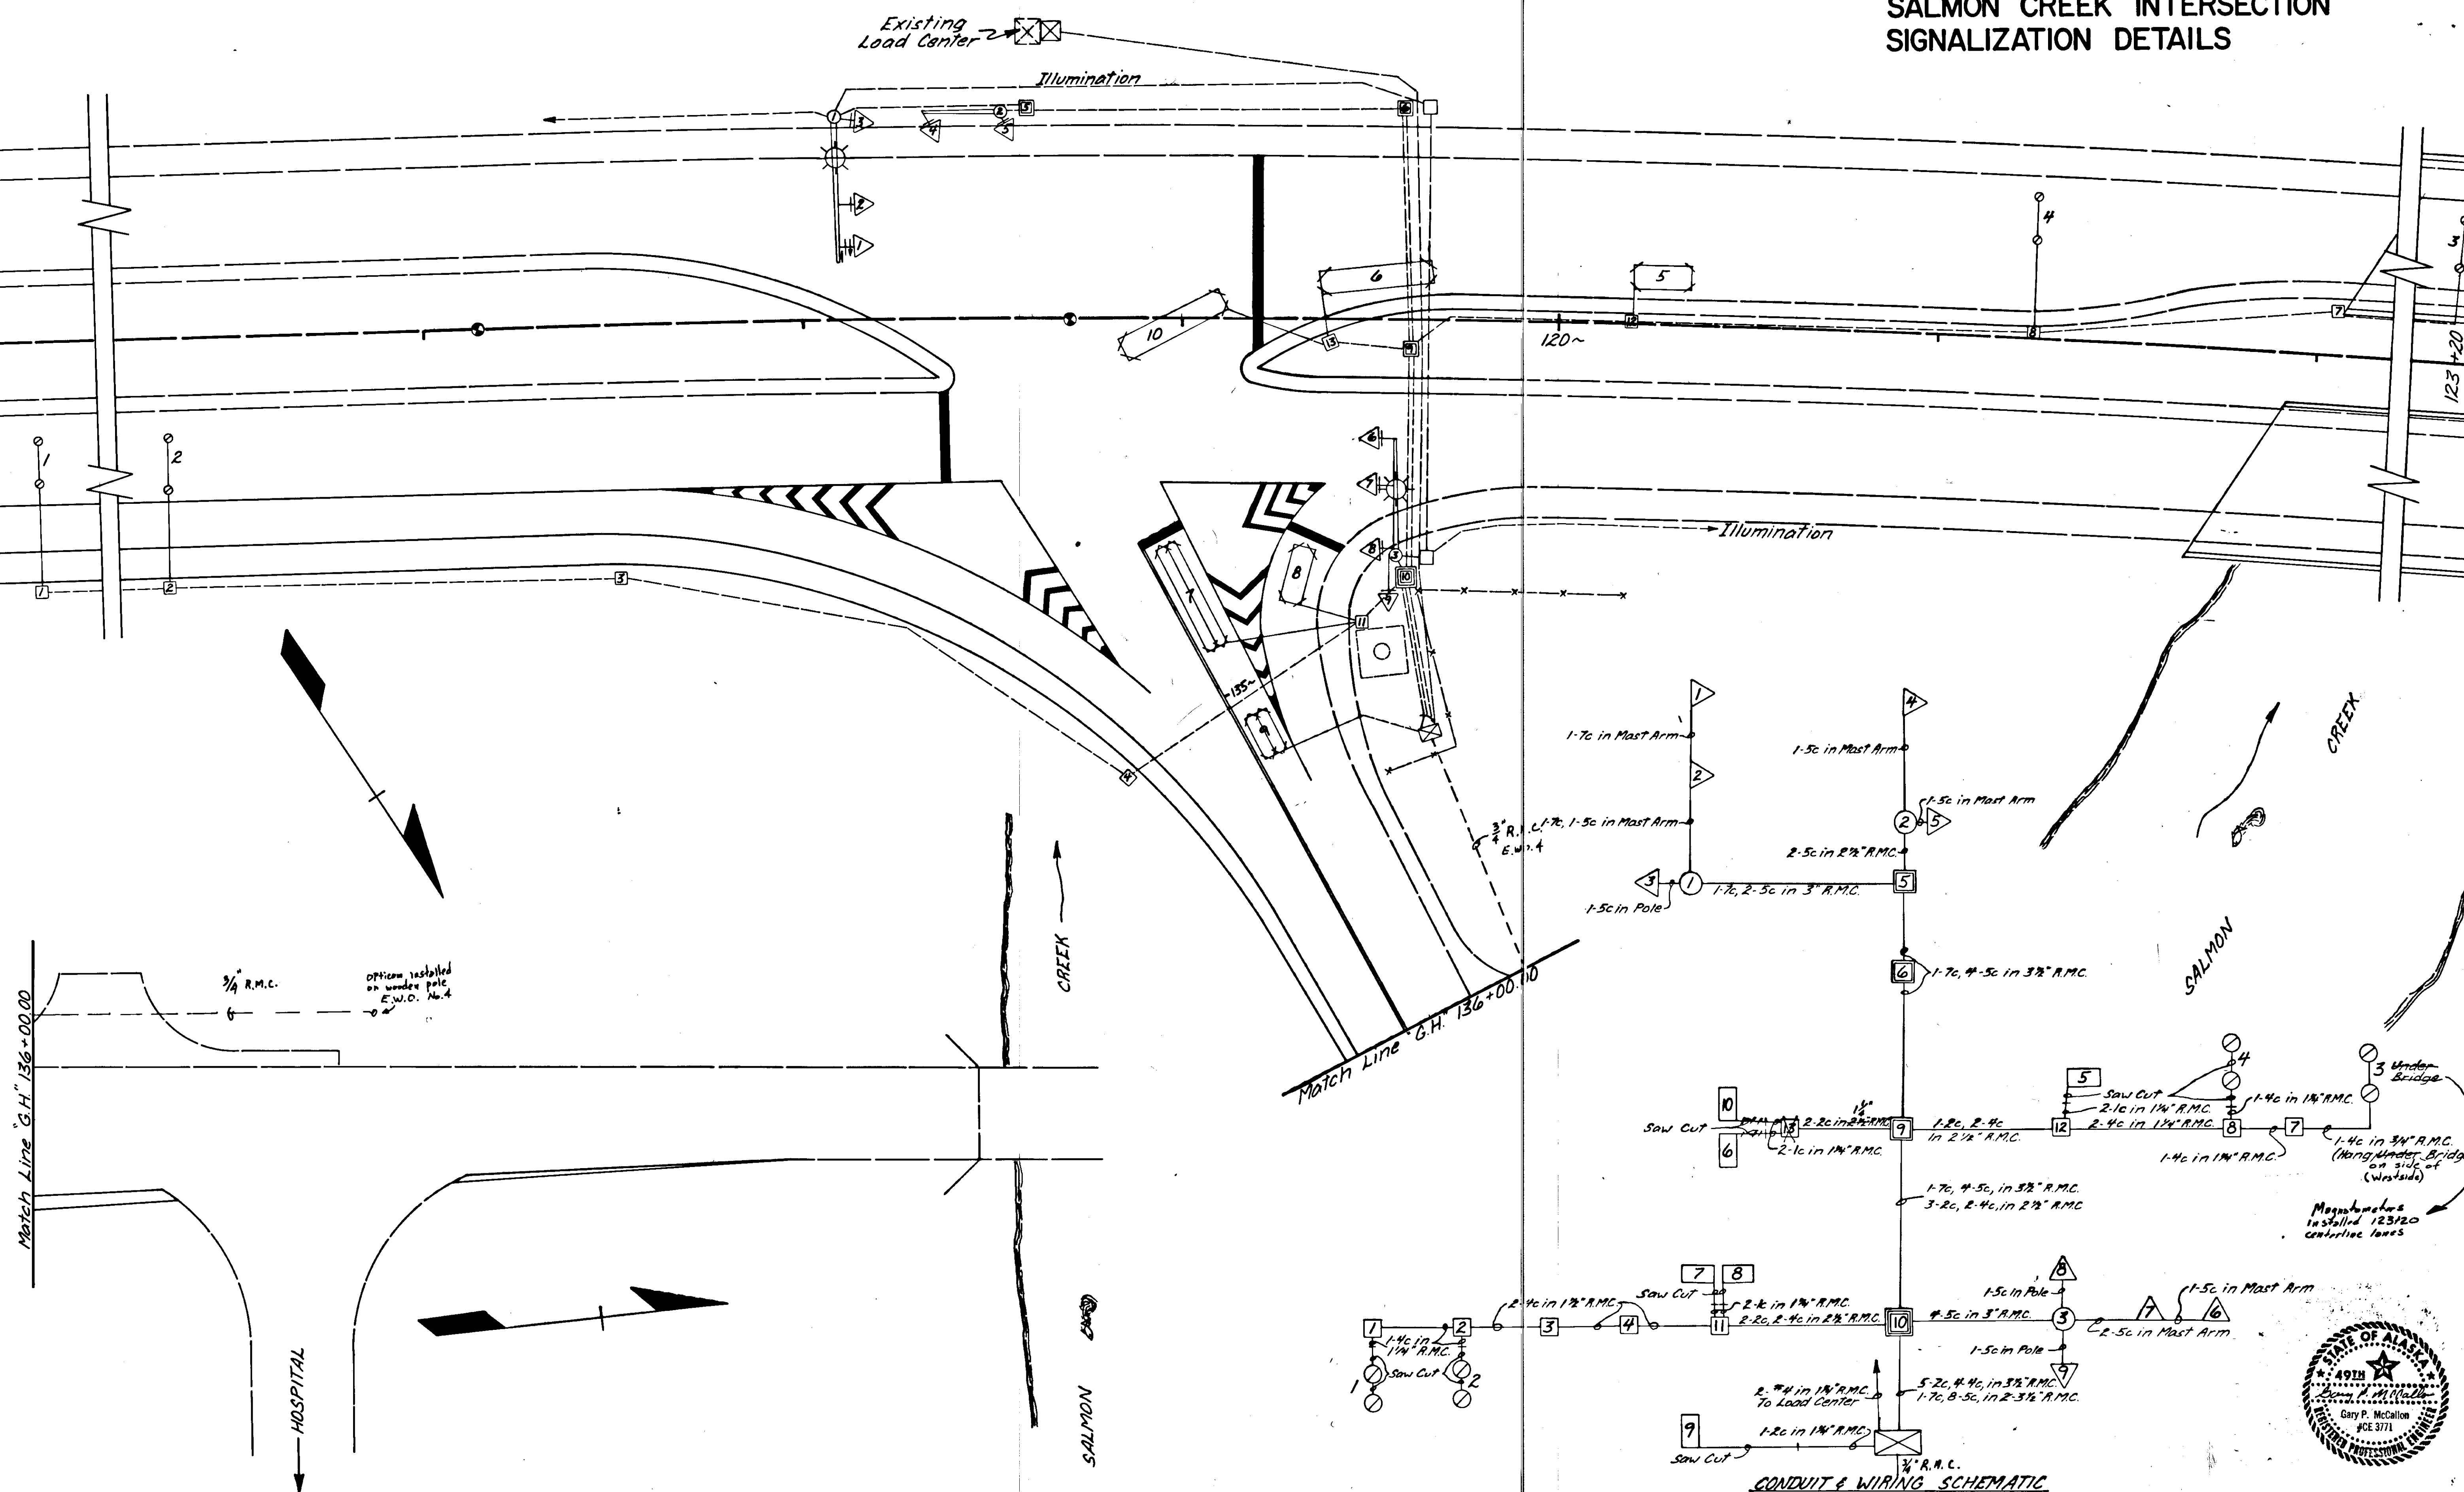

STATE	PROJECT DESIGNATION	YEAR	SHEET NO.	TOTAL SHEETS
ALASKA	F-093-2(9)	1981	19	31

VANDERBILT HILL INTERSECTION SIGNALIZATION DETAILS

ADDENDUM 1, ATTACHMENT 3

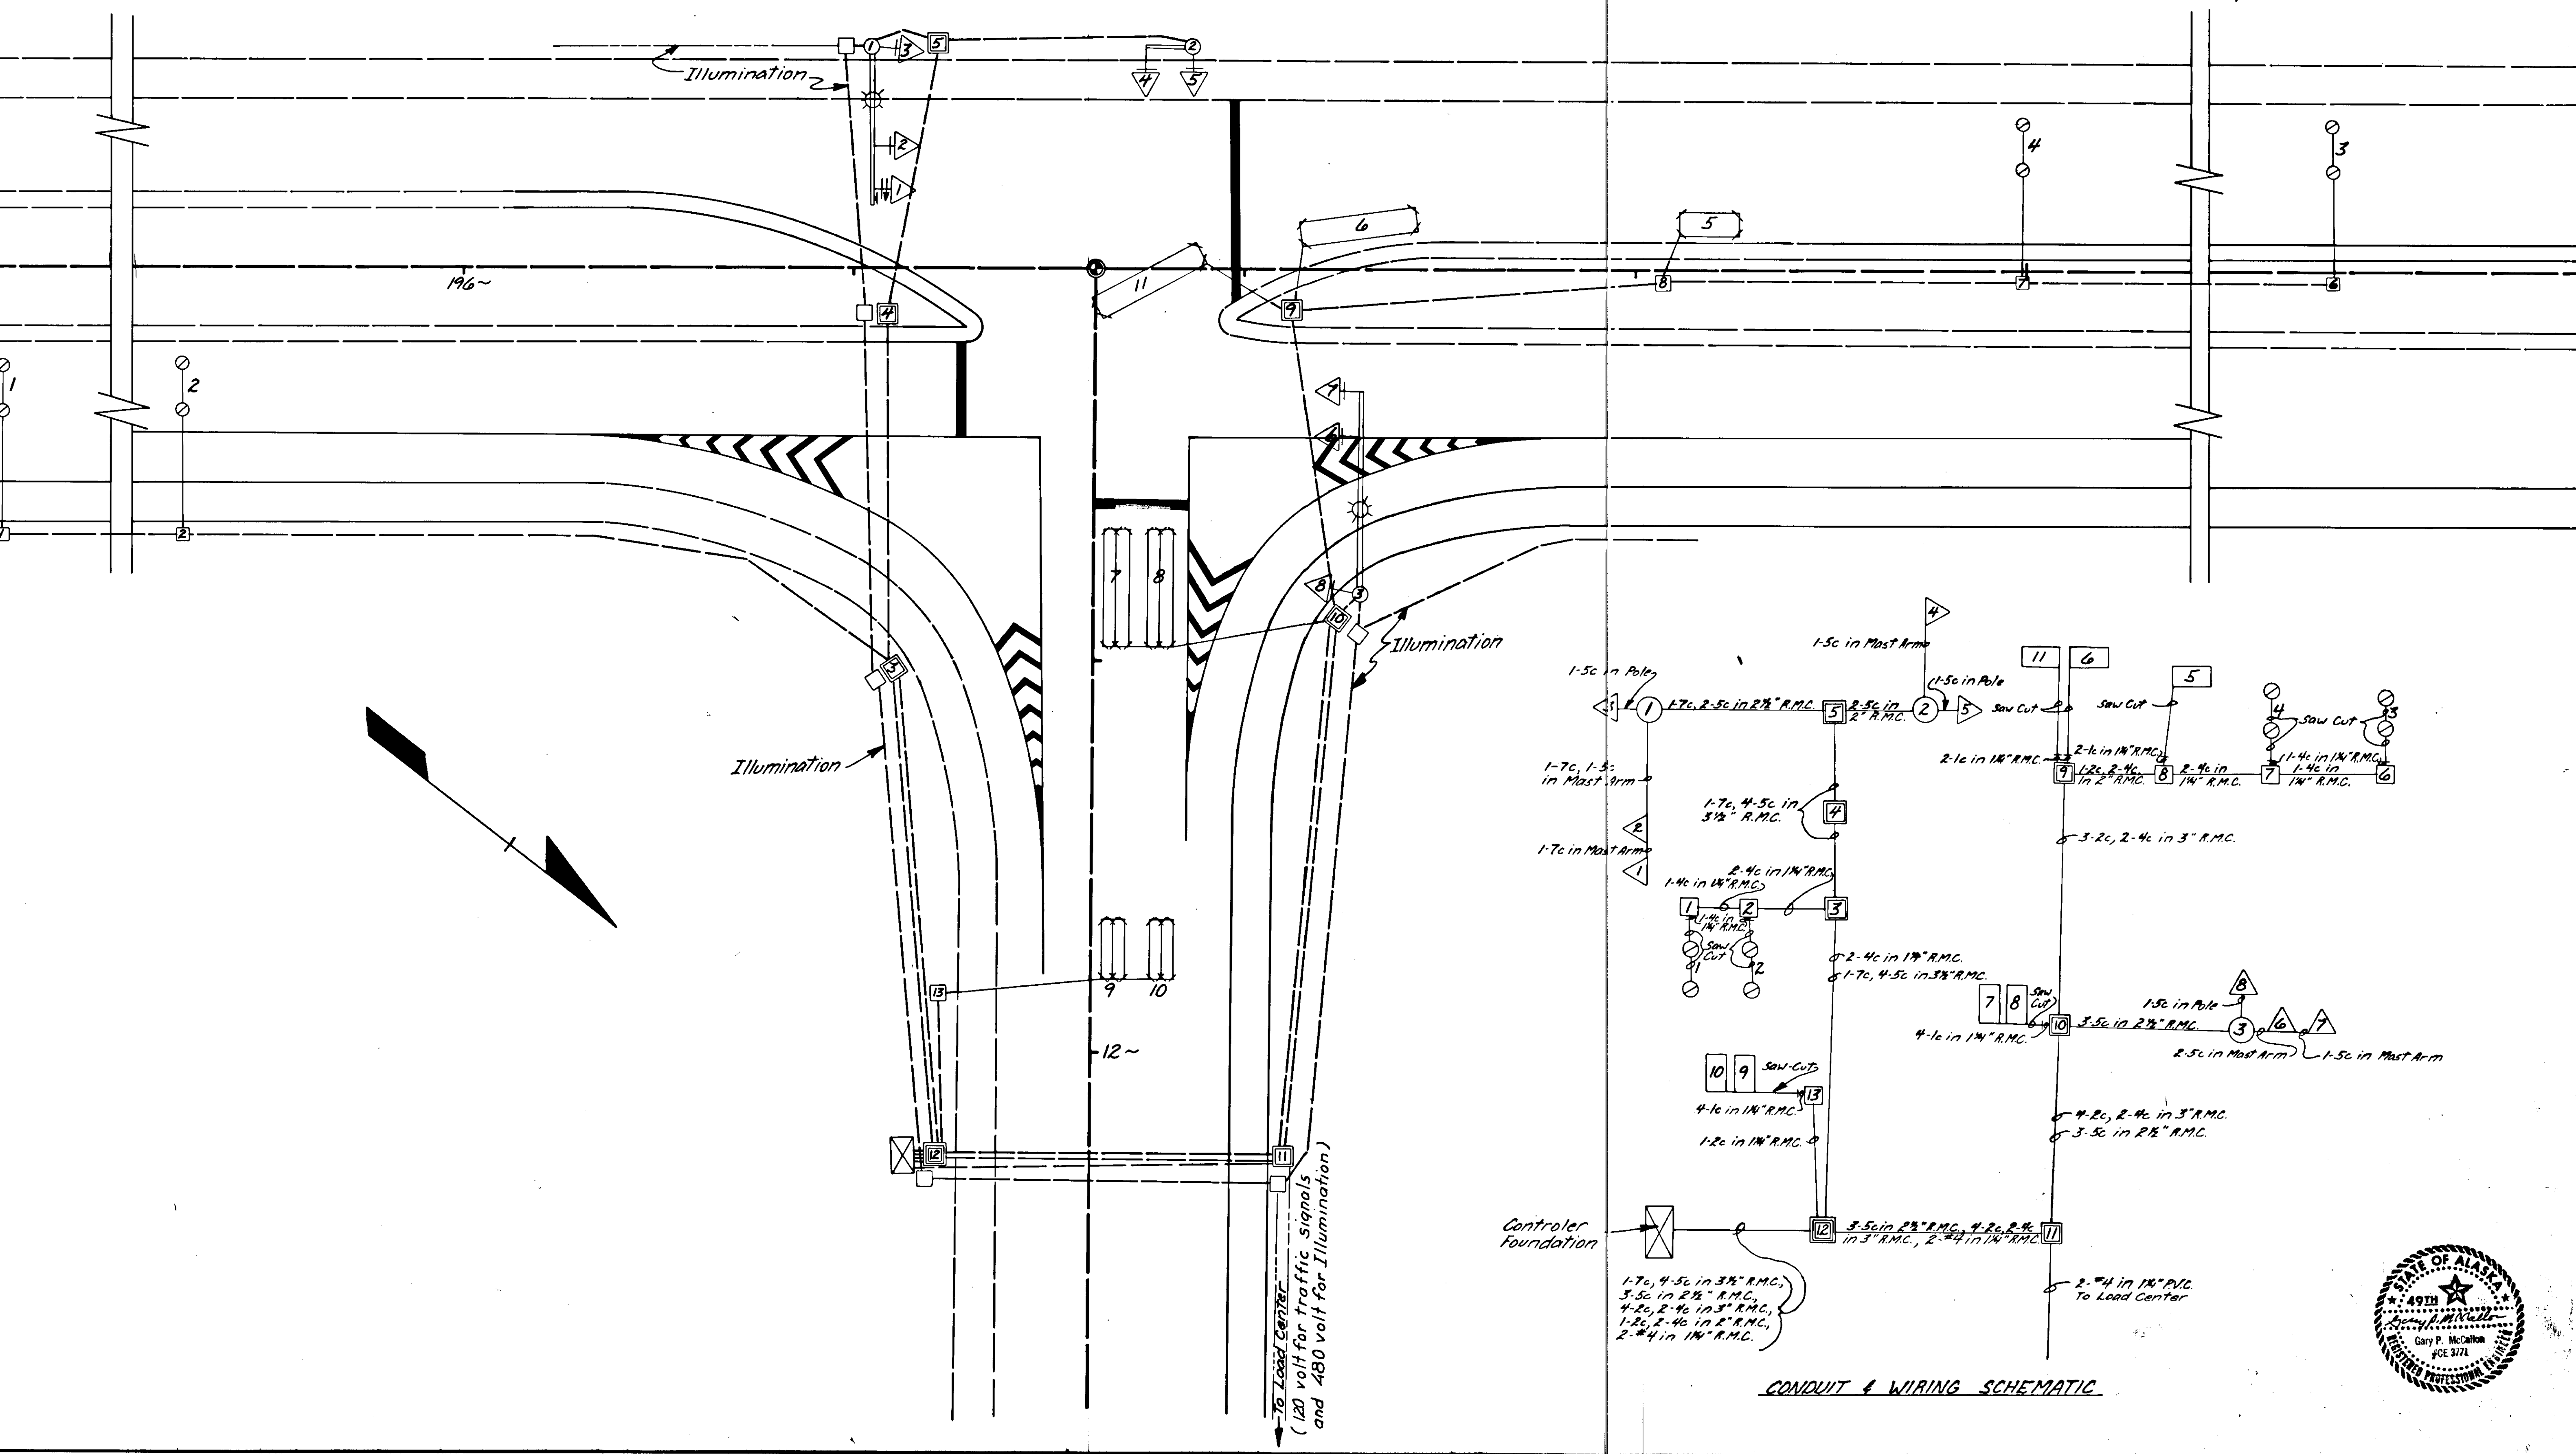

Controller Foundation

1-7c, 4-5c in 3 1/2" R.M.C.
3-5c in 2 1/2" R.M.C.
4-2c, 2-4c in 3" R.M.C.
1-2c, 2-4c in 2" R.M.C.
2-2 1/4 in 1 1/2" R.M.C.

CONDUIT & WIRING SCHEMATIC



SALMON CREEK INTER. Signal Head Schedule

Signal Head	Post	Lens Size	Indications	Type Mounting St. Drawing T 30.00	Phase	Height	Remarks
1	1	12"	R-Y-G-LG+Y*	PLUMBIZER	2+3	16'6"-19'	*See Note on Pole Detail
2	1	12"	R-Y-G	PLUMBIZER	2	16'6"-19'	
3	1	12"	R-Y-G	S-1	2	10'	
4	2	12"	R-Y-G	PLUMBIZER	4	16'6"-19'	
5	2	12"	R-Y-G	S-1	4	10'	
6	3	12"	R-Y-G	PLUMBIZER	1	16'6"-19'	
7	3	12"	R-Y-G	PLUMBIZER	1	16'6"-19'	
8	3	12"	R-Y-G	S-2	1	10'	
9	3	12"	R-Y-G	S-2	4	10'	

VANDERBILT HILL INTER. Signal Head Schedule

1	1	12"	R-Y-G-LG+Y*	PLUMBIZER	1+3	16'6"-19'	*See Note on Pole Detail
2	1	12"	R-Y-G	PLUMBIZER	2	16'6"-19'	
3	1	12"	R-Y-G	S-1	2	10'	
4	2	12"	R-Y-G	PLUMBIZER	4	16'6"-19'	
5	2	12"	R-Y-G	S-1	4	10'	
6	3	12"	R-Y-G	PLUMBIZER	3	16'6"-19'	
7	3	12"	R-Y-G	PLUMBIZER	2	16'6"-19'	
8	3	12"	R-Y-G	S-1	2	10'	

SALMON CREEK INTER. Detector Schedule

NO.	Offset	Station	Type	Phase	Size	Remarks
1	26'-38"	"L" 114+85	Magnetometer Probe	1		
2	26'-38"	"L" 116+35	Magnetometer Probe	1		
3	26'-36"	"L" 123+20	Magnetometer Probe	2		
4	37'-25"	"L" 121+20	Magnetometer Probe	2		
5	12' L	"L" 120+20	Loop	Traffic Counter	6' x 15'	3 Turns-Regular
6	11' L	"L" 119+51	Loop	3	6' x 30'	2 Turns-Regular-Skew 6° - Shall Operate Only During #1 Green
7	3' L	"GH" 134+70	Loop	4	6' x 30'	Quadrupole
8	27' R	"GH" 134+65	Loop	Traffic Counter	6' x 15'	Regular
9	3' L	"GH" 135+14	Loop	Traffic Counter	6' x 15'	Quadrupole
10	2' R	"L" 118+98	Loop	3	6' x 30'	2 Turns-Regular-Skew 27° - Shall Operate Only During #3 Green

VANDERBILT HILL INTER. Detector Schedule

NO.	Offset	Station	Type	Phase	Size	Remarks
1	24'-36"	"L" 193+30	Magnetometer Probes	1		Factory wired in Series
2	24'-36"	"L" 195+30	Magnetometer Probes	1		"
3	36'-24"	"L" 202+00	Magnetometer Probes	2		"
4	36'-24"	"L" 202+00	Magnetometer Probes	2		"
5	11' L	"L" 199+19	Loop	Traffic Counter	6' x 15'	3 Turns Regular
6	10' L	"L" 19+30	Loop	3	6' x 30'	2 Turns-Regular-Skew 8° - Shall Operate Only During #1 Green
7	6' L	"O" 10+82	Loop	4	6' x 30'	Quadrupole
8	18' L	"O" 10+82	Loop	4	6' x 30'	Quadrupole
9	6' L	"O" 11+75	Loop	Traffic Counter	6' x 15'	Quadrupole
10	18' L	"O" 11+75	Loop	Traffic Counter	6' x 15'	Quadrupole
11	3' R	"L" 197+76	Loop	3	6' x 30'	2 Turns-Regular-Skew 28° - Shall Operate Only During #3 Green

SALMON CREEK INTER. Pole & Base Schedule

NO.	Station	Offset	Mast Arm Type	Mast Arm			Footing Type
				K	M	N	
1	"L" 117+97	55' L	Regular	41'	12'	25'	Optional 3'x9'
2	"L" 118+52	53' L	Regular	20'		20'	Optional 3'x9'
3	"L" 119+51	64' R	Regular	30'	12'	18'	Optional 3'x9'
-	"GH" 135+35	45' L	Cabinet Base				Type P-1 Cabinet

VANDERBILT HILL INTER. Pole & Base Schedule

1	"L" 197+05	56' L	Regular	41'	12'	25'	Optional 3'x9'
2	"L" 197+86	56' L	Regular	12'			Optional 3'x9'
3	"L" 198+30	83' R	Regular	50'	12'	38'	Spread Footing
"O"	12+26	47' R	Cabinet Base				Type P-1 Cabinet

SALMON CREEK INTER. Junction Box Schedule


NO.	Station	Offset	Type
1	"L" 114+35	65' R	I
2	"L" 116+35	65' R	I
3	"L" 117+50	65' R	I
4	"GH" 135+05	40' R	I
5	"L" 118+60	54' L	II
6	"L" 119+60	53' L	II
7	"L" 122+02	10' L	I
8	"L" 121+20	2' L	I
9	"L" 119+60	7' R	II
10	"L" 119+60	68' R	III
11	"GH" 135+00	40' R	I
12	"L" 120+20	0'	I
-13-	"L" 119+38	-7' R	-I-

VANDERBILT HILL INTER. Junction Box Schedule

1	"L" 193+30	67' R	I
2	"L" 195+30	67' R	I
3	"L" 197+10	102' R	II
4	"L" 197+10	8' R	II
5	"L" 197+23	56' L	II
6	"L" 202+00	2' R	I
7	"L" 200+00	2' R	I
8	"L" 199+10	2' R	I
9	"L" 198+12	10' R	II
10	"O" 10+89	63' L	II
11	"O" 12+27	49' L	II
12	"O" 12+26	38' R	III
13	"O" 11+85	37' L	I


LIGHT EMITTER EMERGENCY VEHICLE PREEMPTOR TABLE

INTERSECTION	DIRECTIONS PREEMPTED (B.=BOUND)			
	Egan Dr. W.B. & Left Turn	Egan Dr. E.B. & Left Turn	Loop Rd. N.B.	Loop Rd. S.B.
Mendenhall Loop Rd. & Egan Drive				
Vanderbilt Hill Rd. & Egan Drive	Egan Dr. N.W.B.	Egan Dr. S.E.B. & Left Turn	Vanderbilt Hill Rd. S.W.B.	
Salmon Creek (Glacier Hwy.) & Egan Drive	Egan Dr. N.W.B.	Egan Dr. S.E.B. & Left Turn	Glacier Hwy. S.B.	see E.W.O.B.
Main Street & Egan Drive	Egan Dr. W.B.	Egan Dr. E.B. & Left Turn	Main St. S.B.	see E.W.O.B.

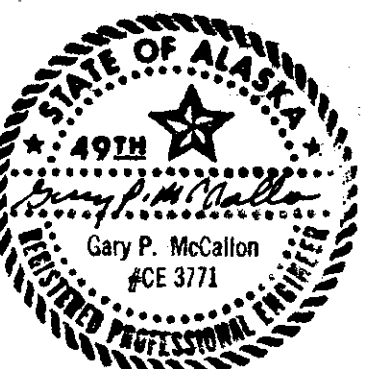


STATE	PROJECT DESIGNATION	YEAR	SHEET NO.	TOTAL SHEETS
ALASKA	F-093-2(9)	1981	21	31

VANDERBILT HILL & SALMON CREEK INTERSECTIONS
EGAN EXPRESSWAY SOUTHBOUND
SIGNAL INSTALLATION DETAIL
POLE NOS. 1 & 1

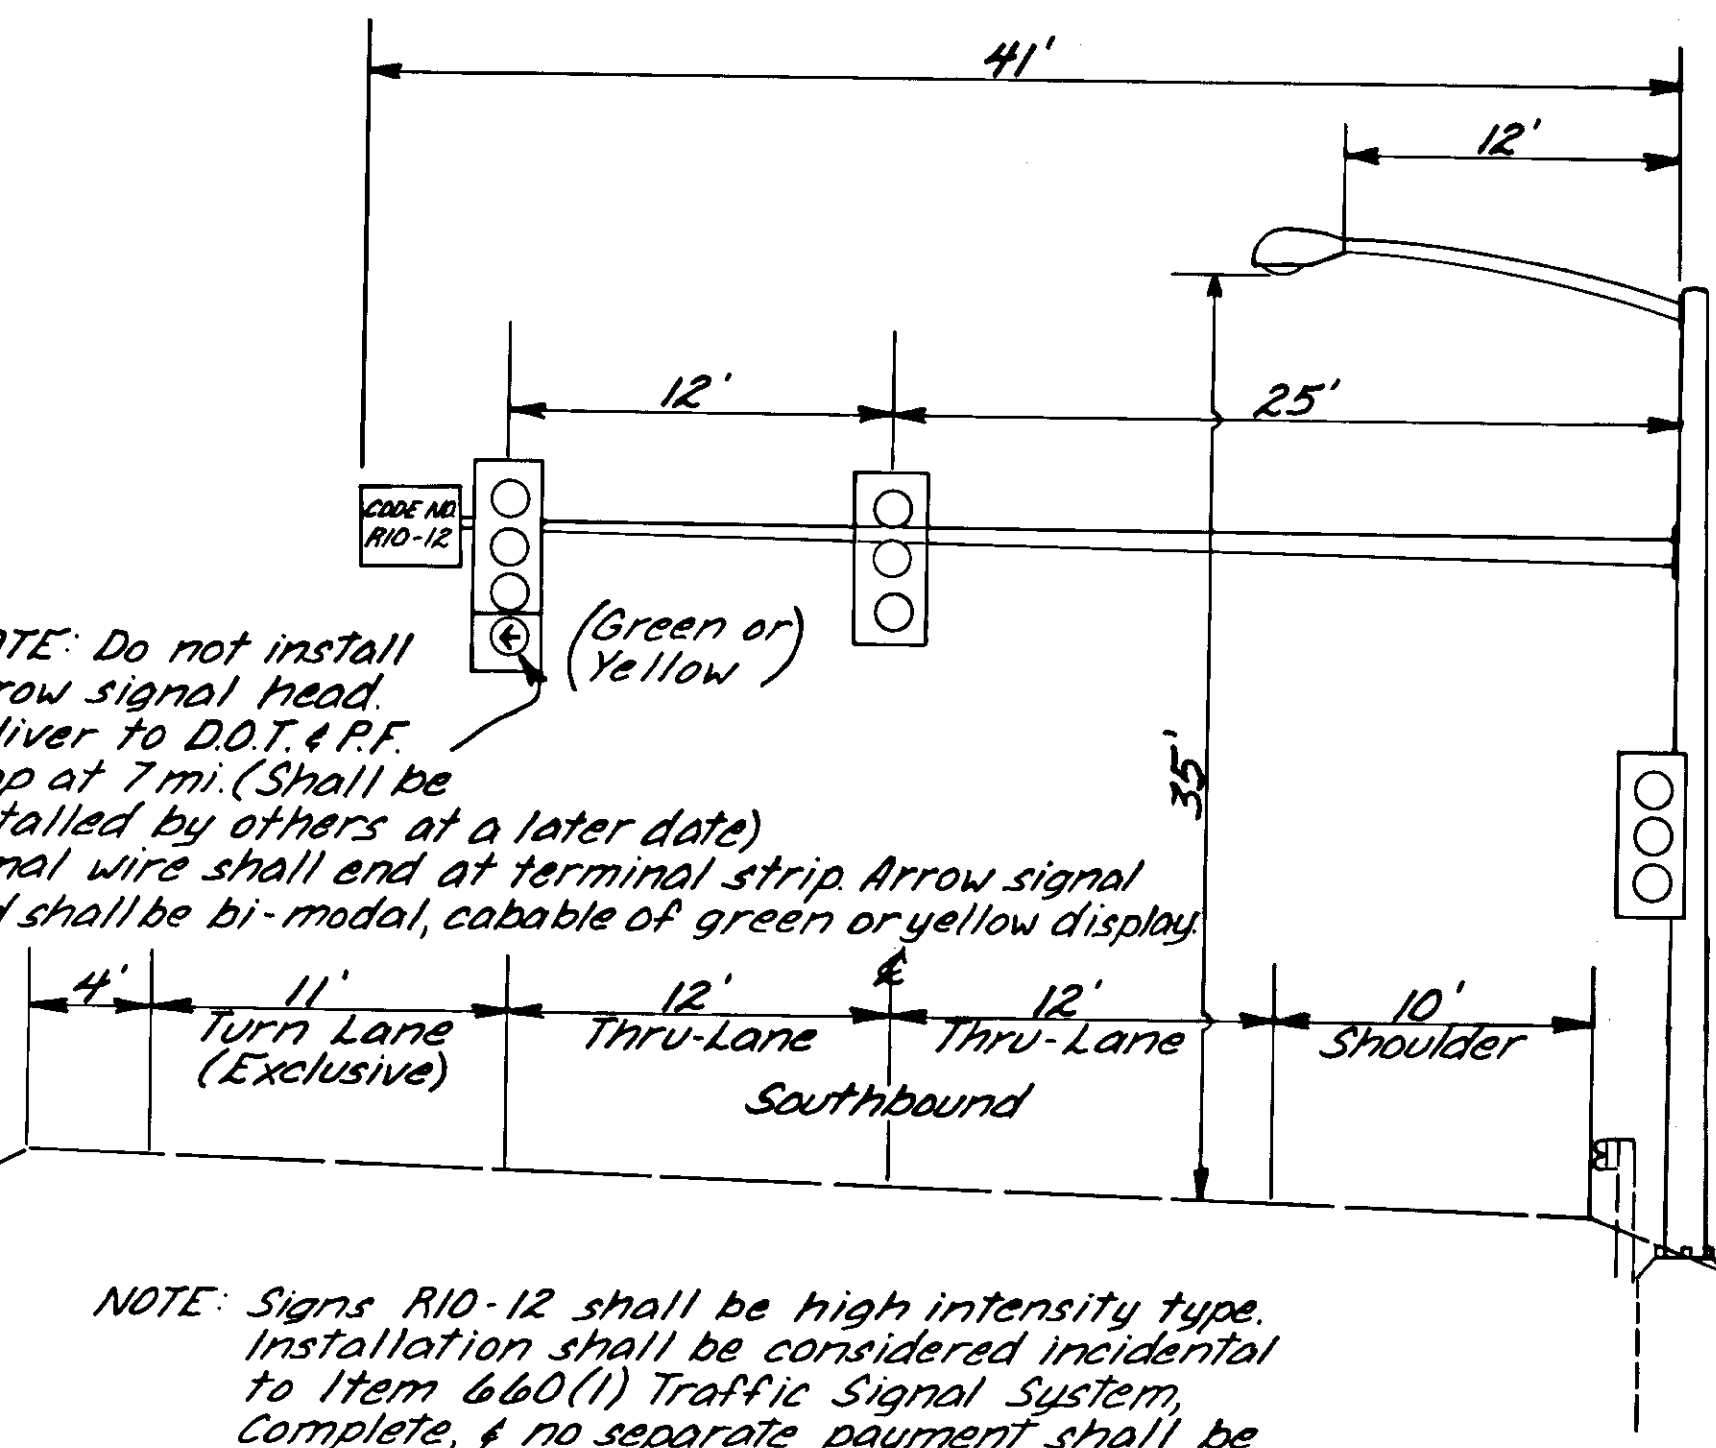


LOAD CENTER DETAIL
BOTH SIGNALS

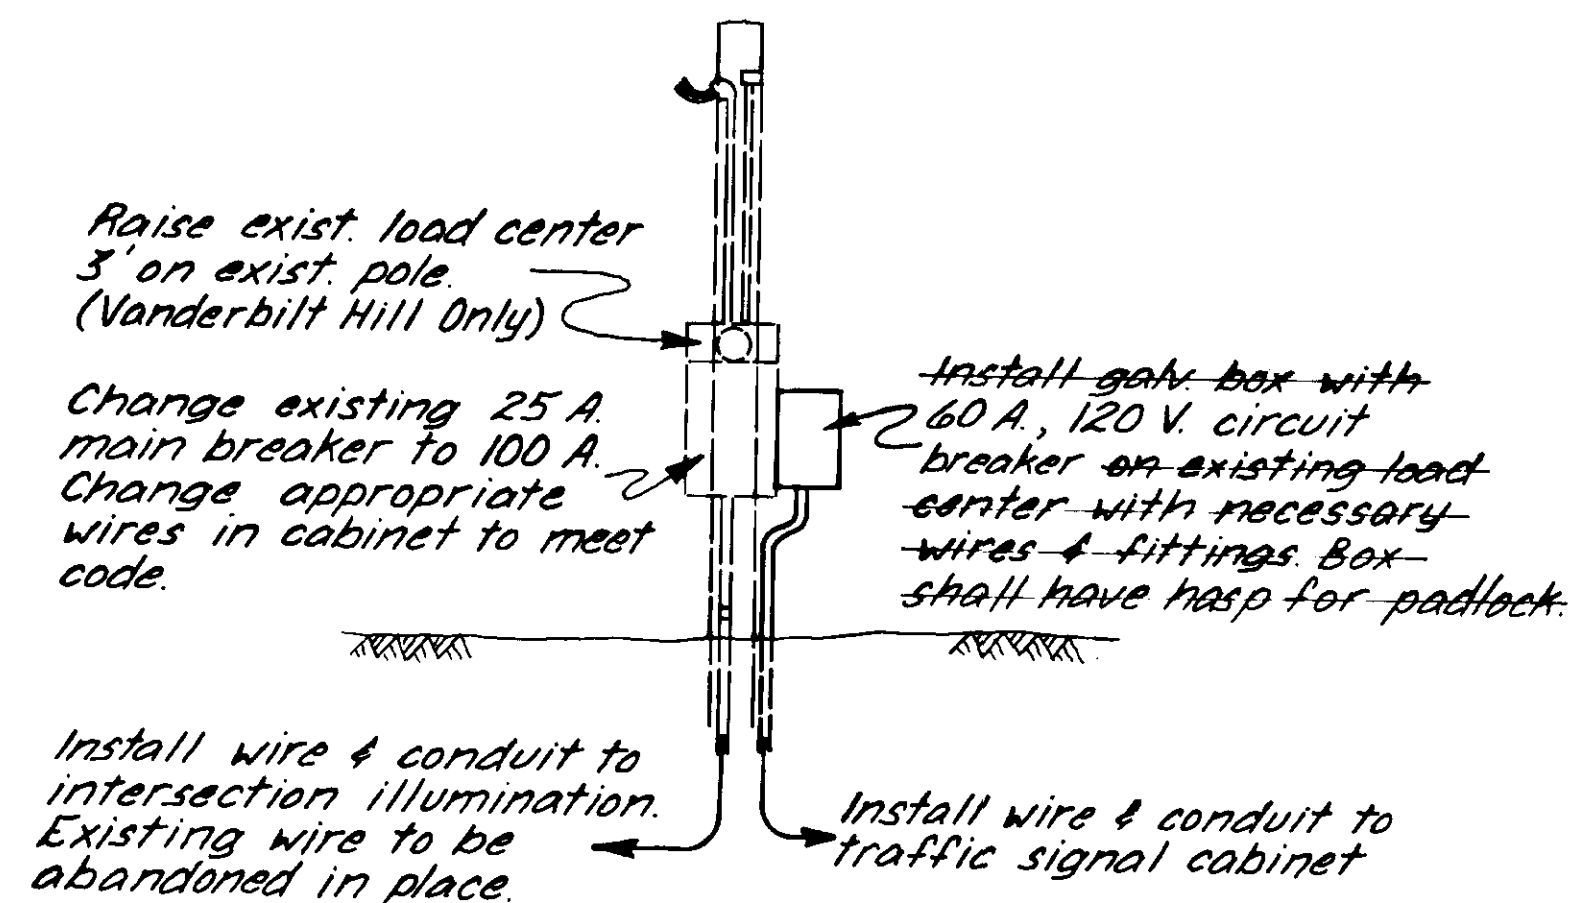

Load Center Locations
Salmon Creek Inter. = L' 118+60, 75' Lt.
Vanderbilt Hill Inter. = A' 26+33, 140' Rt.


PHASE DIAGRAM
BOTH SIGNALS

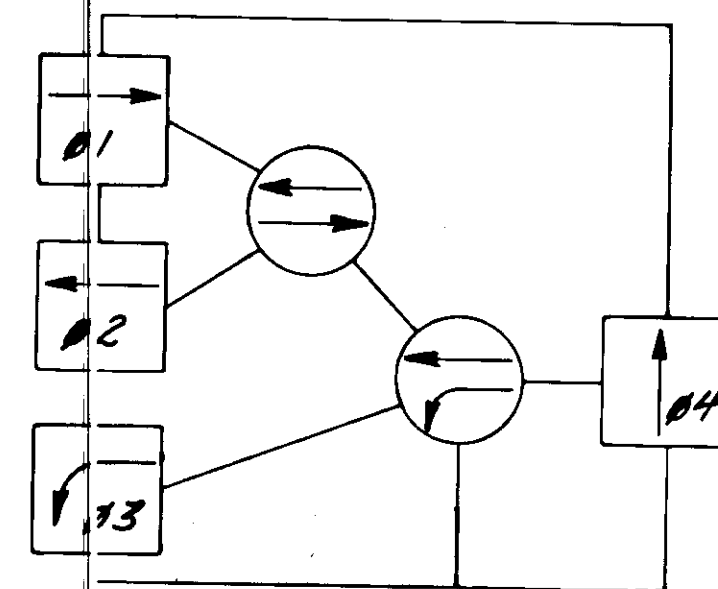


NOTES: 1. #3 & #4 shall be traffic actuated.
2. #1 & #2 shall have modified density.
3. #3 yellow clearance shall not be displayed when followed by #2. Red it shall be displayed when #2 Green continues & #3 terminates.

VANDERBILT HILL & SALMON CREEK INTERSECTIONS
GENERAL SIGNALIZATION NOTES

- All conduit shall be drilled & jacked under all existing pavement to remain in place.
- Each signal head shall have its own "home run" cable.
- All conduit shall be sloped to drain.
- Minimum conduit elevation shall be 21.0' (Extreme High Tide).
- Controller shall have 8 @ capability, be fully actuated with volume density, be operator push-button programmable, & have L.E.D. function and timing indicators. (Honeywell H.M.P. 290 or equal).
- Design wind load for Signal Poles & Mast Arms shall be 100 MPH.
- All conduit shall be Rigid Metal Conduit of a size as shown on the plans.
- The cabinet shall have "Manual Phase Selector Controls" as described in Section 660-3.05 of the Standard Specifications.
- Flash shall be yellow to Egan Drive North & South bound movements. All other signals shall flash red, except arrows, which shall be black.
- All traffic signal equipment, including, but not limited to, Controller, Cabinet, Signal Heads, Detectors, & Amplifiers shall conform to N.E.M.A. Standard's Publication No. T.S.I.-1976 "Traffic Control Systems". Poles & Mast Arms shall be designed to M.A.S.H.T.O. Specifications.
- Loop amplifiers shall have 2 detection channels, with one thumb wheel switch per channel to select pulse or presence & sensitivity, a frequency switch to allow oscillator frequency selection, reset circuit breaker, & be self tuning. Output to be relay with fail in call position. (Canoga Controls Corp. Proximitor P402RT or equal). #3 amps. shall have call delay feature.
- Probe detector amplifiers shall be Canoga Controls Corp. Proximitor P-202-RC or equal.
- Probes under Salmon Creek Bridge shall be placed in non-ferrous protective containers. Exact placement of probes shall be selected by use of a Magnetic Field Analyzer.
- Arrow signals in heads 1 & 1 shall be installed at a later date. They shall be stockpiled at the D.O.T. & P.F. Shop at 6 1/2 mile Glacier Highway until needed.
- Signal shall have the capability of operating as a two phase #1 & #2 as one @ and #4 as the other, as well as being able to be switched to lagging left turn when needed, on #3.
- All locations are approx. only & are subject to minor revisions by the project engineer.
- Controllers shall have coordination capability. It shall be by wireless time-of-day & have 4 cycle lengths with 3 offsets & splits per cycle.
- Both signals shall be equipped with a light emitting emergency vehicle preemptor as specified in the supplemental specifications. In addition, 2 emergency vehicle preemptor systems shall be installed on existing signals as shown in the table on sheet 20. As-Built drawings will be available to the contractor for the 2 existing signals.

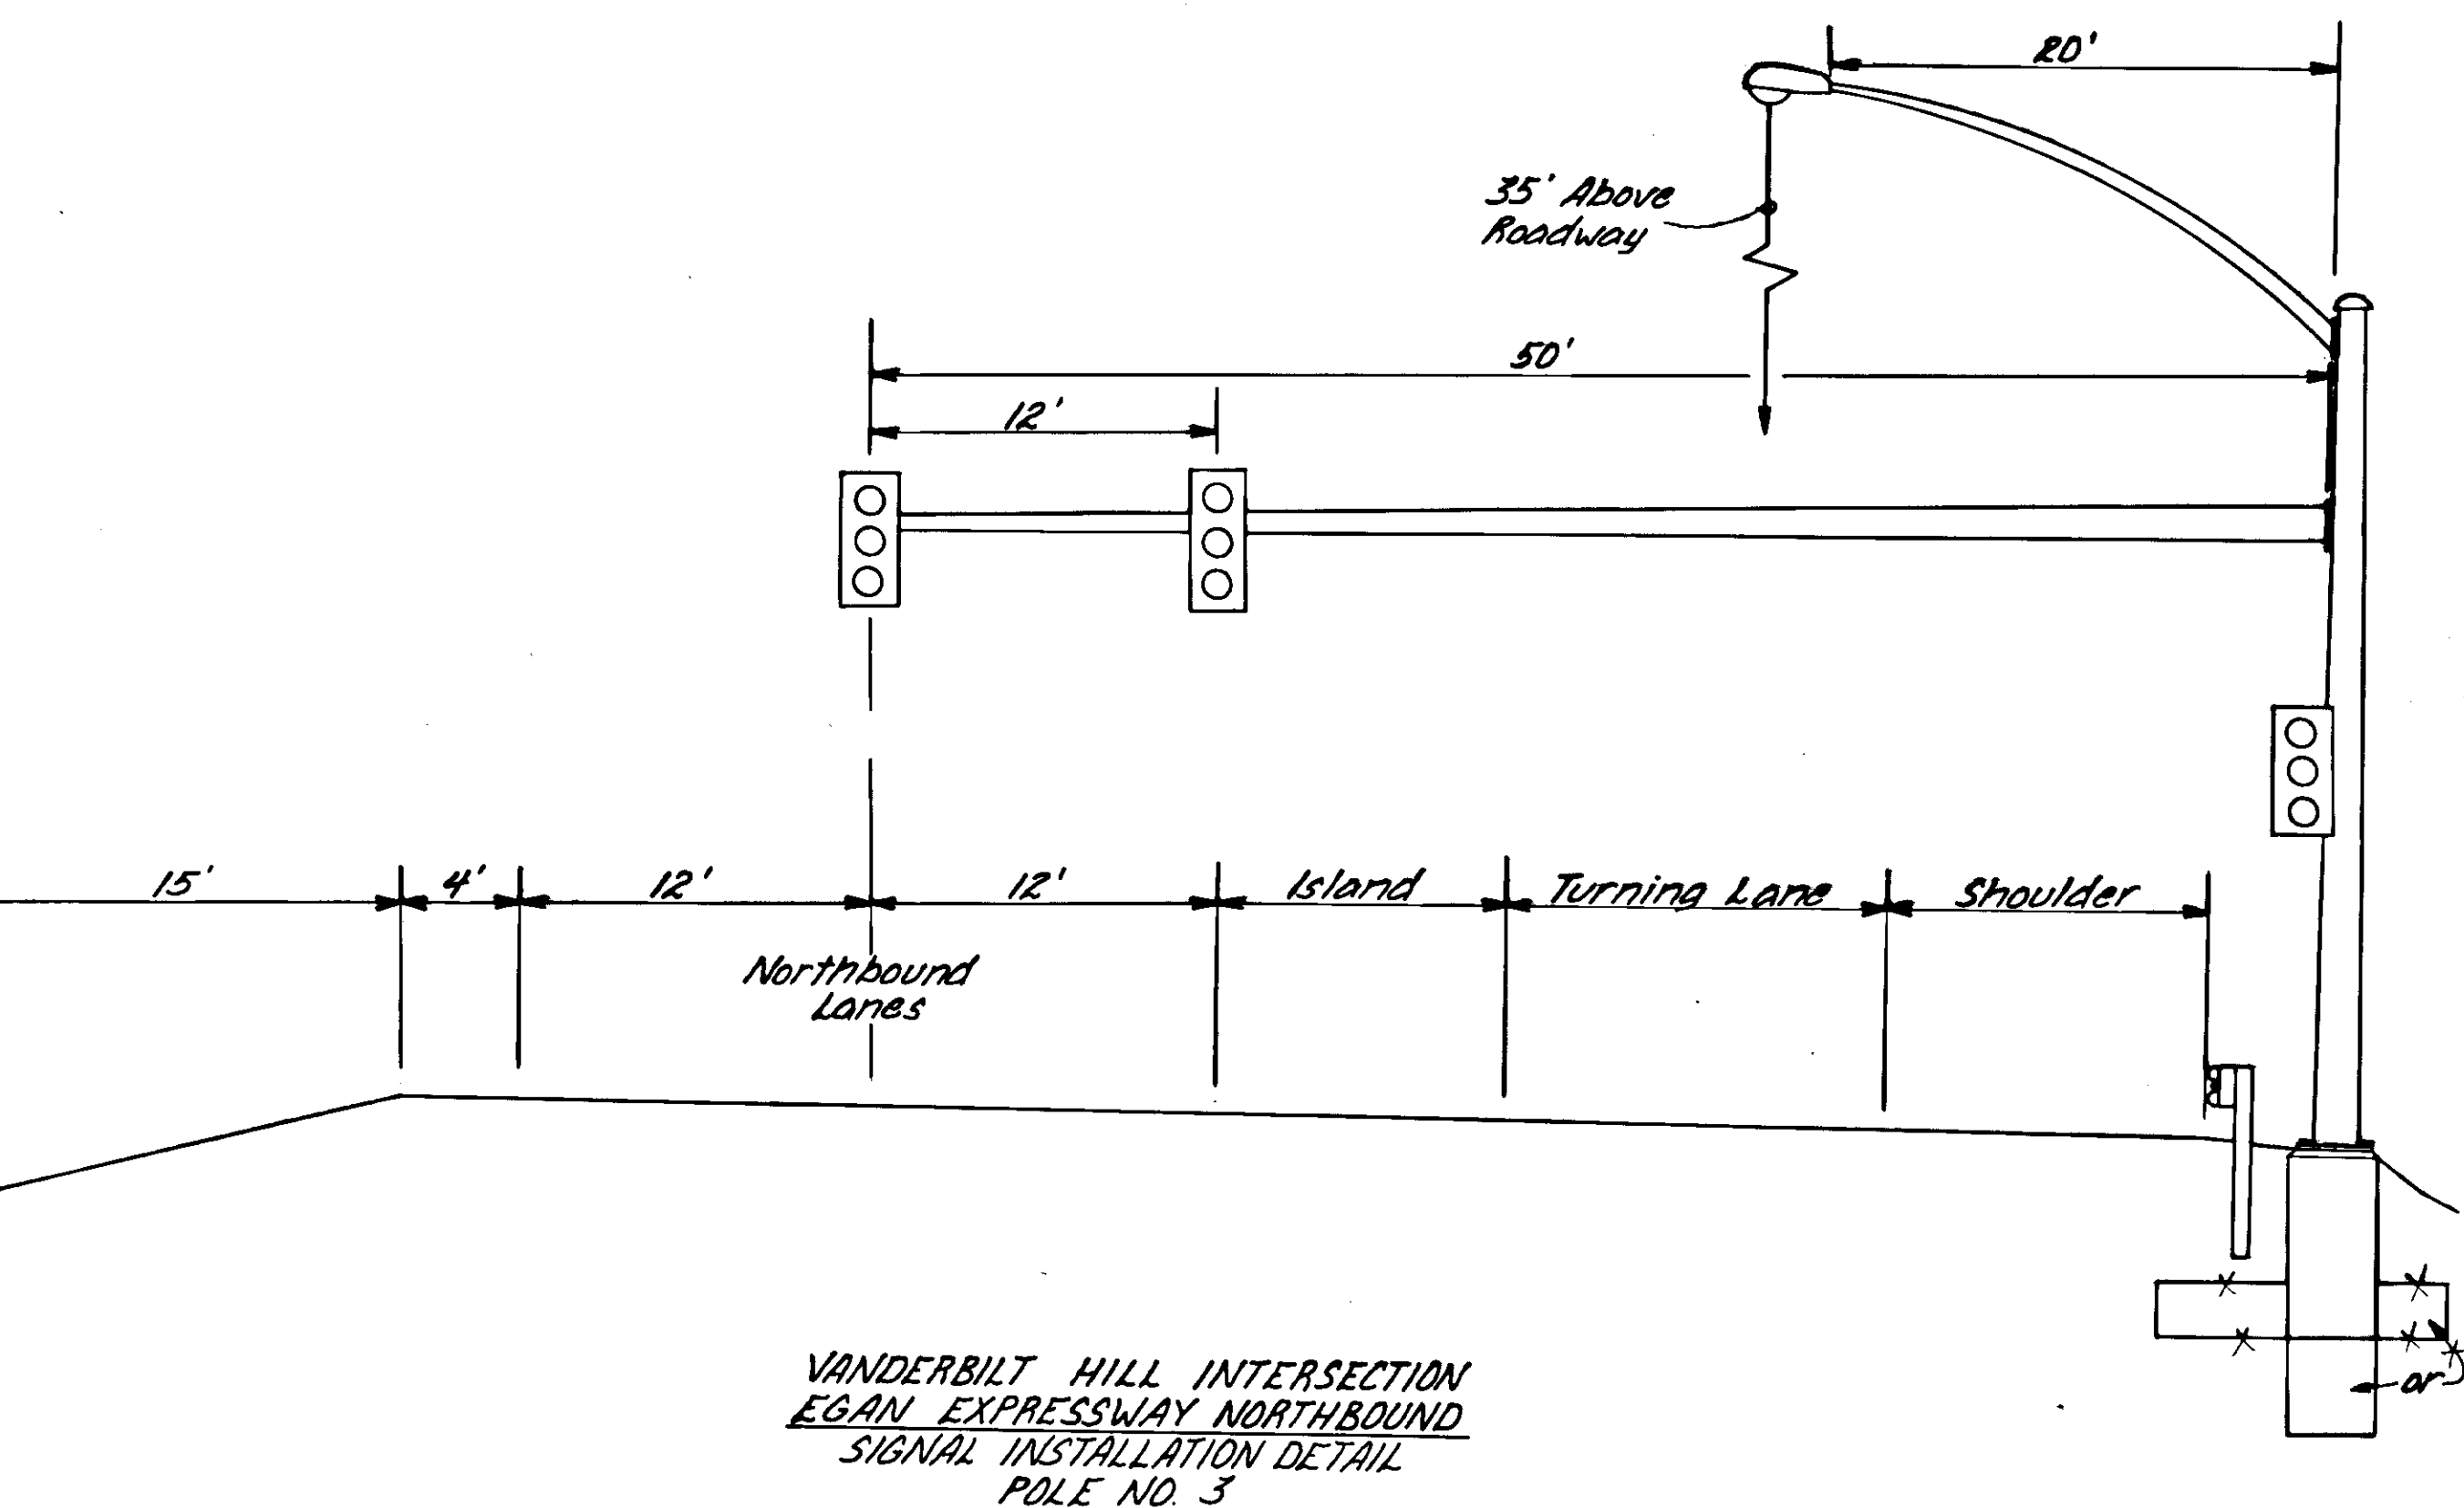


VANDERBILT HILL INTERSECTION
EGAN EXPRESSWAY NORTHBOUND
SIGNAL INSTALLATION DETAIL
POLE NO. 3

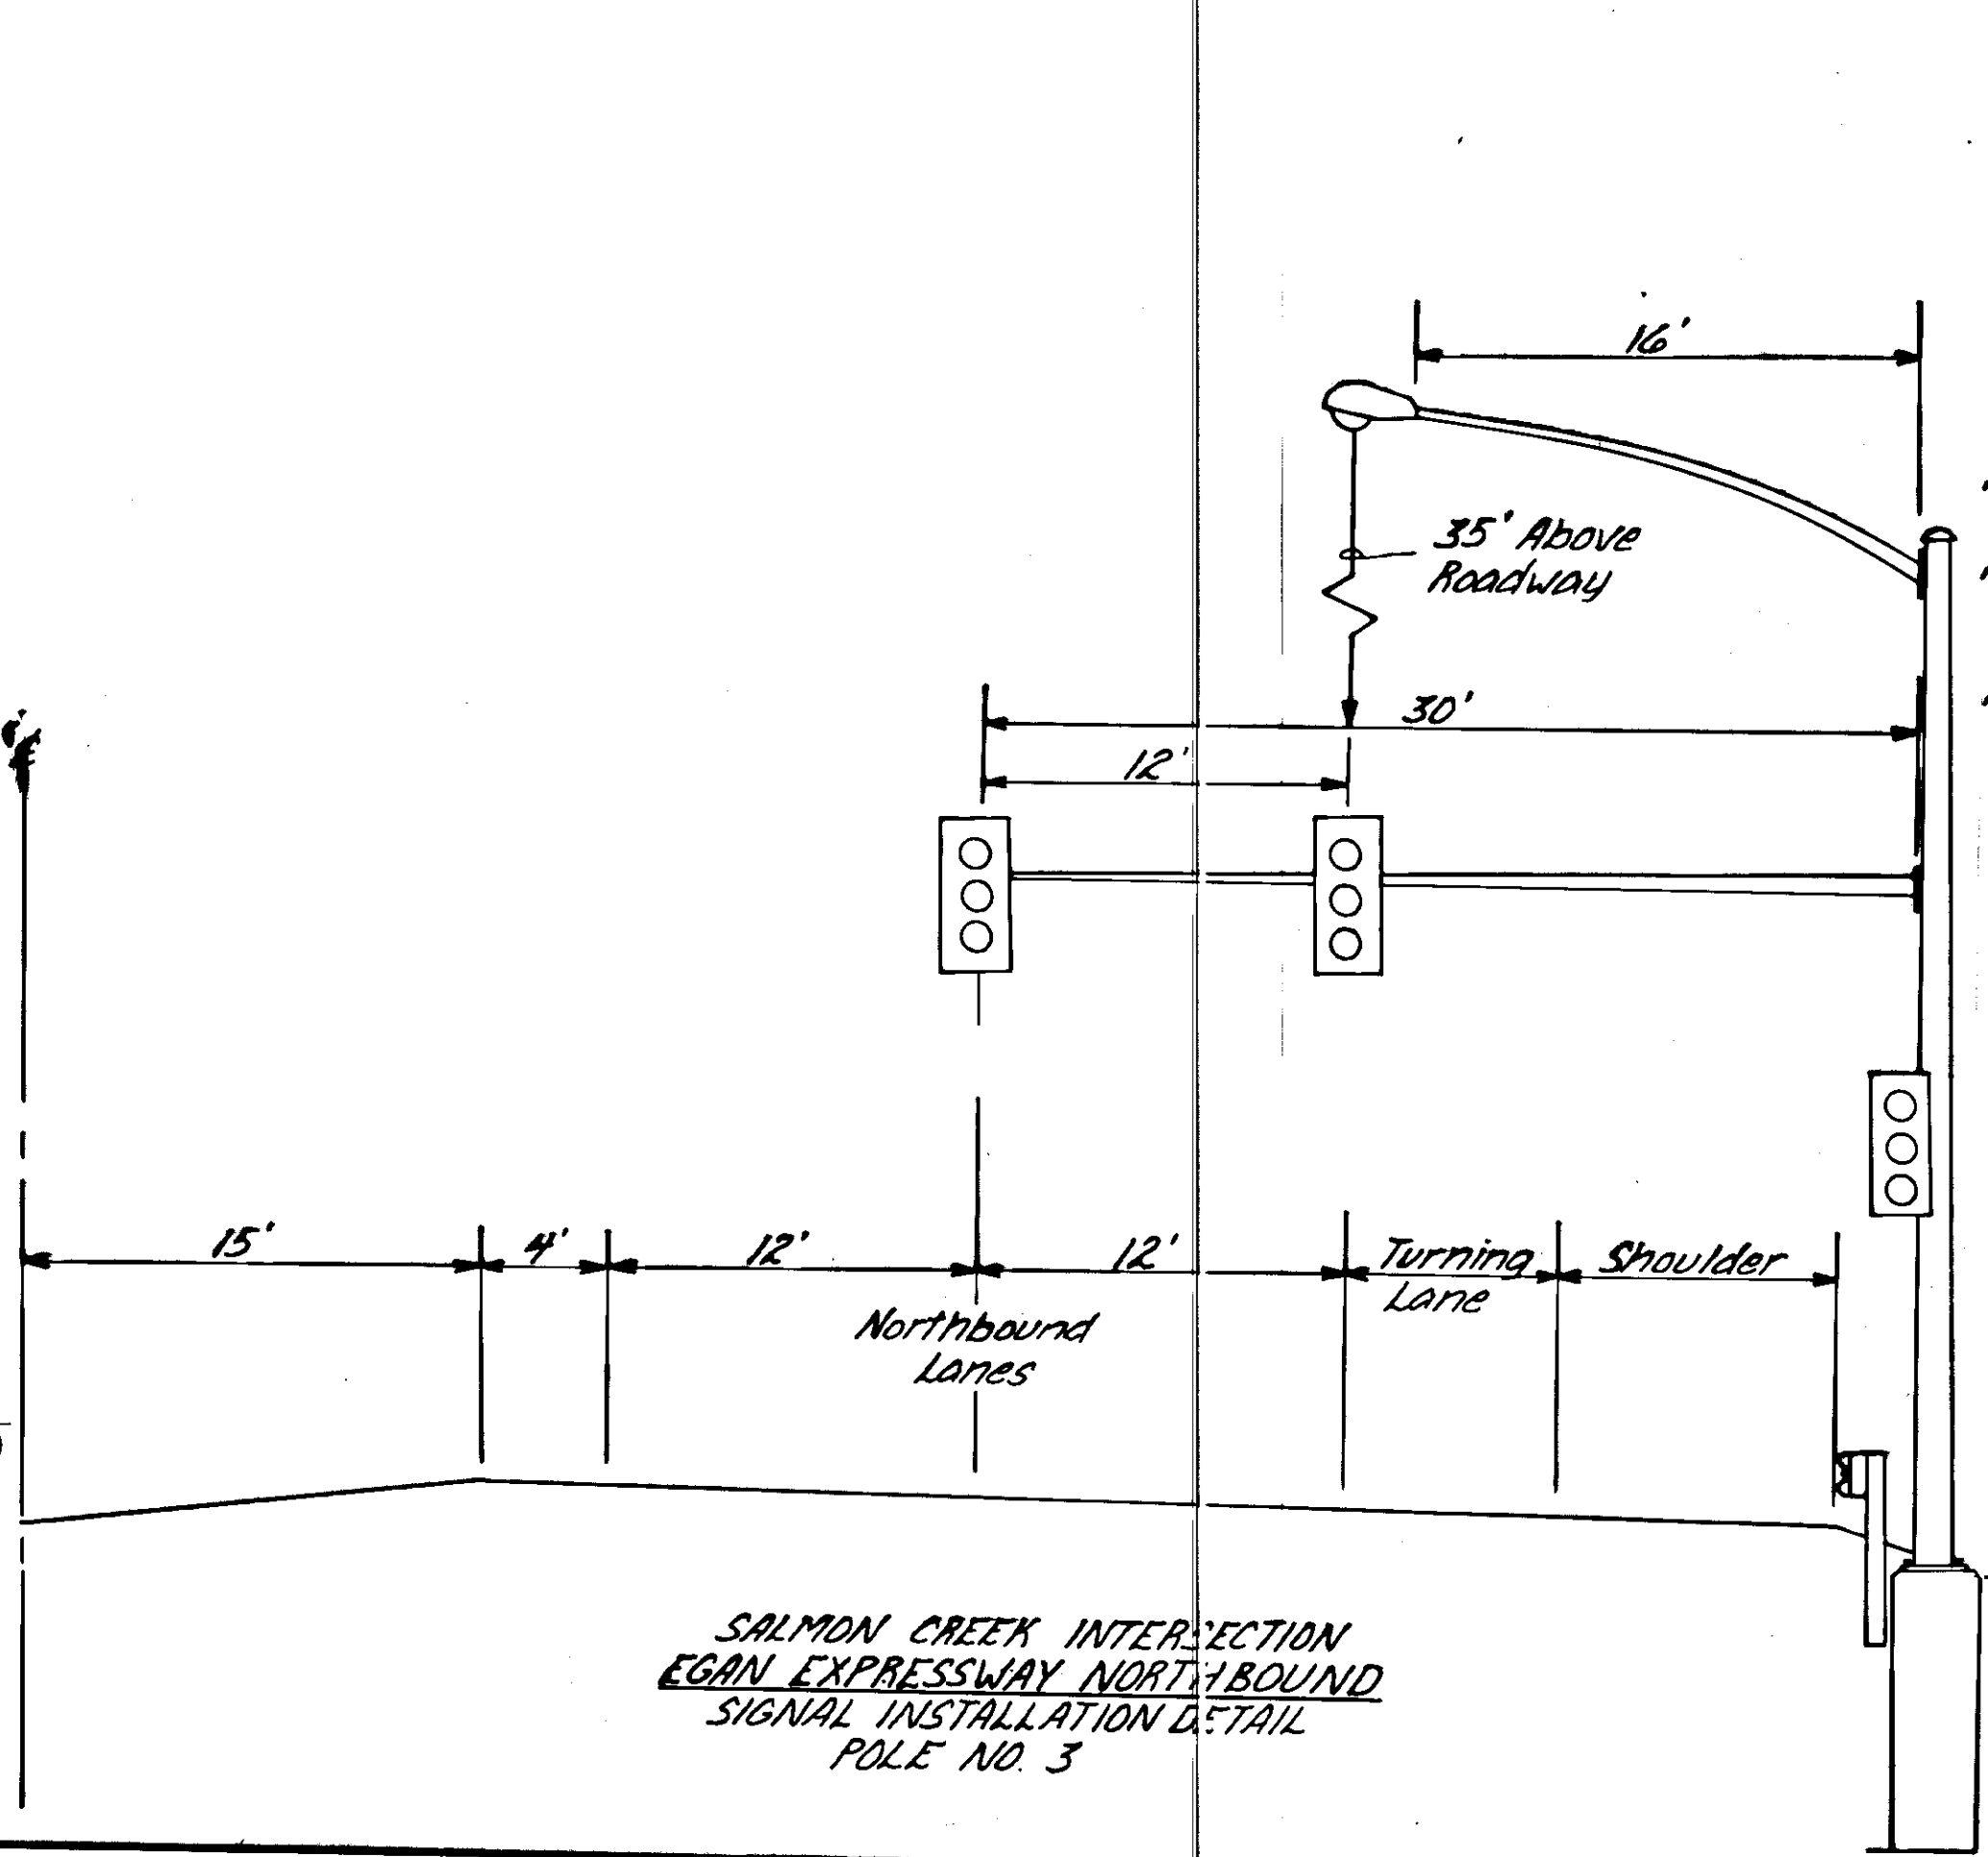

SALMON CREEK INTERSECTION
EGAN EXPRESSWAY NORTHBOUND
SIGNAL INSTALLATION DETAIL
POLE NO. 3

Pole No. 2 = 20' @ Salmon Cr.
Pole No. 2 = 12' @ Vanderbilt

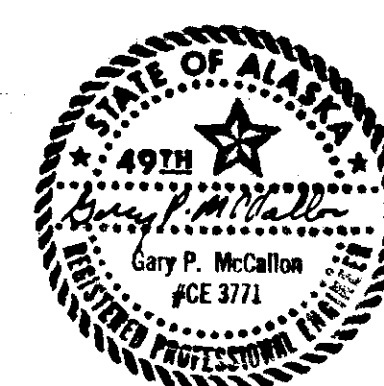


VANDERBILT HILL & SALMON CREEK INTERSECTIONS
SIGNAL INSTALLATION DETAIL
POLE NOS. 2 & 2

STATE	PROJECT DESIGNATION	YEAR	SHEET NO.	TOTAL SHEETS
ALASKA	F-093-2(9)	1981	22	31

TRAFFIC CONTROL PLAN

- At the Salmon Creek Bridge, provide portable concrete barriers along the edges of deck after bridge railing is removed. Barriers shall be continuous over bridge & extend 50' beyond each end of bridge. Each 50' end shall be tapered back from the traveled way in a parabolic shape with 4' min. offset. Payment for the portable conc. barriers shall be incidental to Item 115(1) Traffic Maintenance.
- 2-lane traffic shall be maintained from 7:00 AM to 9:00 AM Southbound & 4:00 PM to 6:00 PM Northbound on Egan Drive, Monday through Friday.
- 1-lane through traffic shall be maintained at all times, both Northbound & Southbound on Egan Drive.
- During & for 3 calendar days following the casting of the Salmon Creek Bridge deck, all vehicles in excess of 5 tons GVW not required for the casting work shall be detoured around the bridge along the Old Glacier Highway. This detouring of traffic shall be in accordance with and paid for under Section 115 of the specifications.
- Prior to all work on roadways & prior to all closures & detours, the contractor shall submit to & receive back from the project engineer, an approved detailed traffic control plan. The plan shall show the exact location of all signs, barricades, cones, flagpeople, & other traffic control devices.
- The contractor shall designate at least one employee to maintain & continuously monitor the condition & placement of all traffic control devices during roadway work operations. This employee shall have no other duties. Any traffic control devices in place on the roadway during non-working hours shall also be maintained.
- Additional speed advisory signs may be required adjacent to the work area.
- No detours and/or closed intersections shall be allowed from 7:00 AM to 9:00 AM & 4:00 PM to 6:00 PM, Monday through Friday. Except as outlined in note 3 above.

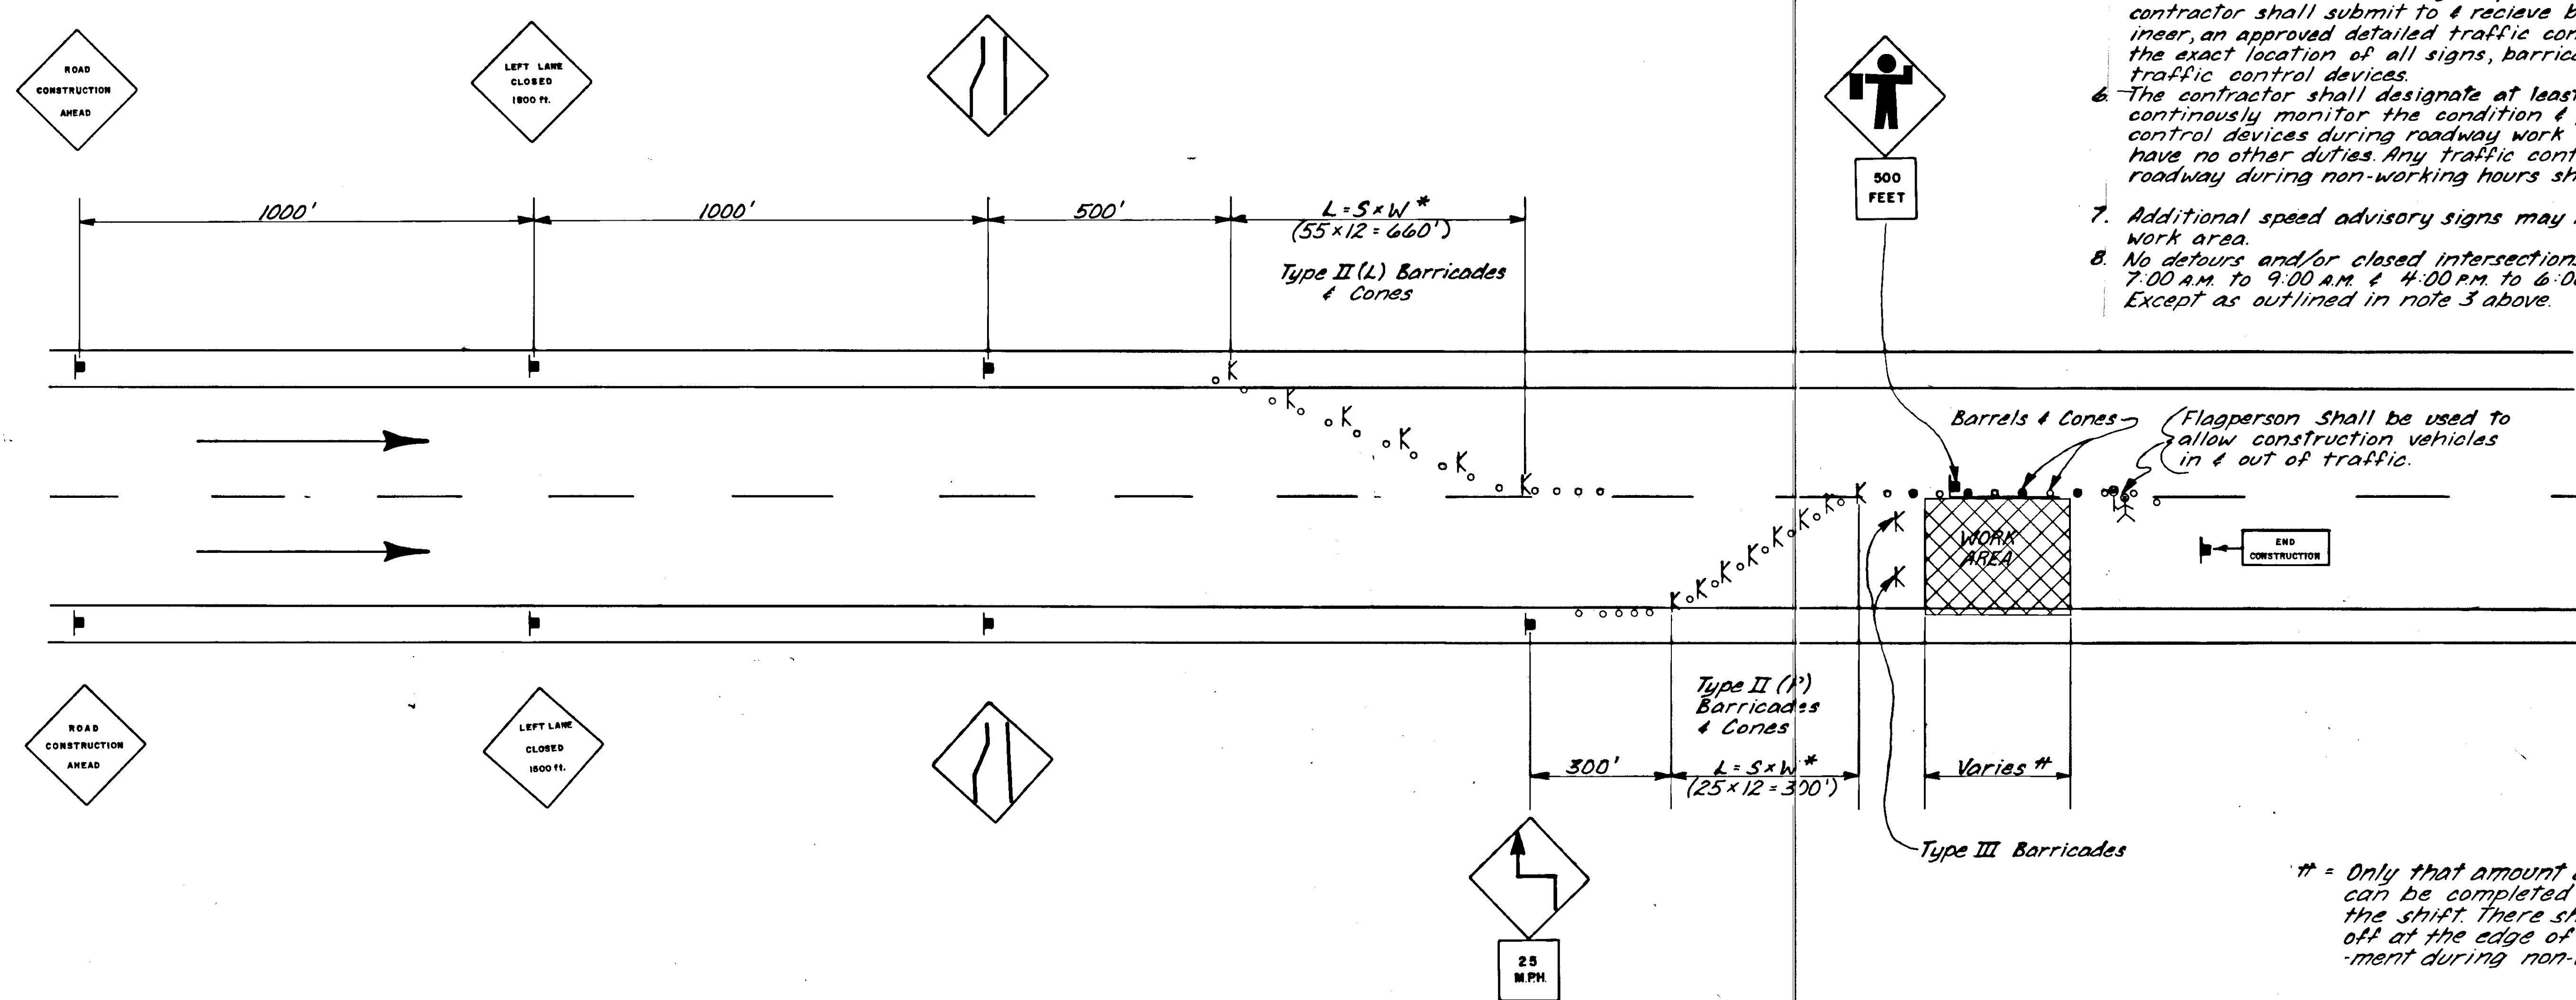


* S = Approach 85 Percentile Speed
 L = Length
 W = Offset Width

= Only that amount of work which can be completed by the end of the shift. There shall be no drop-off at the edge of existing pavement during non-working hours.


TYPICAL LANE CLOSED PLAN



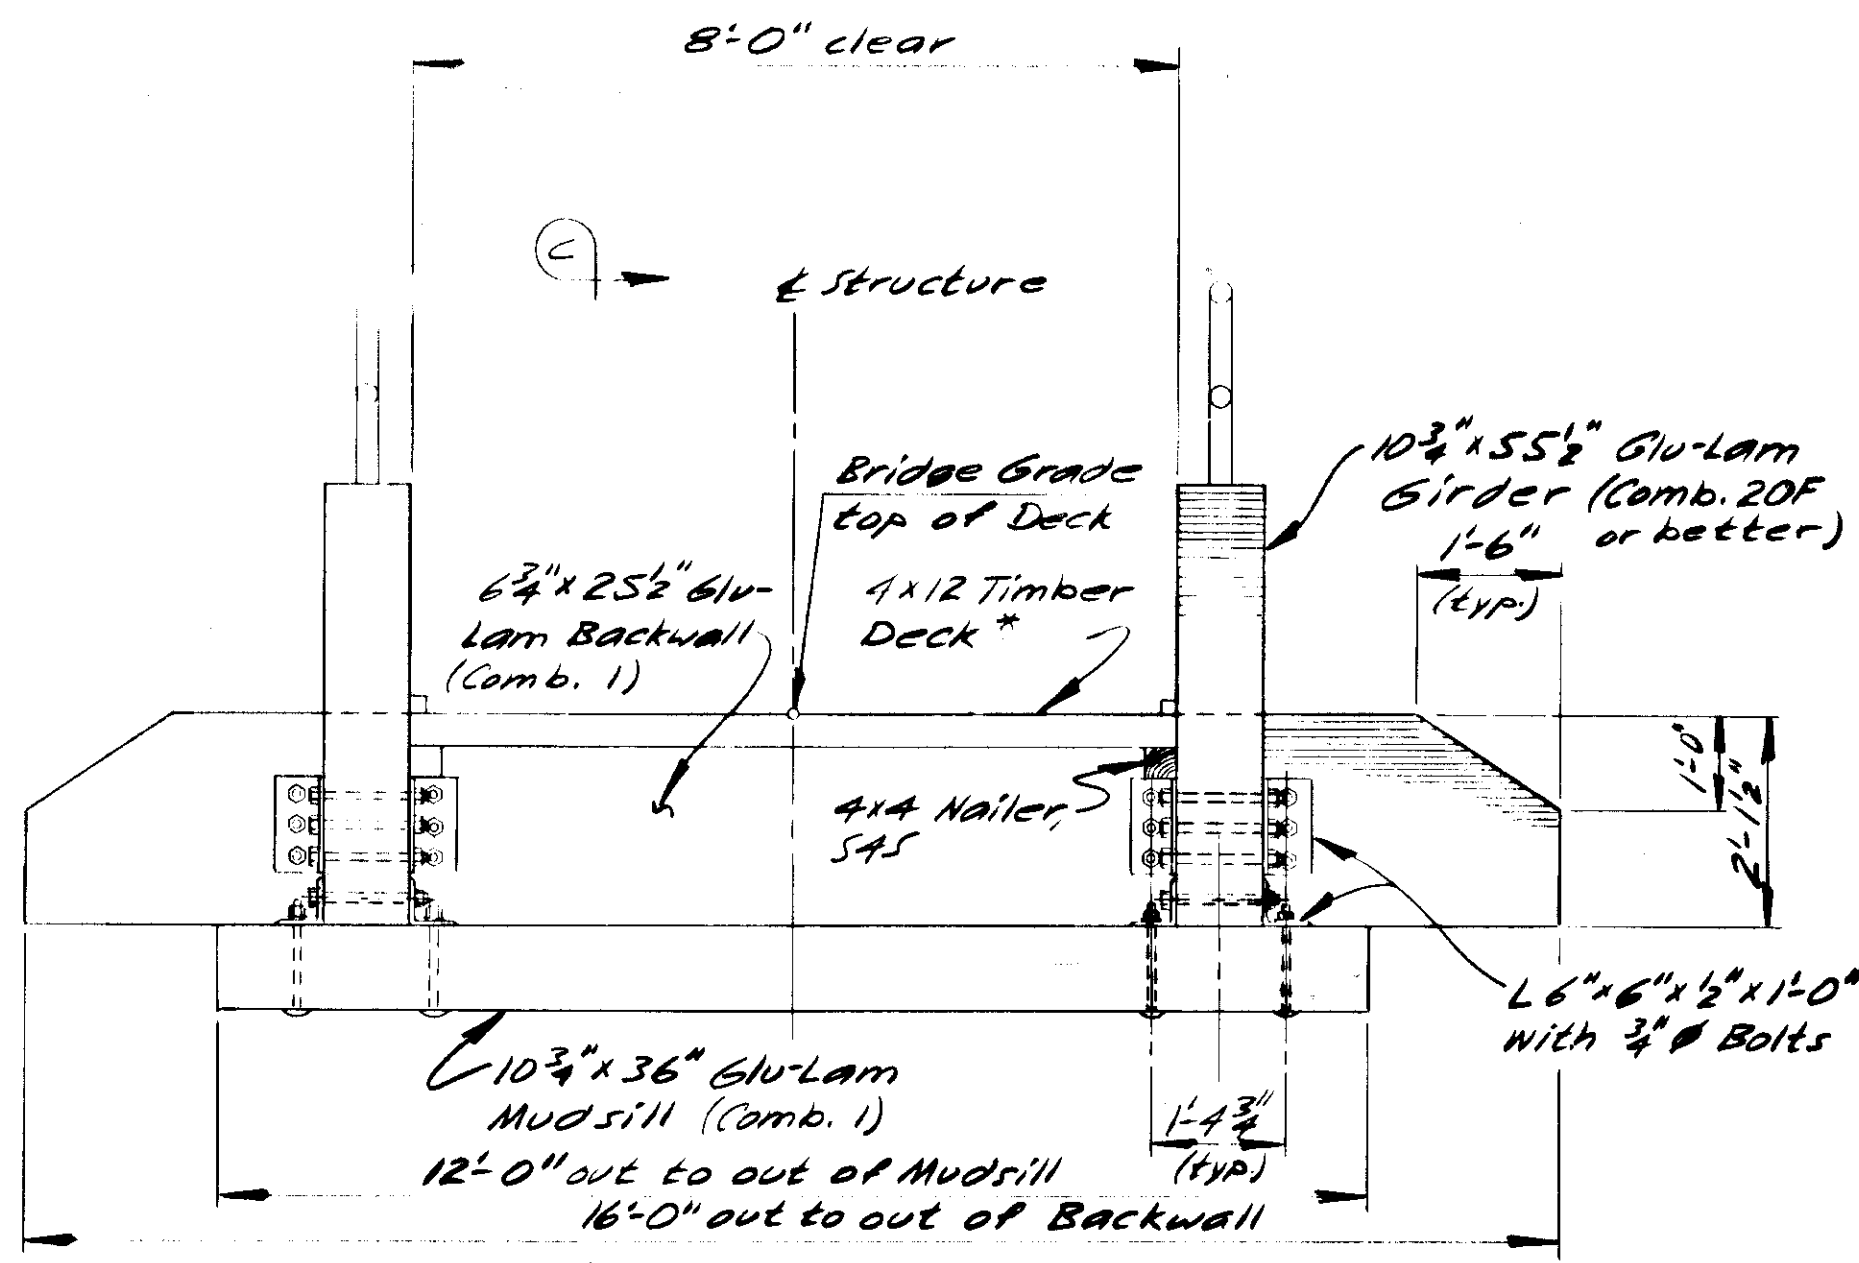


SECTION A-A
No Scale

* S152E place rough side up.
Coat Deck w/ 2 layers CSS-1 and sand (See Special Provisions)

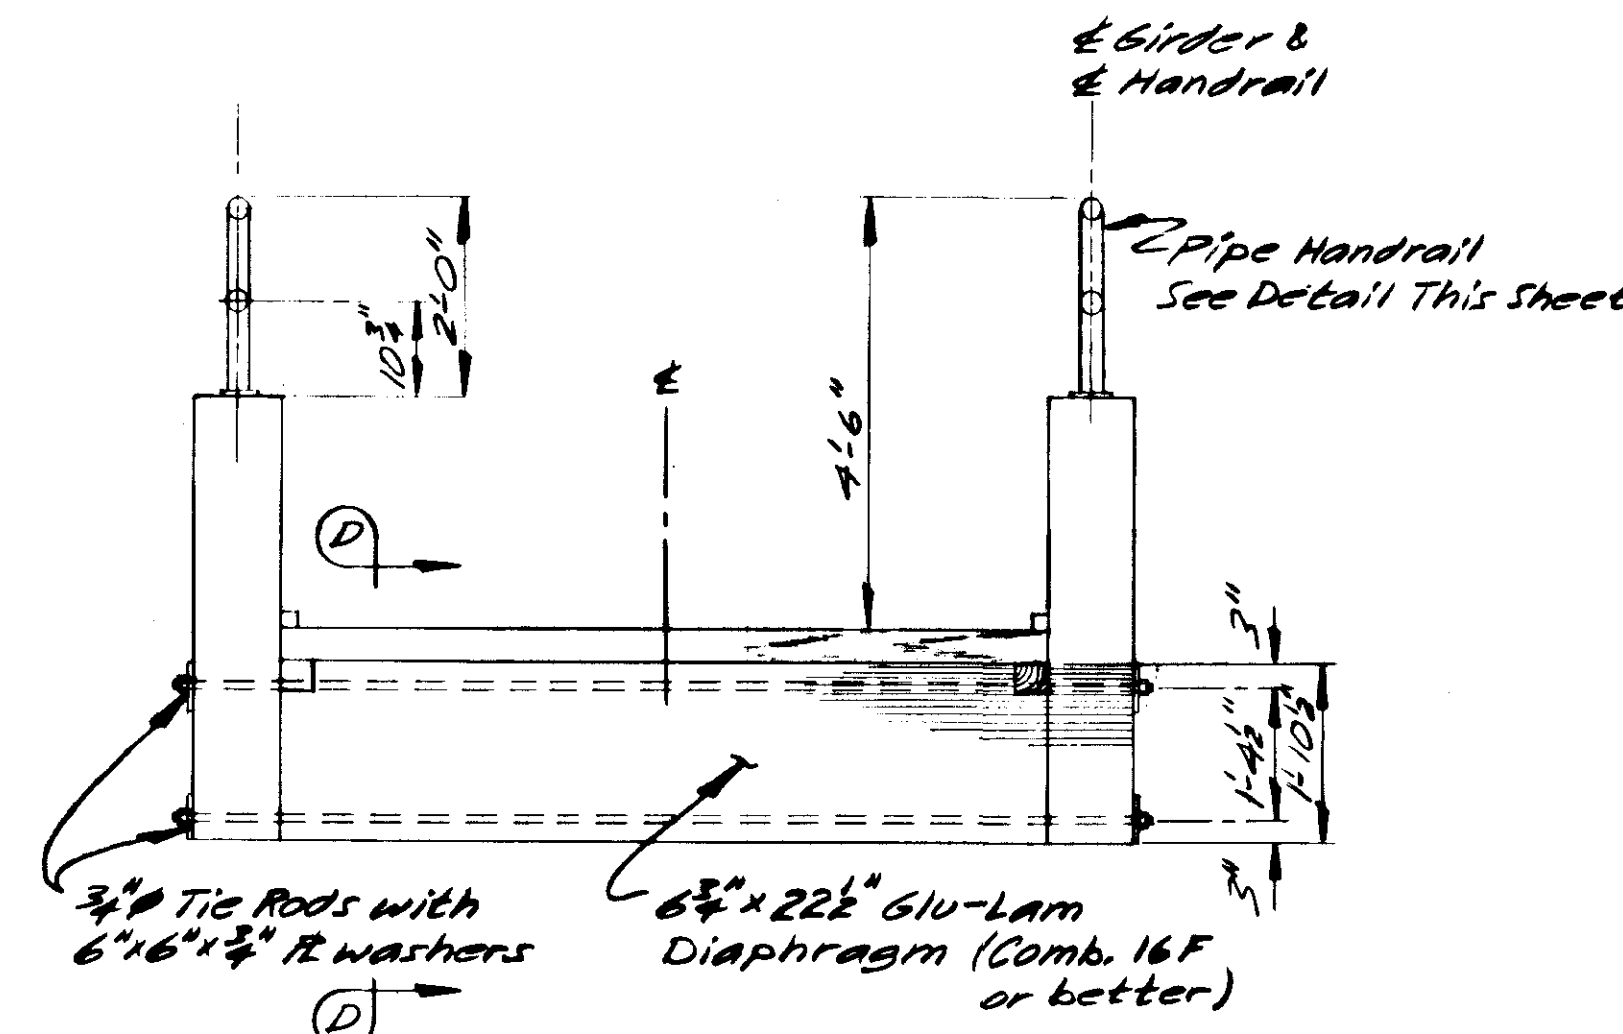


SECTION B-B
No Scale

Joint, 2" x 1/2" Sleeve, sliding fit. Provide joints every second part

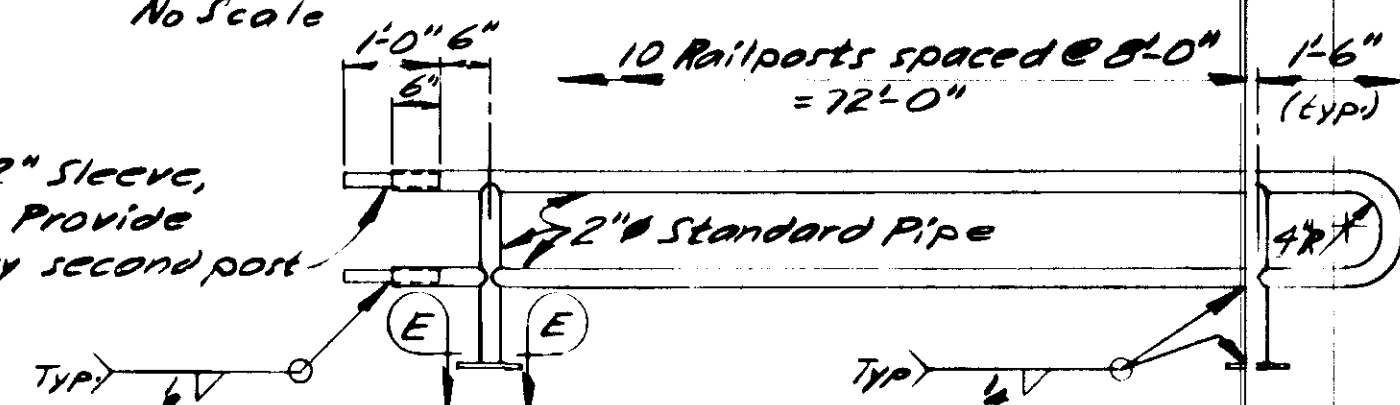


PIPE HANDRAIL
No Scale

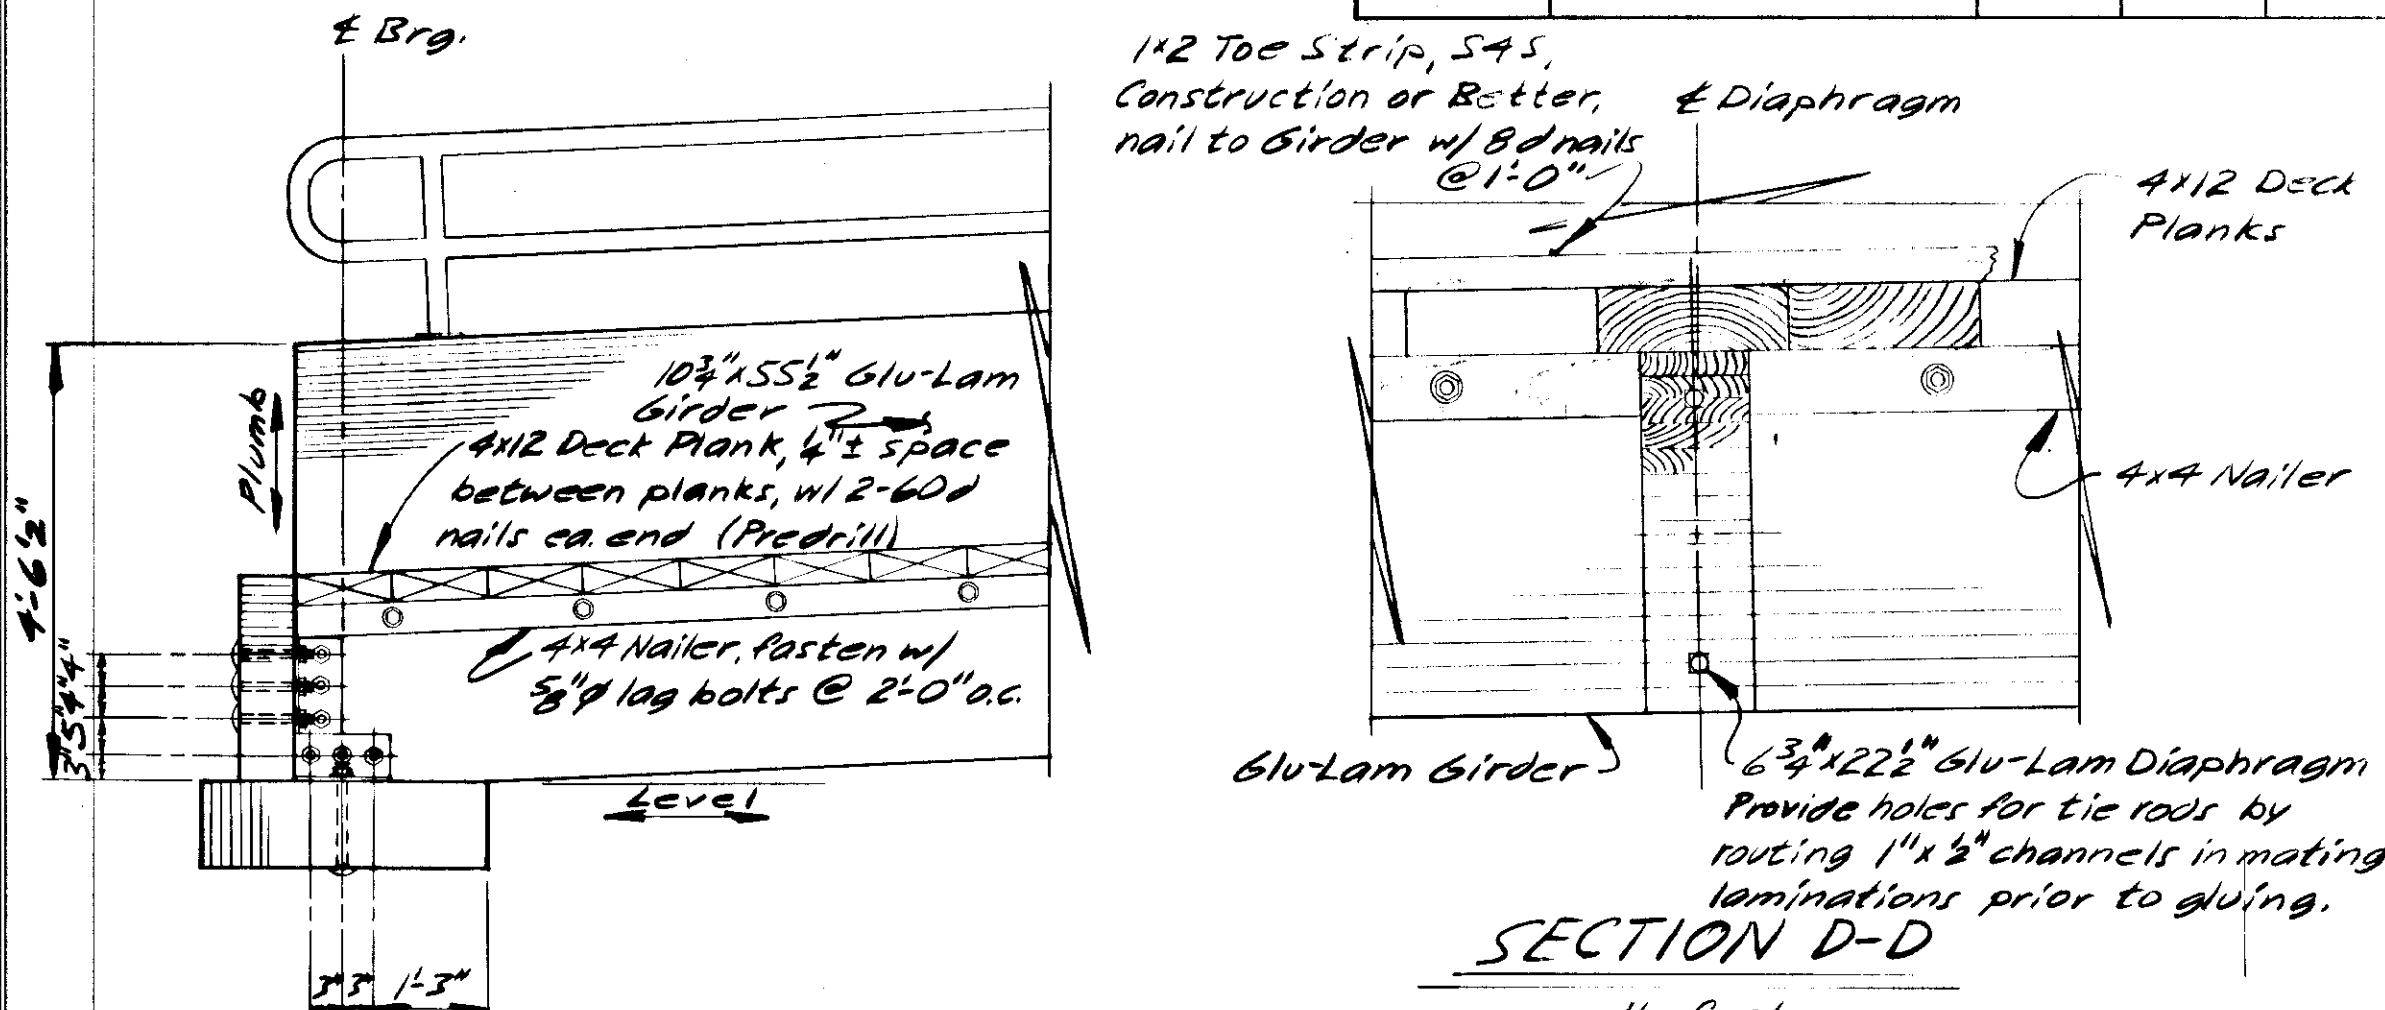


SECTION C-C
No Scale

SECTION D-D
No Scale


GENERAL NOTES
Specifications:
Design: AASHTO Standard Specifications for Highway Bridges, 1977 Edition, with the latest interim specifications.
Construction: State of Alaska Standard Specifications for Highway Construction, 1981, the Standard Modifications and the Special Provisions.
Live Loads: 25% of H20-44 or BS psp
Future Paving Allowance: 25 psp for all paving
Unit Stresses:
Structural Steel: $F_s = 20,000$ psi.
Treated Timber: Glu-Lam Mud sills, Wet Use, $F_b = 1120$ psi, $F_v = 127$ psi, $F_{c\perp} = 257$ psi.
Glu-Lam Backwalls, Wet use, $F_b = 1120$ psi, $F_v = 127$ psi.
Glu-Lam Girders and Diaphragms, Wet use, $F_b = 1600$ psi, $F_v = 127$ psi. Any other timber, wet use, $F_b = 1200$ psi.
Structural Steel & Hardware:
All structural steel shall be A36. All hardware shall be A307, unless otherwise noted. All steel and hardware shall be galvanized after fabrication. All threaded fasteners bearing on timber shall have washers or economy heads.
Timber:
All glued-laminated timber shall be fabricated of Douglas Fir or Western Larch using wet use adhesives. Glu-lam timber shall be of the stress grade combination designated in the details on this sheet. Sawn timber shall be No. 1 Hem Fir or better. All timber shall be pressure treated after fabrication using penta in heavy oil for pieces in ground contact and penta in light oil for all other. All timber treated with penta in light oil shall be stained "dark oak". (See Special Provisions)
Foundation Pressure:
Mud sills, 1.50 ksf max.

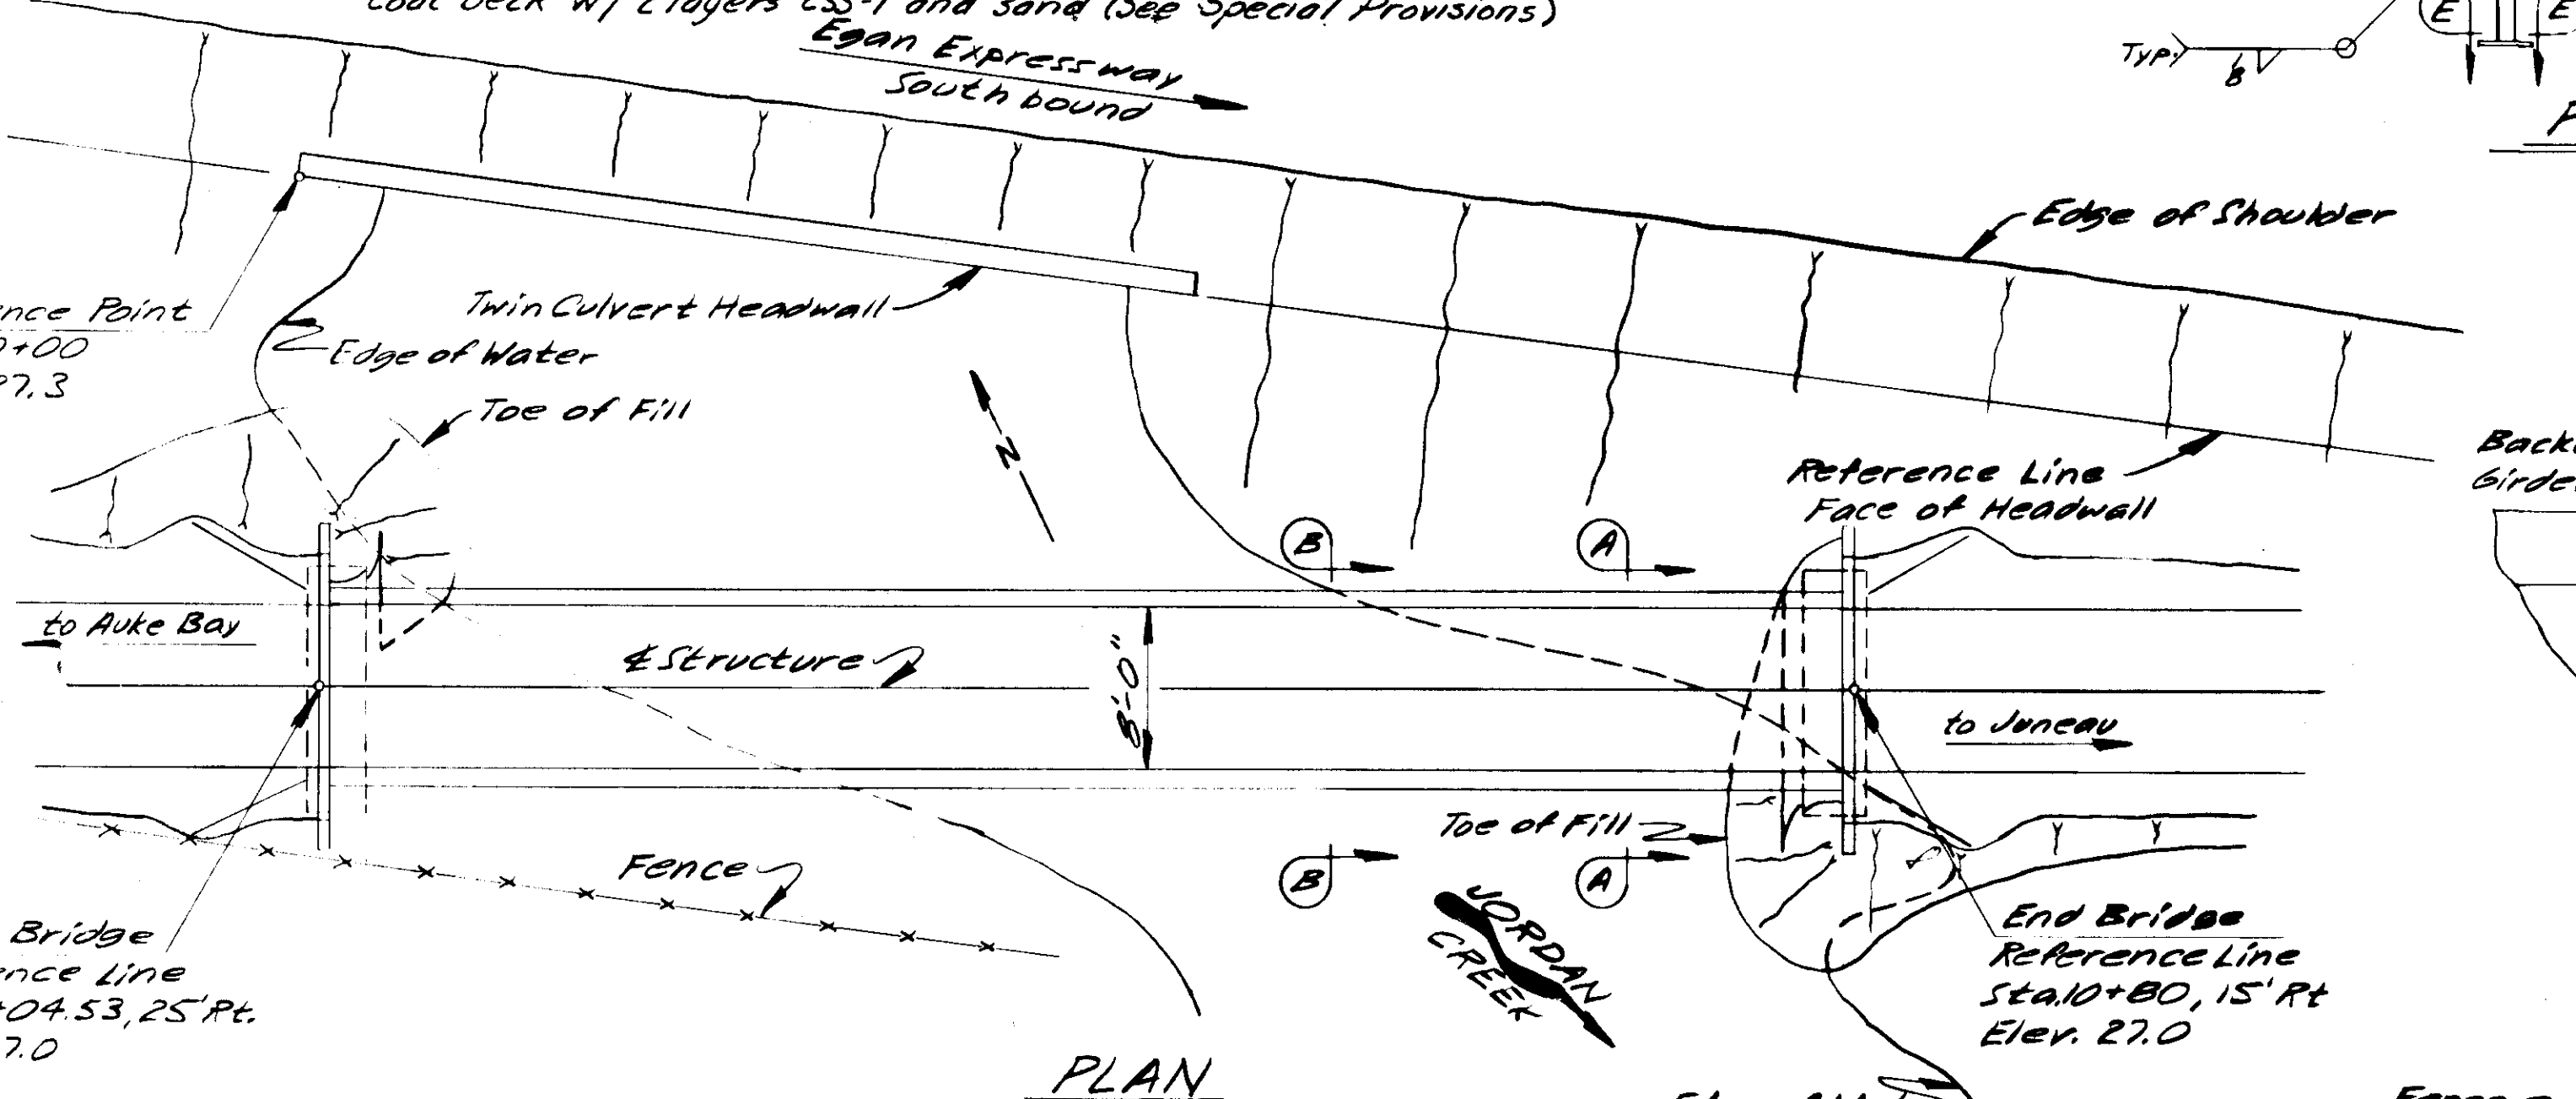

PLAN

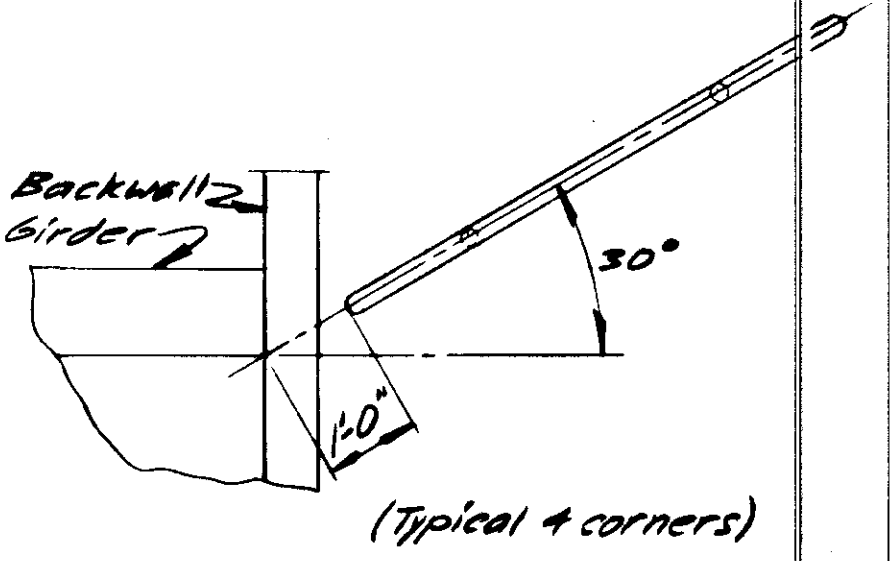

APPROACH RAIL
No Scale


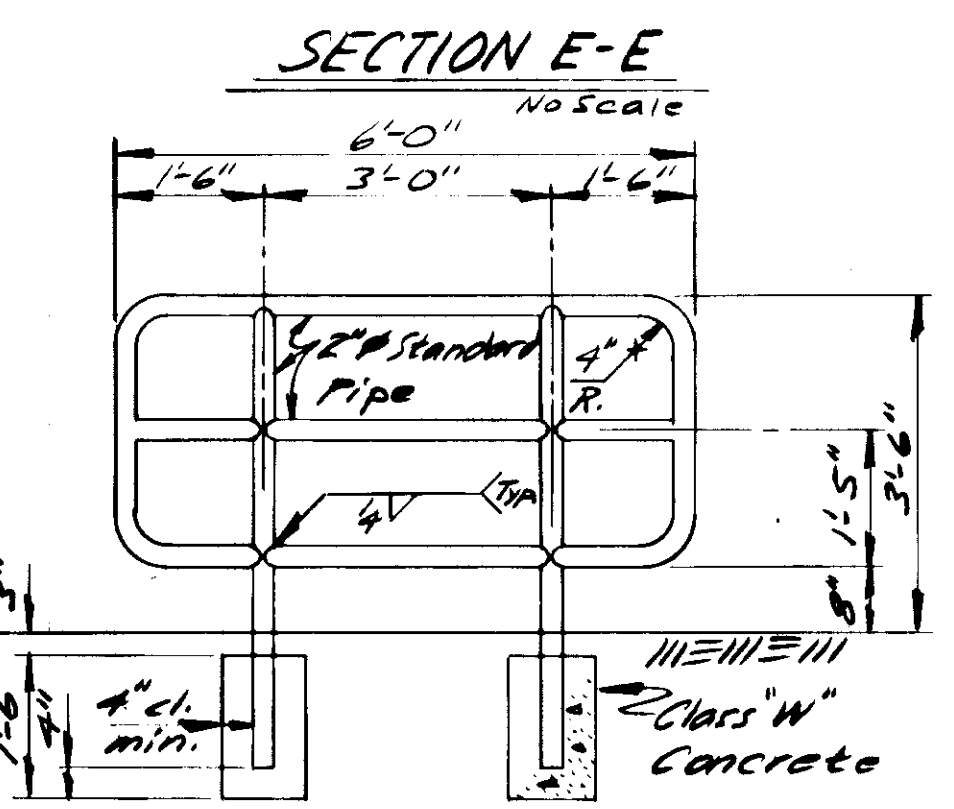


SECTION E-E
No Scale

Notes:
1. Provide 1/8 inch drain holes in railposts and all low points in horizontal rail elements.
2. State furnished bridge number plate to be located on right side of approaching traffic at each end of bridge. Fasten plate to end of girder with 4-1/2 inch lag bolts.

HYDROLOGIC AND HYDRAULIC SUMMARY			
Drainage Area	1 sq. mile		
Exceedance Probability	2%	1%	
Design Discharge	291 cfs	327 cfs	
Design Highwater	24.4	24.6	


ESTIMATED QUANTITIES			
Item	Unit	Substr.	Superstr. Total
Treated Timber	MBM	1.9	14.1 16.0
Pedestrian Rail	LF		150 150
Approach Rail	LF		24 24

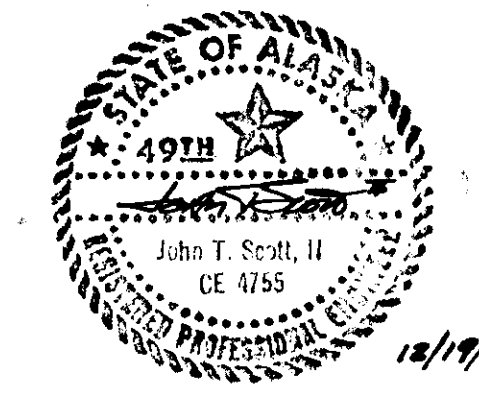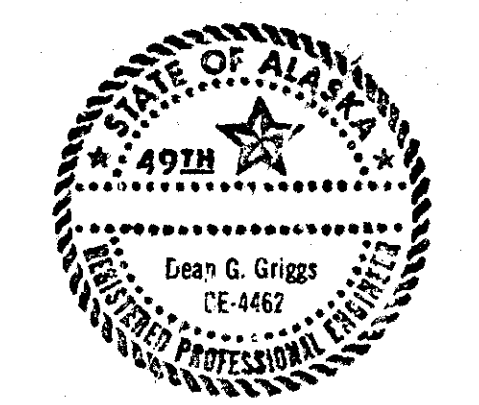




JORDAN CREEK
BIKE PATH BRIDGE

State of Alaska
DEPARTMENT OF TRANSPORTATION
and PUBLIC FACILITIES
Juneau, Alaska


Date _____ Approved _____
BRIDGE NO. 1587
DWNG. NO. 4626

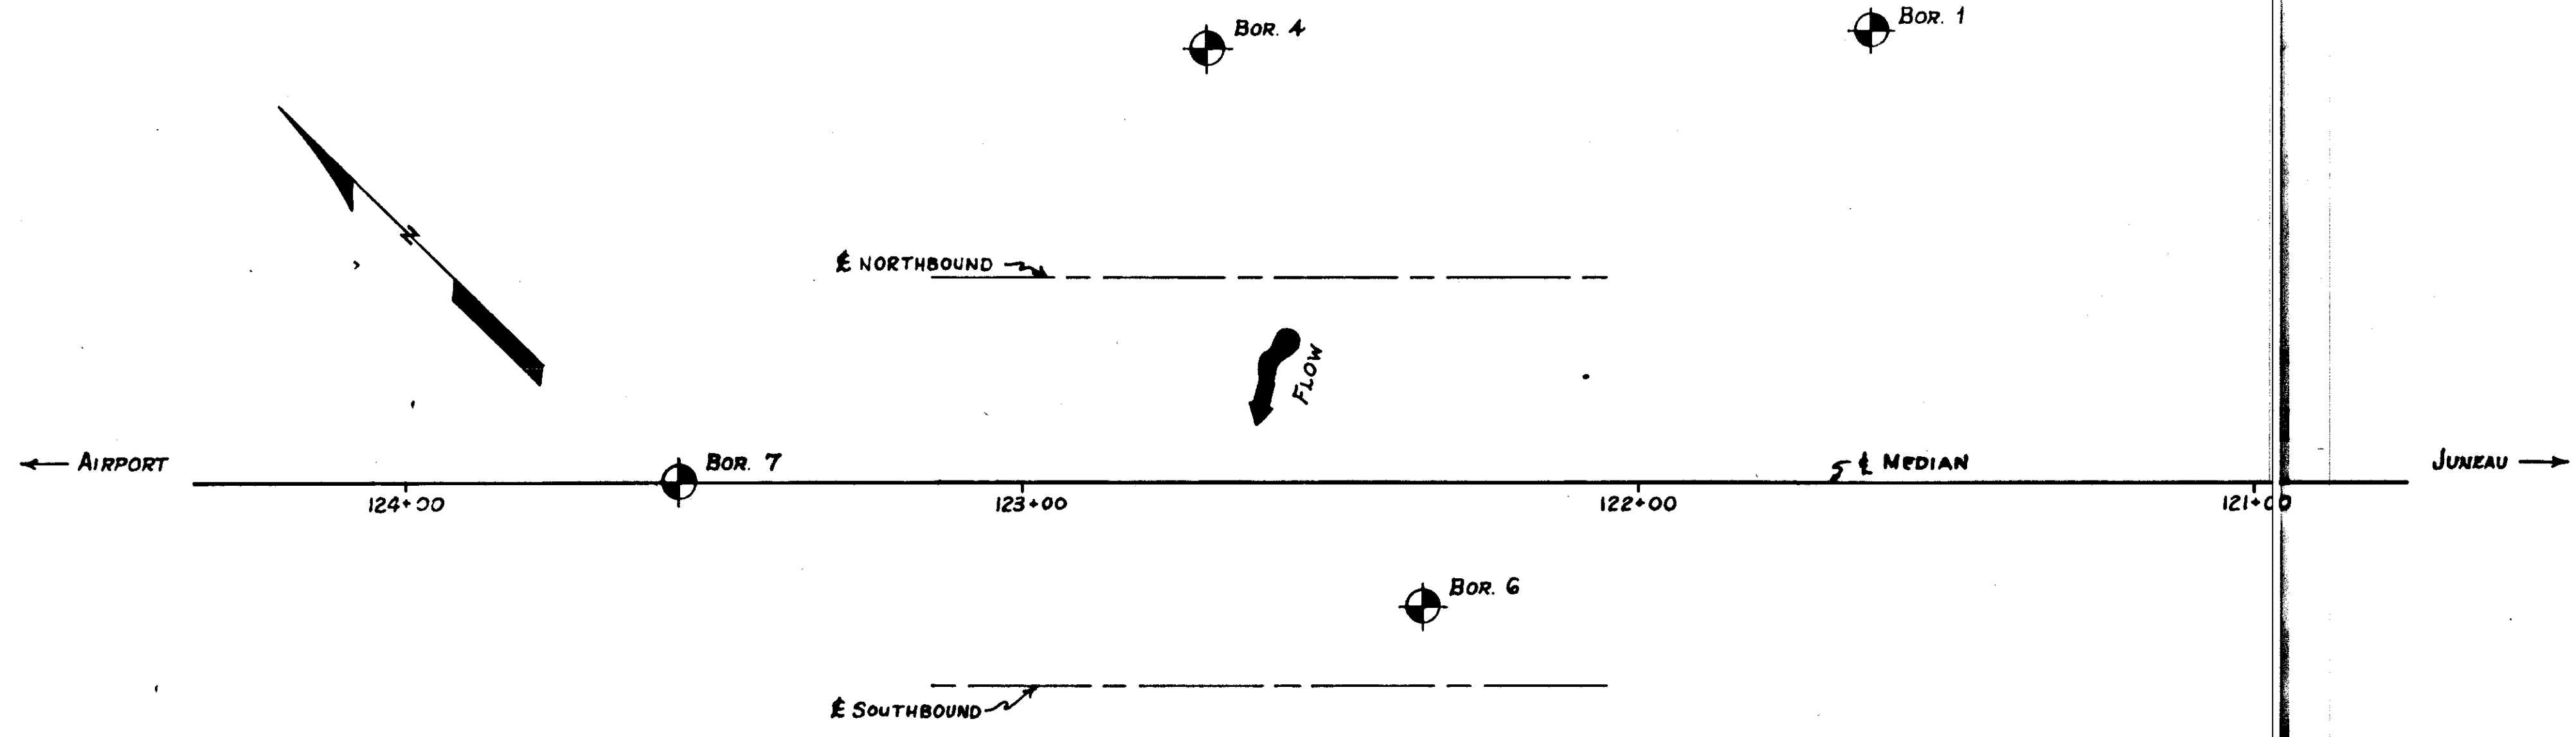

NOTE: SCALE 1"=20'

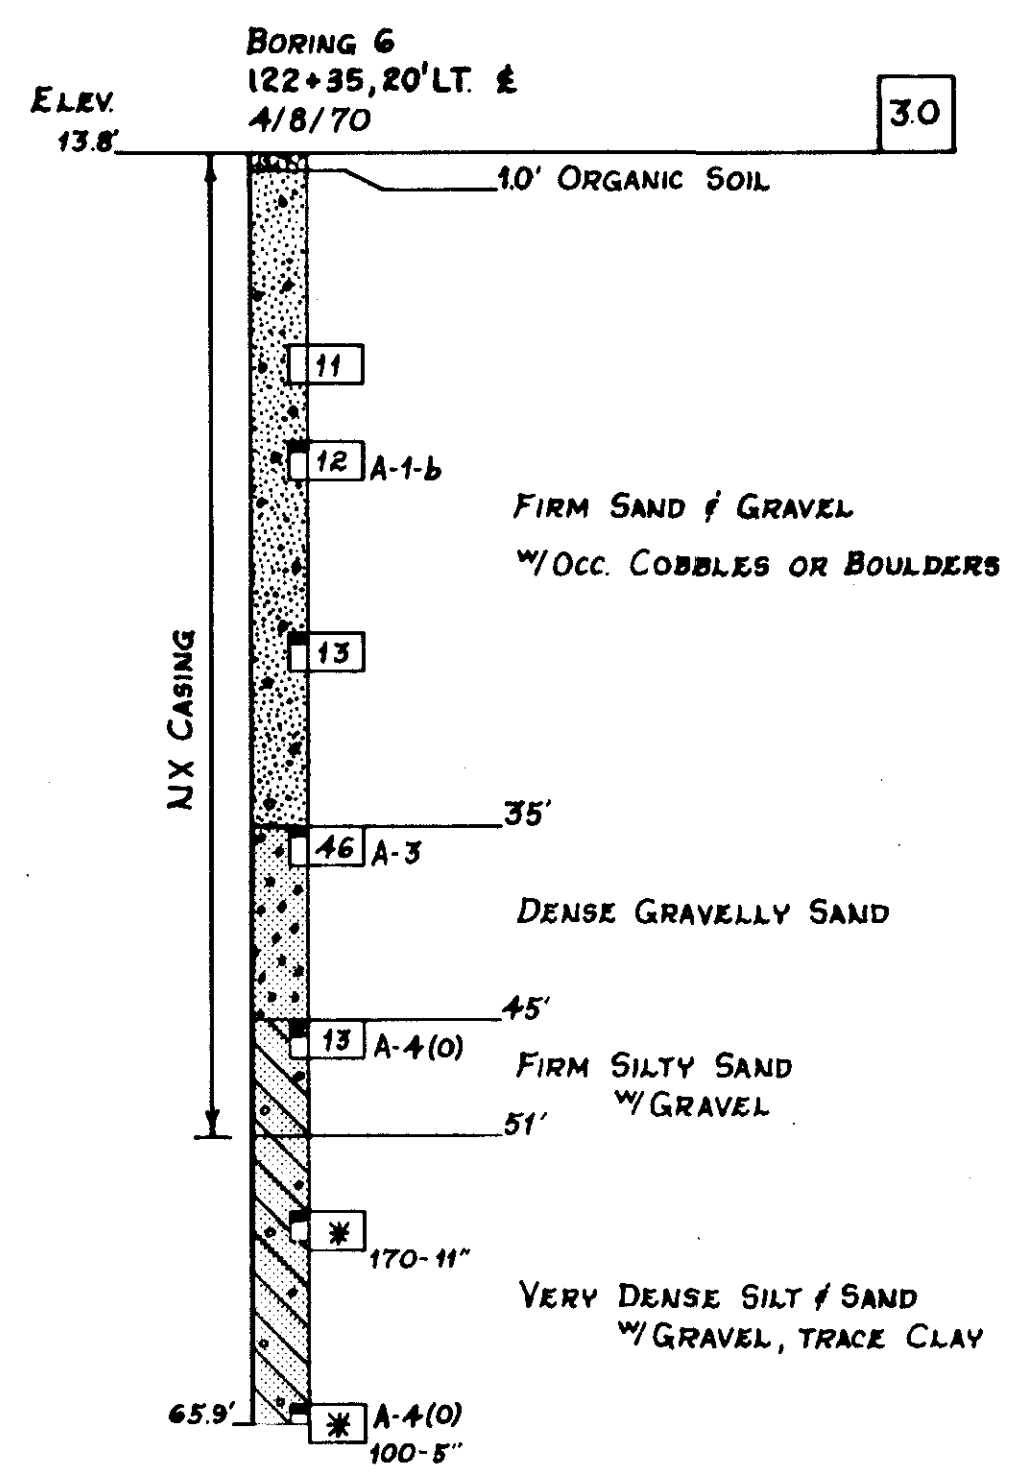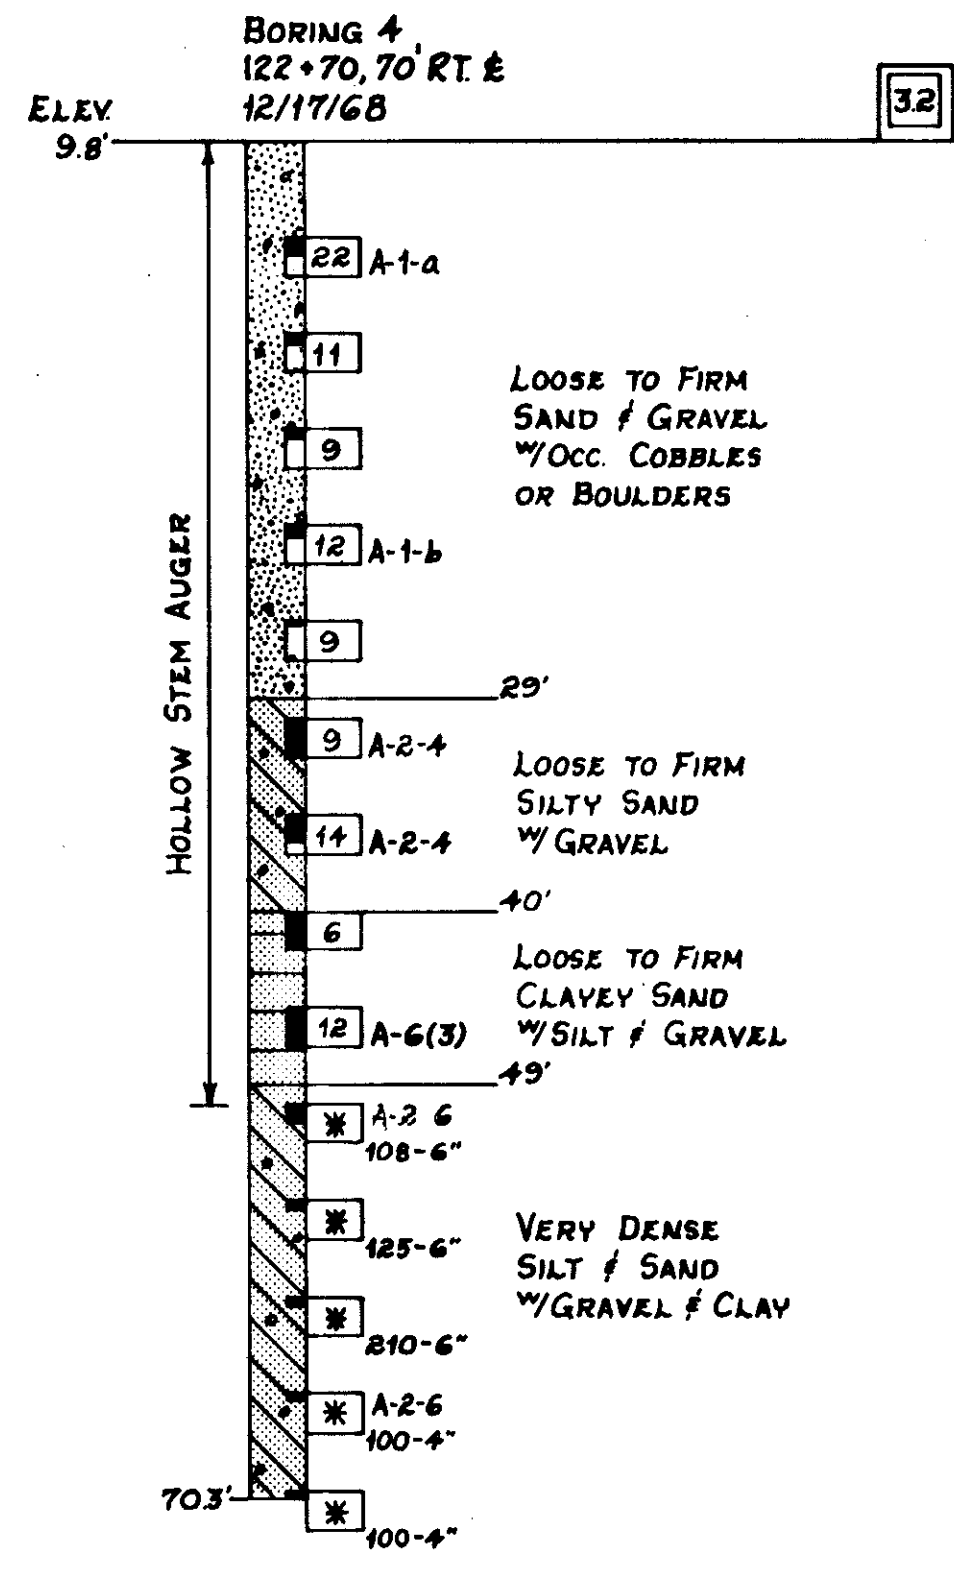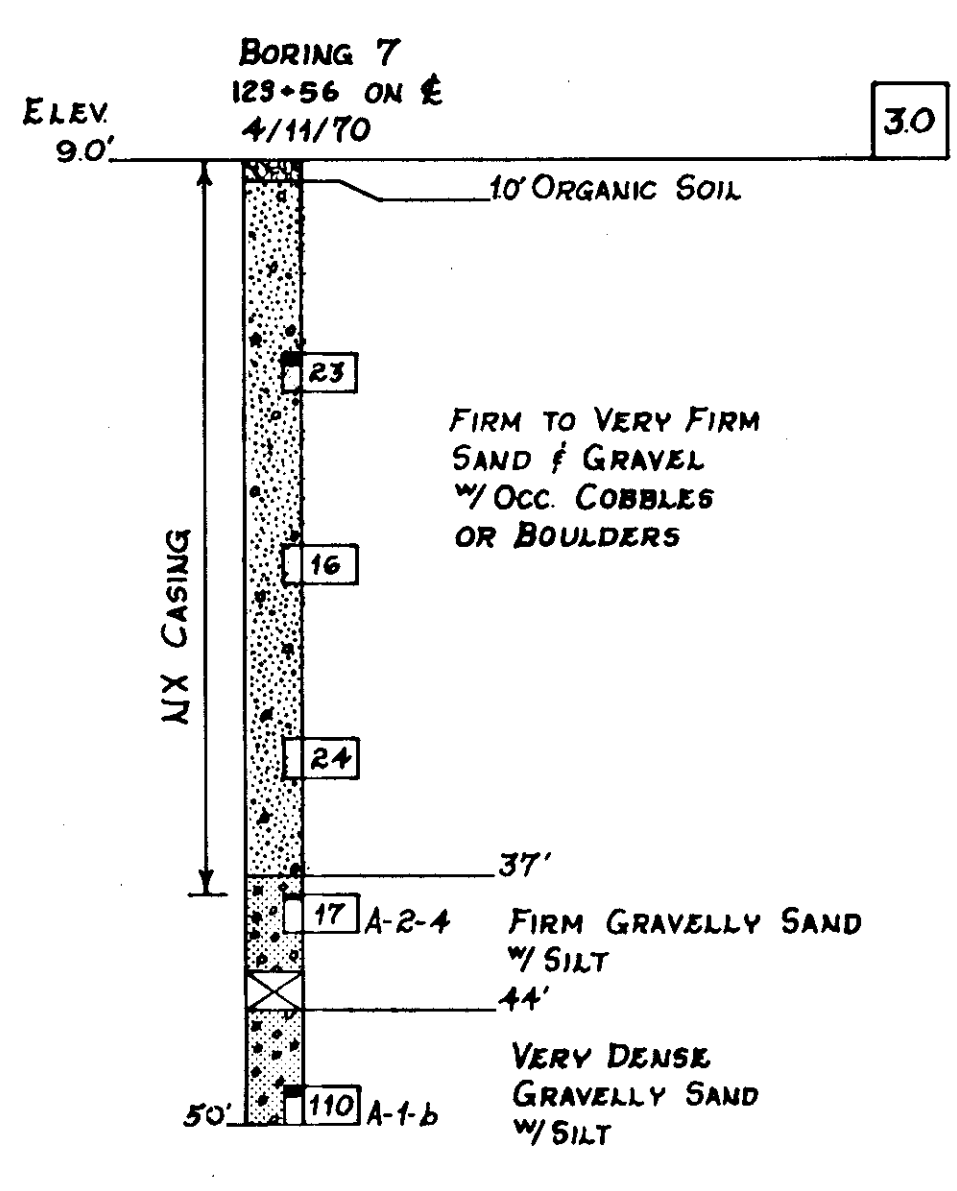

NOTE: * 100'-6" DENOTES REFUSAL w/ STANDARD SAMPLER, 100- INDICATES BLOW COUNT, 6"- INDICATES PENETRATION.

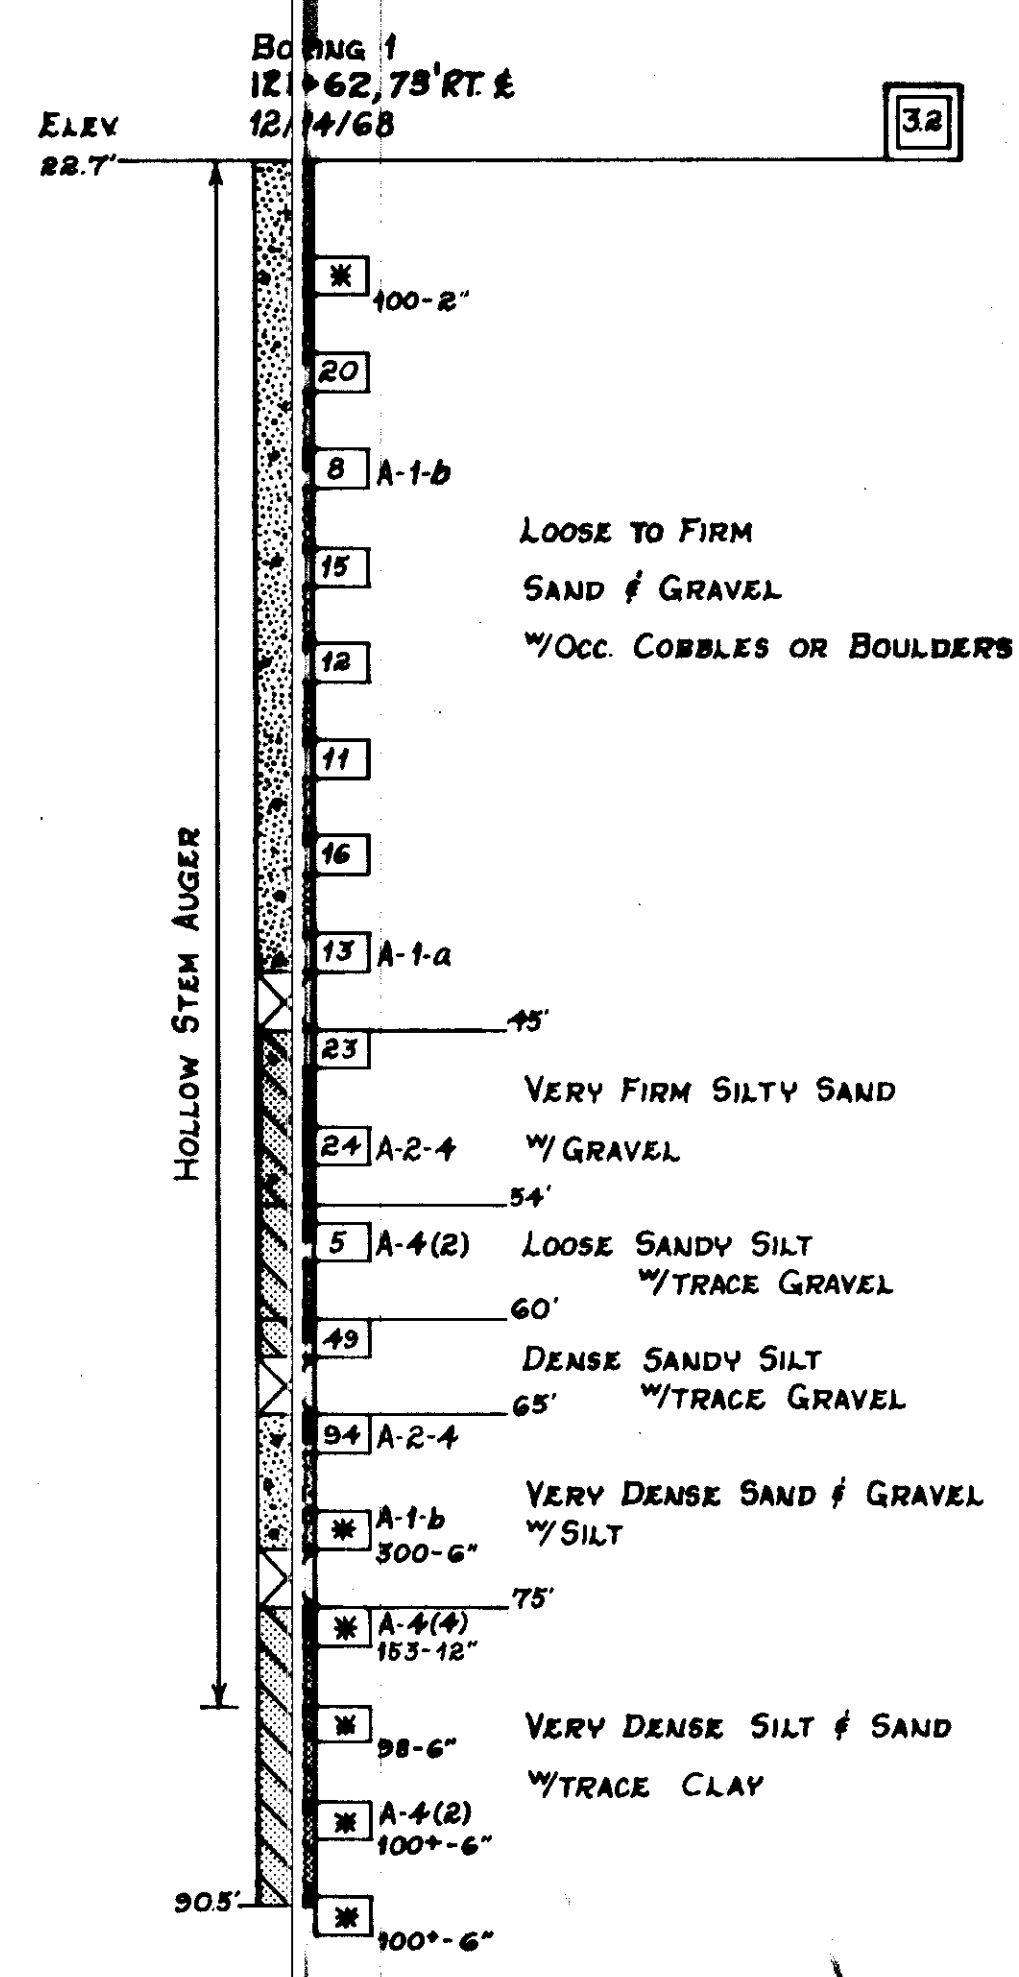

MATERIAL SYMBOLS

	Organics, Organic Silt		Clayey Silt
	Cobbles and Boulders		Sandy Silt
	Sandy Gravel		Gravelly Silt
	Gravelly Sand		Silty Clay
	Gravel		Silty Sand
	Sand		Silty Gravel
	Clay		
	Silt		

BORING SYMBOLS

	Plan of any boring		ROTARY BORING
	Flush penetrometer		Boring No. Location Date
	Bull nose penetrometer		R-Split spoon sampler, 2.5" OD x 20" I.D.
	Rotary boring		ST-Shelby tube sampler, pushed.
	Auger boring		Blow count/ft using standard sampler, 2.0" OD x 1.4" I.D., 140# hammer, 30" freefall.
	Diamond core boring		Gradational material change
	Test pit		Strata change
	Probe		Interval sampled w/ interval recovered blackened in
	Consolidation test		Unconfined compression test
	Direct shear test		
	Triaxial compression test		
	Vane shear test		

PENETROMETER TEST

Number Location Date
479 depth -2.5

RELATIVE DENSITY AND CONSISTENCY CLASSIFICATION

According to Standard Penetration Test

Blows/ft	GRANULAR		COHESIVE	
	Blows/ft	Rel Density	Blows/ft	Consistency
0-4	very loose	0-1	very soft	
5-10	loose	2-4	soft	
11-20	firm	5-8	firm	
21-30	very firm	9-15	stiff	
31-50	dense	15-30	very stiff	
Over 50	very dense	Over 30	hard	


SALMON CREEK BRIDGE
Route No. F-95

LOG OF TEST BORINGS




State of Alaska
DEPARTMENT OF HIGHWAYS
Juneau, Alaska

Date 5/15/70 Bridge no. 1188
Approved [Signature] Drawing no. 4606

STATE	PROJECT DESIGNATION	YEAR	SHEET NO.	TOTAL SHEETS
ALASKA	F-093-2(9)	1981	31	31

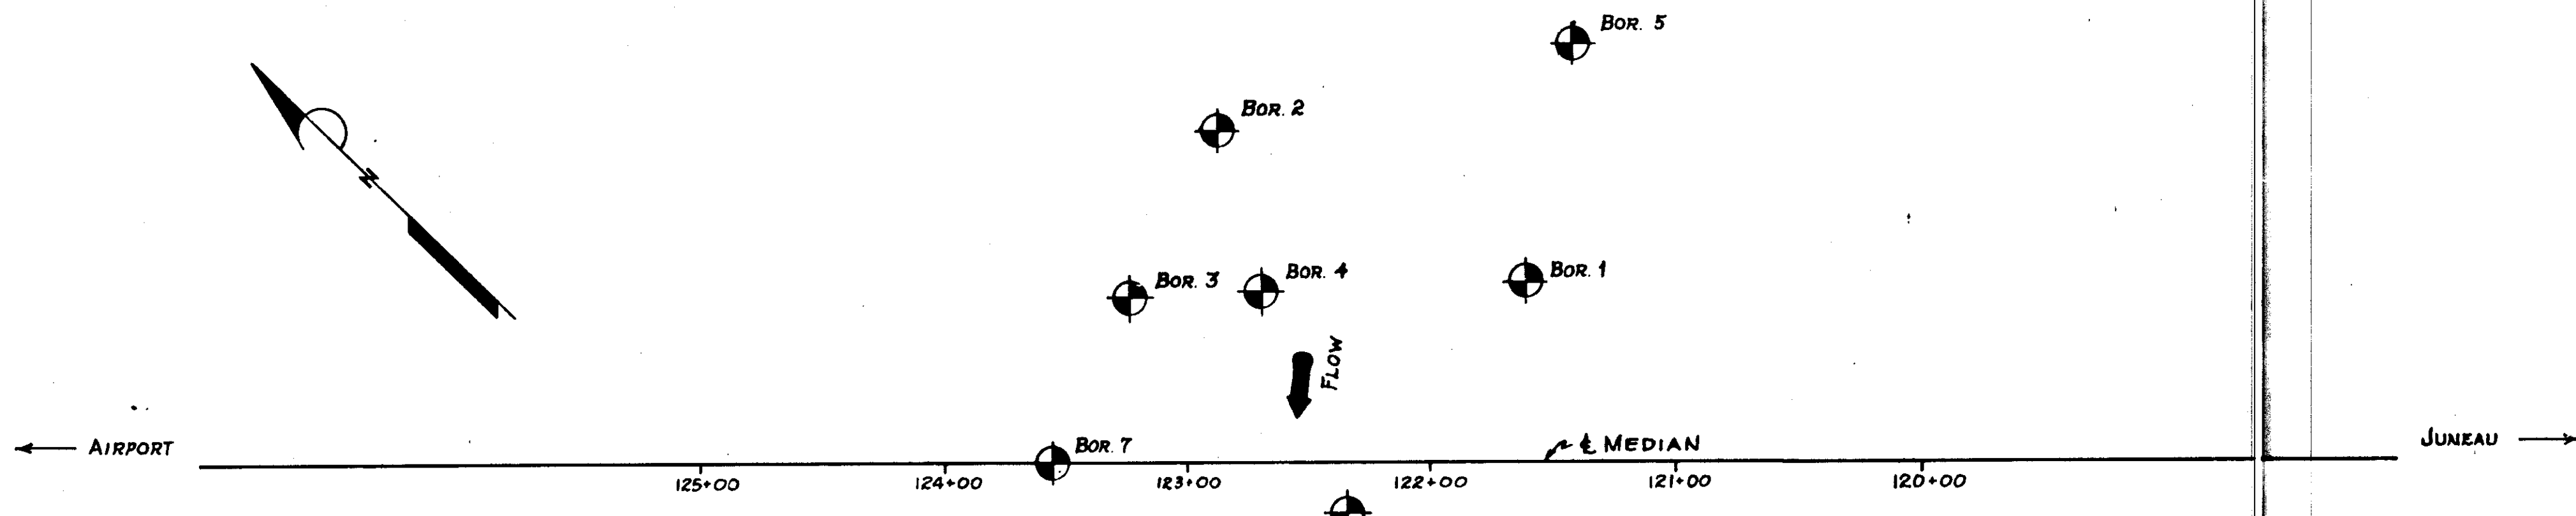


SCALE: 1"=50'

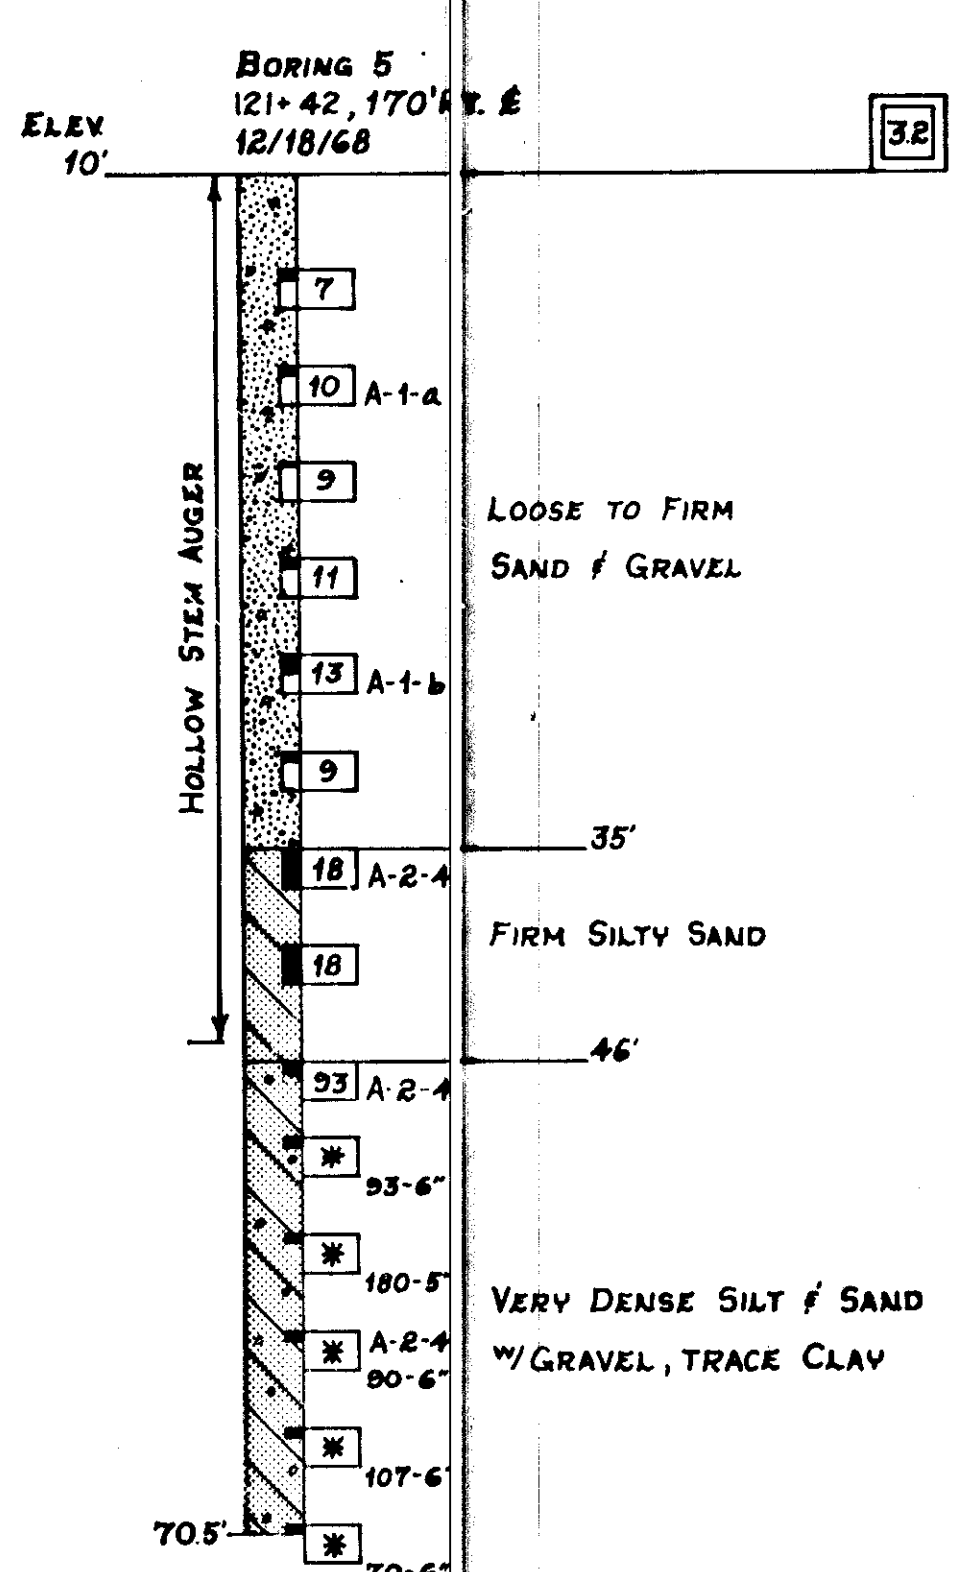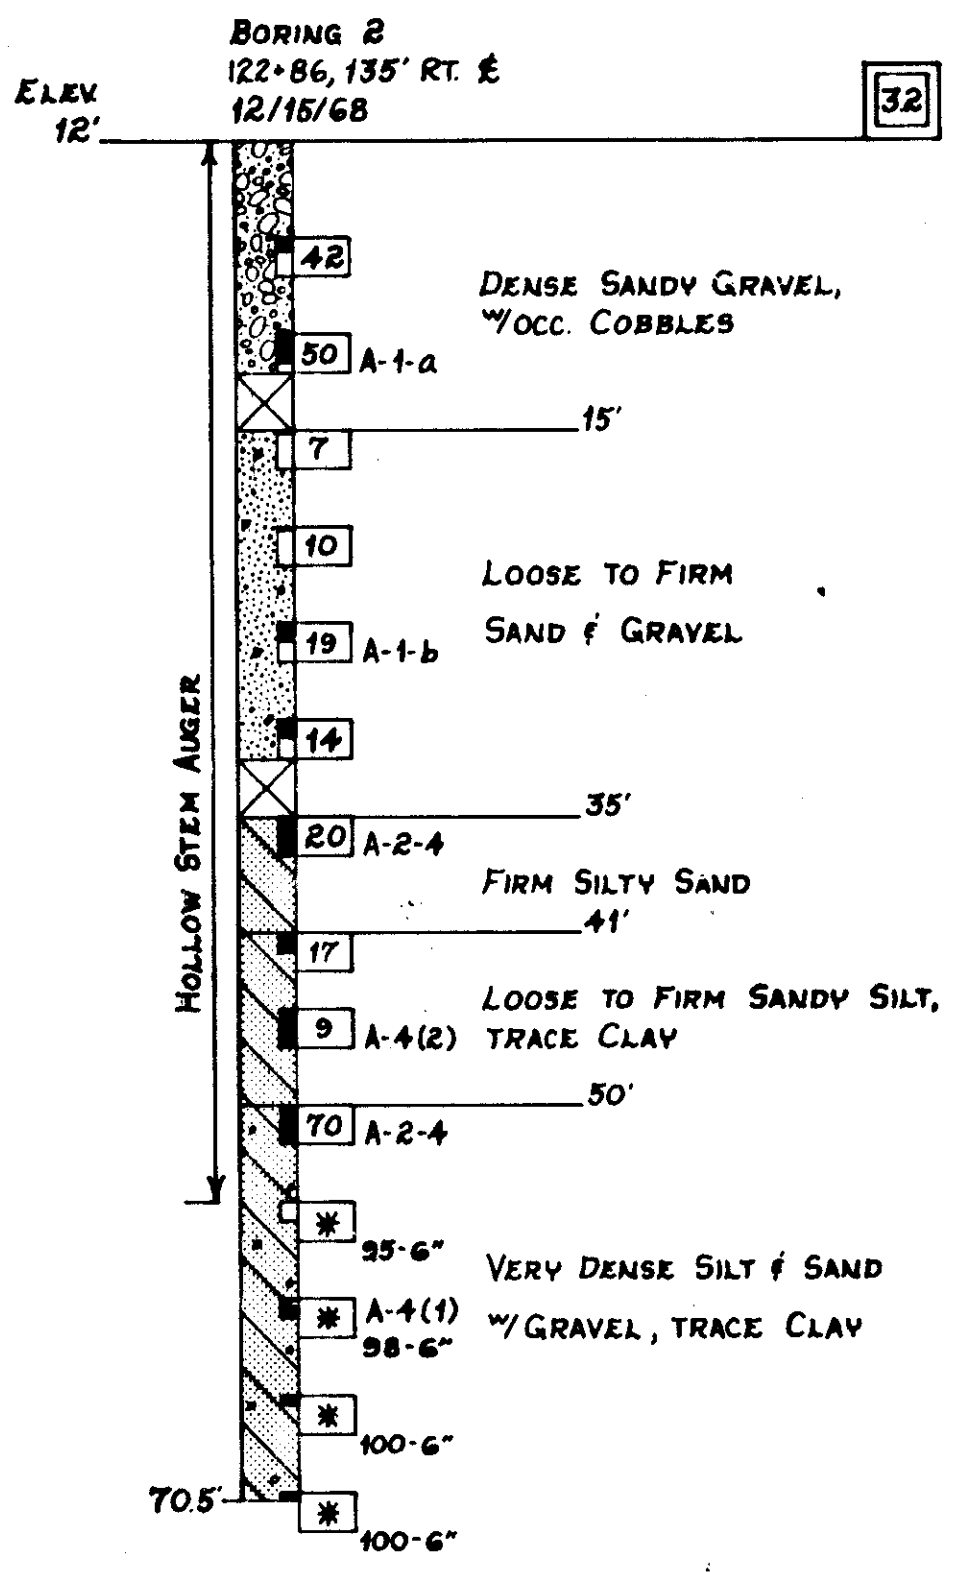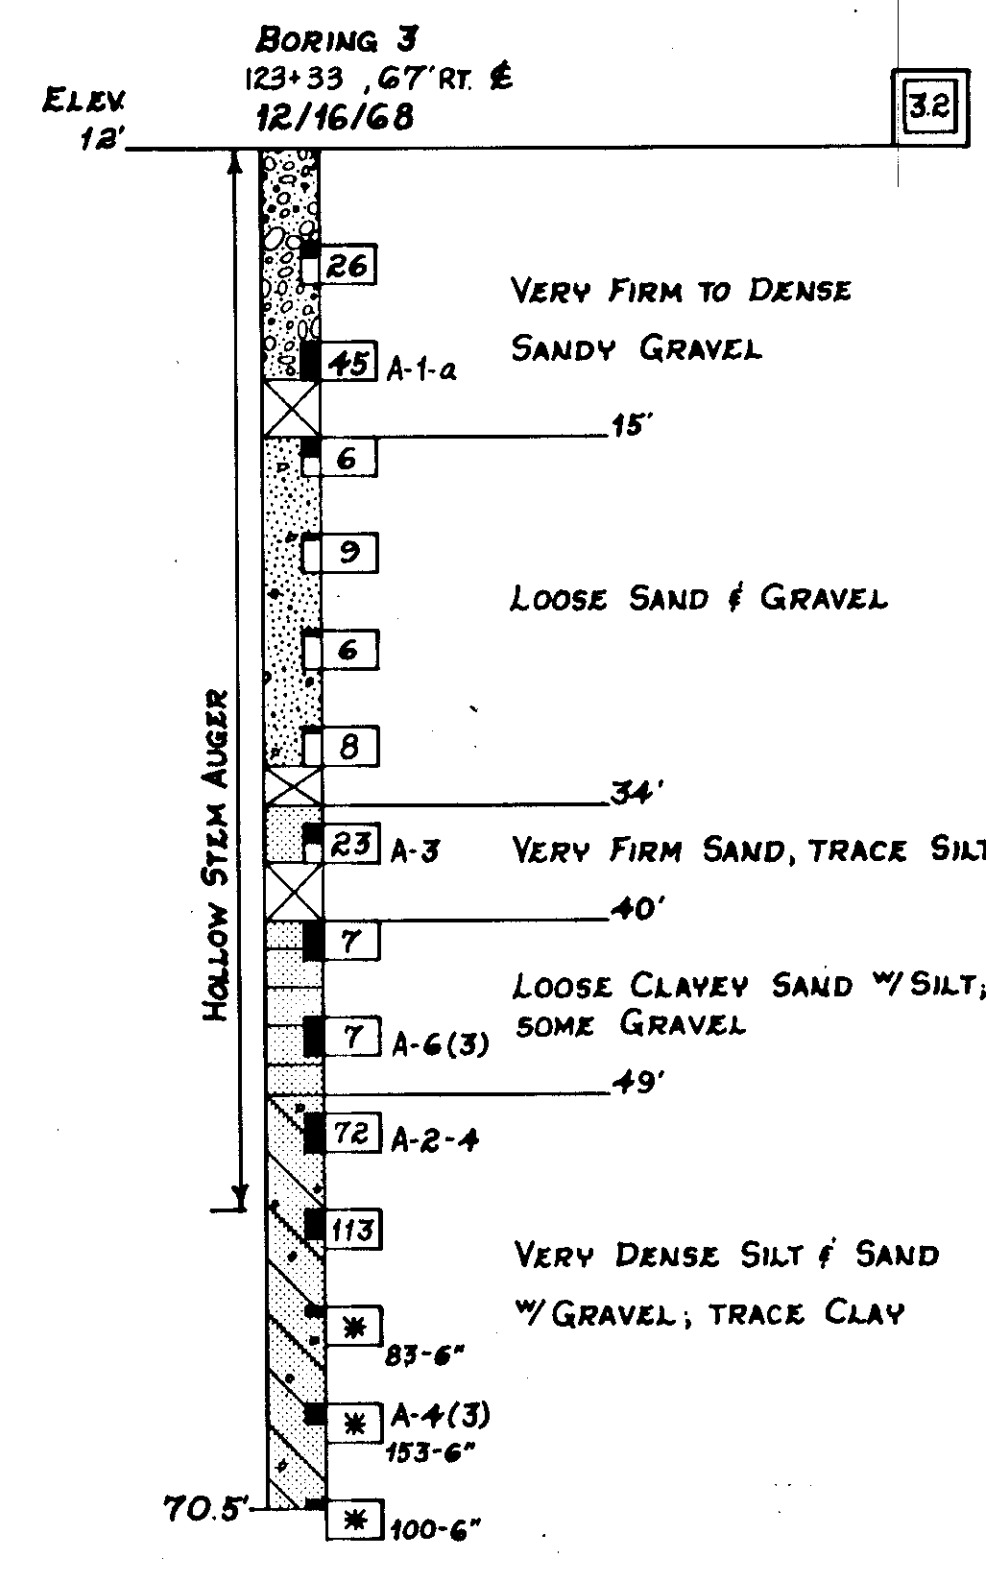

MATERIAL SYMBOLS

	Organics, Organic Silt		Clayey Silt
	Cobbles and Boulders		Sandy Silt
	Sandy Gravel		Gravelly Silt
	Gravelly Sand		Silty Clay
	Gravel		Silty Sand
	Sand		Silty Gravel
	Clay		
	Silt		

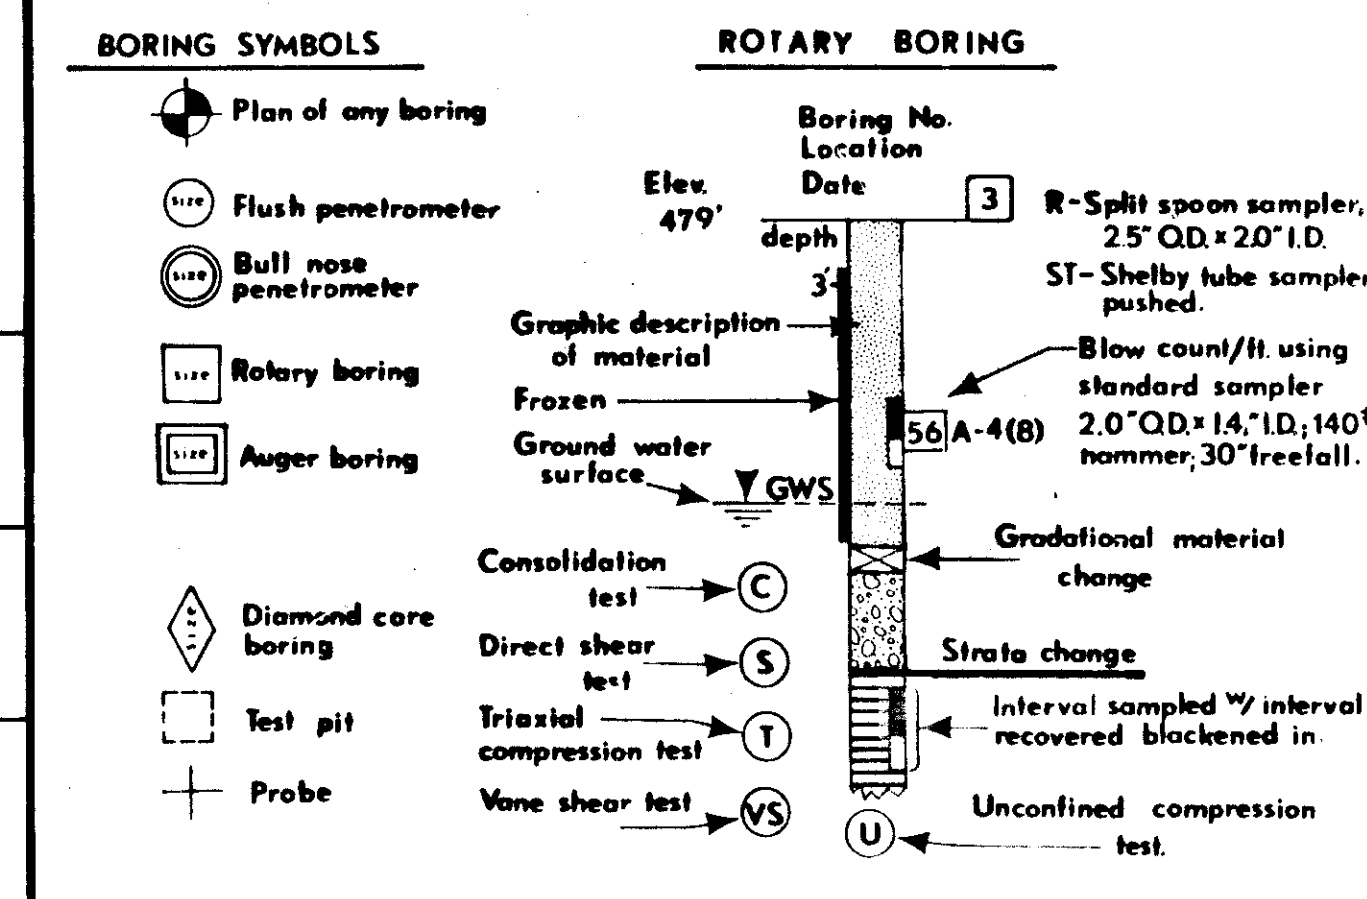

PENETROMETER TEST

Number Location Date
Elev. 479' depth 5'
25

RELATIVE DENSITY AND CONSISTENCY CLASSIFICATION
According to Standard Penetration Test

Blows/ft.	GRANULAR		COHESIVE	
	Rel. Density		Blows/ft.	Consistency
0 - 4	very loose		0 - 1	very soft
5 - 10	loose		2 - 4	soft
11 - 20	firm		5 - 8	firm
21 - 30	very firm		9 - 15	stiff
31 - 50	dense		15 - 30	very stiff
Over 50	very dense		Over 30	hard

NOTE: * 100-6"
 * DENOTES REFUSAL W/ STANDARD SAMPLER,
 100-INDICATES BLOW COUNT,
 6"-INDICATES PENETRATION.

SALMON CREEK BRIDGE
Route No. F-95

LOG OF TEST BORINGS

State of Alaska
DEPARTMENT OF HIGHWAYS
Juneau, Alaska

Date 5/20/70 Bridge no. 1188
 Approved *WLP* Drawing no. 4607