


STATE	ROUTE DESIGNATION	YEAR	SHEET NO.	TOTAL SHEETS
ALASKA	F-095-8(12)	1967	1	32

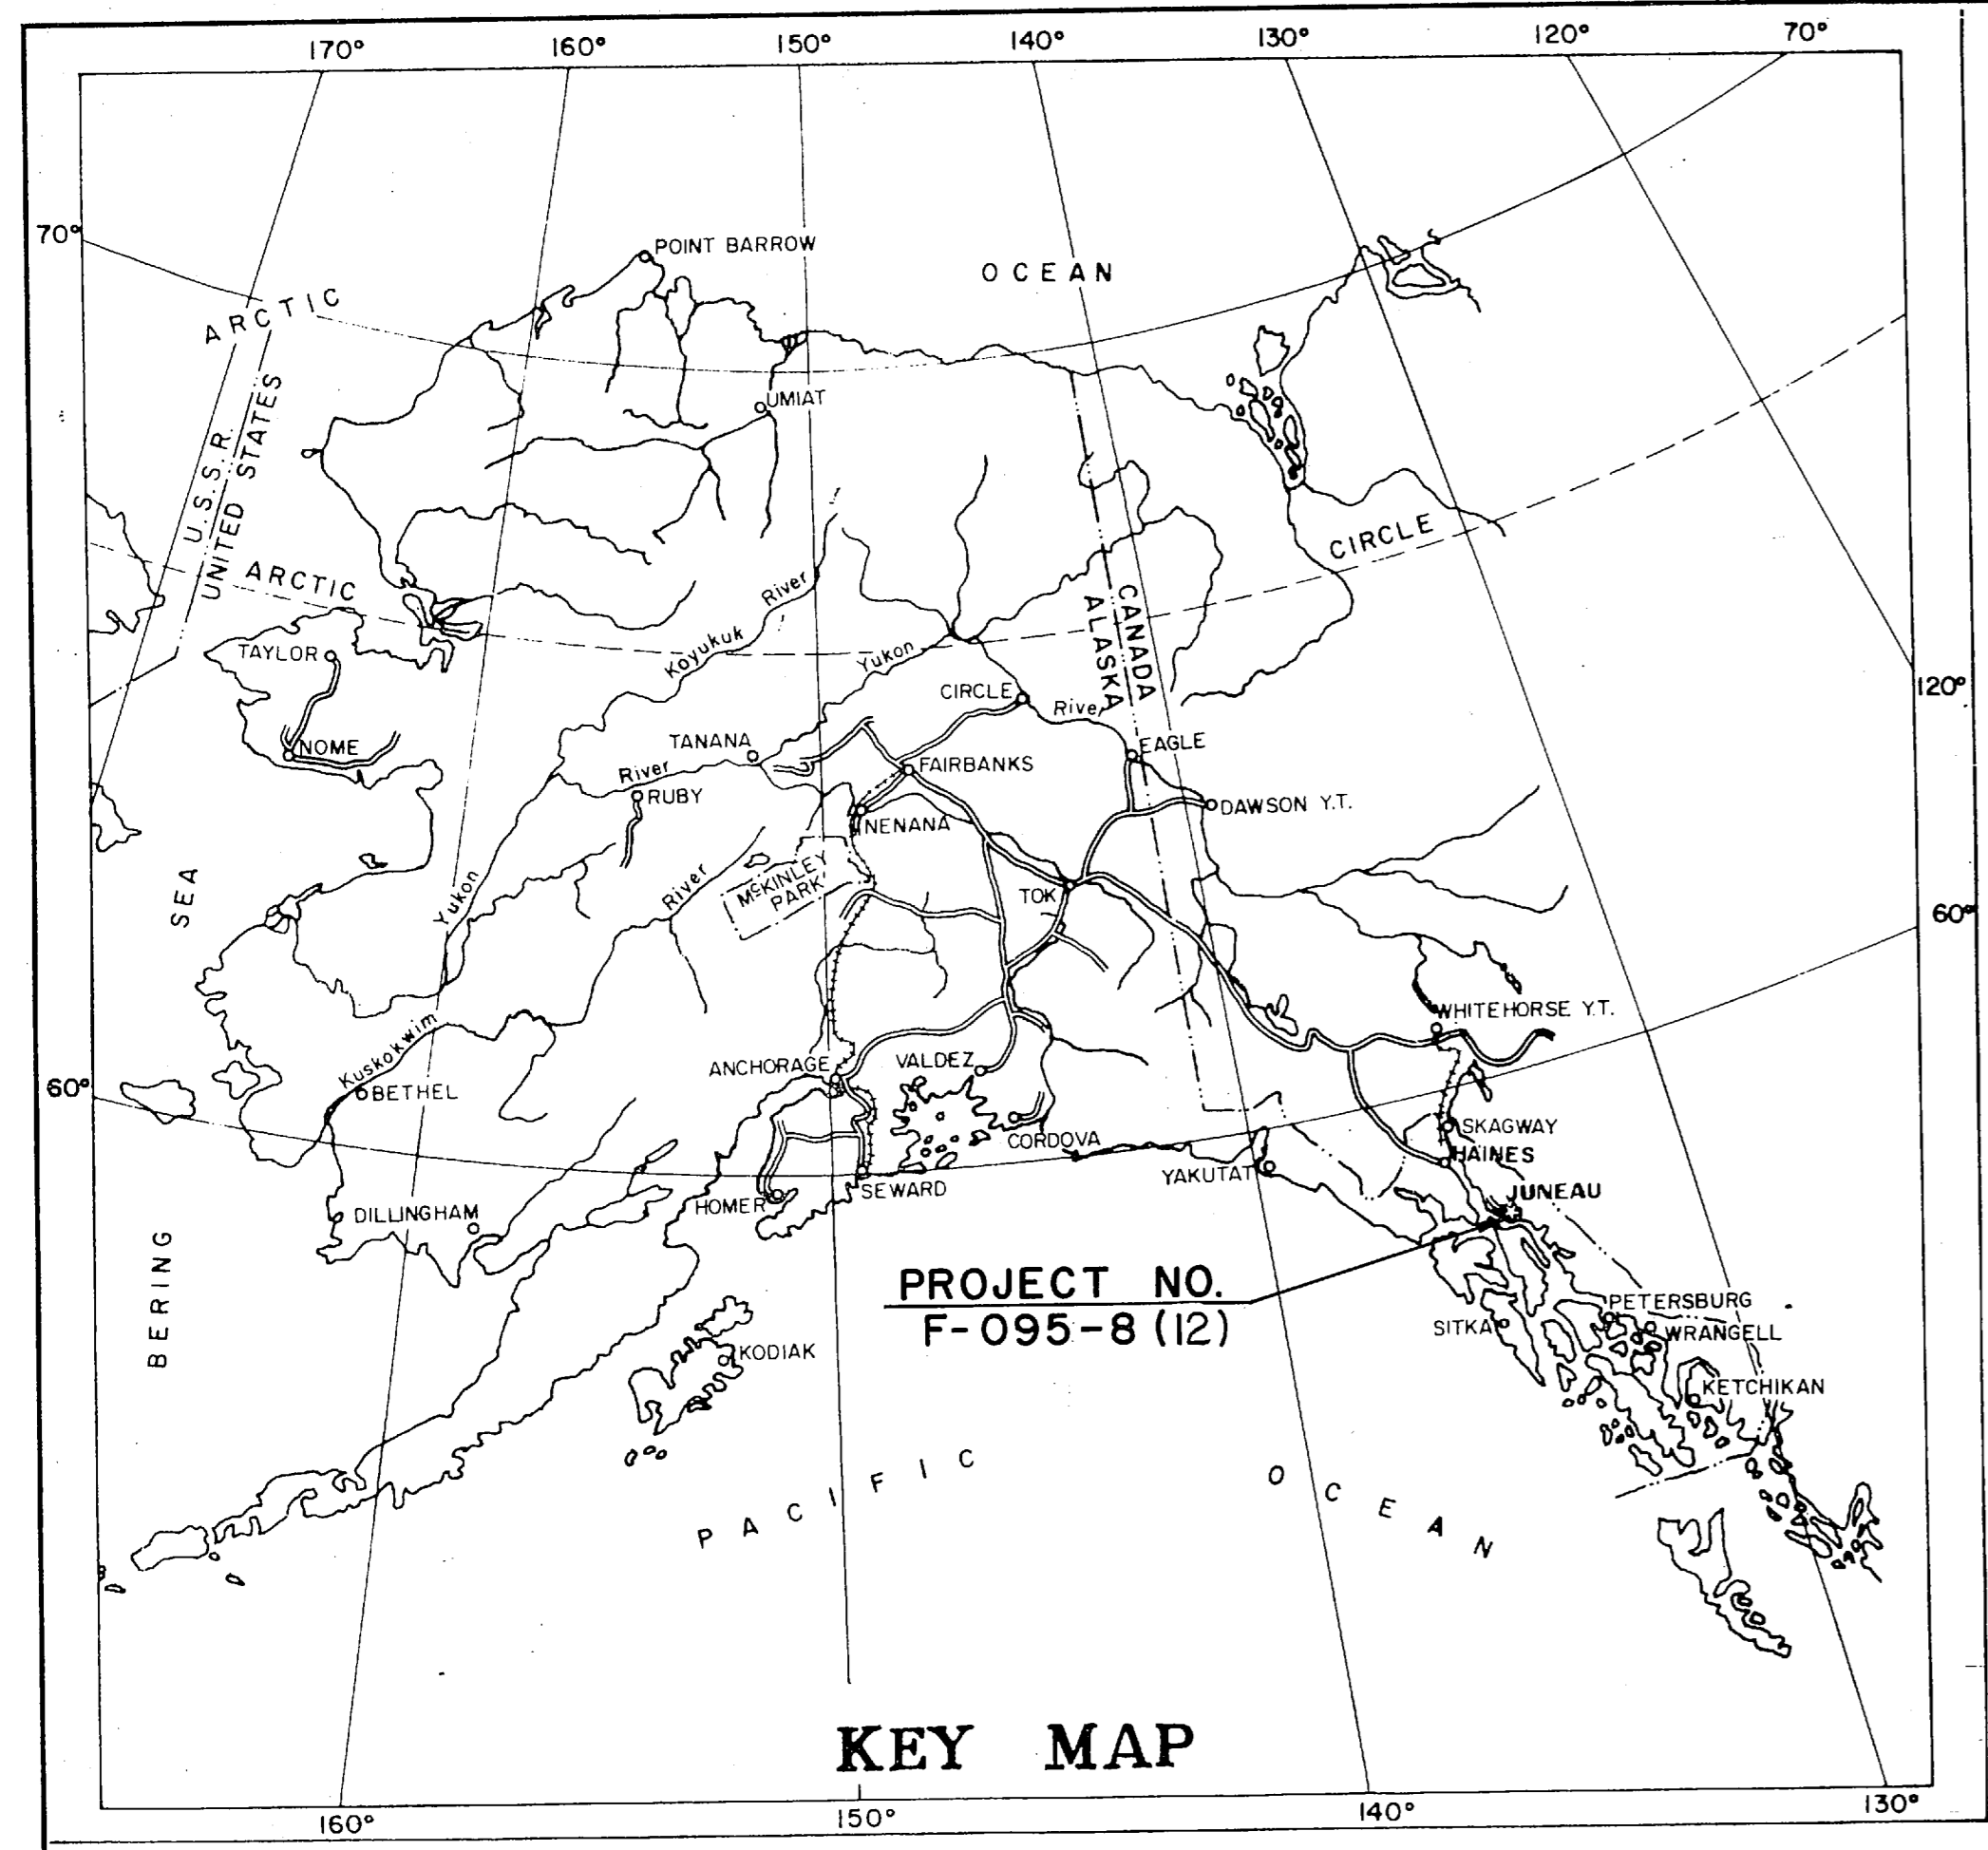

STATE OF ALASKA
DEPARTMENT OF HIGHWAYS

PLAN AND PROFILE
PROPOSED HIGHWAY PROJECT
F-095-8(12)
THIRD STREET IN DOUGLAS
GRADING, DRAINAGE, PAVING,
ROAD SIDE BEAUTIFICATION
& UTILITY RELOCATION

INDEX OF SHEETS

1	TITLE SHEET
2	TYPICAL SECTION
3	ESTIMATE OF QUANTITIES
4-7	PLAN AND PROFILE SHEETS
8	SIDEWALK DETAIL RT. F TO E STREETS
9	STORM SEWER OUTFALL PLAN
10	RETAINING WALL AND UTILITY DETAILS
11	DRAINAGE DETAILS
12	HANDRAIL, CURB, AND SIDEWALK DETAILS
13	CONCRETE STAIR DETAILS
14-17	INTERSECTION PLAN AND PROFILE SHEETS
18-19	CITY OF DOUGLAS UTILITY DETAILS
20	SUMMARY OF STANDARD SIGNS
21	SUMMARY OF BRASS CAP MONUMENTS
The following Standards apply to this project:	
D-1, D-3, D-4,R-1,R-4, T-1, T-6, T-15	
T-16 (sheets 1 & 2), & T-20.	

As-Built Plans
contractor: S.S. Mullen Inc.

92+73.435


G A S T I N E A U C H A N N E L

BEGIN PROJECT
 STA. "0" 93+70

END PROJECT
 STA. "0" 114+50

Began 5-6-68 Completed 7-15-69

- CONVENTIONAL SIGNS
- LUMINAIRE MAST ARM MOUNTED PROPOSED
 - SLOPE LIMIT CUT
 - SLOPE LIMIT FILL
 - POWER POLE EXISTING
 - TELEPHONE POLE EXISTING
 - JOINT USE POWER POLE AND TELEPHONE POLE
 - PROPOSED CONSTRUCTION CENTERLINE
 - PRELIMINARY SURVEY LINE
 - TOWNSHIP LINE
 - SECTION LINE
 - PROPERTY LINE
 - RIGHT-OF-WAY LINE
 - EASEMENT LINE
 - CORPORATED OR CITY LIMITS
 - POWER LINE PROPOSED
 - TELEPHONE OR TELEGRAPH LINE PROPOSED
 - POLE ANCHOR
 - LIGHT POLE
 - WATER LINE
 - SEWER LINE
 - VALVE BOX
 - CATCH BASIN
 - DROP INLET
 - MANHOLE
 - CULVERT PROPOSED
 - CULVERT EXISTING
 - FIRE HYDRANT, EXISTING
 - TRAVELED WAY
 - SWAMP
 - FENCE
 - CURB CUT
 - LAND MONUMENT
 - RIGHT-OF-WAY MONUMENT
 - BRASS CAP MONUMENT
 - FIRE HYDRANT, PROPOSED

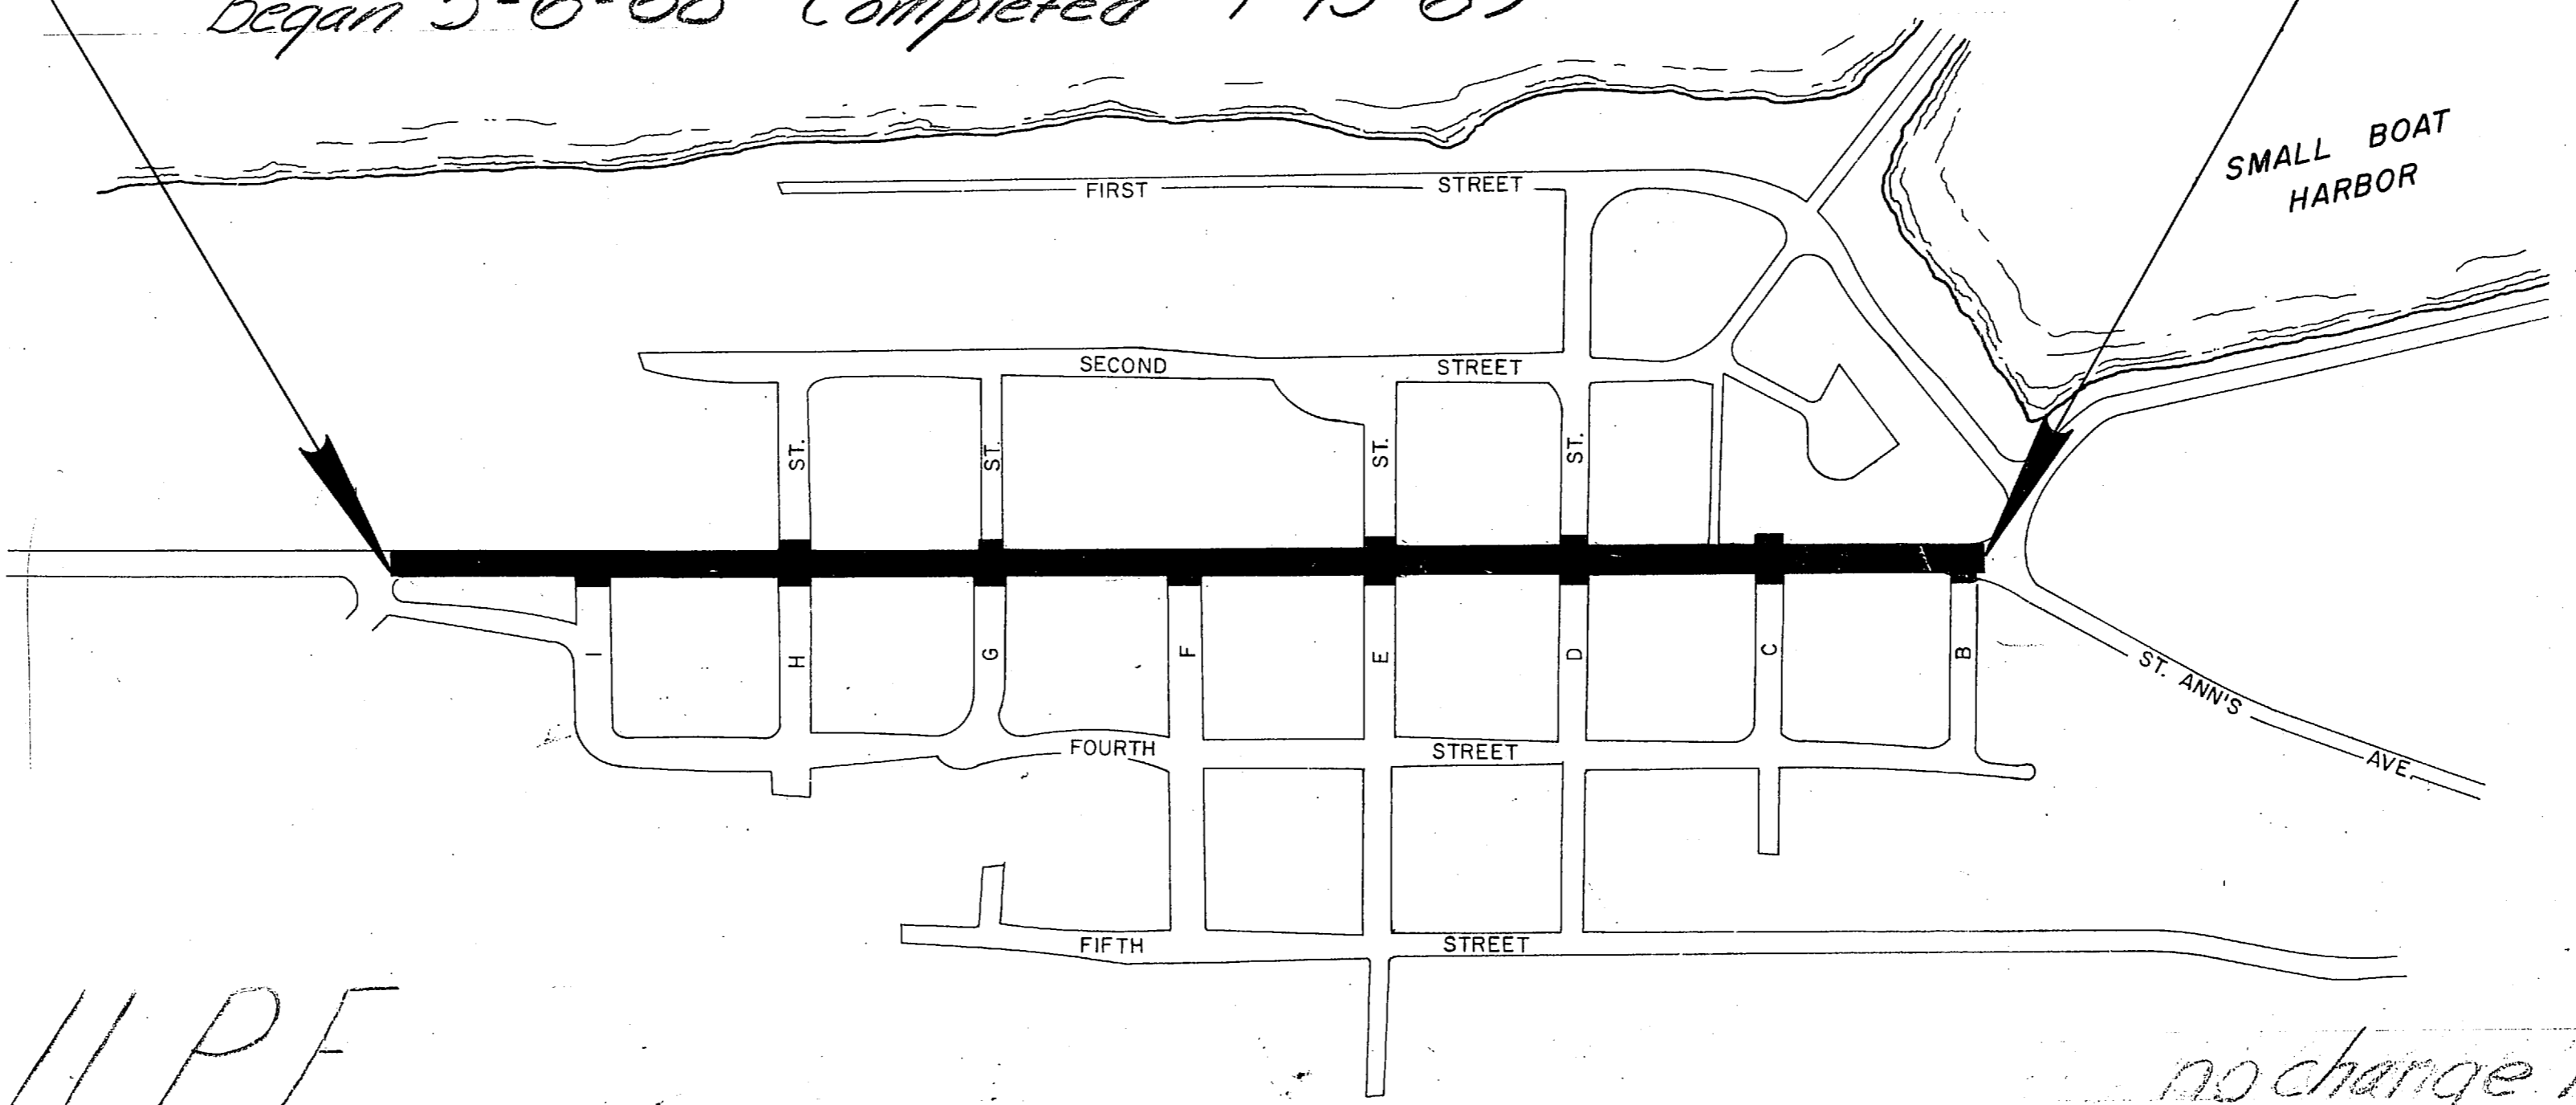

DESIGN DESIGNATION

ADT (1966) =	2800
ADT (1986) =	6650
DHV 12% =	798
D =	45-55
T =	5%
V =	35 M.P.H.


PROJECT SUMMARY

WIDTH OF ROADWAY	44'
WIDTH OF PAVEMENT	41'
LENGTH OF GRADING	2165.20= 0.429mi.
LENGTH OF PAVING	2080.00= 0.394mi.
LENGTH OF PROJECT	2080.00= 0.394mi.
TEMPORARY TRANSITION	0+00 to 0+85.2


B. Bergdoll P.E.

no change in length


STATE OF ALASKA
 DEPARTMENT OF HIGHWAYS
 APPROVED
J.C. Gunnison Date 12/21/67
 COMMISSIONER OF HIGHWAYS

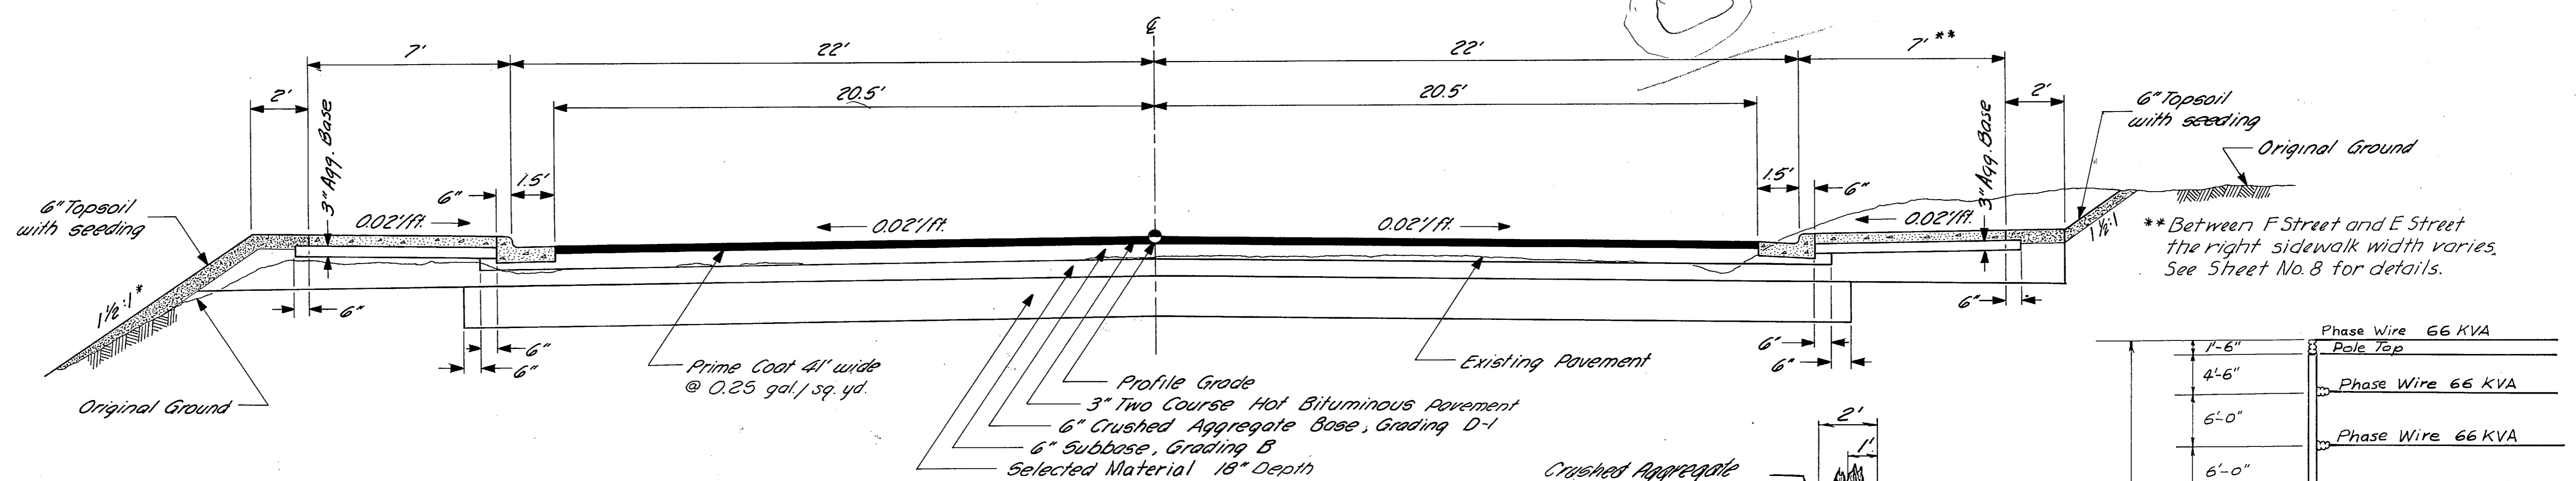


TYPICAL SECTION OF IMPROVEMENT
Sta. "0" 93+70 to Sta. "0" 114+50

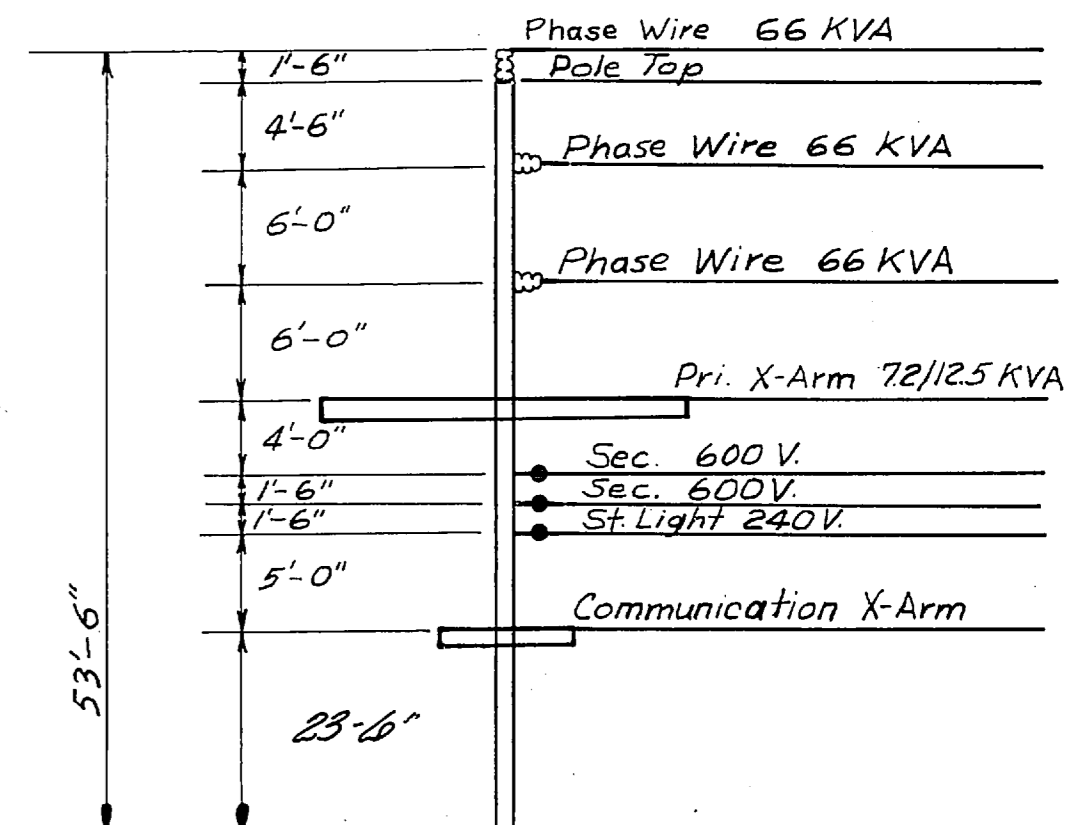

TYPICAL POLE TOP CONFIGURATION
(TO BE DONE BY OTHERS)

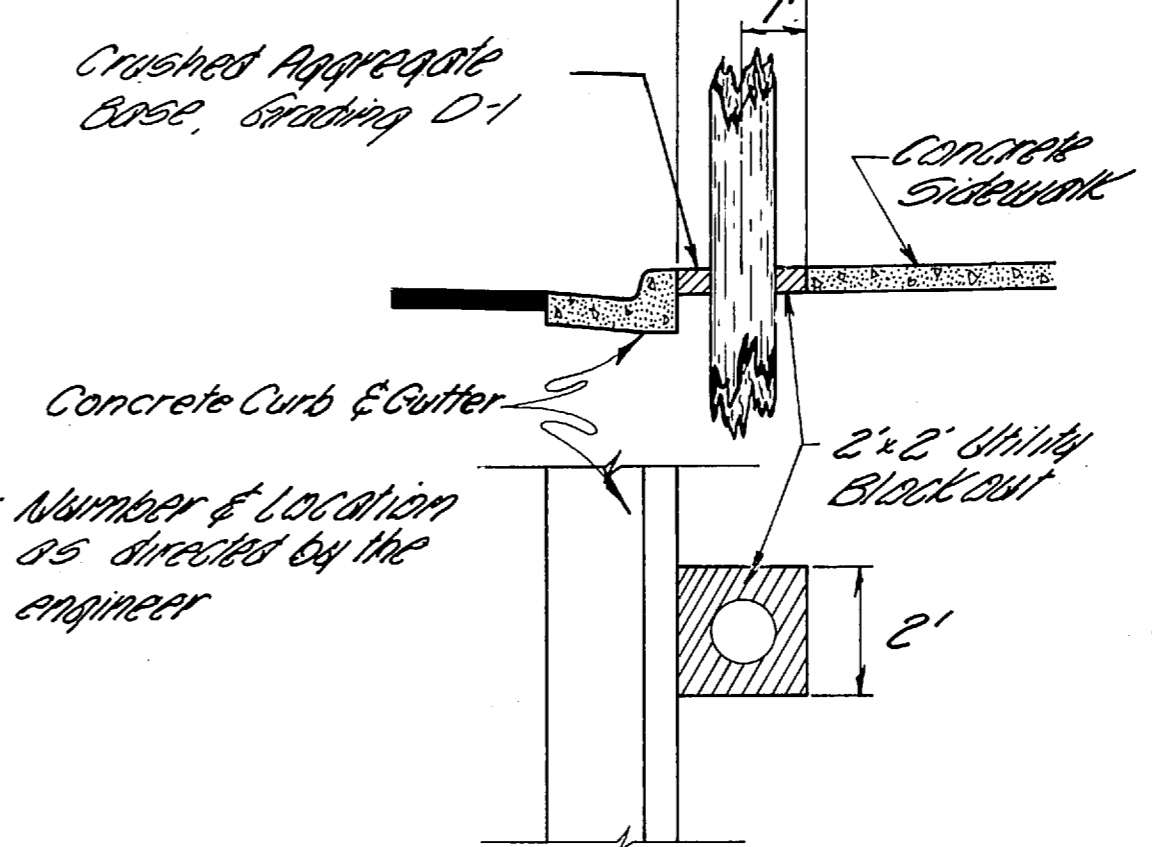

TYPICAL UTILITY BLOCK OUT

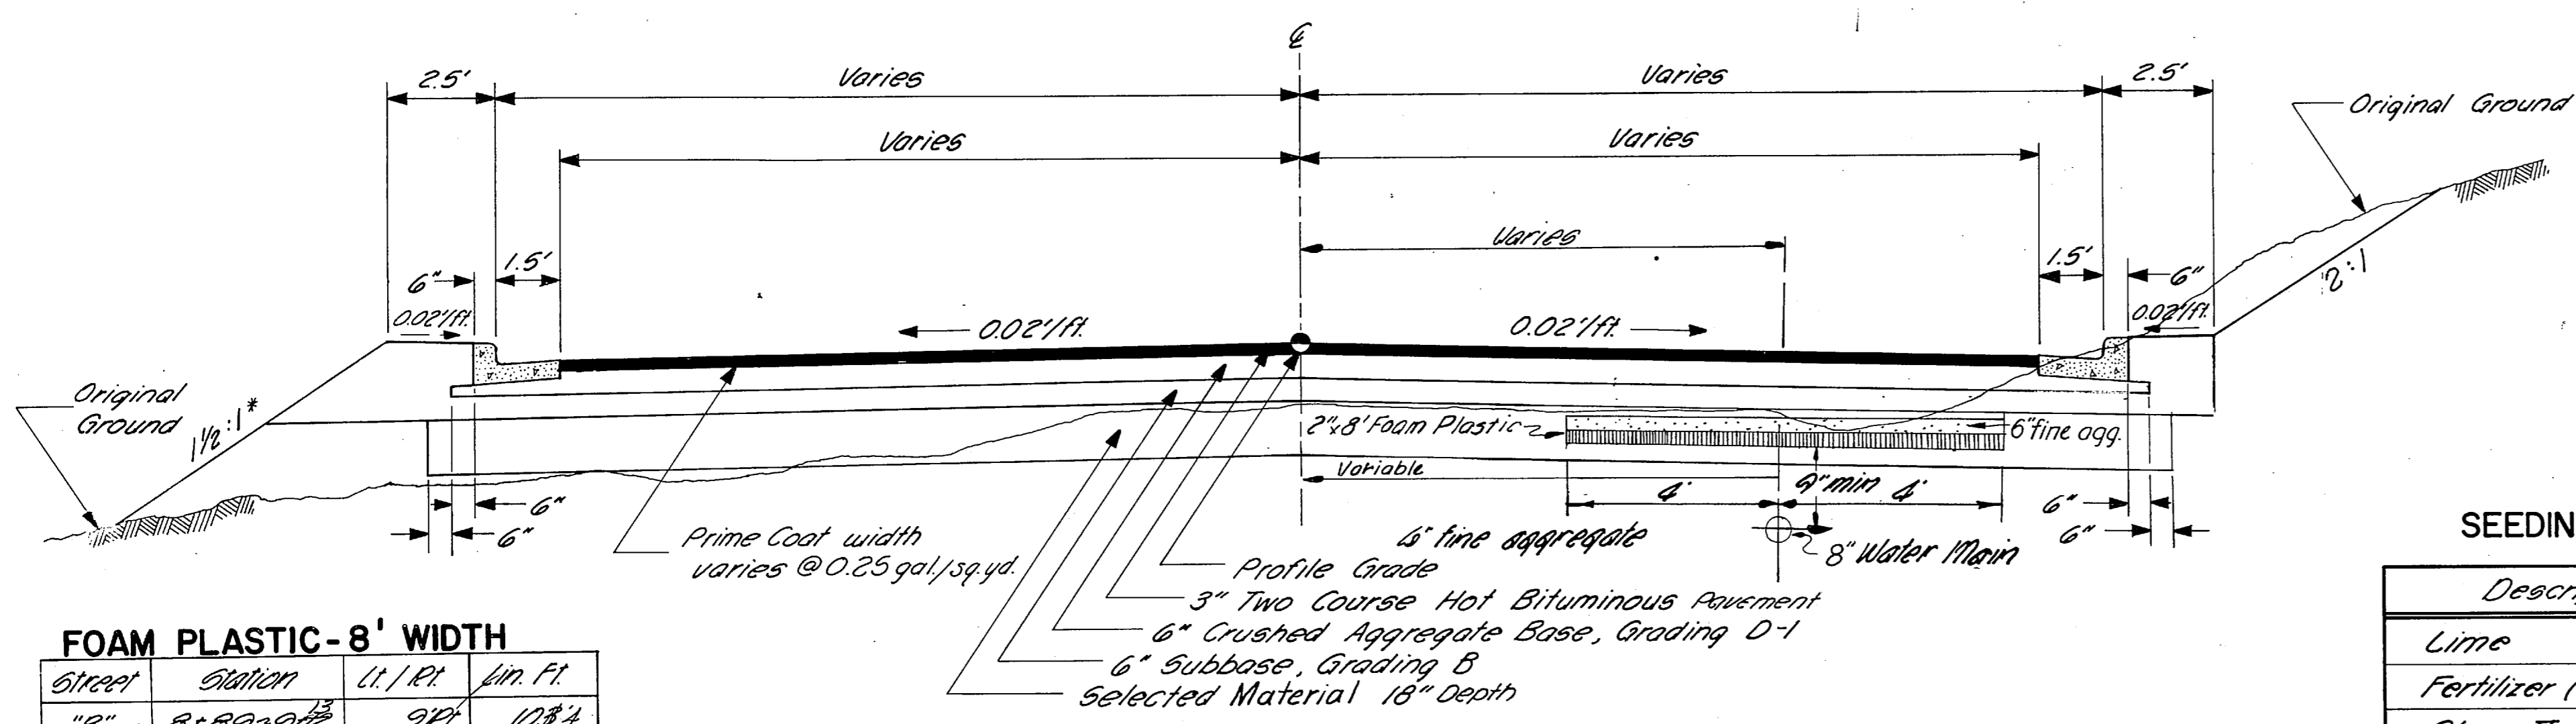

TYPICAL SECTION SIDE STREET PAVED APPROACH

FOAM PLASTIC-8' WIDTH

Street	Station	U. I. P. I.	Lin. Ft.
"B"	8+59-9+12	9RT	1034
"D"	8+90-9+25	12RT	981
"E"	9+16-9+71	8' Lt.	551
"H"	8+22-9+59	4RT	1089
"H"	9+32-1	8' Lt.	1413
"I"	9+23-1	13' Lt.	61
Total Linear Feet			3544


SEEDING APPLICATION RATES

Description	Rate/1,000 sq. ft.
Lime	150# max.
Fertilizer (10-20-20)	15# max.
Class II Seeding	2.5 #
Wood Cellulose Mulch	25 #


① See Special Provisions

BASIS OF ESTIMATE

Item	Estimating Factor
203(5)	1.87 Tons per cubic yd.
304(1)	1.87 Tons per cubic yd.
307(1)	1.87 Tons per cubic yd.
403(1)	145 lbs. per cubic ft.
403(2)	6% of item 403(1)
408(2)	256 gal. per ton (60°F)

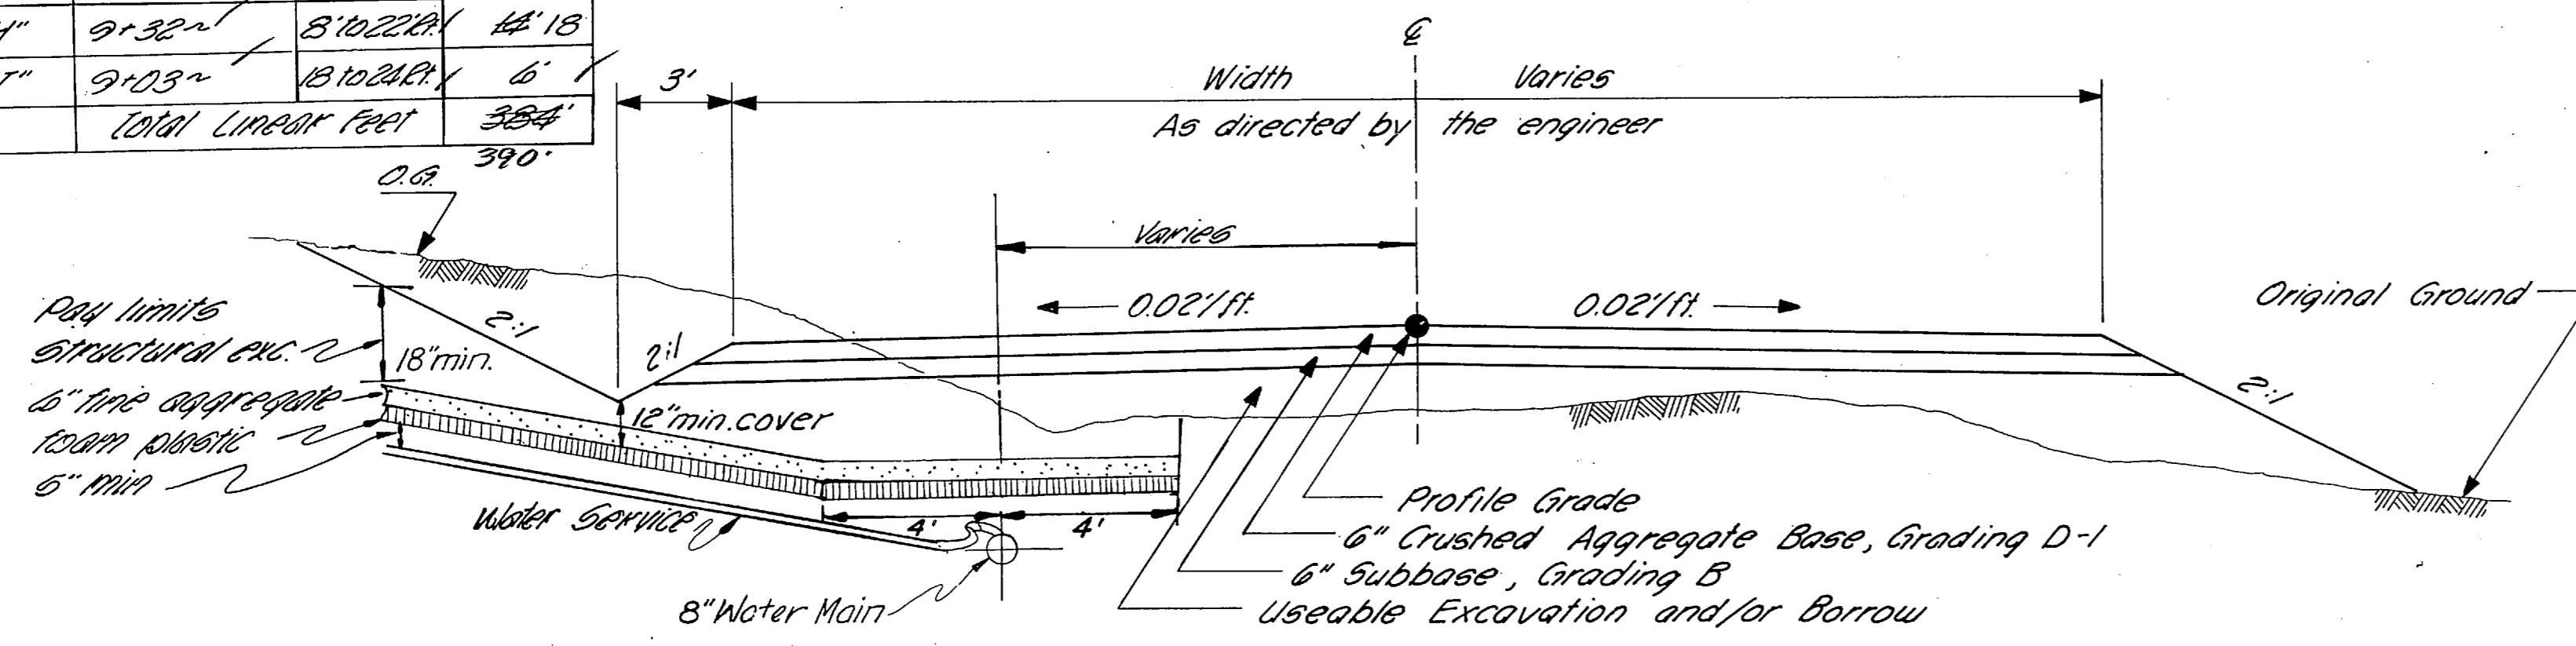

TYPICAL SECTION SIDE STREET (BEYOND PAVING LIMITS) WITH TYPICAL WATER SERVICE INSULATION

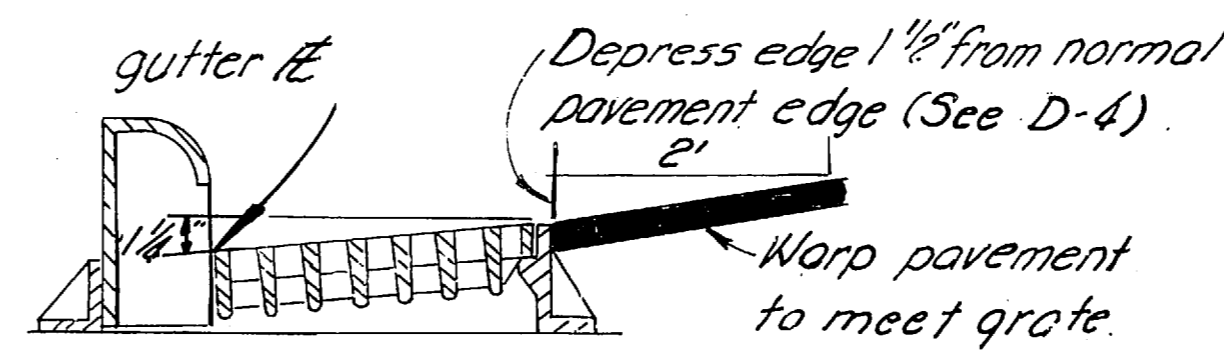

TYPICAL GUTTER DEPRESSION

GENERAL NOTES

- Retaining Walls, Headwalls, Steps and Stairs shall be paid for under Item No. 601(1).
- Culvert lengths and locations are approximate only and are subject to minor revisions.
- Grade and alignment shown on these plans are subject to minor revisions.
- Miscellaneous and minor Right-of-Way encroachments within the construction limits at the time of construction, such as fences, signs, abandoned foundations, concrete structures, etc., shall be removed by the contractor as directed by the engineer. This includes the concrete slabs at Sta. 102+ and Sta. 104+20, as well as other slabs outside the construction limits designated by the engineer. No payment for this work shall be made as it is not a pay item in this contract. Such work will be considered incidental to other items of work performed under this contract.
- All waste and/or surplus material encountered on this project will be disposed of by the contractor at locations of his own choice and as approved by the engineer.
- Class A concrete shall have a minimum compressive strength of 3,000 psi in 28 days. All sidewalk, curbs, and gutter concrete shall be class W. All other concrete shall be Class A.
- The service walk at the Dept. of Highways Building shall be paid for under item 408(1) & "concrete sidewalk".
- When necessary to expedite traffic, aggregate base or bituminous surfacing shall be constructed part width at a time.
- Handrails as shown on the plans will be considered incidental to item No. 601(1) Class A concrete and no separate payment will be made therefor.
- Reinforced concrete, corrugated aluminum, or corrugated steel pipe may be used for item 403(2).
- Existing poles and appurtenances within the limits of construction to be removed by other.

ESTIMATE OF QUANTITIES

STATE	PROJECT DESIGNATION	YEAR	SHEET NO.	TOTAL SHEETS
ALASKA	F-095-8(12)	1967	3	32



ITEM No	ITEM	UNIT	SHEET NUMBER						Roadway Total			
			4	5	6	7	18	19				
201(3)	Clearing and Grubbing	Lump Sum								All Required		
202(2)	Removal of Pavement	Sq. Yd.	1,168	1,349	1,545	1,448				5,510		
202(3)	Removal of Sidewalk	Sq. Yd.				125	132			257		
202(4)	Removal and Disposal of Culvert Pipe	Lin. Ft.	120	41	443	330				934		
203(3)	Unclassified Excavation	Cu. Yd.	2,600	3,400	3,800	3,300				13,100		
203(5)	Borrow	Ton	3,400	6,300	5,400	3,200				18,300		
206(1)	Structure Excavation	Cu. Yd.	161	771	480	615				2,027		
207(1)	Class 1, Excavation for Structures	Cu. Yd.	126	182						308		
304(1)	Crushed Aggregate Base Course, Grading D-1	Ton	920	1,580	1,490	1,410				5,200		
307(1)	Subbase, Grading B	Ton	1425	2100	2225	1825				7575		
403(1)	Hot Bituminous Pavement	Ton	360	500	526	454				1,840		
403(2)	120-150 Pen Asphalt Cement	Ton	21.60	30.00	31.56	27.24				110.4		
408(2)	MC-30 Liquid Asphalt for Prime Coat	Ton	2.1	3.0	3.1	2.7				10.9		
601(1)	Class A Concrete	Lump Sum								All Required		
602(1)	Reinforcing Steel	Lump Sum								All Required		
603(26B)	8" Pipe Conduit	Lin. Ft.	16				26			16		
603(26C)	12" Pipe Conduit	Lin. Ft.	142	212	354	274				982		
603(26E)	18" Pipe Conduit	Lin. Ft.	68	594	332	540				1,534		
603(10F)	21" Asbestos Bonded Bituminous Coated Corrugated Metal Pipe 16 Gage	Lin. Ft.				266				266		
604(1)	Manholes	Each	1	2	3	3				9		
604(2A)	Concrete Inlets, Type A	Each	4	7	11	8				30		
604(4)	Adjust Existing Manholes	Each	1	2	4	3				10		
608(1)	Concrete Sidewalks 4" Depth	Sq. Yd.	466	715	639	632				2,452		
608(4)	Concrete Sidewalk, 6" Depth	Sq. Yd.	51	51	52	33				185		
609(3)	Curb and Gutter, Type 2	Lin. Ft.	775	1,259	1,234	1030				4,298		
610(4F)	Bituminous Coated Structural Plate Pipe 84" Diameter, 8 Gage	Lin. Ft.		20						20		
611(1)A	Riprap, Class 1	Ton		45						45		
614(1)	Survey Monuments	Each	2	2		2				6		
614(2)	Monument Cases	Each	2	2		2				6		
615(1)	Standard Signs	Each	9	13	17	14				53		
618(1)B	Seeding, Class 2	1000 Sq. Ft.	5.9	17.0	7.7	6.0				36.6		
618(2)	Water for Maintenance	1000 Gal.	4	12	5	4				25		
620(2)	Top Soil	1000 Sq. Ft.	5.9	17.0	7.7	6.0				36.6		
640(6)	Fire Hydrant Installation	Each						2	3	5		
640(8)	Fire Hydrant Removal	Each						2	3	5		
640(9A)	3/4" Water Service Connection	Each						8	11	19		
640(9B)	1 1/2" Water Service Connection	Each						1	4	5		
640(11)	Adjust Valve Boxes	Each						5	14	19		
640(12)	Relocate Curb Stop	Each						3	1	4		
640(16)	Insulate Existing Water Lines	MBM	096	1,952	2,448	1,648				6,144		
640(19)	Disconnect Existing Water Service	Each						1	4	5		
640(20)	Plug Existing Water Main	Each						1	1	2		
640(21)	Curb Service Box	Each						3	25	28		
640(22)	Electrical Bond At Curb Box	Each						3	26	29		
645(1)	Construct Sewer Lateral	Each							1	1		
645(2)	Disconnect Existing Sewer Lateral	Each						1	7	8		
670(1)	Painted Traffic Markings	Lump Sum								All Required		

PLAN
 SURVIVED
 NOTE BOOK
 ALIGNMENT CHECKED
 RT. OF WAY CHECKED
 NO.

PROFILE
 SURVIVED
 NOTE BOOK
 GRADES CHECKED
 E. M.F. NOTED
 STRUCTURE NOT IN CHARGE
 NO.

**BEGINNING OF
 TEMPORARY TRANSITION
 STA. 0+00**

**END OF TEMPORARY
 TRANSITION STA. 0+85.20
 BEGINNING OF PROJECT
 F-095-8(7)
 STA. "0" 93+70.00**

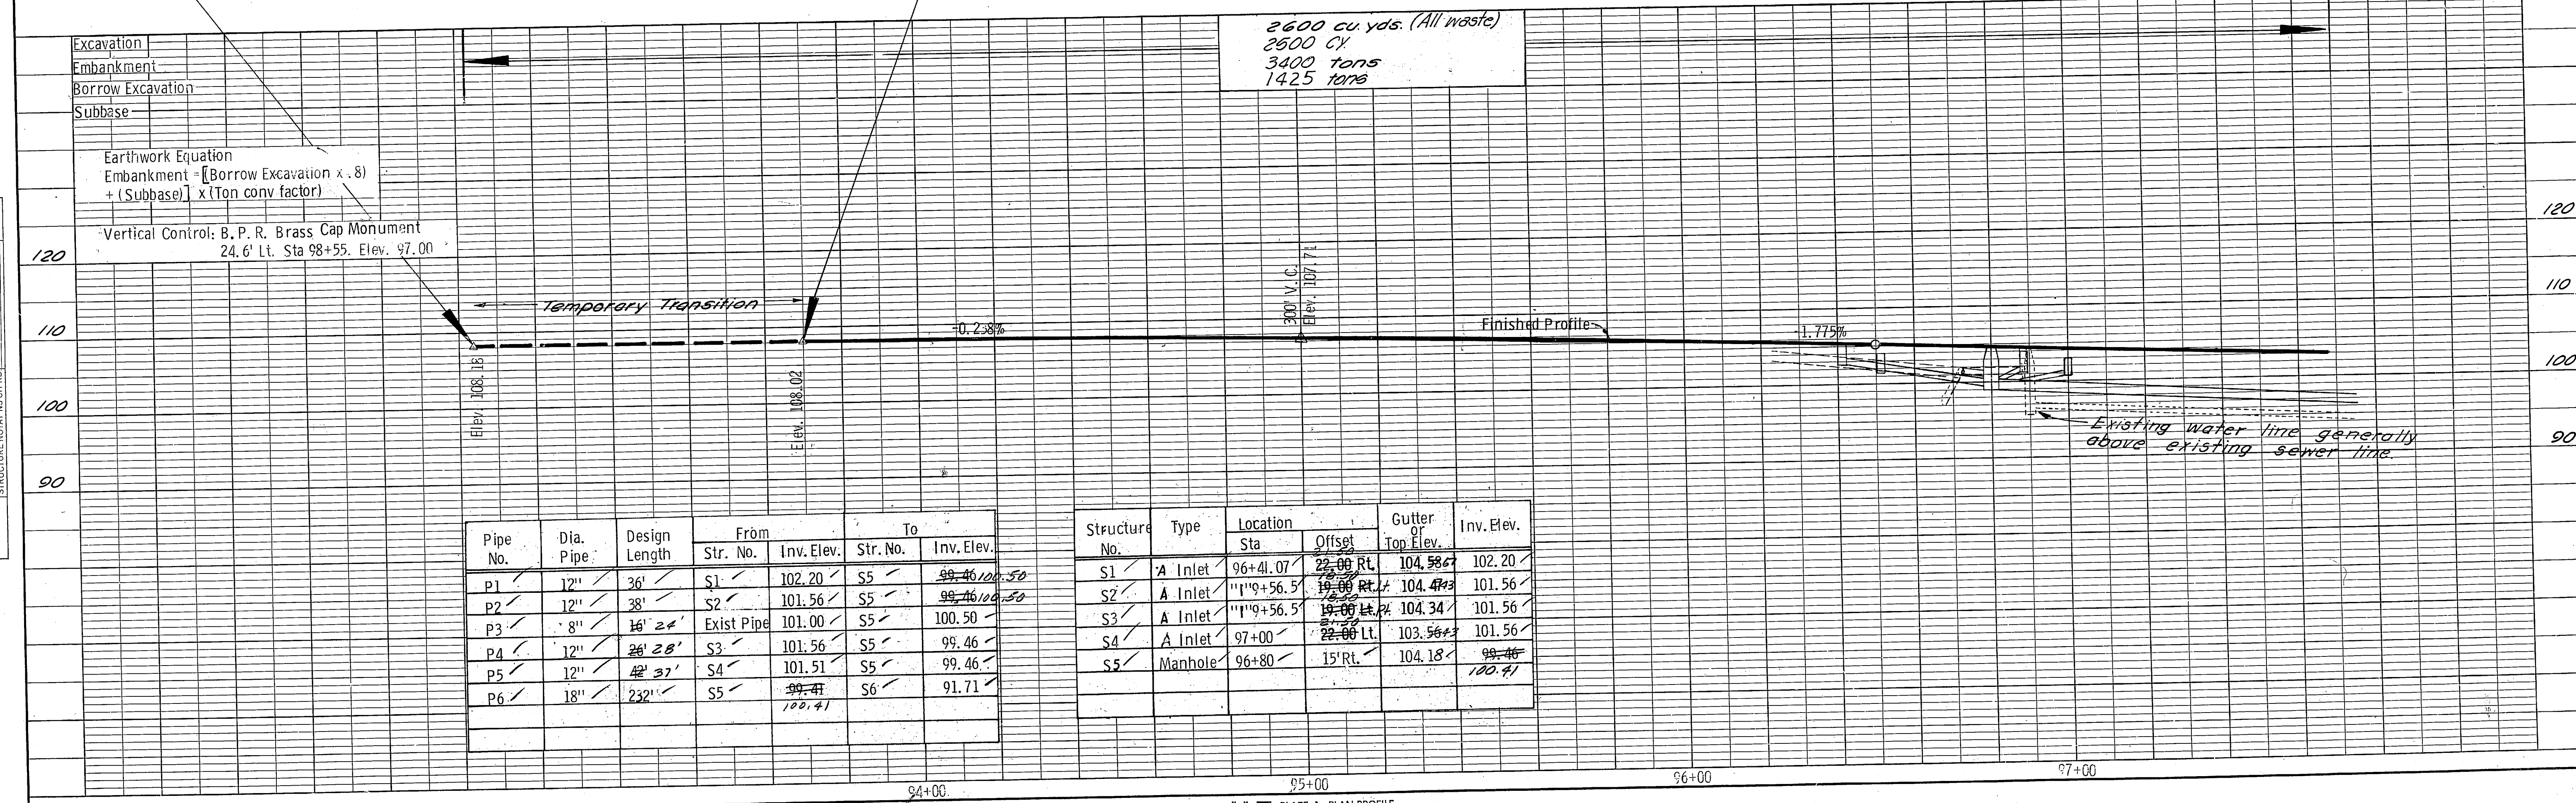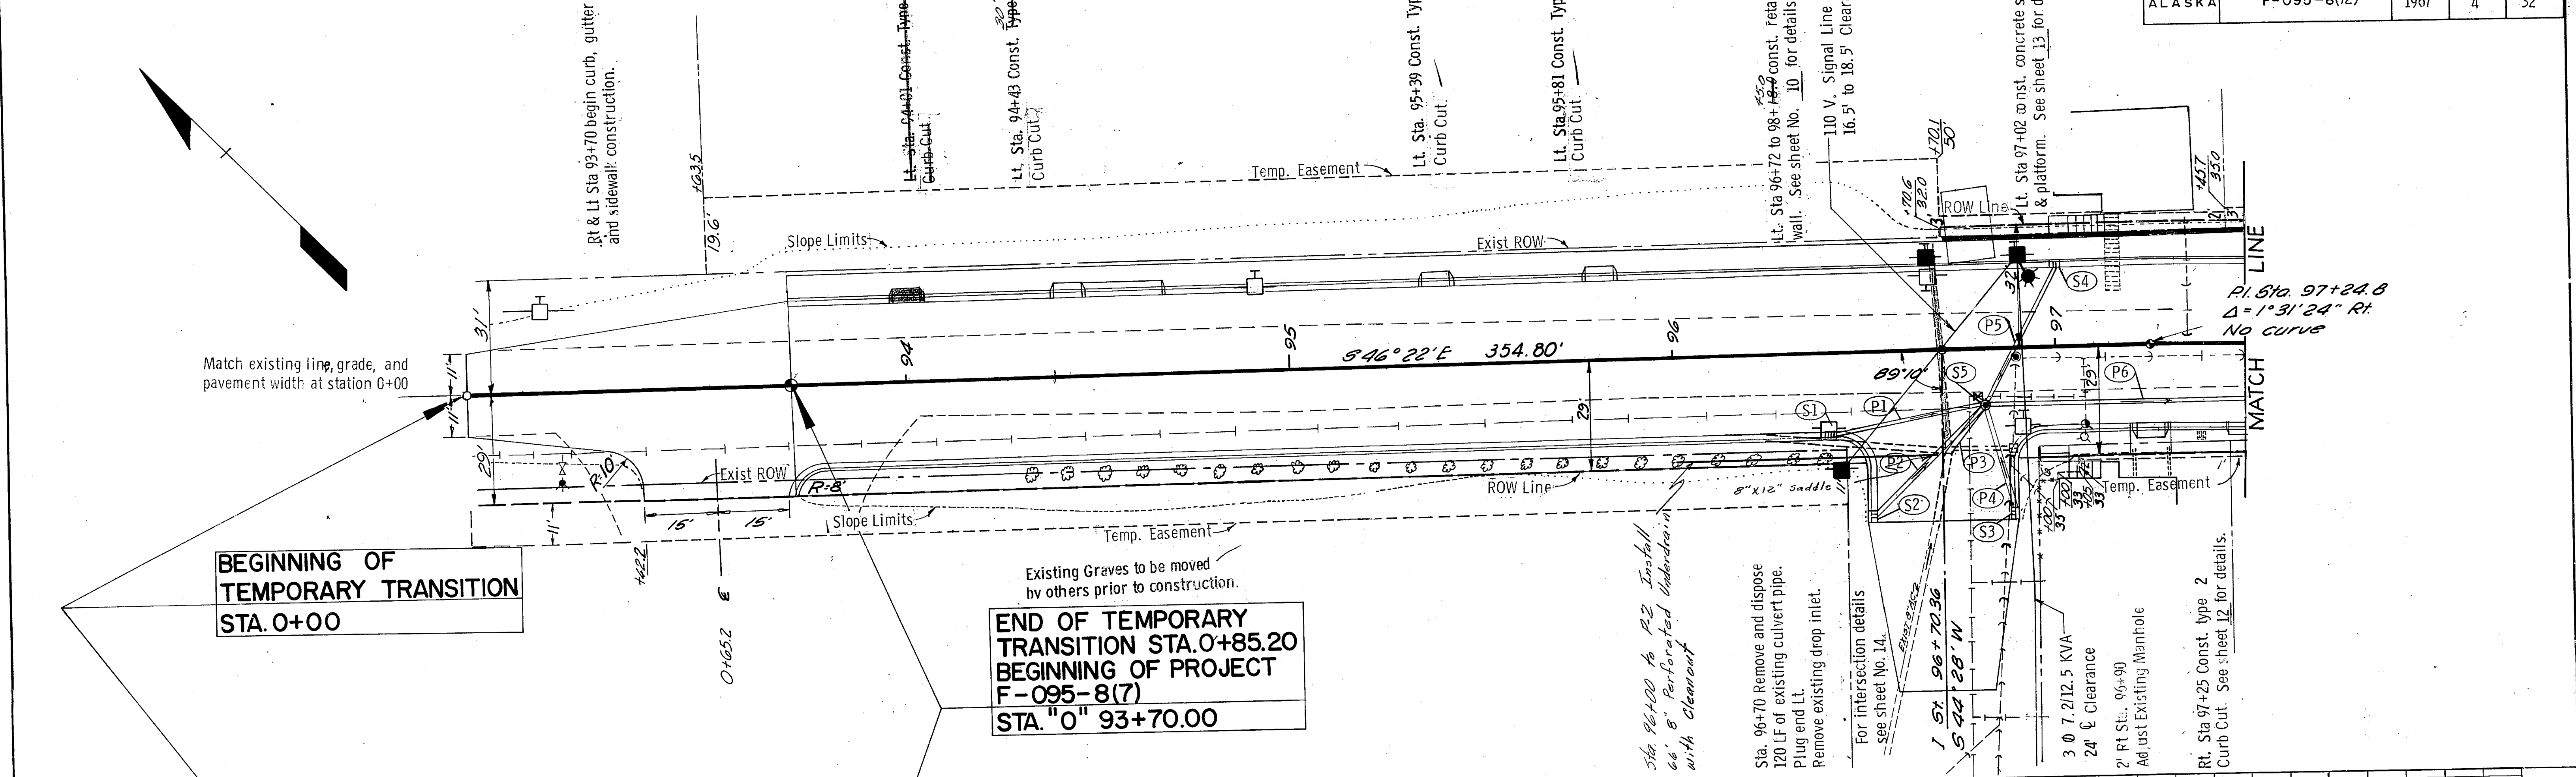



Pipe No.	Dia. Pipe	Design Length	From		To	
			Str. No.	Inv. Elev.	Str. No.	Inv. Elev.
P1	12"	36'	S1	102.20	S5	99.46
P2	12"	38'	S2	101.56	S5	99.46
P3	8"	16' 28"	Exist Pipe	101.00	S5	100.50
P4	12"	28' 28"	S3	101.56	S5	99.46
P5	12"	42' 37"	S4	101.51	S5	99.46
P6	18"	232'	S5	99.41	S6	91.71

Structure No.	Type	Location		Gutter or Top Elev.	Inv. Elev.
		Sta	Offset		
S1	A Inlet	96+41.07	22.00 Rt.	104.58	102.20
S2	A Inlet	96+56.5	19.00 Rt.	104.47	101.56
S3	A Inlet	96+56.5	19.00 Lt.	104.34	101.56
S4	A Inlet	97+00	22.00 Lt.	103.56	101.56
S5	Manhole	96+80	15' Rt.	104.18	99.46

PLAN SURVEYED BY DATE
 PLOTTED BY DATE
 NOTE BOOK ALIGNMENT CHECKED
 RT. OF WAY CHECKED
 NO. _____

PROFILE SURVEYED BY DATE
 PLOTTED BY DATE
 NOTE BOOK GRADES CHECKED
 E. ME. NOTED
 STRUCTURE NOTATIONS CHECKED
 NO. _____

STATE	PROJECT DESIGNATION	YEAR	SHEET NO.	TOTAL SHEETS
ALASKA	F-095-8(12)	1967	5	32

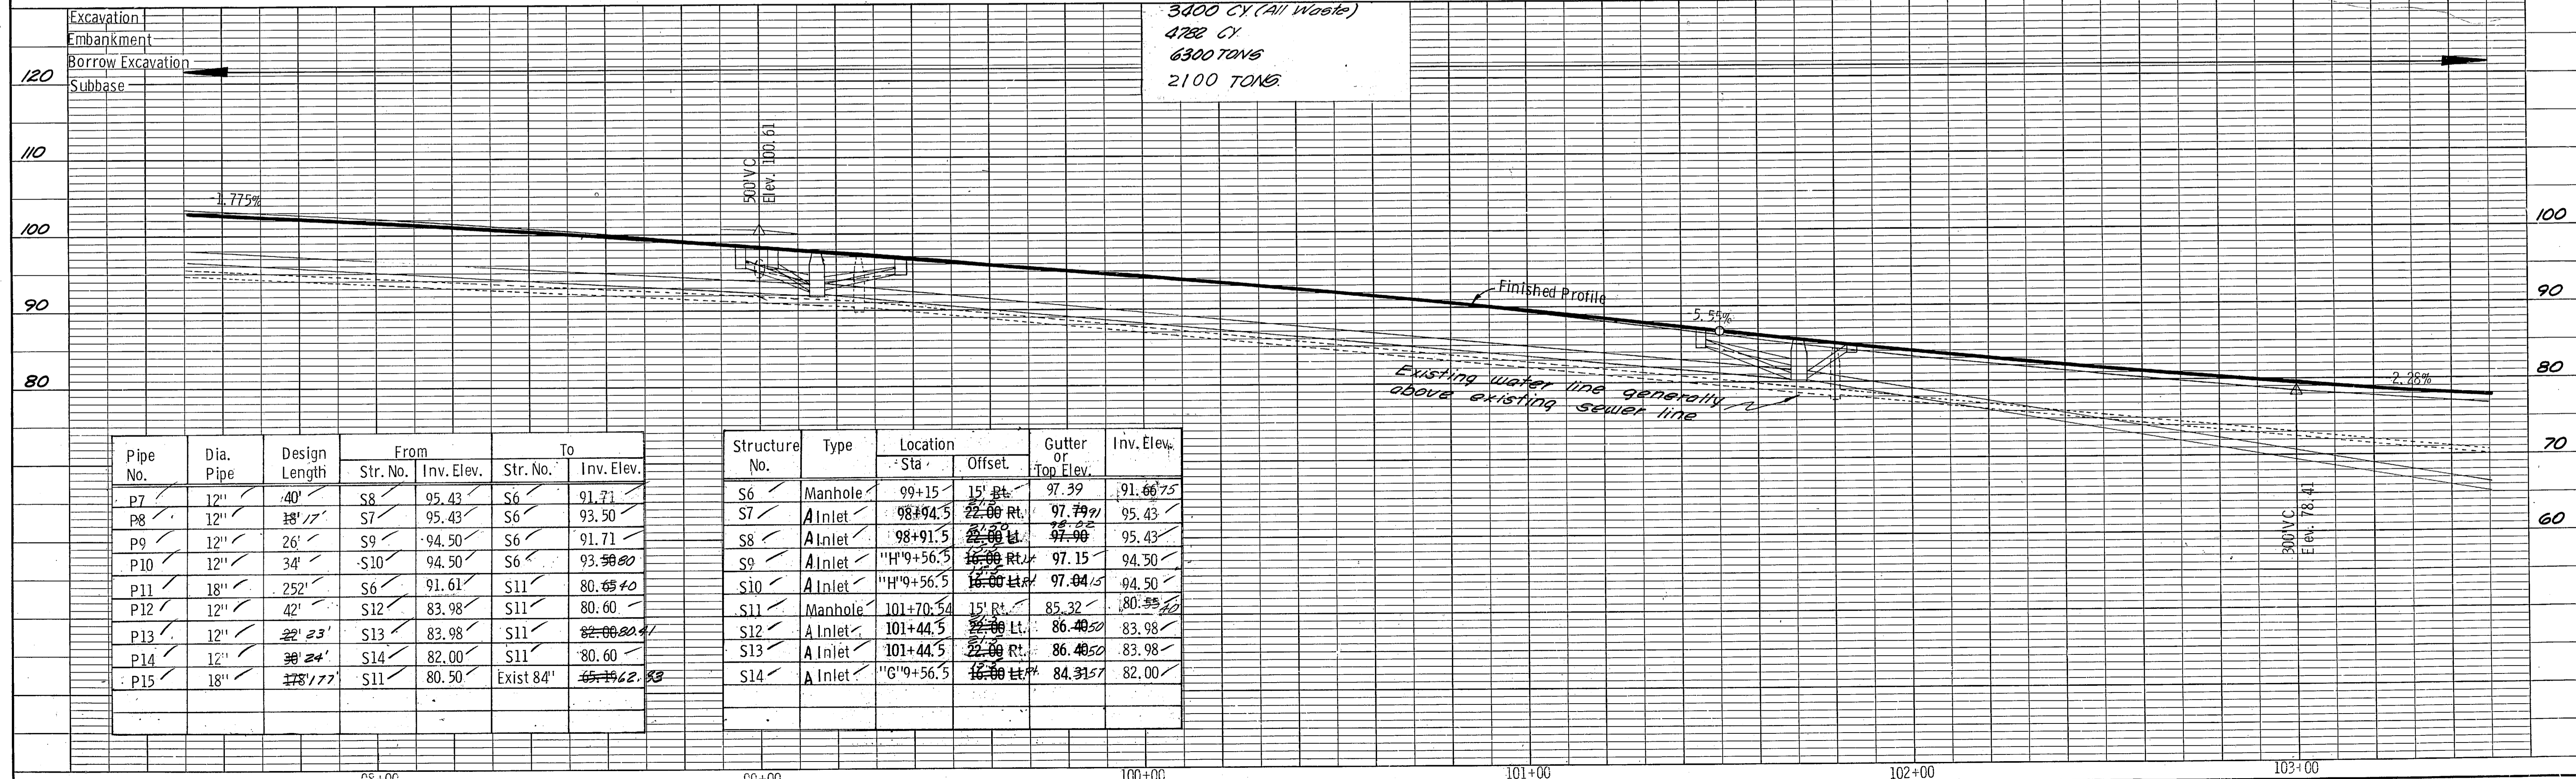
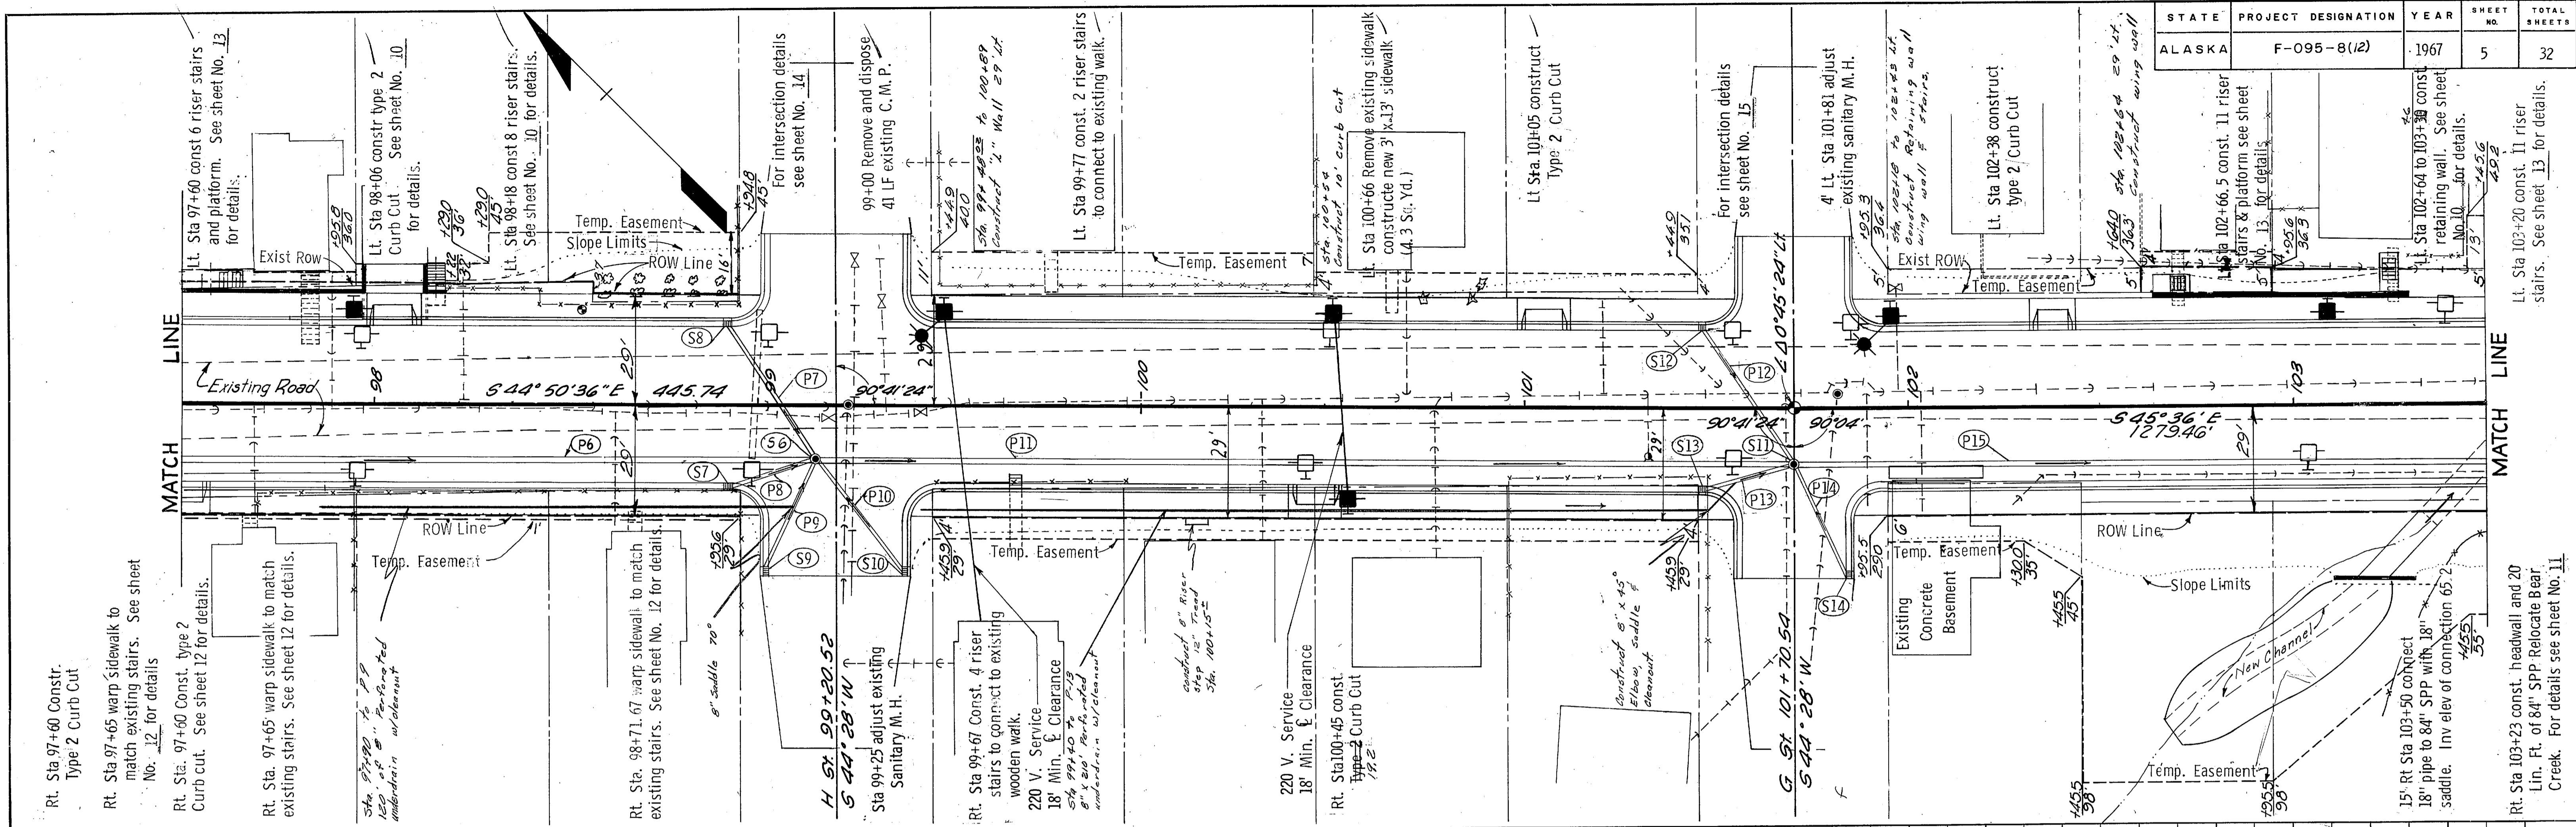


Pipe No.	Dia. Pipe	Design Length	From		To	
			Str. No.	Inv. Elev.	Str. No.	Inv. Elev.
P7	12"	40'	S8	95.43	S6	91.71
P8	12"	18' 17"	S7	95.43	S6	93.50
P9	12"	26'	S9	94.50	S6	91.71
P10	12"	34'	S10	94.50	S6	93.50
P11	18"	252'	S6	91.61	S11	80.65 + 0
P12	12"	42'	S12	83.98	S11	80.60
P13	12"	22' 23"	S13	83.98	S11	82.00 80.4
P14	12"	30' 24"	S14	82.00	S11	80.60
P15	18"	178' 17"	S11	80.50	Exist 84"	65' 12.83

Structure No.	Type	Location		Gutter or Top Elev.	Inv. Elev.
		Sta.	Offset		
S6	Manhole	99+15	15' Rt.	97.39	91.66 75
S7	A Inlet	98+94.5	22.00 Lt.	97.79 71	95.43
S8	A Inlet	98+91.5	22.00 Lt.	97.98	95.43
S9	A Inlet	"H" 9+56.5	16.00 Lt.	97.15	94.50
S10	A Inlet	"H" 9+56.5	16.00 Lt.	97.04 15	94.50
S11	Manhole	101+70.54	15' Rt.	85.32	80.55 40
S12	A Inlet	101+44.5	22.00 Lt.	86.40 50	83.98
S13	A Inlet	101+44.5	22.00 Lt.	86.40 50	83.98
S14	A Inlet	"G" 9+56.5	16.00 Lt.	84.31 57	82.00



PLAN
 SURVEYED, PLOTTED, CHECKED, RT. OF WAY CHECKED.
 NO. _____

PROFILE
 SURVEYED, PLOTTED, CHECKED, GRADES CHECKED, STRUCTURE NOTATIONS CHECKED.
 NO. _____

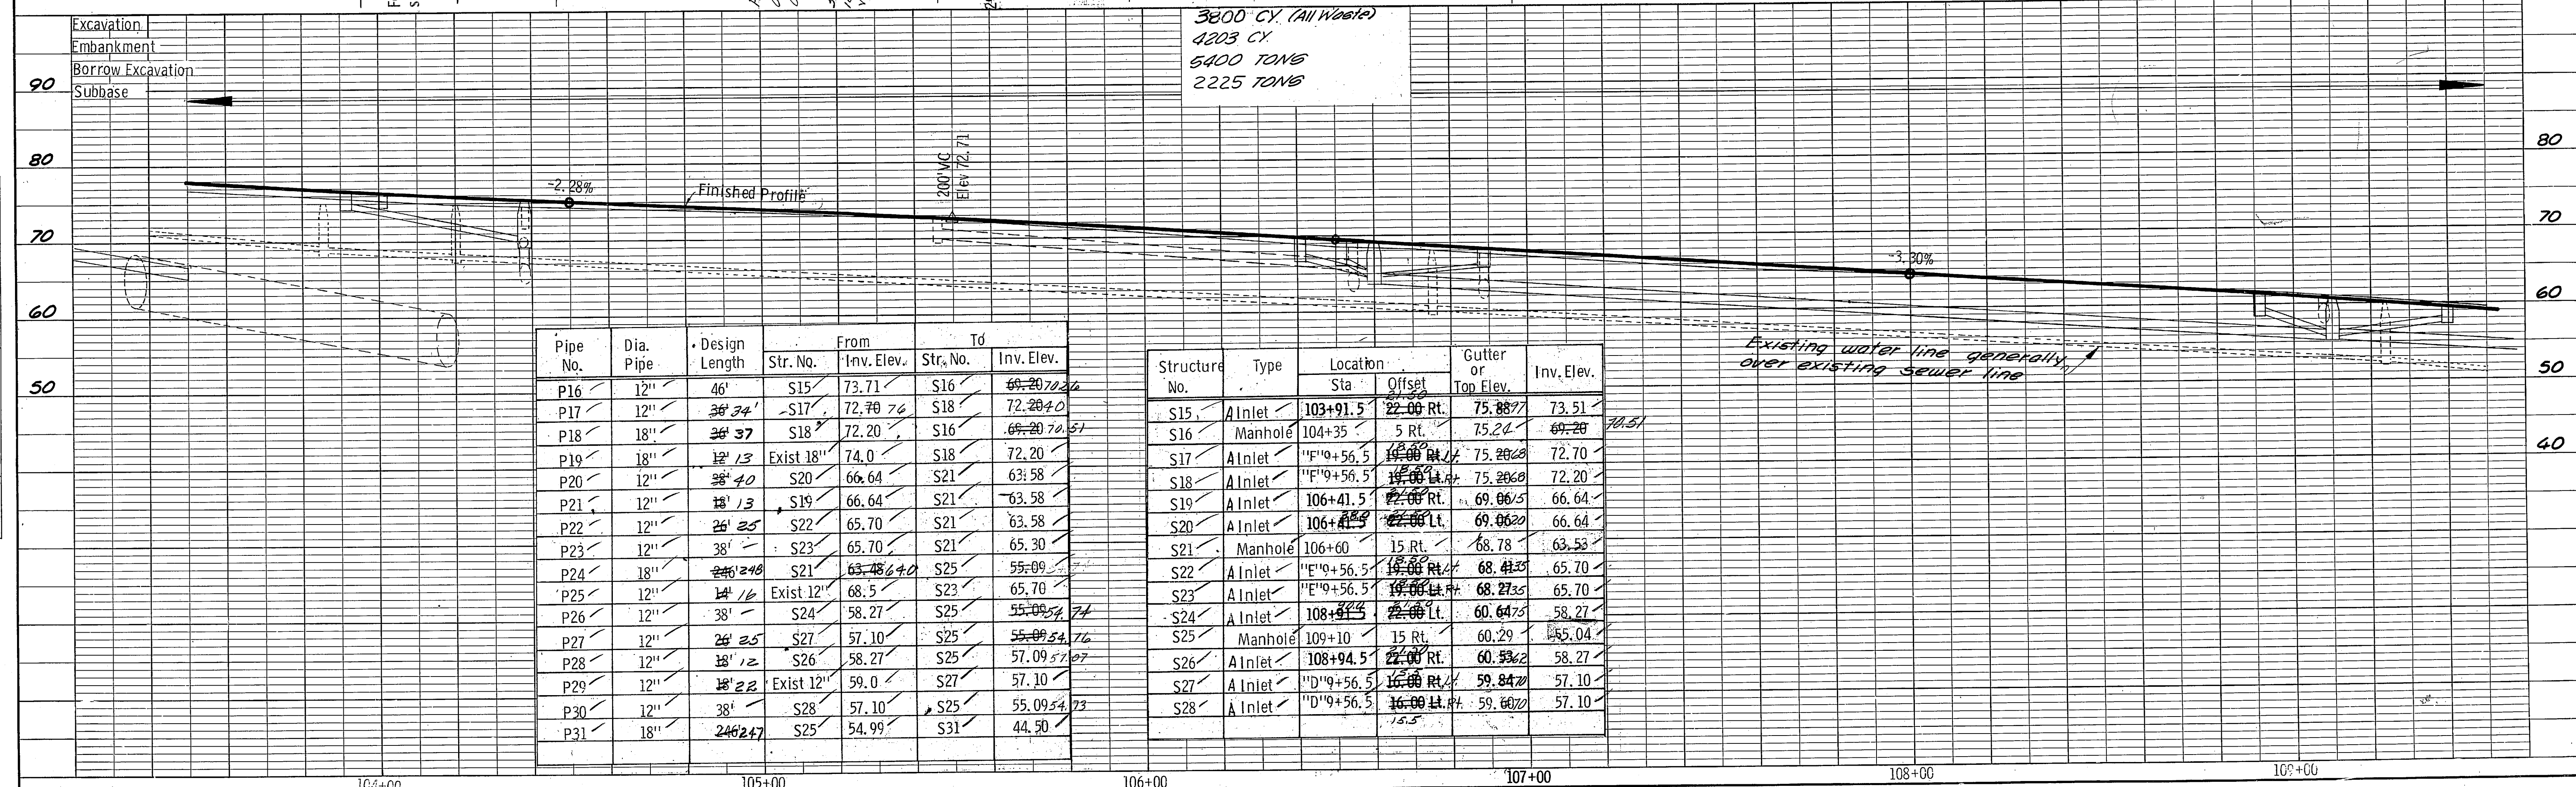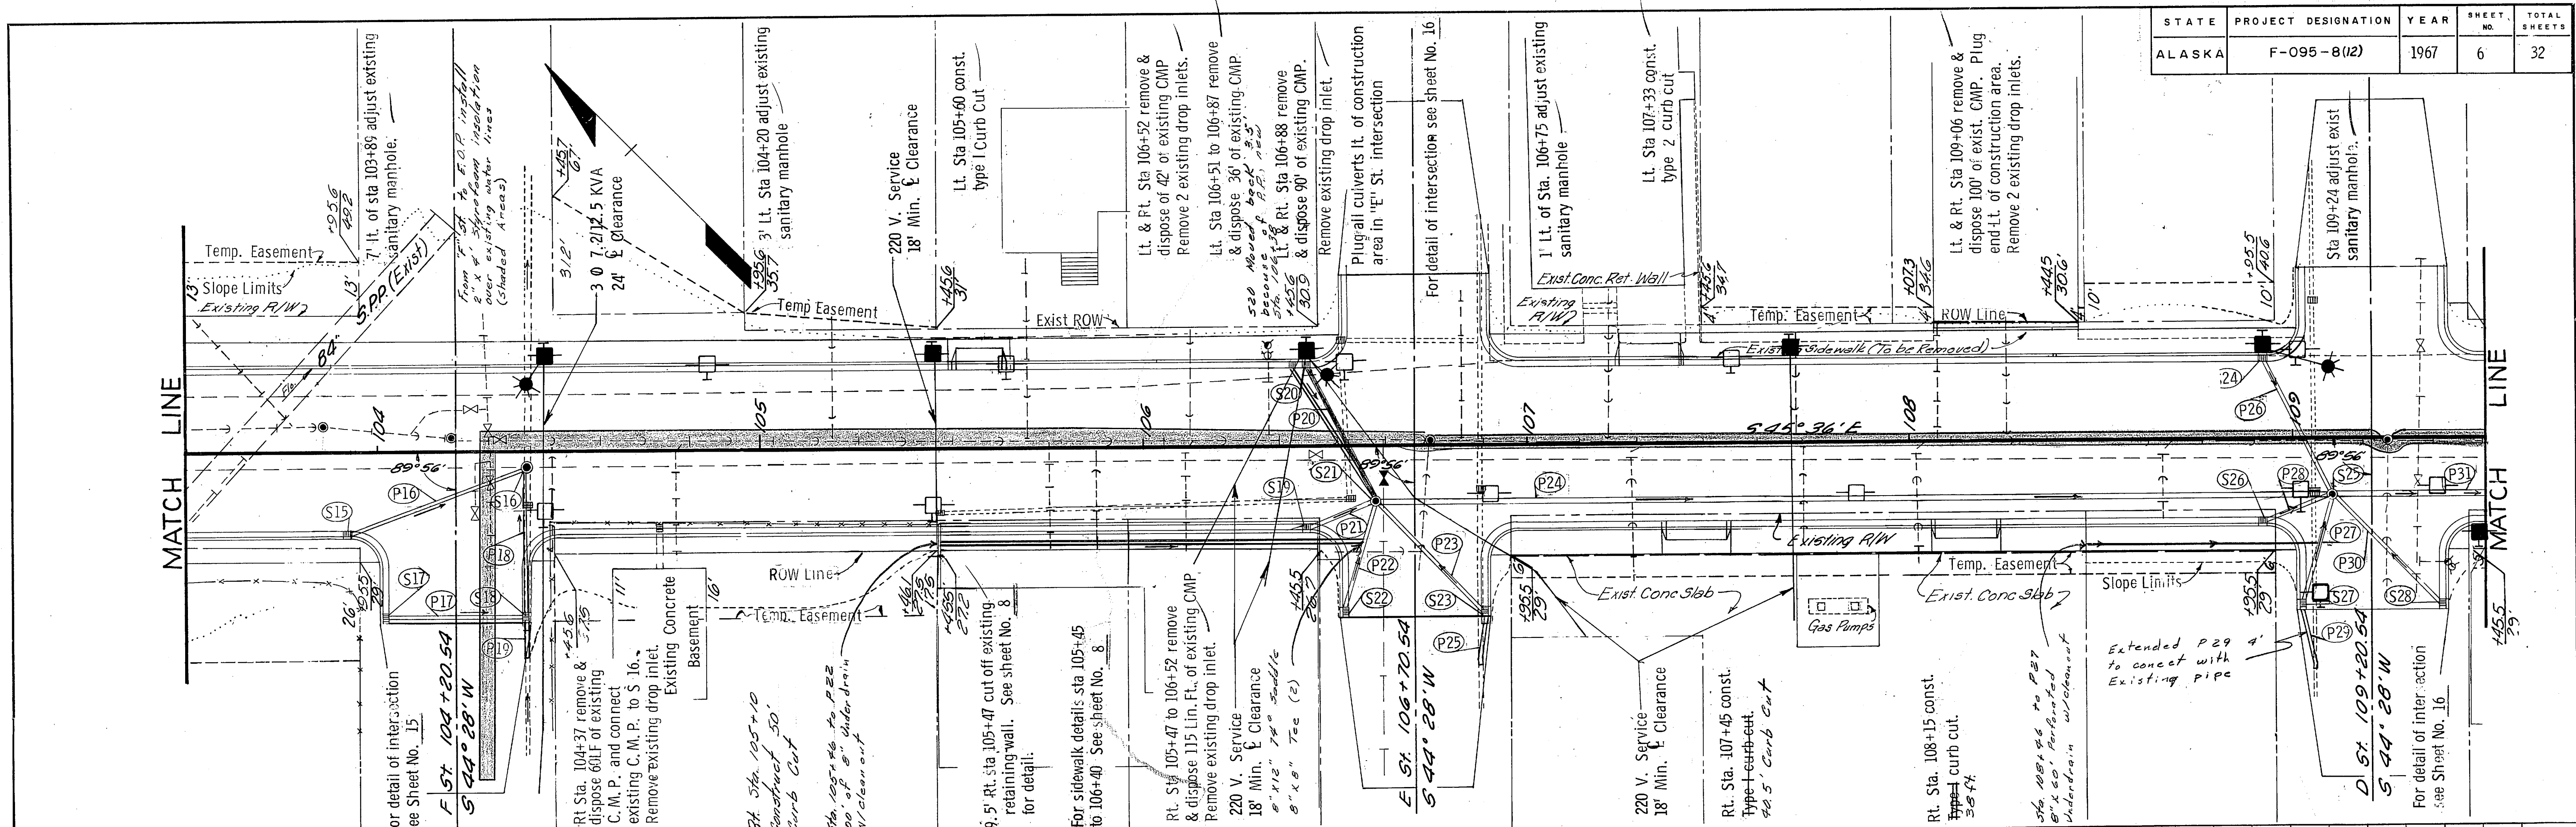


DATE _____ BY _____
 SURVEYED _____
 PLOTTED _____
 NOTE BOOK _____
 ALIGNMENT CHECKED _____
 RT. OF WAY CHECKED _____
 NO. _____

DATE _____ BY _____
 SURVEYED _____
 PLOTTED _____
 NOTE BOOK _____
 GRADES CHECKED _____
 S. R. F. N. E. D. U. S. C. H. K. D. _____
 STRUCTURE NOTATIONS CHECKED _____
 NO. _____

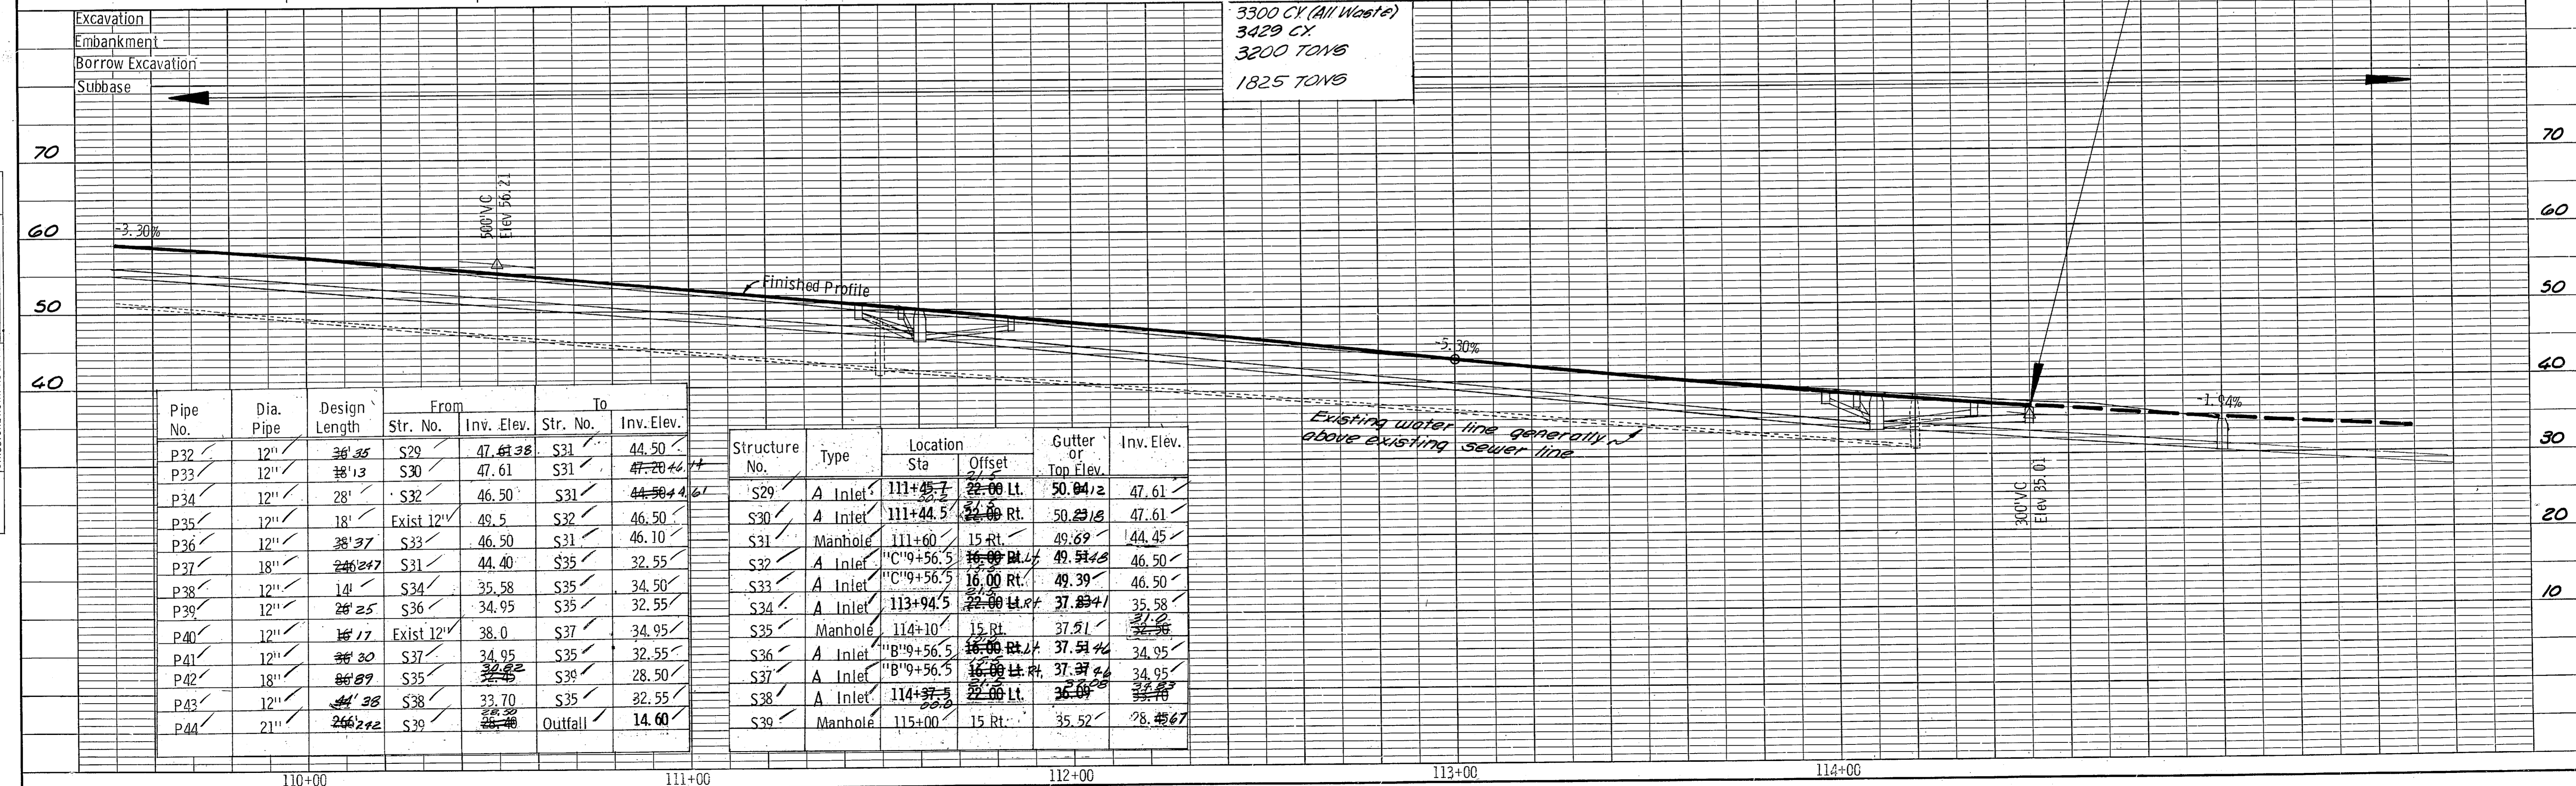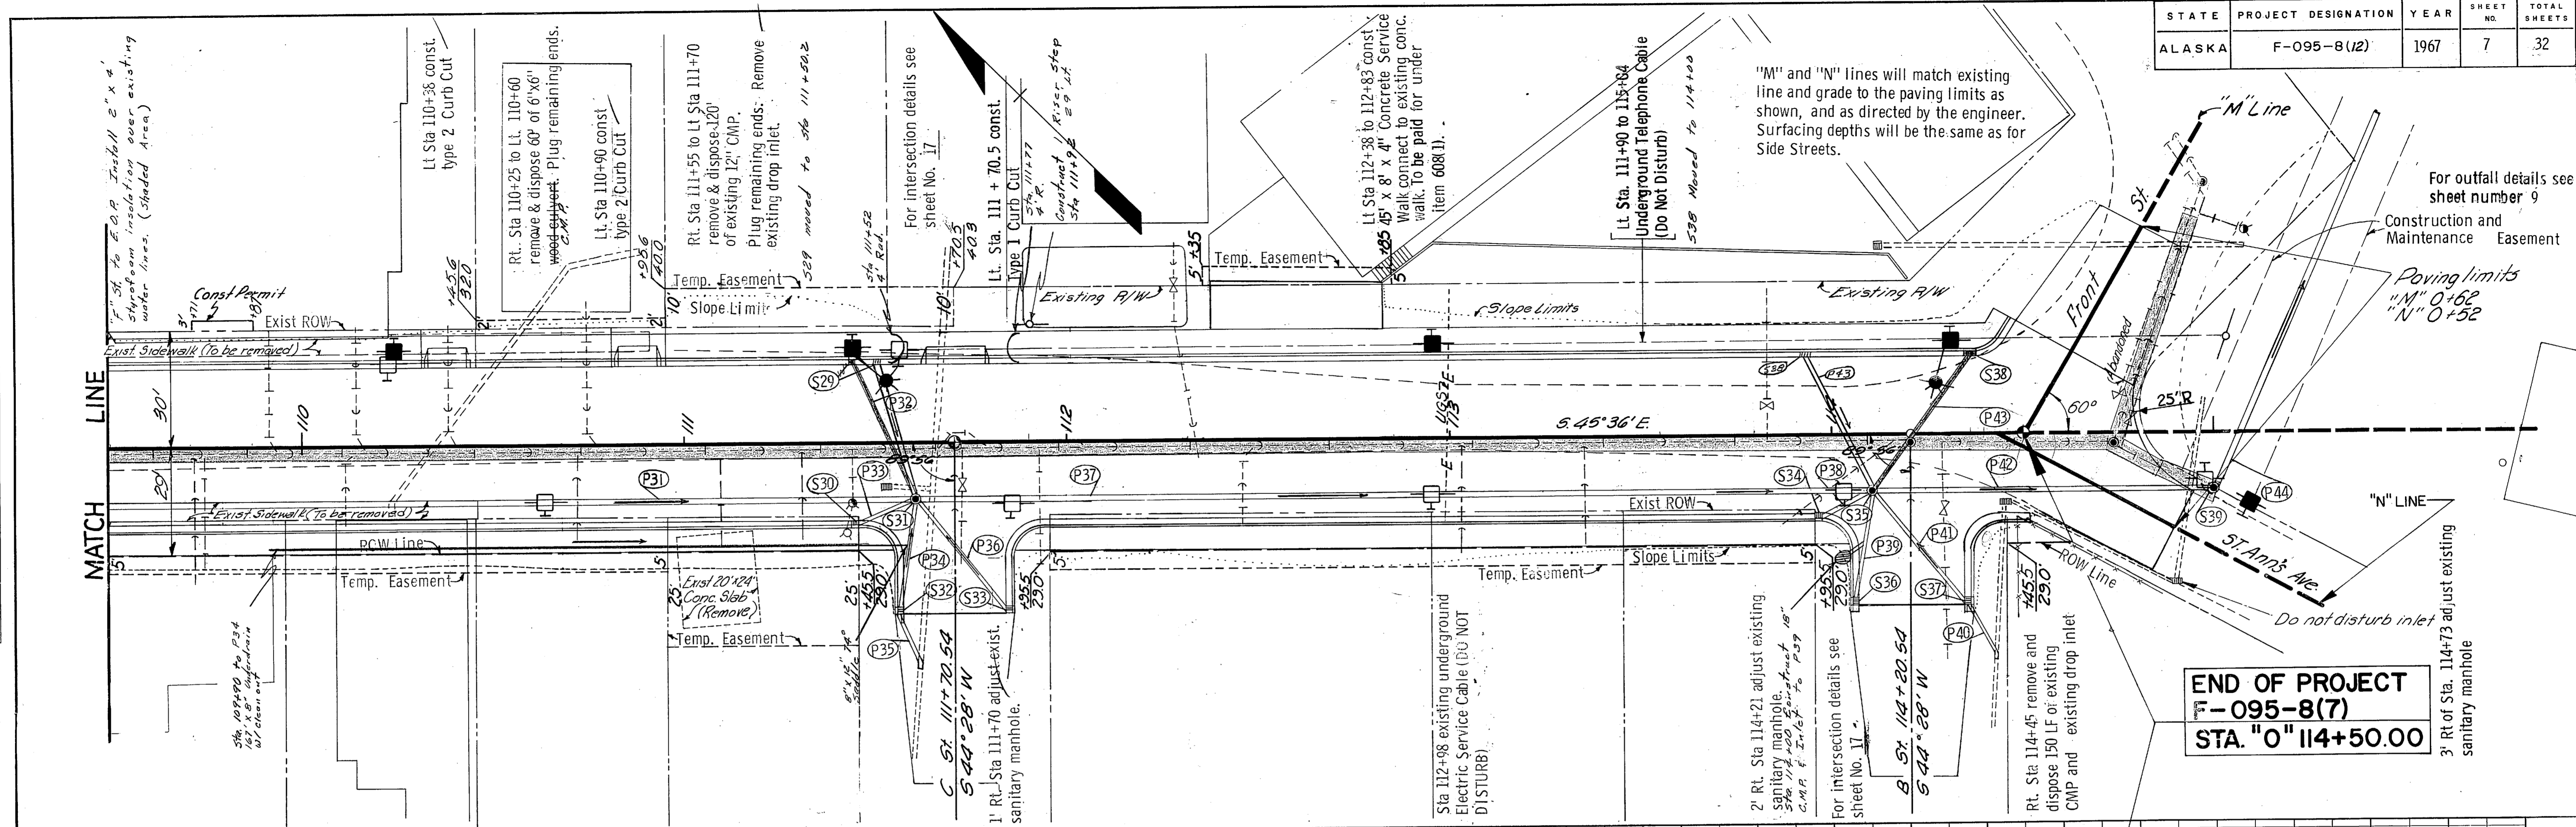

PLAN
 SURVEYED _____
 PLOTTED _____
 ALIGNMENT CHECKED _____
 RT. OF WAY CHECKED _____
 NO. _____


PROFILE
 SURVEYED _____
 GRADES CHECKED _____
 E. M.S. NOTED _____
 STRUCTURE NOTATIONS CHKO _____
 NO. _____

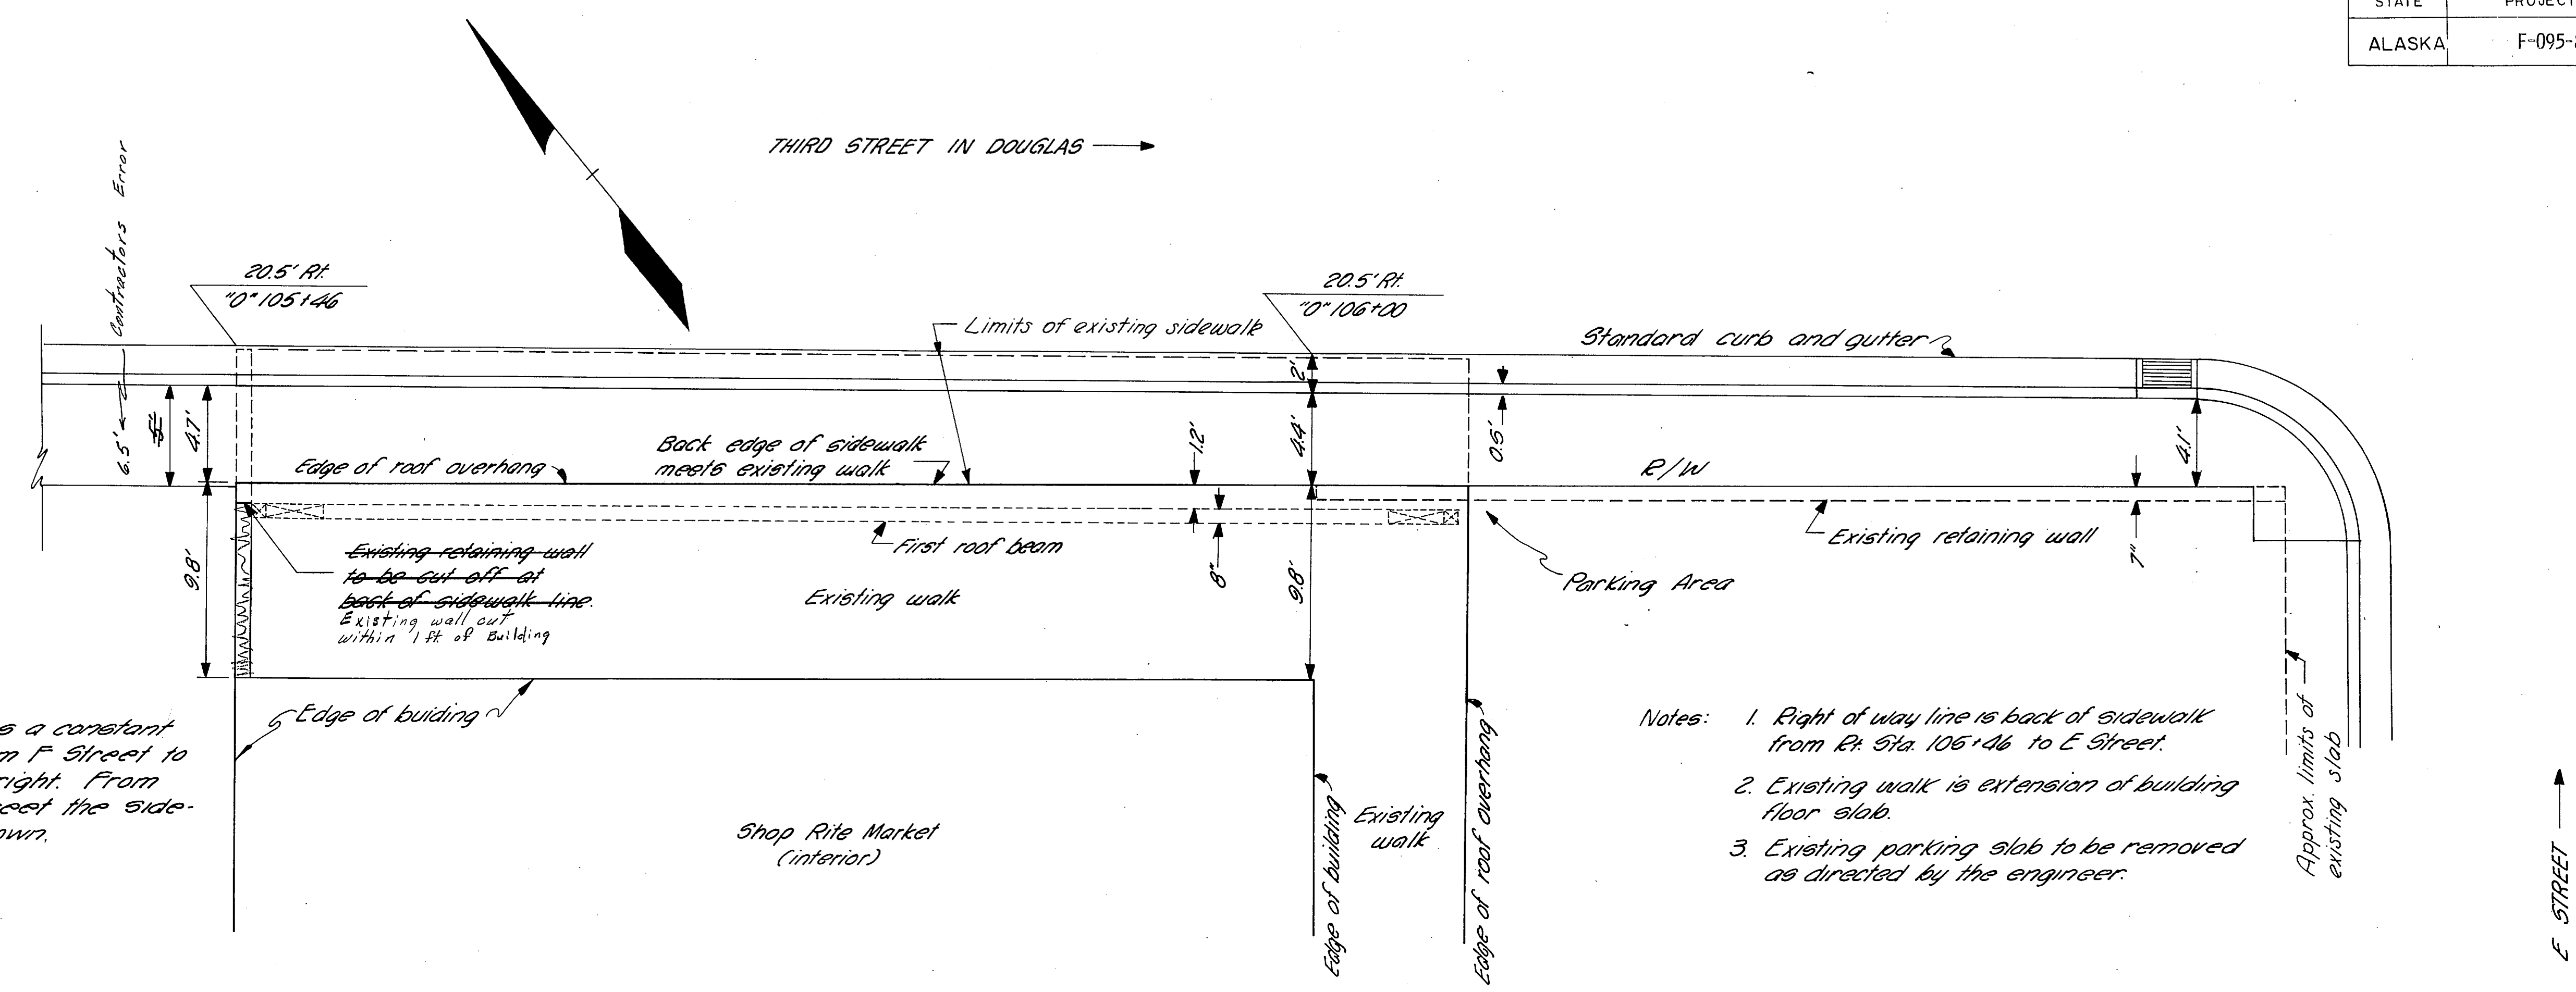

Note: The sidewalk width remains a constant five-foot edge to edge from F Street to Station 105+46 on the right. From Station 105+46 to E Street the sidewalk width varies as shown.


- Notes:
1. Right of way line is back of sidewalk from Rt. Sta. 105+46 to E Street.
 2. Existing walk is extension of building floor slab.
 3. Existing parking slab to be removed as directed by the engineer.

SIDEWALK WIDTH DETAIL
 Rt. F STREET to E STREET

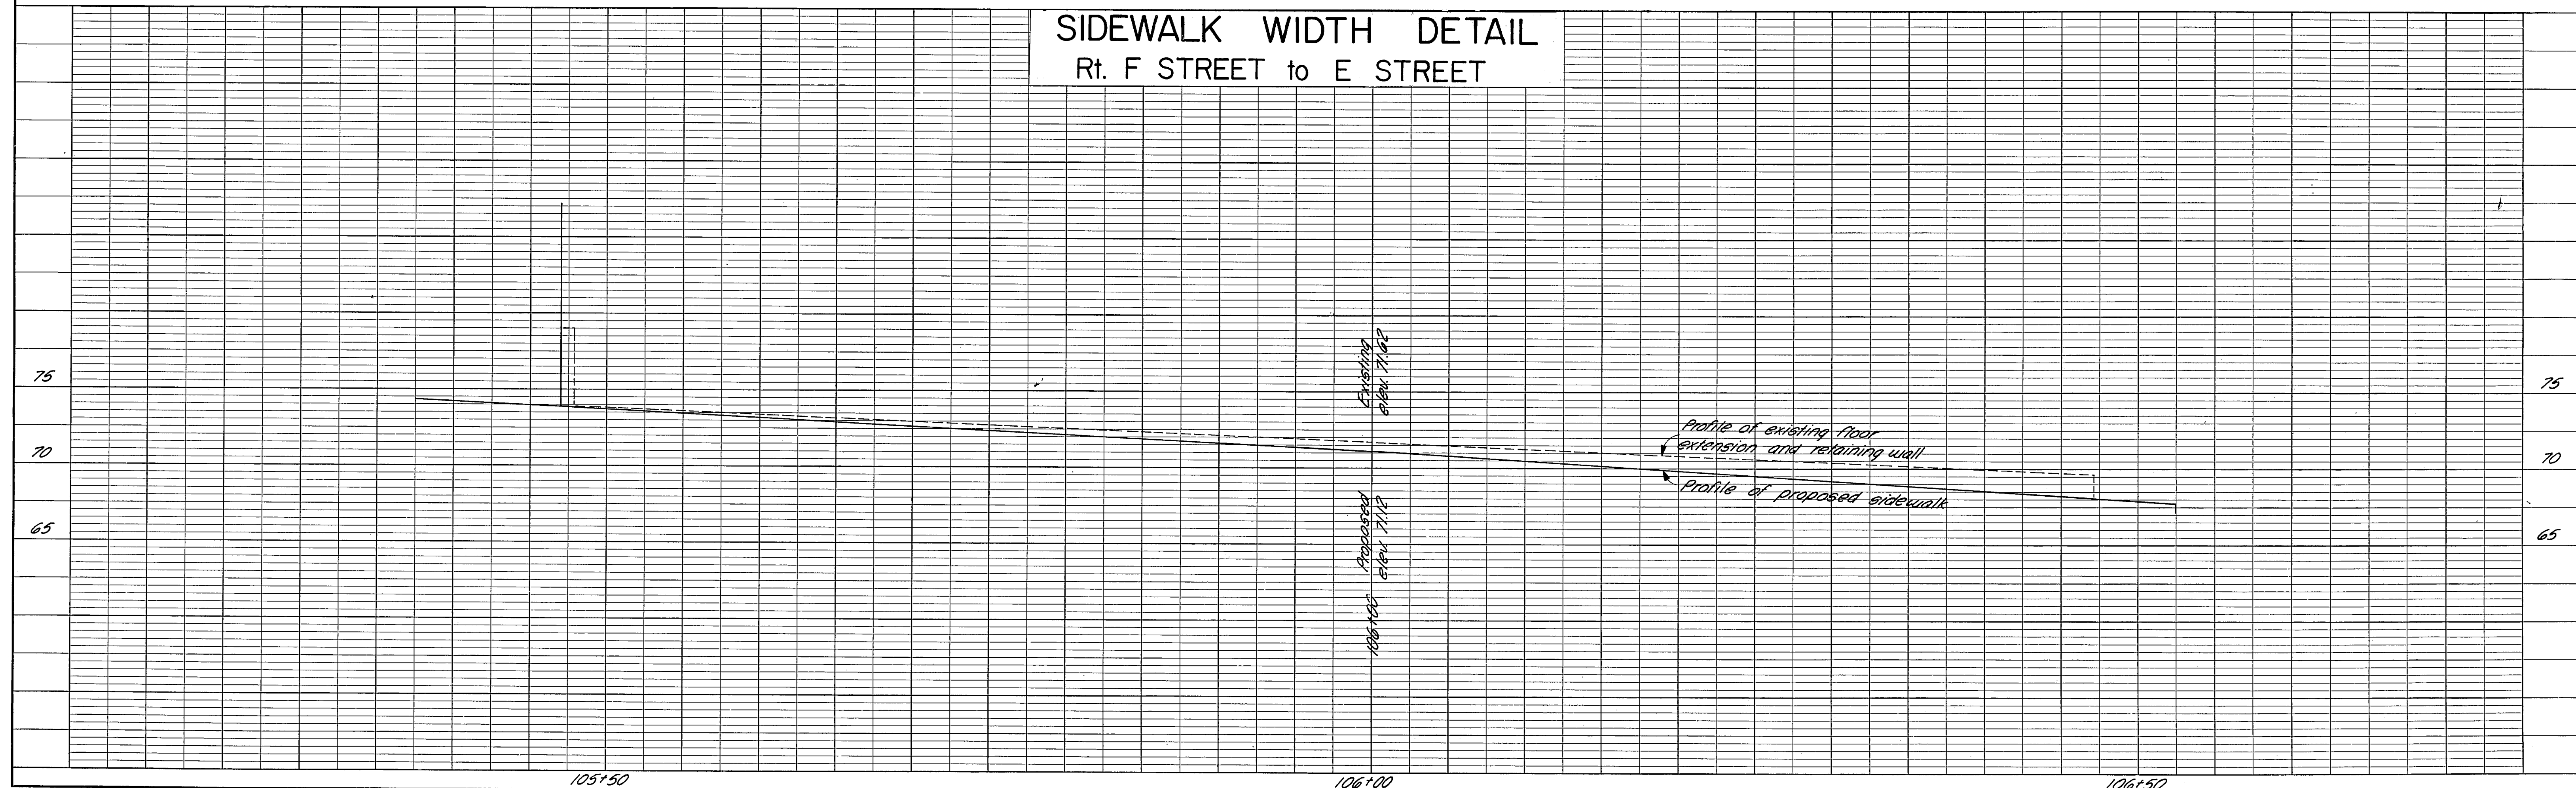


STATE	PROJECT DESIGNATION	YEAR	SHEET NO.	TOTAL SHEETS
ALASKA	F-095-8(12)	1967	9	32


PLAN	DATE
SURVEYED	
DESIGNED	
NOTED	
PLOTTED	
CHECKED	
NO. OF WAY CHECKED	
NO.	

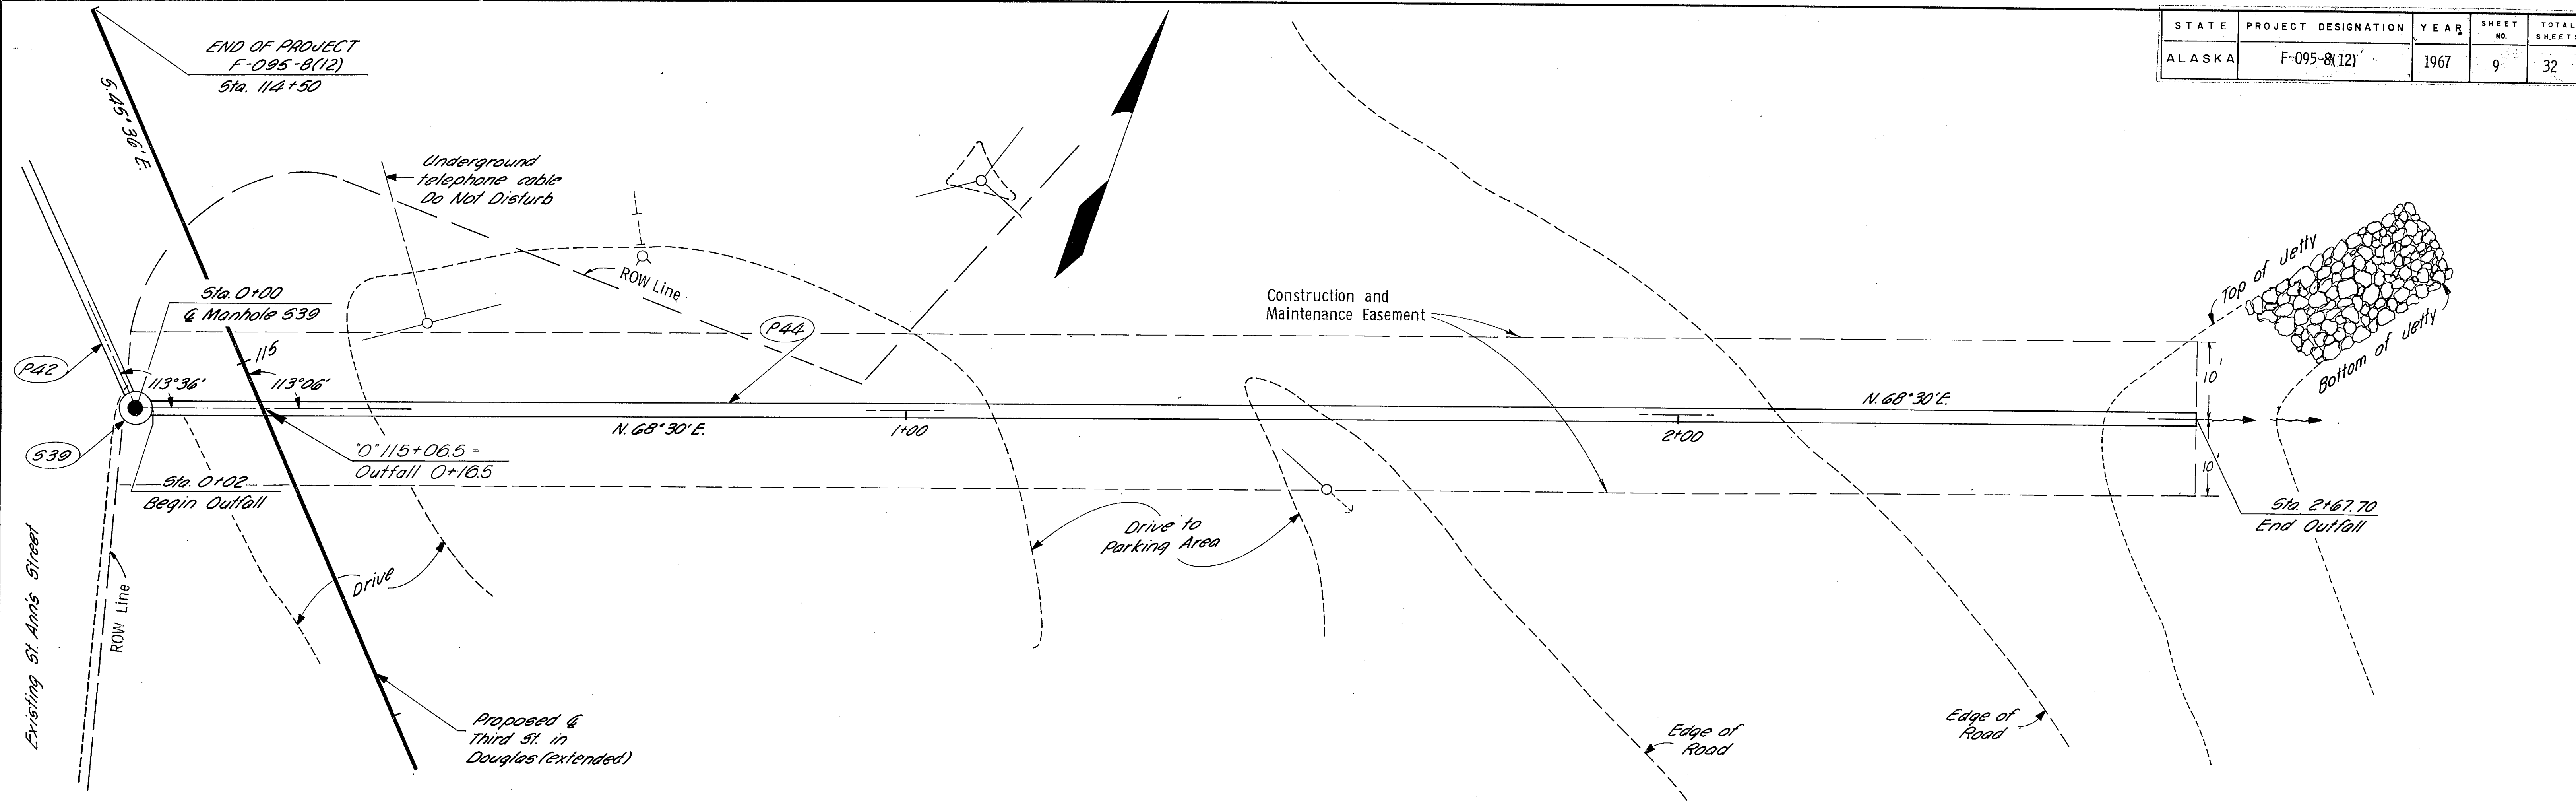


PROFILE	DATE
SURVEYED	
DESIGNED	
NOTED	
PLOTTED	
CHECKED	
NO. OF WAY CHECKED	
NO.	

STORM SEWER OUTFALL

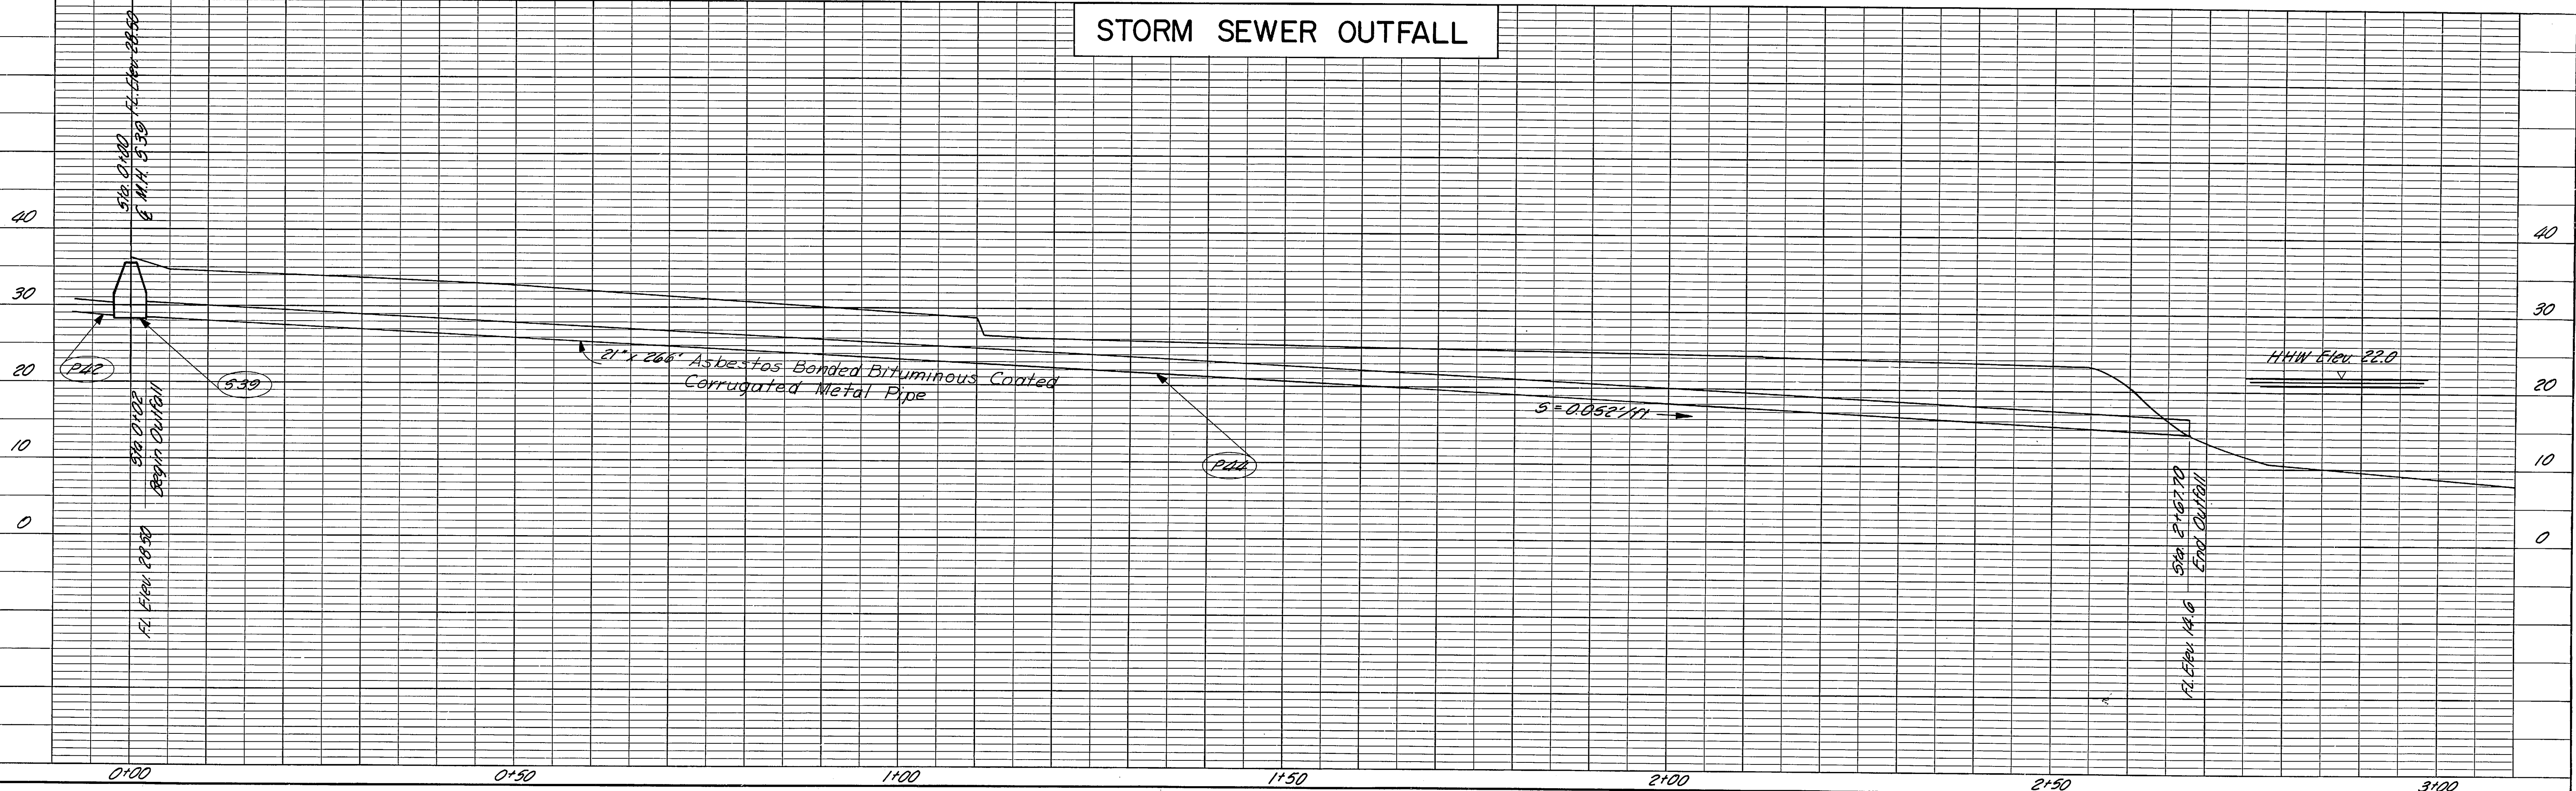


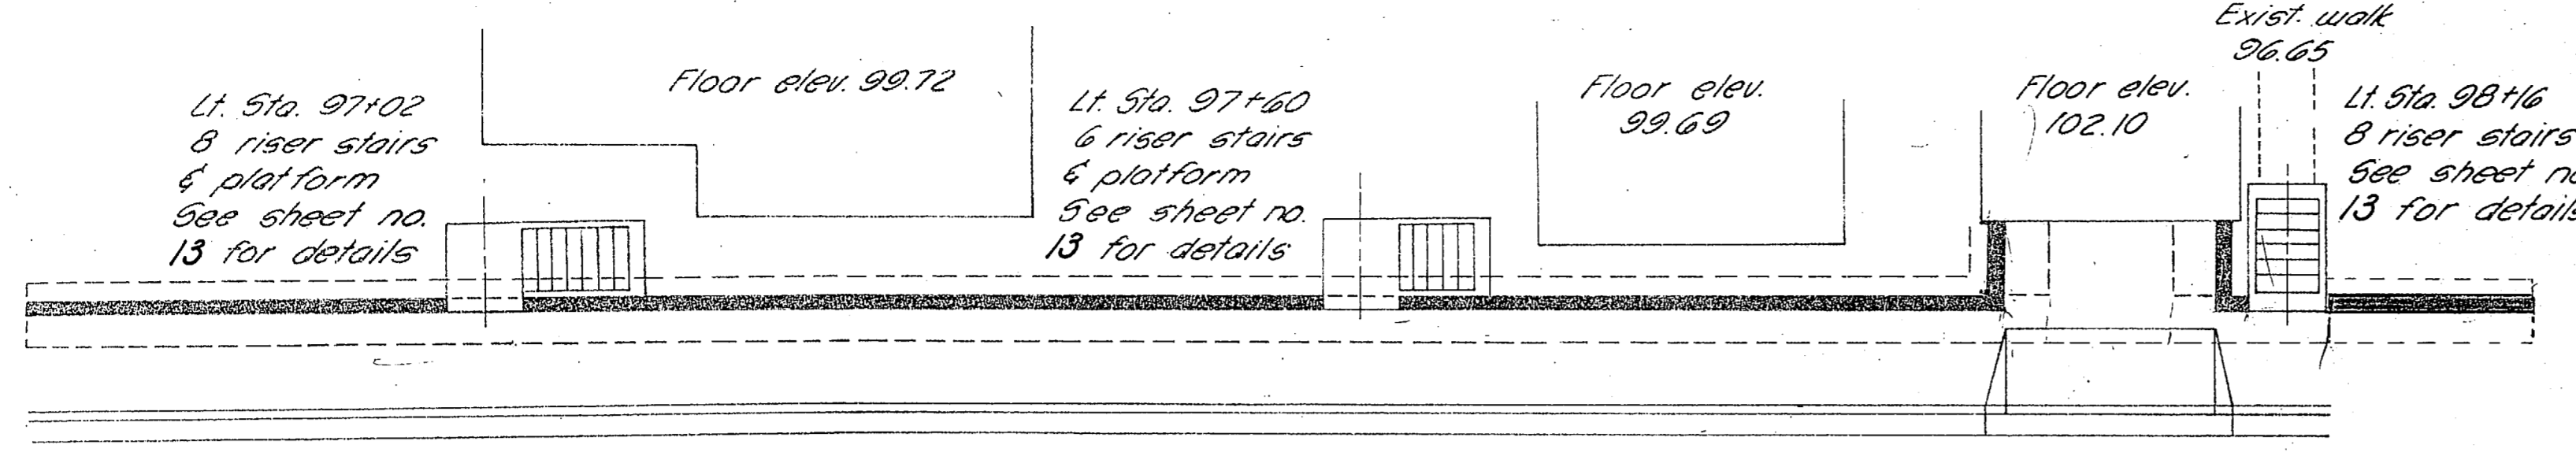


PLAN
WALL A
 Sta. 96+72 to Sta. 98+18

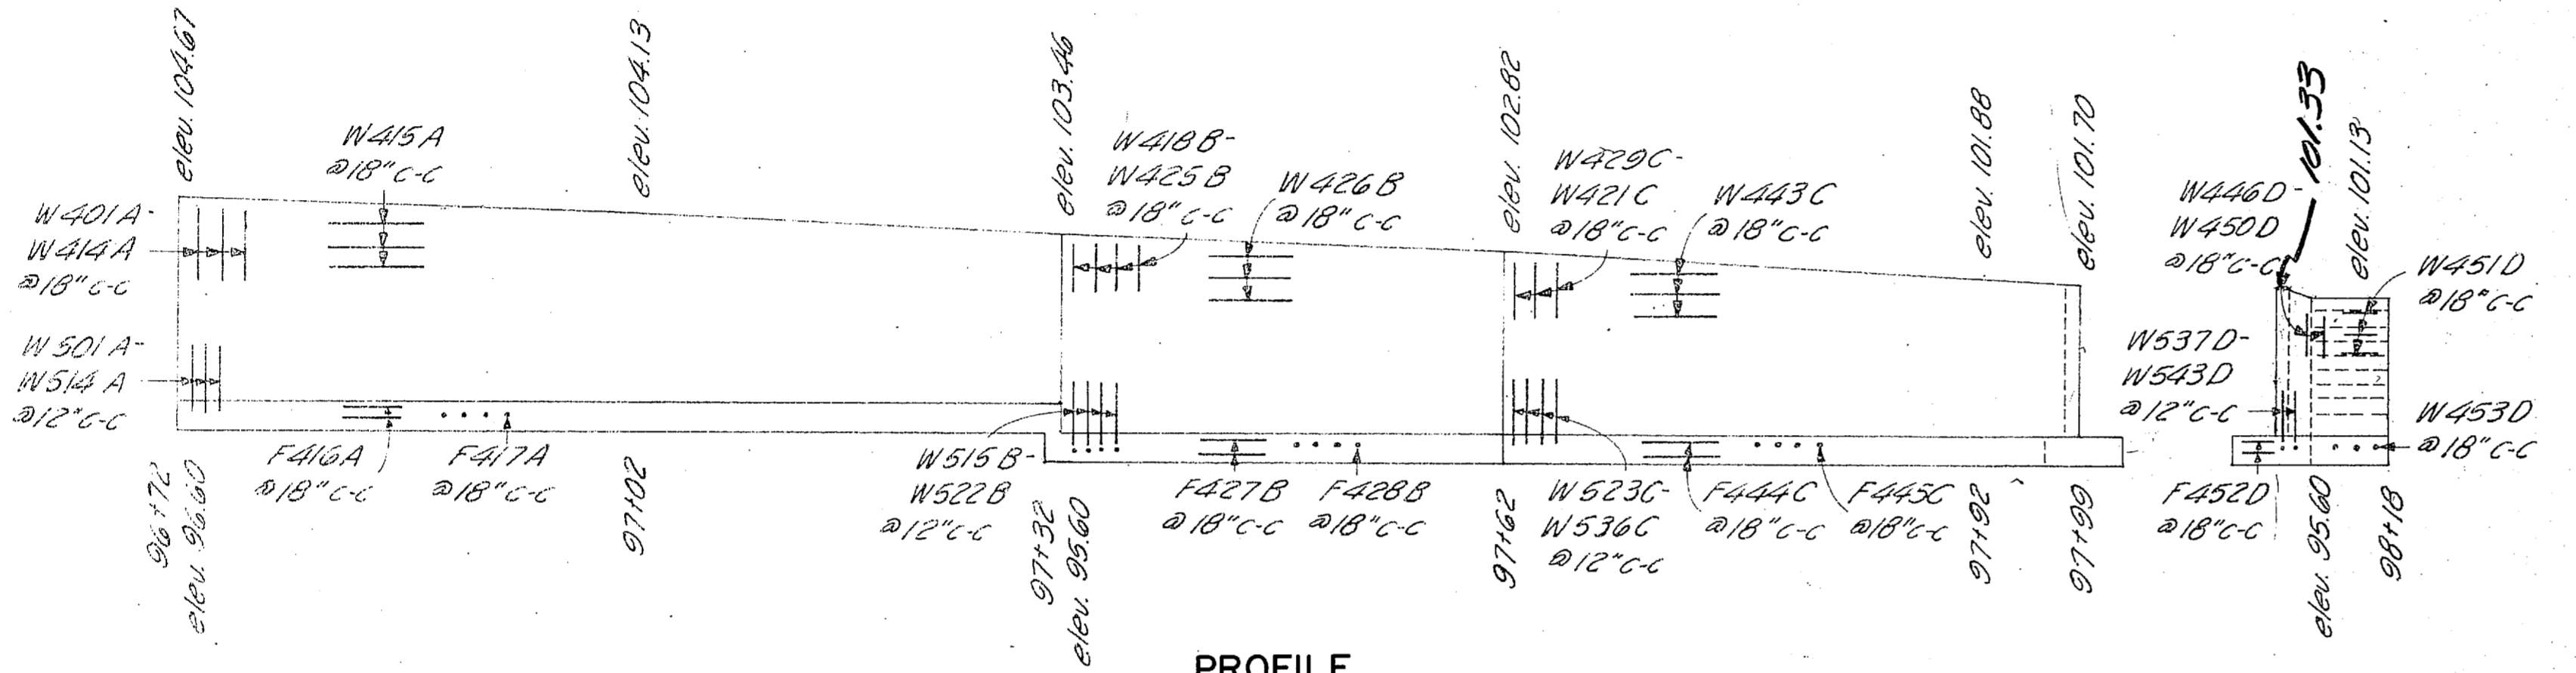


PROFILE

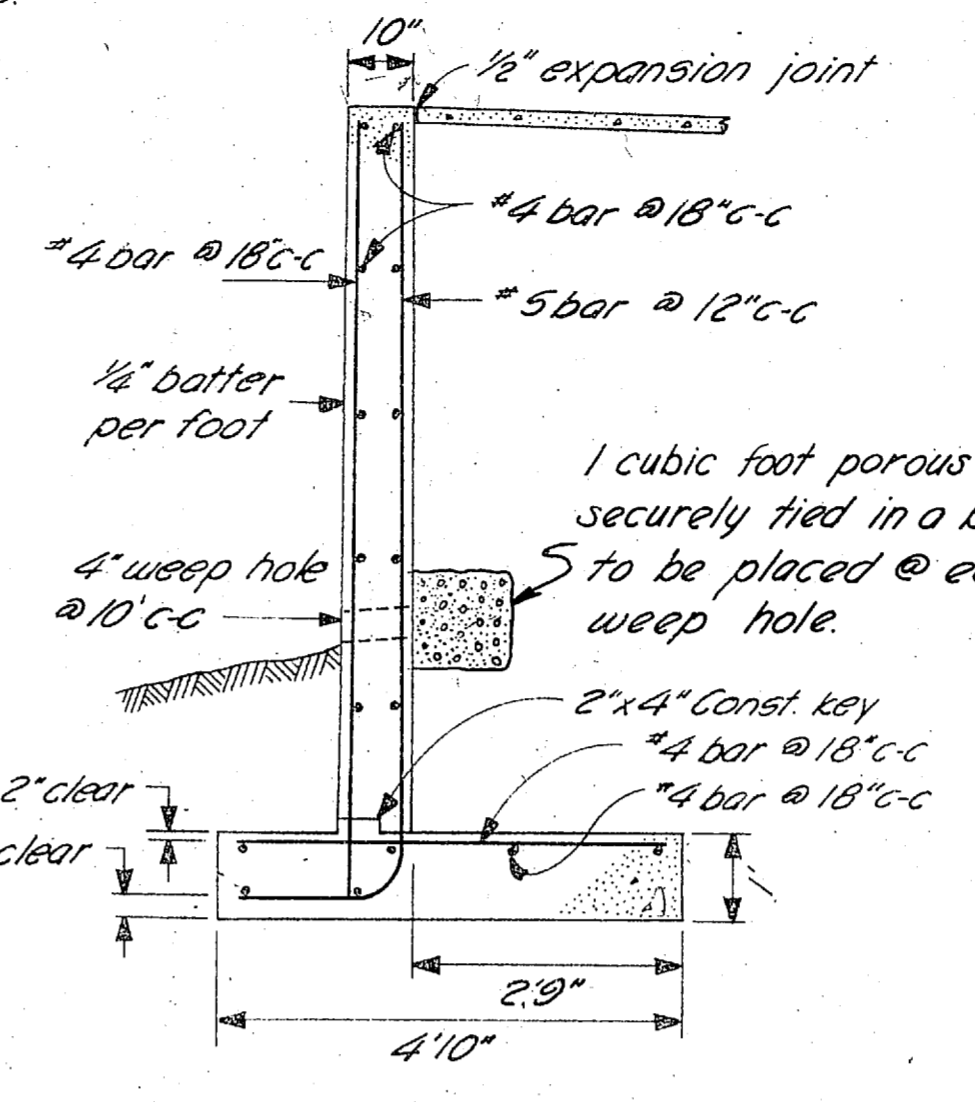


TYPICAL SECTION
 WALL A

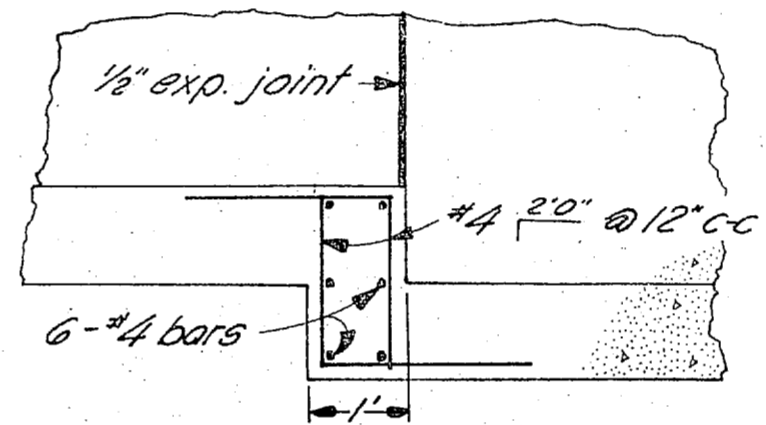

TYPICAL FOOTING
 STEP DETAIL
 Lt. Sta. 97+32 & Sta. 102+97

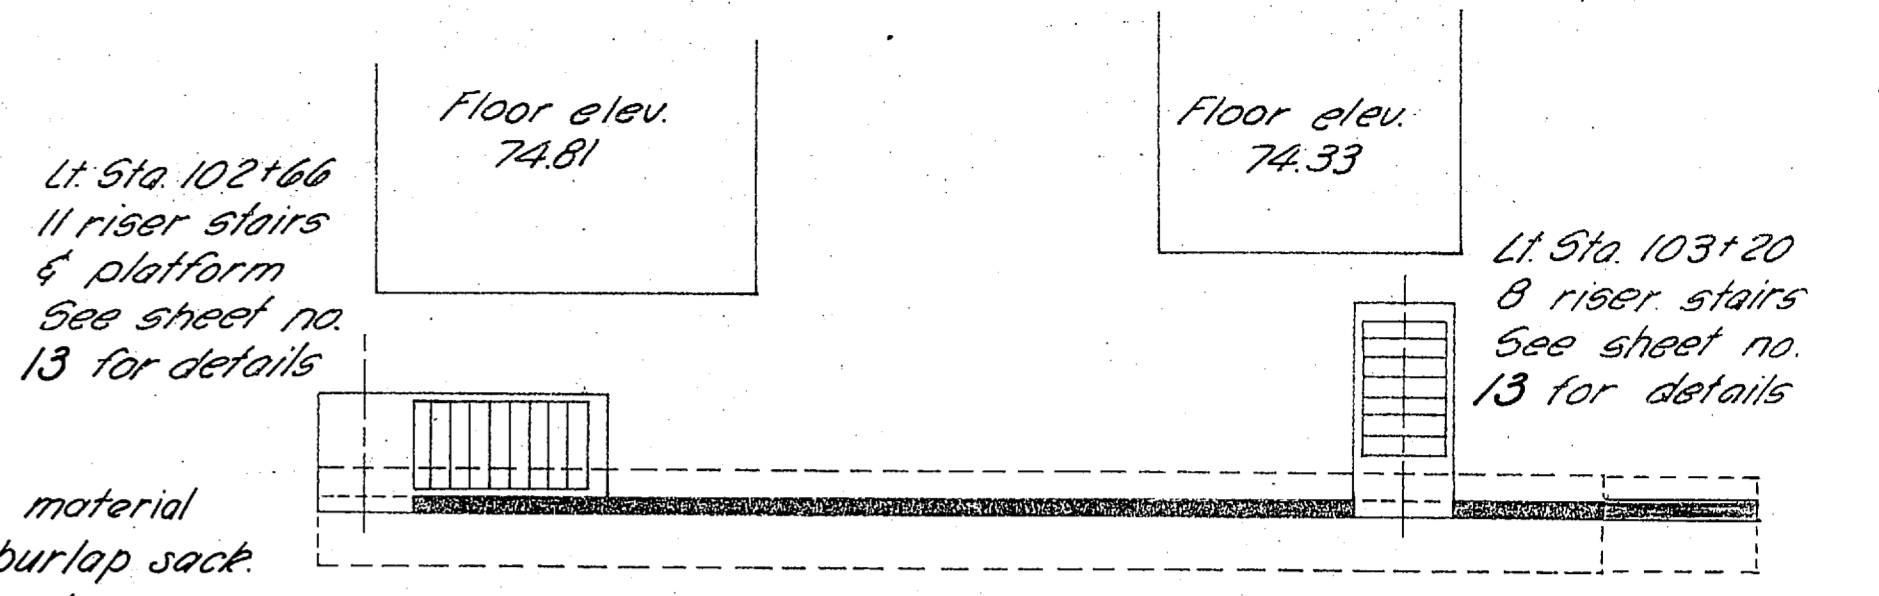


PLAN

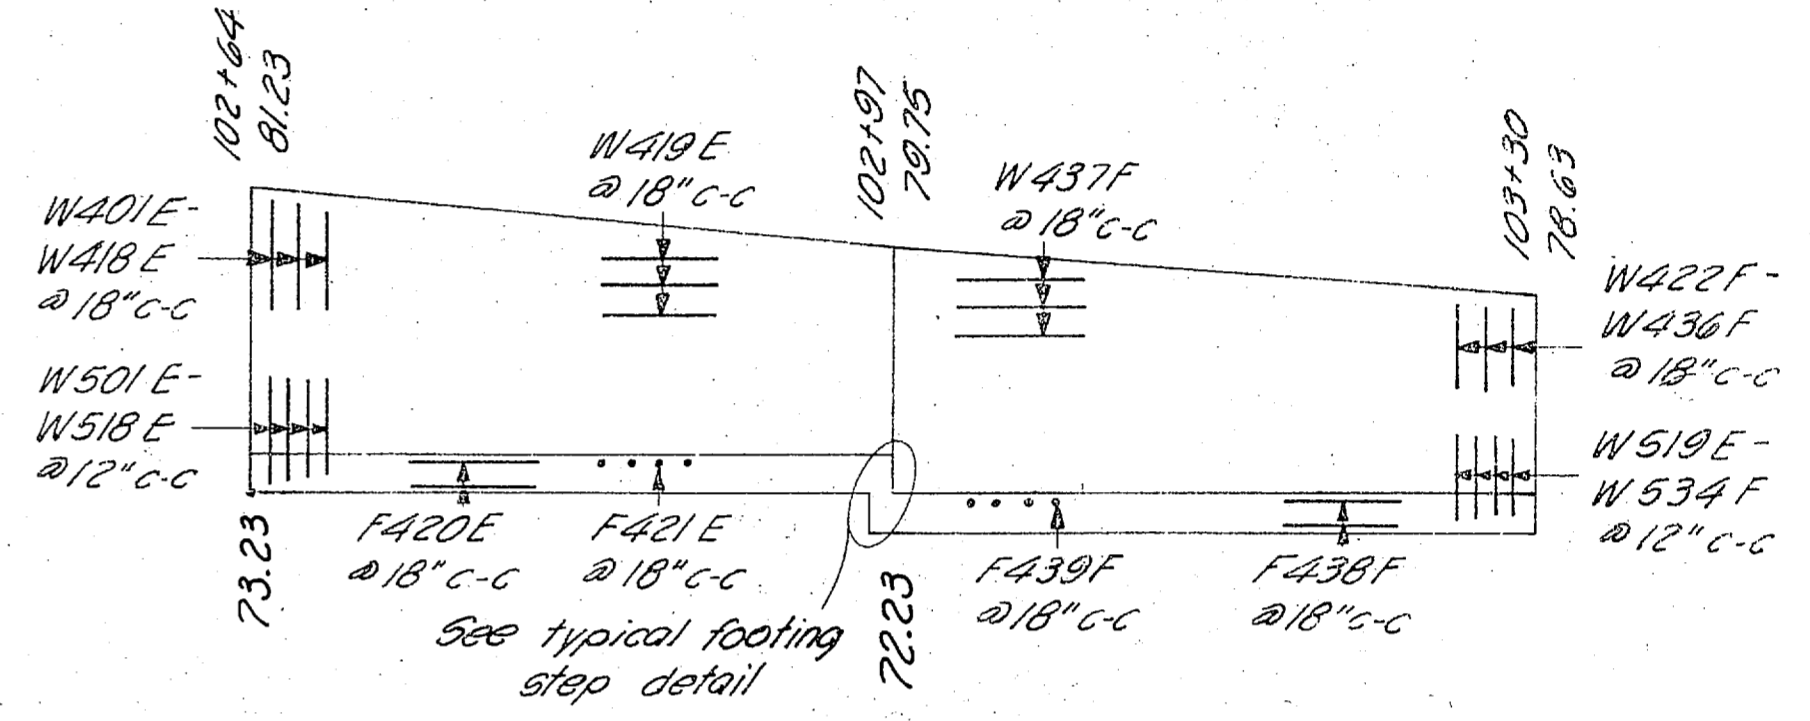


PROFILE

WALL A
 Sta. 102+64 to Sta. 103+30

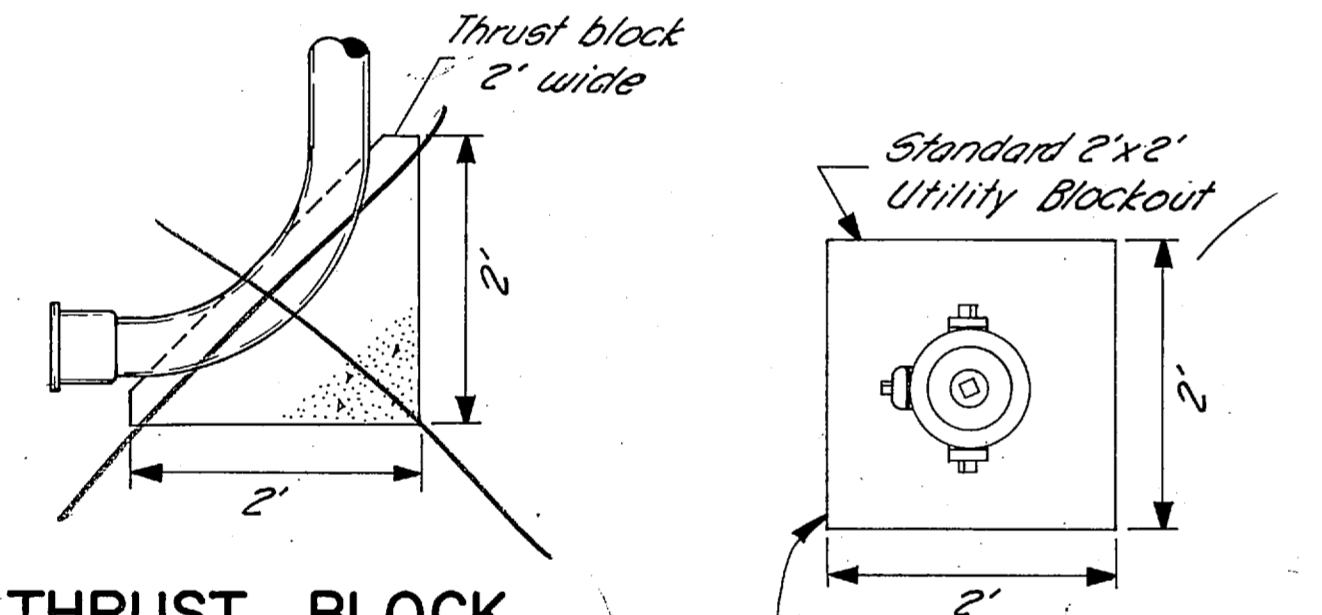


THRUST BLOCK
 DETAIL

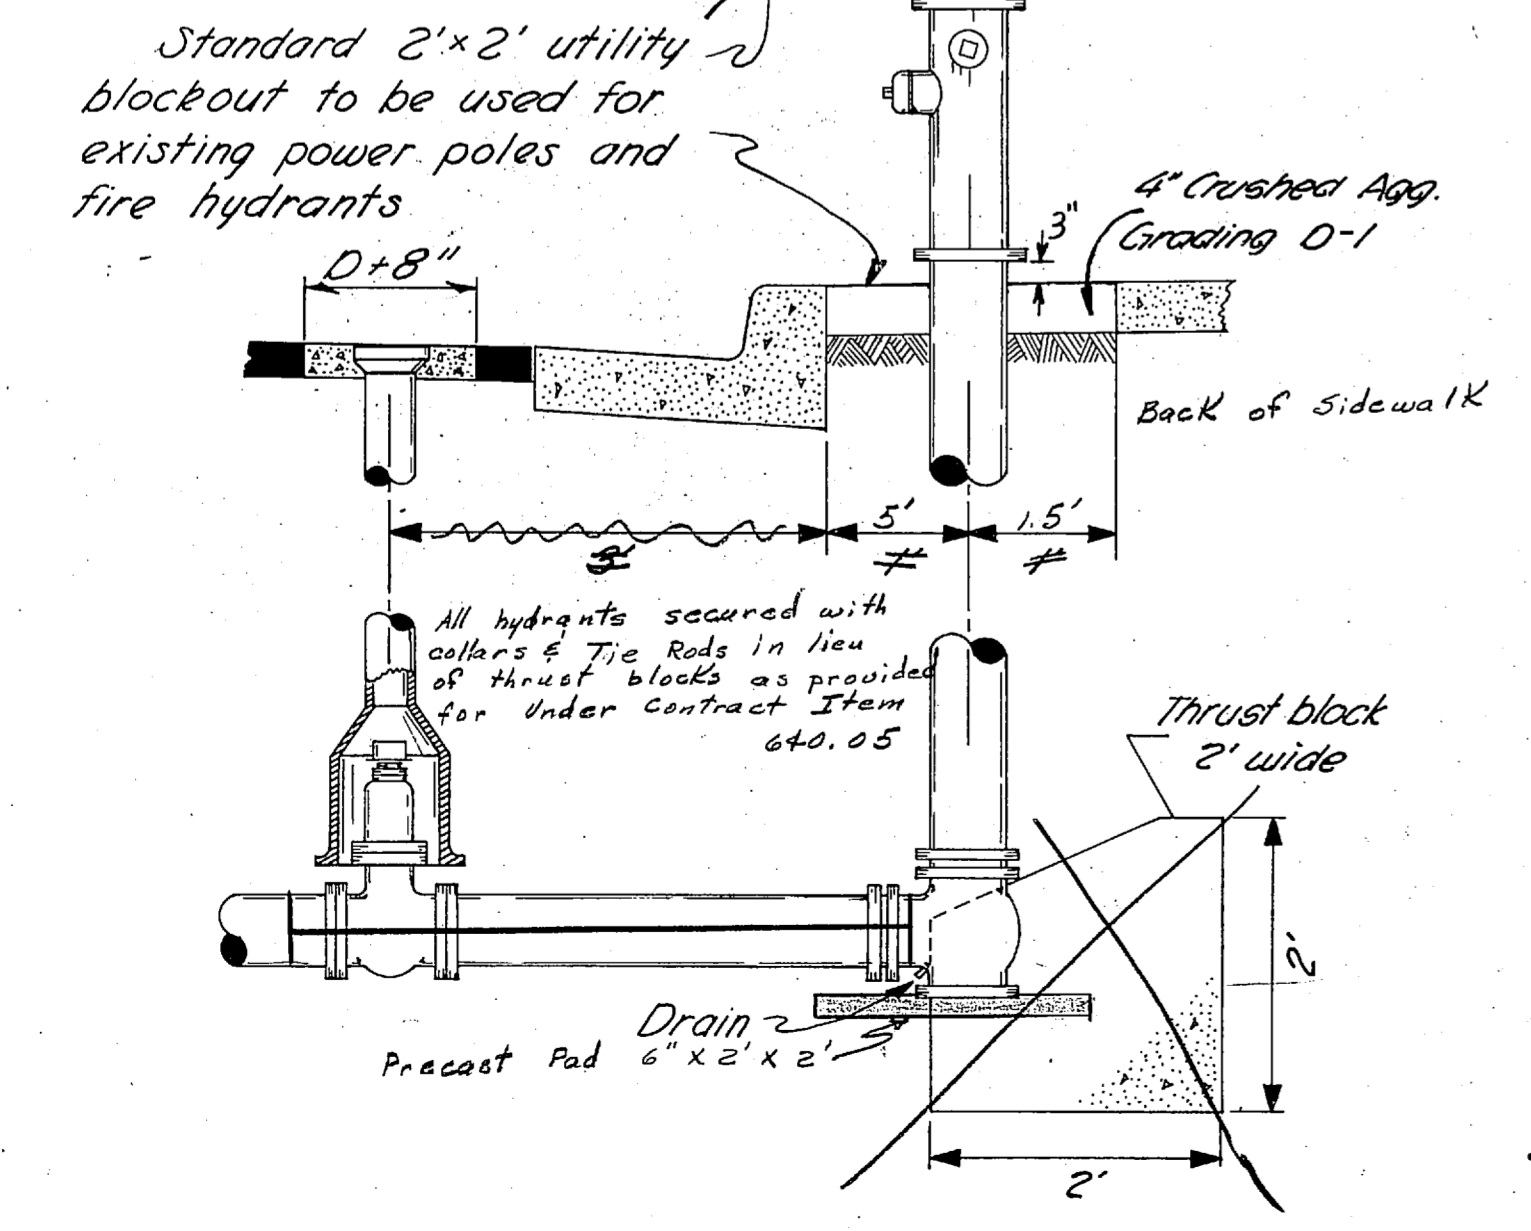


RELOCATION OF FIRE HYDRANT

MANHOLES TO BE ADJUSTED

Station	Left	Right
96+90		2'
99+25	1'	
101+81	2'	
103+89	6'	
104+20	4'	
106+71	1'	
109+24		1'
111+70		2'
114+21		2'
Total	14+73	3'

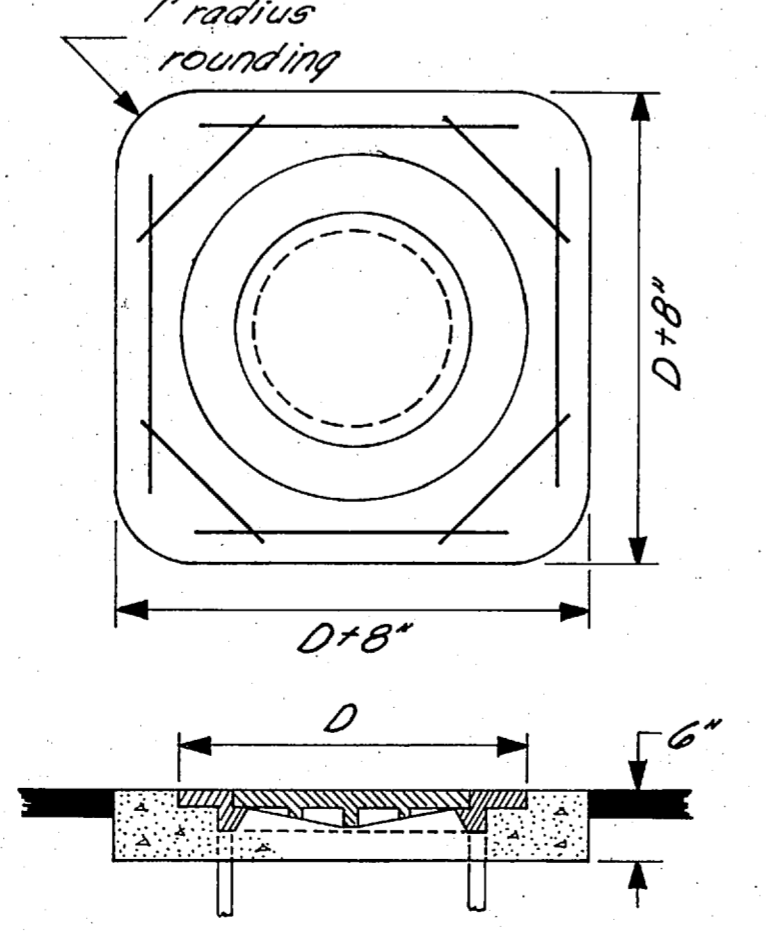

TYPICAL ENCASEMENT
 DETAIL

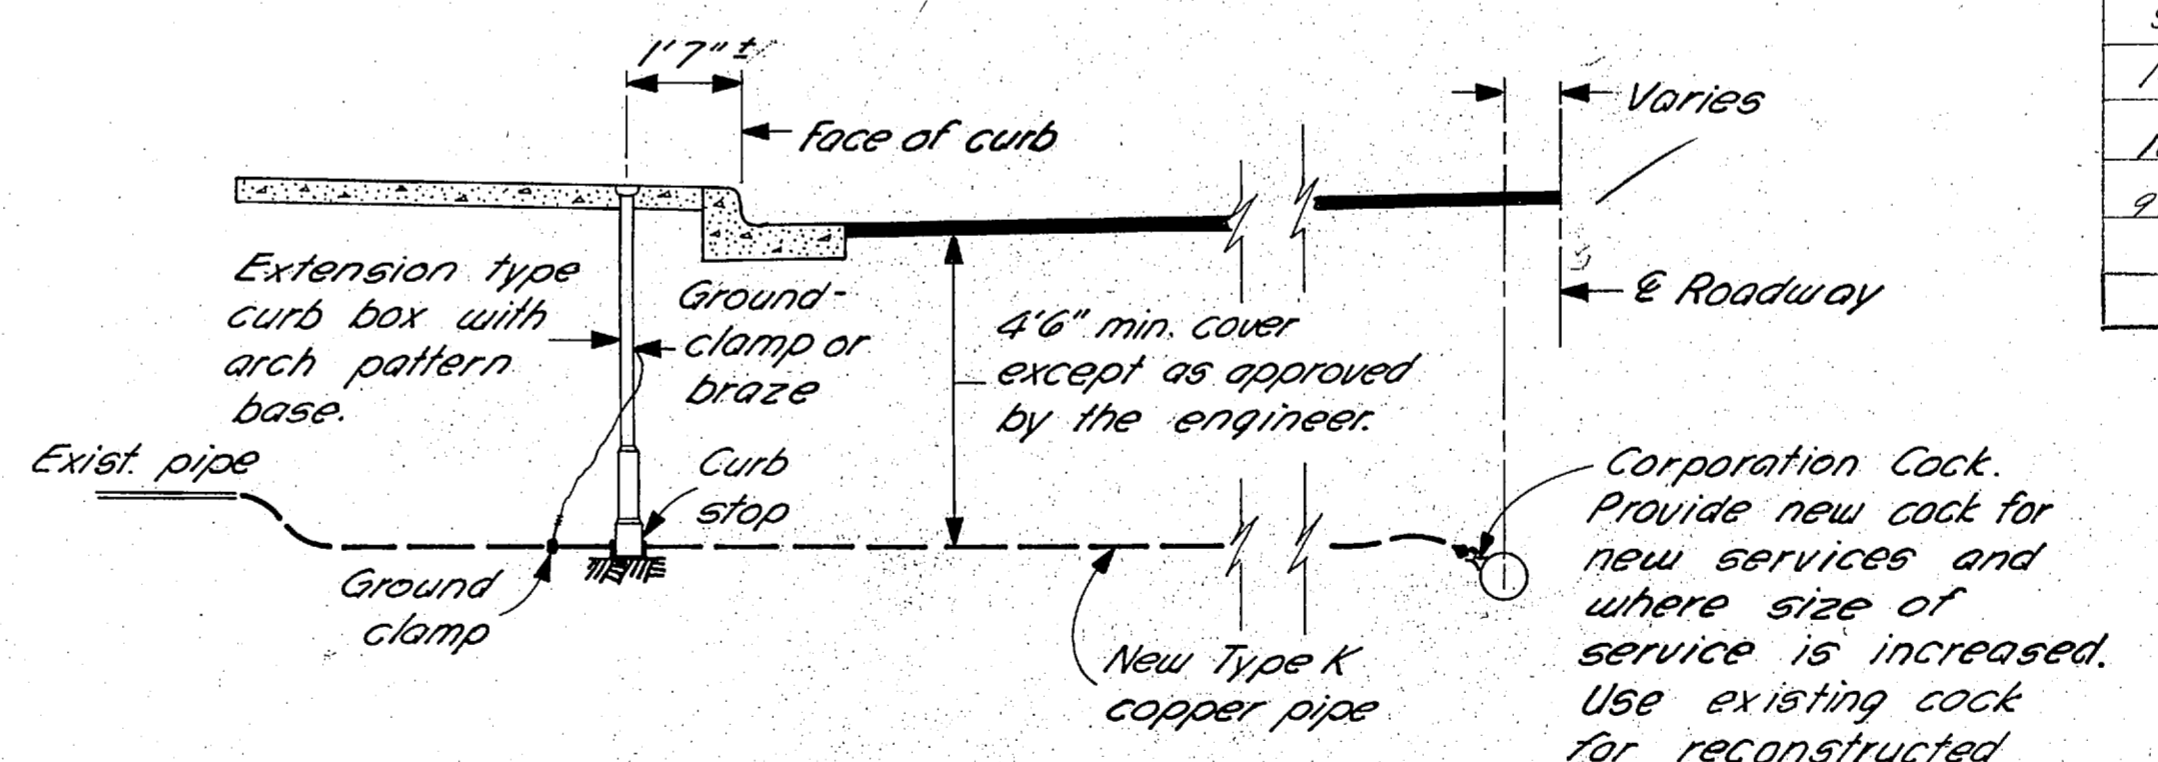

DOUGLAS TYPICAL WATER SERVICE

WATER SERVICE NOTES


- All services shall be 3/4 inch I.D. unless otherwise shown on the plans.
- The top section of curb box shall be bonded to the copper pipe as shown, by the use of copper wire not smaller than No. 4, and approved ground clamps. Wire may be brazed to curb box.

ENCASEMENT NOTES

- All reinforcing steel will be No. 4 bars and have a minimum clear distance of 1 1/2 inches from the face of concrete.
- All manhole, valve box, and cleanout covers falling within the pavement limits shall be encased in Class A concrete as directed by the engineer.

RETAINING WALLS

Station to Station	Location	Wall	Structural Ex.	Concrete	Steel
96+72 to 98+18+5	29' Lt.	A	185.1 Cu. Yd.	258.1 Cu. Yd.	3503 Lbs.
102+64 to 103+30+6	29' Lt.	A	29.0 Cu. Yd.	37.6 Cu. Yd.	1479 Lbs.
102+18 to 102+43	Varies	Additional Wall	15.6 Cu. Yd.	3.3 Cu. Yd.	207 Lbs.
99+48+22 to 100+89	29' Lt.	Additional Wall	6.70 Cu. Yd.	12.3 Cu. Yd.	564 Lbs.
Totals			367.0 Cu. Yd.	411.3 Cu. Yd.	5923 Lbs.

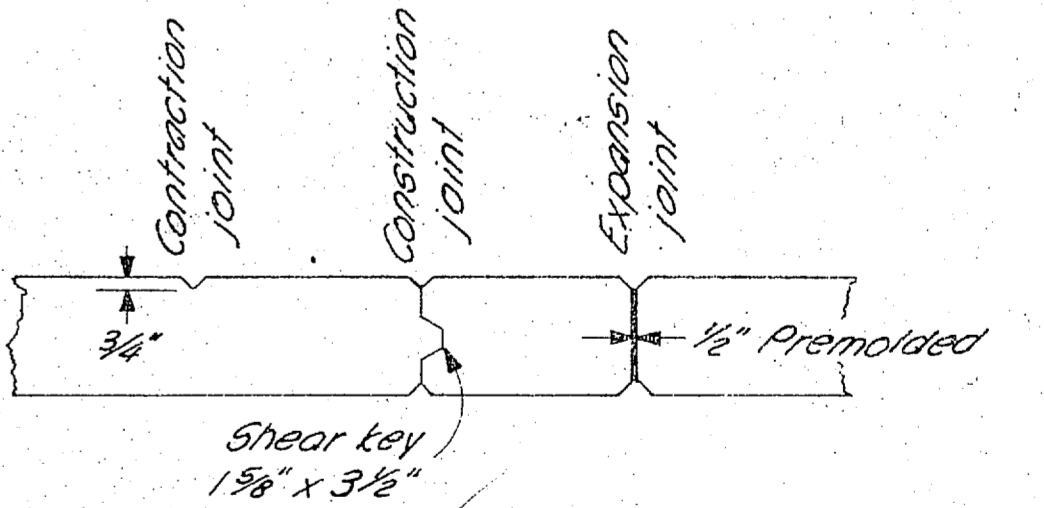

TYPICAL JOINT SECTION



NOTES

- Contraction joints shall have a maximum spacing of 30 feet.
- Expansion joints shall have a maximum spacing of 90 feet.
- 3/4 inch Chamfer on all exposed joint edges.
- Minimum clear distance for all reinforcing steel is 2 inches from the face of concrete unless otherwise shown on the plans.


CULVERT REMOVAL

Station	Lin. Ft.
96+70	122*19
99+00	41
104+37	41
105+97	15*
106+52	42*
106+69	36*37
106+88	90*
109+06	100*
110+34	60
111+80	120*
114+45	150*
Total	934

*Includes removal of one or more existing drop inlets as incidental work.

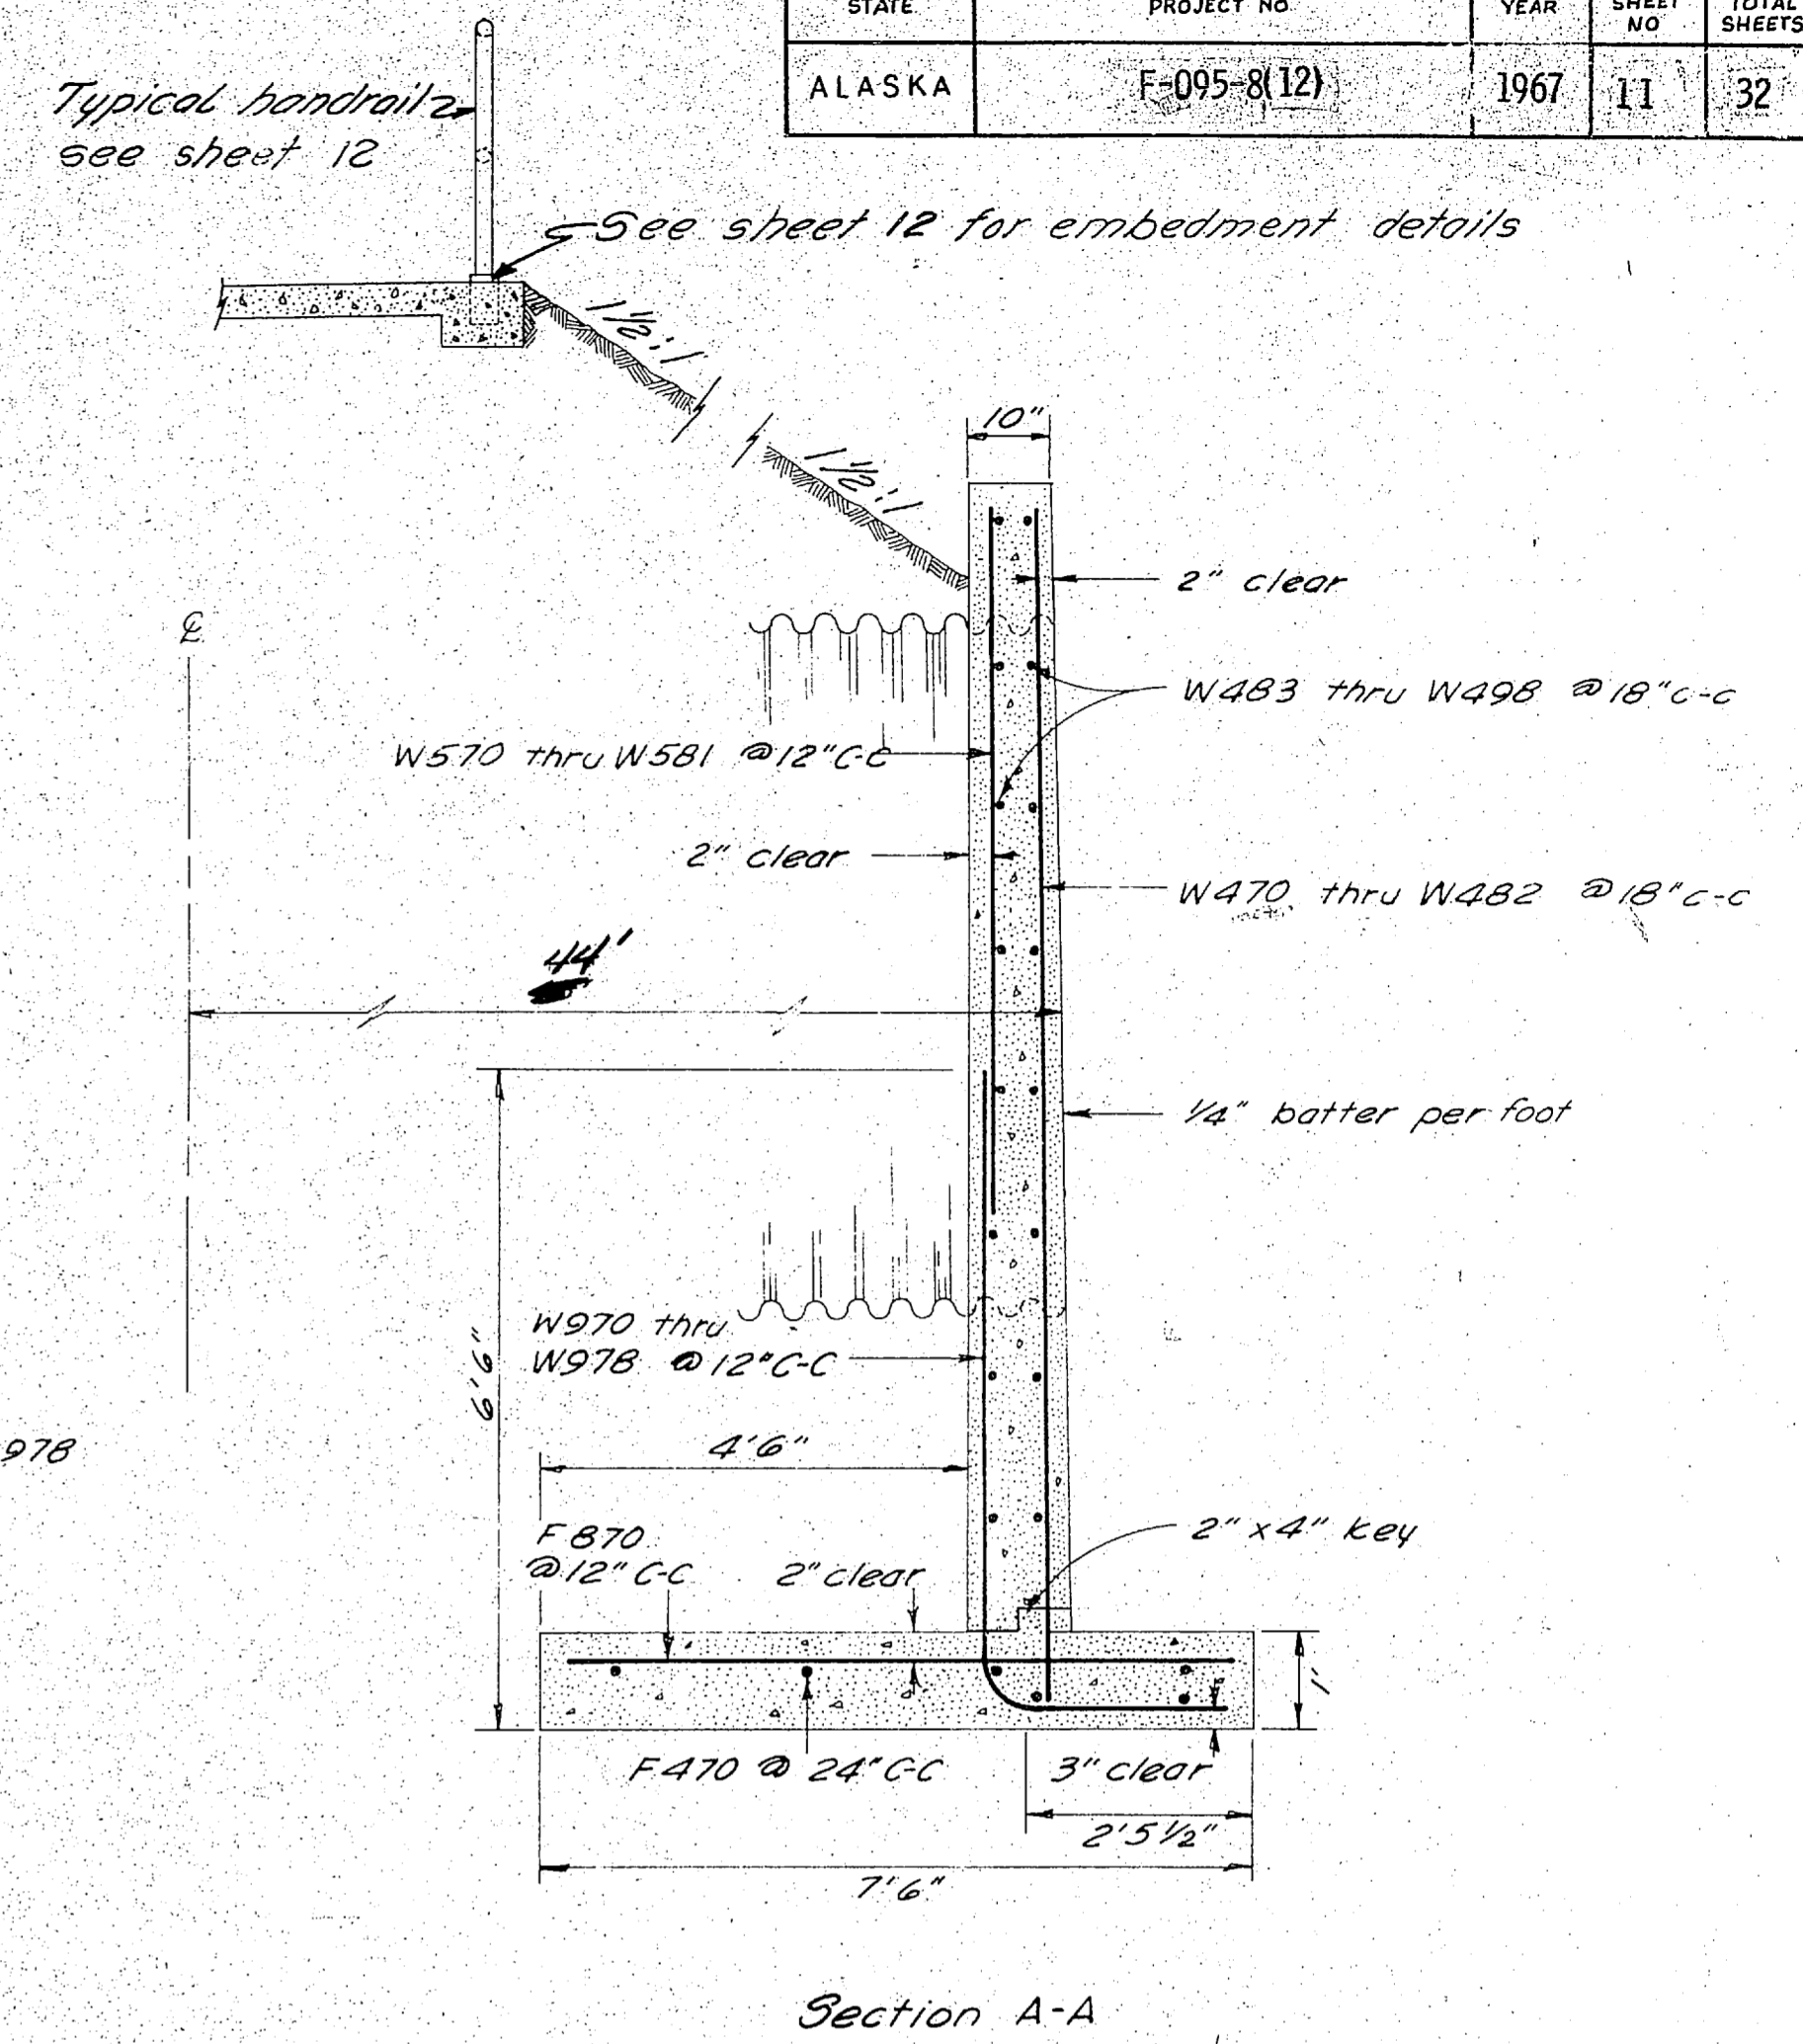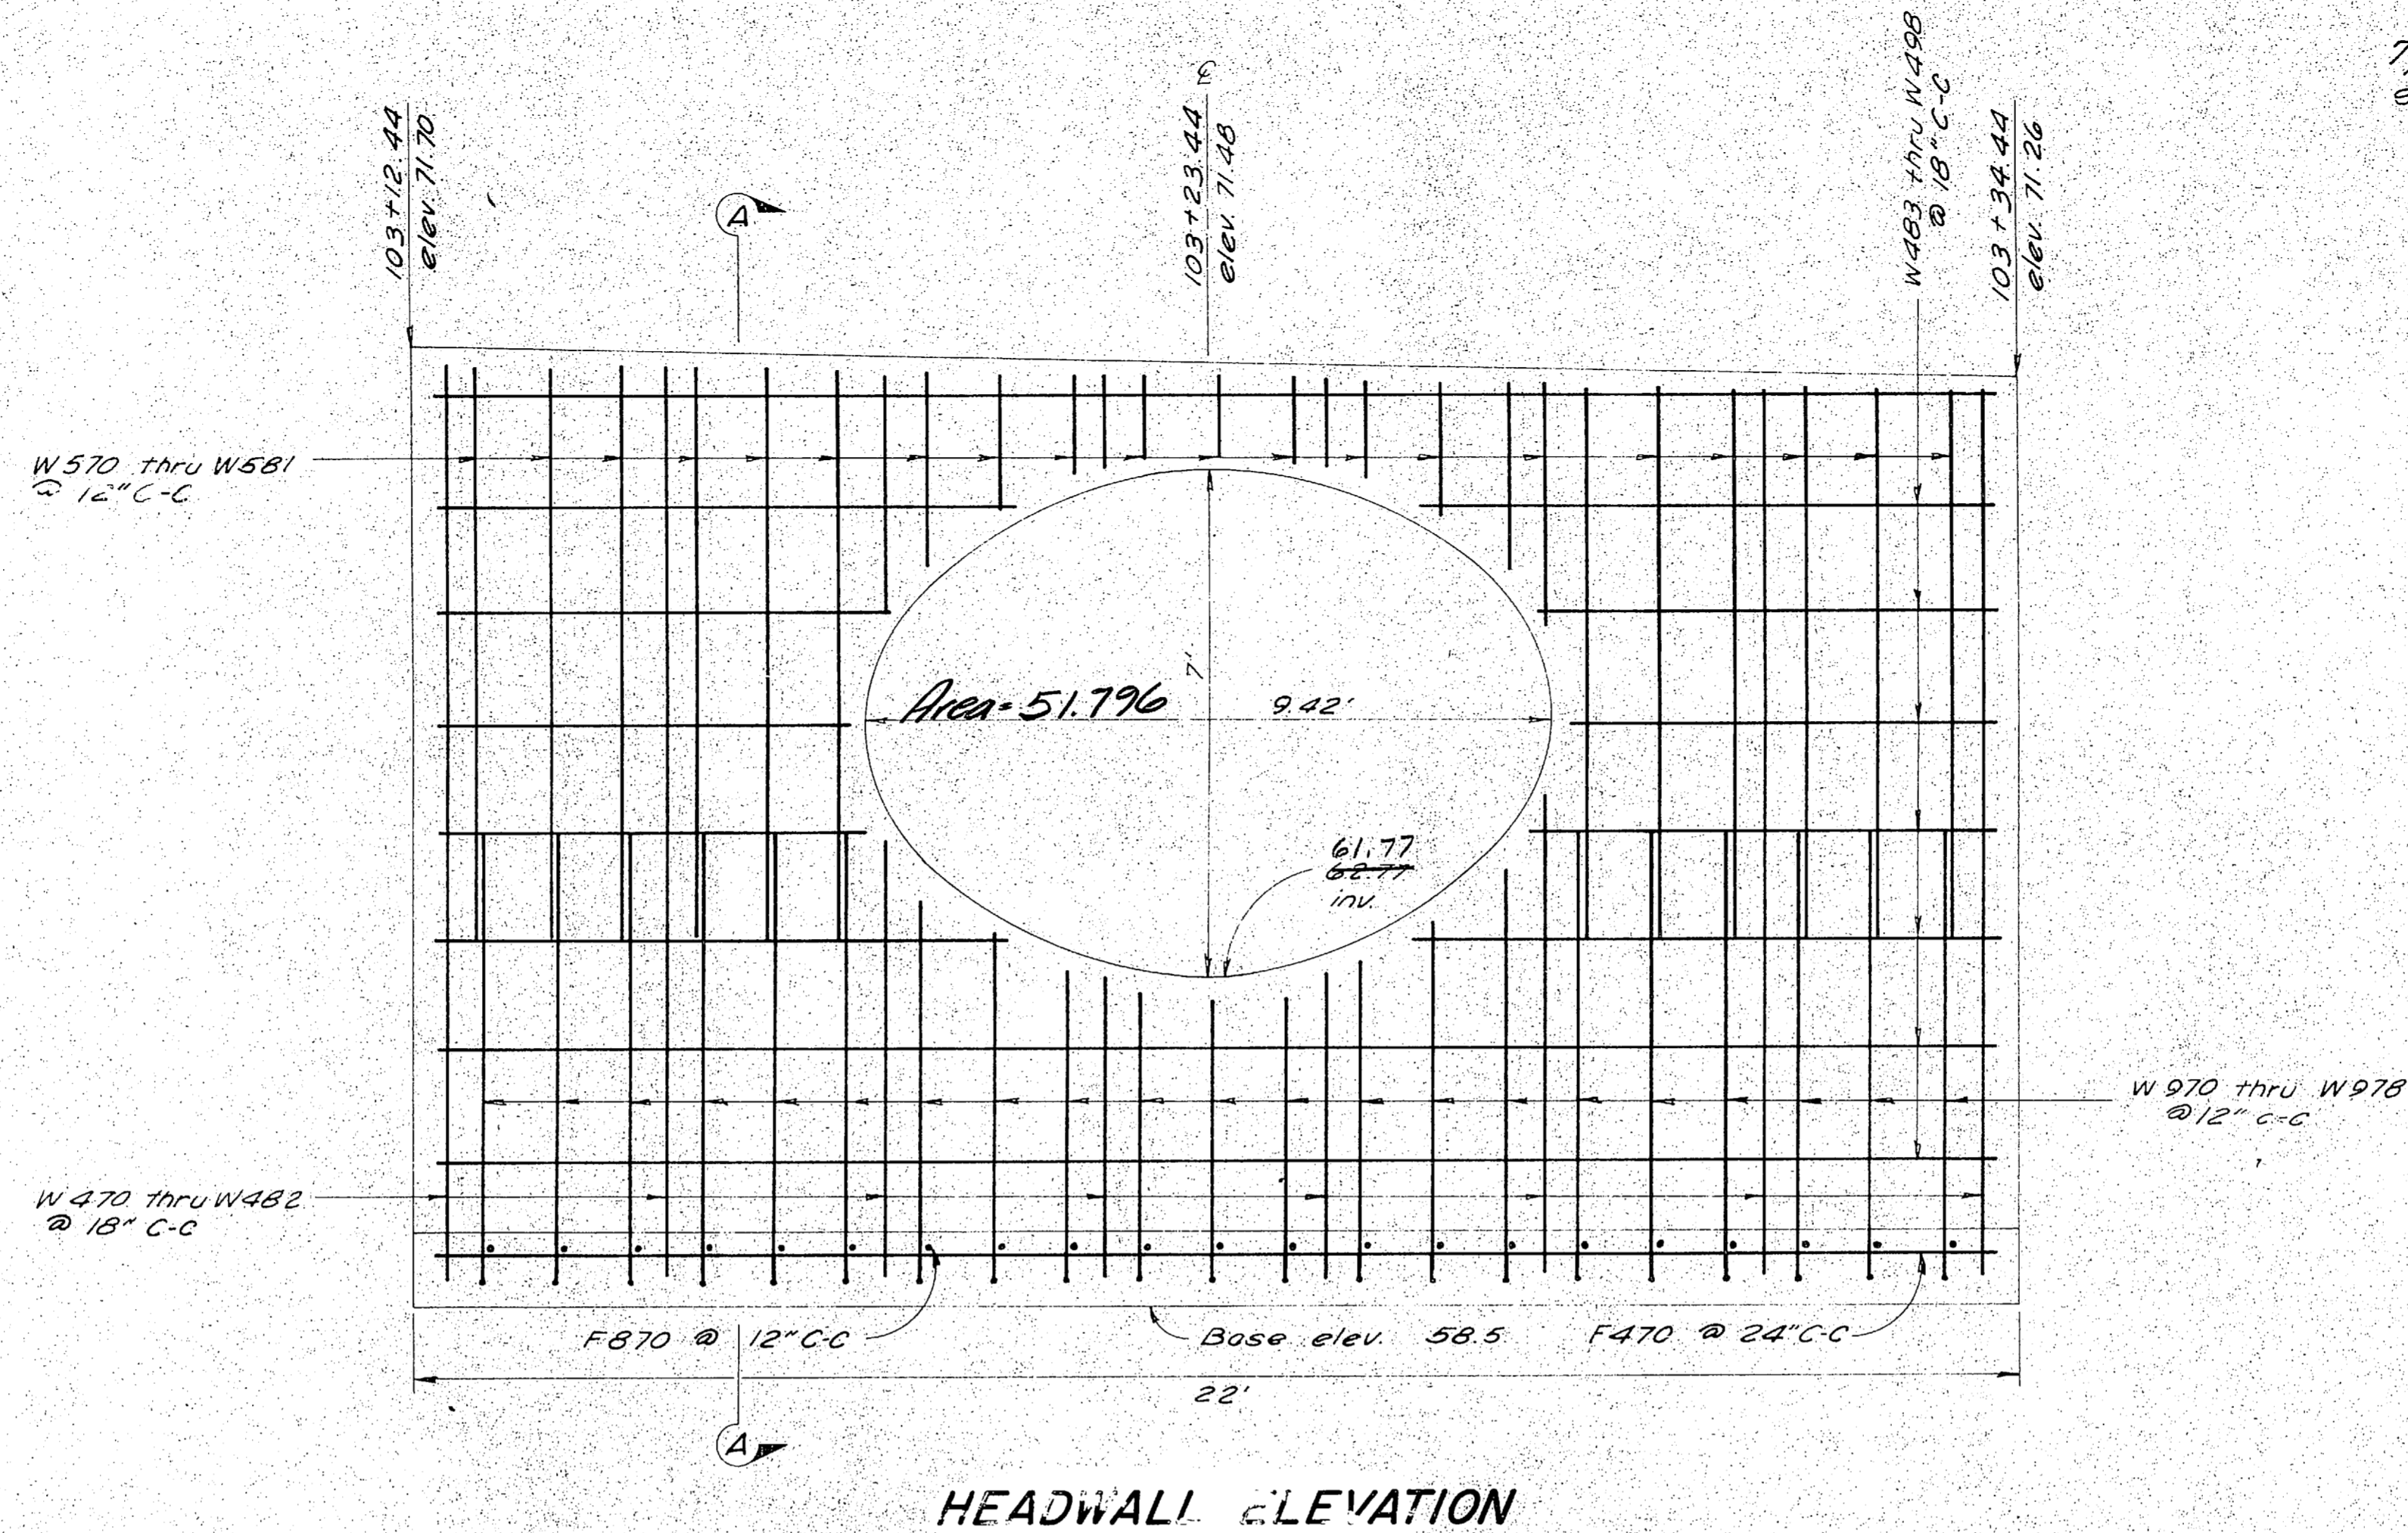


PLAN VIEW OF BEAR CREEK

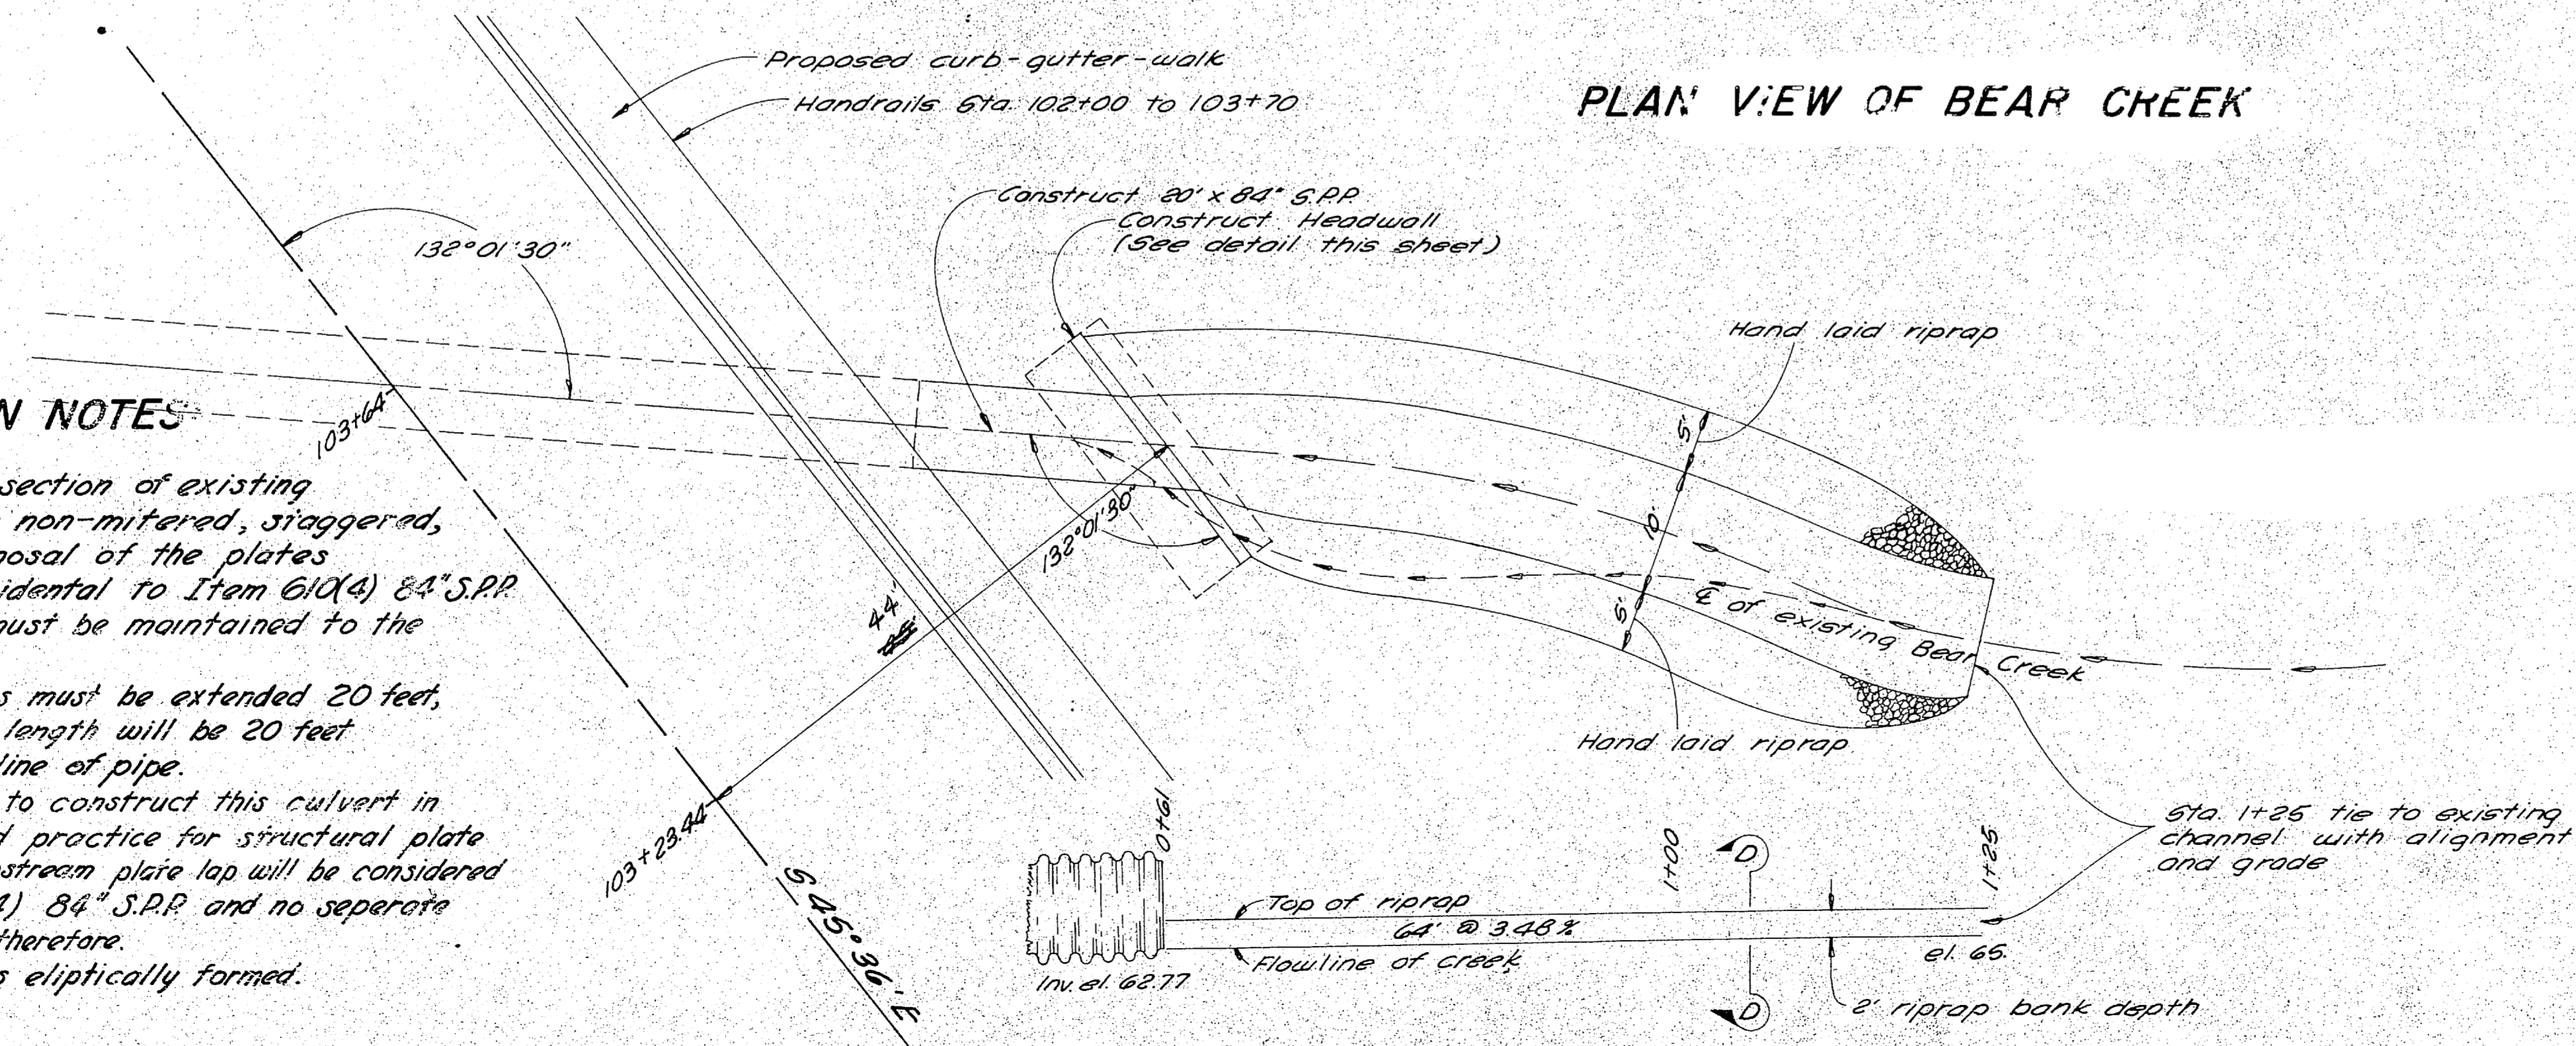

PIPE CONSTRUCTION NOTES


1. Removal of mitered section of existing culvert back to the first non-mitered, staggered, circular section & disposal of the plates will be considered incidental to Item 610(4) 84" S.P.P.
2. Staggered sections must be maintained to the end of the pipe.
3. Invert and top plates must be extended 20 feet, side plates 18 feet. Pay length will be 20 feet measured along centerline of pipe.
4. All work required to construct this culvert in conformance with good practice for structural plate pipe including proper upstream plate lap will be considered incidental to item 610(4) 84" S.P.P. and no separate payment will be made therefore.
5. The existing culvert is elliptically formed.

CHANNEL CHANGE QUANTITIES			
ITEM No	QUANTITY	UNIT	ITEM
203(3)	45	Cu.Yds.	Unclassified excavation
601(1)	14	Cu.Yds.	Class A concrete
602(1)	1643	Lbs.	Reinforcing steel
610(1)	20	Lin. Ft.	S.P.P. 84" dia., 8 gauge
611(1)	53.3 45	Ton.	Riprap, class I
206(1)	45.1 25	Cu. Yds.	Structure Excavation

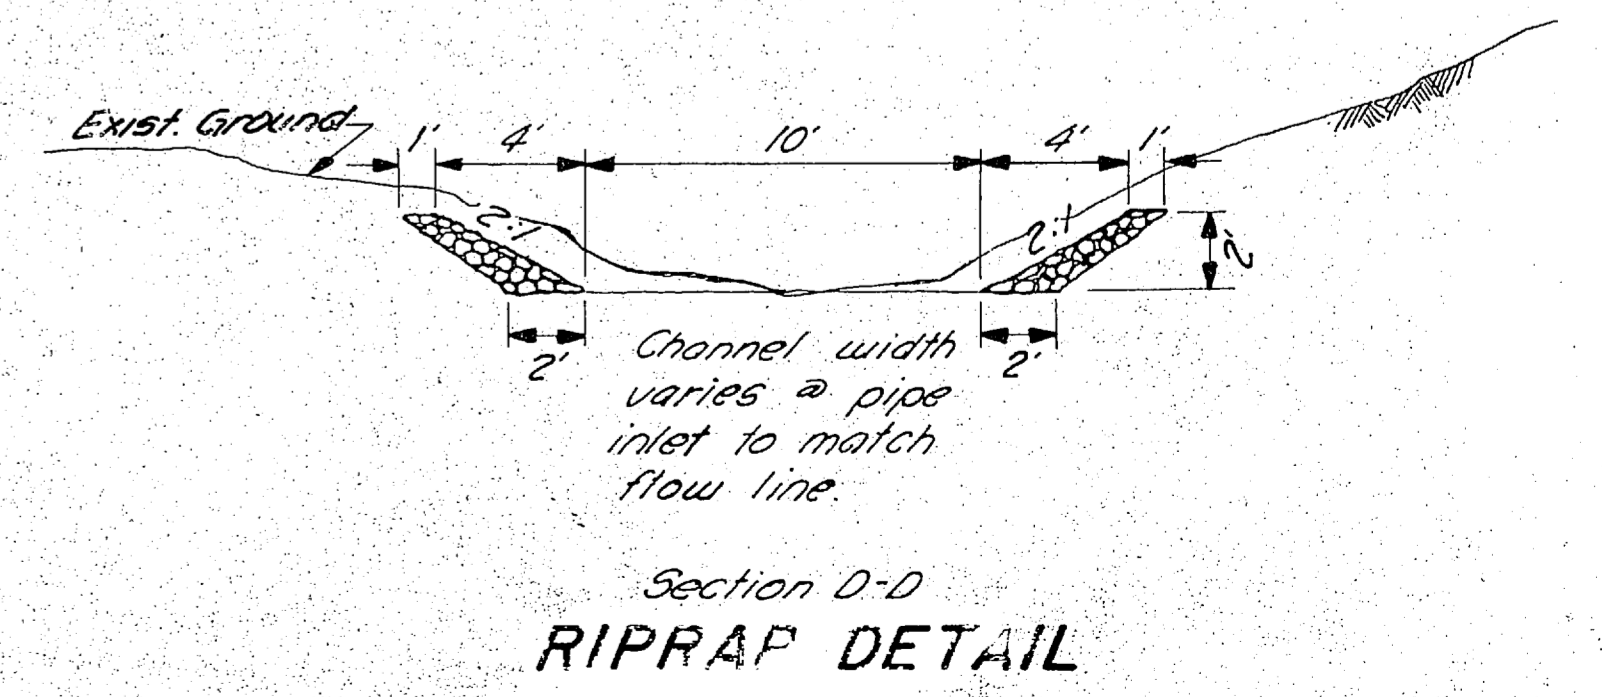

PROPOSED BEAR CREEK PROFILE


INTERSECTION PLAN

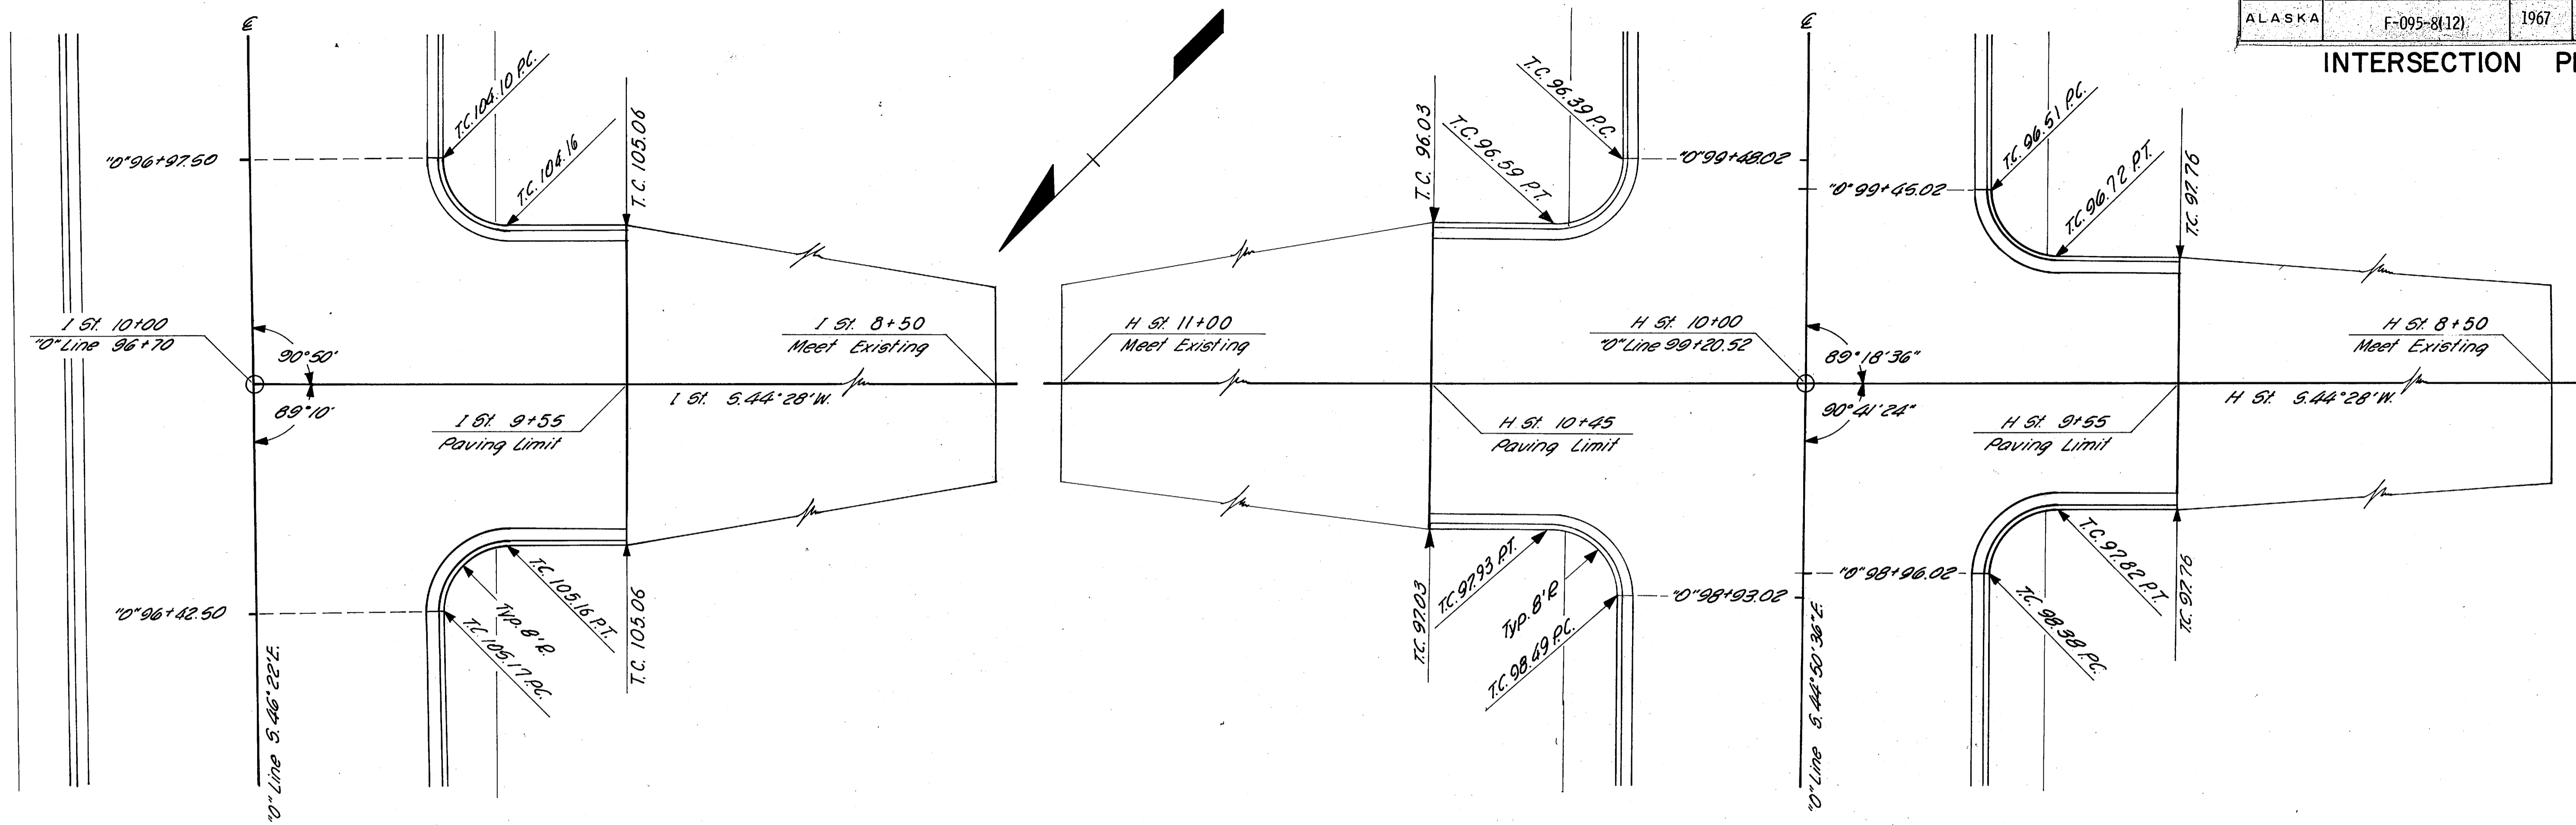

T.C. = Top of Curb

I STREET INTERSECTION


H STREET INTERSECTION

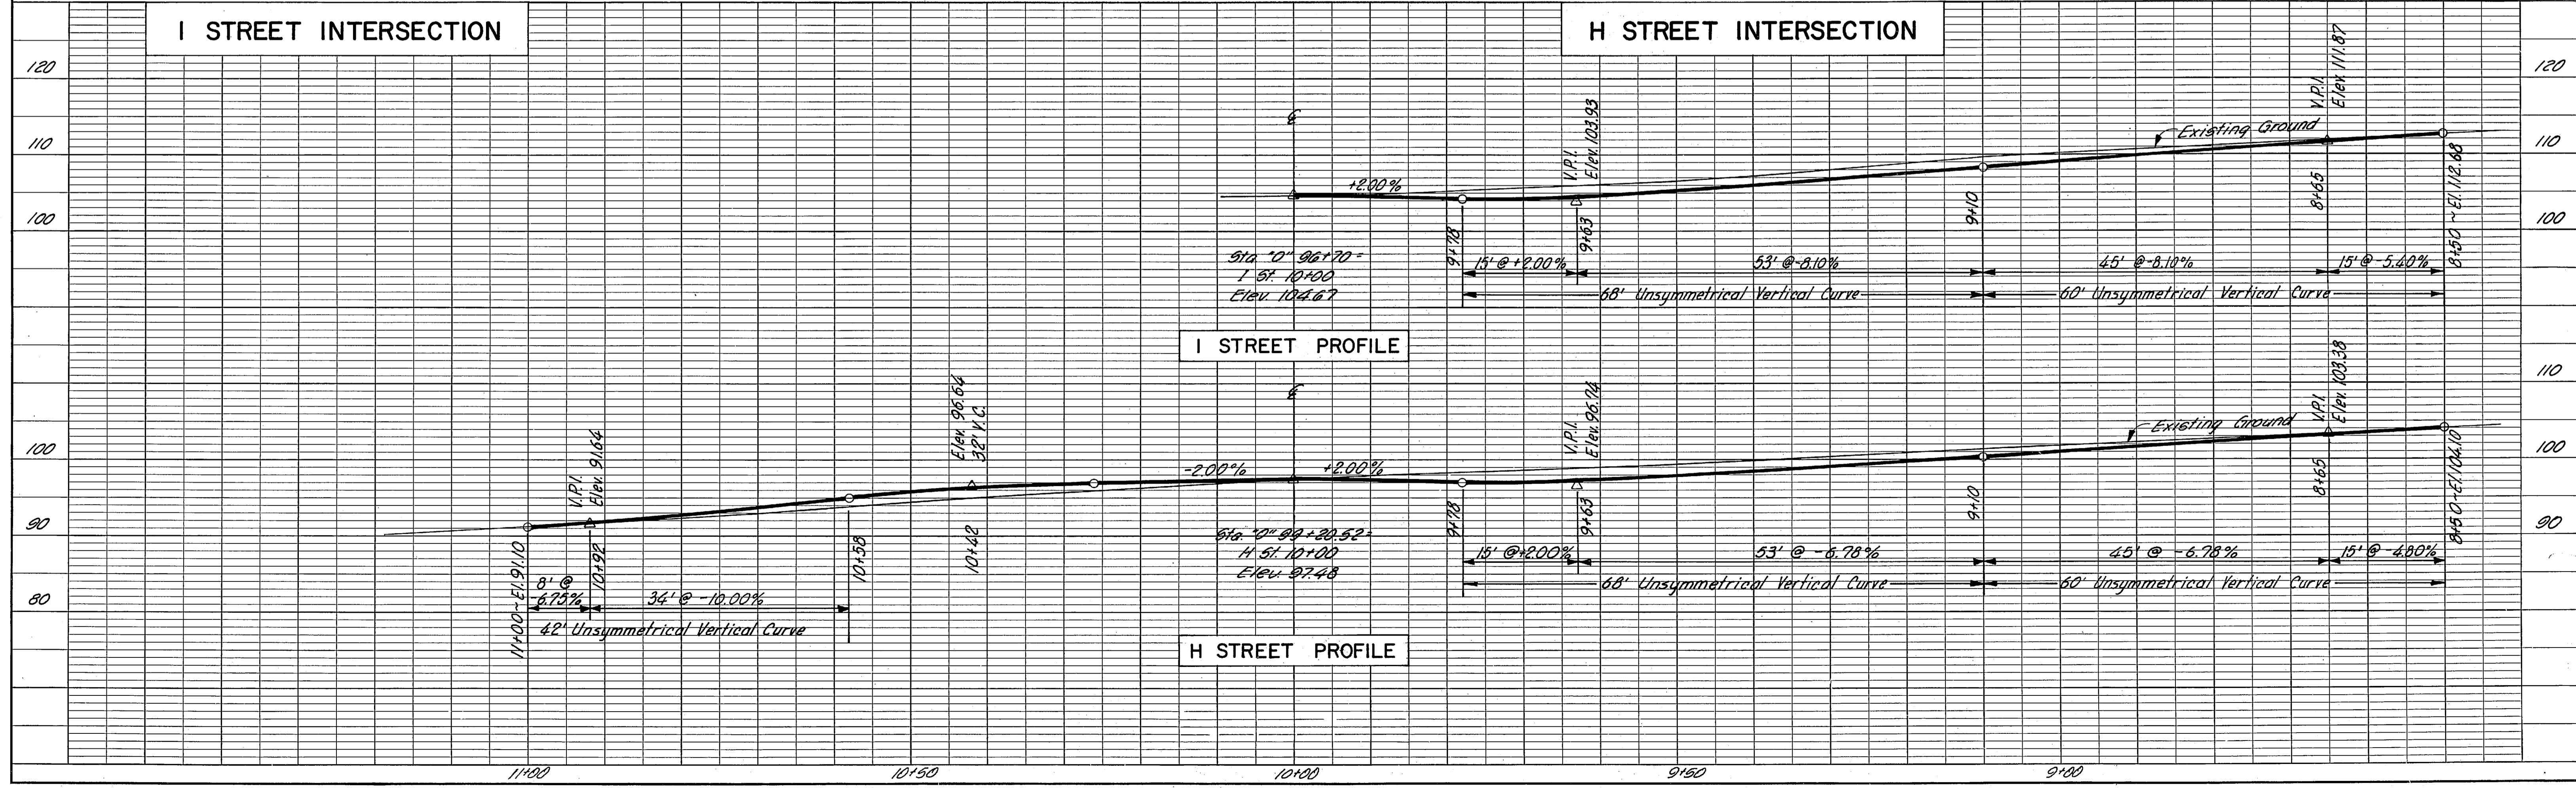

PLAN
 SURVEYED
 ALIGNMENT CHECKED
 RT. OF WAY CHECKED
 NO.

PROFILE
 SURVEYED
 GRADES CHECKED
 B. M. NOTED
 STRUCTURE NOTATIONS CHECKED
 NO.

INTERSECTION PLAN

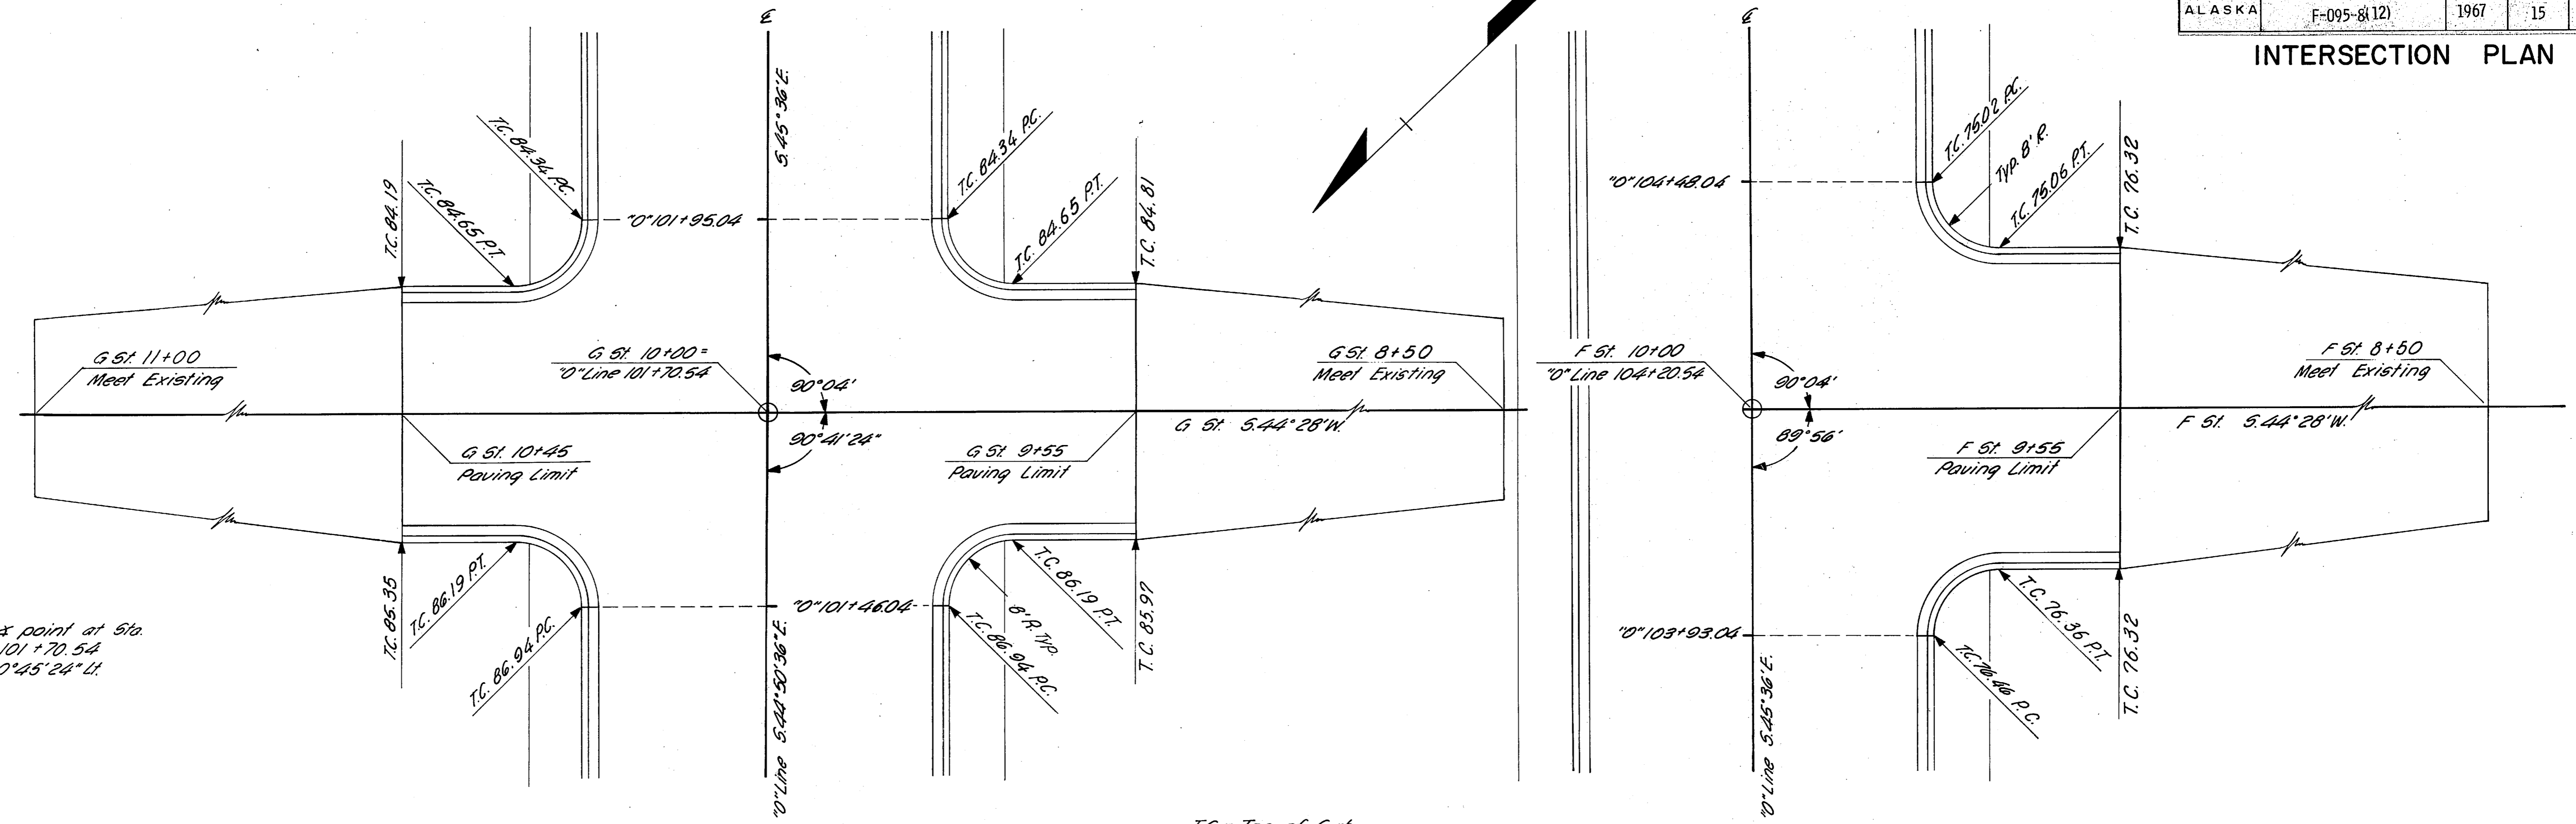


* point at Sta. 101+70.54
0°45'24" L.

T.C. = Top of Curb

G STREET INTERSECTION

F STREET INTERSECTION

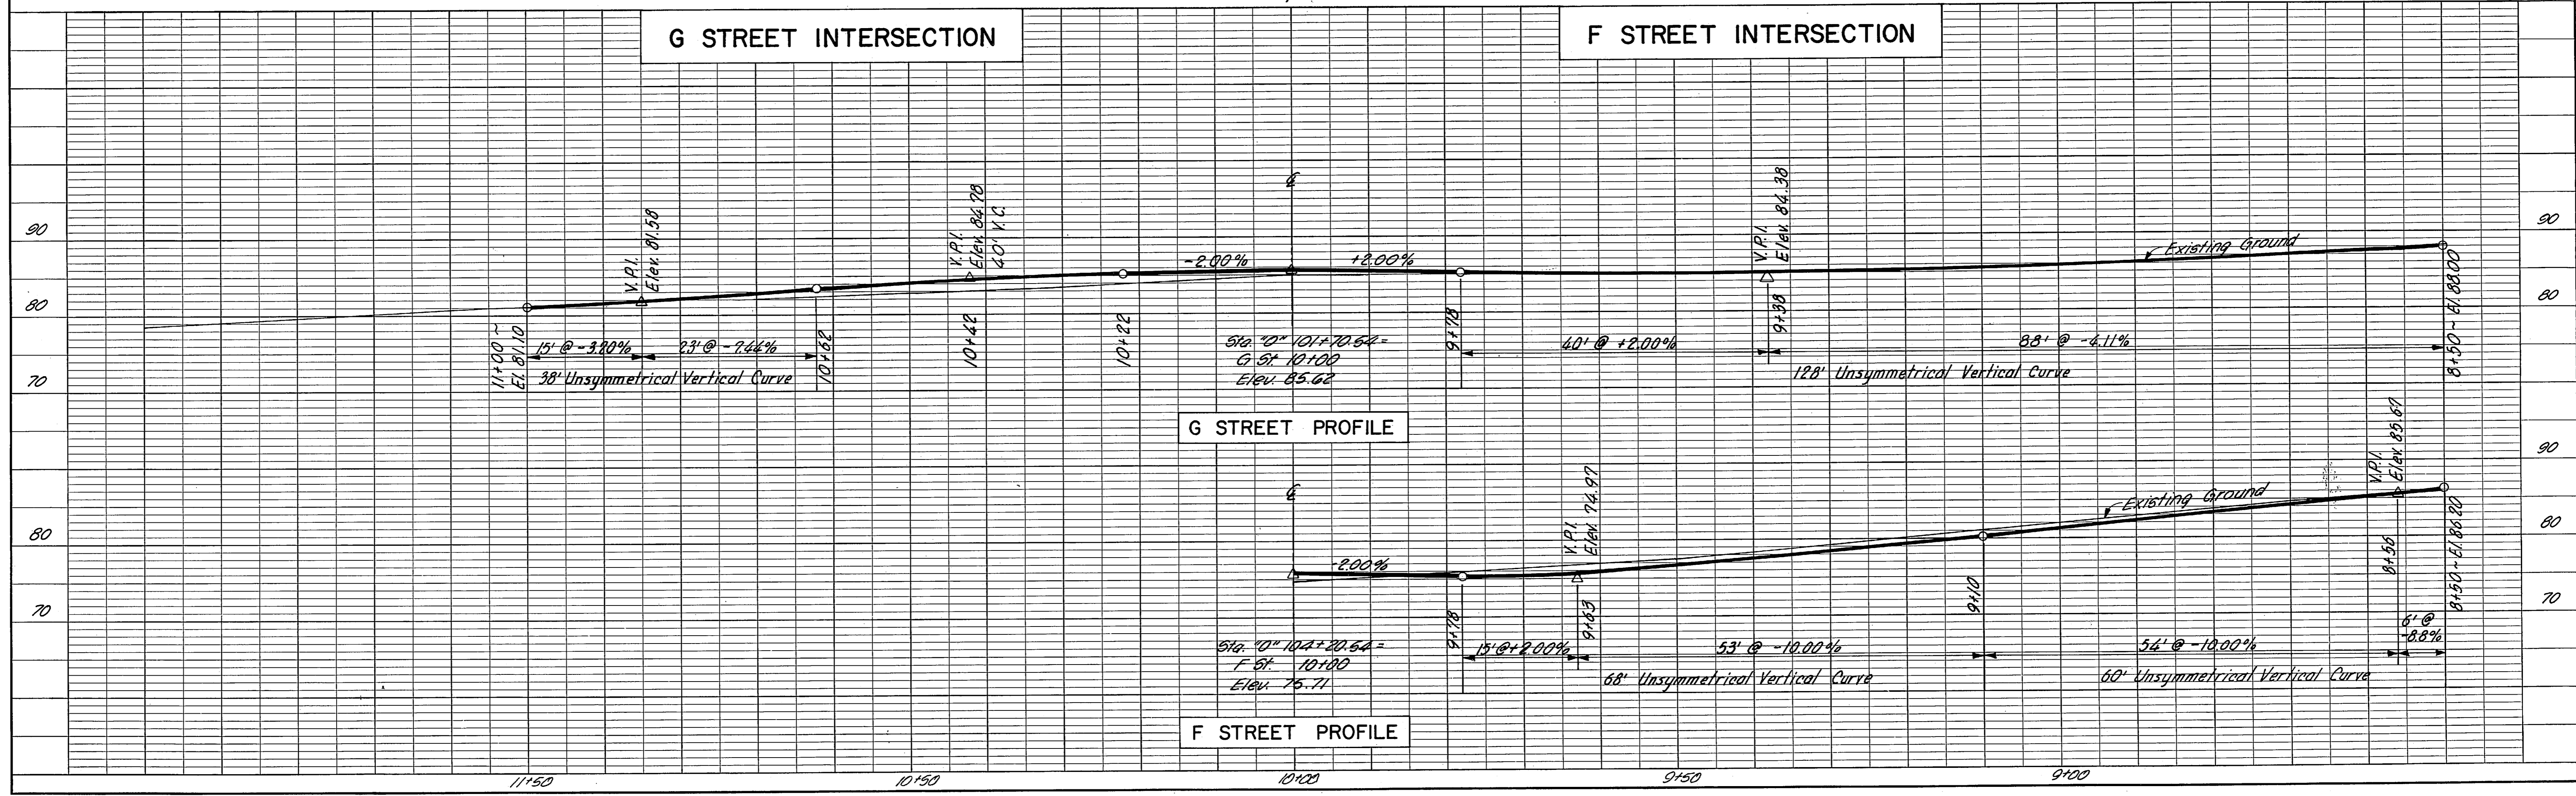


PLAN	DATE
BY	
CHECKED	
DATE	
NO.	

PROFILE	DATE
BY	
CHECKED	
DATE	
NO.	


STATE	PROJECT DESIGNATION	YEAR	SHEET NO.	TOTAL SHEETS
ALASKA	F-095-8(12)	1967	16	32

INTERSECTION PLAN

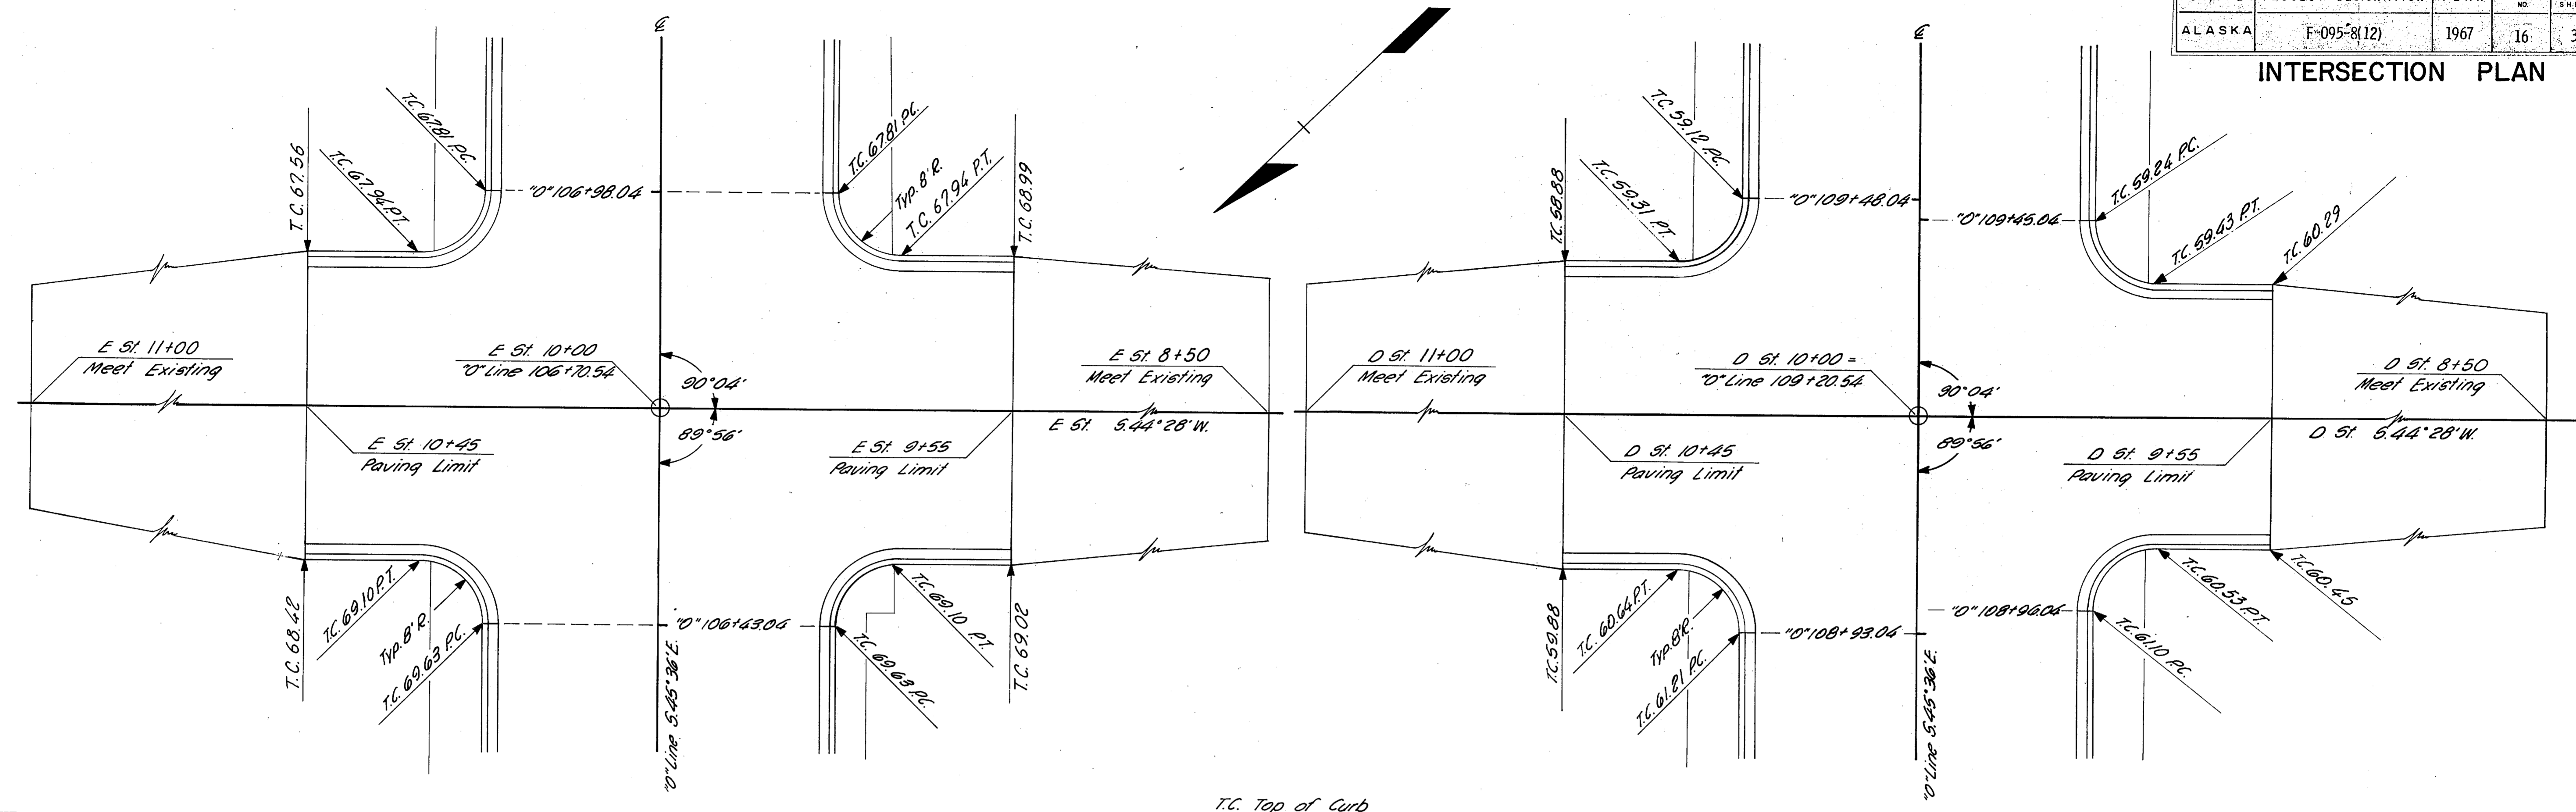


PLAN
 SURVEYED BY
 PLOTTED BY
 NOTE BOOK NO.
 GRADES CHECKED BY
 RT. OF WAY CHECKED BY
 DATE

PROFILE
 SURVEYED BY
 PLOTTED BY
 NOTE BOOK NO.
 GRADES CHECKED BY
 STRUCTURE NOTATIONS CHECKED BY
 DATE

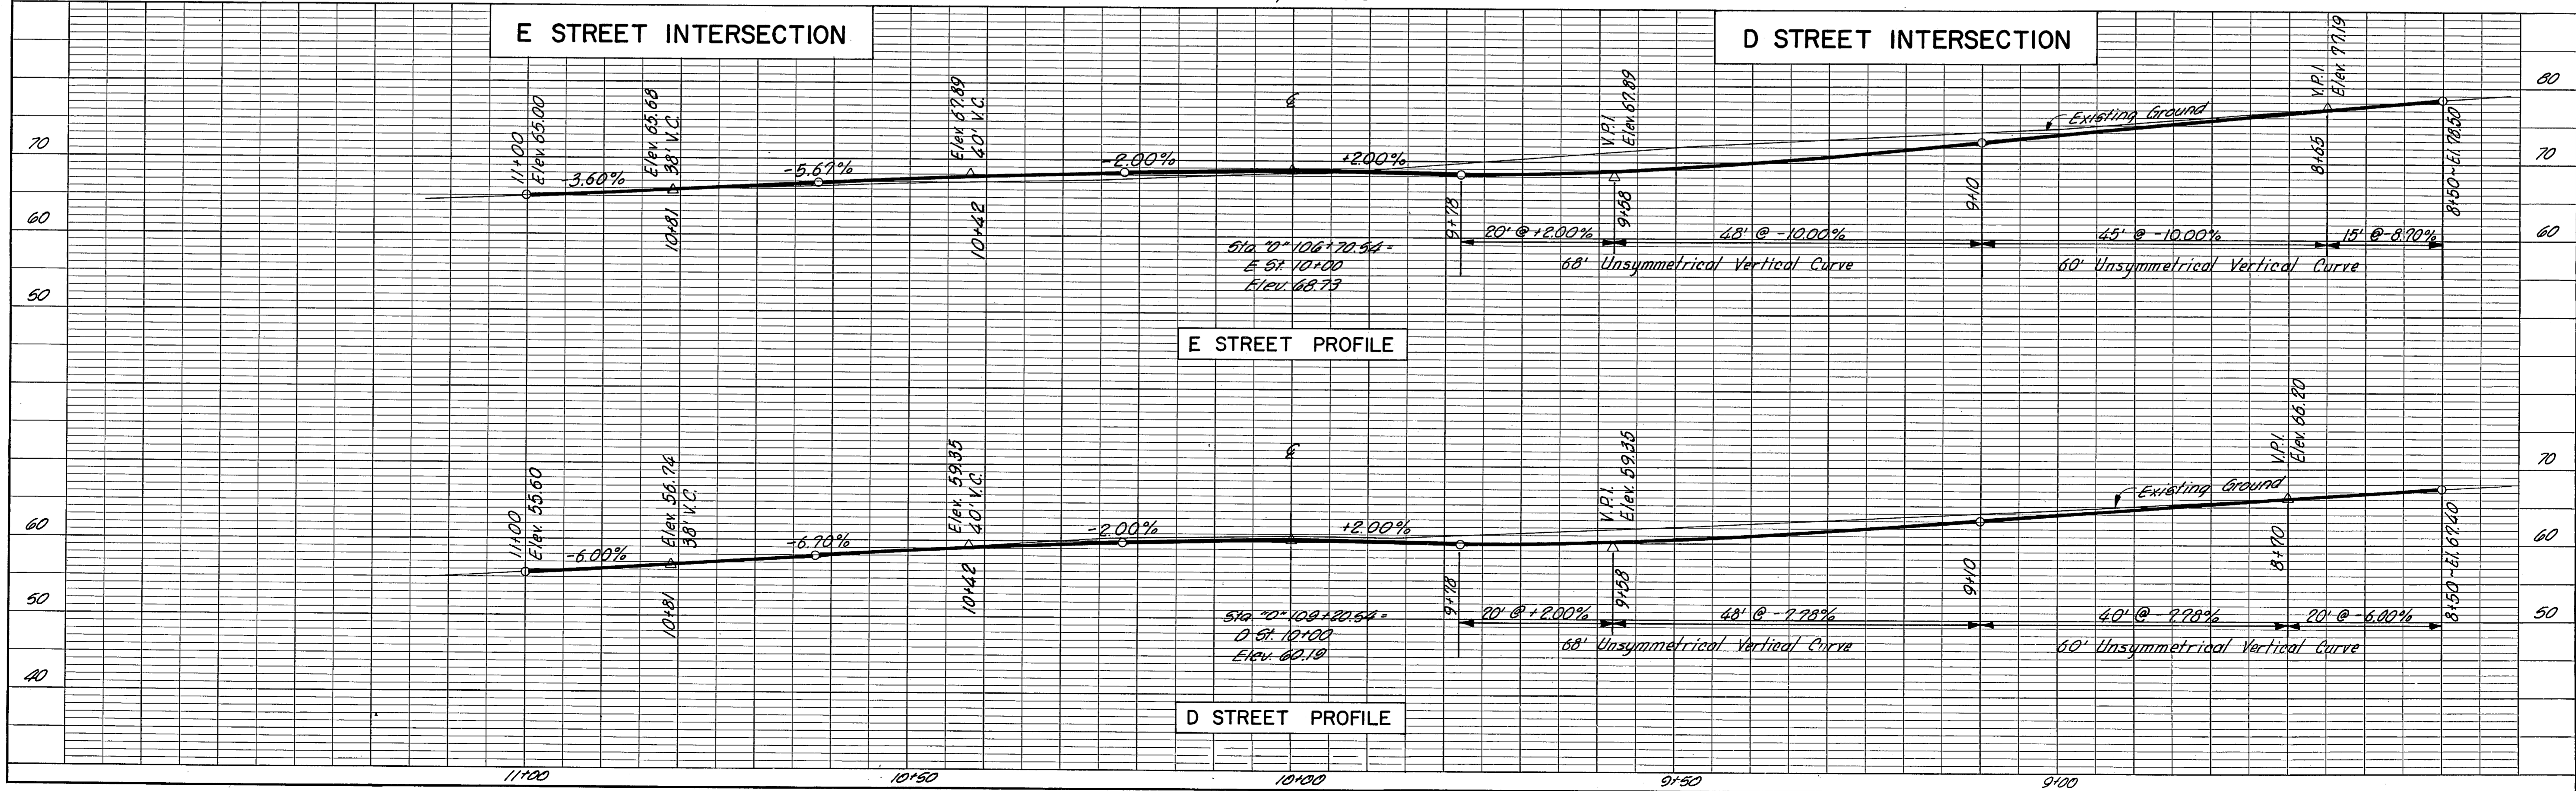

STATE	PROJECT DESIGNATION	YEAR	SHEET NO.	TOTAL SHEETS
ALASKA	F-095-8(12)	1967	17	32


INTERSECTION PLAN

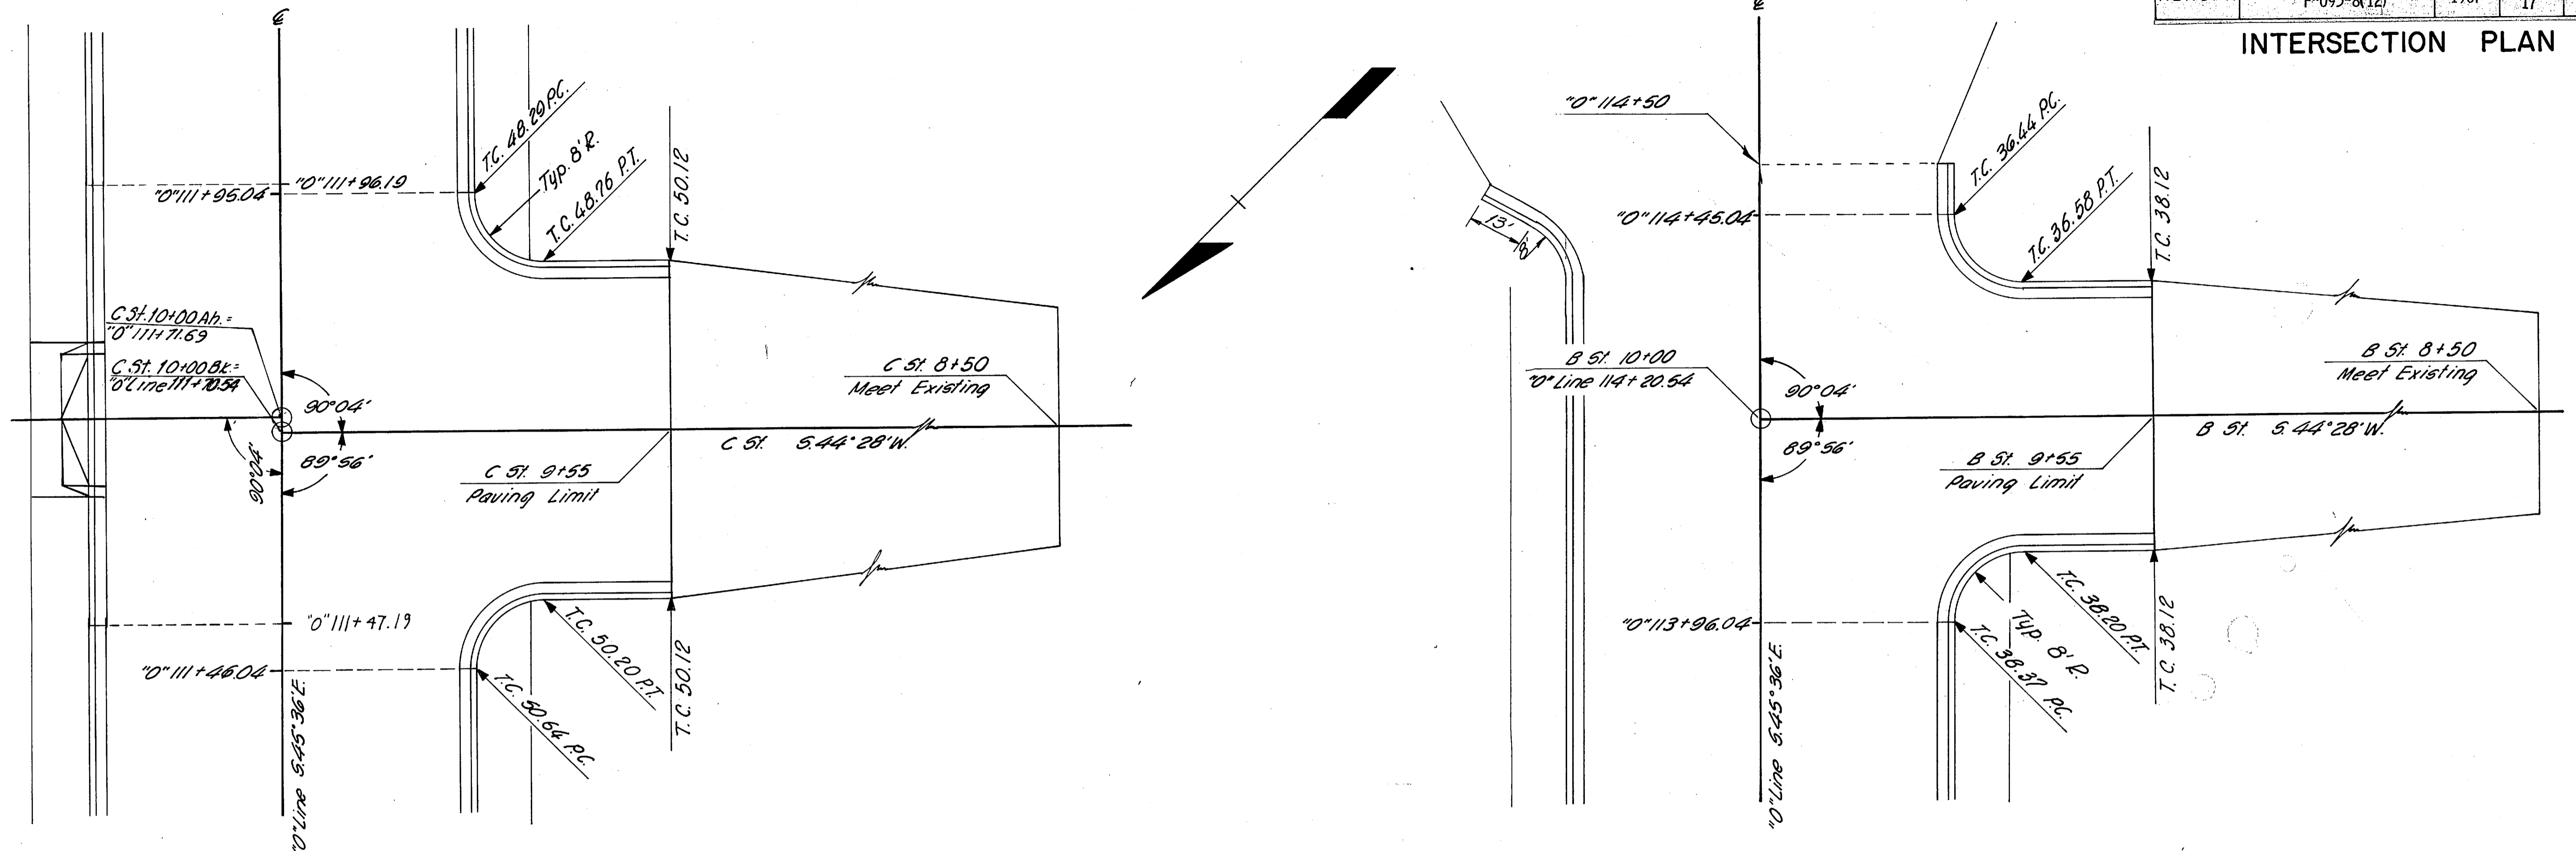

T.C. = Top of Curb

C STREET INTERSECTION

B STREET INTERSECTION

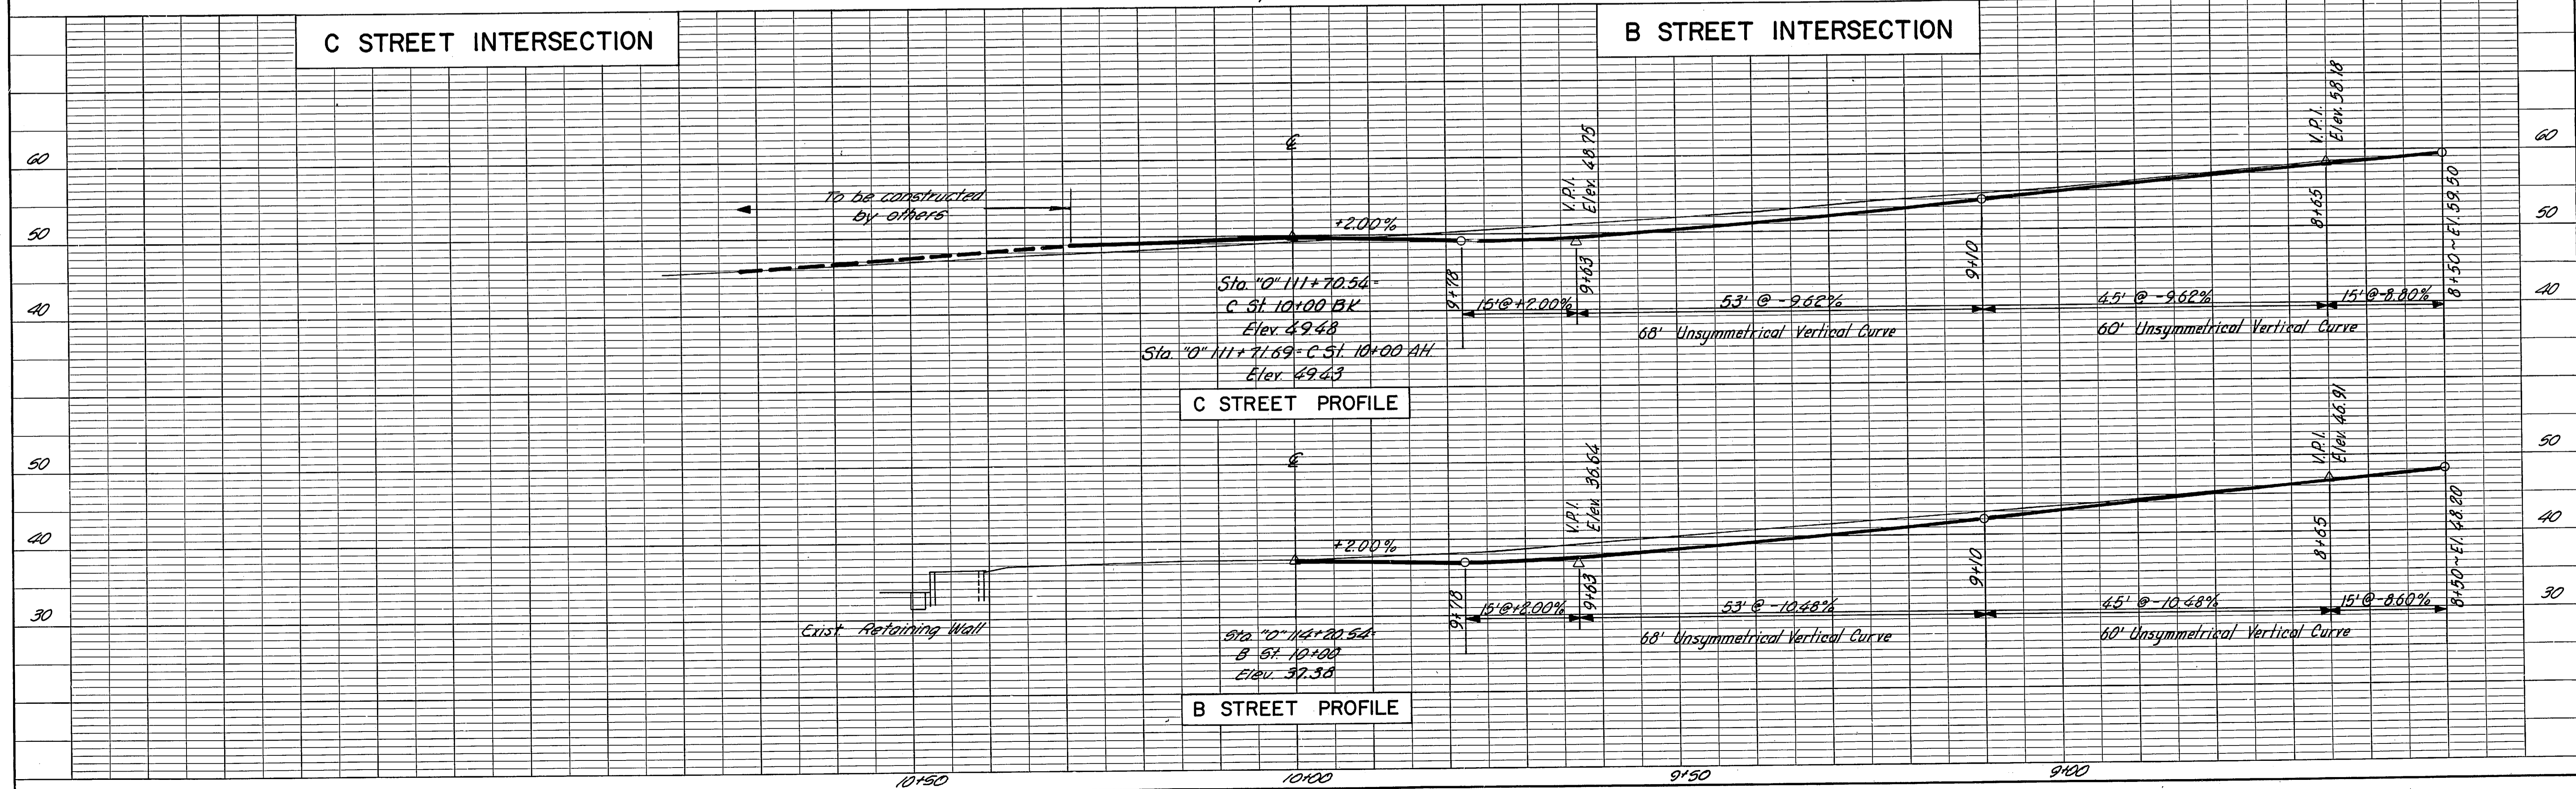



C STREET PROFILE

B STREET PROFILE

PLAN
 SURVEYED, ALIGNED, CHECKED, PLOTTED, RT. OF WAY CHECKED.
 NO. _____
 BY _____
 DATE _____


PROFILE
 SURVEYED, GRADES CHECKED, M.F. NOTED, STRUCTURE NOTATIONS CHECKED.
 NO. _____
 BY _____
 DATE _____

STATE	PROJECT DESIGNATION	YEAR	SHEET NO.	TOTAL SHEETS
ALASKA	F-095-8(12)	1967	18	32

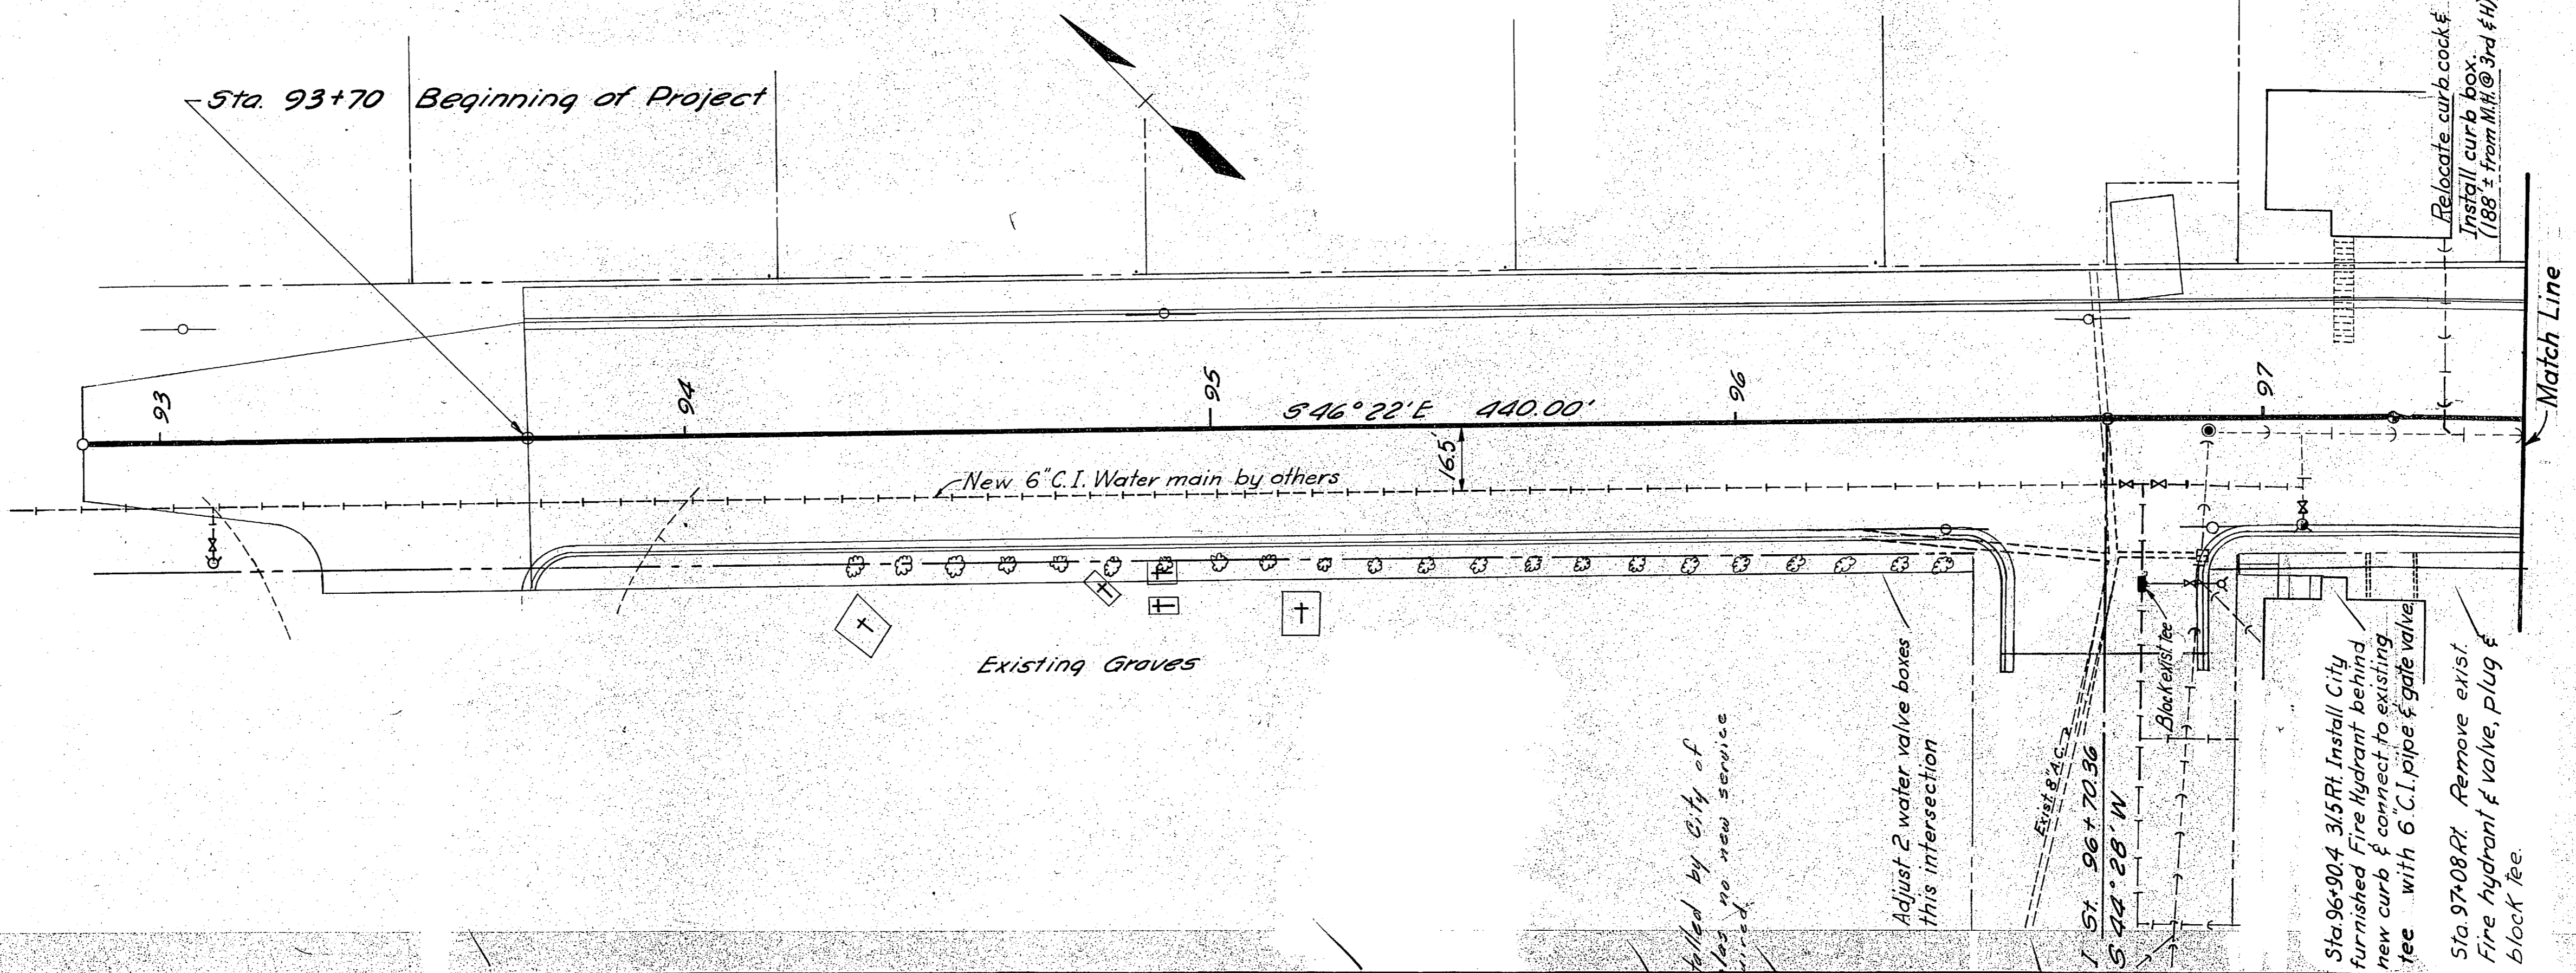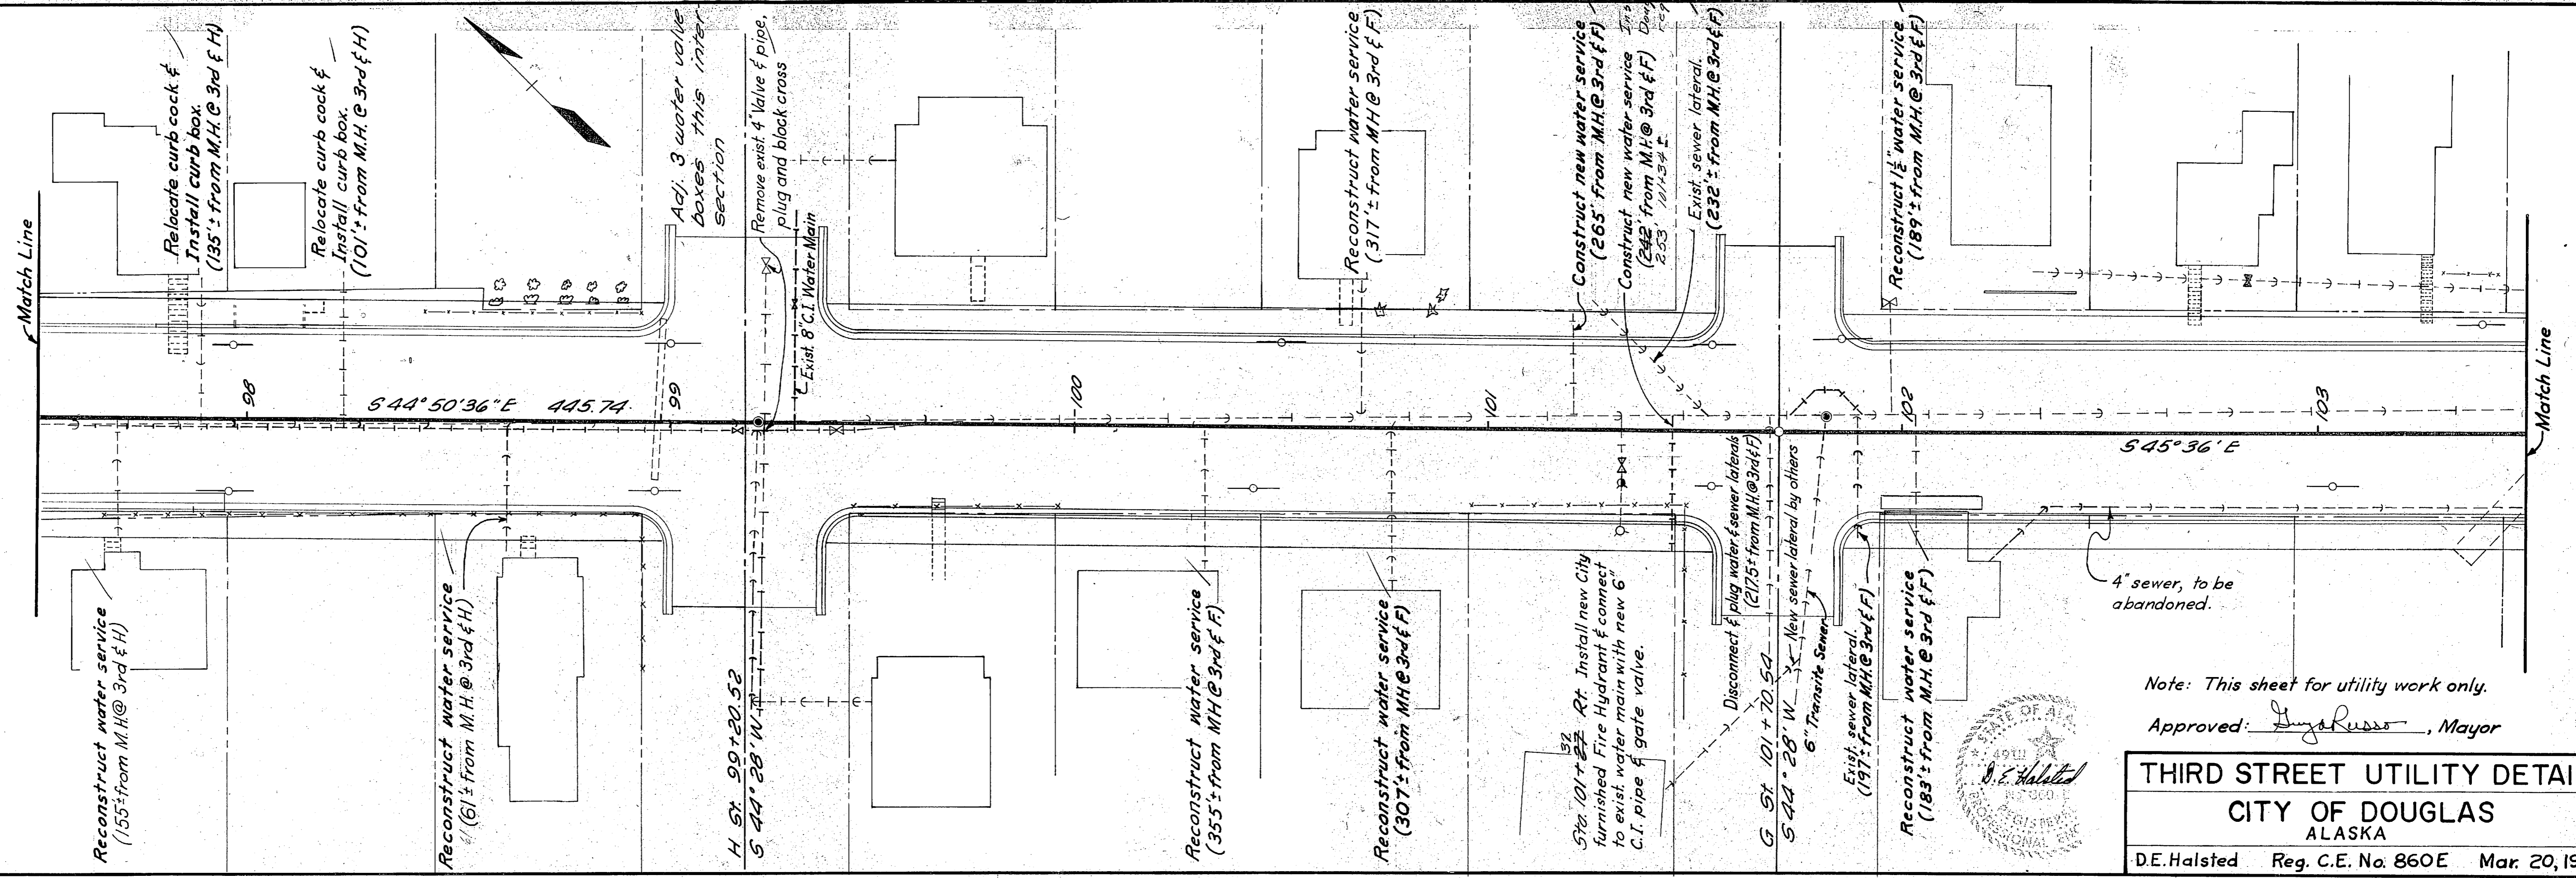

THIRD STREET UTILITY DETAILS
 CITY OF DOUGLAS
 ALASKA
 D.E. Halsted
 Reg. C.E. No. 860E Mar. 20, 1966

STATE	PROJECT DESIGNATION	YEAR	SHEET NO.	TOTAL SHEETS
ALASKA	F-095-8(12)	1967	19	32

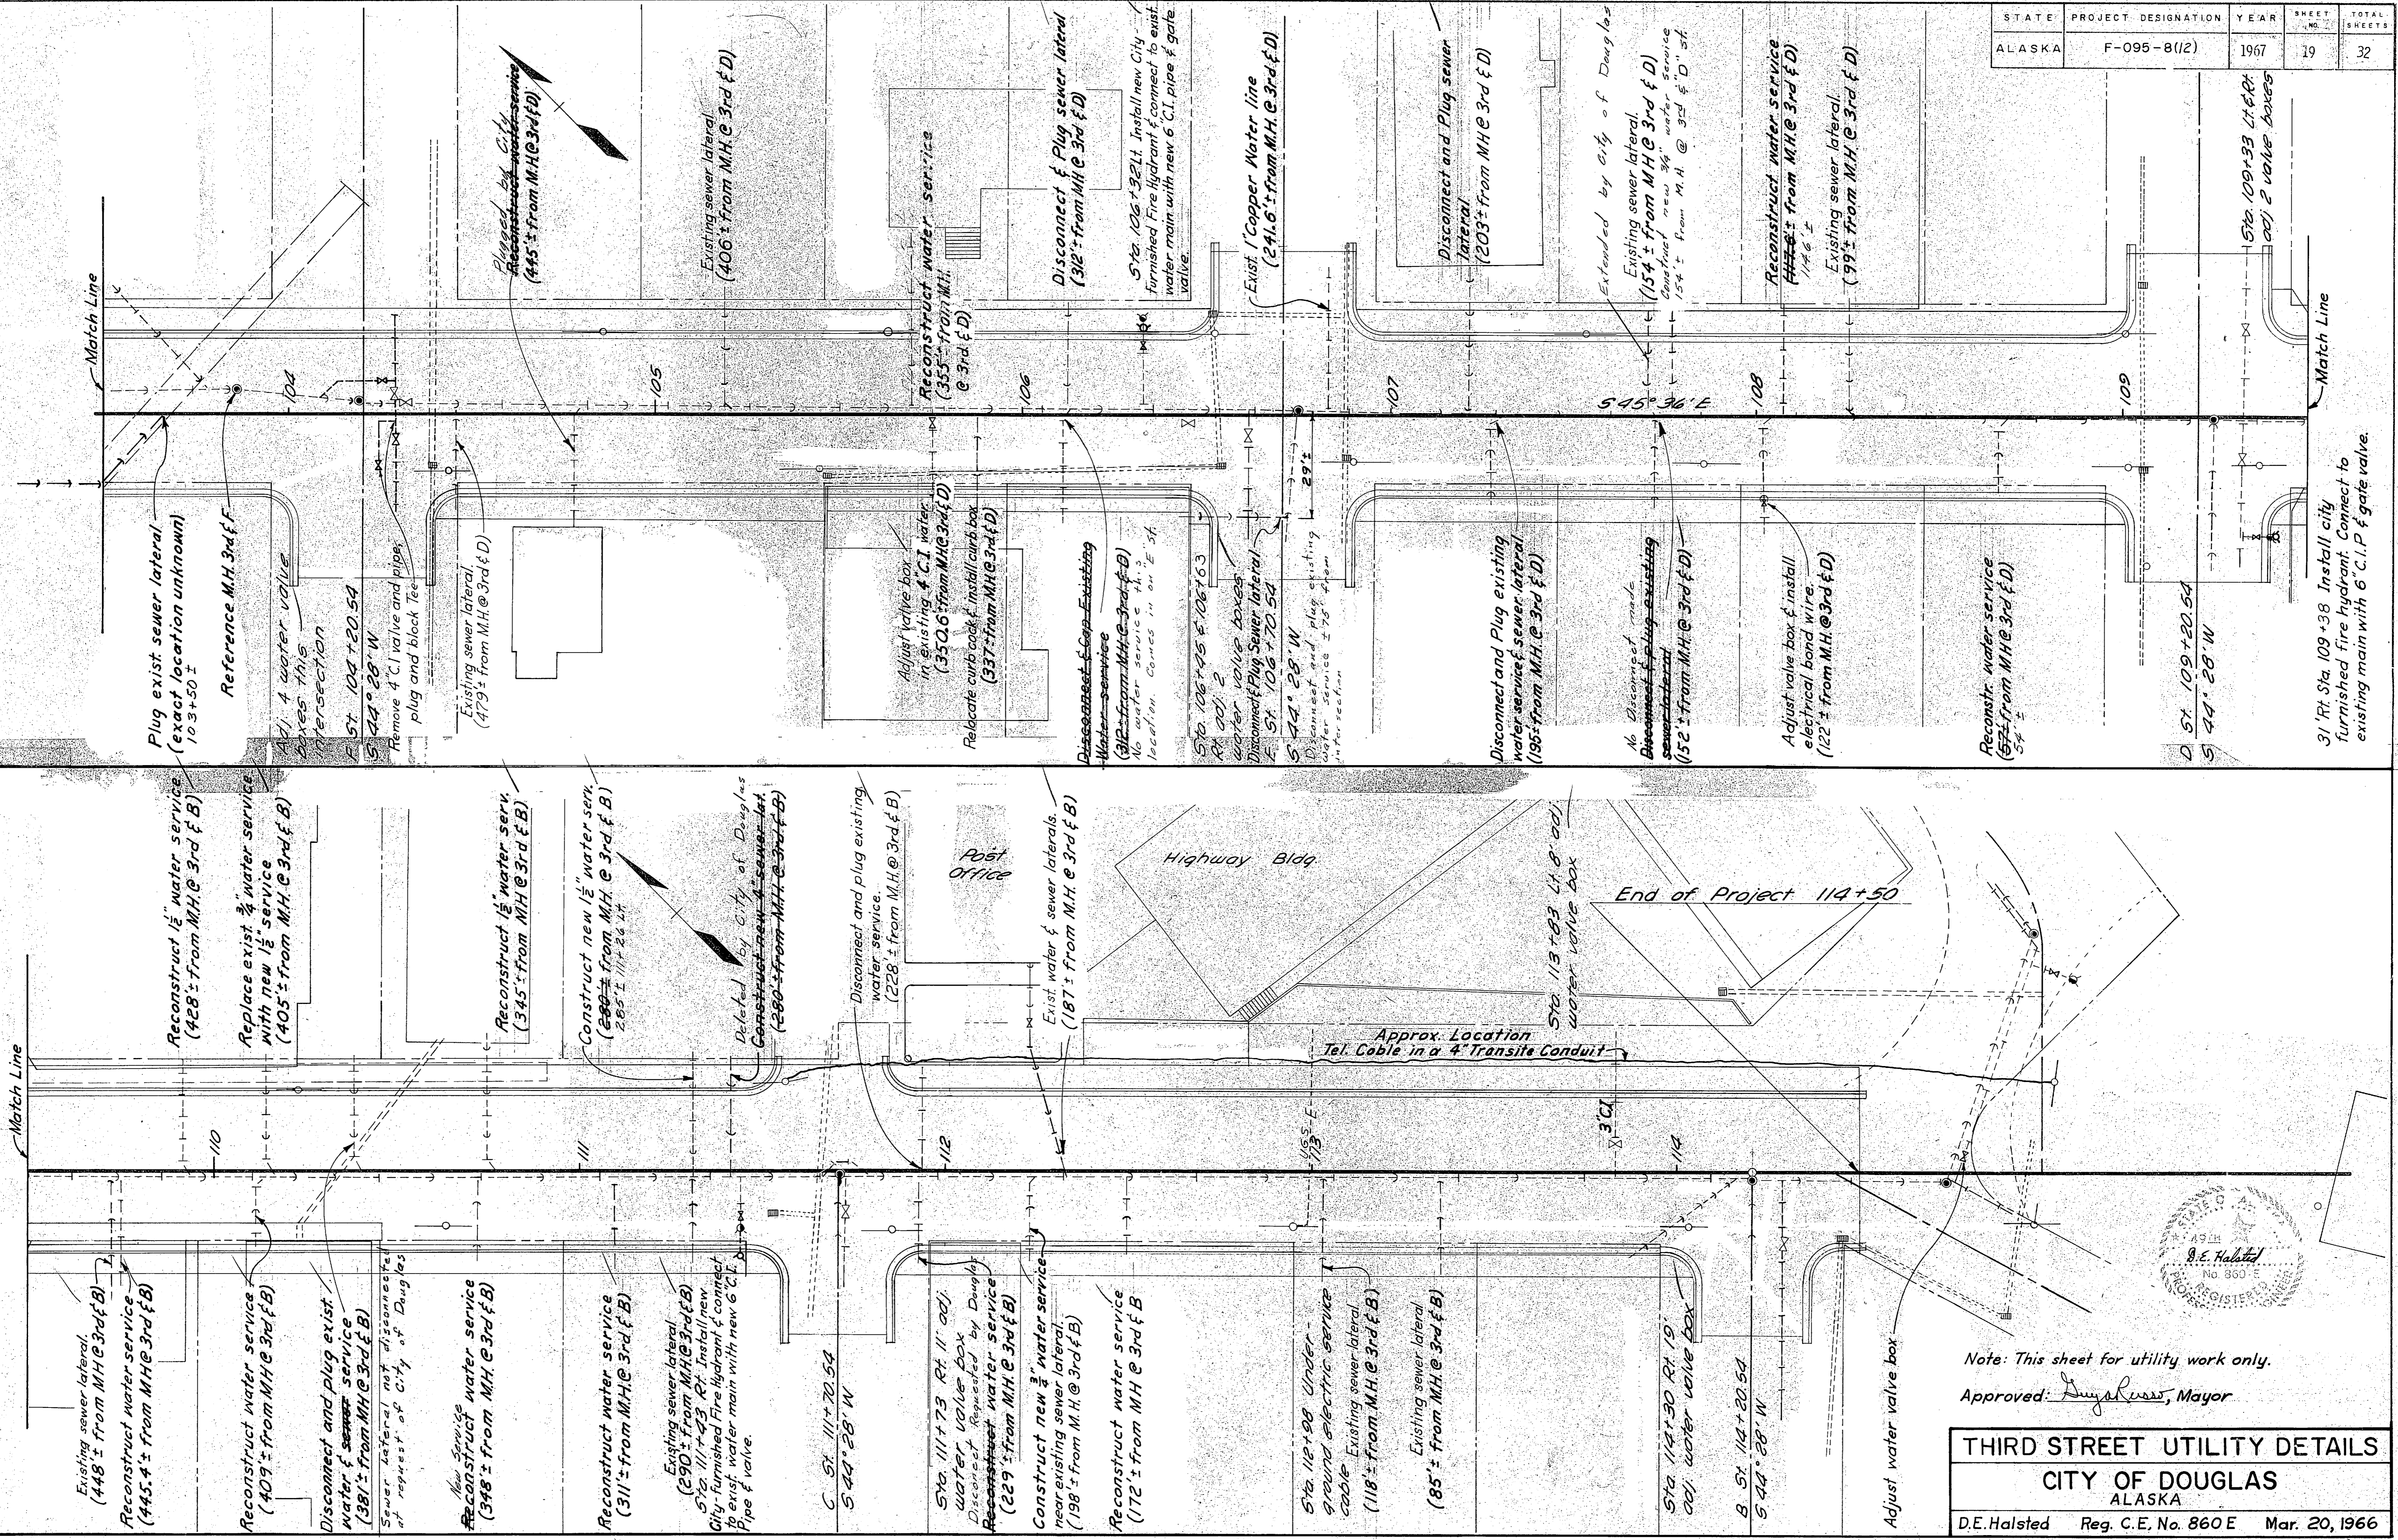

Note: This sheet for utility work only.
 Approved: *Douglass*, Mayor

THIRD STREET UTILITY DETAILS
CITY OF DOUGLAS
 ALASKA

D.E. Halsted Reg. C.E. No. 860 E Mar. 20, 1966



SUMMARY OF STANDARD SIGNS

STATE	PROJECT NO.	YEAR	SHEET NO.	TOTAL SHEETS
ALASKA	F-095-8(12)	1967	20	32

STATION	Dist. from Centerline		Sign No.	LEGEND	STATION	Dist. from Centerline		Sign No.	LEGEND
	Left	Right				Left	Right		
0+00		20'	W9-3	School Crossing Ahead	108+98	33'		R1-1	Stop
0+25	27'		D2-2	Juneau 3 Auke Bay 14	108+98	33'		D3	D St. (Above R1-1)
93+75		28'	R1-1	Stop	108+98	33'		D3	Third St. (Above R1-1)
96+32		27'	W9-2	School Crossing	109+43		33'	R1-1	Stop
96+42	29'		W9-2	School Crossing	109+43		33'	D3	D St. (Above R1-1)
96+70	30'		D3	I St.	109+43		33'	D3	Third St. (Above R1-1)
96+93		33'	R1-1	Stop	111+50	28'		D3	C St.
96+93		33'	D3	I St. (Above R1-1)	111+50	28'		D3	Third St.
96+93		33'	D3	Third St. (Above R1-1)	111+90		33'	R1-1	Stop
98+91	27'		W9-3	School Crossing Ahead	111+90		33'	D3	C St. (Above R1-1)
98+97	33'		R1-1	Stop	111+90		33'	D3	Third St. (Above R1-1)
98+97	33'		D3	H St. (Above R1-1)	111+90		29'	W2-5	Y (Symbol)
98+97	33'		D3	Third St. (Above R1-1)	113+80	30'		R2-1	Speed Limit 25
99+43		33'	R1-1	Stop	114+20	30'		D3	Third St.
99+43		33'	D3	H St. (Above R1-1)	114+20		33'	R1-1	Stop
99+43		33'	D3	Third St. (Above R1-1)	114+40		33'	D3	B St. (Above R1-1)
101+50	33'		R1-1	STOP	114+40		33'	D3	Third St. (Above R1-1)
101+50	33'		D3	G St. (Above R1-1)	114+43	33'		R1-1	Stop
101+50	33'		D3	Third St. (Above R1-1)	114+43	33'		D3	Front St. (Above R1-1)
101+90		33'	R1-1	Stop	114+88			W14-6	9 Button Hazard Marker
101+90		33'	D3	G St. (Above R1-1)				D-3	Third St.
101+90		33'	D3	Third St. (Above R1-1)					
104+20	30'		D3	F St.					
104+20	30'		D3	Third St.					
104+43		33'	R1-1	Stop					
104+43		33'	D3	F St. (Above R1-1)					
104+43		33'	D3	Third St. (Above R1-1)					
106+48	33'		R1-1	Stop					
106+48	33'		D3	E St. (Above R1-1)					
106+48	33'		D3	Third St. (Above R1-1)					
106+93		33'	R1-1	Stop					
106+93		33'	D3	E St. (Above R1-1)					
106+93		33'	D3	Third St. (Above R1-1)					

