

AS BUILT

SUMMARY SHEET

ITEM NO.	QUANTITY	UNIT	ITEM
100(3)	6	Acre	Clearing and Grubbing
102(1)	12,800	Cu. Yd.	Unclassified Excavation
102(7)	100,000	Ton	Selected material, Type I borrow, Case 2
102(7A)	9,000	Ton	Selected material, Type II borrow, Case 2, grading B
102(7B)	6,000	Ton	Selected material, Type III borrow, Case 2
103(1)	525	Cu. Yd.	Excavation for Structures
200(4)	7,350	Ton	Crushed Aggregate Base, Grading D-1
310(3)	6,000	Gal.	Asphalt, grade MC-70, prime coat
314(4)	240	Ton	Aggregate, designation E-70, bituminous surface treatment
314(15)	5,500	Gal.	Cationic Emulsified asphalt, grade RS-3K, bit. surface treat.
322(1)	2,100	Ton	Hot bituminous concrete pavement
322(2)	32,000	Gal.	Asphalt cement 120-150 penetration
453(2G)	274	Lin. Ft.	24" bituminous-coated corr. metal pipe
453(2I)	100	Lin. Ft.	36" bituminous-coated corr. metal pipe
454(2G)	250	Lin. Ft.	50"x31" bituminous-coated corr. metal pipe arch
454(2H)	164	Lin. Ft.	58"x36" bituminous-coated corr. metal pipe arch
454(2I)	208	Lin. Ft.	65"x40" bituminous-coated corr. metal pipe arch
454(2J)	86	Lin. Ft.	72"x44" bituminous-coated corr. metal pipe arch
457(1)	626	Lin. Ft.	Removal of culverts
560(1)	24	Each	Right-of-way monuments
560(3)	16	Each	Culvert marker posts
560(4)	4	Each	Timber guide posts
583(1)	5625	Lin. Ft.	Beam-type guardrail
584(1)	5	Each	Standard Signs

GENERAL NOTES

- Culvert lengths are approximate only and are subject to minor revisions.
- Grades and alignment shown on these plans are subject to minor revisions.
- All fences and other miscellaneous encroachments within the Right-of-Way shall be removed as directed by the Engineer. Payment for this item shall be considered a subsidiary obligation of the Contractor for work done under Section 100.
- Roadway to Bridge and Bridge to Roadway Typical Section Transitions shall be accomplished in the adjacent 0.5 Station of the Roadway.
- Obliteration of old roadway shall require the removal of all of the existing embankment to the original ground level. The material thus obtained shall be used in the construction of the parking area or as directed by the Engineer. It is estimated that 10,300 Cu. Yds. will be available for construction of embankment.
- All waste material from unclassified excavation or obliteration of old roadways shall be disposed of by the Contractor outside the right-of-way limits as approved by the Engineer. The Contractor shall make all the arrangements, financial and otherwise, in securing waste areas and shall assume full responsibility for the disposal of waste materials, including the haul of such material to the waste areas, at no extra cost to the state.
- Guard Rail Terminal Ends shall be of a type similar to that shown in the "Parking Area" details.
- Paving on approaches will only be carried to the radius point.
- Balances found on P&P Sheets include the selected Material Type II & Type I quantities from the Summary Sheet

Station	Lt. or Rt.	D-1	TYPE I	TYPE II	GUARD-RAIL Lin. Ft.	Remarks
		TON	TON	TON		
AsB 17+70	Lt.	22		22		TYPE 2A
18+40	Rt.	22		22		2A
L 23+00	Lt.	192	6766	192		TYPE 2A ACCESS ROADS Lt. & Rt.
L 6+00 to B+00	Rt.	725	16,156	725		Parking Area
B+40	Lt.	123	1122	123	562.5	2B
B+40	Rt.	100	900	100		2A
13+50	Rt.	22	100	22		2A
17+00	Lt.	22		22		2A
20+75	Lt.	22		22		2A
20+75	Rt.	22		22		2A
23+00	Lt.	106	848	106		2B
24+50	Lt.	22		22		2A
24+50	Rt.	22	30	22		2A
26+23	Rt.	22	50	22		2A
26+23	Lt.	46	52	46		2B 2A
L 29+00	Rt.	22	38	22		2A
TOTAL	-	1512	26,062	1512	562.5	-

Station	Hr. of Cover	Type II Structure Excavation	C.M.P.		C.M.P.A.				Marker Posts Each	Culvert Removal LF.	Remarks
			24"	36"	50"x31"	58"x36"	65"x40"	72"x44"			
			Tons	Cu. Yd.	LF.	LF.	LF.	LF.			
AsB 16+75										58	
AsB 16+90		46	41	132	160				2		
AsB 18+40				42						30	
AsB 19+25		52	39			76			2		
L 23+00		50		60					2		
L 12+55		156	11				208		2	132	
13+35										62	
14+50			27		100				2		Ditch in & Out
16+46		80	92					86	2		Ditch in & Out
17+70	Under 10'									58	
25+88		58	111				82		2		Ditch in & Out
25+78		58	111				82				Ditch in & Out
26+20										152	
27+65		56	63			84			2	62	Ditch in & Out
29+00				40						24	
L 31+15						90				48	
L 20+06				80					2		
Total		556	495	874	100	250	164	208	86	76	626
				382			1635		18		






AsB 16+75
AsB 19+72
L 14+39
L 25+43
L 25+53

Station	Dist.		Sign No.	Type of Sign
	Lt.	Rt.		
AsB 17+00		22	W1-2L	Curve
L 6+30	22		W1-2R	Curve
22+50		22	W1-2R	Curve
22+75	22		R1-1	Stop
L 34+00	22		W1-2L	Curve
TOTAL	-	-	-	5 Signs

STATE	PROJECT DESIGNATION	YEAR	SHEET NO.	TOTAL SHEETS
ALASKA	F-095-8(6)	1964	3	30




REVISIONS		
No.	Date	Description

0-5'	4:1
5'-10'	3:1
Over 10'	2:1

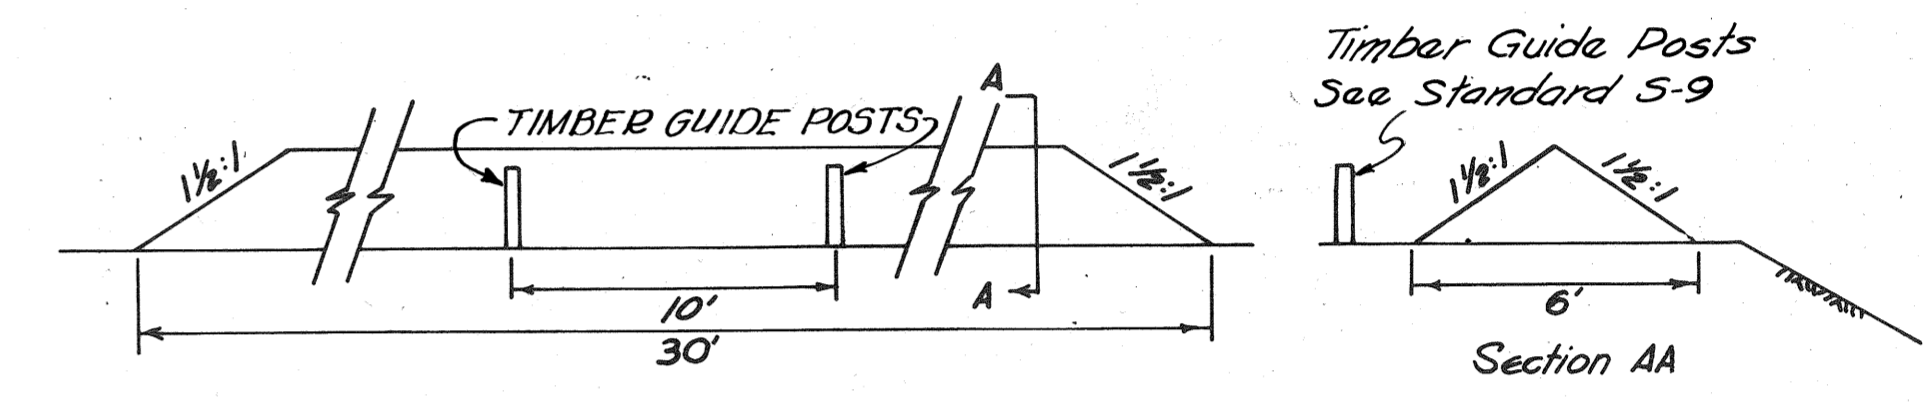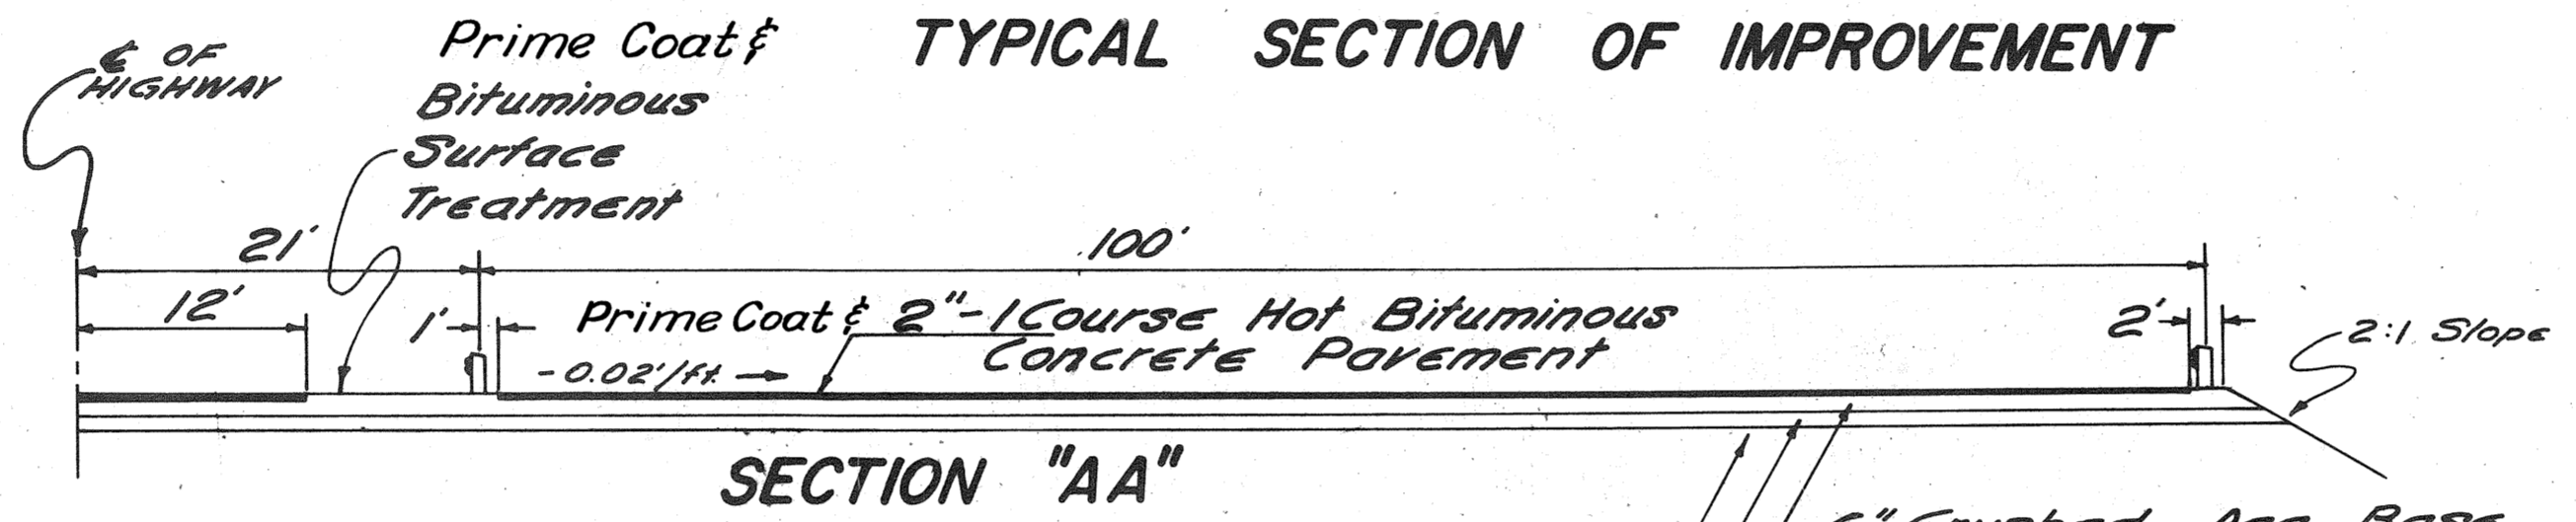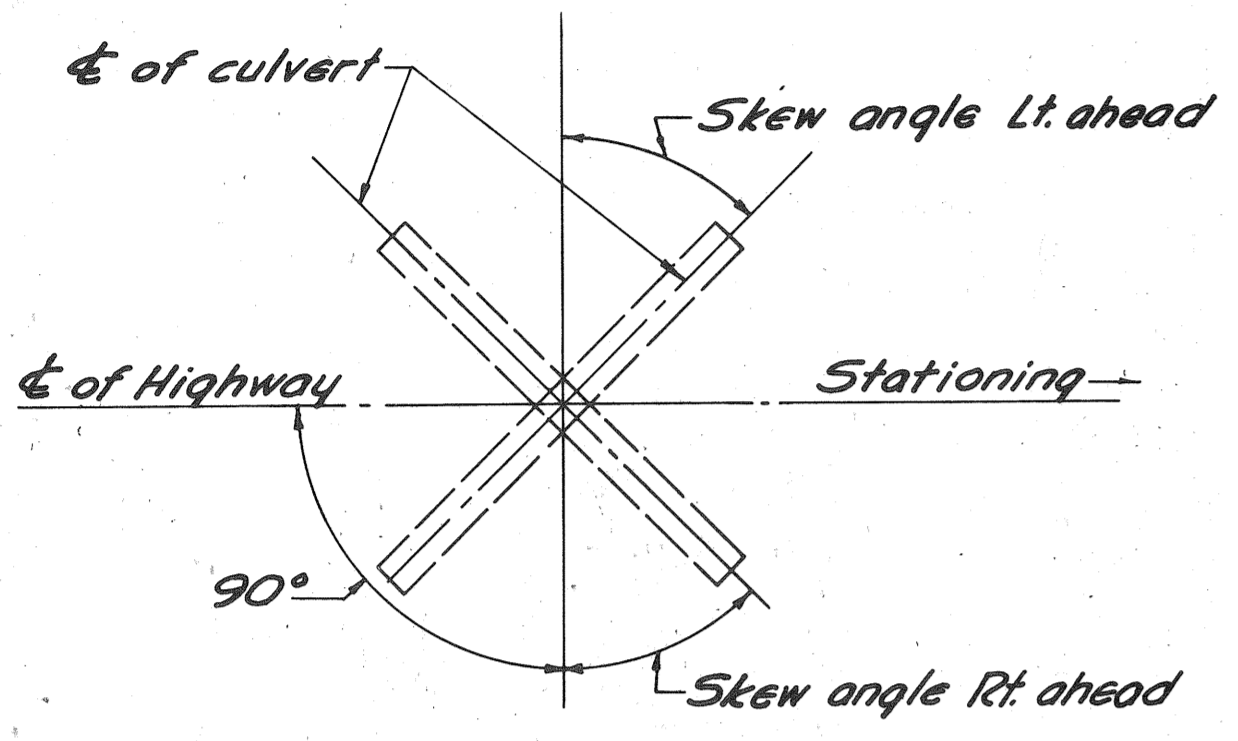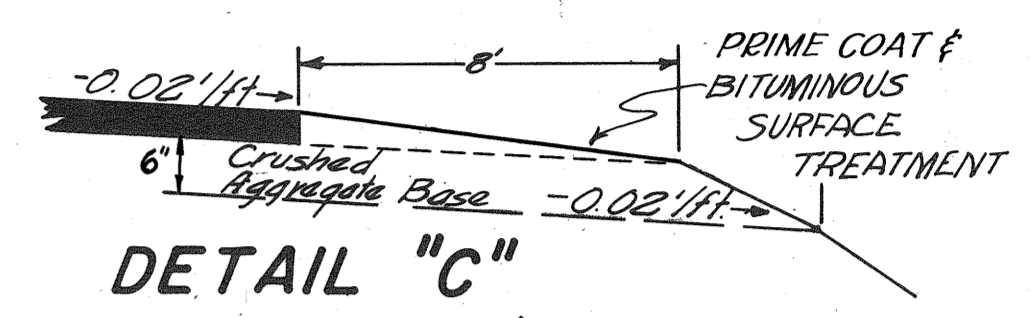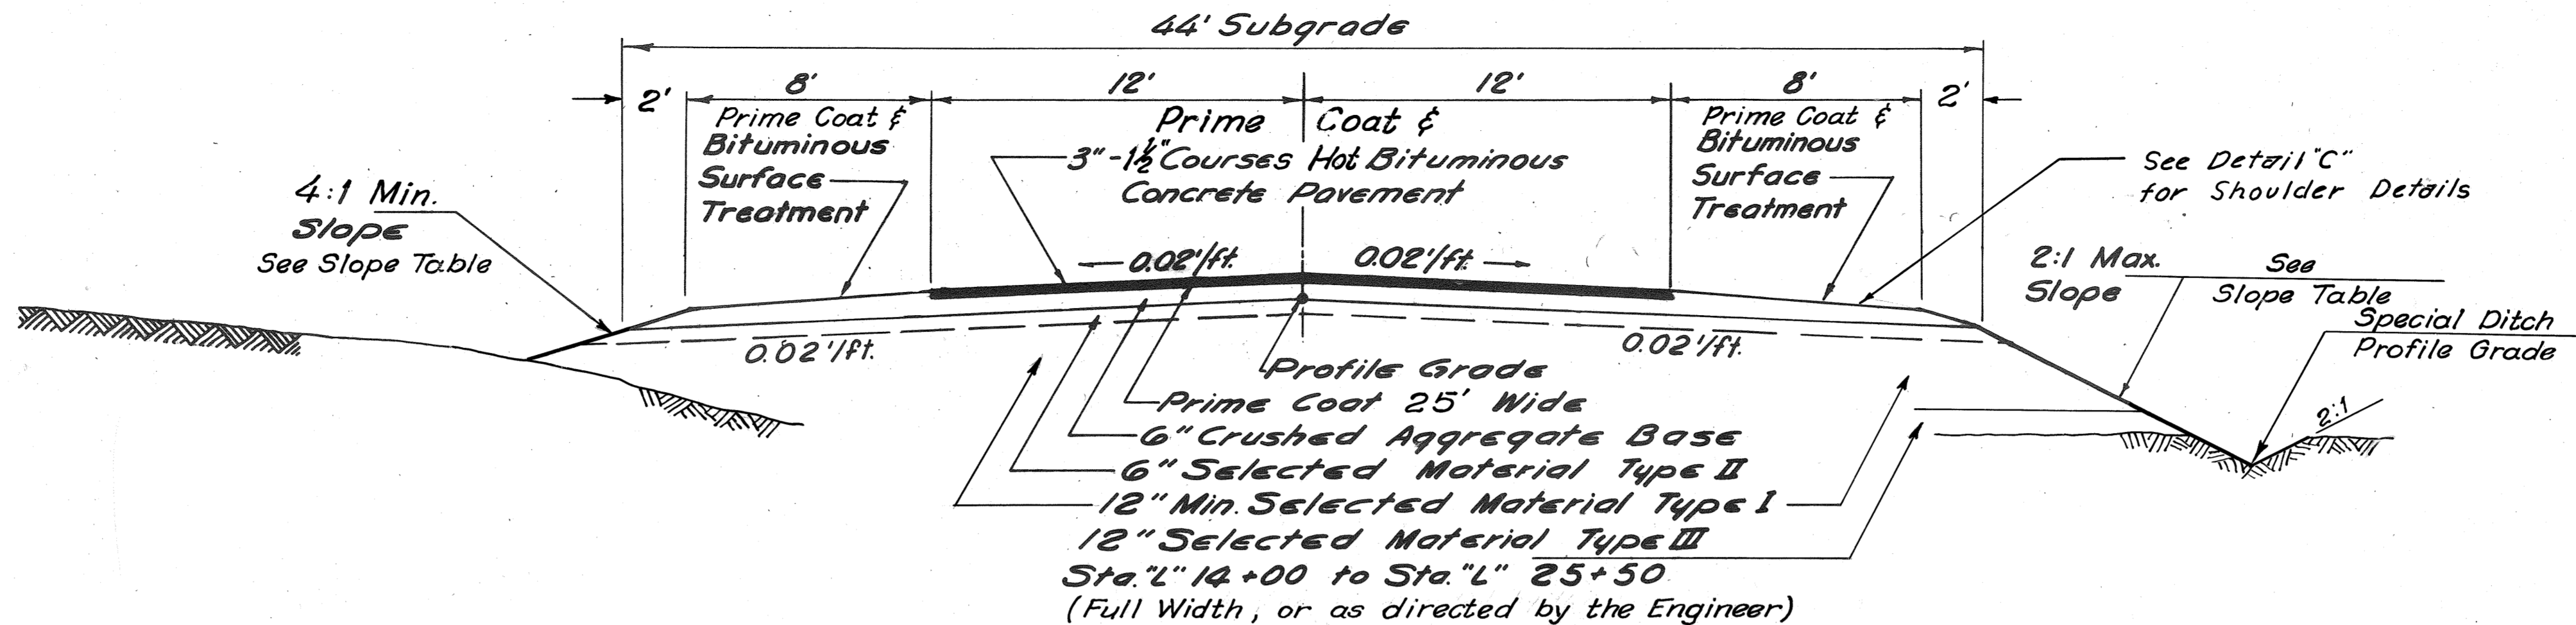


Note: Earth Barricades shall be constructed of useable material from the old road. No measurement will be made for this item and it shall be considered a subsidiary obligation of the Contractor for work performed under Section 102.

EARTH BARRICADE TO
 250' Lt. STA. "L" 20+60 2 GUIDE POST INSTALLED
 135' Lt. STA. "L" 24+60 " " " "

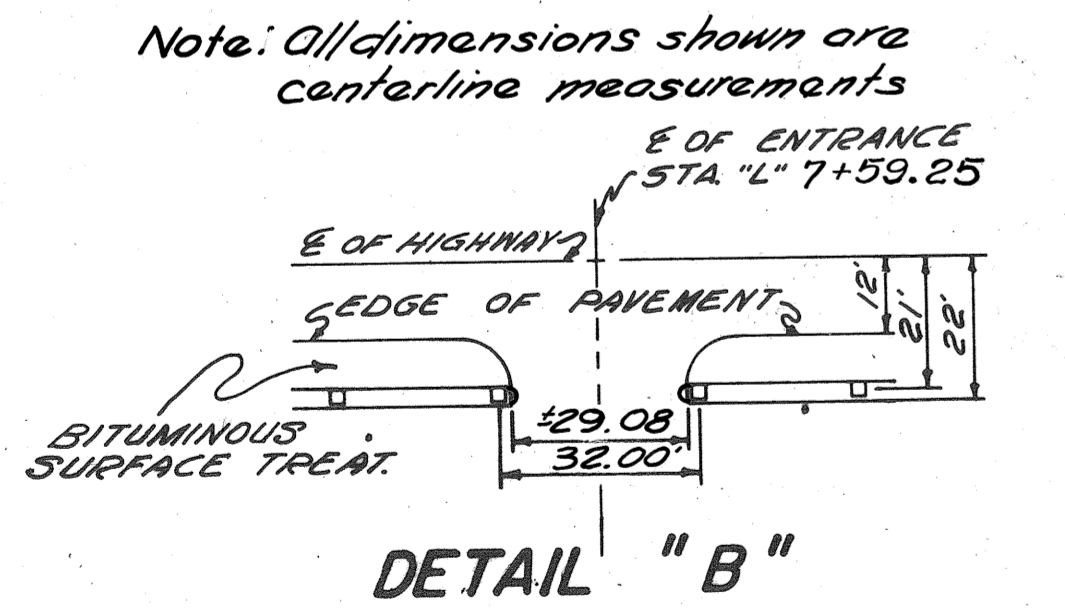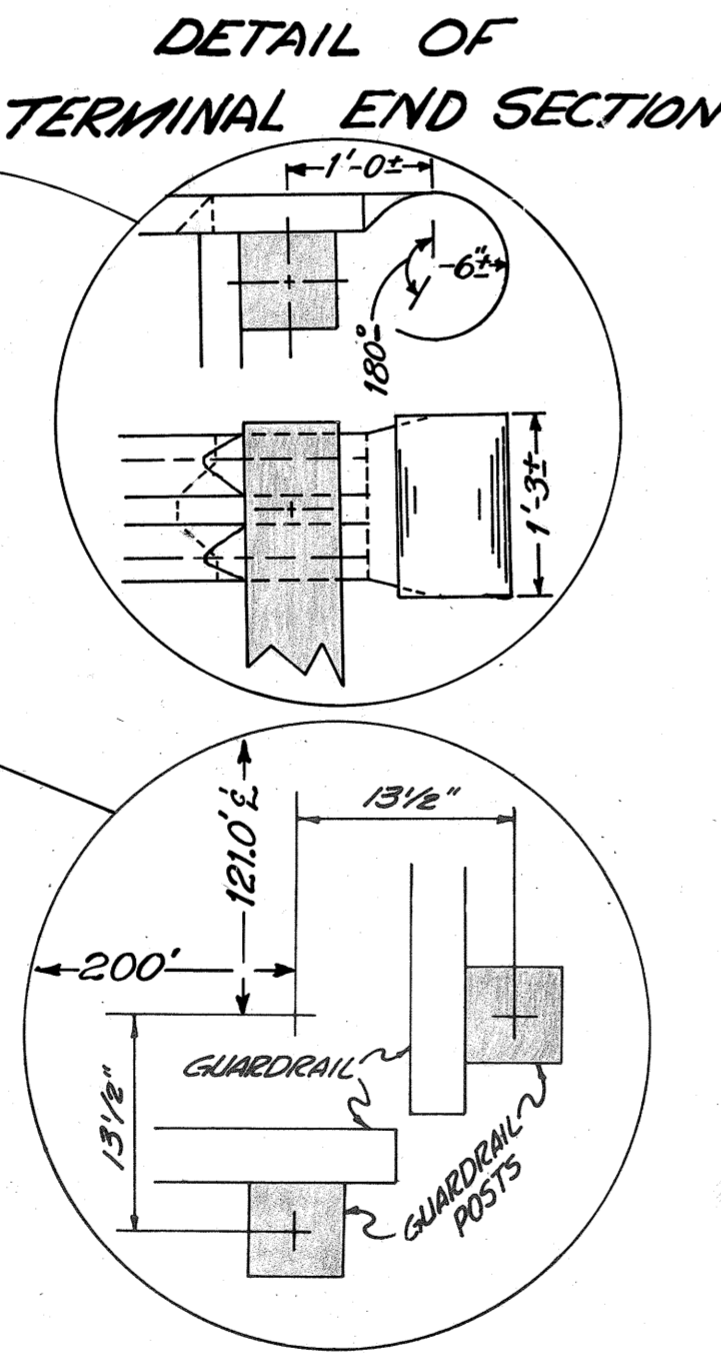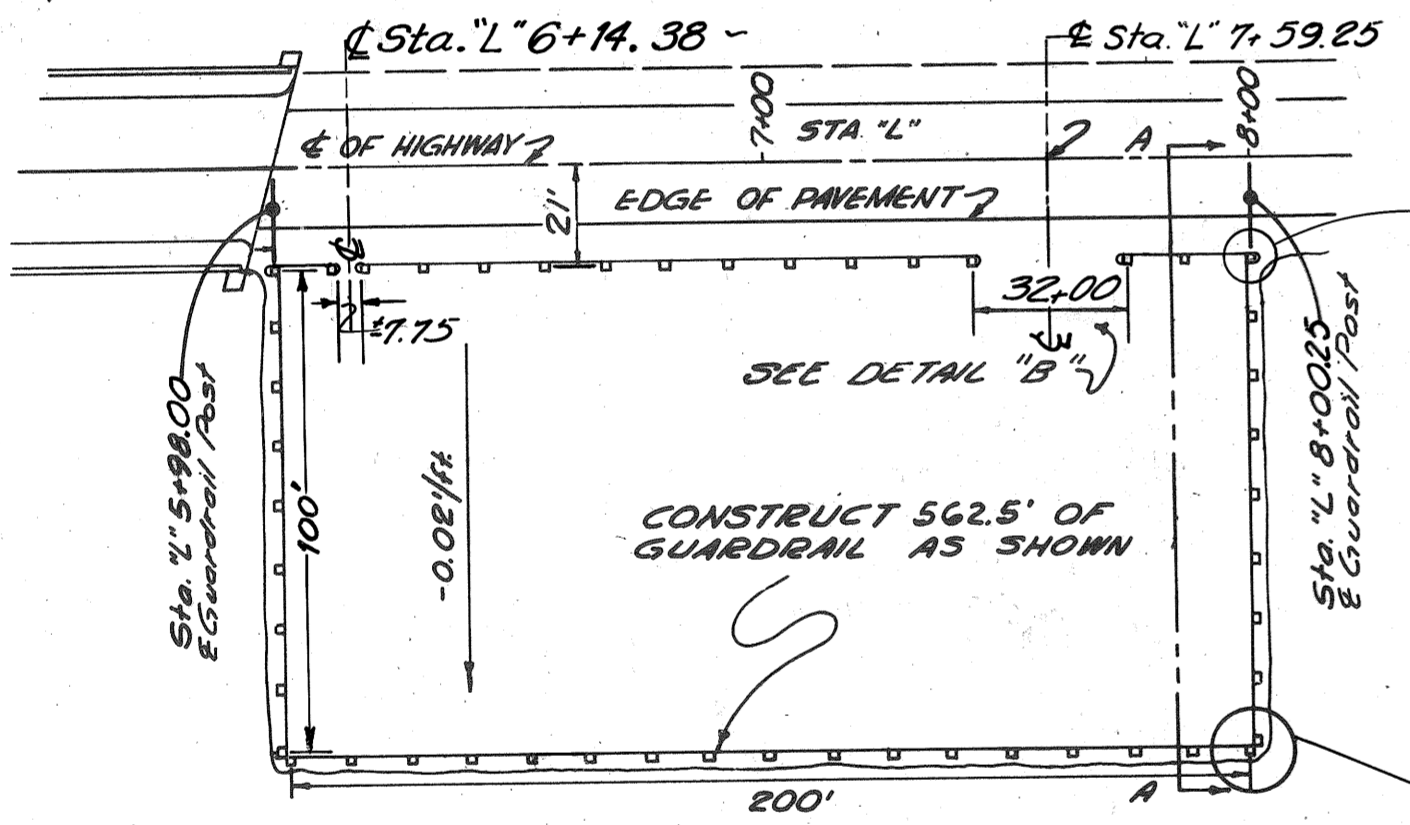

Note: All dimensions shown are centerline measurements

PARKING AREA RIGHT STA. "L" 5+98.00 - STA. "L" 8+00.25

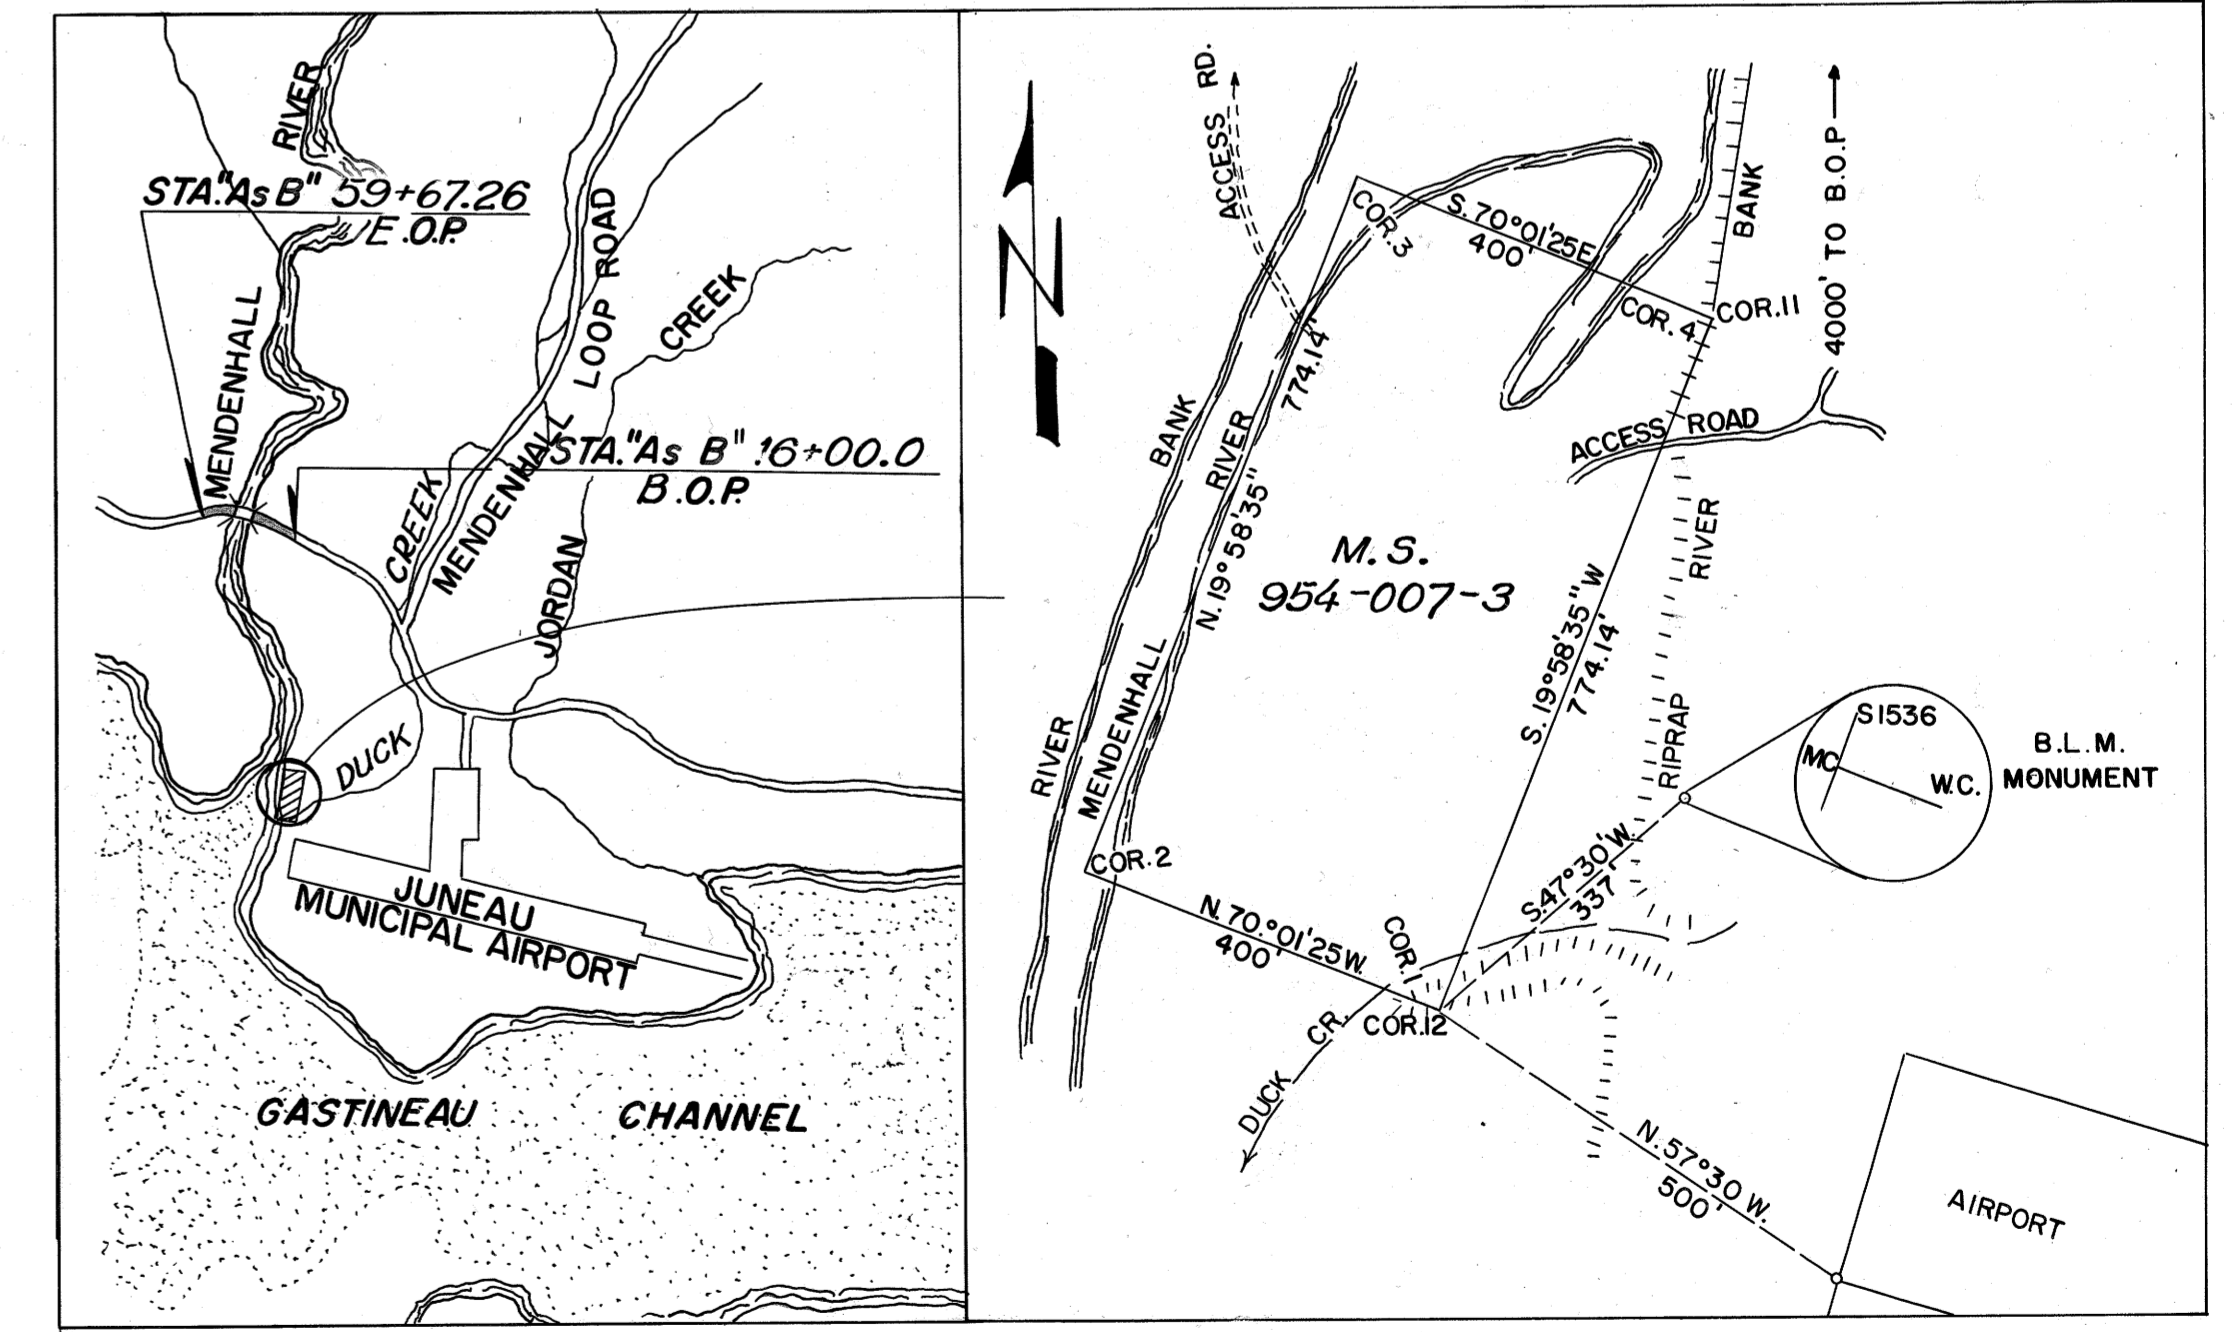


STATE	PROJECT DESIGNATION	YEAR	SHEET NO.	TOTAL SHEETS
ALASKA	F-095-8(6)	1964	5	30

REVISIONS		
No.	Date	Description


AS BUILT

END OF PROJECT
 F-095-8(6)
 STA. "L" 35+00=
 STA. "As B" 59+67.26




PLAN	SURVEYED	DATE

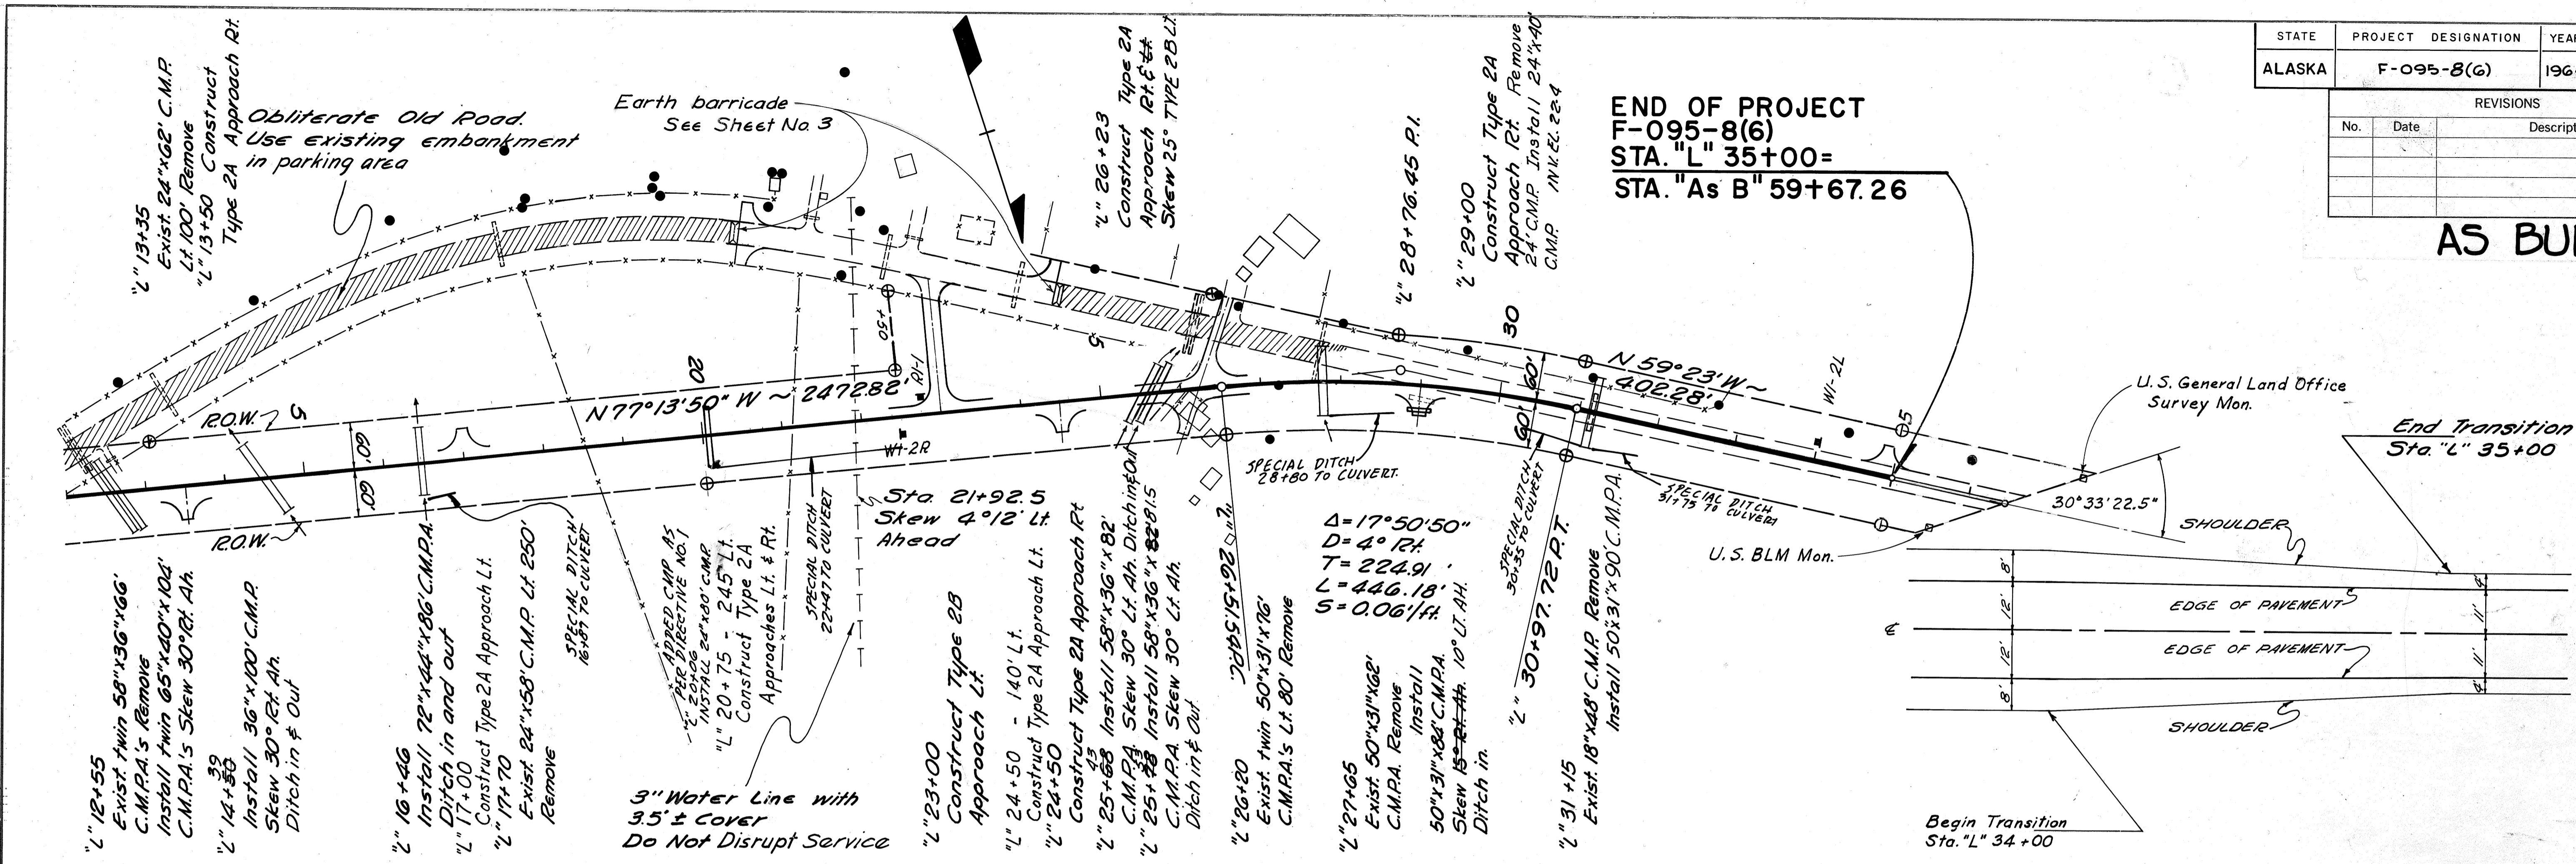


PROFILE	SURVEYED	DATE

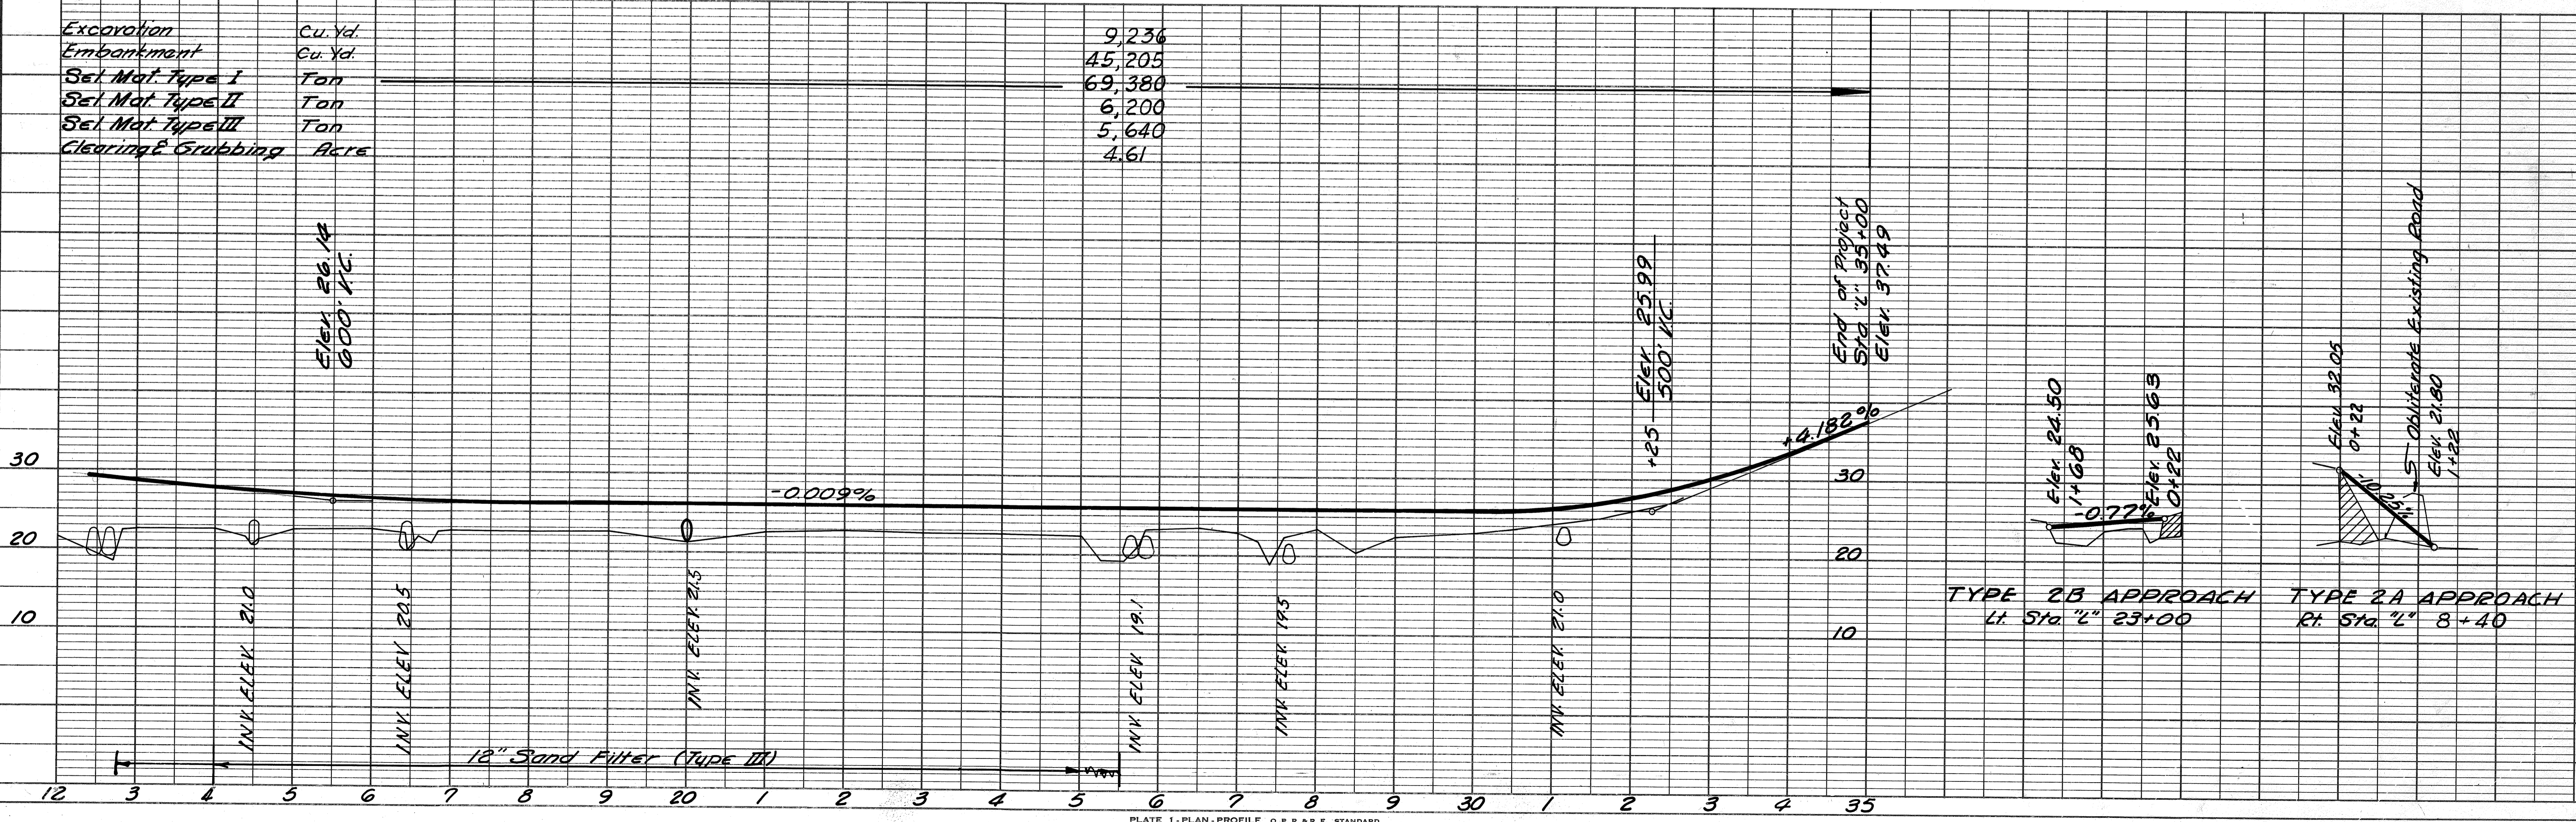

AS BUILT

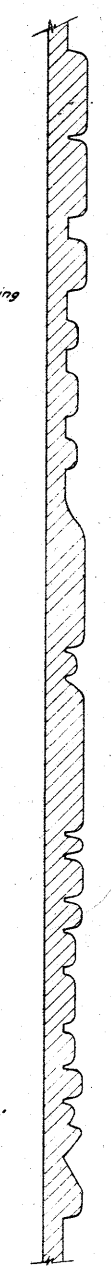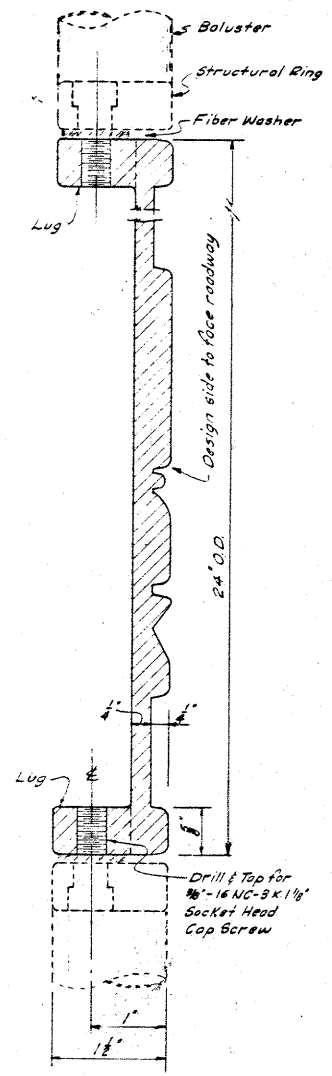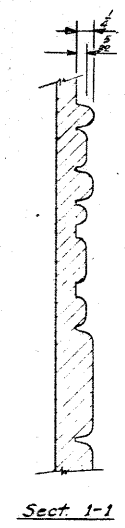

Notes: 1. The profile shown in any section above is not intended to be an actual section of the design, but is intended to indicate areas of relief only.
 2. Highlight raised portions.
 3. Plaques to be Bronze conforming to ASTM Designation B-22, Alloy C.

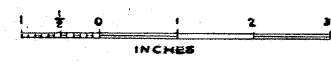

BROTHERHOOD BRIDGE
 ROUTE NO 95
THE A N B CREST

BRIDGE No. 737

Alaska Department of Public Works
 DIVISION OF HIGHWAYS
 Juneau, Alaska

REVISIONS		
No.	Date	Description

Date: 9/2/69
 Approved: *Charles Smith*

DWG. NO. 946

Designed By: _____
 Checked By: _____
 Date: _____