


STATE	PROJECT	SHEET NO.	TOTAL SHEETS
ALASKA	HES-0966 (10)	1	6

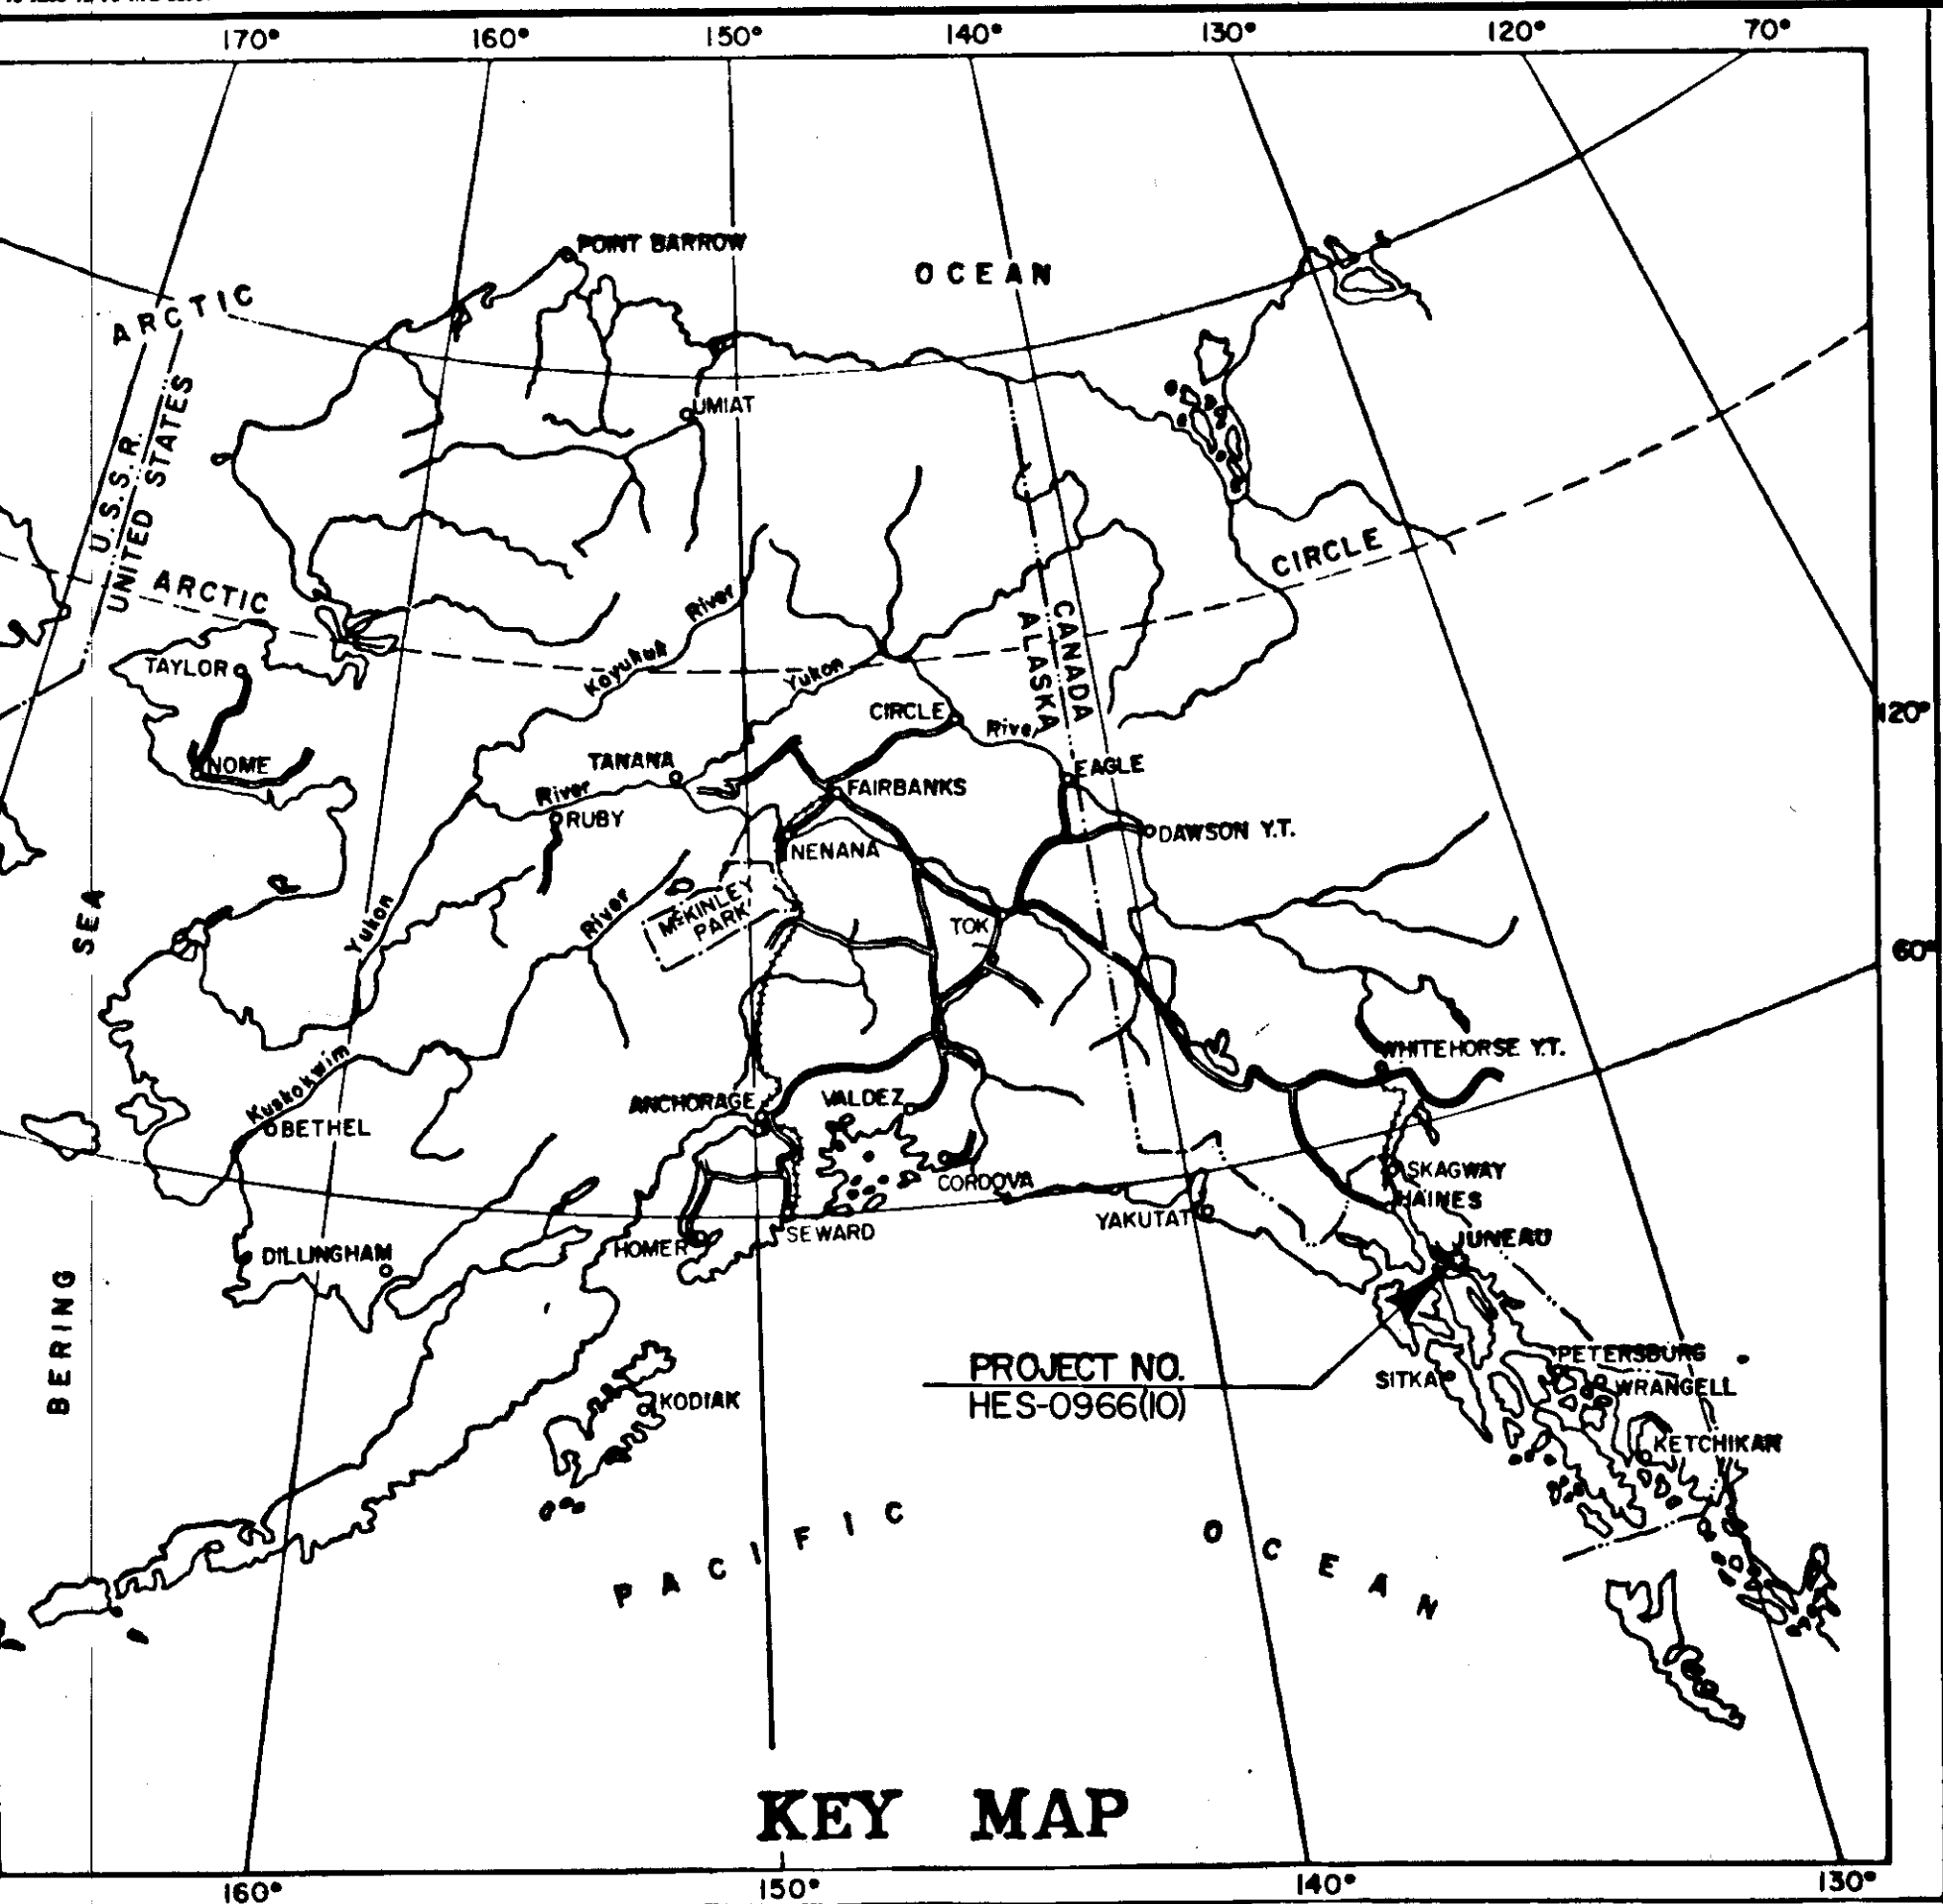

**STATE OF ALASKA
DEPARTMENT OF TRANSPORTATION
&
PUBLIC FACILITIES**

**PLAN AND PROFILE
PROPOSED HIGHWAY PROJECT
MENDENHALL LOOP ROAD & GLACIER SPUR
HES-0966 (10)
BREAK-AWAY BASES
AS BUILT PLANS**

INDEX OF SHEETS


SHEET NO.	DESCRIPTION
1	TITLE SHEET
2	ESTIMATE OF QUANTITIES
2-6	PLANS & DETAIL

THE FOLLOWING STANDARD DRAWINGS APPLY TO THIS PROJECT: A-1, C-00.04, C-10.03, C-11.03, L-10.13, L-30.01

Contractor: Cochran Electric Co., Inc.
Project Engineer: Bill Boyd
Beginning Date: 5-12-79
Completion Date: 3-27-80



**HES-0966(10)
PROJECT SUMMARY**

LENGTH OF PROJECT = 4,616.00 = 2.2 Mi.
 12,930.00 = 2.449 Mi.

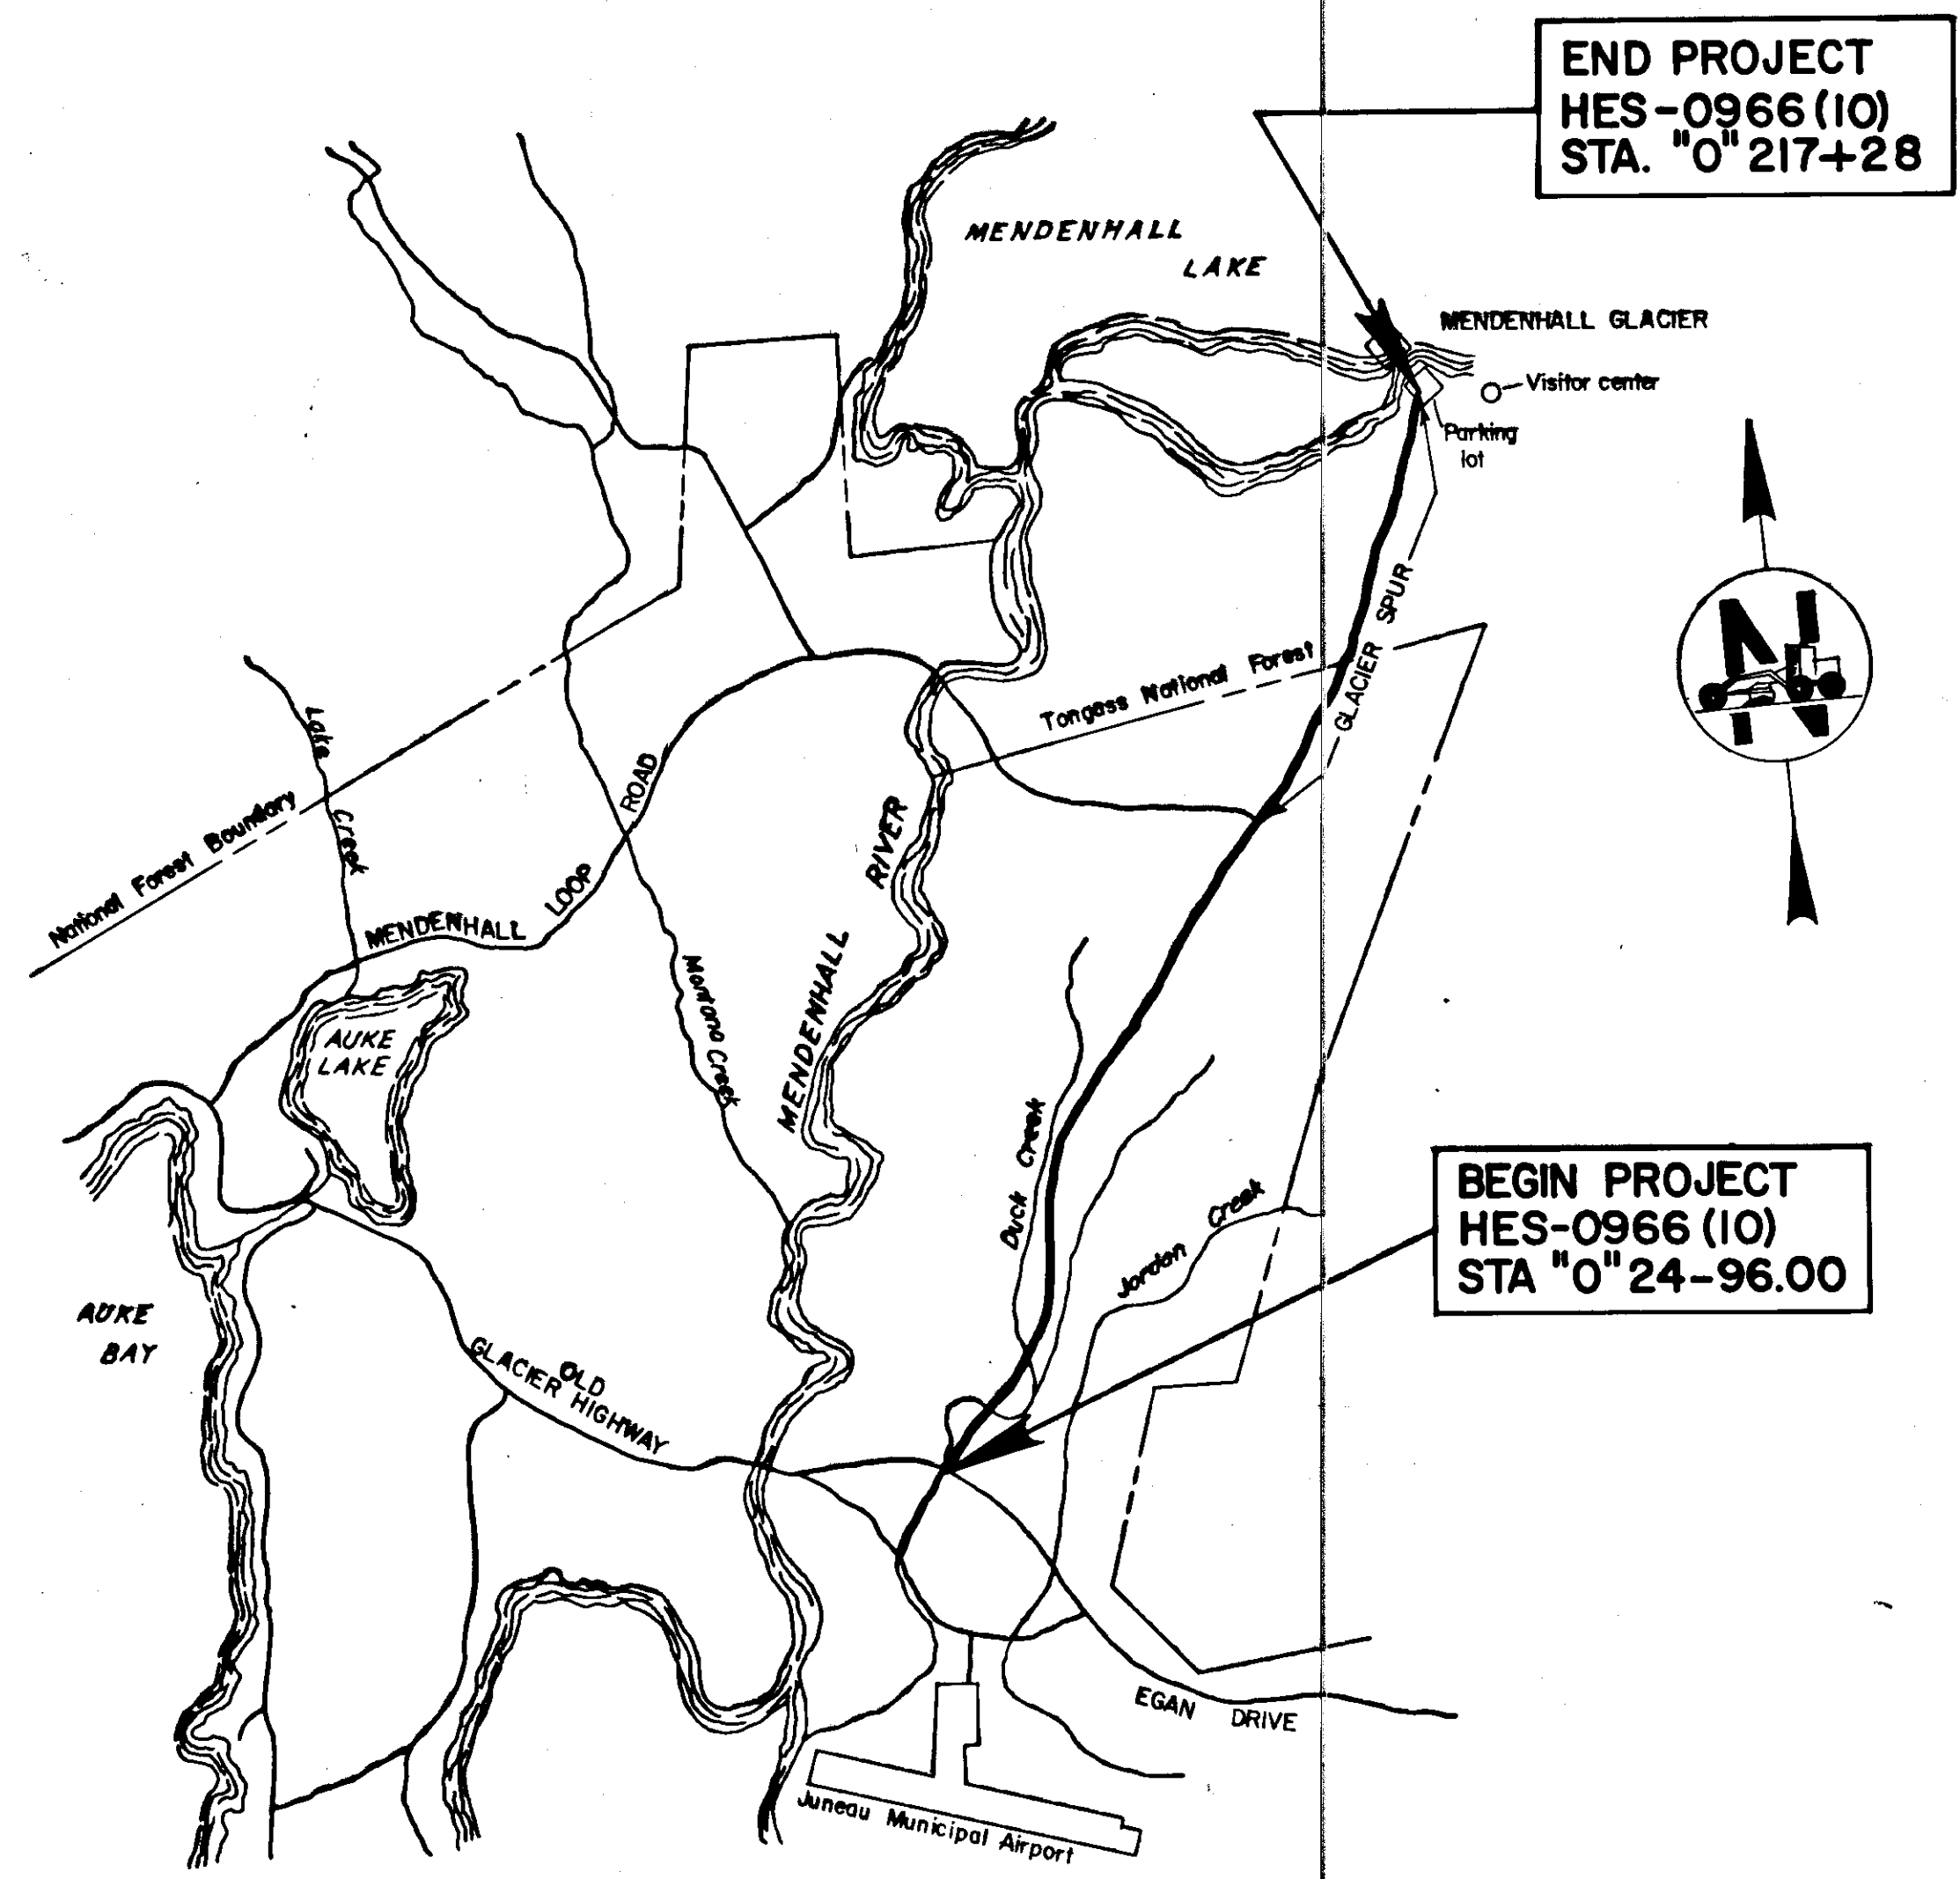


STATE OF ALASKA
DEPARTMENT OF TRANSPORTATION
&
PUBLIC FACILITIES
APPROVED
Wallace K. Wilton DATE 9/7/79
SOUTHEASTERN REGION
DESIGN / CONSTRUCTION ENGINEER

STATE OF ALASKA
DEPARTMENT OF TRANSPORTATION
&
PUBLIC FACILITIES
APPROVED
Charles E. Martek Date 10-24-77
DIRECTOR-HIGHWAY DESIGN & CONSTRUCTION

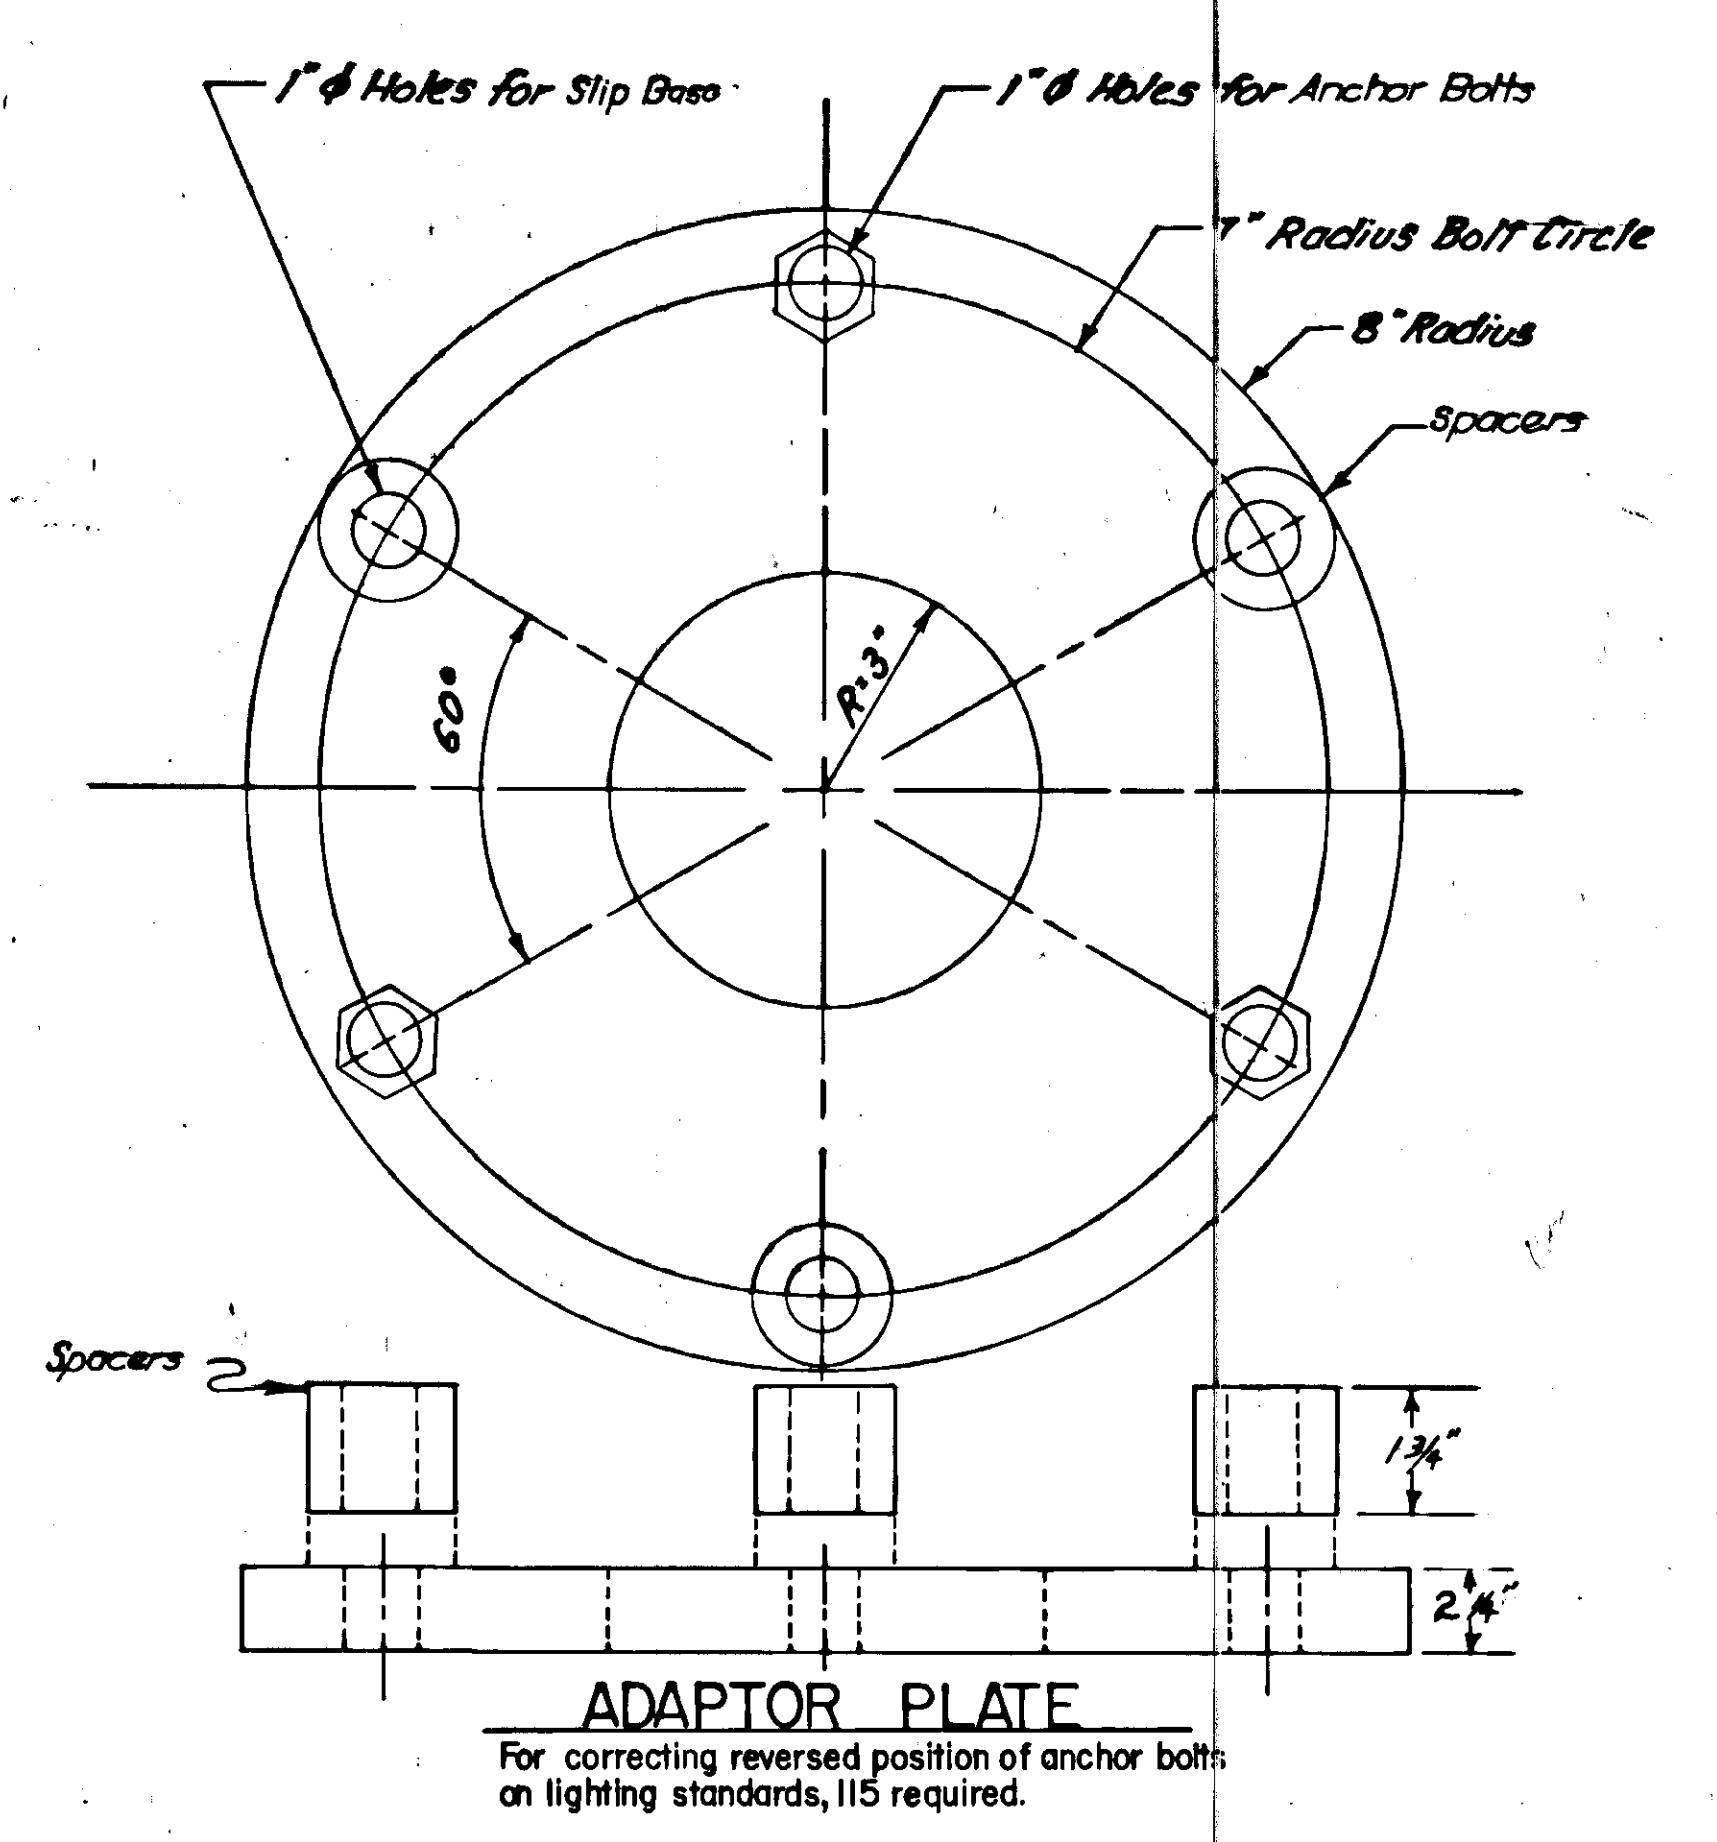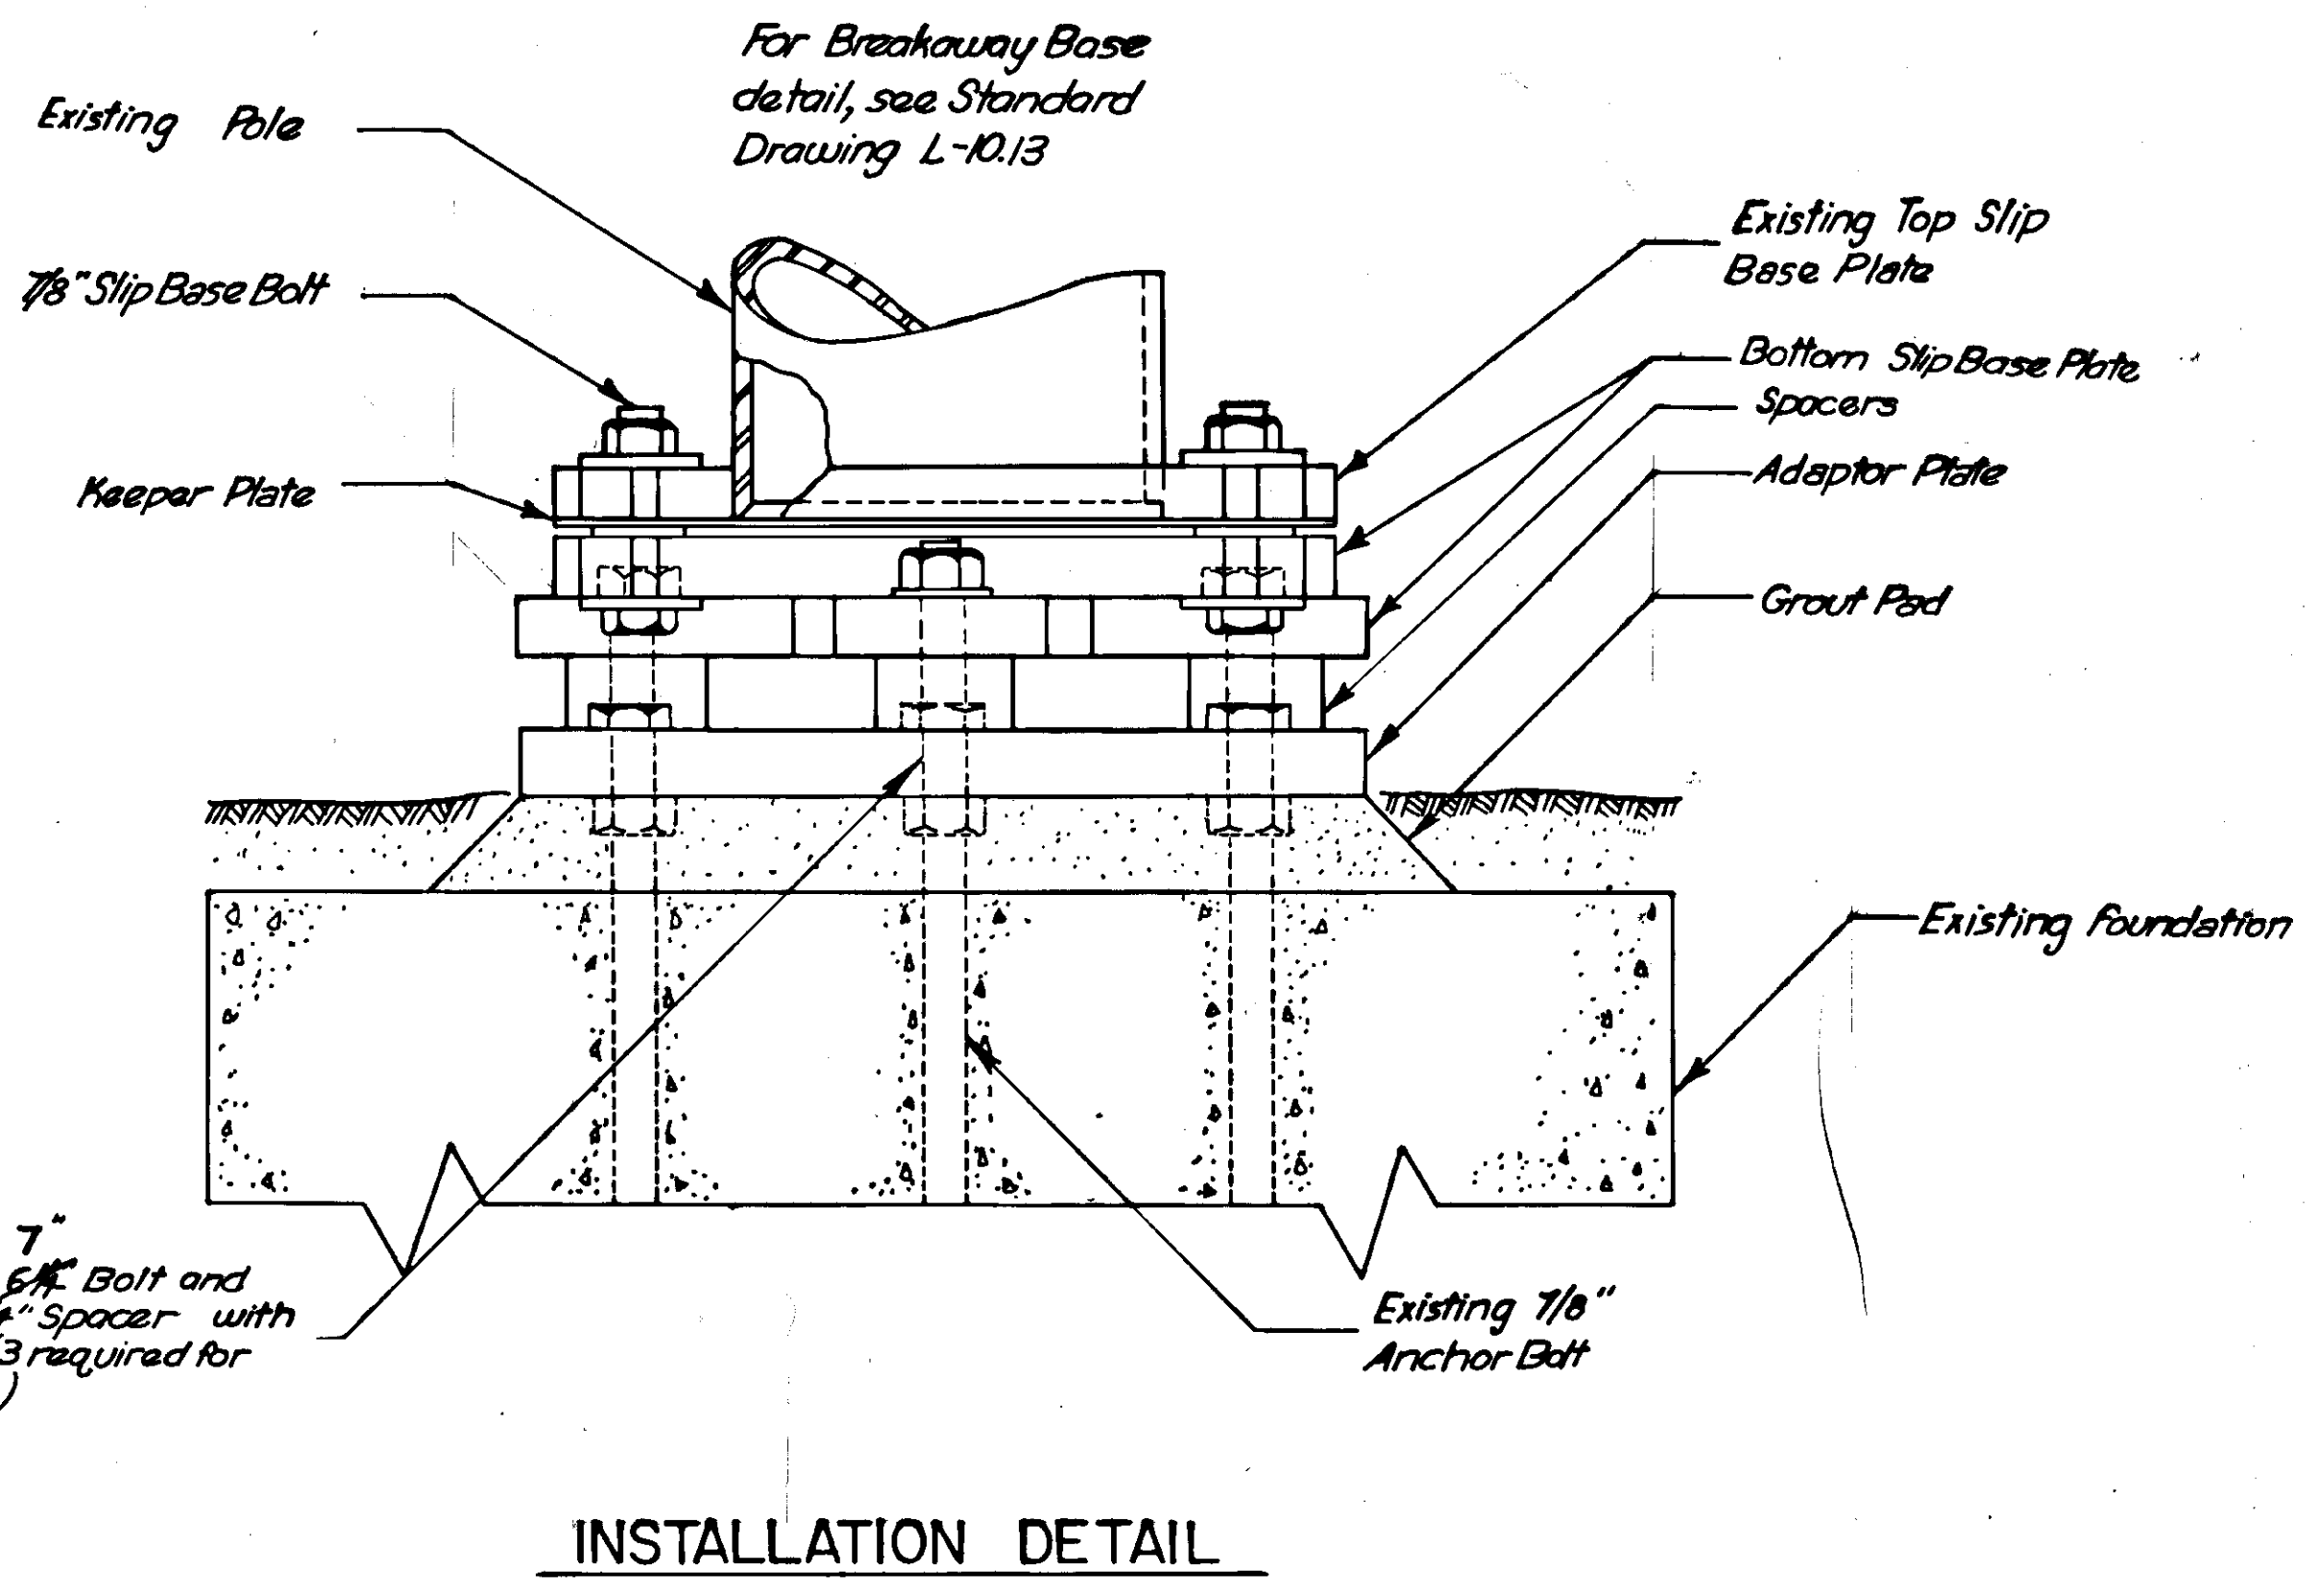


- GENERAL NOTES:**
1. Adaptor Plate and spacers to be Hot Dip Galvanized after fabrication in accordance with ASTM 123.
 2. Torque the 7/8" Slip Base Bolts 1800 in lbs.
 3. Adaptor Plate shall conform to ASTM A36.
 4. The contractor shall furnish (3) 7/8"-9NC x 2 1/4" long bolts with nuts, and (3) 2" x 2 1/4" spacers to fasten the adaptor plate to the bottom slip base plate (each pole).
 5. Bolts, nuts and washers shall conform to ASTM A325. They shall be galvanized in accordance with ASTM A153.
 6. The existing wire splice in each pole base shall be removed and a new fused quick disconnect added. The new disconnects shall be the Y-Type, waterproof, in-the-line fuseholders, with breakaway features and fused at (10) amps.
 7. The disconnects shall be sized to the existing wire size.
 8. If the existing ground wire is broken a new wire shall be installed at the contractors expense.
 9. All existing grout shall be removed from the foundation and pole surface prior to installing the new adaptor plate and slip bases. After installation the base shall be re-grouted.
 10. Breakaway bases to be installed at pole stationing shown on plans.
 11. Wrench tighten the 7/8" adaptor plate bolts to the bottom slip base plate. There is no torque requirement.
 12. Existing anchor bolts may have to be shortened to allow installation of the slip base assembly.


ESTIMATE OF QUANTITIES			
ITEM NO.	ITEM	UNIT	PROJECT TOTAL
110(1)	Mobilization	L.S.	All Req'd
115(1)	Maintenance of Traffic	L.S.	All Req'd
660 (12)	Lighting Standards Shear Base	Each	117
660 (2A)	REROUTE 2" CONDUIT (E.W.O.#1)	L.S.	All Req'd
660 (2B)	REPAIR ANCHOR BOLTS (E.W.O.#2)	L.S.	All Req'd

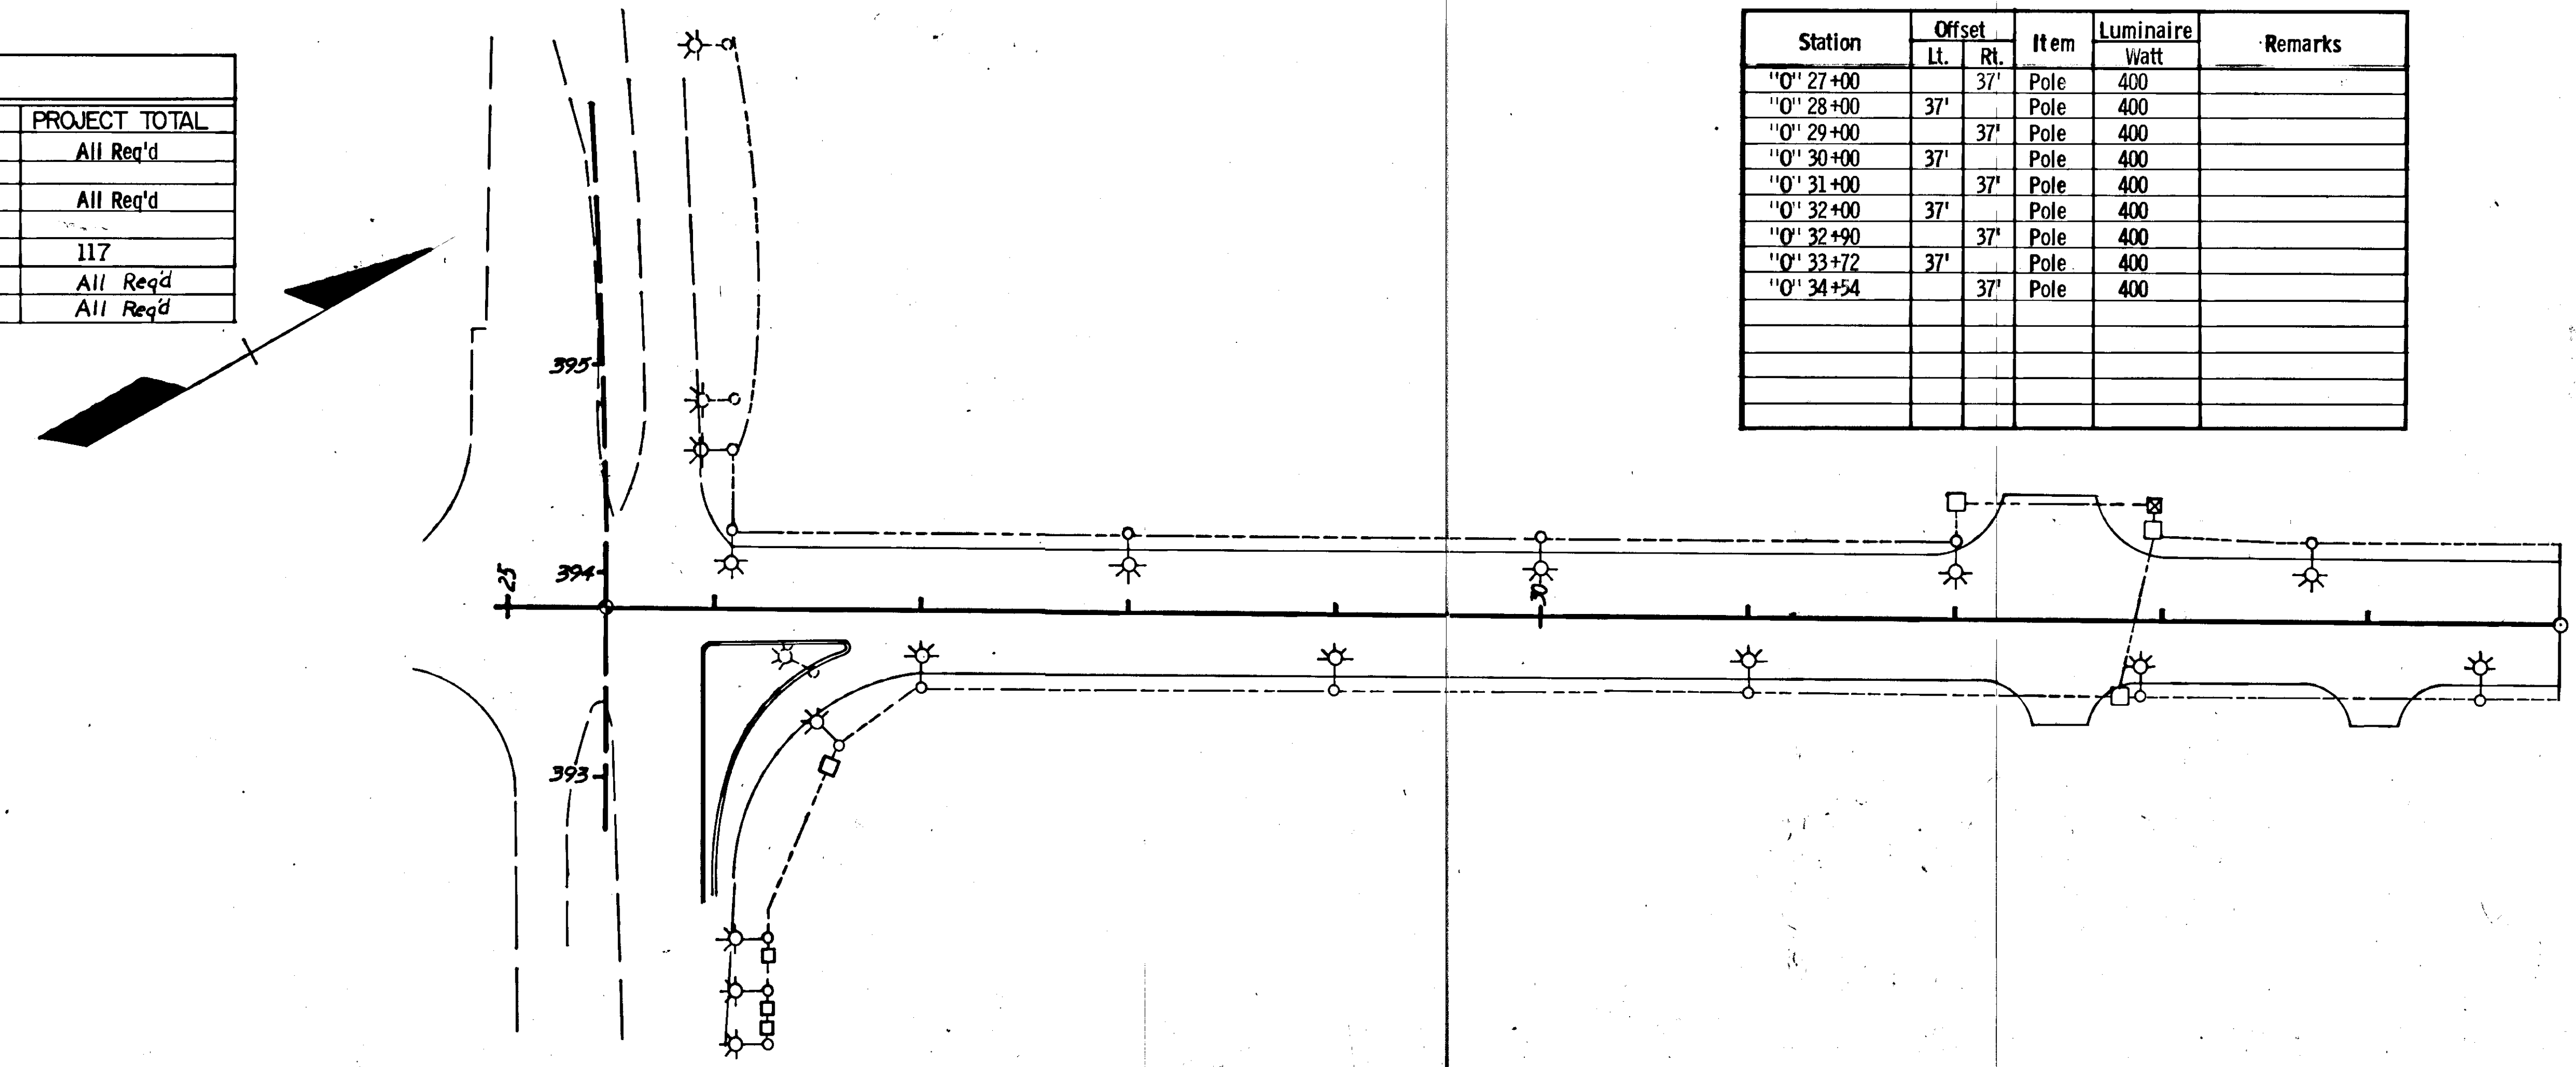

Station	Offset		Item	Luminaire Watt	Remarks
	Lt.	Rt.			
"0' 27+00		37'	Pole	400	
"0' 28+00	37'		Pole	400	
"0' 29+00		37'	Pole	400	
"0' 30+00	37'		Pole	400	
"0' 31+00		37'	Pole	400	
"0' 32+00	37'		Pole	400	
"0' 32+90		37'	Pole	400	
"0' 33+72	37'		Pole	400	
"0' 34+54		37'	Pole	400	

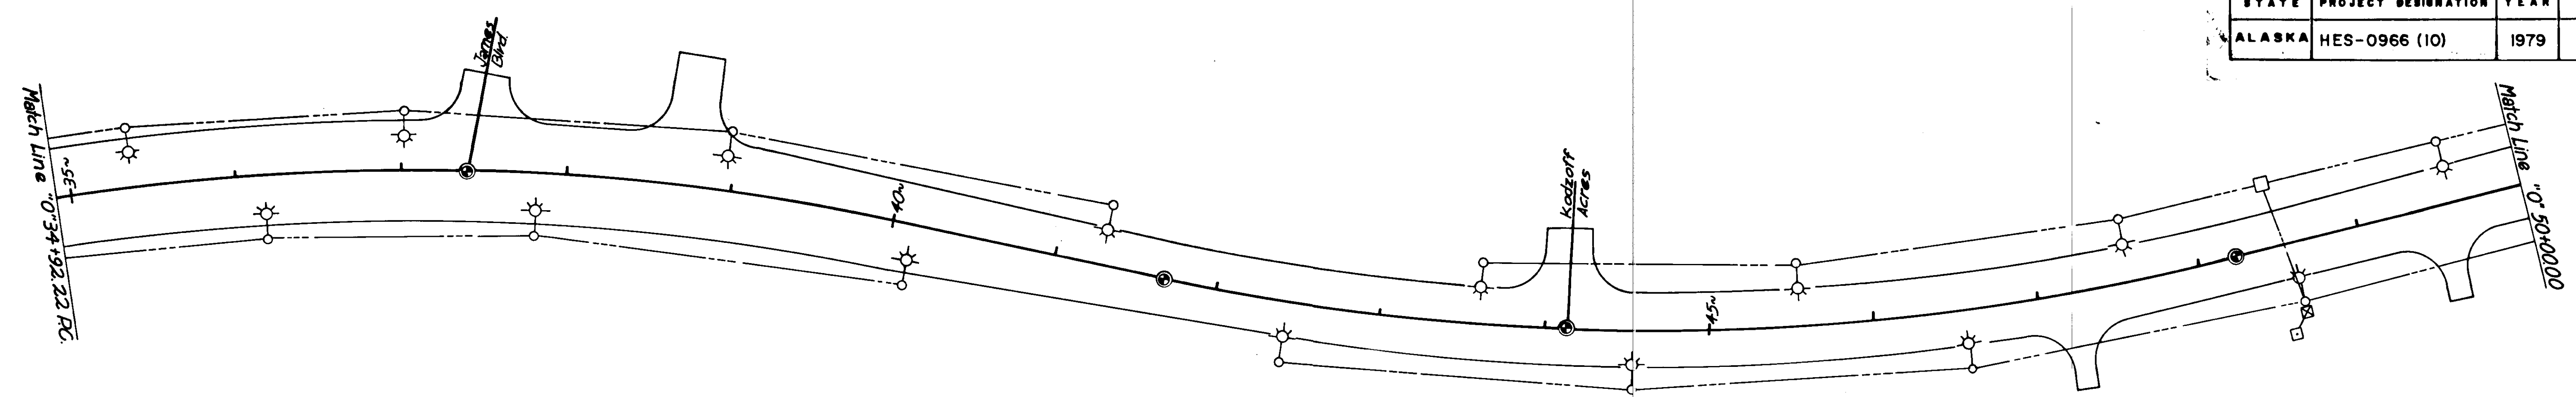


Station	Offset		Item	Luminaire Watt	Remarks
	Lt.	Rt.			
"0' 35+36	37'		Pole	400	
"0' 36+18		37'	Pole	400	
"0' 37+01	37'		Pole	400	
"0' 37+81		37'	Pole	400	
"0' 38+96	37'		Pole	400	
"0' 40+12		37'	Pole	400	
"0' 41+28	37'		Pole	400	
"0' 42+44		37'	Pole	400	
"0' 43+60	37'		Pole	400	
"0' 44+54		37'	Pole	400	
"0' 45+55	37'		Pole	400	
"0' 46+56		37'	Pole	400	
"0' 47+57	37'		Pole	400	
"0' 48+58		37'	Pole	400	
"0' 49+59	37'		Pole	400	

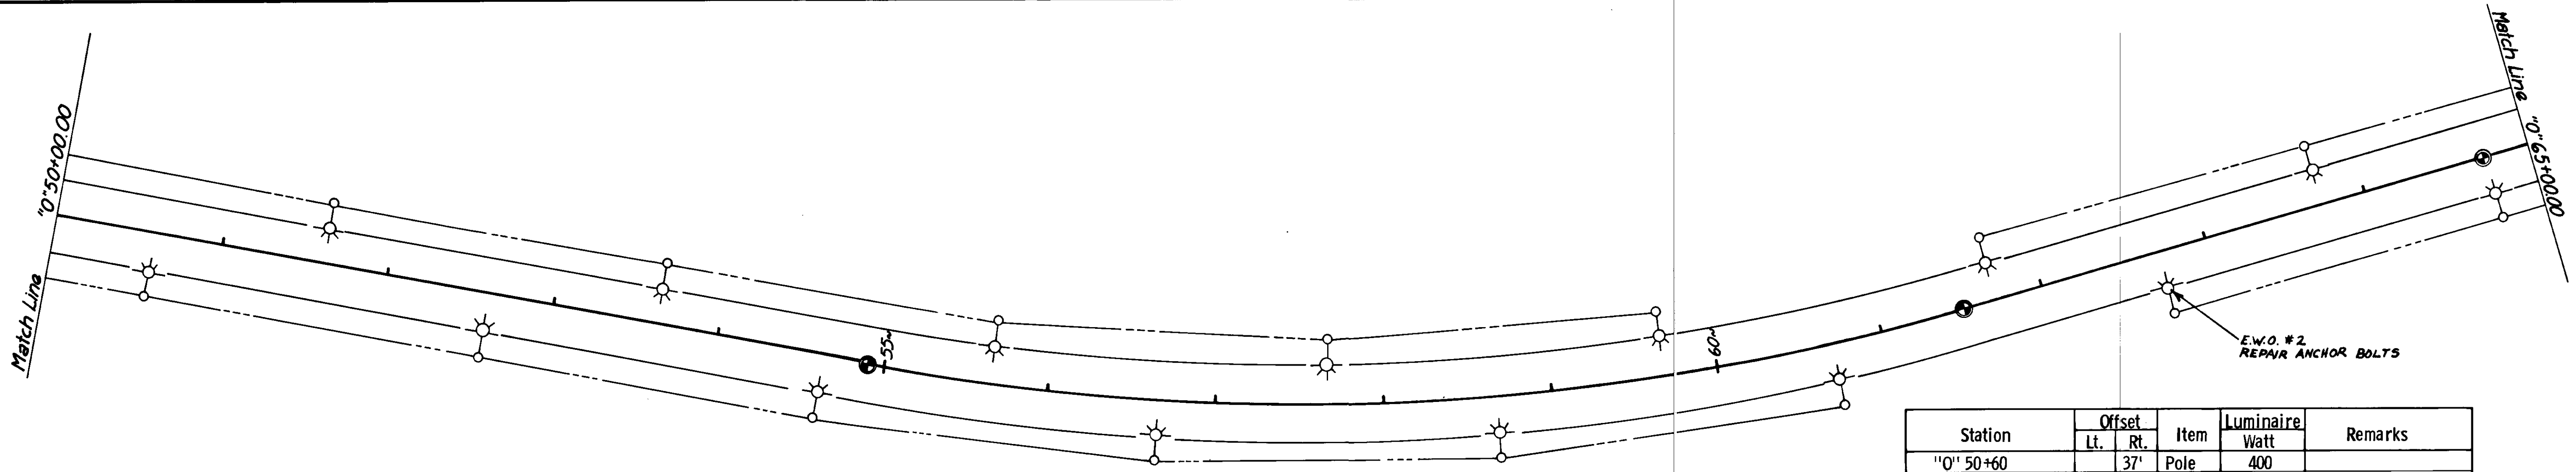


Station	Offset		Item	Luminaire Watt	Remarks
	Lt.	Rt.			
"0' 50+60		37'	Pole	400	
"0' 51+61	37'		Pole	400	
"0' 52+62		37'	Pole	400	
"0' 53+63	37'		Pole	400	
"0' 54+64		37'	Pole	400	
"0' 55+65	37'		Pole	400	
"0' 56+66		37'	Pole	400	
"0' 57+67	37'		Pole	400	
"0' 58+68		37'	Pole	400	
"0' 59+69	37'		Pole	400	
"0' 60+70		37'	Pole	400	
"0' 61+71	37'		Pole	400	
"0' 62+72		37'	Pole	400	E.W.O. #2 REPAIR ANCHOR BOLTS
"0' 63+73	37'		Pole	400	
"0' 64+74		37'	Pole	400	

E.W.O. #2
REPAIR ANCHOR BOLTS


STATE	PROJECT DESIGNATION	YEAR	SHEET NO.	TOTAL SHEETS
ALASKA	HES-0966 (10)	1979	5	6

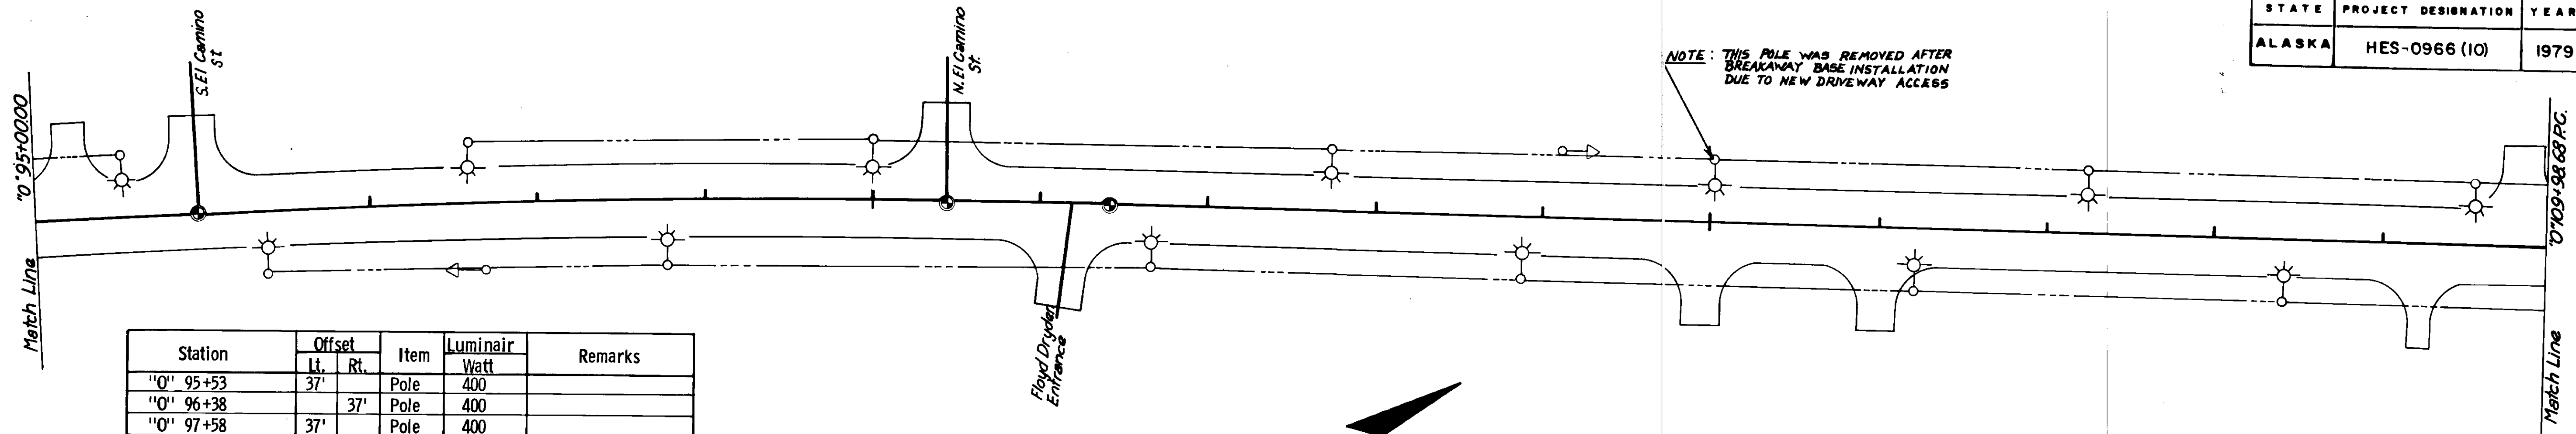




Station	Offset		Item	Luminair Watt	Remarks
	Lt.	Rt.			
"0" 95+53	37'		Pole	400	
"0" 96+38		37'	Pole	400	
"0" 97+58	37'		Pole	400	
"0" 97+68		37'	Flasher	400	NOT PART OF PLAN QUANTITY
"0" 98+78		37'	Pole	400	
"0" 100+00	37'		Pole	400	
"0" 101+67		37'	Pole	400	
"0" 102+78	37'		Pole	400	
"0" 103+88		37'	Pole	400	
"0" 104+10	23'		Flasher	400	NOT PART OF PLAN QUANTITY
"0" 105+01	37'		Pole	400	
"0" 106+22		37'	Pole	400	
"0" 107+24	37'		Pole	400	
"0" 108+42		37'	Pole	400	
"0" 109+56	37'		Pole	400	

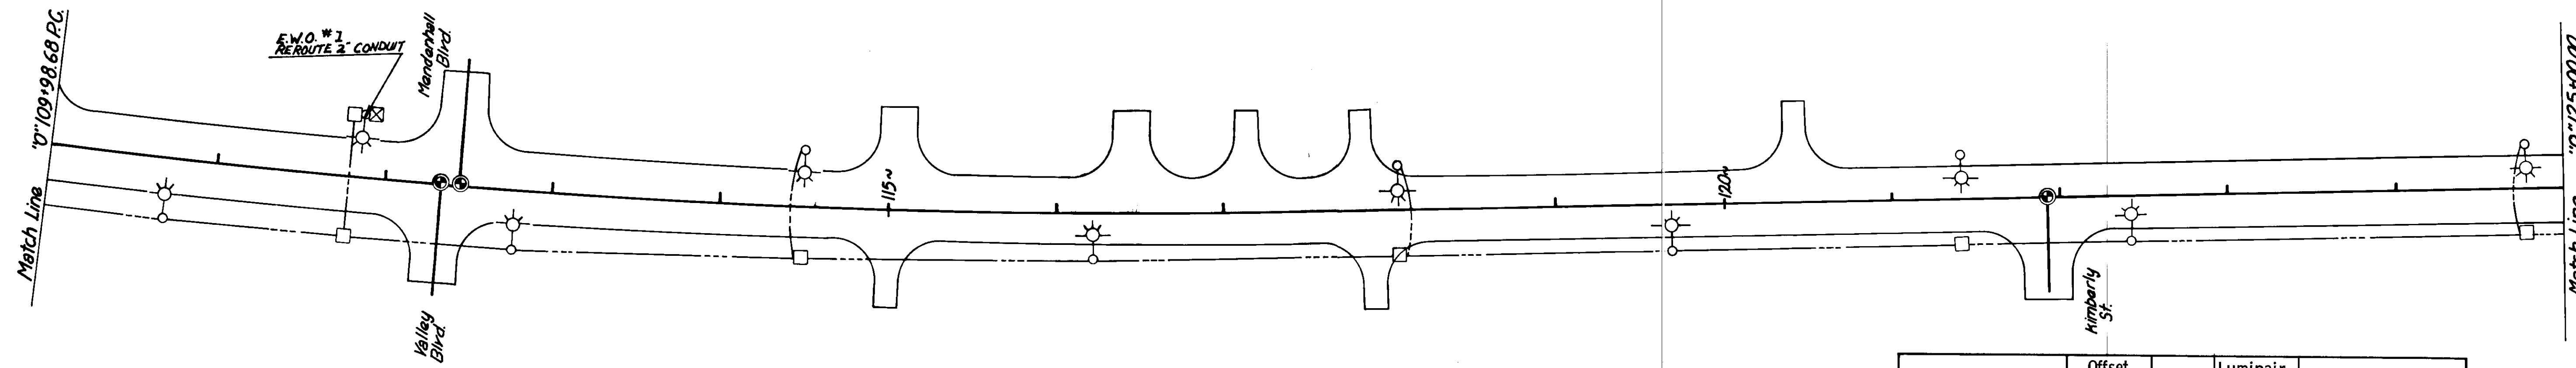

Station	Offset		Item	Luminair Watt	Remarks
	Lt.	Rt.			
"0" 110+70		37'	Pole	400	
"0" 111+84	37'		Pole	400	E.W.O. #2 REROUTE 2" CONDUIT
"0" 112+78		37'	Pole	400	
"0" 114+50	37'		Pole	400	
"0" 116+23		29'	Pole	250	
"0" 118+06	27'		Pole	250	
"0" 119+69		27'	Pole	250	
"0" 121+42	27'		Pole	400	
"0" 122+42		27'	Pole	400	
"0" 124+78	27'		Pole	400	

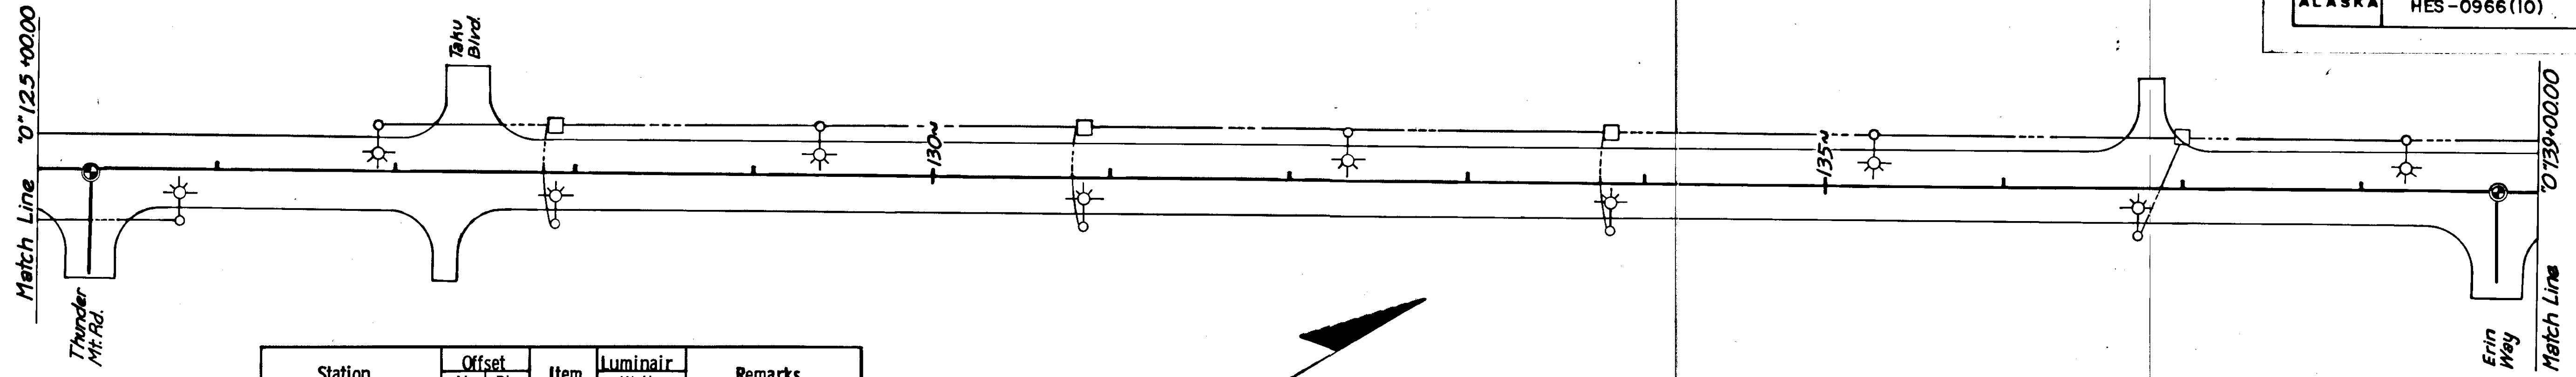

Station	Offset		Item	Luminair Watt	Remarks
	Lt.	Rt.			
"0' 125+78		27'	Pole	400	
"0' 126+89	27'		Pole	400	
"0' 127+89		27'	Pole	400	
"0' 129+37	27'		Pole	250	Use existing shear base
"0' 130+85		27'	Pole	250	
"0' 132+33	27'		Pole	250	
"0' 133+81		27'	Pole	250	
"0' 135+29	27'		Pole	250	
"0' 136+77		27'	Pole	250	
"0' 138+26	27'		Pole	400	

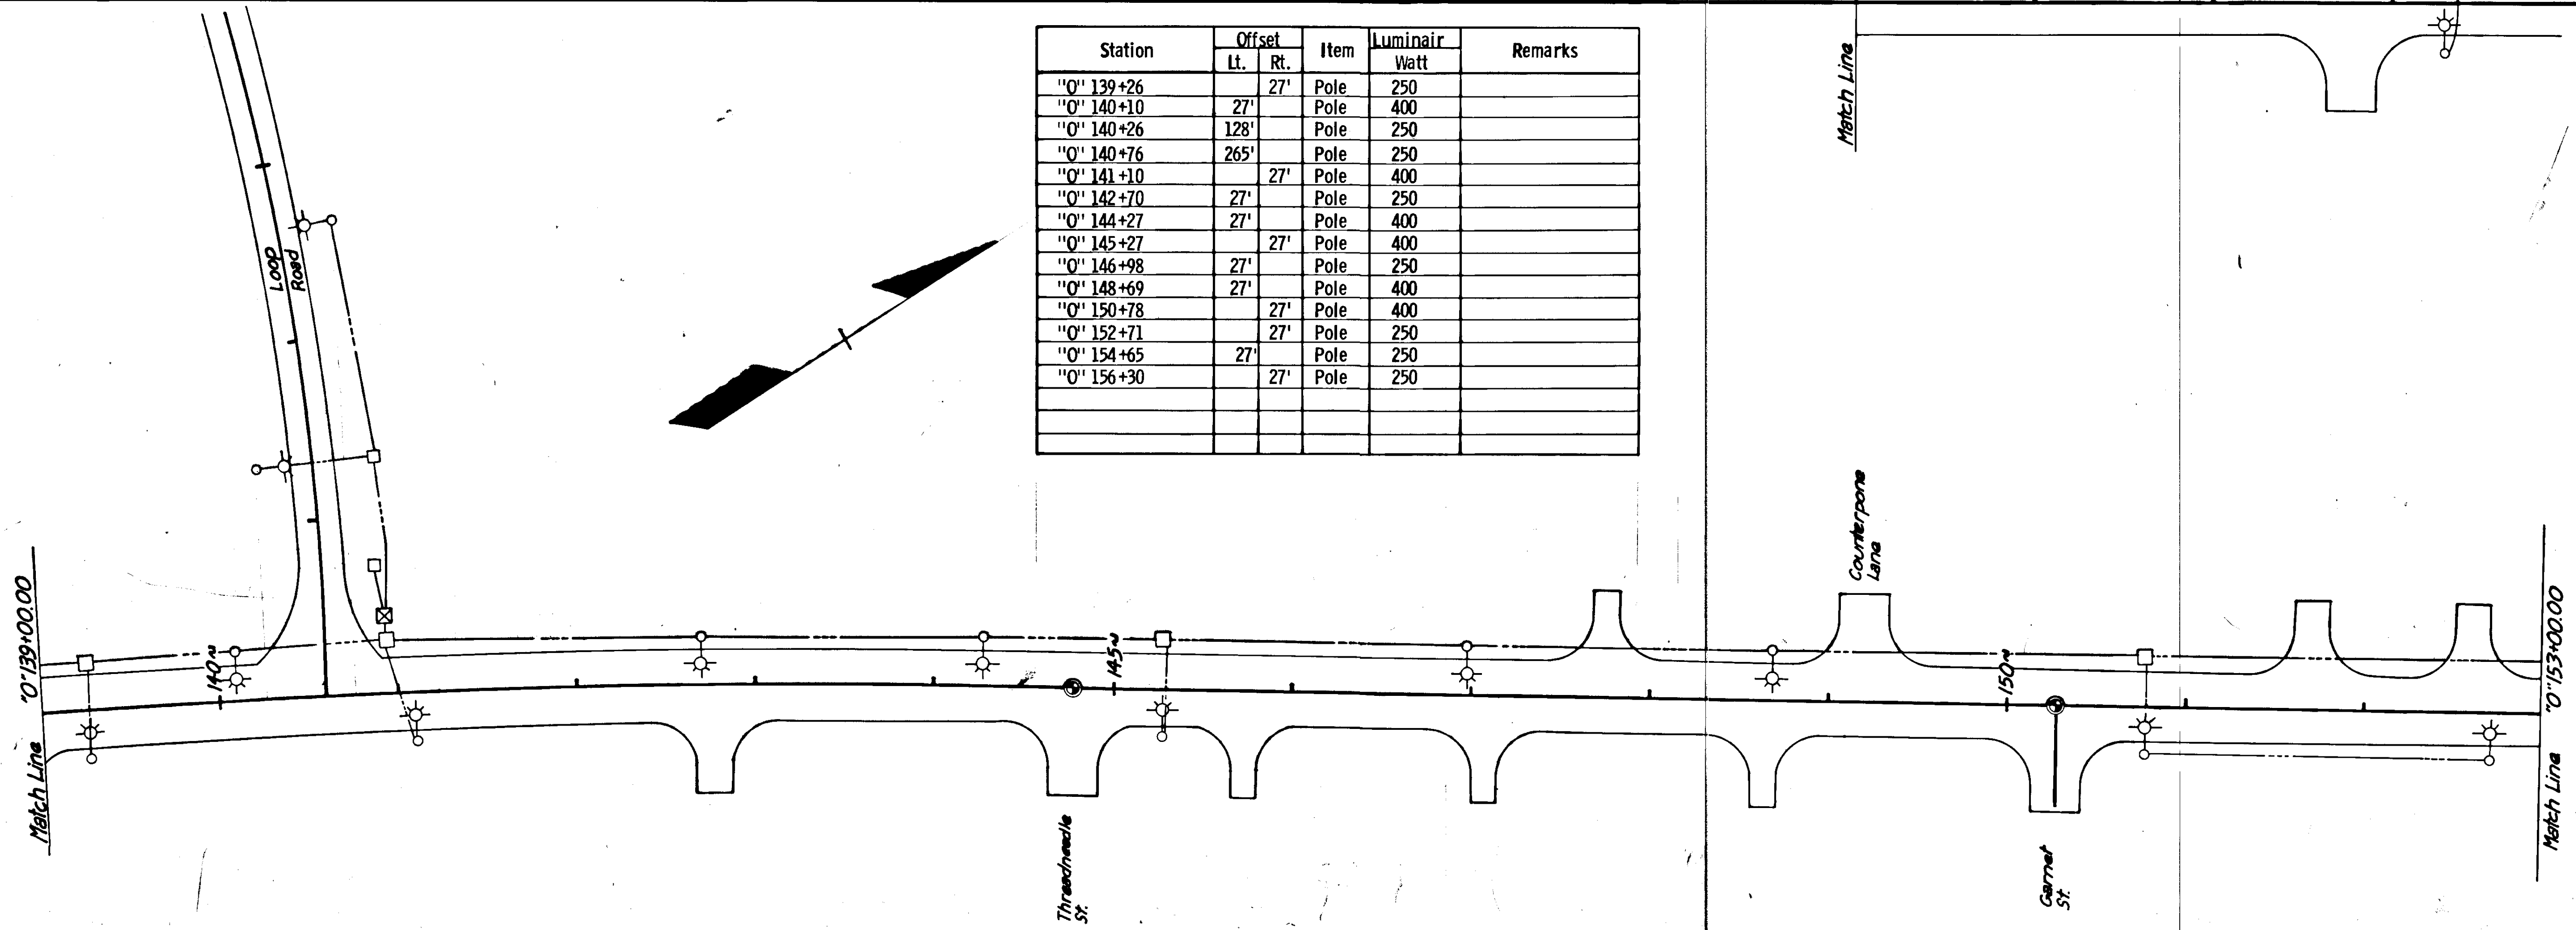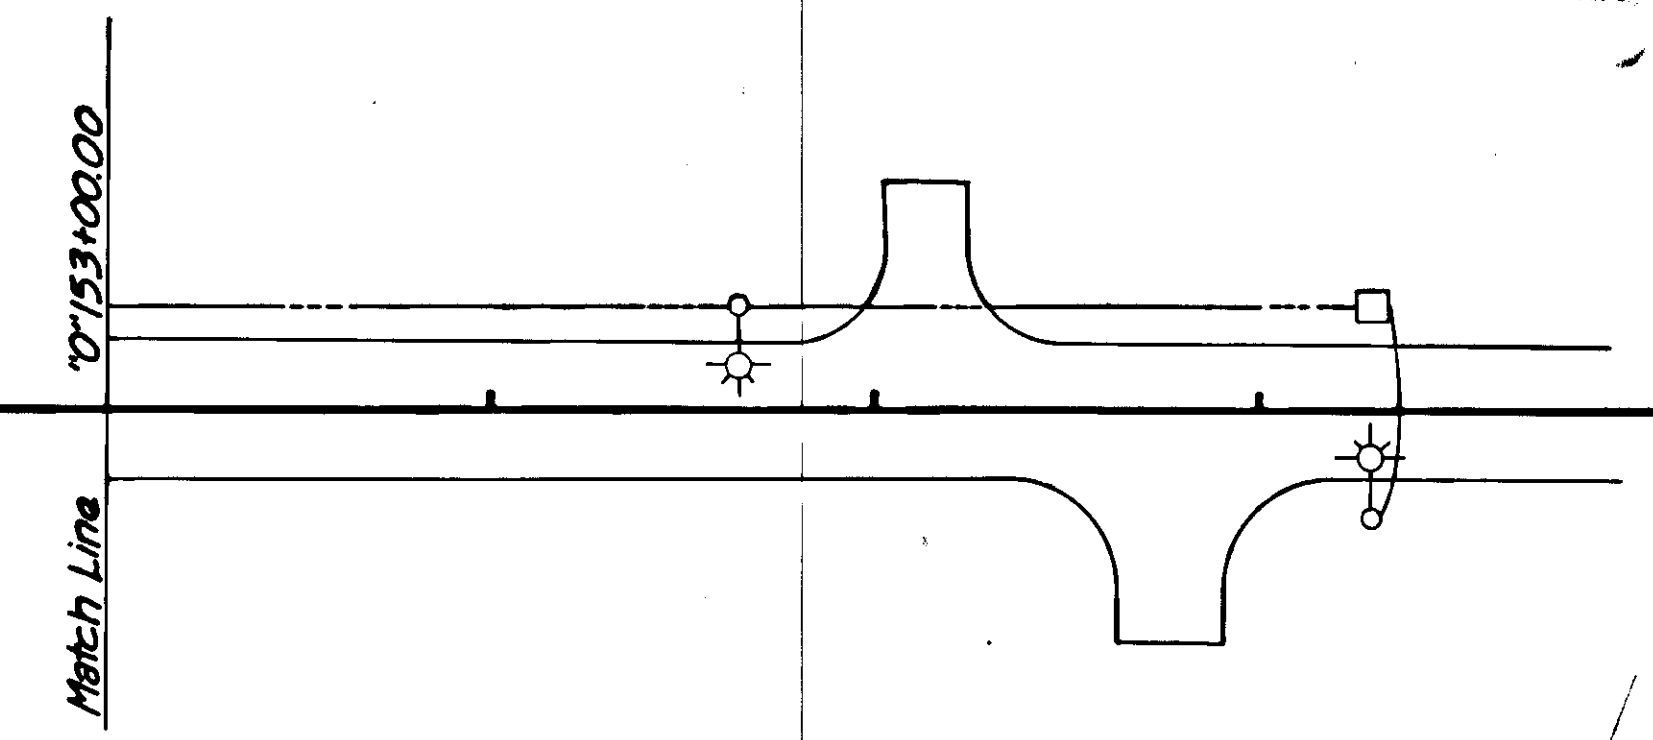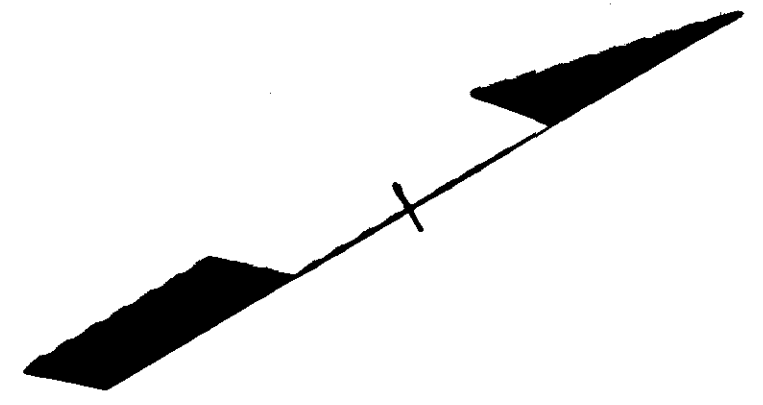

Station	Offset		Item	Luminair Watt	Remarks
	Lt.	Rt.			
"0' 139+26		27'	Pole	250	
"0' 140+10	27'		Pole	400	
"0' 140+26	128'		Pole	250	
"0' 140+76	265'		Pole	250	
"0' 141+10		27'	Pole	400	
"0' 142+70	27'		Pole	250	
"0' 144+27	27'		Pole	400	
"0' 145+27		27'	Pole	400	
"0' 146+98	27'		Pole	250	
"0' 148+69	27'		Pole	400	
"0' 150+78		27'	Pole	400	
"0' 152+71		27'	Pole	250	
"0' 154+65	27'		Pole	250	
"0' 156+30		27'	Pole	250	

