


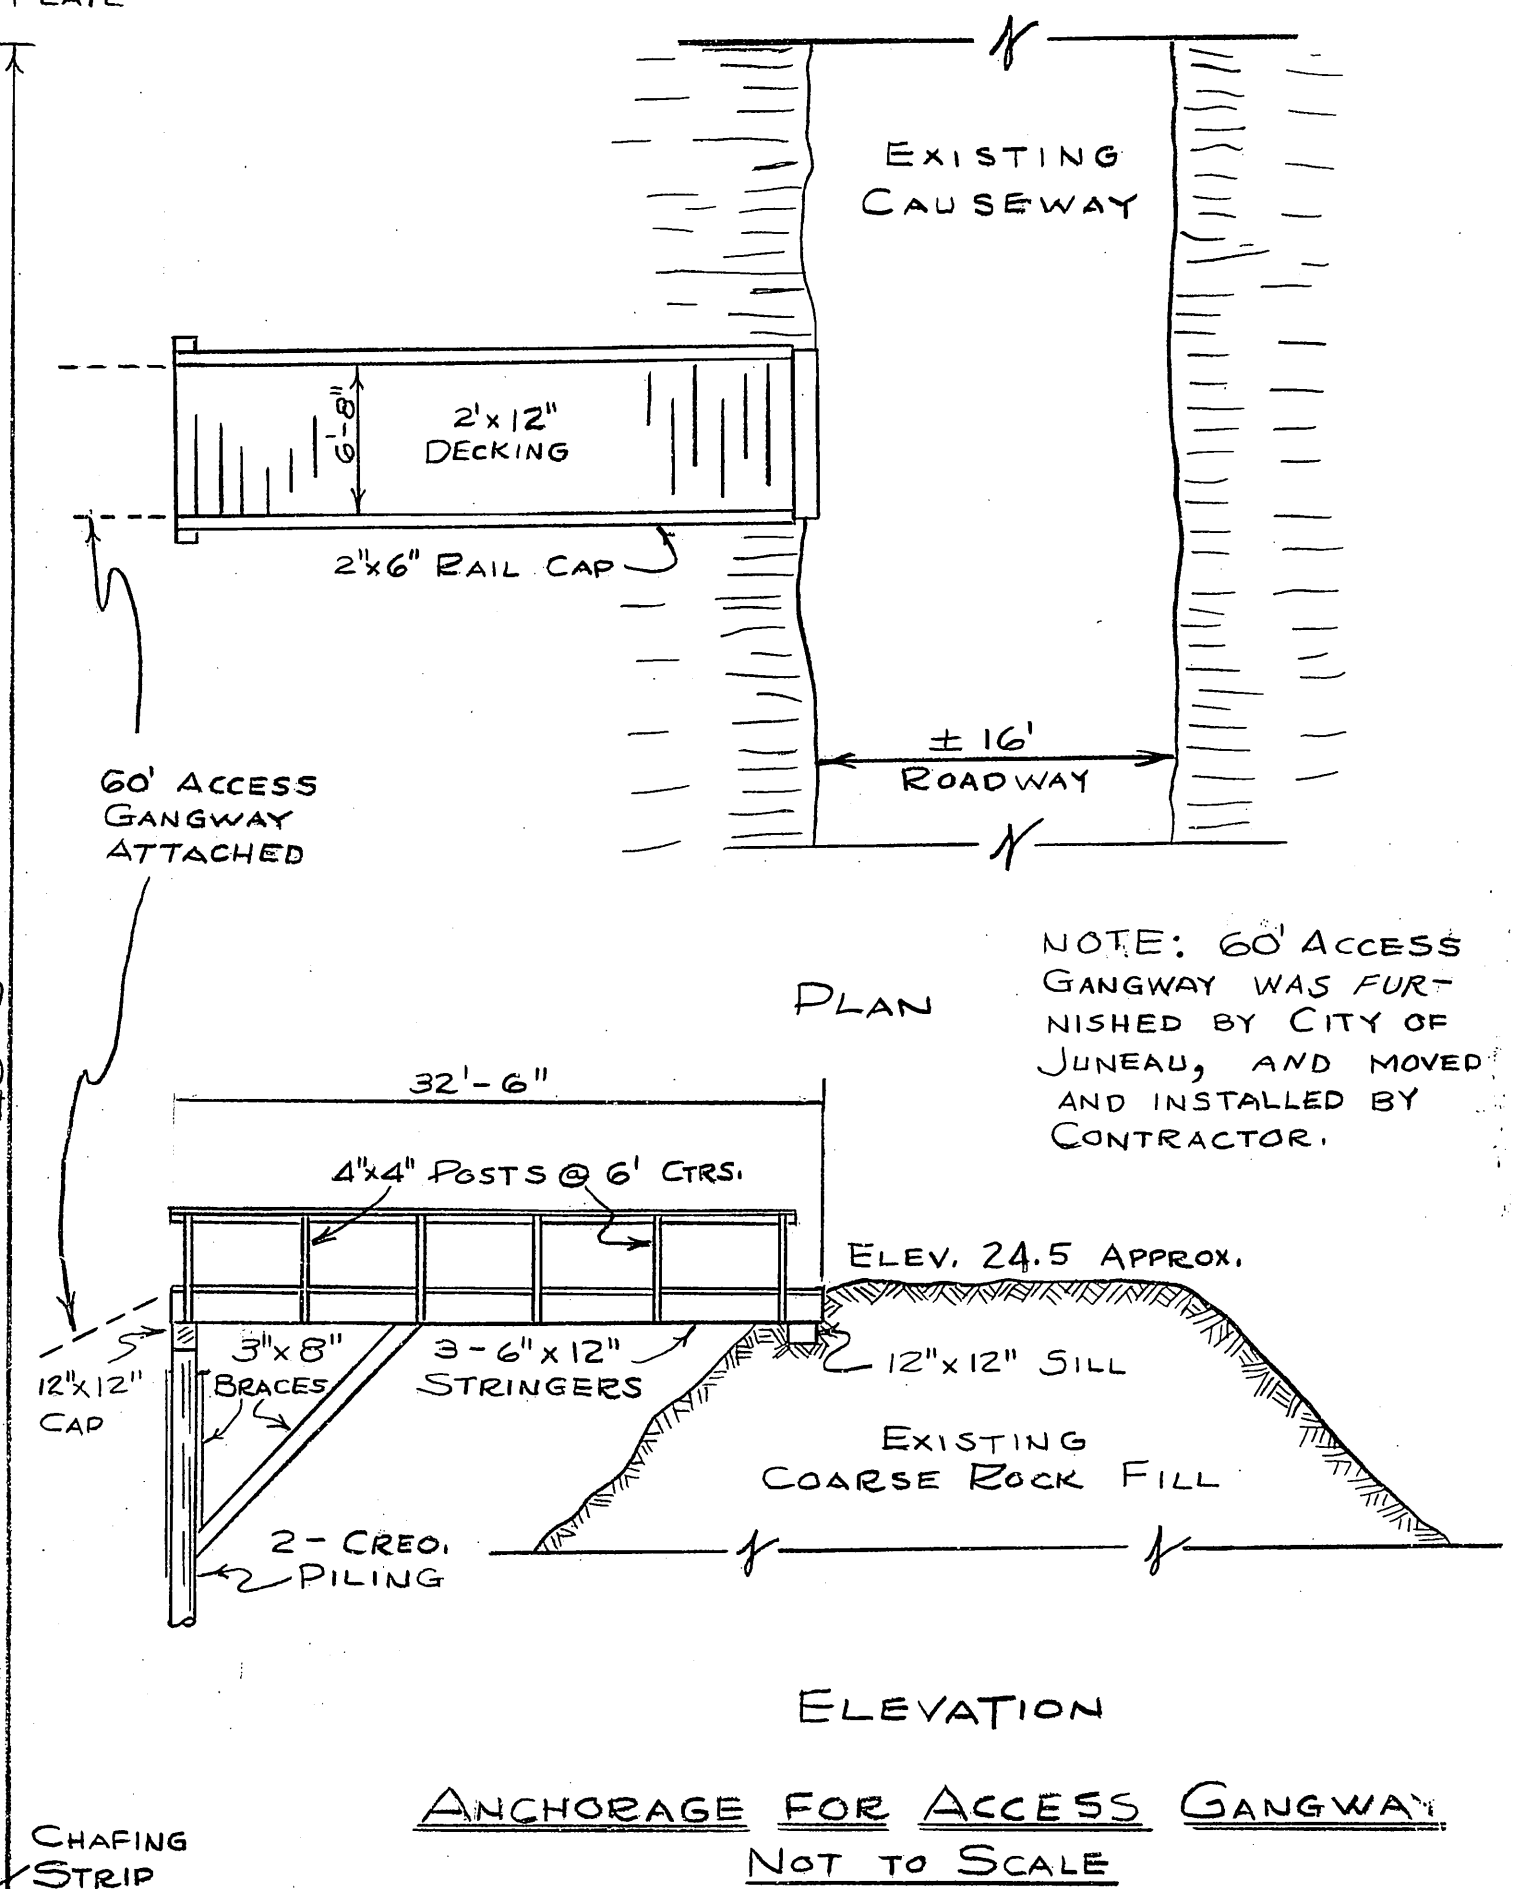


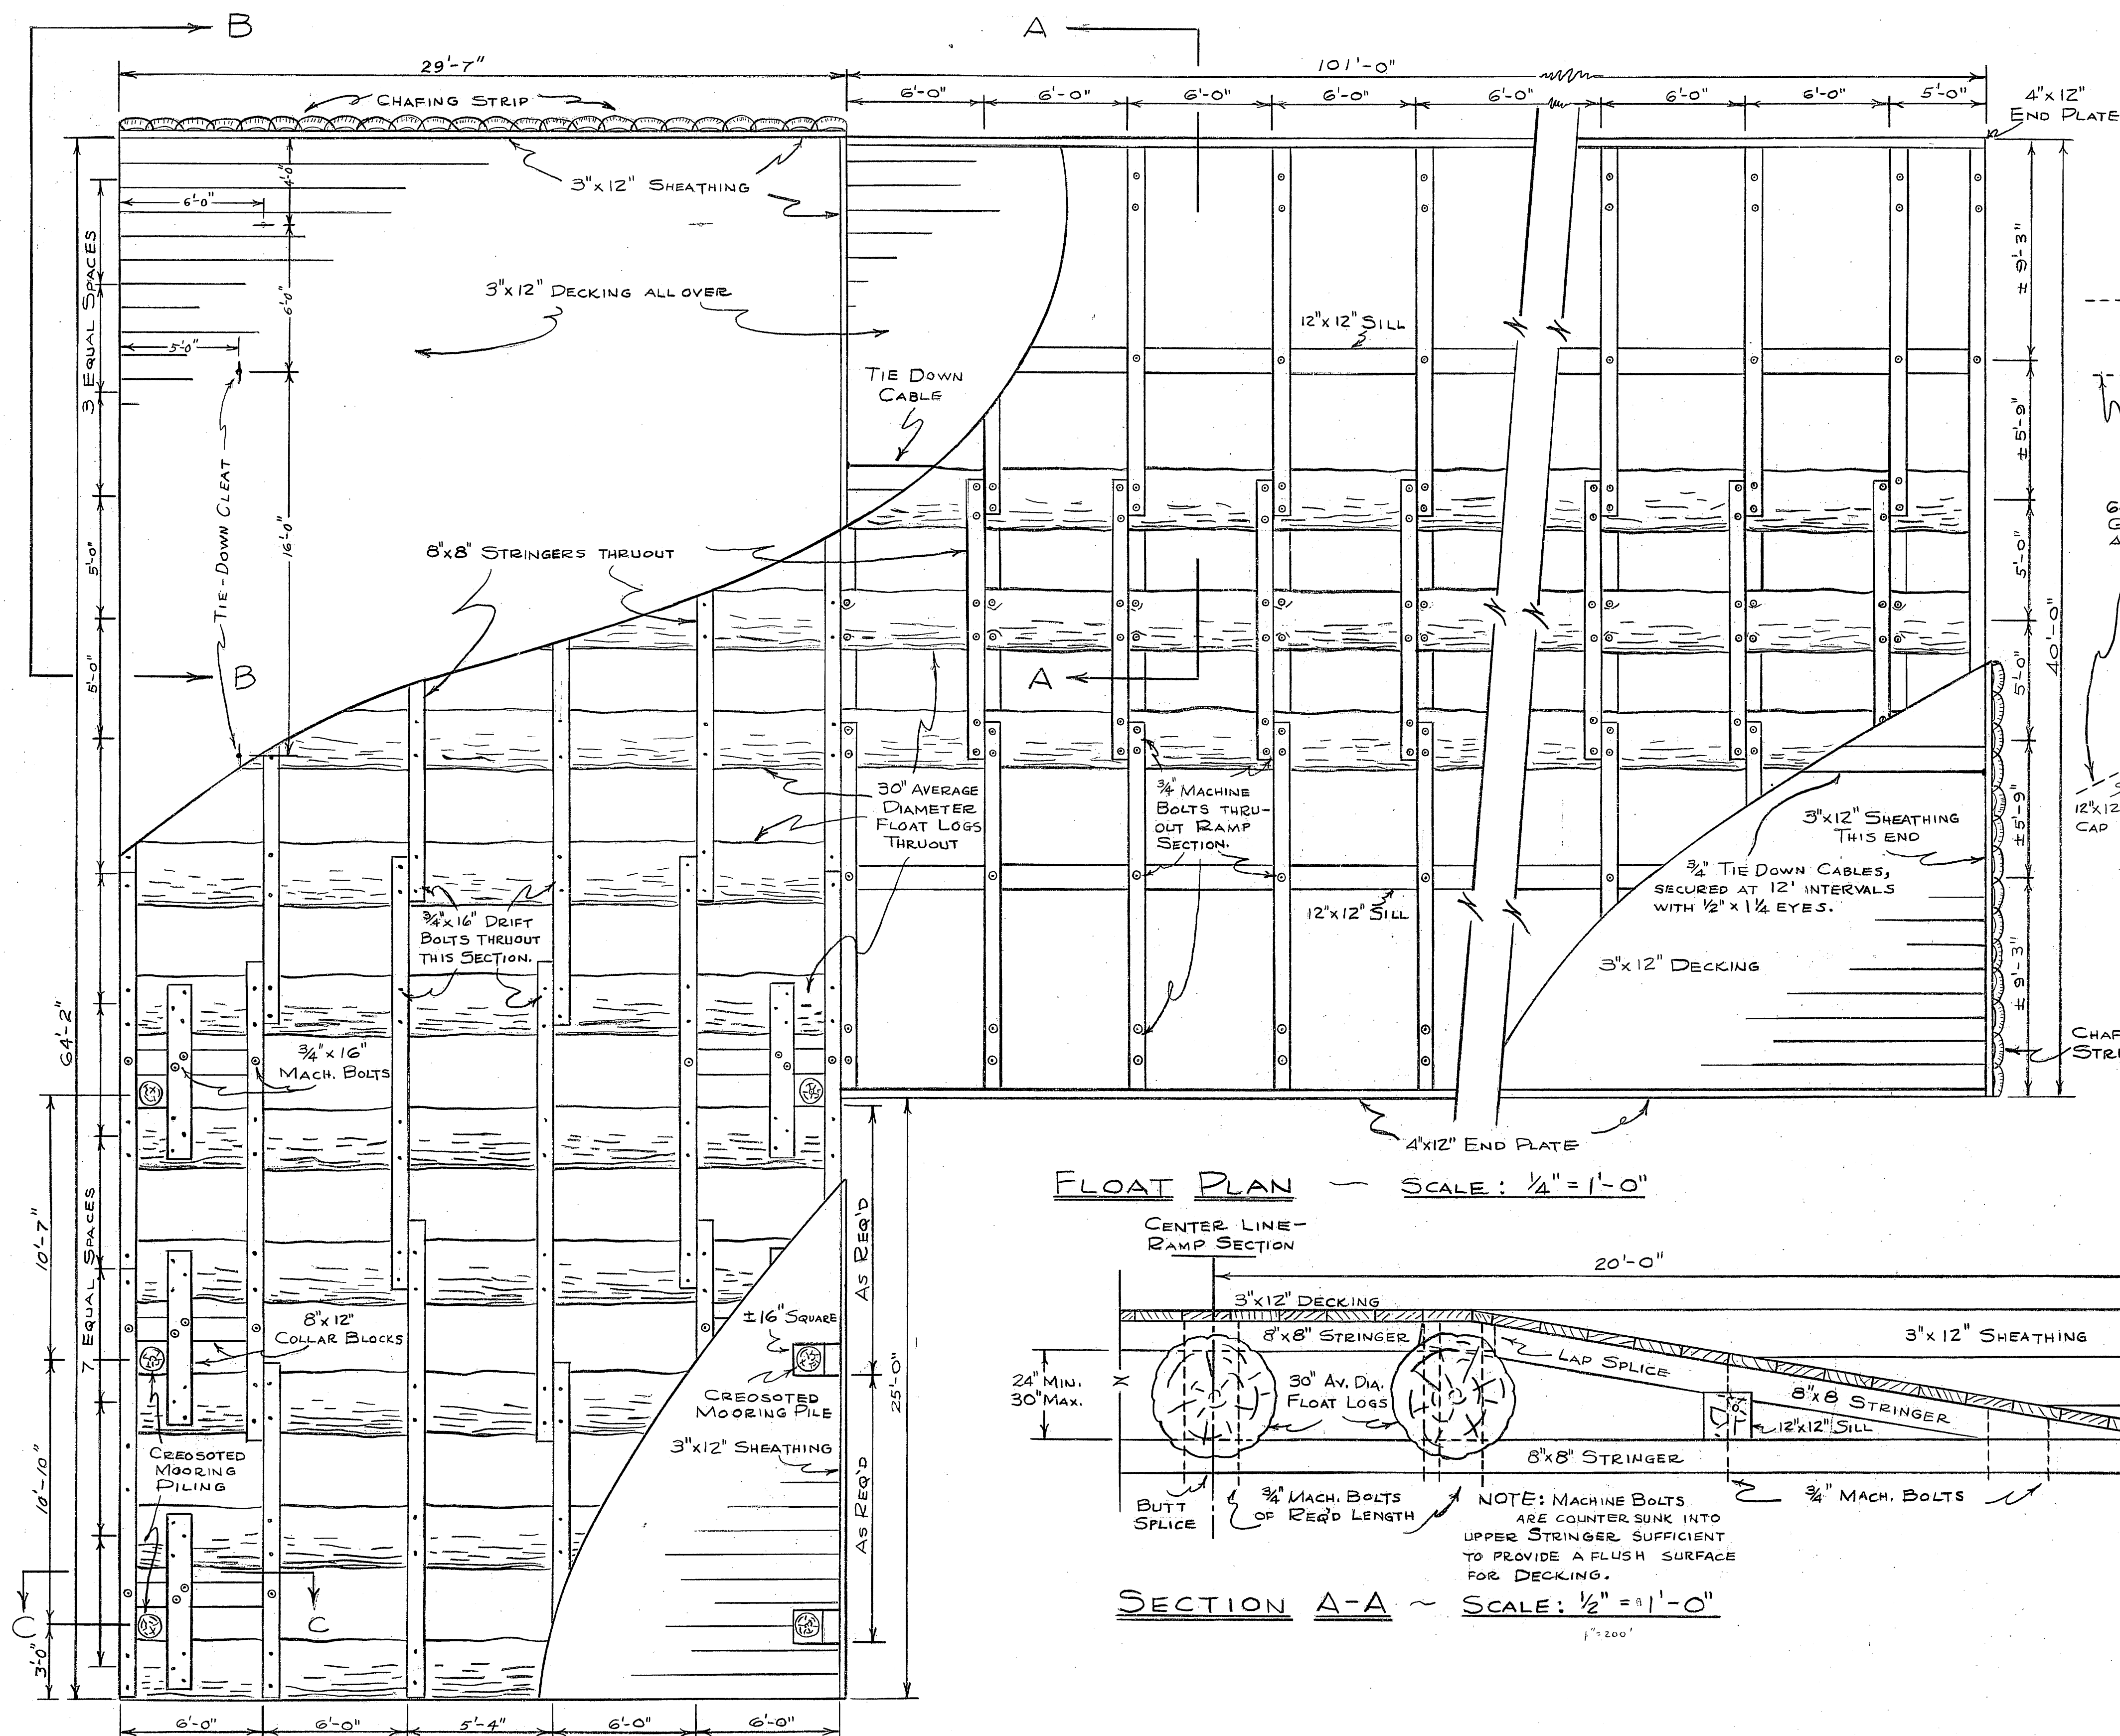


FLOAT PLAN - SCALE: $\frac{1}{4}'' = 1'-0''$

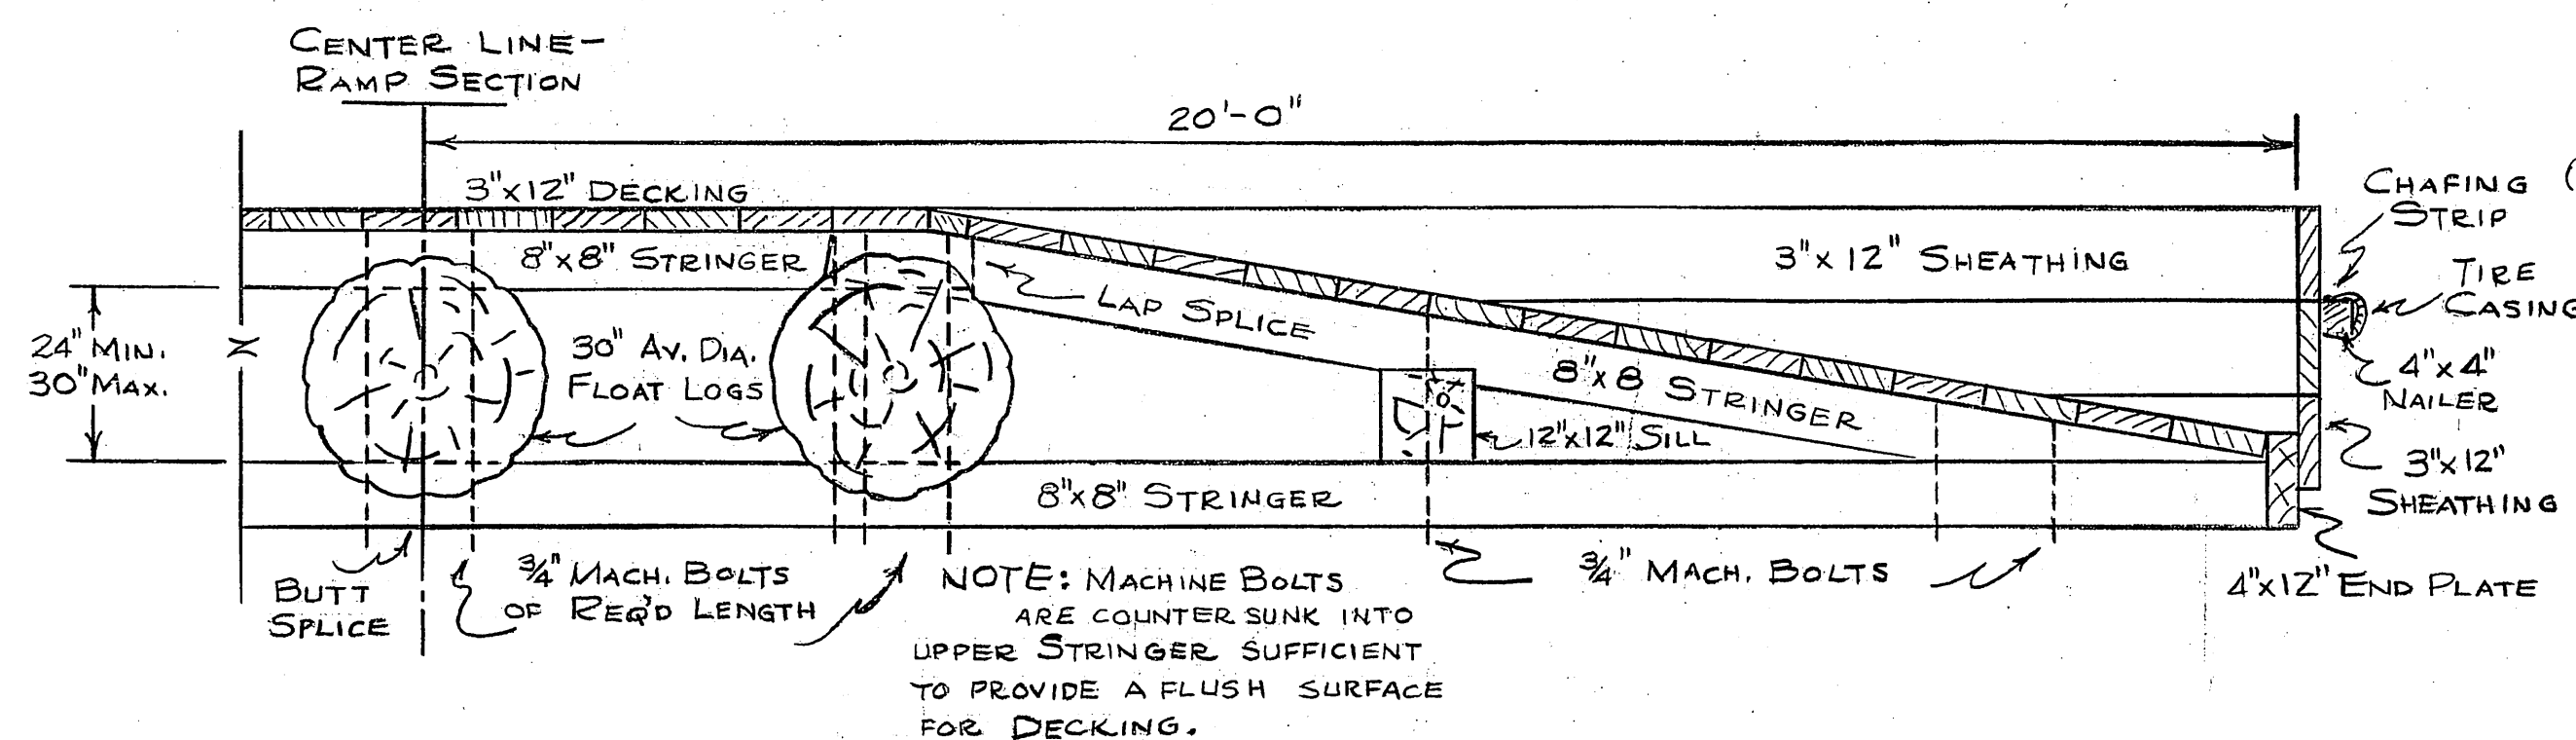


SECTION A-A - SCALE: $\frac{1}{2}'' = 1'-0''$

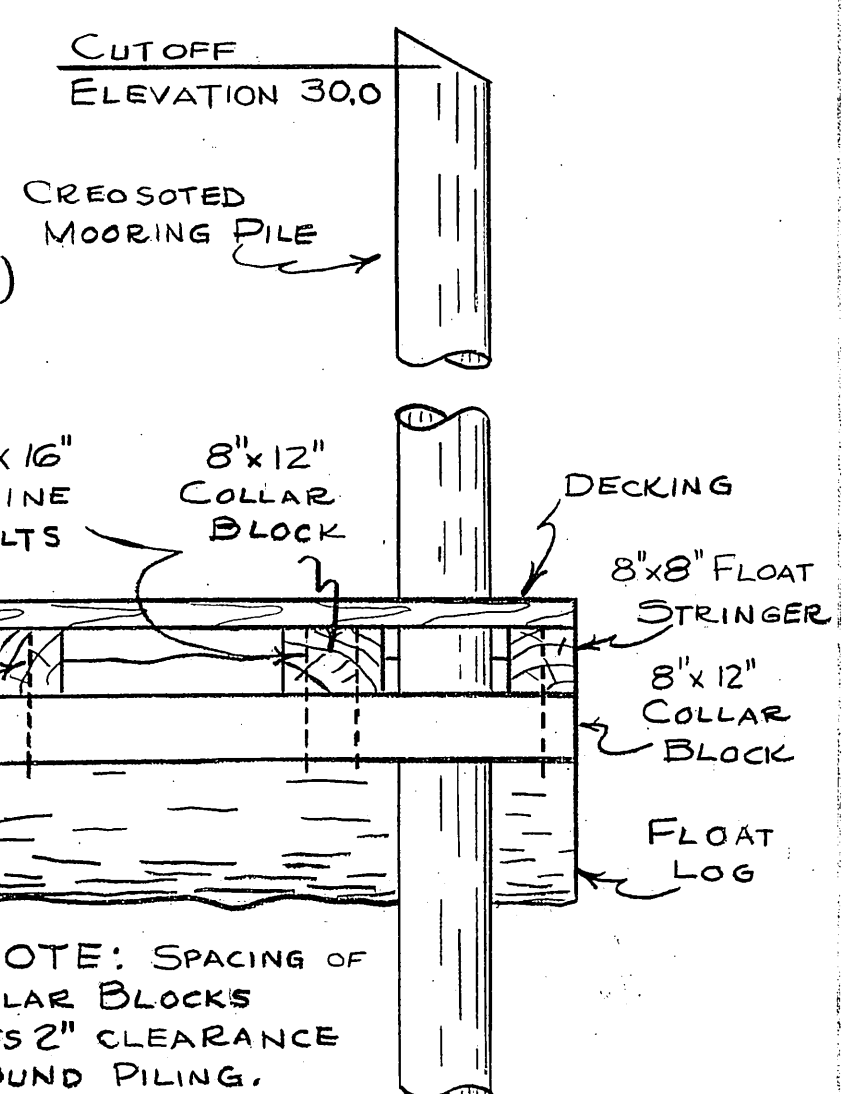

SECTION C-C - SCALE: $\frac{1}{2}'' = 1'-0''$

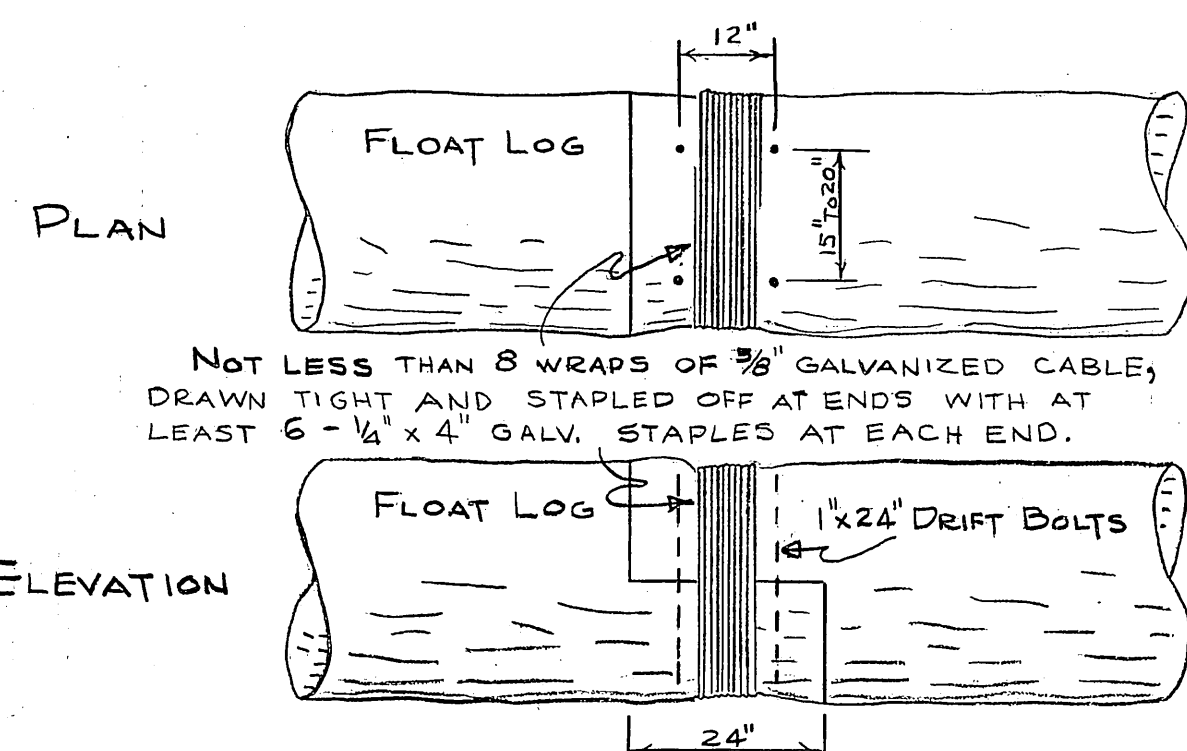

FLOAT LOG SPLICE - SCALE: $\frac{1}{2}'' = 1'-0''$

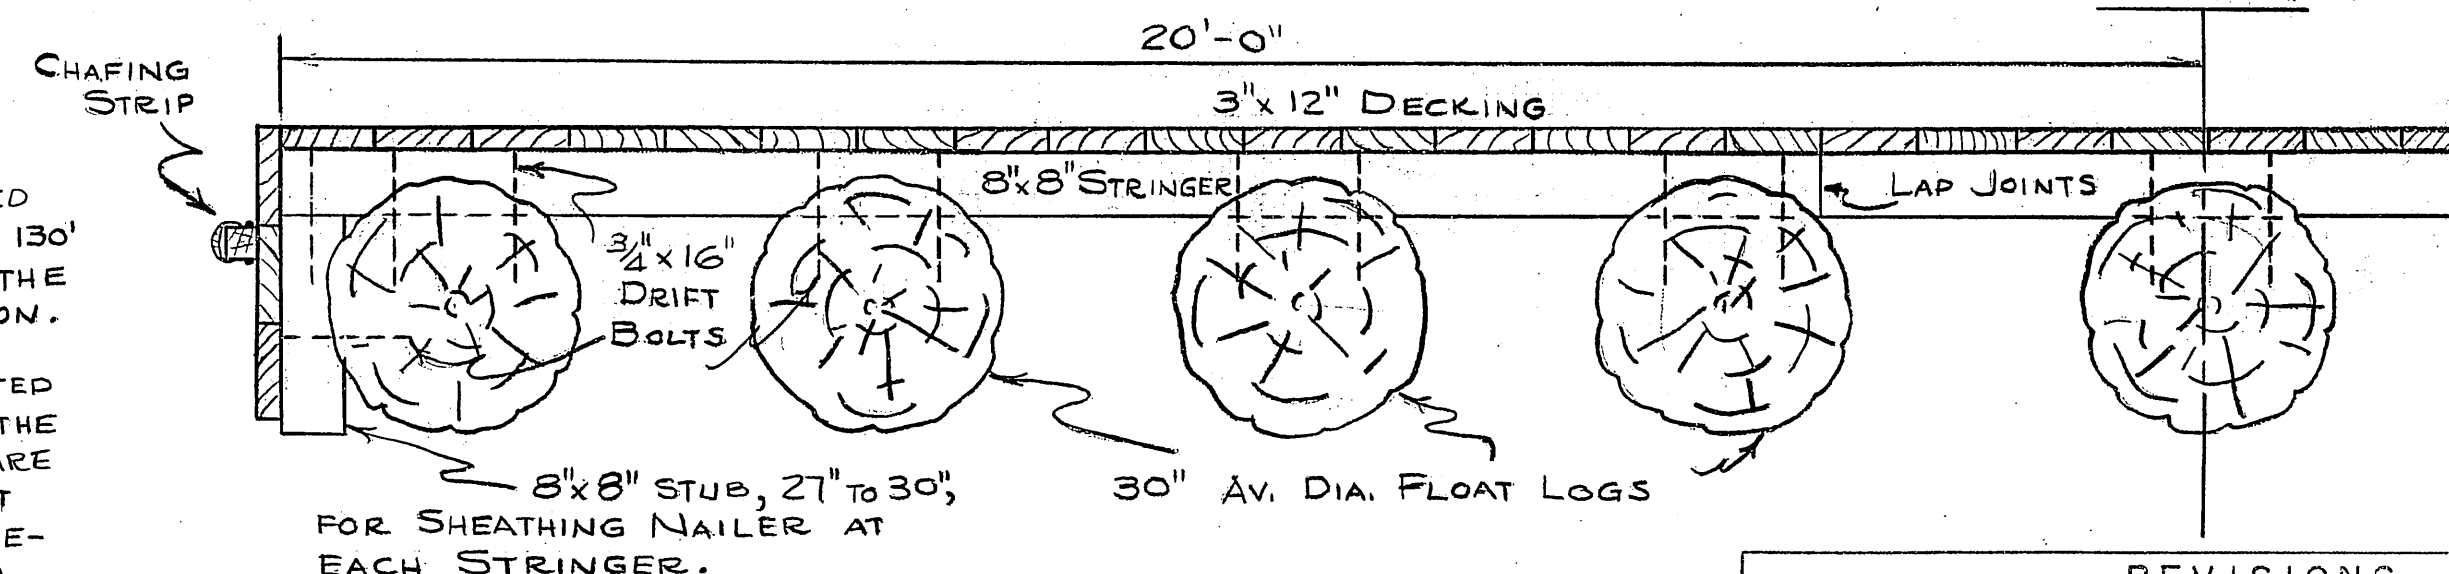

SECTION B-B - SCALE: $\frac{1}{2}'' = 1'-0''$

REVISIONS		
12-30-52	RAH	AS CONSTRUCTED
Date	By	Change

TERRITORY of ALASKA	
DEPARTMENT OF AVIATION	
ALASKA AERONAUTICS & COMMUNICATIONS COMMISSION	
SEAPLANE FACILITY	
Juneau, Alaska	
SEAPLANE FLOAT DETAILS	
Scale: As Noted	Sheet 2 of 2
Designed: F.J.T.	Approved: G. J. Toner, Director of Aeronautics
Drawn: R.A.H.	G. J. Toner, Chief Airports Division - C.A.D.
Checked: F.J.T.	DATE: OCTOBER 1951
FELIX J. TONER, REGISTERED ENGINEER	