

KEY MAP

STATE OF ALASKA
DEPARTMENT OF HIGHWAYS

PLAN AND PROFILE
PROPOSED HIGHWAY PROJECT
MENDENHALL LOOP ROAD & GLACIER SPUR
WIDENING AND BIKEPATH
RS-0960(1) & RS-0966(8)
GRADING, DRAINAGE, PAVING,
ILLUMINATION, SIGNALIZATION &
PEDESTRIAN OVERCROSSING

AB-7

STATE	PROJECT DESIGNATION	YEAR	SHEET NO.	TOTAL SHEETS
ALASKA	RS-0960(1) & RS-0966(8)	1977	1	40

INDEX OF SHEETS

SHEET NO.	DESCRIPTION
1	TITLE SHEET
2	TYPICAL SECTION
3	ESTIMATE OF QUANTITIES
4-5	MISCELLANEOUS DETAILS & SUMMARY TABLES
6-15	PLAN & PROFILE SHEETS
16	STRIP MAP & TYPICAL "0" 153+00 TO "0" 217+28
17-24	INTERSECTION DETAILS
25-31	SIGNING & ILLUMINATION PLANS
32-34	SIGNALIZATION DETAILS
35-40	PEDESTRIAN OVERCROSSING DETAILS

RS-0960(1)
PROJECT SUMMARY

WIDTH OF PAVEMENT	= 36'
LENGTH OF PAVING	= 1,586.19 = 0.300 Mi.
LENGTH OF GRADING	= 1,586.19 = 0.300 Mi.
LENGTH OF PROJECT	= 1,586.19 = 0.300 Mi.

RS-0960(1)
DESIGN DESIGNATION
OLD GLACIER HWY. TO EGAN DRIVE

ADT (1976)	= 2,115
ADT (1997)	= 5,943
DHV (15%)	= 892
D	= 40-60
T	= 4%
V	= 35 M.P.H.

RS-0966(8)
PROJECT SUMMARY


WIDTH OF PAVEMENT	= 36'-60'
LENGTH OF PAVING	= 19,232.00' = 3.642 Mi.
LENGTH OF GRADING	= 19,232.00' = 3.642 Mi.
LENGTH OF PROJCT	= 19,232.00' = 3.642 Mi.

RS-0966(8)
DESIGN DESIGNATION
EGAN DRIVE TO GLACIER SPUR

ADT (1976)	= 6,731
ADT (1997)	= 18,913
DHV (13%)	= 2,459
D	= 40-60
T	= 3%
V	= 40 M.P.H.

RS-0966(8)
DESIGN DESIGNATION
GLACIER SPUR

ADT (1976)	= 779
ADT (1997)	= 2,189
DHV (20%)	= 438
D	= 40-60
T	= 4%
V	= 40 M.P.H.

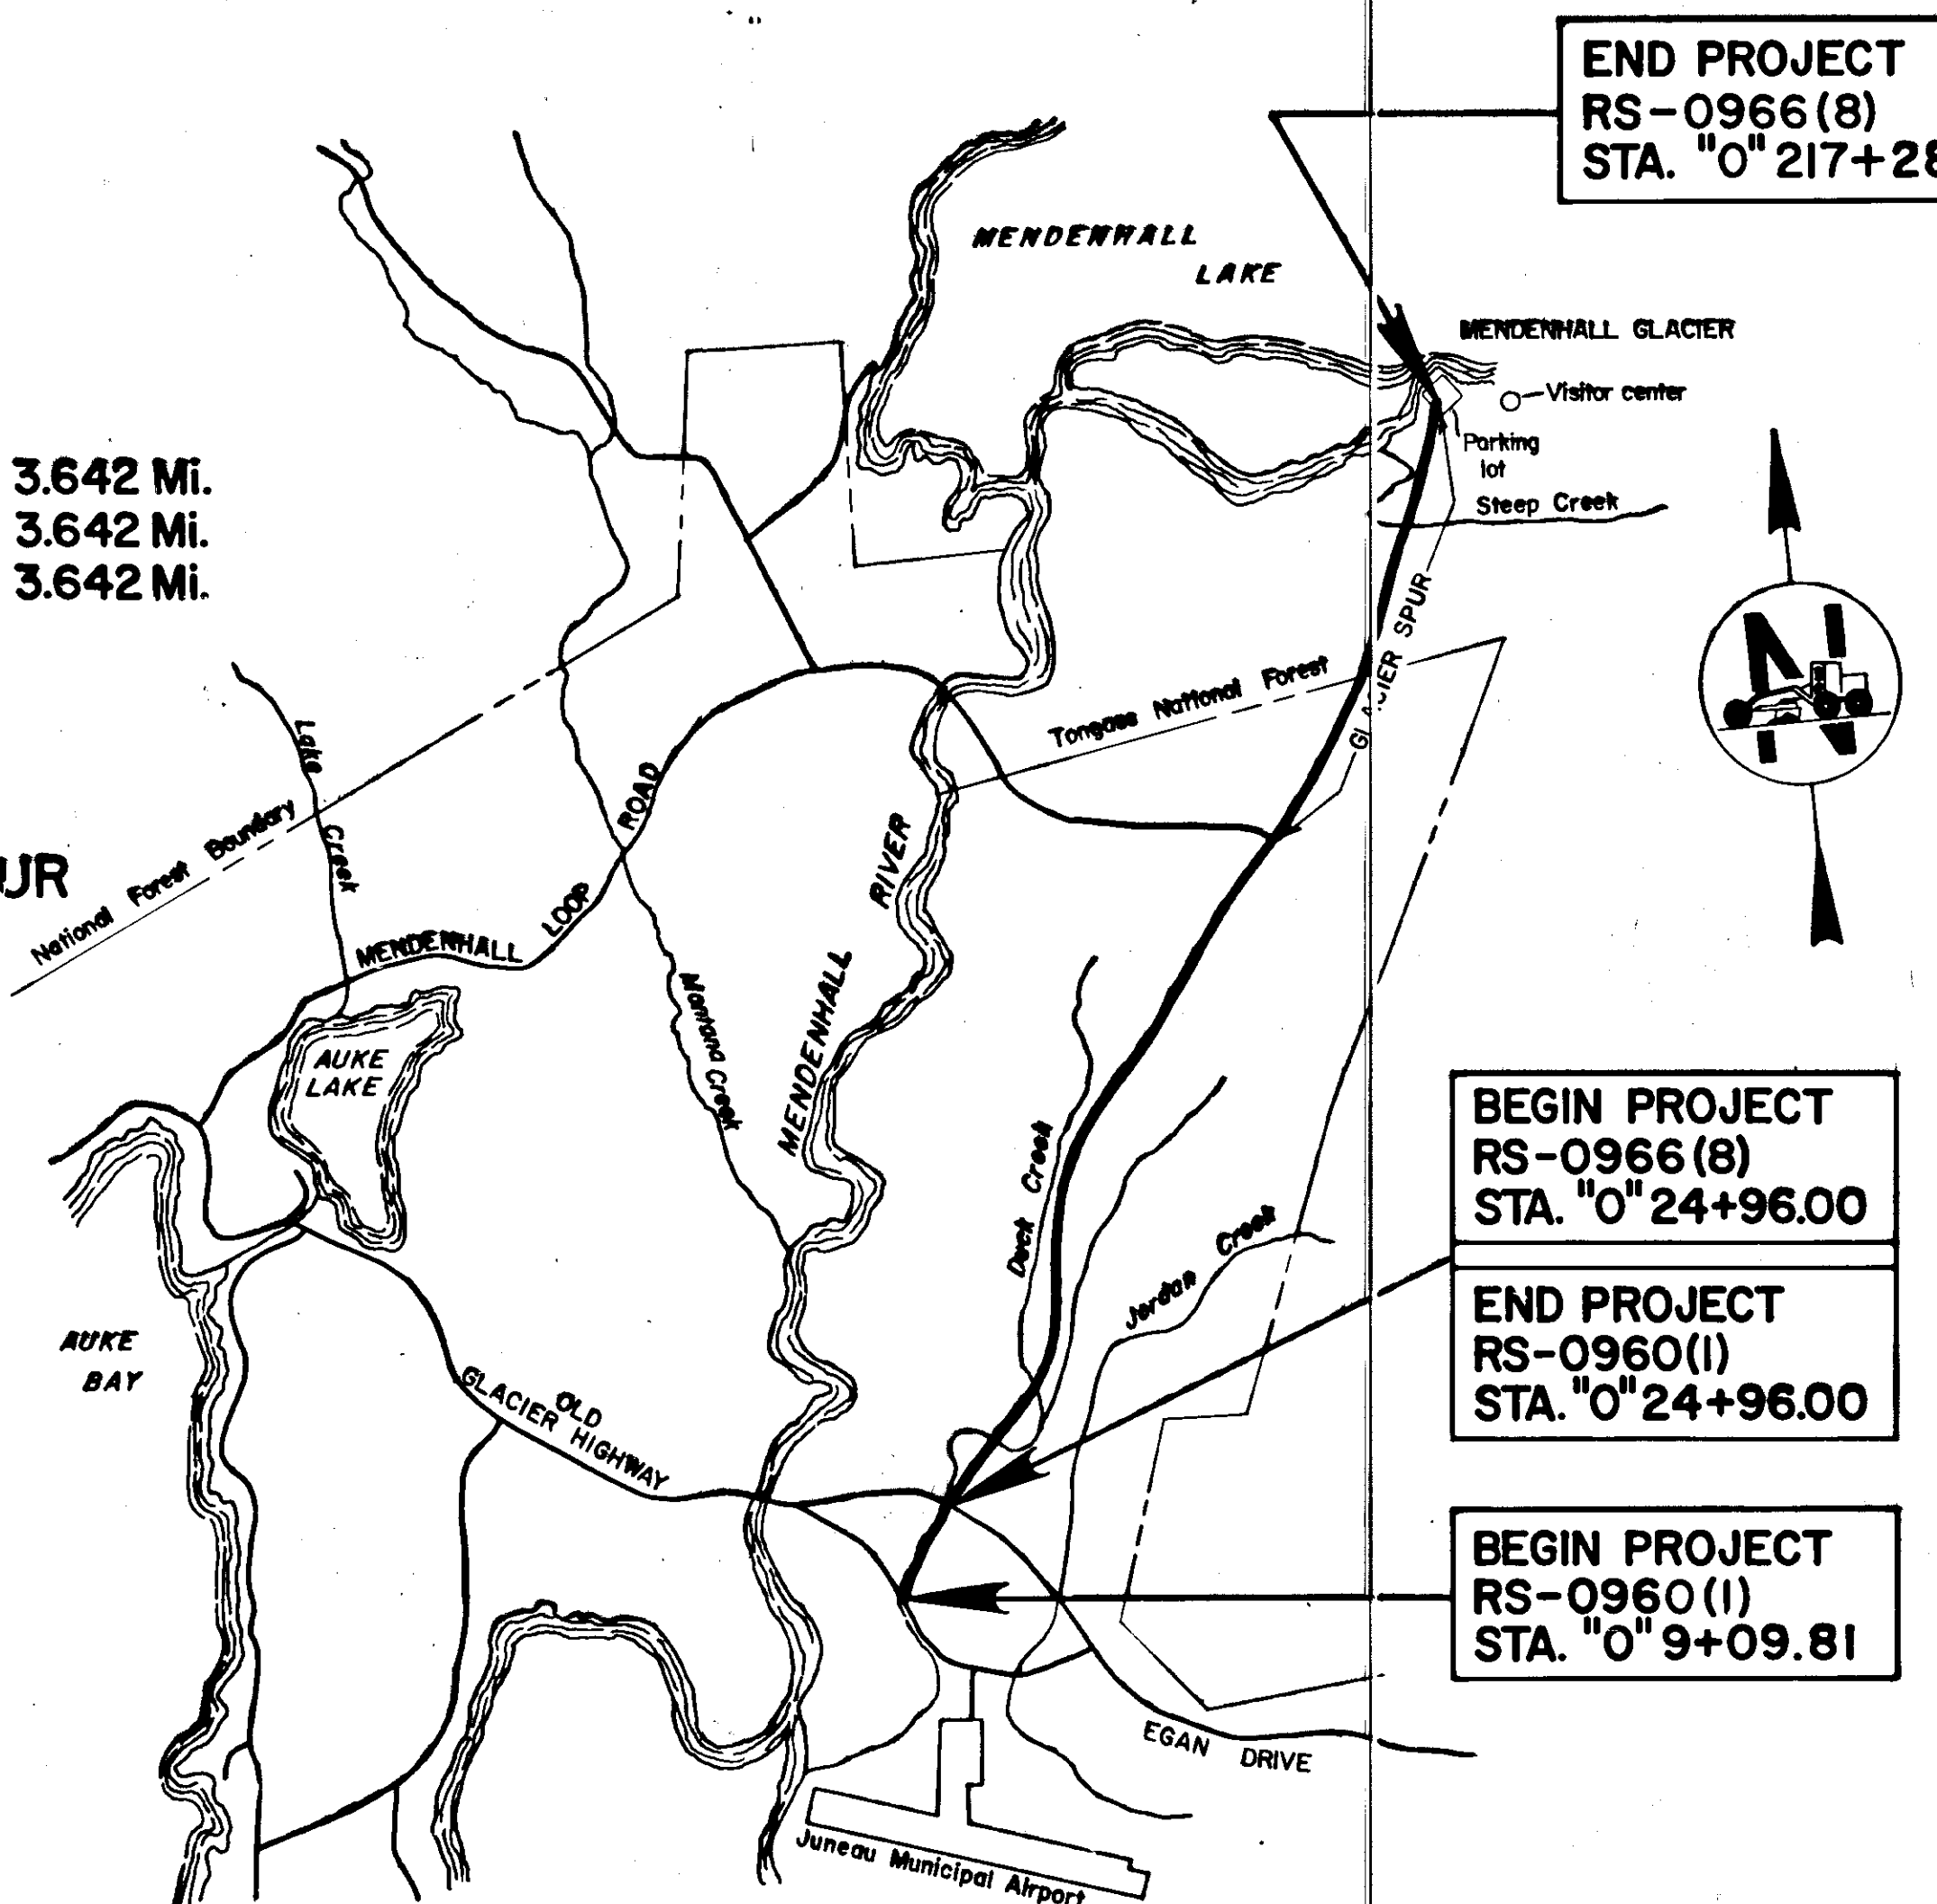

THE FOLLOWING STANDARD DRAWINGS APPLY TO THESE PROJECTS: A-1, C-00.03, C-10.00, C-11.01, D-02.02, D-03.01, D-06.10, F-01.10, G-04.31, G-13.00, G-14.01, I-40.10, I-80.00, L-03.10, L-10.12, L-14.00, L-20.02, L-23.02, L-30.00, M-16.03, M-23.00, S-00.10, S-05.00, S-20.10, S-30.11, T-30.00, T-31.01, T-32.01, T-33.02, T-34.02, T-40.00, T-52.00, D-23.01, D-24.12 AND D-26.01, T-03.00.

AS-BUILT PLANS

CONTRACTOR - RED SAMM CONST. CO.
PROJECT ENGINEER - STEVE N. HIROTSU
BEGINNING DATE - MAY 23, 1977
COMPLETION DATE - JULY 21, 1978


STATE OF ALASKA
DEPARTMENT OF HIGHWAYS

APPROVED
Wallace K. Williams DATE 3/29/77
SOUTHEASTERN DIV. ENGINEER
STATE OF ALASKA
DEPARTMENT OF HIGHWAYS

APPROVED
Phil O'Neil DATE 4/6/77
DEP. COMMISSIONER OF HIGHWAYS

STATE	PROJECT DESIGNATION	YEAR	SHEET NO.	TOTAL SHEETS
ALASKA	RS-0960(1) & RS-0966(8)	1977	2	40

TYPICAL SECTIONS OF IMPROVEMENT

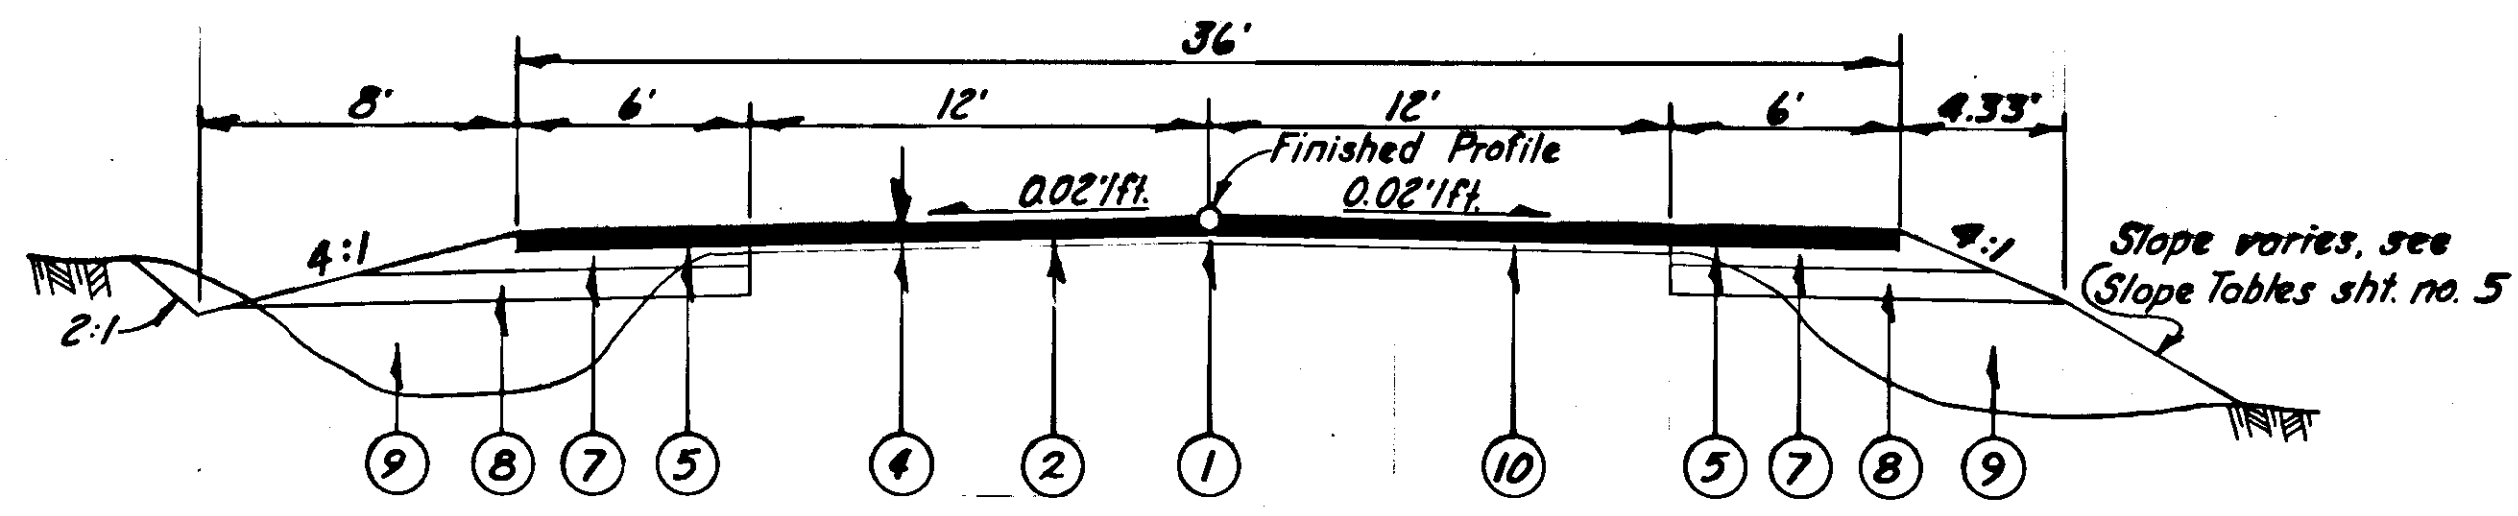


"0"9+09.81 to "0"24+96.00


Note: "0"20+14.49 to "0"24+96.00 The typical section width varies from 36' to 60' see sht. no. 17 for details

LABELING INDEX


- | | |
|---|---|
| ① CSS-1 Emulsified Asphalt for Tack Coat (24' Wide) | ⑥ 4" Crushed Aggregate Base Course |
| ② Leveling Course @ locations as directed by the eng. | ⑦ 5 1/2" Crushed Aggregate Base Course |
| ③ 3" Hot Asphalt Pavement (2 - 1 1/2" lifts) | ⑧ 6" Subbase, Grading "A" |
| ④ 1 1/2" Hot Asphalt Pavement | ⑨ Unclassified Excavation and/or Borrow |
| ⑤ MC-30 Liquid Asphalt for Prime Coat | ⑩ Existing 24' Pavement. |
| ④a 2" Hot Asphalt Pavement | |

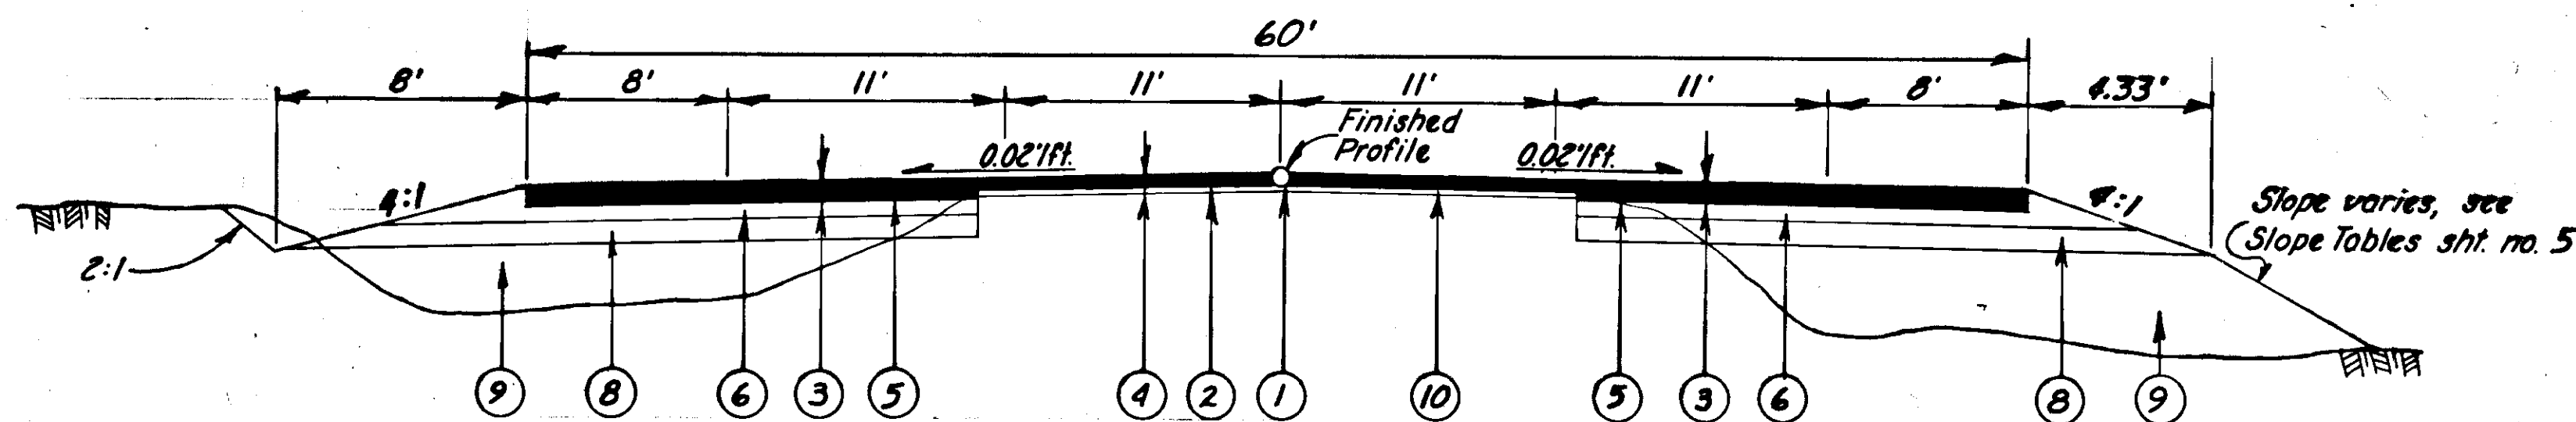

"0" 24+96.00 to "0"39+00.00

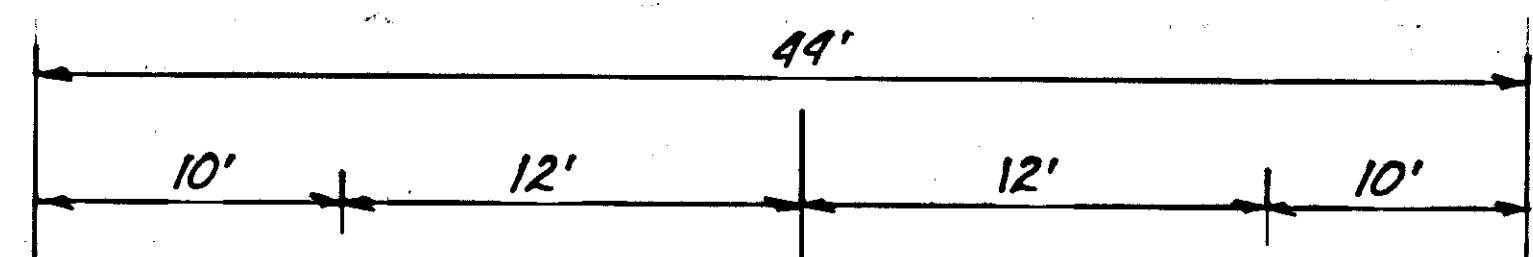


"0" 42+00 to "0"113+00

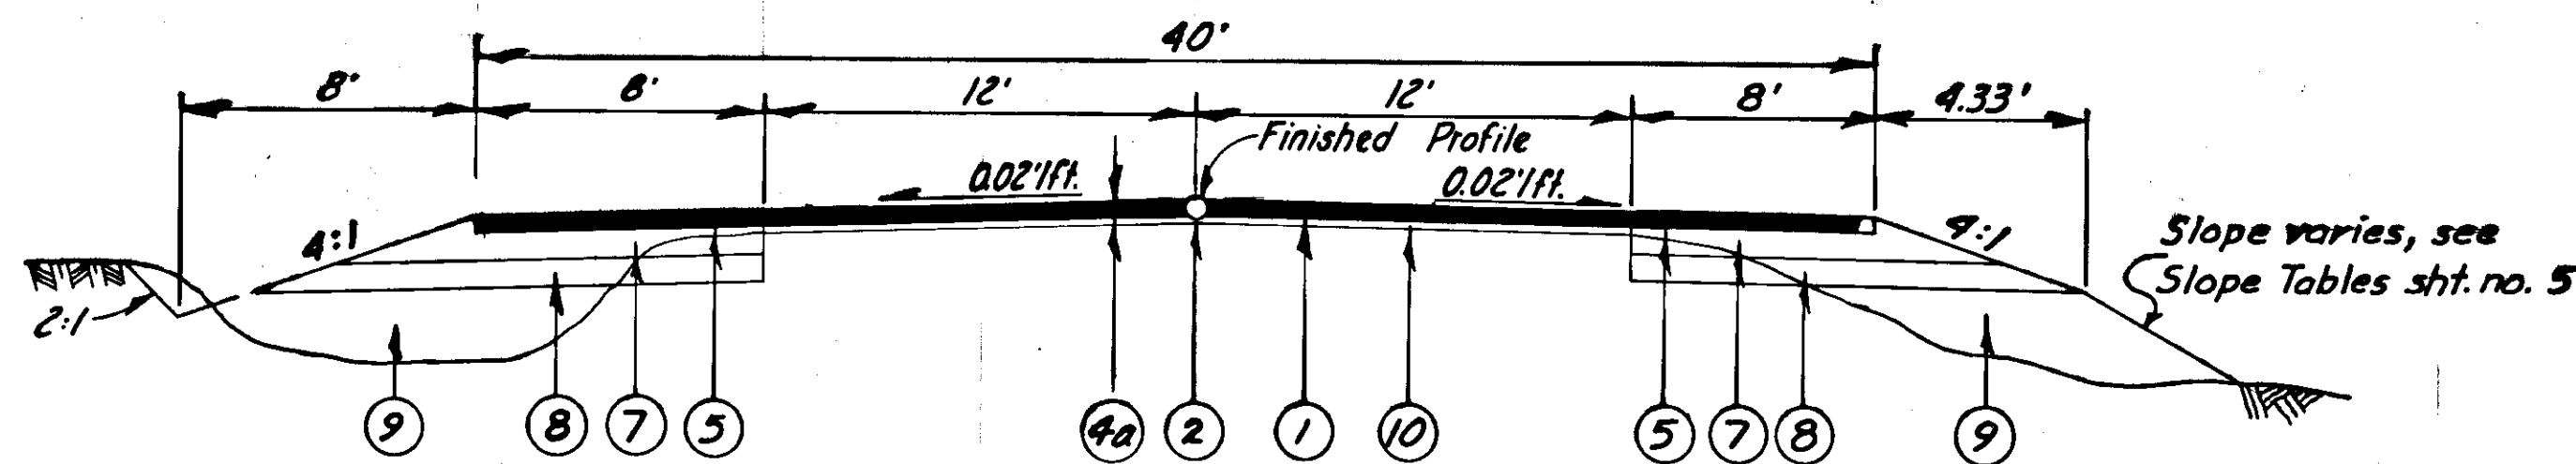


"0"113+00.00 to "0"150+73.36

- Notes:
- "0" 39+00 to "0"42+00 the typical section width varies from 60' to 44'.
 - "0"113+00 to "0"114+00 the typical section width varies from 44' to 40'.
 - "0"150+73.36 to "0"151+75.00 the typical section width varies from 40' to 36'.
 - "0"151+75.00 to 217+28.00 see sheet no. 16 for details.

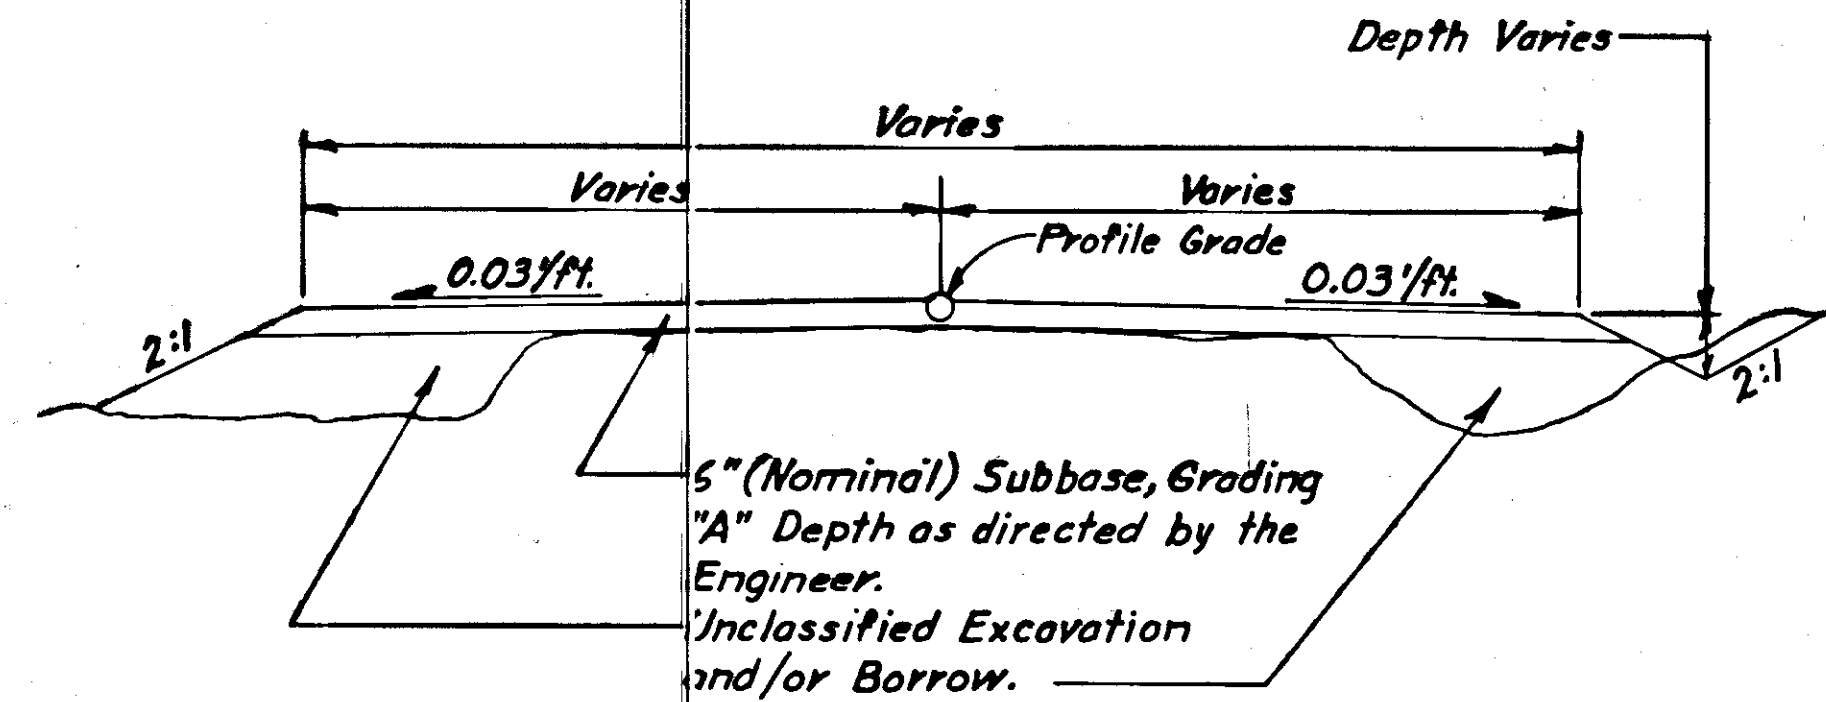


TYPICAL SECTION SIDE STREETS

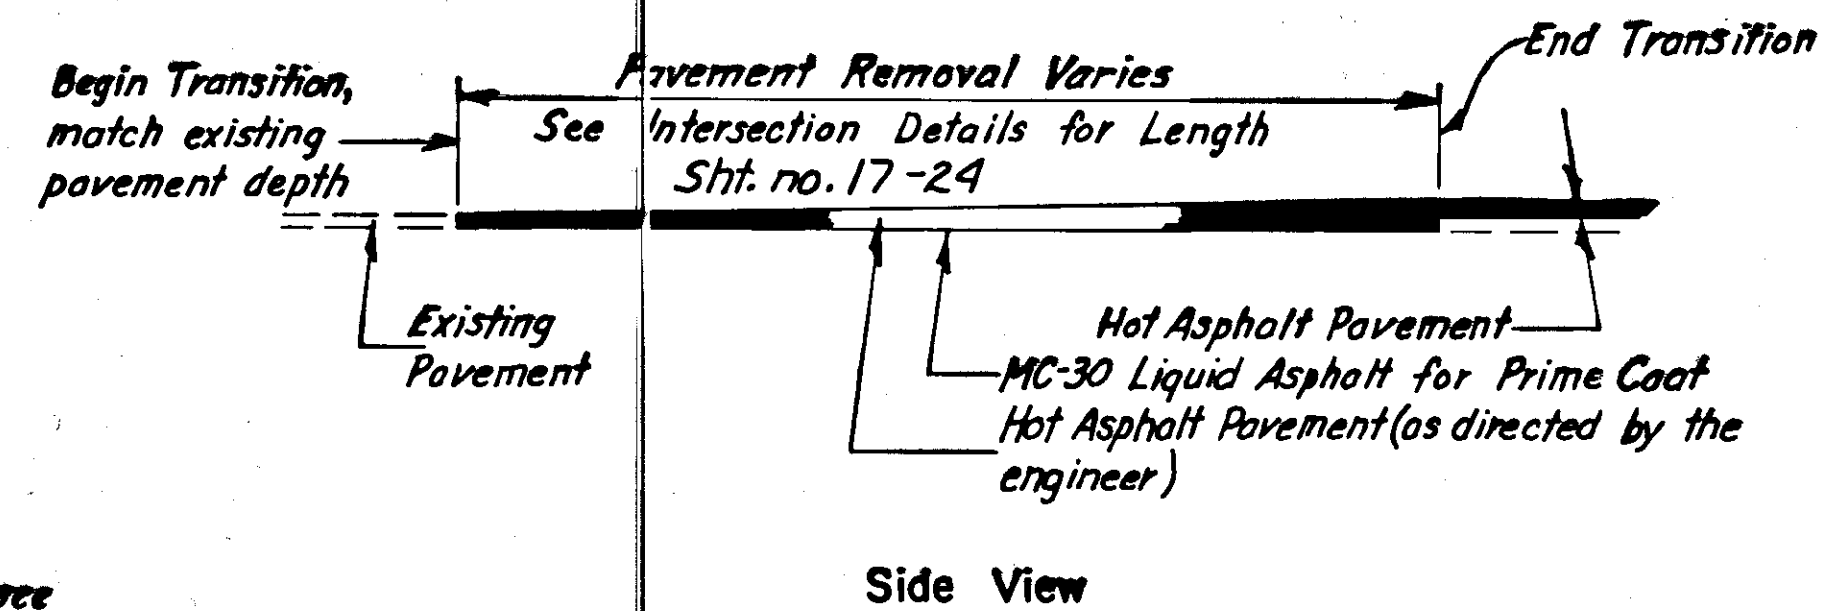

PAVEMENT TRANSITION DETAIL

BASIS OF ESTIMATE	
Item No.	Estimating Factor
203(5B)	1.80 Tons per Cu. Yd.
301(1)	1.96 Tons per Cu. Yd.
304(1)	1.87 Tons per Cu. Yd.
401(1)	112 lbs. per Sq. Yd. per Inch Depth
401(1)	3,780 lbs./Cu. Yd.
401(2)	6% of Item 401(1)
402(2)	0.16 Gal. per Sq. Yd. - 253 Gal. per Ton
403(1)	0.25 Gal. per Sq. Yd. - 256 Gal. per Ton at 60°F.

BIKEPATH TYPICAL SECTION

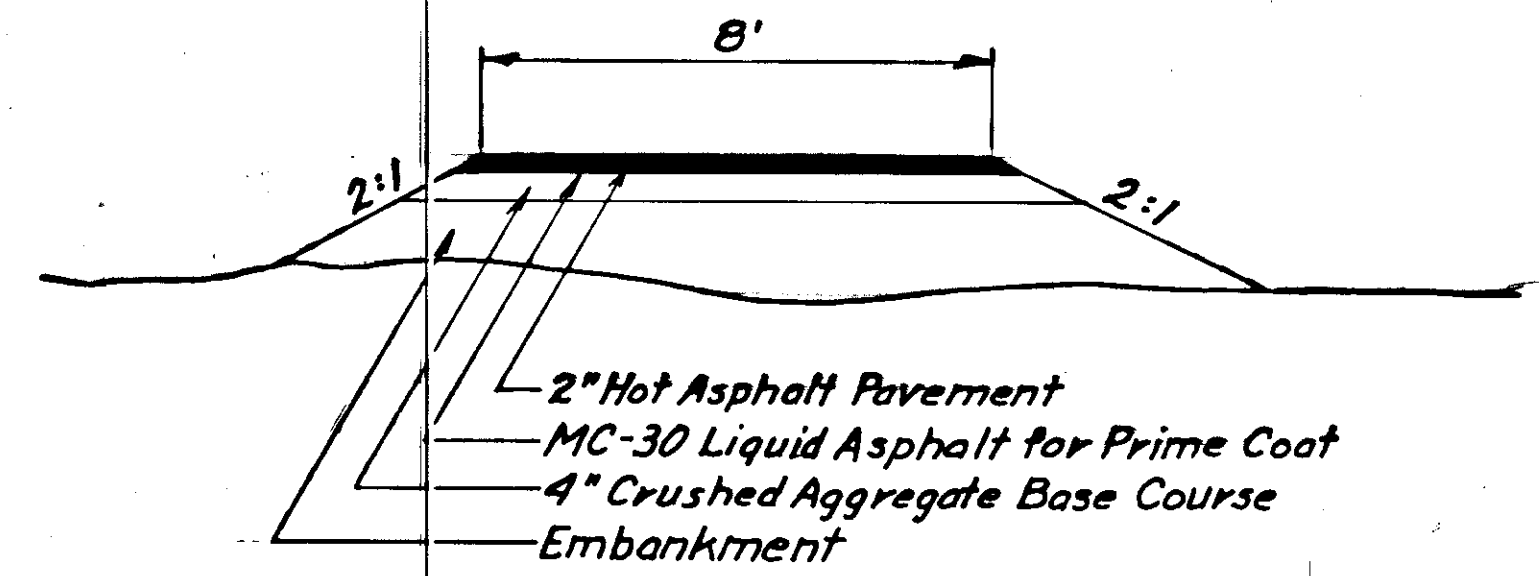

- Notes:
- See plan & profile sheet for the suggested location of the bikepaths.
 - See Section 555 "Contractor Designed Bike path" of Special Provisions for more details.

GENERAL NOTES

- Grade and Alignment shown on these plans are subject to minor revisions.
- Culvert lengths and locations are subject to minor revisions.
- Culvert extension and associated items of work in Duck Creek shall be accomplished between June 1st & August 31st.
- All construction activity in and adjacent to Steep Creek shall be completed prior to July 1. Any work necessary after July 1 shall require Alaska Dept. of Fish & Game approval.
- Superelevation shall be revolved about the inside shoulder, see standard drawing I-80.00
- "0"33+00 to "0"50+00 & "0"53+00 to "0"63+00 The existing super is being reduced from 0.06'/ft. to 0.04'/ft., this may require the leveling course to be 3" thick in some areas. When 1/2" or more of leveling course is required, it shall be put down in a min. of 2 lifts or as directed by the engineer.
- Clearing & Grubbing limits shall be 10' beyond the slope limits in a cut section and 5' beyond the bikepath slope limits in a fill section or to the R/W whichever is less. Sta. "0"26+00 to "0"30+00 left shall be hand cleared and shall be paid for as "Clearing & Grubbing."
- The area to be seeded, shall be from the edge of the roadway shoulder to the clearing limits or to the R/W line whichever is less. The paved separated bikepath shall be excluded from this area.
- Removal of existing pavement shall be considered incidental to pay item 203(3) "Unclassified Excavation" and no separate payment shall be made therefore.
- Existing signs shall be removed by the contractor and returned to the State of Alaska, Dept. of Highways as directed by the engineer. This work shall be considered incidental to pay item 201(3B) "Clearing & Grubbing" and no separate payment shall be made therefore.
- The contractor shall take every precaution not to disturb the existing R/W monuments.
- The existing monuments "Kod", "Mat", etc. shall be referenced and installed by others.
- The location of all utilities shown on the plans are approximate only and should be field verified with the utility.
- The adjustment or reconstruction of existing sanitary sewer manholes and cleanouts shall be performed by the City & Borough of Juneau and are not considered items of work under this contract.
- The installation, adjustment, or removal of utility poles and appurtenances shall be performed by others and are not considered items of work under this contract.
- Both the existing and proposed utility pole locations are shown and are considered informational only.
- Culverts called out to be "Abandon In Place" shall have ends plugged as directed by the engineer. This work shall be considered incidental to other items of work.

ESTIMATE OF QUANTITIES

STATE	PROJECT DESIGNATION	YEAR	SHEET NO.	TOTAL SHEETS
ALASKA	RS-0960(1) & RS-0966(8)	1977	3	40

ITEM No	ITEM	UNIT	SHEET NUMBERS													RS-0960(1)			RS-0966(8)			GRAND						
			6	7	8	9	10	11	12	13	14	15	16	TOTAL			TOTAL			TOTAL								
1	Furnshing and Maintaining Engineering Facilities	L. S.																All Req'd.		All Req'd.		All Req'd.						
110(1)	Mobilization	L. S.																All Req'd.		All Req'd.		All Req'd.						
111(1)	Temporary Erosion and Pollution Control	C. S.																All Req'd.		All Req'd.		All Req'd.						
114(1)	Construction Engineering by the Contractor	L. S.																All Req'd.		All Req'd.		All Req'd.						
201(3B)	Clearing & Grubbing	L. S.																All Req'd.		All Req'd.		All Req'd.						
202(4)	Removal and Disposal of Culvert Pipe	L. F.						46	100		46							0		192		192						
202(10)	Remove and Relocate Traffic Island	L. S.																		All Req'd.		All Req'd.						
203(3)	Unclassified Excavation	C. Y.	334	1,593	479	992	687	654	750	997	1,041	401	2,127					511		9544		10,055						
203(5B)	Borrow	Ton	814	10,035	6,131	315	2,329	2,277	598	25	1,307	1,841	11,563					2,124		35,111		37,235						
301(1)	Crushed Aggregate Base Course	Ton	790	2,079	1,756	1,525	1,631	1,861	1,693	1,642	1,417	1,271	3,143					1,301		17,507		18,808						
304(1)	Subbase Grading "A"	Ton	803	2,581	1,719	1,389	1,391	1,753	1,661	1,515	1,216	1,414	4,189					1,254		18,377		19,631						
401(4)	Anti-Stripping Additive	C. S.																All Req'd		All Req'd		All Req'd						
401(1)	Hot Asphalt Pavement	Ton	566	1,924	2,035	1,792	1,502	1,473	1,400	1,366	1,206	1,228	2,245					794		15,913		16,707						
401(2)	AC-5 Asphalt Cement	Ton	33.96	115.44	122.10	107.52	90.12	88.38	84.00	80.16	72.36	73.68	134.70					47.64		954.78		1,002.42						
402(2)	CSS-1 Cationic Emulsified Asphalt for Tack Coat	Ton	1.11	1.44	1.58	1.58	1.58	1.58	1.58	1.58	1.48	1.48	6.78					1.57		20.20		21.77						
403(1)	MC-30 Liquid Asphalt for Prime Coat	Ton	1.89	8.20	7.14	5.86	6.00	6.81	6.27	5.82	5.28	5.35	9.17					3.45		64.34		67.79						
505(11)	Structural Steel Piles, Furnished	L. F.					480											0		480		480						
508(1)	Loop Road P. O. C. Substructure	L. S.																		All Req'd.		All Req'd.						
508(2)	Loop Road P. O. C. Superstructure	L. S.																		All Req'd.		All Req'd.						
555(1)	Contractor Designed Bike Path	Sta.		4.54	30.16	30.00	30.00	30.00	29.98	30.02	28.00	28.00	6.00					0		246.70		246.70						
602(2J)	Structural Plate Pipe Arch 6'-4" x 4'-9"	L. F.			132												0		132		132							
603(22C)	12" Pipe Conduit	L. F.		96	40			76	136	124	0	238					0		710		710							
603(22E)	18" Pipe Conduit	L. F.		88	54			130	142	56	48	130	64				0		712		712							
603(22G)	24" Pipe Conduit	L. F.	144	198	74			254	294		196		62				240		982		1,222							
604(5)	Type A Inlet	Ea.		2													0		2		2							
607(3)	6' Chain Link Fence	L. F.					550	140									0		690		690							
607(4)	Reconstructed Fence	L. F.		1,405													0		1,405		1,405							
610(1)	Hand-Laid Rock Embankment	C. Y.											17					0		17		17						
614(1)	Survey Monuments	Ea.	2	0	5	3	2	7	3	4	2	3	0					2		29		31						
614(2)	Monument Cases	Ea.	2	0	5	3	2	7	3	4	2	3	0					2		29		31						
615(1)	Standard Sign	Sq. Ft.	40.50	291.85	38.20	0	59.10	97.45	77.40	58.65	49.55	103.15	90.20					105.50		800.55		906.05						
618(1)	Seeding	M. Sq. Ft.	92.99	213.36	63.02	59.20	68.60	48.25	47.10	76.15	96.95	82.80	278.16					129.19		997.39		1,126.58						
618(2)	Water for Maintenance	M. Gal.	8	19	6	5	6	4	4	7	9	7	25					11		89		100						
627(1)	Watering	M. Gal.	24	12	9	9	9	9	9	9	9	9	92					24		176		200						
660(1)	Traffic Signal System Complete	L. S.																All Req'd		All Req'd		All Req'd.						
660(3)	Highway Lighting System Complete	L. S.																All Req'd		All Req'd		All Req'd.						

STATE	PROJECT DESIGNATION	YEAR	SHEET NO.	TOTAL SHEETS
ALASKA	RS-0960(1) & RS-0966(8)	1977	4	40

APPROACH SUMMARY


STATION	Lt.	Rt.	WIDTH	RADIUS	REMARKS
"0" 10+54		x	14'		See Standard Drawing I-40.10
"0" 11+67		x	14'		
"0" 14+19		x	14'		
"0" 15+45		x	24'		
"0" 23+15		x	28'	25'	Hurlock Ave.
"0" 32+57		x	28'	25'	Atlin Ave.
"0" 34+00		x	22'		See Standard Drawing I-40.10
"0" 38+71	x		28'		& Approach Detail This Sheet
"0" 47+20		x	14'		
"0" 49+51		x	14'		
"0" 68+17		x	14'	25'	
"0" 68+35	x		14'		
"0" 71+31	x		14'		
"0" 75+85		x	20'		
"0" 84+78		x	20'		
"0" 85+30; 110' Lt.	x		20'		
"0" 85+52	x		22'		
"0" 86+28	x		24'		
"0" 89+00	x		14'		
"0" 89+34		x	14'		
"0" 90+08	x		22'		
"0" 92+62	x		18'		
"0" 94+60		x	14'		
"0" 95+22	x		20'		
"0" 104+96		x	24'		
"0" 106+00		x	24'		
"0" 109+24		x	14'		
"0" 109+84	x		24'		
"0" 115+00		x	14'		
"0" 115+05	x		22'		
"0" 116+45	x		22'		
"0" 117+14	x		14'		
"0" 117+81	x		14'		
"0" 117+90		x	14'		
"0" 120+42	x		14'		
"0" 127+27		x	14'		Taku Blvd.
"0" 127+39	x		24'		
"0" 136+83	x		14'		
"0" 142+84		x	20'		
"0" 145+79		x	14'		
"0" 147+08		x	14'		
"0" 147+72	x		14'		
"0" 148+64		x	14'		
"0" 149+19	x		28'	25'	Counterpane Lane
"0" 151+70	x		20'		
"0" 152+60	x		20'		
"0" 155+00	x		20'	25'	Gladstone St.
"0" 155+90		x	28'	25'	Gladstone St.

MONUMENT SUMMARY

STATION	Monument	CASE	POINT MONUMENT
"0" 09+46.46	x	x	P.I.
"0" 17+45.82	x	x	P.I.
"0" 37+41.67=	x	x	P.O.C.
"A" 50+00.00			P.O.T.
"0" 37+49.40	x	x	P.I.
"0" 41+68.04	x	x	P.C.
"0" 44+14.00=	x	x	P.O.C.
"B" 50+00.00			P.O.T.
"0" 48+23.22	x	x	P.T.
"0" 54+90.72	x	x	P.C.
"0" 61+50.45	x	x	P.T.
"0" 64+73.52	x	x	P.C.
"0" 70+00.00	x	x	P.O.C.
"0" 78+23.91=	x	x	P.O.C.
"C" 50+00.00			P.O.T.
"0" 81+57.68=	x	x	P.O.C.
"D" 50+00.00			P.O.T.
"0" 84+44.83	x	x	P.I.
"0" 81+99.40=	x	x	P.O.C.
"E" 50+00.00			P.O.T.
"0" 87+12.08=	x	x	P.O.C.
"F" 50+00.00			P.O.T.
"0" 91+35.89=	x	x	P.O.C.
"G" 50+00.00			P.O.T.
"0" 92+94.95=	x	x	P.O.C.
"H" 50+00.00			P.O.T.
"0" 94+48.29	x	x	P.I.
"0" 95+98.17=	x	x	P.O.C.
"I" 50+00.00			P.O.T.
"0" 100+44.66=	x	x	P.O.C.
"J" 50+00.00			P.O.T.
"0" 101+41.74	x	x	P.T.
"0" 112+33.00=	x	x	P.O.C.
"N" 50+00.00			P.O.T.
"0" 112+43.93=	x	x	P.O.C.
"P" 50+00.00			P.O.T.
"0" 114+00.50	x	x	P.I.
"0" 121+92.35=	x	x	P.O.T.
"Q" 50+00.00			P.O.T.
"0" 125+28.36=	x	x	P.O.T.
"R" 50+00.00			P.O.T.
"0" 138+76.50=	x	x	P.O.T.
"S" 50+00.00			P.O.T.
"0" 142+09.82	x	x	P.I.
"0" 144+77.47=	x	x	P.O.T.
"T" 50+00.00			P.O.T.
"0" 150+28.36=	x	x	P.O.T.
"U" 50+00.00			P.O.T.


MAILBOX SUMMARY

STATION	Lt.	Rt.	NO. OF BOXES	REMARKS
"0" 11+30		x	2	See Detail This Sheet
"0" 31+75		x	4	
"0" 84+95		x	1	
"0" 89+40		x	1	
"0" 89+95		x	1	
"0" 90+80	x		7	
"0" 92+40		x	7	
"I" 50+70	x		19	
"0" 105+40		x	1	
"0" 111+60		x	23	
"0" 115+15		x	1	
"0" 116+85		x	2	
"0" 118+10		x	1	
"0" 121+30		x	7	
"0" 147+40	x		1	
"0" 148+60		x	1	See Detail This Sheet
"0" 148+80	x		4	

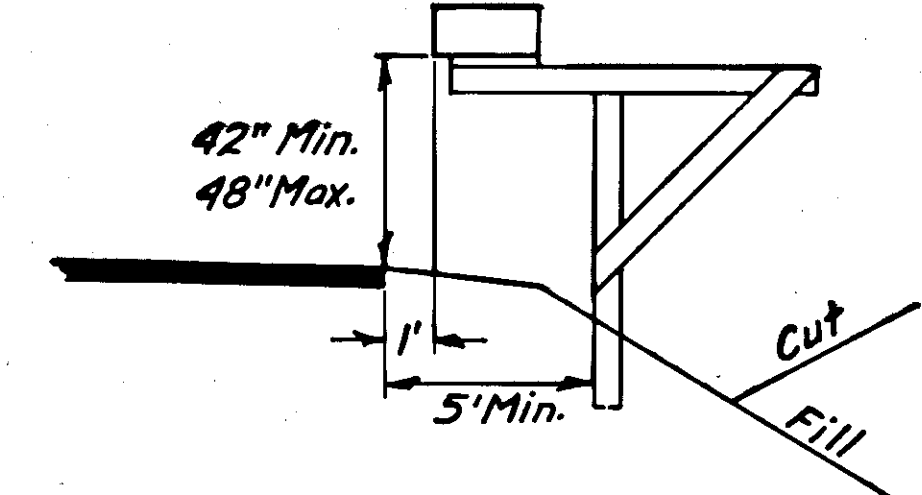

- Notes:
- Existing mailboxes are as shown on the Plan & Profile sheets.
 - Permanent mailbox locations shall be as shown in the table or as directed by the engineer.
 - Newspaper receptacles shall be placed as directed by the engineer.
 - See standard drawing M-23.00 for more details.

MAILBOX REPLACEMENT DETAIL

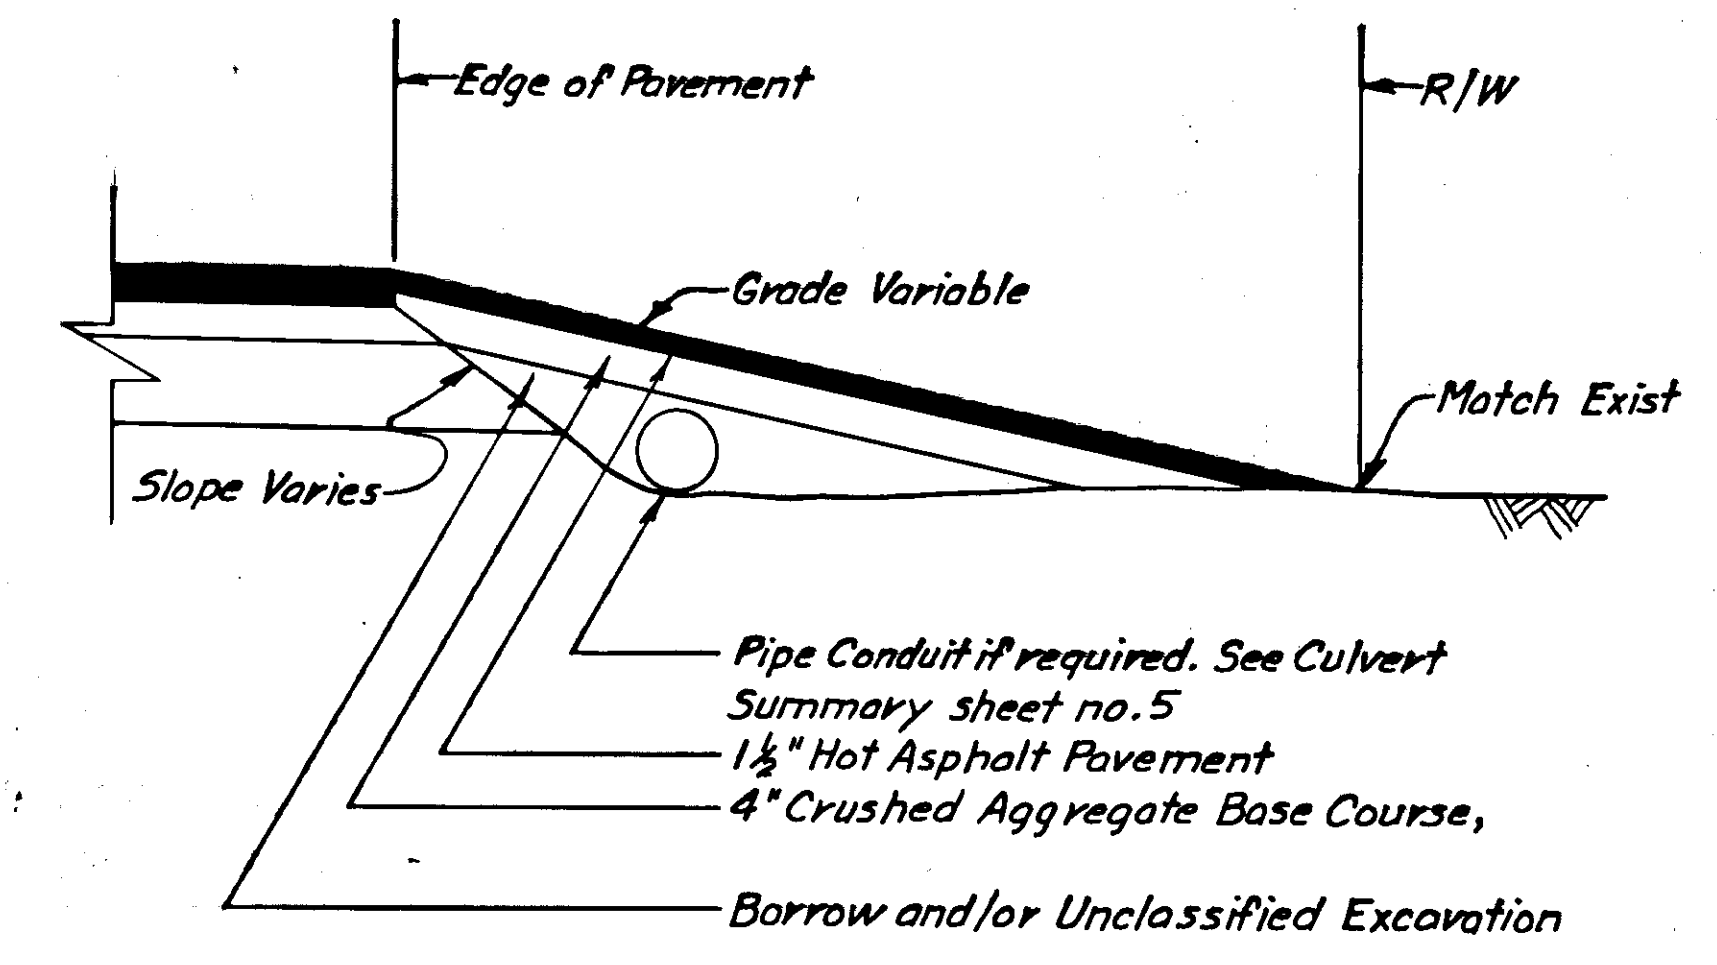

- Notes:
- All Residential Approaches shall be constructed with the materials as detailed above.
 - All street approaches shall be constructed the same as the traveled way.

APPROACH DETAIL

TABLE OF FILL SLOPE

STATION	Lt.	Rt.	STATION	Lt.	Rt.
"0" 09+09			"0" 186+50		
"0" 11+00	3:1	4:1	"0" 187+00	2:1	3:1
"0" 12+50	2:1	4:1	"0" 204+58	4:1	4:1
"0" 15+50	3:1	4:1	"0" 204+74	4:1	4:1
"0" 20+50	4:1	4:1	"0" 205+00	4:1	3:1
"0" 22+80	3:1	4:1	"0" 205+32	3:1	3:1
"0" 25+04	2:1	4:1	"0" 205+44	2:1	3:1
"0" 26+32	Egan Drive	-----	"0" 206+00	2:1	4:1
"0" 29+60	2:1	4:1	"0" 207+61	3:1	4:1
"0" 32+55	3:1	4:1	"0" 209+91	4:1	4:1
"0" 34+40	4:1	4:1	"0" 210+75	4:1	2:1
"0" 38+00	2:1	4:1	"0" 215+50	4:1	4:1
"0" 172+00	4:1	4:1	"0" 215+60	4:1	4:1
"0" 172+75	3:1	4:1	"0" 215+73	3:1	4:1
"0" 173+00	4:1	4:1	"0" 216+80	2:1	4:1
"0" 173+50	4:1	3:1	"0" 217+00	4:1	4:1
"0" 179+00	4:1	4:1	E. O. P.		
"0" 180+00	3:1	4:1			
"0" 185+50	4:1	4:1			
"0" 186+00	3:1	3:1			
	2:1	3:1			

CULVERT SUMMARY

STATION	INSTALL						REMARKS
	REMOVAL & DISPOSAL OF CULVERTS	12" PIPE CONDUIT	18" PIPE CONDUIT	24" PIPE CONDUIT	36" PIPE CONDUIT	6'-0" x 4'-9" PIPE ARCH	
"0" 10+00					12' 68"		3'
"0" 12+50 17					12' 80"		4'
"0" 21+50					86' 77"		3'
"0" 24+50 50					18' 5"		1'
"0" 28+20					182' 104"		6'
"0" 32+50		50'					1'
"0" 50+26		34'					Rest of pipe paid for under Bike Path (12')
"0" 34+00		48' 34"					1'
"0" 36+72					48' 57"		10 ga. Extend Rt.
"A" 50+52 55			54' 58"				& Lt. See General Note No. 3
"0" 41+68				74' 83"			2'
"0" 49+03					84'		10 ga. Extend Rt.
"0" 49+50		40'					& Lt. , Skew 30° Lt. Ahd. See General Note No. 3
"C" 50+45			130'				
"E" 50+45 36			42' 55"				1'
"0" 85+28				118' 105"			3'
"0" 85+38 28				30'			1'
"F" 50+40	46'						1'
"0" 50+45			60'				1'
"0" 91+15				114' 104"			4' Skew 11° Lt. Bk.
"0" 118+20		74'					1'
"0" 92+62		40'					1'
"H" 50+45 35			48' 50"				1'
"0" 94+68 40		36' 25"					1'
"J" 50+75	28'						1'
"J" 50+75				56'			1'
"J" 50+90	30'						1'
"0" 120+23		30'					1'
"J" 50+90		38' 40"					1'
"0" 102+25				96'			2'
"0" 104+96		36'					1'
"0" 106+00		36'					1'
"0" 109+48				142' 148"			1' Skew 45° Lt. Bk.
"0" 109+53	42'						
"0" 146+09		30'		29'			1'
"0" 109+84		34'					1'
"P" 50+32			56' 60"				1' Skew 6° Lt. Bk.
"0" 115+00		40'					1'
"0" 116+45		36'					1'
"0" 117+14		24'					1'
"0" 117+90		24'					1'
"0" 130+04 131+04	46'						3'
"0" 130+04 131+04				116' 114"			1'
"S" 50+45 49			48' 54"				1'
"0" 140+57				80'			1'
"0" 142+84		34'					1'
"T" 50+36			12'				1' Extend Rt.
"0" 145+79		34'					1'
"0" 129+00 other							Backfill Daily
"0" 147+08		34'					1'
"0" 147+72		34'					1'
"0" 148+64		34'					1'
"0" 149+19			60'				1'
"U" 50+45 60			58' 56"				1'
"0" 151+70		34'					1'
"0" 172+10				6'			1'
"0" 152+60		34'					1'
"0" 161+90				12' 38"			1' Extend Rt. & Lt. , Skewed Lt. Ahd.
"0" 164+74				16' 27"			1' Extend Rt. & Lt.
"0" 168+76 86			20'				1' Extend Rt. & Lt.
"0" 170+79 77			12' 11"				1' Extend Rt. & Lt.
"0" 179+80 180+00			16'				1' Extend Rt. , Skewed Lt. Ahd.
"0" 205+55				12'			Paid for under hand laid rock wall
"0" 210+41 40				18' 30"			1' Extend Rt. & Lt.
"0" 211+15 14			14' 8"				1' Extend Rt. & Lt.
"0" 212+86			18' 7"				1' Extend Rt. & Lt.
"0" 131+20				114'			
Storm Sewer Totals			88' 87"				See Drainage Pipe Schedule on Sheet No. 18
"0" 113+00			28'				EWO #2 Bus Stop
"0" 125+00		30'					EWO #5 Bus Stop

STATE	PROJECT DESIGNATION	YEAR	SHEET NO.	TOTAL SHEETS
ALASKA	RS-0960(1) & RS-0966(8)	1977	5	40


BIKE PATH CULVERTS

STATION	OFFSET	12" PIPE	18" PIPE	PIPE ARCH 6'4"x4'9"
0' 29+10	Rt.	18.6		
0' 36+72	Rt. & Lt.			4.0
0' 50+26	Rt. & Lt.	16.0		
0' 91+48	Lt.	15.8		
0' 109+84	Rt.	12.0		
0' 127+88	Lt.	22.2		
0' 134+50	Lt.	15.1		
0' 146+09	Rt.	15.0		
0' 146+09	Lt.	15.0		
0' 139+10	Rt.	30.0		
AS BUILT				
0' 354+00 Ahd.	Rt.	19.8		
0' 356+50 Ahd.	Rt.	16.0		
0' 357+00 Bk.	Rt.		20.0	
0' 357+70 Ahd.	Rt.		18.7	
0' 360+00	Rt.		20.0	
L' 384+50	Rt.		20.1	
L' 388+00	Rt.		20.0	
L' 393+00	Rt.		20.0	

**RS-0960(I) & RS-0966(8)
HORIZONTAL CONTROL**

Bearings for this project are based on Alaska Dept. of Highways Monuments "KEET" & "BING" for the B.O.P.

STATE	PROJECT DESIGNATION	YEAR	SHEET NO.	TOTAL SHEETS
ALASKA	RS-0960(I) & RS-0966(8)	1977	6	40

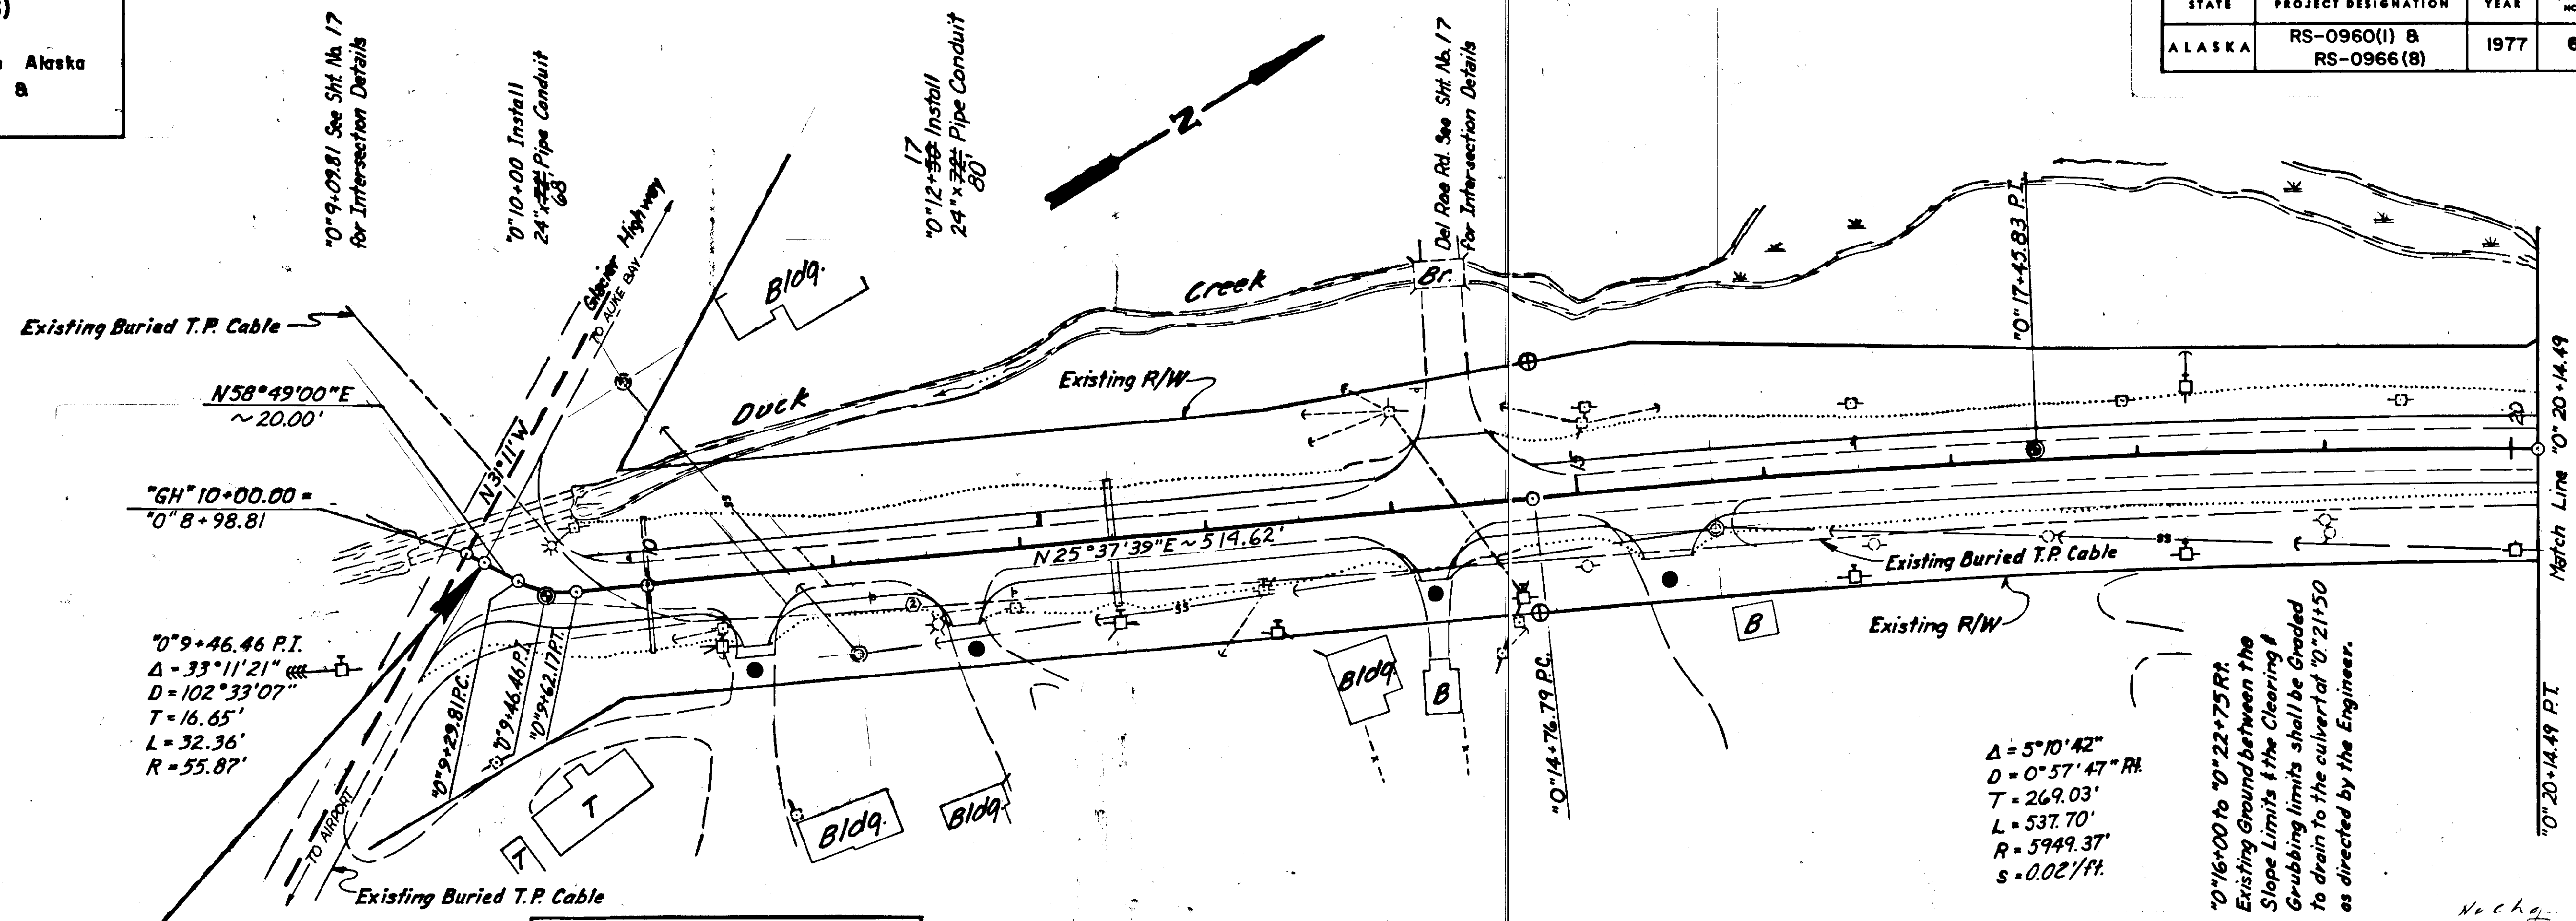

**BEGINNING OF PROJECT
RS-0960(I)
STA. "0"9+09.81**

T.B.M. *10, Spike in Power Pole N.W. Corner of the Intersection of Old Glacier Hwy. and Loop Rd. El. 24.40

- ⊙ Indicates Number of Mail Boxes to be replaced, see sheet no. 4
- Indicates Approaches to be reconstructed, see sheet no. 4

T.B.M. 2L, Concrete Nail near vent of M.H. 20; Elev. 24.42




Earthwork Equation:
 Embankment = Excavation - Waste x Grading Factor + Borrow

Embankment	= 786 Cu. Yds.
Unclassified Excavation	= 334 Cu. Yds. (No Waste)
Borrow	= 814 Tons

**RS-0960(I) & RS-0966(8)
VERTICAL CONTROL**
 Vertical control was derived from U.S.C. & G.S. Benchmark "Airport", a standard disk stamped "Airport 1959", located southeast of the main runway & seaplane landing area, with an elev. of 23.85 M.L.L.W. (U.S.C. & G.S. 1960 Datum).

*0.178% or as directed by the engineer.


NOTES:
 1. All work required to construct "Special Ditches" and "Special Ditch to Culvert Details" shall be incidental to item 203(3) "Unclassified Excavation" and no separate payment shall be made therefore.

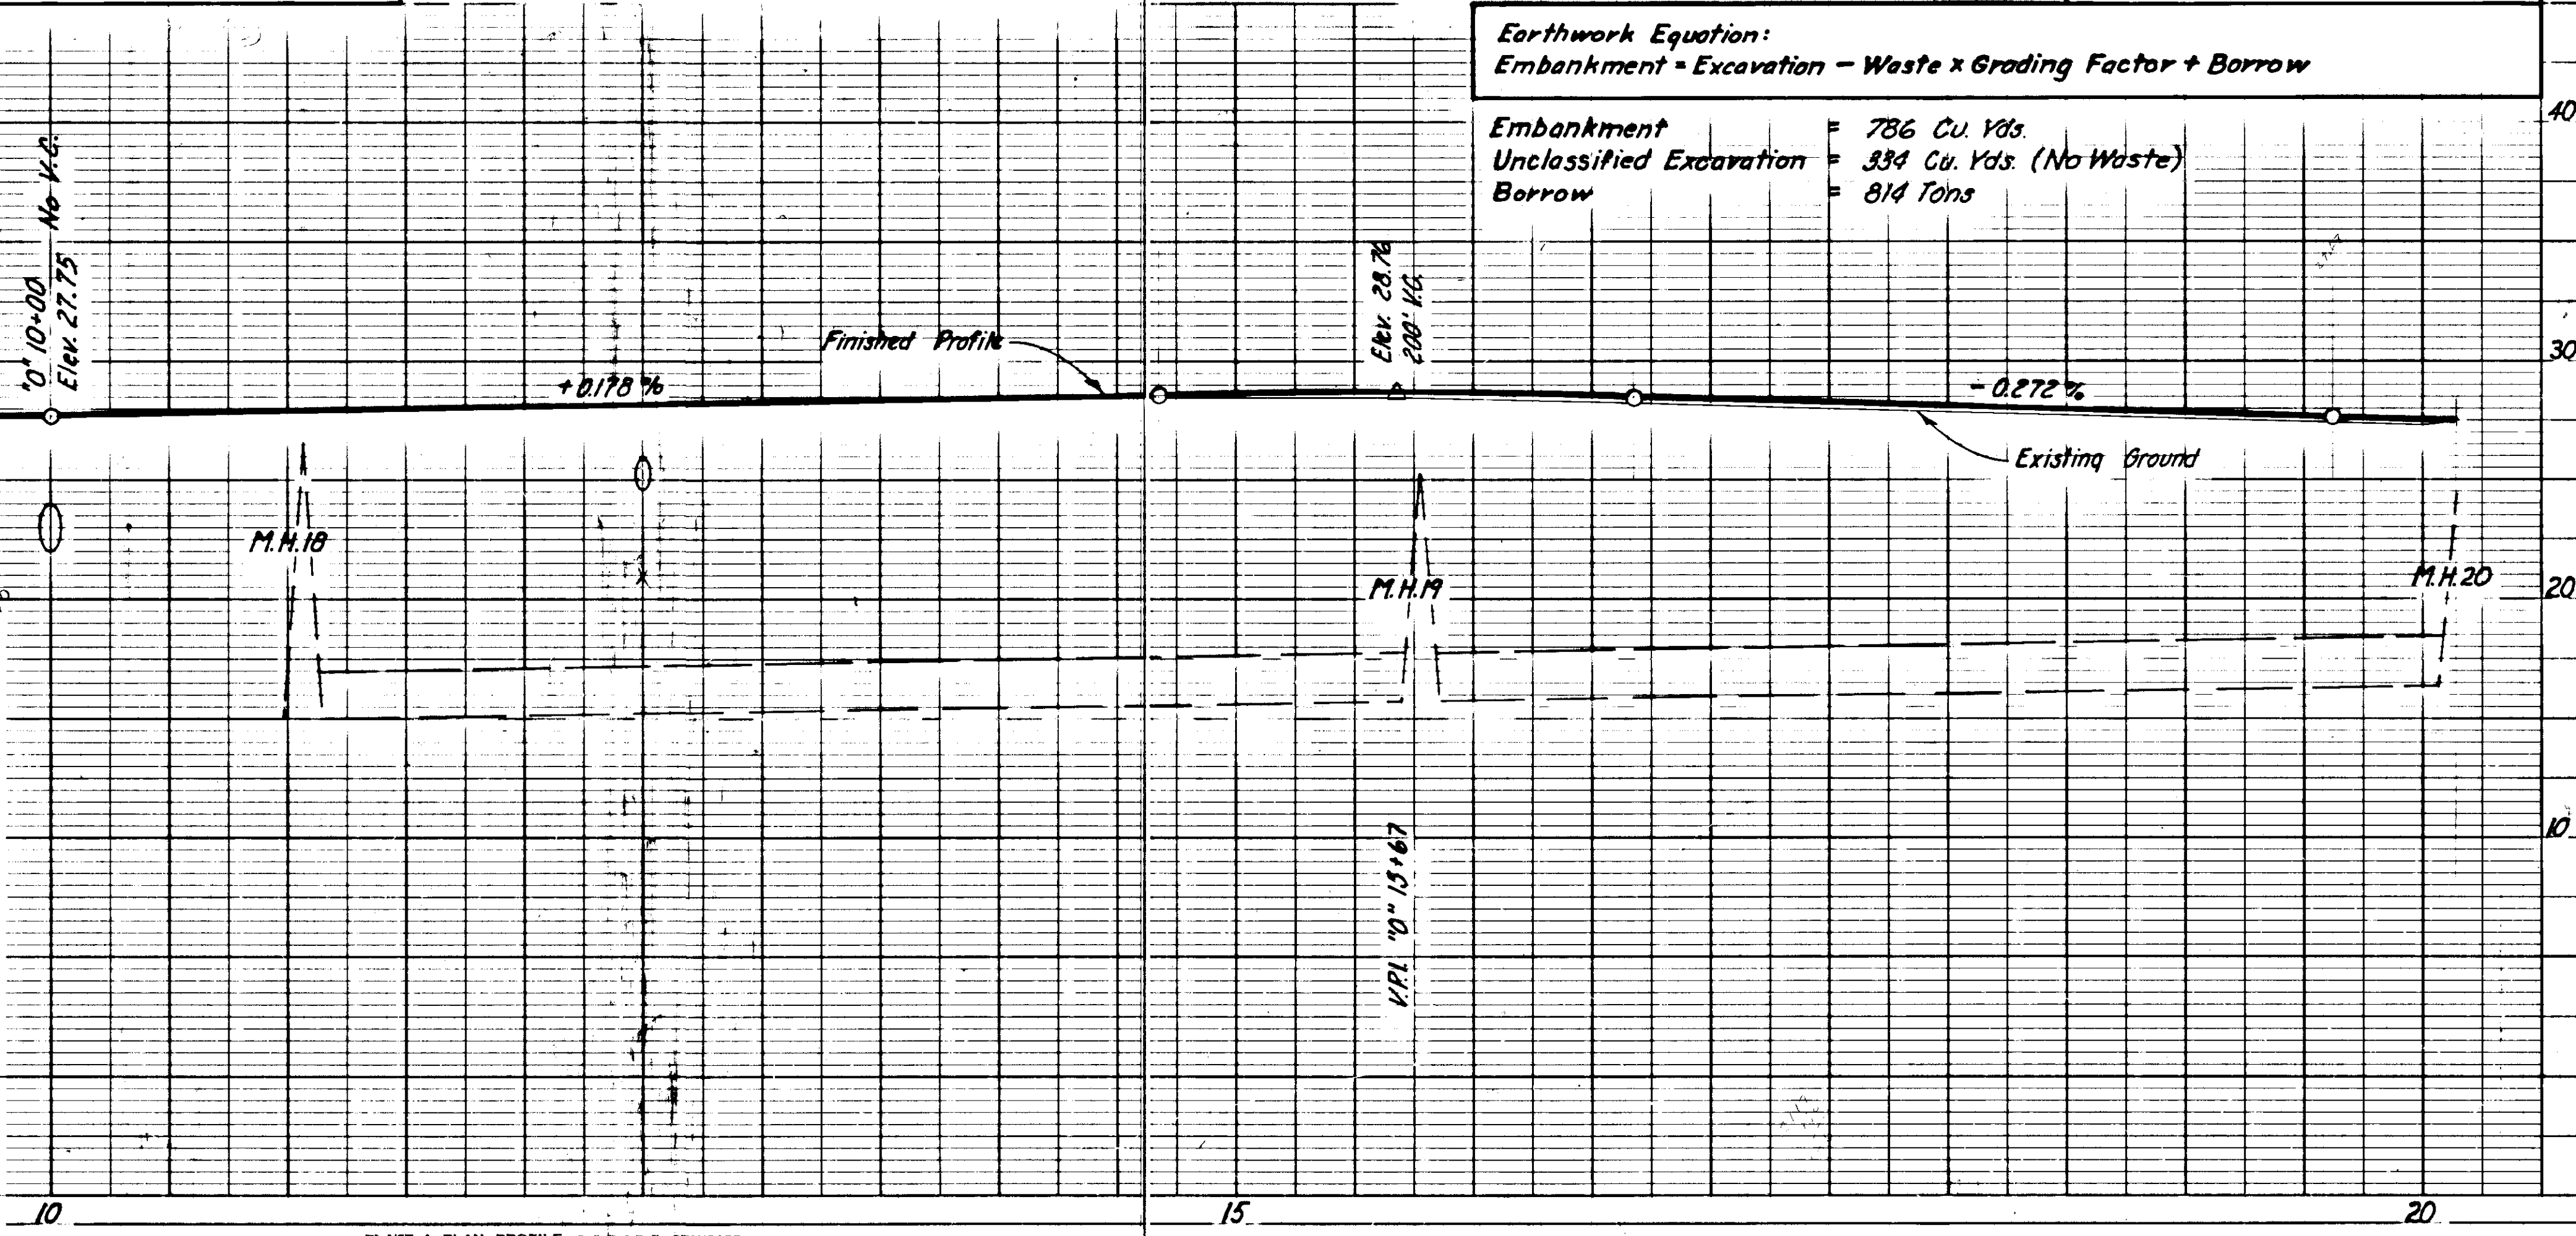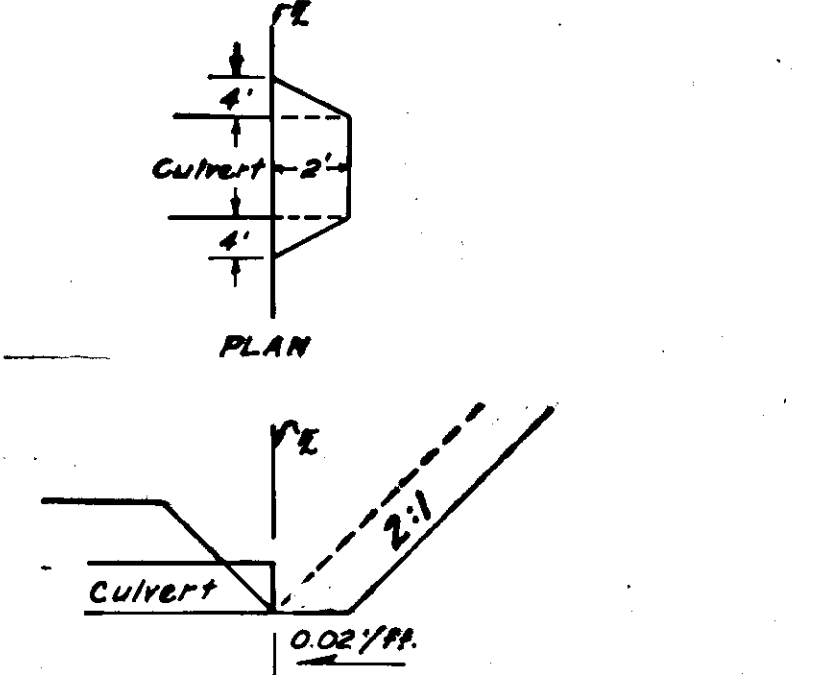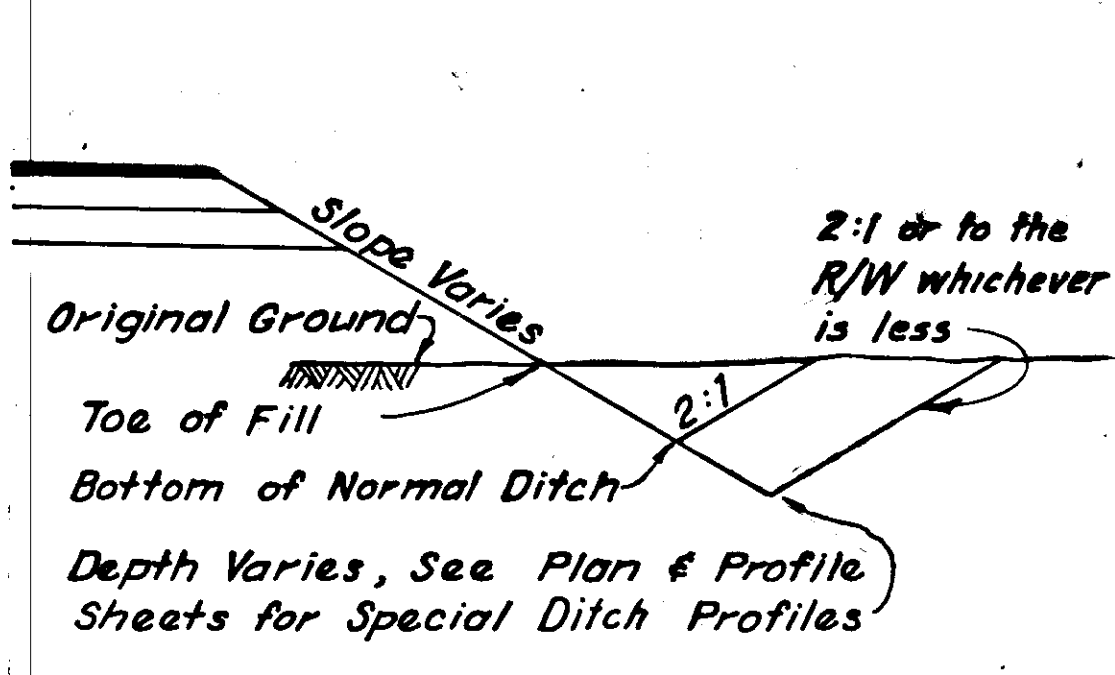

SPECIAL DITCH DETAILS

SPECIAL DITCH TO CULVERT DETAIL


STATE	PROJECT DESIGNATION	YEAR	SHEET NO.	TOTAL SHEETS
ALASKA	RS-0960(I) B RS-0966(8)	1977	7	40

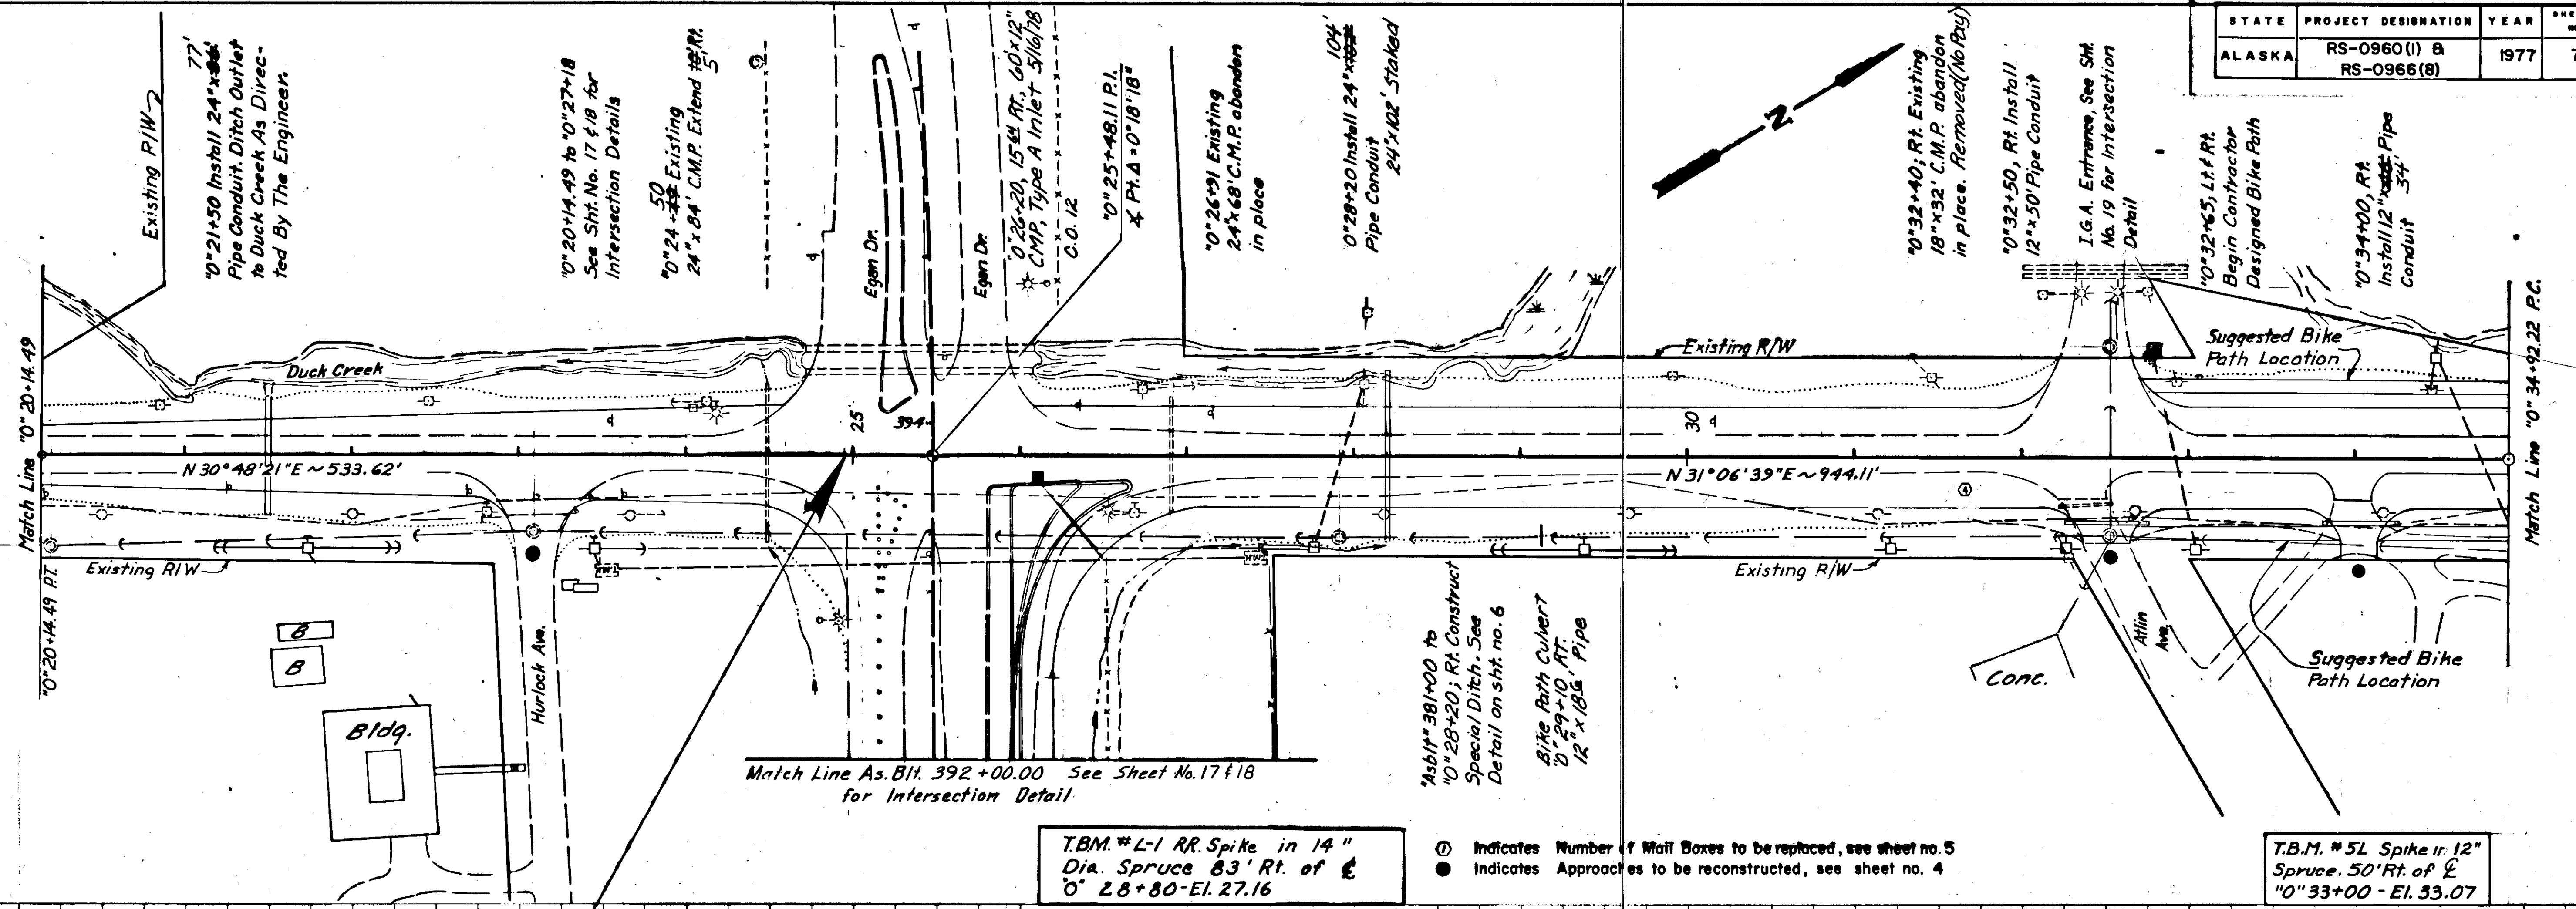


END PROJECT
RS-0960(I)
STA "0" 24+96.00

BEGINNING OF PROJECT
RS-0966(8)
STA. "0" 24+96.00

Roadway
Embankment = 6,030 Cu. Yds.
Unclassified Excavation = 1,593 Cu. Yds. (Includes 1,138 Cu. Yds. Waste)
Borrow = 10,035 Tons

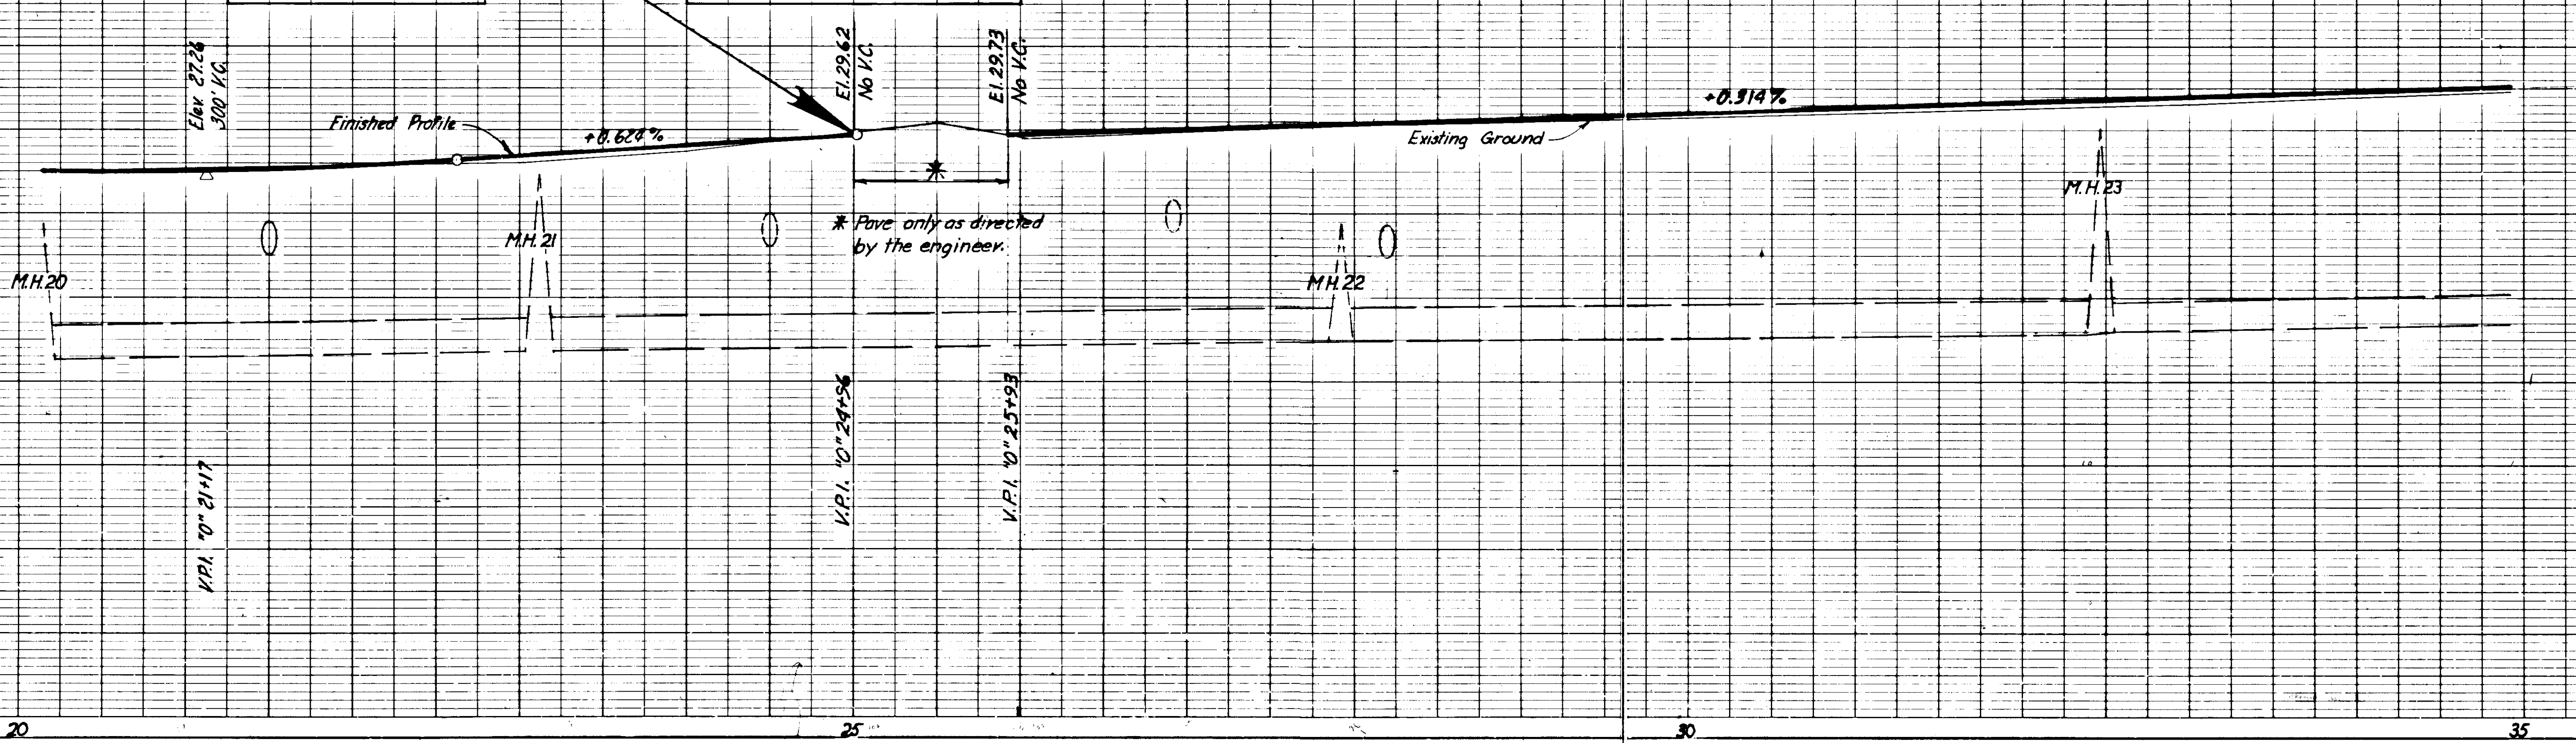

STATE	PROJECT DESIGNATION	YEAR	SHEET NO.	TOTAL SHEETS
ALASKA	RS-0966 (8)	1977	8	40

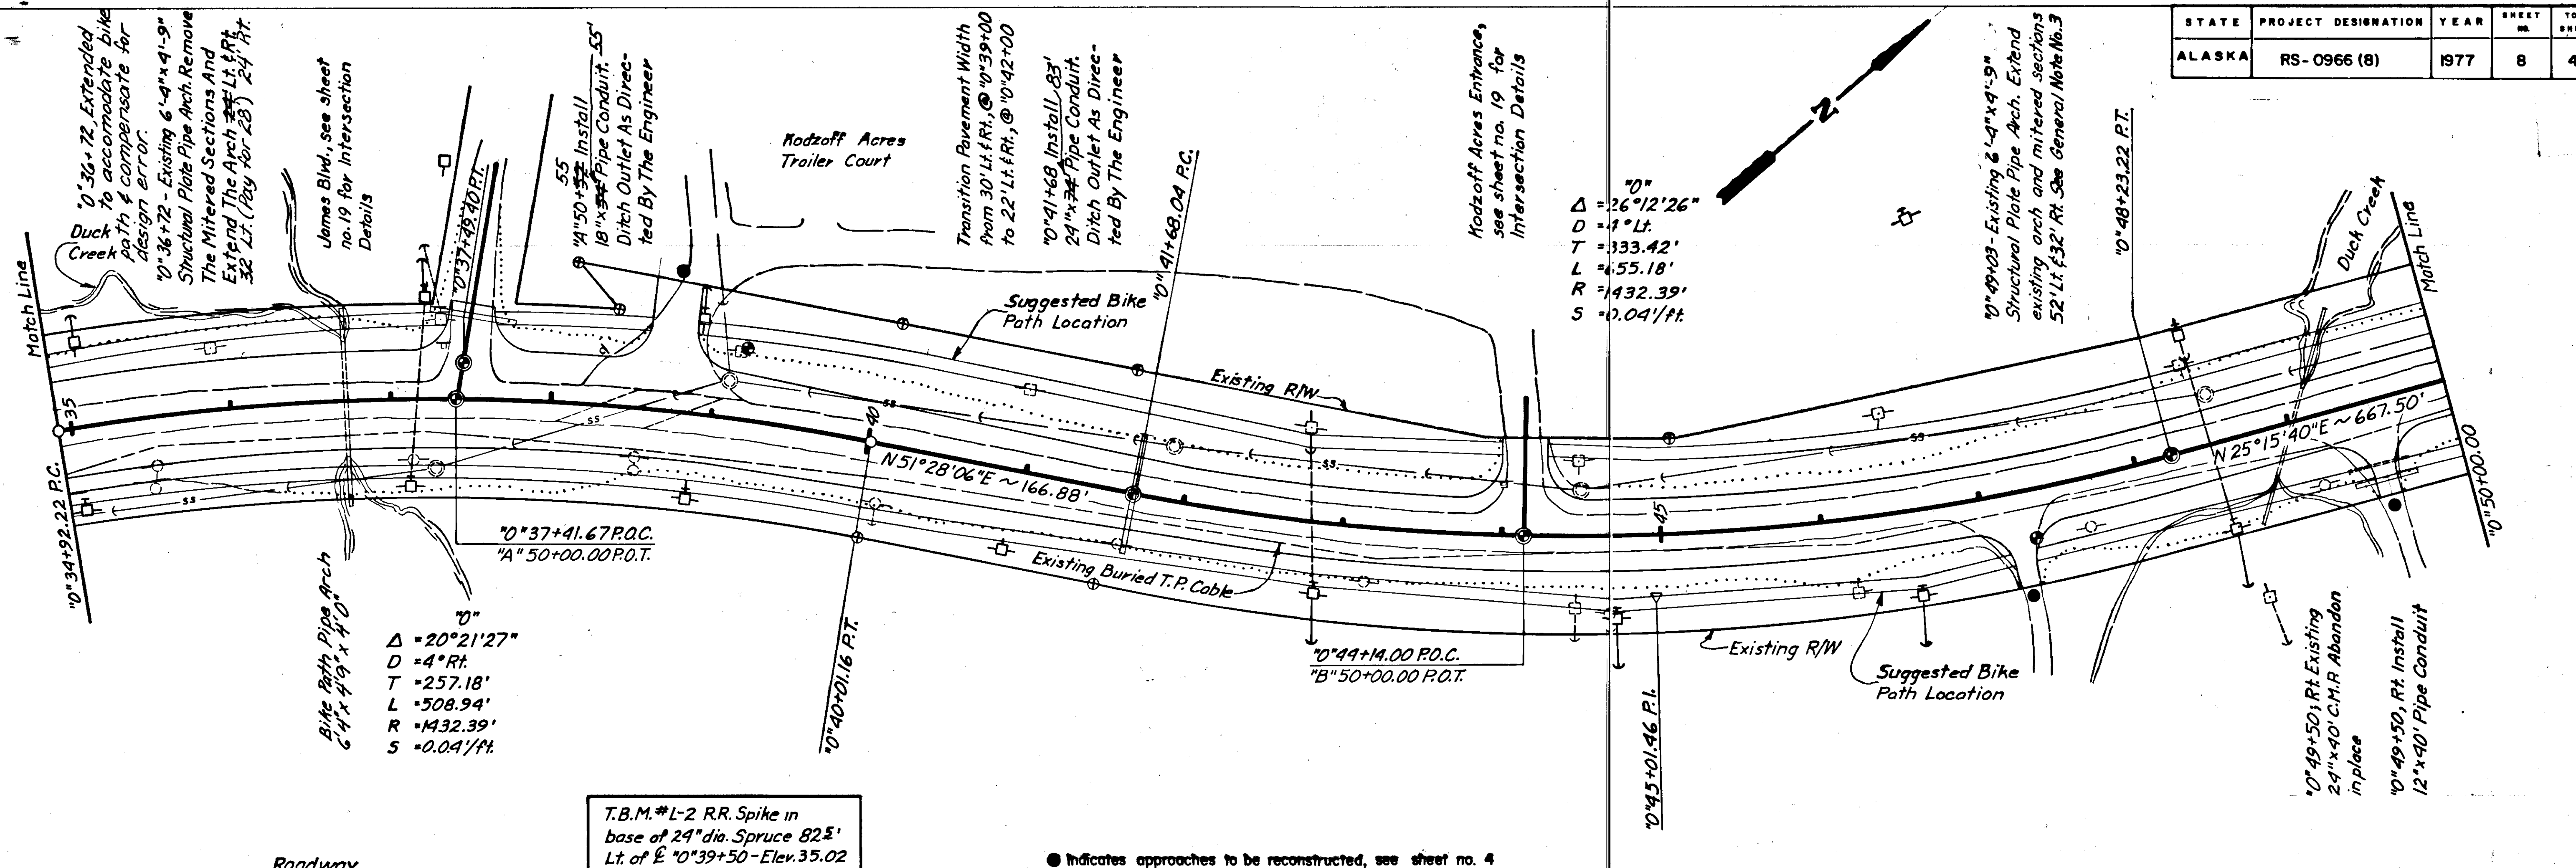


T.B.M. #L-2 RR. Spike in base of 24\" dia. Spruce 82' Lt. of E 0+39+50 - Elev. 35.02


● Indicates approaches to be reconstructed, see sheet no. 4

Roadway


Embankment	3,885 Cu. Yds.
Unclassified Excavation	479 Cu. Yds. (No Waste)
Borrow	6,131 Tons

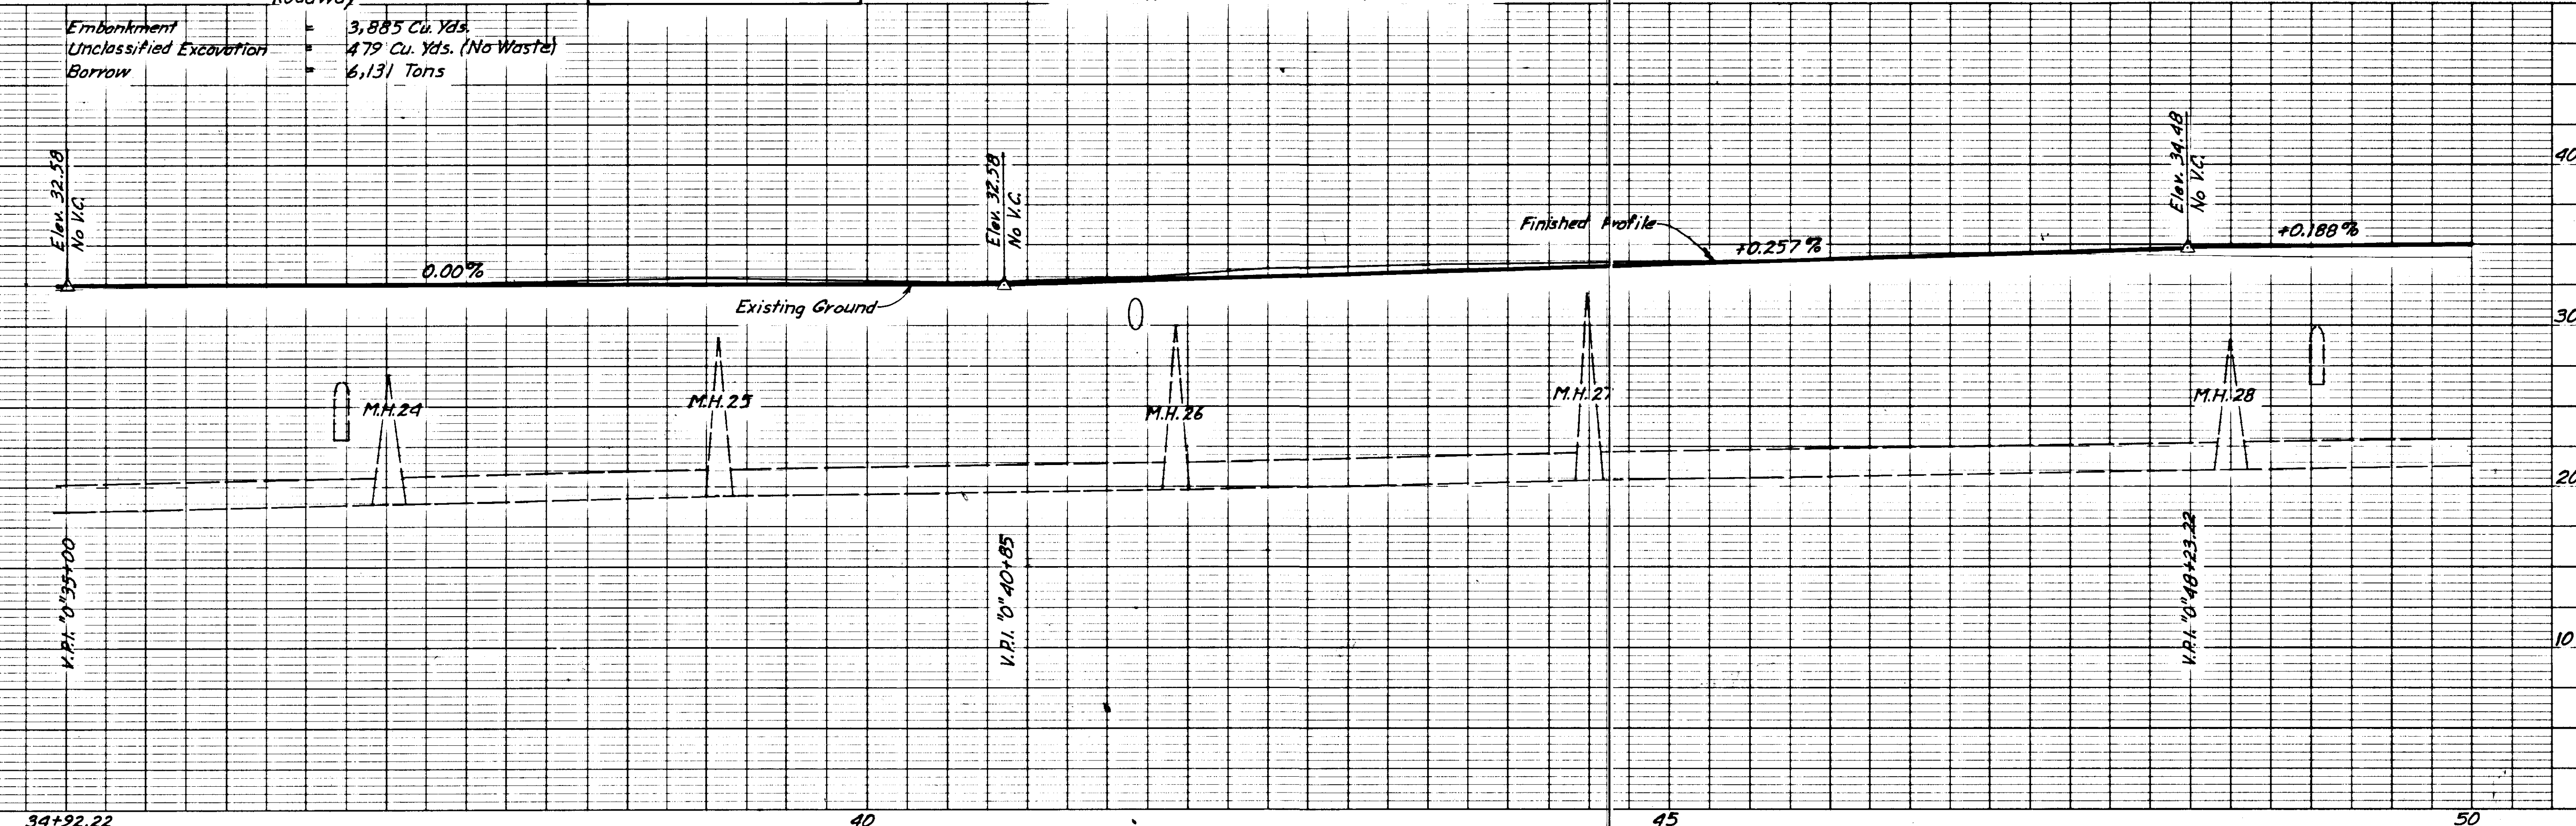


STATE	PROJECT DESIGNATION	YEAR	SHEET NO.	TOTAL SHEETS
ALASKA	RS-0966 (8)	1977	9	40

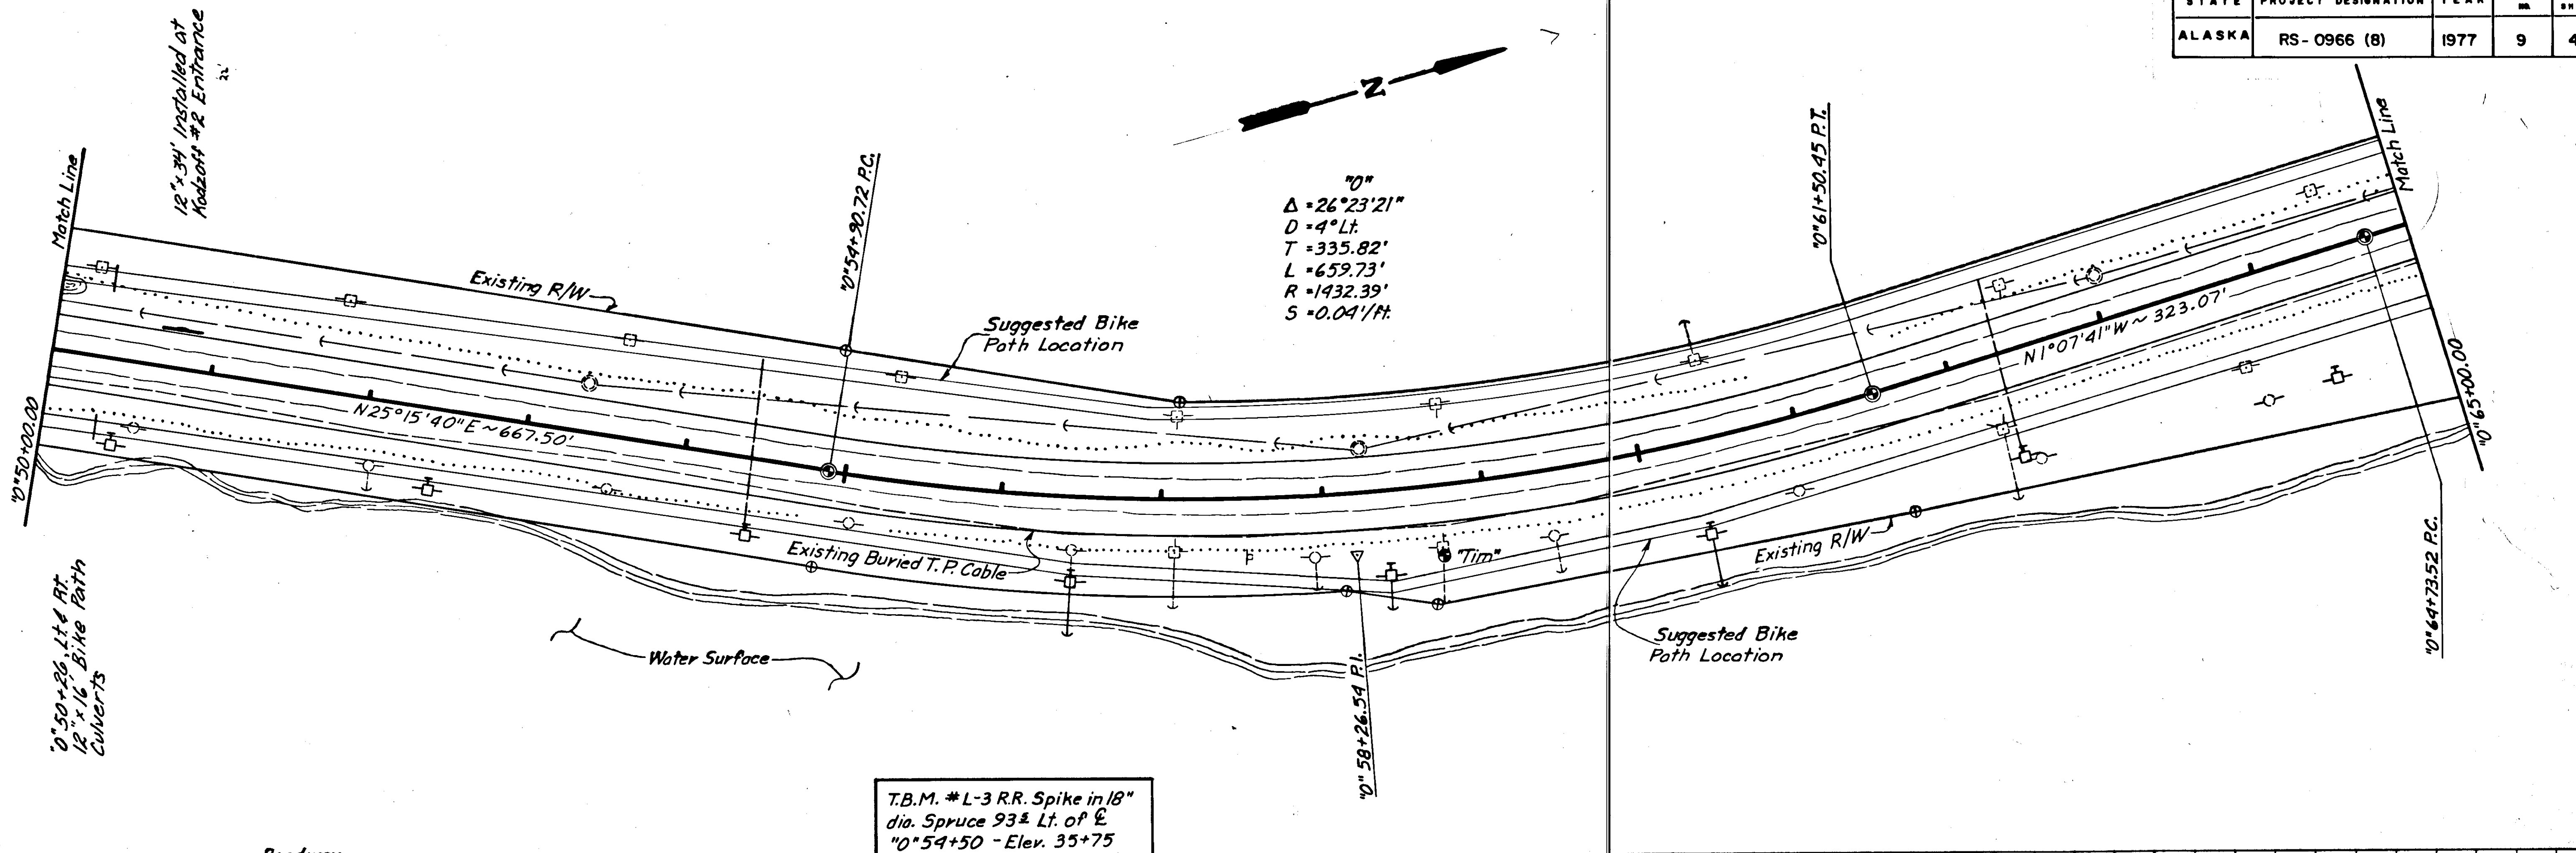


T.B.M. #L-3 R.R. Spike in 18" dia. Spruce 93 \pm Lt. of E
10+54+50 - Elev. 35+75

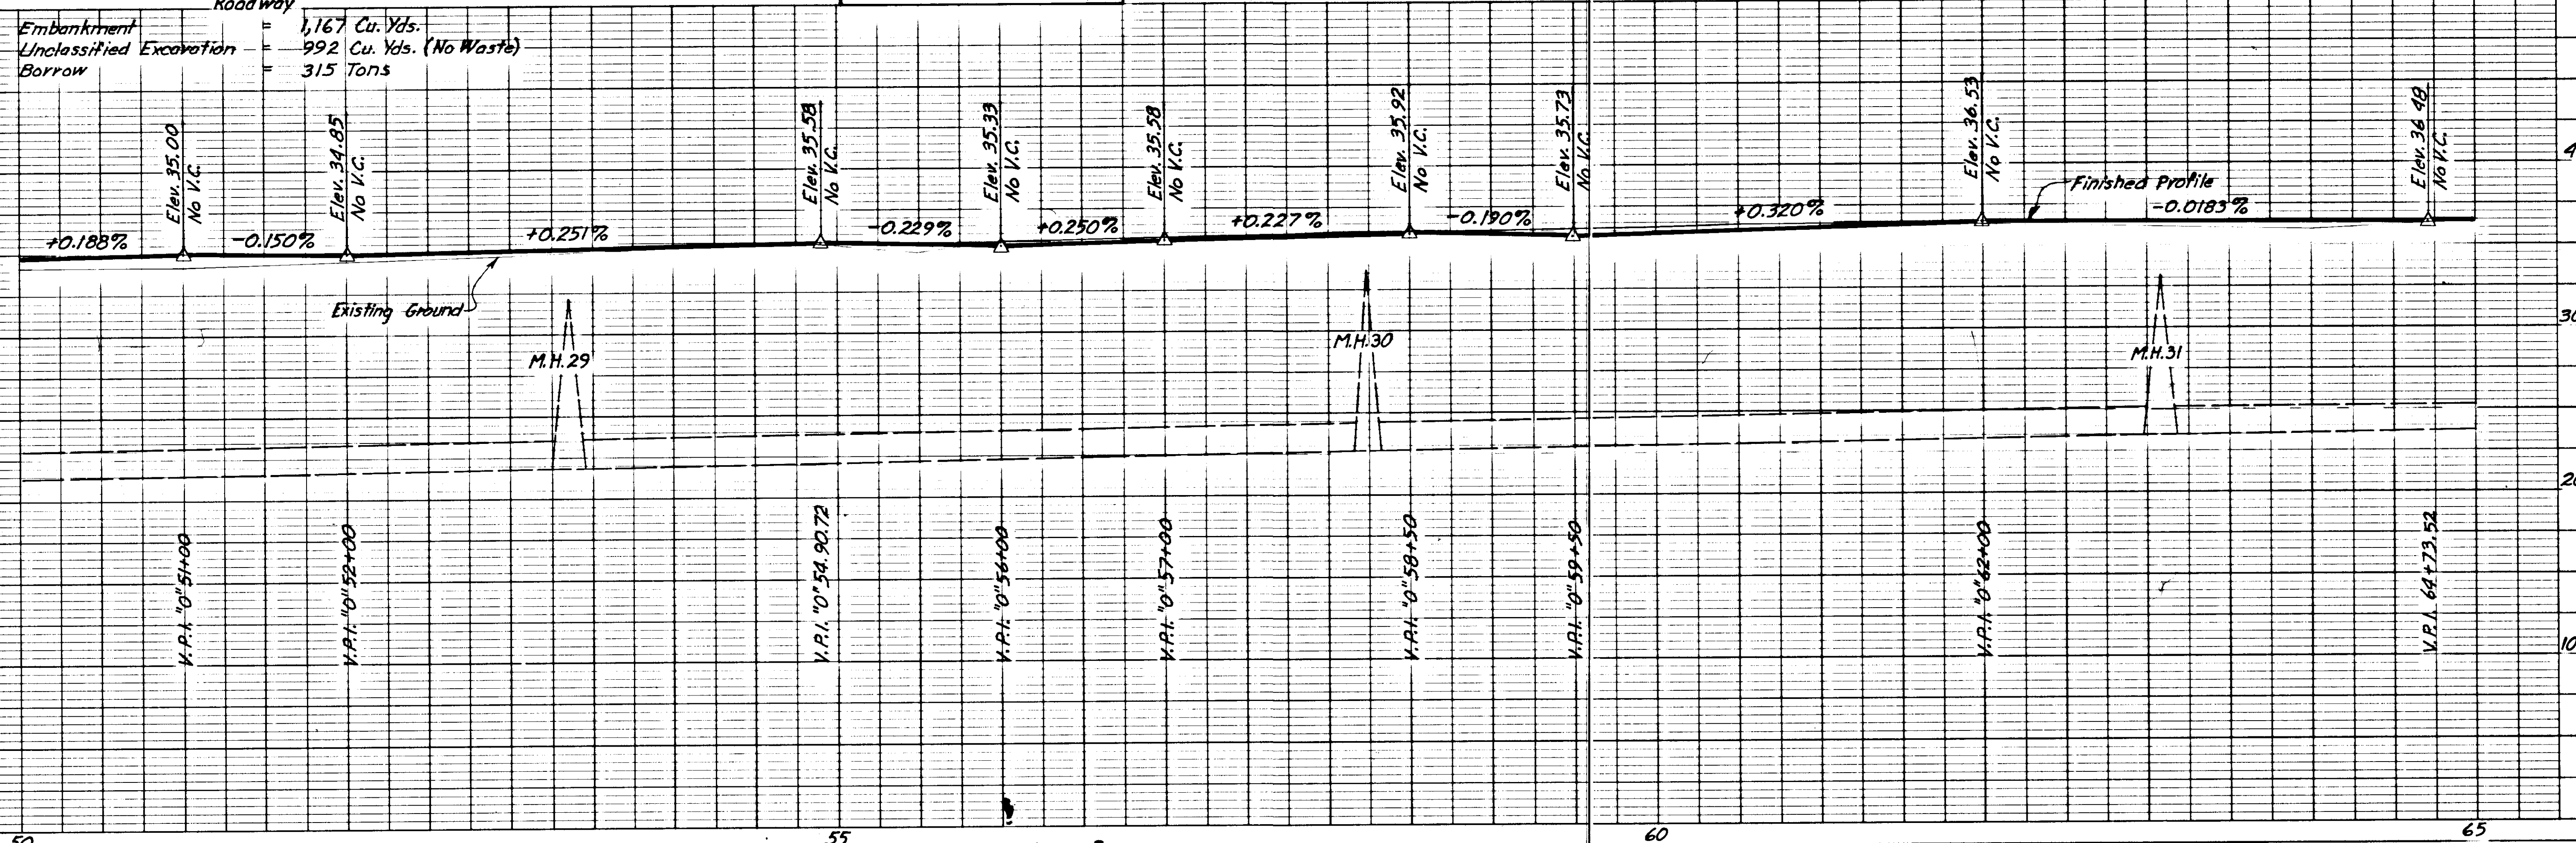



STATE	PROJECT DESIGNATION	YEAR	SHEET NO.	TOTAL SHEETS
ALASKA	RS-0966 (8)	1977	10	40

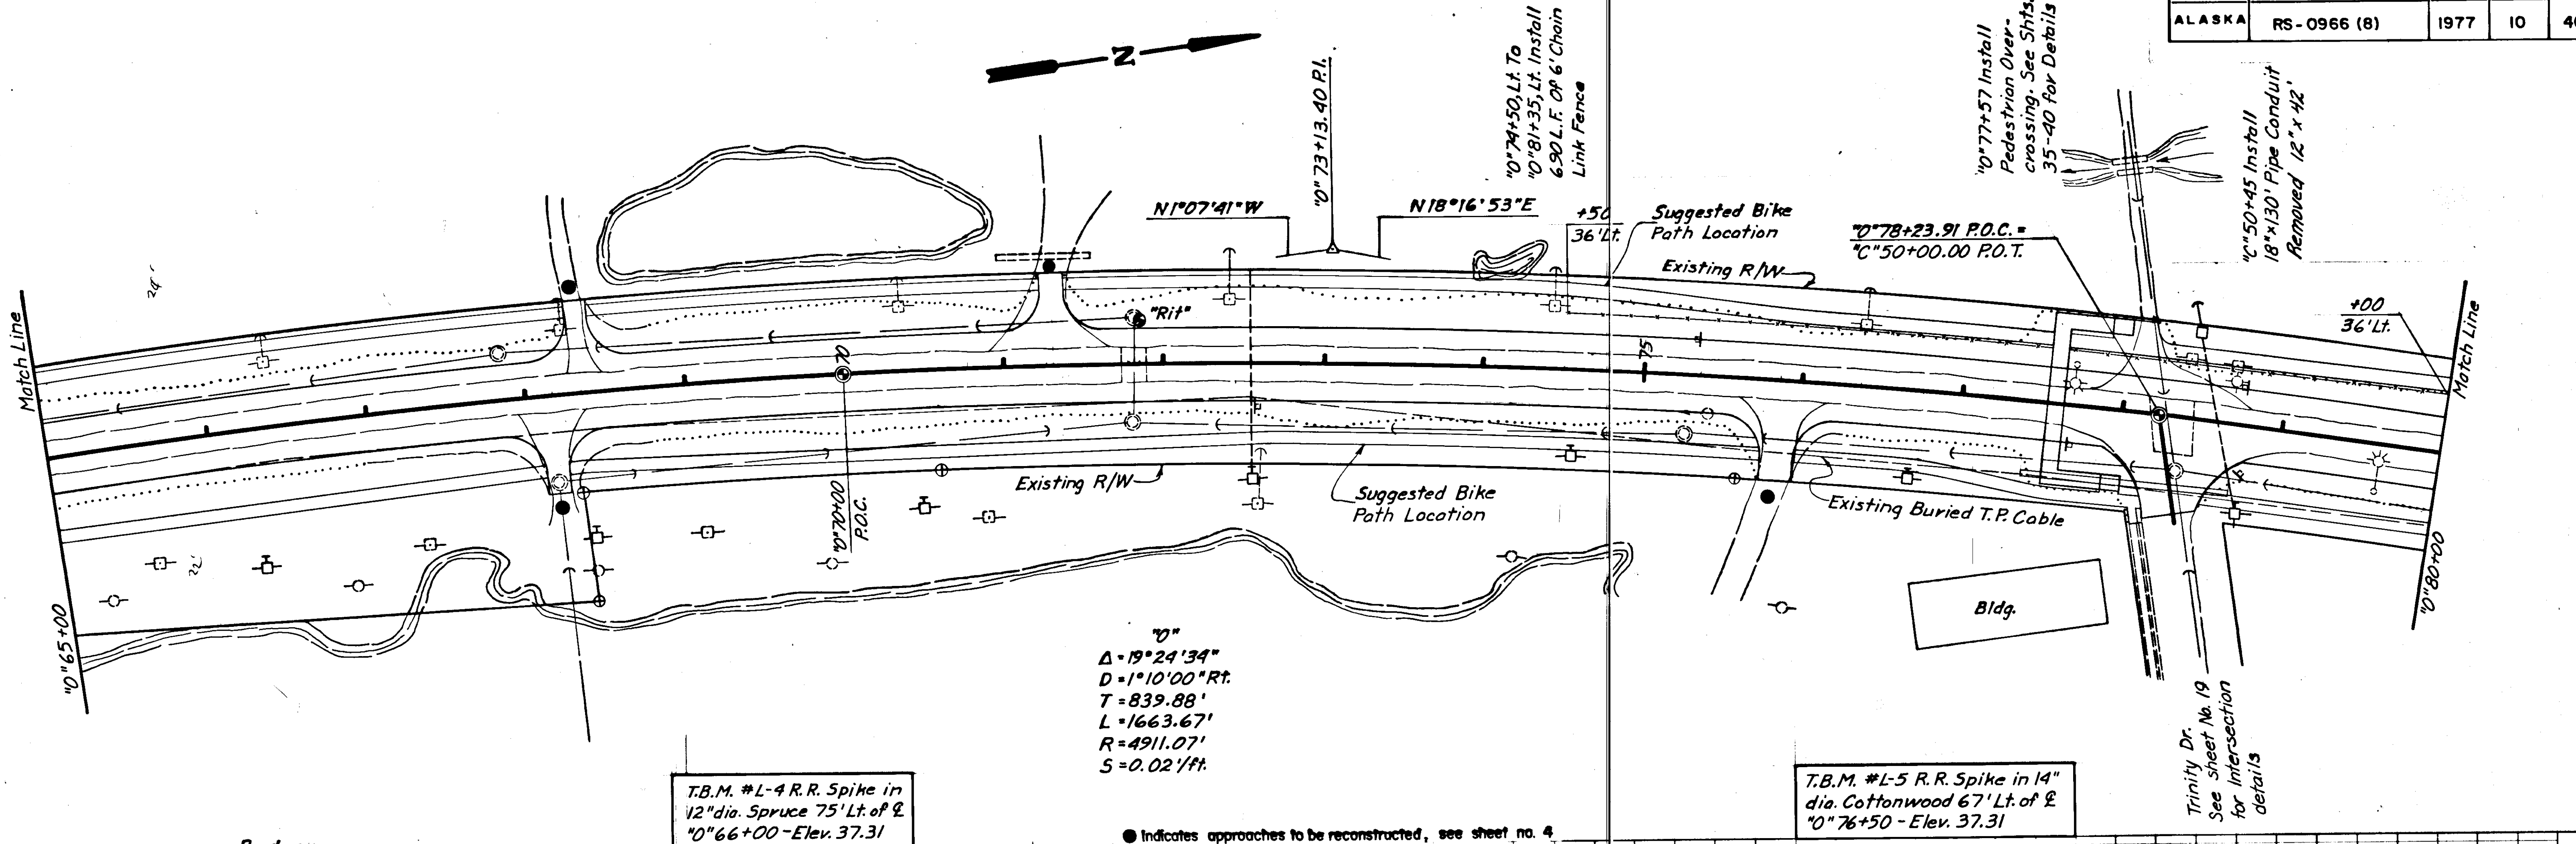

Category	Quantity
Embankment	1,981 Cu. Yds.
Unclassified Excavation	687 Cu. Yds. (No Waste)
Borrow	2,329 Tons

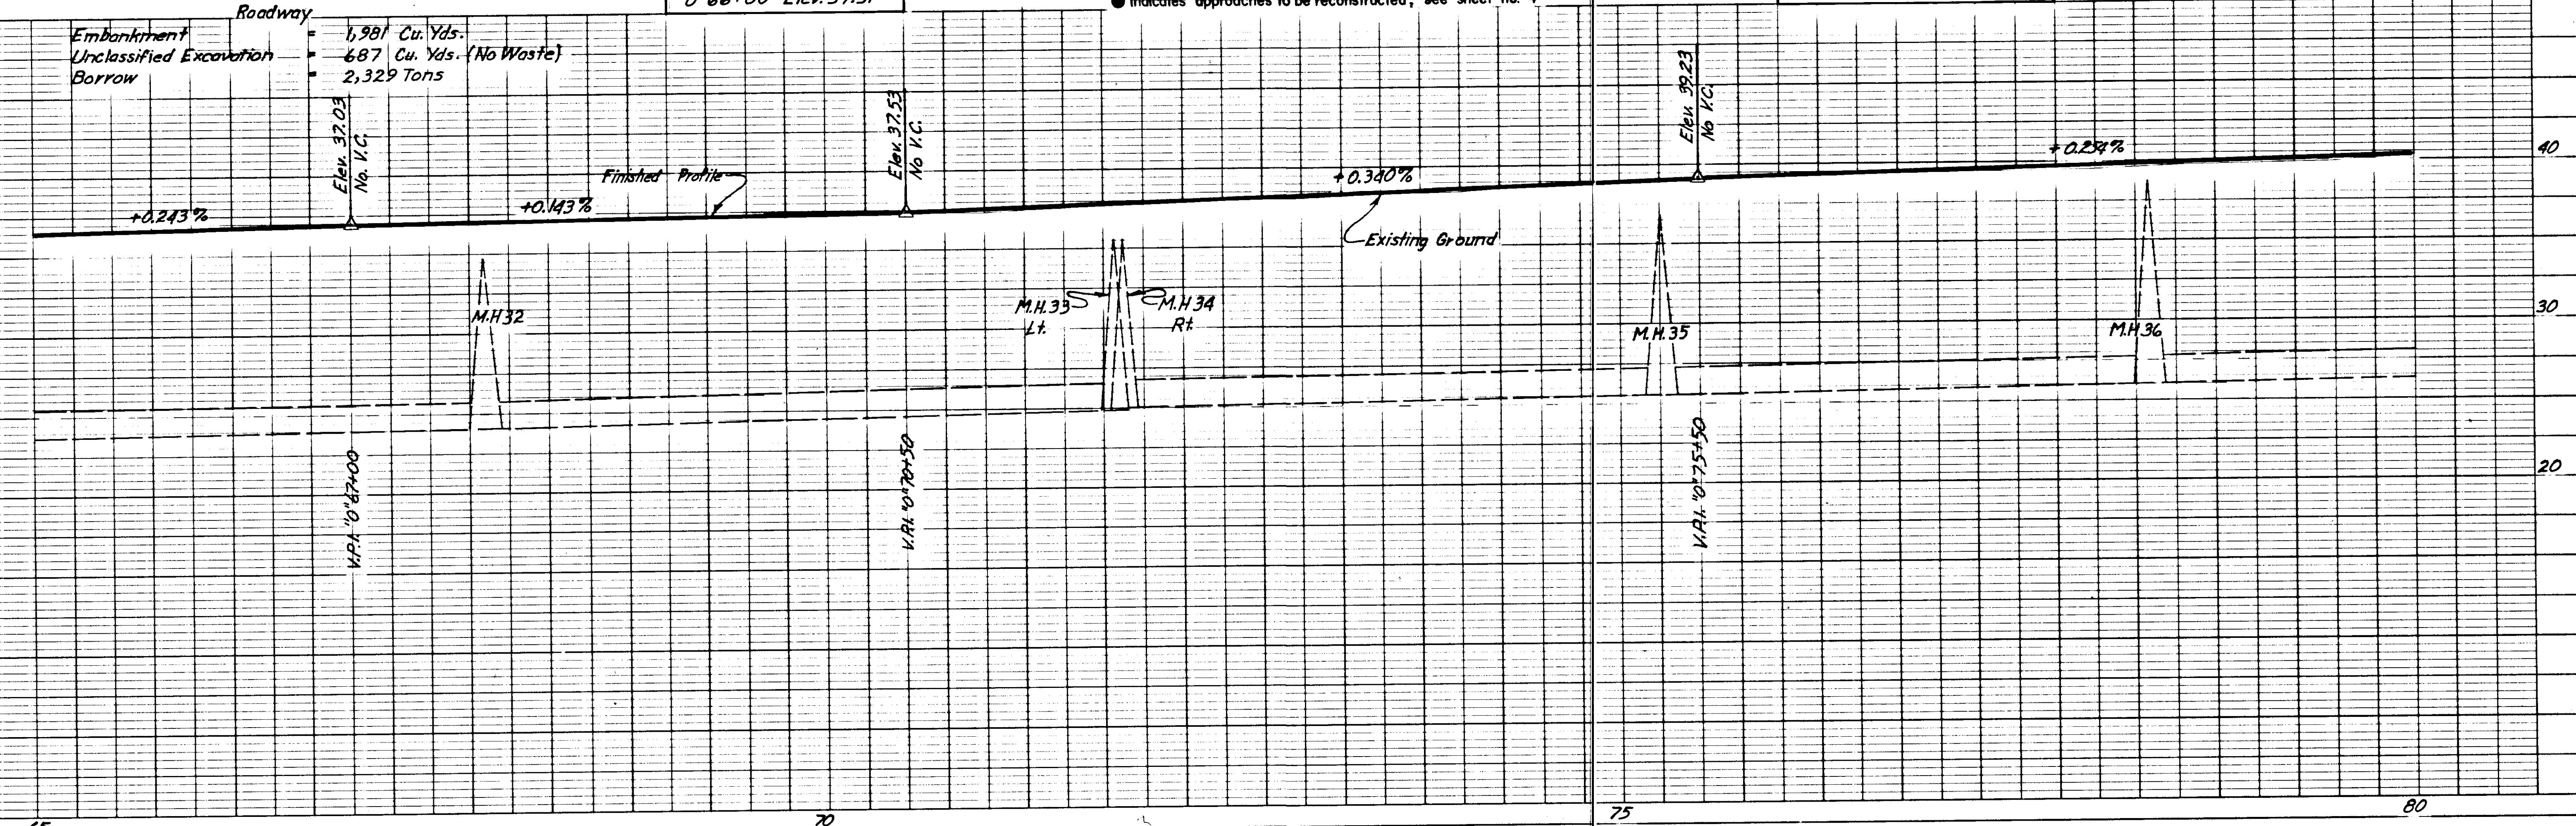

STATE	PROJECT DESIGNATION	YEAR	SHEET NO.	TOTAL SHEETS
ALASKA	RS-0966(8)	1977	13	40

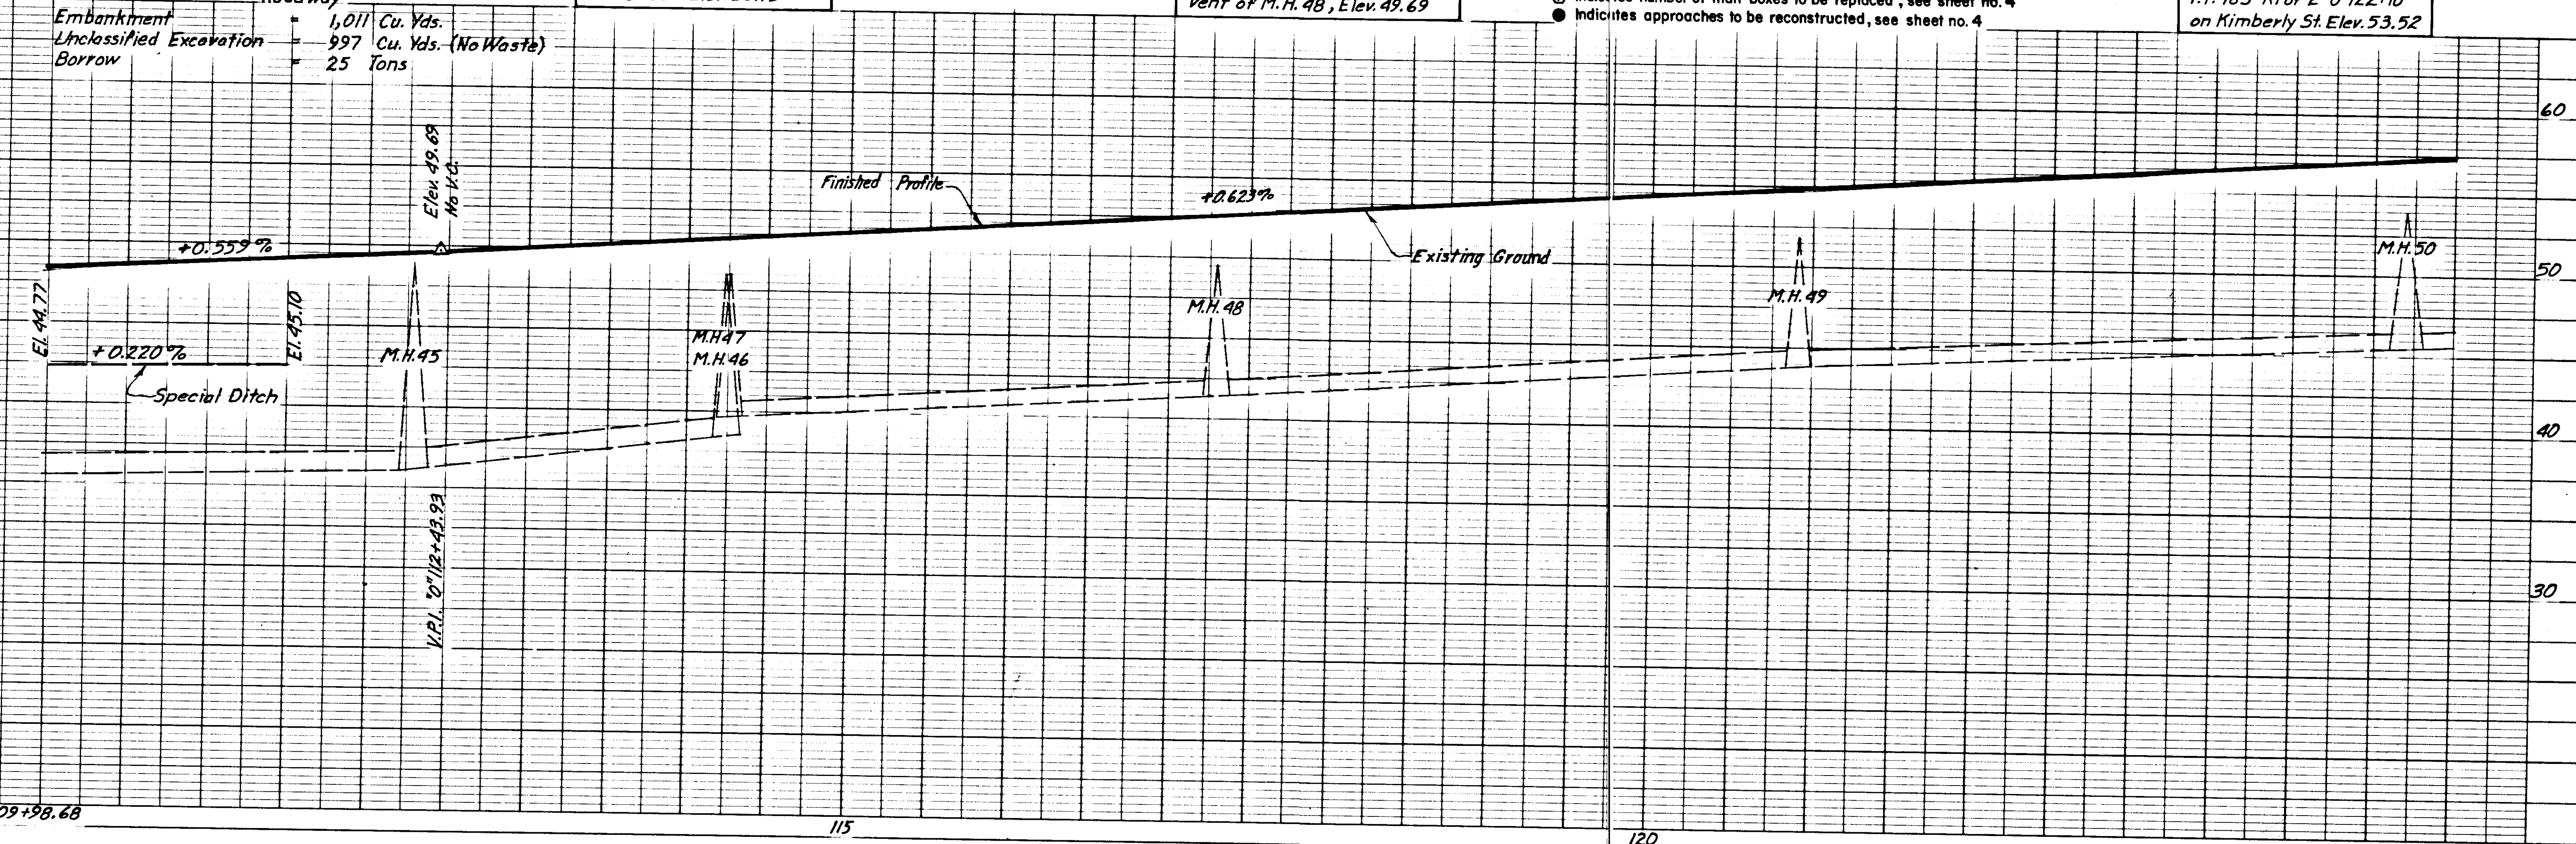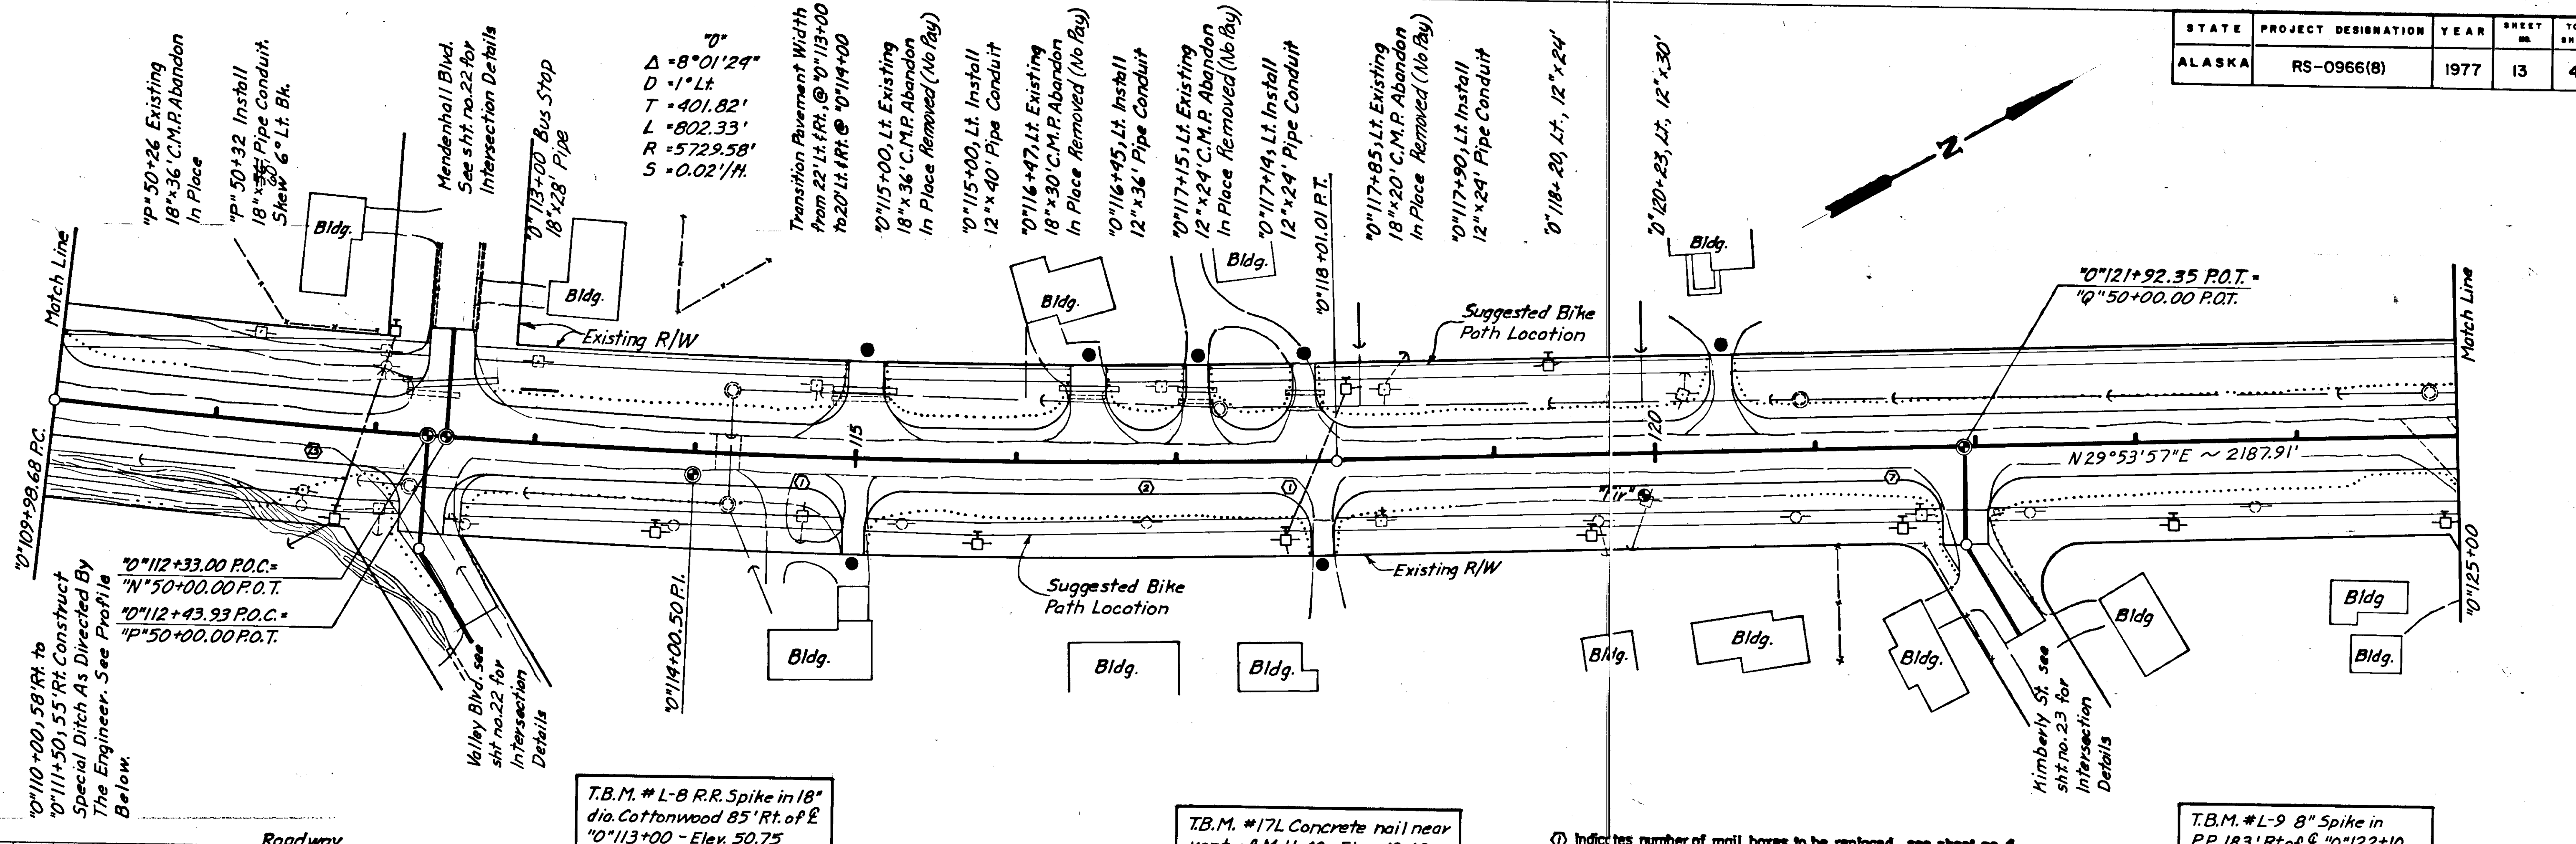


109+98.68

115

120

125


STATE	PROJECT DESIGNATION	YEAR	SHEET NO.	TOTAL SHEETS
ALASKA	RS-0966 (8)	1977	14	40

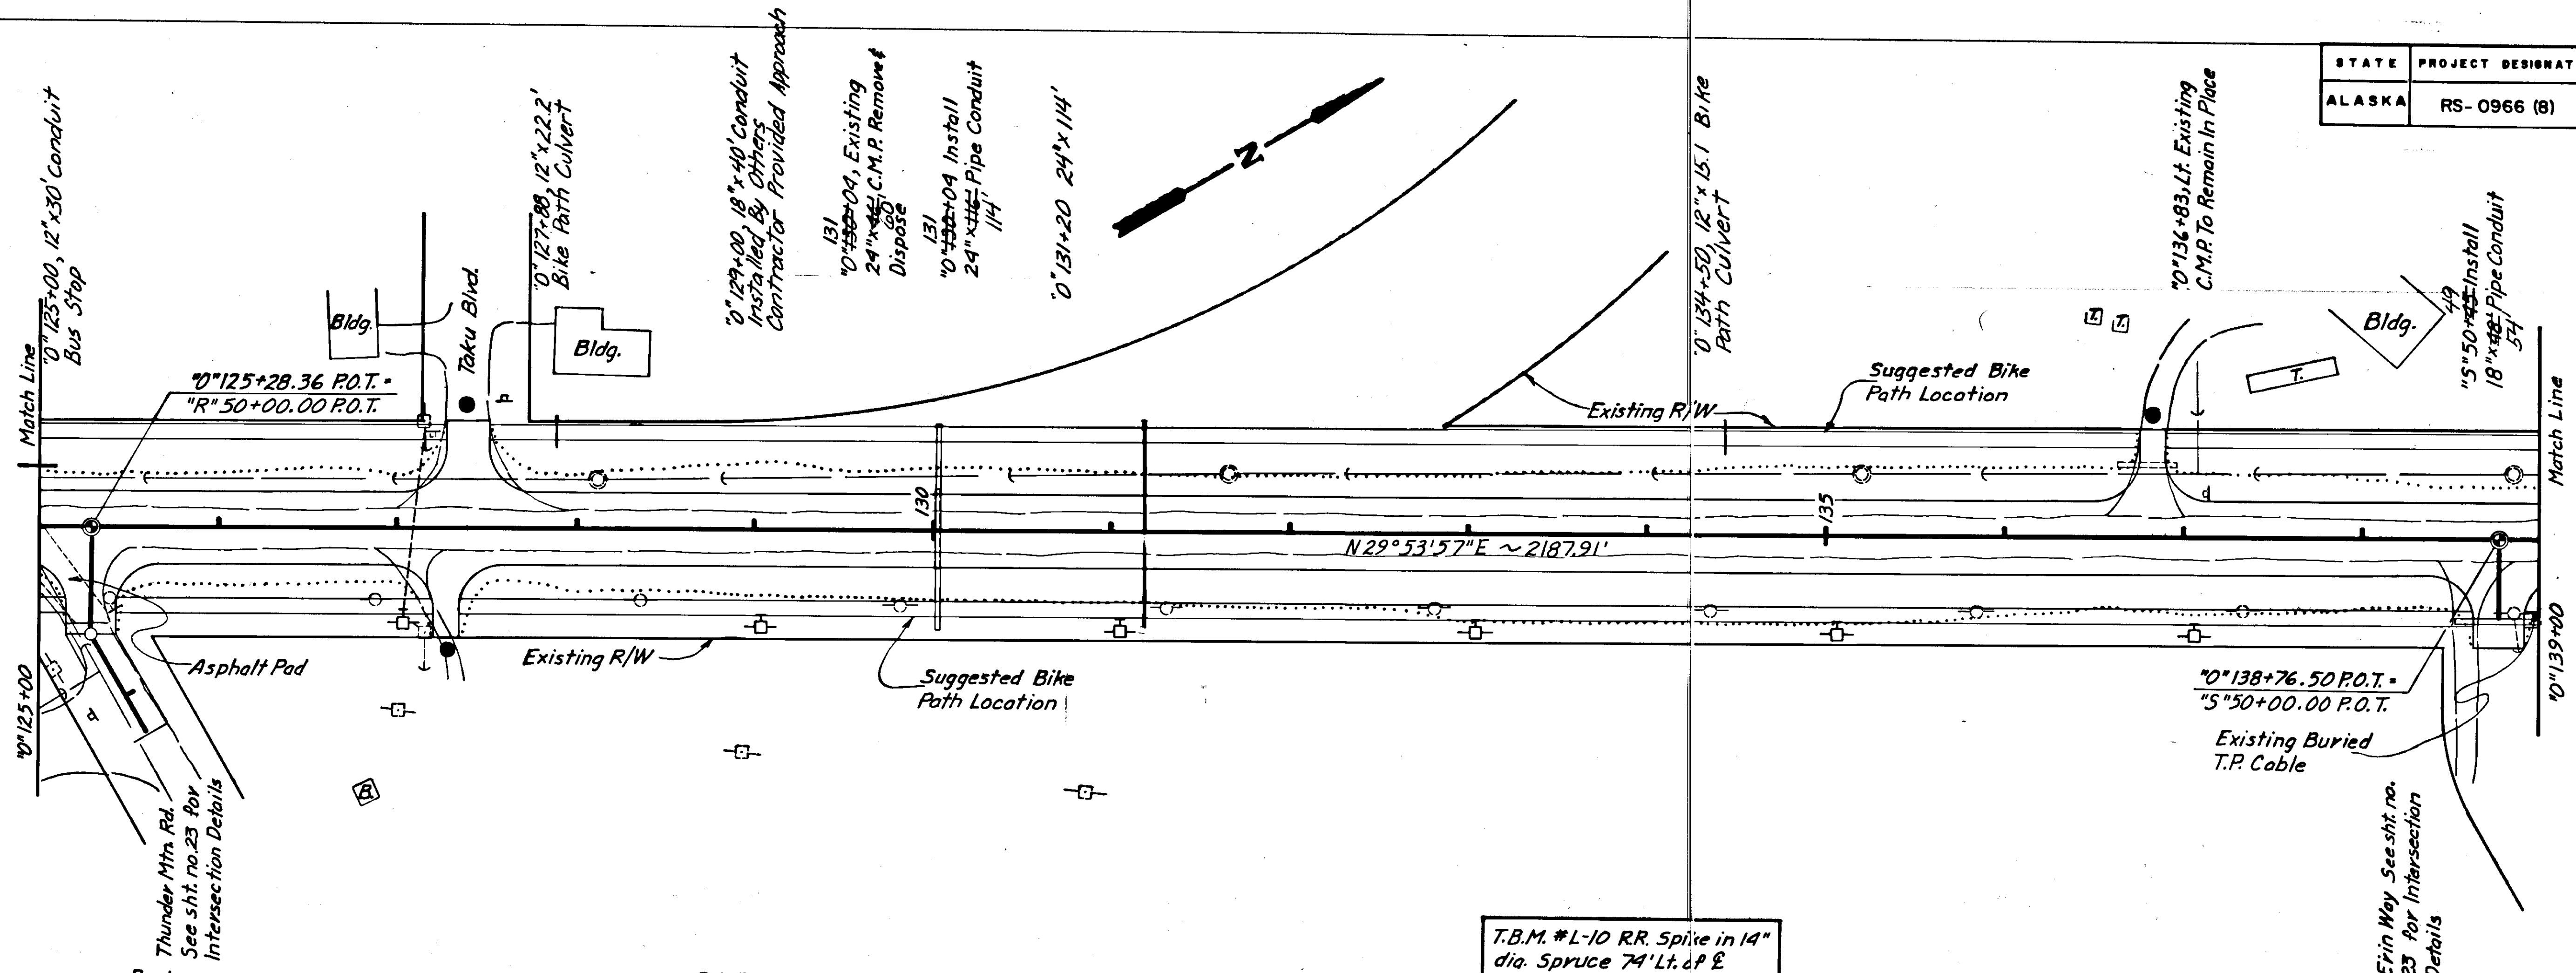


T.B.M. #L-10 RR. Spike in 14" dia. Spruce 74' Lt. of E
 0" 134+00 - Elev. 63.97

● Indicates approaches to be reconstructed, see sheet no. 4

Roadway	Quantity
Embankment	1,767 Cu. Yds.
Unclassified Excavation	1,041 Cu. Yds. (No Waste)
Borrow	1,307 Tons

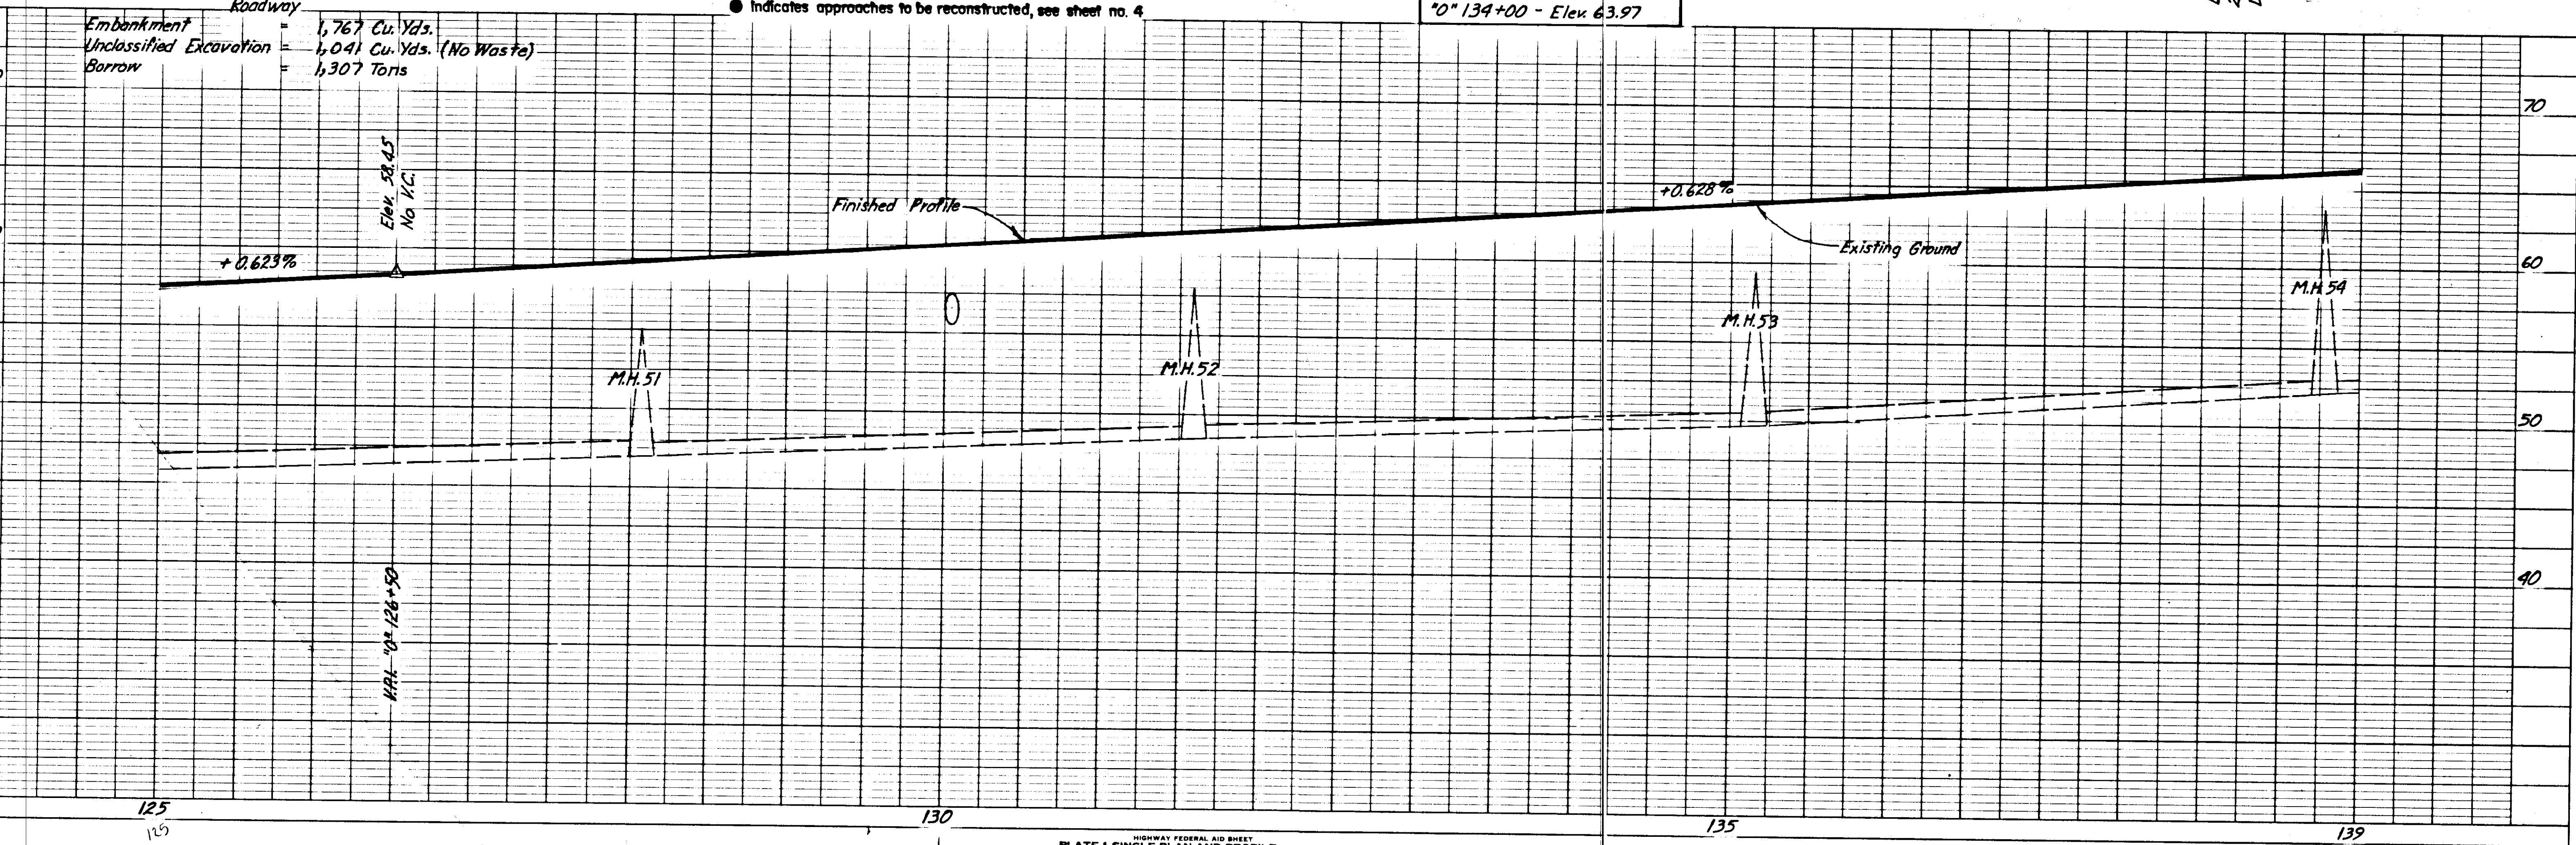


STATE	PROJECT DESIGNATION	YEAR	SHEET NO.	TOTAL SHEETS
ALASKA	RS-0966 (8)	1977	15	40

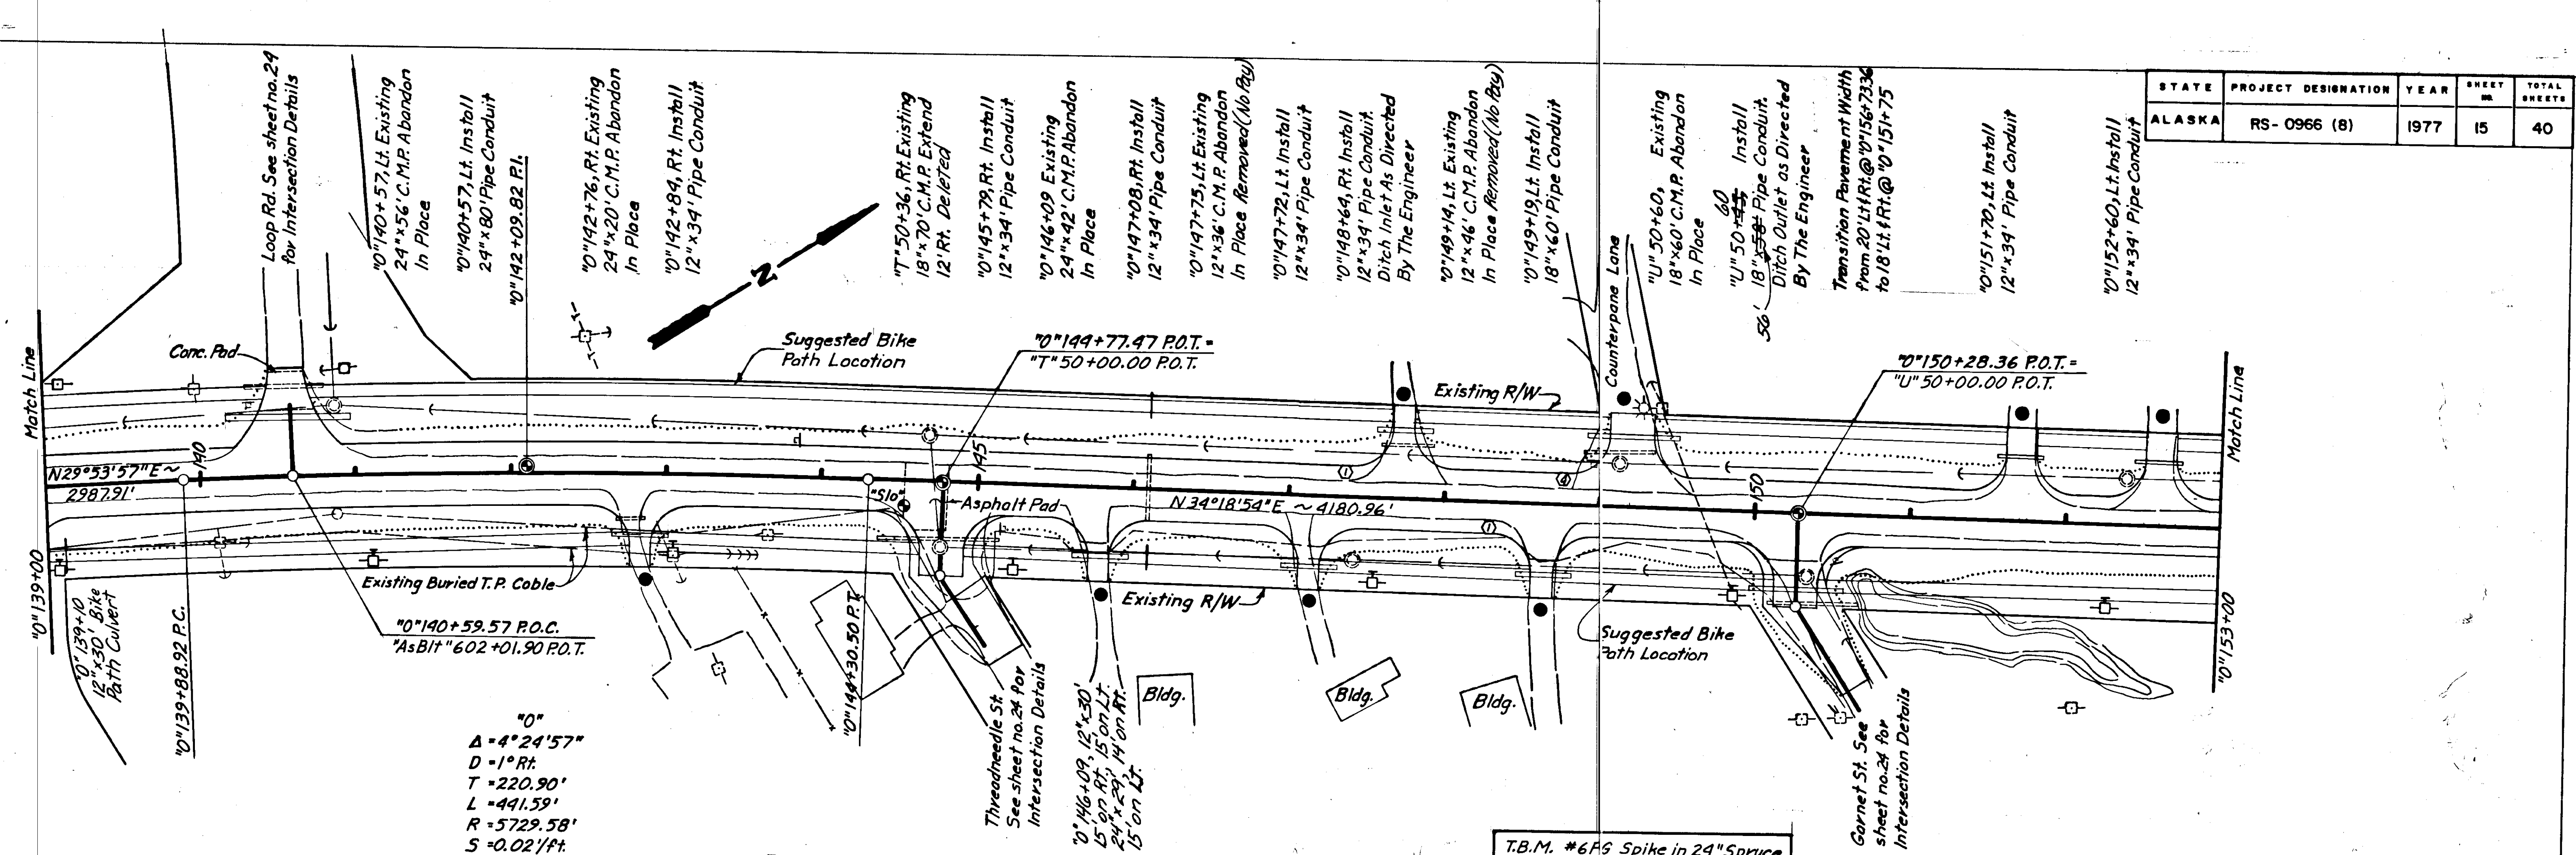

$\Delta = 4^{\circ}24'57''$
 $D = 1^{\circ}Rt.$
 $T = 220.90'$
 $L = 441.59'$
 $R = 5729.58'$
 $S = 0.021/ft.$



- ① Indicates number of mail boxes to be replaced, see sheet no. 4
- Indicates approaches to be reconstructed, see sheet no. 4

T.B.M. #6PS Spike in 24" Spruce near the intersection of Garner St and Loop Rd. - Elev. 69.46

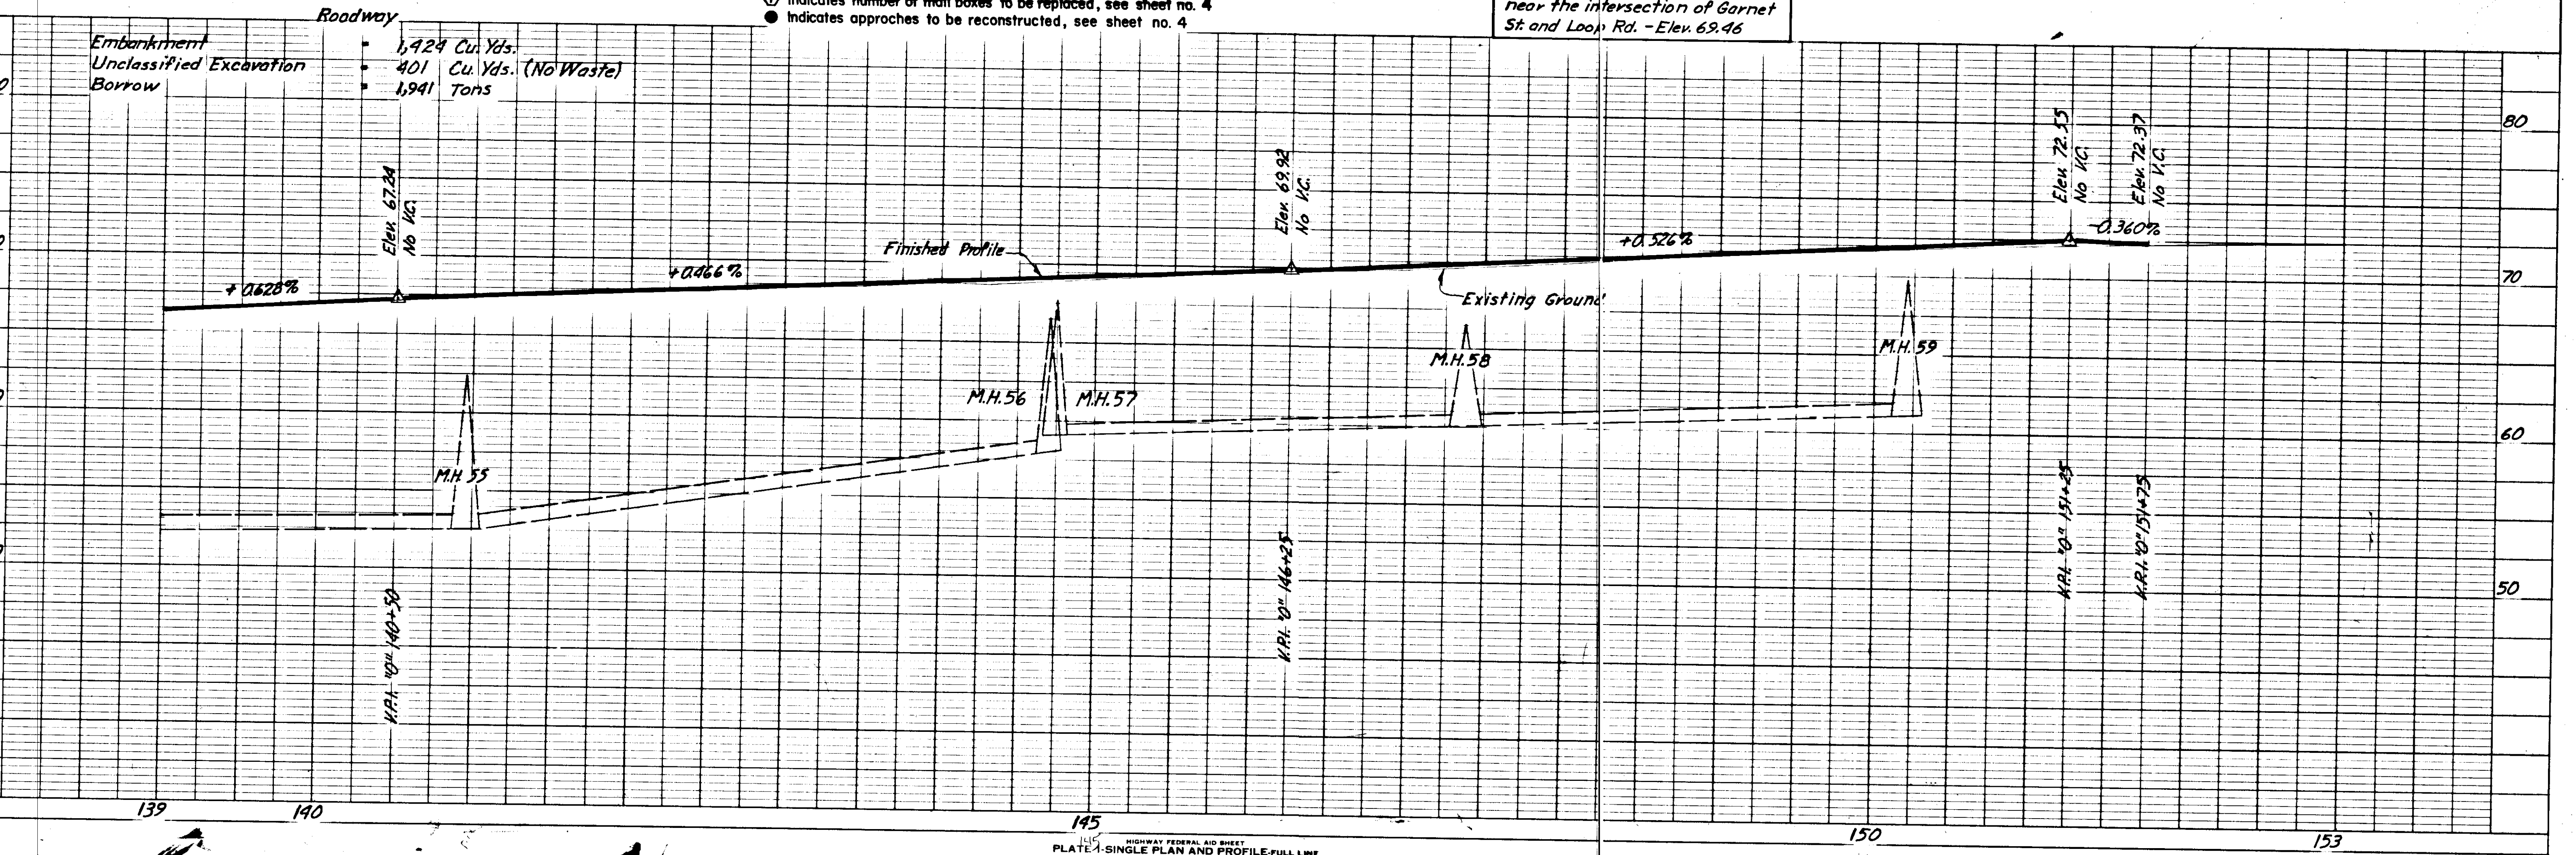

STATE	PROJECT DESIGNATION	YEAR	SHEET NO.	TOTAL SHEETS
ALASKA	RS-0966 (8)	1977	16	40

TYPICAL SECTION OF IMPROVEMENT

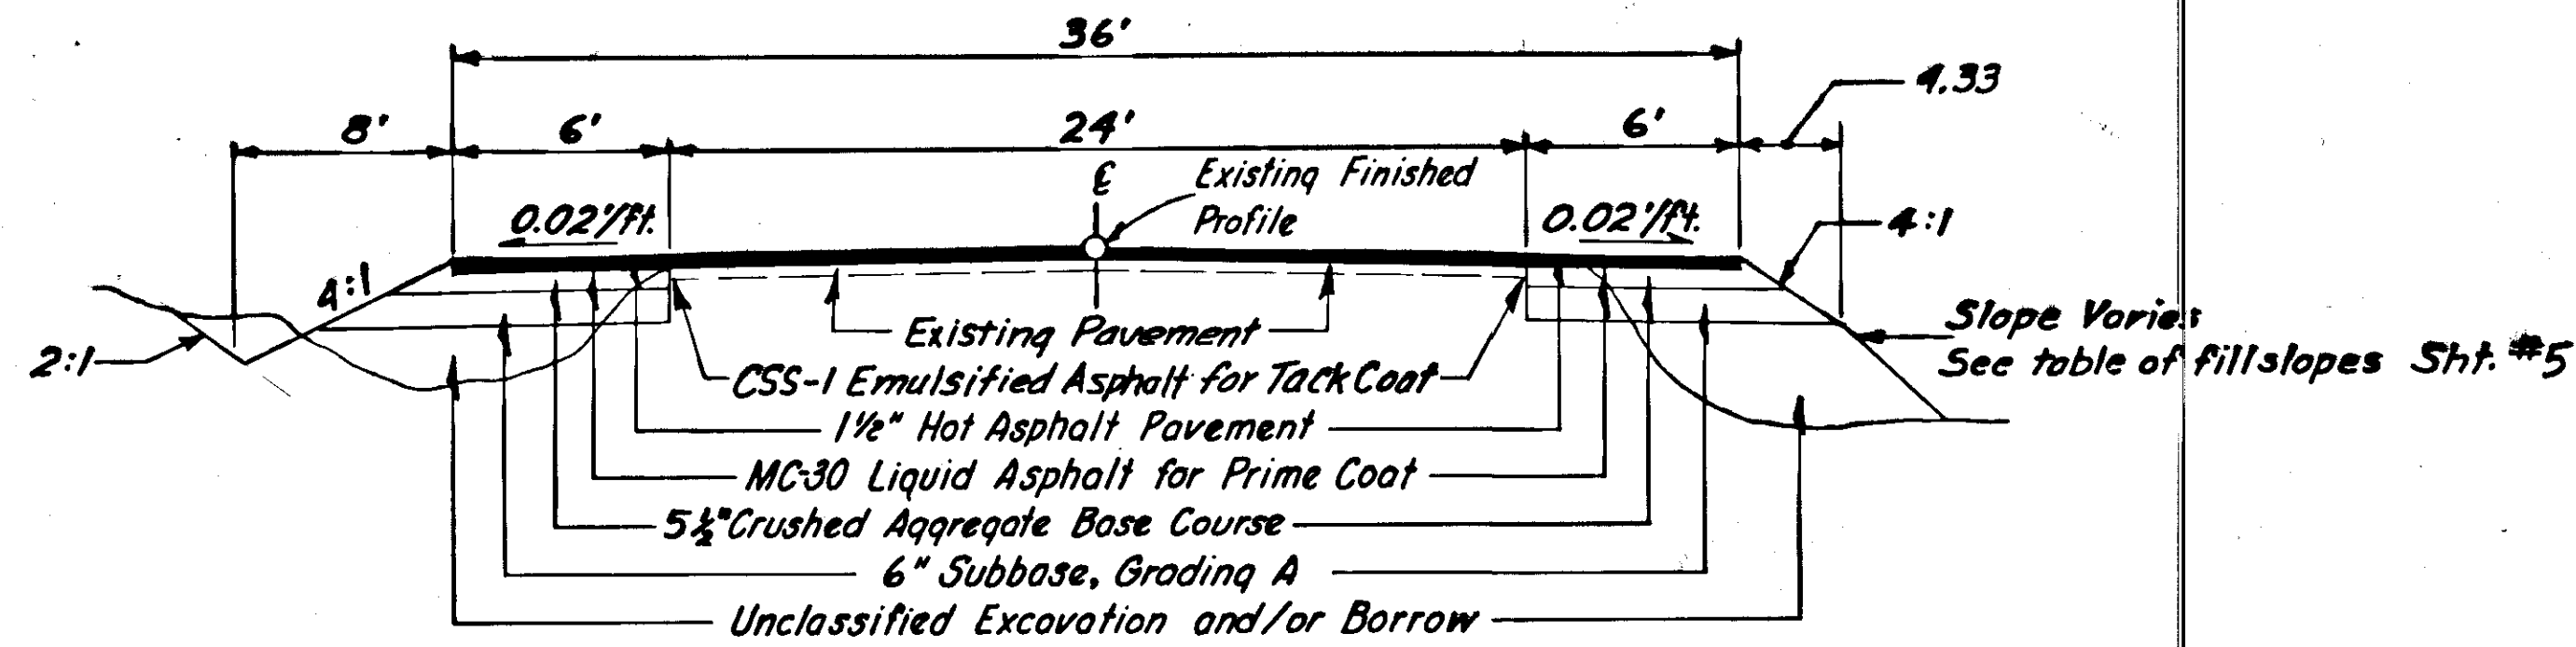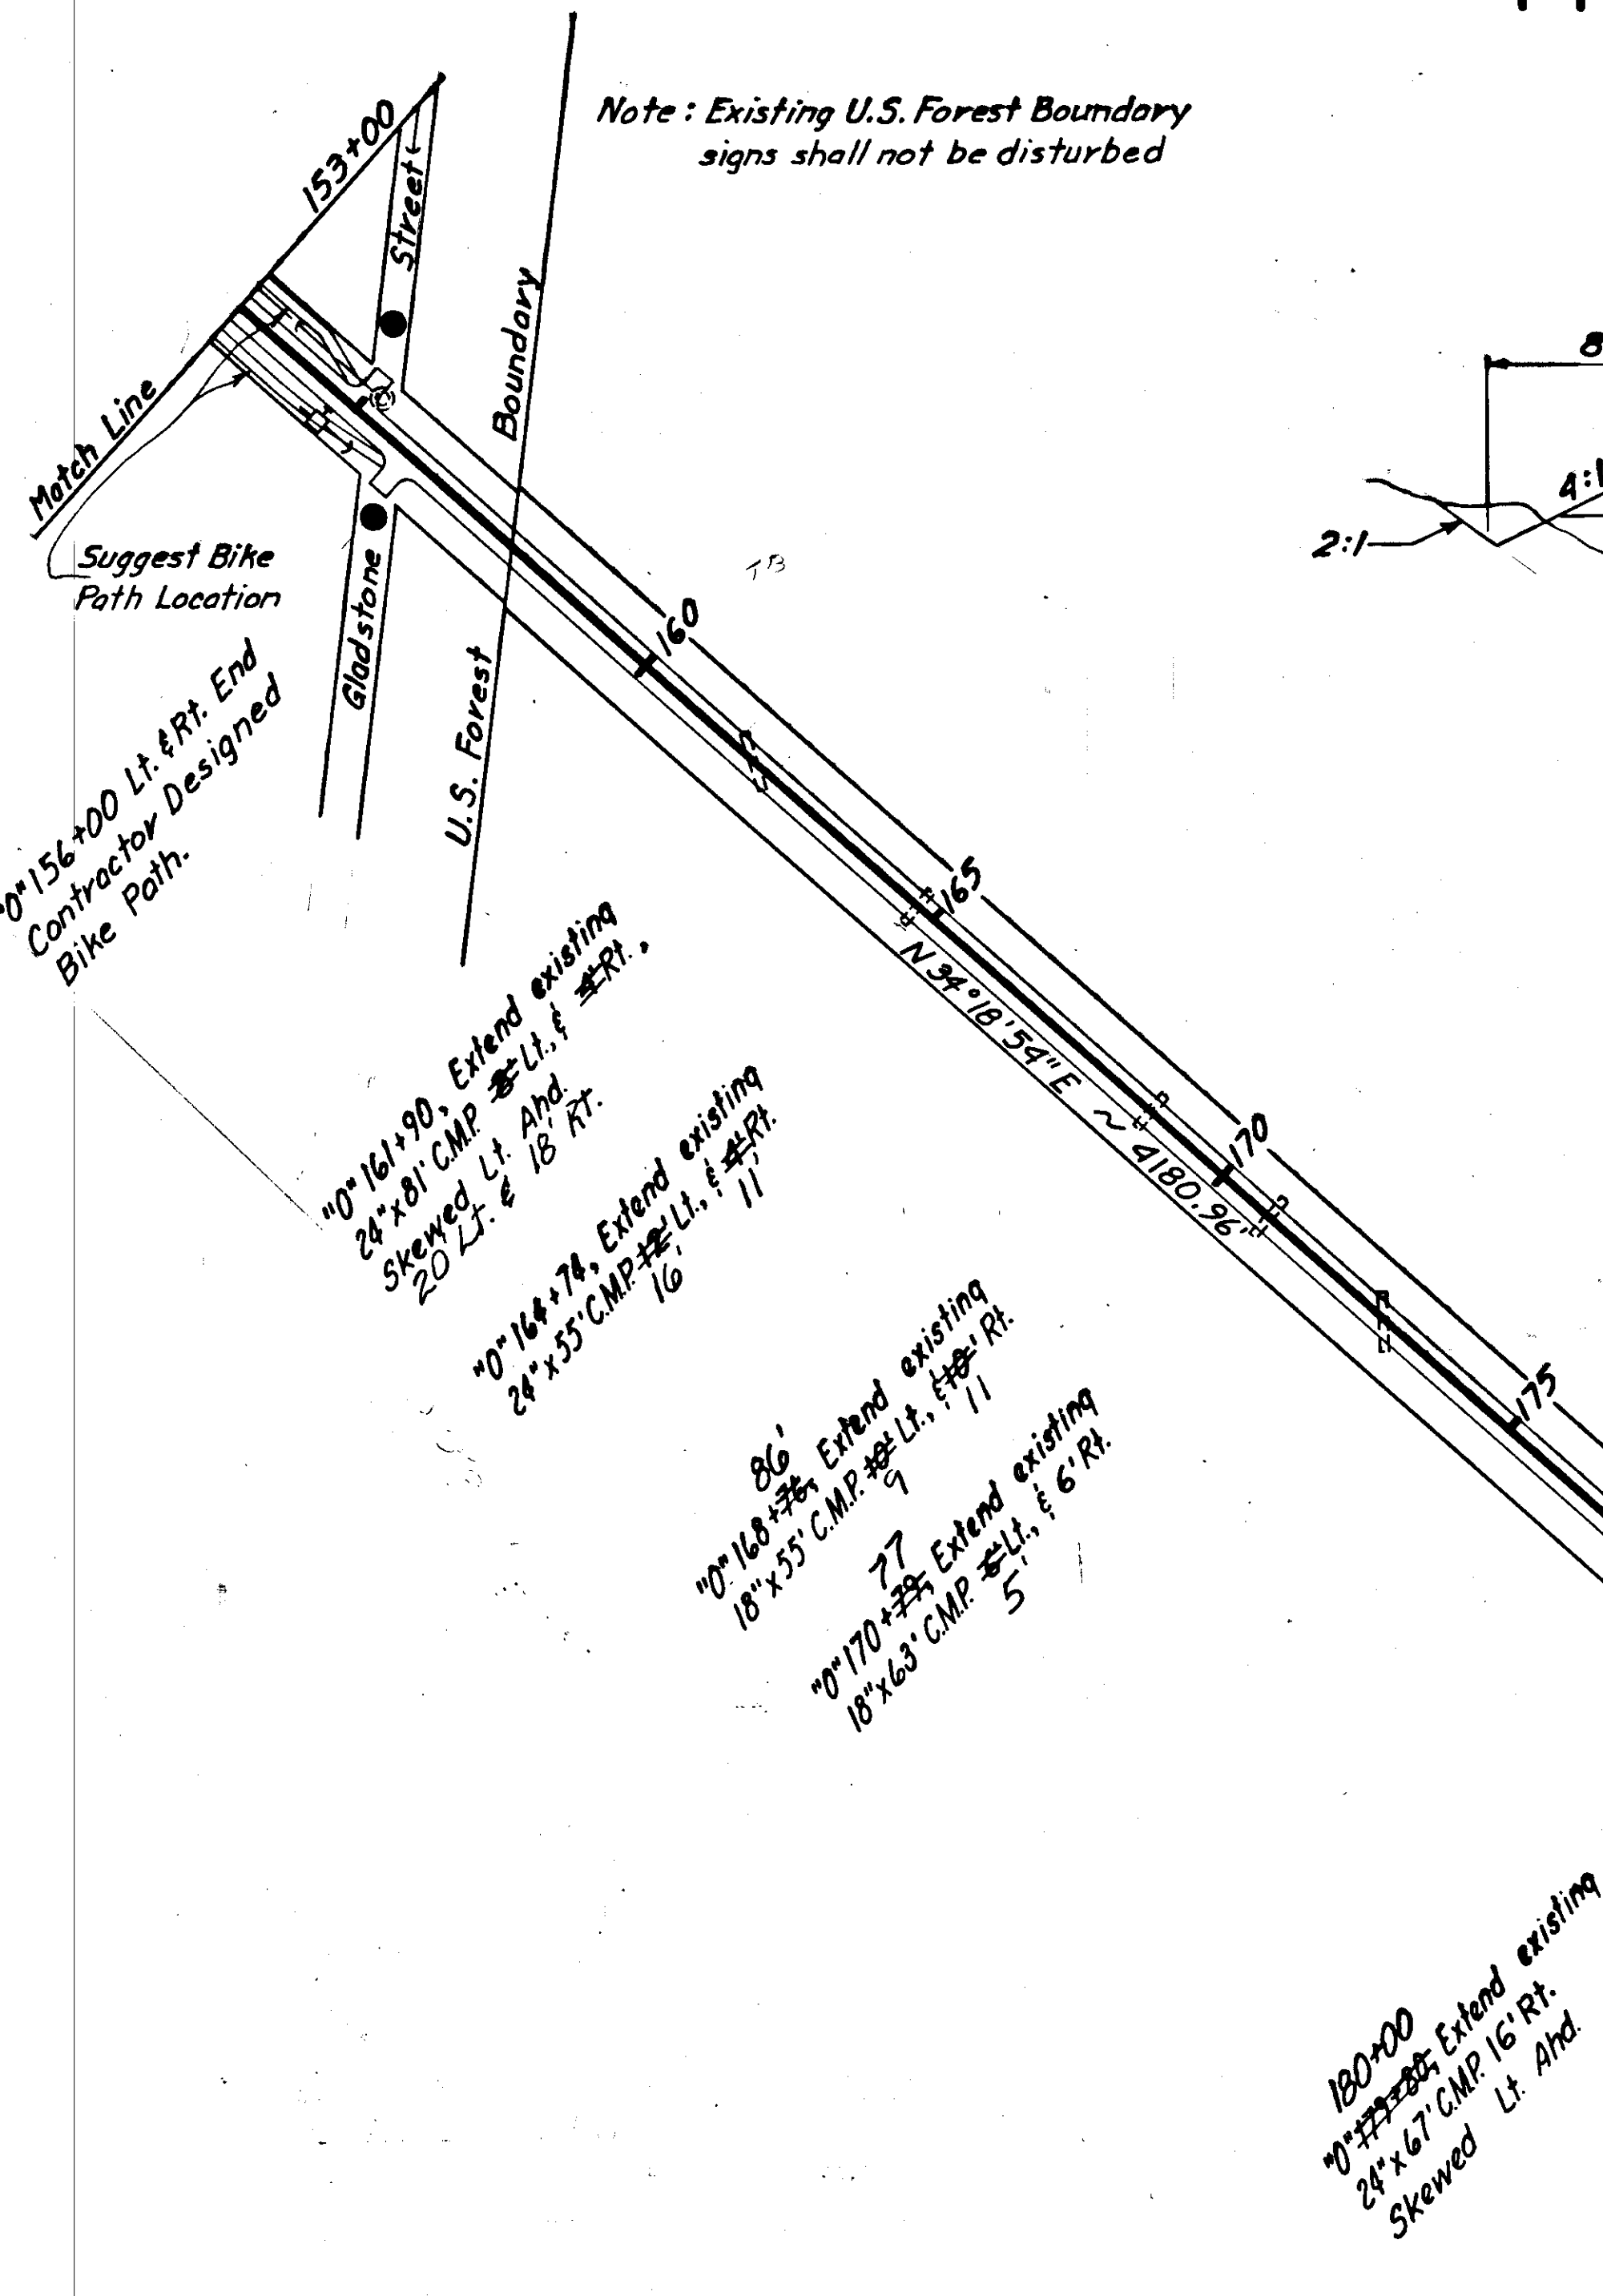



"0" 151+75 to "0" 217+28

"0" 161+90 to "0" 217+28
 All existing C.M.P. end sections shall be removed and salvaged. Upon installation of required C.M.P. extensions the salvaged end sections shall be reconnected as directed by the Engineer. This item of work shall be considered incidental to pay item 603(22E & G), and no separate payment shall be made therefore.

- Indicates approaches to be reconstructed. See sheet no. 4
- Embankment = 8,551 Cu. Yds.
- Unclassified Excavation = 2,127 Cu. Yds.
- Borrow = 11,563 Tons
- Roadway

"0" 210+50 Lt. to "0" 212+75 Lt.
 The existing rock embankment along Steep Creek shall be increased to a height which shall provide a catchpoint for a 4:1 foreslope, or as directed by the engineer. This item of work shall be paid for under item 610(1) "Hand-Laid Rock Embankment."

"0" 216+95 Lt. to "0" 217+22 Lt.
 Remove and dispose of existing Curb & Gutter as directed by the Engineer. This item of work shall be incidental to item 203(3) "Unclassified Excavation" and no separate payment shall be made therefore.

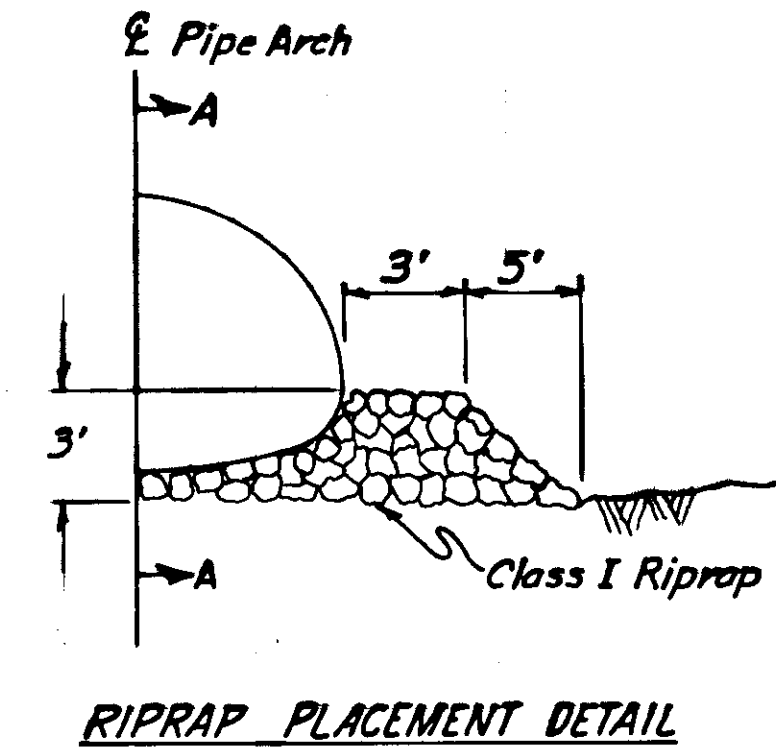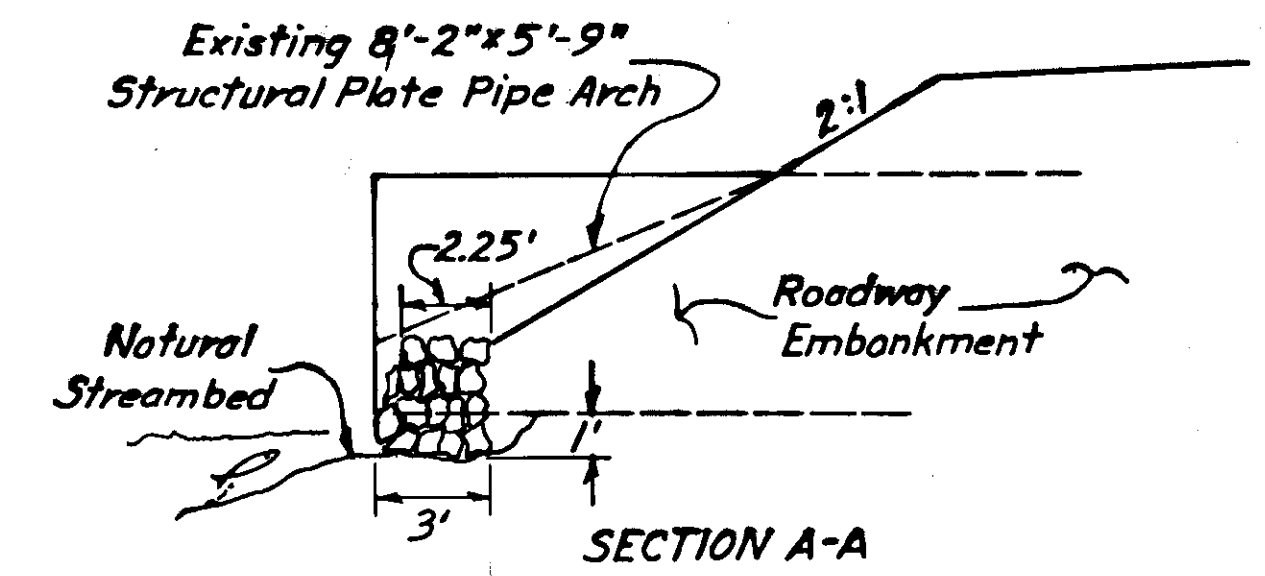

- "0" 205+53.50 Lt.
- The mitered sections on the existing 8'-2" x 5'-9" 10ga. Structural Plate Pipe Arch shall be removed and replaced with 6 unmitered sections.
 - For approximate placement of Class I Riprap, see detail above.
 - The above items of work shall be considered incidental to Item 610(1), "Hand-Laid Rock Embankment", and no separate payment shall be made therefore.

"0"
 $\Delta = 48^\circ 7' 17''$
 $D = 2^\circ 15' 00'' \text{ Lt.}$
 $T = 1137.00'$
 $L = 2138.73'$
 $R = 2546.48'$

END PROJECT
 RS-0966(8)
 STA. "0" 217+28 P.O.C.

T.B.M. # L-11. R.R. Spike in 10" dia. Cottonwood 94' Lt. of "0" 160+00 El. 74.23

T.B.M. # L-12. R.R. Spike in 12" dia. Cottonwood 67' Rt. of "0" 183+00 El. 86.72

T.B.M. # L-13. 1" NUT on 9/8" Foundation Bolt Bent from Vertical in concrete foundation 129' Rt. of "0" 197+00 El. 101.05

T.B.M. # L-14. West bolt on metal Light Pole N.E. corner of Visitor Parking Lot & 44' Rt. of "0" of sidewalk to Visitor Center El. 80.11

"0"
 $\Delta = 30^\circ 29' 30''$
 $D = 6^\circ 30' 00'' \text{ Rt.}$
 $T = 240.25'$
 $L = 469.10'$
 $R = 881.47'$

"0" 216+75 to "0" 217+28
 Construct Pavement Transition
 See sheet no. 2 for details.

40' Extend existing 24"x36" C.M.P. Lt. & Rt. 16'

"0" 211+55 Extend existing 18"x40" C.M.P. 4' Lt. & Rt. 8'

"0" 212+86. Extend existing 18"x55" C.M.P. Lt. & Rt. 7'

Skewed Lt. & Rt.

P.I. "0" 197+48.46

P.C. "0" 196+11.46

P.T. "0" 207+50.19

P.C. "0" 215+42.68


P.I. "0" 217+82.93

Steep Creek

Existing R/W


Existing R/W

INTERSECTION DETAILS

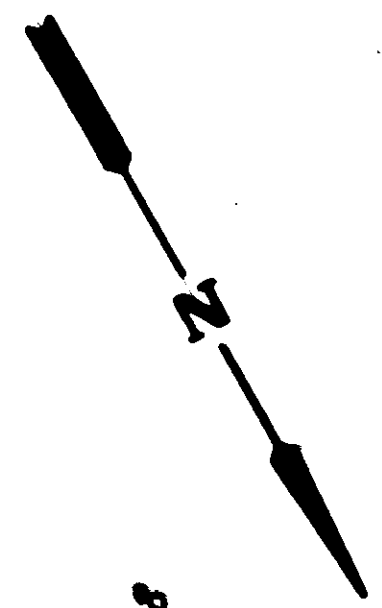

"Asblt" 384+62.37 Bk. = P.C.
"Asblt" 384+62.89 Ahd.

Match Line

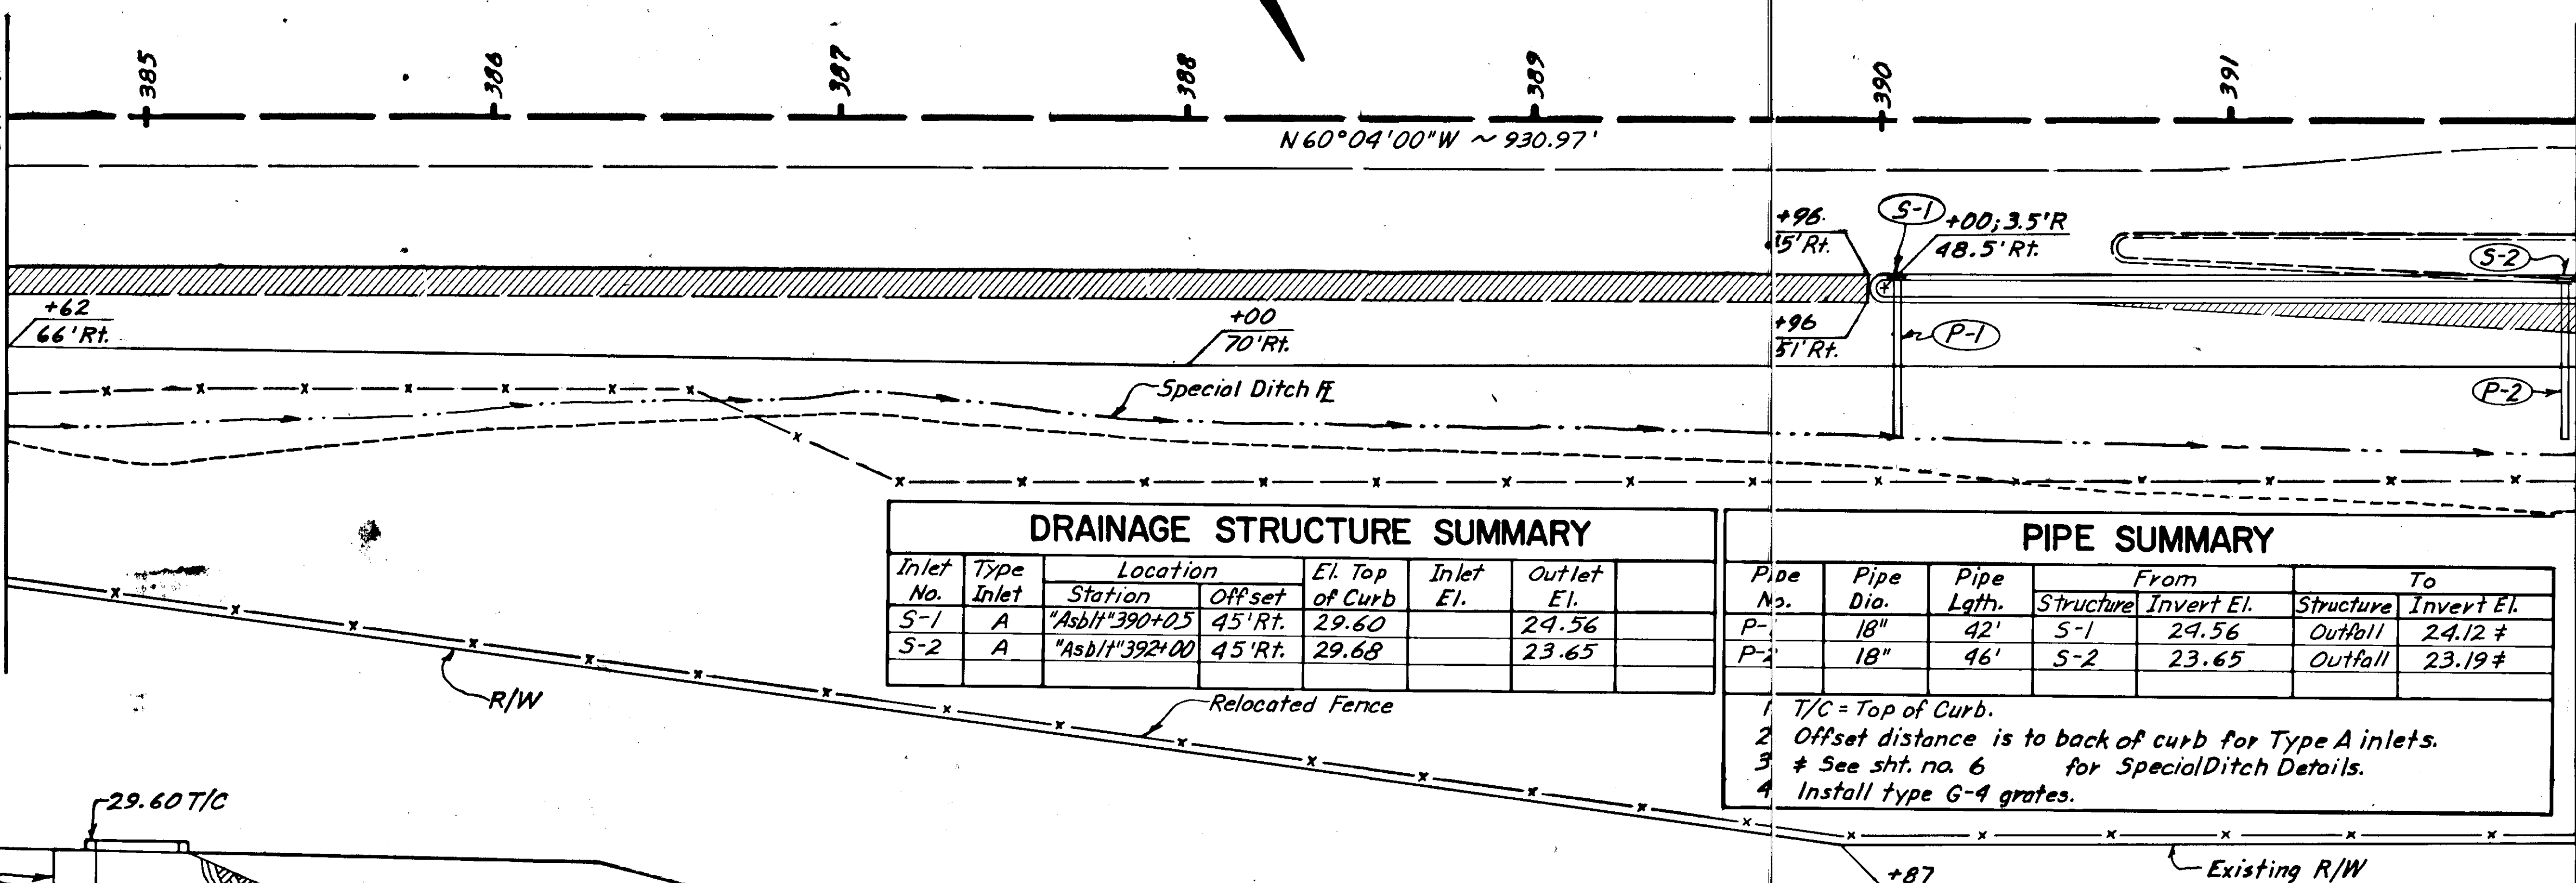


DRAINAGE STRUCTURE SUMMARY

Inlet No.	Type Inlet	Location Station	Offset	El. Top of Curb	Inlet El.	Outlet El.
S-1	A	"Asblt" 390+25	45' Rt.	29.60		24.56
S-2	A	"Asblt" 392+00	45' Rt.	29.68		23.65

PIPE SUMMARY

Pipe No.	Pipe Dia.	Pipe Lgth.	From		To	
			Structure	Invert El.	Structure	Invert El.
P-1	18"	42'	S-1	24.56	Outfall	24.12 †
P-2	18"	46'	S-2	23.65	Outfall	23.19 †

- 1 T/C = Top of Curb.
- 2 Offset distance is to back of curb for Type A inlets.
- 3 † See sht. no. 6 for Special Ditch Details.
- 4 Install type G-4 grates.

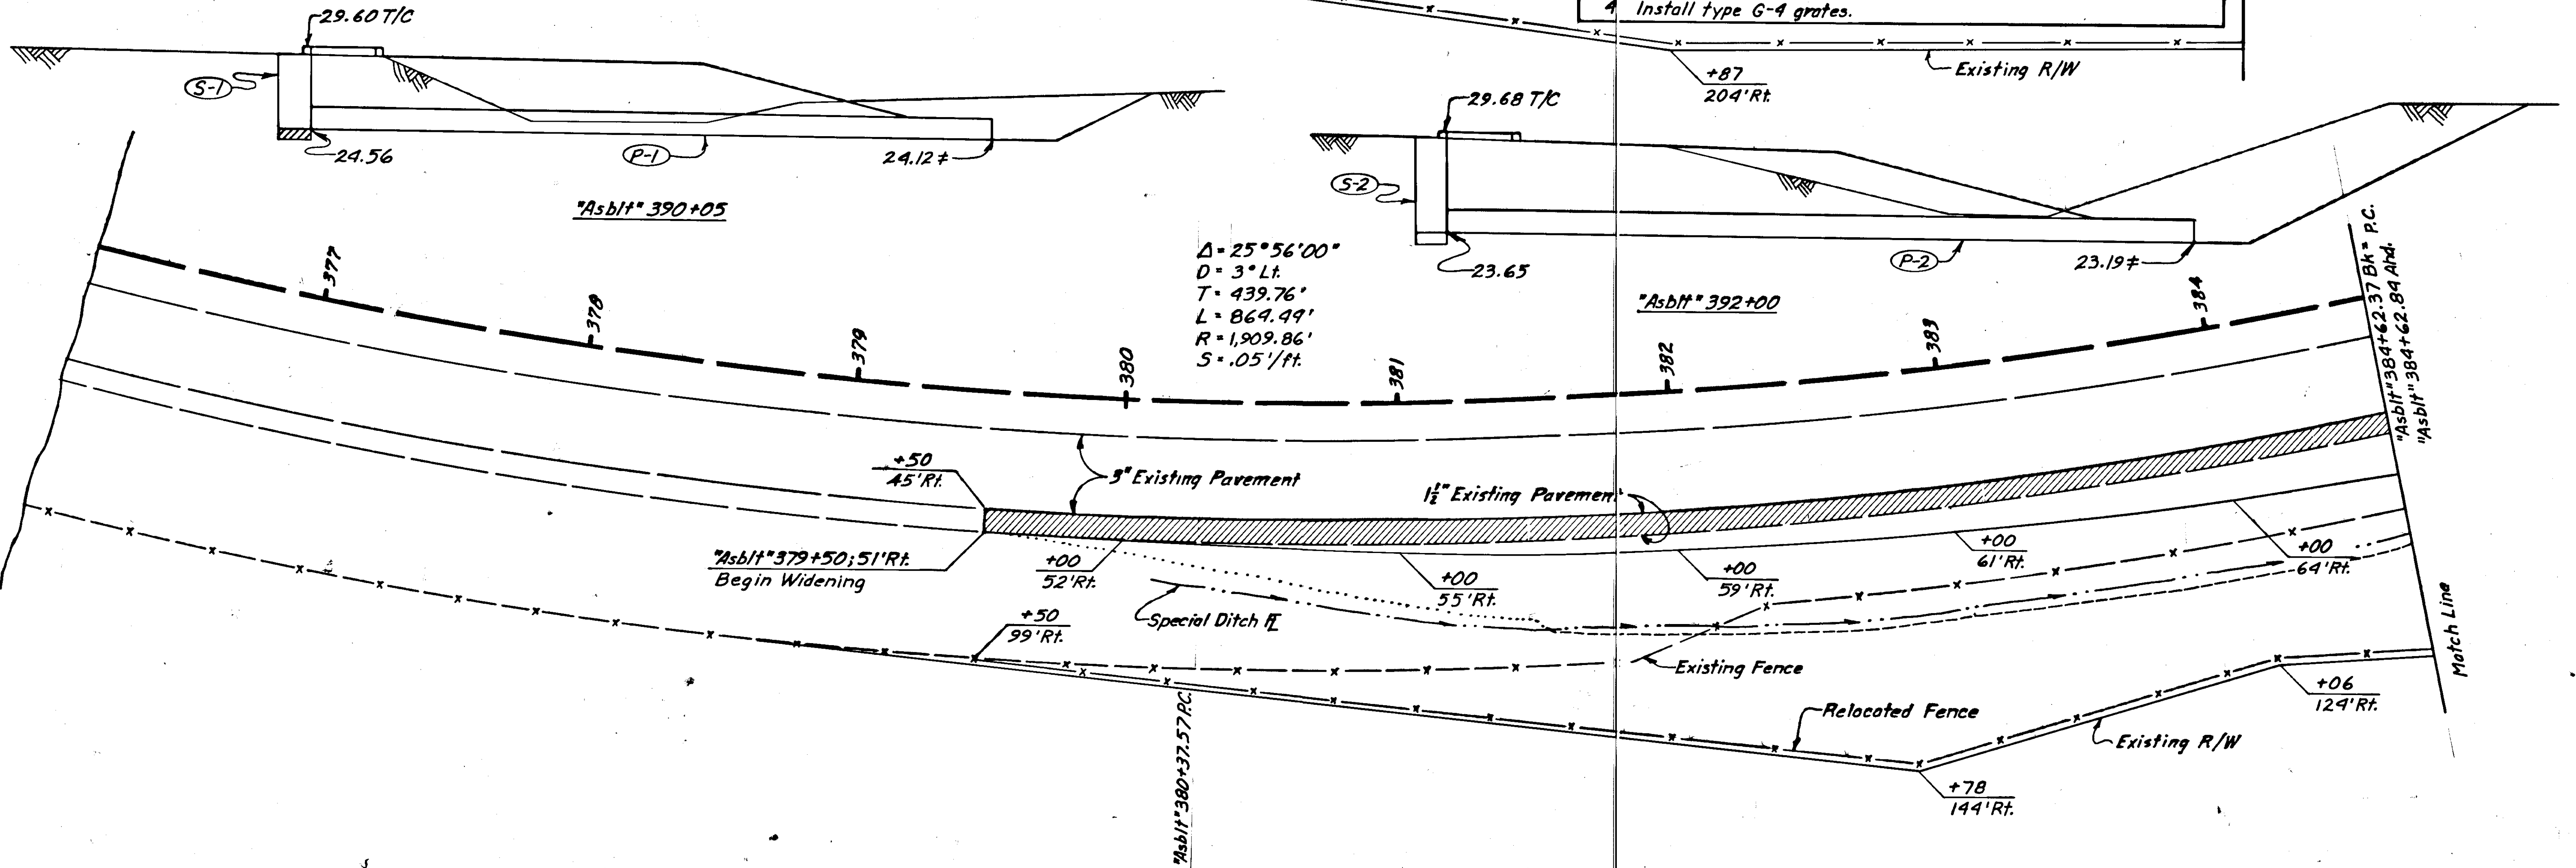


$\Delta = 25^\circ 56' 00''$
 $D = 3^\circ \text{ Lt.}$
 $T = 439.76'$
 $L = 864.49'$
 $R = 1,909.86'$
 $S = .05'/\text{ft.}$

"Asblt" 384+62.37 Bk. = P.C.
"Asblt" 384+62.89 Ahd.


Match Line

STATE	PROJECT DESIGNATION	YEAR	SHEET NO.	TOTAL SHEETS
ALASKA	RS-0966(8)	1977	19	40


INTERSECTION DETAILS

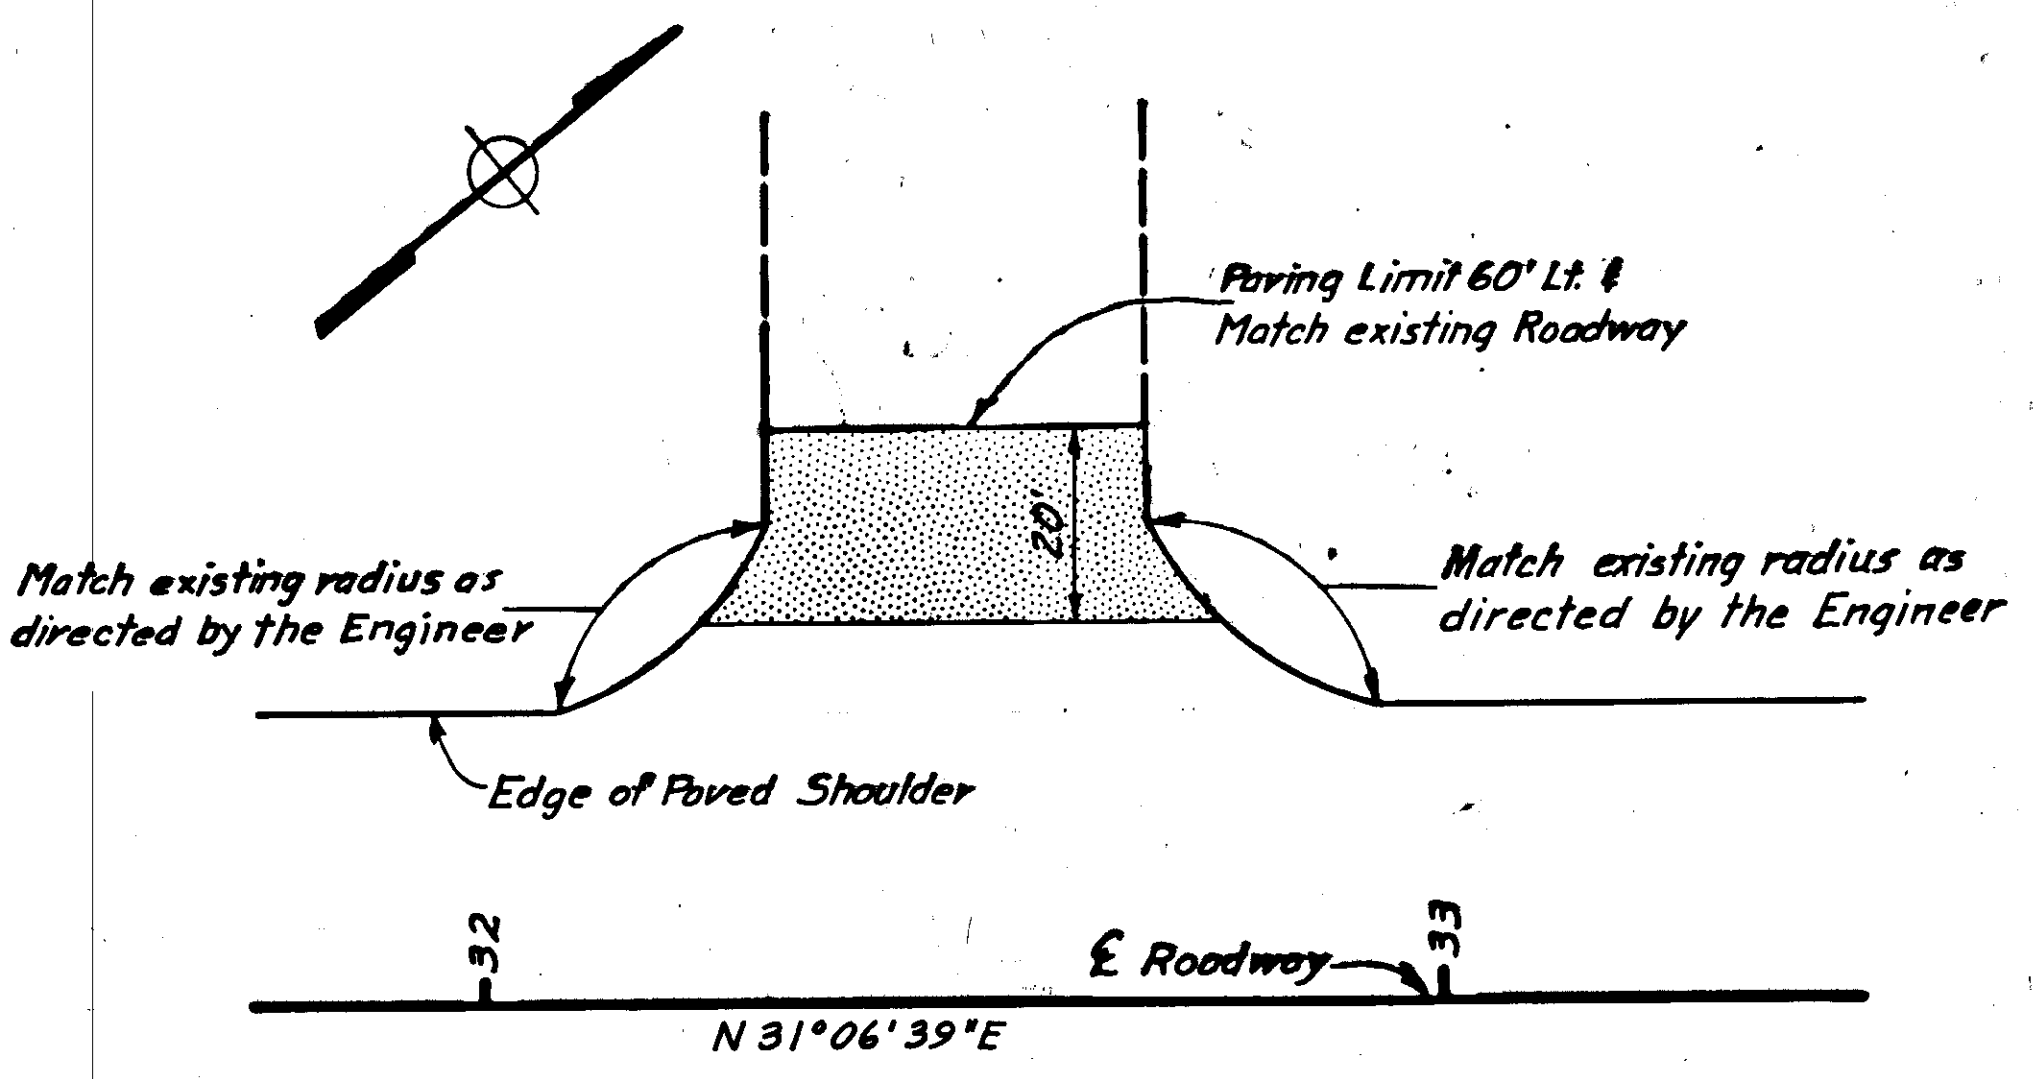


IGA ENTRANCE

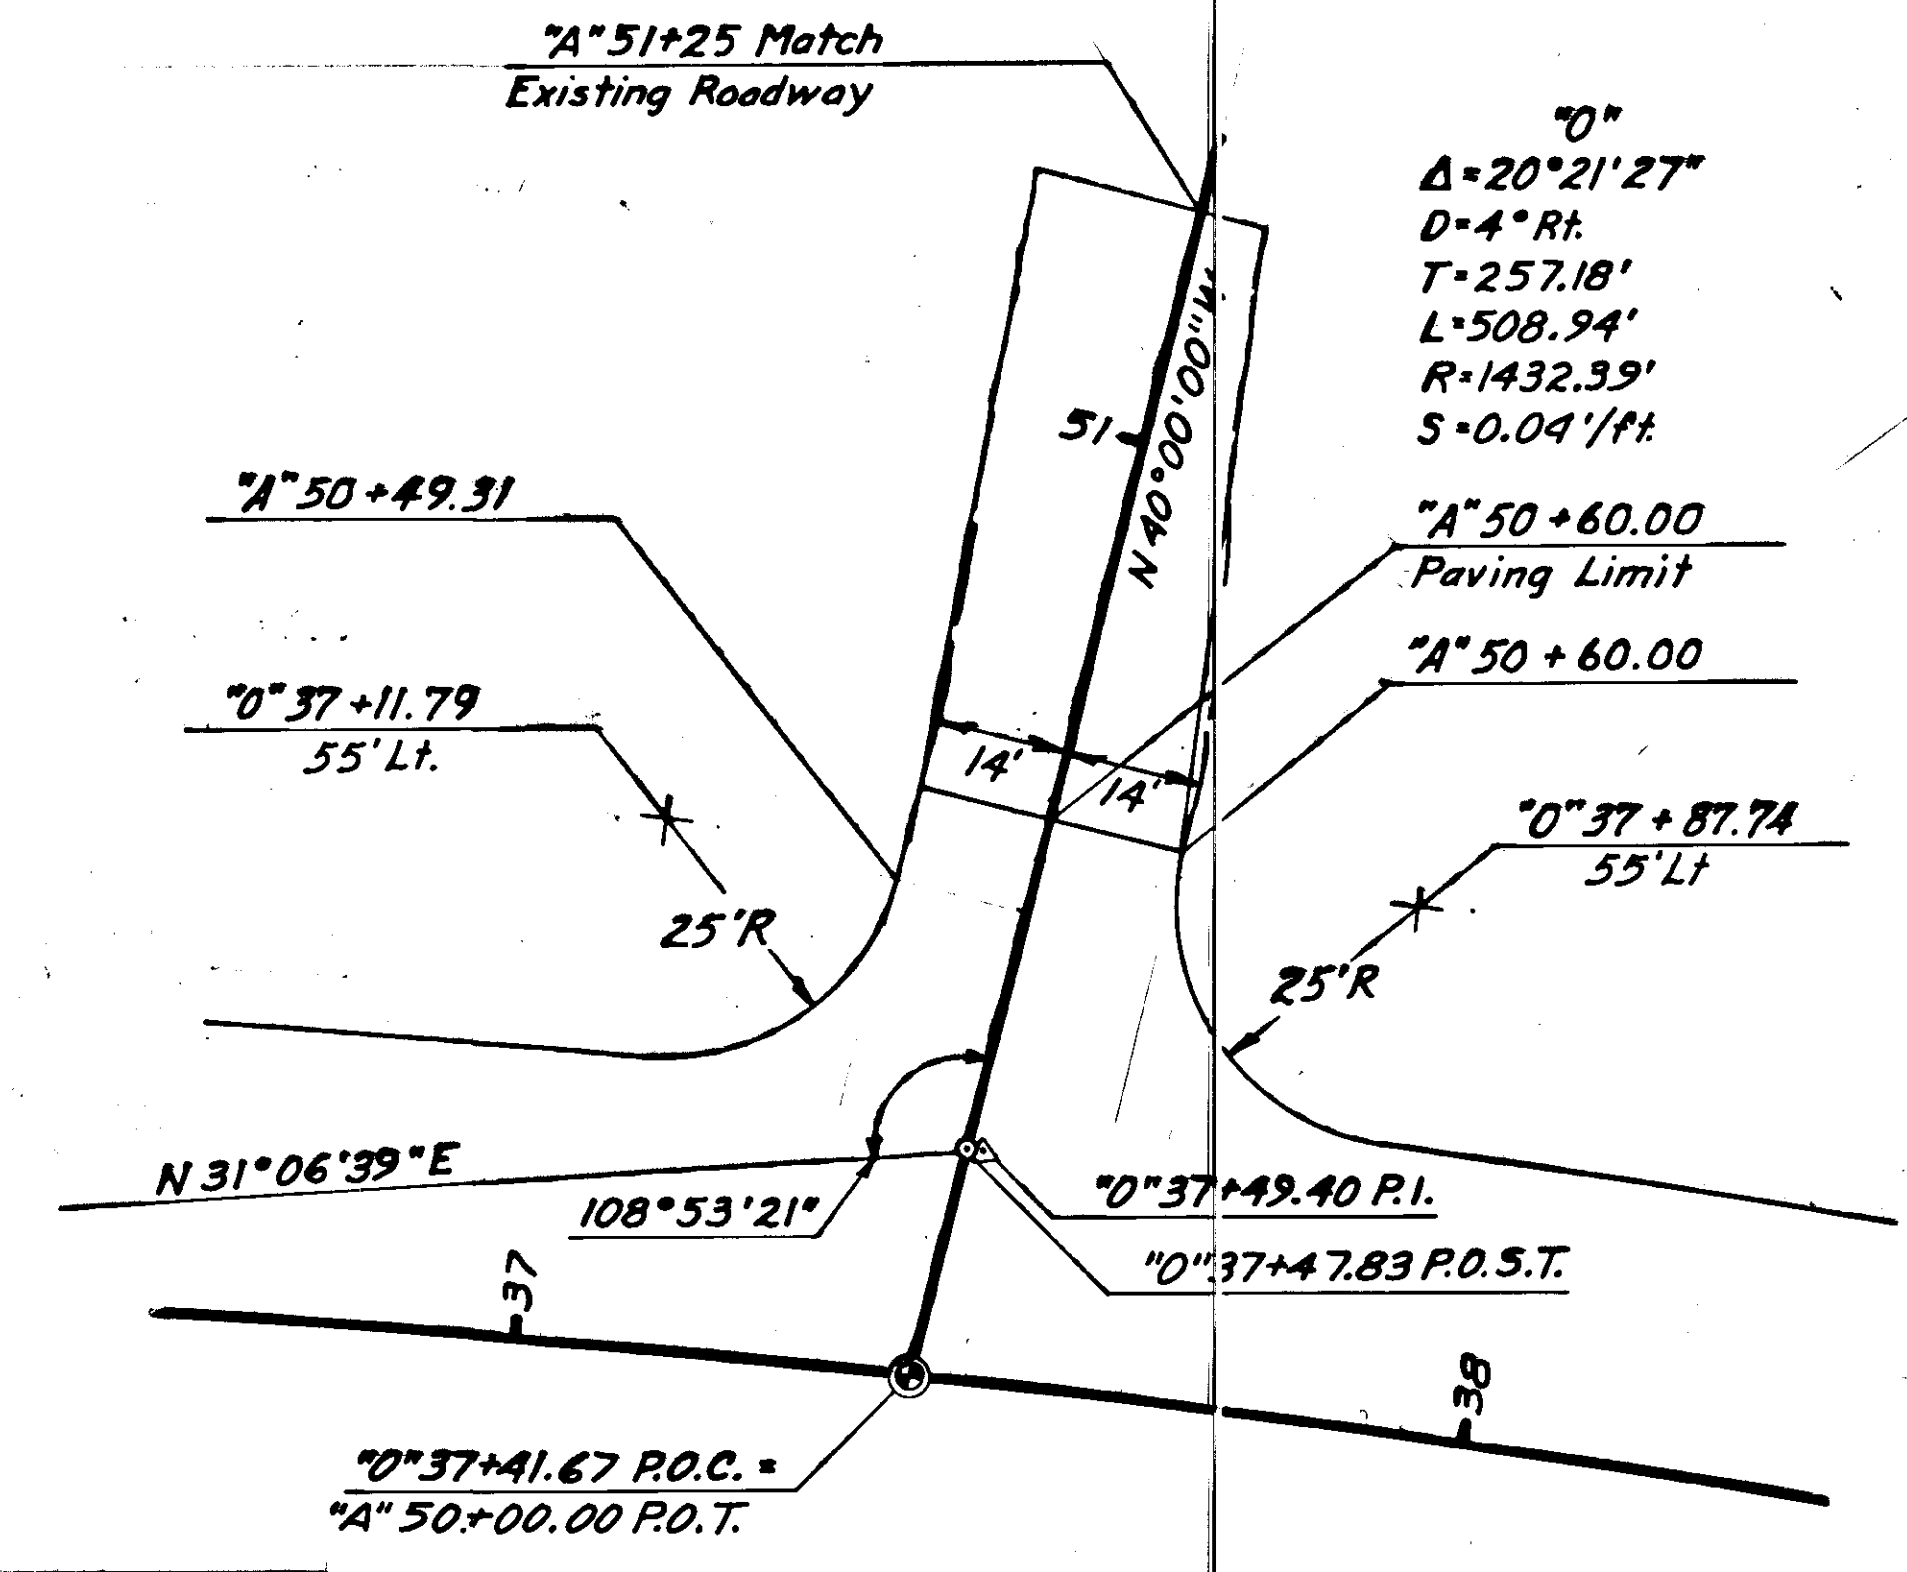



JAMES BLVD.

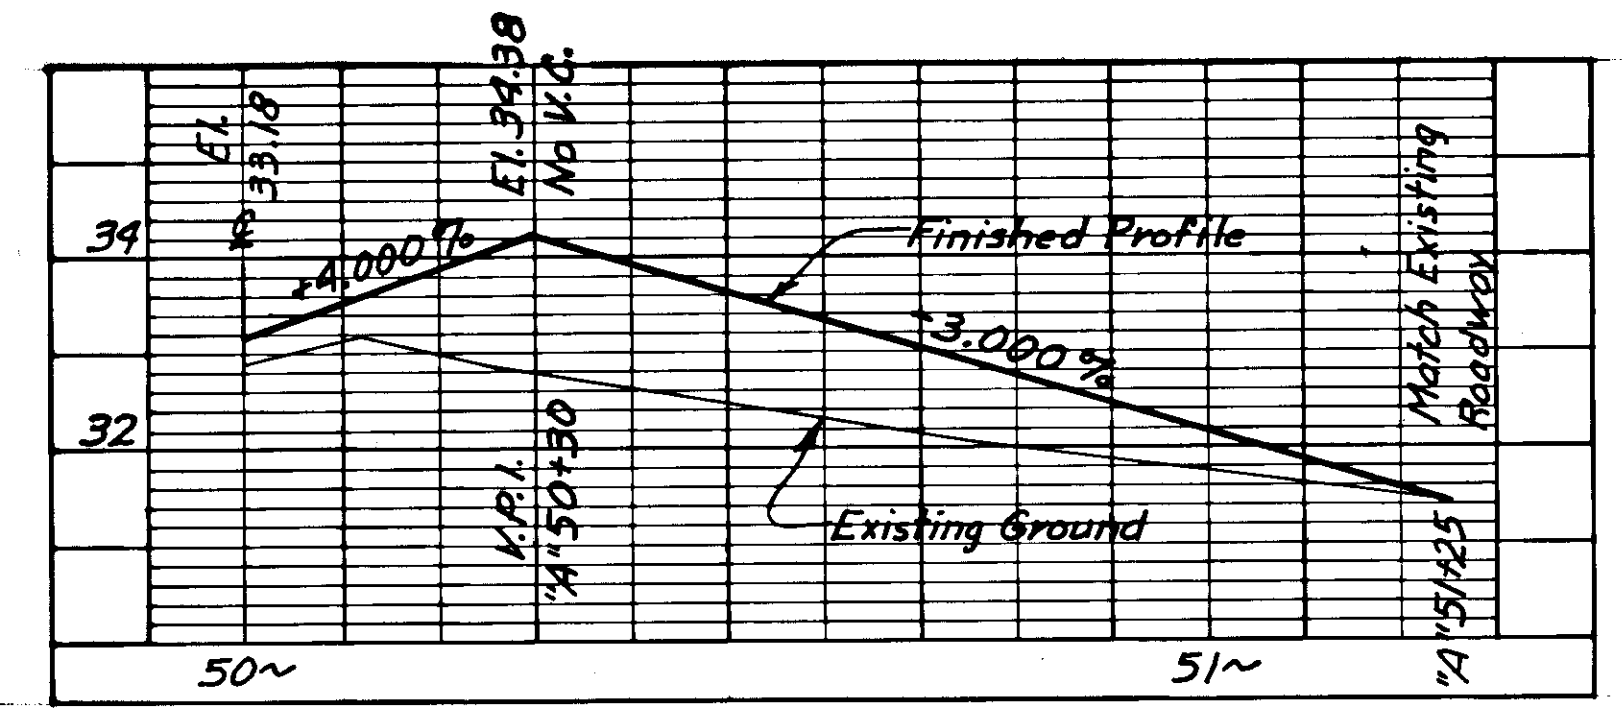


1. See pavement transition detail, sheet no. 2
2. Distances are to edge of pavement or to the shoulder where no pavement is shown.
3. All quantities are included in the appropriate mainline quantities.

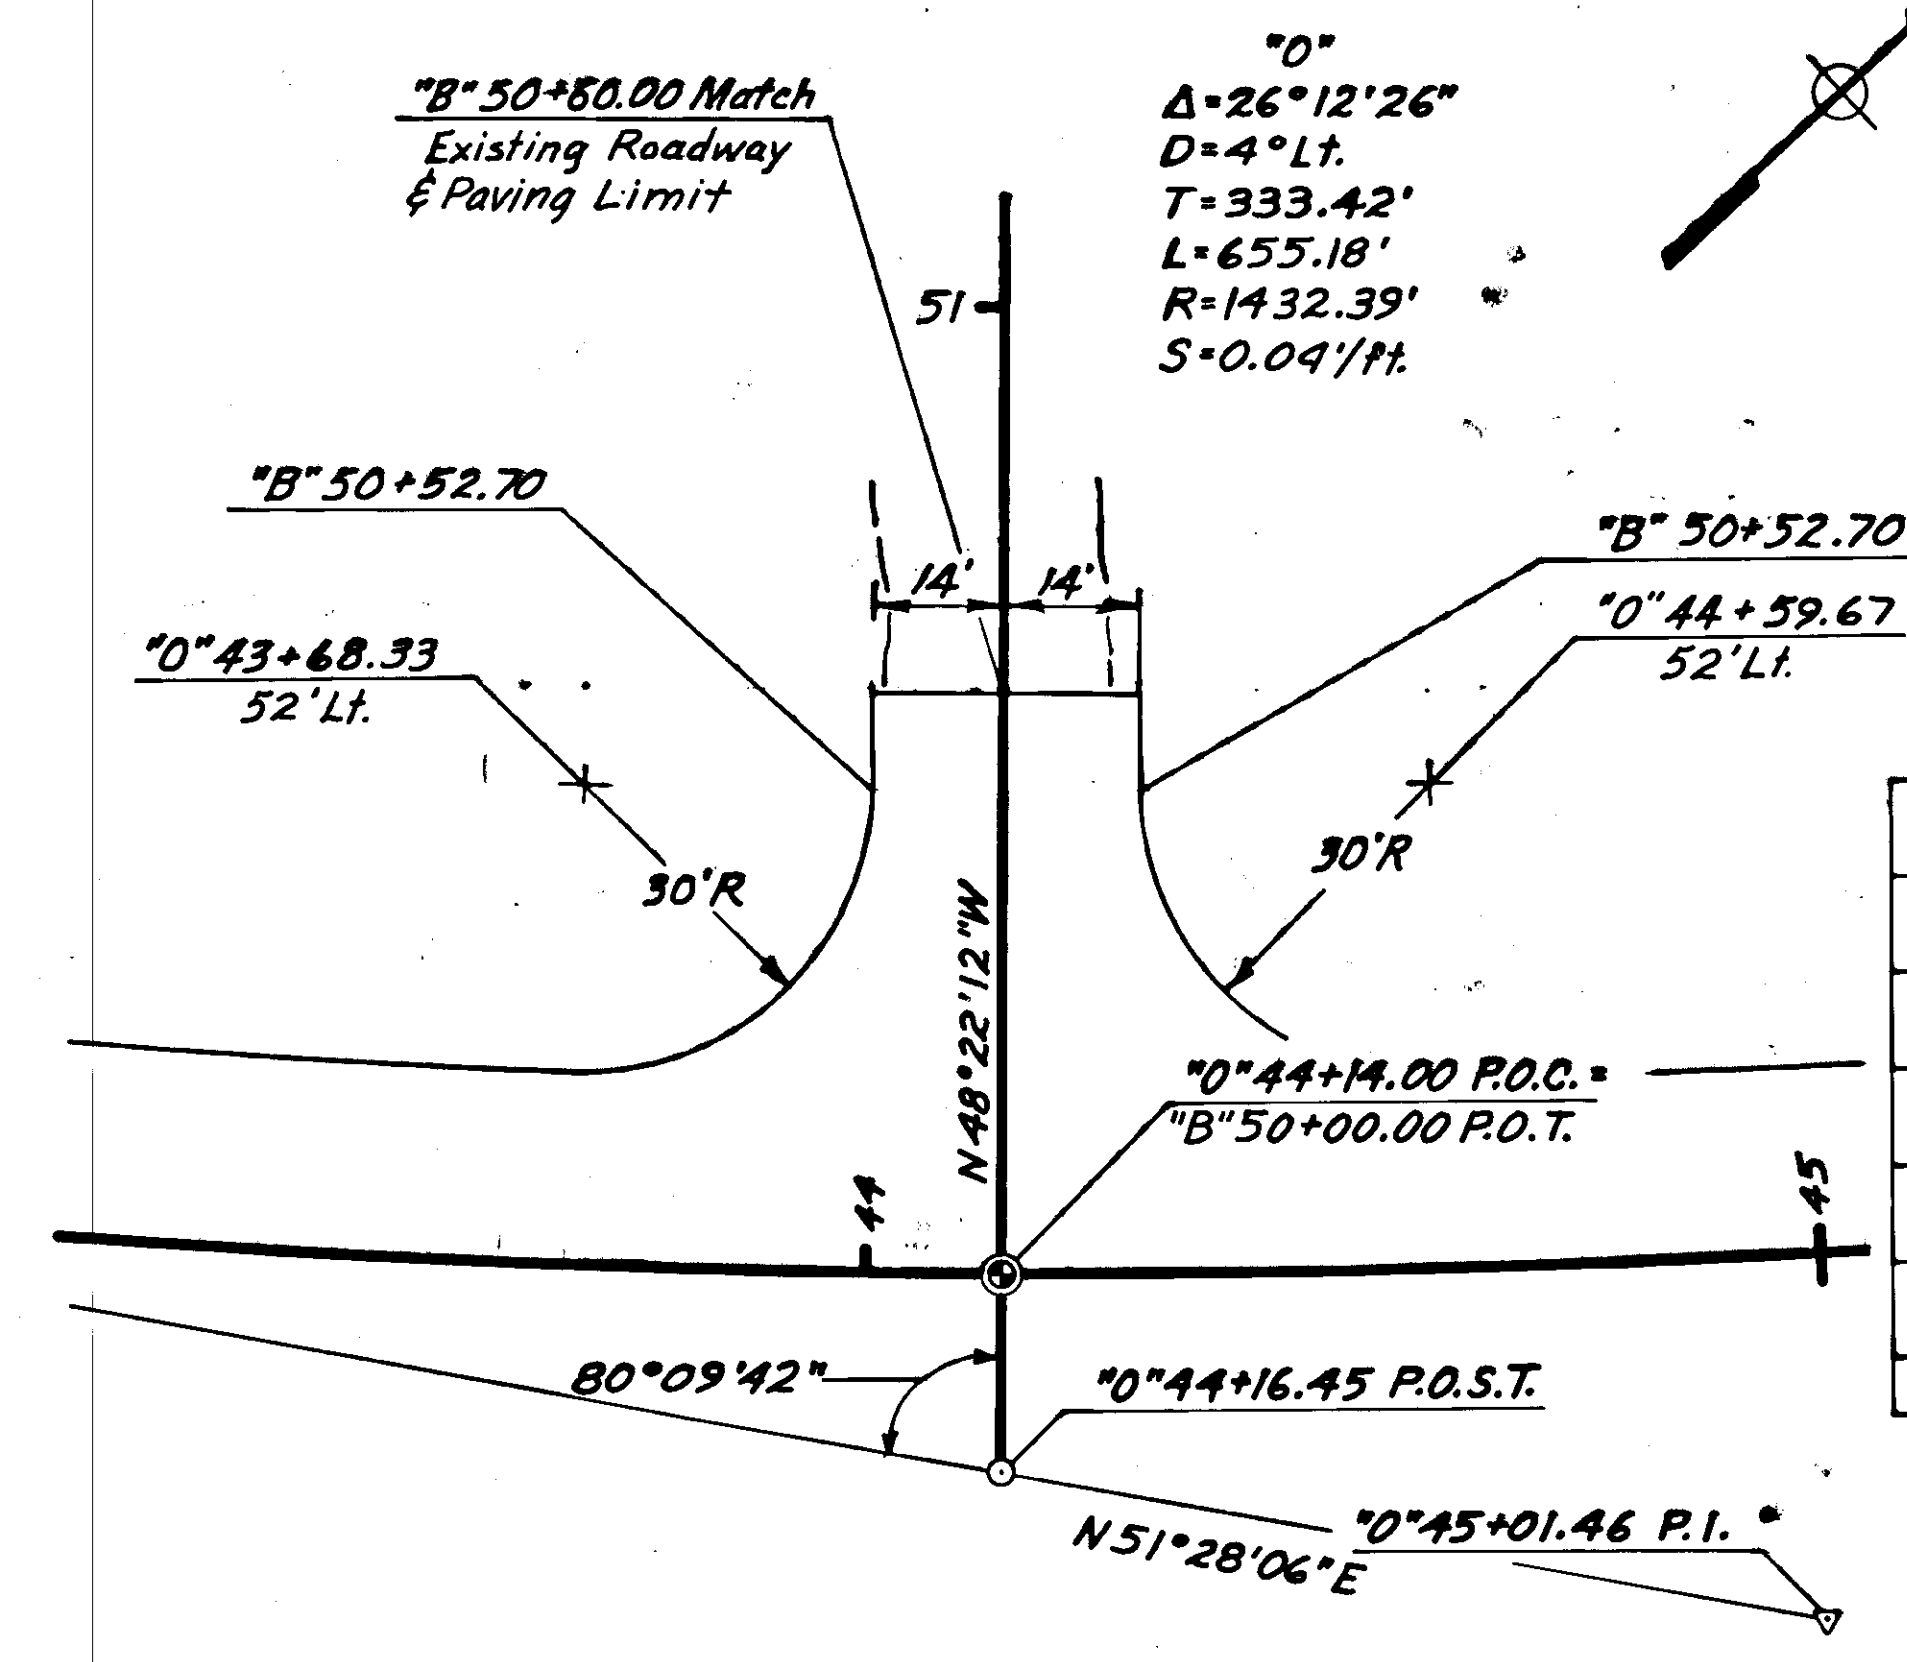

KODZOFF ACRES ENTRANCE


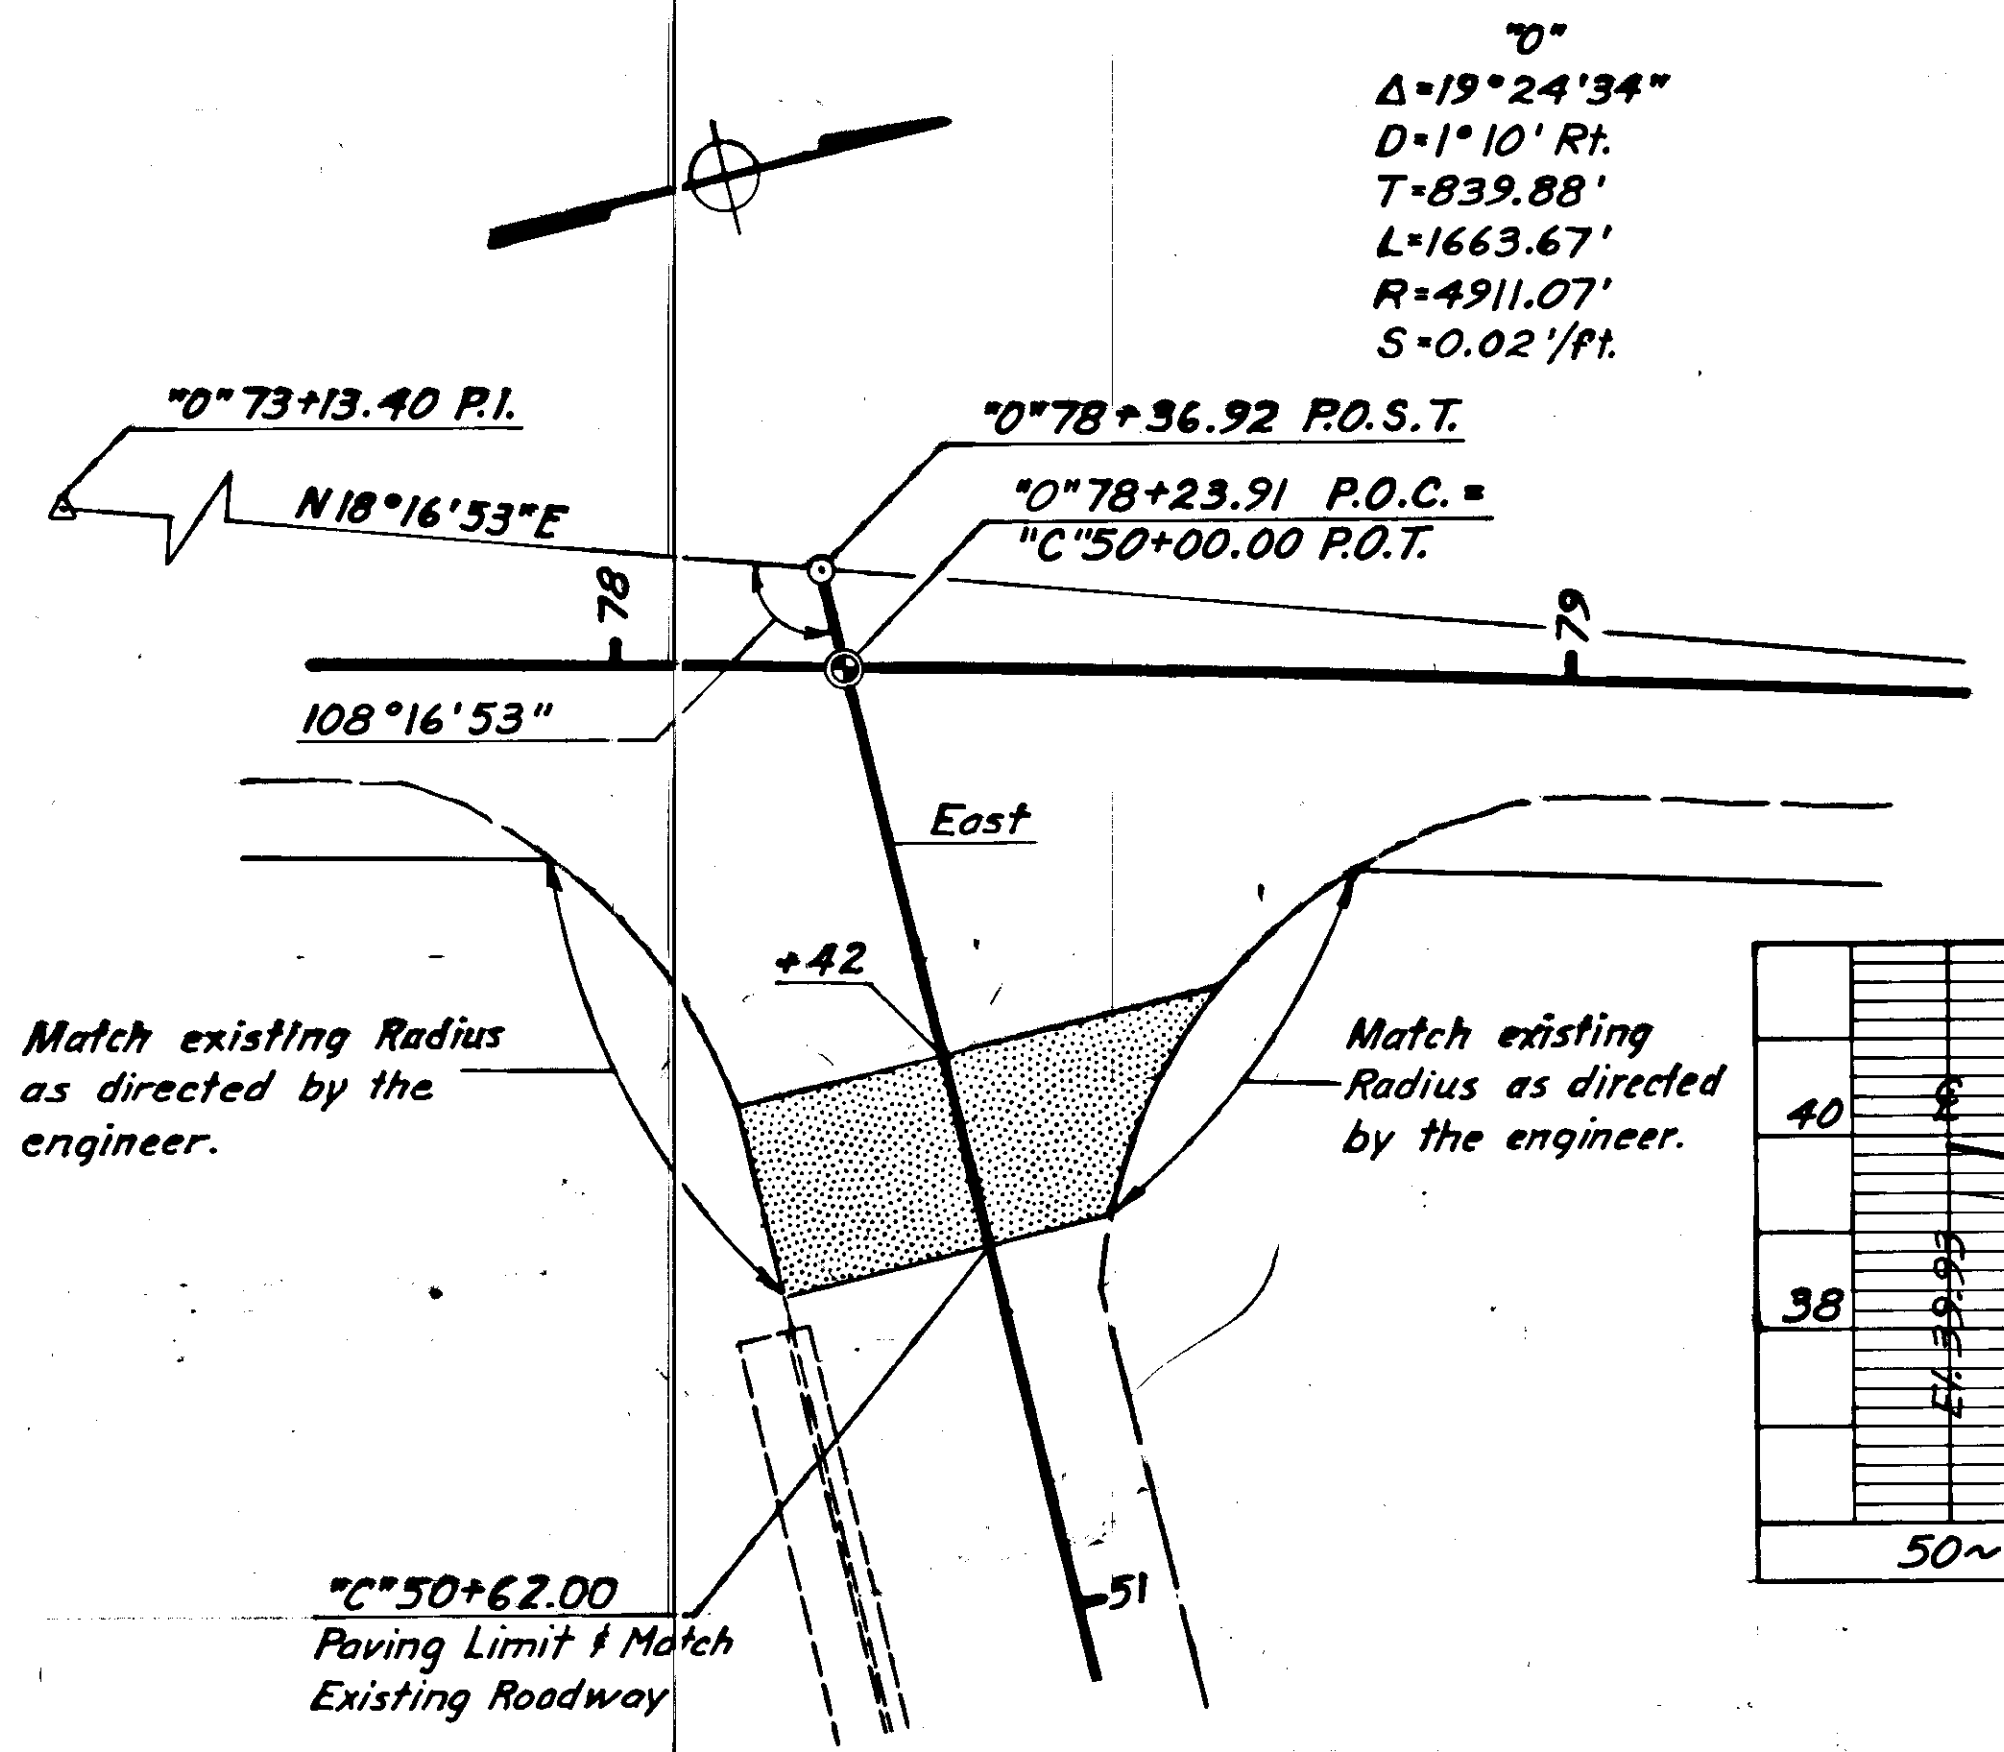
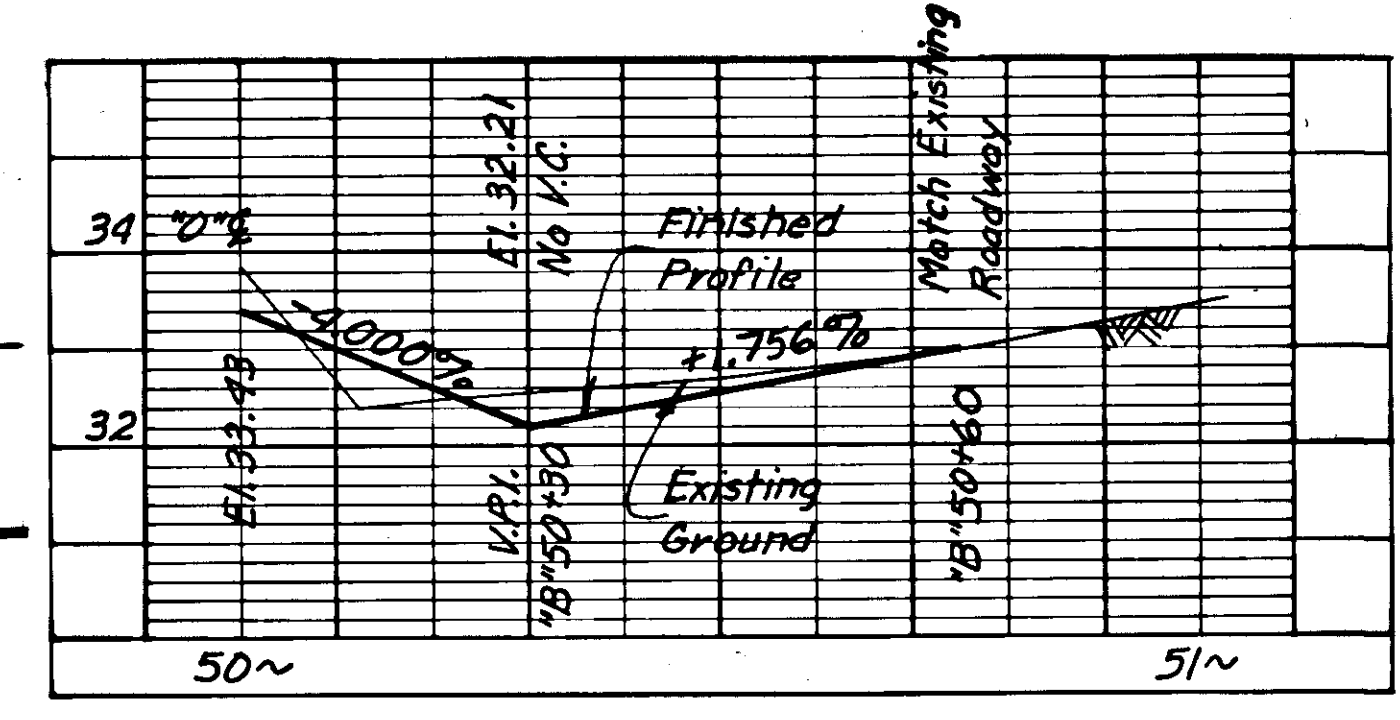


TRINITY DRIVE

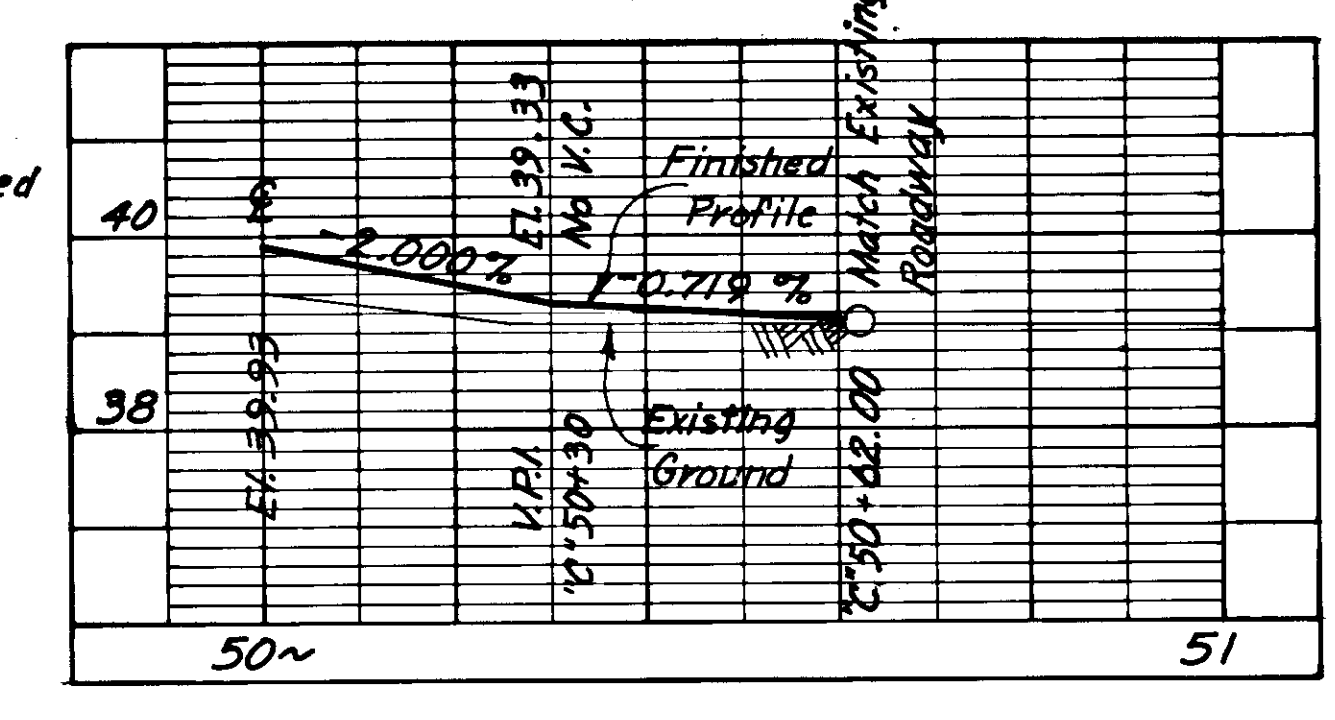


STATE	PROJECT DESIGNATION	YEAR	SHEET NO.	TOTAL SHEETS
ALASKA	RS-0966(8)	1977	20	40


INTERSECTION DETAILS

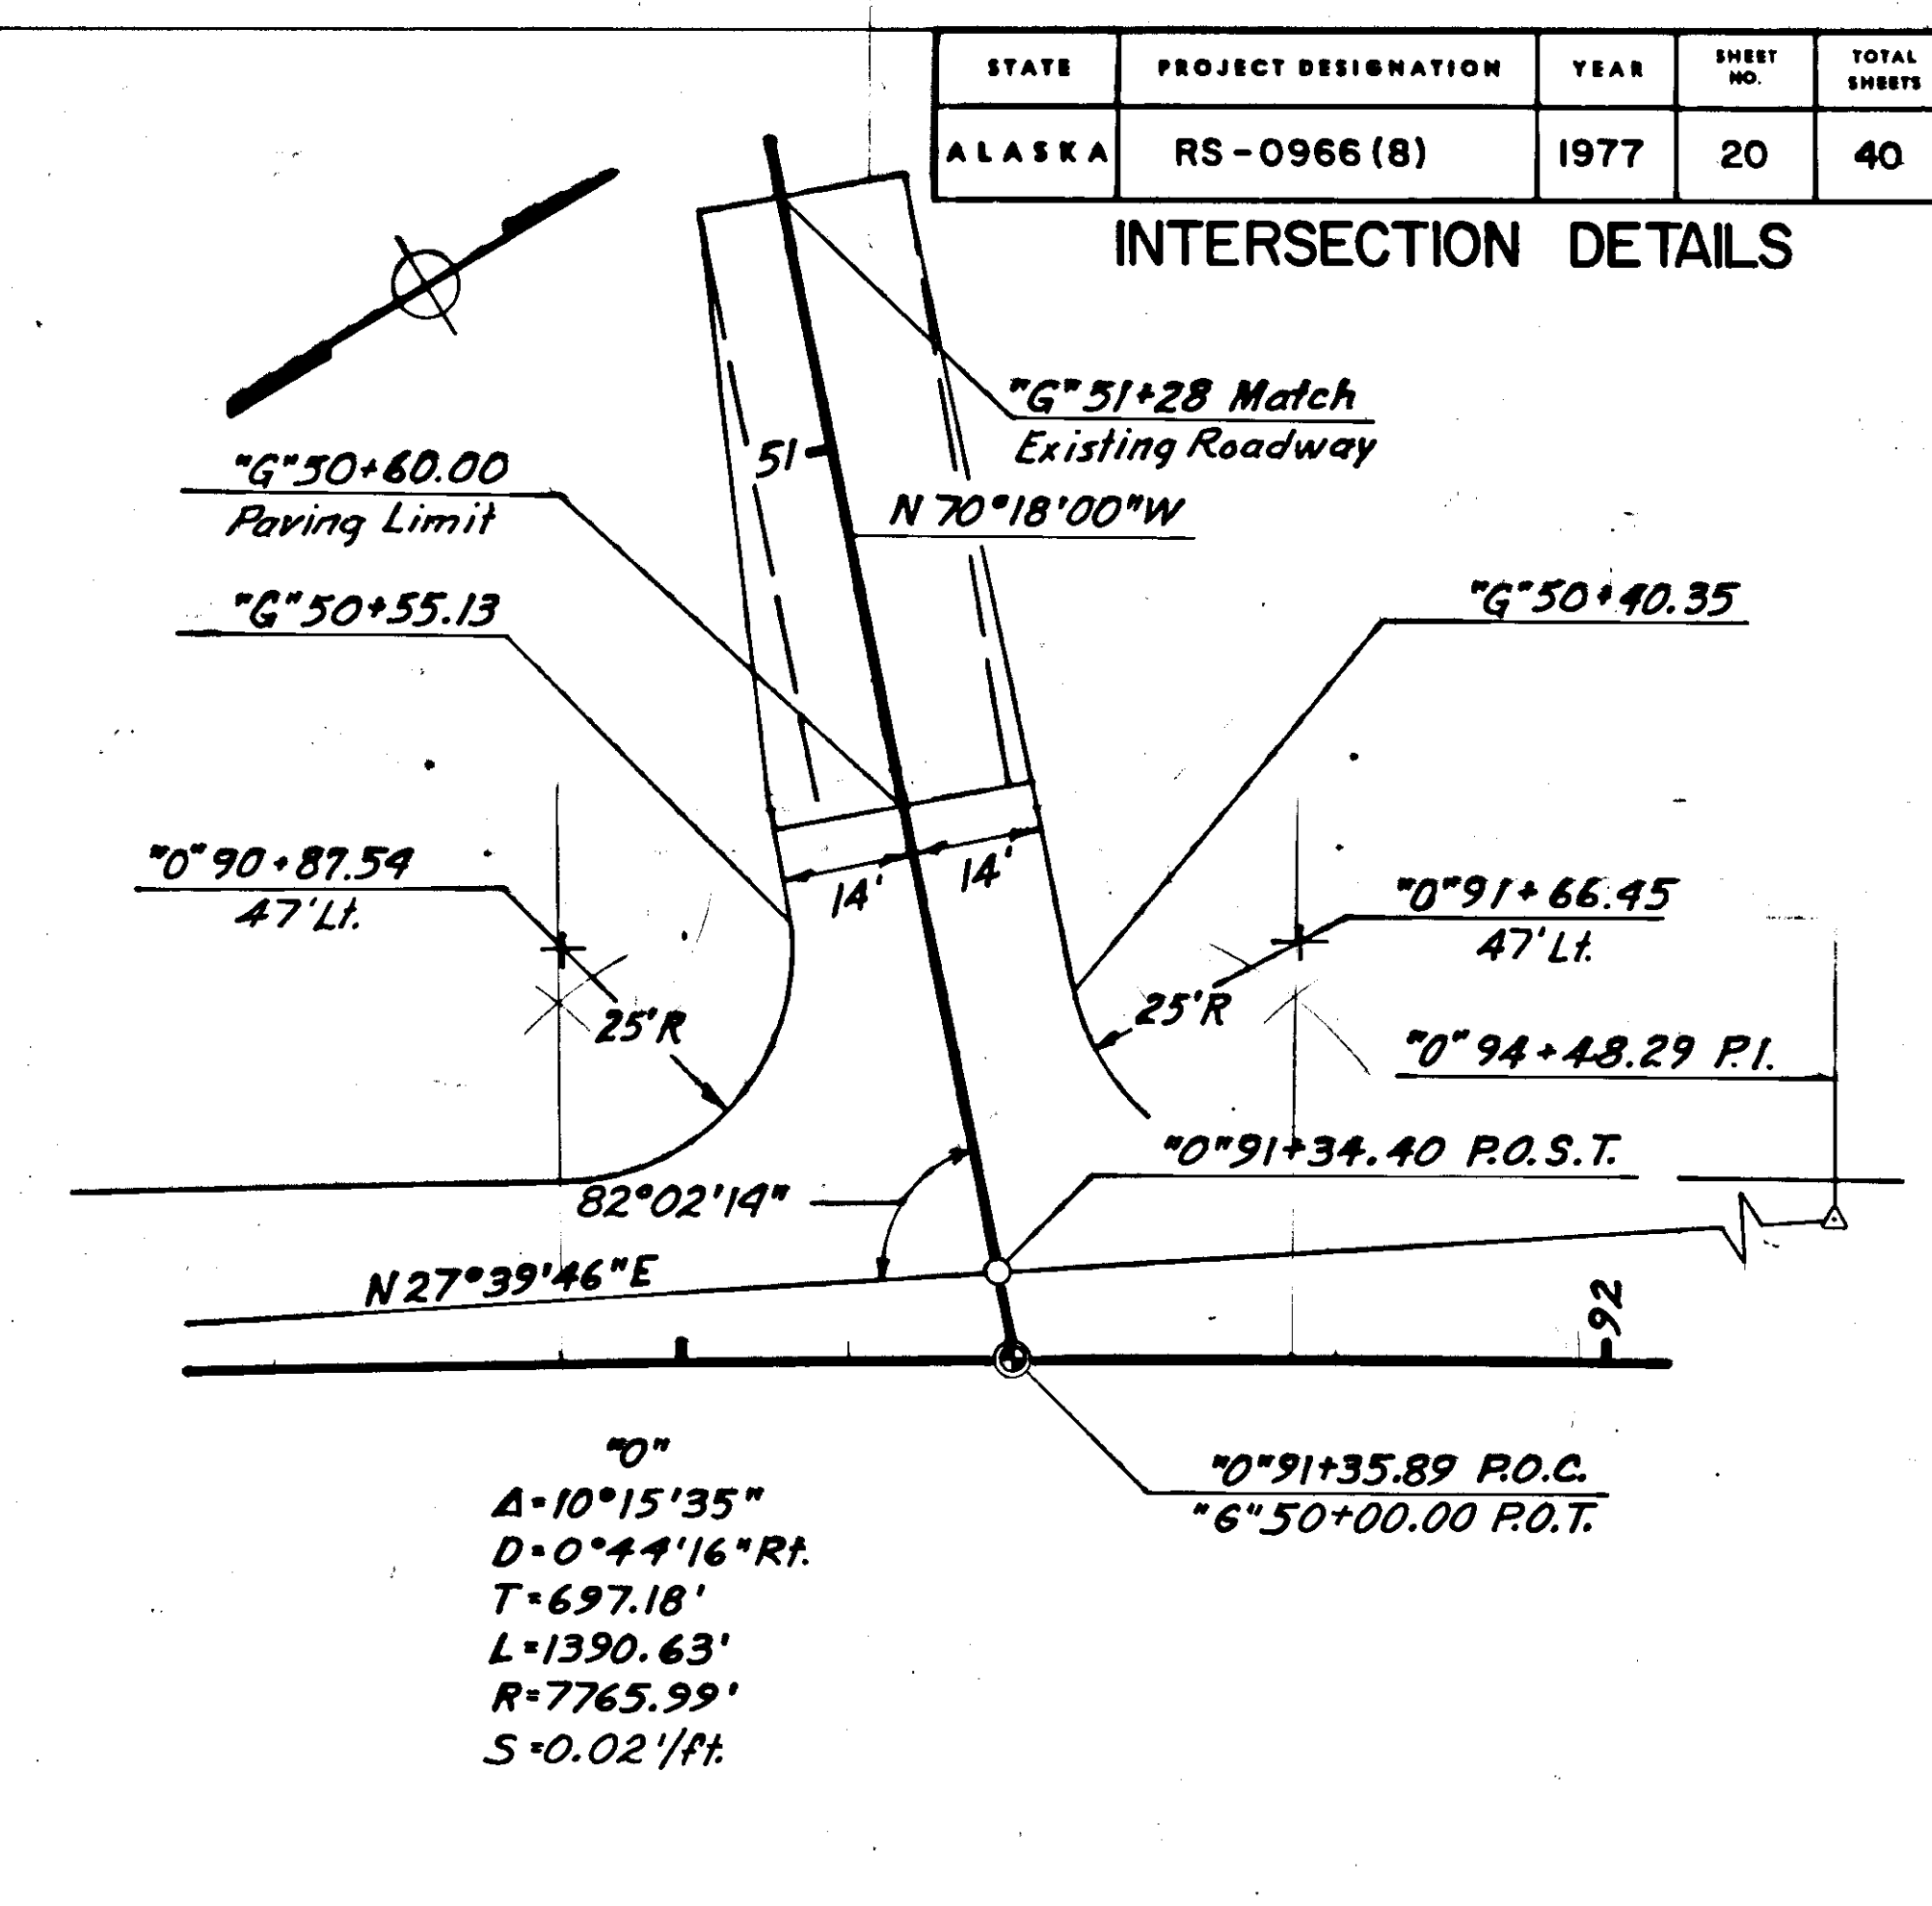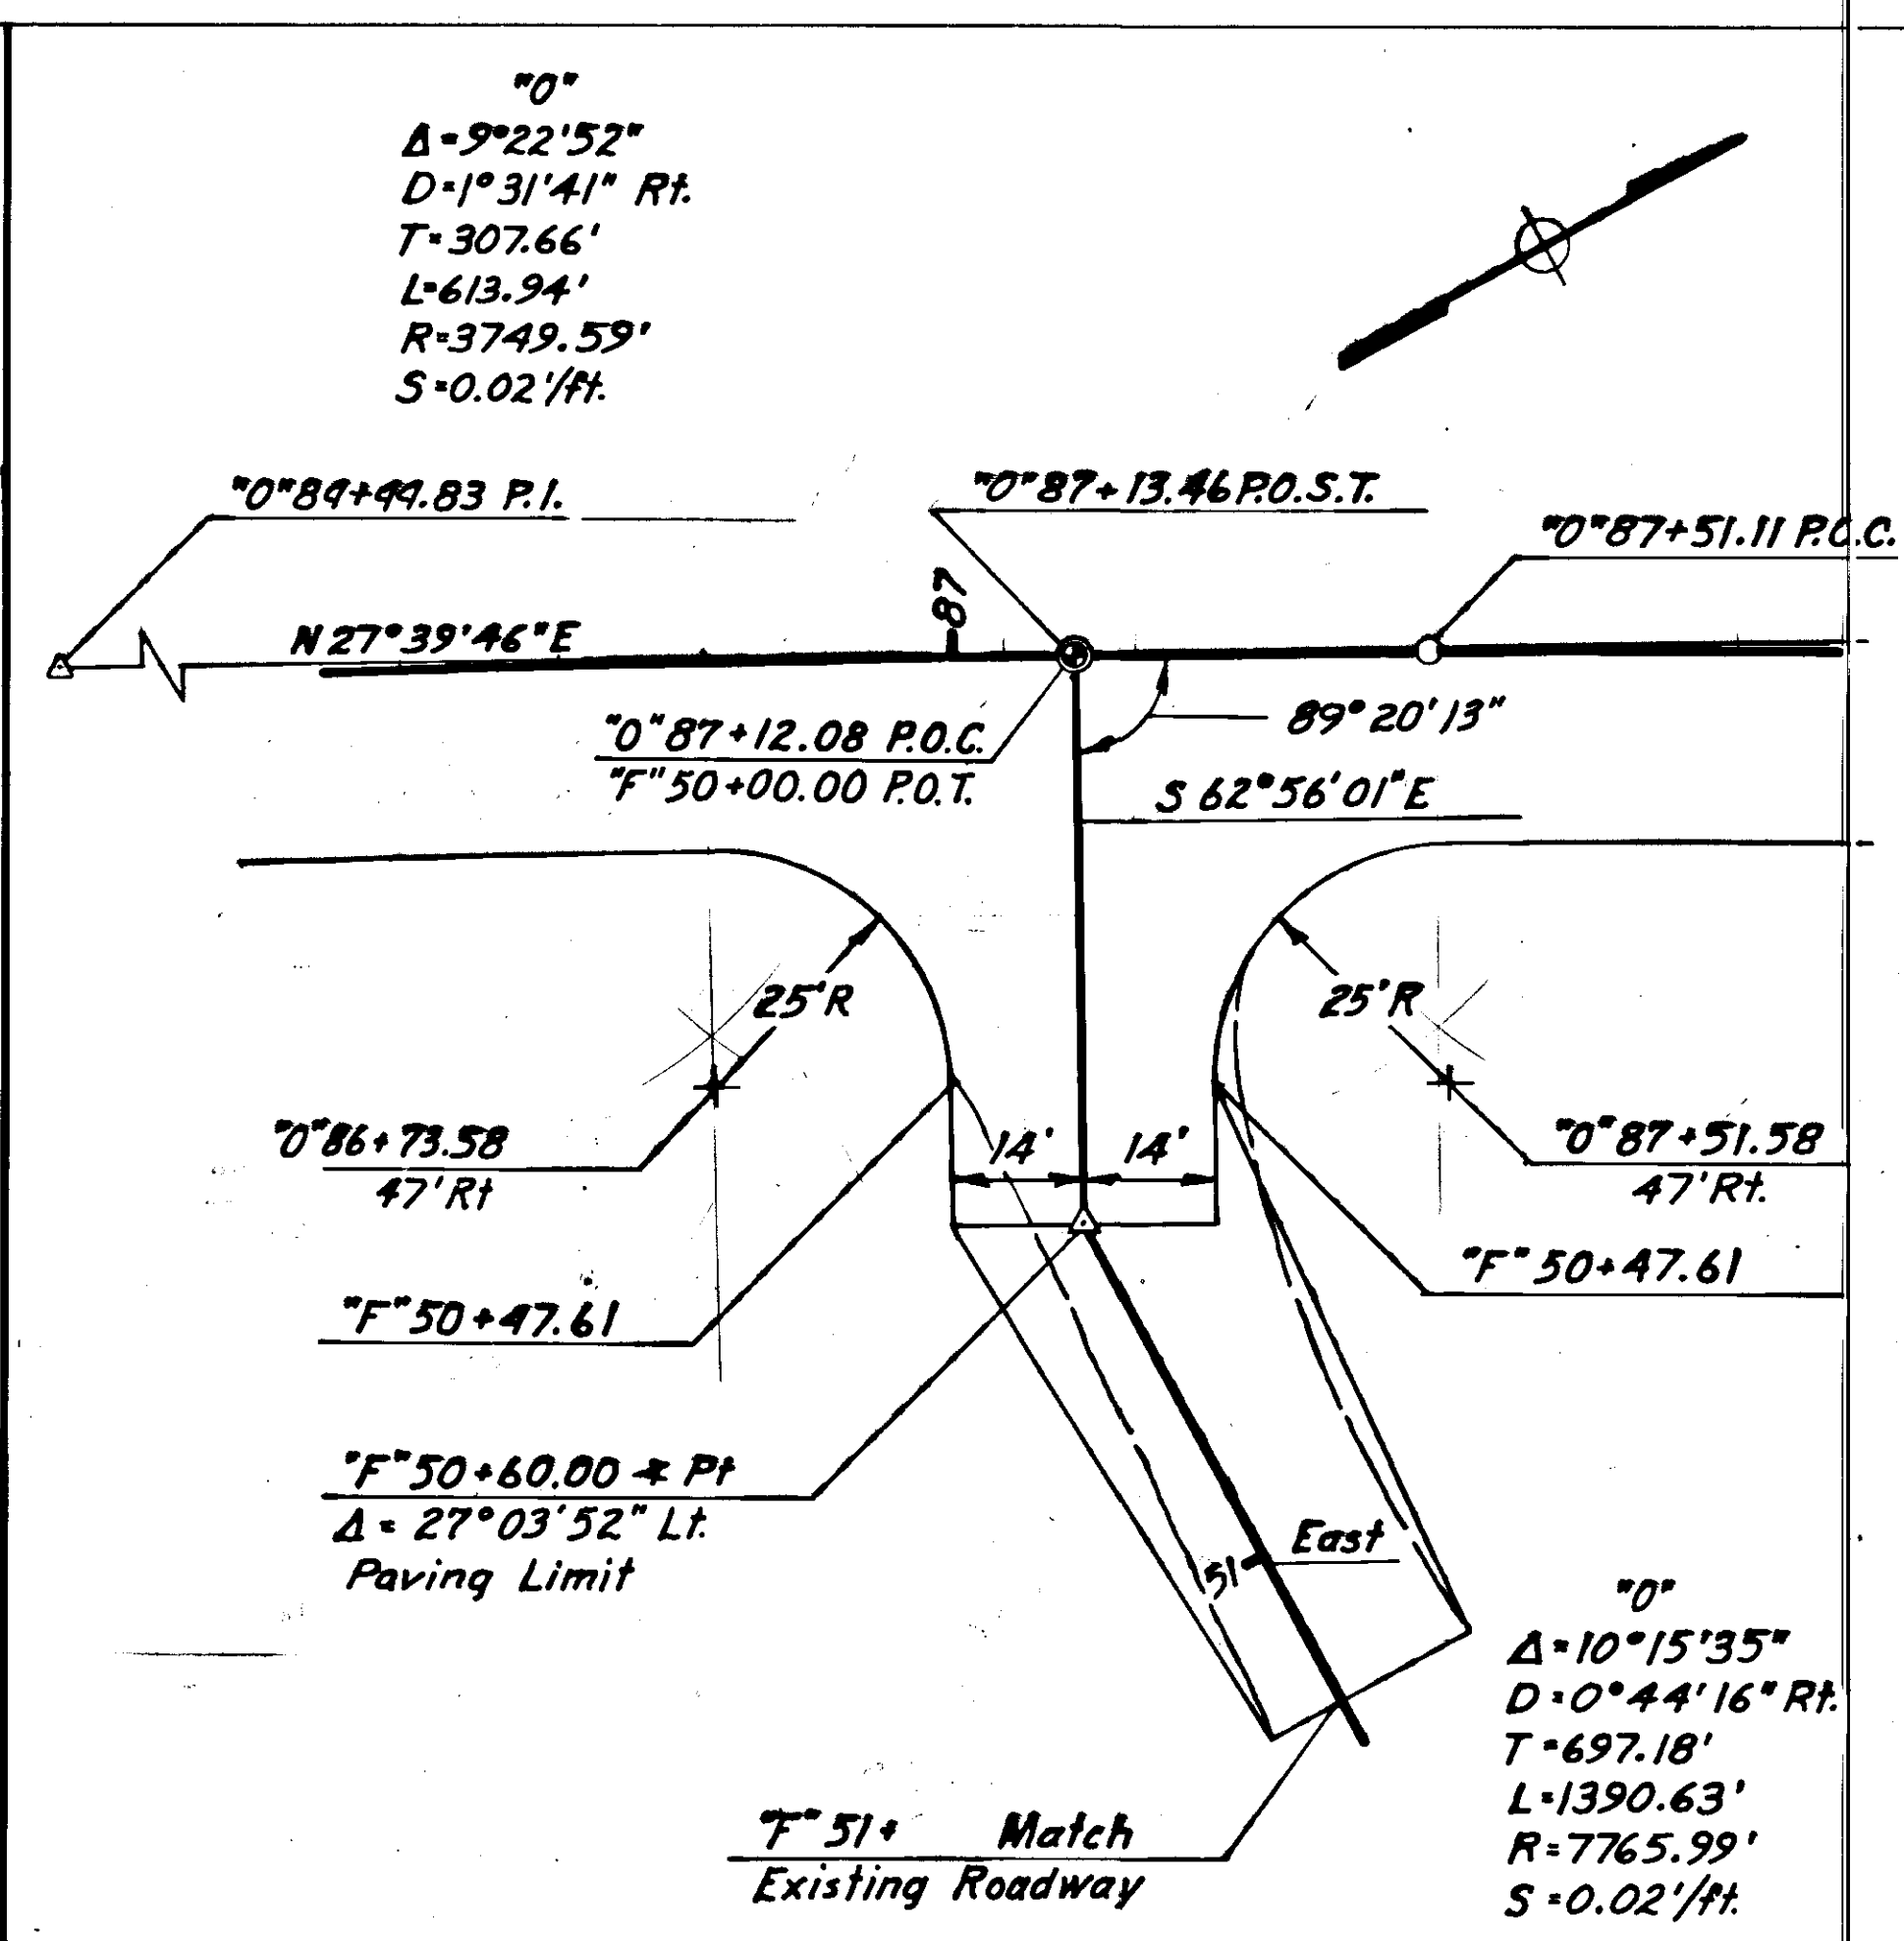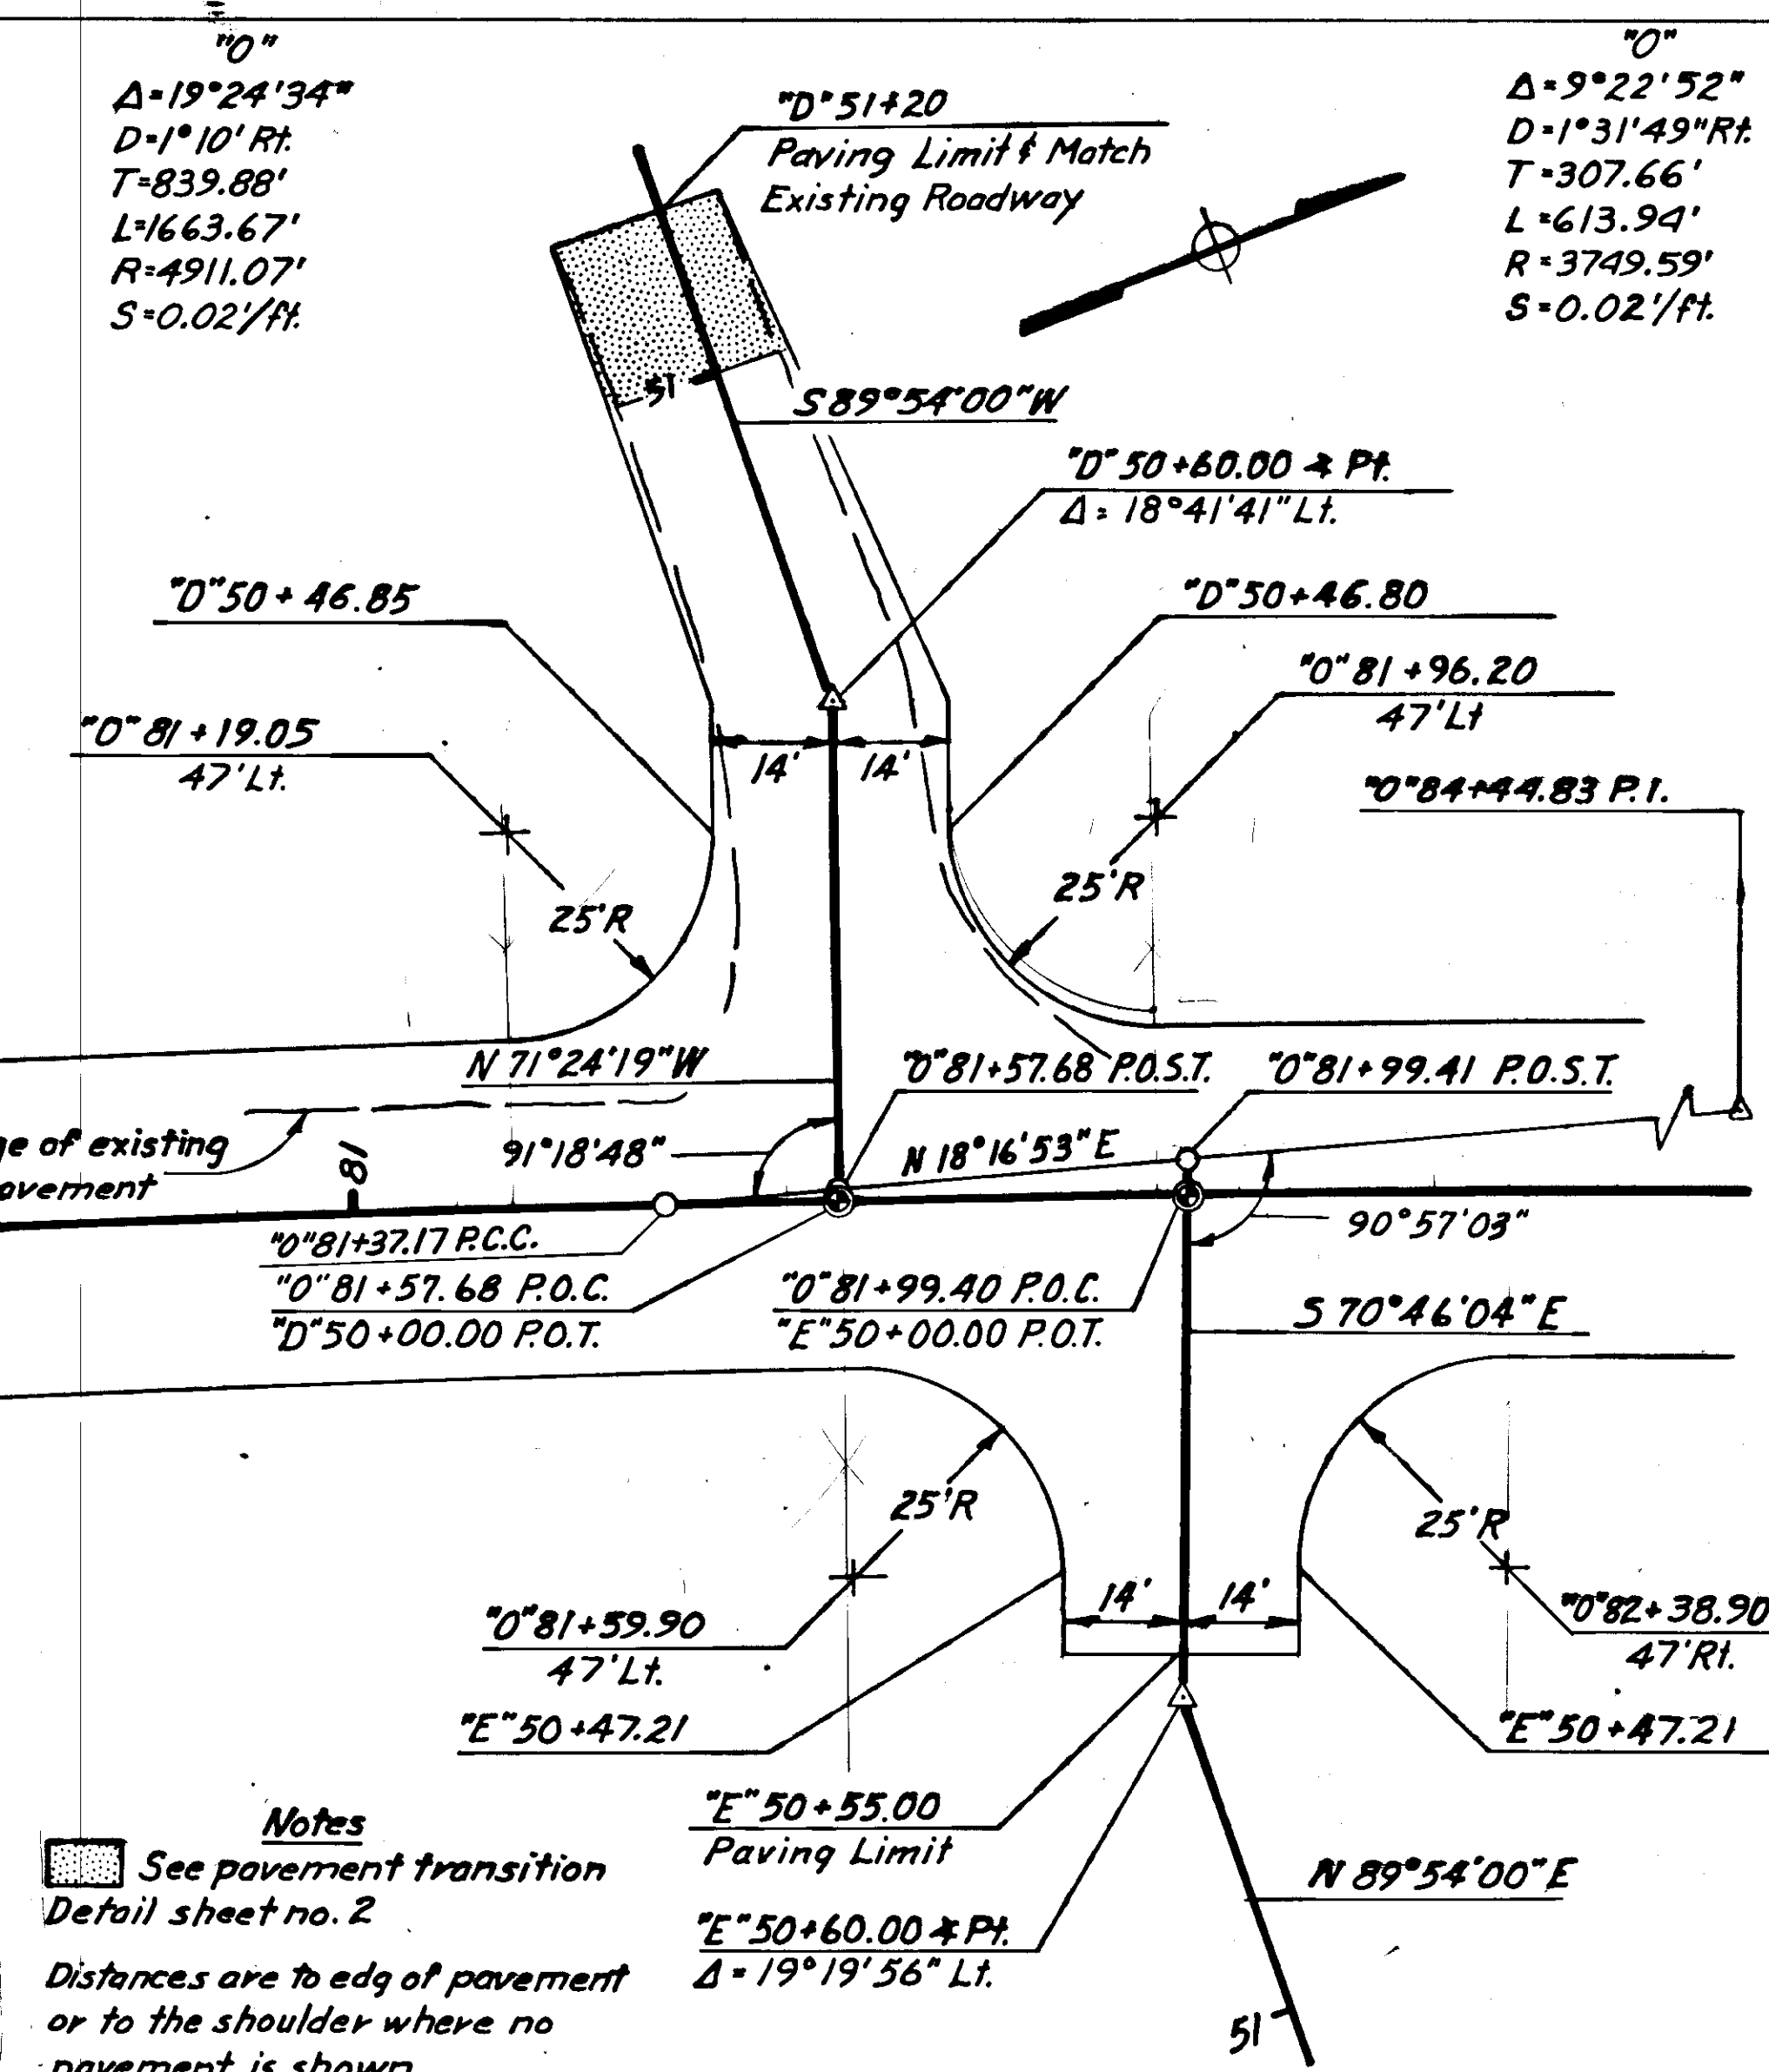


RICHARDS DRIVE & HALOFF WAY

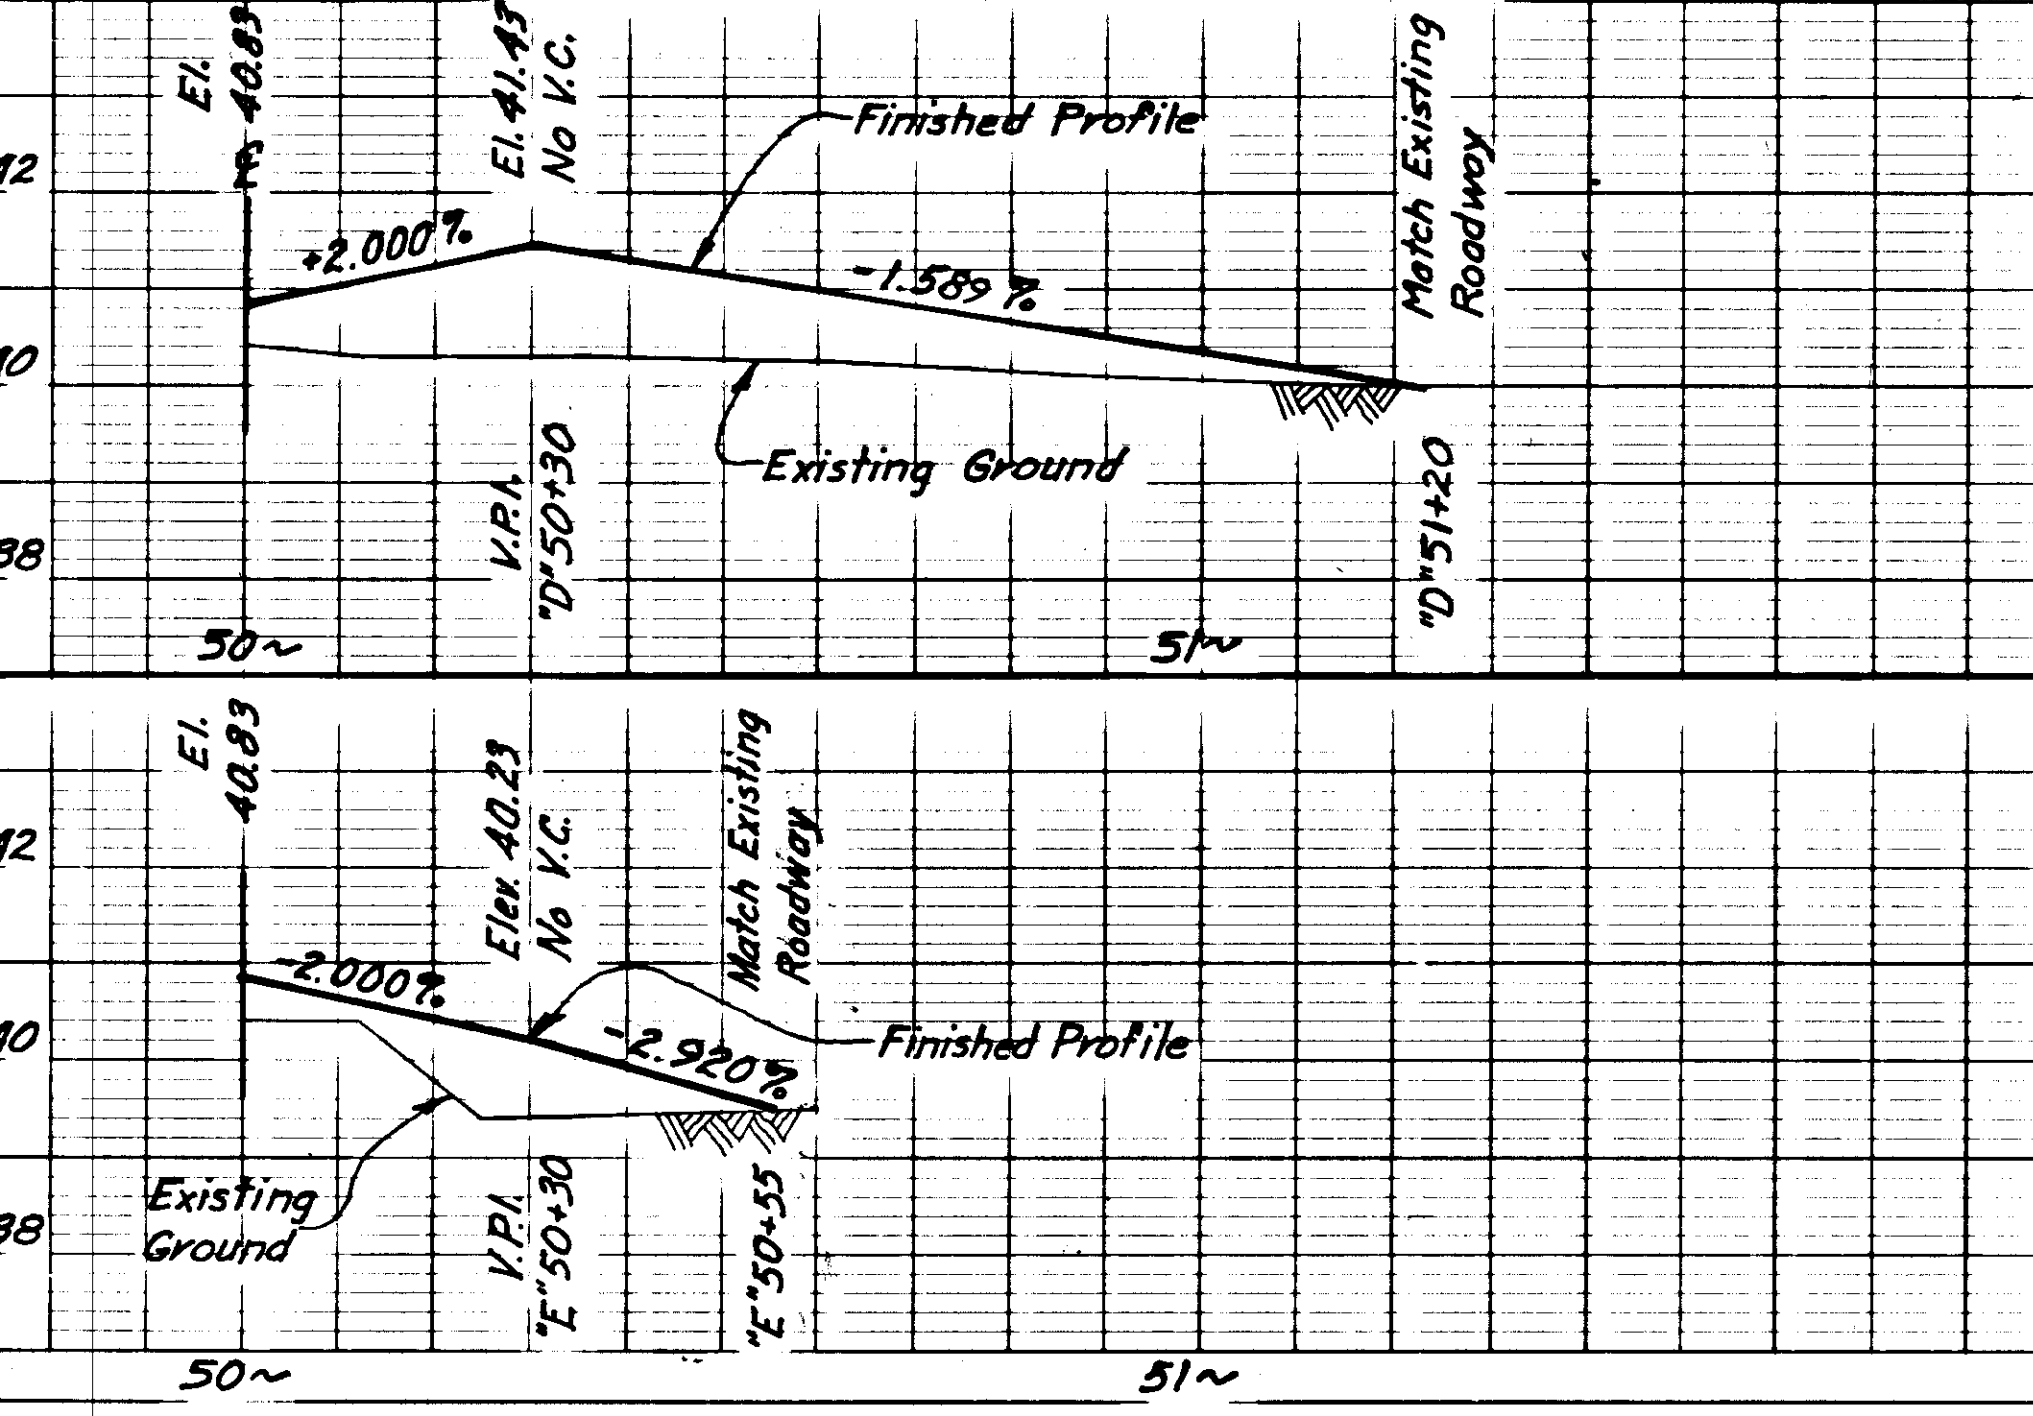

DUDLEY STREET

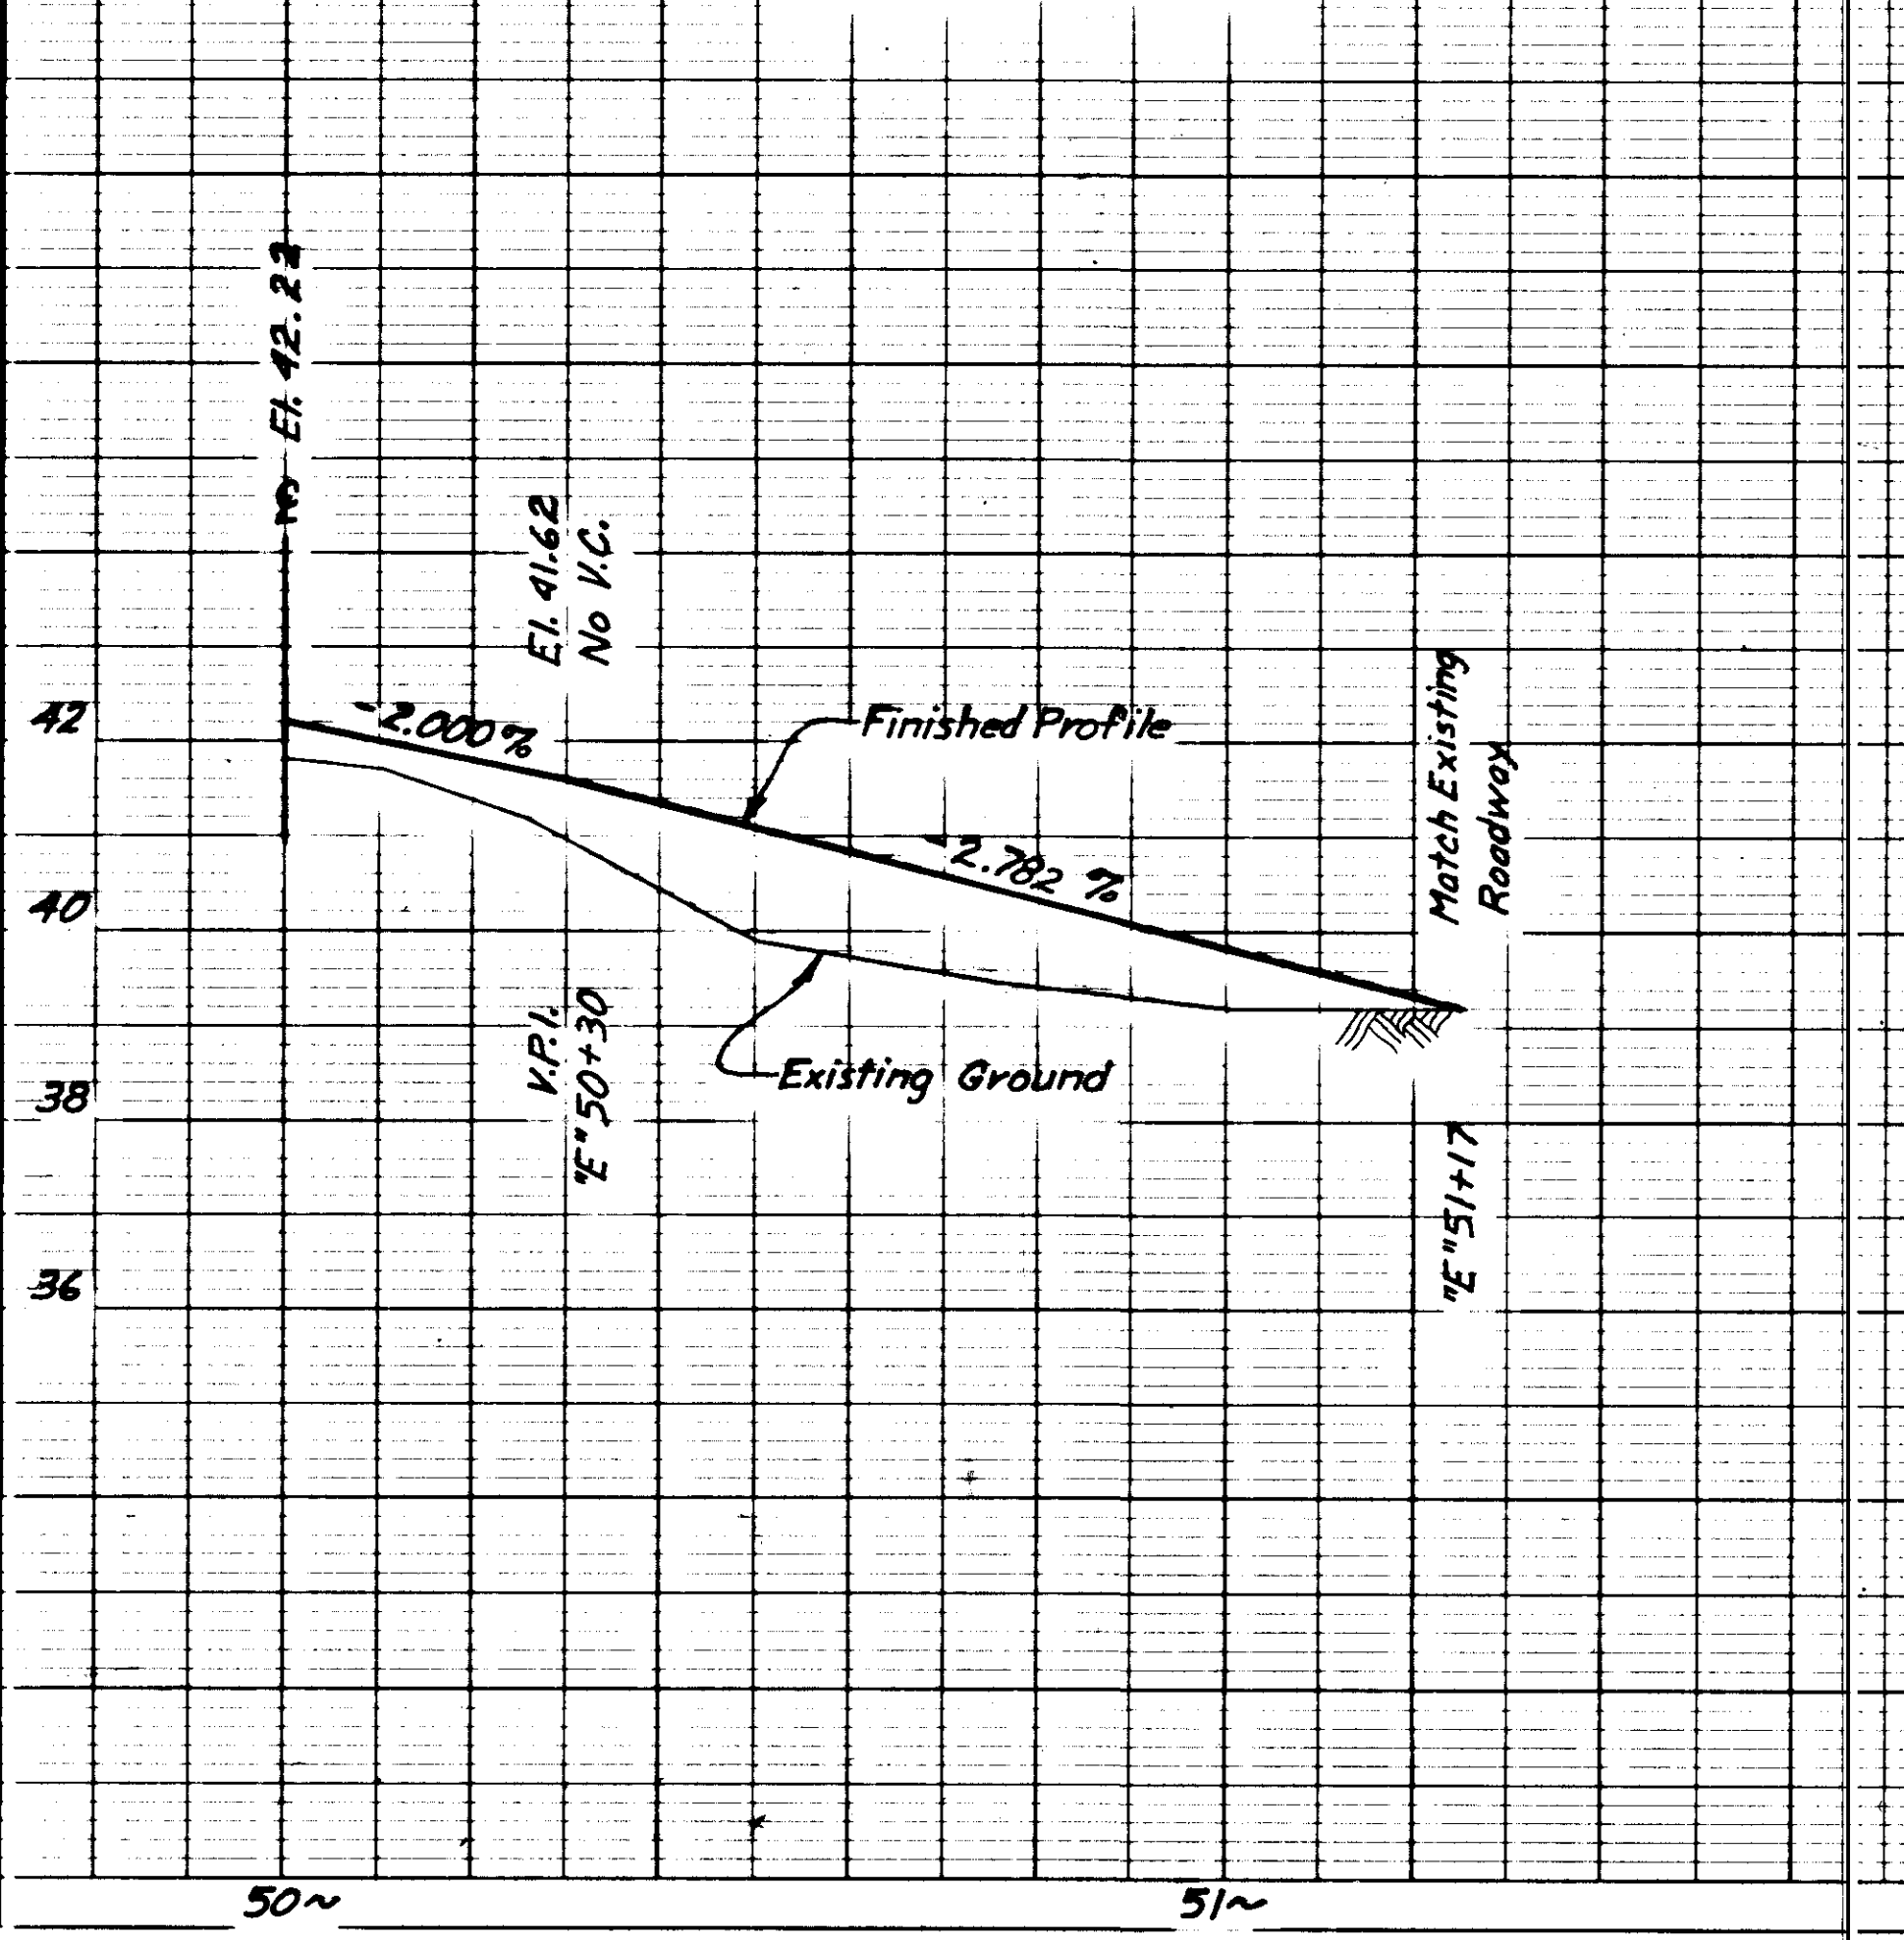


McGINNIS DRIVE

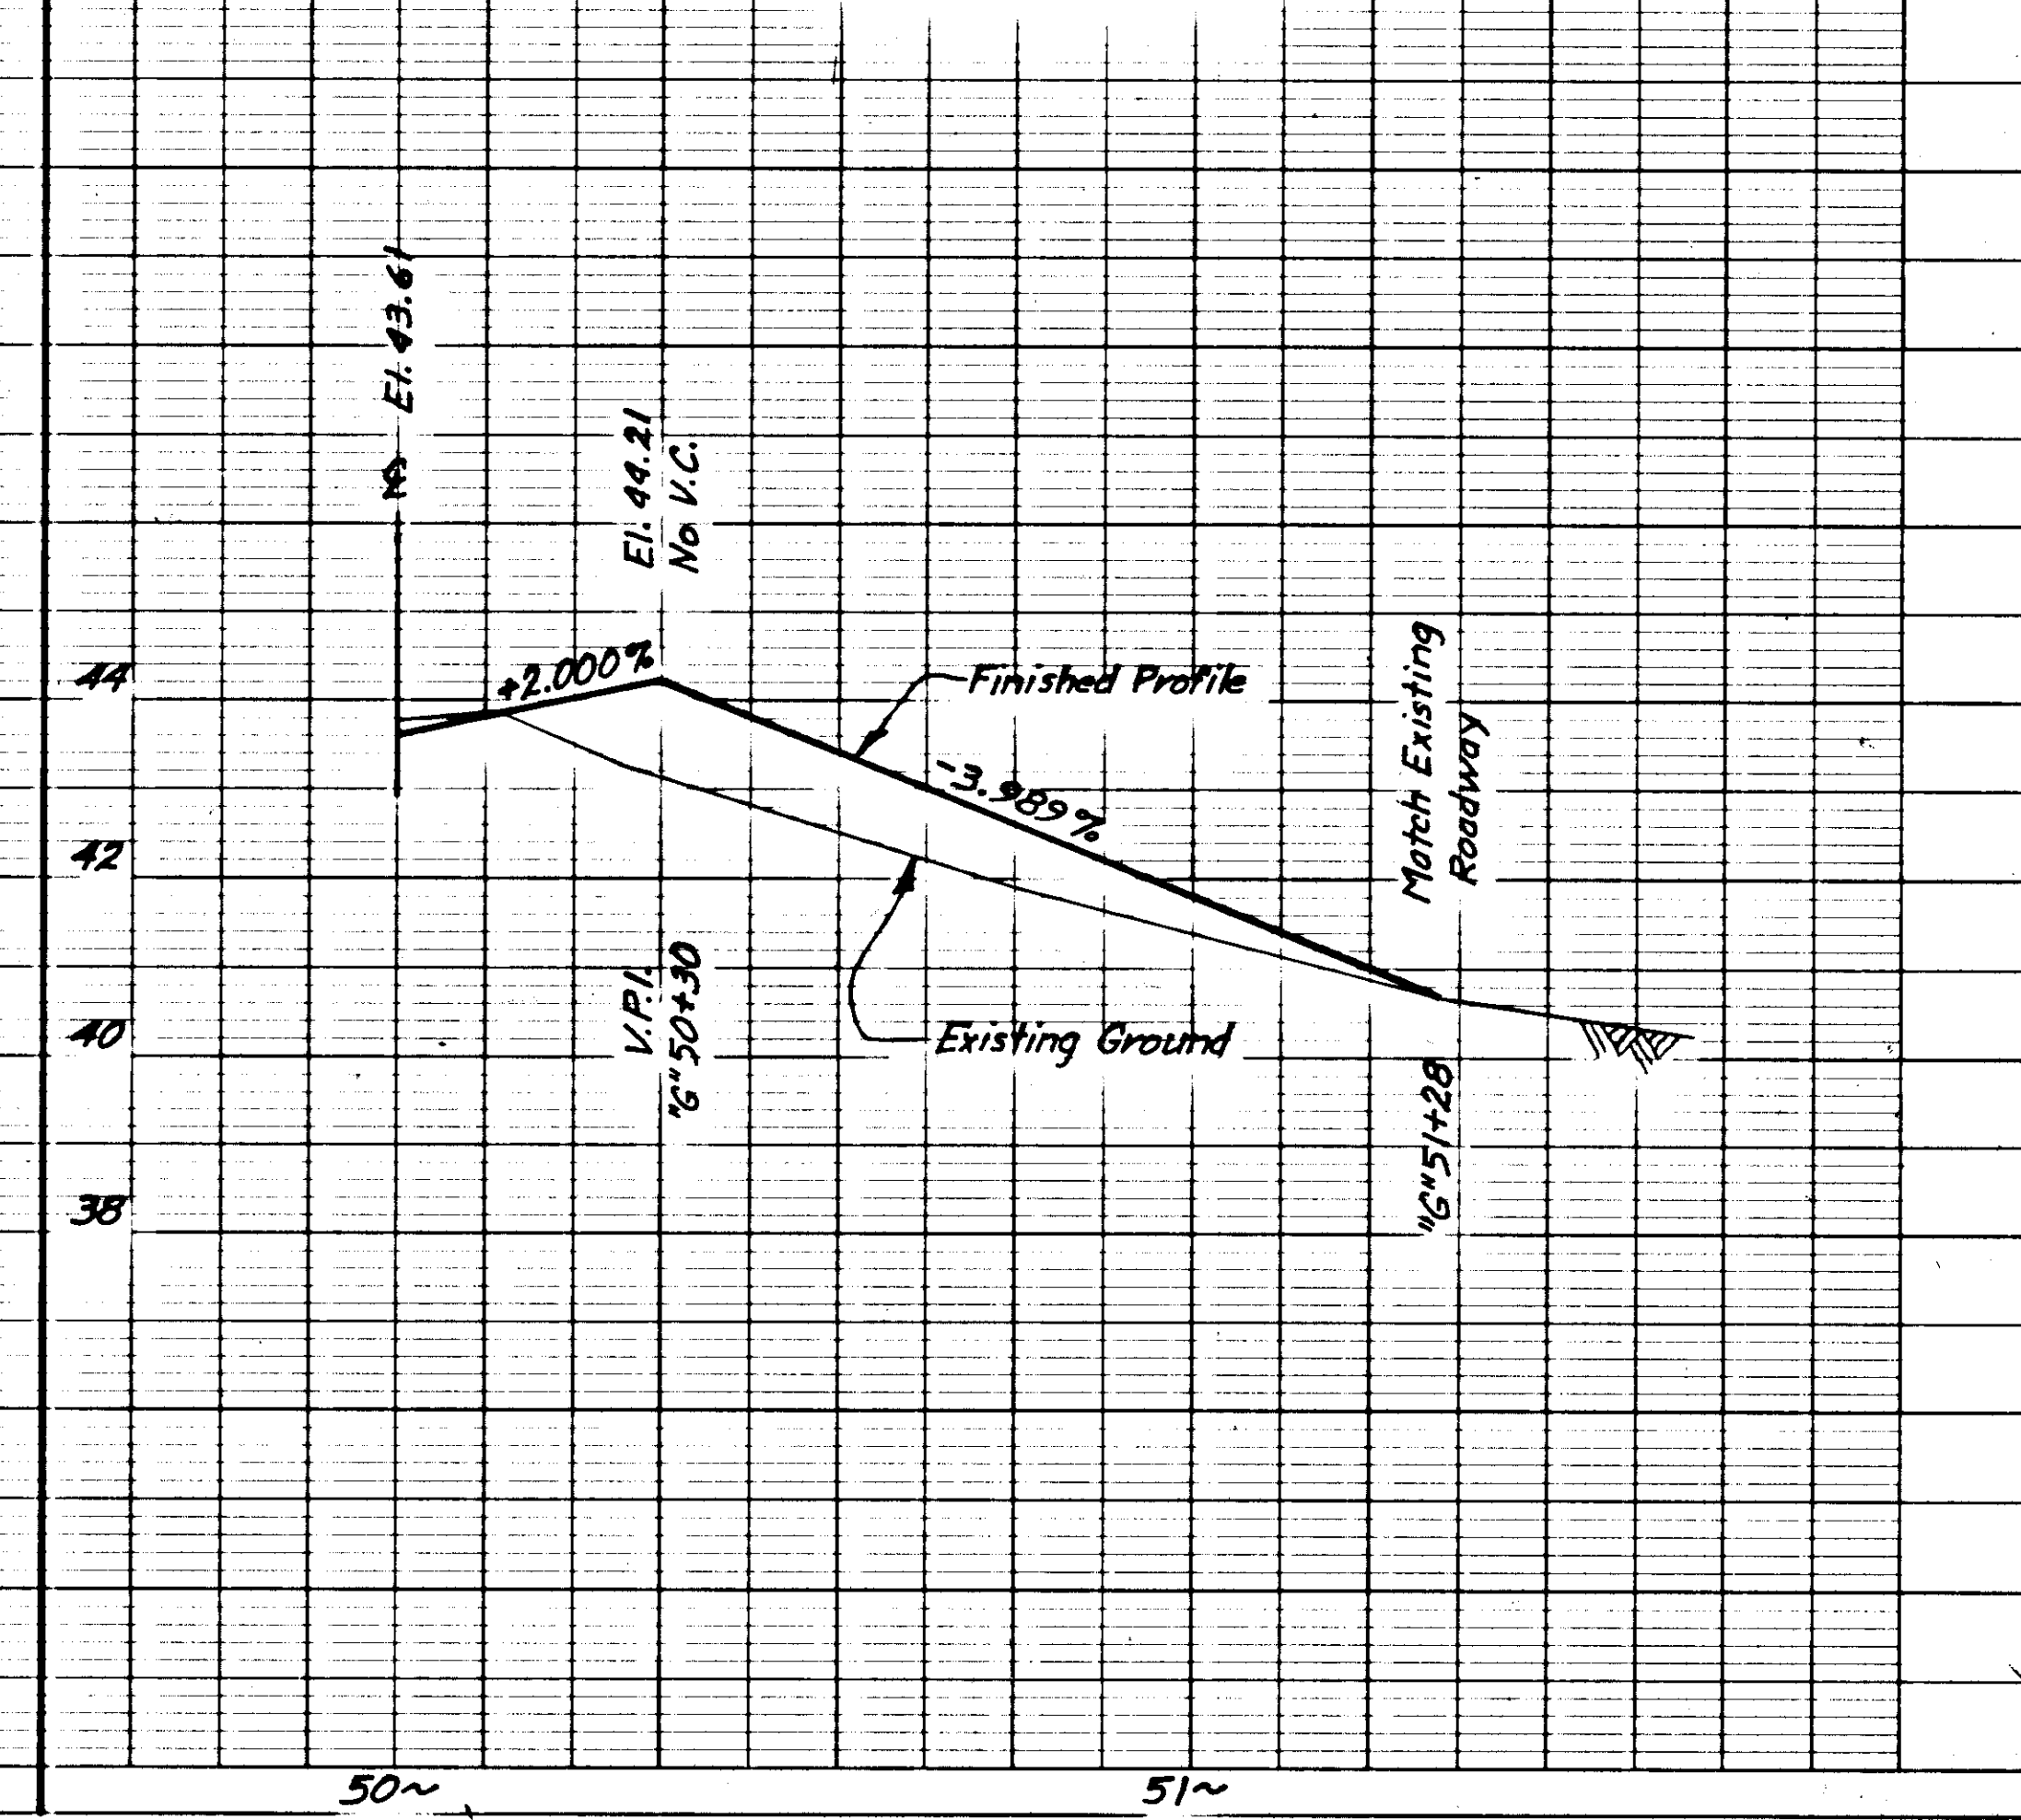


STATE	PROJECT DESIGNATION	YEAR	SHEET NO.	TOTAL SHEETS
ALASKA	RS-0966(8)	1977	21	40

INTERSECTION DETAILS

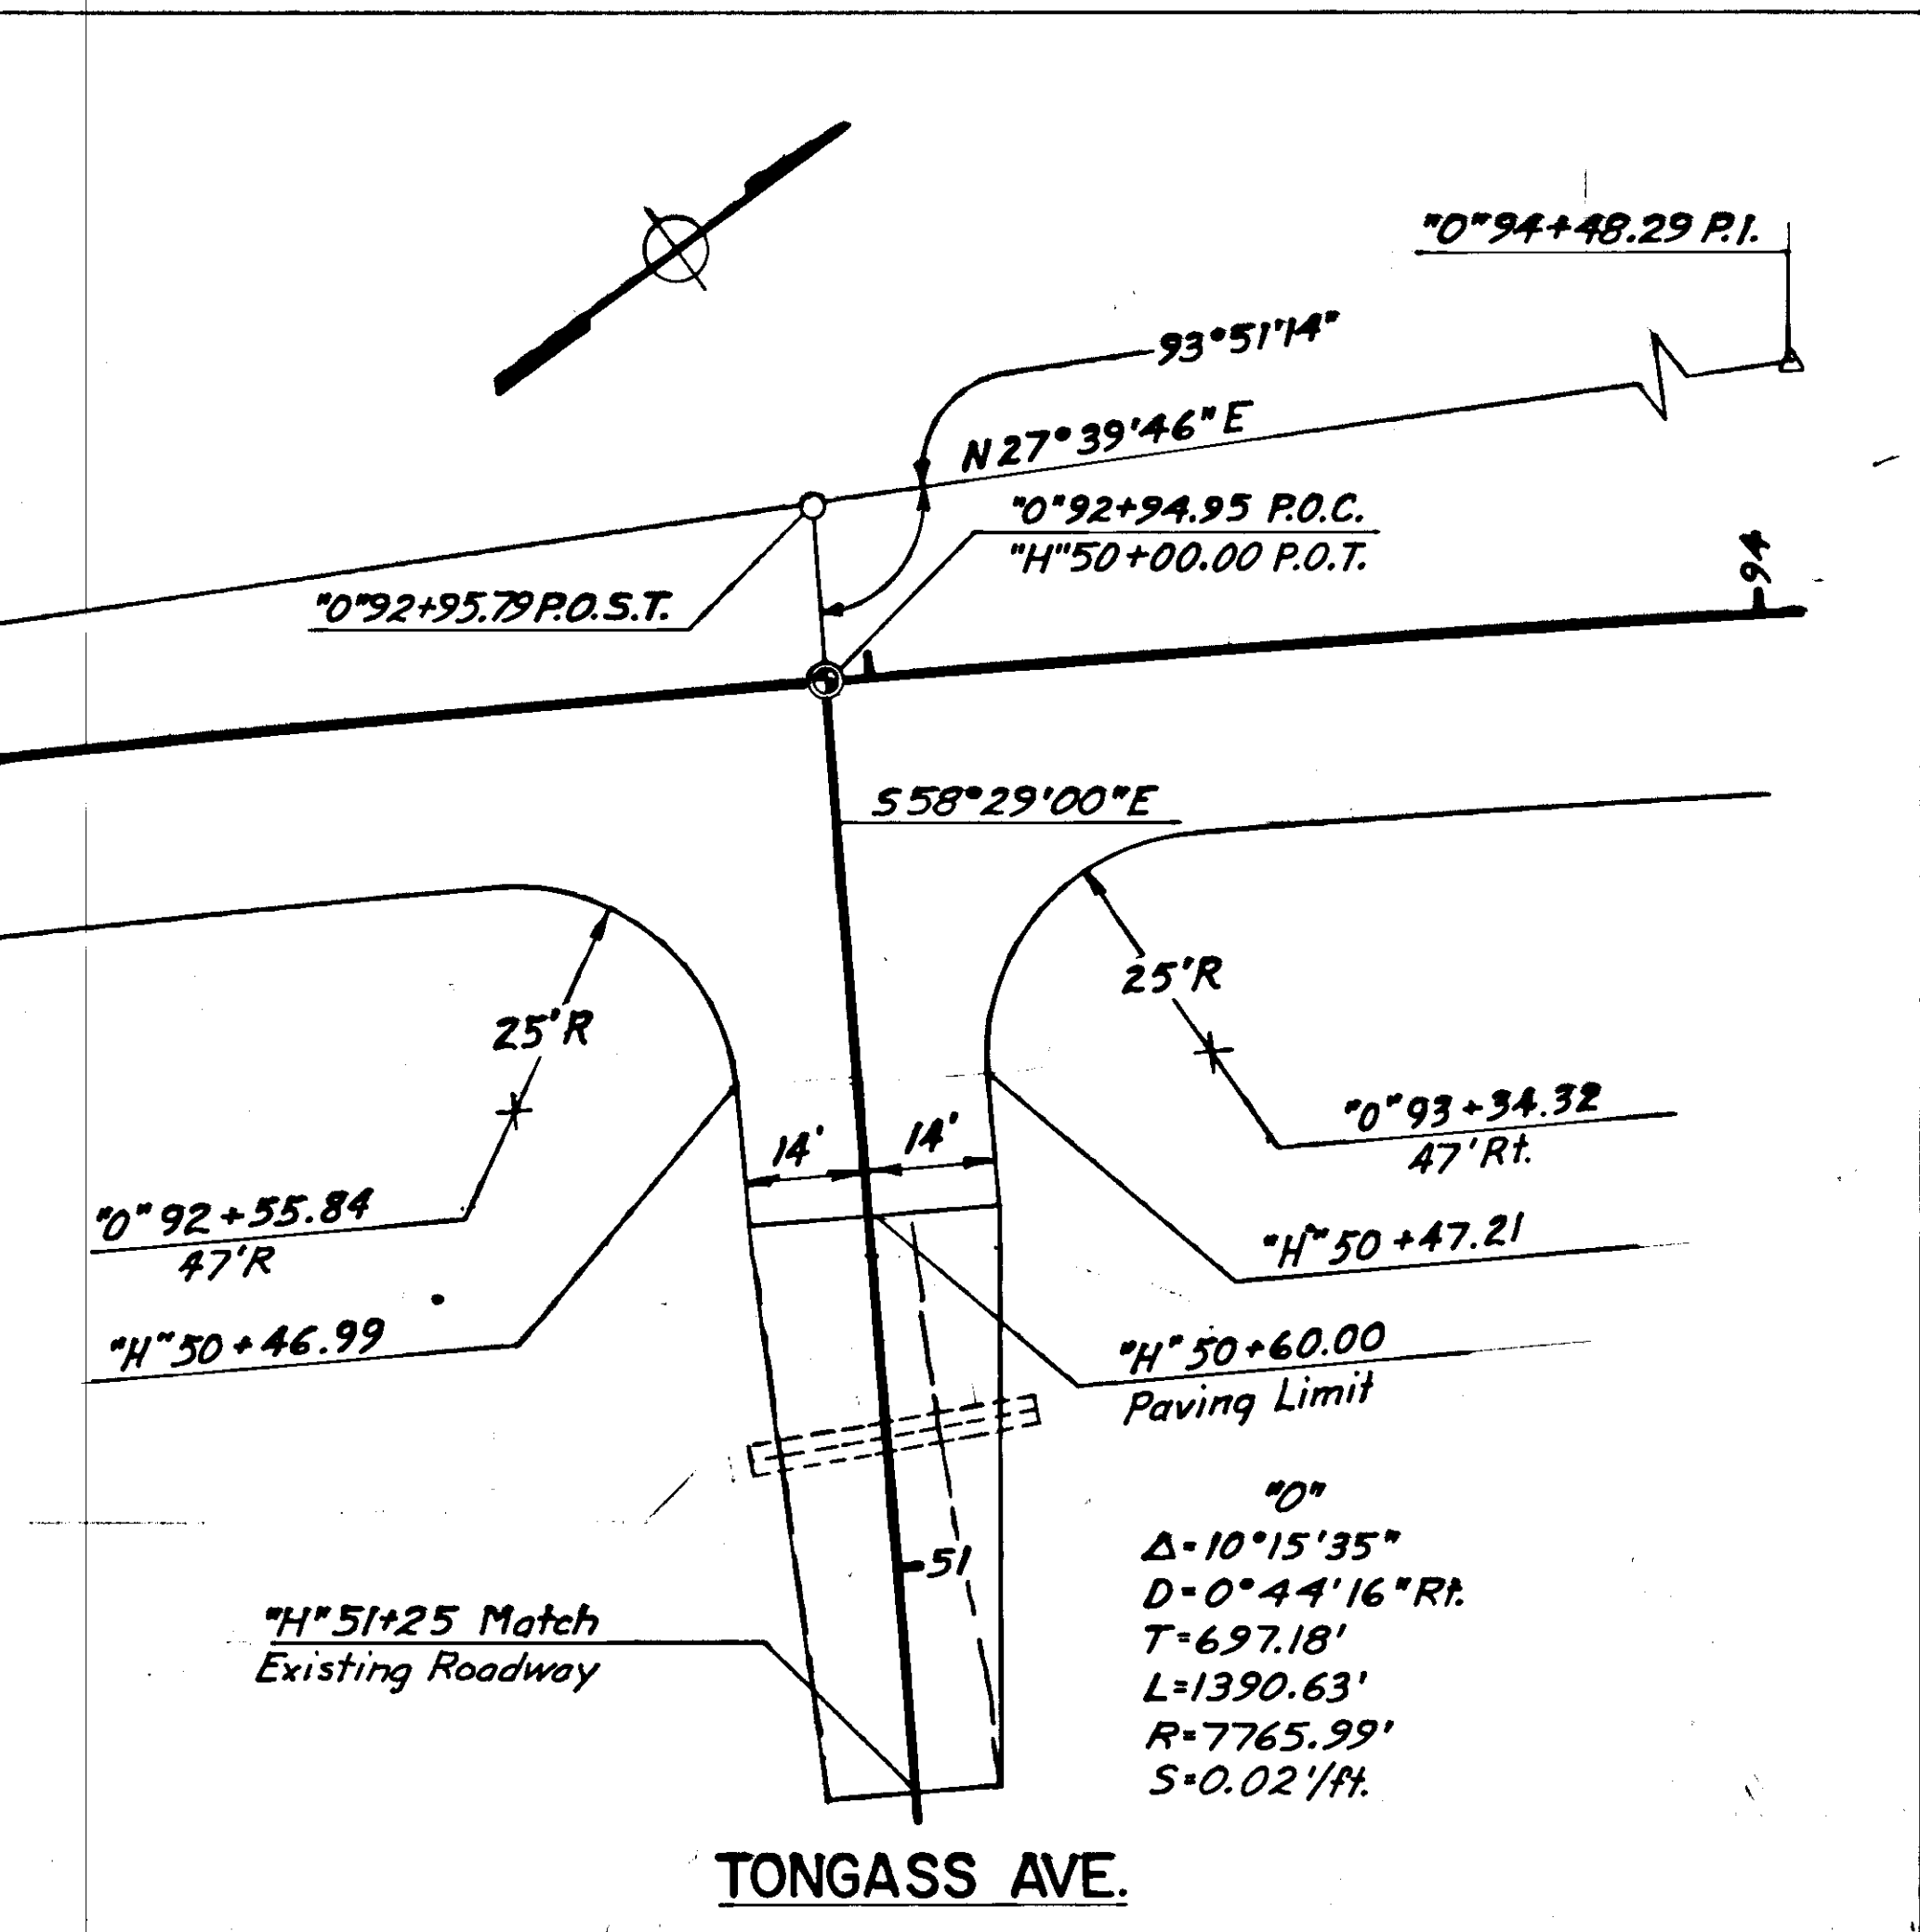


TONGASS AVE.



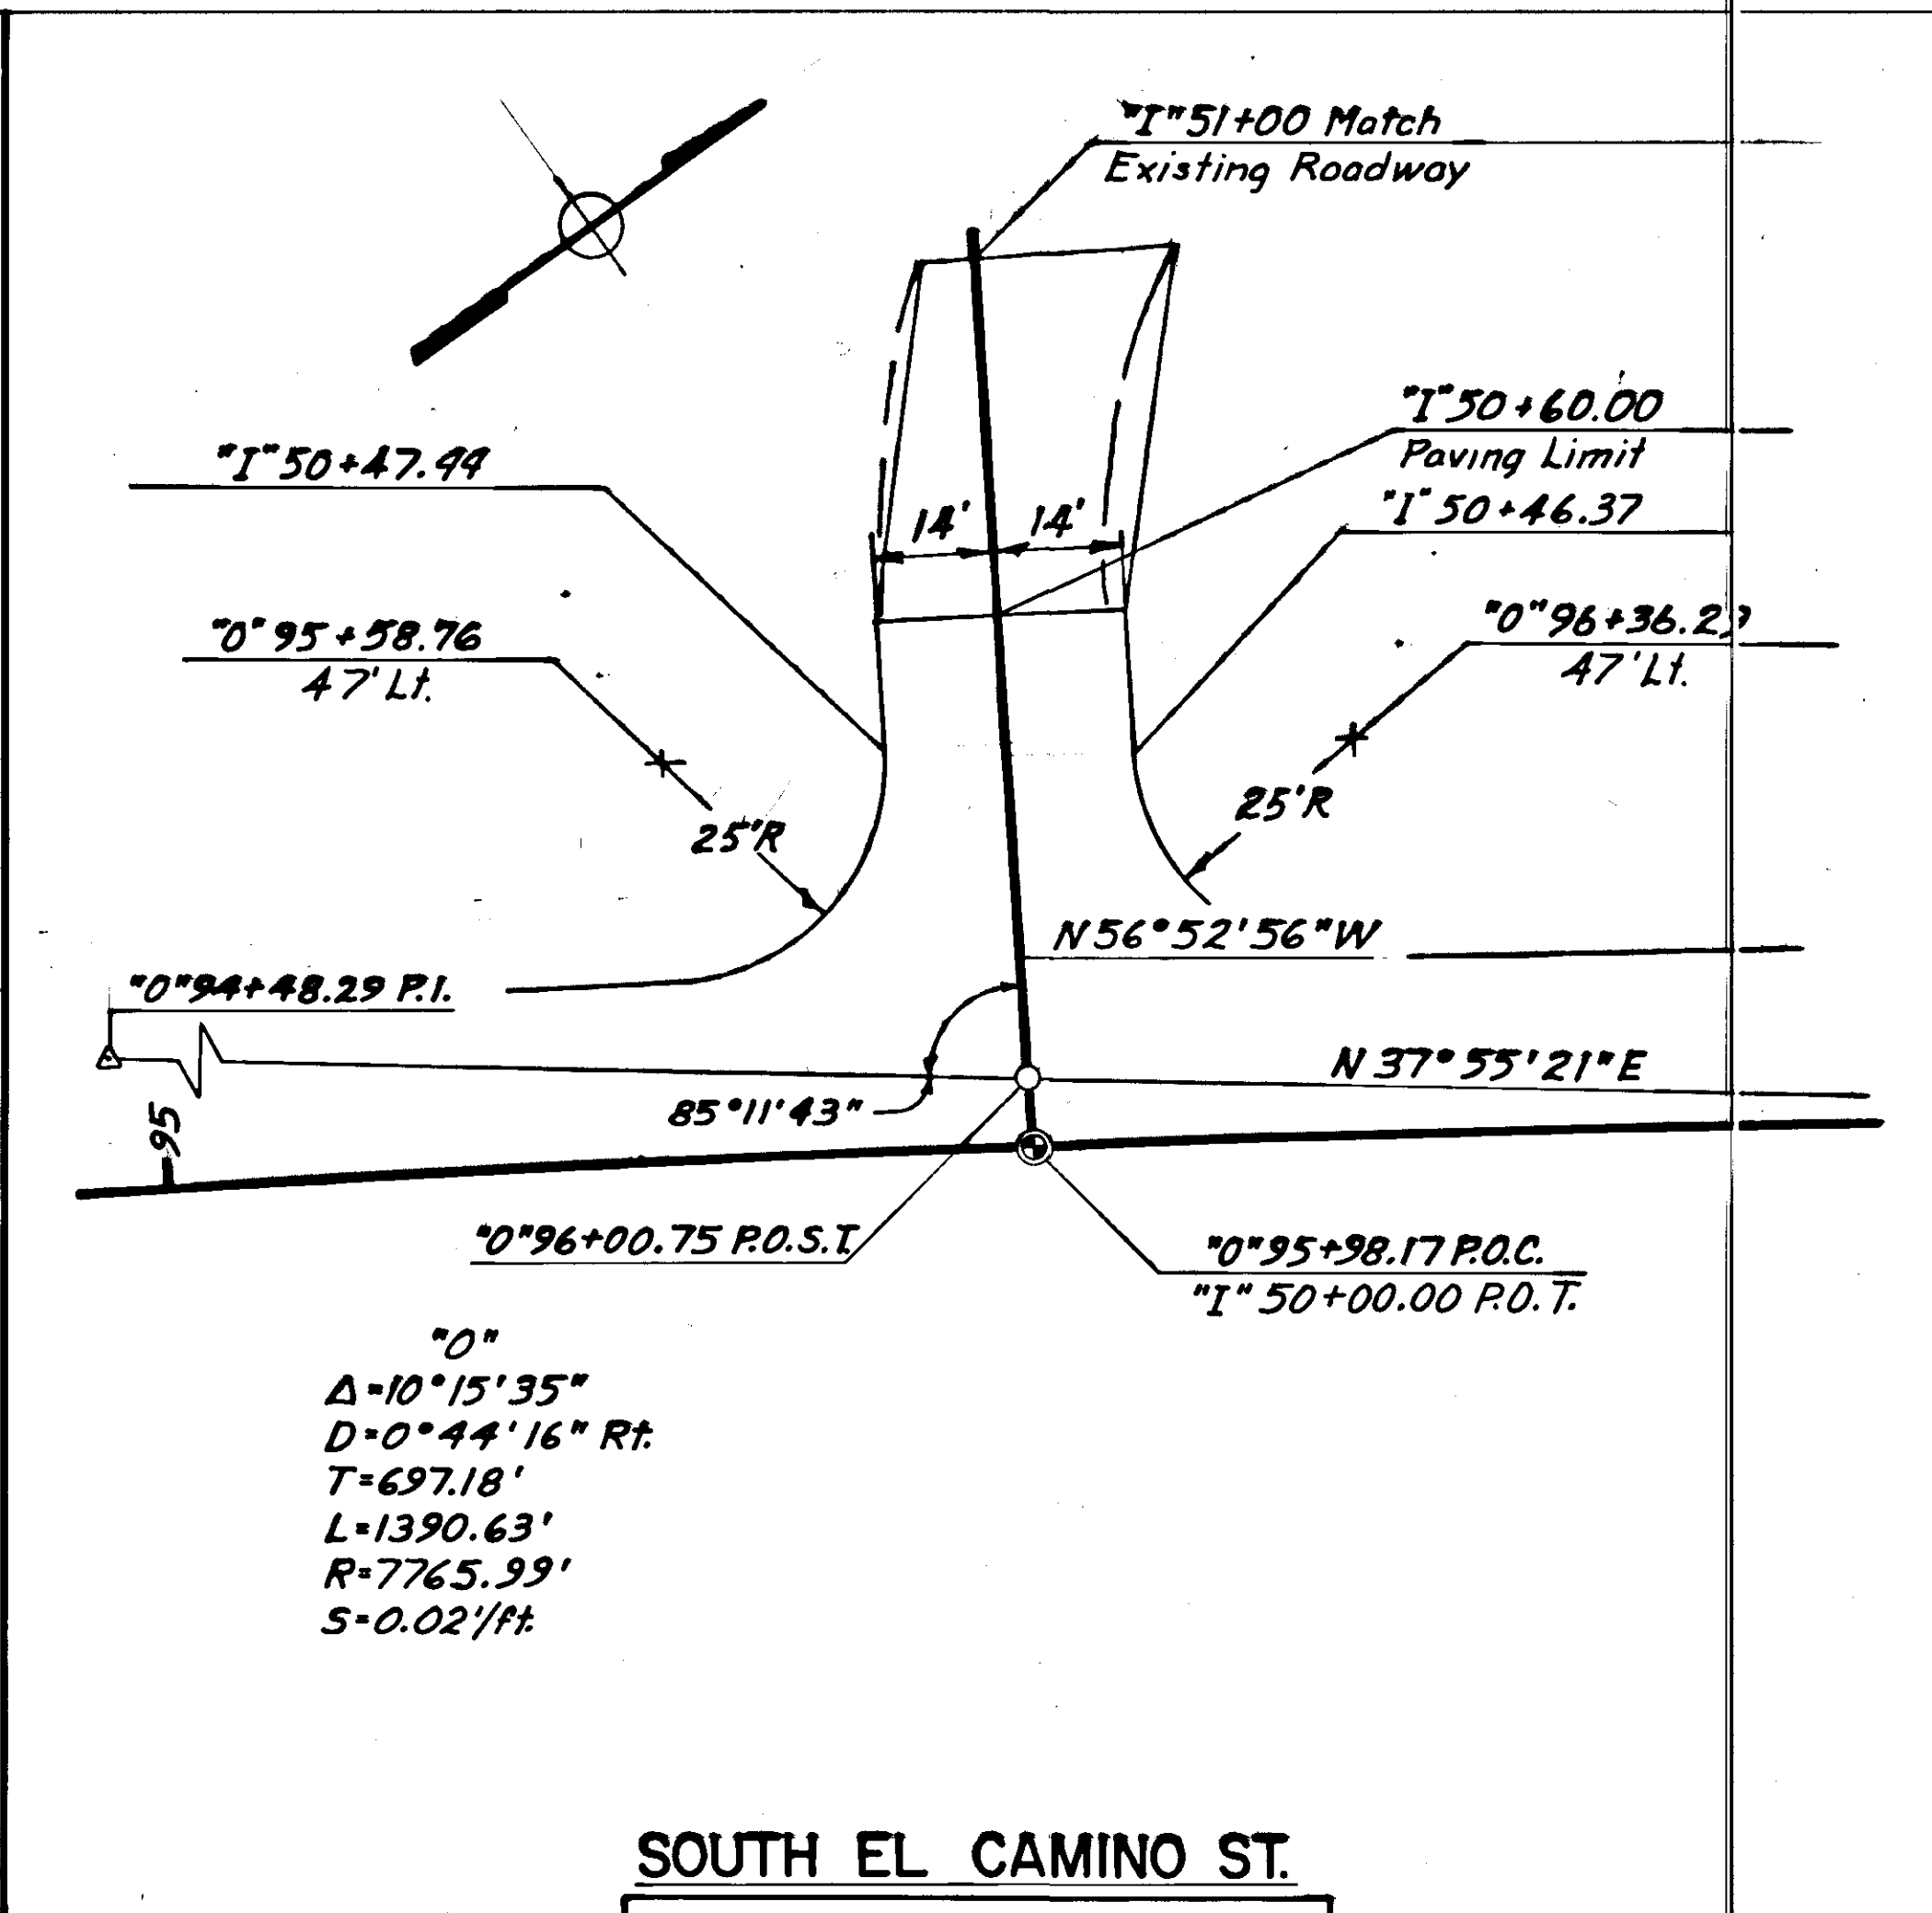


SOUTH EL CAMINO ST.

Notes:
 1. Distances are to edge of Pavement or the shoulder where no pavement is shown.
 2. All quantities are included in the appropriate mainline quantities.

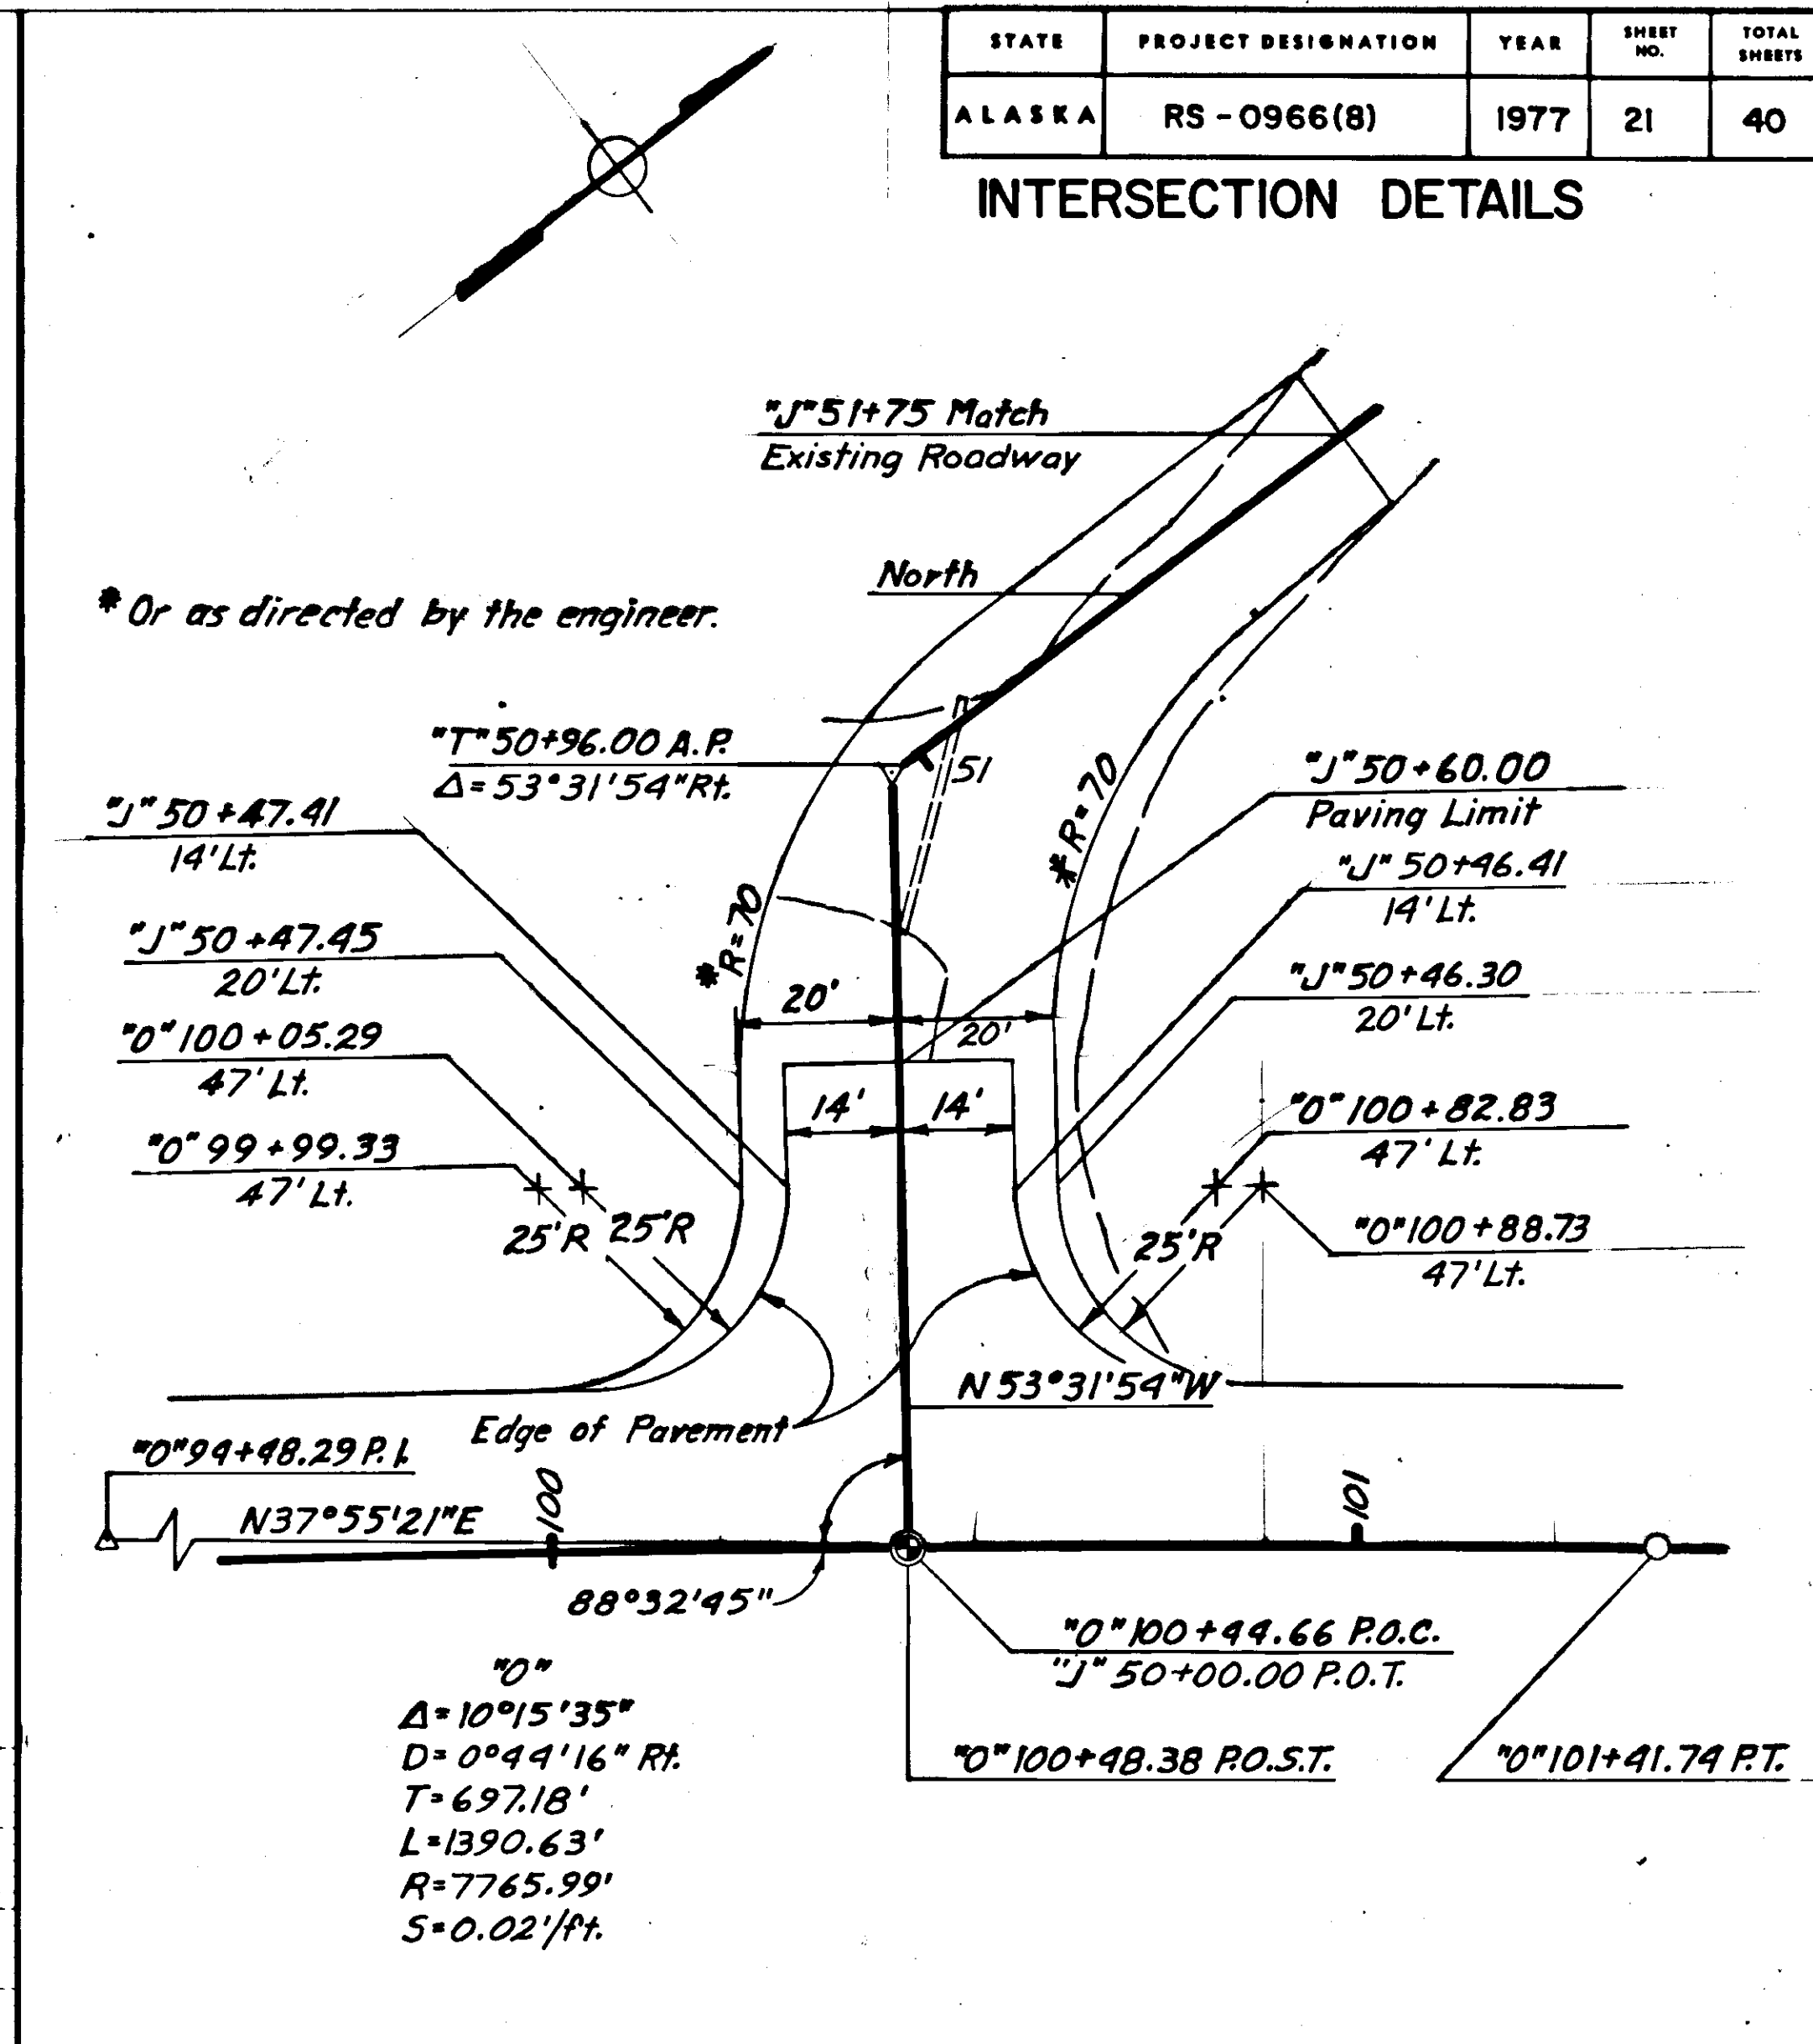


NORTH EL CAMINO ST.

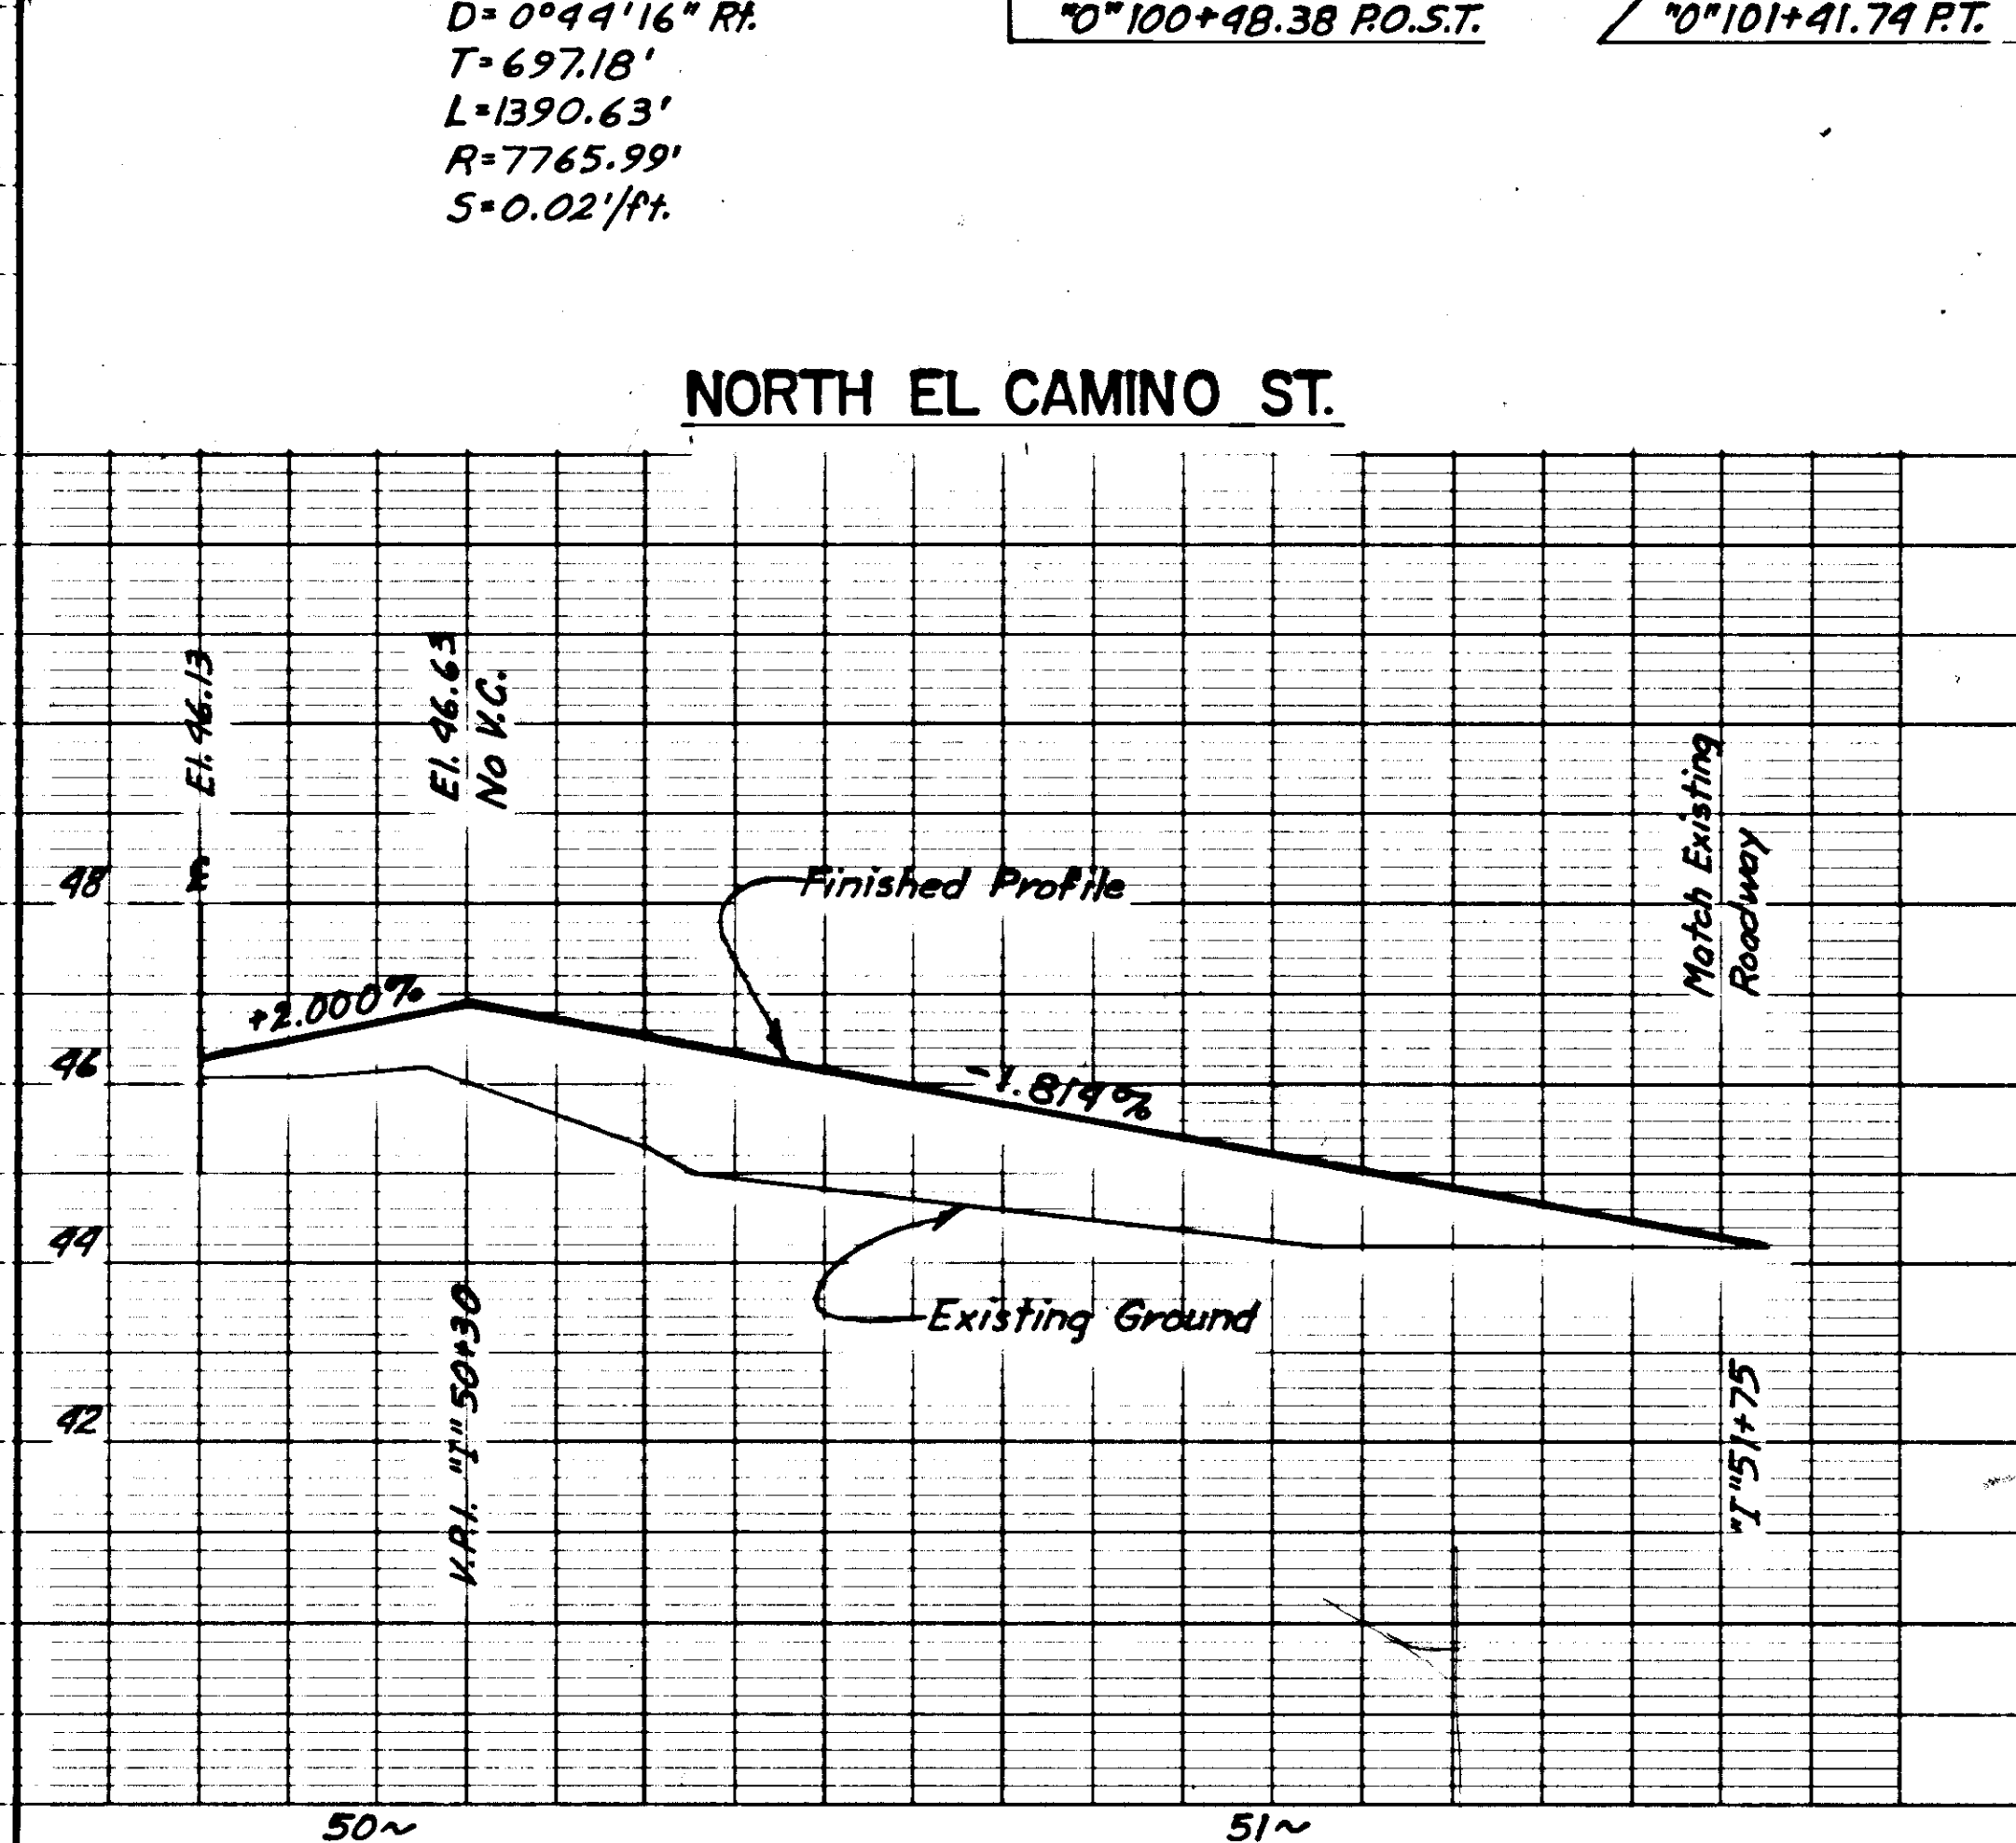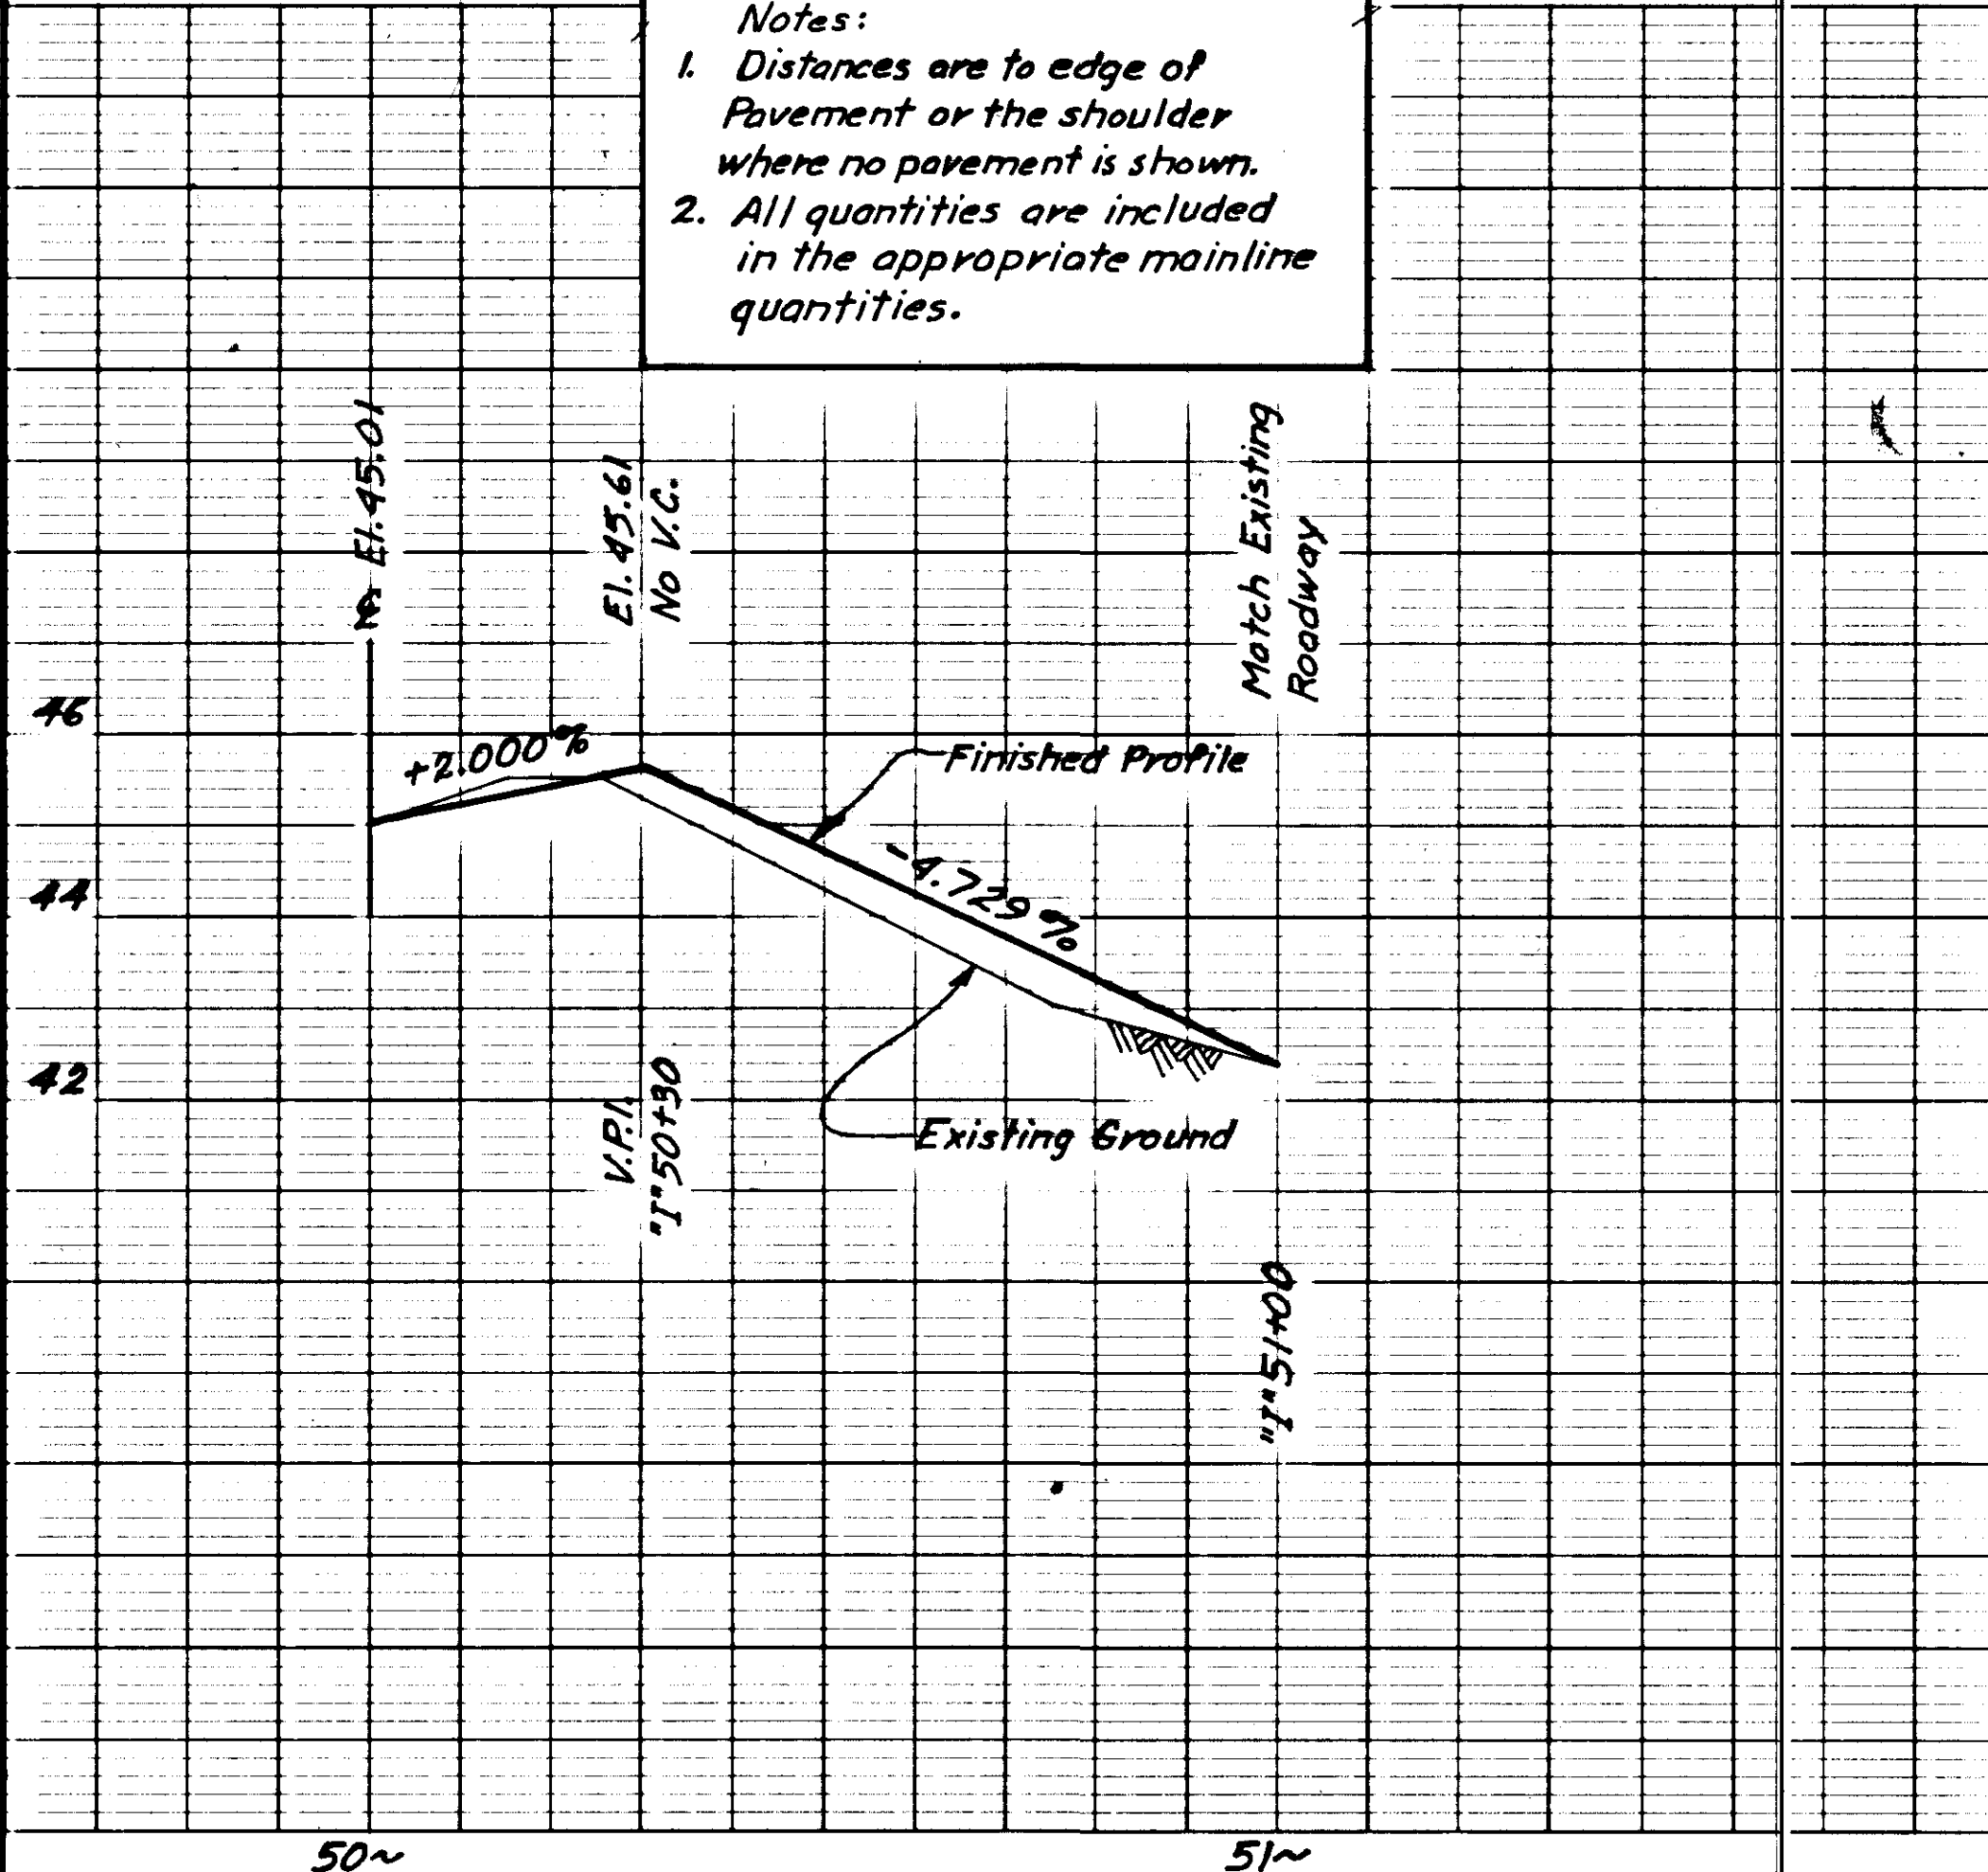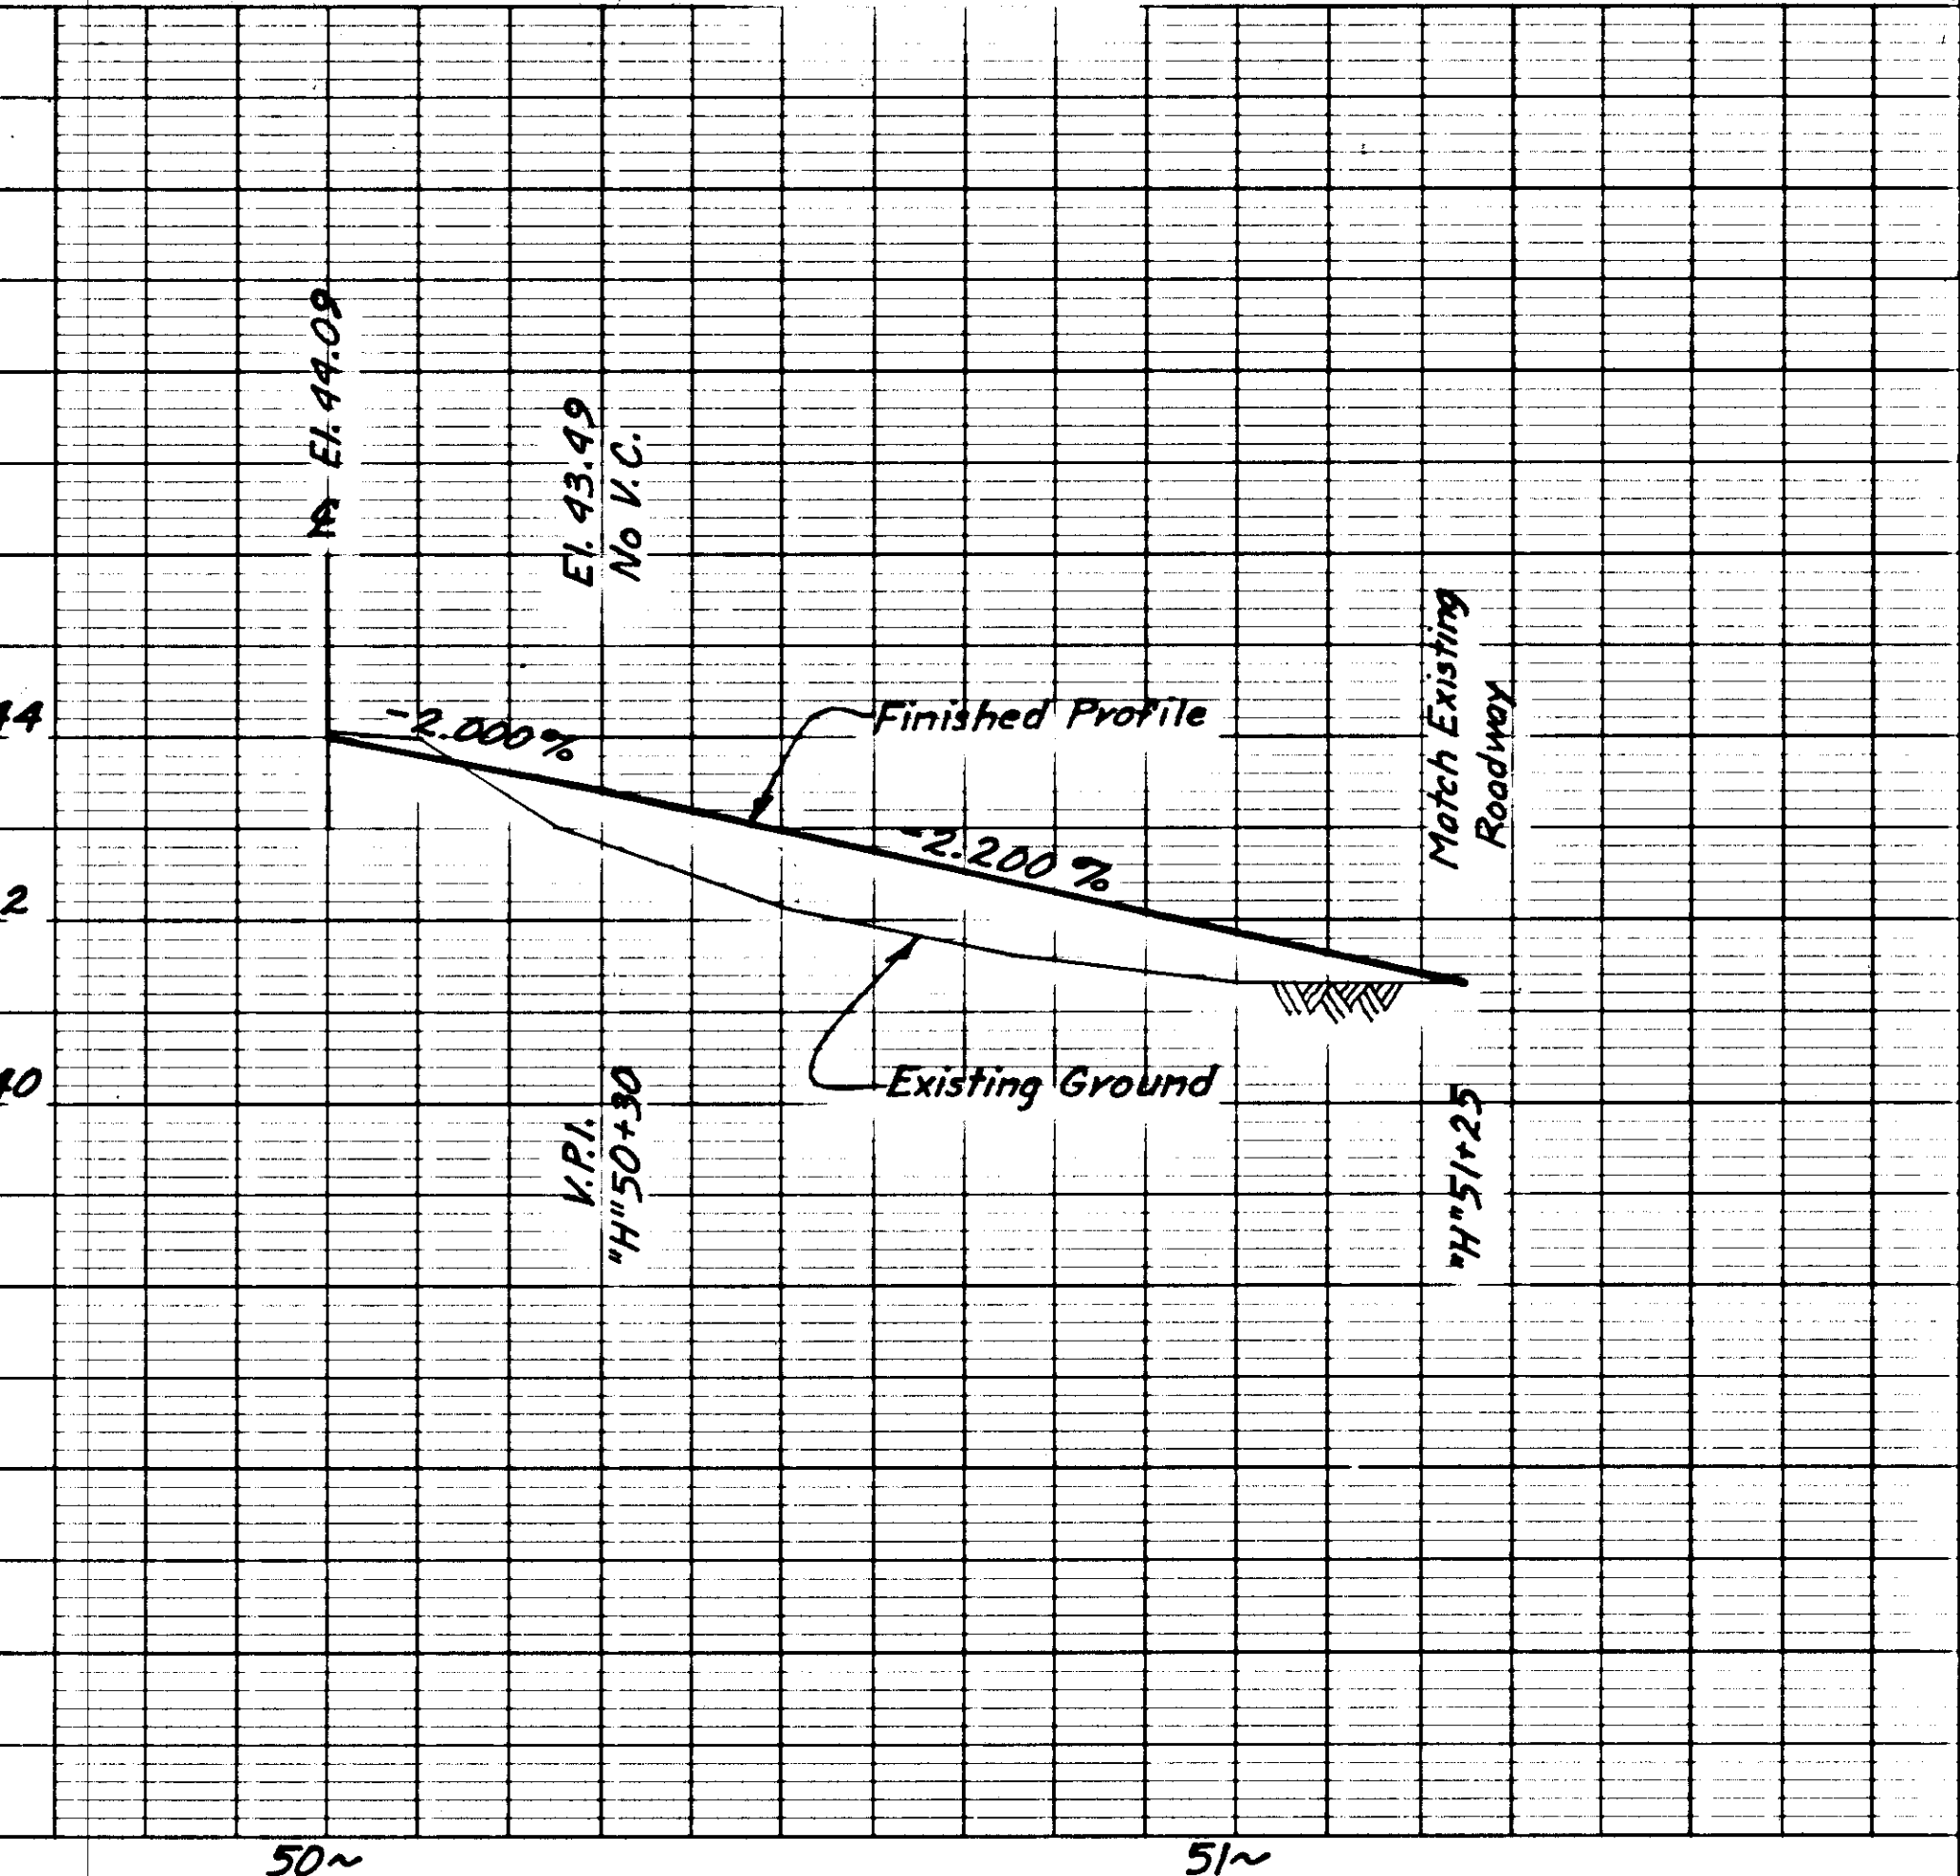


STATE	PROJECT DESIGNATION	YEAR	SHEET NO.	TOTAL SHEETS
ALASKA	RS-0966(8)	1977	23	40

INTERSECTION DETAILS

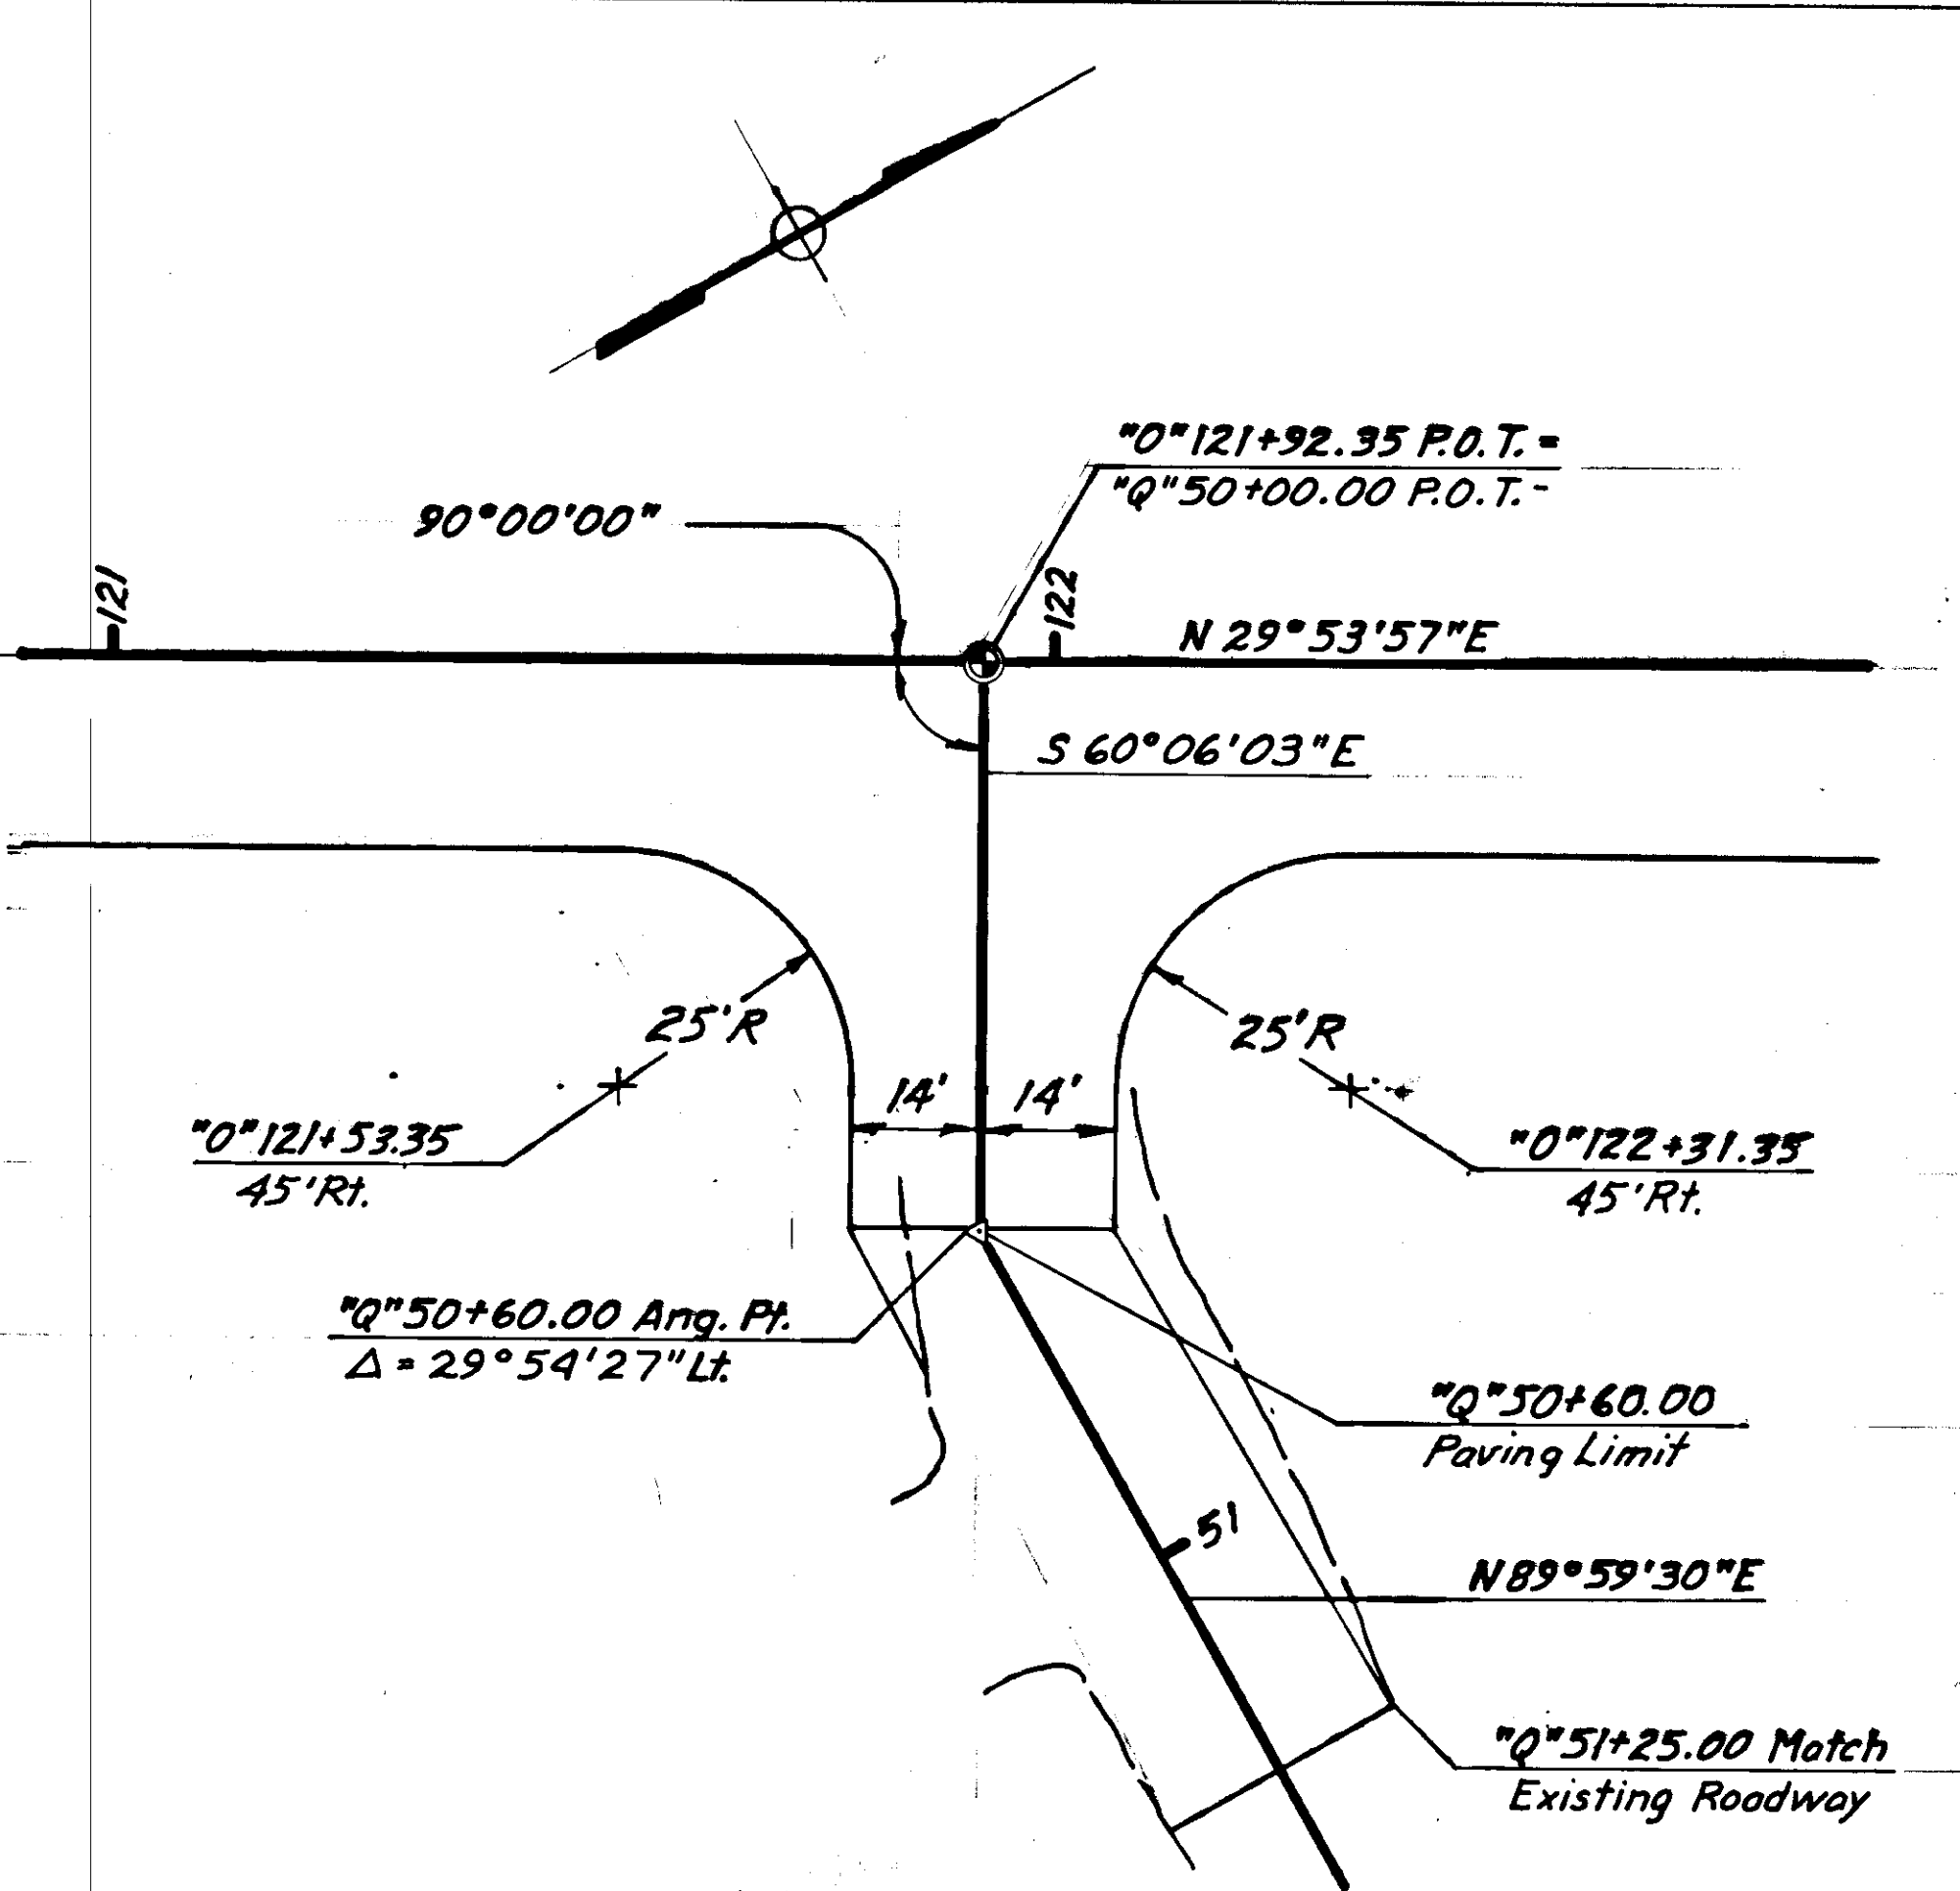


KIMBERLY STREET



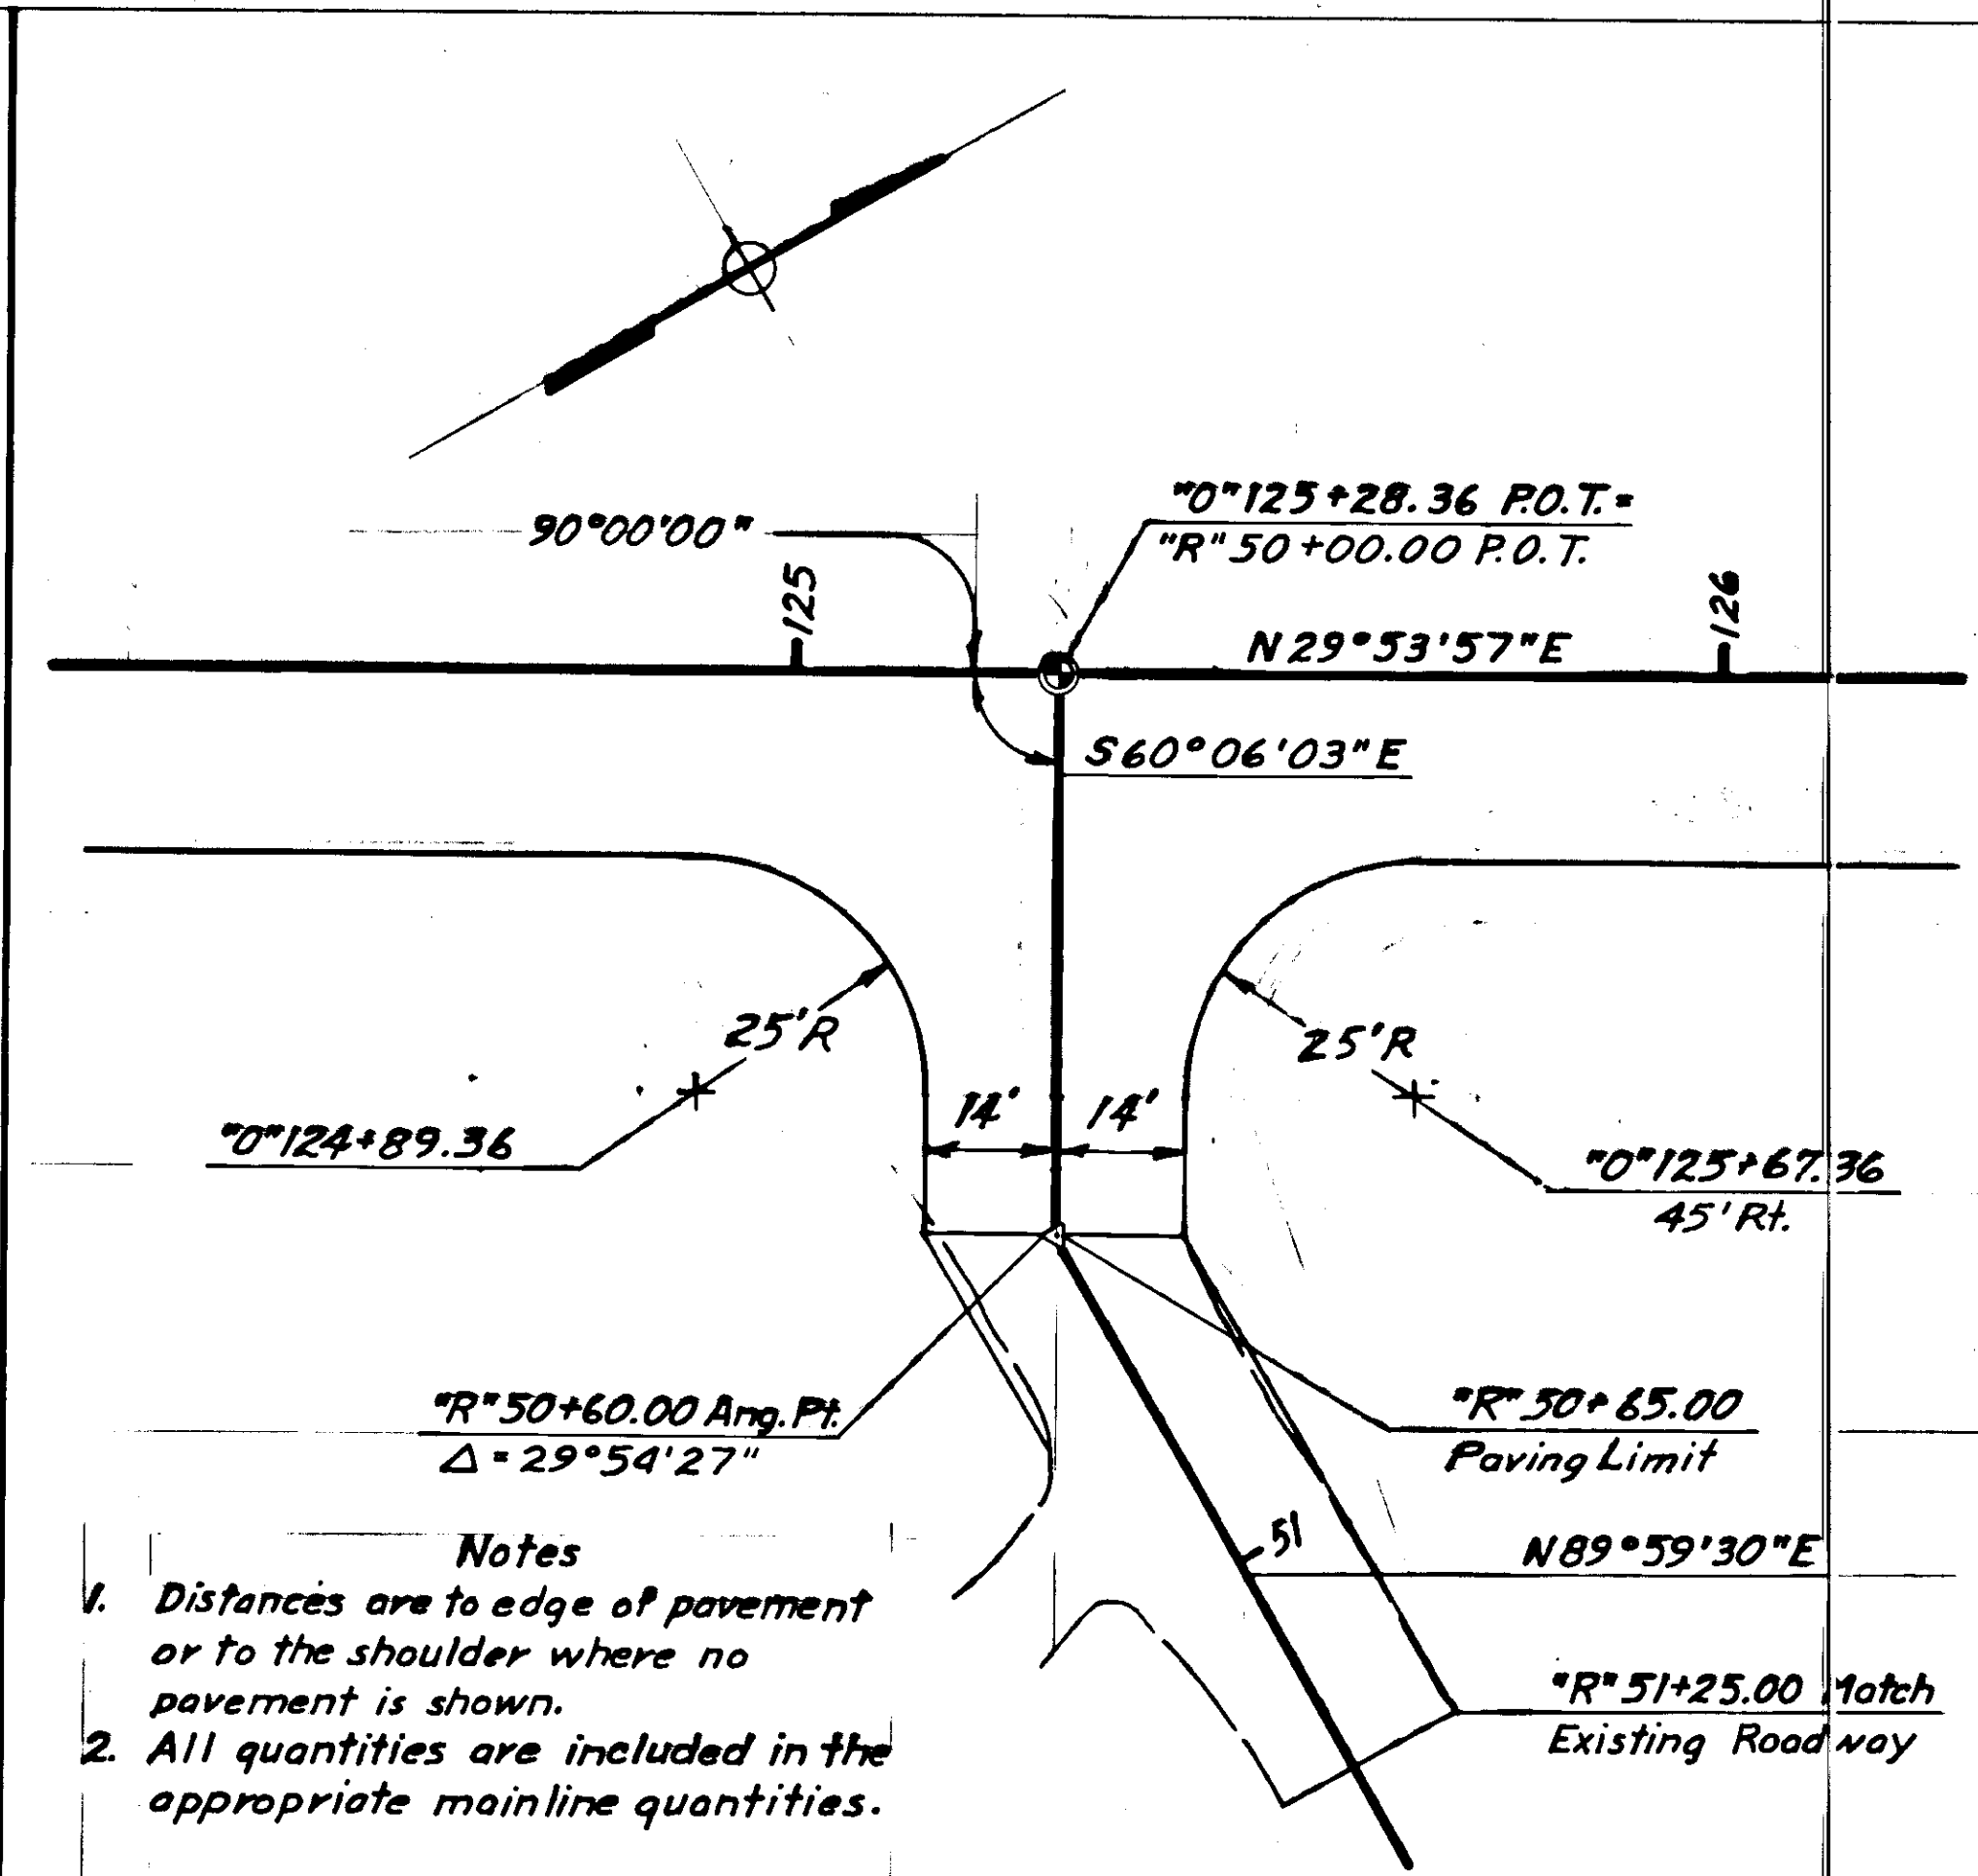


THUNDER MOUNTAIN ROAD

- Notes
1. Distances are to edge of pavement or to the shoulder where no pavement is shown.
 2. All quantities are included in the appropriate mainline quantities.

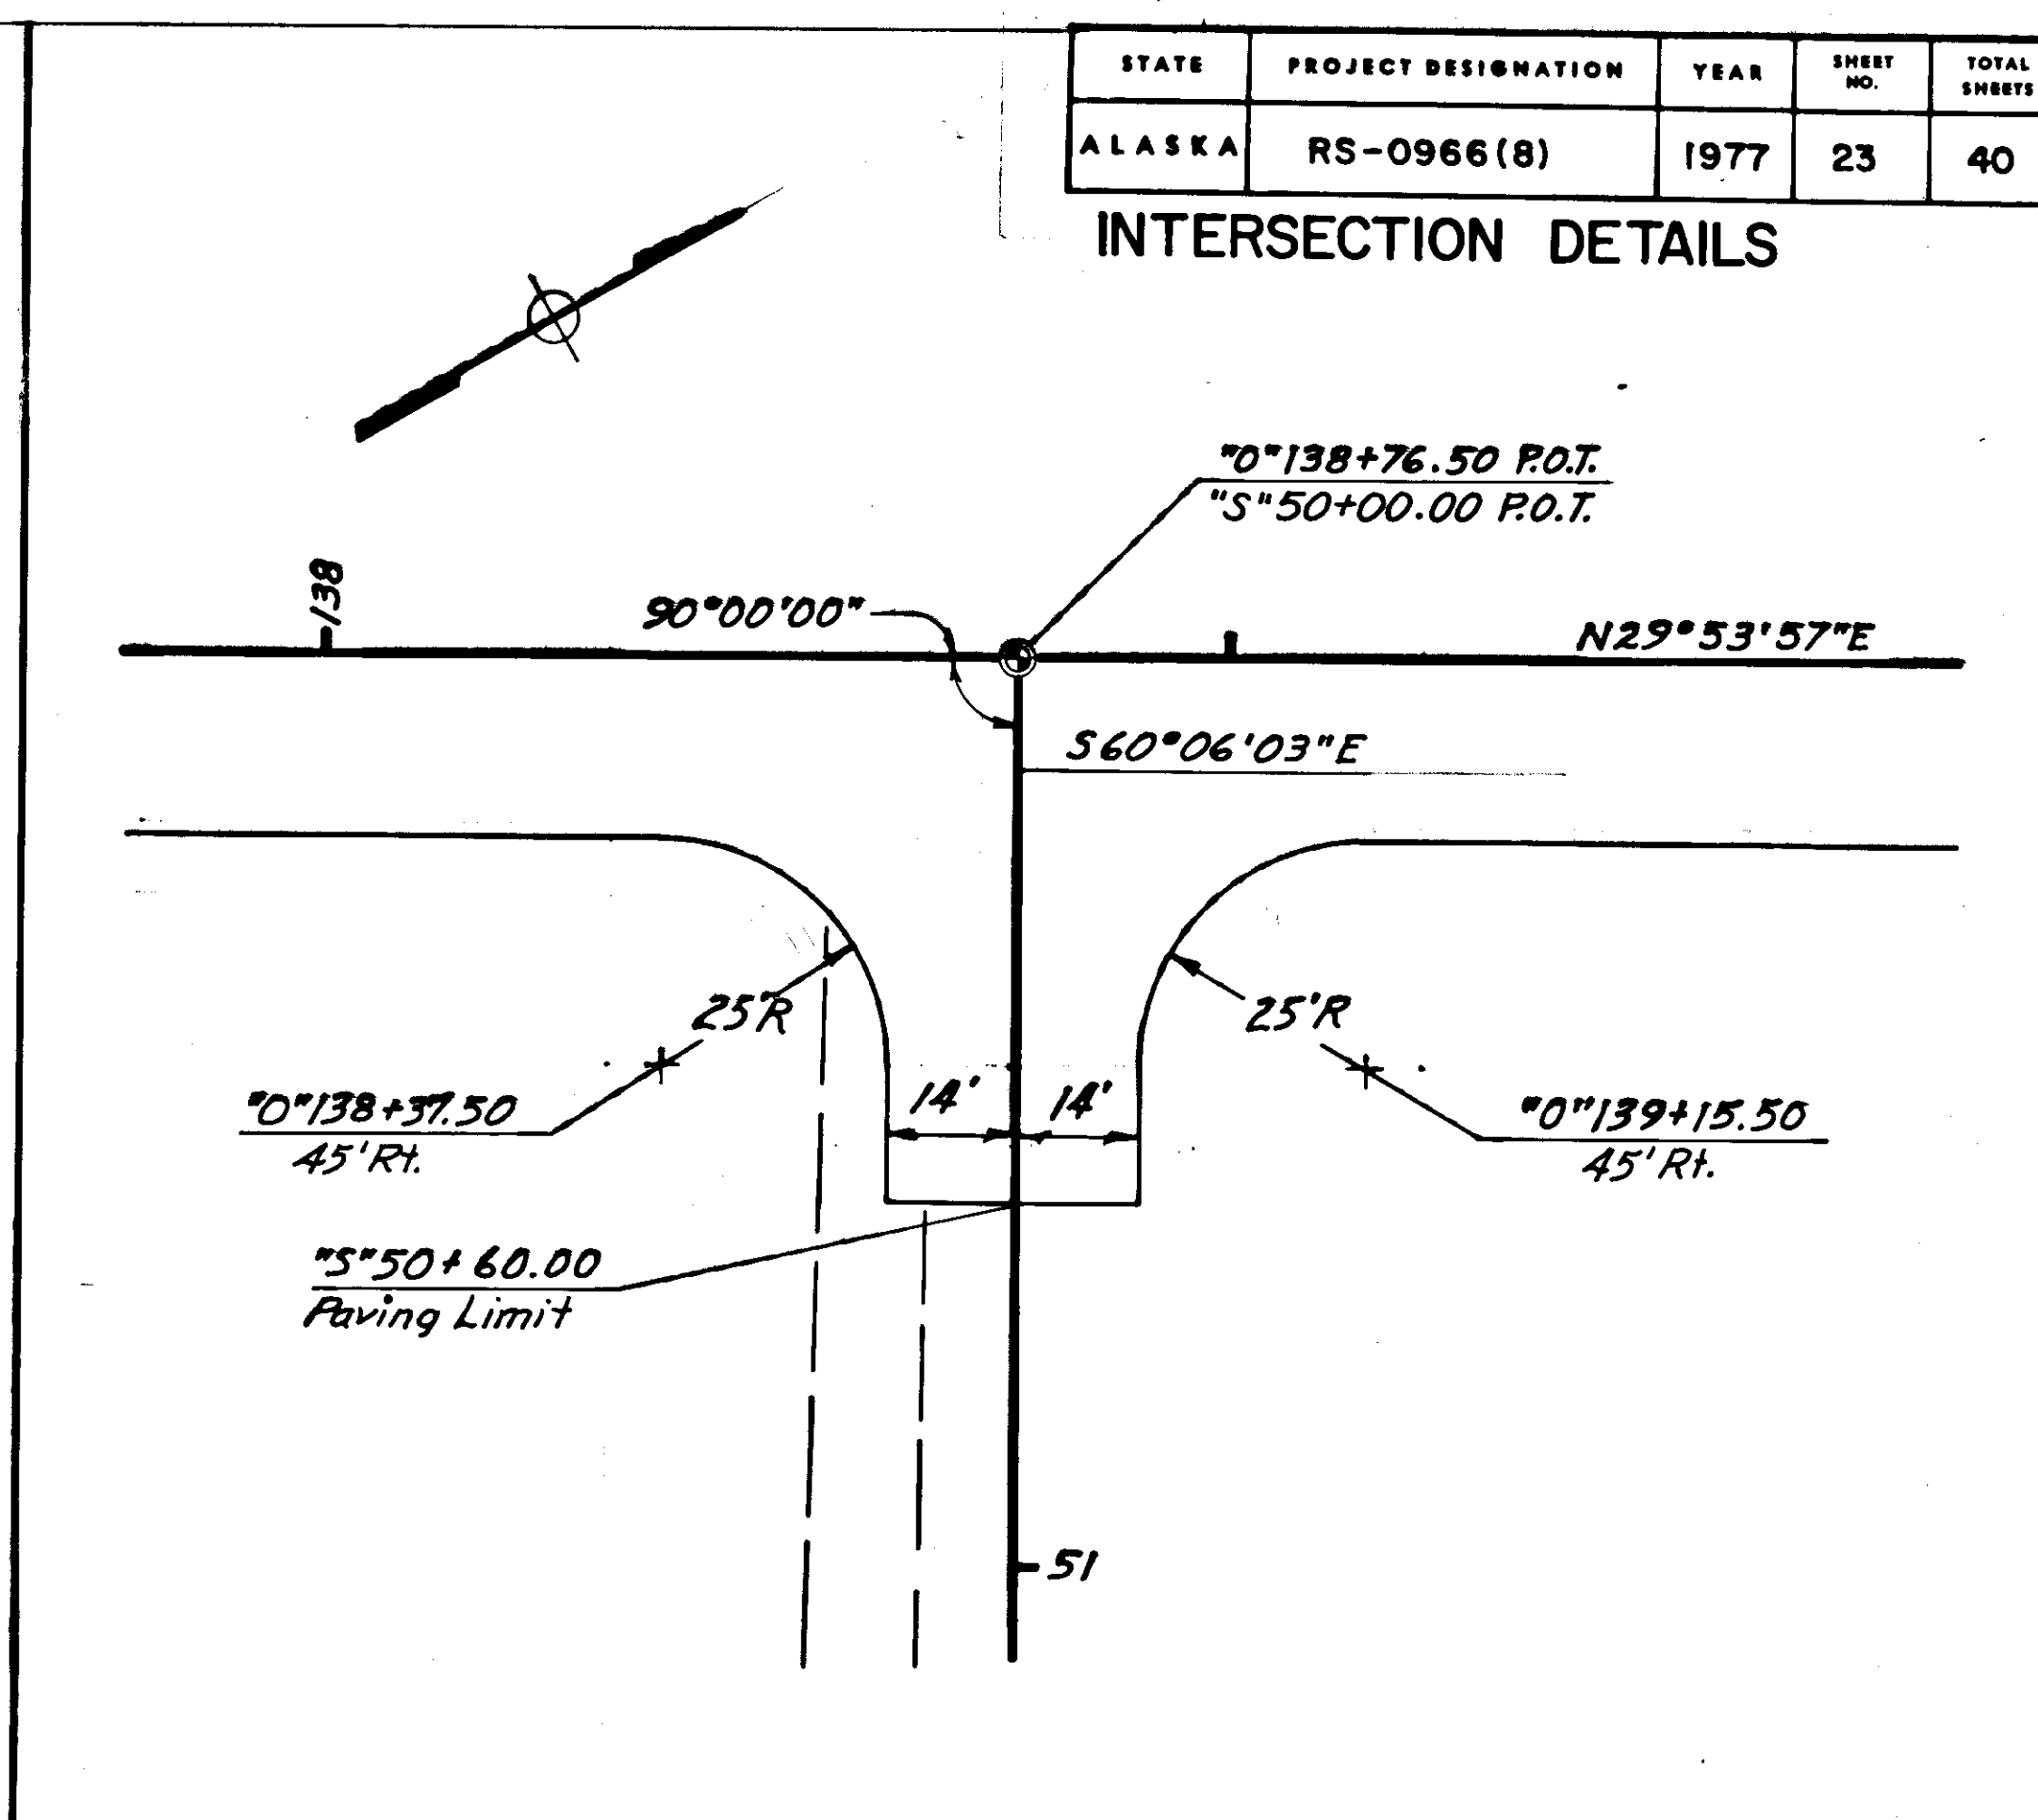


ERIN WAY

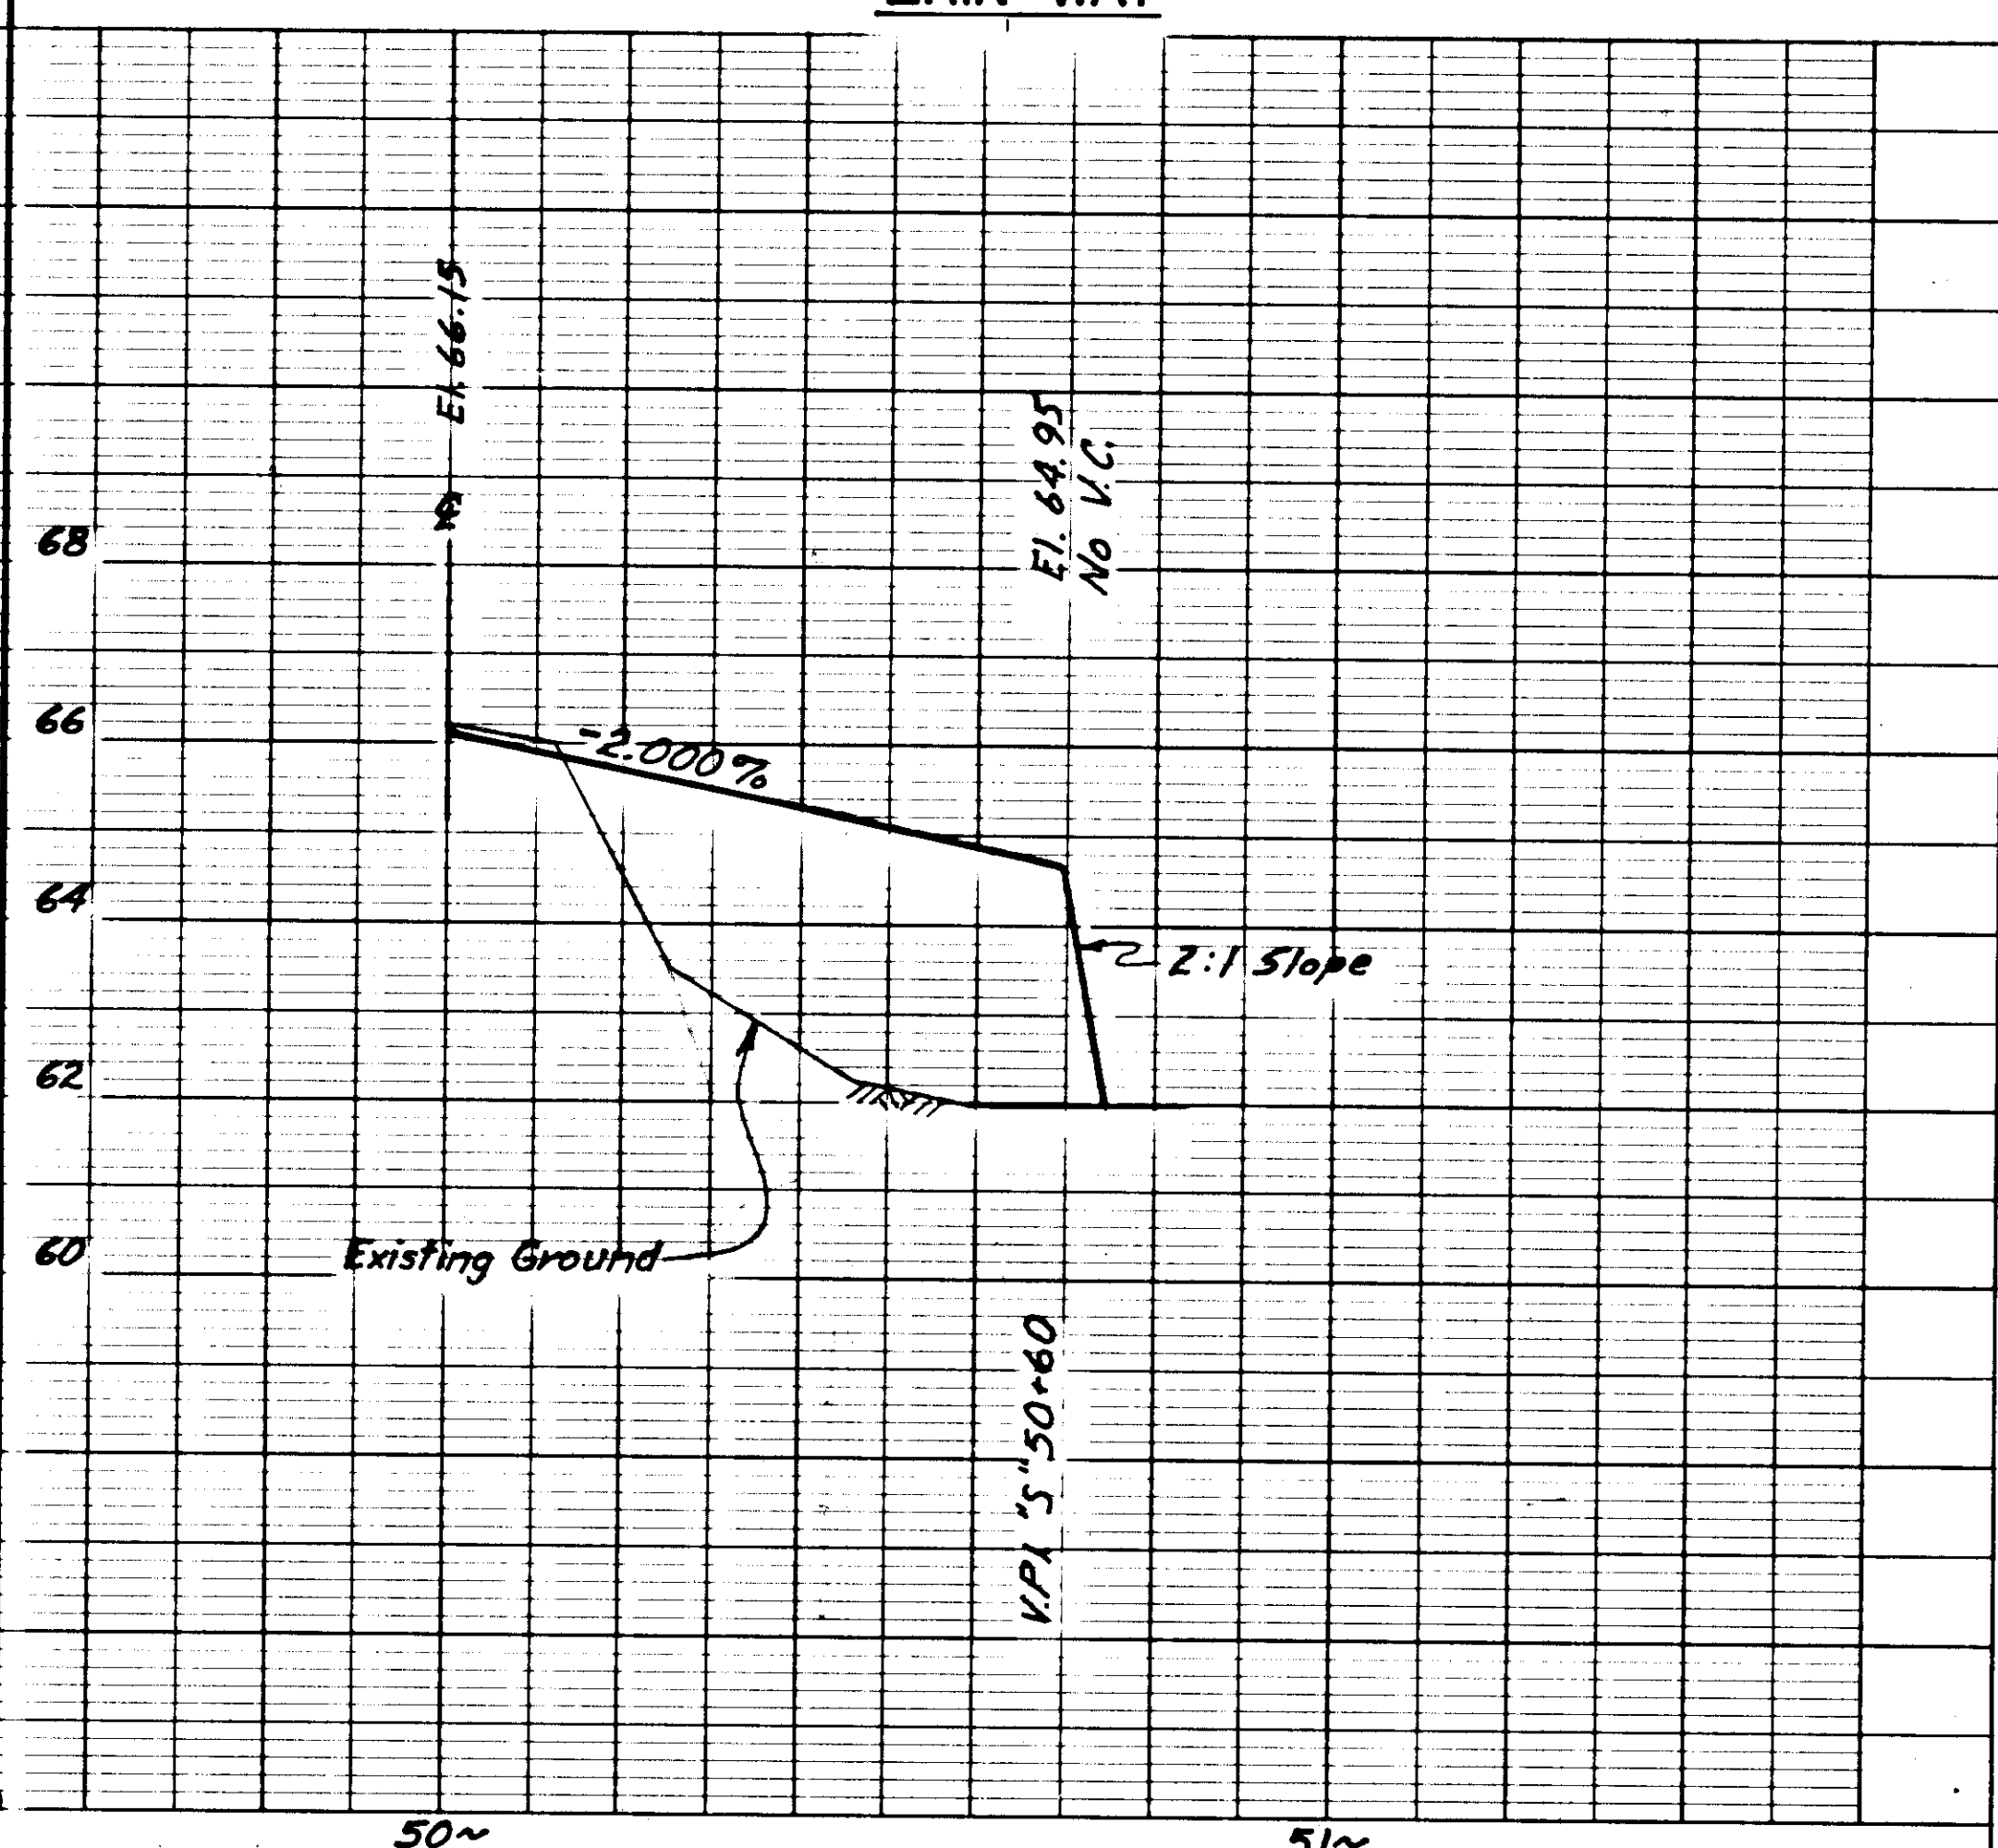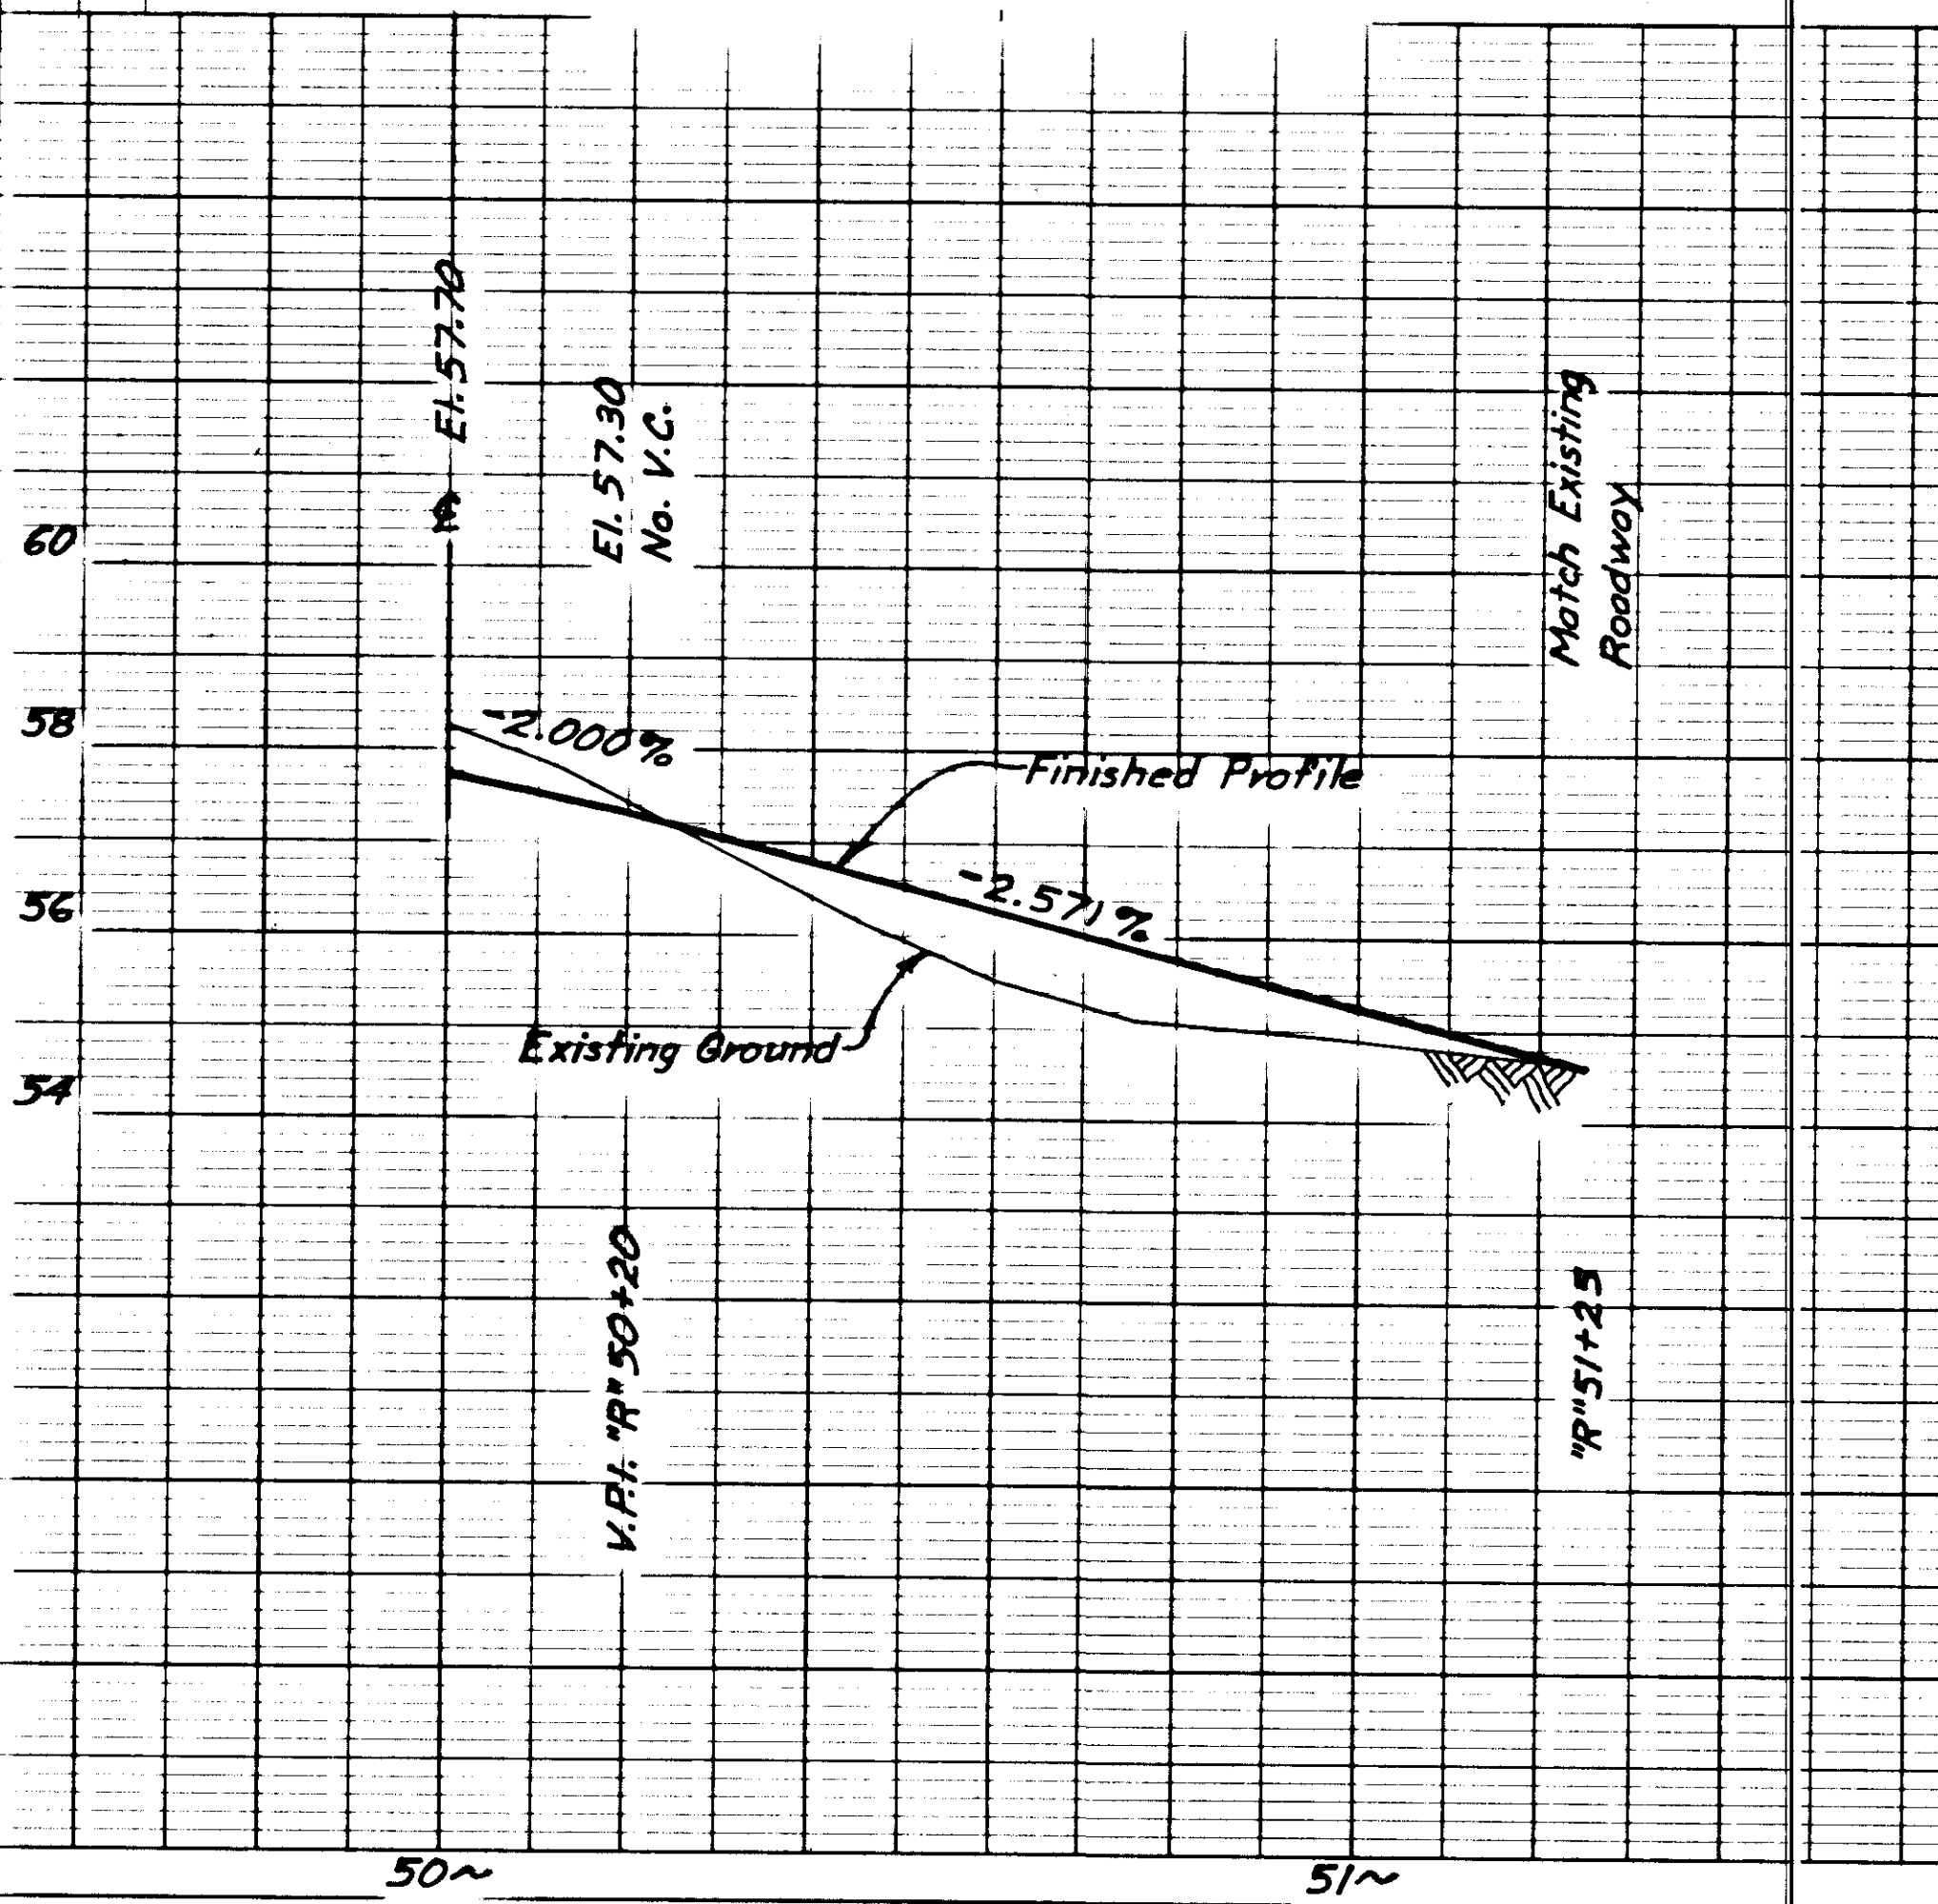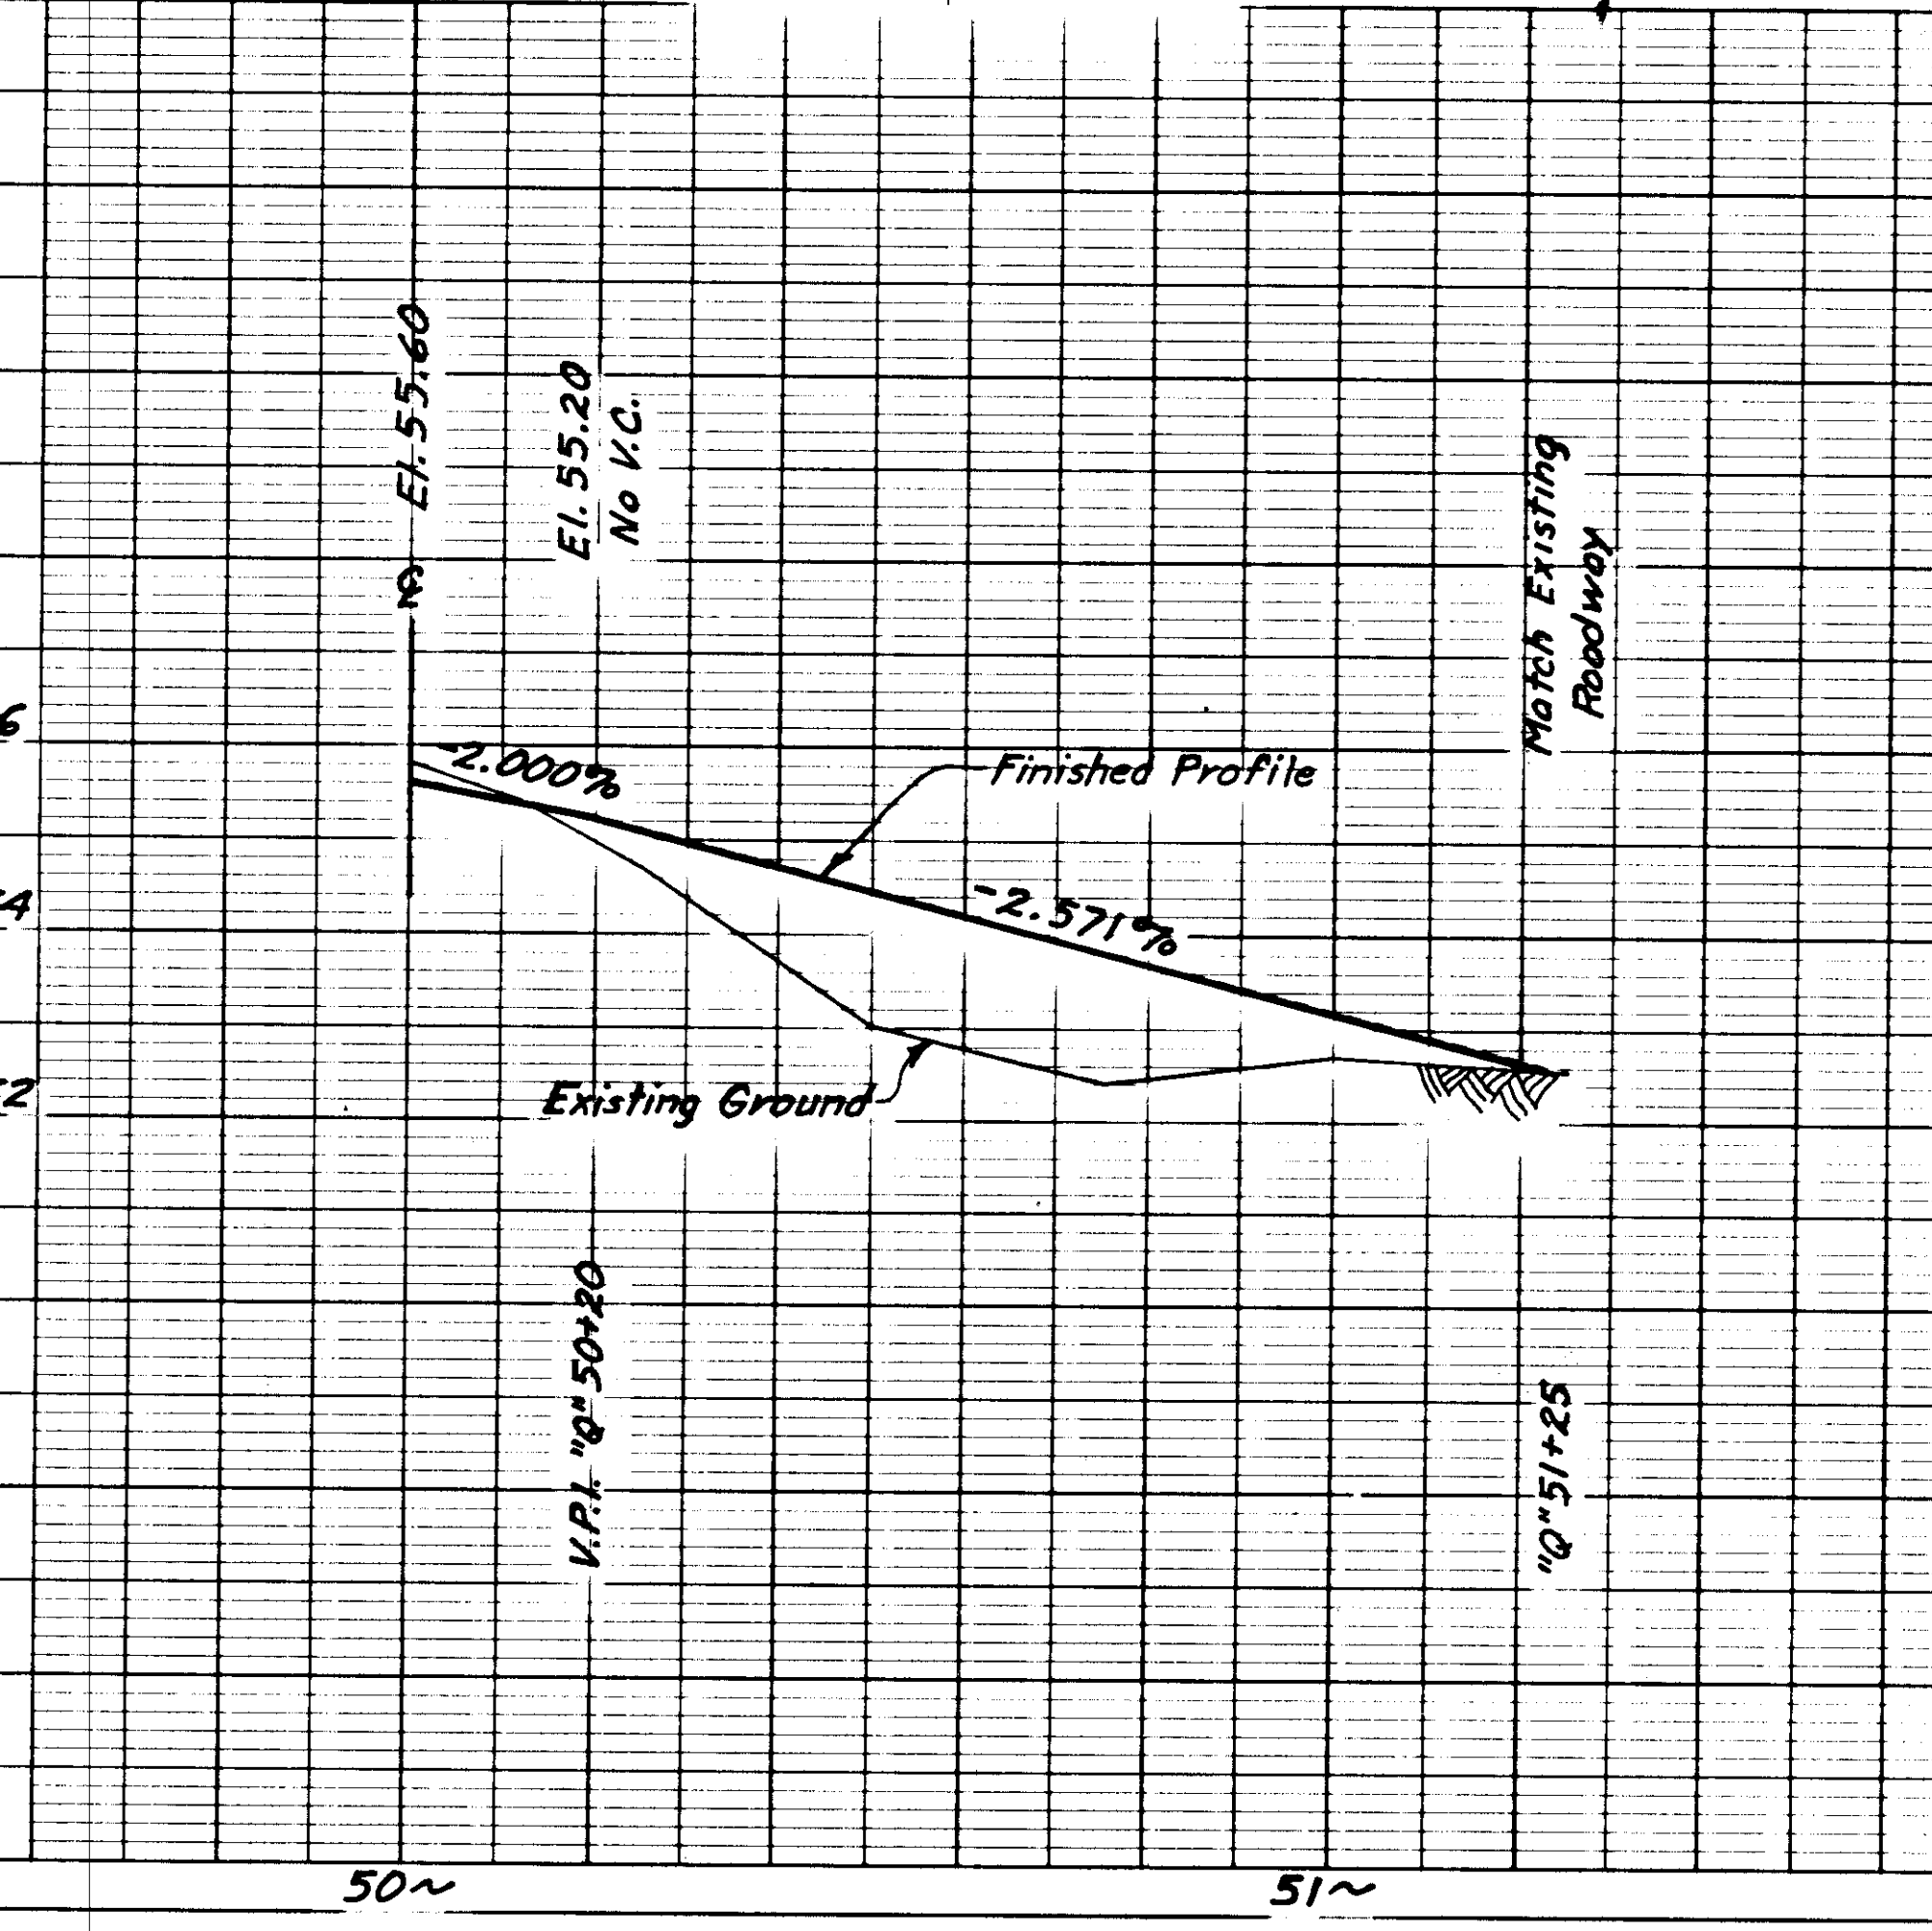


STATE	PROJECT DESIGNATION	YEAR	SHEET NO.	TOTAL SHEETS
ALASKA	RS-0966(8)	1977	24	40


INTERSECTION DETAILS

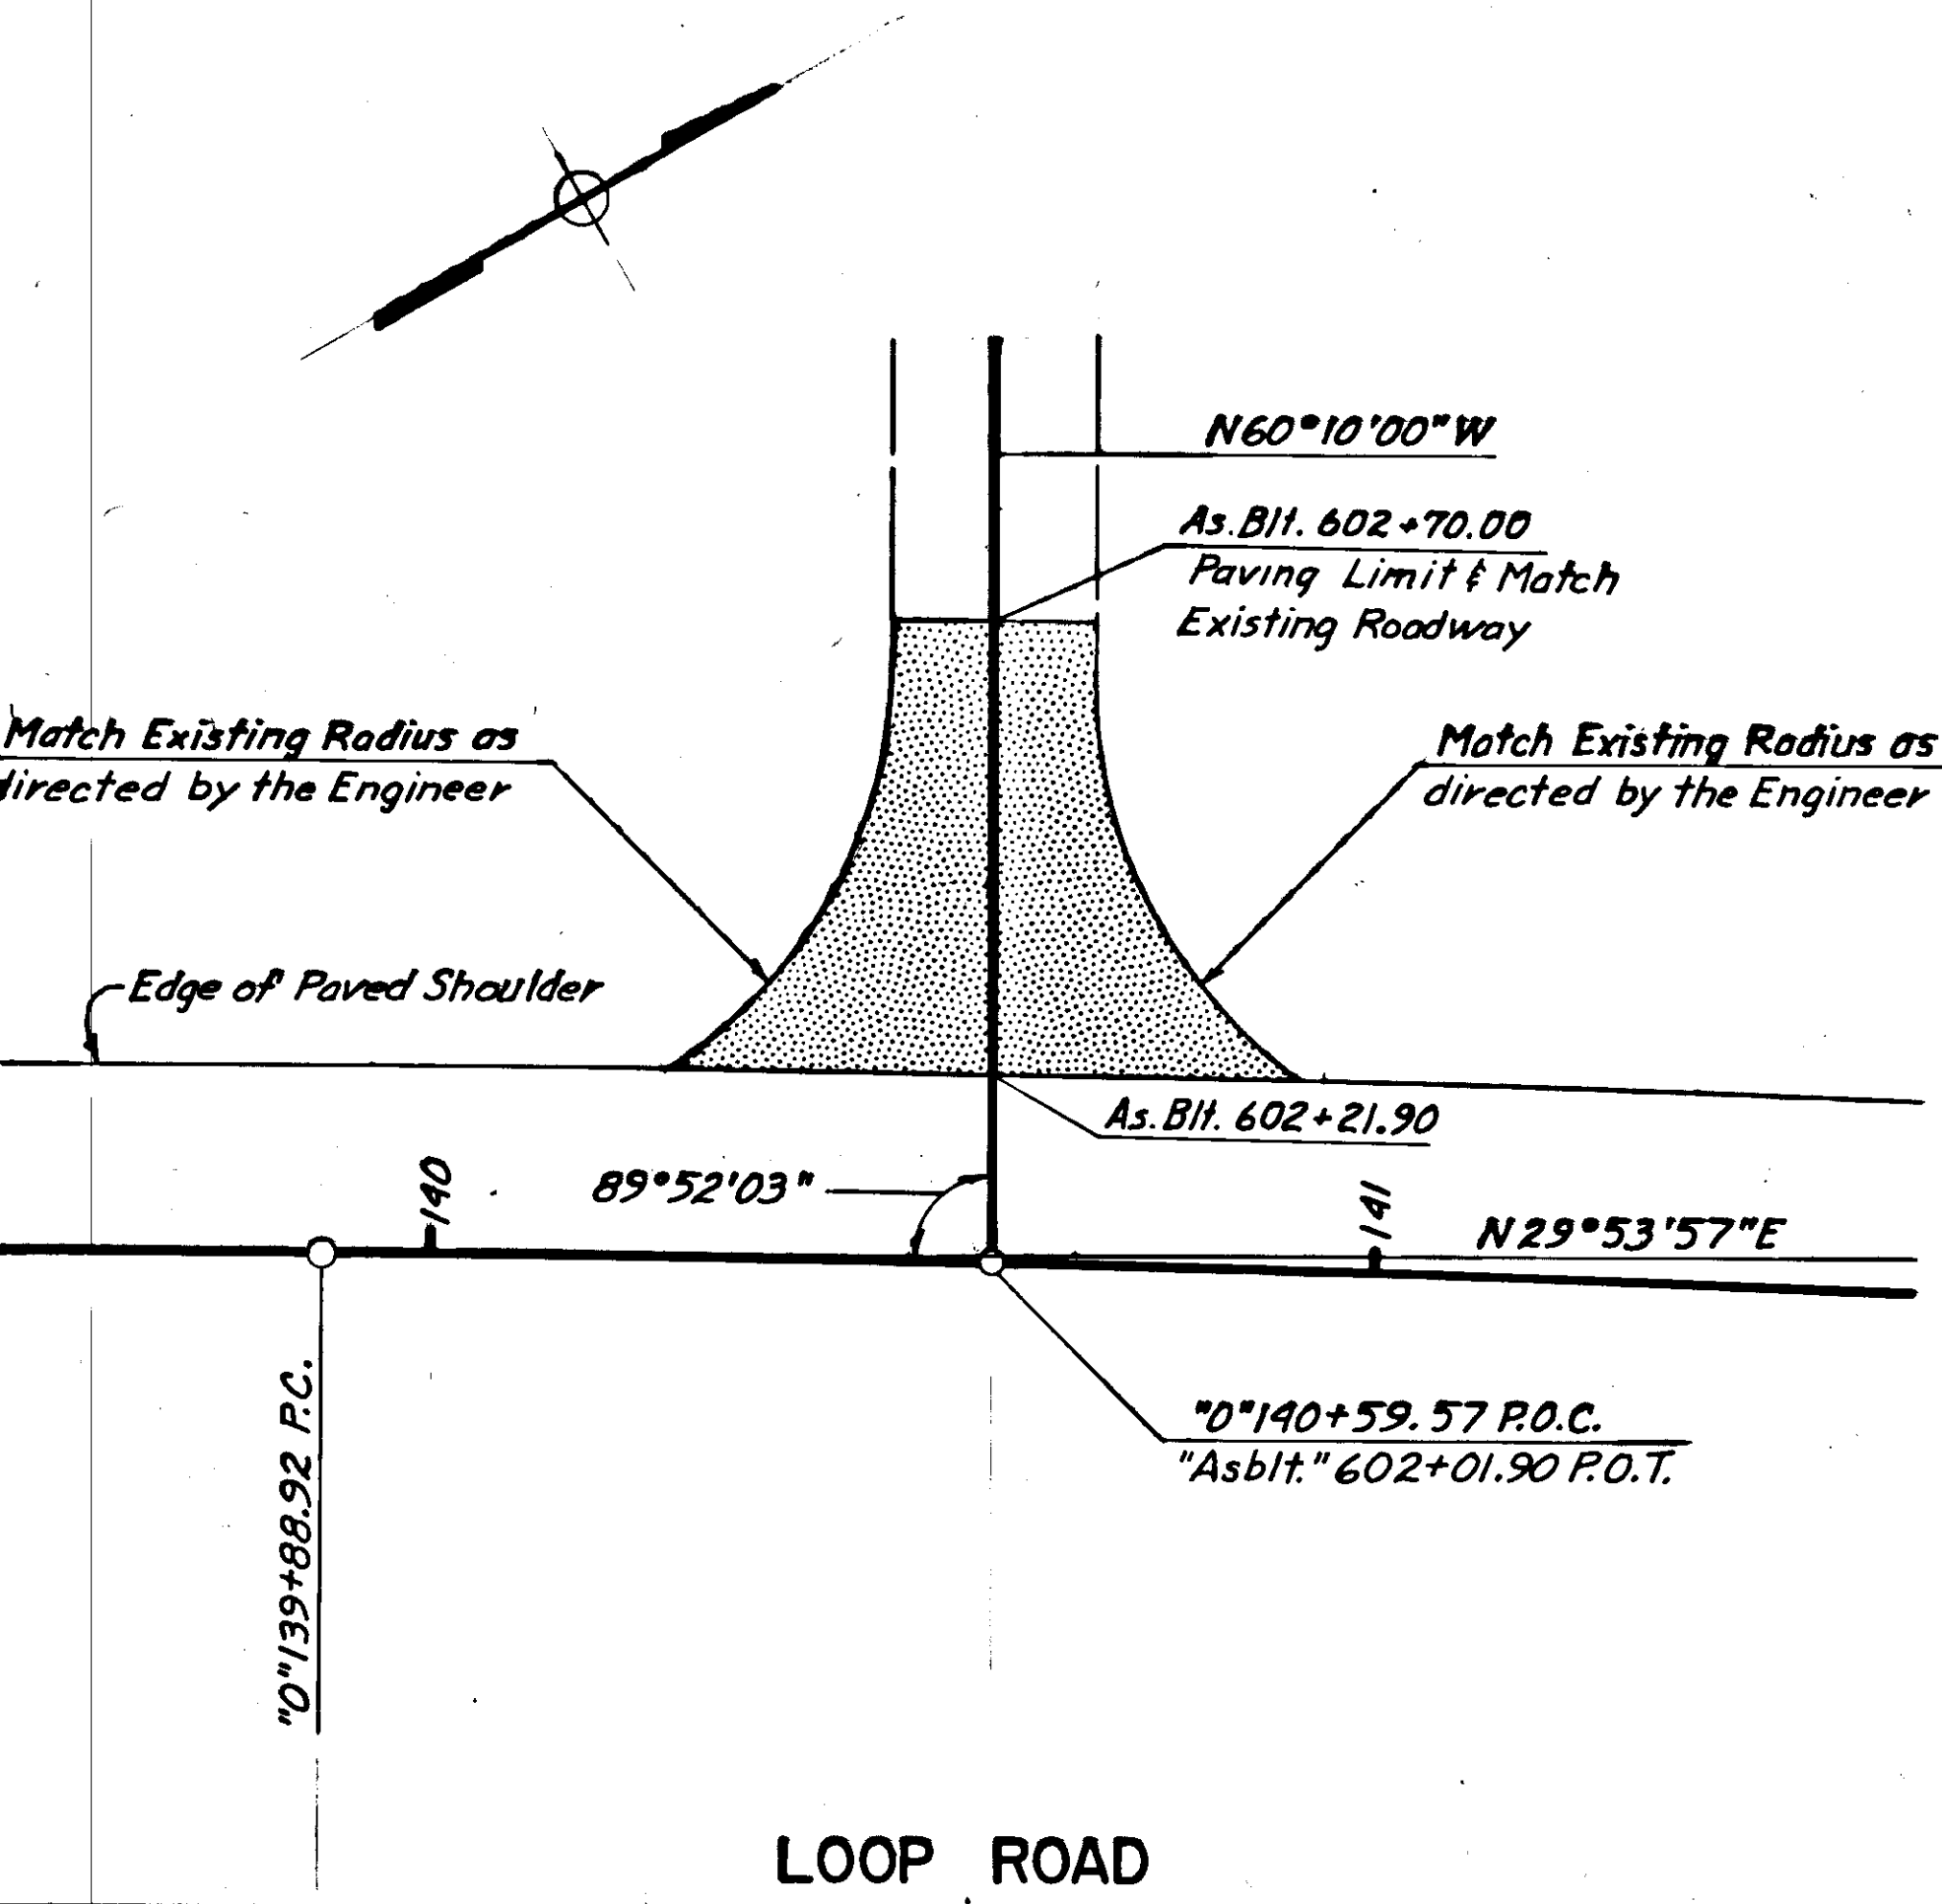

LOOP ROAD


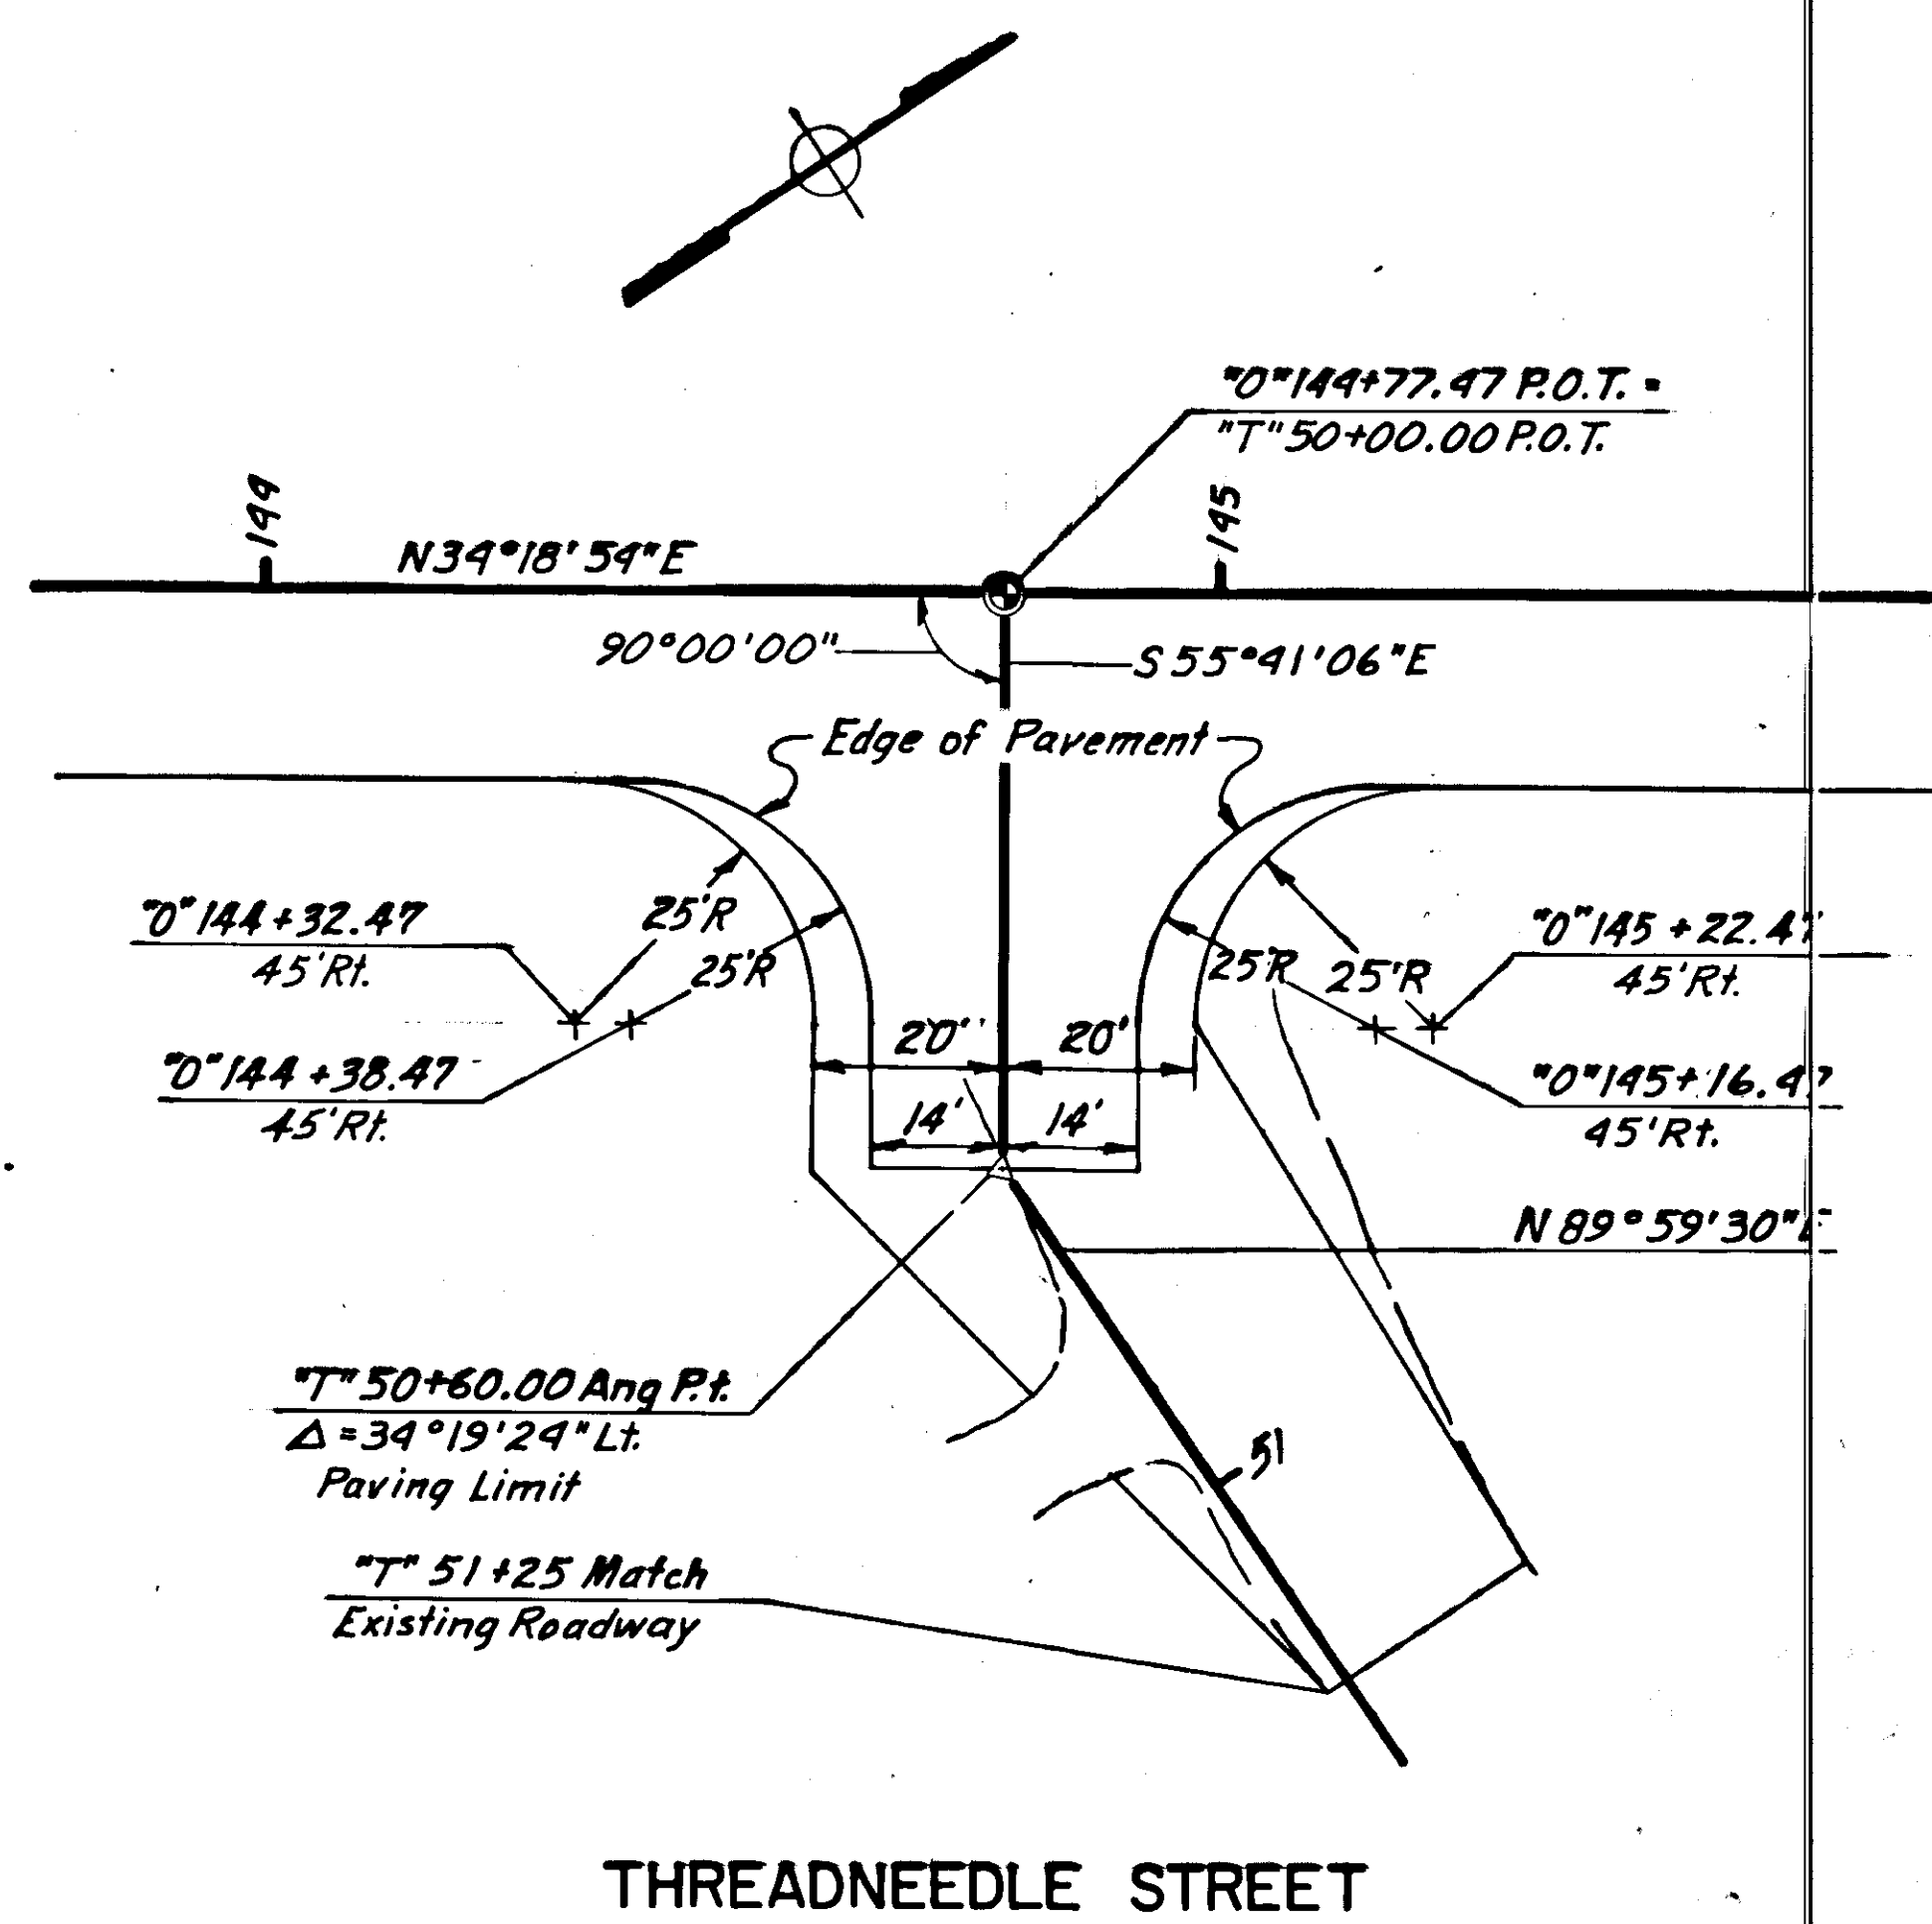


THREADNEEDLE STREET

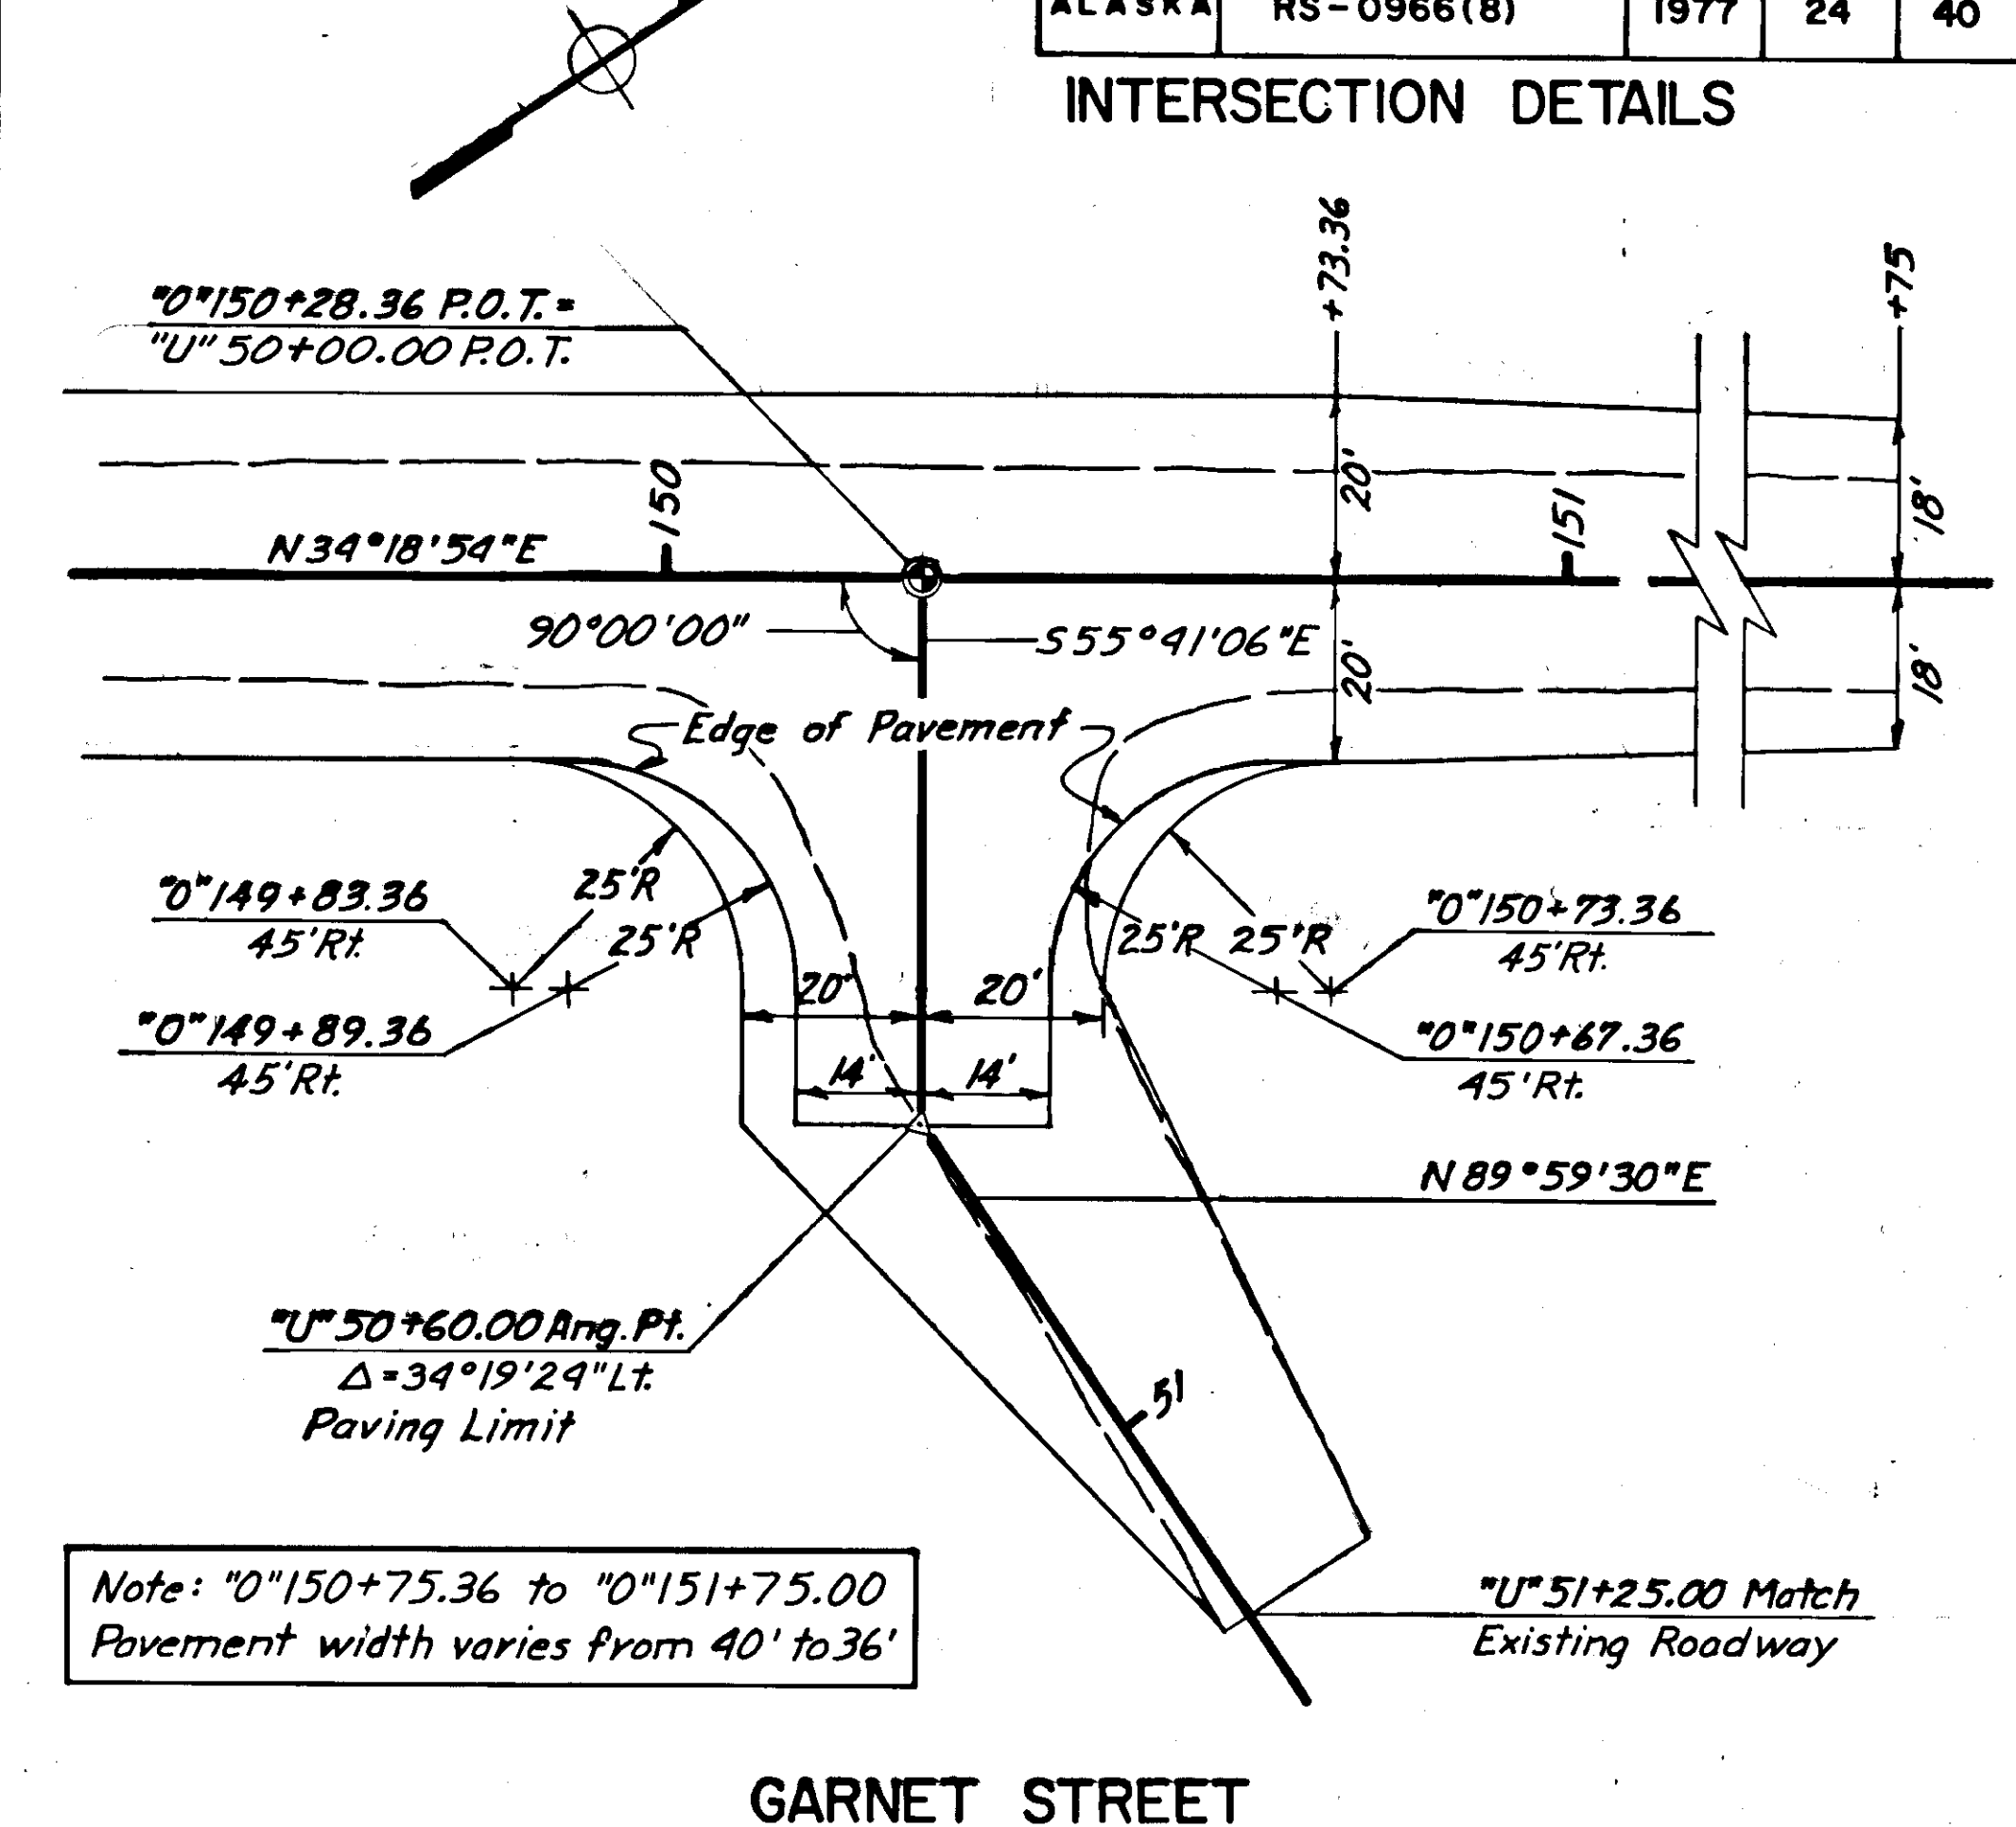

GARNET STREET

1. See paving transition detail, sheet no. 2
2. Distances are to edge of pavement or to the shoulder where no pavement is shown.
3. All quantities are included in the appropriate mainline quantities.

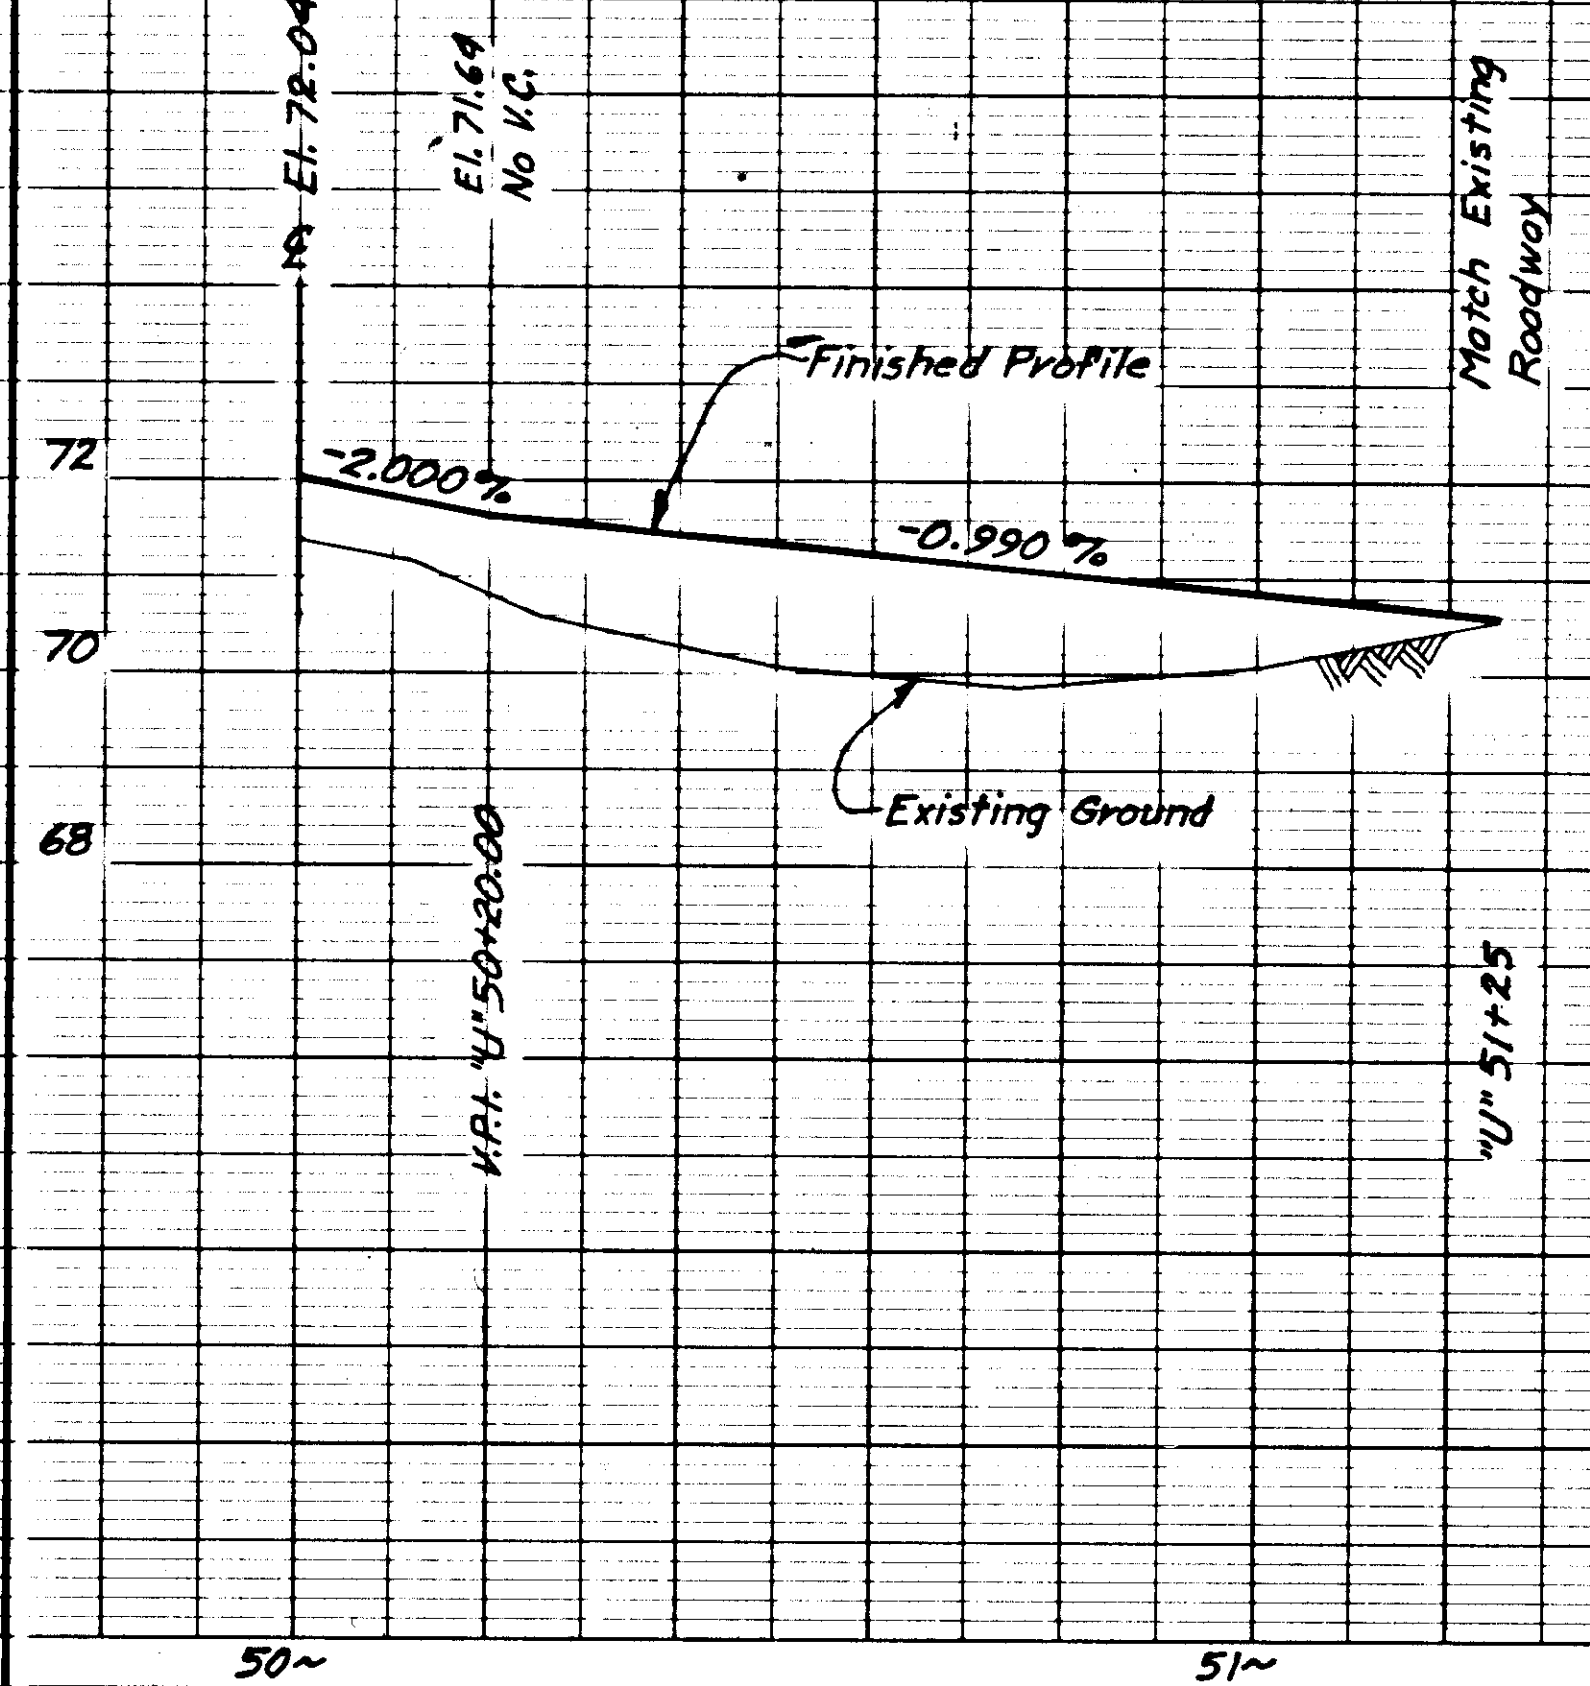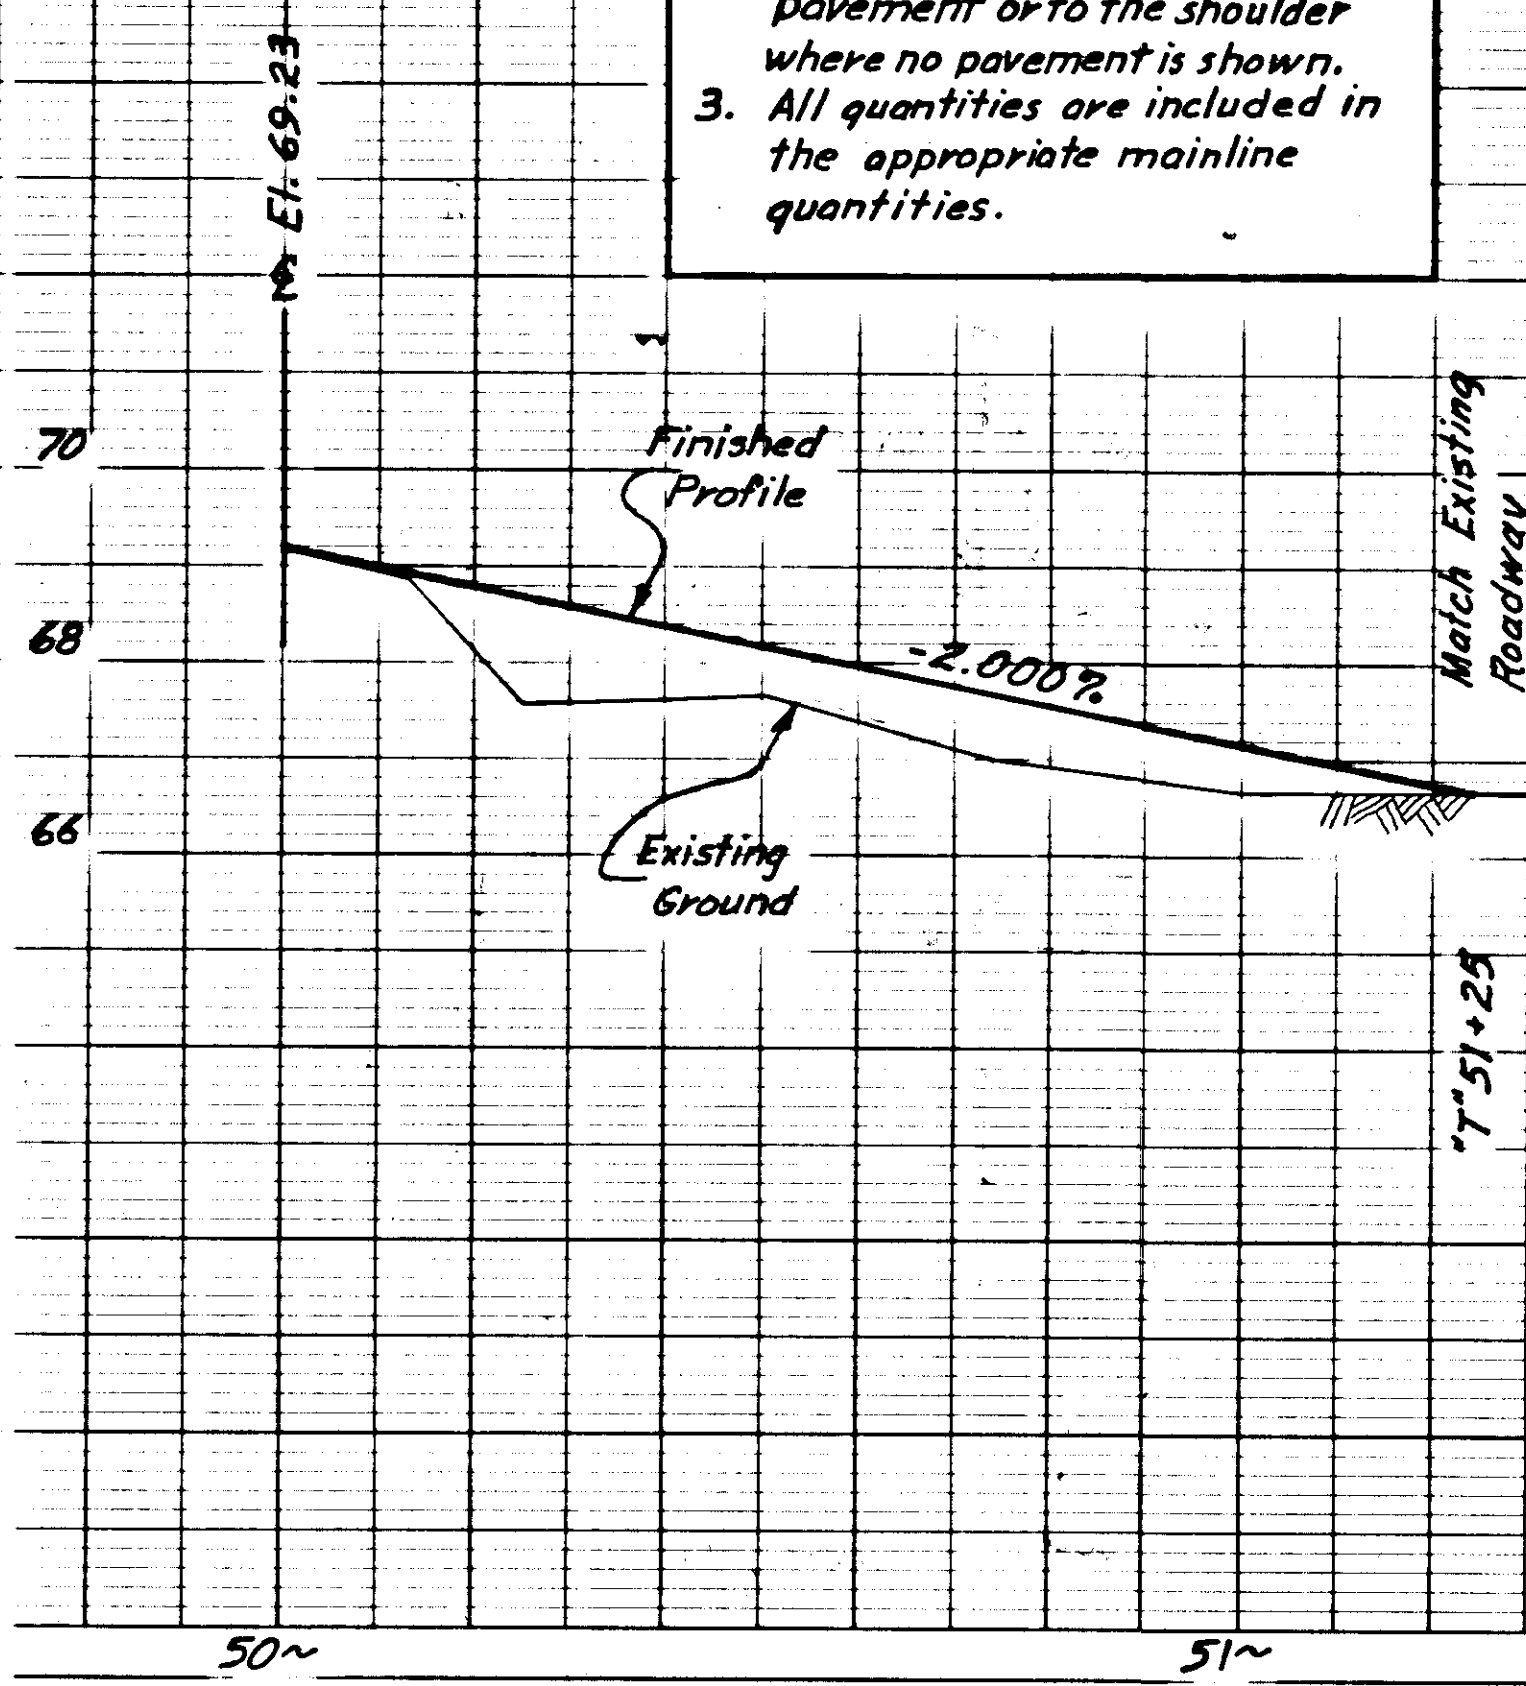

SIGNING SCHEDULE

No.	Station	Dist. from E		Code No.	Legend	Sign Panel Thickness				Post				Facing Traffic	Remarks				
		Lt.	Rt.			Size	Unframed	Framed	Area in S.F.	No. of Post	Type	Size	Length			Embedment			
																	Size	Unframed	Framed
01	"0" 09+53	24'		R1-1	STOP	30"x30"	.063		6.25			1	Tube	2"	13'-6"	3'-0"	S. B.		
02	"0" 11+00	24'		D1-2	Airport Auke Bay	74"x24"	.063		12.30			2	Tube	2"	13'-0"	3'-0"	S. B.	6" Upper Case 4.5" Lower Case	
03	"0" 11+14	24'		R7-1D	No Parking Any Time	12"x18"	.063		1.50			1	Tube	2"	10'-0"	3'-0"	E. B.		
04	"0" 12+50	24'		R7-1D	No Parking Any Time	12"x18"	.063		1.50			1	Tube	2"	10'-0"	3'-0"	W. B.		
05	"0" 12+50	24'		R2-1	Speed Limit 35	30"x36"	.063		7.50			1	Tube	2"	13'-0"	3'-0"	N. B.		
06	"0" 14+04	37'		R1-1	STOP	30"x30"	.063		6.25			1	Tube	2"	12'-6"	3'-0"	E. B.		
07	"0" 14+04	37'		D3-1	DEL RAE RD.	40"x08"	.063		2.20								NB & SB	Mount Above #6.	
08	"0" 17+50	27'		R7-1D	No Parking Any Time	12"x18"	.063		1.50			1	Tube	2"	10'-0"	3'-0"	W. B.		
09	"0" 18+50	24'		R7-1D	No Parking Any Time	12"x18"	.063		1.50			1	Tube	2"	10'-0"	3'-0"	E. B.		
10	"0" 20+50	26'		D1-3	Mendenhall Glacier Auke Bay	82"x51"	.063	.063	29.00			2	Tube	2"	15'-0"	3'-0"	N. B.	6" Upper Case 4.5" Lower Case	
11	"0" 21+08	32'		R7-1D	No Parking Any Time	12"x18"	.063		1.50			1	Tube	2"	10'-0"	3'-0"	W. B.		
12	"0" 22+00	34'		R7-1D	No Parking Any Time	12"x18"	.063		1.50			1	Tube	2"	10'-0"	3'-0"	E. B.		
13	"0" 22+50	30'		R2-1	Speed Limit 35	30"x36"	.063		7.50			See Note #3.					S. B.		
14	"0" 23+39	49'		R1-1	STOP	30"x30"	.063		6.25			1	Tube	2"	12'-6"	3'-0"	W. B.		
15	"0" 23+39	49'		D3-1	HURLOCK AVE.	44"x08"	.063		2.40								NB & SB	Mount Above #14.	
16	"0" 23+70	34'		M1-1	Alaska 7	24"x24"	.063		4.00			See Note #3.					N. B.	Mount Above #17.	
17	"0" 23+70	34'		M6-4	(Directional Arrow)	21"x15"	.063		2.20			See Note #3					N. B.		
18	"0" 24+61	35'		D3-1B	EGAN DRIVE	78"x18"	.080		9.75			See Note #9.					S. B.	8" Up. Case/6" L. Case	
19	"0" 24+61	35'		Special	See Note #7.	5"x7"	.063		0.30								N. B.		
20	"0" 24+61	35'		Special	See Note #6	5"x7"	.063		0.30								N. B.		
	"0" 24+61				Left Lane Must Turn Left	36"x36"			9.0									S. B.	Mount on Sign Pole #1
21	"0" 24+68	39'		Special	See Note #6.	5"x7"	.063		0.30									W. B.	
22	"AsBlt" 393+10	59'		D3-1B	LOOP ROAD	60"x18"	.080		7.50			See Note #9.					E. B.	8" Up. Case/6" L. Case	
23	"AsBlt" 400+00	59'		W3-3		48"x48"	.080		16.00			Band to Existing Light Pole.					E. B.	Mount Above #24	
24	"AsBlt" 400+00	59'		Plaque	Signal Ahead	24"x18"	.063		3.00			Band to Existing Light Pole.					E. B.		
25	"AsBlt" 390+00	48'		16-Type B	Guide Markers (See Sheet 32.)							16	Tube	2"	7'-0"	3'-0"	W. B.	See Note #10.	
26	"0" 26+03	76'		D3-1B	LOOP ROAD	60"x18"	.080		7.50			See Note #9.					W. B.	8" Up. Case/6" L. Case	
27	"0" 26+03	37'		D3-1B	EGAN DRIVE	78"x18"	.080		9.75			See Note #9.					S. B.		
28	"0" 26+03	44'		Special	See Note #7.	5"x7"	.063		0.30								S. B.		
29	"0" 26+03	15'		R3-6L	(Directional Arrow)	30"x36"	.063		7.50			See Note #4.					S. B.		
30	"0" 26+03	4'		R3-5L	ONLY	30"x36"	.063		7.50			See Note #4					S. B.		
31	"AsBlt" 379+60	56'		D1-3	Loop Road Mendenhall Glacier	108"x54"	.080		40.50				2	Tube	2"	15'-0"	3'-0"	W. B.	8" Upper Case 6" Lower Case
32	"AsBlt" 382+80	66'		D7-1R	Directional Arrow	24"x6"	.063		1.00				1	Tube	2"	13'-6"	3'-0"	W. B.	
33	"AsBlt" 382+80	66'		D7-1R	Camping	24"x6"	.063		1.00								W. B.	Mount Above #32	
34	"AsBlt" 382+80	66'		D7-1R	Symbol	30"x30"	.063		6.25			1	Tube	2"	13'-6"	3'-0"	W. B.	Mount Above #33	
35	"AsBlt" 392+75	88'		R5-1	Do Not Enter	48"x48"	.080		16.00			2	Tube	2"	13'-6"	3'-0"	E. B.		
36	"AsBlt" 392+75	88'		R5-5	Ped. & Bic. Prohibited	24"x12"	.063		2.00								E. B.	Mount Below #35	
37	"0" 27+00	37'		R7-1D	No Parking Anytime	12"x18"	.063		1.50			See Note #3					W. B.		
38	"0" 28+00	37'		R7-1D	No Parking Anytime	12"x18"	.063		1.50			See Note #3					E. B.		
39	"0" 29+00	37'		R2-1	Speed Limit 40	30"x36"	.063		7.50			1	Tube	2"	13'-0"	3'-0"	N. B.		
40	"0" 30+00	37'		D1-3	Airport Juneau Auke Bay	82"x42"	.063	.063	23.90				2	Tube	2"	14'-0"	3'-0"	S. B.	6" Upper Case 4.5" Lower Case
41	"0" 31+00	37'		W9-2L	Lane Ends Merge Left	36"x36"	.080		9.00			See Note #3.					N. B.		
42	"0" 32+00	37'		R3-8L	ONLY	30"x30"	.063		6.25			See Note #3.					S. B.		
43	"0" 32+15	50'		R1-1	STOP	30"x30"	.063		6.25			1	Tube	2"	12'-6"	3'-0"	E. B.		
44	"0" 32+74	38'		R1-1	STOP	30"x30"	.063		6.25			1	Tube	2"	12'-6"	3'-0"	W. B.		
45	"0" 32+74	38'		D3-1	ATLIN AVE.	34"x08"	.063		1.90								NB & SB	Mount Above #44.	
46	"0" 33+00	57'		D11-1	Bike Route	24"x18"	.063		3.00			1	Tube	2"	7'-6"	3'-0"	E. B.		
47	"0" 33+00	57'		D11-1G		24"x06"	.063		1.00								E. B.	Mount Below #46.	
48	"0" 33+75	58'		D11-1	Bike Route	24"x18"	.063		3.00			1	Tube	2"	7'-6"	3'-0"	W. B.		
49	"0" 33+75	58'		D11-1F		24"x06"	.063		1.00								W. B.	Mount Below #48.	
50	"0" 33+35	56'		R5-7	No Motor Vehicles	12"x18"	.063		1.50			1	Tube	2"	7'-0"	3'-0"	N. B.		
51	"0" 33+35	56'			No Horses	6"x12"			.50								N. B.	Mount Below #50	
52	"0" 33+35	56'		D11-1B	End	24"x6"	.063		1.00								S. B.	Mount Above #52	
53	"0" 33+35	56'		D11-1	Bike Route	24"x18"	.063		3.00								S. B.	Mount Back of #50	
54	"0" 33+25	34'		R5-4		24"x24"	.063		4.00								N. B.	Mount Above #54	
55	"0" 33+25	34'		Plaque	No Bicycles	24"x18"	.063		3.00			1	Tube	2"	13'-0"	3'-0"	N. B.	Mount Above #56	
56	"0" 33+25	36'		R5-4		24"x24"	.063		4.00								N. B.		
57	"0" 33+25	36'		Plaque	No Bicycles	24"x18"	.063		3.00			1	Tube	2"	13'-0"	3'-0"	N. B.	Mount Above #56	
58	"0" 34+00	57'			No Horses	6"x12"			.50								N. B.	Mount Below #57	
59	"0" 34+00	57'		R5-7	No Motor Vehicles	12"x18"	.063		1.50			1	Tube	2"	7'-6"	3'-0"	N. B.		
60	"0" 34+00	57'		D11-1B	End	24"x6"	.063		1.00								S. B.	Mount Above #59	
61	"0" 34+00	57'		D11-1	Bike Route	24"x18"	.063		3.00								S. B.	Mount Back of #57	
62	"0" 36+18	37'		W4-2	Transition	36"x36"	.080		9.00			See Note #3					S. B.		
63	"0" 36+75	54'		R5-7	No Motor Vehicles	12"x18"	.063		1.50			1	Tube	2"	7'-0"	3'-0"	S. B.	Mount Below #61	

All Signing General Notes are located on sheet #26a.

SIGNING SCHEDULE

No.	Station	Dist. from E		Code No.	Legend	Sign Panel Thickness				Post				Facing Traffic	Remarks			
		Lt.	Rt.			Size	Unframed	Framed	Area in S.F.	No. of Posts	Type	Size	Length			Embedment		
																	Size	Unframed
62	"0" 37+21	56'		R1-1	STOP	30"x30"	.063		6.25			1	Tube	2"	12'-0"	3'-0"	E. B.	
63	"0" 37+21	56'		D3-1	JAMES BLVD.	40"x8"	.063		2.20								N. B. & S. B.	Mount Above #62
64	"0" 37+75	55'		D11-1	Bike Route	24"x18"	.063		3.00			1	Tube	2"	7'-6"	3'-0"	W. B.	
65	"0" 37+75	55'		D11-1H		24"x6"	.063		1.00								W. B.	Mount Below #64
66	"0" 37+81	37'		R7-1D	No Parking Anytime	12"x18"	.063		1.50			See Note #3					E. B.	
67	"0" 38+96	37'		R7-1D	No Parking Anytime	12"x18"	.063		1.50			See Note #3					W. B.	
68	"0" 43+22	56'		R1-1	STOP	30"x30"	.063		6.25			1	Tube	2"	15'-0"	3'-0"	E. B.	
69	"0" 43+22	56'		D3-1	KODZOFF DRIVE	54"x8"	.063		3.00								N. B. & S. B.	Mount Above #68
70	"0" 44+54	37'		R7-1D	No Parking Anytime	12"x18"	.063		1.50			See Note #3					W. B.	
71	"0" 45+55	37'		R7-1D	No Parking Anytime	12"x18"	.063		1.50			See Note #3					E. B.	
72	"0" 69+78	37'		R7-1D	No Parking Anytime	12"x18"	.063		1.50			See Note #3					W. B.	

SIGNING SCHEDULE

No.	Station	Dist. from		Code No.	Legend	Sign Panel Thickness			No. of Post	Type	Post			Facing Traffic	Remarks
		Lt.	Rt.			Size	Unframed	Framed			Area in S.F.	Size	Length		
25	"0" 100+80	X		D11-1H	←	24"x6"	.063	1.00					E. B.	Mount Below #124	
26	"0" 100+65	49'	X	D11-1	↔	24"x18"	.063	3.00	1	Tube	2"	7'-6"	3'-0"	W. B.	
27	"0" 100+65	49'	X	D11-1H	←	24"x6"	.063	1.00					W. B.	Mount Below #126	
28	"0" 101+45	28'	X	S2-1	School Crossing Sign	36"x36"	.080	6.75	1	Tube	2"	13'-0"	3'-0"	S. B.	
29	"0" 101+45	38'	X	R1-1	STOP	30"x30"	.063	6.25	1	Tube	2"	13'-0"	3'-0"	W. B.	
30	"0" 101+80	57'	X	R5-7	No Motor Vehicles	12"x18"	.063	1.50	1	Tube	2"	7'-0"	3'-0"	N.B.	Mount Below #130
31	"0" 103+88	37'		R2-1	Speed Limit 40	30"x36"	.063	7.50	See Note #3				N. B.		
32	"0" 105+01	37'		R7-1D	No Parking Anytime	12"x18"	.063	1.50	See Note #3				W. B.		
33	"0" 106+22	37'		R7-1D	No Parking Anytime	12"x18"	.063	1.50	See Note #3				E. B.		
34	"0" 107+21	37'		S1-1	School Advance Sign	36"x36"	.080	6.75	See Note #3				S. B.		
35	"0" 111+50	52'		R5-7	No Motor Vehicles	12"x18"	.063	1.50					S. B.	Mount Below #135	
36	"0" 112+00	53'	X	D11-1	Bike Route	24"x18"	.063	3.00	1	Tube	2"	7'-6"	3'-0"	E. B.	
37	"0" 112+00	53'	X	D11-1H	←	24"x6"	.063	1.00					E. B.	Mount Below #136	
38	"0" 112+00	26'	X	R5-4	⊘	24"x24"	.063	4.00					S. B.	Mount Above #139	
39	"0" 112+00	26'	X	Plaque	No Bicycles	24"x18"	.063	3.00					S. B.		
40	"0" 112+10	50'		R1-1	STOP	30"x30"	.063	6.25	1	Tube	2"	13'-0"	3'-0"	E. B.	
41	"0" 112+10	50'		D3-1	MENDENHALL BLVD.	58"x8"	.063	3.20					N.B.&S.B.	Mount Above #140	
42	"0" 112+65	45'	X	R1-1	STOP	30"x30"	.063	6.25	1	Tube	2"	13'-0"	3'-0"	W. B.	
43	"0" 112+65	45'	X	D3-1	VALLEY BLVD.	42"x8"	.063	2.30					N.B.&S.B.	Mount Above #142	
44	"0" 112+80	75'	X	D11-1	Bike Route	24"x18"	.063	3.00	1	Tube	2"	7'-6"	3'-0"	W. B.	
45	"0" 112+80	75'	X	D11-1H	←	24"x6"	.063	1.00					W. B.	Mount Below #144	
46	"0" 113+00	26'	X	R5-4	⊘	24"x24"	.063	4.00					N. B.	Mount Above #147	
47	"0" 113+00	26'	X	Plaque	No Bicycles	24"x18"	.063	3.00	1	Tube	2"	13'-0"	3'-0"	N. B.	
48	"0" 113+00	26'	X	R5-7	No Motor Vehicles	12"x18"	.063	1.50	1	Tube	2"	7'-0"	3'-0"	N. B.	
49	"0" 119+69	27'		R7-1D	No Parking Anytime	12"x18"	.063	1.50	See Note #3				E. B.		
50	"0" 121+42	27'		R7-1D	No Parking Anytime	12"x18"	.063	1.50	See Note #3				N. B.	Mount Below #148	
51	"0" 122+15	27'	X	R1-1	STOP	30"x30"	.063	6.25	1	Tube	2"	13'-0"	3'-0"	W. B.	
52	"0" 122+15	27'	X	D3-1	Kimberly St.	44"x8"	.063	2.40					N.B.&S.B.	Mount Above #151	
53	"0" 125+00	53'	X	D11-1	Bike Route	24"x18"	.063	3.00	1	Tube	2"	7'-6"	3'-0"	E. B.	
54	"0" 125+00	53'	X	D11-1H	←	24"x6"	.063	1.00					E. B.	Mount Below #153	
55	"0" 125+54	26'	X	R1-1	STOP	30"x30"	.063	6.25	1	Tube	2"	13'-0"	3'-0"	W. B.	
56	"0" 125+54	26'	X	D3-1	Thunder Mt. Rd.	60"x8"	.063	3.30					N.B.&S.B.	Mount Above #155	
57	"0" 126+00	52'	X	R5-7	No Motor Vehicles	12"x18"	.063	1.50	1	Tube	2"	7'-0"	3'-0"	N. B.	
58	"0" 126+00	52'	X	R5-7	No Motor Vehicles	12"x18"	.063	1.50	1	Tube	2"	7'-0"	3'-0"	S. B.	
59	"0" 127+17	32'	X	R1-1	STOP	30"x30"	.063	6.25	1	Tube	2"	13'-0"	3'-0"	E. B.	
60	"0" 126+00	52'			No Horses	6"x12"	.50						N. B.	Mount Below #157	
61	"0" 127+70	32'	X	D3-1	Taku Blvd.	36"x8"	.063	2.00					N.B.&S.B.	Mount Above #159	
62	"0" 127+70	32'	X	D11-1	Bike Route	24"x18"	.063	3.00	1	Tube	2"	7'-6"	3'-0"	W. B.	
63	"0" 127+70	32'	X	D11-1H	←	24"x6"	.063	1.00					W. B.	Mount Below #161	
64	"0" 132+33	27'		R7-1D	No Parking Anytime	12"x18"	.063	1.50	See Note #3				W. B.		
65	"0" 133+81	27'		R7-1D	No Parking Anytime	12"x18"	.063	1.50	See Note #3				E. B.		
66	"0" 126+76	51'			No Horses	6"x12"	.50						S. B.	Mount Below #158	
67	"0" 136+77	27'		D7-1L	⚠ (Camping Symbol)	24"x24"	.063	4.00					N. B.	Mount Above #166	
68	"0" 136+77	27'		D7-1L	Camping	24"x6"	.063	1.00	See Note #3				N. B.	Mount Above #167	
69	"0" 136+77	27'		D7-1L	↔ Directional Arrow	24"x6"	.063	1.00	See Note #3				N. B.		
70	"0" 138+26	27'		R2-1	Speed Limit 40	30"x36"	.063	7.50	See Note #3				S. B.		
71	"0" 139+00	32'	X	R1-1	STOP	30"x30"	.063	6.25	1	Tube	2"	13'-0"	3'-0"	W. B.	
72	"0" 139+00	32'	X	D3-1	Erin Way	38"x8"	.063	2.00					N.B.&S.B.	Mount Above #169	
73	"0" 139+40	27'	X	D1-3	Mendenhall Glacier	78"x36"	.063	19.50	2	Tube	2"	13'-6"	3'-0"	N. B.	6" Upper Case
74	"0" 139+40	27'	X	D1-3	Auke Bay	78"x36"	.063	19.50	2	Tube	2"	15'-0"	3'-0"	N. B.	4.5" Lower Case
75	"0" 139+75	50'		R5-7	No Motor Vehicles	12"x18"	.063	1.50	1	Tube	2"	7'-0"	3'-0"	S. B.	
76	"0" 140+10	27'		R5-4	⊘	24"x24"	.063	4.00					S. B.	Mount Above #174	
77	"0" 140+10	27'		Plaque	No Bicycles	24"x18"	.063	3.00	See Note #3				S. B.		
78	"0" 139+75	60'			No Horses	6"x12"	.50						S. B.	Mount Below #172	
79	AsBt605+00	27'	X	D1-2	Mendenhall Glacier	80"x24"	.063	13.30	2	Tube	2"	12'-0"	3'-0"	E. B.	6" Upper Case
80	"0" 141+00	140+95	X	D11-1	Bike Route	24"x18"	.063	3.00	1	Tube	2"	7'-6"	3'-0"	W. B.	4.5" Lower Case
81	"0" 141+00	140+95	X	D11-1H	←	24"x6"	.063	1.00					W. B.	Mount Below #176	
82	"0" 141+10	26'		R5-4	⊘	24"x24"	.063	4.00					N. B.	Mount Above #179	
83	"0" 141+10	26'		Plaque	No Bicycles	24"x18"	.063	3.00	1	Tube	2"	13'-0"	3'-0"	N. B.	
84	"0" 143+25	26'	X	D1-2	Airport	78"x24"	.063	13.00	2	Tube	2"	13'-6"	3'-0"	S. B.	6" Upper Case
85	"0" 144+27	27'		D7-1R	⚠ (Camping Symbol)	24"x24"	.063	4.00					S. B.	4.5" Lower Case	
86	"0" 144+27	27'		D7-1R	Camping	24"x6"	.063	1.00	See Note #3				S. B.	Mount Above #183	
87	"0" 144+27	27'		D7-1R	↔ Directional Arrow	24"x6"	.063	1.00	See Note #3				S. B.		
88	"0" 145+10	37'	X	R1-1	STOP	30"x30"	.063	6.25	1	Tube	2"	13'-0"	3'-0"	W. B.	
89	"0" 145+10	37'	X	D3-1	Threadneedle St.	58"x8"	.063	3.20					N.B.&S.B.	Mount Above #184	
90	"0" 148+69	27'		R7-1D	No Parking Anytime	12"x18"	.063	1.50	See Note #3				W. B.		

All signing General Notes are located on sheet #26a


STATE	PROJECT DESIGNATION	YEAR	SHEET NO.	TOTAL SHEETS
ALASKA	RS-0960(1) B RS-0966(8)	1977	26	40

SIGNING SCHEDULE

No.	Station	Dist. from		Code No.	Legend	Sign Panel Thickness			No. of Post	Type	Post			Facing Traffic	Remarks
		Lt.	Rt.			Size	Unframed	Framed			Area in S.F.	Size	Length		
187	"0" 148+92	38'	X	R1-1	STOP	30"x30"	.063	6.25	1	Tube	2"	13'-0"	3'-0"	E. B.	
188	"0" 148+92	38'	X	D3-1	Counterpane Lane	60"x8"	.063	3.30					N.B.&S.B.	Mount Above #187	
189	"0" 150+55	27'	X	R1-1	STOP	30"x30"	.063	6.25	1	Tube	2"	13'-0"	3'-0"	W. B.	
190	"0" 150+55	27'	X	D3-1	Garnet St.	38"x8"	.063	2.10					N.B.&S.B.	Mount Above #189	
191	"0" 150+78	27'		R7-1D	No Parking Anytime	12"x18"	.063	1.50	See Note #3				E. B.		
192	"0" 153+00	47'			No Horses	6"x12"	.50						S. B.	Mount Below #192	
193	"0" 153+00	47'		R5-7	No Motor Vehicles	12"x18"	.063	1.50	1	Tube	2"	7'-0"	3'-0"	S. B.	
194	"0" 153+00	47'		R5-7	No Motor Vehicles	12"x18"	.063	1.50	1	Tube	2"	7'-0"	3'-0"	S. B.	
195	"0" 154+50	22'	X	R5-4	⊘	24"x24"	.063	4.00					S. B.	Mount Above #195	
196	"0" 154+50	22'	X	Plaque	No Bicycles	24"x18"	.063	3.00	1	Tube	2"	13'-0"	3'-0"	S. B.	
197	"0" 154+50	22'	X	R5-4	⊘	24"x24"	.063	4.00					S. B.	Mount Above #197	
198	"0" 154+50	22'	X		No Horses	6"x12"	.50						S. B.	Mount Below #199	
199	"0" 154+60	22'	X	Plaque	No Bicycles	24"x18"	.063	3.00	1	Tube	2"	13'-0"	3'-0"	S. B.	
200	"0" 154+60	22'	X	D11-1	Bike Route	24"x18"	.063	3.00	1	Tube	2"	7'-6"	3'-0"	W. B.	
201	"0" 154+60	22'	X	D11-1G	←	24"x6"	.063	1.00					W. B.	Mount Below #198	
202	"0" 154+92	22'	X	R1-1	STOP	30"x30"	.063	6.25	1	Tube	2"	13'-0"	3'-0"	E. B.	
203	"0" 154+92	22'	X	D3-1	Gladstone St.	48"x8"	.063	2.70					E. B.	Mount Above #200	
204	"0" 155+40	45'	X	D11-1	Bike Route	24"x18"	.063	3.00	1	Tube	2"	7'-6"	3'-0"	E. B.	
205	"0" 155+40	45'	X	D11-1F	↔	24"x6"	.063	1.00					E. B.	Mount Below #202	
206	"0" 155+96	15'	X	R1-1	STOP	30"x30"	.063	6.25	1	Tube	2"	13'-0"	3'-0"	W. B.	
207	"0" 159+40	22'	X	R3-10AA	Rt. Lane Bike Only	24"x30"	.063	5.00	1	Tube	2"	10'-0"	3'-0"	N. B.	See Detail on Sht. 26
208	"0" 180+25	25'	X	R3-10AA	Rt. Lane Bike Only	24"x30"	.063	5.00	1	Tube	2"	10'-0"	3'-0"	S. B.	See Detail on Sht. 26
209	"0" 185+00	26'		R2-1	Speed Limit 40	30"x36"	.063	7.50	1	Tube	2"	13'-6"	3'-0"	S. B.	
210	"0" 185+00	27'	X	R2-1	Speed Limit 40	30"x36"	.063	7.50	1	Tube	2"	13'-6"	3'-0"	N. B.	
211	"0" 190+00	26'	X	R3-10AA	Rt. Lane Bike Only	24"x30"	.063	5.00	1	Tube	2"	10'-0"	3'-0"	N. B.	See Detail on Sht. 26
212	"0" 207+00	27'	X	W14-4	End Road 1000 Ft.	36"x36"	.080	9.00	1	Tube	2"	13'-0"	3'-0"	N. B.	
213	"0" 215+00	22'	X	R2-1	Speed Limit 40	30"x36"	.063	7.50	1	Tube	2"	13'-0"	3'-0"	S. B.	
214	"0" 215+00	22'	X	R3-10AA	Rt. Lane Bike Only	24"x30"	.063	5.00	1	Tube	2"	10'-0"	3'-0"	S. B.	See Detail on Sht. 26
C.O. #11															
215	"0" 38+65	X		R1-1	STOP	30"x30"	.063	6.25	1	Tube	2"	13'	3'-0"	E. B.	Kodzoff #1 South
216	"0" 49+61	X	X	R1-1	STOP	3									

SIGNING & ILLUMINATION DETAILS

BEGIN PROJECT
RS-0960(I)
STA. "0" 9+09.81

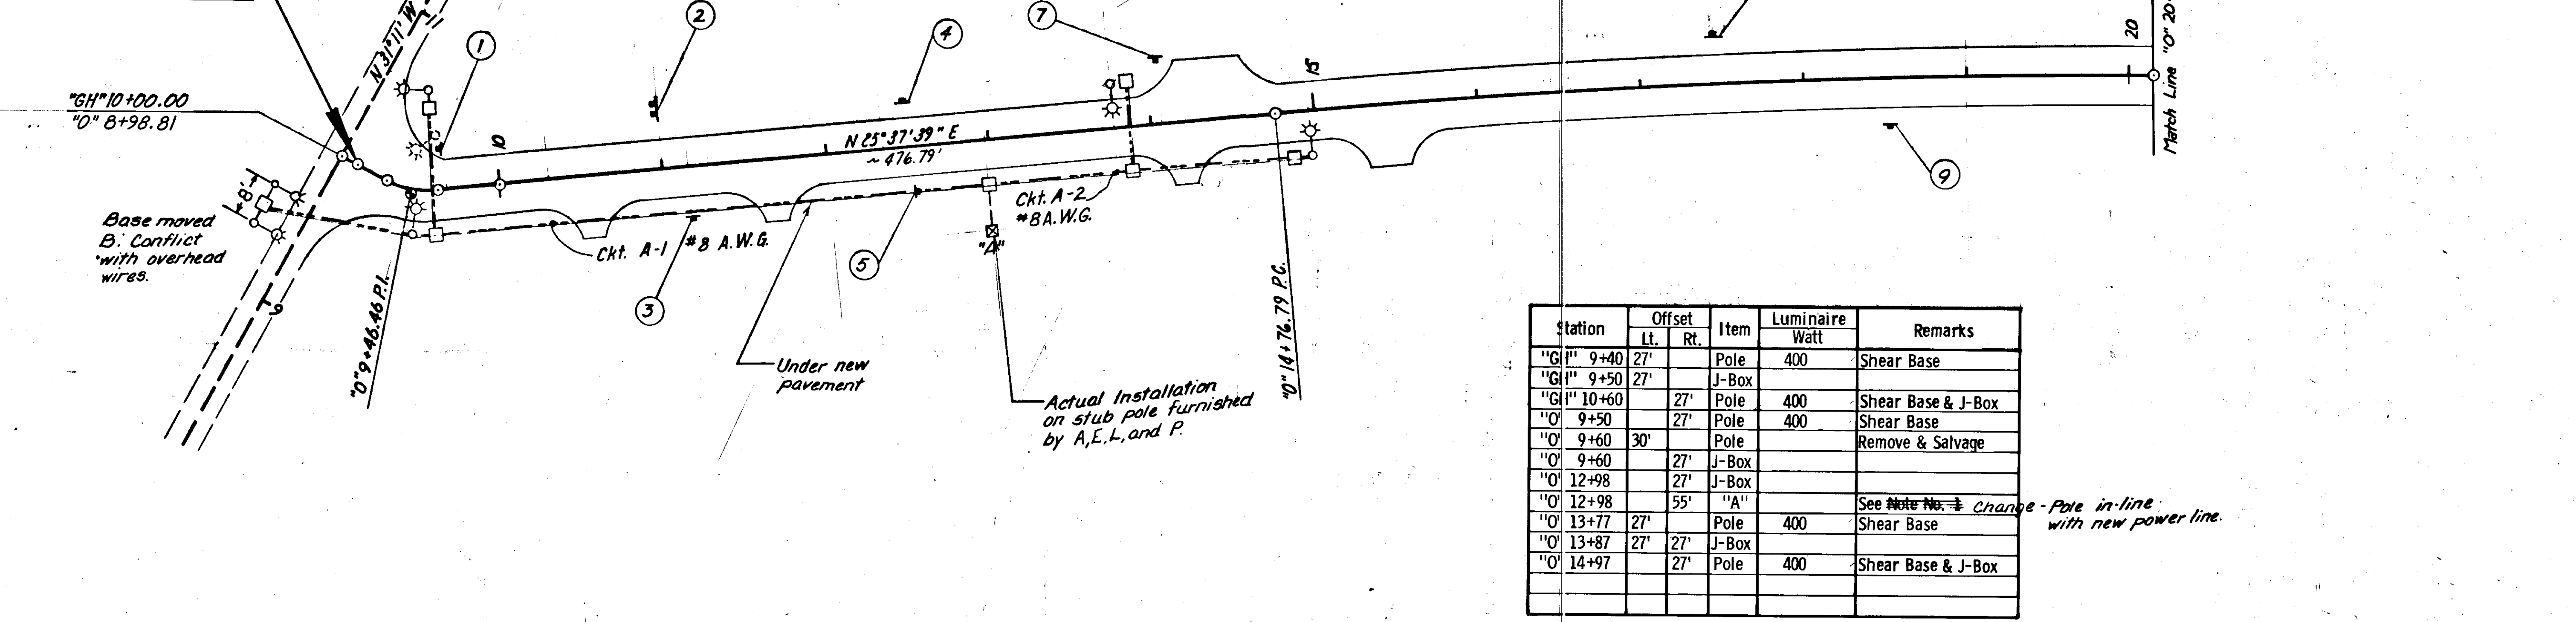


Station	Offset		Item	Luminaire Watt	Remarks
	Lt.	Rt.			
"G" 9+40	27'		Pole	400	Shear Base
"G" 9+50	27'		J-Box		
"G" 10+60		27'	Pole	400	Shear Base & J-Box
"O" 9+50		27'	Pole	400	Shear Base
"O" 9+60	30'		Pole		Remove & Salvage
"O" 9+60		27'	J-Box		
"O" 12+98		27'	J-Box		
"O" 12+98		55'	"A"		See Note No. 3 Change Pole in-line with new power line.
"O" 13+77	27'		Pole	400	Shear Base
"O" 13+87	27'	27'	J-Box		
"O" 14+97		27'	Pole	400	Shear Base & J-Box

Station	Offset		Item	Remarks
	Lt.	Rt.		
"O" 21+75	55'		"B"	See Note No. 3 Change
"O" 21+75	30'		J-Box	
"O" 22+50	31'		Pole	Shear Base
"O" 22+60	32'	32'	J-Boxes	
"O" 22+61	33'	33'	J-Boxes	"Traffic" on cover
"O" 23+70	34'		Pole	Shear Base & J-Box
"O" 24+20	30'			Remove & Salvage
"O" 24+28	40'			See Note No. 2
"O" 24+61	35'			See Note No. 3

Station	Offset		Item	Luminaire Watt	Remarks
	Lt.	Rt.			
"As Bit" 393+10	59'			400	See Note No. 3
"As Bit" 392+81	59'		Pole		Remove & Salvage
"As Bit" 391+56		79'	Pole	250	Shear Base & J-Box
"As Bit" 391+11	59'		Pole		See Note No. 4
"As Bit" 389+81		79'	Pole	250	Shear Base & J-Box
"As Bit" 387+55		79'	Pole	250	Shear Base & J-Box
"O" 26+03	100'				Remove & Salvage
"O" 26+03	76'			400	See Note No. 3
"O" 26+03	37'			400	See Note No. 3

Station	Offset		Item	Luminaire Watt	Remarks
	Lt.	Rt.			
"O" 26+05	270'			400	See Note No. 5
"O" 26+48		30'			Remove & Salvage
"O" 26+60		65'	Pole	250	Shear Base & J-Box
"O" 27+00		37'	Pole	400	
"O" 28+00	37'		Pole	400	
"O" 29+00		37'	Pole	400	
"O" 30+00	37'		Pole	400	
"O" 31+00		37'	Pole	400	

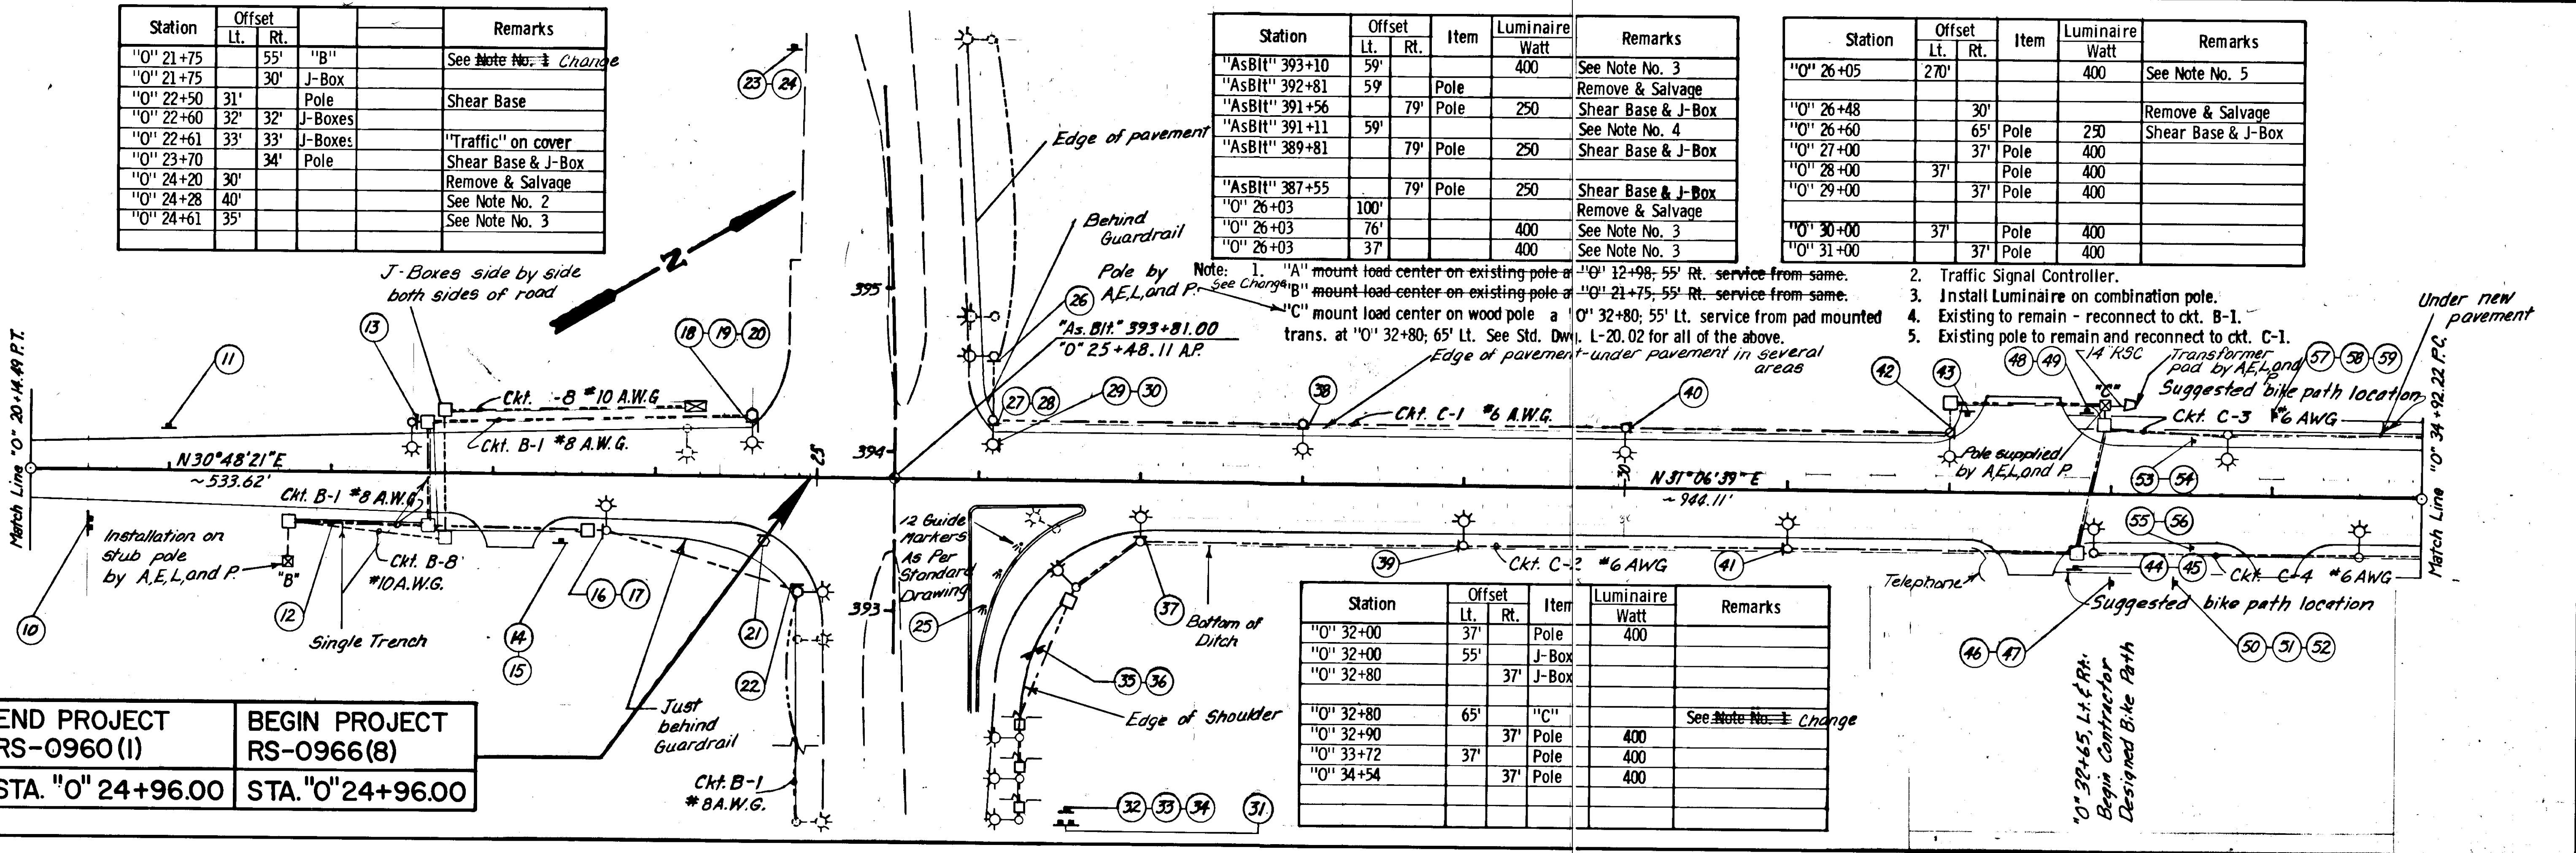

END PROJECT
RS-0960(I)
STA. "O" 24+96.00

BEGIN PROJECT
RS-0966(8)
STA. "O" 24+96.00

Station	Offset		Item	Luminaire Watt	Remarks
	Lt.	Rt.			
"O" 32+00	37'		Pole	400	
"O" 32+00		55'	J-Box		
"O" 32+80		37'	J-Box		
"O" 32+80	65'		"C"		See Note No. 3 Change
"O" 32+90		37'	Pole	400	
"O" 33+72	37'		Pole	400	
"O" 34+54		37'	Pole	400	

Notes:

- "A" mount load center on existing pole at "O" 12+98, 55' Rt. service from same.
- "B" mount load center on existing pole at "O" 21+75, 55' Rt. service from same.
- "C" mount load center on wood pole at "O" 32+80, 55' Lt. service from pad mounted trans. at "O" 32+80, 65' Lt. See Std. Dwg. L-20.02 for all of the above.
- Existing pole to remain and reconnect to ckt. C-1.
- Existing pole to remain and reconnect to ckt. C-1.

14 RSC Transformer pad by A.E.L. and P.

Pole supplied by A.E.L. and P.

12 Guide Markers As Per Standard Drawing

Single Trench

Just behind Guardrail

Edge of pavement

Behind Guardrail

Edge of Shoulder

Bottom of Ditch

Suggested bike path location

Suggested bike path location


Telephone

Under new pavement

"O" 32+65, Lt. & Rt. Begin Contractor Designed Bike Path



SIGNING & ILLUMINATION DETAILS

STATE	PROJECT DESIGNATION	YEAR	SHEET NO.	TOTAL SHEETS
ALASKA	RS-0966 (8)	1977	28	40

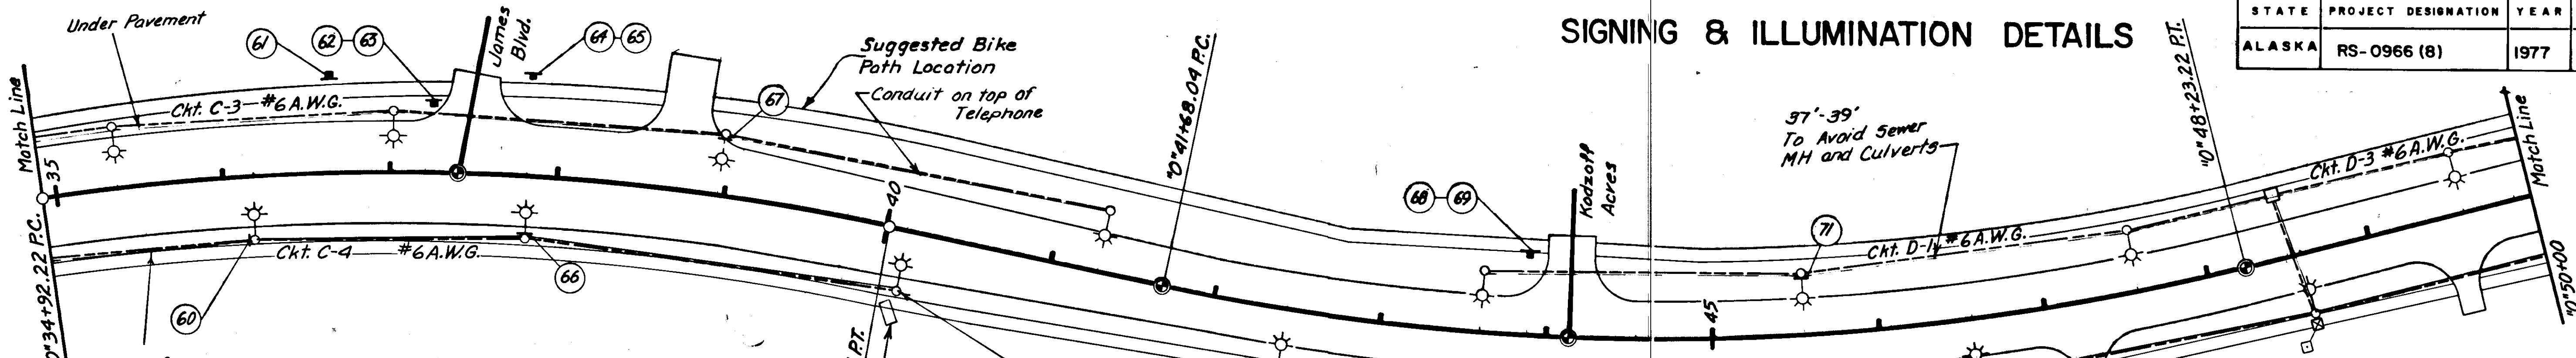


Station	Offset		Item	Luminaire Watt	Remarks
	Lt.	Rt.			
"0" 35+36	37'		Pole	400	
"0" 36+18		37'	Pole	400	
"0" 37+01	37'		Pole	400	
"0" 37+81		37'	Pole	400	
"0" 38+96	37'		Pole	400	
"0" 40+12		37'	Pole	400	
"0" 41+28	37'		Pole	400	
"0" 42+44		37'	Pole	400	
"0" 43+60	37'		Pole	400	
"0" 44+54		37'	Pole	400	
"0" 45+55	37'		Pole	400	
"0" 46+56		37'	Pole	400	
"0" 47+57	37'		Pole	400	
"0" 48+50	37'		J-Box		
"0" 48+58		37'	Pole	400	
"0" 48+58		37'	"D"		See Note No. 1
"0" 49+59	37'		Pole	400	

NOTE:
 1. "D" Mount load center on luminaire pole @ "0" 48+58; 37' Rt. underground service from pole @ "0" 48+48; 55' Rt.

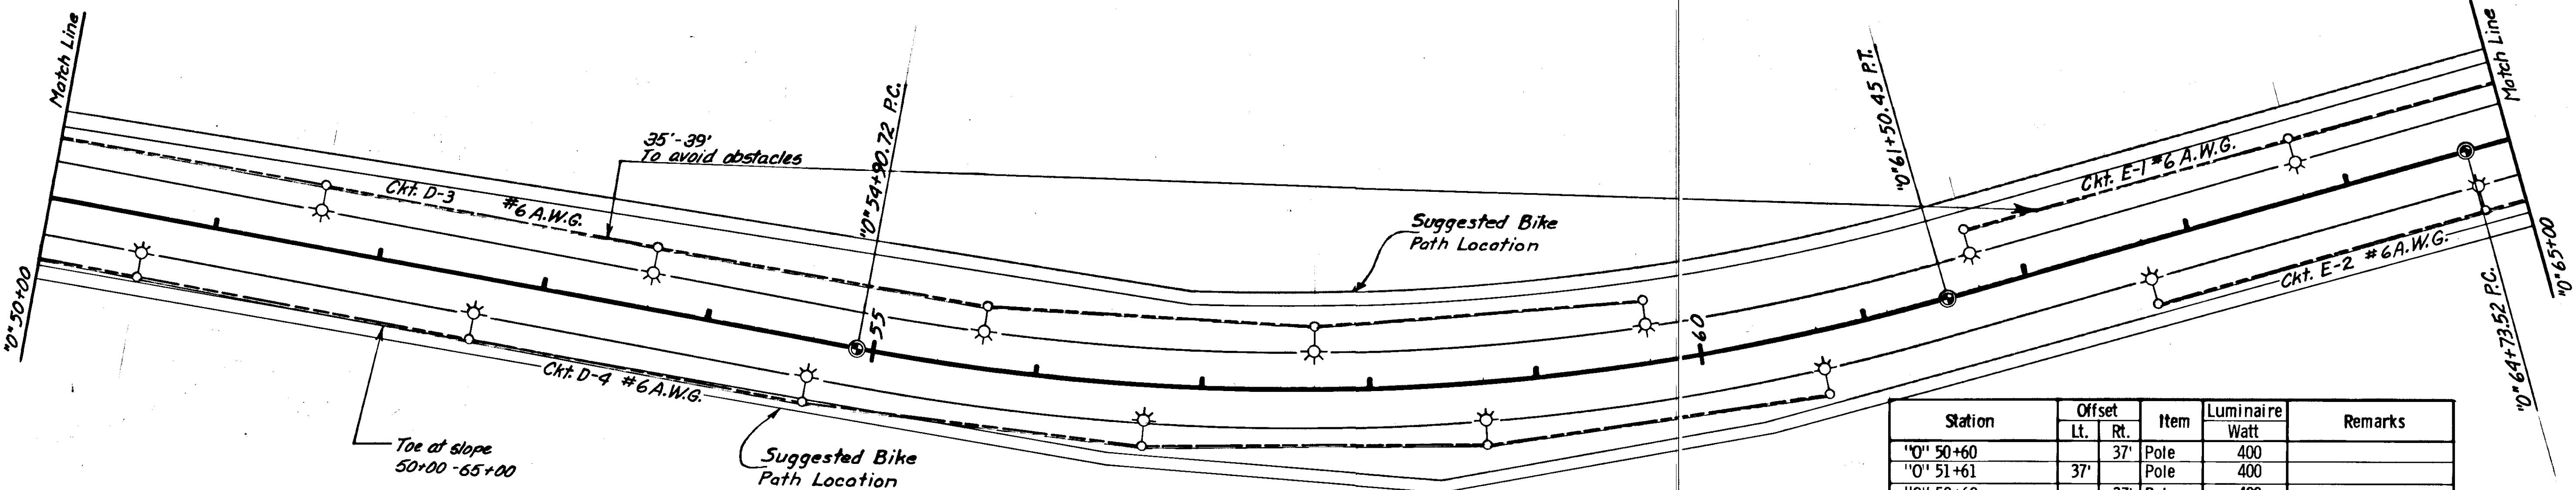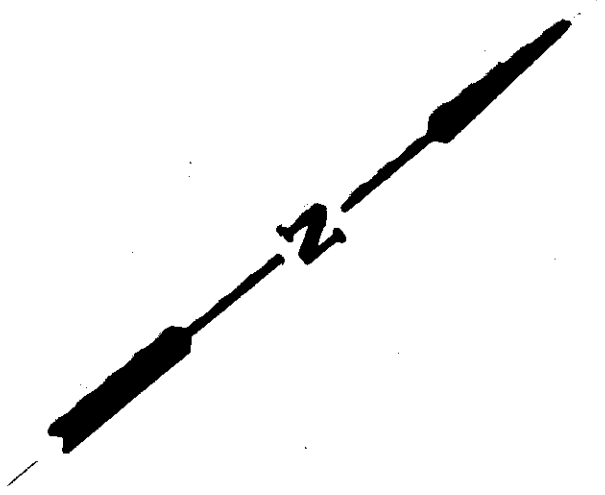


Station	Offset		Item	Luminaire Watt	Remarks
	Lt.	Rt.			
"0" 50+60		37'	Pole	400	
"0" 51+61	37'		Pole	400	
"0" 52+62		37'	Pole	400	
"0" 53+63	37'		Pole	400	
"0" 54+64		37'	Pole	400	
"0" 55+65	37'		Pole	400	
"0" 56+66		37'	Pole	400	
"0" 57+67	37'		Pole	400	
"0" 58+68		37'	Pole	400	
"0" 59+69	37'		Pole	400	
"0" 60+70		37'	Pole	400	
"0" 61+71	37'		Pole	400	
"0" 62+72		37'	Pole	400	
"0" 63+73	37'		Pole	400	
"0" 64+74		37'	Pole	400	

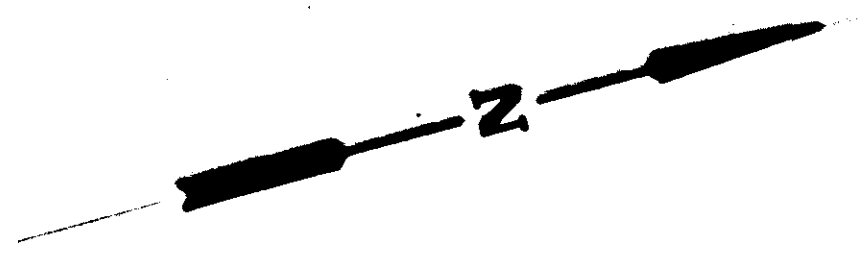

SIGNING & ILLUMINATION DETAILS


STATE	PROJECT DESIGNATION	YEAR	SHEET NO.	TOTAL SHEETS
ALASKA	RS-0966 (8)	1977	29	40

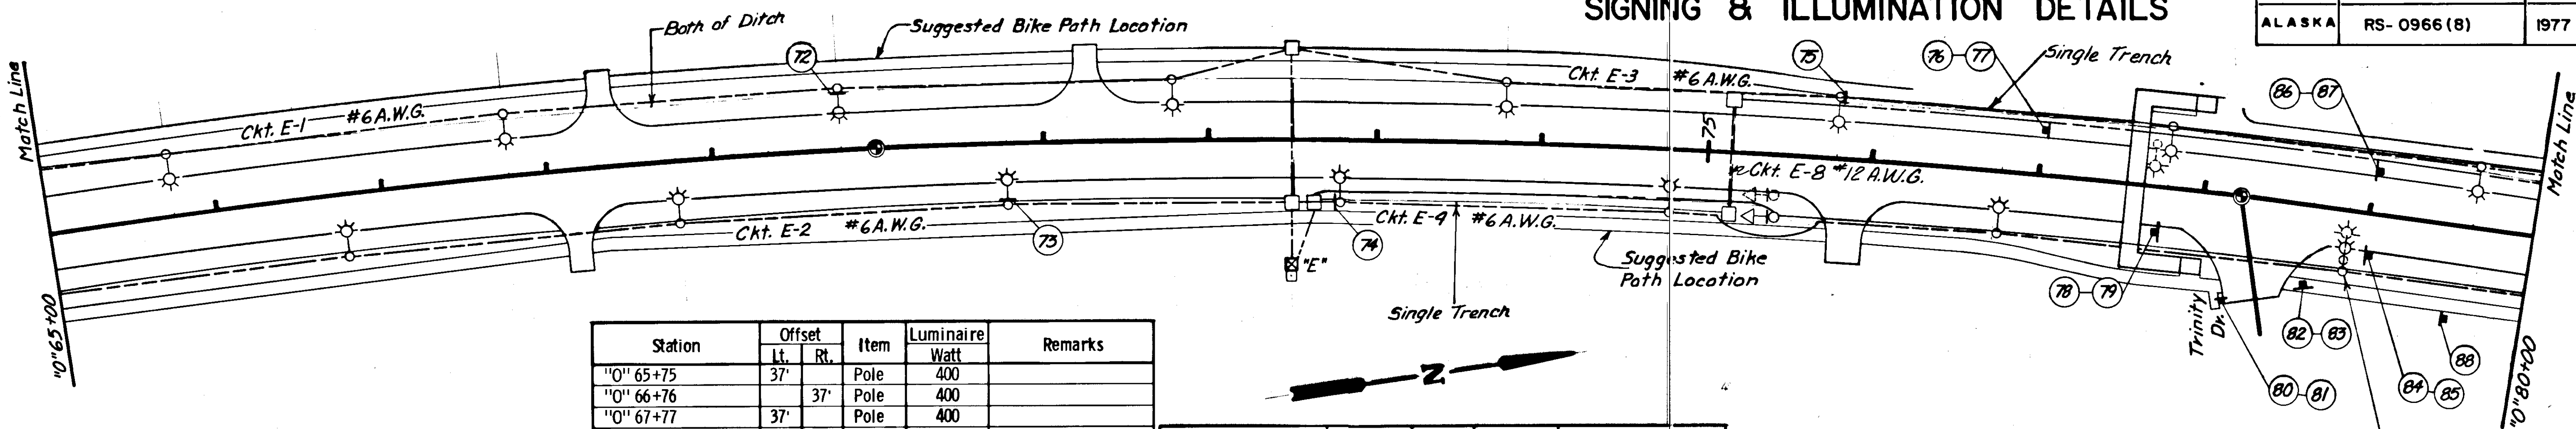

Station	Offset		Item	Luminaire Watt	Remarks
	Lt.	Rt.			
10+65+75	37'		Pole	400	
10+66+76		37'	Pole	400	
10+67+77	37'		Pole	400	
10+68+78		37'	Pole	400	
10+69+78	37'		Pole	400	
10+70+78		37'	Pole	400	
10+71+78	37'		Pole	400	
10+72+50		37'	J-Box		
10+72+50	55'		J-Box		
10+72+55		55'	J-Box		Traffic on Cover
10+72+56		74'	"E"		See Note No. 1
10+72+78		37'	Pole	400	
10+73+78	37'		Pole	400	
10+74+78		37'	Pole	400	
10+75+30		37'	J-Box		Traffic on Cover
10+75+40		24'	Flasher		Salvage Existing
10+75+40		37'	Flasher		See Note 2
10+75+30		37'	J-Box		Traffic on Cover

Station	Offset		Item	Luminaire Watt	Remarks
	Lt.	Rt.			
10+75+78	37'		Pole	400	
10+76+78		37'	Pole	400	
10+77+70		26'	Pole		Remove & Salvage
10+77+78		37'	Pole	400	
10+78+88		37'	Pole	400	
10+79+63		37'	Pole	400	

NOTE: 1. "E" Mount load center on existing pole at 10+72+56; 74' Rt. service from same.
 2. Install flasher base with wiring complete for future installation.

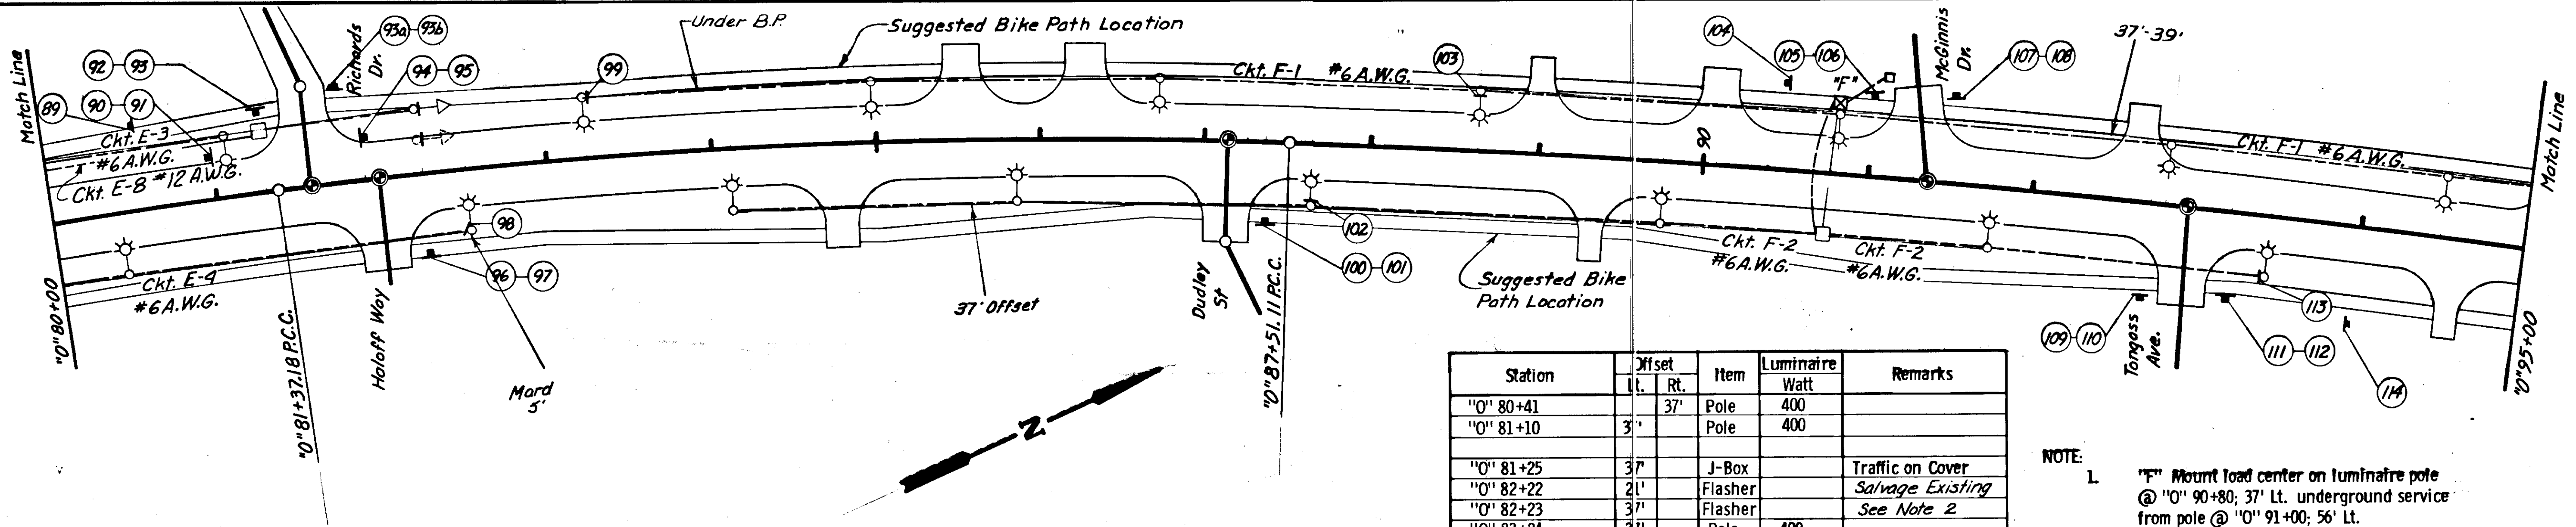


Station	Offset		Item	Luminaire Watt	Remarks
	Lt.	Rt.			
10+80+41		37'	Pole	400	
10+81+10	3'		Pole	400	
10+81+25	37'		J-Box		Traffic on Cover
10+82+22	21'		Flasher		Salvage Existing
10+82+23	37'		Flasher		See Note 2
10+83+24	37'		Pole	400	
10+84+11		37'	Pole	400	
10+84+98	37'		Pole	400	
10+85+85		37'	Pole	400	
10+86+73	37'		Pole	400	
10+87+65		37'	Pole	400	
10+88+64	37'		Pole	400	
10+89+75		37'	Pole	400	
10+90+75		37'	J-Box		
10+90+80	37'		"F"		See Note No. 1
10+90+80	37'		Pole	400	
10+91+75		37'	Pole	400	
10+92+80	37'		Pole	400	
10+93+45		37'	Pole	400	
10+94+47	37'		Pole	400	
10+82+51		37'	Pole	400	


NOTE: 1. "F" Mount load center on luminaire pole @ 10+90+80; 37' Lt. underground service from pole @ 10+91+00; 56' Lt.
 2. Install flasher base with wiring complete for future installation.

SIGNING & ILLUMINATION DETAILS

STATE	PROJECT DESIGNATION	YEAR	SHEET NO.	TOTAL SHEETS
ALASKA	RS-0966 (8)	1977	30	40

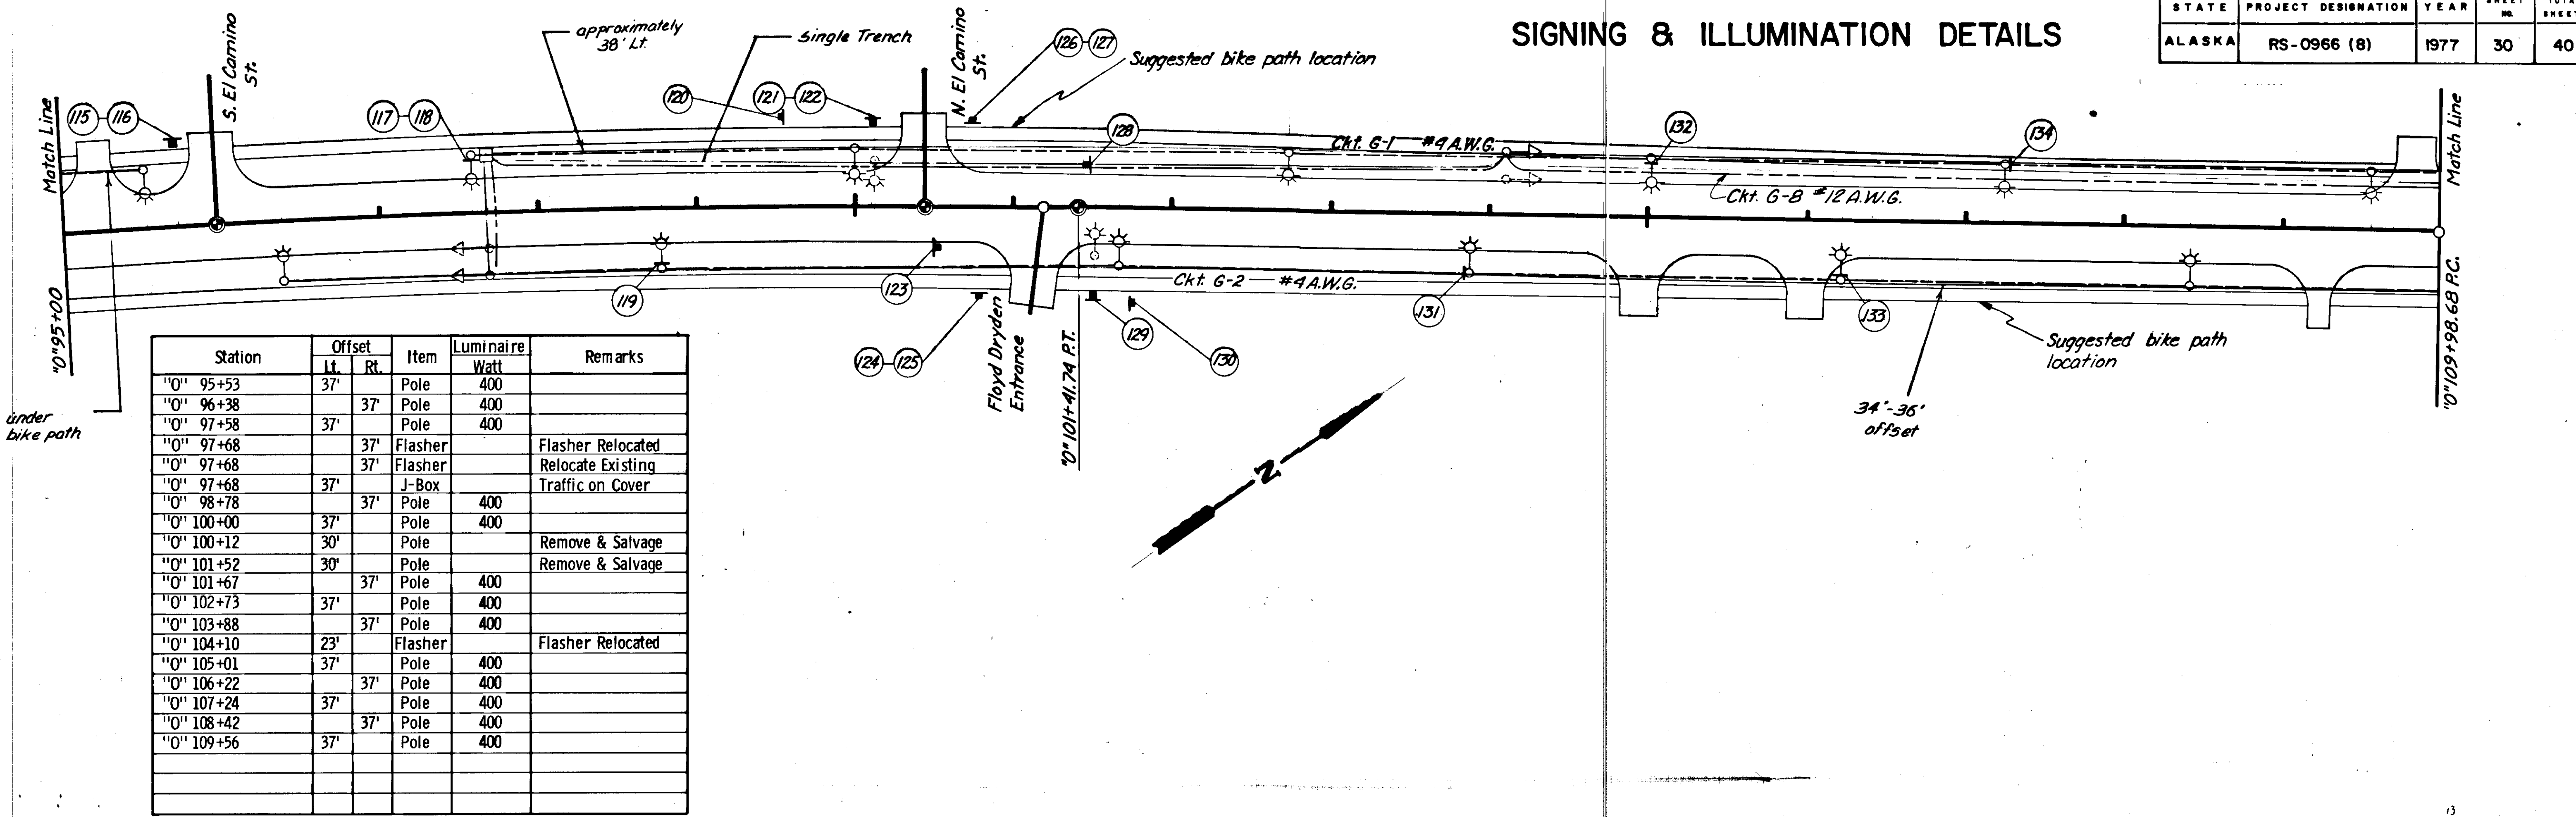

Station	Offset		Item	Luminaire Watt	Remarks
	Lt.	Rt.			
10+95+53	37'		Pole	400	
10+96+38		37'	Pole	400	
10+97+58	37'		Pole	400	
10+97+68		37'	Flasher		Flasher Relocated
10+97+68		37'	Flasher		Relocate Existing
10+97+68	37'		J-Box		Traffic on Cover
10+98+78		37'	Pole	400	
10+100+00	37'		Pole	400	
10+100+12	30'		Pole		Remove & Salvage
10+101+52	30'		Pole		Remove & Salvage
10+101+67		37'	Pole	400	
10+102+73	37'		Pole	400	
10+103+88		37'	Pole	400	
10+104+10	23'		Flasher		Flasher Relocated
10+105+01	37'		Pole	400	
10+106+22		37'	Pole	400	
10+107+24	37'		Pole	400	
10+108+42		37'	Pole	400	
10+109+56	37'		Pole	400	

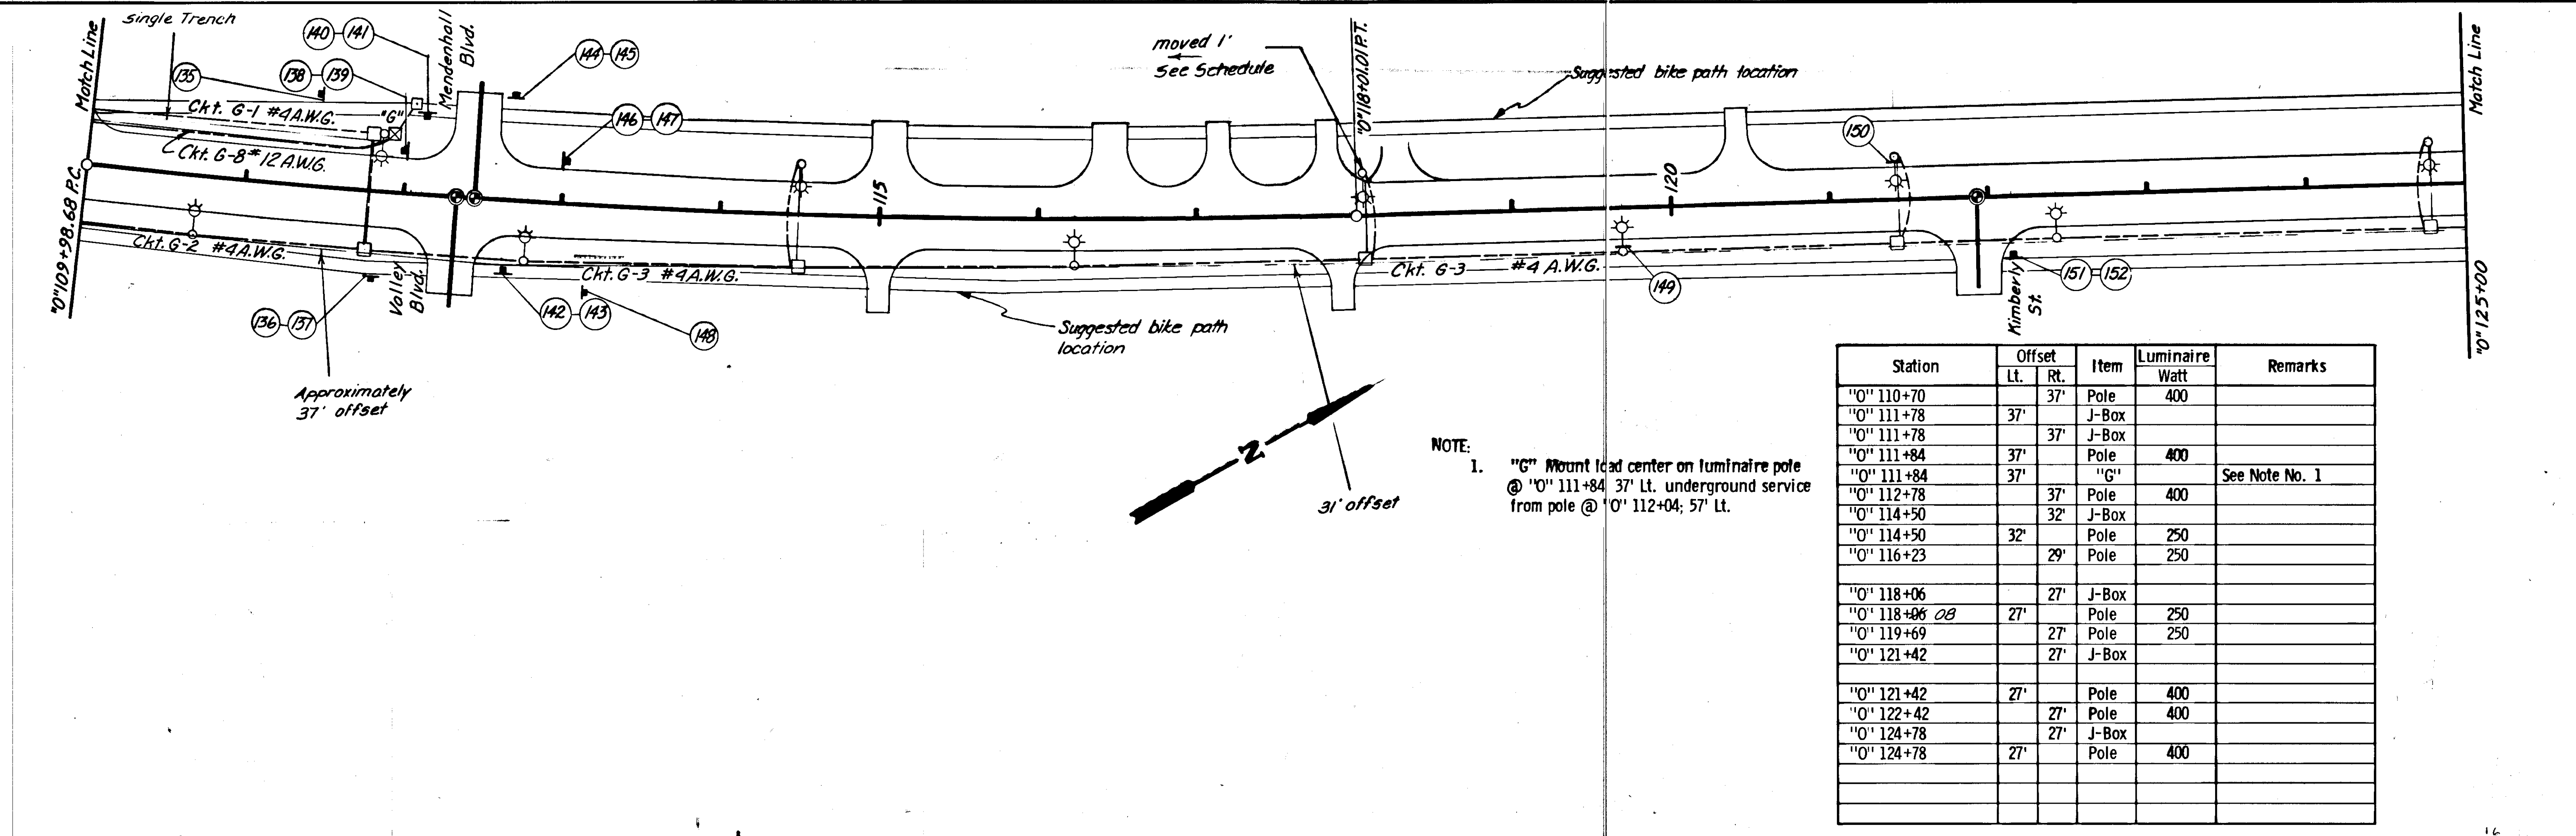


NOTE:
1. "G" Mount lead center on luminaire pole @ 10+111+84 37' Lt. underground service from pole @ 10+112+04; 57' Lt.


Station	Offset		Item	Luminaire Watt	Remarks
	Lt.	Rt.			
10+110+70		37'	Pole	400	
10+111+78	37'		J-Box		
10+111+78		37'	J-Box		
10+111+84	37'		Pole	400	
10+111+84	37'		"G"		See Note No. 1
10+112+78		37'	Pole	400	
10+114+50		32'	J-Box		
10+114+50	32'		Pole	250	
10+116+23		29'	Pole	250	
10+118+06		27'	J-Box		
10+118+06	27'		Pole	250	
10+119+69		27'	Pole	250	
10+121+42		27'	J-Box		
10+121+42	27'		Pole	400	
10+122+42		27'	Pole	400	
10+124+78		27'	J-Box		
10+124+78	27'		Pole	400	

SIGNING & ILLUMINATION DETAILS

STATE	PROJECT DESIGNATION	YEAR	SHEET NO.	TOTAL SHEETS
ALASKA	RS-0966 (B)	1977	31	40

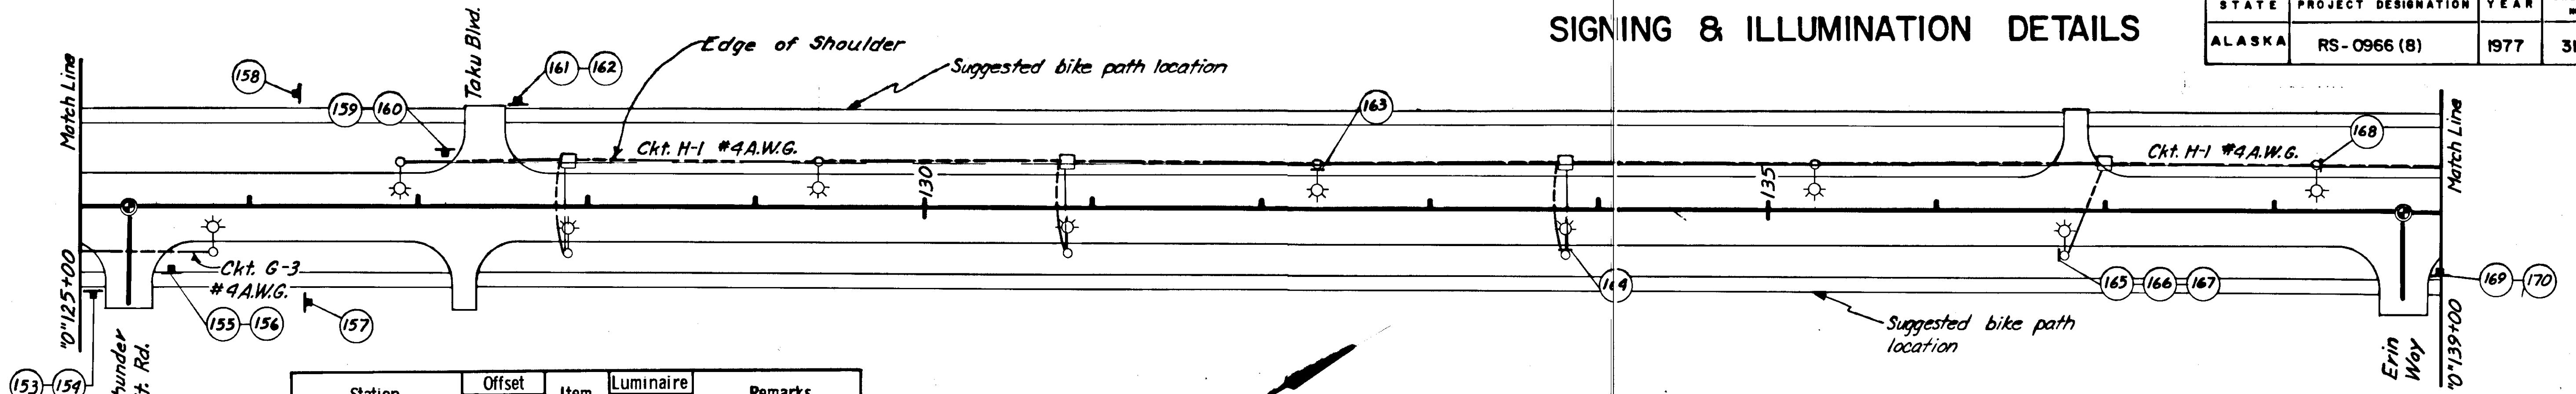


Station	Offset		Item	Luminaire Watt	Remarks
	Lt.	Rt.			
"0" 125+78		27'	Pole	400	
"0" 126+89		27'	Pole	400	
"0" 127+89		27'	J-Box		
"0" 127+89		27'	Pole	400	
"0" 129+37		27'	Pole	250	
"0" 130+85		27'	J-Box		
"0" 130+85		27'	Pole	250	
"0" 132+33		27'	Pole	250	
"0" 133+81		27'	J-Box		
"0" 133+81		27'	Pole	250	
"0" 135+29		27'	Pole	250	
"0" 136+77		27'	Pole	250	
"0" 137+00		27'	J-Box		
"0" 138+26		27'	Pole	400	

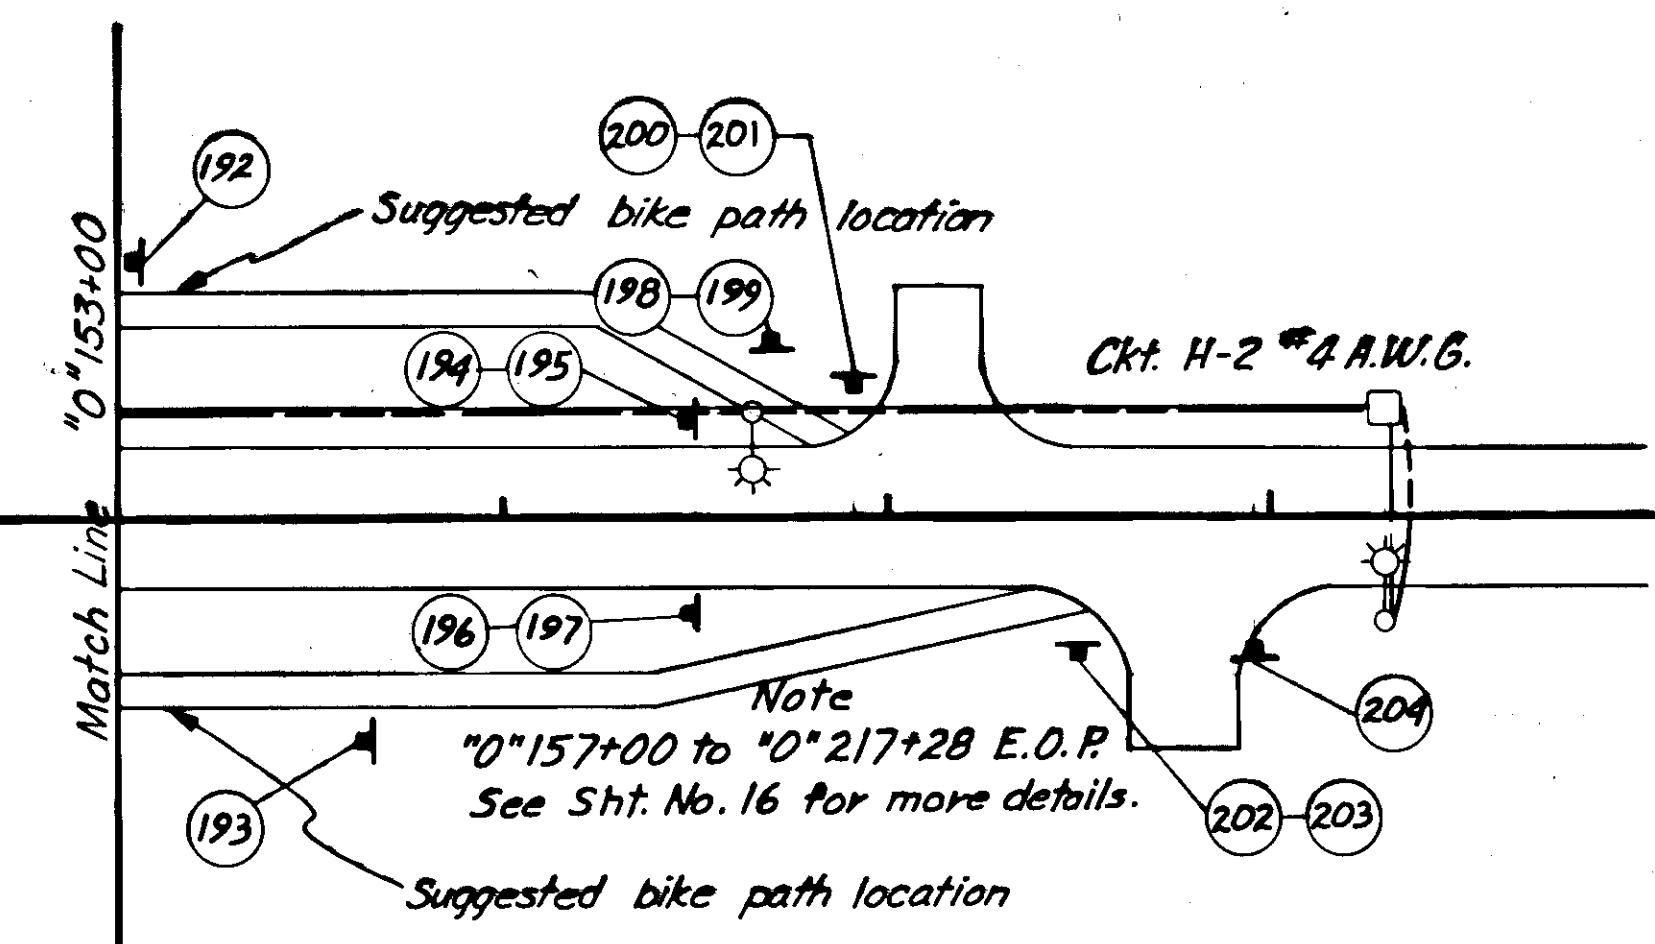

Station	Offset		Item	Luminaire Watt	Remarks
	Lt.	Rt.			
"0" 139+26		27'	J-Box		
"0" 139+26		27'	Pole	250	
"0" 140+10		27'	Pole	400	
"0" 140+75		16'	Pole		Remove & Salvage
"0" 140+95		30'	J-Box		
"0" 140+95		50'	"H"		See Note No. 1
"0" 141+10		27'	Pole	400	
"0" 142+70		27'	Pole	250	
"0" 144+27		27'	Pole	400	
"0" 145+27		27'	J-Box		
"0" 145+27		27'	Pole	400	
"0" 146+98		27'	Pole	250	
"0" 148+69		27'	Pole	400	
"0" 150+78		27'	J-Box		
"0" 150+78		27'	Pole	400	
"0" 152+71		27'	Pole	250	
"0" 154+65		27'	Pole	250	
"0" 156+30		27'	J-Box		
"0" 156+30		27'	Pole	250	

NOTE:
1. "H" Mount load center on wood pole @
"0" 140+95; 50' Lt. underground service
from existing pole @ "0" 140+90; 70' Lt.

"0" 156+00 Lt. & RA
End Contractor
Designed Bike Path

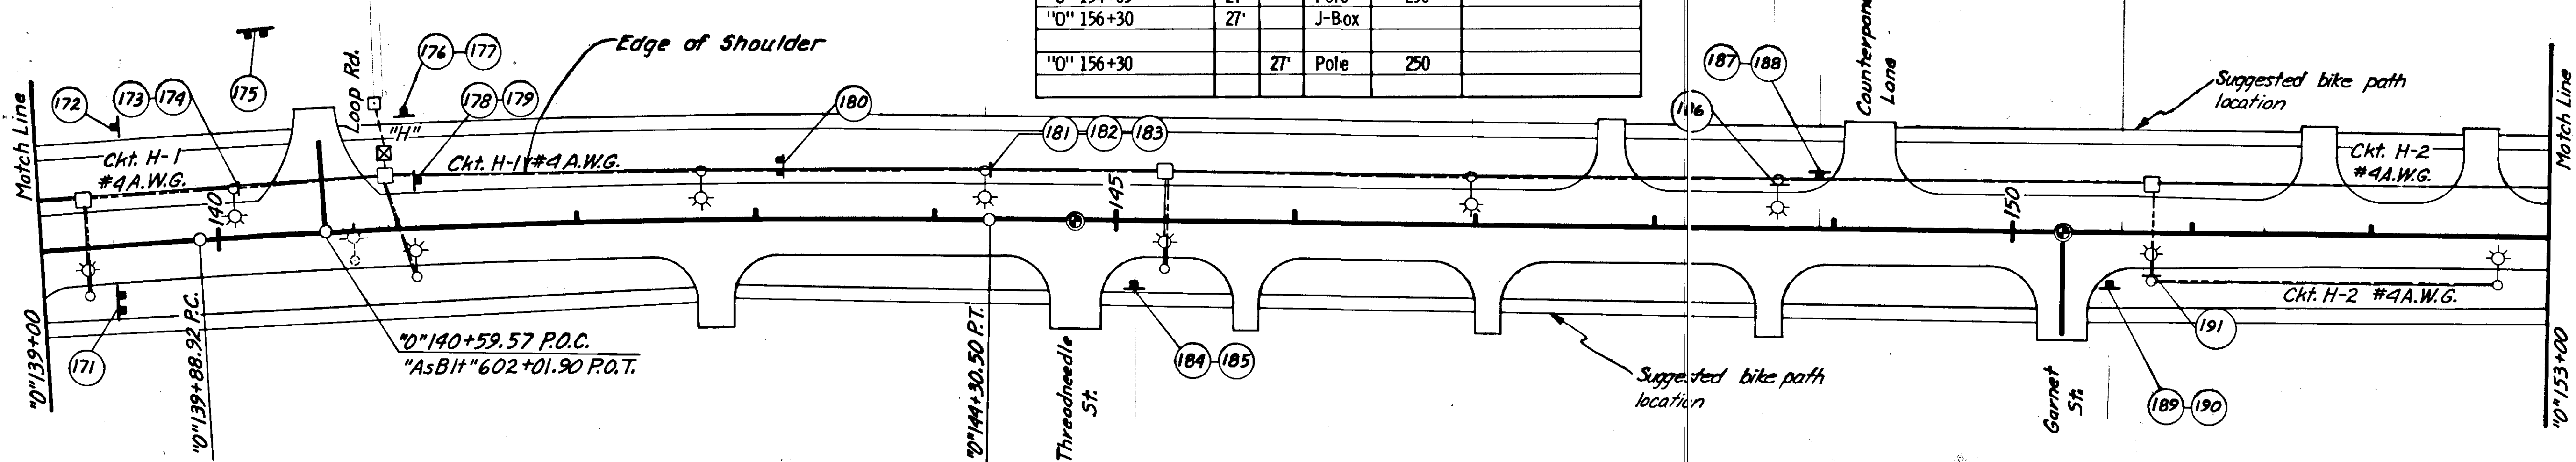

"0" 140+59.57 P.O.C.
"As Bt" 602+01.90 P.O.T.


"0" 144+30.50 P.T.

Threadneedle St.

Garrett St.

STATE	PROJECT DESIGNATION	YEAR	SHEET NO.	TOTAL SHEETS
ALASKA	RS-0966 (8)	1977	32	40

SIGNALIZATION DETAILS

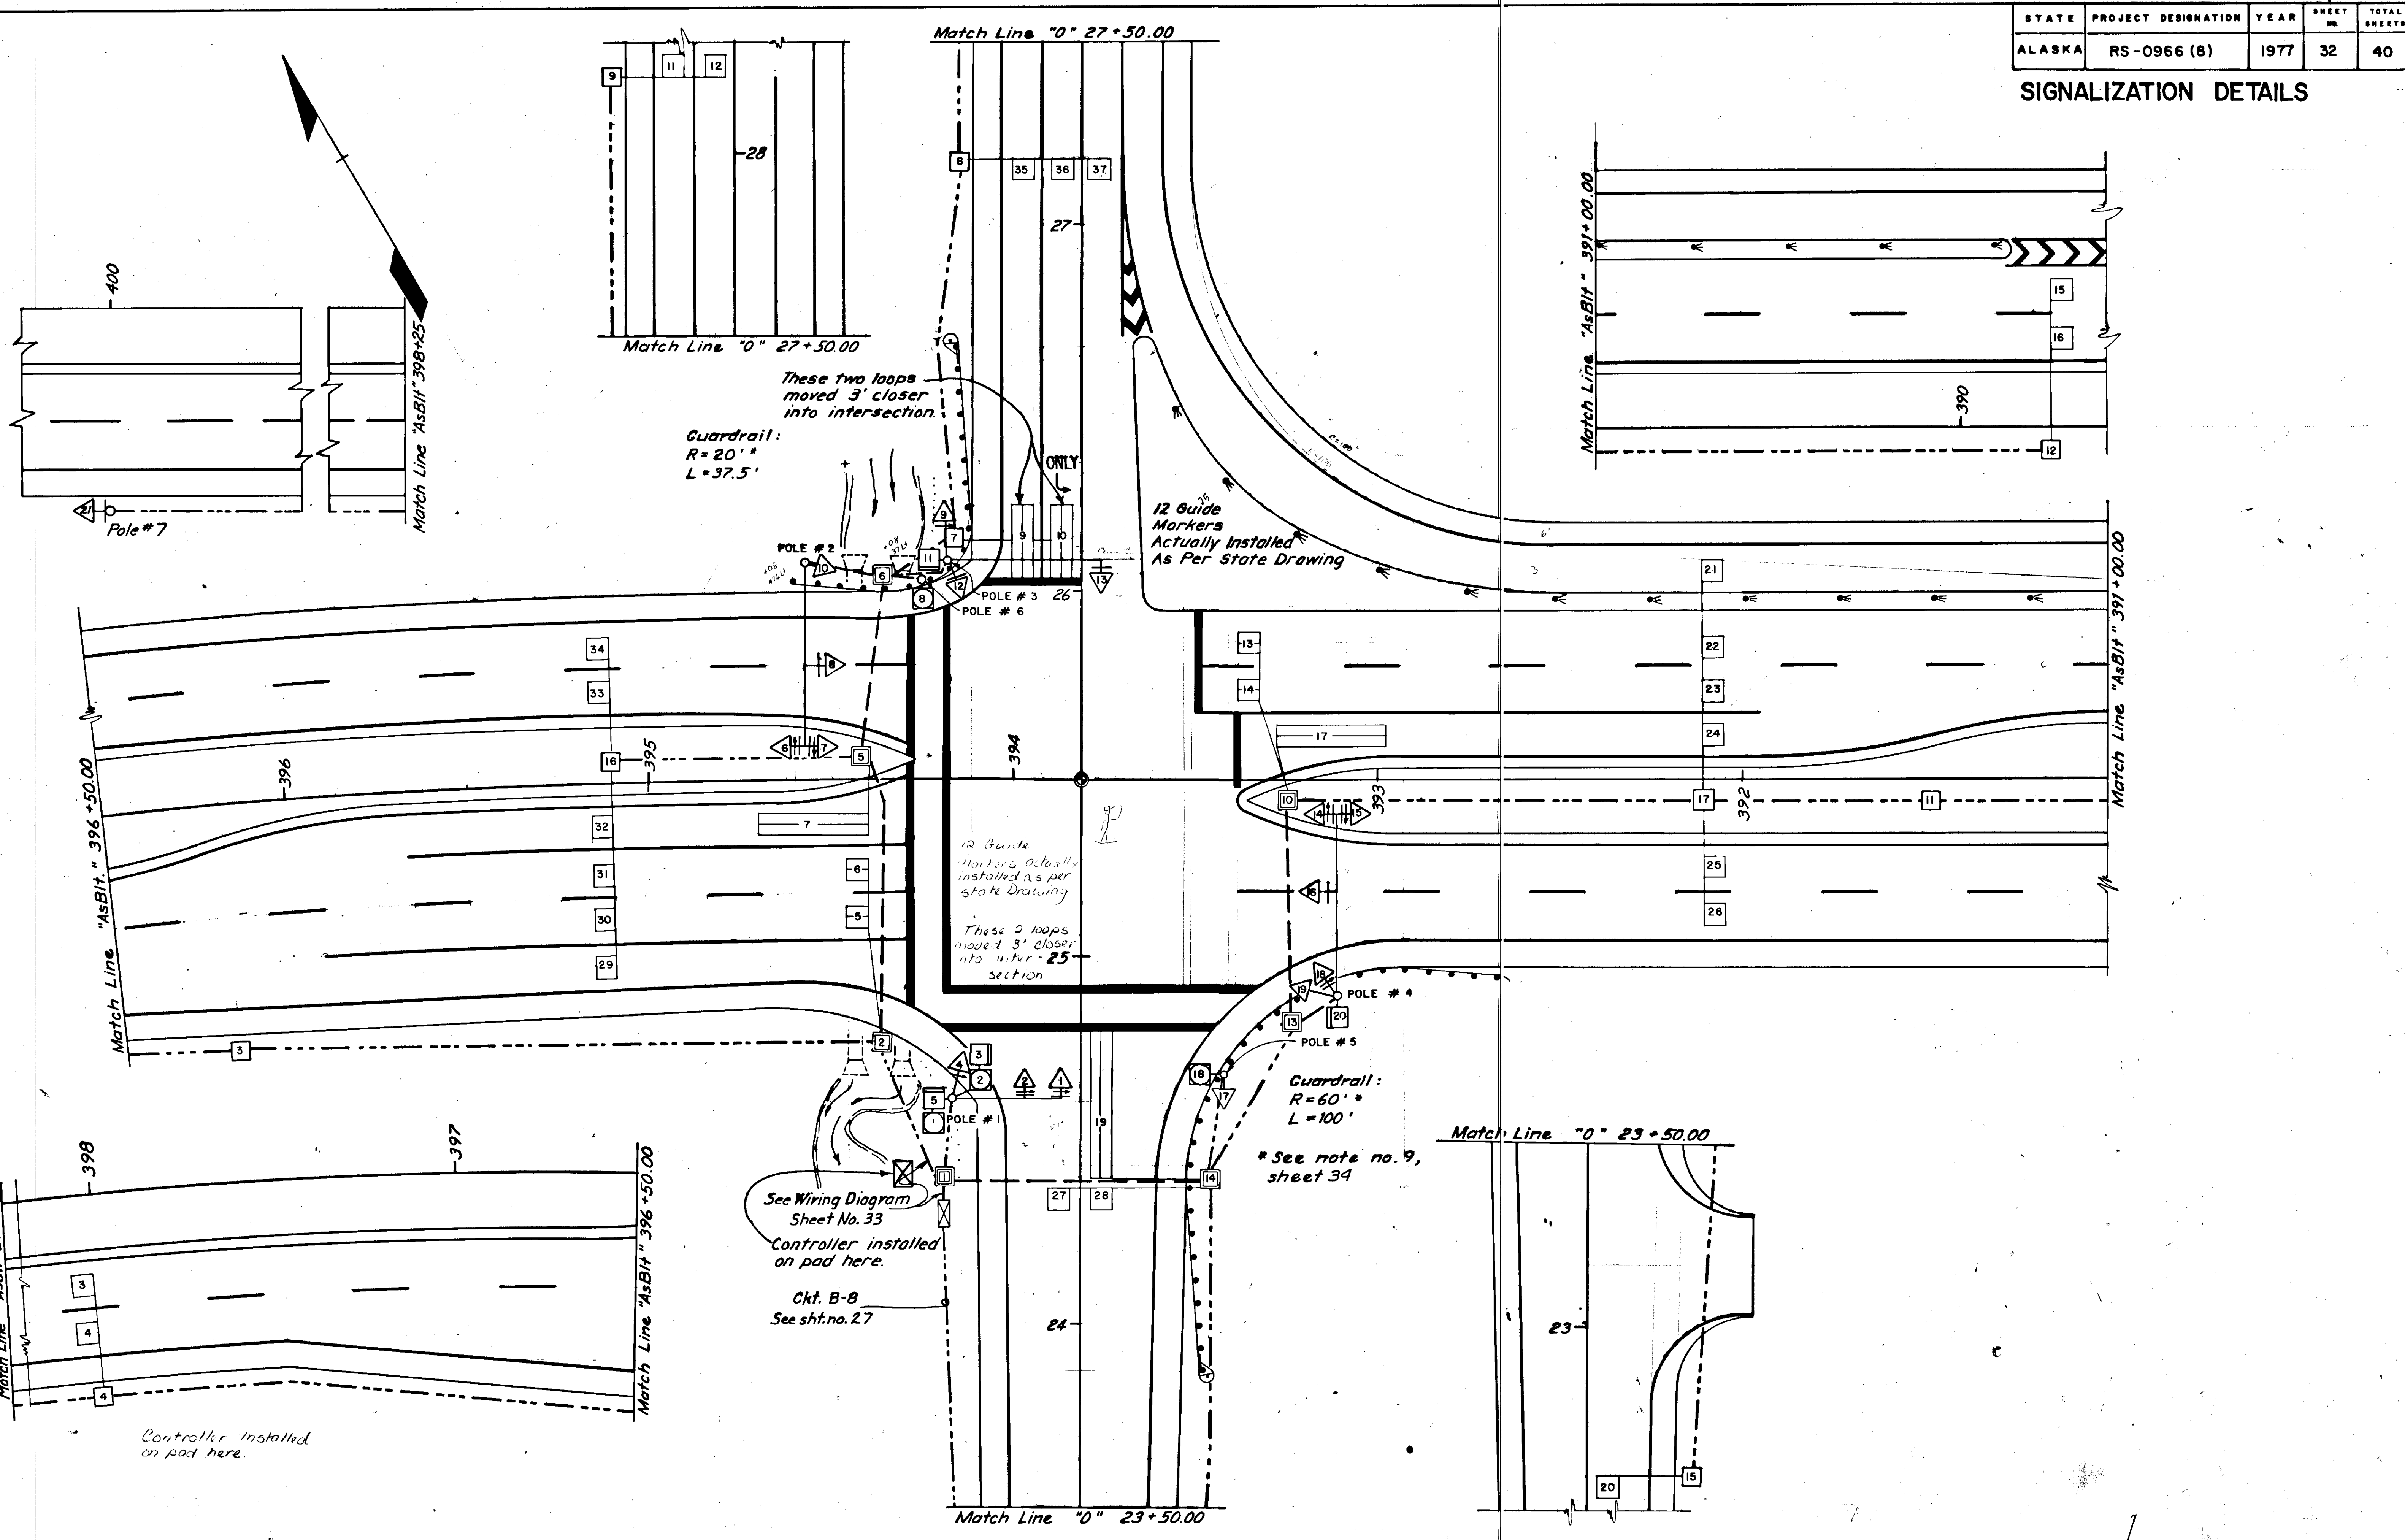

SIGNALIZATION DETAILS


GENERAL NOTES

- All locations given are approximate and subject to adjustments by the Engineer.
- The controller shall be equipped with a flasher connected so that a red ball indication is flashed to Loop Road and a yellow ball to Egan Expressway.
- Install Plecton model H10 tone decode, radio frequency 155.955 MHz, 1901 c.p.s., tone auto reset 1 1/2 min., with antenna for remote mounting on signal pole. Preemption shall be phase 4 and 6 to green ball indication, all others red.
- Signal and luminaire mast arms are in the same plane.
- Separate conduits must be used for signal control cable and luminaire fighting cable.
- All traffic signal equipment, including but not limited to, controller, cabinet, signal heads, detectors, and amplifiers shall conform to the NEMA Standards Publication 1, No. TSI-1976, "Traffic Control Systems." Poles and mast arms shall be designed to specifications in AASHTO.
- Loop amplifiers shall have four detection channels, with one thumbwheel switch per channel to select pulse or presence and sensitivity, a frequency switch to allow oscillator frequency selection, reset circuit breaker and be self-tuning. Output to be relay with fail in call position. (Canoga Controls Corp., Proximitor 404, or equal).

- "O" 23+87.5 Rt. to "AsBit" 392+93 Lt. & "AsBit" 394+60 Rt. to "O" 26+67 Lt., Install a total of 275 L.F. of beam type guardrail. All radii shall be shop formed to the radius and length as shown on sheet no.32. All the above work shall be considered incidental to pay item 660(1), "Traffic Signal System Complete" and no separate payment shall be made therefor.
- Install 1500 watt thermostat controlled, fan forced heater in controller cabinet.
- Conduit shall be 1 1/2" PVC except as shown in the wiring diagram.
- Roadway striping as shown on plans to be done by others.
- Cabinet shall include a combination light socket (with 75 watt bulb) and weather-proof 120V outlet mounted on the right side of the interior with a weather-proof switch in an easily-accessible location. This work shall be approved by the Engineer prior to installation.

Signal Head	Post	Lens Size	Indications	Type Mounting (Std. Drawing T-30.00)	Phase	Height *	Backplate	Remarks
1.	1	12"	LR-LY-LG	Plumbizer	"2	16' 6"	x	Mount 16'-6" above Rdwy.
2.	1	12"	R-Y-G-LG	Plumbizer	"2	"	x	Mount 16'-6" above Rdwy.
3.	1		W-DW	SW-2	"4	7'		
4.	1	8", 12"	R-Y-G-LG	S-1	"2	10'		
5.	1		W-DW	SW-2	"2	7'		
6.	2	12"	LR-LY-LG	Plumbizer	"3	10'		
7.	2	12"	LR-LY-LG	"	"5	10'	x	
8.	2	12"	R-Y-G	"	"6	16' 6"- 19' 0"	x	
9.	3	8", 12"	R-Y-G-LG	S-1	"2	10'		
10.	2	8"	R-Y-G	S-1	"6	10'	x	
11.	3		W-DW	SW-1	"2	7'		
12.	3	12"	R-Y-G	S-1	"1	10'	x	Optically Programmable
13.	3	12"	R-Y-G	Plumbizer	"1	16' 6"- 19' 0"	x	
14.	4	12"	LR-LY-LG	"	"5	10'	x	
15.	4	12"	LR-LY-LG	"	"3	10'	x	
16.	4	12"	R-Y-G	"	"4	16' 6"- 19' 0"	x	
17.	5	8"	R-Y-G	S-1	"1	10'		
18.	4	12"	LR-LY-LG	S-2	"2	10'	x	Optically Programmable
19.	4	8"	R-Y-G	S-2	"4	10'		
20.	4		W-DW	SW-1	"4	7'		
21.	7	8"	Y	T-1		15'		Continuous Flash with Sign Floodlight

* - To Bottom of Backplate

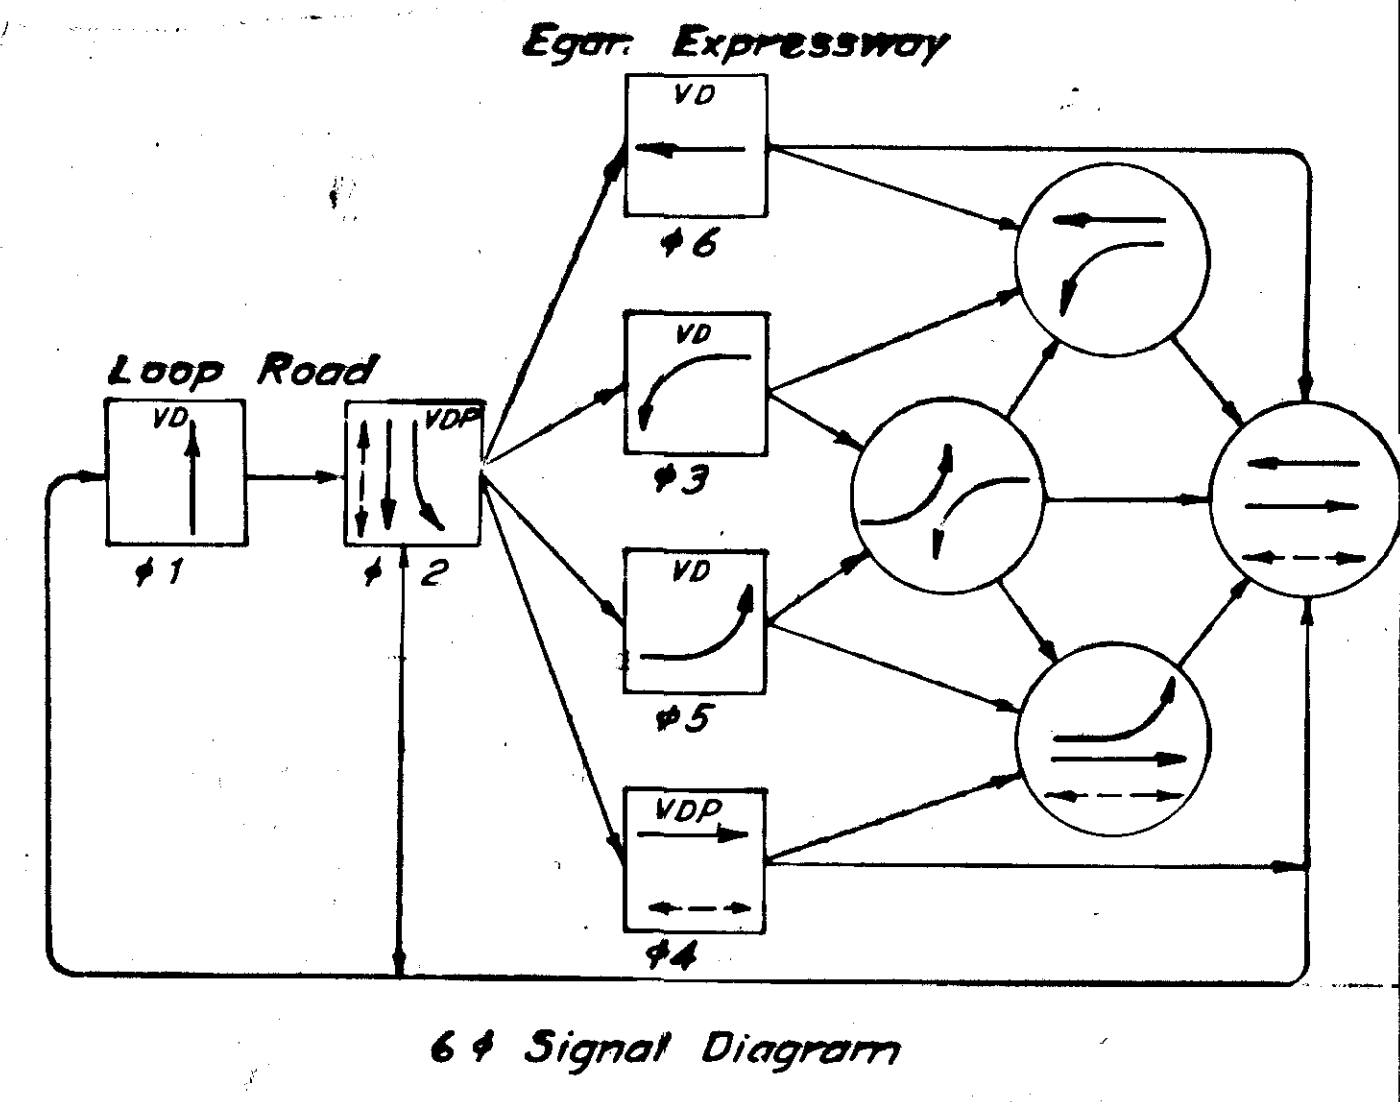

No.	Station	Type	Phase	Size	Remarks
1	"O" 24+61	Ped Push Button	4	See Note 1	See Signing Schedule
2	"O" 24+61	Ped Push Button	2	See Note	See Signing Schedule
3	"AsBit" 398+04	3 Turn Loop	4	6' x 6'	Regular
4	"AsBit" 398+04	3 Turn Loop	4	6' x 6'	Regular
5	"AsBit" 394+43	3 Turn Loop	4	6' x 6'	Quadrupole
6	"AsBit" 394+43	3 Turn Loop	4	6' x 6'	Quadrupole
7	"AsBit" 394+58	2 Turn Loop	5	6' x 30'	Quadrupole
8	"O" 26+03	Ped Push Button	2	See Note 1	See Signing Schedule
9	"O" 26+17	3 Turn Loop	2	6' x 15'	Quadrupole
10	"O" 26+17	3 Turn Loop	2	6' x 15'	Quadrupole
11	"O" 28+24	3 Turn Loop	2	6' x 6'	Regular
12	"O" 28+24	3 Turn Loop	2	6' x 6'	Regular
13	"AsBit" 393+34	3 Turn Loop	6	6' x 6'	Quadrupole
14	"AsBit" 393+34	3 Turn Loop	6	6' x 6'	Quadrupole
15	"AsBit" 389+72	3 Turn Loop	6	6' x 6'	Regular
16	"AsBit" 389+72	3 Turn Loop	6	6' x 6'	Regular
17	"AsBit" 393+10	2 Turn Loop	3	6' x 30'	Quadrupole
18	"O" 24+68	Ped Push Button	4	See Note 1	See Signing Schedule
19	"O" 24+55	2 Turn Loop	1	6' x 30'	Quadrupole
20	"O" 22+59	3 Turn Loop	1	6' x 6'	Regular

NOTES

- Ped push buttons are to have red & green indicator lights; the red energized when the button is activated and the green energized during the walk interval.
- Loops 5 & 6 and 13 & 14 are to detect only during their respective red phase.
- Loops 11 & 12 and 20 are to detect only during their respective red phase.

No.	Station	Offset	Mounting Height	Mast Arm Type	Mast Arm K M N	Luminaire Mast Arm
1.	"O" 24+61	35' Lt.		Regular	30' 10' 20'	
2.	"AsBit" 394+57	59' Rt.	35'	Alternate	50' 23' 27'	15'
3.	"O" 26+08	37' Lt.	35'	Regular	44' See Detail	15'
4.	"AsBit" 393+10	59' Lt.	35'	Alternate	50' 23' 27'	15'
5.	"O" 24+68	39' Rt.	10'			
6.	"O" 26+03	44' Lt.	3.5'			
7.	"AsBit" 400+00	59' Lt.	15'			

J-Box No.	Station	Offset	Type
1	"O" 24+40	30' Lt.	
2	"O" 24+76	52' Lt.	x
3	"AsBit" 396+18	65' Lt.	x
4	"AsBit" 398+01	53' Lt.	x
5	"AsBit" 394+42	06' Rt.	x
6	"AsBit" 394+36	53' Rt.	x
7	"O" 26+14	32' Lt.	x
8	"O" 27+17	31' Lt.	x
9	"O" 28+21	31' Lt.	x
10	"AsBit" 393+25	06' Lt.	x
11	"AsBit" 391+44	06' Lt.	x
12	"AsBit" 389+75	06' Lt.	x
13	"O" 24+83	55' Rt.	x
14	"O" 24+39	33' Rt.	x
15	"O" 22+62	26' Rt.	x
16	"AsBit" 395+10	6' Rt.	x
17	"AsBit" 392+11	6' Lt.	x

Pole No.	SIGNAL BASE	Remarks
1	"O" 24+61	35' Lt. CIDH
2	"AsBit" 394+57	59' Rt. Spread Ftng.
3	"O" 26+08	37' Lt. Spread Ftng.
4	"AsBit" 393+10	59' Lt. Spread Ftng.
5	"O" 24+68	39' Rt. Type "A"
6	"O" 26+03	44' Lt. Type "B"
7	"AsBit" 400+00	59' Lt. Type "A"
Controller	"O" 24+28	40' Lt. Type "D"

No.	Station	Offset	Size	Turns
21.	"AsBit" 392+08	57' Rt.	6' x 6'	3
22.	"AsBit" 392+08	36' Rt.	6' x 6'	3
23.	"AsBit" 392+08	24' Rt.	6' x 6'	3
24.	"AsBit" 392+08	12' Rt.	6' x 6'	3
25.	"AsBit" 392+08	24' Lt.	6' x 6'	3
26.	"AsBit" 392+08	37' Lt.	6' x 6'	3
27.	"O" 24+33	6' Rt.	6' x 6'	3
28.	"O" 24+33	6' Lt.	6' x 6'	3
29.	"AsBit" 395+13	50' Lt.	6' x 6'	3
30.	"AsBit" 395+13	37' Lt.	6' x 6'	3
31.	"AsBit" 395+13	25' Lt.	6' x 6'	3
32.	"AsBit" 395+13	12' Lt.	6' x 6'	3
33.	"AsBit" 395+13	25' Rt.	6' x 6'	3
34.	"AsBit" 395+13	37' Rt.	6' x 6'	3
35.	"O" 27+15	16' Lt.	6' x 6'	3
36.	"O" 27+15	5' Lt.	6' x 6'	3
37.	"O" 27+15	5' Rt.	6' x 6'	3