

STATE OF ALASKA
DEPARTMENT OF HIGHWAYS

PLAN AND PROFILE
PROPOSED HIGHWAY PROJECT
S-0970-(2)
GLACIER HIGHWAY
FRITZ COVE ROAD
GRADING & DRAINAGE

STATE	ROUTE	SECTION	YEAR	SHEET NO.	TOTAL SHEETS
ALASKA	S-0970-(2)		1964	1	25

TYPE 3210 IMPROVEMENT

INDEX OF SHEETS

SHEET NO.	DESCRIPTION
1	TITLE SHEET
2	TYPICAL SECTION & MISC. DETAILS
3	PIT & MISC. DETAILS
4-13	PLAN & PROFILE SHEETS
14-18	CULVERT & MISC. WORK SHEETS
19	STANDARD BRASS CAP MONUMENT & MONUMENT CASE
20	SUMMARY OF STANDARD SIGNS
S-1	STANDARD CULVERTS
S-6	STANDARD PROJECT IDENTIFICATION SIGN
S-8	STANDARD BEAM GUARD RAIL
S-13	STANDARD CULVERT MARKER POST
S-19	STANDARD SUPERELEVATION

AS BUILT PLANS


Contractor - STOCK & GROVE INC.
Proj. Engr. - L. E. SHEPARD
Began Proj. - 9-14-64
End Proj. - 7-9-66

DESIGN DESIGNATION
ADT(1960) = 230
ADT(1980) = 690
DHV = 83
D = 65%
T = 5%
V = 40mph

PROJECT SUMMARY

WIDTH OF SUBGRADE	28'
WIDTH OF SURFACING	24'
LENGTH OF GRADING	13,537.7 = 2.564 MI.
LENGTH OF SURFACING	13,537.7 = 2.564 MI.
LENGTH OF PROJECT	13,537.7 = 2.564 MI.

No Change

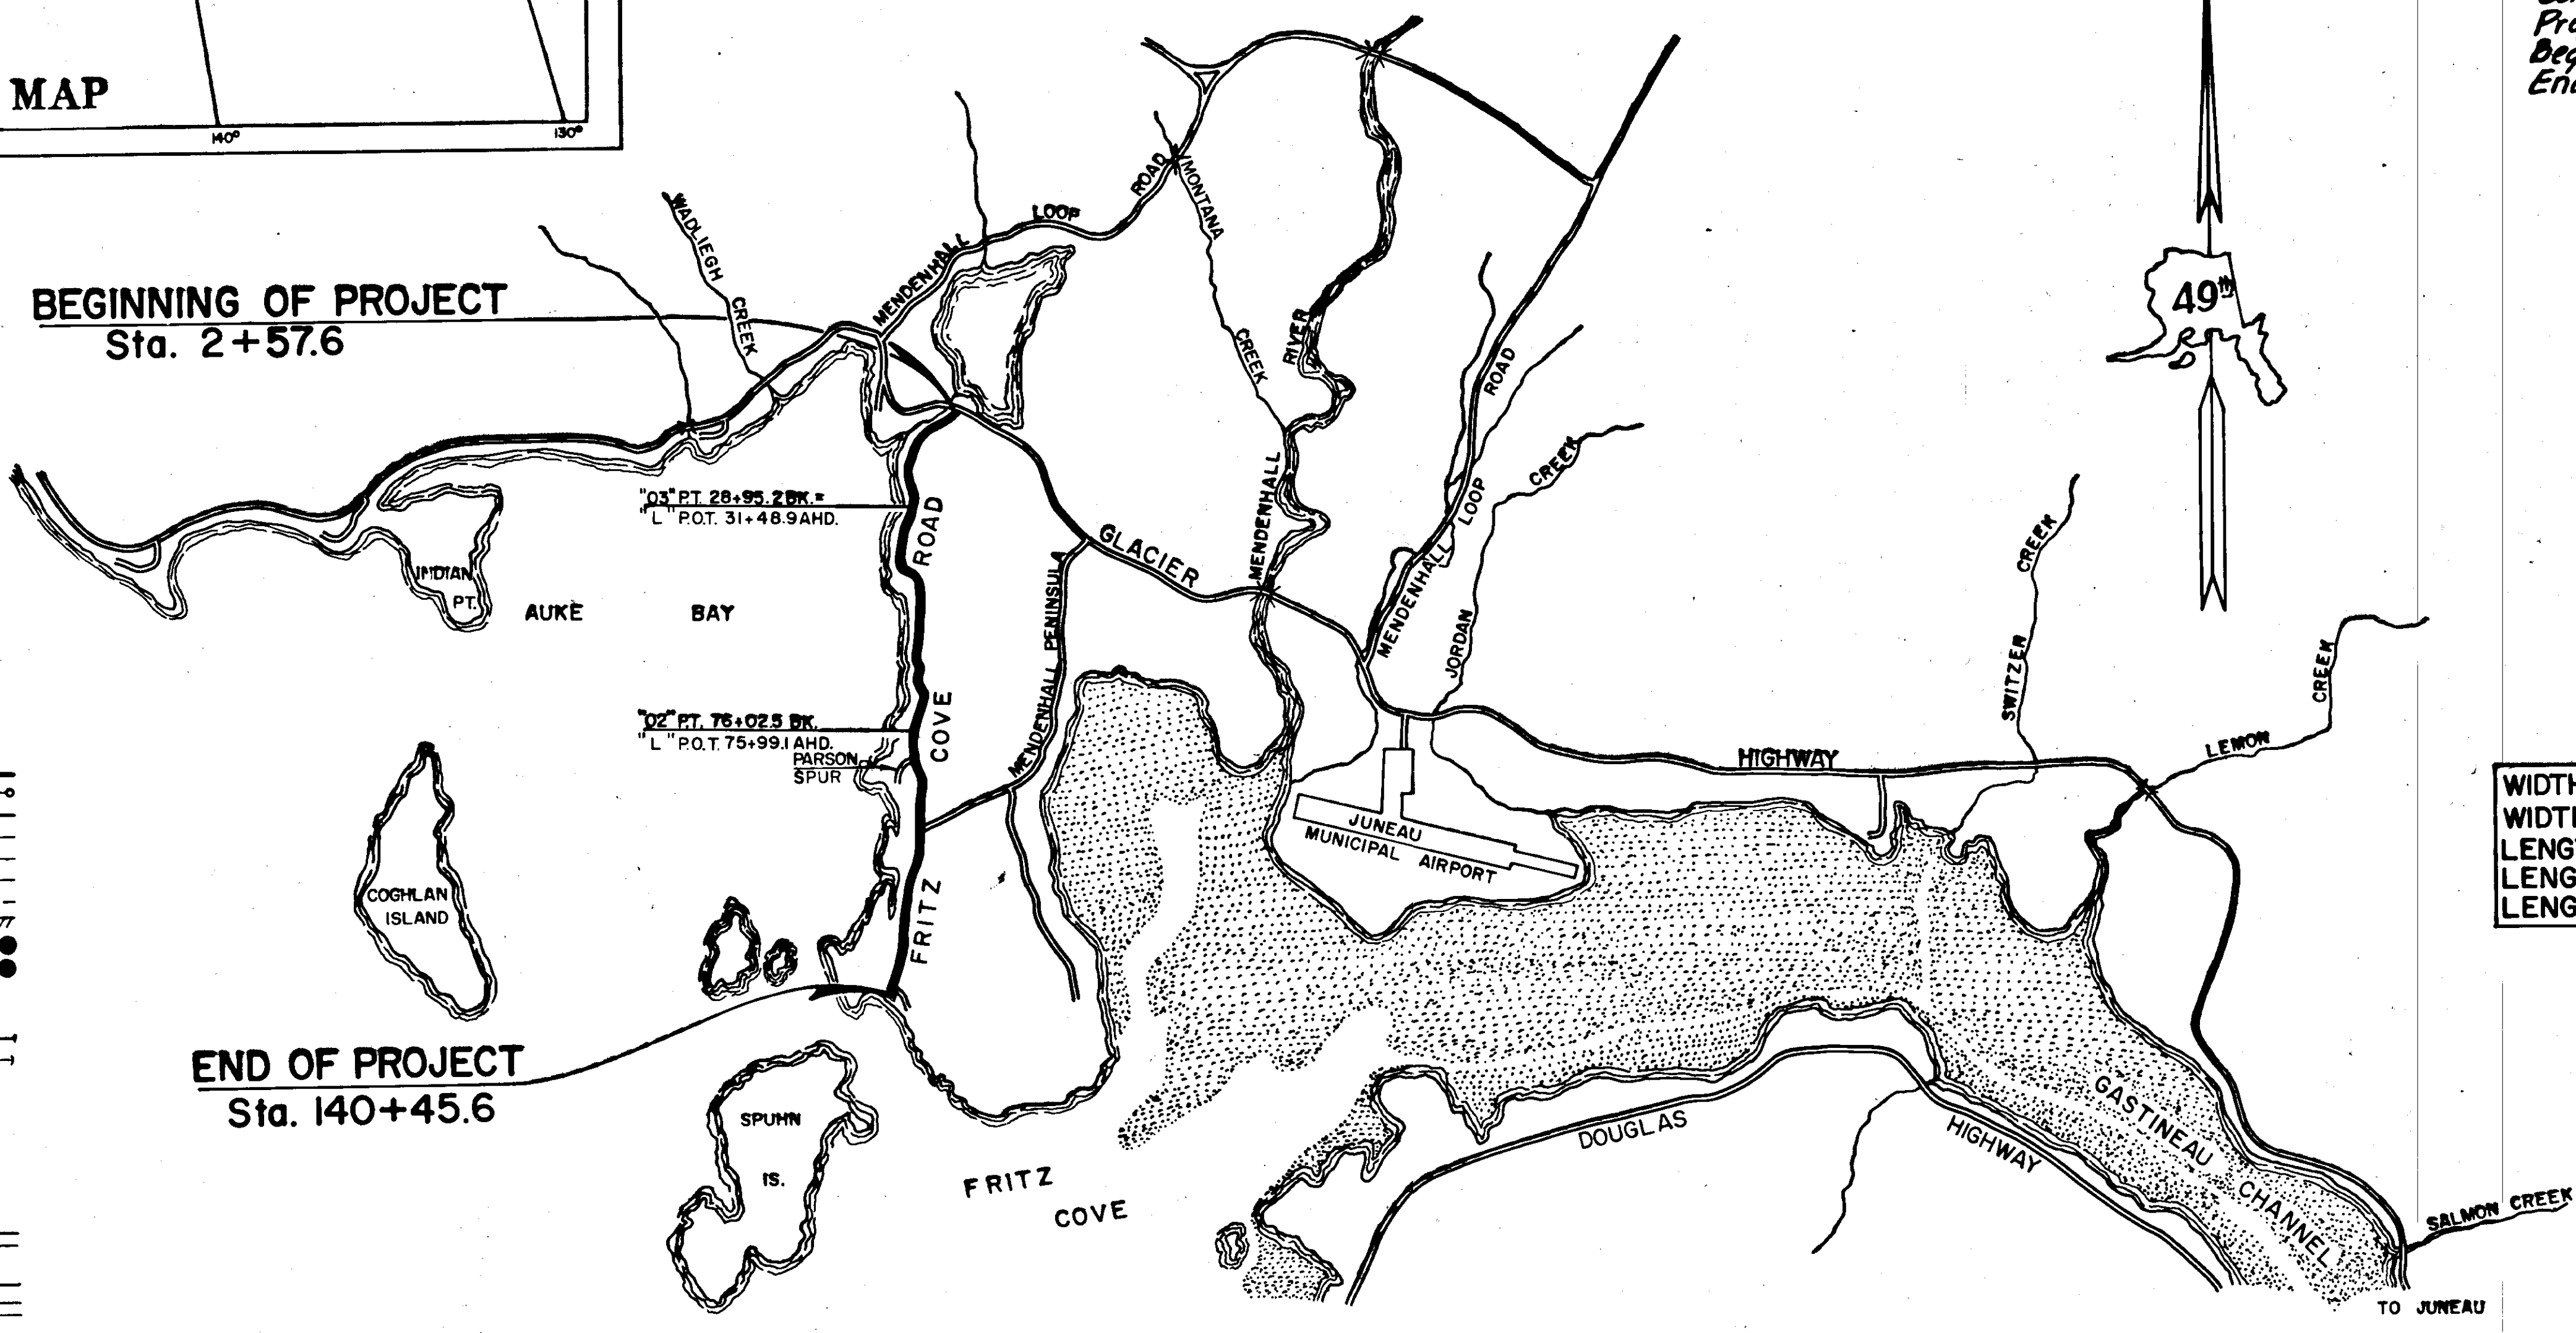

CONVENTIONAL SIGNS


PROPOSED CONSTRUCTION CENTERLINE	
PRELIMINARY SURVEY LINE	
TOWNSHIP LINE	
SECTION LINE	
PROPERTY LINE	
RIGHT-OF-WAY LINE	
EASEMENT LINE	
CORPORATED OR CITY LIMITS	
POWER LINE (EXISTING)	
TELEPHONE OR TELEGRAPH LINE (EXISTING)	
POLE ANCHOR	
LIGHT POLE	
WATER LINE	
SEWER LINE	
VALVE BOX	
CATCH BASIN	
DROP INLET	
MANHOLE	
CULVERT PROPOSED	
CULVERT EXISTING	
FIRE HYDRANT	
TRAVELED WAY	
SWAMP	
FENCE	
CURB CUT	
LAND MONUMENT	
CENTER LINE MONUMENT	

STATE OF ALASKA
DEPARTMENT OF HIGHWAYS


APPROVED Date 7/6/64
COMMISSIONER OF HIGHWAYS

APPROVED _____ Date _____
REGIONAL ENGINEER
BUREAU OF PUBLIC ROADS
REGION TEN

As Built entered 1-3-68 by E. Ward

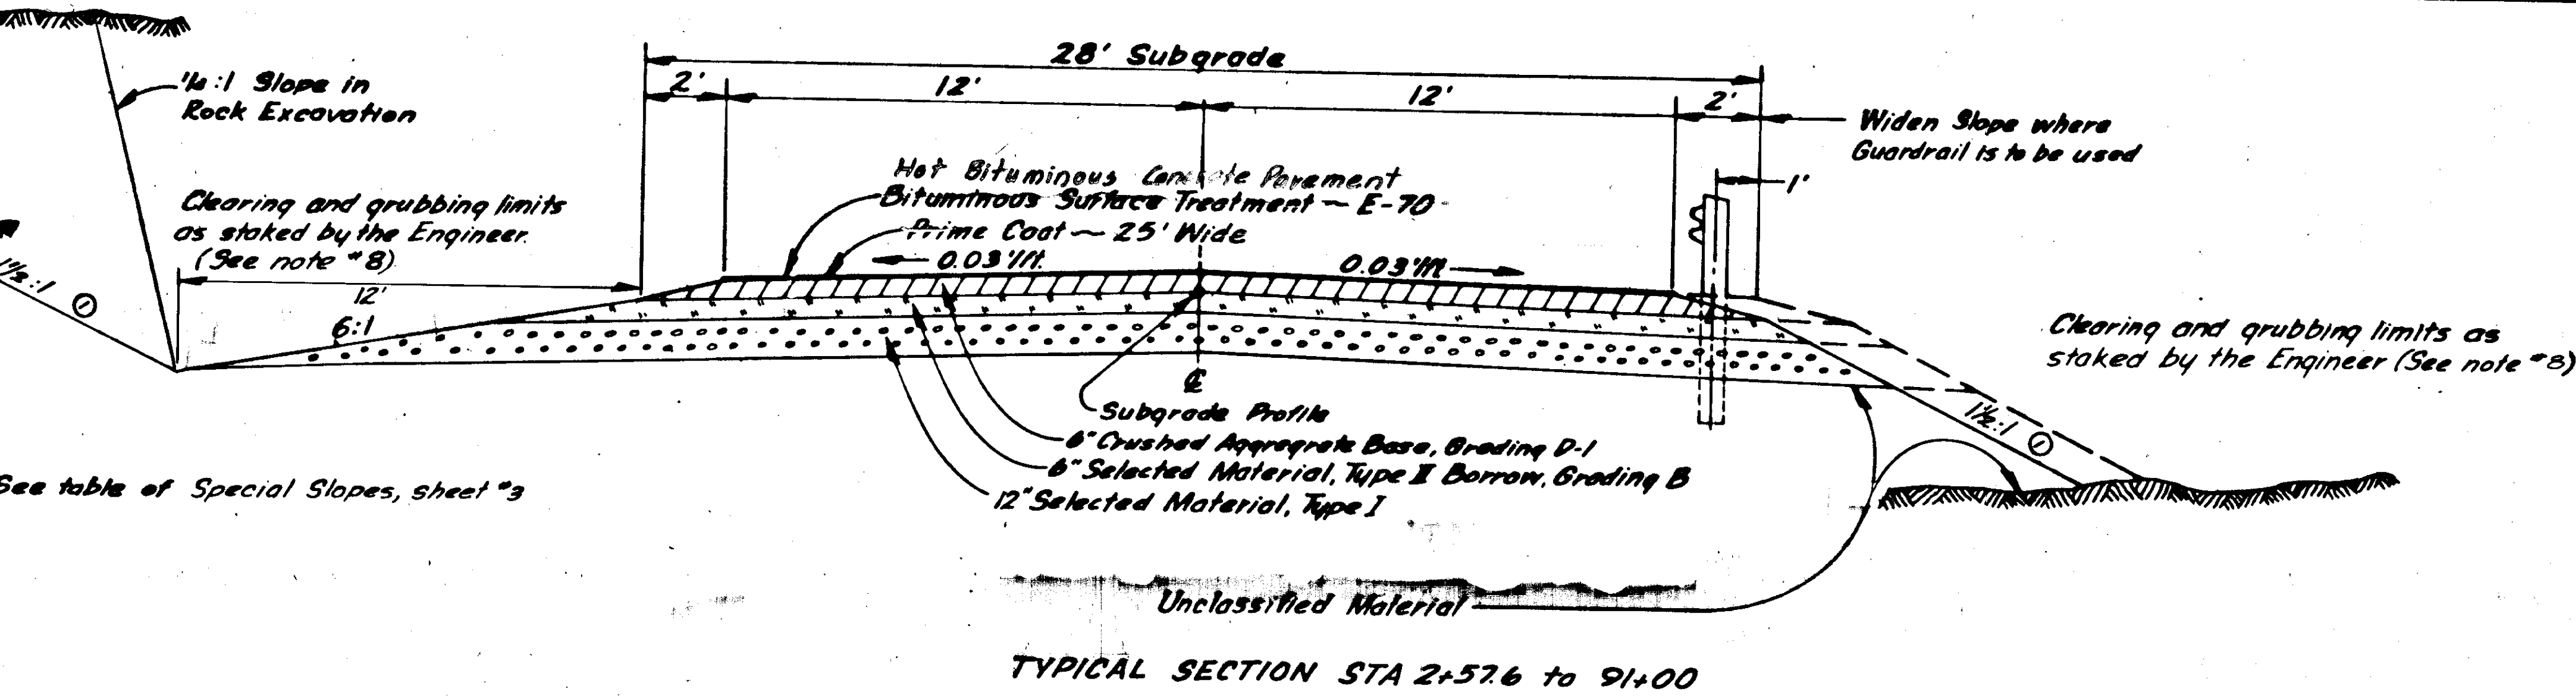


TYPICAL SECTION STA 2+57.6 to 91+00

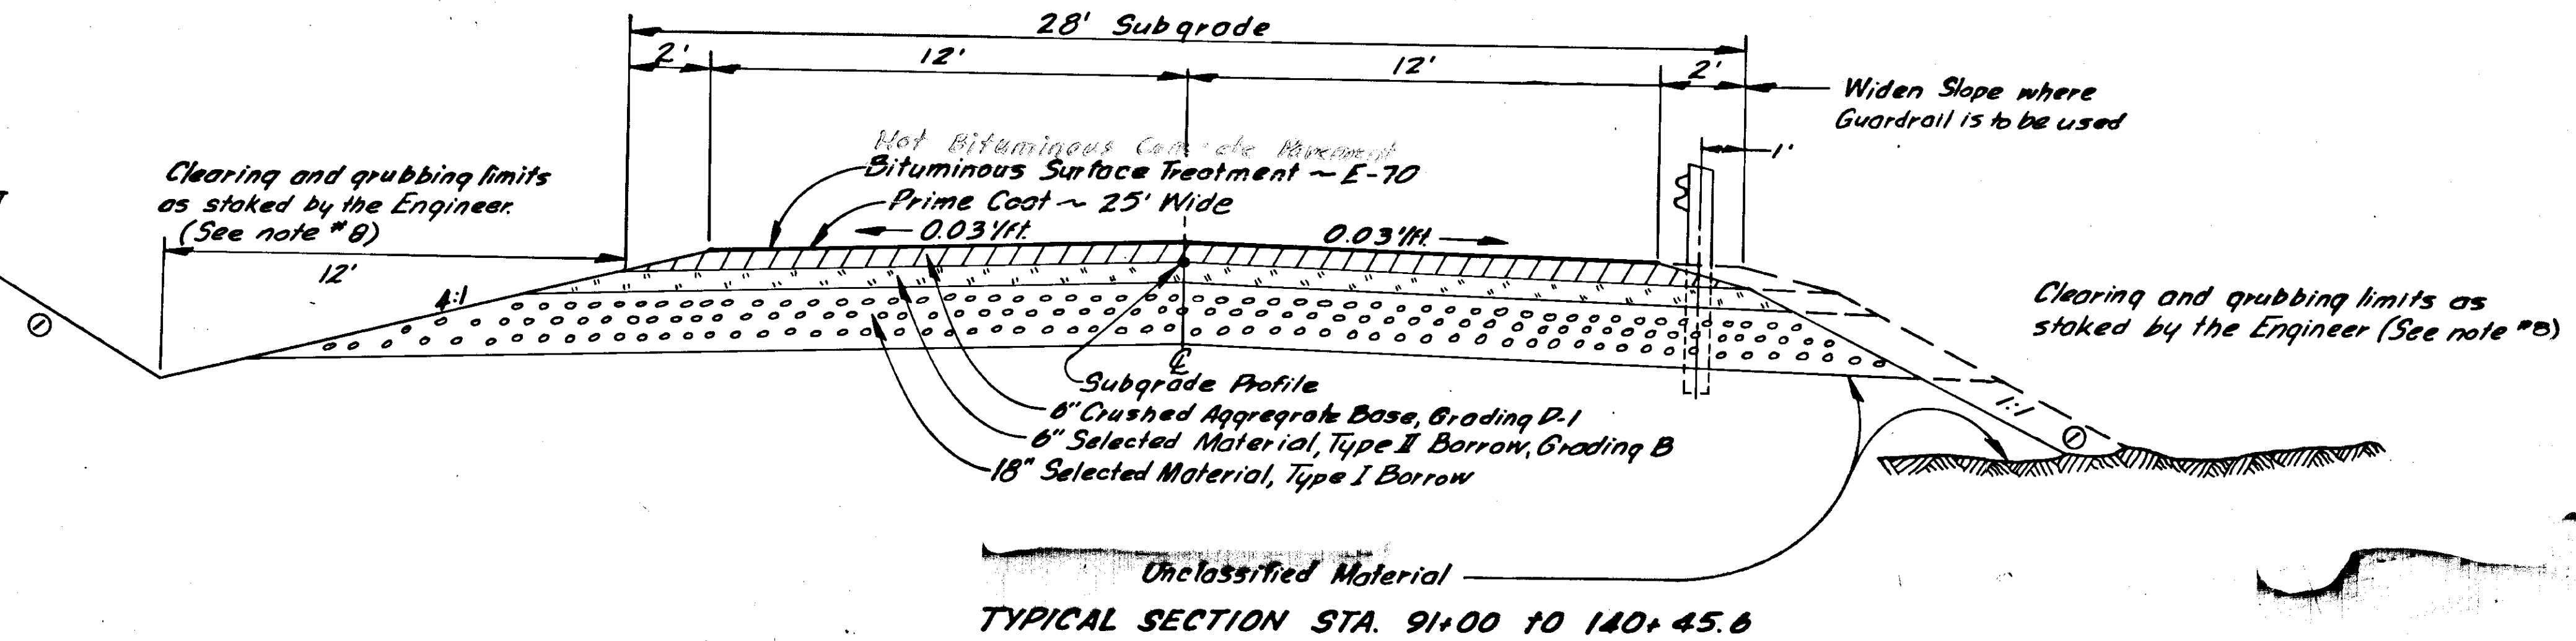

TYPICAL SECTION STA. 91+00 to 140+45.6


ESTIMATE OF QUANTITIES

ITEM NO	QUANTITIES	UNIT	ITEM
10	All Req'd.	LumpSum	Misc Force Account Work As Authorized under articles 9.8 & 9.5
100(5)	All Req'd.	LumpSum	Clearing and Grubbing
102(1)	122,000	Cu. Yd.	Unclassified Excavation
102(7)	13,000	Ton	Selected Material, Type I Borrow, Case 2
102(7A)	16,200	Ton	Selected Material, Type II Borrow, Case 2, Grading B
103(1)	313	Cu. Yd.	Excavation for Structures
103(2)	24,600	Yd-Mi.	Overhaul (2000' Free haul)
200(4)	13,750	Ton	Crushed Aggregate Base, Grading D-1
310(3)	12,300	Gal.	Asphalt, Grade MC-70, Prime Coat
34(4)	1,370	Ton	Aggregate, Designation E-70, Bituminous Surface Treatment
34(5)	36,800	Gal.	Cationic Emulsified Asphalt, Grade RS-3K, Bituminous Surface Treatment
453(5A)	788	Lin. Ft.	8" Corrugated Metal Pipe
453(5B)	688	Lin. Ft.	18" Corrugated Metal Pipe
453(5C)	1304	Lin. Ft.	24" Corrugated Metal Pipe
457(1)	1147	Lin. Ft.	Removal of Culverts
560(3)	40	Each	Culvert Marker Posts
560(5)	42	Each	Brass Cap Monument
561(1)	42	Each	Monument Case
583(1)	3512.5	Lin. Ft.	Beam-Type Guardrail
584(1)	5	Each	Standard Signs
101(1)	4250	Ton	1 1/2" diameter concrete pipe
101(2)	24,300	Gal.	Asphalt, (crucial grade 120-150 penetration)
101(3)	All Req'd.	various	slide barriers, signs

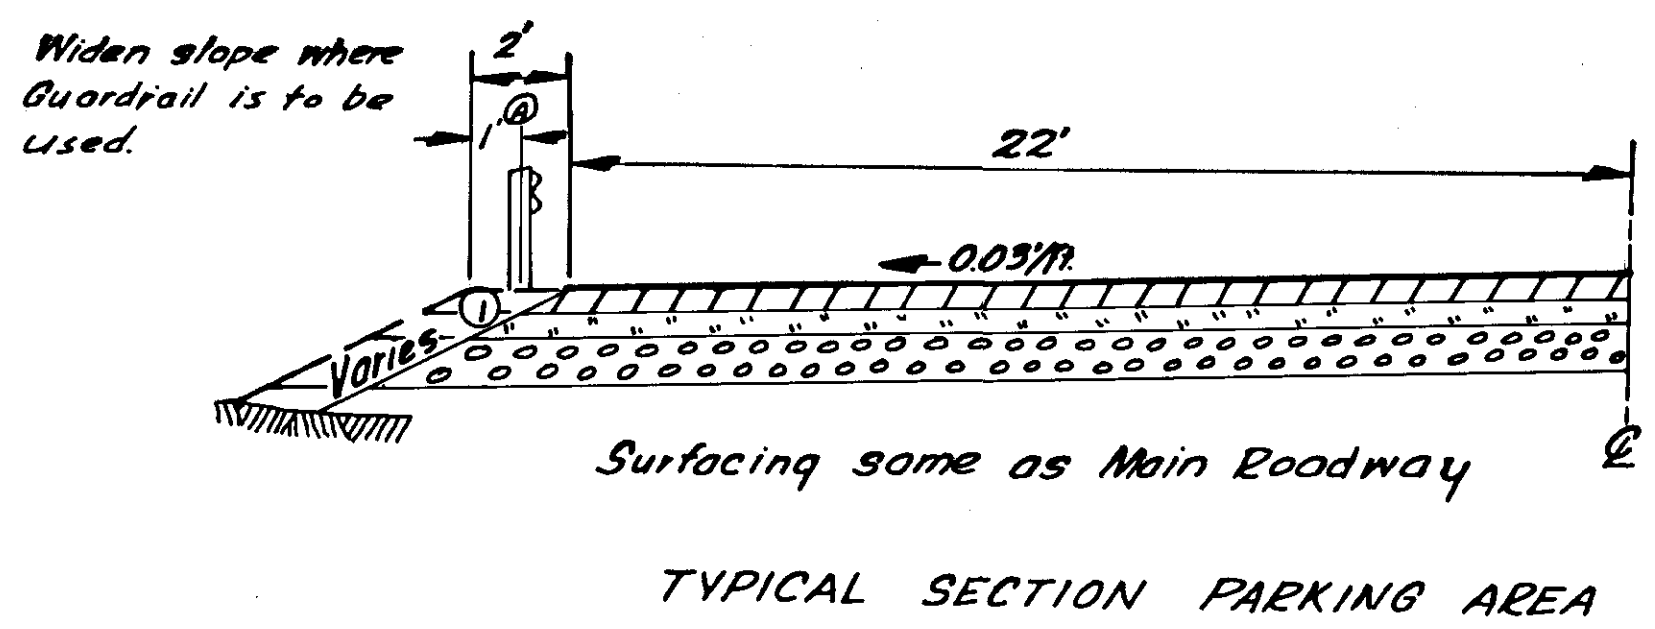

TYPICAL SECTION PARKING AREA

① 3' from: Sta. 57+79.4 to Sta. 60+45.6 RT
Sta. 61+83.1 to Sta. 62+74.3 RT
Sta. 122+25 to Sta. 123+42.2 RT

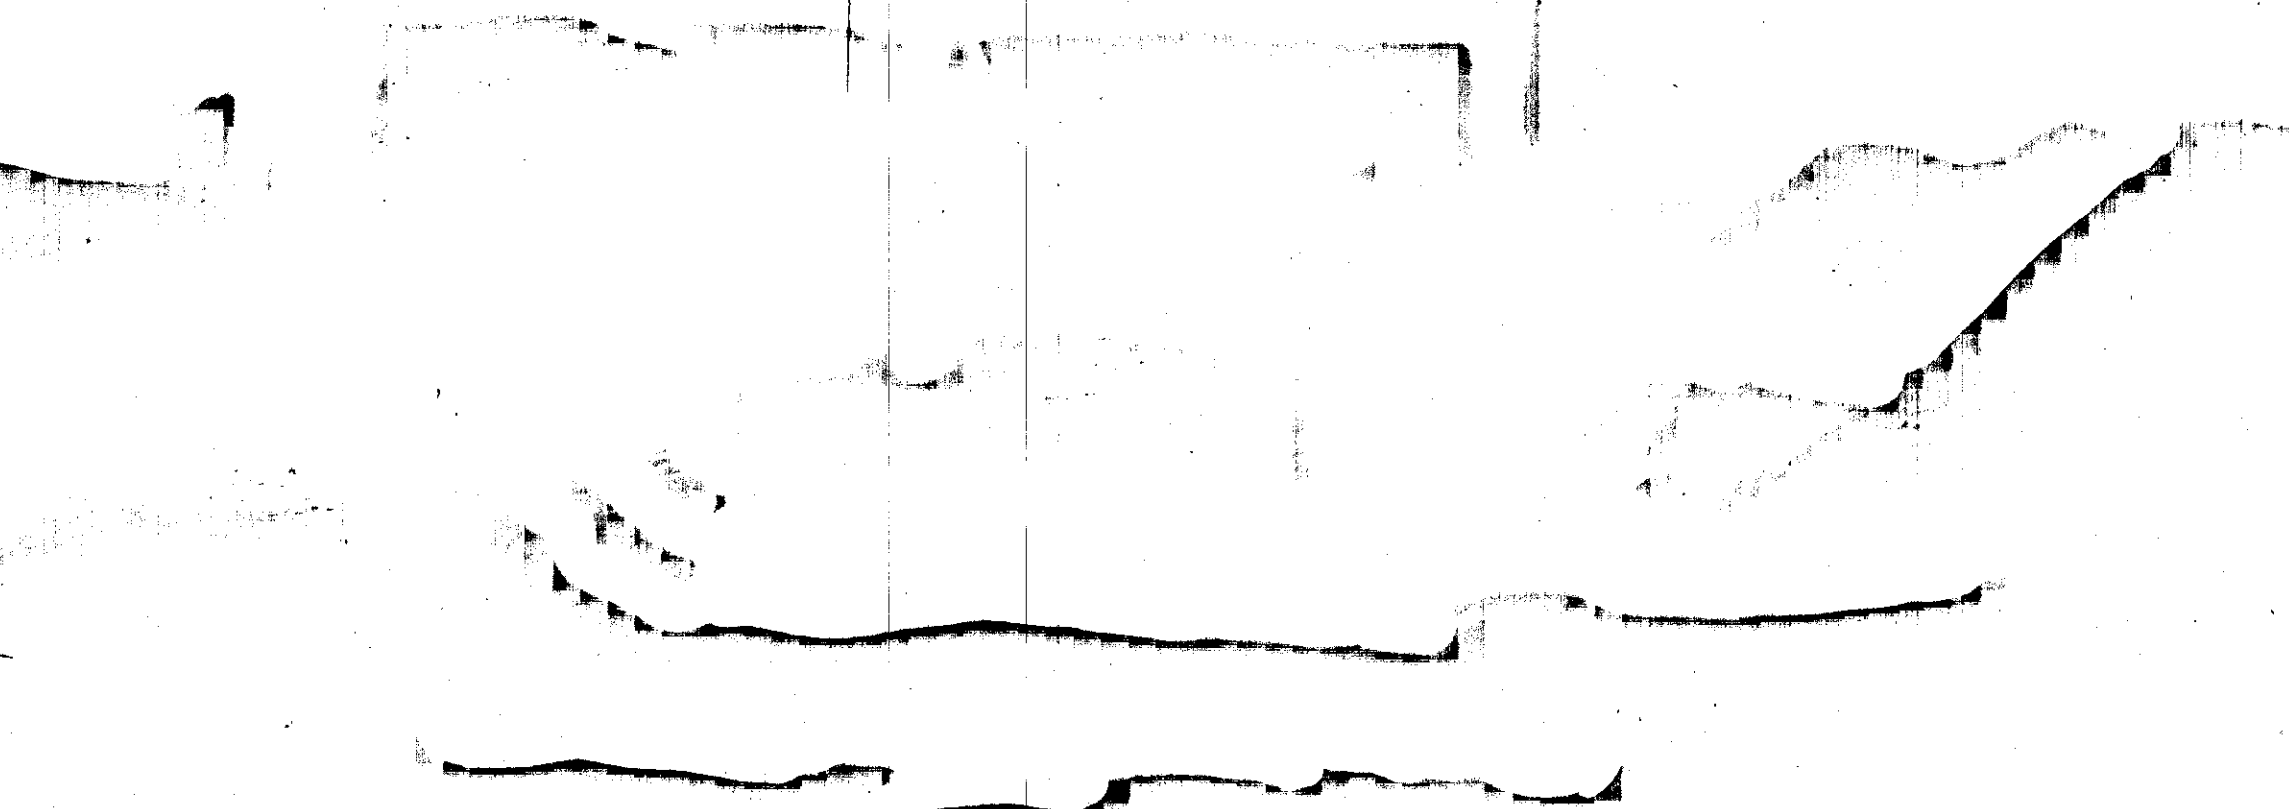

PLAN VIEW PARKING AREA

Sta.	Lt. Rt.	Sta.	Lt. Rt.
58+75	✓	62+35	✓
59+50	✓	122+59	✓
		123+09	✓

No.	Date	Description



STATE	PROJECT DESIGNATION	YEAR	SHEET NO.	TOT. SHEETS
ALASKA	S-0970 (2)	1964	2	25

- GENERAL NOTES**
- Culvert lengths are approximate only and are subject to minor revisions.
 - Grades and alignment shown on these plans are subject to minor revisions.
 - Waste quantities are approximate and are for estimate purposes only.
 - All utility poles within the construction limits will be moved by others.
 - All earthwork for approaches and cross roads is included in balances.
 - All surfacing depths are nominal.
 - Curve data for this project is based on the approximate 1" curve with a R= 5730.0'.
 - Clearing and Grubbing limits shall be 15' outside the Construction limits or to the R.O.W. line, which ever is less.
 - Miscellaneous and minor encroachments, such as existing fences, which fall within the right-of-way will be removed by the contractor and as directed by the engineer. No measurement will be made for this work and payment for such work will be considered as incidental to other items of work covered under Section 100.


REVISIONS		
No.	Date	Description

STATE	PROJECT DESIGNATION	YEAR	SHEET NO.	TOTAL SHEETS
ALASKA	S-0970(2)	1964	3	25


NO. 11161

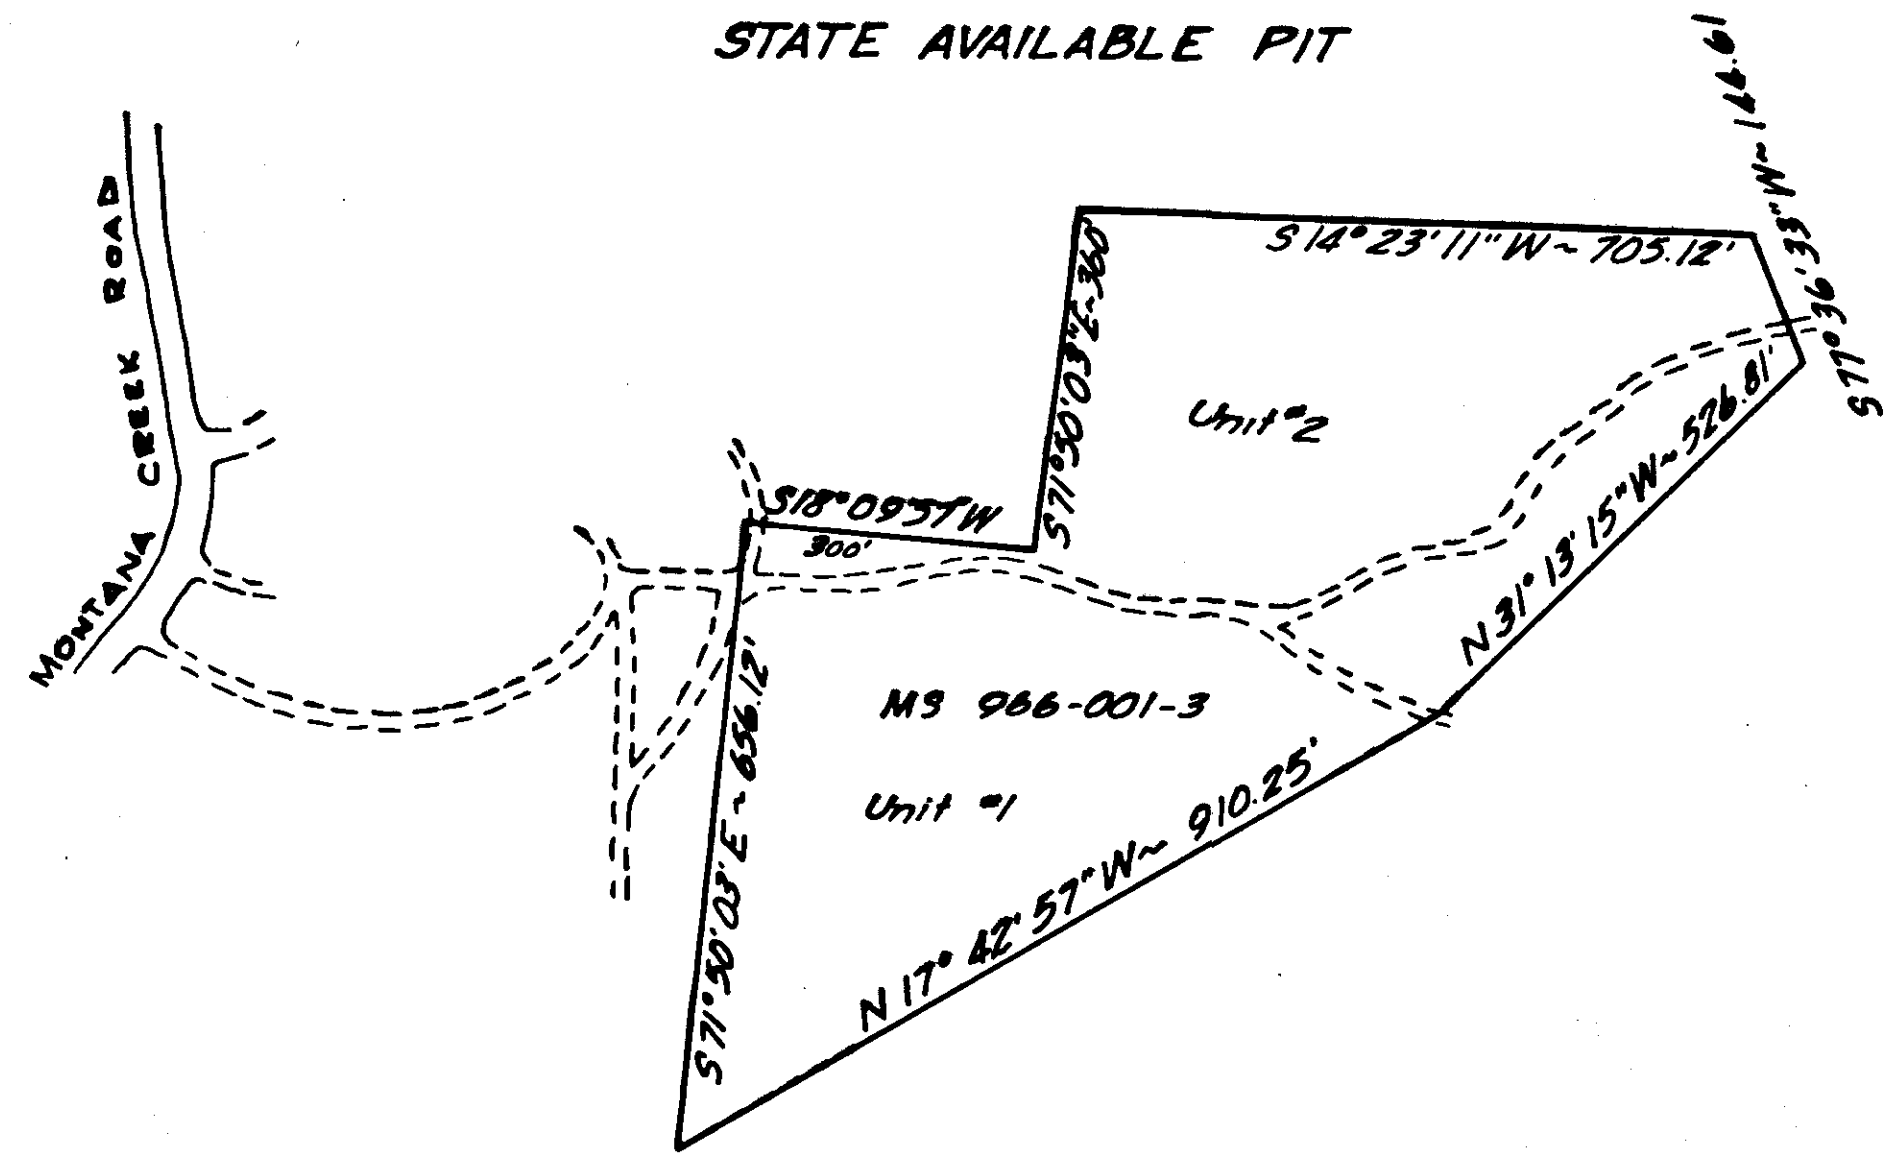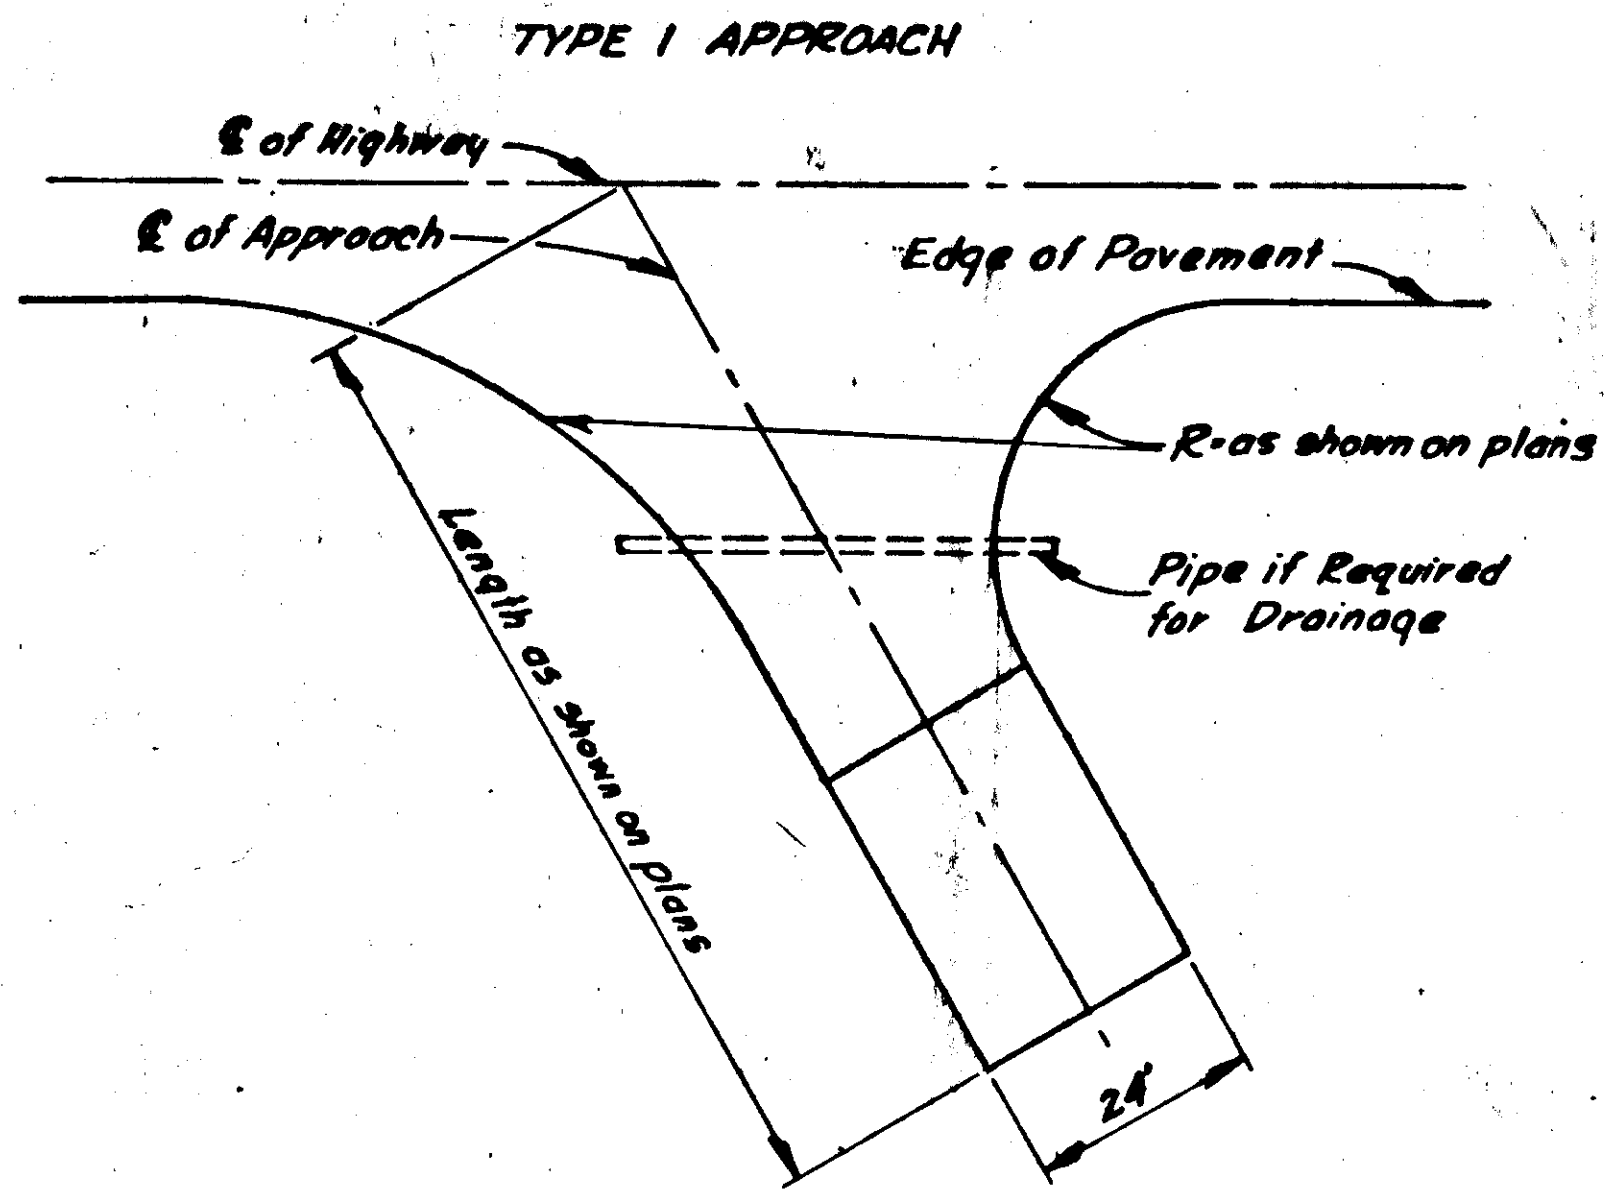

MS 966-001-3
(Saw Mill Pit)

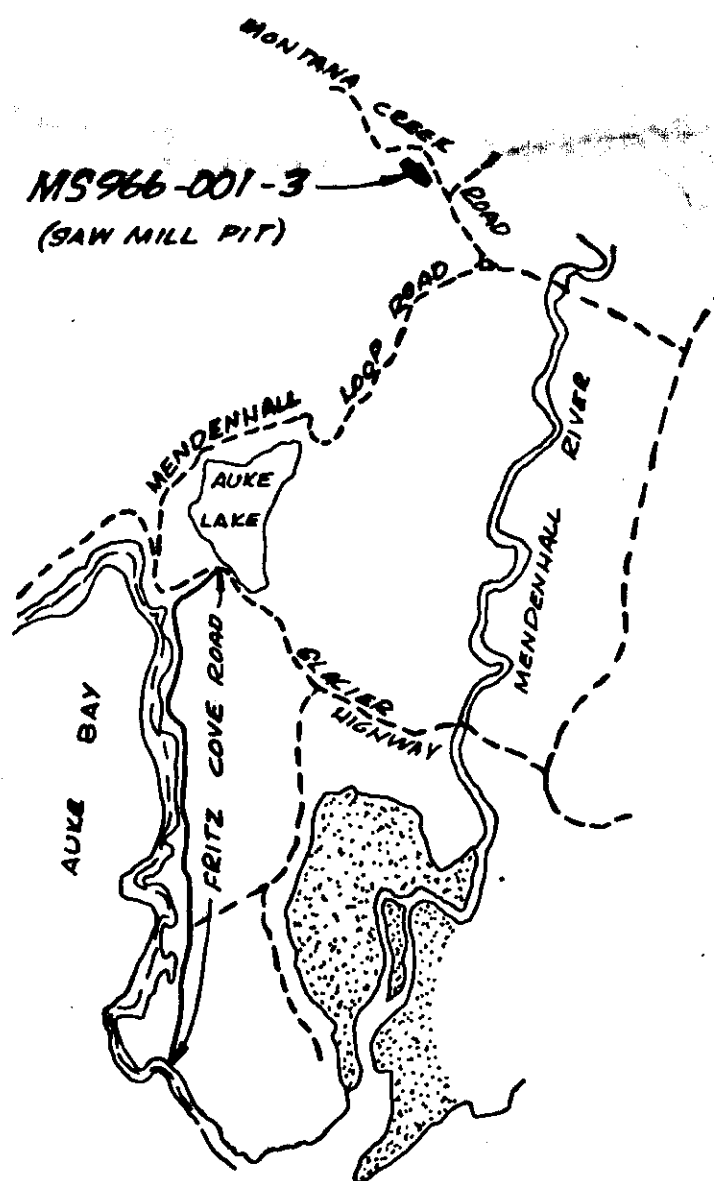

TYPE 2 APPROACH

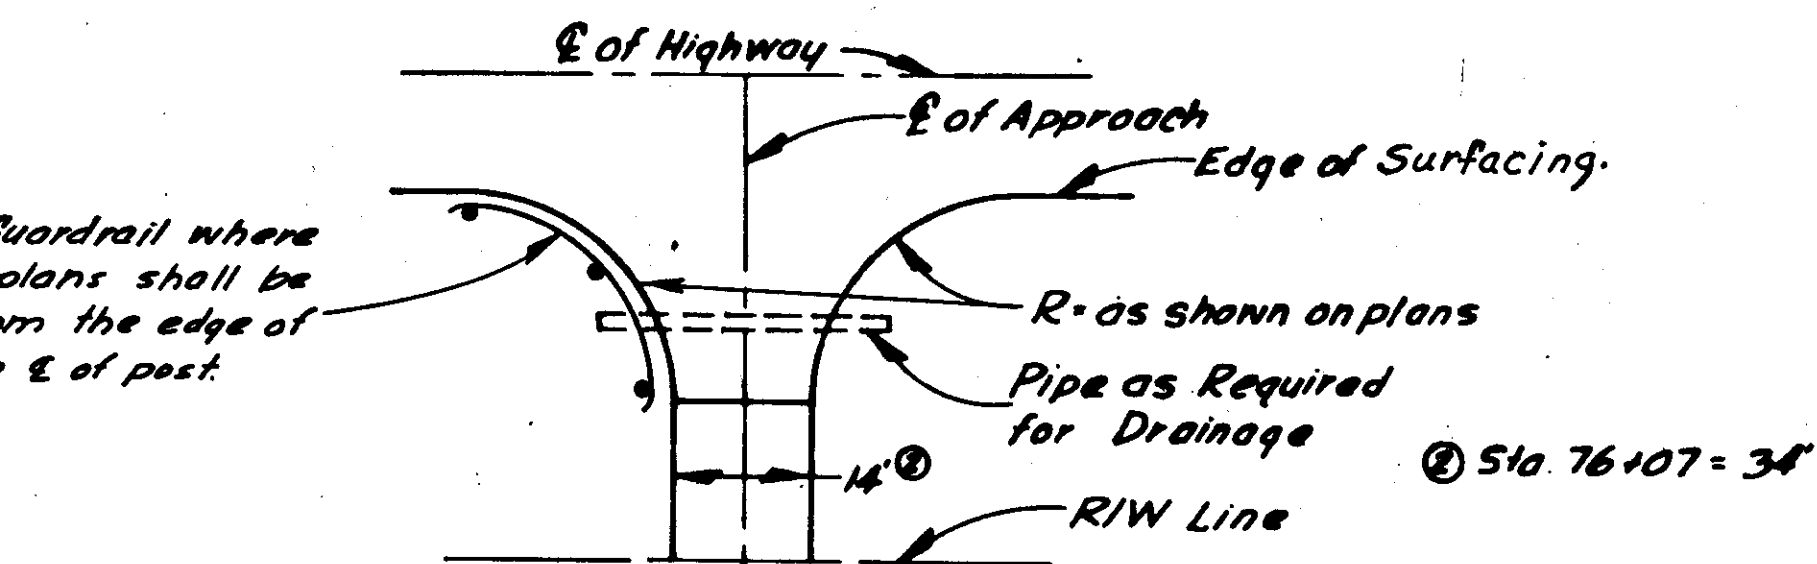

NOTES:


- Type 1 & 2 Approaches shall be surfaced to the radius point with the same type and depth of material as specified for the roadway. Beyond the radius point the approaches shall be surfaced with 6" Type II Borrow and 12" Type I or as directed by Engineer.

SPECIAL SLOPES

Station to Station	Slopes Left		Slopes Right		Remarks
	Shoulder Slope	Back Slope	Shoulder Slope	Back Slope	
3+00 - 3+75			2:1		
11+25 - 14+50			3:1		
14+50 - 18+75			4:1		
18+75 - 22+00	3:1				
26+75 - 27+50		1:1			
27+50 - 28+50			4:1		
28+50 - 28+80		1:1			
28+80 - 28+94			3:1		
31+50 - 49+75			2:1		
49+75 - 50+50	4:1				
51+50 - 52+50			2:1		
52+50 - 54+00			4:1		
54+00 - 55+50		1:1			
62+50 - 63+25		1:1			
65+25 - 67+50					Daylight Et.
67+50 - 68+20		1:1			
68+80 - 69+10		2:1			
69+80 - 69+80		1/2:1			
70+80 - 72+00					Daylight Et.
72+00 - 73+50		2:1			
73+50 - 74+00		2:1	3:1		
74+00 - 74+75		2:1			
74+75 - 75+75		1:1			Daylight Et.
75+75 - 77+75					
77+75 - 81+10		2:1	4:1		
81+10 - 82+50		2:1	2:1		
82+50 - 87+50		2:1	4:1		
87+50 - 89+50		1:1	4:1		
89+50 - 90+25			4:1		
90+25 - 90+75	4:1		2:1		
90+75 - 91+00	4:1		4:1		
95+50 - 96+25			1 1/2:1		
100+50 - 102+50				2:1	
103+50 - 105+25		2:1			
106+50 - 108+50		2:1			
110+75 - 111+75		2:1			
112+50 - 114+50		2:1			
120+50 - 123+50		1 1/2:1			
123+50 - 129+50		1 1/2:1	3:1		
129+50 - 133+50		1 1/2:1			

STATE	ROUTE	YEAR	SHEET NO.	TOTAL SHEETS
ALASKA	S-0970 (2)	1964	4	25

REVISIONS		
No.	Date	Description
		AS BUILT

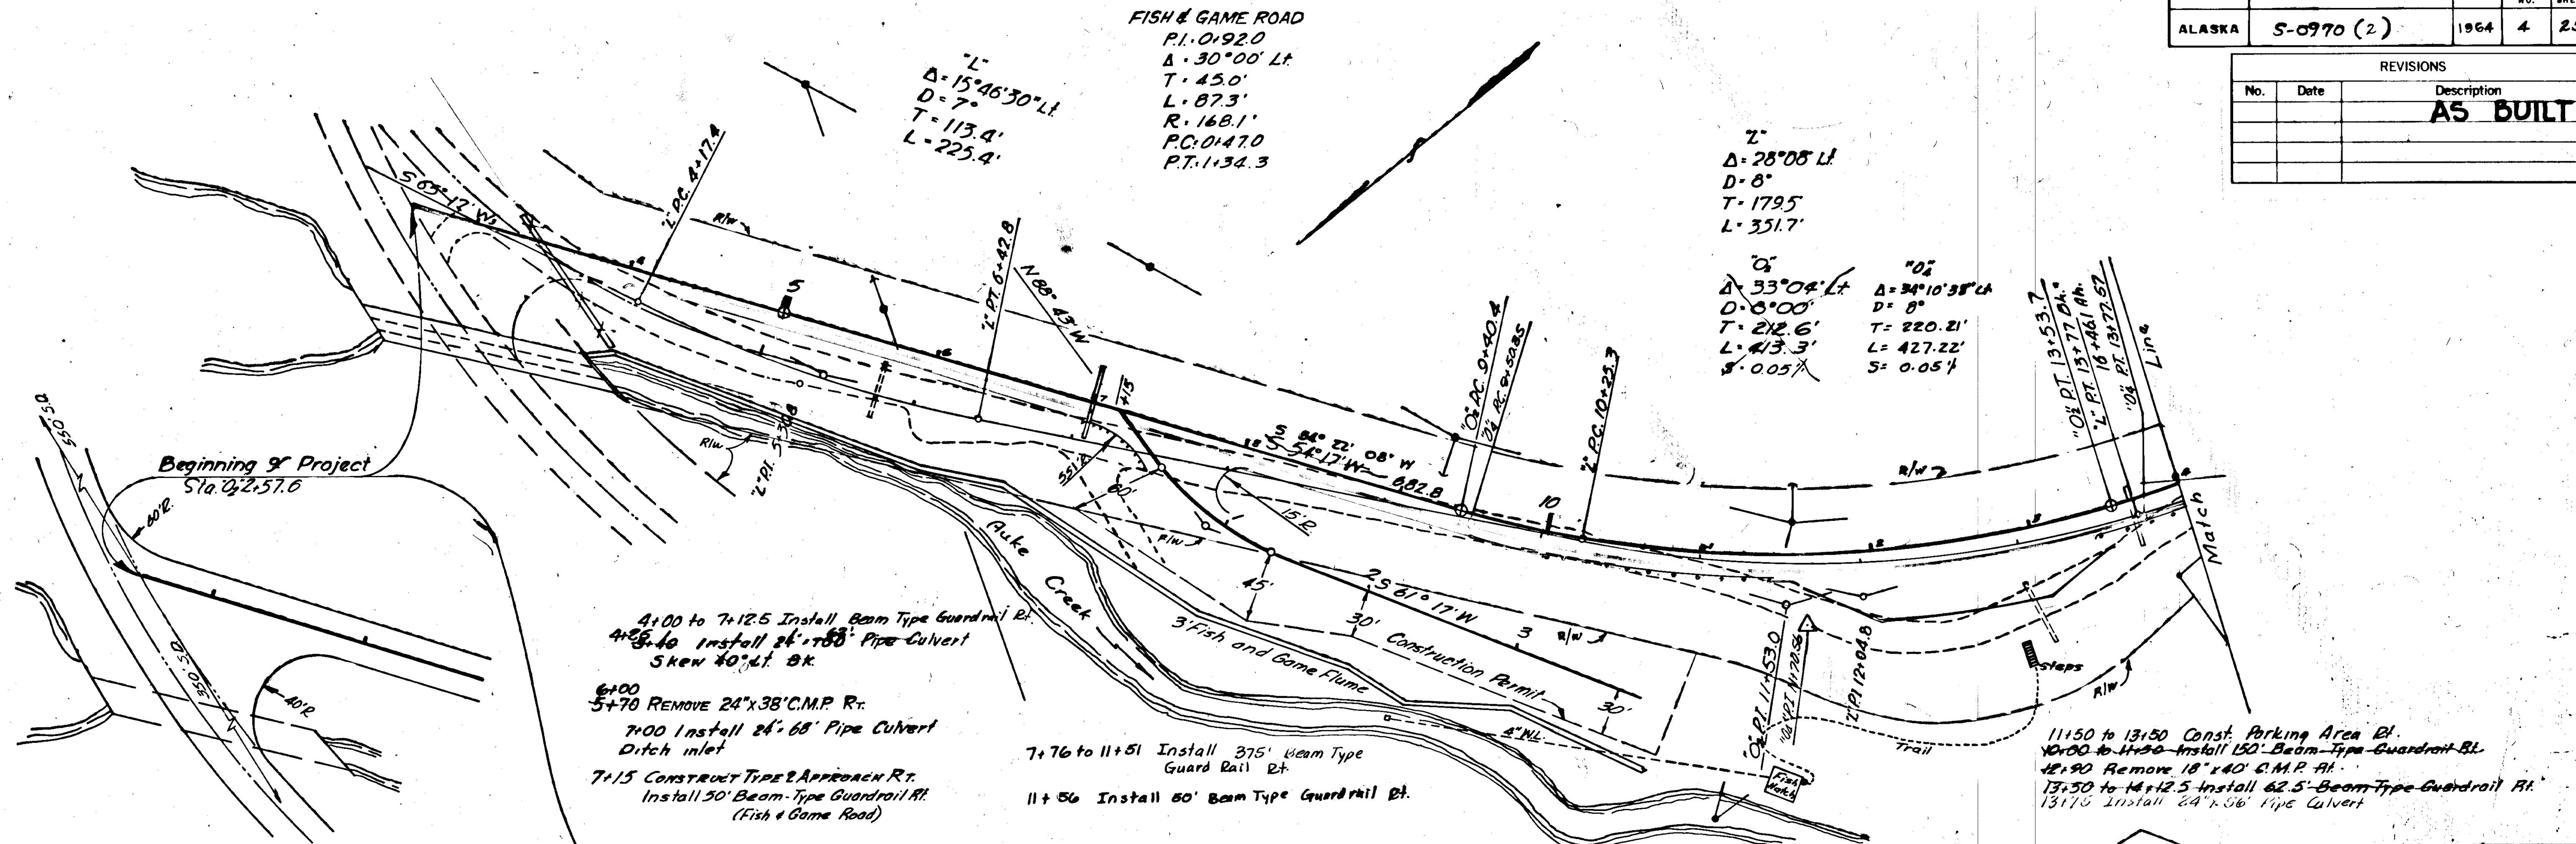

4+00 to 7+12.5 Install Beam Type Guardrail Rt.
 4+55.40 Install 24" x 18" Pipe Culvert
 Skew 40° Lt. Sk.


6+00
 5+70 REMOVE 24" x 38" C.M.P. Rt.
 7+00 Install 24" x 68" Pipe Culvert
 Ditch inlet

7+15 CONSTRUCT TYPE 2 APPROACH RT.
 Install 50' Beam Type Guardrail Rt.
 (Fish & Game Road)

7+76 to 11+51 Install 375' Beam Type
 Guard Rail Rt.

11+56 Install 60' Beam Type Guardrail Rt.

11+50 to 13+50 Const. Parking Area Rt.
 12+00 to 12+50 Install 150' Beam Type Guardrail Rt.
 12+90 Remove 18" x 40" C.M.P. Rt.
 13+50 to 14+25 Install 62.5' Beam Type Guardrail Rt.
 13+75 Install 24" x 56" Pipe Culvert

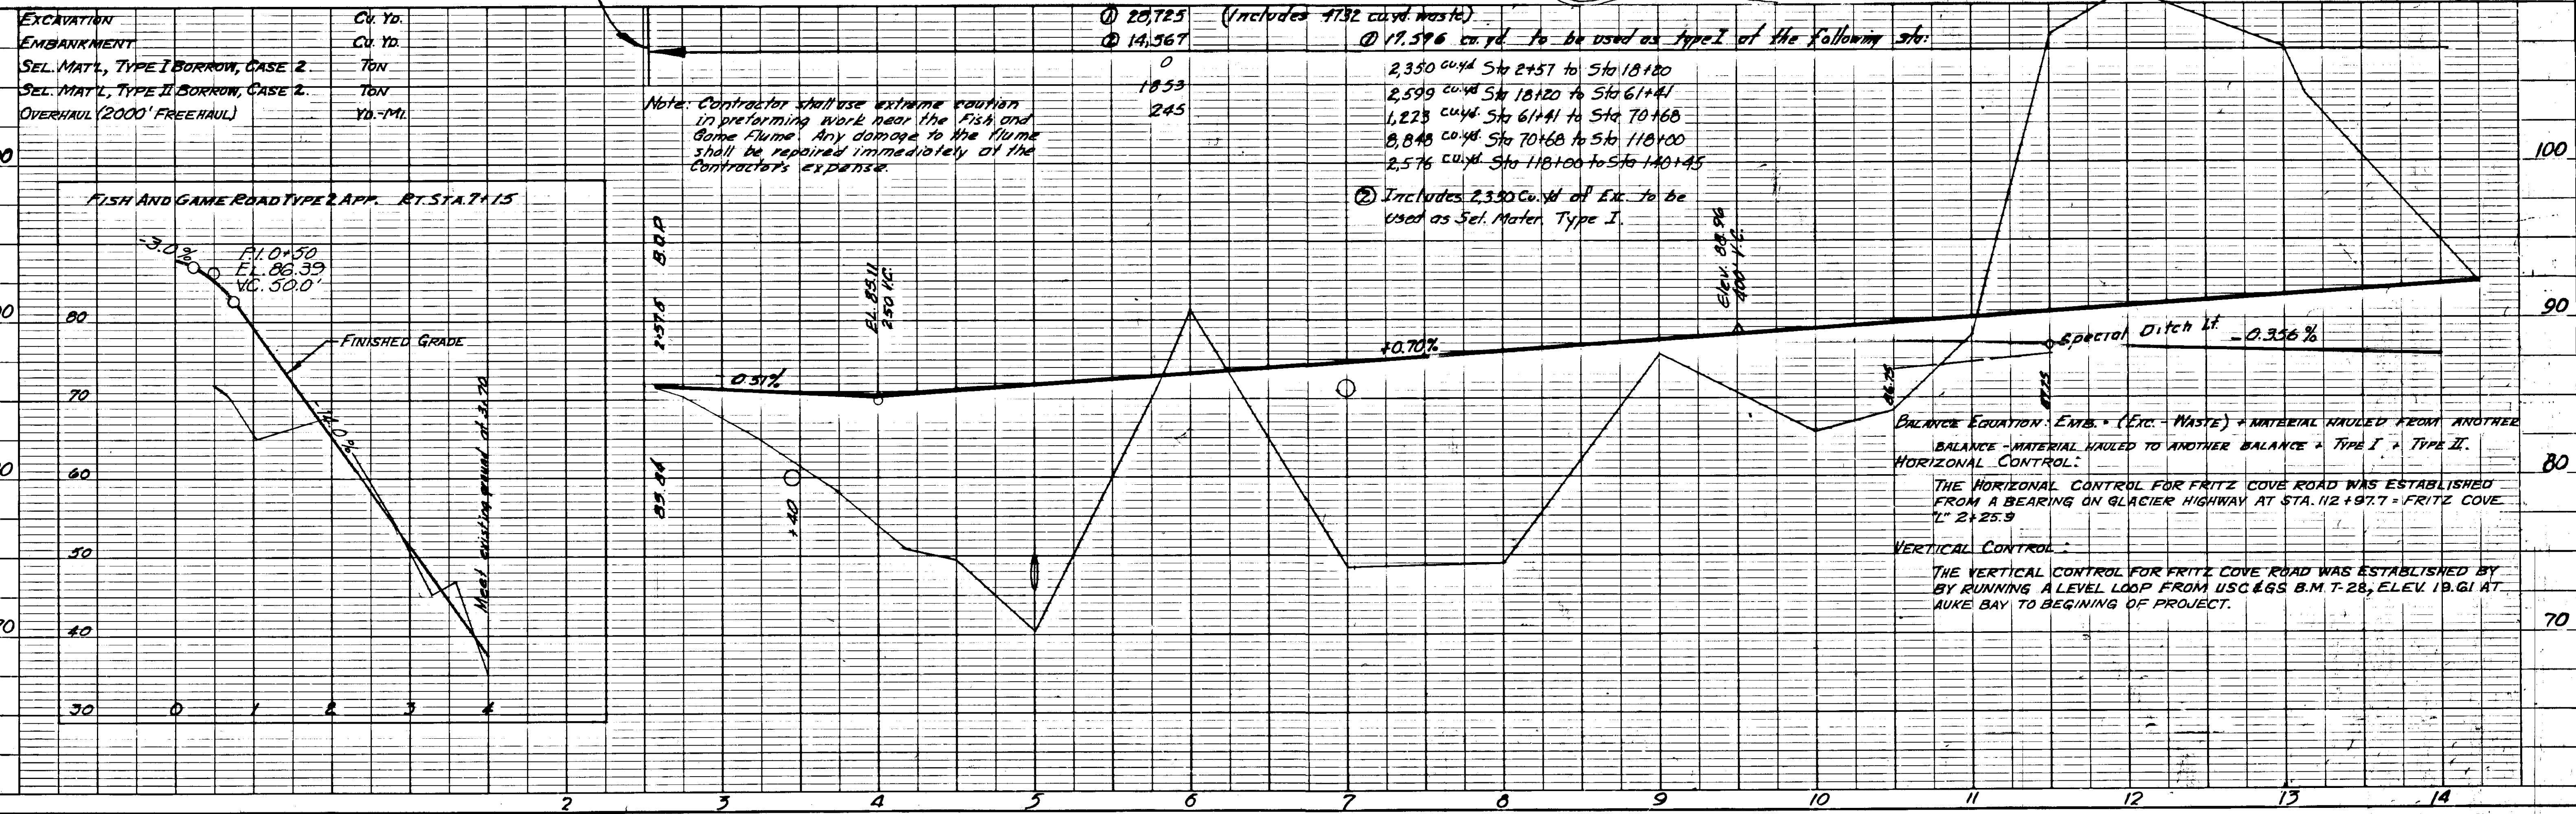



BALANCE EQUATION: EMB. + (Exc. - Waste) + MATERIAL HAULED FROM ANOTHER BALANCE - MATERIAL HAULED TO ANOTHER BALANCE + TYPE I + TYPE II.

HORIZONTAL CONTROL:
 THE HORIZONTAL CONTROL FOR FRITZ COVE ROAD WAS ESTABLISHED FROM A BEARING ON GLACIER HIGHWAY AT STA. 12+97.7 - FRITZ COVE "L" 2+25.9

VERTICAL CONTROL:
 THE VERTICAL CONTROL FOR FRITZ COVE ROAD WAS ESTABLISHED BY RUNNING A LEVEL LOOP FROM USC & GS B.M. T-28, ELEV. 19.61 AT AUKE BAY TO BEGINNING OF PROJECT.

STATE	ROUTE	YEAR	SHEET NO.	TOTAL SHEETS
ALASKA	S-0970(2)	1964	5	25

REVISIONS		
No.	Date	Description
		AS BUILT

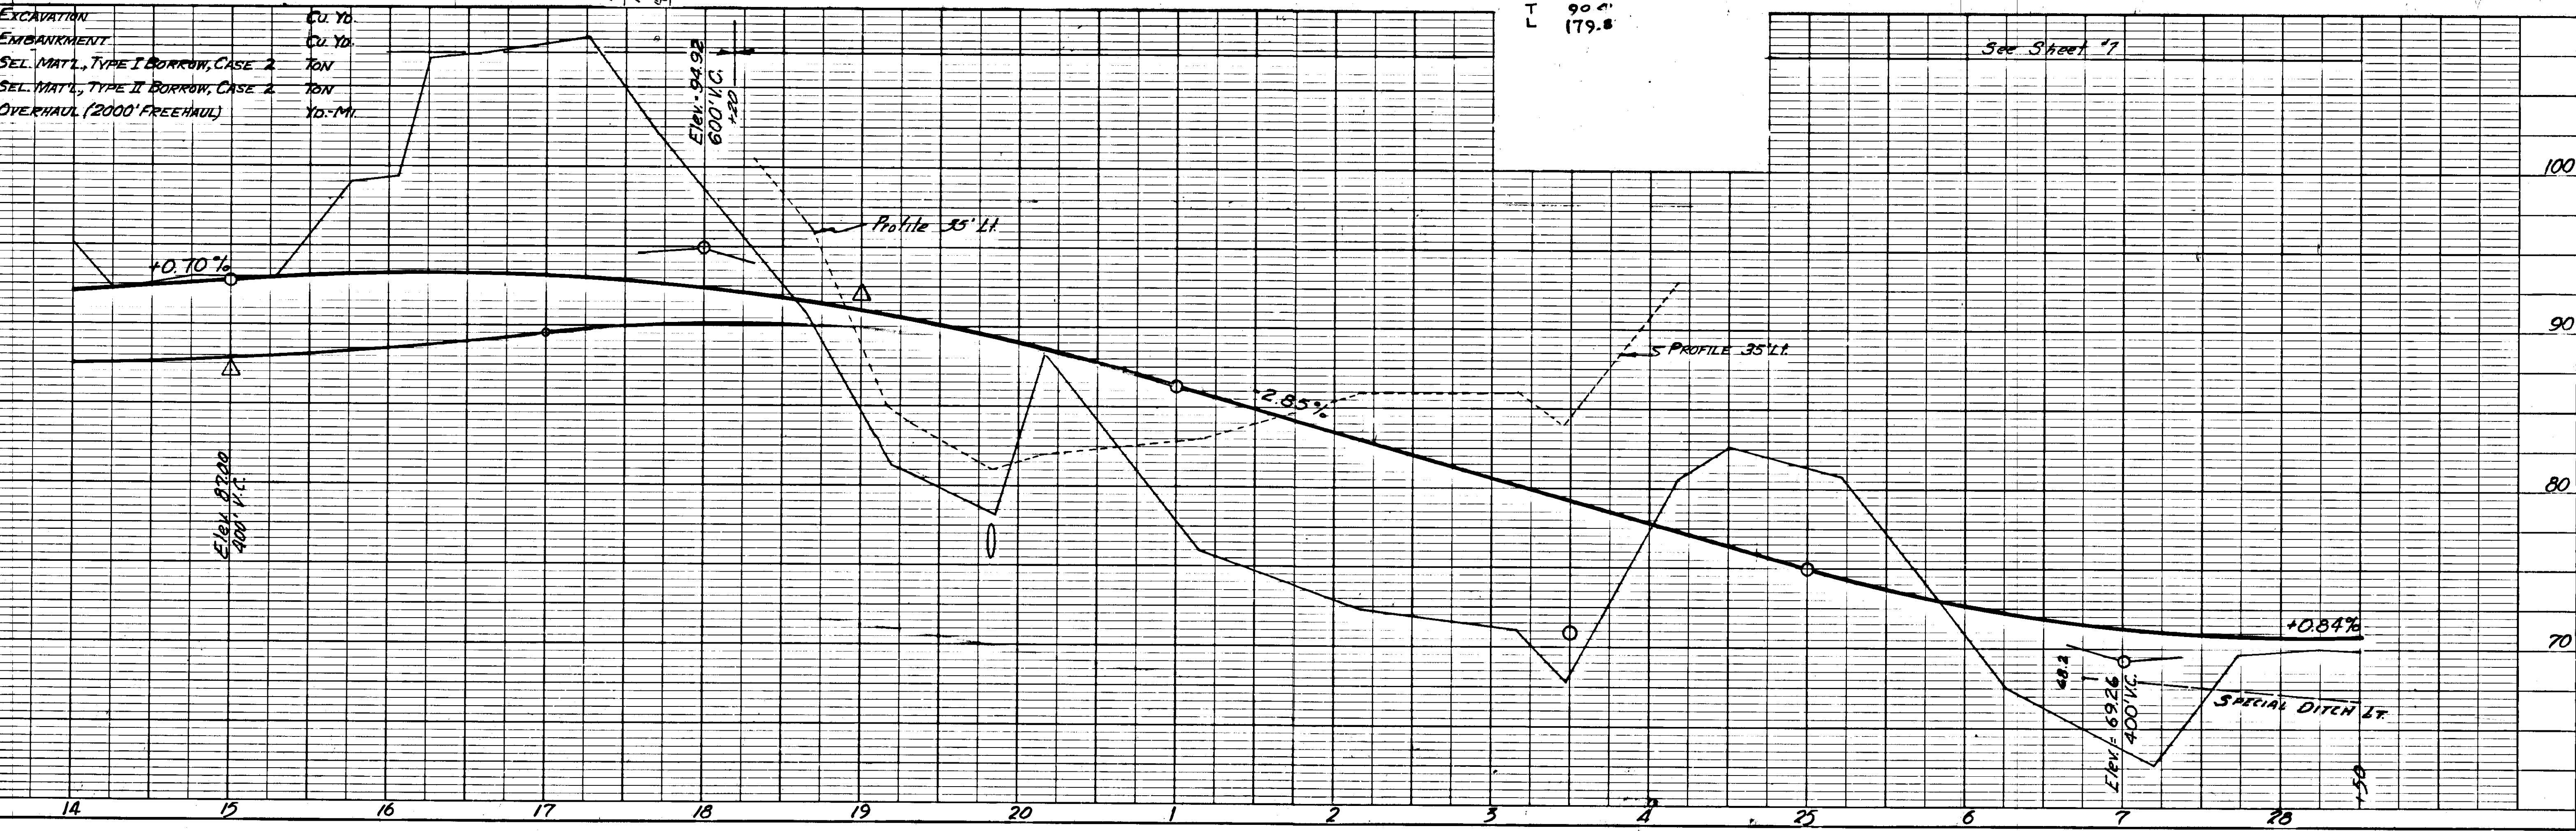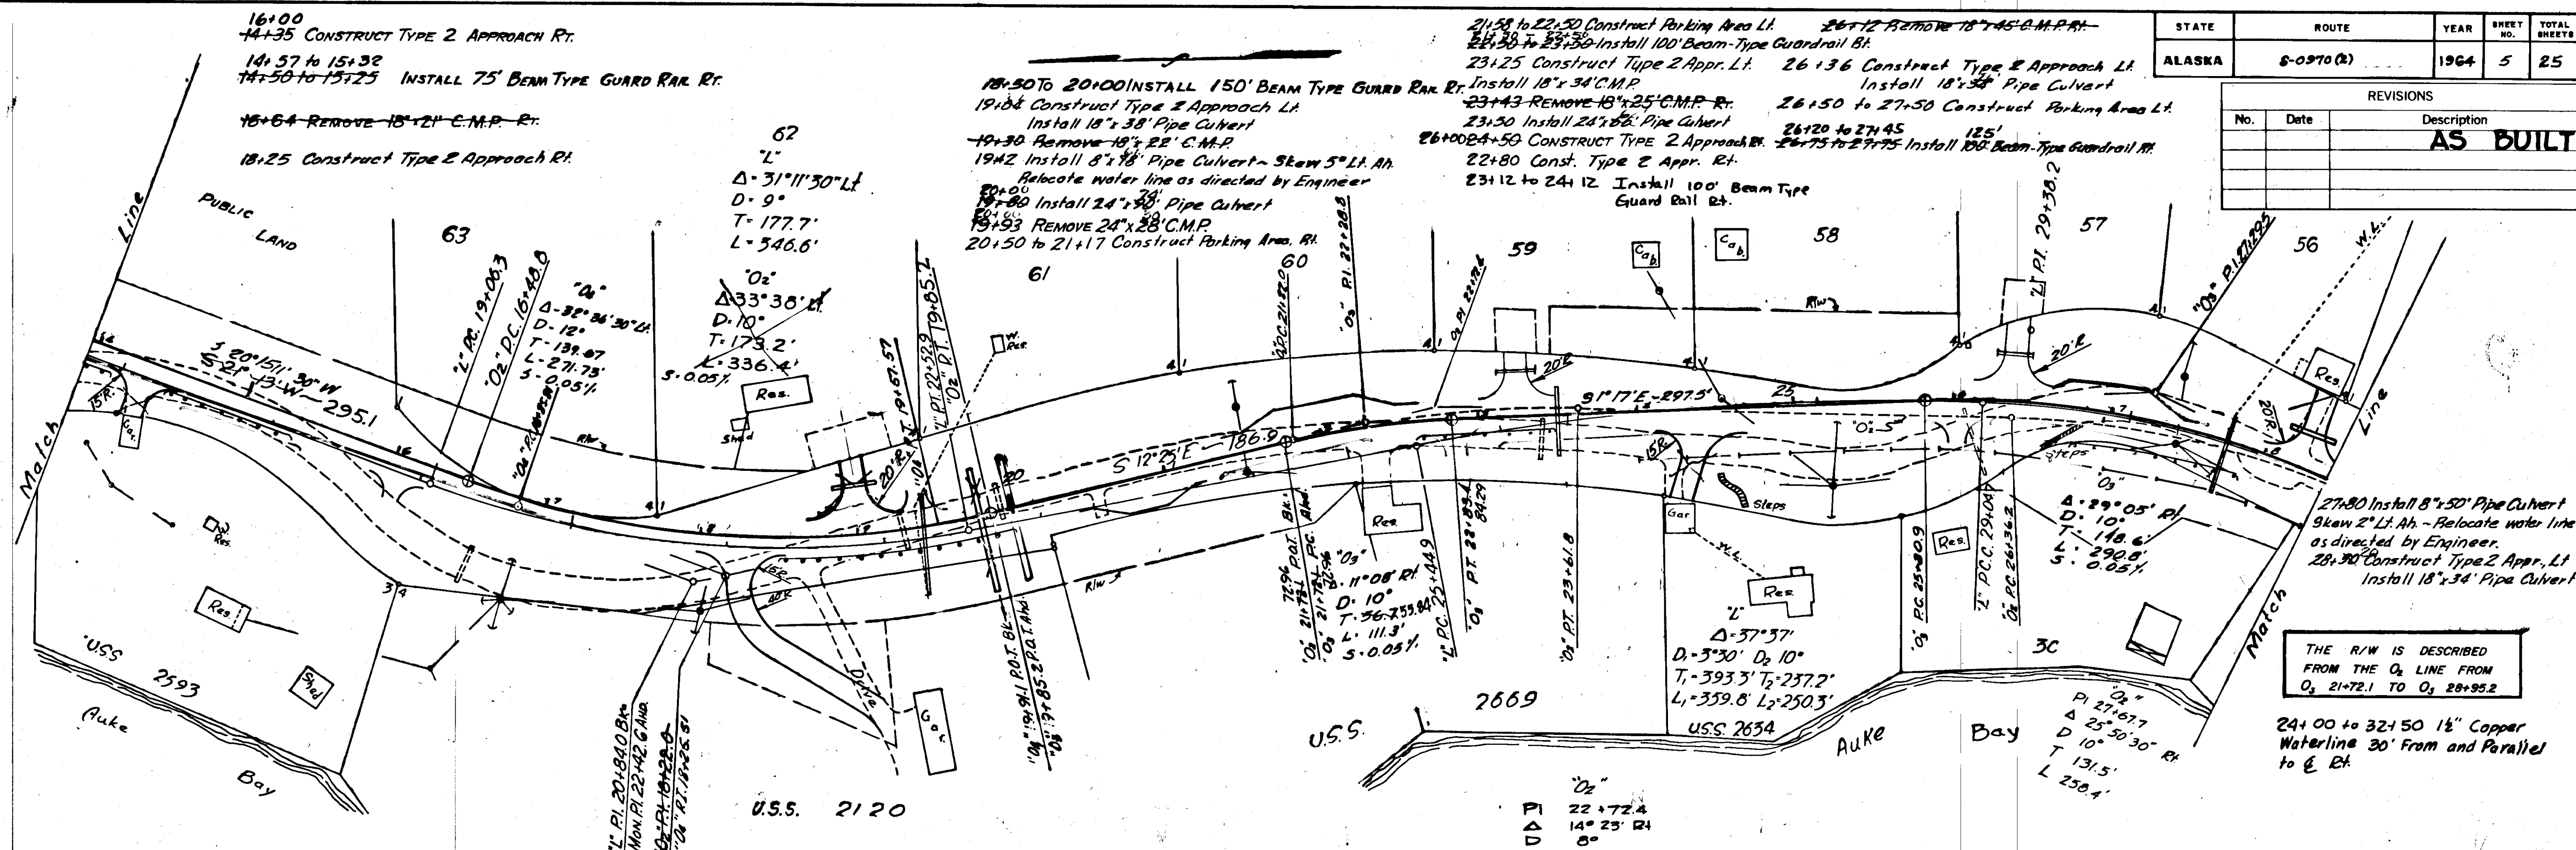

28+60 to 31+70
 28+80 to 31+00 Install 50' Beam-Type Guardrail Rt.
 28+86 Remove 24" x 48" C.M.P.
 Install 24" x 70" Pipe Culvert
 32+60 CONSTRUCT TYPE 2 APPROACH LT.
 INSTALL 18" x 26" Pipe Culvert


35+30 Construct Type 2 App.
 Install 18" x 26" Pipe Culvert Lt.
 35+74 Remove 18" x 24" C.M.P.
 36+71 REMOVE 18" x 20" C.M.P.

38+30 Construct Type 2 Approach Rt.
 38+70 Remove 18" x 19" C.M.P.


40+50 to 41+20 Const. Parking Area Rt.
 41+18 CONSTRUCT TYPE 2 APPROACH RT.
 43+00 to 44+25+37.5 to 43+75 Install 2 3/4" Beam-Type Guardrail Rt.
 43+70 INSTALL 24" x 54" Pipe Culvert
 Remove 18" x 32" C.M.P.
 41+36 Install 8" x 62" Pipe Culvert
 41+62 Install 24" x 52" Pipe Culvert
 41+36 Water Line

STATE	ROUTE	YEAR	SHEET NO.	TOTAL SHEETS
ALASKA	S-0970(2)	1964	6	25

REVISIONS		
No.	Date	Description
		AS BUILT

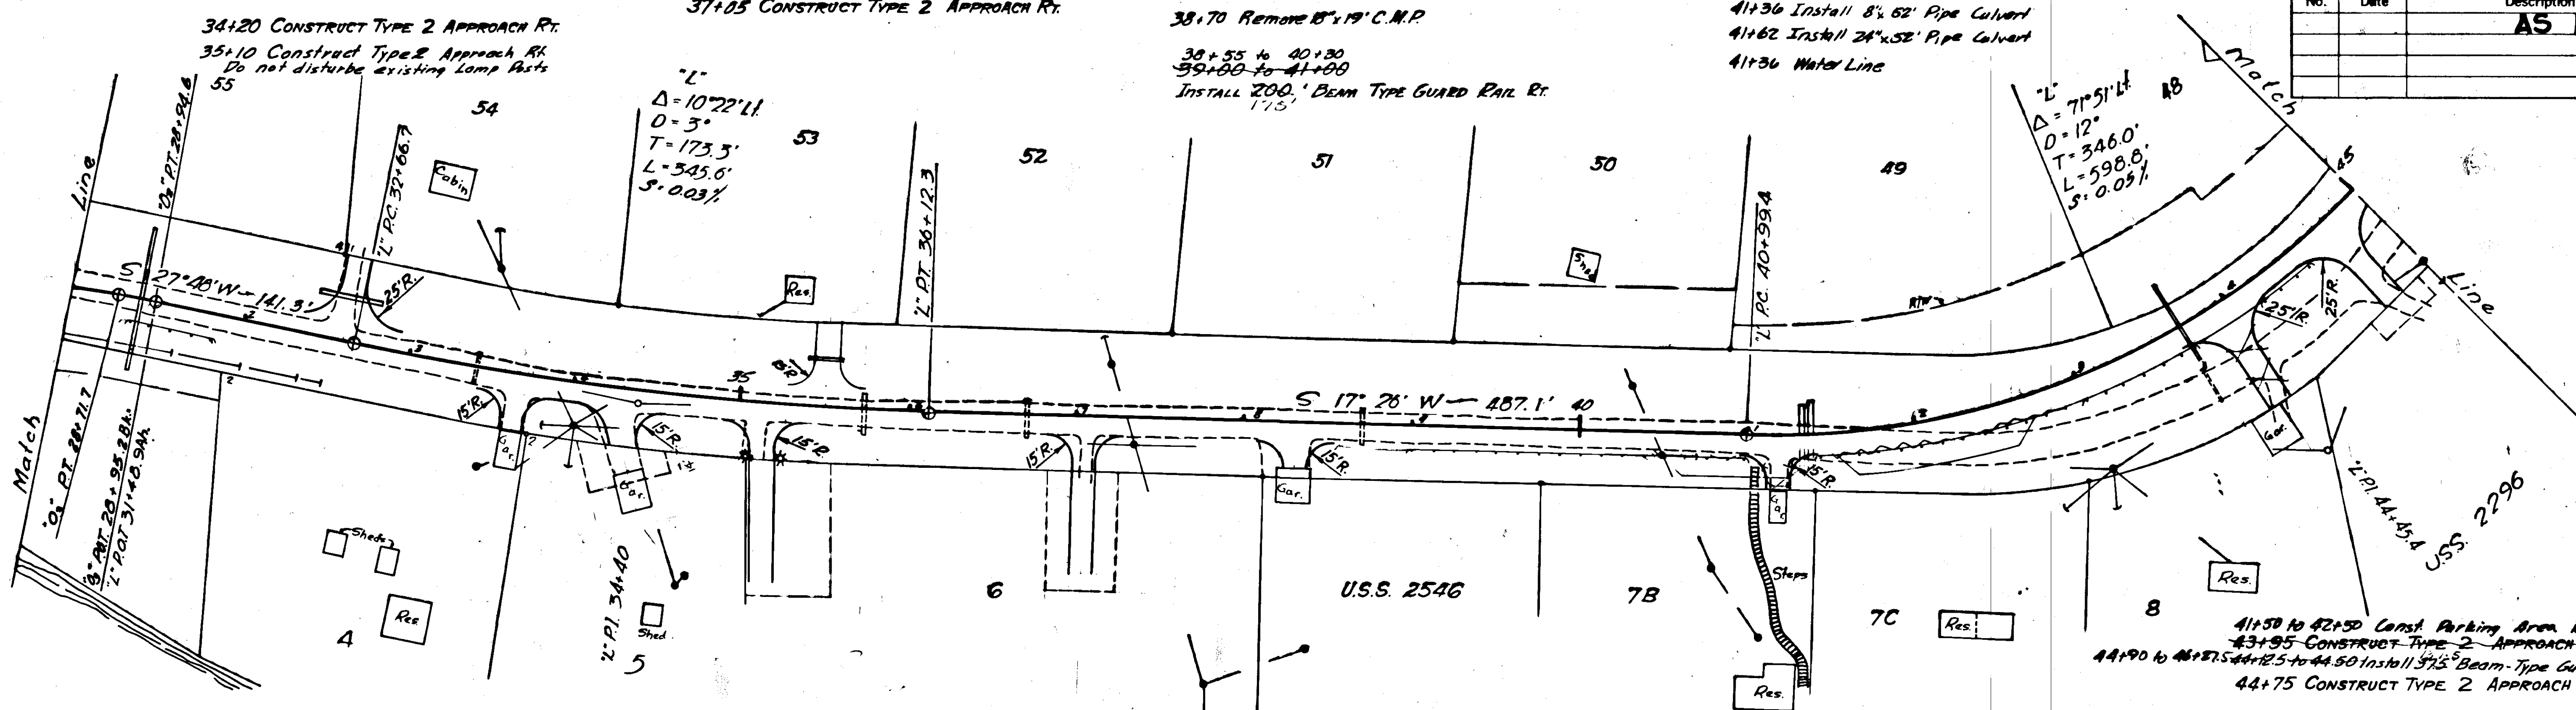

EXCAVATION	Cu. Yd.
EMBANKMENT	Cu. Yd.
REL. MAT'L., TYPE I BORROW, CASE 2.	TON
REL. MAT'L., TYPE II BORROW, CASE 2.	TON
OVERHAUL (2000' FREEHAUL)	YD.-MI.

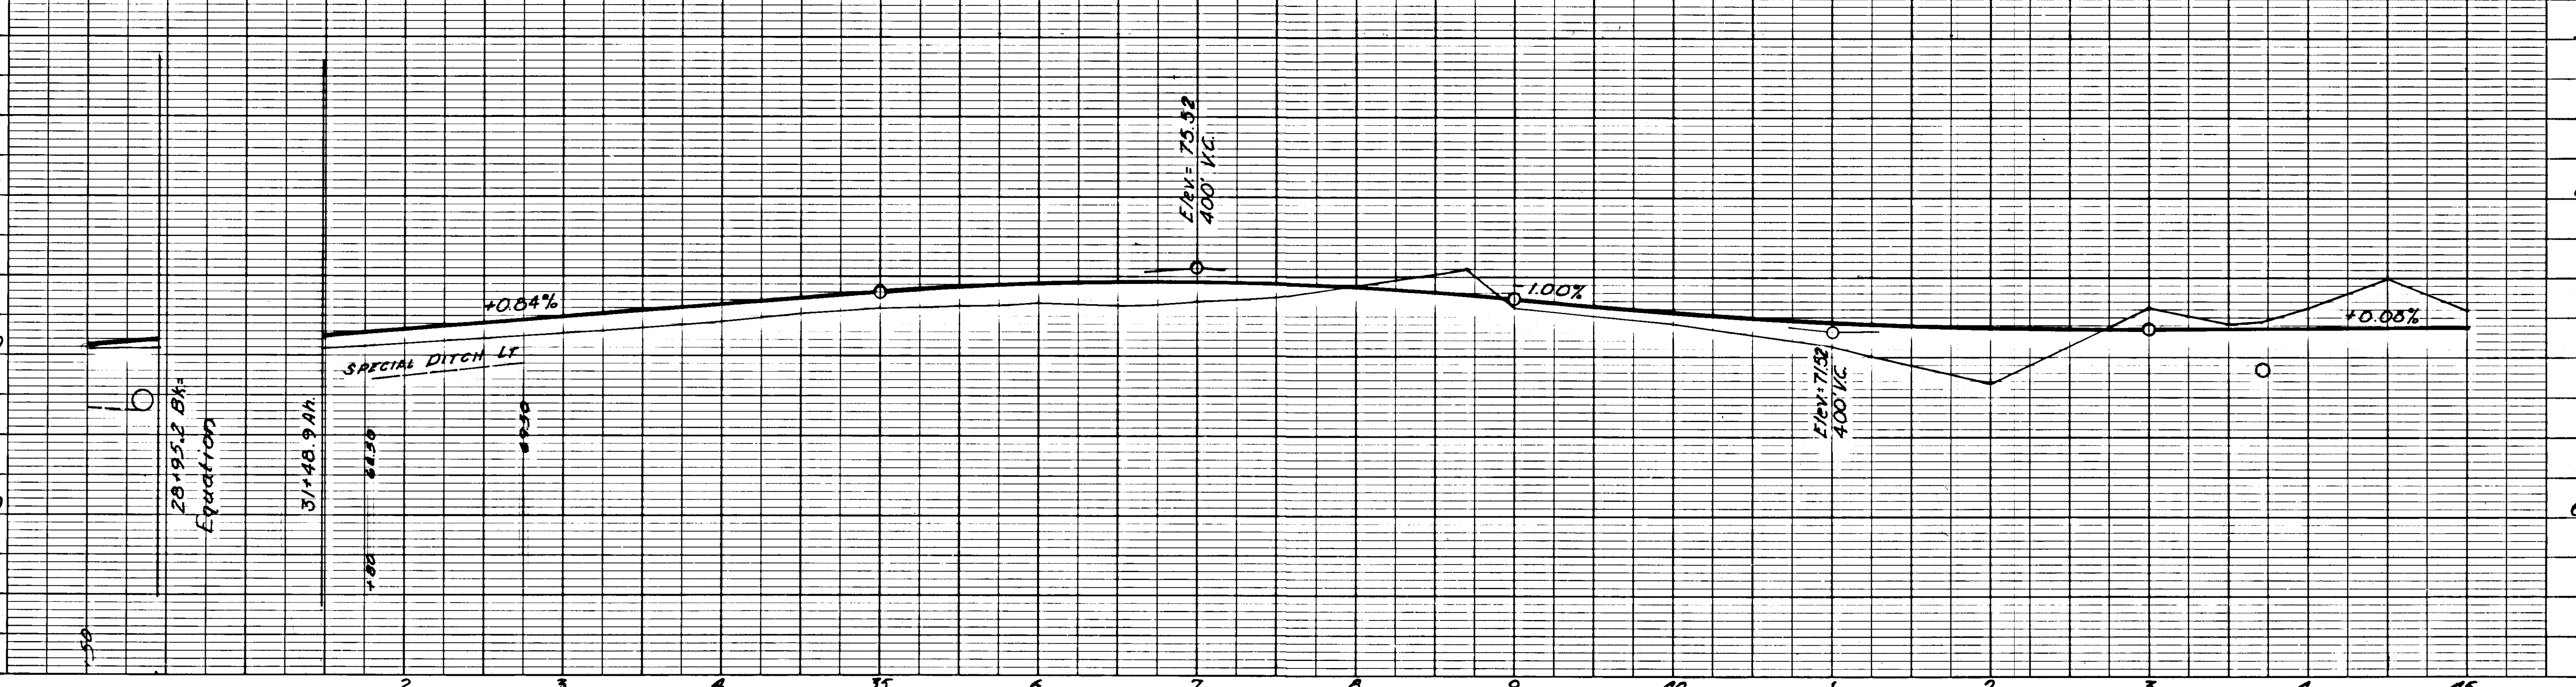

61+75 Remove 18"x26" C.M.P.
 61+66 Install 24"x56" Pipe Culvert
 63+10 Remove 18"x24" C.M.P.
 62+72 to 63+22 Install 50' Beam Type
 Guard Rail Rt.



63+50 Const Type 2 Appr. Rt.
 61+83.1 to 62+74.3 CONSTRUCT PARKING AREA RT.
 63+82.5 to 74+95 Install 1087.5' Beam Type
 Guard Rail, Rt.
 65+60 Install 24"x58" Pipe Culvert
 63+85 to 66+97.5 Install 312.5' Beam Type
 Guard Rail Rt.

67+00 Install 100' Beam Type Guardrail Rt.
 67+27 Remove 18"x24" C.M.P. Lt.
 67+25 to 68+25 Const. Turret Turnout Rt.
 68+60 to 73+97.5 Install 537.5' Beam Type Guardrail
 74+10.5 to 74+94.5 Install 75' Beam Type Guardrail

72+65 Remove 24"x42" C.M.P. Lt.
 72+92 Install 24"x56" Pipe Culvert
 73+00 to 74+00 Construct Parking Area, Lt.
 74+82 Remove 18"x26" C.M.P. Lt.
 Install 24"x54" Pipe Culvert

STATE	ROUTE	YEAR	SHEET NO.	TOTAL SHEETS
ALASKA	S-0970 (2)	1964	8	25

REVISIONS		
No.	Date	Description
		AS BUILT

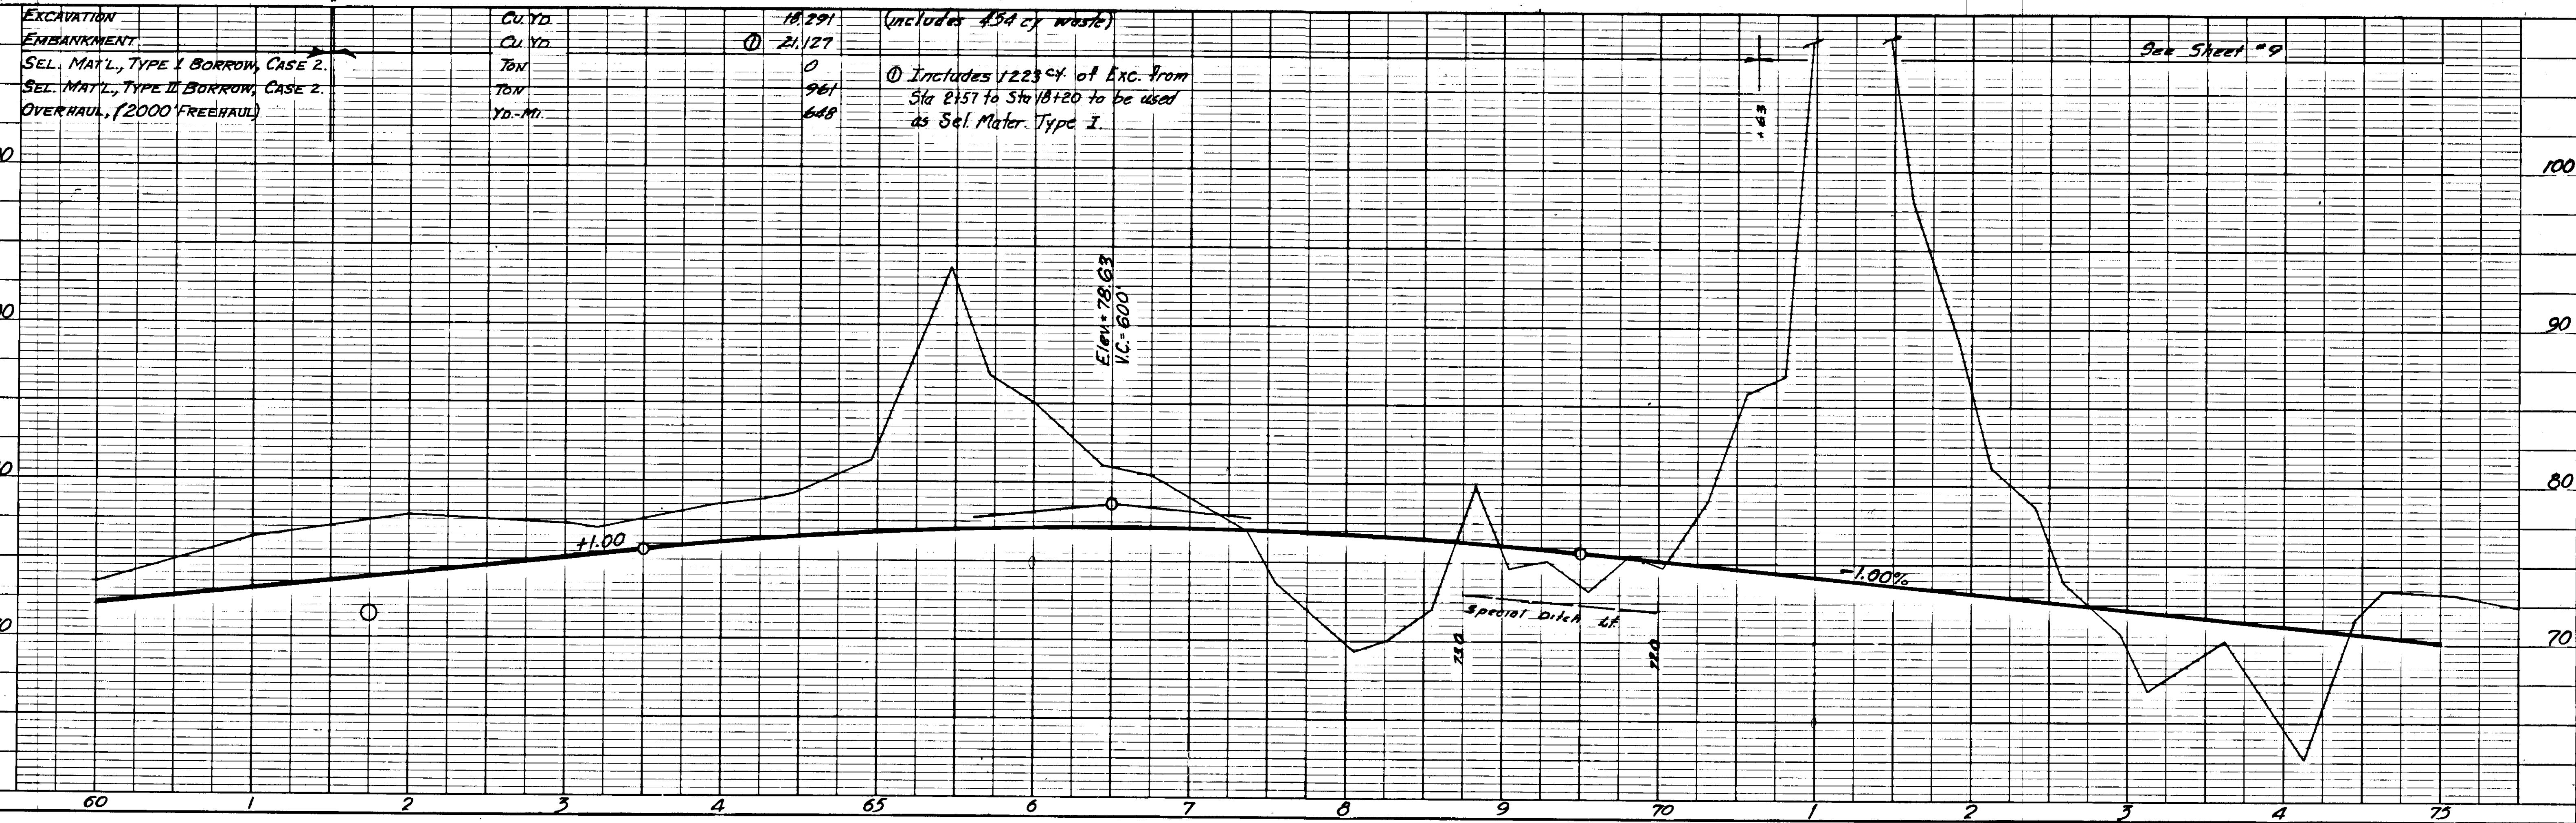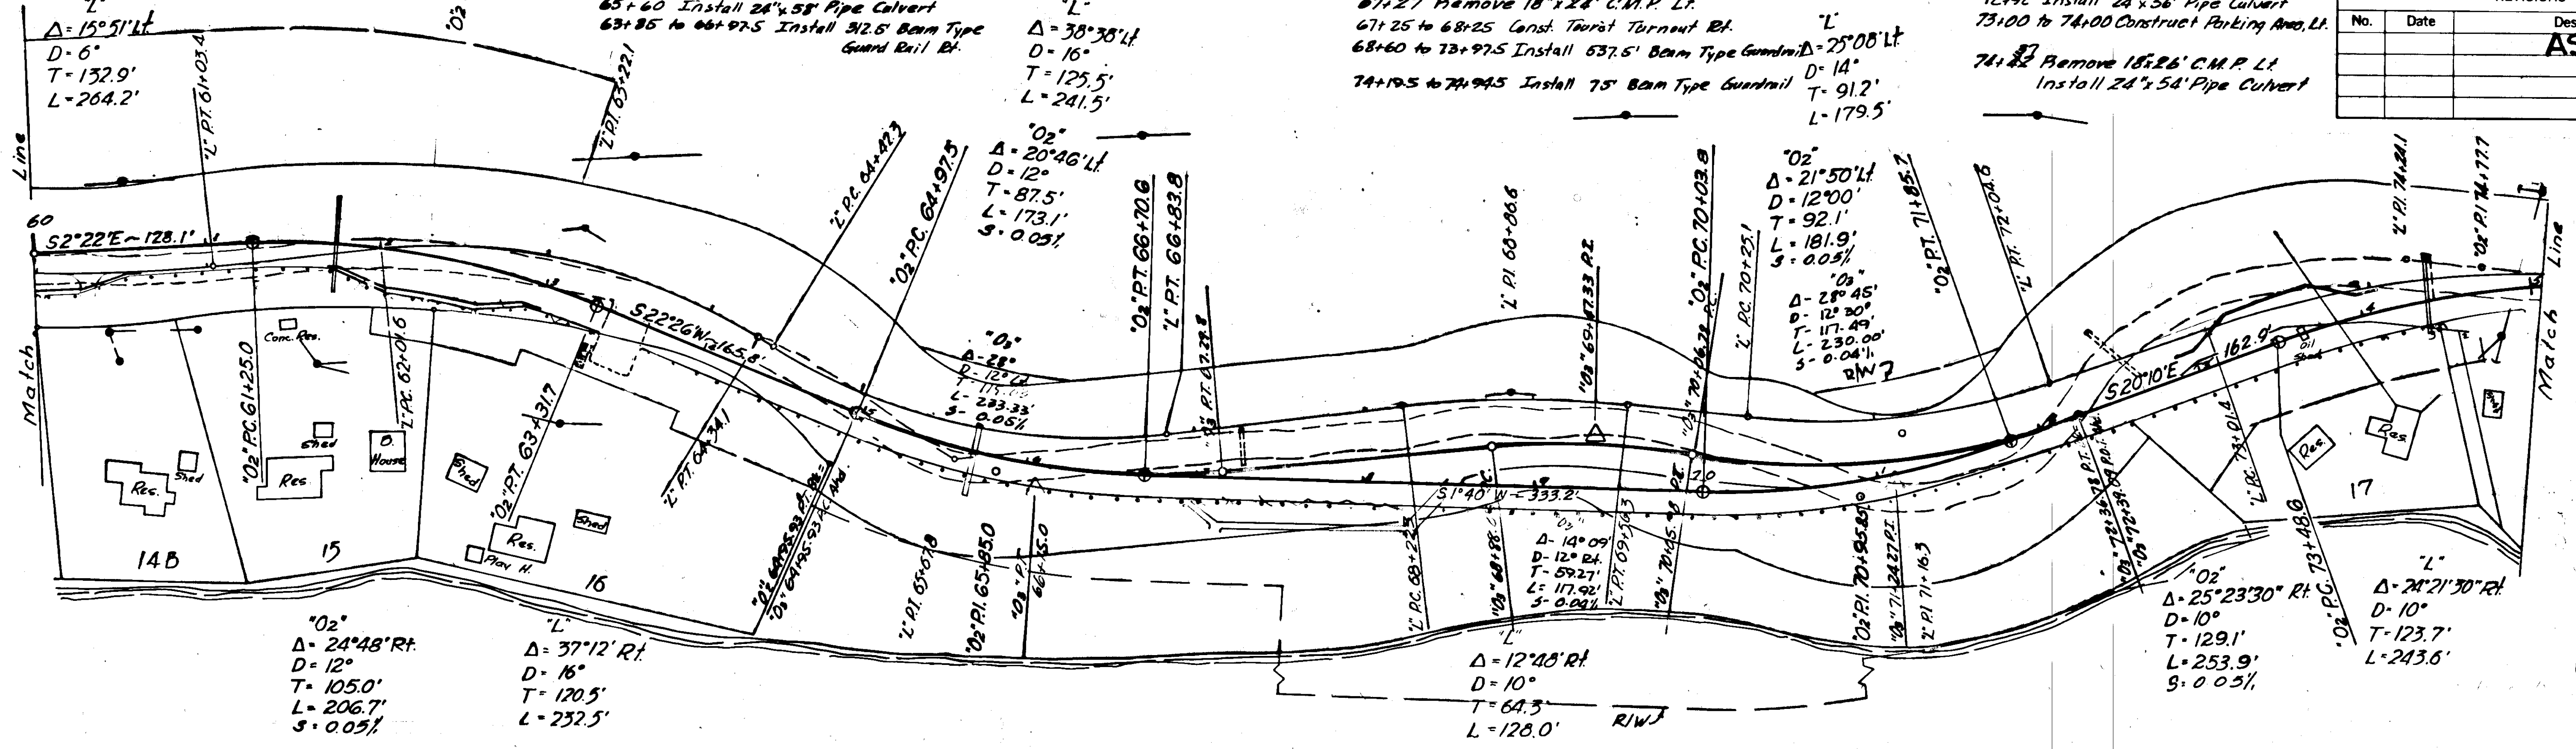


STATE	ROUTE	YEAR	SHEET NO.	TOTAL SHEETS
ALASKA	S-0970 (2)	1964	9	25

REVISIONS		
No.	Date	Description
		AS BUILT



- 75+40 Install 8"x10" Pipe Culvert
- 18" Sewer Bl. Al. Relocate water line as directed by Engineer
- 76+07 Construct Type 2 Approach Rt.
- 76+38 Install 8"x10" Pipe Culvert
- Sewer 42" Bl. Al. Relocate water line as directed by Engineer
- 77+00 Construct Type 2 Approach Rt.
- 78+40 Construct Type 2 Approach Rt.
- 79+45 CONSTRUCT TYPE 2 APPROACH RT.
- 78+20 Remove 12"x20" C.M.P.
- 76+40 Const. Type 2 Appr. Rt.
- 78+09 " " " Lt.
- Install 18"x32" Pipe Culvert
- 78+65 Const. Type 2 Appr. Rt.
- 80+30 Const. Type 2 Appr. Rt.
- 81+14 INSTALL 24"x30" Pipe Culvert
- REMOVE 18"x20" C.M.P.
- 82+31 Install 24"x32" Pipe Culvert
- 82+33 REMOVE 18"x22" C.M.P.
- 83+09 CONSTRUCT TYPE 2 APPROACH RT.
- Install 18"x32" Pipe Culvert
- 86+30 Remove 18"x17" C.M.P.
- Construct Type 2 Approach Lt.
- Install 18"x32" C.M.P.
- 86+75 Remove 12"x24" C.M.P.
- 87+77 Construct Type 1 Approach Rt. 20' Wide
- 87+08 Remove 8"x22" Steel Pipe

L = 36.59' Lt.
 D = 8°
 T = 239.5'
 L = 462.3'
 S = 0.04%

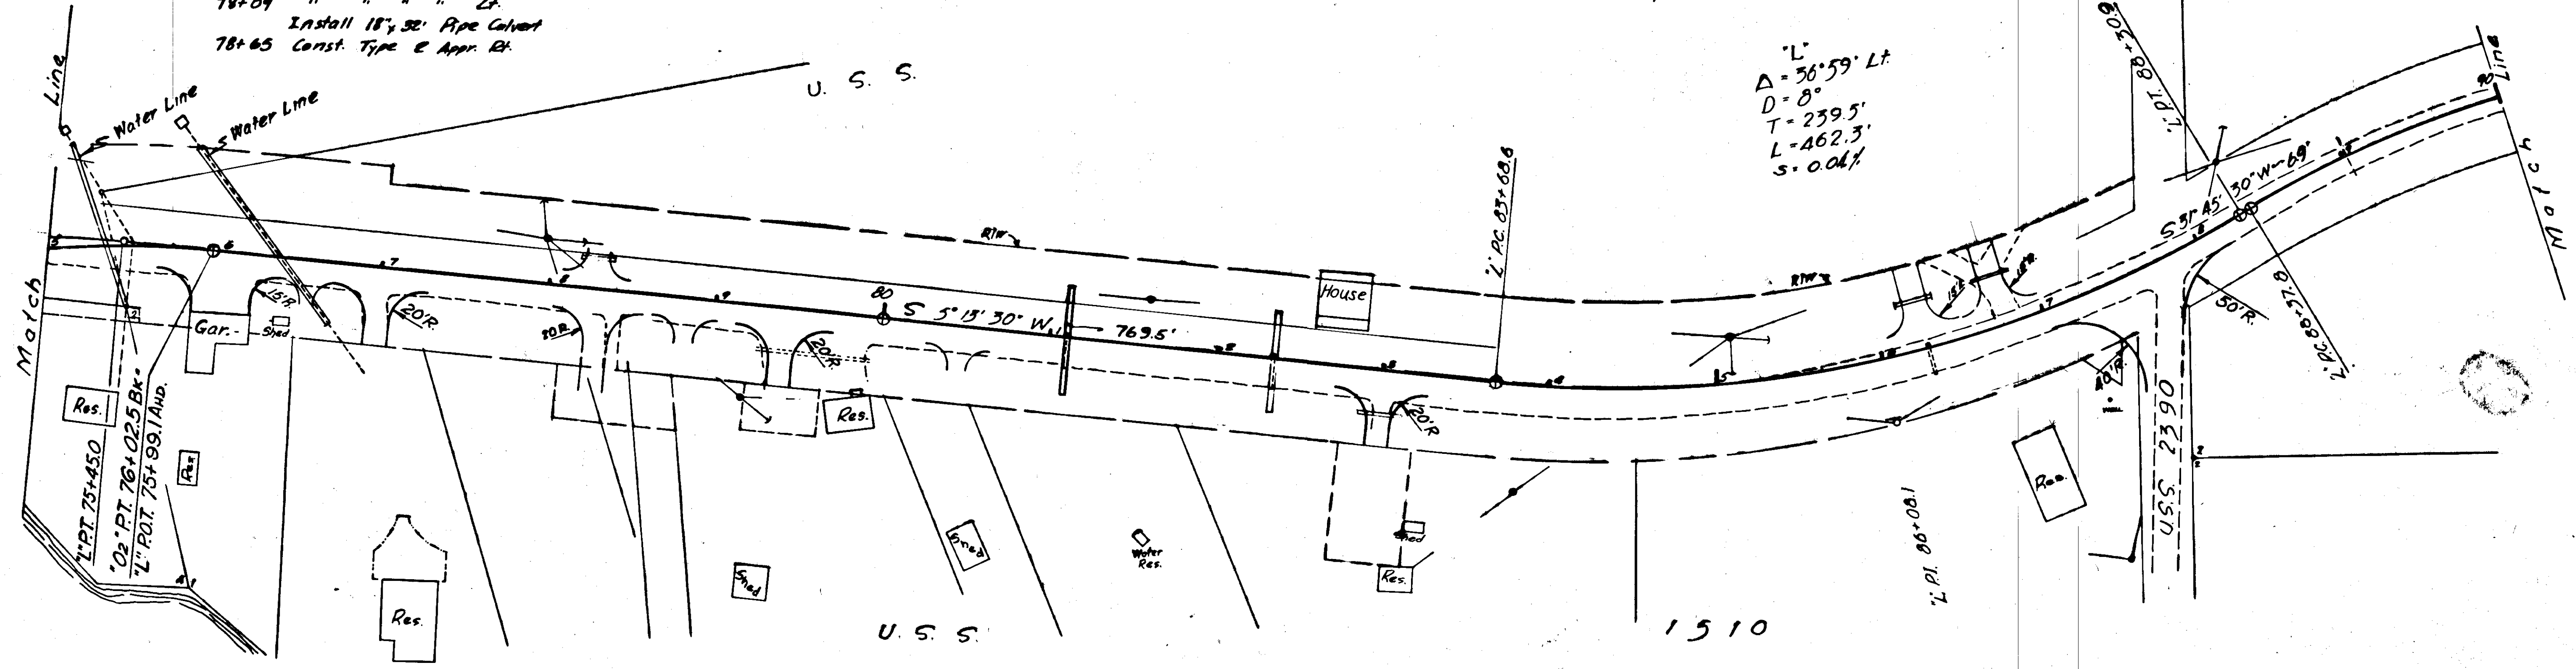


EXCAVATION	CU. YD.	27,424 (includes 10,571 waste)
EMBANKMENT	CU. YD.	30,794
SEL. MAT'L TYPE I BORROW, CASE 2	TON	0
SEL. MAT'L TYPE II BORROW, CASE 2	TON	5,280
OVERHAUL (2000' FREEHAUL)	YD.-MT.	12,992

Includes 2848 cu of Exc. from Sta 2+57 to Sta 18+20 to be used as Sol. Mater. Type I.

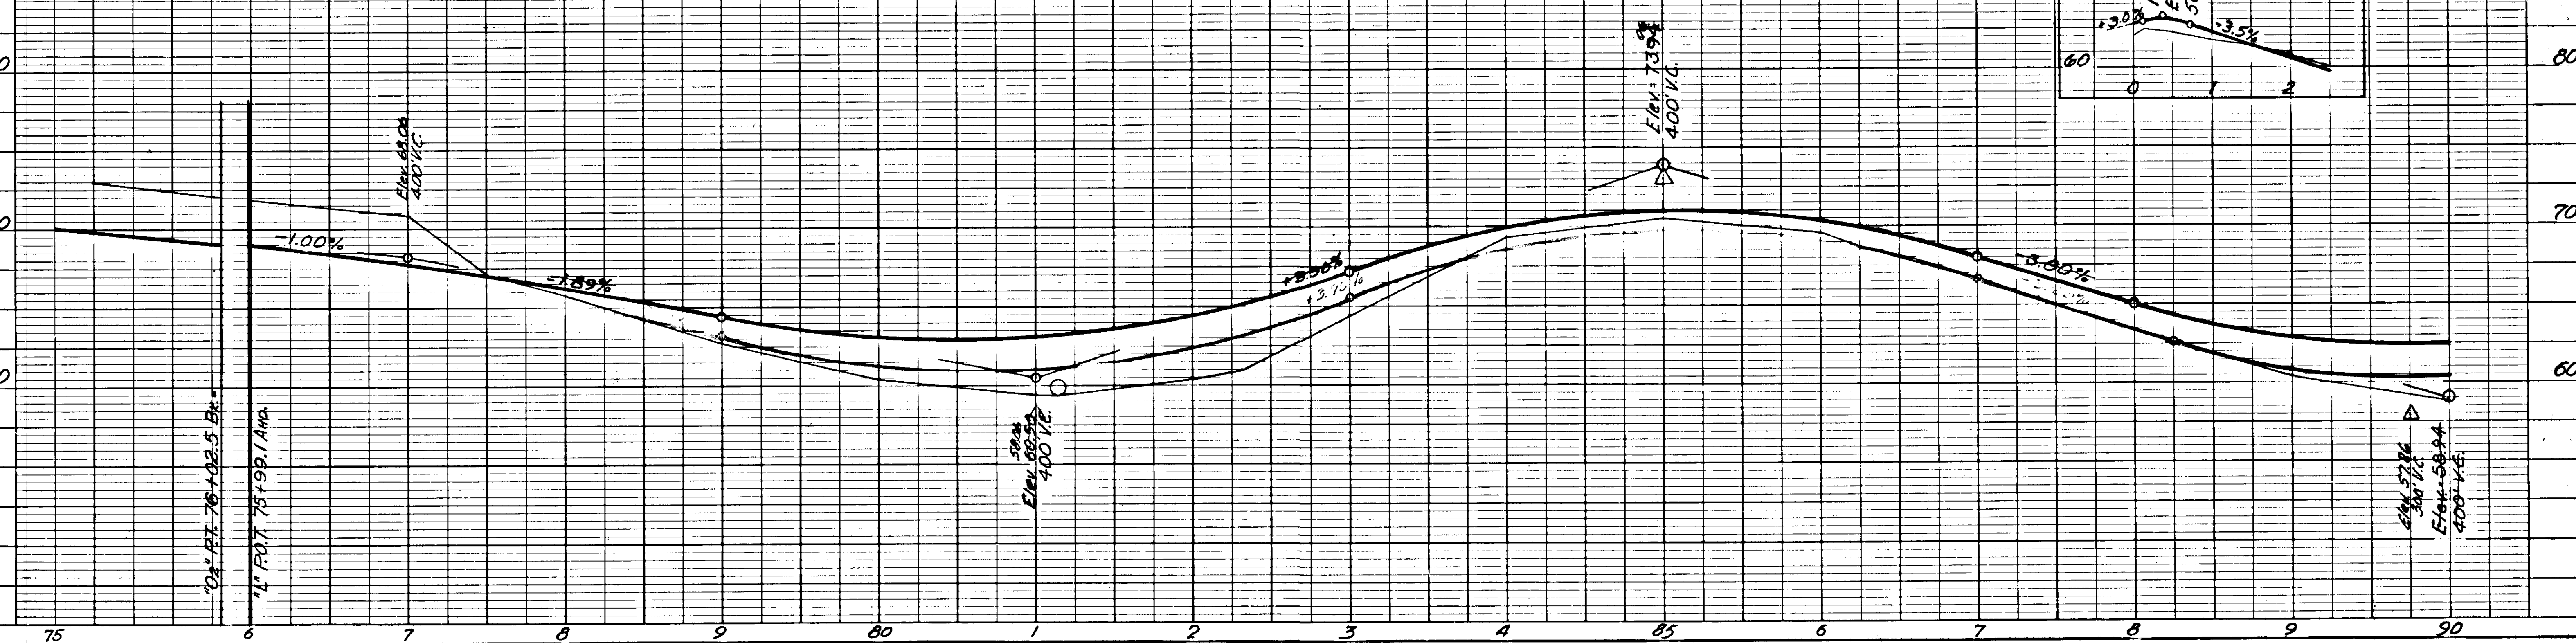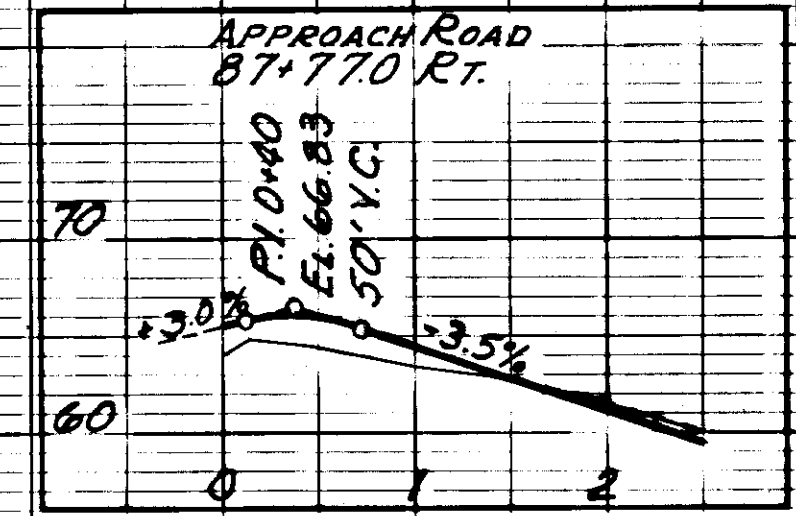

STATE	ROUTE	YEAR	SHEET NO.	TOTAL SHEETS
ALASKA	S-0970(2)	1964	10	2

REVISIONS		
No.	Date	Description
		AS BUILT

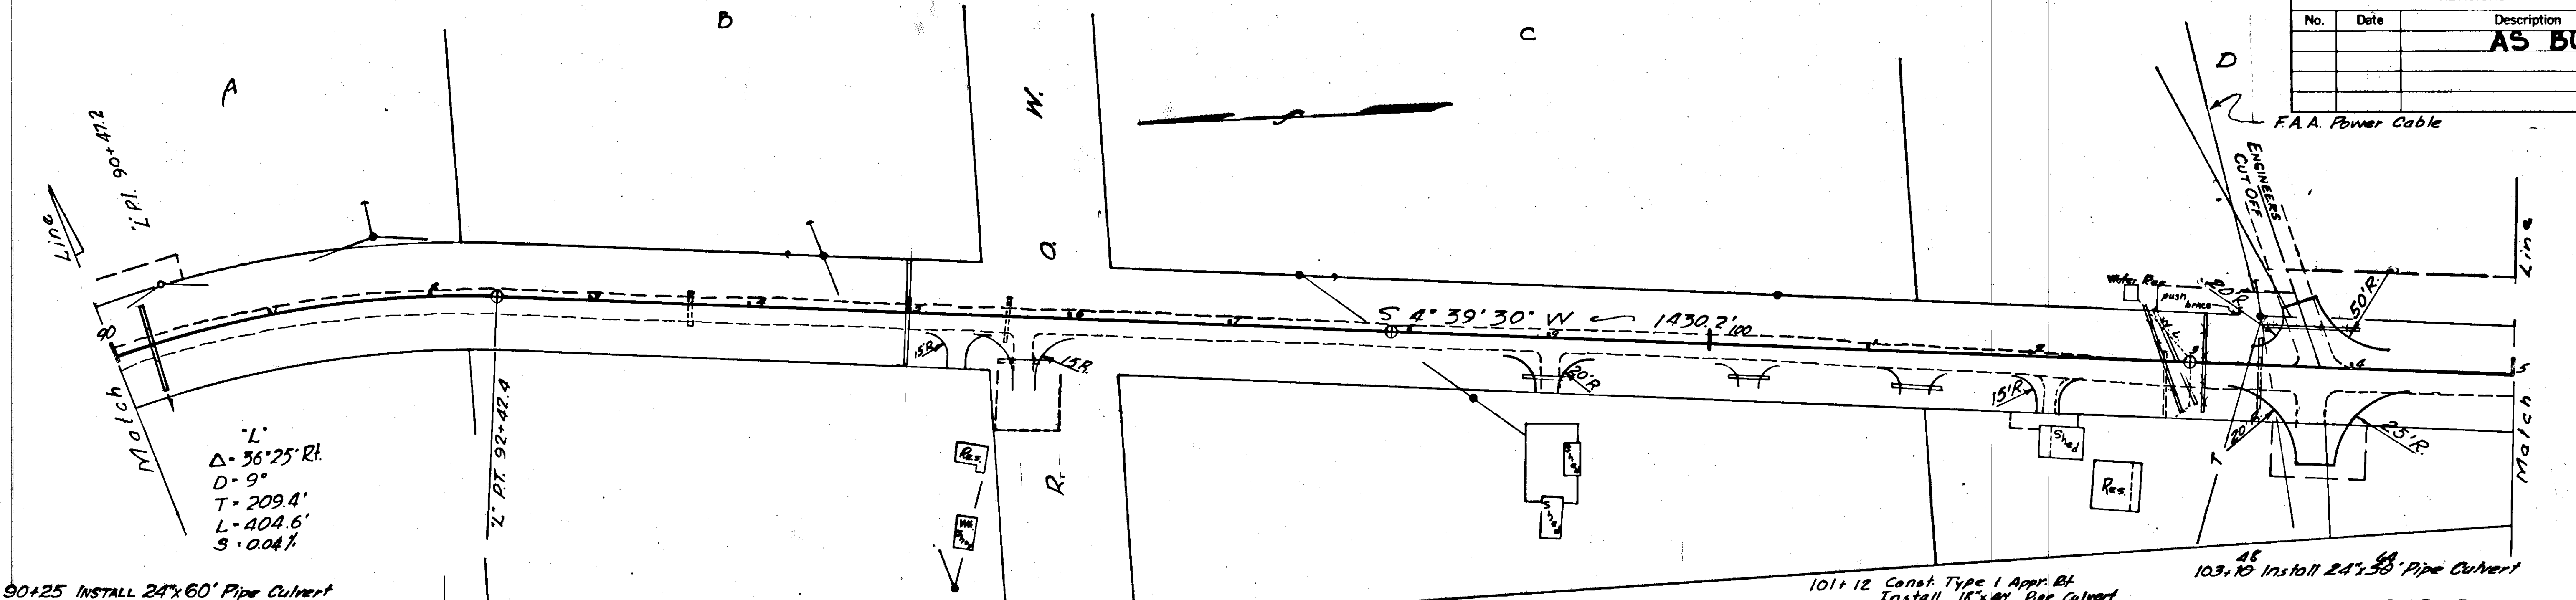

90+25 INSTALL 24"x60' Pipe Culvert
REMOVE 24"x20' C.M.P.

93+63 REMOVE 18"x20' C.M.P.
95+35 Install 18"x64' Pipe Culvert

95+00 Install 24"x60' Pipe Culvert
95+35 Construct Type 2 Approach Rt.
95+63 Remove 18"x26' C.M.P.
95+75 CONSTRUCT TYPE 2 APPROACH RT.
96+25 Remove 12"x20' C.M.P.
96+00 " " " 22' "
98+90 " " " 20' "

U.S.S. 1155

99+00 CONSTRUCT TYPE 2 APPROACH RT.
Install 18"x30' Pipe Culvert

100+05 Const. Type 2 Appr. Rt.
Install 18"x30' Pipe Culvert


101+12 Const. Type 1 Appr. Rt.
Install 18"x40' Pipe Culvert

102+10 Construct Type 2 Approach Rt.
102+22 Install 18"x30' Pipe Culvert
102+84 Remove 18"x41' C.M.P.
Install 8"x70' Pipe Culvert
Stew 21° Rt. Ab. Relocate water line as directed by Engineer.

102+95 Install 8"x53' Pipe Culvert

103+10 Install 24"x60' Pipe Culvert
103+44 REMOVE 18"x26' C.M.P.
103+80 CONSTRUCT TYPE 1 APPROACH LT. & RT.
Install 18"x60' Pipe Culvert Lt.

EXCAVATION	CU. YD.
EMBANKMENT	CU. YD.
SEL. MAT'L, TYPE I BORROW, CASE 2	TON
SEL. MAT'L, TYPE II BORROW, CASE 2	TON
OVERHAUL (2000' FREEHAUL)	Yd-Mi.

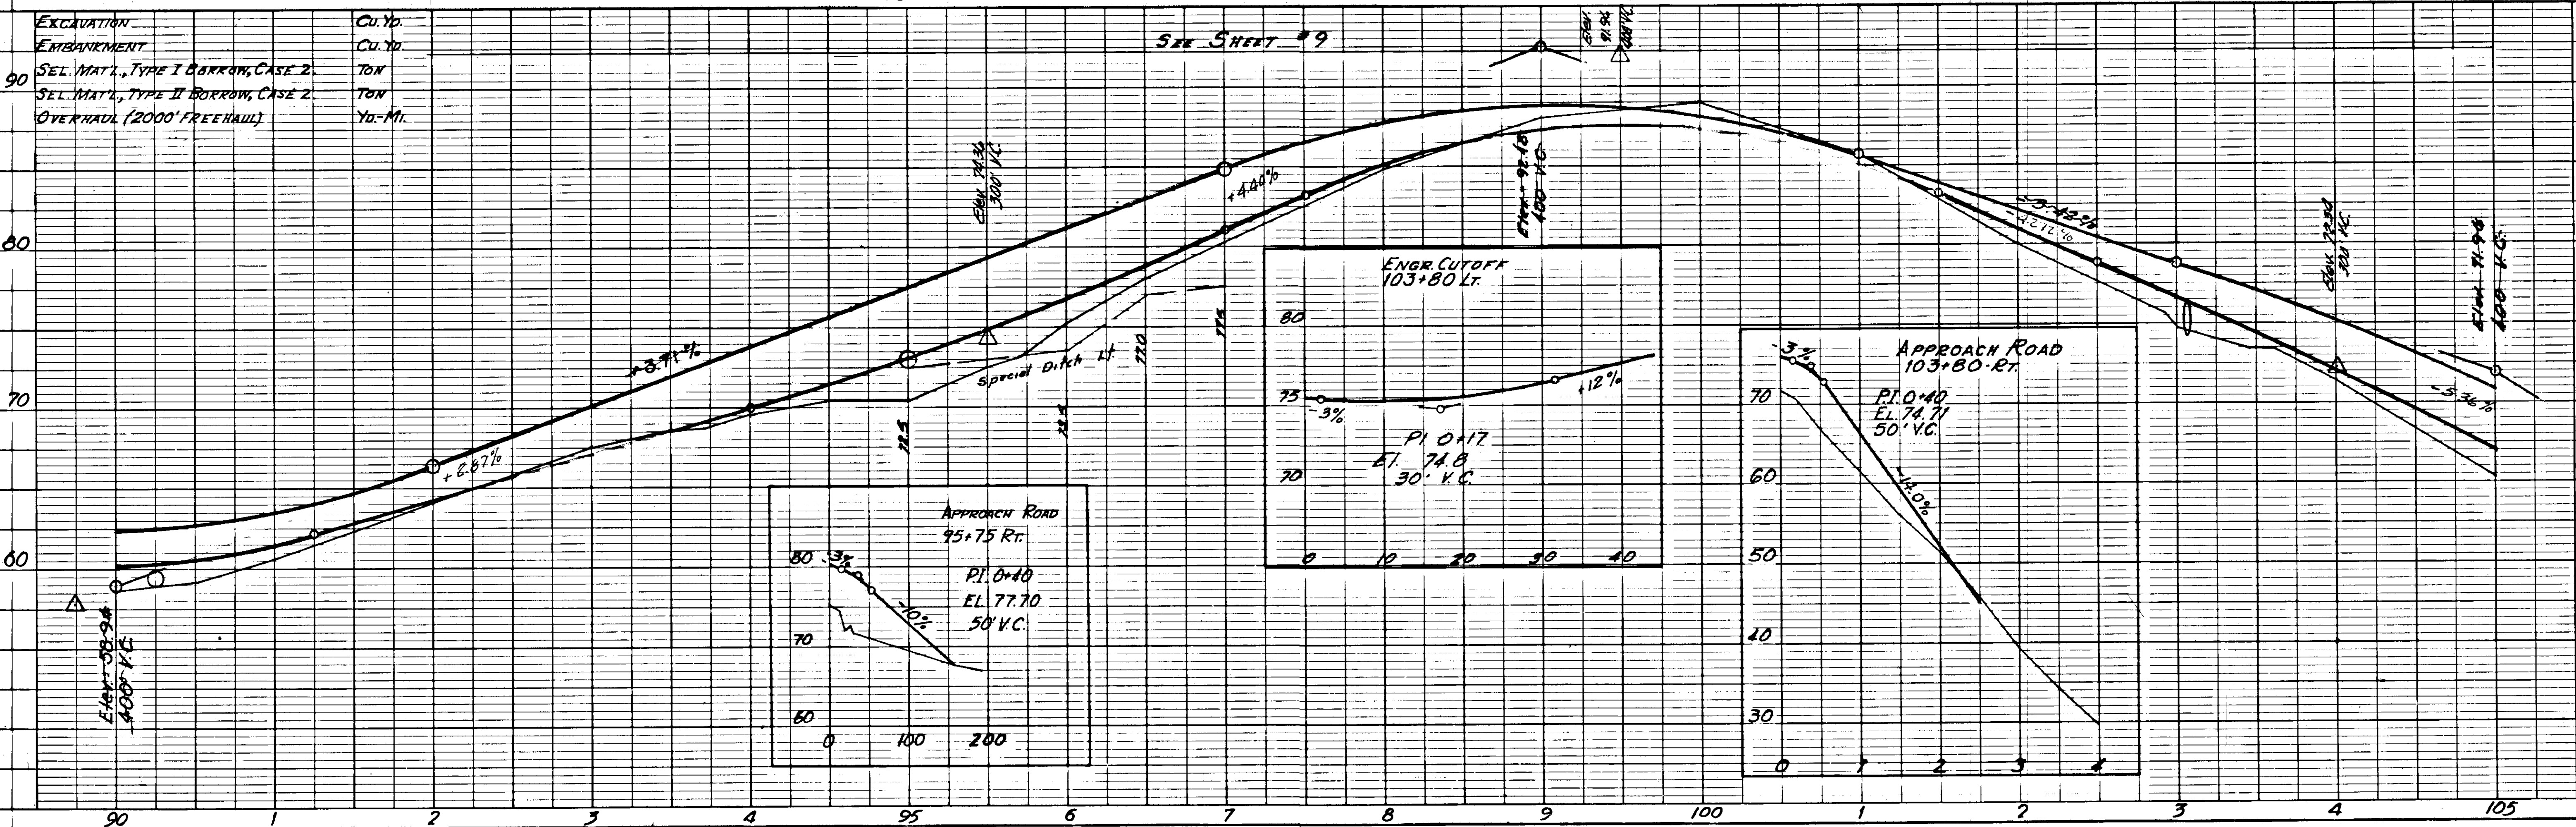

105+47 Remove 18"x16" C.M.P.
 106+00, 105+75 Construct Type 2 Approach Lt.
 Install 18"x26" Pipe Culvert
 106+80 Install 24"x52" Pipe Culvert
 107+10 Construct Type 2 Approach Lt.
 109+60 Construct Type 2 Approach Rt.

109+85 Remove 24"x20" Barrel Culvert
 109+85 Construct Type 2 Approach Lt.
 Install 18"x20" Pipe Culvert
 110+75 Remove 24"x18" C.M.P.
 110+90 Construct Type 2 Approach Rt.
 111+70 Install 24"x70" Pipe Culvert
 Skew 30° Rt. Ah.
 110+90 Remove 18"x22" C.M.P.



111+80 Construct Type 2 Approach Lt.
 Install 18"x30" Pipe Culvert
 Remove 18"x22" C.M.P.
 112+50 Construct Type 2 Approach Rt.
 112+79 to 114+51 Construct Parking Area Rt.
 113+90 Remove 12"x20" C.M.P. Lt.
 Construct Type 2 Approach Lt.
 Install 18"x28" Pipe Culvert
 112+50 Install 18"x30" Pipe Culvert

115+30 Remove 12"x20" C.M.P.
 Construct Type 2 Approach Lt.
 Install 18"x28" Pipe Culvert
 116+15 Remove 24"x18" C.M.P.
 117+60 Const. Type 2 Appr. Rt.

119+00 Construct Type 2 Approach Rt.

STATE	ROUTE	YEAR	SHEET NO.	TOTAL SHEETS
ALASKA	S-0970(2)	1964	11	25

REVISIONS		
No.	Date	Description
		AS BUILT

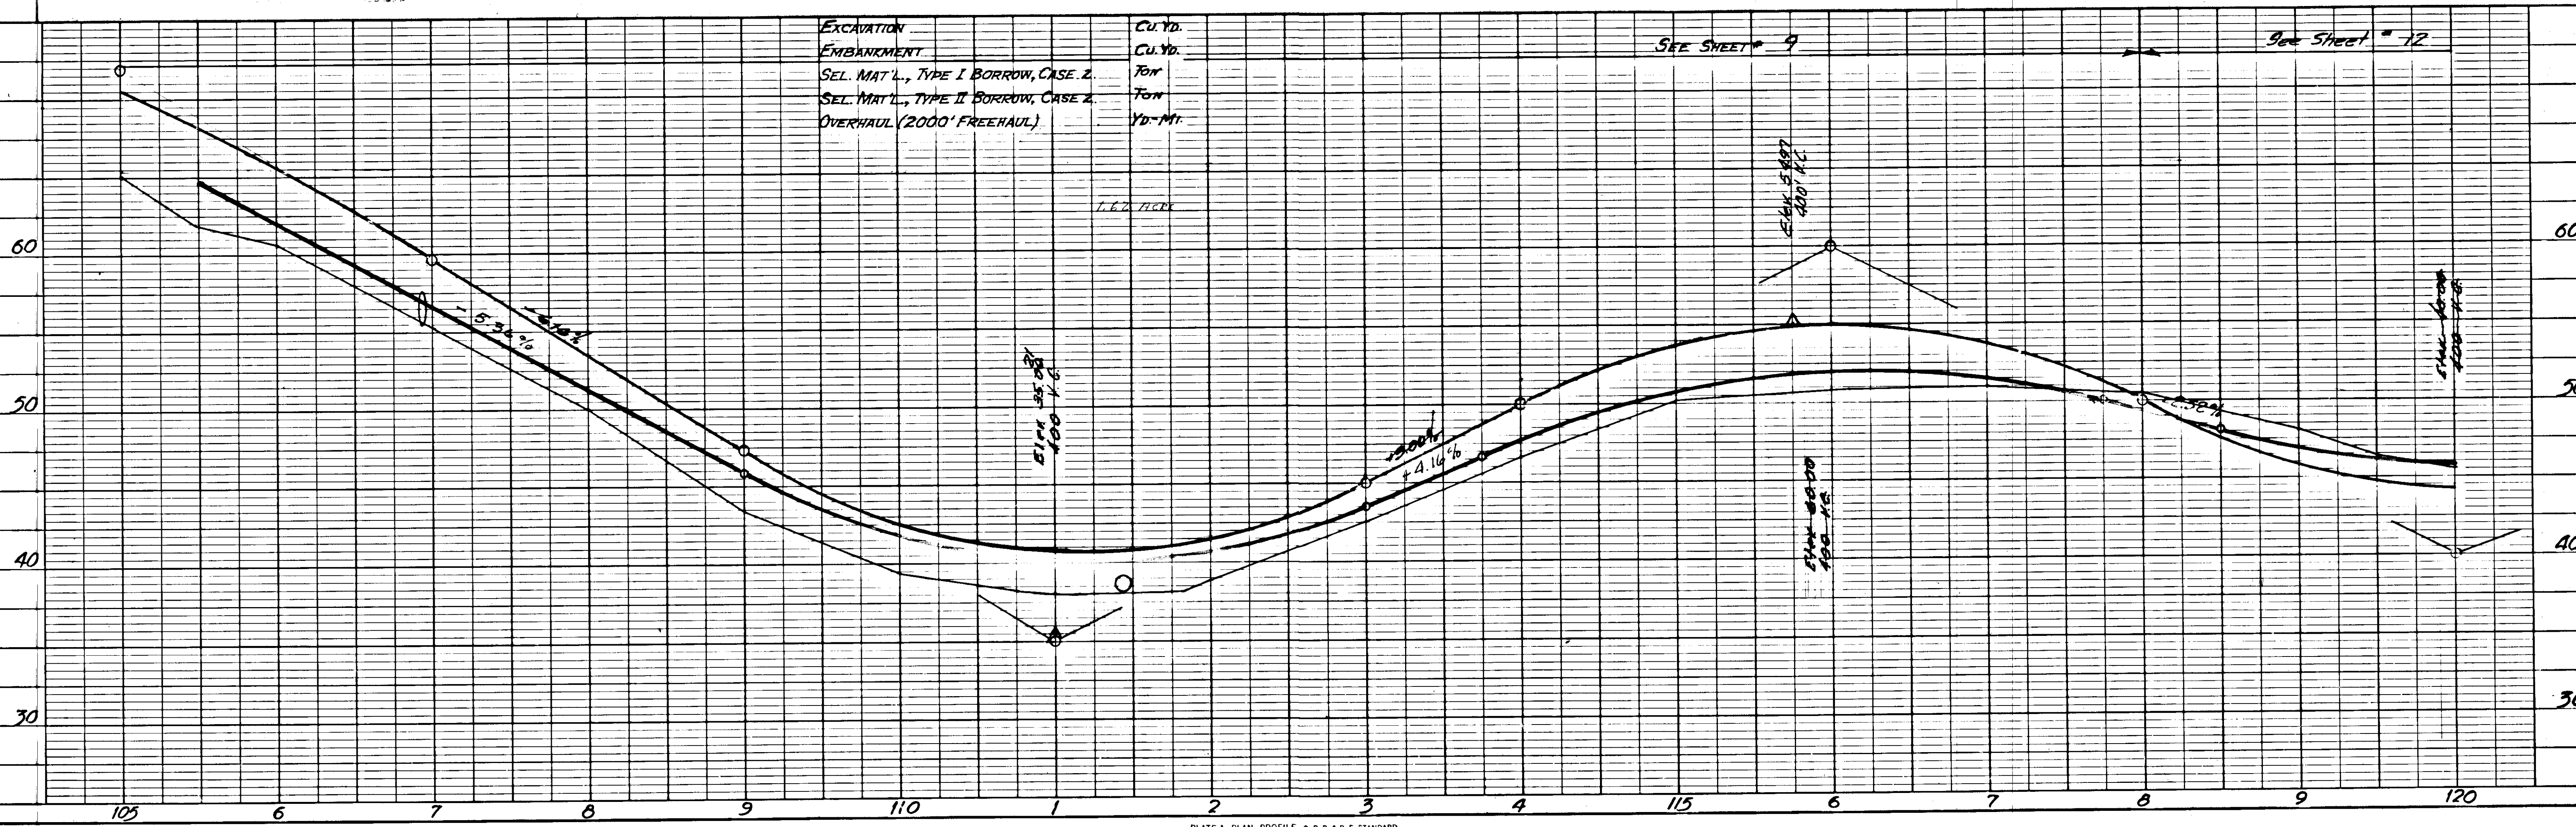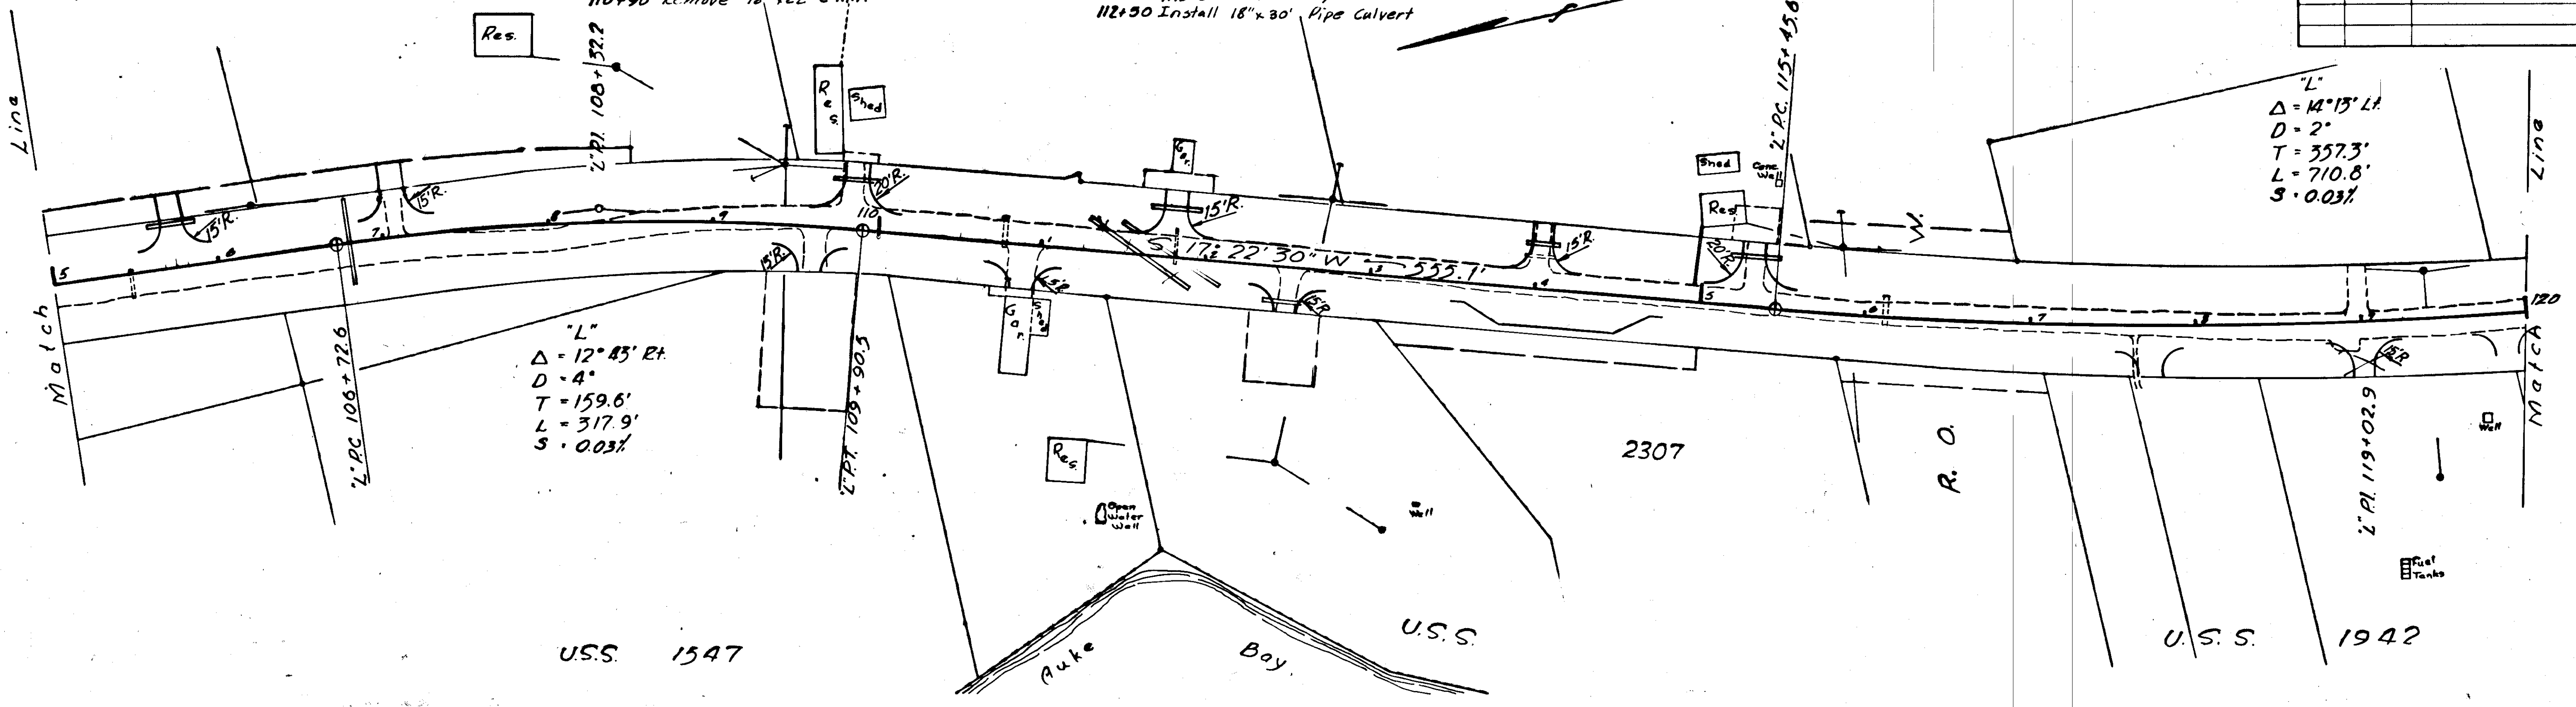

STATE	ROUTE	YEAR	SHEET NO.	TOT SHEETS
ALASKA	S-0970(2)	1964	12	23

REVISIONS		
No.	Date	Description
		AS BUILT


120+58 Const. Type 2 Appr. Lt.
 120+12 Remove 18"x20" C.M.P.
 Install 24"x36" Pipe Culvert, Ditch inlet
 120+30 Construct Type 2 Approach Rt.
 121+29 Construct Type 2 Approach Lt.
 4" Install 18"x36" Pipe Culvert
 121+57 Install 8"x76" Pipe Culvert
 5" x 16" At Atk Relocate water line as directed by Engineer.

121+40 Construct Type 2 Approach Rt.
 122+25 to 123+40 Construct Parking Area Rt.
 Install 1125 Beam type Guardrail with two Pedestrian Access opening
 123+10 Construct Type 2 Approach Lt.
 Install 18"x28" Pipe Culvert

123+20 Install 8"x38" Pipe Culvert
 Relocate water line as directed by Engineer.
 123+50
 124+25 CONSTRUCT TYPE 2 APPROACH LT.
 INSTALL 18"x36" Pipe Culvert
 124+25 REMOVE 18"x21" C.M.P.
 122+82 Const. Type 2 Appr. Rt.
 Install 18"x30" Pipe Culvert



126+25 CONSTRUCT TYPE 2 APPROACH RT.
 127+75 Remove 12"x20" C.M.P. Lt.
 Construct Type 2 Approach
 Install 18"x36" Pipe Culvert
 123+55 Const. Type 2 Appr. Lt.
 126+80 Const. Type 2 Appr. Lt.
 130+00 Install 18"x20" Pipe Culvert
 132+60
 130+00 Install 8"x70" Pipe Culvert

130+50 CONSTRUCT TYPE 2 APPROACH LT.
 INSTALL 18"x40' Pipe Culvert
 131+13 REMOVE 18"x24" C.M.P.
 131+75 Construct Type 2 Approach Rt.
 132+38 INSTALL 8"x60' Pipe Culvert
 Relocate water line as directed by Engineer
 132+70 Construct Type 2 Approach Rt.
 134+00 Remove 18"x20" C.M.P.
 Install 24"x36" Pipe Culvert
 134+15 Remove 12"x20" C.M.P.
 Construct Type 2 Approach Lt.

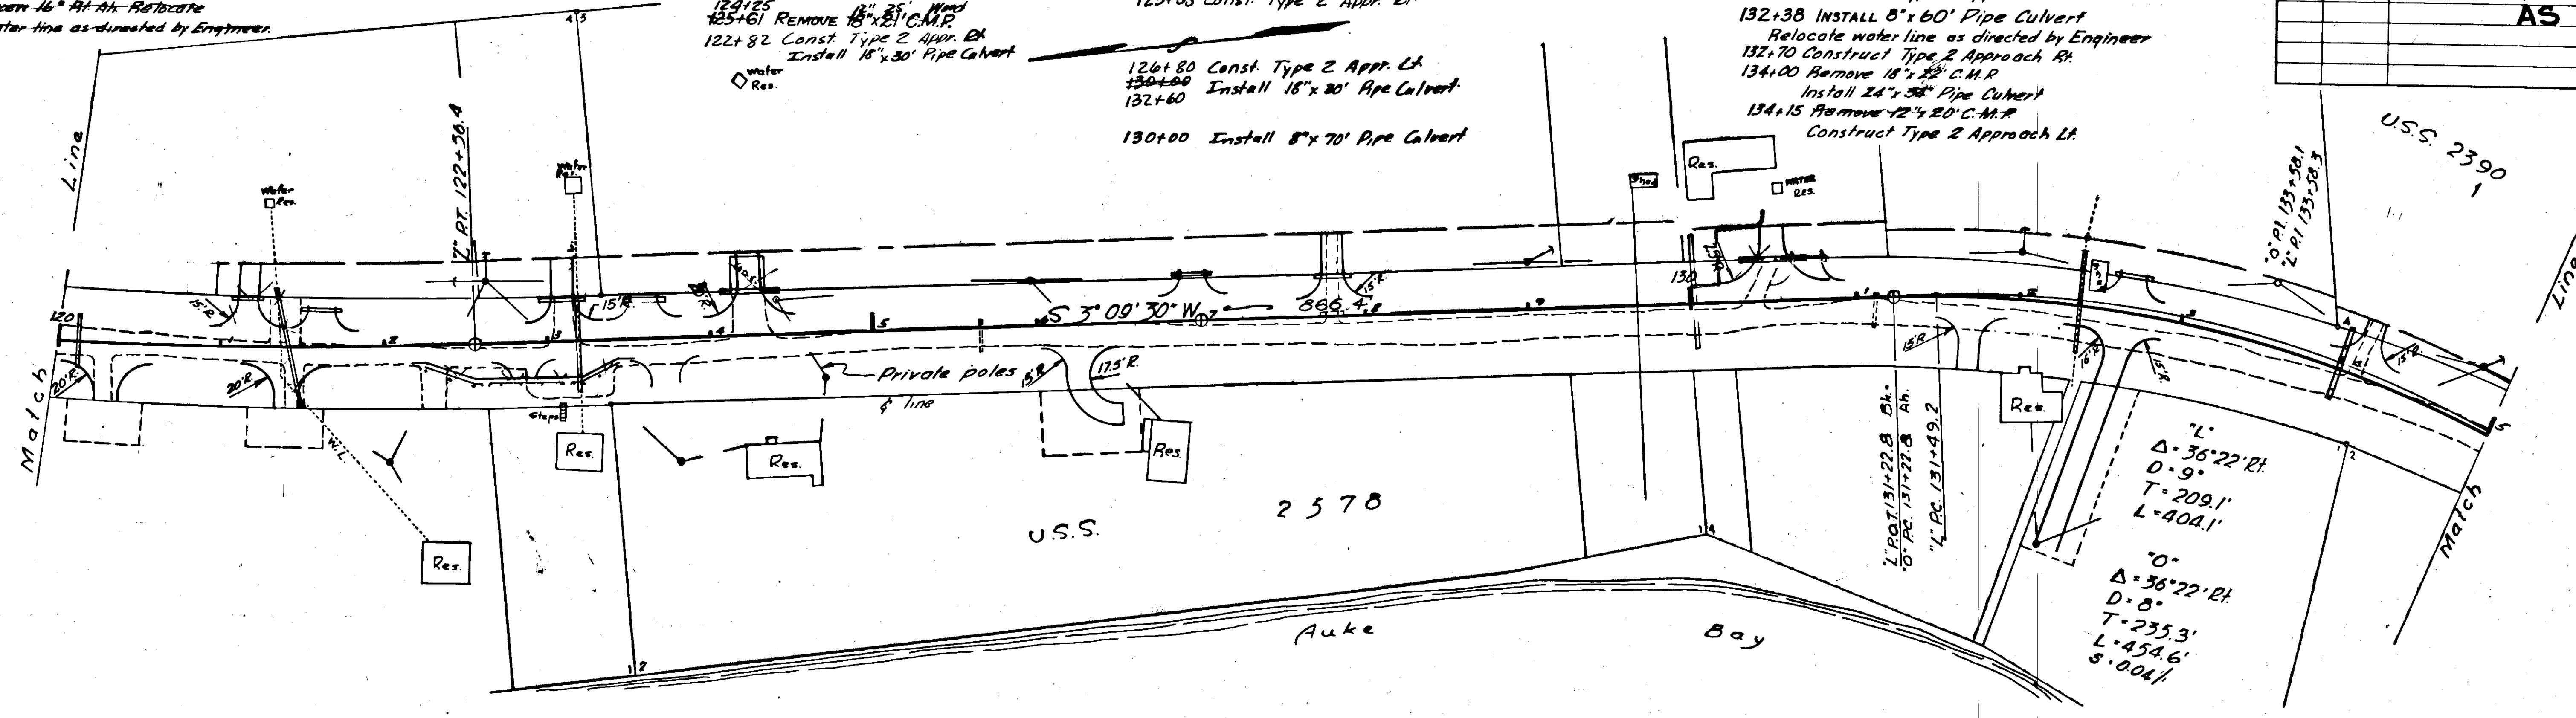

EXCAVATION	Cu. Yd.	10626	(includes 6% of ex. waste)
EMBANKMENT	Cu. Yd.	10211	
SEL. MAT'L, TYPE I BORROW, CASE 2, TON		5850	
SEL. MAT'L, TYPE II BORROW, CASE 2, TON		1338	
OVERHAUL (2000' FREEHAUL), Yd-Mi.		7363	

Includes 25% of ex. from Sta 2751 to Sta 18120 to be used as Sel. Mater Type I.

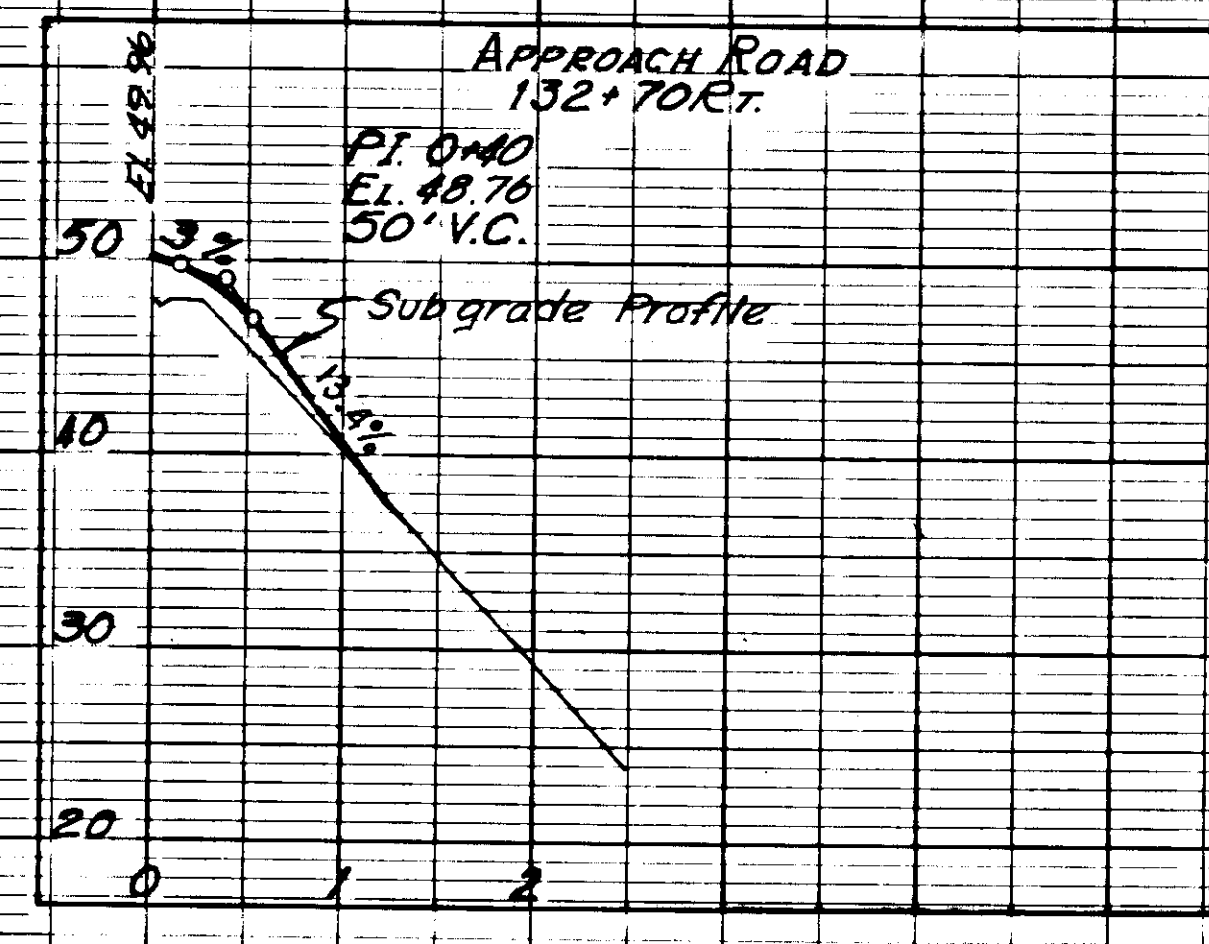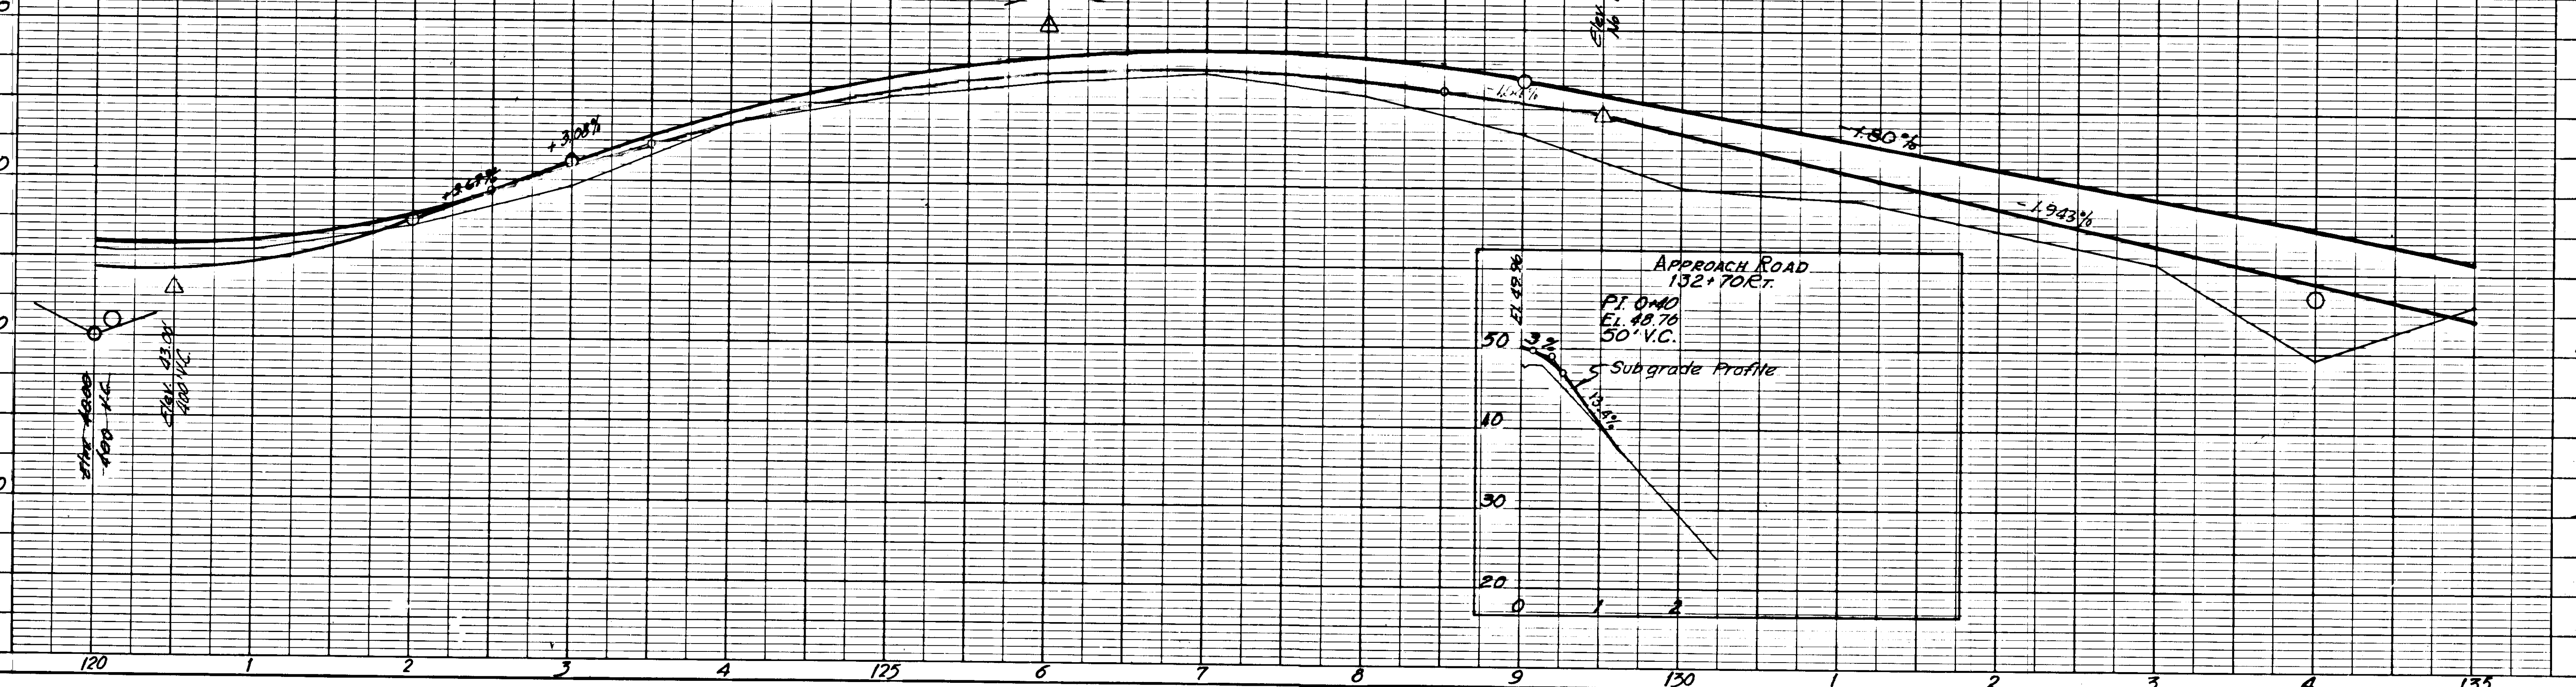

LIST OF CULVERTS AND MISCELLANEOUS WORK

STATE	PROJECT DESIGNATION	YEAR	SHEET NO.	TOTAL SHEETS
ALASKA	S-0970 (2)	1964	14	25

STATION	CONSTRUCT APPROACH	EXCAVATION FOR STRUCTURES	REMOVAL OF CULVERT	8" PIPE CULVERT	16" PIPE CULVERT	24" PIPE CULVERT	CULVERT MARKER POSTS	BEAM - TYPE GUARDRAIL	FILL HEIGHT	REMARKS
02+3.40		28				100	2		5'	skew 40° Lt. Bk.
02+5.70			38							
02+7.00						68	2		9'	Ditch Inlet
02+7.15	2							50		Fish & Game Rd.
02+10.00 to 11+50								150		
02+12.90			40							
02+13.50 to 14+12.5								62.5		
02+14.35	2									
02+14.50 to 15+25								75		
02+16.64			21							
02+18.25	2									
02+18.50 to 20+00								150		
02+19.04	2				38					
02+19.50			22							
02+19.42					78					skew 5° Lt. Ah.
02+19.80			14			90	2		16'	
02+19.93			28							
02+20.50 to 21+17										Parking Area
02+21.58 to 02+22.50										Parking Area
02+23.50 to 25+50								100		
02+23.25	2				34					
02+23.43			25							
02+23.50		5				66	2		9'	
02+24.50	2									
02+26+12			45							
02+26+36	2				34					Parking Area
02+26.50 to 27+50										
02+26.75 to 27+75								100		
02+27+80			50							skew 2° Lt. Ah.

LIST OF CULVERTS AND MISCELLANEOUS WORK

STATE
ALASKA

PROJECT DESIGNATION	YEAR	SHEET NO.	TOTAL SHEETS
S-0970 (2)	1964	16	25

STATION	CONSTRUCT APPROACH	103(I)	457(I)	453(5A)	453(5E)	453(5G)	560(3)	583(I)													
		EXCAVATION FOR STRUCTURES	REMOVAL OF CULVERT	8" PIPE CULVERT	18" PIPE CULVERT	24" PIPE CULVERT	CULVERT MARKER POSTS	BEAM-TYPE GUARDRAIL	CU. YD.	LIN. FT.	LIN. FT.	LIN. FT.	LIN. FT.	EACH	LIN. FT.						
"L" 50+17		54	49			76	2														
"L" 53+35	2																				
"L" 53+48				82																	
"L" 53+88			20																		
"L" 55+50	2																				
"L" 56+25 to 56+85																				Parking Area	
"L" 57+04.4 to 63+36.8								625												(d) Pedestrian Opening	
"L" 57+10		23	18			56	2													8' Ditch Outlet	
"L" 57+79.4 to 60+45.6																					Parking Area
"O2" 61+75		10	26			56	2														3' Parking Area
"O2" 61+83.1 to 62+74.3																					Parking Area
"O2" 63+62.5 to 74+50								1087.5													
"O2" 67+27			24																		
"O2" 72+65			42																		
"O2" 73+00 to 74+00																					Parking Area
"O2" 74+42		15	26			54	2														5' Parking Area
"O2" 75+40				104																	Skew 18° Rt. Ah.
"L" 76+07	2																				
"L" 76+38				130																	Skew 42° Rt. Ah.
"L" 77+00	2																				
"L" 78+40	2																				
"L" 79+45	2																				
"L" 81+14		8	20			50	2														4'
"L" 82+33			22																		
"L" 83+00	2																				
"L" 86+30	2		17		32																
"L" 86+75	2				32																
"L" 87+77	1																				20' Wide
"L" 89+08			25																		4" Steel Pipe
67+25 - 68+25																					tourist turnout

STATION	CONSTRUCT APPROACH	EXCAVATION FOR STRUCTURES	REMOVAL OF CULVERT	8" PIPE CULVERT	18" PIPE CULVERT	24" PIPE CULVERT	CULVERT MARKER POSTS	BEAM-TYPE GUARDRAIL	CU. YD.	LIN. FT.	LIN. FT.	LIN. FT.	LIN. FT.	EACH	LIN. FT.	FILL HEIGHT	REMARKS

AS BUILT

