



FILE: Q:\Jnu\00041\TR\0933045\_Glacier Hwy Safety Improvements\0933045\_A2 Legend.dwg  
 REVISION: 6/24/2016 8:41  
 LAYOUT: HWYS LEGEND SCALE:  
 DESIGNED: POWERS  
 DRAWN: POWERS  
 CHECKED: STATEWIDE COORDINATION TEAM


NO.	DATE	REVISION	STATE	PROJECT DESIGNATION	YEAR	SHEET NO.	TOTAL SHEETS
			ALASKA	SFWHY00041	2016	A2	9

	RECOVERED	SET
BLM MONUMENT		
GLO MONUMENT		
USC&GS MONUMENT		
PRIMARY MONUMENT		
CENTERLINE MONUMENT IN CASING		
PRIMARY R.O.W. MONUMENT		
BEARING OBJECT		
MISCELLANEOUS MONUMENT		
LINE OF SIGHT MONUMENT		
CONCRETE R.O.W. MONUMENT		
BENCHMARK		
REBAR AND CAP		
REBAR		
IRON PIPE		
PK NAIL		
SPIKE		
HUB AND TACK		
CONSTRUCTION CENTERLINE		
MICELLANEOUS CENTERLINE		
STATION EQUATION		
PROJECT RIGHT-OF-WAY LINE		
EXISTING RIGHT-OF-WAY LINE		
EXISTING PROPERTY LINE		
CONTROLLED ACCESS LINE		
EXISTING EASEMENT LINE		
PROPOSED EASEMENT LINE		
PROPOSED CUT SLOPE LIMIT		
PROPOSED FILL SLOPE LIMIT		
SECTION LINE		
1/4 SECTION LINE		
1/16 SECTION LINE		
TOWNSHIP & RANGE LINE		
MEANDER LINE		

	EXISTING	PROPOSED
SANITARY SEWER (FLOW DIRECTION →)		
FUEL LINE		
GAS LINE		
WATER LINE		
METER, VALVE, FIRE HYDRANT		
EXISTING STORM DRAIN (FLOW DIRECTION →)		
PROPOSED STORM DRAIN		
FIBER OPTIC LINE		
DIRECT BURIAL TELEPHONE CABLE		
DIRECT BURIAL ELECTRIC CABLE		
ELECTRIC LINE (OVERHEAD)		
POWER POLE LINE		
JOINT USE POWER & TELEPHONE		
TELEPHONE POLE LINE		
POLE ANCHOR		
STUB POLE (POWER OR TELEPHONE)		
TELEPHONE DUCT		
TELEPHONE PEDESTAL		
BURIED CABLE MARKER		
PIPELINE MARKER OR VALVE		
CATCH BASIN OR DROP INLET		
MANHOLE		
SANITARY SEWER CLEAN OUT		

	EXISTING	PROPOSED
ROADWAY/PAVEMENT EDGE		
FENCE		
CURB AND GUTTER		
DETECTABLE WARNINGS		
GUARDRAIL		
CULVERT PIPE		
SIGN		
MAILBOX		
RAILROAD TRACKS		
RAILROAD DEVICES		
TREE LINE		
WATER BOUNDARY		
ORDINARY HIGH WATER LINE		
FLOW CENTERLINE		
FLOW DIRECTION		
WETLANDS		
EXISTING BUILDINGS		
POST OR BOLLARD		
WELL OR MONITORING WELL		
SEPTIC PIPE		
FUEL TANK FILL PIPE/VENT		
SATELLITE DISH		
TEST HOLE		
CONIFER TREE		
DECIDUOUS TREE		
GRAVE		
THERMOSIPHON		
PARKING METER		
VEHICLE PLUG-IN		
DELINEATOR/GUIDE MARKER		

	EXISTING	PROPOSED
JUNCTION BOX, TYPE IA		
JUNCTION BOX, TYPE II		
JUNCTION BOX, TYPE III		
SIGNAL FACE, VEHICULAR		
SIGNAL FACE, BACKPLATE		
SIGNAL FACE, LEFT TURN, BACKPLATE		
SIGNAL FACE, PEDESTRIAN		
LOOP DETECTOR		
VIDEO DETECTOR		
RADAR DETECTOR		
OPTICOM DETECTOR		
PEDESTRIAN PUSH BUTTON		
SIGNAL POST W/O MAST ARM		
SIGNAL POLE W/MAST ARM		
SIGNAL CONTROLLER		
LOAD CENTER		
LUMINAIRE		
RIGID METAL CONDUIT		

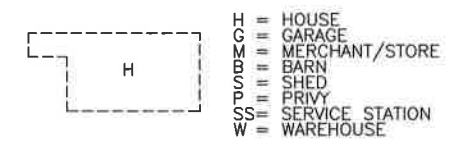

6860 GLACIER HIGHWAY  
 JUNEAU, AK 99811  
 (907) 465-1763



STATE OF ALASKA  
 DEPARTMENT OF TRANSPORTATION  
 AND PUBLIC FACILITIES  
 JNU GLACIER HWY  
 SAFETY IMPROVEMENTS  
 (HSIP)  
 LEGEND

6-27-16


ADDENDUM NUMBER		
ATTACHMENT NUMBER		
RECORD OF REVISIONS		
No.	DATE	DESCRIPTION

JNU GLACIER HIGHWAY  
 SAFETY IMPROVEMENTS  
 (HSIP)

GUARDRAIL TYPICAL SECTION  
 AND DETAILS

6860 GLACIER HIGHWAY  
 JUNEAU, AK 99811  
 (907) 465-1763

DESIGNED BY: D. EPSTEIN

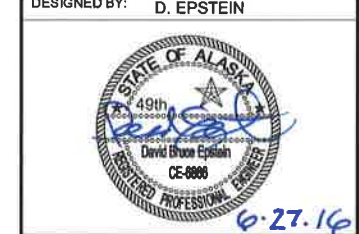

CHECKED BY: D. EPSTEIN  
 DRAWN BY: D. STEVENS


STATE OF ALASKA  
 DEPARTMENT OF TRANSPORTATION  
 & PUBLIC FACILITIES  
 SOUTHCOST REGION

JNU GLACIER HIGHWAY  
 SAFETY IMPROVEMENTS  
 (HSIP)

GUARDRAIL  
 TYPICAL SECTION  
 AND DETAILS

PROJECT DESIGNATION NUMBER  
 SFHWY00041~0933(045)


STATE	YEAR
ALASKA	2016
SHEET NUMBER	TOTAL SHEETS
B1	9

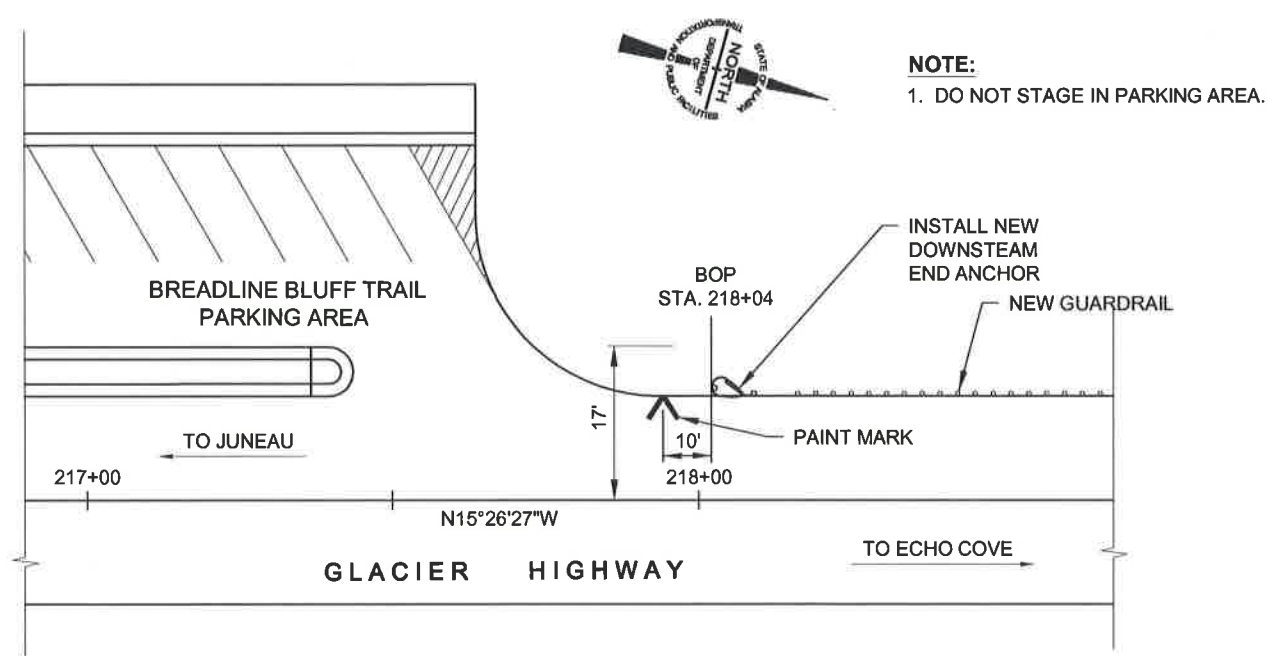

**NOTE:**  
 1. DO NOT STAGE IN PARKING AREA.

**DETAIL "A"**


**NOTES:**  
 1. BOP IS 10 FT. NORTH OF PAINT MARK ON SHOULDER.

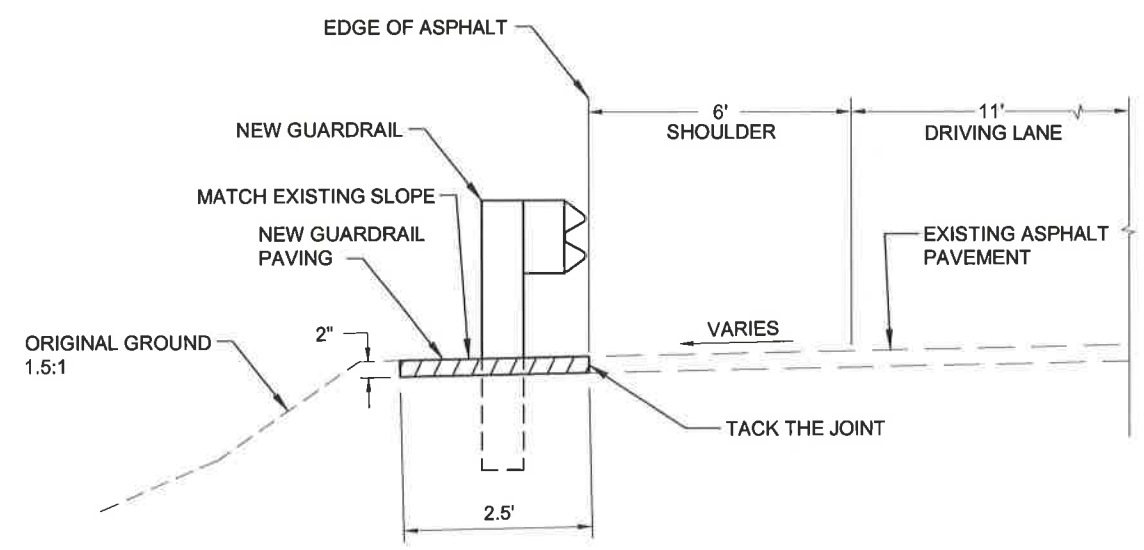

**TYPICAL SECTION**  
 STA. 218+04 LT TO STA. 247+85 LT

- NOTES:**
1. INSTALL PER STANDARD DRAWINGS.
  2. FACE OF GUARDRAIL SHALL BE 2' MIN. FROM TOP OF SLOPE.
  3. EXCAVATE TOP 2" OF SHOULDER AS SHOWN ABOVE. REPLACE WITH 2" OF GUARDRAIL PAVING.
  4. CONTACT SOUTHCOST REGION M&O AT 465-1787 ONE WEEK PRIOR TO CONSTRUCTION FOR REMOVAL OF FLEXIBLE DELINEATORS.

PROJECT AS-BUILT DRAWINGS HAVE BEEN  
 REVIED BY THE PROJECT ENGINEER AND  
 REPRESENT TO THE BEST OF MY  
 KNOWLEDGE THE PROJECT AS  
 CONSTRUCTED.  
 PE: *Emily Delaney*  
 DATE: 12/5/2016

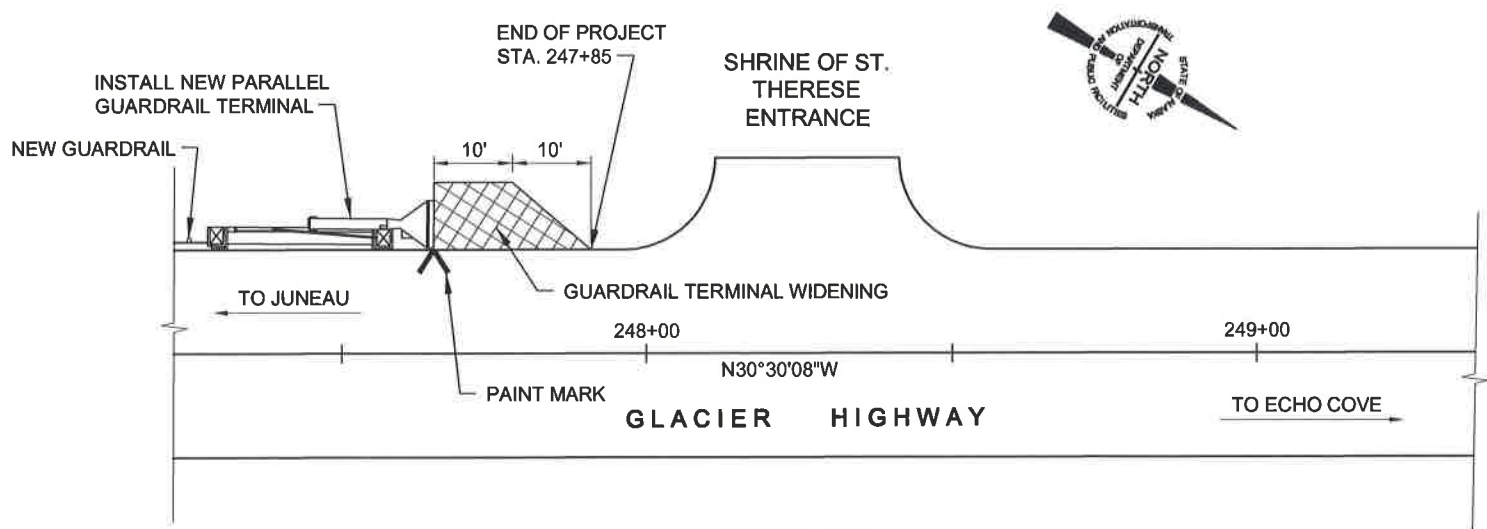

**DETAIL "B"**

- NOTES:**
1. EOP IS DENOTED BY PAINT MARK ON SHOULDER.
  2. FLARE GUARDRAIL TERMINAL PER MANUFACTURER'S INSTALLATION INSTRUCTIONS.
  3. PARALLEL TERMINAL IS 50 FT. LONG.
  4. PAVE HATCHED AREA PER STD. DWG. G-20.11 ALTERNATE GUARDRAIL TERMINAL WIDENING DETAIL.

**DO NOT SCALE FROM THESE DRAWINGS USE DIMENSIONS**

PATH:  
O:\jnu\00041\TR\0933045 Glacier Hwy Safety  
Mon, 08/Aug/16 09:12AM  
PLOT:  
PSPACE 1=1(F) OR MSPACE 1=1(F)  
TAB: TYPICALS

ADDENDUM NUMBER		
ATTACHMENT NUMBER		
RECORD OF REVISIONS		
No.	DATE	DESCRIPTION
1	8/2/16	ADDENDUM 2
2	8/8/16	ADDENDUM 3

**JNU GLACIER HIGHWAY  
SAFETY IMPROVEMENTS  
(HSIP)**  
  
**ESTIMATE OF QUANTITIES  
AND SUMMARIES**

BASIC BID - ESTIMATE OF QUANTITIES			
ITEM NUMBER	ITEM DESCRIPTION	PAY UNIT	QUANTITY
201 (7)	INVASIVE PLANT SPECIES CONTROL, REMOVAL AND DISPOSAL	SQUARE YARD	<del>1,200</del> <b>11</b>
606 (1)	W-BEAM GUARDRAIL	LINEAR FOOT	<del>2,911</del> <b>2937.5</b>
606 (13)	PARALLEL GUARDRAIL TERMINAL	EACH	1
629 (1)	GUARDRAIL PAVING	LINEAR FOOT	2,981
633 (2)	SEDIMENT BARRIER	LINEAR FOOT	<del>275</del> <b>225</b>
640 (1)	MOBILIZATION AND DEMOBILIZATION	LUMP SUM	ALL REQUIRED
641 (1)	EROSION, SEDIMENT AND POLLUTION CONTROL ADMINISTRATION	LUMP SUM	ALL REQUIRED
641 (2)	TEMPORARY EROSION, SEDIMENT, AND POLLUTION CONTROL	CONTINGENT SUM	ALL REQUIRED
641 (6)	WITHOLDING	CONTINGENT SUM	ALL REQUIRED
642 (1)	CONSTRUCTION SURVEYING	LUMP SUM	ALL REQUIRED
643 (2)	TRAFFIC MAINTENANCE	LUMP SUM	ALL REQUIRED
643 (15)	FLAGGING	CONTINGENT SUM	ALL REQUIRED
643 (23)	TRAFFIC PRICE ADJUSTMENT	CONTINGENT SUM	ALL REQUIRED
643 (25)	TRAFFIC CONTROL	CONTINGENT SUM	ALL REQUIRED

SUMMARIES			
606 (1) W-BEAM GUARDRAIL			
FROM STATION	TO STATION	OFFSET	LENGTH
218+04	247+15	LT.	2911 FT.
606 (13) PARALLEL GUARDRAIL TERMINAL			
FROM STATION	TO STATION	OFFSET	LENGTH
247+15	247+65	LT.	50 FT.

- NOTES:**
1. TERMINAL WIDENING EXTENDS 20 FT. PAST END OF PARALLEL GUARDRAIL TERMINAL (STA. 247+65 TO STA. 247+85).
  2. INVASIVE PLANT SPECIES CONTROL IS LIMITED TO THE AREA BEING DISTURBED (NEW GUARDRAIL PAVING, TYPICAL SECTION, SHEET B1).

PROJECT AS-BUILT DRAWINGS HAVE BEEN REVIED BY THE PROJECT ENGINEER AND REPRESENT TO THE BEST OF MY KNOWLEDGE THE PROJECT AS CONSTRUCTED.  
 PE:  
 DATE: 12/5/2016 *Emily Delaney*


6860 GLACIER HIGHWAY  
JUNEAU, AK 99811  
(907) 465-1763



DESIGNED BY: D. EPSTEIN  
DRAWN BY: D. STEVENS


STATE OF ALASKA  
DEPARTMENT OF TRANSPORTATION & PUBLIC FACILITIES  
SOUTHCOST REGION  
**JNU GLACIER HIGHWAY SAFETY IMPROVEMENTS (HSIP)**  
**ESTIMATE OF QUANTITIES AND SUMMARIES**

PROJECT DESIGNATION NUMBER	
SFHWY00041~0933(045)	
STATE	YEAR
ALASKA	2016
SHEET NUMBER	TOTAL SHEETS
C1	9

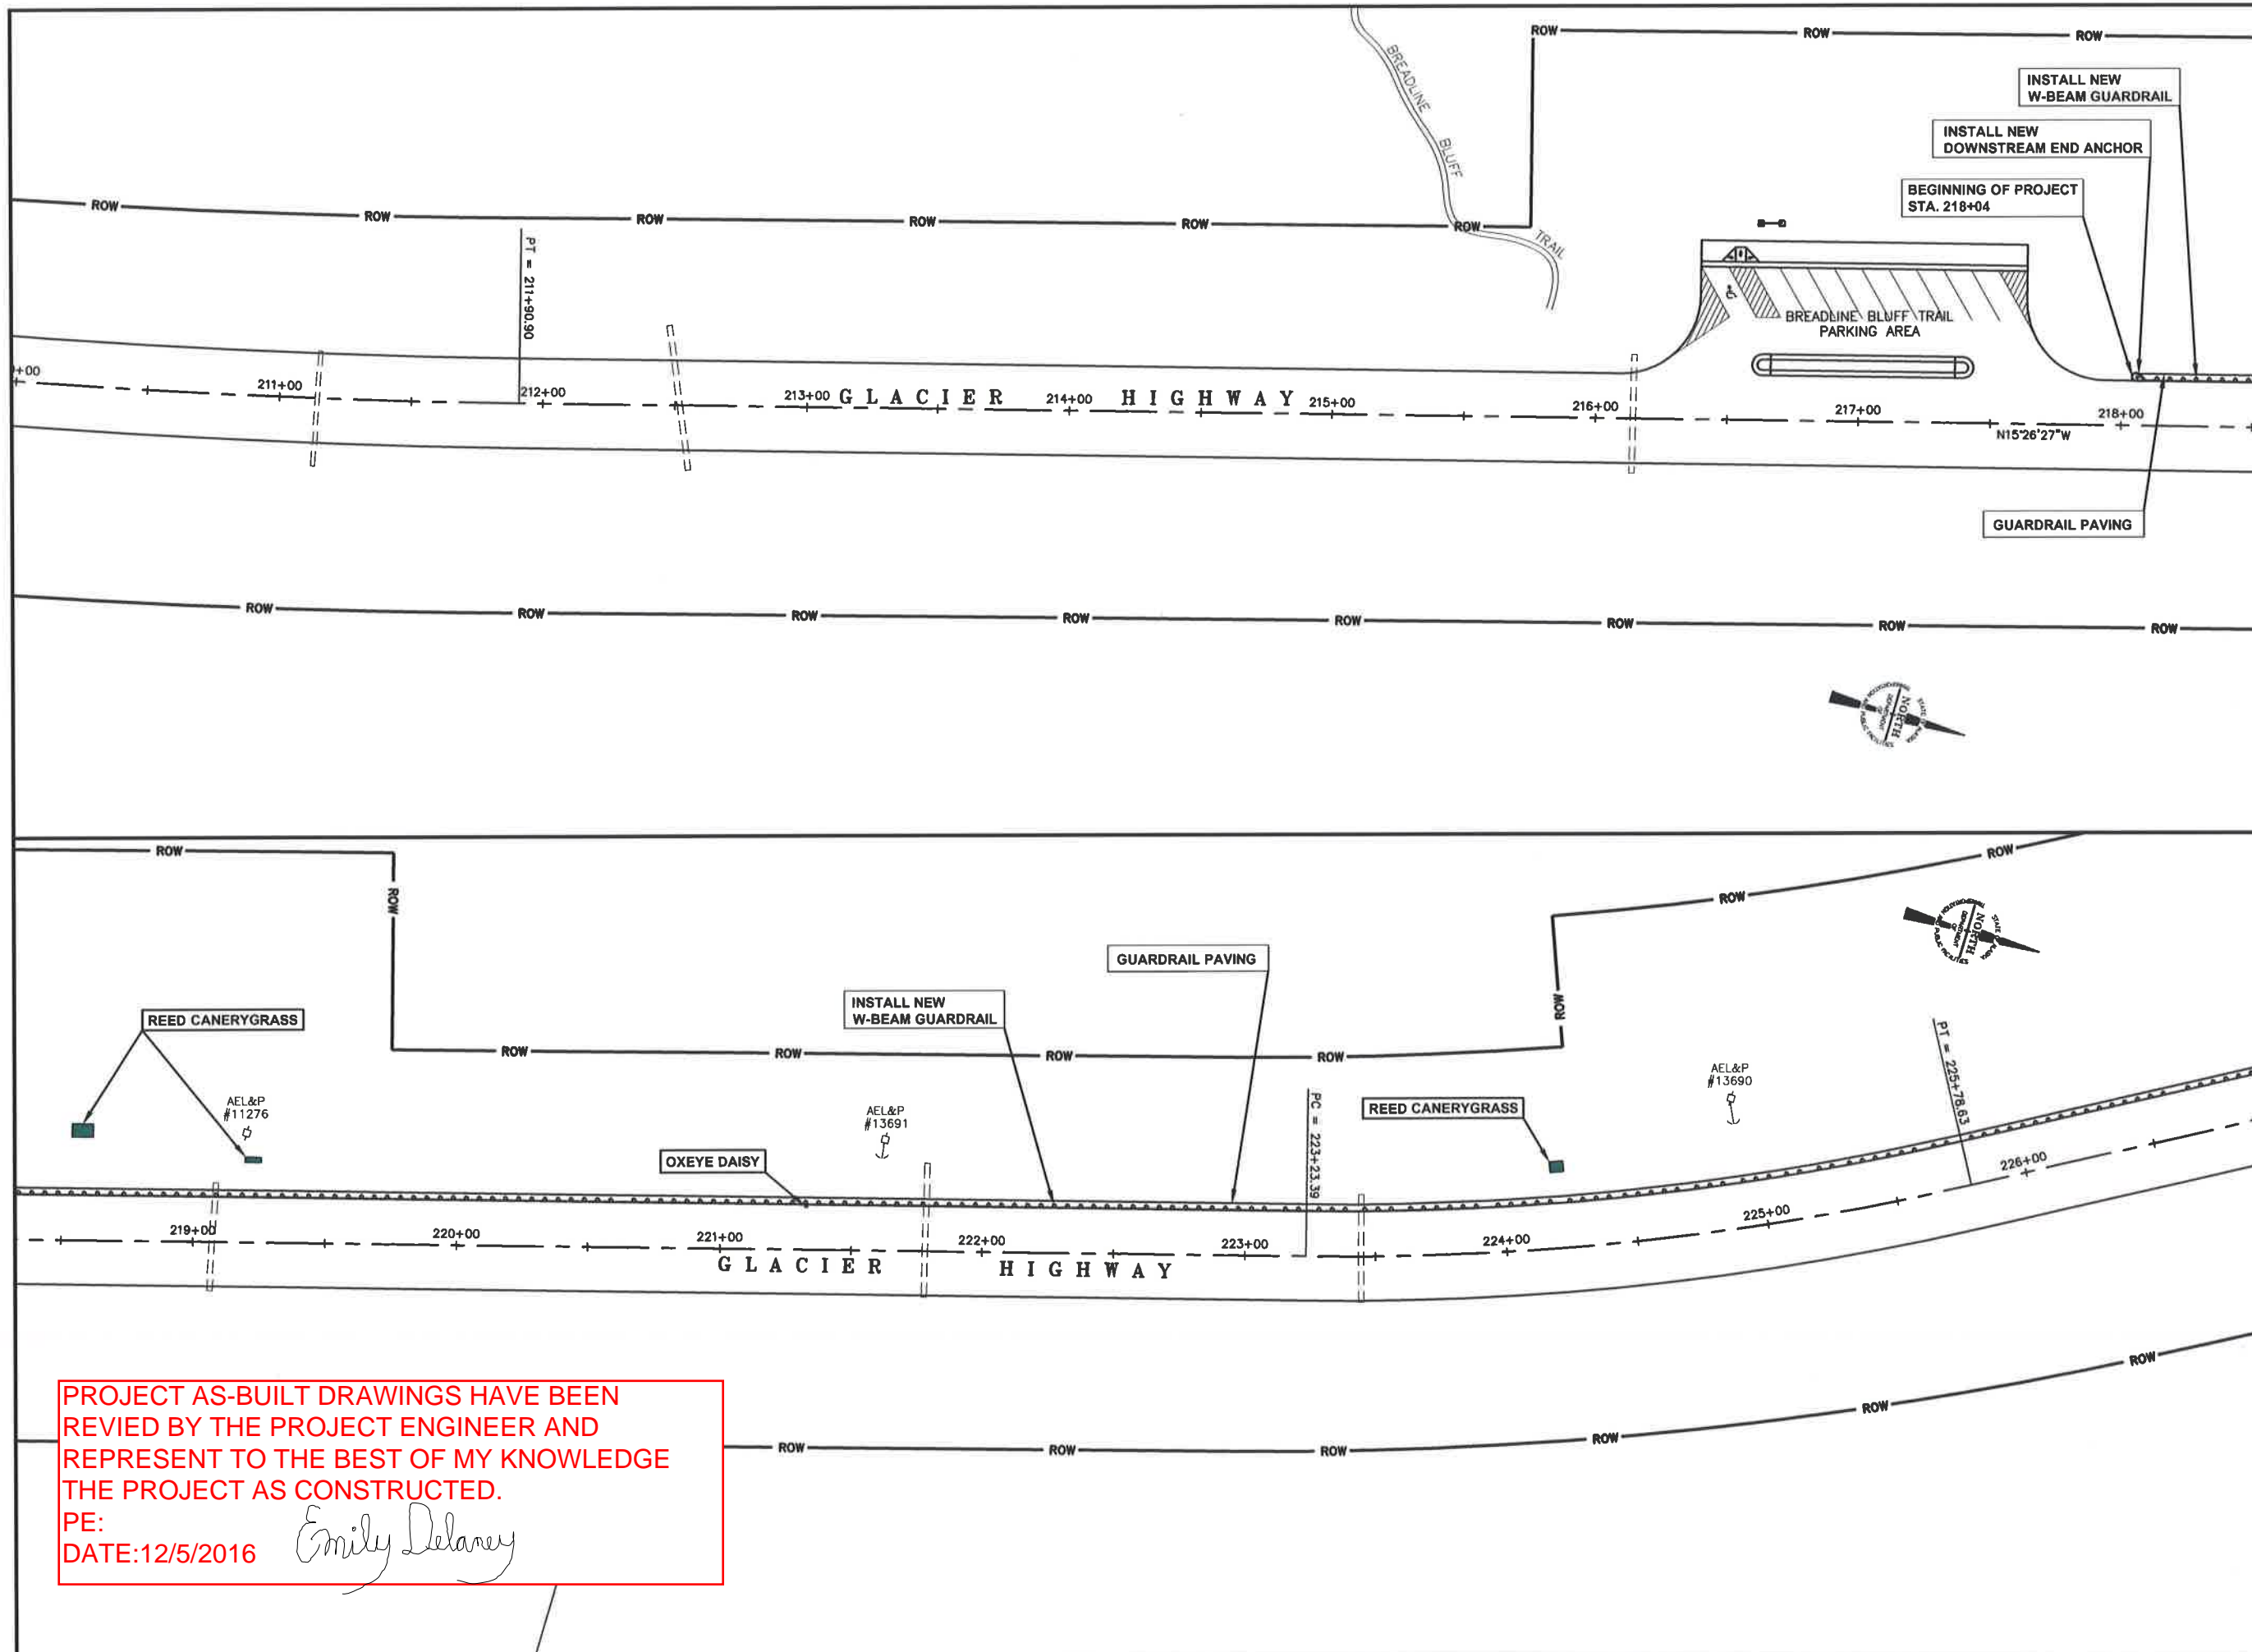

PATH:  
O:\Jnu\00041\TR\0933045 Glacier Hwy Safety  
Mon, 08/Aug/16 09:26AM  
PLOT:  
PSPACE 1=1(F) OR MSPACE 1=1(F)  
TAB: TYPICALS

ADDENDUM NUMBER		
ATTACHMENT NUMBER		
RECORD OF REVISIONS		
No.	DATE	DESCRIPTION
1	8/8/16	ADDENDUM 3

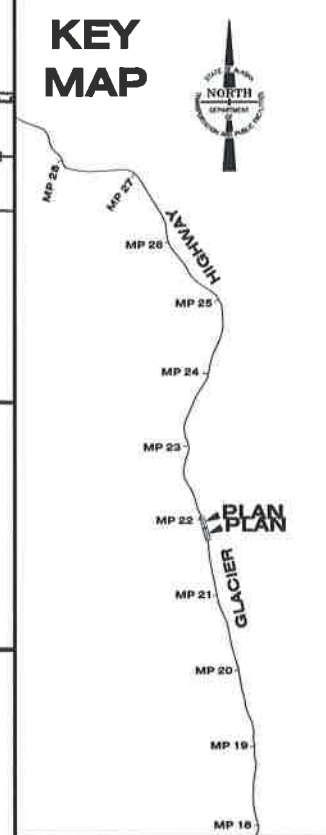

6860 GLACIER HIGHWAY  
JUNEAU, AK 99811  
(907) 465-1763




DESIGNED BY: D. EPSTEIN  
DRAWN BY: D. STEVENS

STATE OF ALASKA  
DEPARTMENT OF TRANSPORTATION  
& PUBLIC FACILITIES  
SOUTHCOST REGION  
**JNU GLACIER HIGHWAY  
SAFETY IMPROVEMENTS  
(HSIP)**

**PLAN SHEET**


PROJECT DESIGNATION NUMBER	
SFHWY00041~0933(045)	
STATE	YEAR
ALASKA	2016
SHEET NUMBER	TOTAL SHEETS
F1	9

PROJECT AS-BUILT DRAWINGS HAVE BEEN REVIED BY THE PROJECT ENGINEER AND REPRESENT TO THE BEST OF MY KNOWLEDGE THE PROJECT AS CONSTRUCTED.  
PE: *Emily Delaney*  
DATE: 12/5/2016

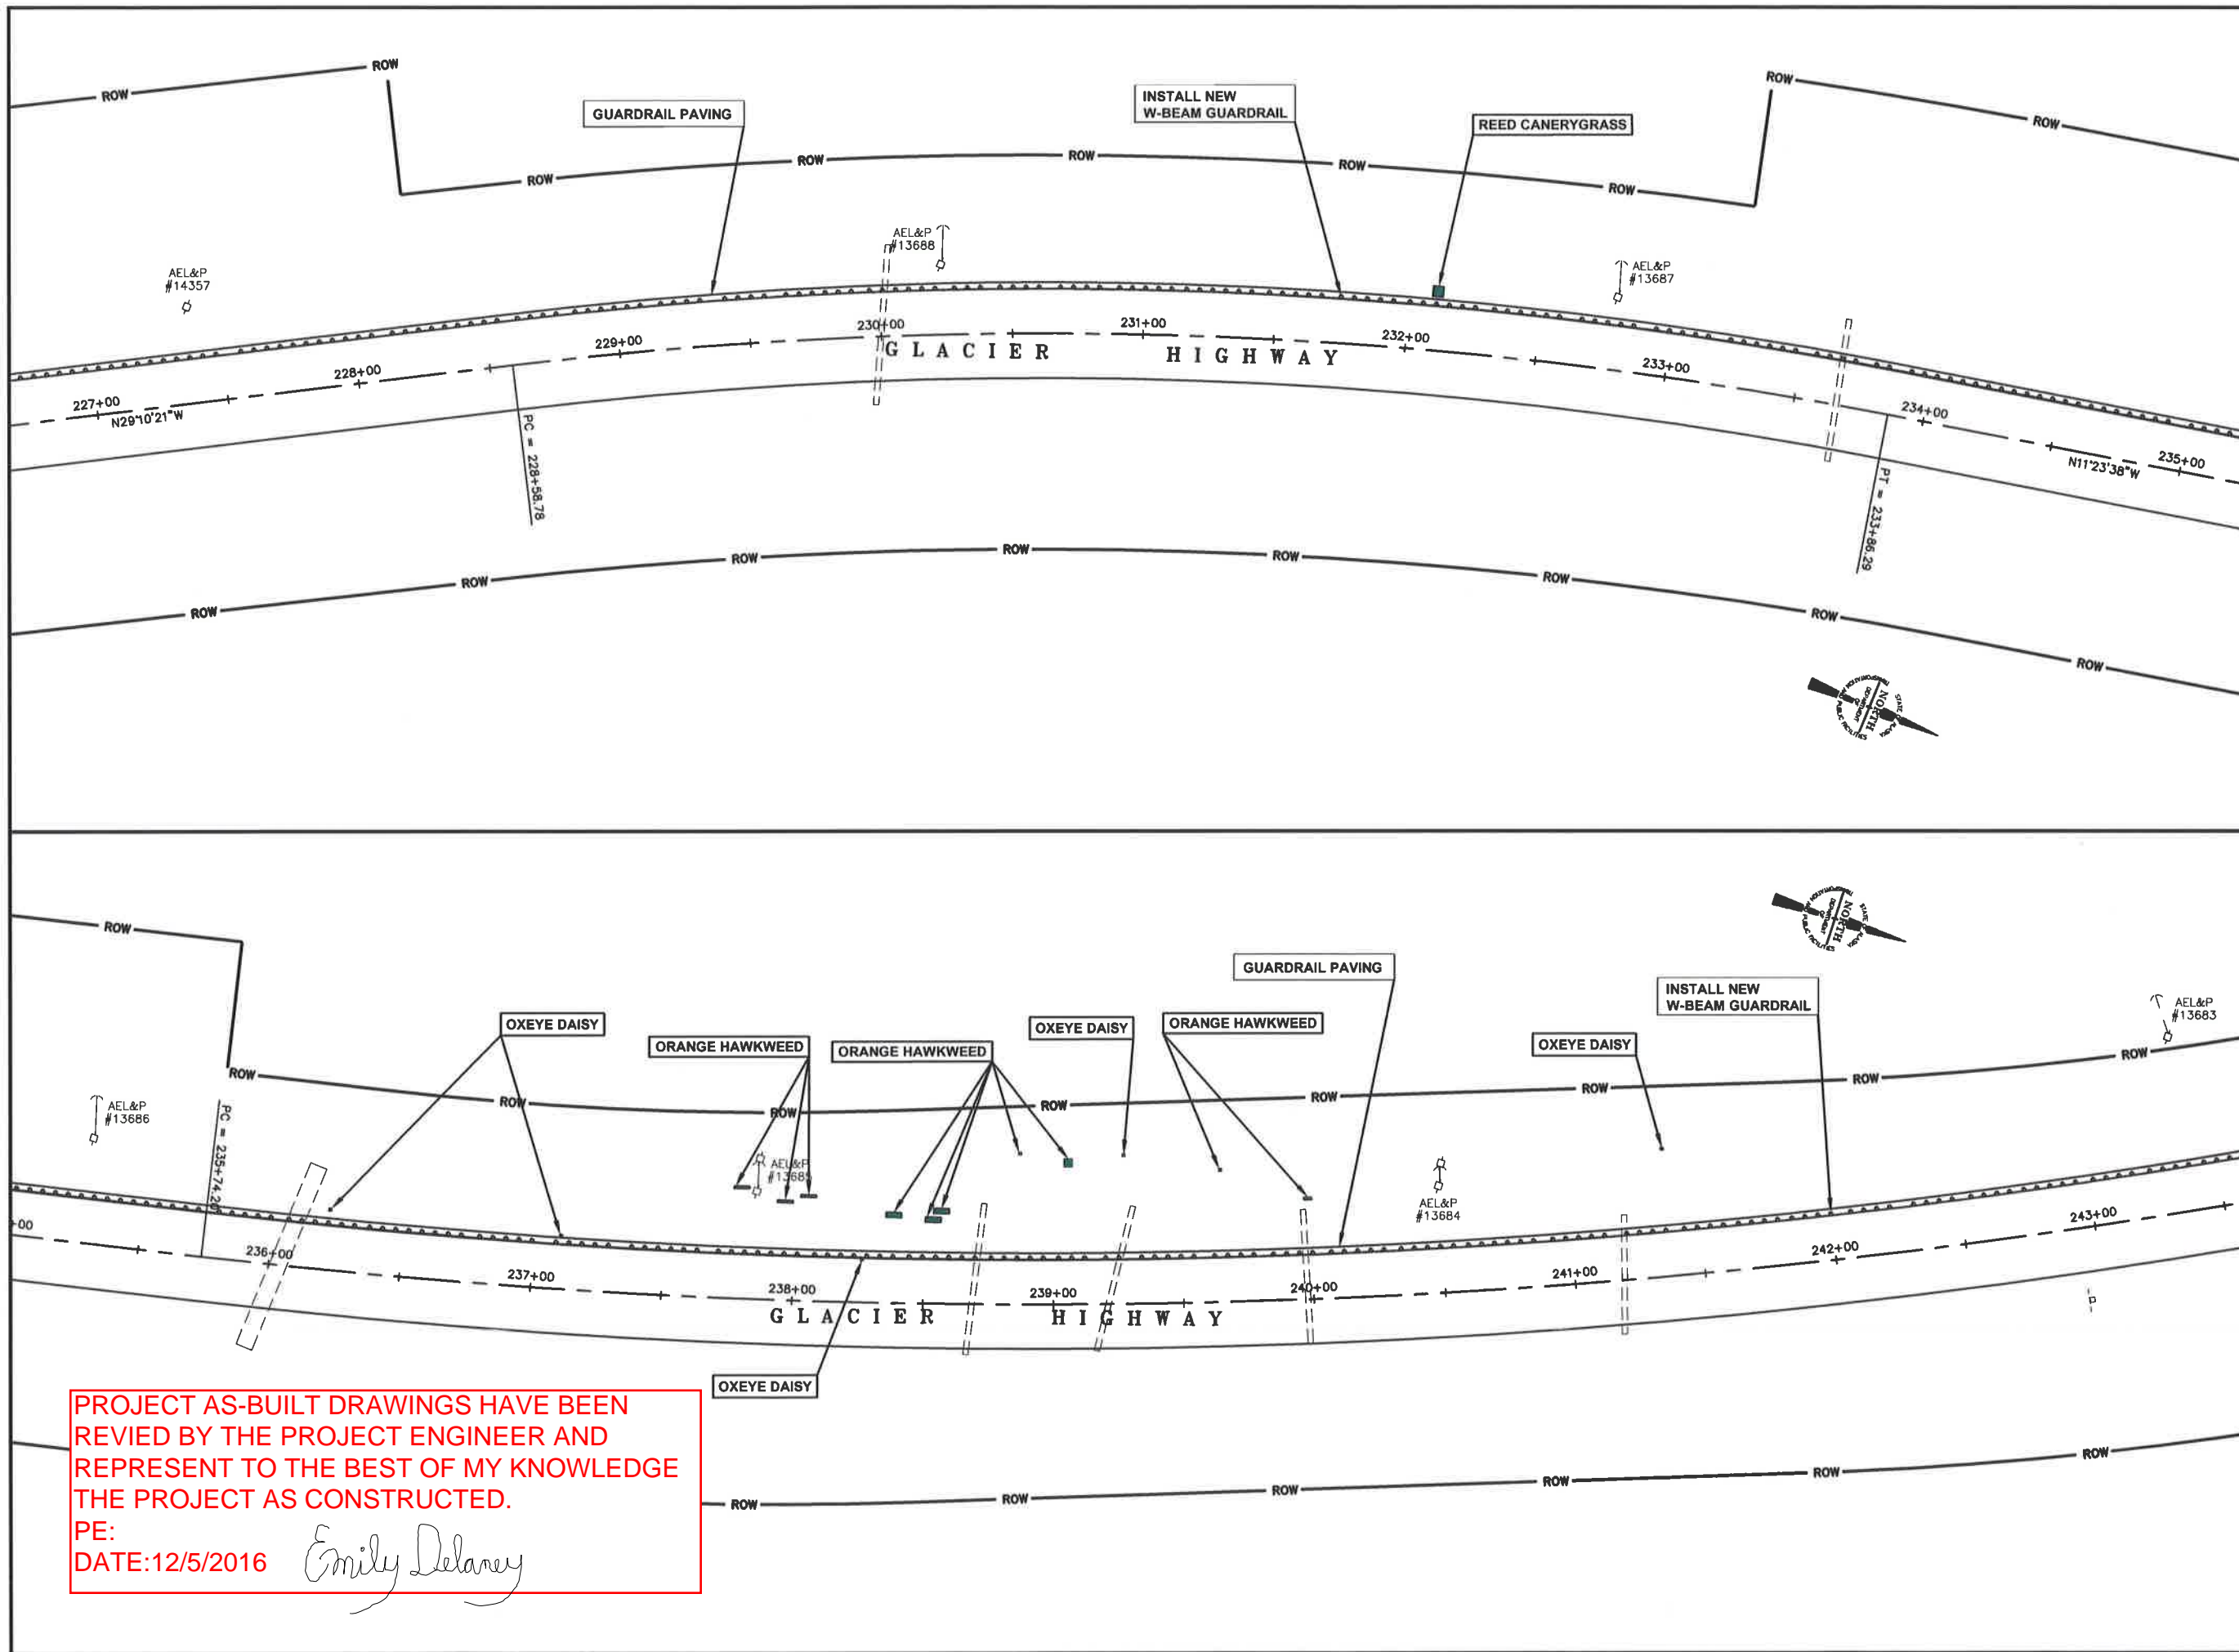

PATH:  
 Q:\jnu\00041\TR\0933045 Glacier Hwy Safety  
 Mon, 08/Aug/16 09:26AM  
 PLOT:  
 PSPACE 1=1(F) OR MSPACE 1=1(F)  
 TAB: TYPICALS

ADDENDUM NUMBER		
ATTACHMENT NUMBER		
RECORD OF REVISIONS		
No.	DATE	DESCRIPTION
1	8/8/16	ADDENDUM 3

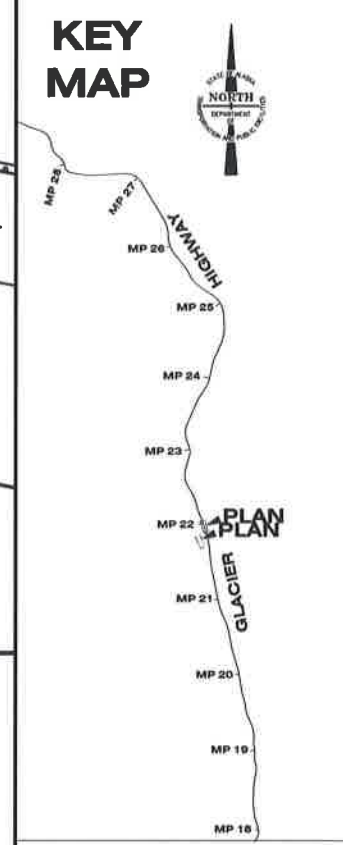

6860 GLACIER HIGHWAY  
 JUNEAU, AK 99811  
 (907) 465-1763




DESIGNED BY: D. EPSTEIN  
 DRAWN BY: D. STEVENS

STATE OF ALASKA  
 DEPARTMENT OF TRANSPORTATION  
 & PUBLIC FACILITIES  
 SOUTHCOAST REGION  
**JNU GLACIER HIGHWAY  
 SAFETY IMPROVEMENTS  
 (HSIP)**

**PLAN SHEET**


PROJECT DESIGNATION NUMBER	
SFHWY00041~0933(045)	
STATE	YEAR
ALASKA	2016
SHEET NUMBER	TOTAL SHEETS
F2	9

**PROJECT AS-BUILT DRAWINGS HAVE BEEN  
 REVIED BY THE PROJECT ENGINEER AND  
 REPRESENT TO THE BEST OF MY KNOWLEDGE  
 THE PROJECT AS CONSTRUCTED.**  
 PE:  
 DATE:12/5/2016 *Emily Delaney*

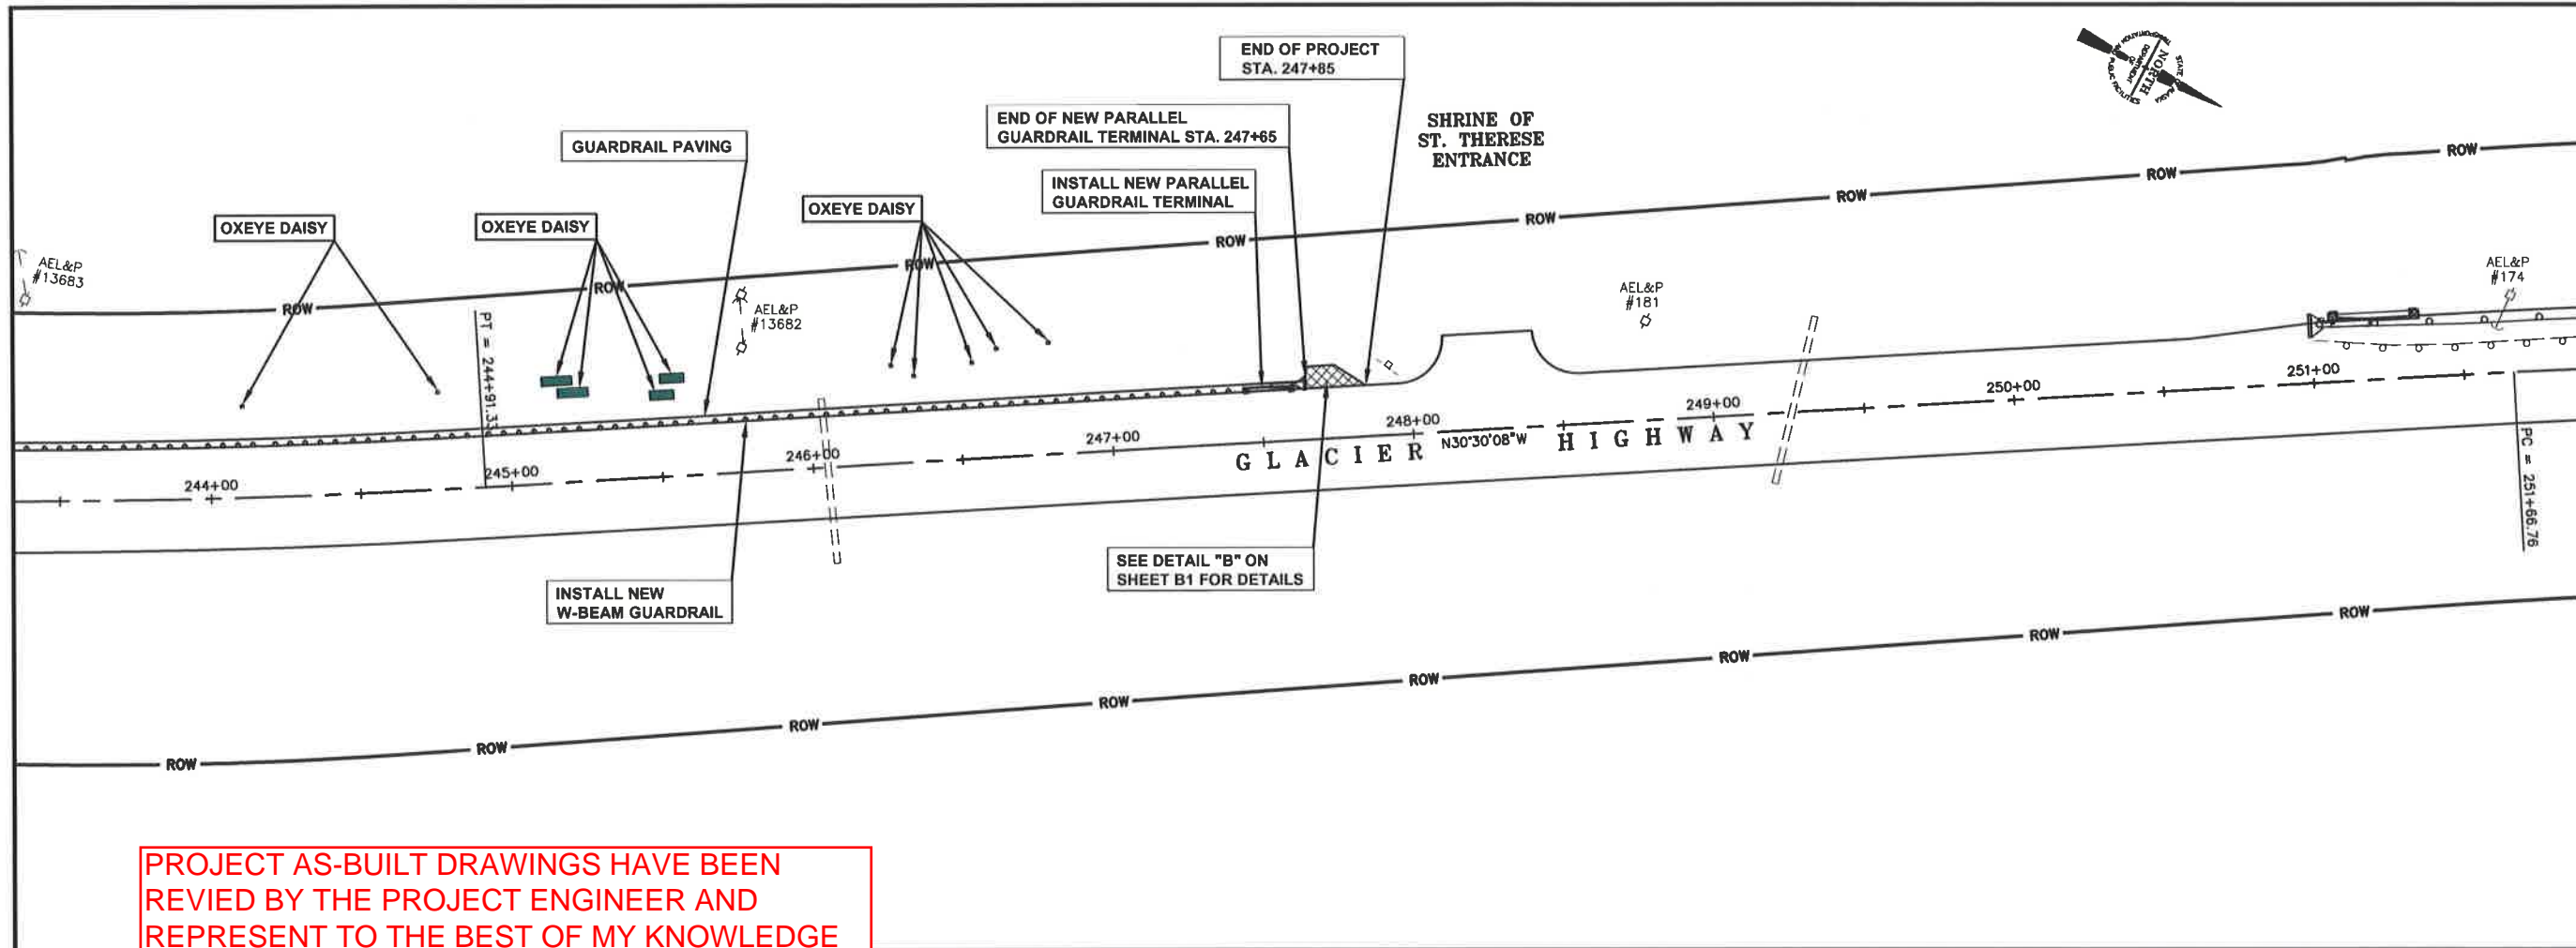

PATH: D:\Jnu\00041\TR\0933045 Glacier Hwy Safety in  
 Mon, 08/Aug/16 09:25AM  
 PLOT: PSPACE 1=1(F) OR MSPACE 1=1(F)  
 TAB: TYPICALS

ADDENDUM NUMBER		
ATTACHMENT NUMBER		
RECORD OF REVISIONS		
No.	DATE	DESCRIPTION
1	8/8/16	ADDENDUM 3

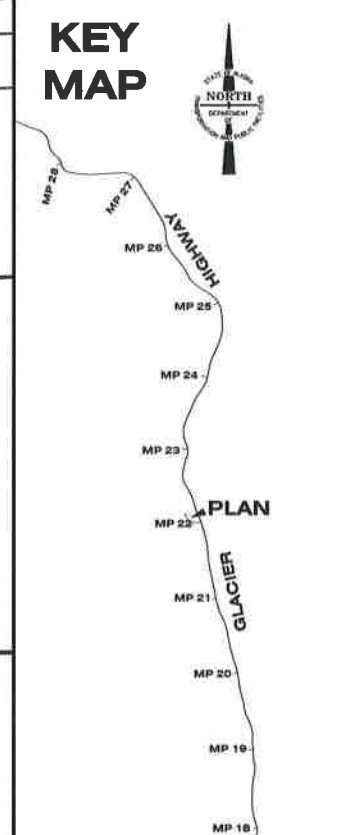

6860 GLACIER HIGHWAY  
 JUNEAU, AK 99811  
 (907) 465-1763



DESIGNED BY: D. EPSTEIN  
 DRAWN BY: D. STEVENS


STATE OF ALASKA  
 DEPARTMENT OF TRANSPORTATION  
 & PUBLIC FACILITIES  
 SOUTHCOAST REGION  
**JNU GLACIER HIGHWAY  
 SAFETY IMPROVEMENTS  
 (HSIP)**

**PLAN SHEET**

PROJECT DESIGNATION NUMBER	
SFHWY00041~0933(045)	
STATE	YEAR
ALASKA	2016
SHEET NUMBER	TOTAL SHEETS
F3	9

**PROJECT AS-BUILT DRAWINGS HAVE BEEN  
 REVIED BY THE PROJECT ENGINEER AND  
 REPRESENT TO THE BEST OF MY KNOWLEDGE  
 THE PROJECT AS CONSTRUCTED.**  
 PE:  
 DATE:12/5/2016 *Emily Delaney*

ADDENDUM NUMBER		
ATTACHMENT NUMBER		
RECORD OF REVISIONS		
No.	DATE	DESCRIPTION

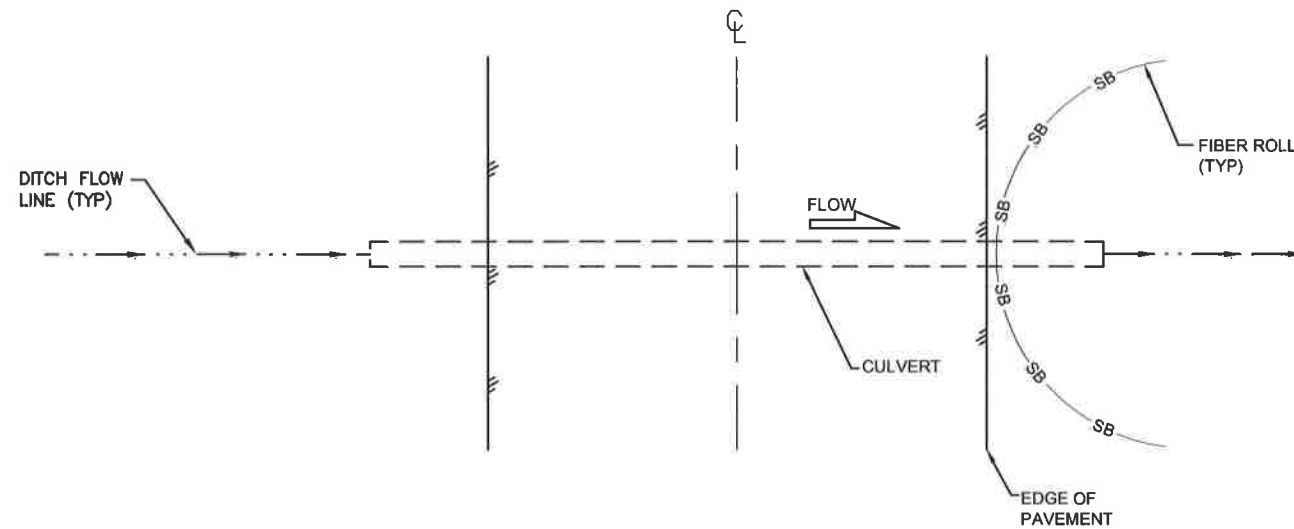

PROJECT AS-BUILT DRAWINGS HAVE BEEN REVIED BY THE PROJECT ENGINEER AND REPRESENT TO THE BEST OF MY KNOWLEDGE THE PROJECT AS CONSTRUCTED.  
PE: *Emily Delaney*  
DATE:12/5/2016

**CULVERT BMP INSTALLATION**

SCALE: NOT TO SCALE

CULVERT BMP INSTALLATION NOTES:

1. INSTALL SEDIMENT CONTROL TO MINIMIZE SEDIMENT DISCHARGE. USE TYPE 1 OR TYPE 2 FIBER ROLL.

JNU GLACIER HIGHWAY  
SAFETY IMPROVEMENTS  
(HSIP)  
**EROSION SEDIMENT  
CONTROL PLAN**

6860 GLACIER HIGHWAY  
JUNEAU, AK 99811  
(907) 465-1763




DESIGNED BY: D. EPSTEIN  
DRAWN BY: D. STEVENS

STATE OF ALASKA  
DEPARTMENT OF TRANSPORTATION  
& PUBLIC FACILITIES  
SOUTHCOAST REGION  
**JNU GLACIER HIGHWAY  
SAFETY IMPROVEMENTS  
(HSIP)**


**EROSION SEDIMENT  
CONTROL PLAN**

PROJECT DESIGNATION NUMBER	
SFHWY00041~0933(045)	
STATE	YEAR
ALASKA	2016
SHEET NUMBER	TOTAL SHEETS
Q1	9

WARNING SIGN SPACING	
SPEED LIMIT	55
A	500'
B	500'
C	500'

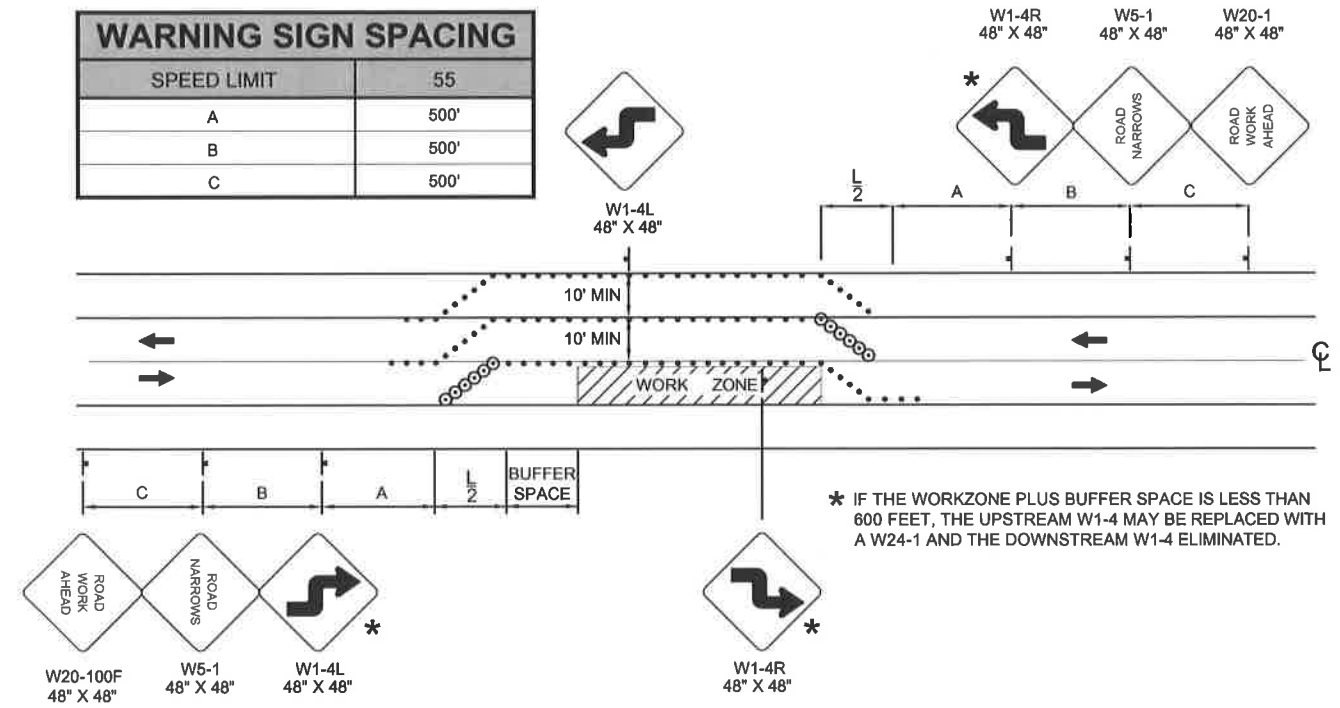

TCP SETUP TABLE									
SPEED LIMIT (MPH)	MIN MERGING TAPER LENGTH, (L) IN FEET			MIN NUMBER OF DEVICES WIDTH OF OFFSET (W) IN FEET			MAX DEVICE SPACING IN FEET		BUFFER SPACE (FT)
	10'	11'	12'	10'	11'	12'	ALONG TAPER	ALONG TANGENT	
55	550	605	660	11	12	13	55	110	495

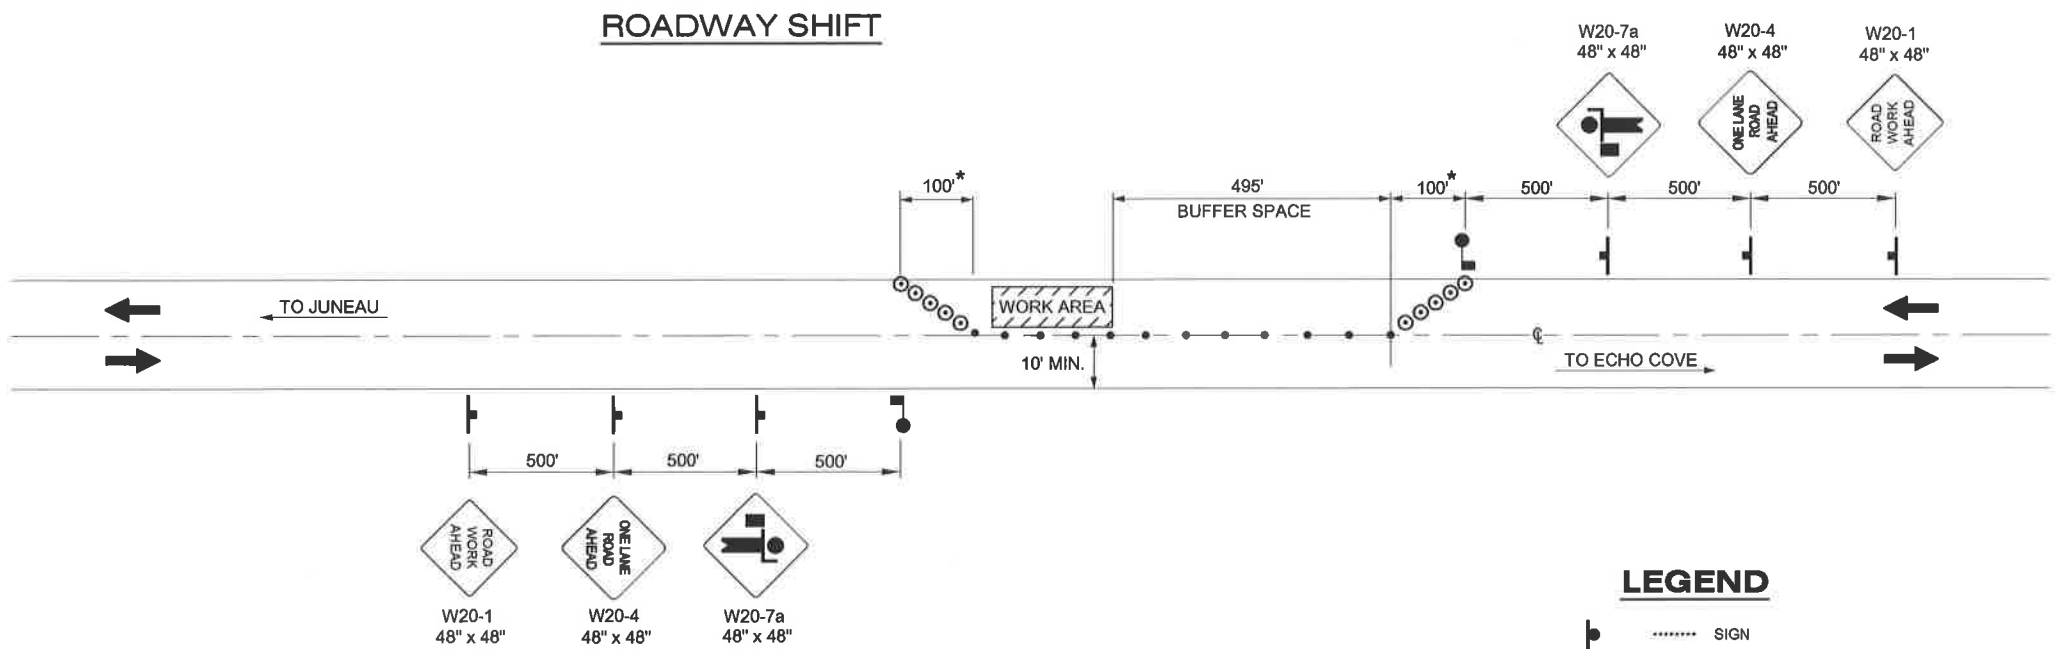

**GLACIER HIGHWAY LEFT LANE CLOSURE**

\* TAPERS ARE 6 DEVICES EVENLY SPACED

**TRAFFIC CONTROL NOTES:**

1. A MINIMUM OF ONE 10 FOOT LANE SHALL BE MAINTAINED AT ALL TIMES, THROUGH ALL WORK AREAS.
2. TWO LANES SHALL BE MAINTAINED AT ALL TIMES IN NON-WORK AREAS AND DURING NON-WORK HOURS.
3. THE LENGTH OF WORK AREA SHALL BE MINIMIZED TO AVOID EXCESSIVE TRAFFIC DELAYS AS DIRECTED BY THE ENGINEER.
4. IT IS THE INTENT OF THIS TRAFFIC CONTROL PLAN (TCP) TO ILLUSTRATE SOME, NOT ALL, OF THE TRAFFIC CONTROL SETUPS WHICH WILL BE REQUIRED ON THIS PROJECT. ALL TCP'S SHALL BE CREATED BY THE CONTRACTOR AND SUBMITTED TO THE ENGINEER FOR APPROVAL. TRAFFIC CONTROL SHALL CONFORM TO THE ALASKA TRAFFIC MANUAL AND THE MUTCD.
5. AT THE END OF EACH WORK SHIFT, INSTALL DRUMS OR TYPE II BARRICADES WITH FLASHING YELLOW WARNING LIGHTS TO DELINEATE INCOMPLETE SECTIONS OF GUARDRAIL AND TERMINAL SECTIONS.

PATH: Q:\jnu\00041\TR\0933045 Glacier Hwy Safety  
 Fri, 15/Jul/16 10:37AM  
 PLOT:  
 PSPACE 1=1(F) OR MSPACE 1=1(F)  
 TAB: TYPICALS

ADDENDUM NUMBER  
 ATTACHMENT NUMBER

RECORD OF REVISIONS		
No.	DATE	DESCRIPTION

**JNU GLACIER HIGHWAY SAFETY IMPROVEMENTS (HSIP)**  
**TRAFFIC CONTROL PLAN**

TCP NOT SEALED IN ACCORDANCE WITH ALASKA HIGHWAY PRECONSTRUCTION MANUAL SECTION 1400.3,5 DATED JANUARY 30, 2012.

DESIGNED BY: D. EPSTEIN  
 DRAWN BY: D. STEVENS

STATE OF ALASKA  
 DEPARTMENT OF TRANSPORTATION & PUBLIC FACILITIES  
 SOUTHCOAST REGION

**JNU GLACIER HIGHWAY SAFETY IMPROVEMENTS (HSIP)**

**TRAFFIC CONTROL PLAN**


PROJECT DESIGNATION NUMBER

**SFHWY00041~0933(045)**

STATE	YEAR
ALASKA	2016
SHEET NUMBER	TOTAL SHEETS
T1	9


**GENERAL NOTES:**

1. All covered hardware shall comply with the AASHTO/AGC/ARTBA "A Guide to Standardized Highway Barrier Hardware", latest edition.

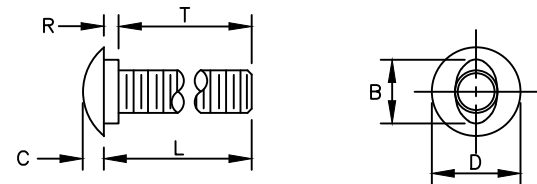


B	C	D	L (Length)	R	T (Thread Length)
15/16"	5/16"	1 5/16" or 1 7/16"	As Required	7/32"	As Required

5/8" BUTTONHEAD BOLT

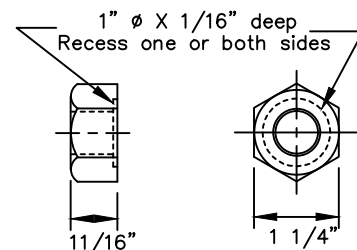


5/8" Dia. RECESSED HEX NUT

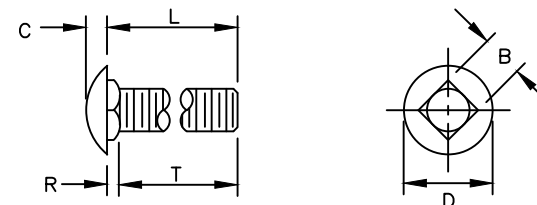


B	C	D	L (Length)	R	T (Thread Length)
5/8"	5/16"	1 5/16"	As Required	3/16"	As Required

5/8" Dia. CARRIAGE BOLT

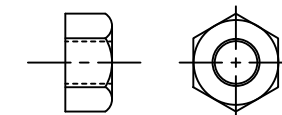


STANDARD HEX NUT

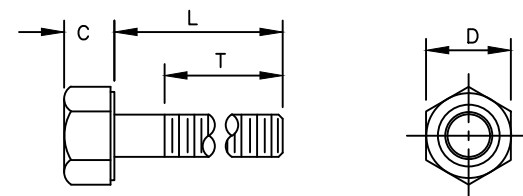


Bolt Size	C	D	L (Length)	T (Thread Length)
5/16"	—	—	1 1/2"	7/8"
5/16"	—	—	1"	1"
3/8"	—	—	7 1/2"	1 1/2"
1/2"	—	—	1 1/2"	1 1/2"
1/2"	—	—	1 1/4"	1 1/4"
5/8" H.S.	5/16"	7/8"	8"	1 1/2"
5/8"-11	—	—	1 1/2"	1 1/2"
3/4"	—	—	1 1/2"	1 1/2"
3/4"	—	—	As Required	2"
3/4" H.S.	15/32"	1 1/4"	2"	1 1/2"

STANDARD HEX BOLTS

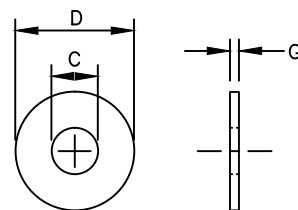

For Bolt $\phi$	C	D	G
3/8"	7/16"	1"	5/64"
1/2"	17/32"	1 1/16"	3/32"
1/2" H.S.	17/32"	1 1/16"	3/32"
5/8"	11/16"	1 3/4"	9/64"
3/4"	13/16"	1 15/32"	9/64"
3/4" H.S.	13/16"	2"	5/32"
1"	1 1/16"	2"	9/64"


STANDARD STEEL WASHERS

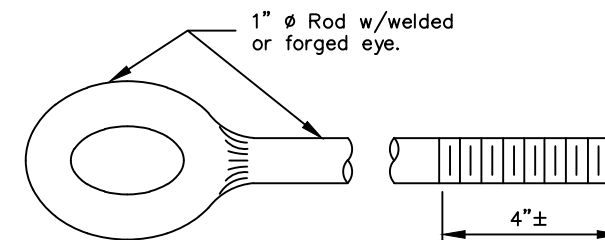


EYE BOLT

**PROJECT AS-BUILT DRAWINGS HAVE BEEN REVIED BY THE PROJECT ENGINEER AND REPRESENT TO THE BEST OF MY KNOWLEDGE THE PROJECT AS CONSTRUCTED.**


PE:  
DATE:12/5/2016 *Emily Delaney*

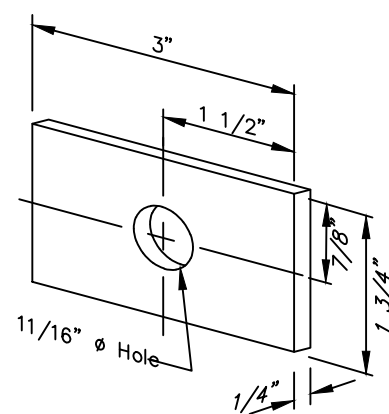

FLAT PLATE WASHER

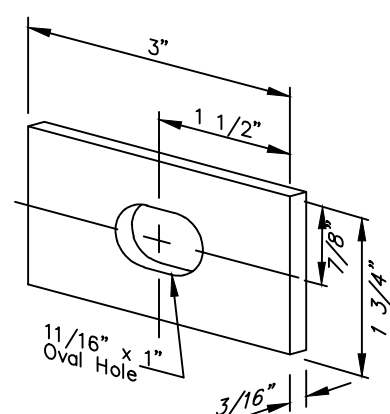

RECTANGULAR POST BOLT WASHER

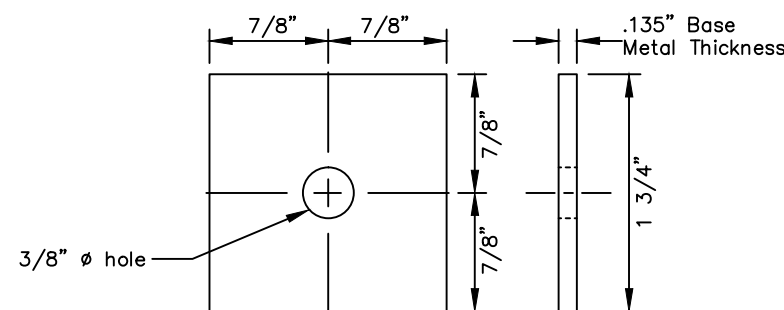


SQUARE STEEL WASHER

REVISIONS		
Date	Description	By
3/15/99	Delete BCT Hardware	KJS

State of Alaska  
Department of Transportation  
& Public Facilities  
**STANDARD GUARDRAIL  
HARDWARE  
(NUTS, BOLTS, WASHERS)**









APPROVED

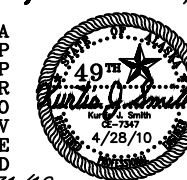

Date 5/31/12

**GENERAL NOTES:**

1. Provide hardware compliant with the AASHTO/AGC/ARTBA "A Guide to Standardized Highway Barrier Hardware, latest edition.
2. Install back-up plates between blockouts and w-beam or thrie-beam rail at intermediate (non-splice) posts when steel blockouts are used but not with wood, rubber, plastic, or other approved blockouts.
3. Provide Thrie beam and W-beam compliant with AASHTO M180A. Use 12 gauge (0.105") thick steel for both.

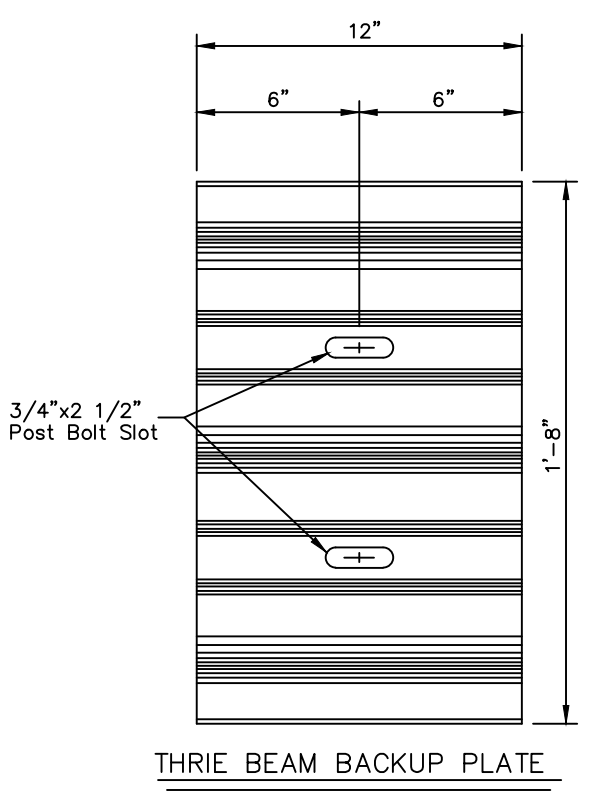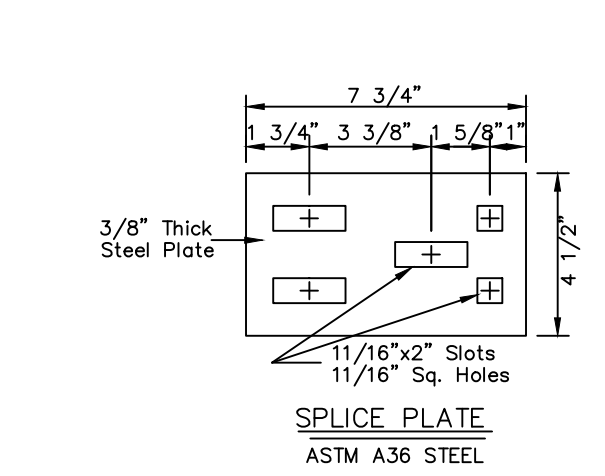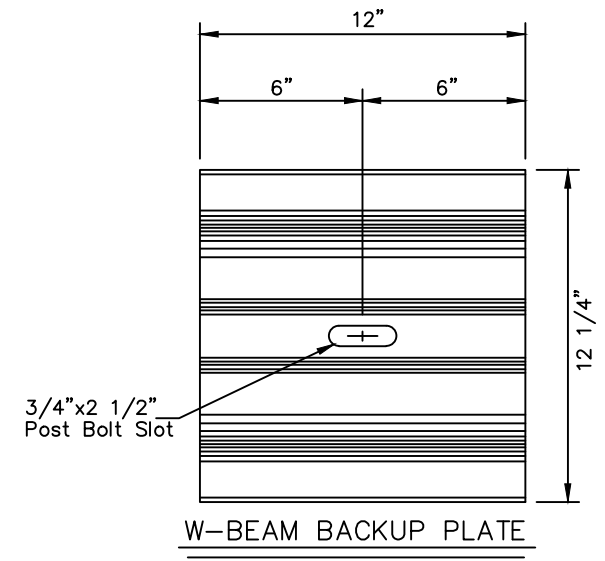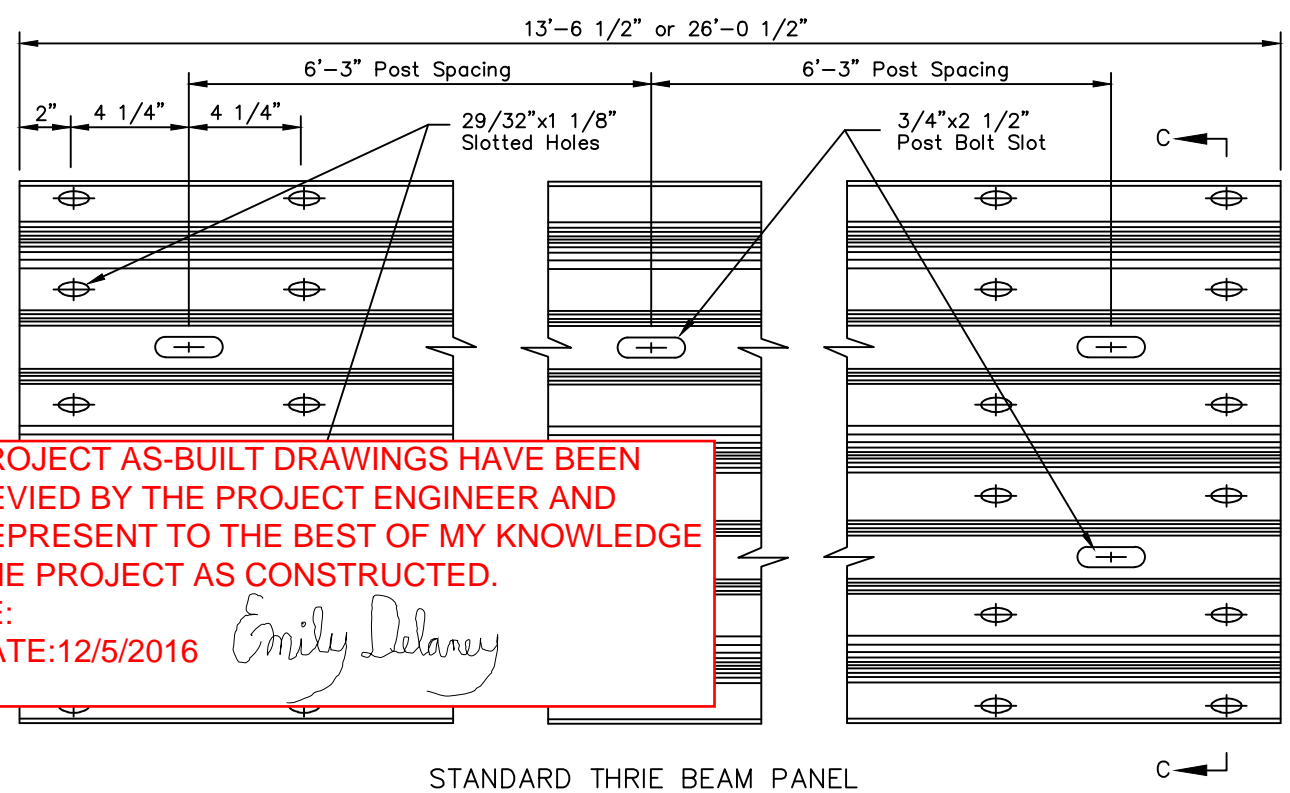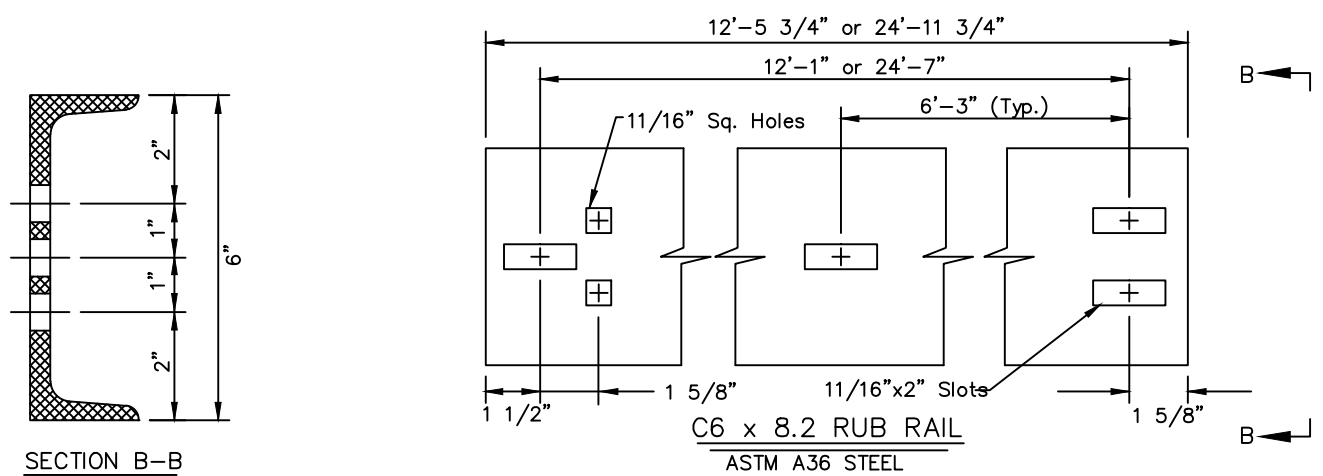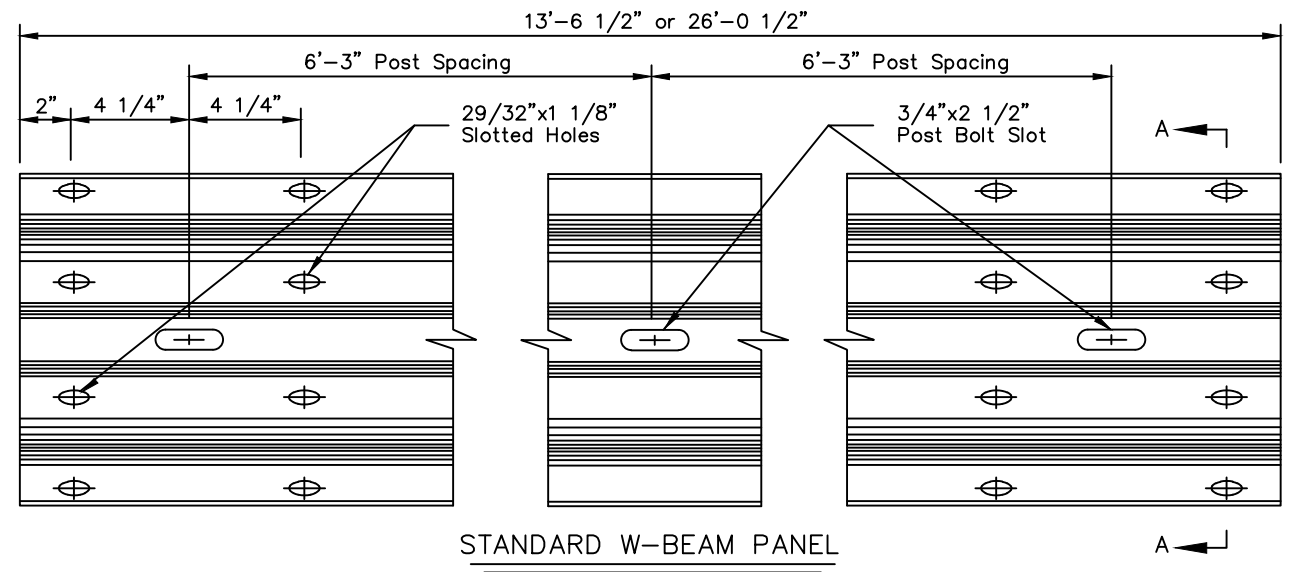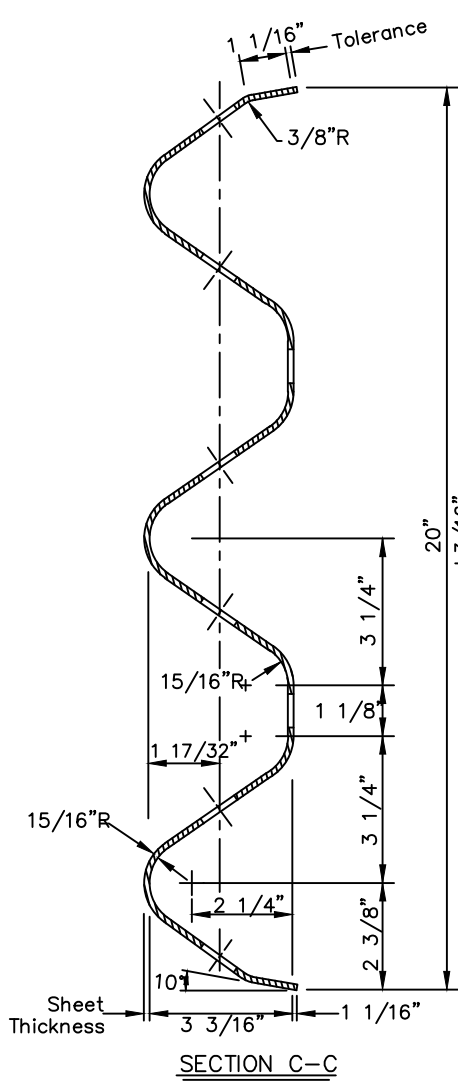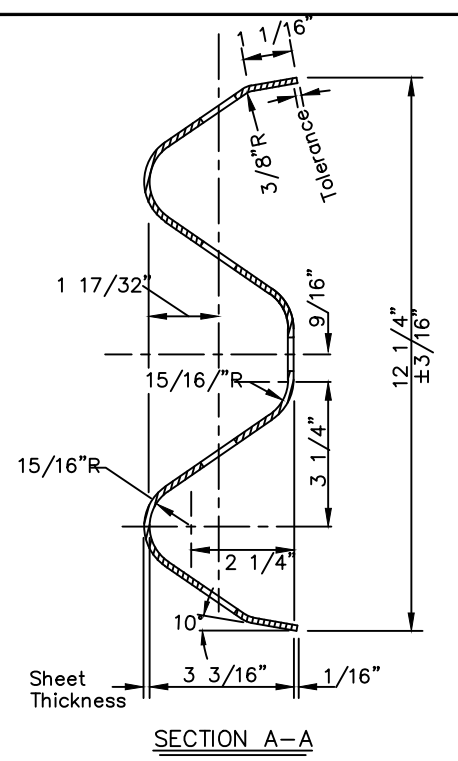

**PROJECT AS-BUILT DRAWINGS HAVE BEEN REVIED BY THE PROJECT ENGINEER AND REPRESENT TO THE BEST OF MY KNOWLEDGE THE PROJECT AS CONSTRUCTED.**  
PE: *Emily Delaney*  
DATE: 12/5/2016

REVISIONS		
Date	Description	By
4/28/10	Revise General Notes	KJS

State of Alaska  
Department of Transportation  
& Public Facilities


**STANDARD GUARDRAIL  
HARDWARE  
(RAILS AND SPLICES)**

APPROVED


Date: 5/31/12

GENERAL NOTES:

1. W-Beam and Thrie Beam Terminal Connectors shall conform to AASHTO M180, Class B, Type 2.
2. W-Beam end sections shall conform to AASHTO M180, Class A, Type 2.
3. All covered hardware shall comply with the AASHTO/AGC/ARTBA "A Guide to Standardized Highway Barrier Hardware", latest edition.

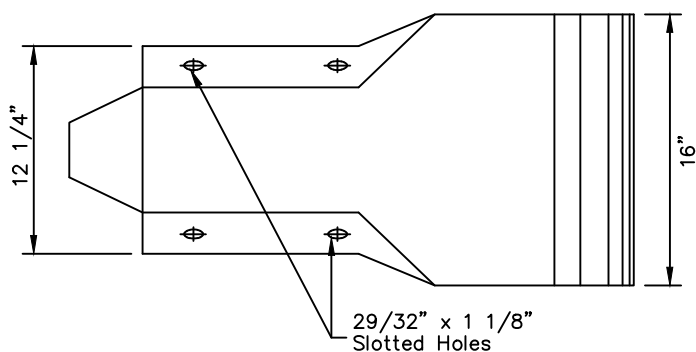


PROFILE

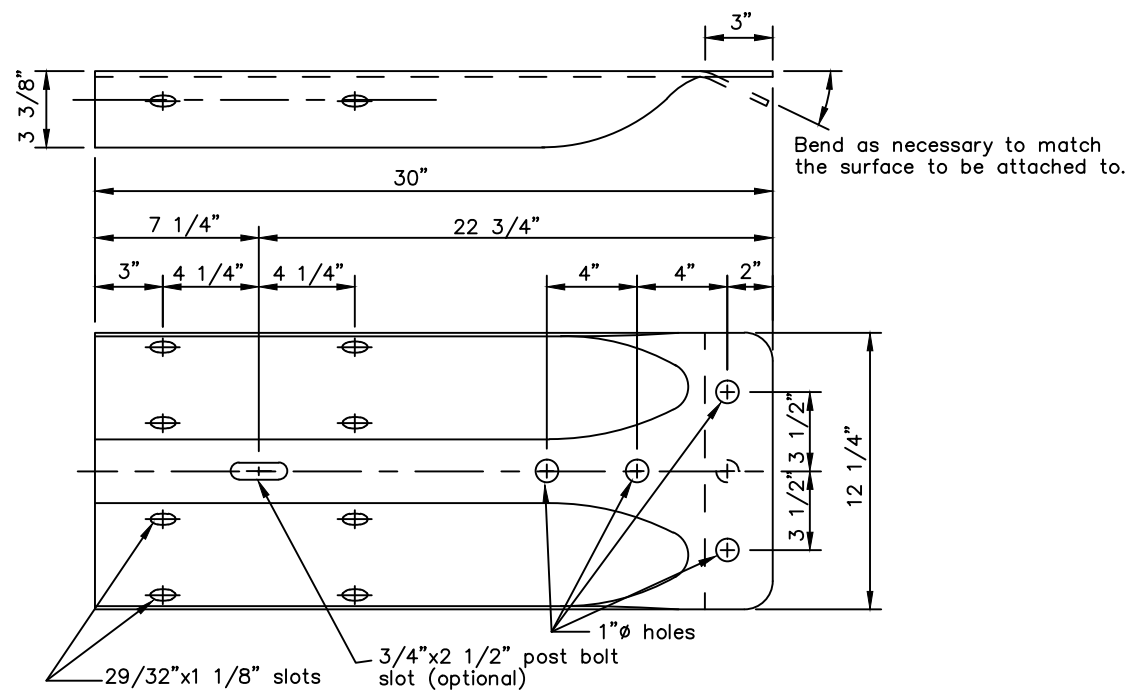


STANDARD W-BEAM TERMINAL CONNECTOR

PROJECT AS-BUILT DRAWINGS HAVE BEEN REVIED BY THE PROJECT ENGINEER AND REPRESENT TO THE BEST OF MY KNOWLEDGE THE PROJECT AS CONSTRUCTED.  
PE: *Emily Delaney*  
DATE:12/5/2016

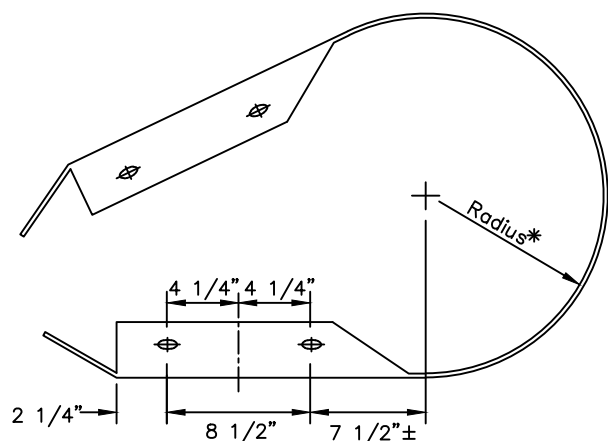

W-BEAM PLAN VIEW  
\*Radius to be specified on the plans

STANDARD W-BEAM END SECTION

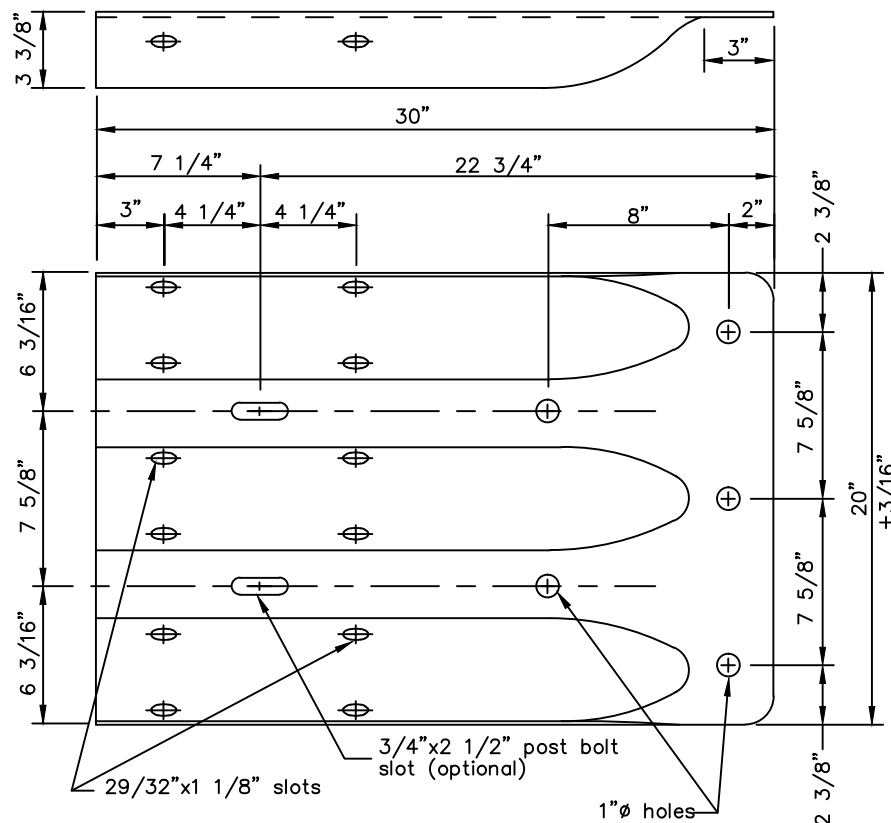


STANDARD THRIE BEAM TERMINAL CONNECTOR

REVISIONS		
Date	Description	By
3/15/99	Delete Thrie End Sect.	KJS

State of Alaska  
Department of Transportation  
& Public Facilities  
**STANDARD GUARDRAIL  
HARDWARE  
(TERMINAL CONNECTORS)**

APPROVED

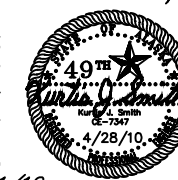


Date 5/31/12


G-00.02

**GENERAL NOTES:**


1. Cable Anchor Plate may be formed in single unit or welded fabrication.
2. Anchor Cable Assembly shall conform to AASHTO M-30 with Type II Wire Rope.
3. Sleeve for Wood Posts shall conform to the requirements of ASTM A120 and shall be of 2-inch galvanized standard pipe. Sleeve shall be a tight, pressed fit in post.
4. Bolts, nuts and washers shall conform to ASTM A-325 and galvanized in accordance with ASTM A-153.
5. Radius ID plates shall be attached to all shop-bent guardrail sections. They shall be bolted to the back side of the guardrail panel with the lower splice bolt nearest the P.C. of the radius.
6. Rail bend radius in feet shall be shown as "XX" on the radius ID plate. Digits shall be etched or stamped and have a min. height of 1 1/2" and a max. width of 3/4". The plate shall be galvanized after digits are marked.
7. All covered hardware shall comply with the AASHTO/AGC/ARTBA "A Guide to Standardized Highway Barrier Hardware", latest edition.

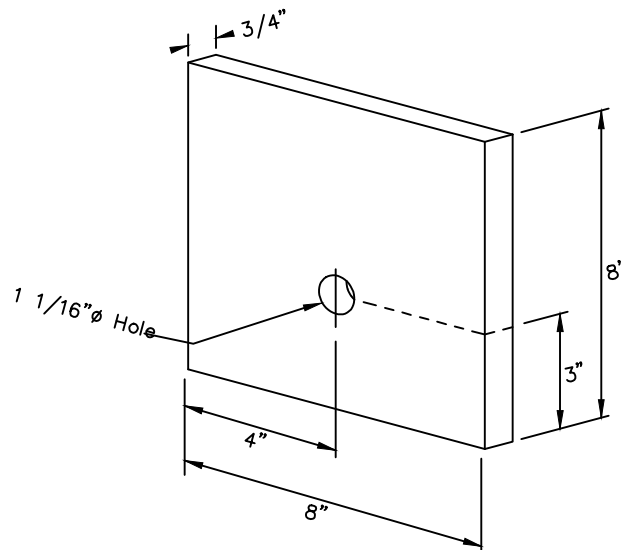


BEARING PLATE for CRT TERMINAL ANCHOR

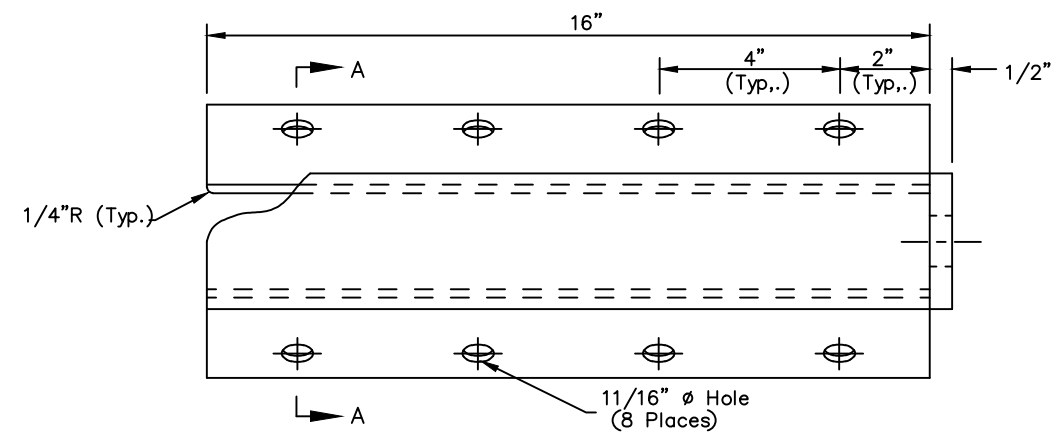


CABLE ANCHOR PLATE

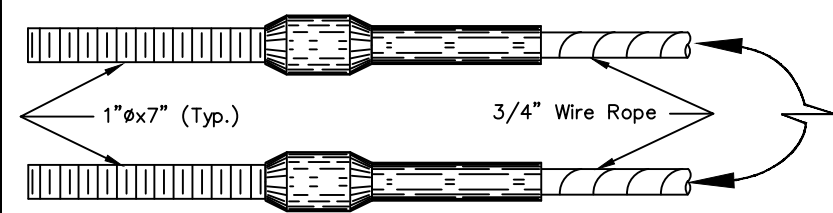

SWAGED FITTING DETAIL

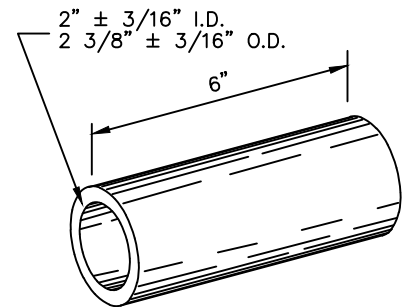


SLEEVE DETAIL

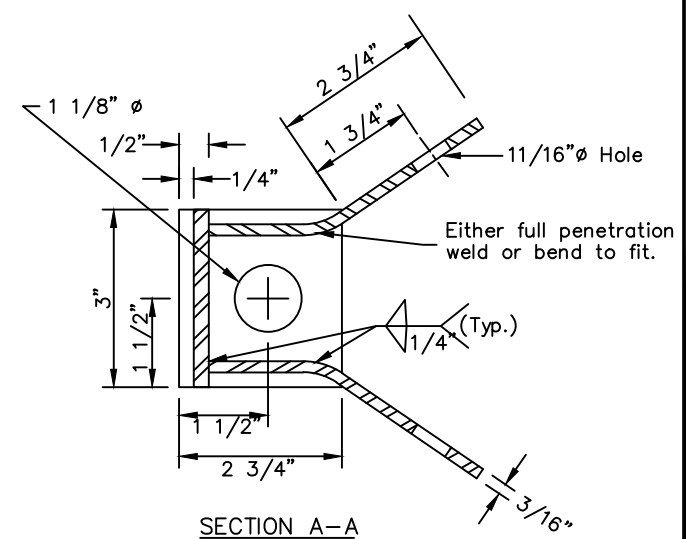


SECTION A-A

**PROJECT AS-BUILT DRAWINGS HAVE BEEN REVIEWED BY THE PROJECT ENGINEER AND REPRESENT TO THE BEST OF MY KNOWLEDGE THE PROJECT AS CONSTRUCTED.**  
 PE:  
 DATE: 12/5/2016 *Emily Delaney*


RELEASED TERMINAL HARDWARE DETAILS

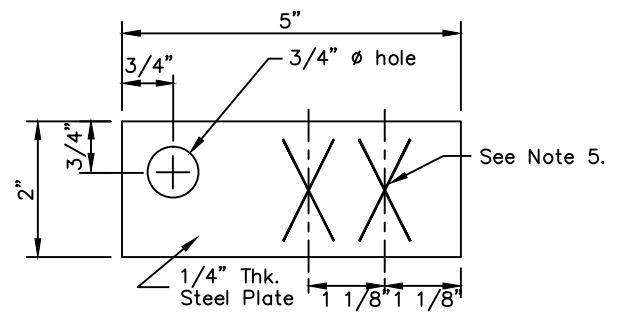

RADIUS I.D. PLATE

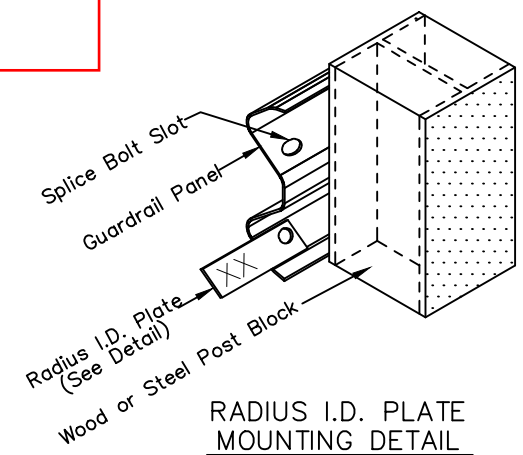

RADIUS I.D. PLATE MOUNTING DETAIL

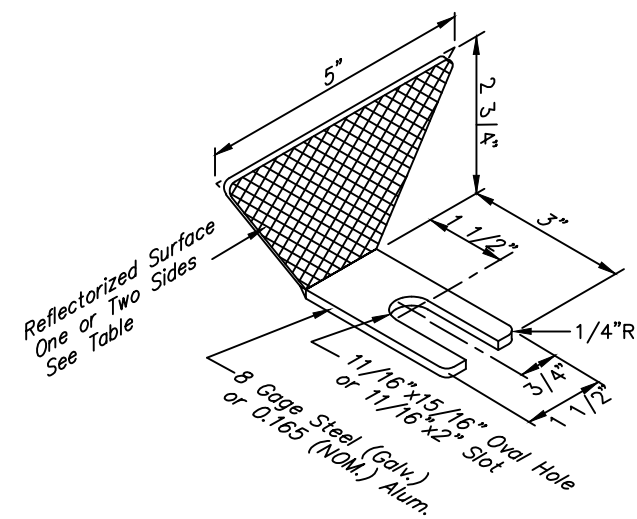


GUARDRAIL REFLECTOR

Type	Guardrail Color	Reflectors ReflectORIZED
A	White	Front & Rear
B	White	Front
C	Yellow	Front
D	Yellow	Front & Rear


REVISIONS		
Date	Description	By
3/15/99	Delete BCT Hardware	KJS

State of Alaska  
 Department of Transportation  
 & Public Facilities


**STANDARD GUARDRAIL  
 HARDWARE  
 (MISCELLANEOUS)**

APPROVED  
  
 4/25/10

Date: 5/31/12

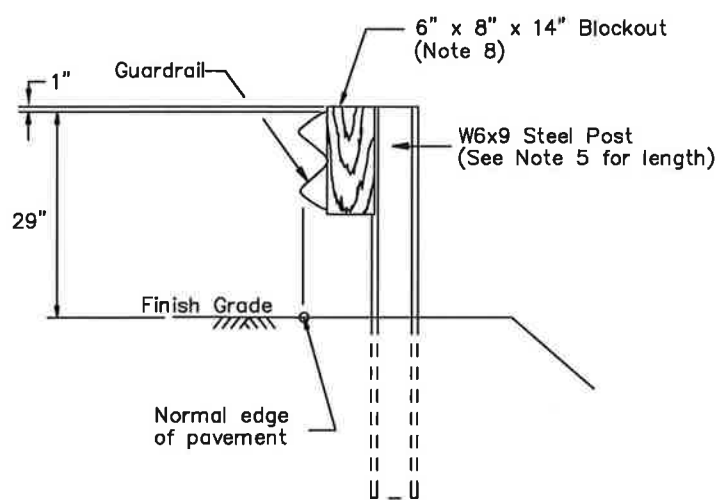


TYPE I POST INSTALLATION

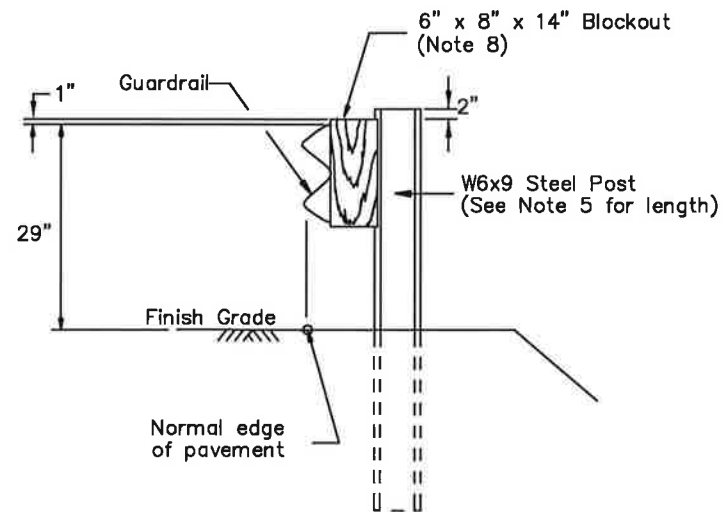

TYPE II POST INSTALLATION

(Facilitates raising rail for future overlays.)

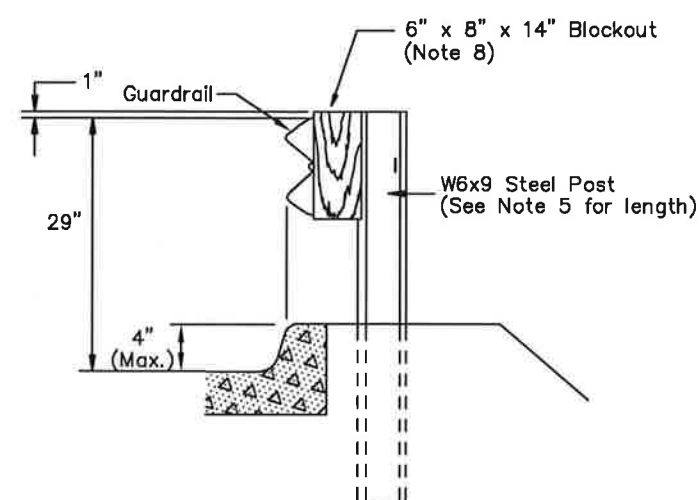

TYPE III POST INSTALLATION


NOTE: Curb should not be installed with guardrail when the speed limit exceeds 40 mph.

GENERAL NOTES:


1. Attach guardrail reflectors at 50' centers beginning with the first post. Use Type A reflectors unless specified otherwise.
2. Provide hardware compliant with the AASHTO/AGC/ARTBA "A Guide to Standardized Highway Barrier Hardware," latest edition.
3. See Standard Drawing G-00 for hardware details.
4. Mount rail to block with bolt on approaching traffic side of block web.
5. See Standard Drawing G-10 for post lengths corresponding to different combinations of slope and behind-post embankment width.
6. Typical post spacing is 6'-3" center to center.
7. This barrier is acceptable under NCHRP 350, TL-3.
8. Use wood, rubber, plastic, or other NCHRP 350 or MASH approved blockouts designed to be used with steel posts.
9. Use 25 linear foot transition to match height of existing or new rail elements and end treatments.
10. W6x8.5 steel post may be substituted for W6x9 steel post.

PROJECT AS-BUILT DRAWINGS HAVE BEEN REVIED BY THE PROJECT ENGINEER AND REPRESENT TO THE BEST OF MY KNOWLEDGE THE PROJECT AS CONSTRUCTED.

PE: *Emily Delaney*  
DATE: 12/5/2016

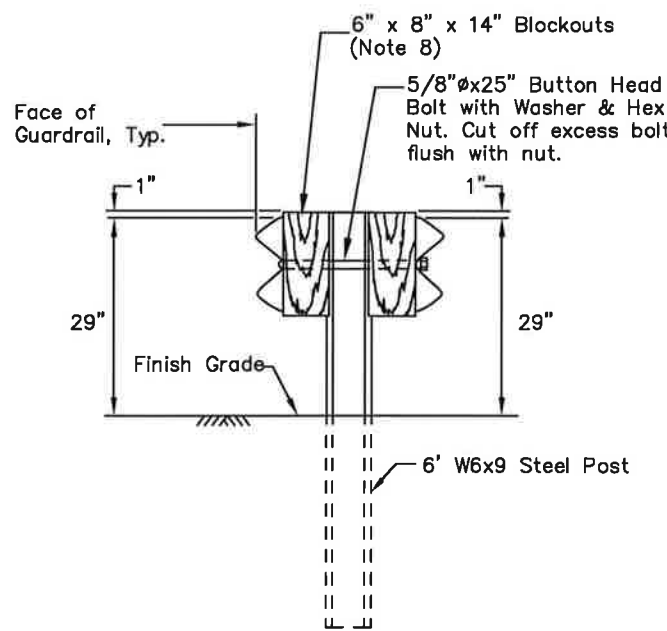


TYPE IV DOUBLE SIDED INSTALLATION

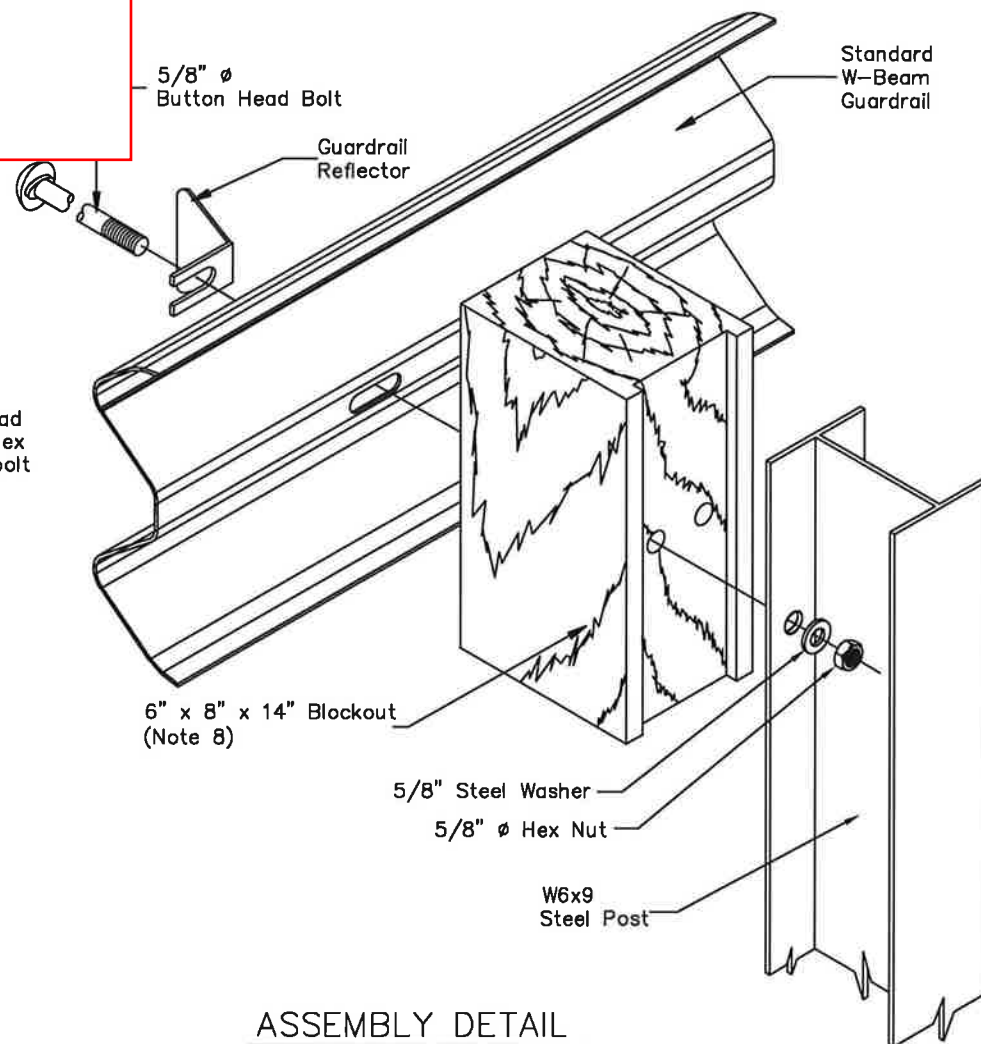

ASSEMBLY DETAIL

(Type I post shown)

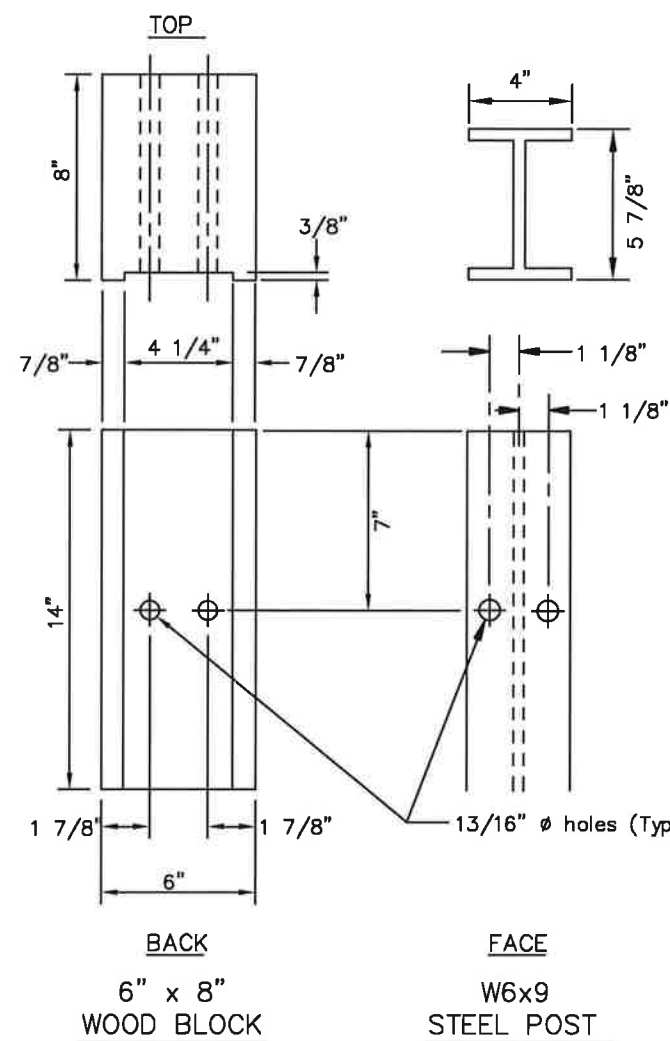

REVISIONS		
Date	Description	By
3/1/83	Revised gen. notes	Gdo
1/1/86	Revised hanger detail	Gdo
3/15/99	Block and post length	KJS
4/1/13	Add double-sided detail and increase g.r. height	JCJ

State of Alaska  
Department of Transportation  
& Public Facilities

STEEL POST  
W-BEAM GUARDRAIL


APPROVED




Date 05/15/13

**GENERAL NOTES:**


1. This drawing is to be used for post length determination only. See the plans for slopes and behind-post embankment widths.
2. To determine post length, identify the case that matches site conditions and read the length corresponding to the pertinent guardrail type.
3. These dimensions apply to both curbed and uncurbed sections.

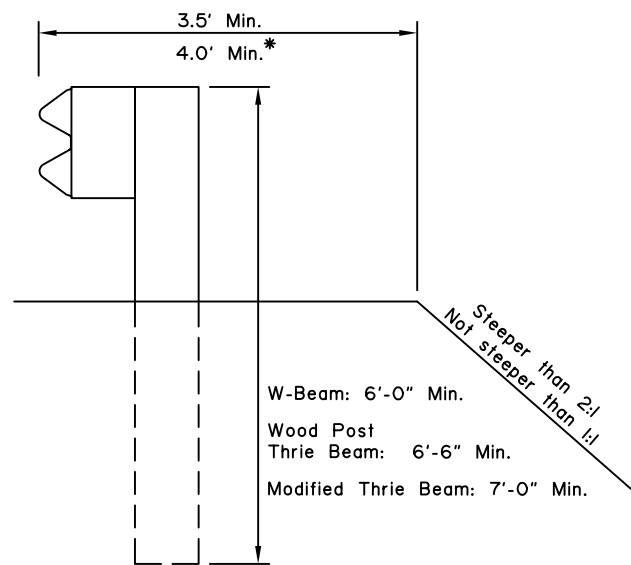

CASE 1

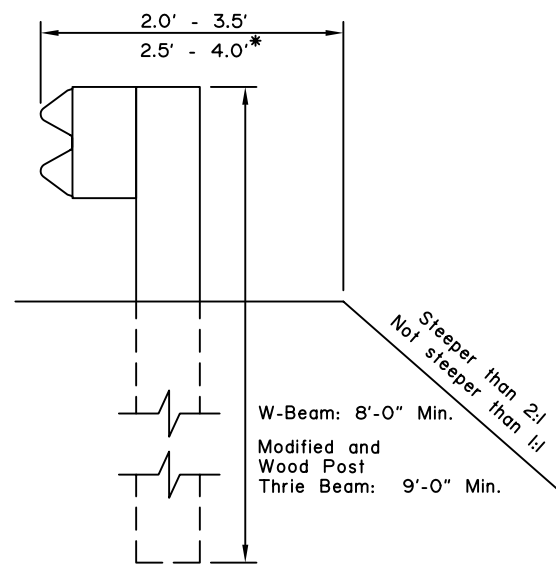

CASE 2

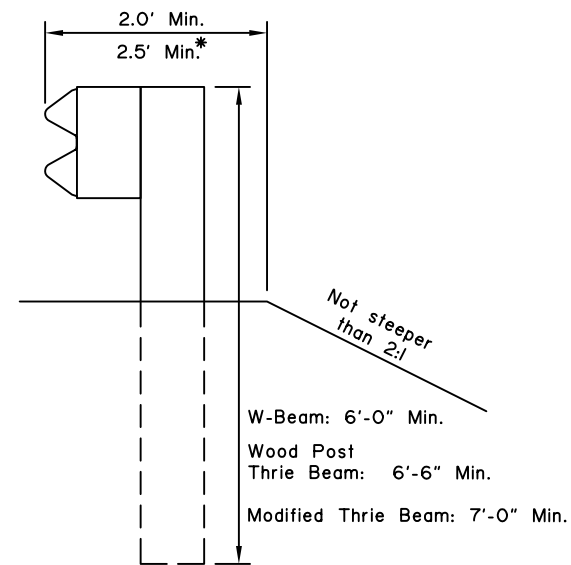

CASE 3

\* with Modified Thrie Beam'

PROJECT AS-BUILT DRAWINGS HAVE BEEN REVIED BY THE PROJECT ENGINEER AND REPRESENT TO THE BEST OF MY KNOWLEDGE THE PROJECT AS CONSTRUCTED.  
PE: *Emily Delaney*  
DATE: 12/5/2016

REVISIONS		
Date	Description	By
12/2/99	Delete Case 4, 5, and 6	KJS

State of Alaska  
Department of Transportation  
& Public Facilities

**BEAM GUARDRAIL  
POST INSTALLATION**





Date 3/15/99

# G-13.00

## GENERAL NOTES:

1. Hardware details not shown here shall conform to drawings G-00, G-04W, G-25W
2. Fasten anchor plate to rail with eight 5/8" x 1 1/2" machine bolts with hex nut and washer. Place washer on face side of rail.
3. Torque outside nut against inside nut a minimum of 100 ft-lbs.
4. Toenail bearing plate with two 10d galvanized nails at corners to prevent turning.
5. All covered hardware shall comply with the AASHTO/AGC/ARTBA "A Guide to Standardized Highway Barrier Hardware", latest edition.
6. This assembly will typically be used on the downstream ends of guardrail runs on one-way streets.
7. This assembly is generally not intended for divided highway applications due to possible 2-way construction detours. Designer should consider future detouring needs when deciding whether to use this terminal.
8. This design does not meet NCHRP 350 TL 3 standards. It is not intended as a crash worthy barrier end treatment for approach end impacts.

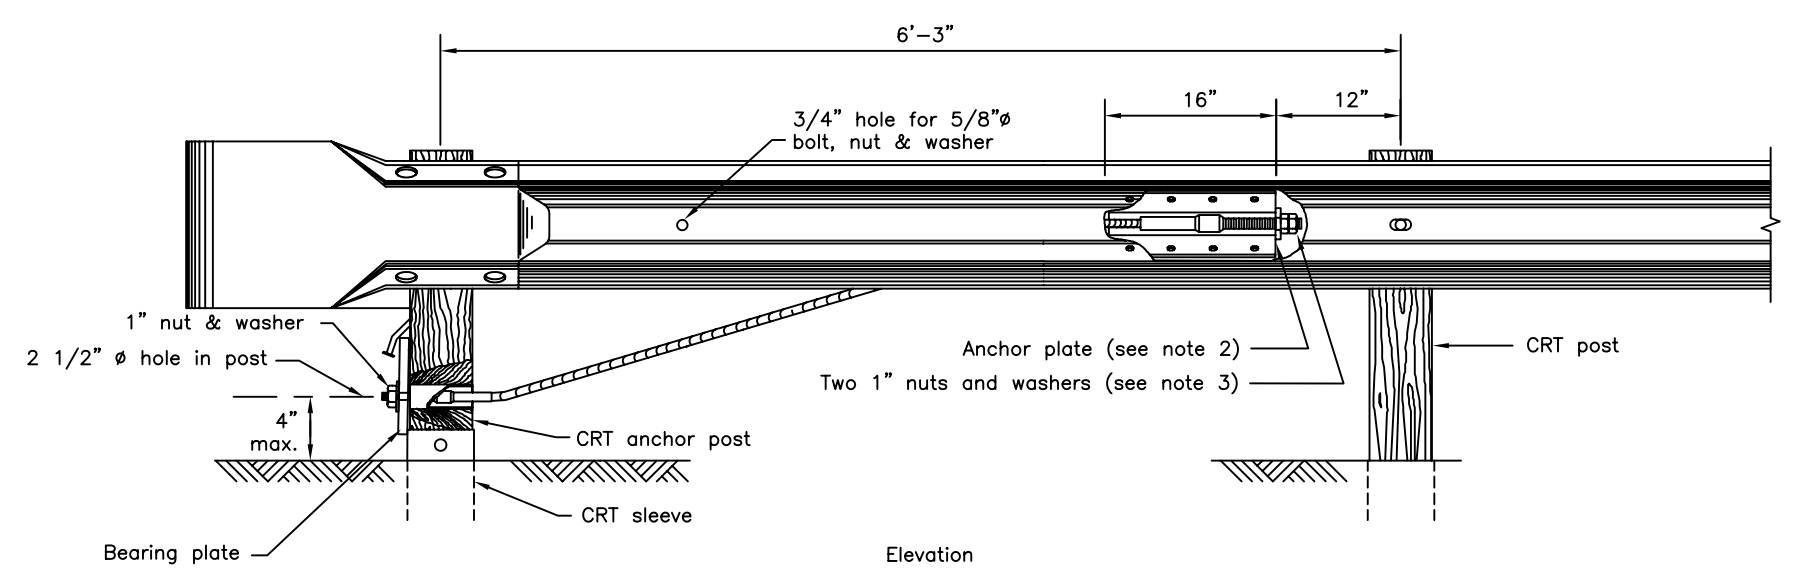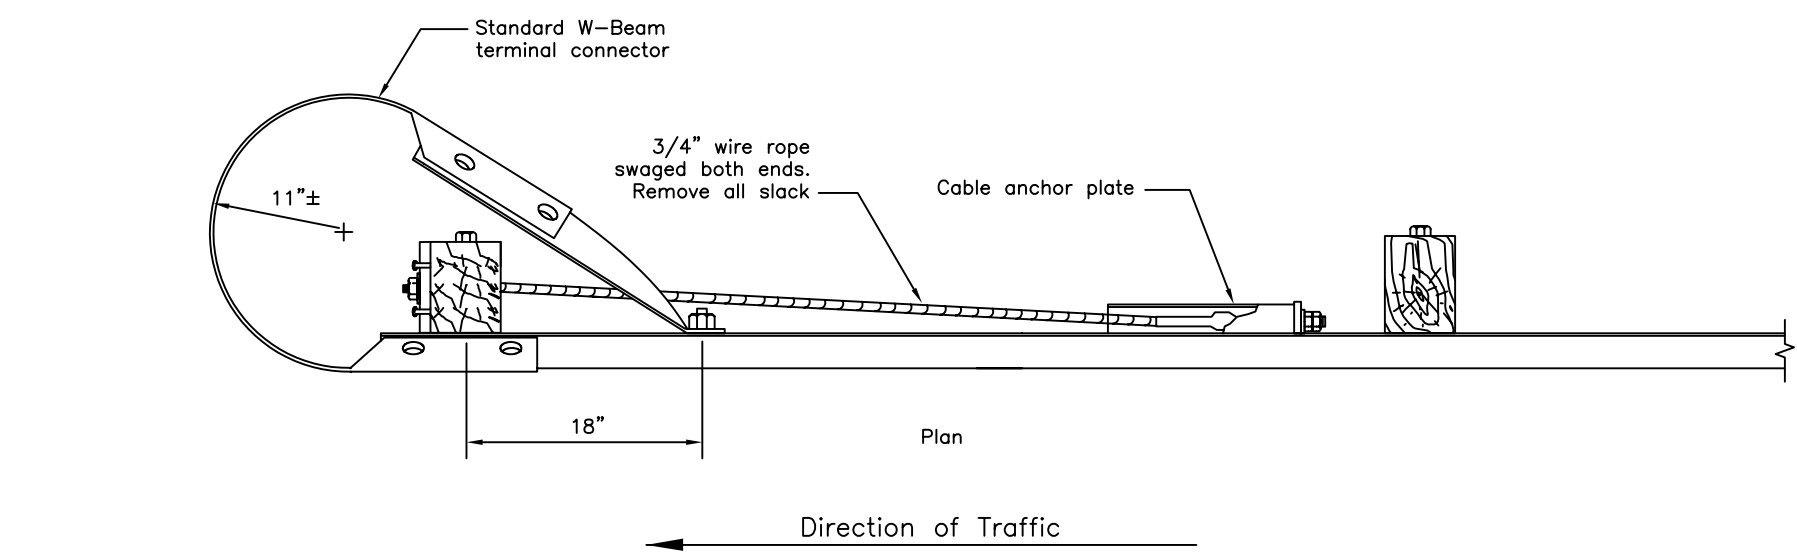

TERMINAL ANCHOR

PROJECT AS-BUILT DRAWINGS HAVE BEEN REVIED BY THE PROJECT ENGINEER AND REPRESENT TO THE BEST OF MY KNOWLEDGE THE PROJECT AS CONSTRUCTED.  
 PE: *Emily Delaney*  
 DATE: 12/5/2016

REVISIONS		
Date	Description	By

Sheet 1 of 1

State of Alaska  
Department of Transportation  
& Public Facilities


**W BEAM GUARDRAIL  
DOWNSTREAM END  
ANCHOR**

APPROVED


DATE

Date: 2/28/03




G-13.00

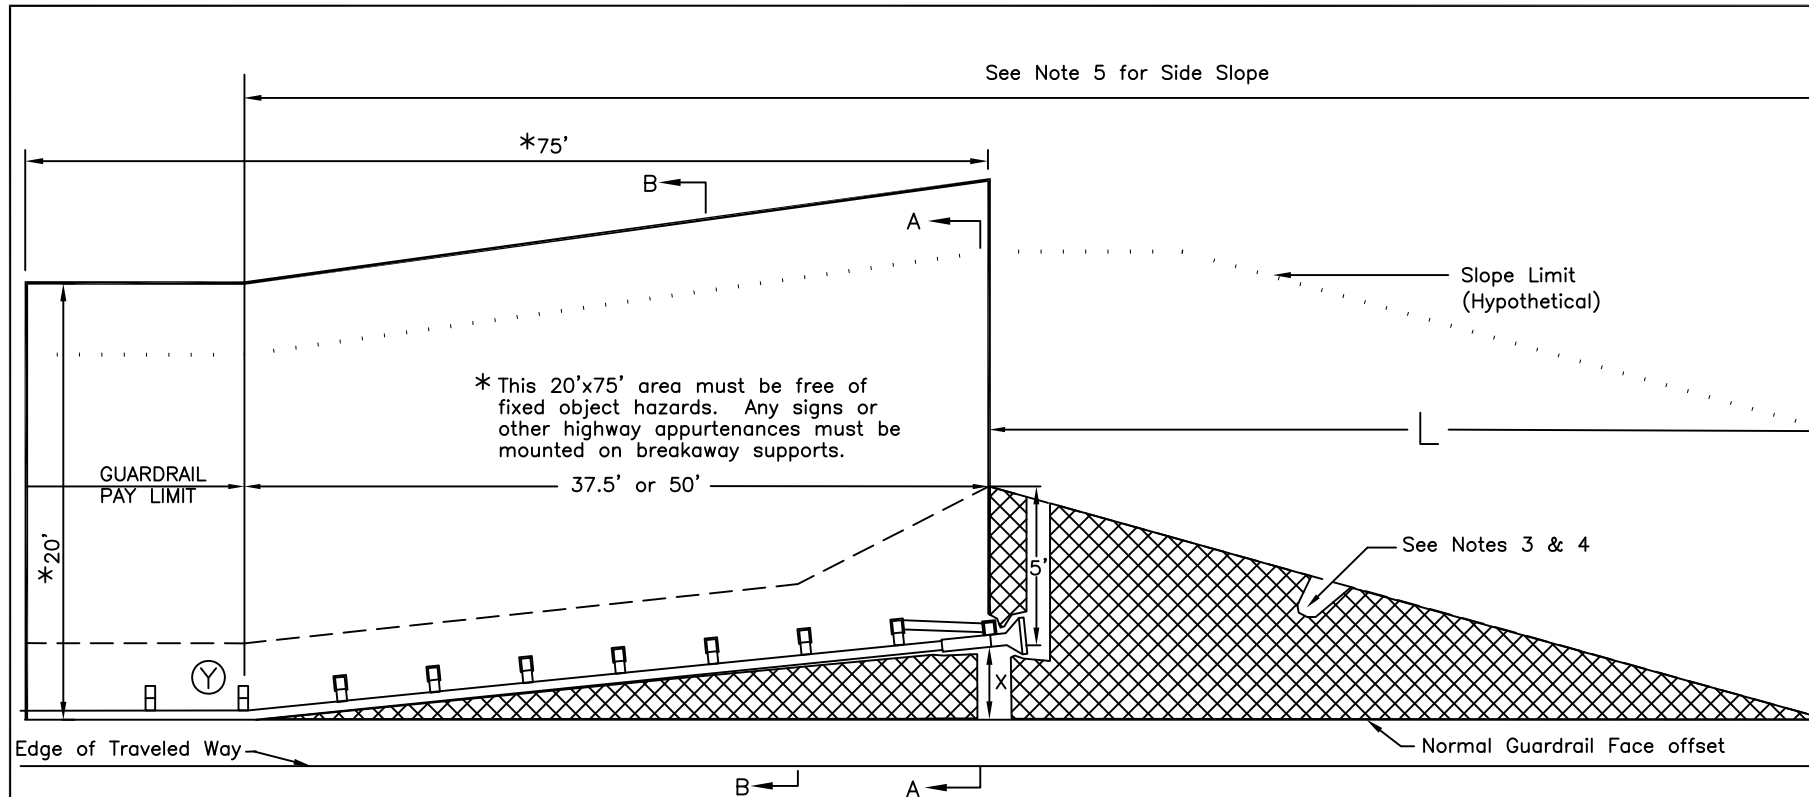

**STANDARD GUARDRAIL TERMINAL WIDENING DETAIL**

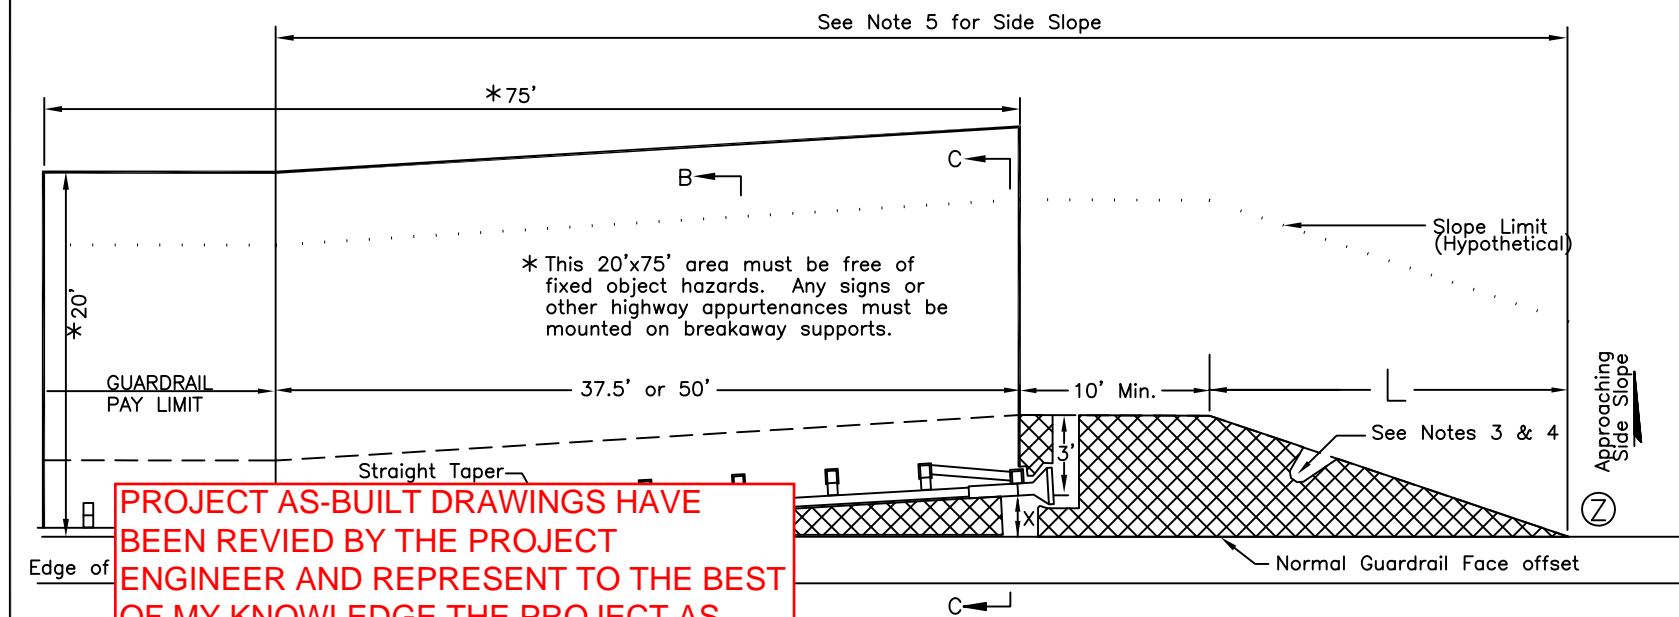

**TERMINAL WIDENING DETAIL**

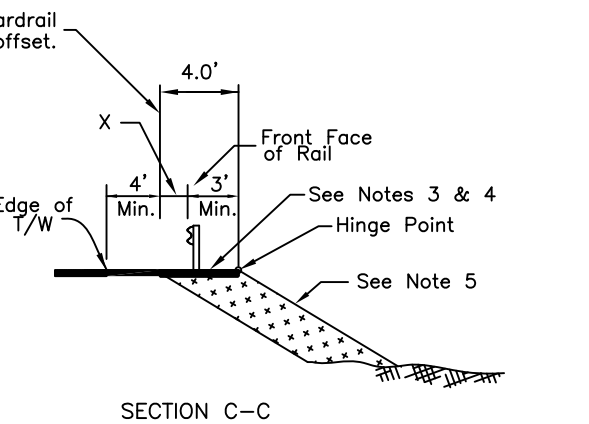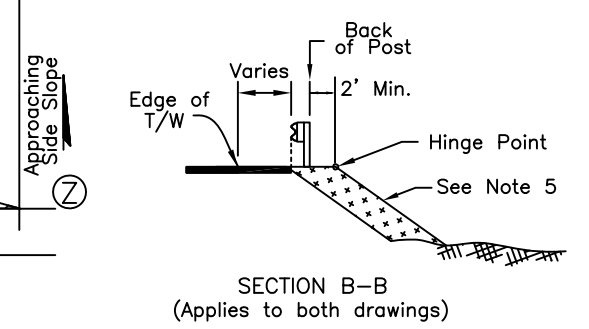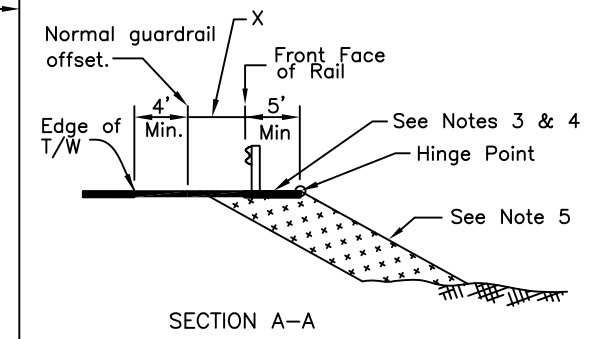

- GENERAL NOTES:**
1. The standard detail applies to all approved guardrail terminals, including those with parabolic flares. The alternate detail may only be used with straight terminals. The terminal details shown are for illustration only – see manufacturer's drawings for actual post, rail, etc. drawings.
  2. Use the standard detail for all terminals except when upgrading existing non-NCHRP 350 or MASH compliant terminals to NCHRP 350 or MASH compliant terminals where site conditions make the use of the standard detail infeasible. In that case, use the alternate detail.
  3. Construct the hatched areas to match the slope of the adjacent shoulder to a maximum slope of 10:1. Maintain 10:1 for steeper shoulders. Match the slope when the shoulder slopes toward the road as well as away from the road.
  4. On paved roads, the hatched areas shall be paved. On gravel roads, surface the hatched areas with the same materials used to surface the travel lanes.
  5. From point (Y) to point (Z) make the side slope match the approaching side slope except where it is flatter than 4:1. In that case, the slope may be steepened to 4:1.
  6. Attach a flexible marker to the first point (where the flare begins) and the end post of each terminal.
  7. The maximum allowable height for foundation tubes or other steel components of terminal post breakaway systems is 4 inches above the surrounding grade.
  8. The details on this sheet do not apply to Controlled Release Terminals (G-25) or Downstream End Anchors (G-13).
  9. On two-way undivided roads, the details on this sheet do apply to NCHRP 350 or MASH compliant guardrail terminals on both the approach and downstream ends.

**PROJECT AS-BUILT DRAWINGS HAVE BEEN REVIEWED BY THE PROJECT ENGINEER AND REPRESENT TO THE BEST OF MY KNOWLEDGE THE PROJECT AS CONSTRUCTED.**  
 PE: *Emily Delaney*  
 DATE: 12/5/2016

X: End offset. See manufacturer's information for the range of acceptable (NCHRP 350 or MASH compliant) end offsets for each terminal.

Taper Lengths (L) for Common End Offsets (X)		
End Offset	Standard Detail	Alternate Detail
0'	15.0'	10.0'
1'	17.0'	10.0'
1.5'	20.0'	15.0'
2'	22.0'	15.0'
2.5'	25.0'	15.0'
4'	30.0'	20.0'

Interpolate if the end offset falls between table values

REVISIONS		
Date	Description	By
3/6/02	Change ET Offset	KJS
2/28/03	Major Revisions	KJS
4/28/10	Revise General Notes	KJS


Sheet 1 of 1

State of Alaska  
 Department of Transportation  
 & Public Facilities


**WIDENING FOR GUARDRAIL  
 END TERMINALS**

APPROVED


Date: 5/31/12

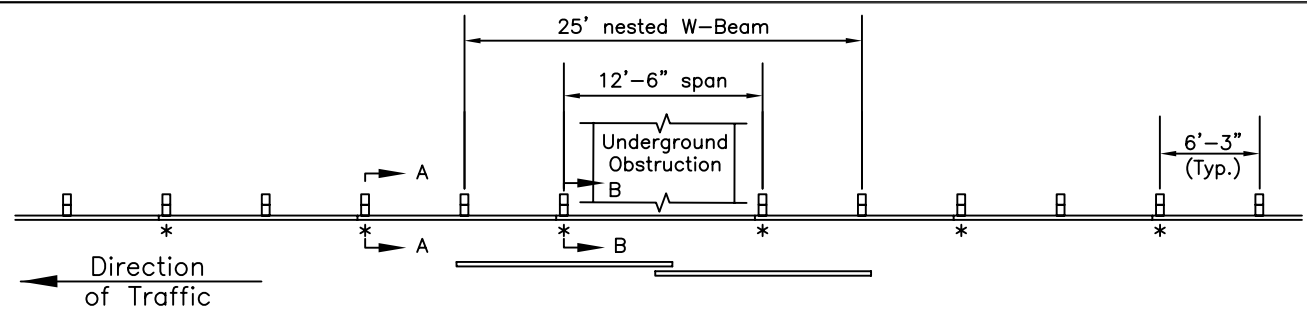


**CASE A – ONE POST OMITTED (NESTED RAIL SPLICE AT OMITTED POST)**  
For obstruction widths up to 10'-6"

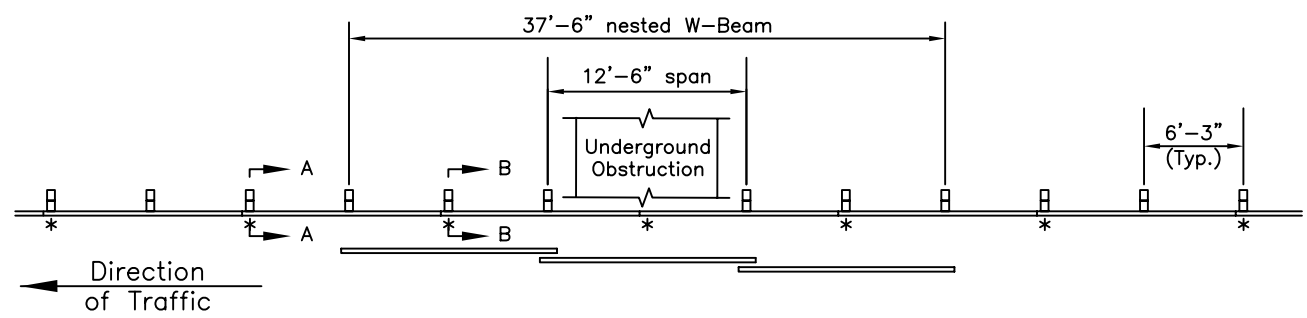

**CASE B – ONE POST OMITTED (NESTED RAIL SPANS OMITTED POST)**  
For obstruction widths up to 10'-6"

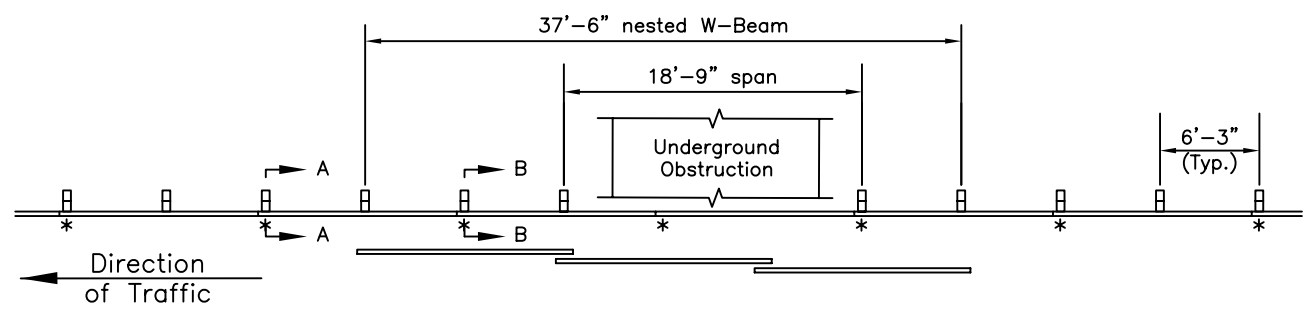


**CASE C – TWO POSTS OMITTED**  
For obstruction widths from 10'-6" to 16'-9"

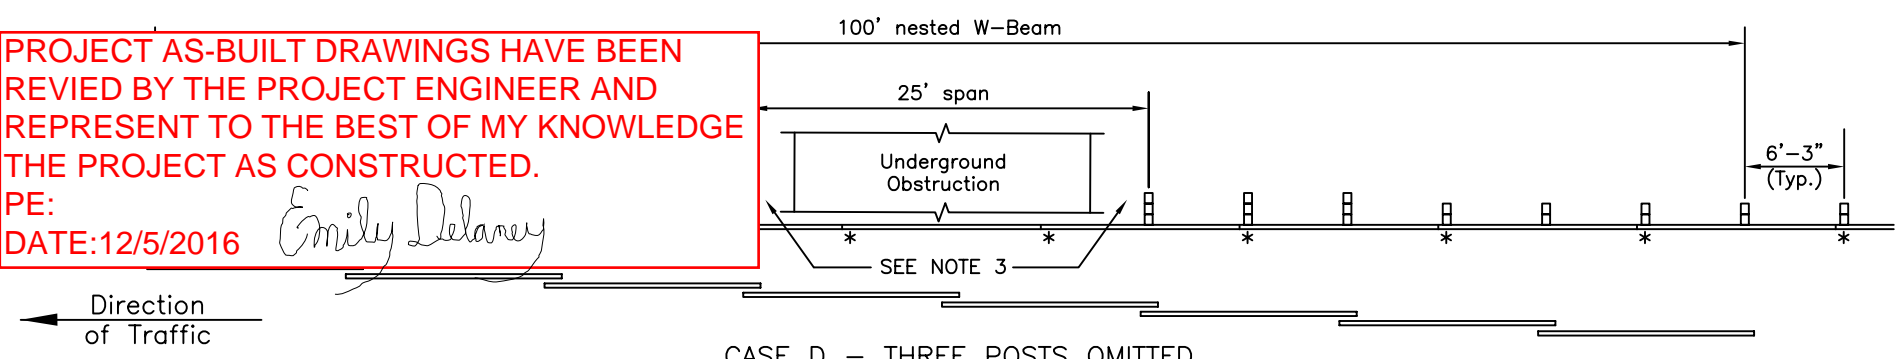


**CASE D – THREE POSTS OMITTED**  
For obstruction widths from 16'-9" to 20'-6"


\* Designates Splice Location

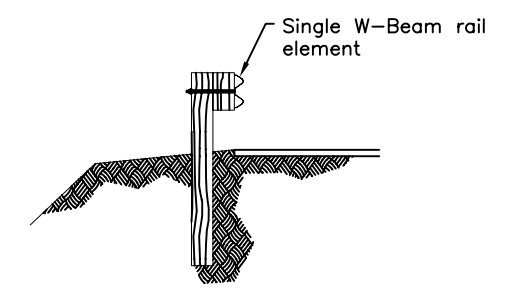

SECTION A-A

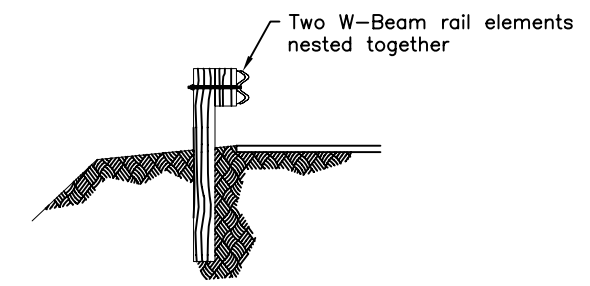

SECTION B-B

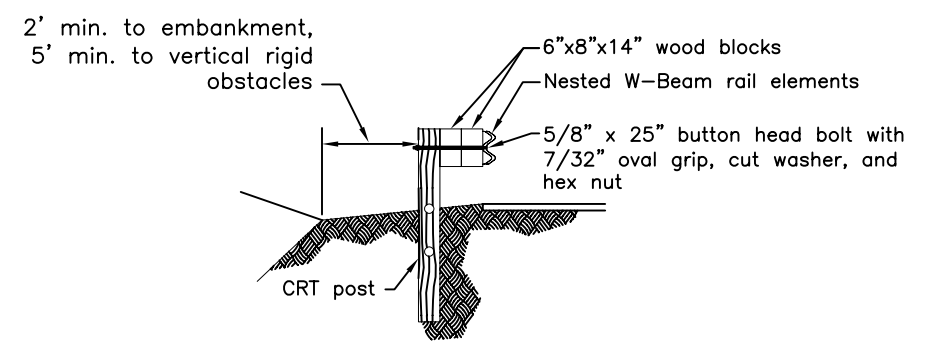

SECTION C-C

CROSS SECTIONS

**GENERAL NOTES**

1. See Standard Drawings G-00, G-04, G-10 for additional details, and G-25 Sheet 1 of 3 for CRT post details.
2. For one-way traffic locations Case D may be modified so that only the posts trailing the span are CRT posts with double blocks.
3. In Case D only, provide 2' minimum clearance between posts and underground obstruction.
4. Standard steel posts with standard wood blocks (or NCHRP 350 compliant synthetic blocks) may be used for all posts except those indicated to be CRT posts.
5. Install nested rail element with leading edge lapped behind primary rail element.
6. Cases A and B were tested under NCHRP 230 guidelines but the FHWA considers them equivalent to an NCHRP 350 Test Level 2 design. Case C has not been tested (as of March, 03) but the FHWA considers it equivalent to an NCHRP 350 Test Level 3 design. Case D is NCHRP 350 Test Level 3 tested and approved.

PROJECT AS-BUILT DRAWINGS HAVE BEEN REVIED BY THE PROJECT ENGINEER AND REPRESENT TO THE BEST OF MY KNOWLEDGE THE PROJECT AS CONSTRUCTED.  
PE: *Emily Delaney*  
DATE: 12/5/2016

REVISIONS		
Date	Description	By

Sheet 1 of 1

State of Alaska  
Department of Transportation  
& Public Facilities

**LONG SPAN  
W BEAM GUARDRAIL**

APPROVED

DATE: 2/28/03