
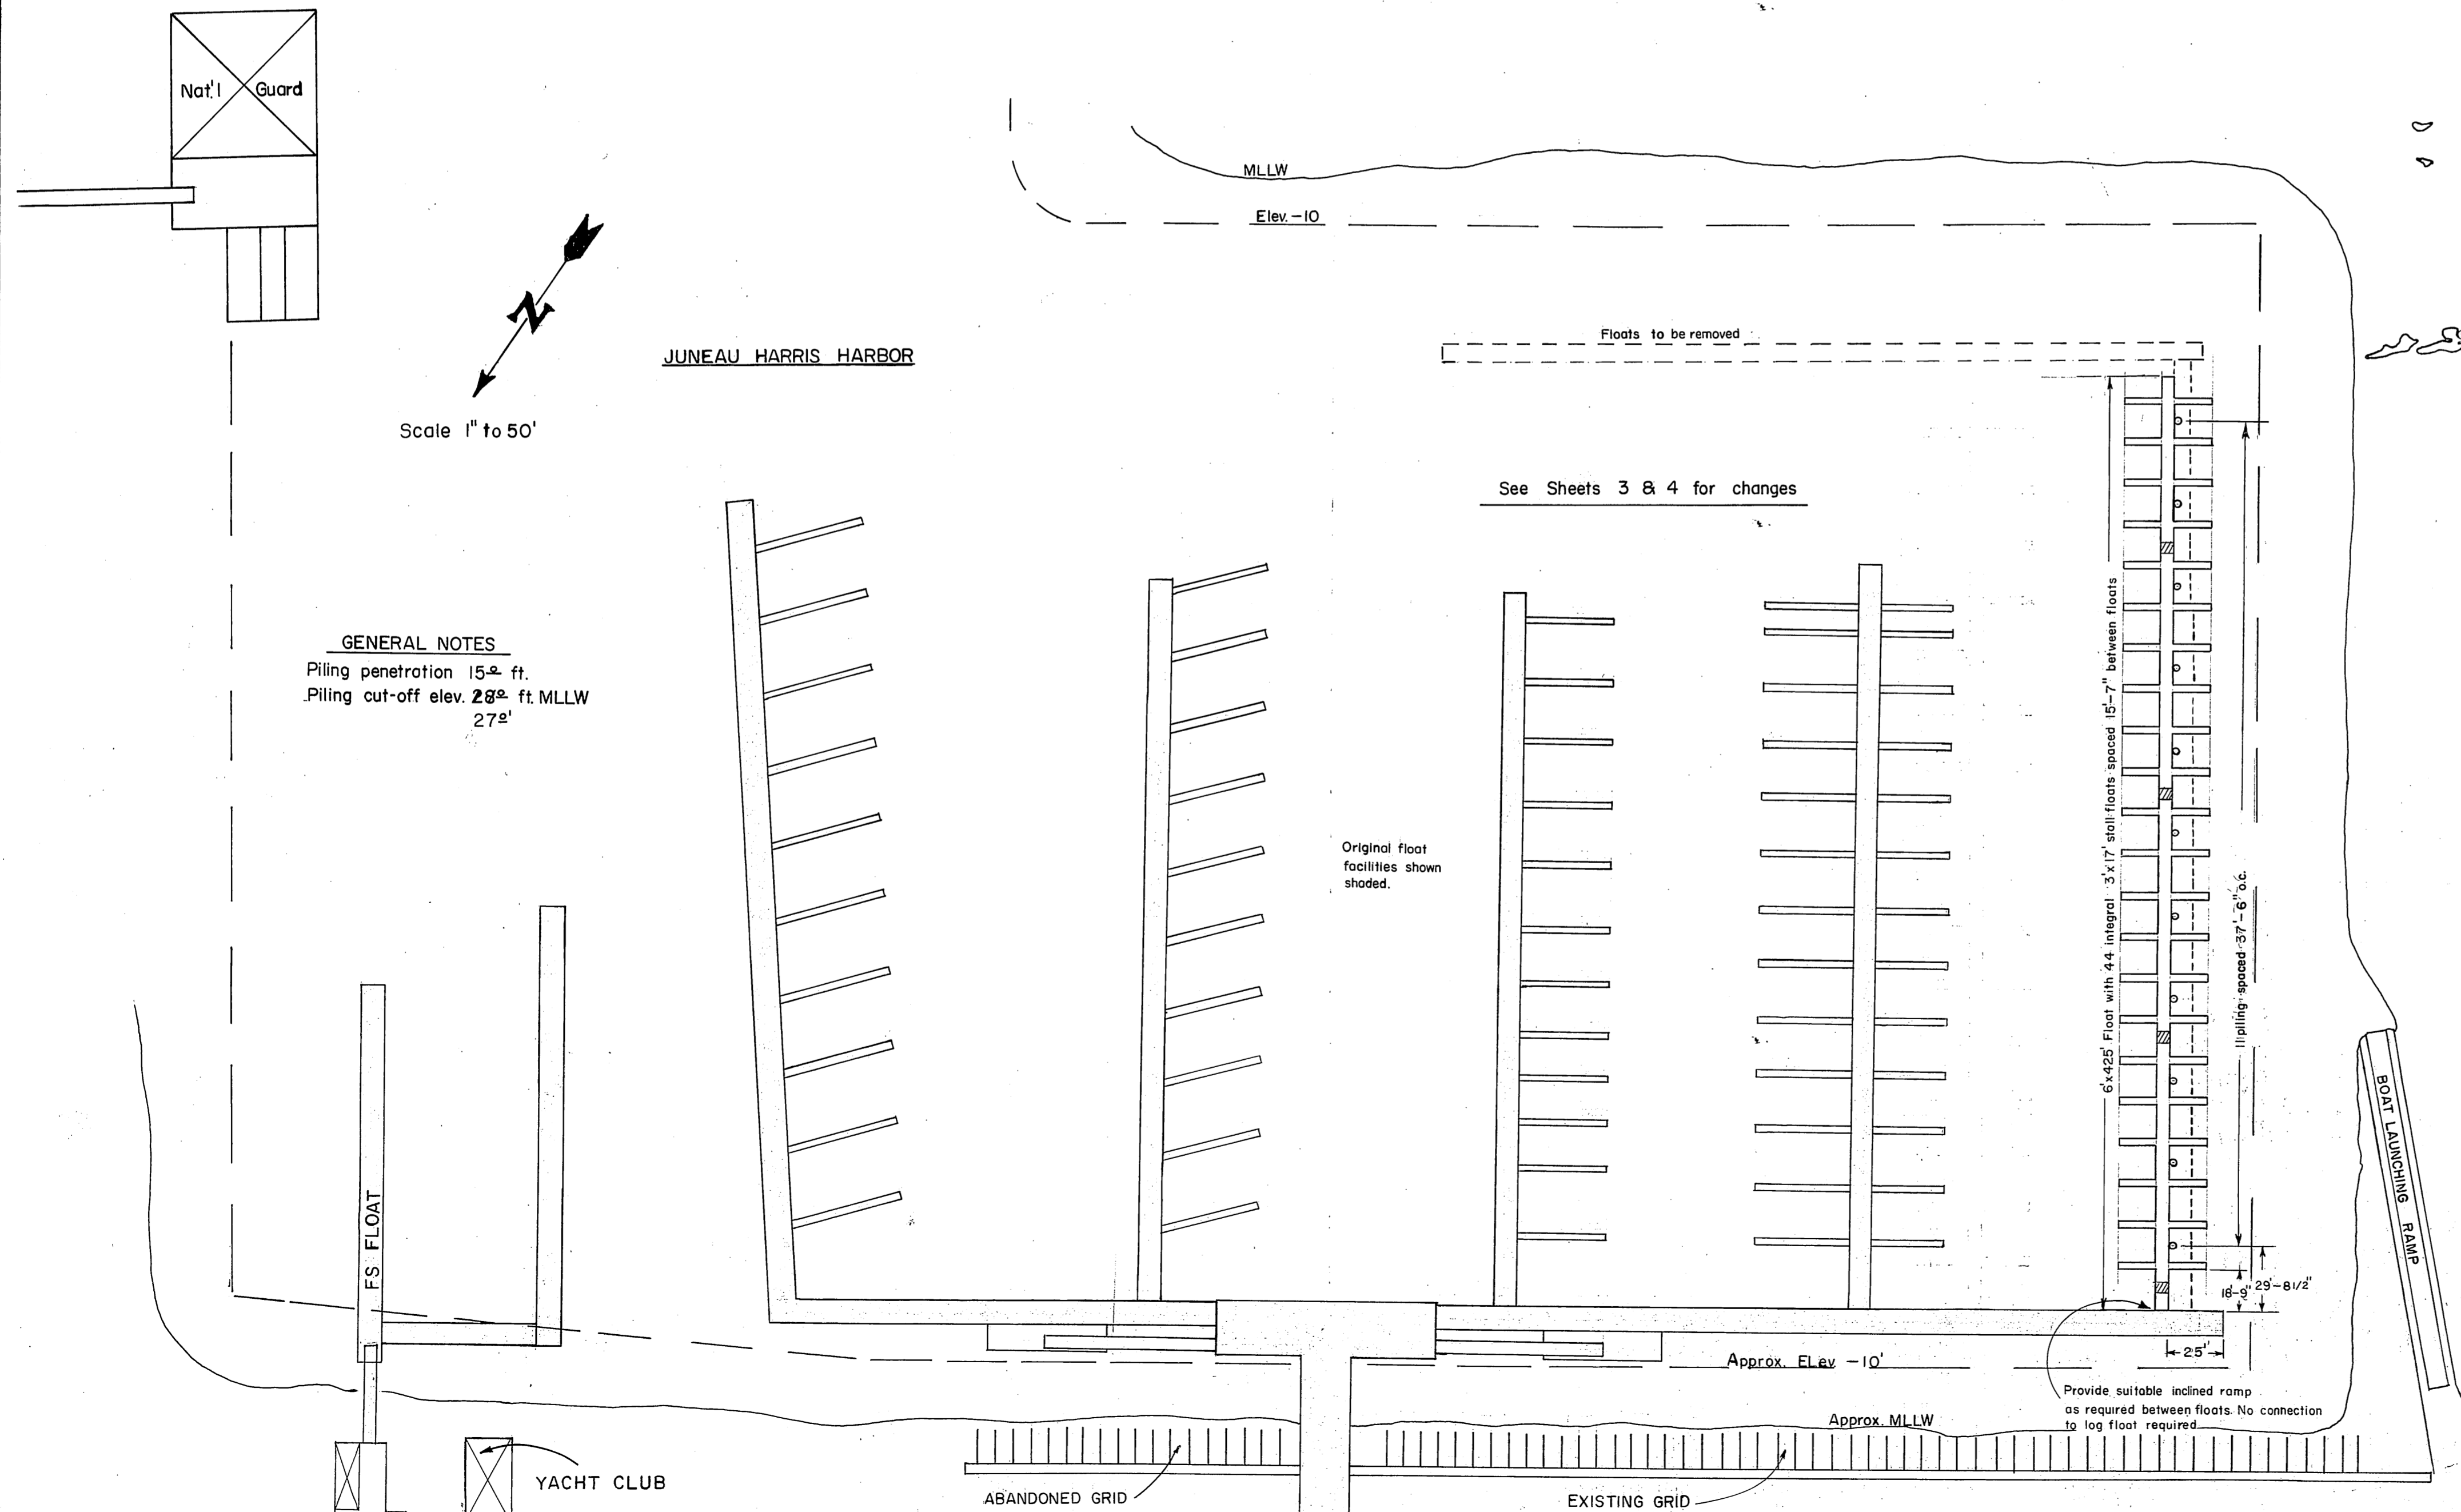


STATE OF ALASKA
 DEPARTMENT OF PUBLIC WORKS
 DIVISION OF WATER & HARBORS
JUNEAU HARRIS HARBOR FACILITIES
 PROJECT No. W-67145

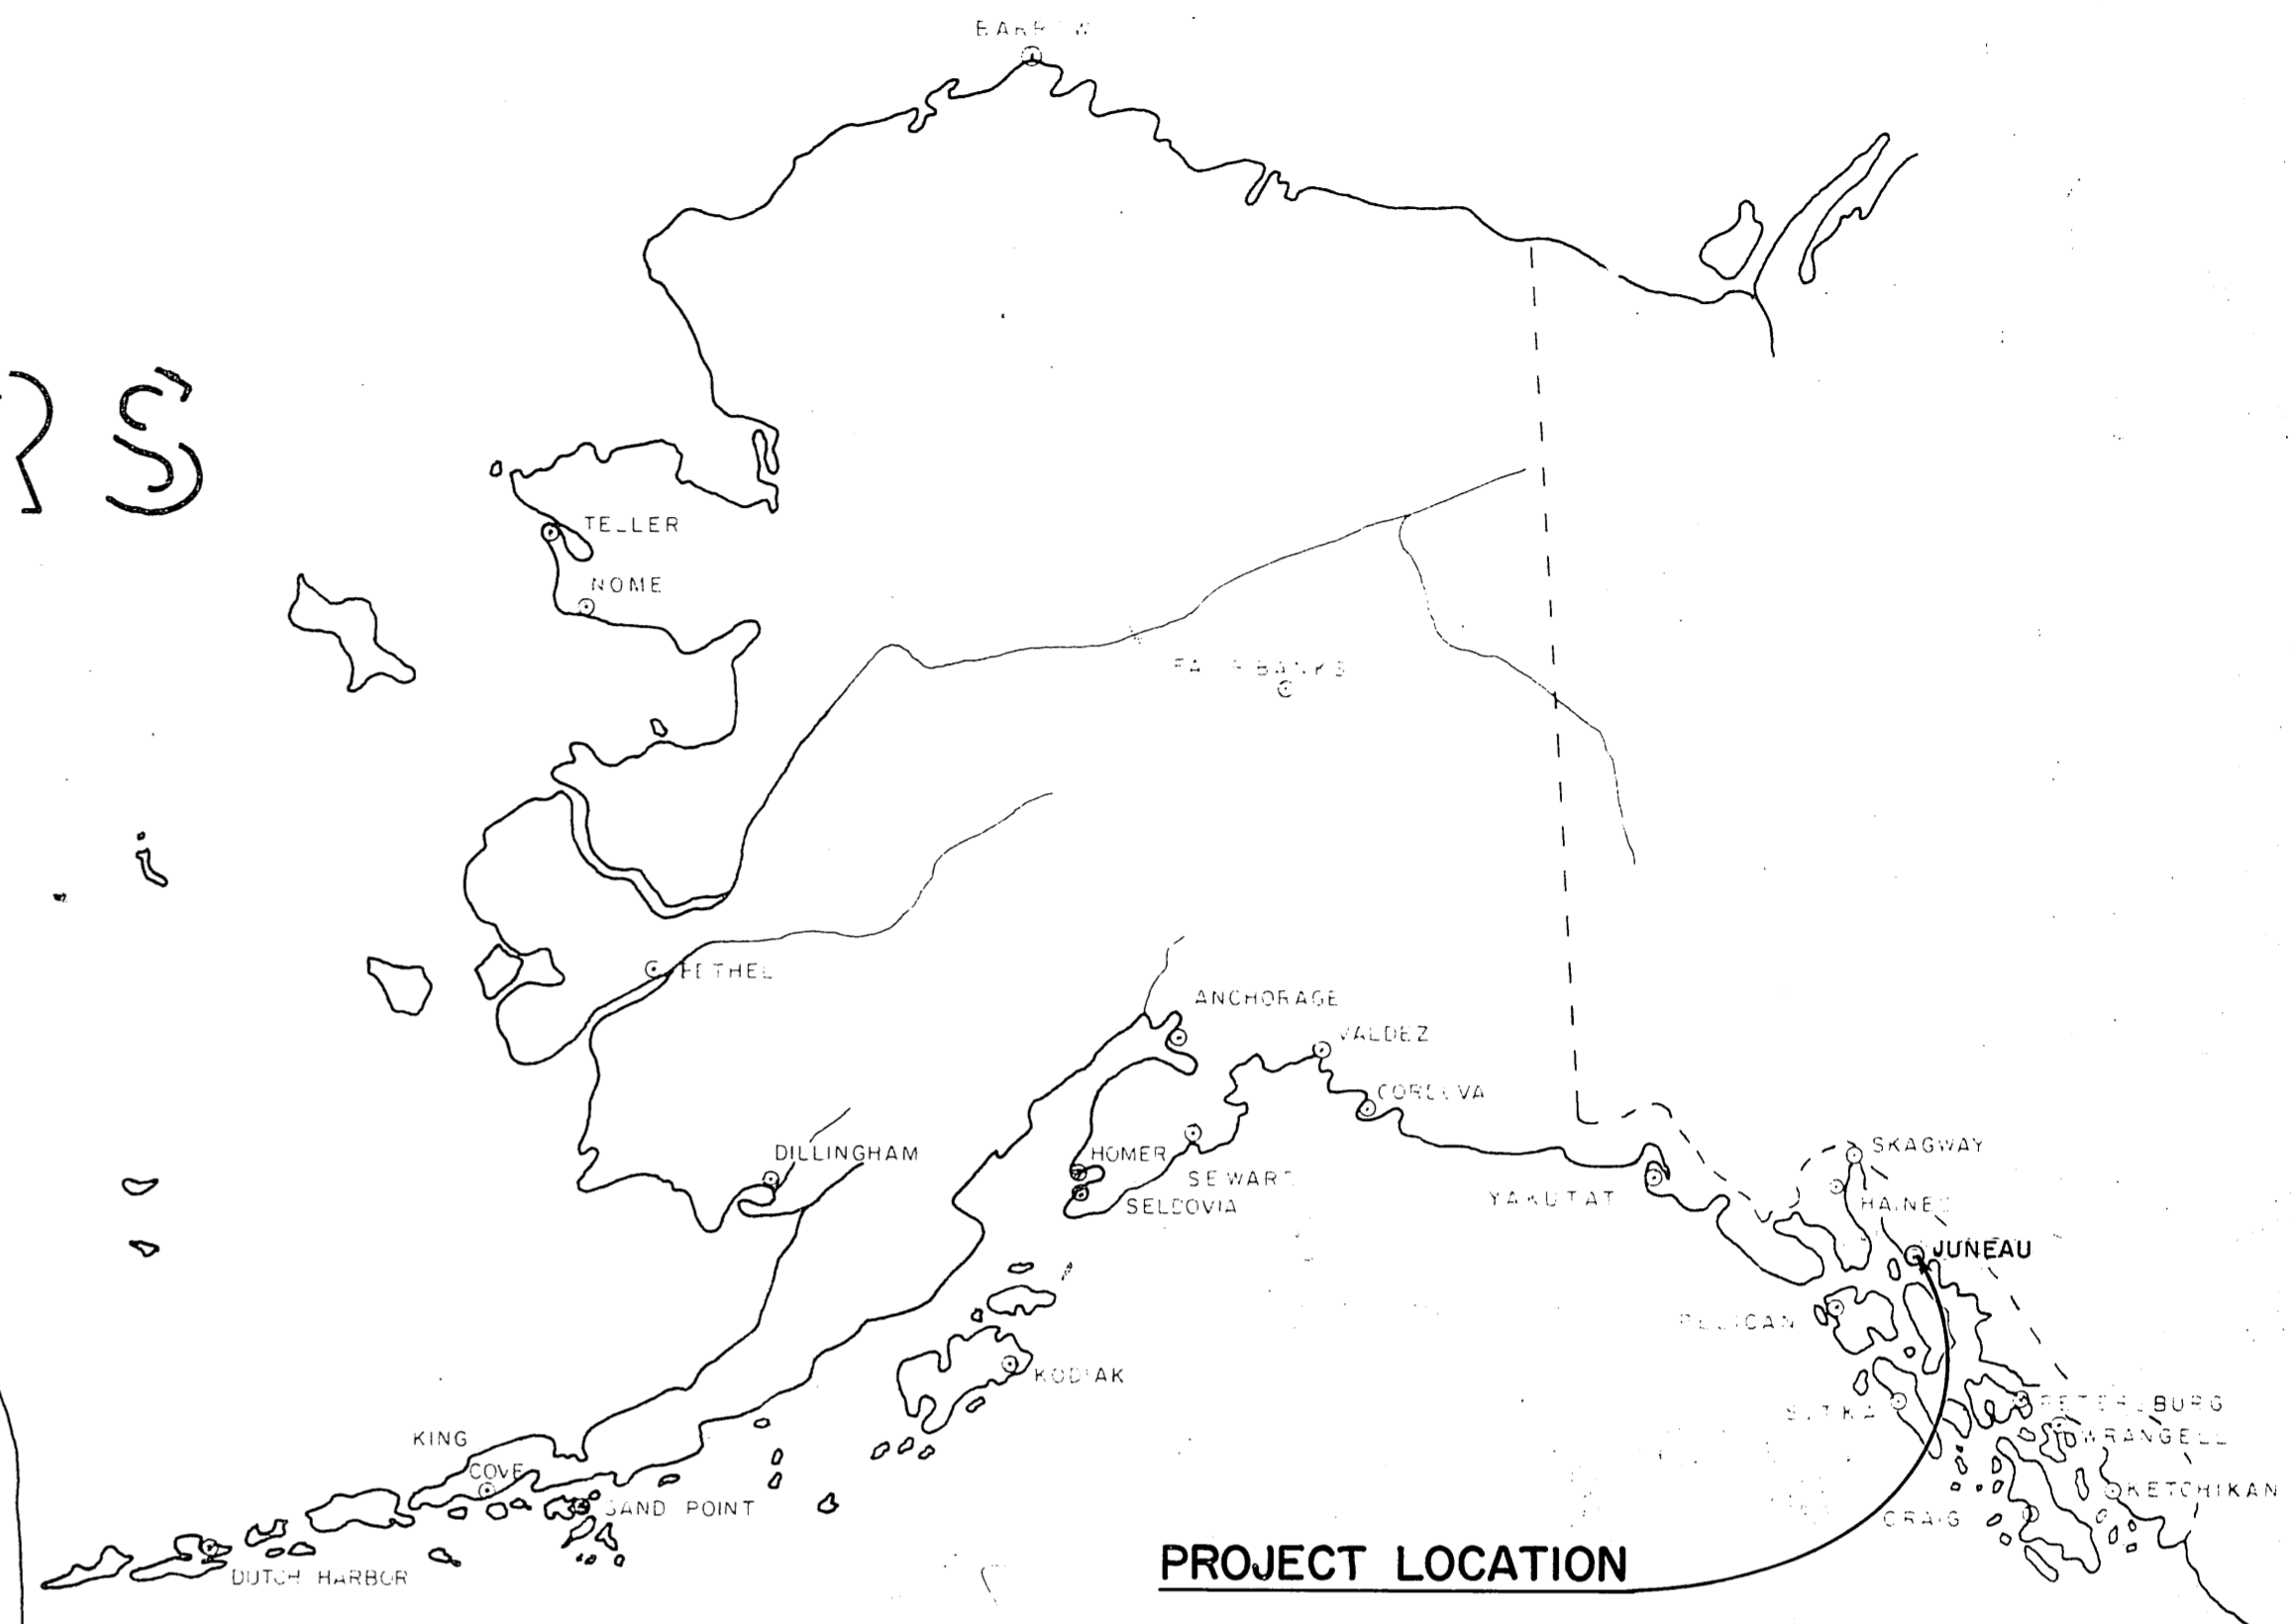


WORK SUMMARY
 Major units of this project shall consist of removing & disposing of approximately 775 lin. ft. of existing log floats, pulling 47 creosote piling, redriving 11 salvaged creosote piling & furnishing & installing 4,919 sq. ft. of polystyrene floats.

INDEX TO SHEETS

TITLE & PROJECT LAYOUT	SHEET No.
TYPICAL 6' FLOAT WITH INTEGRAL STALLS	SHEET No. 2


LEGEND

- Existing floats
- Floats this contract
- Floats to be removed

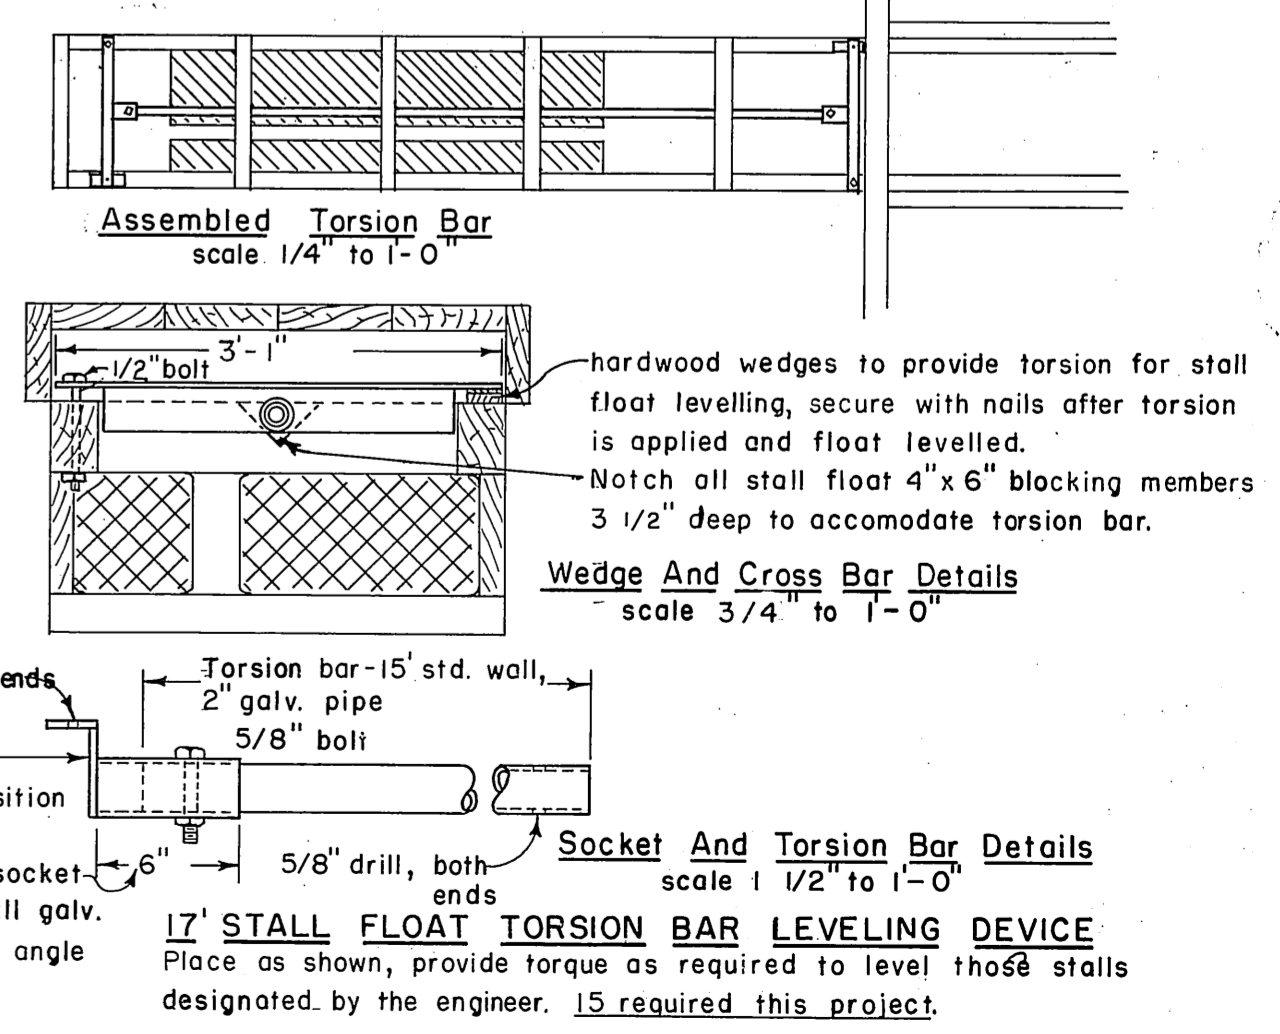


AS BUILT

DATE Apr. 2, 1966 APPROVED *[Signature]*

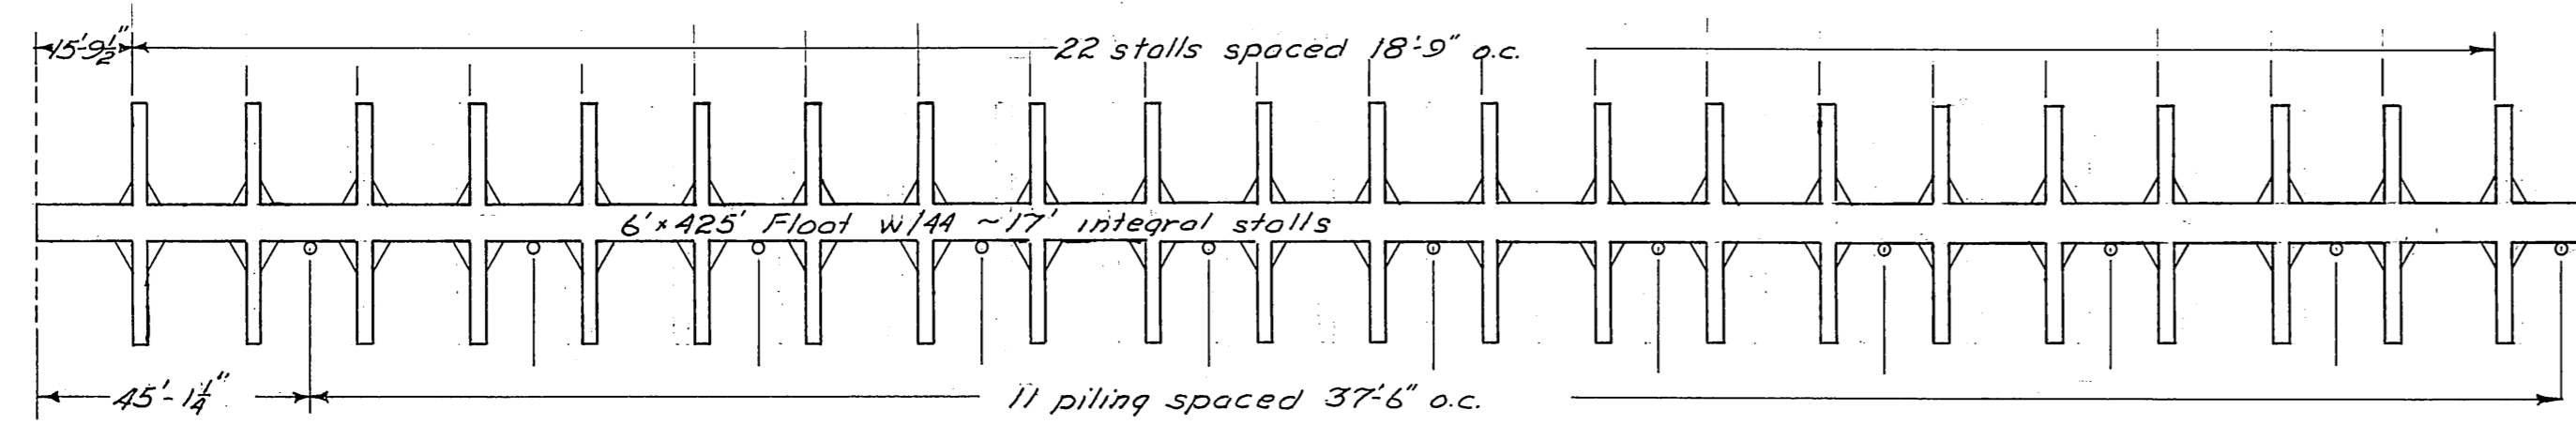

STALL FLOAT & PILING LAYOUT
Scale 1" to 30'

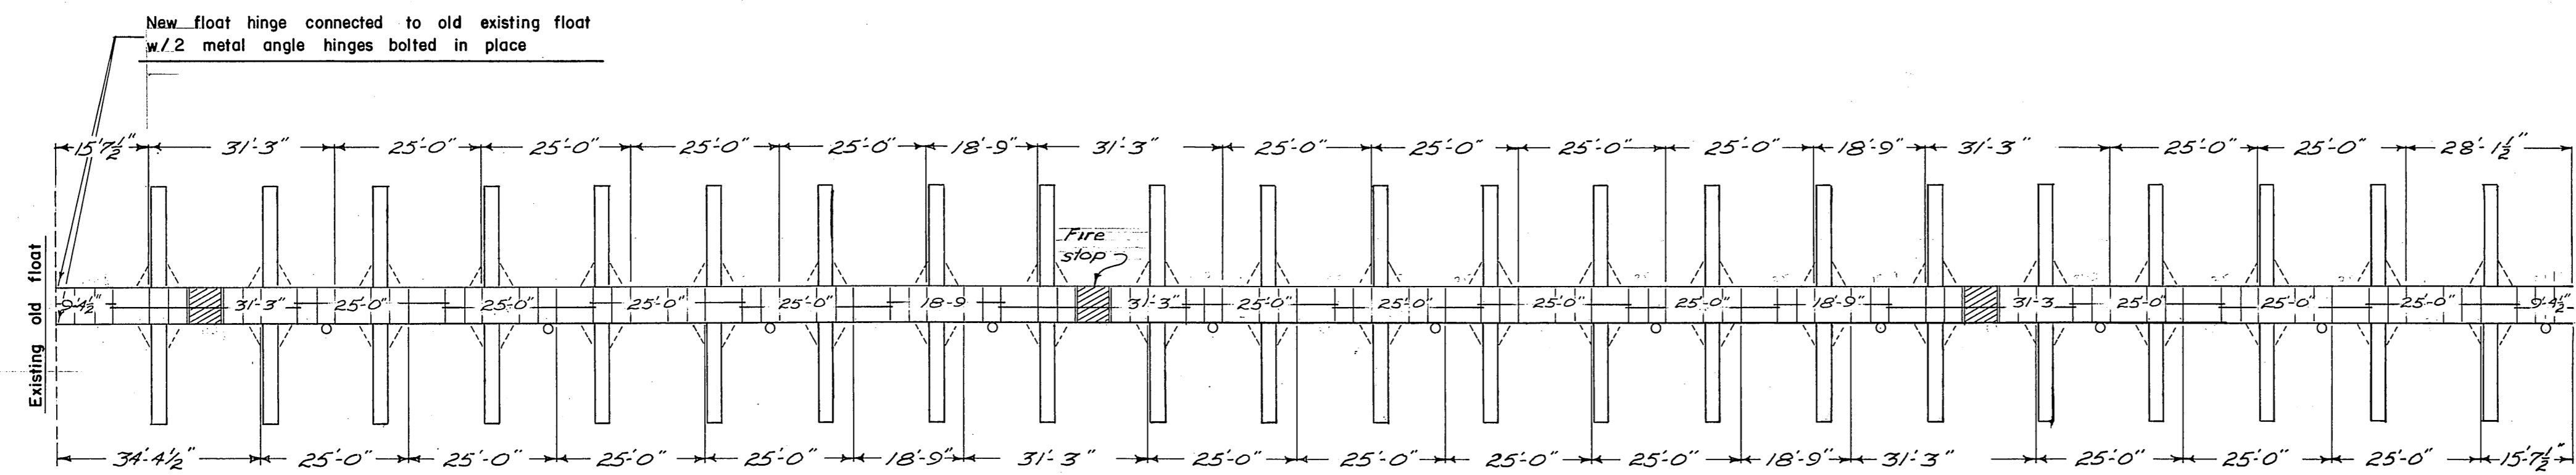

6' FLOAT STRINGER DIAGRAM
Scale 1" to 20'

NOTES:
1. All exterior stringers to be spliced at the locations indicated.
Distances given indicate lengths between centers of dapp joints & lapp splices.

STATE OF ALASKA
DEPARTMENT OF PUBLIC WORKS
DIVISION OF WATER AND HARBORS

CHANGE ORDER #1
JUNEAU HARRIS HARBOR FACILITIES
FLOAT LAYOUT & STRINGER DIAGRAM

SCALE: As shown
DATE: Aug 7, 1966
DRAWN BY: W & T
CHECKED BY: DS

APPROVED: _____
COMMISSIONER