

KEY MAP

STATE OF ALASKA  
DEPARTMENT OF TRANSPORTATION  
&  
PUBLIC FACILITIES

PLAN AND PROFILE  
PROPOSED HIGHWAY PROJECT  
X-30144  
MENDENHALL PENINSULA ROAD  
1.13 MILES  
GRADING & DRAINAGE

STATE	PROJECT	SHEET NO.	TOTAL SHEETS
ALASKA	X-30144	1	2

INDEX OF SHEETS

Sheet No	DESCRIPTION
1	TITLE SHEET
2	TYPICAL SECTIONS & ESTIMATE OF QUANTITIES


The following Standard Drawings apply to this project:  
A-1, C-00.04, C-10.03, C-11.03, D-01.00, D-04.00,  
D-05.00, S-00.11, S-05.00, S-30.12, 1-40.21, 1-80.0

AS-BUILT PLANS

CONTRACTOR: BERG CONST. CO. INC.  
PROJECT ENGINEER: JOHN R. EDWARDS  
BEGINNING DATE: OCT. 15, 1980  
COMPLETION DATE: DEC. 3, 1980

PROJECT SUMMARY

Width of surfacing	22'
Length of project	1.13 miles
DESIGN SPEED	30 m.p.h.
1978 ADT	664

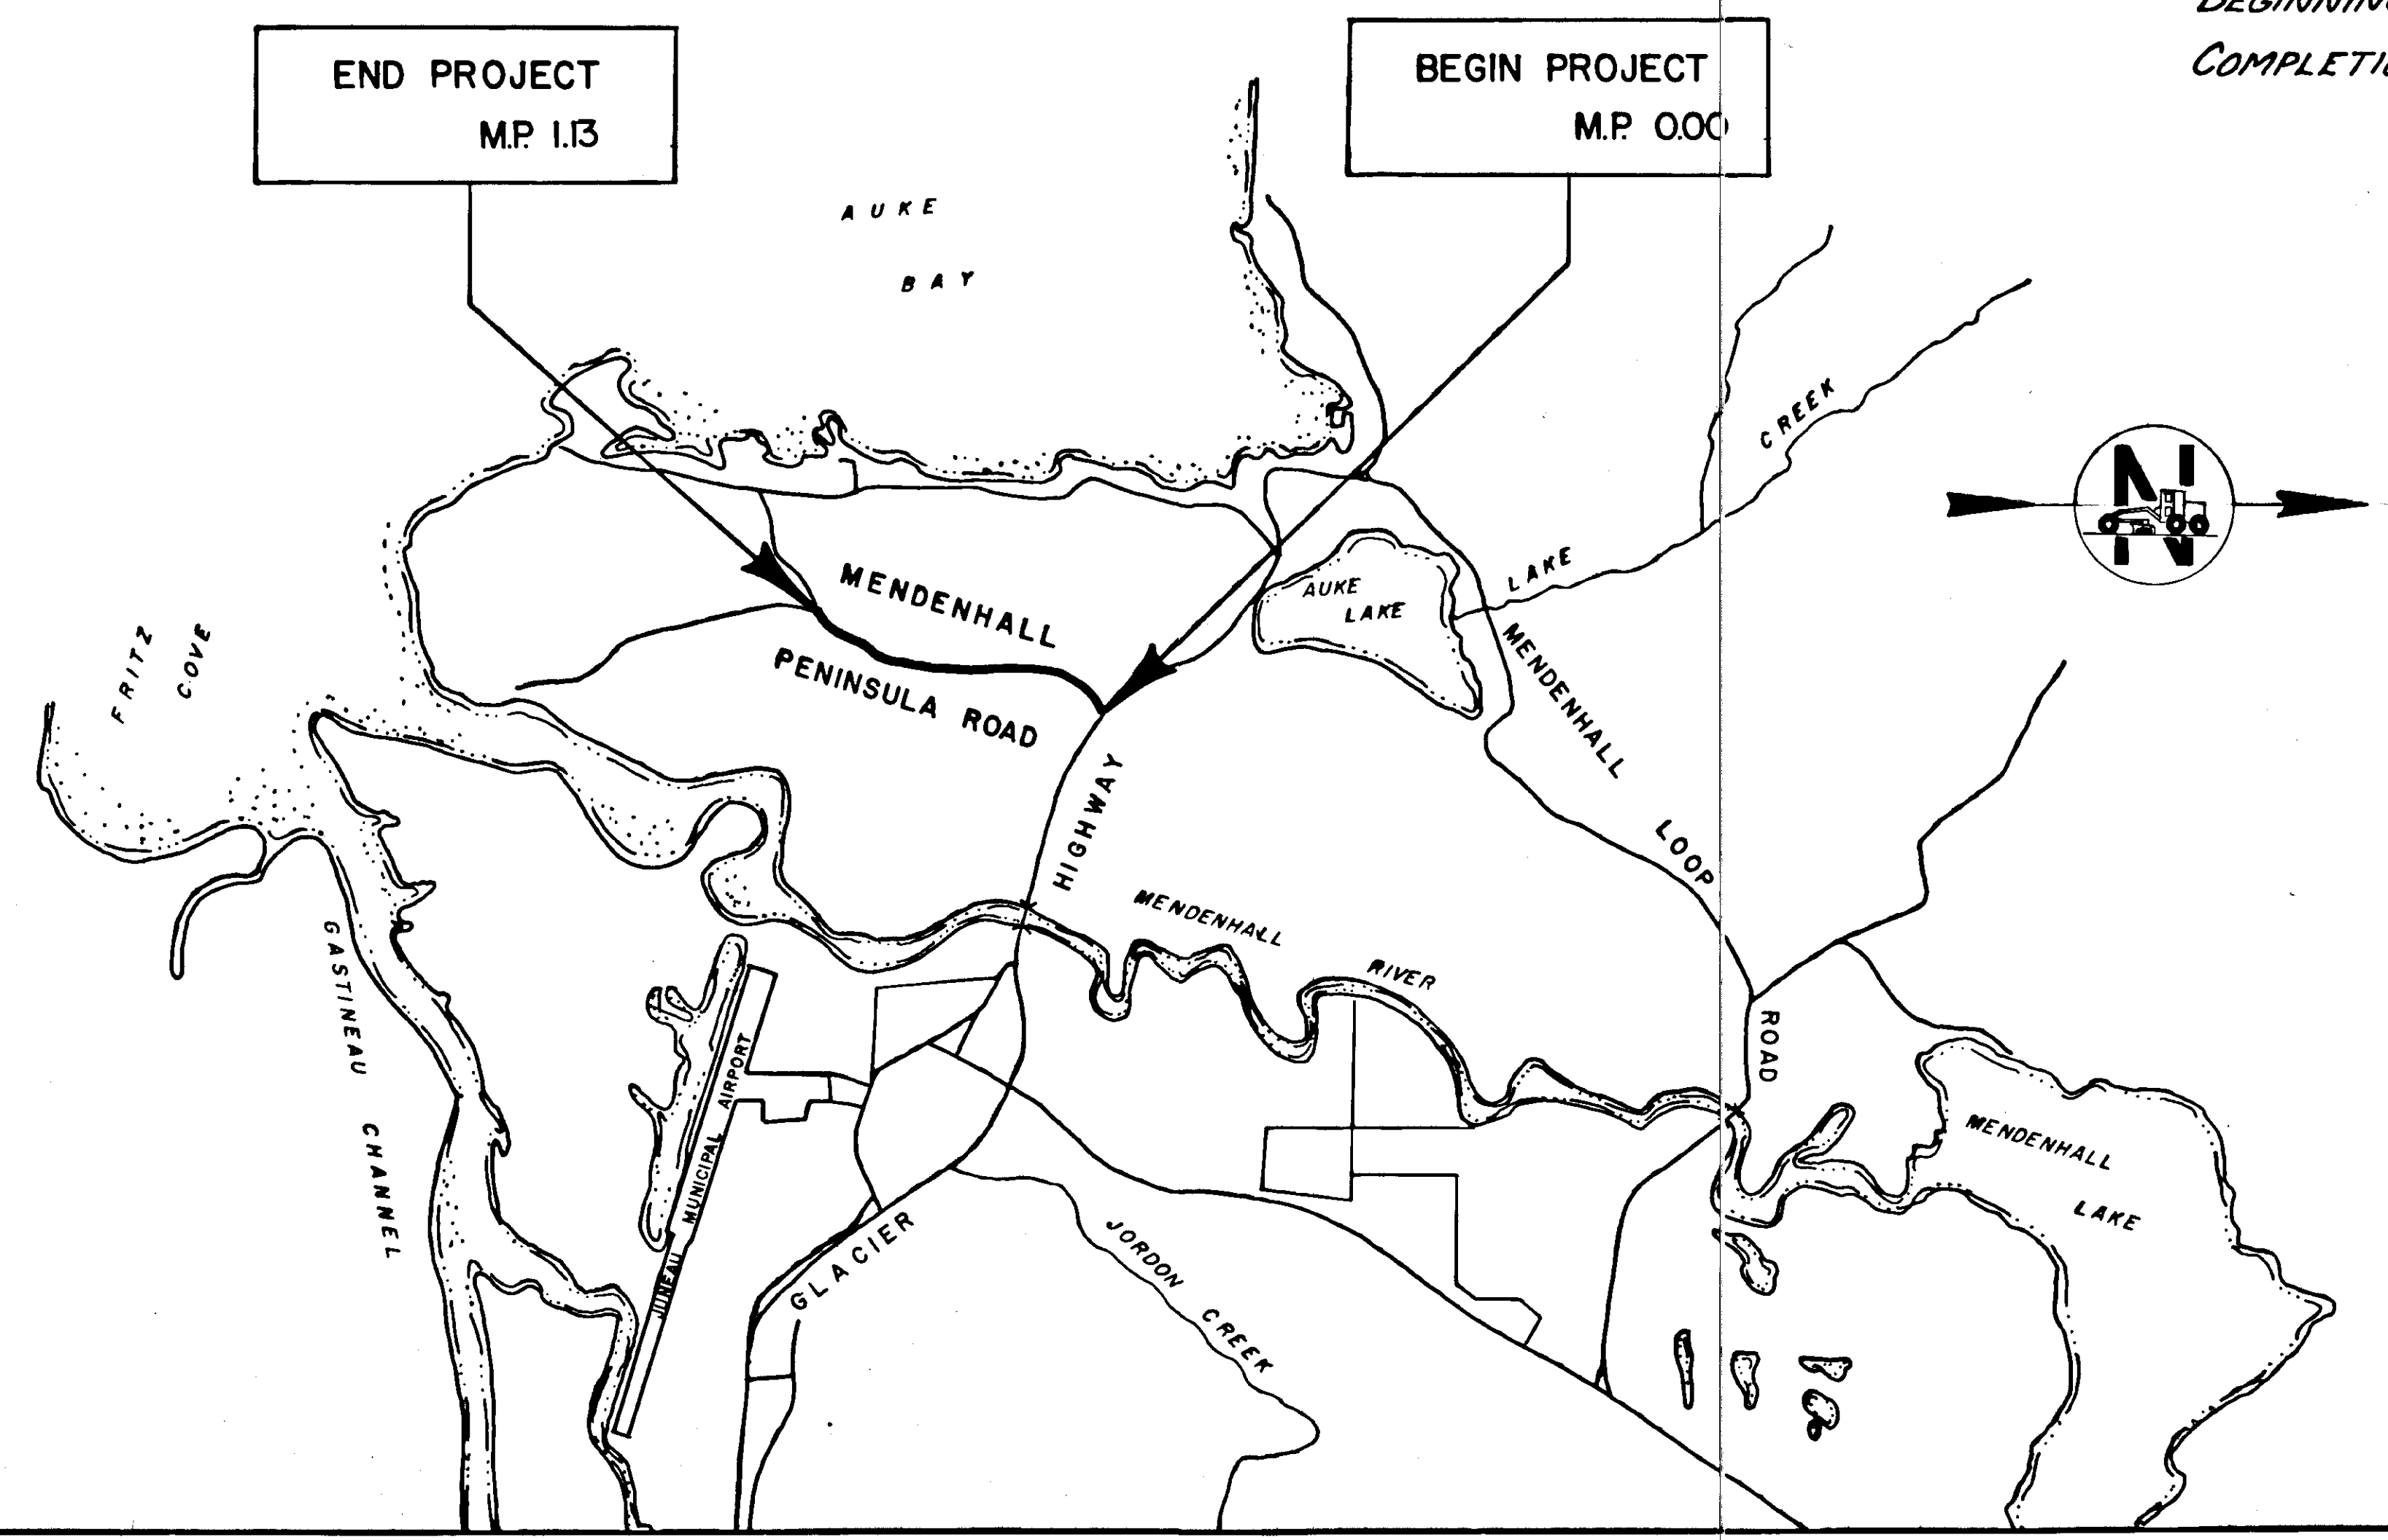

STATE OF ALASKA  
DEPARTMENT OF TRANSPORTATION  
&  
PUBLIC FACILITIES  
APPROVED  
*Wallace K. Wilson* Date 6/19/80  
S.E. REGION DESIGN AND CONSTRUCTION ENGINEER

STATE OF ALASKA  
DEPARTMENT OF TRANSPORTATION  
&  
PUBLIC FACILITIES  
APPROVED  
*Charles E. Stabel* Date 7-9-80  
DIRECTOR-HIGHWAY DESIGN & CONSTRUCTION

### ESTIMATE OF QUANTITIES

NO.	ITEM	UNIT	QUANTITY
0(1)	Mobilization	L.S.	All Required
4(1)	Construction Engineering by the Contractor	L.S.	All Required
5(1)	Traffic Maintenance	L.S.	All Required
2(4)	Removal and Disposal of Culvert Pipe	Lin. Ft.	<del>60</del> 8
3(6A)	Selected Material	CY.	<del>500</del> 934
3(2)	Reconditioning	L.S.	All Required
4(1)	Subbase Grading D	Ton	<del>5000</del> 6,370
3(2F)	18" Pipe Conduit	Lin. Ft.	<del>44</del> 260
3(2G)	24" Pipe Conduit	Lin. Ft.	<del>46</del> 68
5(1)	Standard Signs	Sq. Ft.	<del>22</del> 39

Basis of Estimate  
Item 304(1) 1.96 Tons / cu. yd.

### TABLE OF WORK

MILEAGE	DESCRIPTION
* 0.00	Beginning of Project
0.04	Extend 24" Steel CMP 2' Right
0.20	Extend 24" Steel CMP 4' Each End
0.35	Begin Ditch Excavation in Rock
0.40	End Ditch Excavation in Rock
0.72	Begin Ditch Excavation in Rock
0.79	End Ditch Excavation in Rock
0.80	Begin Ditch Excavation in Rock
0.85	End Ditch Excavation in Rock
0.87	Remove and Install 24" CMP
0.90	Begin Ditch Excavation in Rock
1.13	End Ditch Excavation in Rock
1.13	End of Project

\* Mileage begins 60' from  $\mathcal{C}$  of Exist. Glacier Highway.  
Work begins 100' from  $\mathcal{C}$  of Exist. Glacier Highway.

### SIGNING SCHEDULE

NO.	MILEAGE	CODE	LEGEND	SIZE	AREA, Sq. Ft.	POST LENGTH	REMARKS
1	0.021 Rt.	W1-IRL	Curve Arrow	30x30	6.25	12	
2	0.021 Rt.	W13-1	25 MPH	18x18	2.25		Mount below 1.
3	0.150 Lt.	W1-IRR	Curve Arrow	30x30	6.25	12	
4	0.150 Lt.	W13-1	25 MPH	18x18	2.25		Mount below 3.
5	0.700 Lt.	R2-1	Speed Limit 35	24x30	5.00	12	(Opposite Exist Speed Limit 25)

- General Signing Notes
1. Sign locations and post lengths are approximate only and are subject to minor revisions.
  2. All sign posts shall be square telescoping perforated galvanized steel posts; the 2" size shall be used above ground and the 2 1/4" size shall be used below ground for the sleeve.
  3. All posts shall be installed with the sleeve type embedment in accordance with Standard Drawing 5-30.20, except that the 2 1/4" size shall be used for the entire embedment depth.
  4. Post lengths are from the cut-off in the sleeve to the top of the post. See Standard Drawings 5-05.00 and 5-30.12.

#### ADDITIONAL SIGNS

6	0.7 Rt.	W1-SR	Winding Rd.	30x30	6.25		
7	0.7 Rt.	W13-1	25 M.P.H.	18x18	2.25		
8	1.0 Lt.	W1-SL	Winding Rd.	30x30	6.25		
9	1.0 Lt.	W13-1	25 M.P.H.	18x18	2.25		


### GENERAL NOTES

1. Ditch cleaning is incidental to reconditioning. Ditches over three feet deep will not require cleaning. Ditches will be a nominal minimum depth of 3' and will be graded to provide positive drainage between cross road culverts. In order to provide positive drainage along the roadway, a new ditch line must be established. This will require rock excavation in some locations. This excavation will not be measured directly but will be considered incidental to Reconditioning Item 303(2).
2. Any clearing required to accomplish ditch cleaning or construction shall be incidental to other items of work and no direct payment will be made.
3. Removing and resetting existing mail boxes and newspaper tubes is incidental to other items of work.
4. Material removed during ditch reconditioning and construction will be wasted along the road as directed by the engineer.
5. Grade will be achieved by scarifying the existing roadbed to a depth of four inches and blading the surface to conform to crown and superelevation as well as developing a profile that will afford a good ride on the finished surface. Additional material required will be paid for as selected material.
6. Alignment shall be along the existing roadway. Minor shifts in alignment may be necessary to avoid conflicts with utilities.
7. Superelevation may be rotated about the inside edge of the roadway in order to match existing approaches but generally will be rotated to minimize the need for additional material.
8. Standard Drawing I-40. 21 shall be adhered to except that a 10' radius for drive approaches shall be used. The approaches shall be surfaced for a minimum distance of 10' from the edge of Travel Way.


### DRIVEWAY APPROACH TABLE

EAGE	DESCRIPTION
12	Residence Drive Approach - Lt. 34' - 18" C.M.P.
20	Residence Drive Approach - Lt. 34' - 18" C.M.P.
21	Residence Drive Approach - Lt. 34' - 18" C.M.P.
25	Commercial Drive Approach - Lt. 40' - 18" C.M.P.
50	Residence Drive Approach - Rt. 34' - 18" C.M.P.

### NORMAL SECTION

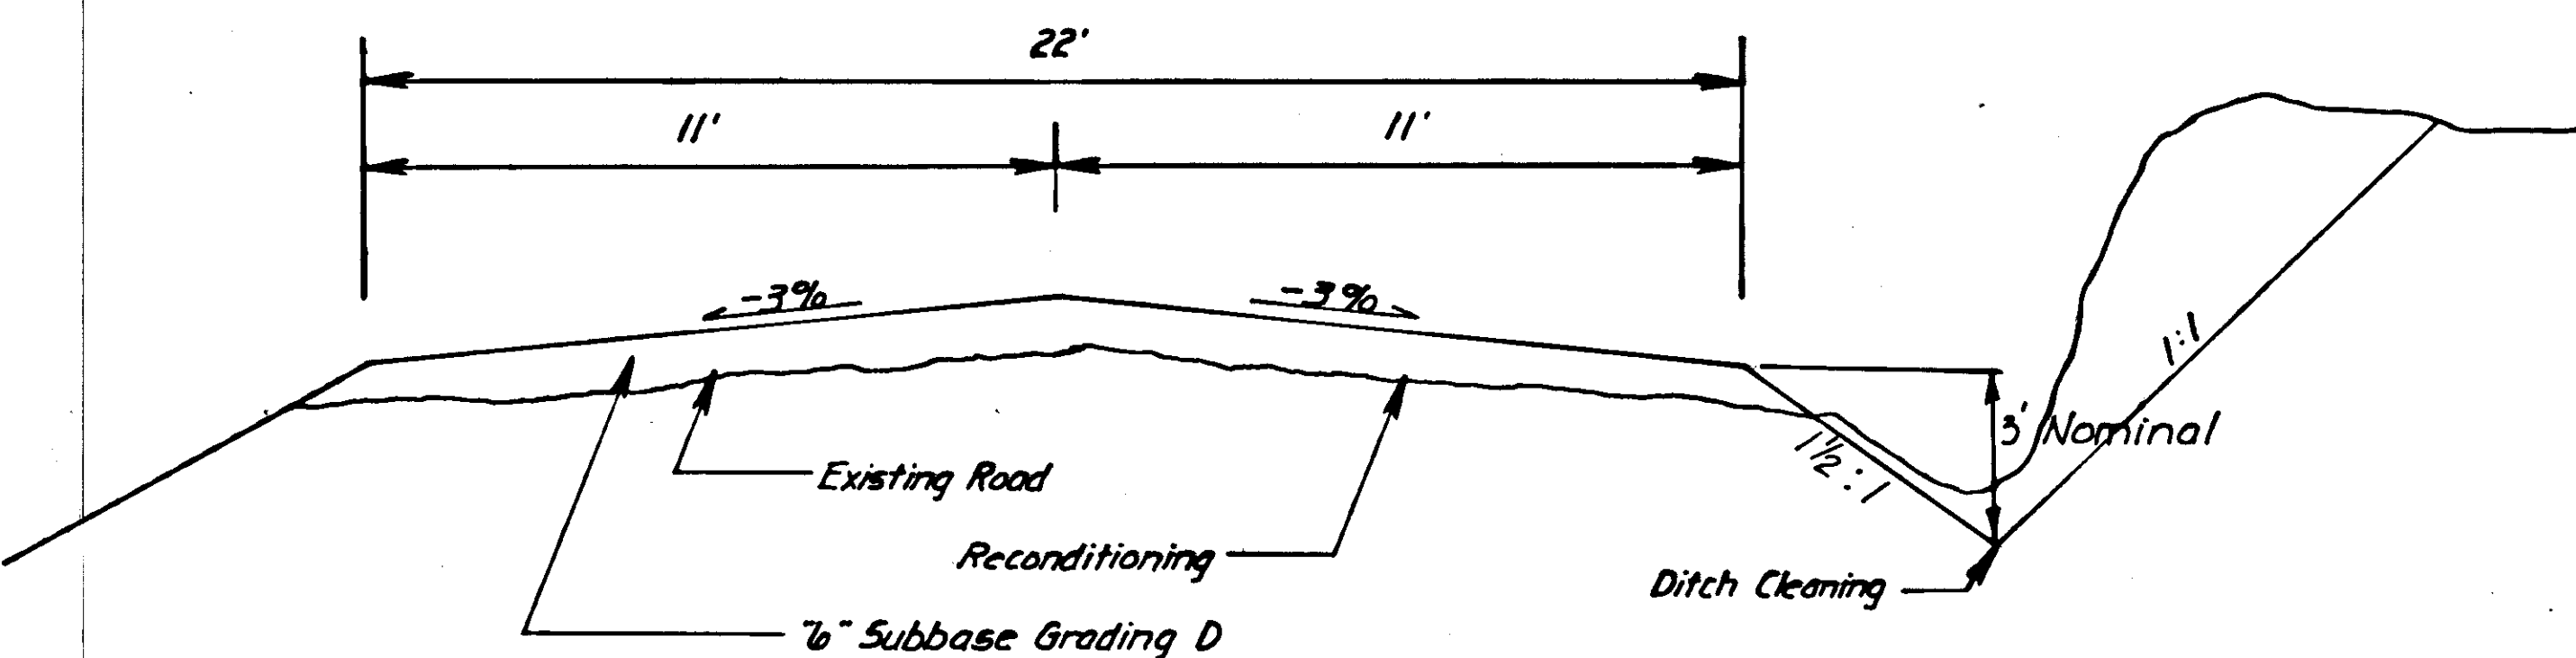

### DITCH EXCAVATION IN ROCK SECTION

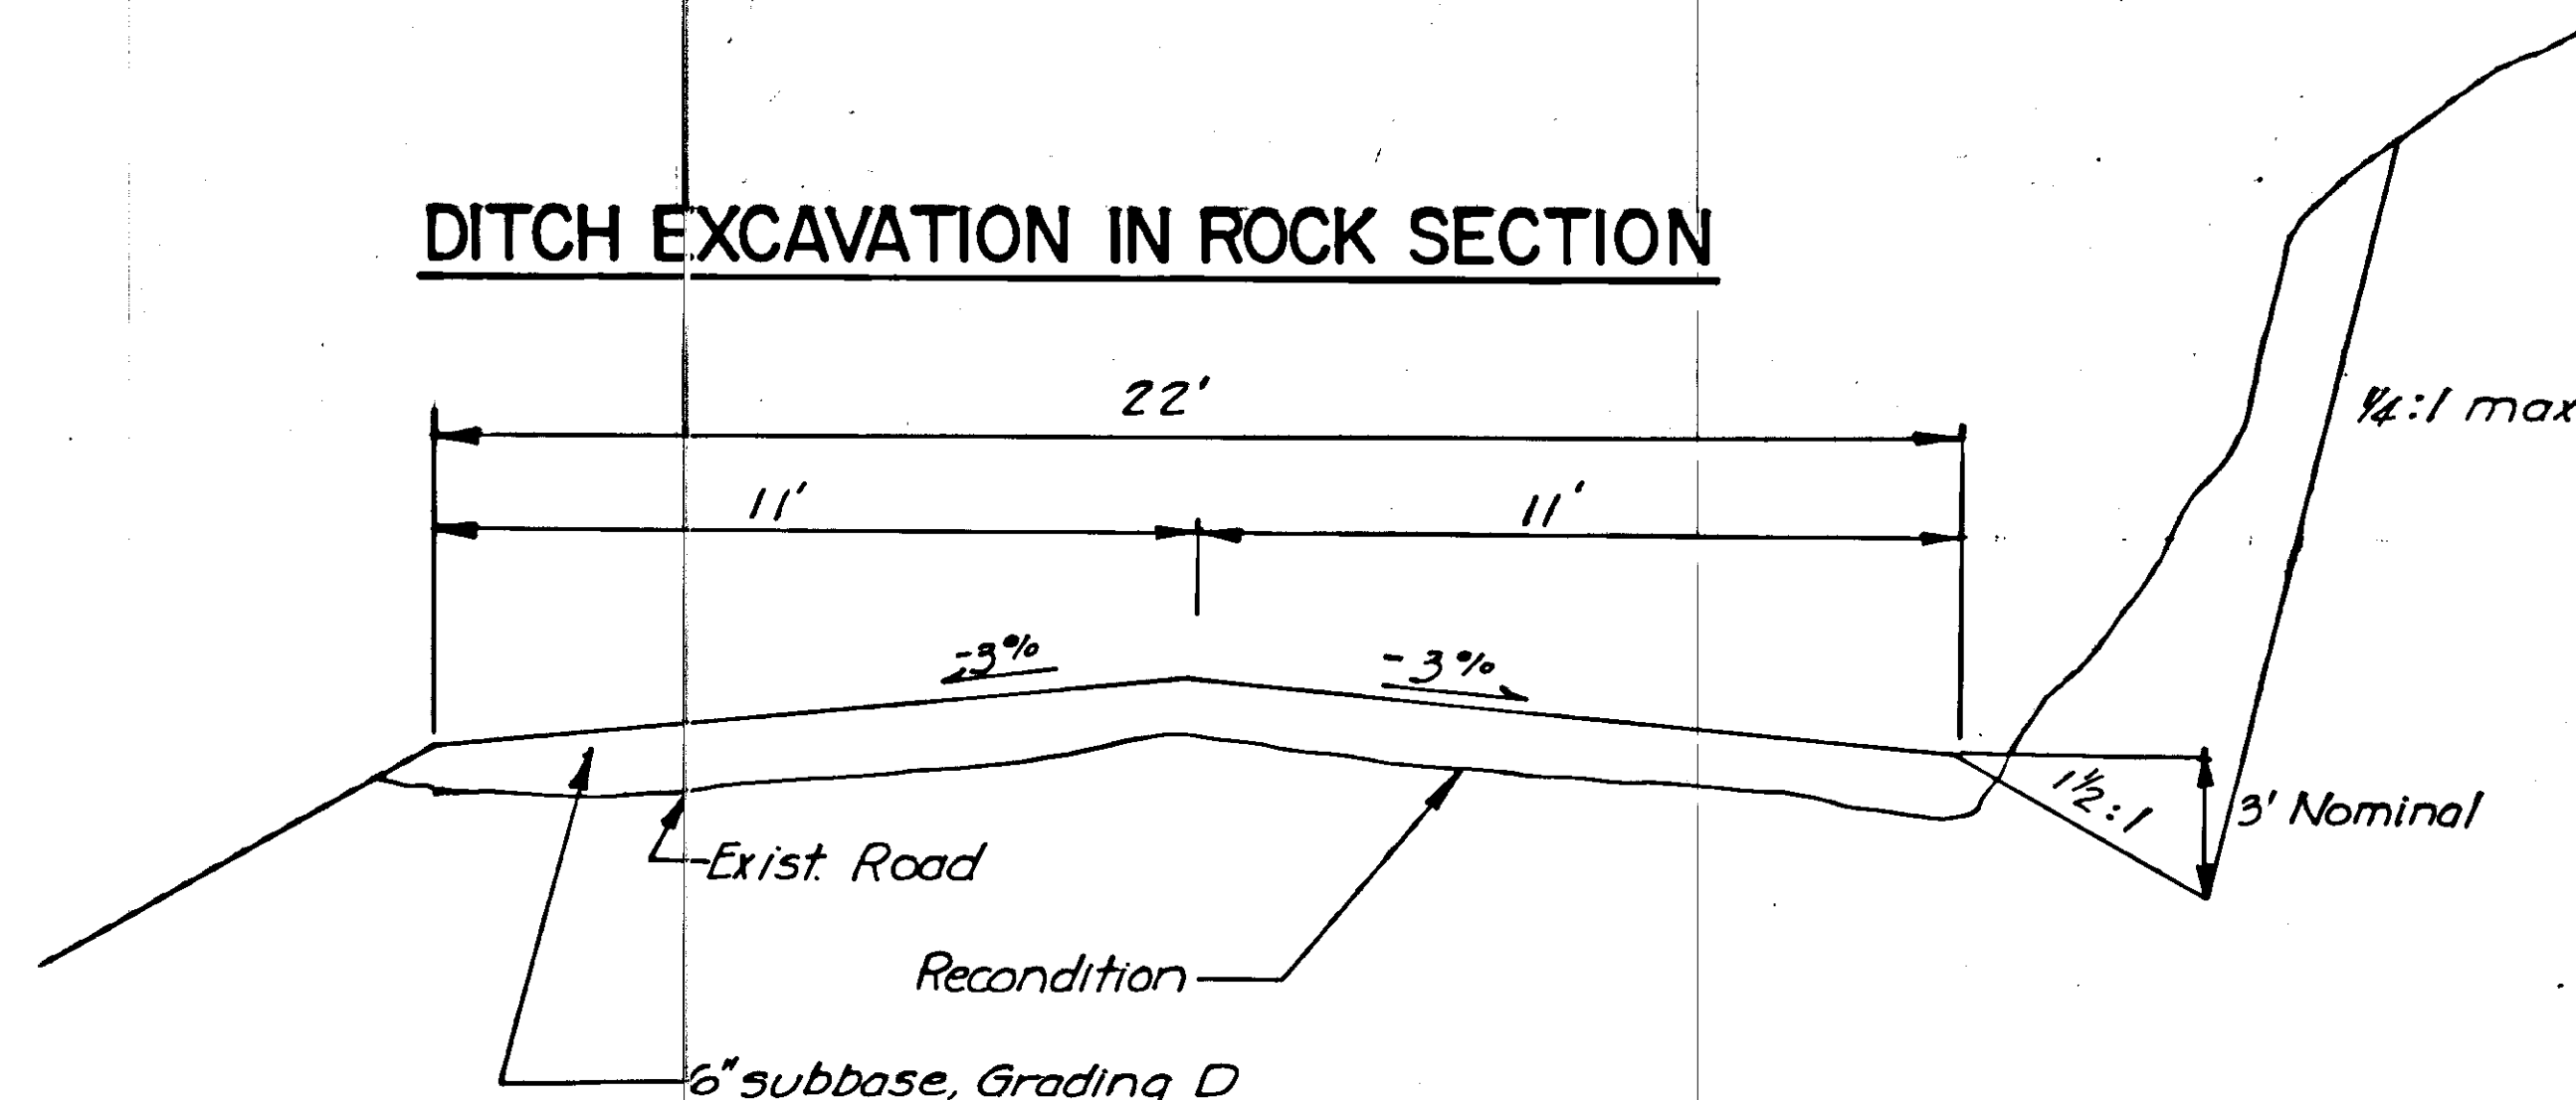

ADDITIONAL ITEMS  
203(2) Rock Excavation L.S. All Req'd.  
606(1) Beam Type Guardrail, Type 1 Post L.F. 937.5