


State of Alaska

Department of Transportation
and Public Facilities - Southeast Region

JNU-GLACIER SPUR ROAD PAVEMENT REHABILITATION PROJECT No. 69348

The undersigned hereby certifies that this duplicated document is an exact and true copy of the original.

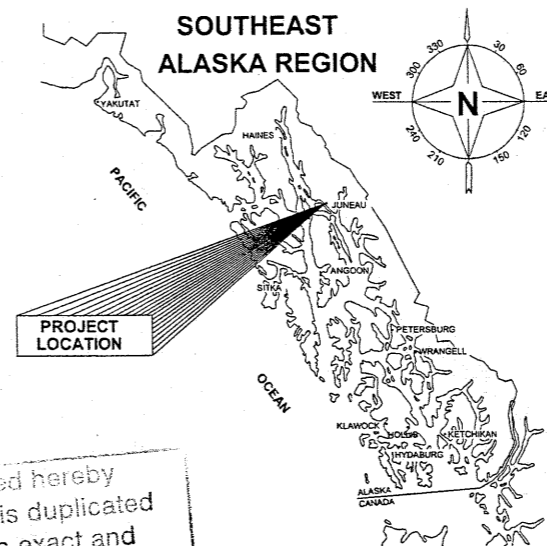

The undersigned hereby certifies that this duplicated document is an exact and true copy of the original.

INDEX	
SHEET NO.	DESCRIPTION
A1	TITLE SHEET
B1	TYPICAL SECTIONS
C1	ESTIMATE OF QUANTITIES
D1	SUMMARIES
F1-F5	PLAN VIEW
G1-G3	MISCELLANEOUS DETAILS
H1	TRAFFIC CONTROL PLAN

AS-BUILT PLANS
 CONTRACTOR: SELON
 PROJECT ENGINEER: Thad Hopper
 BEGIN DATE: JULY 19, 2010
 END DATE: JULY 11, 2011

PATH: Q:\JNU\69348\PLANSET\69348_A1_TITLE.DWG TAB:A1-TITLE SHEET
 Thursday, September 17, 2009 8:16:28 AM
 PLOT: PSPACE OR MSPACE: 1=1(F)

STATE OF ALASKA
 DEPARTMENT OF TRANSPORTATION
 & PUBLIC FACILITIES-SOUTHEAST REGION

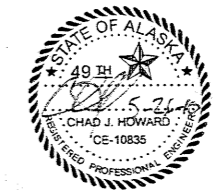

APPROVED: *Victor M. Winters* 5-26-10
 REGIONAL PRE-CONSTRUCTION ENGINEER DATE
 VICTOR M. WINTERS, P.E.

APPROVED: *Gary L. Davis* 5-26-10
 DIRECTOR, SOUTHEAST REGION DATE
 GARY L. DAVIS

CERTIFIED TRUE & CORRECT AS-BUILT OF ACTUAL FIELD
 CONDITION:
John [Signature] 3/2/2012
 CONSTRUCTION PROJECT MANAGER DATE

DESIGN DESIGNATION GLACIER SPUR ROAD


A.D.T. 2008	=	3720
A.D.T. 2031	=	4170
D.H.V. (12.1%) 2031	=	505
% T	=	8%
V	=	20-40 M.P.H.
E.A.L.	=	650,000

PROJECT SUMMARY

LENGTH OF PROJECT	=	1.4 MILES
LENGTH OF RESURFACING	=	1.4 MILES
WIDTH OF RESURFACING	=	36 FT


THE FOLLOWING STANDARD DRAWINGS APPLY TO THIS PROJECT:

A-1	D-23.01	I-20.13	S-00.10	T-20.02
C-03.10		M-16.01	S-05.01	T-21.02
C-04.12			S-20.10	
C-05.10			S-23.00	
			S-30.03	

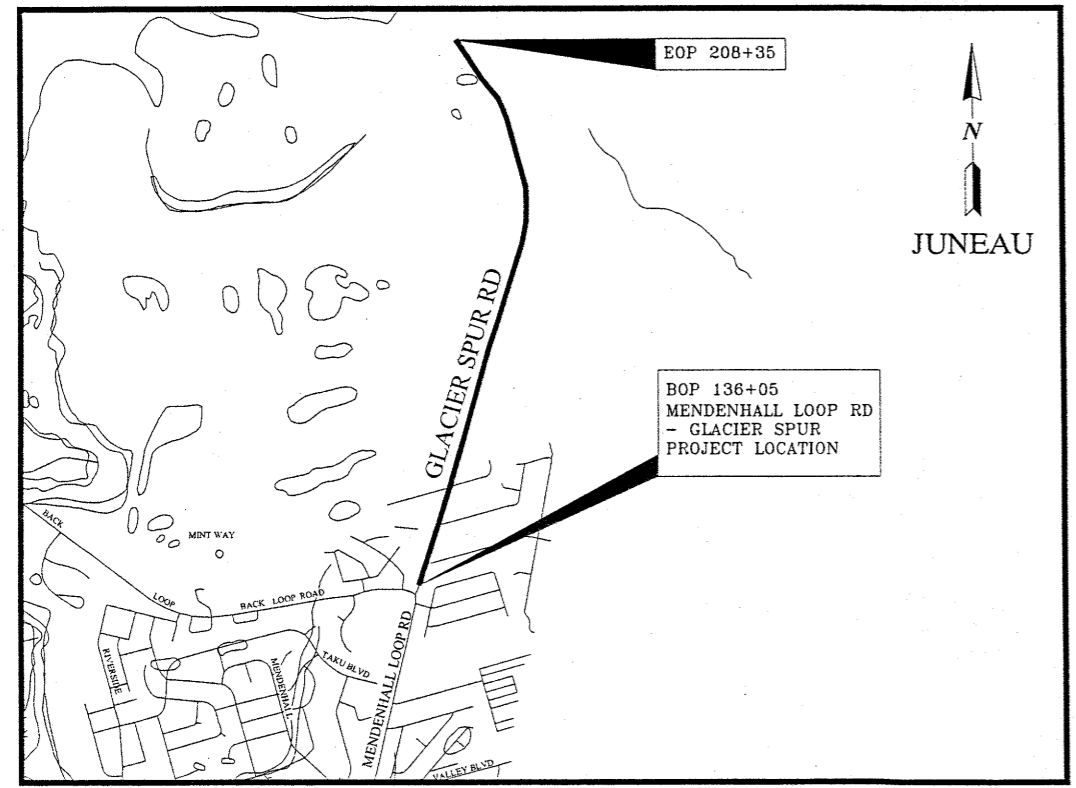


VICINITY MAP
MENDENHALL LOOP ROAD

STATE	PROJECT DESIGNATION	YEAR	SHEET NO.	TOTAL SHEETS
ALASKA	69348	2010	A1	13

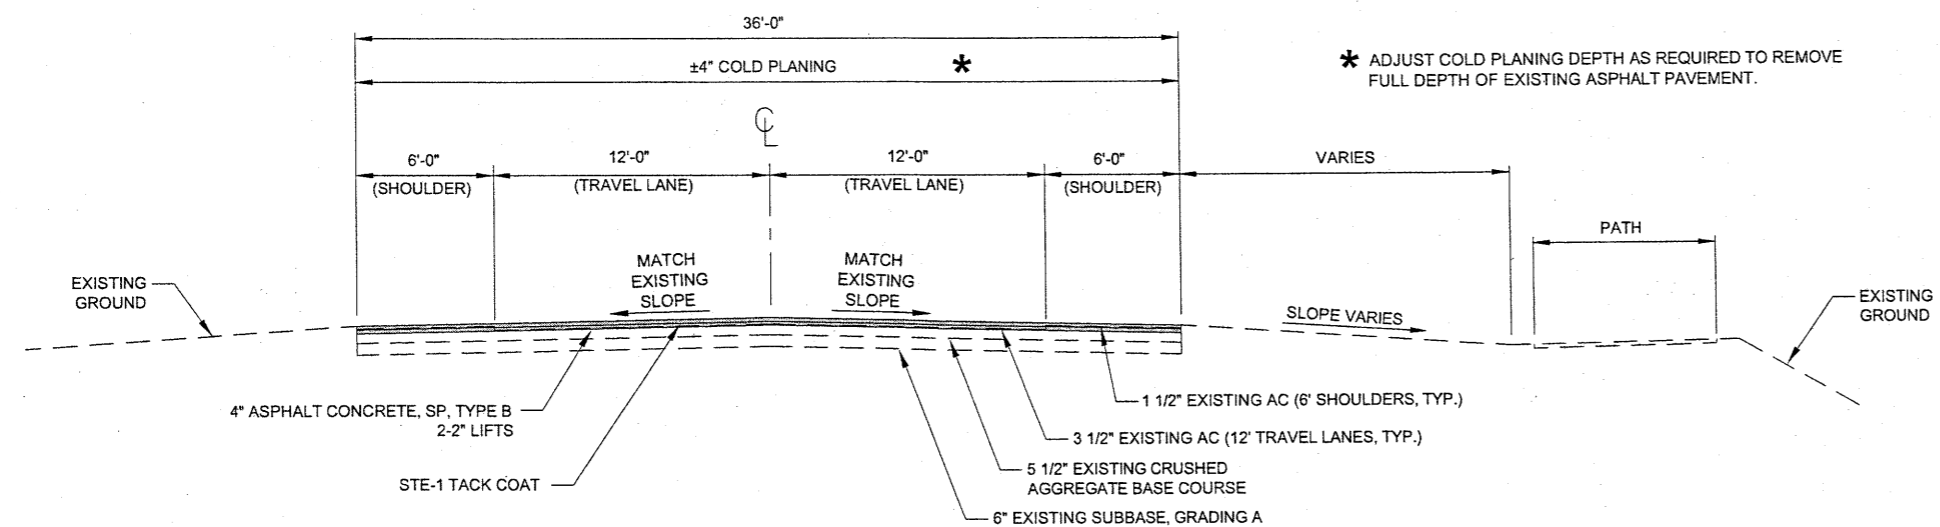


**GLACIER SPUR ROAD
4" COLD PLANING**
STA 136+05 TO STA 140+00
NTS

NOTE:
THE SPOT REPAIR WORK AT AREAS SHOWN IN THE PLANS IS TO BE COMPLETED PRIOR TO THE OVERLAY. THE LOCATIONS SHOWN ARE APPROXIMATE AND SHALL BE IDENTIFIED BY THE ENGINEER PRIOR TO BEGINNING WORK.

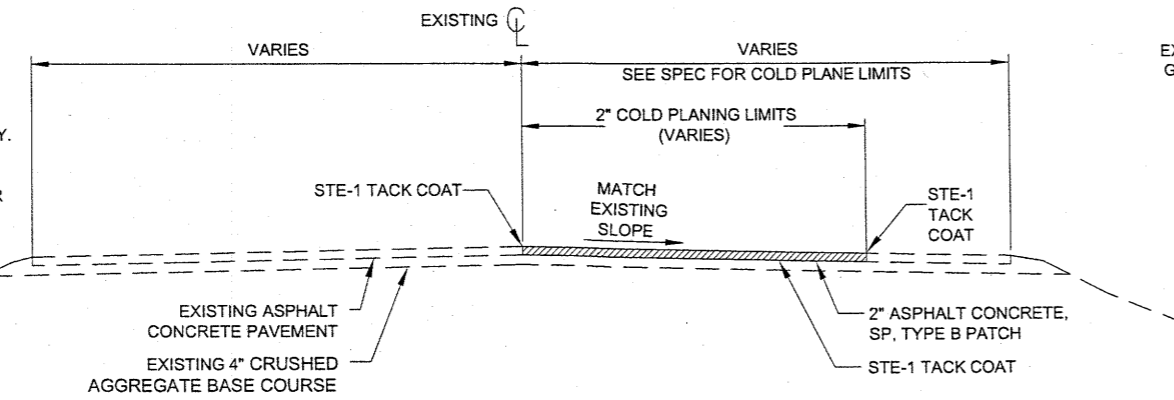


SPOT REPAIR TYPICAL SECTIONS
VARIOUS LOCATIONS IDENTIFIED IN THE PLANS

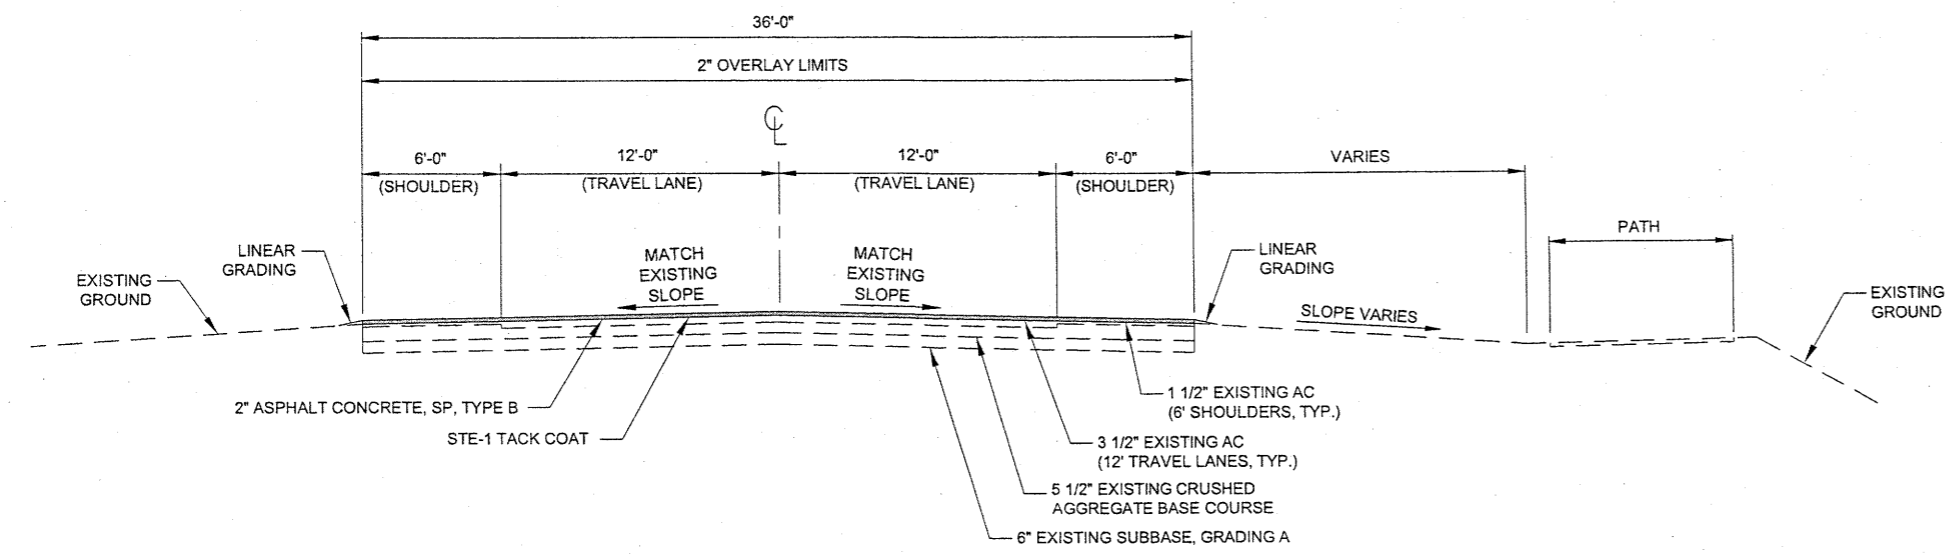

**GLACIER SPUR ROAD
2" OVERLAY**
STA 140+00 TO STA 198+97
NTS

GENERAL NOTES:

1. INFORMATION CONTAINED IN THESE DOCUMENTS HAS BEEN COMPILED FROM AS-BUILT DRAWINGS. FEATURE LOCATIONS ARE APPROXIMATE. ACTUAL LOCATIONS WILL VARY.
2. THE SPOT REPAIR WORK AT AREAS SHOWN IN THE PLANS IS TO BE COMPLETED PRIOR TO THE OVERLAY. THE LOCATIONS SHOWN ARE APPROXIMATE AND SHALL BE IDENTIFIED BY THE ENGINEER PRIOR TO BEGINNING WORK.
3. IT SHALL BE THE CONTRACTORS RESPONSIBILITY TO SET CONTROL FOR THE COLD PLANING, PAVING, TRAFFIC MARKINGS AND OTHER ITEMS AS NECESSARY TO COMPLETE THE WORK. SETTING CONTROL POINTS FOR REINSTALLING TRAFFIC MARKINGS SHALL BE COORDINATED WITH THE ENGINEER.
4. COLD PLANING WIDTHS AND DEPTHS MAY VARY AND ARE SUBJECT TO MINOR REVISIONS AS DETERMINED BY THE ENGINEER.
5. PRIOR TO PLANING OPERATIONS, INLETS, CATCH BASINS, AND DRAINS SHALL BE SUFFICIENTLY BARRICADED SO AS TO PREVENT DEBRIS FROM ENTERING THE DRAINAGE SYSTEM, OR STREAMS.
6. TWO ASPHALT CORES GAVE AN EXISTING ASPHALT THICKNESS RANGING FROM 3 1/2" TO 5".
7. COLD PLANING SHALL LEAVE A CLEAN VERTICAL FACE.
8. THE PAVEMENT REMOVED BY COLD PLANING SHALL BE USED FOR LINEAR GRADING AND FOR USE IN THE PROJECT. ALL UNUSED MATERIAL SHALL BE HAULED AND STOCKPILED TO THE D.O.T. STOCKPILE SITE AT THE INTERSECTION OF MENDENHALL LOOP AND EGAN.
9. SEE SUBSECTIONS 401-3.14 AND 408-3.01 OF THE SPECIAL PROVISIONS REGARDING JOINTS.

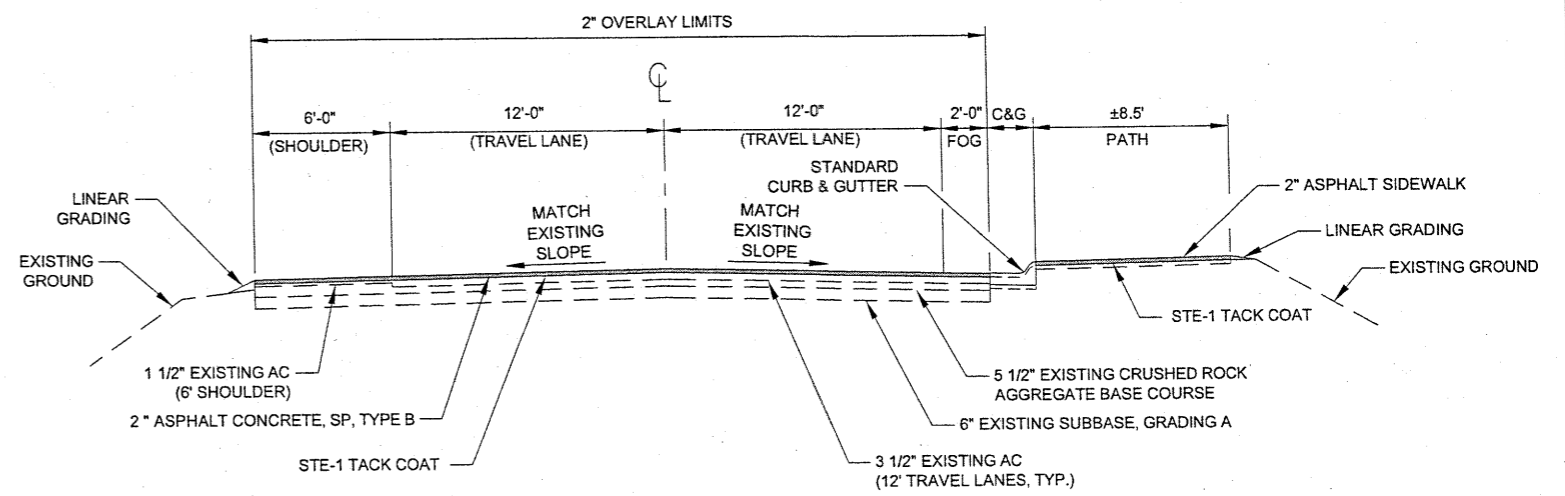

**GLACIER SPUR ROAD
(CURB, GUTTER, & SIDEWALK SECTION)
2" OVERLAY**
STA 198+97 TO STA 208+35 (EOP)
NTS

CORE	LOCATION	THICKNESS
BH-1	136+78 - LT. LANE	5"
BH-2	137+05 - RT. LANE	3 1/2"

DO NOT SCALE FROM THESE DRAWINGS USE DIMENSIONS

CHECKED BY: C. HOWARD

DESIGNED BY: D. MULLINER

DRAWN BY: R. GRANTHAM

PATH: Q:\JNU\69348\PLANSET\69348_B1_TYP.DWG

TAB: B1 Tuesday, May 25, 2010 9:06:35 AM MULLINER, DOUGLAS J (DOT)

STATE OF ALASKA
DEPARTMENT OF TRANSPORTATION
& PUBLIC FACILITIES-SOUTHEAST REGION

JNU
GLACIER SPUR PAVEMENT
REHABILITATION
PROJECT #69348

TYPICAL SECTIONS


NO.	DATE	DESCRIPTION	PROJECT DESIGNATION	YEAR	SHEET NO.	TOTAL SHEETS
			69348	2010	B1	13

ESTIMATE OF QUANTITIES			
ITEM NO.	ITEM DESCRIPTION	PAY UNIT	QUANTITY
202 (9)	REMOVAL OF CURB AND GUTTER	LINEAR FOOT	935 926.0
203 (19)	SUBGRADE REPAIR	CONTINGENT SUM	ALL REQUIRED
301 (1)	AGGREGATE BASE COURSE, GRADING D-1	TON	22 0
303 (3)	LINEAR GRADING	STATION	448-125.12
401 (1)	ASPHALT CONCRETE, SP, CLASS B	TON	3880 3921.36
401 (2)	ASPHALT CEMENT, GRADE PG 64-28	TON	290 280.55
401 (6)	ASPHALT PRICE ADJUSTMENT	CONTINGENT SUM	ALL REQUIRED
402 (1)	STE-1 ASPHALT FOR TACK COAT	TON	15 14.16
408 (1)	ASPHALT COLD PLANING	SQUARE YARD	2000 2255.10
604 (4)	ADJUST EXISTING MANHOLE	EACH	4 0
604 (8)	CURB INLET	EACH	4
608 (3)	ASPHALT SIDEWALK	SQUARE YARD	935 884.10
609 (2)	CURB AND GUTTER, TYPE I	LINEAR FOOT	935 926.0
615 (1)	STANDARD SIGN	SQUARE FOOT	475 170.61
627(10)	ADJUSTMENT OF VALVE BOX	EACH	1
632 (1)	PAVING FABRIC	SQUARE YARD	465 334.80
638 (1)	FIBER ROLL	LINEAR FOOT	4000 1300.0
639 (3)	DRIVEWAY	EACH	43 14
640 (1)	MOBILIZATION AND DEMOBILIZATION	LUMP SUM	ALL REQUIRED
641 (1)	EROSION, SEDIMENT AND POLLUTION CONTROL ADMINISTRATION	LUMP SUM	ALL REQUIRED
641 (3)	TEMPORARY EROSION, SEDIMENT AND POLLUTION CONTROL	LUMP SUM	ALL REQUIRED
641 (4)	TEMPORARY EROSION, SEDIMENT AND POLLUTION CONTROL ADDITIVES	CONTINGENT SUM	ALL REQUIRED
642 (1)	CONSTRUCTION SURVEYING	LUMP SUM	ALL REQUIRED
642 (9)	REFERENCE EXISTING MONUMENT	EACH	3
642 (11)	ADJUST EXISTING MONUMENT CASE	EACH	3
642 (13)	PROTECT BASE LINE MONUMENT	EACH	4
643 (2)	TRAFFIC MAINTENANCE	LUMP SUM	ALL REQUIRED
643 (15)	FLAGGING	CONTINGENT SUM	ALL REQUIRED
643 (25)	TRAFFIC CONTROL	CONTINGENT SUM	ALL REQUIRED
660 (14)	J-BOX ADJUSTMENT	EACH	2
670 (8)	RECESSED PAVEMENT MARKER	EACH	200 117
670 (13)	INLAID METHYL METHACRYLATE PAVEMENT MARKINGS	LUMP SUM	ALL REQUIRED

BASIS OF ESTIMATE		
ITEM NO.	ITEM	ESTIMATING FACTOR
401 (1)	ASPHALT CONCRETE, SP, TYPE B	120 LBS./S.Y./IN.
401 (2)	ASPHALT CEMENT, GRADE PG 64-28	6.0% OF ITEM 401(1)
402 (1)	STE-1 ASPHALT FOR TACK COAT	0.1 GAL/S.Y. (243 GAL/TON)

UTILITY COMPANY POINTS OF CONTACT			
"CALL BEFORE YOU DIG 586-1333"			
ELECTRIC	ALASKA ELECTRIC LIGHT & POWER CO. (AEL&P)	DARRELL WETHERALL	463-6316
TELEPHONE	ALASKA COMMUNICATIONS SYSTEMS (ACS)	MONTY WILLIAMS	463-8987
SEWER	CITY AND BOROUGH OF JUNEAU	TOM TREGO	790-2525 EXT.35
WATER	CITY AND BOROUGH OF JUNEAU	DAVE CRABTREE	780-6808
CABLE	GCI	GREG FARMER	463-1434

DO NOT SCALE FROM THESE DRAWINGS USE DIMENSIONS

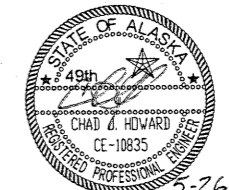CHECKED BY: C. HOWARD	STATE OF ALASKA DEPARTMENT OF TRANSPORTATION & PUBLIC FACILITIES-SOUTHEAST REGION
	JNU GLACIER SPUR PAVEMENT REHABILITATION PROJECT #69348
DESIGNED BY: D. MULLINER	ESTIMATE OF QUANTITIES
DRAWN BY: R. GRANTHAM	
PATH: Q:\JNU\69348\PLANS\EST\69348_C1_EST.DWG	
TAB: C1 Tuesday, May 25, 2010 2:15:06 PM	MULLINER, DOUGLAS J (DOT)
REVISIONS	PROJECT DESIGNATION
NO. DATE DESCRIPTION	69348
	YEAR
	2010
	SHEET NO.
	C1
	TOTAL SHEETS
	13

615 (1) STANDARD SIGN SUMMARY

SIGN #	LEGEND	STATION	OFFSET	ASDS CODE	WIDTH (IN)	HEIGHT (IN)	AREA (SQ FT)	POST	SIGN FACING	COMMENTS
1	CAMPING	136+75	LT	D9-3	24	24	4.00	-	NB	MANUFACTURE SIGNS #1 AND #2 AS A SINGLE SIGN. MOUNT ON ELECTROLIER
2	RIGHT DIRECTIONAL ARROW	136+75	LT	D9-301R	24	6	1.00	-	NB	SEE ABOVE NOTE. SIGN #2 TO BE BELOW SIGN #1
3	↑ AIRPORT // AUKE BAY →	137+71	LT	D1-2-2	72	24	12.00	WOOD	NB	6" UPPERCASE LETTERS, 4.5" LOWERCASE SW FONT
4	GLACIER SPUR RD	138+14	LT	D3-1	48	8	2.67	-	EB/WB	MOUNT ABOVE SIGN # 6. USE 4" LETTERS, FONT SERIES C.
5	EYELET CT	138+14	LT	D3-1	30	8	1.67	-	NB/SB	MOUNT ABOVE SIGN # 6. USE 4" LETTERS, FONT SERIES C.
6	STOP	138+14	LT	R1-1	30	30	6.25	2.5 PST	WB	
7	GLACIER SPUR RD	139+63	LT RT	D3-1	48	8	2.67	-	EB/WB	MOUNT ABOVE SIGN # 9. USE 4" LETTERS, FONT SERIES C.
8	THREADNEEDLE ST	139+63	LT RT	D3-1	48	8	2.67	-	NB/SB	MOUNT ABOVE SIGN #9. USE 4" LETTERS, FONT SERIES C.
9	STOP	139+63	LT RT	R1-1	30	30	6.25	2.5 PST	EB	
10	GLACIER SPUR RD	143+56	LT	D3-1	48	8	2.67	-	EB/WB	MOUNT ABOVE SIGN # 12. USE 4" LETTERS, FONT SERIES C.
11	COUNTERPANE LN	143+56	LT	D3-1	48	8	2.67	-	NB/SB	MOUNT ABOVE SIGN # 12. USE 4" LETTERS, FONT SERIES C.
12	STOP	143+56	LT	R1-1	30	30	6.25	2.5 PST	WB	
13	GLACIER SPUR RD	145+04	RT	D3-1	48	8	2.67	-	EB/WB	MOUNT ABOVE SIGN # 15. USE 4" LETTERS, FONT SERIES C.
14	GARNET ST	145+04	RT	D3-1	30	8	1.67	-	NB/SB	MOUNT ABOVE SIGN # 15. USE 4" LETTERS, FONT SERIES C.
15	STOP	145+04	RT	R1-1	30	30	6.25	2.5 PST	EB	
16	SPEED LIMIT 40	145+44	LT	R2-1	30	36	7.50	2.5 PST	SB	
17	SPEED LIMIT 40	147+23	RT	R2-1	30	36	7.50	-	SB	MOUNT ON ELECTROLIER
18	GLACIER SPUR RD	149+34	LT	D3-1	48	8	2.67	-	EB/WB	MOUNT ABOVE SIGN # 20. USE 4" LETTERS, FONT SERIES C.
19	GLADSTONE ST	149+34	LT	D3-1	42	8	2.33	-	NB/SB	MOUNT ABOVE SIGN # 20. USE 4" LETTERS, FONT SERIES C.
20	STOP	149+34	LT	R1-1	30	30	6.25	2.5 PST	WB	
21	YIELD	150+81	RT	R1-2	24	24	4.00	2.5 PST	EB	
22	NO MOTOR VEHICLES	151+17		R5-3	18	18	2.25	2.5 PST		
23	SPEED LIMIT 40	164+36	LT	R2-1	30	36	7.50	2.5 PST	SB	
24	SPEED LIMIT 30	184+62	RT	R2-1	30	36	7.50	2.5 PST	SB	
25	SPEED LIMIT 40	184+75	LT	R2-1	30	36	7.50	2.5 PST	NB	
26	STOP	197+65	LT	R1-1	30	30	6.25	2.5 PST	WB	
27	ADOPT A HIGHWAY	199+70	LT	I-150	30	36	7.50	2.5 PST	NB	THE MENDENHALL FLYING LIONS CLUB
28	SPEED LIMIT 20	200+59	RT	R2-1	30	36	7.50	2.5 PST	SB	
29	SPEED LIMIT 30	200+75	LT	R2-1	30	36	7.50	2.5 PST	NB	
30	END ROAD 1000 FT	201+40	RT	W14-101	36	36	9	-	SB	MOUNT ON FLASHING LIGHT POLE
31	BEAR XING	201+40	RT	-	-	-	-	-	SB	EXISTING SIGN TO REMAIN
32	END ROAD 500 FT	206+42	RT	W14-101	36	36	9	-	SB	MOUNT ON FLASHING LIGHT POLE
33	SPEED LIMIT 20	207+75	LT	R2-1	30	36	7.50	2.5 PST	NB	

604 (4) ADJUSTMENT OF EXISTING MANHOLES

STATION	OFFSET	REMARKS
443+67	27' LT	SSMH (COUNTERPANE LANE)
444+81	41' RT	SSMH (GARNET STREET)
449+63	27' LT	SSMH (GLADSTONE STREET)
478+05	20' RT	ELECTRICAL MANHOLE

627 (10) ADJUSTMENT OF VALVE BOX

STATION	OFFSET	REMARKS
144+63	28' RT	WV (GARNET STREET)

604 (8) CURB INLET

STATION	OFFSET	REMARKS
203+60	RT	
205+14	RT	
205+90	RT	
207+41	RT	

660 (14) J-BOX ADJUSTMENT

STATION	OFFSET	REMARKS
201+19	RT	
205+06	RT	

639 (3) DRIVEWAY

STATION	OFFSET	WIDTH (ft)	LENGTH (ft)	REMARKS
137+36	RT	24	5	PAVED DRIVEWAY
140+34	RT	20	5	PAVED DRIVEWAY
141+65	RT	20	5	PAVED DRIVEWAY
142+31	LT	22	5	PAVED DRIVEWAY
143+21	RT	18	5	PAVED DRIVEWAY
145+06	LT	15	5	PAVED DRIVEWAY
146+23	LT	25	5	PAVED DRIVEWAY
146+96	RT	20	5	PAVED DRIVEWAY
147+19	LT	15	5	PAVED DRIVEWAY
148+14	RT	20	5	PAVED DRIVEWAY
151+34	LT	18	5	PAVED DRIVEWAY
188+69	RT	22	5	GRAVEL DRIVEWAY
198+200	LT	15.5	5	PAVED DRIVEWAY (BUS PARKING)
203+00	LT	17	4.2	PAVED DRIVEWAY (Parking Lot)

642 (11) ADJUST EXISTING MONUMENT CASE

STATION	REMARKS
136+62	4' LT. MON CASE W/ 2' X 2' CONCRETE COLLAR
139+30	C.L. MON CASE W/ 2' X 2' CONCRETE COLLAR (THREADNEEDLE STREET)
144+81	C.L. MON CASE W/ 2' X 2' CONCRETE COLLAR (GARNET STREET)

642 (13) PROTECT BASE LINE MONUMENT

STATION	OFFSET	REMARKS
147+23	RT	DO NOT DISTURB (NGS BASE LINE MONUMENT)
152+13	RT	DO NOT DISTURB (NGS BASE LINE MONUMENT)
160+70	RT	DO NOT DISTURB (NGS BASE LINE MONUMENT)
180+16	RT	DO NOT DISTURB (NGS BASE LINE MONUMENT)

NOTE: RIGHT SHOULDER MONUMENTS AT STATIONS: 147+23, 152+13, 160+70 AND 180+16 ARE NOT TO BE TAMPERED WITH IN ANY WAY. REFERENCE THE LOCATION OF THESE MONUMENTS. THE CONTRACTOR SHALL FILL MONUMENT CASES WITH A SUITABLE MATERIAL AS DETERMINED BY THE ENGINEER PRIOR TO PAVING. AT THE CONCLUSION OF PAVING, THE MONUMENT CASES SHALL BE SAW CUT OUT AND THE MATERIAL REMOVED.

DO NOT SCALE FROM THESE DRAWINGS USE DIMENSIONS

CHECKED BY: C. HOWARD

DESIGNED BY: D. MULLINER
DRAWN BY: R. GRANTHAM


STATE OF ALASKA
DEPARTMENT OF TRANSPORTATION & PUBLIC FACILITIES-SOUTHEAST REGION

JNU
GLACIER SPUR PAVEMENT REHABILITATION PROJECT #69348

SUMMARIES

PATH: Q:\JNU\69348\PLANSET\69348_D1_SUMS.DWG	Tuesday, May 25, 2010 4:07:44 PM	MULLINER, DOUGLAS J (DOT)
TAB: D1	REVISIONS	PROJECT DESIGNATION
	NO. DATE DESCRIPTION	69348
		YEAR
		2010
		SHEET NO.
		D1
		TOTAL SHEETS
		13

GRANTHAM, RICK L (DOT)		
TAB: F1 Wednesday, May 26, 2010 11:50:37 AM		
ADDENDUM NUMBER		
ATTACHMENT NUMBER		
RECORD OF REVISIONS		
No.	DATE	DESCRIPTION

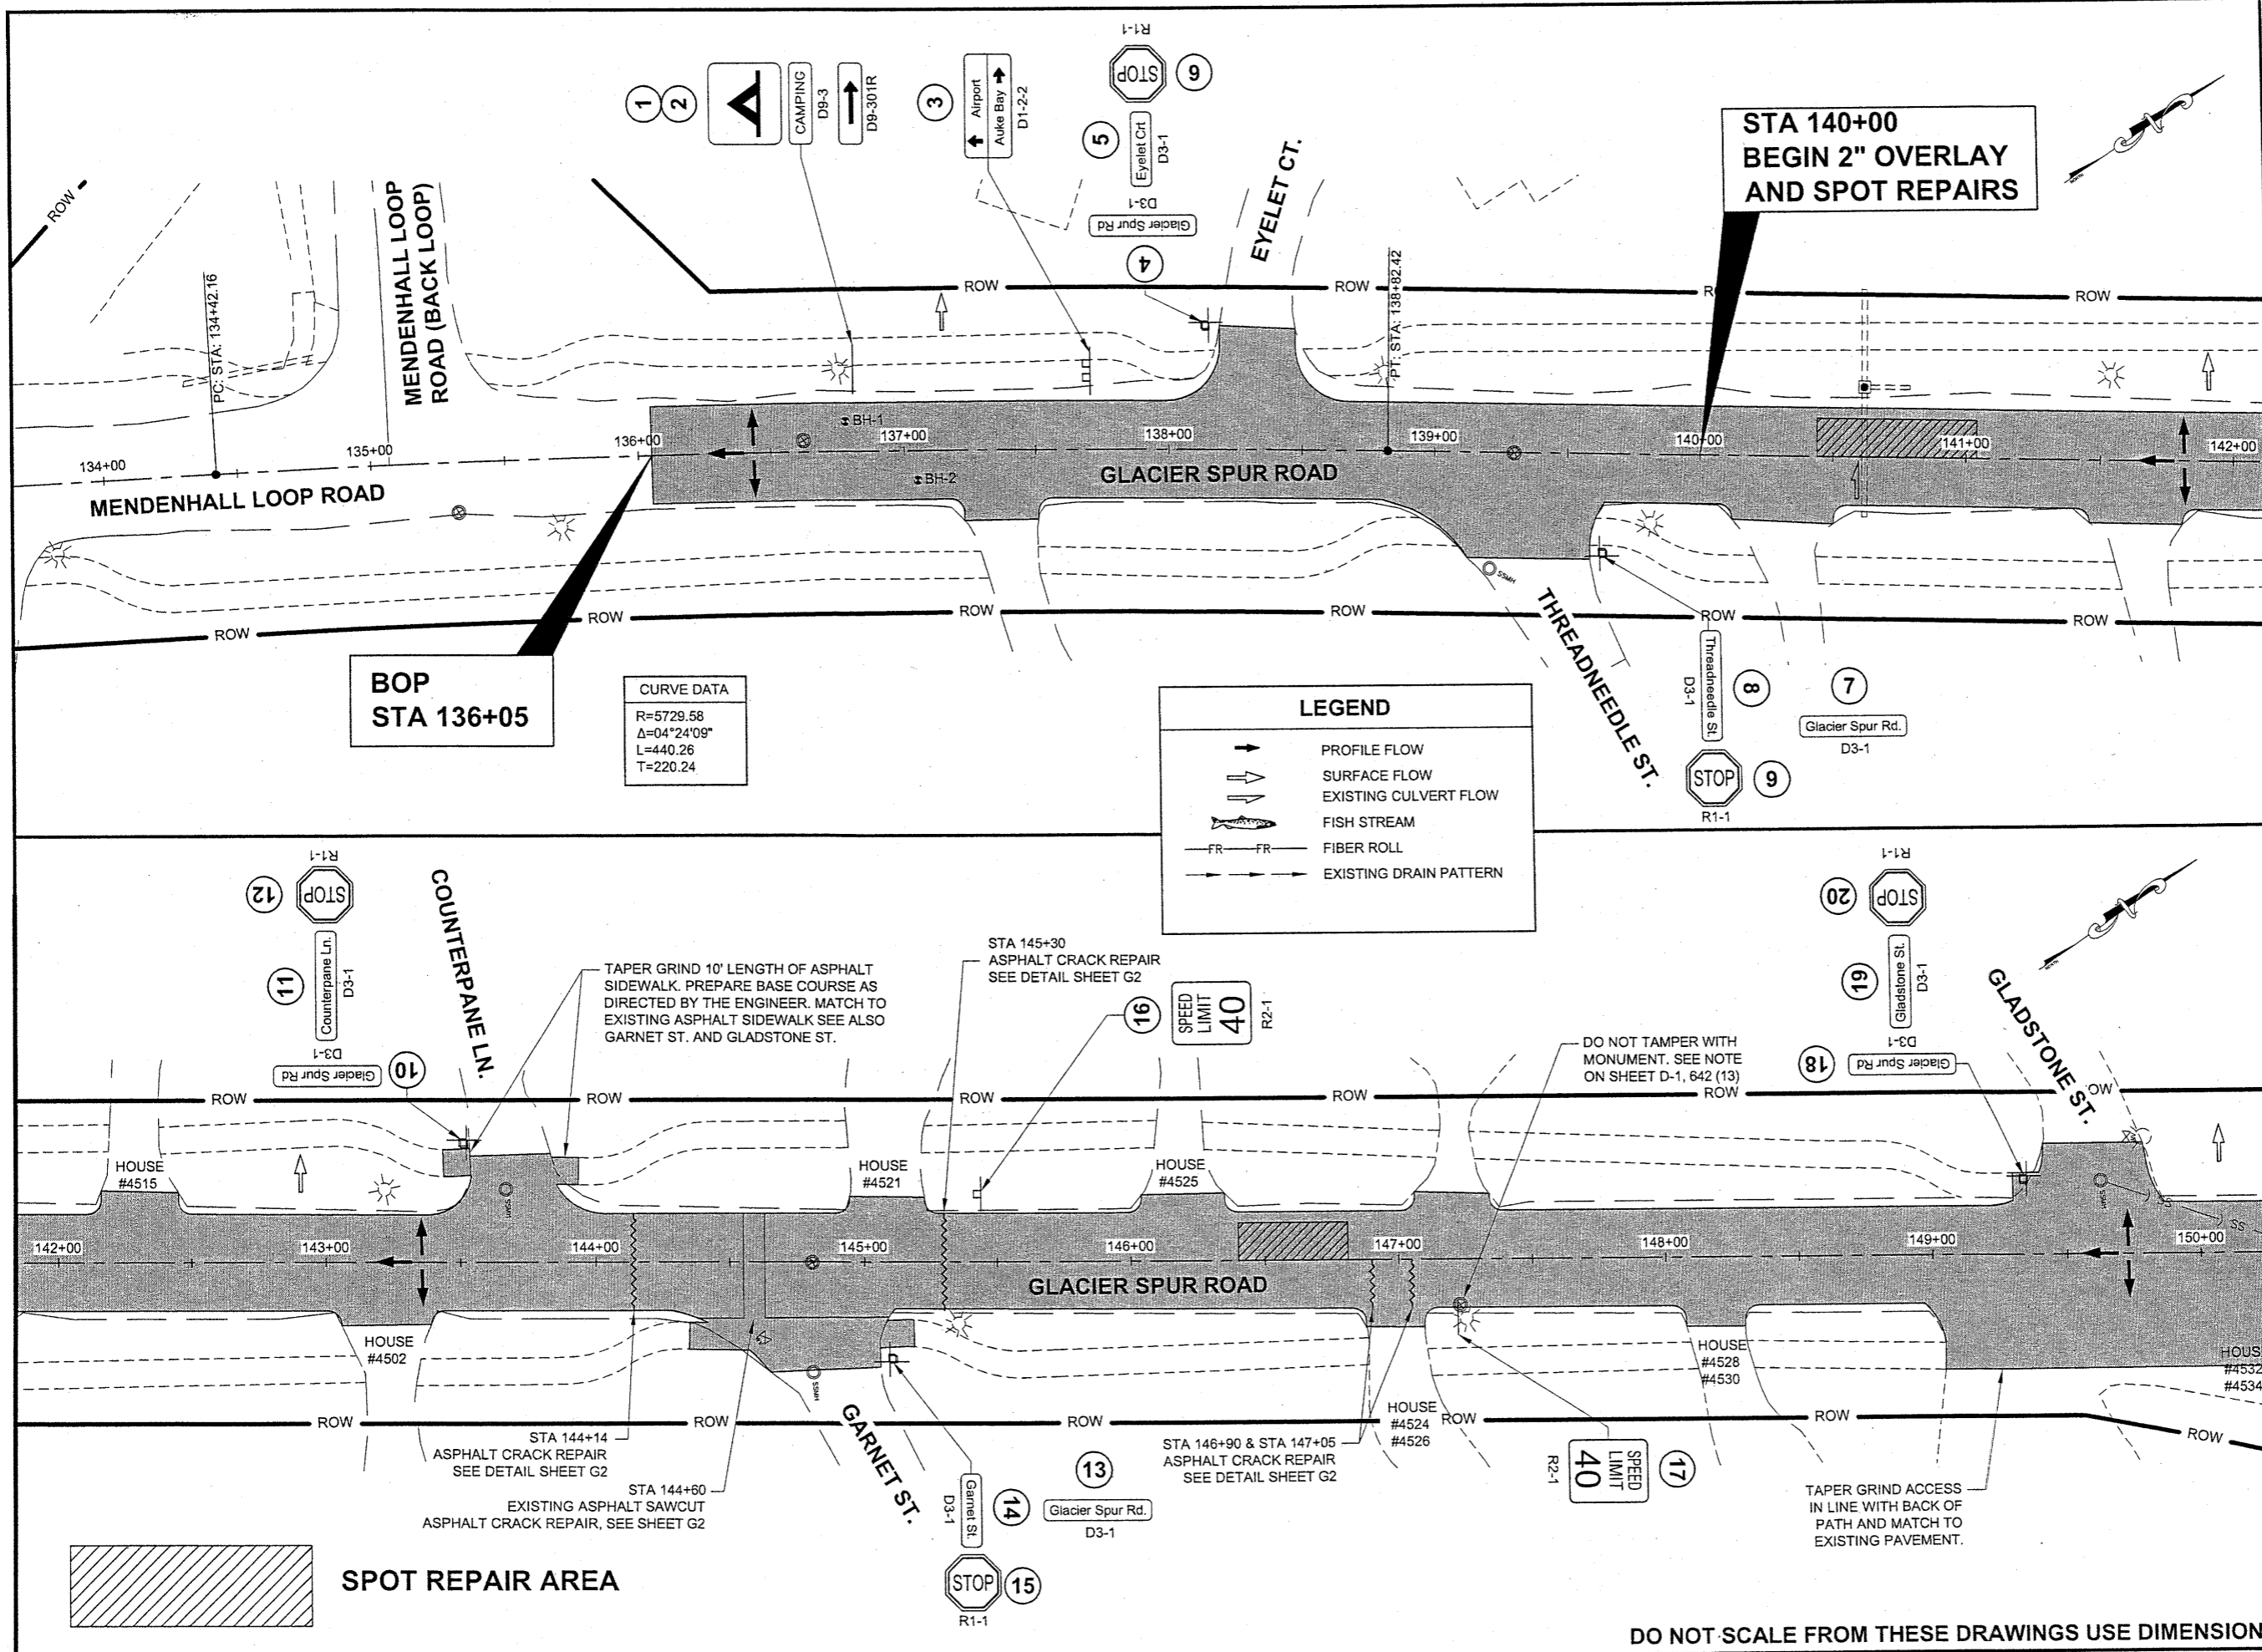

**BOP
STA 136+05**


CURVE DATA

R=5729.58
Δ=04°24'09"
L=440.26
T=220.24

LEGEND

- PROFILE FLOW
- SURFACE FLOW
- EXISTING CULVERT FLOW
- FISH STREAM
- FIBER ROLL
- EXISTING DRAIN PATTERN

SPOT REPAIR AREA

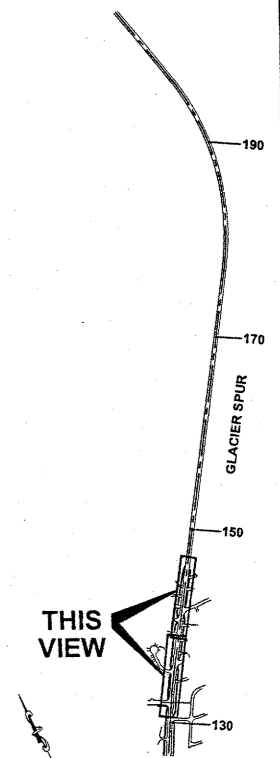

CHECKED BY: C. HOWARD

DESIGNED BY: D. MULLINER
 DRAWN BY: R. GRANTHAM

STATE OF ALASKA
 DEPARTMENT OF TRANSPORTATION & PUBLIC FACILITIES
 SOUTHEAST REGION

JNU
 GLACIER SPUR PAVEMENT REHABILITATION PROJECT #69348

PLAN VIEW




PROJECT DESIGNATION
69348

STATE	YEAR
ALASKA	2010
SHEET NUMBER	TOTAL SHEETS
F1	13

DO NOT SCALE FROM THESE DRAWINGS USE DIMENSIONS

GRANTHAM, RICK L (DOT)
 TAB: F2 Wednesday, May 26, 2010 1:16:50 PM


RECORD OF REVISIONS		
No.	DATE	DESCRIPTION

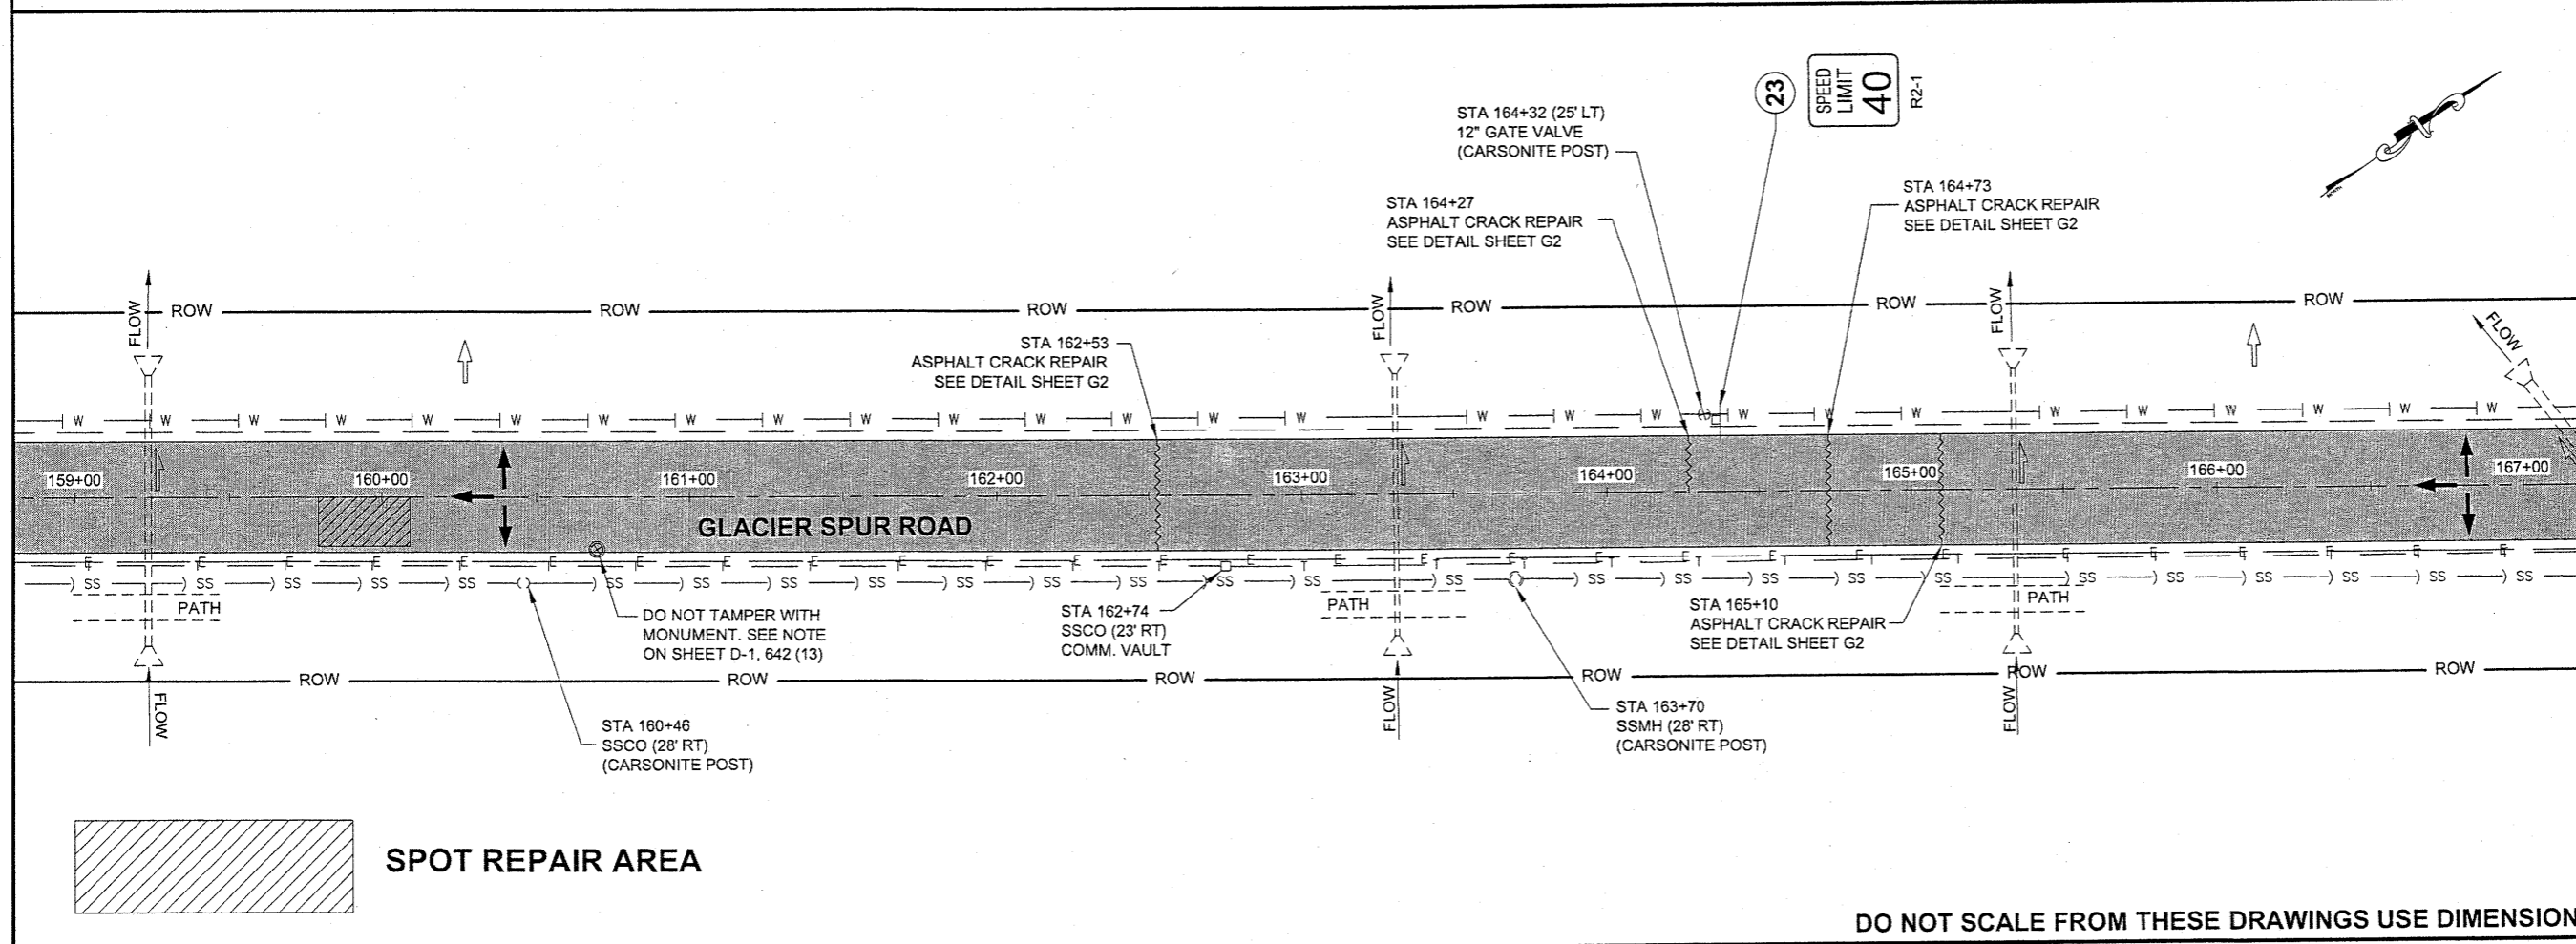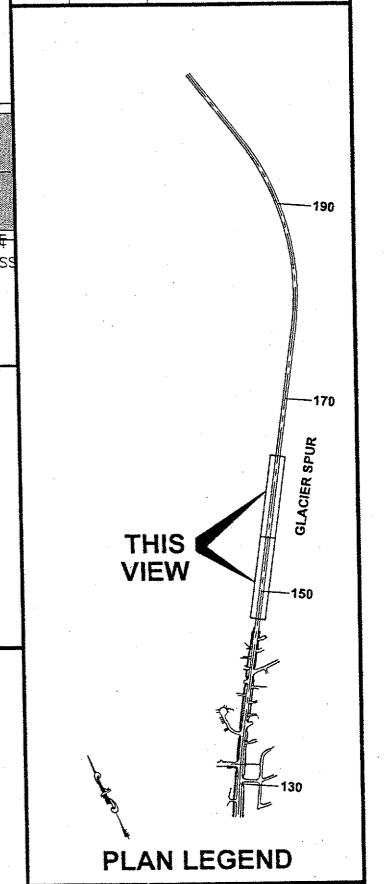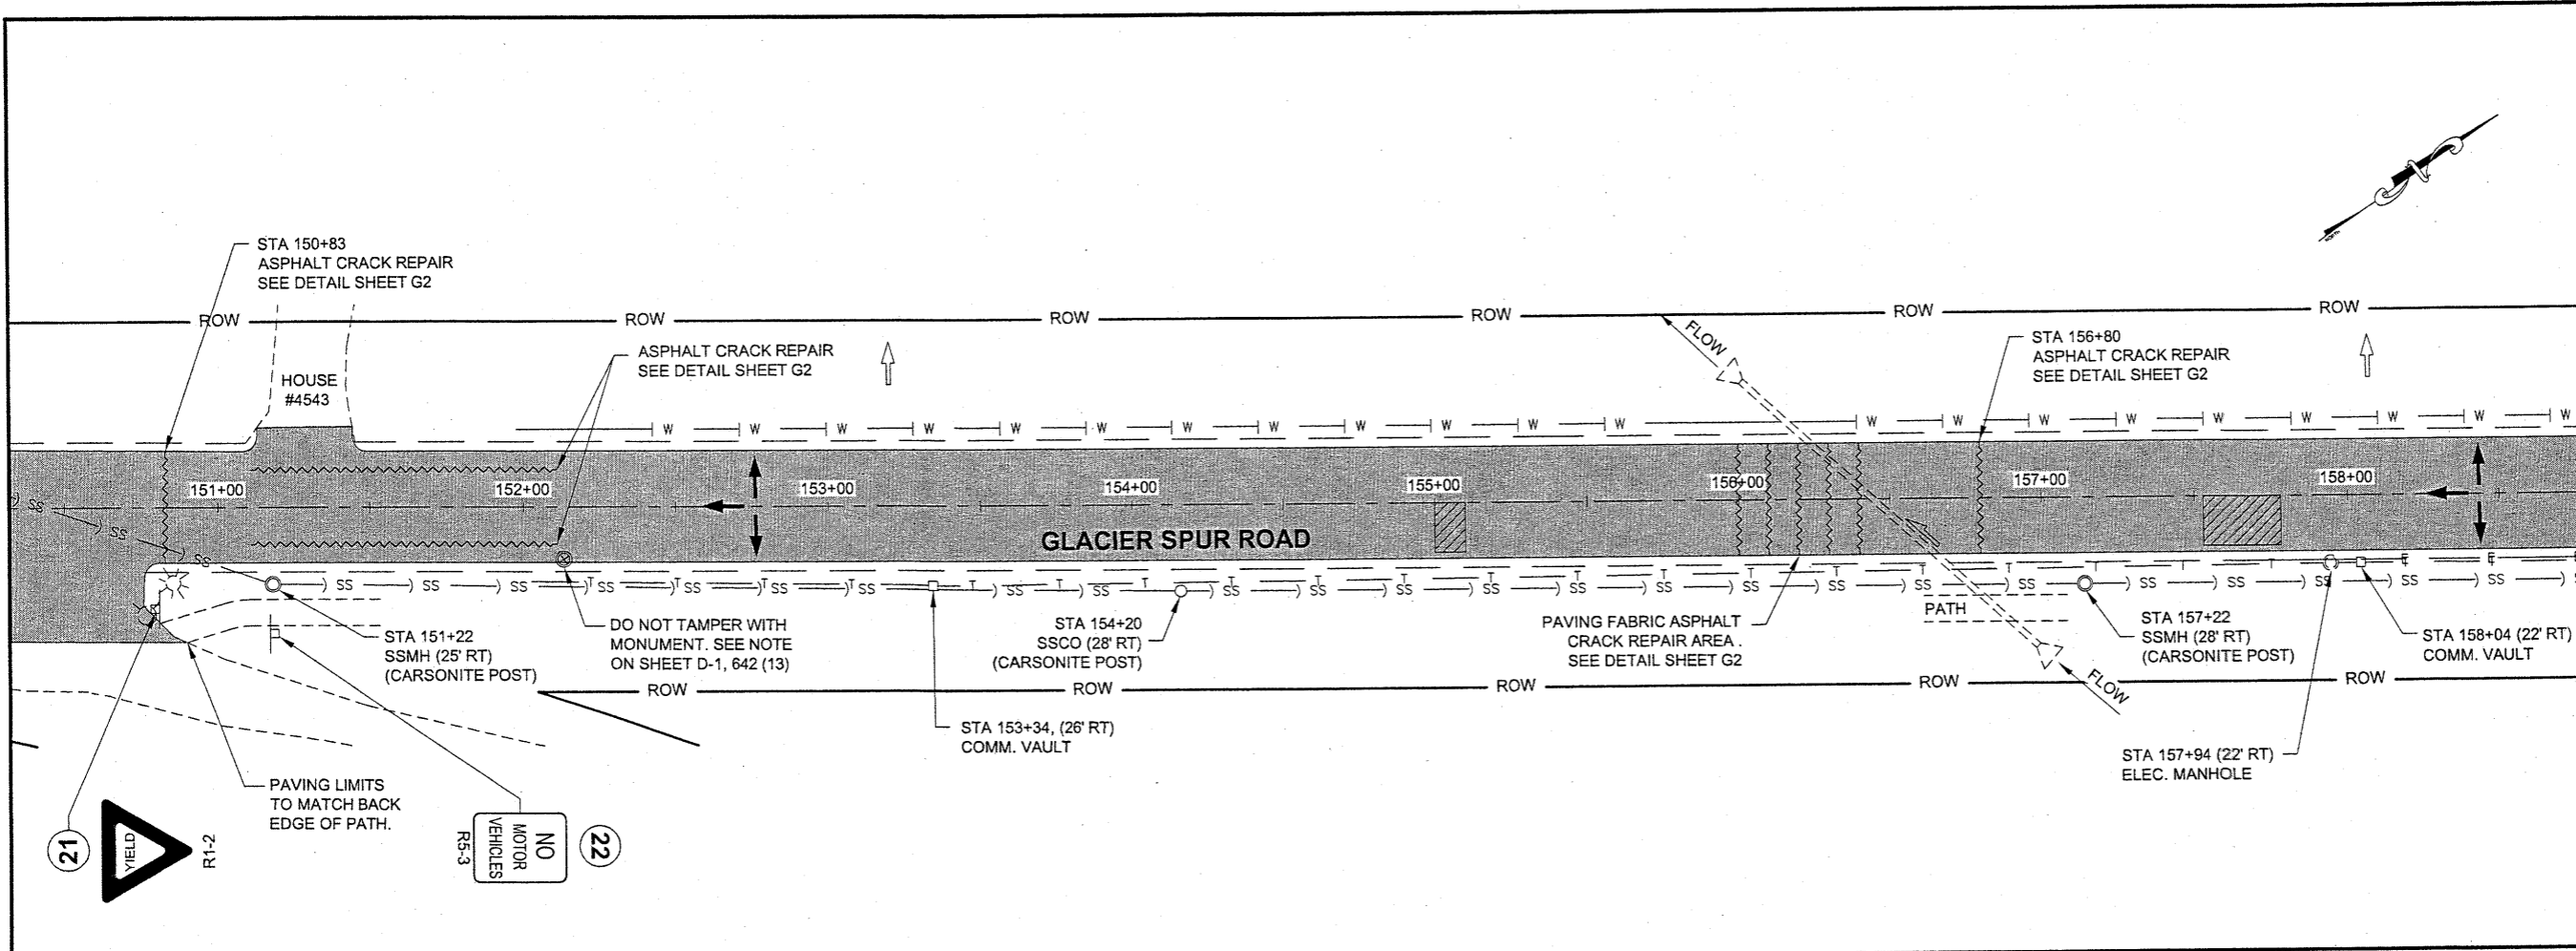

 SPOT REPAIR AREA

DO NOT SCALE FROM THESE DRAWINGS USE DIMENSIONS

CHECKED BY: C. HOWARD

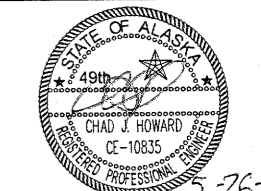

DESIGNED BY: D. MULLINER
 DRAWN BY: R. GRANTHAM

STATE OF ALASKA
 DEPARTMENT OF TRANSPORTATION & PUBLIC FACILITIES
 SOUTHEAST REGION

JNU
 GLACIER SPUR PAVEMENT
 REHABILITATION
 PROJECT #69348



PLAN VIEW

PROJECT DESIGNATION
69348

STATE	YEAR
ALASKA	2010
SHEET NUMBER	TOTAL SHEETS
F2	13



GRANTHAM, RICK L (DOT)
 TAB: F3 Wednesday, May 26, 2010 1:20:54 PM

RECORD OF REVISIONS		
No.	DATE	DESCRIPTION

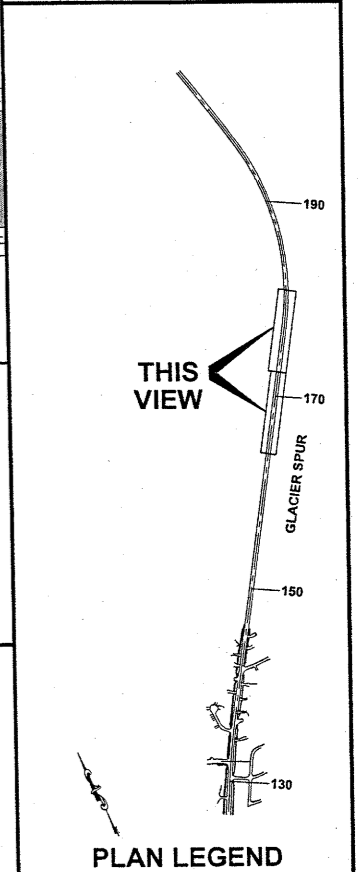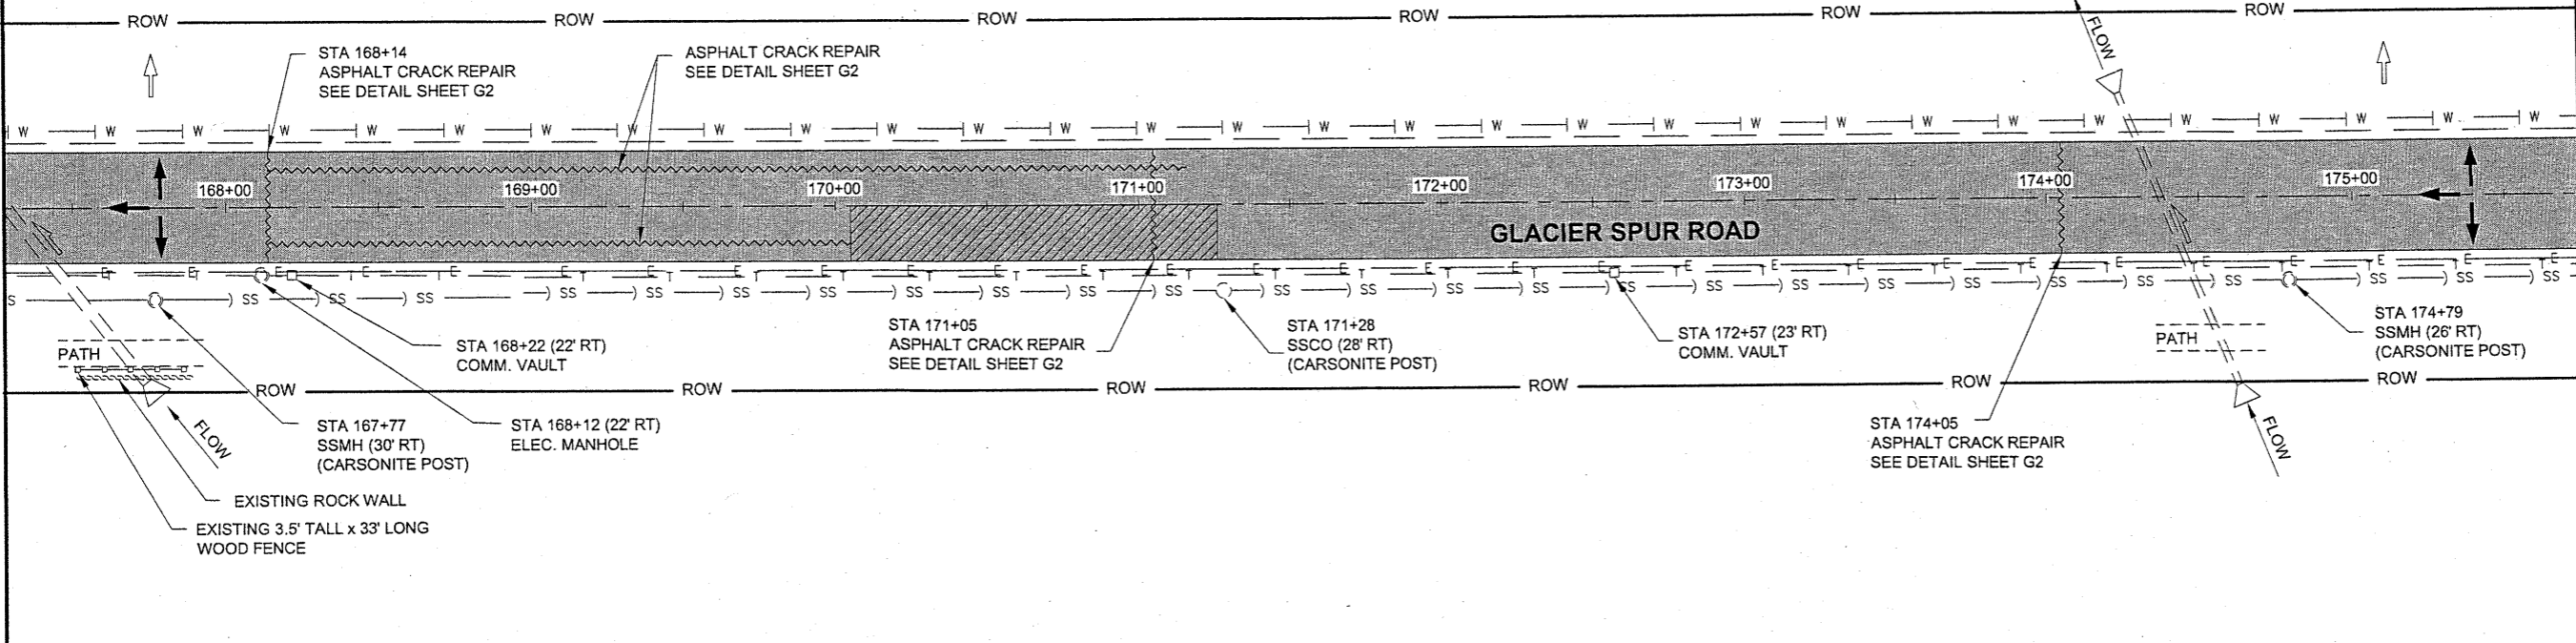

CURVE DATA

R=2546.48
Δ=48°07'17"
L=2138.73
T=1137.00

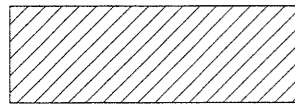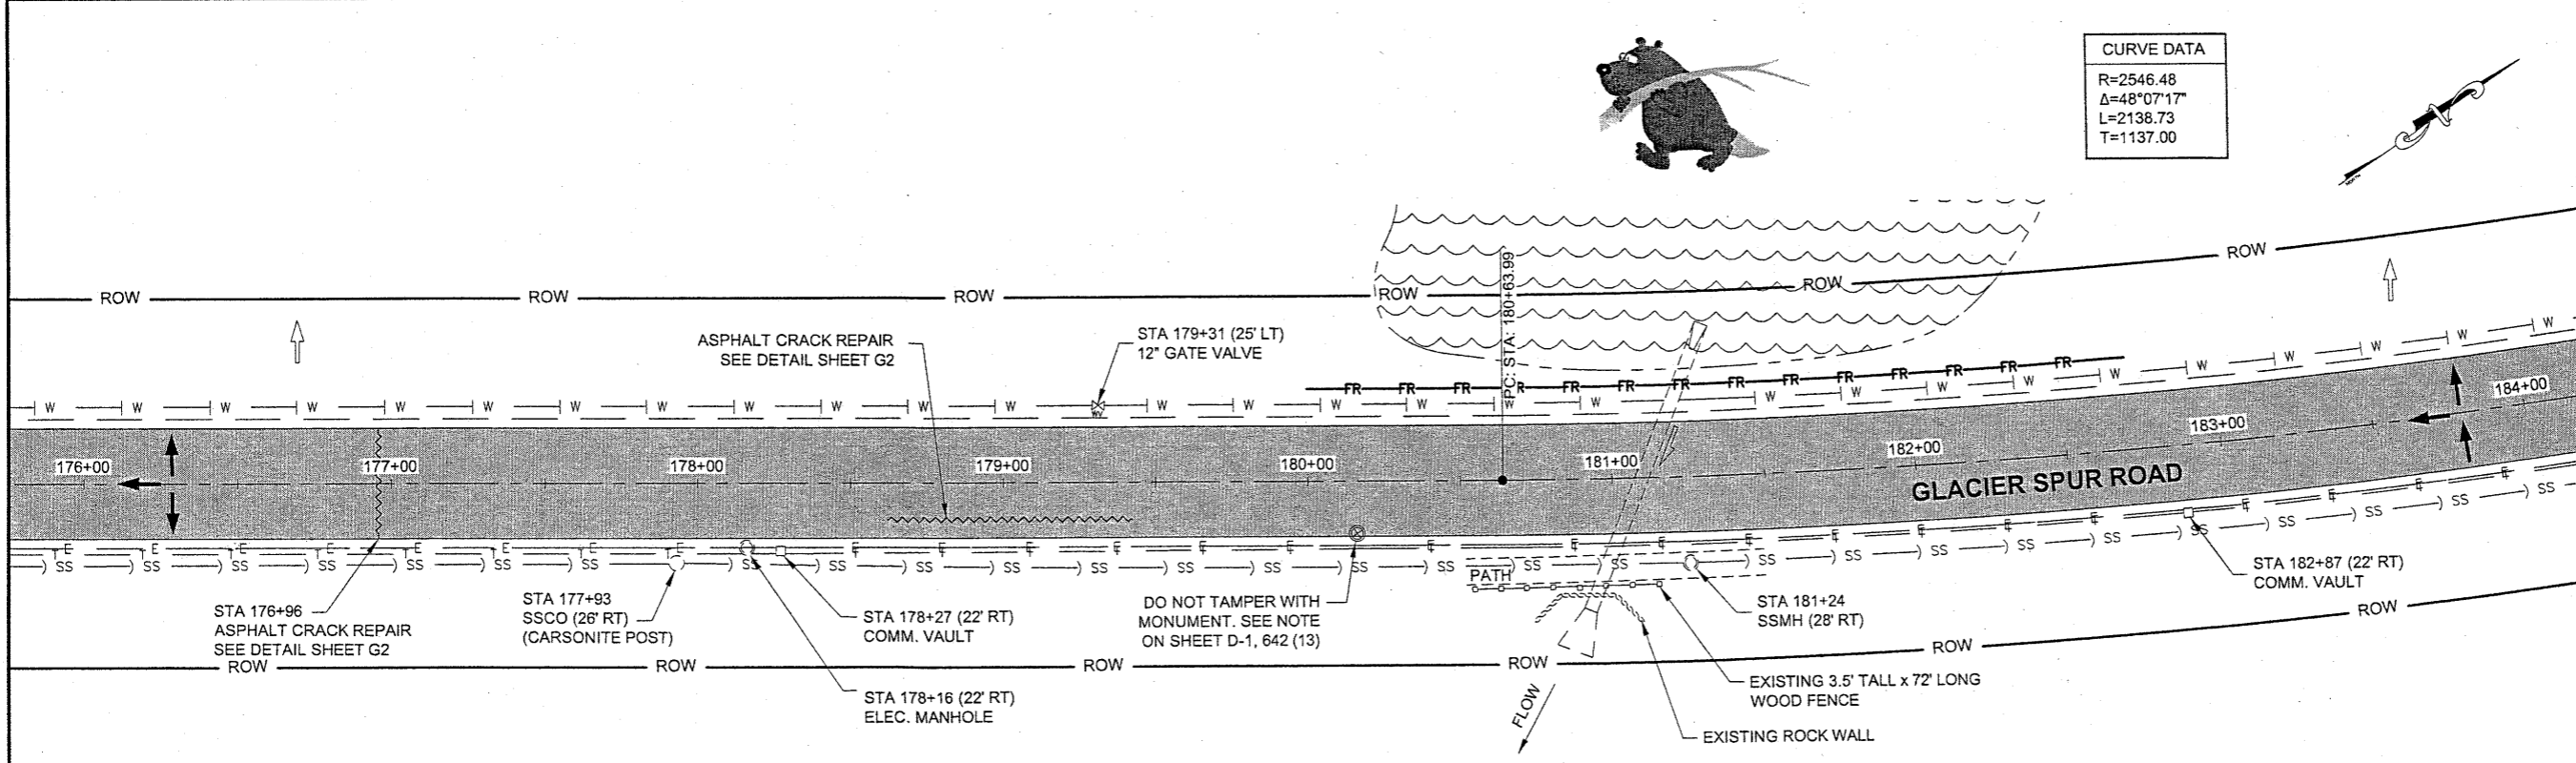

SPOT REPAIR AREA

DO NOT SCALE FROM THESE DRAWINGS USE DIMENSIONS

CHECKED BY: C. HOWARD

DESIGNED BY: D. MULLINER
 DRAWN BY: R. GRANTHAM

STATE OF ALASKA
 DEPARTMENT OF TRANSPORTATION
 & PUBLIC FACILITIES
 SOUTHEAST REGION



**JNU
 GLACIER SPUR PAVEMENT
 REHABILITATION
 PROJECT #69348**

PLAN VIEW

PROJECT DESIGNATION
69348


STATE	YEAR
ALASKA	2010
SHEET NUMBER	TOTAL SHEETS
F3	13

MULLINER, DOUGLAS J (DOT)		
TAB: F4 Monday, May 24, 2010 1:30:04 PM		
ADDENDUM NUMBER		
ATTACHMENT NUMBER		
RECORD OF REVISIONS		
No.	DATE	DESCRIPTION

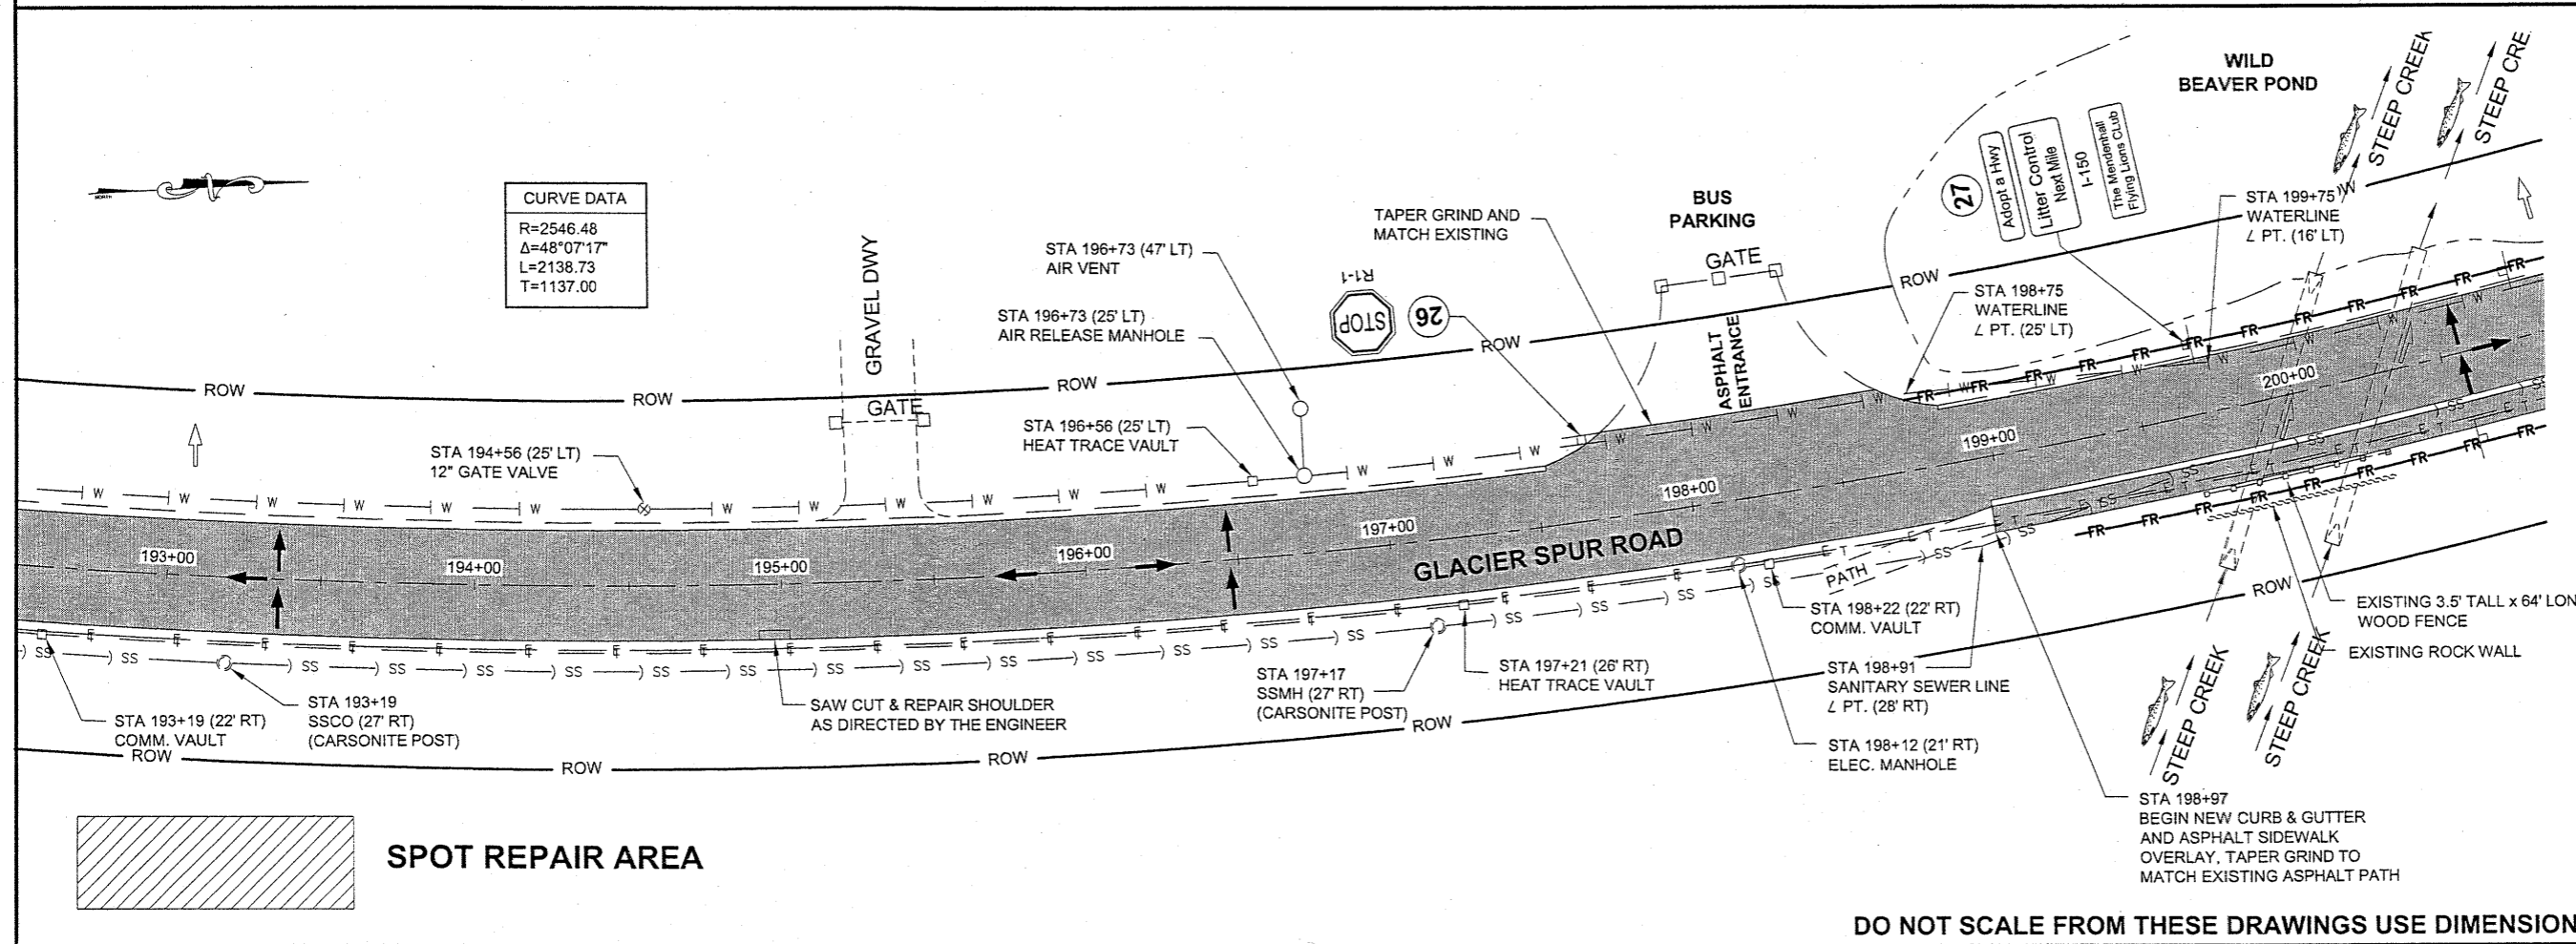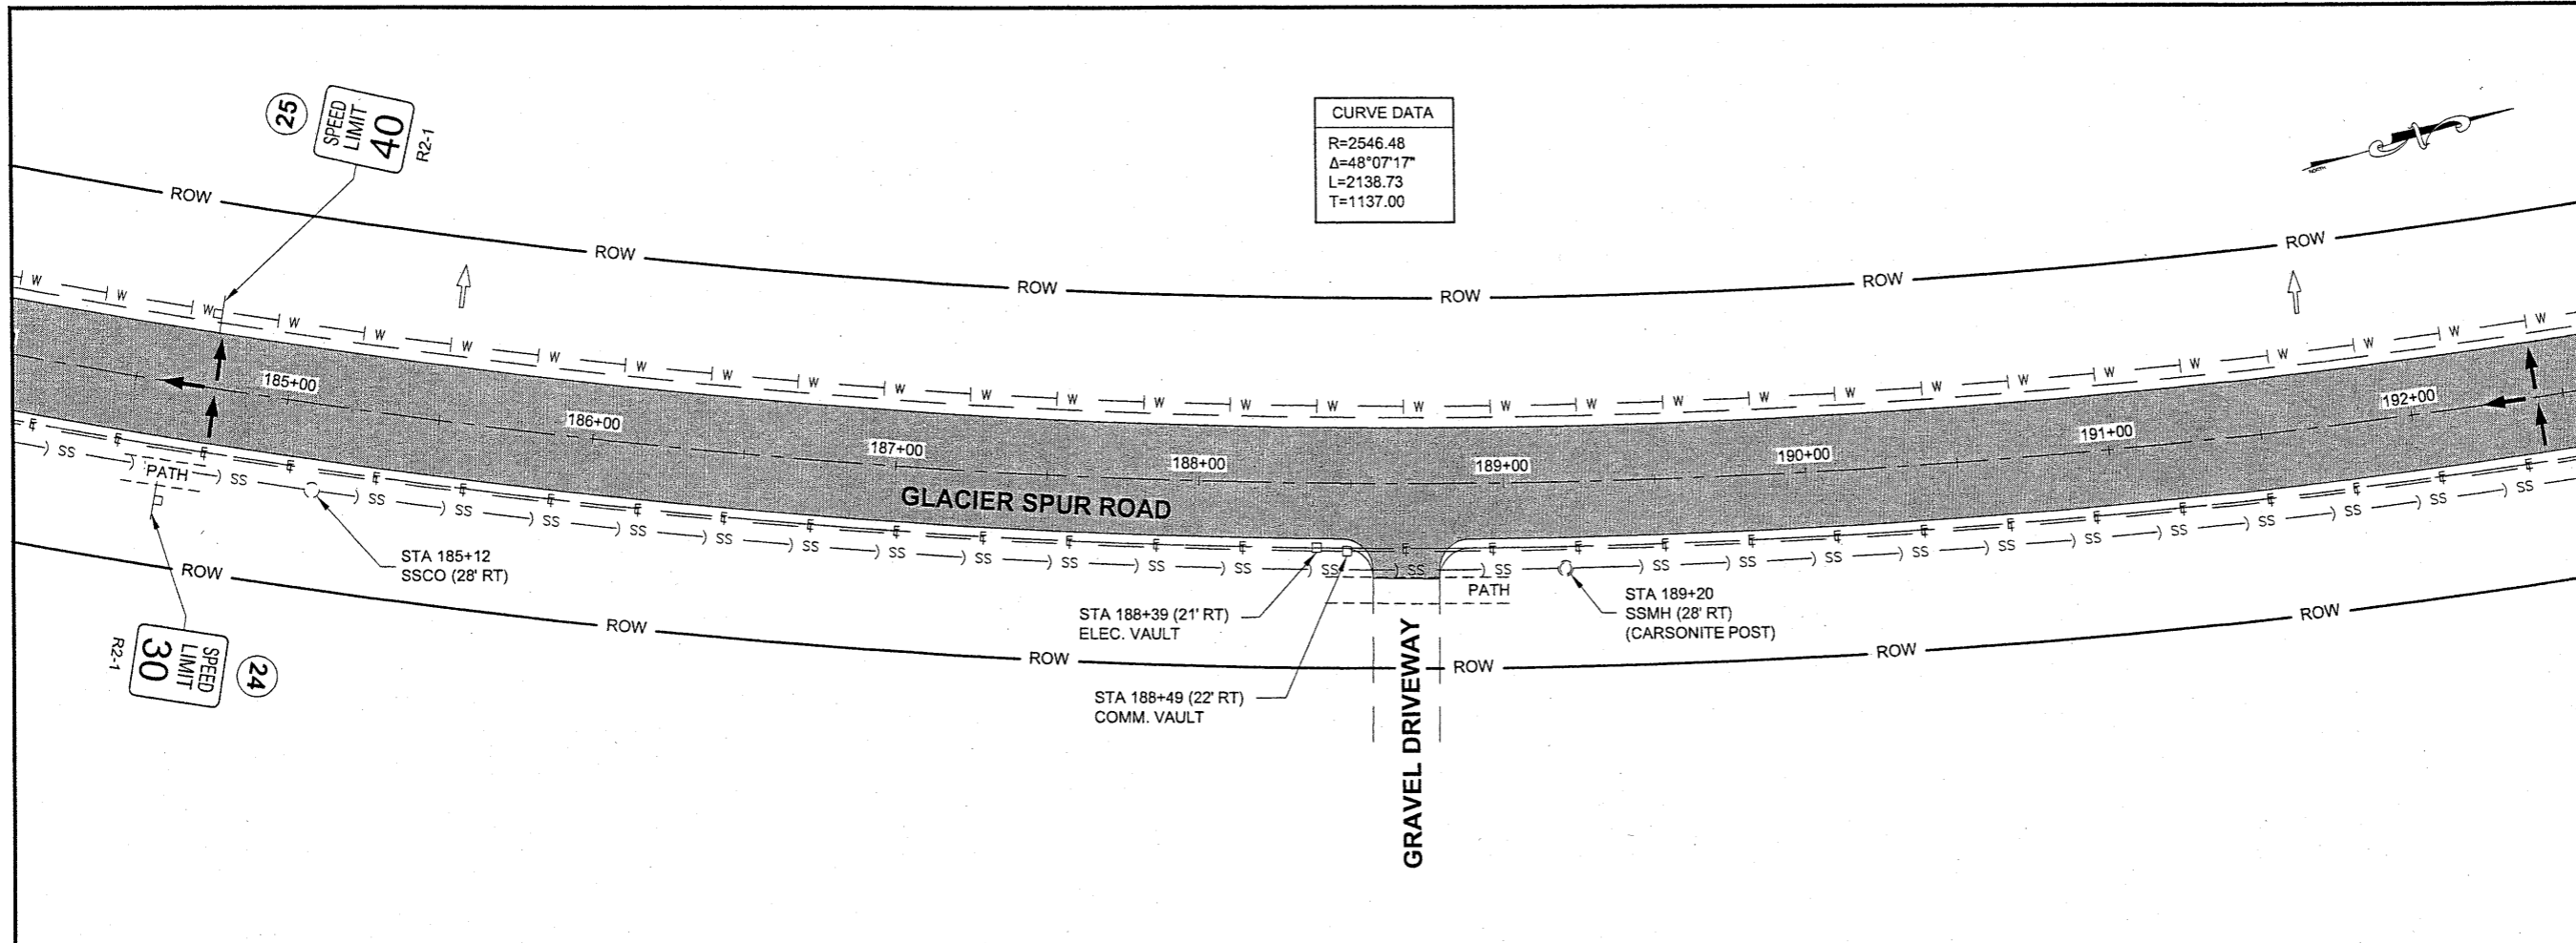


 SPOT REPAIR AREA

DO NOT SCALE FROM THESE DRAWINGS USE DIMENSIONS

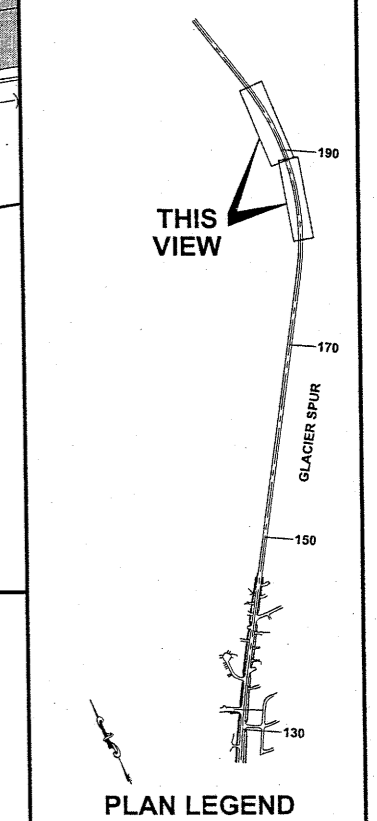

CHECKED BY: C. HOWARD

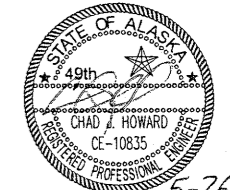

DESIGNED BY: D. MULLINER
DRAWN BY: R. GRANTHAM

STATE OF ALASKA
DEPARTMENT OF TRANSPORTATION & PUBLIC FACILITIES
SOUTHEAST REGION

**JNU
GLACIER SPUR PAVEMENT
REHABILITATION
PROJECT #69348**

PLAN VIEW




PROJECT DESIGNATION
69348

STATE	YEAR
ALASKA	2010
SHEET NUMBER	TOTAL SHEETS
F4	13

CURVE DATA
 R=2546.48
 Δ=48°07'17"
 L=2138.73
 T=1137.00

MULLINER, DOUGLAS J (DOT)
 TAB: F5 Monday, May 24, 2010 1:53:06 PM

ADDENDUM NUMBER		
ATTACHMENT NUMBER		
RECORD OF REVISIONS		
No.	DATE	DESCRIPTION

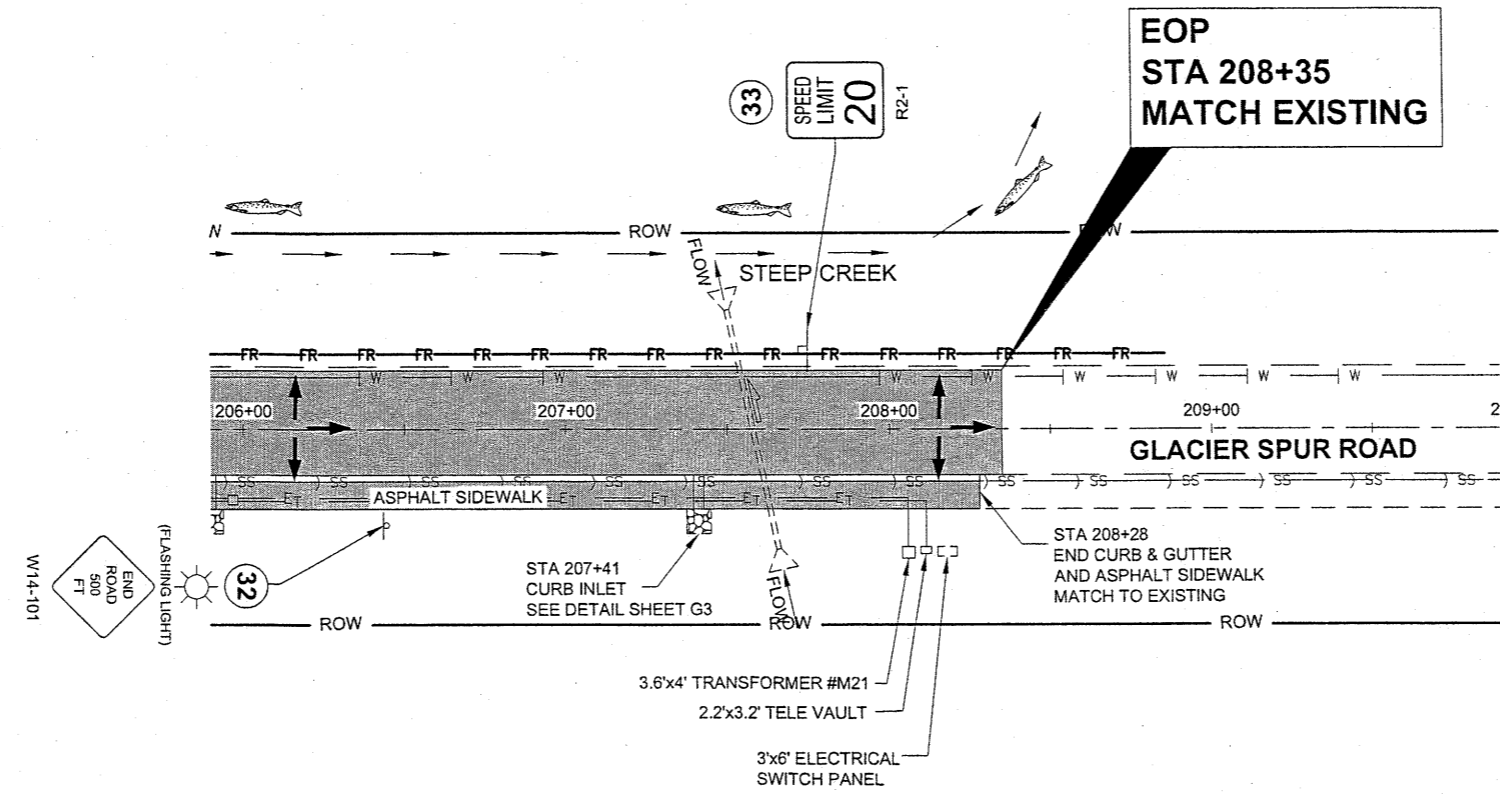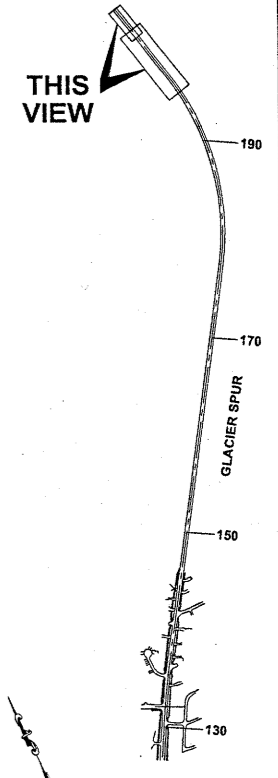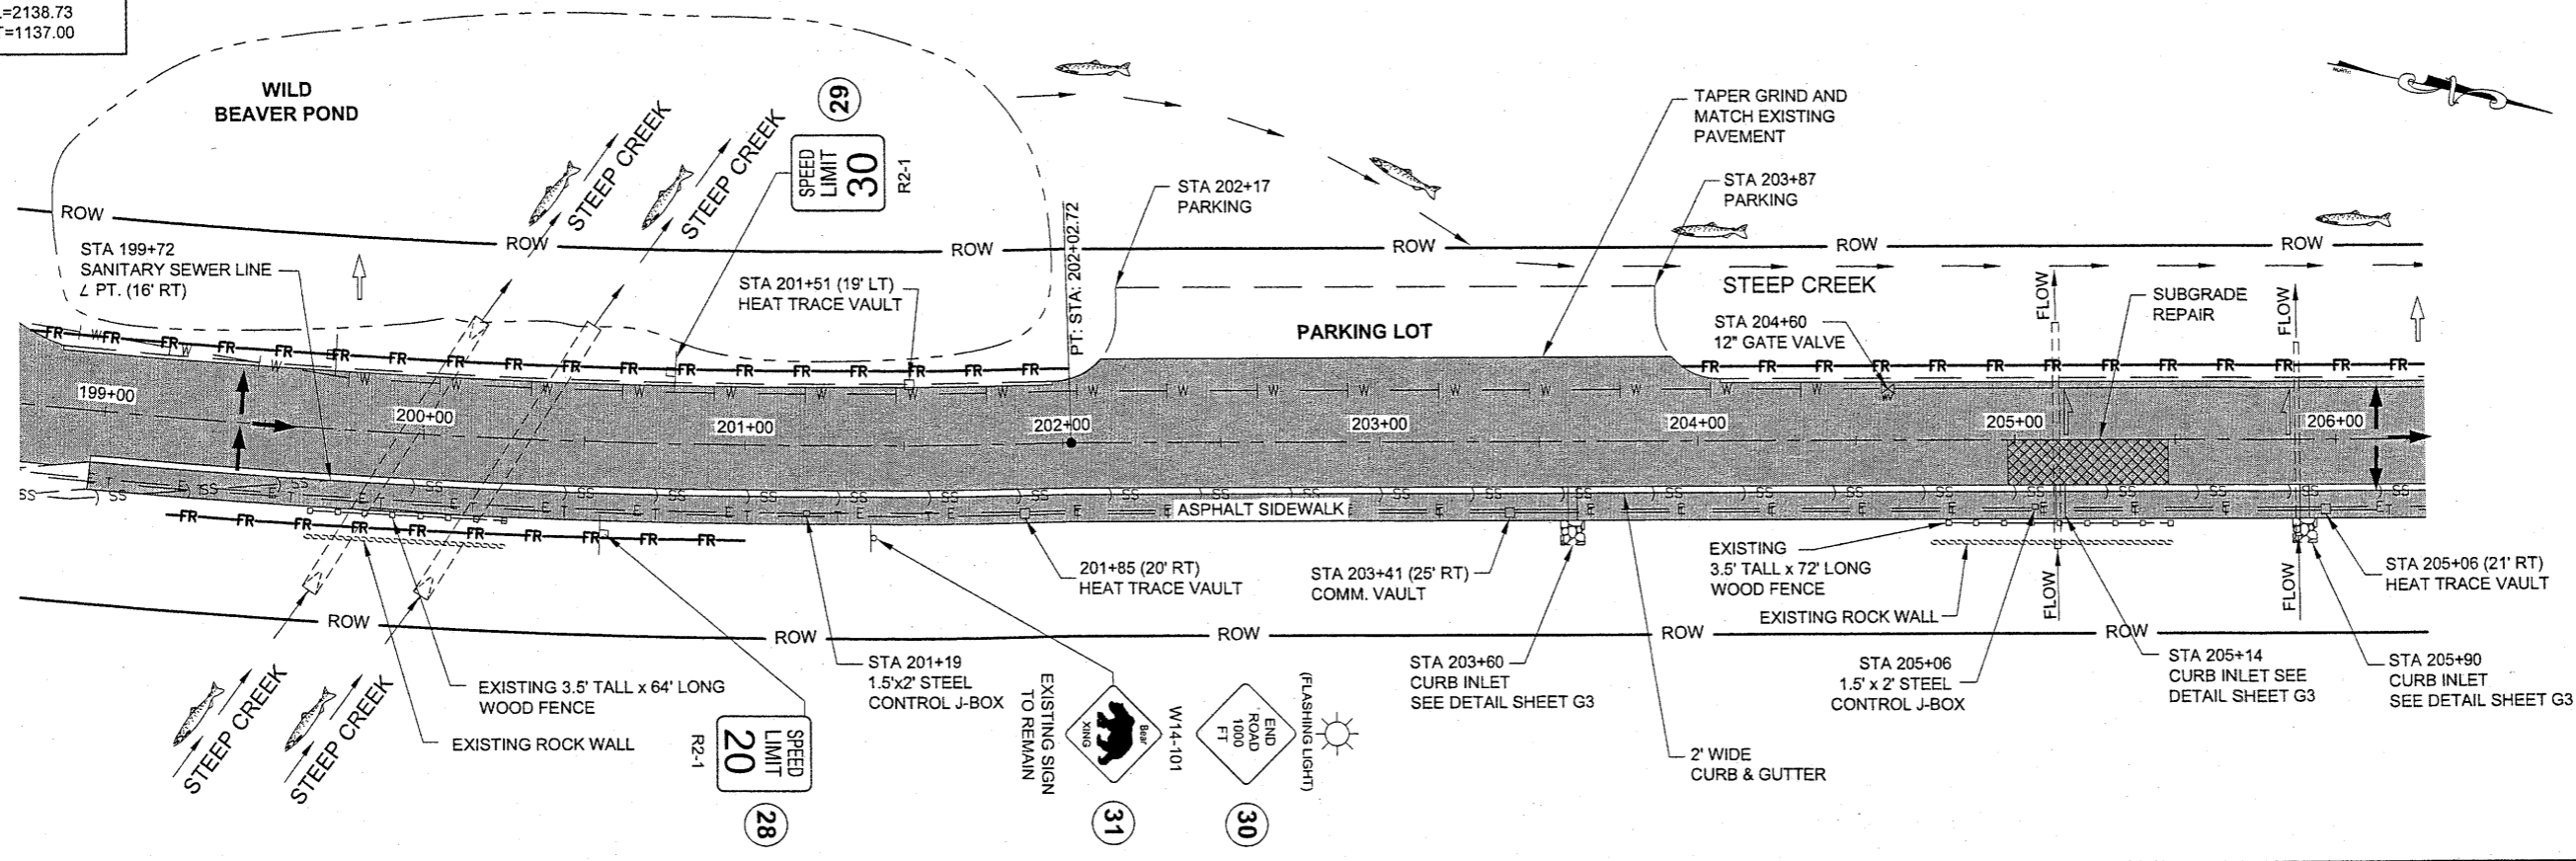

DO NOT SCALE FROM THESE DRAWINGS USE DIMENSIONS

CHECKED BY: C. HOWARD

5-26-10


DESIGNED BY: D. MULLINER
 DRAWN BY: R. GRANTHAM

STATE OF ALASKA
 DEPARTMENT OF TRANSPORTATION & PUBLIC FACILITIES
 SOUTHEAST REGION


JNU
 GLACIER SPUR PAVEMENT REHABILITATION
 PROJECT #69348

PLAN VIEW

PROJECT DESIGNATION	
69348	
STATE	YEAR
ALASKA	2010
SHEET NUMBER	TOTAL SHEETS
F5	13

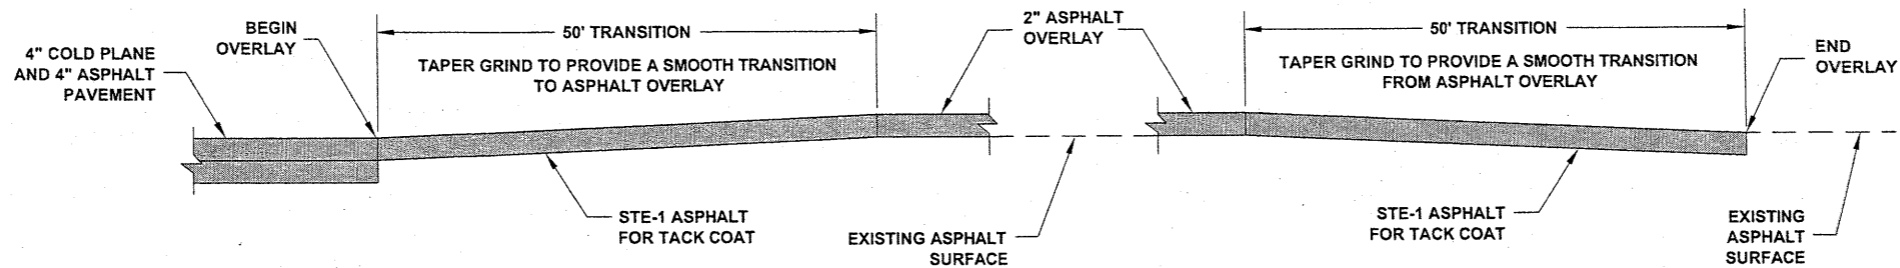


PAVEMENT MATCH JOINT DETAIL

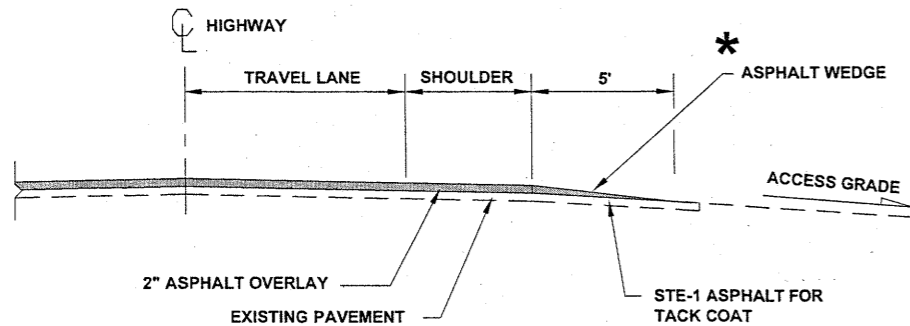


TYPICAL DRIVEWAY PROFILE

* CONSTRUCT AN ASPHALT WEDGE TO PROVIDE A SMOOTH TRANSITION TO PAVED DRIVEWAYS. PROVIDE FULL 2" ASPHALT PAVEMENT THICKNESS AND MATCH TO GRAVEL DRIVEWAYS.

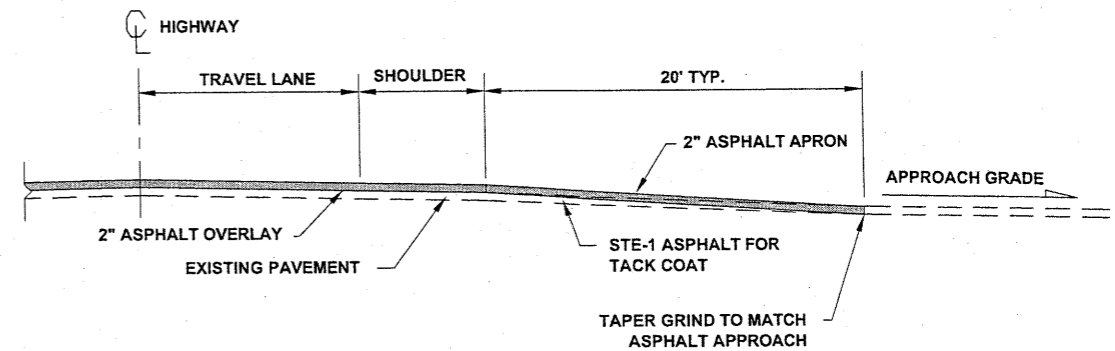


TYPICAL STREET APPROACH PROFILE

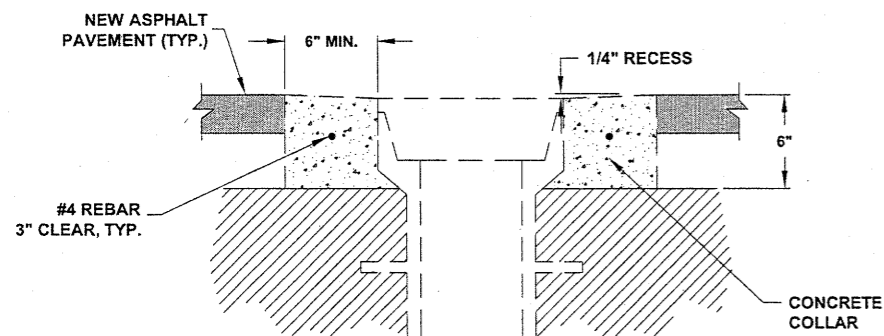

NOTE: RIGHT SHOULDER MONUMENTS AT STATIONS; 147+23, 152+13, 160+70 AND 180+16 ARE NOT TO BE TAMPED WITH IN ANY WAY. REFERENCE THE LOCATION OF THESE MONUMENTS. THE CONTRACTOR SHALL FILL MONUMENT CASES WITH A SUITABLE MATERIAL AS DETERMINED BY THE ENGINEER PRIOR TO PAVING. AT THE CONCLUSION OF PAVING, THE MONUMENT CASES SHALL BE SAW CUT OUT AND THE MATERIAL REMOVED.

CENTERLINE MONUMENT CASE AND VALVE BOX ADJUSTMENT DETAIL

N.T.S.

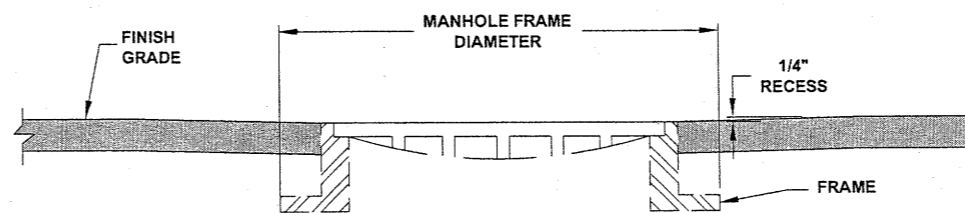


MANHOLE ADJUSTMENT NOTES:

1. ADJUSTING RINGS SHALL BE REPLACED IN ACCORDANCE TO EACH MANHOLE INVESTIGATION, CONDUCTED BY THE PROJECT ENGINEER.
2. MANHOLE CASTING SHALL BE ADJUSTED TO CONFORM WITH SLOPE AND GRADE OF PROPOSED PAVEMENT.
3. ADJUSTING RINGS SHALL BE PROPERLY SIZED FOR THE EXISTING CONE OR FLAT TOP OPENING, AND INSTALLED PER MANUFACTURER'S RECOMMENDATIONS.
4. INSTALLATION OF FRAME, COVER, AND ADJUSTMENT RINGS, ONTO THE EXISTING STRUCTURE SHALL BE WATER-TIGHT.

MANHOLE ADJUSTMENT DETAIL

N.T.S.

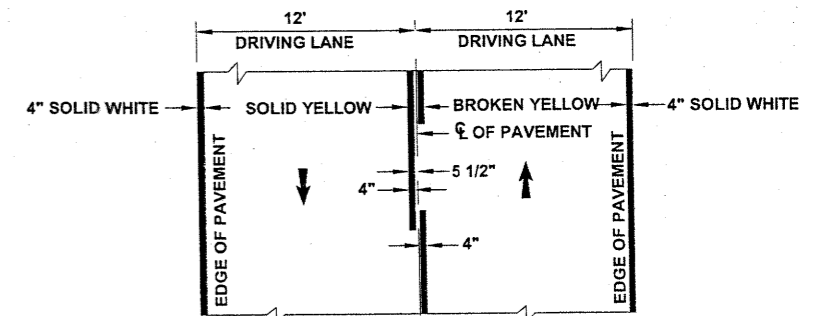



STRIPING DETAIL

STRIPING NOTE:


1. PASSING ZONES SHALL BE LOCATED IN FIELD. THE CONTRACTOR SHALL REFERENCE AND STAKE THE LOCATIONS OF PASSING ZONES PER SPECIAL PROVISION 670.

DO NOT SCALE FROM THESE DRAWINGS USE DIMENSIONS

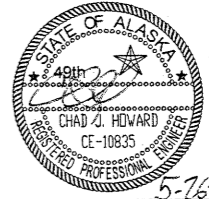CHECKED BY: C. HOWARD  DESIGNED BY: D. MULLINER DRAWN BY: R. GRANTHAM		STATE OF ALASKA DEPARTMENT OF TRANSPORTATION & PUBLIC FACILITIES-SOUTHEAST REGION JNU GLACIER SPUR PAVEMENT REHABILITATION PROJECT #69348 MISC. DETAILS			
PATH: Q:\JNU\69348\PLANSET\69348_G1-G3_MISC.DTL.DWG TAB: G1 Monday, May 24, 2010 1:55:05 PM MULLINER, DOUGLAS J (DOT)		PROJECT DESIGNATION 69348	YEAR 2010	SHEET NO. G1	TOTAL SHEETS 13

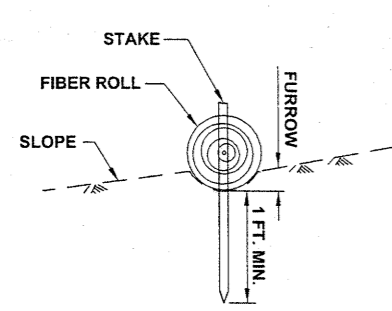


SECTION

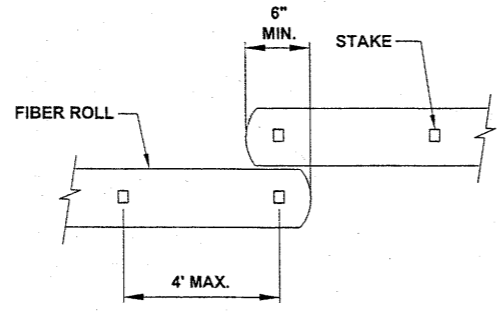


PLAN

FIBER ROLL (TYPE 1)

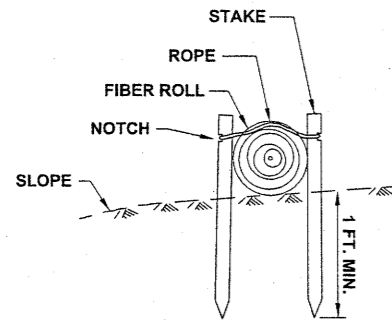


SECTION

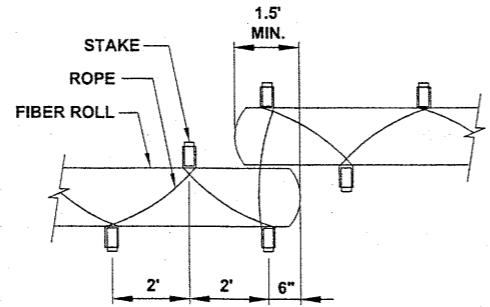


PLAN

FIBER ROLL (TYPE 2)

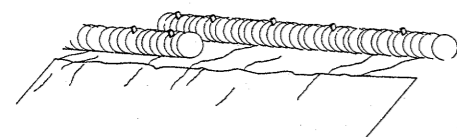


PERSPECTIVE

FIBER ROLL (TYPE 1)

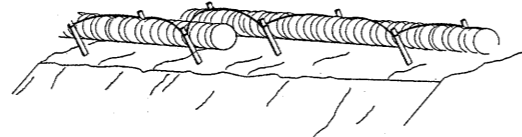

PERSPECTIVE

FIBER ROLL (TYPE 2)

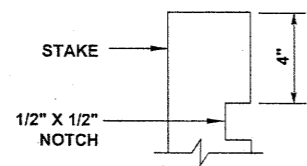

ELEVATION


TYPICAL FIBER ROLL DETAIL

NOTES:

1. THE LOCATION AND LENGTH OF FIBER ROLLS IS DEPENDENT ON THE CONDITION OF THE SITE.
2. LAP ADJACENT FIBER ROLLS TO PREVENT SEDIMENT BYPASS.
3. ANCHOR AS NECESSARY TO FIRMLY SECURE FIBER ROLLS AND PROVIDE CONTINUOUS CONTACT WITH THE SURFACE ON WHICH IT IS INSTALLED.

EROSION & SEDIMENT CONTROL NOTES:

1. REFER TO APPENDIX B OF THE CONTRACT DOCUMENTS FOR THE ENVIRONMENTAL COMMITMENTS.
2. THE LOCATIONS OF TEMPORARY EROSION & SEDIMENT POLLUTION CONTROLS ARE RECOMMENDATIONS. IT IS THE RESPONSIBILITY OF THE CONTRACTOR TO PREPARE AND IMPLEMENT A SWPPP ACCORDING TO SECTION 641 OF THE SPECS.
3. INSTALL EROSION AND SEDIMENT CONTROL DEVICES BEFORE BEGINNING EARTH DISTURBING ACTIVITIES AND COLD PLANING OR AS SPECIFIED ELSEWHERE.
4. MAINTAIN DEVICES. MONITOR DAILY. REMOVE SEDIMENT FROM SEDIMENT TRAPS WHEN 4" OF SEDIMENT HAS ACCUMULATED.

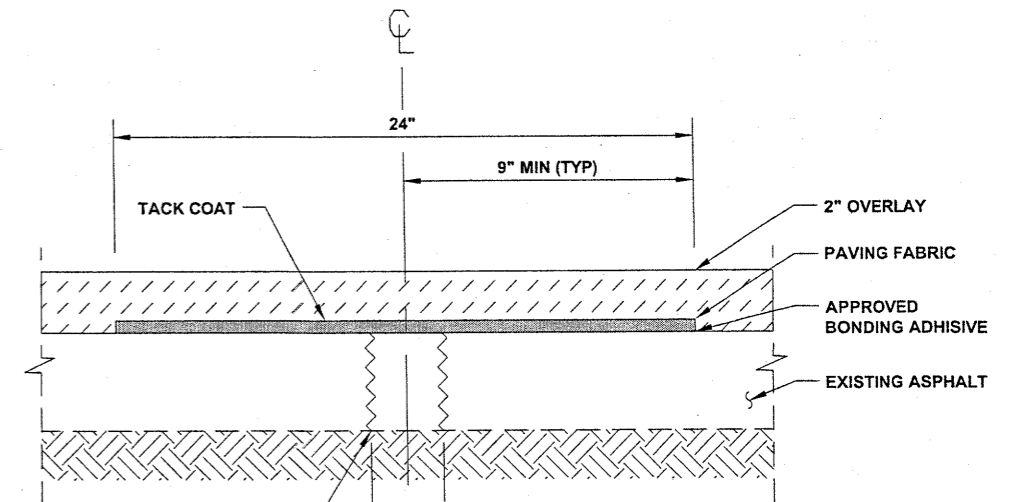


ALL CRACKS >1/4" WILL BE FILLED AND SEALED WITH CRAFCO ROADSAVER 222 OR AN APPROVED EQUAL.

PAVING FABRIC/CRACK REPAIR

NOTES:

1. REFER TO SECTION 632 IN THE SPECIFICATIONS FOR SURFACE PREPARATION.
2. APPLY APPROVED TACK COAT OVER MEMBRANE PRIOR TO PAVING.
3. CRACK REPAIR PAID FOR UNDER ITEM 632(1) PAVING FABRIC.

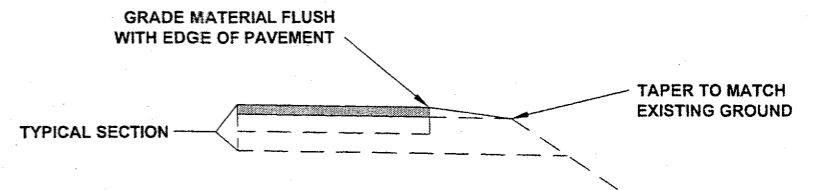

LINEAR GRADING

LEFT AND RIGHT EDGE OF PAVEMENT

NOTES:



1. MATERIAL FOR LINEAR GRADING SHALL MATCH THE REQUIREMENTS OF AGGREGATE BASE COURSE D-1 OR RAM.
2. LINEAR GRADING SHALL BE PAID FOR UNDER ITEM 303 (3).

DO NOT SCALE FROM THESE DRAWINGS USE DIMENSIONS

CHECKED BY: C. HOWARD		STATE OF ALASKA DEPARTMENT OF TRANSPORTATION & PUBLIC FACILITIES-SOUTHEAST REGION	
		<p>JNU GLACIER SPUR PAVEMENT REHABILITATION PROJECT #69348</p> <p>MISC. DETAILS</p>	
DRAWN BY: R. GRANTHAM		MULLINER, DOUGLAS J (DOT)	
PATH: Q:\UNU69348\PLANSET\69348_G1-G3_MISC.DTL.DWG		PROJECT DESIGNATION	YEAR
TAB: G2 Monday, May 24, 2010 2:06:54 PM		69348	2010
REVISIONS		SHEET NO.	TOTAL SHEETS
NO.	DATE	DESCRIPTION	
			13



CURB INLET NOTES:

1. SEE STANDARD DRAWING D-23.01 DISREGARD NOTES 3, 4, & 5.
2. 8" R-3165 TYPE-A COMBINATION INLET FRAME, GRATE, AND CURB BOX (NEENAH FOUNDRY) OR APPROVED EQUAL
3. CONTRACTOR SHALL USE EXTREME CAUTION WHILE EXCAVATING NEAR EXISTING UTILITIES.

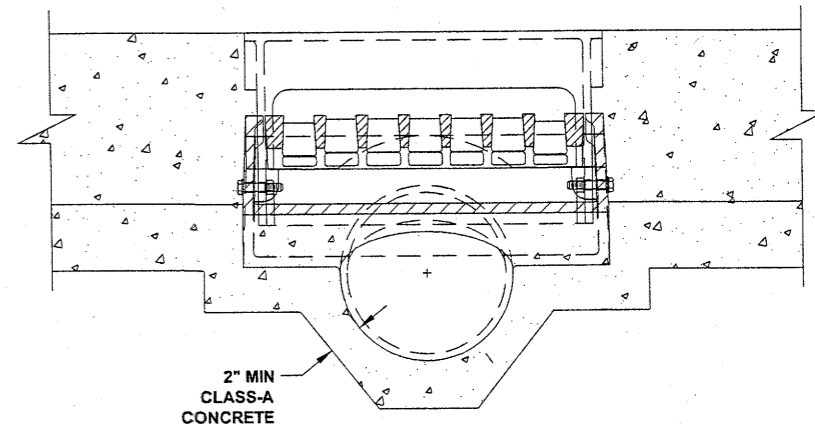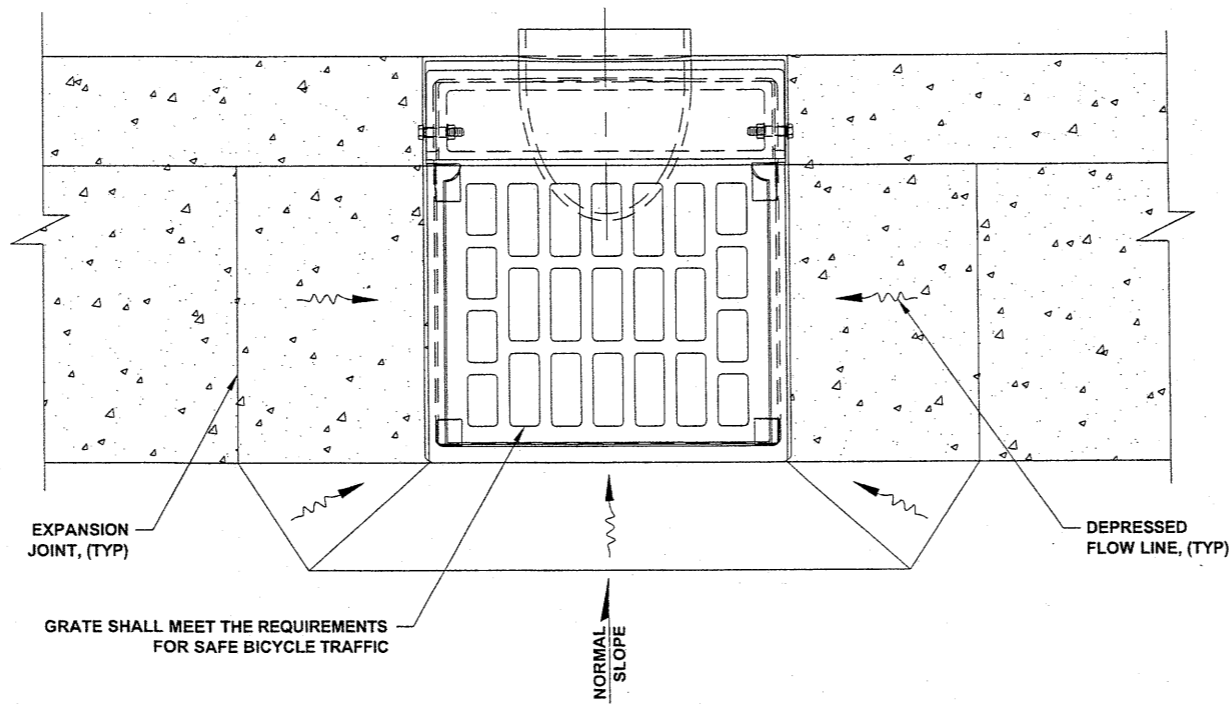


TOP VIEW

FRONT VIEW

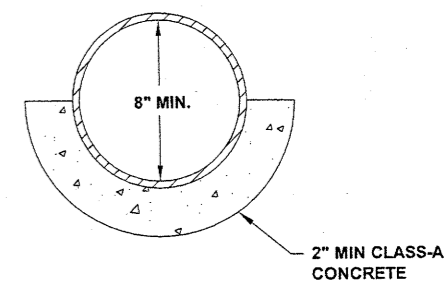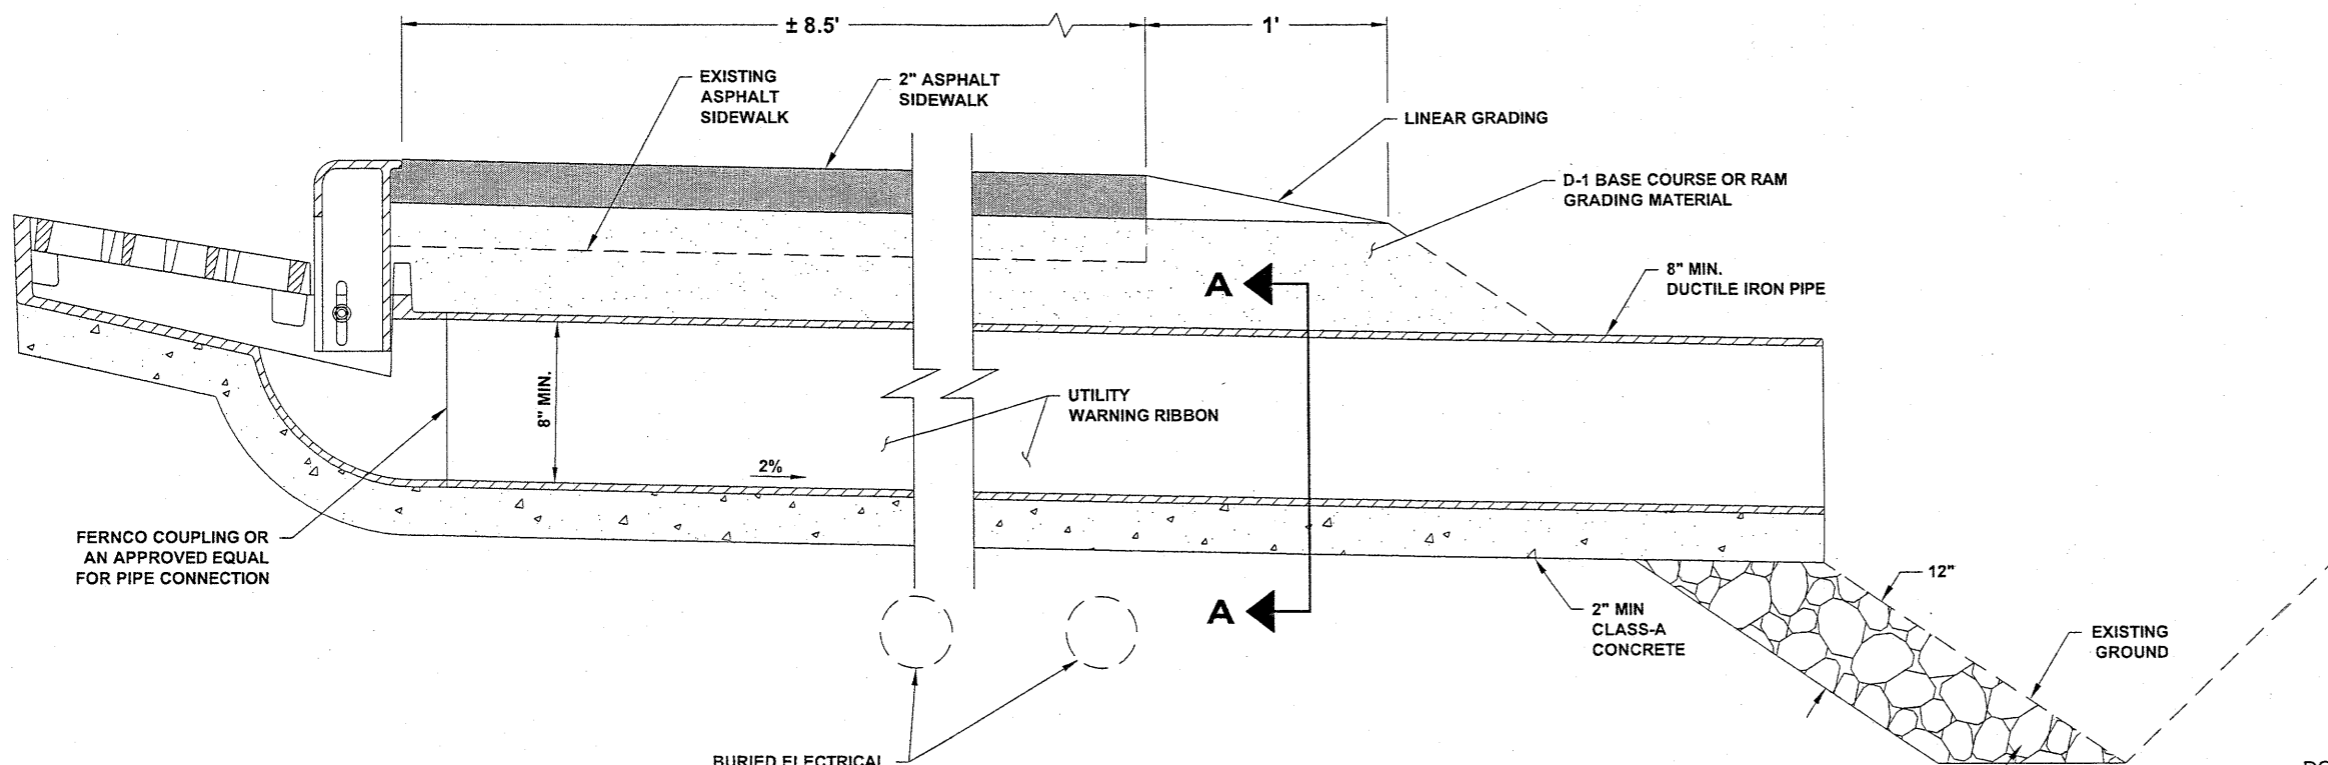

SECTION A-A

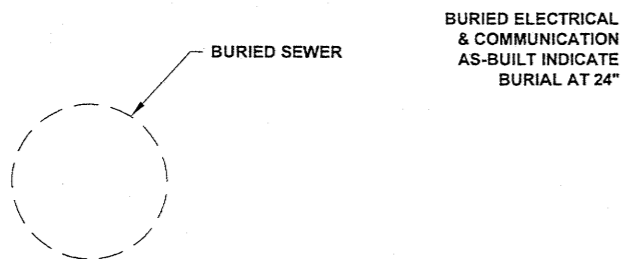


SIDE VIEW
CURB INLET
N.T.S.


APPROVED SLOPE STABILIZATION AS DIRECTED BY ENGINEER EXTEND TO TOE OF SLOPE OR DITCH LINE AS DIRECTED.

DO NOT SCALE FROM THESE DRAWINGS USE DIMENSIONS


CHECKED BY: C. HOWARD		STATE OF ALASKA DEPARTMENT OF TRANSPORTATION & PUBLIC FACILITIES-SOUTHEAST REGION										
		JNU GLACIER SPUR PAVEMENT REHABILITATION PROJECT #69348										
		MISC. DETAILS										
DESIGNED BY: D. MULLINER		PROJECT DESIGNATION	YEAR									
DRAWN BY: R. GRANTHAM		69348	2010									
PATH: Q:\JNU\69348\PLANS\69348_G1-G3_MISC DTL.DWG		SHEET NO.	TOTAL SHEETS									
TAB: G3 Tuesday, May 25, 2010 10:24:10 AM		G3	13									
<table border="1"> <thead> <tr> <th colspan="3">REVISIONS</th> </tr> <tr> <th>NO.</th> <th>DATE</th> <th>DESCRIPTION</th> </tr> </thead> <tbody> <tr> <td> </td> <td> </td> <td> </td> </tr> </tbody> </table>		REVISIONS			NO.	DATE	DESCRIPTION				GRANTHAM, RICK L (DOT)	
REVISIONS												
NO.	DATE	DESCRIPTION										

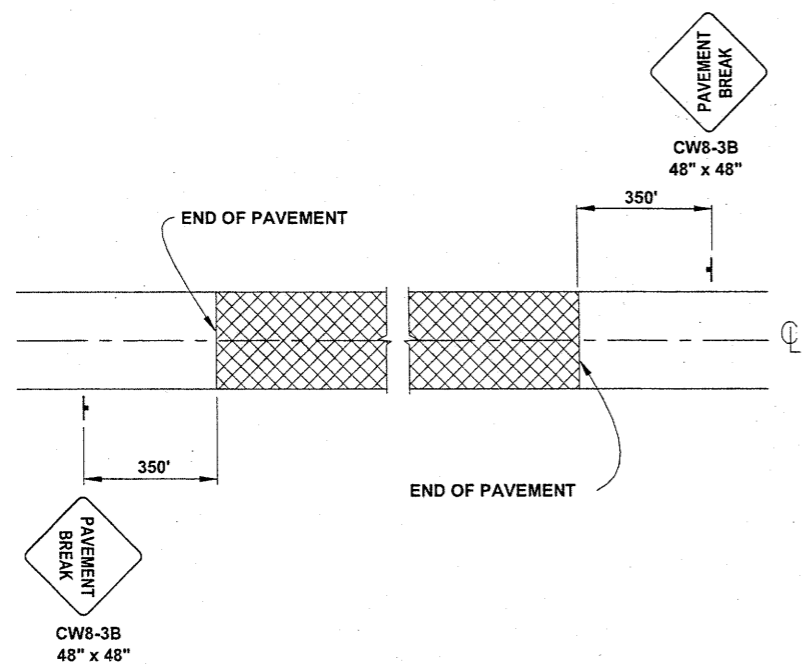

SIGNING FOR UNPAVED AREA

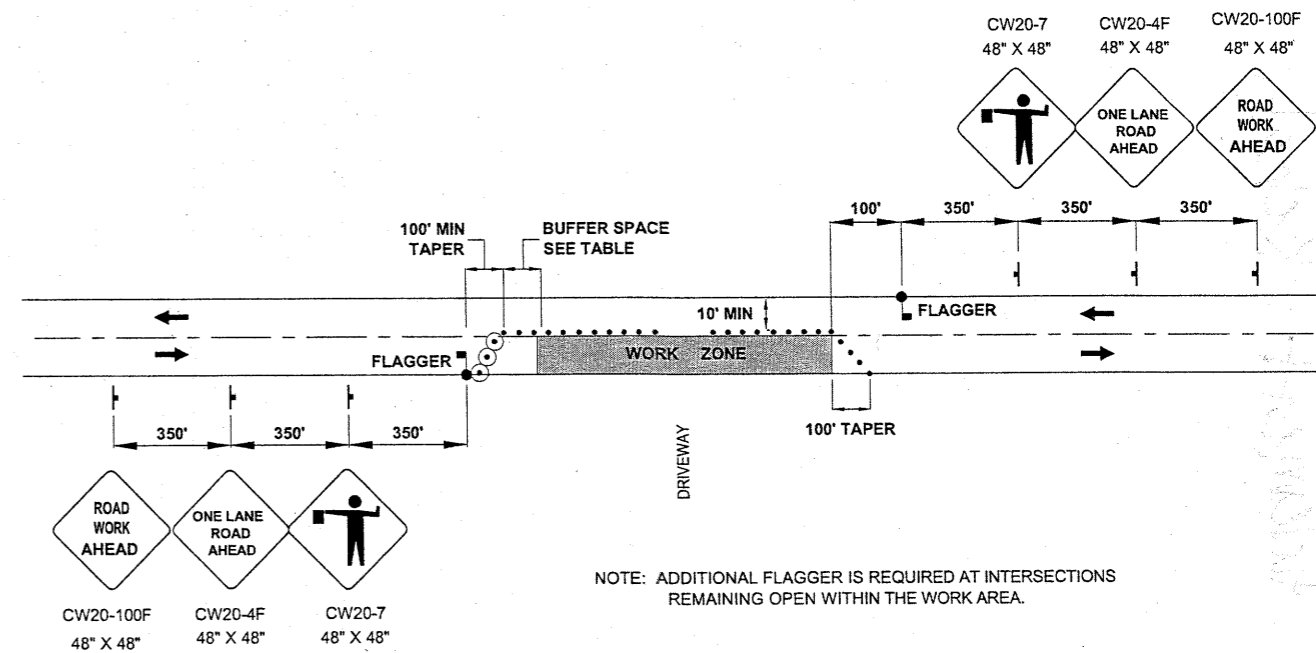

TWO LANE ROADWAY-SINGLE LANE CLOSURE

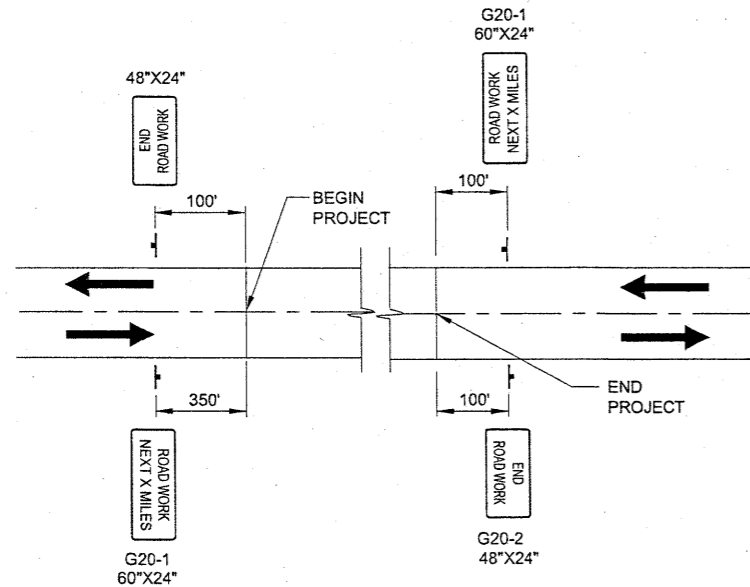

TEMPORARY CONSTRUCTION SIGNING

LEGEND

- SIGN
- CONE
- DRUM
- TYPE III BARRICADE
- FLAGGING STATION

FORMULAS FOR L (TAPER LENGTH)


40 MPH OR LESS $L = \frac{W \times S^2}{60}$

45 MPH OR GREATER $L = W \times S$

WHERE W= WIDTH OF OFFSET
S= POSTED SPEED LIMIT

DRUM OR CONE SPACING = S (IN FEET)

MIN. BUFFER	
S	LENGTH
20	35
25	55
30	85
35	120
40	170
45	220
50	280
55	335
60	415
65	485

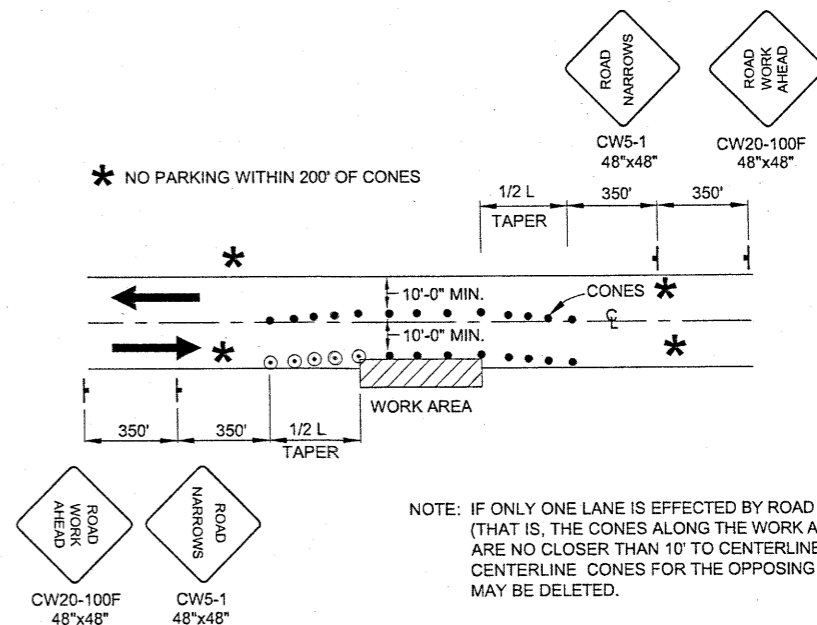

ROADWAY ENCROACHMENT

TRAFFIC CONTROL NOTES

- MINIMUM OF ONE LANE SHALL REMAIN OPEN AT ALL TIMES IN WORK AREAS.
- TEMPORARY DRIVING LANES SHALL HAVE A MINIMUM WIDTH OF 10'-0".
- CONSTRUCTION SIGNING SHALL BE IN PLACE ONLY WHEN THE CONDITIONS EXIST FOR WHICH THE SIGNS ARE INTENDED.
- CHANNELIZATION DEVICES IF USED AT NIGHT SHALL BE LIT IN ACCORDANCE WITH THE ALASKA TRAFFIC MANUAL.
- DRIVEWAYS MAY BE CLOSED DURING ACTUAL WORK ON A GIVEN DRIVEWAY, PROVIDED THAT THE CLOSURE DOES NOT EXCEED 8 HOURS AND THE AFFECTED RESIDENTS HAVE BEEN GIVEN 24 HOURS NOTICE OF THE CLOSURE.
- IT IS THE INTENT OF THIS TRAFFIC CONTROL PLAN (TCP) TO ILLUSTRATE SOME, NOT ALL, OF THE TRAFFIC CONTROL SETUPS WHICH WILL BE REQUIRED ON THIS PROJECT. PLANS FOR CONFIGURATIONS NOT COVERED BY THE TCP SHALL BE CREATED BY THE CONTRACTOR AND SUBMITTED TO THE ENGINEER FOR APPROVAL. WHERE APPROPRIATE, THEY SHALL INCORPORATE APPLICABLE DETAILS FROM THESE SHEETS.
- ALL TRAFFIC CONTROL PLANS SUBMITTED BY THE CONTRACTOR SHALL BE NUMBERED. ALL TRAFFIC CONTROL PLANS THAT USE A TYPICAL APPLICATION AS DESCRIBED IN THE MUTCD SHALL REFERENCE THE TYPICAL APPLICATION. EXAMPLE: TCP 3, MUTCD TA-10.
- THE CONTRACTOR SHALL KEEP THE PUBLIC INFORMED OF HIS CONSTRUCTION ACTIVITIES THROUGH THE USE OF THE LOCAL NEWS MEDIA. NEWS RELEASES SHALL BE APPROVED BY THE PROJECT ENGINEER PRIOR TO THEIR RELEASE. NEWS RELEASES WILL BE REQUIRED BUT NOT LIMITED TO, THE ONSET OF WORK, GRINDING, PAVING, AND CHANGES IN THE LANE CONFIGURATIONS.

DO NOT SCALE FROM THESE DRAWINGS USE DIMENSIONS

CHECKED BY: D. EPSTEIN

STATE OF ALASKA
DEPARTMENT OF TRANSPORTATION
& PUBLIC FACILITIES-SOUTHEAST REGION

JNU
GLACIER SPUR PAVEMENT
REHABILITATION
PROJECT #69348

TRAFFIC CONTROL PLAN

DESIGNED BY: D. MULLINER
DRAWN BY: R. GRANTHAM

PATH: Q:\JNU\69348\PLANSET\69348_H1_TRAF.DWG
TAB: H1 Monday, May 24, 2010 2:12:24 PM MULLINER, DOUGLAS J (DOT)

REVISIONS			PROJECT DESIGNATION	YEAR	SHEET NO.	TOTAL SHEETS
NO.	DATE	DESCRIPTION				
			69348	2010	H1	13