


FIRM DOWL
 FILE c:\dowl_pw\0395244\SA-GN-CV-A1-63330.03.dwg
 ADDRESS 9085 GLACIER HIGHWAY, JUNEAU, AK 99801
 DATE 9/9/2022 11:08 LAYOUT A1
 PHONE (907) 780-3533
 DESIGNED HOBBS
 CHECKED CHRISTIE
 DRAFTED BERG
 CERTIFICATE OF AUTH #: AECL848

STATE OF ALASKA

DEPARTMENT OF TRANSPORTATION & PUBLIC FACILITIES

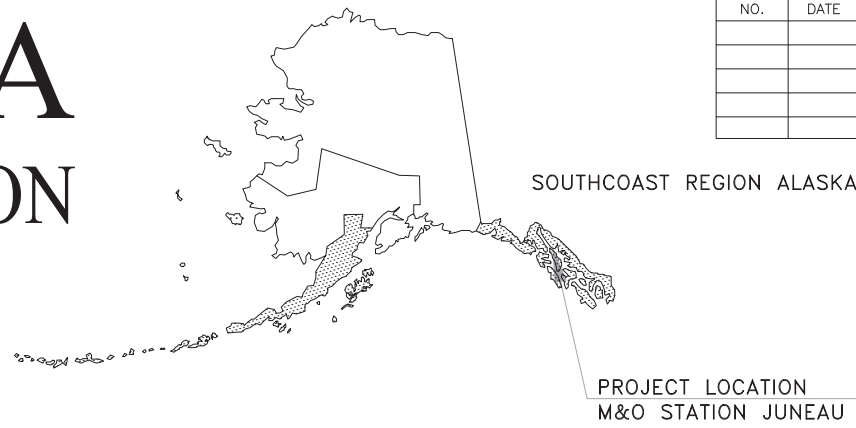

NO.	DATE	REVISIONS	STATE	PROJECT DESIGNATION	YEAR	SHEET NO.	TOTAL SHEETS
			ALASKA	0093002/SFHwy00411	2022	A1	14
			CDS ROUTE: 296150		MILEPOINT: 3.46		
			LATITUDE: 58.331428°N		LONGITUDE: -134.499444°W		


PROPOSED HIGHWAY PROJECT

JNU NORTH DOUGLAS - BONNIE BRAE - DEC 20 SE PR PROJECT NO. 0093002/SFHwy00411

DESIGN DESIGNATIONS	
PROJECT TYPE	EMERGENCY REPAIR
FUNCTIONAL CLASS	MAJOR COLLECTOR
ADT (2022)	1,862
ADT (2045)	3,154
DHV (2022)	212
DHV (2045)	359
PERCENT TRUCKS (T)	1.98%
DIRECTIONAL SPLIT (D)	57%
DESIGN SPEED (V)	45 MPH

PROJECT SUMMARY	
	NORTH DOUGLAS HIGHWAY-BONNIE BRAE
WIDTH OF PAVEMENT	20'
LENGTH OF PAVING	230'
LENGTH OF PROJECT	230'

GRADING, DRAINAGE, PAVING, GUARDRAIL, STRIPING, AND SIDE SLOPE STABILIZATION

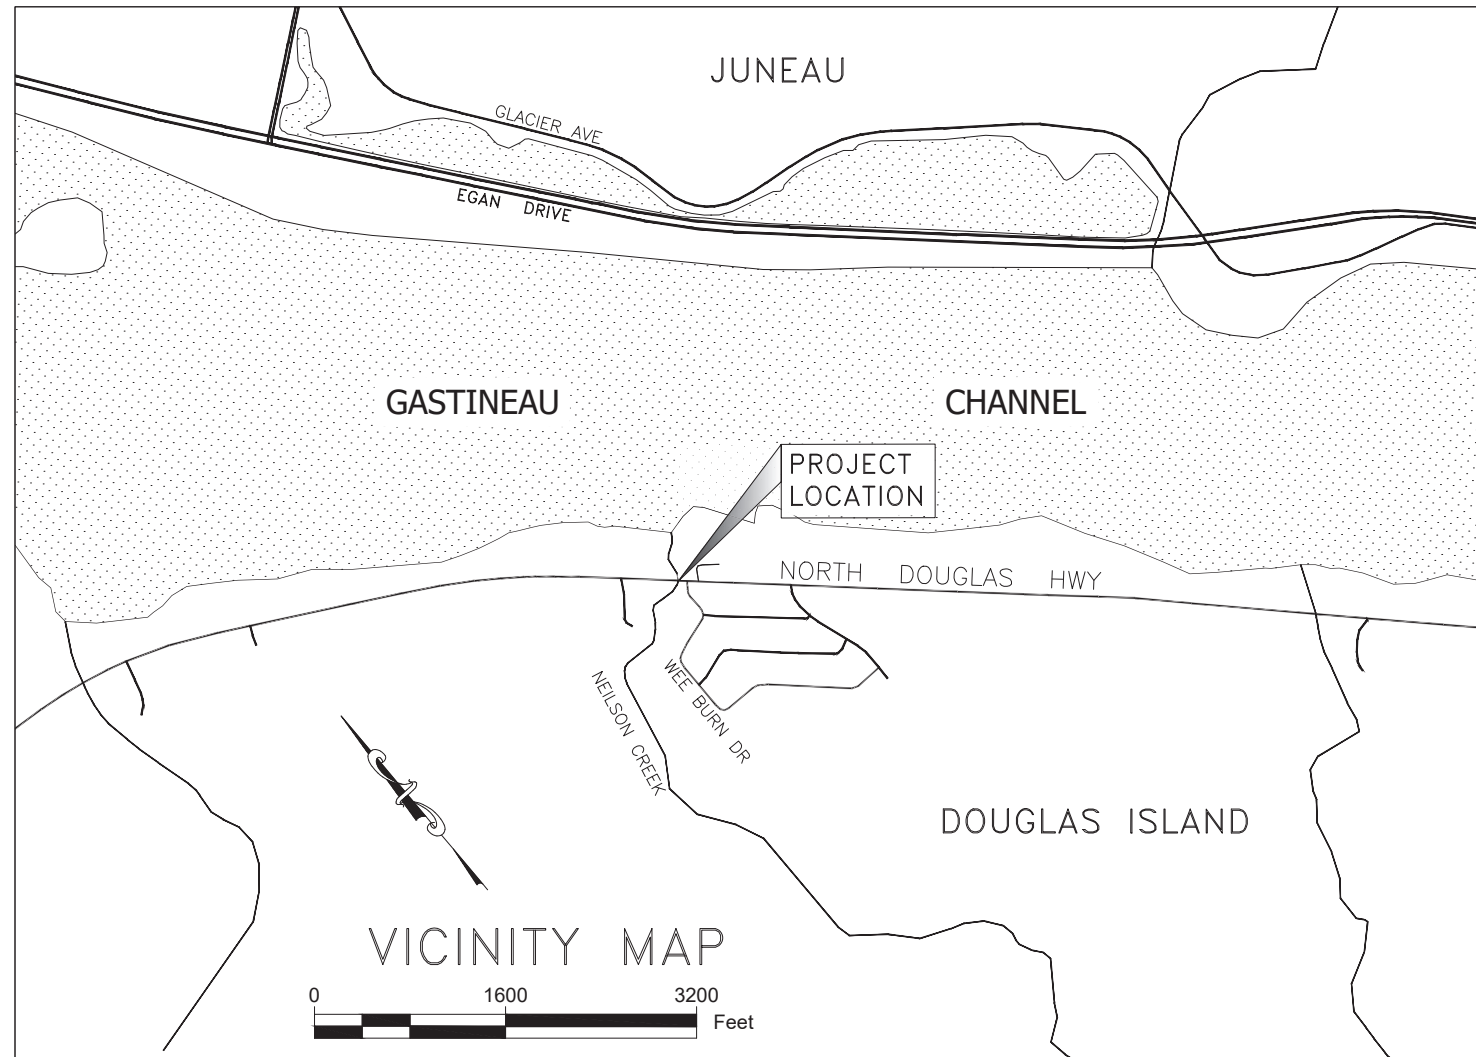


As-Builts
Contractor: SECON
Project Engineer: Dillon Tomaro
Start Date: 7/14/23
End Date: 9/6/23


Record Drawings have been reviewed by the Project Engineer, and represent to the best of my knowledge, the project as constructed.

PE *Dillon Tomaro* Date 10/25/23

USE THESE PLANS IN CONJUNCTION WITH THE STATE OF ALASKA STANDARD SPECIFICATIONS FOR HIGHWAY CONSTRUCTION, 2020 EDITION AND THE PROJECT SPECIAL PROVISIONS.

STATE OF ALASKA
 DEPARTMENT OF TRANSPORTATION & PUBLIC FACILITIES
 6860 GLACIER HIGHWAY, JUNEAU, AK 99801
 (907) 465-1763

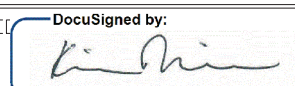APPROVED:  11/9/2022
 KIRK MILLER, P.E.
 REGIONAL PRECONSTRUCTION ENGINEER

CONCUR:  11/10/2022
 D. LANCE MEAKIG, P.E.
 DIRECTOR, SOUTHCOAST REGION

FIRM DOWL
 FILE c:\dowl\p\40395244\SA-GN-CV-A2-63330.03.dwg
 ADDRESS 9085 GLACIER HIGHWAY, JUNEAU, AK 99801
 PHONE (907) 780-3533
 CERTIFICATE OF AUTH # : AECL848

DESIGNED HOBBS
 CHECKED CHRISTIE
 DRAFTED BERG

	RECOVERED	SET
BLM MONUMENT		
GLO MONUMENT		
USC&GS MONUMENT		
PRIMARY MONUMENT		
CENTERLINE MONUMENT IN CASING		
PRIMARY R.O.W. MONUMENT		
BEARING OBJECT		
MISCELLANEOUS MONUMENT		
LINE OF SIGHT MONUMENT		
CONCRETE R.O.W. MONUMENT		
BENCHMARK		
REBAR AND CAP		
REBAR		
IRON PIPE		
PK NAIL		
SPIKE		
HUB AND TACK		
CONSTRUCTION CENTERLINE		
MICELLANEOUS CENTERLINE		
STATION EQUATION	$\frac{L}{L} = \frac{L^2 + 48 + 97.23 \text{ POT BK} = 0}{0} = \frac{L^2 + 48 + 97.23 \text{ PC AHD} = 0}{0}$	
PROJECT RIGHT-OF-WAY LINE		
EXISTING RIGHT-OF-WAY LINE		
EXISTING PROPERTY LINE		
CONTROLLED ACCESS LINE		
EXISTING EASEMENT LINE		
PROPOSED EASEMENT LINE		
PROPOSED CUT SLOPE LIMIT		
PROPOSED FILL SLOPE LIMIT		
SECTION LINE		
1/4 SECTION LINE		
1/16 SECTION LINE		
TOWNSHIP & RANGE LINE		
MEANDER LINE		

	EXISTING	PROPOSED
SANITARY SEWER (FLOW DIRECTION →)		
FUEL LINE		
GAS LINE		
WATER LINE		
METER, VALVE, FIRE HYDRANT		
EXISTING STORM DRAIN (FLOW DIRECTION →)		
PROPOSED STORM DRAIN		
FIBER OPTIC LINE		
DIRECT BURIAL TELEPHONE CABLE		
DIRECT BURIAL ELECTRIC CABLE		
ELECTRIC LINE (OVERHEAD)		
POWER POLE LINE		
JOINT USE POWER & TELEPHONE		
TELEPHONE POLE LINE		
POLE ANCHOR		
STUB POLE (POWER OR TELEPHONE)		
TELEPHONE DUCT		
TELEPHONE PEDESTAL		
BURIED CABLE MARKER		
PIPELINE MARKER OR VALVE		
CATCH BASIN OR DROP INLET		
MANHOLE		
SANITARY SEWER CLEAN OUT		
RIPRAP		
SPECIAL DITCH CENTERLINE		
HIGH TIDE LINE		

	EXISTING	PROPOSED
ROADWAY/PAVEMENT EDGE		
FENCE		
CURB AND GUTTER		
DETECTABLE WARNINGS		
GUARDRAIL		
CULVERT PIPE		
SIGN		
MAILBOX		
RAILROAD TRACKS		
RAILROAD DEVICES		
TREE LINE		
WATER BOUNDARY		
ORDINARY HIGH WATER LINE		
FLOW CENTERLINE		
FLOW DIRECTION		
WETLANDS		
EXISTING BUILDINGS		
POST OR BOLLARD		
WELL OR MONITORING WELL		
SEPTIC PIPE		
FUEL TANK FILL PIPE/VENT		
SATELLITE DISH		
TEST HOLE		
CONIFER TREE		
DECIDUOUS TREE		
GRAVE		
THERMOSIPHON		
PARKING METER		
VEHICLE PLUG-IN		
DELINEATOR/GUIDE MARKER		

	EXISTING	PROPOSED
JUNCTION BOX, TYPE IA		
JUNCTION BOX, TYPE II		
JUNCTION BOX, TYPE III		
SIGNAL FACE, VEHICULAR		
SIGNAL FACE, BACKPLATE		
SIGNAL FACE, LEFT TURN, BACKPLATE		
SIGNAL FACE, PEDESTRIAN		
LOOP DETECTOR		
VIDEO DETECTOR		
RADAR DETECTOR		
OPTICOM DETECTOR		
PEDESTRIAN PUSH BUTTON		
SIGNAL POST W/O MAST ARM		
SIGNAL POLE W/MAST ARM		
SIGNAL CONTROLLER		
LOAD CENTER		
LUMINAIRE		
RIGID METAL CONDUIT		


NO.	DATE	REVISION

STATE	PROJECT DESIGNATION	YEAR	SHEET NO.	TOTAL SHEETS
ALASKA	0093002/SFHwy00411	2022	A2	14

- H = HOUSE
- G = GARAGE
- M = MERCHANT/STORE
- B = BARN
- S = SHED
- P = PRIVY
- SS = SERVICE STATION
- W = WAREHOUSE

Record Drawings have been reviewed by
 the Project Engineer, and represent to the
 best of my knowledge, the project as
 constructed.

PE Dillon Tomaro Date 10/25/23

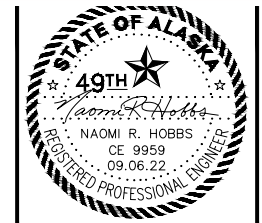


STATE OF ALASKA DEPARTMENT OF TRANSPORTATION
 AND PUBLIC FACILITIES

 JNU NORTH DOUGLAS - BONNIE BRAE
 - DEC 20 SE PR

 LEGEND AND SYMBOLS

NO.	DATE	REVISION	STATE	PROJECT DESIGNATION	YEAR	SHEET NO.	TOTAL SHEETS
1	12/2/2022	DOT STANDARD CORRECTION					
3	12/9/2022	DOT STANDARD CORRECTION	ALASKA	0093002/SFHwy00411	2022	A3	14

FIRM DOWL
 FILE C:\dowl\p\40396244\SA-GN-CV-A3-63330.03.dwg
 ADDRESS 9085 GLACIER HIGHWAY, JUNEAU, AK 99801
 PHONE (907) 780-3533
 CERTIFICATE OF AUTH # : AECL848
 DESIGNED HOBBS
 CHECKED CHRISTIE
 DRAFTED BERG
 LAYOUT A3
 DATE

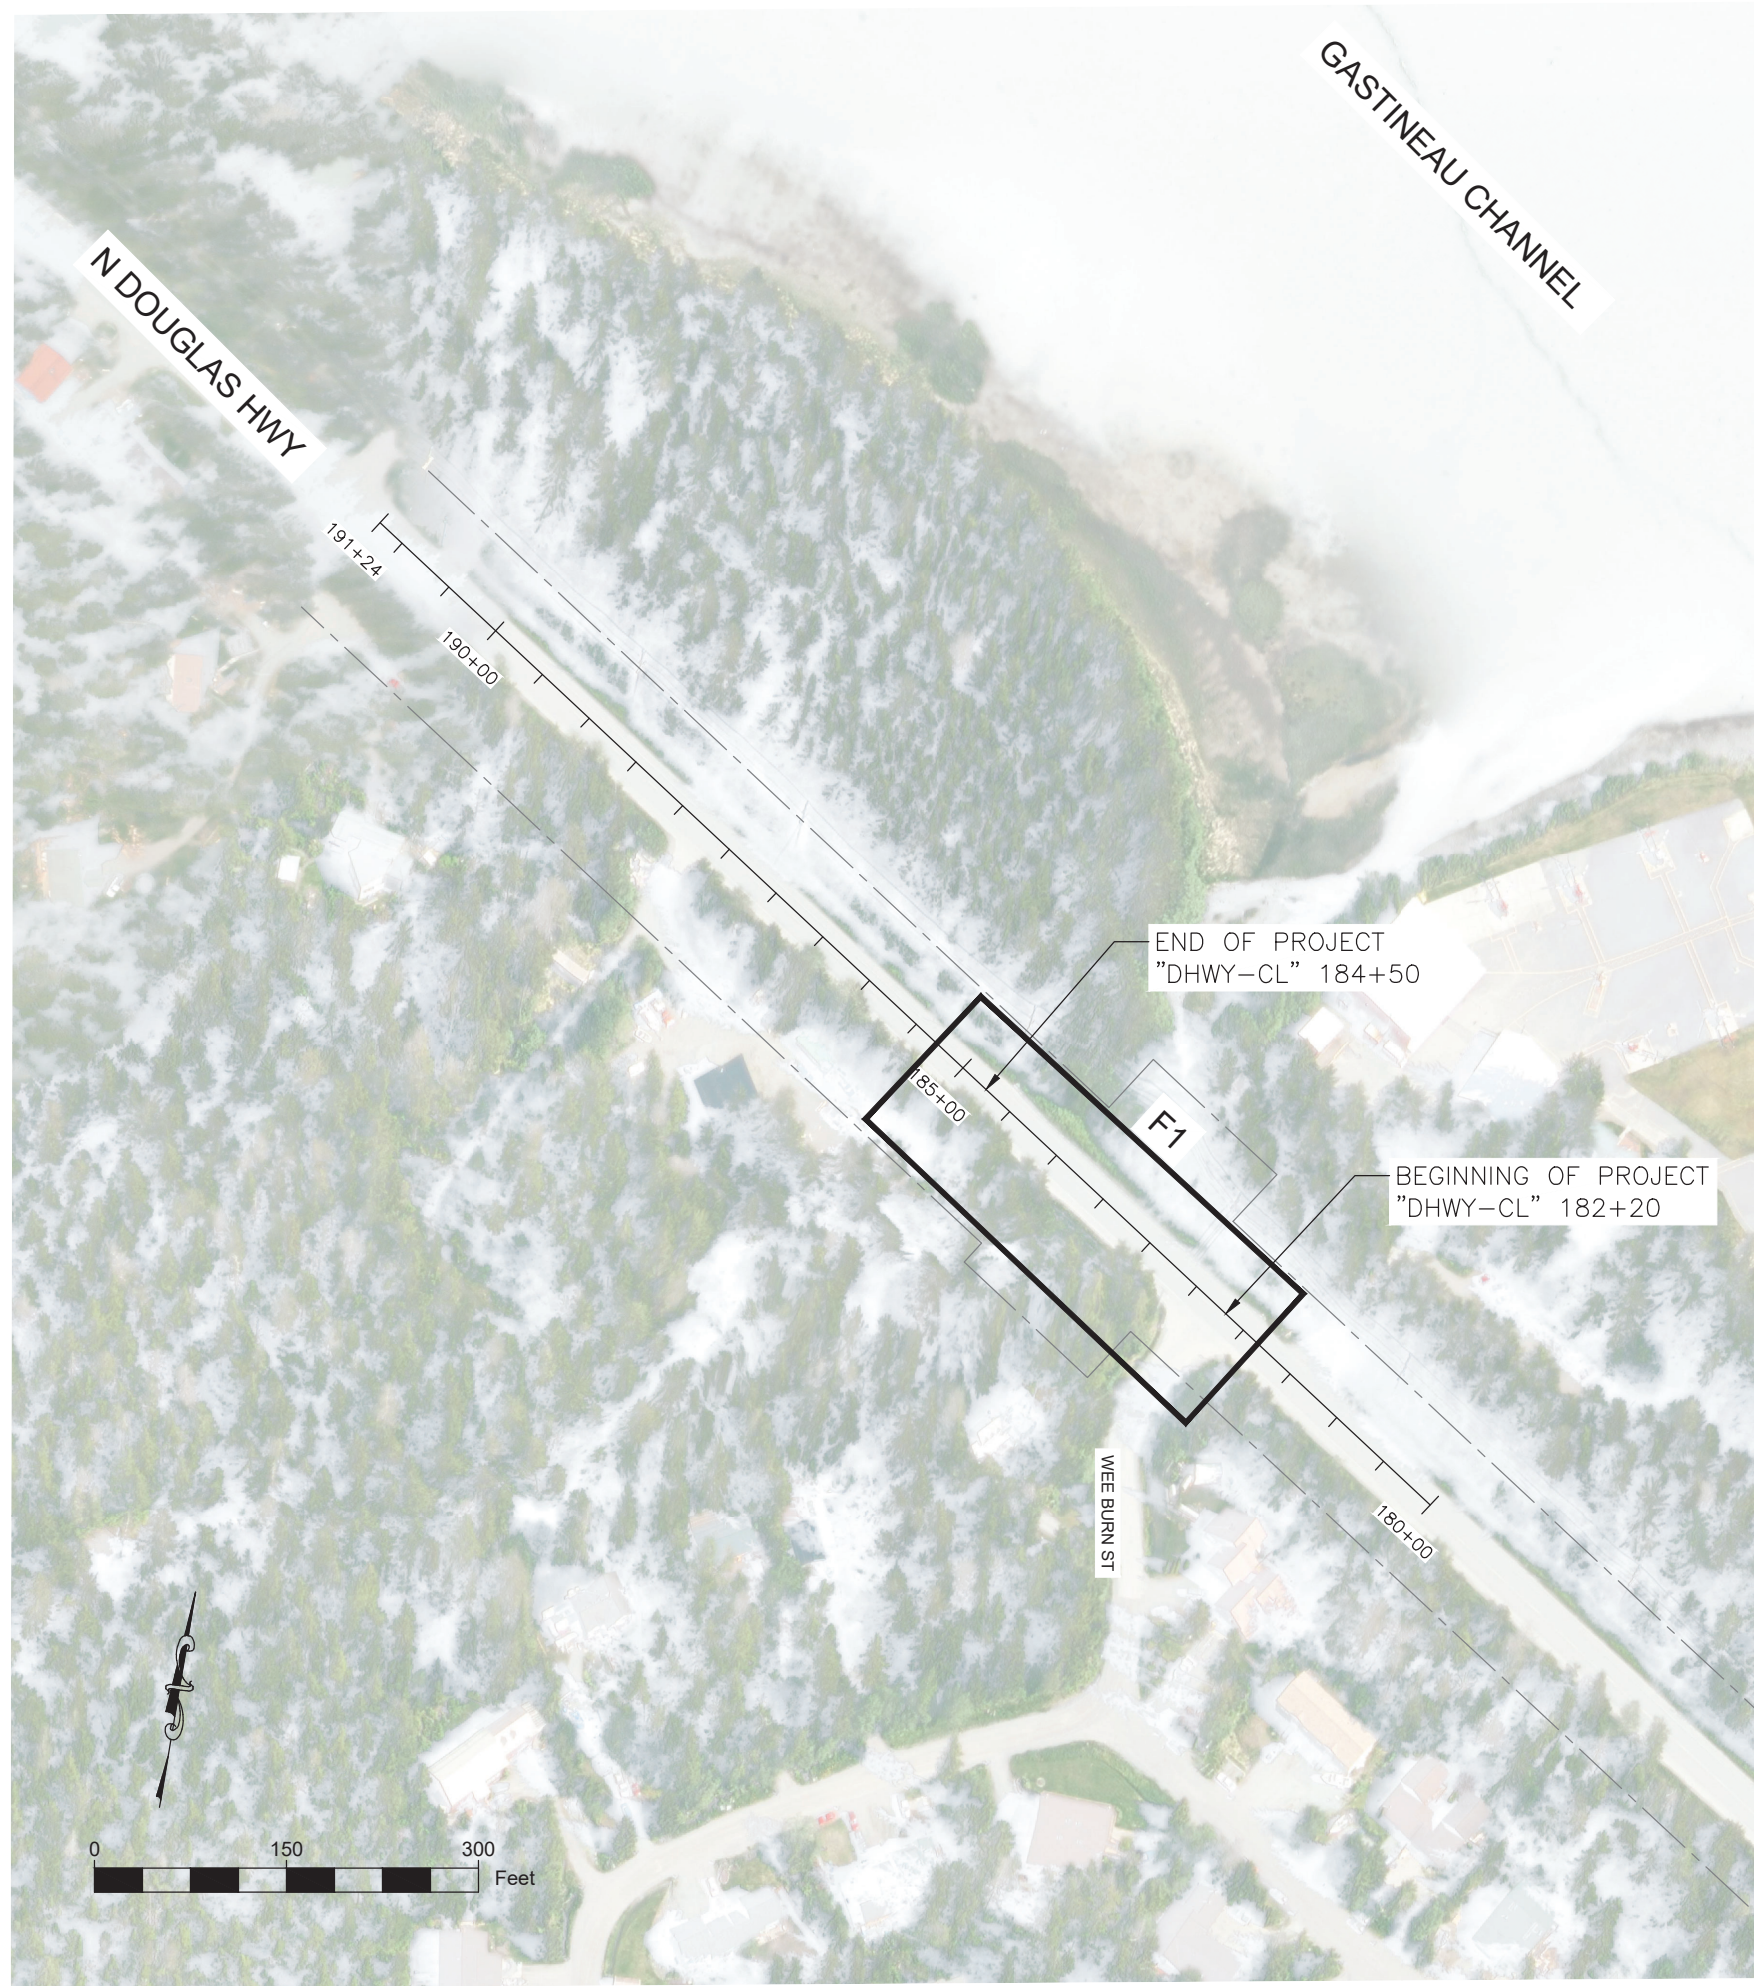


INDEX OF SHEETS	
SHEET NO.	DESCRIPTION
A1	TITLE SHEET
A2	LEGEND AND SYMBOLS
A3	PLAN SCHEMATIC AND INDEX
A4	SURVEY CONTROL
B1	TYPICAL SECTIONS
C1	ESTIMATE OF QUANTITIES
D1	SUMMARY TABLES
E1	DETAILS
F1	PLAN AND PROFILE
H1	STRIPING PLAN
Q1	EROSION SEDIMENT CONTROL PLAN
T1	TRAFFIC CONTROL PLAN
T2	PERMANENT CONSTRUCTION SIGN LAYOUT
T3	CONSTRUCTION PHASING PLAN

3 THE FOLLOWING DOT STANDARD PLANS APPLY:
 C-06.00, G-00.05, G-05.11S, G-09.05S, G-10.21, G-14.01,
 G-20.12, G-26.00, T-21.04, U-03.01

- GENERAL NOTES:
1. MAKE ALL PAVEMENT CUTS CLEAN, VERTICAL, AND TRUE TO REMOVAL LIMITS SHOWN ON PLANS.
 2. DO NOT MEASURE OFF OF THE PLANS.

Record Drawings have been reviewed by the Project Engineer, and represent to the best of my knowledge, the project as constructed.

 PE *Dillon Tomaro* Date 10/25/23

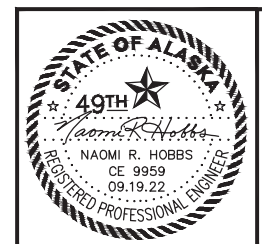

STATE OF ALASKA DEPARTMENT OF TRANSPORTATION AND PUBLIC FACILITIES

 JNU NORTH DOUGLAS - BONNIE BRAE - DEC 20 SE PR

 PLAN SCHEMATIC AND INDEX

FILE C:\nu\SDRERO0322\SV\SOURCE DWGS\BASEMAP_N_Douglas_SCS_022422.dwg DATE 8/23/2022 13:44 LAYOUT A2 DESIGNED J.PAPOI CHECKED E.PEDERSEN DRAFTED J.PAPOI

Project Specific Horizontal Control

- 100: 2.5" Alcap DOT&PF
Set 0.8' from EP. Out Bound Lane. In Line With CL of Bonnie Doon Dr.
57.4' From Stop Sign N24E, 40.1' From PP #10365 S50E
AKSPCS N 2373606.05 FT US , E 2526600.55 FT US
- 101: 2.5" Alcap DOT&PF
Set 0.9' from EP Sub Graded 0.2'. Out Bound Lane. In Line With CL Monument # 10C
59' From 10" Spruce W/Tag N30E, 212' From Stop Sign S70E
AKSPCS N 2374039.10 FT US , E 2526135.40 FT US

NO.	DATE	REVISION	STATE	PROJECT DESIGNATION	YEAR	SHEET NO.	TOTAL SHEETS
			ALASKA	0093002/SFHwy00411	2022	A4	14

Record Drawings have been reviewed by the Project Engineer, and represent to the best of my knowledge, the project as constructed.


PE *Dillon Tomaro* Date 10/25/23

Centerline Monuments					
Point #	Northing	Easting	Description	Station	Offset
1000	2374024.99	2526121.76	1"IP_CL_MON_POT 179+98.44	N/A	N/A
1001	2374795.81	2525298.45	2.5"BC_CL_MON_PC 191+55.44	191+23.58	0.00R
1002	2372901.39	2527327.50	2.5"BC_CL_MON_PC163+50.32	N/A	N/A

The existing CENTERLINE monuments in this table are not anticipated to be disturbed by construction. If any of these CENTERLINE monuments get disturbed by construction activities they **SHALL BE PRESERVED IN PLACE.** All **CENTERLINE monuments** in this **existing CENTERLINE monument** table shall be **preserved** and **referenced** prior to disturbance and replaced at their original horizontal position. **A RECORD OF MONUMENT FORM IN ACCORDANCE WITH A.S.34.65.040 SHALL BE SUBMITTED TO DOT&PF PROJECT ENGINEER FOR REVIEW PRIOR TO RECORDING FOR EACH MONUMENT.**

Survey Control Table						
Point #	Northing	Easting	Elevation	Description	Station	Offset
100	2373606.05	2526600.55	57.91	2.5"ALCAP_DOT&PF	N/A	N/A
101	2374039.10	2526135.40	60.50	2.5"ALCAP_DOT&PF	N/A	N/A

All **SURVEY CONTROL** monuments in this table are provided strictly for survey control. Should any of them be destroyed during construction they **shall not** be replaced.


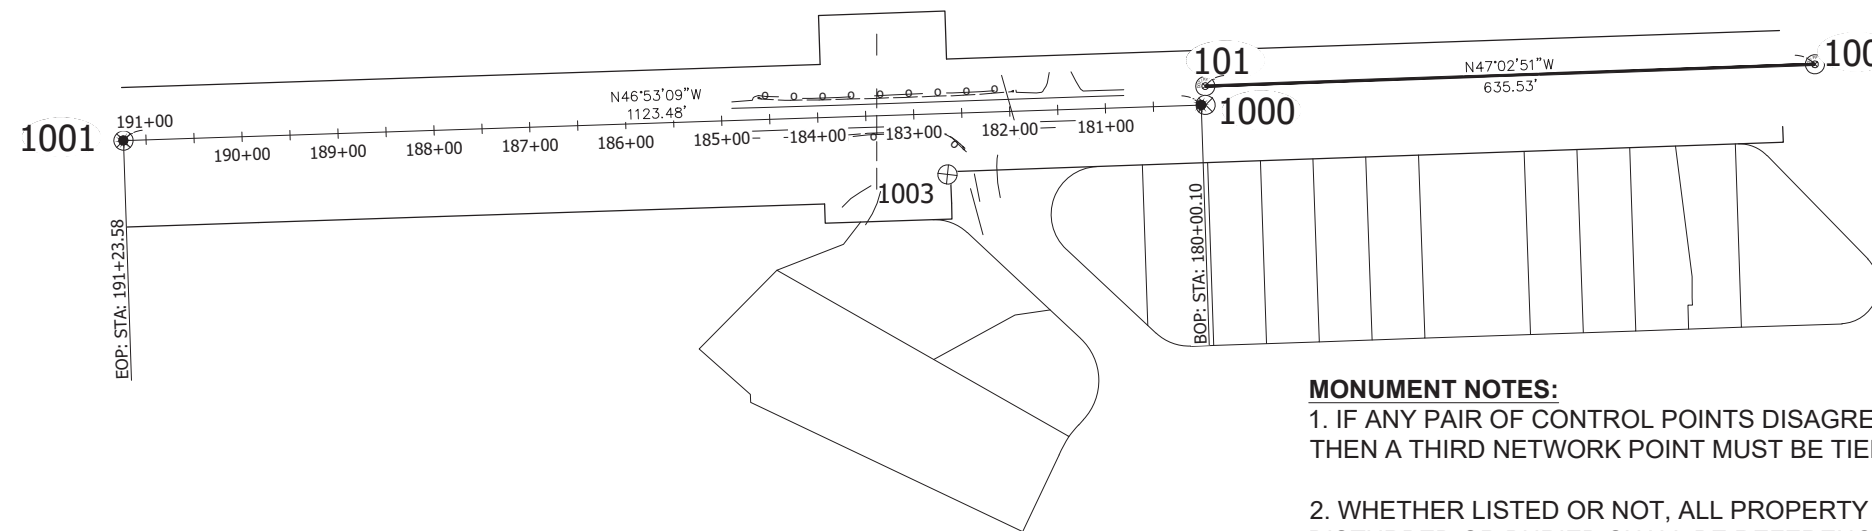


MONUMENT NOTES:

- IF ANY PAIR OF CONTROL POINTS DISAGREES FROM PUBLISHED VALUE BY MORE THAN 1:10,000 HORIZONTALLY OR VERTICALLY THEN A THIRD NETWORK POINT MUST BE TIED TO ASCERTAIN WHICH POINT IS IN ERROR OR HAS BEEN DISTURBED.
- WHETHER LISTED OR NOT, ALL PROPERTY MONUMENTS, PROPERTY MARKERS, CORNERS OR ACCESSORIES WHICH WILL BE DISTURBED OR BURIED SHALL BE REFERENCED PRIOR TO BEING DISTURBED, AND RE-ESTABLISHED IN THEIR ORIGINAL HORIZONTAL POSITION AND A RECORD OF MONUMENT FORM IN ACCORDANCE WITH (A.S.34.65.040) AND (A.S.19.10.260) SHALL BE SUBMITTED TO THE CONSTRUCTION ENGINEER FOR REVIEW PRIOR TO RECORDING. COORDINATE VALUES LISTED ARE FOR INFORMATIONAL PURPOSES AND SHOULD BE USED TO RESET MONUMENTS ONLY AS A LAST RESORT.
- WHEN POSSIBLE ALL ORIGINAL PRIMARY MONUMENTS SHALL BE SAVED AND RESET IN THEIR ORIGINAL HORIZONTAL POSITION AND A RECORD OF MONUMENT FORM IN ACCORDANCE WITH (A.S.34.65.040) AND (A.S.19.10.260) SHALL BE SUBMITTED TO THE CONSTRUCTION ENGINEER FOR REVIEW PRIOR TO RECORDING.
- RIGHT OF WAY LOCATION IS SHOWN FOR GRAPHICAL ORIENTATION PURPOSES ONLY. REFER TO ALASKA DOT&PF RIGHT OF WAY MAPS FOR RIGHT OF WAY INFORMATION.
- HORIZONTAL AND VERTICAL CONTROL MUST BE FIELD VERIFIED BY THE CONTRACTOR. DISCREPANCIES WILL BE REPORTED TO DOT&PF CONSTRUCTION PROJECT ENGINEER.

Existing Property					
Point #	Northing	Easting	Description	Station	Offset
1003	2374163.88	2525880.45	ALCAP3.25"__COR 2/BONNIE BRAE ESTATES_3088-S	182+66.83	63.53L



All **PROPERTY monuments** in these **existing property** tables shall be **preserved** and **referenced** prior to disturbance and replaced at their original horizontal position. **A RECORD OF MONUMENT FORM IN ACCORDANCE WITH A.S.34.65.040 SHALL BE SUBMITTED TO DOT &PF PROJECT ENGINEER FOR REVIEW PRIOR TO RECORDING FOR EACH MONUMENT.**

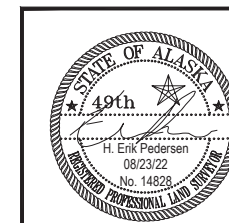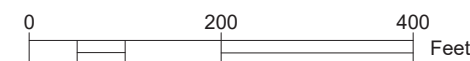

STATE OF ALASKA DEPARTMENT OF TRANSPORTATION AND PUBLIC FACILITIES
 JNU NORTH DOUGLAS – BONNIE BRAE
 – DEC 20 SE PR
 SURVEY CONTROL

NO.	DATE	REVISION	STATE	PROJECT DESIGNATION	YEAR	SHEET NO.	TOTAL SHEETS
1	12/2/2022	DIMENSION CORRECTION	ALASKA	0093002/SFHWY00411	2022	B1	14

FIRM DOWL
 FILE C:\dowl_pw\0396244\SA-CT-DT-B-63330_03.dwg
 ADDRESS 9085 GLACIER HIGHWAY, JUNEAU, AK 99801
 LAYOUT B1
 DATE
 PHONE (907) 780-3533
 DESIGNED HOBBS
 CHECKED CHRISTIE
 DRAFTED BERG
 CERTIFICATE OF AUTH # : AECL848

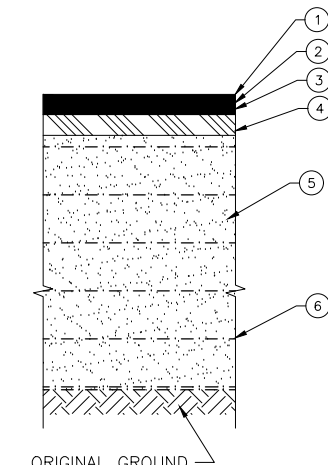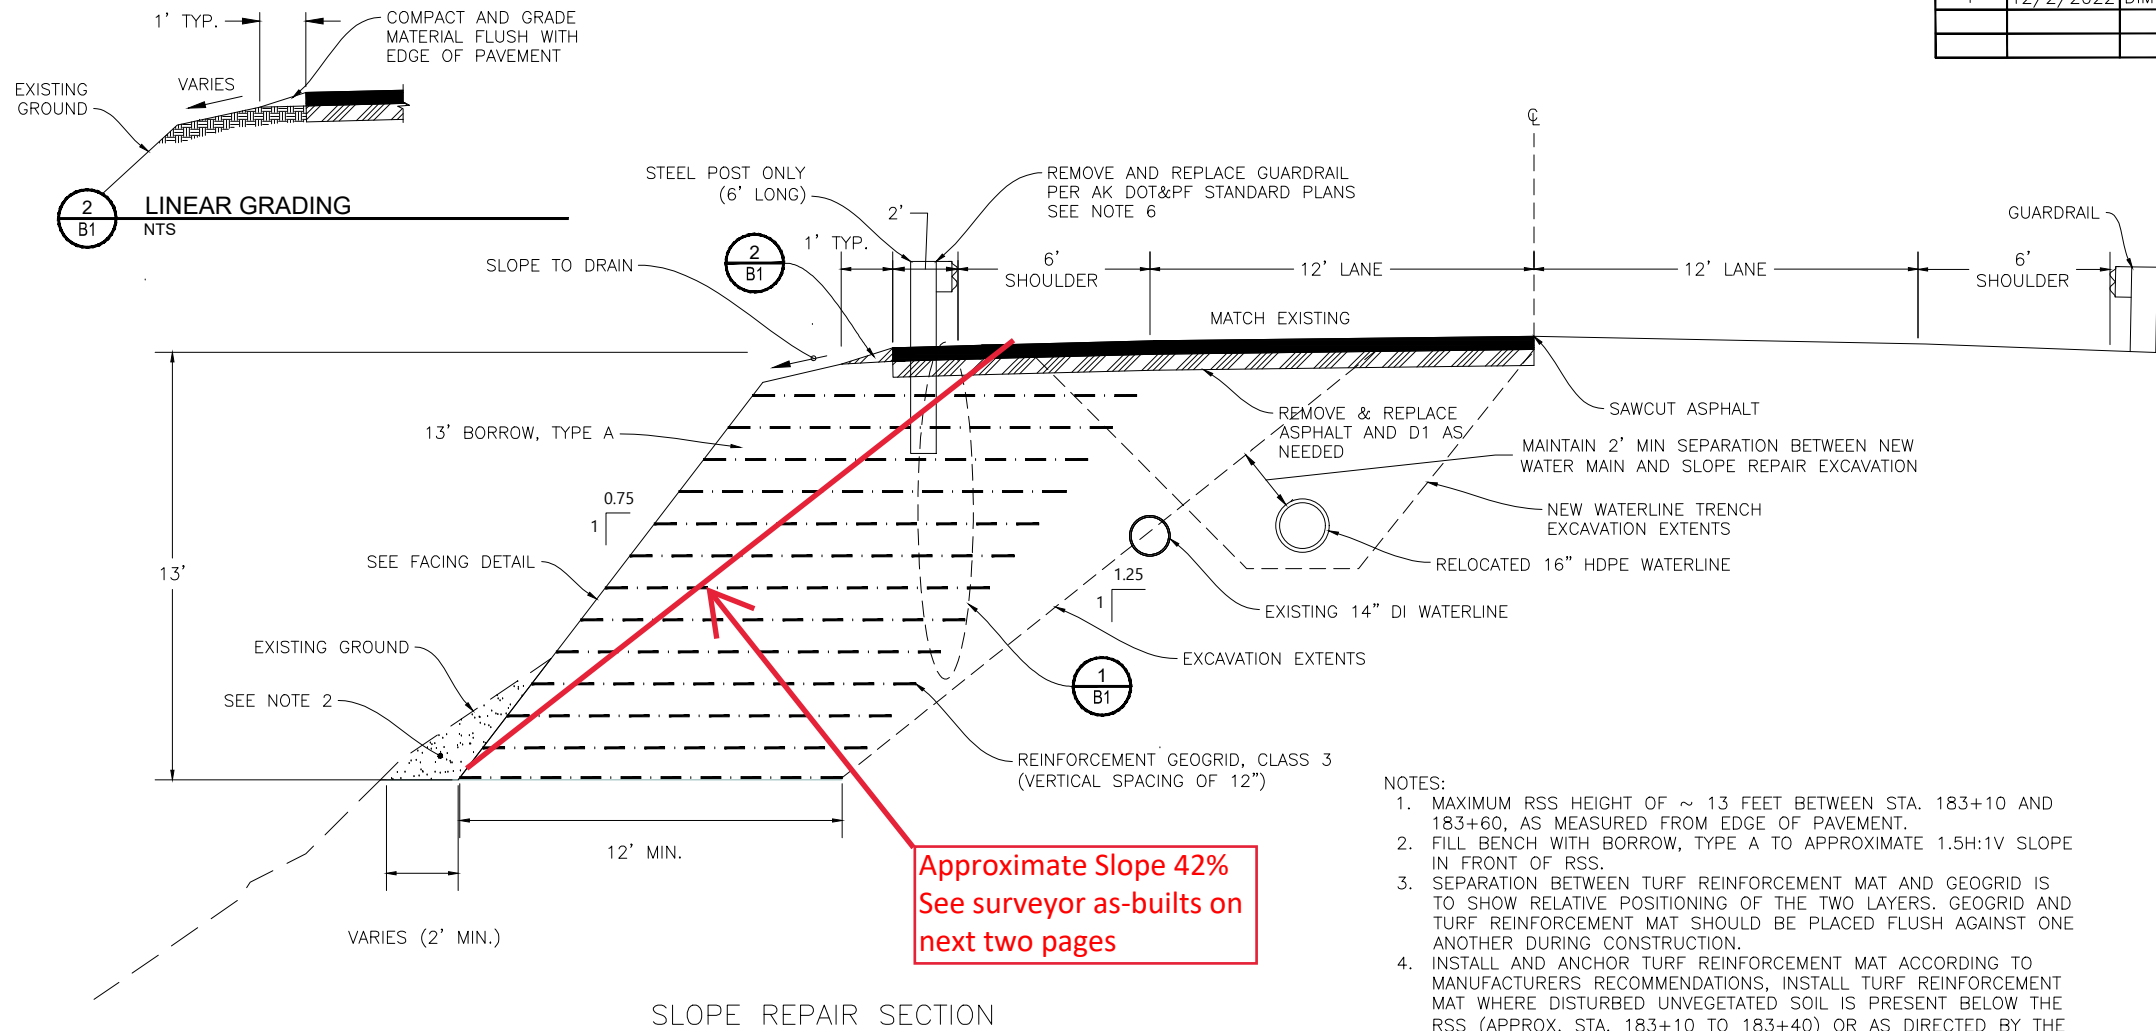


1 B1 PAVEMENT STRUCTURAL SECTION
NTS

Approximate Slope 42%
 See surveyor as-builts on
 next two pages


- NOTES:
1. MAXIMUM RSS HEIGHT OF ~ 13 FEET BETWEEN STA. 183+10 AND 183+60, AS MEASURED FROM EDGE OF PAVEMENT.
 2. FILL BENCH WITH BORROW, TYPE A TO APPROXIMATE 1.5H:1V SLOPE IN FRONT OF RSS.
 3. SEPARATION BETWEEN TURF REINFORCEMENT MAT AND GEOGRID IS TO SHOW RELATIVE POSITIONING OF THE TWO LAYERS. GEOGRID AND TURF REINFORCEMENT MAT SHOULD BE PLACED FLUSH AGAINST ONE ANOTHER DURING CONSTRUCTION.
 4. INSTALL AND ANCHOR TURF REINFORCEMENT MAT ACCORDING TO MANUFACTURERS RECOMMENDATIONS, INSTALL TURF REINFORCEMENT MAT WHERE DISTURBED UNVEGETATED SOIL IS PRESENT BELOW THE RSS (APPROX. STA. 183+10 TO 183+40) OR AS DIRECTED BY THE ENGINEER.
 5. PLACE BORROW, TYPE A WITH A MINIMUM WIDTH OF 3 FEET TO TIE FILL INTO EXISTING SLOPE. BENCH EXISTING SLOPE TO KEY IN FILL WITH A MINIMUM BENCH WIDTH OF 12 INCHES.
 6. DRIVE STEEL GUARDRAIL POSTS. NO AUGERING OR OTHER METHODS ARE PERMITTED FOR INSTALLATION.

LEGEND

①	2" HOT MIX ASPHALT, TYPE II, CLASS B
②	STE-1 TACK COAT
③	3" HOT MIX ASPHALT, TYPE II, CLASS B
④	6" AGGREGATE BASE COURSE, GRADING D-1
⑤	13' BORROW, TYPE A
⑥	REINFORCEMENT GEOGRID, CLASS 3 (SPACED EVERY 12" FROM BOTTOM OF EXCAVATION)

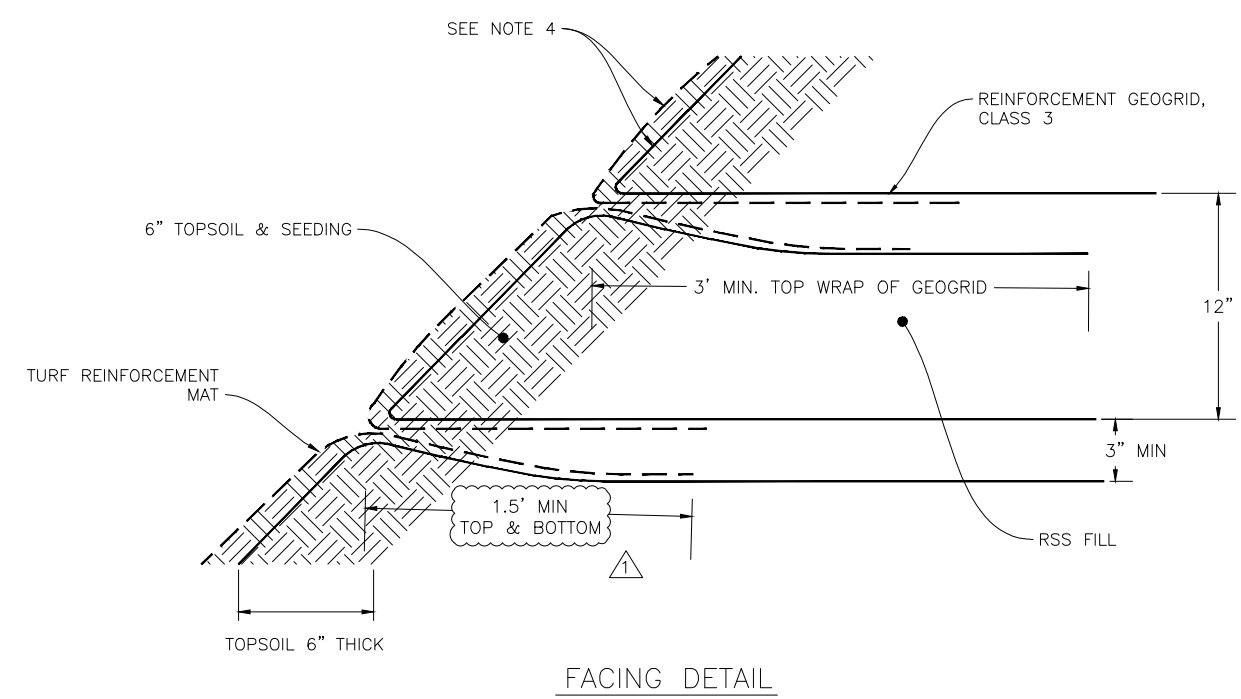


FACING DETAIL

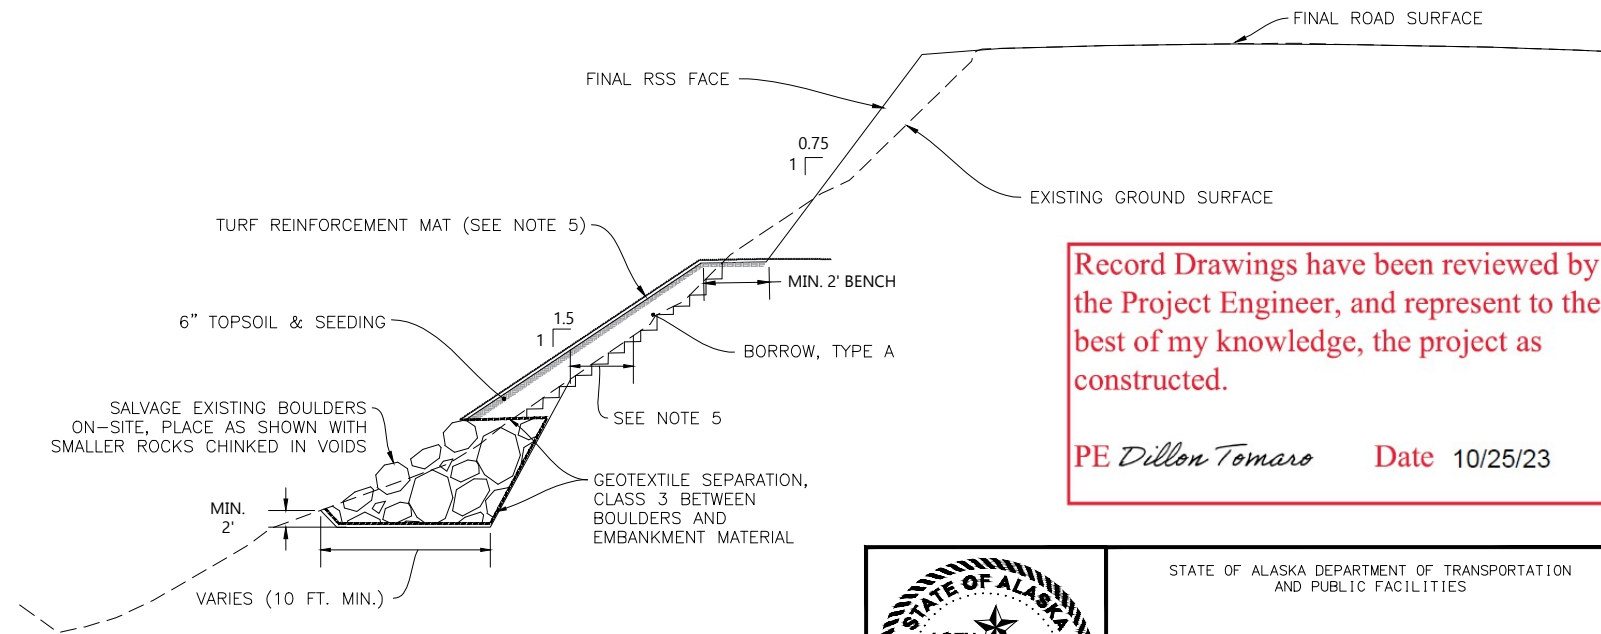

LOWER SLOPE REPAIR SECTION

Record Drawings have been reviewed by
 the Project Engineer, and represent to the
 best of my knowledge, the project as
 constructed.
 PE Dillon Tomaro Date 10/25/23

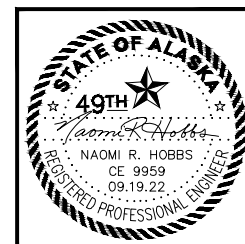







STATE OF ALASKA DEPARTMENT OF TRANSPORTATION AND PUBLIC FACILITIES
 JNU NORTH DOUGLAS - BONNIE BRAE - DEC 20 SE PR

TYPICAL SECTIONS

Record Drawings have been reviewed by the Project Engineer, and represent to the best of my knowledge, the project as constructed.


PE *Dillon Tomaro*

Date 10/25/23

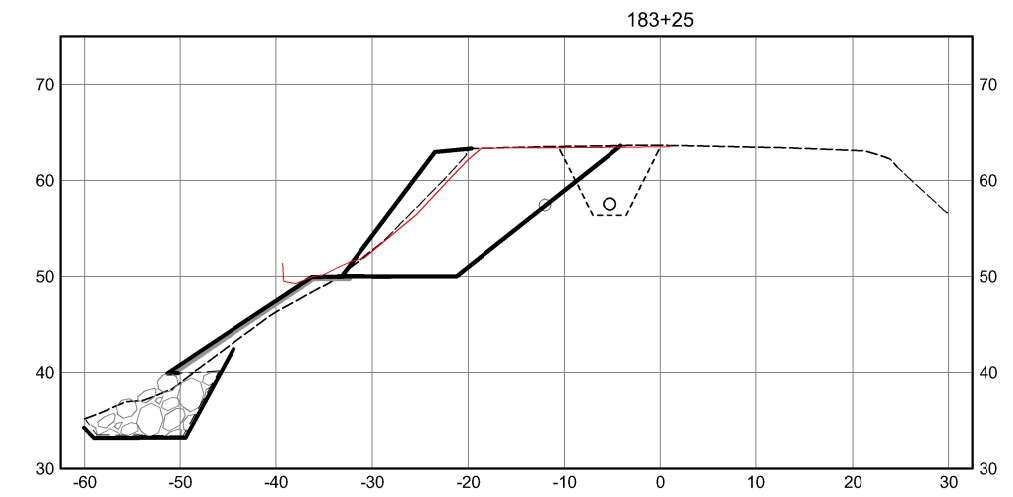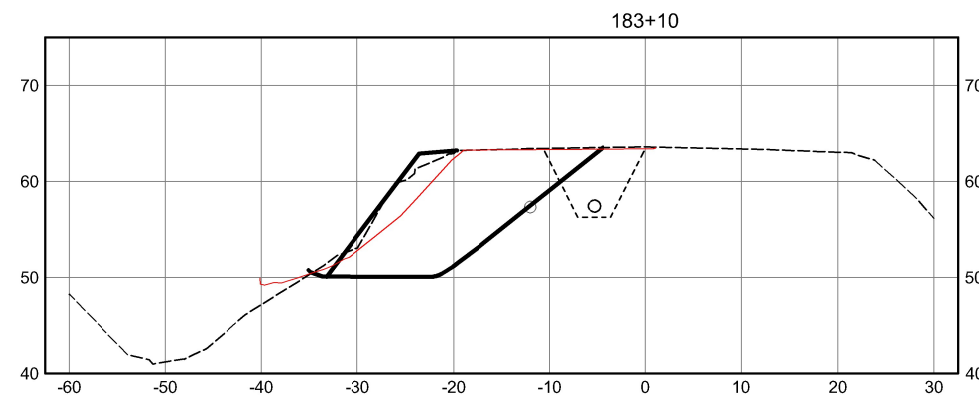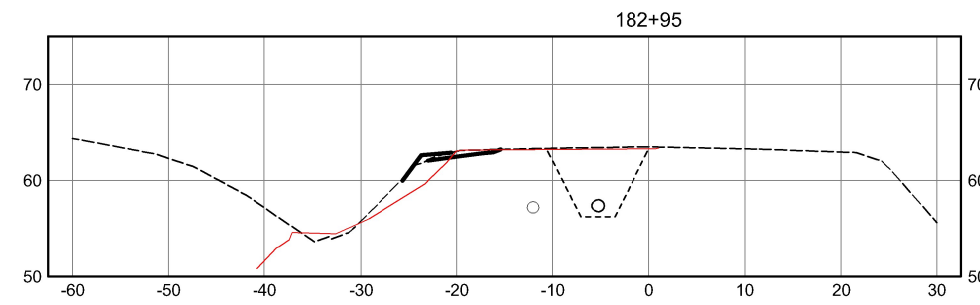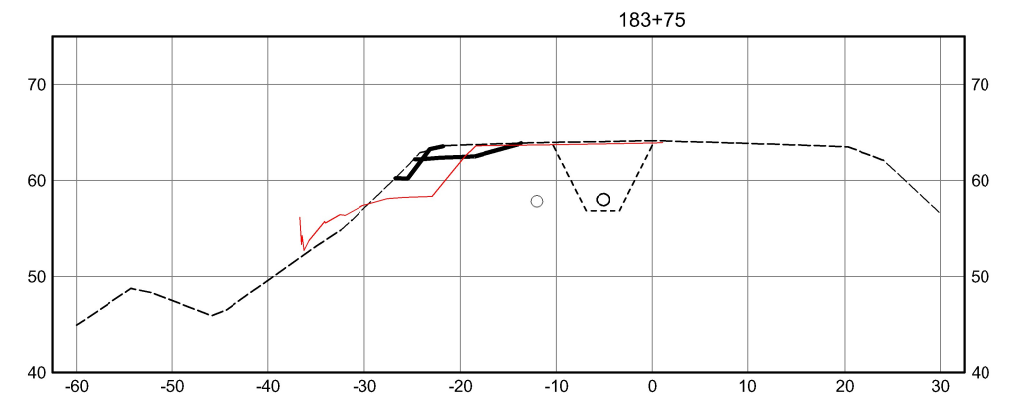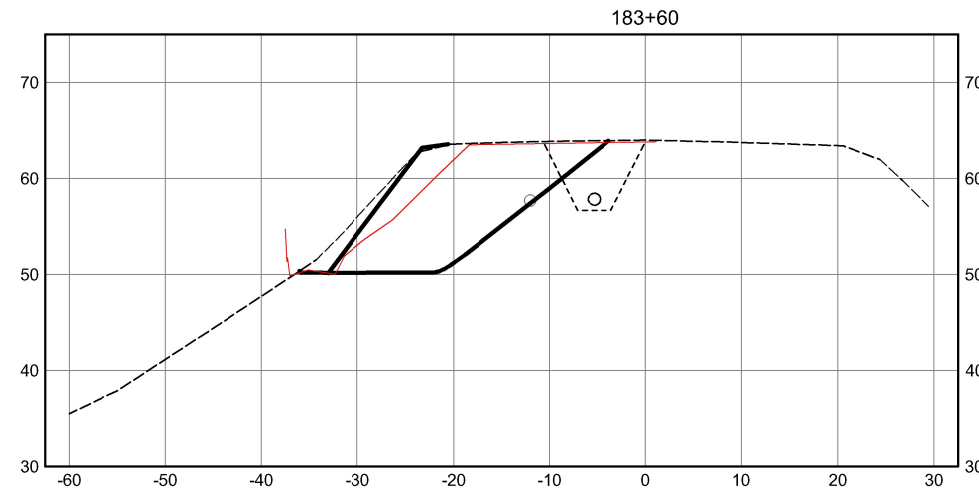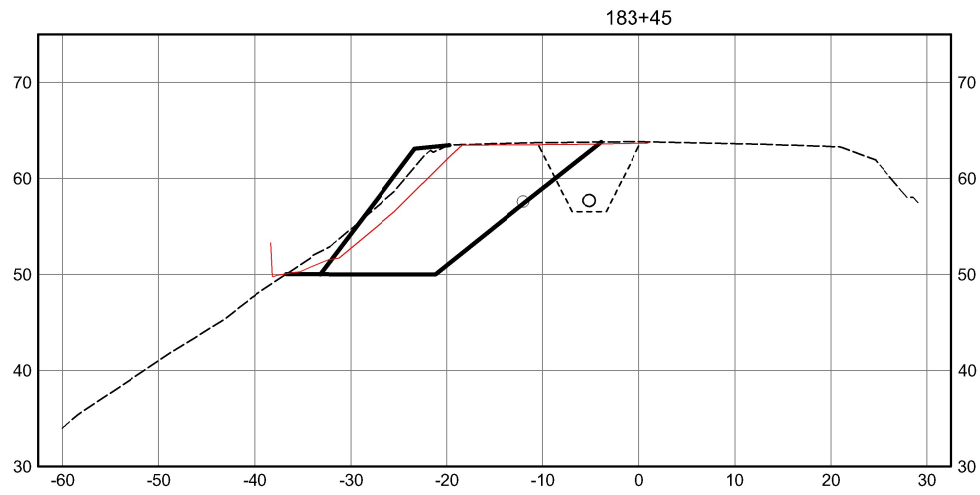

*RSS plotted in red

LINE	PROJECT NUMBER	SHEET NO.	TOTAL SHEETS
	0093002/SFHWO0411	1	1

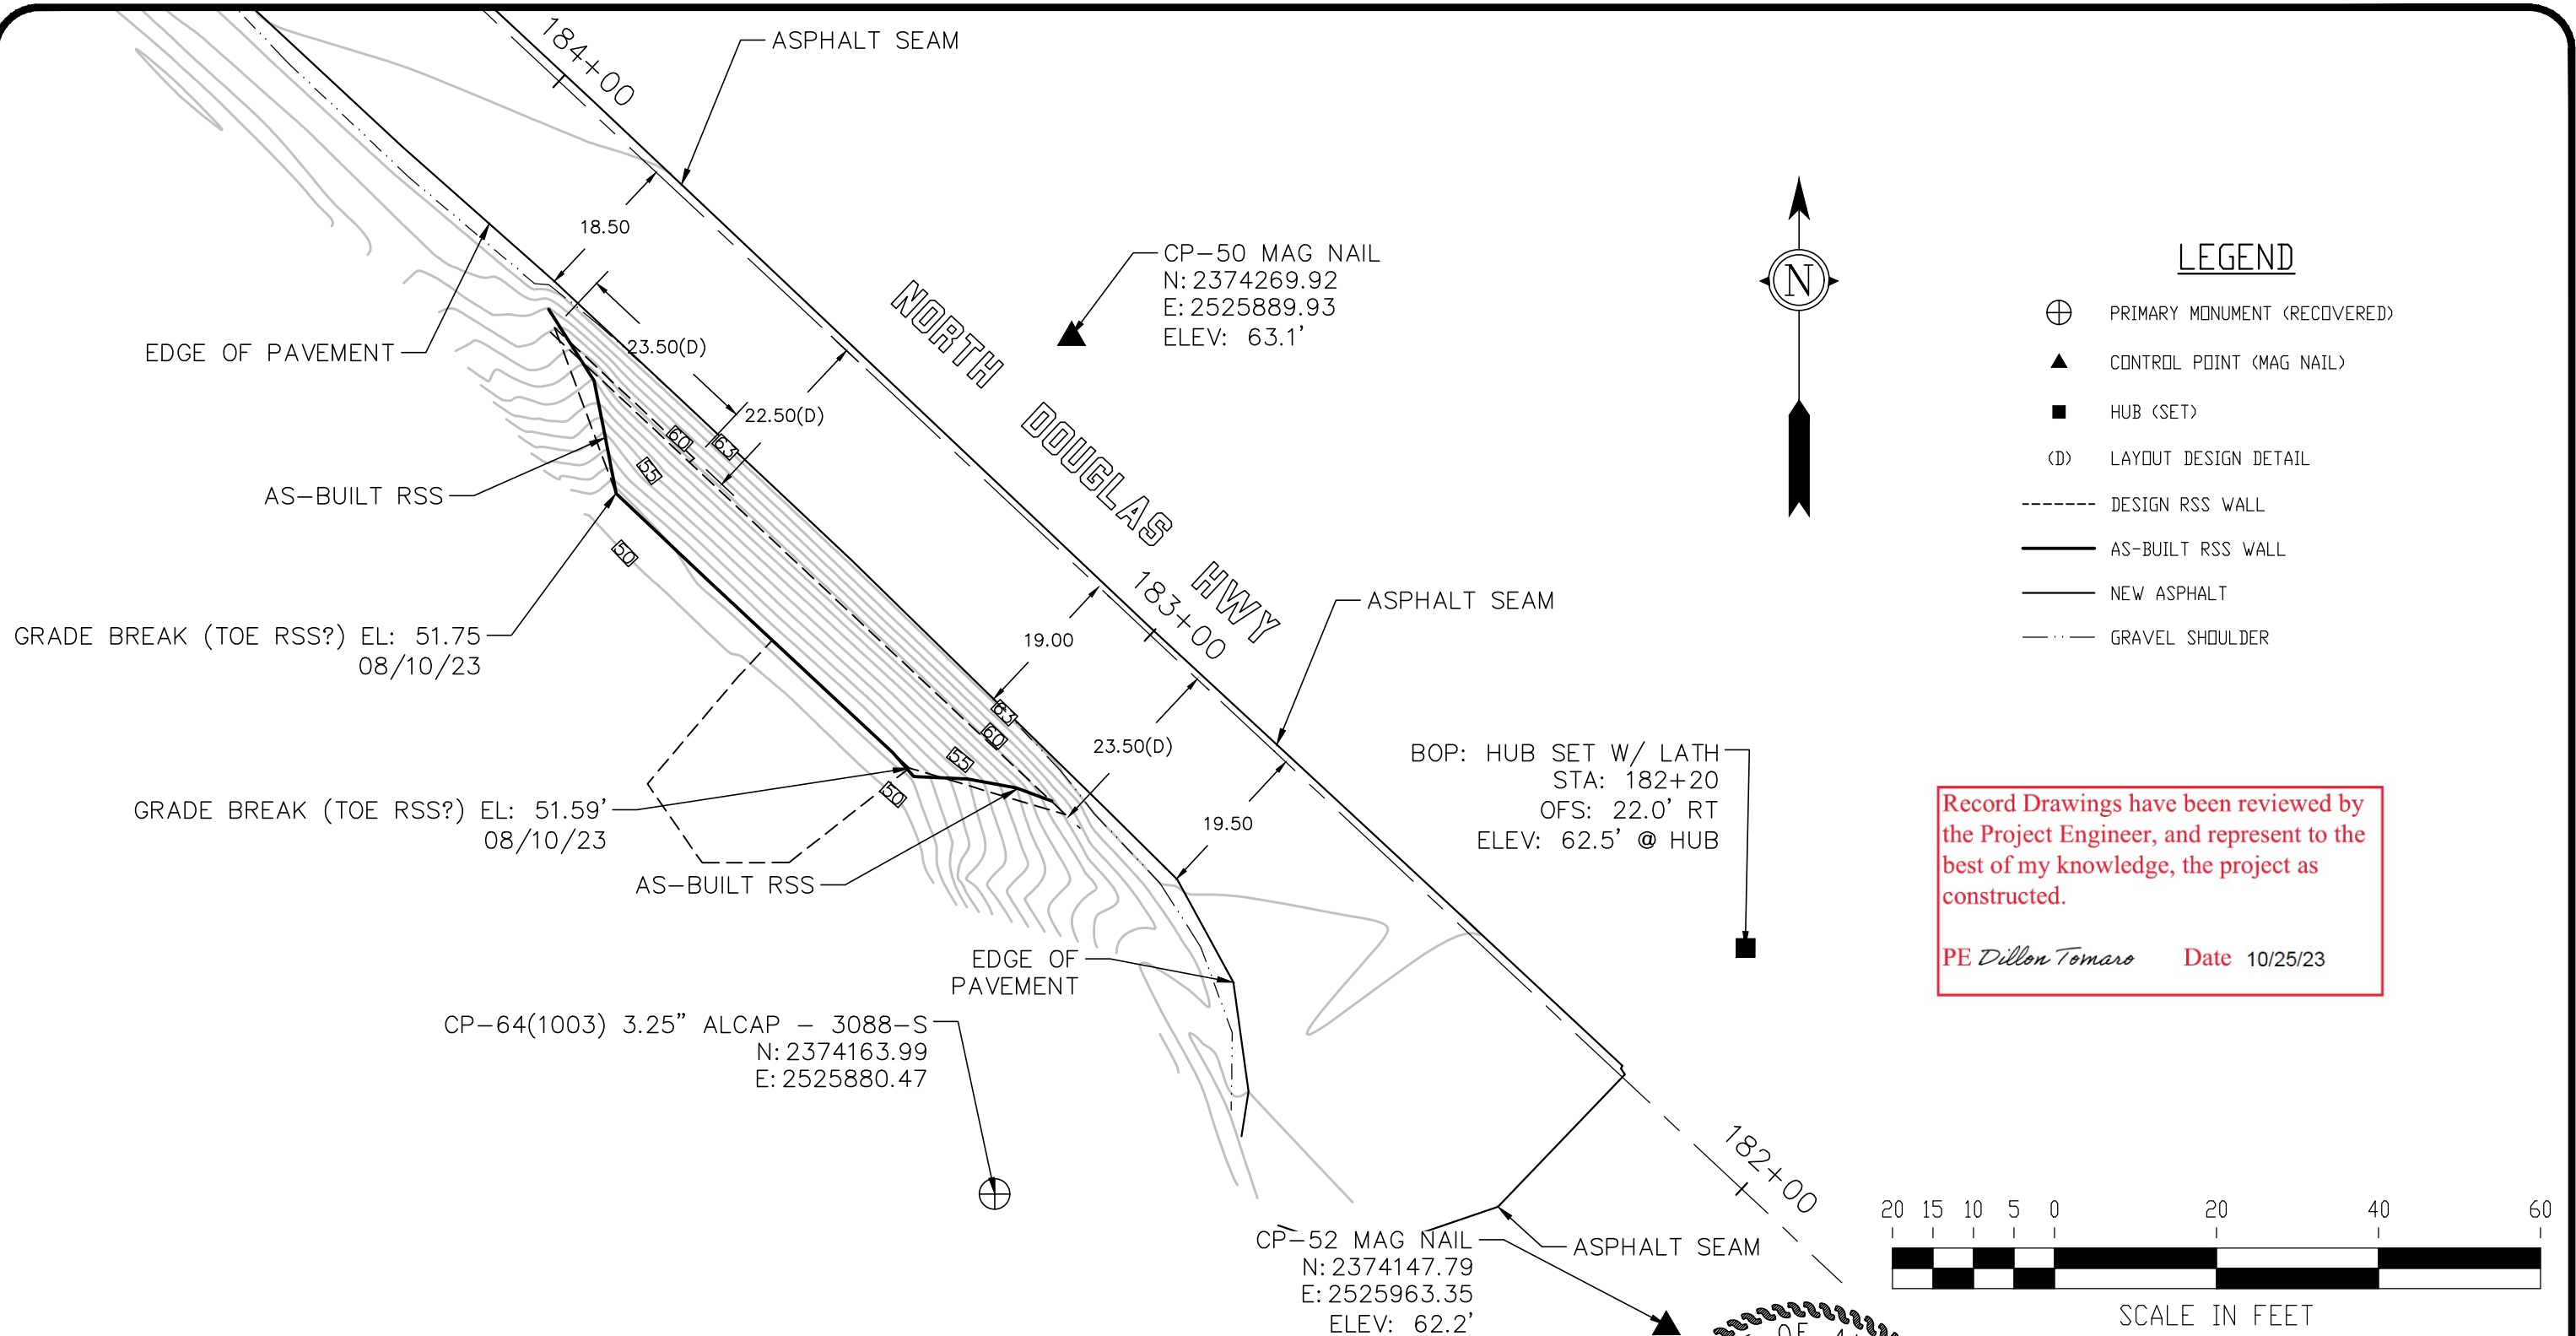


LEGEND

- ⊕ PRIMARY MONUMENT (RECOVERED)
- ▲ CONTROL POINT (MAG NAIL)
- HUB (SET)
- (D) LAYOUT DESIGN DETAIL
- DESIGN RSS WALL
- AS-BUILT RSS WALL
- NEW ASPHALT
- GRAVEL SHOULDER

Record Drawings have been reviewed by the Project Engineer, and represent to the best of my knowledge, the project as constructed.

PE *Dillon Tomaro* Date 10/25/23

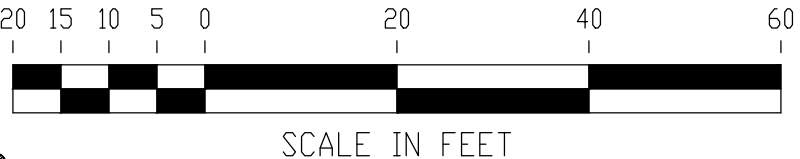


NORTH 57*
LAND SURVEYING LLC
 (907) 747-6700 215-C SMITH STREET, SITKA, AK
 8800 GLACIER HWY., STE 224 1/2, JUNEAU, AK
 MAILING ADDRESS - 2007 CASCADE CREEK ROAD,
 SITKA, AK 99835
 EMAIL: north57landsurveying@yahoo.com

SURVEYOR'S CERTIFICATE

I HEREBY CERTIFY THAT I HAVE SURVEYED THE PROPERTY DESCRIBED ON THIS PLAT. I DECLARE THAT IMPROVEMENTS AND VISIBLE ENCRDACHMENTS HAVE BEEN ESTABLISHED TO THE BEST OF MY PROFESSIONAL KNOWLEDGE AND BELIEF. THIS SURVEY IS FOR THE USE OF LENDING INSTITUTIONS SPECIFICALLY TO SHOW ANY CONFLICTS BETWEEN EXISTING STRUCTURES AND PLATTED LOT LINES OR EASEMENTS. UNDER NO CIRCUMSTANCES SHOULD THE DATA HEREON BE USED FOR POSITIONING ADDITIONAL STRUCTURES, BUILDING FENCES, OR LOCATING BOUNDARY LINES. IT IS THE RESPONSIBILITY OF THE OWNER TO VERIFY THAT IMPROVEMENTS SITUATED ON THIS PARCEL MEET ALL SUBDIVISION COVENANTS AND ZONING ORDINANCES. 0 CORS. SET.

KELLY J. O'NEILL LS 13321 _____
 DATE

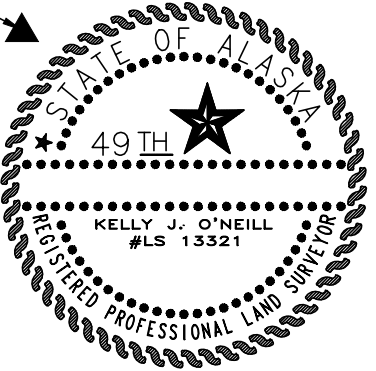

AS-BUILT SURVEY
BONNIE BRAE - RSS WALL
NORTH DOUGLAS HIGHWAY

DRAWN BY: KD/SB/ACAD	DATE SURVEYED: AUG. 2023
CHECKED BY: KD	SCALE: 1" = 20'

NO.	DATE	REVISION	STATE	PROJECT DESIGNATION	YEAR	SHEET NO.	TOTAL SHEETS
2	12/6/2022	QUANTITY CORRECTION	ALASKA	0093002/SFHwy00411	2022	C1	14

Record Drawings have been reviewed by the Project Engineer, and represent to the best of my knowledge, the project as constructed.

PE *Dillon Tomaro* Date 10/25/23

ESTIMATE OF QUANTITIES			
ITEM NO.	ITEM DESCRIPTION	PAY UNIT	QUANTITY
201.0009.0000	CLEARING AND GRUBBING	LUMP SUM	ALL REQUIRED
201.2001.0000	INVASIVE PLANT SPECIES CONTROL, REMOVAL, AND DISPOSAL	SQUARE YARD	188
202.0002.0000	REMOVAL OF PAVEMENT	SQUARE YARD	573
203.0003.0000	UNCLASSIFIED EXCAVATION	CUBIC YARD	881
203.0006.000A	BORROW, TYPE A	TON	1408
301.0001.00D1	AGGREGATE BASE COURSE, GRADING D-1	TON	205
303.2001.0000	LINEAR GRADING	LF	220
401.0001.002B	HMA, TYPE II; CLASS B	TON	179
401.0004.6428	ASPHALT BINDER, GRADE PG 64-28	TON	10
402.0001.STE1	STE-1 ASPHALT FOR TACK COAT	TON	0.2
606.0001.0000	W-BEAM GUARDRAIL	LINEAR FOOT	100
606.0006.0000	REMOVING AND DISPOSING OF GUARDRAIL	LINEAR FOOT	147
606.0009.0000	SHORT RADIUS GUARDRAIL	EACH	1
606.0013.0000	PARALLEL GUARDRAIL TERMINAL	EACH	1
606.2014.0000	GUARDRAIL PAVING	LF	220
611.2005.0000	SALVAGE AND REUSE RIPRAP	LUMP SUM	ALL REQUIRED
618.0002.0000	SEEDING	POUND	2
619.2002.0000	TURF REINFORCEMENT MAT	SQUARE YARD	322
620.0001.0000	TOPSOIL	SQUARE YARD	188
627.2020.0000	WATER MAIN RELOCATION	EACH	1
630.0001.0003	GEOTEXTILE, SEPARATION, CLASS 3	SY	68
634.0002.0000	GEOGRID, REINFORCEMENT, CLASS 3	SQUARE YARD	1777
640.0001.0000	MOBILIZATION AND DEMOBILIZATION	LUMP SUM	ALL REQUIRED
642.0001.0000	CONSTRUCTION SURVEYING	LUMP SUM	ALL REQUIRED
643.0002.0000	TRAFFIC MAINTENANCE	LUMP SUM	ALL REQUIRED
643.0025.0000	TRAFFIC CONTROL	CONTINGENT SUM	ALL REQUIRED
643.0032.0000	FLAGGING	CONTINGENT SUM	ALL REQUIRED
658.0001.0000	EROSION, SEDIMENT, AND POLLUTION CONTROL WITHOUT CGP COVERAGE	LUMP SUM	ALL REQUIRED
658.0002.0000	ESCP CHANGES BY DIRECTIVE	CONTINGENT SUM	ALL REQUIRED
670.0001.0000	PAINTED TRAFFIC MARKINGS	LUMP SUM	ALL REQUIRED

BASIS OF ESTIMATE		
ITEM NO.	ITEM DESCRIPTION	ESTIMATING FACTOR
203.0006.000A	BORROW, TYPE A	1.94 TON/CY
301.0001.00D1	AGGREGATE BASE COURSE, GRADING D-1	1.94 TON/CY
401.0001.002B	HMA, TYPE II; CLASS B	2.0385 TON/CY
401.0004.6428	ASPHALT BINDER, GRADE PG 64-28	5.3% OF ITEM 401.0001.002B
402.0001.STE1	STE-1 ASPHALT FOR TACK COAT	0.000334 TON/SY
618.0002.0000	SEEDING	1.5 LB/MSF
--	BONDED FIBER MATRIX (BFM)	4,000 LB/ACRE

△

△

ESTIMATE OF QUANTITIES			
ITEM NO.	ITEM DESCRIPTION	PAY UNIT	QUANTITY
201.0009.0000	CLEARING AND GRUBBING	LUMP SUM	\$5,000.00
201.2001.0000	INVASIVE PLANT SPECIES CONTROL, REMOVAL, AND DISPOSAL	SY	0.000
202.0002.0000	REMOVAL OF PAVEMENT	SY	572.900
203.0003.0000	UNCLASSIFIED EXCAVATION	CY	896.900
203.0006.000A	BORROW, TYPE A	TON	713.900
301.0001.00D1	AGGREGATE BASE COURSE, GRADING D-1	TON	242.200
303.2001.0000	LINEAR GRADING	LF	120.000
401.0001.002B	HMA, TYPE II; CLASS B	TON	163.960
401.0004.6428	ASPHALT BINDER, GRADE PG 64-28	TON	9.779
402.0001.STE1	STE-1 ASPHALT FOR TACK COAT	TON	0.510
606.0001.0000	W-BEAM GUARDRAIL	LF	100.000
606.0006.0000	REMOVING AND DISPOSING OF GUARDRAIL	LF	147.000
606.0009.0000	SHORT RADIUS GUARDRAIL	EACH	1.000
606.0013.0000	PARALLEL GUARDRAIL TERMINAL	EACH	1.000
606.2014.0000	GUARDRAIL PAVING	LF	220.000
611.2005.0000	SALVAGE AND REUSE RIPRAP	LUMP SUM	\$3,100.00
618.0002.0000	SEEDING	POUND	2.000
619.2002.0000	TURF REINFORCEMENT MAT	SY	375.000
620.0001.0000	TOPSOIL	SY	93.700
627.0010.0000	Adjustment of Valve Box	EACH	3.000
627.2020.0000	WATER MAIN RELOCATION	EACH	1.000
627.2033.0000	WATER SYSTEM COMPLETE	LUMP SUM	\$2,781.81
630.0001.0003	GEOTEXTILE, SEPARATION, CLASS 3	SY	90.000
634.0002.0000	GEOGRID, REINFORCEMENT, CLASS 3	SY	1,499.000
640.0001.0000	MOBILIZATION AND DEMOBILIZATION	LUMP SUM	\$41,000.00
642.0001.0000	CONSTRUCTION SURVEYING	LUMP SUM	\$14,000.00
643.0002.0000	TRAFFIC MAINTENANCE	LUMP SUM	\$50,000.00
643.0025.0000	TRAFFIC CONTROL	CONTINGENT SUM	\$6,882.70
643.0032.0000	FLAGGING	CONTINGENT SUM	\$33,052.50
658.0001.0000	EROSION, SEDIMENT, AND POLLUTION CONTROL WITHOUT CGP COVERAGE	LUMP SUM	\$11,000.00
658.0002.0000	ESCP CHANGES BY DIRECTIVE	CONTINGENT SUM	\$0.00
670.0001.0000	PAINTED TRAFFIC MARKINGS	LUMP SUM	\$6,500.00
698.2000.0000	NEGOTIATED PRICE ADJUSTMENT	LUMP SUM	-\$60,000.00

FIRM DOWL
 FILE C:\dowl_pw\0395244\SA-CT-DT-C-63330_03.dwg
 ADDRESS 9085 GLACIER HIGHWAY, JUNEAU, AK 99801
 PHONE (907) 780-3533
 DESIGNED HOBBS
 CHECKED CHRISTIE
 DRAFTED BERG
 CERTIFICATE OF AUTH # : AECL848

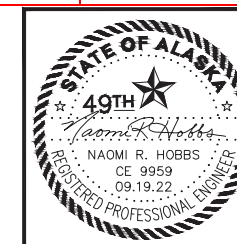

STATE OF ALASKA DEPARTMENT OF TRANSPORTATION AND PUBLIC FACILITIES
 JNU NORTH DOUGLAS - BONNIE BRAE - DEC 20 SE PR
 ESTIMATE OF QUANTITIES

FIRM: DOWL
 FILE: c:\dowl_pw\40399244\SA-CT-DT-D-63330_03.dwg
 ADDRESS: 9085 GLACIER HIGHWAY, JUNEAU, AK 99801
 PHONE: (907) 780-3533
 DESIGNED: HOBBS
 CHECKED: CHRISTIE
 DRAFTED: BERG
 CERTIFICATE OF AUTH #: AECL848
 BERG

NO.	DATE	REVISION	STATE	PROJECT DESIGNATION	YEAR	SHEET NO.	TOTAL SHEETS
			ALASKA	0093002/SFHwy00411	2022	D1	14

202.0002.0000 REMOVAL OF PAVEMENT				
SHEET	START STATION	END STATION	AREA (SY)	REMARKS
F1	182+20	184+50	576	

202.0002.0000 REMOVAL OF PAVEMENT				
SHEET	START STATION	END STATION	AREA (SY)	REMARKS
F1	182+20	184+50	576	

203.0003.0000 UNCLASSIFIED EXCAVATION					
SHEET	START STATION	END STATION	VOLUME (CY)	UNSUITABLE MATERIAL VOLUME (CY)	REMARKS
F1	182+90	183+80	881	881	

303.2001.0000 LINEAR GRADING						
SHEET	START		END		LENGTH (LF)	REMARKS
	STATION	OFFSET	STATION	OFFSET		
F1	182+48	40' LT	184+68	20' LT	220	

606.0001.0000 W-BEAM GUARDRAIL						
SHEET	START		END		LENGTH (LF)	REMARKS
	STATION	OFFSET	STATION	OFFSET		
F1	182+77	18' LT	183+45	20' LT	68	

606.0006.0000 REMOVING AND DISPOSING OF GUARDRAIL					
SHEET	START STATION	END STATION	OFFSET	LENGTH (LF)	REMARKS
F1	182+48	183+95	LT	147	

203.0003.0000 UNCLASSIFIED EXCAVATION					
SHEET	START STATION	END STATION	VOLUME (CY)	UNSUITABLE MATERIAL VOLUME (CY)	REMARKS
F1	182+20	184+50	576	881	

303.2001.0000 LINEAR GRADING						
SHEET	START		END		LENGTH (LF)	REMARKS
	STATION	OFFSET	STATION	OFFSET		
F1	182+48	40' LT	183+08	20' LT	120	
	184+08	20' LT	184+68	20' LT		

606.0009.0000 SHORT RADIUS GUARDRAIL							
SHEET	START STATION	OFFSET	END STATION	OFFSET	LENGTH (LF)	QUANTITY (EA)	REMARKS
F1	182+40	74' LT	182+77	18' LT	97	1	CURVE RADIUS 36'


606.0013.0000 PARALLEL GUARDRAIL TERMINAL						
SHEET	START STATION	END STATION	LENGTH (LF)	OFFSET	QUANTITY (EA)	REMARKS
F1	183+45	183+95	50	LT	1	

606.2014.0000 GUARDRAIL PAVING						
SHEET	START		END		LENGTH (LF)	REMARKS
	STATION	OFFSET	STATION	OFFSET		
F1	182+48	40' LT	184+68	20' LT	220	

627.2020.0000 WATER MAIN RELOCATION						
SHEET	FROM STATION	OFFSET	TO STATION	OFFSET	LENGTH (FT)	REMARKS
F1	182+33	19' LT	184+38	24' LT	220	

Record Drawings have been reviewed by the Project Engineer, and represent to the best of my knowledge, the project as constructed.

PE Dillon Tomaro **Date 10/25/23**

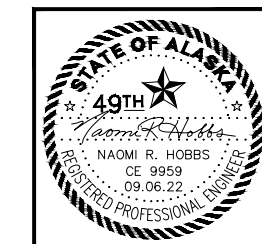

STATE OF ALASKA DEPARTMENT OF TRANSPORTATION AND PUBLIC FACILITIES
 JNU NORTH DOUGLAS - BONNIE BRAE - DEC 20 SE PR
 SUMMARY TABLES

FIRM DOWL
 FILE C:\dowl\p\40396244\SA-CT-DT-E-63330_03.dwg
 ADDRESS 9085 GLACIER HIGHWAY, JUNEAU, AK 99801
 PHONE (907) 780-3533
 DESIGNED HOBBS
 CHECKED CHRISTIE
 DRAFTED BERG
 CERTIFICATE OF AUTH # : AECL848

CORROSION PROTECTION SPECIFICATIONS AND NOTES:

NO.	DATE	REVISION	STATE	PROJECT DESIGNATION	YEAR	SHEET NO.	TOTAL SHEETS
6	4/14/2023	WATERMAIN CONNECTION DETAILS	ALASKA	0093002/SFHWHY00411	2022	E1	14

ANODES


1. ANODES SHALL BE 18-LBS BARE WEIGHT ZINC WITH PREPACKAGED ANODE BACKFILL.
2. ACCEPTABLE ANODE MODELS ARE:
 - a. MODEL NO. ZUR-18 FROM FARWEST INDUSTRIES
 - b. MODEL S18 FROM MESA PRODUCTS
 - c. APPROVED EQUAL
3. INSTALL TYPE, SIZE, AND NUMBER OF ANODES SPECIFIED.
4. INSTALL 2 ANODES TO ALL CONNECTIONS TO EXISTING C.I. OR D.I. PIPE 12-INCH DIAMETER AND LARGER.
5. CONDUCTOR WIRE SHALL BE A MINIMUM OF 10- FEET IN LENGTH, SIZE #8 OR LARGER, AND INSULATED WITH HIGH MOLECULAR WEIGHT POLYETHYLENE (HMWPE).
6. PREPACKAGED ANODE SHALL BE SATURATED WITH WATER PRIOR TO BACKFILL.
7. ANODES SHALL BE PLACED IN NATIVE EARTH BACKFILL. DO NOT PLACE IN PIPE BEDDING MATERIAL.

THERMITE (EXOTERMIC) WELDING

1. THERMITE WELD MATERIALS SHALL BE DESIGNED FOR CONNECTION OF COPPER TO DUCTILE IRON AND CAST IRON SURFACES AND SHALL BE INSTALLED PER MANUFACTURERS INSTRUCTIONS.
2. ACCEPTABLE MANUFACTURES OF THERMITE WELD PRODUCTS ARE:
 - a. CADWELD BY ERICO PRODUCTS INC.
 - b. THERMOWELD BY CONTINENTAL INDUSTRIES INC.
 - c. APPROVED EQUAL
3. A 2-INCH SQUARE AREA IN THE PIPE SURFACE SHALL BE GROUND CLEAN PER MANUFACTURERS RECOMMENDATIONS PRIOR TO THERMITE WELDING.
4. WIRE ENDS SHALL HAVE PROPER ADAPTER SLEEVES TO ENSURE PROPER BOND. #8 AWG SHALL HAVE ADAPTER SLEEVES SPECIFIED BY THERMITE WELD MANUFACTURER. FIELD INSTALLED SLEEVES SHALL HAVE WIRE CONDUCTOR EXTEND 1/4-INCH BEYOND ENDS OF SLEEVE.
5. WIRE CONNECTION SHALL BE TESTED FOR INTEGRITY PRIOR TO COATING.
6. CONTINUITY STRAPS SHALL BE #2 AWG COPPER STRANDED WIRE WITH THW INSULATION AND SHALL BE ATTACHED TO THE PIPE BY THERMITE WELDING AND COATED AND SEALED AS DESCRIBED BELOW.


COATING AND SEALING

1. ALL THERMITE WELDS SHALL BE PROTECTED AND SEALED BY:
 - a. PREFABRICATED THERMITE WELD CAPS, SIZED ACCORDING TO WIRE SIZE, MINIMUM DIMENSIONS OF 4-INCH BY 4-INCH FILLED WITH ELASTOMERIC MASTIC COATING OR,
 - b. HEAT SHRINK SLEEVE PIPE ENCASEMENT AFTER COATING THERMITE WELD WITH ELASTOMERIC MASTIC COATING - HEAT SHRINK SLEEVE SHALL BE CANUSA AQUA SEAL OR APPROVED EQUAL.
2. ALL PIPE SURFACE COATING DAMAGED BEYOND THE WELD CAPS OR HEAT SHRINK SHALL BE COATED WITH PROTAL 7125 FROM DENSO NORTH AMERICA OR APPROVED EQUAL.

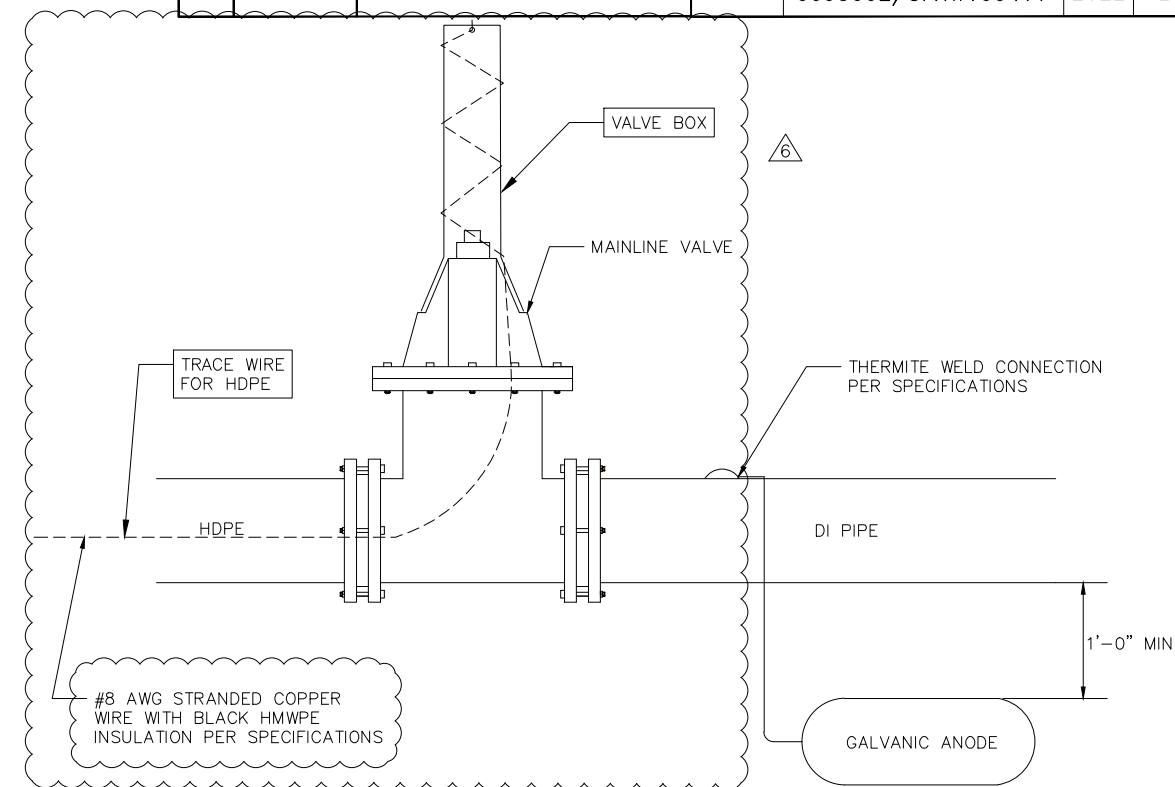

GALVANIC ANODE INSTALLATION AT MAINLINE WATER VALVES

NTS

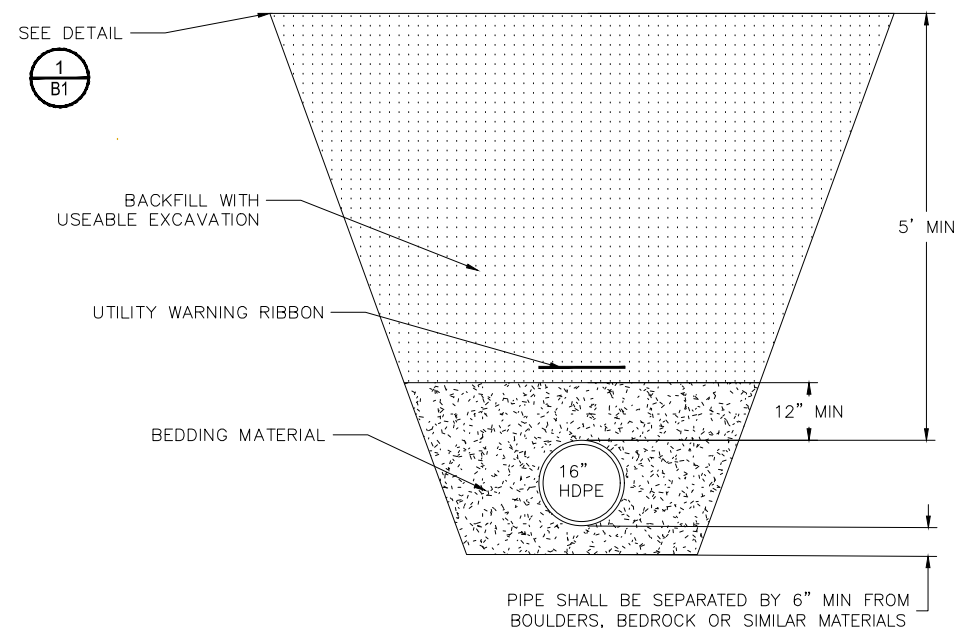


WATER MAIN TRENCH DETAIL

NTS

NOTES:

1. BEDDING & BACKFILL SHALL BE COMPACTED TO 95% OF MAXIMUM DENSITY.
2. SLOPE TRENCH WALLS ACCORDING TO SOIL CONDITIONS AND O.S.H.S. SAFETY STANDARDS AND TO STAY WITHIN HIGHWAY LANE AS SHOWN ON PLANS.

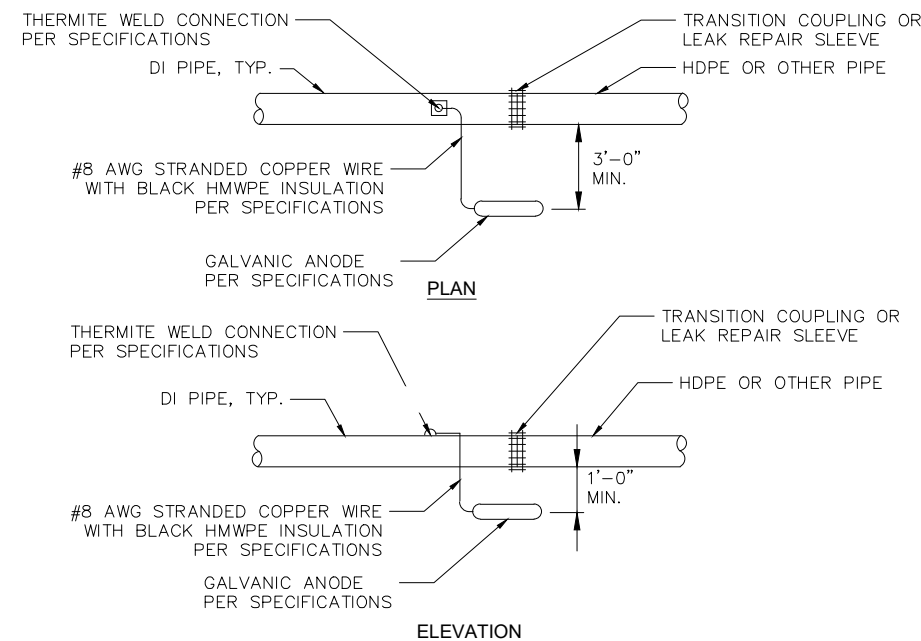


GALVANIC ANODE INSTALLATION FOR EXISTING METALLIC PIPE CONNECTIONS OR LEAK REPAIR LOCATIONS DETAIL

NTS

Record Drawings have been reviewed by the Project Engineer, and represent to the best of my knowledge, the project as constructed.

PE Dillon Tomaro

Date 10/25/23

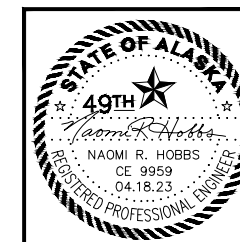



STATE OF ALASKA DEPARTMENT OF TRANSPORTATION AND PUBLIC FACILITIES

JNU NORTH DOUGLAS - BONNIE BRAE - DEC 20 SE PR

WATER MAIN DETAILS

FIRM DOWL
 FILE C:\dowl_pw\0395244\SC-CT-RD-F-63330_03_1.dwg
 ADDRESS 9085 GLACIER HIGHWAY, JUNEAU, AK 99801
 PHONE (907) 780-3533
 DESIGNED HOBBS
 CHECKED CHRISTIE
 DRAFTED BERG
 CERTIFICATE OF AUTH # : AECL848


NO.	DATE	REVISION	STATE	PROJECT DESIGNATION	YEAR	SHEET NO.	TOTAL SHEETS
			ALASKA	0093002/SFHwy00411	2022	F1	14

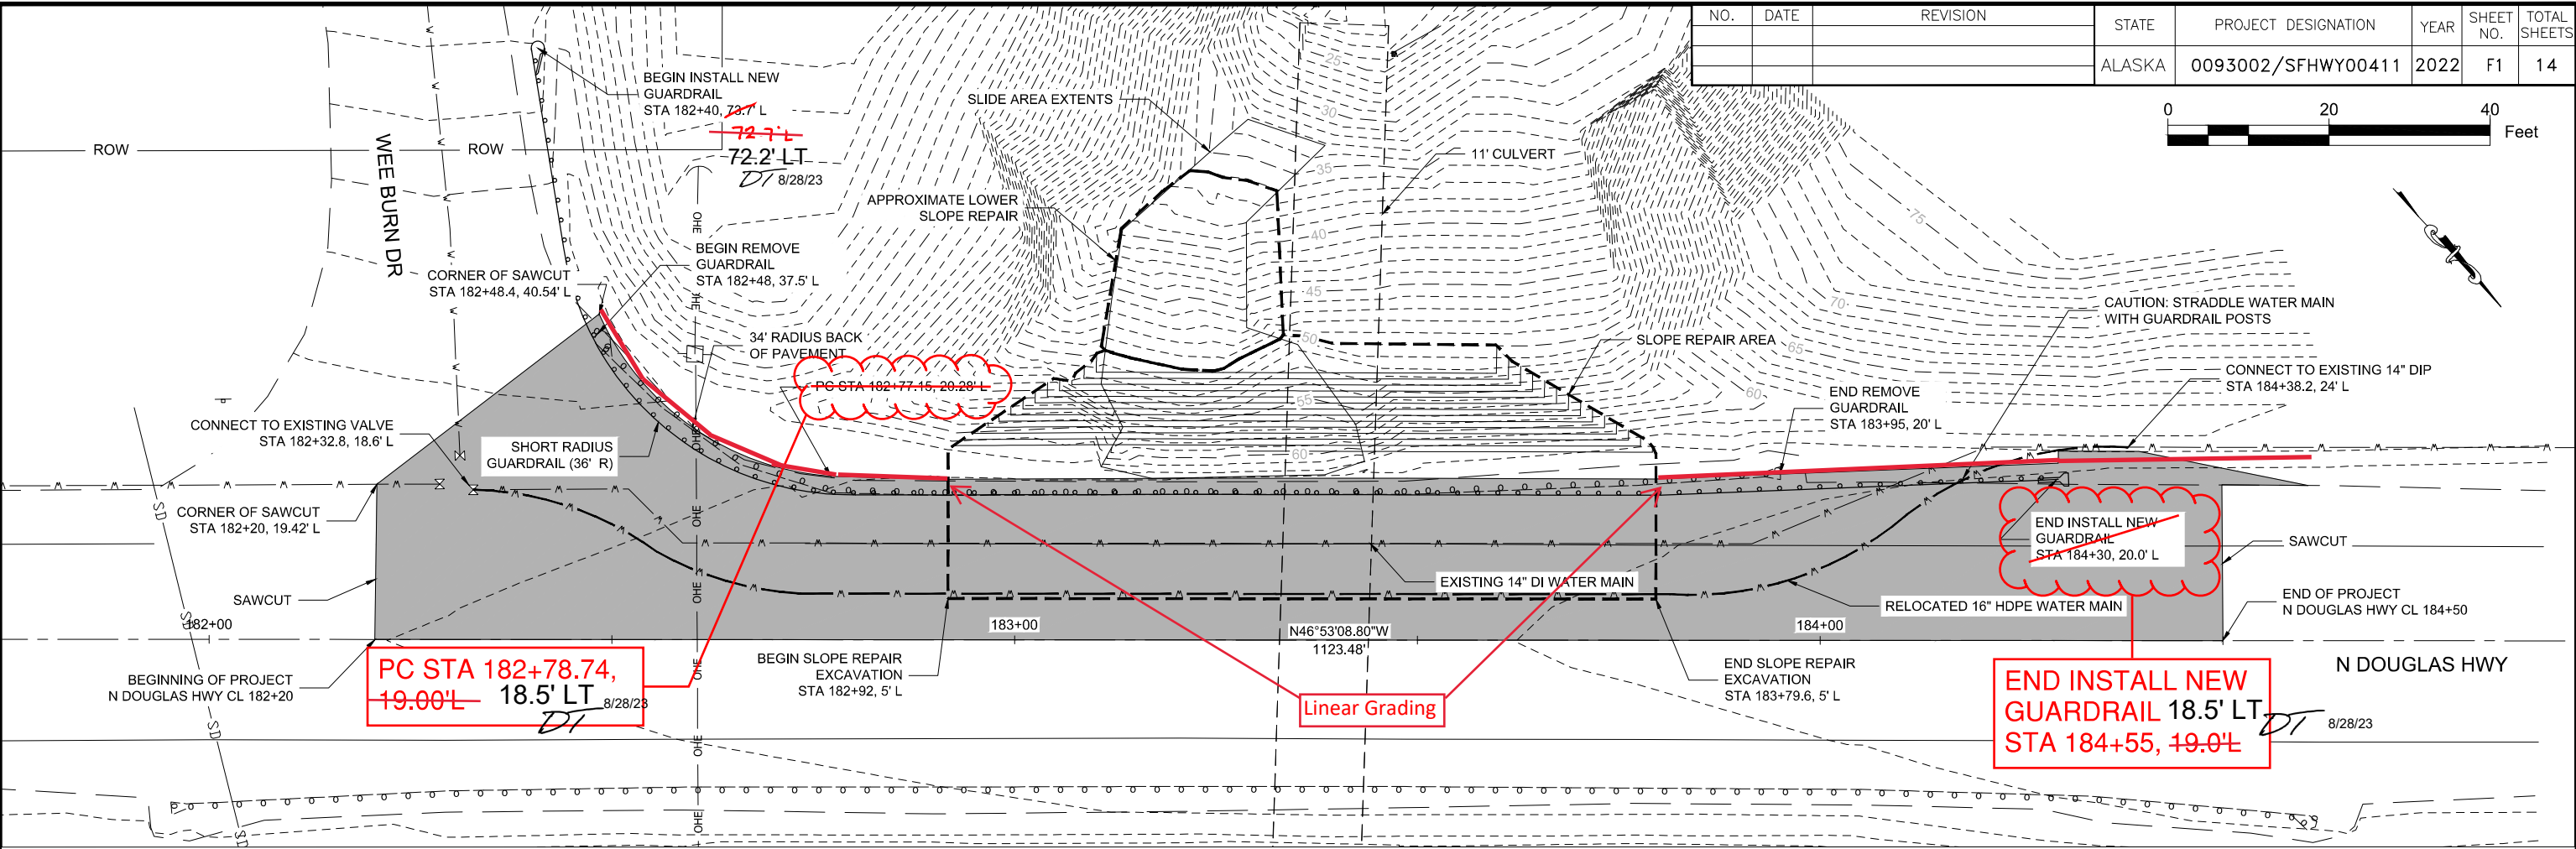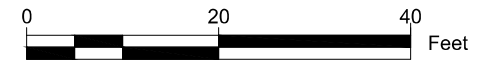

PC STA 182+78.74,
 19.00'L 18.5' LT
 DT 8/28/23


END INSTALL NEW
 GUARDRAIL 18.5' LT
 STA 184+55, 19.0'L
 DT 8/28/23

See next page for surveyor as-builts

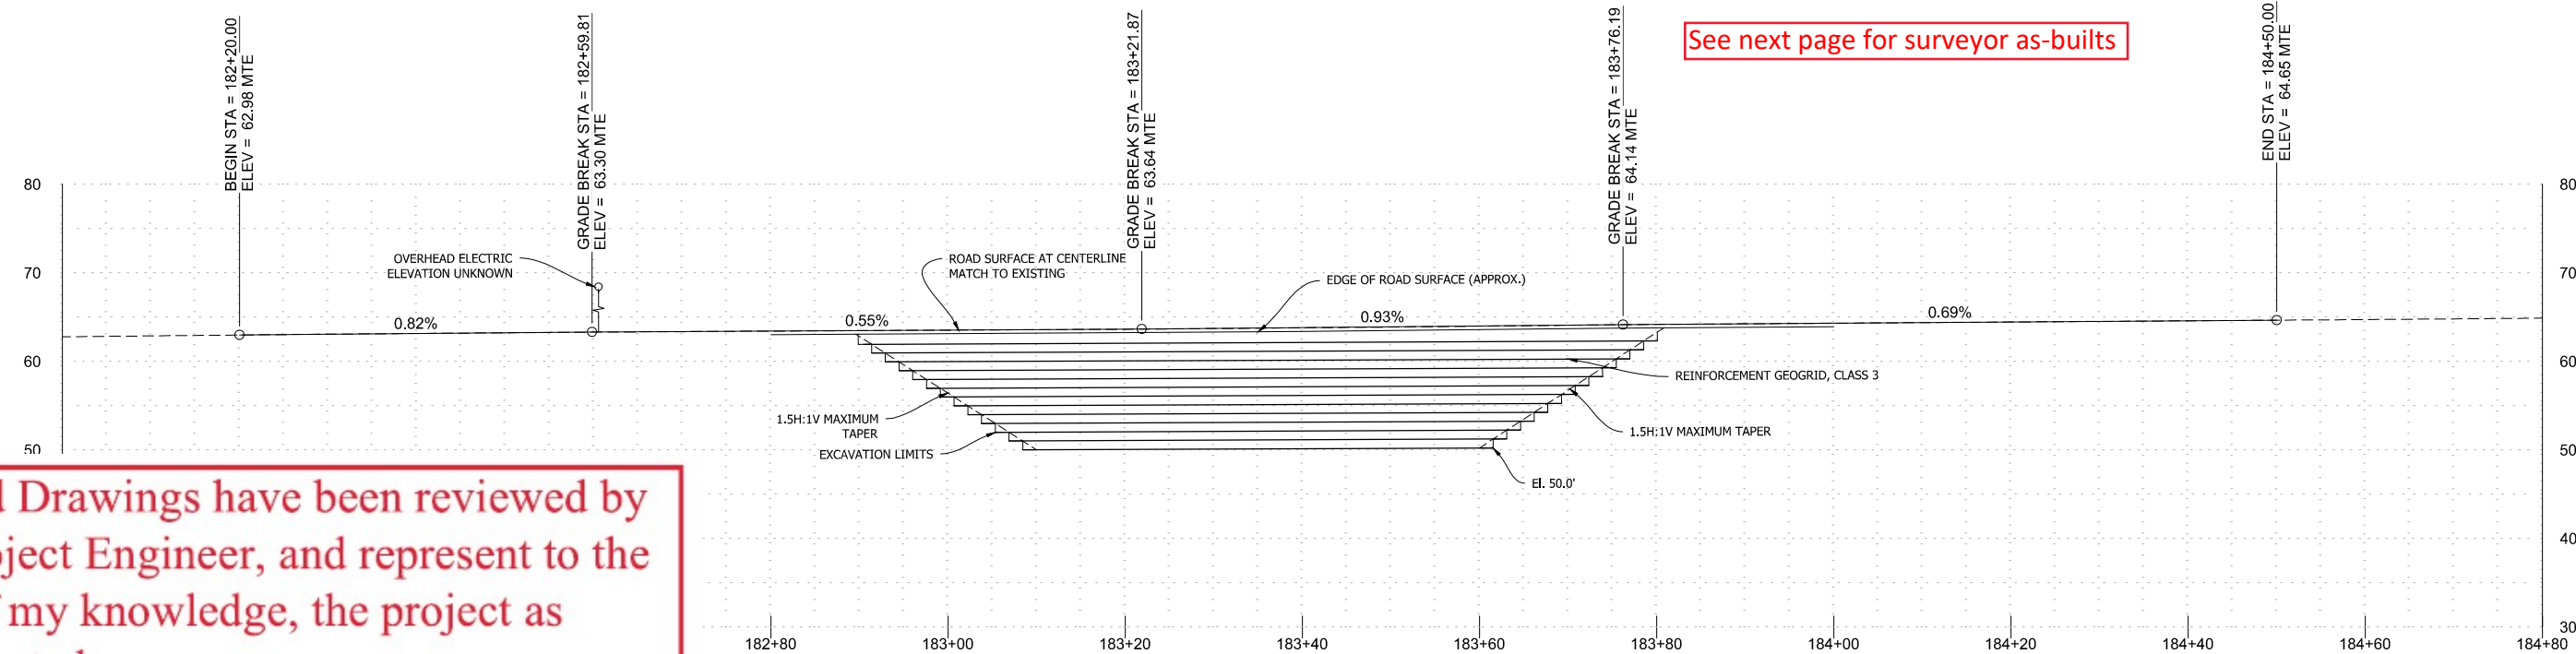


Record Drawings have been reviewed by the Project Engineer, and represent to the best of my knowledge, the project as constructed.

 PE *Dillon Tomaro* Date 10/25/23

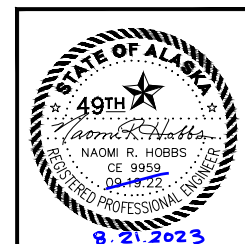

STATE OF ALASKA DEPARTMENT OF TRANSPORTATION AND PUBLIC FACILITIES
 JNU NORTH DOUGLAS - BONNIE BRAE - DEC 20 SE PR

PLAN AND PROFILE

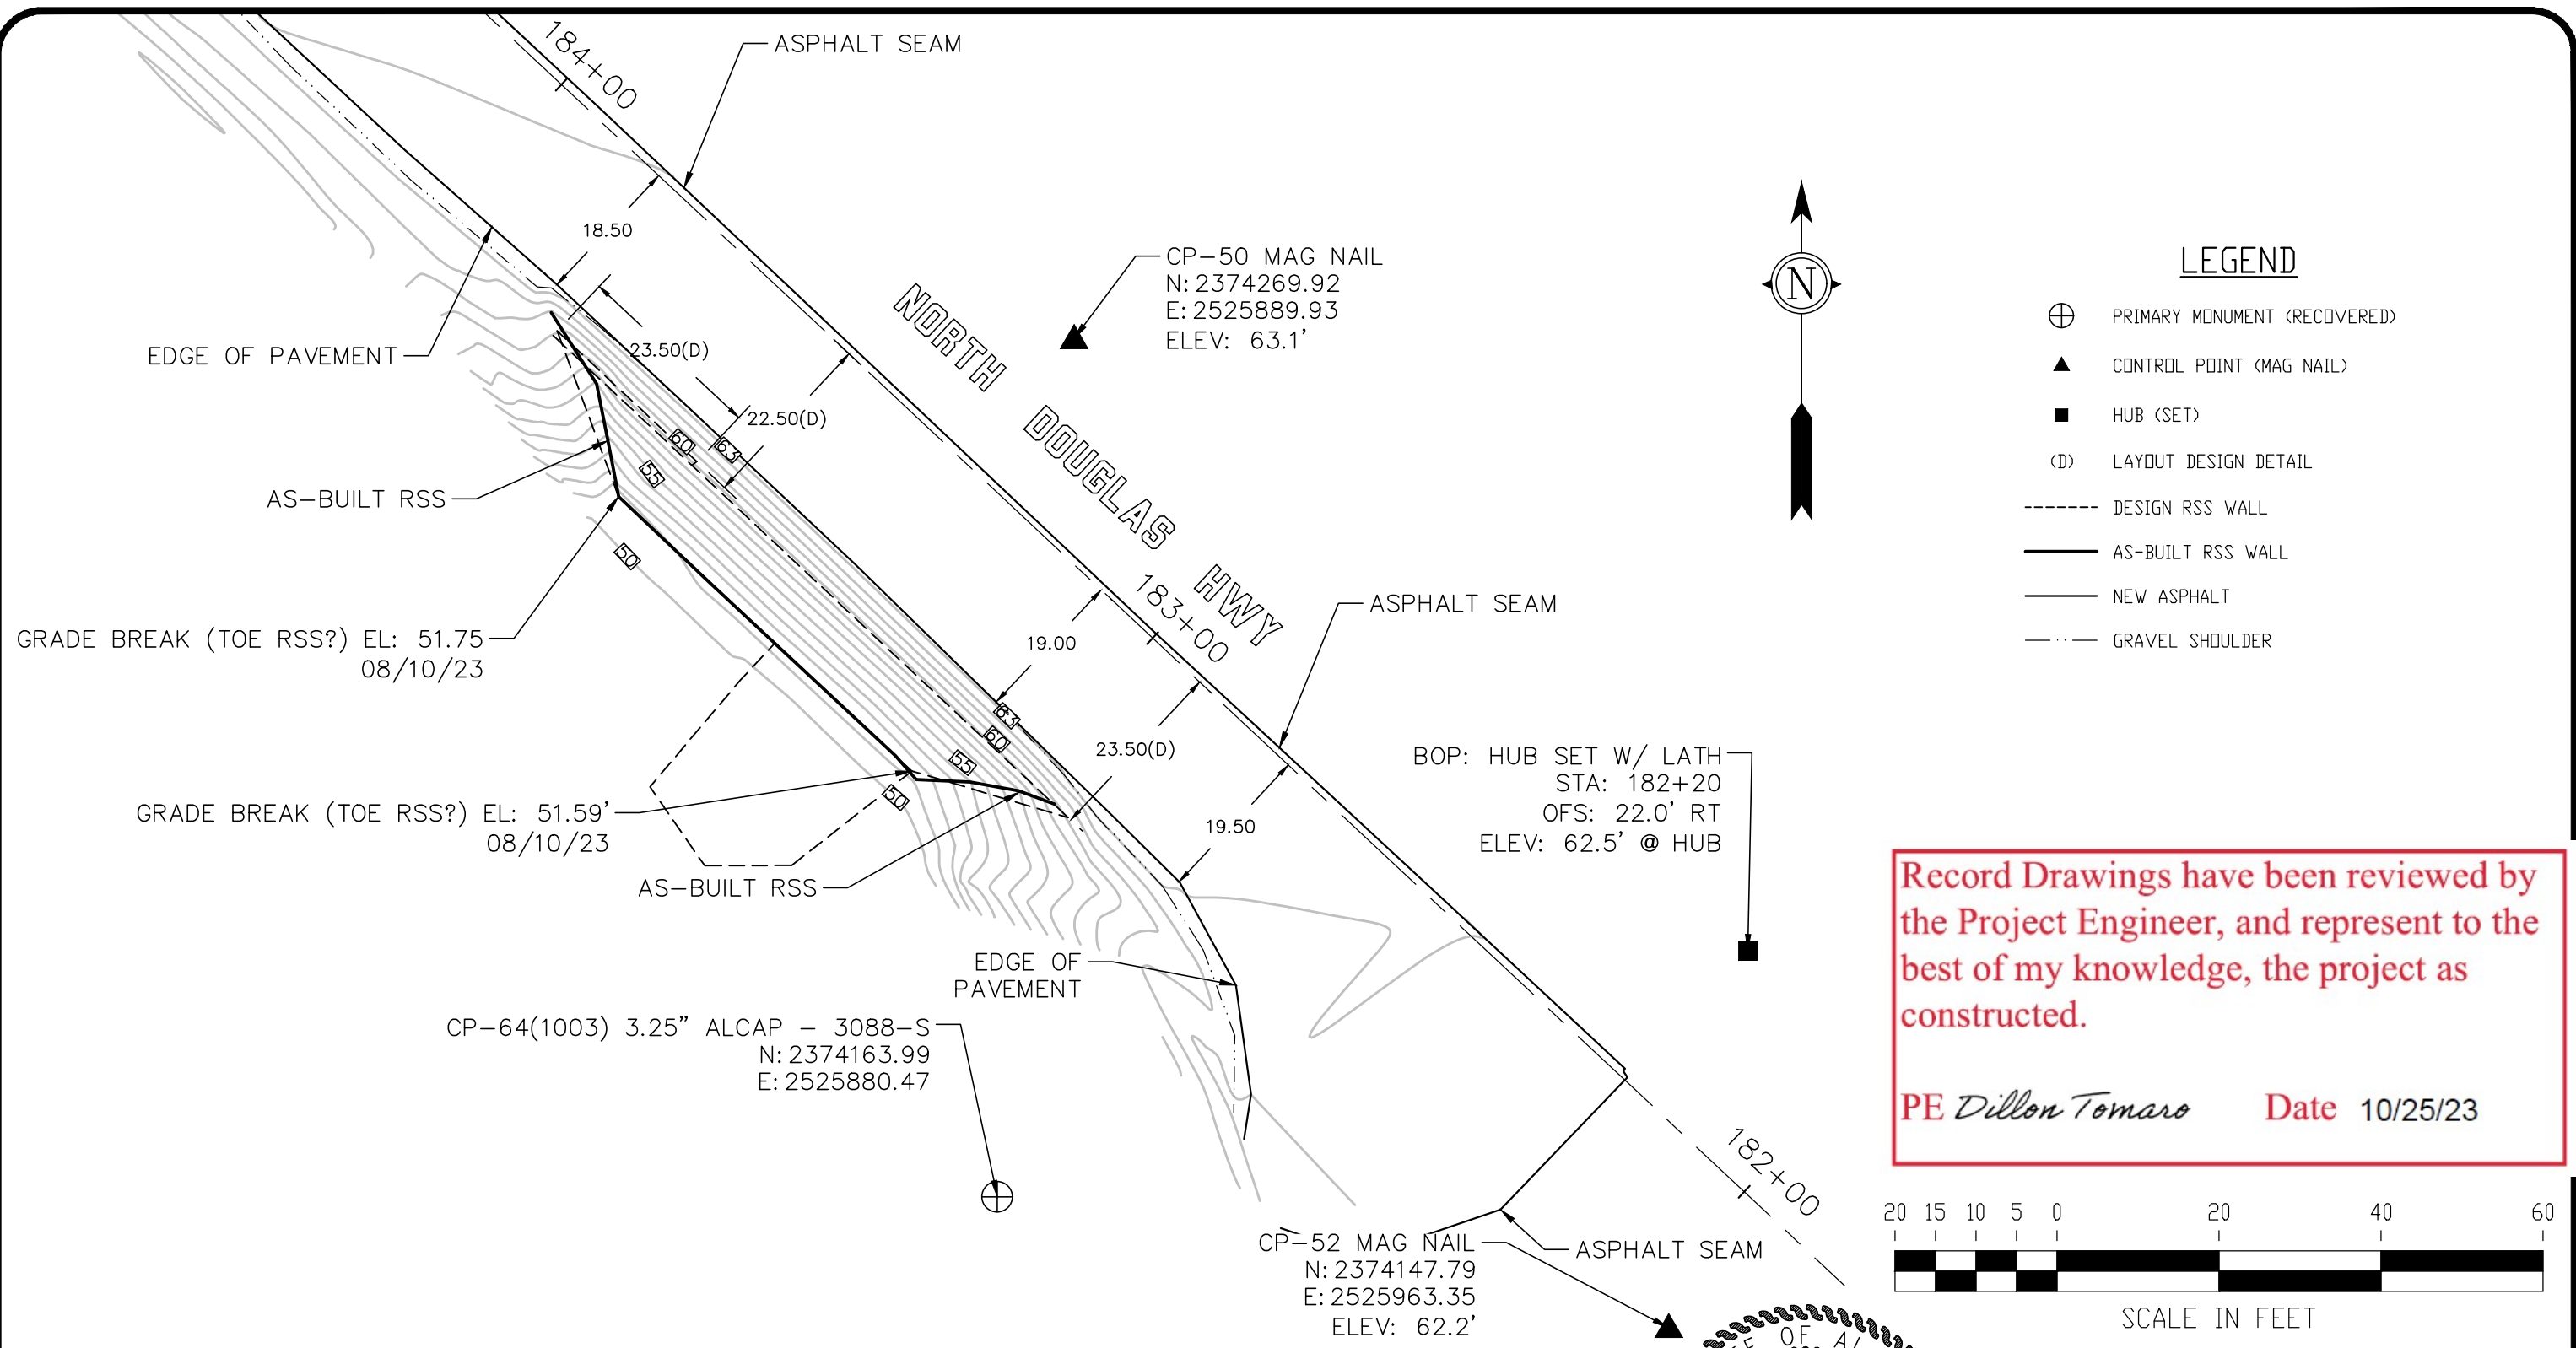

Record Drawings have been reviewed by the Project Engineer, and represent to the best of my knowledge, the project as constructed.


PE *Dillon Tomaro* Date 10/25/23

NORTH 57
LAND SURVEYING LLC
 (907) 747-6700 215-C SMITH STREET, SITKA, AK
 8800 GLACIER HWY., STE 224 1/2, JUNEAU, AK
 MAILING ADDRESS - 2007 CASCADE CREEK ROAD,
 SITKA, AK 99835
 EMAIL: north57landsurveying@yahoo.com

SURVEYOR'S CERTIFICATE

I HEREBY CERTIFY THAT I HAVE SURVEYED THE PROPERTY DESCRIBED ON THIS PLAT. I DECLARE THAT IMPROVEMENTS AND VISIBLE ENCRDACHMENTS HAVE BEEN ESTABLISHED TO THE BEST OF MY PROFESSIONAL KNOWLEDGE AND BELIEF. THIS SURVEY IS FOR THE USE OF LENDING INSTITUTIONS SPECIFICALLY TO SHOW ANY CONFLICTS BETWEEN EXISTING STRUCTURES AND PLATTED LOT LINES OR EASEMENTS. UNDER NO CIRCUMSTANCES SHOULD THE DATA HEREON BE USED FOR POSITIONING ADDITIONAL STRUCTURES, BUILDING FENCES, OR LOCATING BOUNDARY LINES. IT IS THE RESPONSIBILITY OF THE OWNER TO VERIFY THAT IMPROVEMENTS SITUATED ON THIS PARCEL MEET ALL SUBDIVISION COVENANTS AND ZONING ORDINANCES. 0 CORS. SET.

KELLY J. O'NEILL LS 13321 _____
 DATE

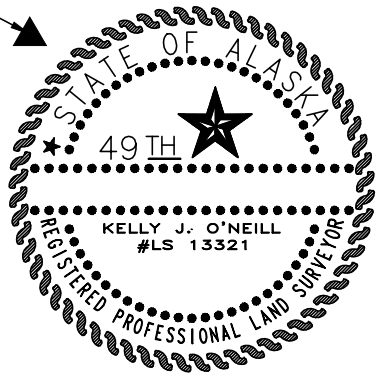


AS-BUILT SURVEY
BONNIE BRAE - RSS WALL
NORTH DOUGLAS HIGHWAY

DRAWN BY: KD/SB/ACAD	DATE SURVEYED: AUG. 2023
CHECKED BY: KD	SCALE: 1" = 20'

FIRM DOWL
 FILE c:\dowl_pw\0395244\SC-CT-EC-0-63330_03.dwg
 ADDRESS 9085 GLACIER HIGHWAY, JUNEAU, AK 99801
 PHONE (907) 780-3533
 DESIGNED HOBBSJC
 CHECKED CHRISTIE
 DRAFTED BERGMAN
 CERTIFICATE OF AUTH # : AECL848
 DATE LAYOUT 01

NO.	DATE	REVISION	STATE	PROJECT DESIGNATION	YEAR	SHEET NO.	TOTAL SHEETS
			ALASKA	0093002/SFHWHY00411	2022	Q1	14



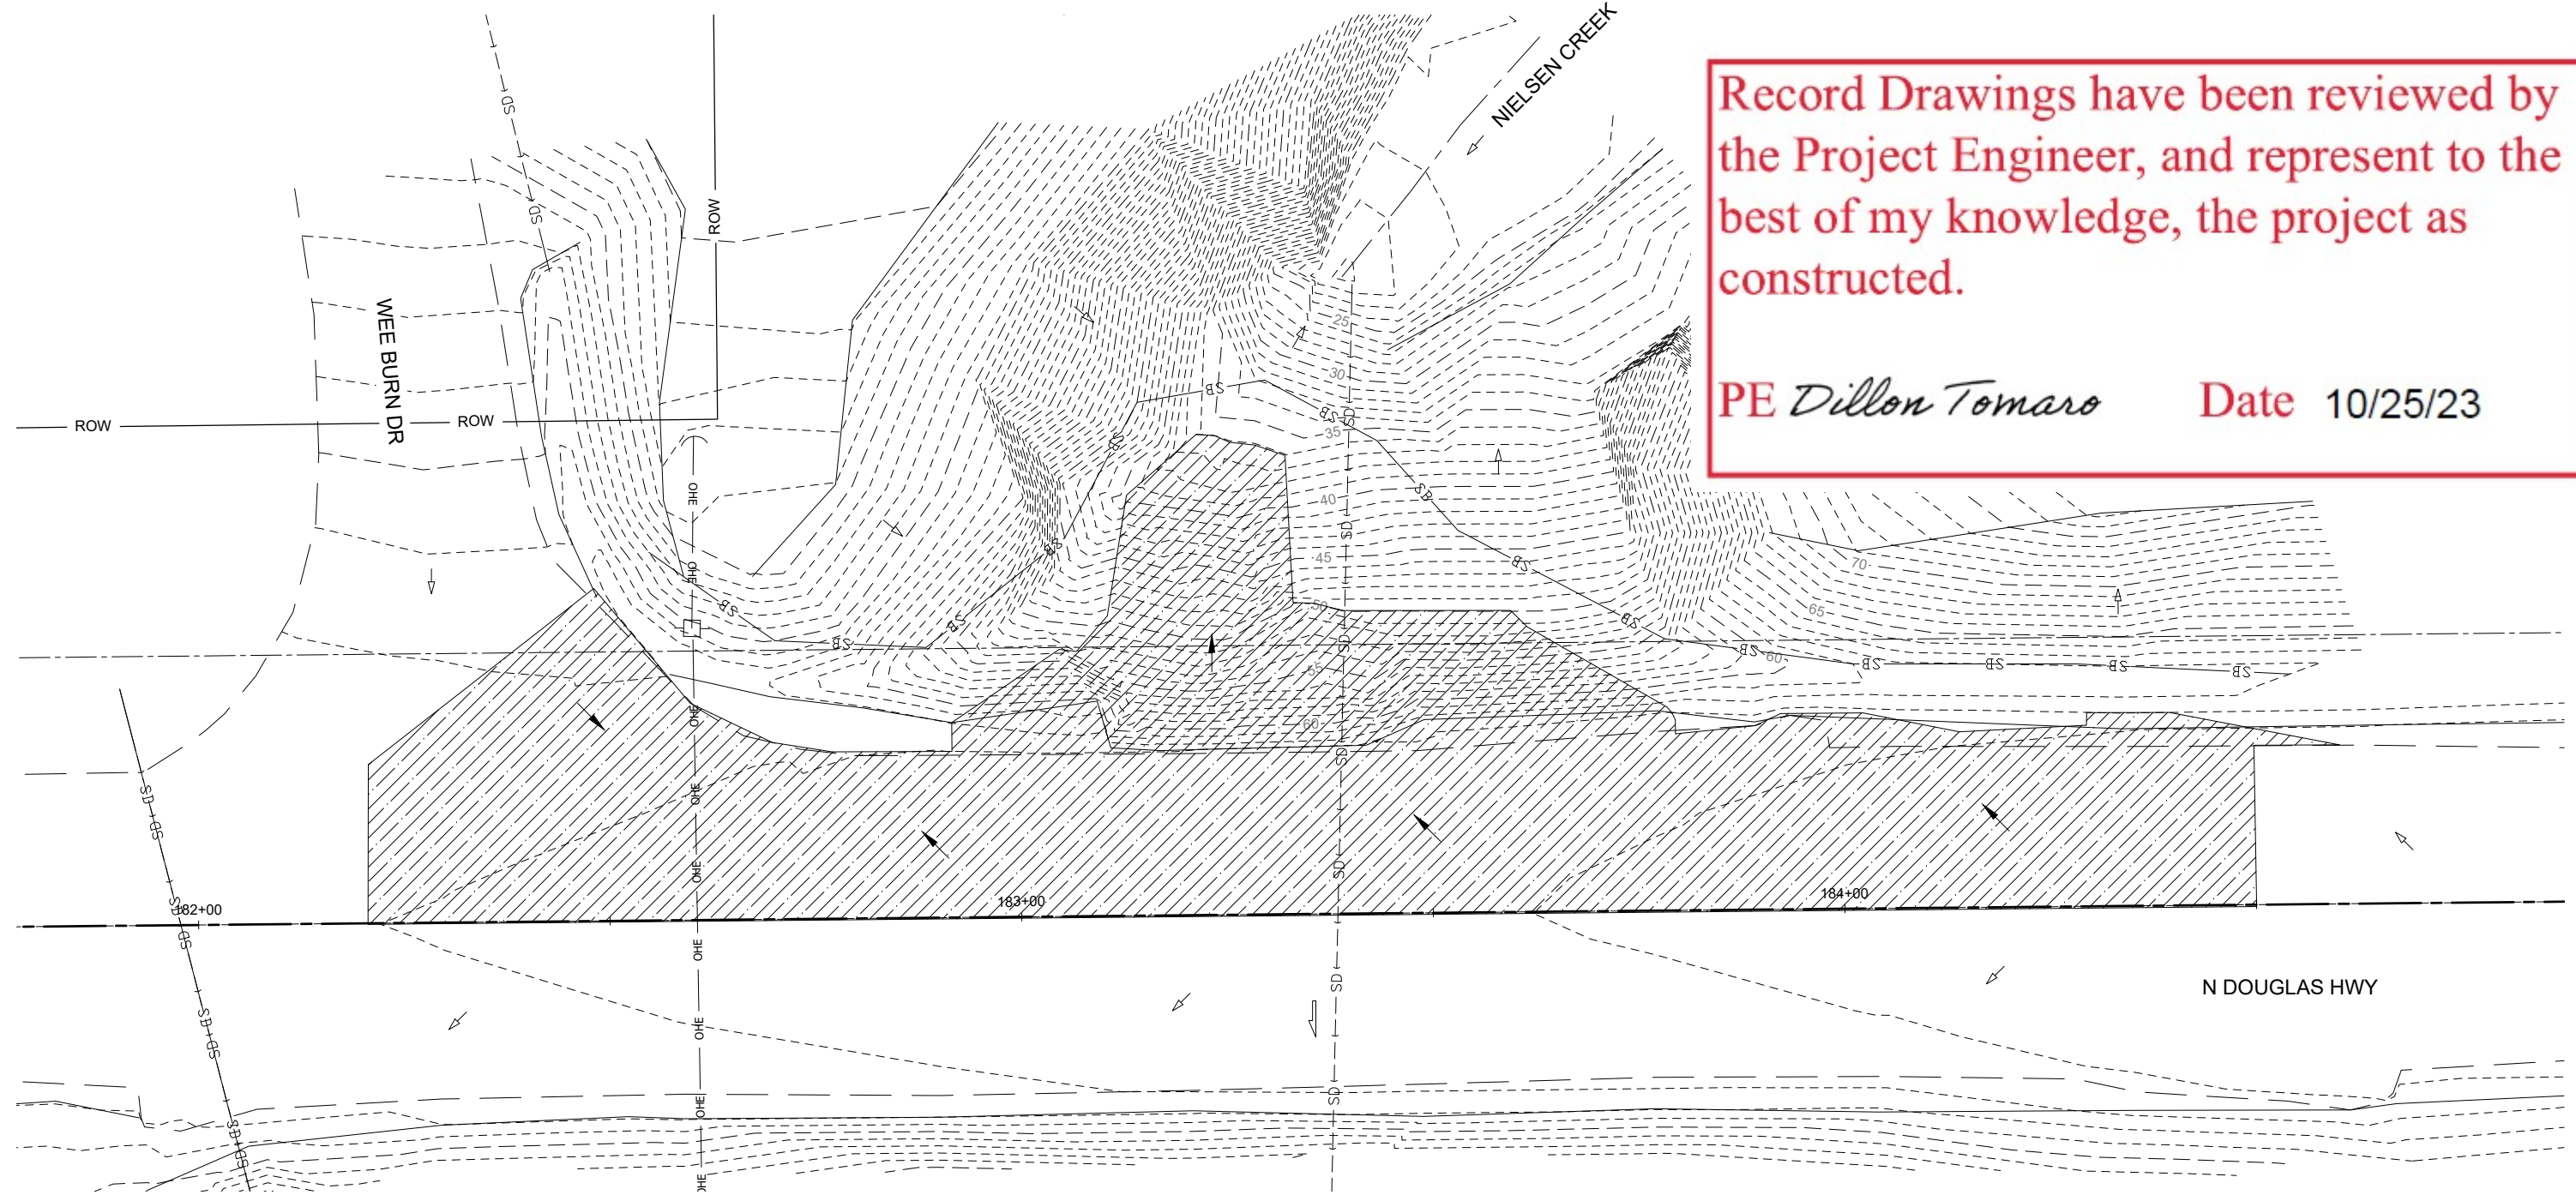


Record Drawings have been reviewed by the Project Engineer, and represent to the best of my knowledge, the project as constructed.

 PE *Dillon Tomaro* Date 10/25/23

ESCP NOTES:

1. REFER TO ESCP IN APPENDIX C OF THE SPECIAL PROVISIONS.
2. INSTALL EROSION AND SEDIMENT CONTROL MEASURES PRIOR TO EARTH DISTURBING ACTIVITIES.
3. THE LOCATIONS OF TEMPORARY EROSION AND SEDIMENT CONTROL MEASURES ARE RECOMMENDATIONS. IT IS THE RESPONSIBILITY OF THE CONTRACTOR TO INSTALL AND MAINTAIN ACCORDING TO CONTRACT SPECIFICATION SECTION 658 AND THE ESCP.

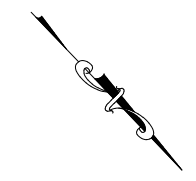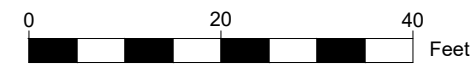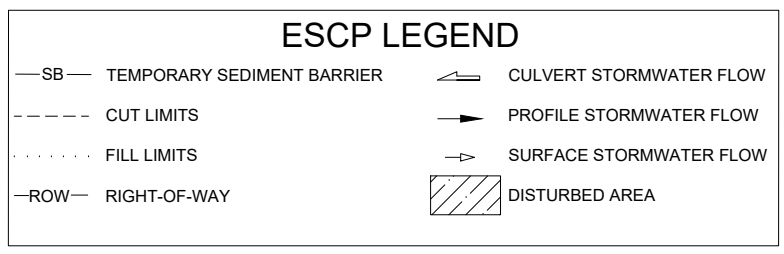

ESCP NOT SEALED IN ACCORDANCE WITH ALASKA HIGHWAY PRECONSTRUCTION MANUAL SECTION 1120.7.3 DATED NOVEMBER 15, 2013

STATE OF ALASKA DEPARTMENT OF TRANSPORTATION AND PUBLIC FACILITIES


 JNU NORTH DOUGLAS – BONNIE BRAE – DEC 20 SE PR

EROSION SEDIMENT CONTROL PLAN

NO.	DATE	REVISION	STATE	PROJECT DESIGNATION	YEAR	SHEET NO.	TOTAL SHEETS
			ALASKA	0093002/SFHWHY00411	2022	H1	14


Record Drawings have been reviewed by the Project Engineer, and represent to the best of my knowledge, the project as constructed.

PE *Dillon Tomaro* Date 10/25/23

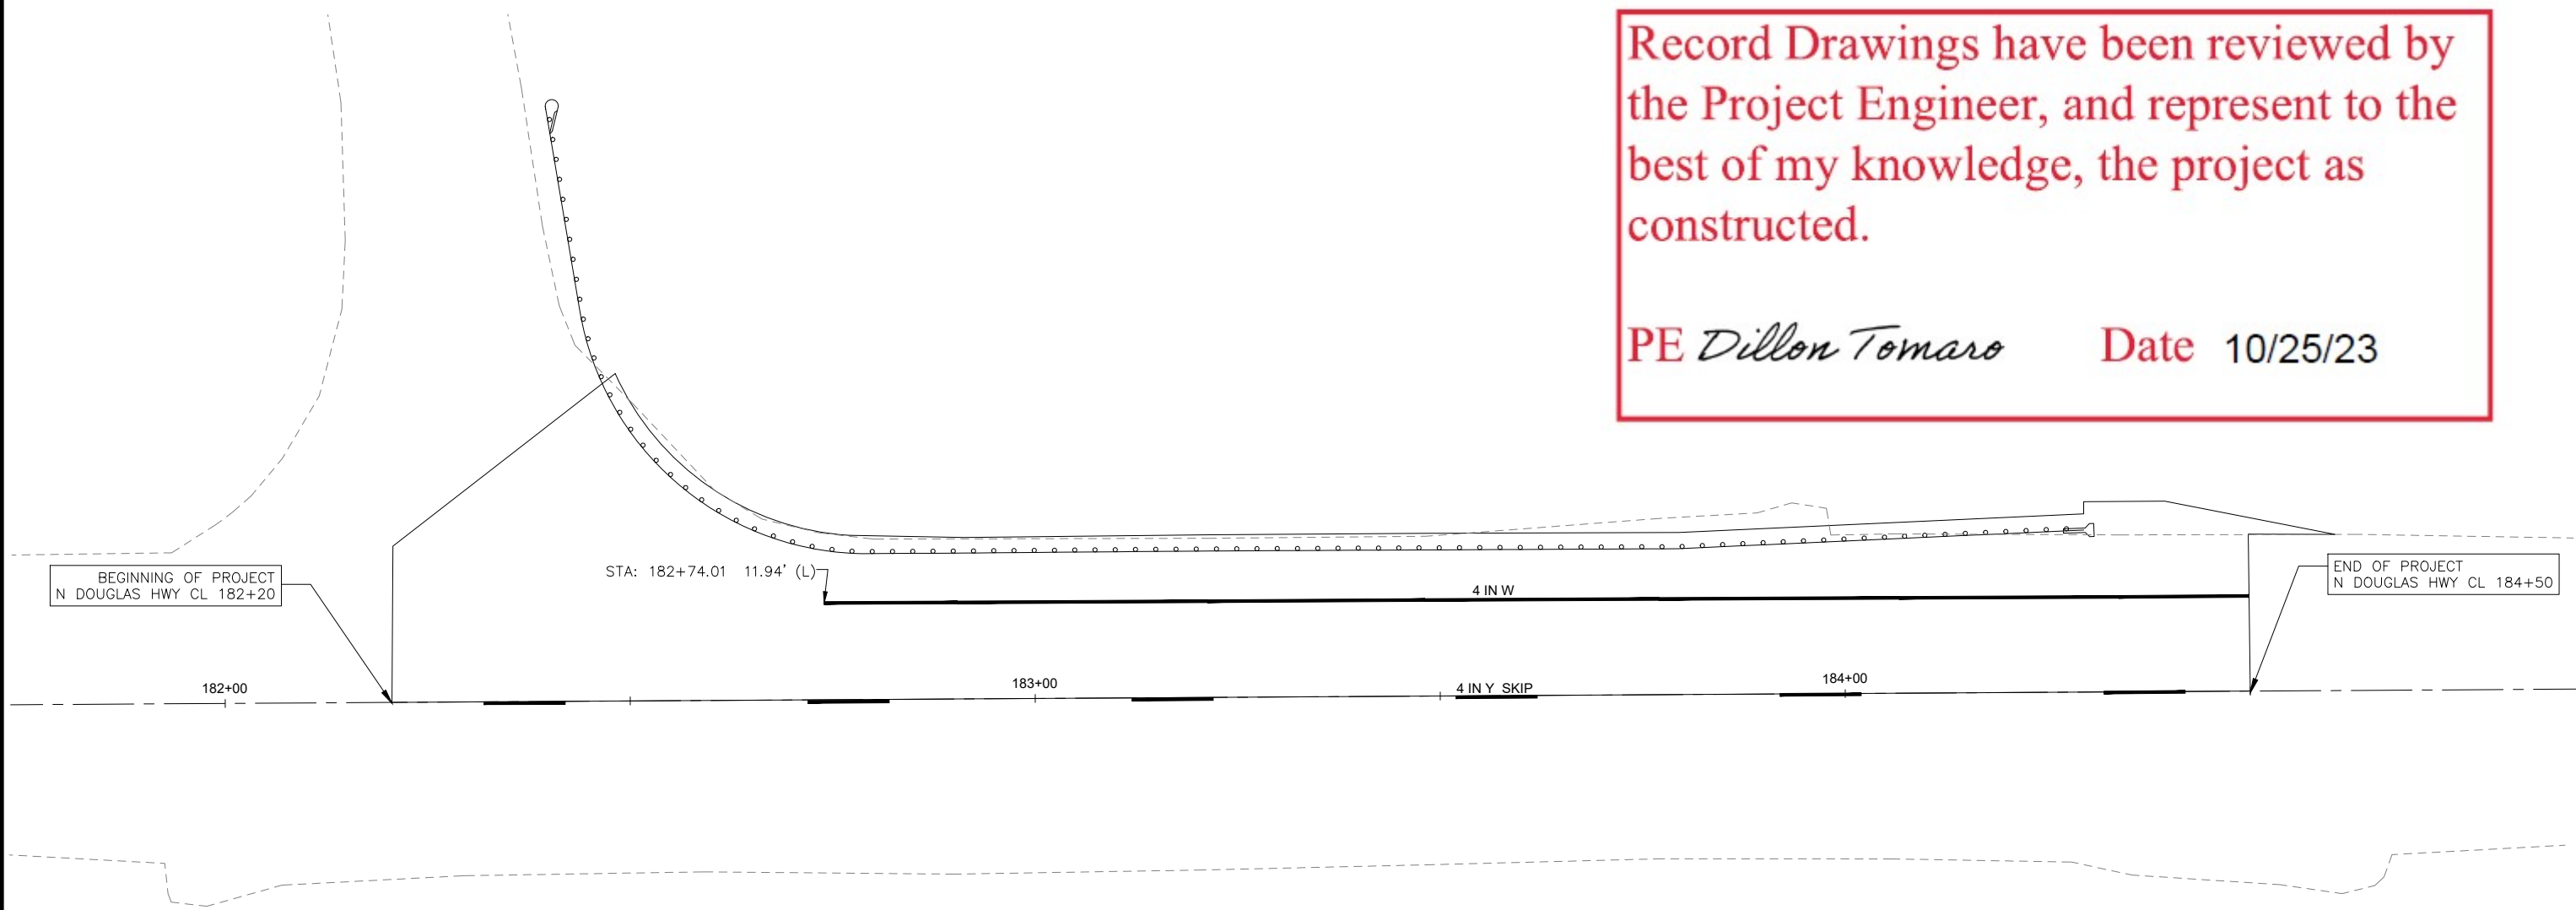

NOTE: MATCH EXISTING PAVEMENT MARKINGS AT EACH END OF PROJECT.

STRIPING LEGEND			
SYMBOL	DESCRIPTION	WIDTH	PATTERN
4 IN W	SOLID WHITE	4"	————
4 IN Y SKIP	YELLOW SKIP	4"	- - - -

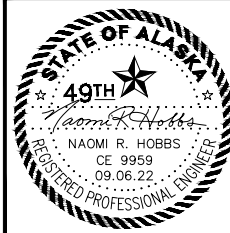

STATE OF ALASKA DEPARTMENT OF TRANSPORTATION AND PUBLIC FACILITIES

JNU NORTH DOUGLAS – BONNIE BRAE
– DEC 20 SE PR


STRIPING PLAN

FIRM: DOWL
 FILE: c:\dowl_pw\40395244\SC-CT-SG-H-63303-03.dwg
 ADDRESS: 9085 GLACIER HIGHWAY, JUNEAU, AK 99801
 PHONE: (907) 780-3533
 DESIGNED: HOBBS
 CHECKED: CHRISTIE
 DRAFTED: BERG
 LAYOUT: H1
 DATE:

CERTIFICATE OF AUTH # : AECL848
 CHRISTIE

NO.	DATE	REVISION	STATE	PROJECT DESIGNATION	YEAR	SHEET NO.	TOTAL SHEETS
3	12/9/2022	BARRIER AND NOTE REVISIONS	ALASKA	0093002/SFHWY00411	2022	T1	14
5	12/13/2022	DRUM, NOTE & SIGN REVISION					


FIRM DOWL
 FILE C:\dowl_pw\0395244\SC-C1-T-63330_03.dwg
 ADDRESS 9085 GLACIER HIGHWAY, JUNEAU, AK 99801
 PHONE (907) 780-3533
 CERTIFICATE OF AUTH # : AECL848
 CHECKED CHRISTIE
 DRAFTED BERG
 DESIGNED HOBBS
 LAYOUT T1
 DATE

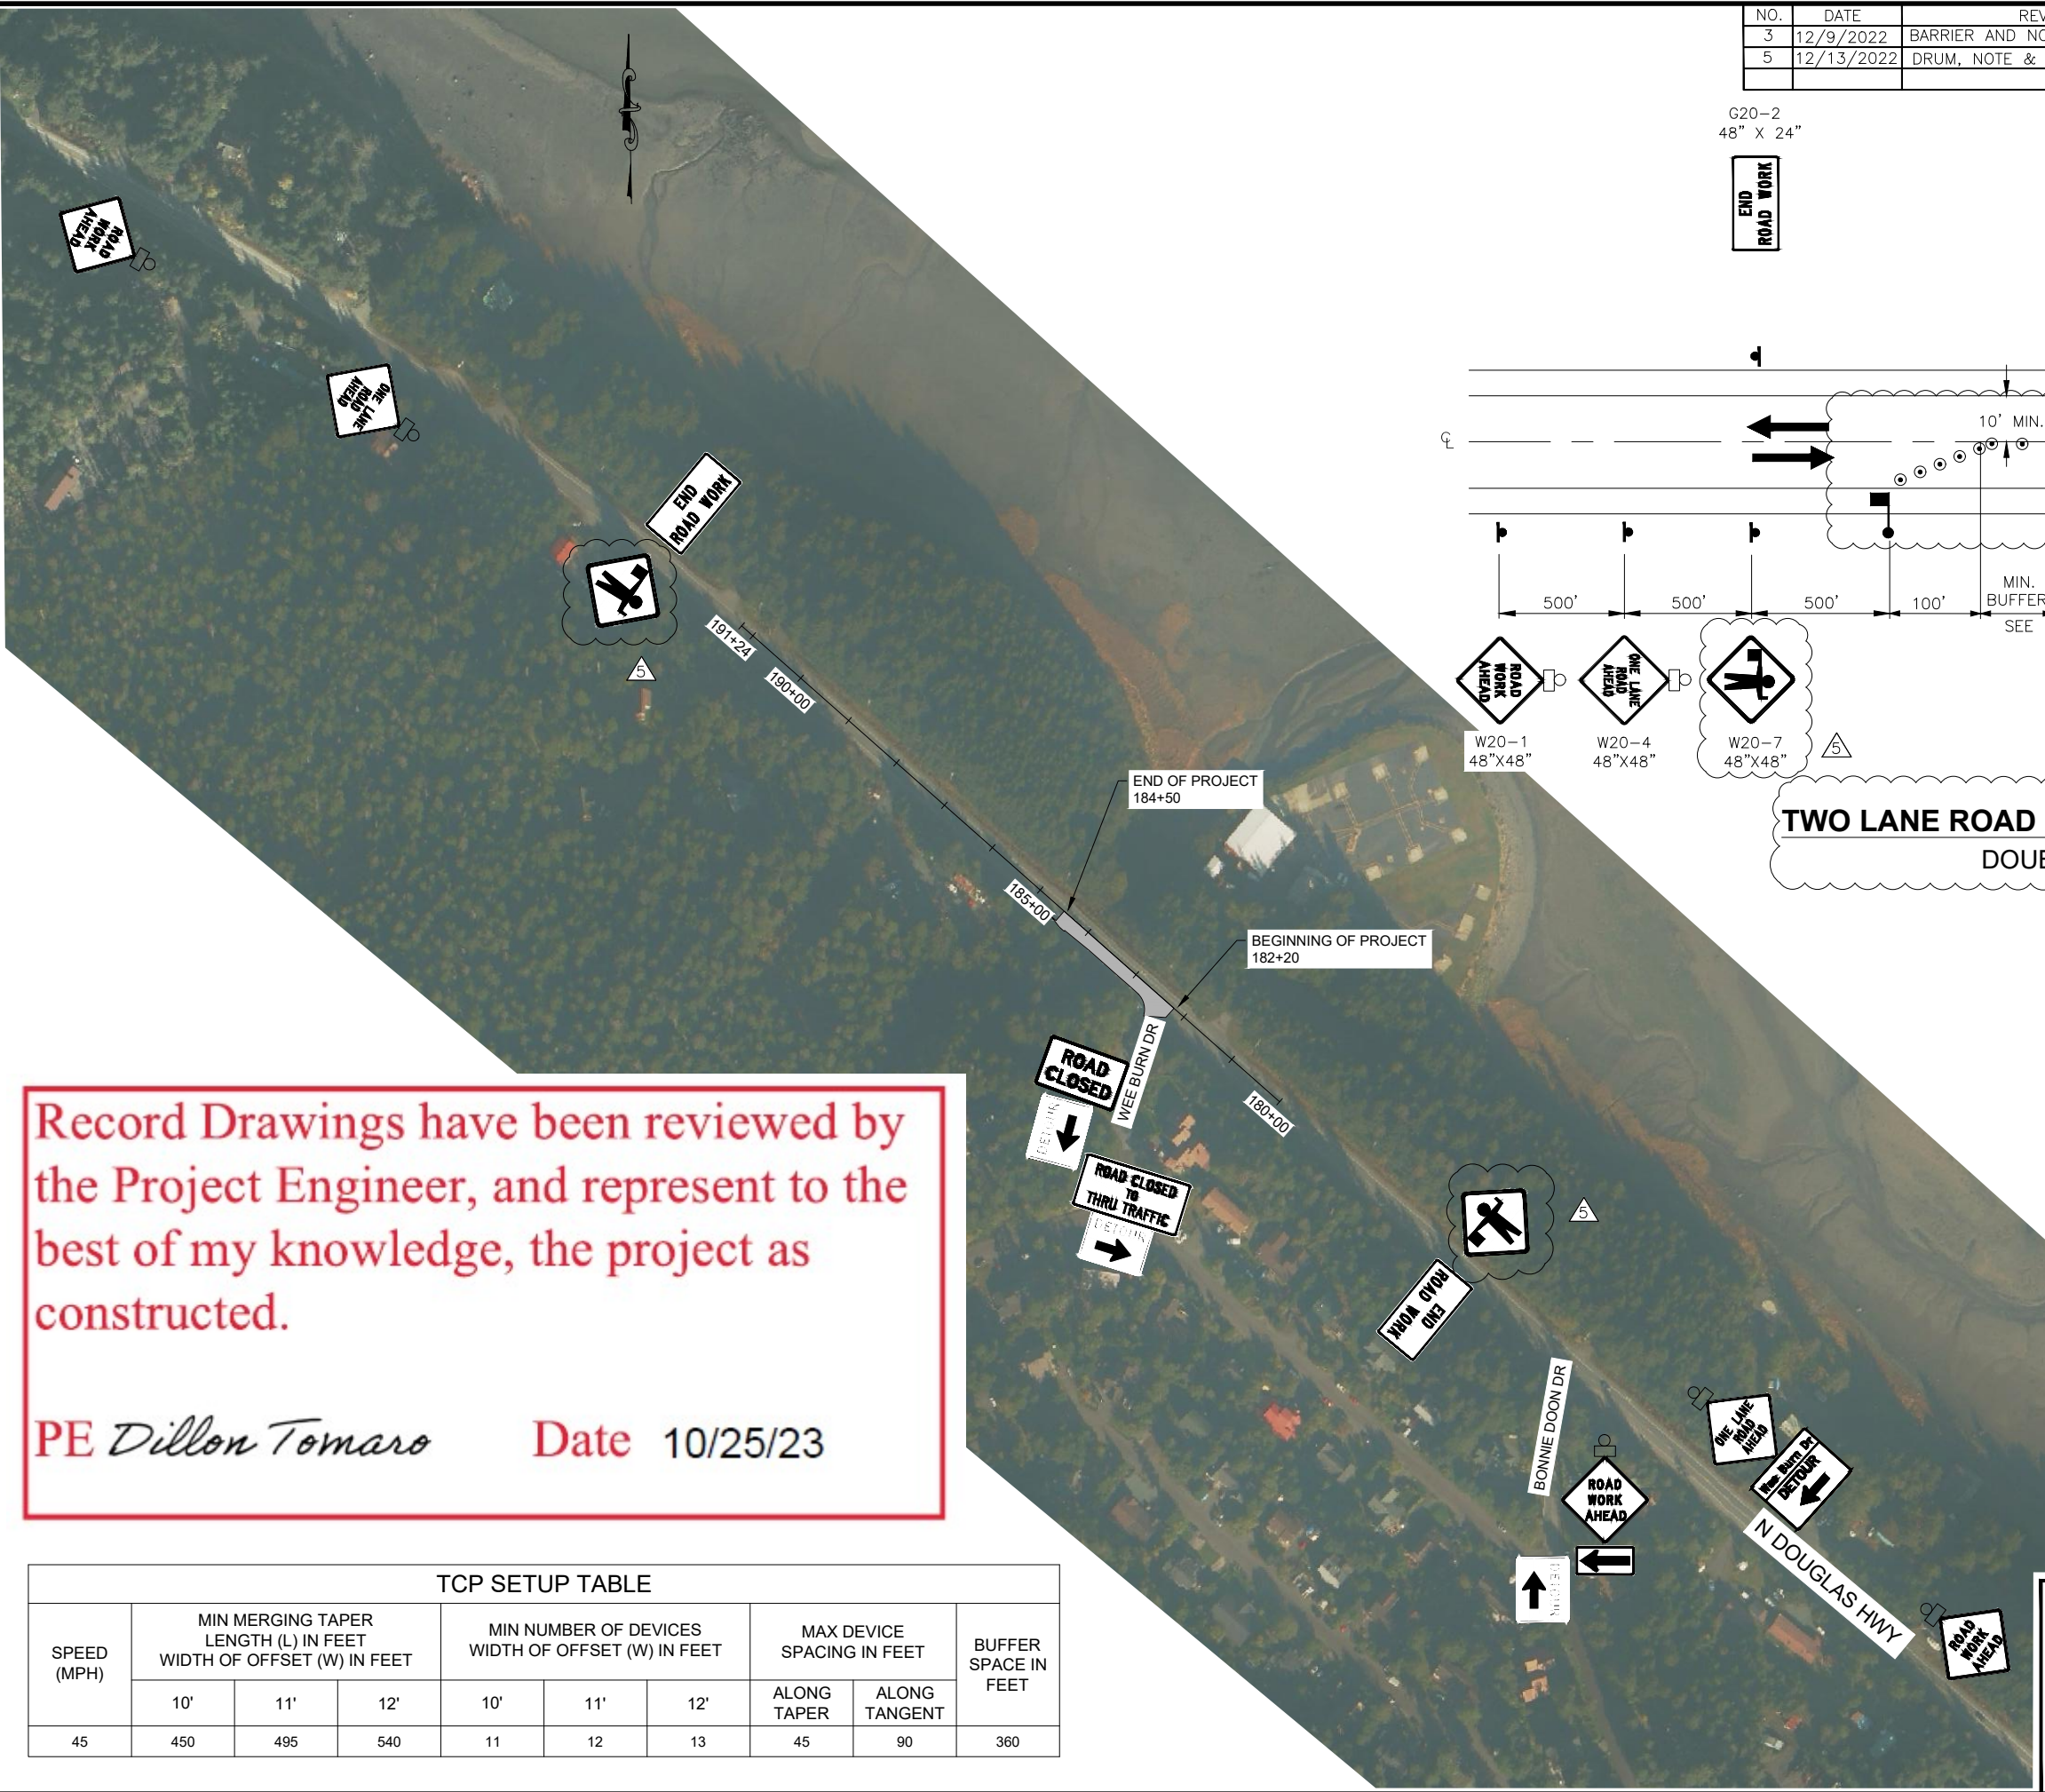


Record Drawings have been reviewed by the Project Engineer, and represent to the best of my knowledge, the project as constructed.

 PE *Dillon Tomaro* Date 10/25/23

SPEED (MPH)	MIN MERGING TAPER LENGTH (L) IN FEET WIDTH OF OFFSET (W) IN FEET			MIN NUMBER OF DEVICES WIDTH OF OFFSET (W) IN FEET			MAX DEVICE SPACING IN FEET		BUFFER SPACE IN FEET
	10'	11'	12'	10'	11'	12'	ALONG TAPER	ALONG TANGENT	
45	450	495	540	11	12	13	45	90	360

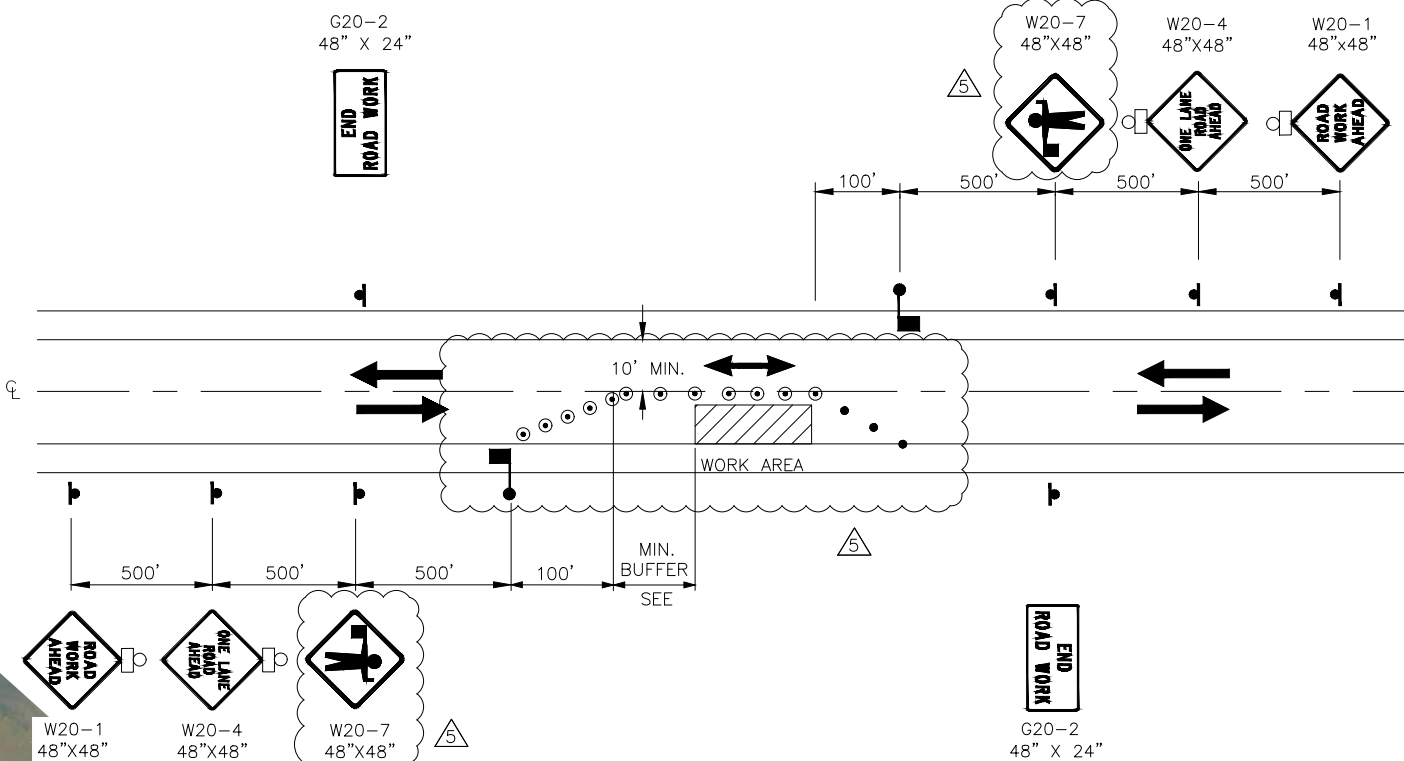

TWO LANE ROAD - SINGLE LANE CLOSURE
DOUBLE FLAGGER

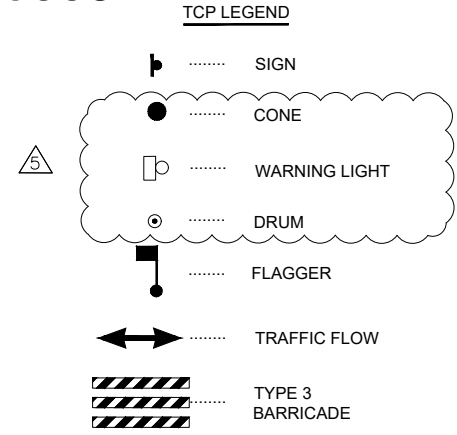

- TRAFFIC CONTROL NOTES:**
- SUBMIT ALL TCPs TO THE ENGINEER FOR APPROVAL.
 - TEMPORARY DRIVING LANES SHALL HAVE A MINIMUM WIDTH OF 10'-0".
 - PLACE CONSTRUCTION SIGNS SUCH THAT THEY DO NOT OBSCURE EXISTING TRAFFIC SIGNS.

TCP NOT SEALED IN ACCORDANCE WITH ALASKA HIGHWAY RECONSTRUCTION MANUAL SECTION 1400.3.5 DATED JANUARY 20, 2012


STATE OF ALASKA DEPARTMENT OF TRANSPORTATION AND PUBLIC FACILITIES

 JNU NORTH DOUGLAS - BONNIE BRAE - DEC 20 SE PR

TRAFFIC CONTROL PLAN

FIRM DOWL
 FILE c:\dowl_pw\0395244\SC-C1-T-63330_03.dwg
 ADDRESS 9085 GLACIER HIGHWAY, JUNEAU, AK 99801
 PHONE (907) 780-3533
 CERTIFICATE OF AUTH # : AECL848
 DESIGNED HOBBS
 CHECKED CHRI STIE
 DRAFTED BERG
 LAYOUT T2
 DATE

NO.	DATE	REVISION	STATE	PROJECT DESIGNATION	YEAR	SHEET NO.	TOTAL SHEETS
			ALASKA	0093002/SFHWHY00411	2022	T2	14

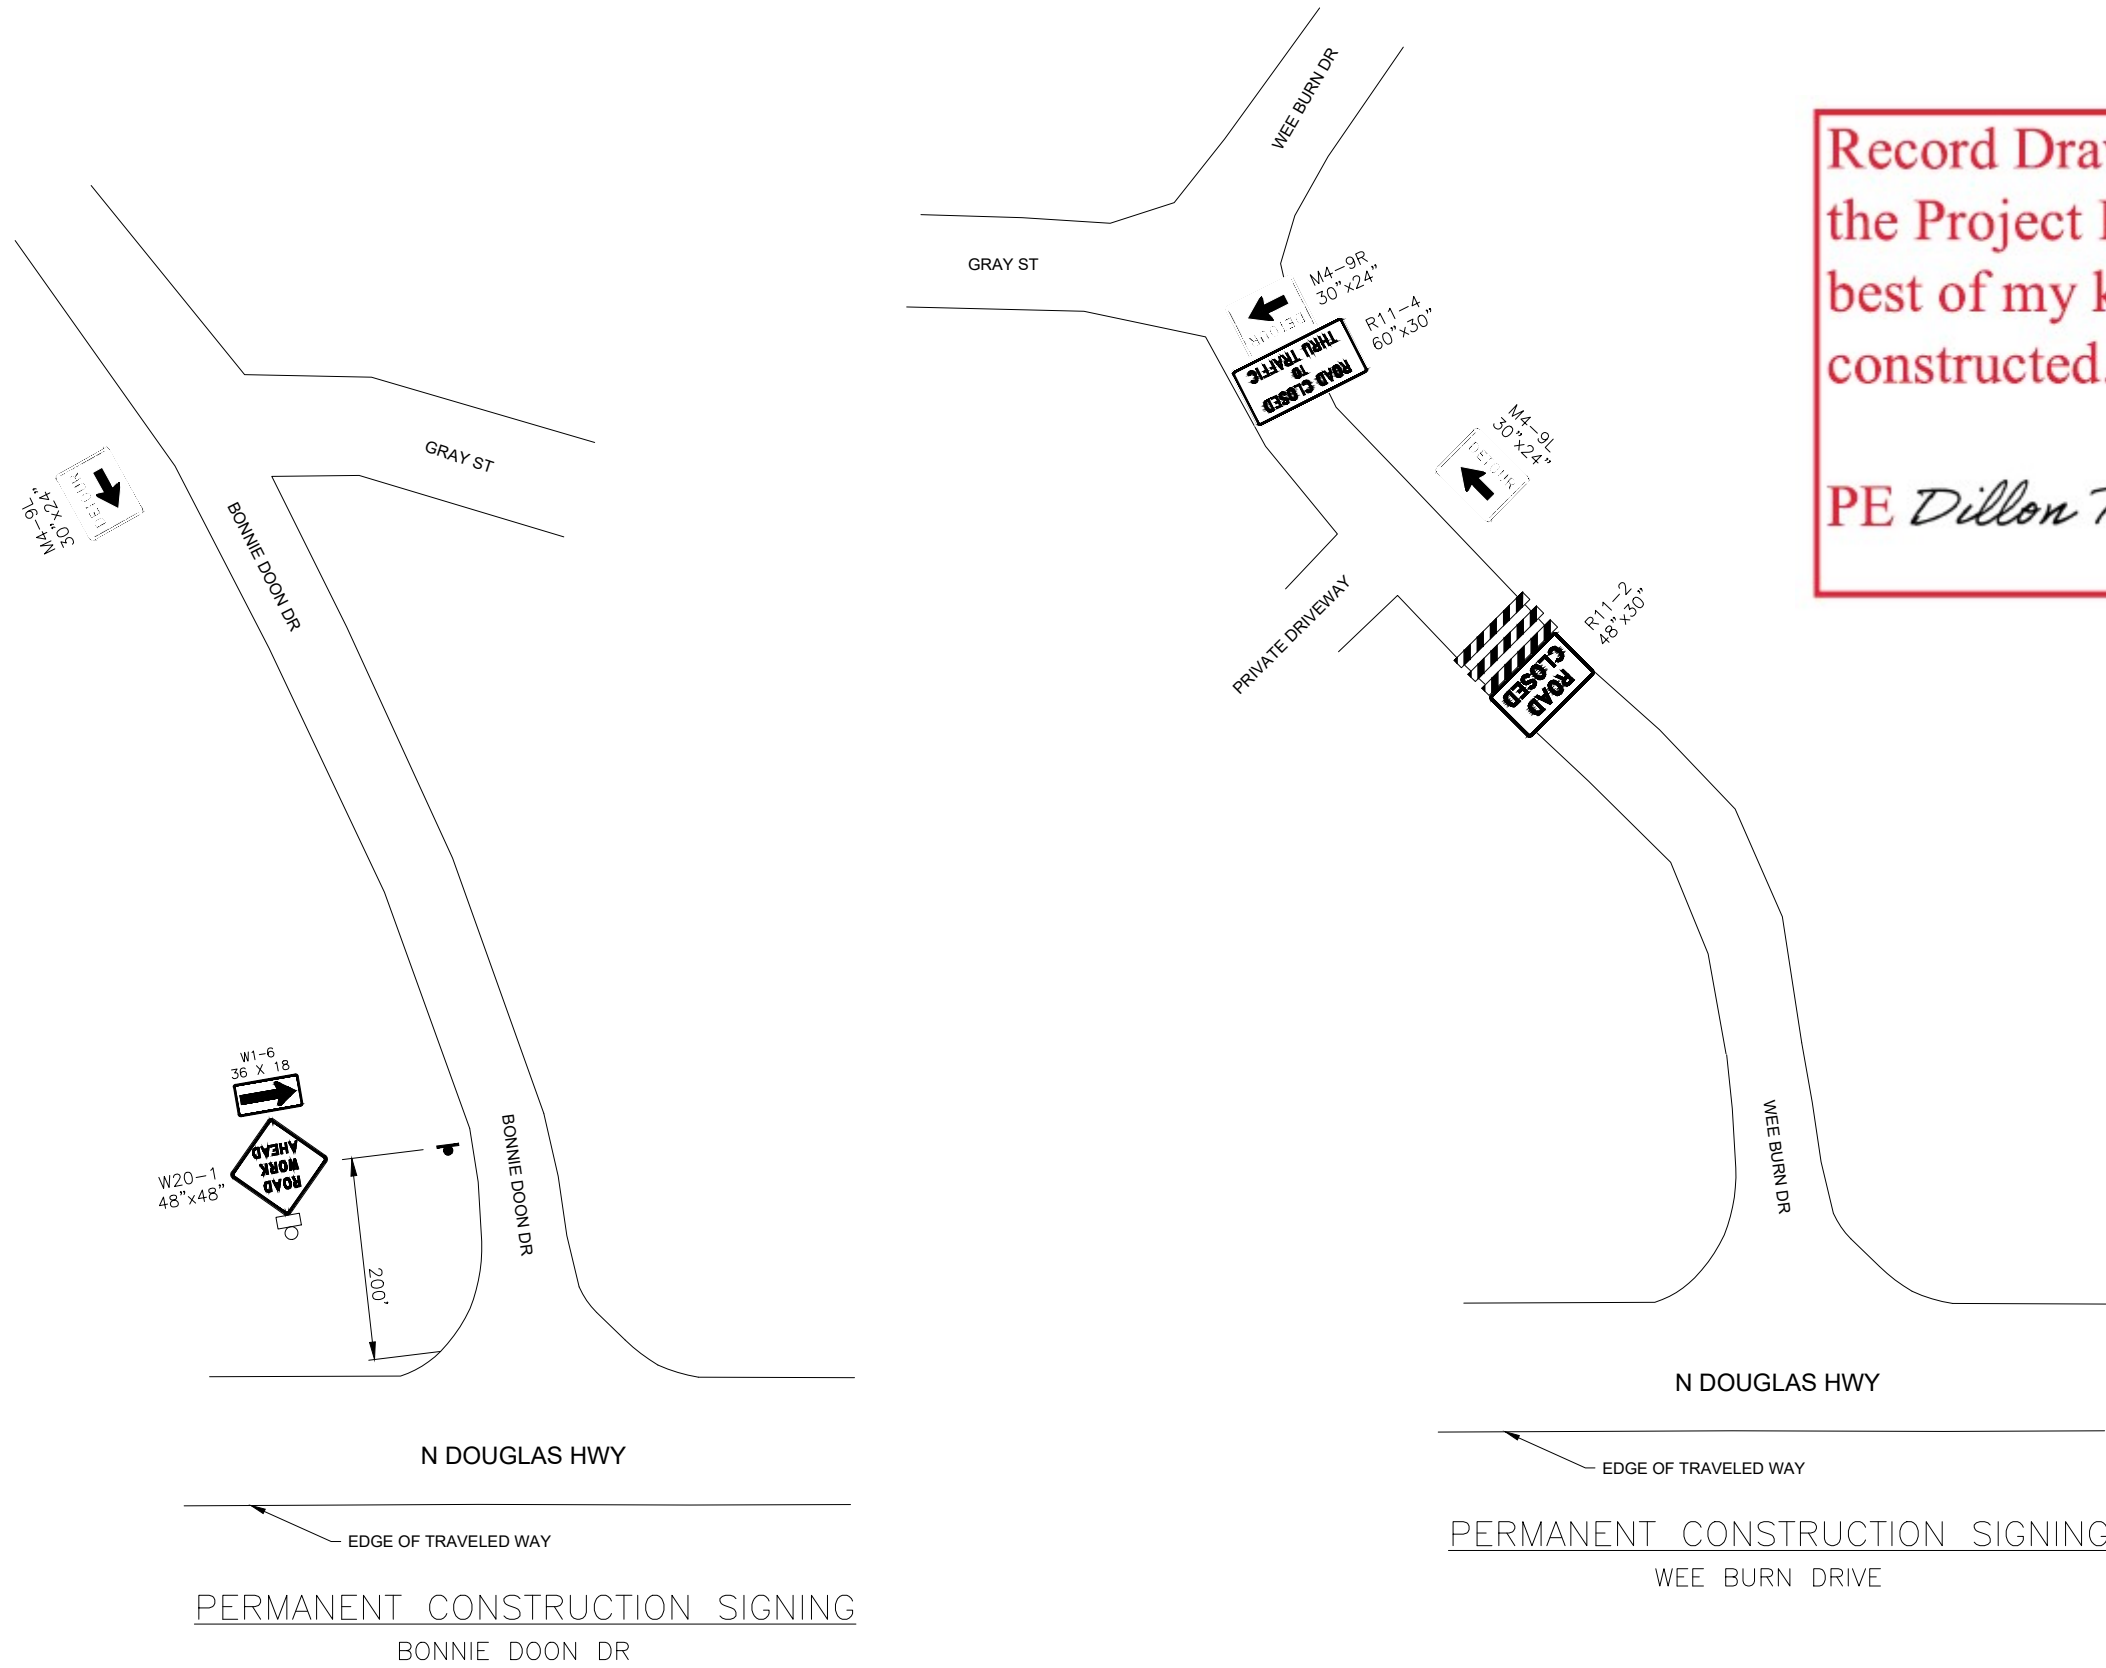

Record Drawings have been reviewed by the Project Engineer, and represent to the best of my knowledge, the project as constructed.


 PE *Dillon Tomaro* Date 10/25/23

TCP NOT SEALED IN ACCORDANCE WITH ALASKA HIGHWAY RECONSTRUCTION MANUAL SECTION 1400.3.5 DATED JANUARY 20, 2012	STATE OF ALASKA DEPARTMENT OF TRANSPORTATION AND PUBLIC FACILITIES JNU NORTH DOUGLAS – BONNIE BRAE – DEC 20 SE PR PERMANENT CONSTRUCTION SIGNS LAYOUT
--	---

NO.	DATE	REVISION	STATE	PROJECT DESIGNATION	YEAR	SHEET NO.	TOTAL SHEETS
3	12/9/2022	BARRIER AND LANE REVISION	ALASKA	0093002/SFHwy00411	2022	T3	14
5	12/13/2022	DRUM REVISION					

Record Drawings have been reviewed by the Project Engineer, and represent to the best of my knowledge, the project as constructed.

PE *Dillon Tomaro* Date 10/25/23

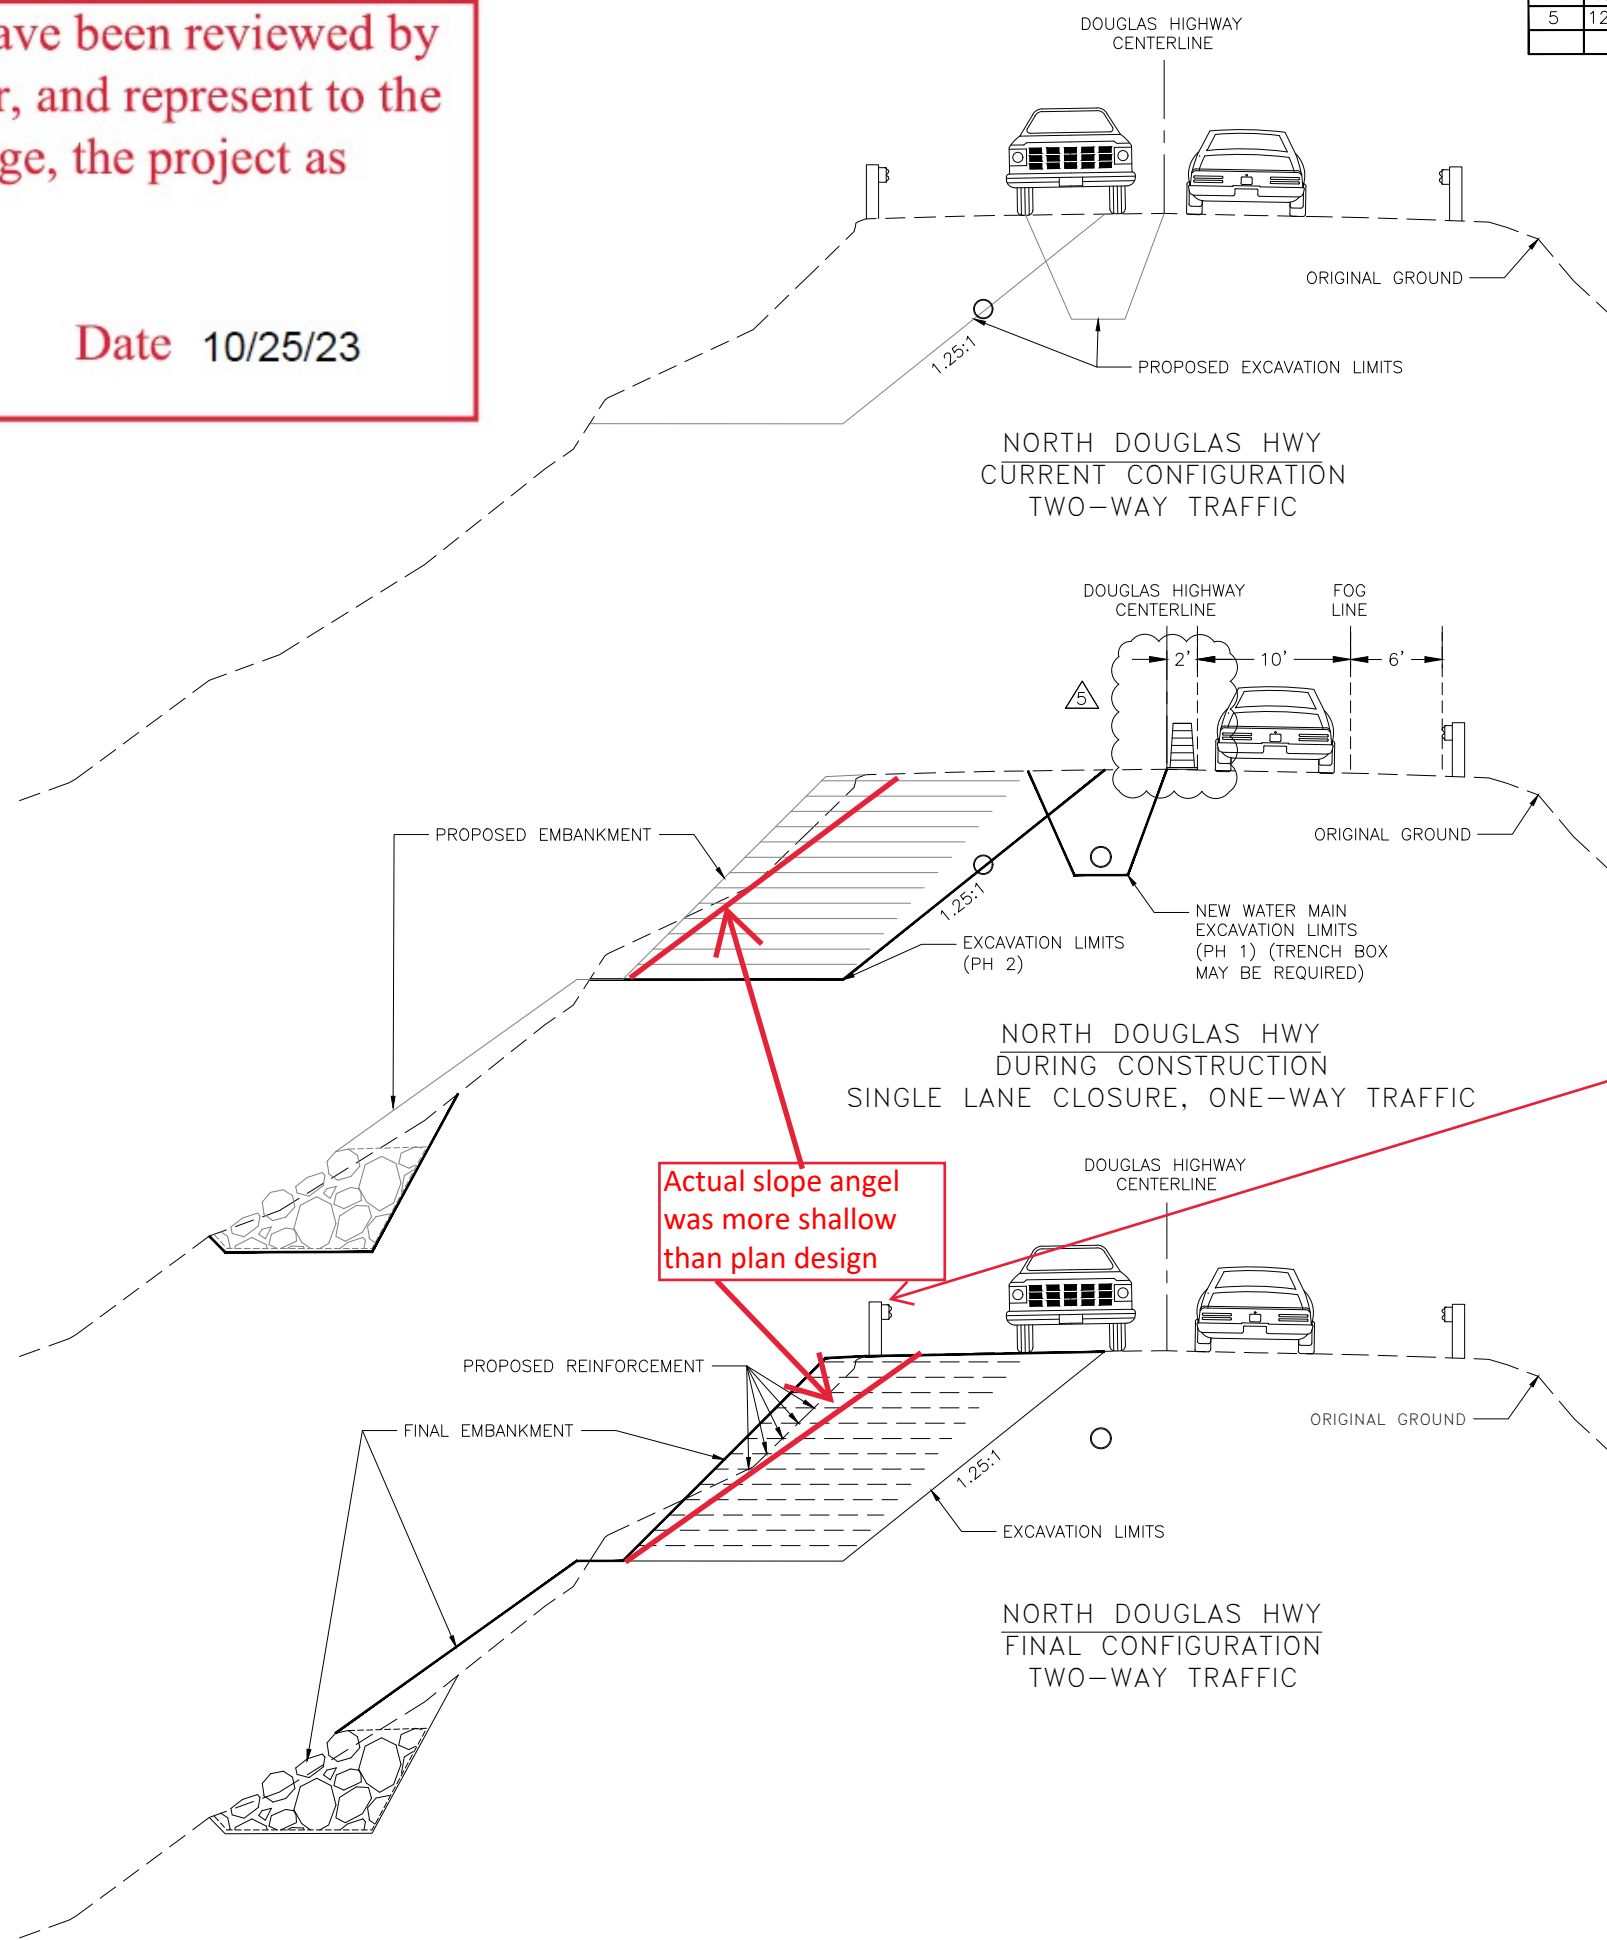

SUGGESTED CONSTRUCTION PHASING:

1. REMOVE PAVEMENT FROM BEGINNING OF PROJECT TO END OF PROJECT IN SOUTHEAST BOUND LANE. MAINTAIN A SINGLE LANE OF TRAFFIC ON THE NORTHWEST BOUND LANE. UTILIZE MODIFIED MUTCD TYPICAL APPLICATION 10 FOR TRAFFIC CONTROL SETUP.
2. EXCAVATE THE SOUTHEAST BOUND ROAD EMBANKMENT AS NEEDED TO INSTALL NEW WATER MAIN AS SHOWN IN PLANS. KEEP WORK WITHIN SOUTHEAST BOUND LANE AND EXCAVATE AS NEEDED TO REACH DESIRED DEPTH, TRENCH BOX MAY BE REQUIRED. MAINTAIN SOUTHEAST BOUND SINGLE LANE CLOSURE.
3. EXCAVATE THE SOUTHEAST BOUND LANE TO THE DATUM OF PAVEMENT STRUCTURAL SECTION NO. 1 AS SHOWN IN THE TYPICAL SECTION. MAINTAIN SOUTHEAST BOUND SINGLE LANE CLOSURE.
4. CONSTRUCT EMBANKMENT ON THE SOUTHEAST BOUND LANE AS SHOWN IN TYPICAL SECTION UNTIL THE GRADE IS BROUGHT EVEN WITH THE PAVEMENT STRUCTURAL SECTION NO. 1 DATUM GRADE. MAINTAIN SOUTHEAST BOUND SINGLE LANE CLOSURE.
5. PAVE THE ROAD AS SHOWN IN THE TYPICAL SECTIONS. MAINTAIN SOUTHEAST BOUND SINGLE LANE CLOSURE.
6. CONSTRUCTION PHASING SHOWN ON THIS SHEET ARE FOR CONCEPTUAL VIEW ONLY. NO WORK SHALL COMMENCE ON SITE UNTIL THE CONSTRUCTION PHASING PLAN (SECTION 643) HAS BEEN APPROVED BY THE ENGINEER.

Guardrail posts with a face of guardrail and slope distance of 2' to 3.5' were driven with 8' posts in accordance standard plans sheet G-10.21 Case 2.

Actual slope angel was more shallow than plan design

FIRM DOWL
 FILE C:\dowl_pw\0395244\SC-C1-T-63330_03.dwg
 ADDRESS 9085 GLACIER HIGHWAY, JUNEAU, AK 99801
 PHONE (907) 780-3533
 CERTIFICATE OF AUTH # : ACCL848
 BERGMAN
 DRAFTED
 CHECKED
 HOBBSJC
 DESIGNED
 T3
 LAYOUT
 DATE

TCP NOT SEALED IN ACCORDANCE WITH ALASKA HIGHWAY RECONSTRUCTION MANUAL SECTION 1400.3.5 DATED JANUARY 20, 2012	STATE OF ALASKA DEPARTMENT OF TRANSPORTATION AND PUBLIC FACILITIES
	JNU NORTH DOUGLAS - BONNIE BRAE - DEC 20 SE PR
	CONSTRUCTION PHASING PLAN

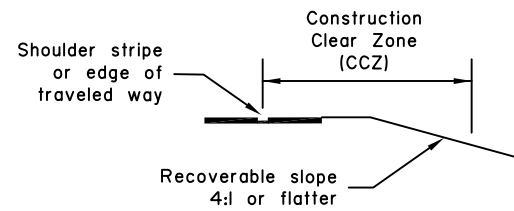


FIGURE 1

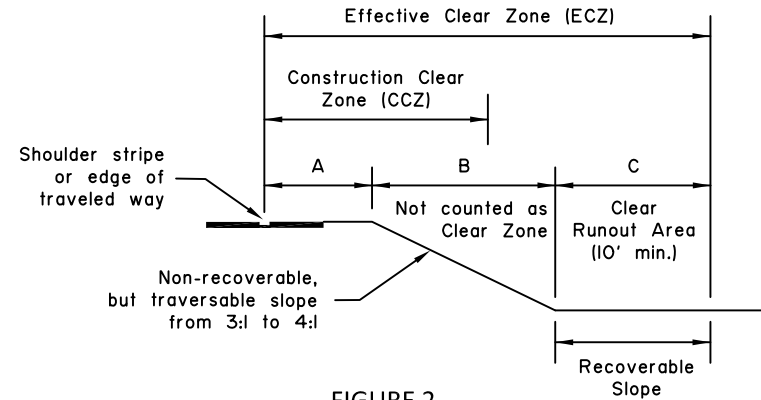


FIGURE 2

Table 1 - Width of Construction Clear Zone (feet)

Hazard	AADT	Posted Speed Limit (MPH)							
		<=30 MPH		35 to 40 MPH		45 to 55 MPH		>=60 MPH	
		6:1 or flatter	5:1 to 4:1	6:1 or flatter	5:1 to 4:1	6:1 or flatter	5:1 to 4:1	6:1 or flatter	5:1 to 4:1
Fill (Fore) & Cut (Back) Slopes	Under 750	5'	5'	6'	8'	8'	12'	12'	16'
	750 - 6,000	6'	10'	8'	12'	14'	18'	20'	26'
	Over 6,000	10'	10'	12'	14'	16'	20'	22'	28'
Fixed Objects	All	15'		30'					

Table 2 - Treatment for Hazards Within Construction Clear Zone

Roadside Condition to be Treated	Category	Treatment
Fill (Fore) Slopes, including trenches	Steeper than 3:1 or water 3 ft. or deeper	Use Table 5 to select from the following two options: 1. Install rigid barrier or guardrail if the condition warrants barrier, or 2. Use drums or Type II barricades if the condition does not warrant barrier.
	3 : 1 to 4 : 1	1. Use drums or Type II barricades if 10 ft. of runoff at the bottom of the slope is not clear of obstructions. 2. No traffic control devices are required if 10 ft. of runoff at the bottom of the slope is clear of obstructions. 3. If water 3 ft. or deeper is at bottom of slope, use Table 5.
	Flatter than 4 : 1	No traffic control devices are required, except when water 3 ft. or deeper is in construction clear zone use Table 5.
Fixed Objects	All	Install rigid barrier or guardrail if called for by the plans or specifications. Otherwise use SSHC Section 643-3.04.3 - Fixed Objects.

GENERAL NOTES:

1. The "Construction Clear Zone" (CCZ) may be called "Work Zone Clear Zone" or "Clear Zone in Work Zones" in other publications.
2. In the case of conflicts, this Standard Plan has lesser precedence than Section 643 (Traffic Maintenance) of the Standard Specifications for Highway Construction (SSHC).
3. During seasonal shutdown or if construction activity is scheduled for suspension for 45 days or more, treat hazards within a 30 foot CCZ width or within the permanent design clear zone (CZ) width.
4. These guidelines are not comprehensive and are not intended to limit the use of safety measures.
5. During pilot car operations, keep fixed objects and other hazards, 2 feet or farther, away from the edge of traveled way and delineate with channelizing devices as required by the Engineer.

INSTRUCTIONS FOR USING TABLES 1 THROUGH 5:

Use The following tables to determine how to treat roadside fixed object or slopes (including trenches, berms and material stockpiles) in construction clear zones.

TABLE 1: Use to determine whether the hazard is within the CCZ

TABLE 2: Use to determine the appropriate treatment for hazards within the CCZ. No treatment is required for fixed objects or slopes outside the CCZ.

TABLES 3a and 3b: Use to determine appropriate treatment for pavement edge dropoffs.

TABLE 4: Use to determine barrier flare rates.

TABLE 5: Use to determine whether drums or Type II barricades, or temporary barrier or guardrail, are required on fill slopes or for water hazards.

TABLE 1 NOTES:

1. Measure CCZ from the shoulder stripe. If there is no shoulder stripe, measure from the edge of the traveled way. See Figure 1.
2. If CCZ include or ends on a slope of 3:1 to 4:1, use the Effective Clear Zone (ECZ) that extends beyond the bottom of the slope to provide a clear runout area of 10 foot minimum width. The ECZ width must equal or greater than the CCZ width from Table 1. See Figure 2 and verify that A+C ≥ CCA and C ≥ 10 feet.
3. If a CCZ includes or ends on a slope steeper than 3:1, the top of slope must be delineated by channelizing devices or protected by barrier.
4. The term "fixed objects" is defined in Section 643-1.02 of the SSHC.
5. AADT stands for Average Annual Daily Traffic. Use the higher of the as listed in the plans or the average of June/July/August ADT's, unless otherwise specified by the Engineer.

TABLE 2 NOTES:

1. Eliminate non-traversable slopes (those steeper than 3:1) and fixed objects (as defined in Section 643-1.02 of the SSHC) within the CCZ when practicable. They should only be left in place and treated as shown in this table when elimination is not practicable.
2. Maintain a 2-foot minimum wide lateral buffer space between the edge of traveled way and work areas. This provides an area to install barriers or other delineation by channelizing devices.
3. If necessary to treat multiple hazards on the same road segment (slopes and fixed objects), choose treatments from Table 2 that satisfy the requirements for the most significant of the multiple hazards.

**State of Alaska DOT&PF
ALASKA STANDARD PLAN
ROADSIDE SAFETY TREATMENT
FOR WORK ZONES**

Adopted as an Alaska Standard Plan by: *Carolyn A. Morehouse*
Carolyn Morehouse, P.E.
Chief Engineer

Adoption Date: 09/15/2022

Last Code and Stds. Review
By: LRG Date: 09/15/2022

Next Code and Standards Review date: 09/15/2032

C-06.00

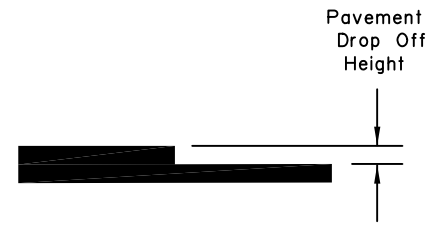


FIGURE 3
Pavement Drop-off Detail

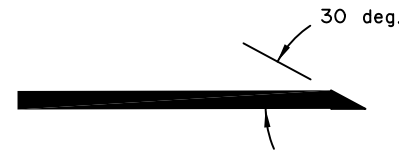


FIGURE 4
Safety Edge Detail

Table 3a - Treatment for Pavement Edge Drop-offs for Posted Speeds > 30 MPH

Nominal Lift Thickness / Height of Pavement Edge Drop-off	Between Active Lanes of traffic moving in same direction	Between Active Lanes of traffic moving in opposing directions	Outside Pavement Edge (if within 3' of traveled way)	Outside Pavement Edge if more than 3' from traveled way and within the CCZ	Across Active Lane, and Entrance and Exit Ramps
0 to 1.0"	No Edge Treatment or Signage Required				
More than 1.0" to 2.0"	UNEVEN LANE Signs		LOW SHOULDER Signs		
More than 2.0" to 3.0"	UNEVEN LANES Signs - Use Channelizing Devices or Safety Edge	UNEVEN LANES Signs - Use Channelizing Devices	LOW SHOULDER Signs - Use Channelizing Devices - Consider Safety Edge	LOW SHOULDER Signs	
More than 3.0" to 6.0"	UNEVEN LANES Signs - Use Channelizing Devices and Use Safety Edge	UNEVEN LANES Signs - Use Channelizing Devices	SHOULDER DROP OFF Signs - Use Channelizing Devices and Safety Edge; or Use Barrier	SHOULDER DROP OFF Signs - Use Channelizing Devices or Barrier	
More than 6"	Prohibited		Barrier - Installed on traffic side of drop-off	Channelizing Devices or Barrier according to Table 5	

TABLE 3 NOTES:

1. This table applies to pavement edge drop-offs that are adjacent to traffic and left after the pavement shift ends and for posted speeds > 30 mph. Use engineering judgment for edge treatment for posted speeds ≤ 30 mph.
2. Use interim pavement markings and signs as required according to Standard Plan C-05 (for all conditions).
3. A Safety Edge is a formed pavement edge taper sloped at approximately 30°, but not more than 35° from horizontal.
4. Use a Safety Edge for longitudinal or diagonal pavement edge drop-offs more than 2 inches within a traveled lane. See Figure 3. Use a Safety Edge on longitudinal joints between lanes as required by Table 3a.
5. The "Across Active Lane, and Entrance and Exit Ramps" column applies to any location where motorists will cross pavement drop-offs (includes transverse construction joints) at an acute angle (45° or more). Taper may be reduced to 6:1 at posted speeds of 30 mph or less.
6. Signage applies to all posted speed for edge drop-offs as shown in Table 3a. For information on signs and locations, see SSHC Section 643-3.04 and the Alaska Traffic Manual (ATM). Signs should be placed at the beginning and end points of each paved segment, and in locations between as specified. Also, see Table 3b.
7. "Channelizing Devices" means drums with steady-burn lights, candle, or cones.
8. Treatment for pavement edge drop-offs are in addition to Treatment for Hazards within Construction Clear Zones (CCZs) (i.e. fixed obstacle or slope protection may also be required).

BARRIER TERMINATION AND TABLE 4 NOTES:

1. Terminate portable rigid barrier (concrete or metal) with one of the following methods:
 - a) An NCHRP 350 or MASH TL-3 approved end treatment or crash cushion.
 - b) An NCHRP 350 or MASH TL-3 approved buried-in-backslope treatment
 - c) A Thrie-Beam transition according to Std. Plan G-32 (except attached to a rigid barrier instead of a bridge rail) and terminated with a MASH TL-3 end treatment.
 - d) Terminate outside the CCZ by flaring barriers away from the roadway at the rate shown in Table 4 for rigid barriers (maximum 10:1 cross slope in front of the barrier).
 - e) Sloped ends may be used to terminate barriers within the CZ when the regulatory (black on white sign) speed limit is 30 mph or below. For speeds more than 30 mph, the Engineer may approve sloped ends if they determine NCHRP 350 or MASH compliant end treatments are impracticable. See Std. Plan G-46 for concrete barrier sloped ends.
2. Terminate temporary W-Beam guardrail with one of the following methods:
 - a. With a MASH TL-3 approved end treatment
 - b. By burying it in a backslope according to Std. Plan G-16
 - c. By flaring the guardrail away from the road at the rate shown in Table 4 for semi-rigid barriers (maximum 10:1 cross slope in front of the guardrail).
 - d. Terminate outside the CZ.

Table 3b - Sign Numbers

Legend	Number	ATM * Ref.
UNEVEN LANES	W8-11	6F.45
LOW SHOULDER	W8-9	6F.44
SHOULDER DROP OFF (Symbol)	W8-17	6F.44
SHOULDER DROP OFF (Plaque)	W8-17P	6F.44
BUMP	W8-1	2C.28

* ATM = Alaska Traffic Manual

Table 4 - Barrier Flare Rates

Speed (mph)	Flare Rate	
	Rigid	Semi-Rigid
70	20:1	15:1
60	18:1	14:1
55	16:1	12:1
50	14:1	11:1
45	12:1	10:1
40	10:1	8:1
30	8:1	7:1

State of Alaska DOT&PF
ALASKA STANDARD PLAN


**ROADSIDE SAFETY TREATMENT
FOR WORK ZONES**

Adopted as an Alaska Standard Plan by: *Carolyn H. Morehouse*
Carolyn Morehouse, P.E.
Chief Engineer

Adoption Date: 09/15/2022


Last Code and Stds. Review
By: LRG Date: 09/15/2022

Next Code and Standards Review date: 09/15/2032

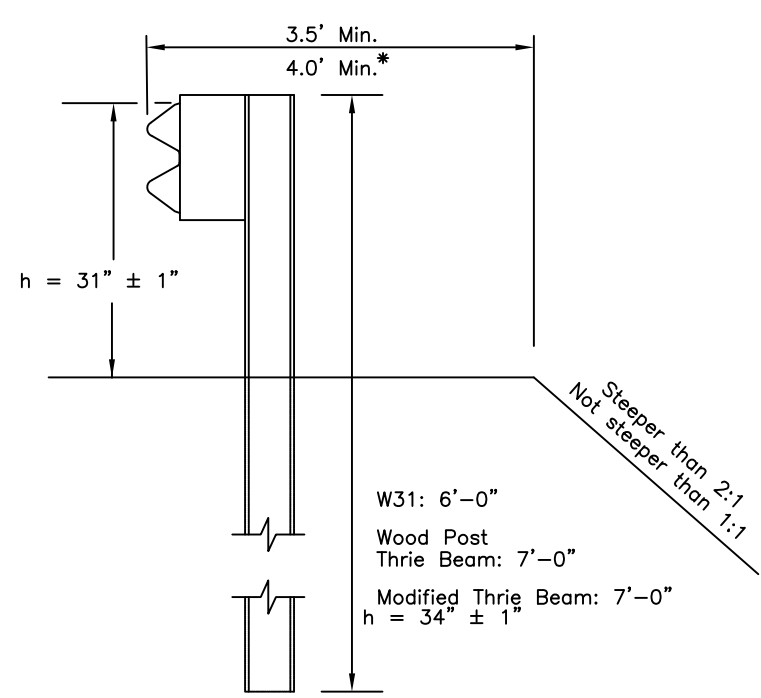


CASE 1

* with Modified Thrie Beam

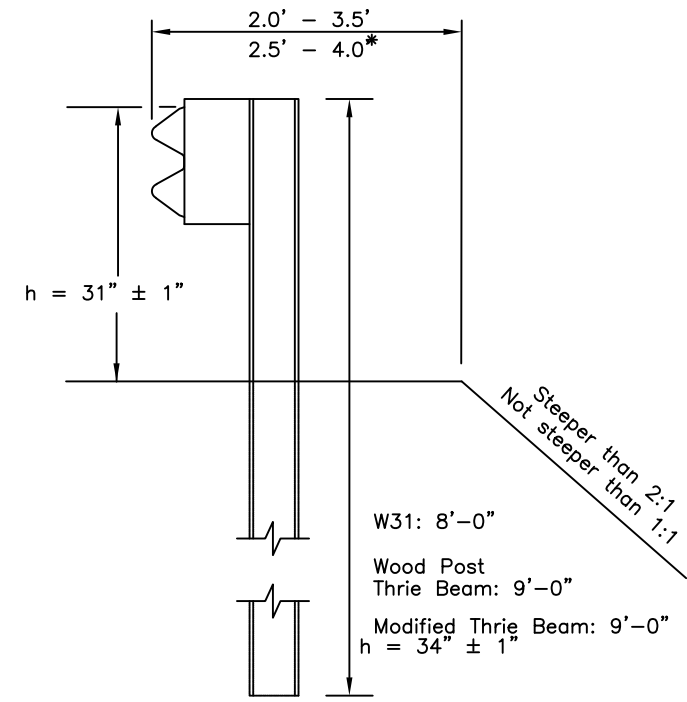


CASE 2

* with Modified Thrie Beam

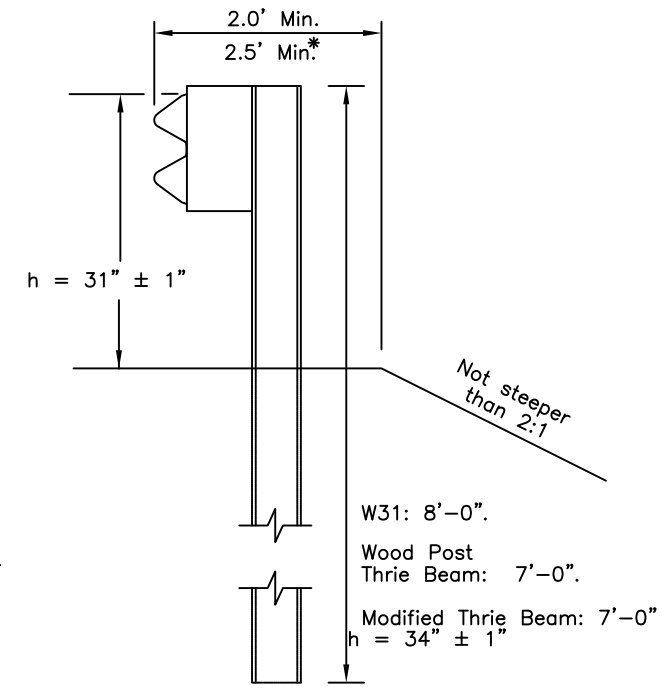


CASE 3

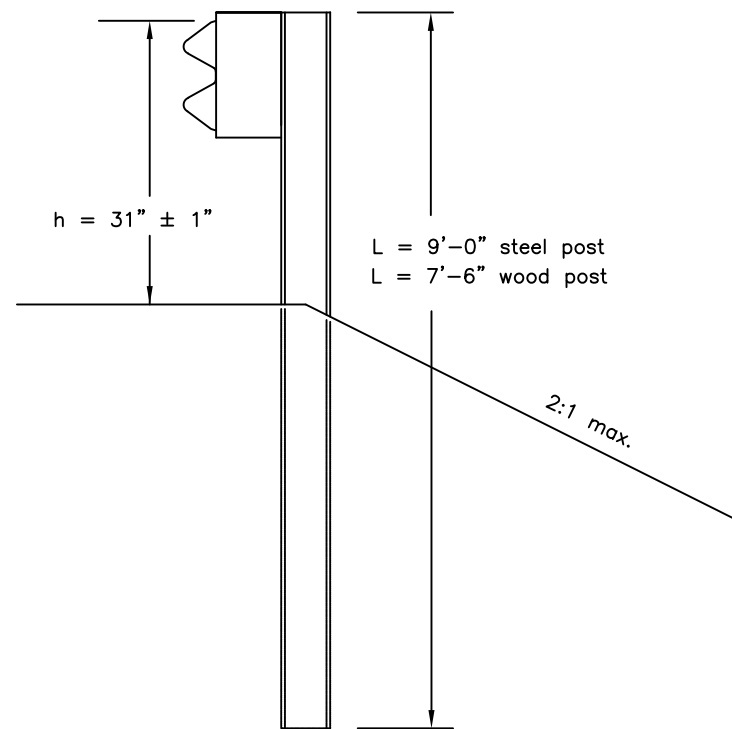

CASE 4

(See Note 5)

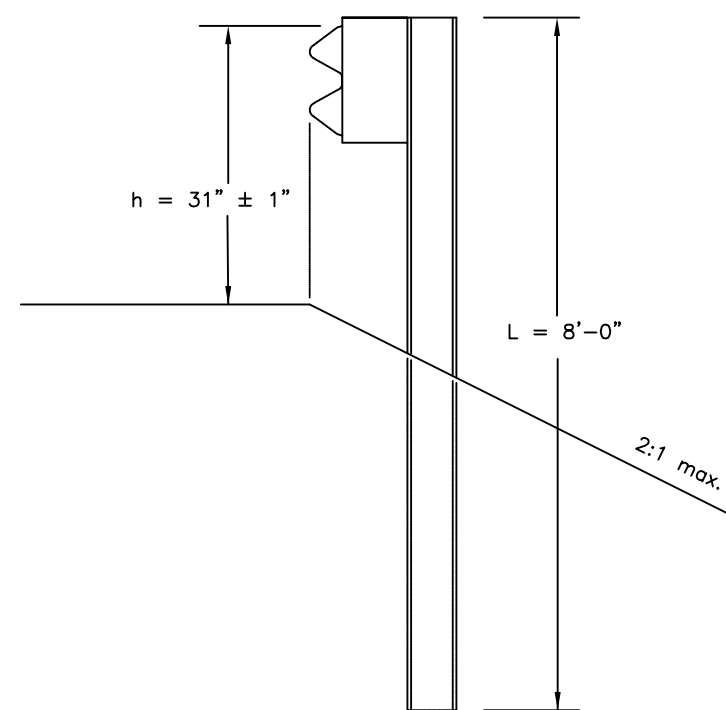

CASE 5

(See Note 5)

CONSTRUCTION NOTES:

1. This drawings is to be used for post length determination only. See Plans for slopes and behind-post embankment widths.
2. To determine post length, identify the case that matches site conditions and read the length corresponding to the pertinent guardrail type.
3. These dimensions apply to both curbed and uncurbed section.
4. Case 1, 2 and 3 are shown with steel posts. Wood posts may be substituted when allowed by specifications. Wood Post Thrie Beam installations must use wood posts only.
5. Case 4 and 5 apply to W31 guardrail only.

DESIGN NOTES:

1. No fixed objects allowed within 48" of the back of post for Cases 1, 2, 3, 4, and 5.

State of Alaska DOT&PF
ALASKA STANDARD PLAN

GUARDRAIL POST
INSTALLATION

Adopted as an Alaska Standard Plan by: *Carolyn H Morehouse*

Carolyn Morehouse, P.E.
Chief Engineer

Adoption Date: 09/15/2022

Last Code and Stds. Review
By: LRG Date: 09/15/2022

Next Code and Standards Review date:09/15/2032