

NO.	DATE	REVISION	STATE	PROJECT DESIGNATION	YEAR	SHEET NO.	TOTAL SHEETS
			ALASKA	0093003/SFHWHY00414	2024	A1	24
CDS ROUTE: 296000			MILEPOINT: 12.000 TO 12.114				
LATITUDE: 58° 23' 07"N			LONGITUDE: 134° 39' 30"W				

STATE OF ALASKA
DEPARTMENT OF TRANSPORTATION
&
PUBLIC FACILITIES

PROPOSED HIGHWAY PROJECT

0093003/SFHWHY00414

JNU WAYDELICH CREEK: UPPER & LOWER WALL REPAIRS

FHWA FUNDING SOURCES: UPPER WALL (ER) & LOWER WALL (PM)

GRADING, DRAINAGE, PAVING, STRIPING, AND RETAINING WALL STABILIZATION

DESIGN DESIGNATIONS

FUNCTIONAL CLASS:	PRINCIPAL ARTERIAL
ADT (2022)	7,500
ADT (2045)	8,363
DHV (2022)	833
DHV (2045)	928
PERCENT TRUCKS (T)	5.16%
DIRECTIONAL SPLIT (D)	35-65%
DESIGN SPEED (V)	35 MPH

PROJECT SUMMARY

WIDTH OF PAVEMENT	8'
LENGTH OF PAVING	90'
LENGTH OF PROJECT	600'

Record Drawings have been reviewed by the Project Engineer and represent the project as constructed.

Dillon Tomaro 3/26/26
Signature Date

The undersigned hereby certifies that this duplicated document is an exact and true copy of the original.

Ray Kim

October 4, 2024

As-Built Plans


Contractor: SECON
Project Engineer: Dillon Tomaro
Start Date of Physical Work: 3/27/25
End Date of Physical Work: 7/31/25

USE THESE PLANS IN CONJUNCTION WITH THE STATE OF ALASKA STANDARD SPECIFICATIONS FOR HIGHWAY CONSTRUCTION, 2020 EDITION AND THE PROJECT SPECIAL PROVISIONS.


JOEL OSBURN, P.E., PROJECT MANAGER

STATE OF ALASKA
DEPARTMENT OF TRANSPORTATION
&
PUBLIC FACILITIES


DocuSigned by: *Kirk Miller* 6/27/2024
APPR CFE1F1F341494BA... DATE
Kirk Miller, P.E.
Precor DocuSigned by: *Christopher Goins* 6/27/2024
ACCE 2E12E08EB67041B... DATE
Christopher Goins, P.E., C.M.
Regional Director, Southcoast Region

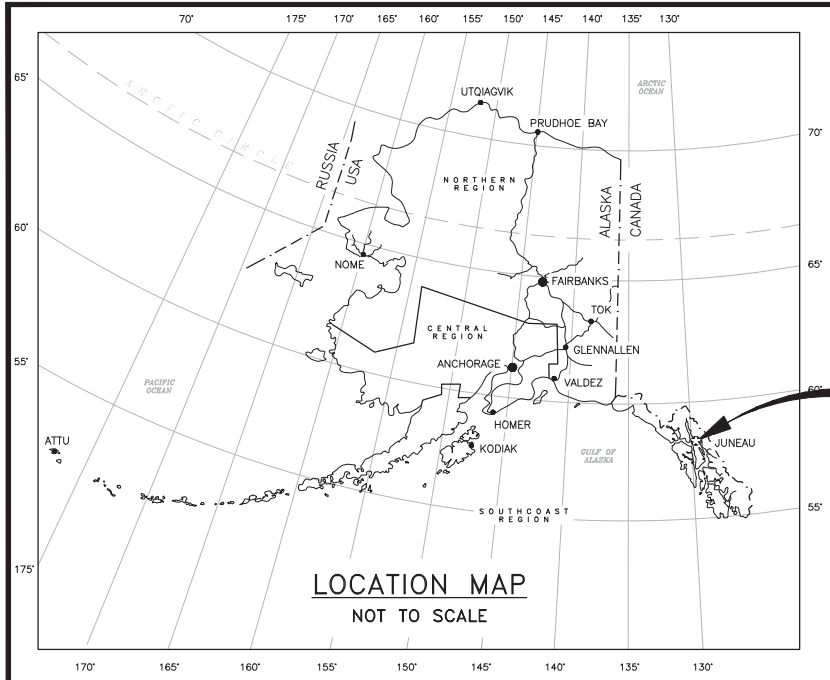

PROJECT LOCATION
M&O
STATION
JUNEAU

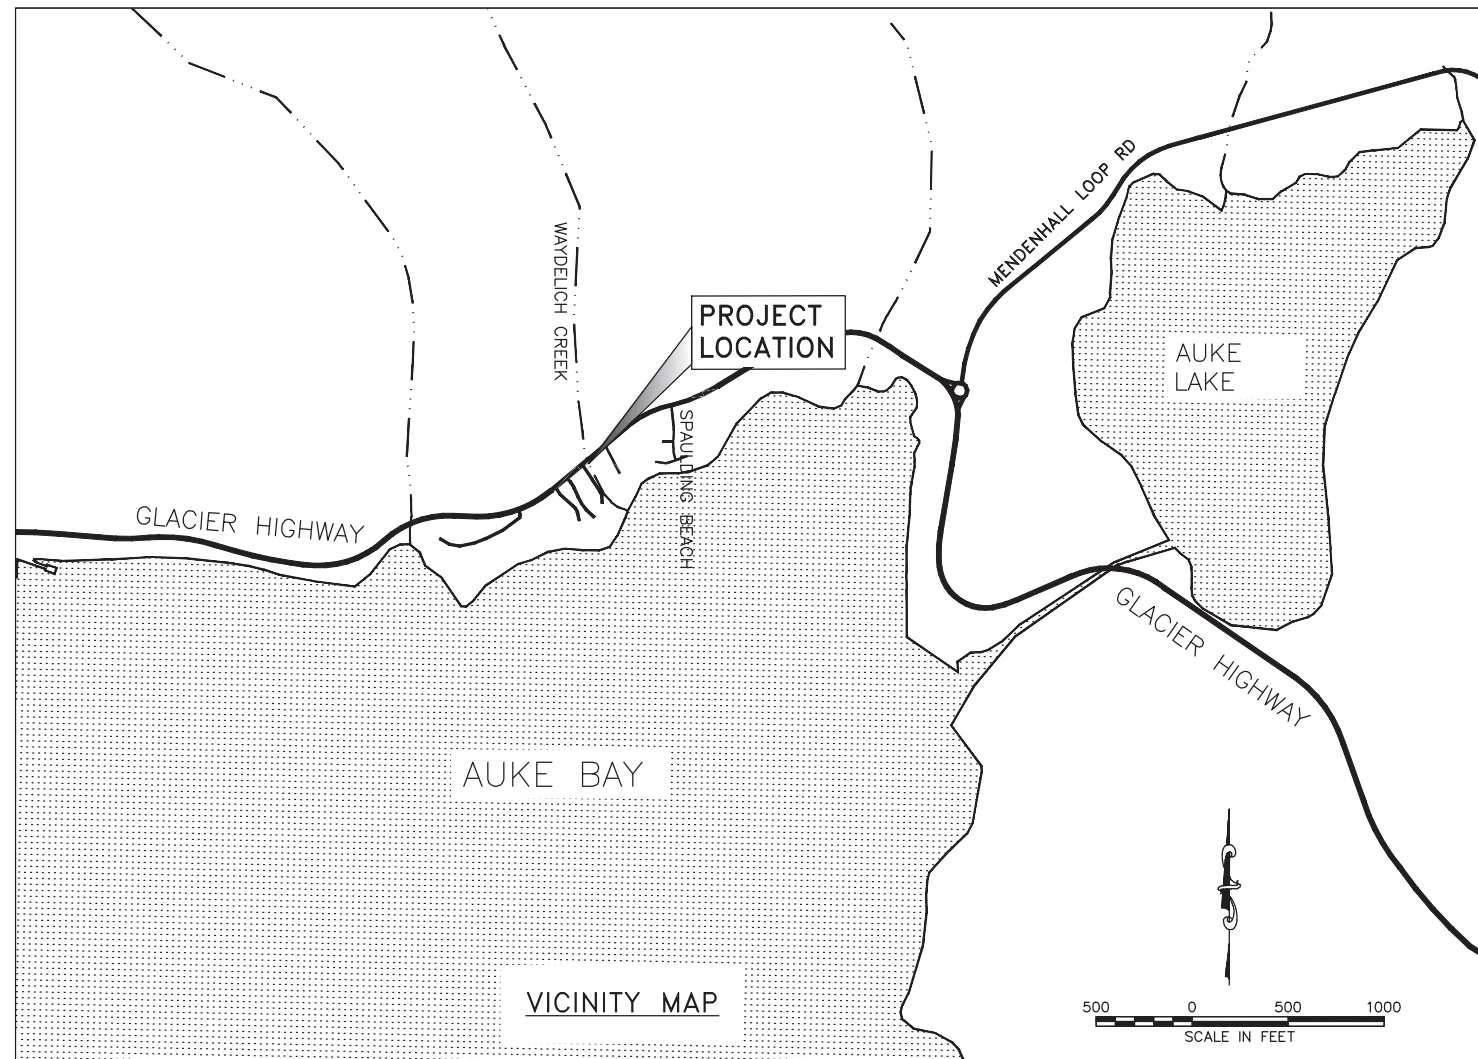

FILE C:\dow\pw\04041218\SA-GN-CV-A2-63330-04.dwg DATE 5/10/2024 14:45 LAYOUT A2 DESIGNED KOZAK TINSLEY CHECKED CHRISTIE DRAFTED KIM

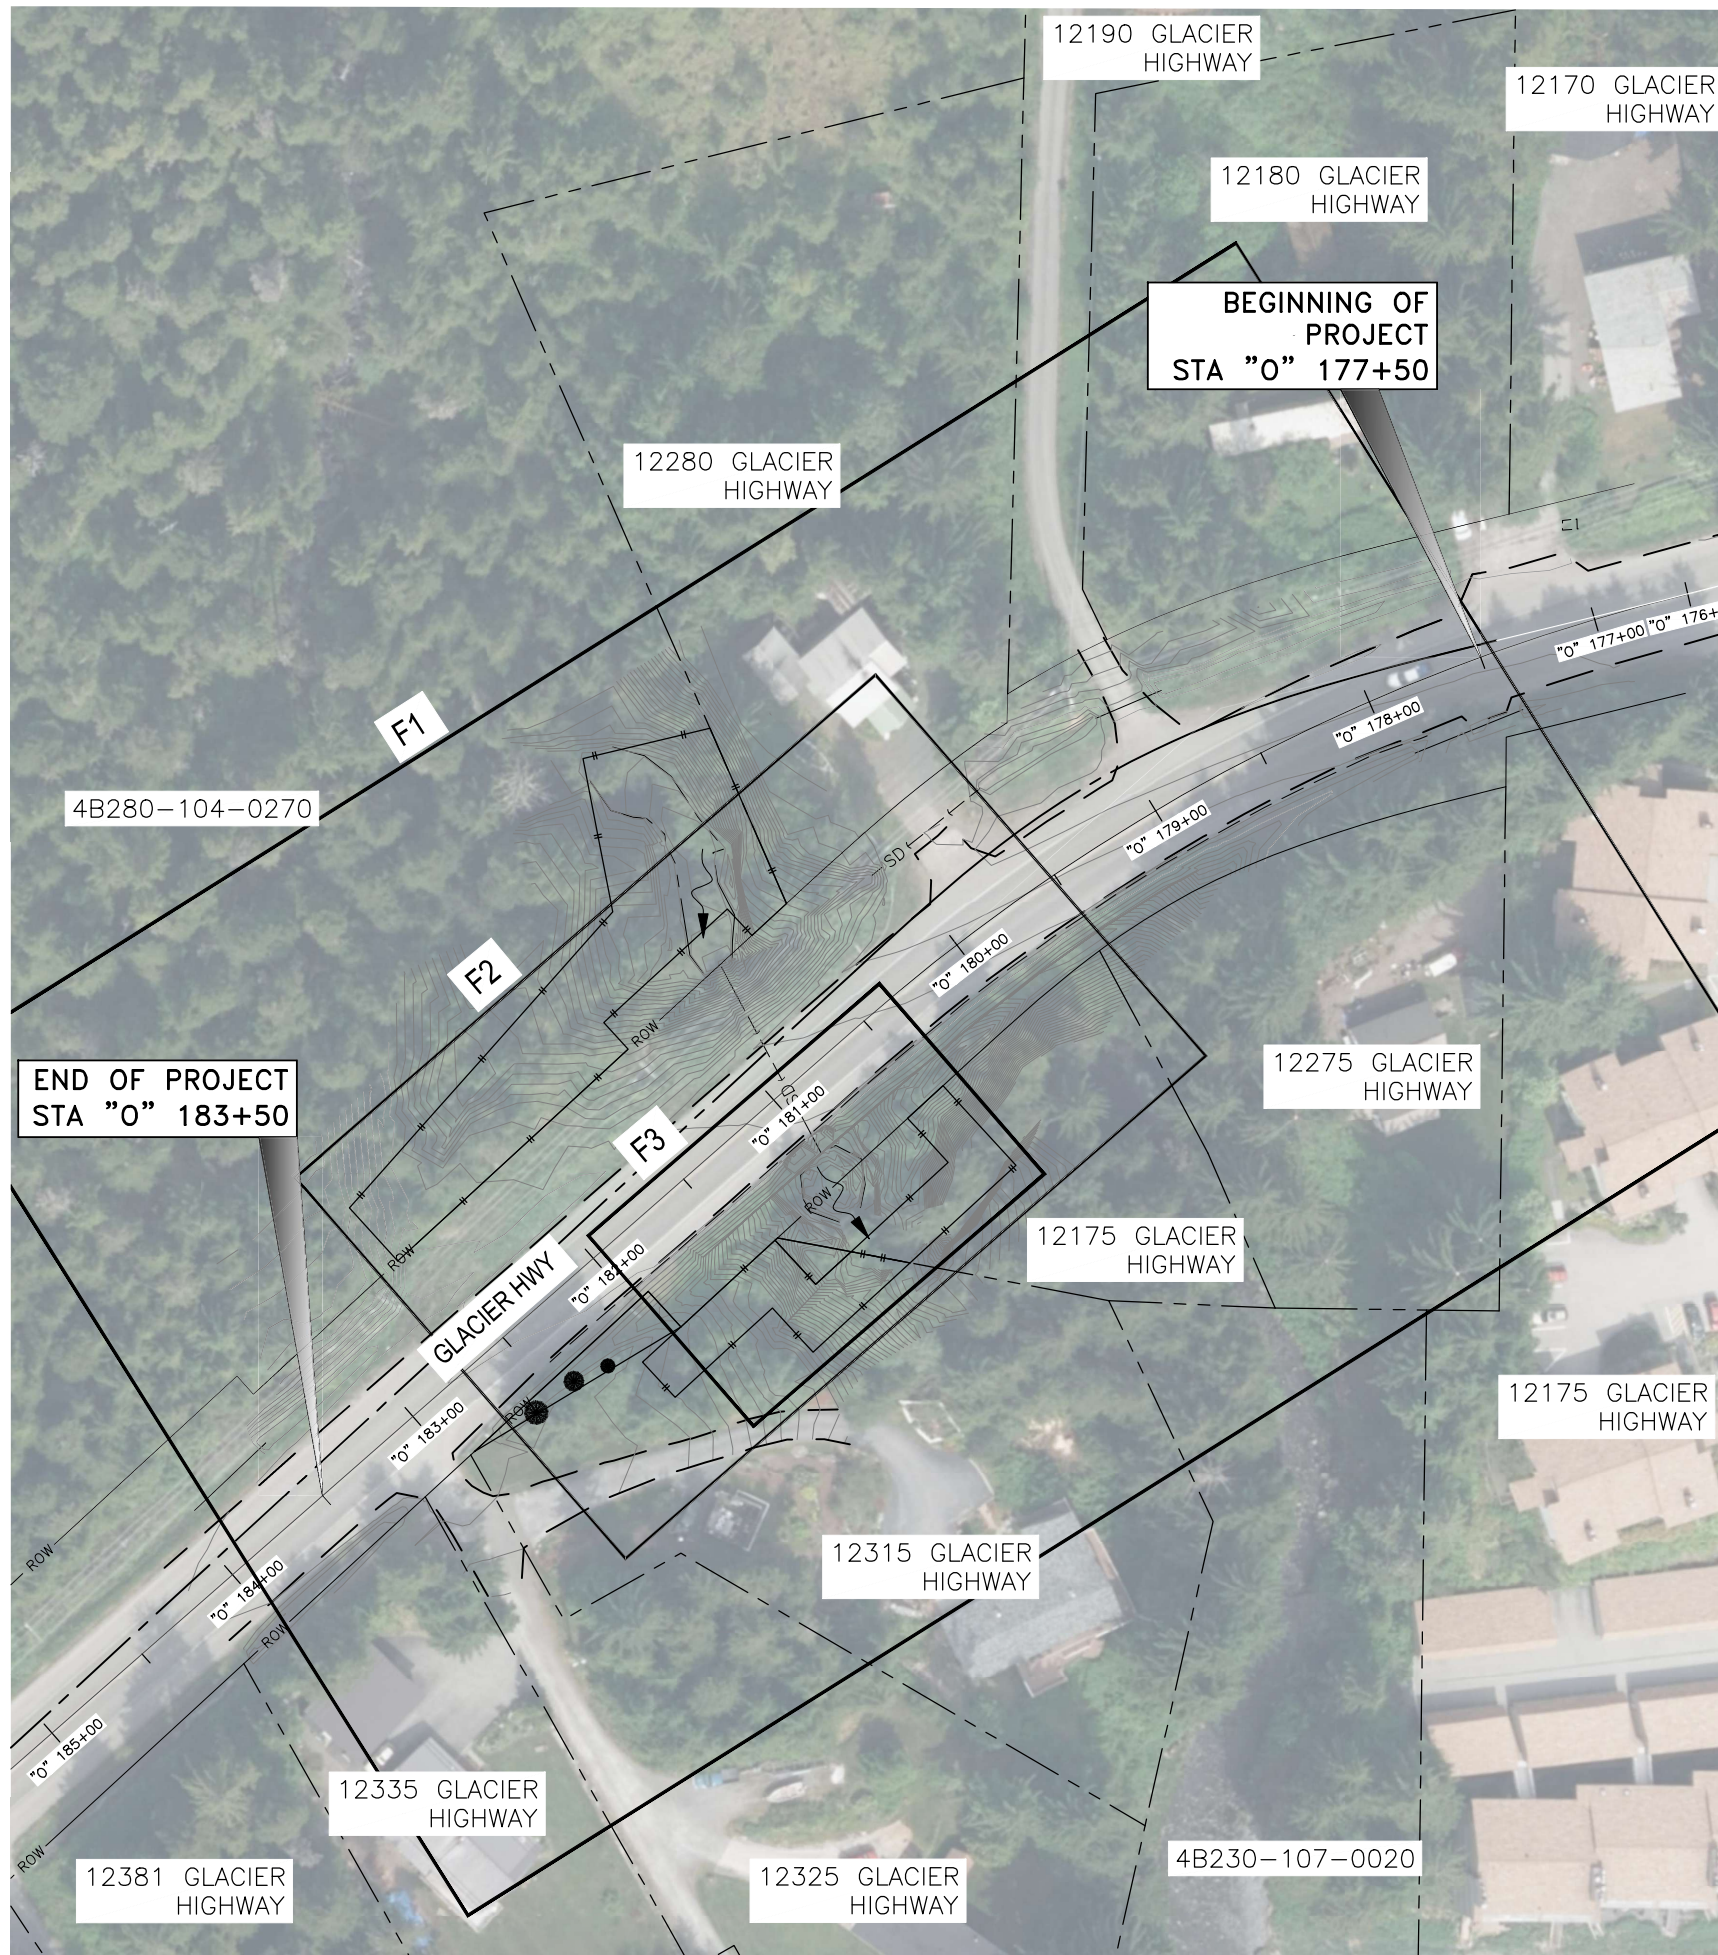

NO.	DATE	REVISION	STATE	PROJECT DESIGNATION	YEAR	SHEET NO.	TOTAL SHEETS
			ALASKA	0093003/SFHWHY00414	2024	A2	24

ALIGNMENT DESIGNATIONS		
ALIGNMENT NAME	ABBREVIATION	SHEET
GLACIER HIGHWAY CENTERLINE	"O"	F1-F3
FLUME DOWNDRAIN FLOW LINE	"F"	E2

INDEX OF SHEETS	
SHEET NO.	DESCRIPTION
A1	TITLE SHEET
A2-A3	SHEET LAYOUT, INDEX, LEGEND, SYMBOLS AND ABBREVIATIONS
A4	SURVEY CONTROL
B1-B3	TYPICAL SECTIONS
C1	ESTIMATE OF QUANTITIES
D1-D2	SUMMARY TABLES
E1-E3	DRAINAGE DETAILS
F1-F3	UPPER & LOWER WALL PLANS
H1	SIGNING & STRIPING PLAN
M1	WALL REPAIR DETAILS
Q1	EROSION SEDIMENT CONTROL PLAN
S1-S2	CONSTRUCTION PHASING PLANS & STREAM DIVERSION PLANS
T1-T3	TRAFFIC CONTROL PLAN & SECTIONS


THE FOLLOWING ALASKA STANDARD PLANS APPLY TO THIS PROJECT:
 C-06.00, D-01.02, D-04.22, D-06.10, G-00.05, G-05.11S, G-10.21, G-14.01, G-20.12, I-20.20, M-20.15, M-23.13, S-05.02

GENERAL NOTES:

- DO NOT MEASURE OFF OF THE PLANS.
- ROW, PARCEL LINES, PERMANENT, AND TEMPORARY CONSTRUCTION EASEMENT LINES WERE PROVIDED BY DOT&PF.
- MAKE ALL PAVEMENT CUTS CLEAN, VERTICAL, AND TRUE TO REMOVAL LIMITS SHOWN ON PLANS.

Record Drawings have been reviewed by the Project Engineer and represent the project as constructed.

Dillon Tomaro 3/26/26
 Signature Date

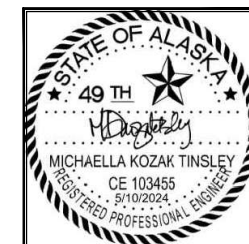

STATE OF ALASKA
 DEPARTMENT OF TRANSPORTATION
 AND PUBLIC FACILITIES
 JNU WAYDELICH CREEK:
 UPPER & LOWER WALL REPAIRS
 SHEET LAYOUT AND INDEX



FILE c:\dsw\pw\0401218\SA-GN-CV-A3-63330-04.dwg DATE 5/10/2024 15:46 LAYOUT A3 DESIGNED KOZAK TINSLEY CHECKED CHRISTIE DRAFTED RIM

NO.	DATE	REVISION	STATE	PROJECT DESIGNATION	YEAR	SHEET NO.	TOTAL SHEETS
			ALASKA	0093003/SFHUY00414	2024	A3	24

	RECOVERED	SET
BLM MONUMENT		
GLO MONUMENT		
USC&GS MONUMENT		
PRIMARY MONUMENT		
CENTERLINE MONUMENT IN CASING		
PRIMARY R.O.W. MONUMENT		
BEARING OBJECT		
SECONDARY MONUMENT		
LINE OF SIGHT MONUMENT		
CONCRETE R.O.W. MONUMENT		
BENCHMARK		
REBAR AND CAP		
REBAR		
IRON PIPE		
PK NAIL		
SPIKE		
HUB AND TACK		
CONSTRUCTION CENTERLINE		
MISCELLANEOUS CENTERLINE		
STATION EQUATION	"L"48+97.23 POT BK= "O"48+97.23 PC AHD	
PROJECT RIGHT-OF-WAY/ PERMANENT EASEMENT		
EXISTING RIGHT-OF-WAY LINE		
EXISTING PROPERTY LINE		
CONTROLLED ACCESS LINE		
UTILITY EASEMENT LINE		
TEMPORARY EASEMENT LINE (TCP OR TCE)		
ACCESS OR SECTION LINE EASEMENT		
PROPOSED CUT SLOPE LIMIT		
PROPOSED FILL SLOPE LIMIT		
SECTION LINE		
1/4 SECTION LINE		
1/16 SECTION LINE		
TOWNSHIP & RANGE LINE		

	EXISTING	PROPOSED
SANITARY SEWER (FLOW DIRECTION →)		
FUEL LINE		
GAS LINE		
WATER LINE		
METER, VALVE, FIRE HYDRANT		
EXISTING STORM DRAIN (FLOW DIRECTION →)		
PROPOSED STORM DRAIN		
FIBER OPTIC LINE		
DIRECT BURIAL TELEPHONE CABLE		
DIRECT BURIAL ELECTRIC CABLE		
ELECTRIC LINE (OVERHEAD)		
POWER POLE LINE		
JOINT USE POWER & TELEPHONE		
TELEPHONE POLE LINE		
POLE ANCHOR		
STUB POLE (POWER OR TELEPHONE)		
TELEPHONE DUCT		
TELEPHONE PEDESTAL		
BURIED CABLE MARKER		
PIPELINE MARKER OR VALVE		
CATCH BASIN OR DROP INLET		
MANHOLE		
SANITARY SEWER CLEAN OUT		
RIPRAP (CLASS AS INDICATED ON THE PLANS)		
ASPHALT PAVEMENT		
AGGREGATE BASE COURSE		
BORROW		
CONCRETE (CLASS AS INDICATED ON THE PLANS)		
FILTER FABRIC		
GROUT MIX 1 OR 2		

	EXISTING	PROPOSED
ROADWAY/PAVEMENT EDGE		
FENCE		
CURB AND GUTTER		
DETECTABLE WARNINGS		
GUARDRAIL		
CULVERT PIPE		
SIGN		
MAILBOX		
RAILROAD TRACKS		
RAILROAD DEVICES		
TREE LINE		
WATER BOUNDARY		
ORDINARY HIGH WATER LINE		
FLOW CENTERLINE		
FLOW DIRECTION		
WETLANDS		
EXISTING BUILDINGS		
POST OR BOLLARD		
WELL OR MONITORING WELL		
SEPTIC PIPE		
FUEL TANK FILL PIPE/VENT		
SATELLITE DISH		
TEST HOLE		
CONIFER TREE		
DECIDUOUS TREE		
GRAVE		
THERMOSIPHON		
PARKING METER		
VEHICLE PLUG-IN		
DELINEATOR/GUIDE MARKER		

	EXISTING	PROPOSED
JUNCTION BOX, TYPE IA		
JUNCTION BOX, TYPE II		
JUNCTION BOX, TYPE III		
SIGNAL FACE, VEHICULAR		
SIGNAL FACE, BACKPLATE		
SIGNAL FACE, LEFT TURN, BACKPLATE		
SIGNAL FACE, PEDESTRIAN		
LOOP DETECTOR		
VIDEO DETECTOR		
RADAR DETECTOR		
OPTICOM DETECTOR		
PEDESTRIAN PUSH BUTTON		
SIGNAL POST W/O MAST ARM		
SIGNAL POLE W/MAST ARM		
SIGNAL CONTROLLER		
LOAD CENTER		
LUMINAIRE		
RIGID METAL CONDUIT		

H = HOUSE
G = GARAGE
M = MERCHANT/STORE
B = BARN
S = SHED
P = PRIVY
SS = SERVICE STATION
W = WAREHOUSE

ABBREVIATIONS:

AGG.	AGGREGATE
APPROX	APPROXIMATELY
BMP	BEST MANAGEMENT PRACTICE
BOP	BEGINNING OF PROJECT
B.W.	BOTTOM OF WALL
C	CENTERLINE
CLSM	CONTROLLED LOW-STRENGTH MATERIAL
CMP	CORRUGATED METAL PIPE
CY	CUBIC YARD
DIP	DUCTILE IRON PIPE
E	EAST, EASTING
ELEV	ELEVATION
EOP	END OF PROJECT
ESCP	EROSION SEDIMENT CONTROL PLAN
FT	FOOT, FEET
H	HORIZONTAL
IE	INVERT ELEVATION
IN "	INCH, INCHES
L	LENGTH OF CURVE
LCL	LEFT OF CENTERLINE
LT	LEFT
LVC	LENGTH OF VERTICAL CURVE
MAX	MAXIMUM
MIN	MINIMUM
MSE	MECHANICALLY STABILIZED EARTH
N	NORTH, NORTHING
NO.	NUMBER

NTS	NOT TO SCALE
OC	ON CENTER
PC	POINT OF CURVATURE
POT	POINT ON TANGENT
PT	POINT OF TANGENCY
PVI	POINT OF VERTICAL INTERSECTION
R	RADIUS
RCL	RIGHT OF CENTERLINE
ROW	RIGHT OF WAY
RT	RIGHT
S	SOUTH
SF	SQUARE FOOT
SY	SQUARE YARD
STA	STATION
T	TANGENT
TBD	TO BE DECIDED
TCE	TEMPORARY CONSTRUCTION EASEMENT
T.O.C.	TOP OF CONCRETE
TS	TUBE STEEL
TYP	TYPICAL
V	VERTICAL
VPC	VERTICAL POINT OF CURVATURE
VPI	VERTICAL POINT OF INTERSECTION
VPT	VERTICAL POINT OF TANGENCY
W	WEST
WWR	WELDED WIRE REINFORCEMENT
Ø	DIAMETER

Record Drawings have been reviewed by the Project Engineer and represent the project as constructed.

Dillon Tomaro 3/26/26
Signature Date



STATE OF ALASKA
DEPARTMENT OF TRANSPORTATION
AND PUBLIC FACILITIES

JNU WAYDELICH CREEK:
UPPER & LOWER WALL REPAIRS

LEGEND, SYMBOLS, AND
ABBREVIATIONS

FILE G:\nu\SDRERO0322\VA\SOURCE DWGS\BASEMAP\Waydelich_Ck_SCS_090523.dwg DATE 5/10/2024 11:41 LAYOUT A2 DESIGNED J.Papoi CHECKED H.Pedersen DRAFTED J.Papoi


MONUMENT NOTES:

1. IF ANY PAIR OF CONTROL POINTS DISAGREES FROM PUBLISHED VALUE BY MORE THAN 1:10,000 HORIZONTALLY OR VERTICALLY THEN A THIRD NETWORK POINT MUST BE TIED TO ASCERTAIN WHICH POINT IS IN ERROR OR HAS BEEN DISTURBED.
2. WHETHER LISTED OR NOT, ALL PROPERTY MONUMENTS, PROPERTY MARKERS, CORNERS OR ACCESSORIES WHICH WILL BE DISTURBED OR BURIED SHALL BE REFERENCED PRIOR TO BEING DISTURBED, AND RE-ESTABLISHED IN THEIR ORIGINAL HORIZONTAL POSITION AND A RECORD OF MONUMENT FORM IN ACCORDANCE WITH (A.S.34.65.040) AND (A.S.19.10.260) SHALL BE SUBMITTED TO THE CONSTRUCTION ENGINEER FOR REVIEW PRIOR TO RECORDING. COORDINATE VALUES LISTED ARE FOR INFORMATIONAL PURPOSES AND SHOULD BE USED TO RESET MONUMENTS ONLY AS A LAST RESORT.
3. WHEN POSSIBLE ALL ORIGINAL PRIMARY MONUMENTS SHALL BE SAVED AND RESET IN THEIR ORIGINAL HORIZONTAL POSITION AND A RECORD OF MONUMENT FORM IN ACCORDANCE WITH (A.S.34.65.040) AND (A.S.19.10.260) SHALL BE SUBMITTED TO THE CONSTRUCTION ENGINEER FOR REVIEW PRIOR TO RECORDING.
4. RIGHT OF WAY LOCATION IS SHOWN FOR GRAPHICAL ORIENTATION PURPOSES ONLY. REFER TO ALASKA DOT&PF RIGHT OF WAY MAPS FOR RIGHT OF WAY INFORMATION.
5. HORIZONTAL AND VERTICAL CONTROL MUST BE FIELD VERIFIED BY THE CONTRACTOR. DISCREPANCIES WILL BE REPORTED TO DOT&PF CONSTRUCTION PROJECT ENGINEER.

WAYDELICH CREEK DESIGN ALIGNMENT									
SEGMENT	STATION	NORTHING	EASTING	DISTANCE	BEARING	STATION	RADIUS	LENGTH	DELTA
C1	176+59.79	2394507.96	2495924.62			180+52.89	818.51	393.10	27°31'02"
L1	180+52.89	2394328.53	2495579.09	728.59	S48° 47' 18"W	187+81.48			

COORDINATES LISTED ABOVE HOLD OVER DISTANCE AND BEARING

NO.	DATE	REVISION	STATE	PROJECT DESIGNATION	YEAR	SHEET NO.	TOTAL SHEETS
			ALASKA	0093003/SFHWHY00414	2024	A4	24

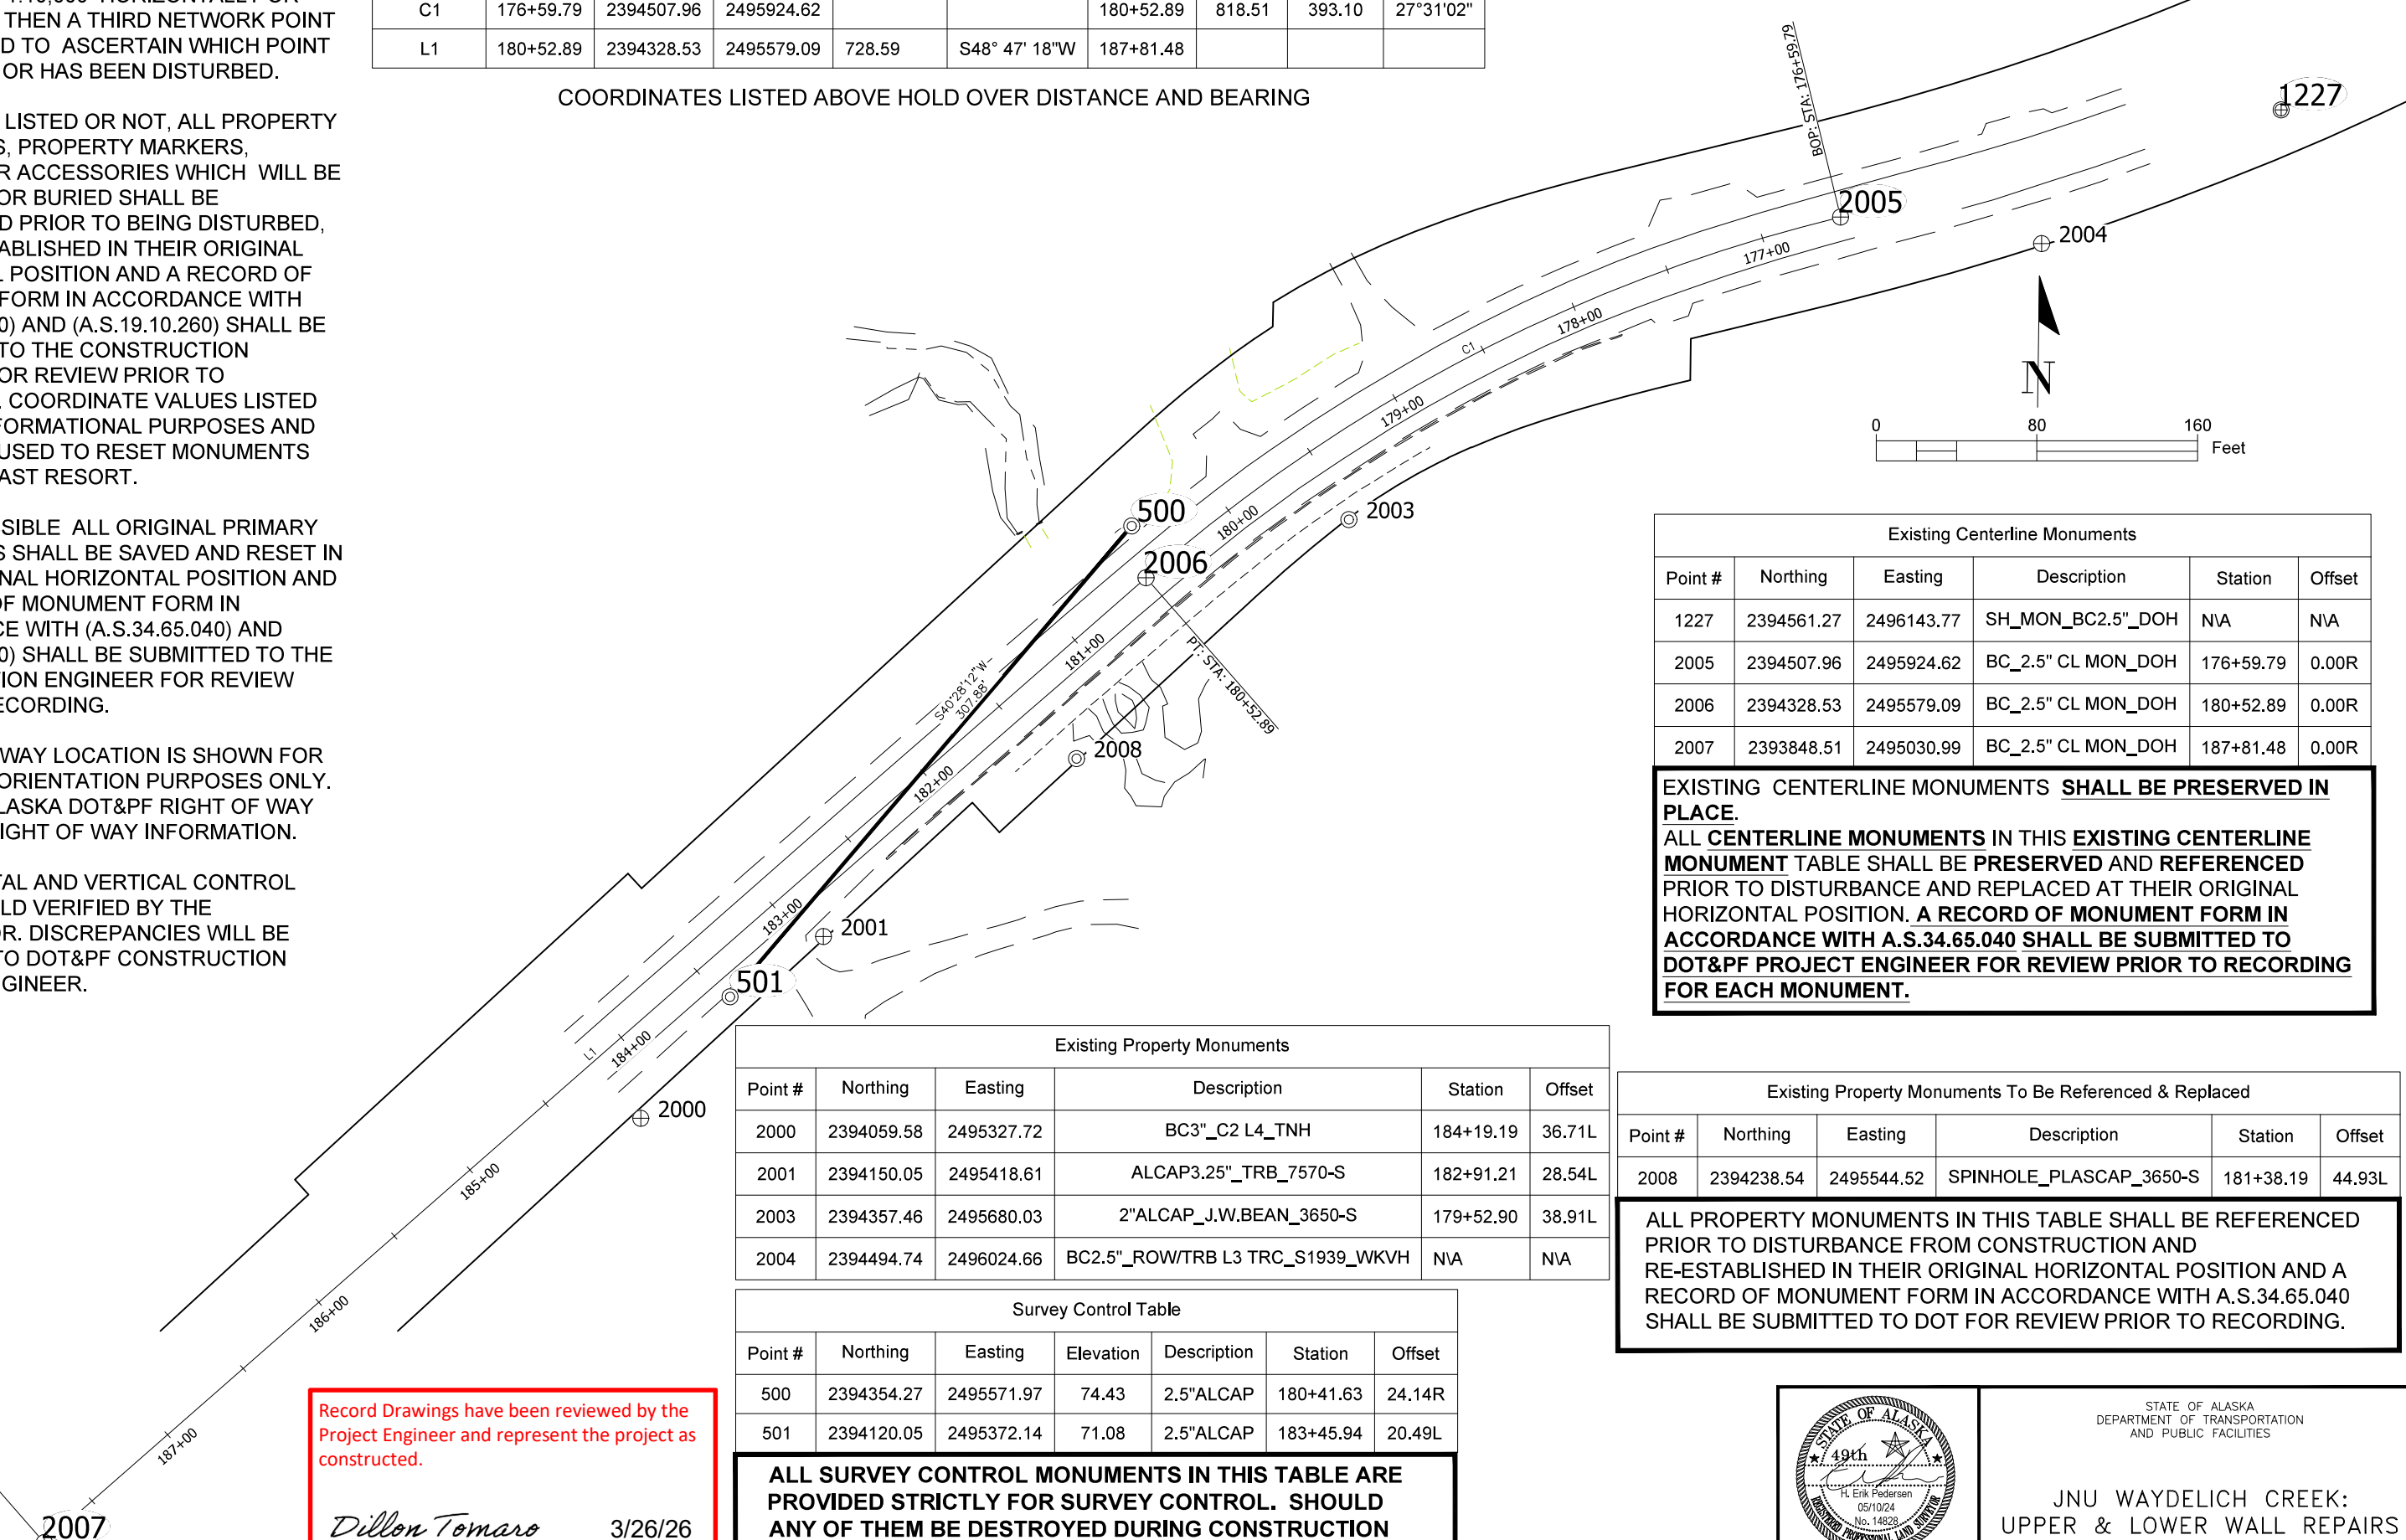

Existing Centerline Monuments					
Point #	Northing	Easting	Description	Station	Offset
1227	2394561.27	2496143.77	SH_MON_BC2.5" DOH	N/A	N/A
2005	2394507.96	2495924.62	BC_2.5" CL MON DOH	176+59.79	0.00R
2006	2394328.53	2495579.09	BC_2.5" CL MON DOH	180+52.89	0.00R
2007	2393848.51	2495030.99	BC_2.5" CL MON DOH	187+81.48	0.00R

EXISTING CENTERLINE MONUMENTS SHALL BE PRESERVED IN PLACE.
ALL CENTERLINE MONUMENTS IN THIS EXISTING CENTERLINE MONUMENT TABLE SHALL BE PRESERVED AND REFERENCED PRIOR TO DISTURBANCE AND REPLACED AT THEIR ORIGINAL HORIZONTAL POSITION. A RECORD OF MONUMENT FORM IN ACCORDANCE WITH A.S.34.65.040 SHALL BE SUBMITTED TO DOT&PF PROJECT ENGINEER FOR REVIEW PRIOR TO RECORDING FOR EACH MONUMENT.


Existing Property Monuments					
Point #	Northing	Easting	Description	Station	Offset
2000	2394059.58	2495327.72	BC3" C2 L4 TNH	184+19.19	36.71L
2001	2394150.05	2495418.61	ALCAP3.25" TRB_7570-S	182+91.21	28.54L
2003	2394357.46	2495680.03	2"ALCAP J.W.BEAN_3650-S	179+52.90	38.91L
2004	2394494.74	2496024.66	BC2.5" ROW/TRB L3 TRC_S1939_WKVH	N/A	N/A

Existing Property Monuments To Be Referenced & Replaced					
Point #	Northing	Easting	Description	Station	Offset
2008	2394238.54	2495544.52	SPINHOLE_PLASCAP_3650-S	181+38.19	44.93L

ALL PROPERTY MONUMENTS IN THIS TABLE SHALL BE REFERENCED PRIOR TO DISTURBANCE FROM CONSTRUCTION AND RE-ESTABLISHED IN THEIR ORIGINAL HORIZONTAL POSITION AND A RECORD OF MONUMENT FORM IN ACCORDANCE WITH A.S.34.65.040 SHALL BE SUBMITTED TO DOT FOR REVIEW PRIOR TO RECORDING.

Survey Control Table						
Point #	Northing	Easting	Elevation	Description	Station	Offset
500	2394354.27	2495571.97	74.43	2.5"ALCAP	180+41.63	24.14R
501	2394120.05	2495372.14	71.08	2.5"ALCAP	183+45.94	20.49L

ALL SURVEY CONTROL MONUMENTS IN THIS TABLE ARE PROVIDED STRICTLY FOR SURVEY CONTROL. SHOULD ANY OF THEM BE DESTROYED DURING CONSTRUCTION THEY SHALL NOT BE REPLACED.

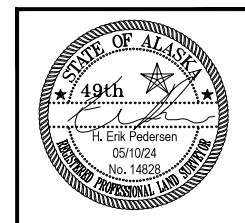


STATE OF ALASKA
 DEPARTMENT OF TRANSPORTATION
 AND PUBLIC FACILITIES

JNU WAYDELICH CREEK:
 UPPER & LOWER WALL REPAIRS

SURVEY CONTROL

NO.	DATE	REVISION	STATE	PROJECT DESIGNATION	YEAR	SHEET NO.	TOTAL SHEETS
			ALASKA	0093003/SFHUY00414	2024	B2	24

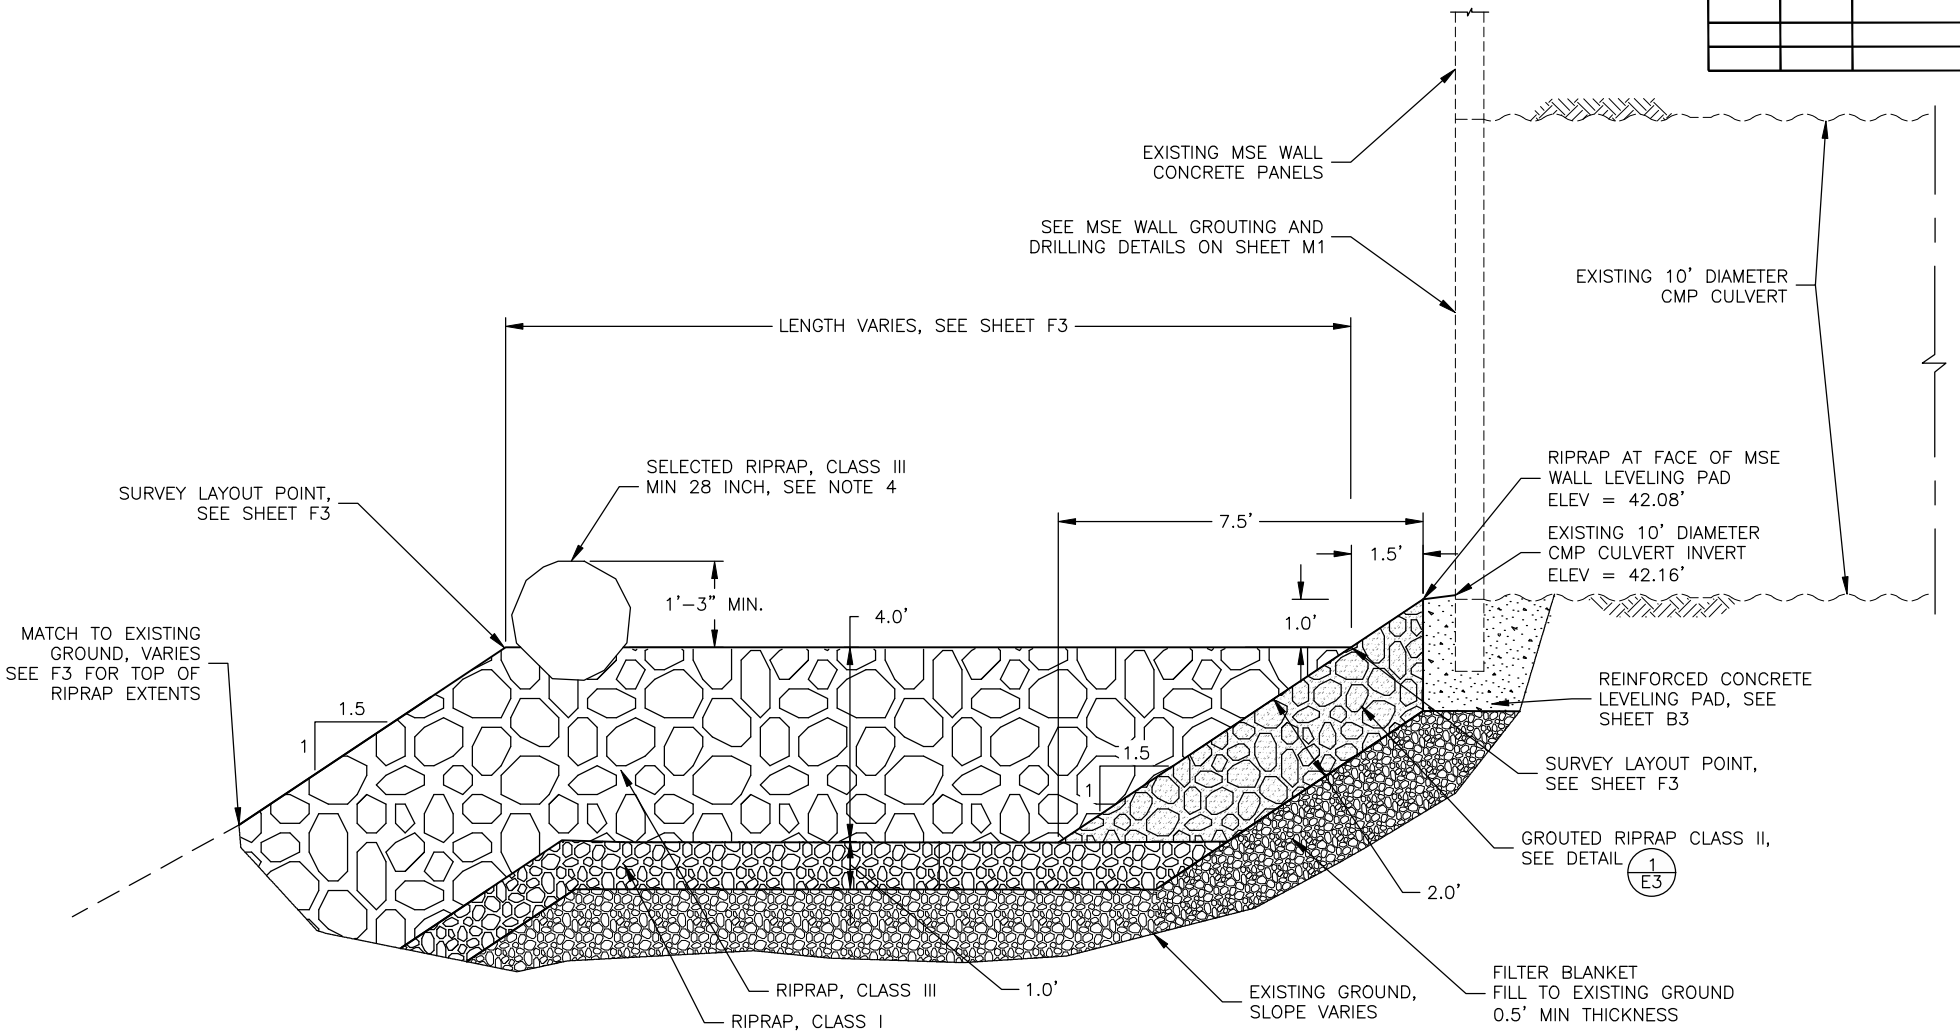


1 RIPRAP OUTLET PROTECTION SECTION
F3 NTS


Record Drawings have been reviewed by the Project Engineer and represent the project as constructed.

Dillon Tomaro 3/26/26
Signature Date

- NOTES:
- SEE SHEET F2 AND F3 FOR SECTION LOCATION AND TOP OF RIPRAP EXTENTS STATION, OFFSET AND ELEVATIONS.
 - RIPRAP OUTLET PROTECTION TO BE CONSTRUCTED AFTER THE STREAM DIVERSION/BYPASS IS IN PLACE AND OPERATING.
 - PRESENCE AND DEPTH OF BEDROCK IS UNKNOWN AT THE CULVERT OUTLET. CONTRACTOR SHALL REMOVE EXISTING CHANNEL MATERIAL AS SHOWN OR TO THE EXISTING BEDROCK SURFACE. FILTER BLANKET SHALL NOT BE PLACED ON TOP OF BEDROCK SURFACES.
 - SELECTED RIPRAP CLASS III, WILL CONSIST OF INDIVIDUAL ROCKS WITH A MINIMUM SIZE OF 28 INCHES. PLACE SELECTED RIPRAP CLASS III ROCKS ON TOP OF OUTLET PROTECTION WITH 2-8 INCH SPACING. EMBED INDIVIDUAL ROCKS A MINIMUM OF 8 INCHES BELOW TOP OF OUTLET PROTECTION. CONTRACTOR SHALL ACQUIRE ENGINEERS APPROVAL OF SELECTED RIPRAP, CLASS III MATERIAL AND PLACEMENT.

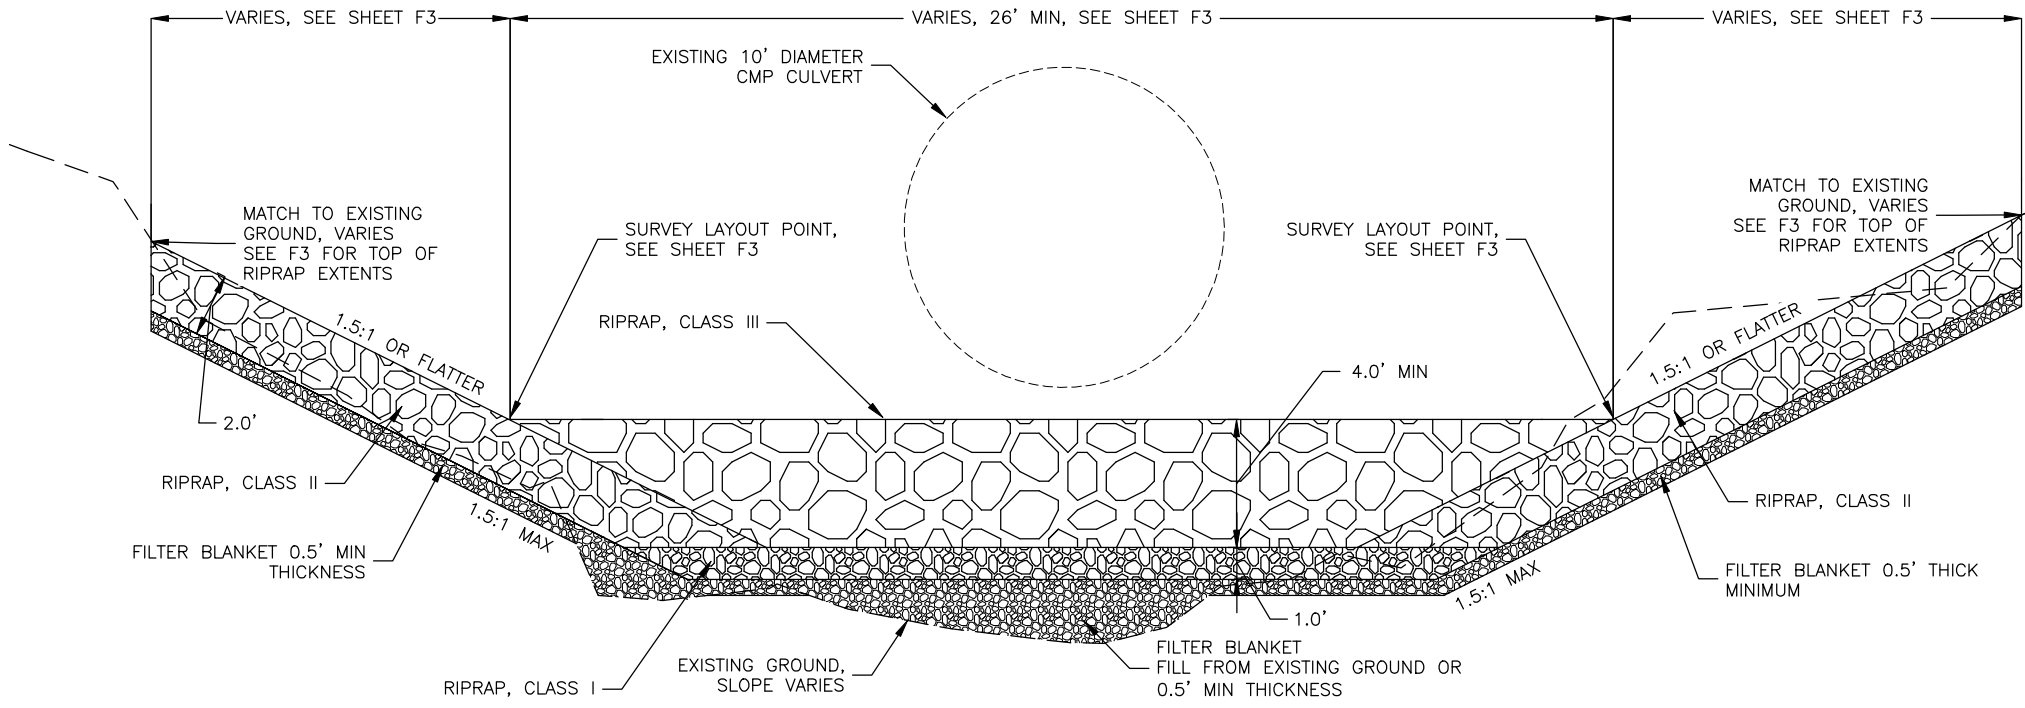

2 RIPRAP OUTLET PROTECTION SECTION
F3 NTS

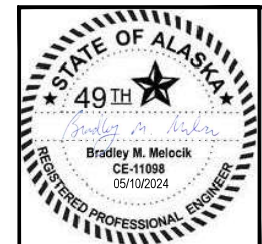

STATE OF ALASKA
DEPARTMENT OF TRANSPORTATION
AND PUBLIC FACILITIES


JNU WAYDELICH CREEK:
UPPER & LOWER WALL REPAIRS

TYPICAL SECTIONS:
LOWER WALL STORM DRAINAGE

FILE c:\dow\l_pw\0401218\SA-CT-DT-B-63330-04.dwg DATE 5/10/2024 15:43 LAYOUT B2 DESIGNED KOZAK TINSLEY CHECKED CHRISTIE DRAFTED KIM

NO.	DATE	REVISION	STATE	PROJECT DESIGNATION	YEAR	SHEET NO.	TOTAL SHEETS
			ALASKA	0093003/SFHWHY00414	2024	B3	24

FILE c:\dow\pm\0401218\SA-CT-DT-B-63330-04.dwg DATE 5/10/2024 15:43 LAYOUT B3 DESIGNED KOZAK TINSLEY CHECKED CHRISTIE DRAFTED KIM

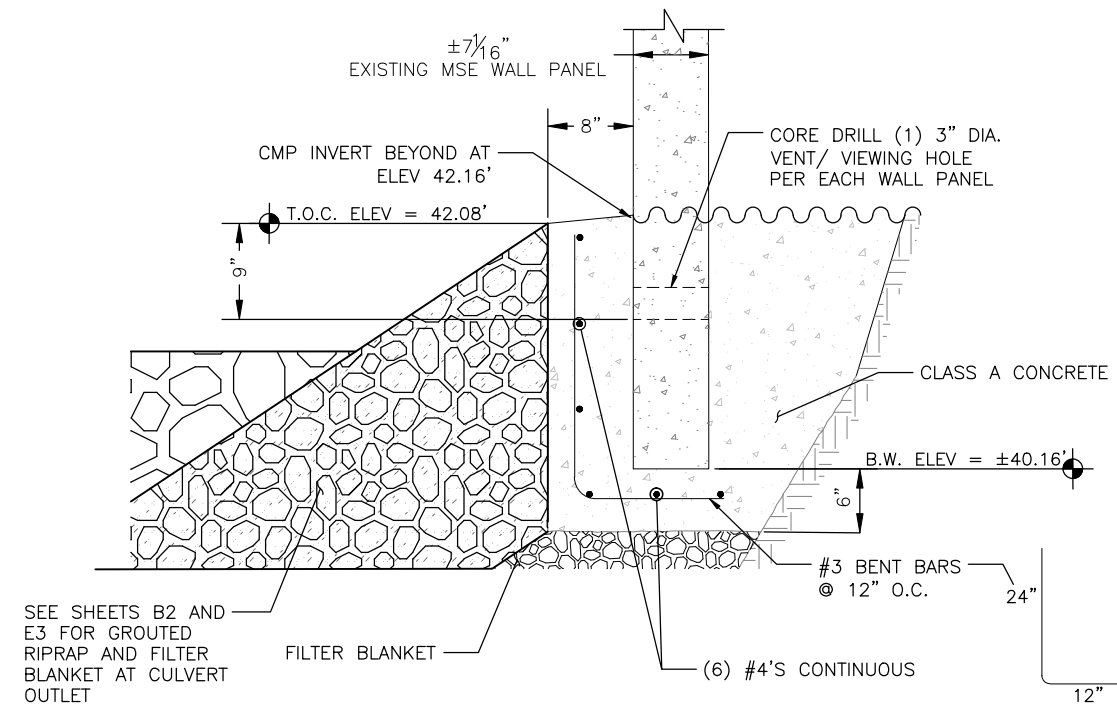

NOTES:

1. LOWER WALL LEVELING PAD REPAIR SEQUENCE:

- a) DEMOLISH SEGMENTS OF THE REMAINING (~7.5 LINEAL FEET) LEVELING PAD VISIBLE UNDER THE FULLY EXPOSED WALL PANELS AND WHERE POSSIBLE LEAVE A SEGMENT HAVING A LENGTH OF NO LESS THAN 0.5 FEET TO SERVE AS A SHIM. WHERE THE LEVELING PAD NO LONGER EXISTS, INSERT A SHIM, SUCH AS A CONCRETE DOBIE, TO VERTICALLY SUPPORT THE WALL DURING EXCAVATION, FORM CONSTRUCTION, REBAR PLACEMENT AND CORE DRILLING ACTIVITIES. EXERCISE CARE TO AVOID DISTURBING AND OR DAMAGING THE MSE WALL PANELS IN THE VICINITY OF THE LEVELING PAD WORK AND ABOVE.
- b) PLACE AND COMPACT FILTER BLANKET MATERIAL UP TO ELEVATION 39.66'.
- c) THE SURFACE OF THE WALL PANELS AND HEADWALL IS TO BE SCANNED WITH A FERROMAGNETIC REBAR LOCATOR FOR MARKING THE LOCATION OF THE REINFORCING STEEL. CUTTING OF REINFORCING STEEL IS PROHIBITED. CORE DRILL 3-INCH DIAMETER VENT/OBSERVATION HOLES IN THE CENTER OF THE MSE WALL PANELS AND CMP HEADWALL AS SHOWN IN THE ATTACHED CROSS-SECTION FOR A TOTAL OF SEVEN (7) HOLES.
- d) REMOVE LOOSE DEBRIS AND MINOR EXCAVATION AT THE BASE OF THE WALL TO FACILITATE CONSTRUCTION OF NEW LEVELING PAD.
- e) INSTALL STEEL REINFORCEMENT AS SHOWN.
- f) FORM AND POUR NEW CONCRETE LEVELING PAD USING CLASS A CONCRETE UP TO THE CULVERT INVERT AS SHOWN. IT IS ANTICIPATED THAT A HIGH-RANGE WATER REDUCING ADMIXTURE WILL BE ADDED TO THE READY-MIX CONCRETE AT THE JOBSITE TO ACHIEVE MAXIMUM WORKABILITY WITH NO MORE THAN A 9-INCH SLUMP AT THE POINT OF DISCHARGE. PLACE CONCRETE AT THE BASE OF WALL AS SHOWN, VIBRATE CONCRETE DURING PLACEMENT TO ENSURE CONCRETE COMPLETELY FILLS THE VOID UNDERNEATH AND IMMEDIATELY BEHIND THE WALL PANELS AND CMP HEADWALL. FORMWORK FOR THE NEW LEVELING PAD IS TO BE SEALED AT THE BASE AND ALONG ITS ENTIRE LENGTH TO PREVENT DISCHARGING WET CONCRETE INTO THE STREAM CHANNEL BELOW THE WORK.
- g) FILL SCOUR HOLE AS SHOWN ON SHEETS F2 AND B2.
- h) VOIDS BEHIND THE MSE WALL PANELS ABOVE THE NEW LEVELING PAD ARE TO BE GROUTED AS DETAILED ON SHEET M1.


LOWER WALL LEVELING PAD REPAIR

NTS

STA "0" 180+76.18 TO STA 181+18.24

Record Drawings have been reviewed by the Project Engineer and represent the project as constructed.

Dillon Tomaro 3/26/26
Signature Date

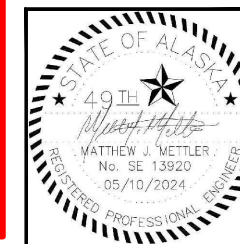

STATE OF ALASKA
DEPARTMENT OF TRANSPORTATION
AND PUBLIC FACILITIES
JNU WAYDELICH CREEK:
UPPER & LOWER WALL REPAIRS
TYPICAL SECTIONS:
LOWER WALL LEVELING PAD REPAIR

FILE C:\dow\pw\0401218\SC-CT-DT-C-63330-04.dwg
 DATE 5/11/2024 11:28 LAYOUT C1
 DESIGNED KOZAK TINSLEY CHECKED CHRISTIE DRAFTED RIM

*See Sheet C1.1 for As-Built Quantities

NO.	DATE	REVISION	STATE	PROJECT DESIGNATION	YEAR	SHEET NO.	TOTAL SHEETS
			ALASKA	0093003/SFHWHY00414	2024	C1	24

ESTIMATE OF QUANTITIES					
ITEM NO.	PAY ITEM	PAY UNIT	UPPER WALL (T02015) QUANTITY	LOWER WALL (T02A15) QUANTITY	QUANTITY TOTAL
201.0009.0000	CLEARING AND GRUBBING	LUMP SUM	ALL REQUIRED	ALL REQUIRED	ALL REQUIRED
202.0001.0000	REMOVAL OF STRUCTURES AND OBSTRUCTIONS	LUMP SUM	ALL REQUIRED	ALL REQUIRED	ALL REQUIRED
202.0002.0000	REMOVAL OF PAVEMENT	SQUARE YARD	147		147
202.0012.0000	DOUBLE MAILBOX INSTALLATION	EACH	1		1
202.0022.0000	REMOVAL OF DOUBLE MAILBOX	EACH	1		1
203.0003.0000	UNCLASSIFIED EXCAVATION	CUBIC YARD	175	147	322
203.0005.000A	BORROW, TYPE A	CUBIC YARD	200		200
205.0005.0000	CONTROLLED LOW-STRENGTH MATERIAL	CUBIC YARD		10	10
206.0001.0000	FILTER BLANKET	CUBIC YARD	6	60	66
301.0001.00D1	AGGREGATE BASE COURSE, GRADING D-1	TON	60	17	77
401.0001.002B	HMA, TYPE II; CLASS B	TON	43		43
501.0004.0000	CLASS A CONCRETE	CUBIC YARD		13	13
503.0002.0000	EPOXY-COATED REINFORCING STEEL	LUMP SUM		ALL REQUIRED	ALL REQUIRED
511.0001.0001	MECHANICALLY STABILIZED EARTH WALL REPAIR GROUTING PROGRAM	LUMP SUM		ALL REQUIRED	ALL REQUIRED
511.2004.0000	MECHANICALLY STABILIZED EARTH WALL GROUT	CY		45	45
550.0003.0000	CLASS B CONCRETE	CUBIC YARD		10	10
603.0001.0018	CSP 18 INCH	LINEAR FOOT	20		20
603.0003.0018	END SECTION FOR CSP 18 INCH	EACH	1		1
606.0001.0000	W-BEAM GUARDRAIL	LINEAR FOOT	355		355
606.0006.0000	REMOVING AND DISPOSING OF GUARDRAIL	LINEAR FOOT	514		514
606.0013.0000	PARALLEL GUARDRAIL TERMINAL	EACH	2		2
609.0001.0001	CURB, TYPE 1, DRAINAGE CURB	LINEAR FEET	291		291
611.0001.0001	RIPRAP, CLASS I	CUBIC YARD	17	20	37
611.0001.0002	RIPRAP, CLASS II	CUBIC YARD		128	128
611.0001.0003	RIPRAP, CLASS III	CUBIC YARD		92	92
615.0002.0000	REMOVE AND RELOCATE SIGN	EACH	2		2
618.0004.0000	SEEDING	SQUARE YARD	110	25	135
619.2002.0000	TURF REINFORCEMENT MAT	SQUARE YARD	110	25	135
640.0001.0000	MOBILIZATION AND DEMOBILIZATION	LUMP SUM	ALL REQUIRED	ALL REQUIRED	ALL REQUIRED
642.0001.0000	CONSTRUCTION SURVEYING	LUMP SUM	ALL REQUIRED	ALL REQUIRED	ALL REQUIRED
642.0007.0000	REPLACE EXISTING WITH SECONDARY MONUMENT	EACH	1		1
643.0002.0000	TRAFFIC MAINTENANCE	LUMP SUM	ALL REQUIRED	ALL REQUIRED	ALL REQUIRED

ESTIMATE OF QUANTITIES					
ITEM NO.	PAY ITEM	PAY UNIT	UPPER WALL (T02015) QUANTITY	LOWER WALL (T02A15) QUANTITY	QUANTITY TOTAL
643.0023.0000	TRAFFIC PRICE ADJUSTMENT	CONTINGENT SUM	ALL REQUIRED	ALL REQUIRED	ALL REQUIRED
643.0025.0000	TRAFFIC CONTROL	CONTINGENT SUM	ALL REQUIRED	ALL REQUIRED	ALL REQUIRED
658.0001.0000	EROSION, SEDIMENT, AND POLLUTION CONTROL WITHOUT CGP COVERAGE	LUMP SUM	ALL REQUIRED	ALL REQUIRED	ALL REQUIRED
658.0002.0000	ESCP CHANGES BY DIRECTIVE	CONTINGENT SUM	ALL REQUIRED	ALL REQUIRED	ALL REQUIRED
670.0001.0000	PAINTED TRAFFIC MARKINGS	LUMP SUM	ALL REQUIRED		ALL REQUIRED
671.2005.0000	STREAM DIVERSION AND DEWATERING	LUMP SUM		ALL REQUIRED	ALL REQUIRED

QUANTITY ASSUMPTIONS - 401.0001.002B HMA, TYPE II; CLASS B				
ITEM NO.	ITEM DESCRIPTION	PAY UNIT	TOTAL QUANTITY	REMARKS
401.0001.002B	HMA, TYPE II; CLASS B	TON	43	SEE SHEET D1 FOR QUANTITIES
	ASPHALT BINDER, GRADE PG 58-28E	TON	2.28	FROM STA "0" 177+82 TO STA "0"182+85
	STE-1 ASPHALT FOR TACK COAT	TON	0.0780	FROM STA "0" 177+82 TO STA "0"182+85

BASIS OF ESTIMATE		
ITEM NO.	ITEM DESCRIPTION	ESTIMATING FACTOR
301.0001.00D1	AGGREGATE BASE COURSE, GRADING D-1	1.94 TON/CY
401.0001.002B	HMA, TYPE II; CLASS B	113 LBS/SY/IN
401.0001.002B	ASPHALT BINDER, GRADE PG 58-28E	5.3% OF ITEM 401.0001.002B
401.0001.002B	STE-1 ASPHALT FOR TACK COAT	0.1 GAL/SY; 243 GAL/TON
618.0004.0000	SEEDING	0.0135 LB/SY

Record Drawings have been reviewed by the Project Engineer and represent the project as constructed.

Dillon Tomaro 3/26/26
 Signature Date



STATE OF ALASKA
 DEPARTMENT OF TRANSPORTATION AND PUBLIC FACILITIES

JNU WAYDELICH CREEK:
 UPPER & LOWER WALL REPAIRS

ESTIMATE OF QUANTITIES

*This sheet is added for As-Built purposes and is informational in nature

STATE	PROJECT DESIGNATION	YEAR	SHEET NO.	TOTAL SHEETS
ALASKA	0093003/SFHWHY00414	2024	C1.1	

AS BUILT QUANTITIES - ORIGINAL ITEMS						
ITEM NO.	PAY ITEM	PAY UNIT	UPPER WALL (T02015) QUANTITY	LOWER WALL (T02A15) QUANTITY	QUANTITY TOTAL	Remarks
201.0009.0000	Clearing and Grubbing	LS	All Req'd	All Req'd	All Req'd	
202.0001.0000	Removal of Structures and Obstructions	LS	All Req'd	All Req'd	All Req'd	
202.0002.0000	Removal of Pavement	SY	154.40	0.00	154.400	
202.0012.0000	Double Mail Box Installation	EACH	1.00	1.00	1.00	
202.0022.0000	Removal of Double Mail Box	EACH	1.00	1.00	1.00	
203.0003.0000	Unclassified Excavation	CY	221.60	105.04	326.64	
203.0005.000A	Borrow, Type A	CY	205.44	0.00	205.44	
205.0005.0000	Controlled Low-Strength Material	CY	0.00	8.00	8.00	
206.0001.0000	Filter Blanket	CY	0.00	0.00	0.00	Item deleted via CO-9
301.0001.00D1	Aggregate Base Course, Grading D-1	TON	65.86	20.86	86.72	
401.0001.002B	HMA, Type II; Class B	TON	48.76	0.00	48.76	
501.0004.0000	Class A Concrete	CY	0.00	15.00	15.00	
503.0002.0000	Epoxy-Coated Reinforcing Steel	LS	All Req'd	All Req'd	All Req'd	
511.0001.0001	Mechanically Stabilized Earth Wall	LS	All Req'd	All Req'd	All Req'd	
511.2004.0000	Mechanically Stabilized Earth Wall Grout	CY	0.00	4.61	4.61	
550.0003.0000	Class B Concrete	CY	0.00	5.00	5.00	
603.0001.0018	CSP 18 Inch	LF	20.00	0.00	20.00	
603.0003.0018	End Section for CSP 18 Inch	EACH	1.00	0.00	1.00	
606.0001.0000	W-Beam Guardrail	LF	358.50	0.00	358.50	
606.0006.0000	Removing and Disposing of Guardrail	LF	514.00	0.00	514.00	
606.0013.0000	Parallel Guardrail Terminal	EACH	2.00	0.00	2.00	
609.0001.0001	Curb, Type 1	LF	291.00	0.00	291.00	
611.0001.0001	Riprap, Class I	CY	17.36	16.76	34.12	
611.0001.0002	Riprap, Class II	CY	0.00	64.78	64.78	
611.0001.0003	Riprap, Class III	CY	0.00	0.00	0.00	All Riprap, Class III was salvaged and reused
615.0002.0000	Remove and Relocate Sign	EACH	2.00	0.00	2.00	
618.0004.0000	Seeding	SY	0.00	0.00	0.00	Item deleted via CO-8
619.2002.0000	Turf Reinforcement Mat	SY	30.00	12.00	42.00	
640.0001.0000	Mobilization and Demobilization	LS	All Req'd	All Req'd	All Req'd	
642.0001.0000	Construction Surveying	LS	All Req'd	All Req'd	All Req'd	
642.0007.0000	Replace Existing with Secondary Monument	EACH	1.00	1.00	1.00	
643.0002.0000	Traffic Maintenance	LS	All Req'd	All Req'd	All Req'd	
643.0023.0000	Traffic Price Adjustment	CS	0.00	0.00	0.00	
643.0025.0000	Traffic Control	CS	\$ 31,211.10	\$ 15,157.70	\$ 46,368.80	
658.0001.0000	Erosion, Sediment, and Pollution Control Without CGP Coverage	LS	All Req'd	All Req'd	All Req'd	
658.0002.0000	ESCP Changes by Directive	CS	0.00	0.00	0.00	
670.0001.0000	Painted Traffic Markings	LS	0.00	0.00	0.00	Item deleted via CO-7
671.2005.0000	Stream Diversion and Dewatering	LS	All Req'd	All Req'd	All Req'd	

AS BUILT QUANTITIES - NEW ITEMS						
ITEM NO.	PAY ITEM	PAY UNIT	UPPER WALL (T02015) QUANTITY	LOWER WALL (T02A15) QUANTITY	QUANTITY TOTAL	Remarks
511.2004.0000	Mechanically Stabilized Earth Wall Grout - VOID. NOT USED.	CY	0.00	0.00	0.00	Added Via CO-4
618.0004.0000	Seeding - Reduced Price UW	SY	110.70	0.00	110.70	Added Via CO-8
618.0004.0000	Seeding - Reduced Price LW	SY	0.00	25.00	25.00	Added Via CO-8
206.0001.0000	Filter Blanket - Reduced Price UW	CY	5.78	0.00	5.78	Added Via CO-9
206.0001.0000	Filter Blanket - Reduced Price LW	CY	0.00	35.05	35.05	Added Via CO-9
698.2000.0000	Negotiated Adjustment - MSE Wall Grout Equitable Adjustment/Differing Site Condition	LS	All Req'd	All Req'd	All Req'd	Added Via CO-10

Record Drawings have been reviewed by the Project Engineer and represent the project as constructed.

Dillon Tomaro 3/26/26
Signature Date

FILE C:\dow\pw\0401218\SA-CT-DT-D-63330-04.dwg
 DATE 7/1/2024 12:27
 LAYOUT DT
 DESIGNED KOZAK TINSLEY CHECKED CHRISTIE
 DRAFTED RIM

NO.	DATE	REVISION	STATE	PROJECT DESIGNATION	YEAR	SHEET NO.	TOTAL SHEETS
			ALASKA	0093003/SFHwy00414	2024	D1	24

201.0009.0000 CLEARING AND GRUBBING					
SHEET	START STATION	END STATION	OFFSET	AREA (ACRE)	REMARKS
F1	"0" 180+54	"0" 183+80	LT	0.24	EMBANKMENT REPAIR, FLUME, GUARDRAIL WIDENING
TOTAL:				0.24	
PAY ITEM QUANTITY:				ALL REQUIRED	LUMP SUM

203.0005.000A BORROW, TYPE A					
SHEET	START STATION	END STATION	OFFSET	VOLUME (CY)	REMARKS
F1	"0" 180+54	"0" 181+44	LT	190	
F1	"0" 178+00	-	LT	6	GUARDRAIL WIDENING
F1	"0" 182+75	-	LT	4	GUARDRAIL WIDENING
TOTAL:				200	CY
PAY ITEM QUANTITY:				200	CY

501.0004.0000 CONCRETE, CLASS A					
SHEET	START STATION	END STATION	OFFSET	VOLUME (CY)	REMARKS
F1	"0" 180+63	"0" 180+87	RT	7	INLET
F2	"0" 180+76	"0" 181+18	LT	6	OUTLET
TOTAL:				13	CY
PAY ITEM QUANTITY:				13	CY

603.0003.0018 END SECTION FOR CSP 18 INCH				
SHEET	STATION	OFFSET	QUANTITY (EA)	REMARKS
F1	"0" 177+78	LT	1	GUARDRAIL TERMINAL WIDENING
TOTAL:			1	EACH
PAY ITEM QUANTITY:			1	EACH

202.0001.0000 REMOVAL OF STRUCTURES AND OBSTRUCTIONS				
SHEET	START STATION	END STATION	OFFSET	REMARKS
F1	"0" 177+83	"0" 182+45	LT	EXISTING CONCRETE CURB
F2	"0" 180+63	"0" 180+87	RT	EXISTING CULVERT HEADWALL
F2	"0" 180+89	"0" 181+11	LT	EXISTING MSE WALL CONCRETE LEVELING PAD
TOTAL:				ALL REQUIRED
PAY ITEM QUANTITY:				ALL REQUIRED

205.0005.0000 CONTROLLED LOW-STRENGTH MATERIAL					
SHEET	START STATION	END STATION	OFFSET	VOLUME (CY)	REMARKS
F1	"0" 180+54	"0" 181+44	LT	10	
TOTAL:				10	CY
PAY ITEM QUANTITY:				10	CY

503.0002.0000 EPOXY-COATED REINFORCING STEEL					
SHEET	START STATION	END STATION	OFFS ET	WEIGHT (LB)	REMARKS
F2	"0" 180+63	"0" 180+87	RT	528	
F2	"0" 180+72	"0" 181+12	LT	202	
TOTAL:				730	LB
PAY ITEM QUANTITY:				ALL REQUIRED	LUMP SUM

606.0001.0000 W-BEAM GUARDRAIL					
SHEET	START STATION	END STATION	LENGTH (LF)	REMARKS	
F1	"0" 178+62	19.4' LT	"0" 182+17	19.2' LT	355
TOTAL:				355	LF
PAY ITEM QUANTITY:				355	LF

202.0002.0000 REMOVAL OF PAVEMENT					
SHEET	START STATION	END STATION	OFFSET	AREA (SY)	REMARKS
F1	"0" 180+54	"0" 181+44	LT	80	
	"0" 178+94	"0" 180+54	LT	53	
	"0" 181+44	"0" 181+85	LT	14	
TOTAL:				147	SY
PAY ITEM QUANTITY:				147	SY

206.0001.0000 FILTER BLANKET					
SHEET	START STATION	END STATION	OFFSET	VOLUME (CY)	REMARKS
F1	"0" 181+88.61	"0" 181+29.42	LT	6	FLUME DOWNDRAIN
F3	"0" 180+73	"0" 181+29	LT	60	LOWER WALL, UNDER PAD
TOTAL:				66	CY
PAY ITEM QUANTITY:				66	CY

511.2004.0000 MECHANICALLY STABILIZED EARTH WALL GROUT				
SHEET	START STATION	END STATION	VOLUME (CY)	REMARKS
F2	"0" 180+54	"0" 181+44	45	
TOTAL:			45	CY
PAY ITEM QUANTITY:			45	CY

606.0006.0000 REMOVING AND DISPOSING OF GUARDRAIL				
SHEET	START STATION	END STATION	LENGTH (LF)	REMARKS
F1	"0" 177+82	"0" 182+96	LT	514
TOTAL:			514	LT
PAY ITEM QUANTITY:			514	LT

202.0012.0000 DOUBLE MAILBOX INSTALLATION				
SHEET	START STATION	OFFSET	QUANTITY (EA)	REMARKS
F1	"0" 182+82	23.1' LT	1	
TOTAL:			1	EACH
PAY ITEM QUANTITY:			1	EACH

301.0001.00D1 AGGREGATE BASE COURSE, GRADING D-1					
SHEET	START STATION	END STATION	OFFSET	WEIGHT (TON)	REMARKS
F1	"0" 180+54	"0" 181+44	LT	26	SHOULDER REPAVE
F1	"0" 178+00	-	LT	6	GUARDRAIL TERMINAL WIDENING
F1	"0" 182+72	-	LT	6	GUADRAIL TERMINAL WIDENING
F1	"0" 178+94	"0" 180+54	LT	17	SAWCUT
F1	"0" 178+94	"0" 181+54	LT	1	DRAINAGE CURB
F1	"0" 181+44	"0" 181+85	LT	4	SAWCUT
F1	"0" 181+44	"0" 181+85	LT	0.3	DRAINAGE CURB
F2	"0" 181+00	-	LT	17	UPPER COLLAR/TOE/CROWN
TOTAL:				77.3	TON
PAY ITEM QUANTITY:				77	TON

550.0003.0000 CLASS B CONCRETE				
SHEET	START STATION	END STATION	VOLUME (CY)	REMARKS
F3	"0" 180+72	"0" 181+14	10	
TOTAL:			10	CY
PAY ITEM QUANTITY:			10	CY

606.0013.0000 PARALLEL GUARDRAIL TERMINAL						
SHEET	START STATION	END STATION	LENGTH (LF)	OFFSET	QUANTITY (EA)	REMARKS
F1	"0" 178+12	"0" 178+62	50	LT	1	
F1	"0" 182+17	"0" 182+67	50	LT	1	
TOTAL:					2	EACH
PAY ITEM QUANTITY:					2	EACH

202.0022.0000 REMOVAL OF DOUBLE MAILBOX				
SHEET	START STATION	OFFSET	QUANTITY (EA)	REMARKS
F1	"0" 182+82	23.1' LT	1	
TOTAL:			1	EACH
PAY ITEM QUANTITY:			1	EACH

603.0001.0018 CSP 18 INCH					
SHEET	START STATION	END STATION	OFFSET	LENGTH (LF)	REMARKS
F1	"0" 177+87	"0" 178+07	LT	20	GUARDRAIL TERMINAL WIDENING
TOTAL:				20	LF
PAY ITEM QUANTITY:				20	LF

609.0001.0000 CURB, TYPE 1, DRAINAGE CURB					
SHEET	START STATION	END STATION	OFFSET	QUANTITY (LF)	REMARKS
F1	"0" 180+54	"0" 181+44	LT	90	DRAINAGE CURB IN REPAVE AREA
F1	"0" 178+94	"0" 180+54	LT	160	DRAINAGE CURB OUTSIDE ASPHALT
F1	"0" 181+44	"0" 181+85	LT	41	DRAINAGE CURB OUTSIDE ASPHALT
TOTAL:				291	LF
PAY ITEM QUANTITY:				291	LF

203.0003.0000 UNCLASSIFIED EXCAVATION					
SHEET	START STATION	END STATION	OFFSET	VOLUME (CY)	REMARKS
F1	"0" 180+54	"0" 181+44	LT	175	UPPER
F2-F3	"0" 180+65	"0" 181+29	LT	147	LOWER
TOTAL:				322	CY
PAY ITEM QUANTITY:				322	CY

401.0001.002B HMA, TYPE II; CLASS B					
SHEET	START STATION	END STATION	OFFSET	WEIGHT (TON)	REMARKS
F1	"0" 180+54	"0" 181+44	LT	18	
F1	"0" 178+94	"0" 180+54	LT	12	DRAINAGE CURB SAWCUT
F1	"0" 178+00	-	LT	5	GUARDRAIL TERMINAL WIDENING
F1	"0" 181+44	"0" 181+85	LT	3	DRAINAGE CURB SAWCUT
F1	"0" 182+75	-	LT	5	GUARDRAIL TERMINAL WIDENING
TOTAL:				43	TON
PAY ITEM QUANTITY:				43	TON

Record Drawings have been reviewed by the Project Engineer and represent the project as constructed.

Dillon Tomaro 3/26/26
 Signature Date



STATE OF ALASKA
 DEPARTMENT OF TRANSPORTATION AND PUBLIC FACILITIES

 JNU WAYDELICH CREEK:
 UPPER & LOWER WALL REPAIRS

 SUMMARY TABLES

FILE c:\dswl_pw\0401218\SA-CT-DT-D-63330-04.dwg DATE 5/10/2024 15:45 LAYOUT D2 DESIGNED KOZAK TINSLEY CHECKED CHRISTIE DRAFTED RIM

NO.	DATE	REVISION	STATE	PROJECT DESIGNATION	YEAR	SHEET NO.	TOTAL SHEETS
			ALASKA	0093003/SFHWHY00414	2024	D2	24

611.0001.0001 RIPRAP, CLASS I					
SHEET	START STATION	END STATION	OFFSET	VOLUME (CY)	REMARKS
F1	"0" 180+54	"0" 181+44	LT	17	UPPER WALL
F2	"0" 180+74	"0" 181+30	LT	20	LOWER WALL
TOTAL:				37	CY
PAY ITEM QUANTITY:				37	CY

611.0001.0002 RIPRAP, CLASS II					
SHEET	START STATION	END STATION	OFFSET	VOLUME (CY)	REMARKS
F2	"0" 180+74	"0" 181+30	LT	128	LOWER WALL
TOTAL:				128	CY
PAY ITEM QUANTITY:				128	CY

611.0001.0003 RIPRAP, CLASS III					
SHEET	START STATION	END STATION	OFFSET	VOLUME (CY)	REMARKS
F2	"0" 180+74	"0" 181+30	LT	92	LOWER WALL
TOTAL:				92	CY
PAY ITEM QUANTITY:				92	CY

615.0002.0000 REMOVE AND RELOCATE SIGN				
SHEET	STATION	OFFSET	QUANTITY (EA)	REMARKS
F1	"0" 182+52	LT	1	35 MPH SPEED LIMIT
F1	"0" 182+03	LT	1	WAYDELICH CREEK
TOTAL:			2	EACH
PAY ITEM QUANTITY:			2	EACH

618.0004.0000 SEEDING					
SHEET	START STATION	END STATION	OFFSET	AREA (SY)	REMARKS
F1	"0" 180+54	"0" 181+44	LT	80	
F1	"0" 178+00	-	LT	24	GUARDRAIL TERMINAL WIDENING
F1	"0" 182+75	-	LT	6	GUARDRAIL TERMINAL WIDENING
F2	"0" 180+72	"0" 180+90	RT	25	
TOTAL:				135	SY
PAY ITEM QUANTITY:				135	SY

619.2002.0000 TURF REINFORCEMENT MAT					
SHEET	START STATION	END STATION	OFFSET	AREA (SY)	REMARKS
F1	"0" 180+54	"0" 181+44	LT	80	
F1	"0" 178+00	-	LT	24	GUARDRAIL TERMINAL WIDENING
F1	"0" 182+75	-	LT	6	GUARDRAIL TERMINAL WIDENING
F2	"0" 180+72	"0" 180+90	RT	25	
TOTAL:				135	SY
PAY ITEM QUANTITY:				135	SY

642.0007.0000 REPLACE EXISTING WITH SECONDARY MONUMENT				
SHEET	STATION	OFFSET	QUANTITY (EA)	REMARKS
F1	"0" 181+38	LT	1	
TOTAL:			1	EACH
PAY ITEM QUANTITY:			1	EACH

670.0001.0000 PAINTED TRAFFIC MARKINGS				
SHEET	START STATION	END STATION	QTY (LF)	REMARKS
F1	"0" 180+54	"0" 181+44	90	FOG LINE
TOTAL:			90	LF
PAY ITEM QUANTITY:			ALL REQUIRED	LUMP SUM

Record Drawings have been reviewed by the Project Engineer and represent the project as constructed.

Dillon Tomaro 3/26/26
Signature Date




STATE OF ALASKA
DEPARTMENT OF TRANSPORTATION
AND PUBLIC FACILITIES
JNU WAYDELICH CREEK:
UPPER & LOWER WALL REPAIRS

SUMMARY TABLES

FILE c:\dwl_pw\0401218\SA-CT-DT-E-63330-04.dwg DATE 5/10/2024 15:55 LAYOUT E3 DESIGNED KOZAK TINSLEY CHECKED CHRISTIE DRAFTED KIM

NO.	DATE	REVISION	STATE	PROJECT DESIGNATION	YEAR	SHEET NO.	TOTAL SHEETS
			ALASKA	0093003/SFHWHY00414	2024	E3	24

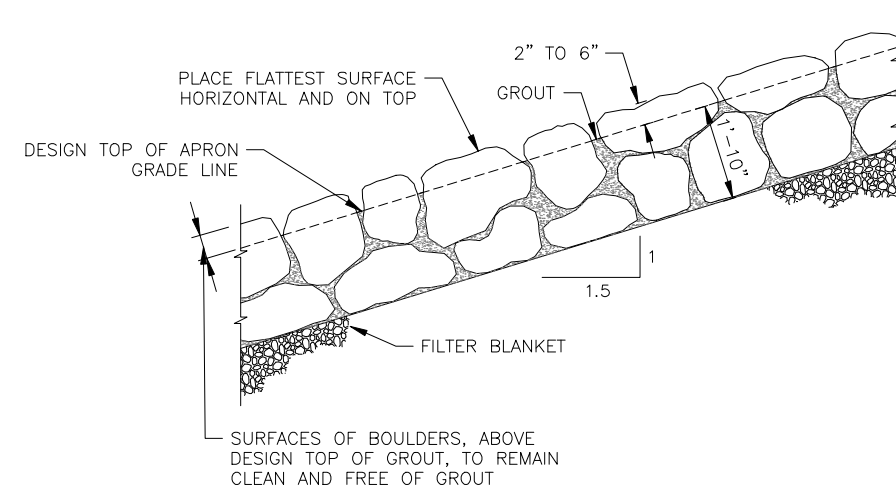


NOTES:

1. GROUT USED FOR THE GROUTED ROCK APRON SHALL CONSIST OF CLASS B CONCRETE AS SPECIFIED IN THE SPECIAL PROVISIONS.
2. APRON ROCK CONSISTS OF ROCK (PREFERABLY ROUNDED TO SUB-ROUNDED) CONFORMING TO CLASS II RIPRAP GRADATION.
3. BEFORE GROUTING, CLEAN ALL DIRT AND MATERIALS FROM ROCK THAT COULD PREVENT THE GROUT FROM BONDING TO ROCK. FINAL PLACEMENT OF BOULDERS TO BE APPROVED BY THE ENGINEER OR OWNER PRIOR TO GROUTING.
4. PLACE GROUT BY INJECTION METHODS TO FILL VOIDS TO THE SPECIFIED GROUT DEPTH. CLEAN EXCESS GROUT FROM ALL EXPOSED SURFACES. REFER TO SPECIFICATIONS FOR ADDITIONAL REQUIREMENTS.
5. CONTROL THE GROUT MIX AND PLACEMENT PROCEDURES TO ACHIEVE THE SPECIFIED THICKNESS AND GRADE OF THE GROUT LAYER.
6. ELEVATION OF UPPERMOST GROUTED ROCK MUST BE LOWER THAN CULVERT OUTLET INVERT.

1
B2
GRouted ROCK APRON PLACEMENT
NTS

Record Drawings have been reviewed by the Project Engineer and represent the project as constructed.


Dillon Tomaro 3/26/26
Signature Date

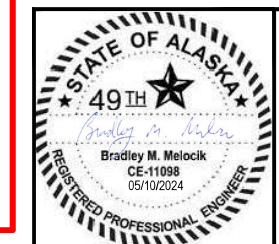

STATE OF ALASKA
DEPARTMENT OF TRANSPORTATION
AND PUBLIC FACILITIES

JNU WAYDELICH CREEK:
UPPER & LOWER WALL REPAIRS
DRAINAGE DETAILS:
LOWER WALL
CULVERT OUTLET APRON

NO.	DATE	REVISION	STATE	PROJECT DESIGNATION	YEAR	SHEET NO.	TOTAL SHEETS
			ALASKA	0093003/SFHWHY00414	2024	F2	24

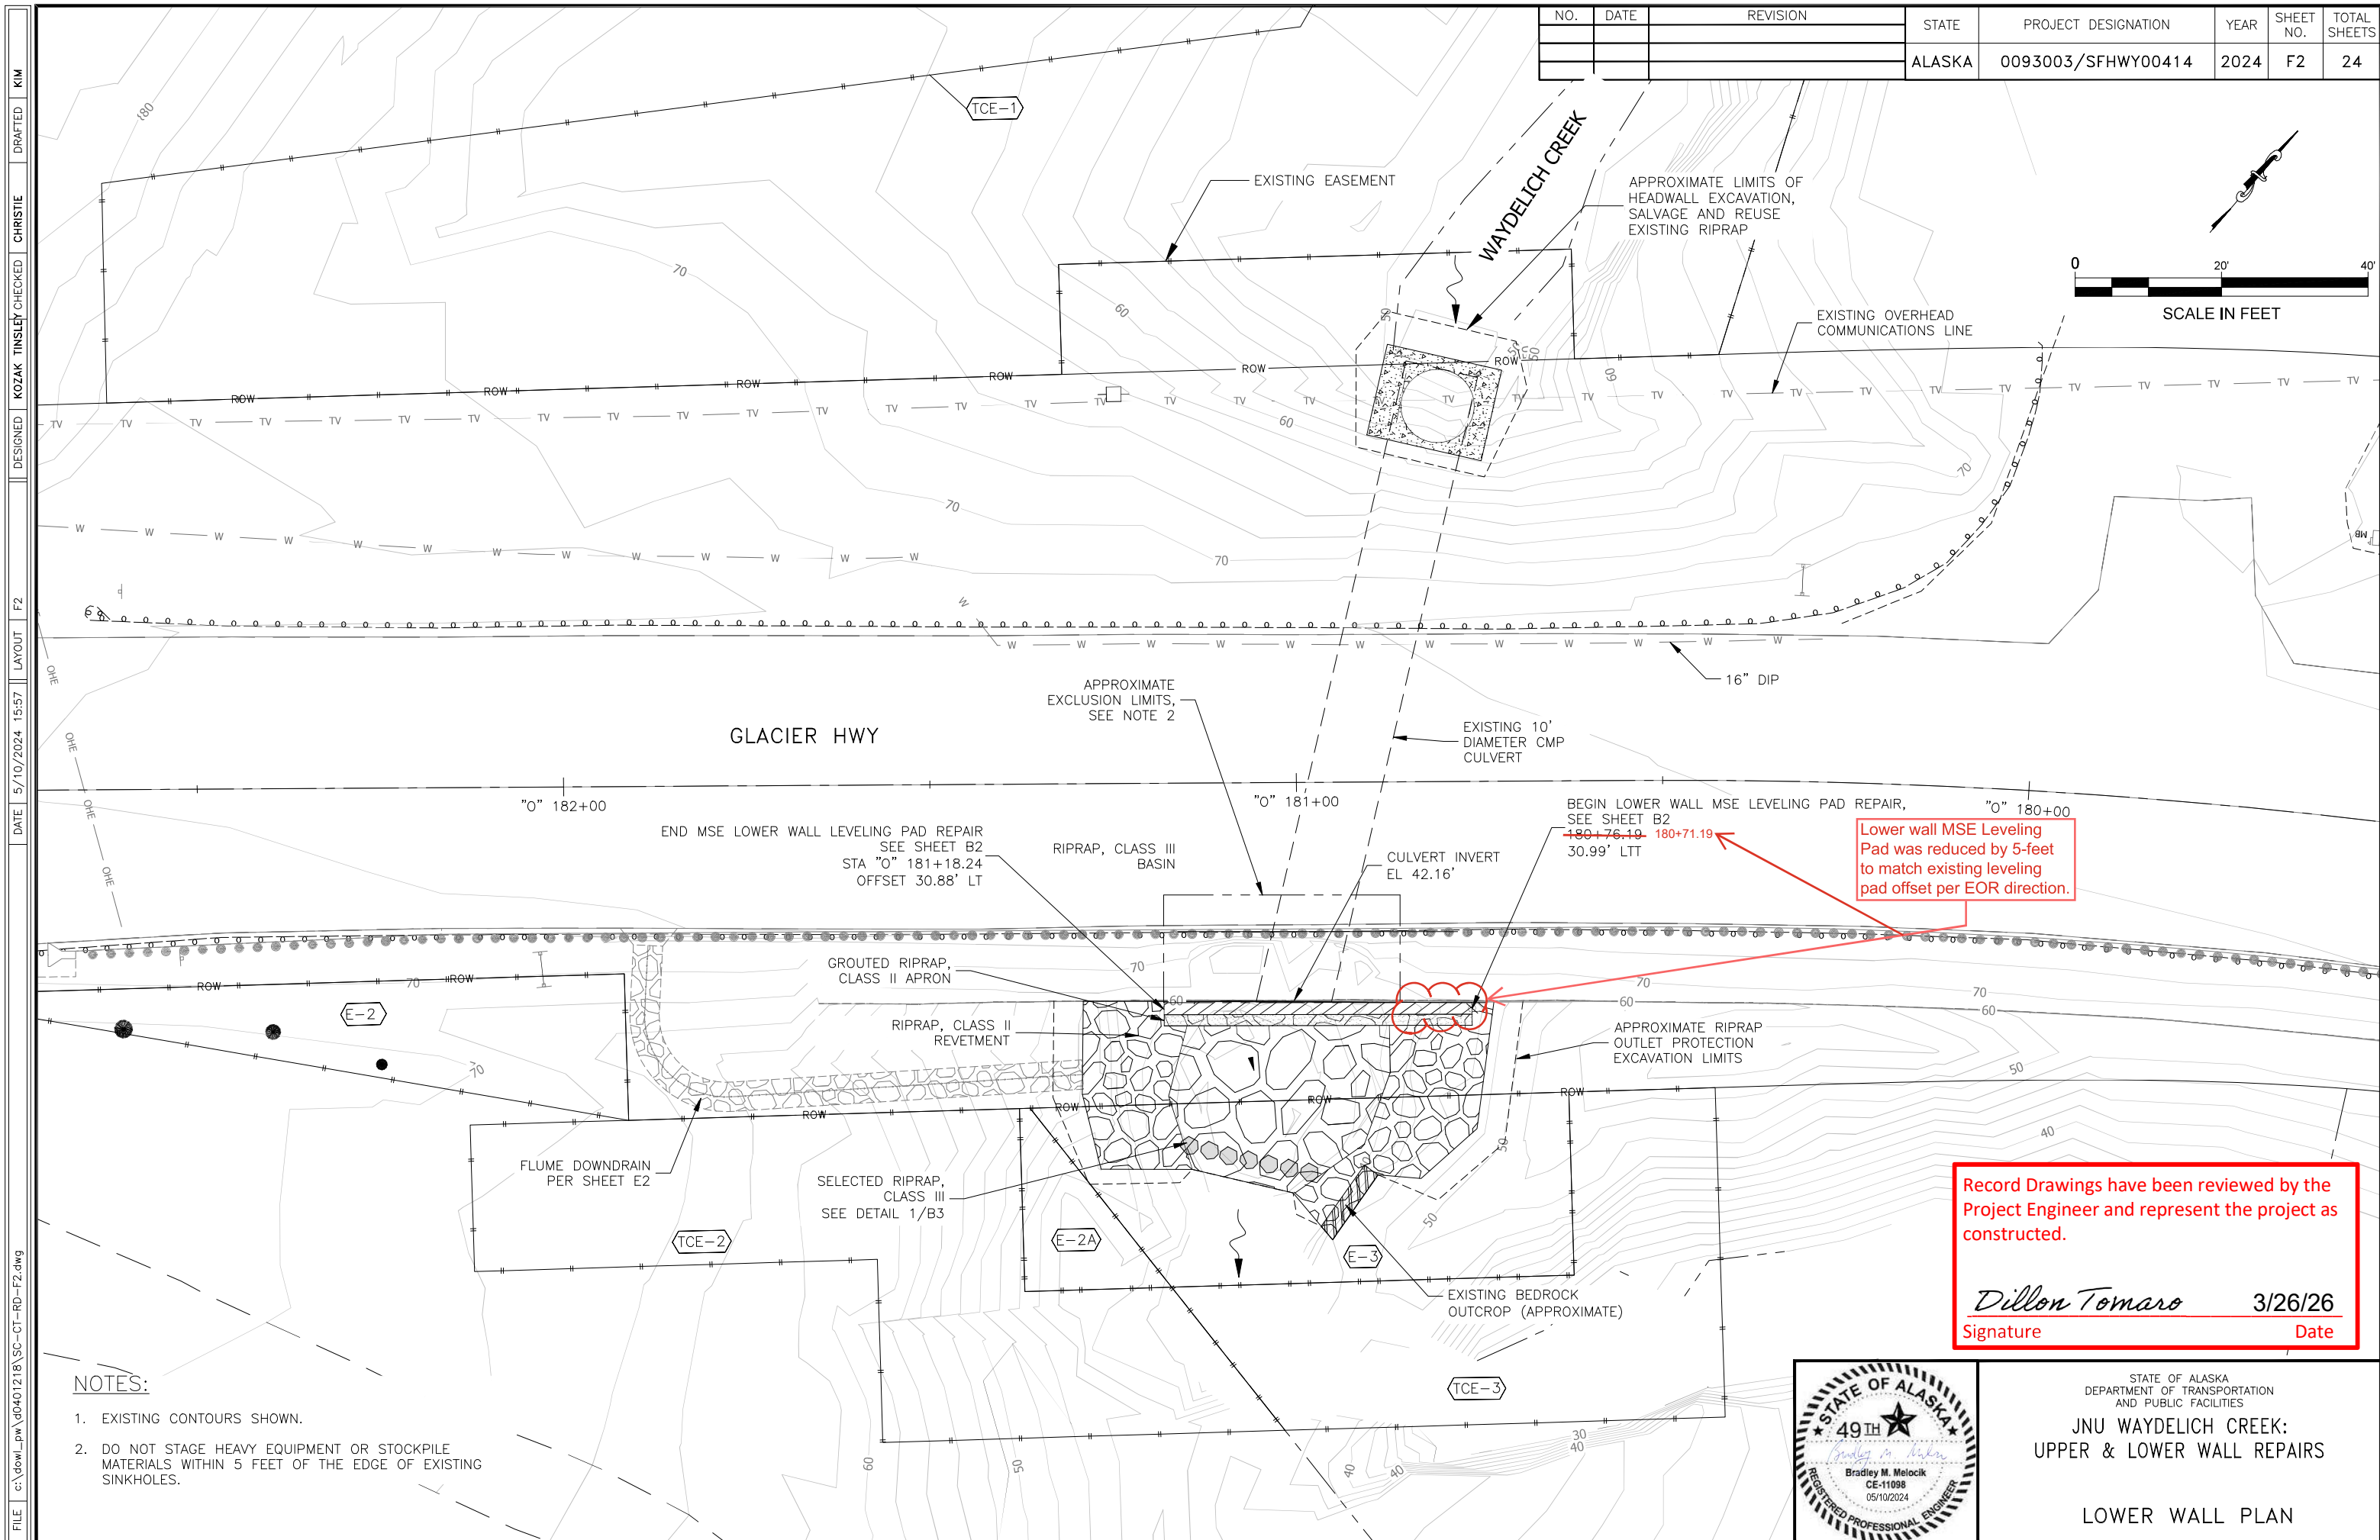


Lower wall MSE Leveling Pad was reduced by 5-feet to match existing leveling pad offset per EOR direction.

Record Drawings have been reviewed by the Project Engineer and represent the project as constructed.

Dillon Tomaro 3/26/26
Signature Date

- NOTES:
- EXISTING CONTOURS SHOWN.
 - DO NOT STAGE HEAVY EQUIPMENT OR STOCKPILE MATERIALS WITHIN 5 FEET OF THE EDGE OF EXISTING SINKHOLES.

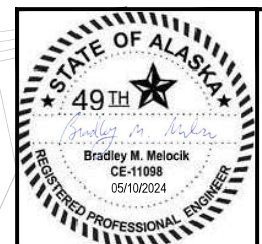

STATE OF ALASKA
DEPARTMENT OF TRANSPORTATION
AND PUBLIC FACILITIES
JNU WAYDELICH CREEK:
UPPER & LOWER WALL REPAIRS
LOWER WALL PLAN


FILE: c:\dwg\pw\0401218\SC-CT-RD-F2.dwg
 DATE: 5/10/2024 15:57
 LAYOUT: F2
 DESIGNED: Kozak
 TINSLEY: CHECKED
 CHRISTIE
 DRAFTED: KIM

NO.	DATE	REVISION	STATE	PROJECT DESIGNATION	YEAR	SHEET NO.	TOTAL SHEETS
			ALASKA	0093003/SFHWHY00414	2024	F3	24


SURVEY CONTROL TABLE				
POINT #	ELEV.	STA.	OFF.	DESCRIPTION
5000	41.20	181+15.10	33.13	SEE NOTE 1
5001	41.20	181+17.70	42.72	SEE NOTE 1
5002	41.20	181+14.51	52.74	SEE NOTE 1
5003	41.20	181+00.80	56.02	SEE NOTE 1
5004	41.20	180+91.03	49.40	SEE NOTE 1
5005	41.20	180+87.40	39.69	SEE NOTE 1
5006	41.20	180+87.54	33.23	SEE NOTE 1
5007	48.00	181+29.25	29.69	SEE NOTE 2
5008	48.00	181+29.47	42.35	SEE NOTE 2
5009	46.00	181+26.97	52.64	SEE NOTE 2
5010	46.00	180+95.43	62.47	SEE NOTE 2
5011	46.50	180+83.30	54.15	SEE NOTE 2
5012	46.50	180+75.63	47.42	SEE NOTE 2
5013	46.50	180+73.24	30.22	SEE NOTE 2

Record Drawings have been reviewed by the Project Engineer and represent the project as constructed.


Dillon Tomaro 3/26/26
Signature Date

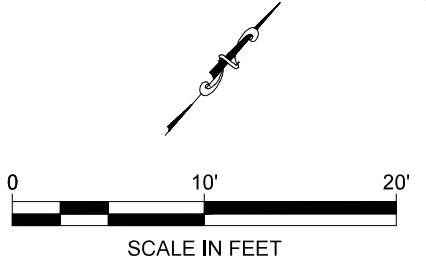

- SURVEY CONTROL TABLE NOTES:
1. FINISHED OUTLET PROTECTION BASIN TRANSITION BETWEEN RIPRAP CLASS III AND CLASS II, MEASURED AT TOP OF SURFACE.
 2. FINISHED OUTLET PROTECTION REVETMENT EXTENT OF RIPRAP CLASS II MEASURED AT TOP OF SURFACE.

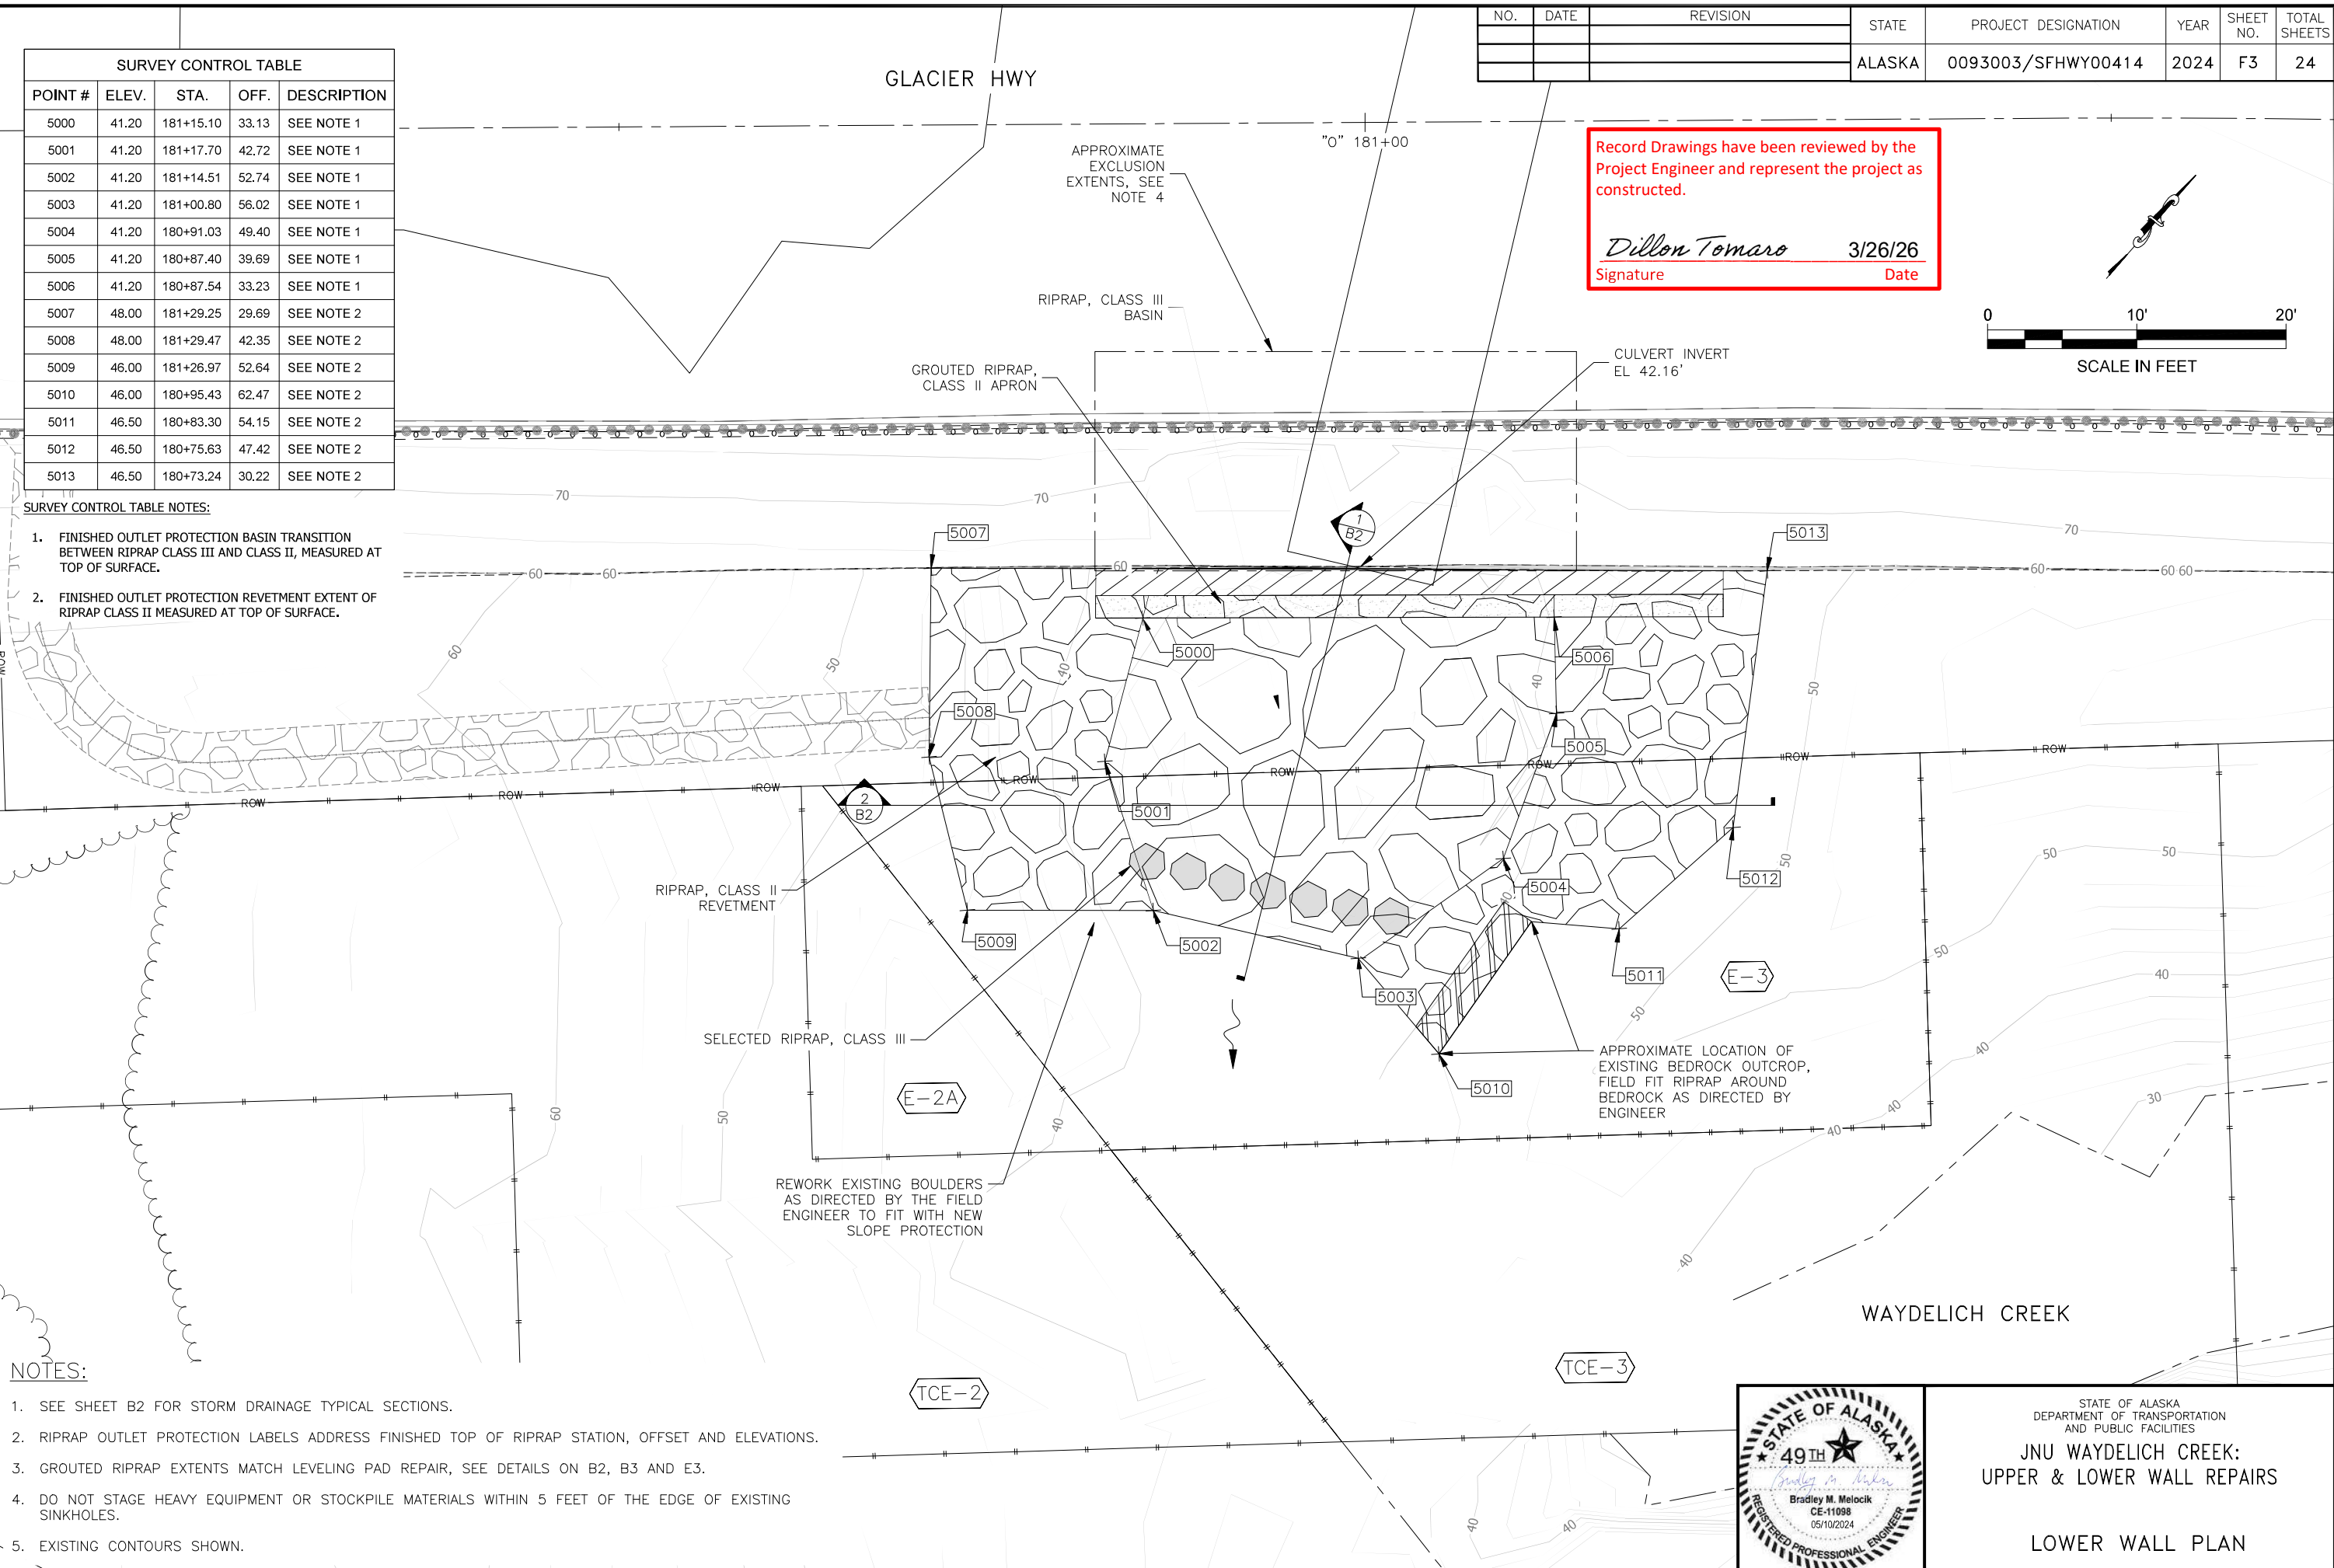

- NOTES:
1. SEE SHEET B2 FOR STORM DRAINAGE TYPICAL SECTIONS.
 2. RIPRAP OUTLET PROTECTION LABELS ADDRESS FINISHED TOP OF RIPRAP STATION, OFFSET AND ELEVATIONS.
 3. GROUTED RIPRAP EXTENTS MATCH LEVELING PAD REPAIR, SEE DETAILS ON B2, B3 AND E3.
 4. DO NOT STAGE HEAVY EQUIPMENT OR STOCKPILE MATERIALS WITHIN 5 FEET OF THE EDGE OF EXISTING SINKHOLES.
 5. EXISTING CONTOURS SHOWN.

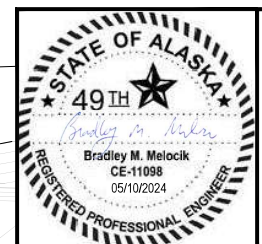

STATE OF ALASKA
DEPARTMENT OF TRANSPORTATION
AND PUBLIC FACILITIES


JNU WAYDELICH CREEK:
UPPER & LOWER WALL REPAIRS

LOWER WALL PLAN

FILE C:\dow\pw\0401218\SC-CT-RD-F3.dwg
 DATE 5/10/2024 15:55 LAYOUT F3
 DESIGNED KOZAK TINSLEY CHECKED CHRISTIE
 DRAFTED RIM

NO.	DATE	REVISION	STATE	PROJECT DESIGNATION	YEAR	SHEET NO.	TOTAL SHEETS
			ALASKA	0093003/SFHwy00414	2024	H1	24

FILE c:\dswl_pw\0401218\SC-CT-SG-H-63330-04.dwg
 DATE 5/10/2024 15:58 LAYOUT H1 DESIGNED KOZAK TINSLEY CHECKED CHRISTIE DRAFTED KIM

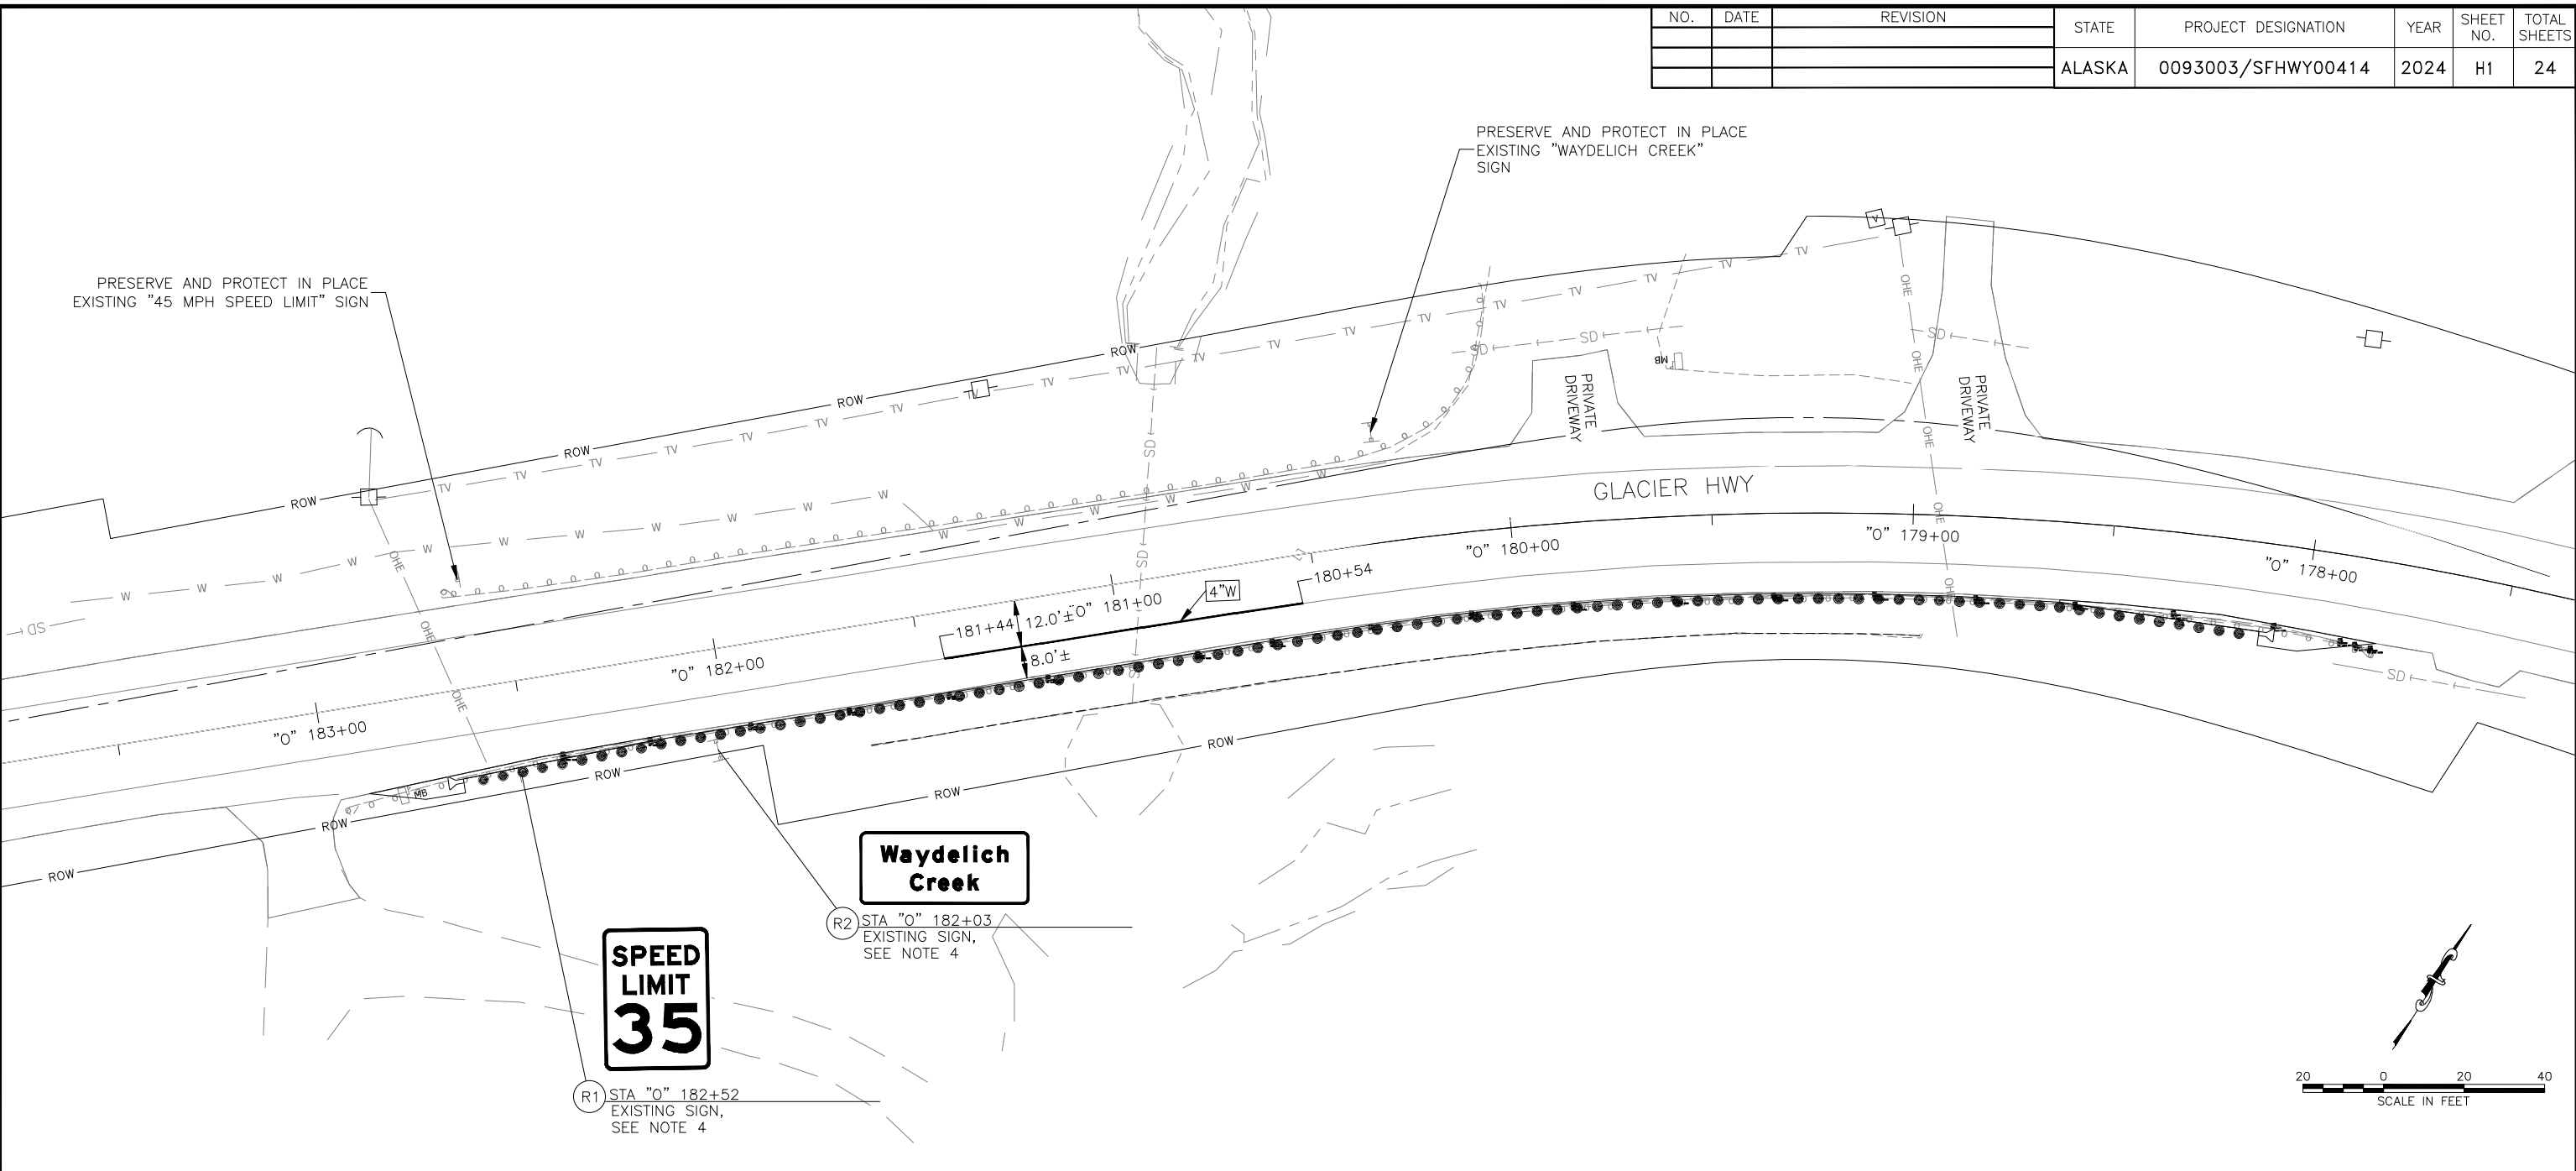

TRAFFIC MARKING KEY

4"W 4" WHITE LINE

SIGNING KEY

STATION
 SIGN LOCATION #

TRAFFIC MARKING NOTES

1. ALL PROPOSED PAVEMENT MARKINGS SHALL BE TRAFFIC PAINT.
2. DIMENSIONS REFER TO THE CENTER OF STRIPE, STRIPE GROUP, AND PAVEMENT EDGE.
3. STRIPING CONFIGURATIONS IN THIS PLAN SET ARE APPROXIMATE. THE CONTRACTOR SHALL PERFORM PRELIMINARY SPOTTING (RABBIT TRACKING) OF STRIPING AT LEAST 48 HOURS PRIOR TO APPLICATION OF MARKINGS. THE ENGINEER WILL THEN APPROVE THE LAYOUT OR MAKE MODIFICATIONS AS REQUIRED.
4. REMOVE EXISTING SIGNS R1 AND R2 AS REQUIRED FOR GUARDRAIL INSTALLATION, RELOCATE EXISTING SIGNS WHERE INDICATED ON THE PLAN. OFFSET AND HEIGHT PER ALASKA STANDARD PLAN S-05.02.

Record Drawings have been reviewed by the Project Engineer and represent the project as constructed.

Dillon Tomaro 3/26/26
 Signature Date





STATE OF ALASKA
 DEPARTMENT OF TRANSPORTATION
 AND PUBLIC FACILITIES

**JNU WAYDELICH CREEK:
 UPPER & LOWER WALL REPAIRS**

 SIGNING AND STRIPING PLAN

NO.	DATE	REVISION	STATE	PROJECT DESIGNATION	YEAR	SHEET NO.	TOTAL SHEETS
			ALASKA	0093003/SFHWHY00414	2024	S1	24

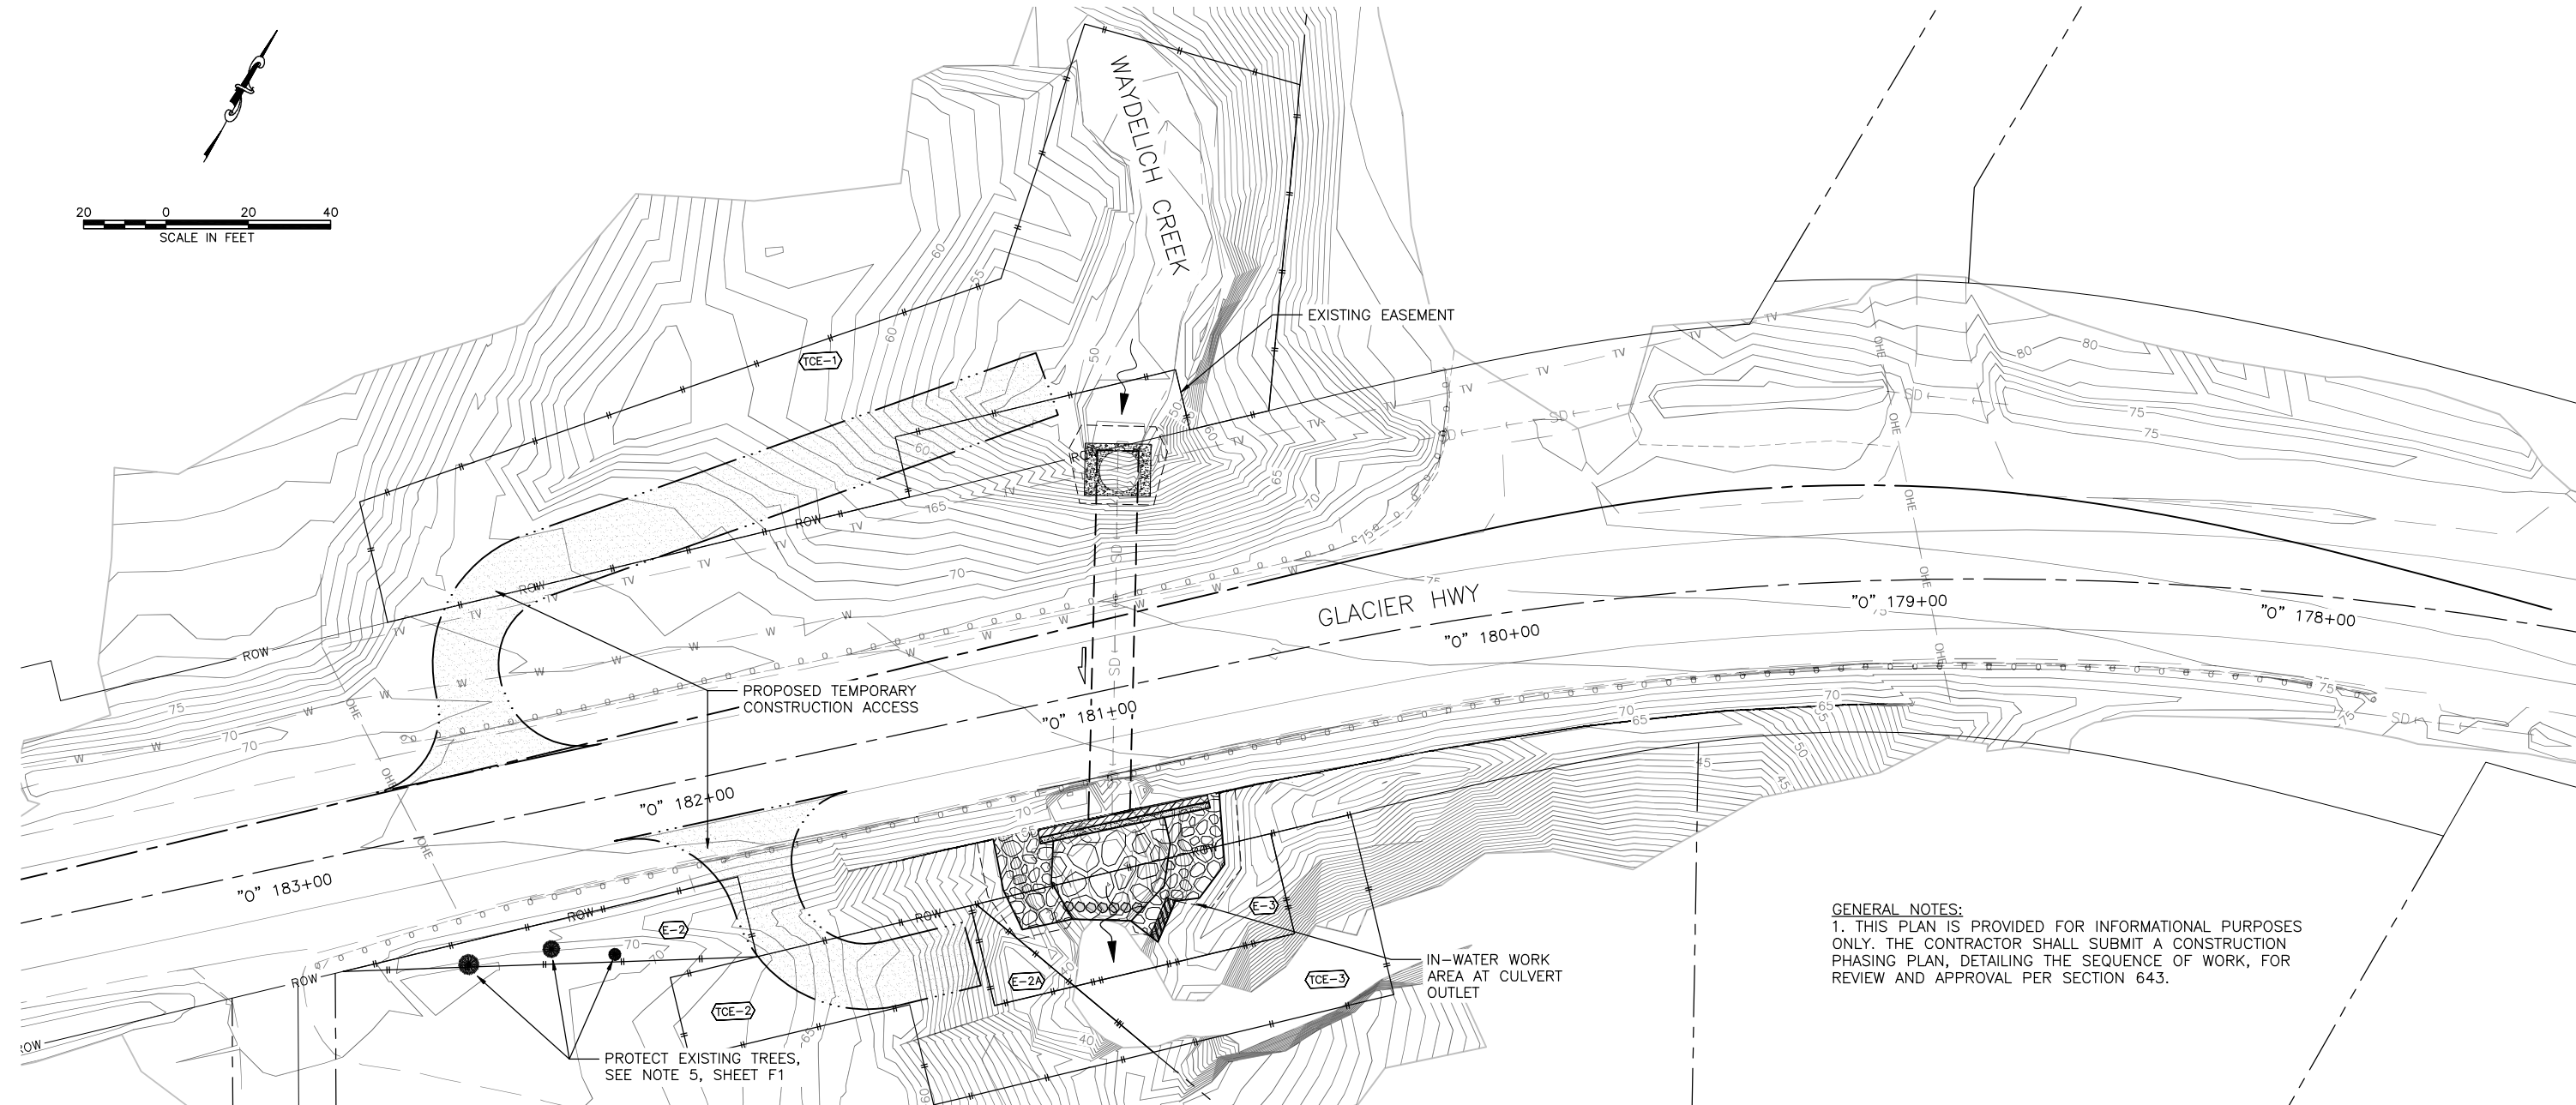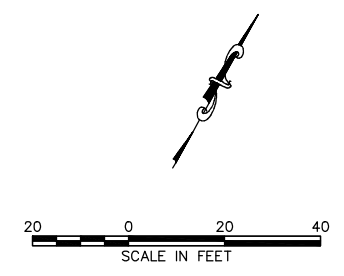

GENERAL NOTES:
 1. THIS PLAN IS PROVIDED FOR INFORMATIONAL PURPOSES ONLY. THE CONTRACTOR SHALL SUBMIT A CONSTRUCTION PHASING PLAN, DETAILING THE SEQUENCE OF WORK, FOR REVIEW AND APPROVAL PER SECTION 643.

CONSTRUCTION PHASING NOTES:

CONSTRUCTION PHASING AT CULVERT INLET:

- DIVERT WAYDELICH CREEK
 - DIVERSION STAYS IN PLACE FOR INLET AND OUTLET WORK.
- DEWATER ADDITIONAL WATER FROM SCOUR POOL AT INLET
 - THIS WATER WILL REQUIRE FILTRATION PRIOR TO DISCHARGING BACK INTO THE STREAM. CONTRACTOR WILL LOCATE FILTER SYSTEM WITHIN THE TCE'S INDICATED.
- CONSTRUCT CAST-IN-PLACE INLET END TREATMENT.
 - REMOVE LOOSE DEBRIS AND RIPRAP WITHIN SLOPE FOOTPRINT.
 - DEMOLISH EXISTING CONCRETE HEADWALL AT THE CULVERT INLET.
 - TRIM CULVERT END AS NECESSARY.
 - CONDUCT MINOR EXCAVATION BELOW THE UNDERMINED HEADWALL TO FACILITATE THE CONSTRUCTION OF THE NEW CONCRETE INLET END TREATMENT TO A MINIMUM THICKNESS OF 6-INCHES BELOW THE PROPOSED INLET END TREATMENT AND INTEGRAL CUT-OFF WALL.
 - CONSTRUCT FORMWORK AND PLACE REINFORCING STEEL FOR THE NEW INLET END TREATMENT.
 - USING CLASS A CONCRETE POUR NEW INLET END TREATMENT.
- BACKFILL EXCAVATION WITH AGGREGATE BASE COURSE, REPLACE EXISTING RIPRAP, RE-ESTABLISH ANY DISTURBED SLOPES, PLACE TURF REINFORCEMENT MAT, AND SEED.


CONSTRUCTION PHASING AT CULVERT OUTLET:

- DEWATER ADDITIONAL WATER FROM SCOUR POOL AT OUTLET
 - THIS WATER WILL REQUIRE FILTRATION PRIOR TO DISCHARGING BACK INTO THE STREAM. CONTRACTOR WILL LOCATE FILTER SYSTEM WITHIN THE TCE'S INDICATED.
- REMOVE EXISTING MSE WALL CONCRETE LEVELING PAD.
- PLACE FILTER BLANKET MATERIALS WITHIN THE SCOUR POOL TO APPROXIMATE ELEVATION 39.66 FEET.
- COMMENCE WITH LEVELING PAD CONSTRUCTION:
 - CORE DRILL THE ACCESS/VENT HOLES IN THE LOWER WALL PANELS.
 - REMOVE LOOSE DEBRIS AT THE BASE OF THE WALL.
 - MINOR EXCAVATION BELOW THE UNDERMINED WALL PANELS TO FACILITATE CONSTRUCTION OF A NEW LEVELING PAD. MAINTAIN A MINIMUM THICKNESS OF 6-INCHES BELOW THE EXISTING PANELS.
 - DURING THE CONSTRUCTION AT THE BASE OF THE WALL, THE SINKHOLES AT THE TOP SHOULD BE CONSIDERED A HIGH-RISK AREA AND THE CONTRACTOR WILL NEED TO WORK AROUND THEM.
 - CONSTRUCT FORMWORK AND PLACE REINFORCING STEEL FOR THE NEW LEVELING PAD.
 - USE CLASS A CONCRETE FOR POURING THE NEW LEVELING PAD WITH THE INTENT OF HAVING THE NEW PAD EXTEND ABOVE THE WALL TO ABOUT ELEVATION 42.08 FEET.

- ONCE THE NEW LEVELING PAD IS IN PLACE AND CURED FOR AT LEAST 24 HOURS, THE FORMS CAN BE STRIPPED AND REMOVED FROM THE WORK AREA.
- PLACE RIPRAP CLASS I AND GROUTED RIPRAP CLASS II IN THE SCOUR HOLE.
- REPAIR THE MSE WALL USING THE FOLLOWING GROUTING SEQUENCE
 - SEAL ALL GAPS BETWEEN WALL PANELS PRIOR TO THE START OF GROUTING.
 - DRILL GROUT HOLE AND INJECT GROUT. GROUT SUBSEQUENT LIFTS ONLY AFTER THE PREVIOUS LIFT HAS ACHIEVED A COMPRESSIVE STRENGTH OF 50 PSI.
 - PLACEMENT OF CLSM INTO THE SINKHOLES AT THE TOP OF THE WALL CANNOT TAKE PLACE UNTIL THE LEVELING PAD HAS BEEN REPLACED, THE BASE OF THE WALL IS SEALED, AND GROUTING BEHIND THE MSE WALL PANELS IS COMPLETE.
- PLACEMENT OF CLASS III RIPRAP IN THE SCOUR HOLE AND THE RIPRAP CLASS II UP THE BANKS OF THE CHANNEL MAY RESUME AFTER COMPLETION OF OTHER WORK AT THE OUTLET OF THE CULVERT.
- REMOVE THE STREAM DIVERSION CULVERT AND RETURN FLOW TO EXISTING CULVERT.
- AFTER THE MSE WALL GROUT REPAIRS HAVE SUFFICIENTLY CURED, REPAIR OF THE ROADWAY EMBANKMENT AND SINKHOLES CAN COMMENCE.
 - REMOVE ORGANIC AND OTHER LOOSE MATERIAL AND PERFORM SHOULDER EXCAVATION.
 - PLACE SELECTED MATERIAL, TYPE A AS INDICATED IN THE PLANS AND SPECIFICATIONS.
 - GROUT SHALL BE PLACED TO A MINIMUM THICKNESS OF 6-INCHES ABOVE THE UPPER MOST MSE WALL REINFORCING STEEL STRIP.
- CONSTRUCT PAVEMENT STRUCTURAL SECTION, DRAINAGE CURB, AND GUARDRAIL.
- REMOVE TEMPORARY CONSTRUCTION ACCESS ROADS AND EQUIPMENT PADS, RE-ESTABLISH ANY DISTURBED SLOPES, PLACE TOPSOIL, AND SEED.

Record Drawings have been reviewed by the Project Engineer and represent the project as constructed.

Dillon Tomaro 3/26/26
 Signature Date

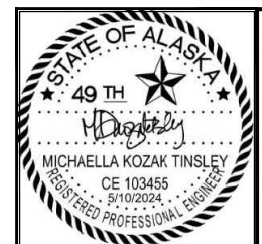

STATE OF ALASKA
 DEPARTMENT OF TRANSPORTATION
 AND PUBLIC FACILITIES

JNU WAYDELICH CREEK:
 UPPER & LOWER WALL REPAIRS



CONSTRUCTION PHASING PLAN

FILE C:\down_low\04041218\SA-CT-CP-S1.dwg DATE 7/2/2024 13:08 LAYOUT S1 DESIGNED KOZAK TINSLEY CHECKED CHRISTIE DRAFTED KIM

NO.	DATE	REVISION	STATE	PROJECT DESIGNATION	YEAR	SHEET NO.	TOTAL SHEETS
			ALASKA	0093003/SFHWHY00414	2024	S2	24

Record Drawings have been reviewed by the Project Engineer and represent the project as constructed.

Dillon Tomaro 3/26/26
Signature Date

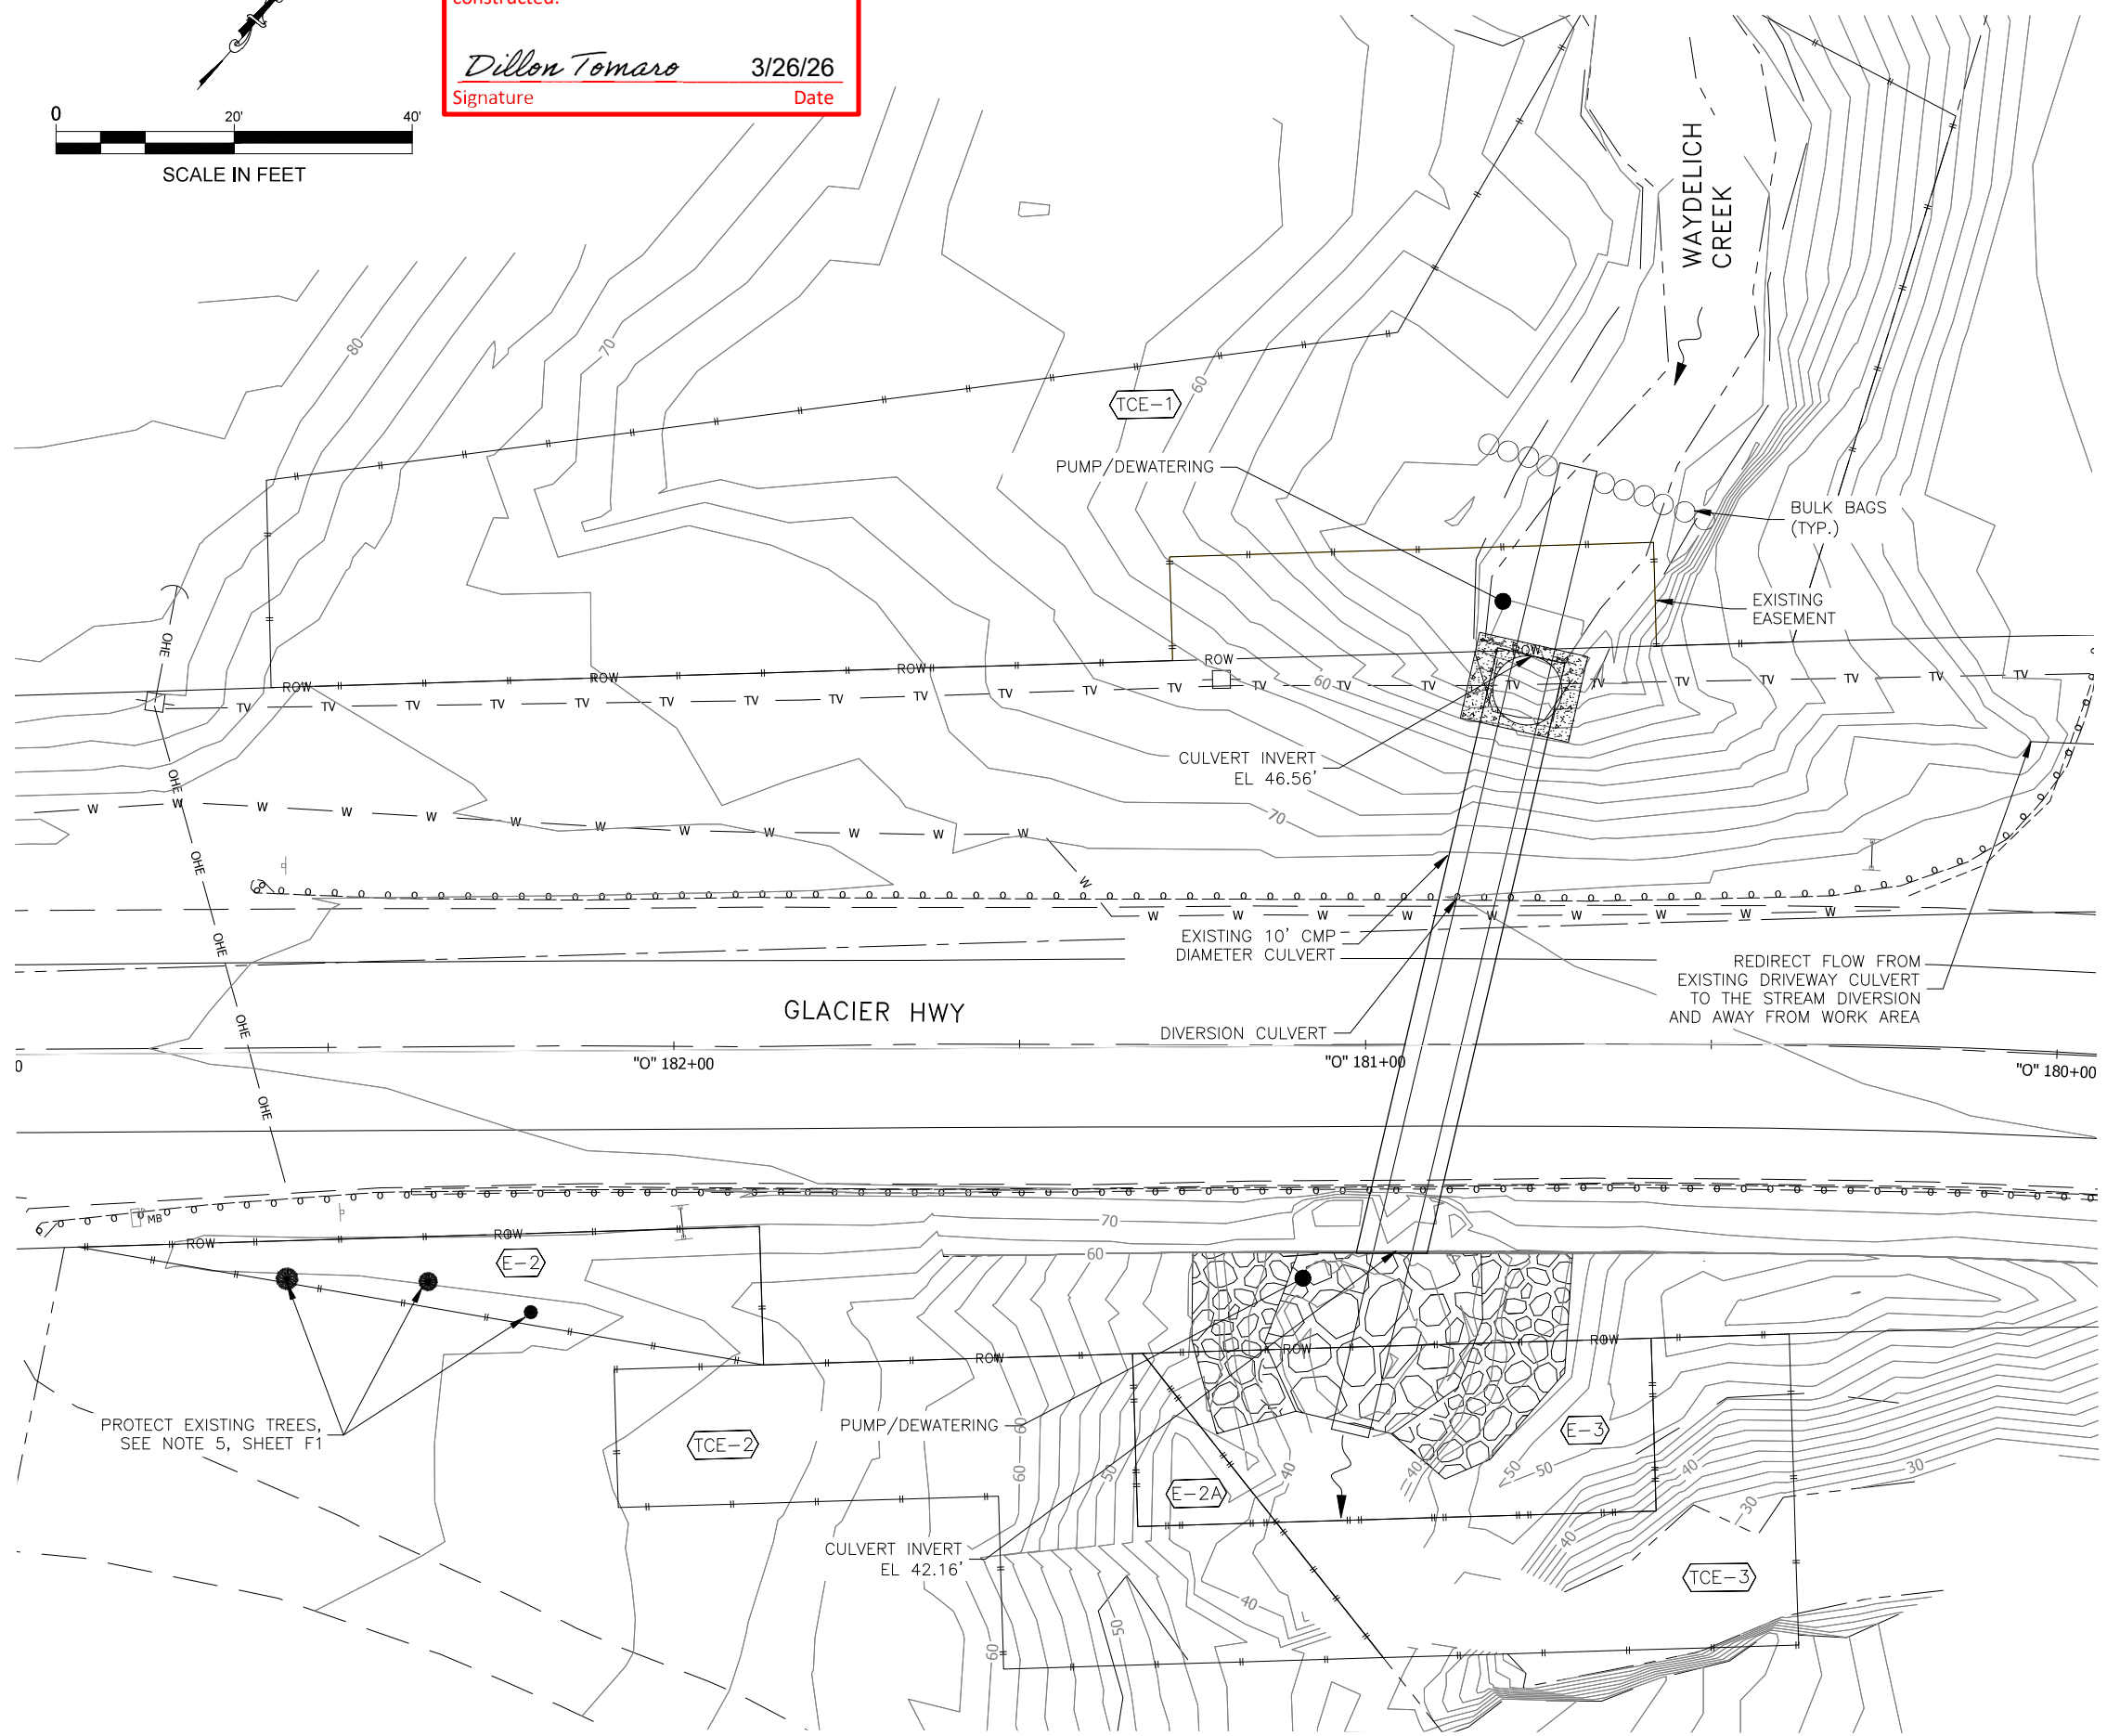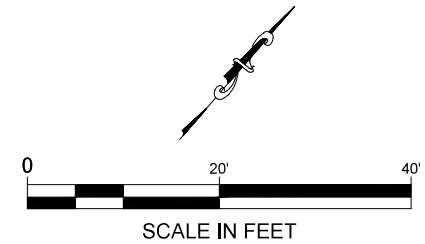


STREAM DIVERSION NOTES:

A COFFERDAM, OR OTHER DIVERSION STRUCTURE, MAY BE NEEDED TO REDUCE GROUNDWATER FLOW INTO EXCAVATED AREA. TEMPORARY DIKES OR BERMS MAY BE USED TO ISOLATE THE WORK AREA FROM WATERS OF THE SURROUNDING AREA. THIS WORK MAY REQUIRE A DIVERSION OF STREAM WATER. THE DESIGNERS RECOGNIZE THAT DIFFERENT CONTRACTORS WILL HAVE VARIOUS APPROACHES FOR CONTROLLING WATER AND CONSTRUCTION SEQUENCING. THIS DIVERSION PLAN HAS BEEN DEVELOPED TO CHECK FOR CONSTRUCTABILITY AND AS A STARTING POINT FOR A CONTRACTOR-GENERATED PLAN. CONTRACTOR MUST SUBMIT DIVERSION PLANS TO ENGINEER FOR APPROVAL PRIOR TO IMPLEMENTATION.

- DIVERSION PLAN:**
1. PLACE BARRICADES, SIGNS AND/OR TEMPORARY ROAD DETOUR IN COMPLIANCE WITH SPECIFICATIONS. COORDINATE WITH CONTRACTORS WHO MAY BE PRESENT IN THE AREA.
 2. NOTIFY ALL UTILITY COMPANIES PRIOR TO EXCAVATION.
 3. ONE 66" MINIMUM DIAMETER (OR LARGER) CULVERT CAN BE USED THROUGH EXISTING CULVERT FOR DIVERSION. ESTIMATED 2-YEAR STORM FLOW IS 170 CFS. ANNUAL LOW FLOW PERIOD IS TYPICALLY FEBRUARY THROUGH APRIL.
 4. DIVERSION MUST ALLOW MANEUVERABILITY/CLEARANCE FOR CONSTRUCTION OF OUTLET PROTECTION
 5. USE BULK BAGS (SUPERSACKS) OVERLAYED WITH VISQUEEN TO DIVERT STREAM FLOW. LOCATION OF DIVERSION INLET/OUTLET IS APPROXIMATE AND SUBJECT TO SITE CONDITIONS AND METHODS.
 6. REPAIR RETAINING WALL AND RECONSTRUCT INLET/OUTLET PROTECTION.
 7. DIVERT CREEK FLOW THROUGH EXISTING 10' CULVERT.
 8. REMOVE CULVERT OR OTHER MATERIAL AND EQUIPMENT USED FOR DIVERSION.
 9. STABILIZE AND REVEGETATE ALL REMAINING DISTURBED AREAS.

- DEWATERING NOTES:**
1. DEWATER TRENCH AND WORK AREA WITH PUMP HOSE IF REQUIRED.
 2. ALL DISCHARGE POINTS REQUIRE PERMANENT OR TEMPORARY VELOCITY CONTROLS.
 3. SILT BAG OR SIMILAR DEVICE SHALL BE USED TO REDUCE SEDIMENT FROM PUMPING OPERATIONS. DISCHARGE POINT SHALL BE AT LEAST 100' FROM CREEK.
 4. SEDIMENT REMOVAL FOR ALL DEWATERING ACTIVITY PRIOR TO DISCHARGE FROM THE PROJECT INTO ANY WATER OF THE U.S. MUST COMPLY WITH PERMITS.
 5. PROVIDE SPARE (EXTRA) PUMPS FOR BOTH UPSTREAM AND DOWNSTREAM DEWATERING PUMP.
 6. EXISTING RIPARIAN VEGETATION SHOULD BE PROTECTED TO MINIMIZE DISTURBANCE.
 7. EROSION AND SEDIMENT CONTROL MEASURES WILL BE IMPLEMENTED TO MEET PERMIT REQUIREMENTS.
 8. ALL DISTURBED GROUND CAPABLE OF SUPPORTING VEGETATION SHALL BE REVEGETATED FOR FINAL STABILIZATION. ALL AREAS NOT REVEGETATED FOR FINAL STABILIZATION SHALL BE 100% COVERED BY ROCK OR OTHER PERMANENT NON-ERODIBLE MATERIAL. FINAL STABILIZATION SHALL BE AS APPROVED BY THE ENGINEER.

FILE: C:\dow\pw\04041218\SA-CT-CP-S2.dwg DATE: 5/10/2024 15:41 LAYOUT: S2 DESIGNED: KOZAK TINSLEY CHECKED: CHRISTIE DRAFTED: KIM


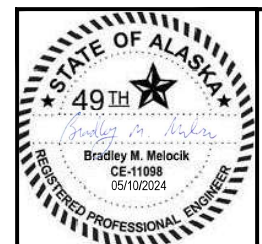


STATE OF ALASKA
DEPARTMENT OF TRANSPORTATION
AND PUBLIC FACILITIES

JNU WAYDELICH CREEK:
UPPER & LOWER WALL REPAIRS

STREAM DIVERSION PLAN

NO.	DATE	REVISION	STATE	PROJECT DESIGNATION	YEAR	SHEET NO.	TOTAL SHEETS
1	7/19/24	REVISED TEXT	ALASKA	0093003/SFHWHY00414	2024	T2	23
2	7/19/24	REVISED CHANNELIZING DEVICE					

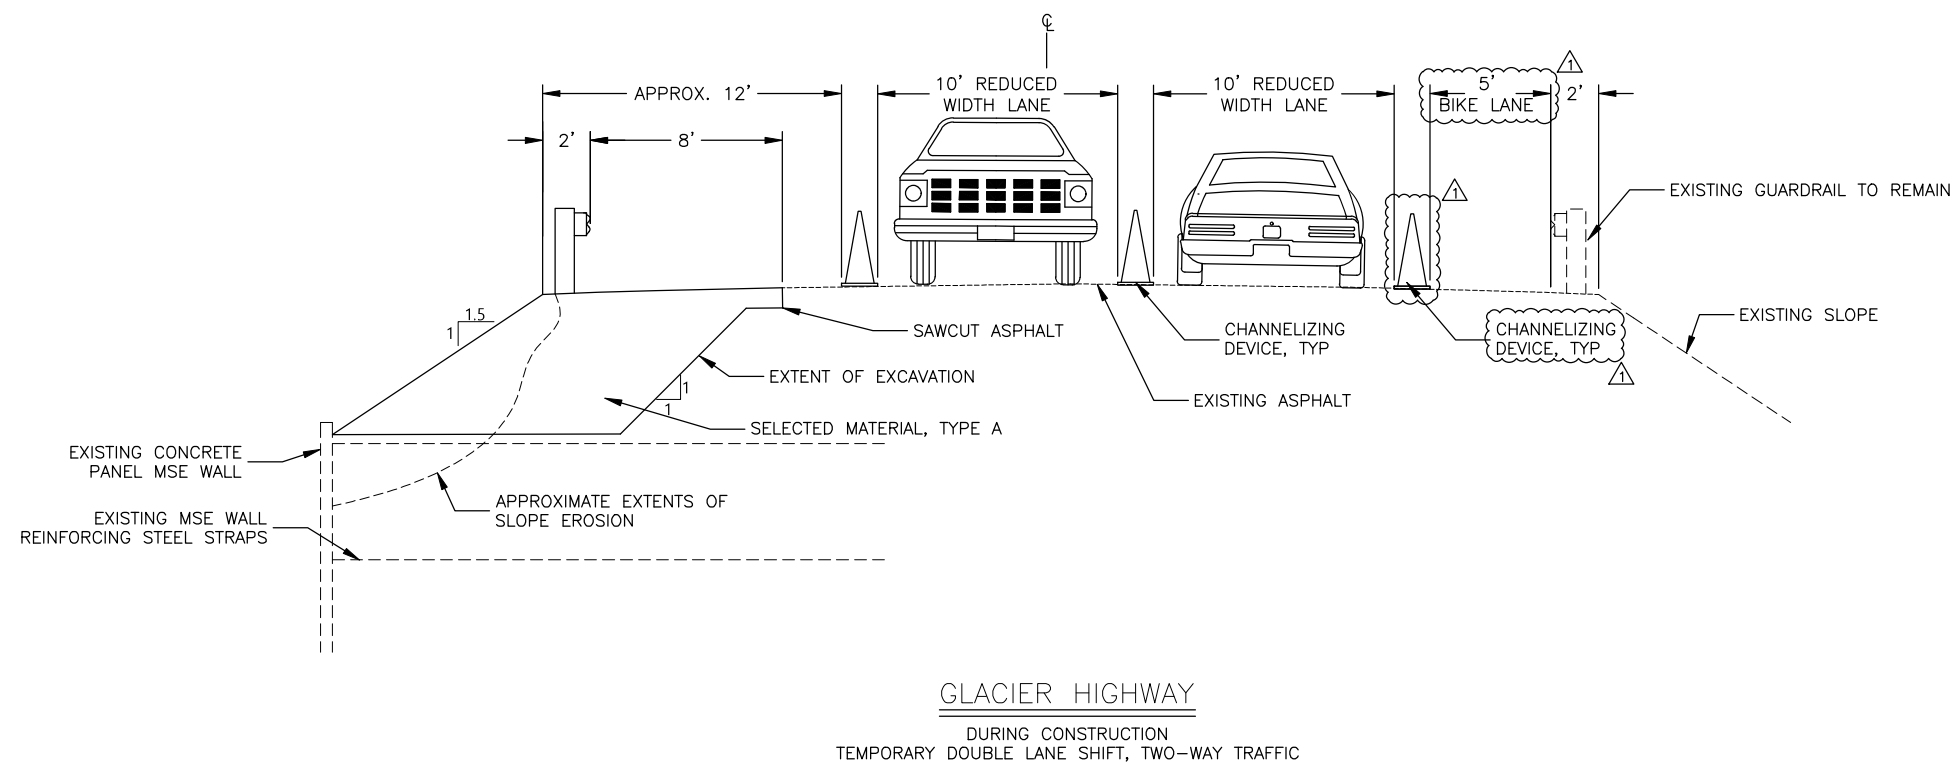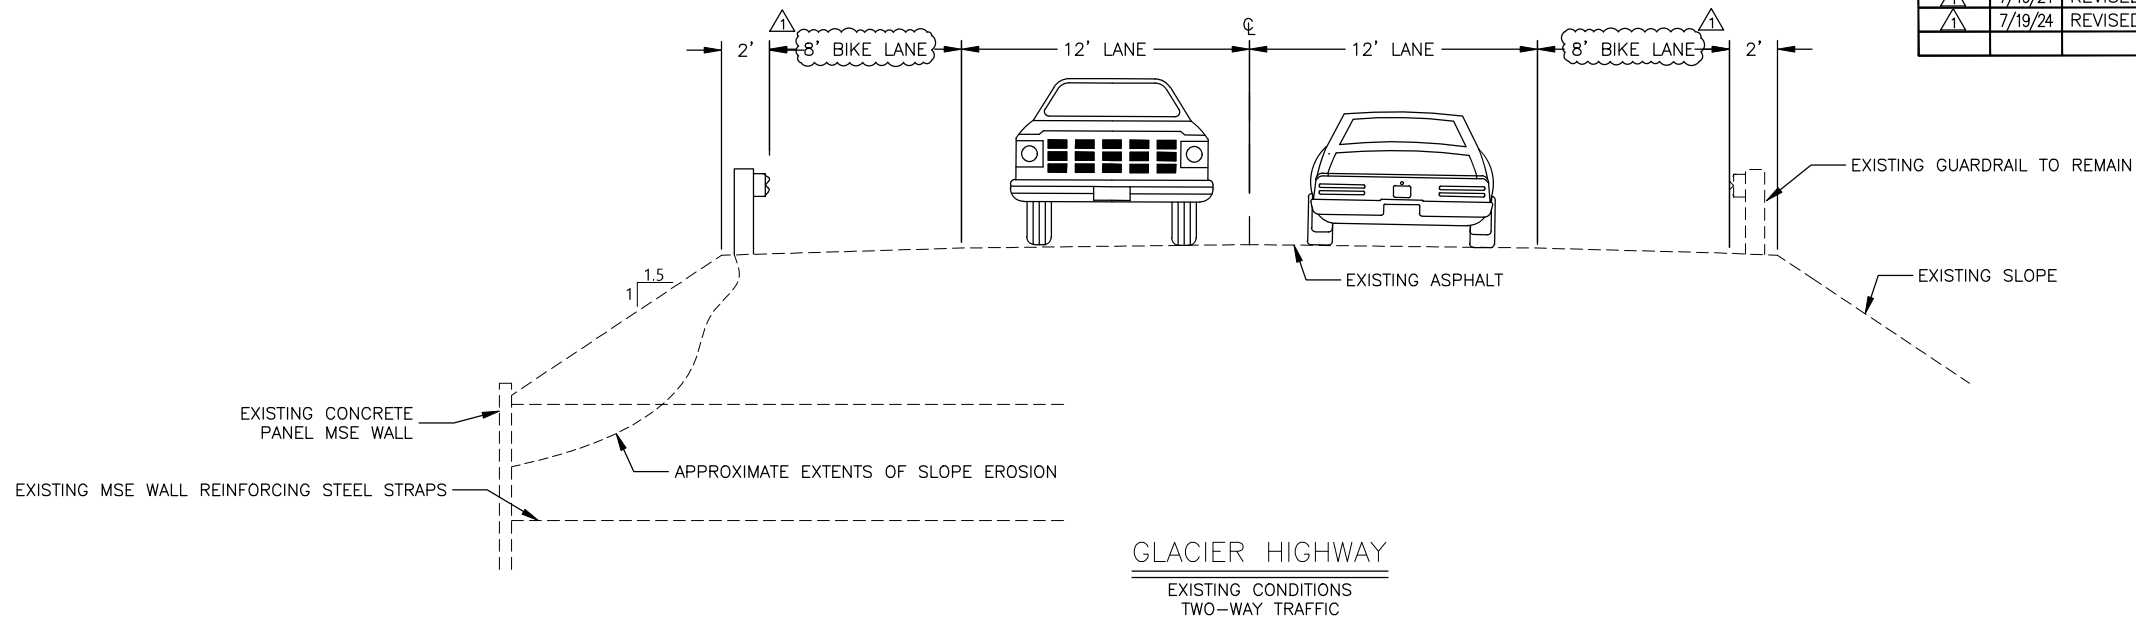

Record Drawings have been reviewed by the Project Engineer and represent the project as constructed.

Dillon Tomaro 3/26/26
Signature Date

TCP NOT SEALED IN ACCORDANCE WITH ALASKA HIGHWAY PRECONSTRUCTION MANUAL SECTION 1400.3.4 DATED SEPTEMBER 2, 2022

STATE OF ALASKA
DEPARTMENT OF TRANSPORTATION AND PUBLIC FACILITIES
JNU WAYDELICH CREEK:
UPPER & LOWER WALL REPAIRS
TRAFFIC CONTROL SECTIONS

FILE C:\dow\pw\0401218\SC-CT-T2-63330-04.dwg DATE 7/18/2024 16:19 LAYOUT T2 DESIGNED KOZAK TINSLEY CHECKED CHRISTIE DRAFTED KIM


NO.	DATE	REVISION	STATE	PROJECT DESIGNATION	YEAR	SHEET NO.	TOTAL SHEETS
			ALASKA	0093003/SFHwy00414	2024	T3	24

FILE c:\dswl_bw\0401218\SC-CT-T3-63330.04.dwg DATE 5/6/2024 15:22 LAYOUT T3 DESIGNED KOZAK TINSLEY CHECKED CHRISTIE DRAFTED KIM



Record Drawings have been reviewed by the Project Engineer and represent the project as constructed.

Dillon Tomaro 3/26/26
 Signature Date

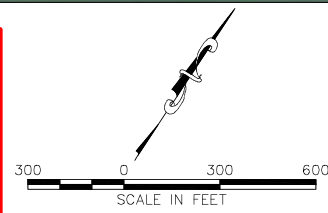

TCP NOT SEALED IN ACCORDANCE WITH ALASKA HIGHWAY PRECONSTRUCTION MANUAL SECTION 1400.3.4 DATED SEPTEMBER 2, 2022

STATE OF ALASKA
 DEPARTMENT OF TRANSPORTATION AND PUBLIC FACILITIES

JNU WAYDELICH CREEK:
 UPPER & LOWER WALL REPAIRS

TRAFFIC CONTROL PLAN:
 TEMPORARY PEDESTRIAN DETOUR