

STATE OF ALASKA  
DEPARTMENT OF TRANSPORTATION  
and PUBLIC FACILITIES  
S.E. REGION DESIGN & CONSTRUCTION DIVISION

THE FOLLOWING STANDARD DRAWINGS  
SHALL APPLY TO THIS PROJECT:  
A-1, C-01.01, C-02.00, D-01.00, D-04.01,  
D-05.01, M-16.00, S-05.00.

CONSTRUCTION PLANS FOR  
**KAKE AIRPORT EXPANSION**



APRON & RUNWAY EXTENSION,  
LIGHTING & RELATED ITEMS

PROJECT NO. 67496 - D-19712  
A.I.P. NO. 831-3-02-0398-01-83

AS-BUILT SET  
Do Not Use For Other  
PURPOSES

SPONSORED BY  
THE STATE OF ALASKA

AS-BUILT PLANS  
WYMAN CONSTRUCTION CO.  
GREG BROWNING - PROJECT ENGINEER  
OCT. 27, 1985 - NOV. 12, 1986

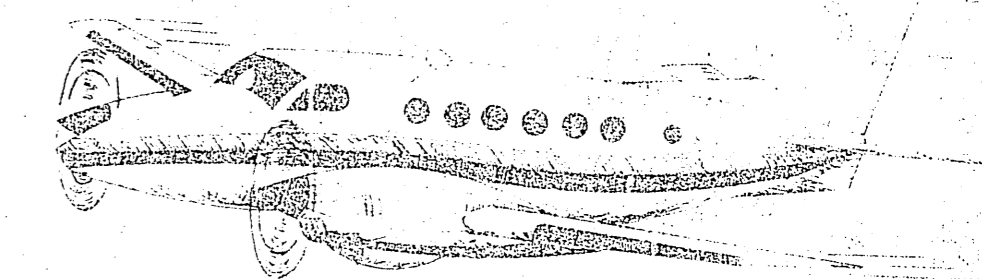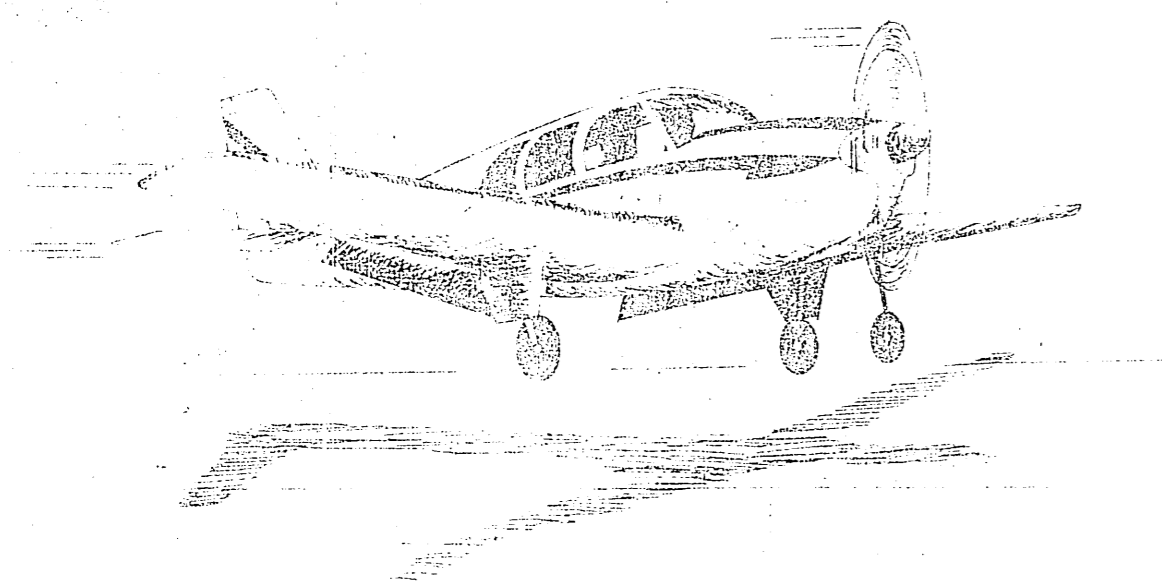

APPROVED


*R. Dieckmann*  
RONALD D. DIECKMANN, DIRECTOR, S.E. REGION DESIGN & CONSTRUCTION  
DATE 8/12/85

APPROVED


*Walter Williams*  
WALTER K. WILLIAMS, DESIGN CHIEF, S.E. REGION DESIGN & CONSTRUCTION  
DATE 8/12/85

STATE	PROJECT DESIGNATION	YEAR	SHEET NO.	TOTAL SHEETS
ALASKA				

# INDEX

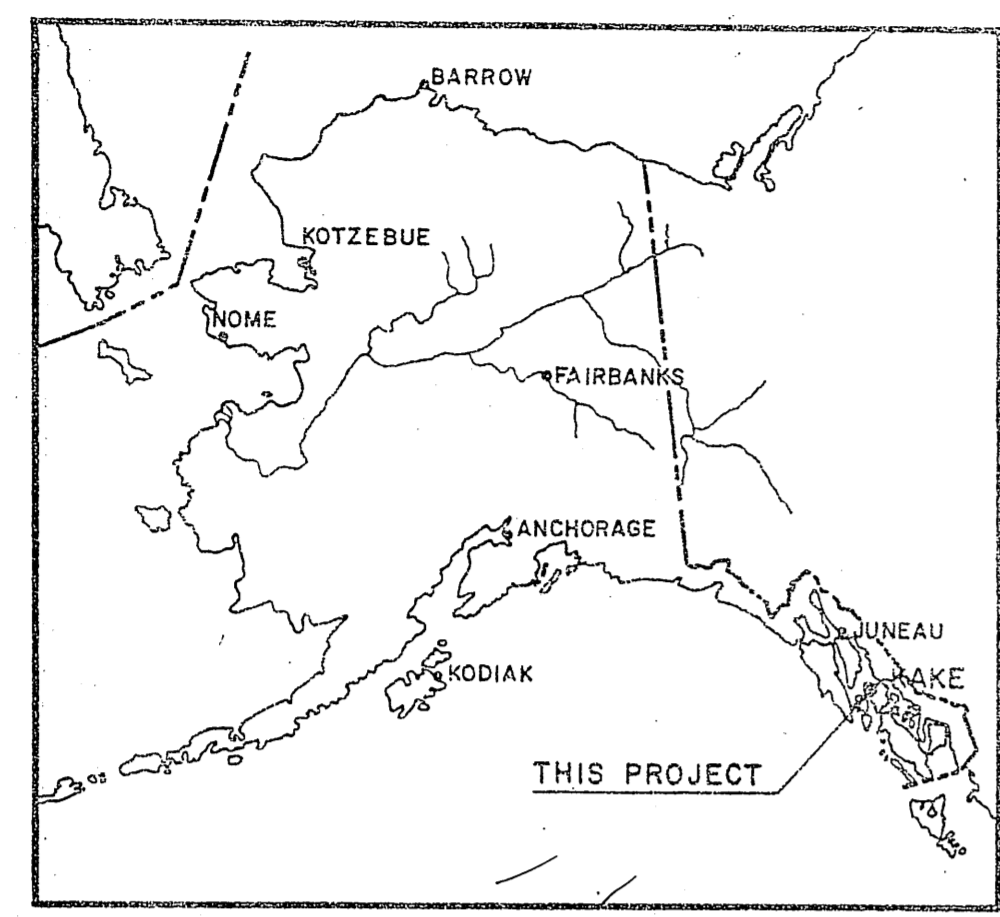

LOCATION MAP

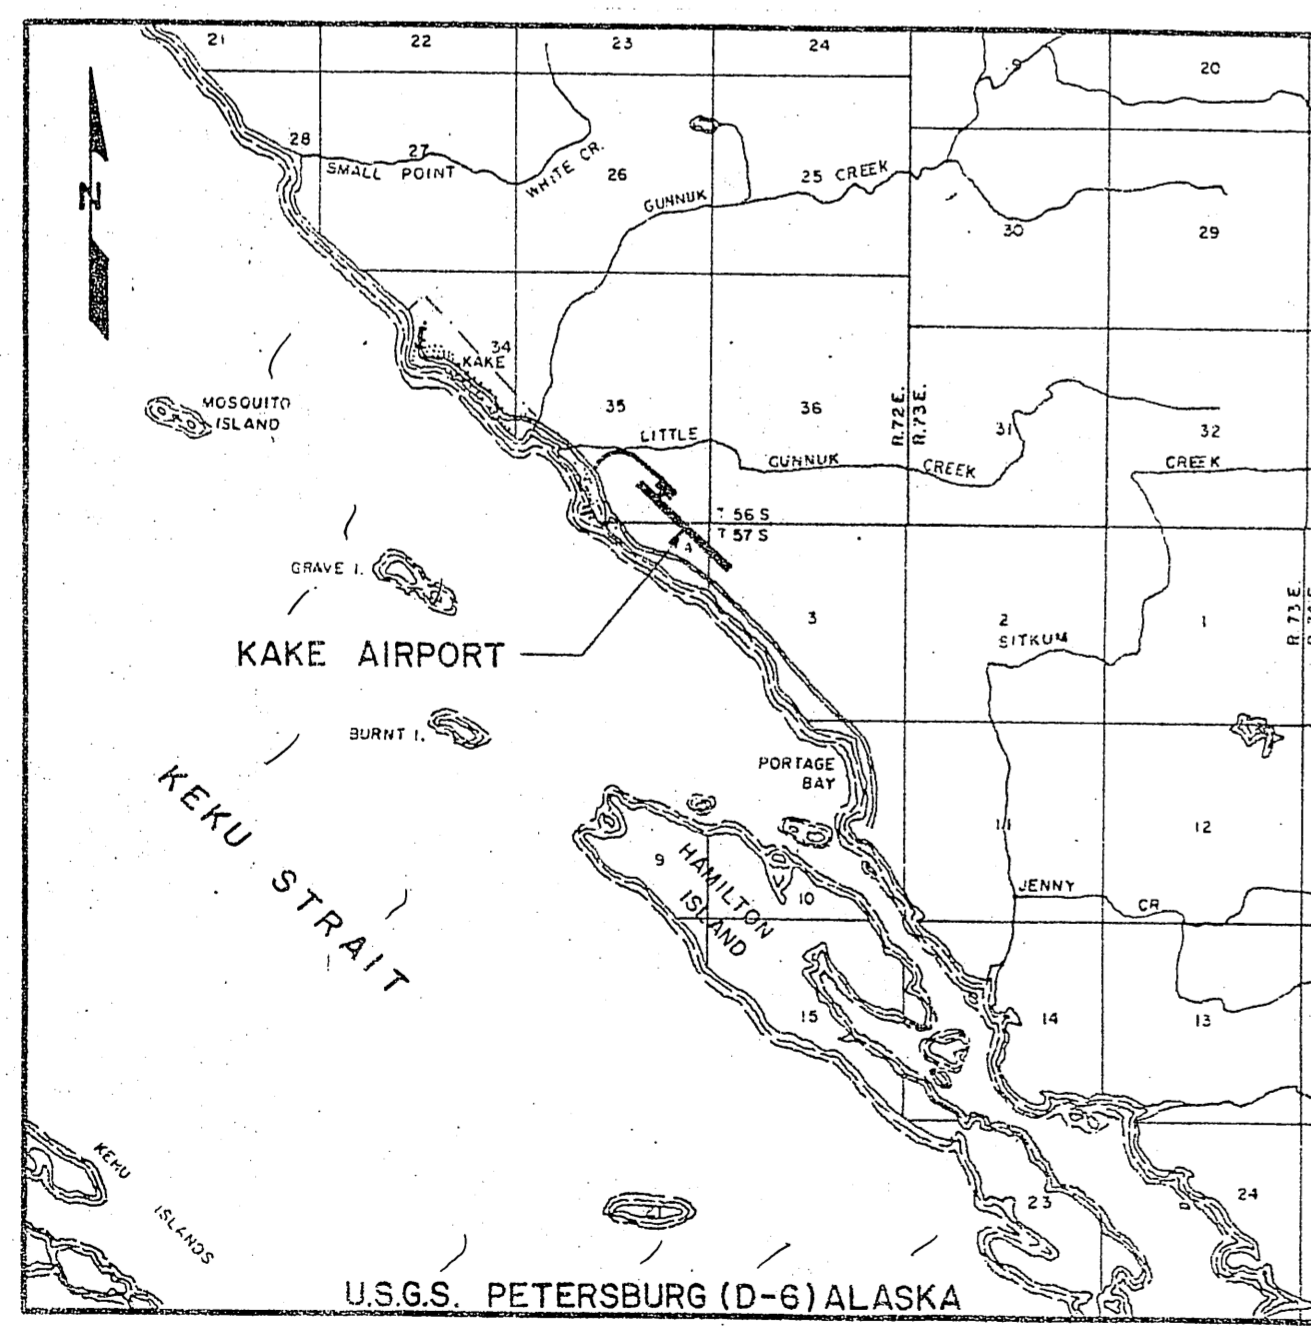


VICINITY MAP  
1" = 1 mile

## SHEET TITLE

## SHEET NUMBER

TITLE SHEET	1
LOCATION MAP, VICINITY MAP, & INDEX	2
SUMMARY TABLES	3
RUNWAY WASTE REMOVAL AND ACCESS ROAD - TYPICAL SECTION	4
RUNWAY TYPICAL SECTIONS	5
APRON PLAN & PROFILE	6
ACCESS ROAD PLAN & PROFILE	7
RUNWAY PLAN & PROFILE	8-10
REFLECTIVE MARKER PLAN	11
LIGHTING PLAN	12
POWER & TELEPHONE PLAN	13
LIGHTING DETAILS - PAPI	14
LIGHTING DETAILS	15
EQUIPMENT SHELTER	16
EQUIPMENT SHELTER - ONE LINE DIAGRAM	17
LIGHTING DETAIL - CONTROLLER	18
POWER & TELEPHONE DETAIL	19-20
CLEARING LIMITS	21
PROPERTY PLAN	22-24
MISCELLANEOUS DETAILS	25

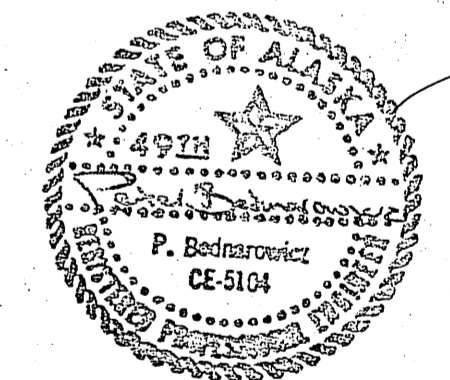

STATE OF ALASKA  
DEPARTMENT OF TRANSPORTATION  
AND PUBLIC FACILITIES  
S.E. REGION, DIVISION OF AVIATION DESIGN & CONSTRUCTION

KAKE AIRPORT  
PROJECT NO. D-19712  
A.I.P. NO. 831-3-02-0398-01-83  
LOCATION MAP, VICINITY MAP, & INDEX

APPROVED BY:		<i>Wallace K. Williams</i> 8/12/85 WALLACE K. WILLIAMS, P.E. CHIEF OF DESIGN	
APPROVED BY:		<i>William L. Baumgartner</i> 8/12/85 WILLIAM L. BAUMGARTNER, P.E. DESIGN CHIEF GROUP "B"	
BY	DATE	CHANGE	SCALE
			N.T.S.
DESIGNED: MJC		DRAWN: SS	
CHECKED:		DATE:	
REVISIONS			
			SHEET 2 OF 25

# ESTIMATE OF QUANTITIES

ITEM NO.	ITEM	UNIT	SHEET NUMBER										TOTAL		
			6	7	8	9	10	11	12	13	21				
90	MBE & WBE Adjustments	C.S.													All Req'd.
100	Mobilization & Demobilization	L.S.													All Req'd.
121	Construction Surveying by the Contractor	L.S.													All Req'd.
125	Engineer's Transportation	E.A.													3
130	Engineer's Field Office & Laboratory	L.S.													All Req'd.
200a	Clearing	Acre	1.475	0.221											50.255 38.3
200e	Clearing & Grubbing	Acre	X6	<del>1.676</del>	0.971										9.41281 11 15.557
330a	Common Excavation	E.Y.													11,000
330b	Rock Excavation	E.Y.													165,000
330c	Embankment	E.Y.	27,400	4,600	6,510										123,600 162,110
400	Corrugated Metal Pipe (36" Aluminum, 8 gage)	L.F.	1491.85	562.71	1211.93										487 2,055.49
540	Aggregate Surface Course	C.Y.	1,510	560	4,500										1211.93 4,330 2,730
550b	Geotextile Reinforcement, Type 1	S.Y.	9,887	1133	1,225										2,000 8,855
550c	Geotextile Reinforcement, Type 2	S.Y.			21819										2,000 1819
701	Survey Monument	Each	1	1	1										2
730	Reflective Markers	Each								16					16
800	Portland Cement Concrete	C.Y.	4746.3												47 46.3
820a	Tiedown Anchors	Each	36												36
900	Seeding	MSF	59,325												198,150 258 258.1
			(Calcs. Access, Abrasion)												
1000c	New Remote Control Panel, L-821	Each													1
1000e	New Medium Intensity Runway Marker Lights, L-861	Each													53
1000f	New Taxiway Marker Light, L-861T	Each													10
1000g	New Handhole, L-867	Each													1918
1000i	2" Rigid Steel Conduit	L.F.													2,970 2,364
1000k	2" PVC Conduit	L.F.													14,038 14,713
1000l	Underground Cable #8AWG Copper, 5kv Type "B", L-824	L.F.													19,000 18,989
1000m	#6 Bare Copper Ground Conductor	L.F.													15,200 15,115
1000n	Multiconductor Control Cable	L.F.													354 406
1000p	Underground Cable, Copper, 600V, Type "B", L-824	L.F.													13,699 13,600
1000q	Ground Rod	Each													19 20
1000r	3" PVC Conduit	L.F.													4,956 4,820
1000s	Radio Controller, L-854	Each													1
1000t	Underground Vault (36"x36"x36")	Each													8 6 8.4
1030a	P.A. P.I. - 4" L-880, Style A, Class II	Pair													8 1
1030b	Omnidirectional R.E.L., L-859	Pair													2
1040	Electrical Work - Structures	L.S.													All Req'd
1050a	URD Cable, 15kv	L.F.													2,529 2,502
1050b	25 Pair Communication Cable	L.F.													2,529 2,479
1050c	25 KVA, 7200V Transformer w/Base	L.S.													All Req'd
1050d	Load Break	Each													2
121(i)	Approach Zone Surveying	L.S.													All Req'd
200 f	Windrow Clearing	L.S.													All Req'd
330d	Borrow Embankment	C.Y.	22,741.56	1,4587.57	6,169.63										3,1605.03 140,123.15
330e	Unclassified Excavation	C.Y.	-0-	775.92	1853.93										-0- 72,408.85
330f	Blue Clay Slope Reconstruct	L.S.													All Req'd

\* All lighting equipment quantities related to runway lighting are listed in this column (Sheet 12).

### SETTLEMENT PLATFORM SUMMARY

STATION	REMARKS
"R" 10+05	Install Lt & Rt on Shoulders
"R" 10+30	Install on Centerline
"R" 10+55	Install Lt & Rt on Shoulders
ABOVE WERE BURIED AT CONTRACTS END	

### AIRPORT LIGHTING PAD SCHEDULE


STATION	REMARKS
"R" 20+50	Install at Lt. Shoulder
"R" 42+30	Install at Rt. Shoulder
"R" 53+00	Install at Lt. and Rt. Shoulder
"R" 13+00	Install at Lt. and Rt. Shoulder

### MONUMENT INSTALLATION SUMMARY

STATION	POINT	REMARKS
"A" 14+98.62	P.T.	Adjust
"A" 20+78.45	P.O.T.	13' Lt. of E End Access Rd. Begin Apron Expansion
"R" 56+00	P.O.T.	End of Runway
"R" 10+00	P.O.T.	BELOW RUNWAY
"R" 45+60 P.T.	Property Corner	USS 3852 C2

### PIPE CONDUIT SUMMARY

STATION	PIPE LENGTH		REMARKS
	36"		
"R" 46+10.51	200'	219'	
"R" 51+50.07	262'	268'	
Total	462'	487'	

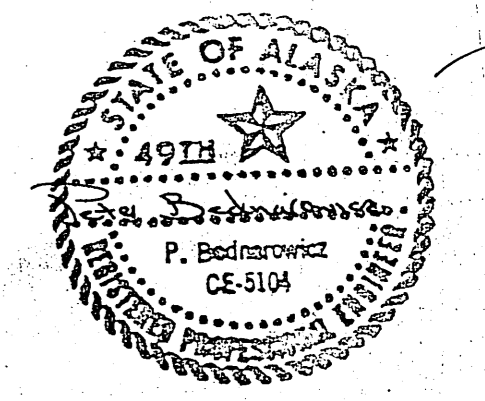

STATE OF ALASKA  
DEPARTMENT OF TRANSPORTATION  
AND PUBLIC FACILITIES  
S.E. REGION, DIVISION OF AVIATION DESIGN & CONSTRUCTION

KAKE AIRPORT  
PROJECT NO. D19712  
A.I.P. NO. 831-3-02-0398-01-83

SUMMARY TABLES

APPROVED BY: *Wallace K. Williams* 8/12/85  
Wallace K. Williams, P.E. Design Chief S.E. Region

APPROVED BY: *Paul Bednarowicz* 8/12/85  
William L. Baumgartner, P.E. Design Chief Group B


BY: DATE: CHANGE: SCALE: No Scale

DESIGNED: MJC CHECKED: DATE: DRAWN: SS

REVISIONS

SHEET 3 OF 25



STATE	PROJECT DESIGNATION	YEAR	SHEET NO.	TOTAL SHEETS
ALASKA				

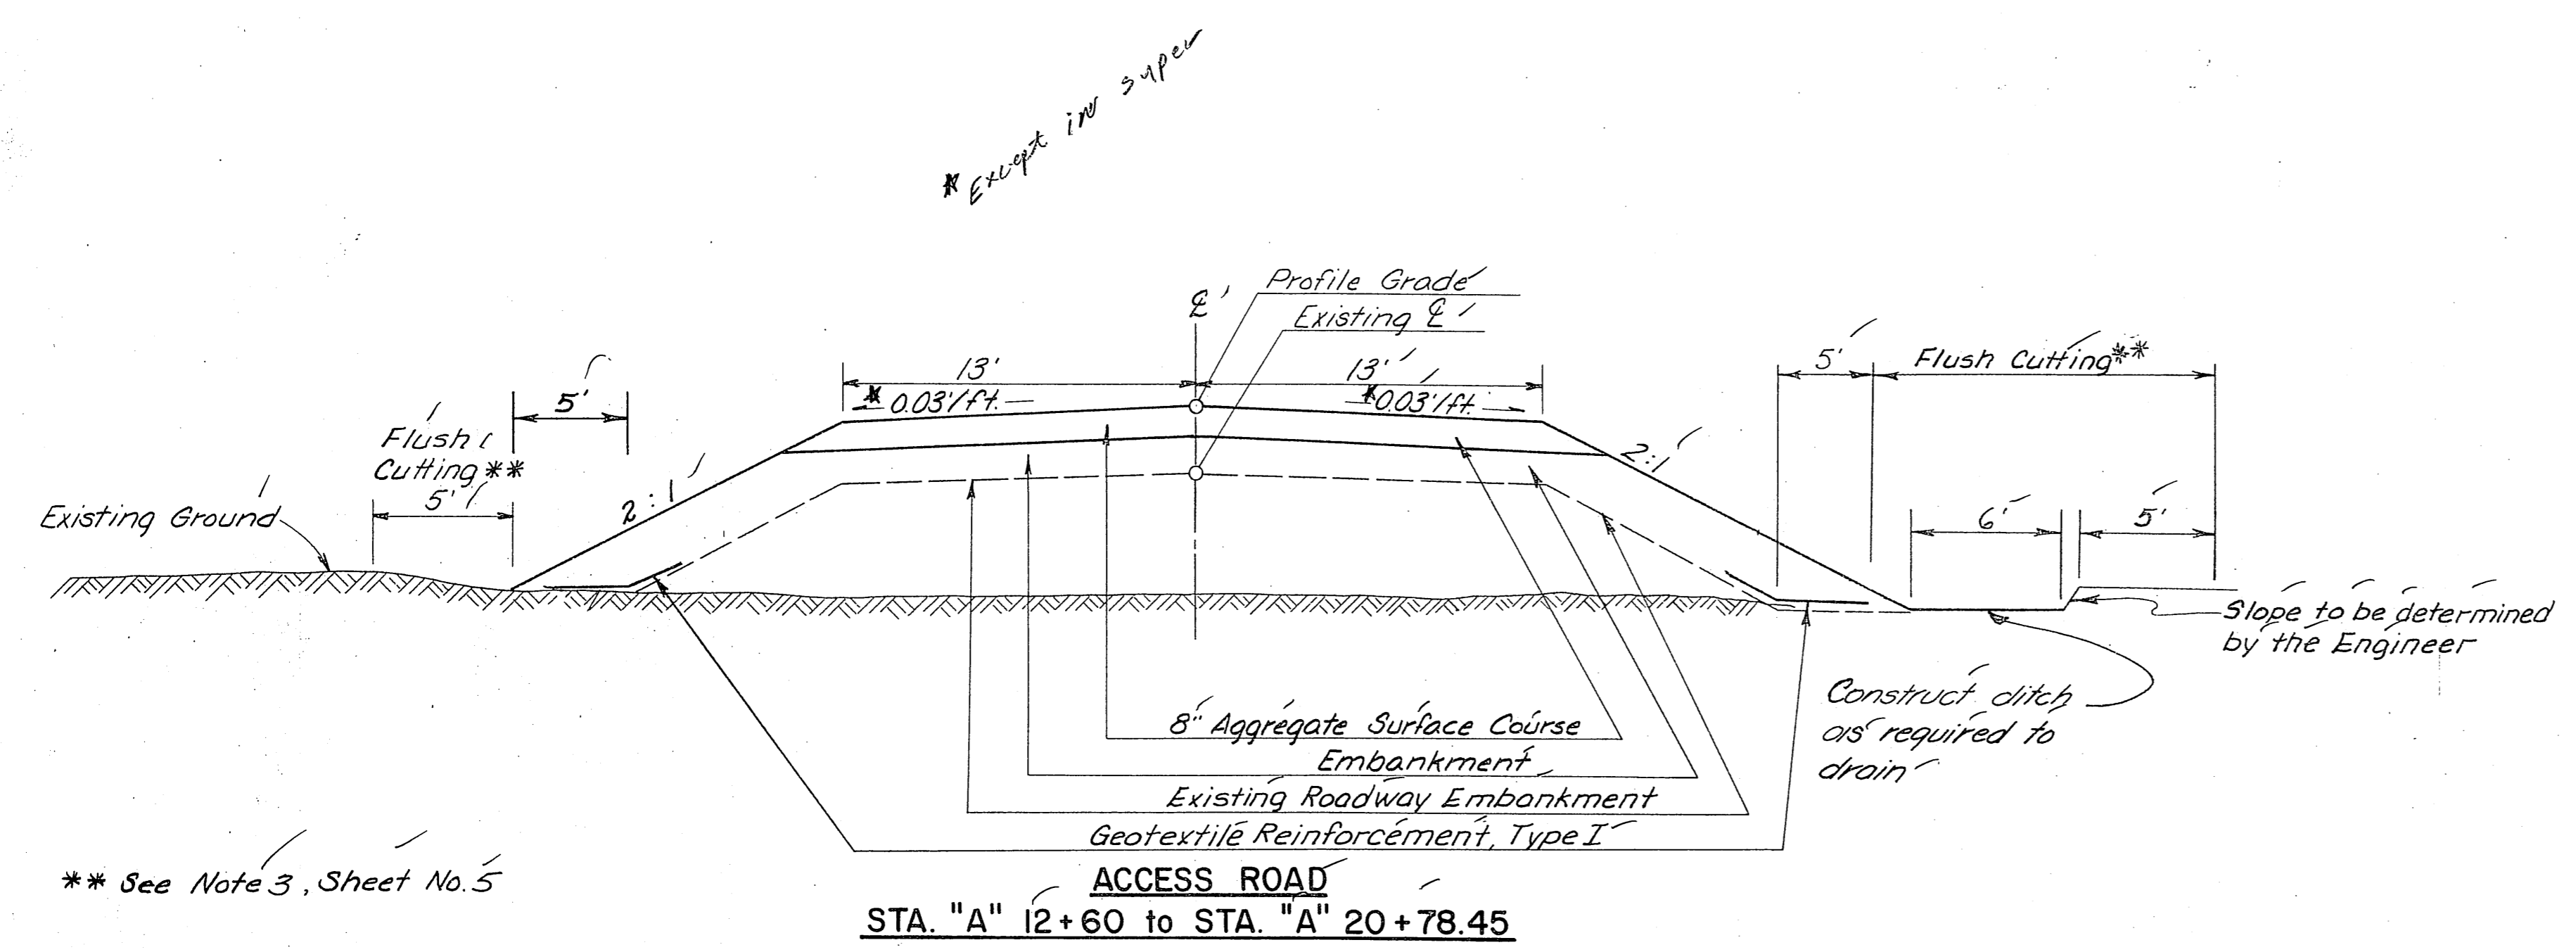

\*\* See Note 3, Sheet No. 5

**GENERAL NOTES:**

- Vertical and Horizontal alignments shown on these plans are subject to minor field revisions.
- Pipe conduit lengths and locations are approximate only and are subject to field adjustments.
- Clearing and Grubbing Limits shall be 10' beyond the slope limits in cut areas and 5' beyond the slope limits in fill areas.
- If the Contractor elects to stockpile useable excavation for reuse elsewhere on the Project, no measurement of quantities will be made and all work involved shall be considered a subsidiary obligation of the Contractor.
- All waste material shall be disposed of at approved locations on the Project Site or at an adjacent site with proper approvals. The Engineer will determine the height and width of the waste embankment adjacent to the Runway. In no case shall the waste be above the Runway. The designated waste area adjacent to the Runway is available for all project waste if the Contractor elects to use this area.
- A Cushion Blanket (4" minus material) 12" thick shall be placed on all woven Geotextile overlaps. This material shall be included for payment as Embankment.
- When rock material is encountered in seeding limits, that area shall not be seeded.
- Stationing for the property monuments are approximate only. The exact location of the existing property monuments are to be tied out and reset by a Registered Land Surveyor. See Section 701. This work shall be considered incidental to other items of work.

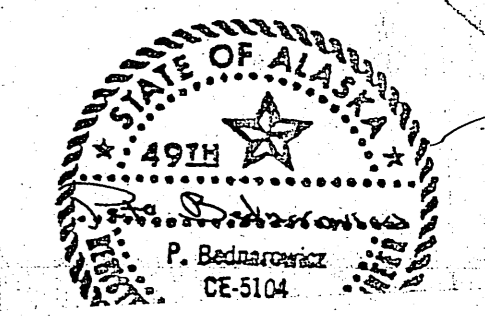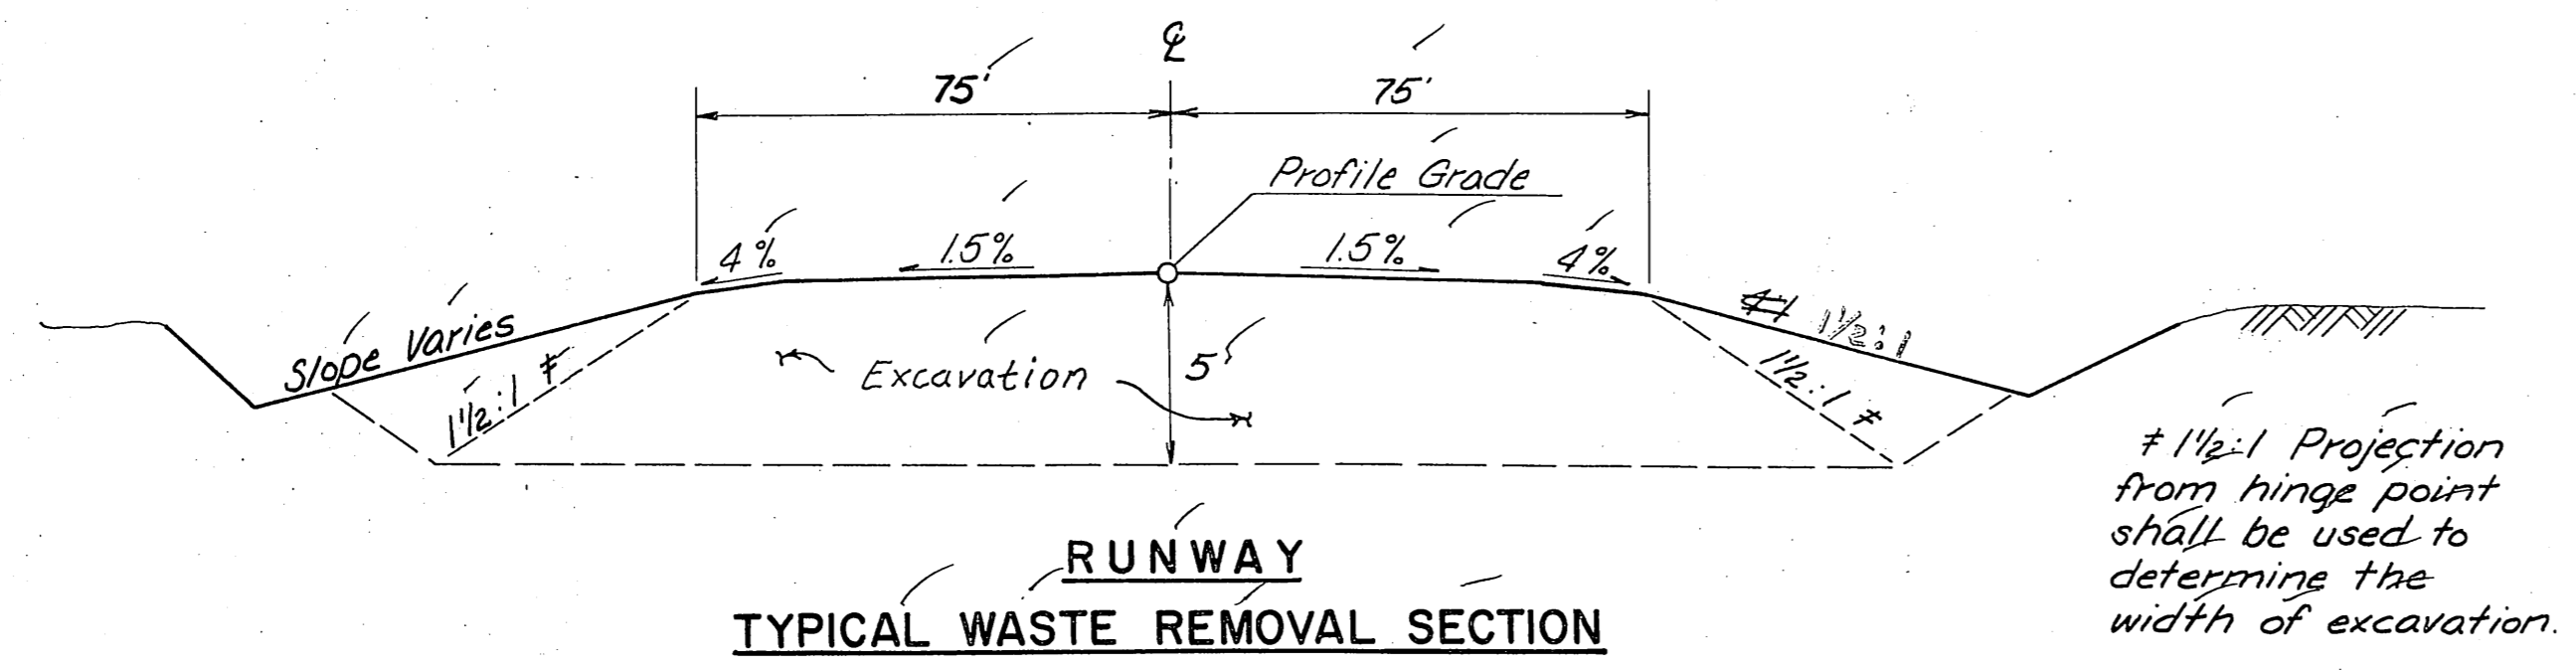

STATE OF ALASKA  
DEPARTMENT OF TRANSPORTATION  
AND PUBLIC FACILITIES  
S.E. REGION, DIVISION OF AVIATION DESIGN & CONSTRUCTION

KAKE AIRPORT  
PROJECT NO. D-19712  
A.I.P. NO. 831-3-02-0398-01-83  
RUNWAY WASTE REMOVAL AND  
ACCESS ROAD - TYPICAL SECTION

APPROVED BY: *Wallace K. Williams* 8/12/95  
WALLACE K. WILLIAMS, P.E. CHIEF OF DESIGN

APPROVED BY: *William L. Baumgartner* 8/12/95  
WILLIAM L. BAUMGARTNER, P.E. DESIGN CHIEF GROUP "B"


SCALE: NO SCALE  
DESIGNED: MJC  
DRAWN: SS  
CHECKED: DATE: SHEET 4 OF 25

BY	DATE	CHANGE

REVISIONS

# TYPICAL RUNWAY SECTIONS


STATE	PROJECT DESIGNATION	YEAR	SHEET NO.	TOTAL SHEETS
ALASKA				

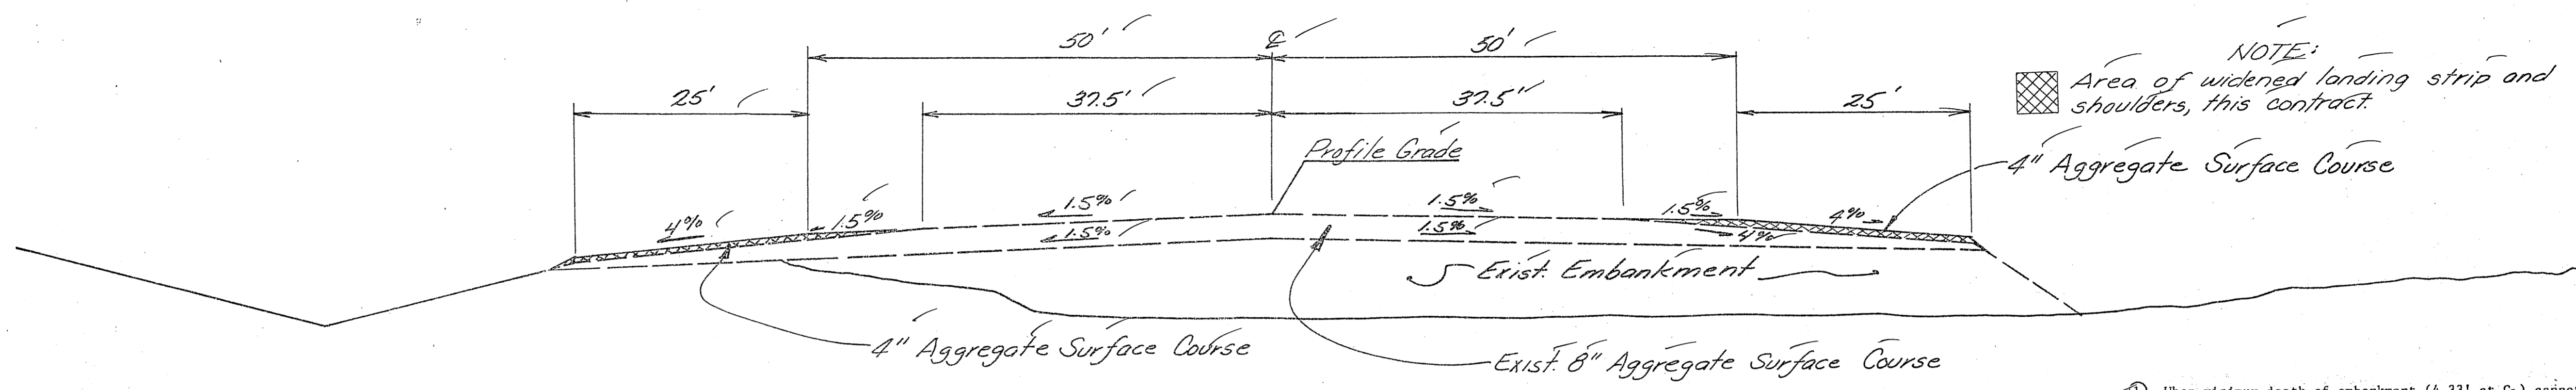


NOTE:  
Area of widened landing strip and shoulders, this contract.

## RUNWAY SECTION STA. "R" 10+60 TO STA. "R" 45+40

- When minimum depth of embankment (4.33' at  $G_1$ ) cannot be achieved, refer to Typical Waste Removal Section.
- Waste material may include vegetation, muskeg, organic soils and other materials which are unsuitable for use in Embankment as determined by the Engineer. Note: The thickness and amounts of waste material varies throughout the project. The Typical Waste Removal Section does not apply when in ground suitable for embankment.
- Flush cutting shall be done in lieu of Clearing and Grubbing, and shall be paid for as Clearing and Grubbing.
- No waste placement shall be permitted between Sta. "R" 51+00 and "R" 52+00.
- May be reduced to 1 1/2:1 in areas of waste placement.
- Slope varies 2:1 to 4:1, to be determined by the Engineer.
- All trees are cleared 250' Rt. and 1000' Lt. of centerline except as noted on the plans.

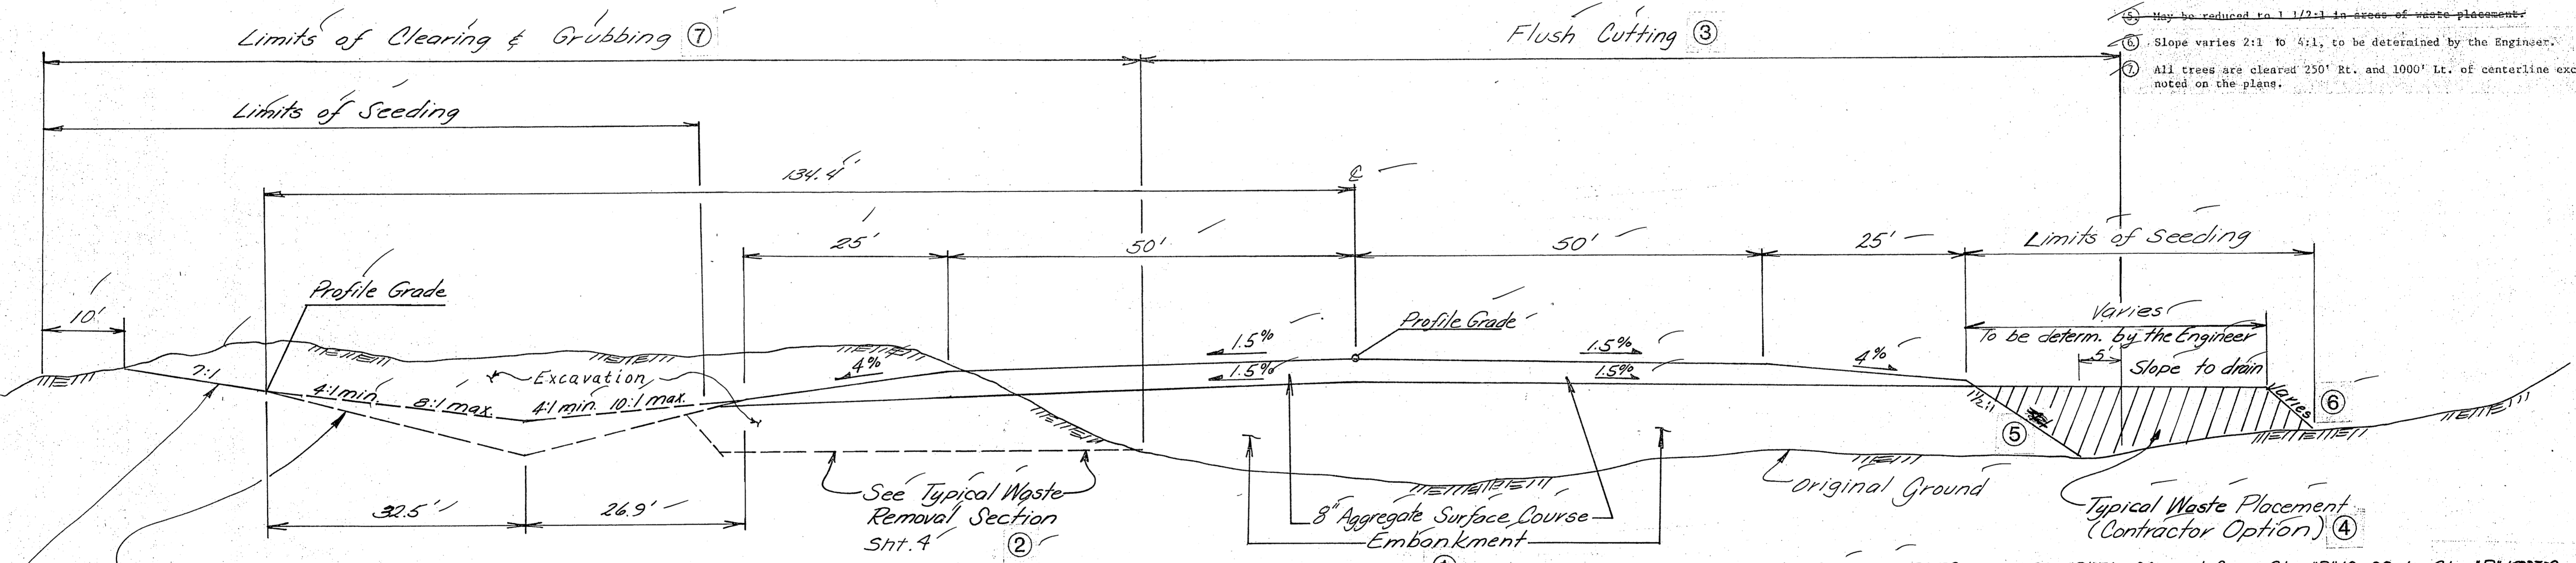

Ditch slope & depth varies. See sheets 8-10 for flowline elevation.  
Ditch section does not apply between Sta. 10+00 & Sta. 10+60. Use a 4:1 fill slope.

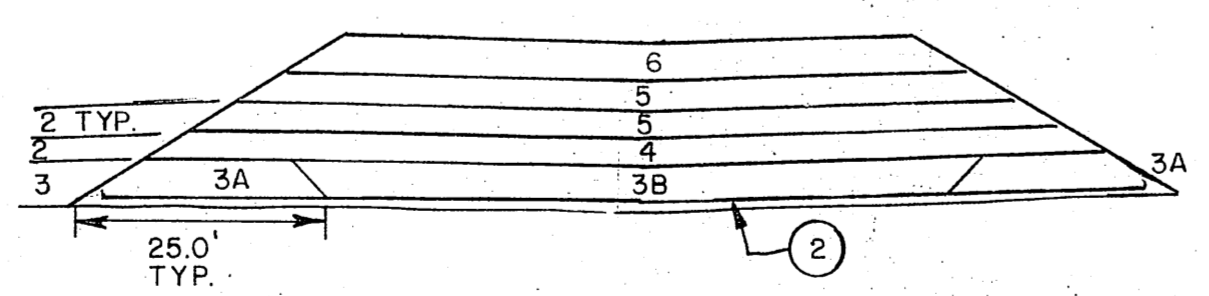


### SEQUENCE OF CONSTRUCTION STA. "R" 10+00 TO STA. "R" 10+60

- INSTALL SETTLEMENT PLATFORMS.
- PLACE GEOTEXTILE REINFORCEMENT, TYPE 2 PERPENDICULAR TO  $G_1$  ON ORIGINAL GROUND.
- CONSTRUCT OUTSIDE SECTIONS OF INITIAL LIFT.
- CONSTRUCT INTERIOR SECTION OF INITIAL LIFT. NEXT, WAIT 10 DAYS.
- CONSTRUCT SECOND LIFT, 2' MAX. NEXT WAIT 10 DAYS.
- REPEAT STEP 4 AND WAITING PERIOD, UNTIL EMBANKMENT HAS BEEN CONSTRUCTED TO THE BOTTOM OF SUBBASE.
- CONSTRUCT AGGREGATE SURFACE COURSE LIFT.

## RUNWAY SECTIONS STA. "R" 45+40 TO STA. "R" 56+00\* STA. "R" 10+00 TO STA. "R" 10+60 \*+†

- \* From Sta. "R" 53+00 to Sta. "R" 56+00 and from Sta. "R" 10+00 to Sta. "R" 10+60 reduce aggregate surface course thickness to 2."
- † Place Reinforcing Fabric perpendicular to  $G_1$  on original ground.
- ‡ 10+00 to 10+60 Fill slopes will remain 4:1

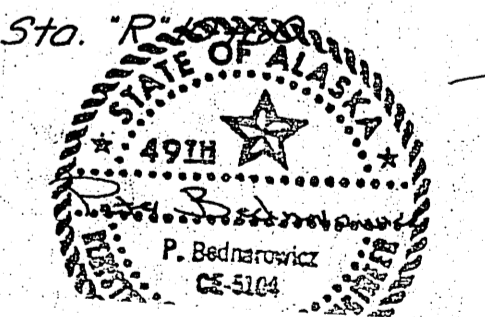

STATE OF ALASKA  
DEPARTMENT OF TRANSPORTATION  
AND PUBLIC FACILITIES  
S.E. REGION, DIVISION OF AVIATION DESIGN & CONSTRUCTION


KAKE AIRPORT  
PROJECT NO. D-19712  
A.I.P. NO. 831-3-02-0398-01-83  
RUNWAY TYPICAL SECTIONS

APPROVED BY:	Wallace K. Williams 8/12/85 WALLACE K. WILLIAMS, P.E. CHIEF OF DESIGN
APPROVED BY:	William L. Baumgartner 8/12/85 WILLIAM L. BAUMGARTNER, P.E. DESIGN CHIEF GROUP "B"
DESIGNED:	MJC
DRAWN:	CA
CHECKED:	
DATE:	

NO	SCALE	REVISIONS

STATE	PROJECT DESIGNATION	YEAR	SHEET NO.	TOTAL SHEETS
ALASKA				



### TYPICAL APRON EXPANSION SECTION N.T.S.

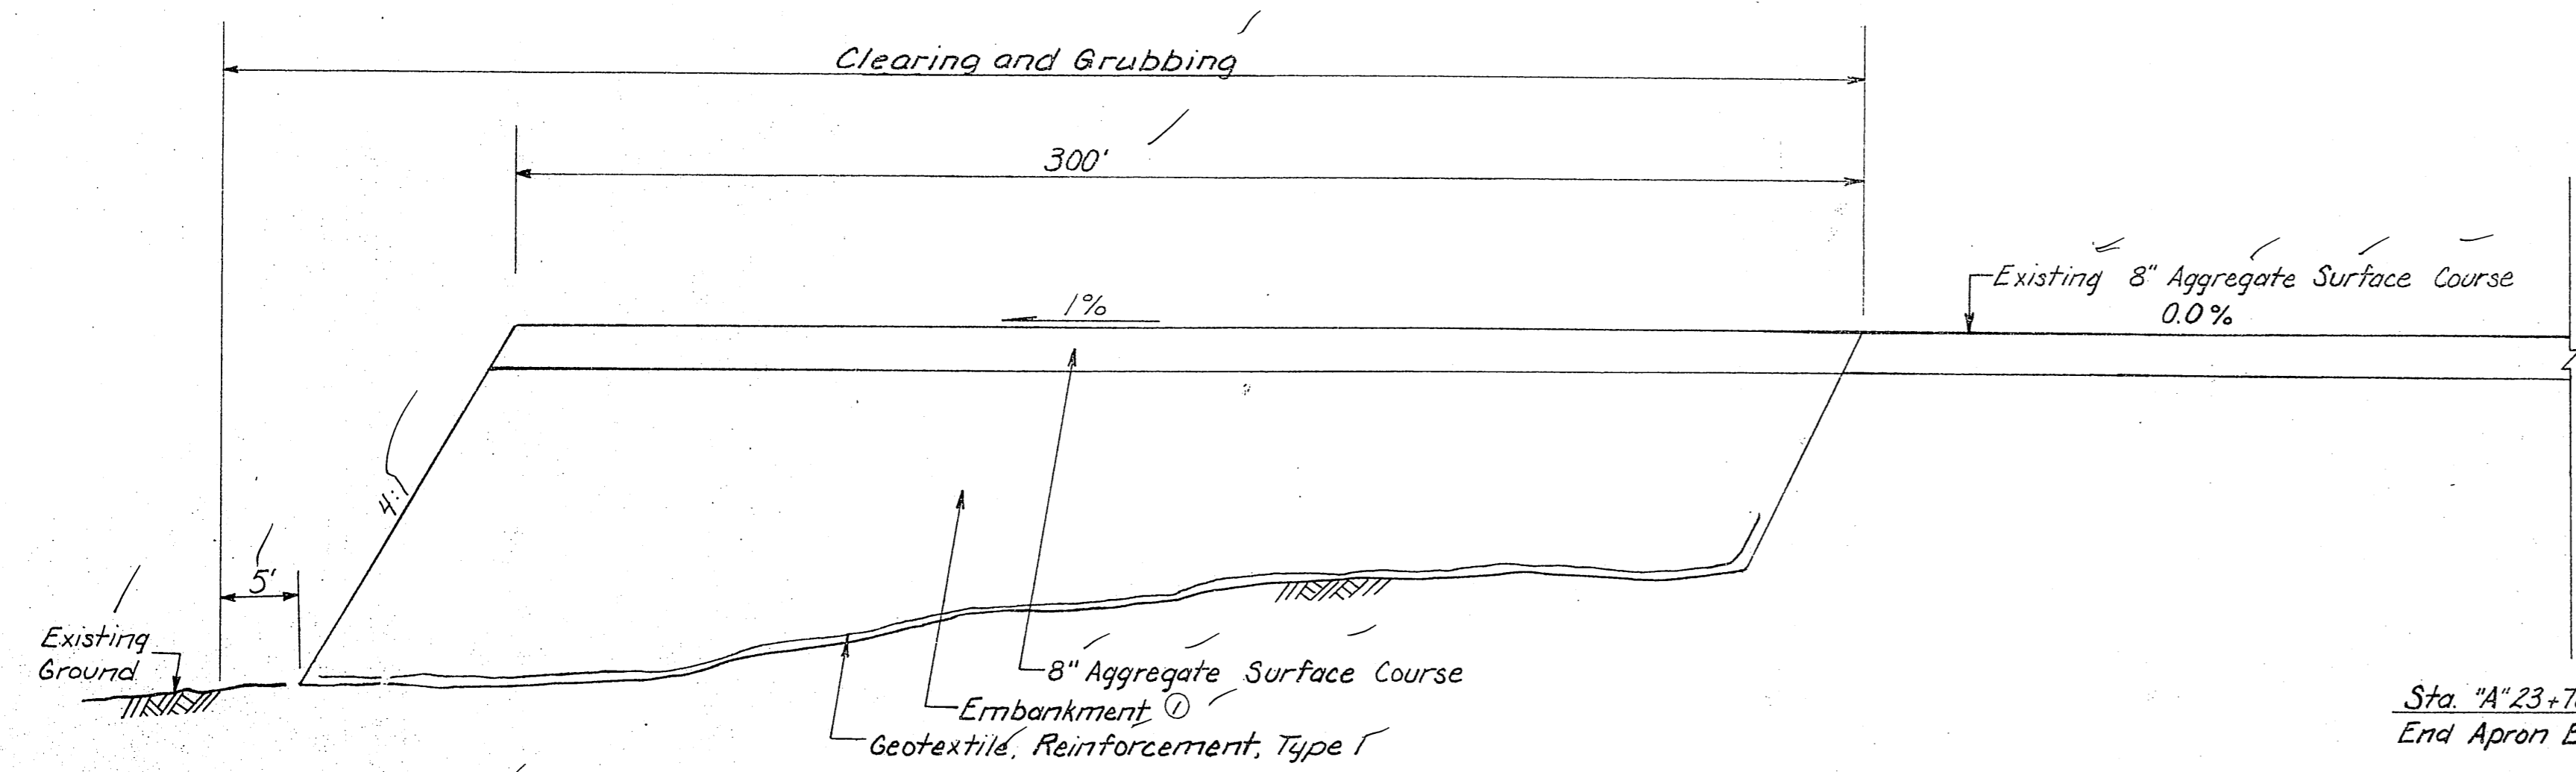


**General Notes**

- Minimum 5ft depth in material unsuitable for embankment or excavate to rock or suitable base material as determined by the engineer.
- Geotextile shall be placed over unsuitable base material and shall overlap 6ft over rock or suitable base material. All other geotextile overlaps shall be per manufacturer's recommendation.
- Remove existing tie down anchors in conflict with Run-up pad. This work shall be considered incidental to Item 800.

### CONCRETE RUN-UP DETAIL

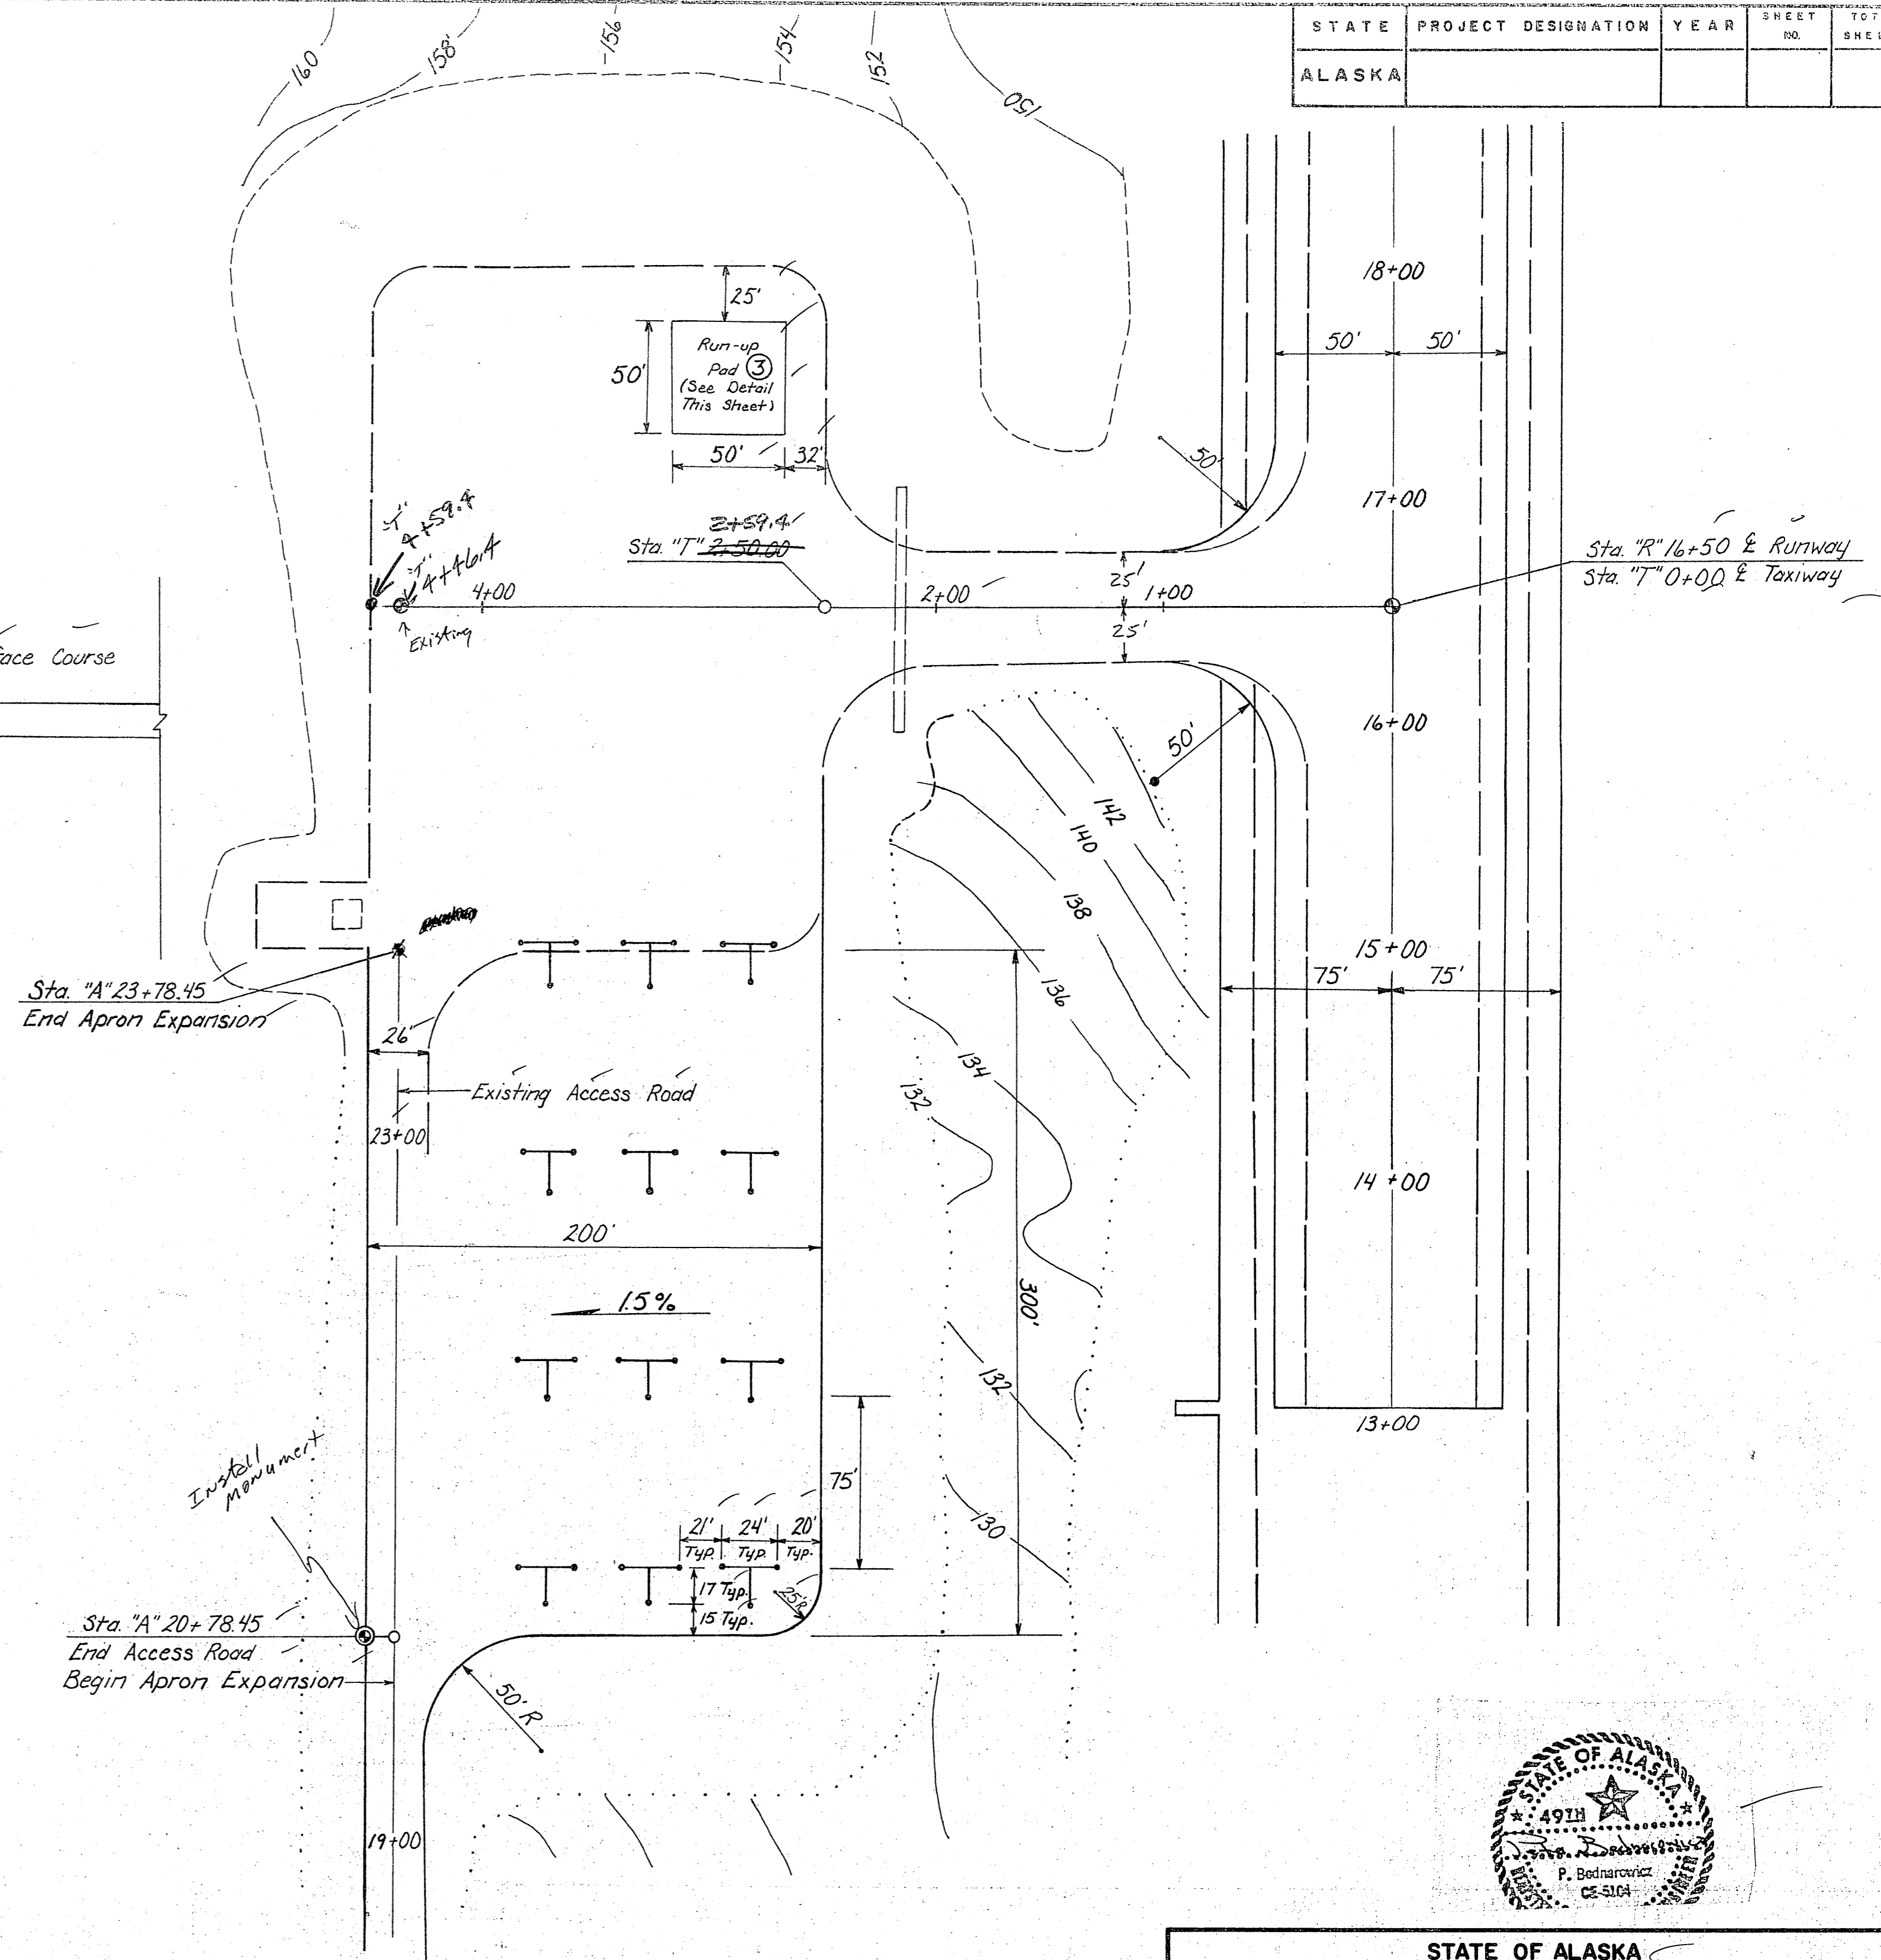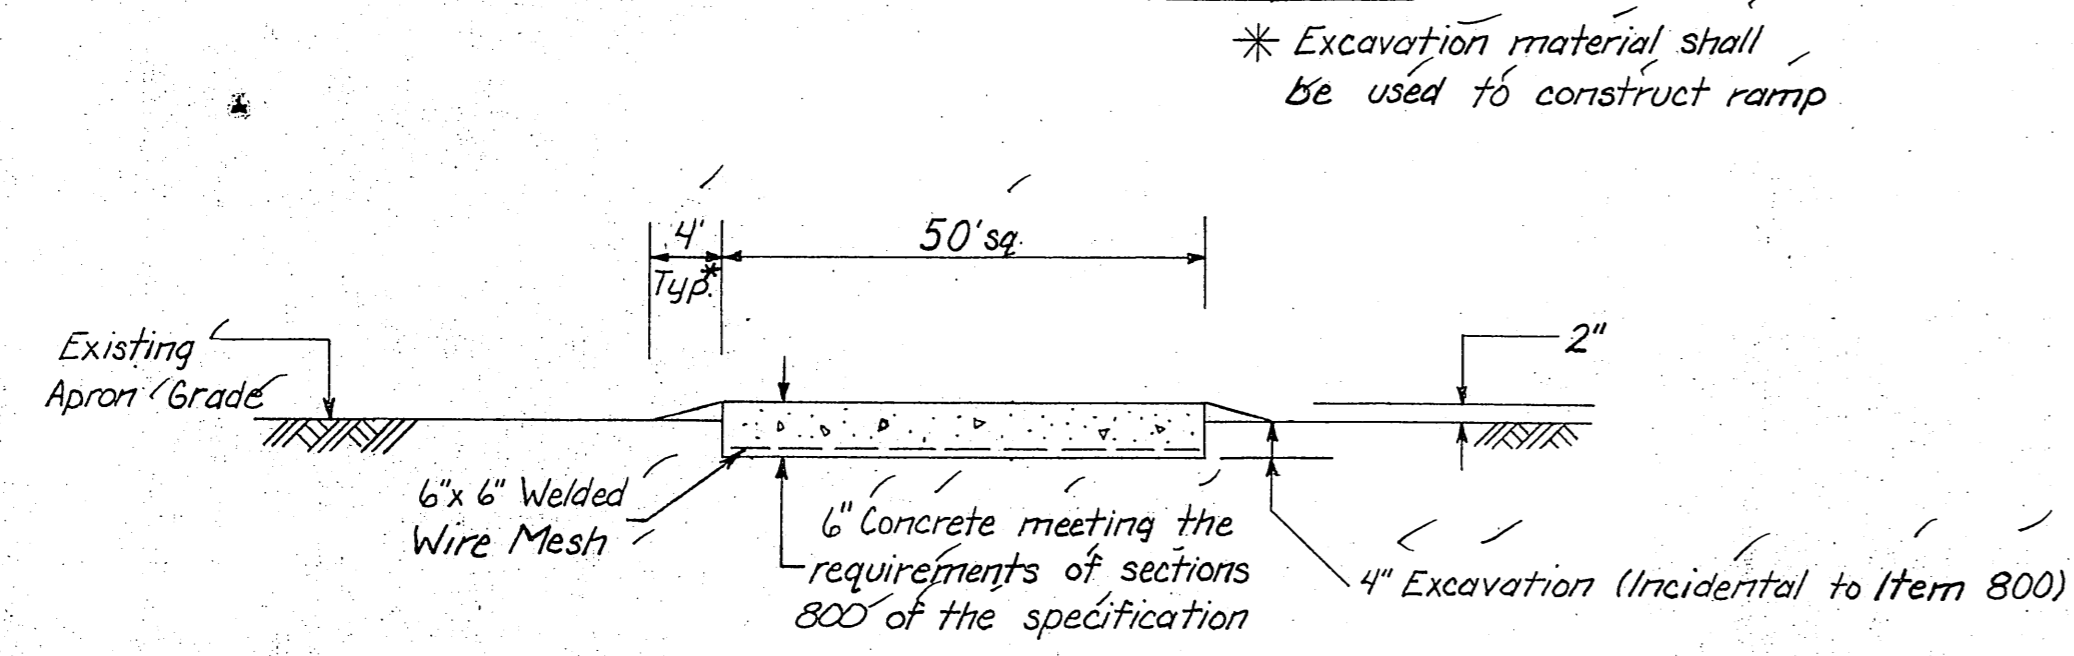

### APRON EXPANSION PLAN

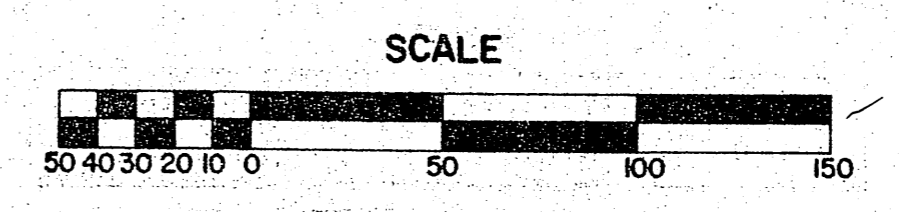


STATE OF ALASKA  
DEPARTMENT OF TRANSPORTATION  
AND PUBLIC FACILITIES  
S.E. REGION, DIVISION OF AVIATION DESIGN & CONSTRUCTION

KAKE AIRPORT  
PROJECT NO. D-19712  
A.I.P. NO. 831-3-02-0398-01-83  
APRON PLAN & TYPICAL SECTION



APPROVED BY: <i>Wallace K. Williams</i> 8/12/85 WALLACE K. WILLIAMS, P.E. CHIEF OF DESIGN	
APPROVED BY: <i>Wm. L. Baumgartner</i> 8/12/85 WILLIAM L. BAUMGARTNER, P.E. DESIGN CHIEF GROUP "B"	
BY: _____	DATE: _____
REVISIONS	
SCALE: AS SHOWN	DESIGNED: MJC
CHECKED: _____	DRAWN: MR
DATE: _____	SHEET 6 OF 25

PLAN	SURVEYED	DATE
	PLOTTED	
	NOTED	
	BY	
	NO.	

PROFILE	SURVEYED	DATE
	PLOTTED	
	NOTED	
	BY	
	NO.	

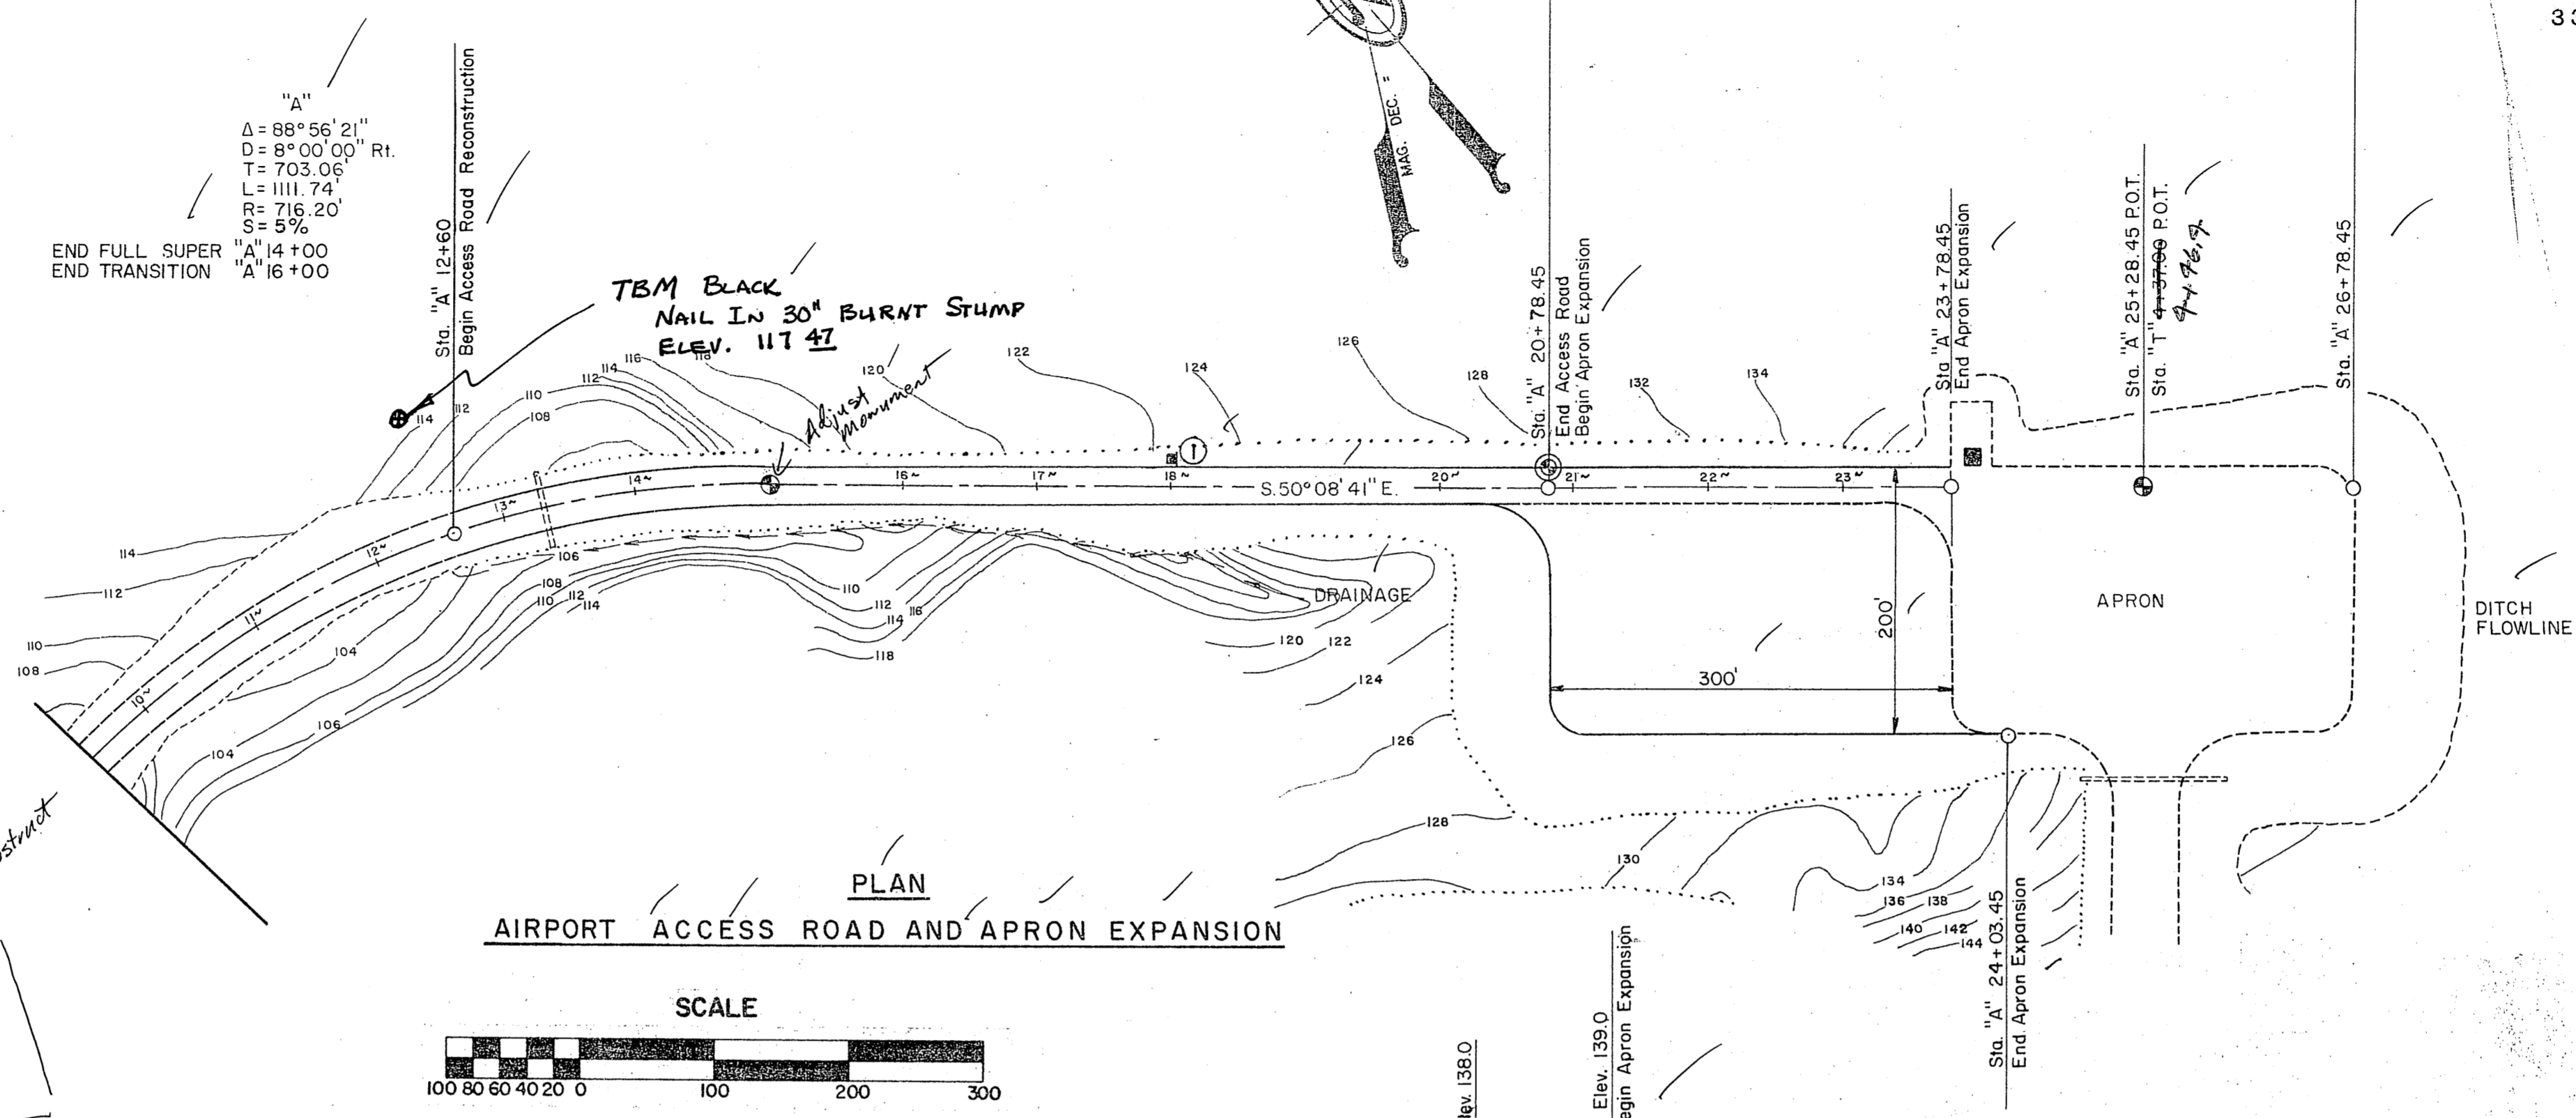

① Adjust existing sign as directed by the Engineer.  
This work shall be considered incidental to Item 330c.

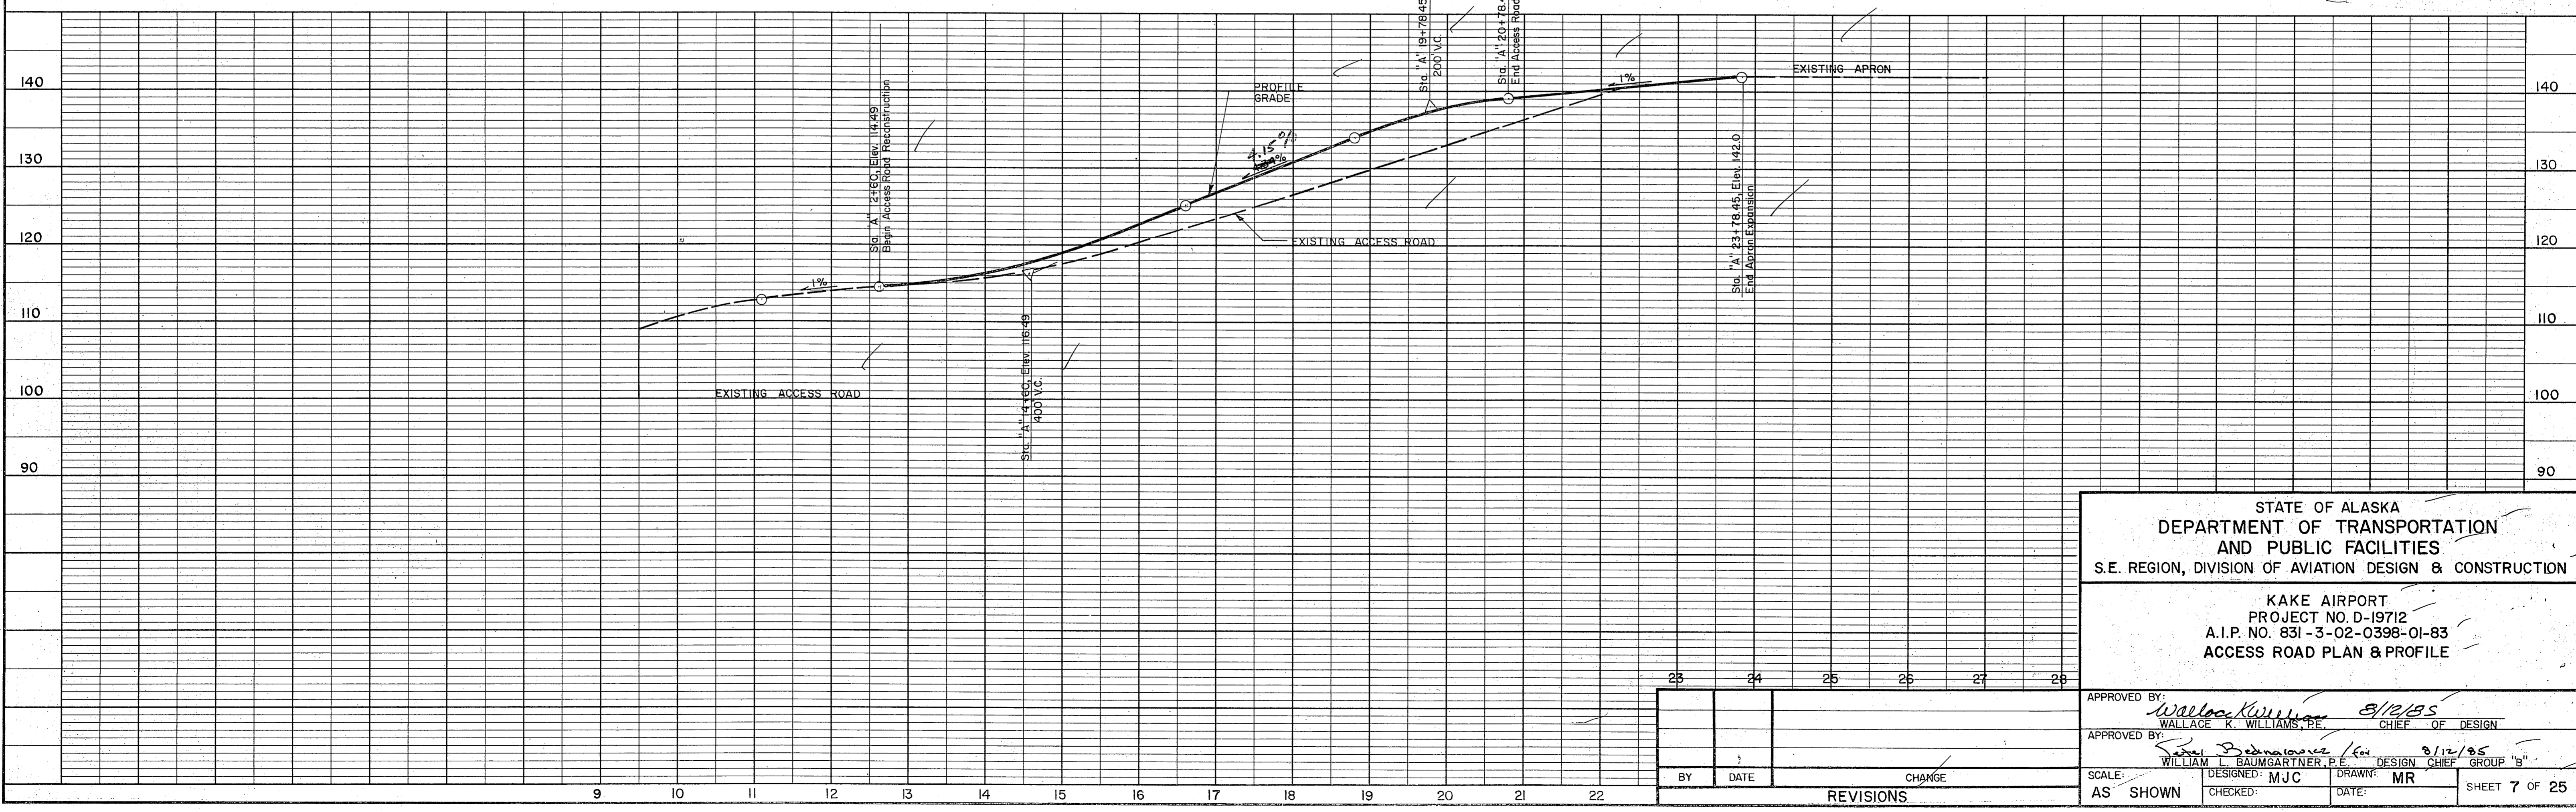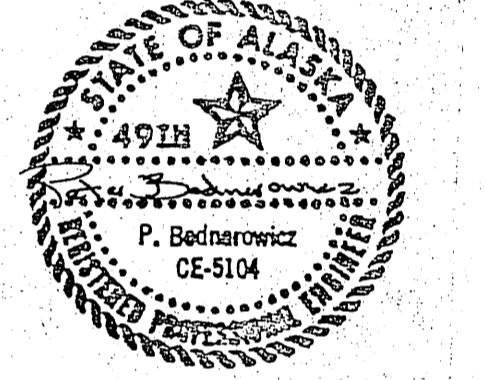

STATE OF ALASKA  
DEPARTMENT OF TRANSPORTATION  
AND PUBLIC FACILITIES  
S.E. REGION, DIVISION OF AVIATION DESIGN & CONSTRUCTION

KAKE AIRPORT  
PROJECT NO. D-19712  
A.I.P. NO. 831-3-02-0398-01-83  
ACCESS ROAD PLAN & PROFILE


APPROVED BY:	<i>Wallace K. Williams</i>	8/12/85
	WALLACE K. WILLIAMS, P.E.	CHIEF OF DESIGN
APPROVED BY:	<i>Pavel Bednarowicz</i>	8/12/85
	WILLIAM L. BAUMGARTNER, P.E.	DESIGN CHIEF GROUP "B"
SCALE:	AS SHOWN	
DESIGNED:	MJC	
CHECKED:		
DRAWN:	MR	
DATE:		

BY	DATE	CHANGE

REVISIONS

PLAN	SURVEYED	DATE
	PLOTTED	BY
	ALIGNMENT CHECKED	
	RT. OF WAY CHECKED	
NO.		





PROFILE	SURVEYED	DATE
	PLOTTED	BY
	GRADES CHECKED	
	STRUCTURE NOTATIONS CHECKED	
NO.		

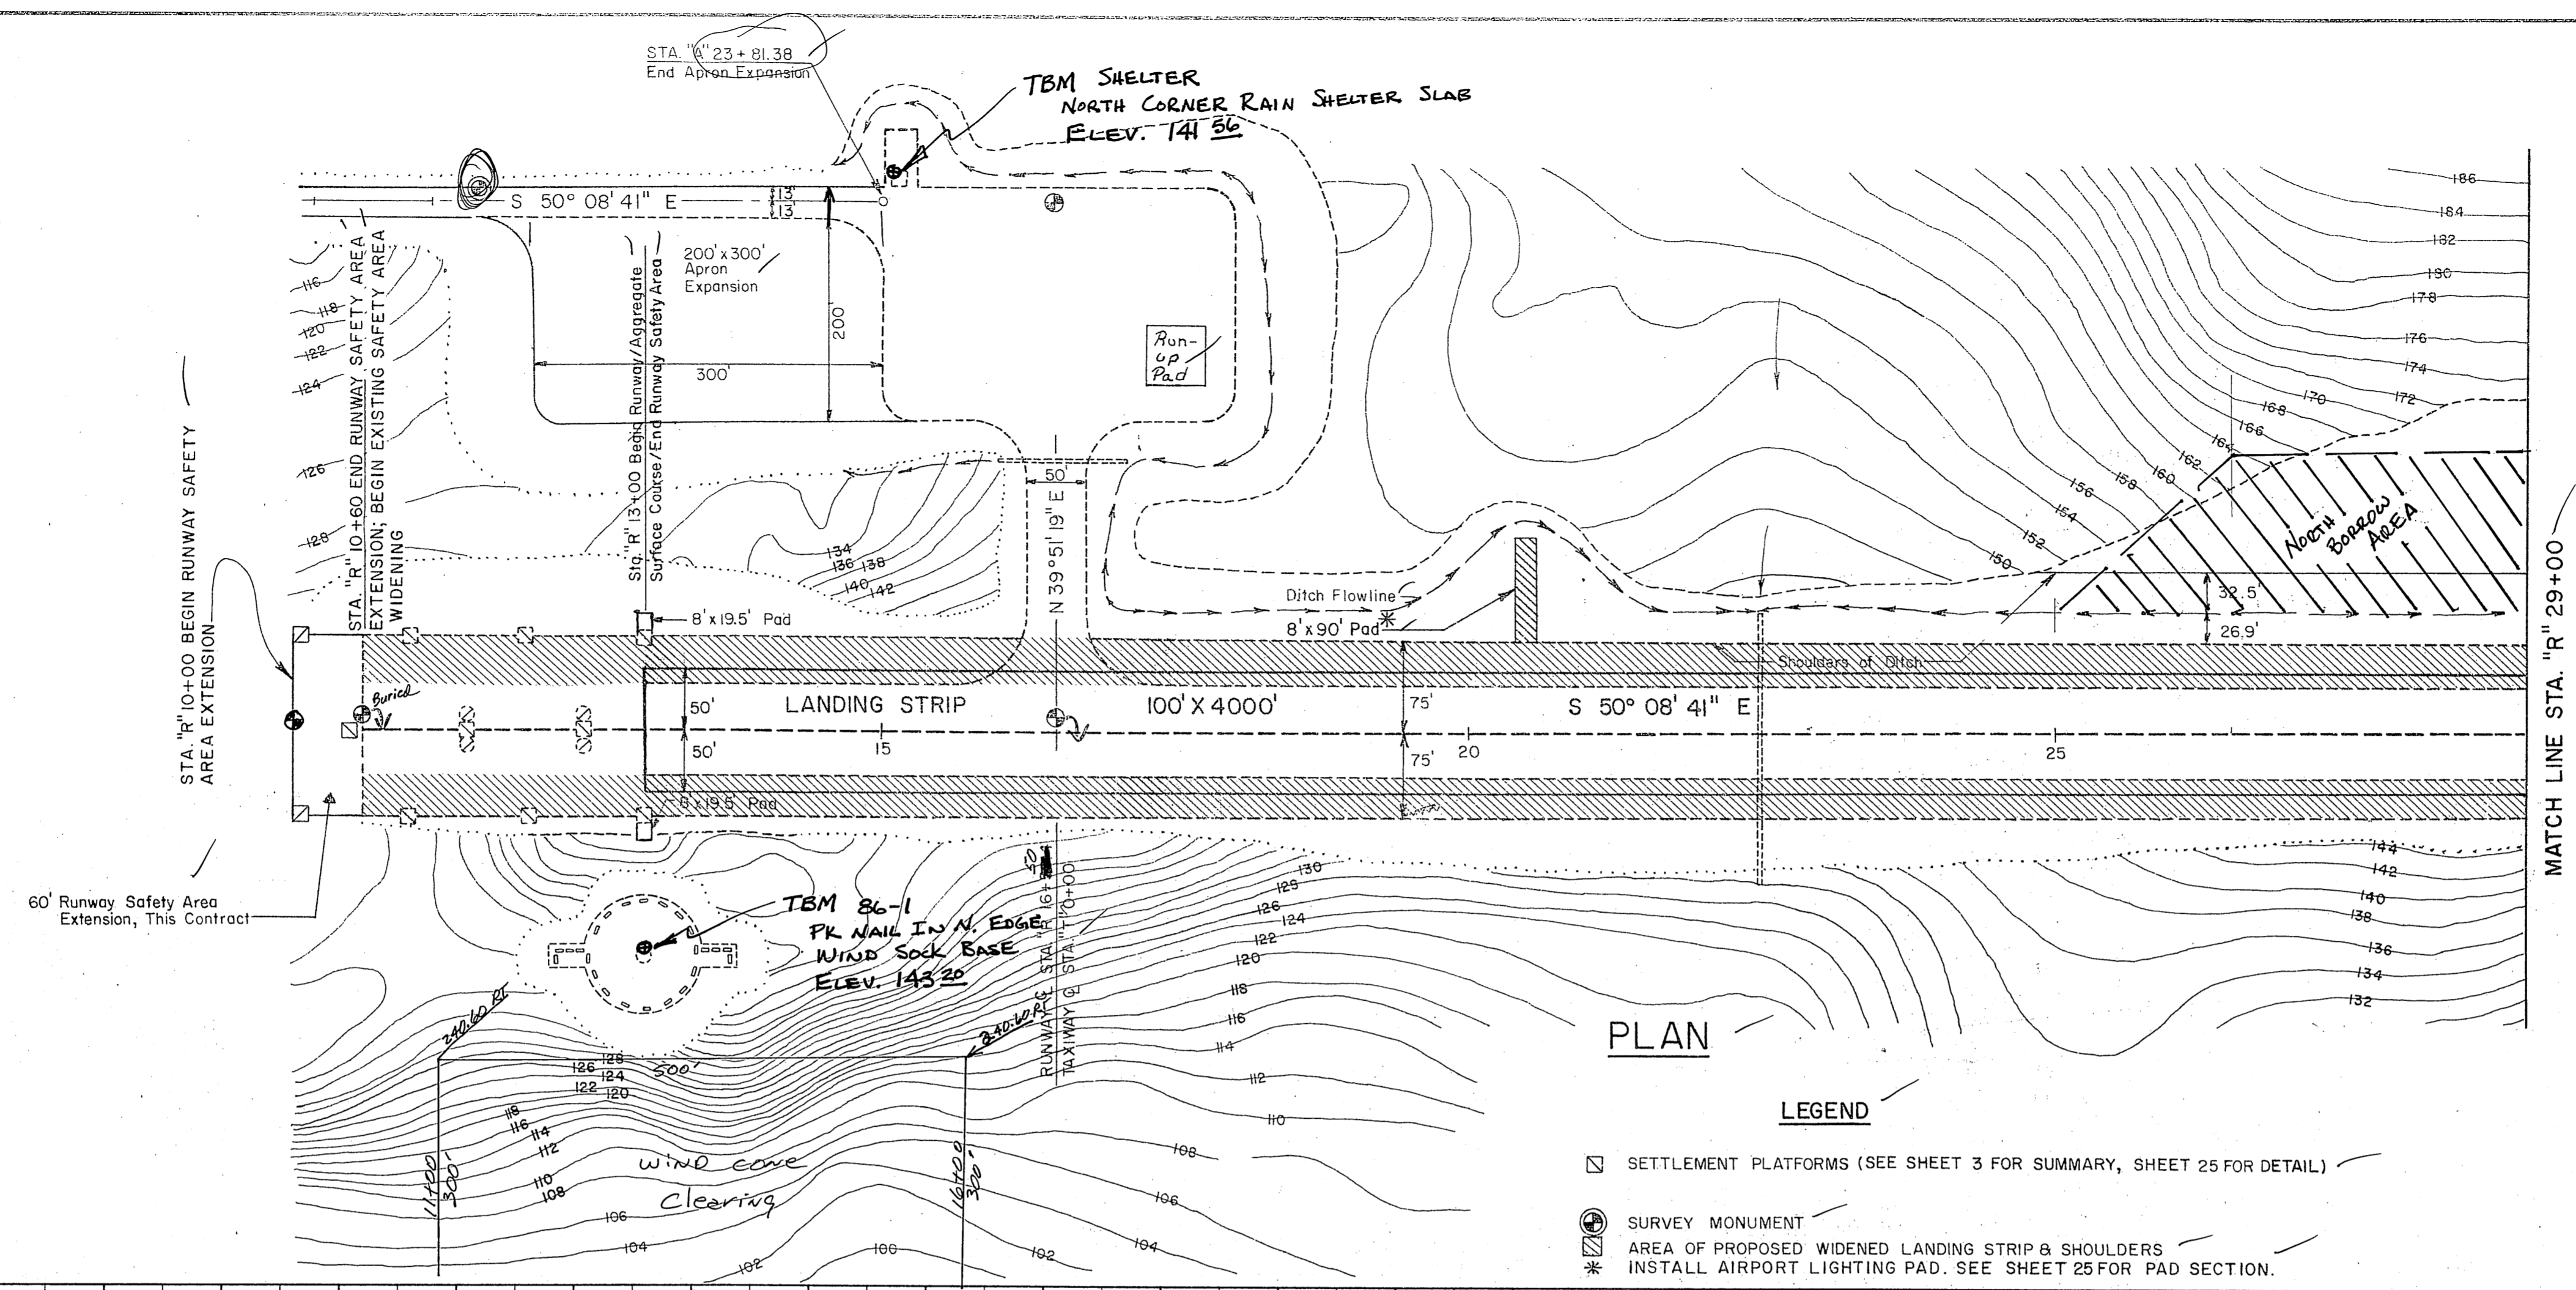

PLAN

LEGEND

- ▣ SETTLEMENT PLATFORMS (SEE SHEET 3 FOR SUMMARY, SHEET 25 FOR DETAIL)
- ⊕ SURVEY MONUMENT
- ▨ AREA OF PROPOSED WIDENED LANDING STRIP & SHOULDERS
- \* INSTALL AIRPORT LIGHTING PAD. SEE SHEET 25 FOR PAD SECTION.

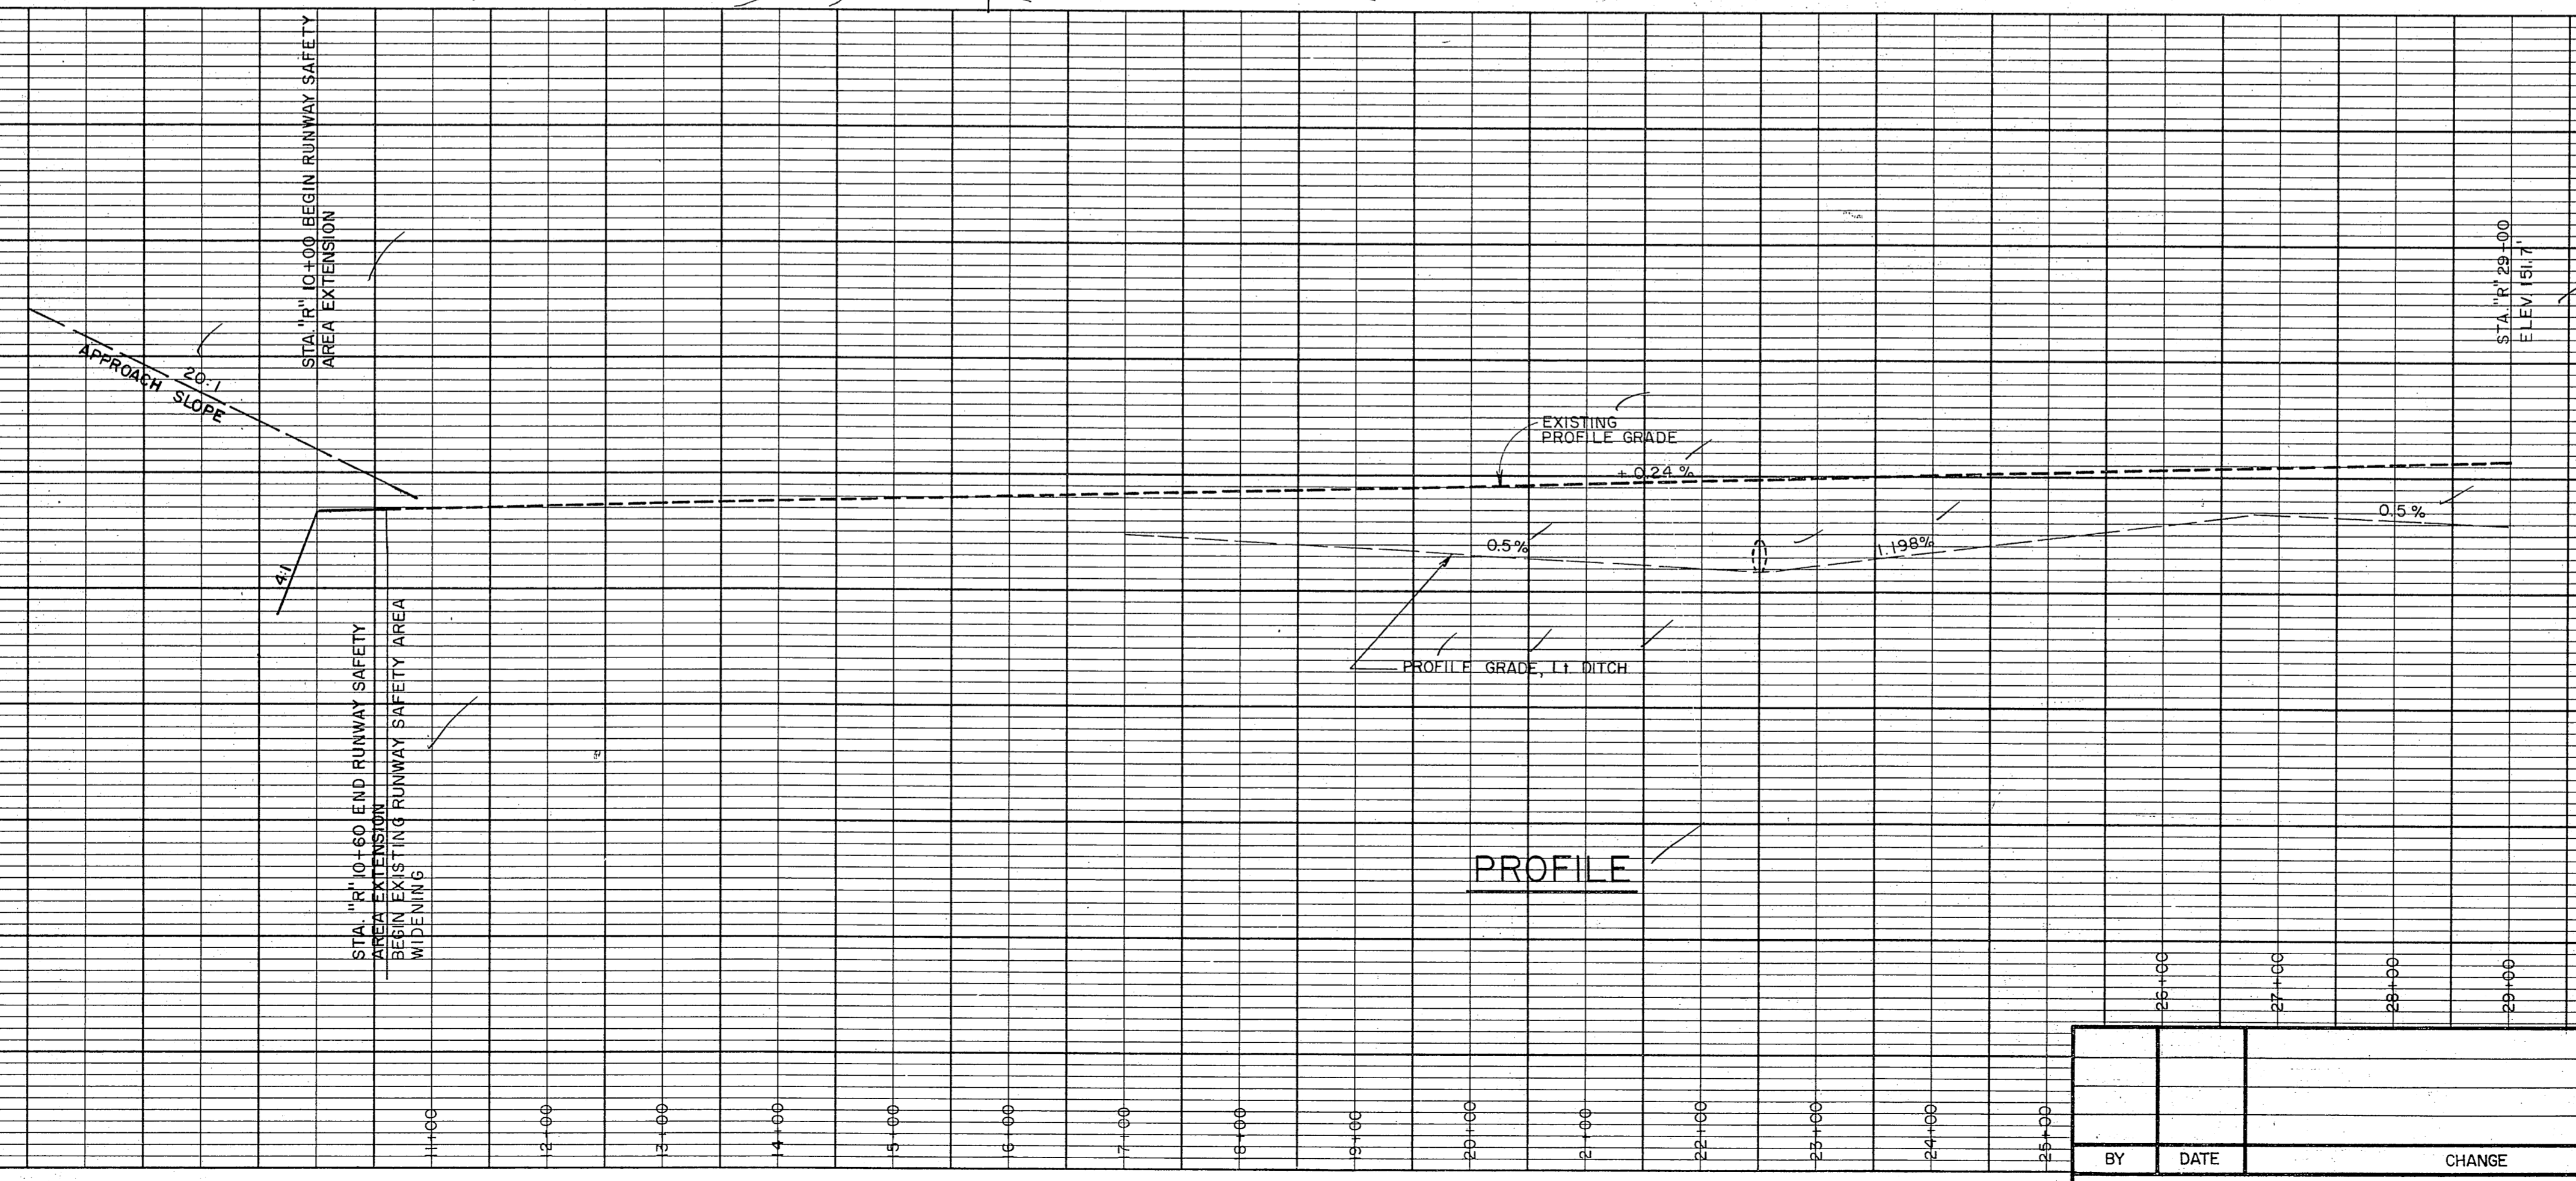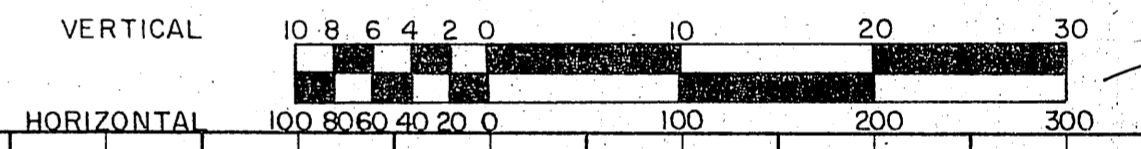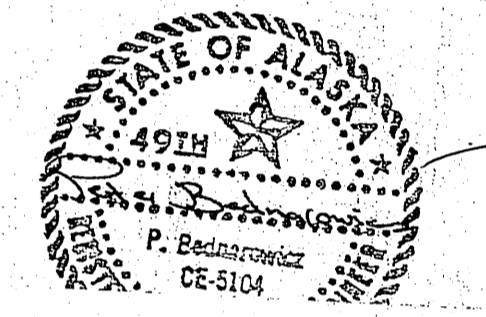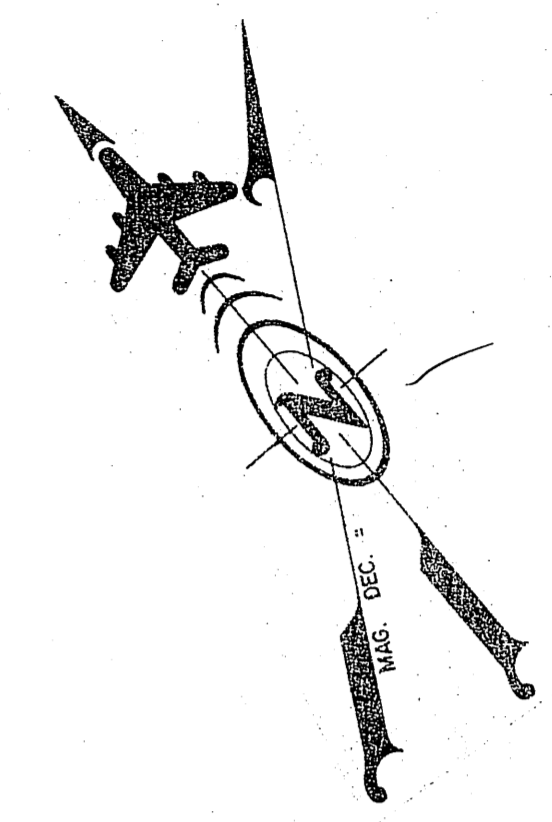

PROFILE



STATE OF ALASKA  
 DEPARTMENT OF TRANSPORTATION  
 AND PUBLIC FACILITIES  
 S.E. REGION, DIVISION OF AVIATION DESIGN & CONSTRUCTION

KAKE AIRPORT  
 PROJECT NO. D-19712  
 A.I.P. NO. 831-3-02-0398-01-83  
 PLAN & PROFILE  
 "R" 10+00 to "R" 29+00



APPROVED BY:	<i>Wallace K. Williams</i> 8/12/85	CHIEF OF DESIGN
APPROVED BY:	<i>William L. Baumgartner</i> 8/12/85	DESIGN CHIEF GROUP "B"
SCALE:	AS SHOWN	CHECKED: MJC
DATE:		DATE: SS

BY	DATE	CHANGE


PLAN	SURVEYED	DATE
	PLOTTED	
	NOTE BOOK	
	ALIGNMENT CHECKED	
	RT. OF WAY CHECKED	
	NO.	

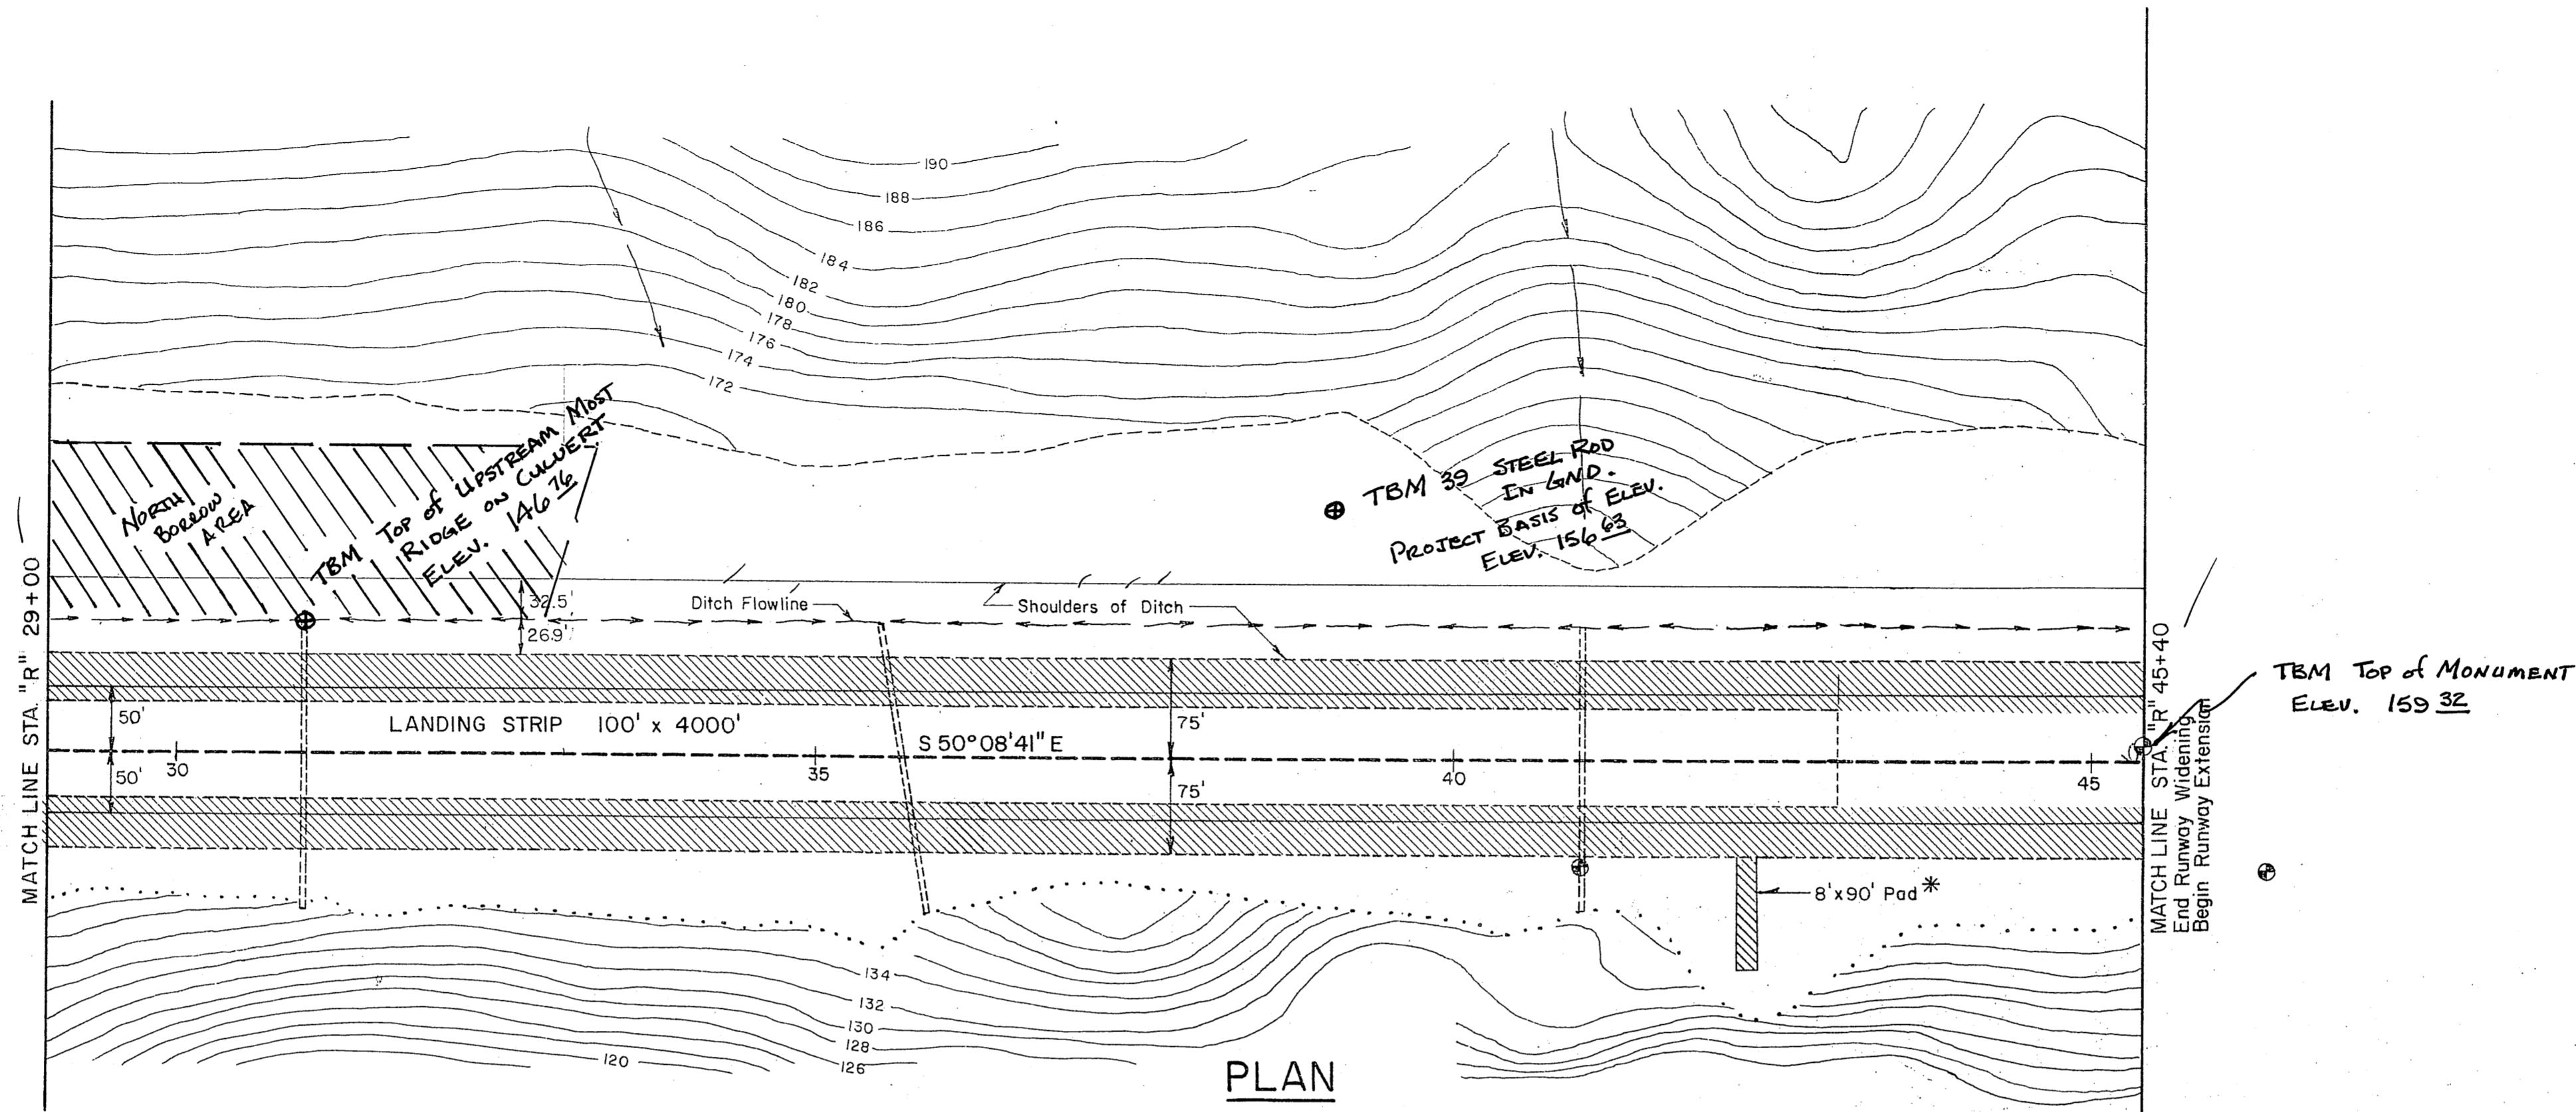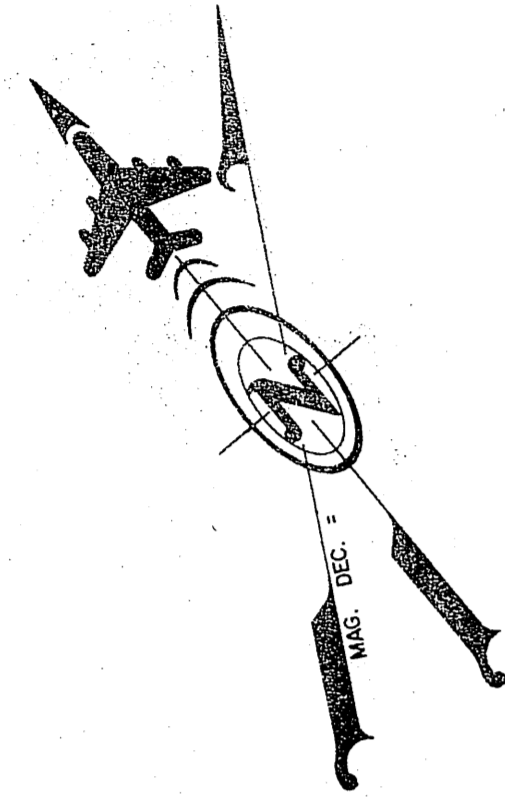

[Hatched Area] - Area of proposed widened Landing Strip & Shoulders  
 \* Install Airport Lighting Pad. See sheet 23 for Pad Section.

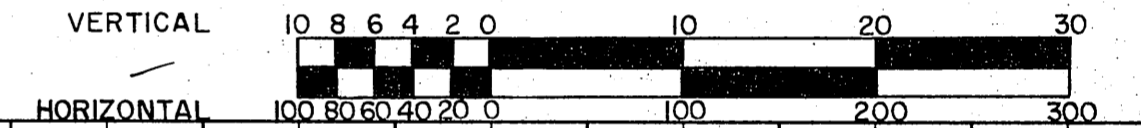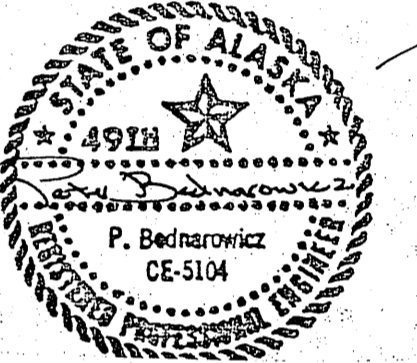

PROFILE	SURVEYED	DATE
	PLOTTED	
	GRADES CHECKED	
	STRUCTURE NOTATIONS CHK'D	
	NO.	

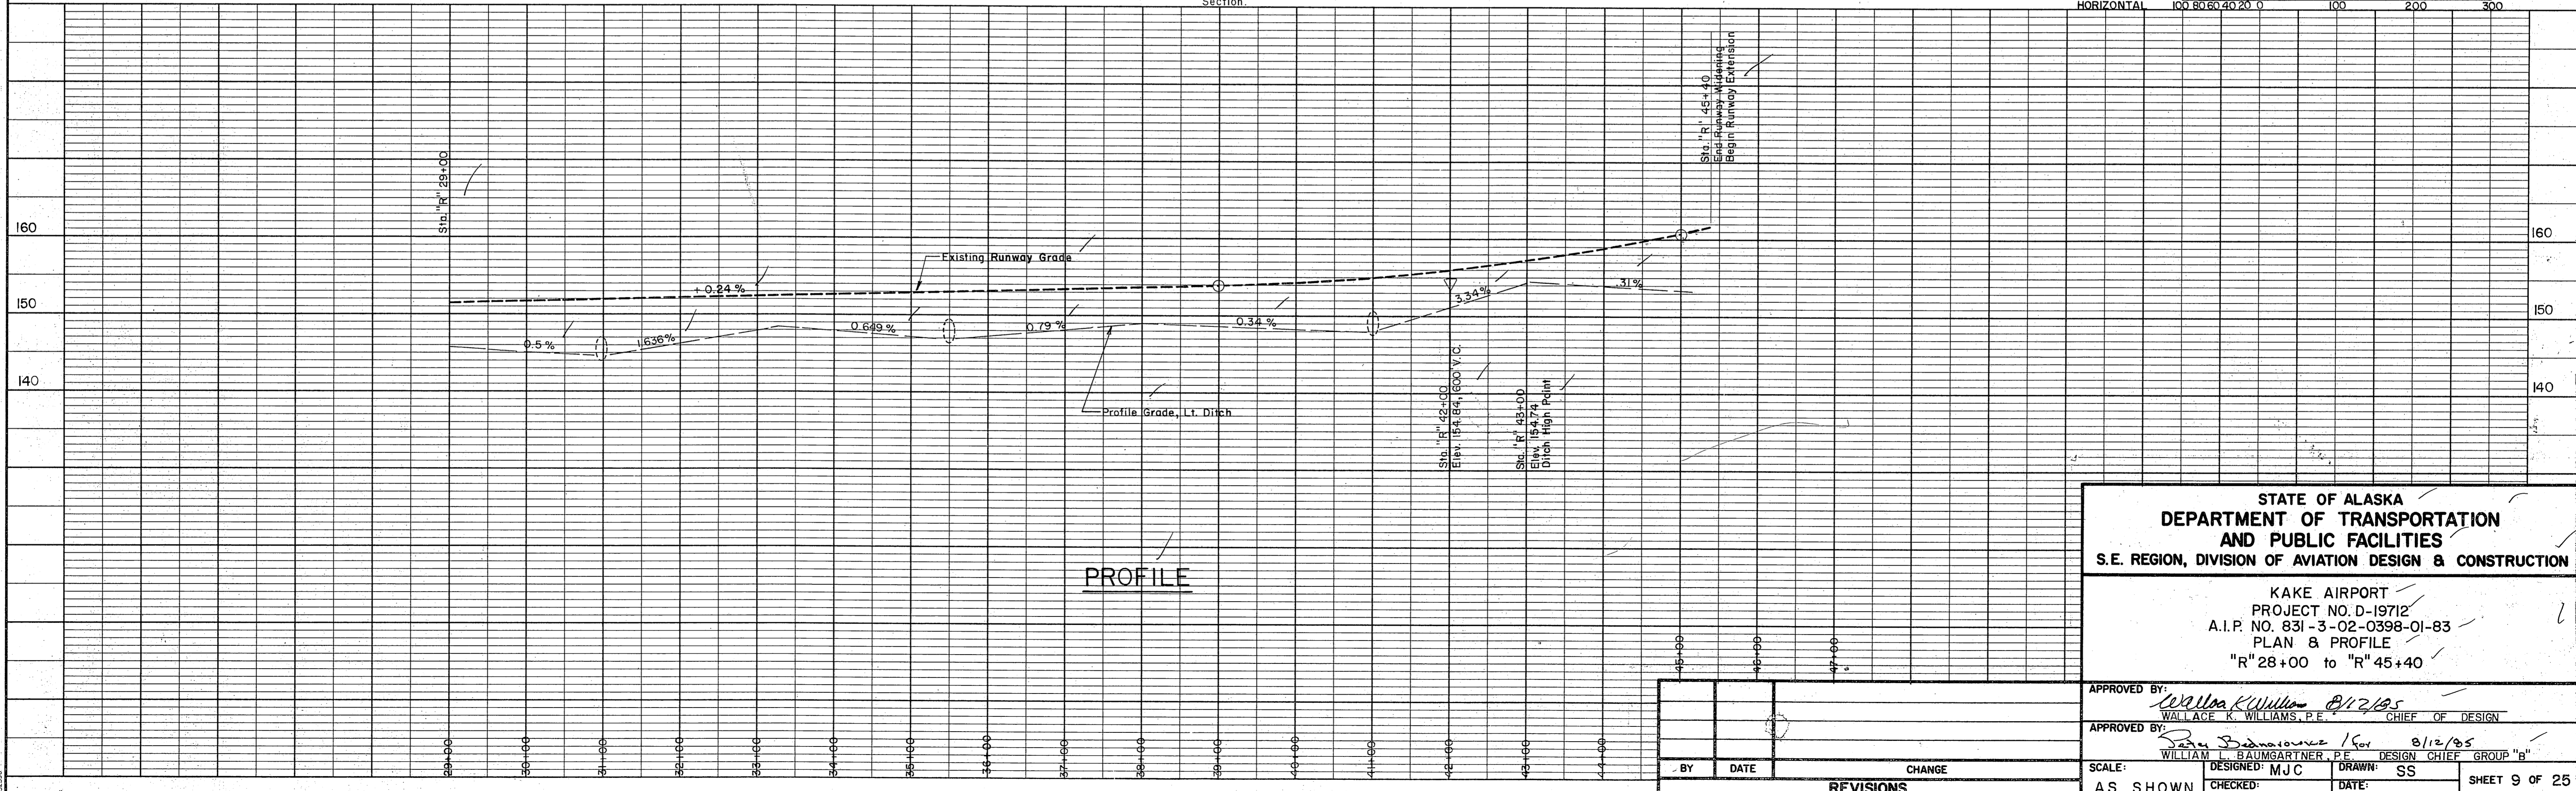

STATE OF ALASKA  
 DEPARTMENT OF TRANSPORTATION  
 AND PUBLIC FACILITIES  
 S.E. REGION, DIVISION OF AVIATION DESIGN & CONSTRUCTION

KAKE AIRPORT  
 PROJECT NO. D-19712  
 A.I.P. NO. 831-3-02-0398-01-83  
 PLAN & PROFILE  
 "R" 28+00 to "R" 45+40



APPROVED BY:	<i>Wallace K. Williams</i> 8/12/85 WALLACE K. WILLIAMS, P.E. CHIEF OF DESIGN
APPROVED BY:	<i>Peter Bednarowicz</i> 8/12/85 WILLIAM L. BAUMGARTNER, P.E. DESIGN CHIEF GROUP "B"
SCALE:	AS SHOWN
DESIGNED:	MJC
DRAWN:	SS
CHECKED:	
DATE:	

BY	DATE	CHANGE


REVISIONS

PLAN	SURVEYED	DATE
	PLOTTED	BY
	CHECKED	
	RT. OF WAY CHECKED	
NO.		

PROFILE	SURVEYED	DATE
	GRADES CHECKED	BY
	NOTED	
	STRUCTURE NOTATIONS CHK'D	
NO.		

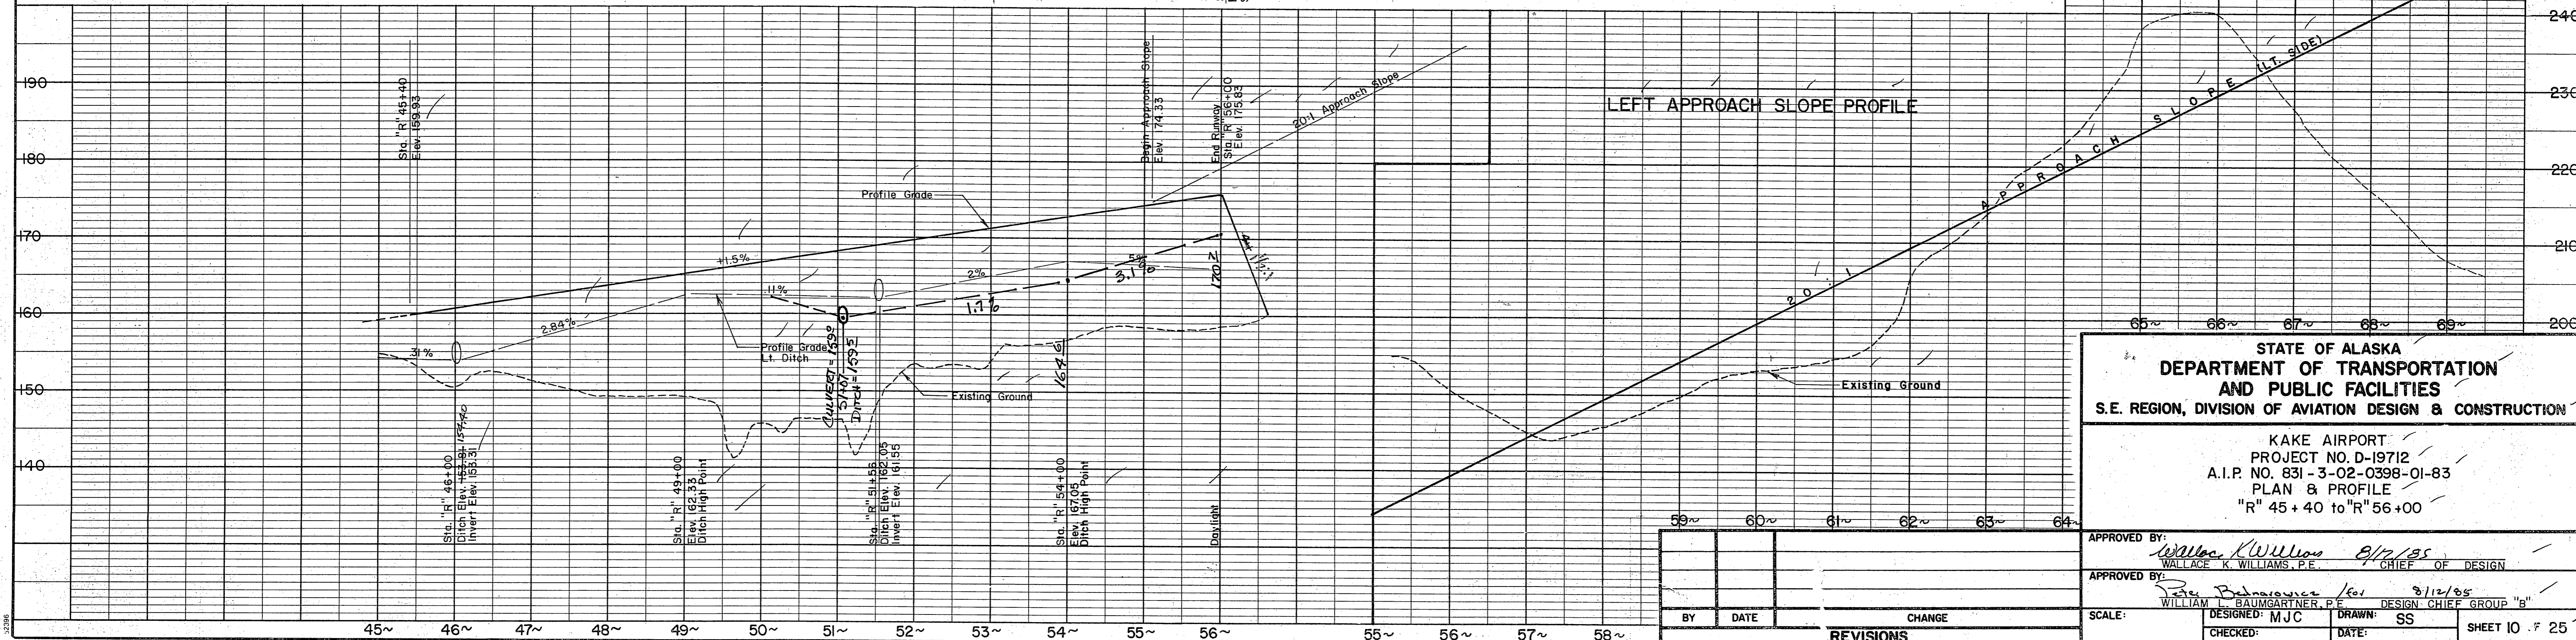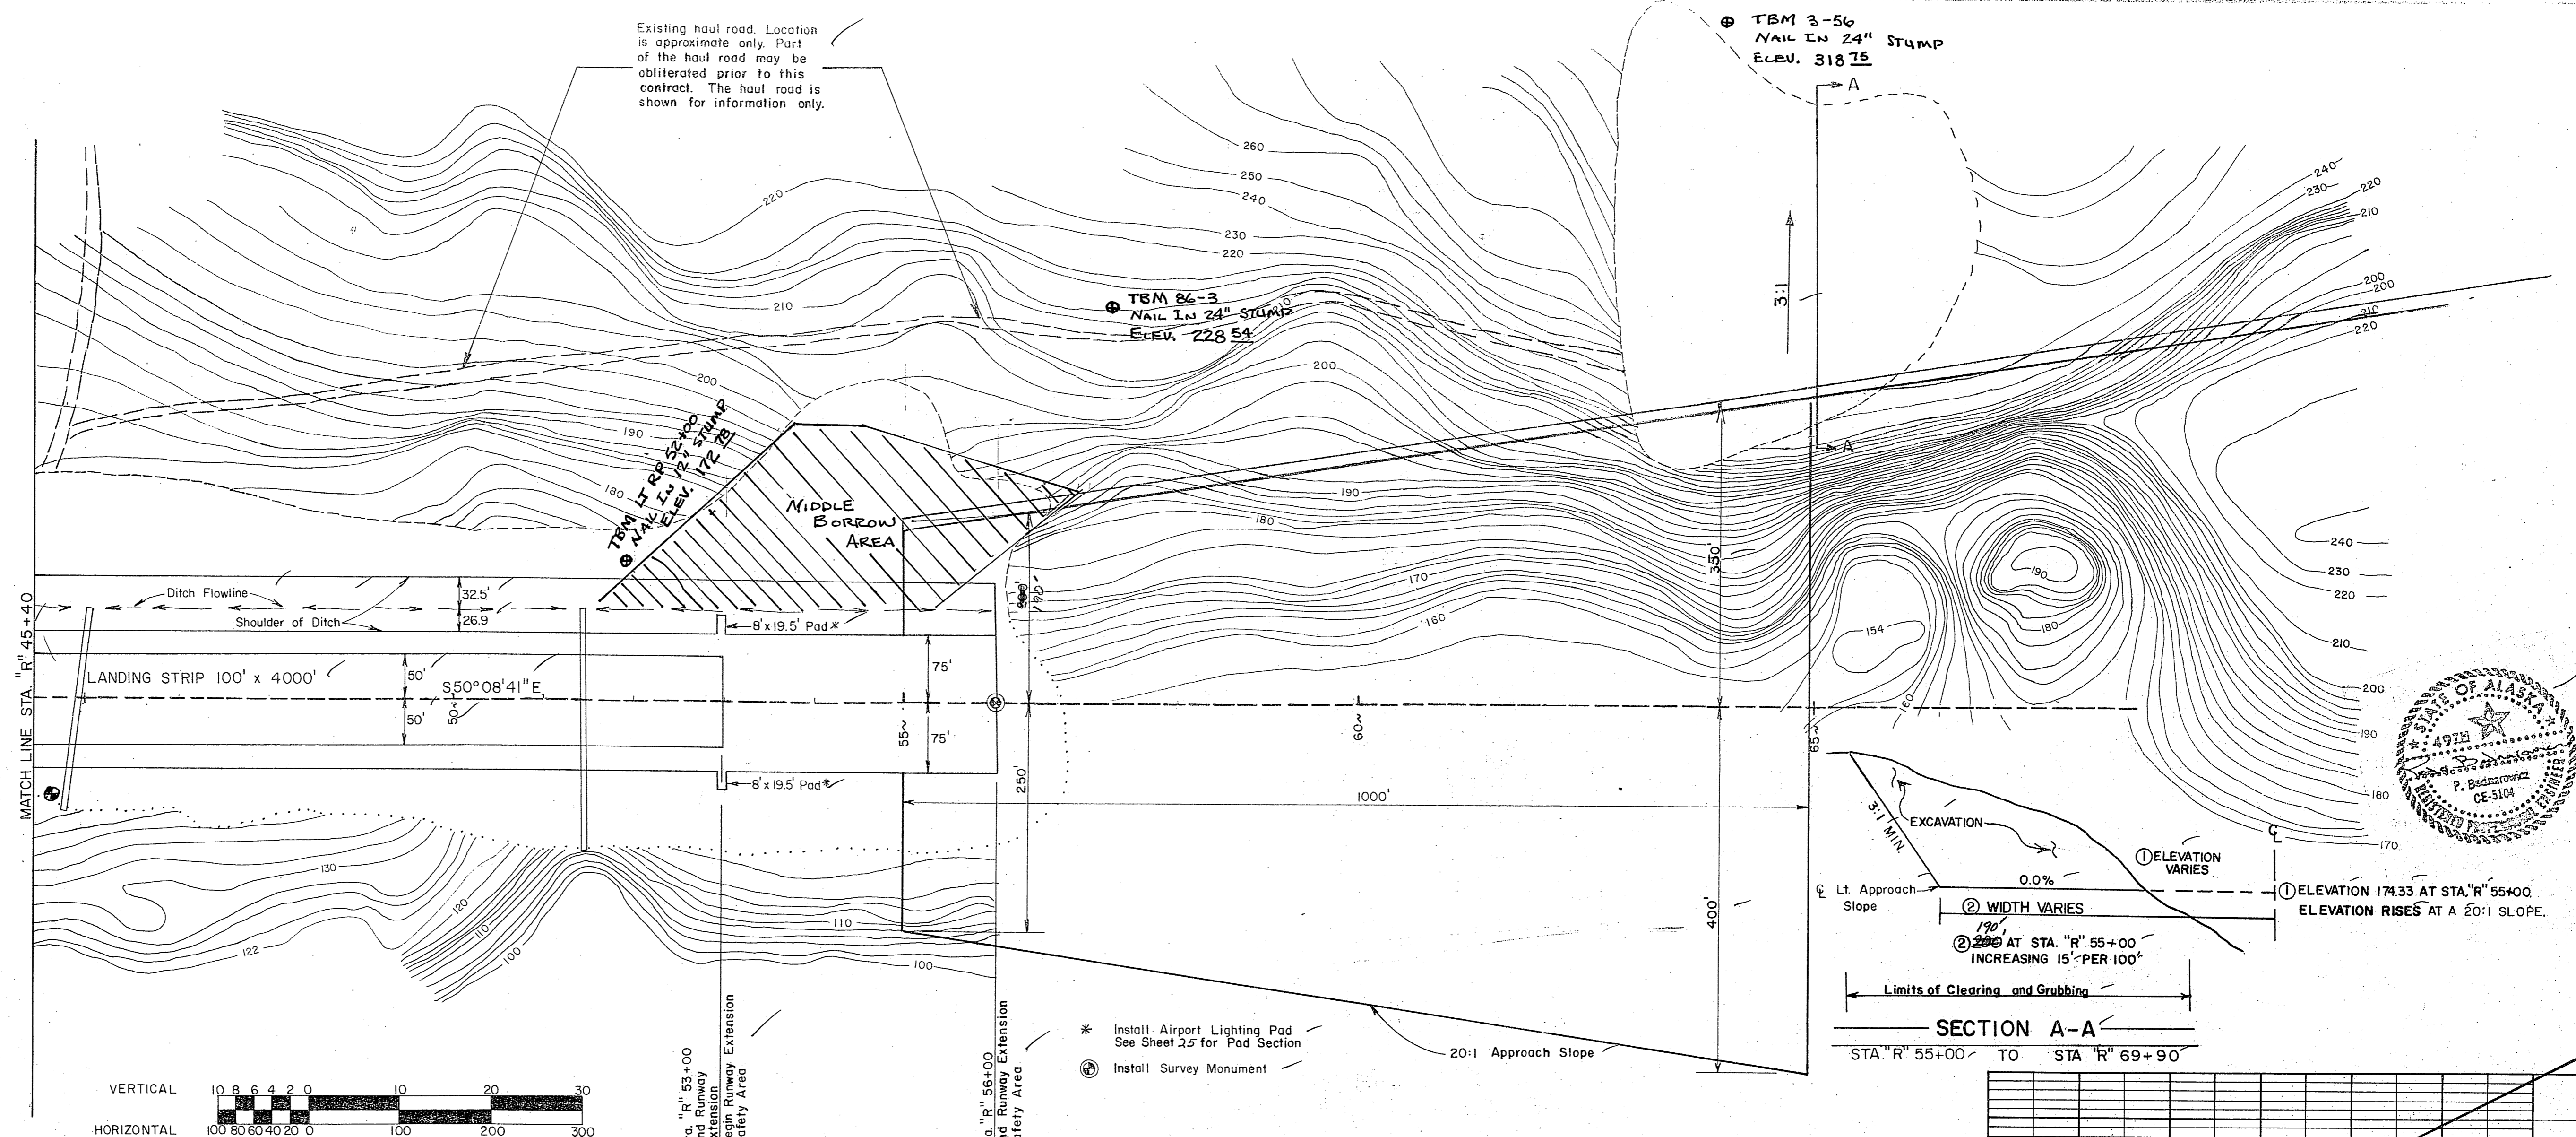


## TYPE II REFLECTIVE MARKER PLAN

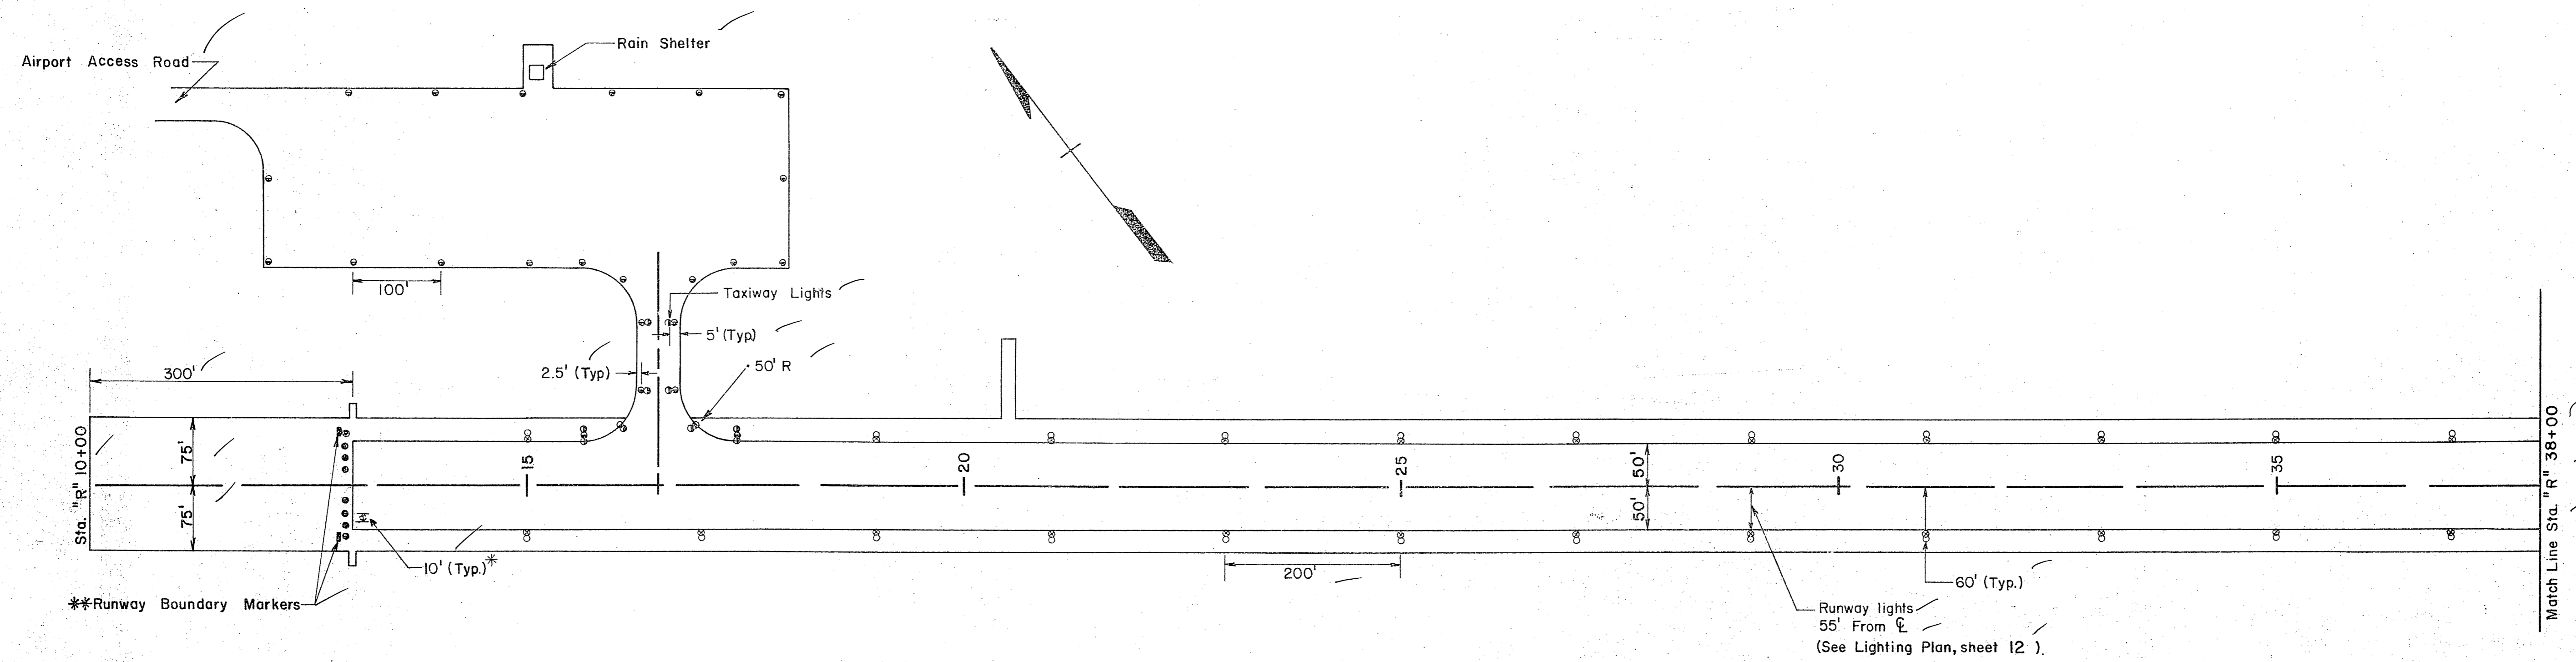

\*\*Runway Boundary Markers

Runway lights  
55' From  $\phi$   
(See Lighting Plan, sheet 12).



\* Threshold Reflective Markers shall be placed in line with and approximately 5' outboard (away from centerline) of each threshold light. See lighting plan sheet 12.

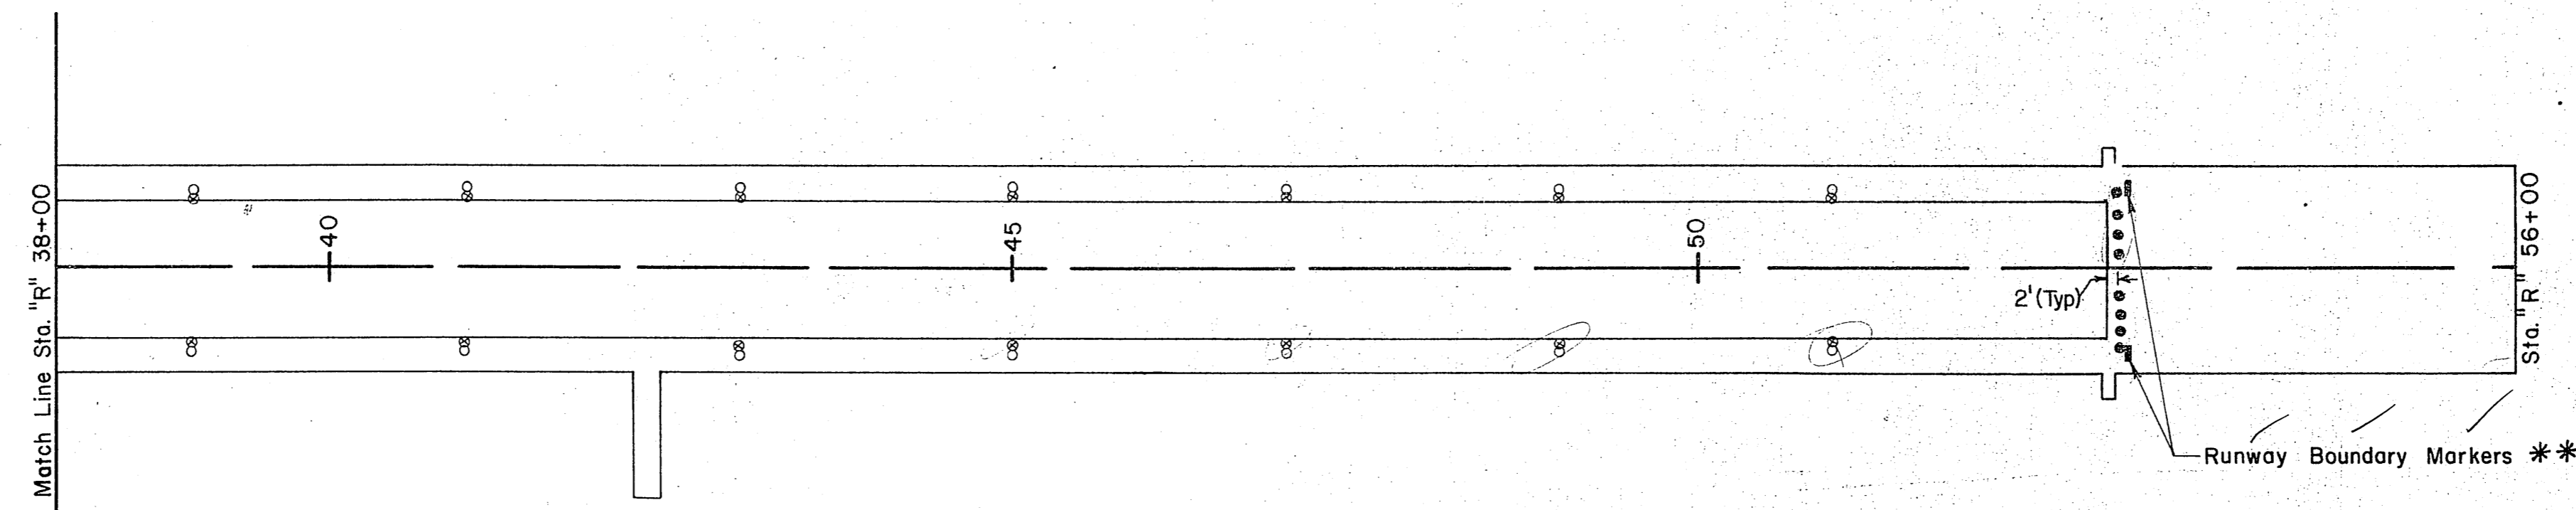

\*\* Remove existing Runway Boundary Markers located at Sta. 43+10 and install at Sta. 53+10, 50' ~~40'~~ Rt. and Lt. of  $\phi$ . See sht. 25 for details. This work shall be considered incidental to other items of work.

REFLECTIVE MARKERS SUMMARY				
SYMBOL	NO. EXISTING	NO. REQUIRED	LOCATION	COLOR
○	27	10	RUNWAY	WHITE
⊙	19	6	APRON TAXIWAY	YELLOW
●	16	0	THRESHOLD	GREEN
TOTAL	62	16		

⊙ - RUNWAY LIGHT  
⊙ - TAXIWAY LIGHT

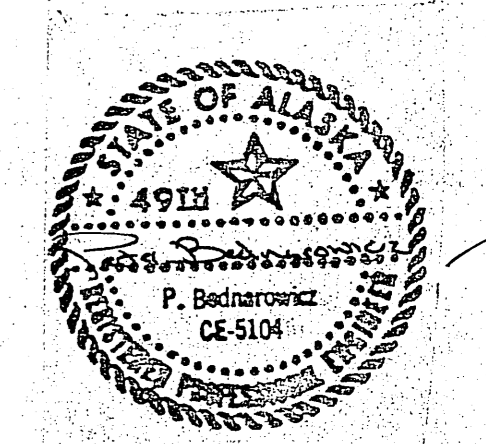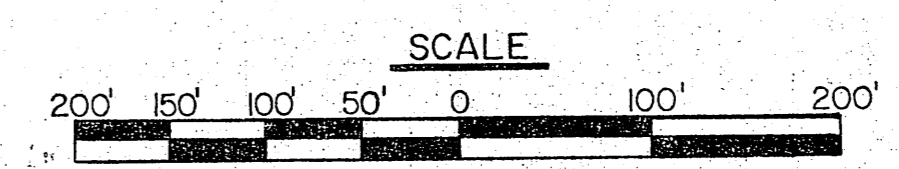

**STATE OF ALASKA  
DEPARTMENT OF TRANSPORTATION  
AND PUBLIC FACILITIES  
S.E. REGION, DIVISION OF AVIATION DESIGN & CONSTRUCTION**

KAKE AIRPORT  
PROJECT NO. D-19712  
A.I.P. NO. 831-3-02-0398-01-83  
REFLECTIVE MARKER  
PLAN

APPROVED BY: *Wallace K. Williams* 8/12/85  
WALLACE K. WILLIAMS, P.E. CHIEF OF DESIGN

APPROVED BY: *William L. Baumgartner* 8/12/85  
WILLIAM L. BAUMGARTNER, P.E. DESIGN CHIEF GROUP "B"

SCALE: AS SHOWN  
CHECKED: MJC  
DRAWN: MR  
DATE: \_\_\_\_\_

SHEET 11 OF 25



BY	DATE	CHANGE

REVISIONS

# RUNWAY LIGHTING PLAN

NOTE: ALL HANDHOLE & VAULT ELEVATIONS ARE TOP OF COVER.



NOTE: Following conduit installation, All trenching shall be brought back to grade to the satisfaction of the Engineer at no additional cost to the state.

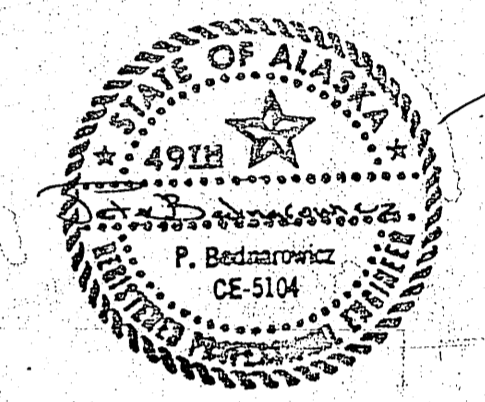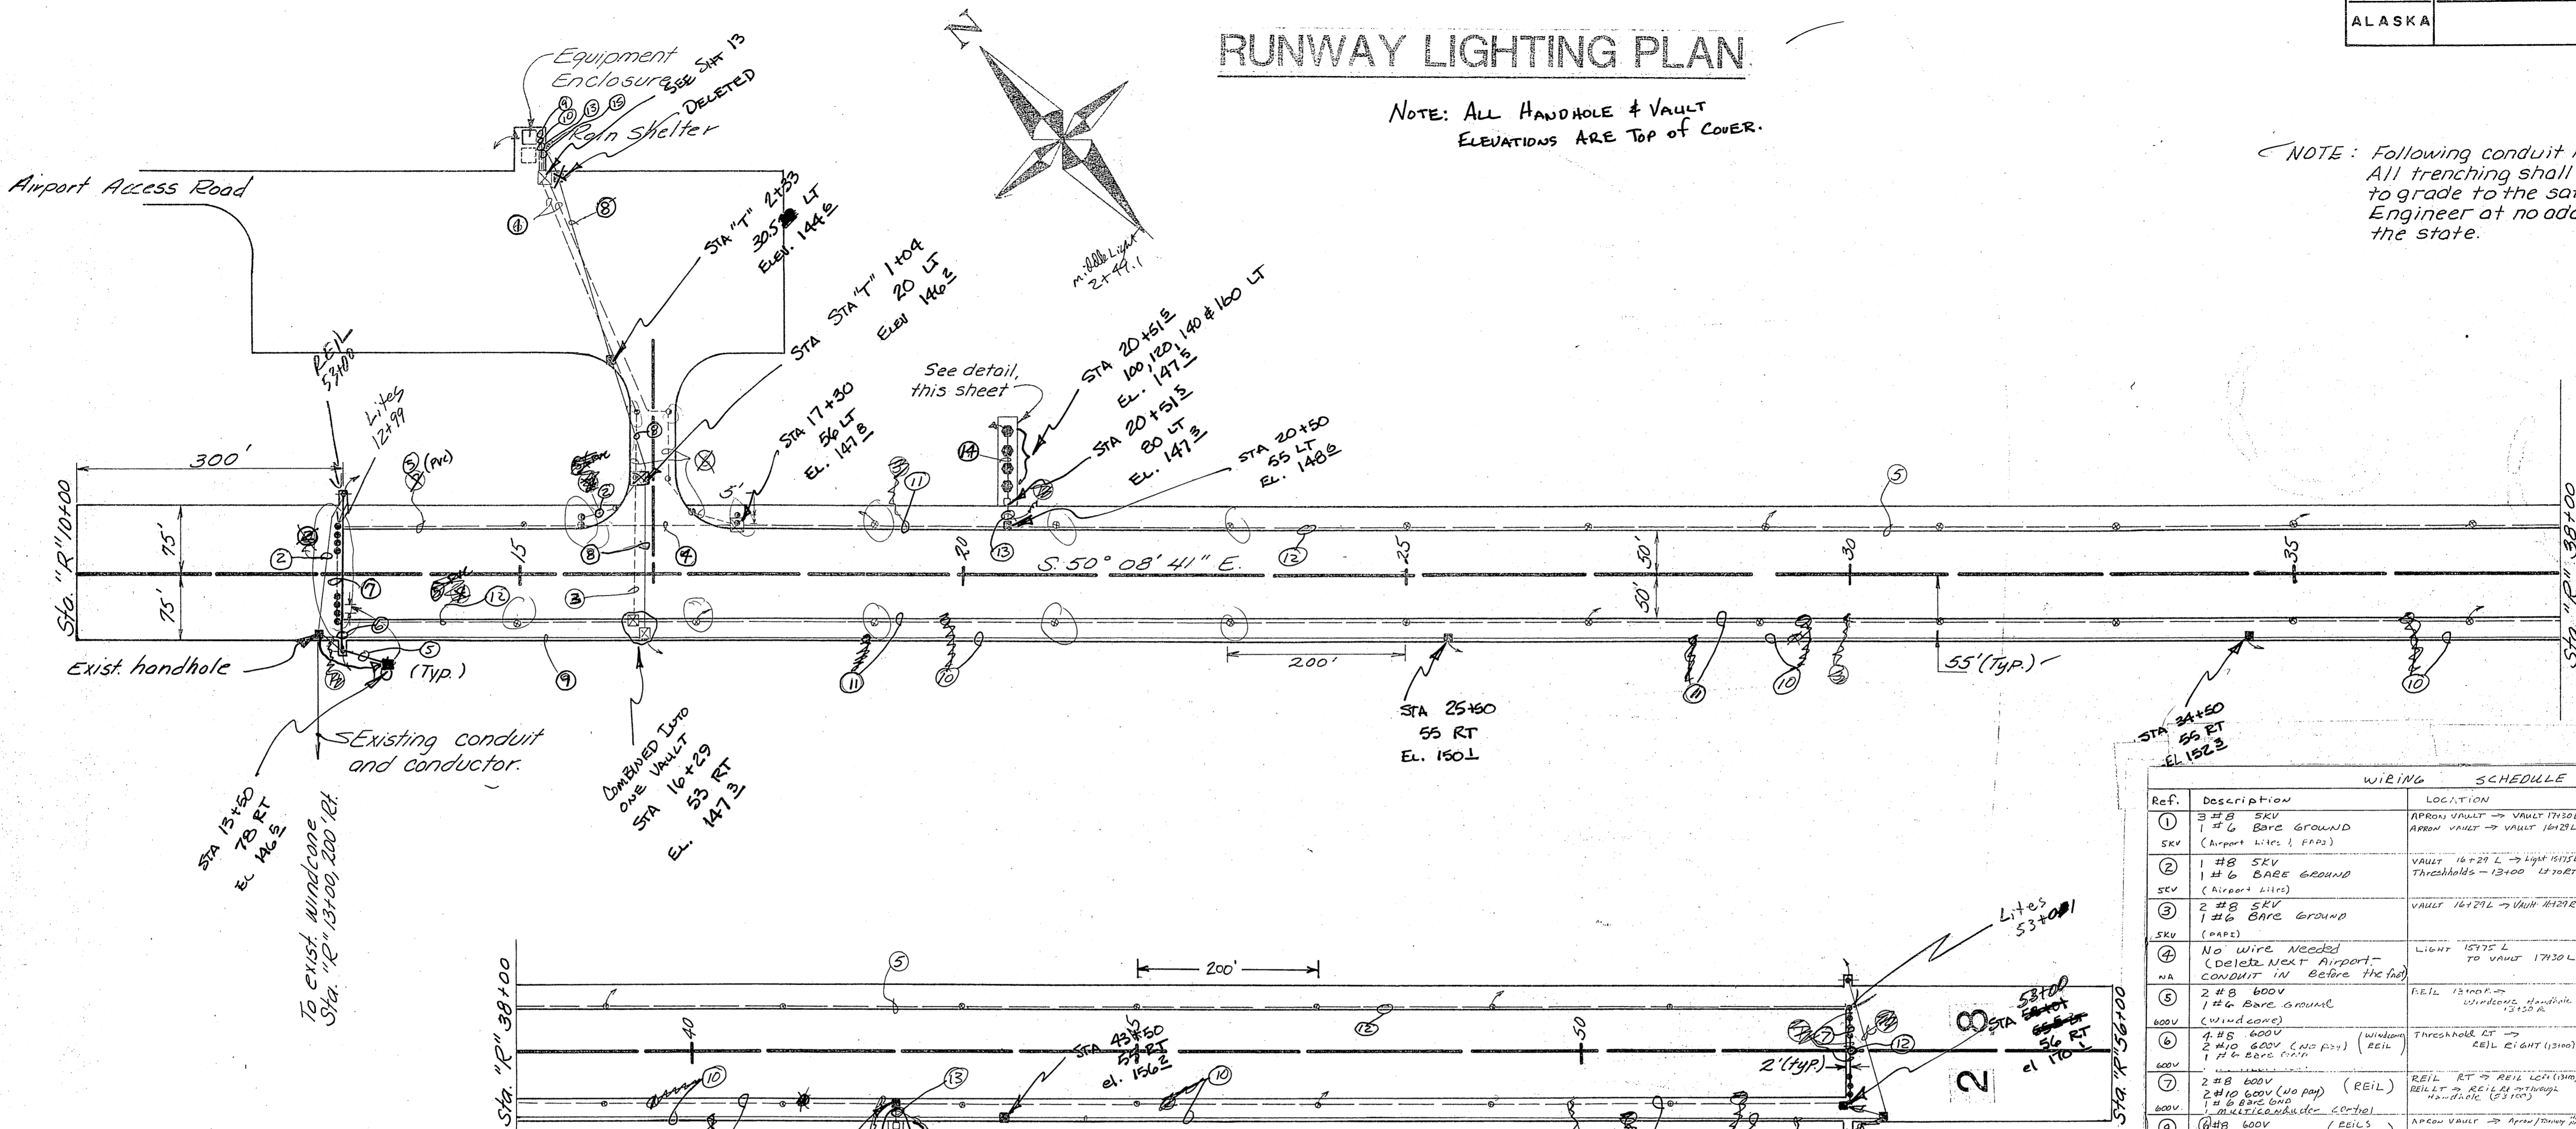

Ref.	Description	LOCATION	CONDUIT LENGTH	CONDUIT TYPE	TOTAL WIRE
1	3 #8 SKV 1 #6 BARE GROUND (Airport Lites & PAPI)	APRON VAULT → VAULT 1730L	305' TOTAL	RSC (2")	2696 (5KV) 882 (6KV)
2	1 #8 SKV 1 #6 BARE GROUND (Airport Lites)	VAULT 16+29 L → LIGHT 1515E	78'	RSC (2")	187 (5KV) 187 (6KV)
3	2 #8 SKV 1 #6 BARE GROUND (PAPI)	VAULT 16+29 L → VAULT 1429E	156' TOTAL	RSC (2")	312 (5KV) 156 (6KV)
4	No wire needed (Delete Next Airport- CONDUIT IN Before the end)	LIGHT 1515E L TO VAULT 1730L	135' TOTAL NO WIRE	RSC (2")	N/A
5	2 #8 600V 1 #6 BARE GROUND (Windcore)	REIL 1210000 → WINDCORE VAULT 13150 R	52' TOTAL	RSC (2")	104 (600V) 52 (6KV)
6	4 #8 600V 2 #10 600V (NO PAPI) 1 #6 BARE GND	THRESHOLD LT → REIL EIGHT (12100)	30' TOTAL	RSC (2")	120 (600V) 30 (6KV)
7	2 #8 600V 2 #10 600V (NO PAPI) 1 #6 BARE GND	REIL RT → REIL L (11100)	170'	RSC (2")	340 (600V) 85 (6KV)
8	6 #8 600V 2 #10 600V (NO PAPI) 1 #6 BARE GROUND	APRON VAULT → APPROXIMATE REIL RT → VAULT 1429E TH 1001 RAIL	230' TOTAL	RSC (2")	3372 (600V) 562 (6KV)
9	4 #8 600V 2 #10 600V (NO PAPI) 1 #6 BARE GND (REIL) WINDCORE	VAULT 1629 L → APPROXIMATE APRON VAULT → VAULT 13100 R	321' TOTAL	PCV (2")	1284 (600V) 347 (6KV)
10	2 #8 600V 2 #10 600V (NO PAPI) 1 #6 BARE GND	VAULT 1429 L → H.H. 25150 RT H.H. 25150 RT → H.H. 34150 RT H.H. 34150 RT → H.H. 42150 RT VAULT 1429 L → H.H. 42150 RT	900' TOTAL	PCV (2")	3738 (600V) 2674 (6KV)
11	3 #8 SKV 1 #6 BARE GND (AIRPORT LITES & PAPI)	VAULT 1429 L → H.H. 42150 RT VAULT 1730 L → H.H. 20150 RT	260' TOTAL	PCV (2")	2769 (5KV) 2923 (6KV)
12	1 #8 SKV 1 #6 BARE GND (AIRPORT LITES)	LIGHT 1515E L → THRESHOLD THRESHOLD → VAULT 1639 R VAULT 1639 R → THRESHOLD	327' TOTAL	PCV (2")	5037 (5KV) 5037 (6KV)
13	2 #8 SKV 1 #6 BARE GND (PAPI & Airport Lites)	H.H. 20150 RT → 80' RT H.H. 42150 RT → 80' RT	20'	PCV (2")	168 (5KV) 84 (6KV)
14	6 #8 SKV 1 #6 BARE GND (PAPI)	APRON VAULT → SHELTER 42150 RT → 160' LT 42150 RT → 160' LT	160' TOTAL	PCV (2")	960 (5KV) 160 (6KV)
15	4 #8 SKV 1 #6 BARE GND (PAPI)	APRON VAULT → SHELTER	40' TOTAL	PCV (2")	160 (5KV) 40 (6KV)
16	2 #8 600V 2 #10 600V (NO PAPI) 1 #6 BARE GND (REIL Intensity)	APRON VAULT → SHELTER	40' TOTAL	PCV (2")	80 (600V) 40 (6KV) 80 (6KV)

Symbol	No. Required	Description	Remarks
⊗	37	Runway Lights	White Light
⊕	4	Reil	White Light
⊙	10	Taxiway Lights	Blue Light
⊛	8	PAPI	Red/White Light
■	16	Handhole	See Note
⊠	36	36" x 36" x 36" D Vault	PAPI INCLUDED
⤴	19	Ground Rod	
▲	1	Transformer	
⊙	16	Threshold Lights	Red / Green
□	2	Handhole for mounting PAPI Equipment	
—	See Wiring Schedule	2" Conduit w/ 1600 V. Circuit	
—	See Wiring Schedule	2" Conduit w/ 240 V. Circuit	

NOTE: Total includes 8 L-867 Lightbases Type 1-12" dia. with Base Plate and Gasket. See sheet 14. for details.

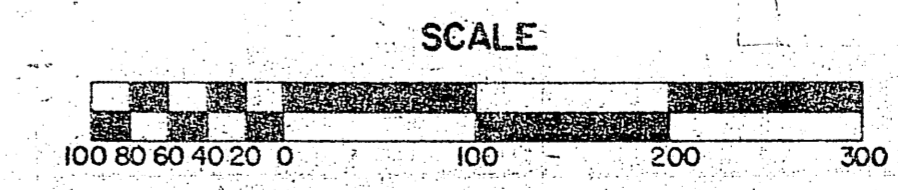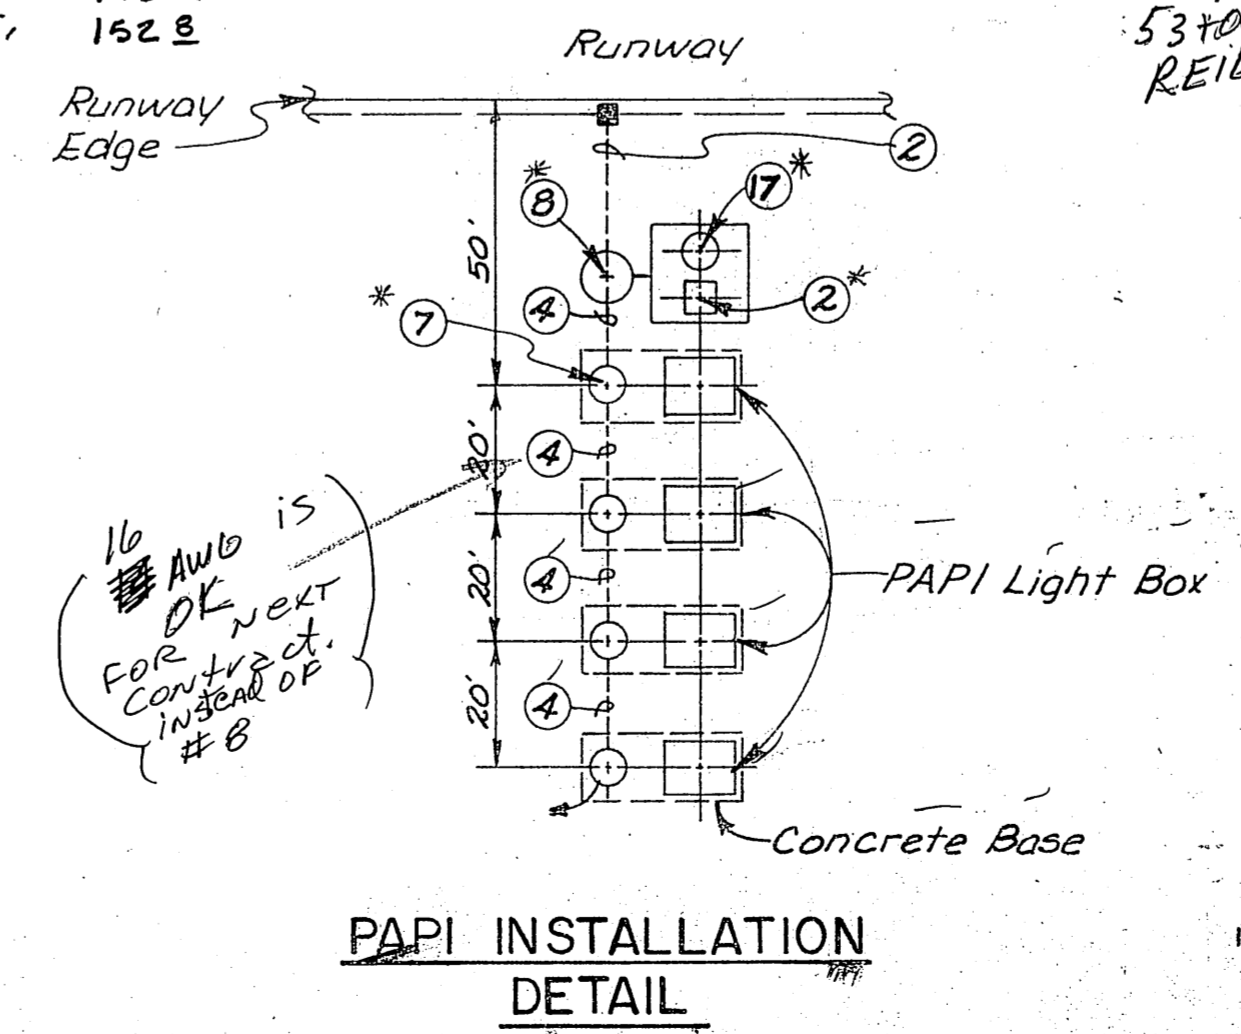


BY	DATE	CHANGE

KAKE AIRPORT  
PROJECT NO. D-19712  
A.I.P. NO. 831-3-02-0398-01-83  
RUNWAY LIGHTING PLAN

APPROVED BY: *Wallace K. Williams* 8/12/85  
WALLACE K. WILLIAMS, P.E. CHIEF OF DESIGN

APPROVED BY: *P. Bednarowicz* 8/12/85  
WILLIAM L. BAUMGARTNER, P.E. DESIGN CHIEF GROUP "B"

SCALE: AS SHOWN  
DESIGNED: MJC  
DRAWN: SS  
CHECKED: DATE: SHEET 12 OF 25

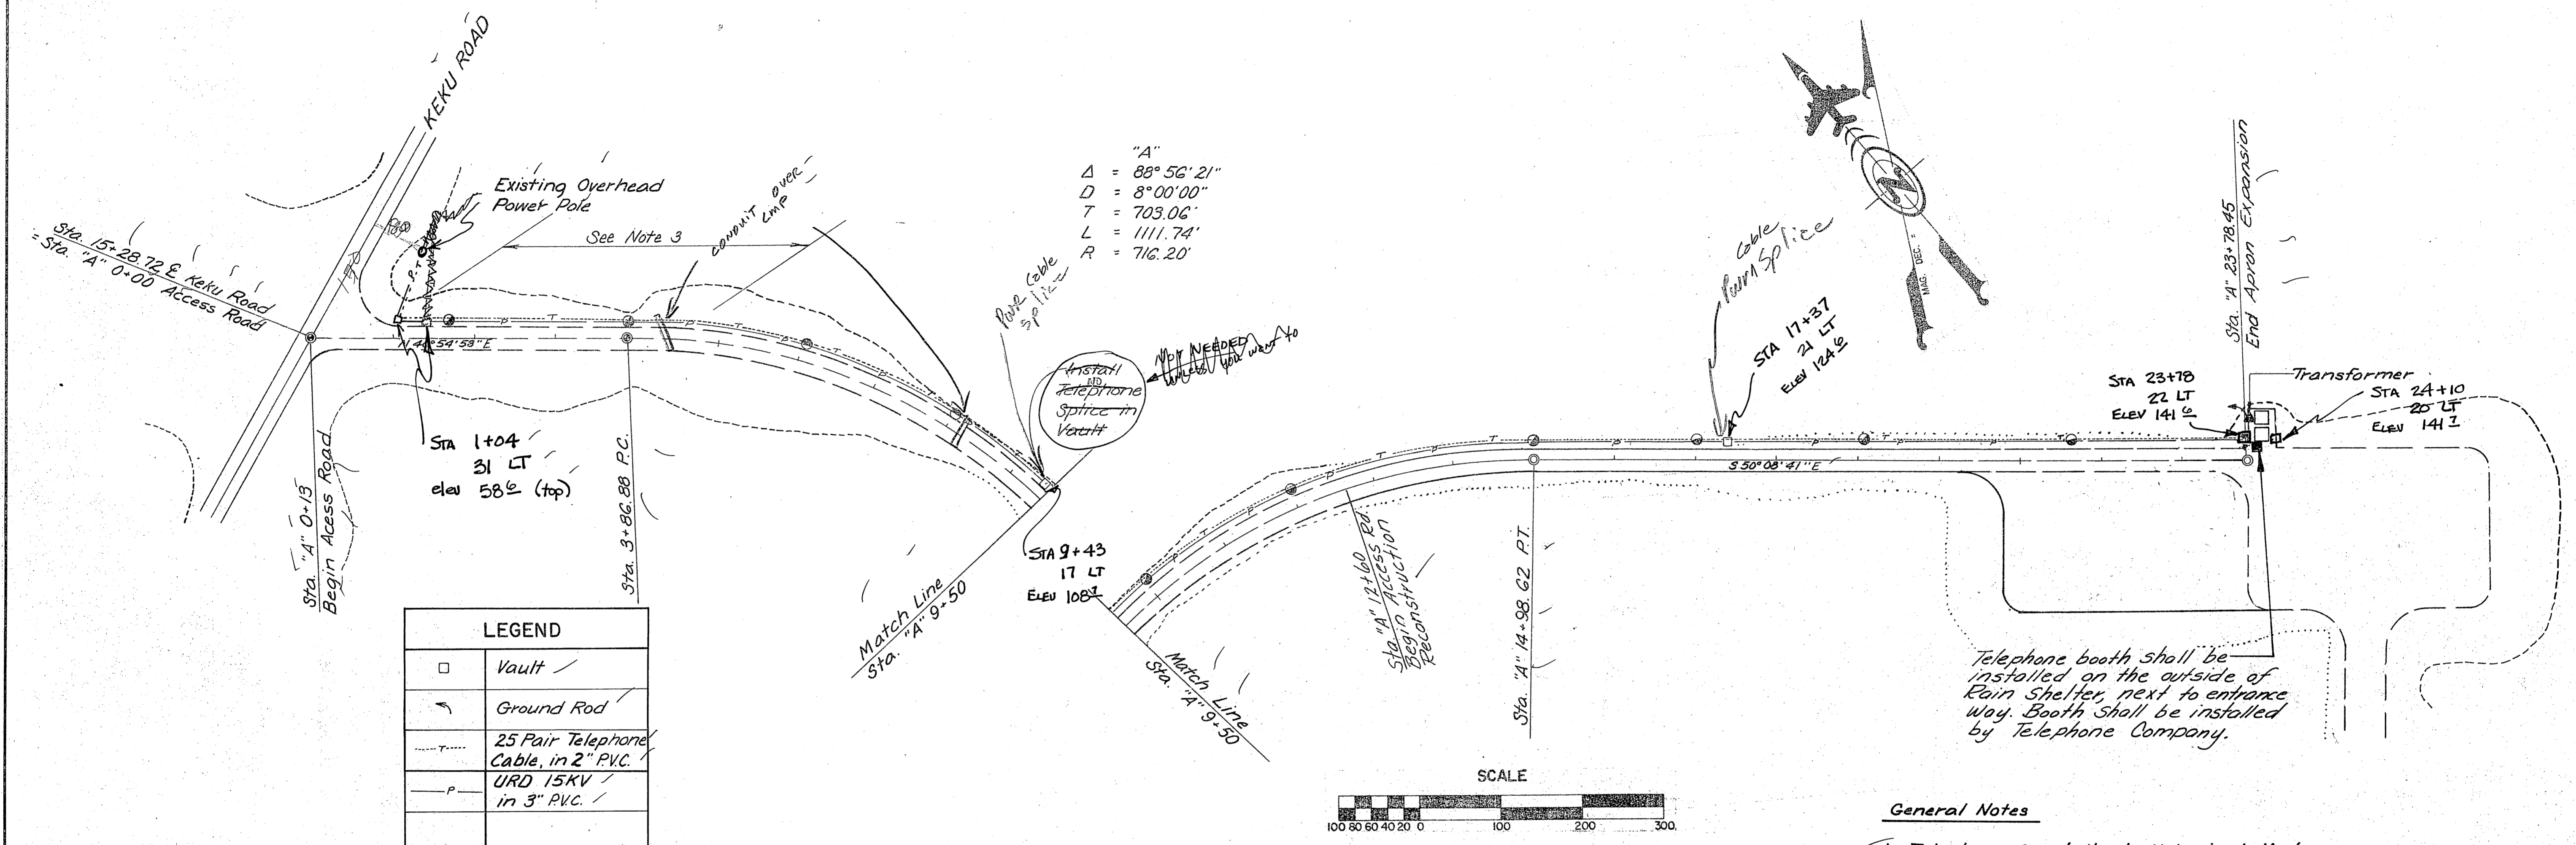


"A"  
 $\Delta = 88^{\circ} 56' 21''$   
 $D = 8^{\circ} 00' 00''$   
 $T = 703.06'$   
 $L = 1111.74'$   
 $R = 716.20'$

LEGEND	
□	Vault ✓
⊥	Ground Rod ✓
---	25 Pair Telephone Cable, in 2" PVC. ✓
-P-	URD 15KV in 3" PVC. ✓
●	Cable Markers ✓
▲	Transformer** ✓

UNDERGROUND VAULT		
STATION	OFFSET	RT/LT
"A" 1+40	13'	Lt.
"A" 9+50	29.5'	Lt.
"A" 17+00	26.5'	Lt.
"A" 24+10	20'	Lt.


CABLE MARKER SUMMARY				
STATION	OFFSET	RT/LT	REMARKS	
2+50	"A" 1+70	13'	Lt.	Post
3+86	"A" 3+86	13'	Lt.	Post
5+50	"A" 6+00	13'	Lt.	Post
6+50	"A" 8+00	13'	Lt.	Post
7+50	"A" 10+00	13'	Lt.	Post
11+50	"A" 12+00	13'	Lt.	Post
13+50	"A" 14+98	13'	Lt.	Post
15+50	"A" 17+00	13'	Lt.	Post
19+50	"A" 19+10	13'	Lt.	Post
21+50	"A" 21+50	13'	Lt.	Post

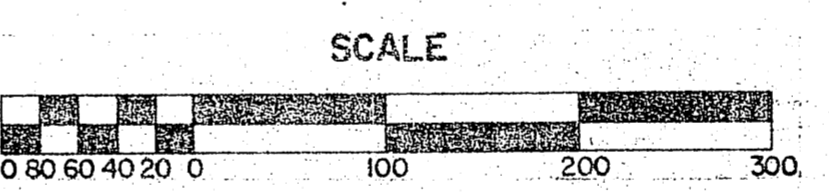

POWER & TELEPHONE PLAN

General Notes

- Telephone Conduit shall be installed in the same trench a minimum of 6" spacing from Power Conduit.
- Cable Marker Posts and Utility Marker Tape shall be incidental to conduit installation.
- Rock excavation <sup>WILL</sup> be encountered approximately between Sta. 0+00 to Sta. 5+00. All blasting and rock excavation shall be incidental to conduit installation.
- Conduit shall be installed adjacent to the Left toe of slope with a min. cover of 36". Any destruction of the structural section as a result of conduit installation shall be repaired to the satisfaction of the Engineer, and at no additional cost to the state.

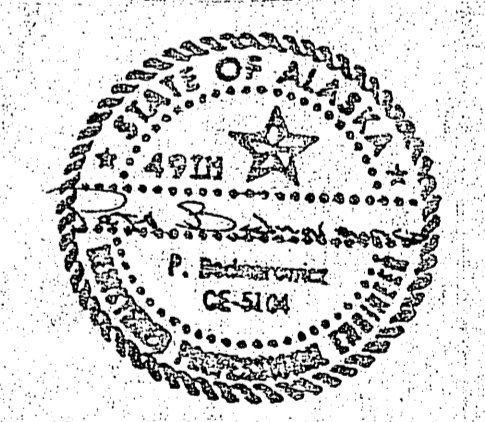

STATE OF ALASKA  
 DEPARTMENT OF TRANSPORTATION  
 AND PUBLIC FACILITIES  
 S.E. REGION, DIVISION OF AVIATION DESIGN & CONSTRUCTION


KAKE AIRPORT  
 PROJECT NO. D19712  
 A.I.P. NO. 831-3-02-0398-01-83

POWER & TELEPHONE PLAN


APPROVED BY:	<i>Wallace K. Williams</i> 8/12/85	CHIEF OF DESIGN
APPROVED BY:	<i>William L. Baumgartner</i> 8/12/85	DESIGN CHIEF GROUP "B"
SCALE:	DESIGNED: MJC	DRAWN: SS
AS SHOWN	CHECKED:	DATE: 2/16/84

BY	DATE	CHANGE

REVISIONS

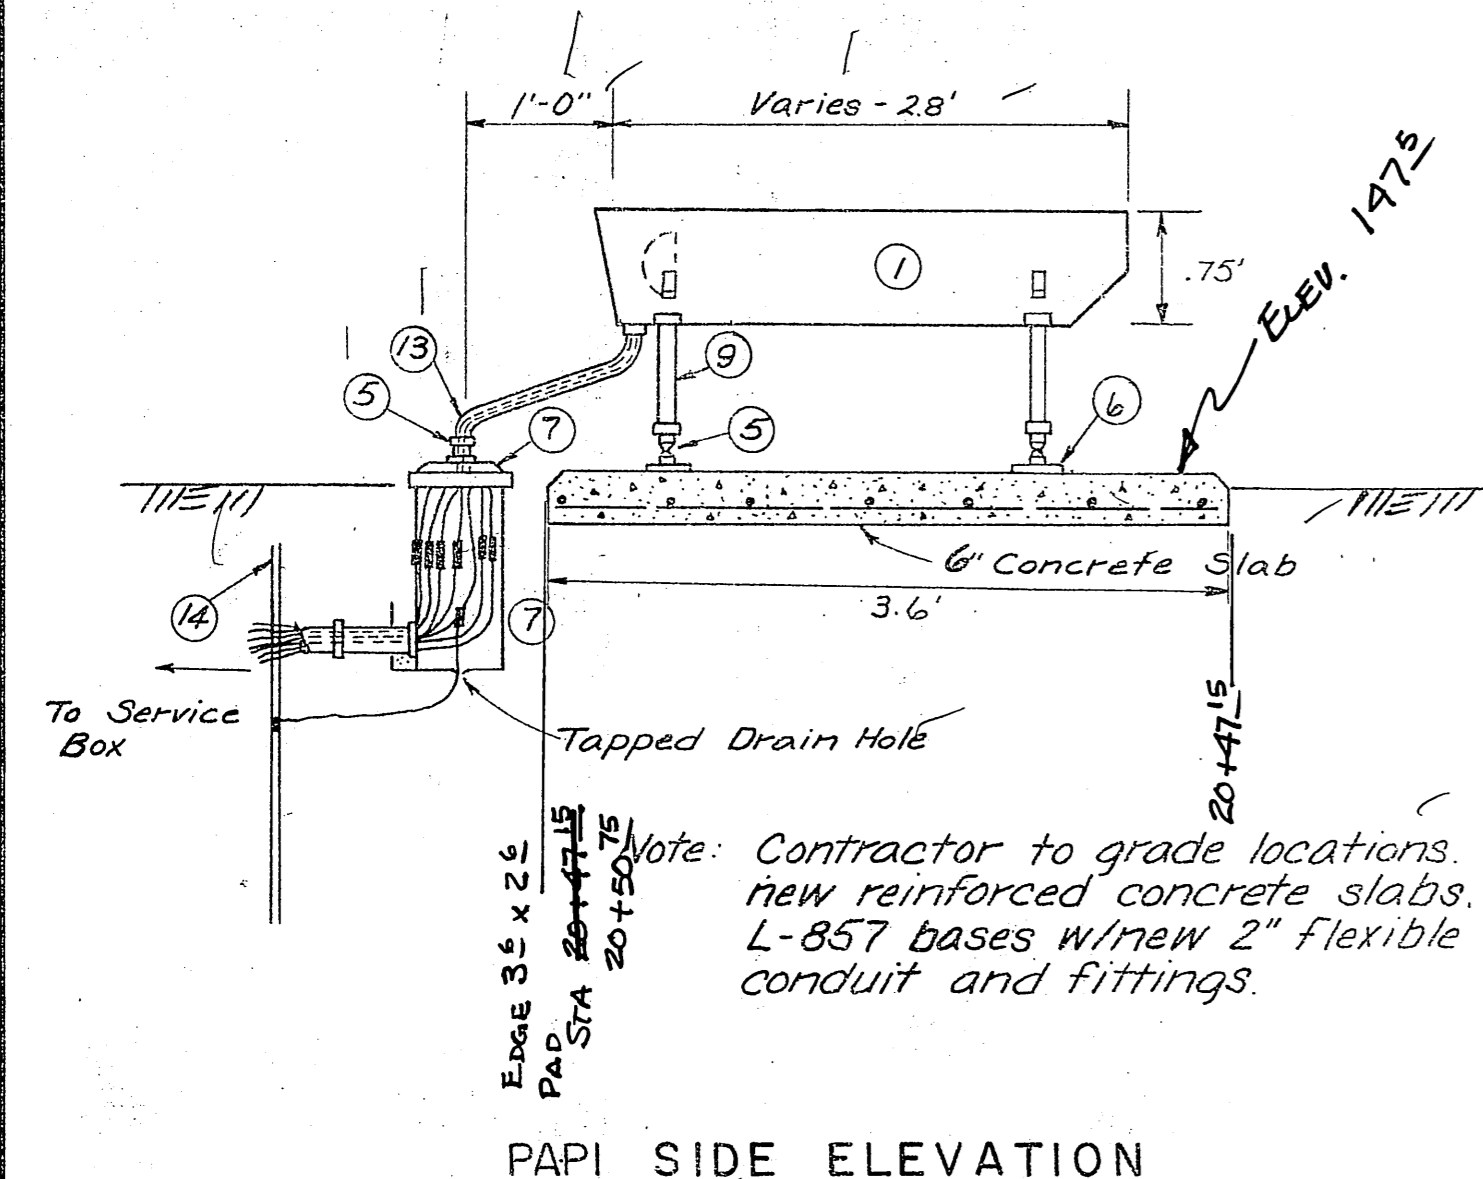


PAPI SIDE ELEVATION

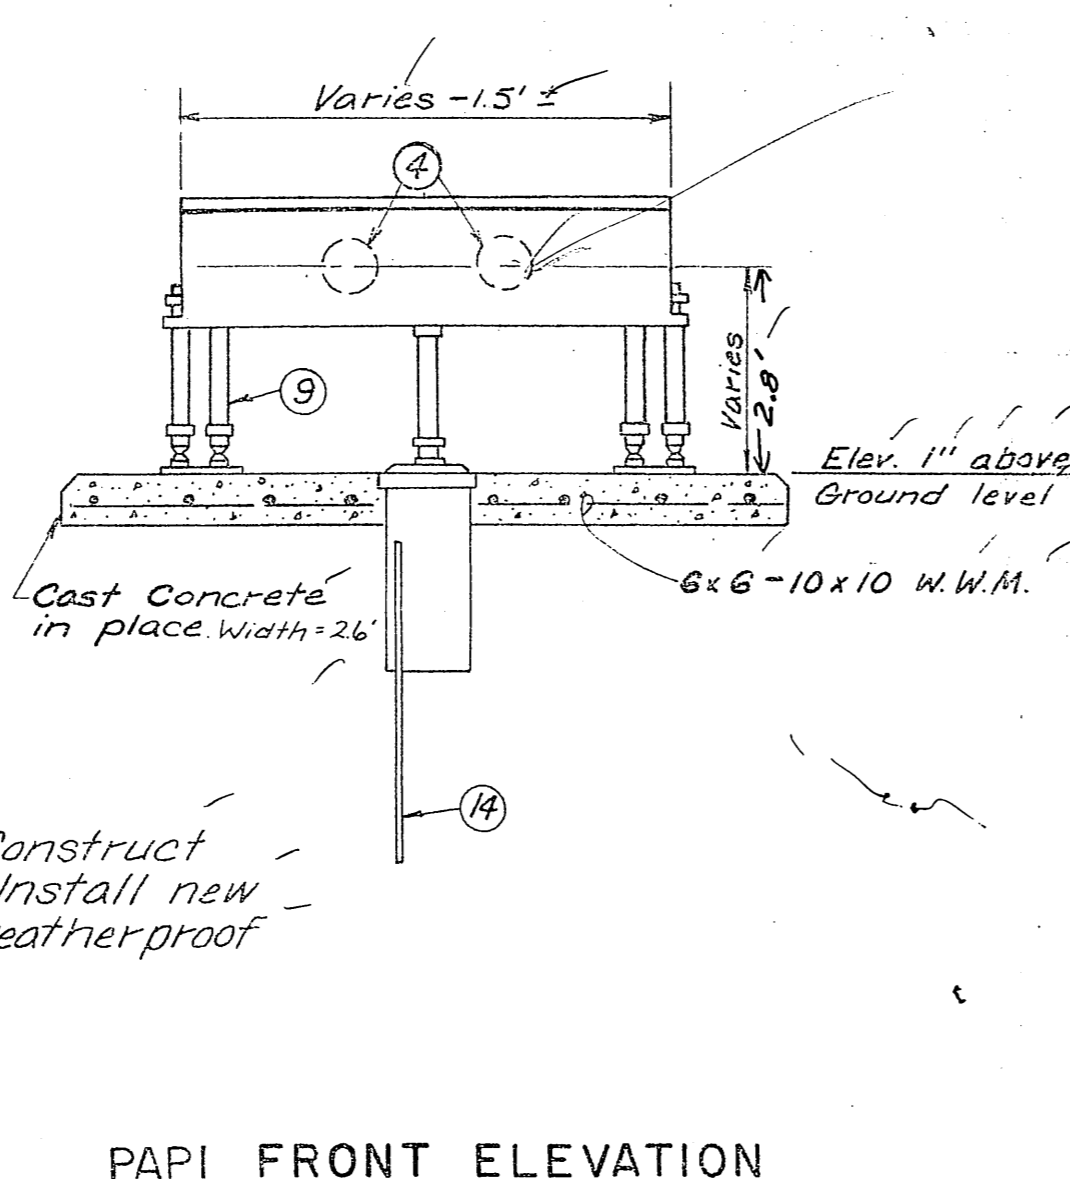


PAPI FRONT ELEVATION

WIRING SCHEDULE				
Ref.	Description	LOCATION	CONDUIT LENGTH	TOTAL WIRE
1	3 #8 SKV 1 #6 BARE GROUND (Airport Lites, PAPI)	APRON VAULT → VAULT 1730L	52' TOTAL	2676 (SKV) 882 (GND)
2	1 #8 SKV 1 #6 BARE GROUND (Airport Lites)	VAULT 16+29 L → LIGHT 1575L THRESHOLDS - 13+00 LT 70RT	128'	187 (SKV) 187 (GND)
3	2 #8 SKV 1 #6 BARE GROUND (PAPI)	VAULT 16+29 L → VAULT 1612R	156'	312 (SKV) 156 (GND)
4	No wire needed (Delete Next Airport CONDUIT IN Before the fact)	LIGHT 1575 L TO VAULT 1730L	155' TOTAL NO WIRE	N/A
5	2 #8 600V 1 #6 BARE GROUND (Window)	FEEL 13+00R → WINDOW HANDHOLE 13+50 R	52' TOTAL	104 (600V) 52 (GND)
6	4 #8 600V 2 #10 600V (NO PAY) 1 #6 BARE GND	THRESHOLD RT REIL LIGHT (13+00)	30' TOTAL	120 (600V) 60 (GND)
7	2 #8 600V (REIL) 2 #10 600V (NO PAY) 1 #6 BARE GND (REIL)	REIL RT → REIL LCP (13+00) REIL LT → REIL LCP (13+00)	170' 170' 340' TOTAL	680 (600V) 340 (GND) 1020 (GND)
8	2 #8 600V (REIL'S WINDOW) 2 #10 600V (NO PAY) 1 #6 BARE GND	APRON VAULT → APRON VAULT APRON VAULT → VAULT 16+29 L THRESHOLD RT	250' 322' 572' TOTAL	2372 (600V) 562 (GND) 2934 (GND)
9	4 #8 600V (NO PAY) 2 #10 600V (NO PAY) 1 #6 BARE GND (REIL'S WINDOW)	VAULT 16+29 L → THRESHOLD 13+00 RT LEADING VAULT → REIL	321' 40' 361' TOTAL	1408 (600V) 361 (GND) 1769 (GND)
10	2 #8 600V 2 #10 600V (NO PAY) 1 #6 BARE GND (REIL'S)	VAULT 16+29 L → H.H. 26+50 RT H.H. 26+50 R → H.H. 39+50 RT H.H. 39+50 R → H.H. 43+00 RT H.H. 43+00 RT → H.H. 53+00 RT	923' 900' 40' 360' TOTAL	7348 (600V) 3674 (GND) 11022 (GND)
11	3 #8 SKV 1 #6 BARE GND (AIRPORT LIGHTS & PAPI)	VAULT 16+29 L → H.H. 42+00 RT VAULT 1730 L → H.H. 20+50 LT	2803' 320' 3123' TOTAL	8769 (SKV) 2723 (GND) 11492 (GND)
12	1 #8 SKV 1 #6 BARE GND (AIRPORT LITES)	LIGHT 1575 L → THRESHOLD 13+00 THRESHOLD 13+00 → VAULT 16+29 L VAULT 16+29 L → THRESHOLD 13+00	280' 4430' 5037' TOTAL	5037 (SKV) 5037 (GND) 10074 (GND)
13	2 #8 SKV 1 #6 BARE GND (PAPI'S Airport Lites)	H.H. 20+50 LT → 80' RT H.H. 42+00 RT → 80' RT	25' 25' 50' TOTAL	168 (SKV) 84 (GND) 252 (GND)
14	6 #8 SKV 1 #6 BARE GND (PAPI'S)	30+50 80' RT → 42+30 80' RT →	80' 80' 160' TOTAL	960 (SKV) 160 (GND) 1120 (GND)
15	4 #8 SKV 1 #6 BARE GND (PAPI'S)	APRON VAULT → SHELTER	40' TOTAL	160 (SKV) 40 (GND) 200 (GND)
16	2 #8 600V (NO PAY) 2 #10 600V (NO PAY) (Window Lanes) (REIL Intensity)	APRON VAULT → SHELTER	40' TOTAL	80 (600V) 80 (GND) 160 (GND)


ITEM	QUAN.	DESCRIPTION
1	8	L-880 Precision Approach Path Indicator (PAPI) Lamp Housing
2	2	Power Control Unit (PCU) w/Day Night Intensity
3	Not Shown	Leveling Device & Calibration Bar For installation & Maintenance (becomes property of the sponsor).
4	3216	PAPI indicator Lamps per AC 150/5345-28D, 200 Watts 66A-1000 hours (incl. spares for maintenance)
5	As Req'd.	Breakable Coupling, 2" thread, for EMT or Liquid Tight Conduit
6	As Req'd.	Flange, Aluminum
7	8	L-867 Light Base, Type-1-12" Dia. with Base Plate and Gasket (Paid for under Item 1000g)
8	2	Type III handhole for mounting PAPI equip. Carlon PS 4238 P or equal (Paid for under Item 1000g)
9	Lot	2" EMT Conduit and or Adjustable Mounting Leg
10	Lot	2" Rigid Conduit, w/ Coupling & Fitting
11	As Req'd.	1/2" No. 8-5KV Type L-824 Type B Cables with Connectors
12	As Req'd. (not shown)	Frangible Couplings, for Rigid Conduit.
13	Lot	2" Flexible Weatherproof Conduit
14	As Req'd.	3/4" x 10'-0" Ground Rod "Copper Weld" or equal (Paid for under Item 1000g)
15	Not Shown	Instruction Books, Drawings, Installation Data becomes property of sponsor
16	2	Safety Switch, 600V, 30 Amp, Fusible, NEMA-3R ENC. 2 Pole equipped w/ Amp Bussmann FRS Fuses, or equal
17	2	Step Down Transformer, 20 KVA, 600V PRI 120/140V Sec 60 Hz. 2-5% FCBN Taps, Indoor or Outdoor

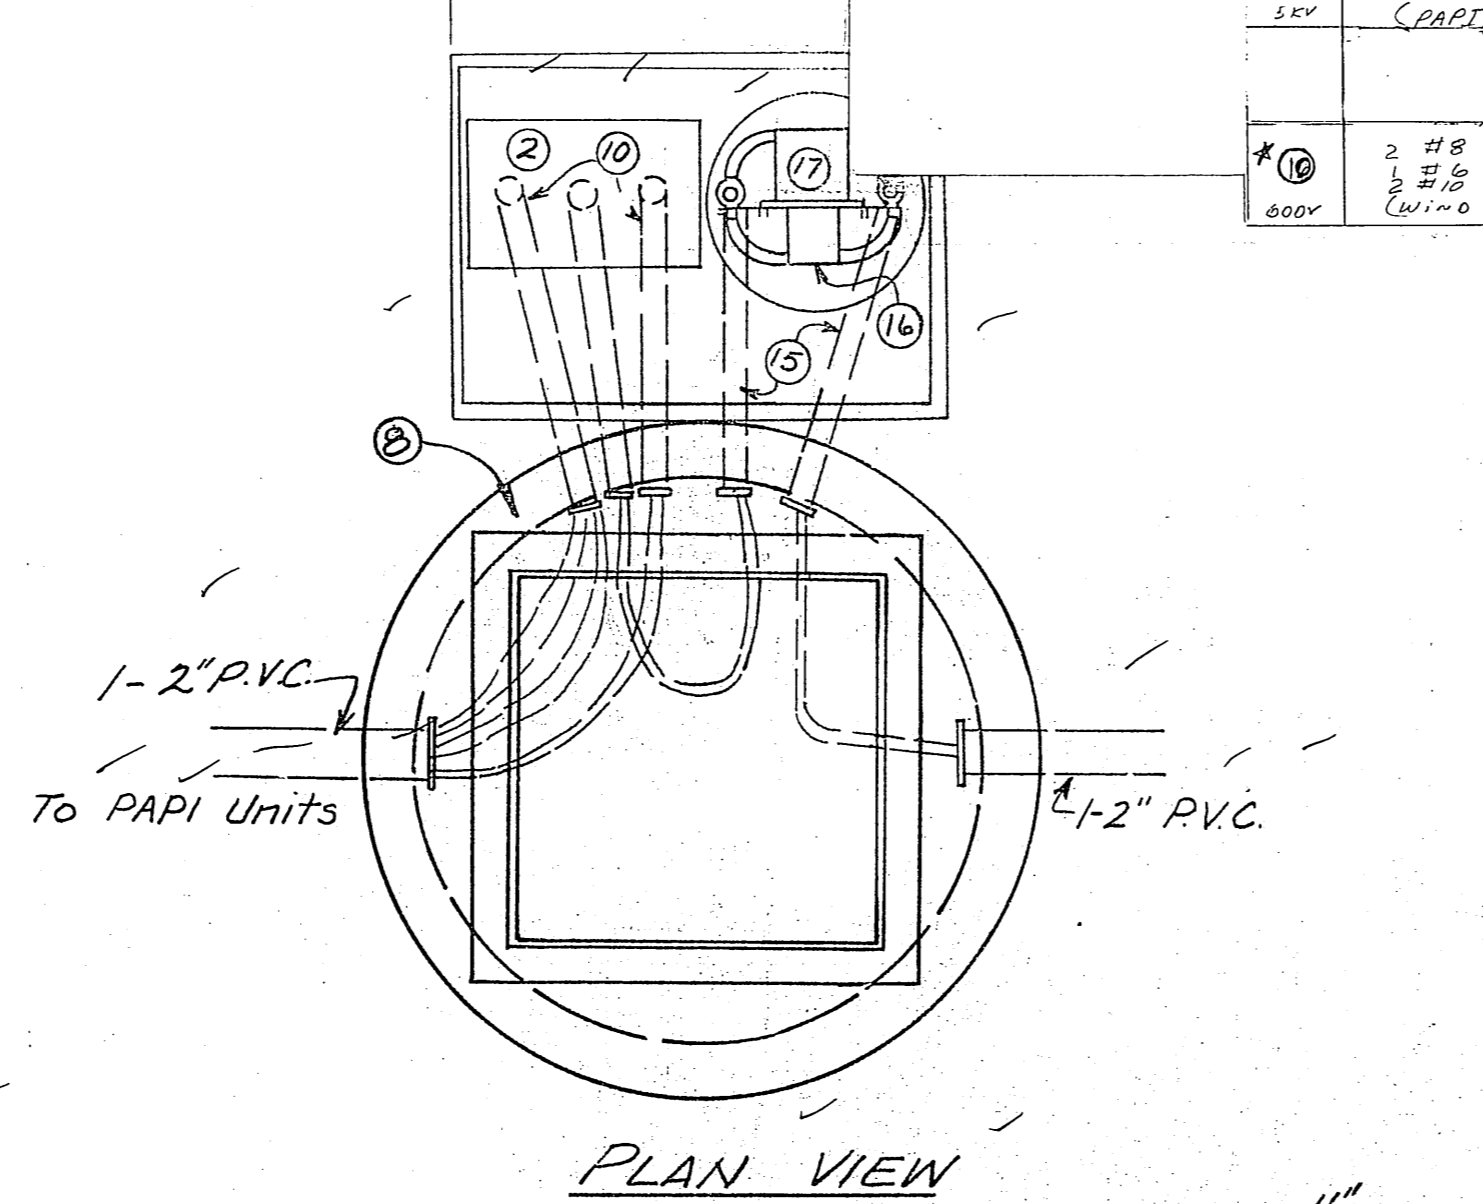


PLAN VIEW

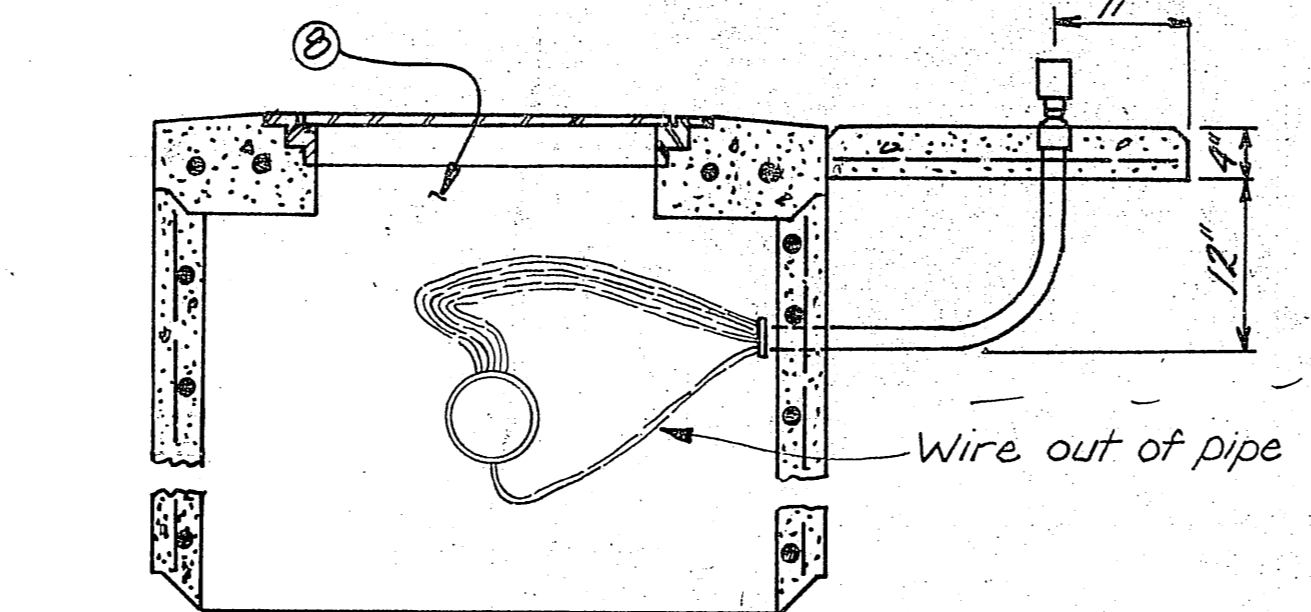

SIDE VIEW  
HANDHOLE FOR MOUNTING PAPI EQUIPMENT

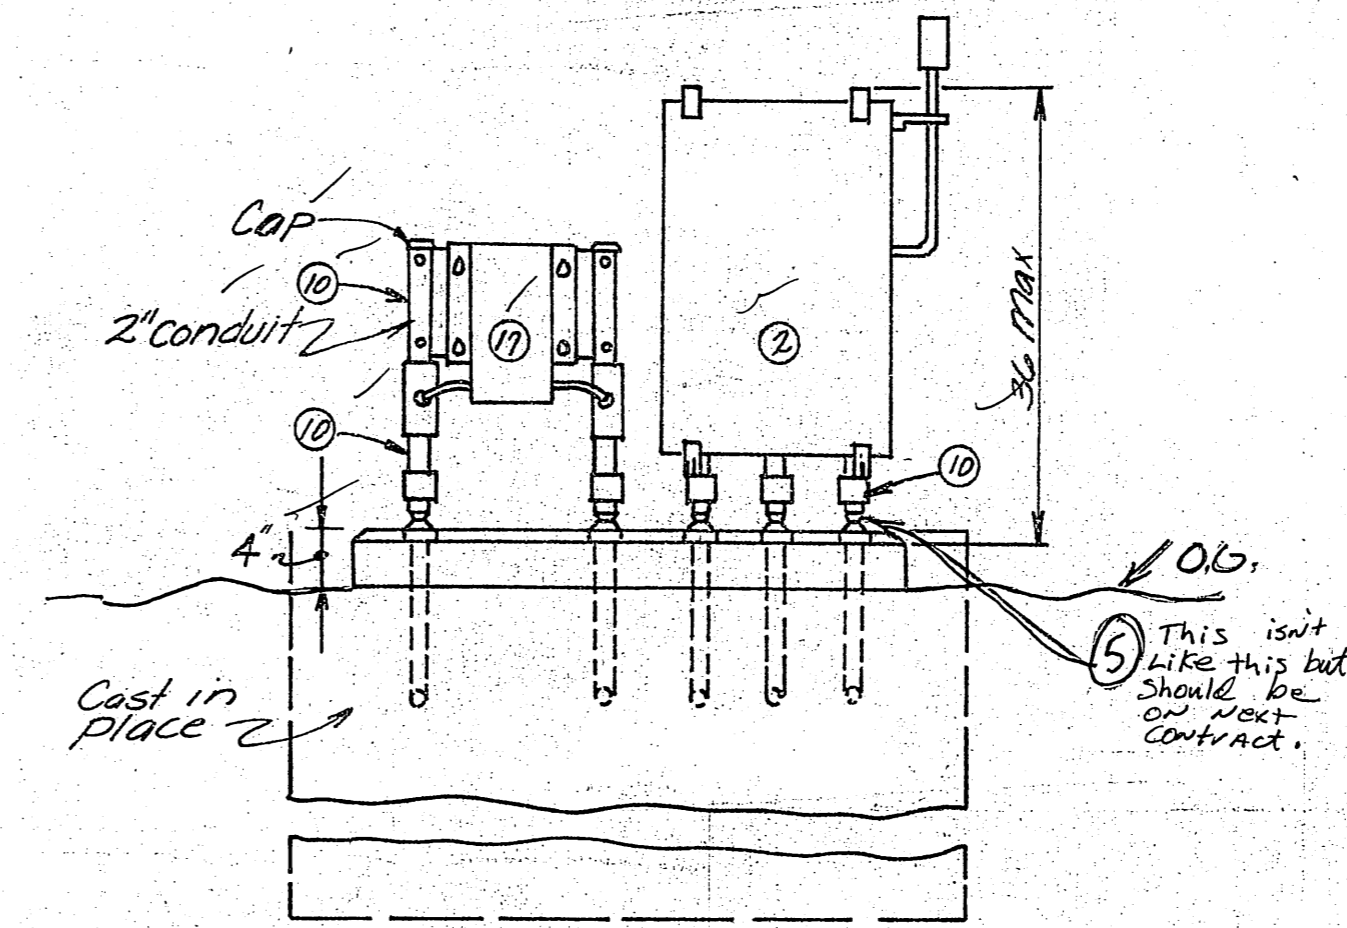

POWER CONTROL UNIT & TRANSFORMER  
FRANGIBLE MOUNTING

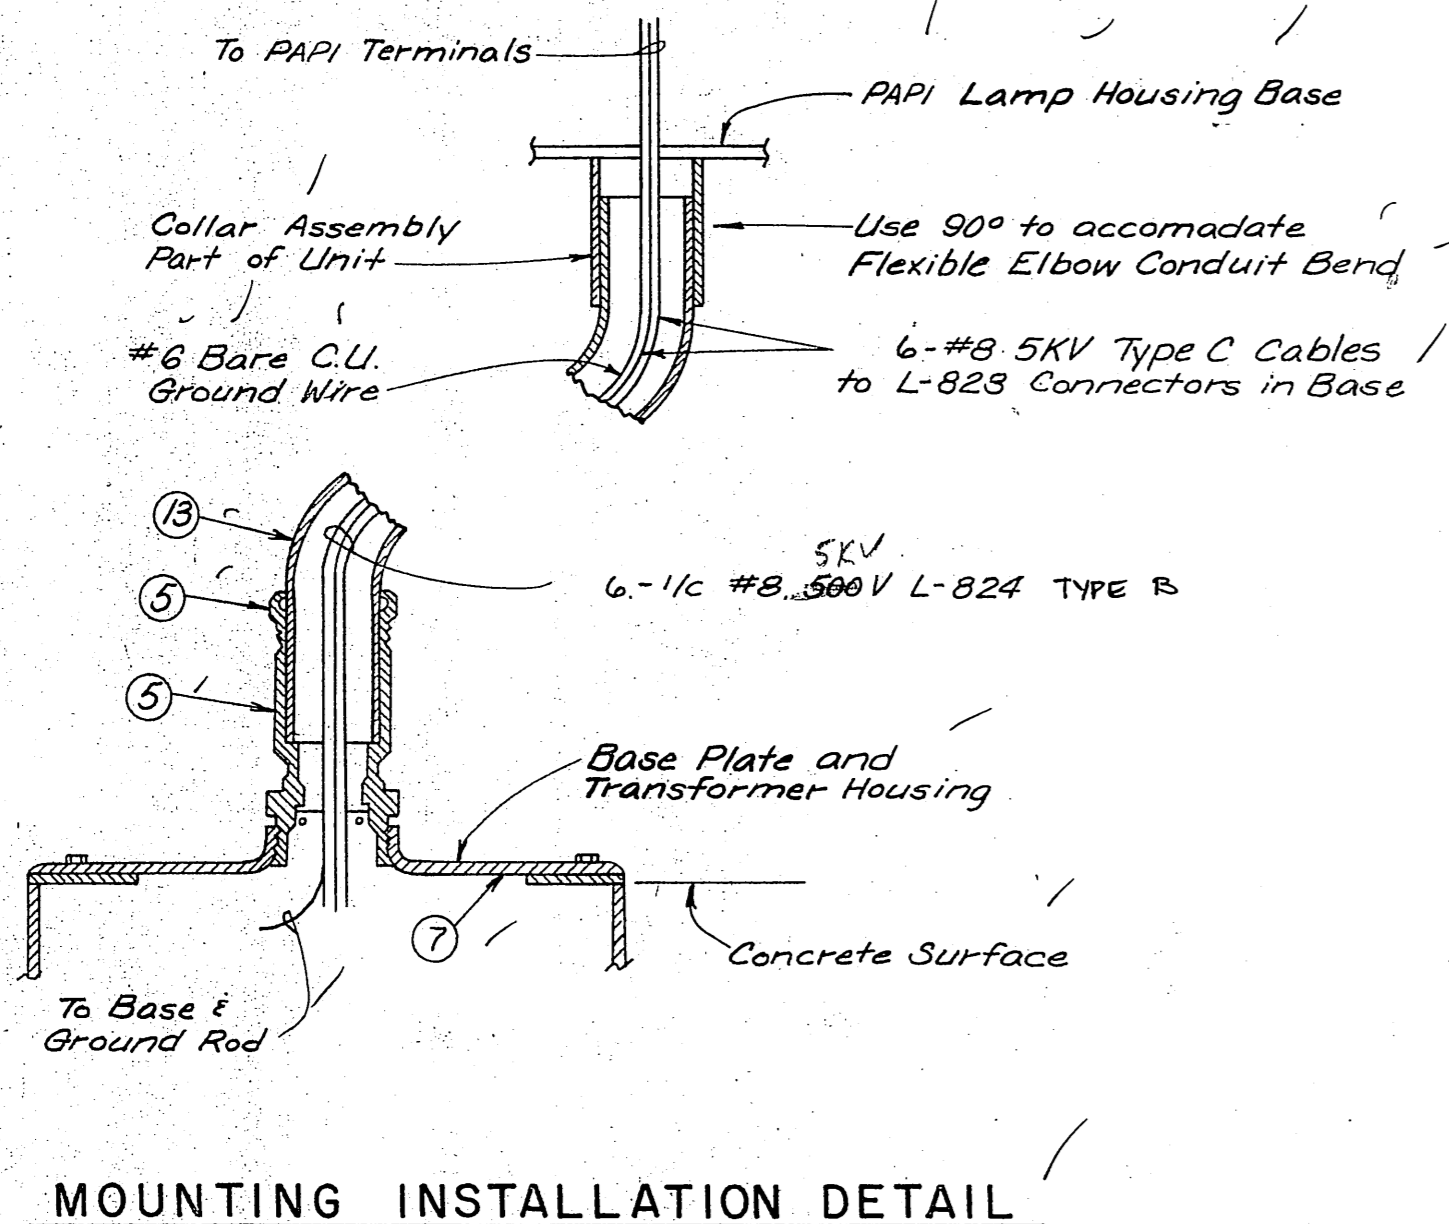

MOUNTING INSTALLATION DETAIL

PAPI SITING DETAILS					
RUNWAY	STATION	PAPI Unit	Offset From E	ELEVATION PAPI LIGHT	AIMING ANGLE
28	42+30	1	100	156.1	3.50
"	"	2	120	156.1	3.17
"	"	3	140	156.1	2.83
"	"	4	160	156.1	2.50
10	20+50	1	100	149.7	3.50
"	"	2	120	149.7	3.17
"	"	3	140	149.7	2.83
"	"	4	160	149.7	2.50

STATE OF ALASKA  
DEPARTMENT OF TRANSPORTATION  
AND PUBLIC FACILITIES  
S.E. REGION, DIVISION OF AVIATION DESIGN & CONSTRUCTION

KAKE AIRPORT  
PROJECT NO. D19712  
A.I.P. NO. 831-3-02-0398-01-83  
LIGHTING DETAILS - PAPI

APPROVED BY: *Wallace K. Williams* 8/12/85  
WALLACE K. WILLIAMS, P.E. CHIEF OF DESIGN


APPROVED BY: *William L. Baumgartner* 8/12/85  
WILLIAM L. BAUMGARTNER, P.E. DESIGN CHIEF GROUP "B"

SCALE: N.T.S. DESIGNED: MJC DRAWN: SS CHECKED: DATE: 2/16/84 SHEET 14 OF 25

BY	DATE	CHANGE




REVISIONS



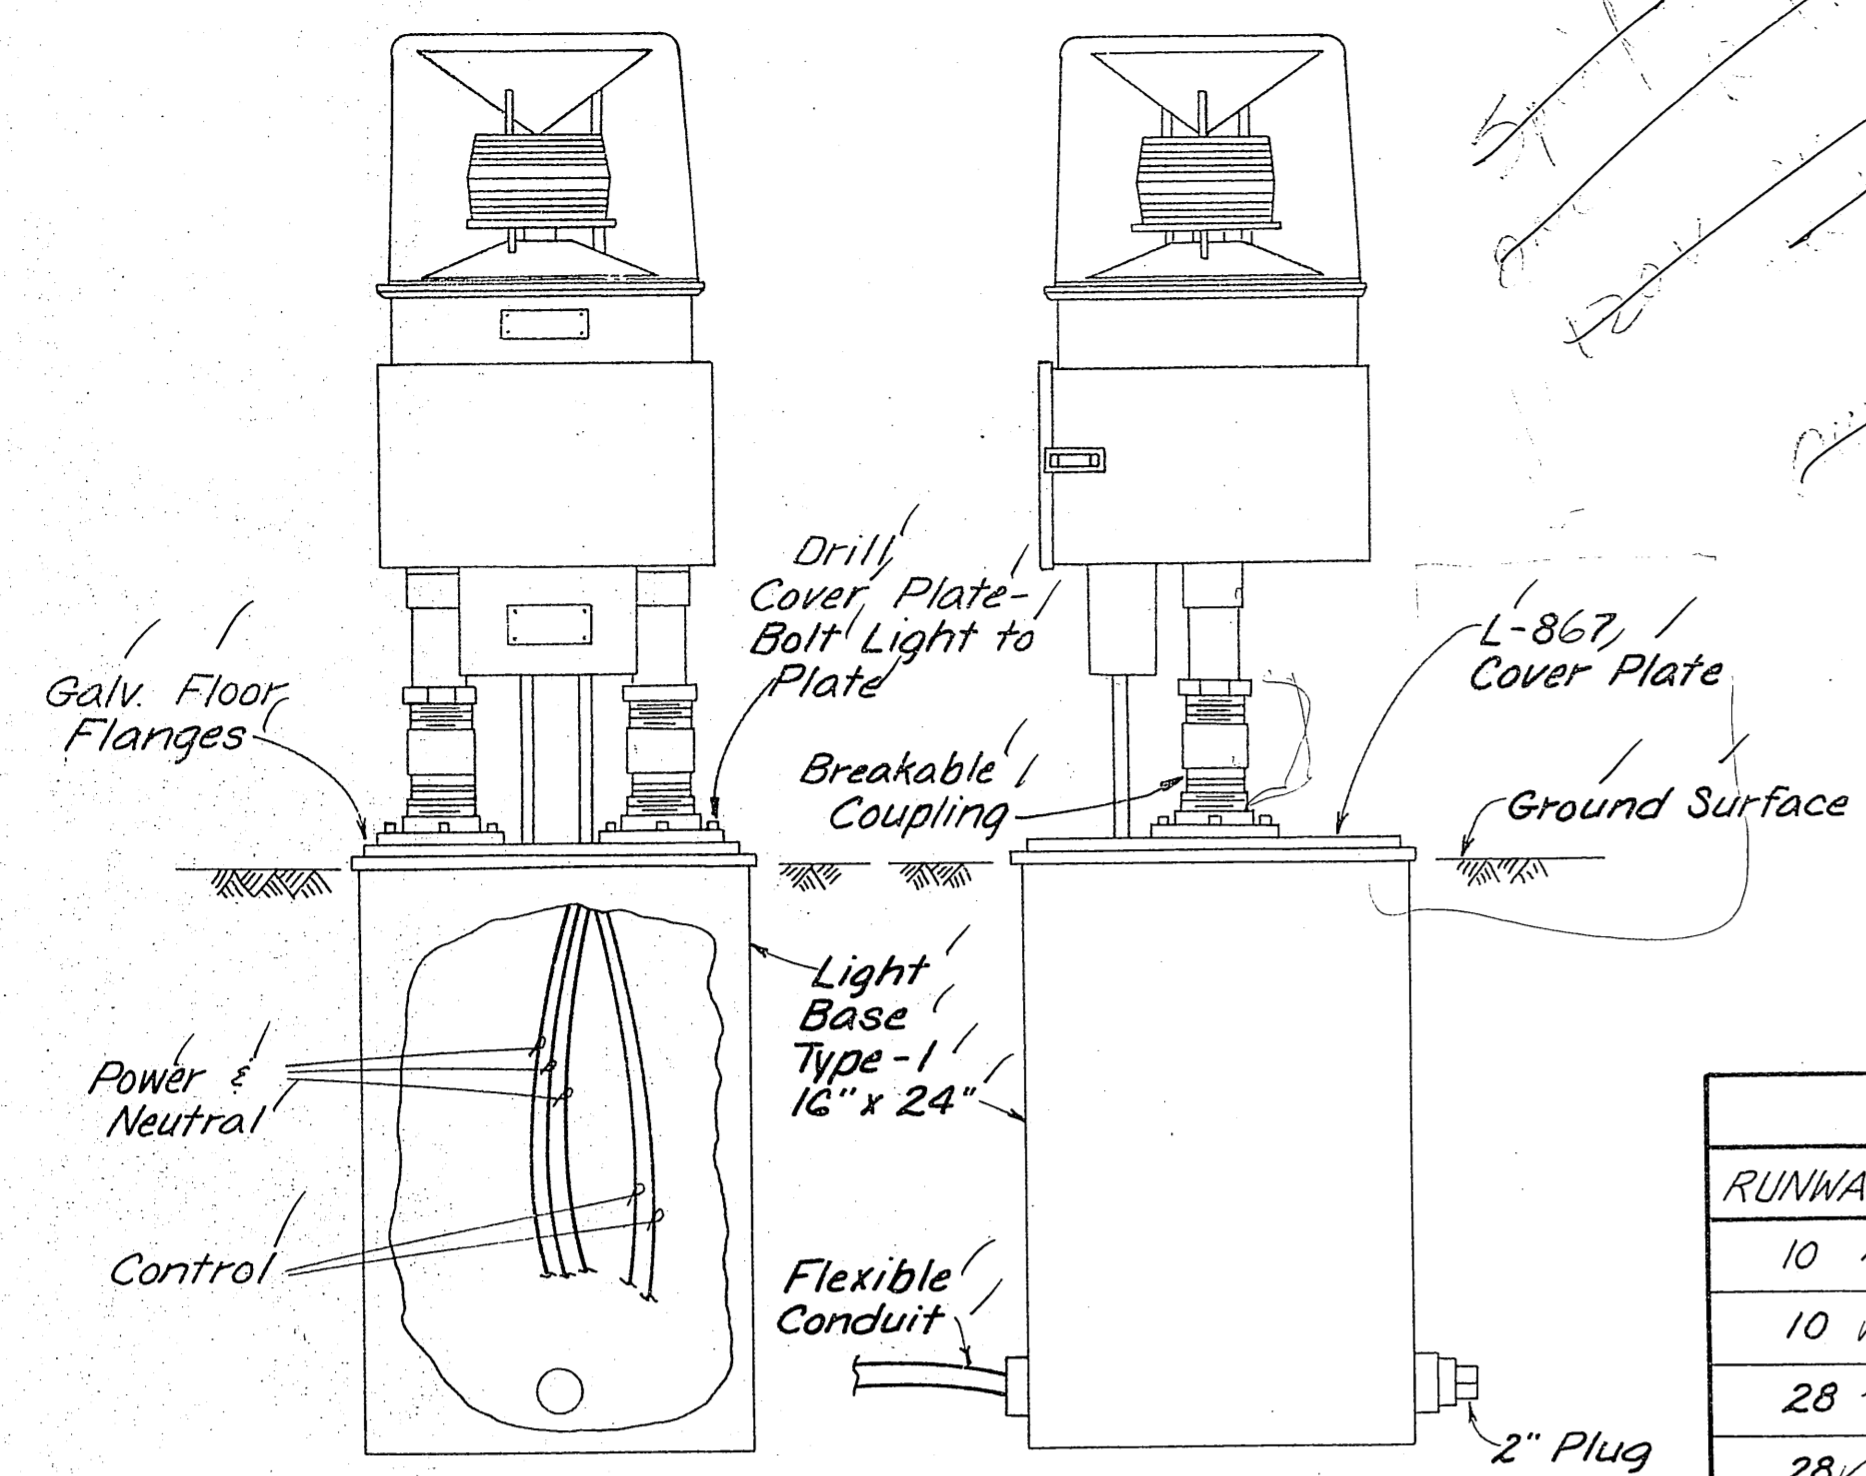


DETAIL L859  
INSTALLATION OF OMNIDIRECTIONAL  
RUNWAY END IDENTIFIER LIGHT  
N.T.S. /


REIL SITING DETAILS					
RUNWAY	POSITION	STATION	REIL ELEV.	GROUND ELEV.	OFFSET FROM CL
10	Left	13+00	148.2	145.7	85'
10	Right	13+00	148.2	145.7	85'
28	Left	53+00	171.7	169.2	85'
28	Right	53+00	171.7	169.2	85'

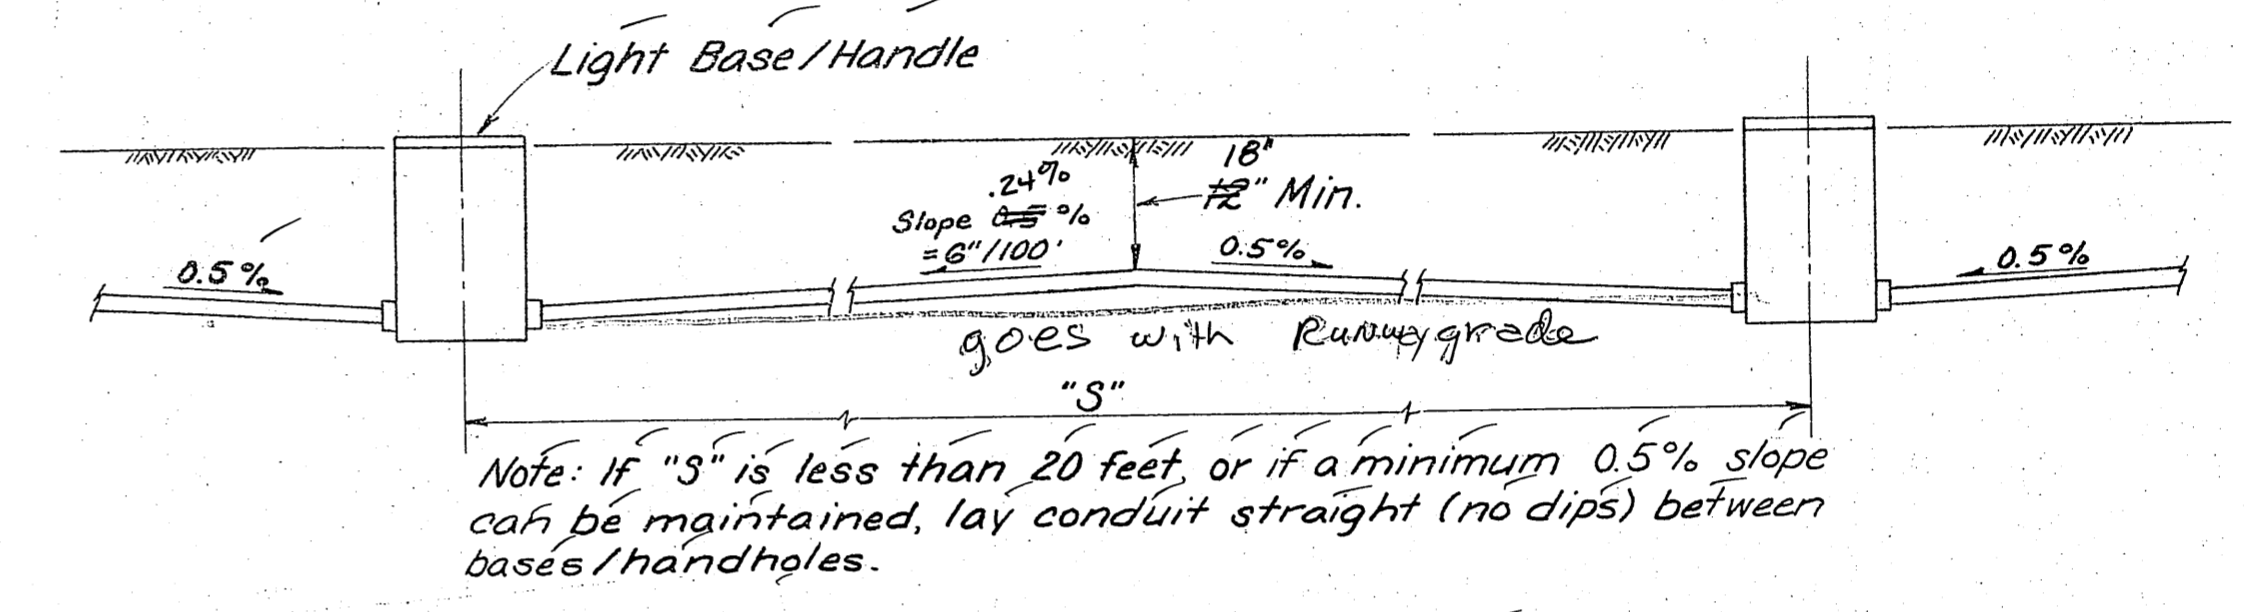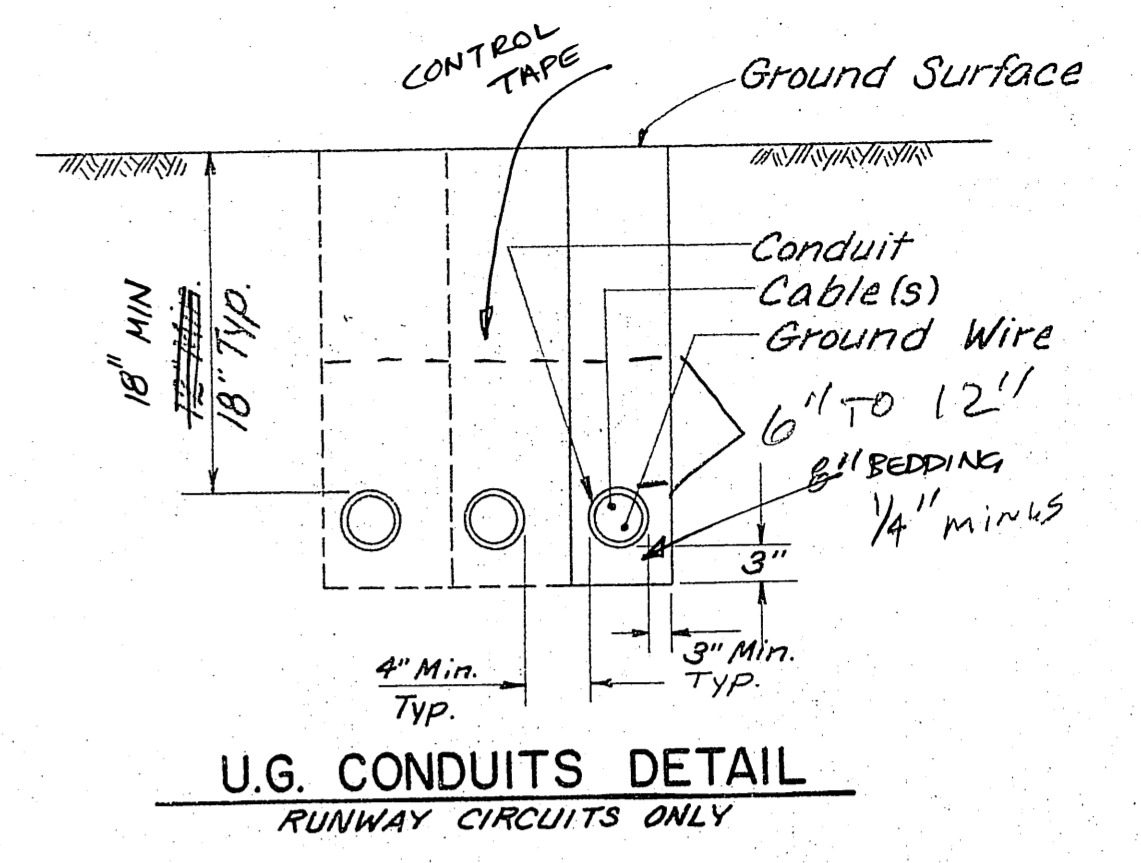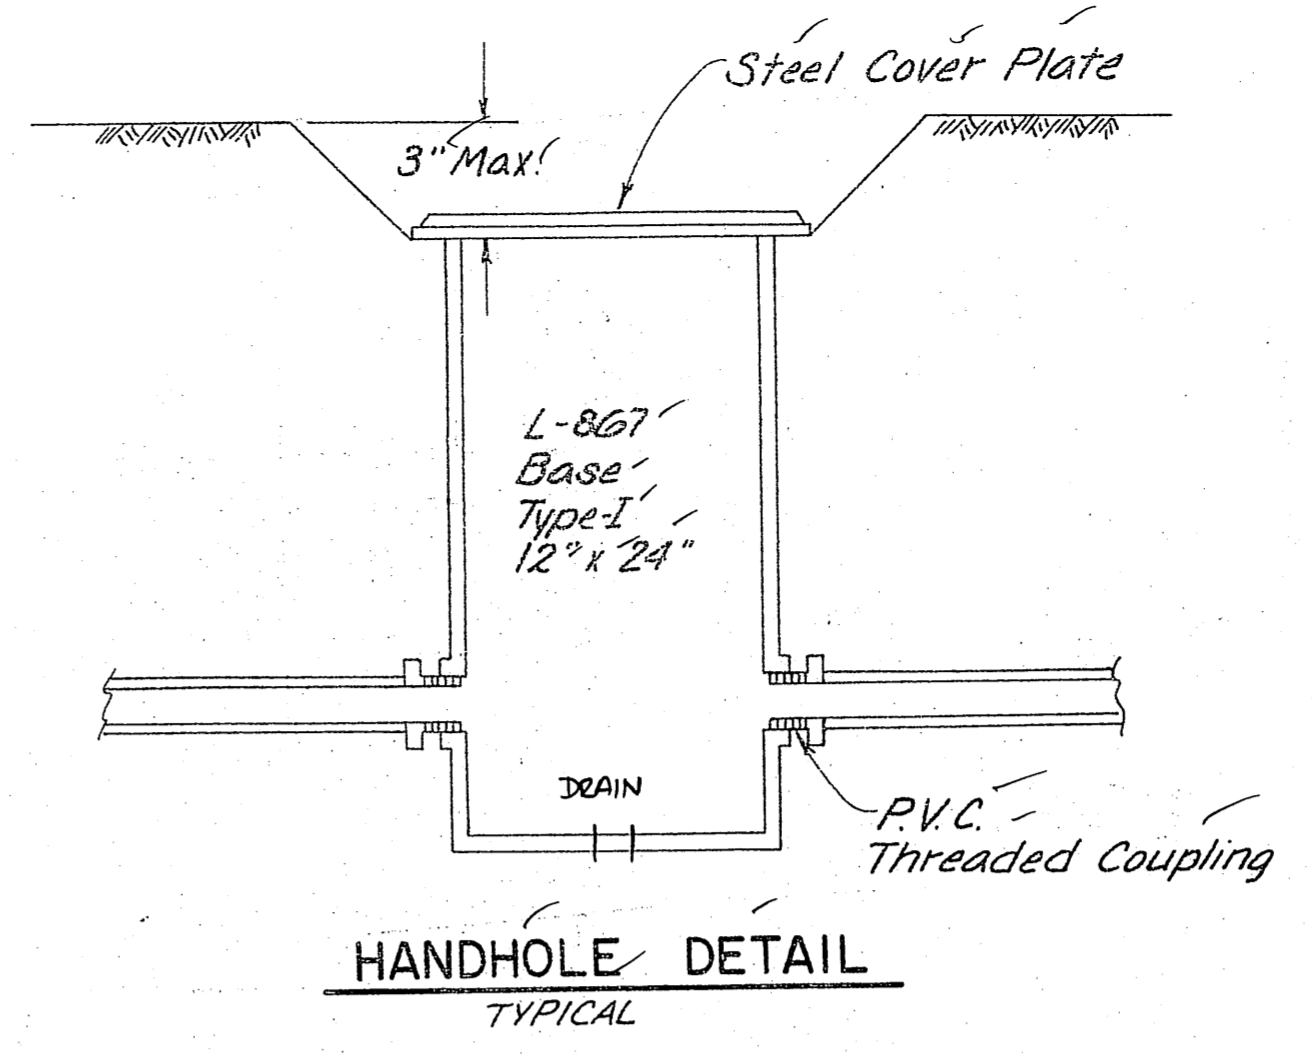

CONDUIT INSTALLATION DETAIL

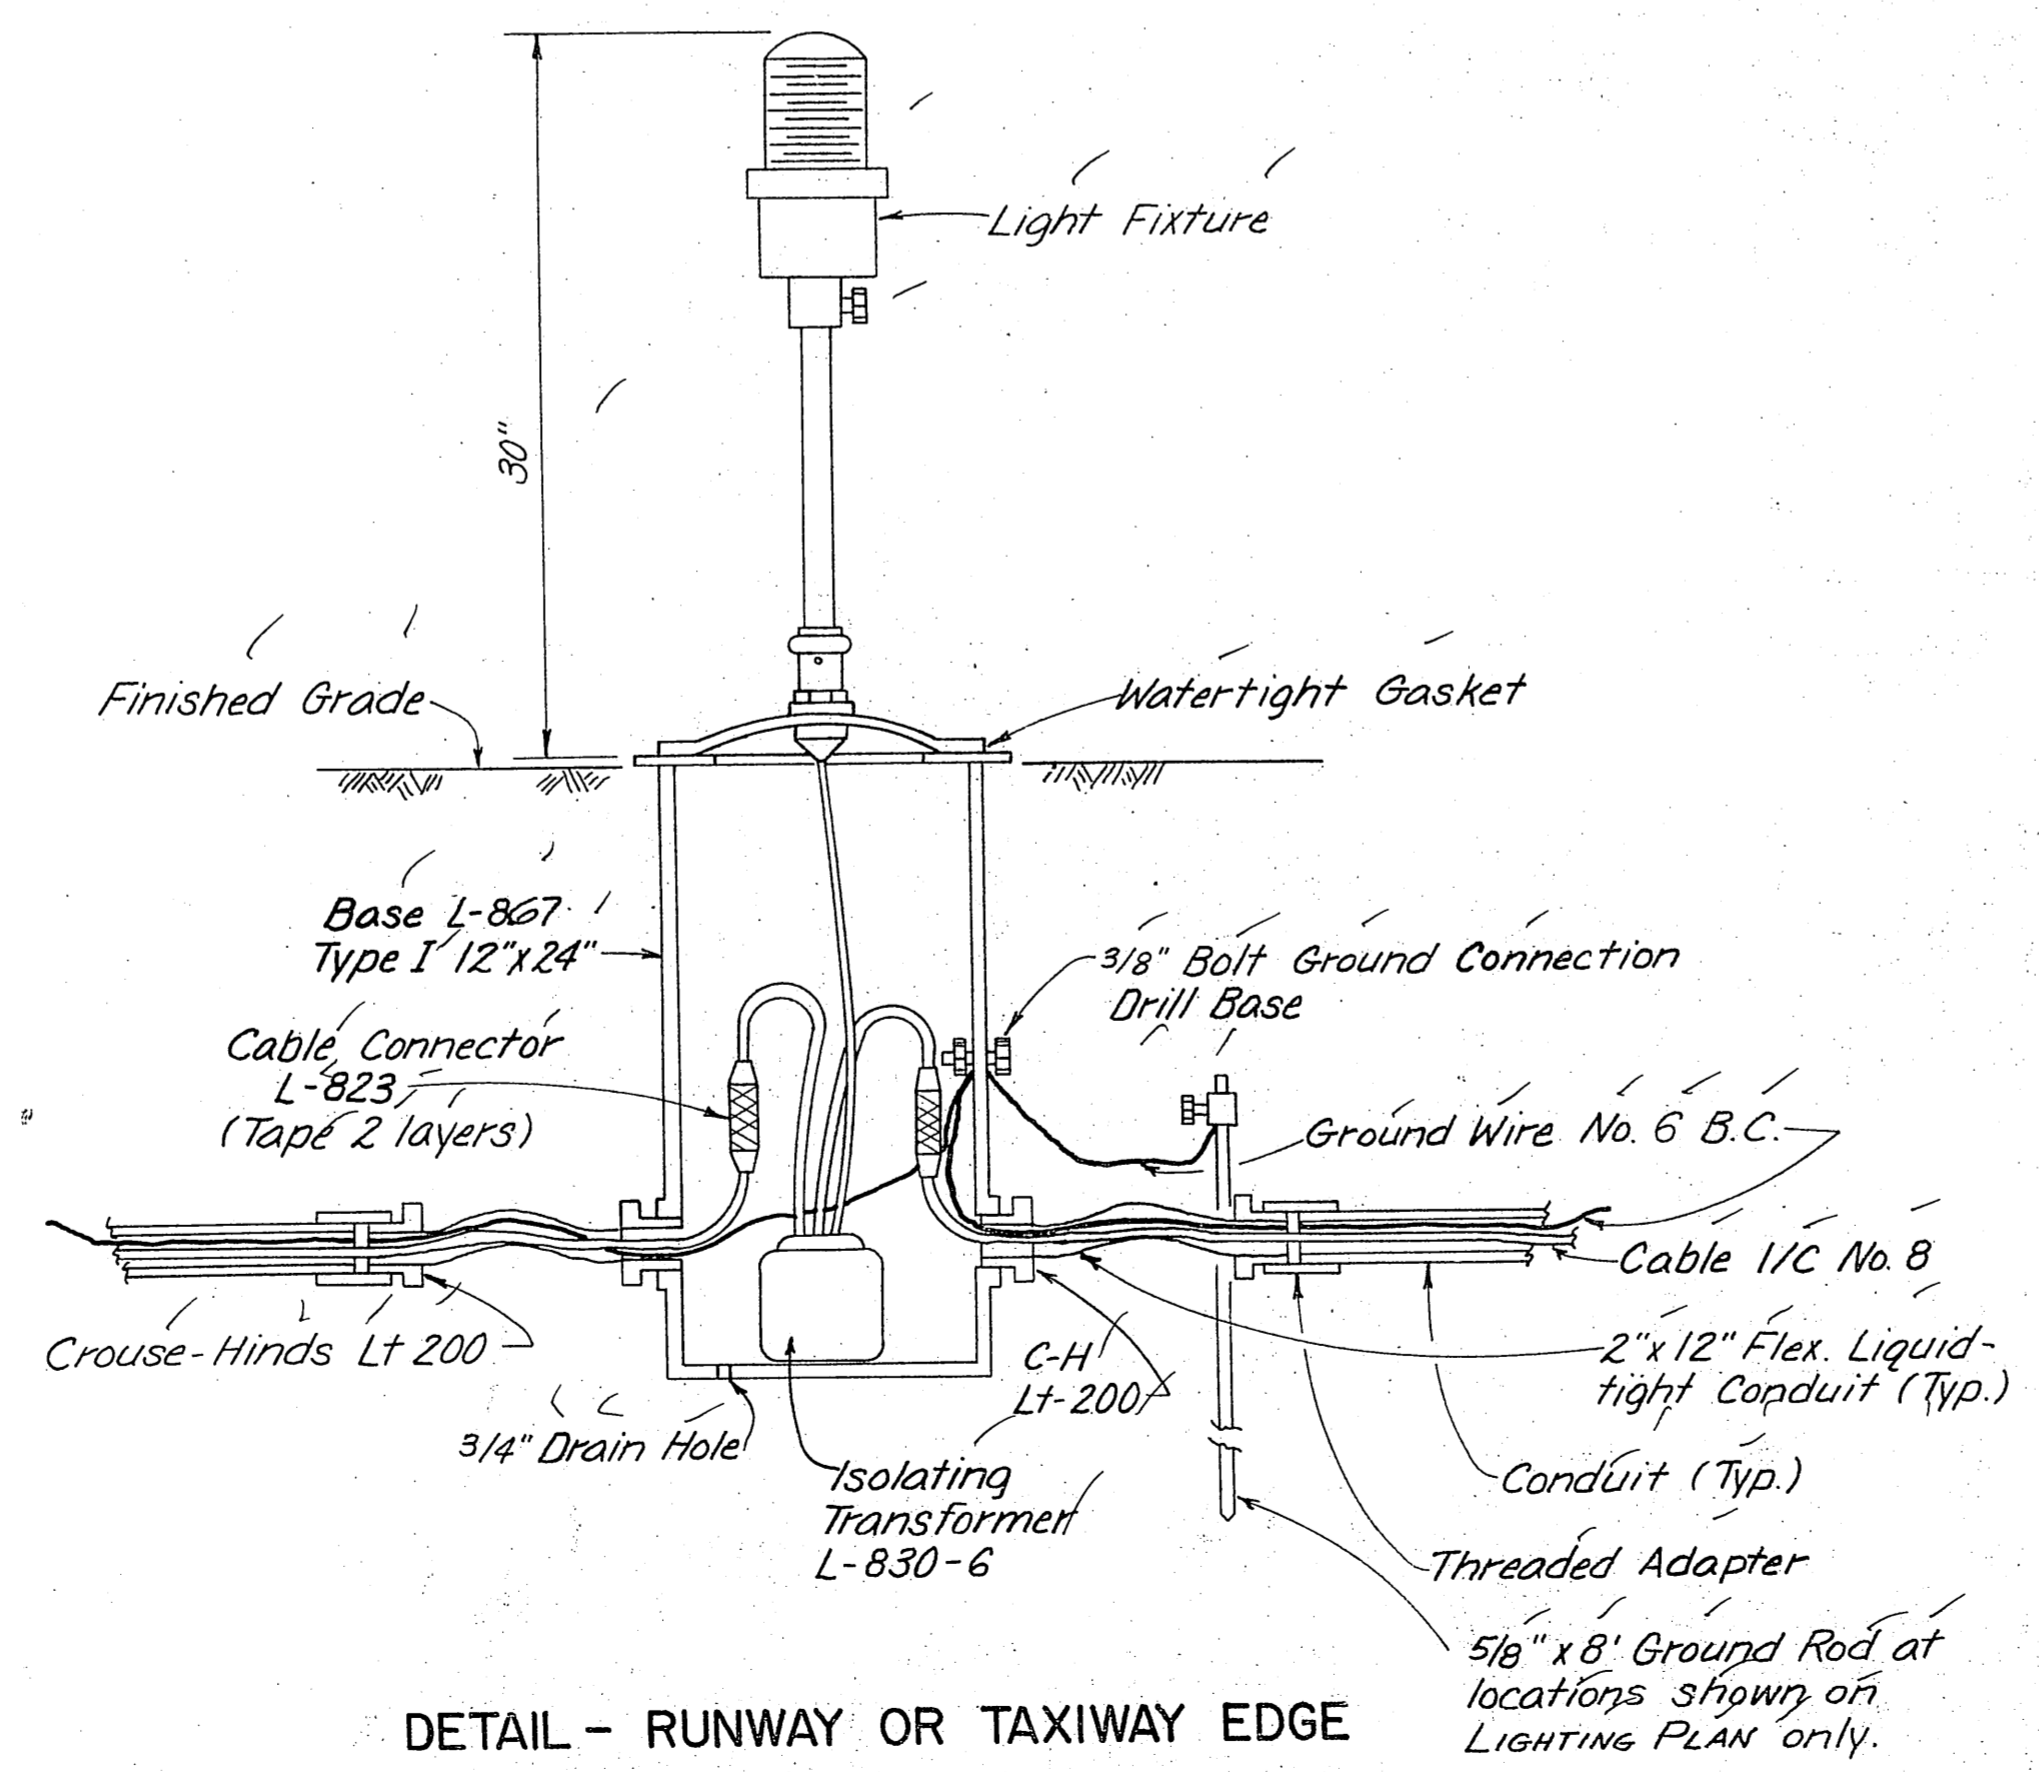

DETAIL - RUNWAY OR TAXIWAY EDGE  
LIGHT OR THRESHOLD LIGHT

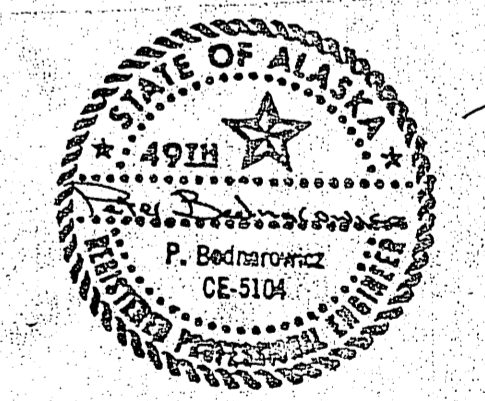

STATE OF ALASKA  
DEPARTMENT OF TRANSPORTATION  
AND PUBLIC FACILITIES  
S.E. REGION, DIVISION OF AVIATION DESIGN & CONSTRUCTION



KAKE AIRPORT  
PROJECT NO. D19712  
A.I.P. NO. 831-3-02-0398-01-83  
LIGHTING DETAILS

APPROVED BY: *Wallace K. Williams* 8/12/85  
WALLACE K. WILLIAMS, P.E. CHIEF OF DESIGN

APPROVED BY: *F. Bodnarowicz* 8/12/85  
F. BODNAROWICZ, P.E. DESIGN CHIEF GROUP "B"


SCALE: N.T.S. DESIGNED: MJC DRAWN: SS SHEET 15 OF 25  
CHECKED: DATE: 2/16/84

BY	DATE	CHANGE
REVISIONS		

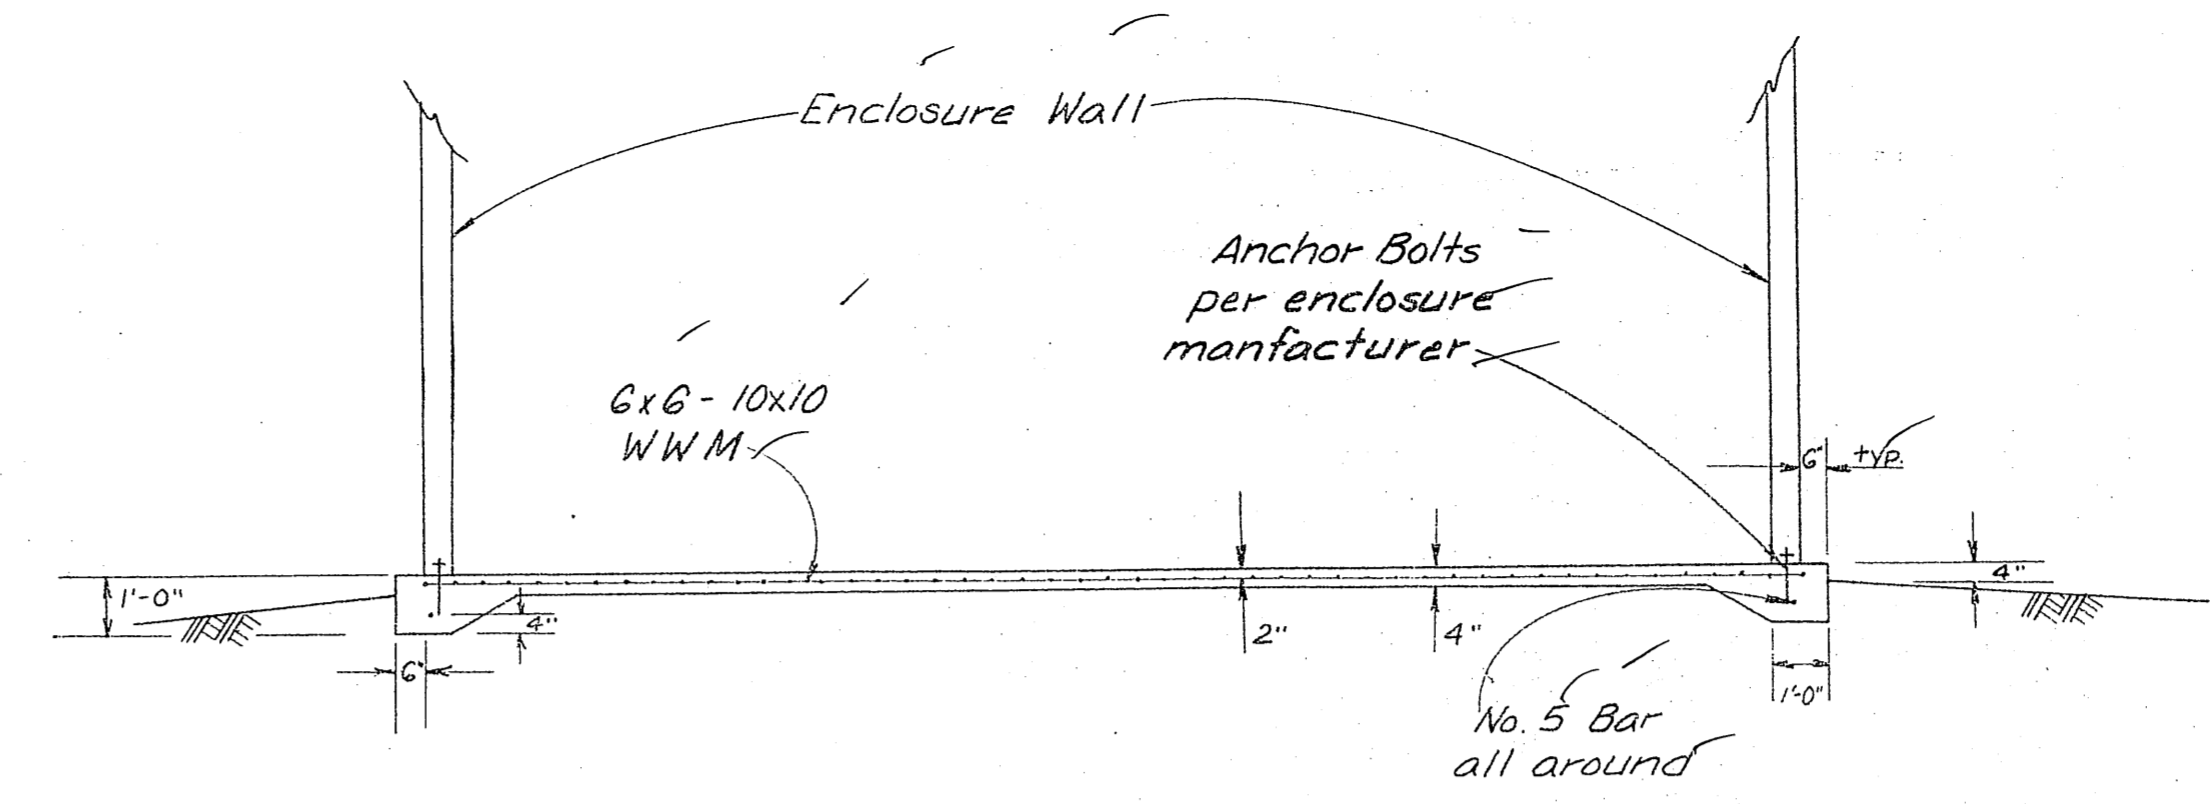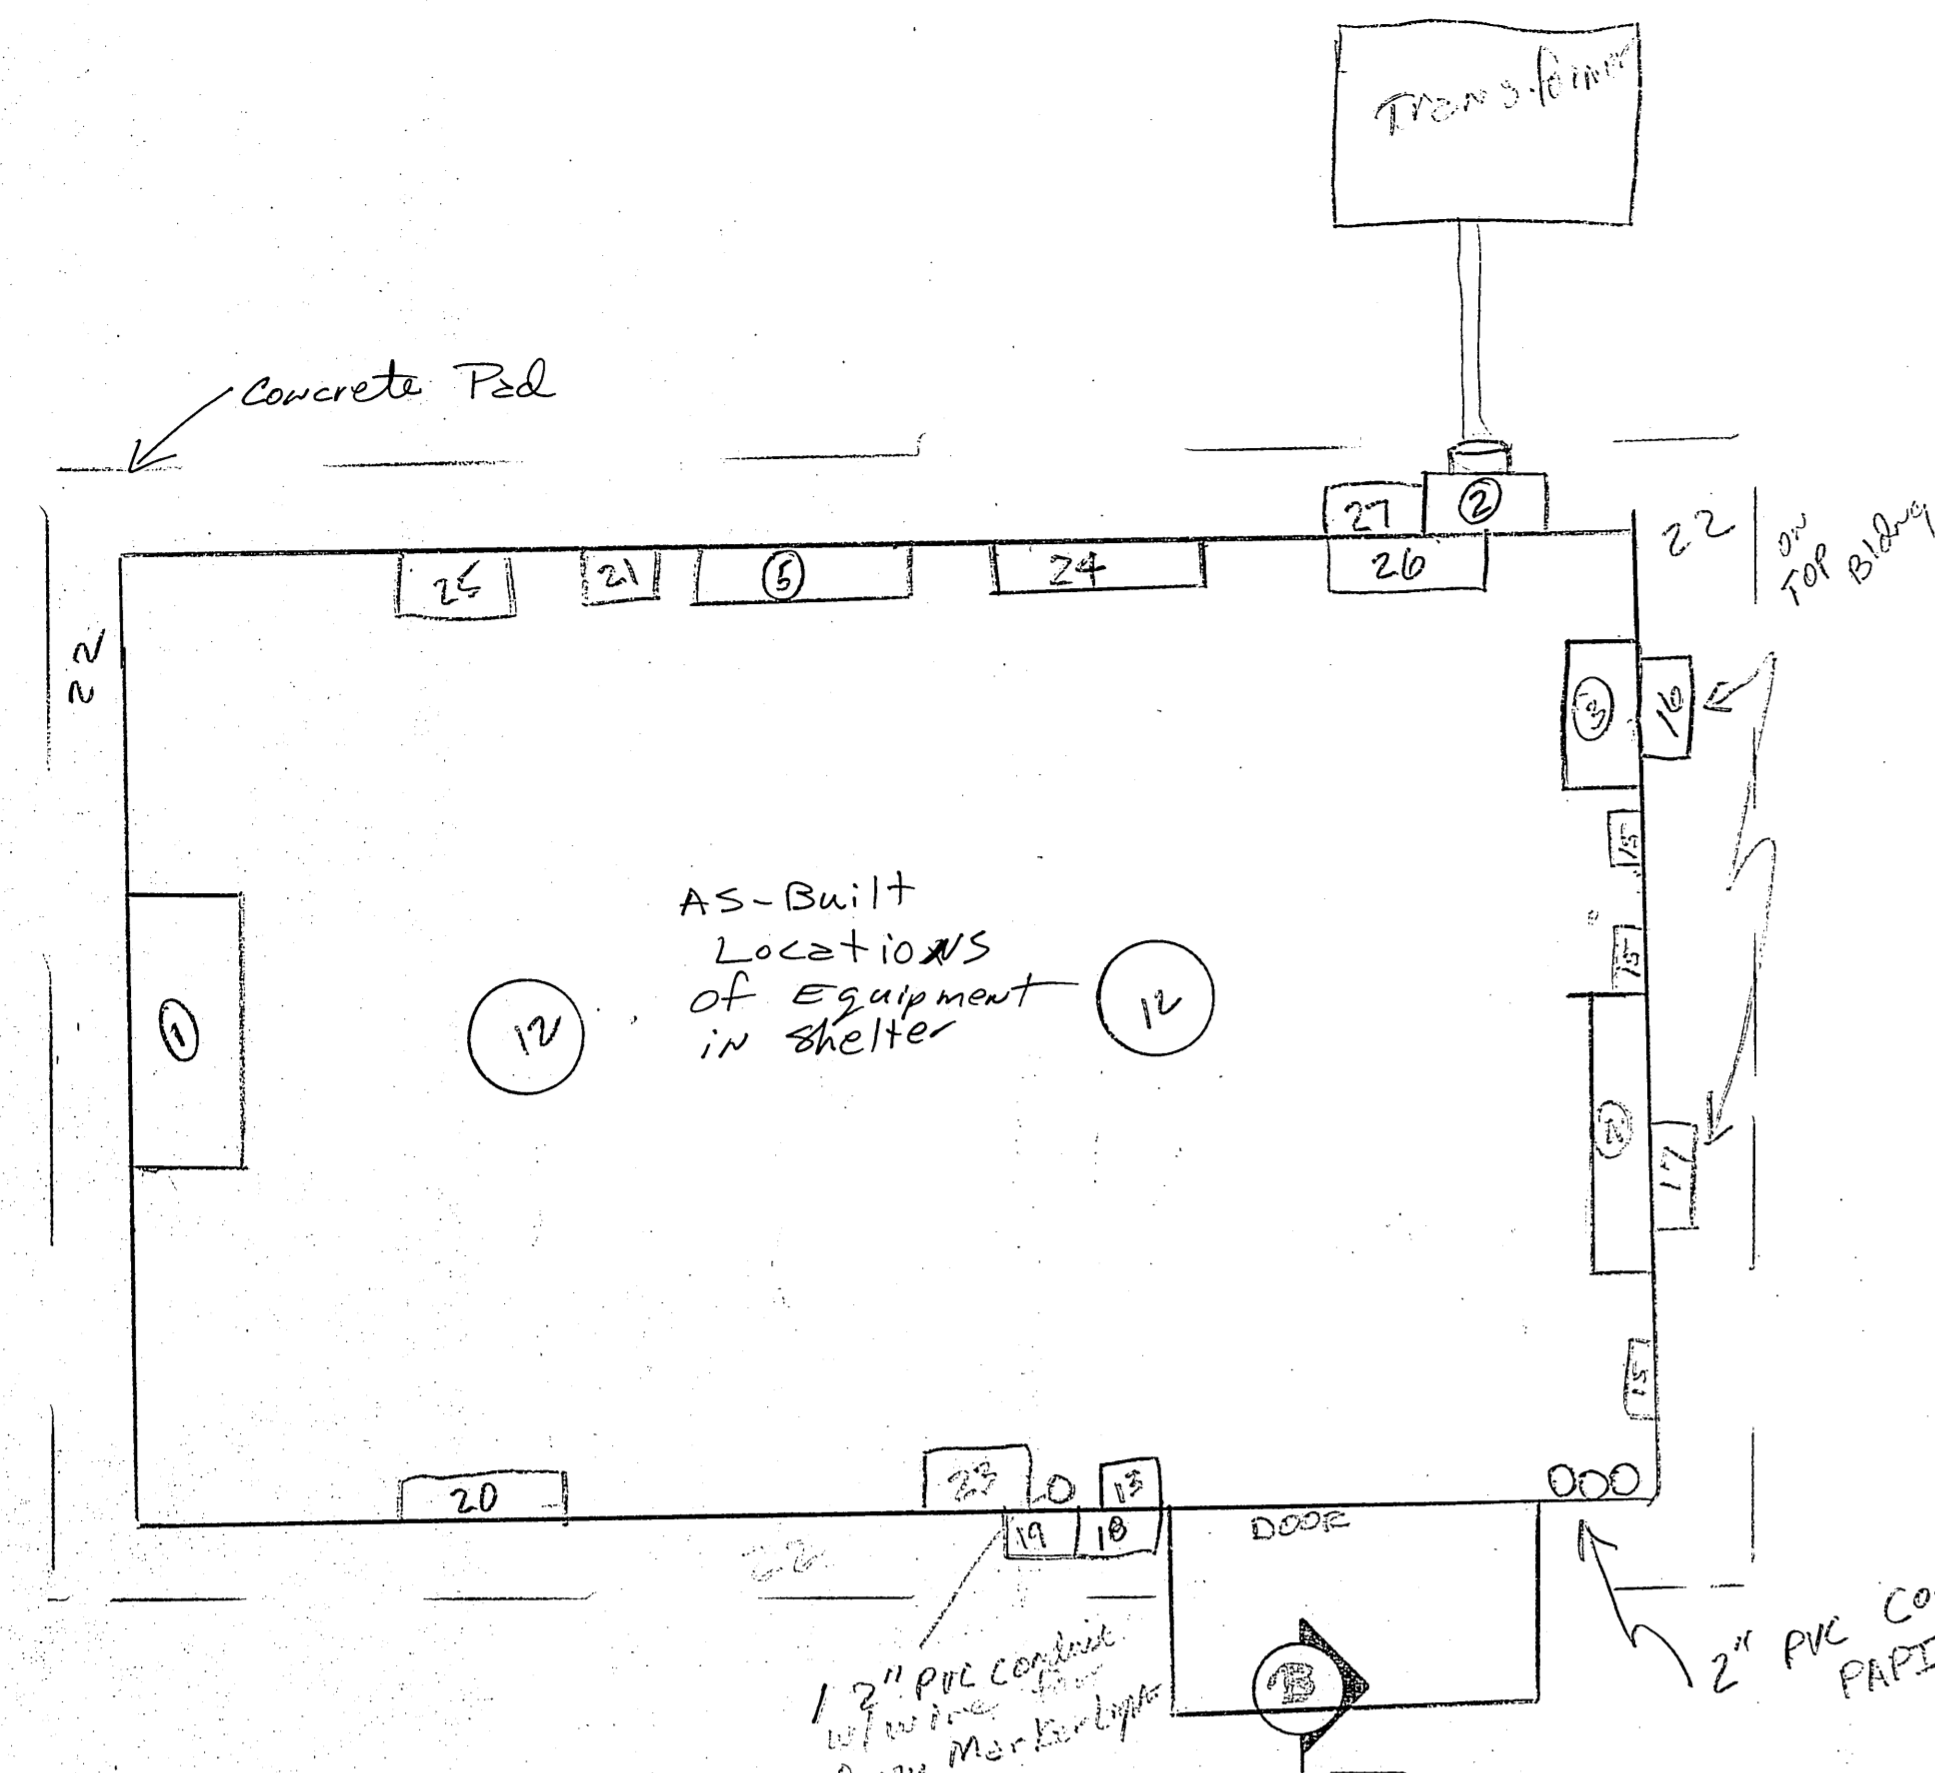


SHELTER FOUNDATION  
DETAIL  
n.f.s.


- Enclosure Equipment List
- ① Runway Lighting Constant Current Regulator
  - ② Combination Service Entrance Meter Base
  - ③ Lighting Distribution Power Panel (Panel A)
  - ④ Airport Lighting Control Panel
  - ⑤ Airport Lighting Radio Control Unit
  - ⑥ Liquidtight Flexible Metal Conduit (Typ.) 3/4"
  - ⑦ Unistrut (or Equal) Channel, P-3000 (Typ.)
  - ⑧ Wireway with Hinged Cover, 4"x4" (6" better for future airports)
  - ⑨ Wireway Reducer, 4"x4" to 6"x6"
  - ⑩ Wireway Transition, 6"x6"
  - ⑪ 1 1/2" I.M.C.
  - ⑫ Vaportight Light Fixture with shallow dome
  - ⑬ Building Light Switch, Single Pole
  - ⑭ Liquidtight Flexible Metal Conduit (Typ.) 2"
  - ⑮ Duplex Recepticle, Nema 5-20R, 120 VAC, 20A, or equal
  - ⑯ Photocell Switch for Lighting Control
  - ⑰ Radio Control Lighting Receiving Antenna
  - ⑱ External Push Button for Control of Runway Lights
  - ⑲ External Push Button for Control of Apron Floodlights
  - ⑳ 12" Exhaust Fan
  - ㉑ Exhaust Fan Thermostat
  - ㉒ Concrete Slab
  - ㉓ Plug Cutout
  - ㉔ Step Up Transformer for PAPI
  - ㉕ Electric Heater
  - ㉖ Manual Transfer Switch
  - ㉗ Nema 3R Enclosure for future generator

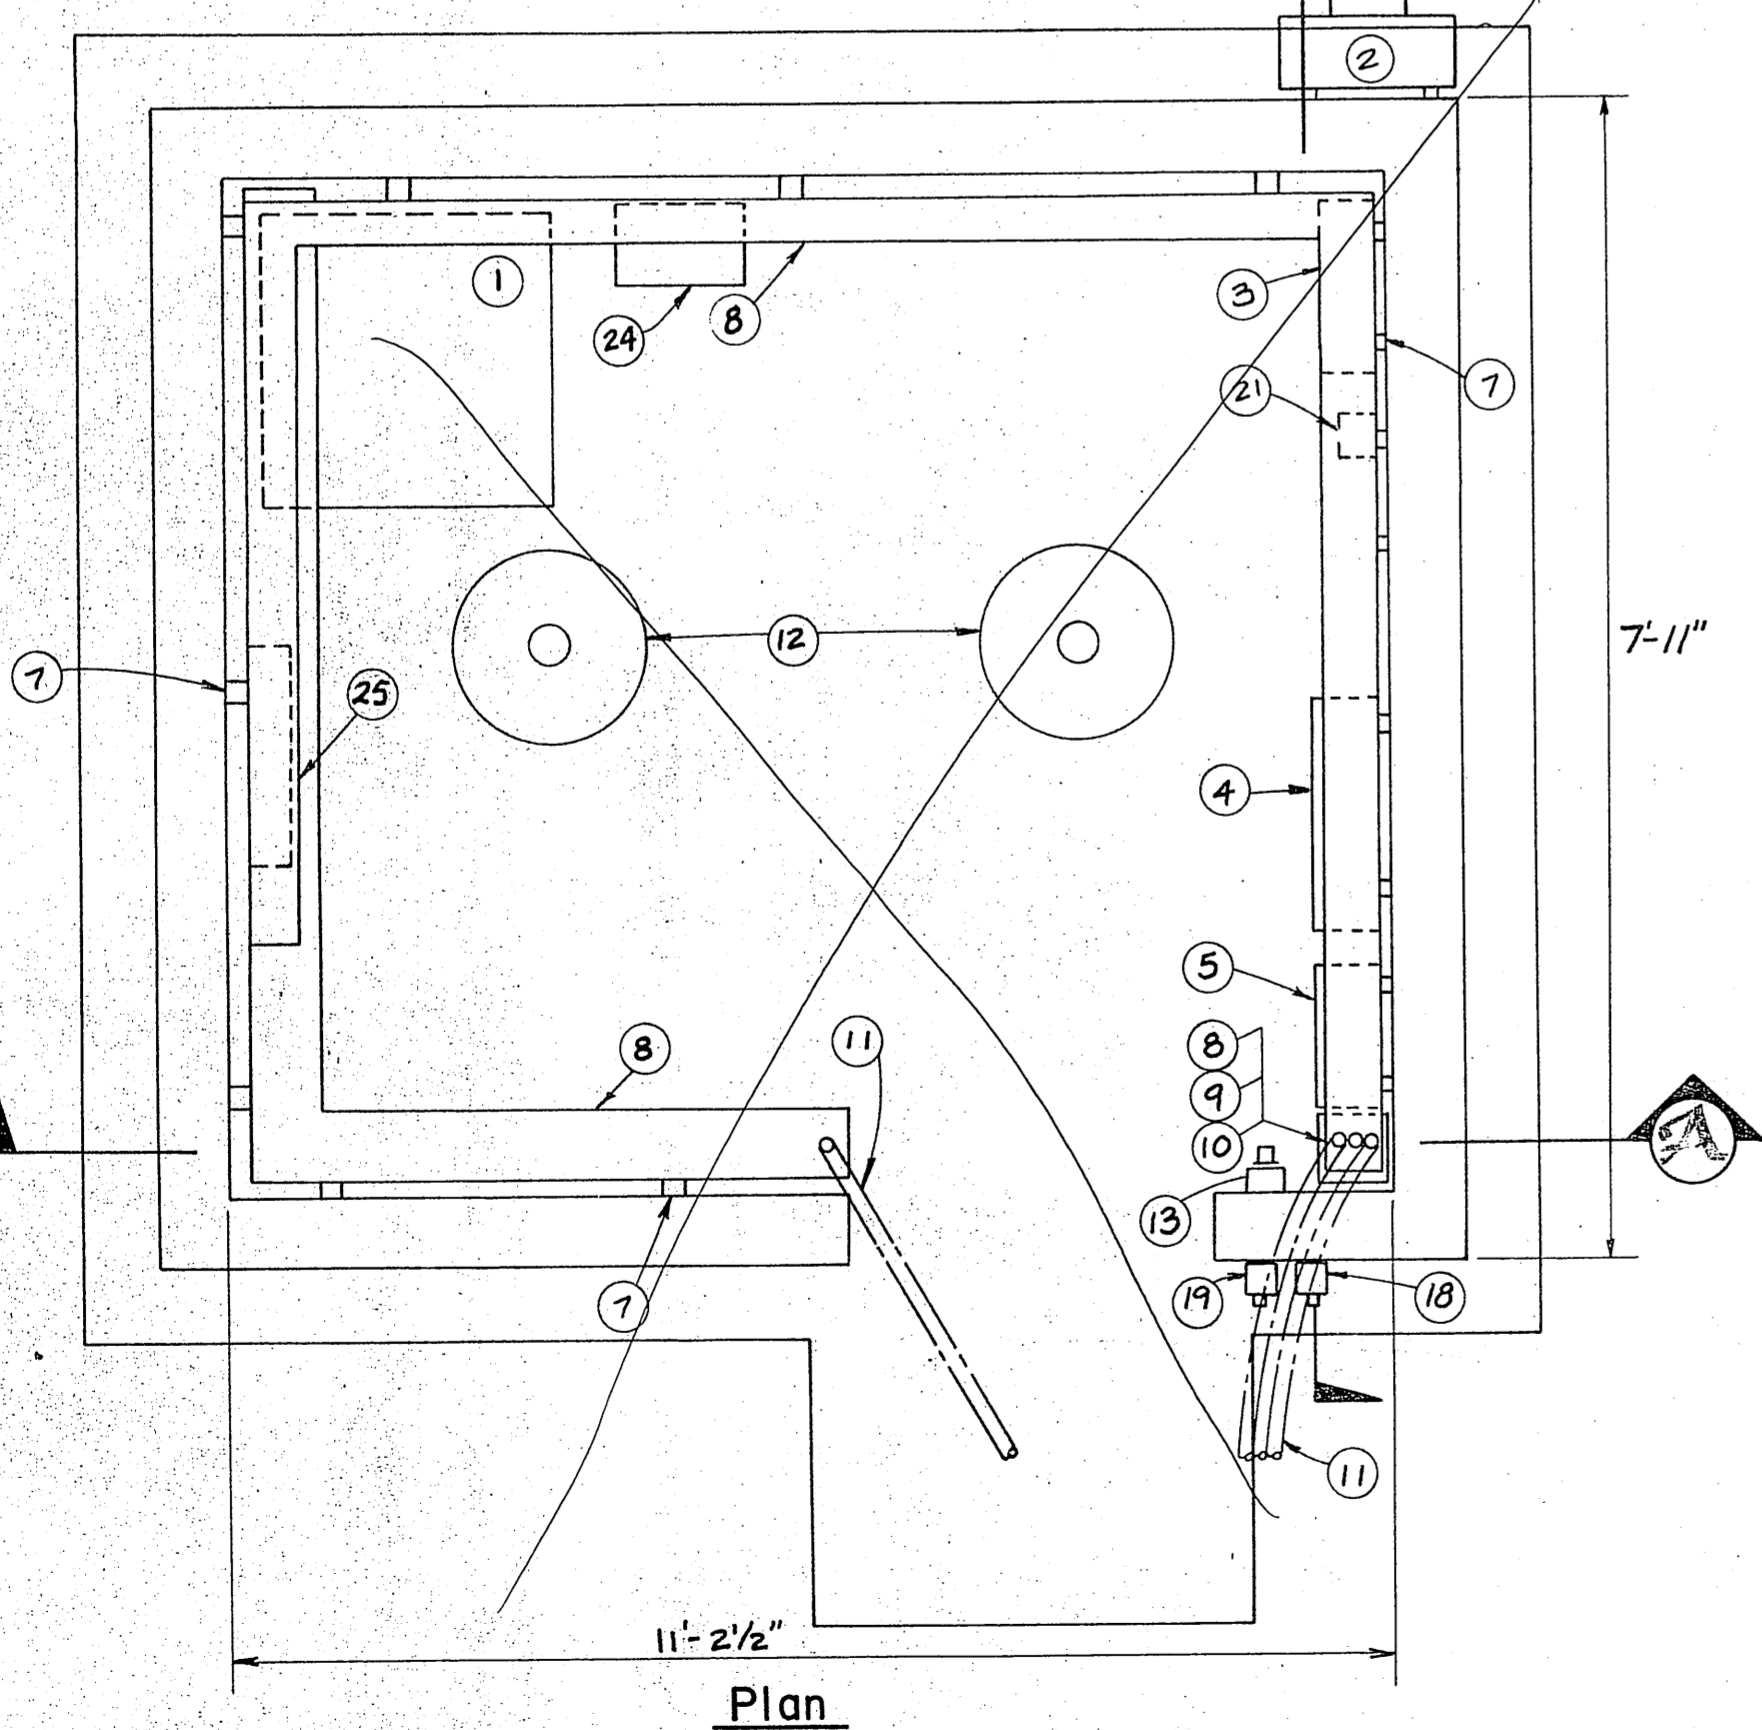

Plan

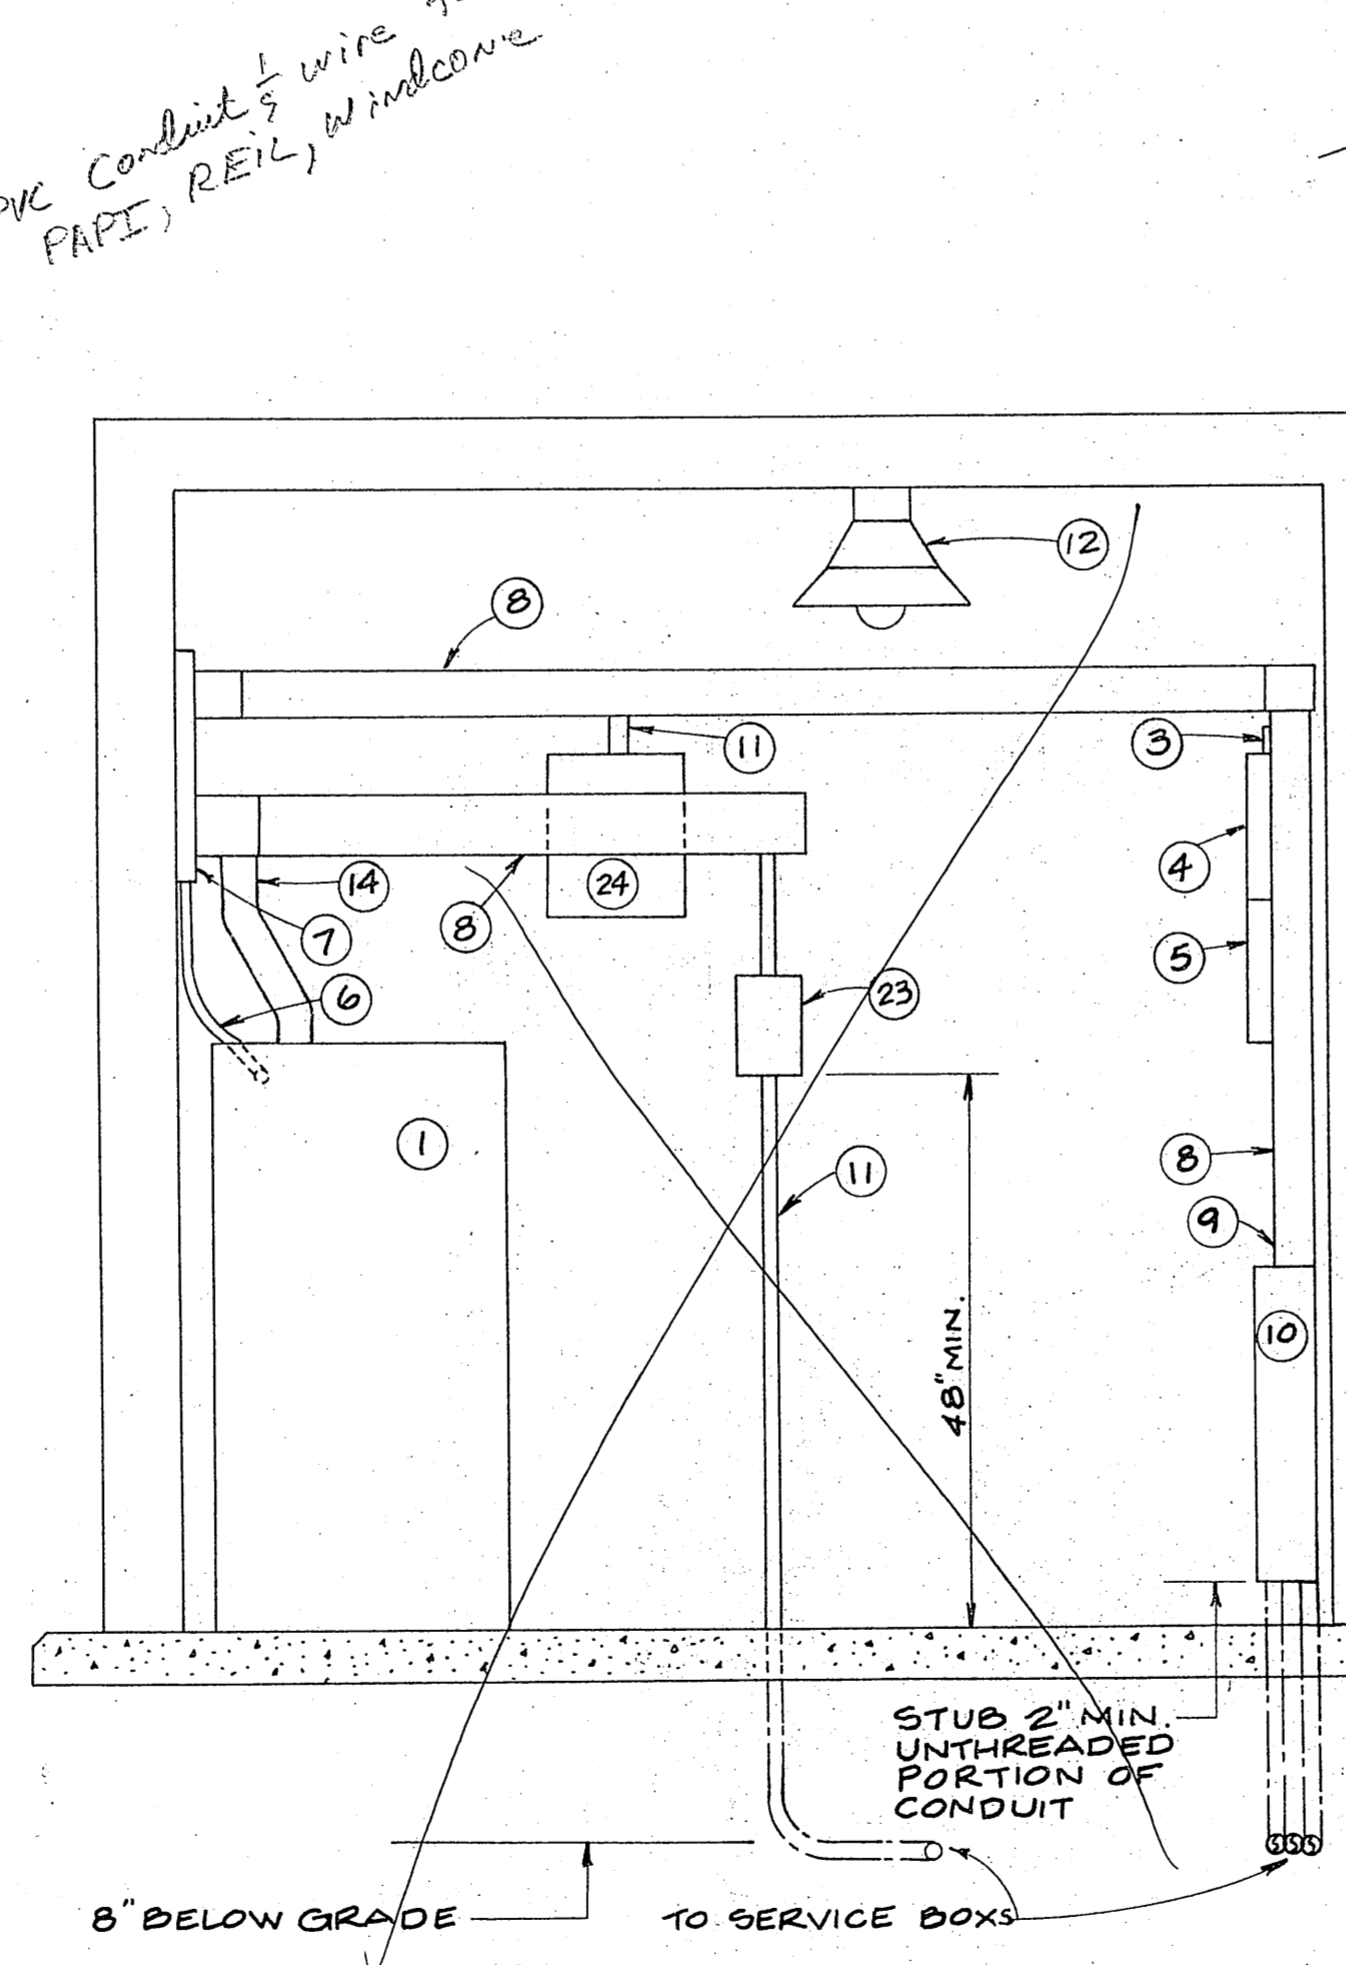

Section A

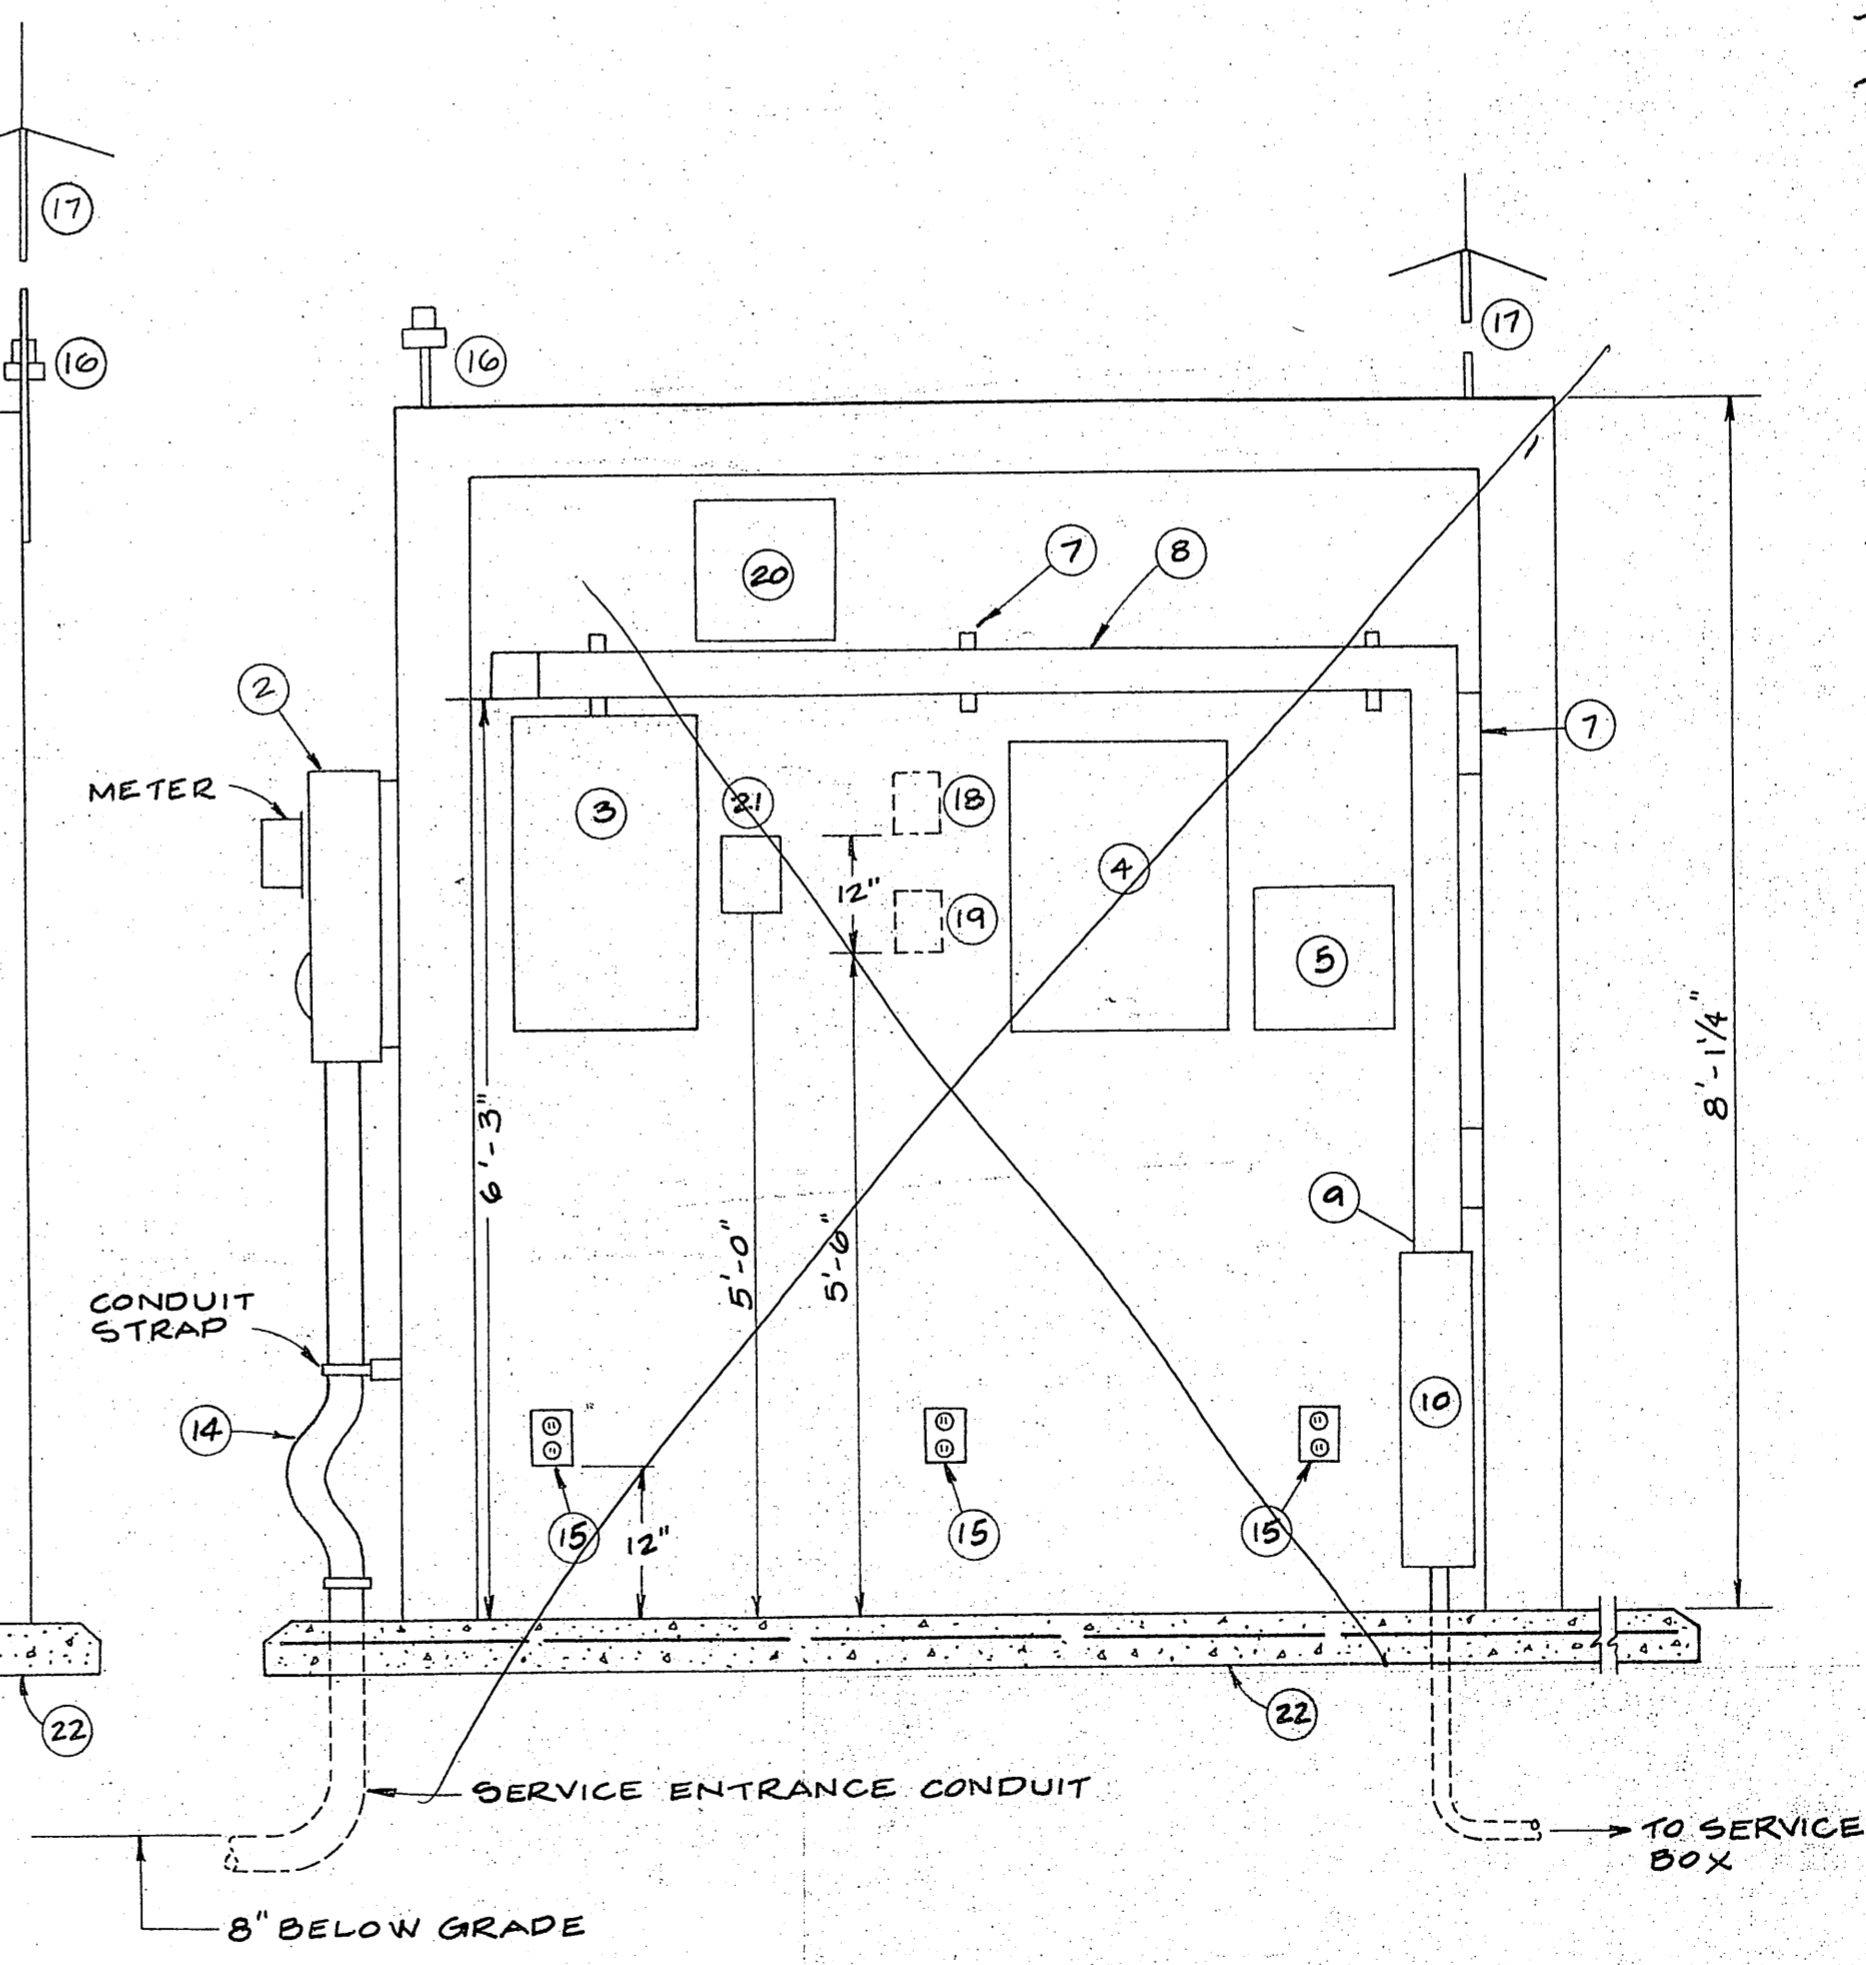

Section B

EQUIPMENT ENCLOSURE DETAIL  
n.s.



STATE OF ALASKA  
DEPARTMENT OF TRANSPORTATION  
AND PUBLIC FACILITIES  
S.E. REGION, DIVISION OF AVIATION DESIGN & CONSTRUCTION

KAKE AIRPORT  
PROJECT NO. D19712  
A.I.P. NO. 831-3-02-0398-01-83  
EQUIPMENT SHELTER


APPROVED BY: *Wallace R. Williams* 8/12/85  
WALLACE R. WILLIAMS, P.E. CHIEF OF DESIGN

APPROVED BY: *William L. Baumgartner* 8/12/85  
WILLIAM L. BAUMGARTNER, P.E. DESIGN CHIEF GROUP "B"


SCALE: N.T.S. DESIGNED: MJC DRAWN: SS  
CHECKED: DATE: 2/16/84 SHEET 16 OF 25

BY	DATE	CHANGE

REVISIONS

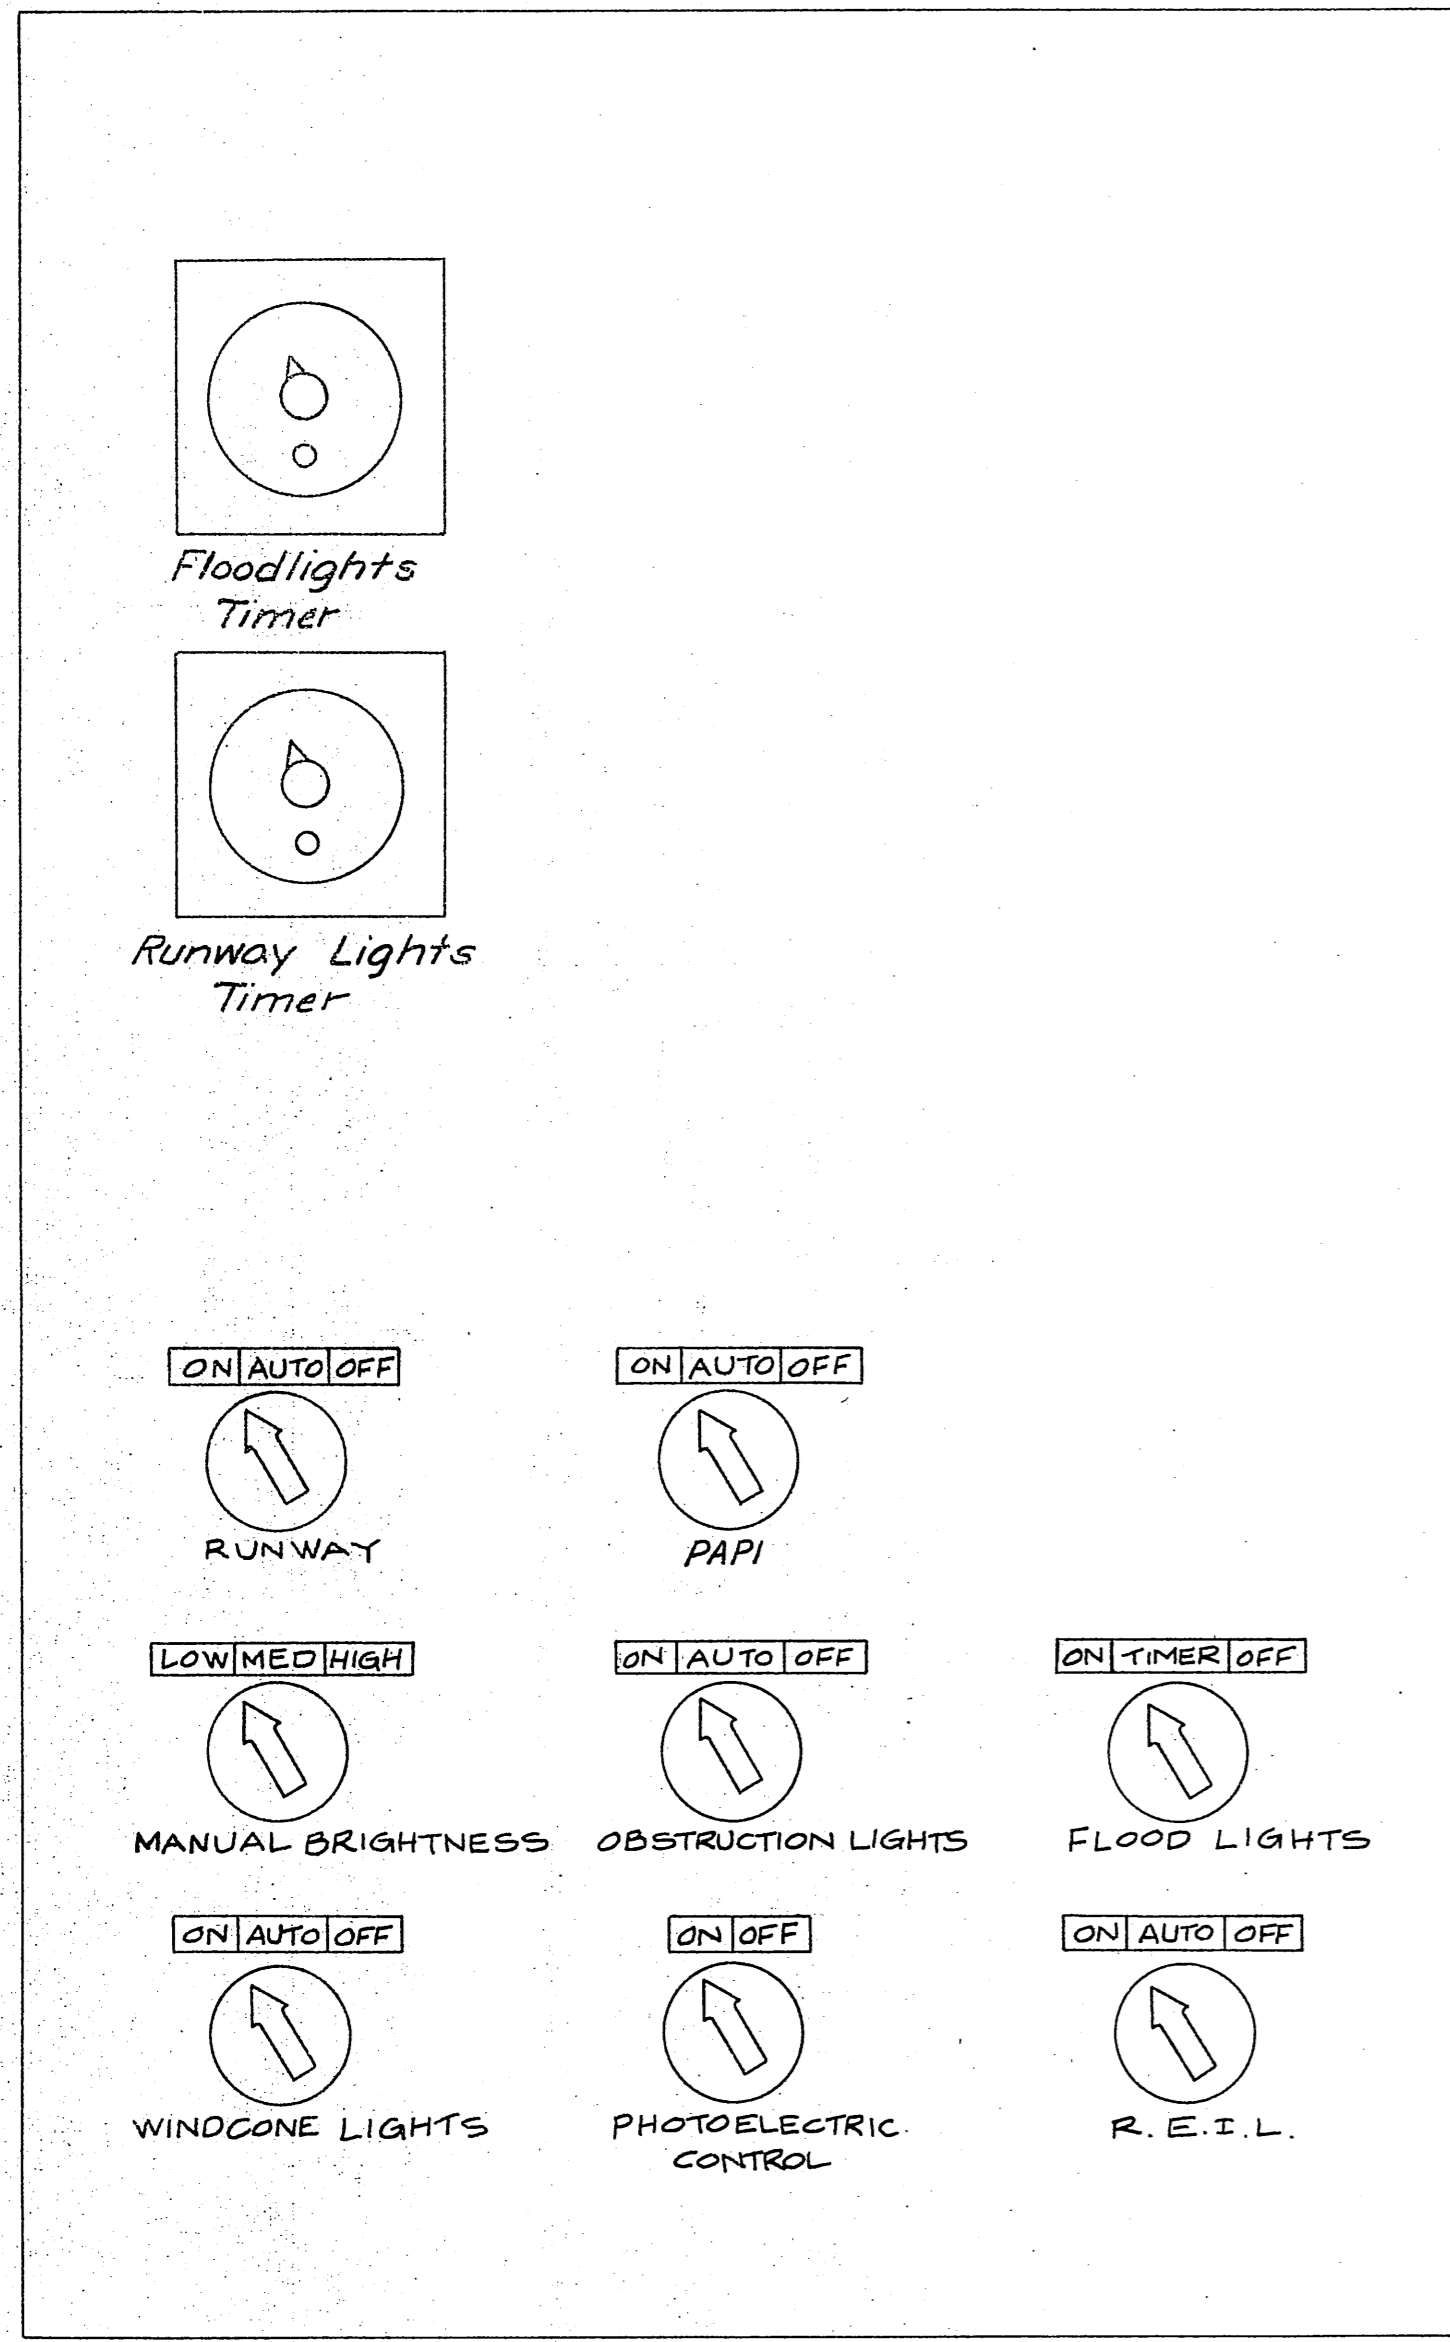

**CONTROL PANEL**  
n.t.s.

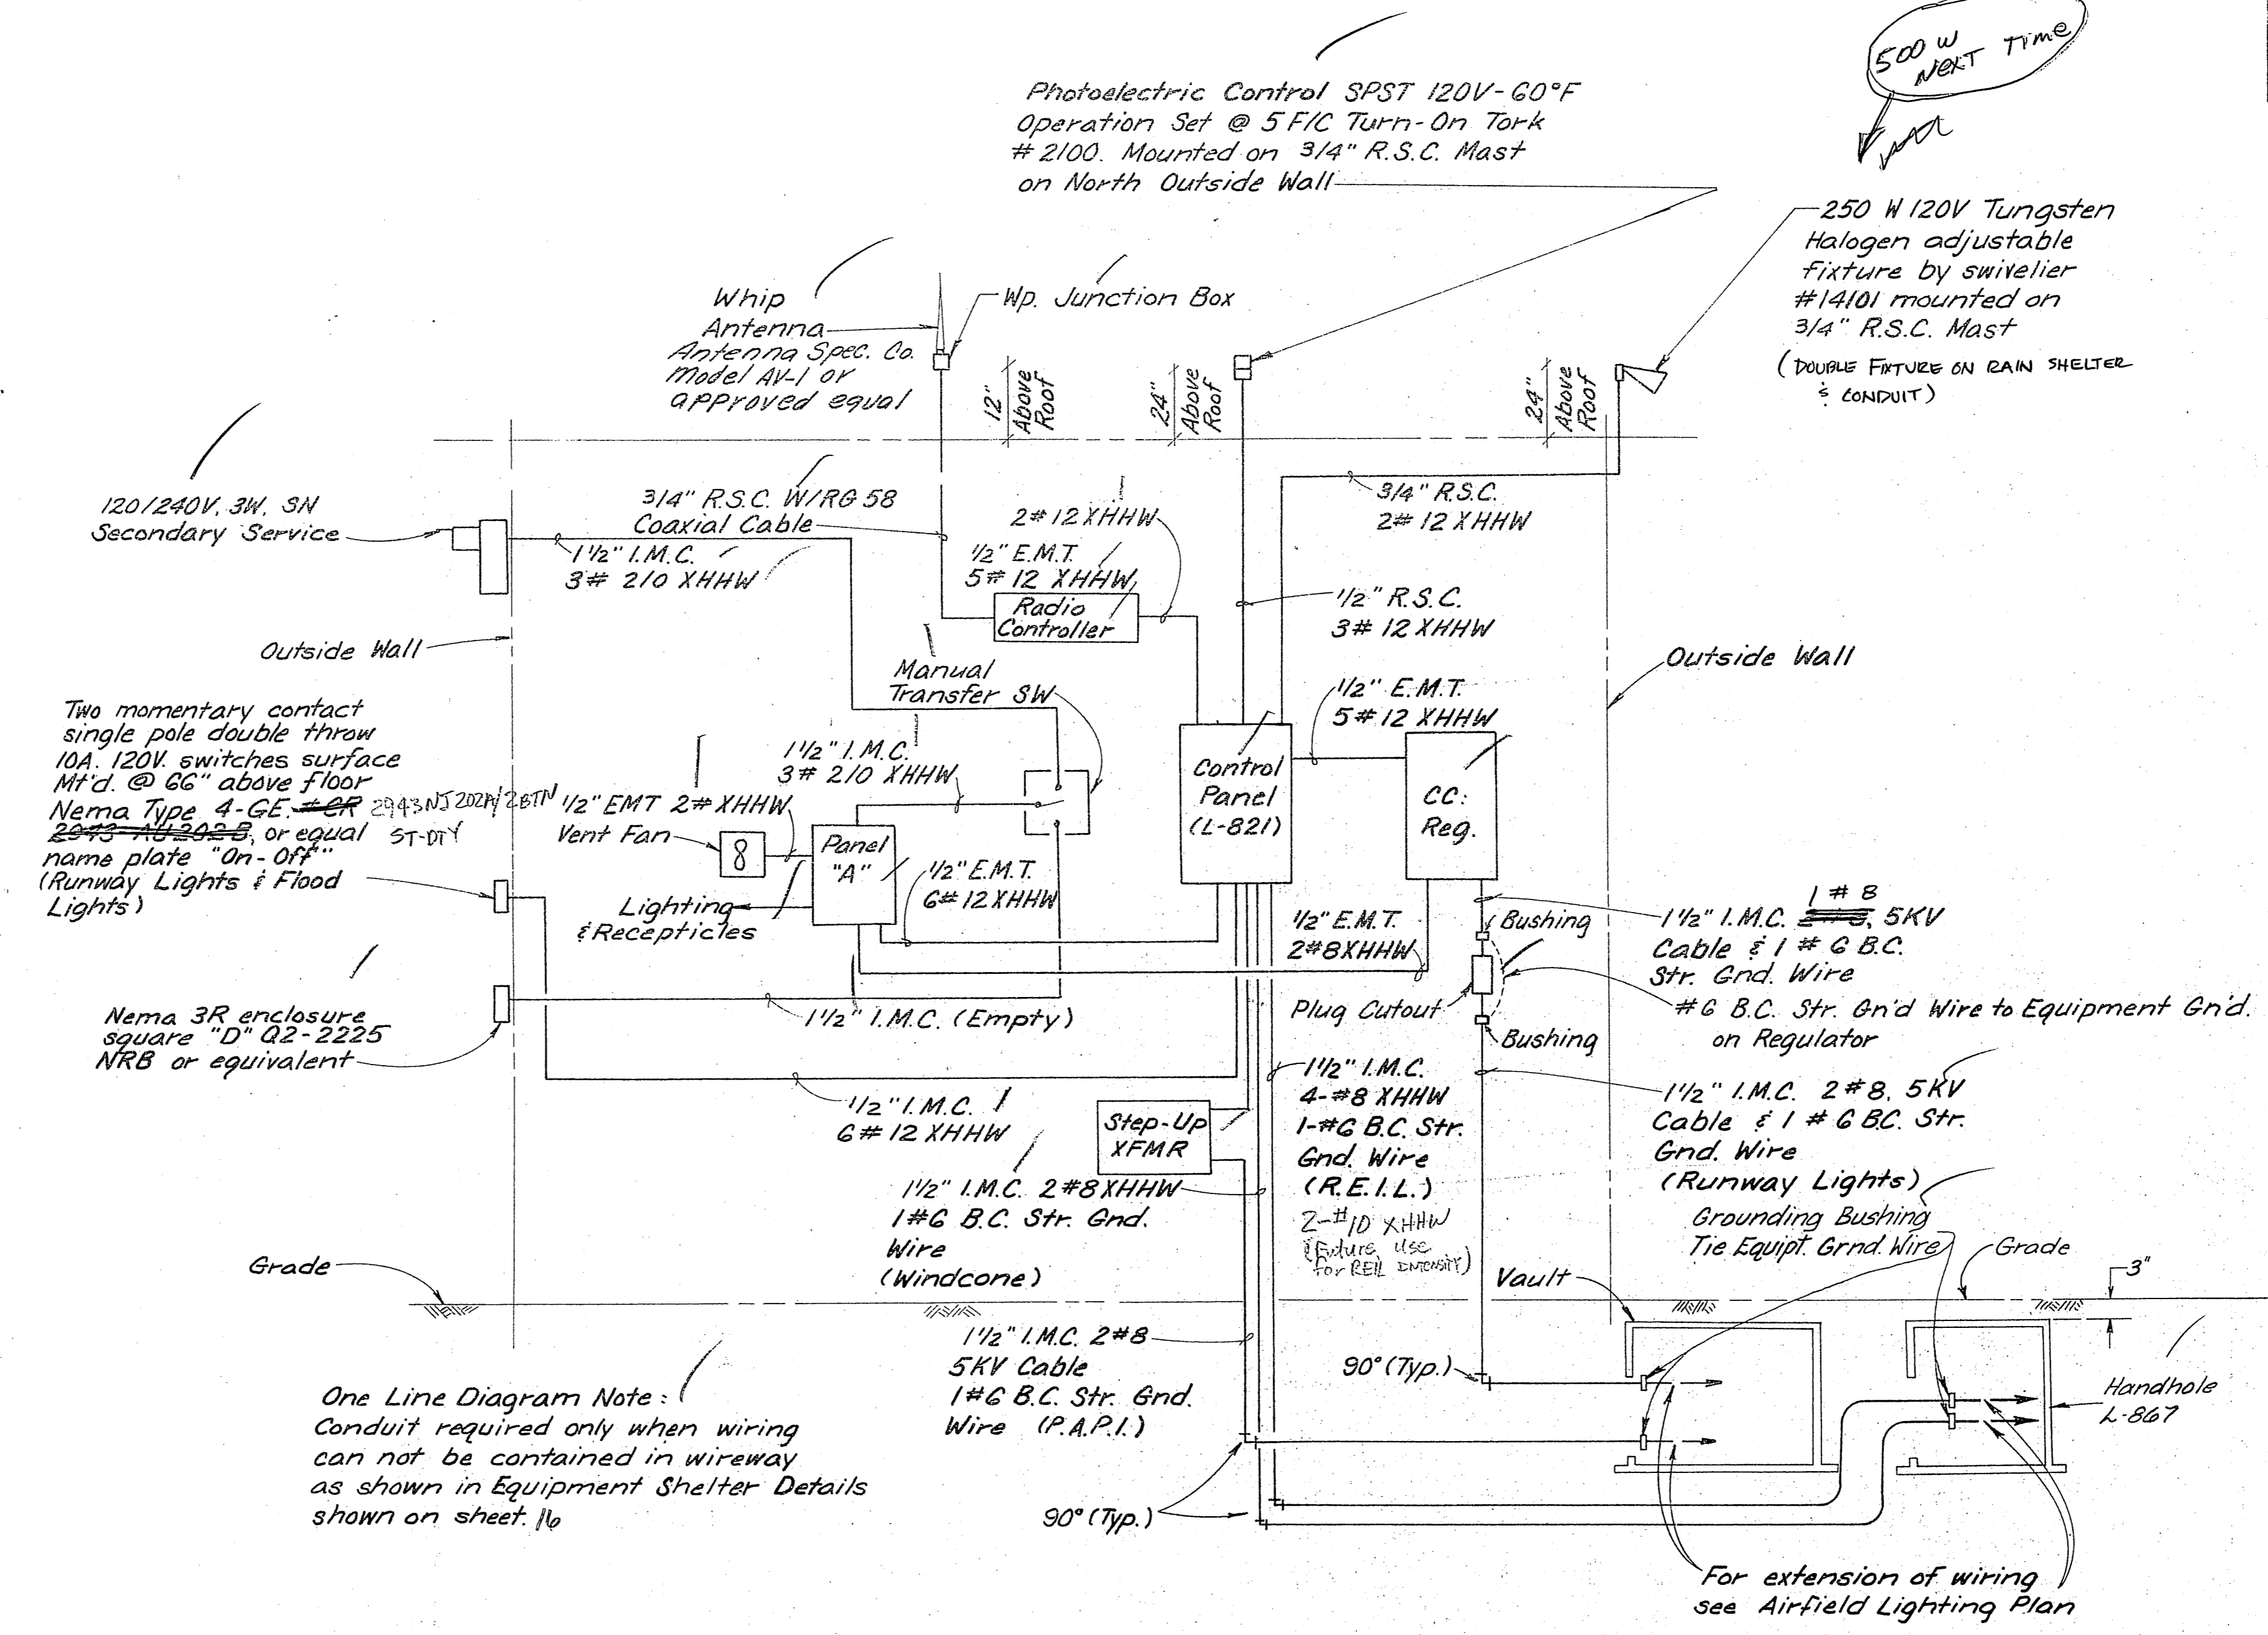

**POWER ONE-LINE WIRING DIAGRAM FOR REGULATOR & CONTROL**  
n.t.s.

500 W NEXT TIME

Photoelectric Control SPST 120V-60°F  
Operation Set @ 5 F/C Turn-On Tork  
# 2100. Mounted on 3/4" R.S.C. Mast  
on North Outside Wall

250 W 120V Tungsten Halogen adjustable  
Fixture by swiveller  
#14101 mounted on  
3/4" R.S.C. Mast  
(DOUBLE FIXTURE ON RAIN SHELTER  
& CONDUIT)

Equipment:  
200A, 3W, 240V. S/N DBL. Throw, Non-Fusible Manual Transfer Switch, NEMA 1, Heavy Duty Square "D" #DTU223NRB or equal.

Panels:  
Combination Service Entrance Meter Device:  
Square "D" Meter Panel, CO 200 (R.P.) with 200A CB (012 200VH) or equal

Panel "A"  
225 Amp Mains with 150A 3 Pole Main Bkr. 120/240V, 1ø 3 Wire. Surface Mt'd. Square "D" Type NQOB

1-2P-60A Bkr. (4 KW C.C. Regulator)

6-1P-20A Bkr. (Control Flood Lights, Wind Cone, Beacon Lights, Receipts, PAPI, R.E.I.L.)


1-2P-30A Bkr. (PAPI)

1-1P-20A Bkr.'s (Spares)

Equipment Notes:  
1. Label all breakers indicating load function.  
2. All 2 pole breakers rated 10,000 A.I.C.  
3. 4.0 KW constant current regulator required. Install and wire to plug cutout for lights.

One Line Diagram Note:  
Conduit required only when wiring can not be contained in wireway as shown in Equipment Shelter Details shown on sheet 10

For extension of wiring see Airfield Lighting Plan

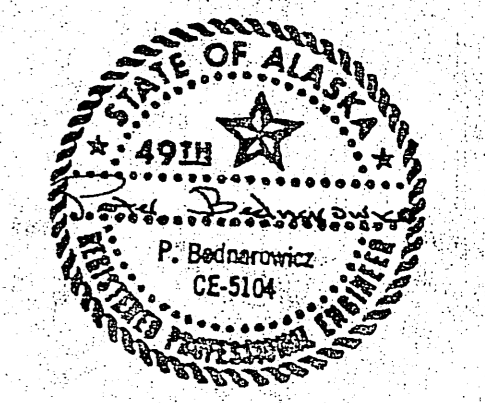






STATE OF ALASKA  
DEPARTMENT OF TRANSPORTATION  
AND PUBLIC FACILITIES  
S.E. REGION, DIVISION OF AVIATION DESIGN & CONSTRUCTION

KAKE AIRPORT  
PROJECT NO. D19712  
A.I.P. NO. 831-3-02-0398-01-83  
EQUIPMENT SHELTER - ONE LINE DIAGRAM

APPROVED BY:		Wallace Williams WALLACE & WILLIAMS, P.E. CHIEF OF DESIGN	
APPROVED BY:		William L. Baumgartner WILLIAM L. BAUMGARTNER, P.E. DESIGN CHIEF GROUP "B"	
BY	DATE	CHANGE	REVISIONS
SCALE:	N/A	DESIGNED: MJC	DRAWN: SS
CHECKED:		DATE: 2/16/84	SHEET 17 OF 25

- ① Control Relay, 3PDT, GE No. CR 120HC47 W02 \*
- ② Contactor, GE No. CR 205K002 ADA \*
- ③ Timing Relay 3-100 Min., GE No. CR 122E 1046 B02 \*
- ④ Switch, SPDT, GE No. CR 104 PSG 21 B91
- ⑤ Switch, 3-Position, GE No. CR 104 RSG 36 B92
- ⑥ Push-Button Station Off-On Momentary Contact Water Dust Tight, Corrosion Resistant GE No. CR 2943 NJ 202A/201W
- ⑦ Terminal Strip, 20A, 13-Point GE No. CR 151 B 213 B \*
- ⑧ Photoelectric Control Tork No. 2100 \*
- ⑨ Rain Proof Combination Service Entrance Meter Device - 200A Single Phase (150A CB Installed)
- ⑩ Step Up Transformer for PAPI
- ⑪ Regulator for Runway Lights
- ⑫ Vent Fan with Automatic Damper, Dayton 20 710 or equivalent. Install adjacent Thermostat, Dayton 2E 207 or equivalent.
- ⑬ Electric Heater, 1,000 W Intertherm, or equal (240V)

\* or equivalent

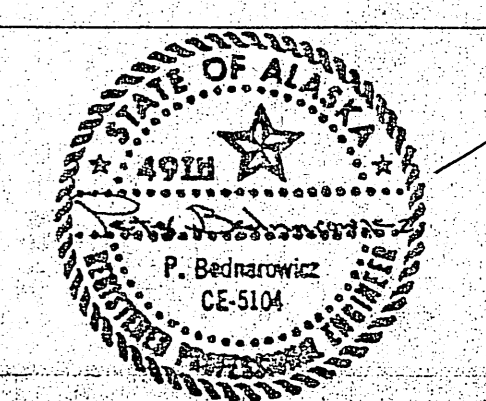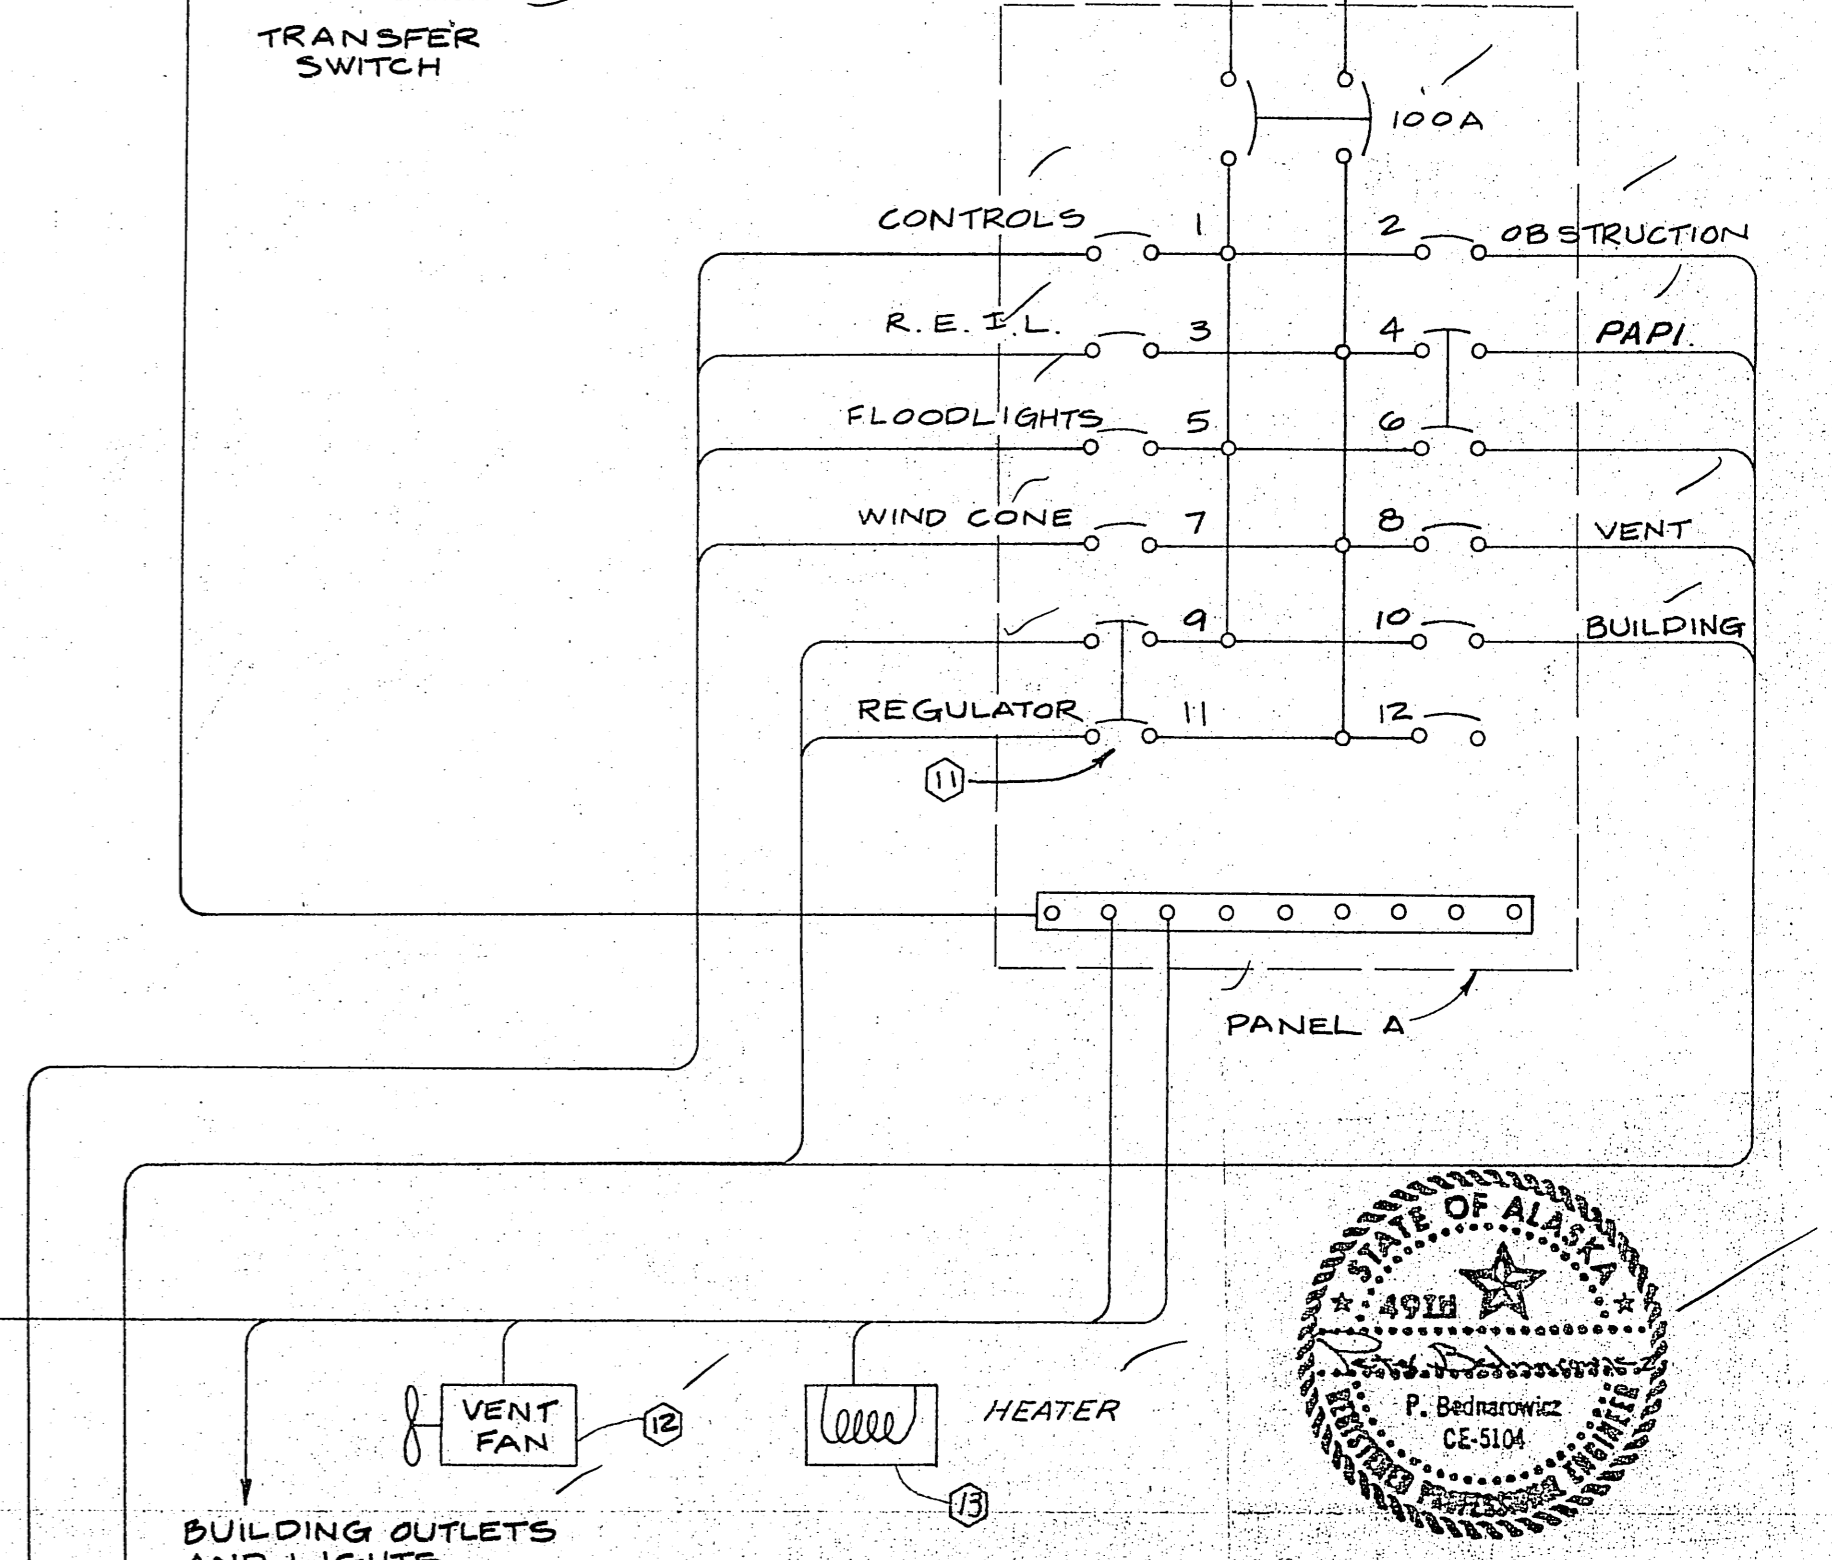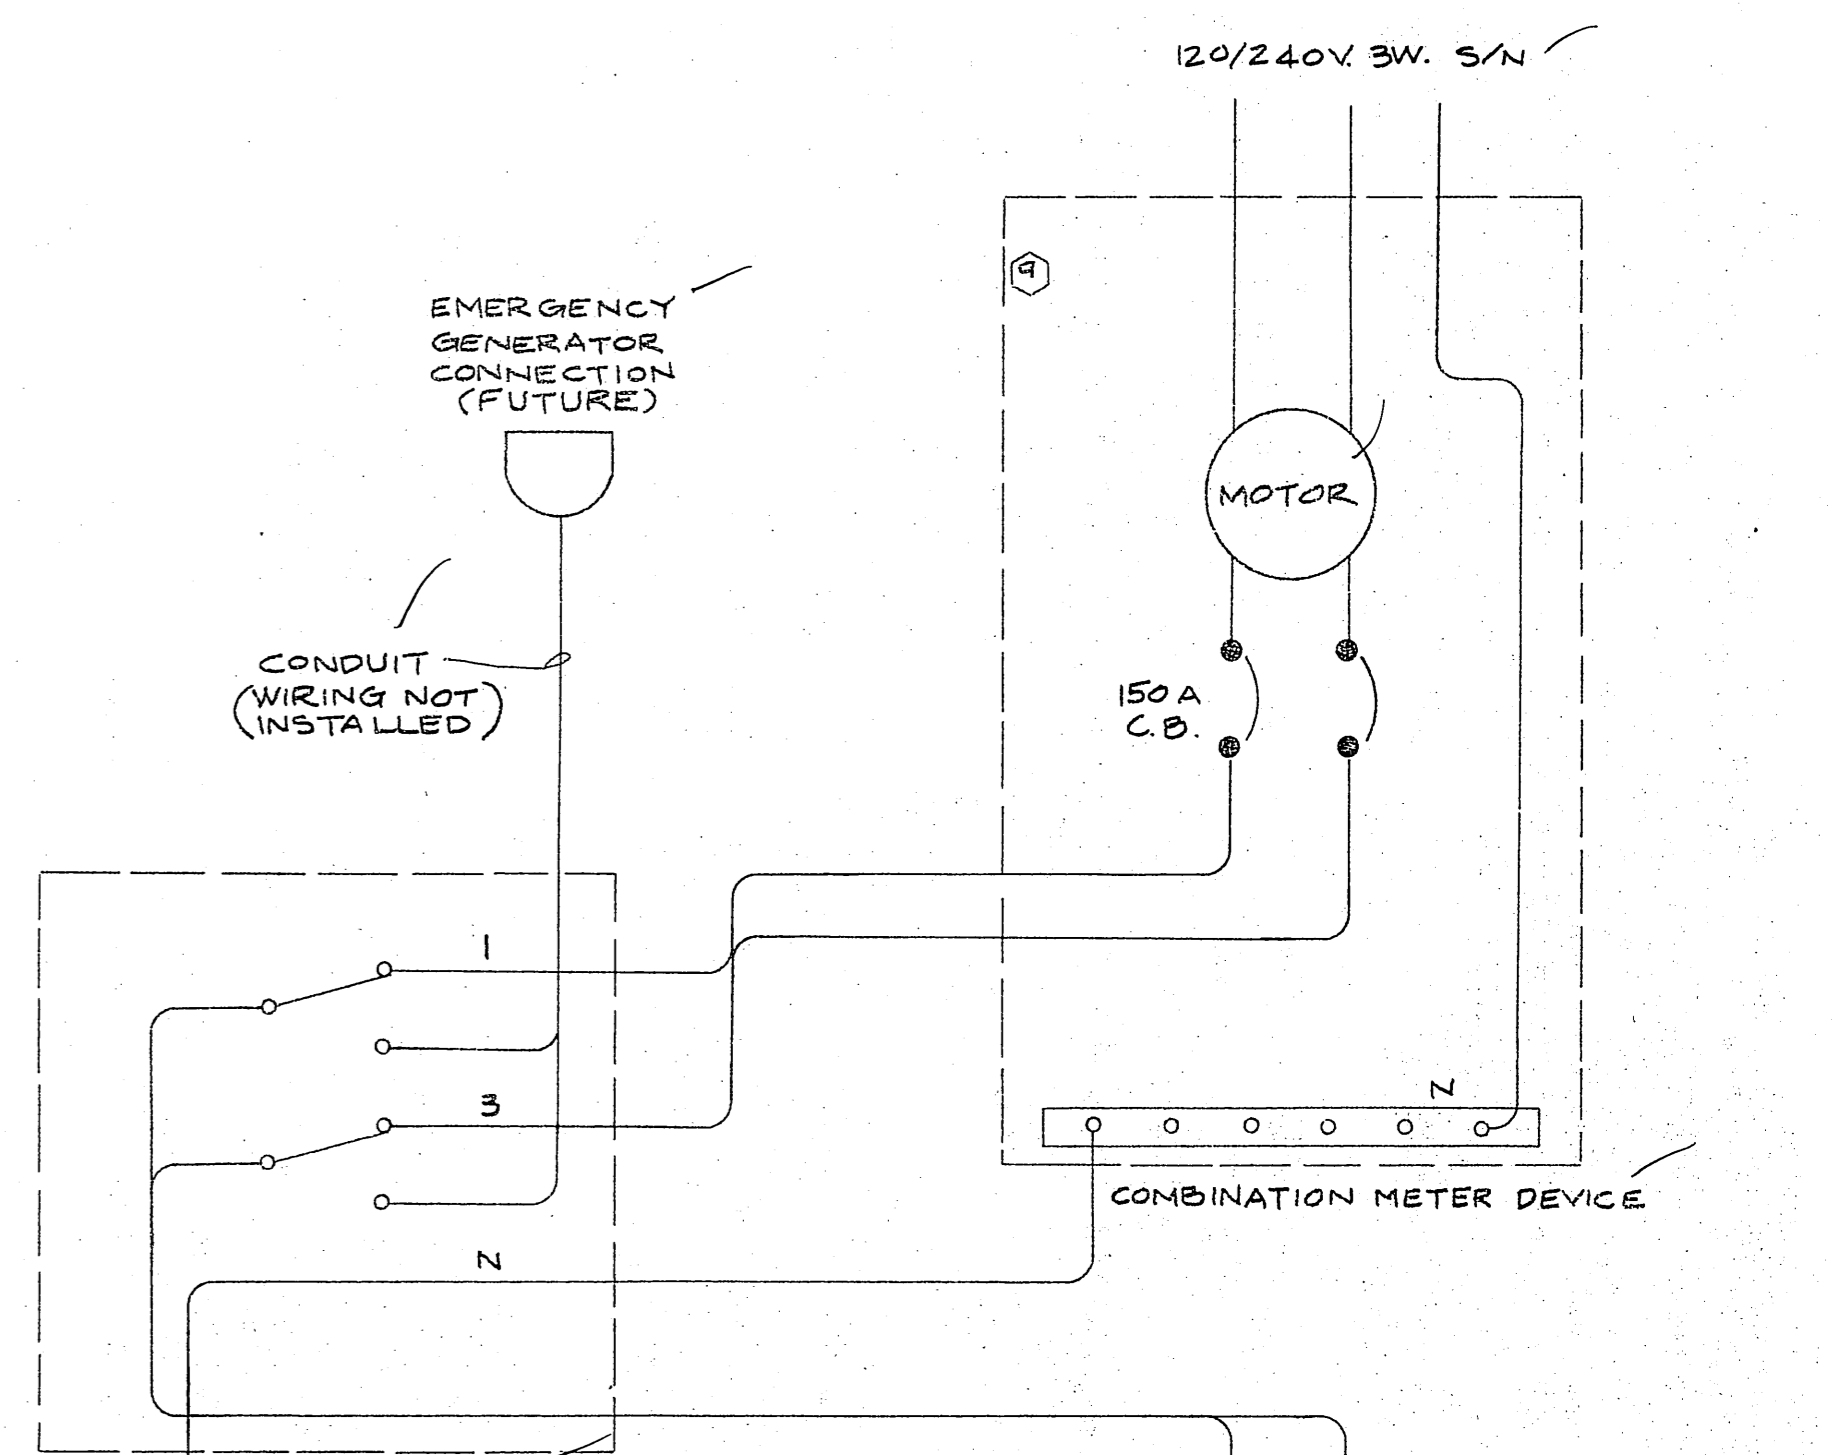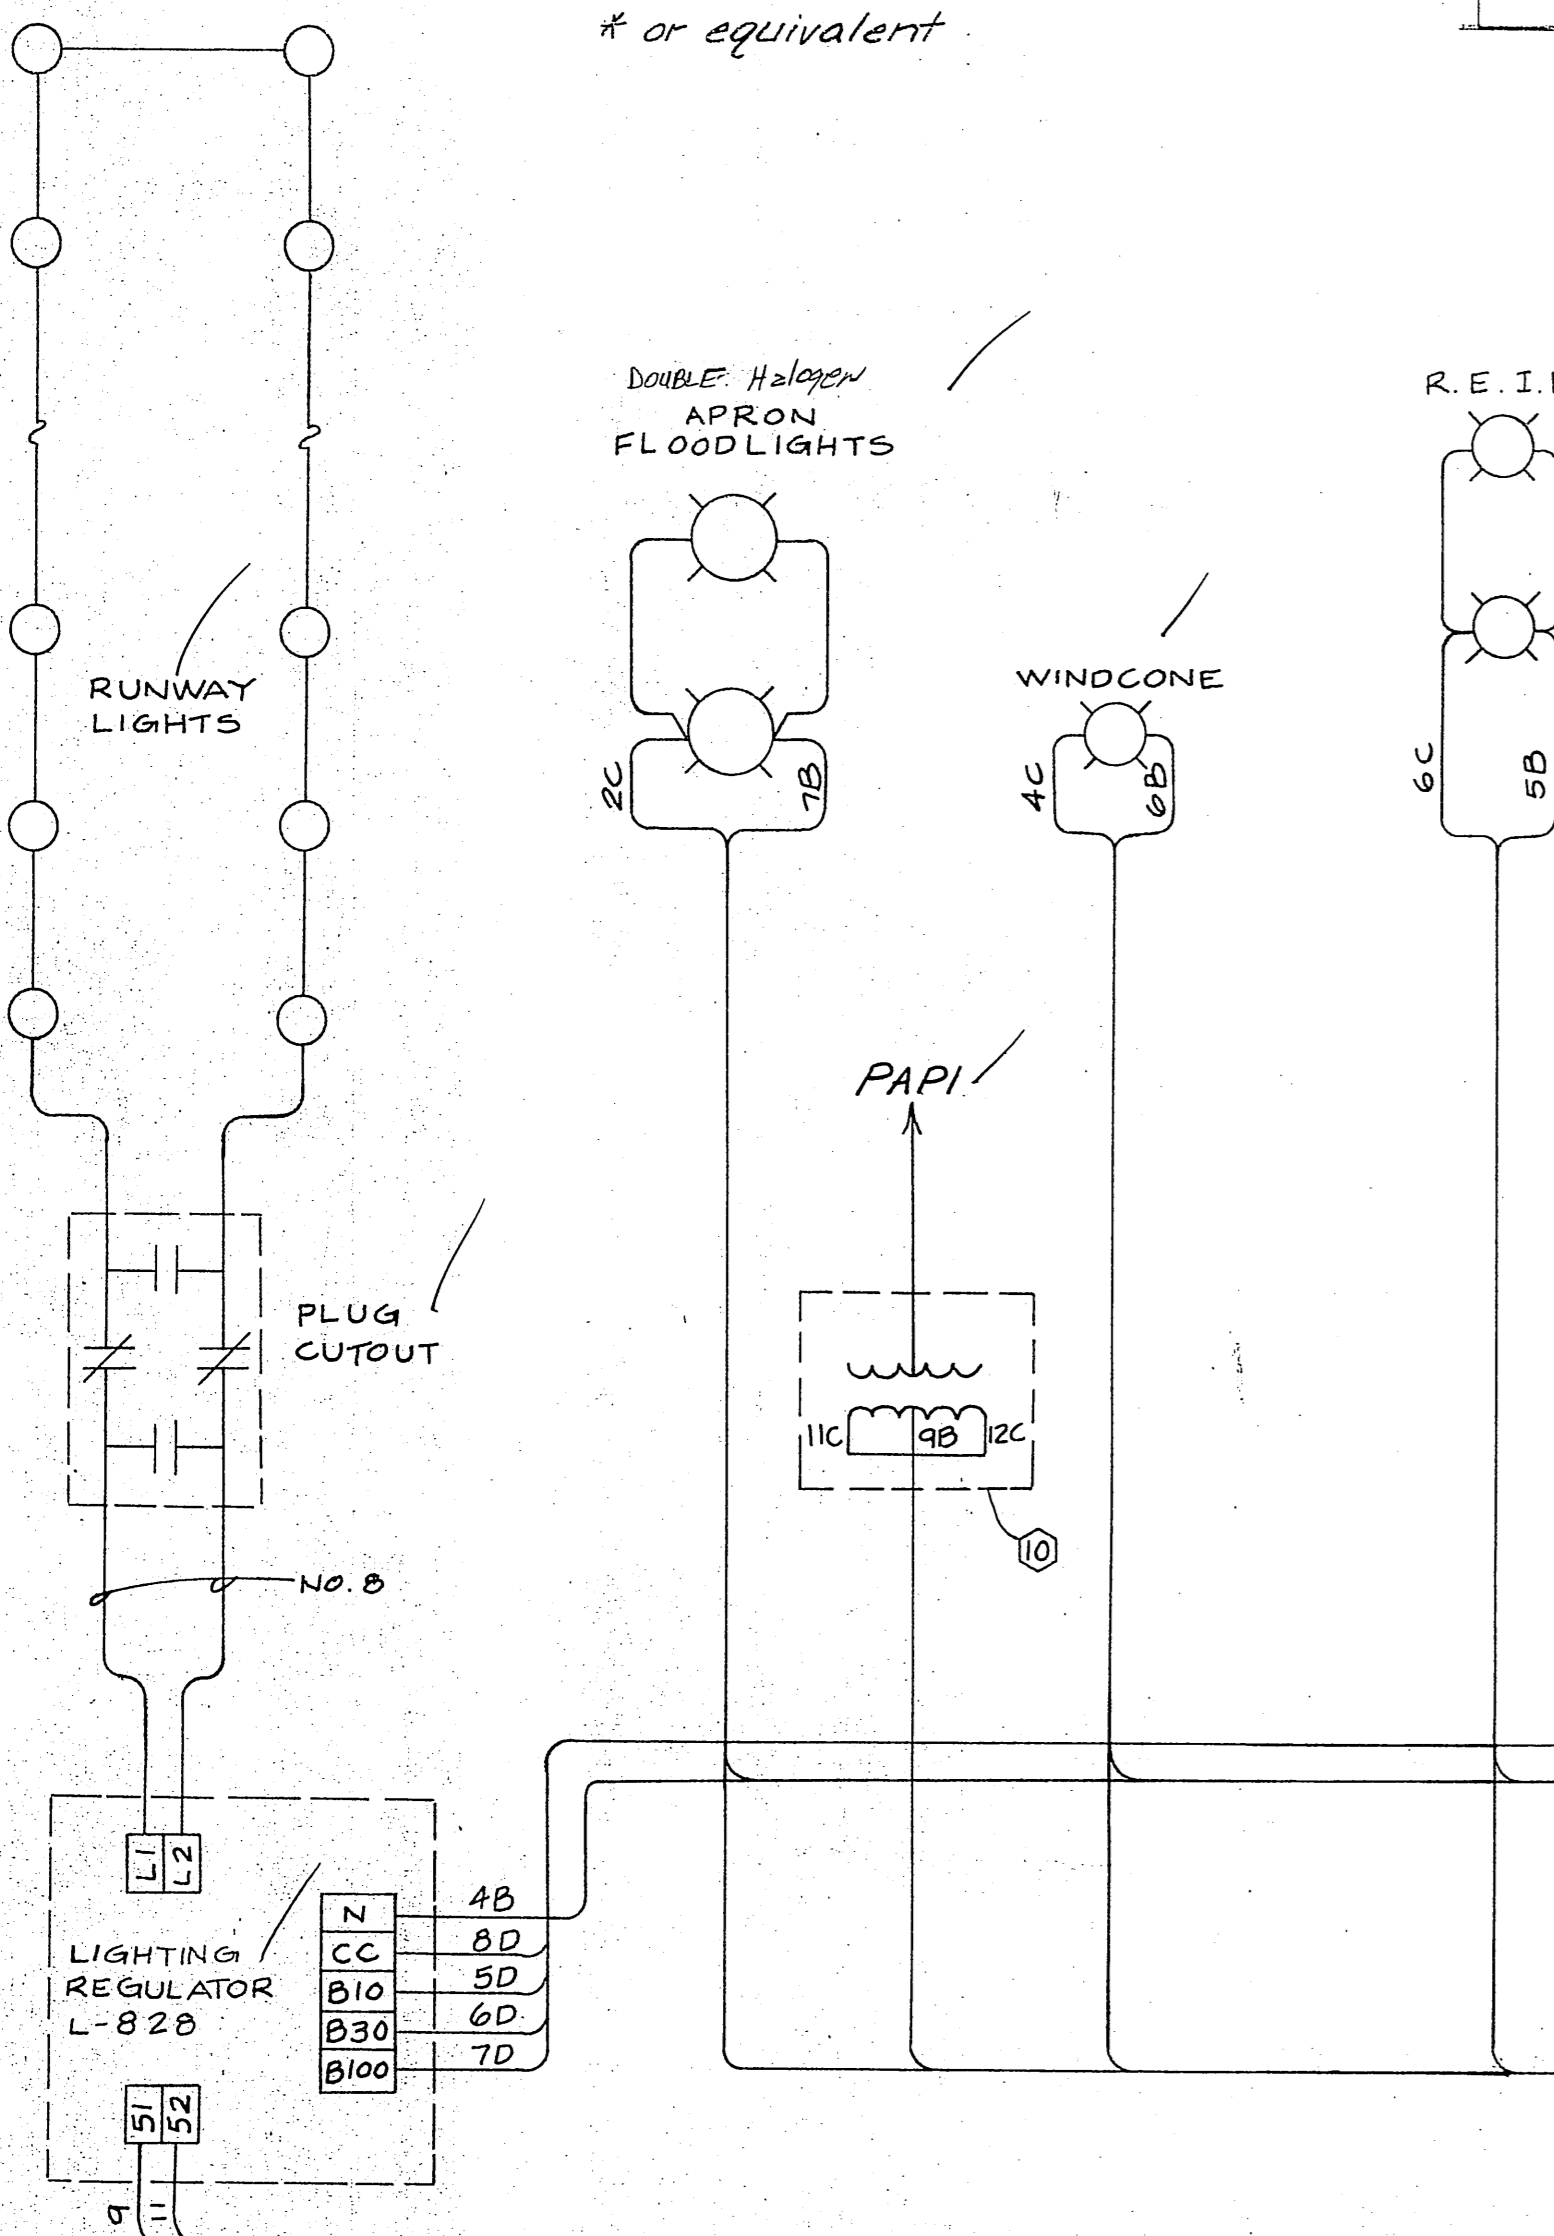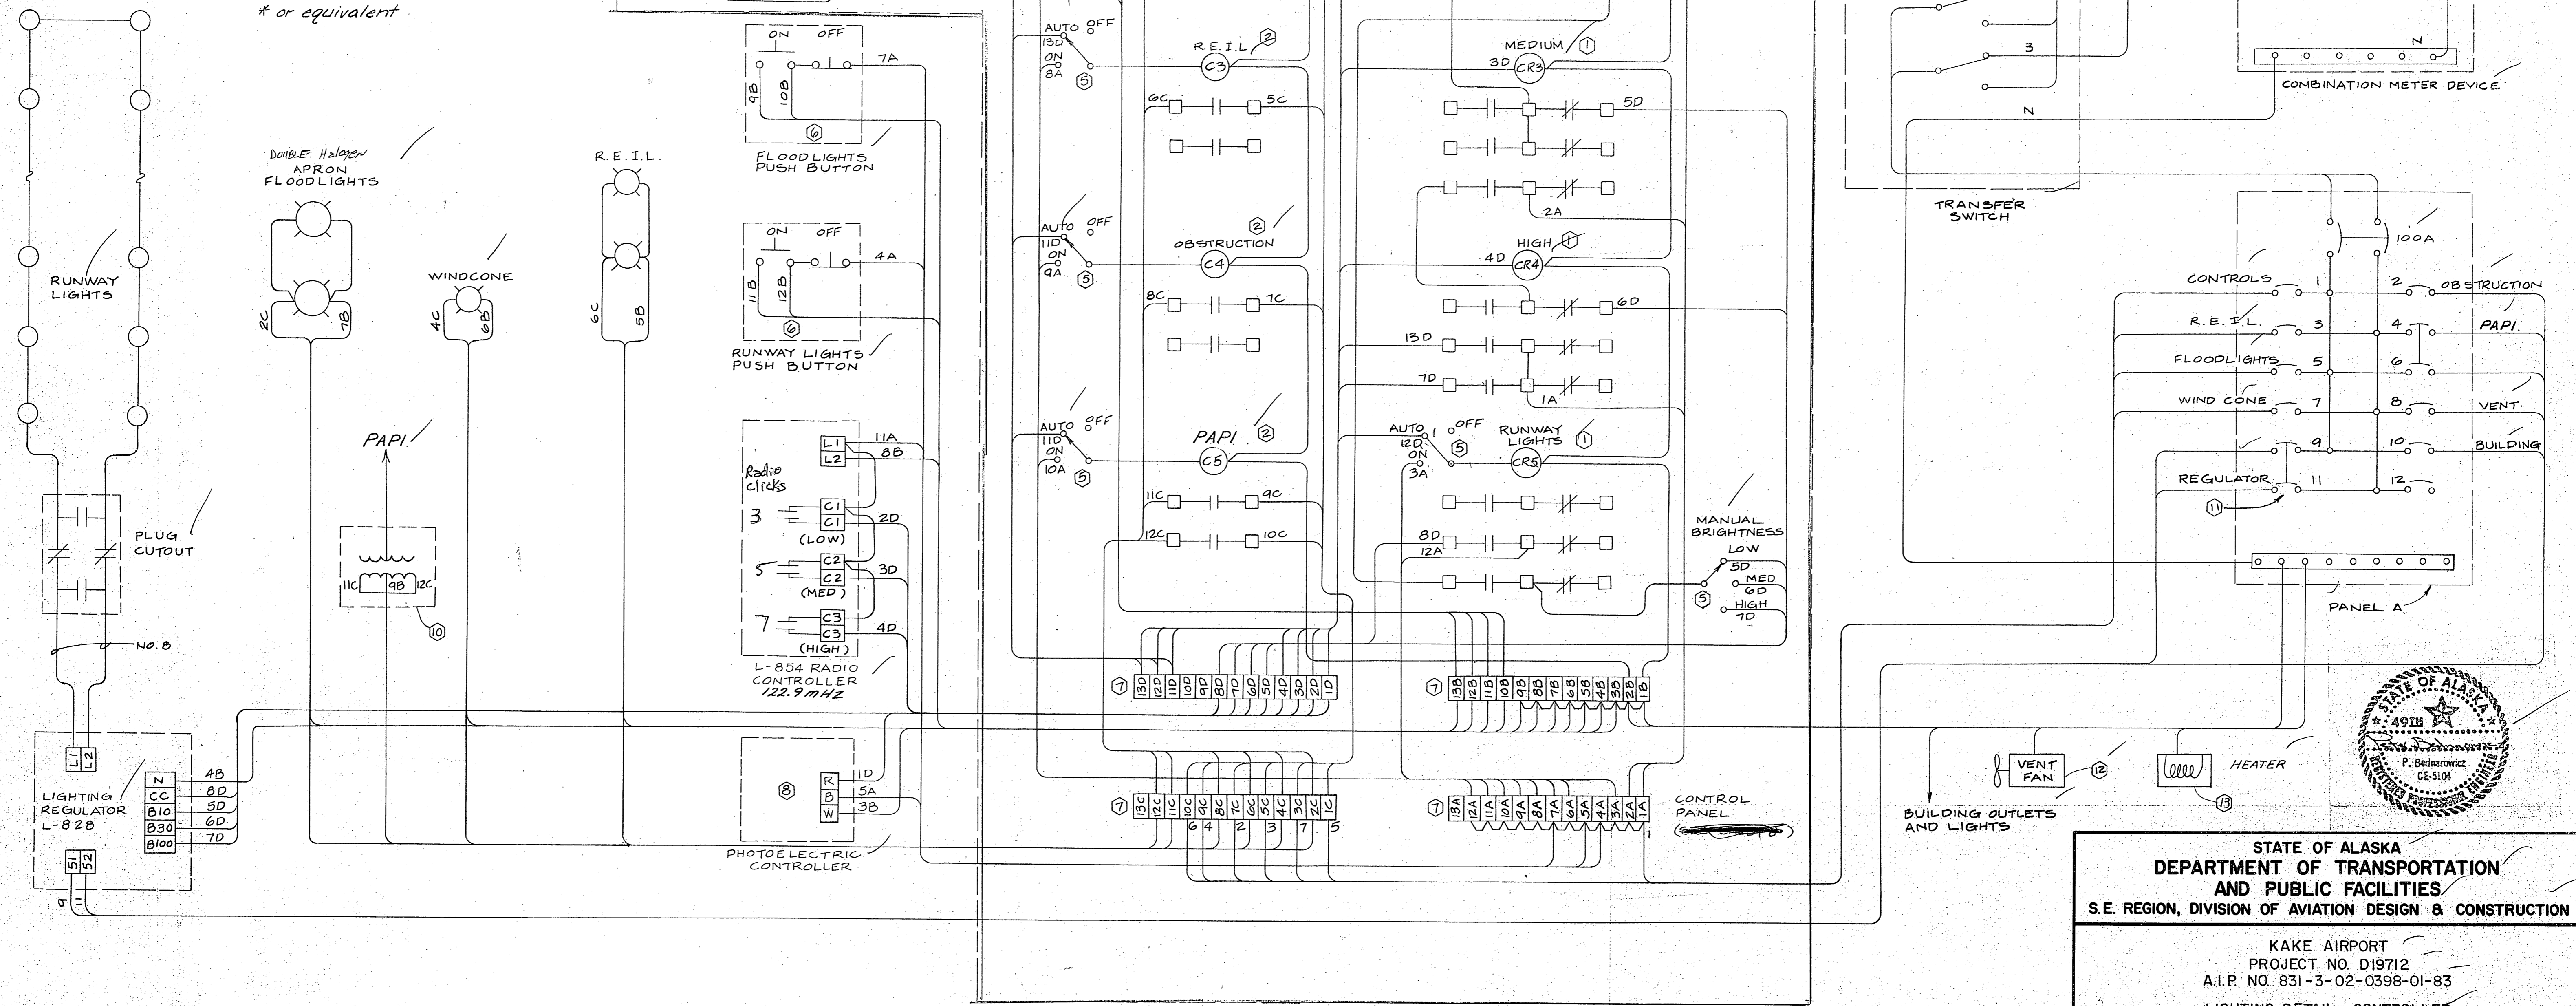

STATE OF ALASKA  
DEPARTMENT OF TRANSPORTATION  
AND PUBLIC FACILITIES  
S.E. REGION, DIVISION OF AVIATION DESIGN & CONSTRUCTION

KAKE AIRPORT  
PROJECT NO. D19712  
A.I.P. NO. 831-3-02-0398-01-83  
LIGHTING DETAIL - CONTROLLER

APPROVED BY: *Wallace K. Williams* 8/12/85  
WALLACE K. WILLIAMS, PE CHIEF OF DESIGN


APPROVED BY: *William L. Baumgartner* 8/12/85  
WILLIAM L. BAUMGARTNER, PE DESIGN CHIEF GROUP "B"

SCALE: N/A  
DESIGNED: MJC  
DRAWN: SS  
CHECKED: DATE: SHEET 18 OF 25


BY	DATE	CHANGE

REVISIONS

STATE	PROJECT DESIGNATION	YEAR	SHEET NO.	TOTAL SHEETS
ALASKA				

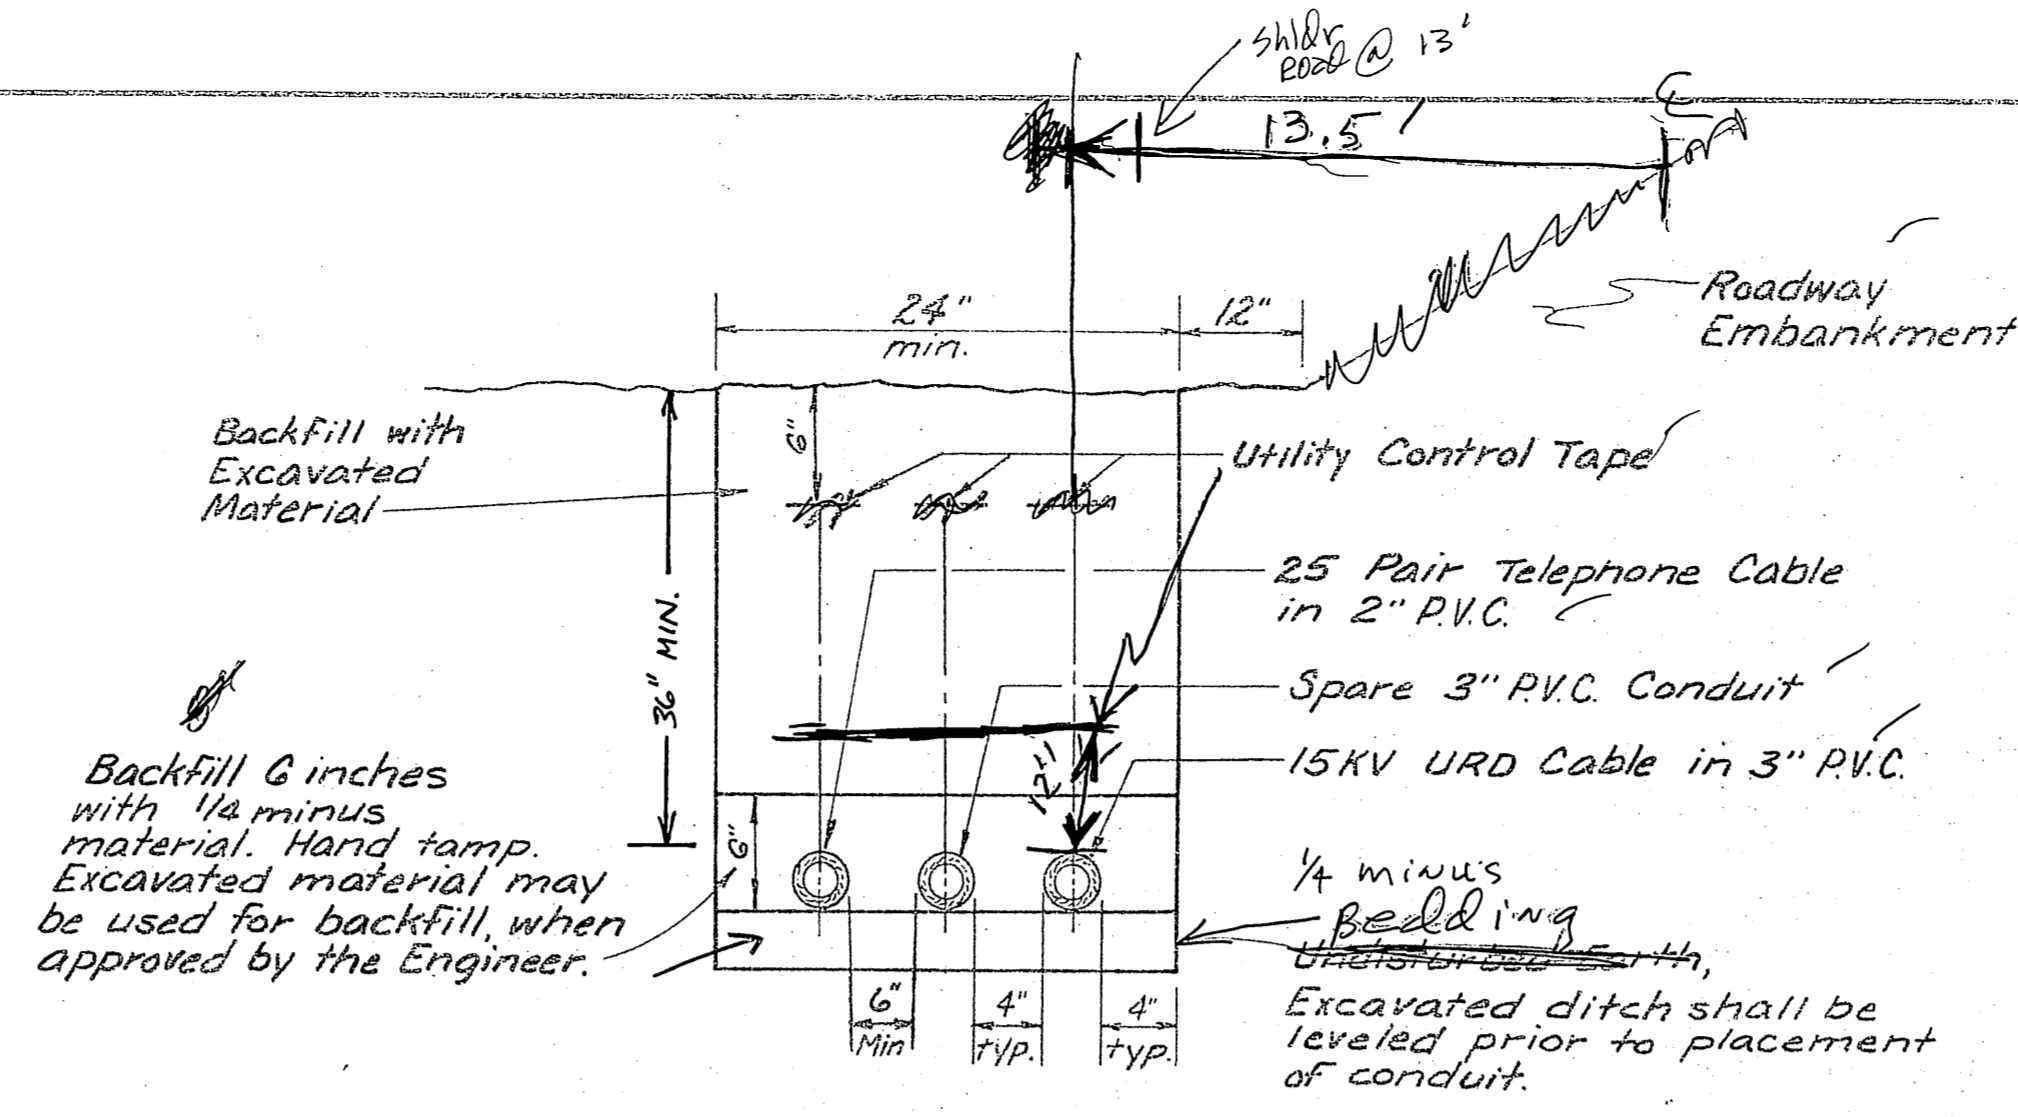


**U.G. CONDUIT DETAIL**  
**POWER & TELEPHONE CONDUIT**  
 n.t.s.

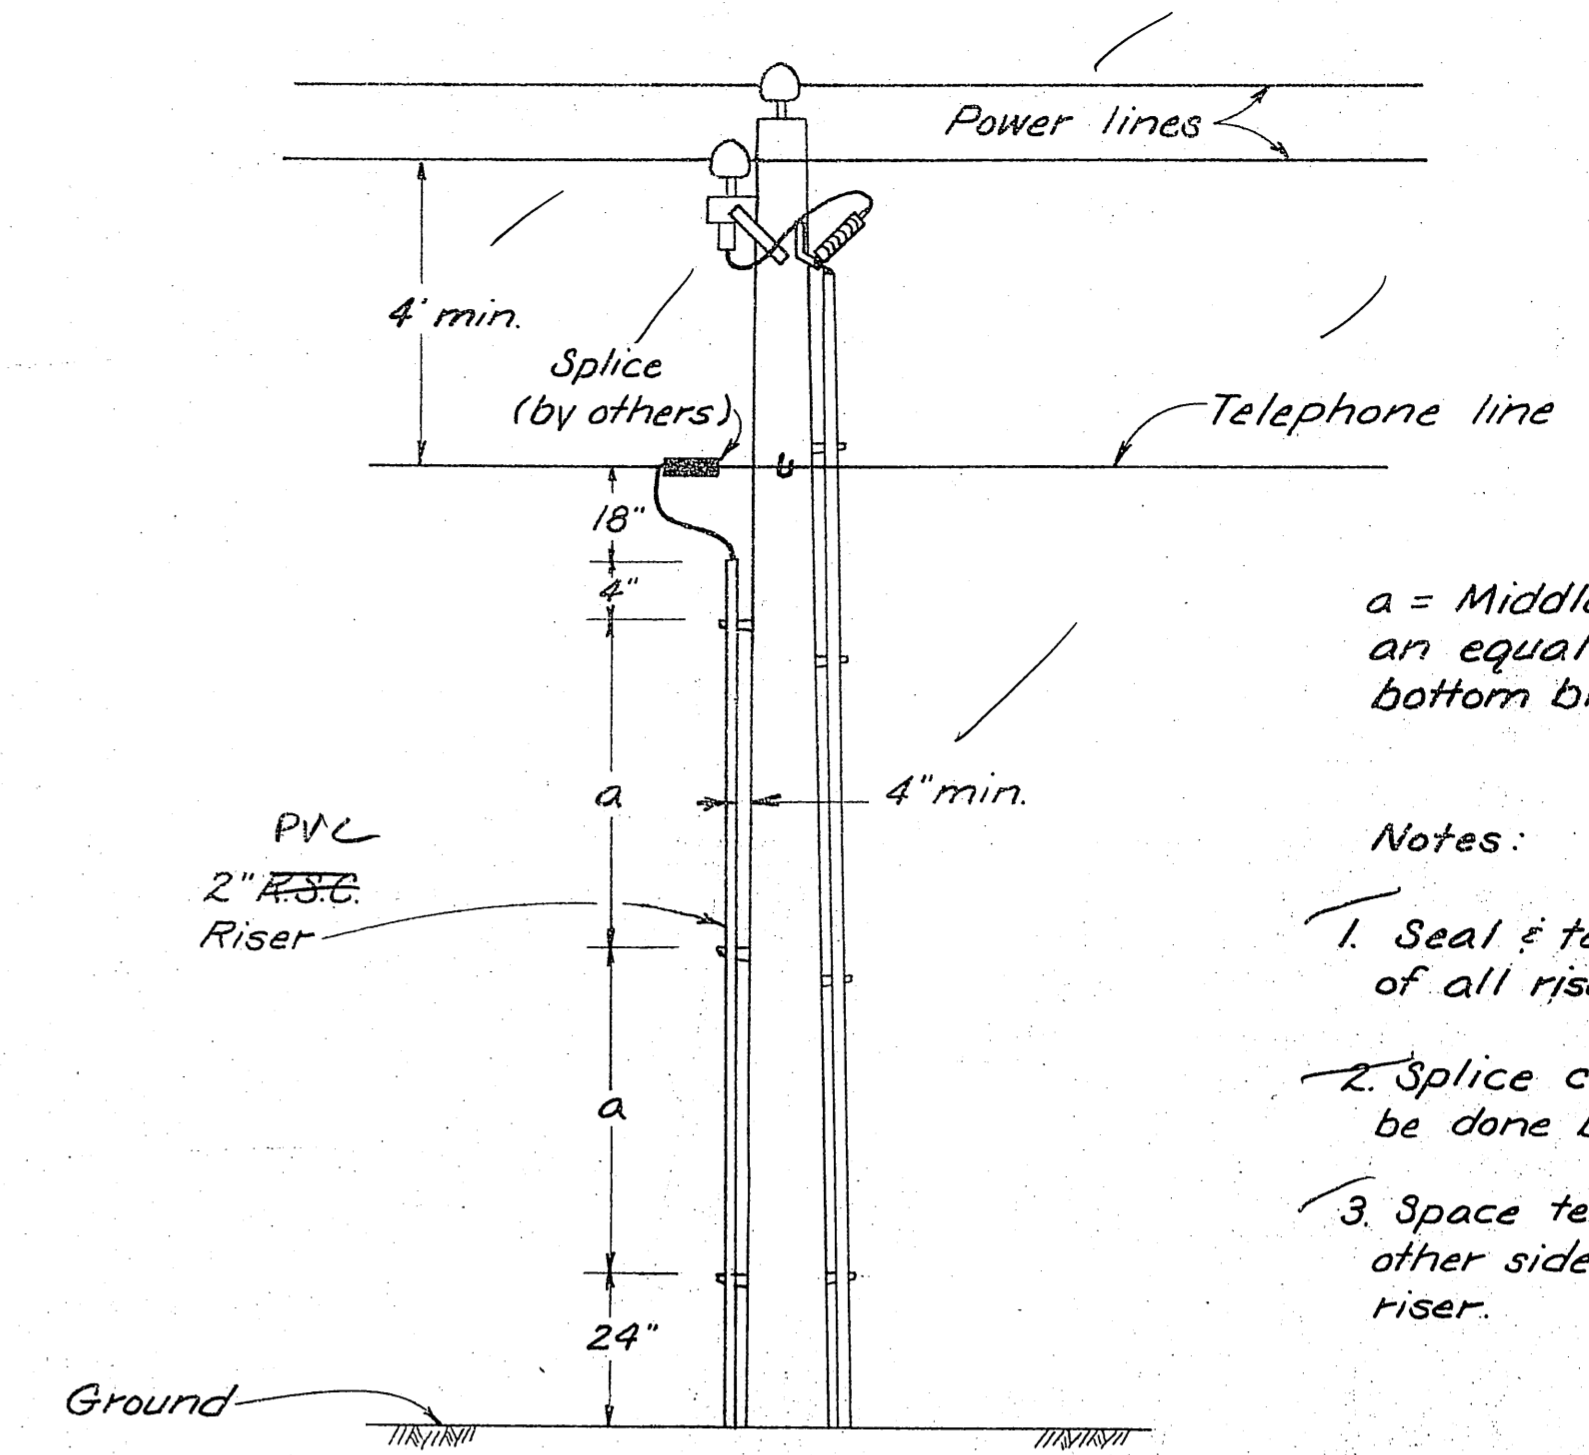


**TELEPHONE STAND-OFF RISER**  
 n.t.s.


- Notes:
1. Seal & tape around cable at top of all risers.
  2. Splice connection to existing shall be done by others.
  3. Space telephone conduit riser on other side of pole from power conduit riser.

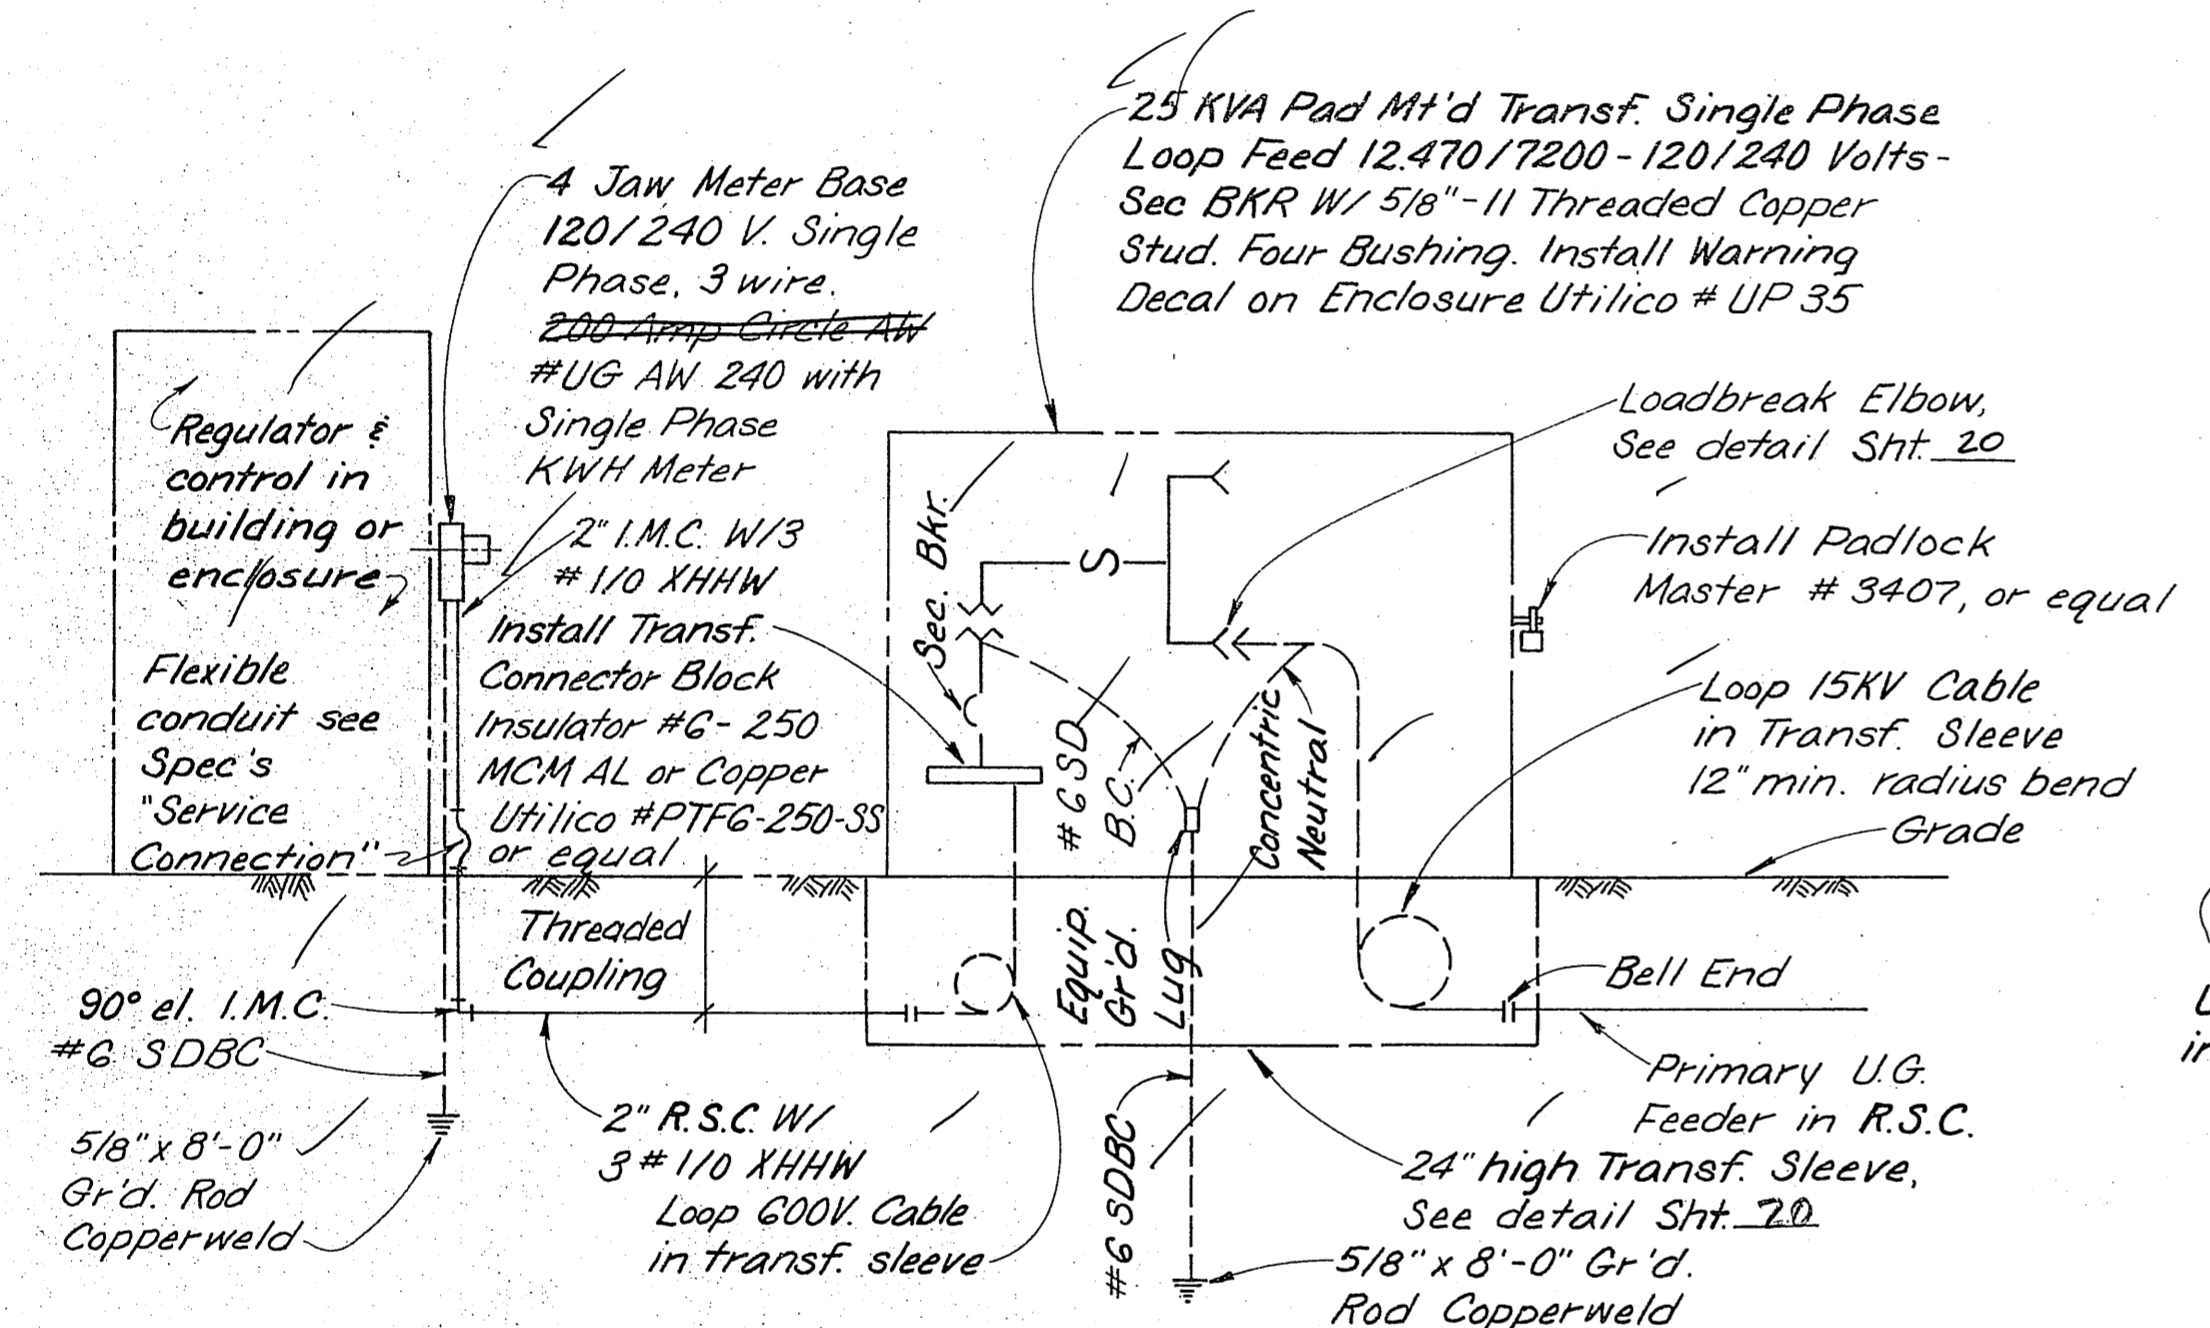


**DETAIL**  
**PAD MOUNTED TRANSFORMER ON GRADE**  
 n.t.s.

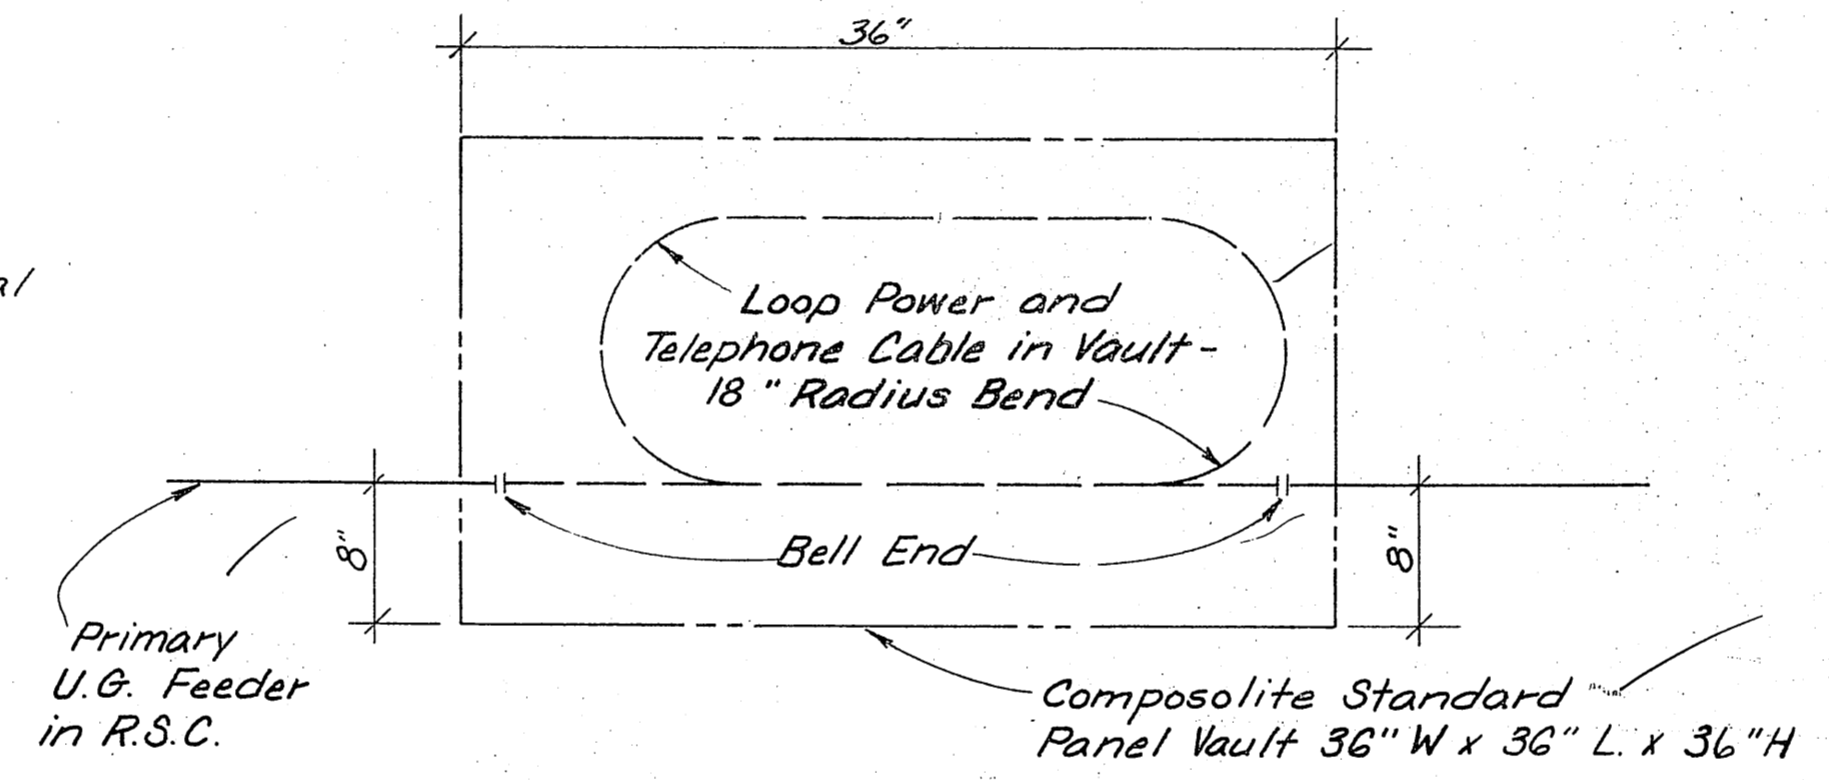

**DETAIL**  
**PLAN VIEW ELECTRICAL VAULT END ENTRANCE**  
**NO TERMINATION**  
 n.t.s.

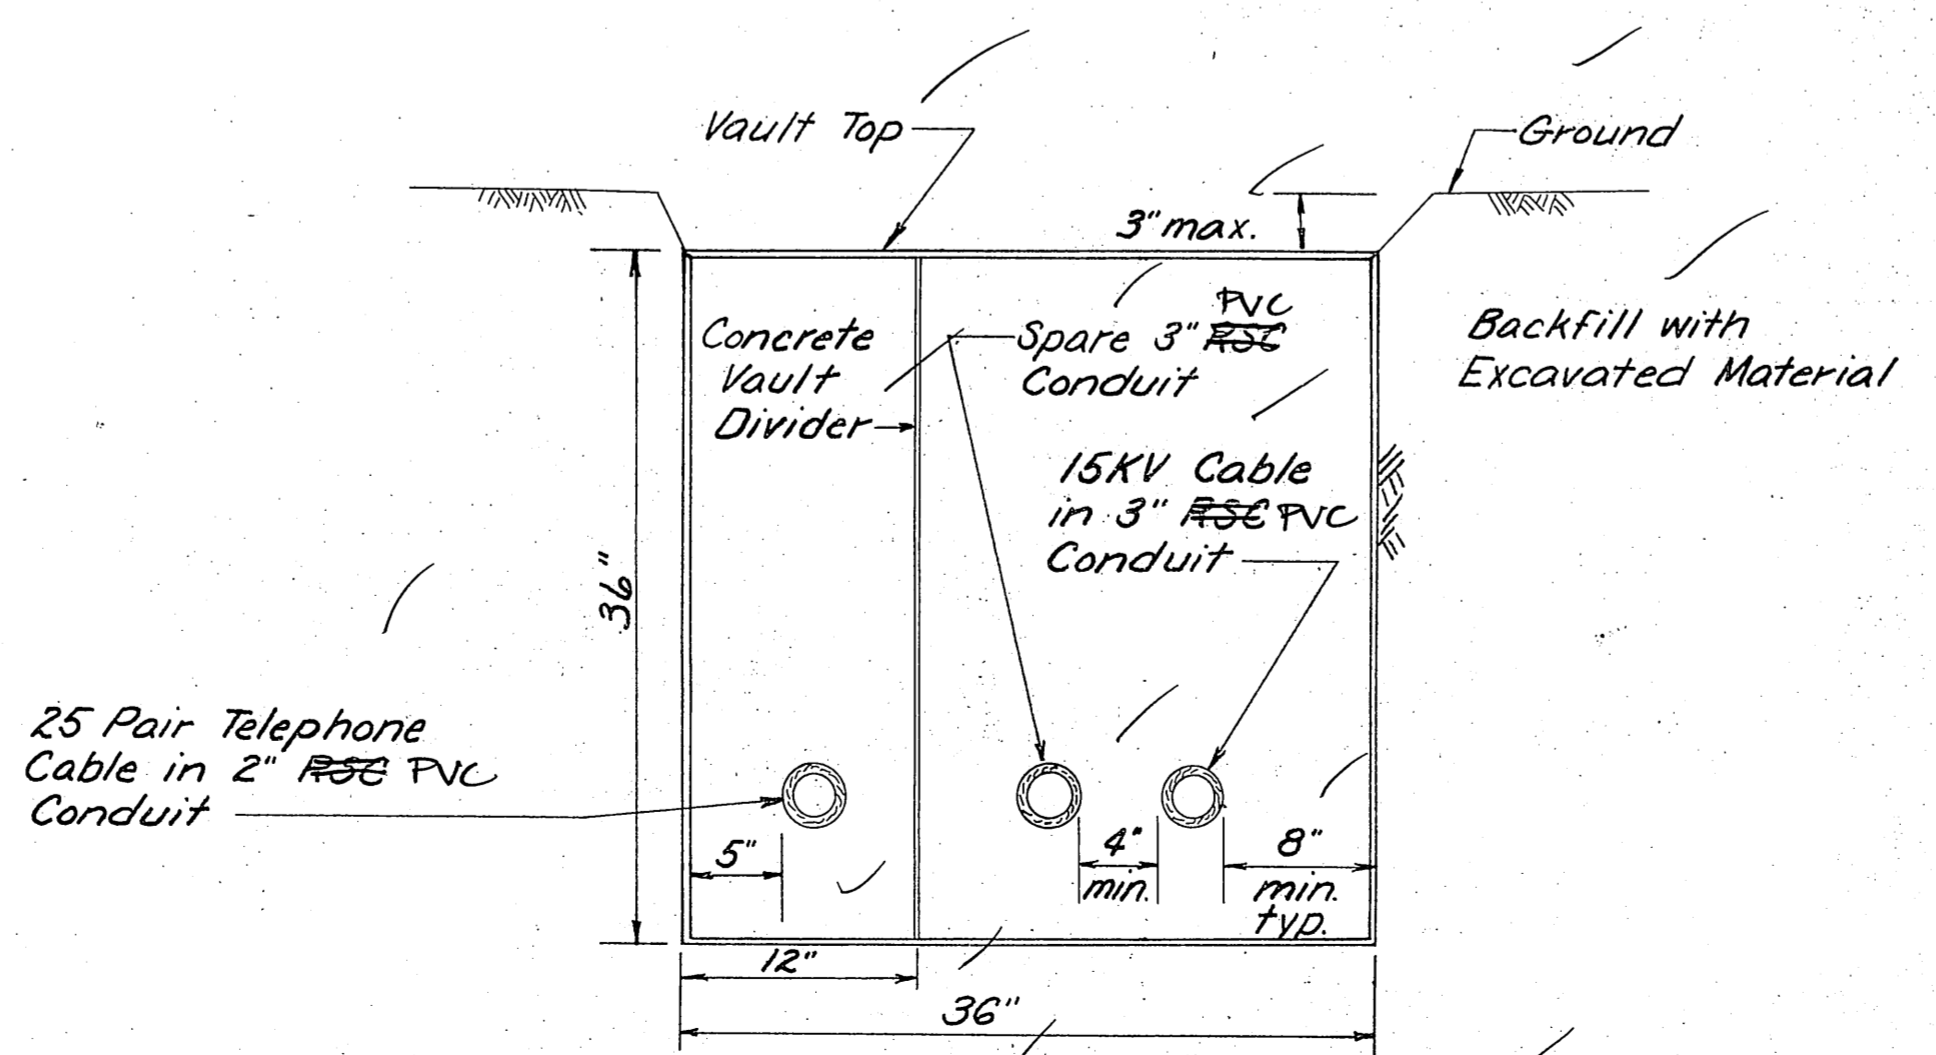

**FRONT VIEW ELECTRIC VAULT END ENTRANCE -**  
**NO TERMINATION**  
 n.t.s.

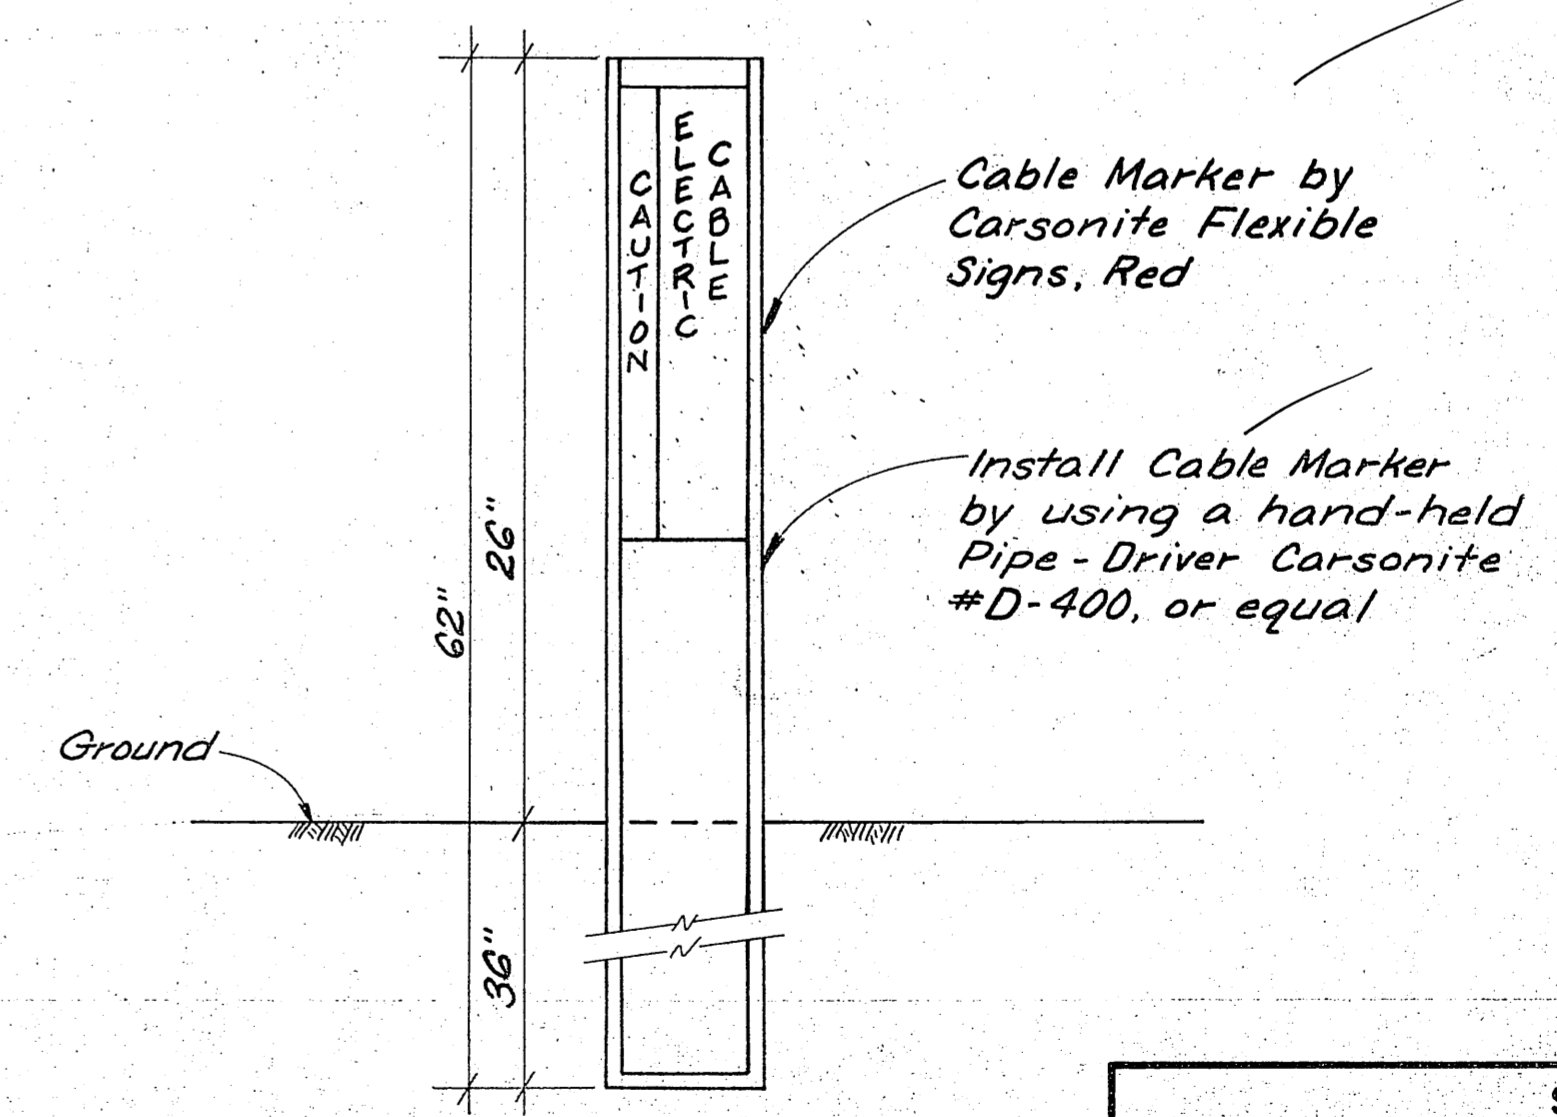

**DETAIL**  
**CABLE MARKER**  
 n.t.s.




STATE OF ALASKA  
 DEPARTMENT OF TRANSPORTATION  
 AND PUBLIC FACILITIES  
 S.E. REGION, DIVISION OF AVIATION DESIGN & CONSTRUCTION

KAKE AIRPORT  
 PROJECT NO. D19712  
 A.I.P. NO. 831-3-02-0398-01-83  
 POWER & TELEPHONE DETAILS

BY	DATE	CHANGE	SCALE:	DESIGNED:	DRAWN:	CHECKED:	DATE:	SHEET	TOTAL
			N.T.S.	MJC	SS		2/16/84	19	25

APPROVED BY: *Wallace K. Williams* 8/12/85  
 WALLACE K. WILLIAMS, P.E. CHIEF OF DESIGN

APPROVED BY: *William L. Baumgartner* 8/12/85  
 WILLIAM L. BAUMGARTNER, P.E. DESIGN CHIEF GROUP "B"

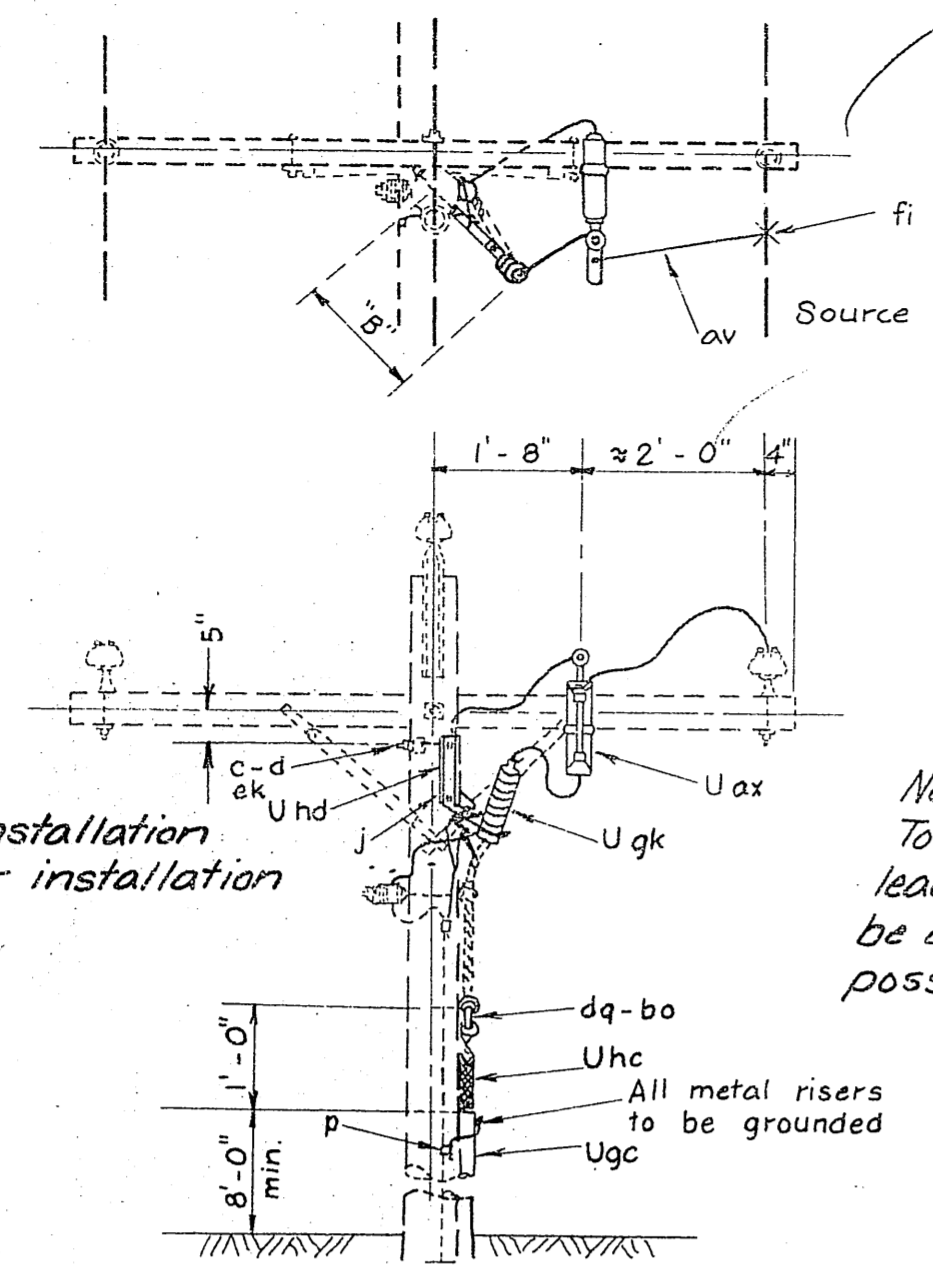

Designate as:  
 UM 2-3 Single arrester installation  
 UM 2-3A Parallel arrester installation  
 7.2/12.5kV only.


"B" minimum -  
 7.2/12.5kV = 15"  
 14.4/24.9kV = 20"

Note:  
 Total arrester  
 lead length must  
 be as short as  
 possible.


ITEM	NO.	MATERIAL
c	1	Bolt, machine, 5/8" x required length
d	1	Washer, square, 2 1/4"
j		Screw, lag, 1/2" x 4", as required
dq	1	Eye screw, elliptical
p		Connectors, as required
av		Jumpers, as required
Uax	1	Cutout, load break type and single arrester combination (UM 2-3)
bo	1	Shackle, anchor
ek		Locknuts, as required
fi	1	Connector, hot line tap assembly
Ugc	1	Cable riser shield, length as required
Uqk	1	Cable termination
Uhc	1	Cable support
Uhd	1	Bracket, pothead mounting
Uax	1	Cutout, load break type and parallel arrester combination (UM 2-3A)

**THREE-PHASE OVERHEAD SOURCE  
 SINGLE-PHASE UNDERGROUND WITH COMBINATION  
 CUT-OUT AND ARRESTER**  
 n.t.s.


Load Break Elbow 200 AMP 15KV Class, #2 Aluminum Direct Burial Primary Cable, 7 Strand, 175 MIL XLPE Insulation, 10-#14 Copper Concentric Neutral, Elastimold #165LRR-FB-220

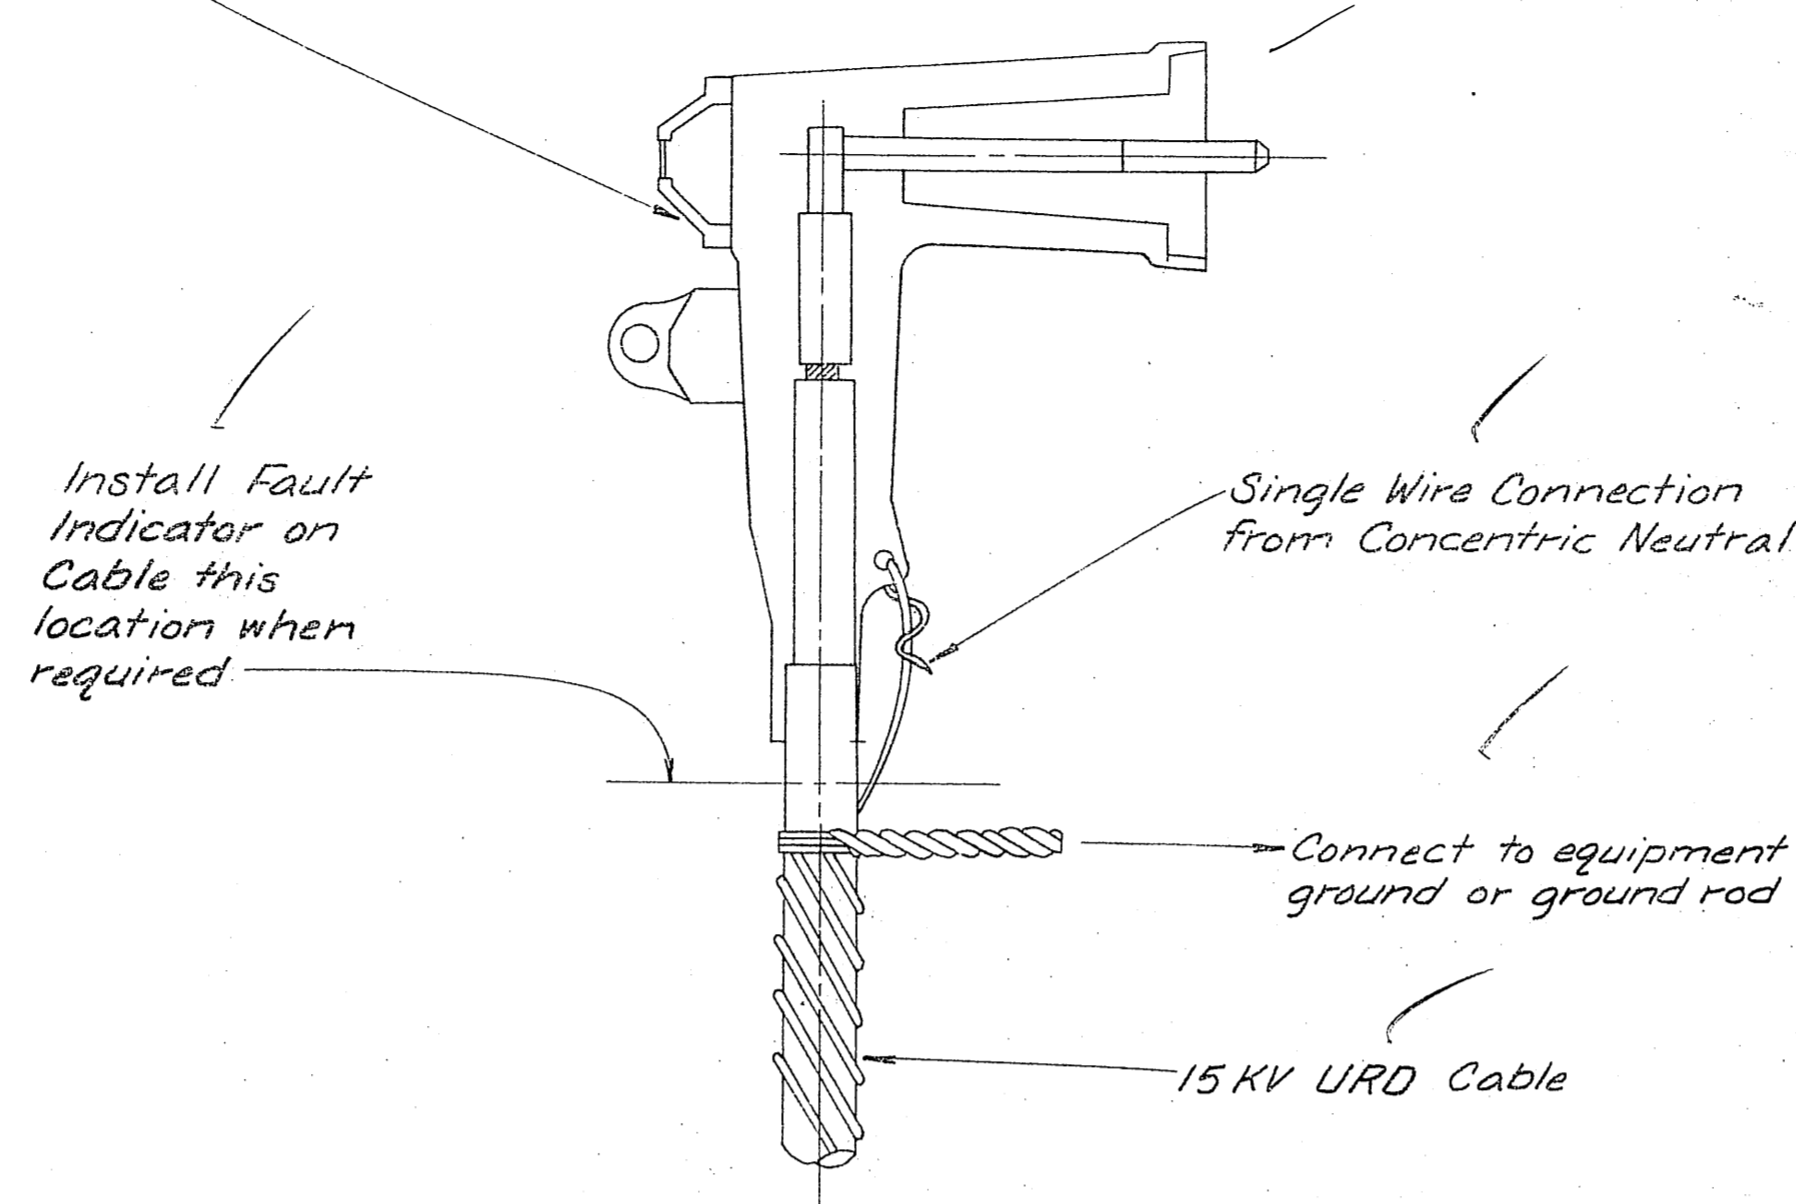


**DETAIL 15KV LOADBREAKER ELBOW**  
 n.t.s.

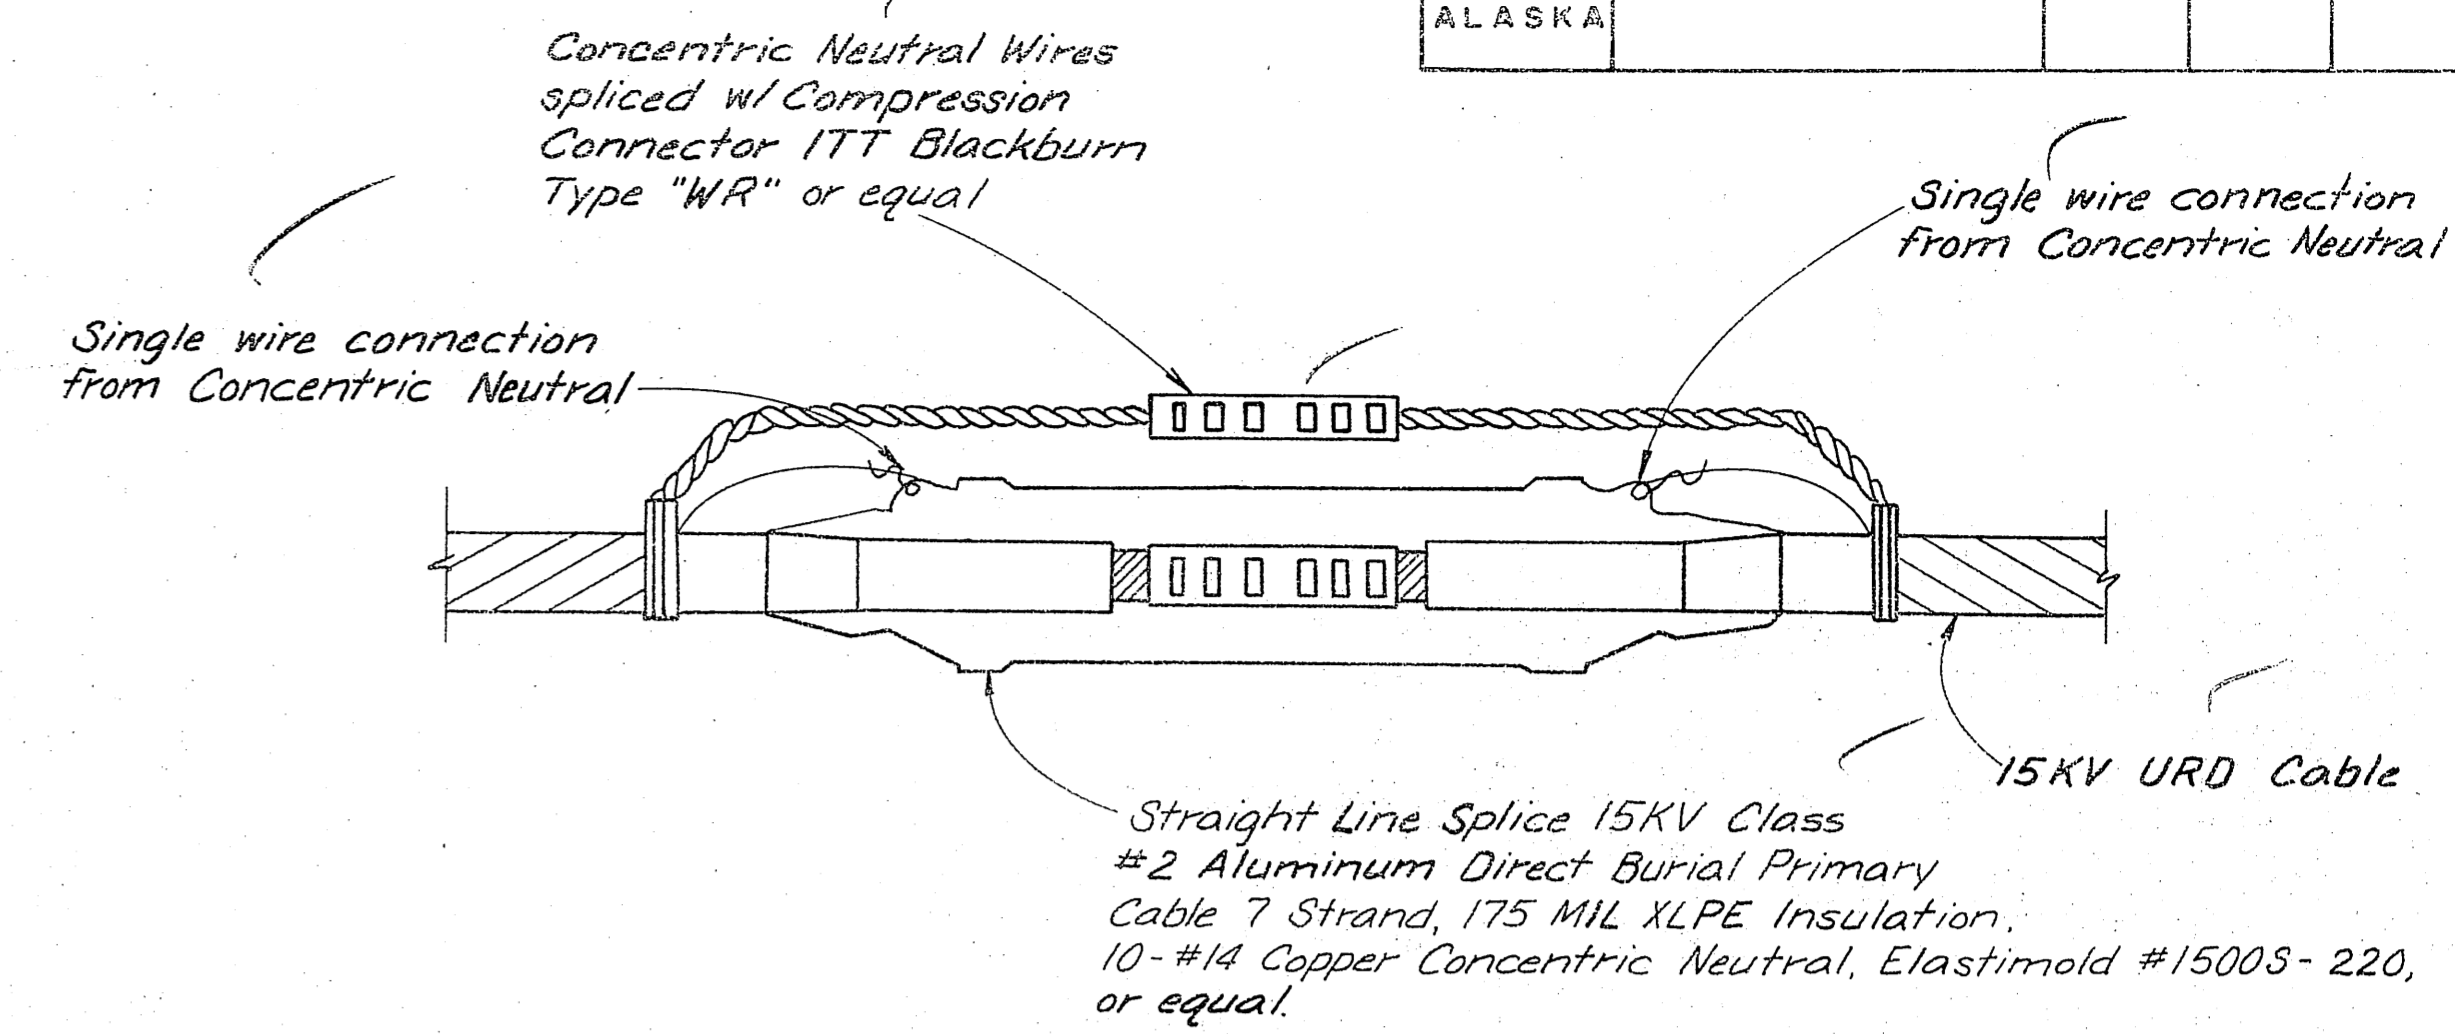


**DETAIL 15KV STRAIGHT LINE SPLICE**  
 n.t.s.  
 see sheet 13 for splice locations

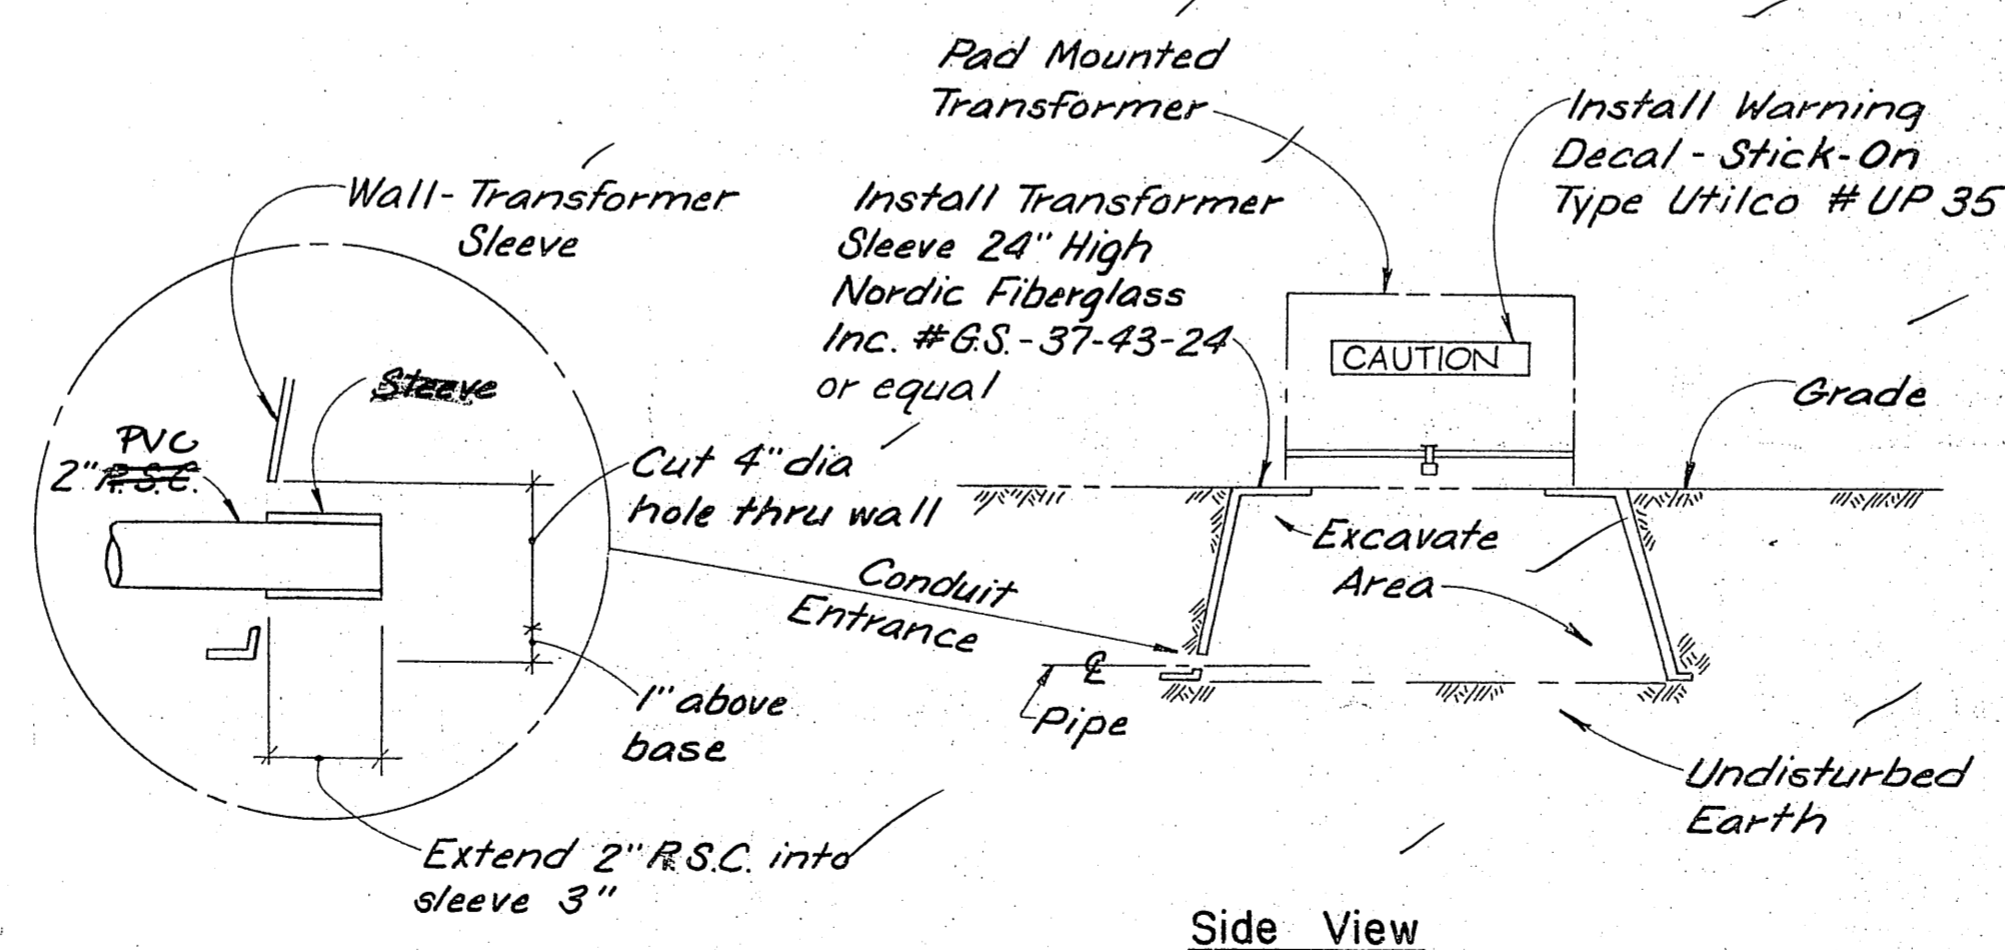

**DETAIL PAD MOUNTED TRANSFORMER SLEEVE**  
 n.t.s.

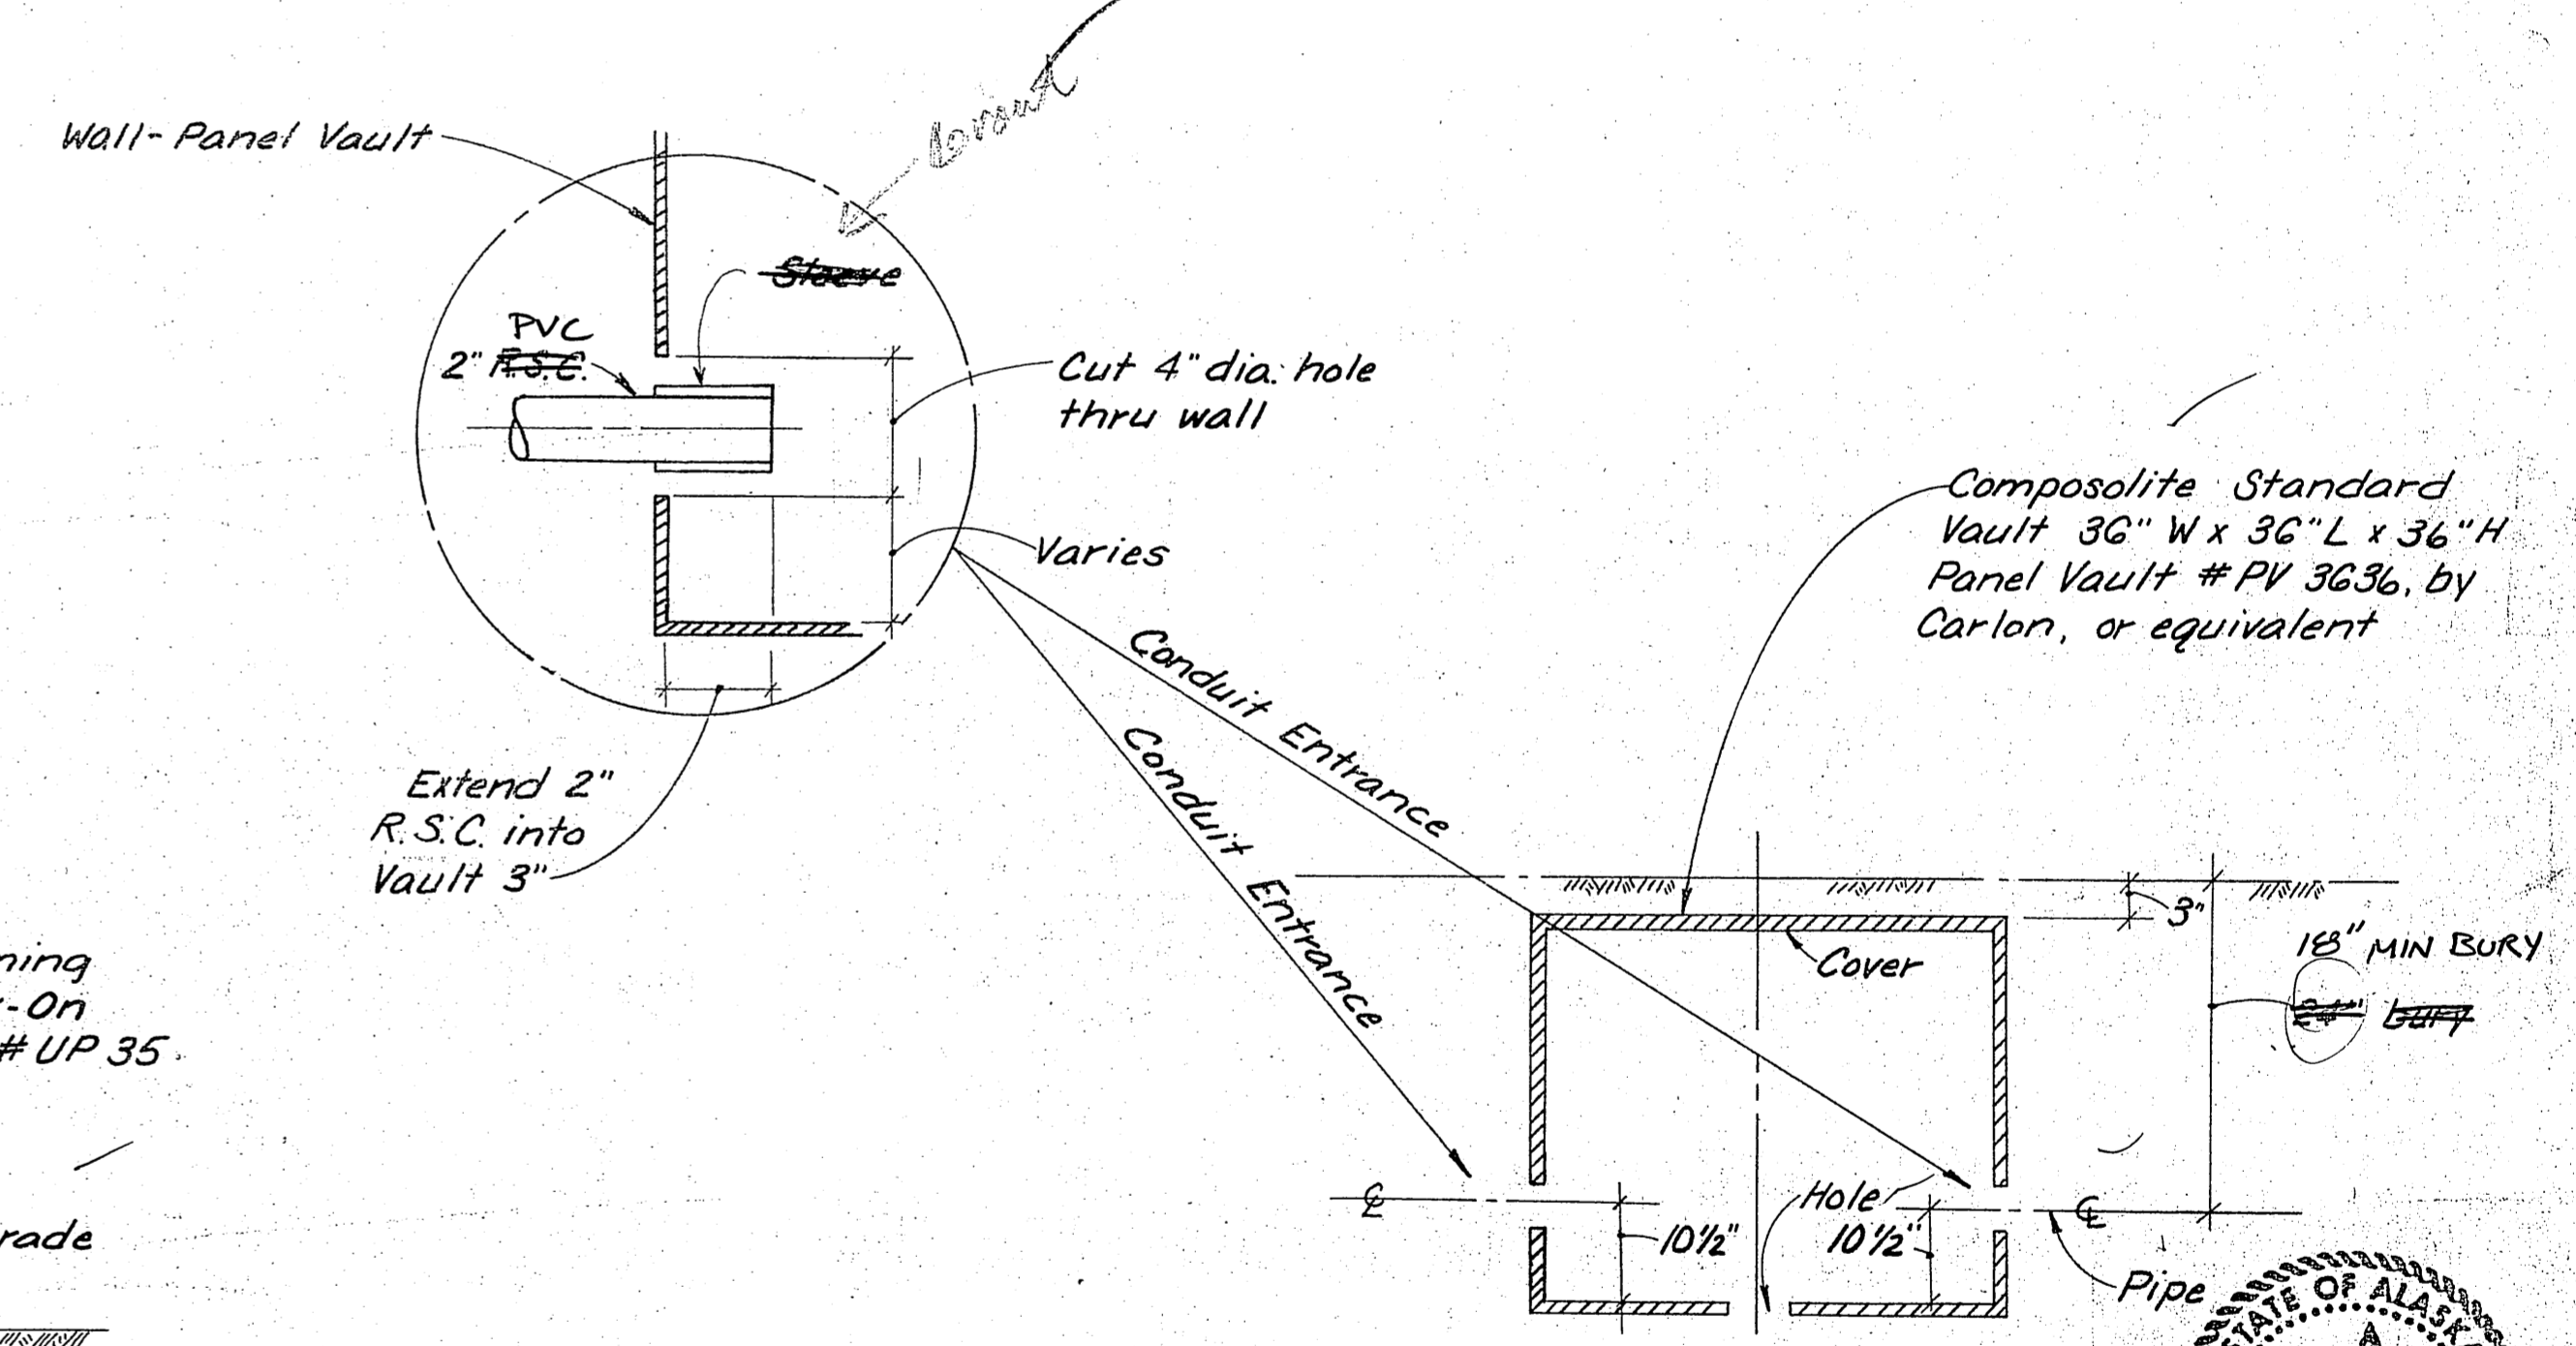

**DETAIL ELECTRIC VAULT**  
 n.t.s.

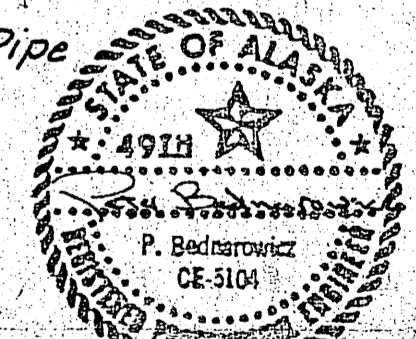

STATE OF ALASKA  
 DEPARTMENT OF TRANSPORTATION  
 AND PUBLIC FACILITIES  
 S.E. REGION, DIVISION OF AVIATION DESIGN & CONSTRUCTION

KAKE AIRPORT  
 PROJECT NO. D19712  
 A.I.P. NO. 831-3-02-0398-01-83



POWER & TELEPHONE DETAILS

APPROVED BY:		W. Williams 8/12/85	
WALLACE K. WILLIAMS, P.E.		CHIEF OF DESIGN	
APPROVED BY:		R. Baumgartner 8/12/85	
WILLIAM E. BAUMGARTNER, P.E.		DESIGN CHIEF GROUP "B"	
BY	DATE	CHANGE	SCALE:
			N.T.S.
DESIGNED: M J C		DRAWN: SS	
CHECKED: PJ		DATE: 2/16/84	
REVISIONS			

STATE	PROJECT DESIGNATION	YEAR	SHEET NO.	TOTAL SHEETS
ALASKA				

U.S. FOREST SERVICE  
(KAKE TRIBAL OVERSELECTION)

 - CLEARING THIS CONTRACT

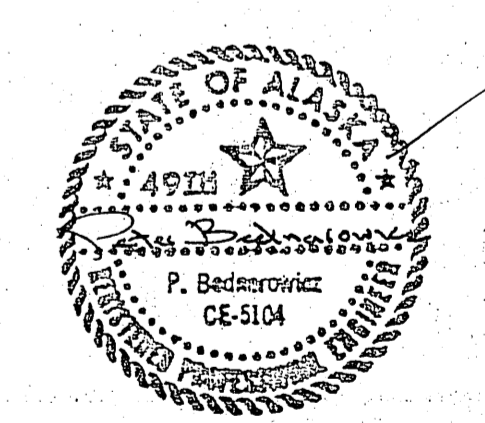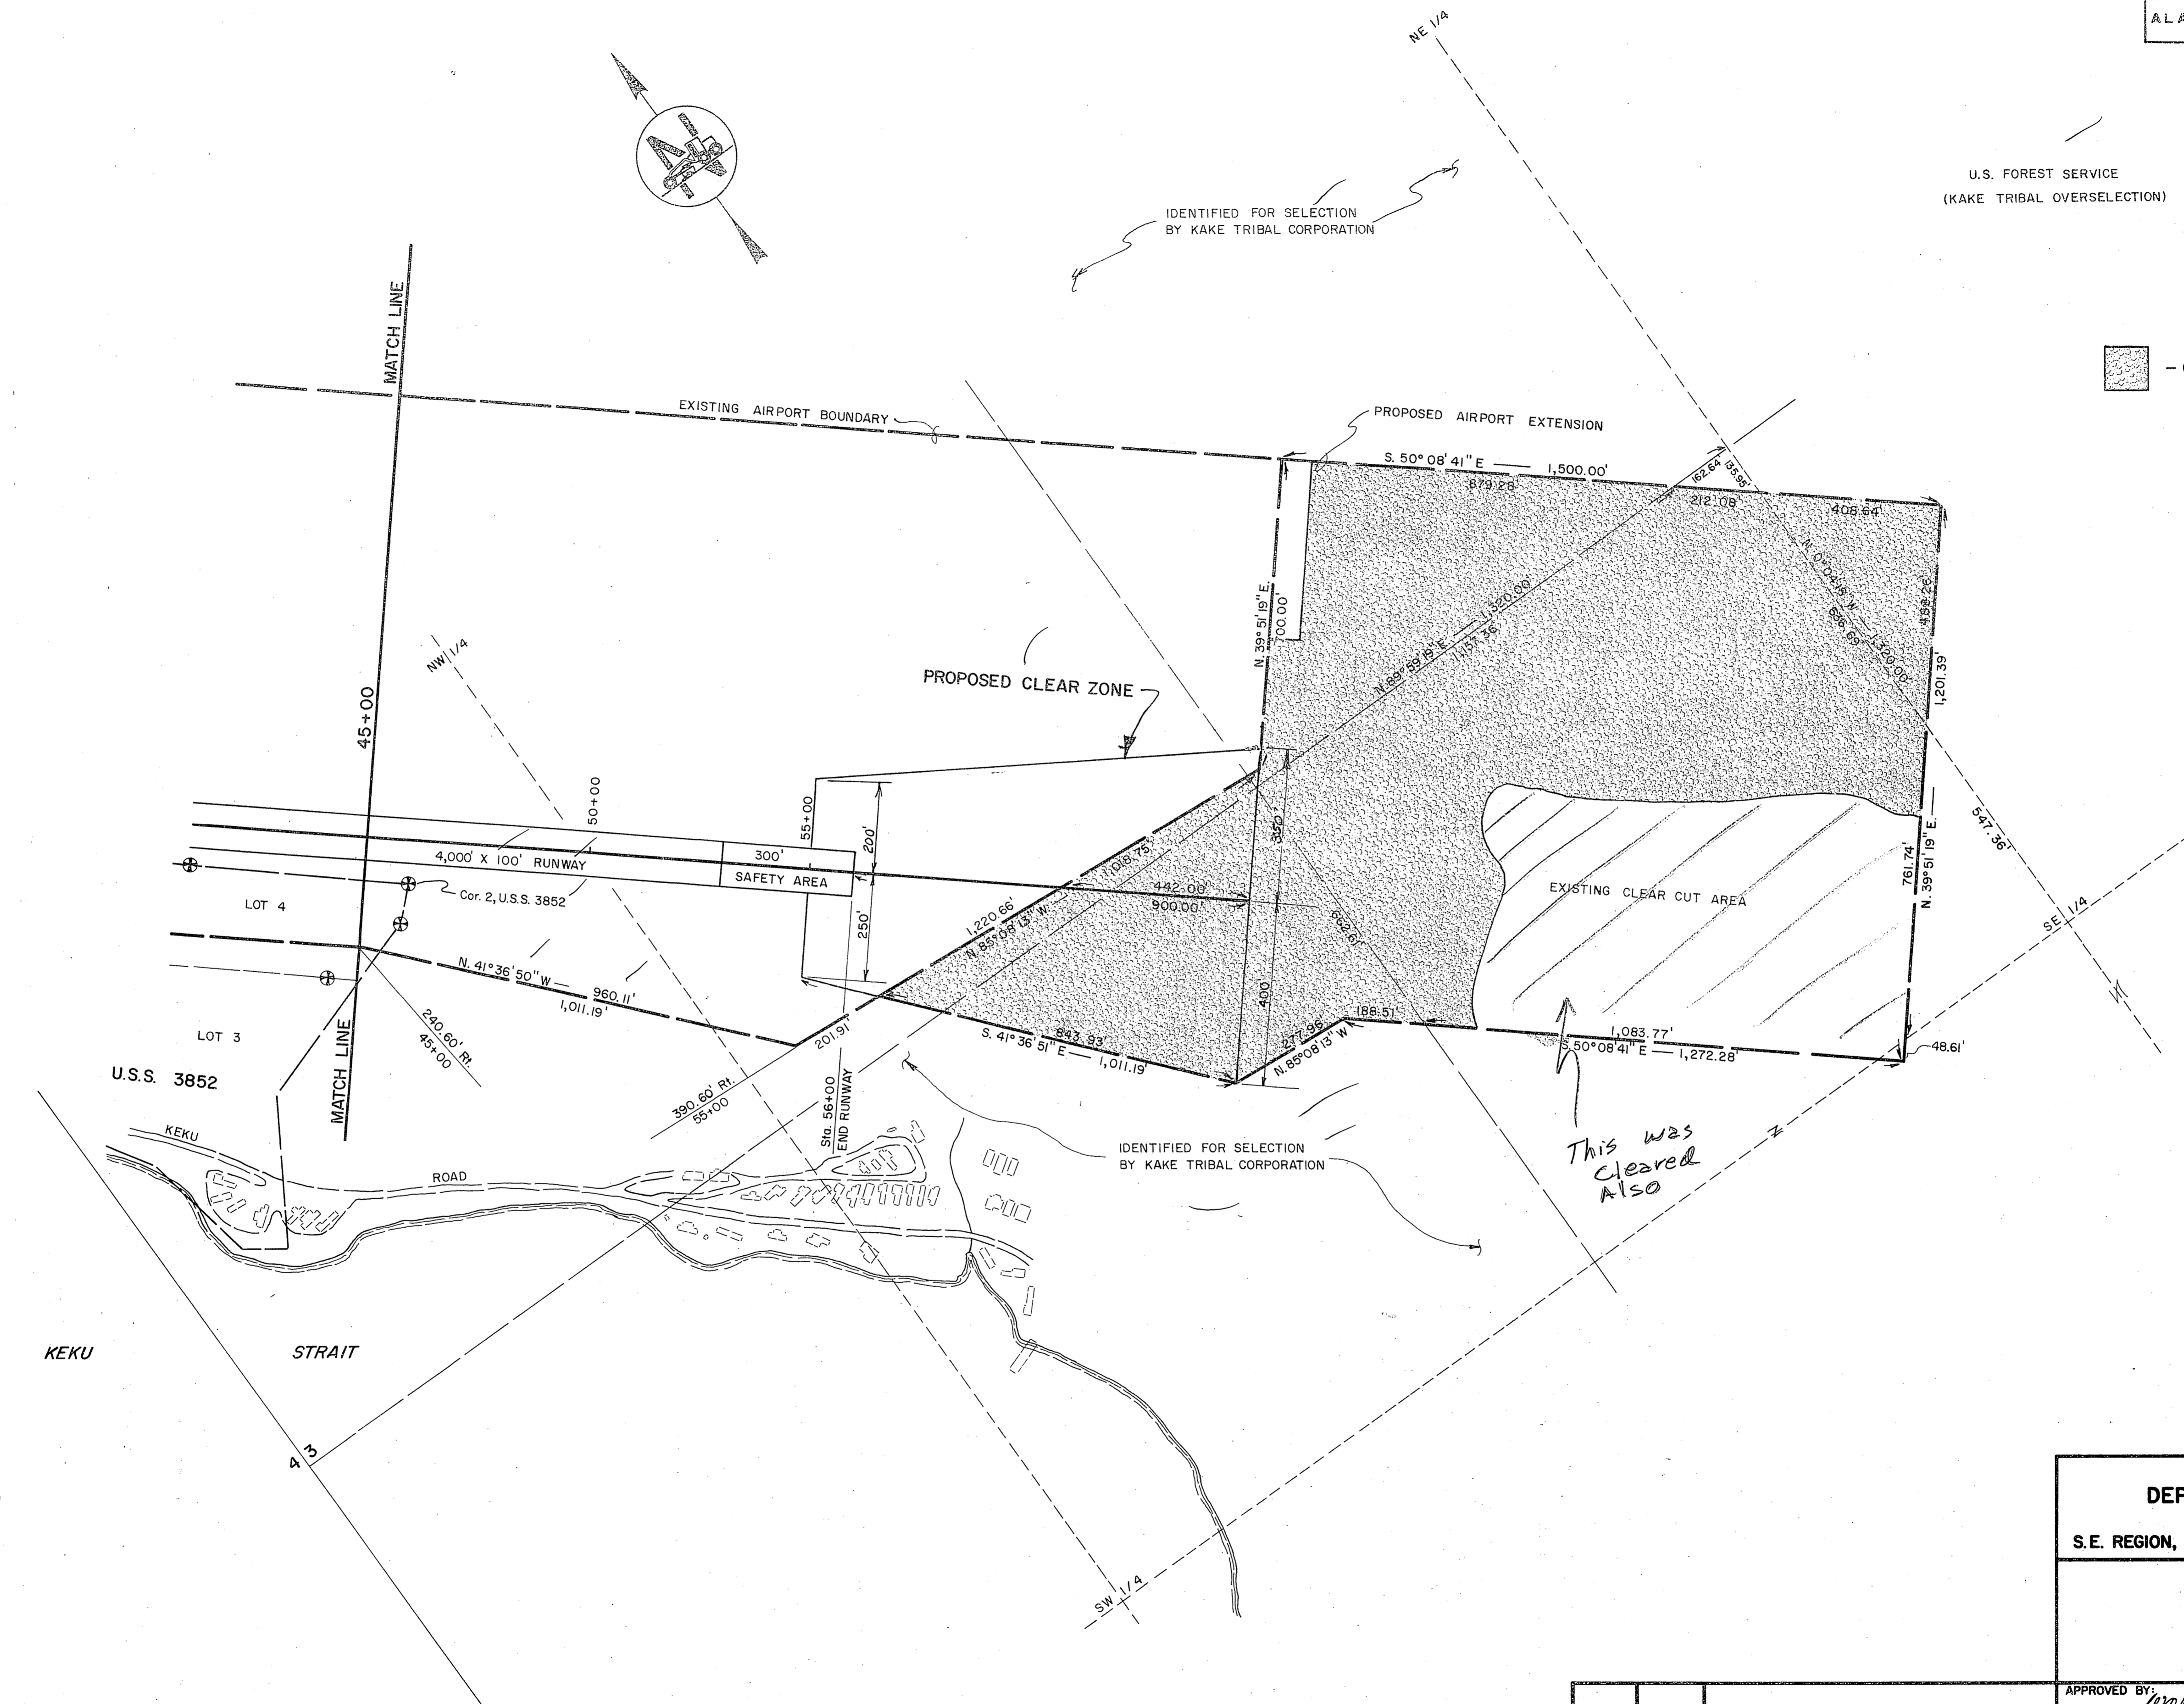

STATE OF ALASKA  
 DEPARTMENT OF TRANSPORTATION  
 AND PUBLIC FACILITIES  
 S.E. REGION, DIVISION OF AVIATION DESIGN & CONSTRUCTION


KAKE AIRPORT  
 PROJECT NO. D-19712  
 A.I.P. NO. 831-3-02-0398-01-83  
 CLEARING PLAN

APPROVED BY:	<i>Wallace K. Williams</i> 8/12/85 WALLACE K. WILLIAMS, P.E. CHIEF OF DESIGN
APPROVED BY:	<i>William L. Baumgartner</i> 8/12/85 WILLIAM L. BAUMGARTNER, P.E. DESIGN CHIEF GROUP "B"
SCALE:	1" = 200'
DESIGNED:	MJC
DRAWN:	SS
CHECKED:	
DATE:	

BY	DATE	CHANGE

REVISIONS




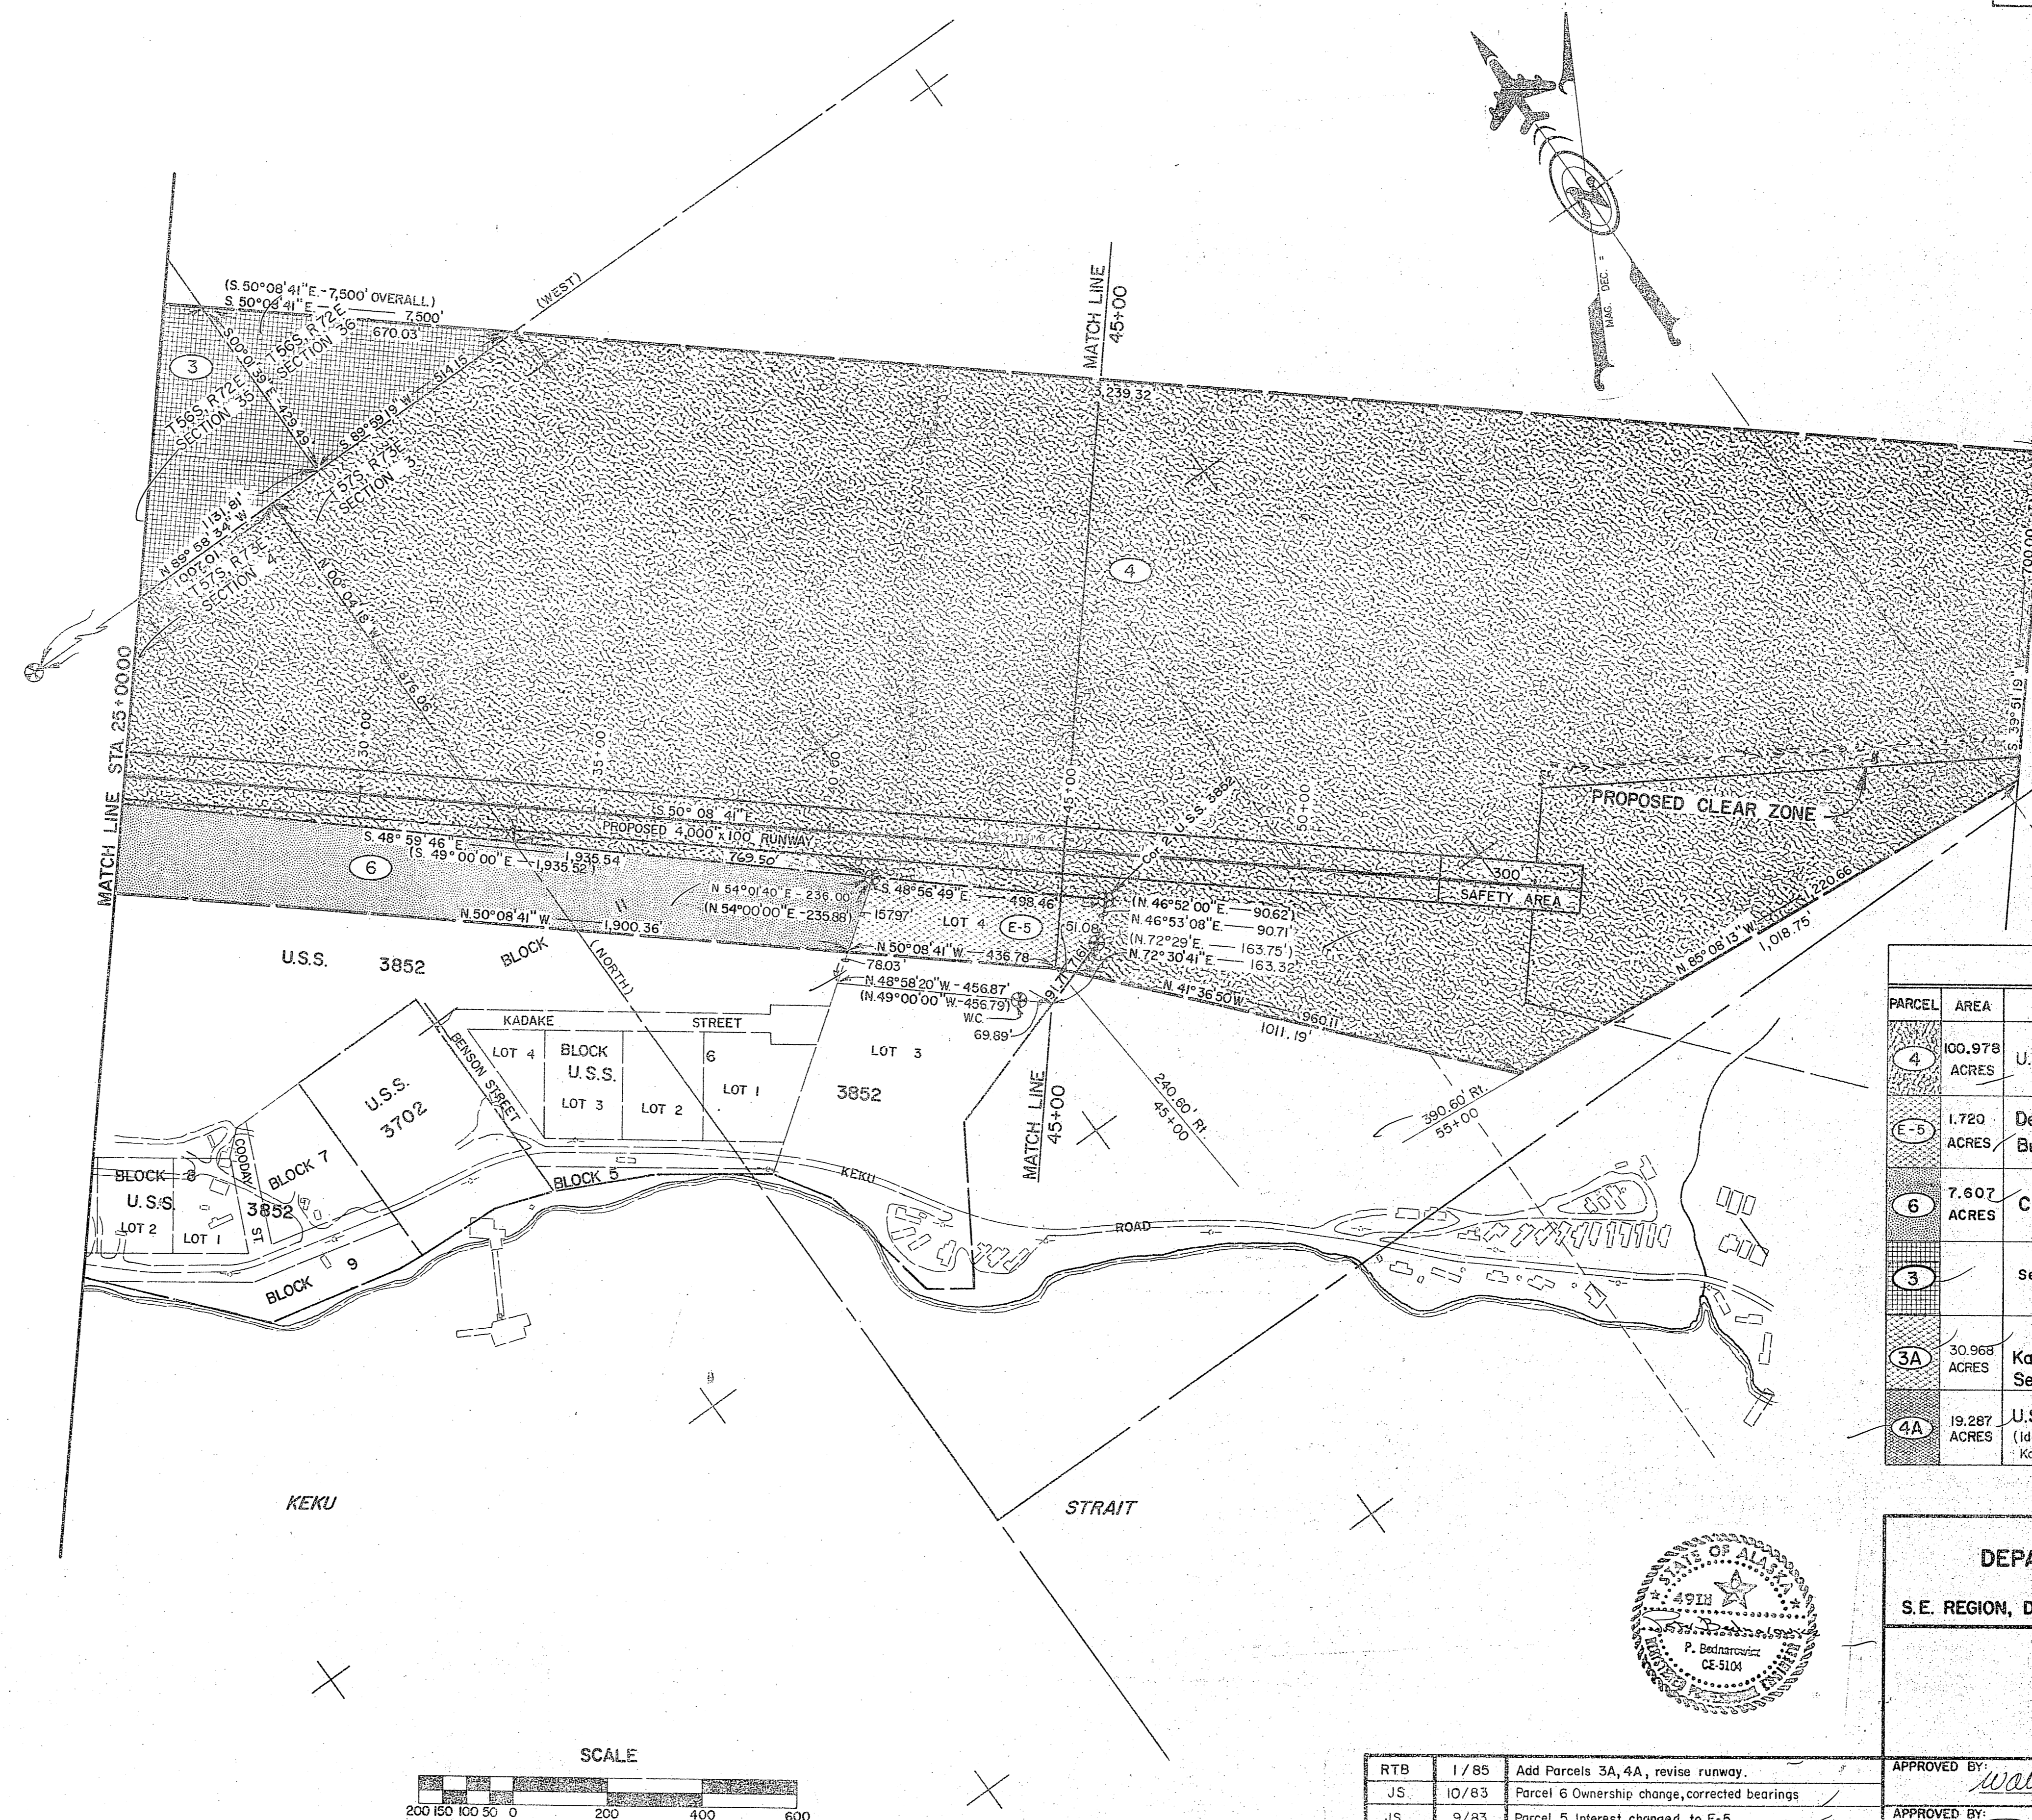

PROPERTY STATUS			
PARCEL	AREA	OWNER	INTEREST
4	100.978 ACRES	U.S. Forest Service	20 year Special Land Use Permit (5/11/84) Fee Simple to be Acquired
E-5	1.720 ACRES	Dept. of the Interior Bureau of Indian Affairs	Perpetual Easement 9/16/83
6	7.607 ACRES	City of Kake	Corp. Warranty Deed 9/7/83
3		See Sheet 22	
3A	30.968 ACRES	IC. 525 and IC. 526 TO Kake Tribal Corporation & Sealaska Corporation	Corp. Warranty Deeds 2/28/85
4A	19.287 ACRES	U.S. Forest Service (Identified for selection by Kake Tribal Corporation)	20 year Special Land Use Permit Fee Simple to be Acquired


STATE OF ALASKA  
DEPARTMENT OF TRANSPORTATION  
AND PUBLIC FACILITIES  
S.E. REGION, DIVISION OF AVIATION DESIGN & CONSTRUCTION

KAKE AIRPORT  
D-19712  
PROPERTY PLAN

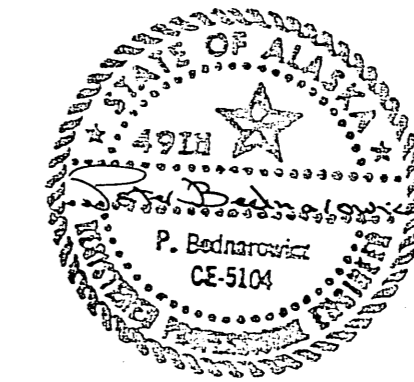



RTB	DATE	CHANGE
	1/85	Add Parcels 3A, 4A, revise runway.
	10/83	Parcel 6 Ownership change, corrected bearings
	9/83	Parcel 5 Interest changed to E-5
	6/83	Corrected Callouts Parcel 3
BY	DATE	CHANGE

APPROVED BY:	<i>Walton K. Williams</i> 5/31/84
APPROVED BY:	<i>Paul Bednarowicz</i> for 9/12/85
SCALE:	1" = 200'
DESIGNED:	GEP
CHECKED:	JS
DATE:	3/83
SHEET 23 OF 25	

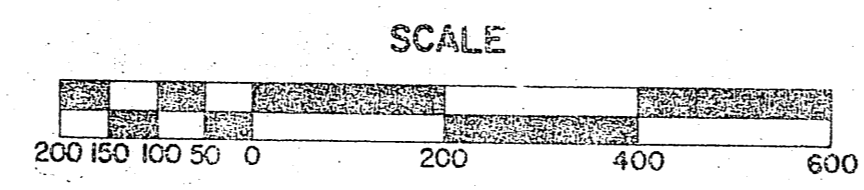


STATE	PROJECT DESIGNATION	YEAR	SHEET NO.	TOTAL SHEETS
ALASKA	D-19712	1984	3	3

U.S. Forest Service  
(KAKE TRIBAL OVERSELECTION)

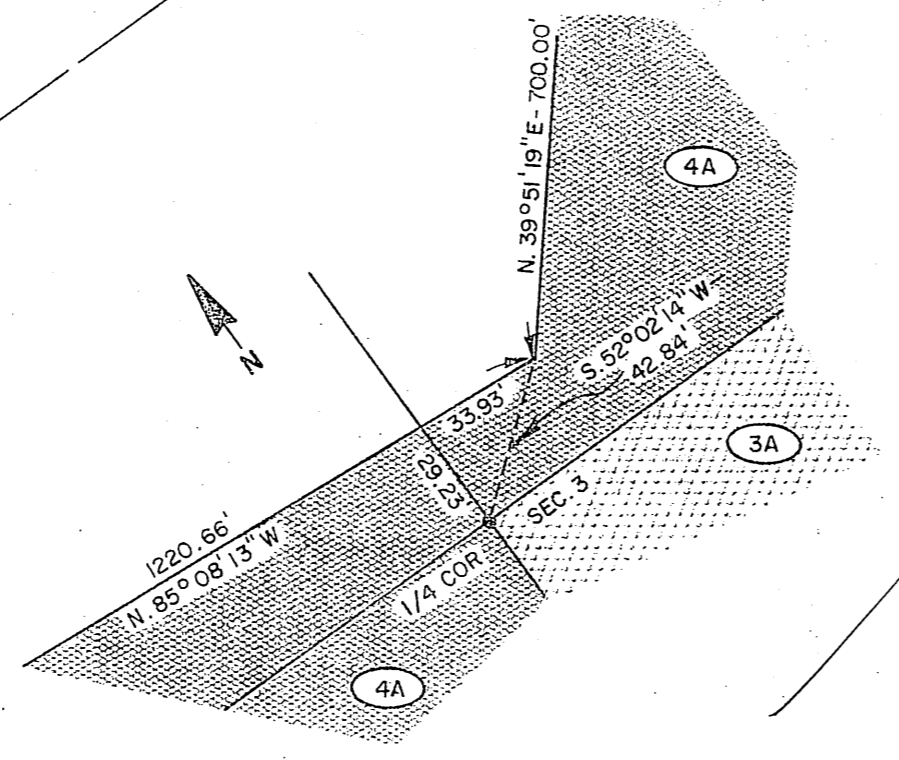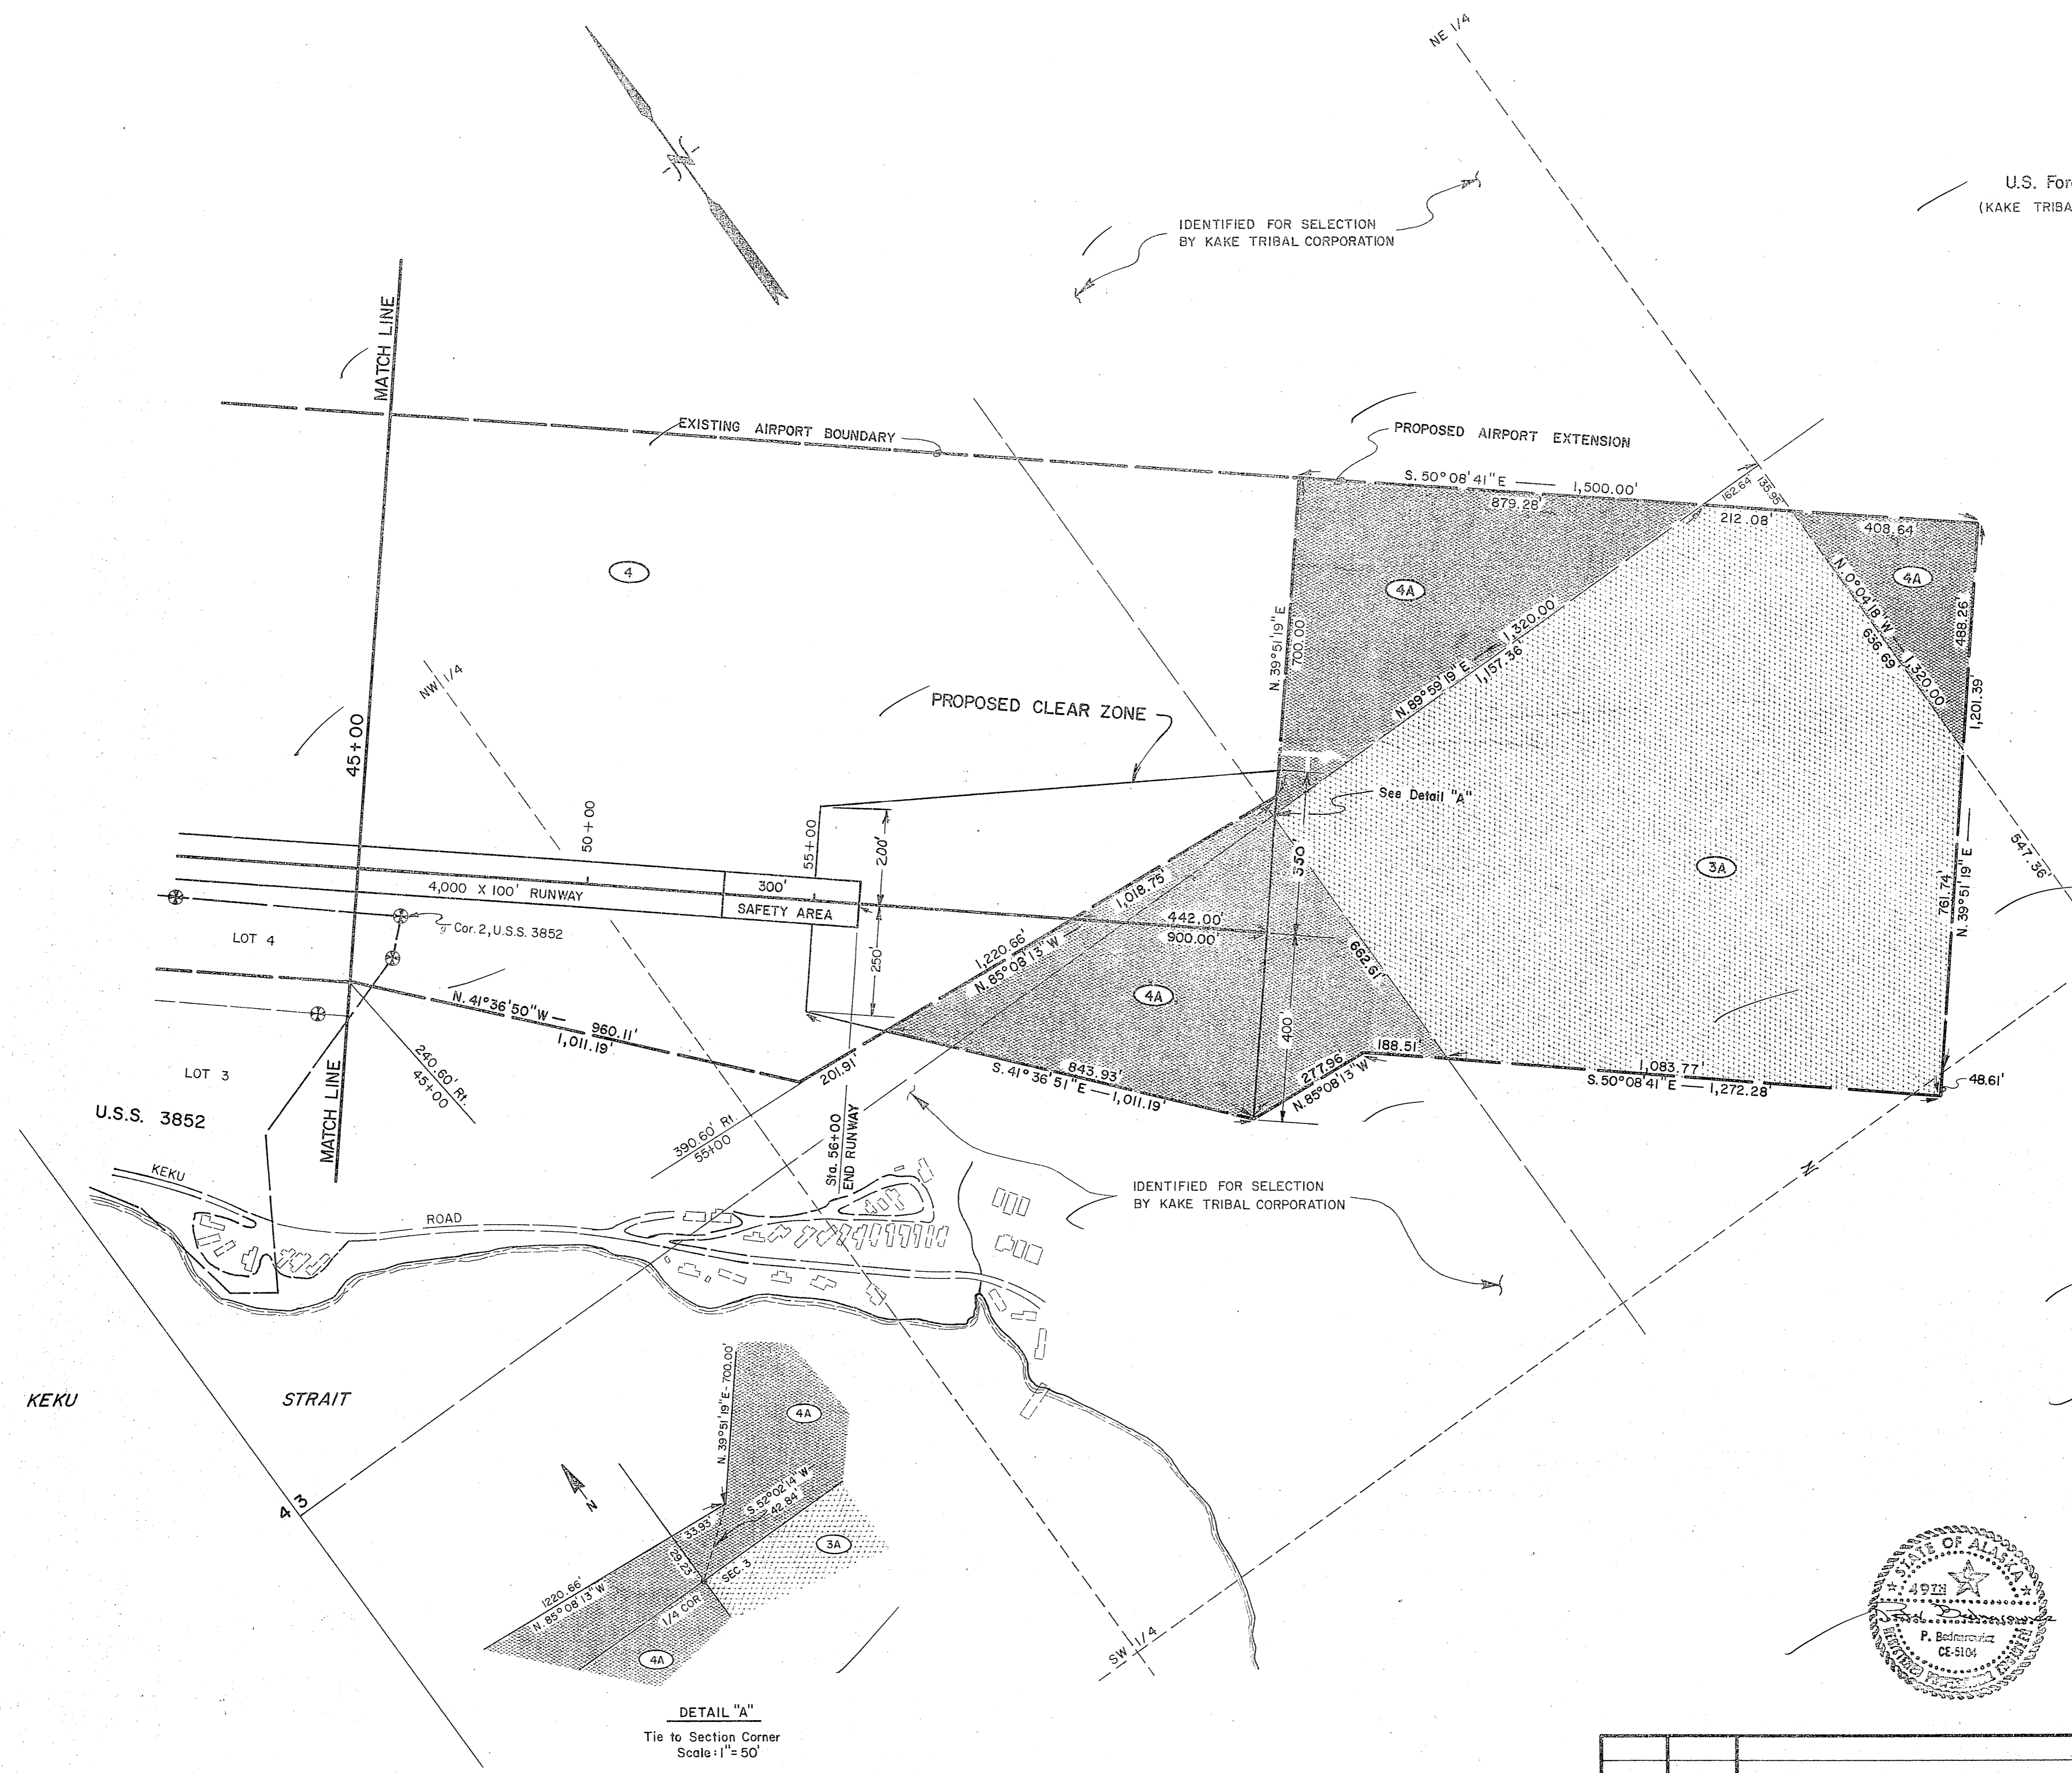

PROPERTY STATUS			
PARCEL	AREA	OWNER	INTEREST
3A	30.968 ACRES	I.C. 525 and I.C. 526 to Kake Tribal Corporation & Sealaska Corporation	Corp. Warranty Deeds 2 / 28 / 85
4A	19.287 ACRES	U.S. Forest Service (Identified for selection by Kake Tribal Corporation)	20 year Special Land Use Permit Fee Simple to be Acquired







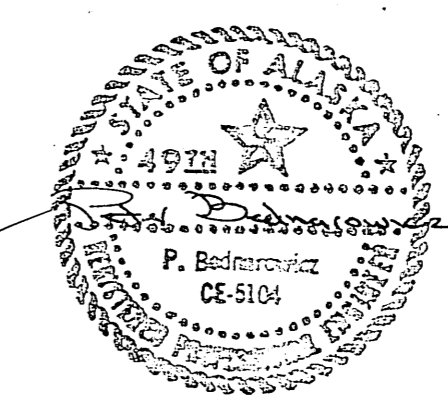


STATE OF ALASKA  
DEPARTMENT OF TRANSPORTATION  
AND PUBLIC FACILITIES  
S.E. REGION, DIVISION OF AVIATION DESIGN & CONSTRUCTION

KAKE AIRPORT  
D-19712  
PROPERTY PLAN

APPROVED BY:		<i>Walter K Williams</i> 1/22/85	
APPROVED BY:		<i>Peter Bednarek</i> 1/8/85	
RTB	1/85	Add Sheet 3, Parcels 3A, 4A, revise runway.	
BY	DATE	CHANGE	
REVISIONS			
SCALE:	DESIGNED:	DRAWN:	RTB
1" = 200'	CHECKED:	DATE:	1/85
	JS		
			SHEET 24 OF 25

\* Slope shall be  $\frac{1}{2}$  flat for PAPI pads located at Sta. "0" 20+50 and Sta. 2+0 for R" 42+30 "R" 42+30.

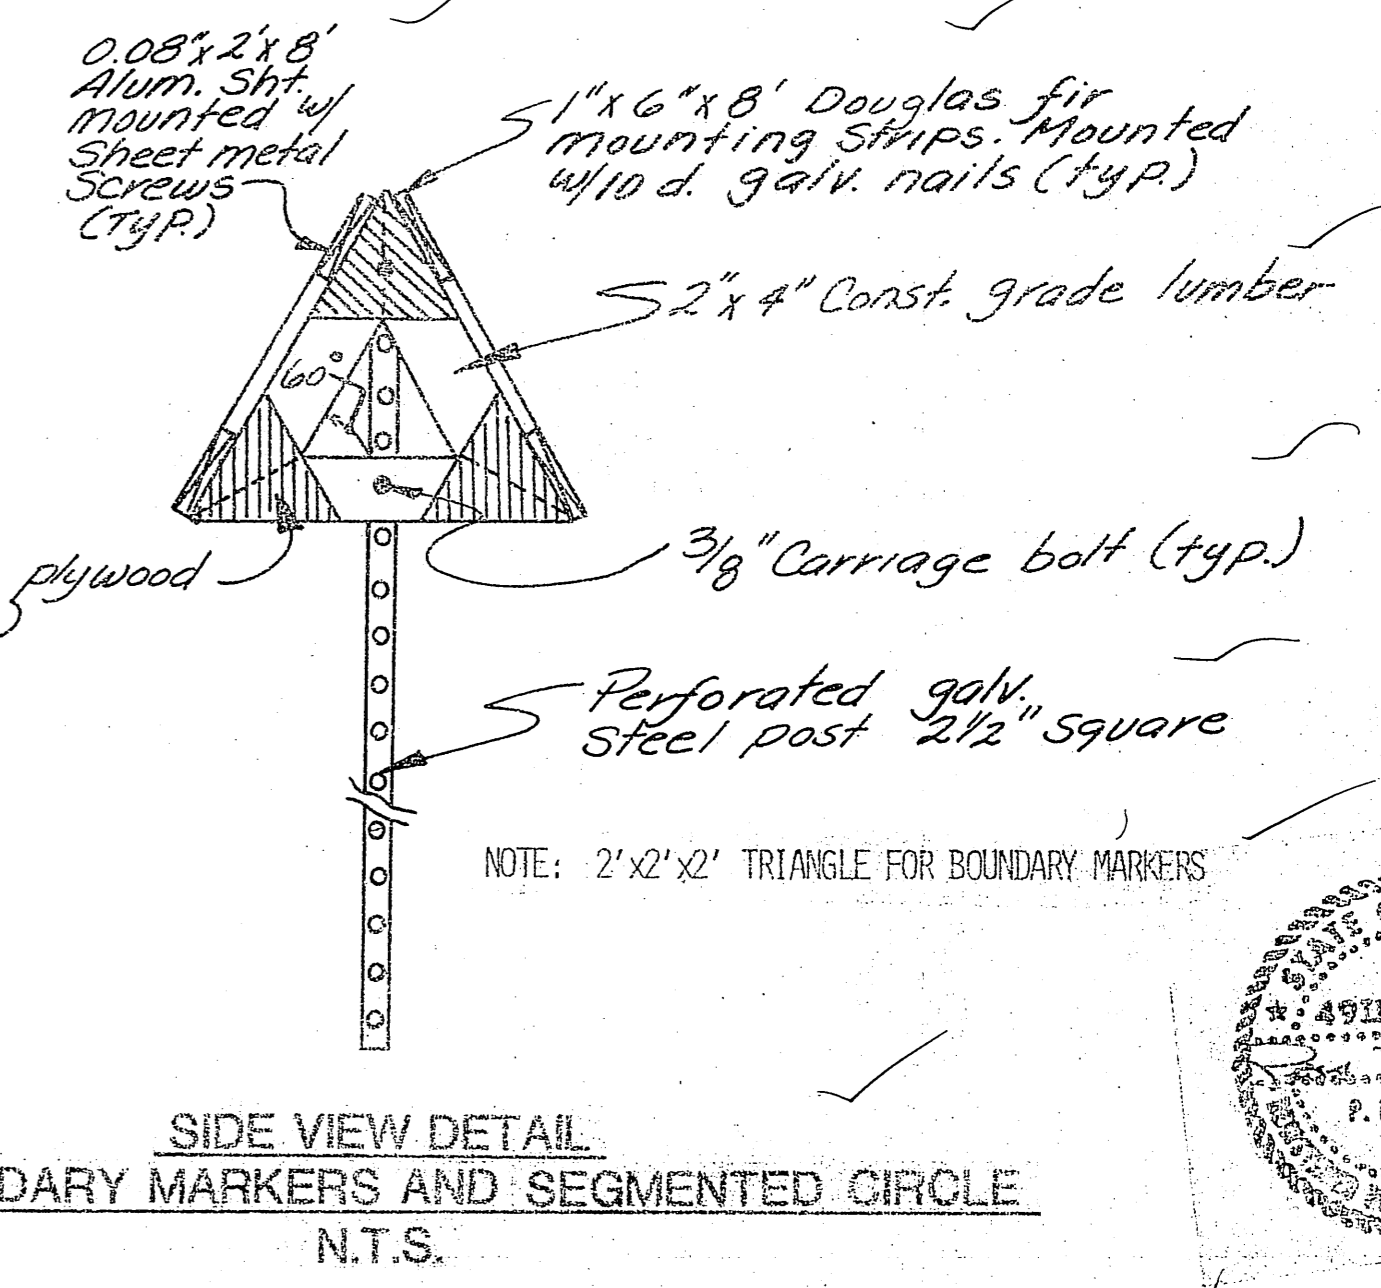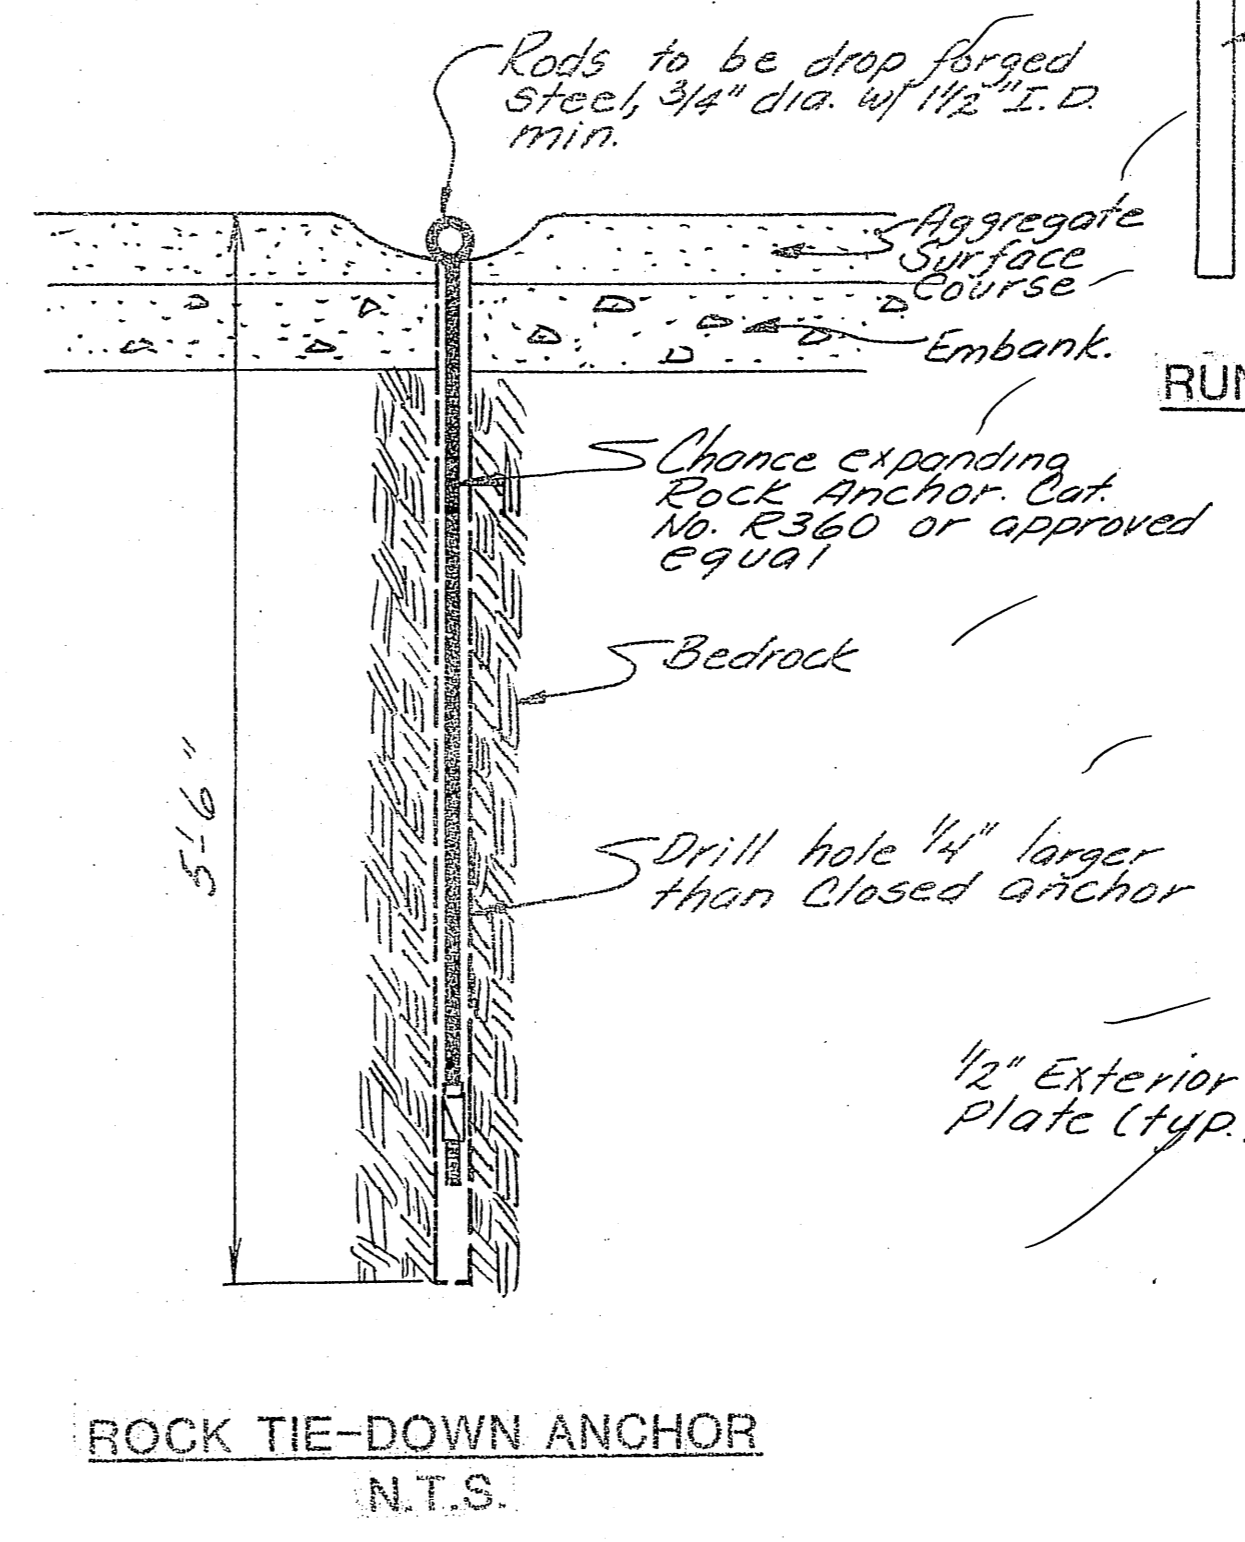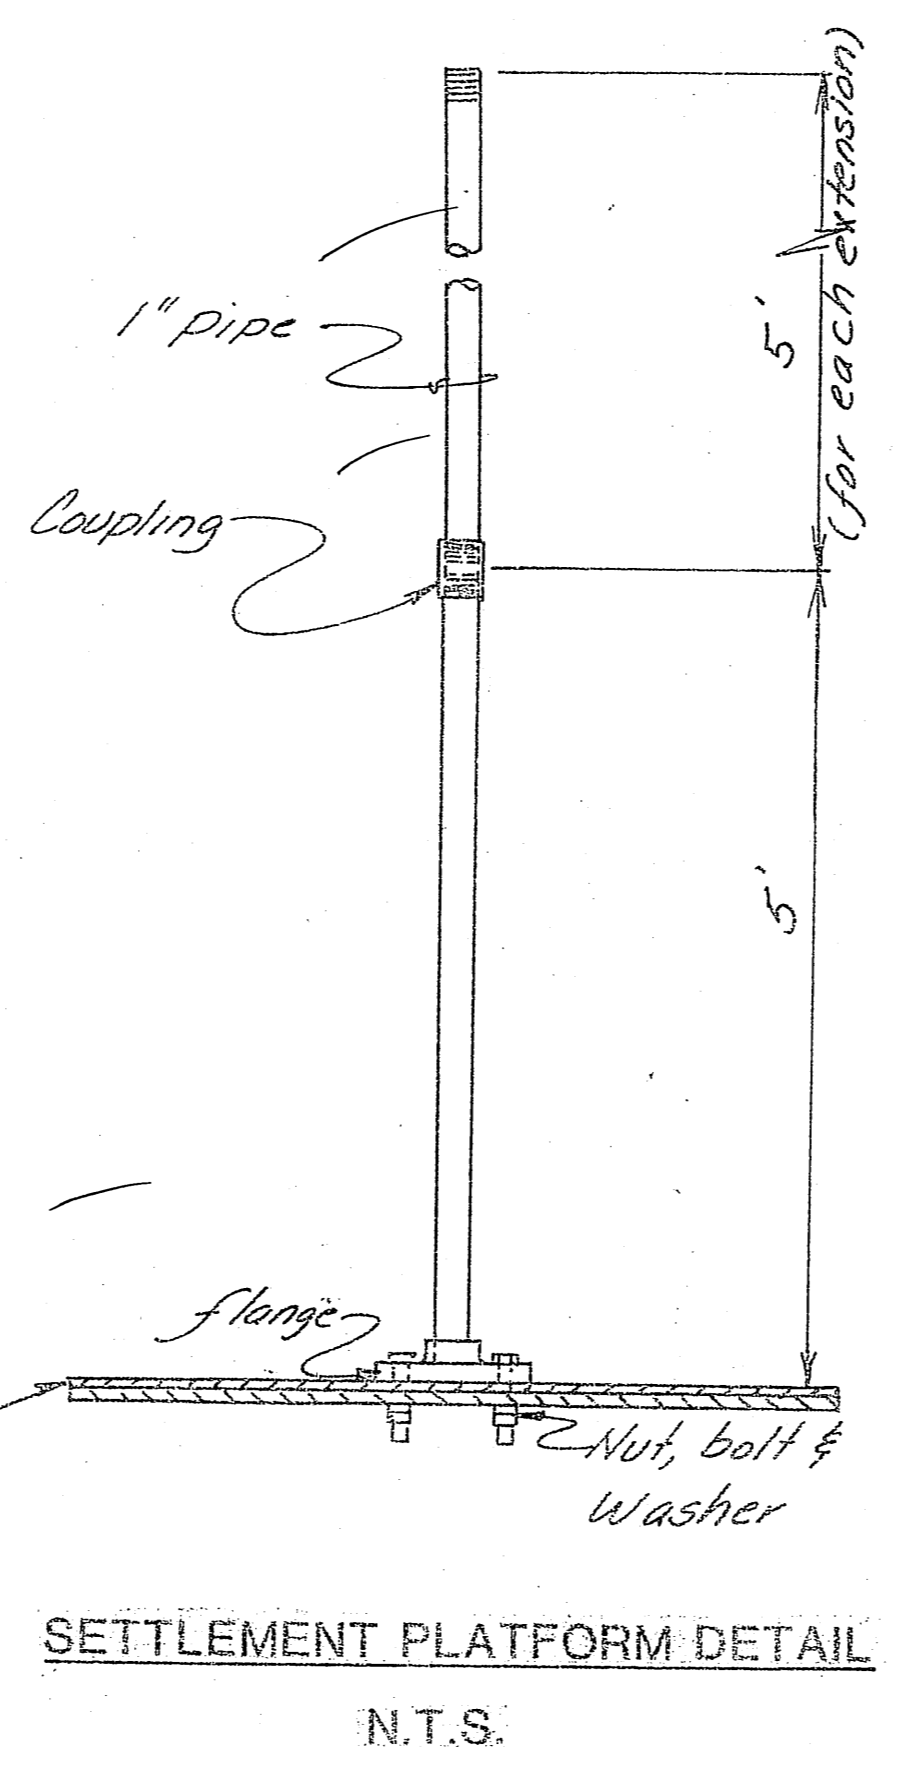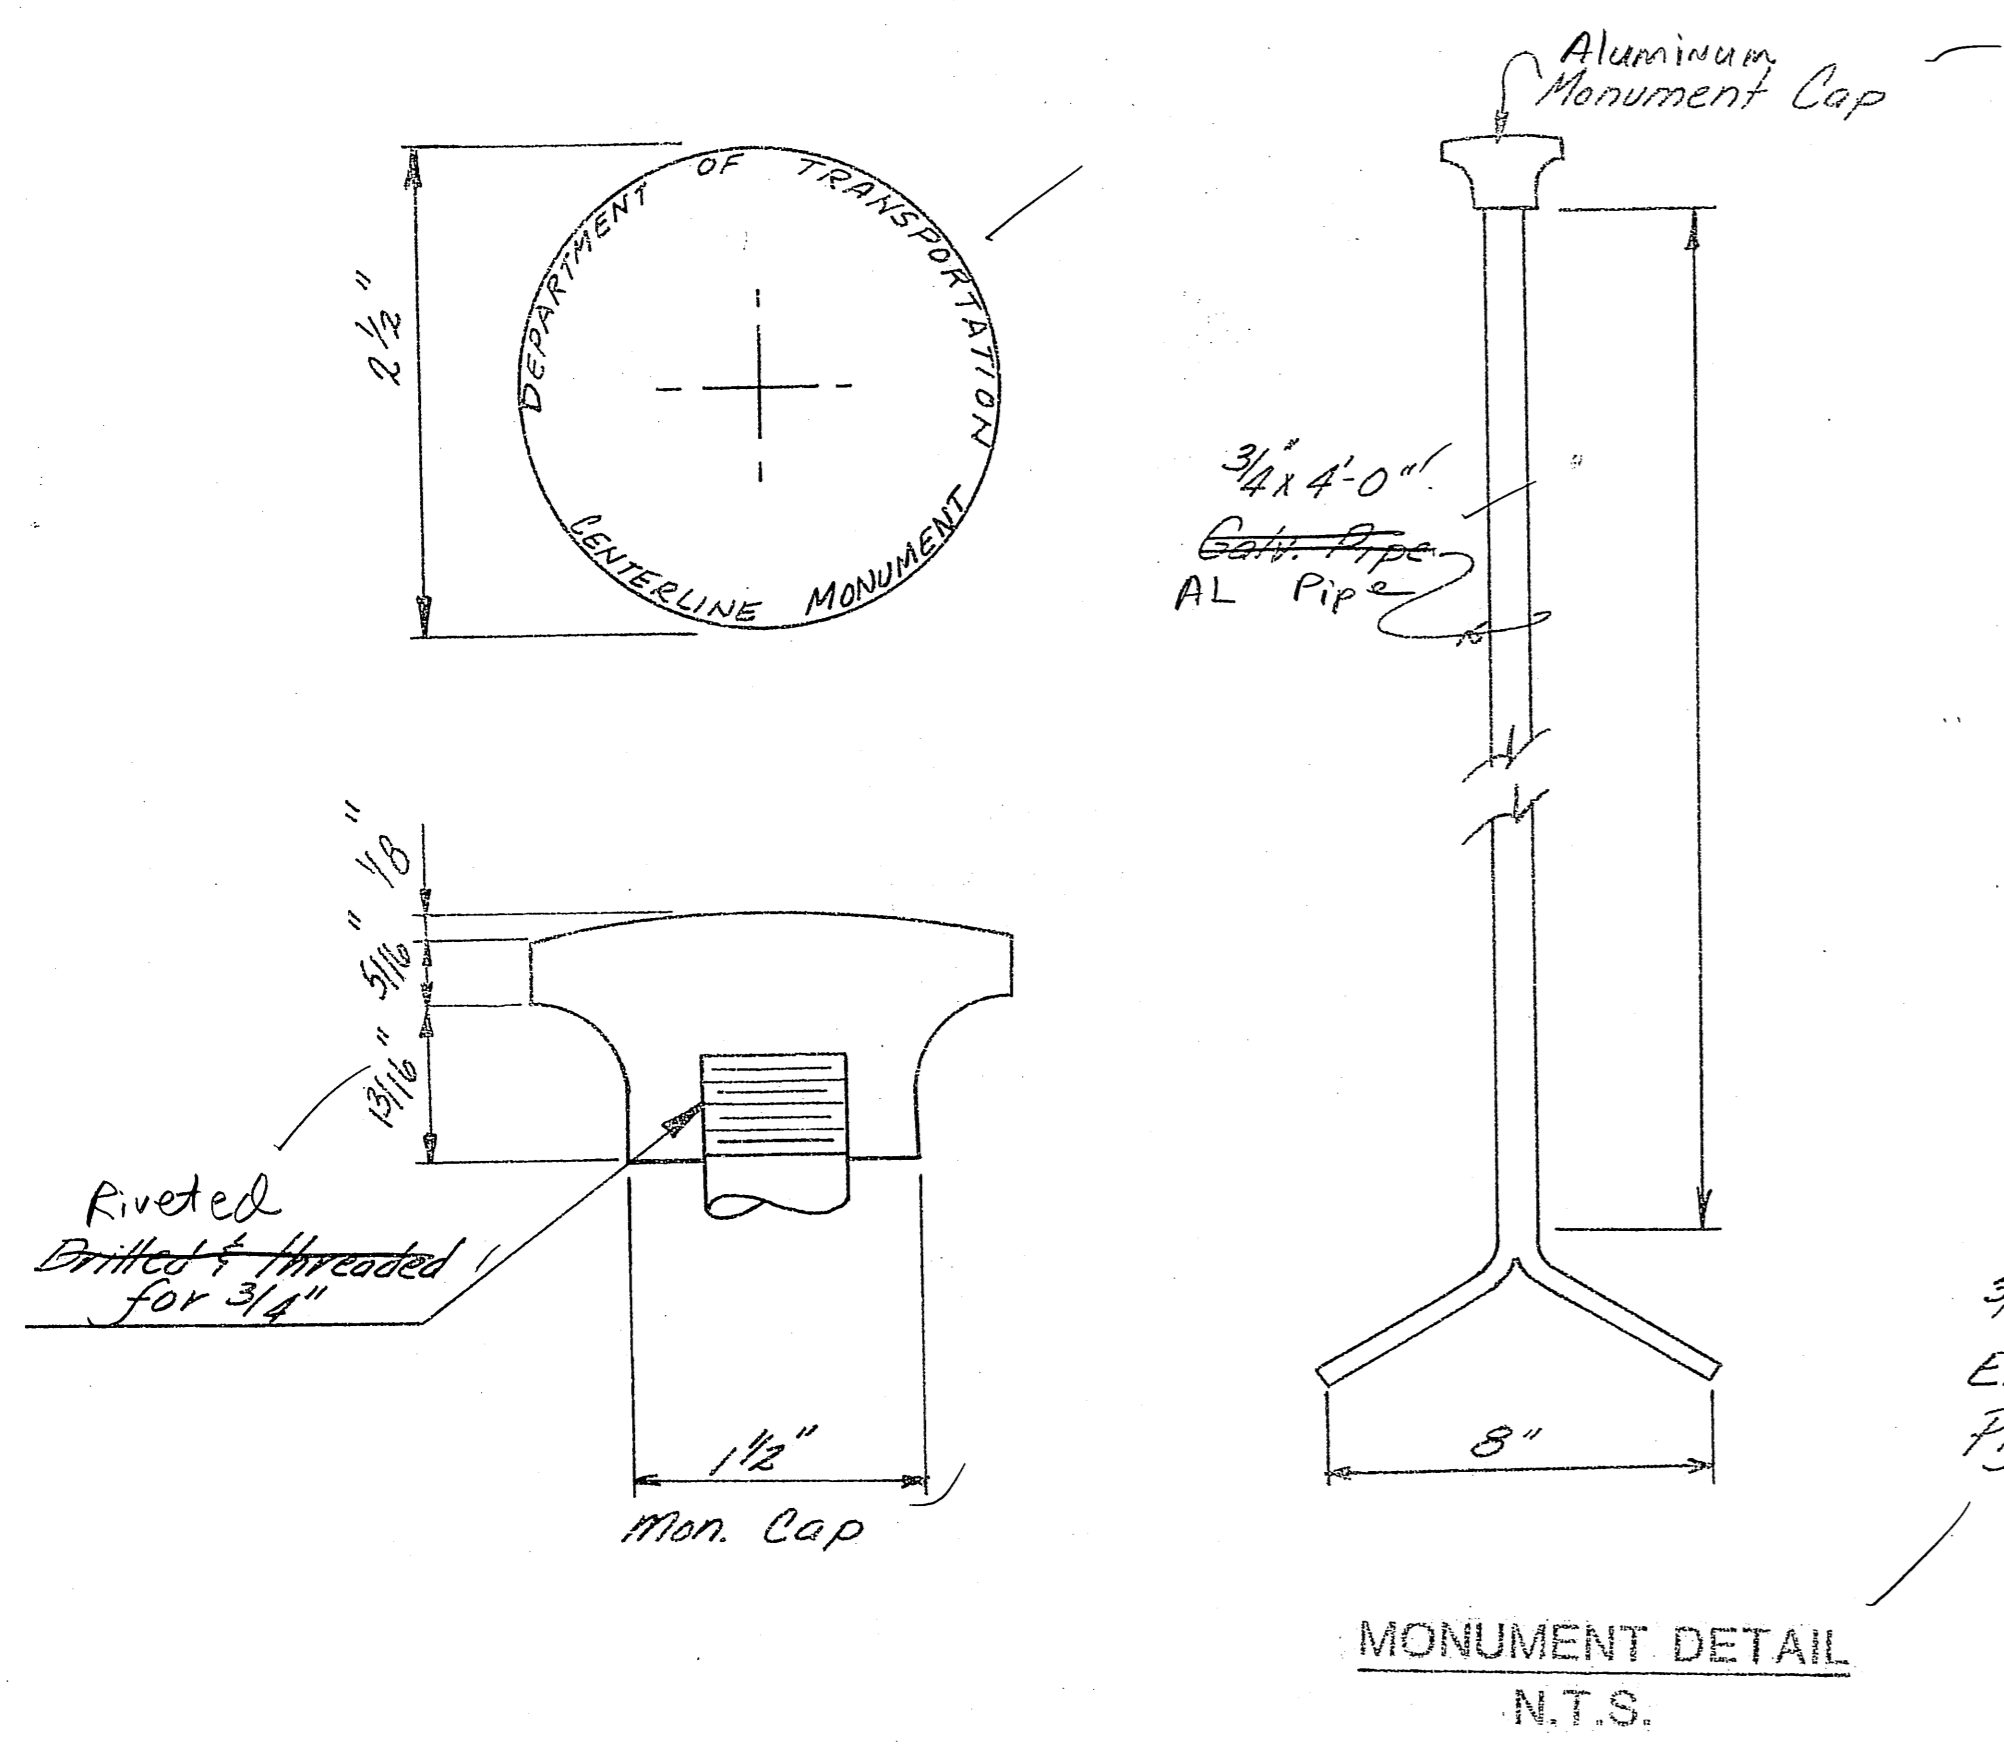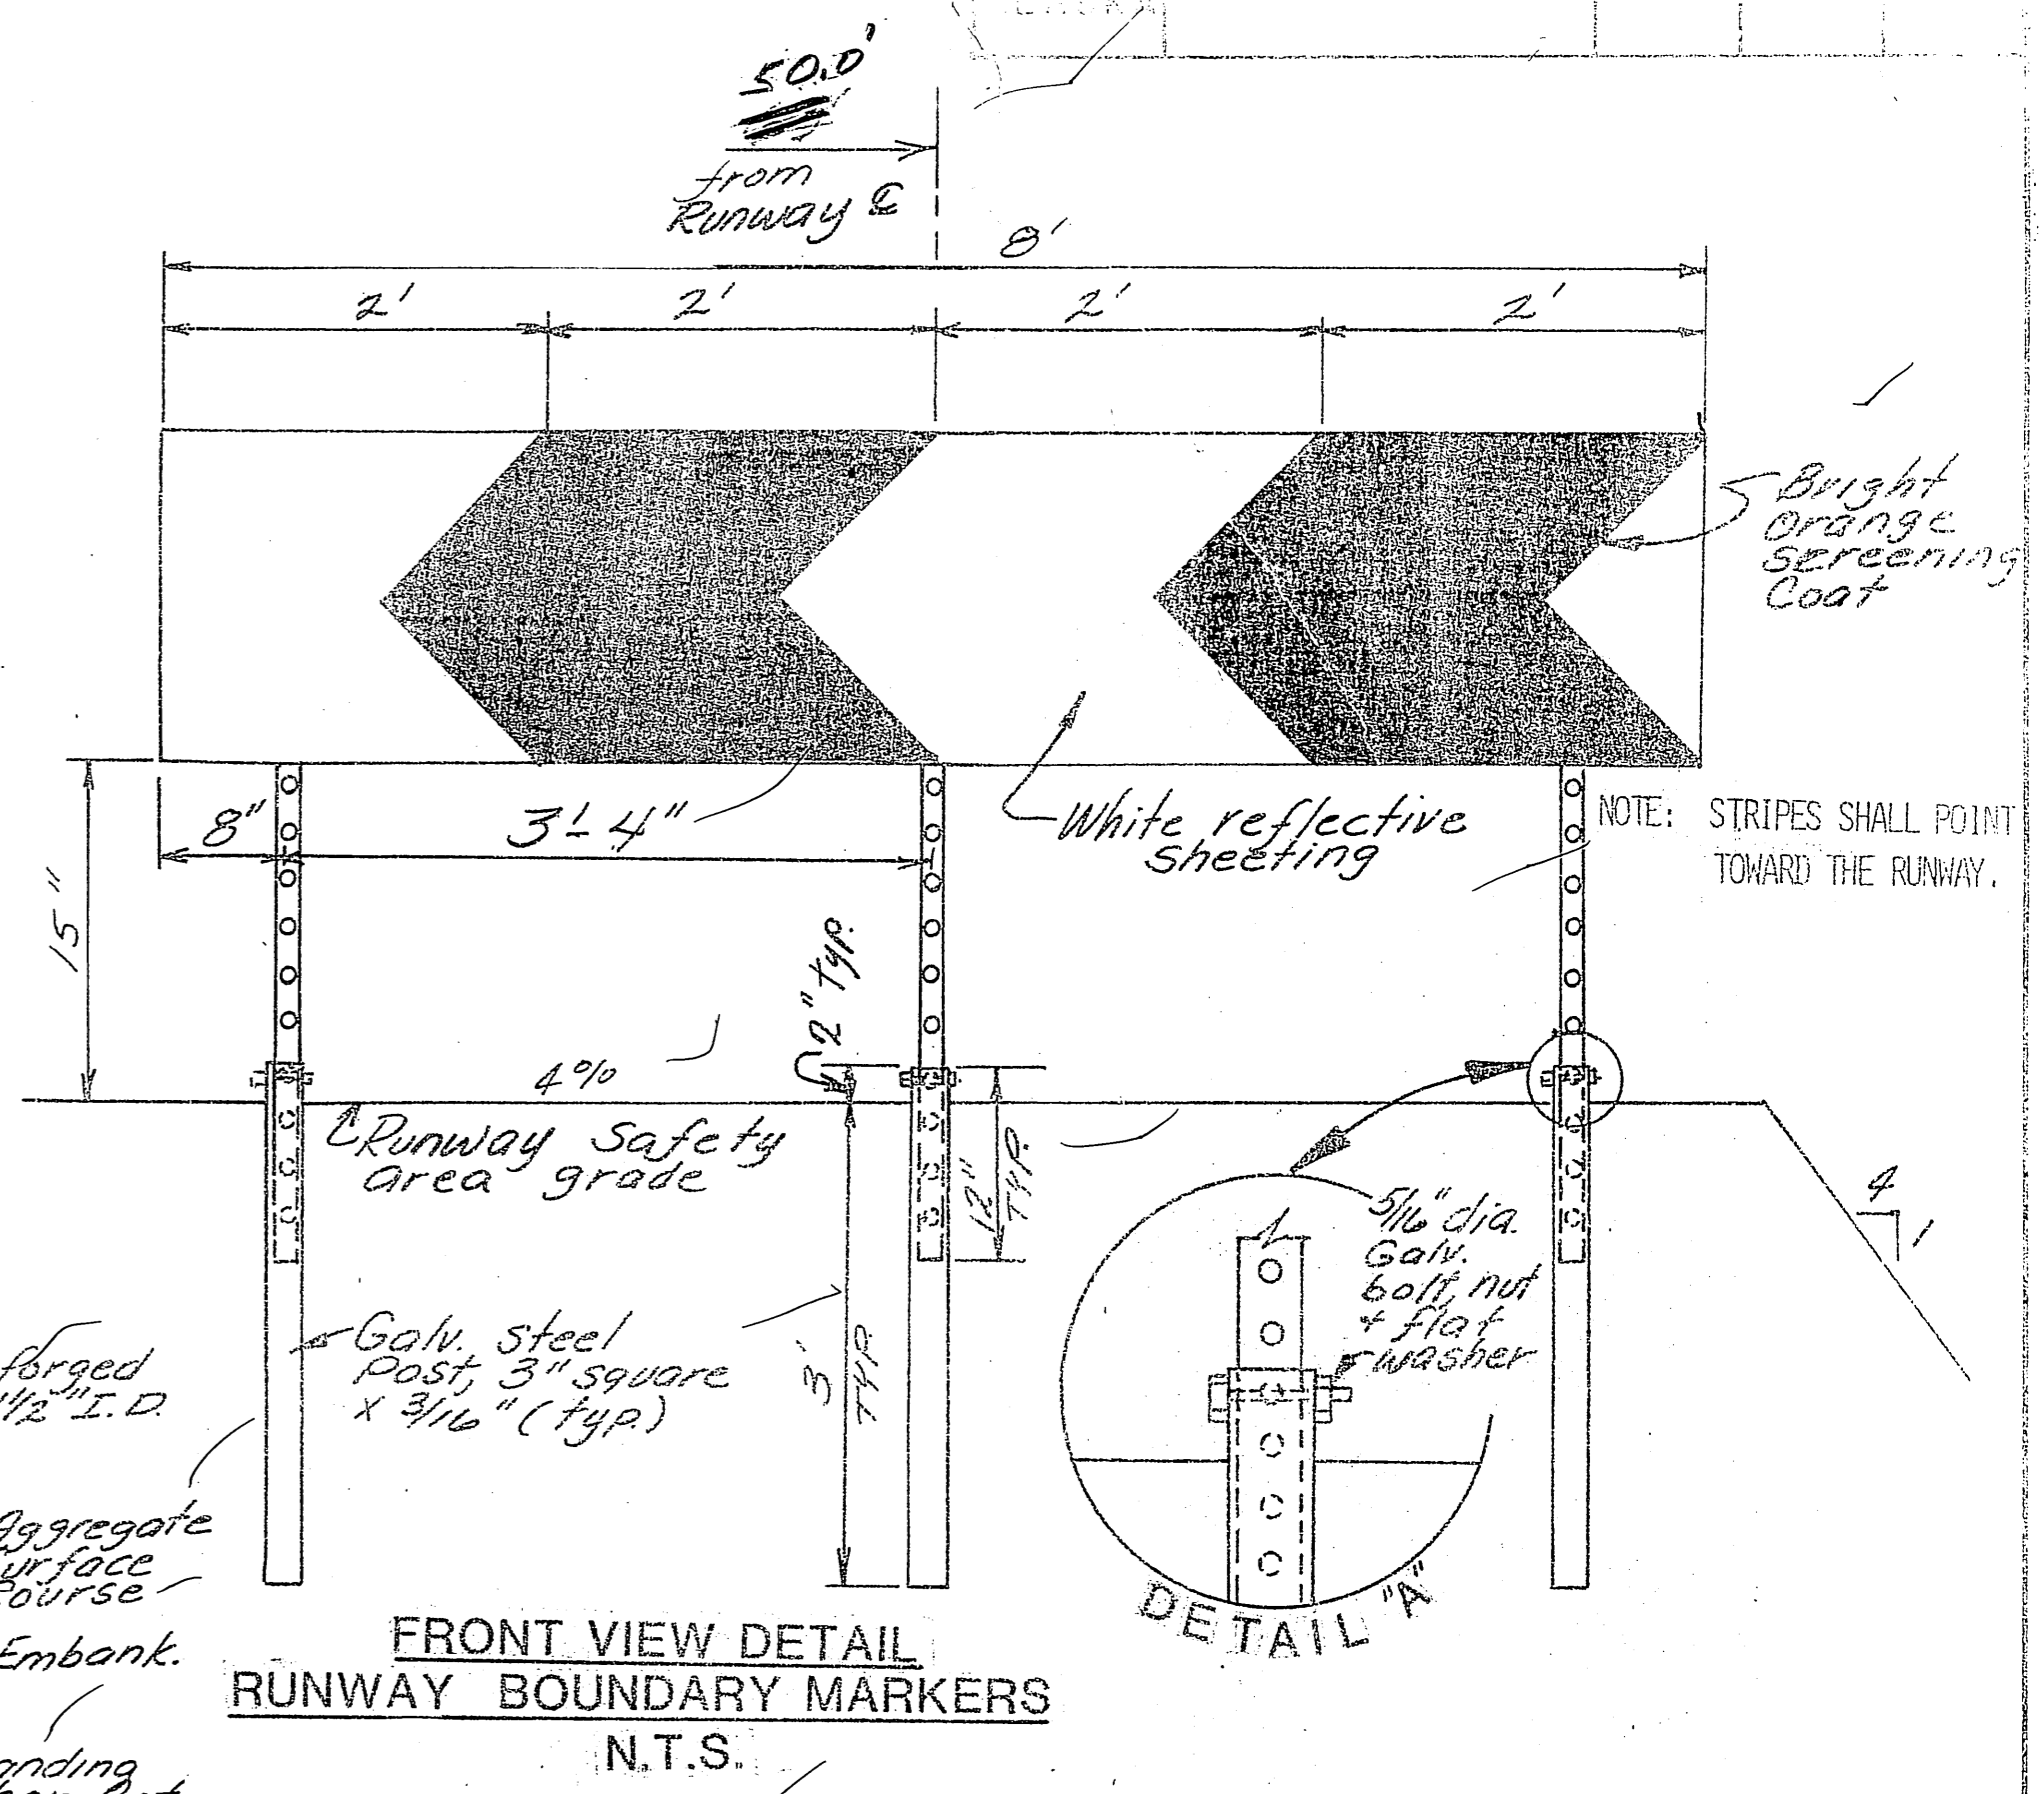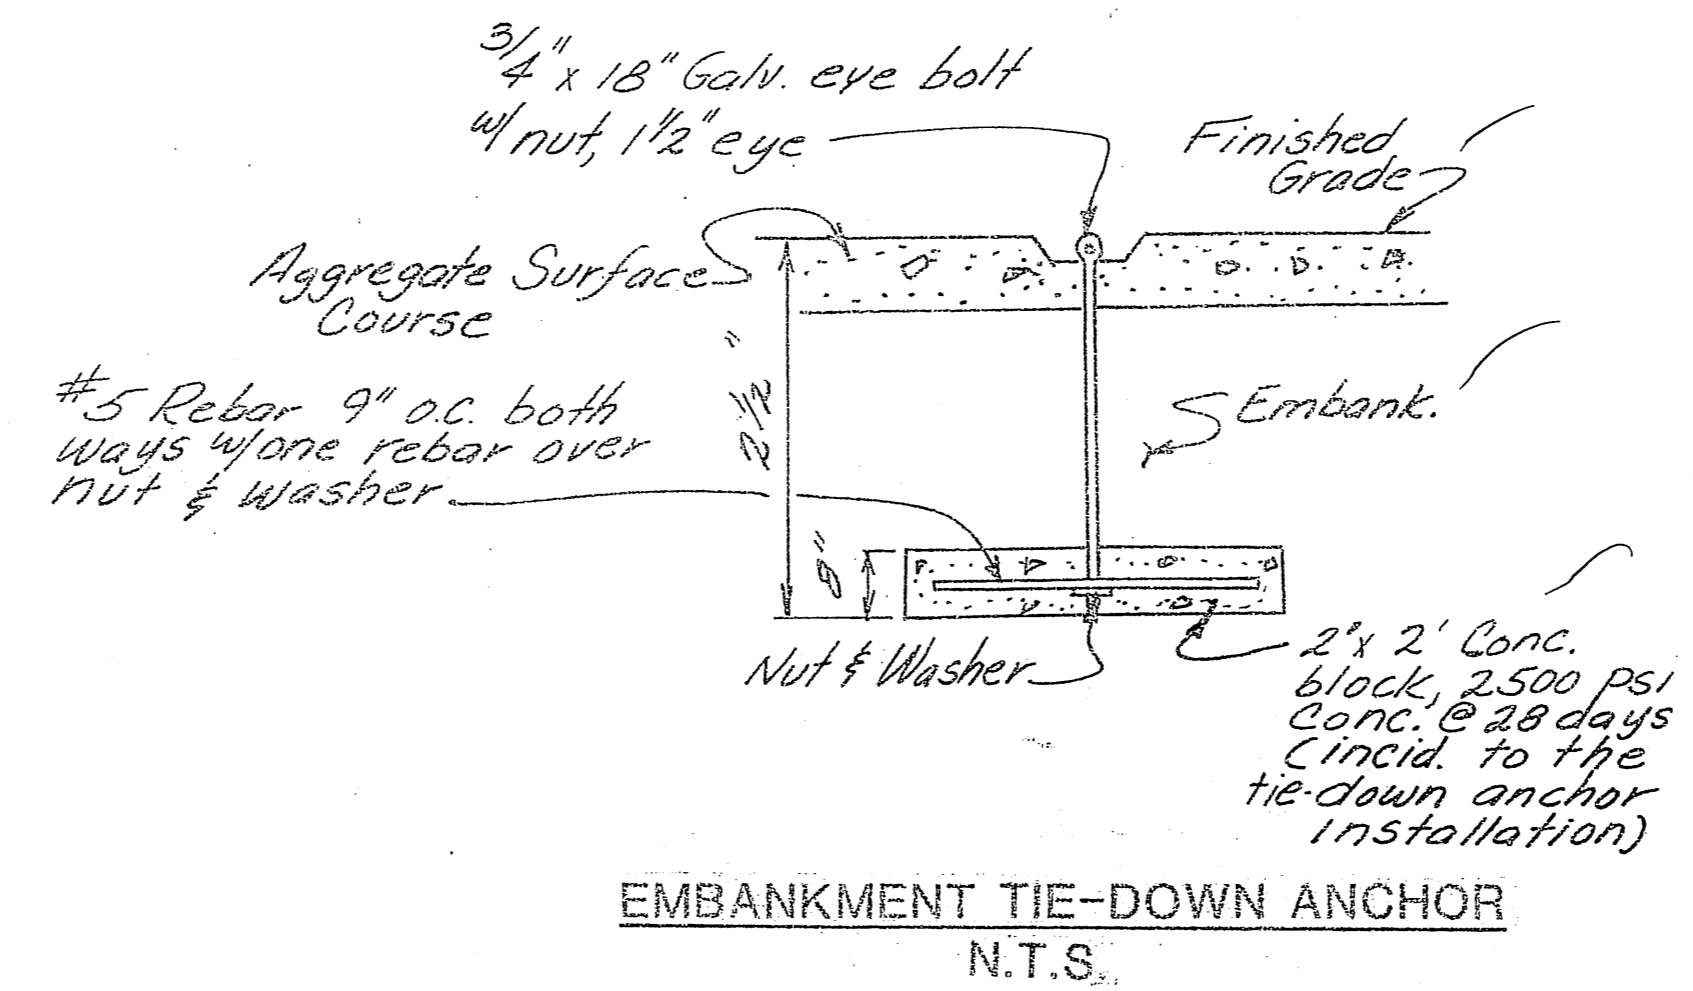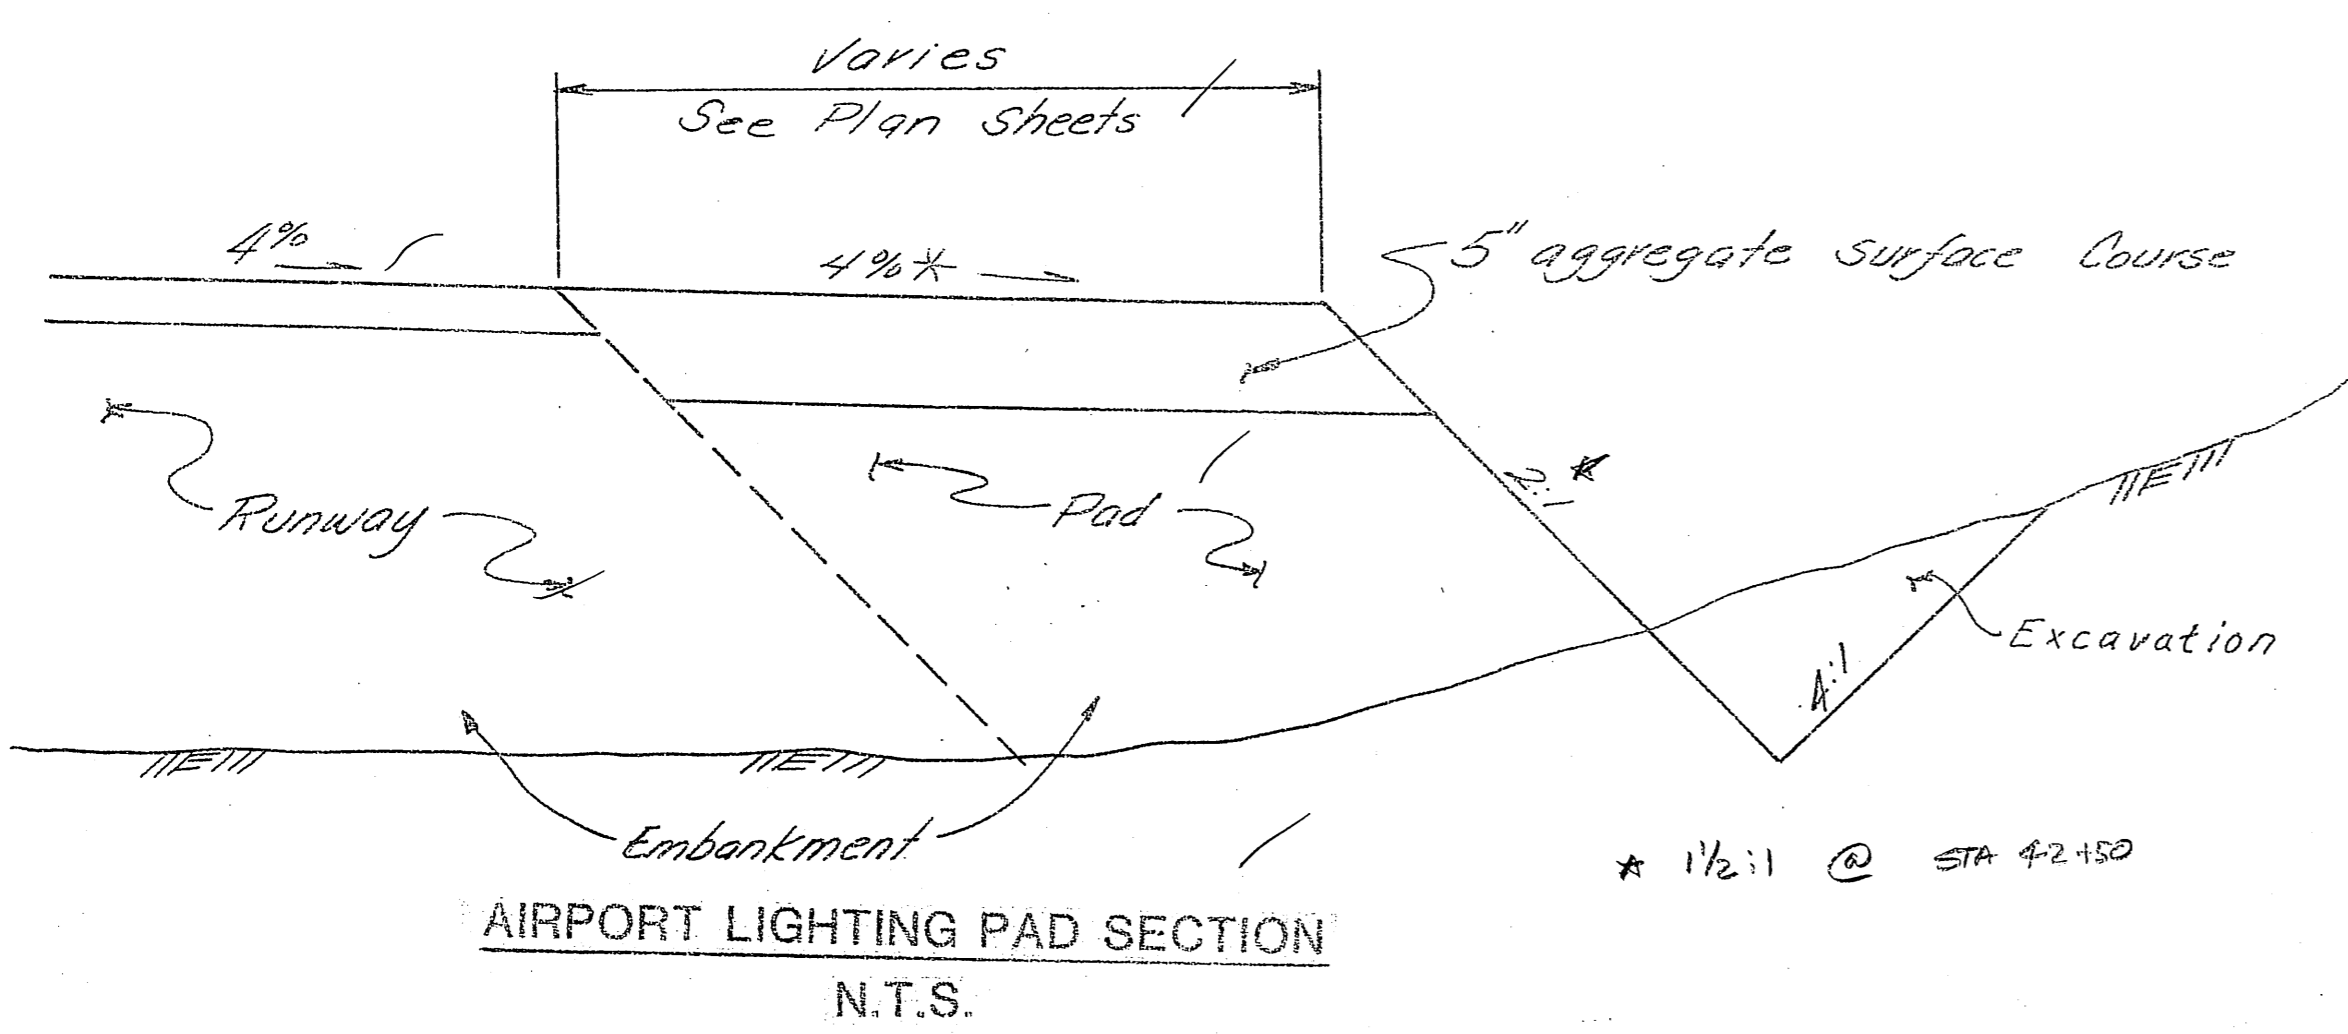


MONUMENT DETAIL NOTES

1. IN SOLID ROCK, DRILL A 2" DIA. HOLE A MINIMUM OF 1'-0" DEEP. FILL WITH MORTAR AND SET CAP 3/4" x 9" GALVANIZED PIPE, DESIGNATED LENGTH WHEN SET IN MORTAR.
2. MONUMENTS SHALL BE PLACED 6" BELOW TOP OF THE FINISHED SURFACE.

TIE-DOWN ANCHOR NOTES

1. IT IS THE CONTRACTOR'S RESPONSIBILITY TO VERIFY THE TYPE OF MATERIAL IN THE TIE-DOWNS.
2. DEPTH OF ANCHOR SHALL BE AS REQUIRED TO DEVELOP 5000 LBS. OF PULL-OUT STRENGTH PER ANCHOR.
3. WHEN ROCK IS ENCOUNTERED, ROCK ANCHORS SHALL BE USED. ROD DIAMETER SHALL BE 3/4"
4. ALL EYE-BOLTS SHALL BE ASTM A-36, 40,000 P.S.I. MIN. YIELD STRENGTH.

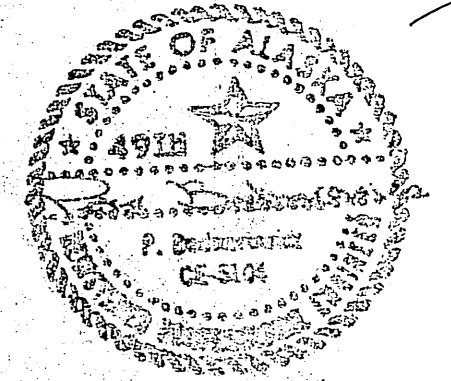

STATE OF ALASKA  
DEPARTMENT OF TRANSPORTATION  
AND PUBLIC FACILITIES  
S.E. REGION, DIVISION OF AVIATION DESIGN & CONSTRUCTION


KAKE AIRPORT  
PROJECT NO. D-19712  
A.I.P. NO. 831-3-02-0398-01-83  
MISC. DETAILS

APPROVED BY: *Wallace K. Williams* 8/12/85  
WALLACE K. WILLIAMS, P.E. CHIEF OF DESIGN


APPROVED BY: *William L. Baumgartner* 8/12/85  
WILLIAM L. BAUMGARTNER, P.E. DESIGN CHIEF GROUP "B"

BY	DATE	CHANGE

SCALE: NO SCALE  
DESIGNED: MJC  
DRAWN: SS  
CHECKED: MJC  
DATE: 8/12/85  
SHEET 25 OF 25

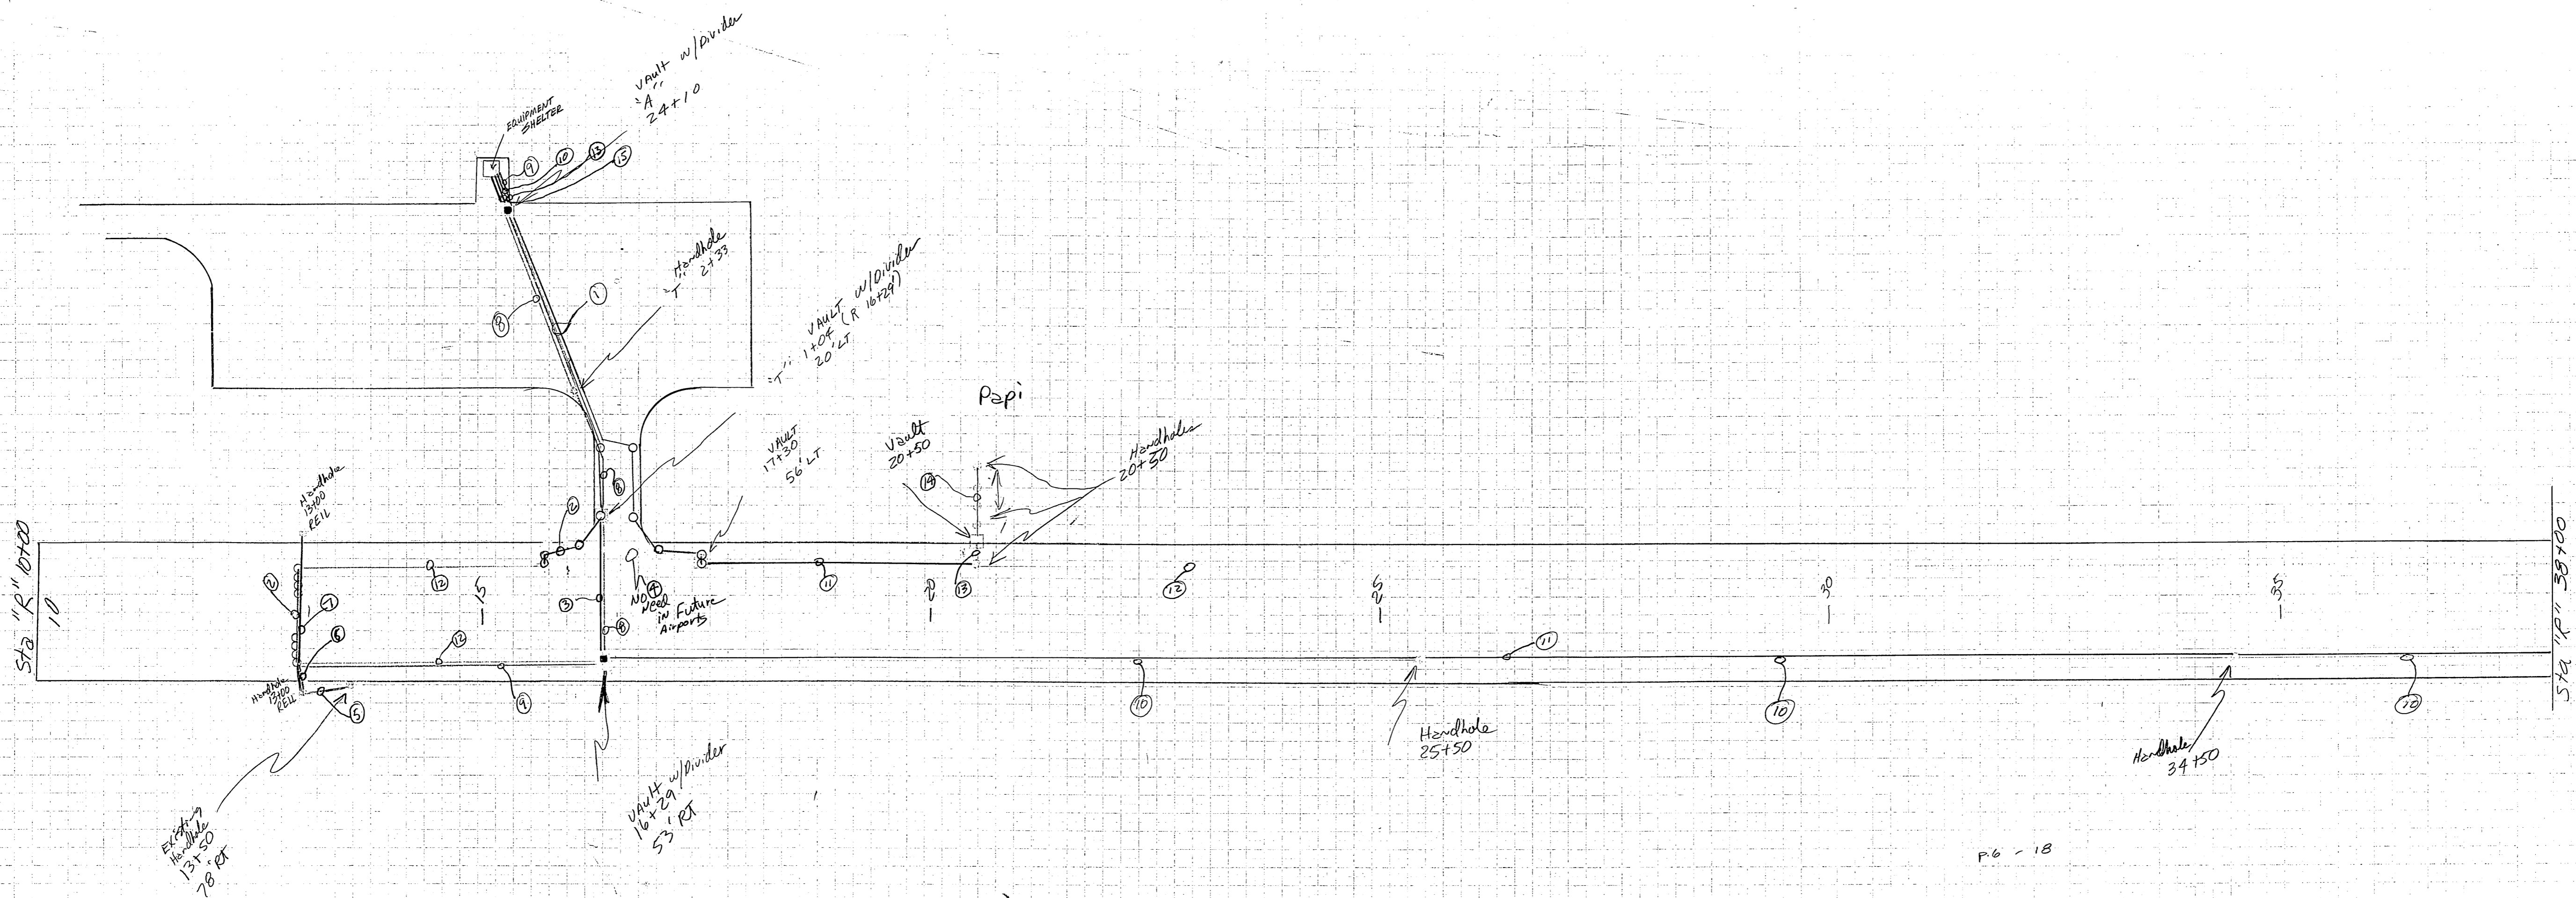

P.6 - 18

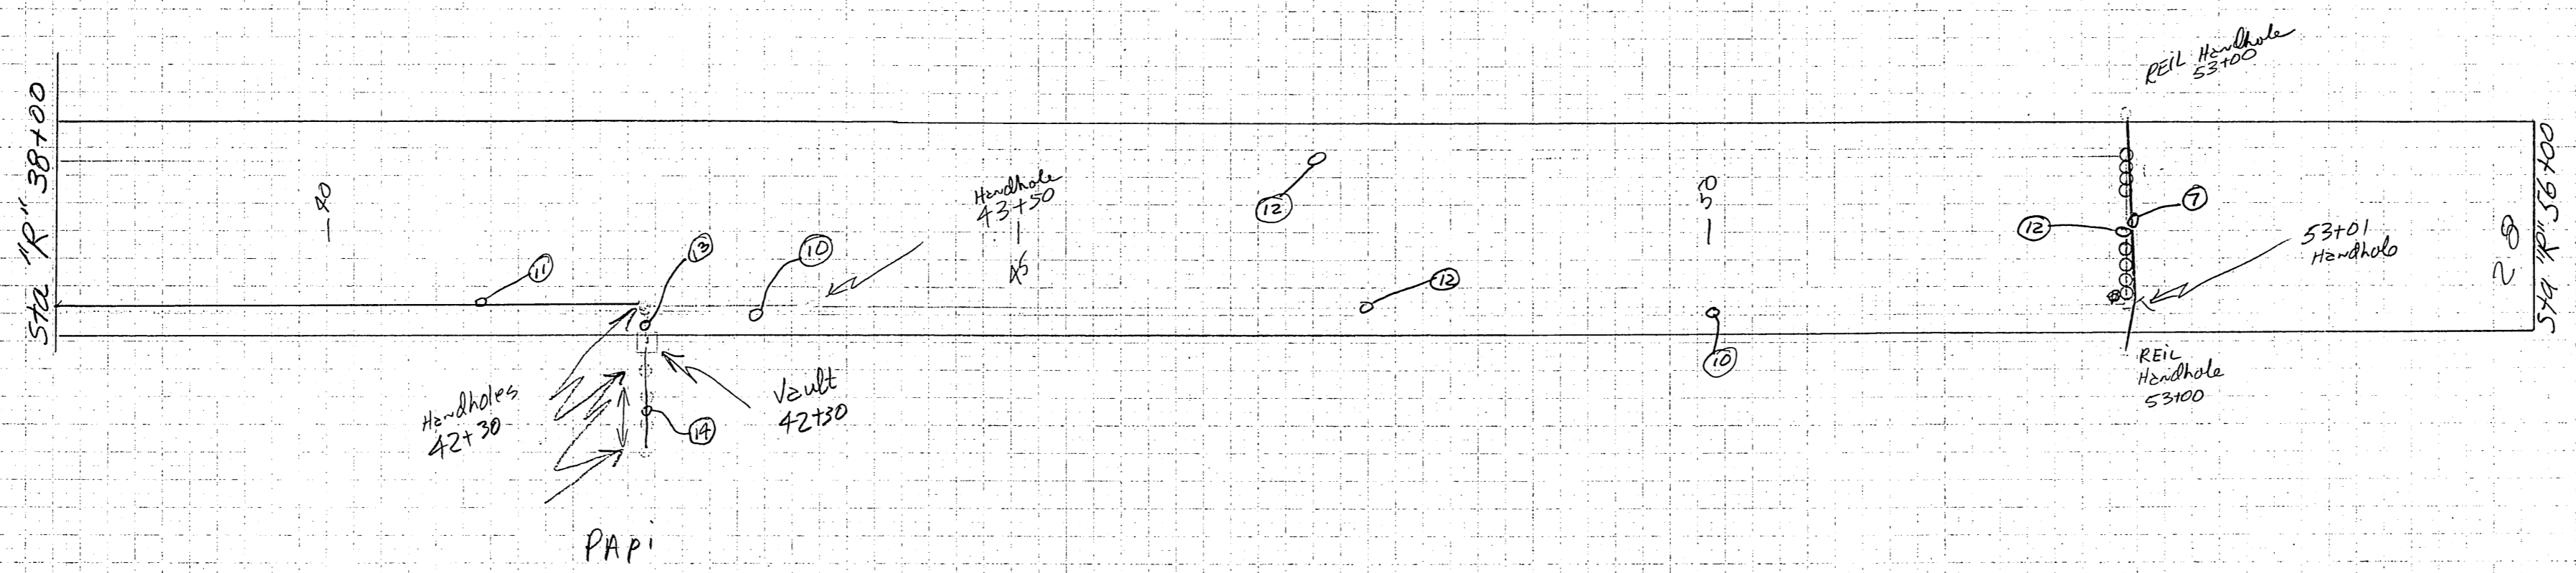

3,172

REF.	DESCRIPTION	LOCATION	CONDUIT LENGTH	CONDUIT TYPE	TOTAL WIRE
1	3 #8 SKV 1 #6 BARE GROUND (Airport Lites, PAPI)	APRON VAULT → VAULT 17x30	• 50' ± • 377' ± • 892' TOTAL	RSC (2")	2646 (SKV) 882 (GND)
2	1 #8 SKV 1 #6 BARE GROUND (Airport Lites)	VAULT 16x24 L → Light 157x22 Thresholds - 13400 → 12700R	• 78' ± • 186' ± • 187' TOTAL	RSC (2")	187 (SKV) 187 (GND)
3	2 #8 SKV 1 #6 BARE GROUND (PAPI)	VAULT 16x24 L → VAULT 41x24	• 156' ± • 156' TOTAL	RSC (2")	312 (SKV) 156 (GND)
4	No wire needed (Delete next airport - conduit in before the fact)	Light 157x22 L TO VAULT 17x30 L	• 155' TOTAL NO WIRE	RSC (2")	N/A
5	2 #8 600V 1 #6 BARE GROUND (wind cone)	REIL 13400R → wind cone, Handhole 13400R	• 52' TOTAL	RSC (2")	104 (600V) 52 (GND)
6	4 #8 600V 2 #10 600V (NO PAY) 1 #6 BARE GND	Window Threshold RT → REIL 13400R (13400R)	• 30' TOTAL	RSC (2")	120 (600V) 60 (600V) 60 (600V) 60 (600V)
7	2 #8 600V 2 #10 600V (NO PAY) 1 #6 BARE GND MULTI-CONDUCTOR CONTROL	REIL RT → REIL LEFT (1000) REIL RT → REIL RT THROUGH HANDHOLE (53100)	• 170' ± • 170' ± • 340' TOTAL	RSC (2")	680 (600V) 340 (GND) 680 (600V)
8	3 #8 600V (NO PAY) 1 #6 BARE GND (WIND CONE)	APRON VAULT → APRON VAULT APRON VAULT → VAULT 16x24 L THRESHOLD	• 250' ± • 312' ± • 562' TOTAL	RSC (2")	3372 (600V) 562 (GND) (1124) (GND)
9	1 #8 600V 2 #10 600V (NO PAY) 1 #6 BARE GND (REIL) WIND CONE	VAULT 16x24 L → Threshold 13400 RT APRON VAULT → Shelter	• 37' ± • 50' ± • 267' TOTAL	PCV (2")	1468 (600V) 367 (GND) 734 (GND)
10	2 #8 600V 2 #10 600V (NO PAY) 1 #6 BARE GND (REIL)	VAULT 16x24 L → N.H. 25150 RT THRESHOLD → N.H. 34500 RT THRESHOLD → N.H. 43500 RT THRESHOLD → N.H. 53100 RT	• 923' ± • 900' ± • 900' ± • 3672' TOTAL	PCV (2")	7348 (600V) 3674 (GND) (7348) (GND)
11	3 #8 600V 1 #6 BARE GND (AIRPORT LITES & PAPI)	VAULT 17x30 L → N.H. 20150 LT	• 283' ± • 320' ± • 2923' TOTAL	PCV (2")	8769 (SKV) 2923 (GND)
12	1 #8 SKV 1 #6 BARE GND (AIRPORT LITES)	Light 157x22 L → Thresh. 15100 L THRESHOLD 13400R → VAULT 16x24 L VAULT 16x24 L → VAULT 42x30	• 280' ± • 327' ± • 430' ± • 5037' TOTAL	PCV (2")	5037 (SKV) 5037 (GND)
13	2 #8 SKV 1 #6 BARE GND (PAPI & Airport Lites)	N.H. 20150 LT → 80' LT N.H. 42300 RT → 80' LT APRON VAULT → Shelter	• 85' ± • 85' ± • 34' ± • 84' TOTAL	PCV (2")	168 (SKV) 84 (GND)
14	1 #8 SKV 1 #6 BARE GND (PAPI)	APRON VAULT → Shelter	• 80' ± • 80' ± • 160' TOTAL	PCV (2")	960 (SKV) 160 (GND)
15	1 #8 SKV 1 #6 BARE GND (PAPI)	APRON VAULT → Shelter	• 40' TOTAL	PCV (2")	160 (SKV) 40 (GND)
*16	2 #8 600V 2 #10 600V (NO PAY) (wind cone) (REIL Intensity)	APRON VAULT → Shelter	• 40' TOTAL	PCV (2")	80 (600V) 40 (GND) 80 (GND)