


STATE	PROJECT	SHEET NO.	TOTAL SHEETS
ALASKA	FH-40-1(1)	1	19

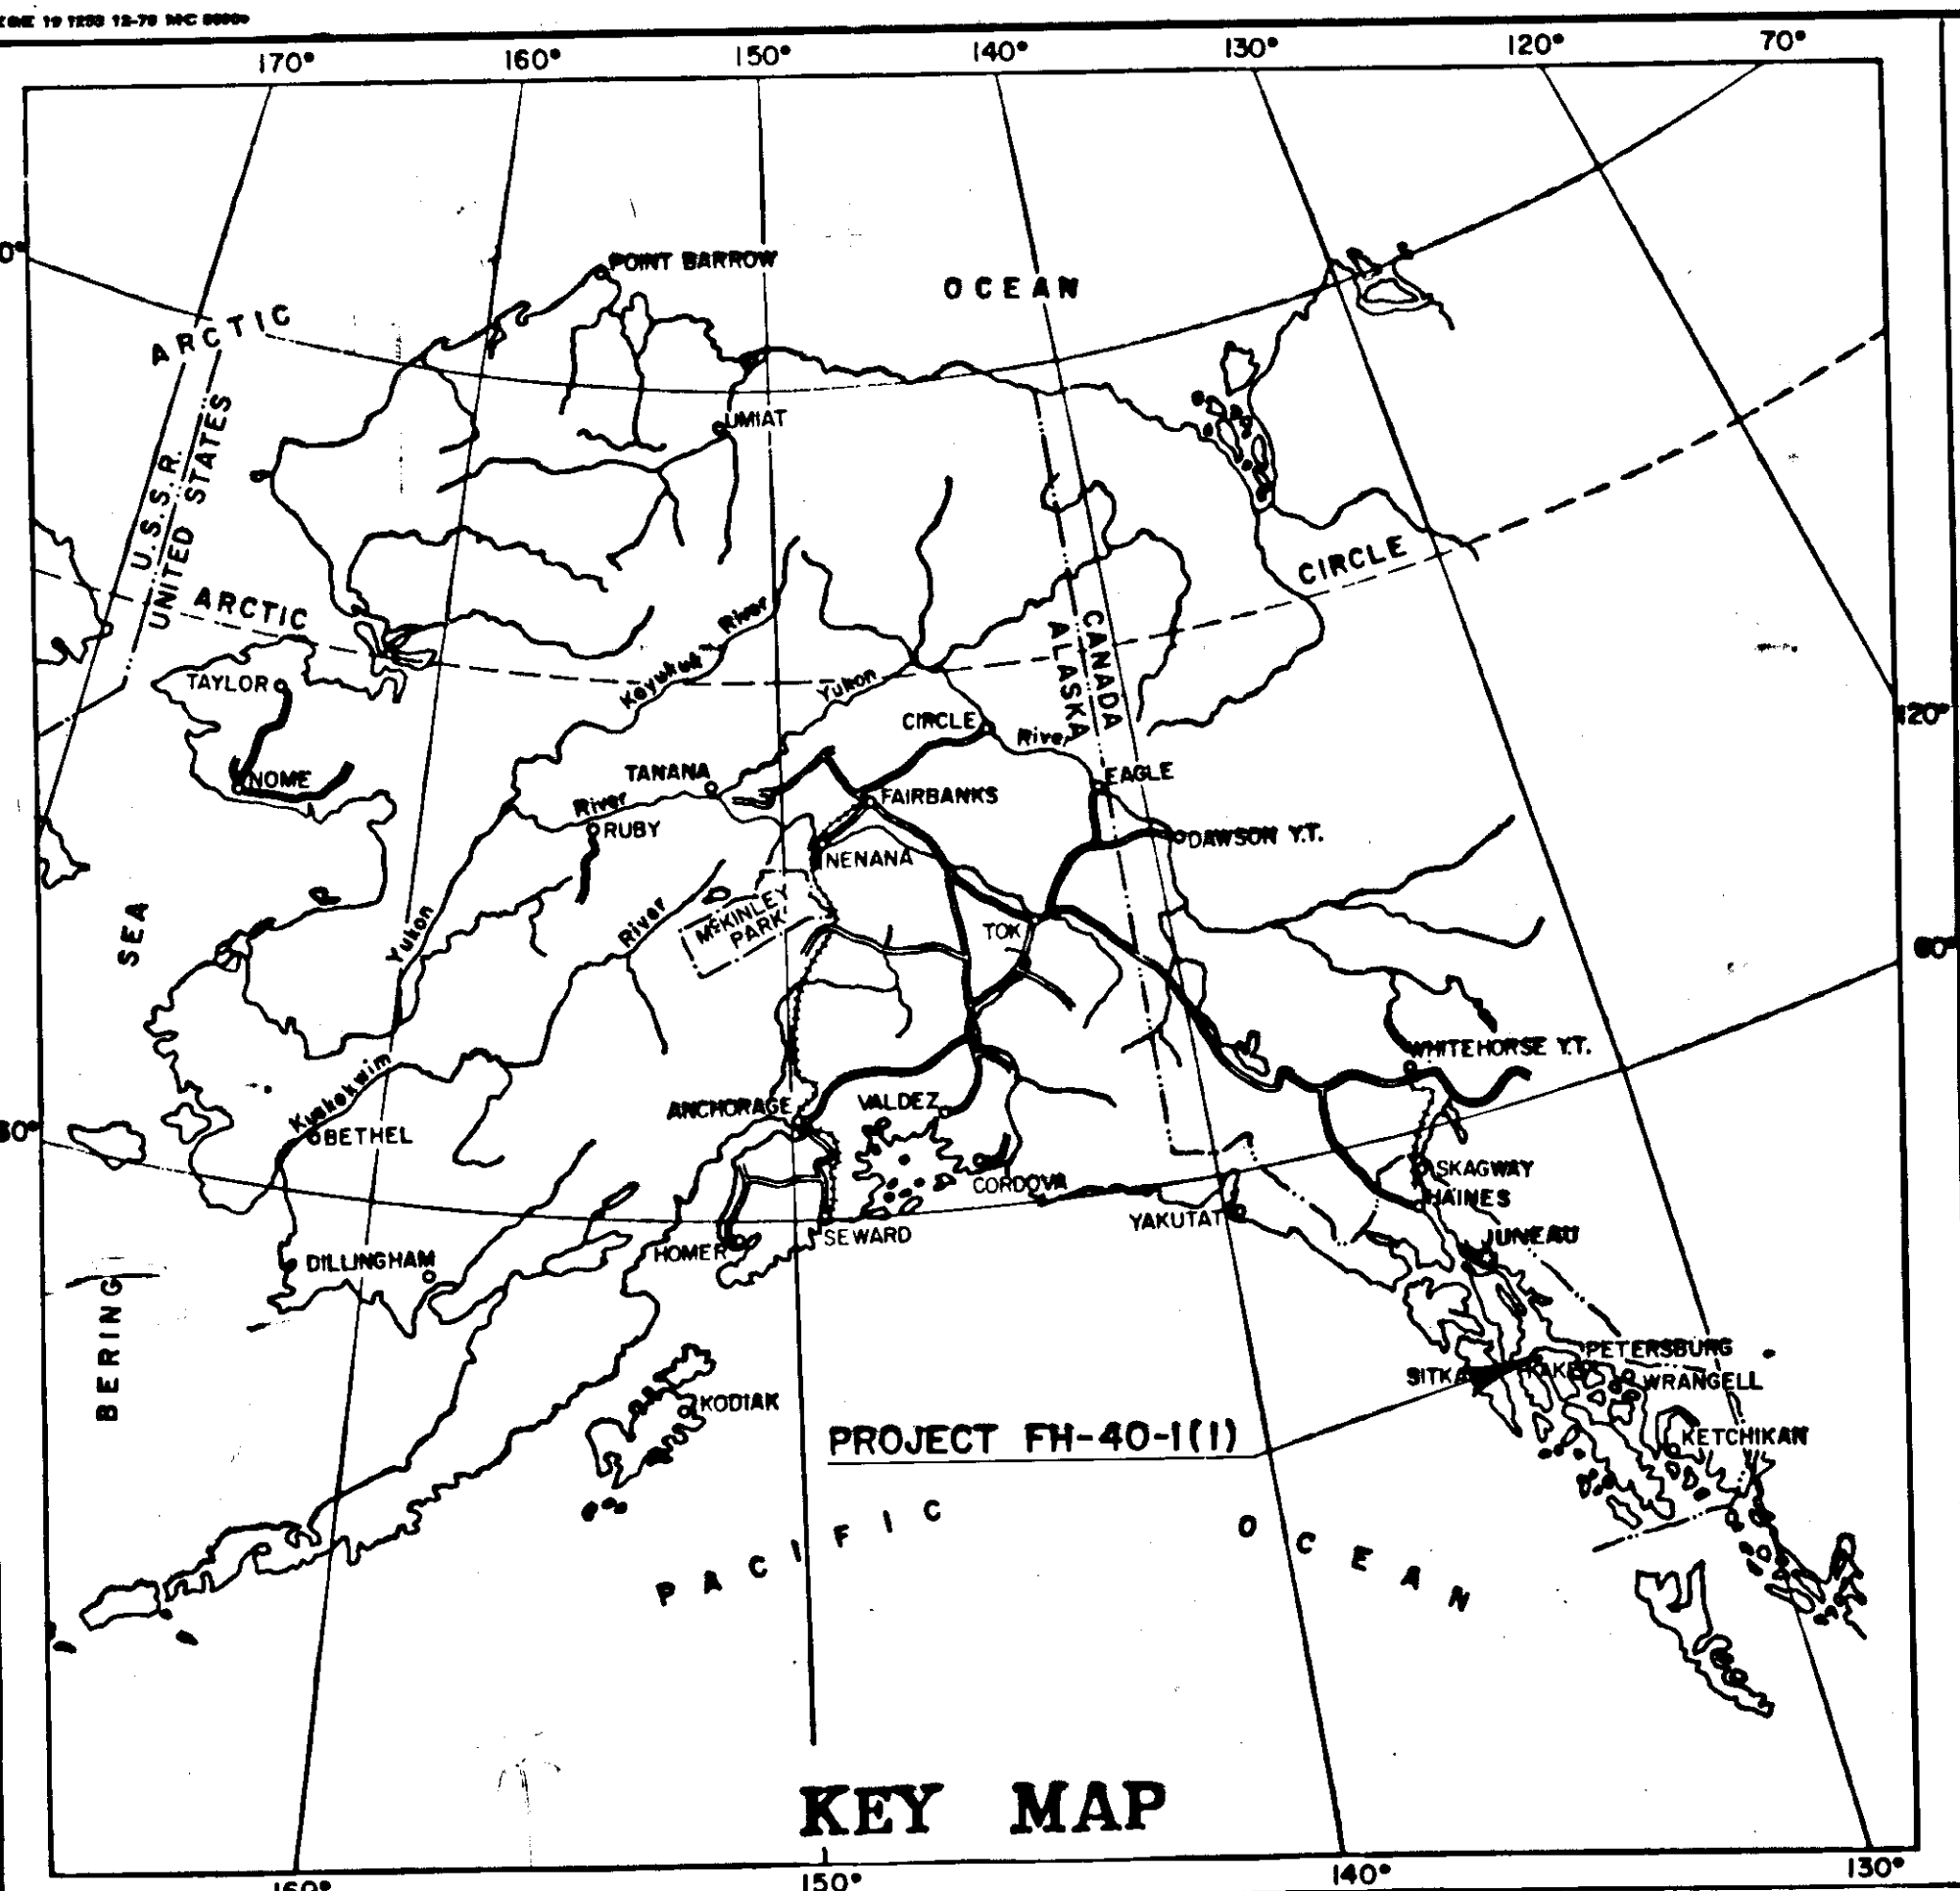

**STATE OF ALASKA
DEPARTMENT OF TRANSPORTATION
&
PUBLIC FACILITIES**

**PLAN AND PROFILE
PROPOSED HIGHWAY PROJECT
KAKE-KEKU ROAD
FERRY TERMINAL TO
BOAT HARBOR**

FH-40-1(1) (67518)

GRADING & DRAINAGE

SHEET NO.	INDEX
1	TITLE SHEET
2	TYPICAL SECTIONS
3	ESTIMATE OF QUANTITIES
4-5	SUMMARY TABLES
6-18	PLAN & PROFILE SHEETS
19	MATERIAL SITE

THE FOLLOWING STANDARD DRAWINGS APPLY TO THIS PROJECT: A-1, C-01.02, C-02.00, C-03.01, D-01.00, D-04.10, D-05.10, G-02.00, G-04.02S, G-14.03S, G-18.01, I-40.00, S-00.00, S-05.00, S-20.00, S-30.01, U-03.00

**LOCAL ROADS AND STREETS
DESIGN DESIGNATION**

ADT 1987.....	259
ADT 2007.....	316
DHV (16%).....	51
% T.....	5%
T.I.....	5.5
V.....	30


PROJECT SUMMARY

WIDTH OF SUBBASE = 24'
LENGTH OF GRADING = 6722.10 = 1.273 mi.
LENGTH OF PROJECT = 6722.10 = 1.273 mi.

DESIGN EXCEPTIONS

1. USE OF STEEPER THAN USUAL FILL SLOPES THROUGHOUT THE PROJECT.
2. USE OF MODIFIED SUPERELEVATION TRANSITIONS AT STATIONS: "O" 151+54, "O" 159+58, "O" 162+55, "O" 170+37, & "O" 175+58. (FLAT), 118+03, 156+80, 173+08

EXCEPTIONS WERE GRANTED BY FHWA ON JULY 8, 1986.

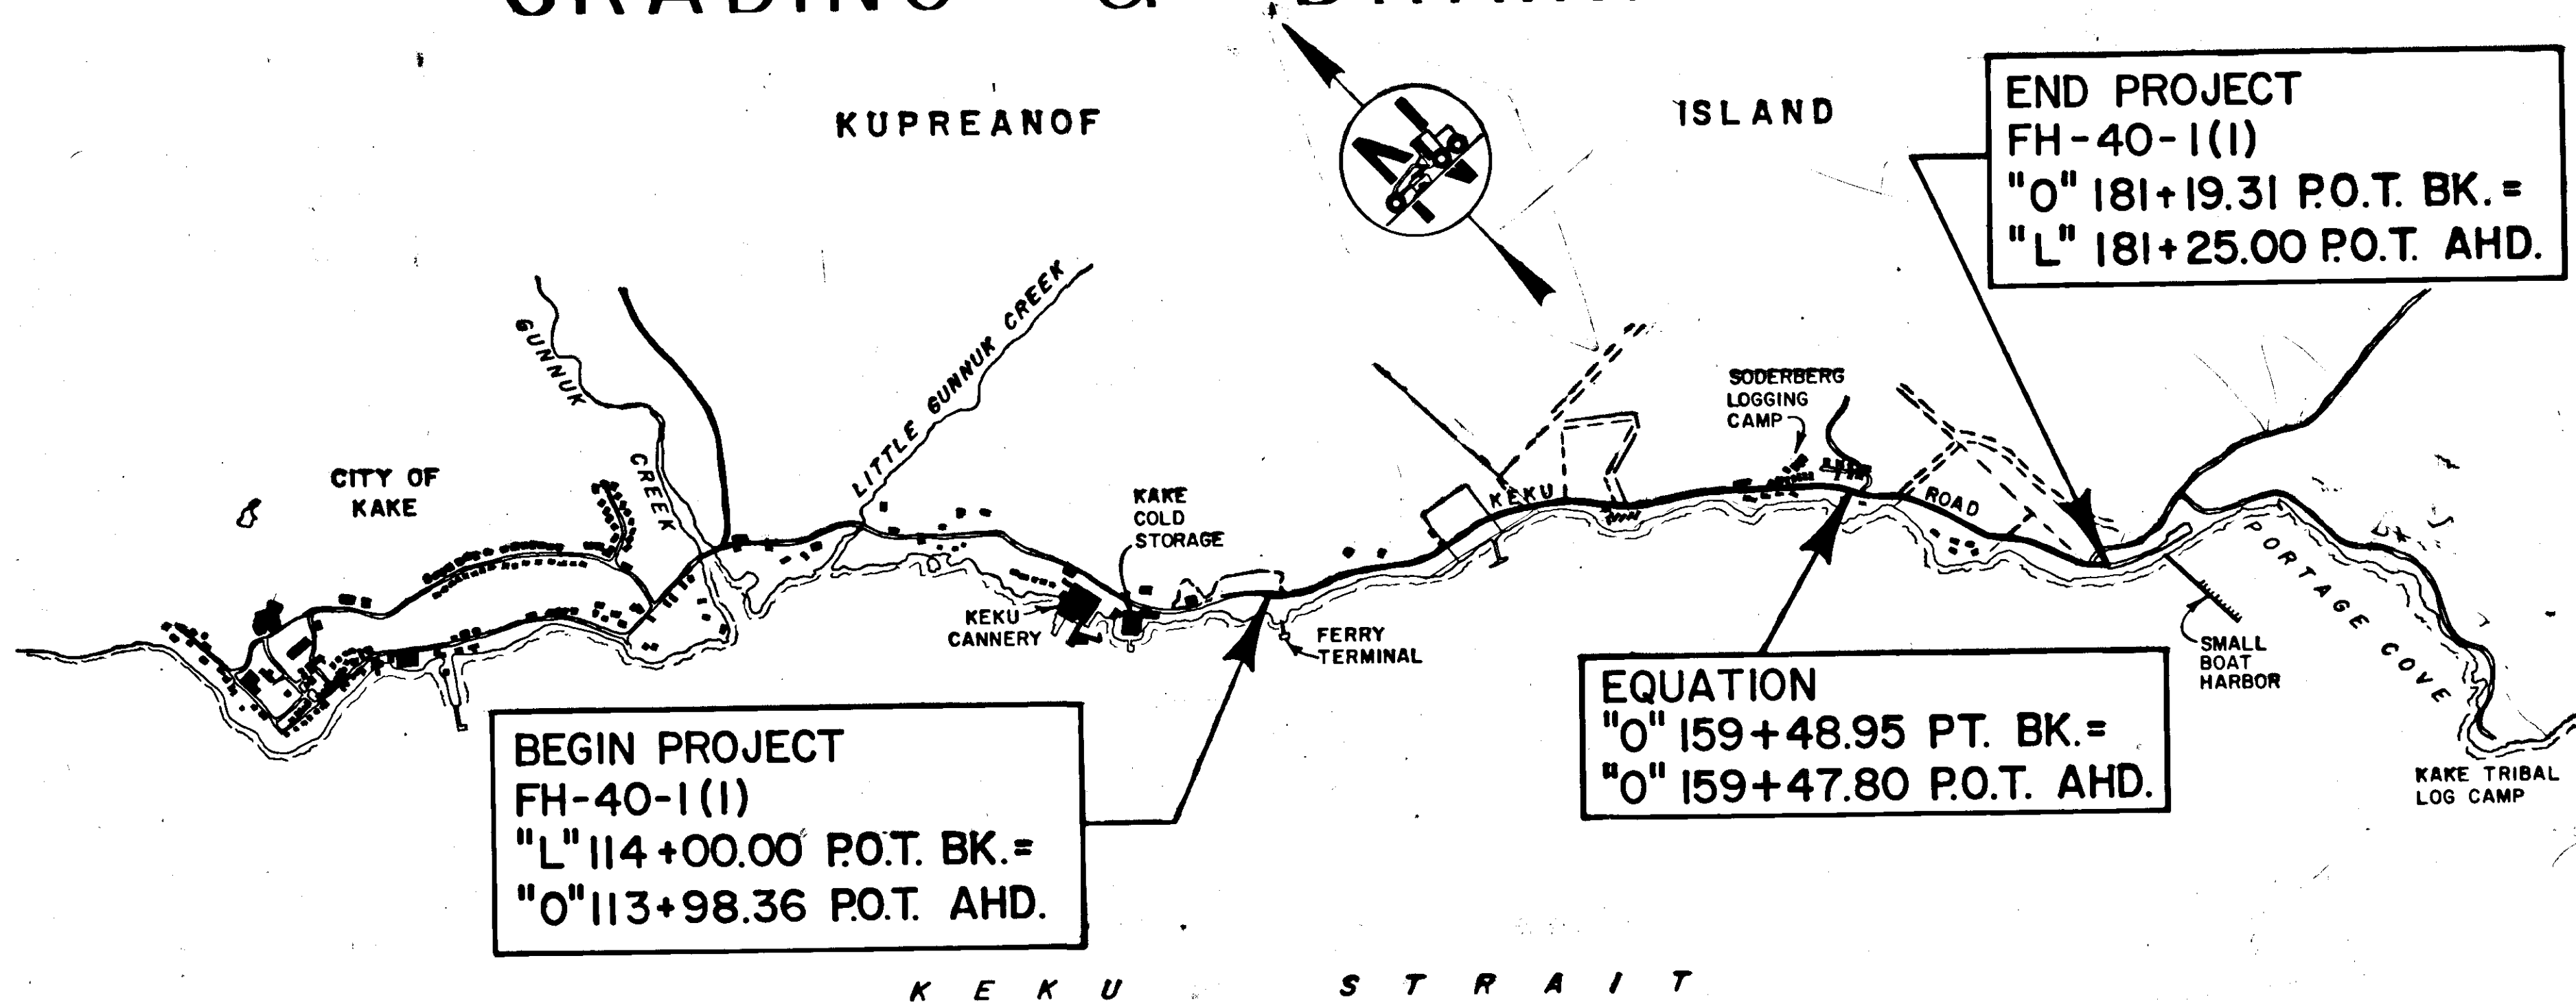

AS-BUILT PLANS

APRIL 1988 TO OCTOBER 1988
POOL ENGINEERING - CONTRACTOR
GREG BROWNING PROJECT ENGINEER

STATE OF ALASKA
DEPARTMENT OF TRANSPORTATION
&
PUBLIC FACILITIES

APPROVED
Wallace K. Williams Date 5/5/87
SOUTHEASTERN REGION DESIGN ENGINEER

STATE OF ALASKA
DEPARTMENT OF TRANSPORTATION
&
PUBLIC FACILITIES


APPROVED
W.D. Dickerson Date 5-5-86
DIRECTOR, S.E. DESIGN/CONSTRUCTION

7.059
3.2
2.7
5.275
23531.4


TYPICAL SECTIONS OF IMPROVEMENT

GENERAL NOTES


- Grades and Alignments shown on the Plans are subject to minor revisions by the Engineer.
- Culvert lengths and locations are subject to minor revisions by the Engineer.
- Clearing and Grubbing limits shall be 10' beyond the slope limits in cut areas, and 5' beyond the slope limits in fill areas, or to the R/W line, easement line or permit line as directed by the Engineer.
- All waste material shall be disposed of outside of the R/W limits at a location selected by the Contractor and approved by the Engineer.
- Superelevation Transition lengths shall be as shown on the plans with the pivot point on centerline. Two-thirds of the Transition Length shall lie outside the Horizontal Curve. There are five tangent sections that are too short to accommodate the superelevation transition length required to return to a standard typical section between reversing curves. In these areas transition from EFS to BFS without going back to the standard crown section between the curves.
- All common excavation will be considered waste.
- Electric, Telephone, and Cable Television Utilities are to be relocated by the serving utility during project construction. The Contractor is responsible for the notification of the Utilities and the coordination of the work.
- The major components of Item 202(1) may include discarded steel cable, equipment parts, junk cars, logs or stumps, heavy equipment, etc.
- Special ditching may be required at isolated locations to provide proper drainage to culverts. A minimum cover of 1.0 ft. from top of pipe to finish grade will be allowed. Pipe outlets at some locations may be elevated above toe of fill, as allowed by the Engineer to avoid steep pipe grades. Ditching will be incidental to Item 203(1).
- The Filter Cloth Riprap Liner shall meet the requirements of Section 729-2.01. Payment will be incidental to Item 611(1).
- The Traffic Control Plan for this project shall be accomplished as specified in Standard Drawings C-01.02, C-02.00, & C-03.01.
- Waterline location is as shown from available information. The Contractor shall verify the exact location of the waterline, sewerline or elect conduits prior to any work in the vicinity of these items. Actual depth may be only 1' in some areas.
- Payment for any cones or warning lights used will be incidental to Item 115(1).
- Driveways not having profile details shown on the plan & profile sheets require only minimal earthwork, as directed by the Engineer, to meet the proposed roadway.
- Any relocation of the electric conduit shown near Station "0" 160+50 will be incidental to Item 628(12).
- Guardrail posts from Station "0" 117+90 to Station "0" 119+50 shall have 8" x 24" x 1/4" Soil Plates added as per Standard Drawing E-02.00.

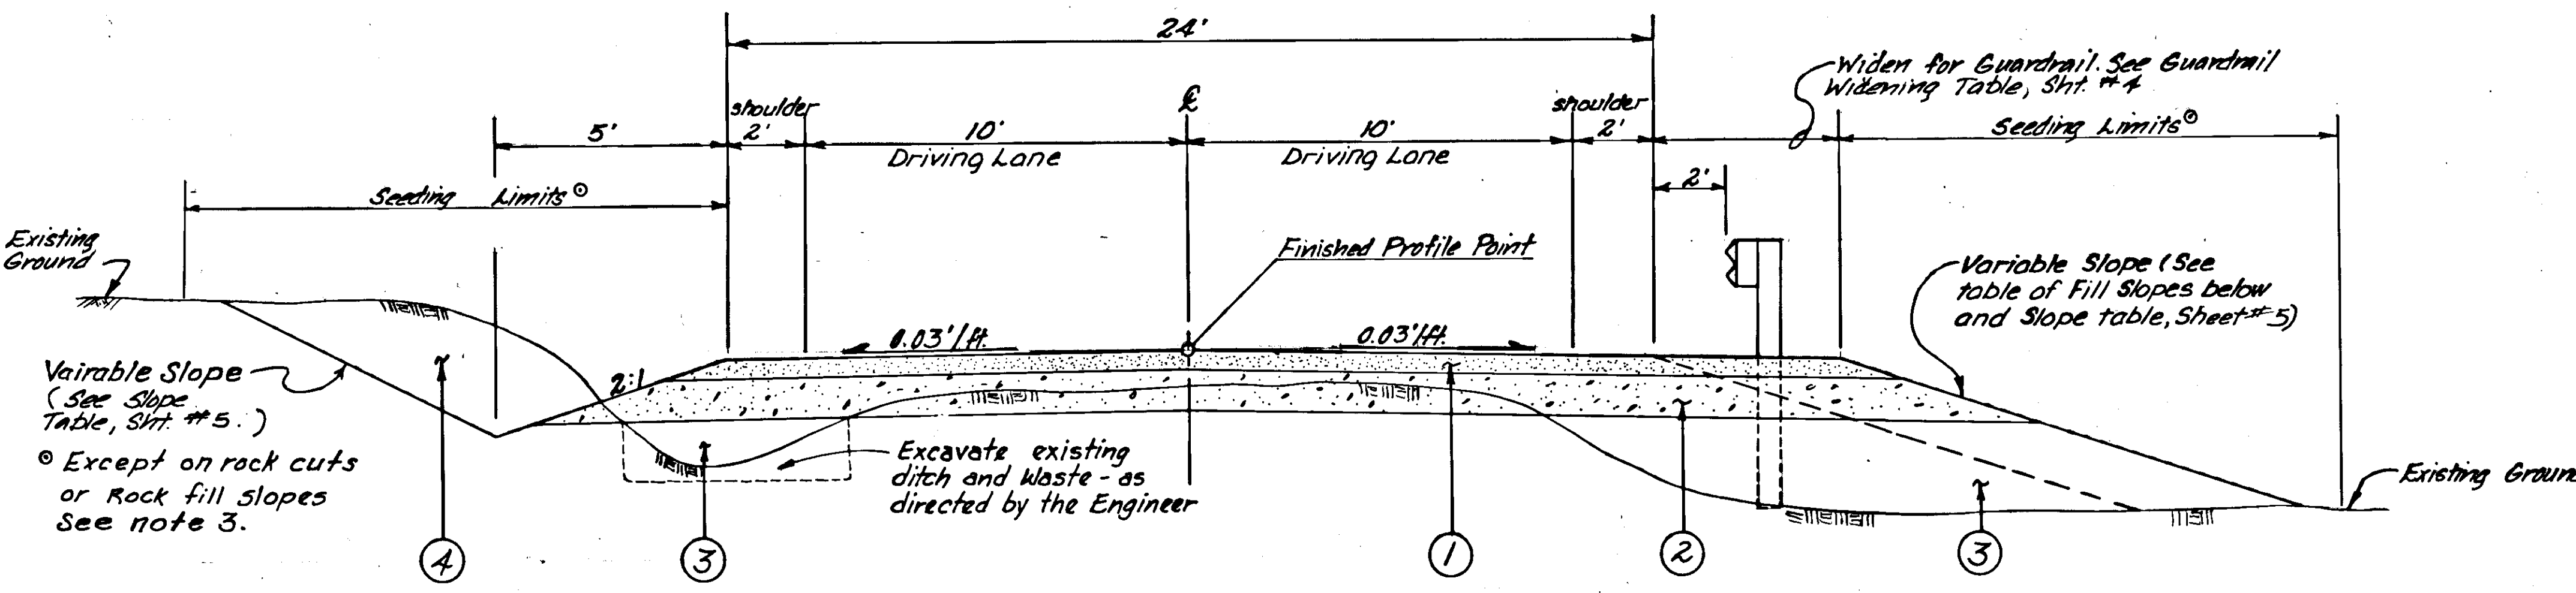

TYPICAL SECTION OF IMPROVEMENT
 "0" 115+00.00 to E.O.P. "0" 181+19.31
 (For B.O.P. to "0" 115+00 detail, see Sht. 3)

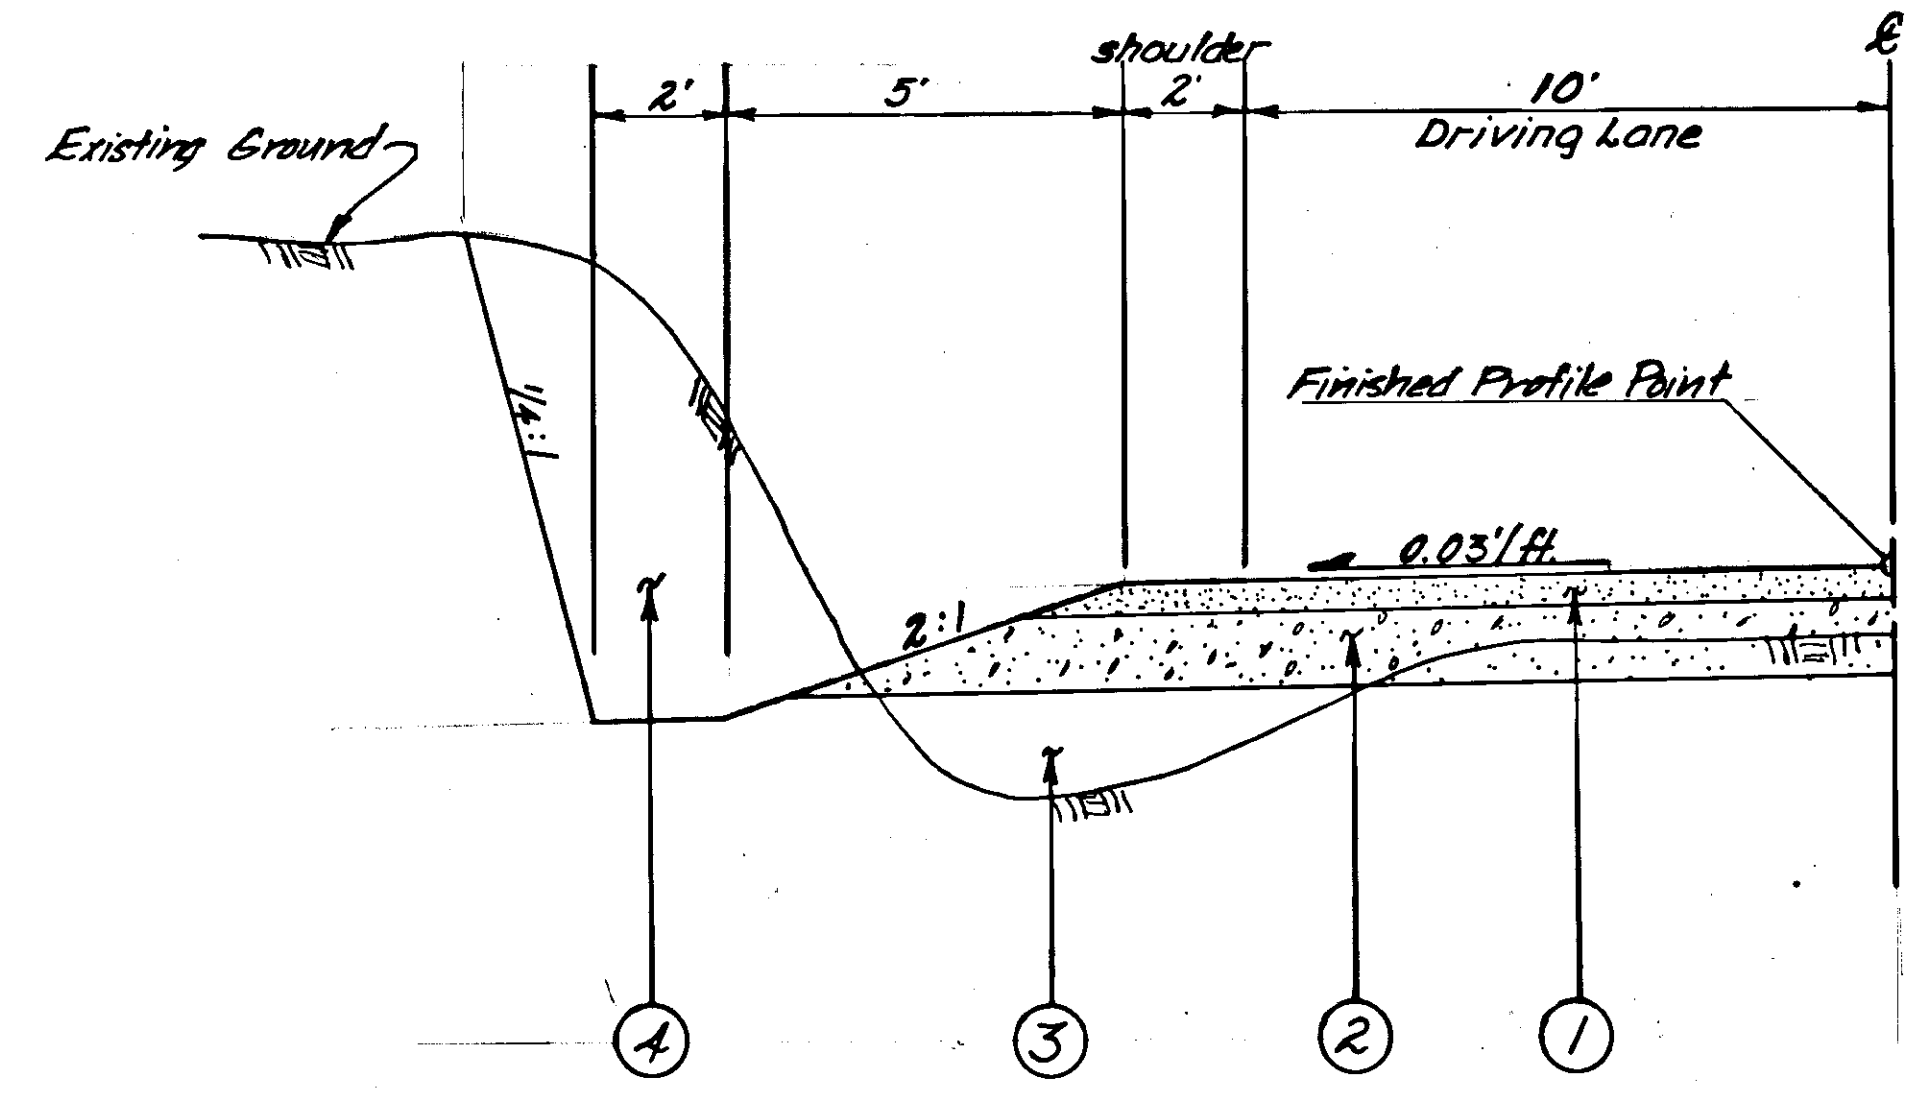

FLAT BOTTOM DITCH TYPICAL
 See Slope Table, Sht. #5,
 for locations of Flat Bottom Ditches.

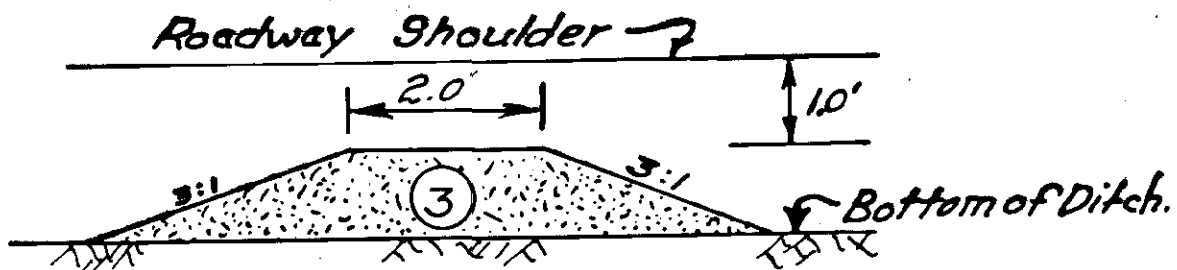


Construction of Ditch Dikes will be as directed by the Engineer. Payment will be incidental to other items of work performed under Sec. 203.


TYPICAL DITCH BLOCK

TABLE OF FILL SLOPES	
Height	Slope
0-5 ft.	3:1
5-10 ft.	2:1
10+ ft.	1 1/2:1

BASIS OF ESTIMATE	
ITEM NO.	QUANTITIES
203(5A)	1.87 Tons per cubic yard
304(2)	1.96 Tons per cubic yard
611(1)	1.80 Tons per cubic yard

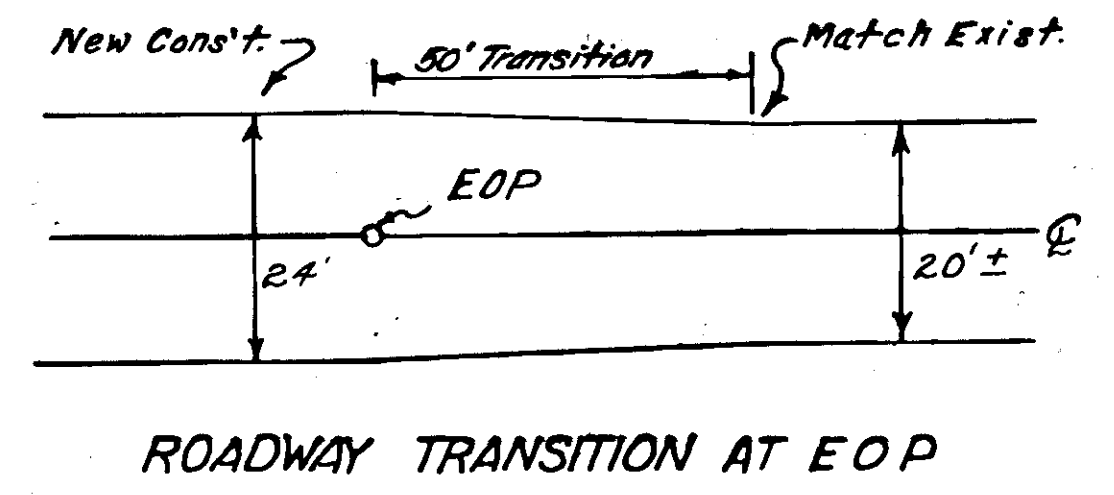


ROADWAY TRANSITION AT E.O.P.

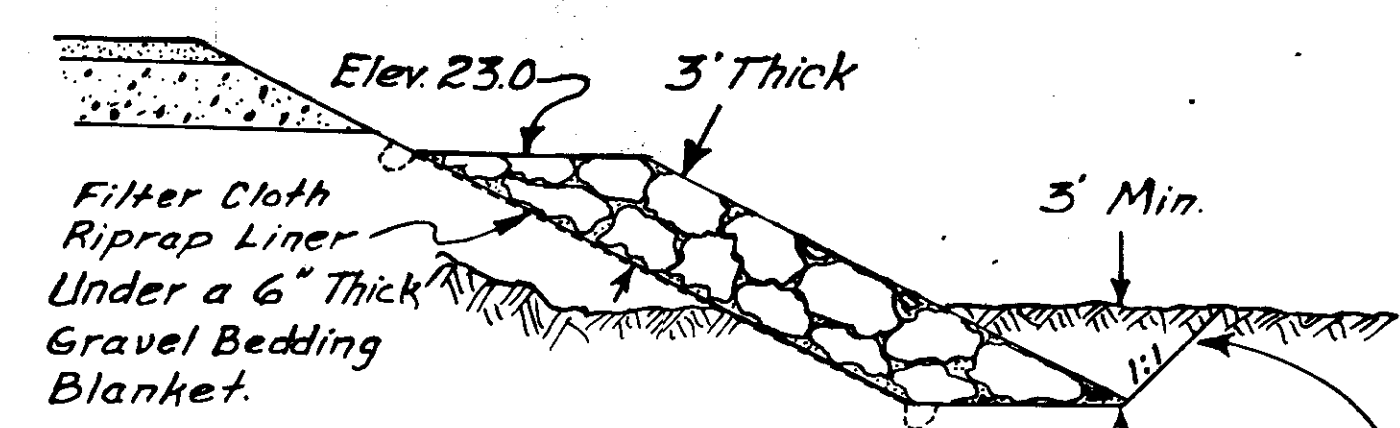

Excavate as shown, or as directed by the Engineer. Backfill to original ground with material originally excavated, after placement of loose riprap. Extreme High & Low Tides are 19.0 to -4.2 M.L.L.W.

RIPRAP DETAIL

LABELING INDEX	
①	6" Subbase, Grading "D" 6" CRUSHED (C.O.*1)
②	18" Minimum, Borrow, Type A *
③	Borrow, Type A
④	Rock or Common Excavation
○	
○	* 6" Minimum in Rock Excavation areas

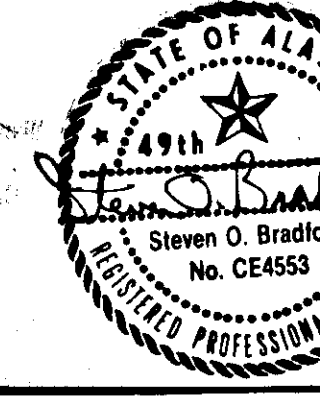


ESTIMATE OF QUANTITIES


ITEM NO.	ITEM	UNIT	SHEET NUMBERS																	TOTAL
			6	7	8	9	10	11	12	13	14	15	16	17	18	19				
109(2)	DBE and WBE Adjustment	C.S.																	All Required	
110(2)	Mobilization and Demobilization	L.S.																	All Required	
111(1)	Temporary Erosion and Pollution Control	C.B.																	All Required	
112(1)	Training Program - 1 Trainee	Man Hr.																	All Required	
113(1)	Flagging	Man Hr.																	500	
114(1)	Construction Surveying by the Contractor	L.S.																	1000	
115(1)	Traffic Control	L.S.																	All Required	
115(2)	Construction Signs	S.F.																	All Required	
115(3)	Barricades, Type II	Each																	110	
116(1)	Furnishing and Maintaining Field Office	L.S.																	50	
116(2)	Furnishing and Maintaining Field Laboratory	L.S.																	All Required	
116(6)	Furnishing and Maintaining Engineering Transportation	L.S.																	All Required	
201(2A)	Clearing and Grubbing	Acre																	All Required	
202(1)	Removal of Structures and Obstructions	L.S.																	4	
202(4)	Removal of Culvert Pipe	L.F.	36	0	152	38	30	184	70	0	34	37	0	30	40				All Required	
203(1)	Common Excavation	C.Y.	544	1277	644	692	473	1988	460	1089	658	189	524	699	335				651	
203(5A)	Borrow, Type A	C.Y.	1242	357	1986	2154	1528	1073	1368	1063	1893	2066	1001	2133	1385				9,572	
203(2)	Rock Excavation	C.Y.		1753															19,249	
304(2)	Subbase Grading "D"	C.Y.	197	308	302	305	312	286	269	262	292	245	236	283	174				1,753	
603(13-18)	18-Inch Corrugated Aluminum Pipe	L.F.	0	0	82	0	0	0	86	0	0	0	0	0	0				3,471	
603(13-24)	24-Inch Corrugated Aluminum Pipe	L.F.	46	50	130	48	44	0	92	0	0	50	0	0	54				118	
603(13-30)	30-Inch Corrugated Aluminum Pipe	L.F.	0	0	0	0	0	0	0	0	65	0	0	65	0				514	
603(13-36)	36-Inch Corrugated Aluminum Pipe	L.F.	0	0	0	0	0	102	0	0	0	0	0	0	0				130	
606(2)	Beam Type Guardrail, Type II, Post	L.F.	350	487.5	450	400	350	0	0	0	437.5	250	0	275	0				3,000	
606(6)	End Anchorages	Each	1	0	1	2	2	0	0	0	5	1	0	4	0				16	
611(1)	Riprap, Class II	C.Y.					674												674	
614(1)	Survey Monuments	Each		1								2							3	
615(1)	Standard Signs	S.F.	13.75	0	0	0	0	0	0	0	0	0	0	0	17.50				31.25	
618(1)	Seeding	M.S.F.	5.8	12.3	12.8	9.3	10.2	9.9	9.0	17.0	13.1	7.4	8.3	10.1	10.1				140.9	
618(4)	Water for Maintenance	M.Gal.	1.2	2.5	2.6	1.9	2.0	2.0	1.8	3.4	2.6	1.5	2.0	2.0	2.0			5.6	27.5	
628(7)	Fire Hydrant Relocation	Each	0	0	0	1	0	1	0	1	0	0	1	0	0				4	
628(11)	Adjustment of Valve Box	Each	0	0	0	1	0	0	1	0	0	0	1	0	0				3	
628(12)	Waterline Adjustments	L.F.						200											200	
635(1)	Insulation Board	M.B.M.	0	0	0	.032	.032	.064	.064	0	.064	.064	0	.064	.064				0.448	
639(1)	Approaches	Each	1	1	2	1	0	2	1	1	2	0	2	0	1				14	

- 3.1

1353

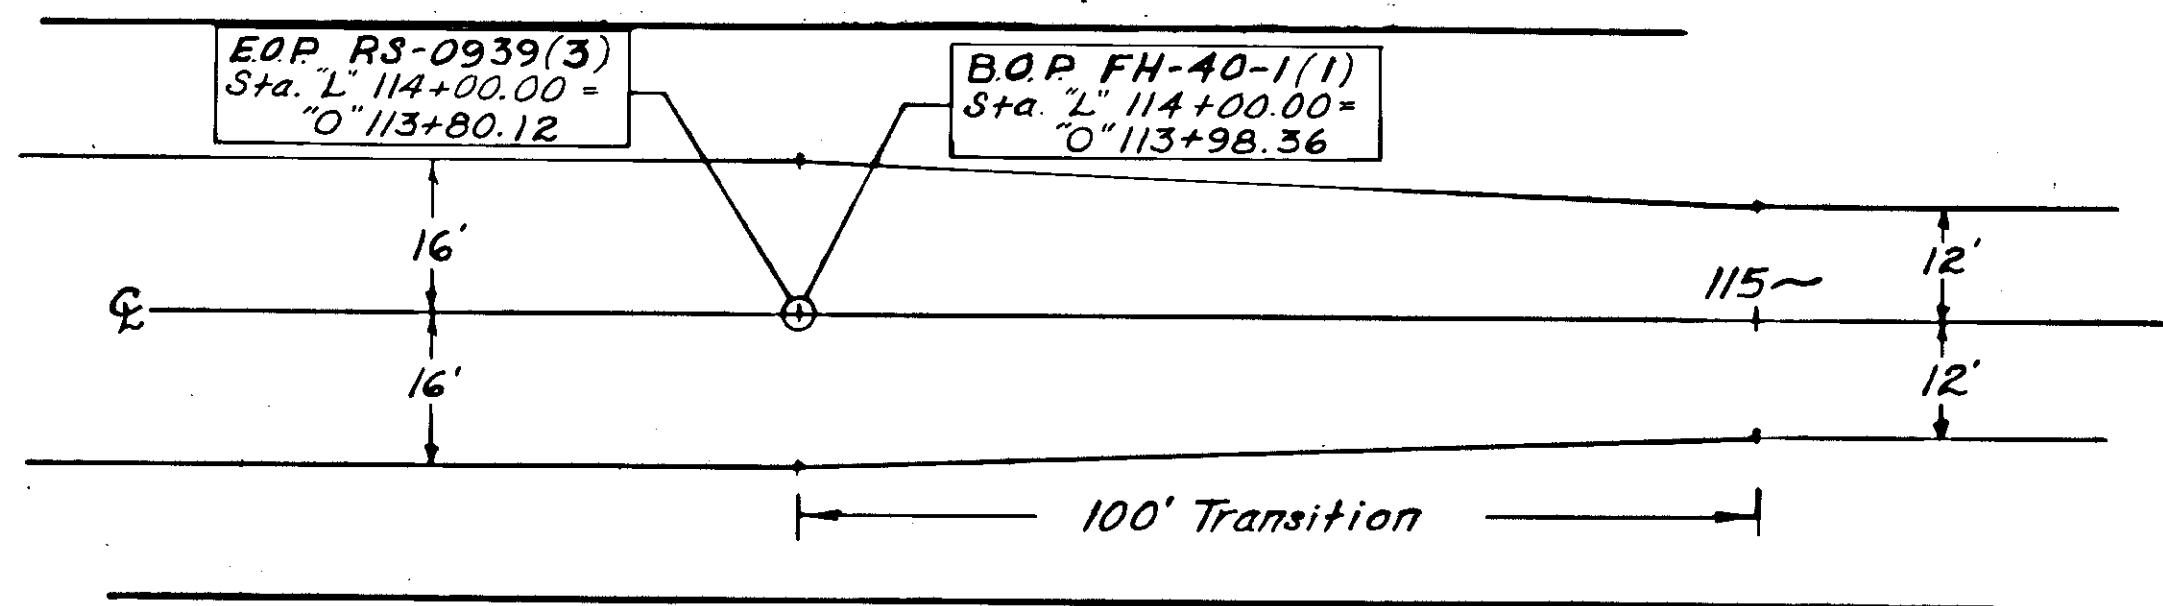

ROADWAY TRANSITION AT B.O.P.

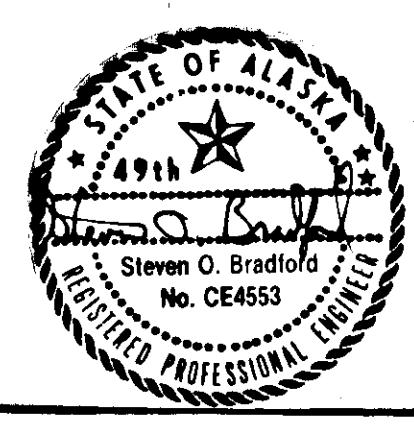

CULVERT REMOVAL SUMMARY

STATION	LENGTH	STATION	LENGTH
0+115+35, E	36'	0+158+03, E	34'
0+122+88, E	30'	0+163+18, E	37'
0+123+10, 8' LT.	40'	0+173+26, E	30'
0+123+30, E	34'	0+179+13, E	40'
0+126+90, E	48'	162+92	20'
0+130+39, E	38'	150+20	36'
0+139+06, E	30'		
0+142+37, E	184'		
0+148+72, E	30'		
0+149+10, E	40'		

GUARDRAIL SUMMARY

STATION TO STATION	LOCATION		QUANT.	REMARKS
	LEFT	RIGHT		
0+114+84, 80' rt.		X	62.5 L.F.	Extend Guardrail 60' ± to 80' ± rt.
0+115+00		X	1225 L.F.	Rail approx. 23' rt. @ Sta. 0+115+00
0+129+37		X	400 L.F.	
0+136+00		X	350 L.F.	
0+157+55		X	175 L.F.	
0+157+50		X	112.5 L.F.	
0+160+75		X	400 L.F.	
0+172+40		X	137.5 L.F.	
0+172+80		X	137.5 L.F.	

PIPE CONDUIT SUMMARY

STATION	PIPE LENGTH				REMARKS
	18"	24"	30"	36"	
0+115+35, E		46'			
0+118+50, E		50'			
0+123+10, 24' LT.	34'				
0+123+40, E		50'			Skewed 40°
0+126+75, E		80'			
0+127+90, 24' LT.	48'				
0+130+40, E		48'			
0+139+10, E		44'			
0+142+37, E			102'		Skewed 8°
0+148+00, E		44'			
0+149+44, E		48'			
0+150+20, 24' LT.	36'				
0+158+03, E			65'		
0+164+50, E		50'			
0+173+26, E			65'		
0+179+13, E		54'			
171+50, 27' LT	46'				

WIDEN FOR GUARDRAIL *

STATION TO STATION	OFFSET		WIDTH OF WIDENING	REMARKS
	LEFT	RIGHT		
0+115+00		X	4.5'	
0+117+90, 87.5		X	2.5'	See General Note 16.
0+119+50		X	4.5'	
0+129+37		X	4.5'±2.5'	
0+136+00		X	4.5'	
0+157+55		X	4.5'	
0+157+50		X	4.5'	
0+160+75		X	4.5'	
0+172+40		X	4.5'	
0+172+80		X	4.5'	



* The widening shown does not include the additional widening required at end sections. See Standard Drawing 6-14.03.5.

SIGNING SCHEDULE

NO.	STATION	OFFSET		CODE NO.	LEGEND	Size	SIGN THICKNESS		Area-S.F.	POST				FACING TRAFFIC	REMARKS	
		LEFT	RIGHT				Framed	Unframed		No. of Posts	Type	Size	Length			Embedment
		1	0+115+00					25'		R1-1	STOP	30"×30"	.080			6.25
2	0+115+75		15'	R2-1	SPEED LIMIT 30	30"×36"	.080	7.50	1	PST	2"×2"	12'-6"	3'-6"	E.B.		
3	0+178+50		17'	R2-1	SPEED LIMIT 30	30"×36"	.080	7.50	1	PST	2"×2"	13'-0"	3'-6"	W.B.		
4	0+179+95		35'	R1-1	STOP	30"×30"	.080	5.00	1	PST	2"×2"	13'-0"	3'-6"	S.B.		
5	0+180+50		17'	W4-2B	END ROAD 500 FT.	30"×30"	.080	5.00	1	PST	2"×2"	13'-0"	3'-6"	E.B.		

APPROACH SUMMARY

STATION	OFFSET		WIDTH	REMARKS
	LT.	RT.		
0+114+50		X	30'	Match Existing Drive
0+119+66	X		14'	See 'A' Line, Sht. # 7.
0+123+06.50	X		14'	
0+127+87	X		25'±36'	COMMERCIAL DRIVE
0+133+75		X	14'	See 'B' Line, Sht. # 9.
0+142+27		X	30'	See 'C' Line, Sht. # 11.
0+143+17		X	14'	See 'D' Line, Sht. # 11.
0+150+18	X		14'	
0+151+47	X		14'	
143+76		X		ADD ON
0+160+46		X	24'	
0+161+53	X		36'	Commercial Drive
0+168+00		X	15'	
0+171+39		X	20'	
0+180+00	X		24'	Match Existing Drive

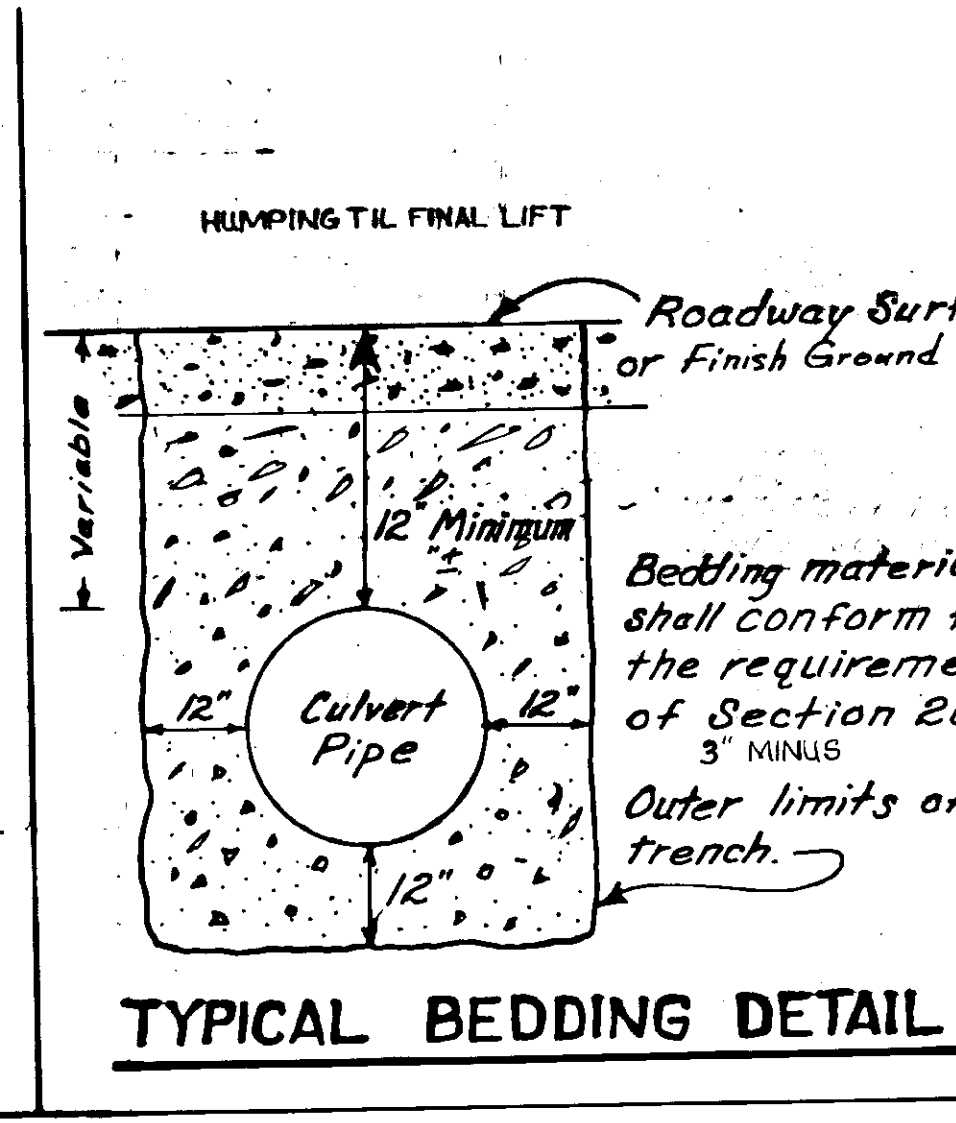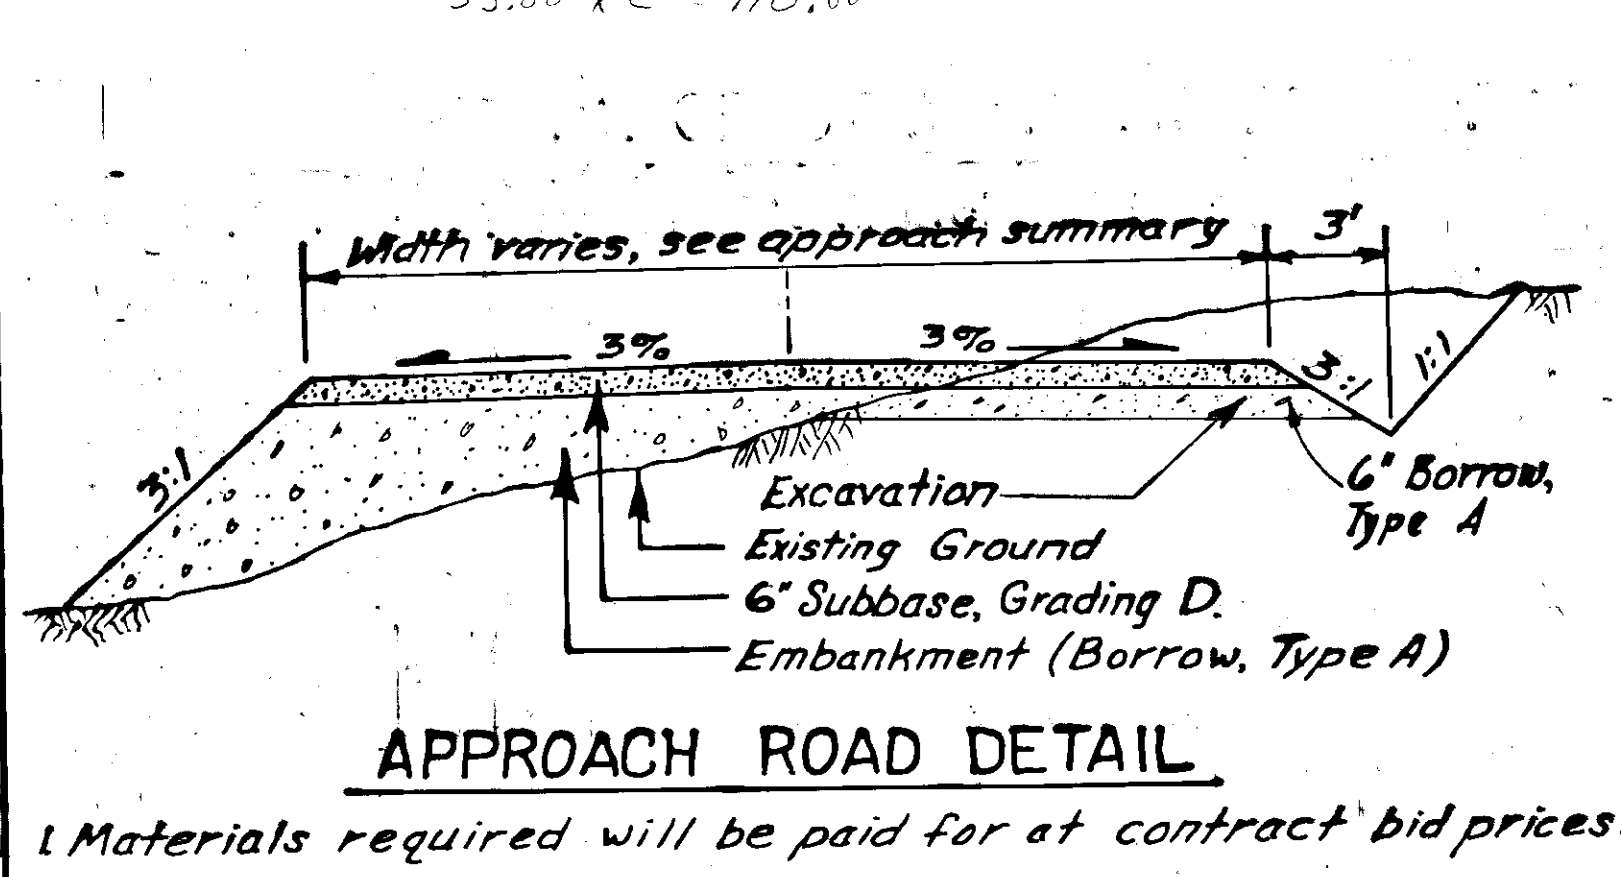


WATERLINE ADJUSTMENT SUMMARY

STATION TO STATION	OFFSET		REMARKS
	LT.	RT.	
0+140+60			4' minimum depth of cover. See General Note No. 12, Sht. 2.


SEWERLINE ADJUSTMENT SUMMARY


STATION TO STATION	OFFSET		REMARKS
	LT.	RT.	
			See General Note No. 12, Sht. 2.

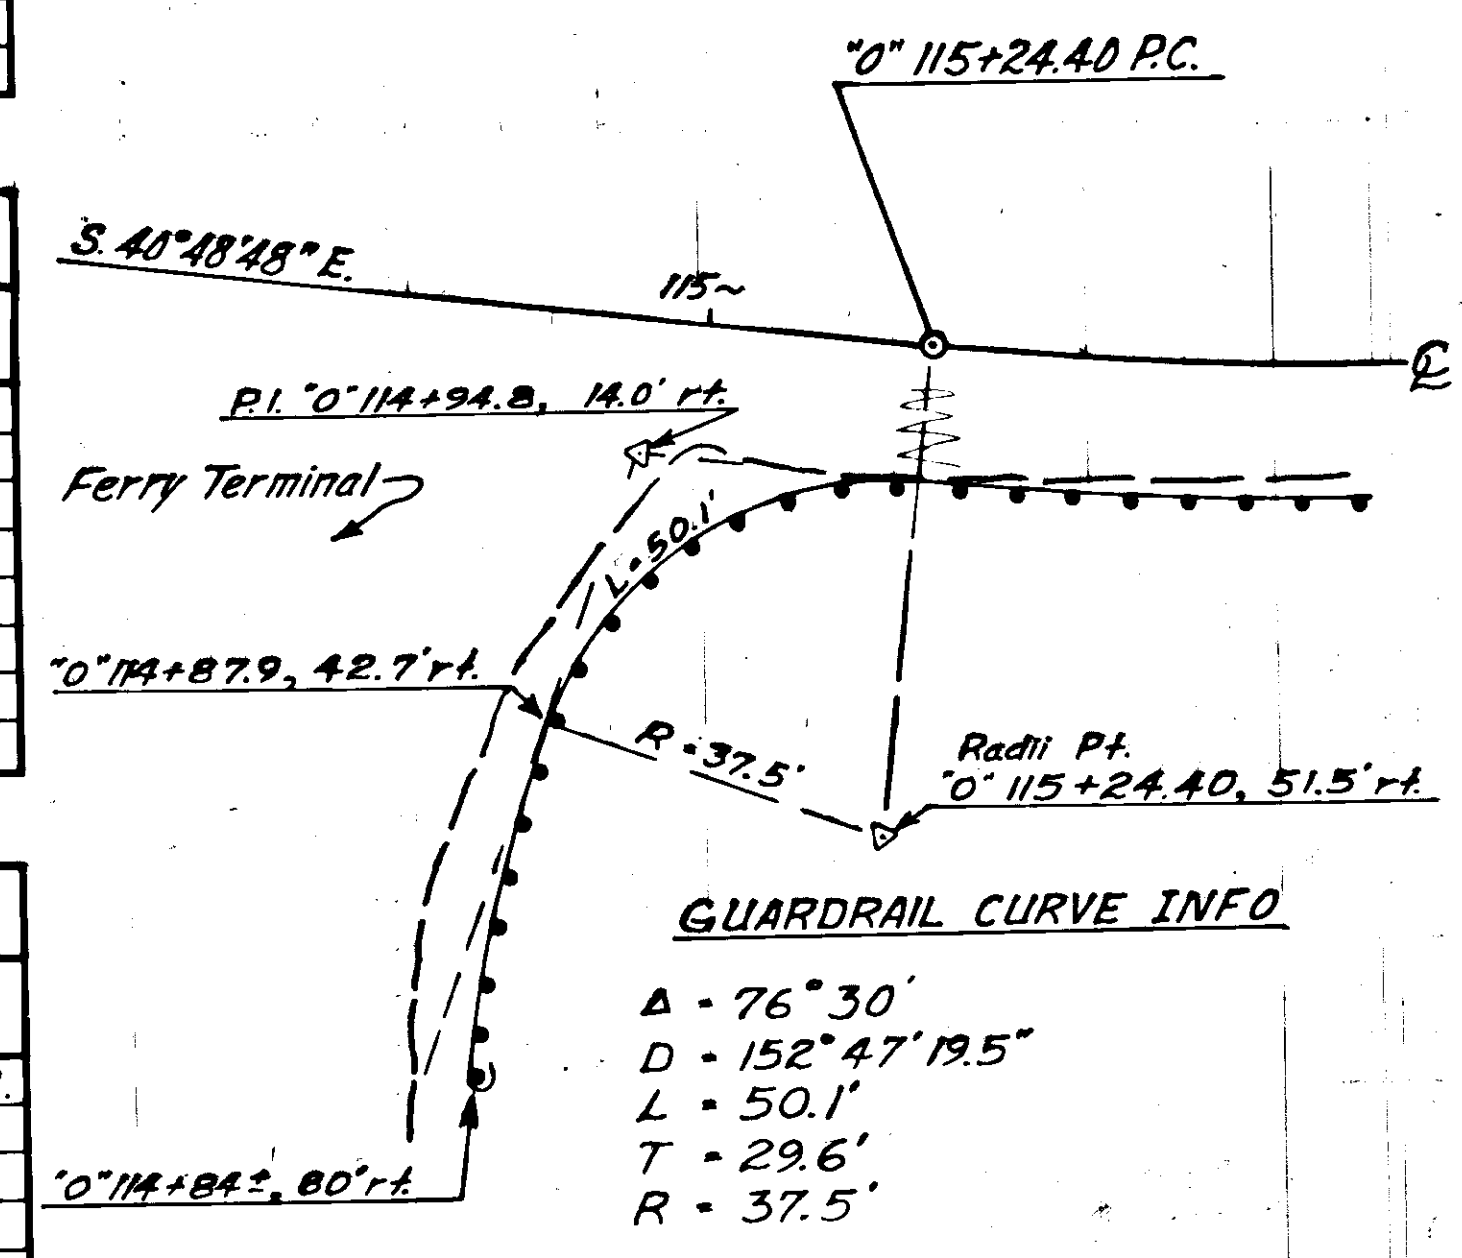

GUARDRAIL DETAIL



- NOTES:
- Guardrail locations are subject to minor revisions by the Engineer.
 - Guardrail elements used in the curve at the Ferry Terminal shall be shop formed to the radius of 37.5 feet. Four (4) elements are required.

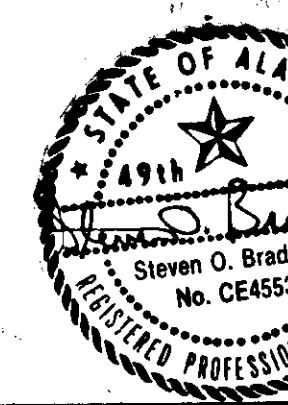

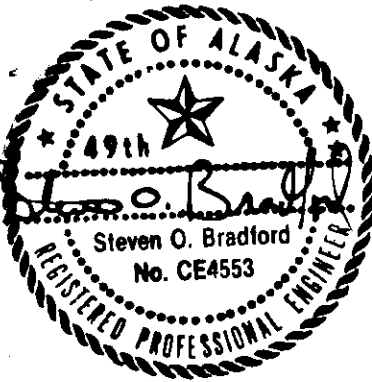

SLOPE TABLE

LEFT				RIGHT				RIGHT (CONTINUED)						
STATION	FILL SLOPE	CUT SLOPE FORE	CUT SLOPE BACK	WIDTH OF FLAT BOTTOM DITCH	STATION	FILL SLOPE	CUT SLOPE FORE	CUT SLOPE BACK	WIDTH OF FLAT BOTTOM DITCH	STATION	FILL SLOPE	CUT SLOPE FORE	CUT SLOPE BACK	WIDTH OF FLAT BOTTOM DITCH
0'113+98.36		2:1	2:1		0'113+98.36		2:1	2:1		0'173+00		1 1/2:1		
0'116+50		2:1	2:1		0'115+50		2:1	2:1		0'173+50		2:1		
0'117+00	3:1				0'116+00	1 1/2:1				0'174+00		2:1		
0'118+00	3:1				0'119+35	1 1/2:1				0'174+50	3:1			
0'118+75		2:1	2:1		0'119+75		2:1	2:1		0'175+00		2:1	2:1	
0'119+35		2:1	2:1		0'121+50		2:1	2:1		0'175+50	2:1			
0'119+75		2:1	1 1/4:1	2'	0'122+00	1 1/2:1				0'176+00		2:1	2:1	
0'122+00		2:1	1 1/4:1	2'	0'123+50	1 1/2:1				0'177+50		2:1	2:1	
0'122+30	3:1				0'124+00	2:1				0'178+00	2:1			
0'123+00	3:1				0'124+50	2:1				0'179+00	2:1			
0'123+50		2:1	1 1/4:1	2'	0'125+00	1 1/2:1				0'179+50	3:1			
0'125+25		2:1	1 1/4:1	2'	0'125+50	1 1/2:1				0'180+00		2:1	2:1	
0'125+50		2:1	1 1/2:1		0'126+00	3:1				0'181+19.31		2:1	2:1	
0'126+25		2:1	1 1/2:1		0'126+50	2:1								
0'126+50	3:1				0'127+50	2:1								
0'127+50	3:1				0'128+00	3:1								
0'128+00		2:1	2:1	FLATTEN @ S.O.S. STORE	0'128+50	3:1								
0'129+50		2:1	2:1		0'129+00		2:1	2:1						
0'130+00	3:1				0'129+50		2:1	2:1						
0'130+50		2:1	1 1/2:1		0'130+00	1 1/2:1								
0'132+50		2:1	1 1/2:1		0'132+50	1 1/2:1								
0'133+00		2:1	2:1		0'133+00	2:1								
0'136+50		2:1	2:1		0'133+50	3:1								
0'137+00		2:1	1:1		0'134+00		2:1	2:1						
0'137+50		2:1	2:1		0'136+50		2:1	2:1						
0'138+00	3:1				0'137+00	1 1/2:1								
0'138+50		2:1	1 1/2:1		0'138+50	1 1/2:1								
0'144+50		2:1	1 1/2:1		0'139+00		2:1	2:1						
0'144+75		2:1	1 1/4:1	2'	0'139+50	1 1/2:1								
0'146+75		2:1	1 1/4:1	2'	0'140+00	1 1/2:1								
0'147+00		2:1	1 1/2:1		0'140+50		2:1	2:1						
0'149+50		2:1	1 1/2:1		0'142+00		2:1	2:1						
0'150+00	3:1				0'142+50	3:1								
0'150+50	3:1				0'144+50	3:1								
0'150+75		2:1	2:1		0'145+00		2:1	2:1						
0'151+00	3:1				0'148+00		2:1	2:1						
0'151+50	3:1				0'148+50	2:1								
0'152+00		2:1	2:1		0'149+50	2:1								
0'152+50		2:1	2:1		0'150+00	3:1								
0'153+00		2:1	1 1/2:1		0'150+70		2:1	2:1						
0'157+80		2:1	1 1/2:1		0'151+25		2:1	2:1						
0'158+00	2:1				0'151+75	3:1								
0'158+50	3:1				0'154+50	3:1								
0'159+50	3:1				0'155+00		2:1	2:1						
0'160+00		2:1	2:1		0'157+40		2:1	2:1						
0'162+00		2:1	2:1		0'157+70	1 1/2:1								
0'162+25	3:1				0'158+00		2:1	2:1						
0'162+75	3:1				0'158+50		2:1	2:1						
0'163+00	2:1				0'160+00	3:1								
0'163+50	3:1				0'160+50	3:1								
0'165+75	3:1				0'161+00		2:1	2:1						
0'166+00		2:1	2:1		0'161+50	3:1								
0'167+50		2:1	2:1		0'162+00	1 1/2:1								
0'168+00	3:1				0'163+00	1 1/2:1								
0'169+00	3:1													
0'169+50		2:1	2:1		0'163+50	2:1								
0'170+75		2:1	2:1		0'164+00	2:1								
0'171+00	2:1				0'164+50	3:1								
0'171+50		2:1	2:1		0'165+00		2:1	2:1						
0'172+50		2:1	2:1		0'165+50	3:1								
0'173+00	1 1/2:1				0'166+00		2:1	2:1						
0'174+00	1 1/2:1				0'166+50		2:1	2:1						
0'174+50		2:1	2:1		0'167+00	3:1								
0'177+50		2:1	2:1		0'167+50	3:1								
0'178+00	3:1				0'168+00		2:1	2:1						
0'179+25	3:1				0'168+50		2:1	2:1						
0'179+50		2:1	2:1		0'169+00	3:1								
0'181+19.31		2:1	2:1		0'169+50		2:1	2:1						
					0'172+50		2:1	2:1						

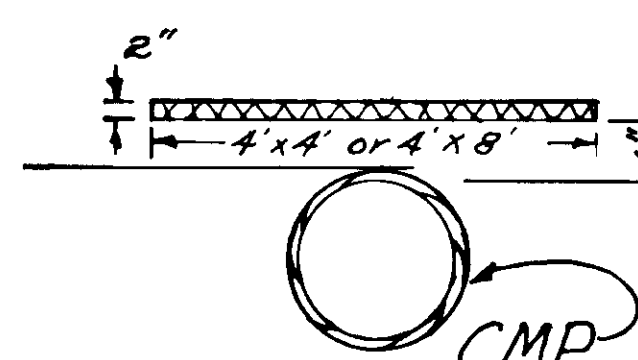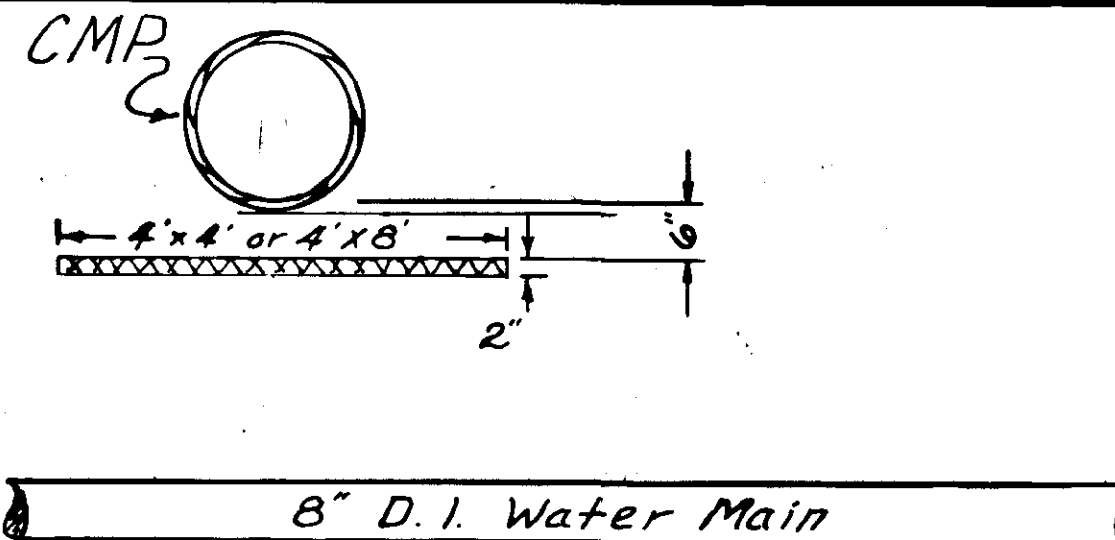

FIRE HYDRANT RELOCATION SUMMARY

REMOVE	OFFSET		INSTALL	OFFSET	
	LT.	RT.		LT.	RT.
0'129+65	20'		0'129+65	24'	
0'142+80	19'		0'142+80	24'	
0'152+41	19'		0'152+41	24'	
0'169+07	16'		0'169+07	24'	

VALVE BOX ADJUSTMENT SUMMARY




STATION	OFFSET		REMARKS
	LT.	RT.	
0'129+65	17'		*
0'129+73	17'		
0'142+80	14'		*
0'148+63	7.5'		UNABLE TO LOCATE
0'152+41	14'		*
0'167+43	11'		UNABLE TO LOCATE
0'169+07	16'		*

*Incidental to Fire Hydrant relocation.



MONUMENT SUMMARY

STATION	OFFSET		REMARKS
	LT.	RT.	
0'121+65	18'		Within Slope Limits
0'162+50	15'		Bearing Tree
0'162+75	28'		Within Slope Limits

WATERLINE DETAILS FOR EXISTING 8" D.I. (For Adjustment Information Only)

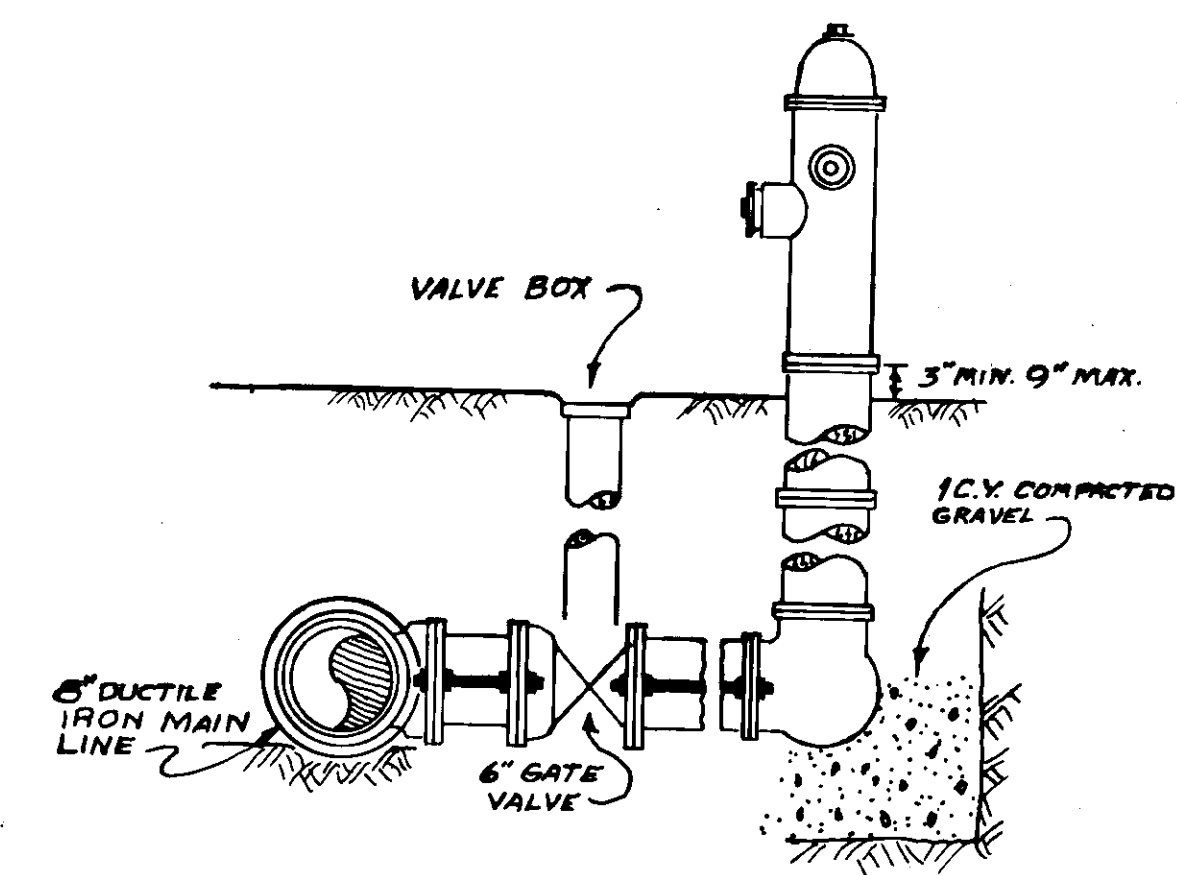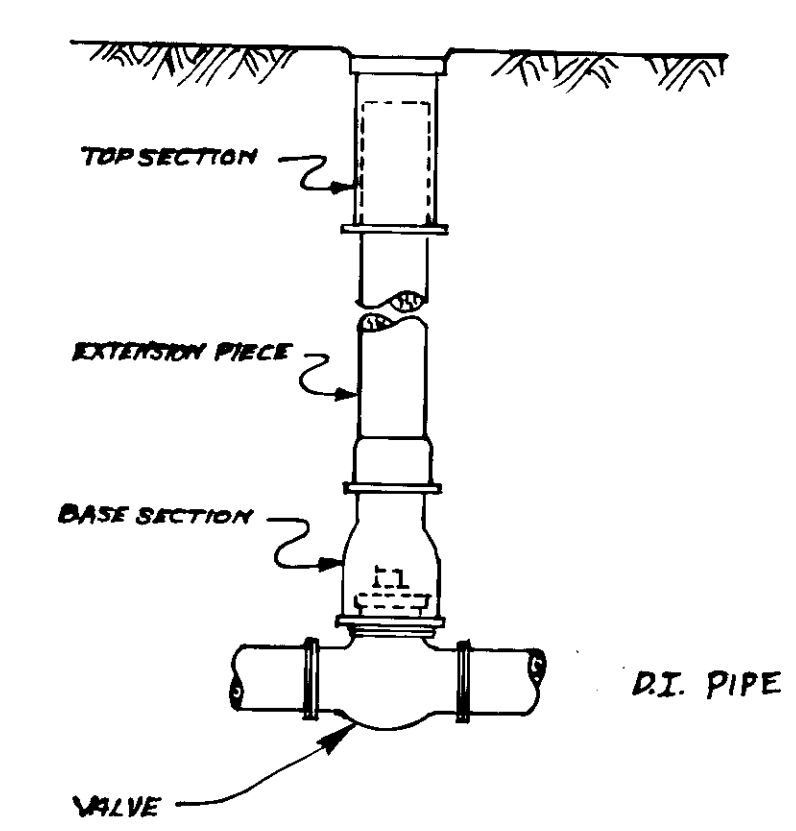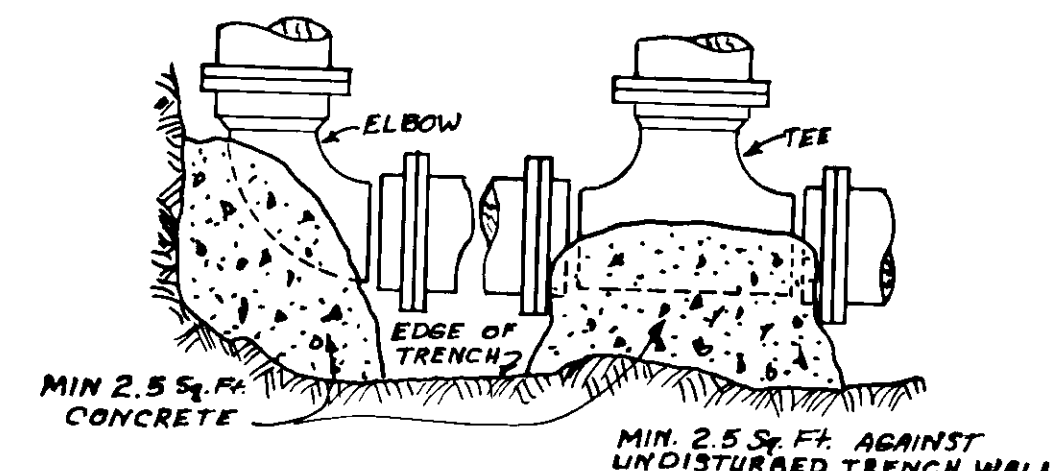

- #### HYDRANT INSTALLATION NOTES
- HYDRANT BARREL MUST BE INSTALLED PLUMB AND THE LEG MUST BE INSTALLED LEVEL.
 - AUXILIARY GATE VALVE BOX TO BE INSTALLED ACCORDING TO DETAIL FOR TYPICAL VALVE BOX.

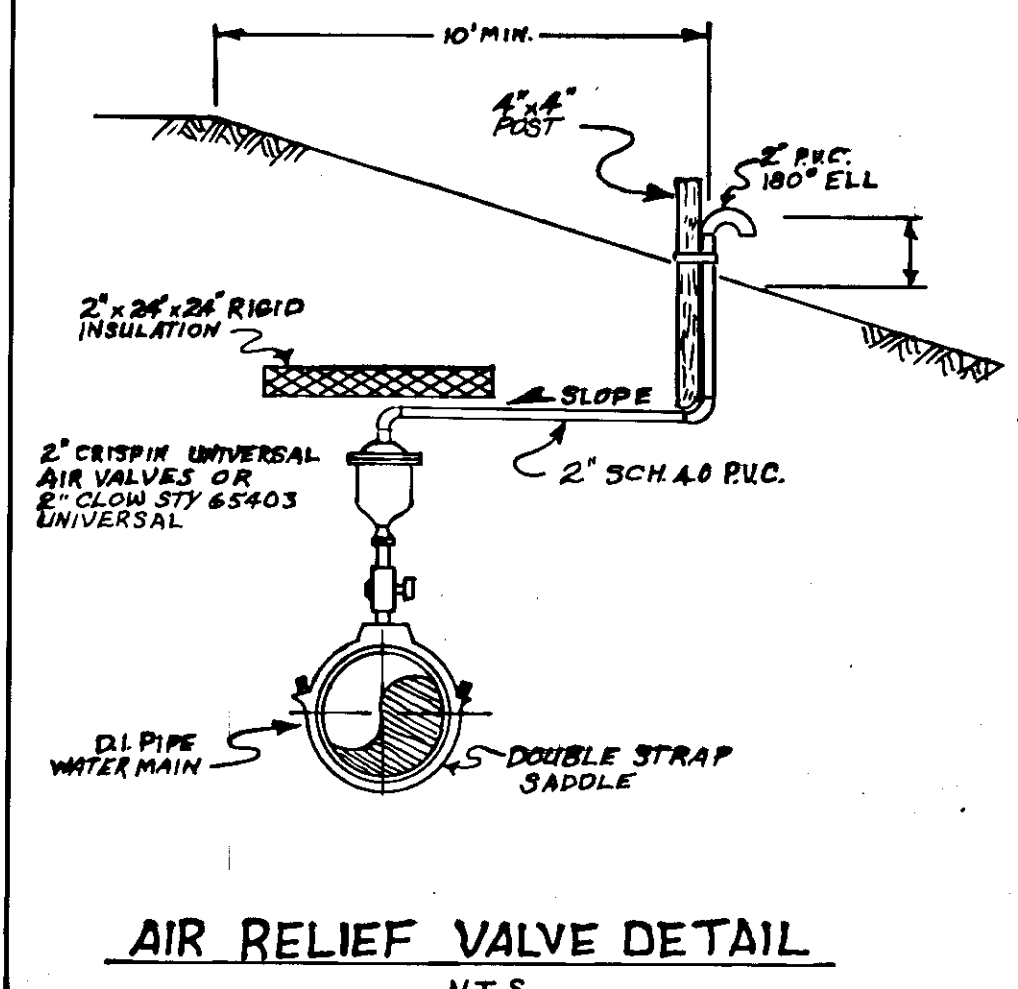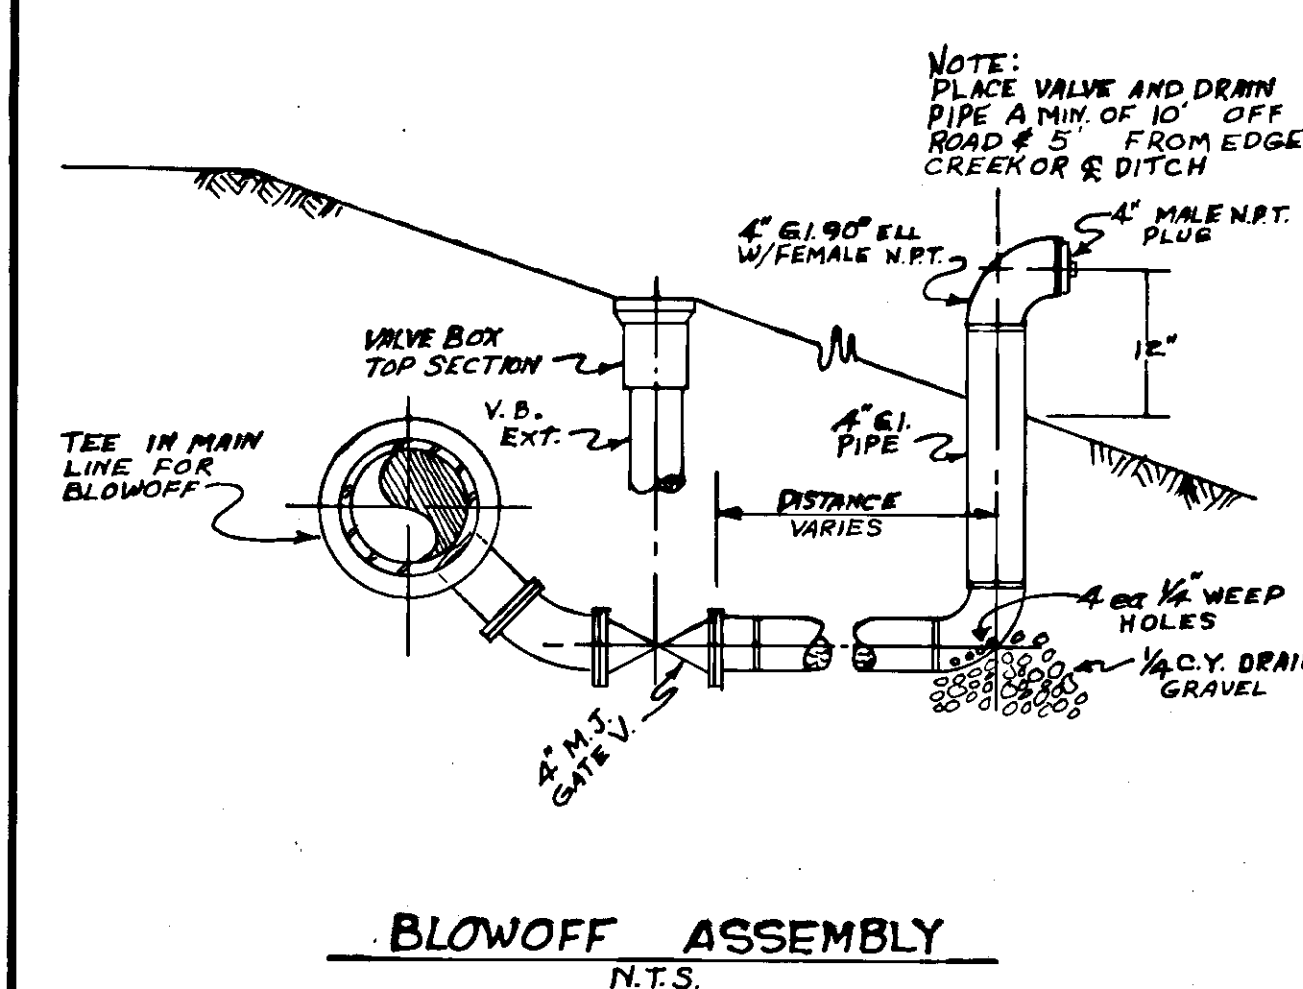

STATE	PROJECT DESIGNATION	YEAR	SHEET NO.	TOTAL SHEETS
ALASKA	FH-40-1(I)	1987	6	19

VERTICAL CONTROL


The basis of Vertical Control for this project was N.O.S. Tidal Bench Mark No. 4, Kake, Keku Strait, 1962, with a published elevation of 14.51 M.L.L.W. (1964 Mean Value). Bench Mark is a standard disk set in a rock point outcropping, northwest of the Keku Canning Company, located approximately 2,000 feet N.W. of the project B.O.P.

HORIZONTAL CONTROL



The basis of bearing was the line-of-sight between N.O.S. Station "Kake" and U.S.K.H. Engineers photocontrol point No. 61 (1981), with an A.S.P. Grid Bearing of S 53°06'10"E, based on the following accepted values:

U.S.C. and G.S. "Kake" (1927)
 Lat. 56° 58' 26.945" N.
 Long. 133° 56' 57.815" W.
 (Y) 1,877,872.15 N.
 (X) 2,629,236.43 E.


U.S.K.H. No. 61 (1981)
 Lat. 56° 57' 42.495" N.
 Long. 133° 55' 08.529" W.
 (Y) 1,873,337.785" N.
 (X) 2,635,276.252" E.

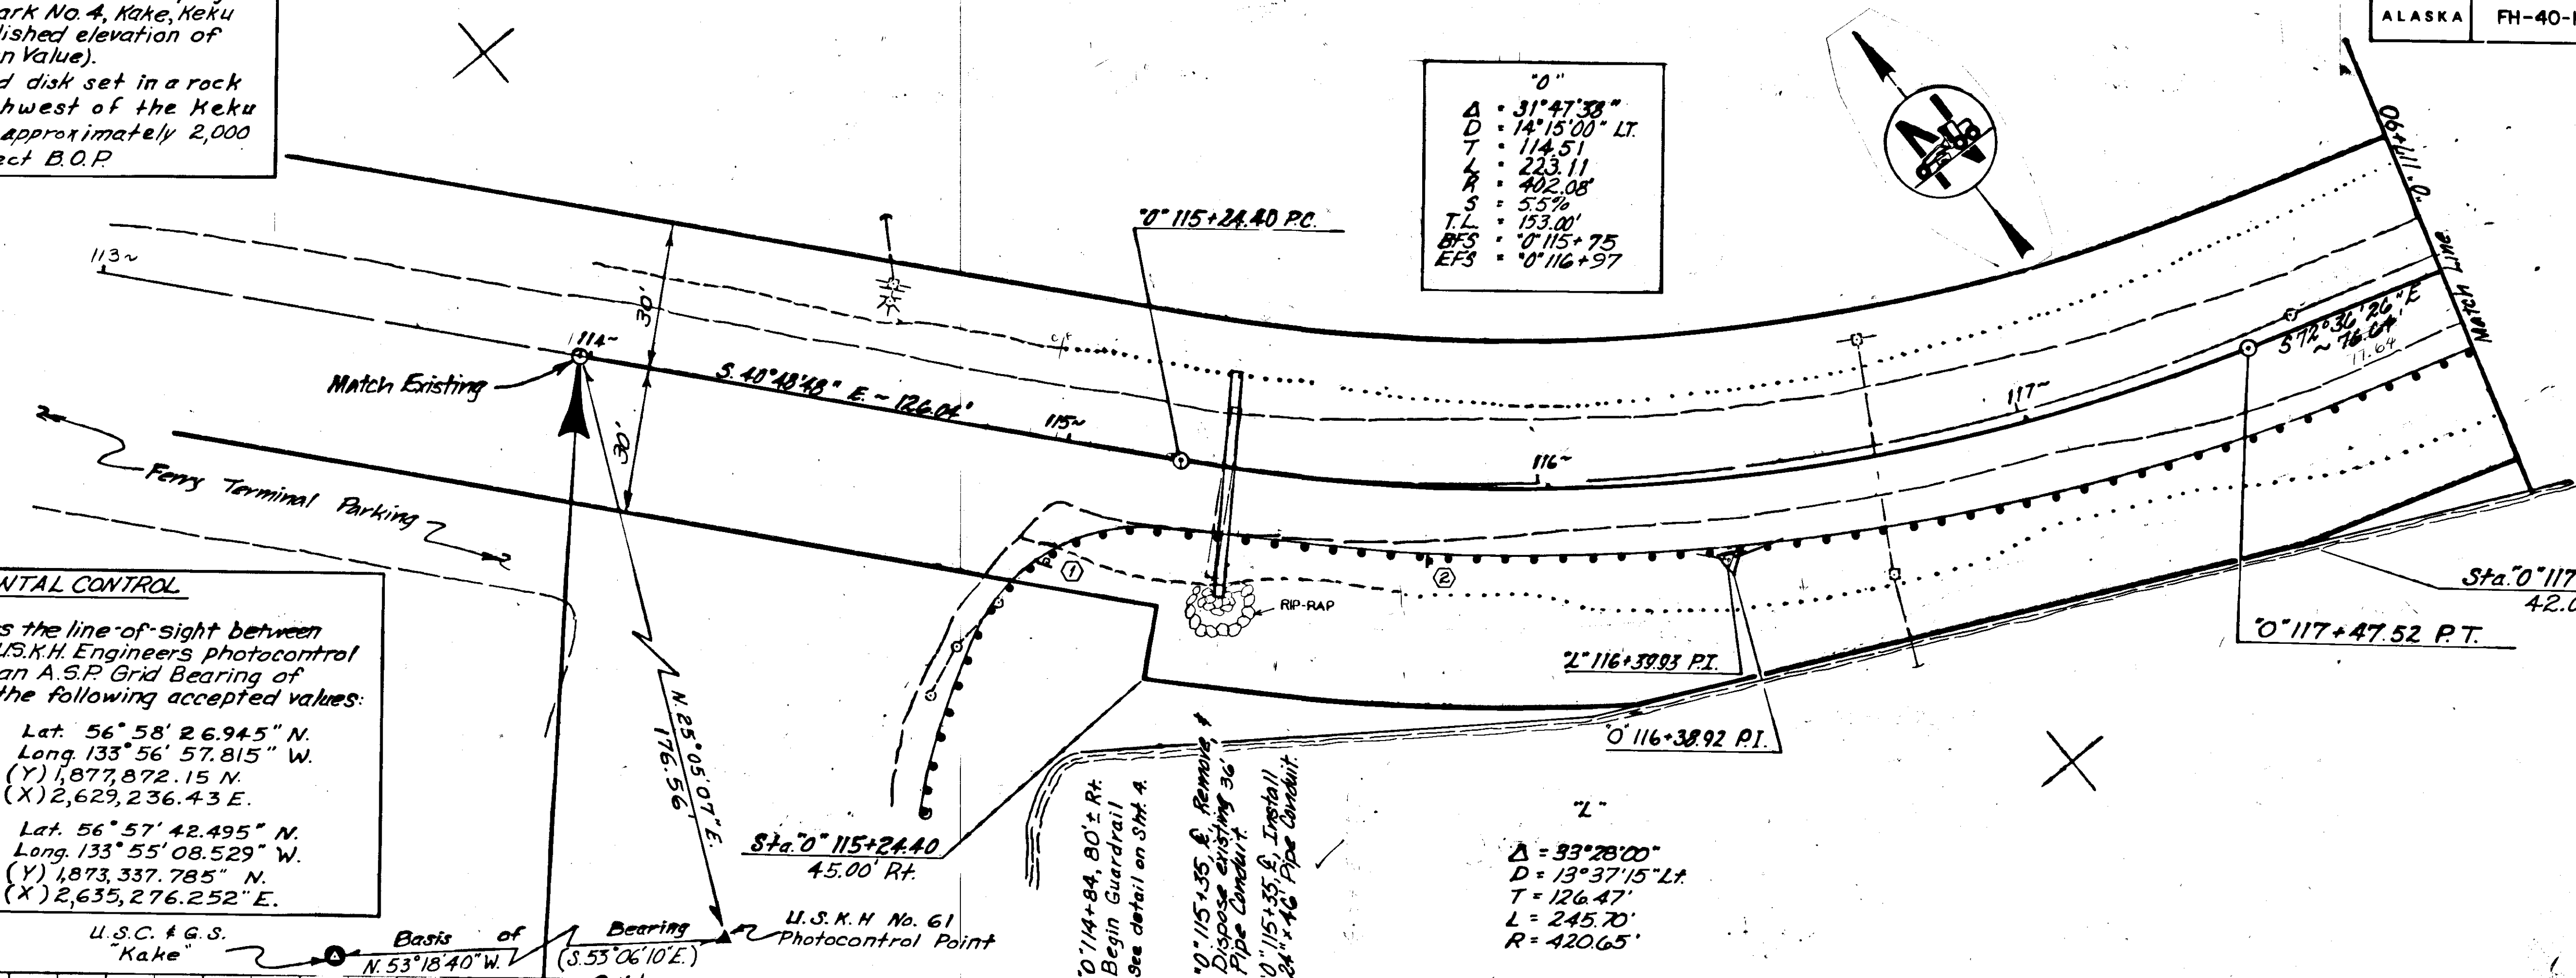

BEGIN PROJECT
 FH+40-1(I)
 "L" 114+00.00 P.O.T. BK. =
 "O" 113+98.36 P.O.T. AHD.

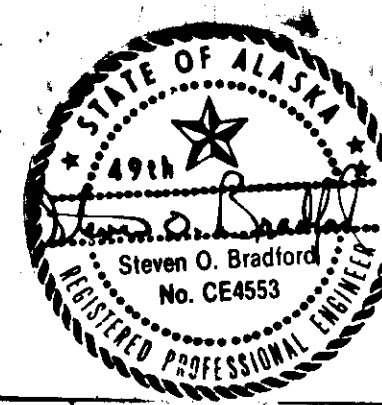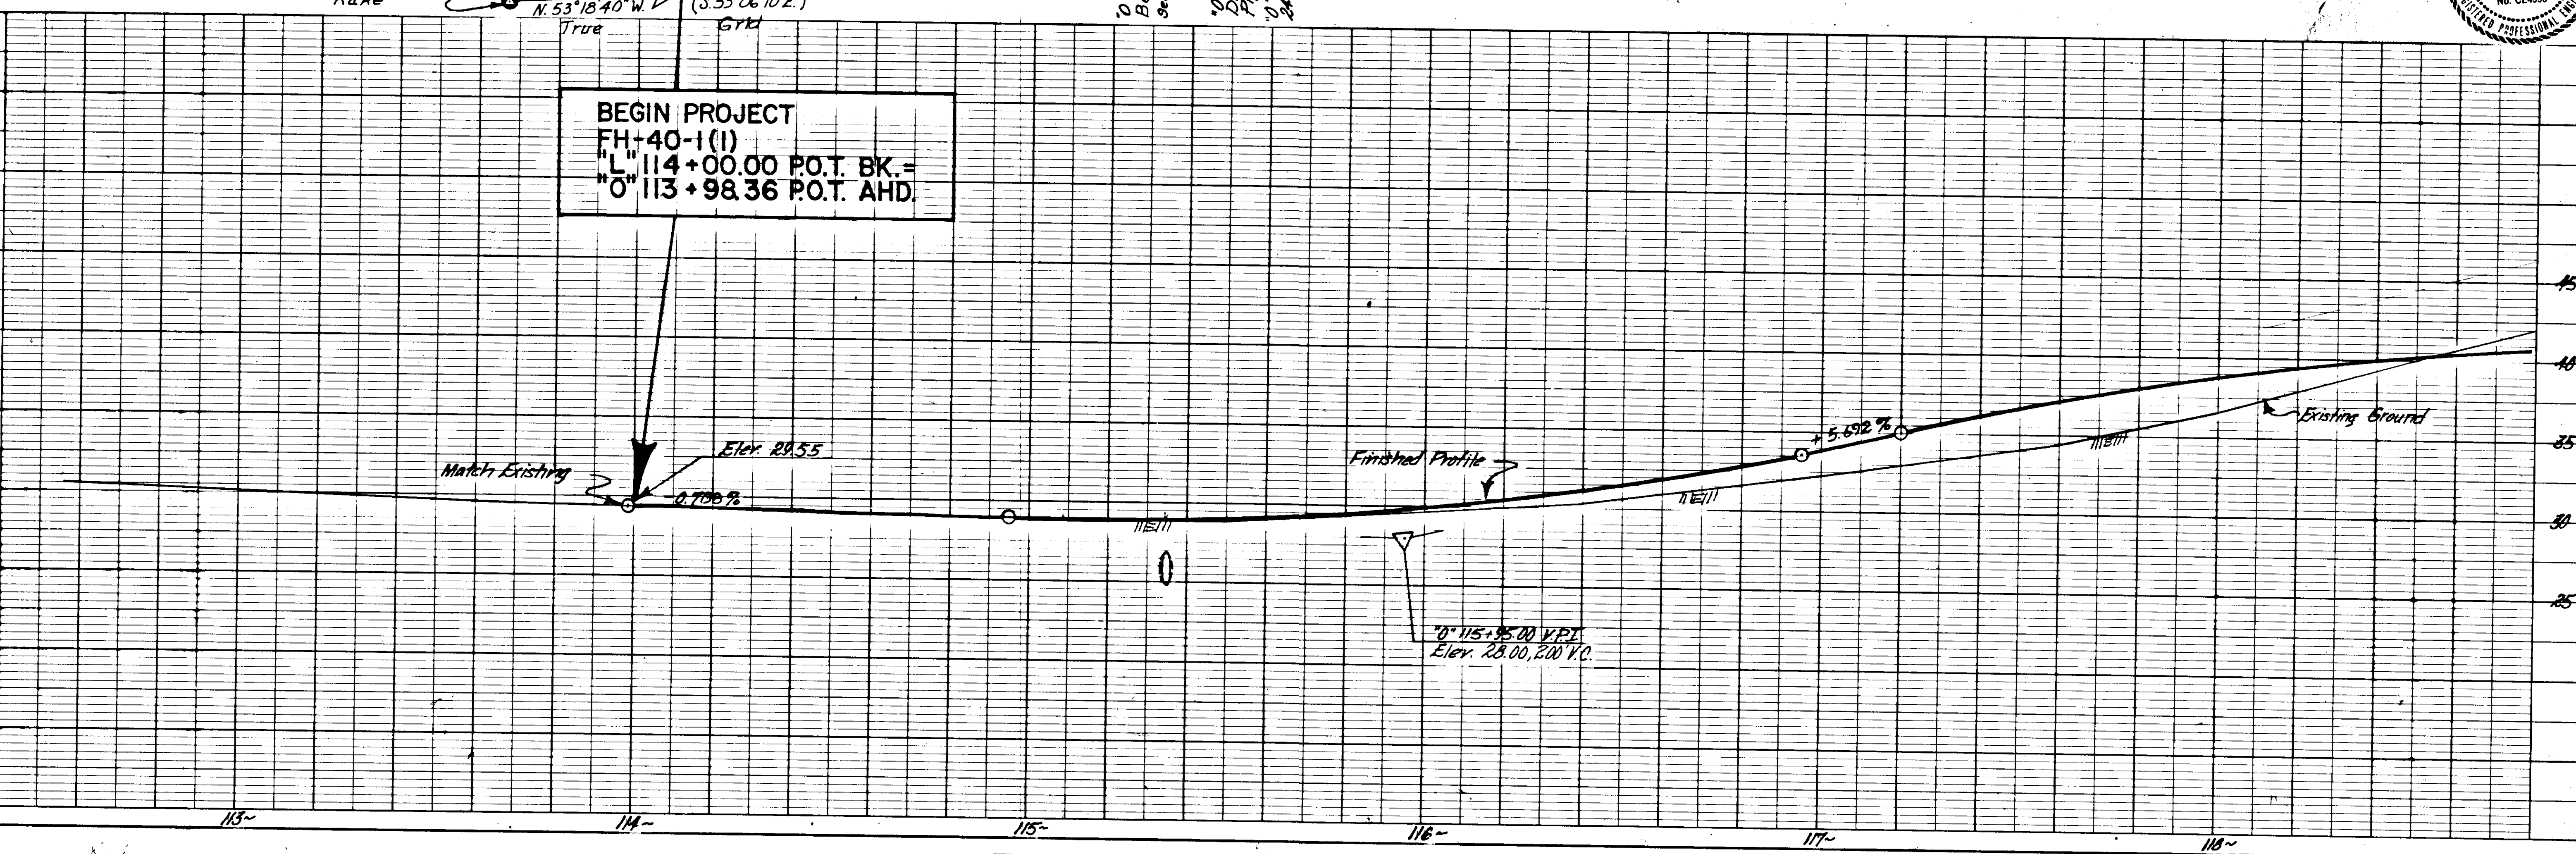

STATE	PROJECT DESIGNATION	YEAR	SHEET NO.	TOTAL SHEETS
ALASKA	FH-40-1 (I)	1987	7	19

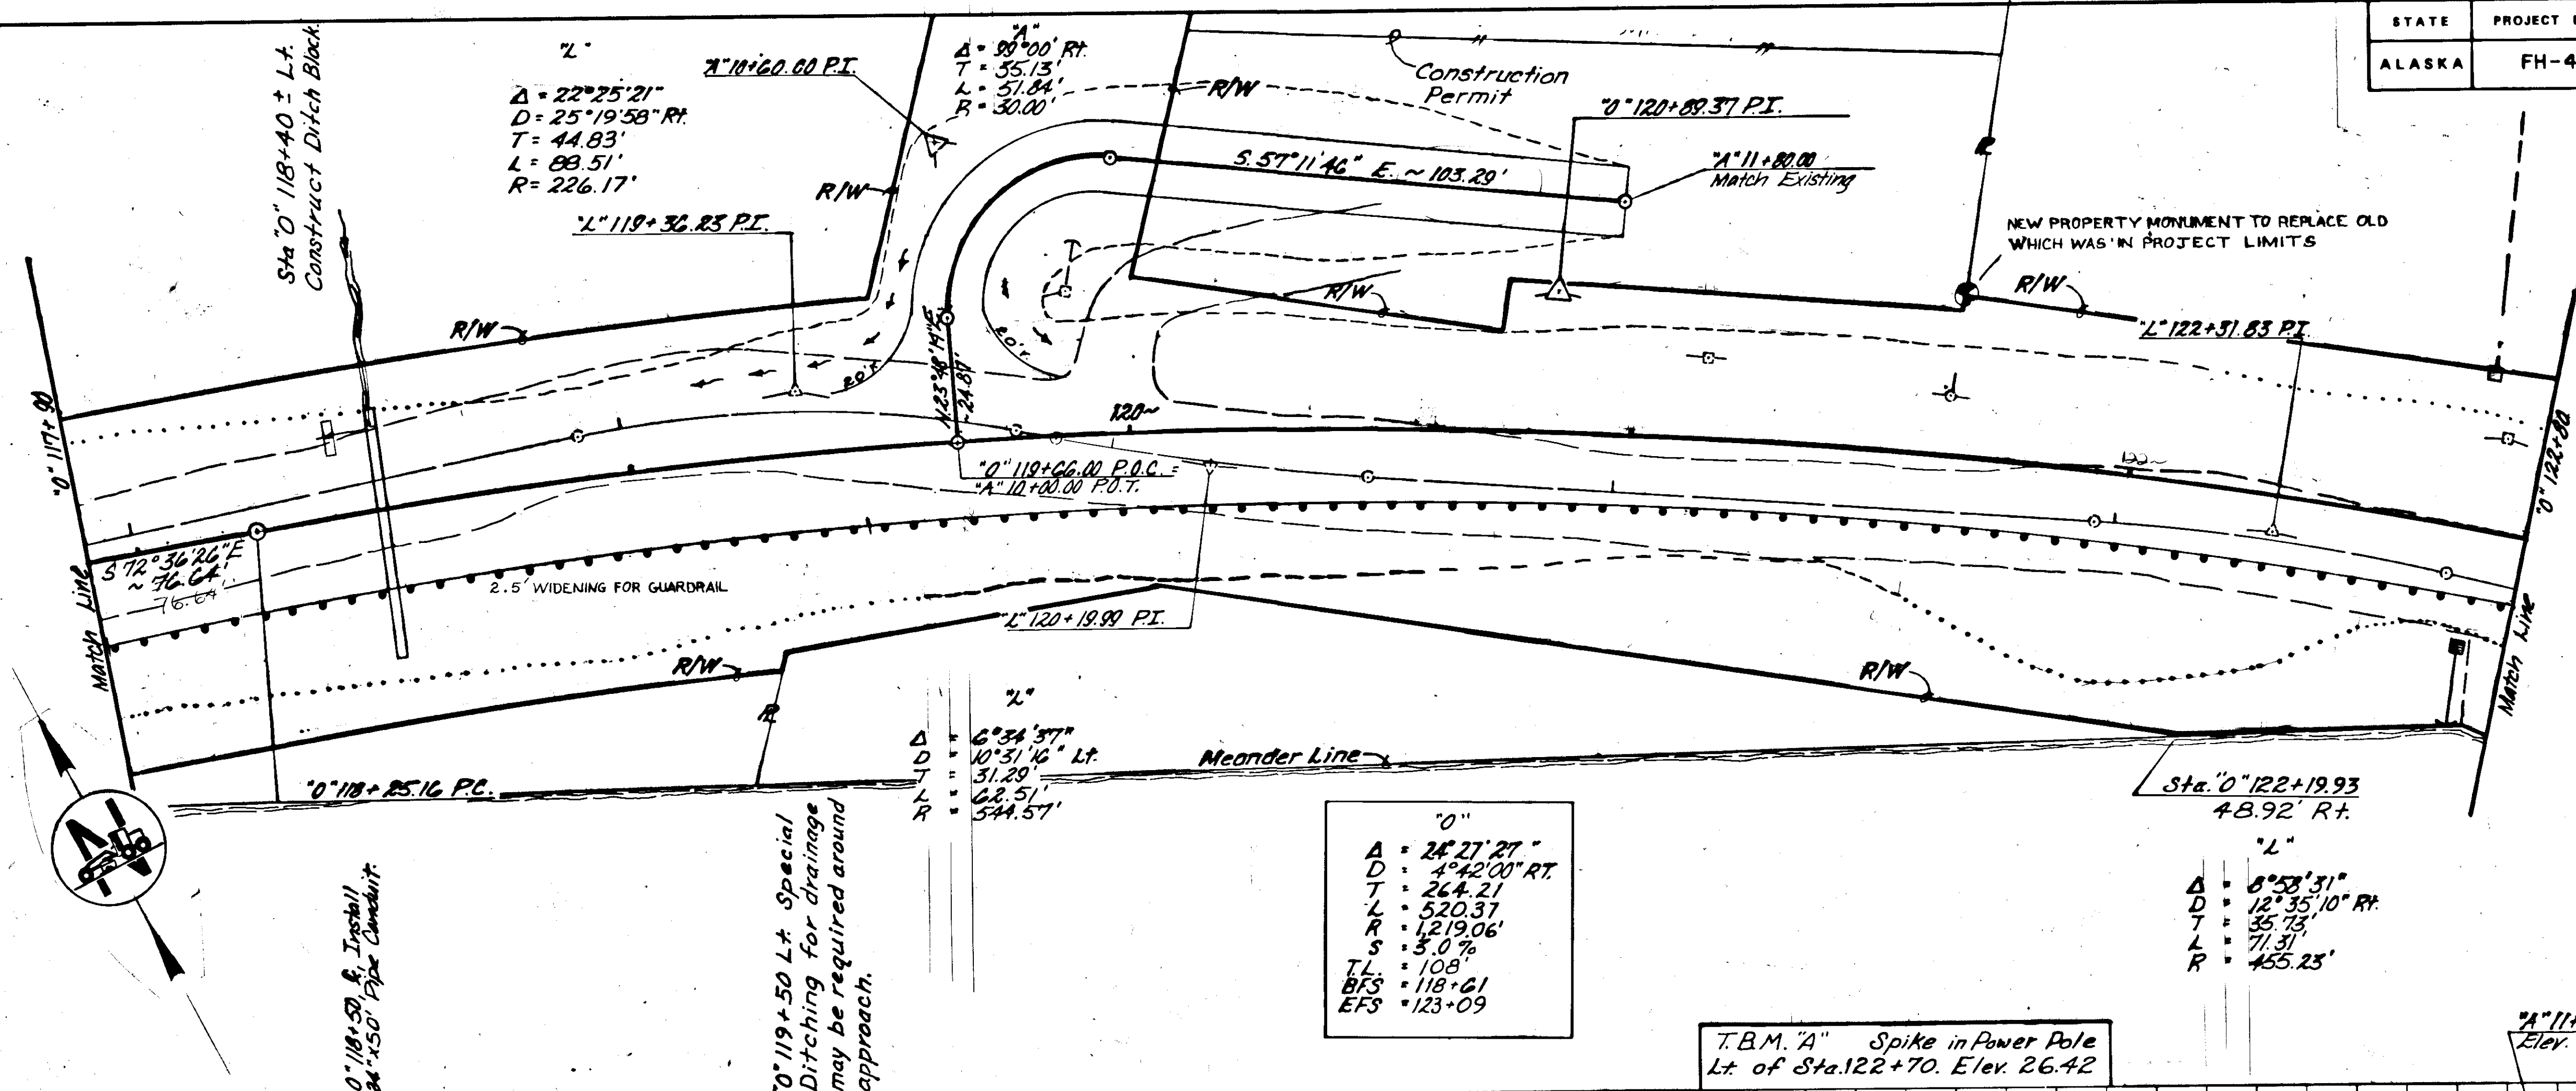

"L"
 $\Delta = 22^\circ 25' 21"$
 $D = 25^\circ 19' 58" \text{ RT}$
 $T = 44.83'$
 $L = 88.51'$
 $R = 226.17'$

"A"
 $\Delta = 80^\circ 00' \text{ RT}$
 $T = 35.13'$
 $L = 51.84'$
 $R = 30.00'$

"L"
 $\Delta = 6^\circ 34' 37"$
 $D = 10^\circ 51' 16" \text{ Lt}$
 $T = 31.29'$
 $L = 62.51'$
 $R = 544.57'$

"O"
 $\Delta = 24^\circ 21' 27"$
 $D = 4^\circ 42' 00" \text{ RT}$
 $T = 264.21'$
 $L = 520.37'$
 $R = 1219.06'$
 $S = 3.0\%$
 $TL = 108'$
 $BFS = 118+61$
 $EFS = 123+09$



"L"
 $\Delta = 8^\circ 58' 31"$
 $D = 12^\circ 35' 10" \text{ RT}$
 $T = 35.73'$
 $L = 71.31'$
 $R = 455.25'$

"O" 118+50 & Install
 24" x 450' Pipe Channel

"O" 119+50 Lt. Special
 Ditching for drainage
 may be required around
 approach.



T.B.M. "A" Spike in Power Pole
 Lt. of Sta. 122+70. Elev. 26.42

"A" 114+55 V.P.I.
 Elev. 53.00, 50' VC.

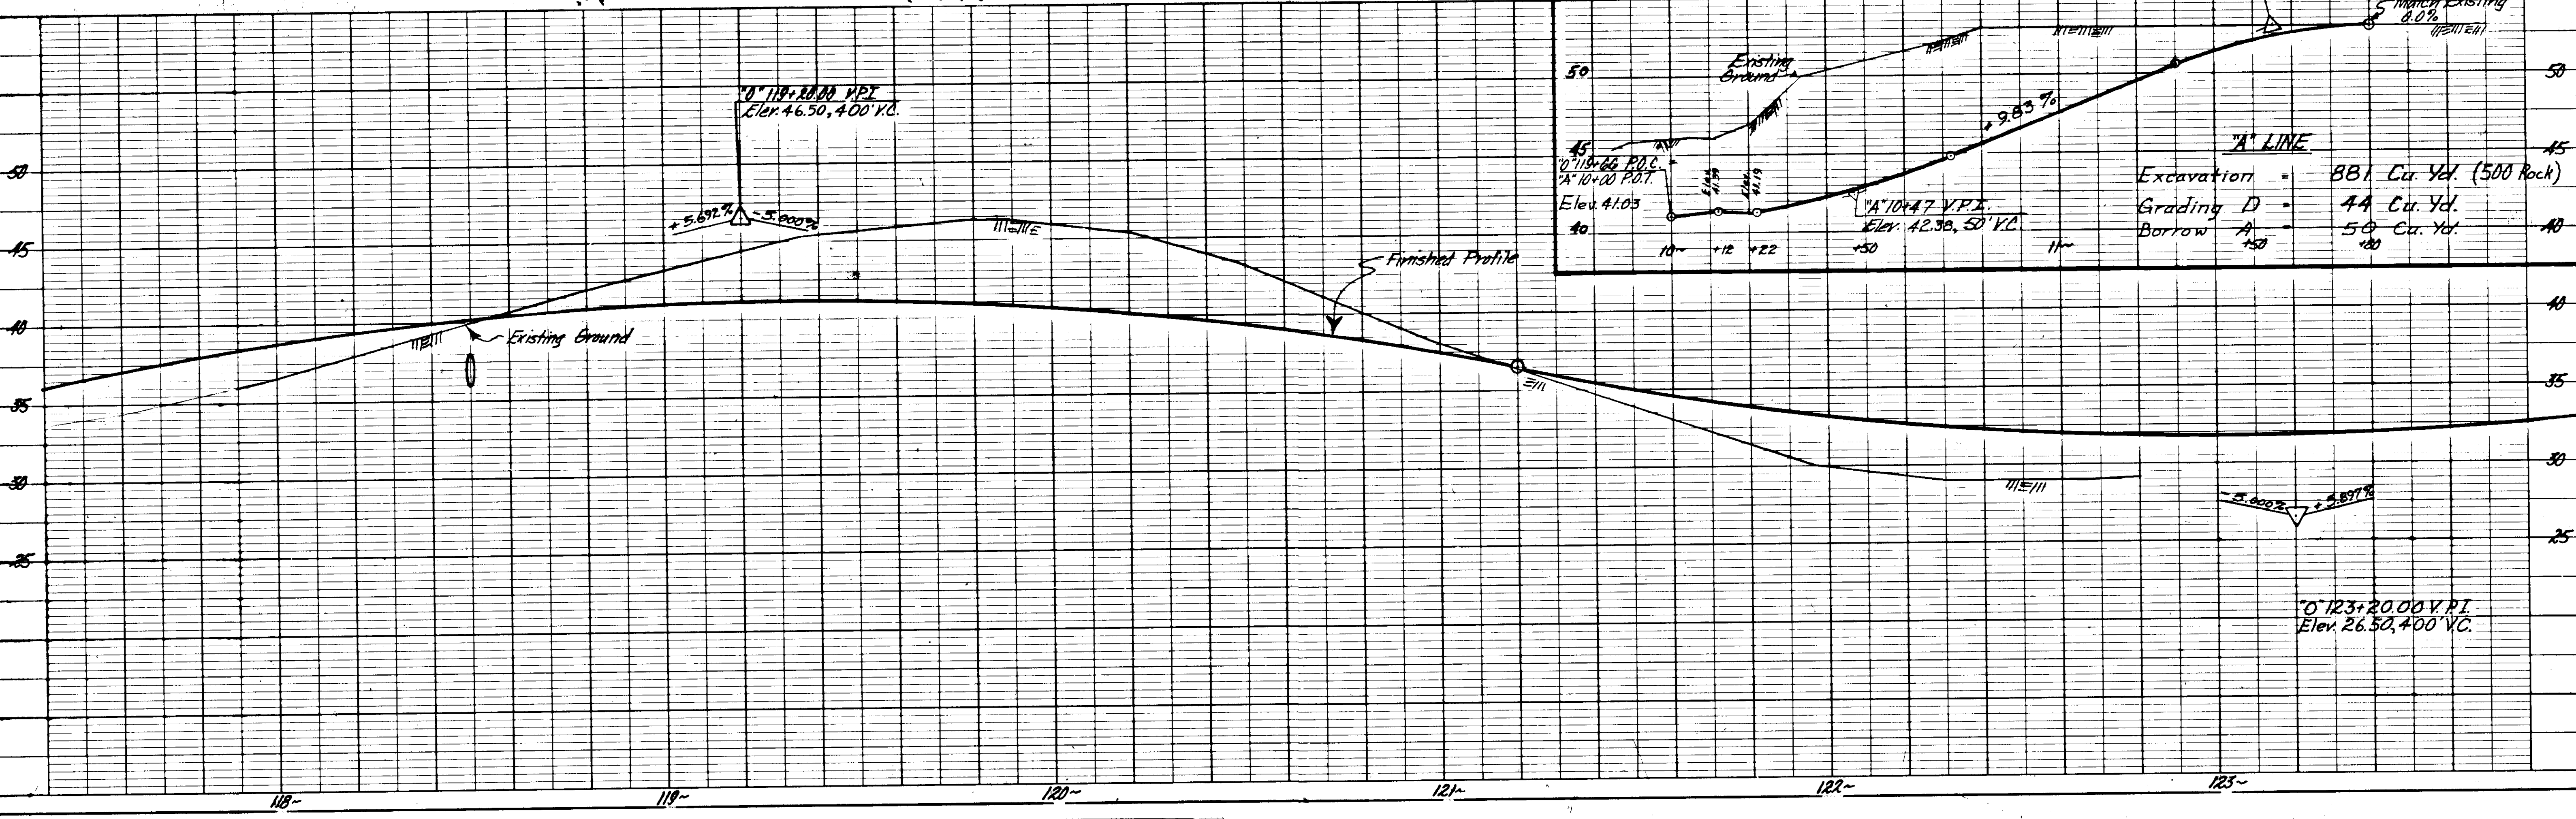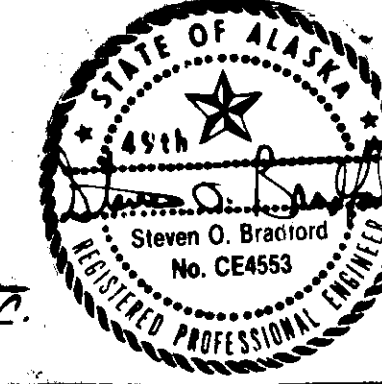


"A" LINE
 Excavation = 881 Cu. Yd. (500 Rock)
 Grading D = 44 Cu. Yd.
 Borrow A = 50 Cu. Yd.

STATE	PROJECT DESIGNATION	YEAR	SHEET NO.	TOTAL SHEETS
ALASKA	FH-40-1(1)	1987	8	19

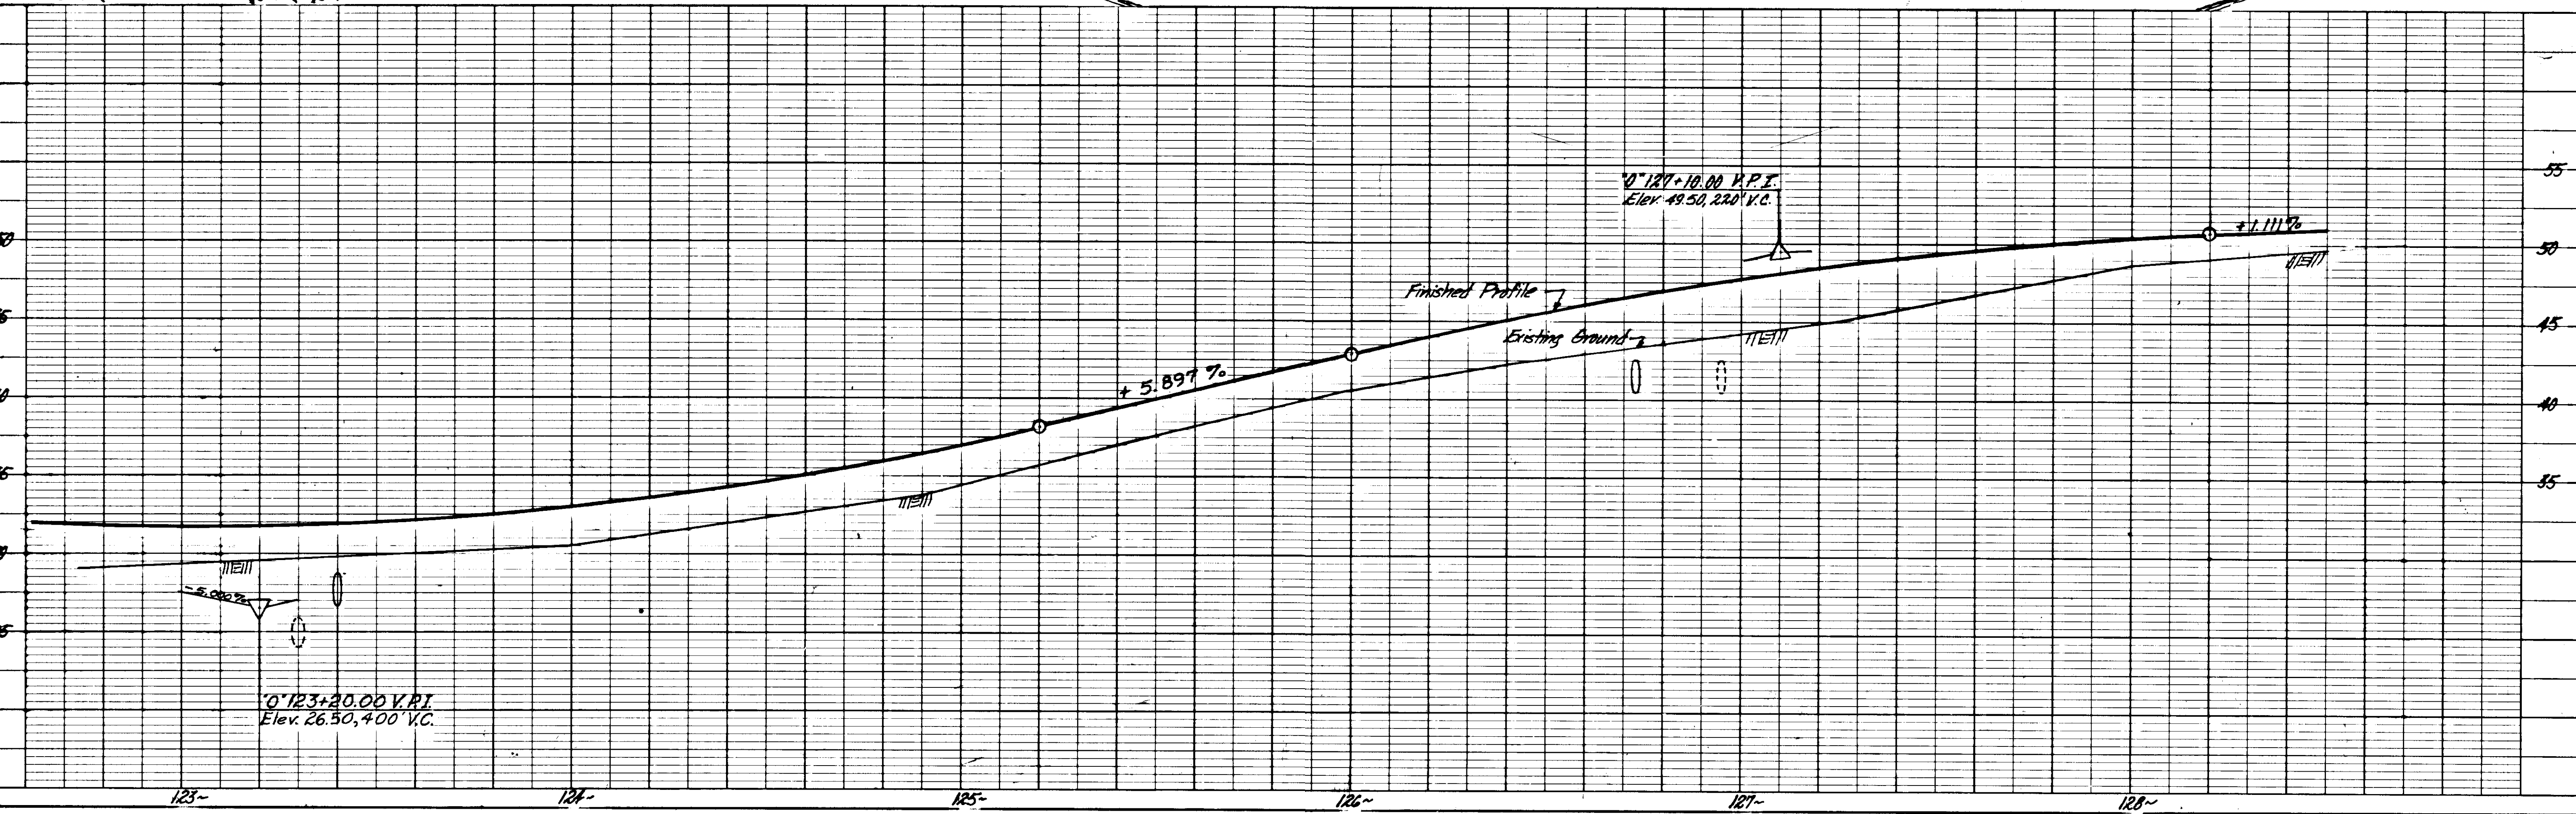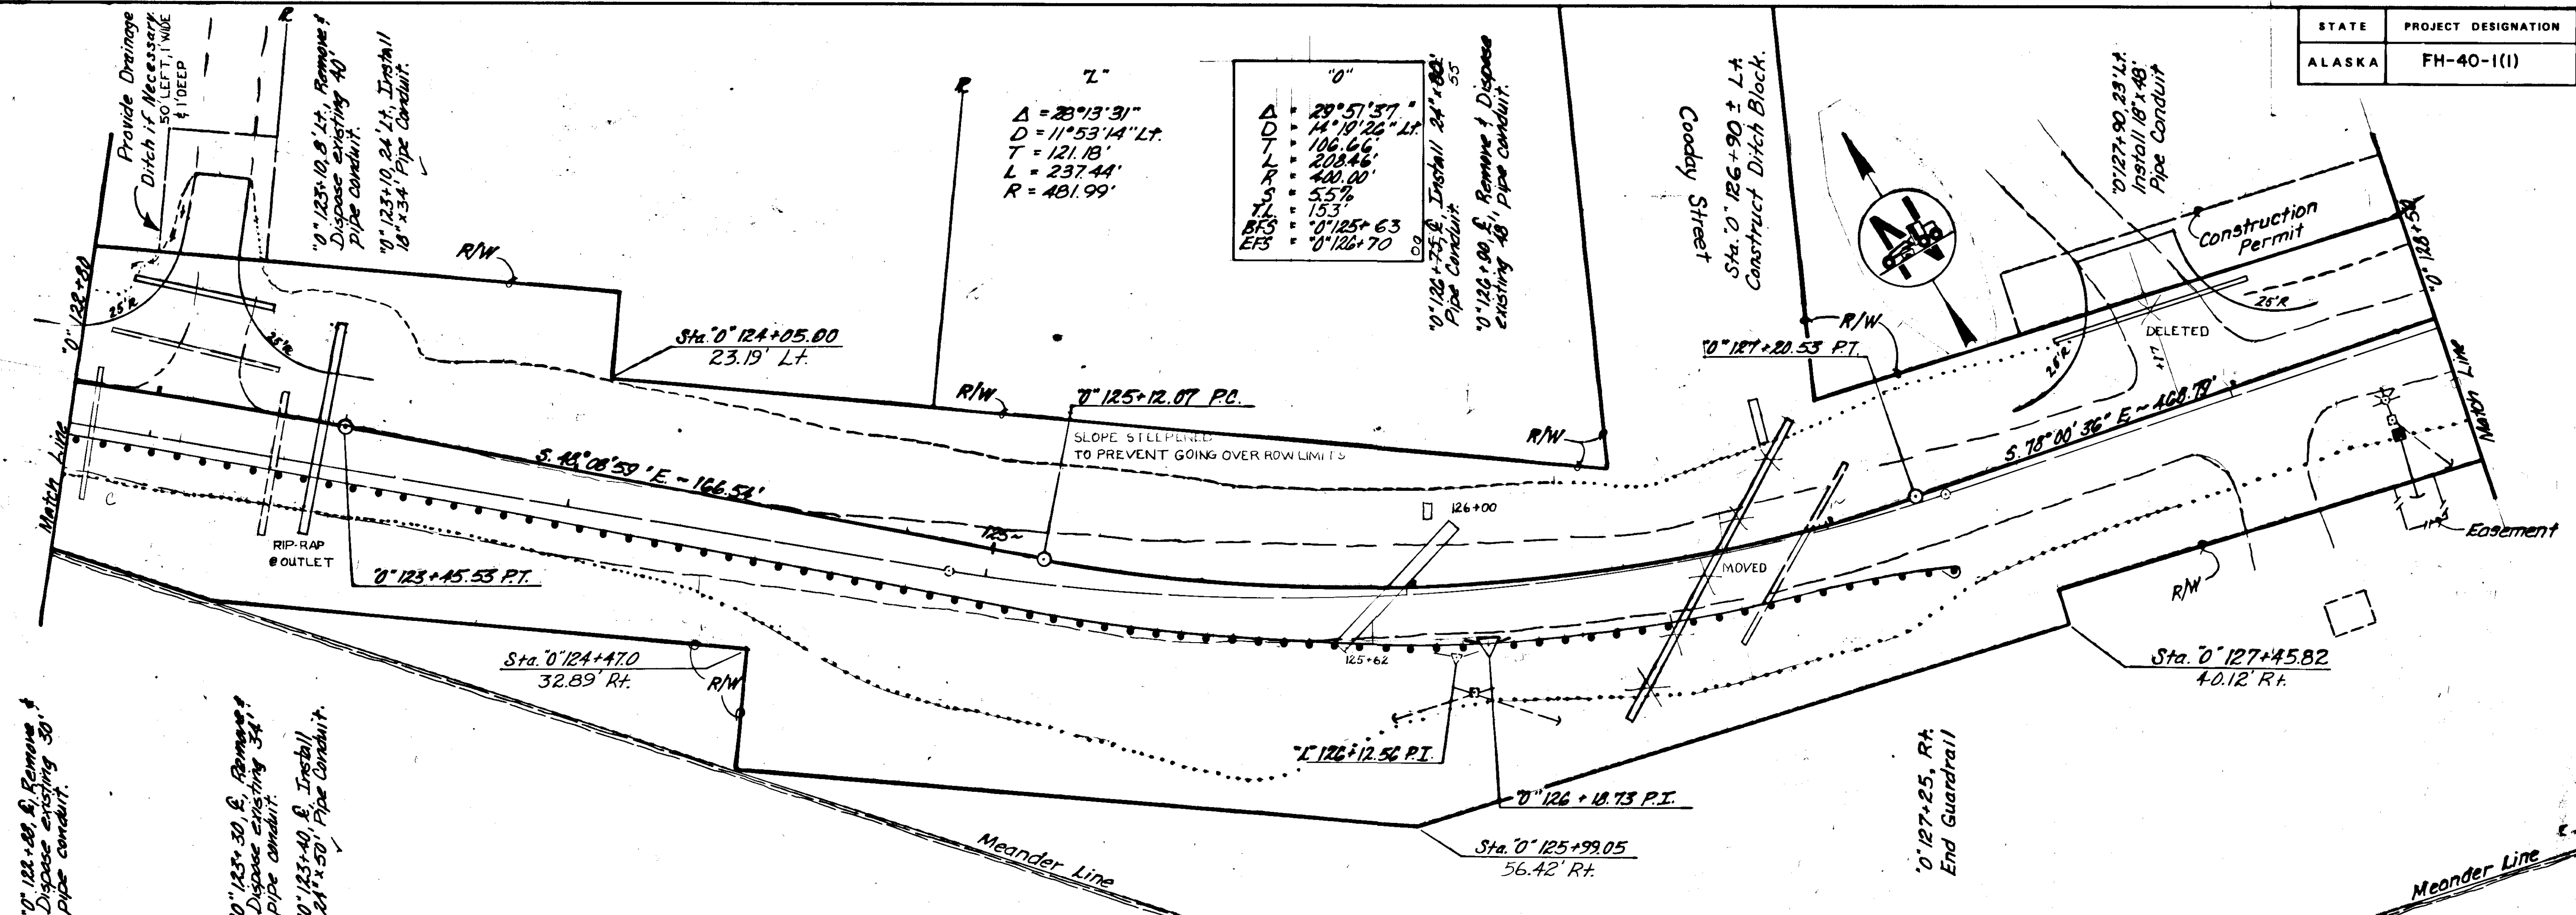

STATE	PROJECT DESIGNATION	YEAR	SHEET NO.	TOTAL SHEETS
ALASKA	FH-40-1(1)	1987	9	19

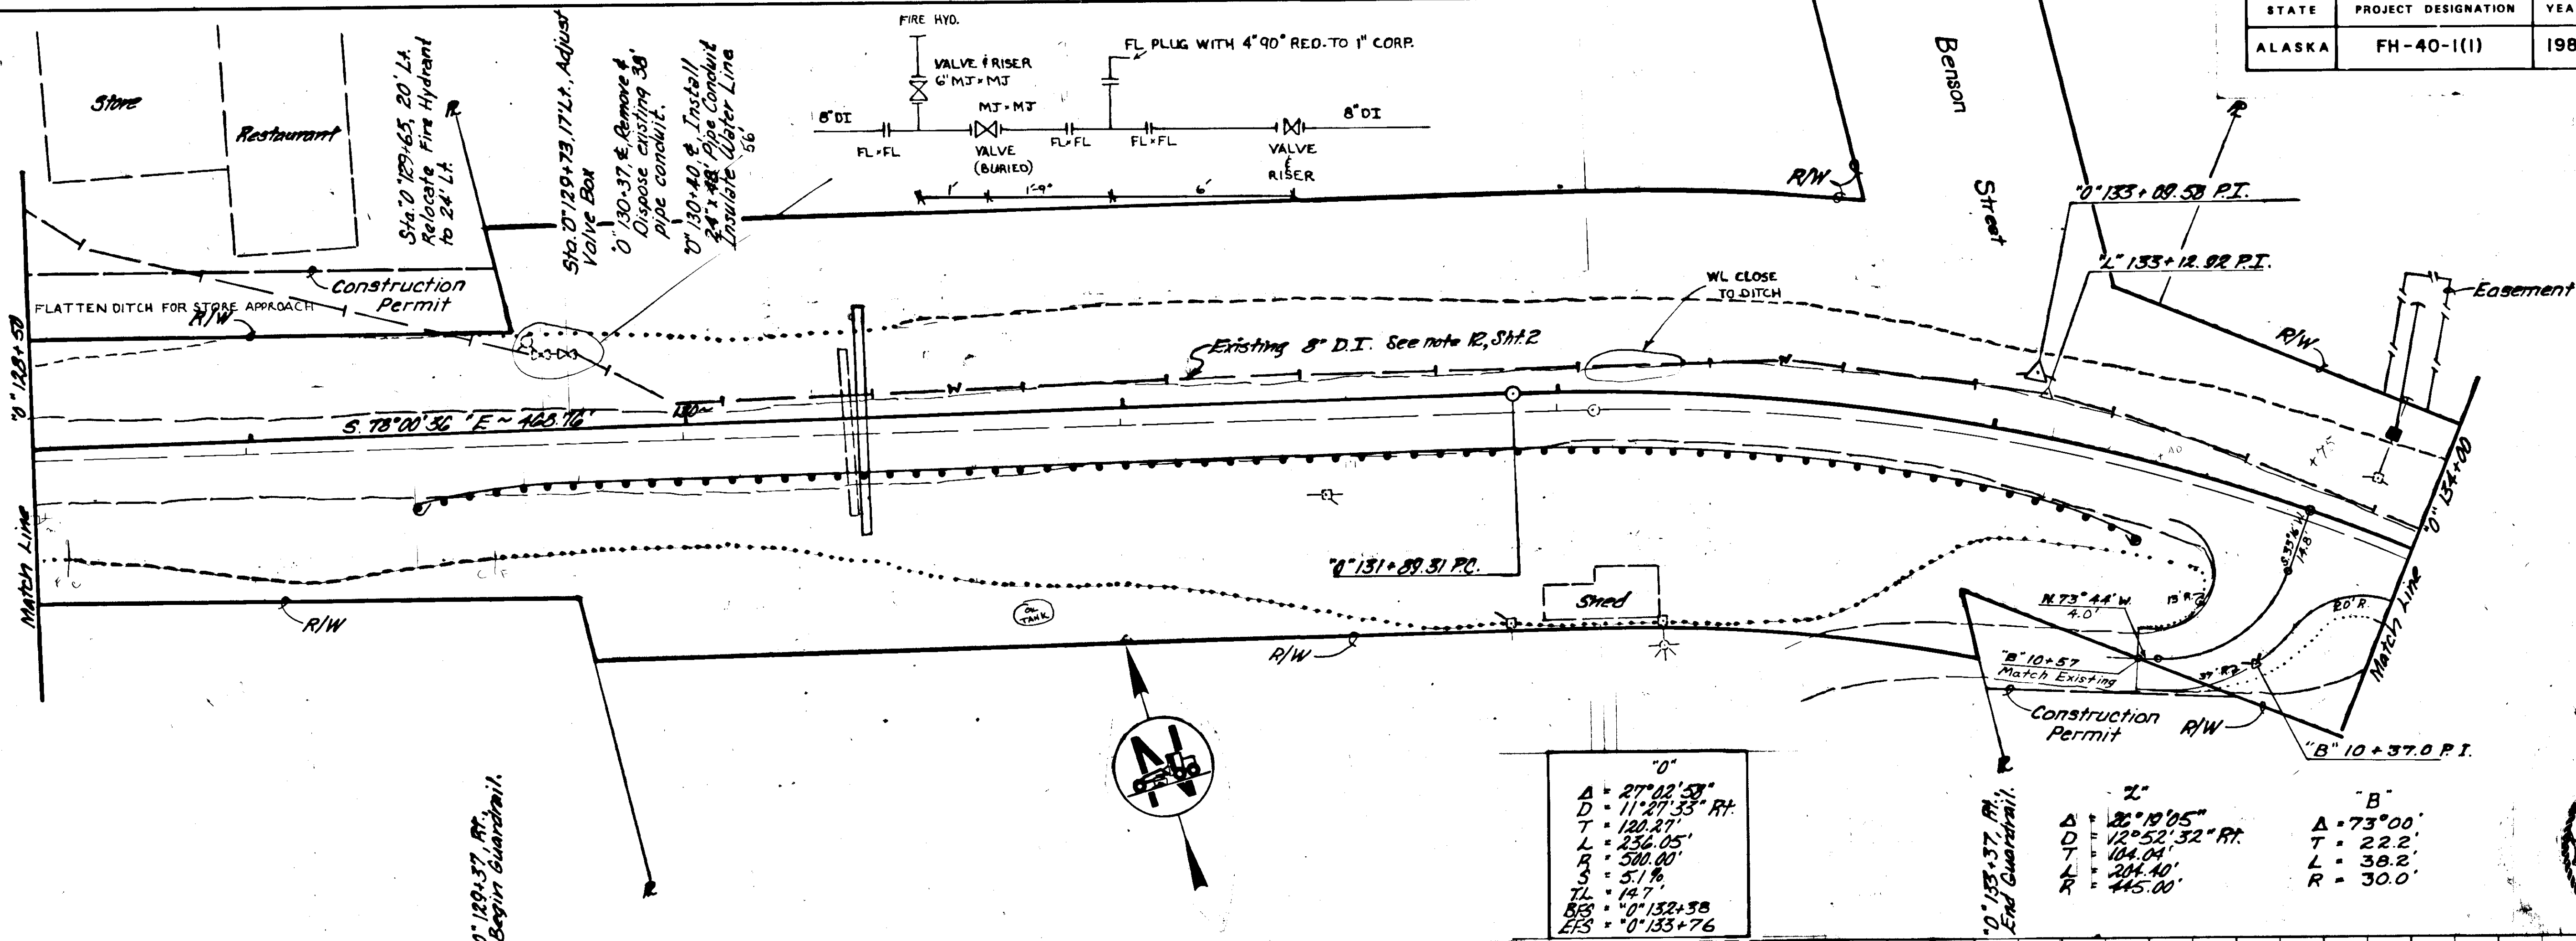

"0"



A	27° 02' 59"
D	11° 27' 33" Rt.
T	120.27'
L	236.05'
R	500.00'
S	5.1%
TL	14.7'
BEG	0° 132+38
END	0° 133+76

"2"


A	26° 19' 05"
D	12° 52' 32" Rt.
T	104.04'
L	204.40'
R	445.00'

"B"

A	73° 00'
T	22.2'
L	38.2'
R	30.0'

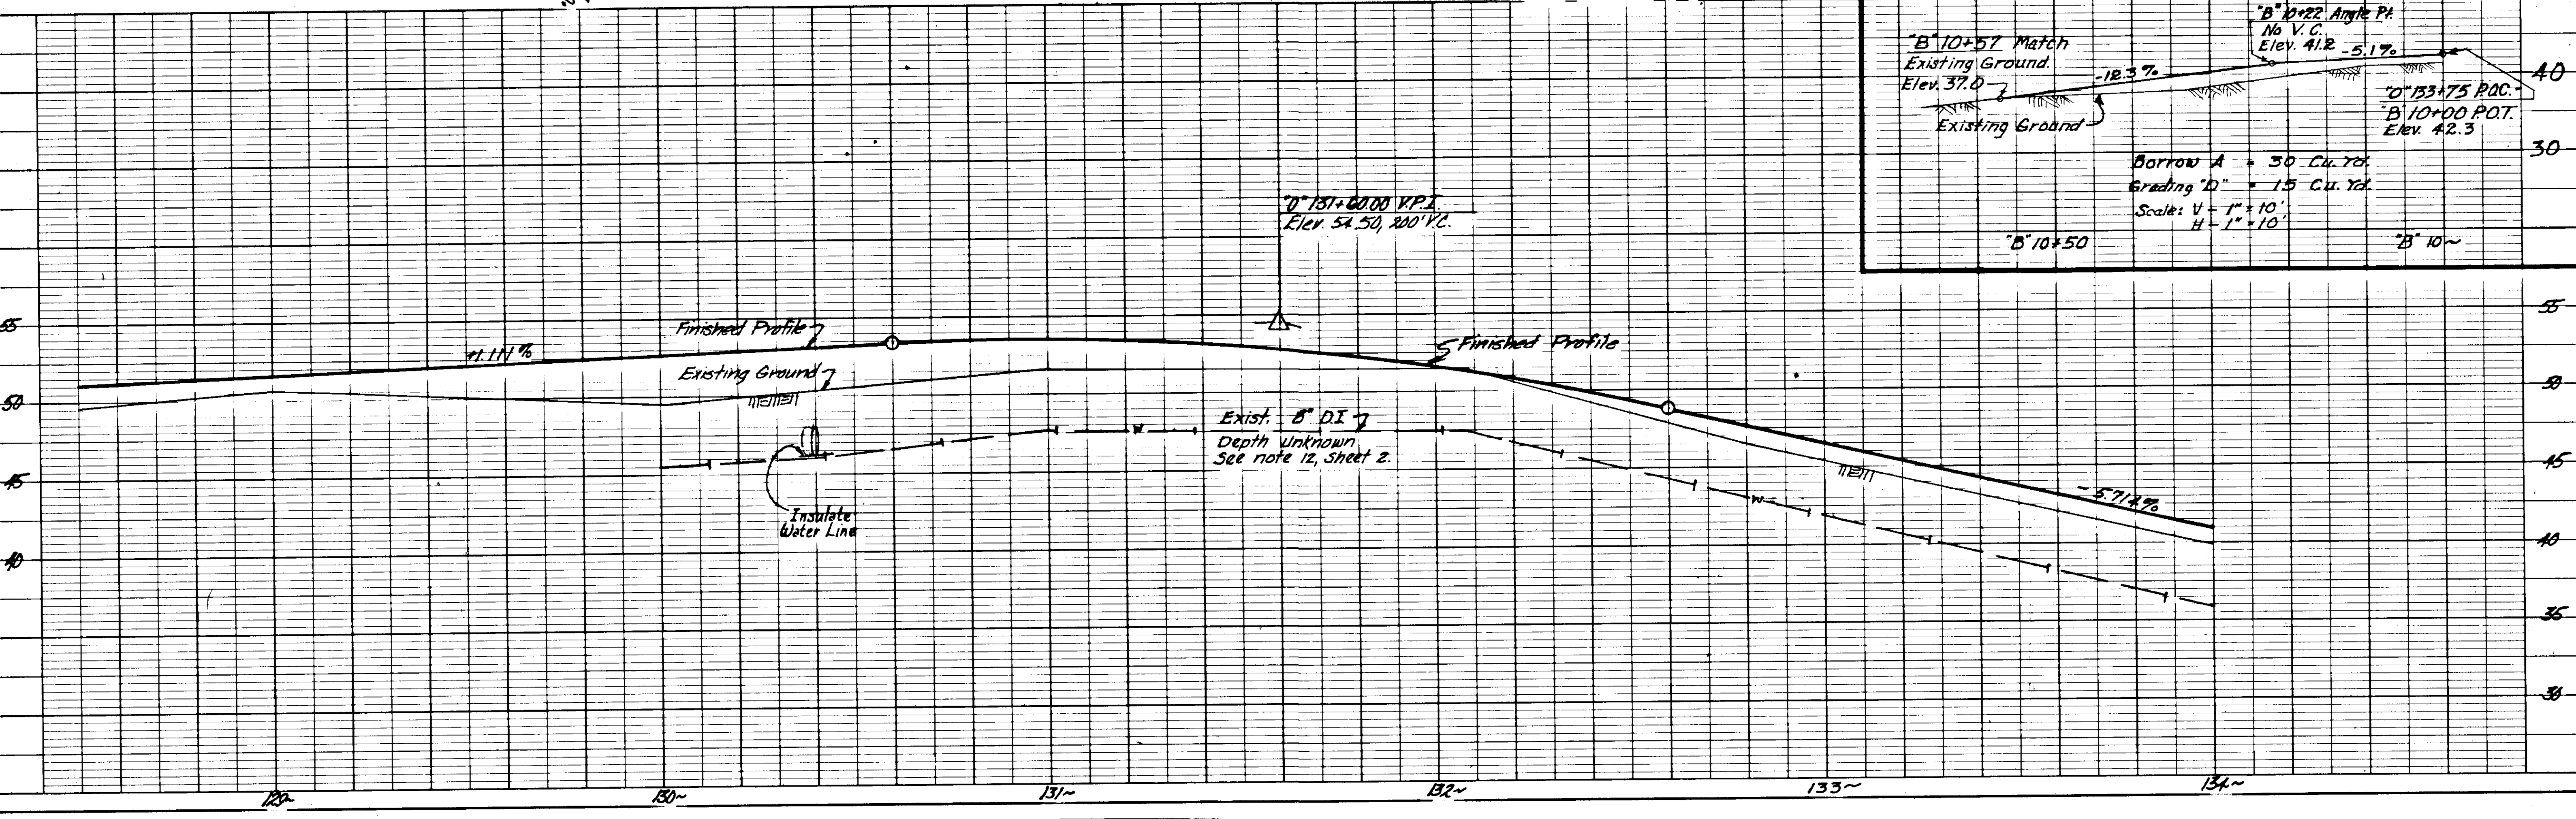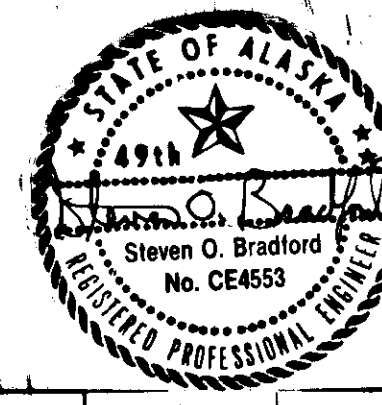

STATE	PROJECT DESIGNATION	YEAR	SHEET NO.	TOTAL SHEETS
ALASKA	FH-40-1(I)	1987	11	19

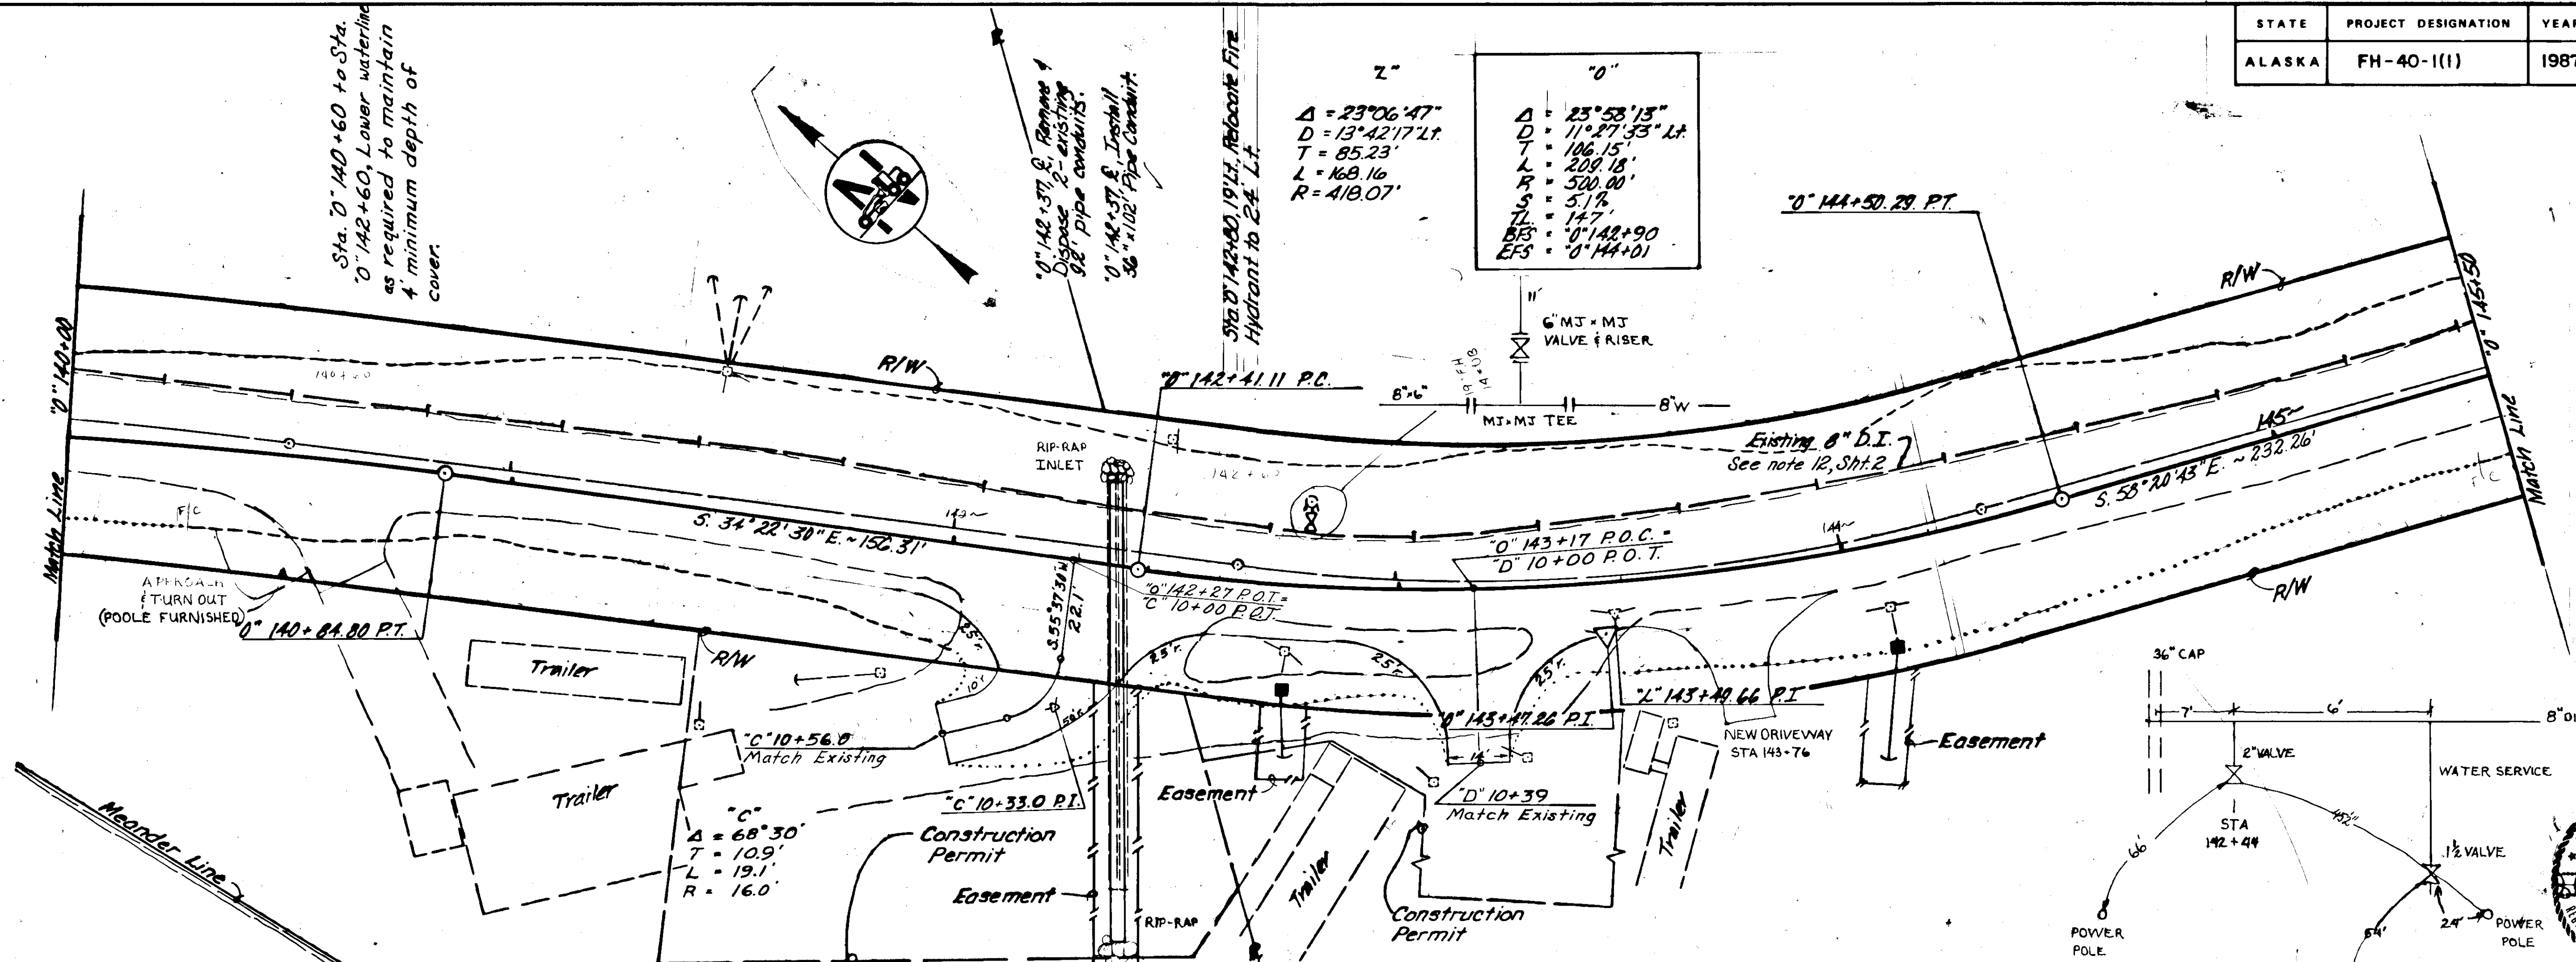

$\Delta = 23^{\circ}06'47''$
 $D = 13^{\circ}42'17''$
 $T = 85.23'$
 $L = 168.16'$
 $R = 418.07'$





$\Delta = 23^{\circ}58'13''$
 $D = 11^{\circ}27'33''$
 $T = 106.15'$
 $L = 209.18'$
 $R = 500.00'$
 $S = 5.17'$
 $TL = 147'$
 $BIS = 0^{\circ}142+90$
 $EFS = 0^{\circ}144+01$

Sta. 0" 140+60 to Sta. 0" 142+60, Lower waterline as required to maintain 4' minimum depth of cover.


0" 142+37 E. Ramona 4 Digose 2- existing 8" pipe conduits.
0" 142+37 E. Install 36" 1102" Pipe Conduit.

Sta. 0" 142+80, 19" LI. Reducate Fire Hydrant to 24" LI.

$\Delta = 68^{\circ}30'$
 $T = 10.9'$
 $L = 19.1'$
 $R = 16.0'$

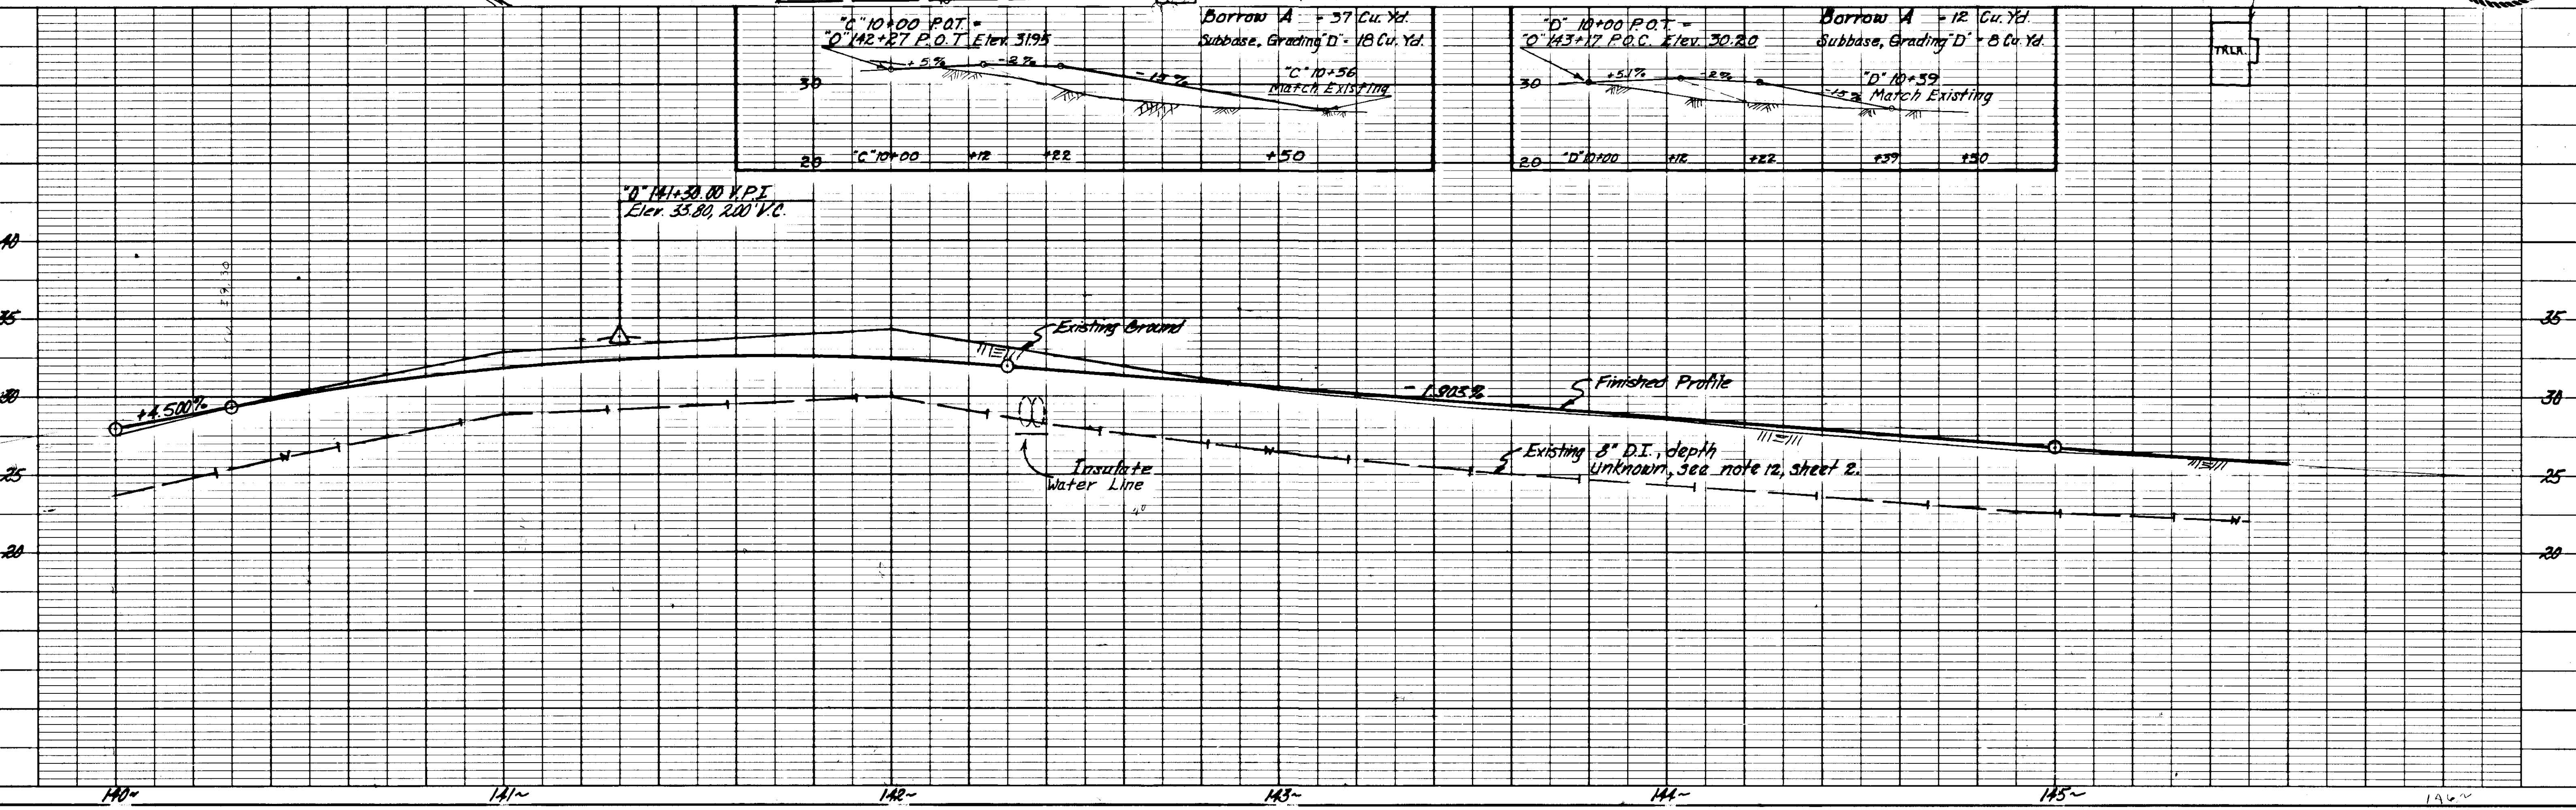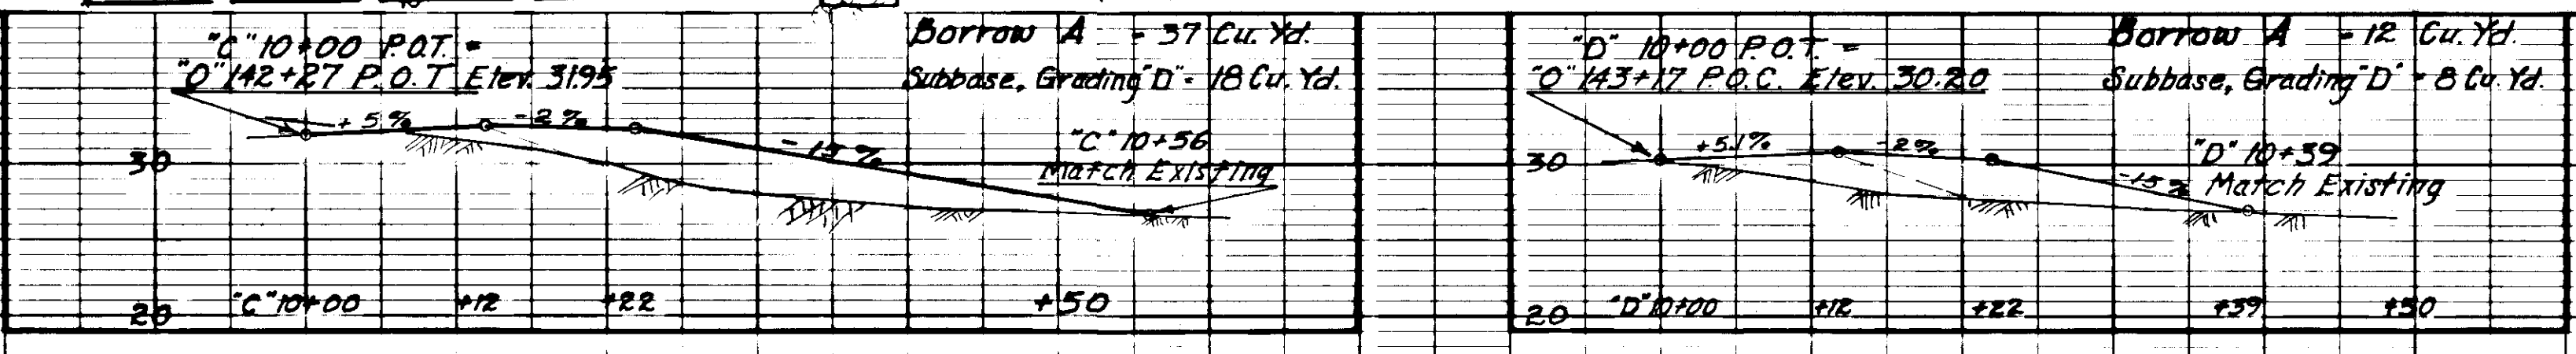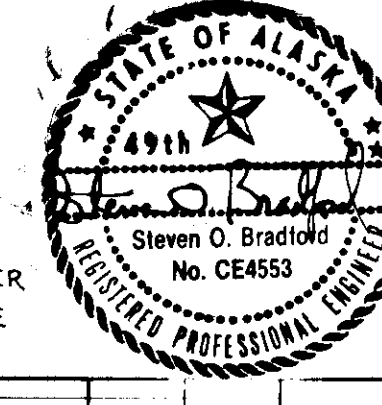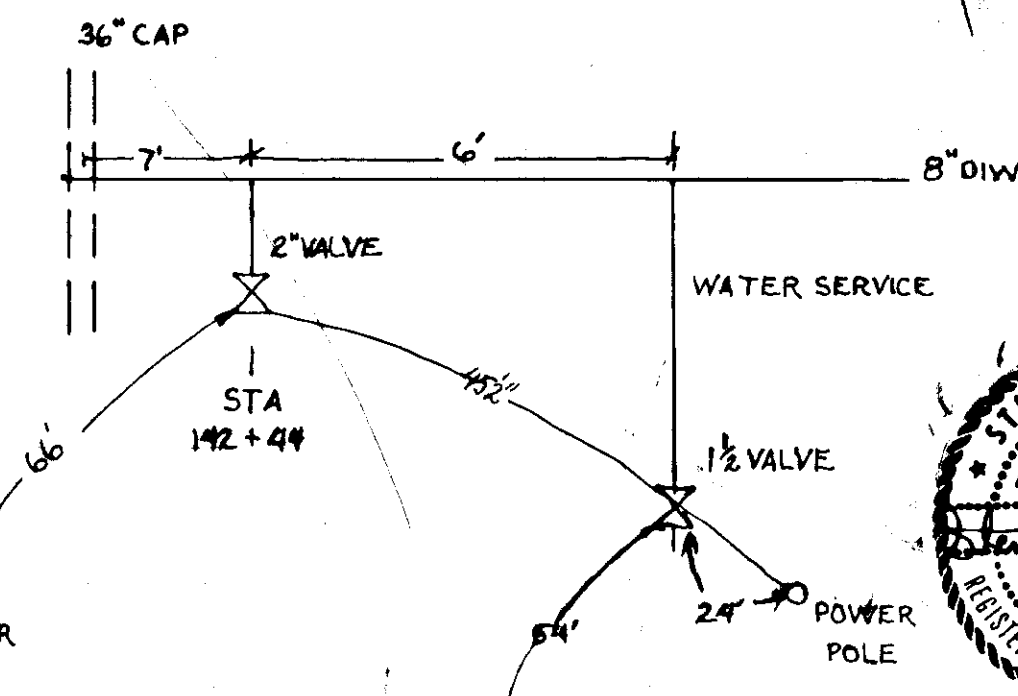



STATE	PROJECT DESIGNATION	YEAR	SHEET NO.	TOTAL SHEETS
ALASKA	FH-40-1(I)	1987	12	19

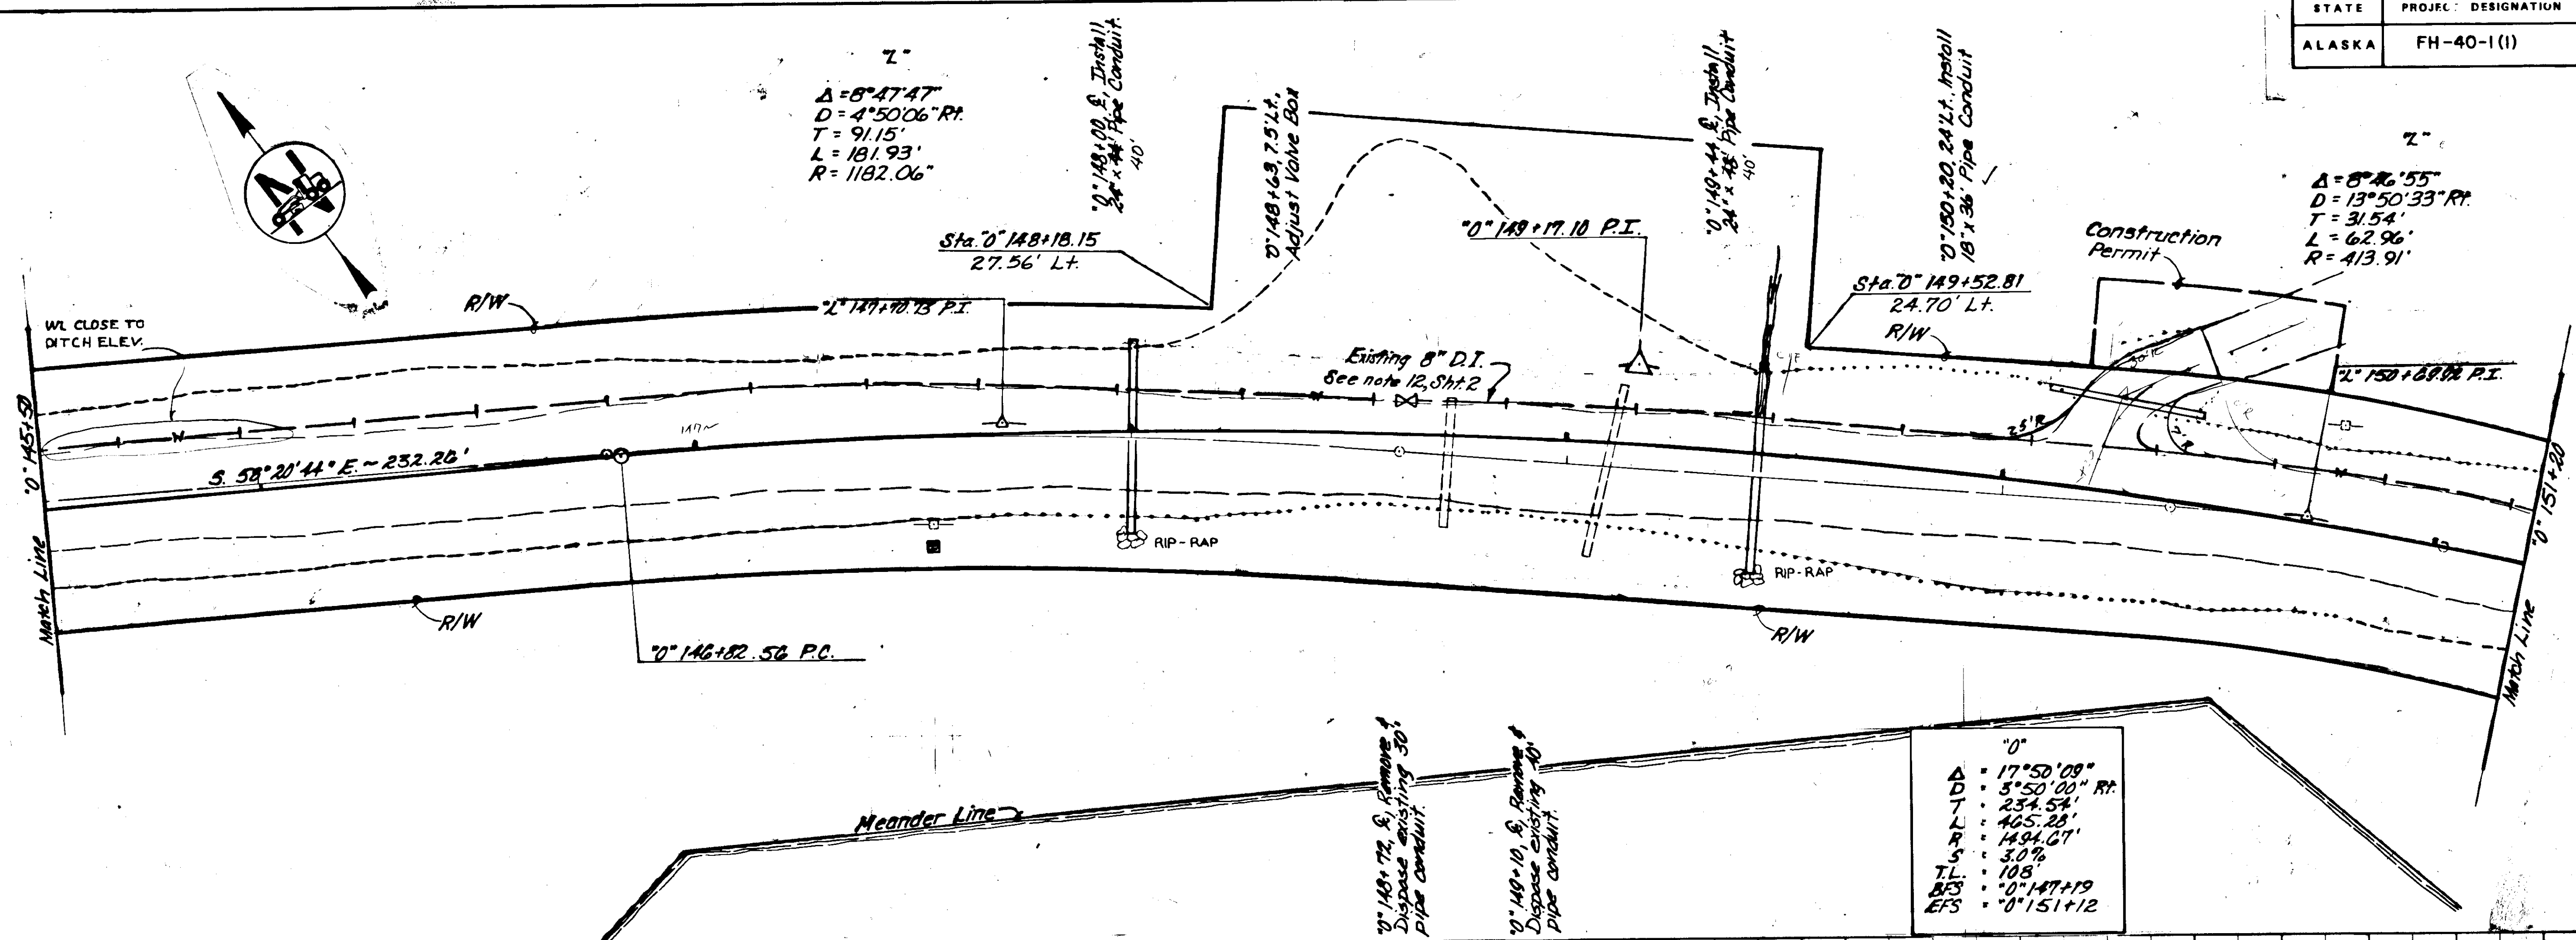

$\Delta = 8^{\circ}47'47''$
 $D = 4^{\circ}50'06''$ R.P.
 $T = 91.15'$
 $L = 181.93'$
 $R = 1182.06'$

$\Delta = 8^{\circ}46'55''$
 $D = 13^{\circ}50'33''$ R.P.
 $T = 31.54'$
 $L = 62.96'$
 $R = 413.91'$




$\Delta = 17^{\circ}50'09''$
 $D = 5^{\circ}50'00''$ R.P.
 $T = 234.54'$
 $L = 465.28'$
 $R = 1494.67'$
 $S = 3.0\%$
 $T.L. = 108'$
 $BFS = 0^{\circ}147^{\circ}19'$
 $EFS = 0^{\circ}151^{\circ}12'$

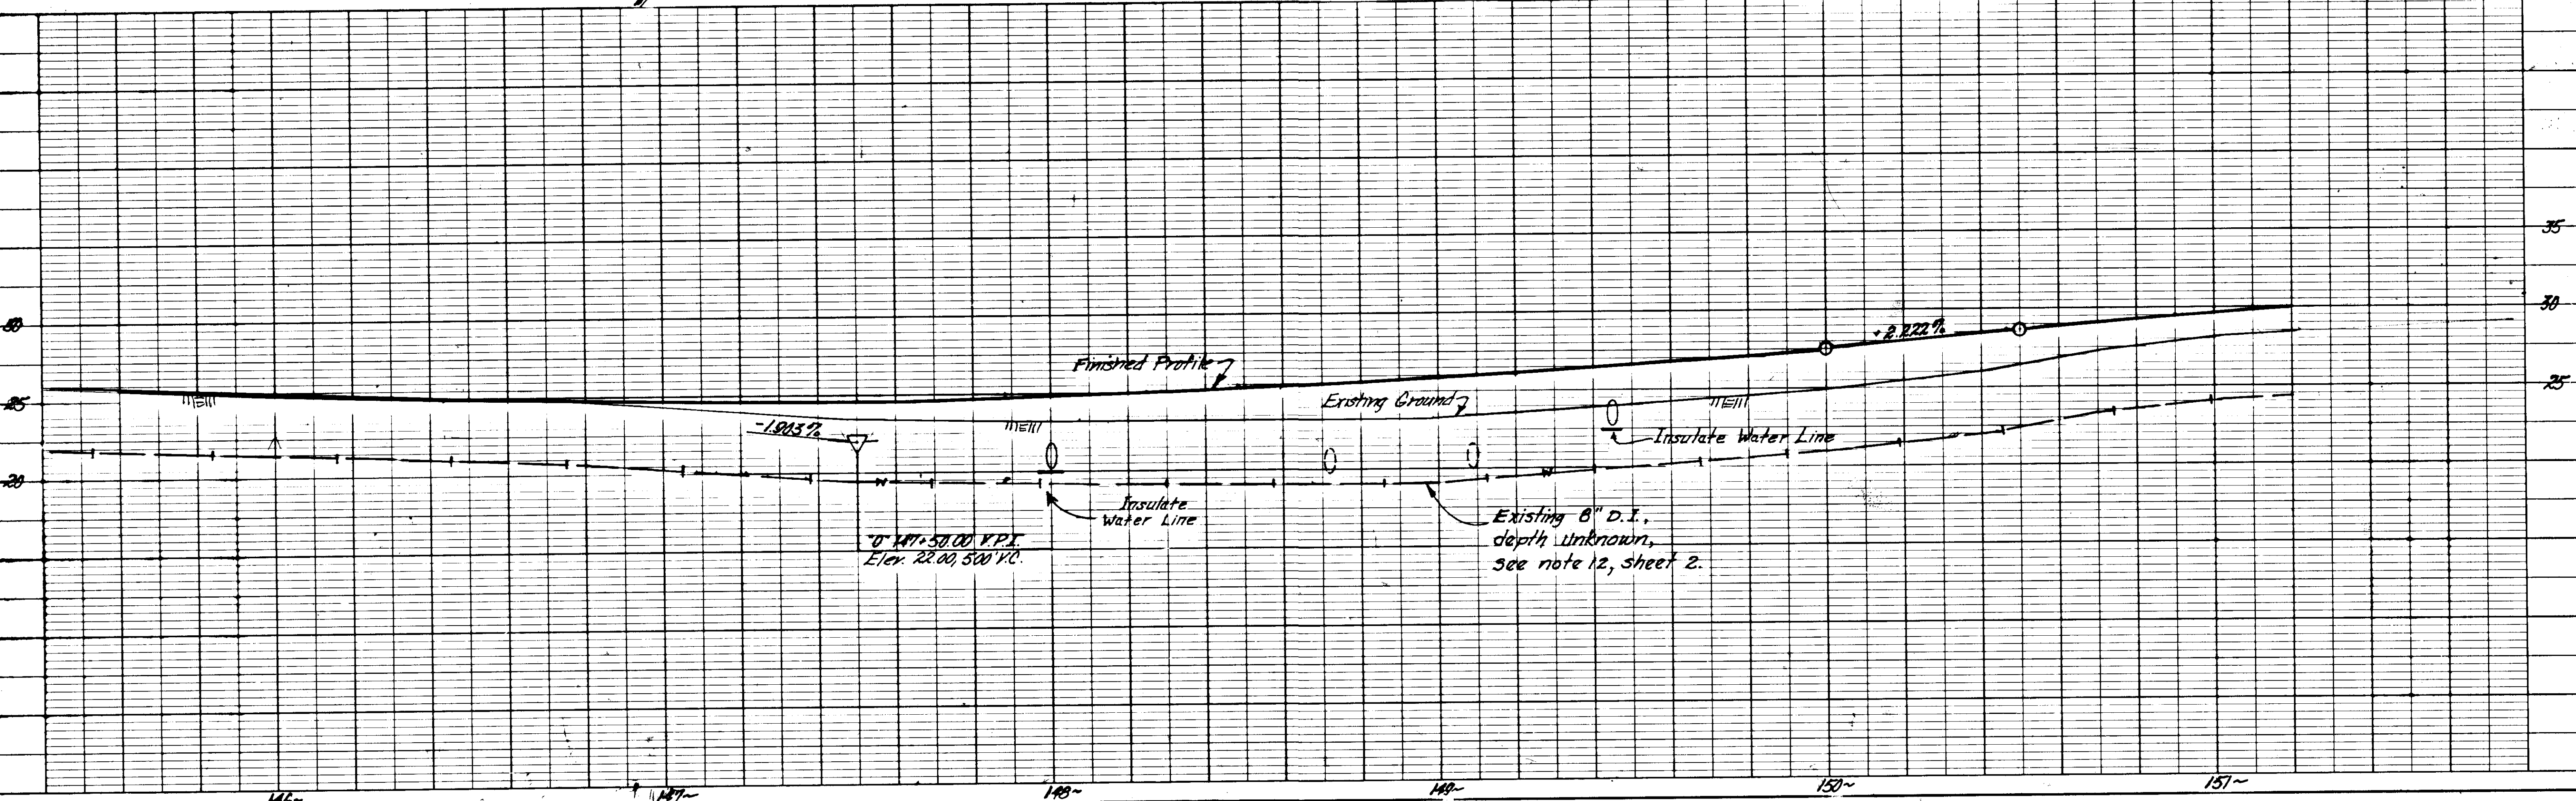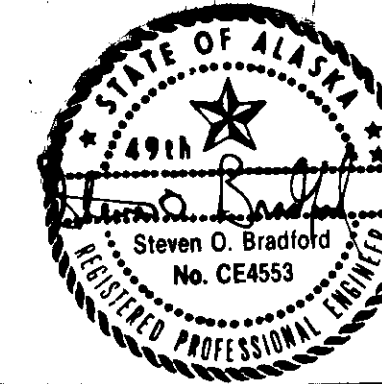

$0^{\circ}147^{\circ}50'00''$ P.P.I.
 Elev. 22.00, 500 V.C.


Existing 8" D.I.,
 depth unknown,
 see note 12, sheet 2.

STATE	PROJECT DESIGNATION	YEAR	SHEET NO.	TOTAL SHEETS
ALASKA	FH-40-(11)	1987	13	19

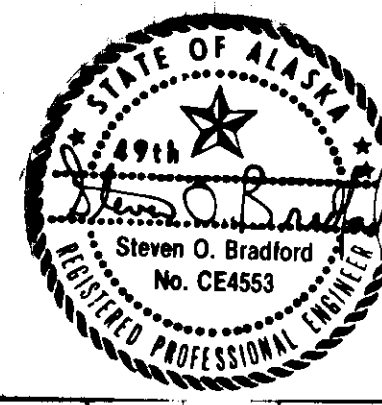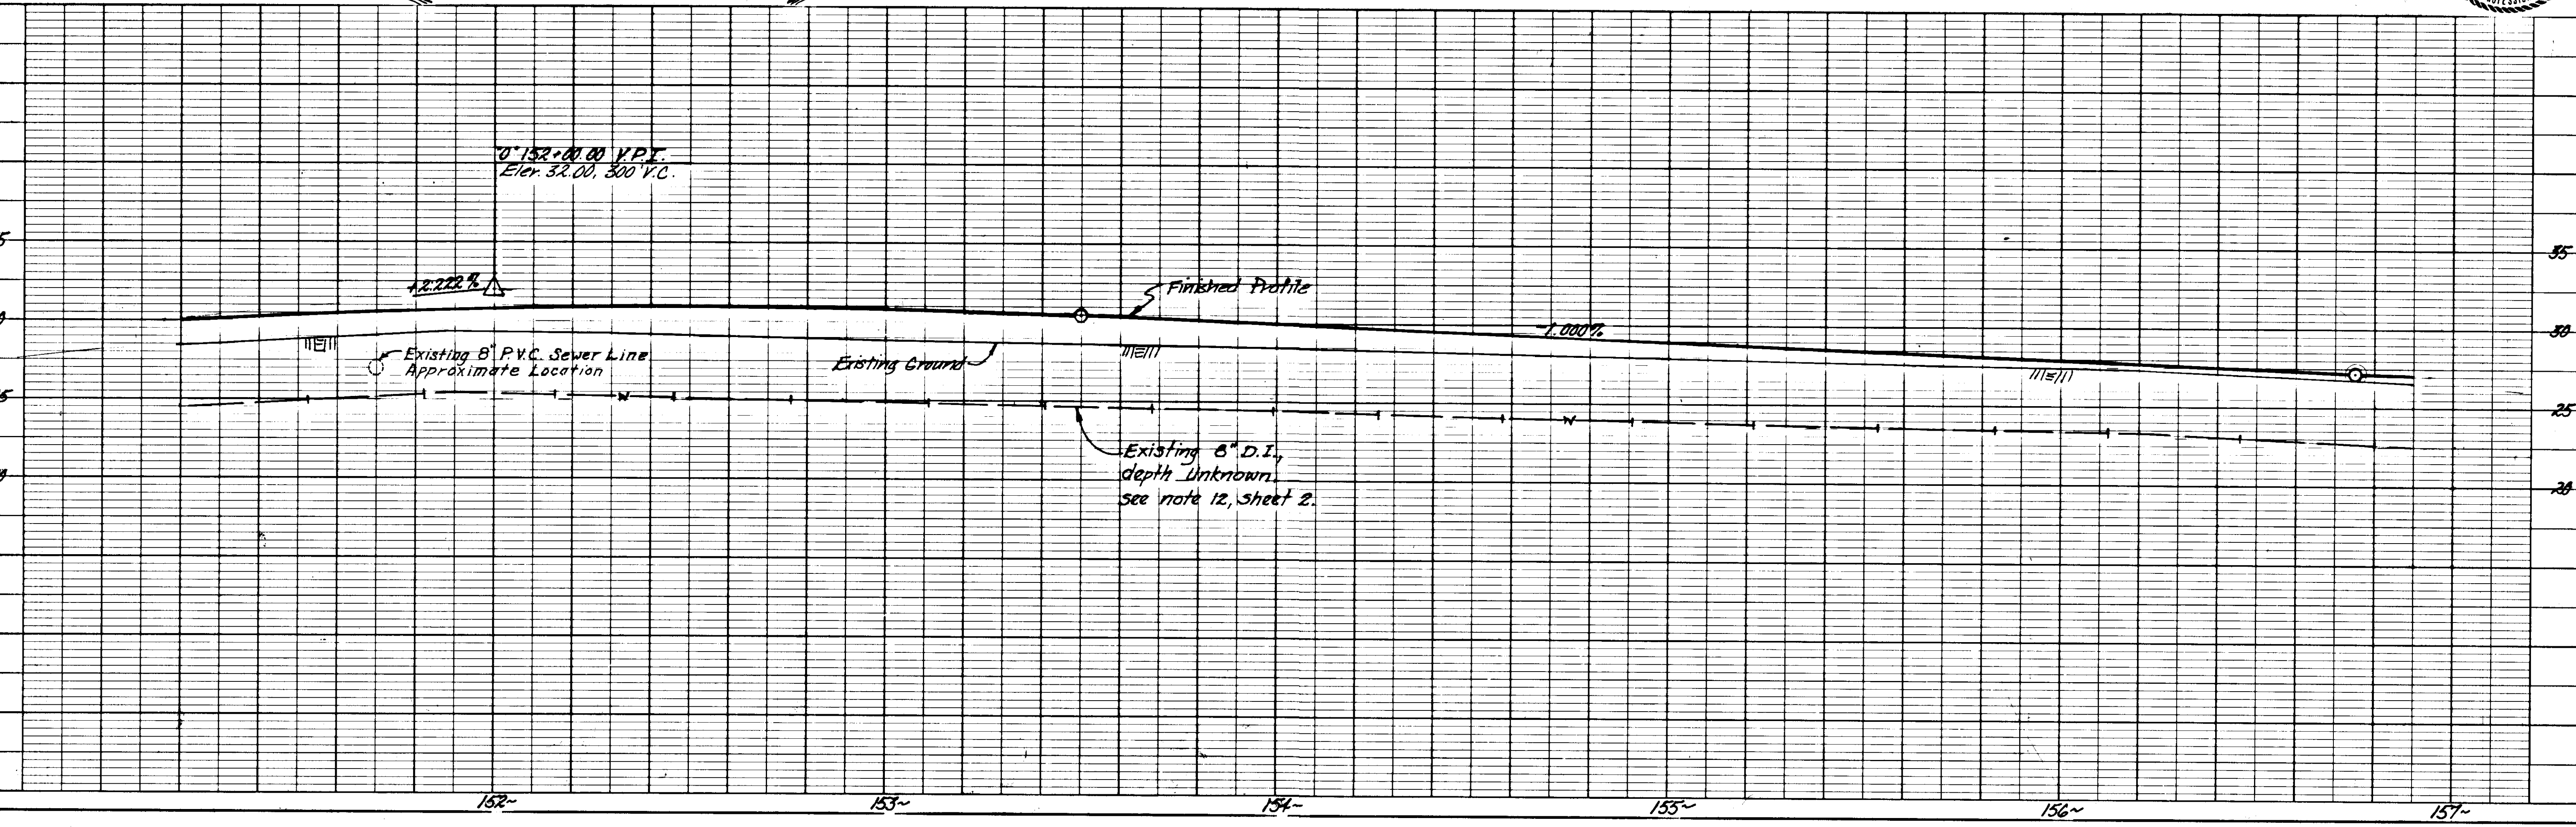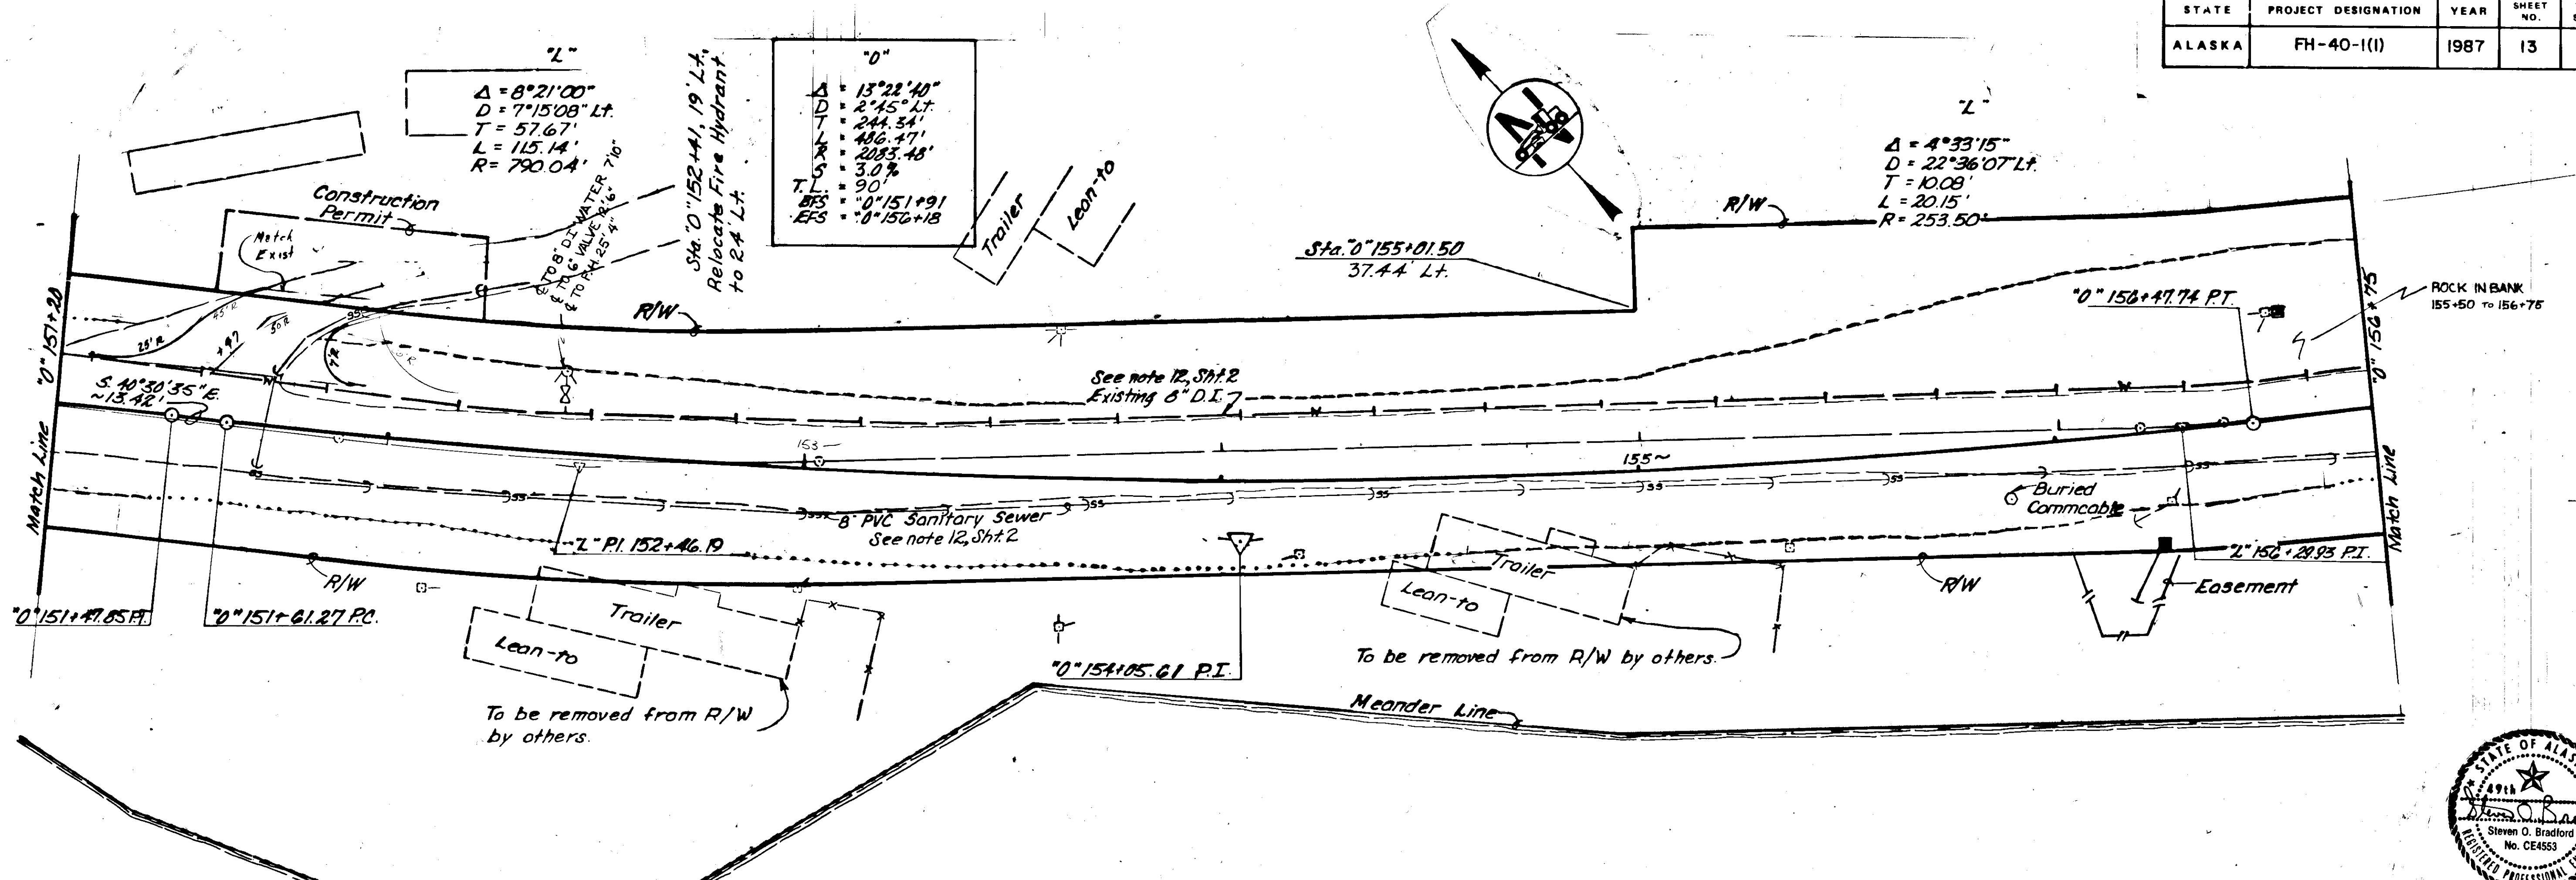

STATE	PROJECT DESIGNATION	YEAR	SHEET NO.	TOTAL SHEETS
ALASKA	FH-40-1(I)	1987	14	19


"0"
 $\Delta = 32^{\circ}45'04''$
 $D = 16^{\circ}22'32'' \text{ Lt.}$
 $T = 102.82'$
 $L = 200.00'$
 $R = 349.89'$
 $S = 5.87\%$
 $TL = 159'$
 $BFS = 160+71$
 $EPS = 161+65$

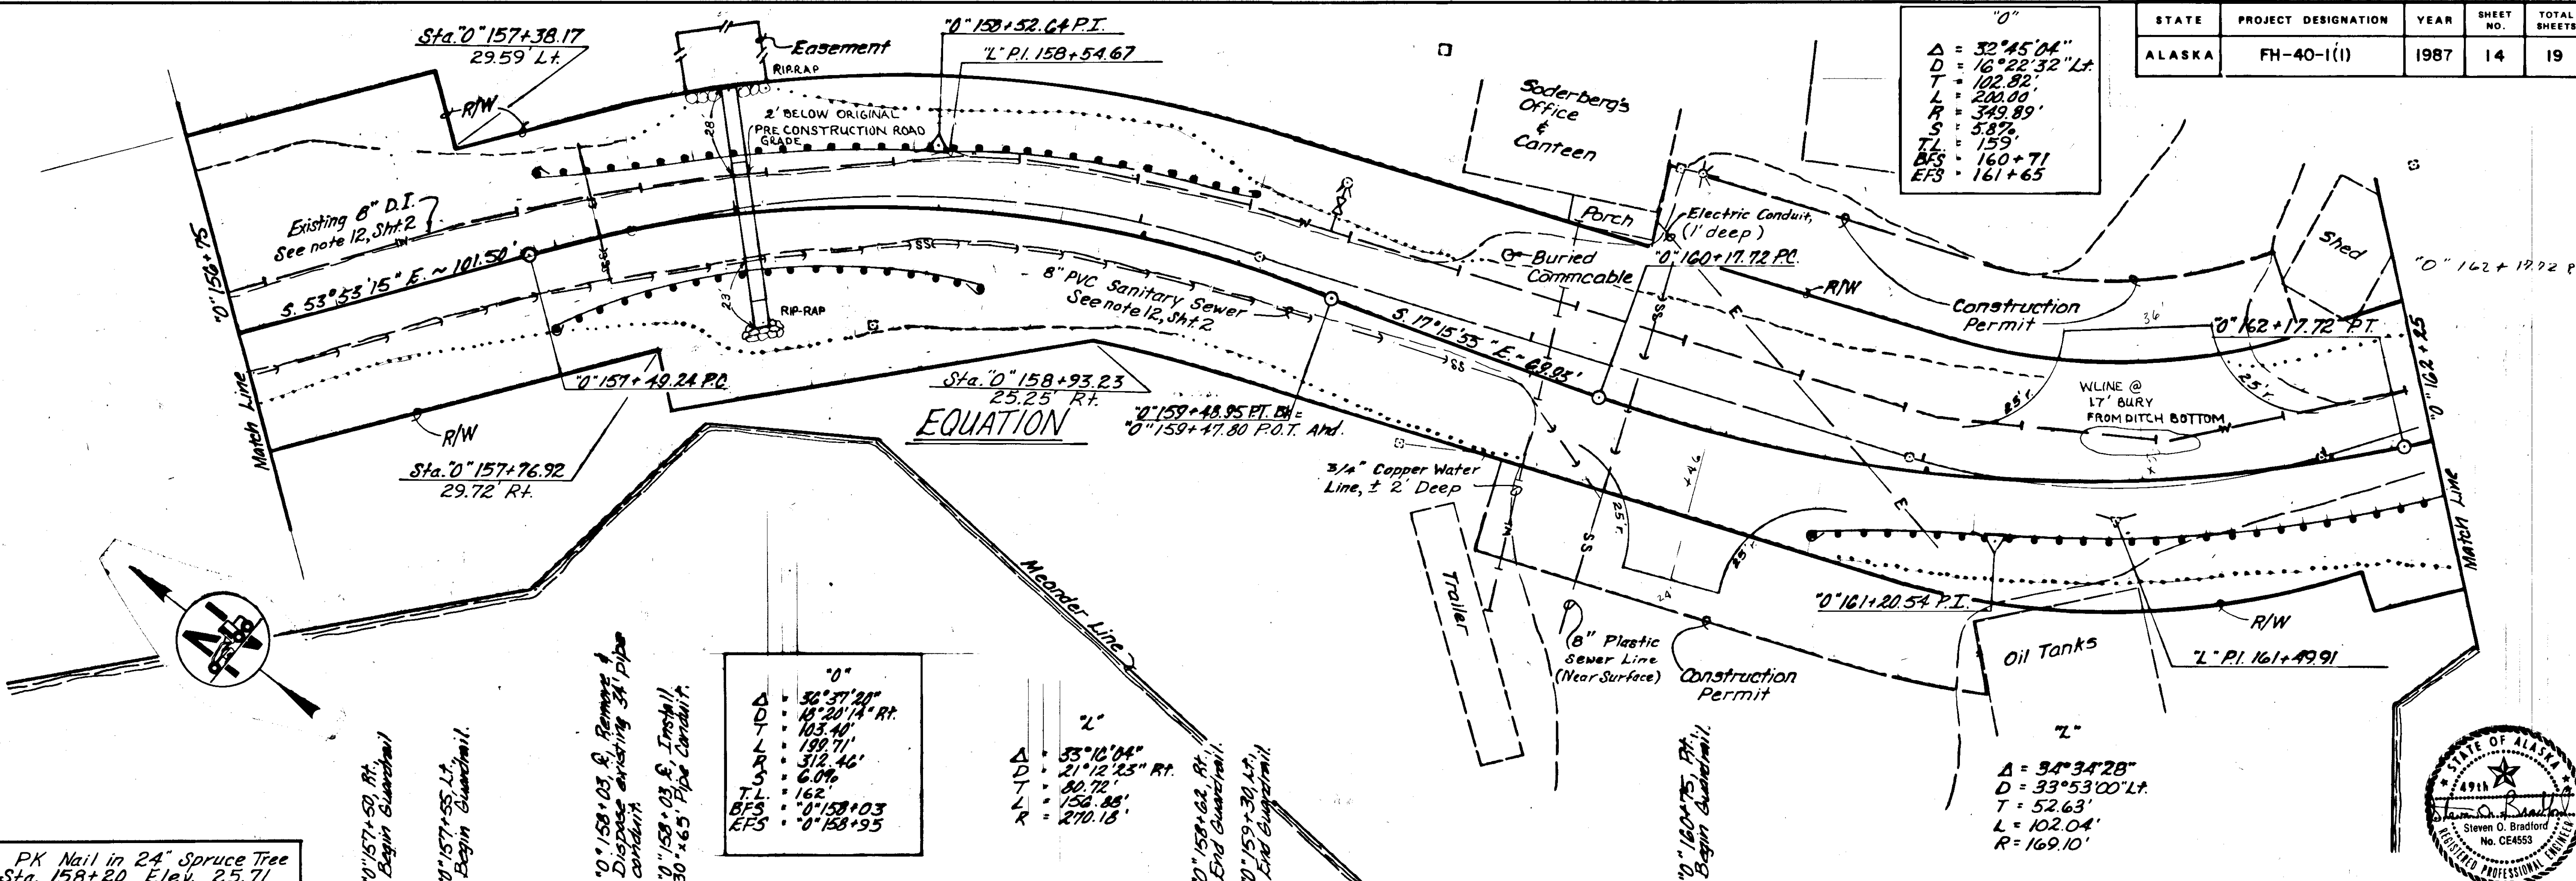

"0"
 $\Delta = 36^{\circ}37'20''$
 $D = 18^{\circ}20'14'' \text{ Rt.}$
 $T = 103.40'$
 $L = 199.71'$
 $R = 312.46'$
 $S = 6.0\%$
 $TL = 162'$
 $BFS = 0^{\circ}158+03$
 $EPS = 0^{\circ}158+95$

"2"
 $\Delta = 53^{\circ}10'04''$
 $D = 21^{\circ}12'23'' \text{ Rt.}$
 $T = 80.72'$
 $L = 150.88'$
 $R = 270.18'$

"2"
 $\Delta = 94^{\circ}34'28''$
 $D = 33^{\circ}53'00'' \text{ Lt.}$
 $T = 52.63'$
 $L = 102.04'$
 $R = 169.10'$

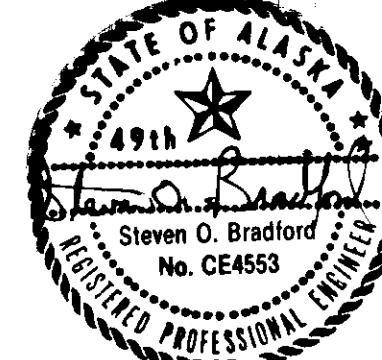

C.B.M. "C" PK Nail in 24" Spruce Tree
 5' Rt. of Sta. 158+20 Elev. 25.71

0^{\circ}157+50 Rt. Begin Guardrail


0^{\circ}157+55 Lt. Begin Guardrail

0^{\circ}158+03 E. Remove & Dispose existing 34 pipe conduit
 0^{\circ}158+03 E. Install 30 x 6.5 Pipe Conduit


0^{\circ}158+62 Rt. End Guardrail

0^{\circ}159+30 Lt. End Guardrail

0^{\circ}160+75 Rt. Begin Guardrail


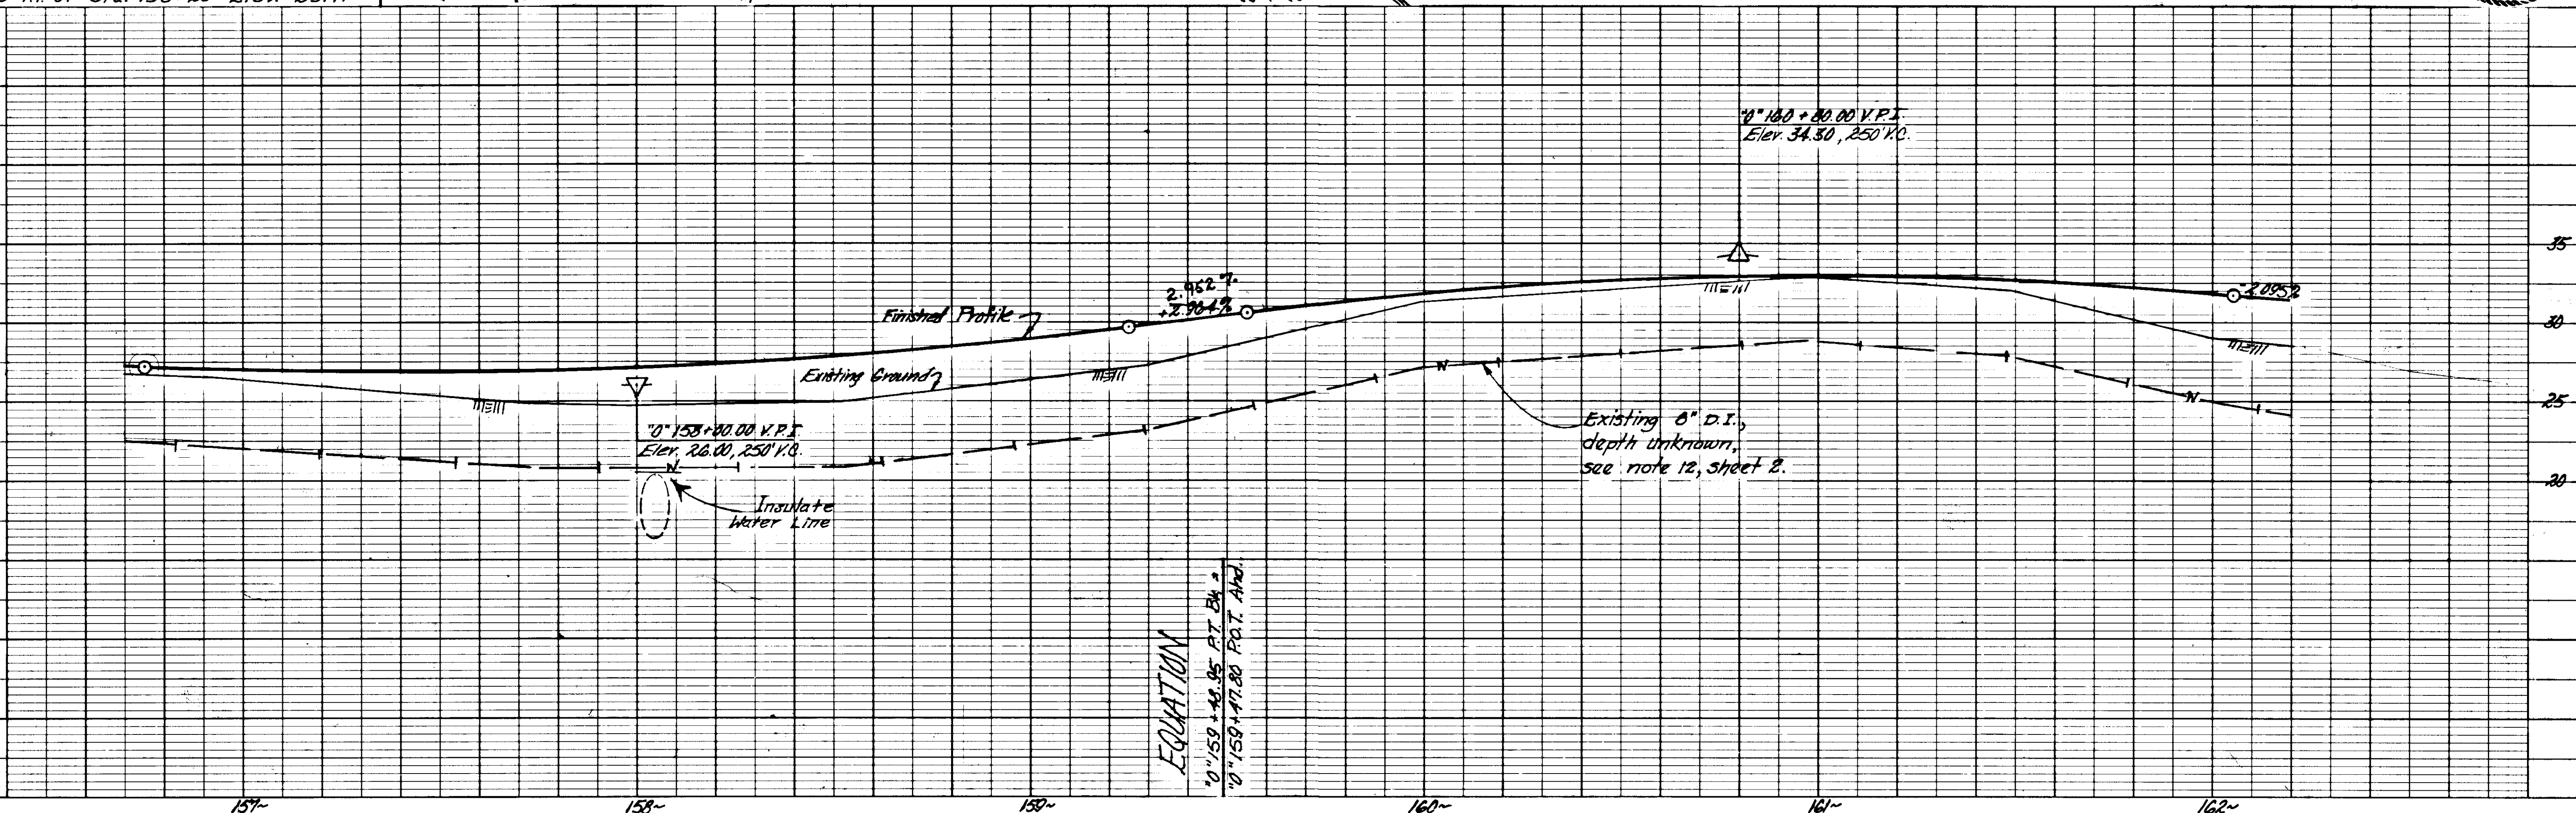





EQUATION
 $0^{\circ}159+49.95 \text{ Pt. Bk.}$
 $0^{\circ}159+47.80 \text{ P.O.T. Adv.}$

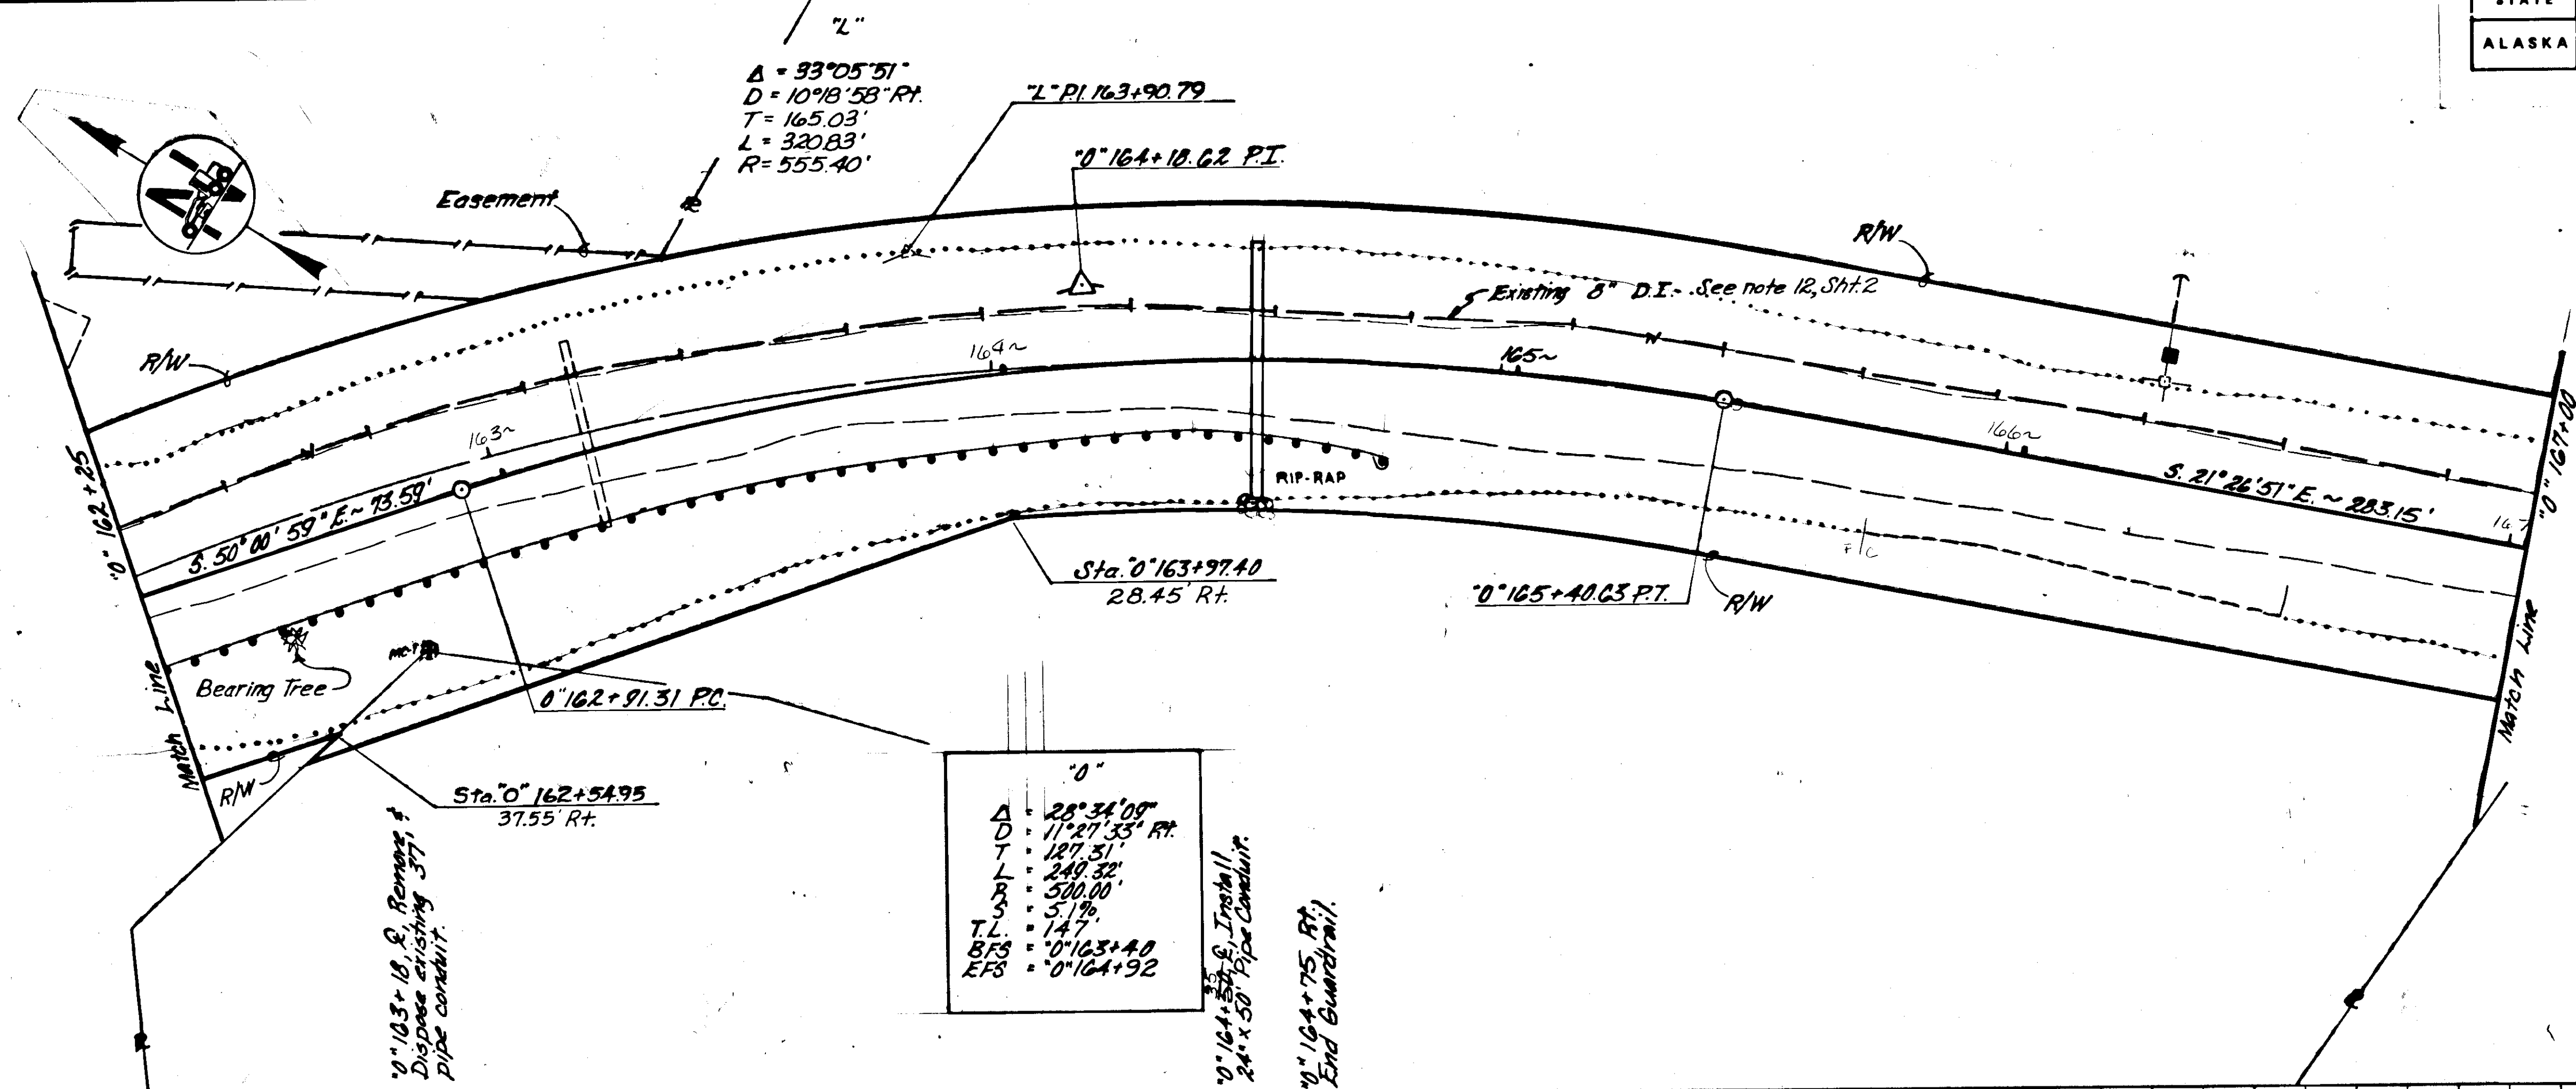


"0"	
Δ	$28^\circ 34' 09"$
D	$11^\circ 27' 35" \text{ Rt.}$
T	$187.31'$
L	$249.32'$
R	$500.00'$
S	5.1%
$T.L.$	$14.7'$
$B.F.S.$	$0+163+40$
$E.F.S.$	$0+164+92$

0" 164+75 P.T. Install 24" x 50" Pipe Conduit.
 0" 164+75 P.T. End Guardrail.

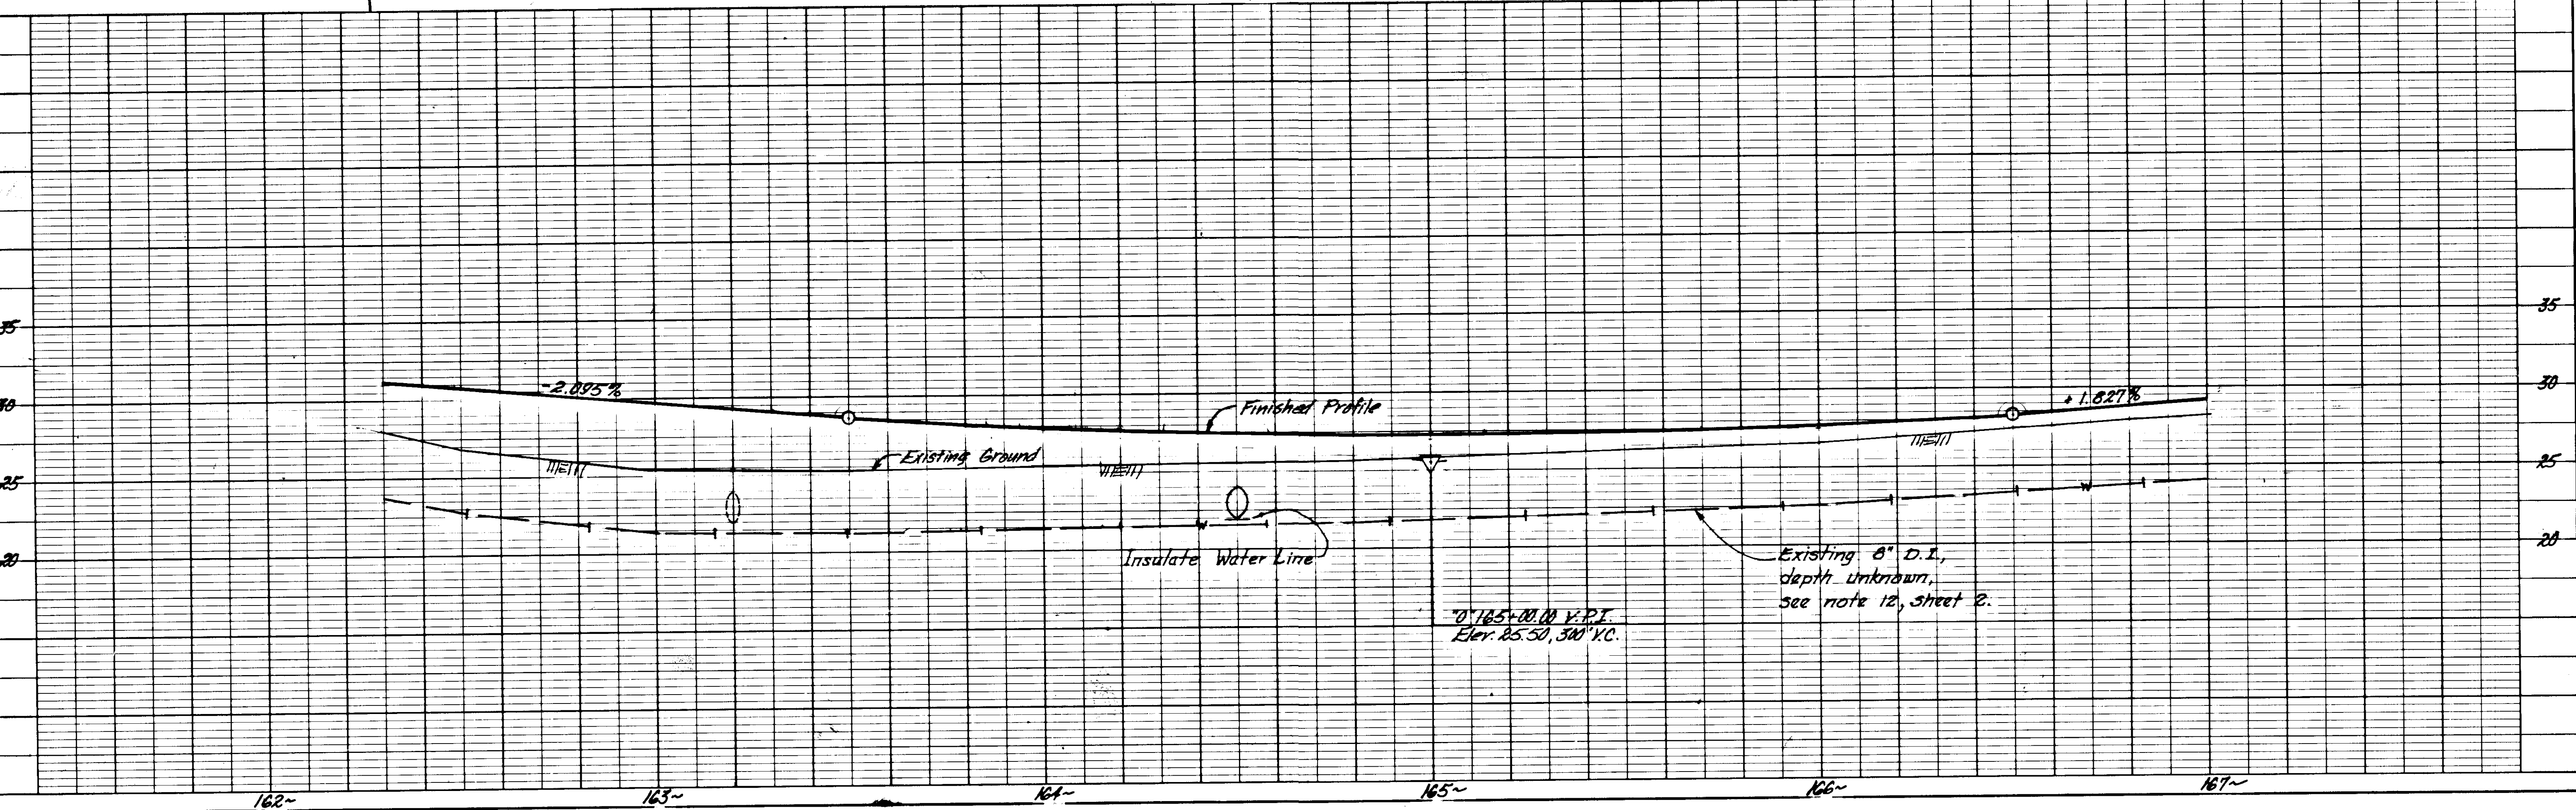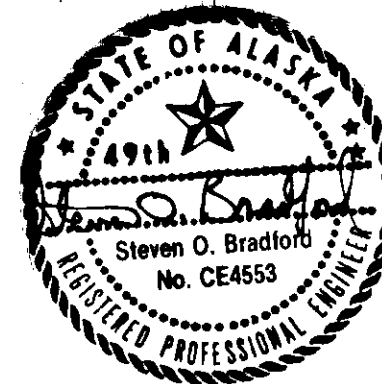

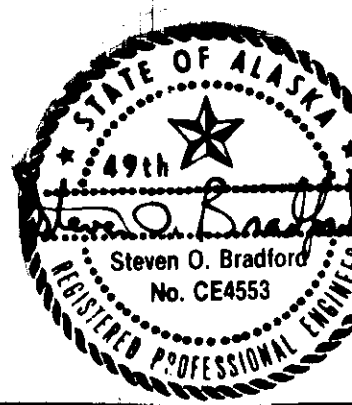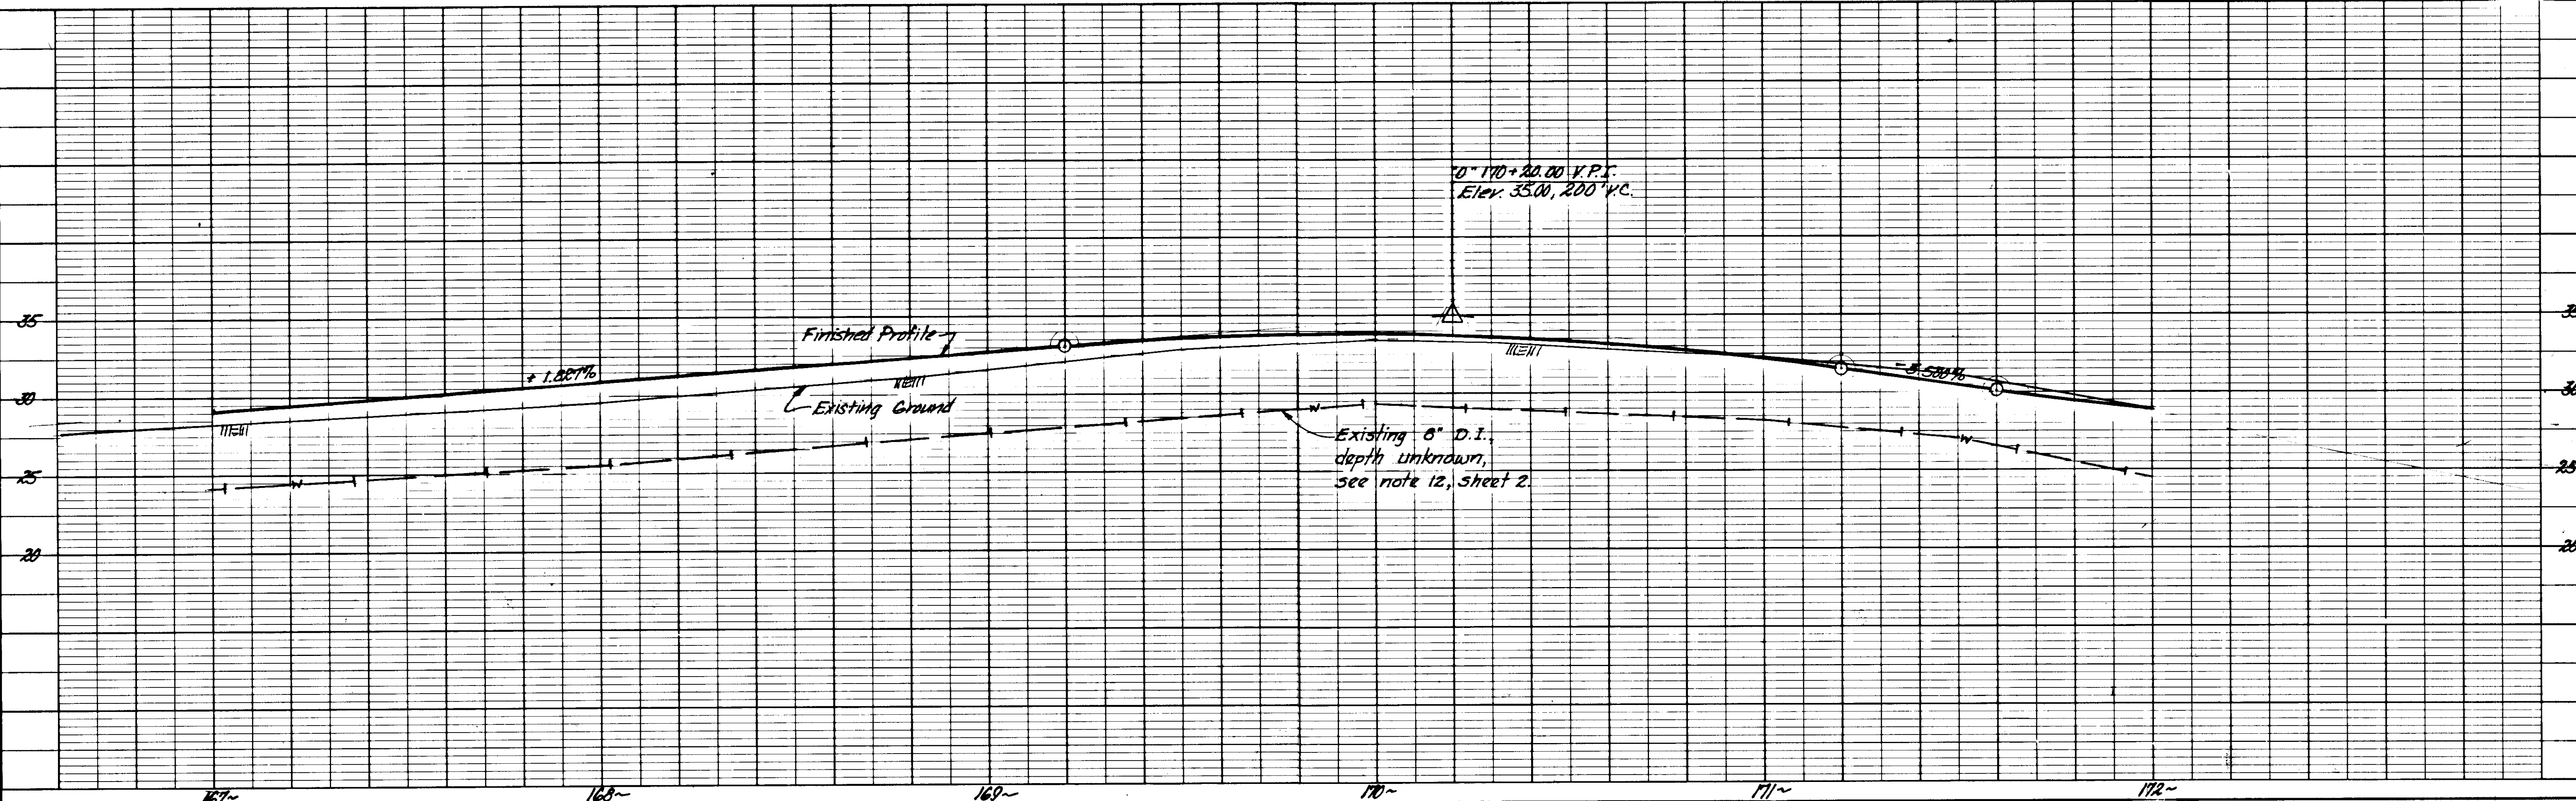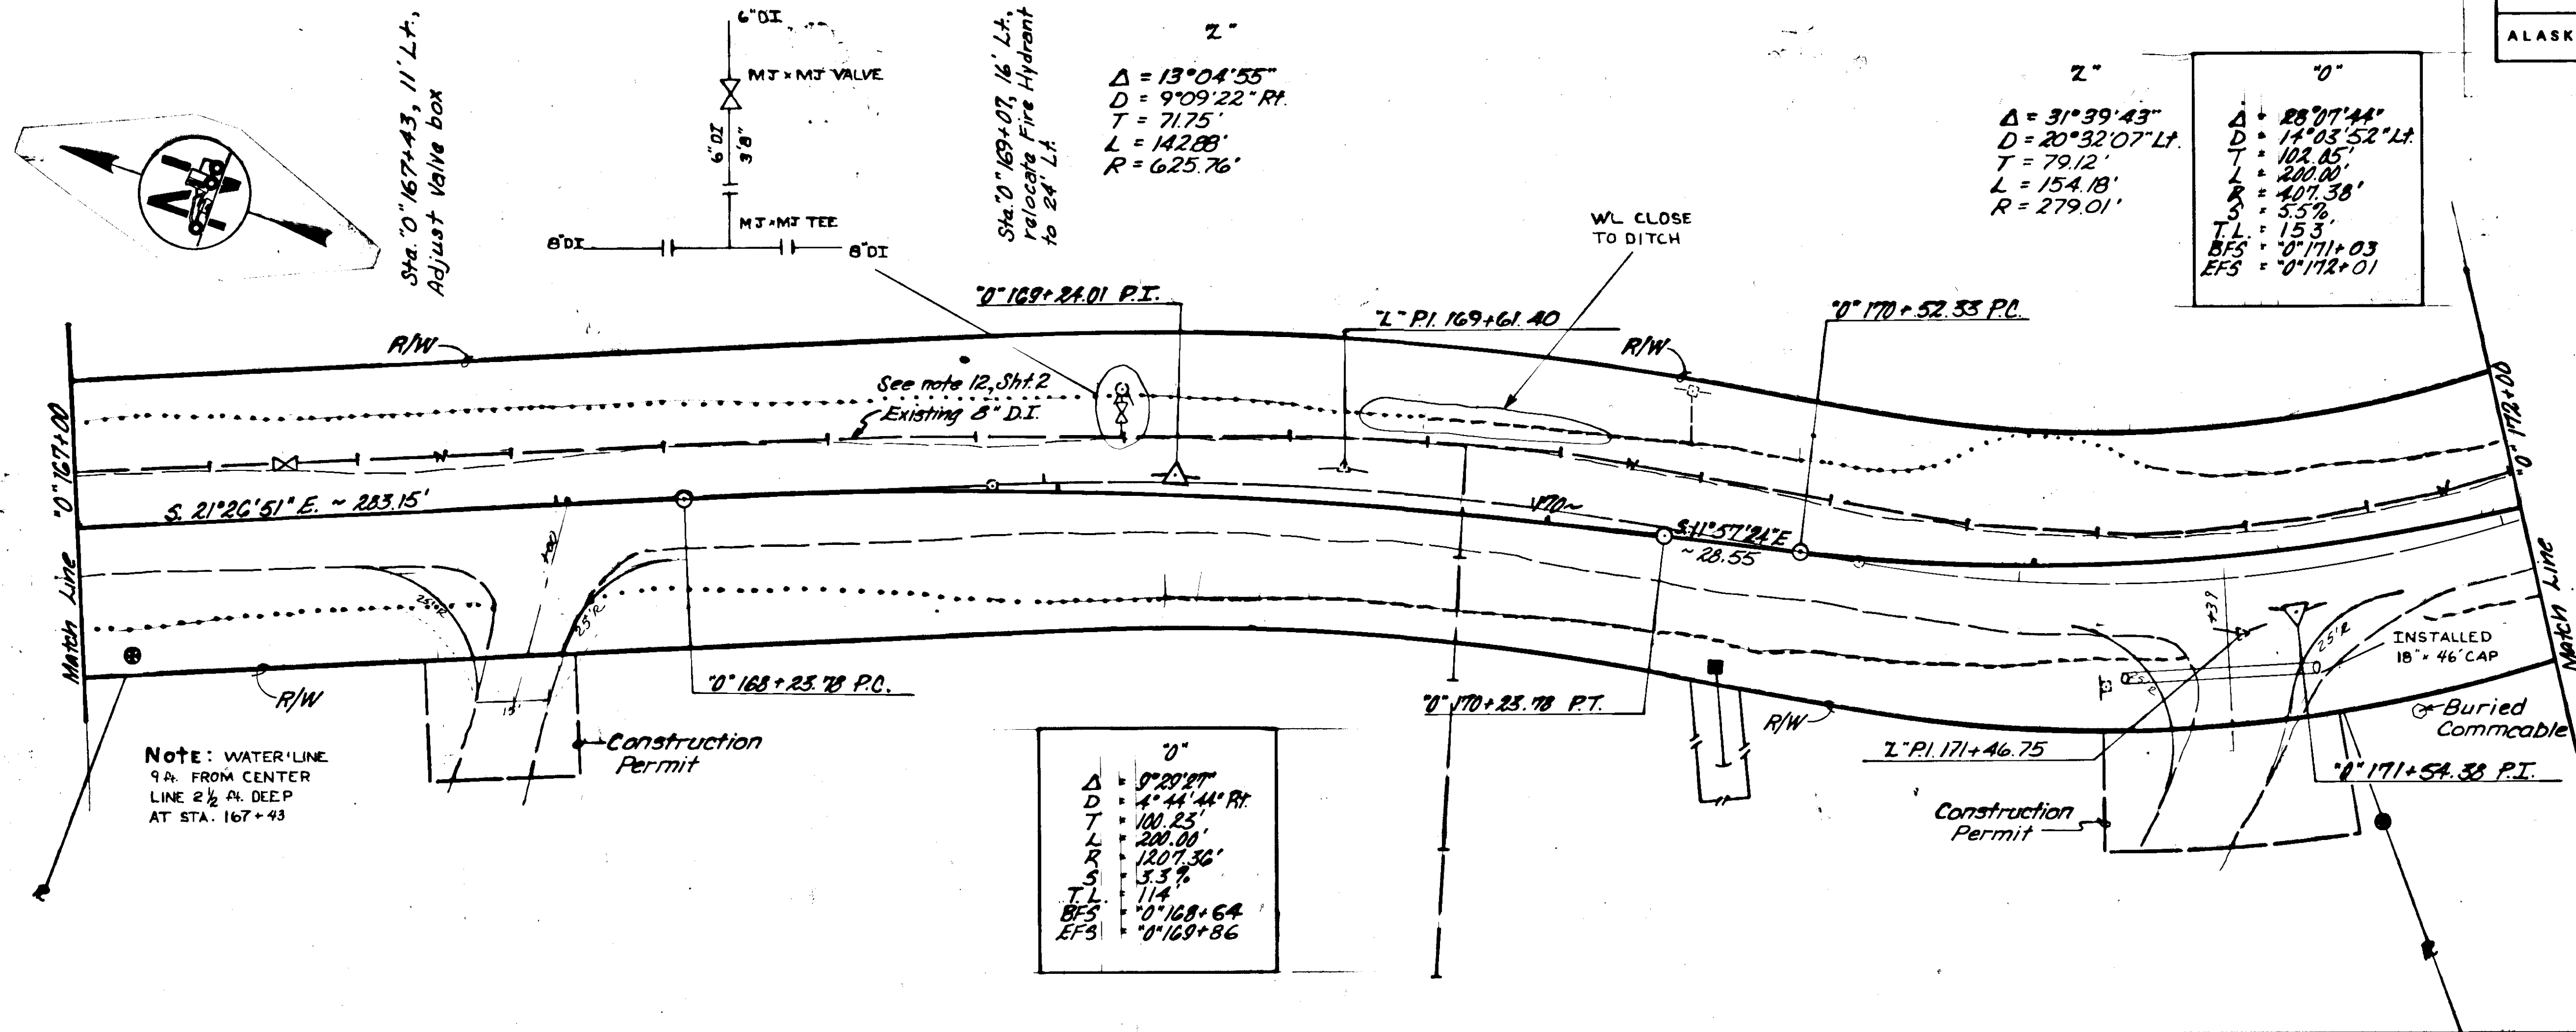


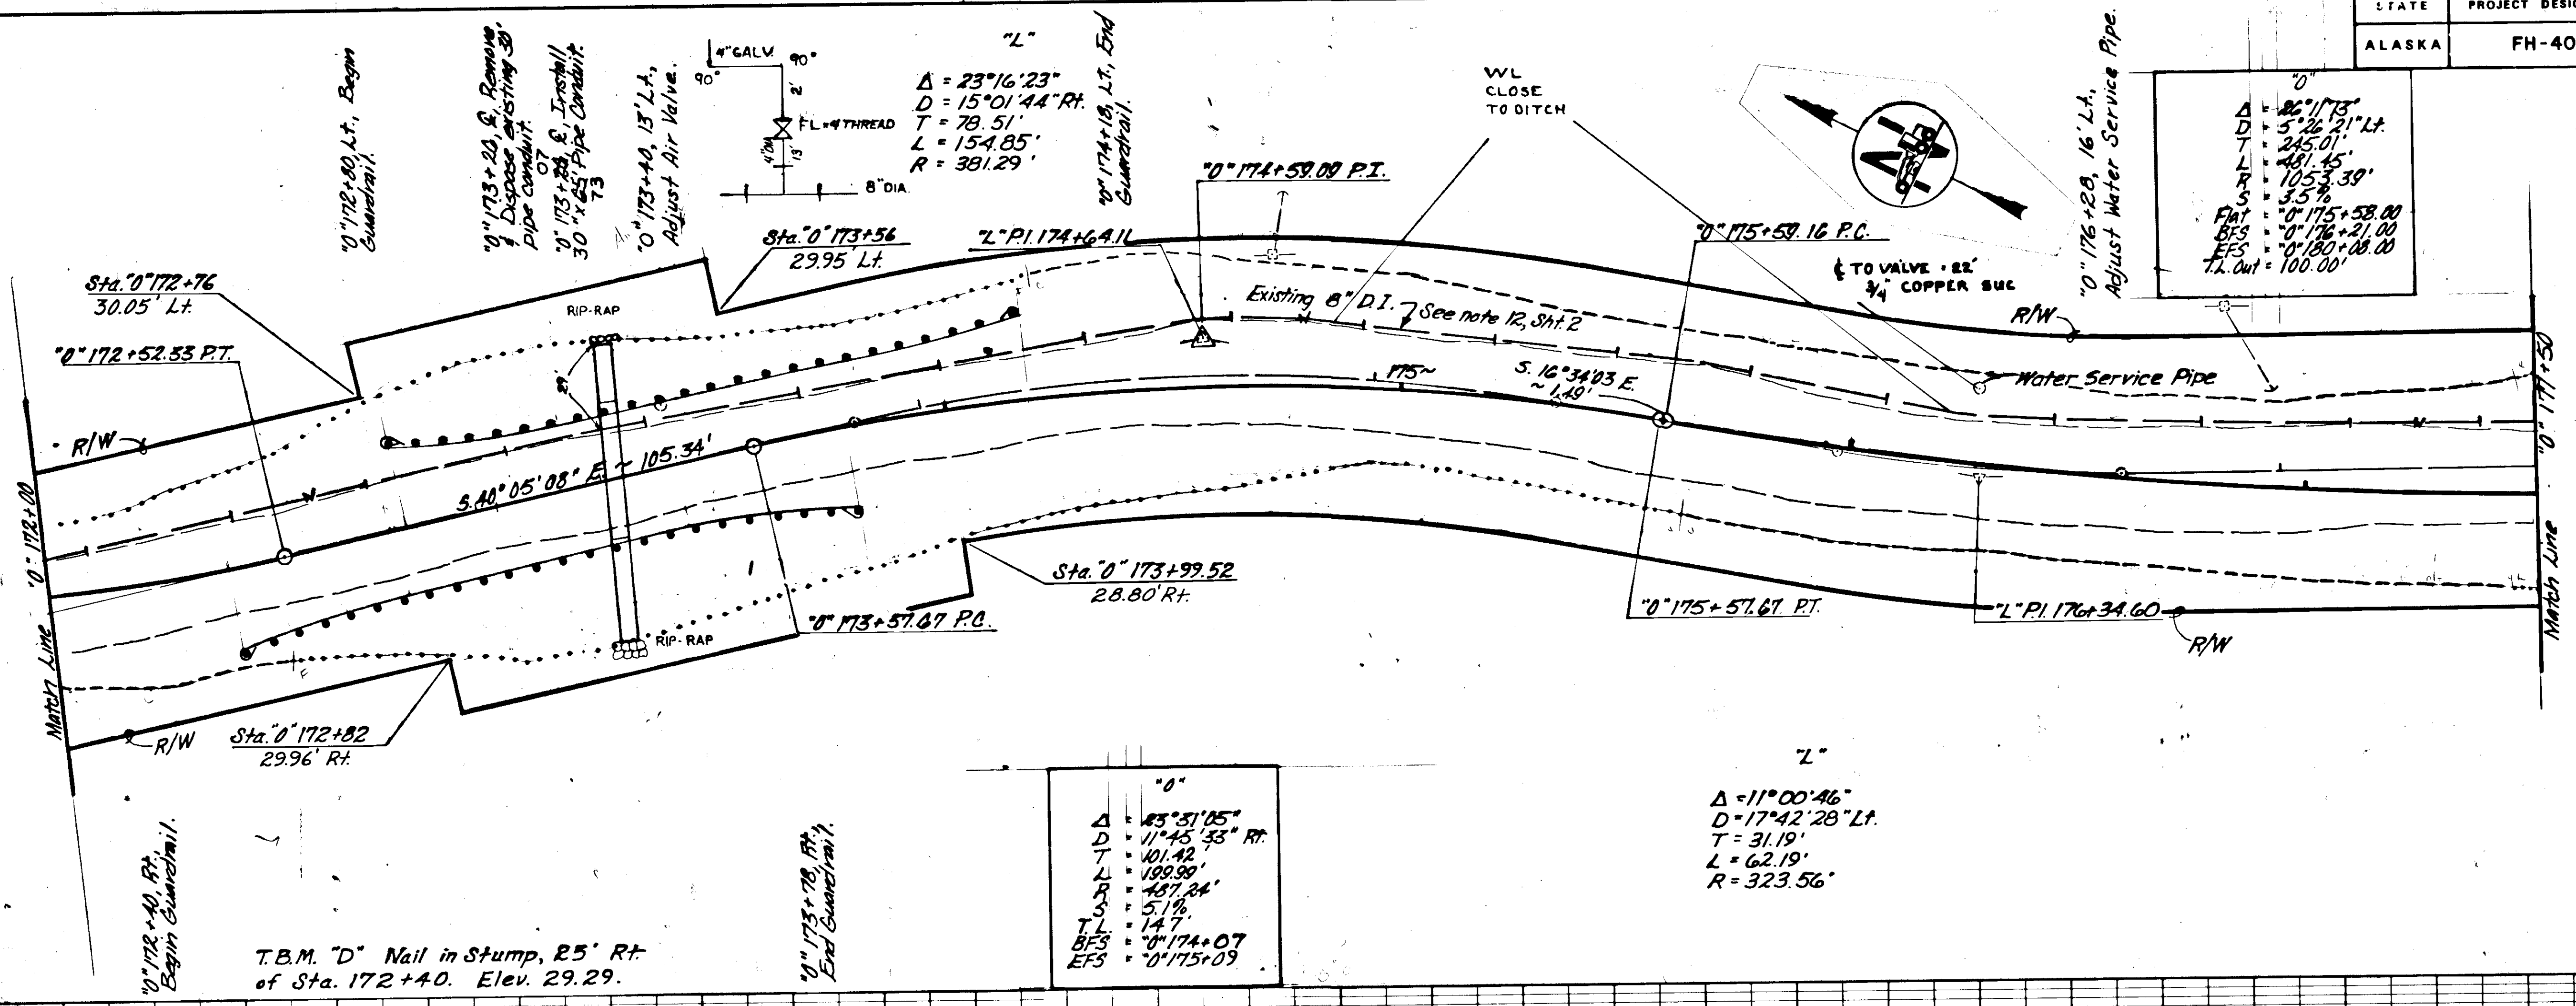


0	86°17'3"
Δ	5°26'21" Lt.
D	245.01'
T	481.45'
L	1053.39'
R	3.5%
S	0°175+58.00
Flat	0°176+21.00
BFS	0°180+08.00
EFS	TL Out = 100.00'


0	83°31'05"
Δ	11°45'53" Rt.
D	101.42'
T	199.99'
L	487.84'
R	5.1%
S	14.7'
TL	BFS = 0°174+07
BFS	EFS = 0°175+09

L	Δ = 11°00'46"
D	17°42'28" Lt.
T	31.19'
L	62.19'
R	323.56'

T.B.M. "D" Nail in Stump, 25' Rt. of Sta. 172+40. Elev. 29.29.

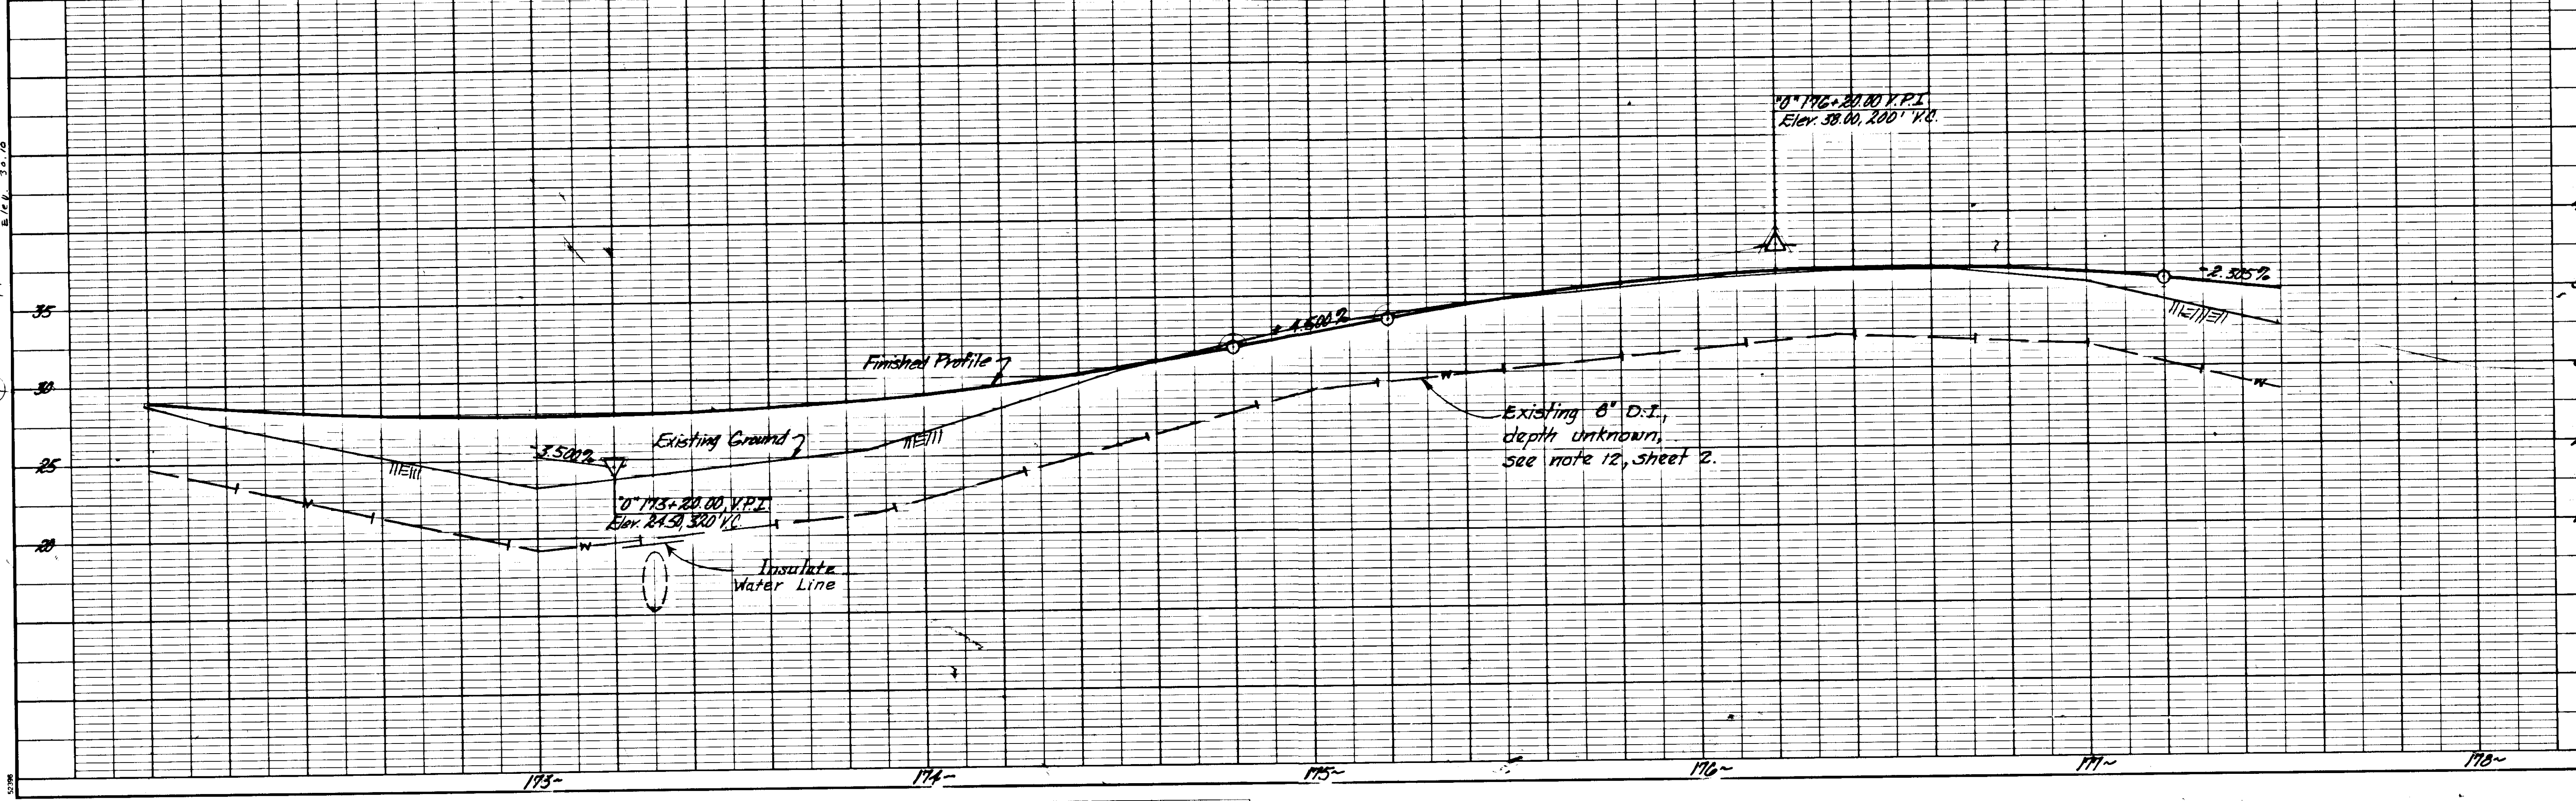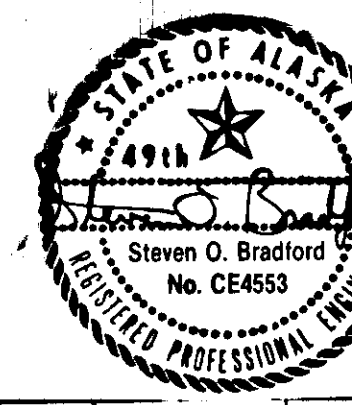

STATE	PROJECT DESIGNATION	YEAR	SHEET NO.	TOTAL SHEETS
ALASKA	FH-40-1(1)	1987	18	19

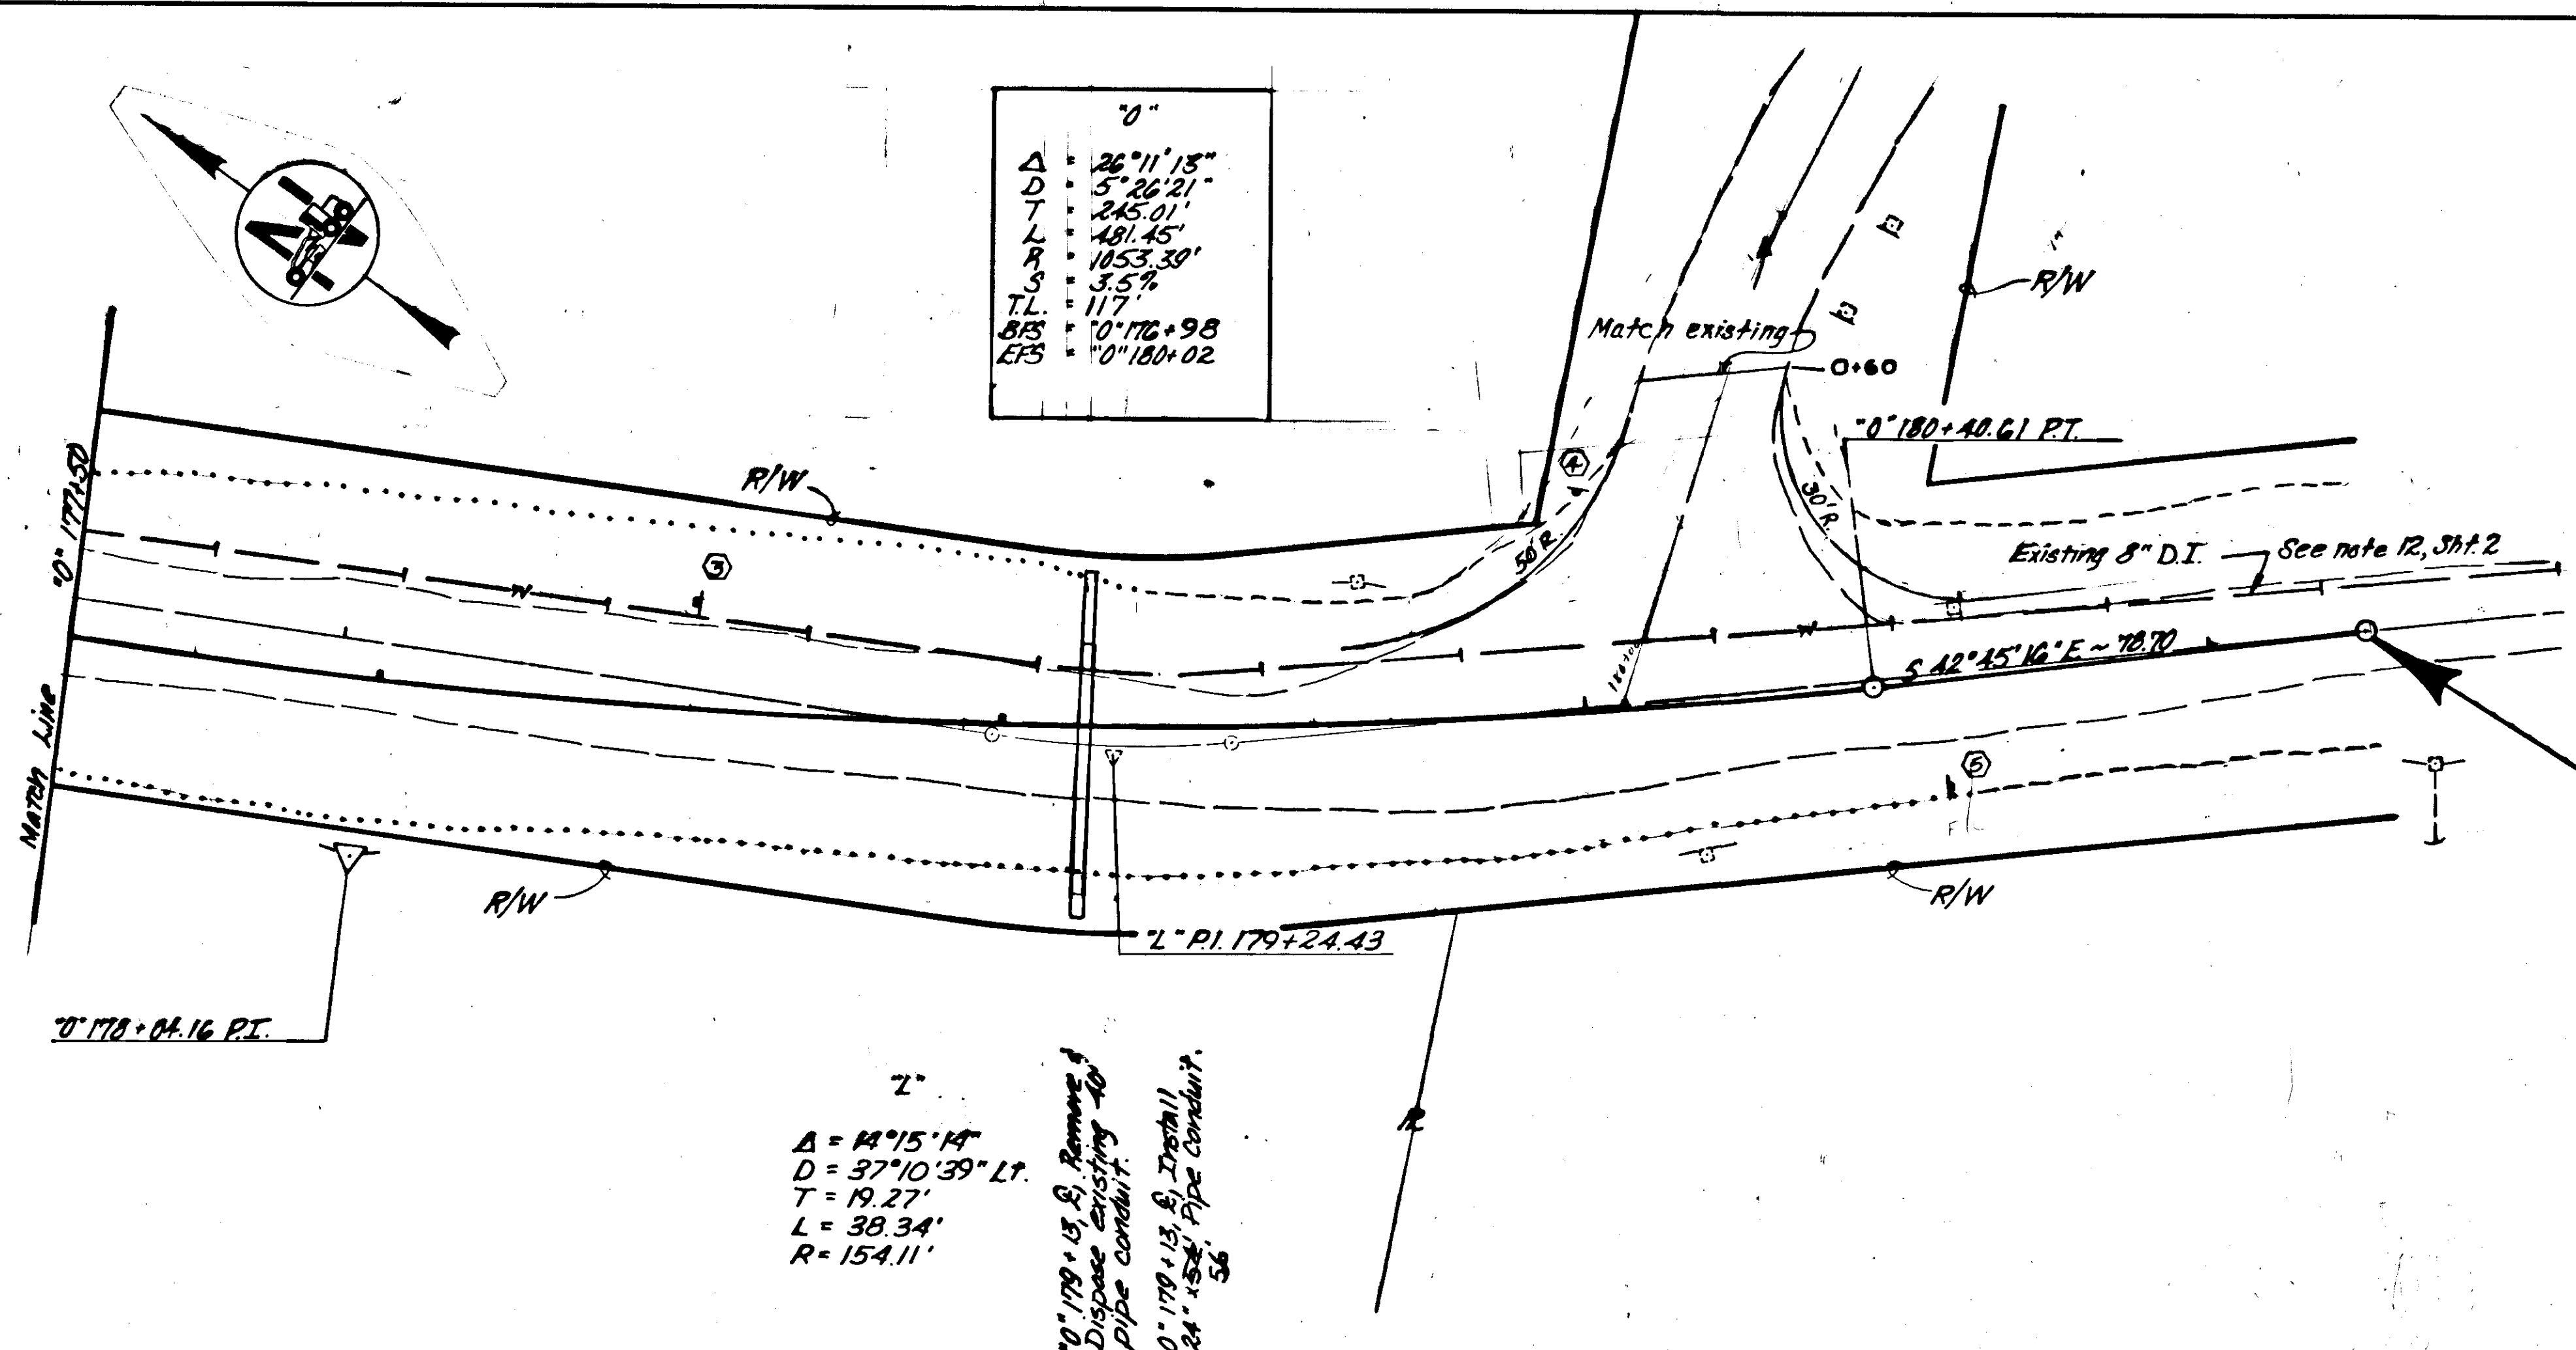


"O"	
Δ	26°11'13"
D	5°26'21"
T	245.01'
L	181.45'
R	1053.30'
S	3.5%
T.L.	117
BIS	0+170+98
EFS	0+180+02


"Z"	
Δ	14°15'14"
D	37°10'39" Lt.
T	19.27'
L	38.34'
R	154.11'

0+179+13 & Remove & Dispose existing 40" pipe conduit.
 0+179+13 & Install 24" x 56" pipe conduit.
 36

END PROJECT
 FH-40-1(1)
 "O" 181+19.31 P.O.T. BK.=
 "L" 181+25.00 P.O.T. AHD.

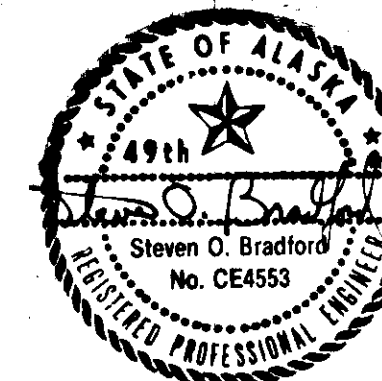

T.B.M. "E" Spike in Power Pole 35' left of Sta. 185+65. Elev. 23.09.

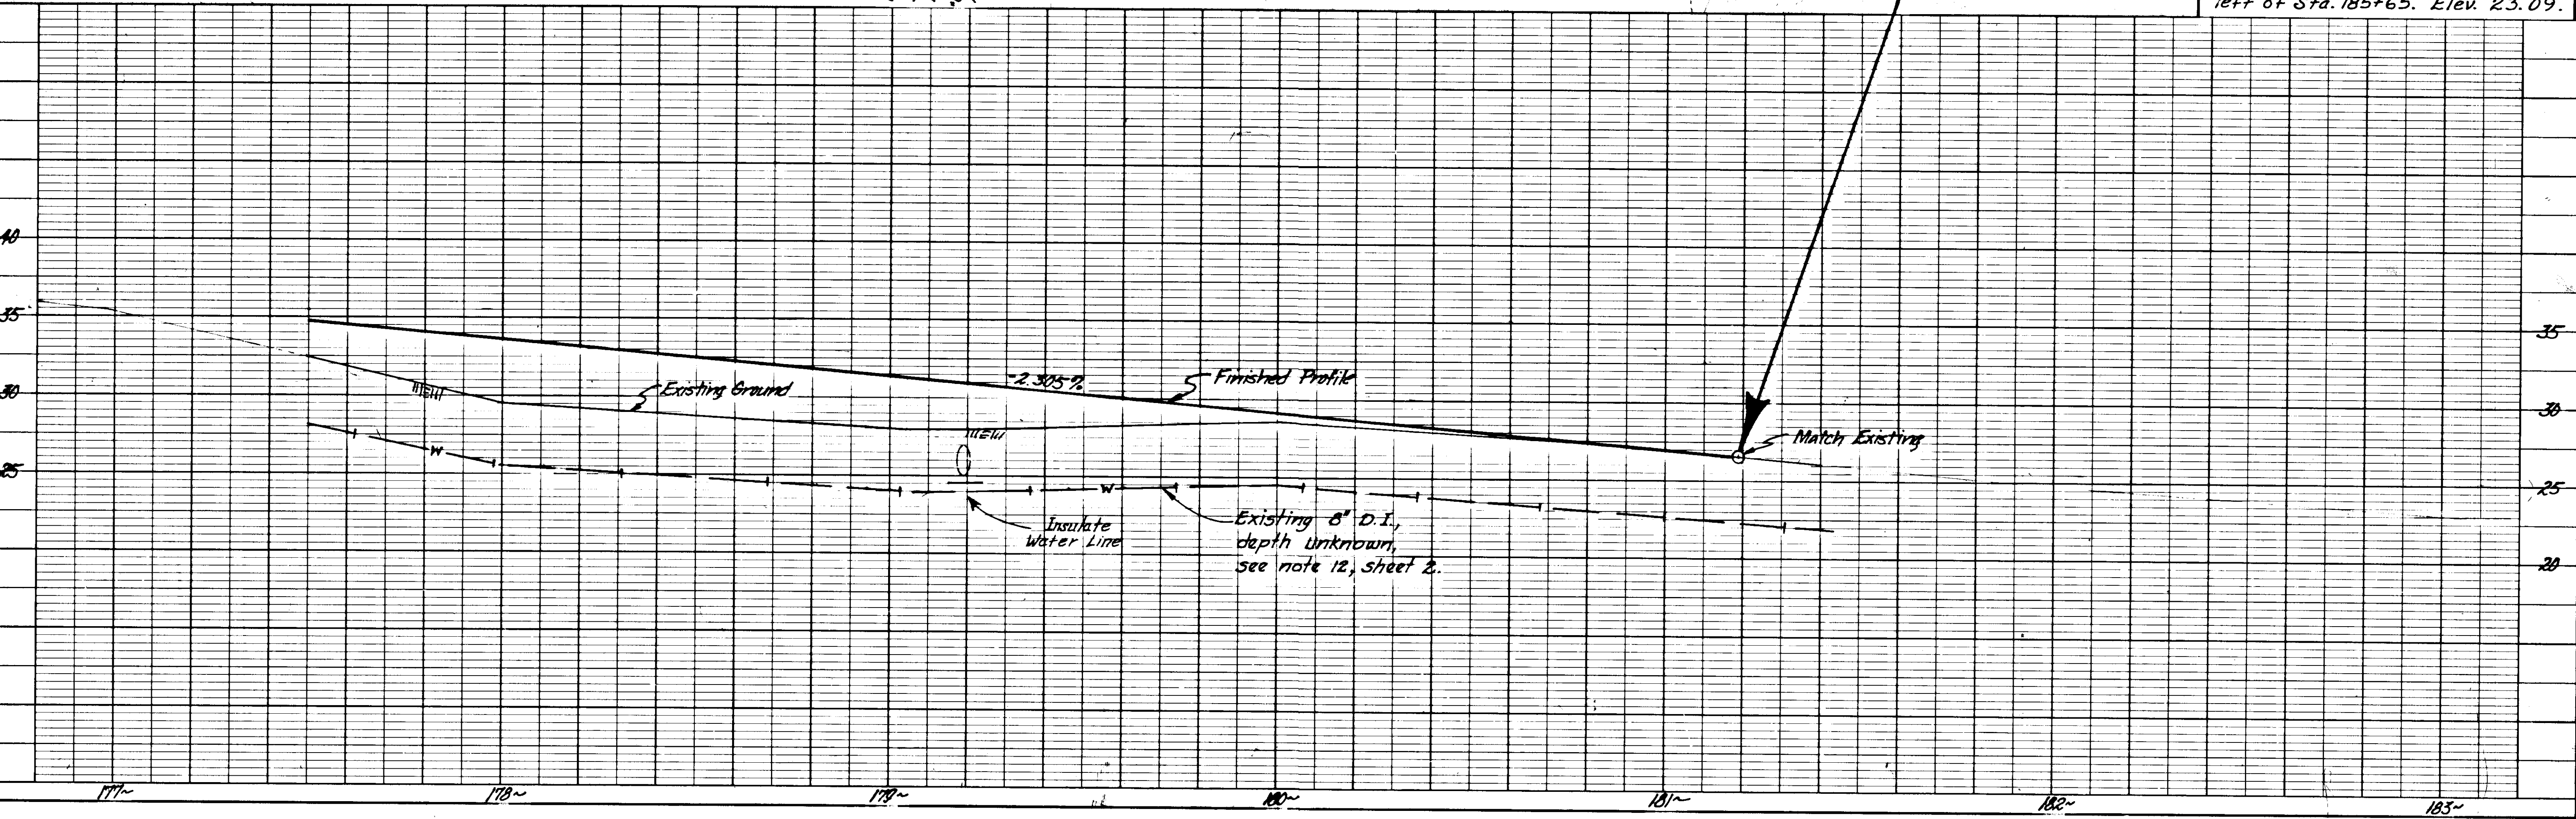

STATE	PROJECT DESIGNATION	YEAR	SHEET NO.	TOTAL SHEETS
ALASKA	FH-40-1(1)	1987	19	19

NOTES:

1. No work shall be performed in any area of the site other than on lands owned by the State of Alaska.
2. All work in the quarry shall be performed from the top to the bottom.
3. Stripping of the existing overburden shall extend a minimum of 15' beyond top of quarry. The overburden slopes shall be graded 1 1/2:1. All overburden and organic material encountered in this source shall be disposed of in the Contractor furnished disposal area.
4. Maximum bench height shall be 30', minimum bench width shall be 30'.
5. Upon completion of work in the quarry, the quarry floor shall be left in such a manner so as not to impede the flow of water. Remaining overburden in stripped areas will be seeded.
6. Any existing processed material within the pit area is owned by others.
7. For additional information, see the Materials Report for this project dated November 2, 1987.

