


STATE OF ALASKA  
DEPARTMENT OF TRANSPORTATION  
and PUBLIC FACILITIES  
S.E. REGION AVIATION—DESIGN & CONSTRUCTION

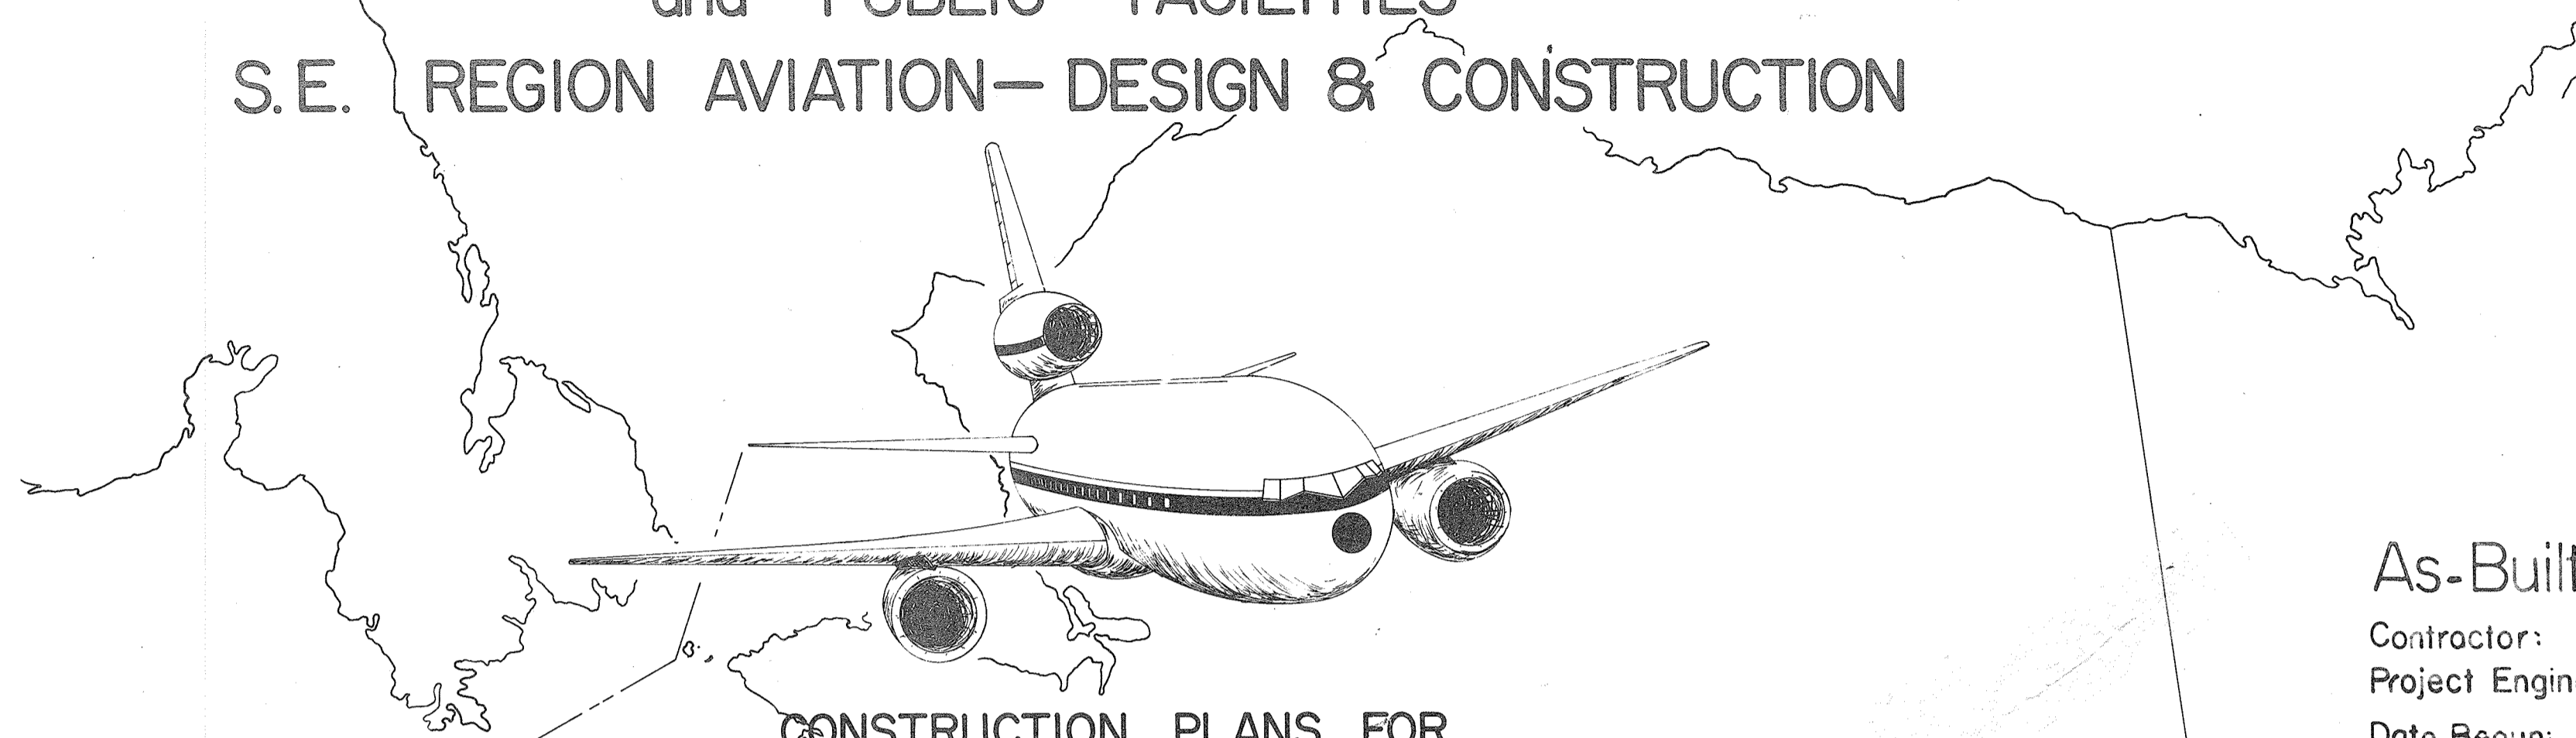

As-Built Plans

Contractor: South Coast, Inc.  
Project Engineer: Greg Browning  
Date Begun: 7-27-84  
Date Complete: 10-25-85

CONSTRUCTION PLANS FOR  
**KAKE AIRPORT**  
CONSTRUCTION OF 75' x 3,000' RUNWAY, APRON,  
ACCESS ROAD AND RELATED ITEMS

A.I.P. NO. 831-3-02-0398-01-83



STATE NO. D19712

1983

SPONSORED BY  
THE STATE OF ALASKA

JUNEAU

KAKE

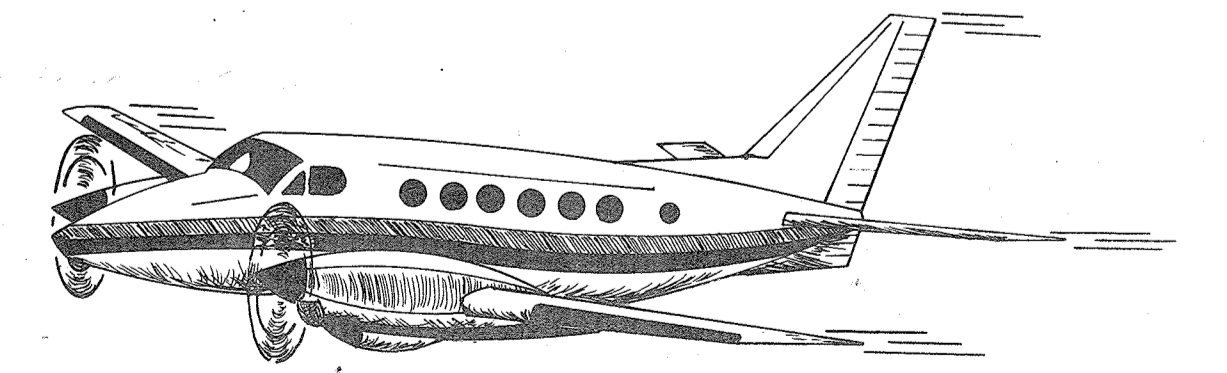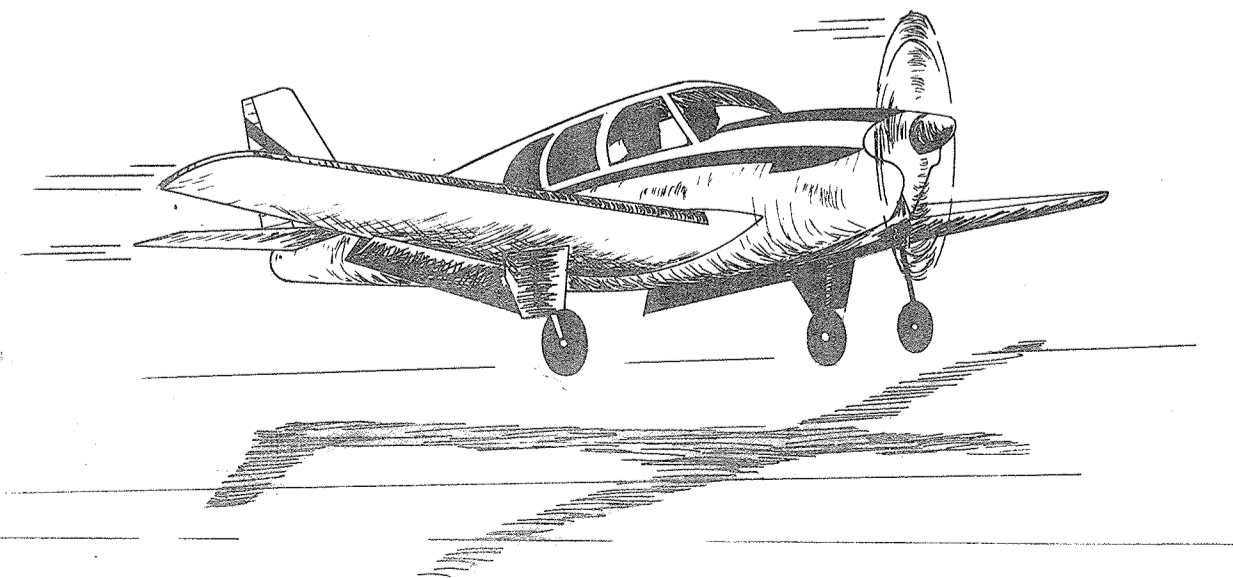

APPROVED

*Charles S. Matlock*  
CHARLES S. MATLOCK, DIRECTOR, S.E. REGION DESIGN & CONSTRUCTION

DATE 7-14-83

APPROVED

*Wallace K. Williams*  
WALLACE K. WILLIAMS, CHIEF, S.E. REGION HIGHWAY & AVIATION DESIGN & CONSTRUCTION

DATE 6/29/83

STATE	PROJECT DESIGNATION	YEAR	SHEET NO.	TOTAL SHEETS
ALASKA				


ESTIMATED QUANTITIES

<u>ITEM NO.</u>	<u>ITEM</u>	<u>QUANTITY</u>	<u>UNIT</u>
100	MOBILIZATION AND DEMOBILIZATION	ALL REQ'D	LUMP SUM
<del>120a</del>	<del>MEALS</del>	<del>4500</del>	<del>PER MAN-MEAL</del>
<del>120b</del>	<del>LODGING</del>	<del>1500</del>	<del>PER MAN-NIGHT</del>
121	CONSTRUCTION SURVEYING BY THE CONTRACTOR	ALL REQ'D	LUMP SUM
125	ENGINEER'S VEHICLE	3	EACH
130	ENGINEER'S FIELD OFFICE & LABORATORY	ALL REQ'D	LUMP SUM
200a	CLEARING	<del>176</del> 158.4	ACRE
200e	CLEARING AND GRUBBING	<del>37</del> 34.9	ACRE
330a	COMMON EXCAVATION	<del>133,300</del> 109,810	CUBIC YARD
330b	ROCK EXCAVATION	<del>109,800</del> 116,563	CUBIC YARD
330c	EMBANKMENT	<del>129,200</del> 116,563	CUBIC YARD
400a	CORRUGATED METAL PIPE (30",ALUMINUM, TYPE-C, 8 GAGE)	<del>228</del> 320	LINEAR FEET
400b	CORRUGATED METAL PIPE (36",ALUMINUM, TYPE-C, 8 GAGE)	<del>870</del> 996	LINEAR FEET
<del>421</del>	<del>DITCH LINING</del>	<del>3070</del>	<del>SQUARE YARD</del>
540	AGGREGATE SURFACE COURSE	<del>11,350</del> 11,458	CUBIC YARD
550a	WOVEN POLYMERIC FABRIC	<del>21,600</del> 21,407	SQUARE YARD
<del>550b</del>	<del>NON-WOVEN POLYMERIC FABRIC</del>	<del>3070</del>	<del>SQUARE YARD</del>
553	EROSION CONTROL FABRIC	<del>9480</del> 2297	SQUARE YARD
701	SURVEY MONUMENTS	11	EACH
702	STANDARD SIGNS	<del>41.25</del> 49.25	SQUARE FOOT
710	RUNWAY BOUNDARY MARKERS	4	EACH
722	SEGMENTED CIRCLE	ALL REQ'D	LUMP SUM
730b	REFLECTIVE MARKERS-TYPE II	70	EACH
820a	TIE-DOWN ANCHORS	15	EACH
900	SEEDING	<del>930</del> 583	M.S.F.
980	RAIN SHELTER BUILDING	ALL REQ'D	LUMP SUM
1010	8 FOOT LIGHTED WIND CONE	ALL REQ'D	LUMP SUM
1200	WATER SYSTEMS	<del>590</del> 588	LINEAR FEET
1300	PAD DEVELOPMENT	ALL REQ'D	CONTINGENT SUM
550c	REINFORCING FABRIC	<del>7,600</del> 6739	SQUARE YARD
121(i)	CLEAR ZONE SURVEYING	ALL REQ'D	LUMP SUM
330f	BORROW	52,035	CUBIC YARD
330g	BORROW for DIKE and STRUCTURES	13,770	C.Y.V.M.
400c	FREIGHT for Add'l. 36" C.M.P.	ALL REQ'D	LUMP SUM


INDEX

<u>SHEET TITLE</u>	<u>SHEET NUMBER</u>
TITLE SHEET	1
LOCATION MAP, VICINITY MAP, INDEX & EST. QUANTITIES	2
SUMMARY TABLES	3
ACCESS ROAD TYPICAL SECTIONS	4
ACCESS ROAD PLAN & PROFILE	5
KEKU ROAD TYPICAL SECTION & PLAN & PROFILE	6
APRON & TAXIWAY PLAN & PROFILE	7
RUNWAY TYPICAL SECTIONS	8-9
RUNWAY PLAN & PROFILE	10-11
RUNWAY BOUNDARY MARKER PLANS	12
REFLECTIVE MARKER PLANS	13
RAIN SHELTER BUILDING	14-15
RIGHT OF WAY & CLEARING LIMITS	16-17
MISCELLANEOUS DETAILS	18-19

THE FOLLOWING STANDARD DRAWINGS SHALL APPLY TO THIS PROJECT: A-1, C-00.00, C-10.01, C-11.01, D-04.01, S-00.00, S-05.00, S-30.00, U-03.00

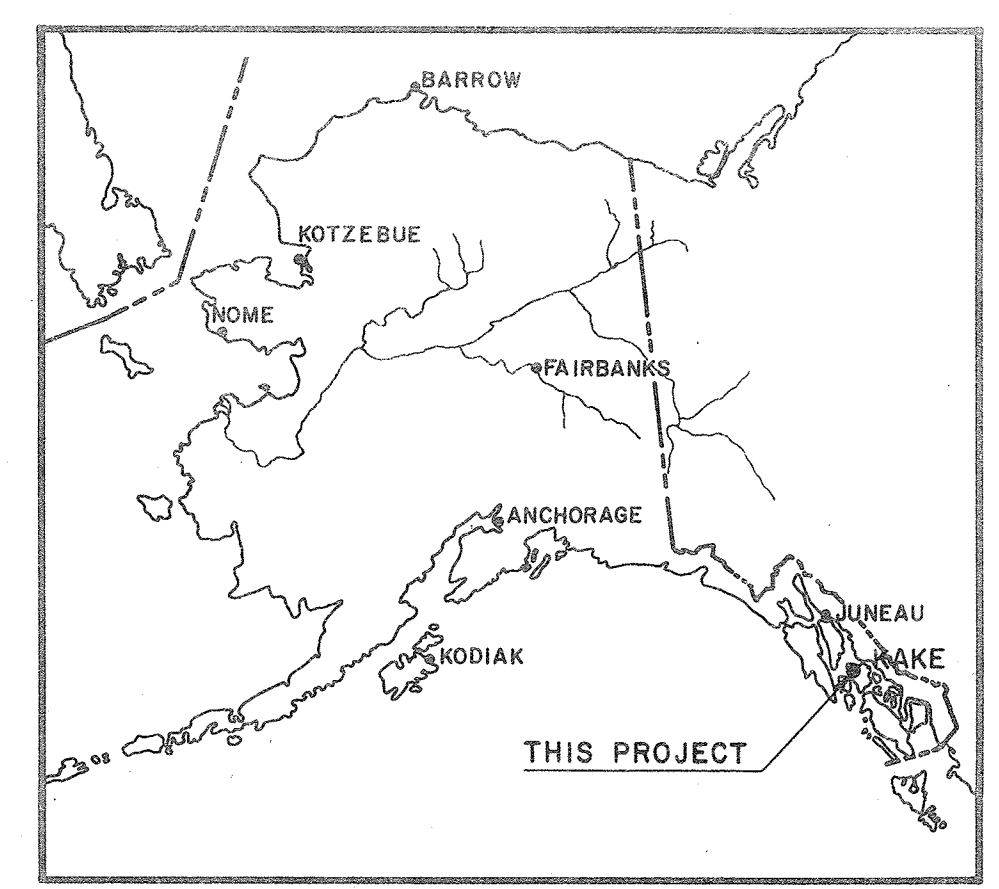

LOCATION MAP

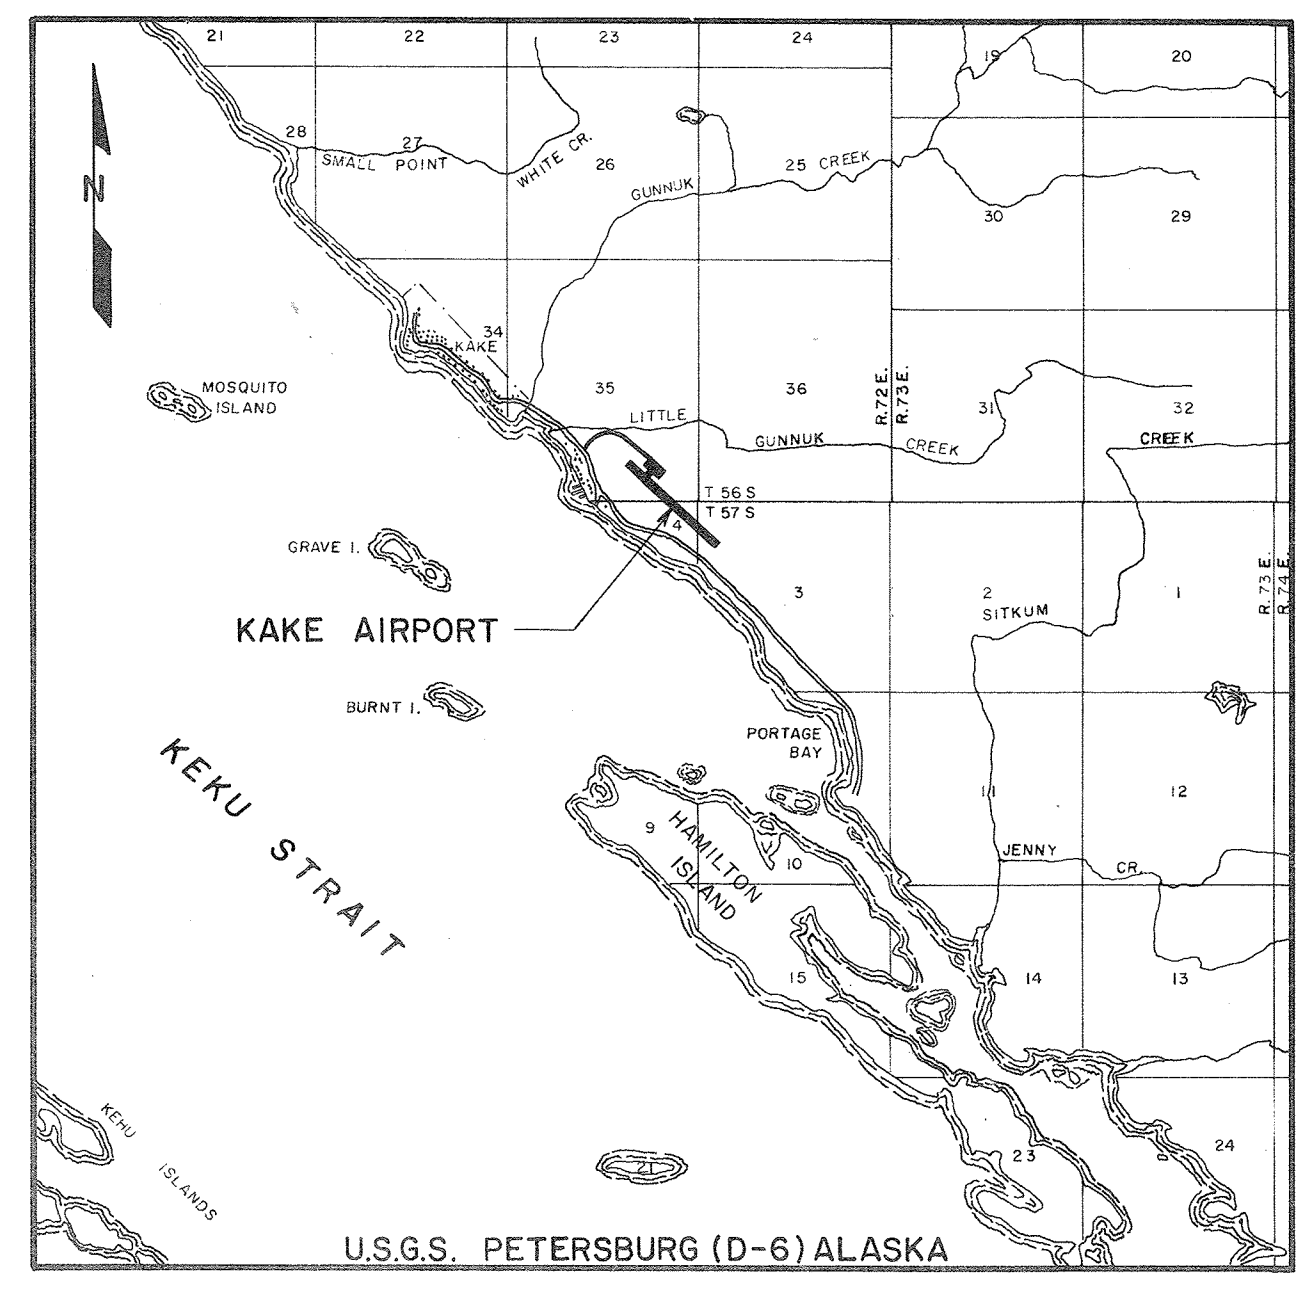

VICINITY MAP  
1" = 1 mile



STATE OF ALASKA  
DEPARTMENT OF TRANSPORTATION  
AND PUBLIC FACILITIES  
S.E. REGION, DIVISION OF AVIATION DESIGN & CONSTRUCTION

KAKE AIRPORT  
A.I.P. NO. 831-3-02-0398-01-83 PROJECT NO. D-19712  
LOCATION & VICINITY MAPS  
ESTIMATED QUANTITIES & INDEX

P.B. 4/18/84 Added Item 550c

APPROVED BY: *William A. Locher*  
WILLIAM A. LOCHER, P.E. S.E. REGION AVIATION DESIGN ENGINEER

APPROVED BY: *William L. Baumgartner*  
WILLIAM L. BAUMGARTNER, P.E. S.E. REGION DESIGN ENGINEER

BY	DATE	CHANGE
		REVISIONS

SCALE: As Shown  
DESIGNED: *OKH*  
DRAWN: *OKH*  
CHECKED: *PB*  
DATE: 6/29/83  
SHEET 2 OF 19

STATE	PROJECT DESIGNATION	YEAR	SHEET NO.	TOTAL SHEETS
ALASKA				

### SUMMARY TABLES

ITEM NO.	ITEM	UNIT	ACCESS ROAD	TAXIWAY & APRON	RUNWAY	GRAND TOTAL
100	Mobilization and Demobilization	L.S.	All Req'd	All Req'd	All Req'd	All Req'd
120a	Meals	Man-meals	Estimated	Quantity =	4500	4500
120b	Lodging	Man-night	Estimated	Quantity =	4500	4500
121	Construction Surveying by Contractor	L.S.	All Req'd	All Req'd	All Req'd	All Req'd
125	Engineer's Vehicle	Each				3
130	Engineer's Field Office with Laboratory	L.S.	All Req'd	All Req'd	All Req'd	All Req'd
200a	Clearing	Acre	Estimated	Quantity =	176.158.4	176.158.4
200e	Clearing & Grubbing	Acre	7-5.80	3-3.14	27-25.95	37.34.9
330a	Common Excavation	C.Y.	25355.34,700	17394.15,300	66461.83,300	109191.33,300
330b	Rock Excavation	C.Y.	23907.26,100	0-4700	8775.79,000	46507.00,000
330c	Embankment	C.Y.	12755.16,400	741.2.12,600	3440.100,200	13506.26,200
400a	Corrugated Metal Pipe (30" Alum-inum, type E, 8 gauge)	L.F.	118-105	110-125	0	228-230
400b	Corrugated Metal Pipe (30" Alum-inum, type E, 8 gauge)	L.F.	0	0	870-996	870-996
421	Ditch Lining	S.Y.	2300	320	450	3070
540	Aggregate Surface Course	C.Y.	1301.2050	1002.1800	8247.7500	11350.145.8
550a	Woven Polymeric Fabric	S.Y.	14,000	1600	7600	21,600
550b	Non-Woven Polymeric Fabric	S.Y.	2300	320	450	3070
553	Erosion Control Fabric	S.Y.	2297.9450	0	0	9450-2297
701	Survey Monuments	Each	3	1	7	11
702	Standard Signs	S.F.	49.25	4.25	0	41.25
710	Runway Boundary Markers	Each	0	0	4	4
722	Segmented Circle	L.S.	0	0	All Req'd	All Req'd
730b	Reflective Markers, Type II	Each	0	21	49	70
820a	Tiedown Anchors	Each	0	15	0	15
900	Seeding	M.S.F.	23.1	121	17.3	26
980	Rain Shelter Building	L.S.	0	All Req'd	0	All Req'd
1010	8 Foot Lighted Wind Cone	L.S.	0	0	All Req'd	All Req'd
1200	Water Systems	L.F.	590-588	0	0	590-588
1300	Pad Development	C.S.	All Req'd	0	0	All Req'd
550c	Reinforcing Fabric	S.Y.	0	0	7600-67.39	7600-67.39

STATION	TO	STATION	REMARKS
"A" 5+00	19' Rt.	"A" 8+50	19' Rt.
Beginning of ditch to discharge to 30" cross culvert (E Sta. 4+78)			
"A" 9+50	19' Rt.	"A" 12+50	19' Rt.

STATION	TO	STATION	REMARKS
"T" 2+15	50' Lt.	"T" 2+60	230' Lt.
Ditch to discharge to existing creek channel			
"A" 8+50	19' Rt.	"A" 9+50	19' Rt.
"A" 12+50	19' Rt.	"A" 18+00	39' Rt.
Ditch shall form a smooth transition into the natural creek channel			

STATION	TO	STATION	REMARKS
"A" 4+52	19' Lt.	"A" 5+30	19' Lt.

STATION	TO	STATION	REMARKS
"A" 4+25	55' Lt.	"A" 4+55	19' Lt.
"A" 5+35	20' Lt.	"A" 5+75	60' Lt.
Discharge to existing natural creek channel			
"R" 46+00	140' Lt.	"R" 46+00	30' Rt.

STATION	REMARKS
"R" 11+00	Install on both shoulders
"R" 11+50	Install on centerline
"R" 12+00	Install on both shoulders
"R" 12+50	Install on centerline
"R" 13+00	Install on both shoulders
(All above were obliterated during construction)	

### GENERAL NOTES

- Vertical and Horizontal alignments shown on these plans are subject to minor field revisions.
- Pipe conduit lengths and locations are approximate only and are subject to field adjustments.
- Clearing and Grubbing limits shall be 10' beyond the slope limits in cut areas and 5' beyond the slope limits in fill areas, except on Keku (See Typical Keku Road Section).
- If the Contractor elects to stockpile useable excavation for reuse elsewhere on the Project, no measurement of quantities will be made and all work involved shall be considered a subsidiary obligation of the Contractor.
- All waste material shall be disposed of at approved locations on the Project Site or at an adjacent site with proper approvals. The Engineer will determine the height and width of the waste embankment adjacent to the Runway. In no case shall the waste be above the Runway.
- All work and materials involved with the maintenance of Keku Road in conformance with Section 122, Traffic Maintenance, shall be considered incidental to other items of work.
- A Cushion Blanket (4" minus material) 12" thick shall be placed on all woven fabric overlaps. This material shall be included for payment as Embankment.
- When rock material is encountered in seeding limits, that area shall not be seeded.
- Special Ditch Work and Creek Diversion Channel will be paid for in accordance with Section 421.
- Stationing for the property monuments are approximate only. The exact location of the existing property monuments are to be tied out and reset by a Registered Land Surveyor. See Section 701.

### SIGNING NOTES

- Sign locations and post lengths are approximate only and are subject to minor revisions.
- All sign posts shall be telescoping, perforated and galvanized steel posts; the 2" size shall be used above ground and the 2 1/4" size shall be used below ground for the sleeve.
- All posts shall be installed with the sleeve type embedment in accordance with Standard Drawing 3-30.00, except that the 2 1/4" size shall be used for the entire embedment depth.

NO.	STATION	OFFSET		CODE NUMBER	LEGEND	SIGN PANEL THICKNESS			NO. OF POSTS	TYPE	POST SIZE	LENGTH	EMBEDMENT	FACING TRAFFIC	REMARKS
		LT.	RT.			SIZE	UNFRAMED	FRAMED							
1	12+55		15'	I-5	Airport Symbol	24"x36"	.080	6.00	1	PST	2"x2"	11'	3'	SB	
2	15+29		16'	D-1-2	Kake Ferry Terminal	24"x48"	.080	8.00	2	PST	2"x2"	10'	3'	WB	
3	18+25	15'		I-5	Airport Symbol	24"x36"	.080	6.00	1	PST	2"x2"	11'	3'	NB	
4	"A" 0+65	15'		R1-1	Stop	30"x30"	.080	6.25	1	PST	2"x2"	11'	3'	WB	
5	"A" 3+40, 4+40	15'		R2-1	Speed Limit 35	30"x36"	.080	7.50	1	PST	2"x2"	11'	3'	EB	
6	"A" 18+00	15'		R2-1	Speed Limit 35	30"x36"	.080	7.50	1	PST	2"x2"	11'	3'	WB	
TOTAL								49.25							
								41.25							


STATION	REMARKS
"R" 13+00	Install Lt. and Rt. of Shoulder
"R" 15+10	Install at Lt. Shoulder
"R" 20+10	Install at Lt. Shoulder
"R" 35+50	Install at Rt. Shoulder
"R" 40+50	Install at Rt. Shoulder
"R" 43+00	Install Lt. and Rt. of Shoulder

STATION	POINT	REMARKS
15+28.72	P.O.T.	Beginning of Access Rd.
"A" 0+00.00	P.O.T.	
"A" 3+86.88	P.C.	Access Road
"A" 14+93.62	P.T.	Access Road
"A" 25+28.45	P.O.T.	
"T" 4+37.4+46.4	P.O.T.	Apron
"R" 10+60	P.O.T.	Beginning of Runway
"R" 45+40	P.O.T.	End Runway
"R" 16+50.00	P.O.T.	
"T" 0+00.00	P.O.T.	Runway / Taxiway

STATION	PIPE LENGTH			REMARKS
	30"	36"	36"	
"T" 2+15	125	40'		
"R" 22+50	22+75	230'	262	
"R" 31+00	31+10	200'	242	
"R" 35+50	35+15	210'	242	
"R" 41+00		230'	250	
"A" 4+78	4+50	70	62'	
"A" 13+20		74	56'	
"A" 8+05		51		
TOTAL				936
				228' 870'

STATION	REMARKS
40.6	
"R" 19+90, 50' Rt.	
43.6	
"R" 21+60, 55' Rt.	
60.5	
"R" 41+00, 90' Rt.	
90.6	
"R" 46+00, 100' Rt.	

P.B.	DATE	CHANGE
	4/18/84	Added Item 550c.

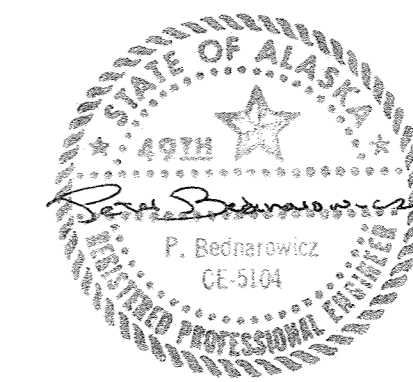

STATE OF ALASKA  
DEPARTMENT OF TRANSPORTATION  
AND PUBLIC FACILITIES  
S.E. REGION, DIVISION OF AVIATION DESIGN & CONSTRUCTION

**KAKE AIRPORT**  
A.I.P. NO. 831-3-02-0398-01-83  
PROJECT NO. D-19712  
SUMMARY TABLES

APPROVED BY: *William A. Locher*  
WILLIAM A. LOCHER, S.E. REGION AVIATION DESIGN ENGINEER



APPROVED BY: *William L. Baumgartner*  
WILLIAM L. BAUMGARTNER, S.E. REGION DESIGN ENGINEER

SCALE: None  
DESIGNED: *CKM*  
CHECKED: *PK*  
DRAWN: *CKM*  
DATE: 6/29/83

SHEET 3 OF 19

DATE	
BY	
SUPERVISOR	
ALIGNMENT CHECKED	
NOTE BOOK	
RT. OF WAY CHECKED	
No.	

DATE	
BY	
SUPERVISOR	
GRADE CHECKED	
NOTE BOOK	
B. M.'S. NOTED	
STRUCTURE NOTATIONS CHECKED	
No.	

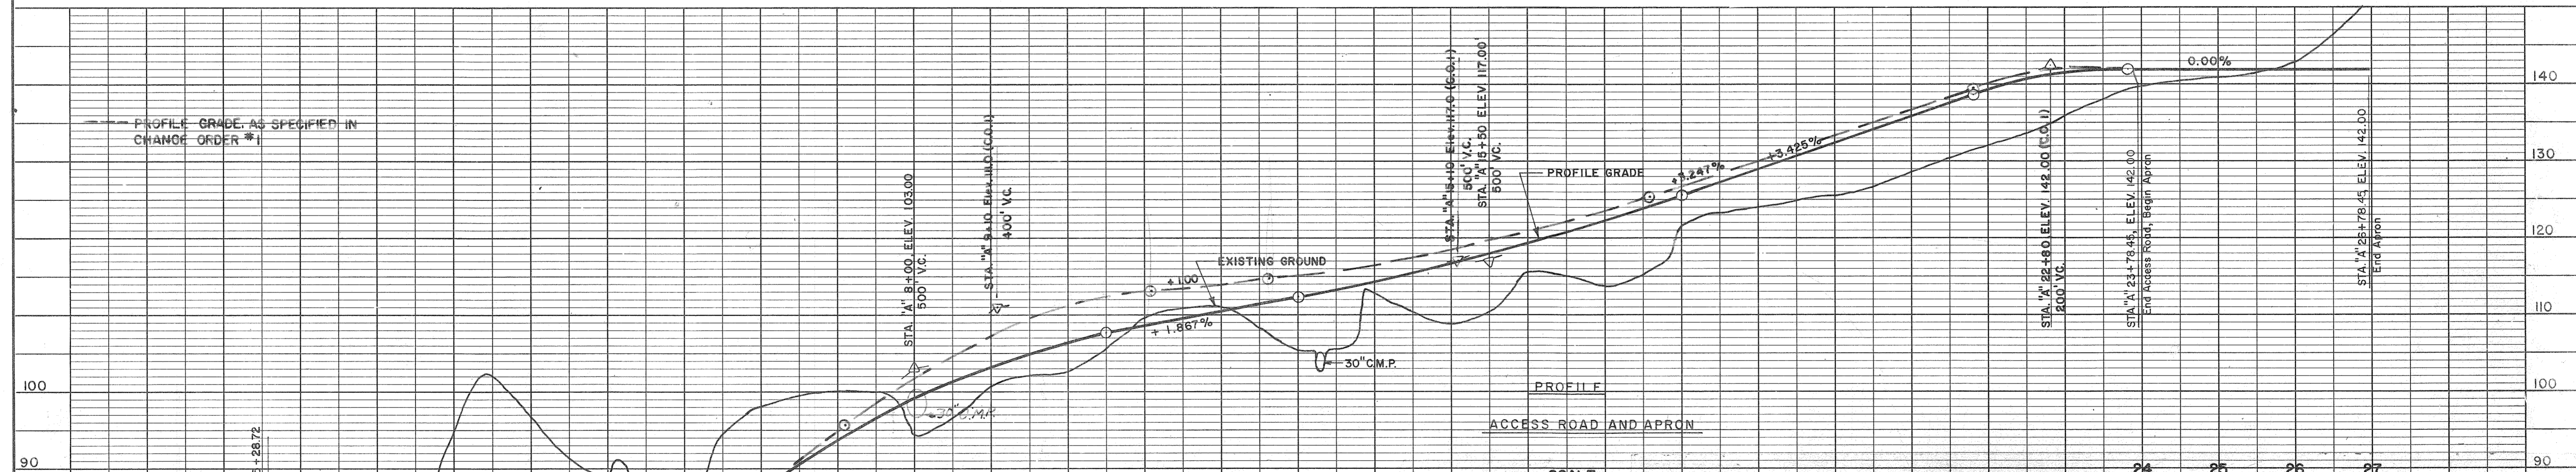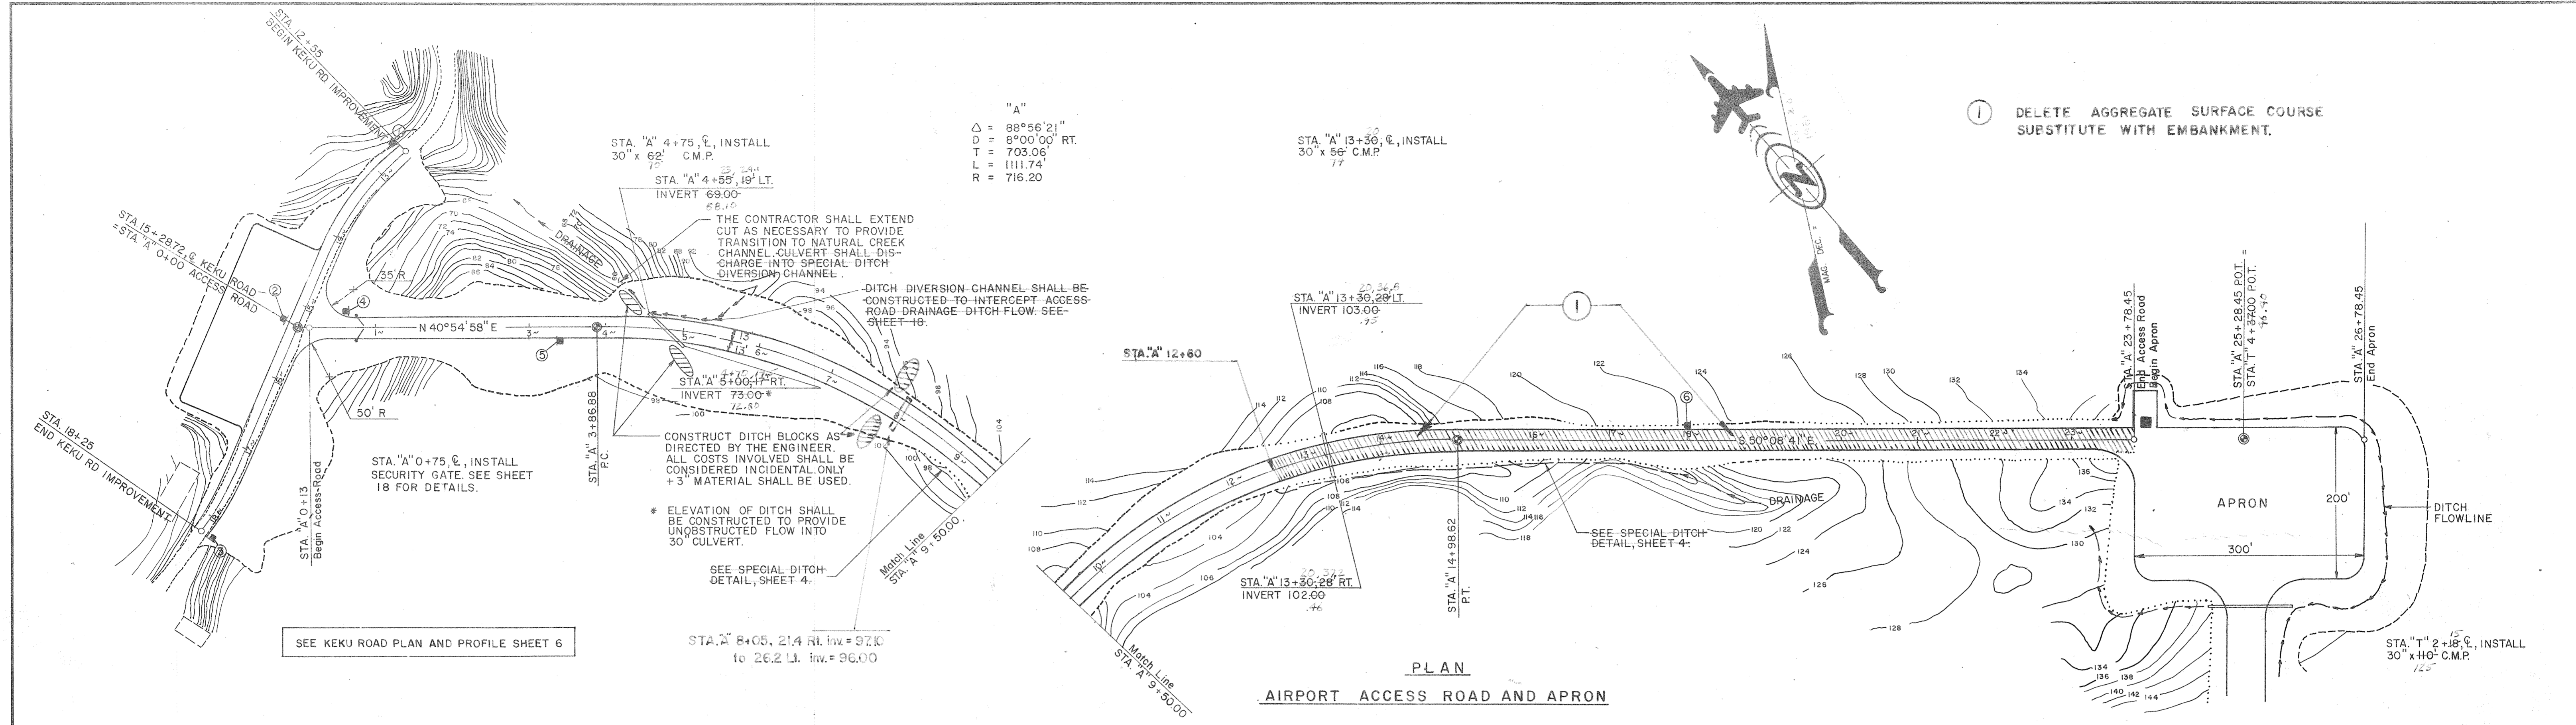

STATE OF ALASKA  
 DEPARTMENT OF TRANSPORTATION  
 AND PUBLIC FACILITIES  
 S.E. REGION, DIVISION OF AVIATION DESIGN & CONSTRUCTION

ACCESS ROAD & APRON  
 PROJECT NO. D-19712  
 A.I.P. NO. 831-3-02-0398-01-83  
 PLAN & PROFILE






APPROVED BY: *William A. Locher*  
 WILLIAM A. LOCHER, P.E., S.E. REGION, AVIATION DESIGN ENGINEER

APPROVED BY: *William L. Baumgartner*  
 WILLIAM L. BAUMGARTNER, P.E., S.E. REGION, DESIGN ENGINEER

SCALE: \_\_\_\_\_  
 DESIGNED: \_\_\_\_\_  
 DRAWN: *CPH*

# TYPICAL ACCESS ROAD SECTIONS

STATE	PROJECT DESIGNATION	YEAR	SHEET NO.	TOTAL SHEETS
ALASKA				

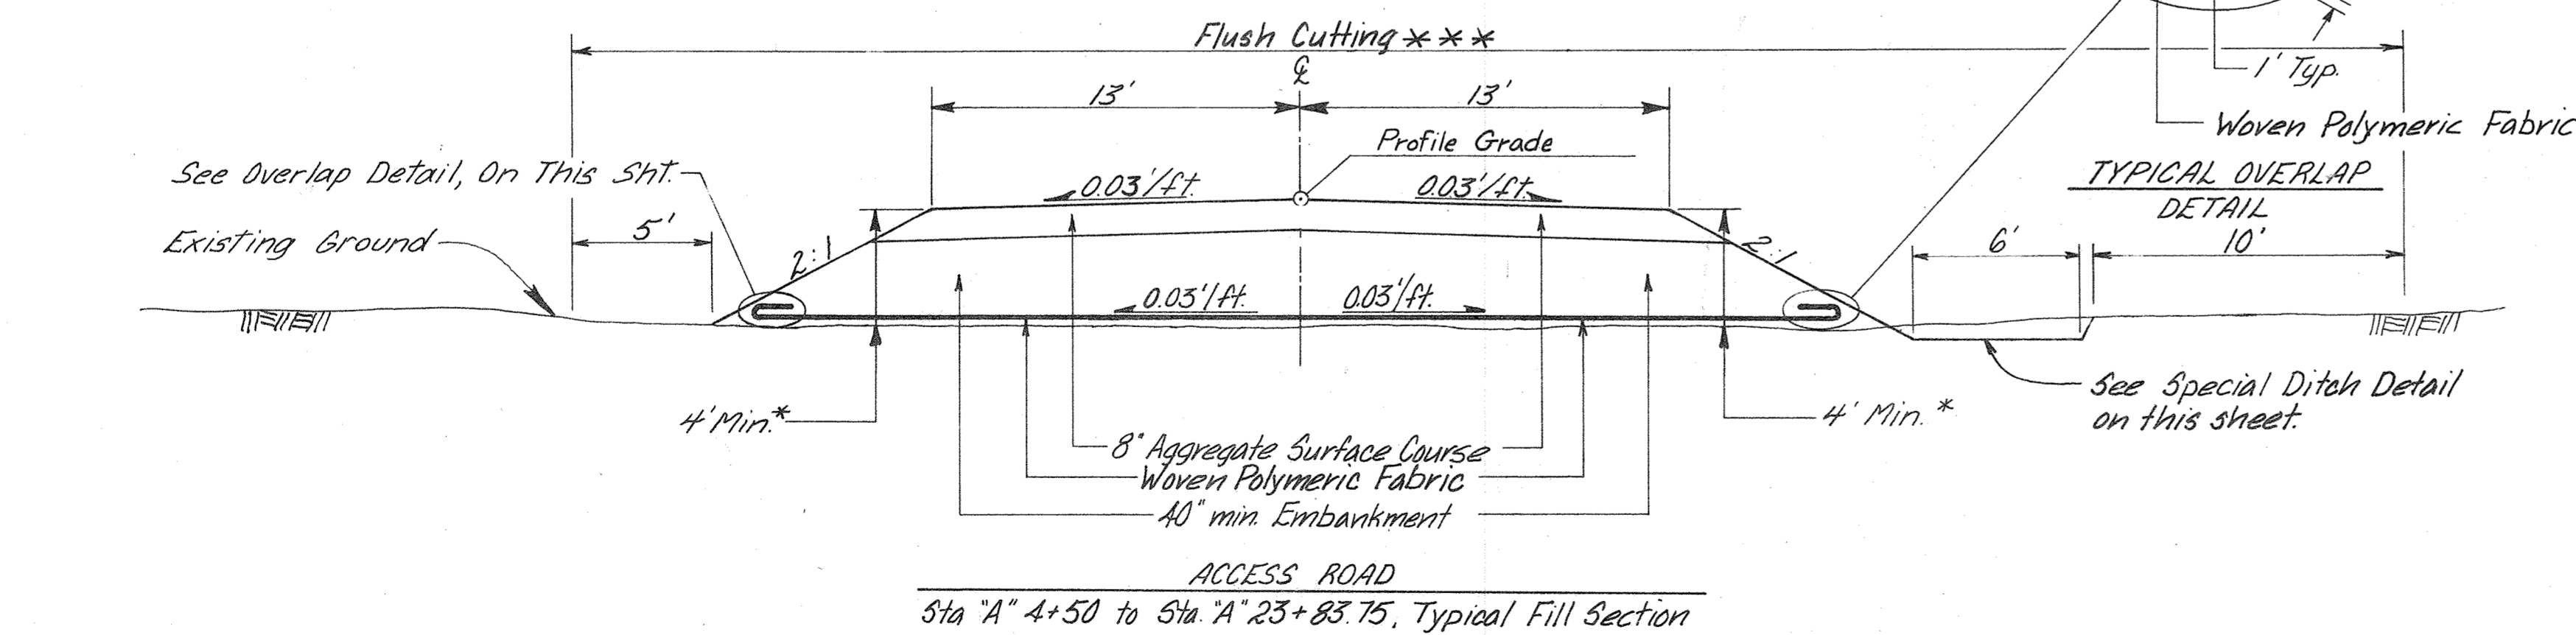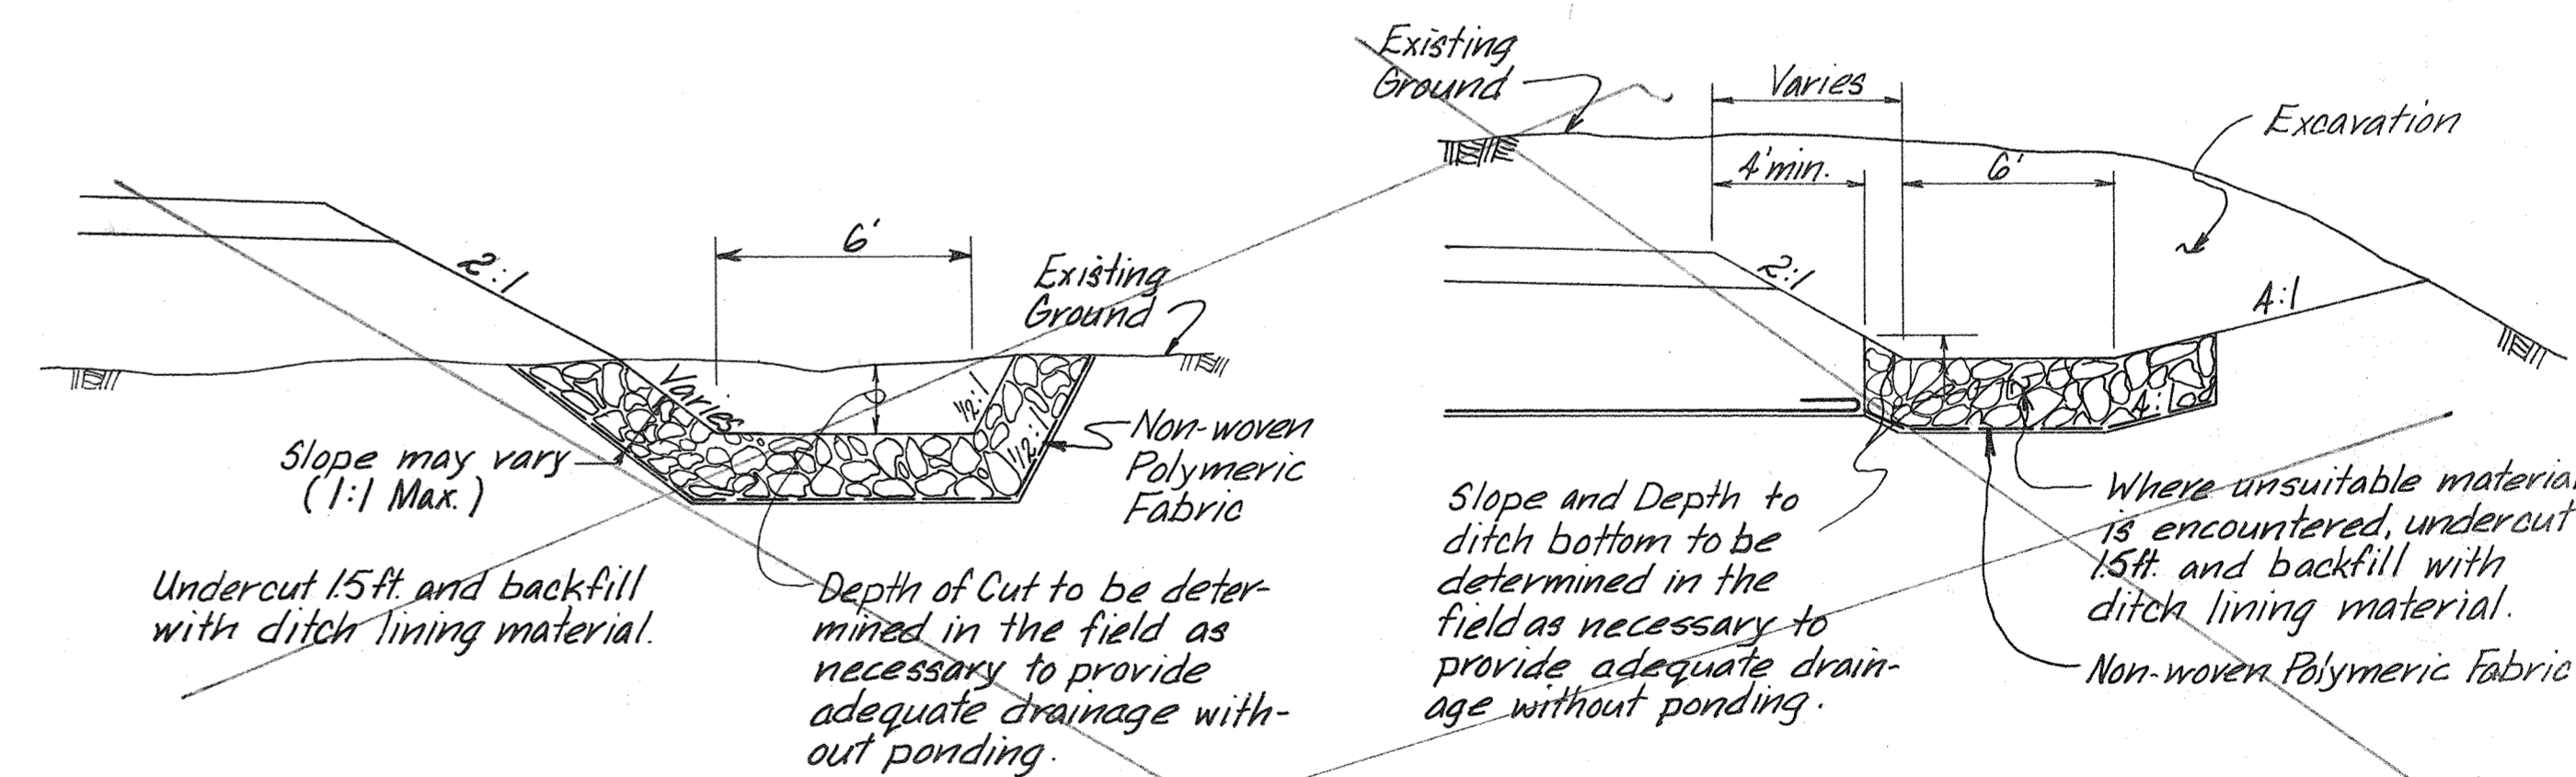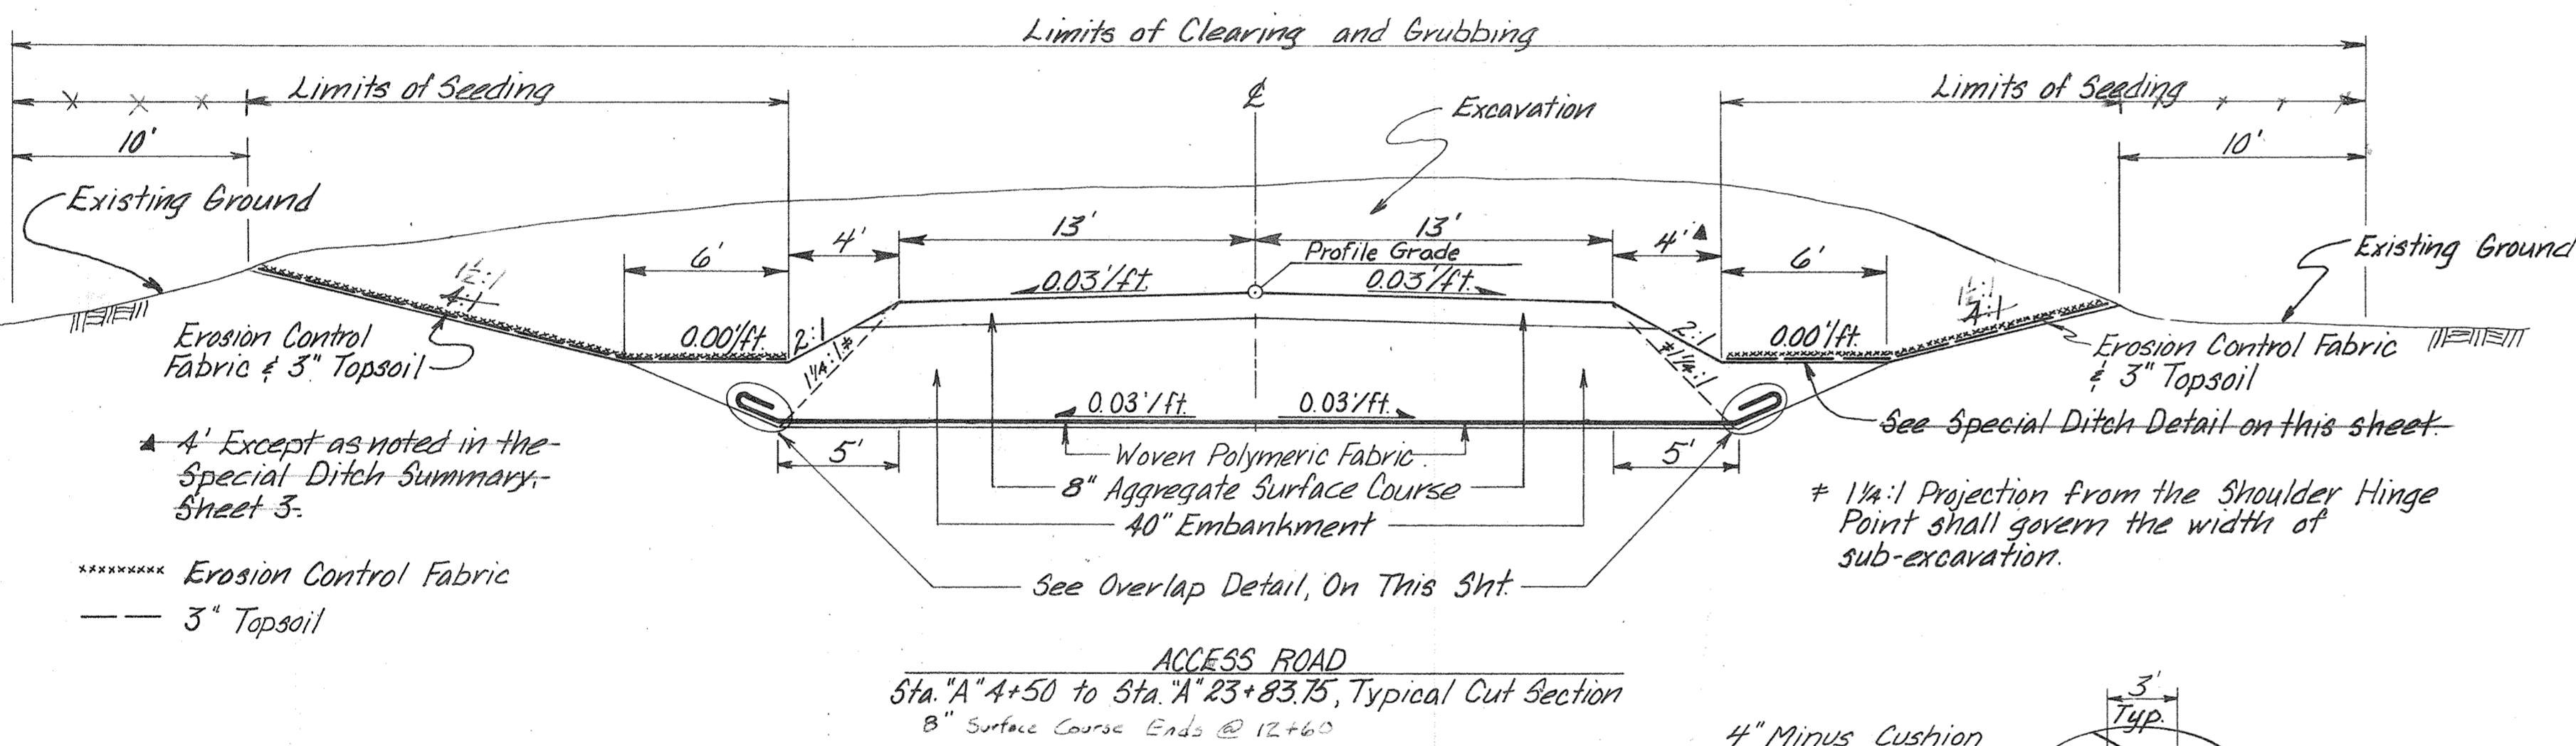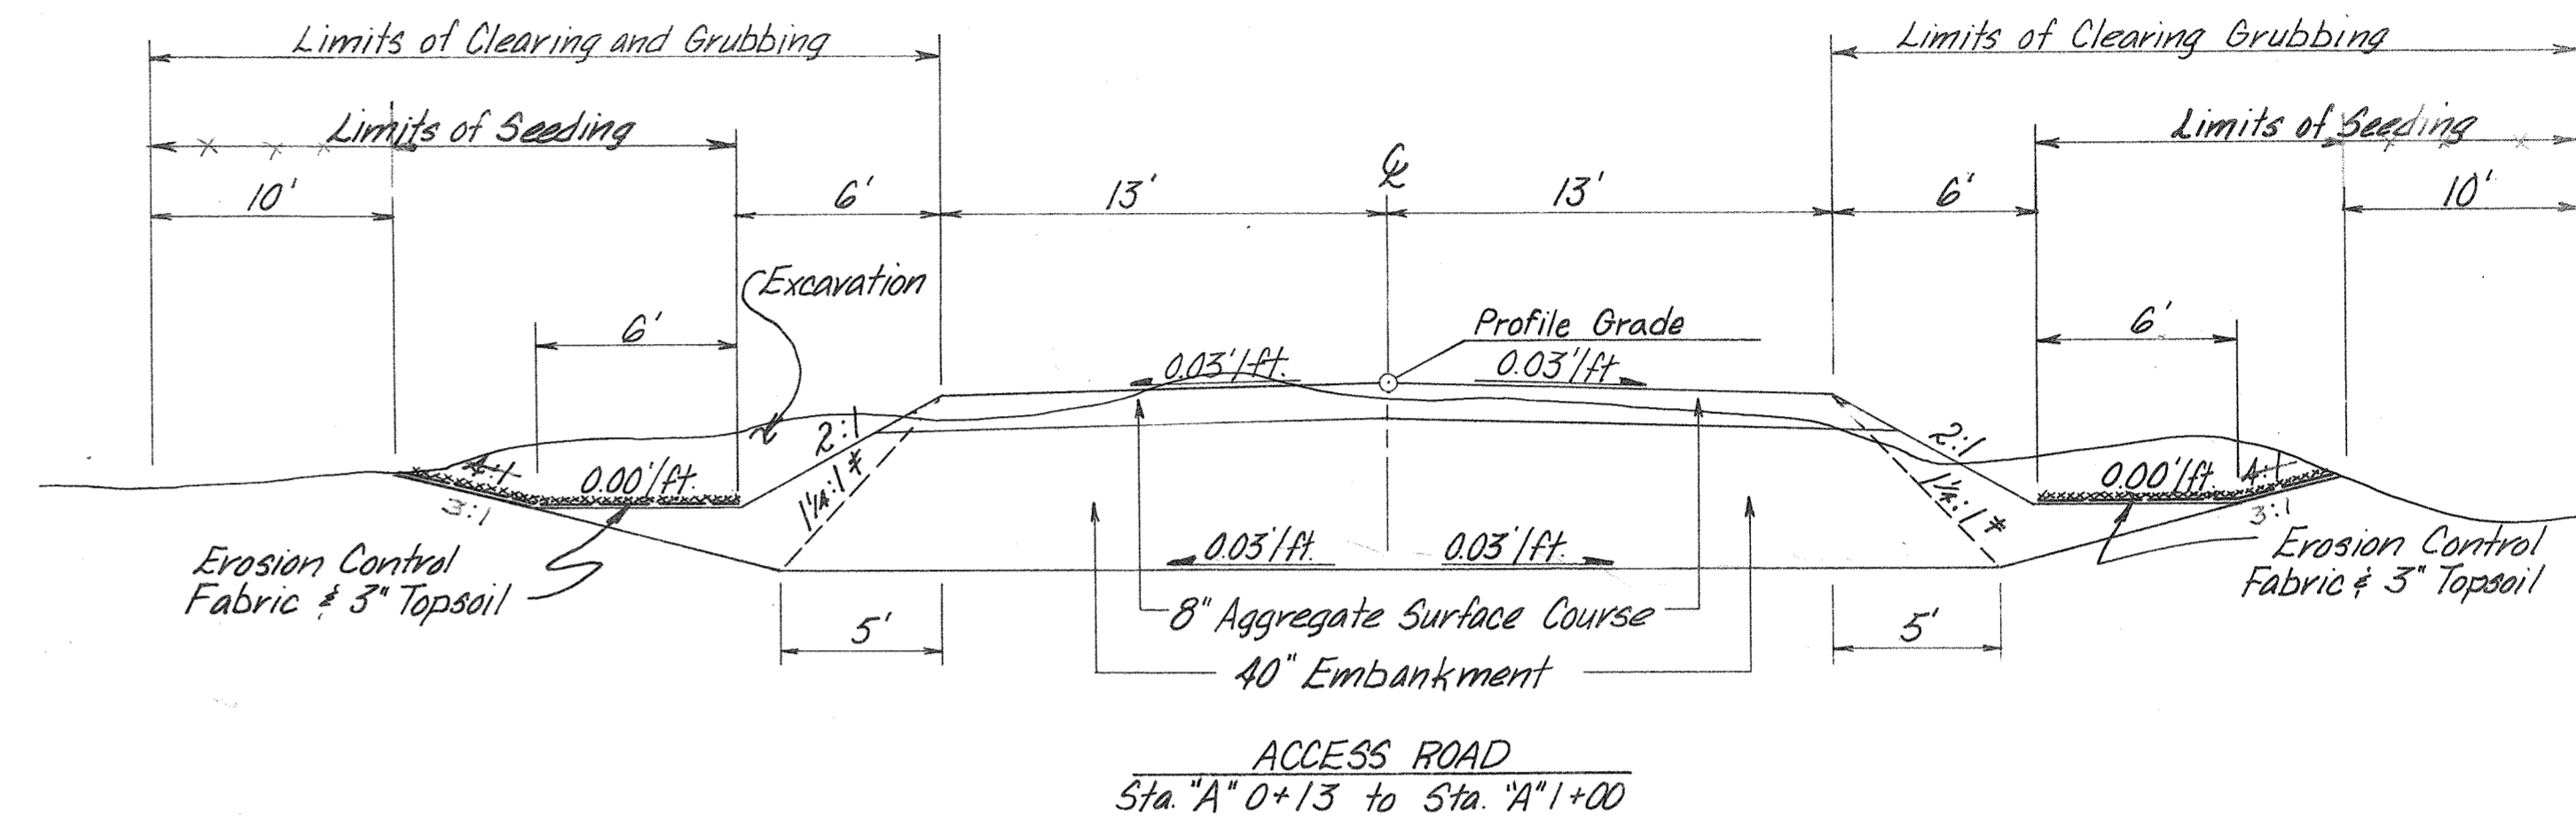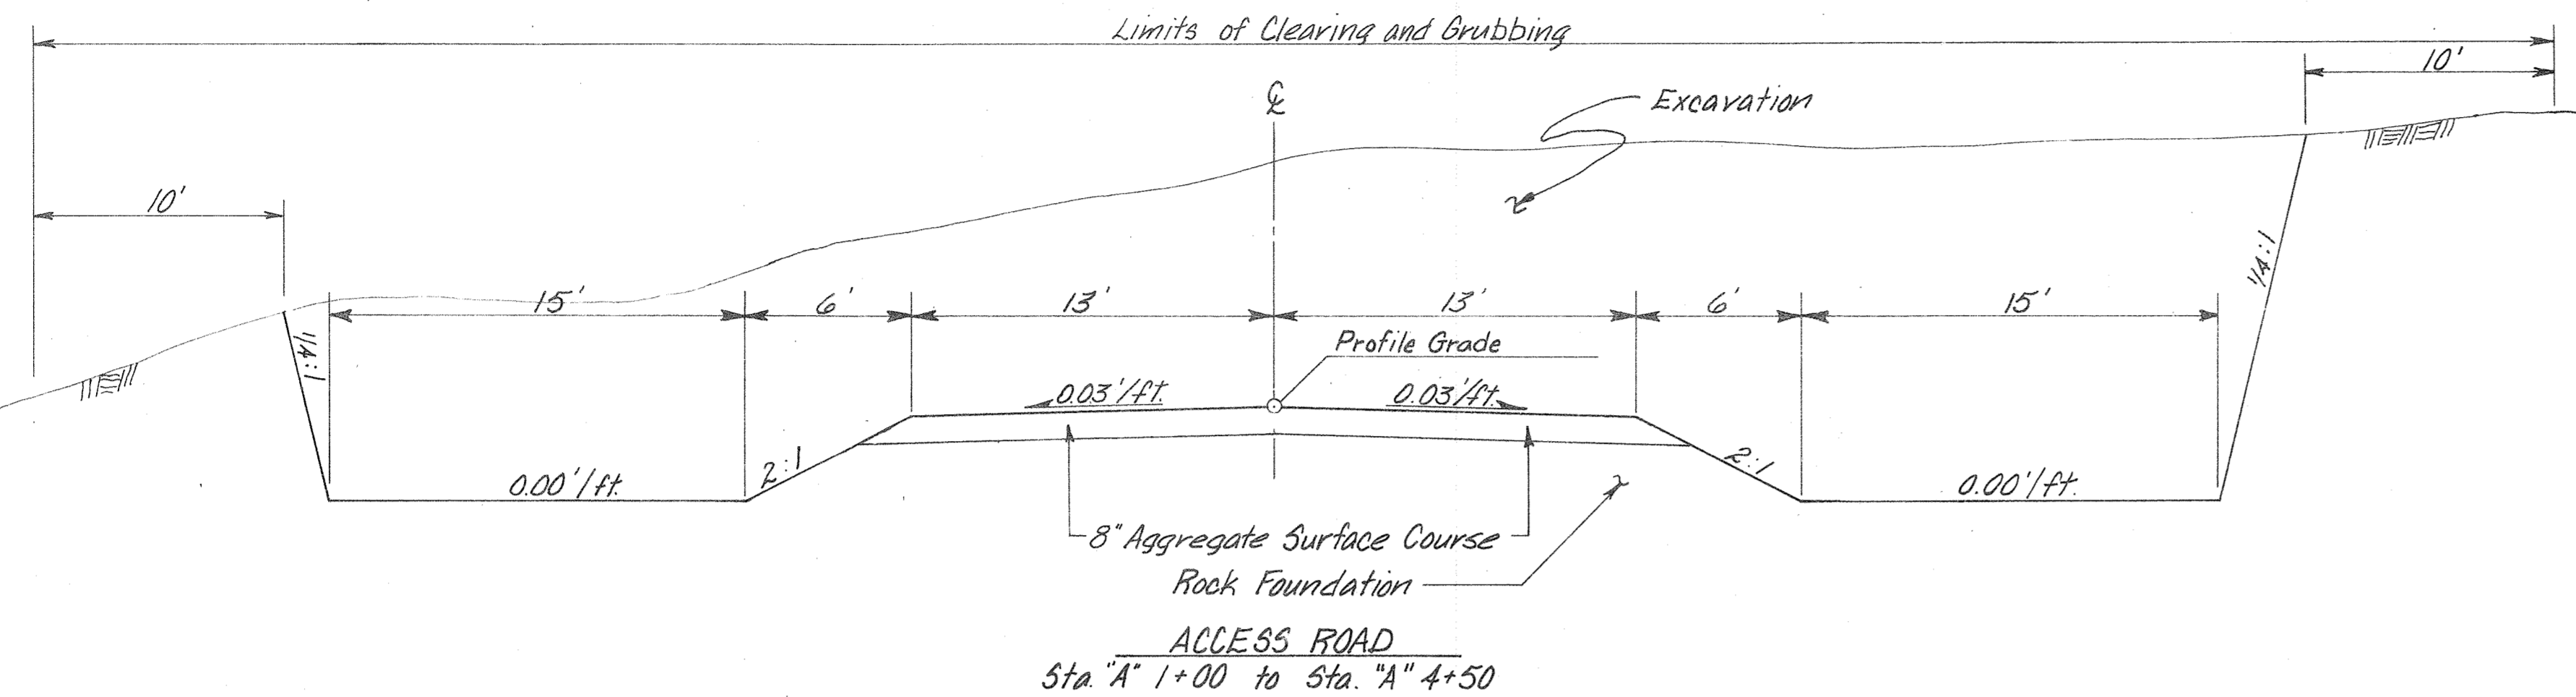

\* Where necessary, subcut to obtain minimum fill depth.

\*\* 4" minus Cushion Blanket Material shall be 1 ft. in depth and laid along fabric overlap.

\*\*\* See Note 4, Sheet 9



STATE OF ALASKA  
DEPARTMENT OF TRANSPORTATION  
AND PUBLIC FACILITIES  
S.E. REGION, DIVISION OF AVIATION DESIGN & CONSTRUCTION


KAKE AIRPORT  
A.I.P. NO. 831-3-02-0398-01-83  
PROJECT NO. D-19712  
ACCESS ROAD TYPICAL SECTIONS

APPROVED BY:	<i>William A. Locher</i> WILLIAM A. LOCHER, P.E. S.E. REGION AVIATION DESIGN ENGINEER							
APPROVED BY:	<i>William L. Baumgartner</i> WILLIAM L. BAUMGARTNER, P.E. S.E. REGION DESIGN ENGINEER							
BY	DATE	CHANGE	SCALE:	DESIGNED:	DRAWN:	CHECKED:	DATE:	SHEET
			No Scale				6/29/83	4 of 19
REVISIONS								

DATE: \_\_\_\_\_  
 BY: \_\_\_\_\_  
 SURVEYED: \_\_\_\_\_  
 NOTED: \_\_\_\_\_  
 ADJUSTMENT CHECKED: \_\_\_\_\_  
 RT. OF WAY CHECKED: \_\_\_\_\_  
 No. \_\_\_\_\_

DATE: \_\_\_\_\_  
 BY: \_\_\_\_\_  
 SURVEYED: \_\_\_\_\_  
 NOTED: \_\_\_\_\_  
 ADJUSTMENT CHECKED: \_\_\_\_\_  
 RT. OF WAY CHECKED: \_\_\_\_\_  
 No. \_\_\_\_\_

**TYPICAL KEKU ROAD SECTION**



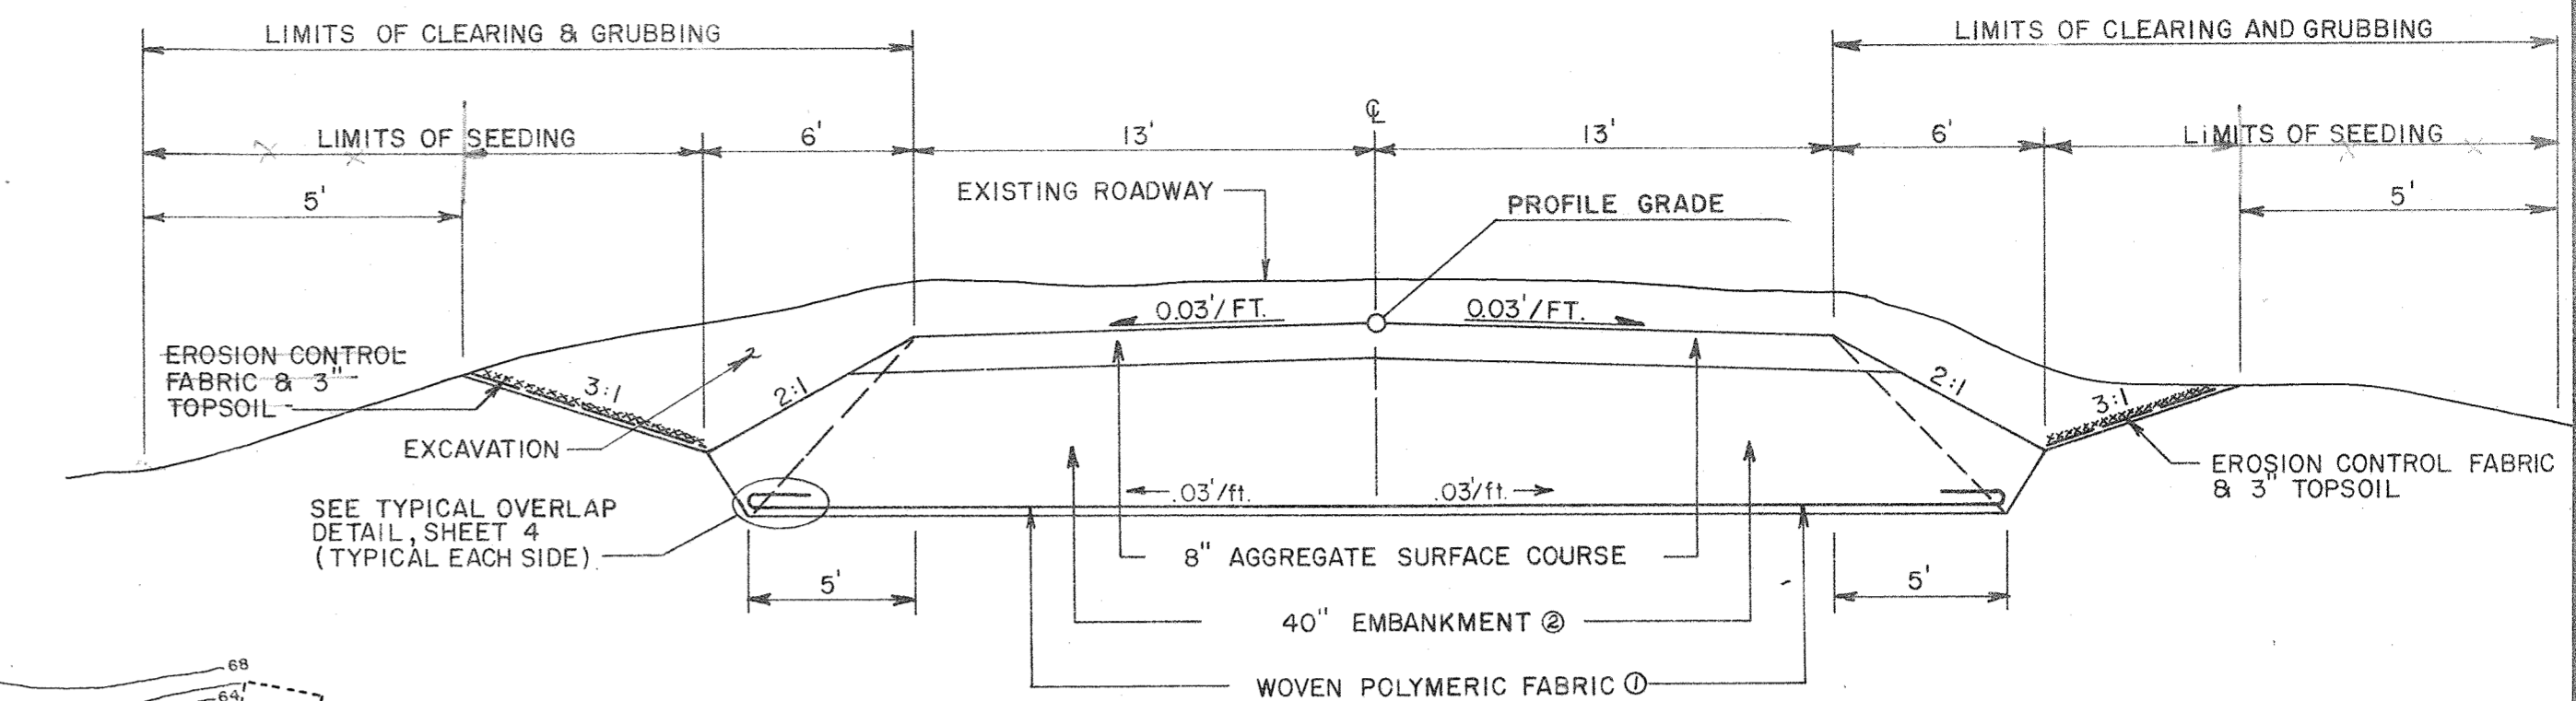


**KEKU ROAD**  
 STA. 12+55 TO STA. 18+25

- ① FABRIC MAY BE DELETED IF ON ROCK
- ② 40" DOES NOT APPLY WHEN ON SUITABLE BASE MATERIAL

**NOTES**

1. INSTALLATION OF GATE VALVE, ADJUSTMENT OF EXISTING HYDRANT, CURB STOP AND CORPORATION STOP, AND CONNECTION OF NEW WATERLINE TO OLD WATERLINE IS INCIDENTAL TO ITEM 1200 WATER SYSTEMS, AND NO COMPENSATION WILL BE MADE.
2. THE MAINTENANCE FOREMAN OF KAKE BELIEVES THE WATERLINE TO BE ALONG THE RIGHT SIDE OF KEKU ROAD. THE CONTRACTOR SHALL VERIFY THE SIZE, TYPE AND LOCATION OF THE WATERLINE PRIOR TO EXCAVATION ON KEKU ROAD. THE ABANDONED WATERLINE SHALL BE DISPOSED OF IN ANY WASTE DISPOSAL AREA SHOWN ON THE PLANS OR AT THE CONTRACTOR'S CHOICE, AS APPROVED BY THE ENGINEER. (INCIDENTAL TO ITEM 1200, WATER SYSTEMS)
3. REFER TO THE SPECIAL PROVISIONS FOR WORKING AROUND AND FOR RELOCATION (BY OTHERS) OF THE POWER, TELEPHONE AND CABLE TV POLE LINE FACILITIES.
4. WHEN THE WATERLINE IS LOCATED ON UNSUITABLE MATERIAL (DETERMINED BY THE ENGINEER), REMOVE UNSUITABLE MATERIAL AND BACKFILL IN ACCORDANCE WITH ITEMS 330a, 330b & 330c. BEDDING MATERIAL SHALL BE TYPE "C" GRADATION IN ACCORDANCE WITH SECTION 400.
5. Hydrant at 12+55 was omitted during the location survey. Contractor installed as a public service to Kake. (needed for temporary bypass)

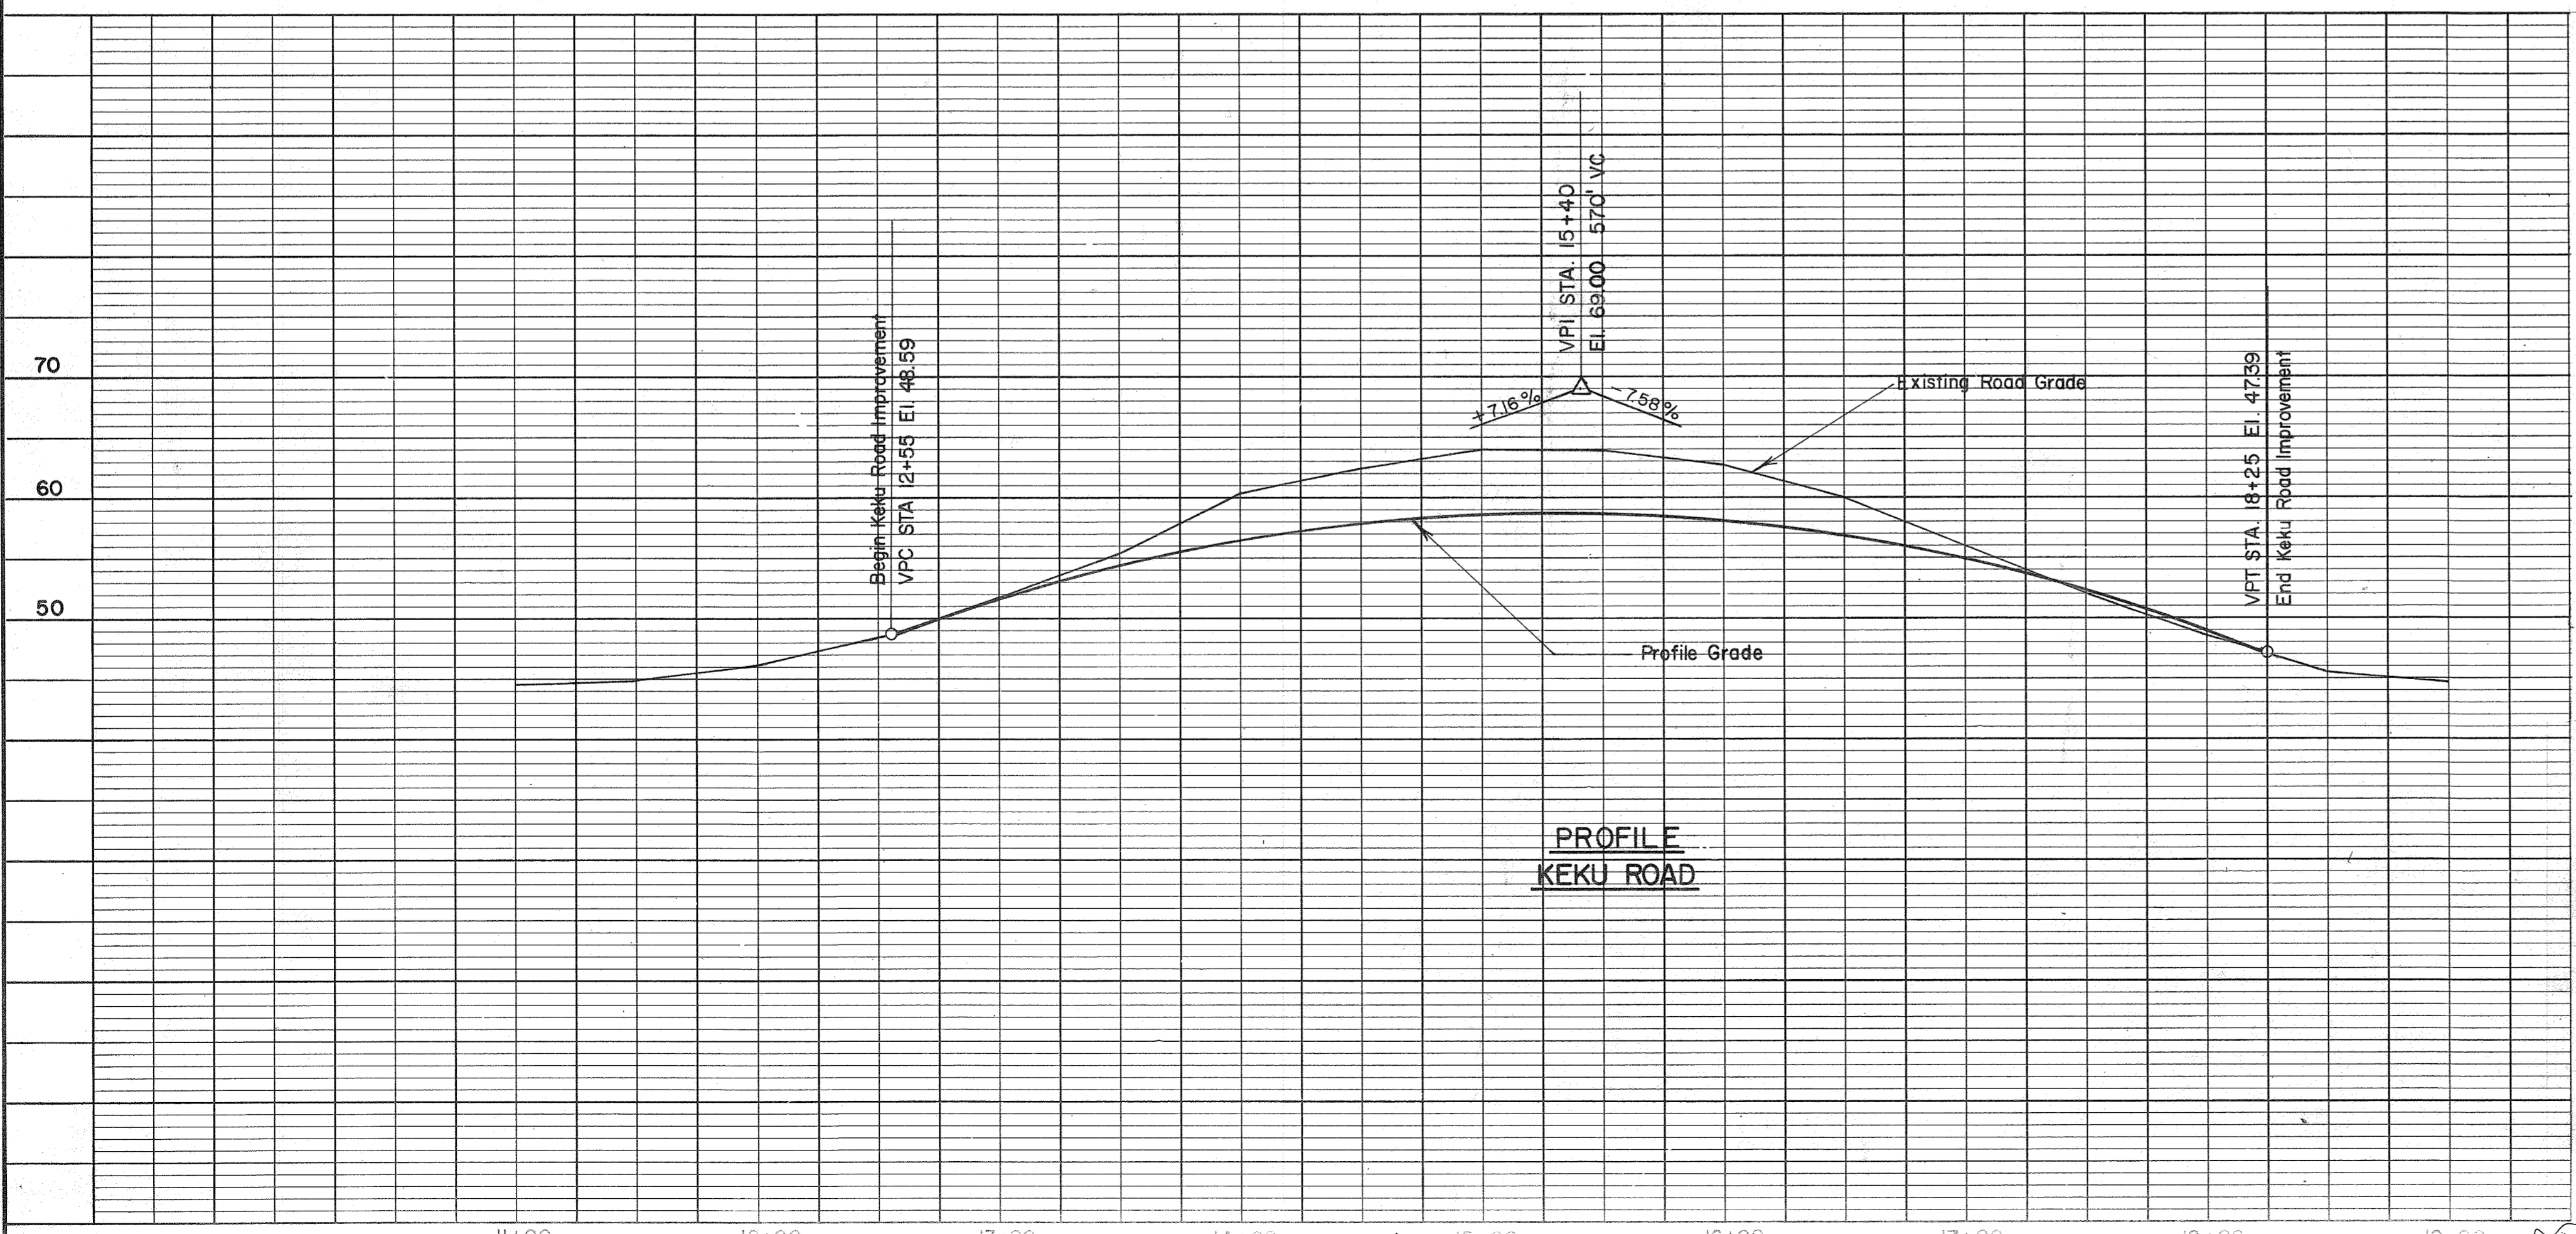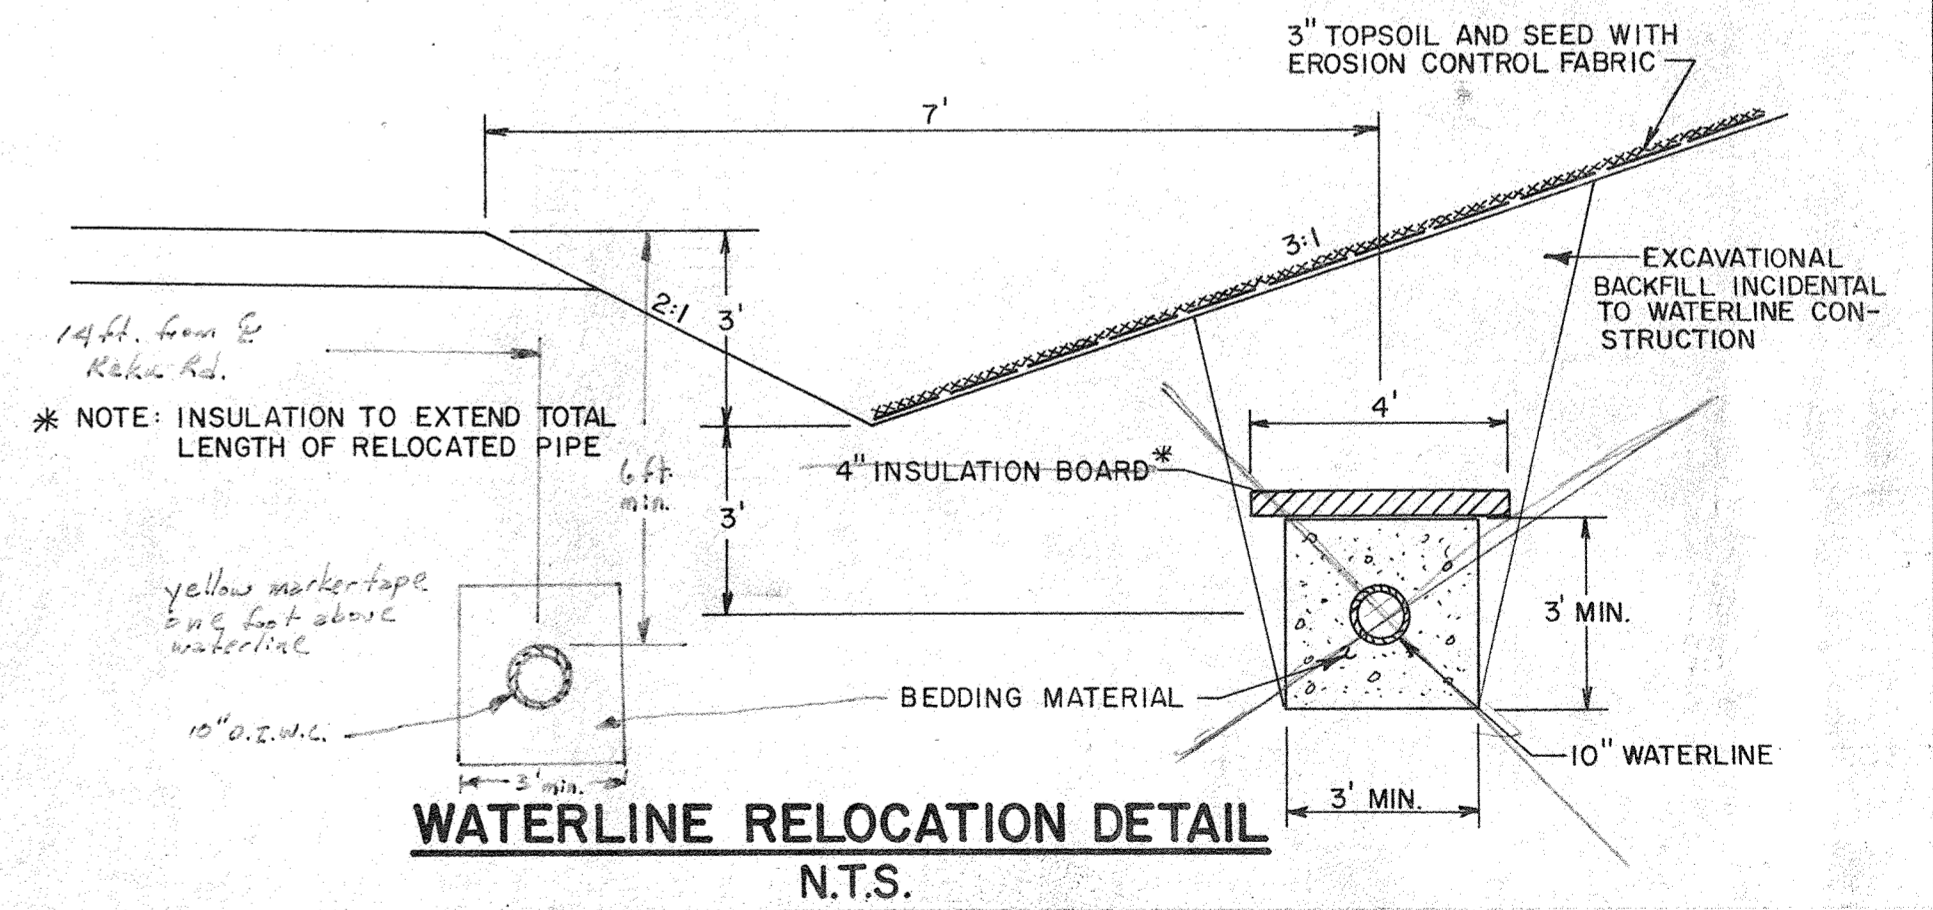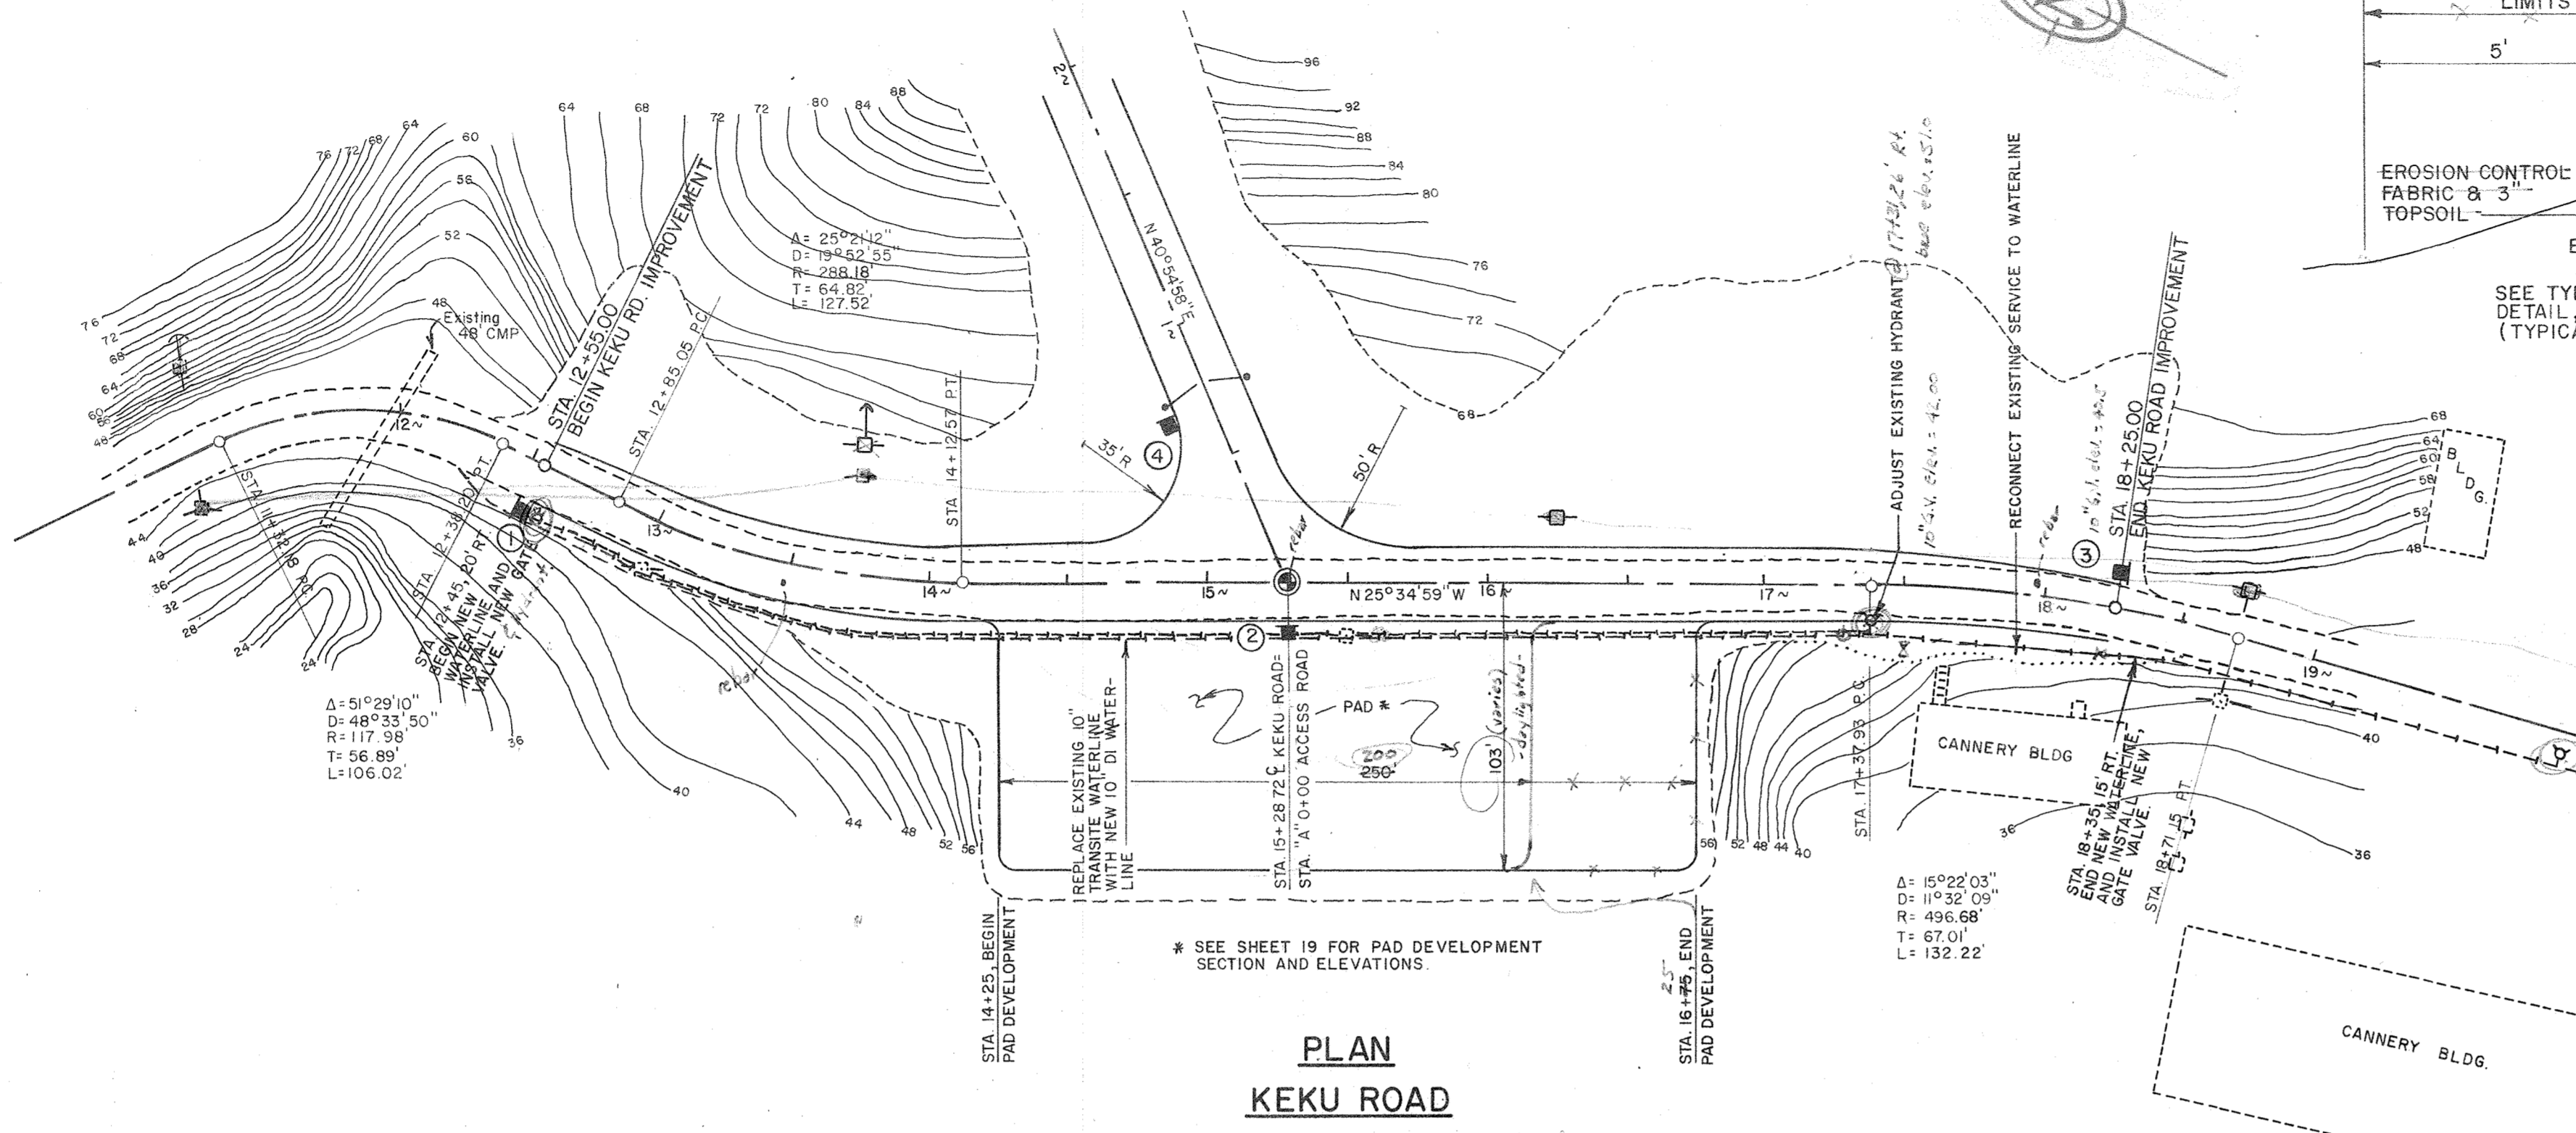

STATE OF ALASKA  
 DEPARTMENT OF TRANSPORTATION  
 AND PUBLIC FACILITIES  
 S.E. REGION, DIVISION OF AVIATION DESIGN & CONSTRUCTION

KEKU ROAD  
 PROJECT NO. D19712  
 A.I.P. 831-3-02-0398-01-83  
 PLAN, PROFILE & TYPICAL SECTION

APPROVED BY: *William A. Locher*  
 WILLIAM A. LOCHER, P.E. S.E. REGION AVIATION DESIGN ENGINEER

APPROVED BY: *William L. Baumgartner*  
 WILLIAM L. BAUMGARTNER, P.E. S.E. REGION DESIGN ENGINEER

SCALE: As Shown  
 CHECKED: *DL* DATE: *1/20/12*

BY: \_\_\_\_\_ DATE: \_\_\_\_\_ CHANGE: \_\_\_\_\_

REVISIONS



SHEET 6 OF 19



STATE	PROJECT DESIGNATION	YEAR	SHEET NO.	TOTAL SHEETS
ALASKA				


# TYPICAL RUNWAY SECTIONS

TYPICAL OVERLAP DETAIL (Each Side)

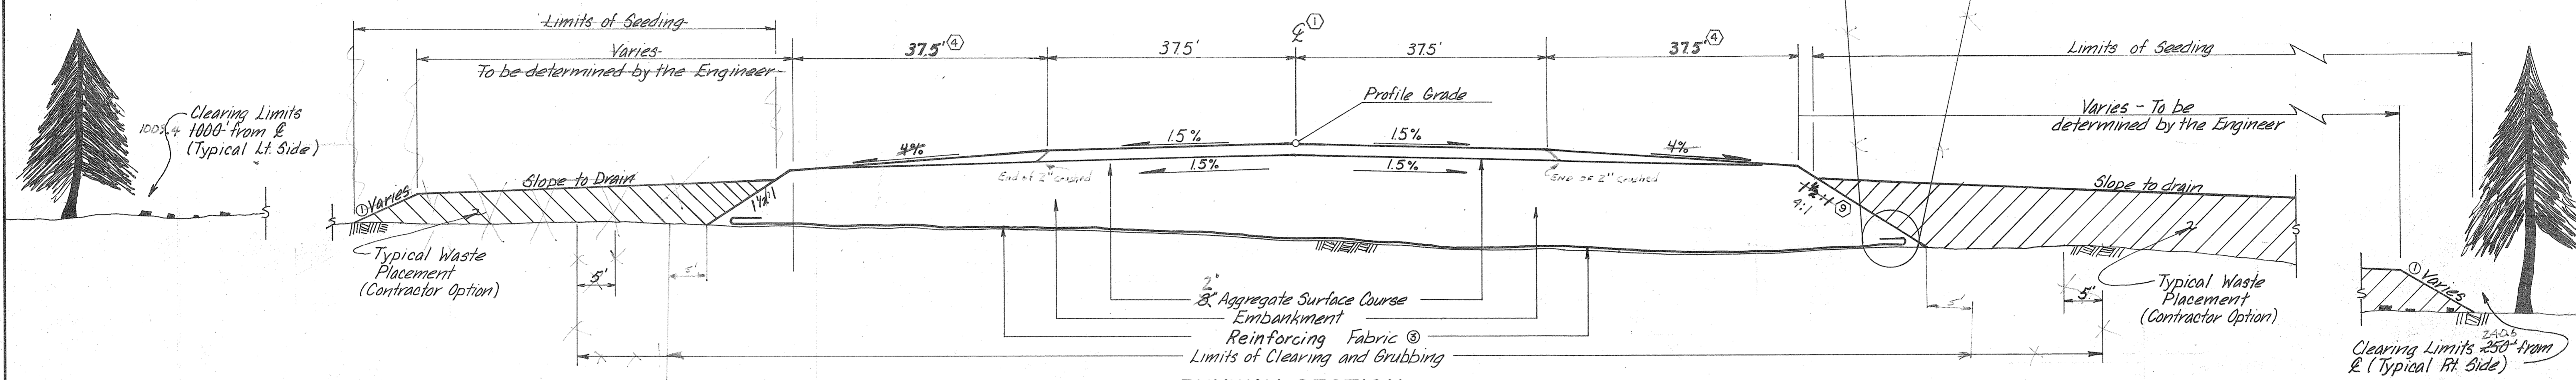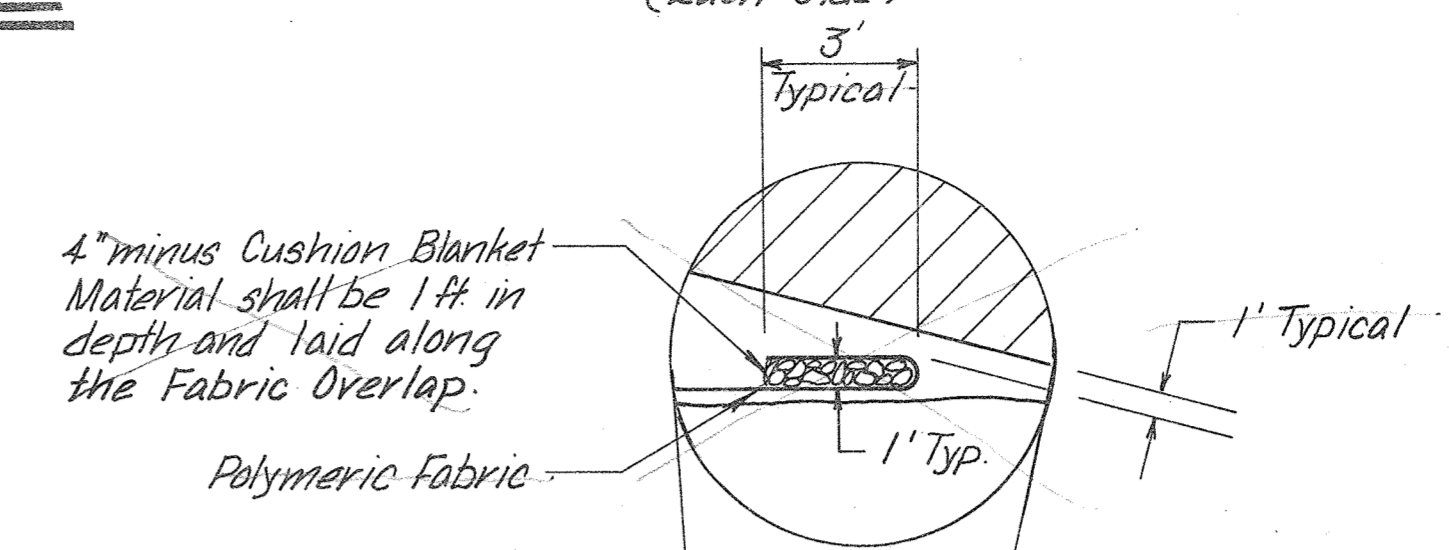


**RUNWAY SECTION**  
STA. 10+60 TO STA. 13+50  
SEE SEQUENCE OF CONSTRUCTION

- ① Slope Varies 2:1 to 4:1, to be determined by the Engineer.
- ② See General Note 8, Sheet 3.
- ③ Reinforcing Fabric, Item 550 (c.)
- ④ See General Note 7, Sheet 3.

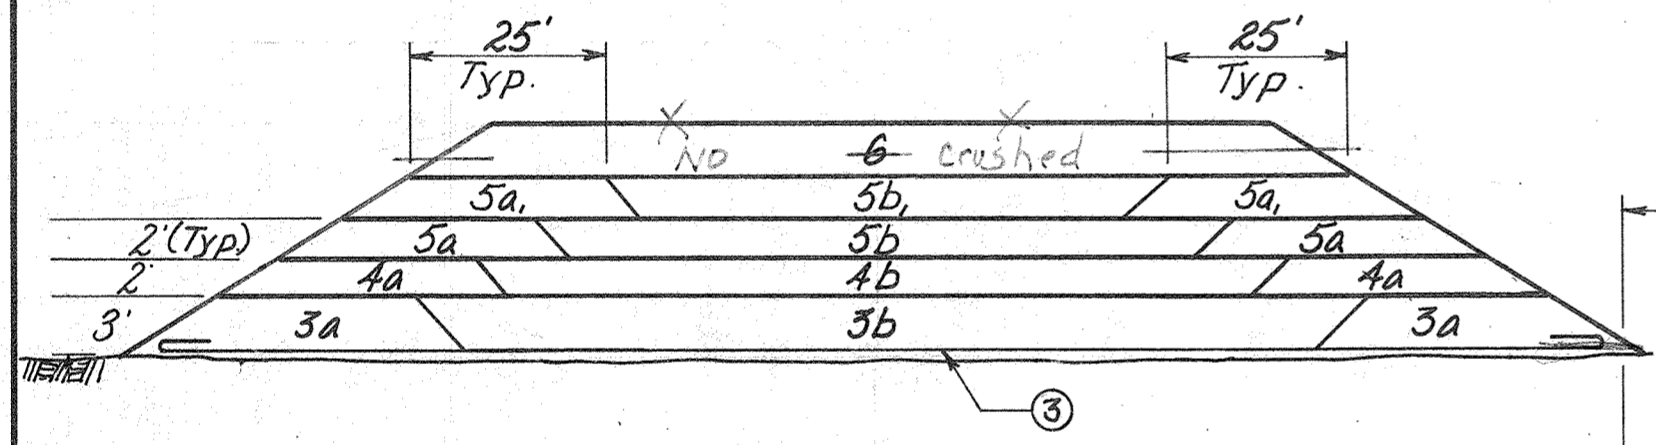


**SEQUENCE OF CONSTRUCTION**  
STA. 10+60 TO STA. 13+50

- 1) Install Settlement Platforms and Piezometers.
- 2) Place Fabric Perpendicular to  $\ell$  on Original Ground.
- 3a) Construct Outside Sections of Initial Lift.
- 3b) Construct Interior Section of Initial Lift.  
Next, Wait 10 Days Maximum, or Until Pore Pressure is Reduced to an Acceptable Level.
- 4a) Construct Outside Sections of Second Lift.
- 4b) Construct Interior Section of Second Lift.  
Next, Wait 10 Days Maximum, or Until Pore Pressure is Reduced to an Acceptable Level.
- 5) Repeat Steps 3a, 3b and Waiting Period, until Embankment has been Constructed to the Bottom of Subbase.
- 6) Construct Aggregate Surface Course Lift.

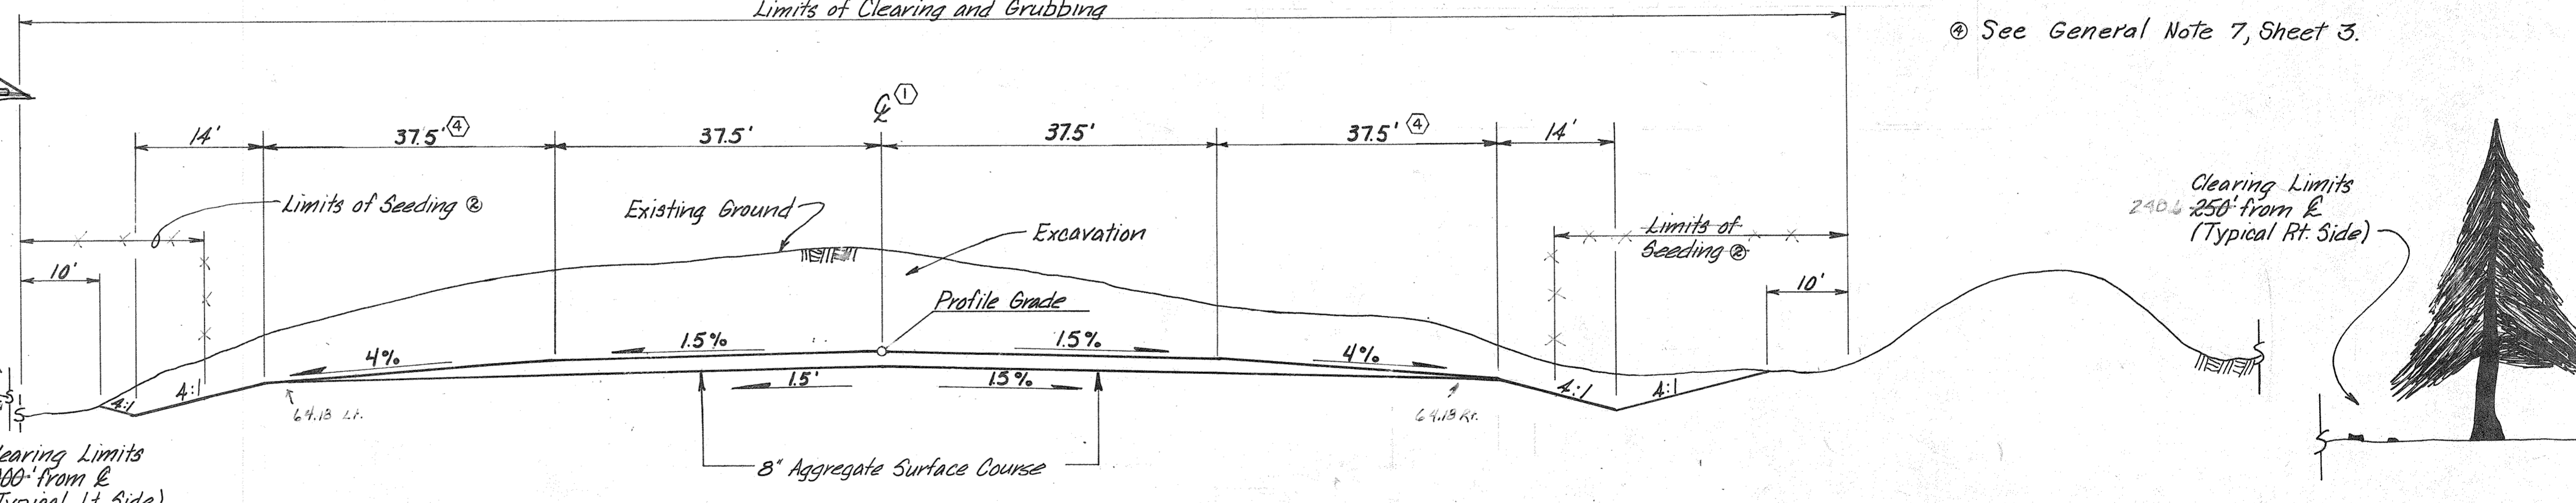

**RUNWAY SECTION**  
STA. 13+50 TO STA. 17+00

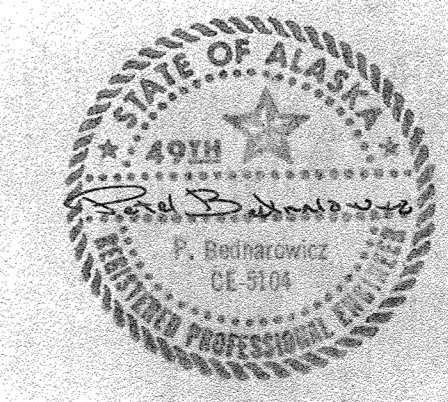

STATE OF ALASKA  
DEPARTMENT OF TRANSPORTATION  
AND PUBLIC FACILITIES  
S.E. REGION, DIVISION OF AVIATION DESIGN & CONSTRUCTION


**KAKE AIRPORT**  
A.I.P. NO. 831-3-02-0398-01-83  
PROJECT NO. D-19712  
RUNWAY TYPICAL SECTIONS

BY	DATE	CHANGE
P.B.	4/18/84	Minor Revisions made to Fabric
P.B.	10/12/84	CHANGE ORDER # 3 & 6
REVISIONS		

APPROVED BY: <i>William A. Locher</i> WILLIAM A. LOCHER, P.E. S.E. REGION AVIATION DESIGN ENGINEER
APPROVED BY: <i>William L. Baumgartner</i> WILLIAM L. BAUMGARTNER, P.E. S.E. REGION DESIGN ENGINEER
SCALE: No Scale
DESIGNED: <i>CKA</i>
CHECKED: <i>ff</i>
DATE: 6/29/83
SHEET 8 OF 19

# TYPICAL RUNWAY SECTIONS



STATE	PROJECT DESIGNATION	YEAR	SHEET NO.	TOTAL SHEETS
ALASKA				

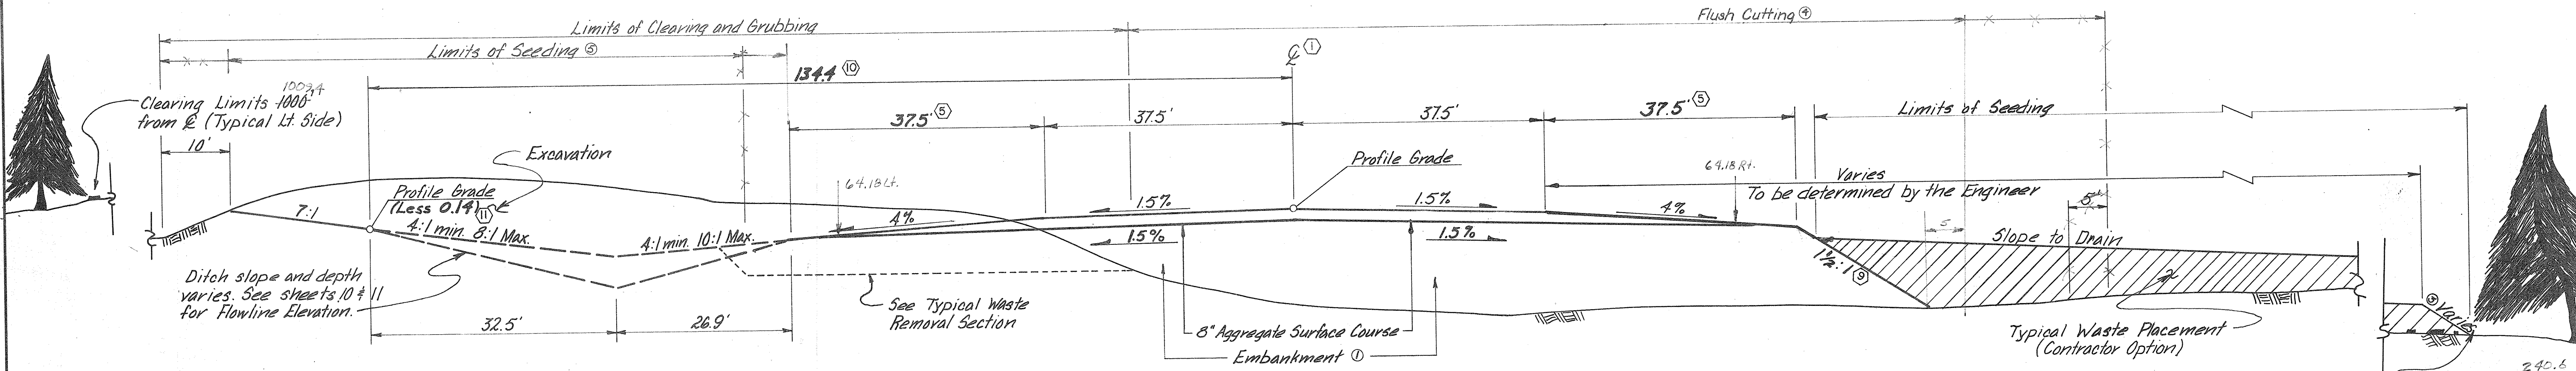

**RUNWAY SECTION**  
 STA. 17+00 TO STA. 19+00  
 &  
 STA. 25+00 TO STA. 45+00

- ① When minimum depth of Embankment (4.33' at  $\mathcal{E}$ ) cannot be achieved, refer to Typical Waste Removal Section.
- ② Waste material may include vegetation, muskeg organic soils and other materials which are unsuitable for use in Embankment as determined by the Engineer. Note, the thickness and amounts of waste material varies throughout the Project. The Typical Waste Removal Section does not apply when in ground suitable for Embankment.
- ③ Varies 2:1 to 4:1, to be determined by the Engineer.
- ④ Flush Cutting shall be done in lieu of Clearing & Grubbing, and shall be paid for as Clearing & Grubbing.
- ⑤ See General Note B, Sheet 3.
- ⑥ No waste placement between 41+00 & 45+40. Maintain 4:1 slopes.

**TYPICAL WASTE REMOVAL SECTION**  
 TOTAL LENGTH OF RUNWAY<sup>⑥</sup>  
 (WHERE APPROPRIATE)

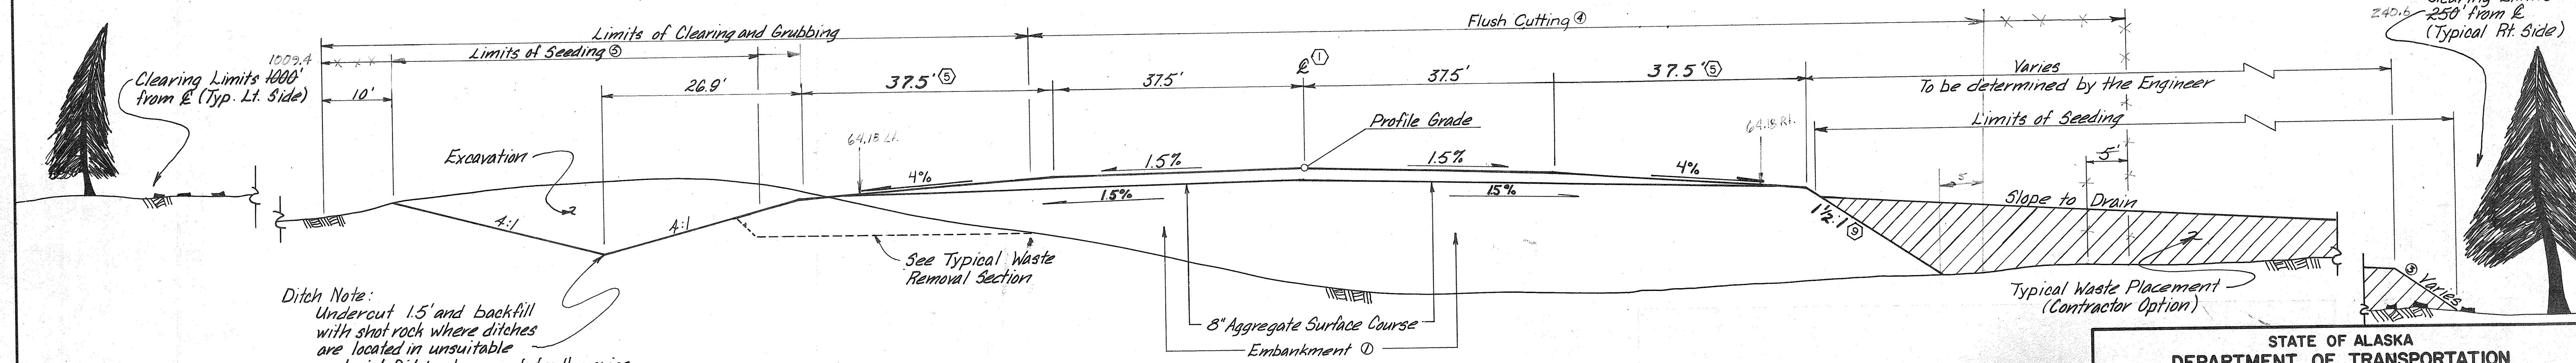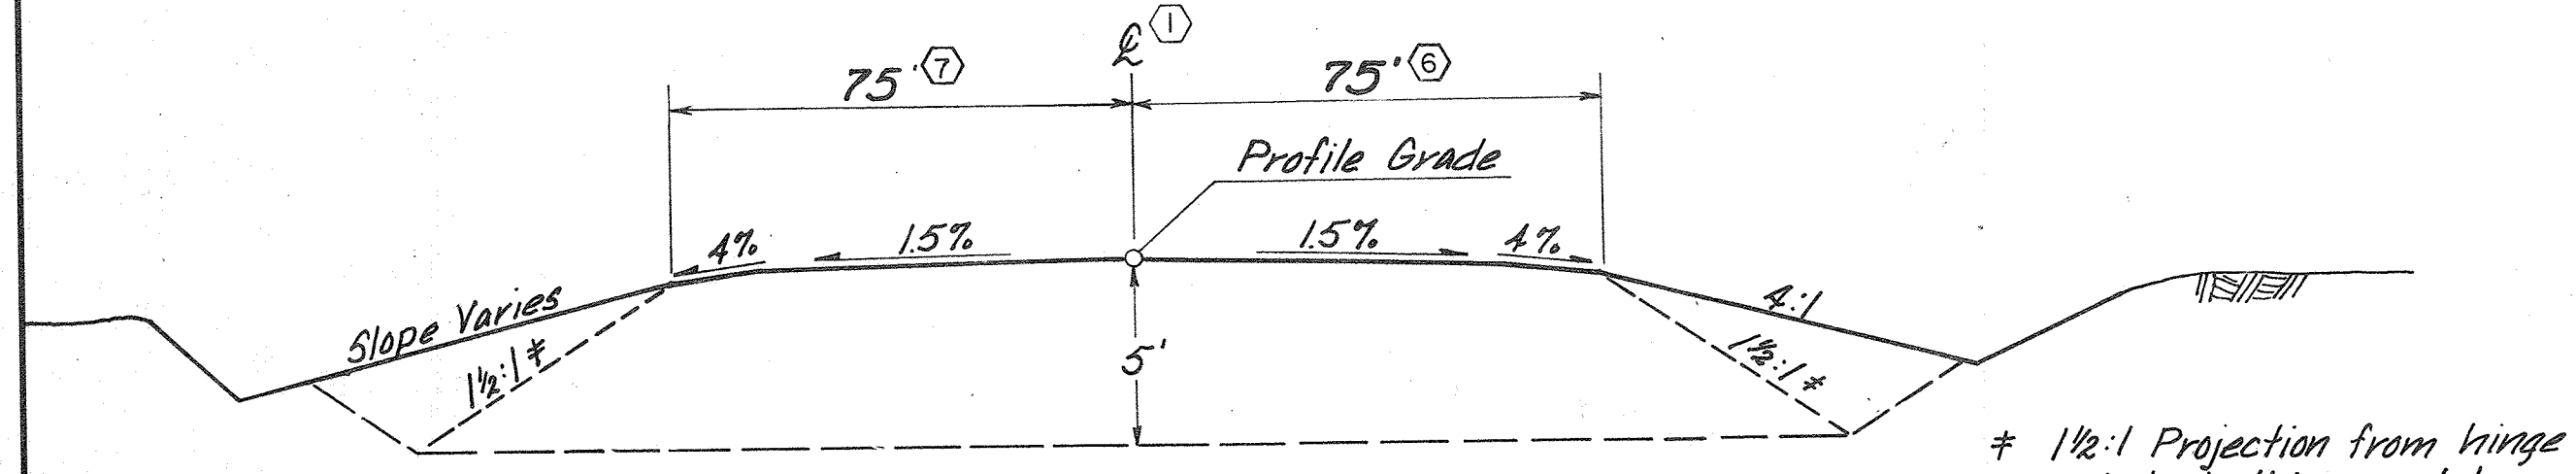

**RUNWAY SECTION**  
 STA. 19+00 TO STA. 25+00

**Ditch Note:**  
 Undercut 1.5' and backfill with shot rock where ditches are located in unsuitable material. Ditch slope and depth varies. See Sheet 10 for Flowline Elevation.



STATE OF ALASKA  
 DEPARTMENT OF TRANSPORTATION  
 AND PUBLIC FACILITIES  
 S.E. REGION, DIVISION OF AVIATION DESIGN & CONSTRUCTION

**KAKE AIRPORT**  
 A.I.P. NO. 831-3-02-0398-01-83  
 PROJECT NO. D-19712  
 RUNWAY TYPICAL SECTIONS

APPROVED BY: <i>William A. Locher</i> WILLIAM A. LOCHER, P.E. S.E. REGION AVIATION DESIGN ENGINEER	APPROVED BY: <i>William L. Baumgartner</i> WILLIAM L. BAUMGARTNER, P.E. S.E. REGION DESIGN ENGINEER
P.B. 10/12/84	CHANGE ORDER # 3 & # 6
BY DATE	CHANGE
SCALE: No Scale	DESIGNED: <i>CRH</i> DRAWN: <i>CRH</i> CHECKED: <i>WB</i> DATE: 6/29/83

REVISIONS	



DATE	
BY	
SURVISED	
PLOTTED	
NOTED	
NO. OF WAY CHECKED	
NO.	

DATE	
BY	
SURVISED	
PLOTTED	
NOTED	
NO. OF WAY CHECKED	
NO.	

\* Install Airport Lighting Pad - See sheet 19 for pad section

Wind Sock & Segmented #1 Circle, Sta. R' 13+00, 200' R1 Pad Elev. 143.50



\*\* Excavation and Embankment for Pad shall be paid for under Section 330.

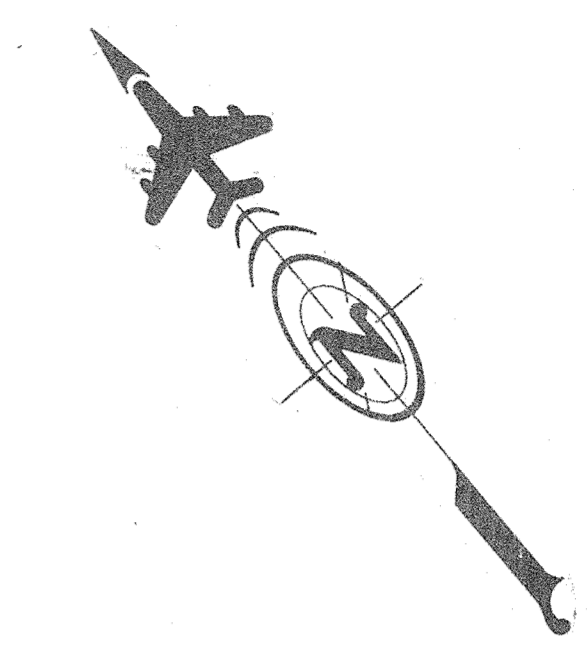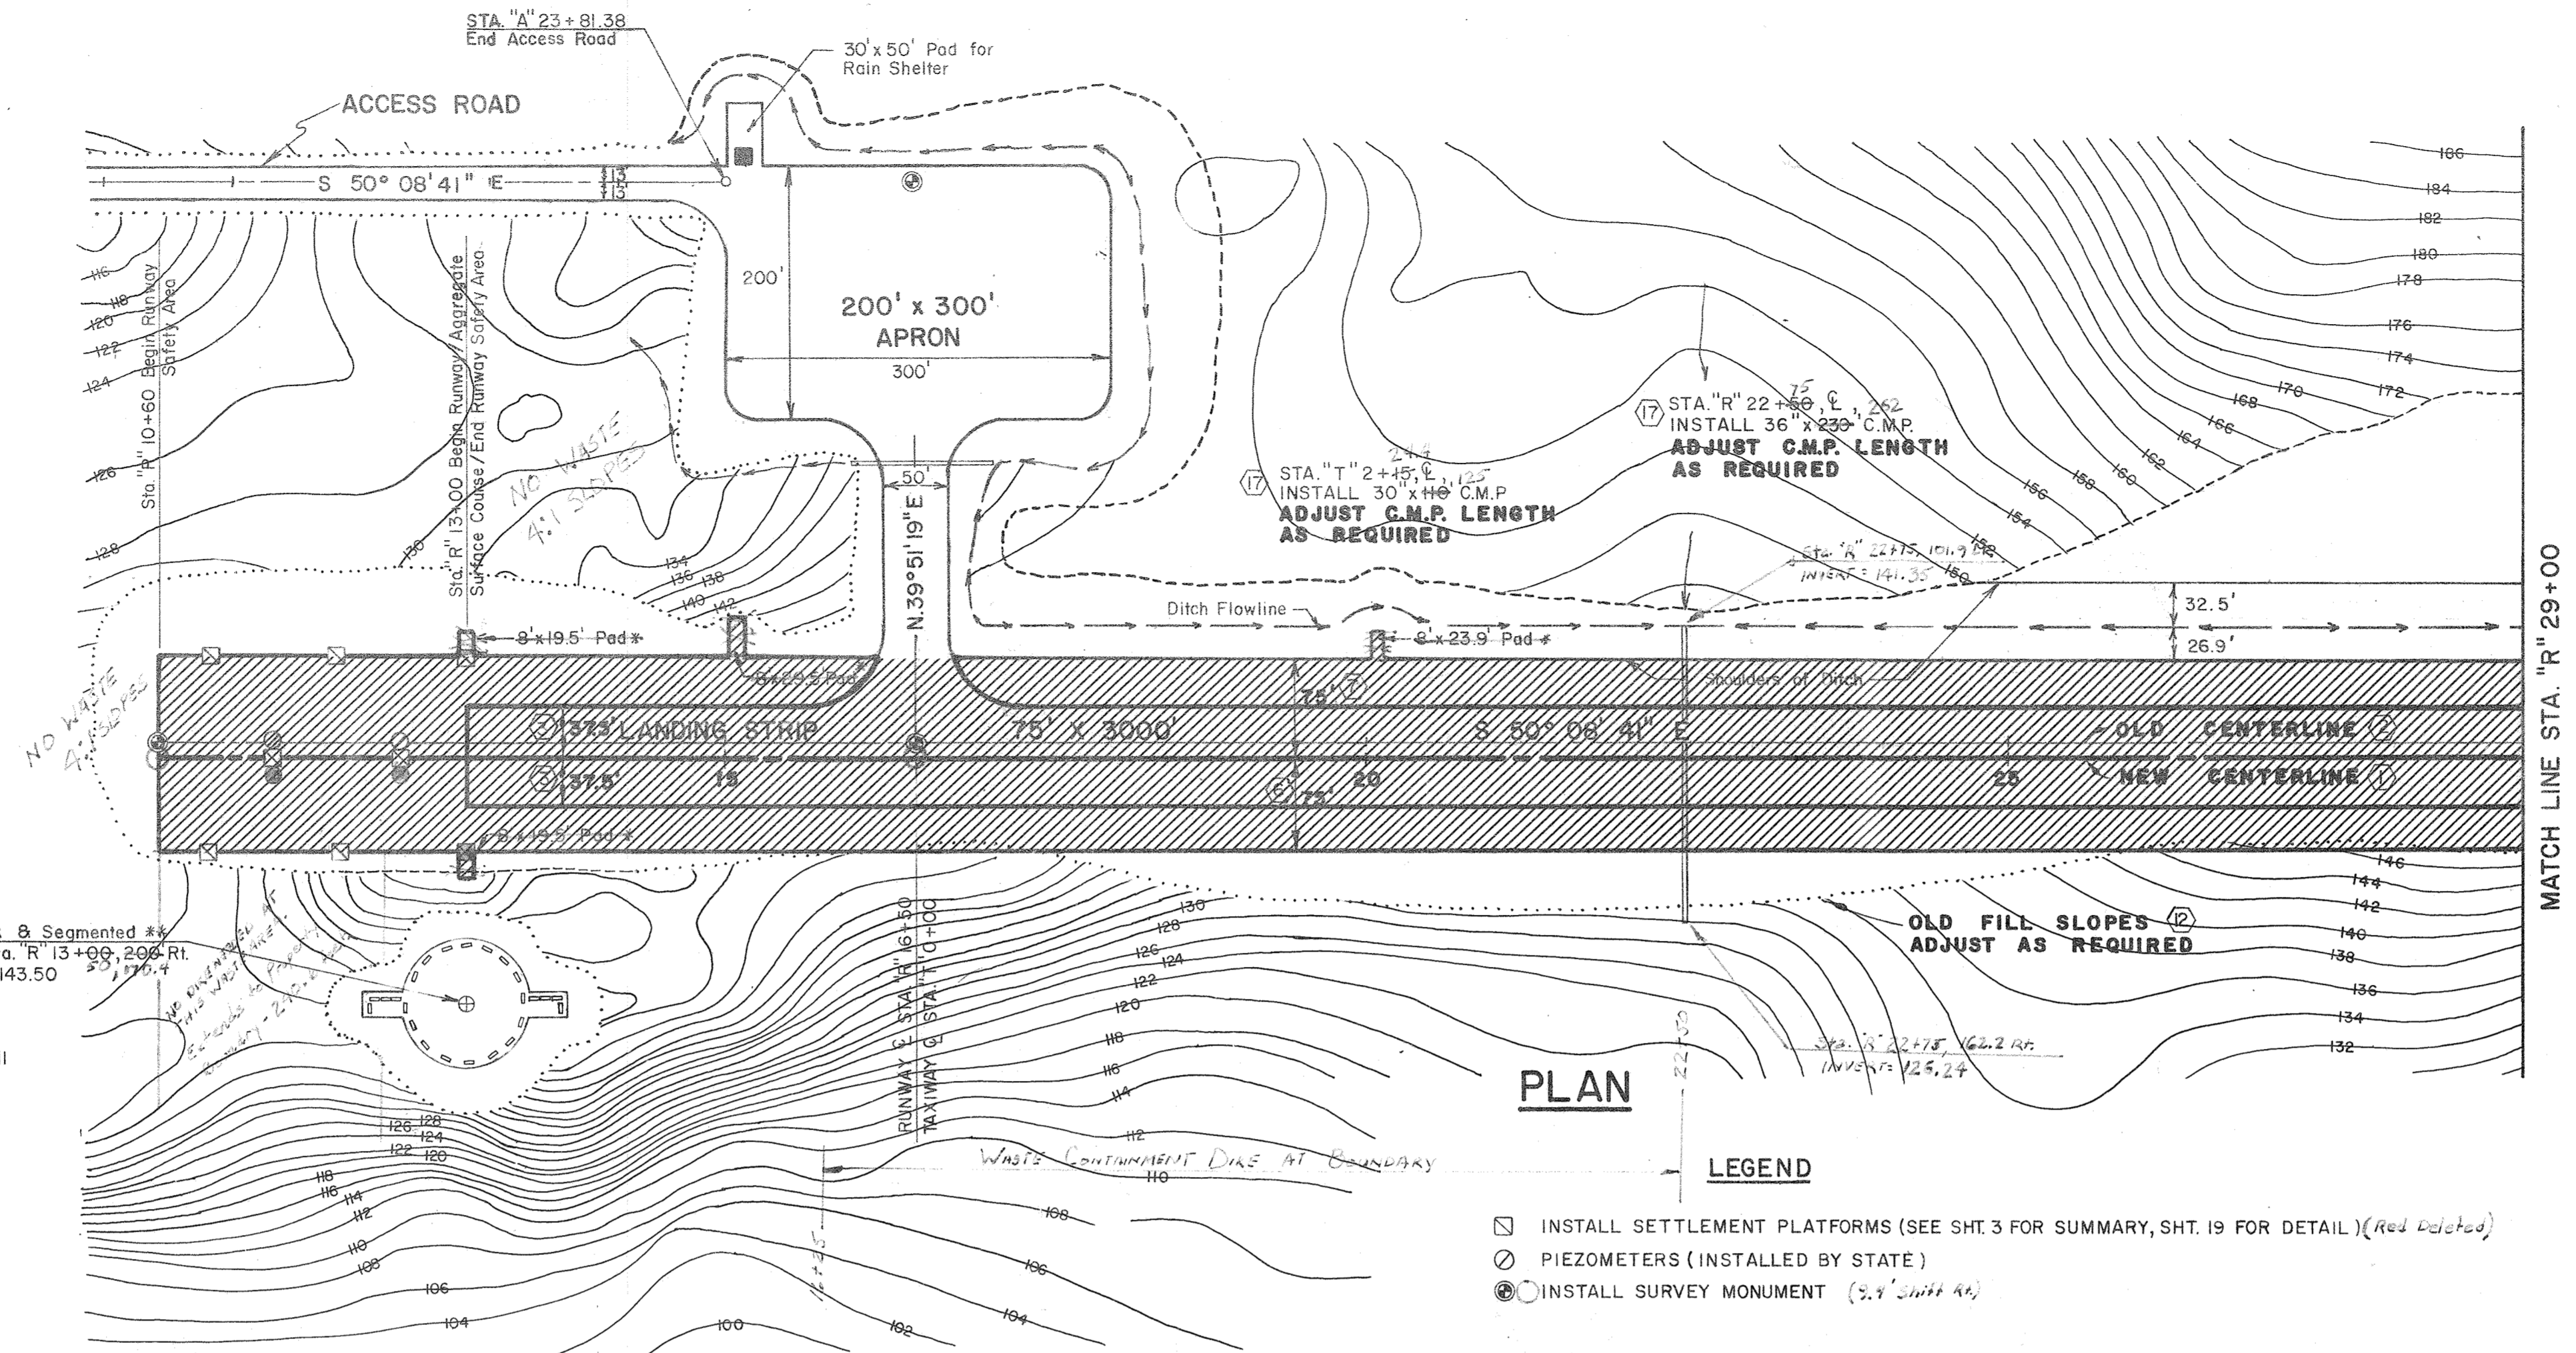


AREA OF NEW PROPOSED WIDEN LANDING STRIP & SHOULDERS (14)

**PLAN**  
**LEGEND**

- INSTALL SETTLEMENT PLATFORMS (SEE SHT. 3 FOR SUMMARY, SHT. 19 FOR DETAIL) (Red Washed)
- PIEZOMETERS (INSTALLED BY STATE)
- ⊙ INSTALL SURVEY MONUMENT (2.9' DIA. 40')

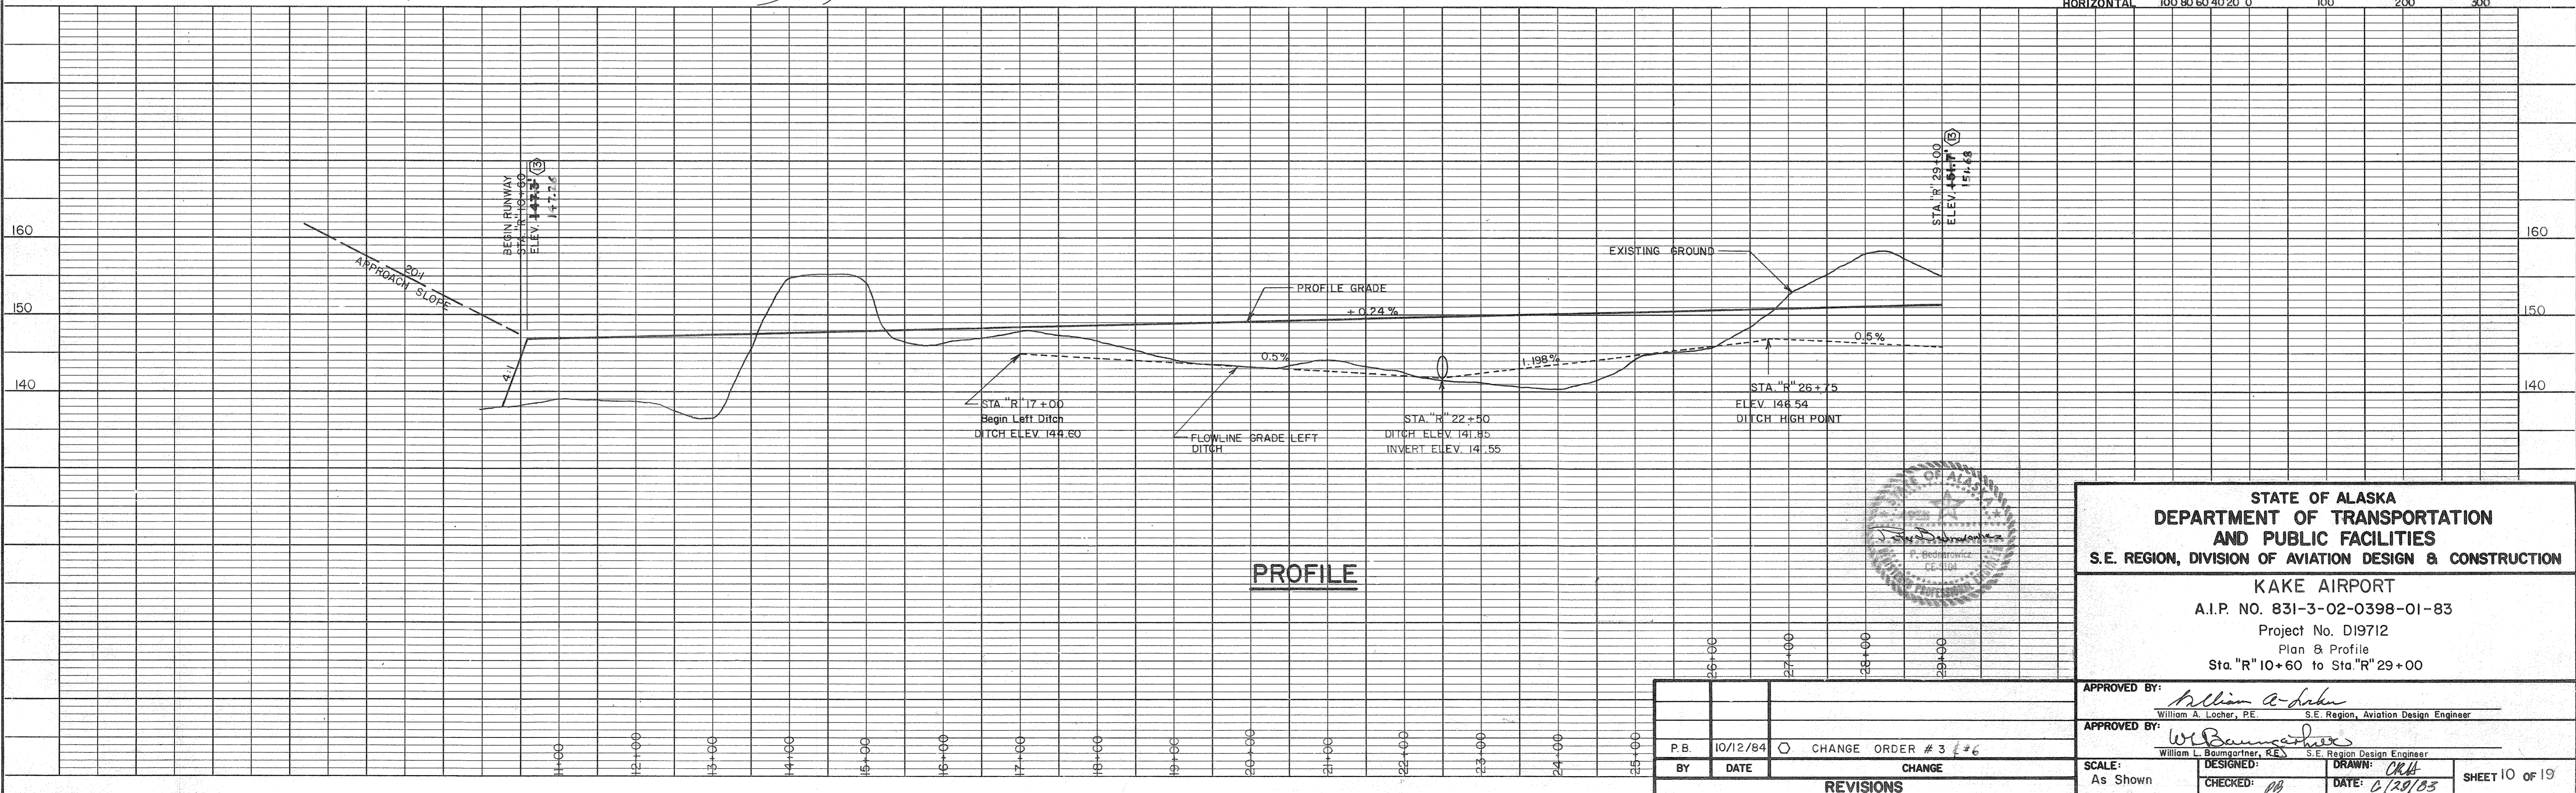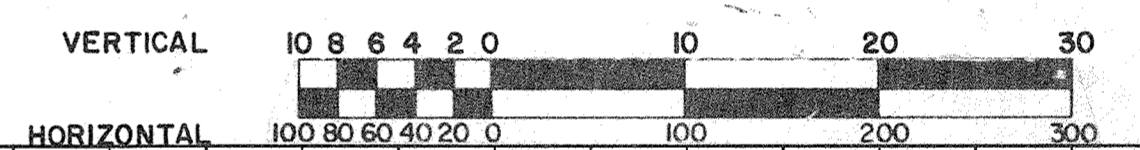

**PROFILE**

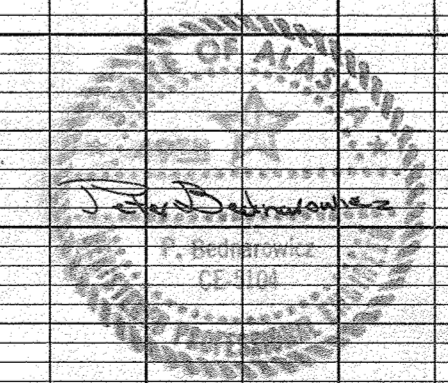

STATE OF ALASKA  
DEPARTMENT OF TRANSPORTATION  
AND PUBLIC FACILITIES  
S.E. REGION, DIVISION OF AVIATION DESIGN & CONSTRUCTION


KAKE AIRPORT  
A.I.P. NO. 831-3-02-0398-01-83  
Project No. D19712  
Plan & Profile  
Sta. "R" 10+60 to Sta. "R" 29+00

APPROVED BY:	<i>William A. Locher</i> William A. Locher, P.E. S.E. Region, Aviation Design Engineer
APPROVED BY:	<i>William L. Baumgartner</i> William L. Baumgartner, R.E. S.E. Region Design Engineer
SCALE:	As Shown
CHECKED:	<i>OB</i>
DATE:	6/29/83
SHEET	10 OF 19


BY	DATE	CHANGE




STATE	PROJECT DESIGNATION	YEAR	SHEET NO.	TOTAL SHEETS
ALASKA				

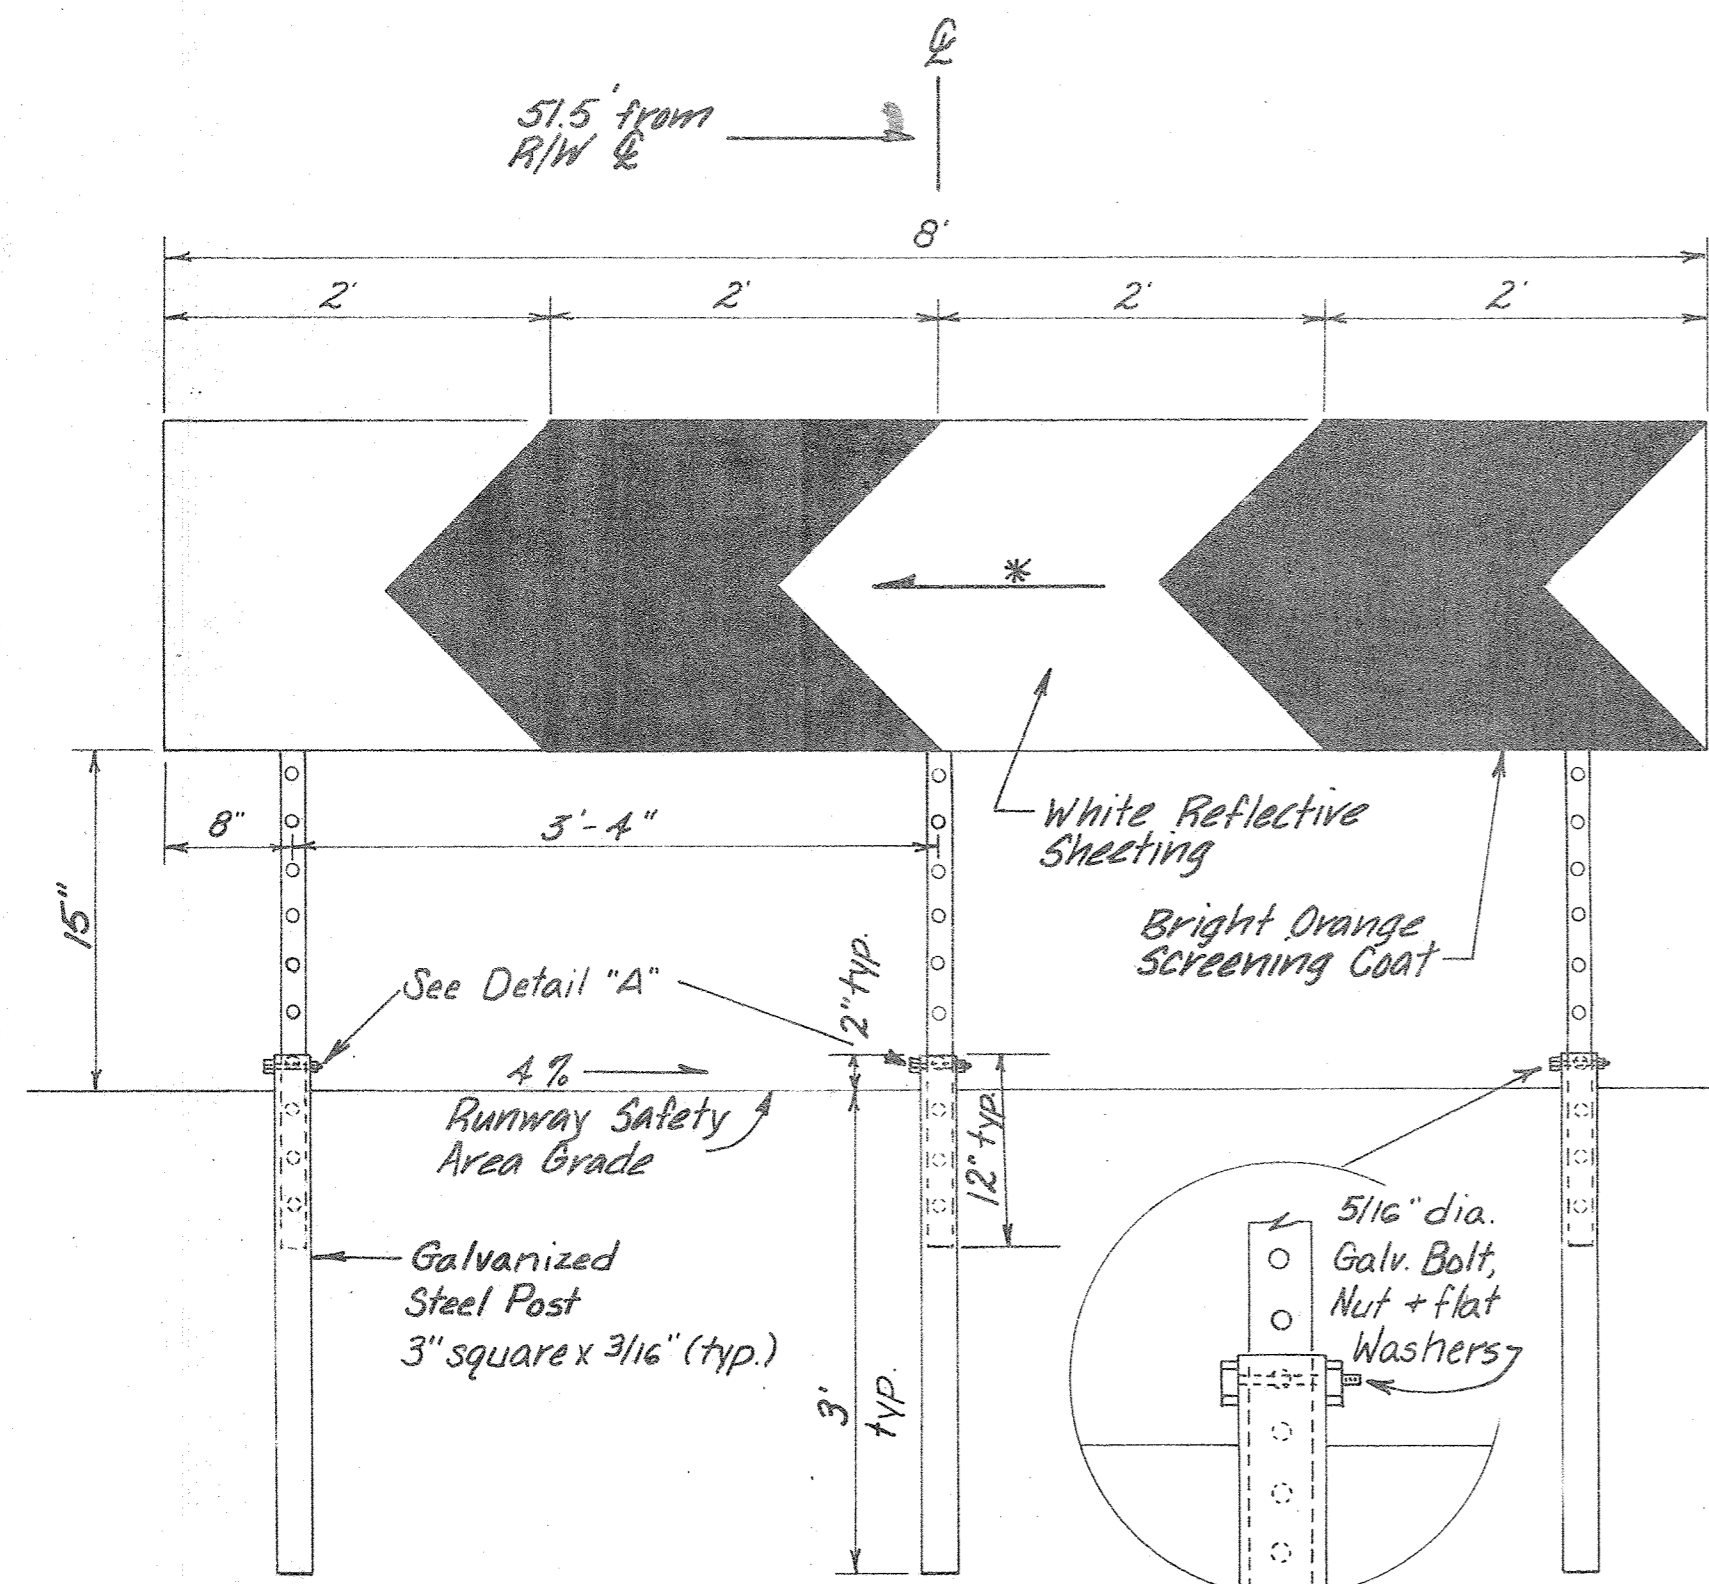



FRONT VIEW DETAIL  
RUNWAY BOUNDARY MARKERS  
no scale

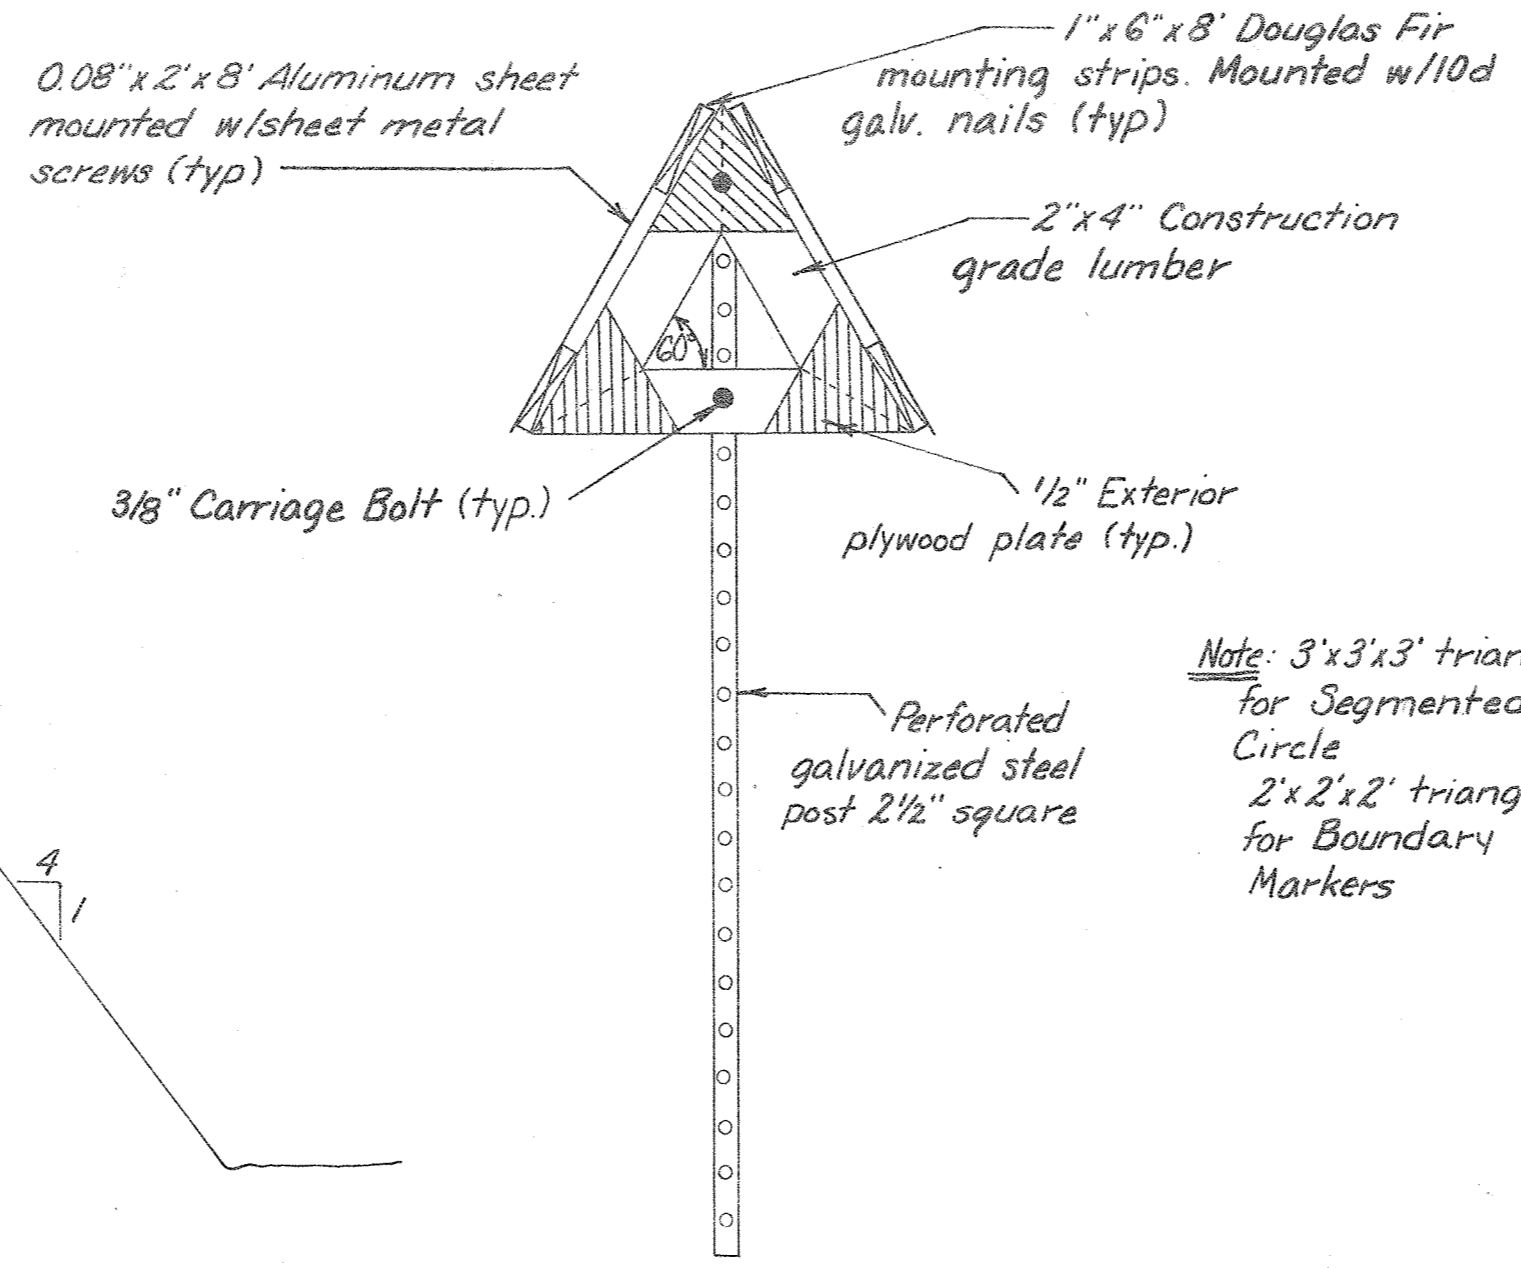

SIDE VIEW DETAIL, BOUNDARY  
MARKERS & SEGMENTED CIRCLE  
no scale


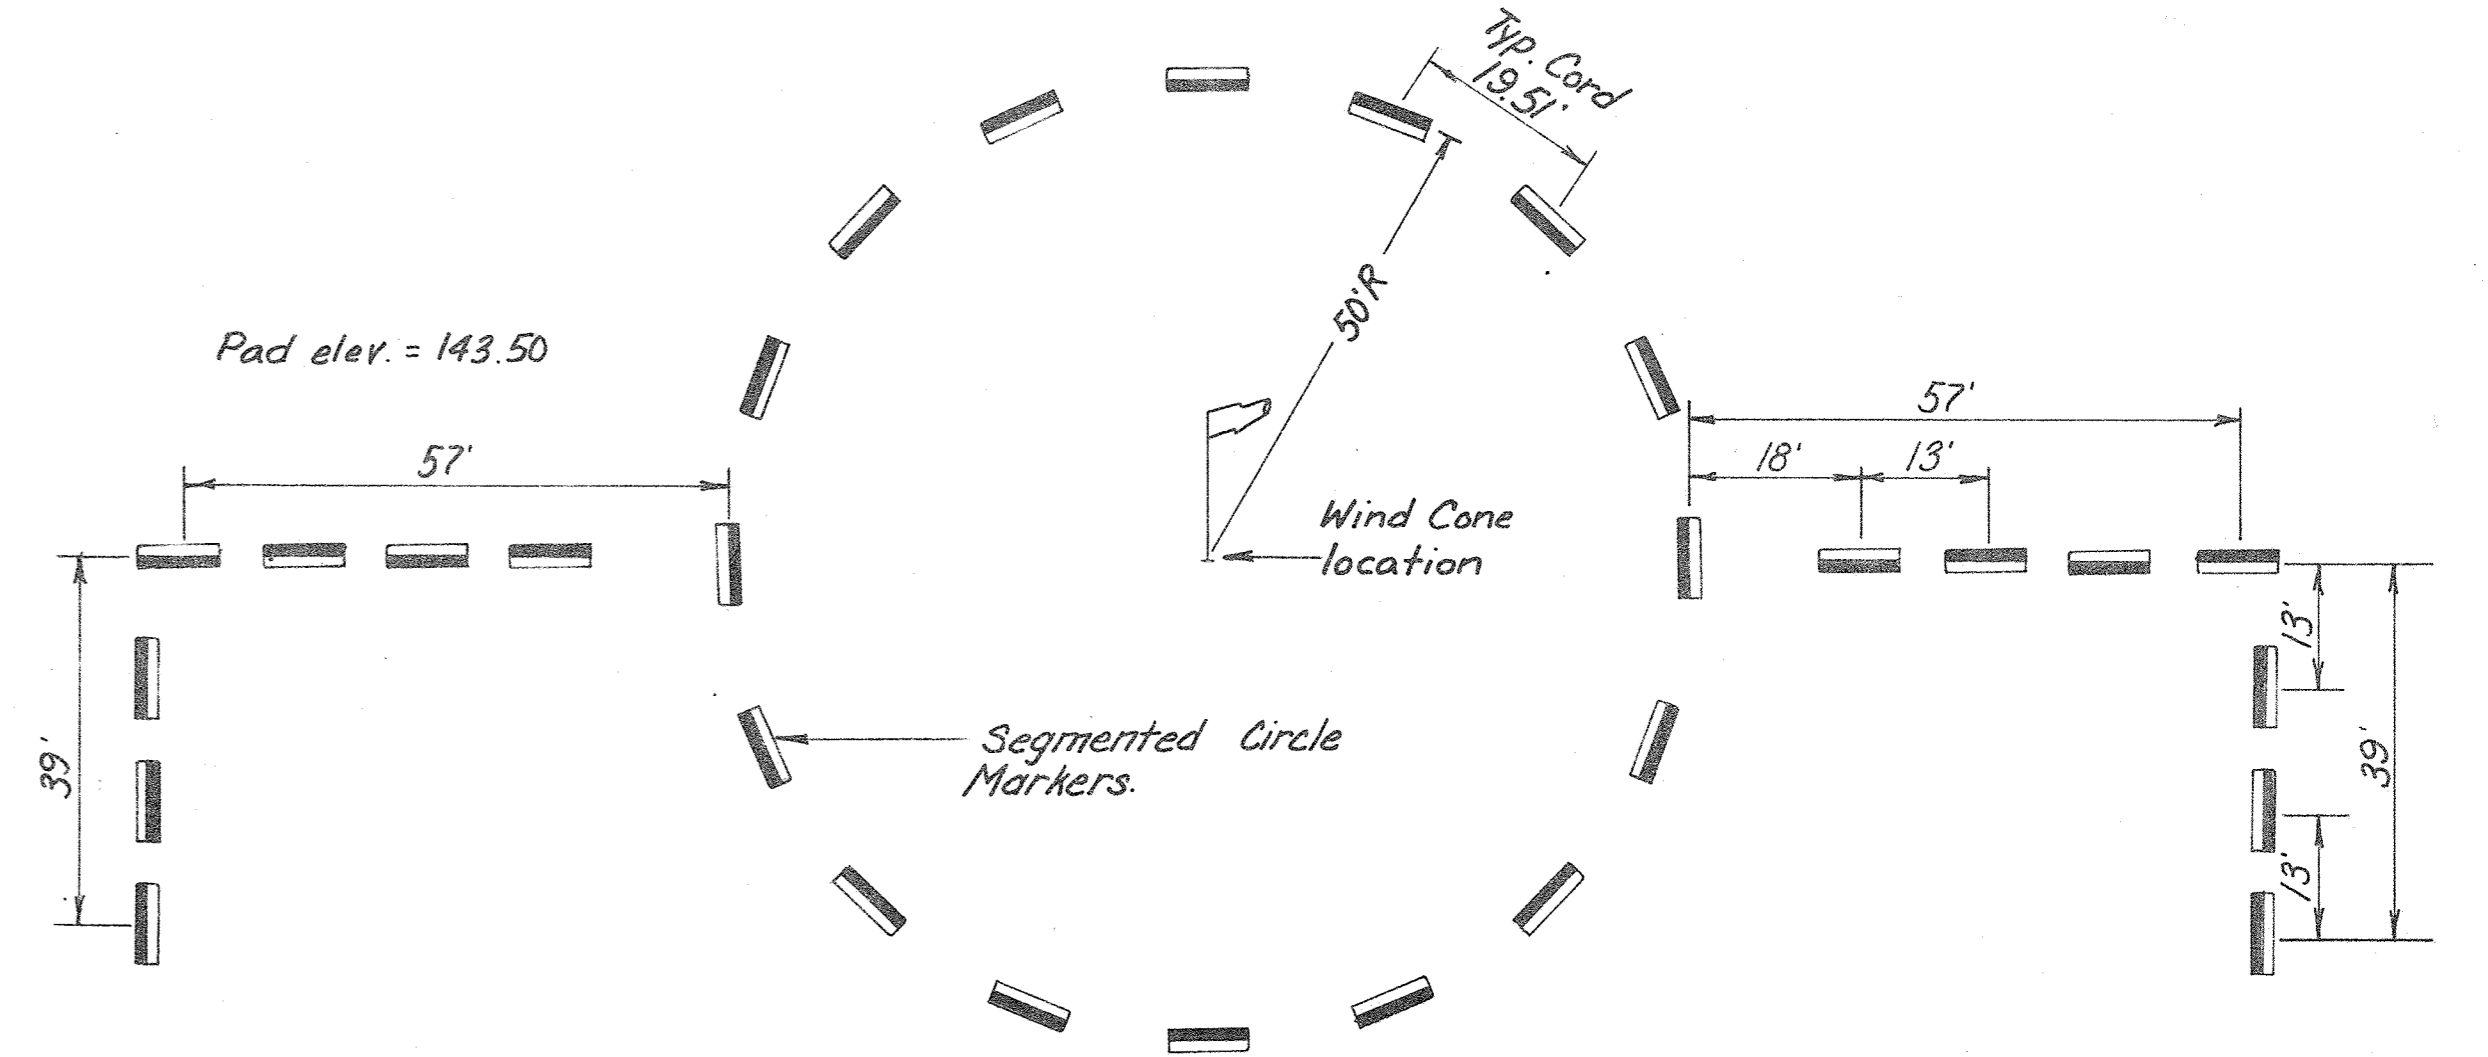


SEGMENTED CIRCLE DETAIL WITH TRAFFIC PATTERN INDICATORS  
1" = 20 ft.

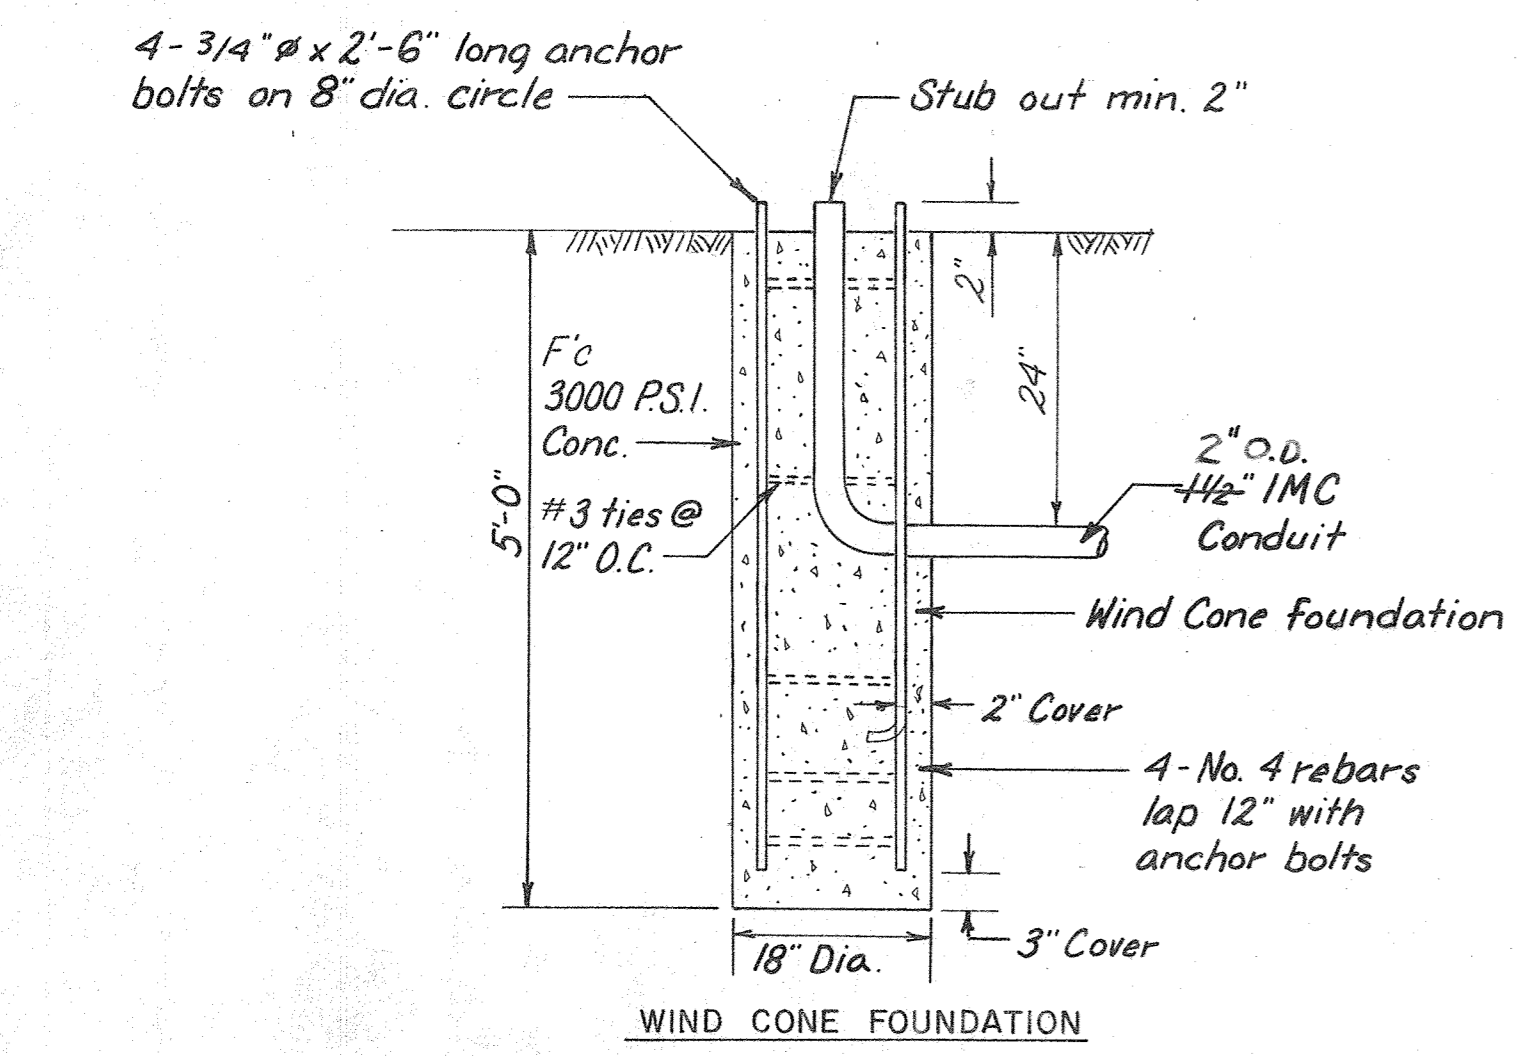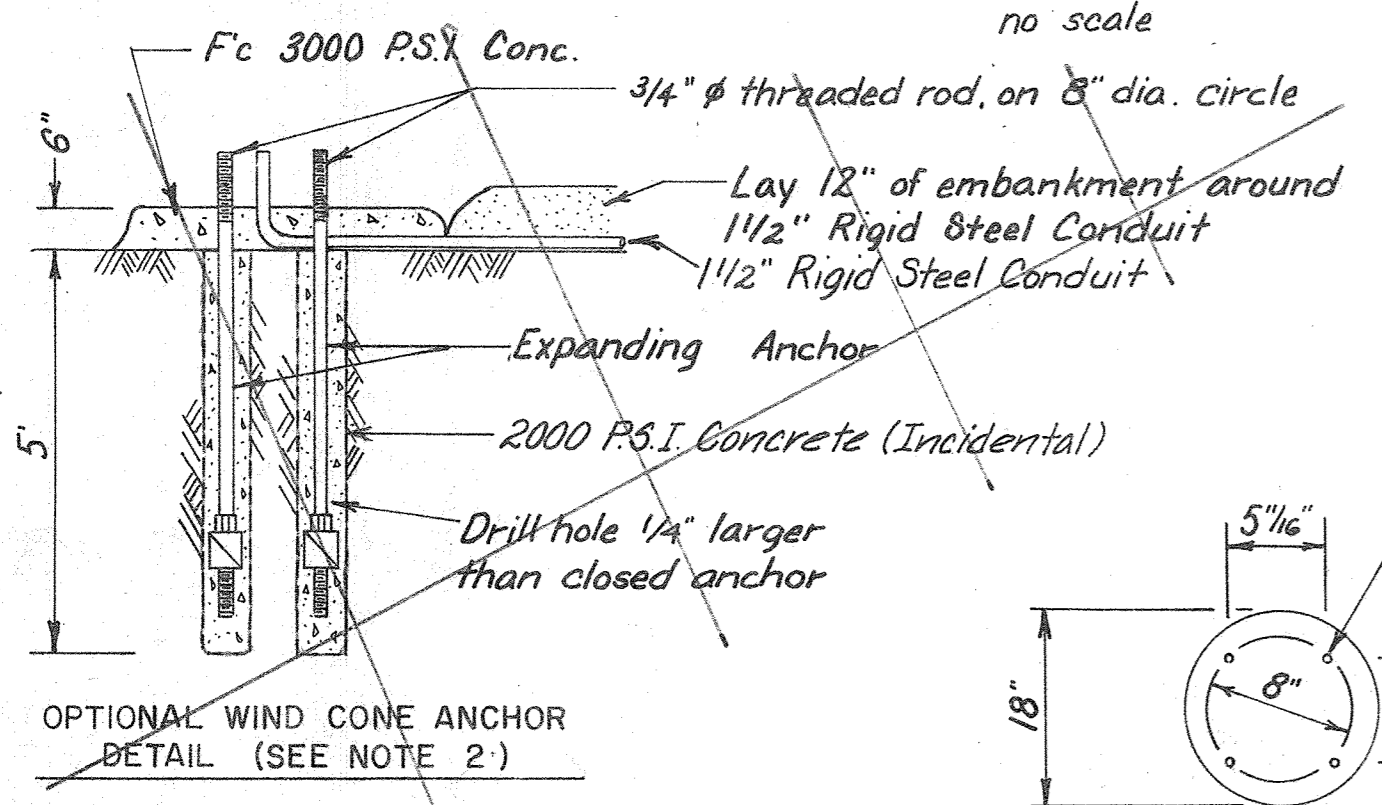

TYPE I, L-807 EIGHT FOOT LIGHTED  
WIND CONE & FOUNDATION DETAIL  
no scale

\* Note: Stripes shall point toward the runway

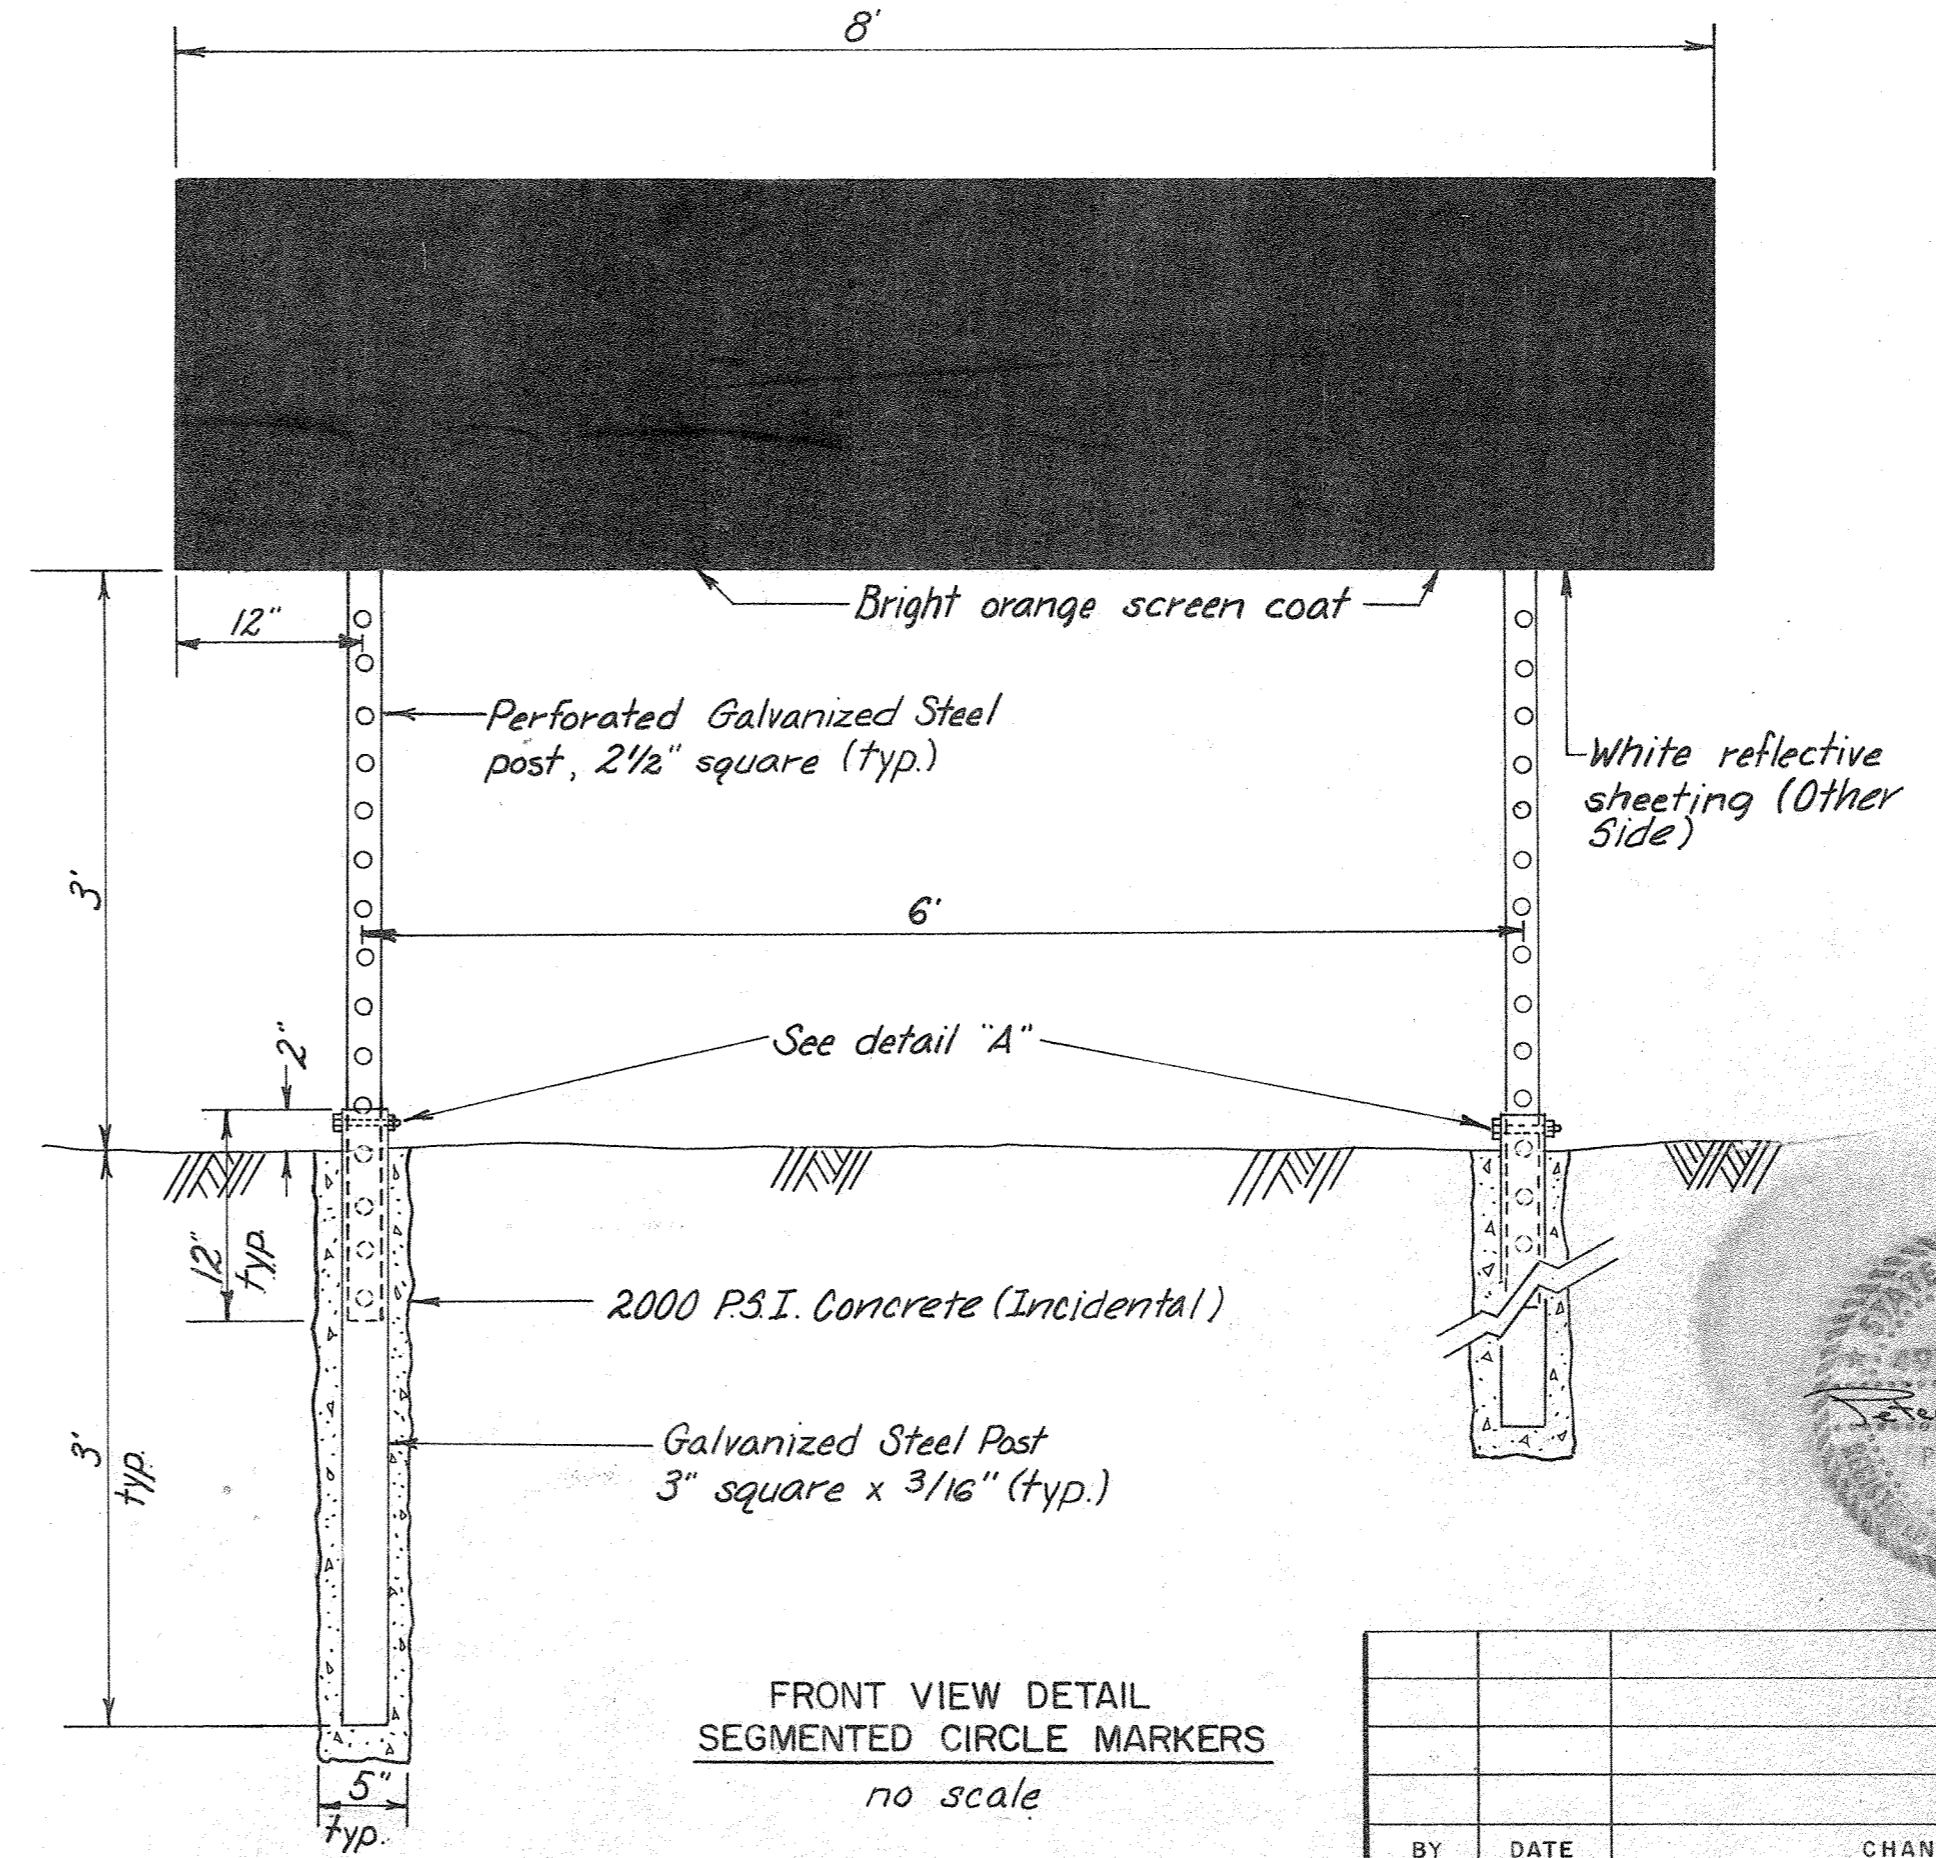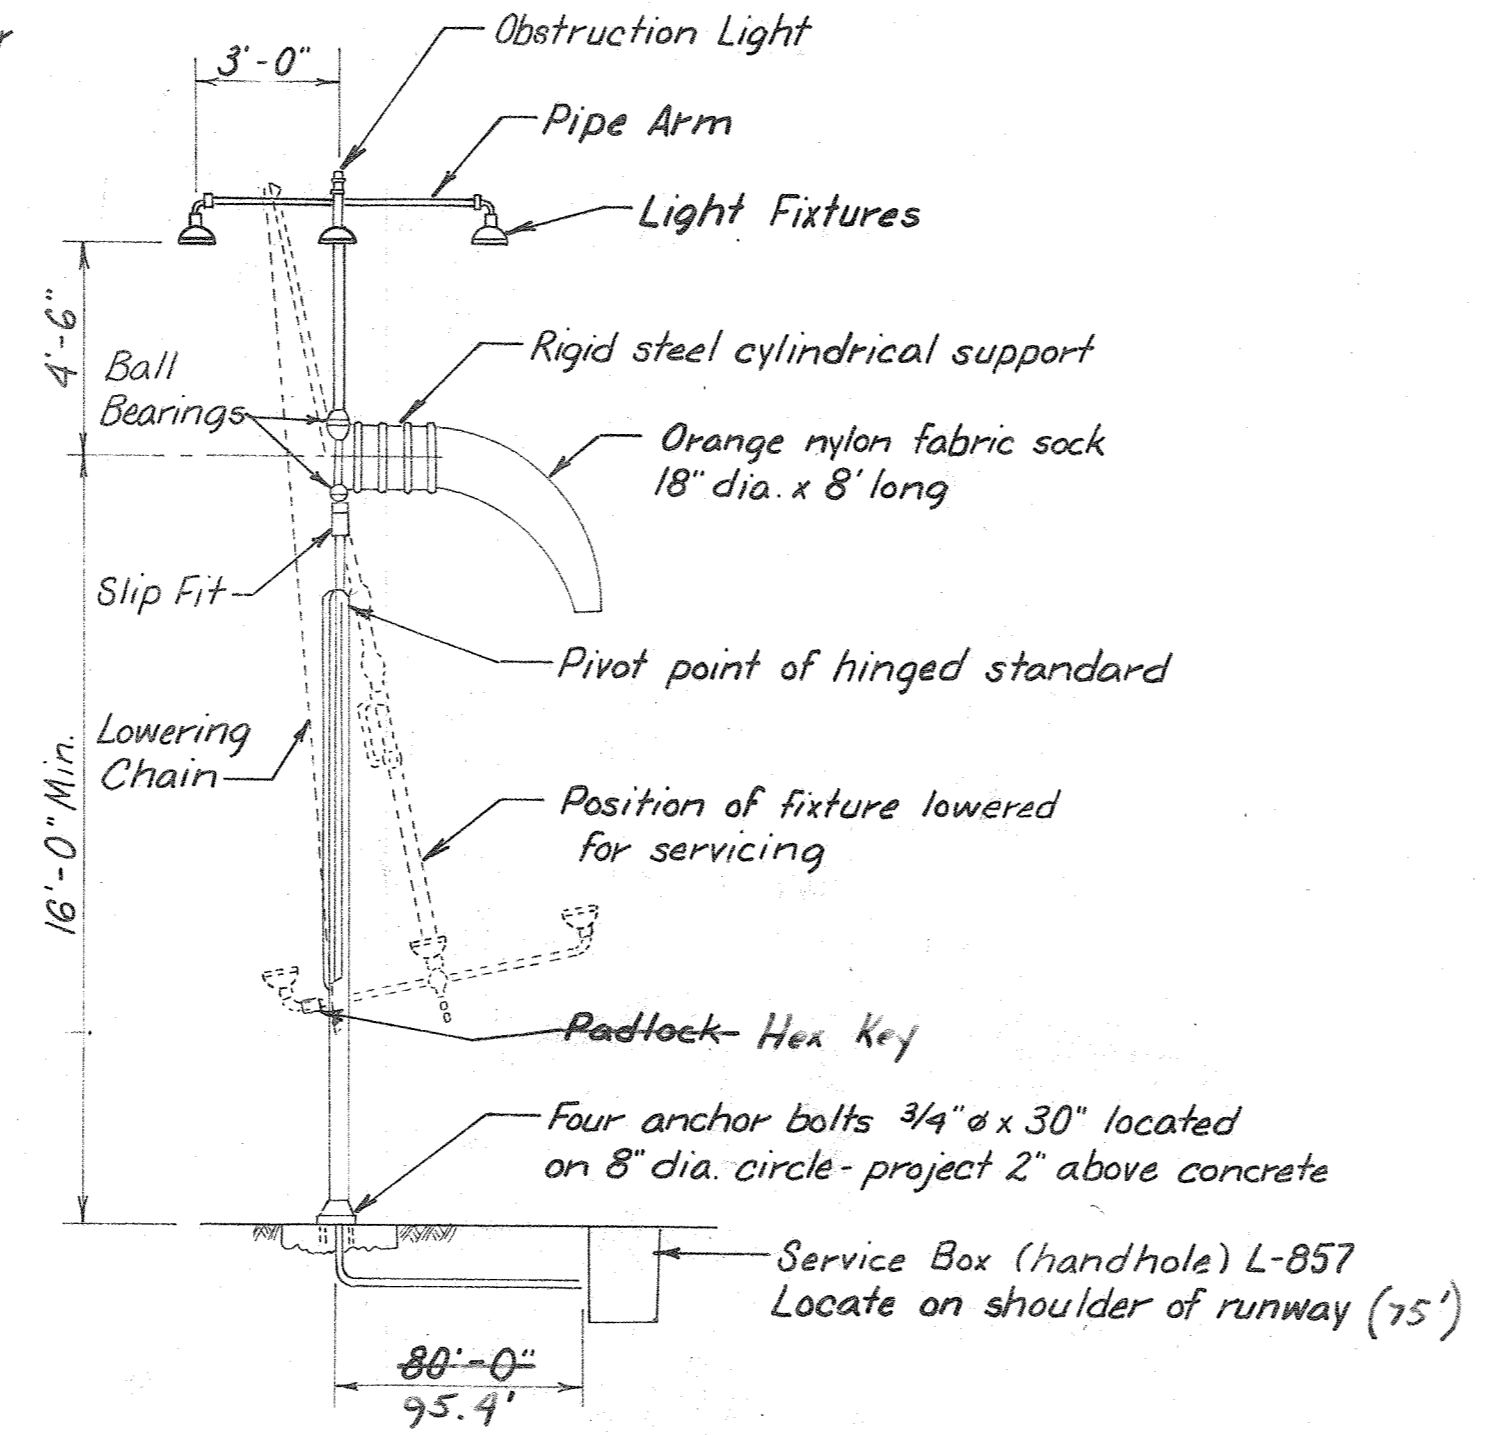



FRONT VIEW DETAIL  
SEGMENTED CIRCLE MARKERS  
no scale

NOTES:


- All work and materials including drilling and concrete as required, per details on this sheet are incidental to their respective pay item (Items 710, 722 and 1010) and no separate payment will be made for this work.
- If the wind cone is not located on rock, an excavated area large enough to accommodate the wind cone foundation, as detailed on this sheet, will be necessary. Backfill with 4" minus material in 6" or 12" layers and compact thoroughly. 3/4" dia. expanding rock anchors may be substituted for the wind cone foundation, only if feasible to both drill the required holes, and obtain 5,000 lb pullout strength when installed.
- Locate Runway Boundary Markers 51.5' Lt. & Rt. of Stations "R" 12+90 & "P" 43+10 as shown on sheet 13. Locate Segmented Circle at Sta. "R" 13+00, 200'-Rt., as shown on sheet 10.
- The boundary markers and segmented circle triangular mounting frames shall be fastened to the steel posts with two 3/8" x 5" galvanized carriage bolts. Fasten mounting strips to 2" x 4" frame with exterior cement and galvanized nails. Prepunch aluminum sheets on 12" centers, 3" from top and bottom. Fasten to mounting strips with 1/2" x #8 pan head zinc coated sheet metal screws.

BY		DATE	CHANGE	REVISIONS
<p>STATE OF ALASKA DEPARTMENT OF TRANSPORTATION AND PUBLIC FACILITIES DIVISION OF AVIATION-DESIGN AND CONSTRUCTION KAKE AIRPORT A.I.P. NO. 831-3-02-0398-01-83 PROJECT NO. D-19712 WIND CONE, SEGMENTED CIRCLE, AND RUNWAY BOUNDARY MARKER DETAILS</p>				
APPROVED	<p>William A. Locher WILLIAM A. LOCHER, P.E. S.E. REGION AVIATION DESIGN ENGINEER</p>			
APPROVED	<p>William L. Baumgartner WILLIAM L. BAUMGARTNER, P.E. S.E. REGION DESIGN ENGINEER</p>			
SCALE	DESIGNED	DRAWN		
As shown	CRH	CRH		
CHECKED	DATE			
BB	6/20/83	SHEET 12 OF 19		

## TYPE II REFLECTIVE MARKER PLAN

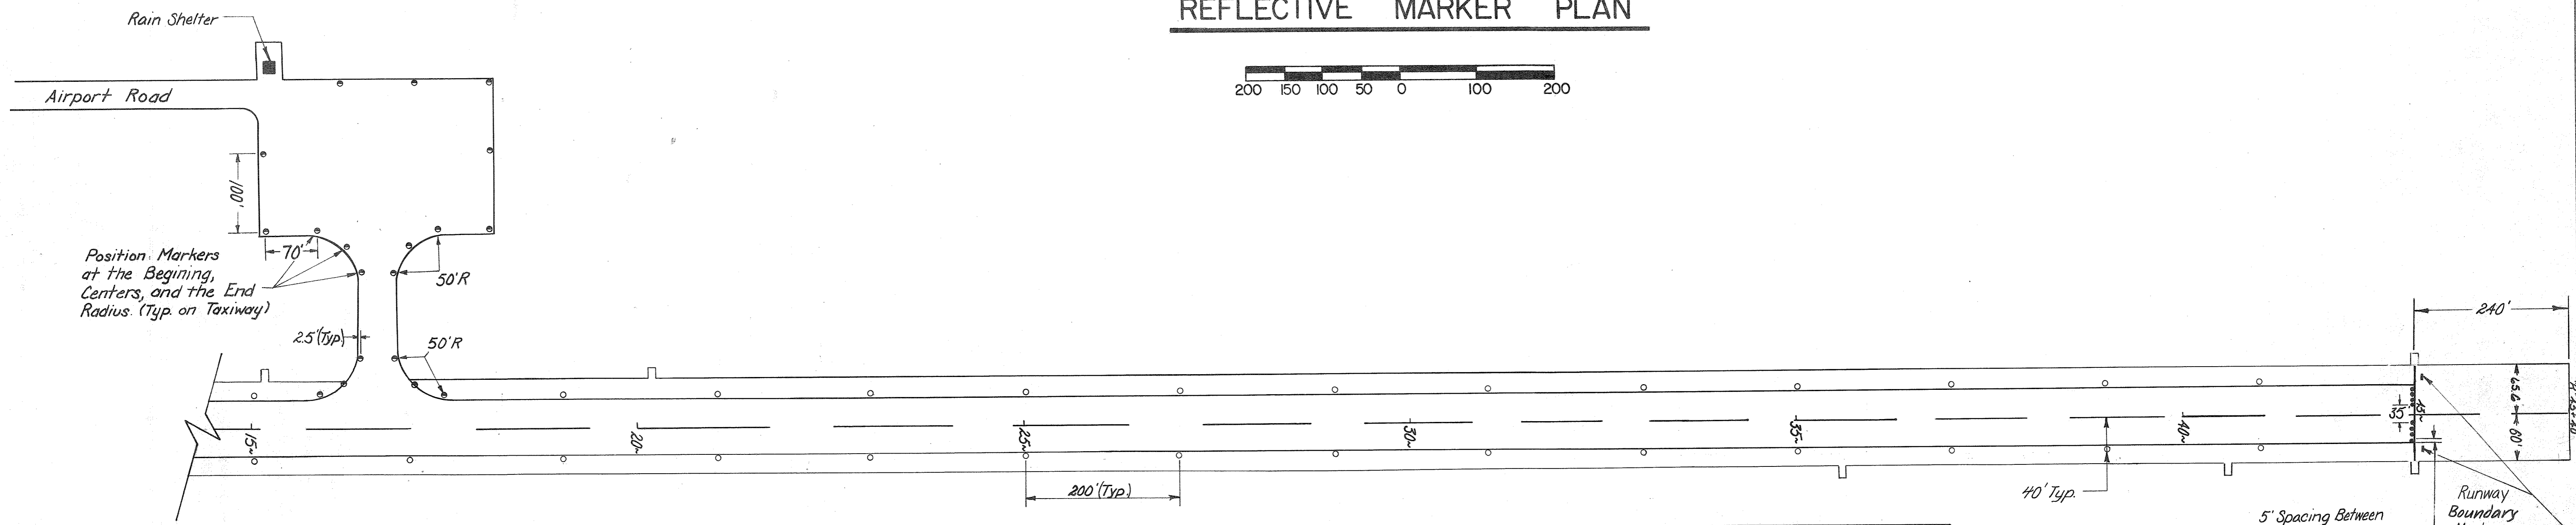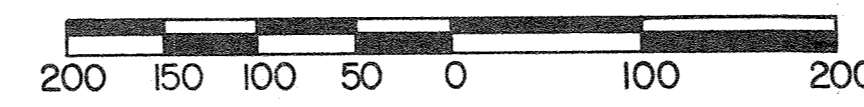


Position Markers at the Beginning, Centers, and the End Radius. (Typ. on Taxiway)

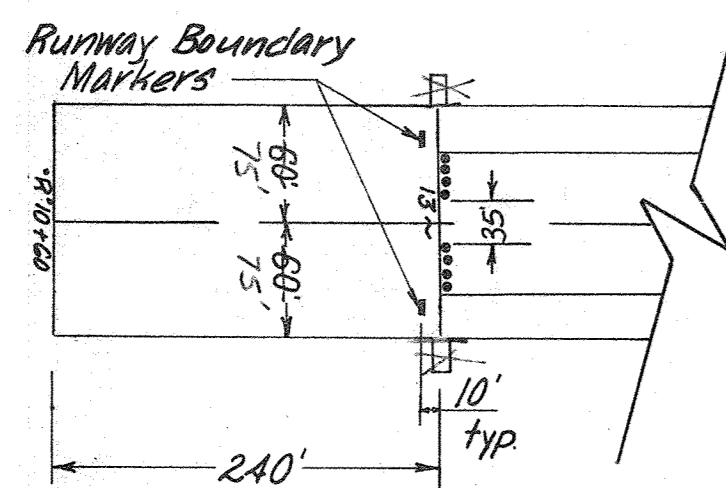

REFLECTIVE MARKERS SUMMARY			
Symbol	No. Required	Location	Color
•	16	Threshold	Green
○	27	Runway	White
•	19	Taxiway	Yellow
Extra	4	Runway	White
Extra	2	Taxiway	Yellow
Extra	2	Threshold	Green
Total	70		

5' Spacing Between Threshold Reflective Markers (Typ. Both Sides)

Runway Boundary Markers Not installed. To be installed on expansion contract.

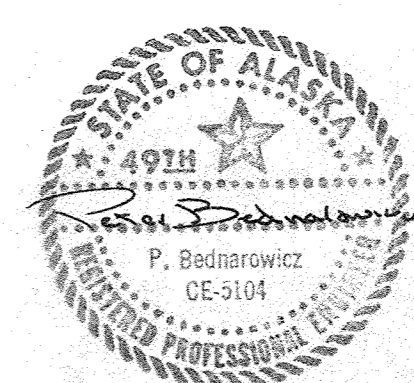

STATE OF ALASKA  
DEPARTMENT OF TRANSPORTATION  
AND PUBLIC FACILITIES  
S.E. REGION, DIVISION OF AVIATION DESIGN & CONSTRUCTION


KAKE AIRPORT  
PROJECT NO. D19712  
A.I.P. NO. 831-3-02-0398-01-83  
REFLECTIVE MARKER PLAN

BY	DATE	CHANGE
REVISIONS		


APPROVED BY:	<i>William A. Locher</i> WILLIAM A. LOCHER S.E. REGION AVIATION DESIGN ENGINEER
APPROVED BY:	<i>William L. Baumgartner</i> WILLIAM L. BAUMGARTNER S.E. REGION DESIGN ENGINEER
SCALE:	AS SHOWN
DESIGNED:	CHK
DRAWN:	CHK
CHECKED:	18
DATE:	6/29/83




**MIDSPAN CONNECTOR PLATE**

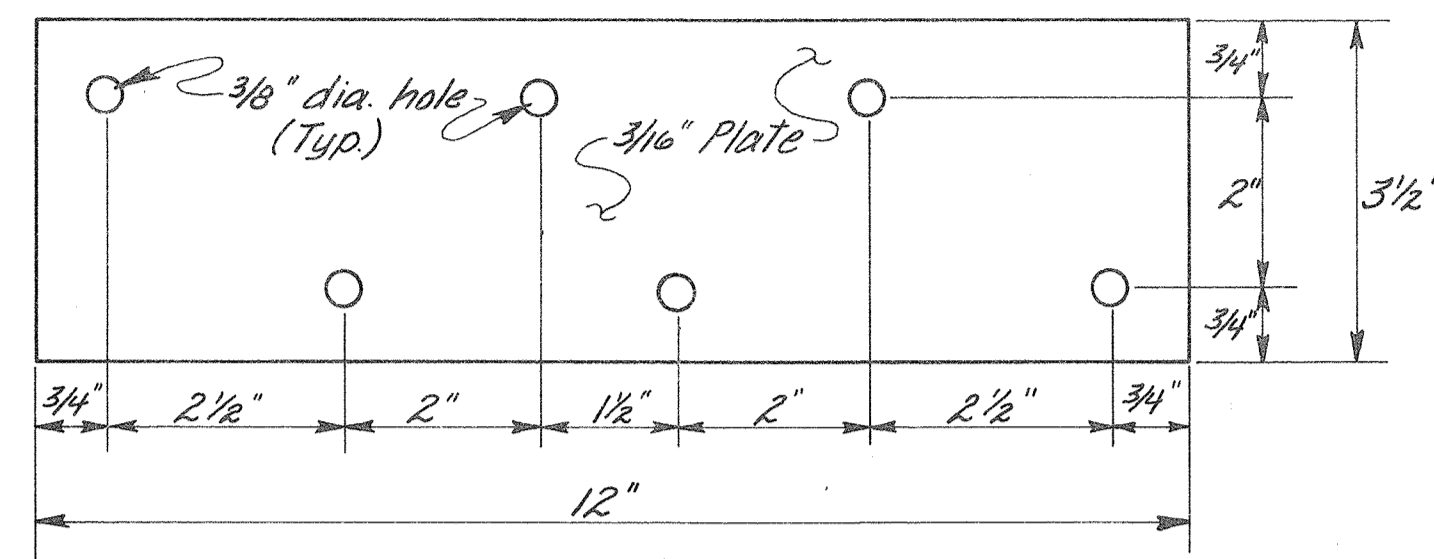


**MIDSPAN CONNECTOR PLATE  
DETAIL**

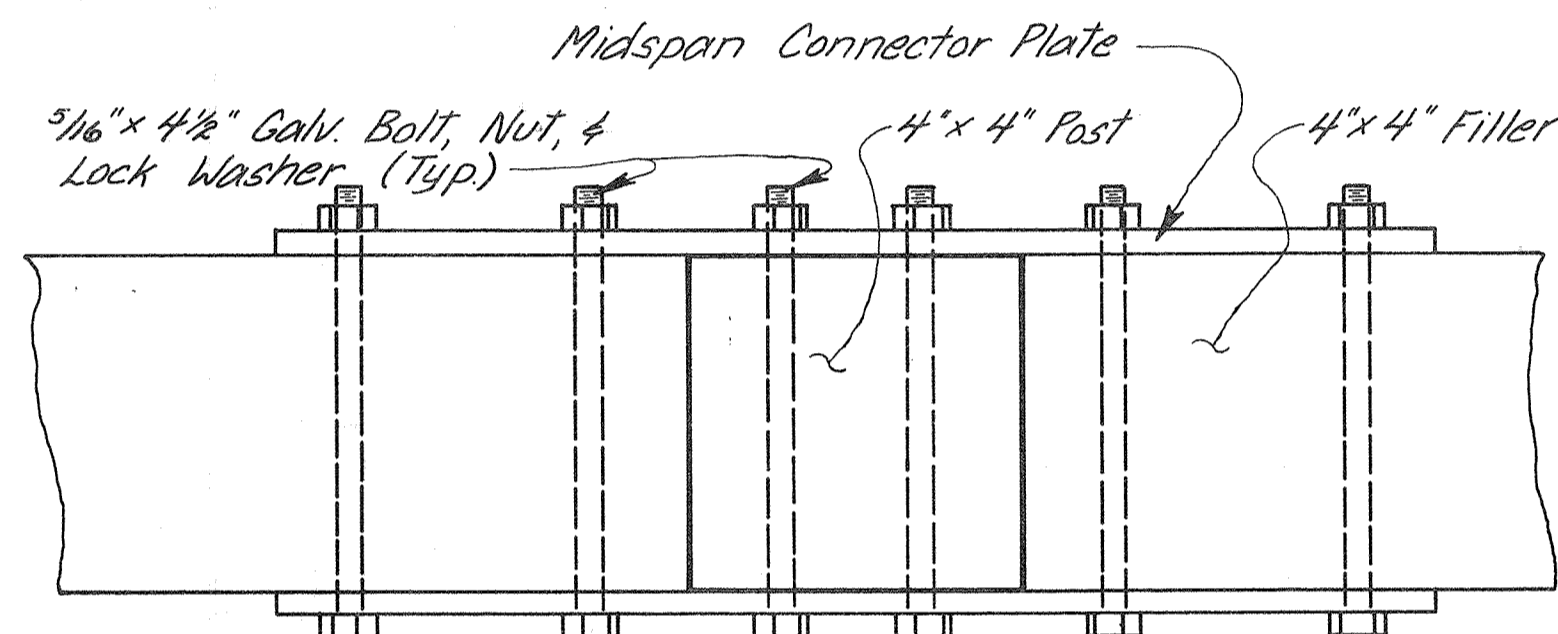


**INSIDE CORNER BRACKET**

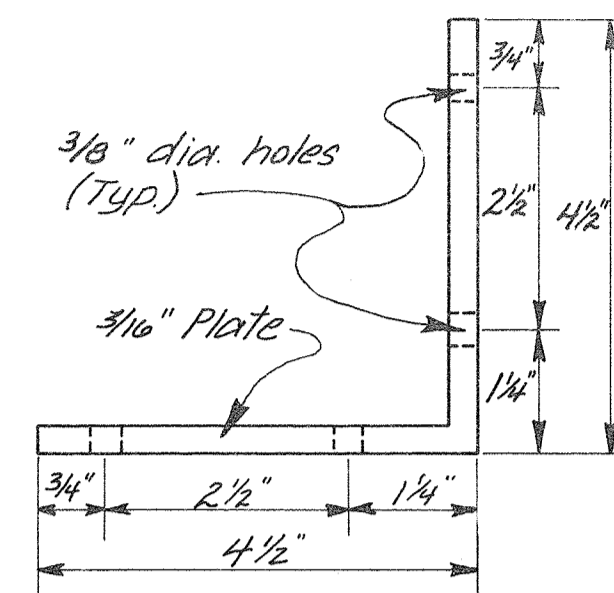


**INSIDE CORNER BRACKET  
SIDE VIEW**

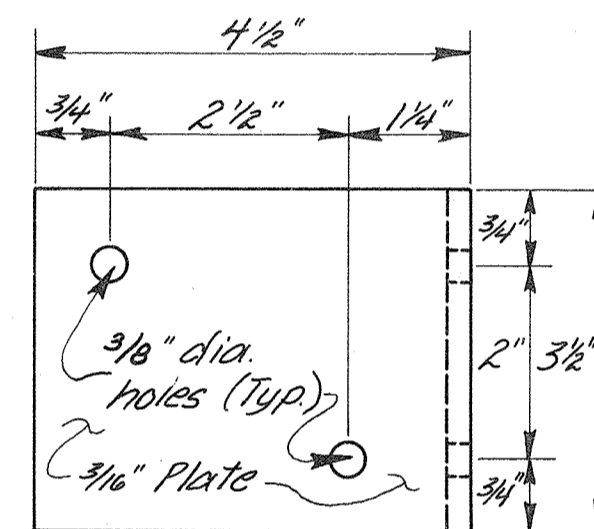


**BENCH BRACKET**

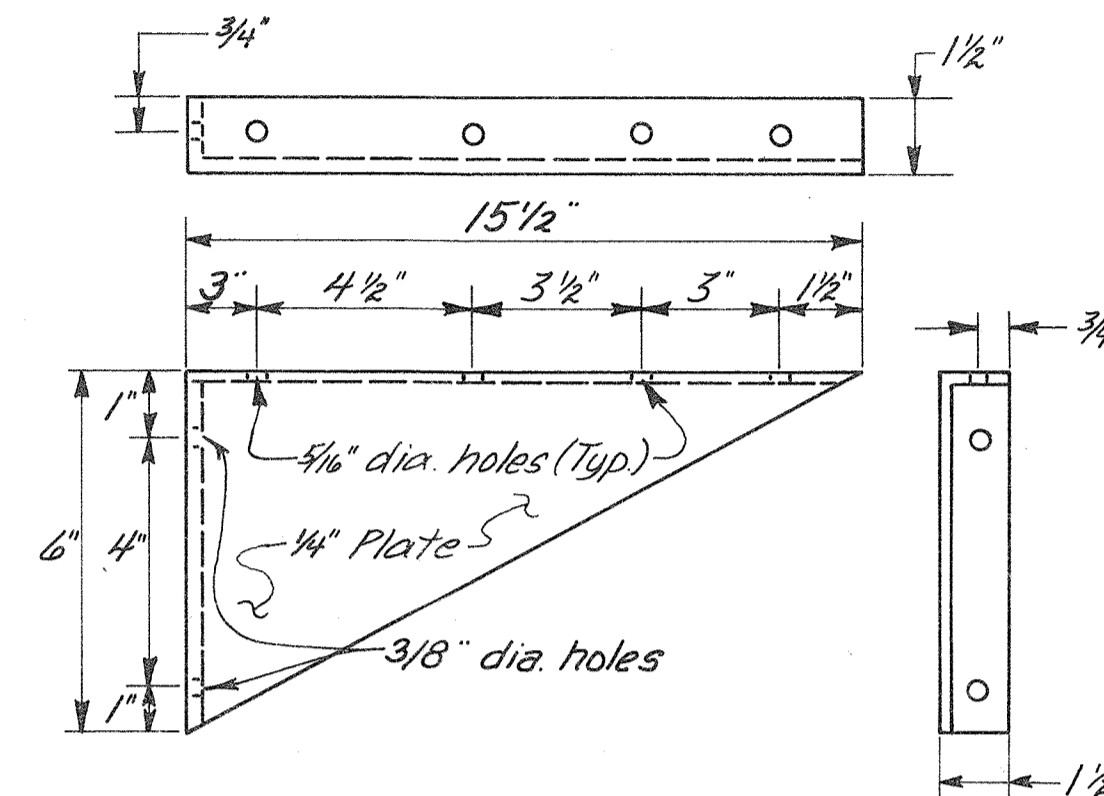


**SECTION A-A  
BENCH DETAIL**

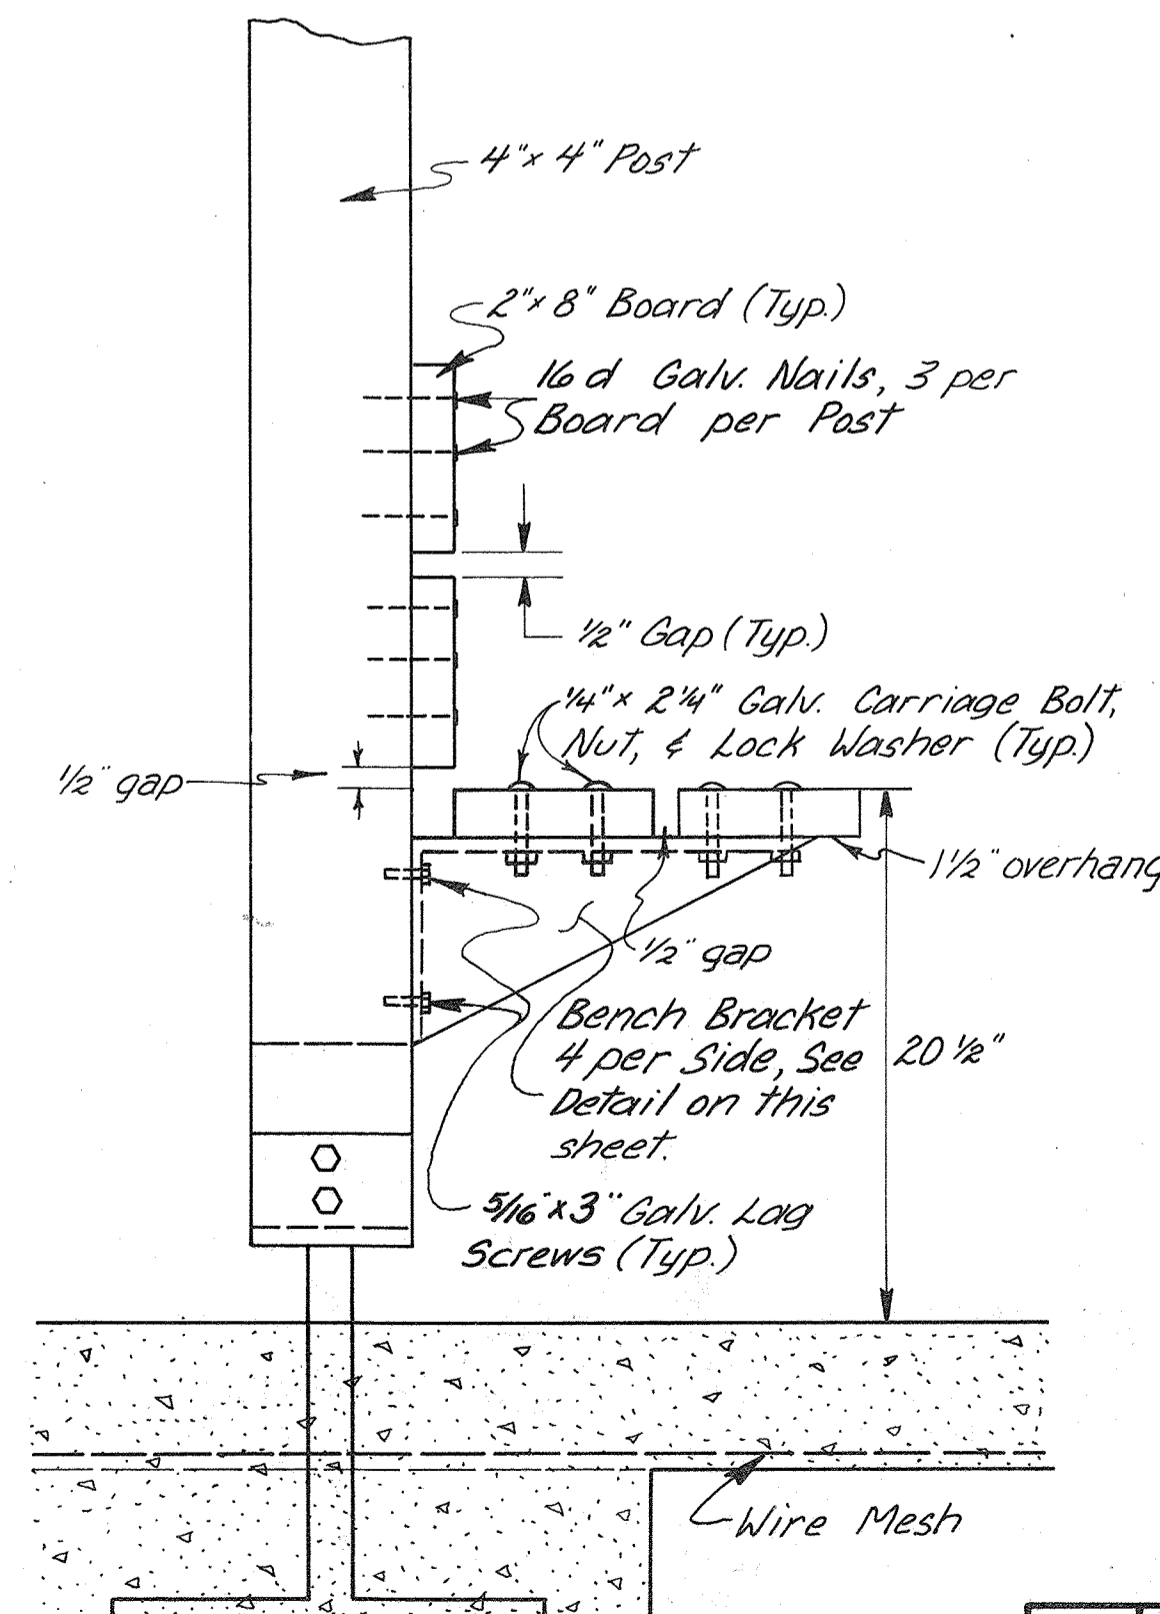


**OUTSIDE CORNER AND ENTRYWAY  
CONNECTOR PLATE**

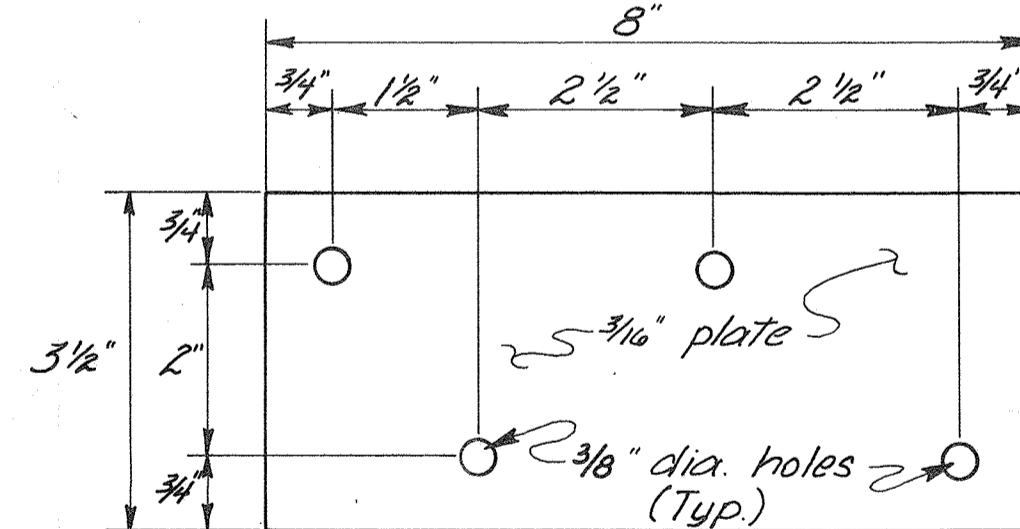

**ENTRYWAY CONNECTOR PLATE  
DETAIL**

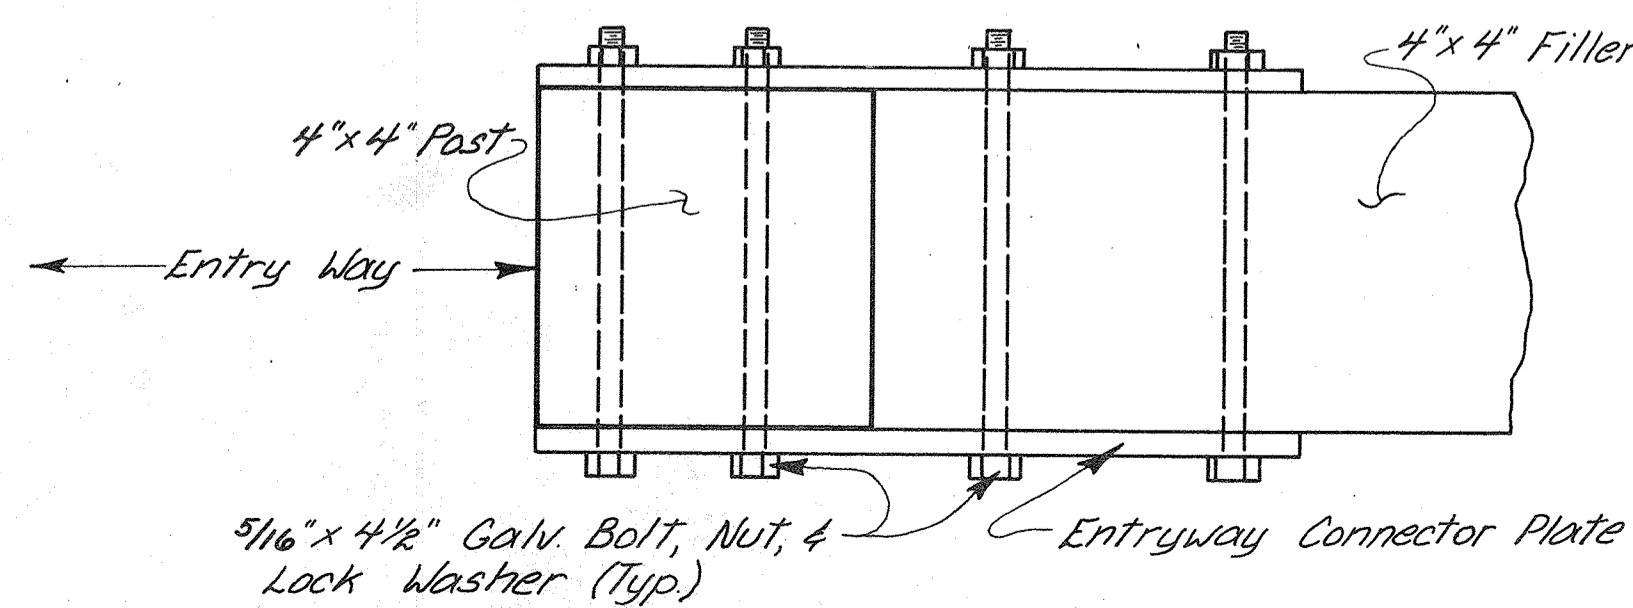

**OUTSIDE CORNER CONNECTOR PLATE  
AND INSIDE CORNER BRACKET  
DETAIL**

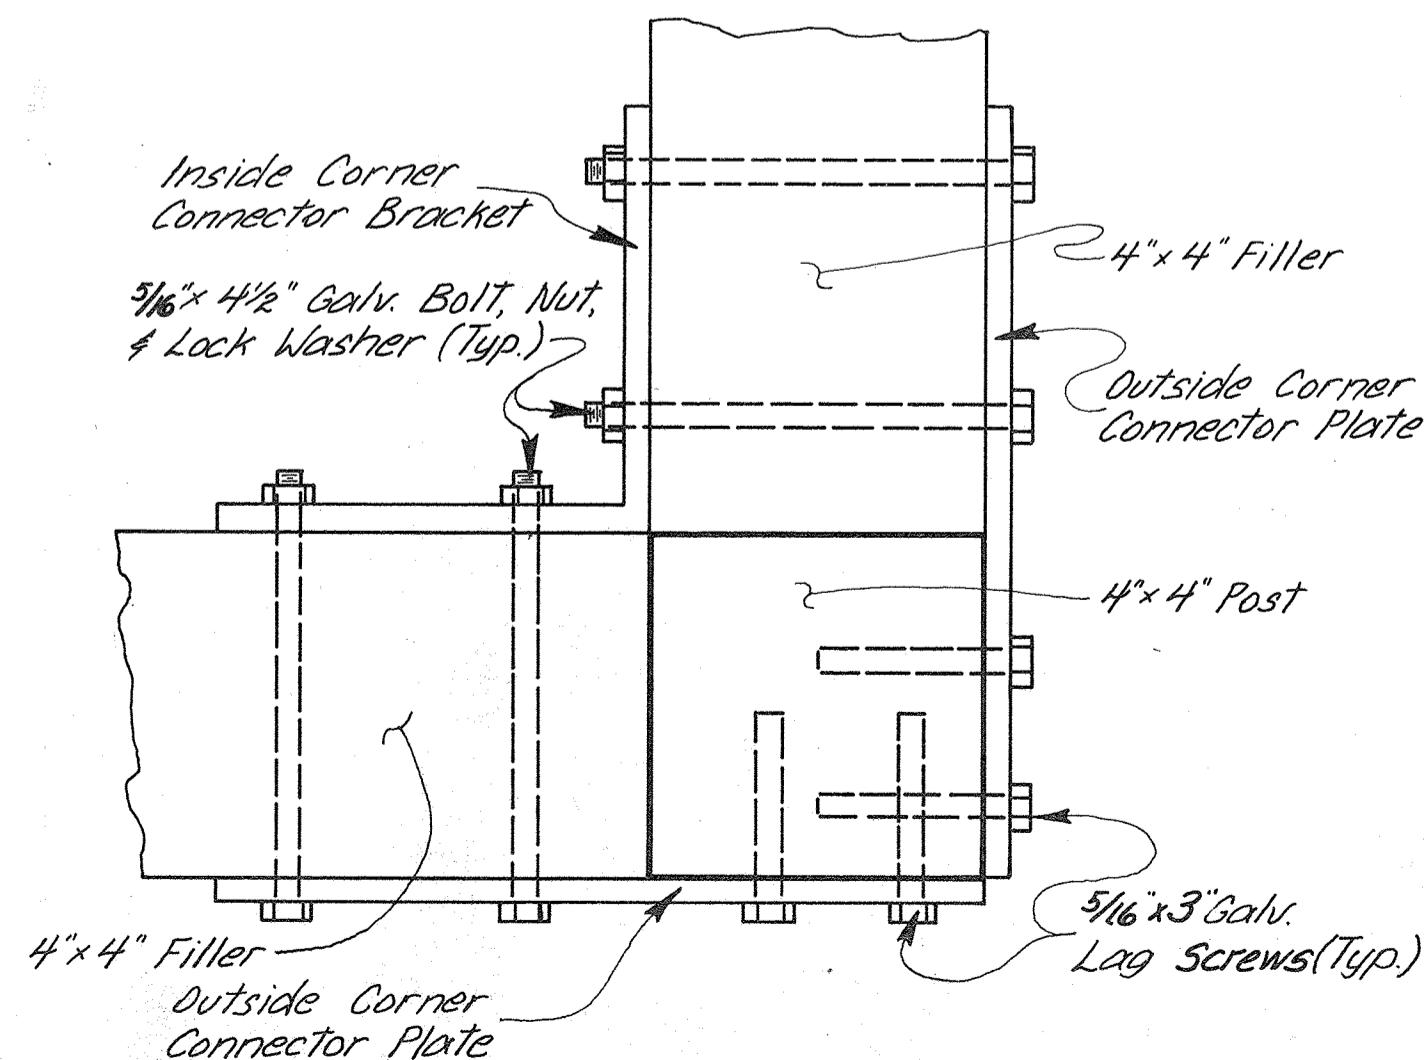


**ESTIMATE OF QUANTITIES**

ITEM	QUANTITY
Post Supports	16 ea.
5/16" x 4 1/2" Galv. Bolts, Nuts, & Lock Washers	200 ea.
4" x 4"	280 b.m.
2" x 4"	30 b.m.
2" x 6"	160 b.m.
2" x 8"	260 b.m.
4" x 8" x 5/8" CDX Plywood-	6 shfs.
15 Lbs. Roof Felt	1-600 sq. roll
Tar	2-100# blocks
Galv. Flashing	60 l.f.
4" x 8" x 1/4" Clear Polycarbonate Panels	8 shfs.
3/4" x 3/4" x 1/4" Aluminum Angle	575 l.f.
3 1/2" x 8" Outside Corner & Entryway Connector Plates	24 ea.
3 1/2" x 12" Midspan Connector Plates	40 ea.
Inside Corner Connector Brackets	8 ea.
Bench Brackets	16 ea.
5/16" x 3" Galv. Lag Screws	64 ea.
1/4" x 2 1/4" Galv. Carriage Bolts, Nuts, & Lock Washers	64 ea.
#7 x 1 1/2" Aluminum Round Head Wood Screws	700 ea.
1 1/2" Roof Drain	1 ea.
16 d Galv. Nails	5 lb.
Portland Cement Concrete	3.24 cy.
6 x 6" No. 10 Welded Wire Mesh	22.9 sq. yd.
Galv. Joist Straps	28 ea.
8 d Galv. Nails	6 lbs.
Excavation	1.6 c.y.
12 d Galv. Nails	1 lb.

**GENERAL NOTES**

- All lumber shall be S-4-S, Douglas Fir or Hemlock, & shall be construction grade no. 1 or better.
- Sizing of the polycarbonate panels for expansion shall be in accordance with the manufacturers specifications.
- All wood shall be stained with linseed oil base semi-transparent stain. Stain specifications, manufacturers application recommendations, & color samples shall be submitted to the engineer for approval prior to the application of any stain.
- Approved equal rain shelter building (prefabricated or like designs) may be used, subject to approval by the Aviation Design Engineer.
- Post supports, bench brackets, & connector plates shall be shop fabricated & shall receive two coats of metal paint prior to installation.
- Pre-drill and stain all holes for all bolts.

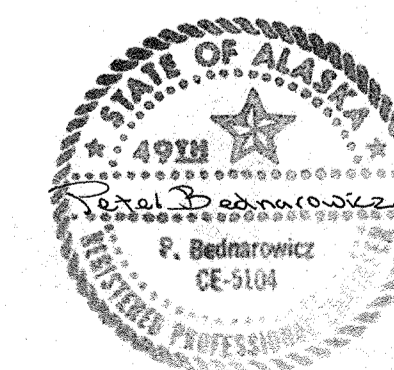

STATE OF ALASKA  
DEPARTMENT OF TRANSPORTATION  
AND PUBLIC FACILITIES  
S.E. REGION, DIVISION OF AVIATION DESIGN & CONSTRUCTION  
KAKE AIRPORT  
A.I.P. NO. 831-3-02-0398-01-83  
PROJECT NO. D-19712  
RAIN SHELTER DETAILS


APPROVED *William A. Locher*  
WILLIAM A. LOCHER S.E. REGION AVIATION DESIGN ENGINEER  
APPROVED *William L. Baumgartner*  
WILLIAM L. BAUMGARTNER S.E. REGION DESIGN ENGINEER  
SCALE DESIGNED DRAWN  
NONE CHECKED DATE 6/29/83 SHEET 15 OF 19

BY	DATE	CHANGE


**SURVEYOR'S CERTIFICATE**  
 I hereby certify that I am properly registered and licensed to practice land surveying in the State of Alaska and that this plat represents a survey made by me or under my direct supervision and that the monuments shown hereon actually exist as described, and that all dimensions and other details are correct.

5115-S Registered Surveyor Date 6-25-83  
 John Lauritzen No. 5115-S

**DETAIL "A"**

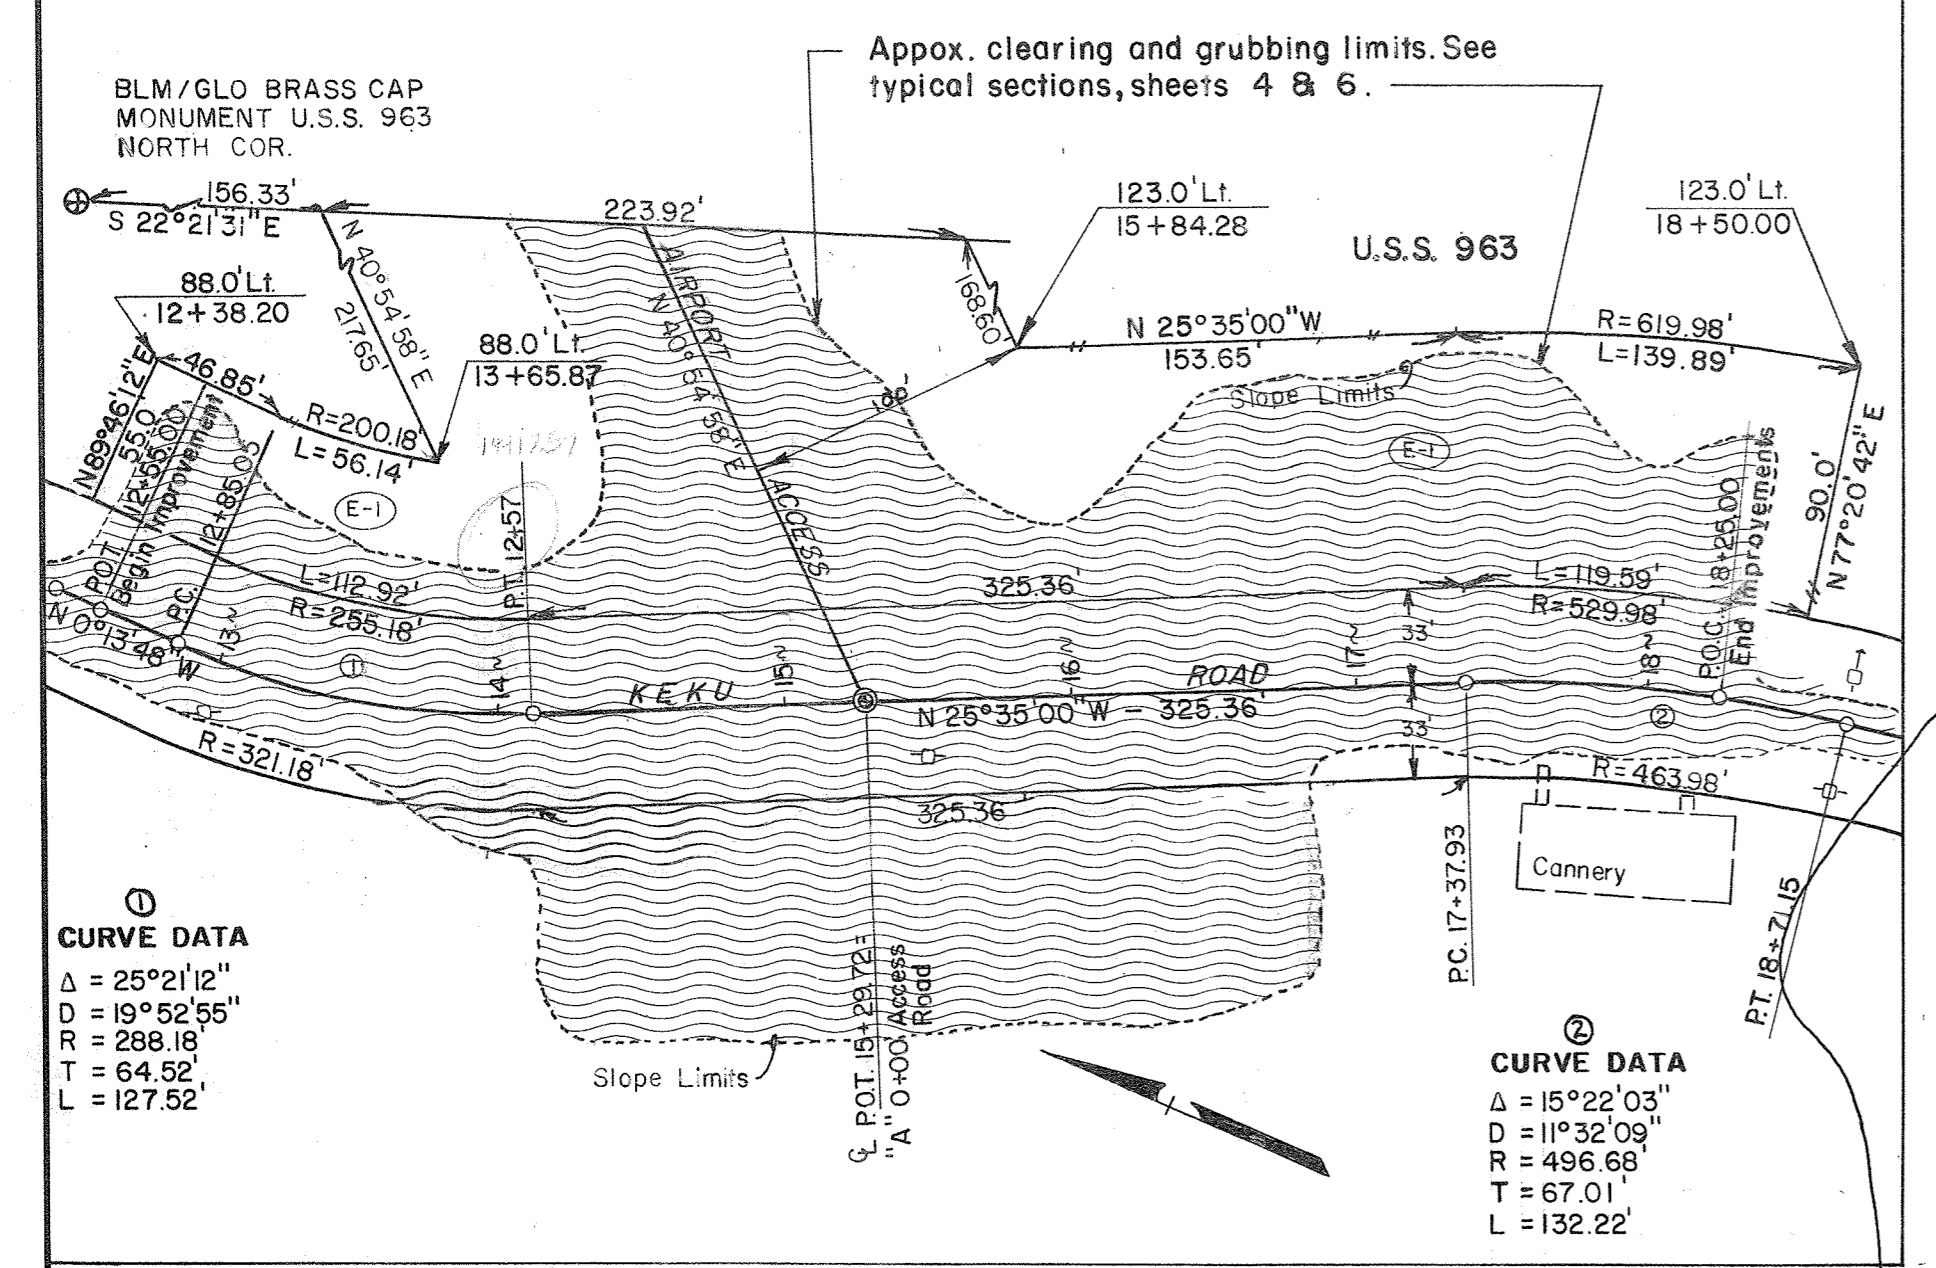

CREEK

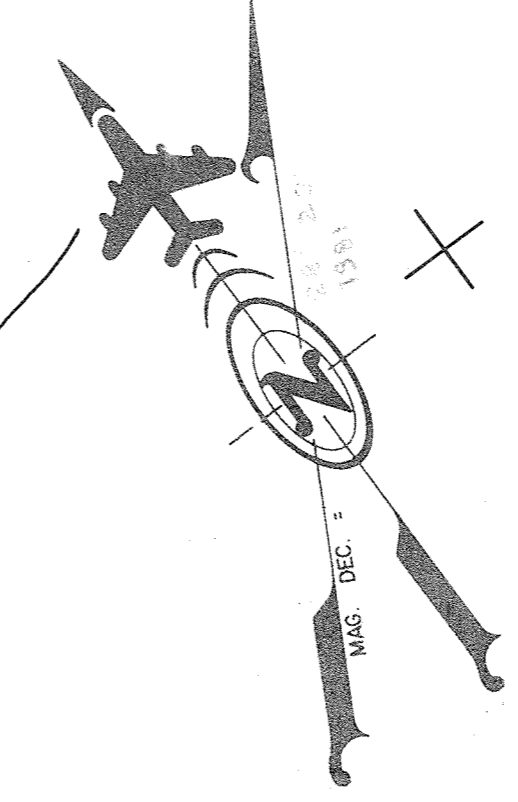

SECTION 36  
 SECTION 35

**VERTICAL CONTROL**  
 THE BASIS OF VERTICAL CONTROL FOR THIS PROJECT WAS N.O.S. TIDAL BENCH MARK NO. 4, KAKE, KEKU STRAIT, 1962, WITH A PUBLISHED ELEVATION OF 1451' M.L.L.W. (1964 MEAN VALUE).

**TIDAL DATUMS**

MEAN HIGHER HIGH WATER	14.00
MEAN HIGH WATER	13.10
MEAN TIDE LEVEL	7.25
MEAN LOW WATER	1.40
MEAN LOWER LOW WATER	0.00
ESTIMATED HIGHEST TIDE	18.00
ESTIMATED LOWEST TIDE	-4.00

**HORIZONTAL CONTROL**  
 THE BASIS OF BEARING WAS THE LINE-OF-SIGHT BETWEEN N.O.S. STATION "KAKE" AND U.S.K.H. ENGINEERS PHOTOCONTROL POINT NO. 61 (1981), WITH AN A.S.P. GRID BEARING OF S.53°06'10"E. BASED ON THE FOLLOWING ACCEPTED VALUES:

U.S.C. & G.S. "KAKE" (1927)	LAT. 56°58'26.945" N LONG. 133°56'57.815" W (Y) 1,877,872.15 N (X) 2,629,236.43 E
U.S.K.H. NO. 61 (1981)	LAT. 56°57'42.495" N LONG. 133°55'08.529" W (Y) 1,873,337.785 N (X) 2,635,276.252 E


**PROJECT COORDINATES**  
 A LOCAL SYSTEM OF COORDINATES FOR THIS PROJECT WAS DEVELOPED ON A PLANE WITH ITS POINT OF TANGENCY AT C-1, U.S.S. 3852 AND THE FOLLOWING PROJECT AVERAGE GRID VALUES APPLIED IN CONVERTING THE A.S.P. VALUES.

PROJECT AVERAGE GAMMA = -0°12'30"  
 PROJECT AVERAGE SCALE FACTOR = .9999031

C-1, U.S.S. 3852	N 75,561.200	E 34,677.865
A.S.P. GRID	(Y) 1,875,561.200N	(X) 2,634,677.865E
C-2, U.S.S. 3852	N 72,394.795	E 38,316.833
0+00, L RUNWAY	N 75,425.202	E 34,854.109
45+00, L RUNWAY	N 72,541.380	E 38,308.609

**NOTES**

- 1) THE SECTION LINES, AS SHOWN, WHERE THEY ARE NOT MONUMENTED, ARE BASED ON PROTRACTED VALUES TAKEN FROM THE OFFICIAL D.N.R. PROTRACTOR DIAGRAMS CR-40 & CR-41.
- 2) RECORD BEARINGS AND DISTANCES ARE SHOWN ENCLOSED WITH PARENTHESES, THOSE MEASURED OR COMPUTED BY THIS SURVEY ARE WITHOUT PARENTHESES.

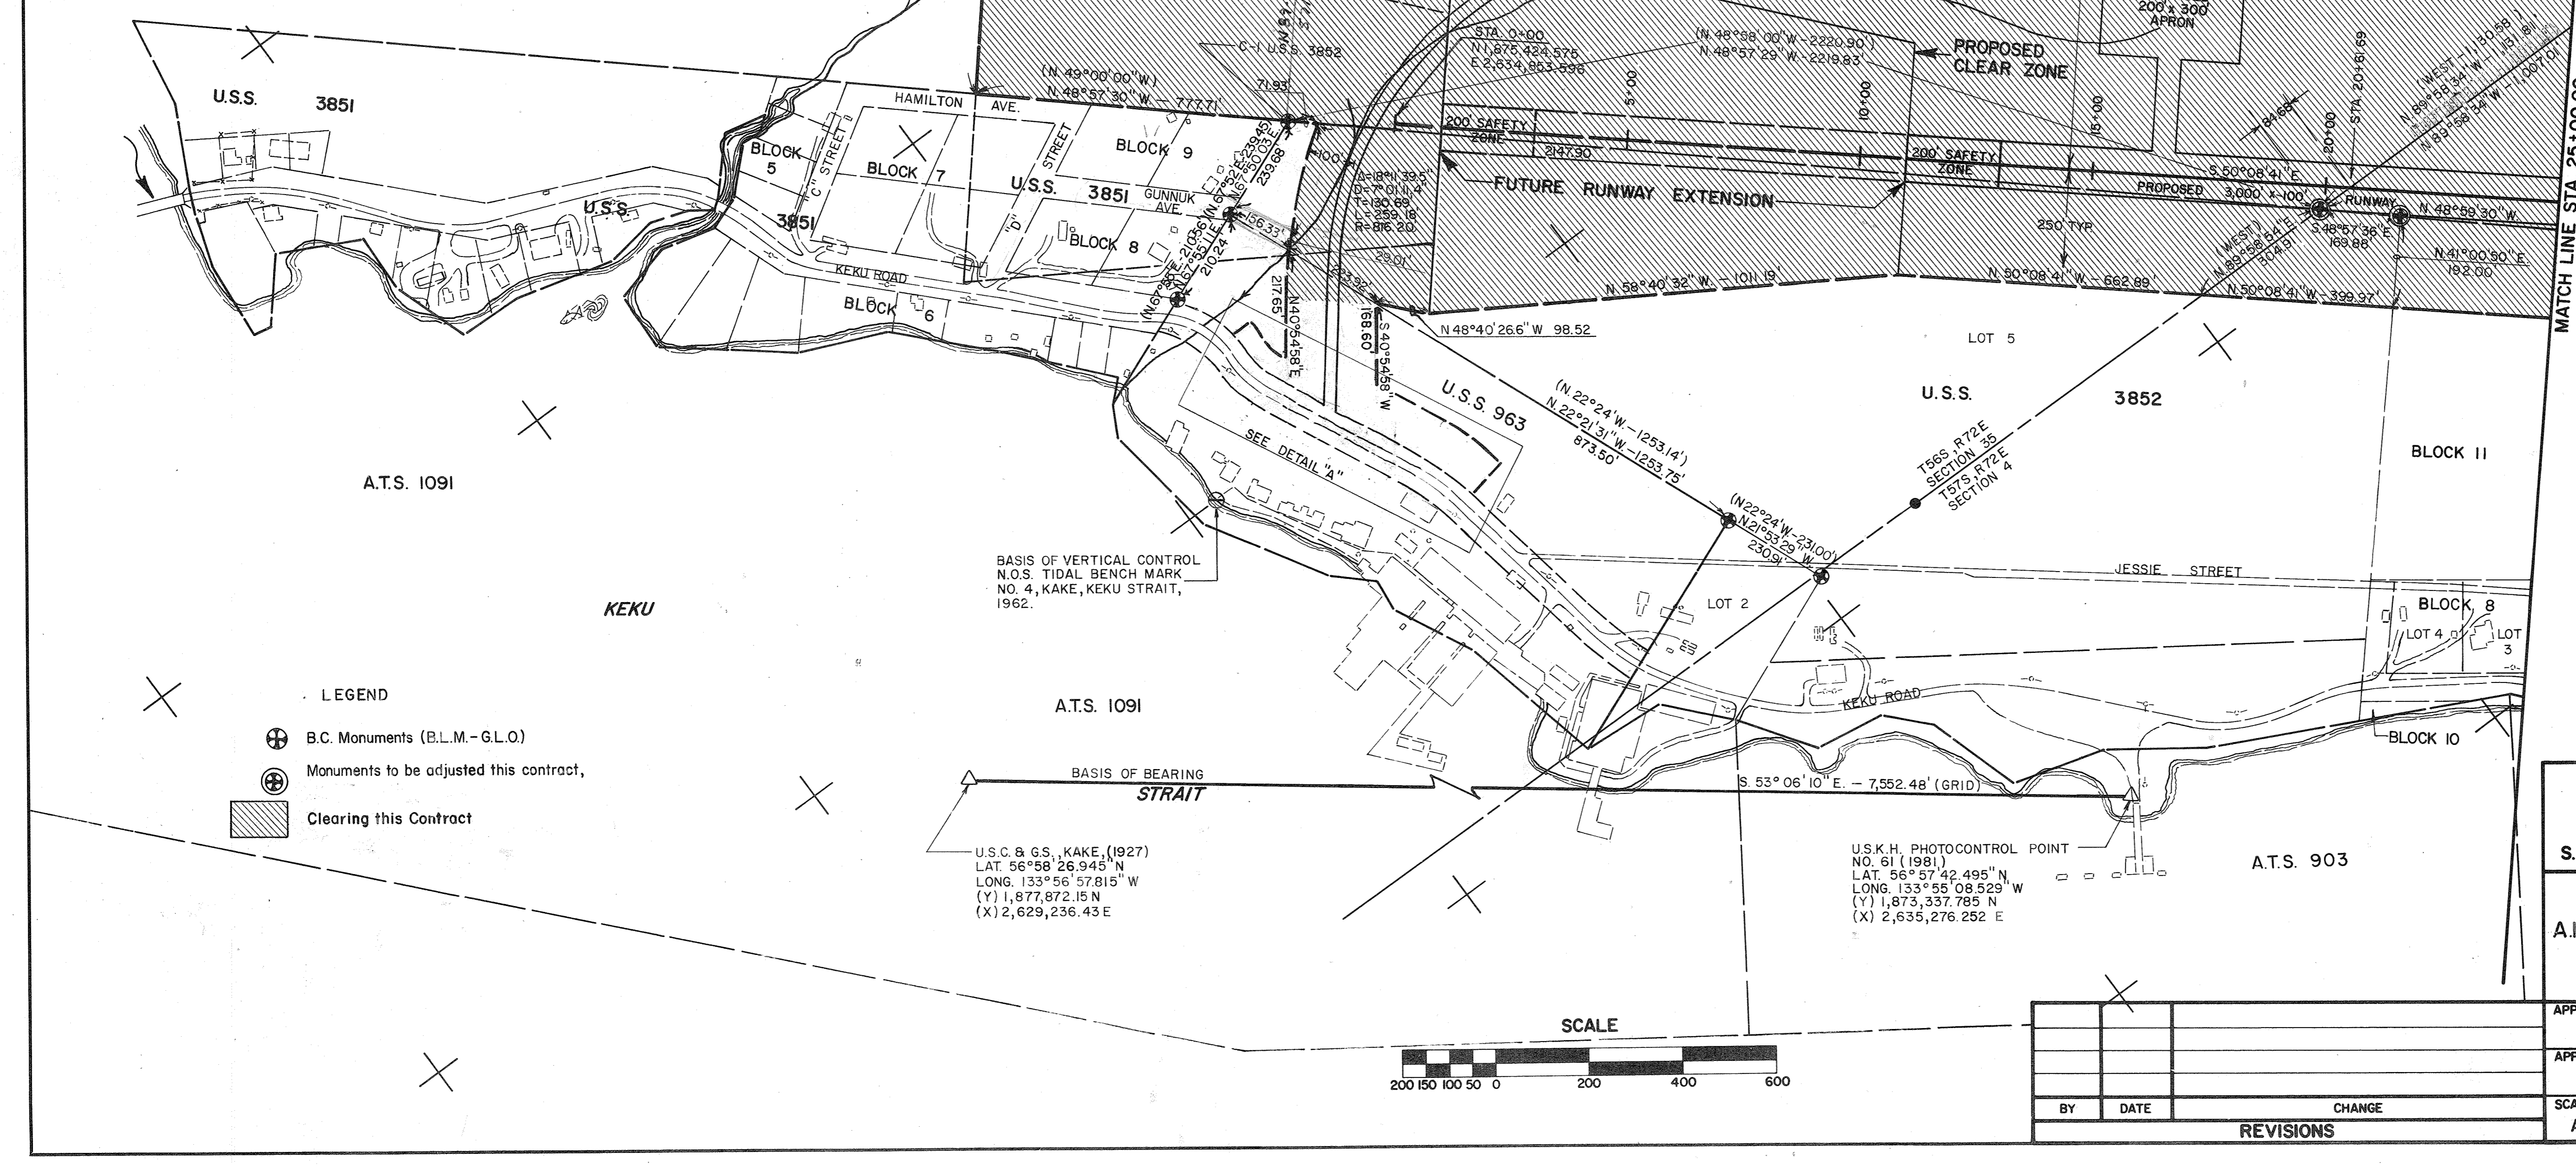

**LEGEND**

- ⊕ B.C. Monuments (B.L.M.-G.L.O.)
- ⊕ Monuments to be adjusted this contract,
- ▨ Clearing this Contract

**STATE OF ALASKA**  
**DEPARTMENT OF TRANSPORTATION AND PUBLIC FACILITIES**  
**S.E. REGION, DIVISION OF AVIATION DESIGN & CONSTRUCTION**

**KAKE AIRPORT**  
 A.I.P. NO. 831-3-02-0398-01-83 PROJECT NO. D19712  
**CLEARING LIMITS & PROPERTY PLAN**

APPROVED BY: *William A. Locher*  
 William A. Locher, S.E. Region Aviation Design Engineer



APPROVED BY: *William L. Baumgartner*  
 William L. Baumgartner, S.E. Region Design Engineer

BY	DATE	CHANGE




SCALE: AS SHOWN  
 DESIGNED: [blank]  
 DRAWN: [blank]  
 CHECKED: 18  
 DATE: 6/29/83


SHEET 16 OF 19

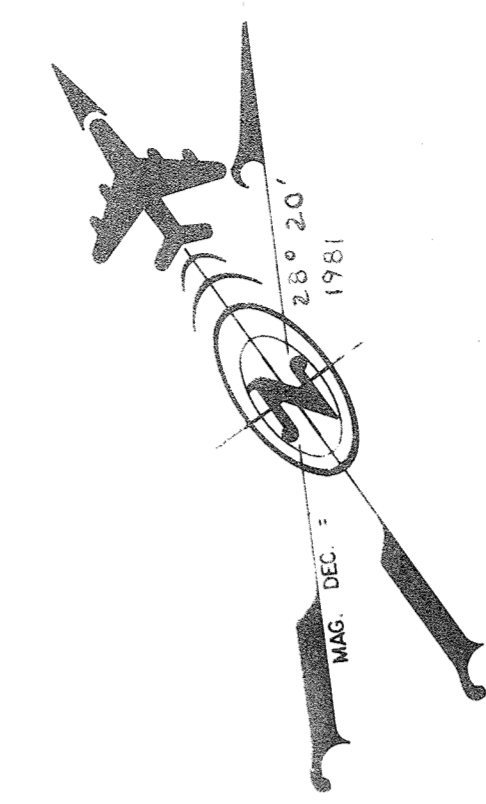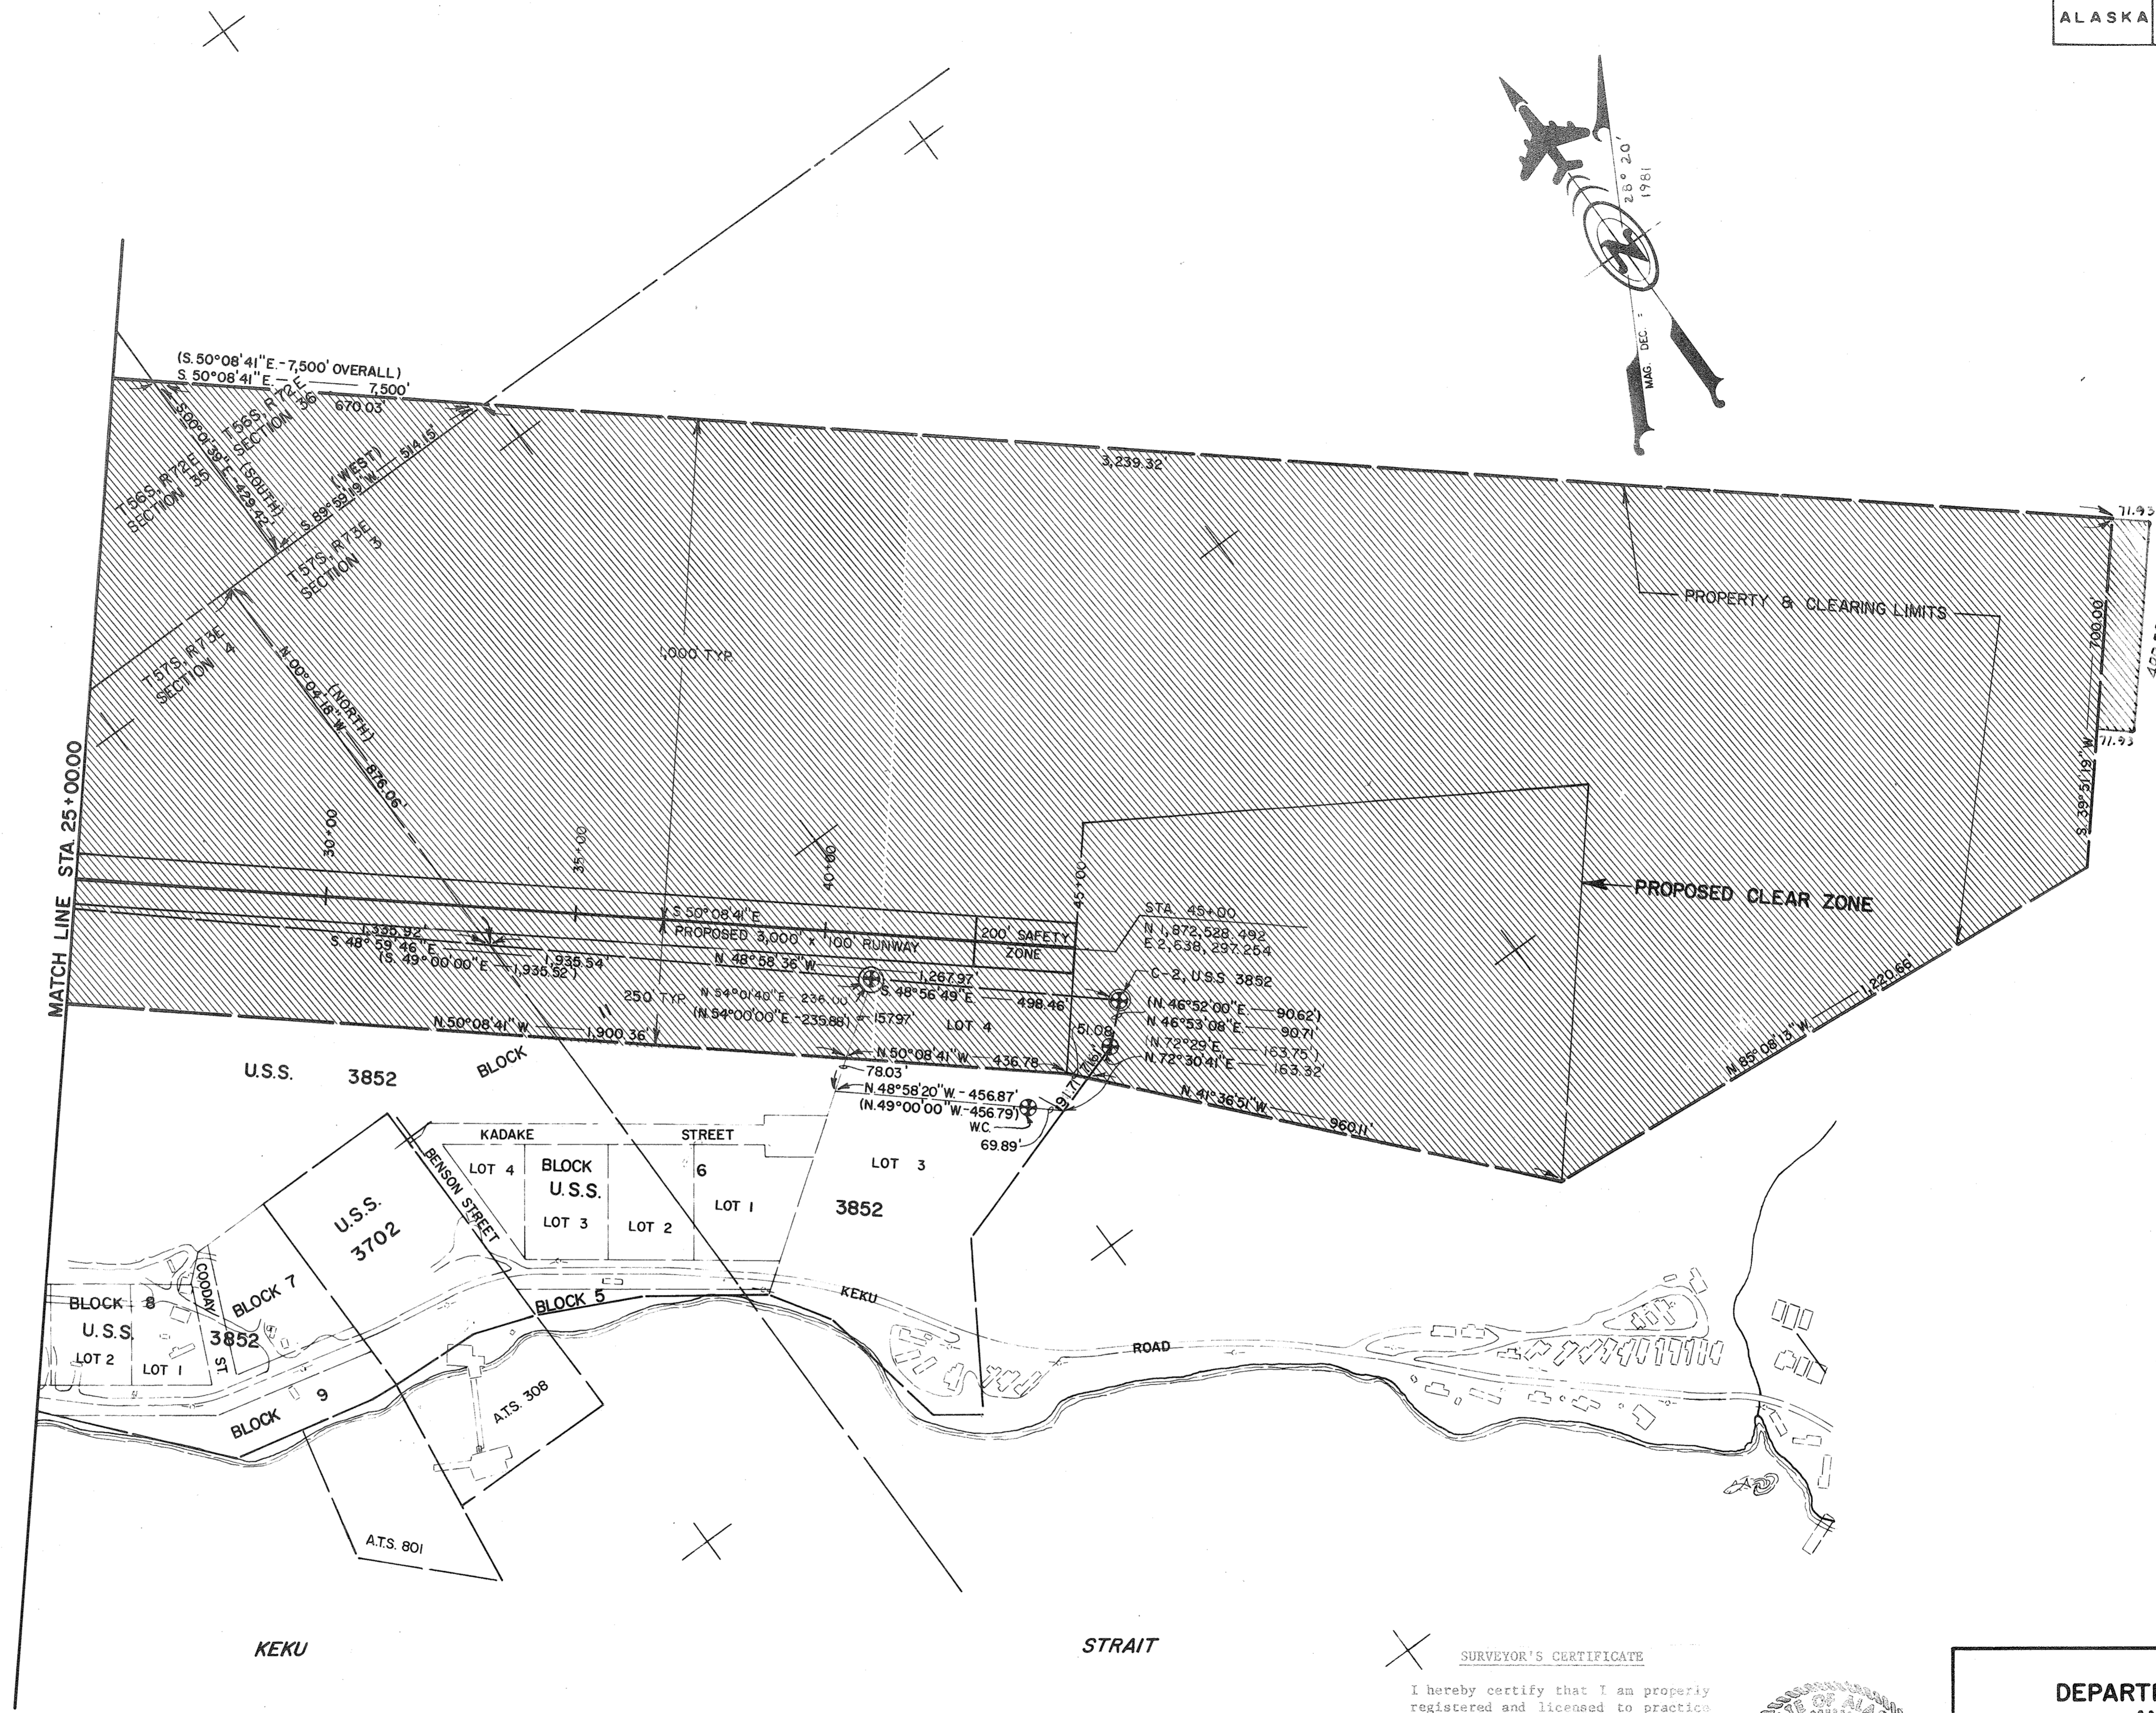STATE	PROJECT DESIGNATION	YEAR	SHEET NO.	TOTAL SHEETS
ALASKA				



**LEGEND**

-  B.C. Monuments (B.L.M.-G.L.O.)
-  Monuments to be adjusted, this contract,
-  Clearing this Contract

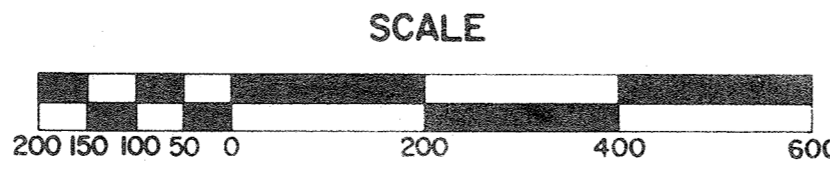

**SURVEYOR'S CERTIFICATE**

I hereby certify that I am properly registered and licensed to practice land surveying in the State of Alaska and that this plat represents a survey made by me or under my direct supervision and that the monuments shown hereon actually exist as described, and that all dimensions and other details are correct.



5115-S Registered Surveyor 6-25-83 Date

BY	DATE	CHANGE

**REVISIONS**

**STATE OF ALASKA  
DEPARTMENT OF TRANSPORTATION  
AND PUBLIC FACILITIES  
S.E. REGION, DIVISION OF AVIATION DESIGN & CONSTRUCTION**

**KAKE AIRPORT  
A.I.P. NO. 831-3-02-0398-01-83 PROJECT D-19712  
CLEARING LIMITS & PROPERTY PLAN**


APPROVED BY: *William A. Locher*  
William A. Locher S.E. Region Aviation Design Engineer

APPROVED BY: *William L. Baumgartner*  
William L. Baumgartner S.E. Region Design Engineer

SCALE: AS SHOWN DESIGNED: DRAWN: DATE: 6/29/83

CHECKED: *18* SHEET 17 OF 19


MISCELLANEOUS DETAILS

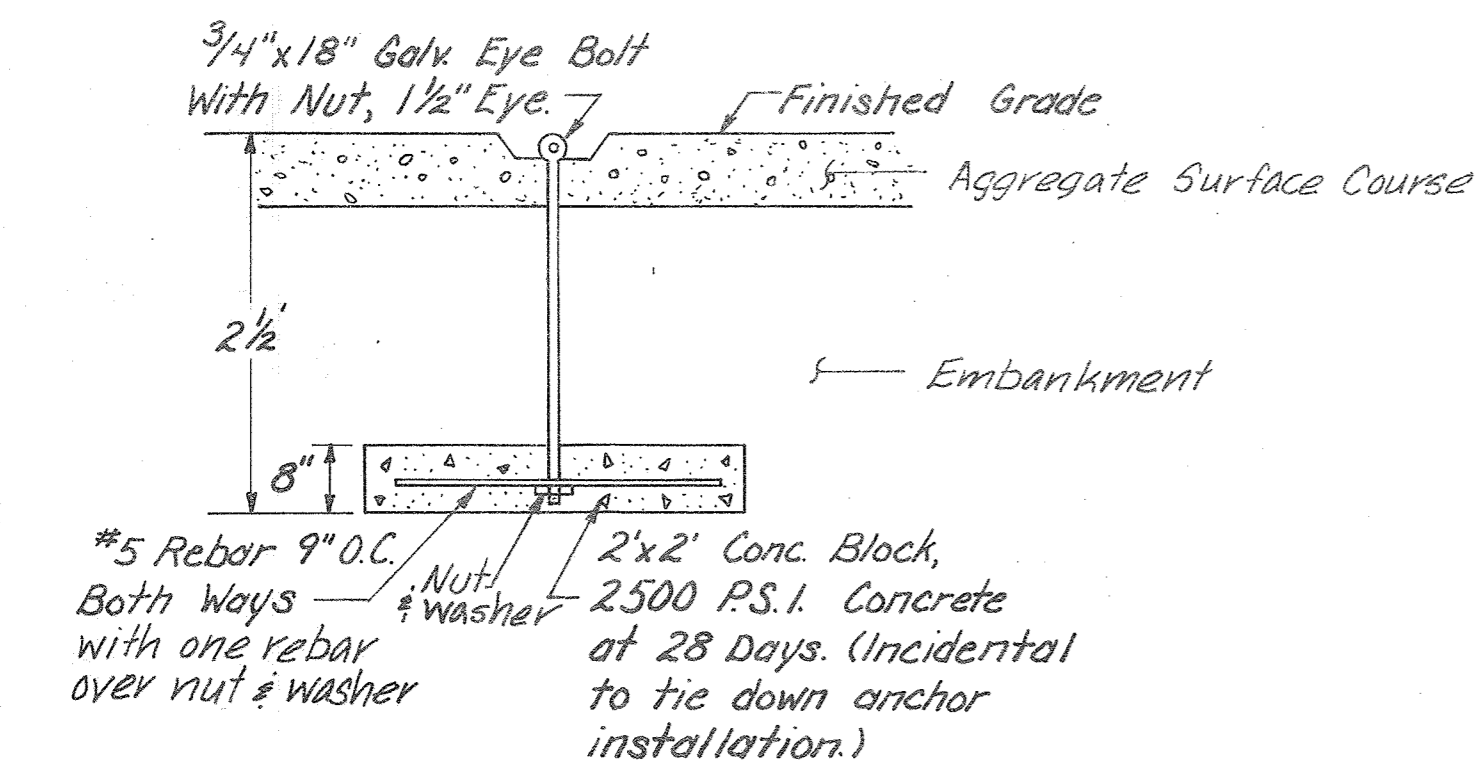


**EMBANKMENT TIE-DOWN ANCHOR**  
N.T.S.

TIE-DOWN ANCHOR NOTES

- 1) It is the Contractor's responsibility to verify the type of material in the Tie-Downs.
- 2) Depth of anchor shall be as required to develop 5000 lbs. of pullout strength per anchor.
- 3) When rock is encountered, rock anchors shall be used. Rod diameter shall be 3/4".
- 4) All eye-bolts shall be ASTM A-36, 40,000 P.S.I. min. yield strength.

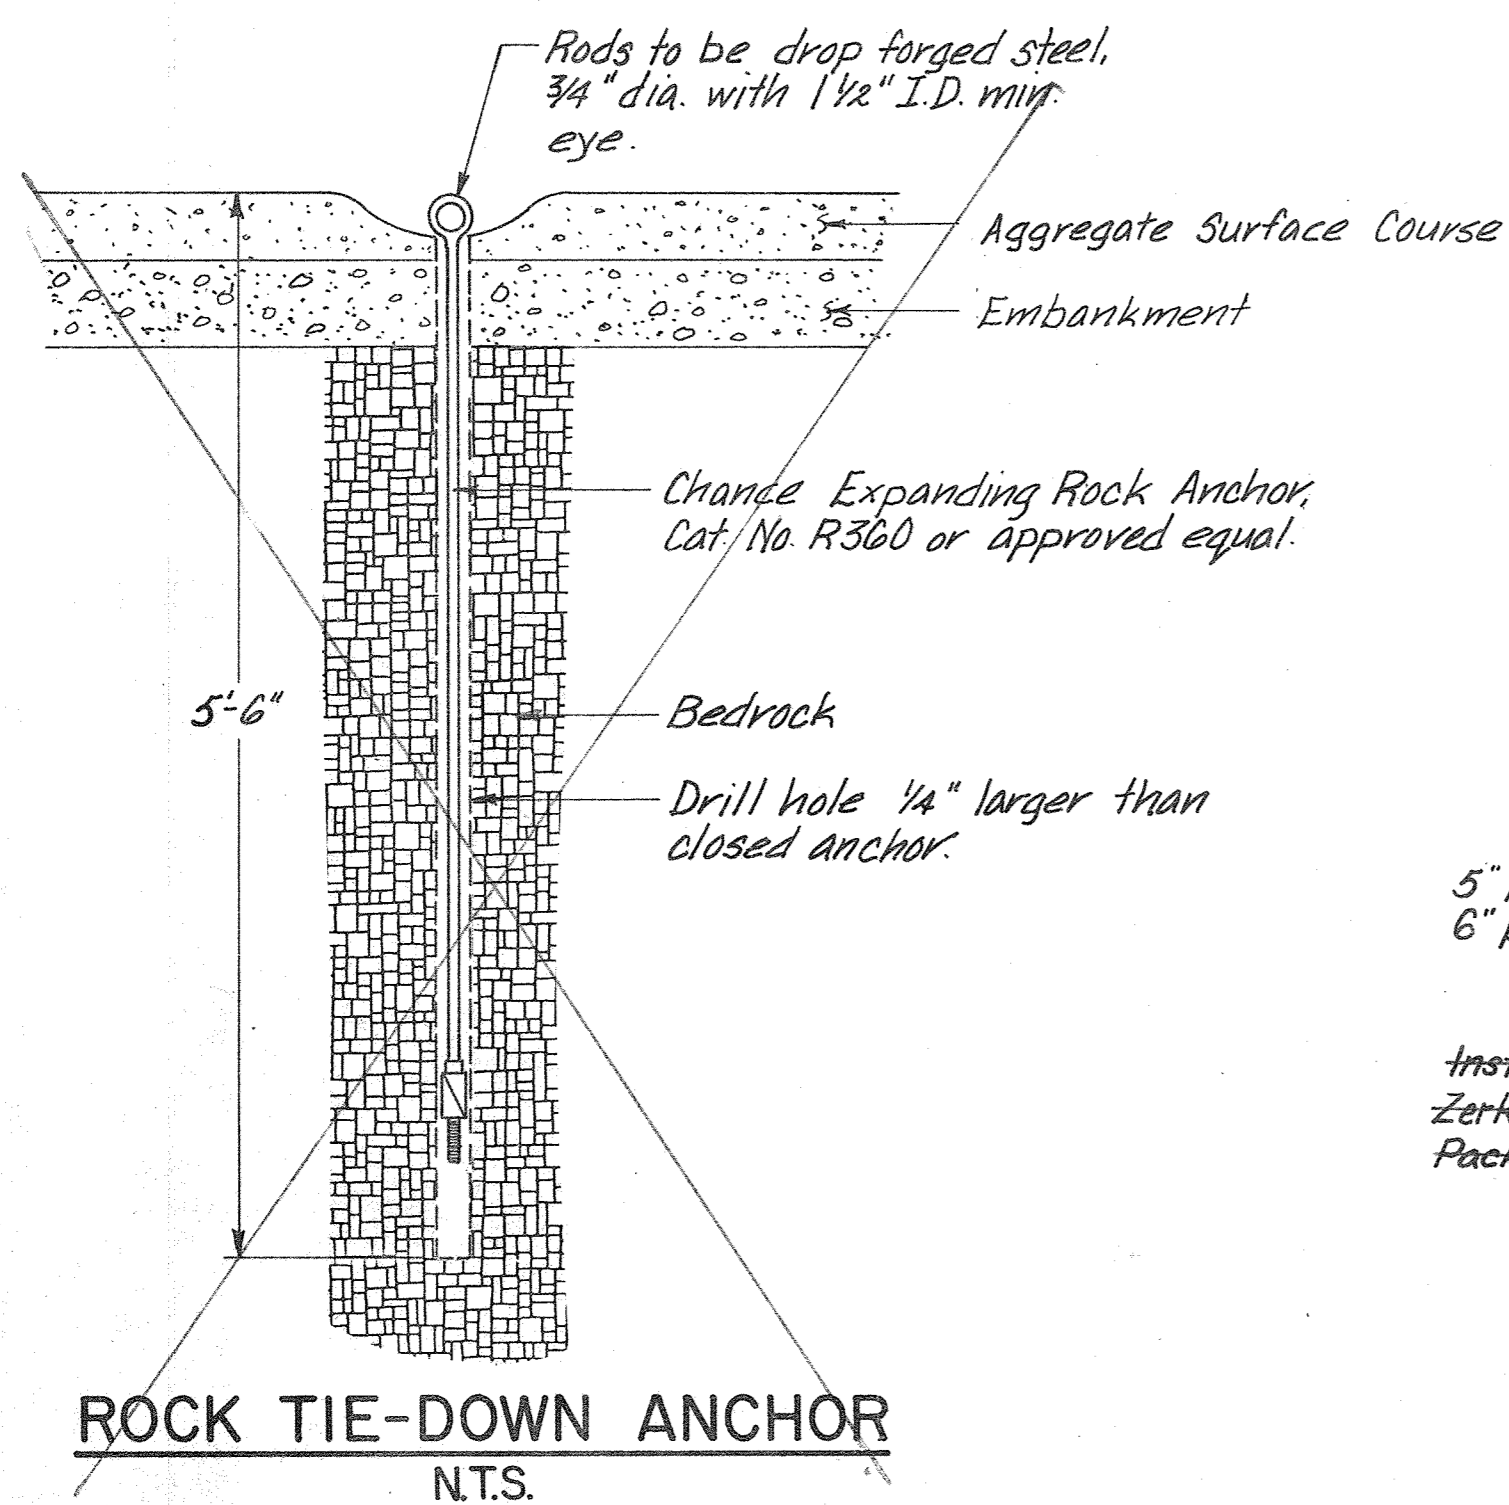


**ROCK TIE-DOWN ANCHOR**  
N.T.S.

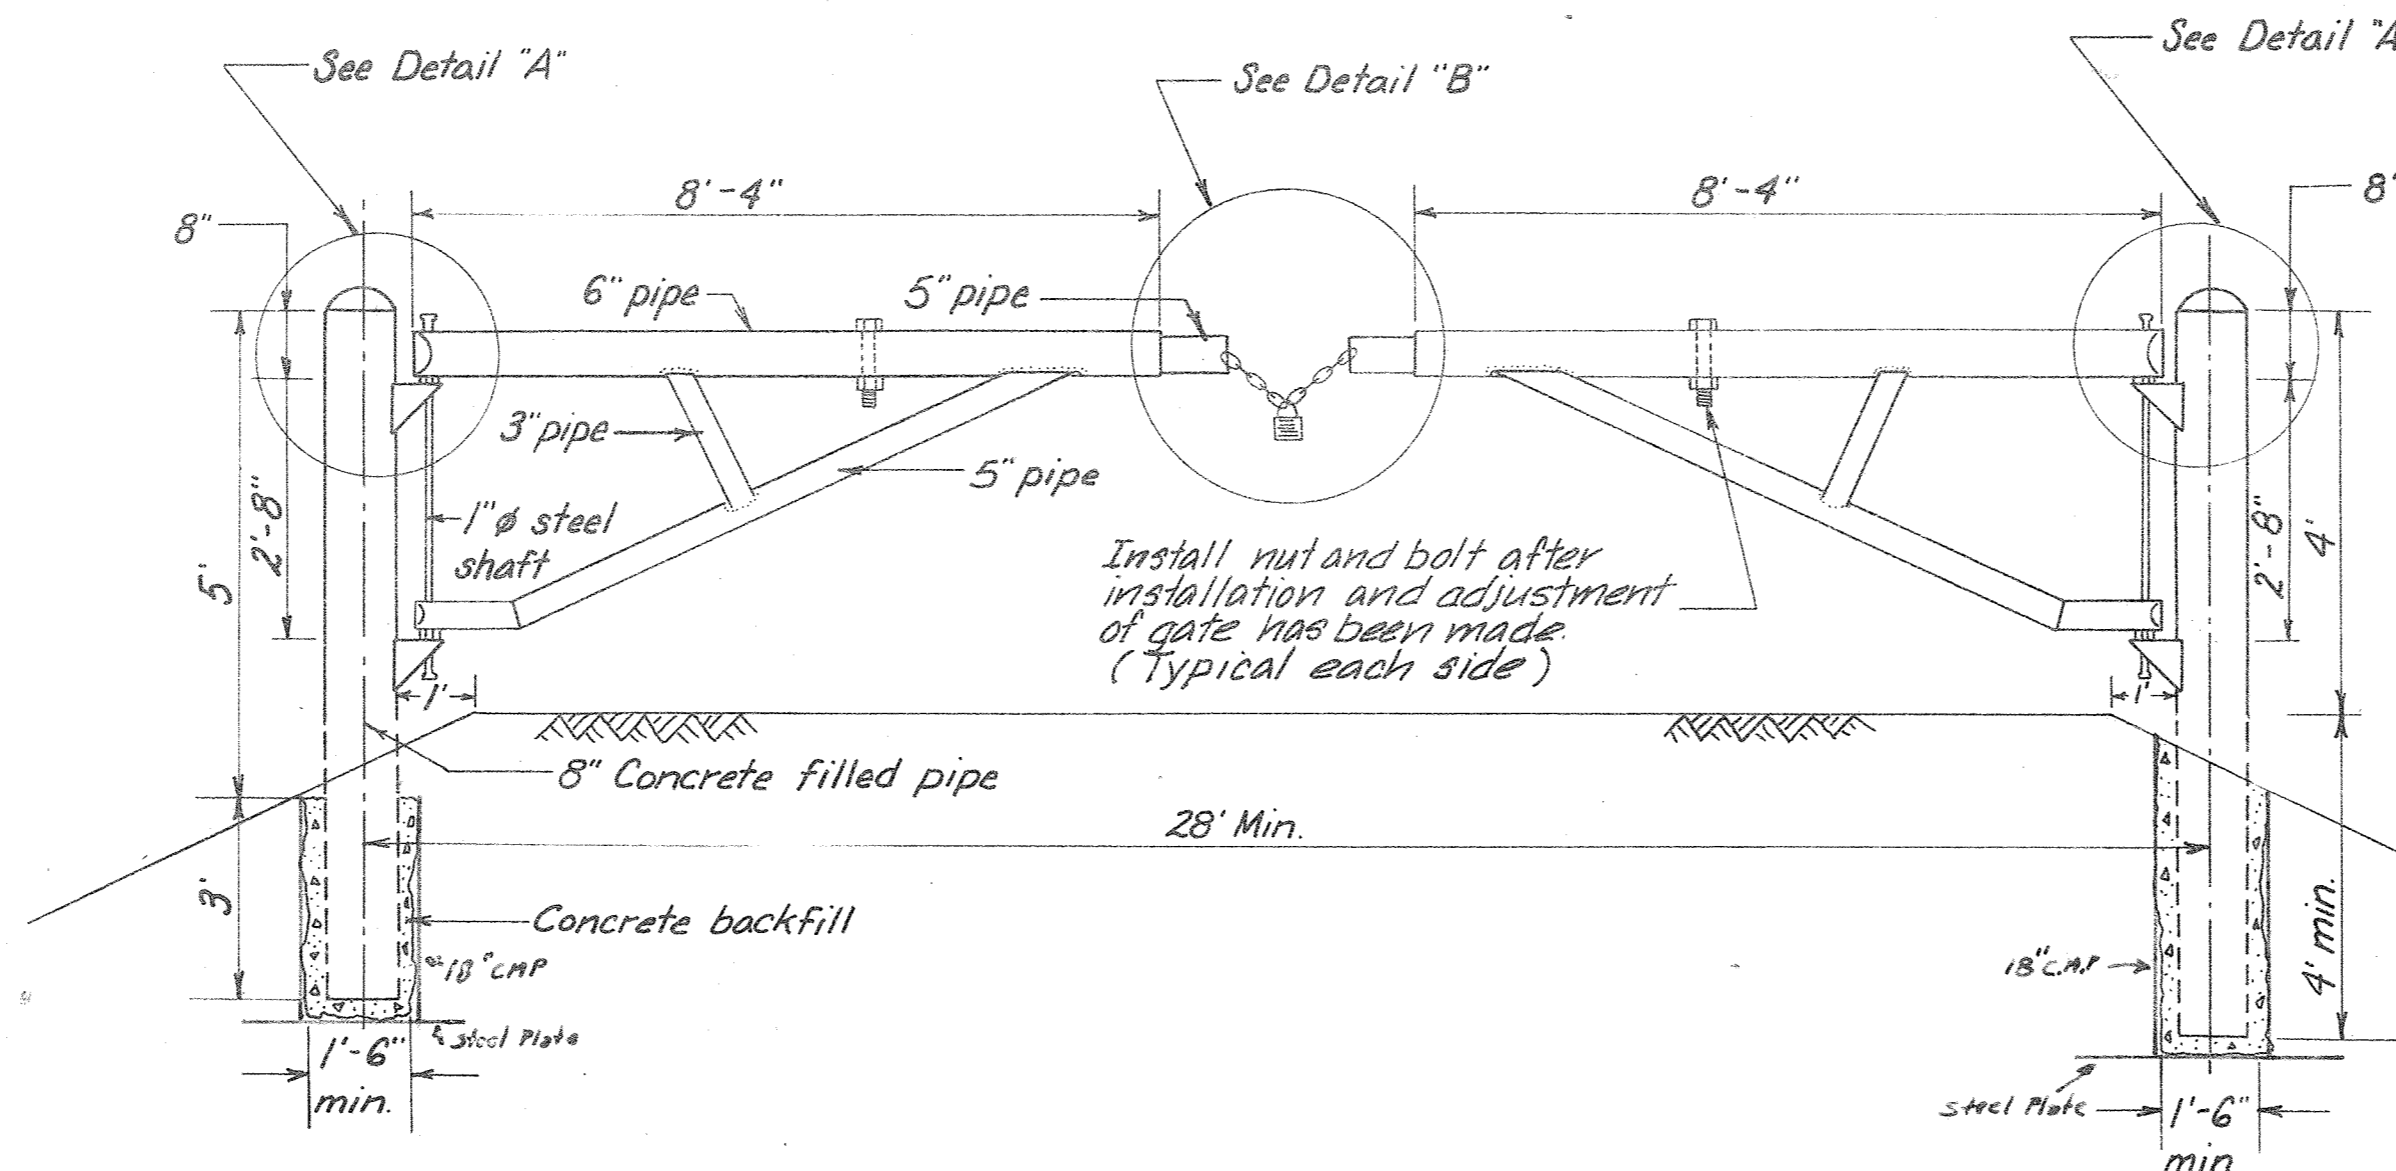


**SECURITY GATE DETAIL \***  
STA. "A" 0+75  
N.T.S.


\* Security Gate is incidental to other Pay Items of Work

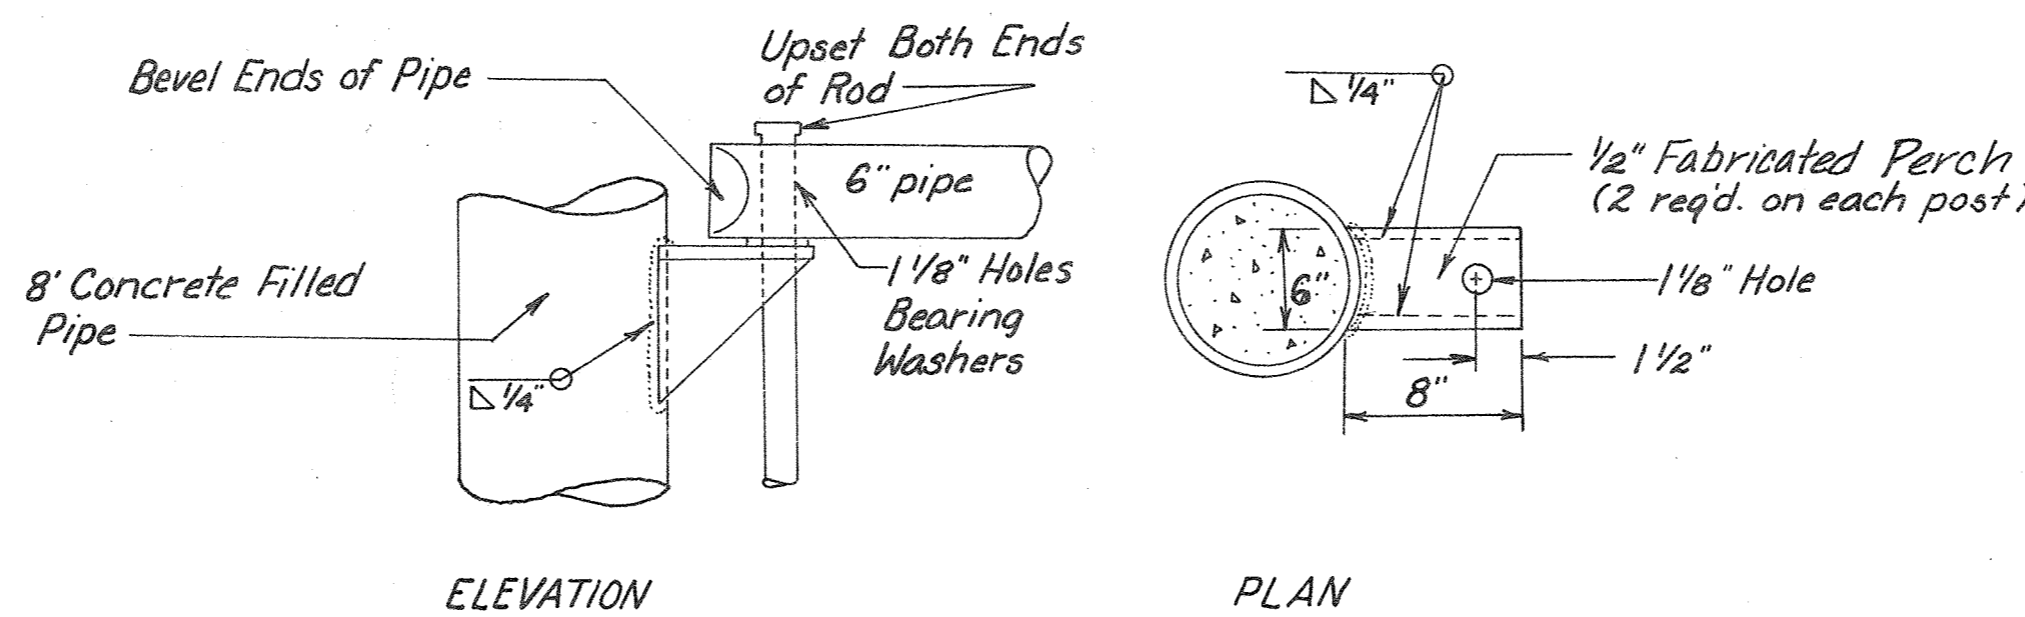


**DETAIL "A"**  
N.T.S.

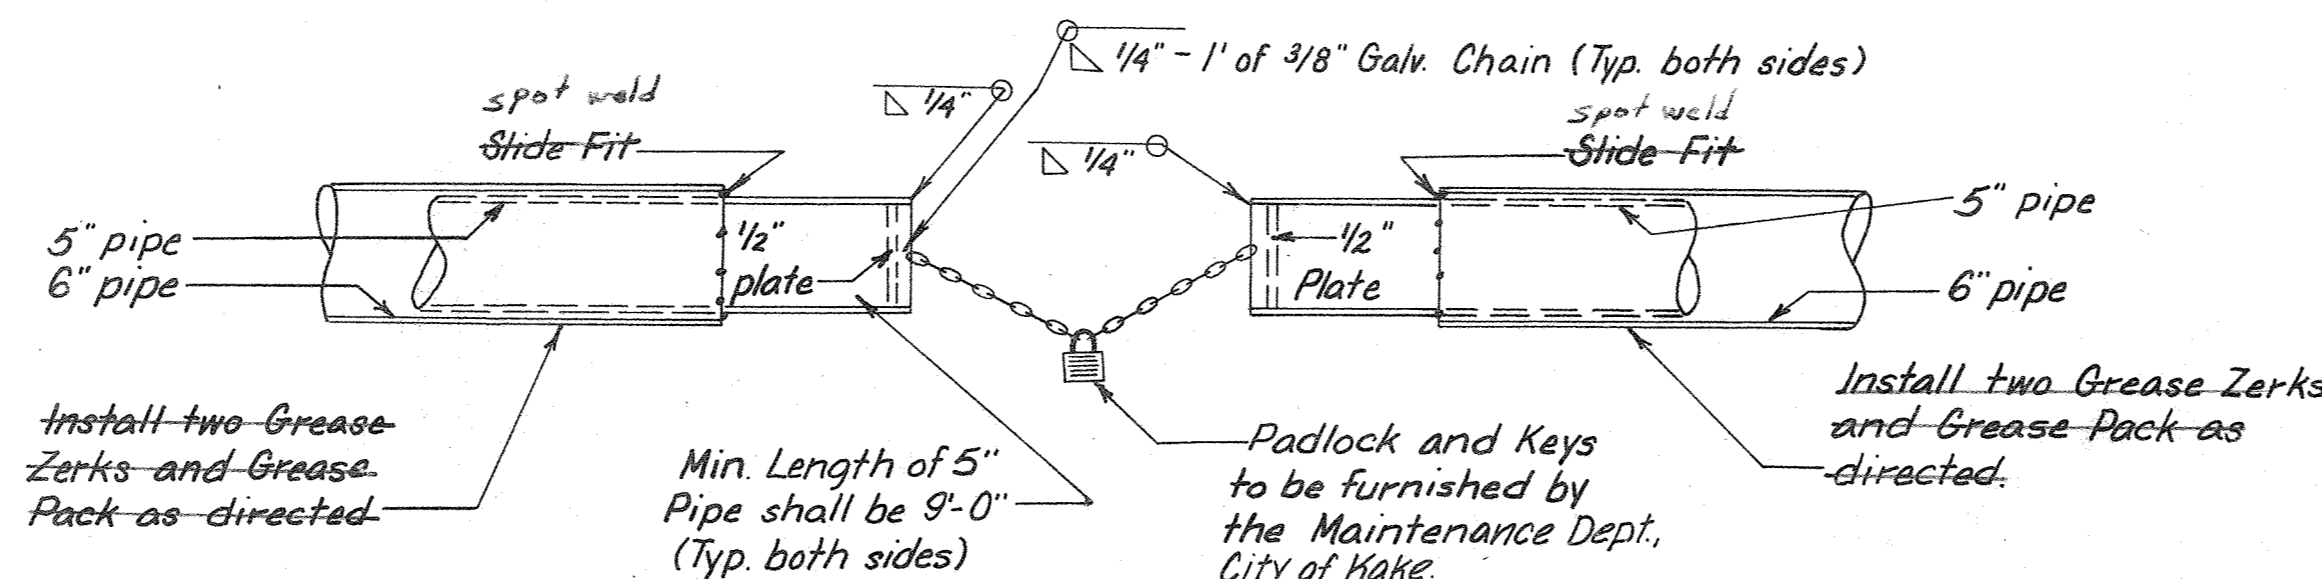

**DETAIL "B"**  
N.T.S.

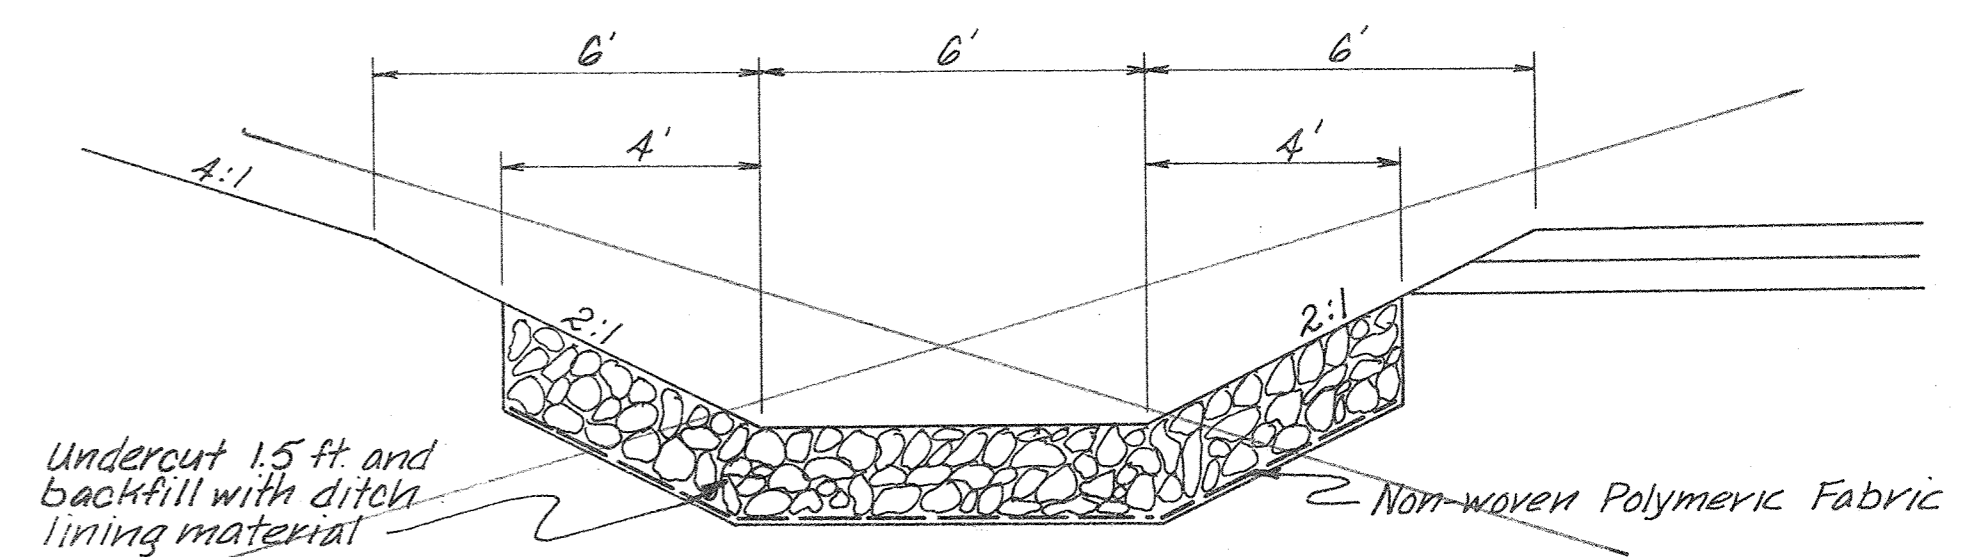


**SPECIAL DITCH DIVERSION CHANNEL**  
See Summary Table, Sheet 3

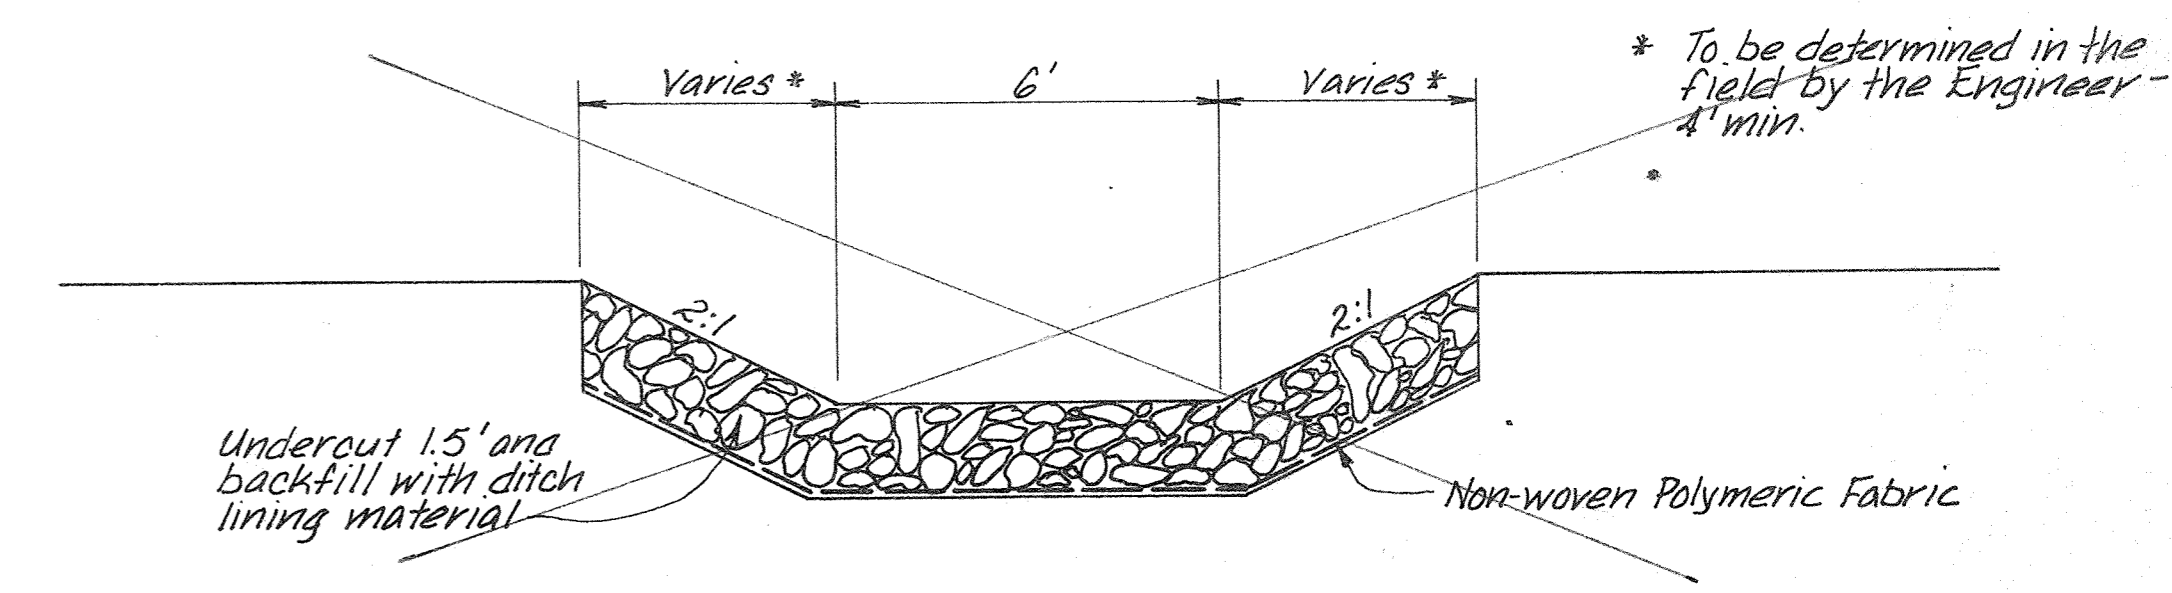

**CROSS SLOPE CREEK DIVERSION CHANNEL**  
See Summary Table, Sheet 3

SECURITY GATE NOTES

- 1) All pipe shall be schedule 40 pipe.
- 2) All items to be fabricated shall be made of 1/2" mild steel plate or flat bar.
- 3) Prior to erecting the gate, it shall be painted with one coat of Zinc Chromate Primer and one coat of International Orange Paint.

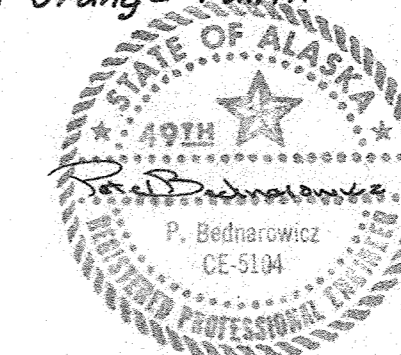


STATE OF ALASKA  
DEPARTMENT OF TRANSPORTATION  
AND PUBLIC FACILITIES  
S.E. REGION, DIVISION OF AVIATION DESIGN & CONSTRUCTION

**KAKE AIRPORT**  
A.I.P. NO. 831-3-02-0398-01-83  
PROJECT NO. D-19712  
MISCELLANEOUS DETAILS


APPROVED BY: <i>William A. Locher</i> WILLIAM A. LOCHER, P.E. S.E. REGION AVIATION DESIGN ENGINEER	
APPROVED BY: <i>William L. Baumgartner</i> WILLIAM L. BAUMGARTNER, P.E. S.E. REGION DESIGN ENGINEER	
BY	DATE
REVISIONS	
SCALE: AS SHOWN	CHECKED: PB
DESIGNED: DM	DATE: 6/29/83
SHEET 18 OF 19	

MISCELLANEOUS DETAILS

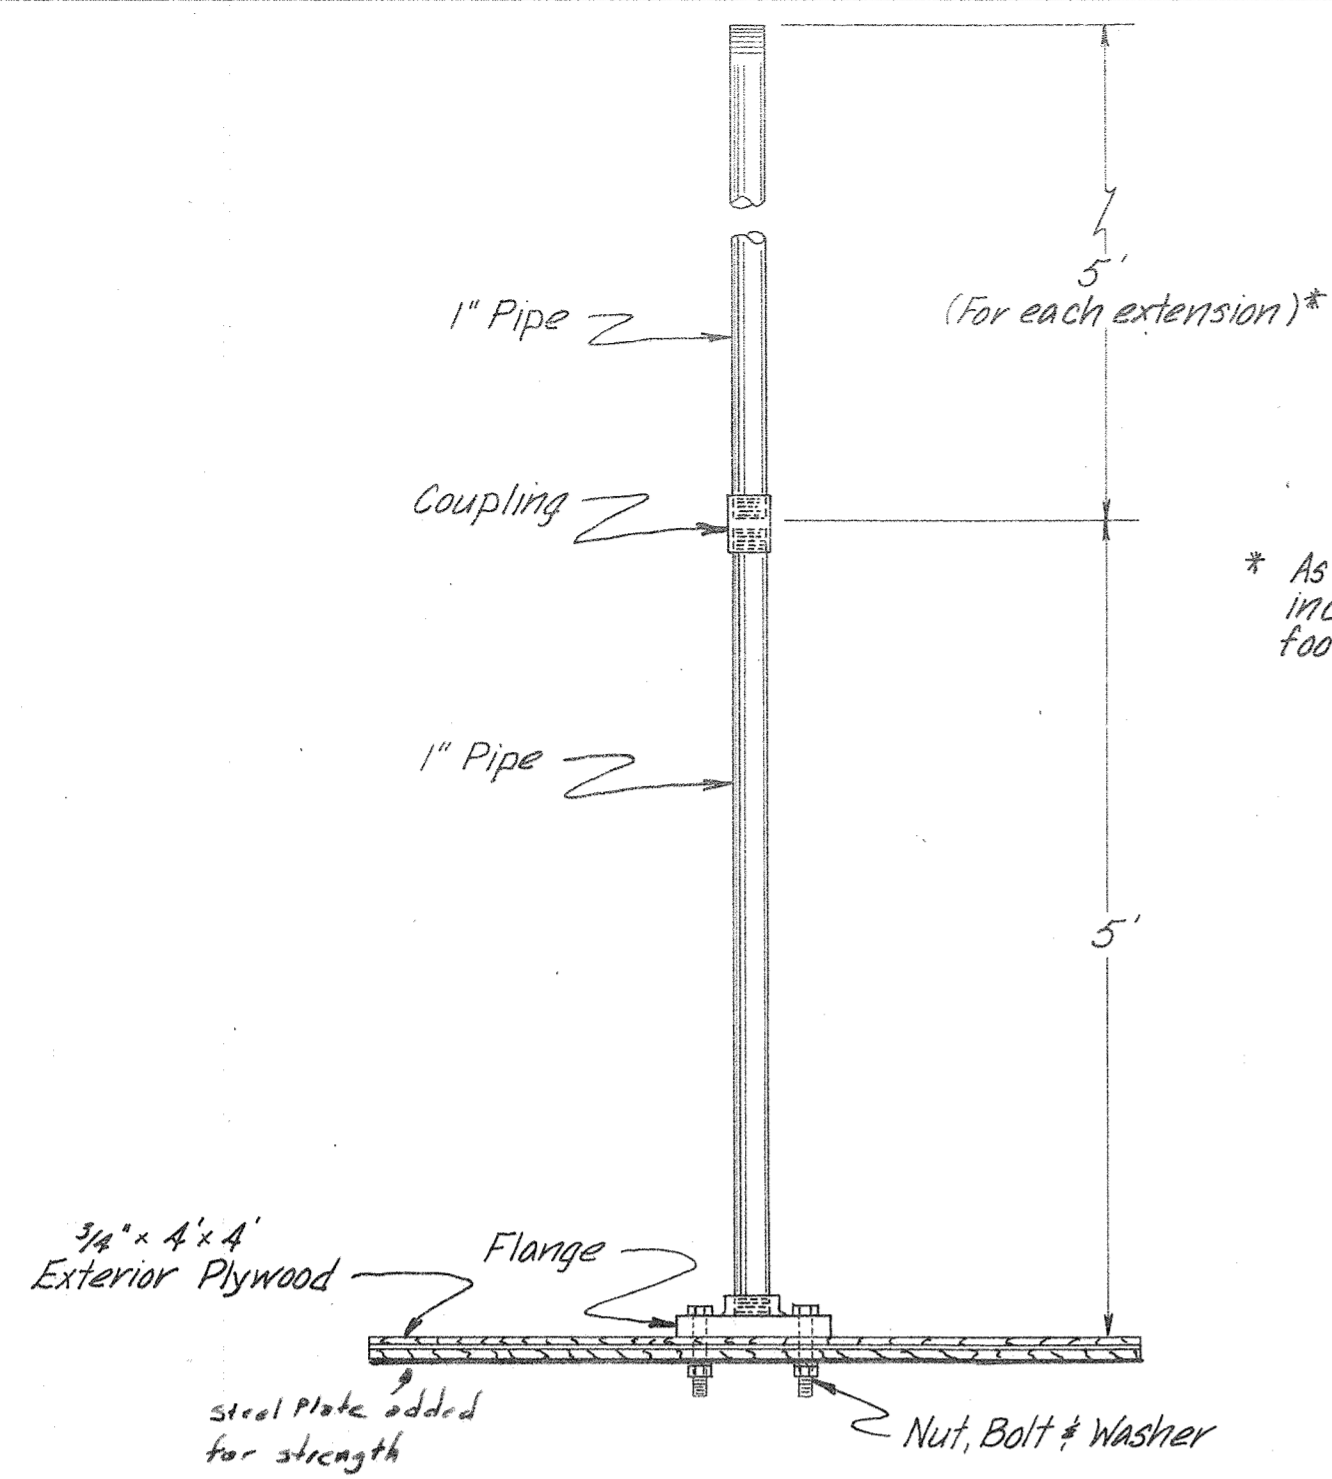

SETTLEMENT PLATFORM DETAIL

N.T.S.  
See Summary Table, Sheet 3

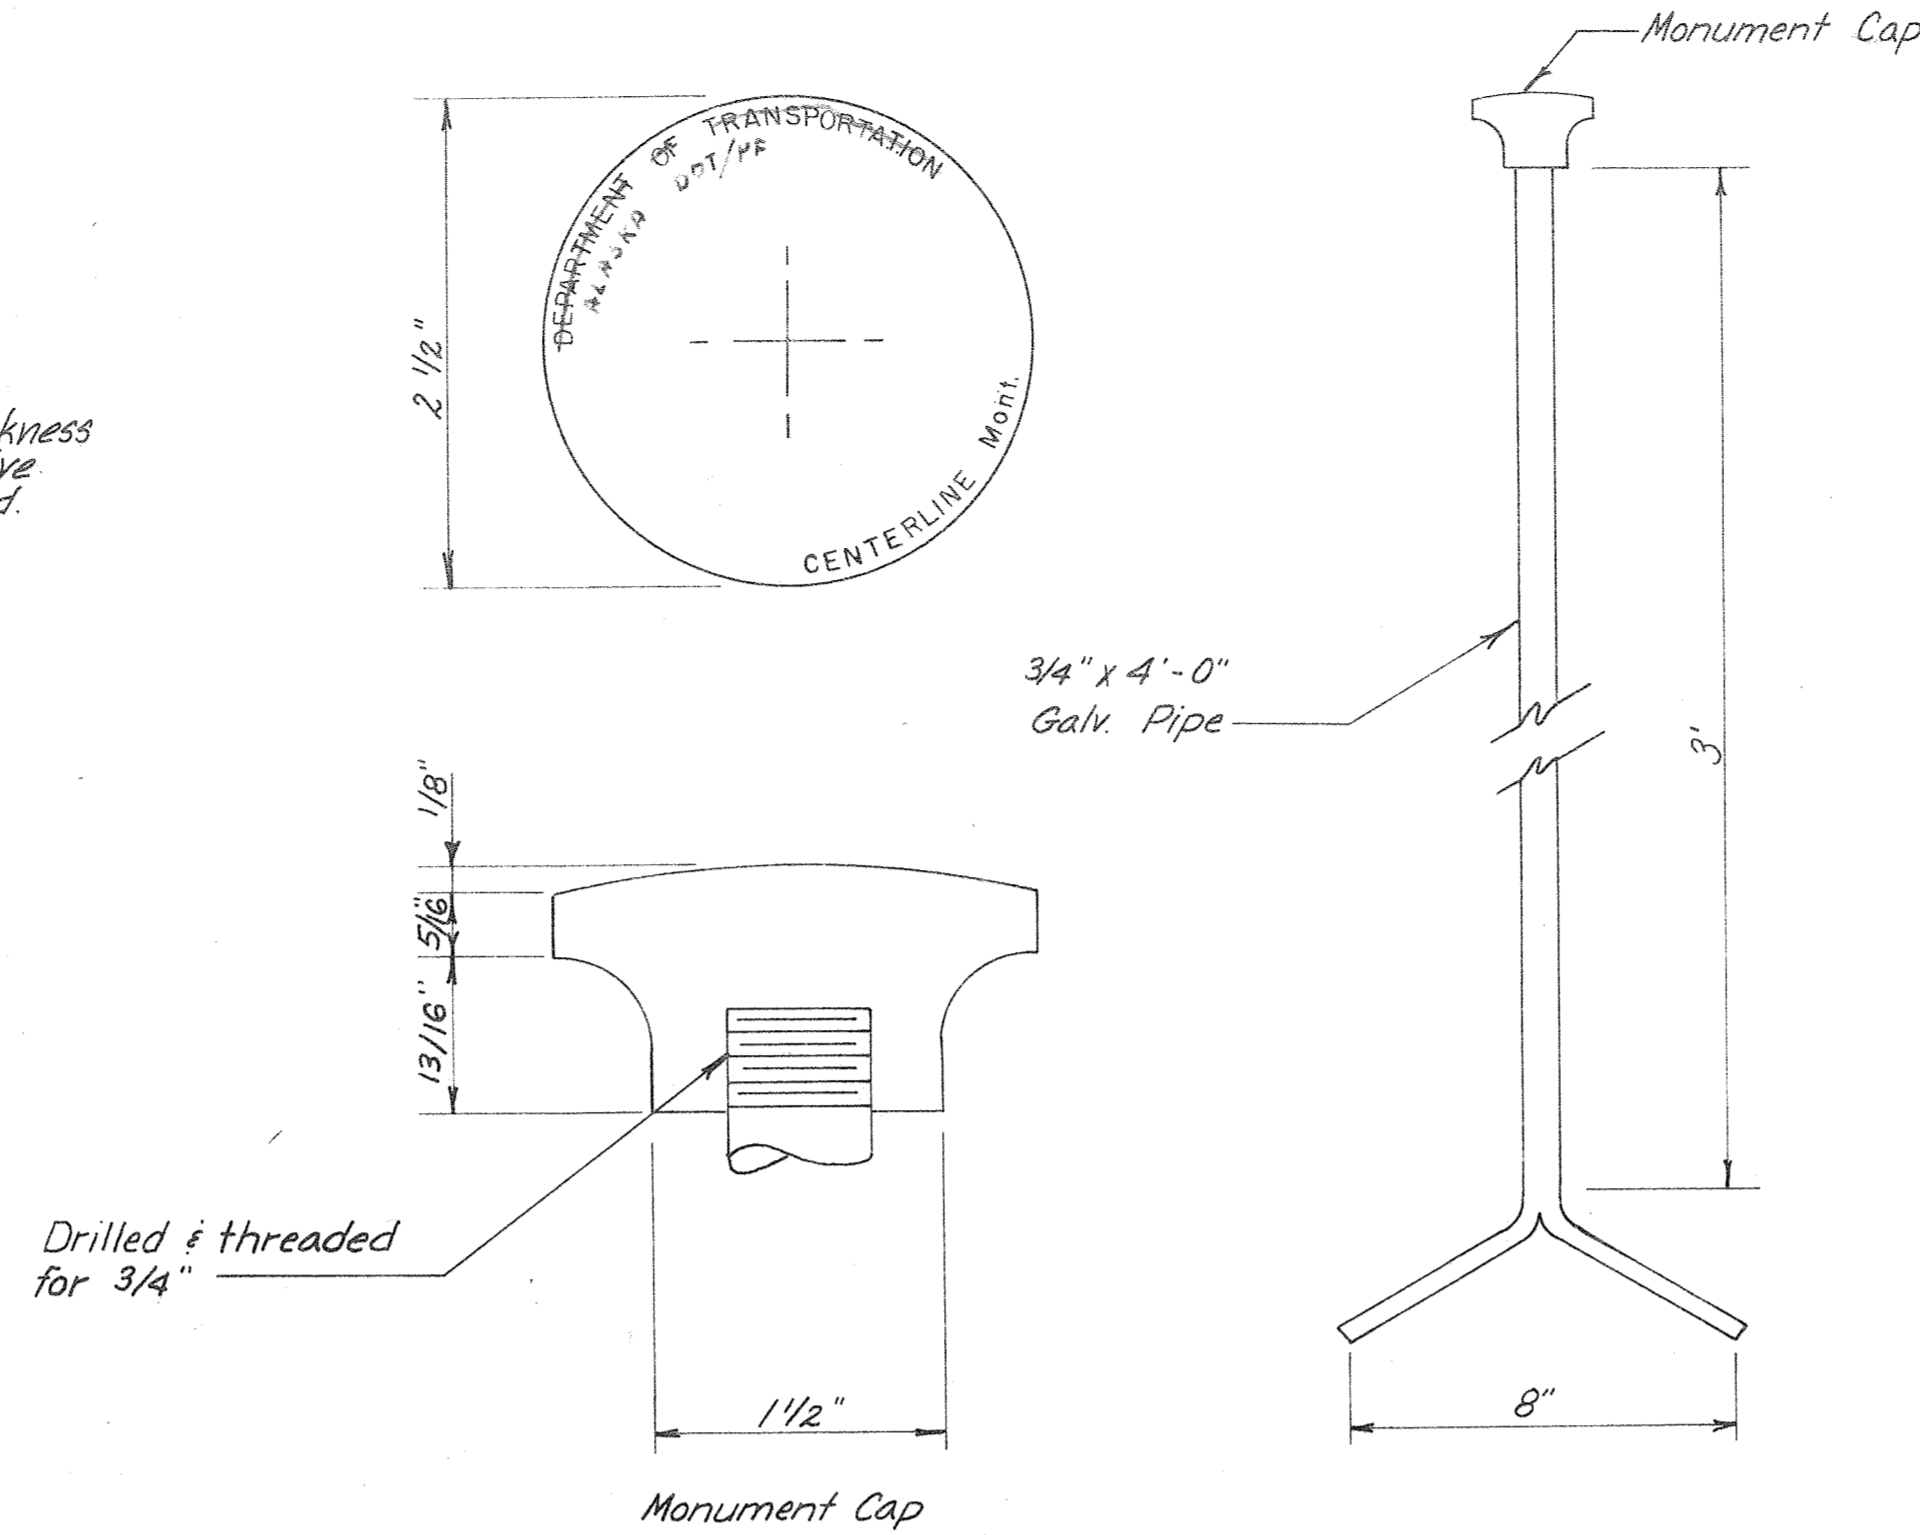


MONUMENT DETAIL

N.T.S.


MONUMENT DETAIL NOTES

1. In solid rock, drill a 2" dia. hole a minimum of 1'-0" deep, fill with mortar and set cap. 3/4" x 9" galvanized pipe, designated length when set in mortar.
2. Monuments shall be placed 6" below top of the finished surface.

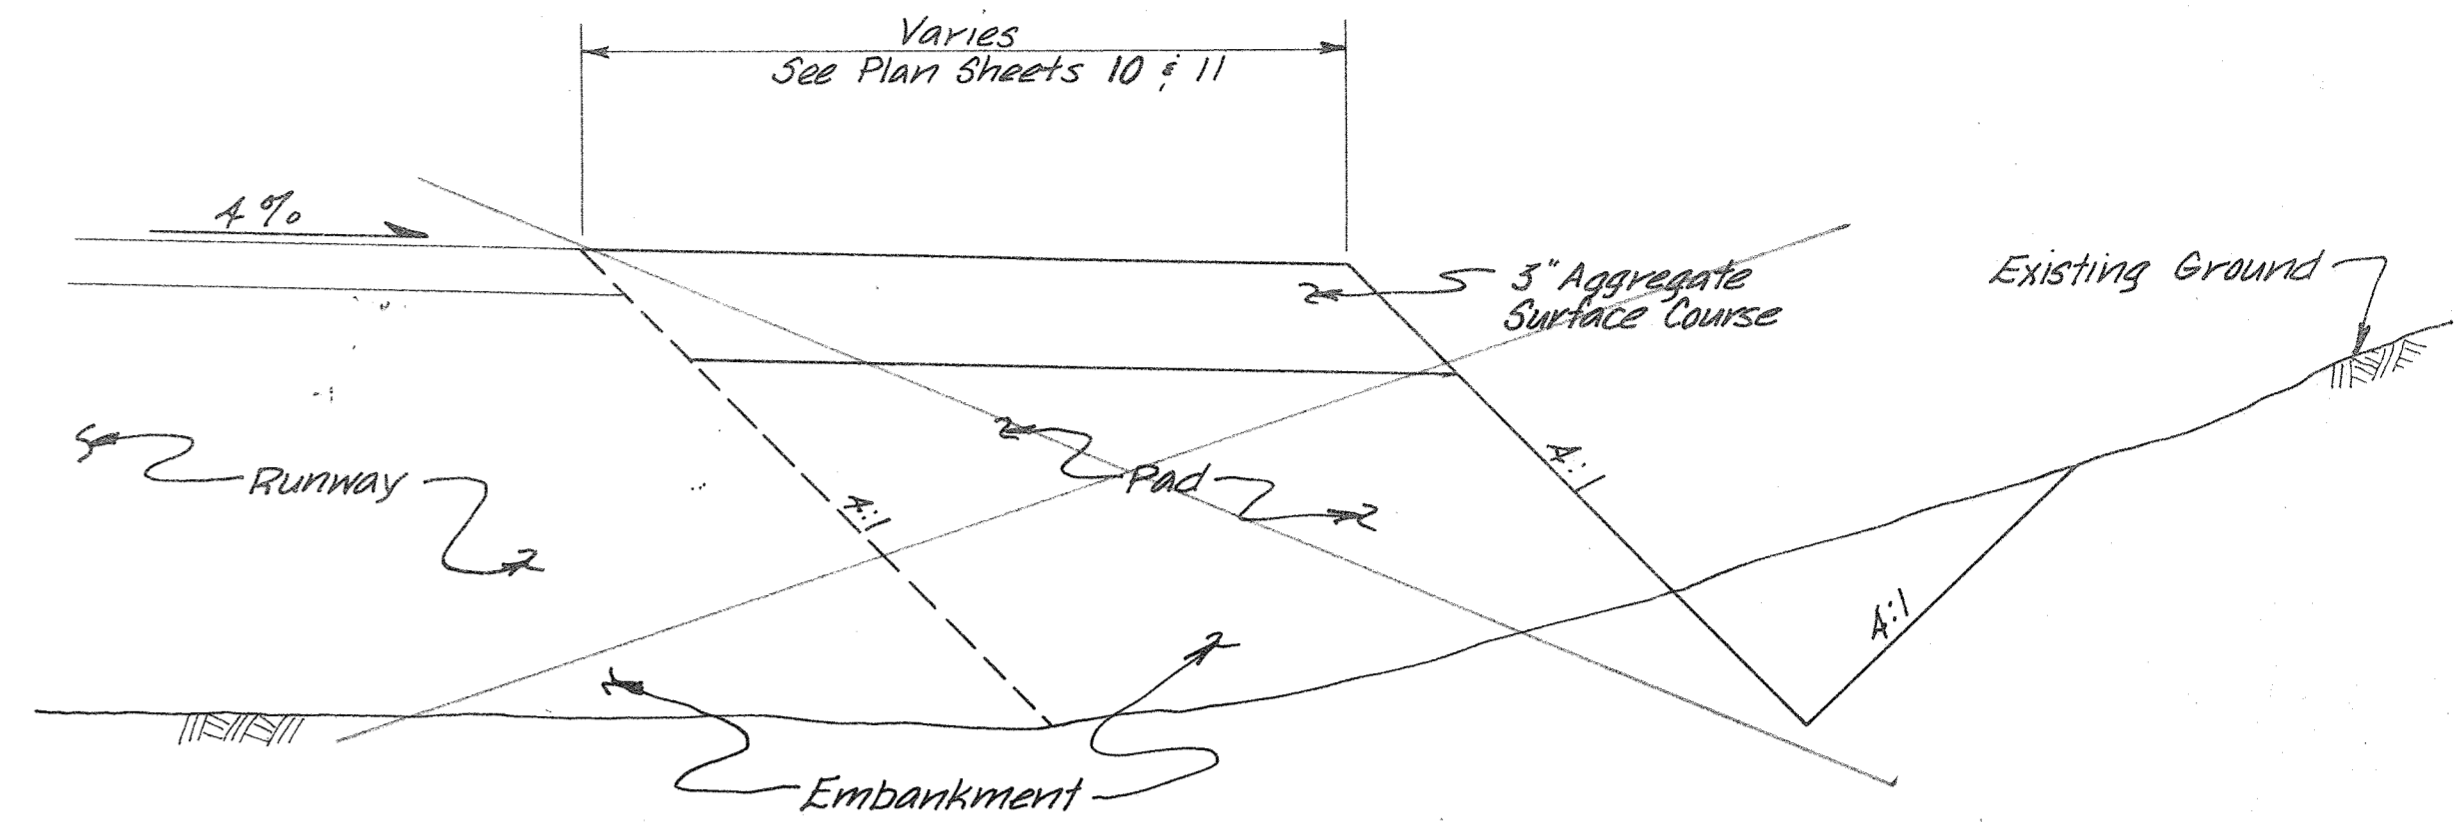

AIRPORT LIGHTING PAD SECTION

N.T.S.

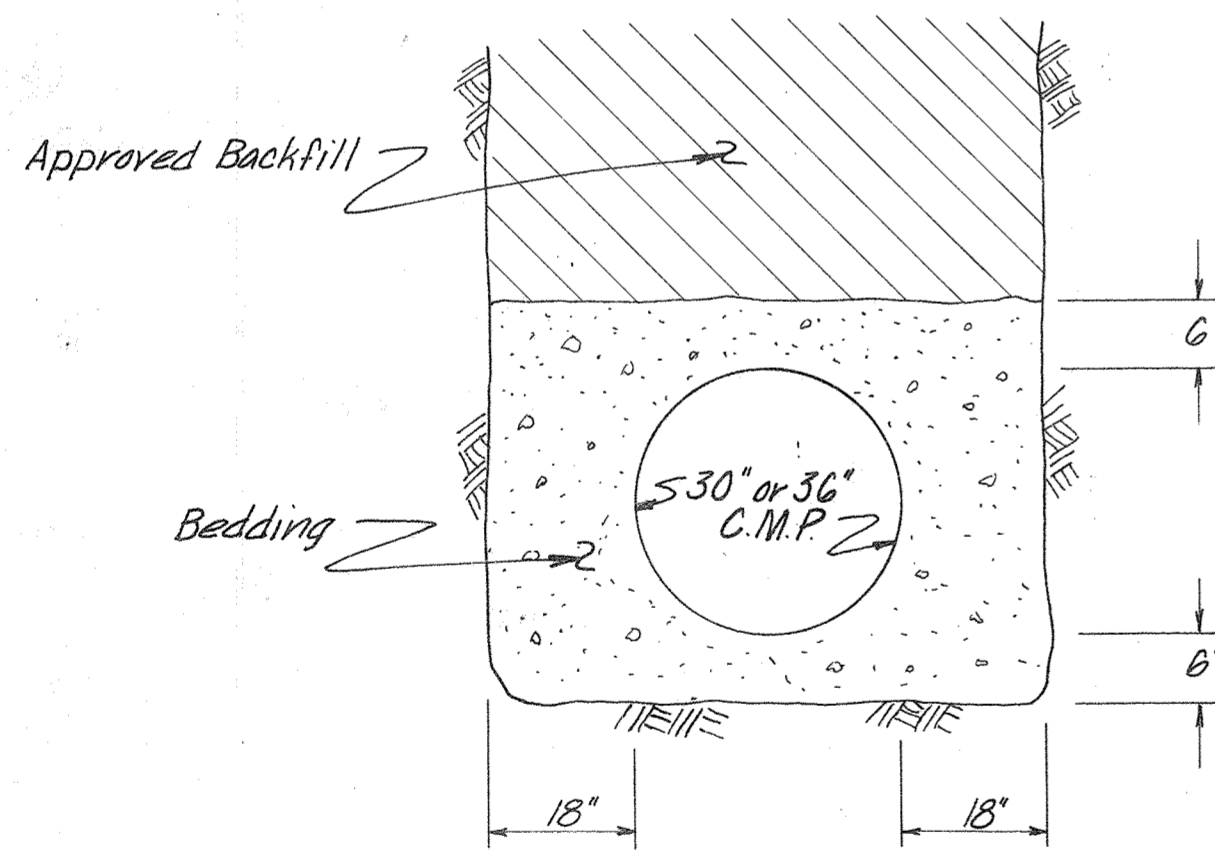


PIPE BEDDING DETAIL

N.T.S.


PIPE BEDDING NOTES

- 1) When the pipe is located on unsuitable material (determined by the Engineer), remove unsuitable material and backfill in accordance with Items 330a, 330b and 330c.
- 2) Bedding material shall be Type "C" gradation, in accordance with Section 400.

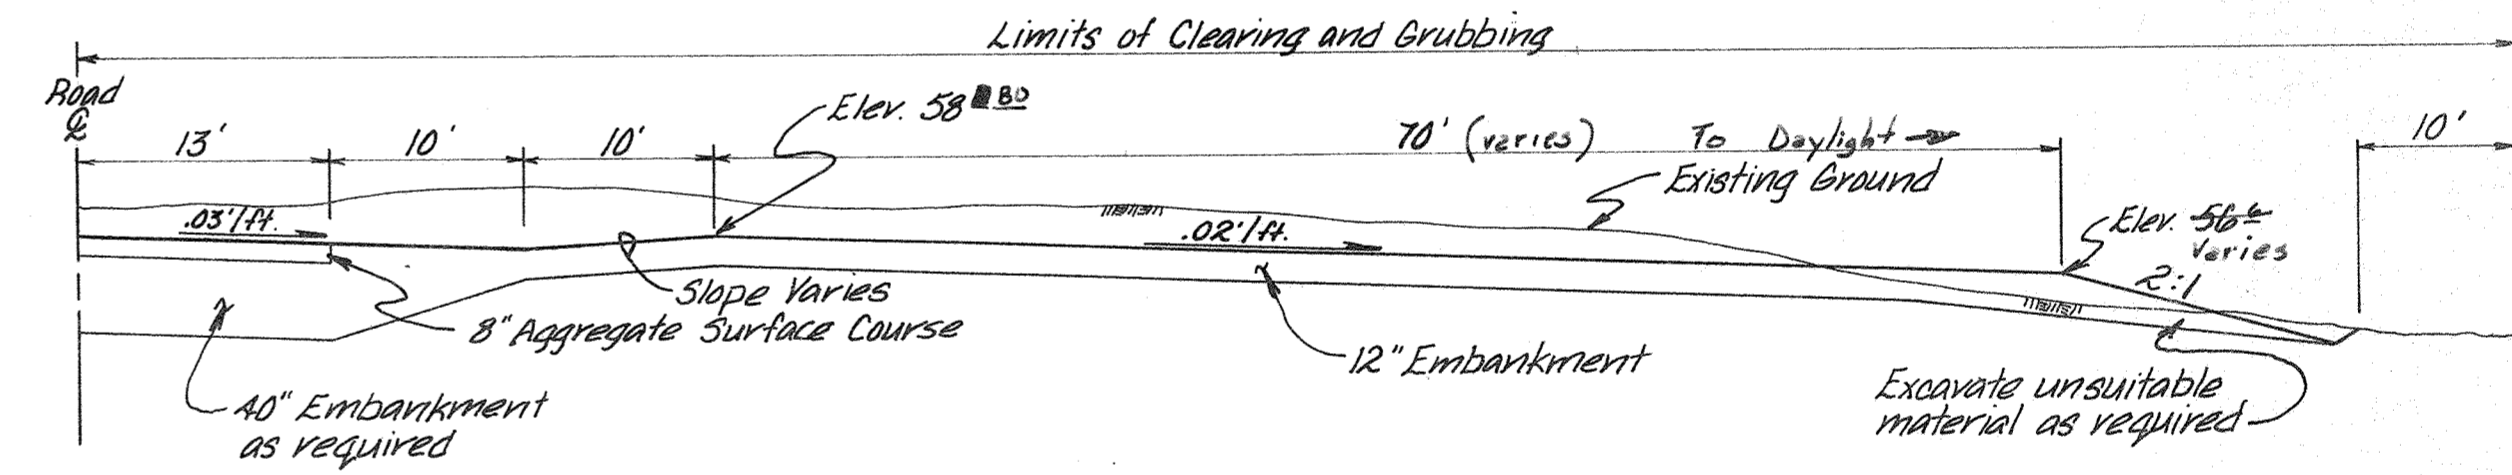

PAD DEVELOPMENT SECTION

N.T.S.

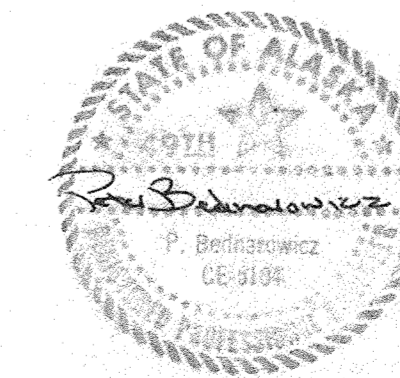

STATE OF ALASKA  
DEPARTMENT OF TRANSPORTATION  
AND PUBLIC FACILITIES  
S.E. REGION, DIVISION OF AVIATION DESIGN & CONSTRUCTION

KAKE AIRPORT  
A.I.P. NO. 831-3-02-0398-01-83  
PROJECT NO. D-19712  
MISCELLANEOUS DETAILS

APPROVED BY: *William A. Locher*  
WILLIAM A. LOCHER, P.E. S.E. REGION AVIATION DESIGN ENGINEER



APPROVED BY: *William L. Baumgartner*  
WILLIAM L. BAUMGARTNER, P.E. S.E. REGION DESIGN ENGINEER

BY	DATE	CHANGE	SCALE:	DESIGNED:	DRAWN:	CHECKED:	DATE:	SHEET 19 OF 19
			AS SHOWN				6/29/83	

REVISIONS

PLAN	DATE	BY	CHKD.
NO.			

PROFILE	DATE	BY	CHKD.
NO.			

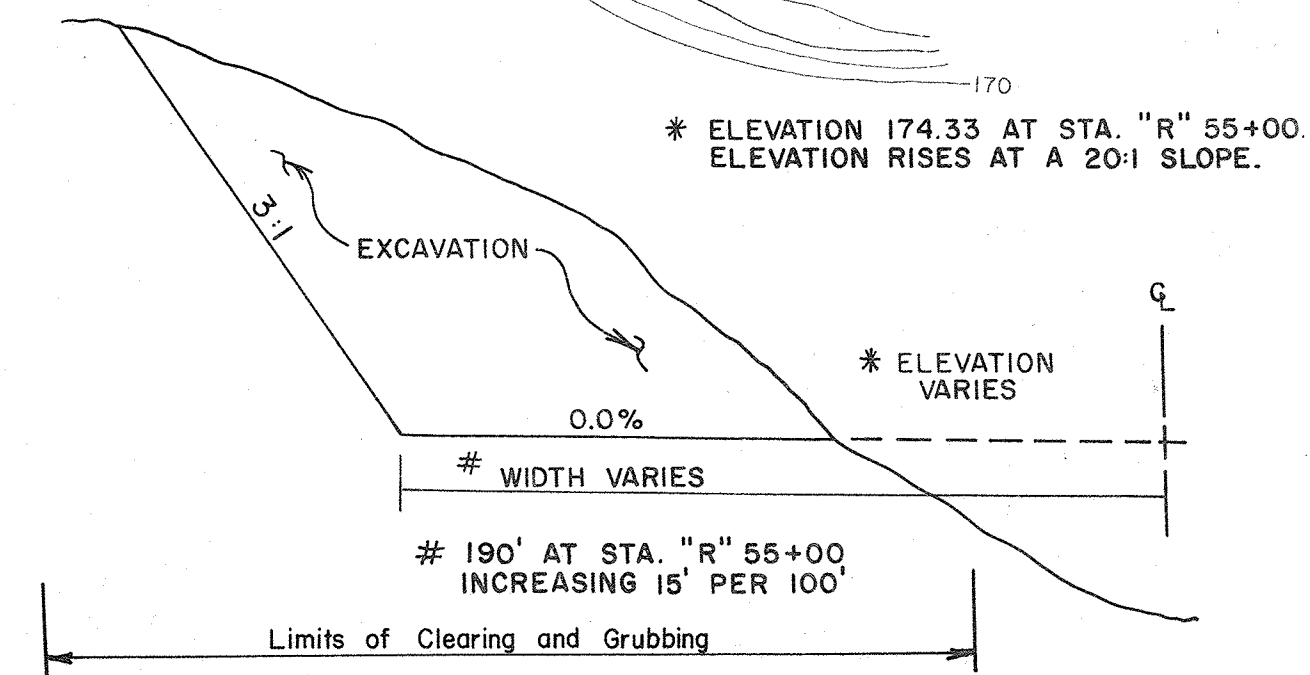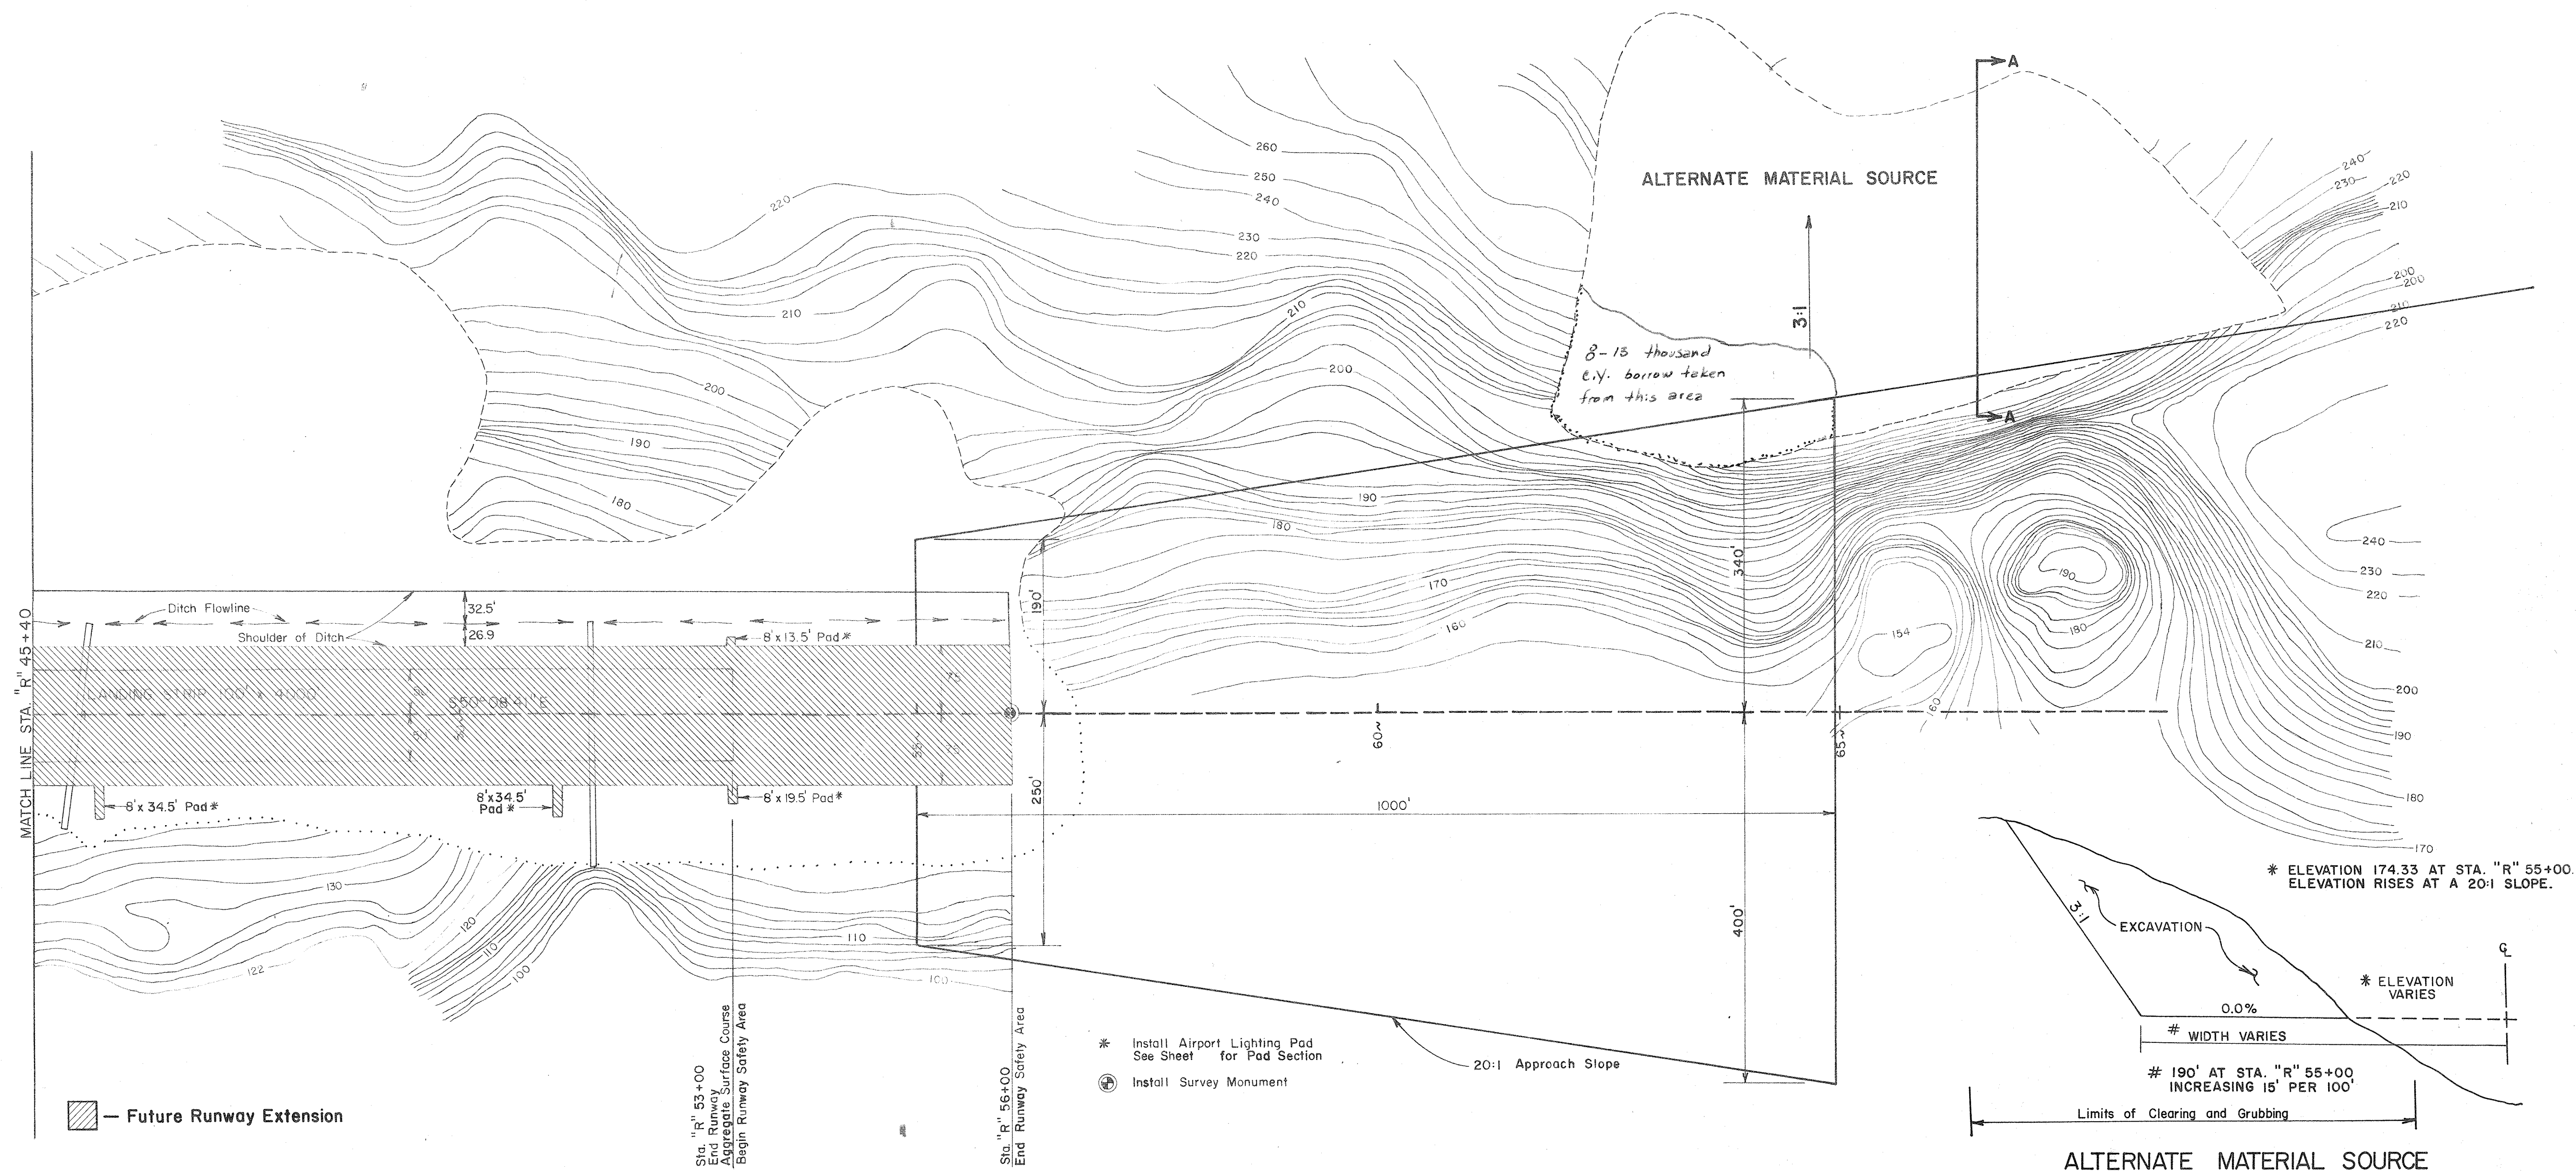

ALTERNATE MATERIAL SOURCE  
SECTION A-A  
STA. "R" 61+80 TO STA. "R" 69+90

