





**GENERAL NOTES**

1. Culvert lengths are approximate only and are subject to minor revisions.
2. Grades and alignment shown on these plans are subject to minor revisions.

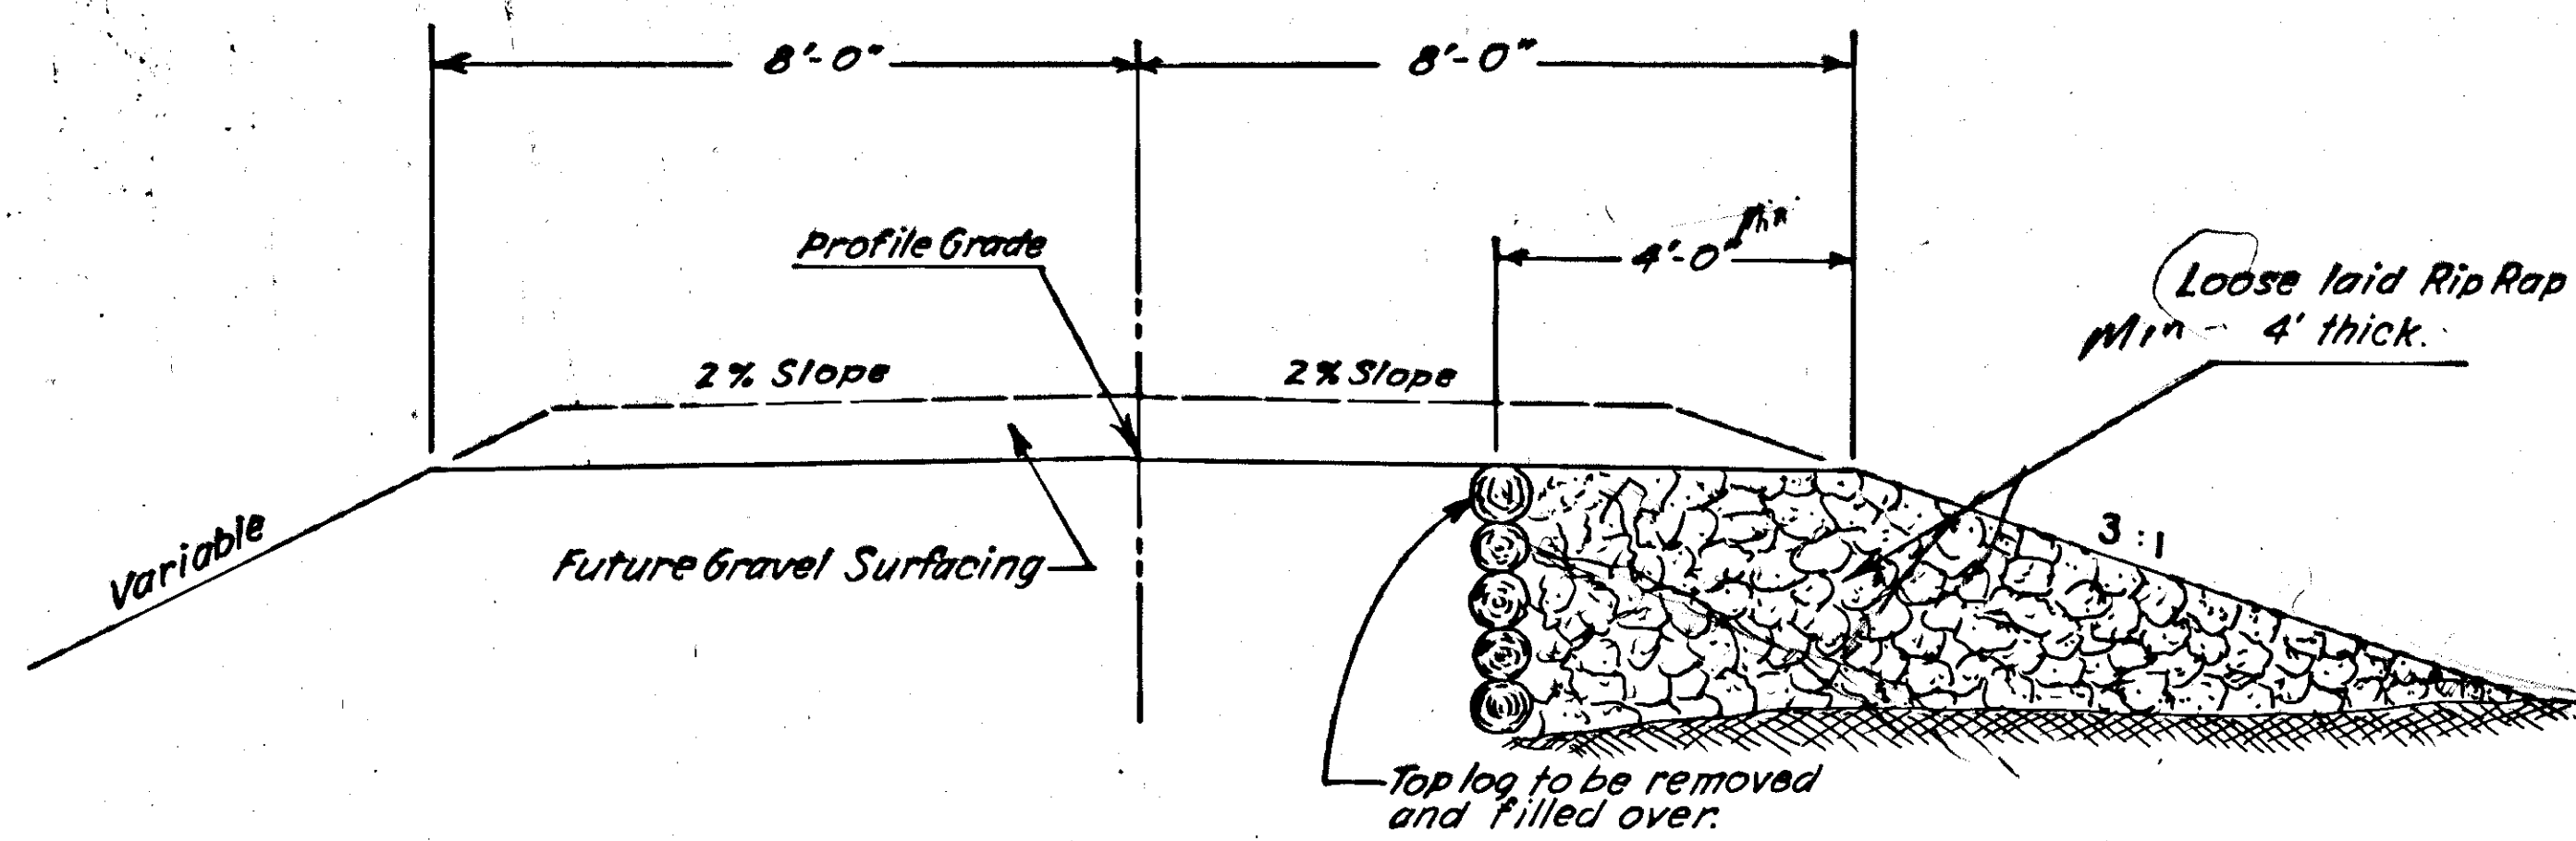


TYPICAL FILL SECTION

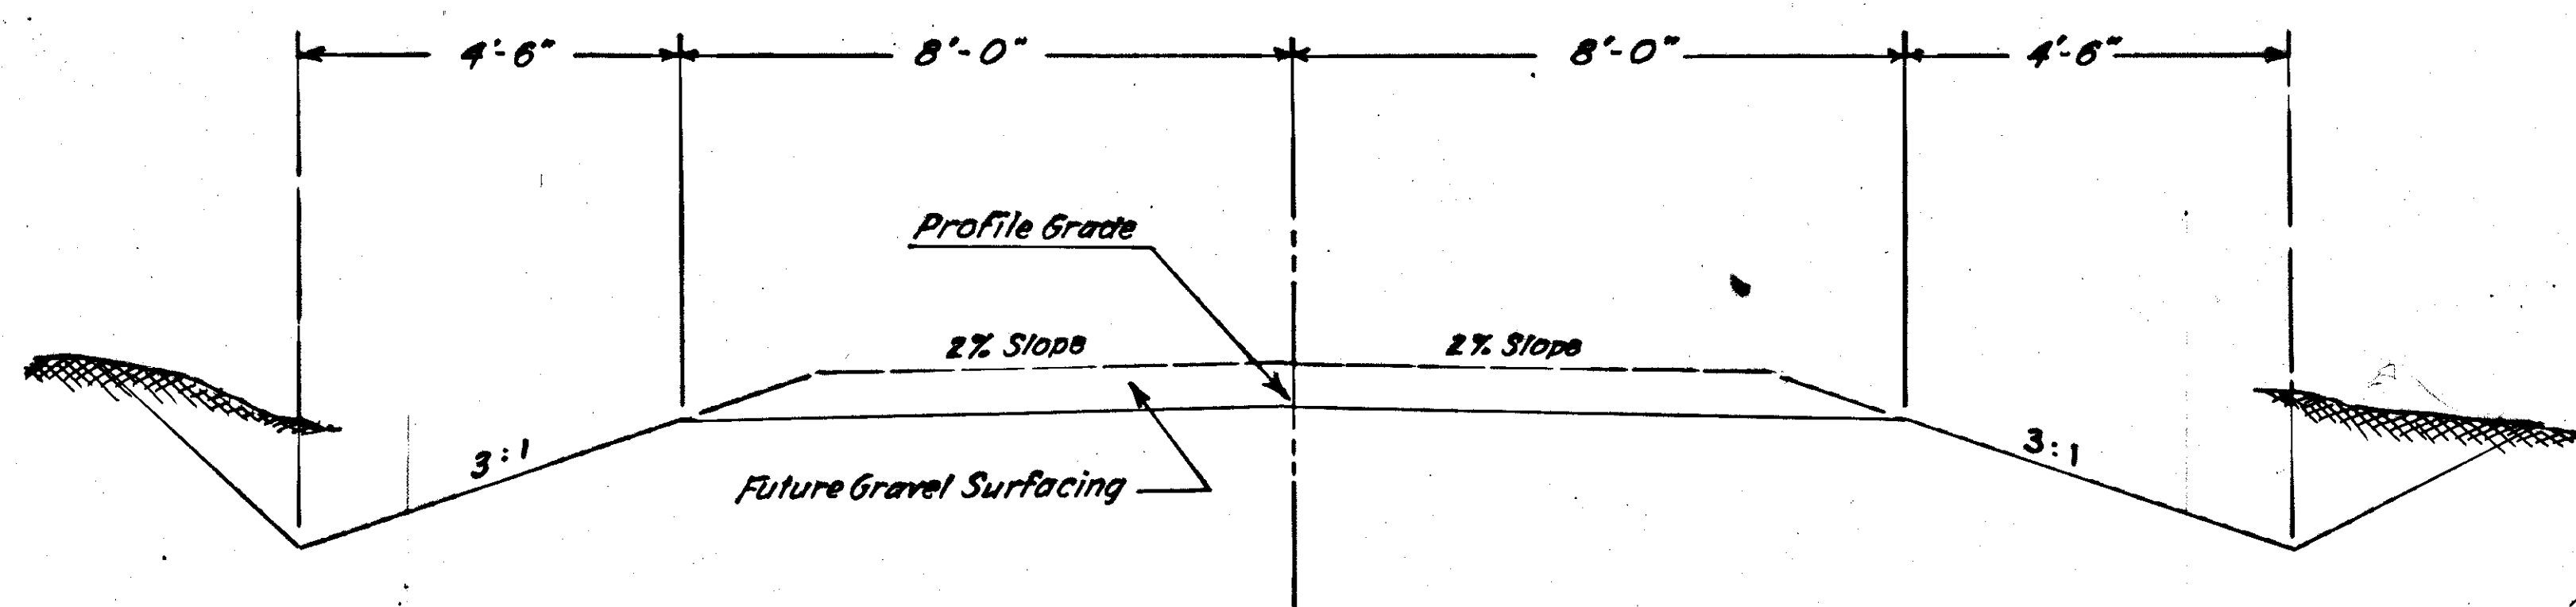

TYPICAL THRU CUT SECTION

ESTIMATE OF QUANTITIES

ITEM NO.	QUANTITY	UNIT	ITEM

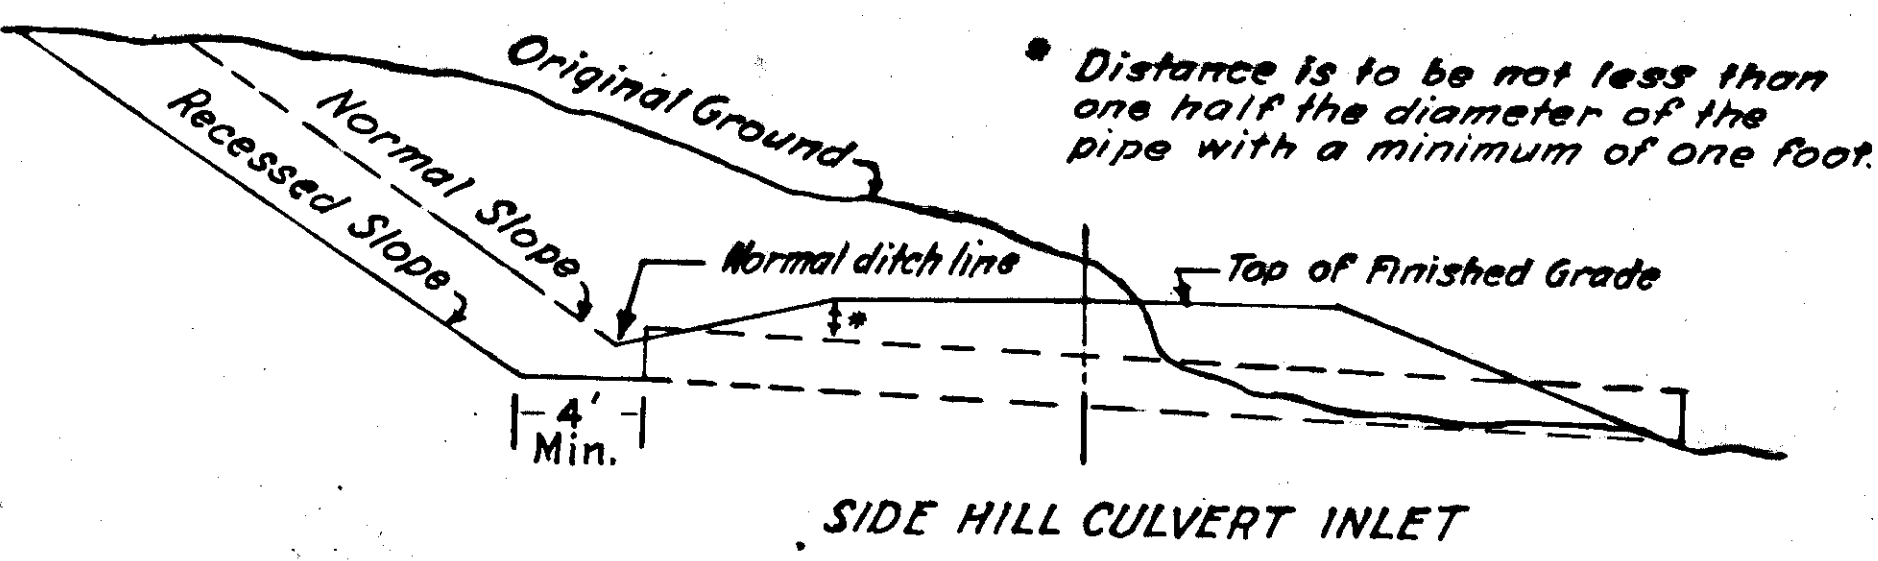

SIDE HILL CULVERT INLET

*[Handwritten signature]*

