

**STATE OF ALASKA  
DEPARTMENT OF TRANSPORTATION  
&  
PUBLIC FACILITIES**

**PLAN AND PROFILE  
PROPOSED HIGHWAY PROJECT  
BRS-0939(I)  
GUNNUK CREEK BRIDGE  
AND APPROACHES  
&  
RS-0939(I)  
KEKU ROAD**

STATE	PROJECT	SHEET NO.	TOTAL SHEETS
ALASKA	BRS-0939(I) & RS-0939(I)	1	16

INDEX OF SHEETS	
1	TITLE SHEET
2	TYPICAL SECTION & SUMMARIES
3-6	PLAN & PROFILE
7	HEADWALL DETAILS
8	PIPE ARCH DETAILS
9-15	BRIDGE DETAILS
16	BORING LOGS

THE FOLLOWING STANDARD DRAWINGS SHALL APPLY TO THESE PROJECTS: A-1, C-00.04, C-10.03, C-11.03, D-01.00, D-04.00, D-05.00, G-04.15, G-04.34, G-13.15, G-14.07, G-18.12, G-24.00, G-24.10, G-45.00, I-40.21, I-80.00, M-16.03, S-00.11, S-05.00, S-20.10, S-30.12, & U-03.00

**DESIGN DESIGNATION**


ADT 1979 = 100  
ADT 2000 = 149  
DHV 20% = 30  
D = 60-40  
T = 2%

**BRS-0939(I)  
PROJECT SUMMARY**

WIDTH OF SUBBASE = 28'  
LENGTH OF GRADING = 820' = .16 mi.  
LENGTH OF BRIDGE = 130' = .02 mi.  
LENGTH OF PROJECT = 950' = .18 mi.

**RS-0939(I)  
PROJECT SUMMARY**

WIDTH OF SUBBASE = 28'  
LENGTH OF PROJECT = 1,190.78' = .23 mi.  
850.0' = .16

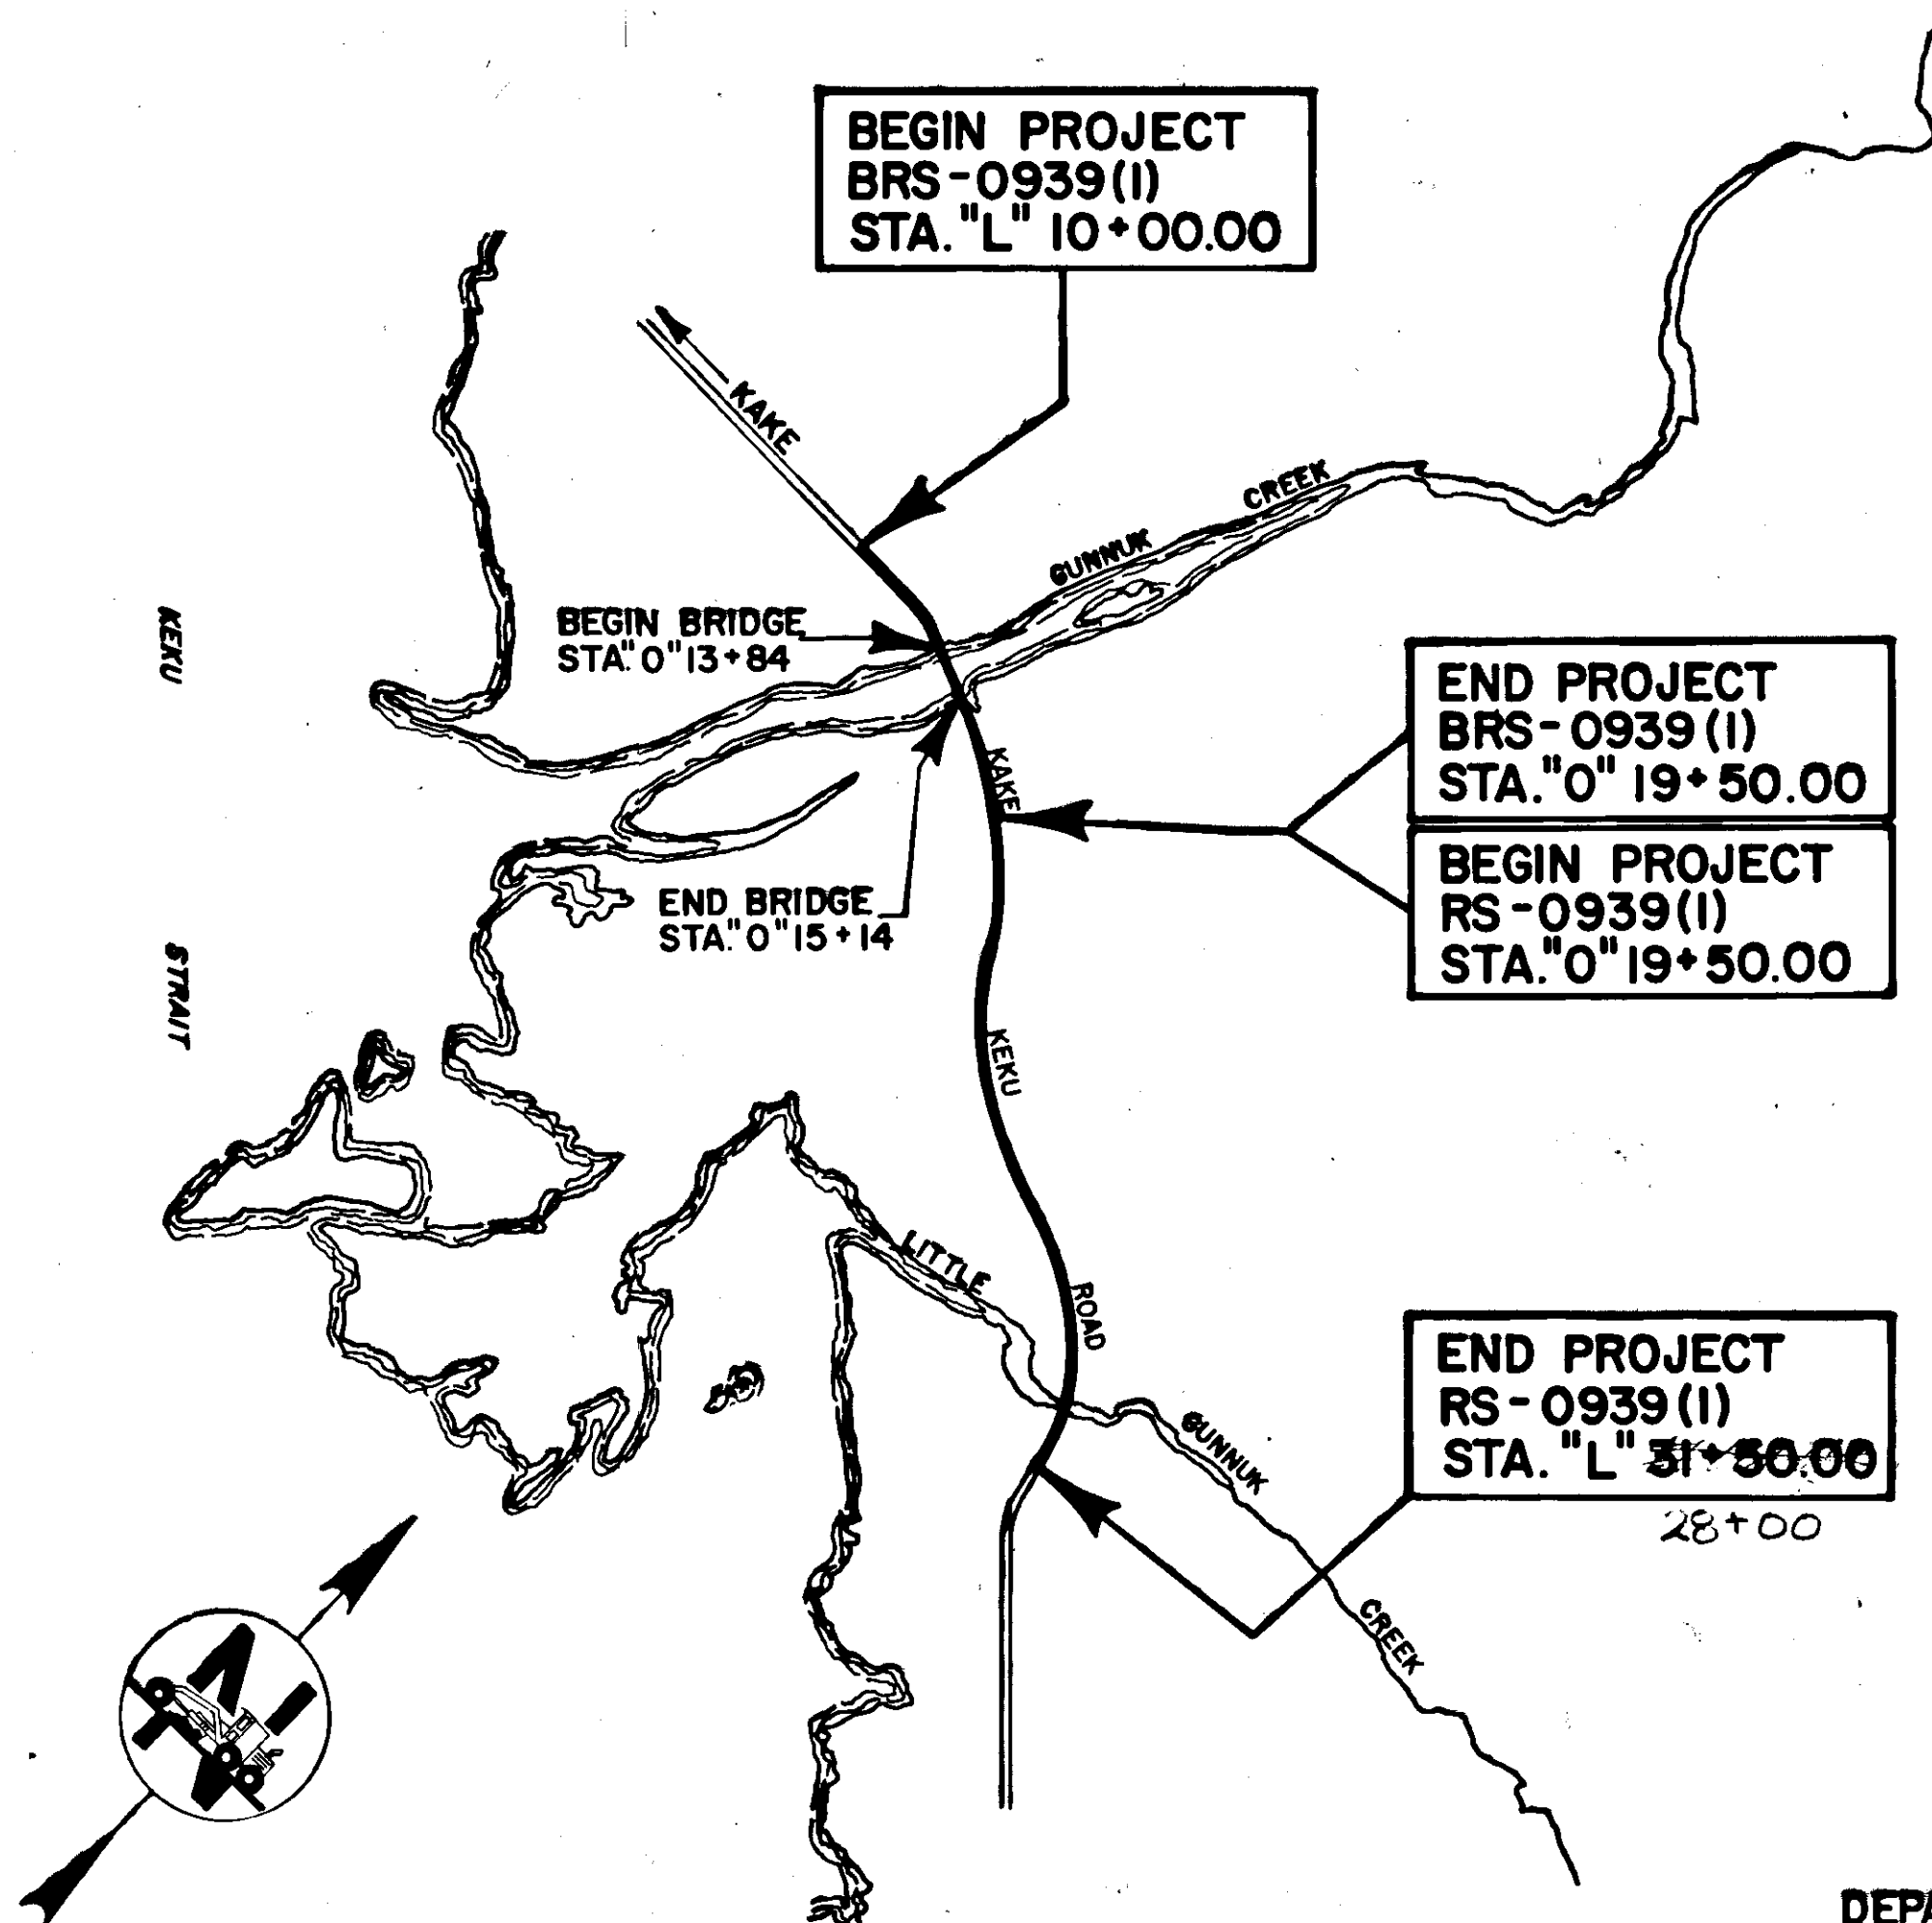

*"AS BUILT PLAN"*  
BUND CONSTRUCTION  
P.E. PAUL JONES  
BEGIN CONSTRUCTION: APRIL 4, 1981  
END CONSTRUCTION: AUGUST 19, 1981


STATE OF ALASKA  
DEPARTMENT OF TRANSPORTATION  
&  
PUBLIC FACILITIES

APPROVED  
*Wallace K.W. Wilson* DATE 2-2-81  
SOUTHEAST REGION DESIGN/CONSTRUCTION ENG.

STATE OF ALASKA  
DEPARTMENT OF TRANSPORTATION  
&  
PUBLIC FACILITIES

APPROVED  
*[Signature]* Date 3/4/81  
DIRECTOR, HIGHWAY DESIGN/CONSTRUCTION

**TYPICAL SECTION**  
STA. "0"10+00 TO "L"31+50  
18+00

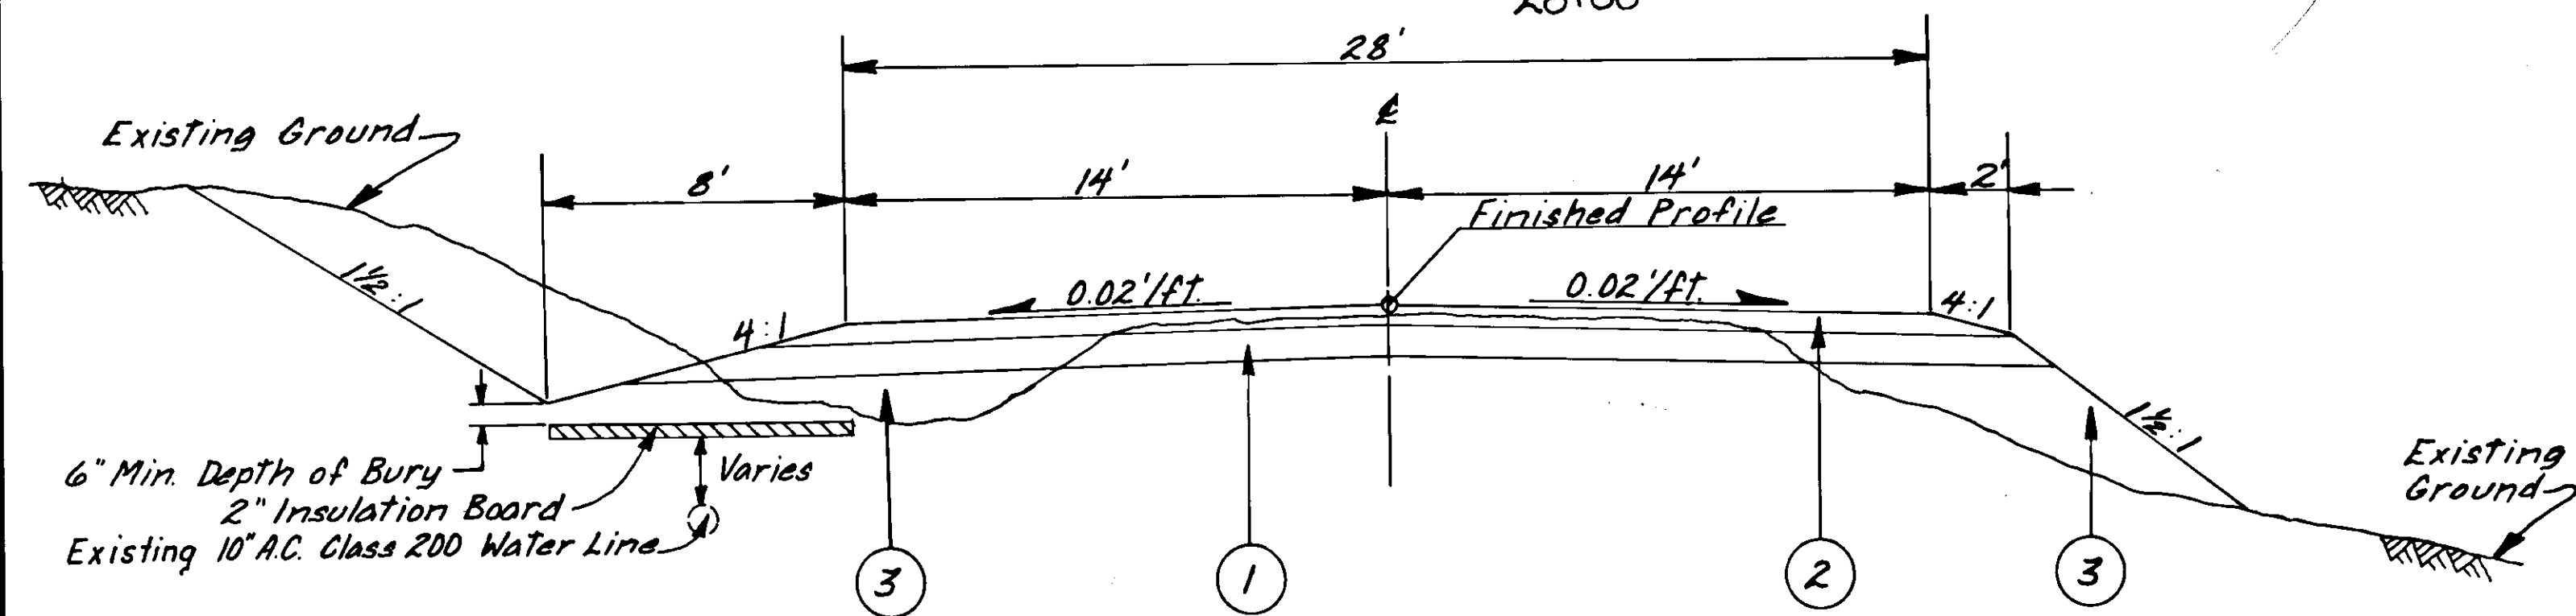

LABELING INDEX	
①	9" Select Material
②	6" Subbase, Grading B
③	Embankment

REMOVAL OF STRUCTURES & OBSTRUCTIONS SUMMARY			
Station to Station	Offset	Remarks	
"0"13+86	"0"15+14	21' LT.	Gunnuk Crk. Bridge
"0"15+32	"0"15+67	£	10' x 35' Existing Wood Bridge Deck
"0"26+90	"0"27+06	£	Little Gunnuk Crk. Wood Crib Wall & Box Culvert

MANHOLE SUMMARY		
STATION	OFFSET	REMARKS
"0"11+65	3' RT.	Reconstruct Exist. M.H.
Deleted	Co # 1	

MONUMENT SUMMARY				
STATION	MON.	CASE	POINT	REMARKS
10+00.00	X	X	B.O.P.	
"L"12+13.82 Bk.	X	X	P.O.T. Bk.	
"0"12+13.82 Ahd.	X	X	P.C. Ahd.	
"0"13+41.40	X	X	P.T.	
"0"16+07.54	X	X	P.C.	
"0"18+28.45	X	X	P.T.	
"0"20+25.03	X	X	P.C.	
"0"22+26.96 Bk.	X	X	P.T.	
"0"22+33.08 Ahd.	X	X	P.C. Ahd.	
"0"24+56.07	X	X	P.C.	
"0"27+11.52	X	X	P.T.	
"0"28+63.47	X	X	P.C.	Deleted EWO #2
"0"28+87.88 Bk.	X	X	P.O.T. Bk.	Deleted EWO #2
"0"28+87.88 Ahd.	X	X	P.C. Ahd.	Deleted EWO #2
"L"31+50.00	X	X	E.O.P.	Deleted EWO #2

INSULATION BOARD SUMMARY		
STATION	OFFSET	REMARKS
"0"22+50	17' LT.	Begin
"0"26+00	17.5' LT.	End
"0"27+50	22' LT.	Begin
"0"29+00	11.5' LT.	End

NOTE: Approx. quantity required 8 M.B.M.

CULVERT INSTALL. SUMMARY					
STATION	LENGTH	DIA.	OFFSET		REMARKS
			LT.	RT.	
"L"10+44	22'	18"	16'		
"L"11+71	22'	18"	22'		
"0"18+47	48'	24"			£
"0"22+15	42'	24"			Deleted EWO #2
"0"29+50	46'	24"			Deleted EWO #2
"0"26+97.30	13'-10" ARCH PIPE	21" DIA.	STATE FURNISHED		
"0"17+16	22'	18"	22'		
"0"18+30	22'	18"	22'		

FENCE RECONSTRUCTION SUMMARY		
STATION TO STATION	OFFSET	REMARKS
"0"15+38 To "0"16+43	RT.	Relocate Exist. fence behind ROW

SIGNING SCHEDULE									
NO.	STATION	OFFSET		CODE NO.	LEGEND	SIZE	AREA	NO. of POSTS	REMARKS
		LT.	RT.						
1	"L"12+00	17'		W5-1	Road Narrows	30"x30"	6.25	1	
2	"0"13+47		24'	R1-1	Stop	30"x30"	6.25	1	
3	"0"13+80		16'	I-3	Gunnuk Creek	24"x48"	8.0	2	
4	"0"15+19	16'		I-3	Gunnuk Creek	24"x48"	8.0	2	
5	"0"26+90	17'		I-3	Little Gunnuk Creek	36"x48"	12.0	2	
6	"0"27+10	17'		I-3	Little Gunnuk Creek	36"x48"	12.0	2	
7	"0"29+75	17'		W5-1	Road Narrows	30"x30"	6.25	1	
	"0"26+00								

**SIGNING NOTES**

- Sign locations & post lengths are approximate only & are subject to minor revisions.
- All sign posts shall be telescoping, perforated, & galvanized steel posts; the 2" size shall be used above ground & the 2 1/4" size shall be used below ground for the sleeve.
- All posts shall be installed with the sleeve type embedment in accordance with Standard Drawing S-30.12, except that the 2 1/4" size shall be used for the entire embedment depth.
- All signs shall be unframed.
- All signs shall be .063" thick.

**ESTIMATE OF ROADWAY QUANTITIES**

ITEM NO.	ITEM	UNIT	QUANTITY		TOTAL QUANTITY
			BRS-0939(1)	RS-0939(1)	
1	Furnish & Maintain Engineering Facilities	L.S.	Lump Sum	Lump Sum	All Required
109(1)	Petroleum Escalation	L.S.	"	"	"
110(1)	Mobilization	L.S.	"	"	"
111(1)	Temporary Erosion & Pollution Control	L.S.	"	"	"
114(1)	Construction Engineering by the Contractor	L.S.	"	"	"
115(1)	Traffic Maintenance	L.S.	"	"	"
202(1)	Removal of Structures & Obstructions	L.S.	Lump Sum	Lump Sum	All Required
203(3)	Unclassified Excavation	C.Y.	1,055	2,201	3,256
203(5D)	Embankment	C.Y.	2,623	749	3,372
304(2)	Subbase, Grading B	C.Y.	556		556
502(1)	Prestressed Concrete Structural Members (128'-8" Bulb Tees)	EA.	5		5
507(1)	Metal Bridge Railing	L.F.	260		260
602(4)	STRUCTURAL PLATE PIPE ARCH (STATE FURNISHED) SPAN 13'-10" RISE 11'-7"	L.S.		Lump Sum	All Required
603(22E)	18" Pipe Conduit	L.F.	88		88
603(22B)	24" Pipe Conduit	L.F.	48		48
604(3)	Reconstruct Existing Manholes	EA.	X		X
606(1)	Beam Type Guardrail, Type I Post	L.F.	225	175	400
607(4)	Reconstructed Fence	L.F.	118		118
611(1)	Riprap, Class I	C.Y.	550		550
614(1)	Survey Monument & Case	EA.	5	4	9
615(1)	Standard Signs	S.F.	28.5	30.25	58.75
628(2A)	Ductile Iron Water Conduit	L.F.	233		233
628(7)	Fire Hydrant Relocation	EA.	1	1	2
635(1)	Insulation Board	L.S.		Lump Sum	All Required
ALTERNATE "A"					
110(1)	Mobilization	L.S.	Lump Sum	Lump Sum	All Required
501(5)	Precast Abutment	EA.	2		2
505(3A)	STRUCTURAL STEEL PILING, PRECAST ABUTMENT (FURNISHED & DRIVEN)	L.F.	490		490
ALTERNATE "B"					
501(1)	Mobilization	L.S.	Lump Sum	Lump Sum	All Required
501(1)	Class "A" Concrete	L.S.			
503(1)	Reinforcing Steel	L.S.	Lump Sum	Lump Sum	All Required
505(3)	Structural Steel Piling (Furnished & Driven)	L.F.	362		362

GUARD RAIL INSTALLATION SUMMARY					
BEGIN	END	LENGTH	LT.	RT.	REMARKS
"0"13+47	"0"13+84	50'		RT.	25' Radius
"0"13+34	"0"13+84	50'	LT.		
"0"15+15	"0"15+89	75'	LT.		
"0"15+15	"0"15+64	50'		RT.	
"0"26+22.30	"0"27+22.30	100'		RT.	
"0"26+72.30	"0"27+47.30	75'	LT.		

**GENERAL NOTES**

- Alignment shown on these plans is subject to minor revisions.
- Grades shown on these plans are subject to minor revisions.
- Culvert lengths & locations are approx. only & are subject to minor revisions.
- The locations of all utilities shown on the plans are approx. only & should be field verified with the utility.
- All existing signs shall be removed by the contractor & returned to the State of Alaska, Dept. of Transportation Maintenance Yard, as directed by the engineer. This work shall be considered incidental to other items of work & no separate payment shall be made therefor.
- Protection of existing underground utilities shall be considered incidental to Item 203(3) Unclassified Excavation. No measurement for payment shall be made for this required protective work.
- Disposal of waste material shall be in a disposal area to be provided by the contractor & approved by the engineer.
- Instream activity shall be limited to the period May 1 through July 15. However, bridge piling may be removed outside this time restriction with prior approval of the Dept. of Fish & Game.
- Removal & disposal of existing culvert pipe shall be considered incidental to other items of work.

FIRE HYDRANT SUMMARY		
STATION	OFFSET	REMARKS
"0"11+10.5	26' LT.	Relocation
"0"19+91	32' LT.	Relocation

APPROACH SUMMARY		
STATION	WIDTH	
	LEFT	RIGHT
"L"10+44	18'	
"L"11+71	14'	
"L"11+76		14'
"0"12+36		52'*
"0"13+33		14'
"0"16+18	14'	
"0"16+72		17'
"0"17+16	14'	
"0"18+30	14'	
"0"20+72		24'
"0"22+86		74'*
"0"23+75		24'
"0"29+22	24'	


NOTE: \* Denotes a parking area.

STATE	PROJECT DESIGNATION	YEAR	SHEET NO.	TOTAL SHEETS
ALASKA	BRS-0939(1) & RS-0939(1)	1981	3	16

Horizontal Control: Based on a bearing of  $S. 31^{\circ} 39' 12'' W.$  from brass cap monument at U.S.S. 3851 MC-1 To Alaska Tidelands Survey 1091 RM-3.

2" 10' x 7 1/2' LT. Remove & Dispose Existing 8" Pipe Conduit  
Install 18" x 22' Pipe Conduit


2" 11' x 7 1/2' LT. Remove & Dispose Existing 8" Pipe Conduit  
Install 18" x 22' Pipe Conduit

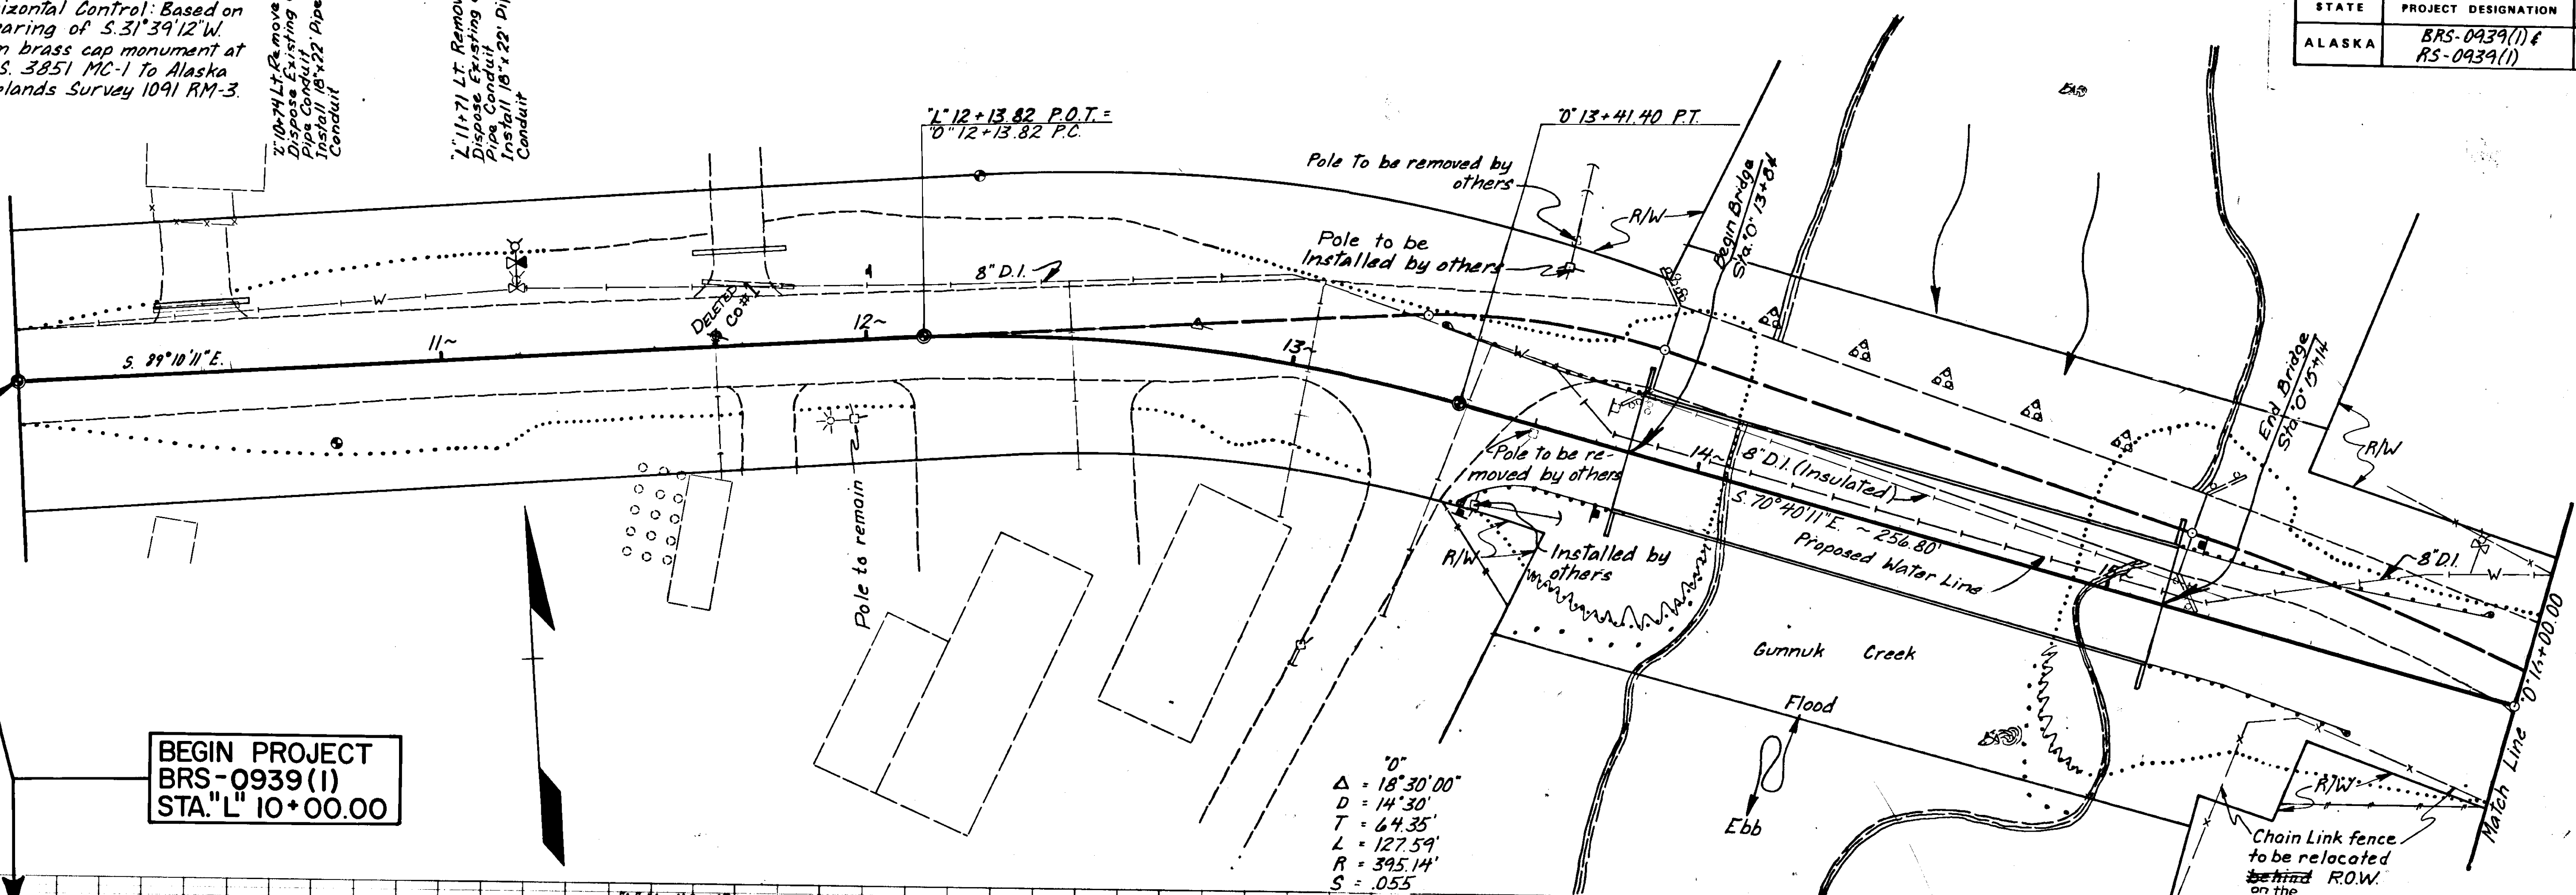

BEGIN PROJECT  
BRS-0939(1)  
STA. "L" 10+00.00



0°  
Δ = 18° 30' 00"  
D = 14' 30"  
T = 64.35'  
L = 127.59'  
R = 395.14'  
S = .055

EMBANKMENT = 1985 Cu. Yds. (Includes 454 Cu. Yds. Select. Mat'l.)  
UNCLASSIFIED EXCAVATION = 462 Cu. Yds.

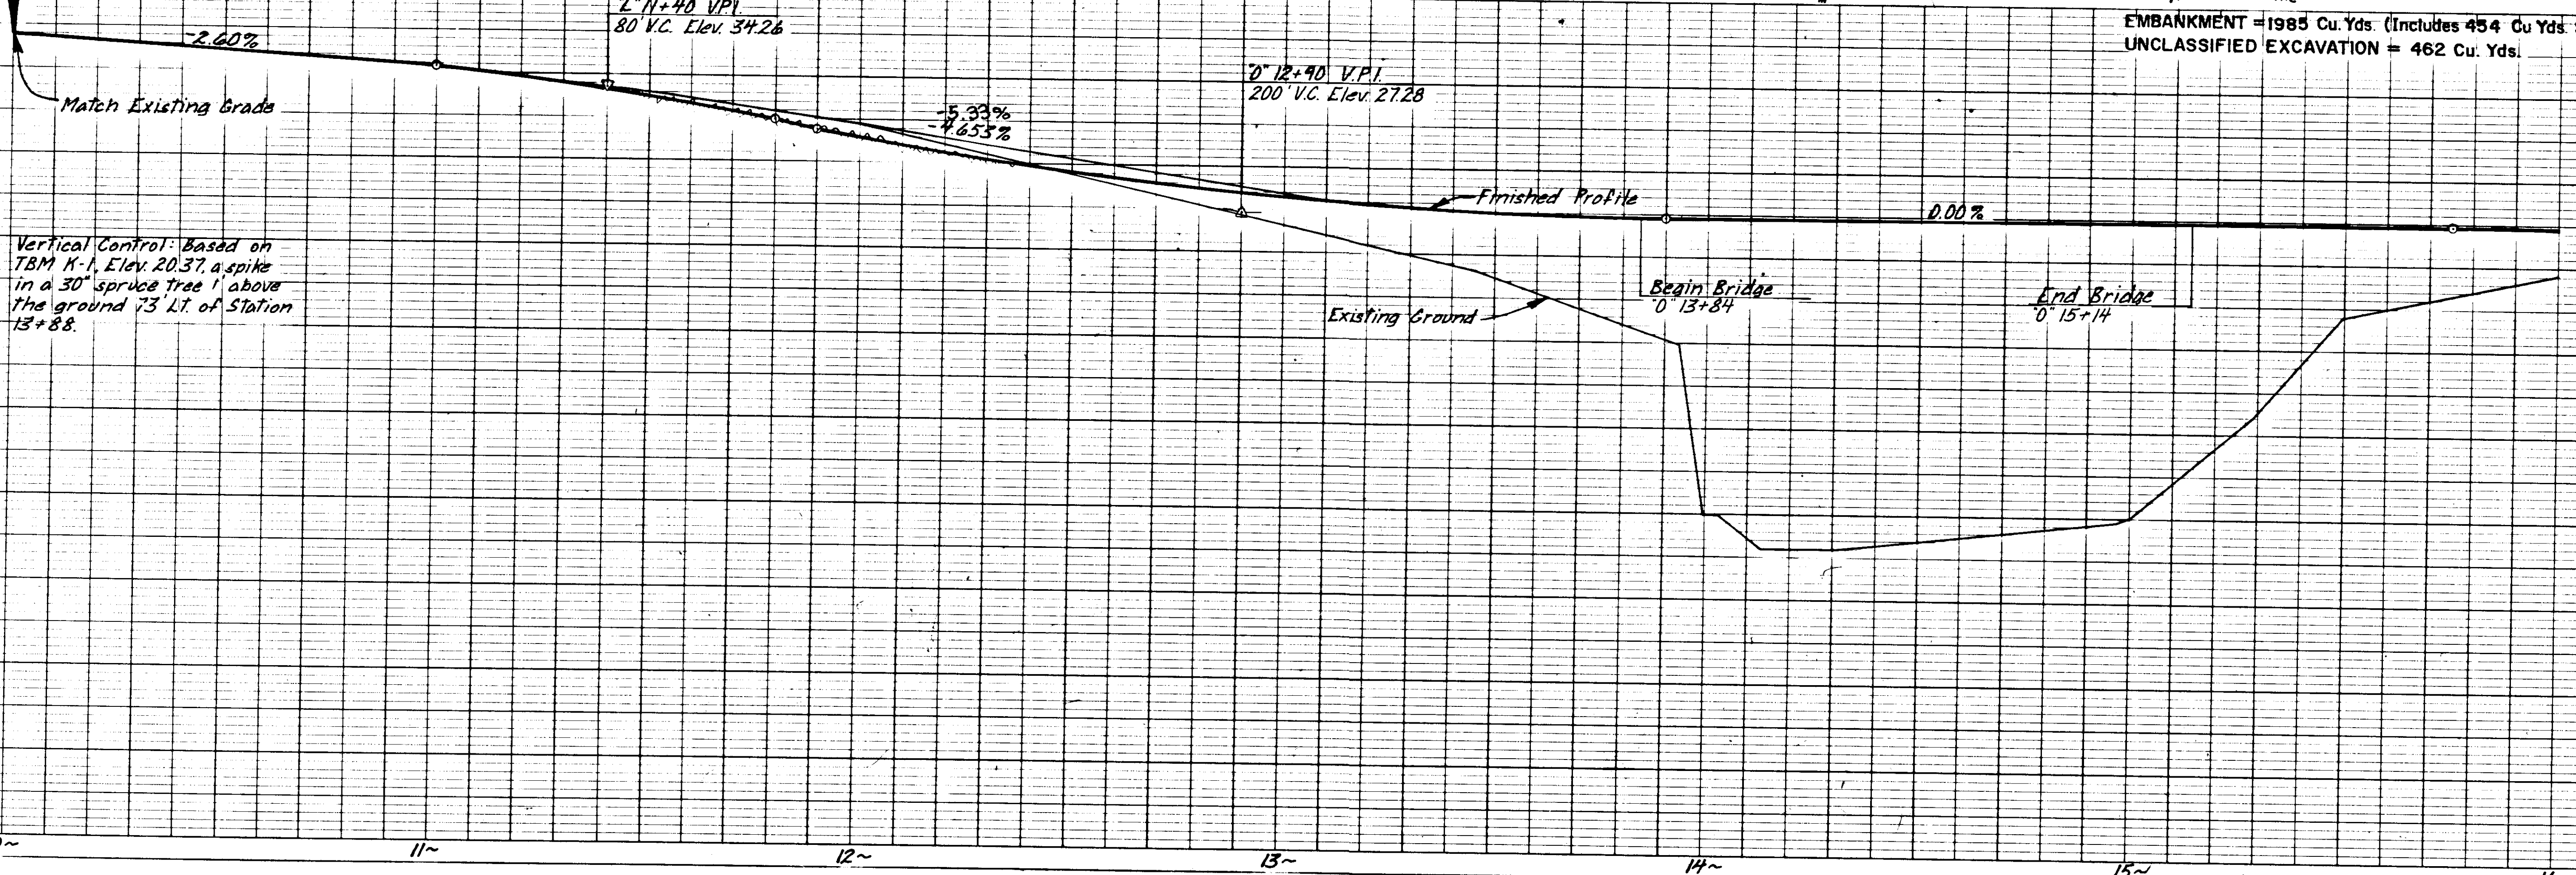


Vertical Control: Based on TBM K-1, Elev. 20.37, a spike in a 30" spruce tree 1' above the ground 73' LT. of Station 13+88.

STATE	PROJECT DESIGNATION	YEAR	SHEET NO.	TOTAL SHEETS
ALASKA	BRS-0939(1) & RS-0939(1)	1981	4	16

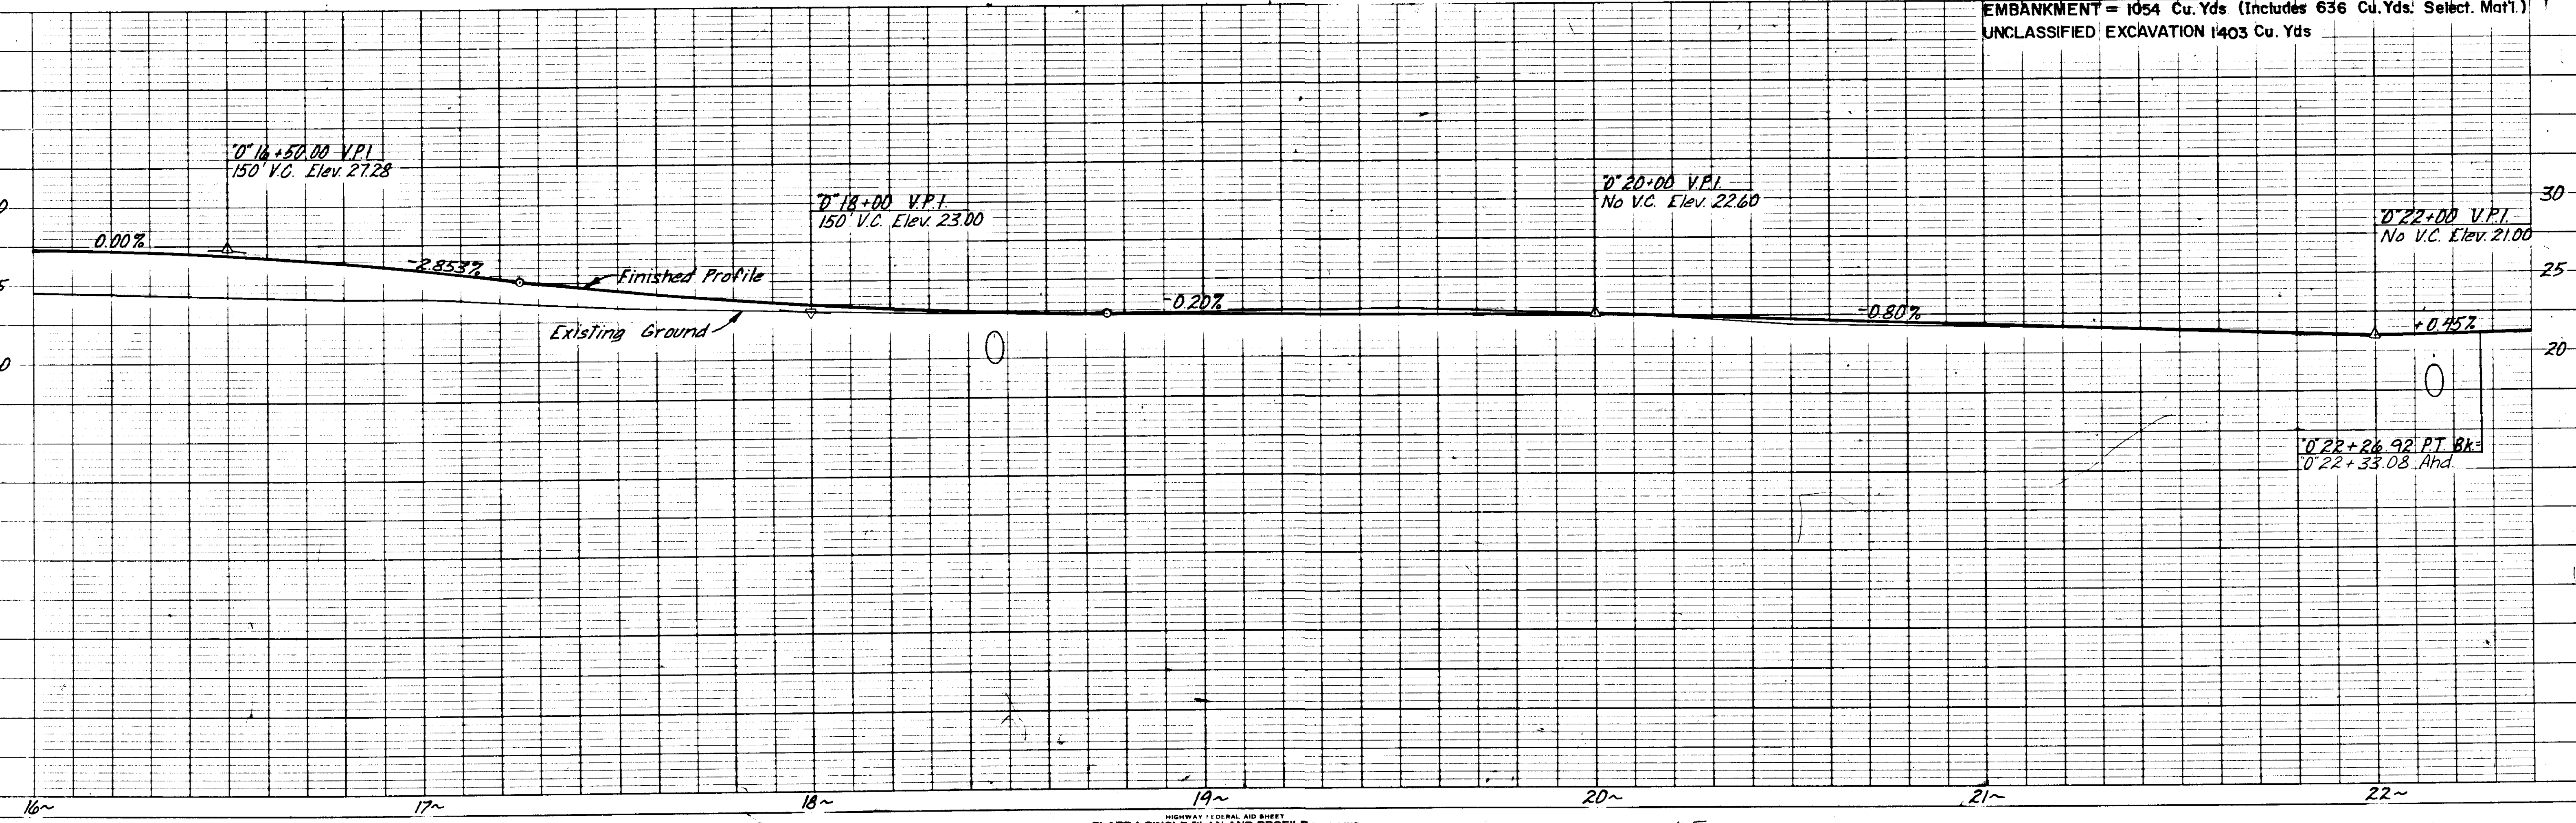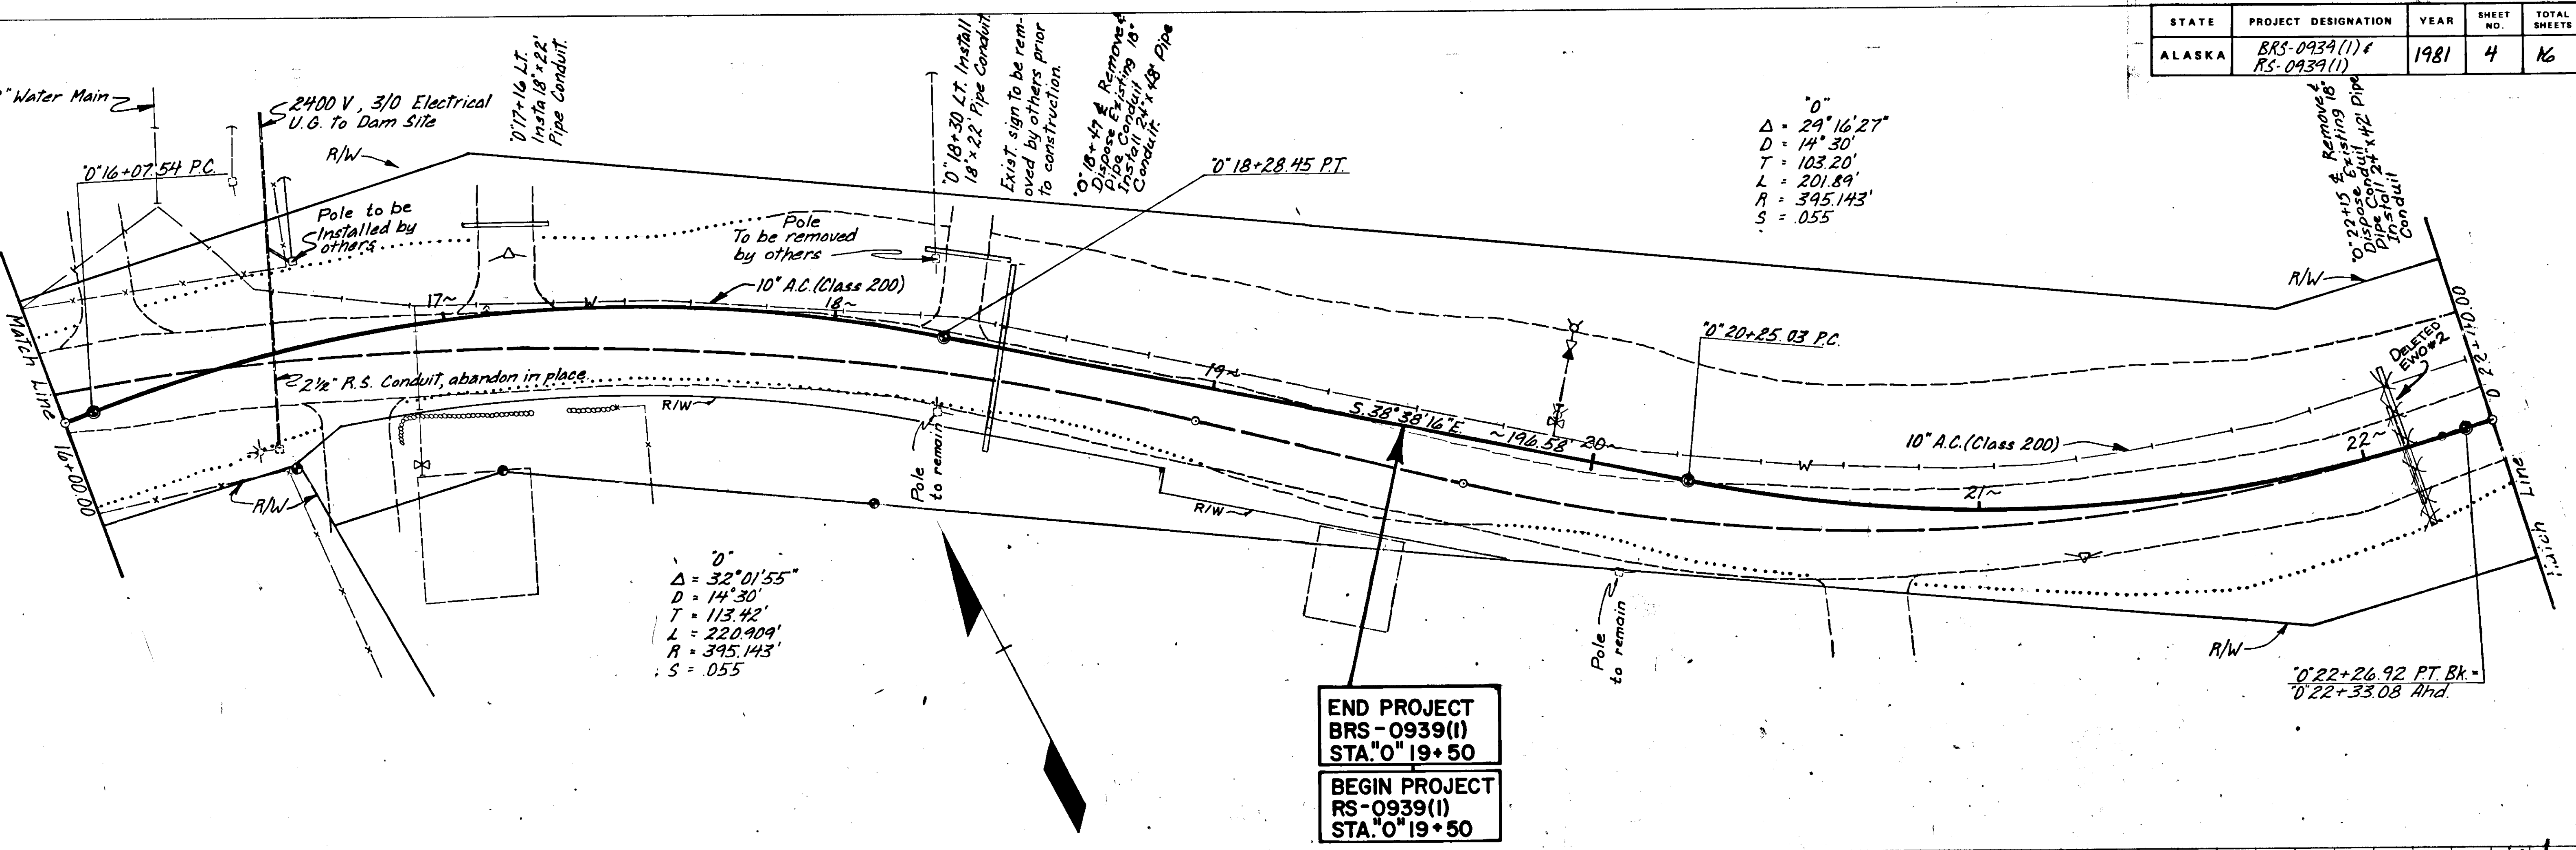

STATE	PROJECT DESIGNATION	YEAR	SHEET NO.	TOTAL SHEETS
ALASKA	BRS-0939(1) & RS-0939(1)	1981	5	16

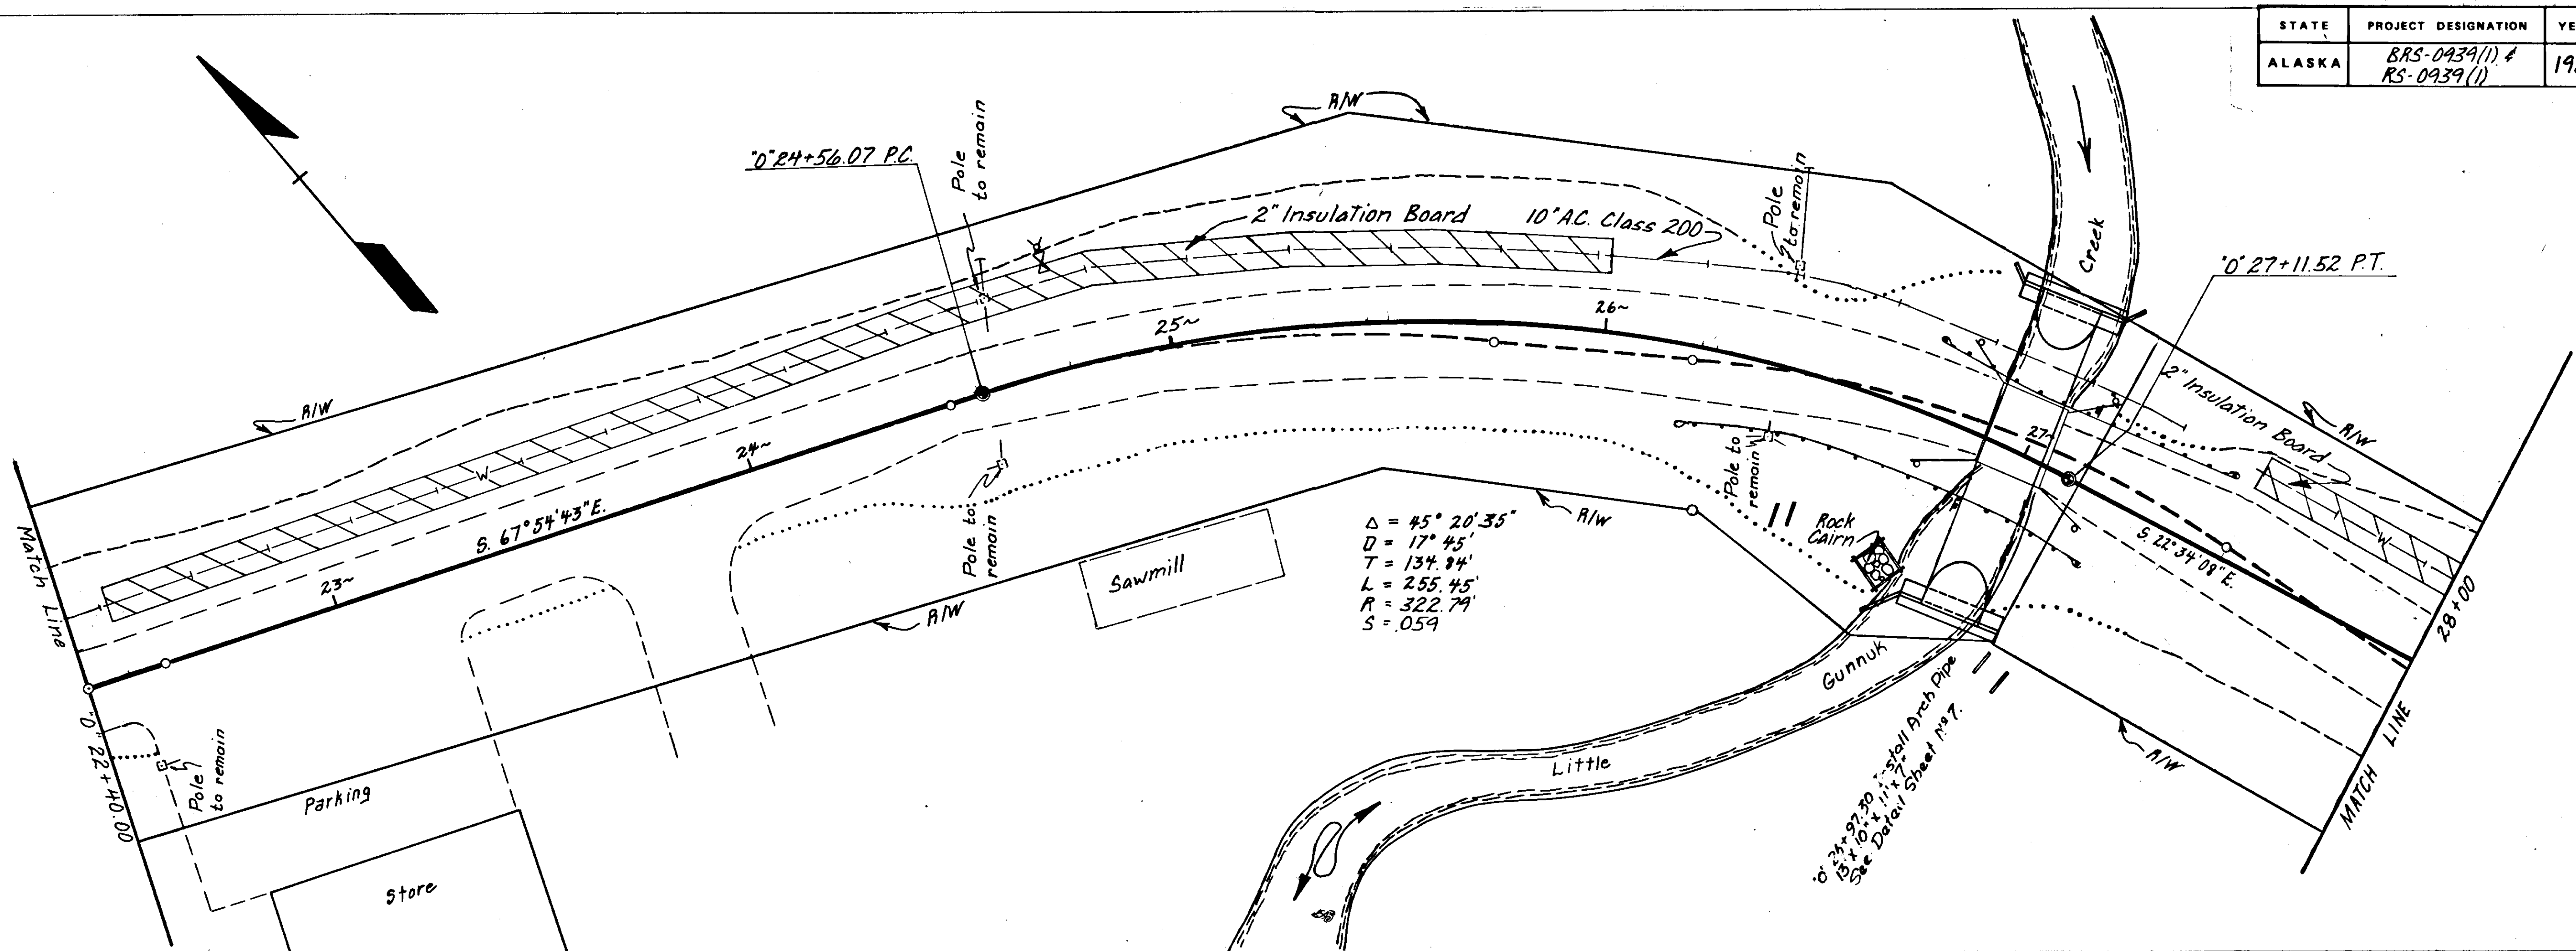

$\Delta = 45^\circ 20' 35''$   
 $D = 17' 45''$   
 $T = 134.94'$   
 $L = 255.45'$   
 $R = 322.79'$   
 $S = 0.59$

EMBANKMENT = 959 Cu. Yds. (Includes 549 Cu. Yds. Select Mat.)  
 UNCLASSIFIED EXCAVATION = 1232 Cu. Yds.



**HYDRAULIC & HYDROLOGIC SUMMARY**


Drainage Area = 3.2 Sq. Mi.  
 Design Flood Frequency = 50 Yr. - 100 Yr.  
 Design Discharge = 965 CFS - 1065 CFS  
 Design High Water\* = 19 FT. - 19 FT.  
 Anticipated Backwater = None - .2 Ft.

\*Design high water is controlled by wind driven tide which is considered to be a 100 year storm.


STATE	PROJECT DESIGNATION	YEAR	SHEET NO.	TOTAL SHEETS
ALASKA	BRS-0939(1) & RS-0939(1)	1981	6	16

Delete this sheet  
E.W.O. #2


Delete this sheet  
E.W.O. #2

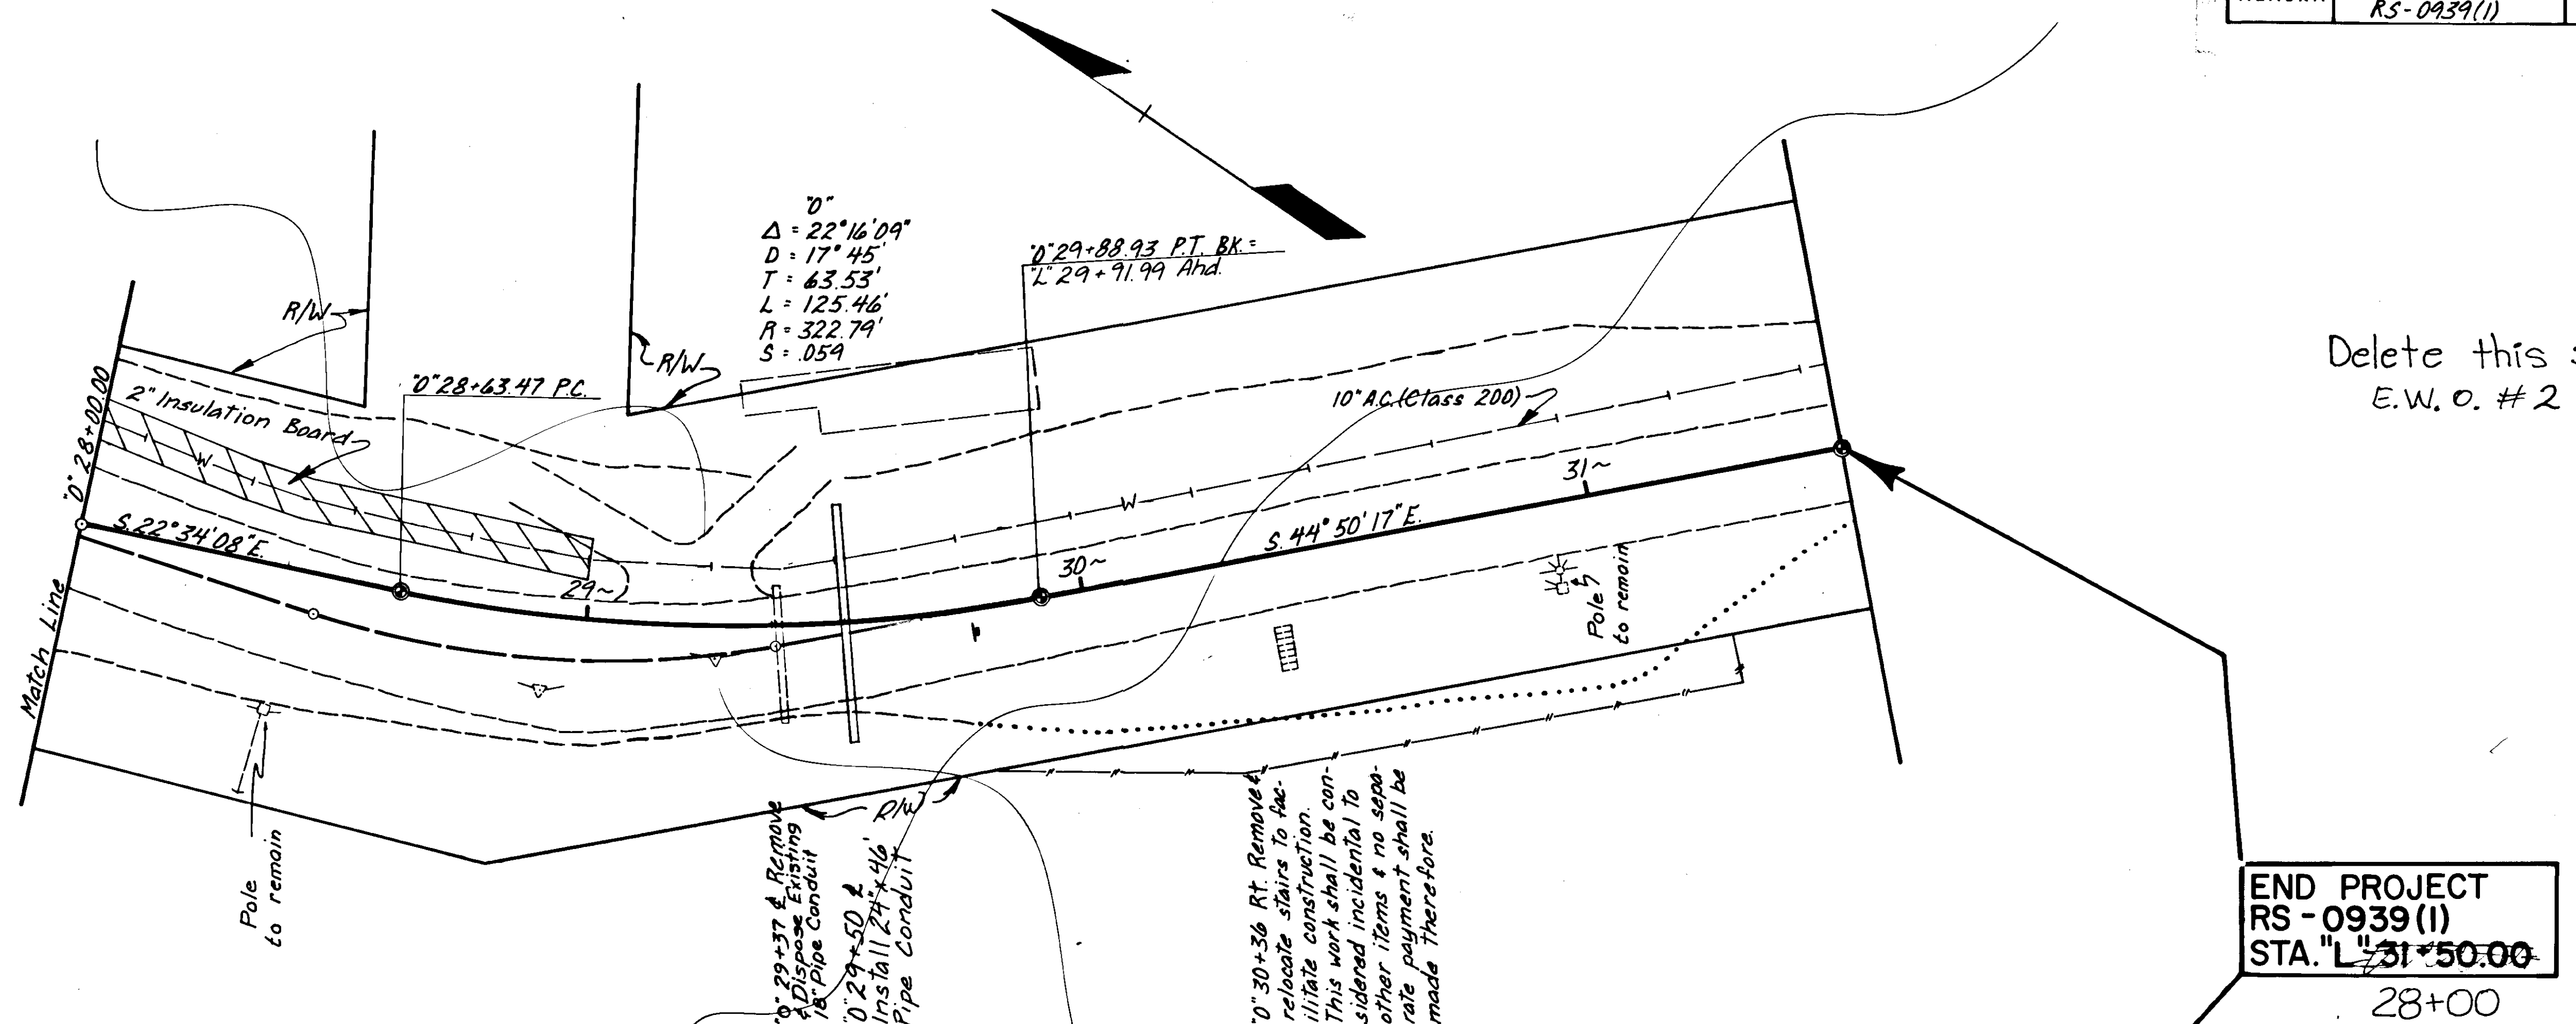

**END PROJECT**  
RS-0939(1)  
STA. "L" 31+50.00  
28+00

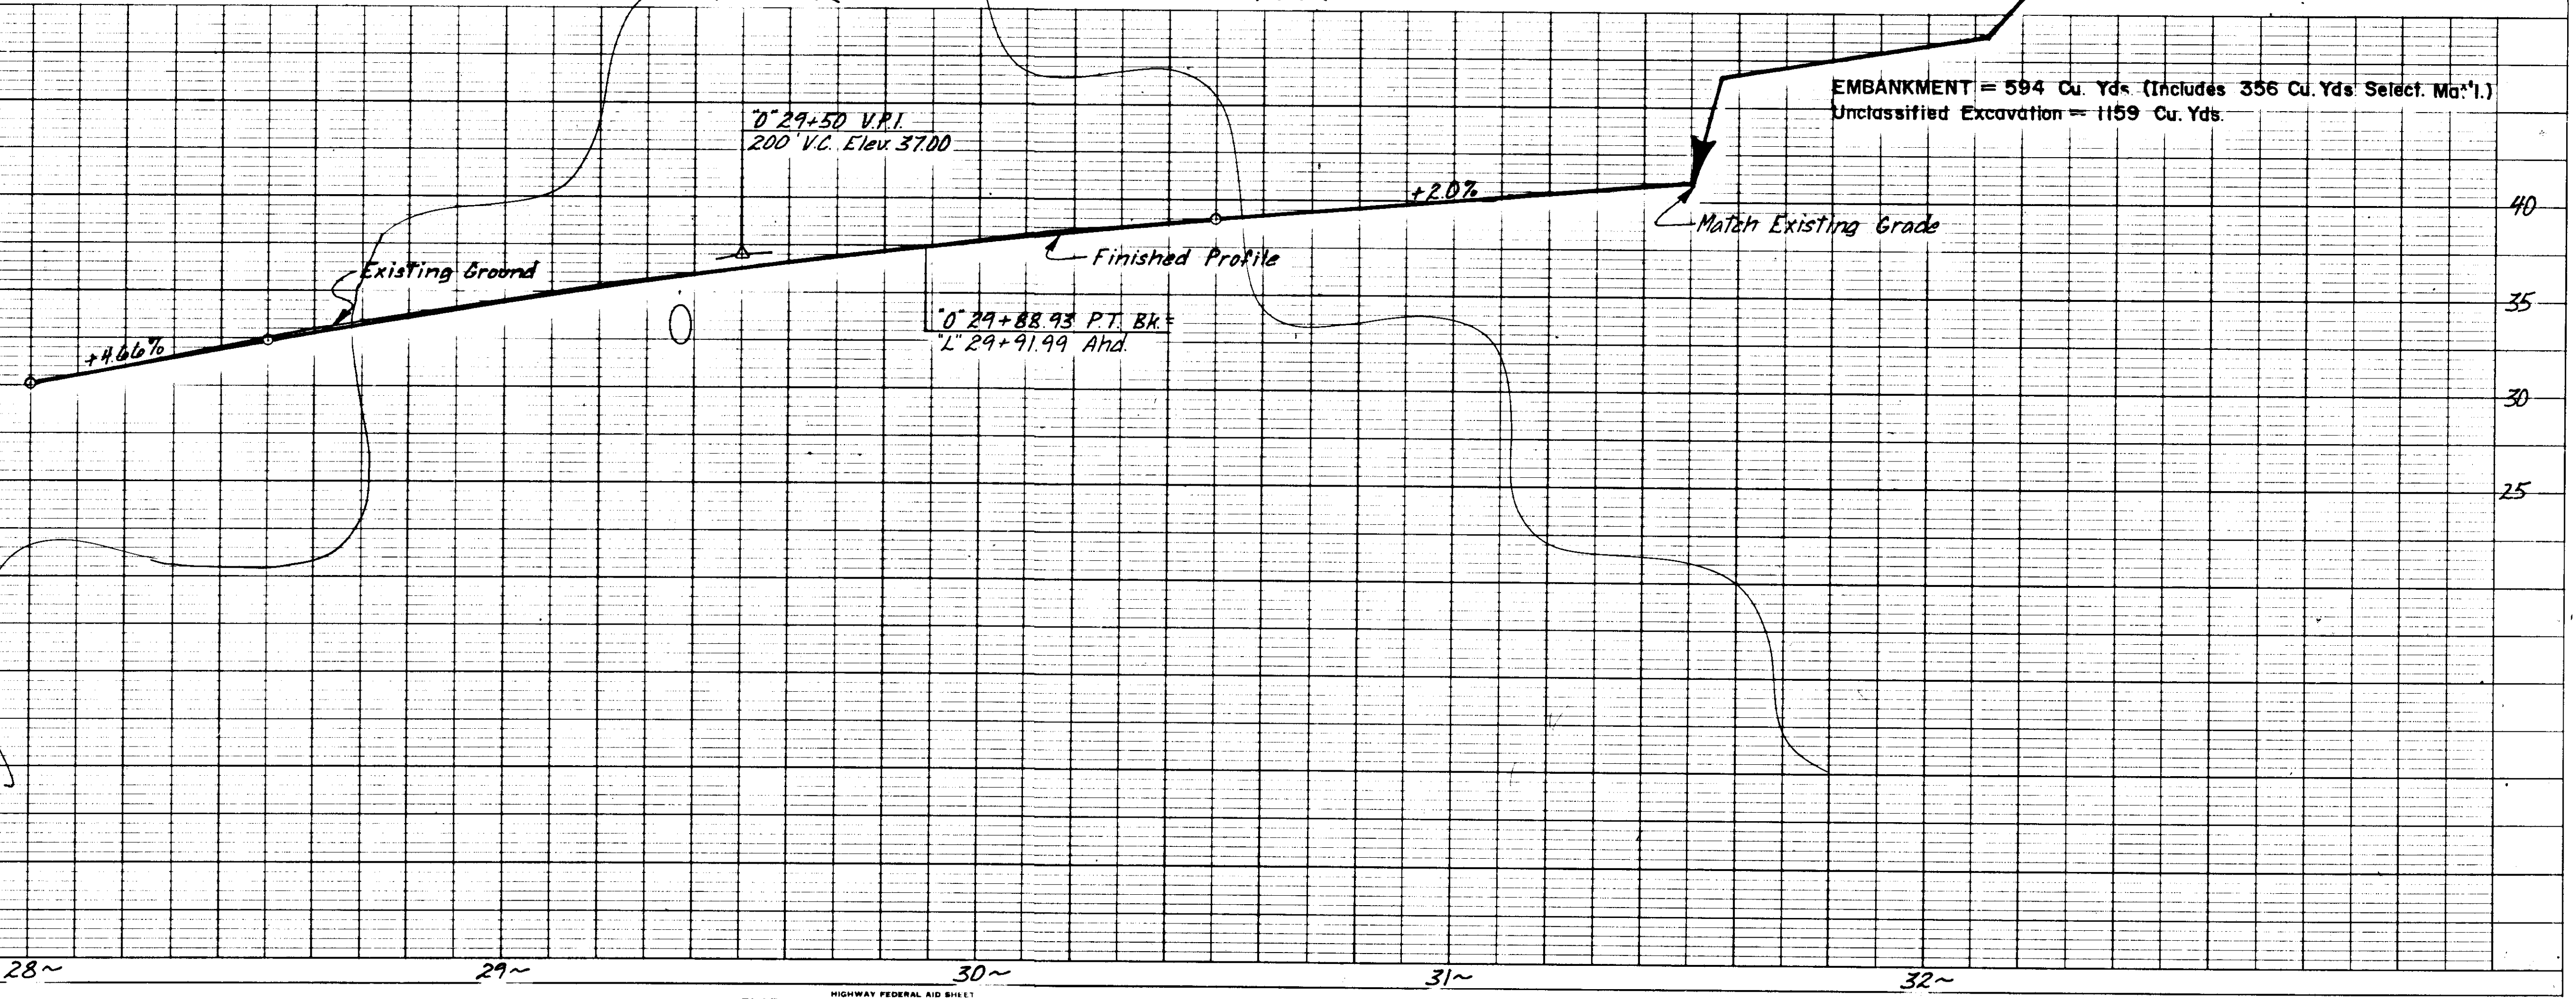


## HEADWALL DETAILS NO SCALE

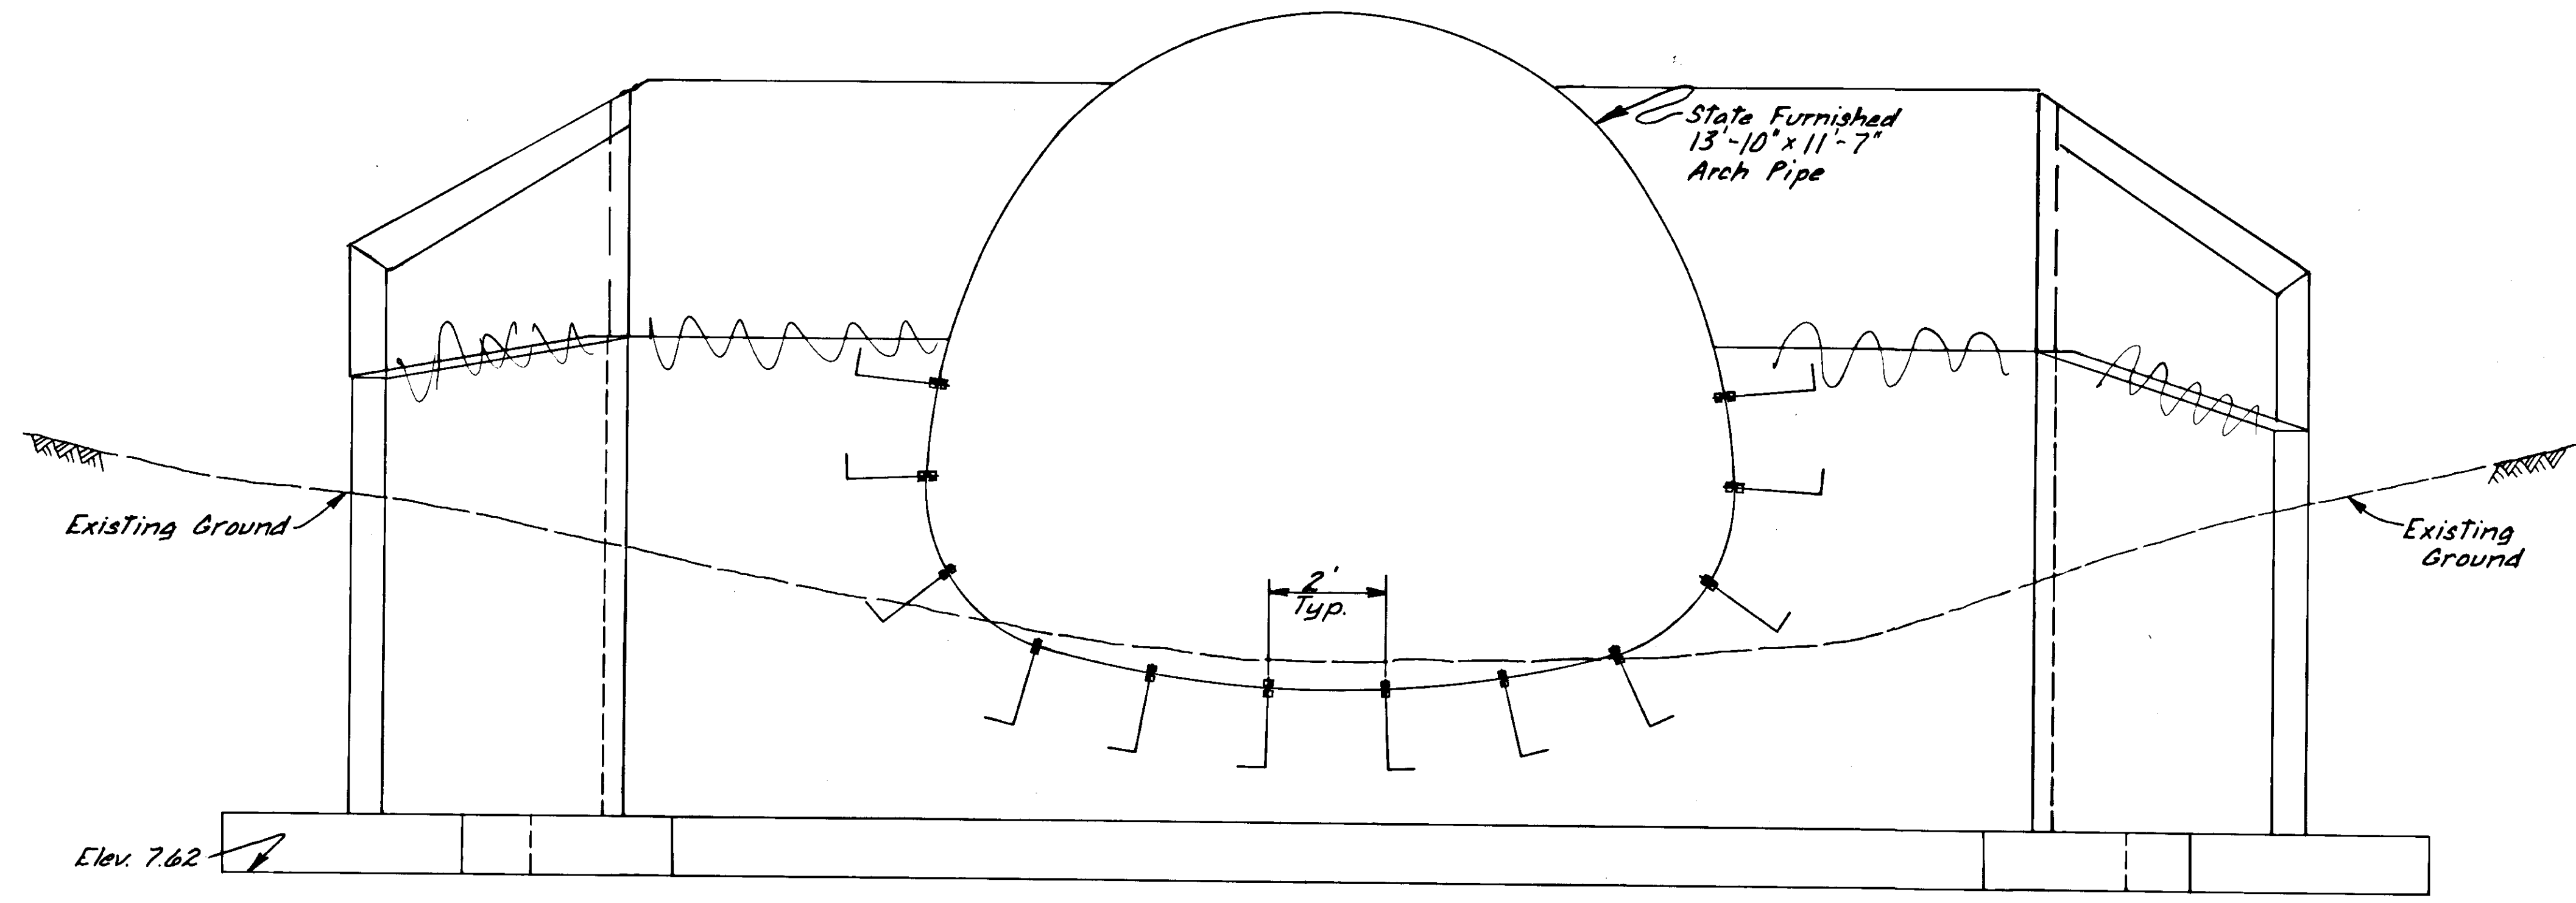


**ELEVATION**  
Looking Down Stream

- NOTES**
1. Furnishing & installing hookbolts in place shall be considered incidental to Item 602(4) Structural Plate Pipe Arch (State Furnished) Span: 13'-10" - Rise 11'-7".
  2. All hookbolts & culvert nuts shall be aluminum.
  3. All exposed concrete corners shall be chamfered 3/4".
  4. Class "A" concrete shall be used on headwalls.
  5. Reinforcement shall be placed 2" clear from surfaces of concrete unless otherwise noted.
  6. Reinforcement steel shall conform to ASTM A615.
  7. All instream work shall be accomplished between the period from May 1 to July 15.


ESTIMATE OF QUANTITIES (HEADWALLS)	
INLET	
14.9 Cu. Yd. Class "A" Concrete	
1,323 Lbs. Reinforcing Steel	
OUTLET	
12.6 Cu. Yd. Class "A" Concrete	
1,113 Lbs. Reinforcing Steel	

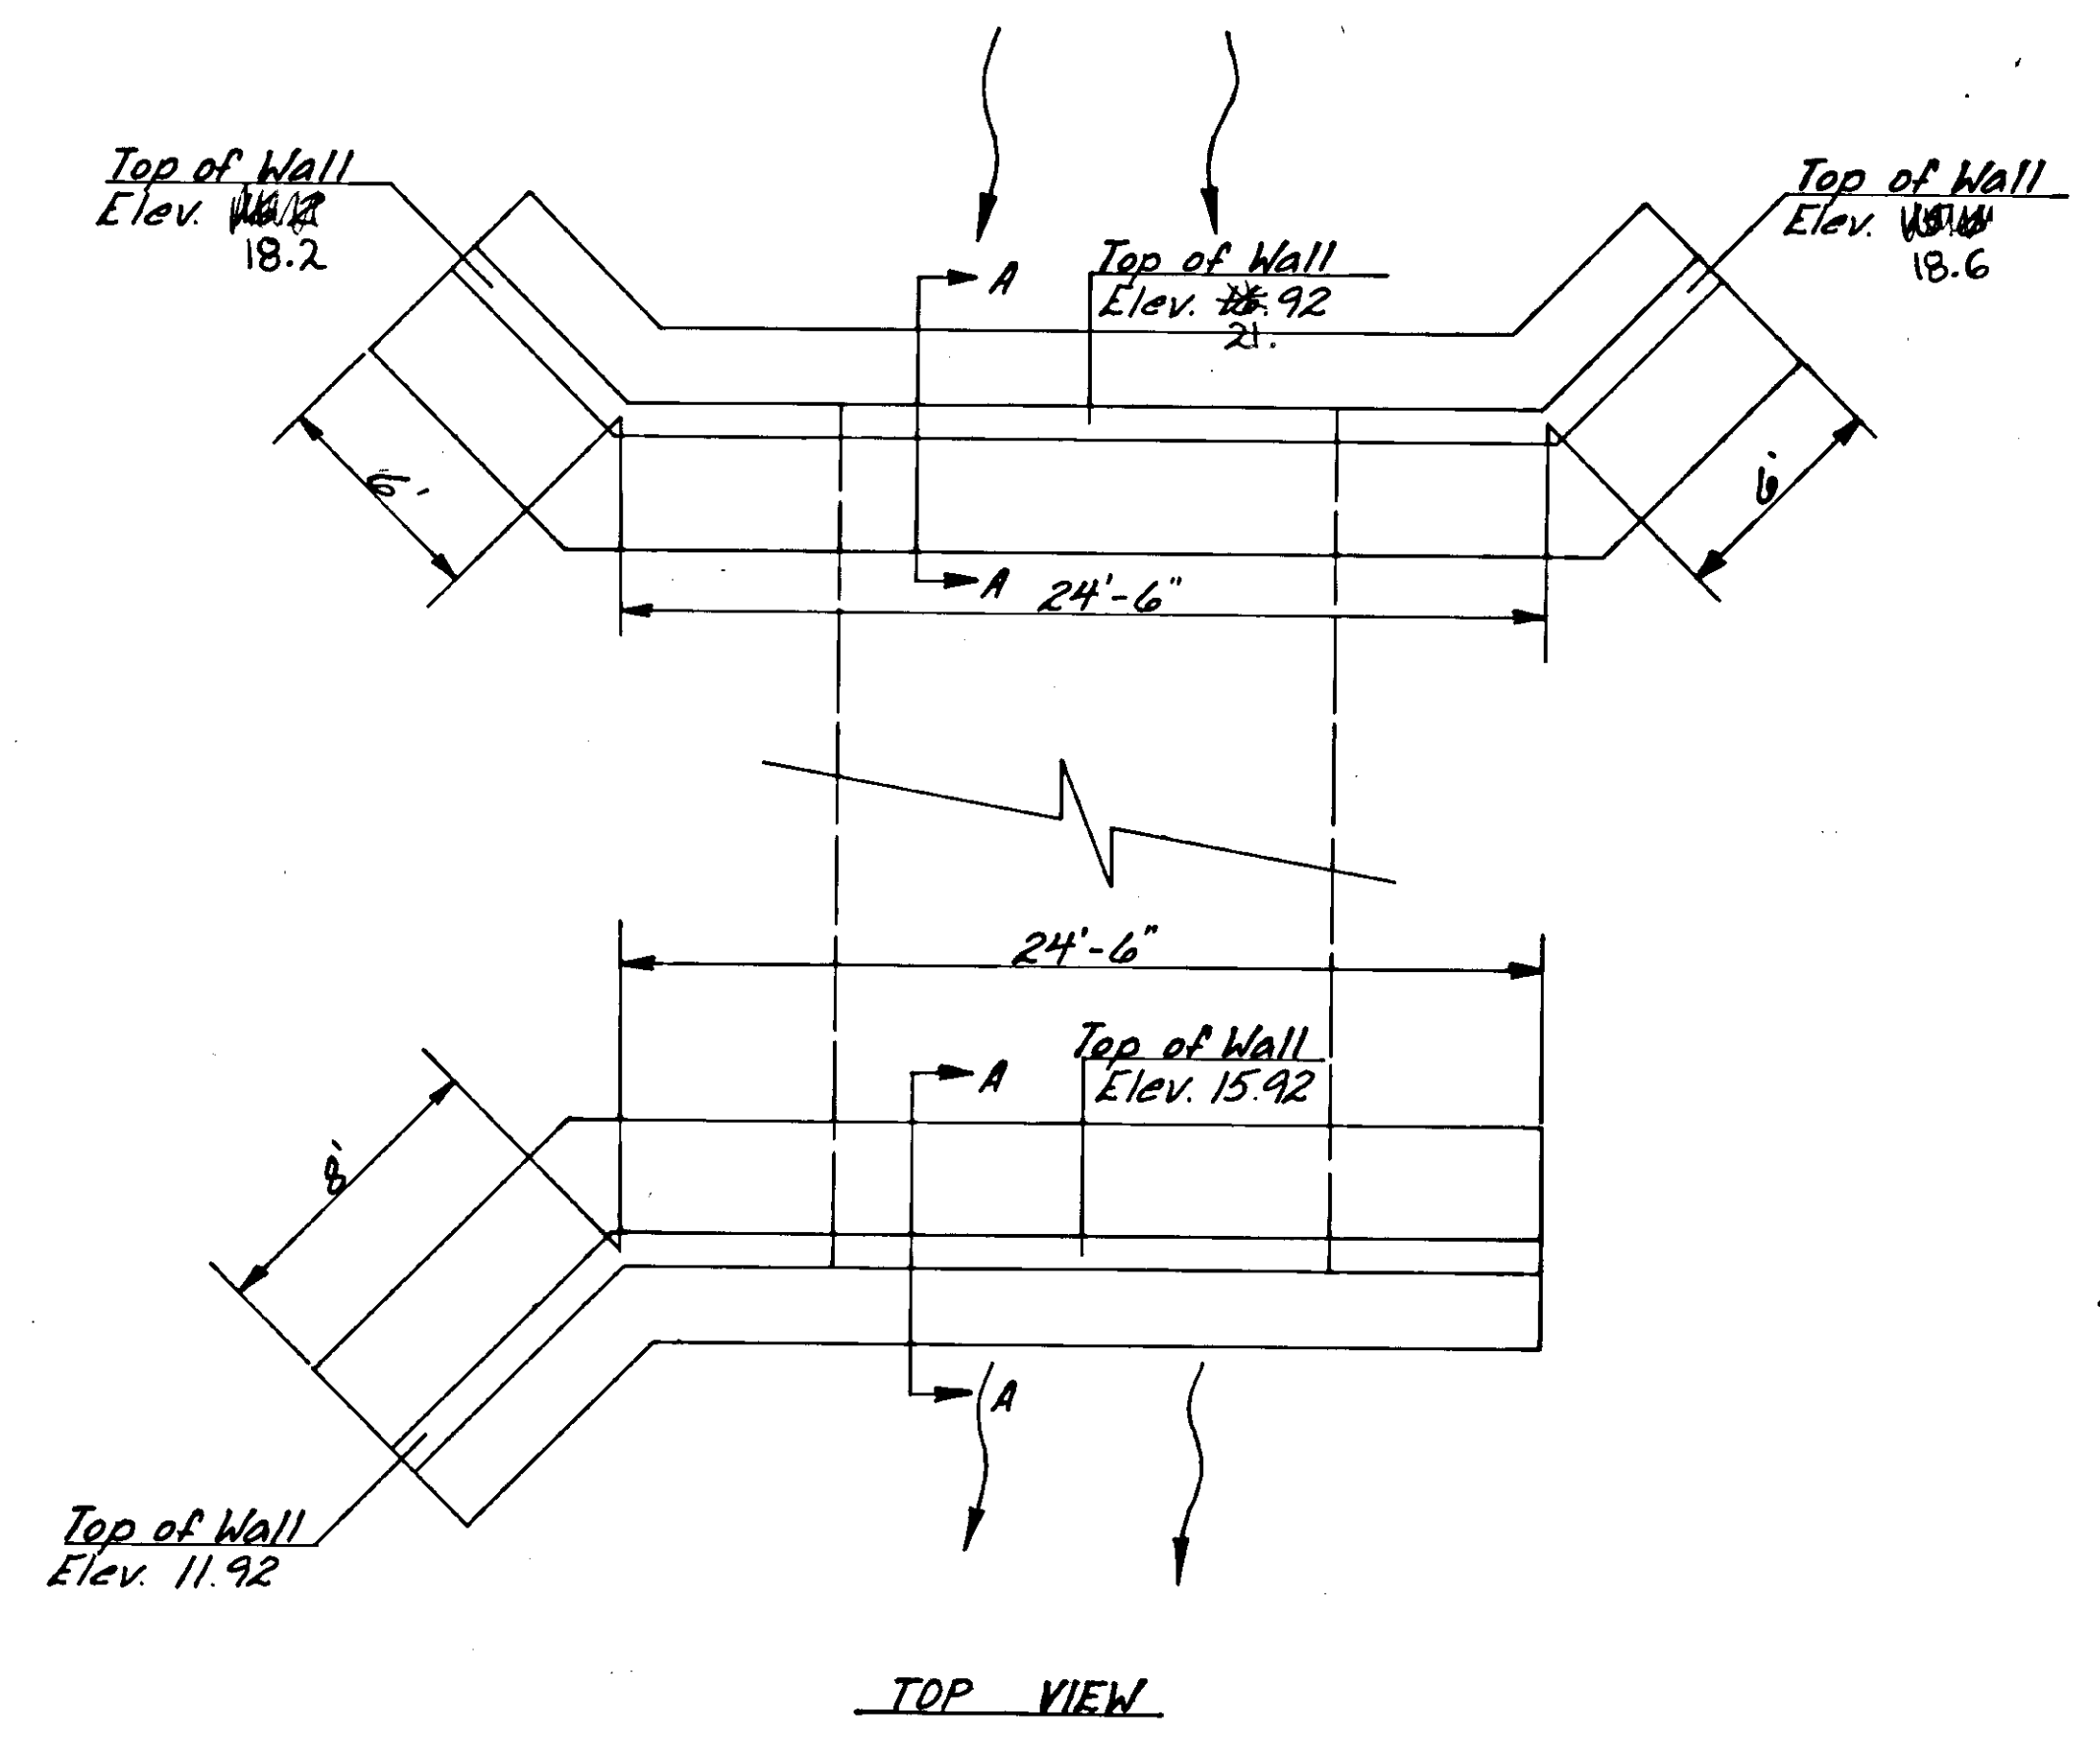


**TOP VIEW**

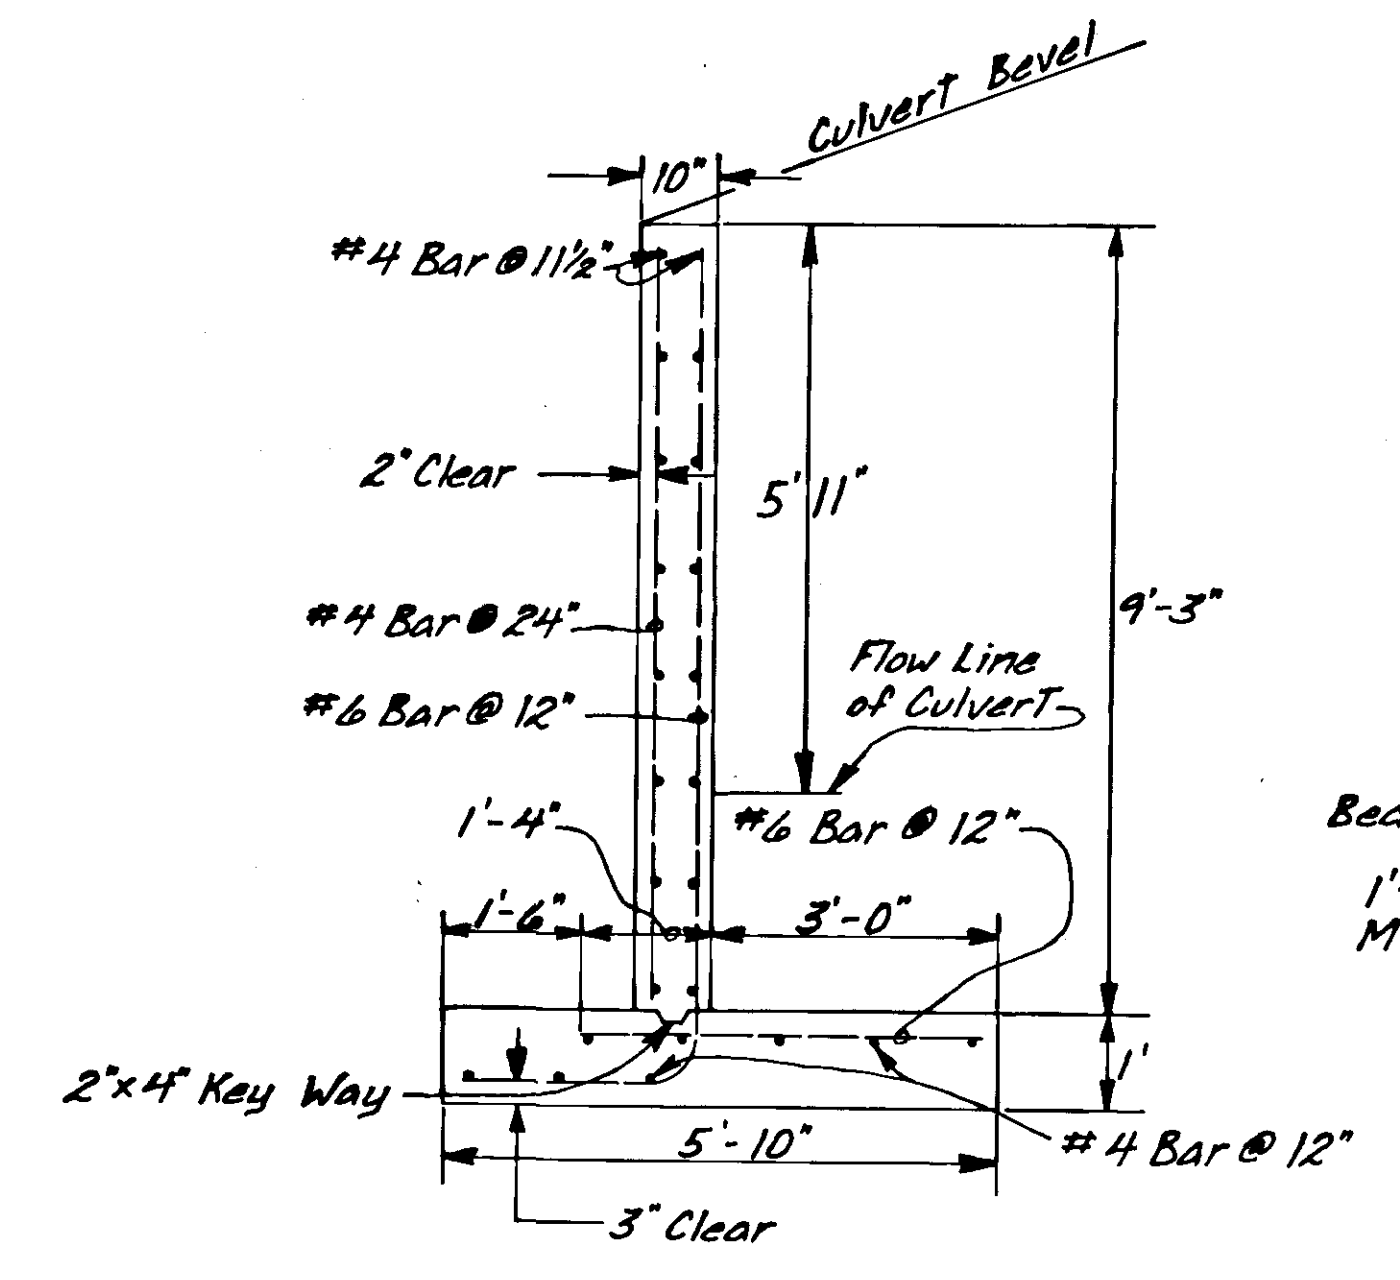

**SECTION A-A**

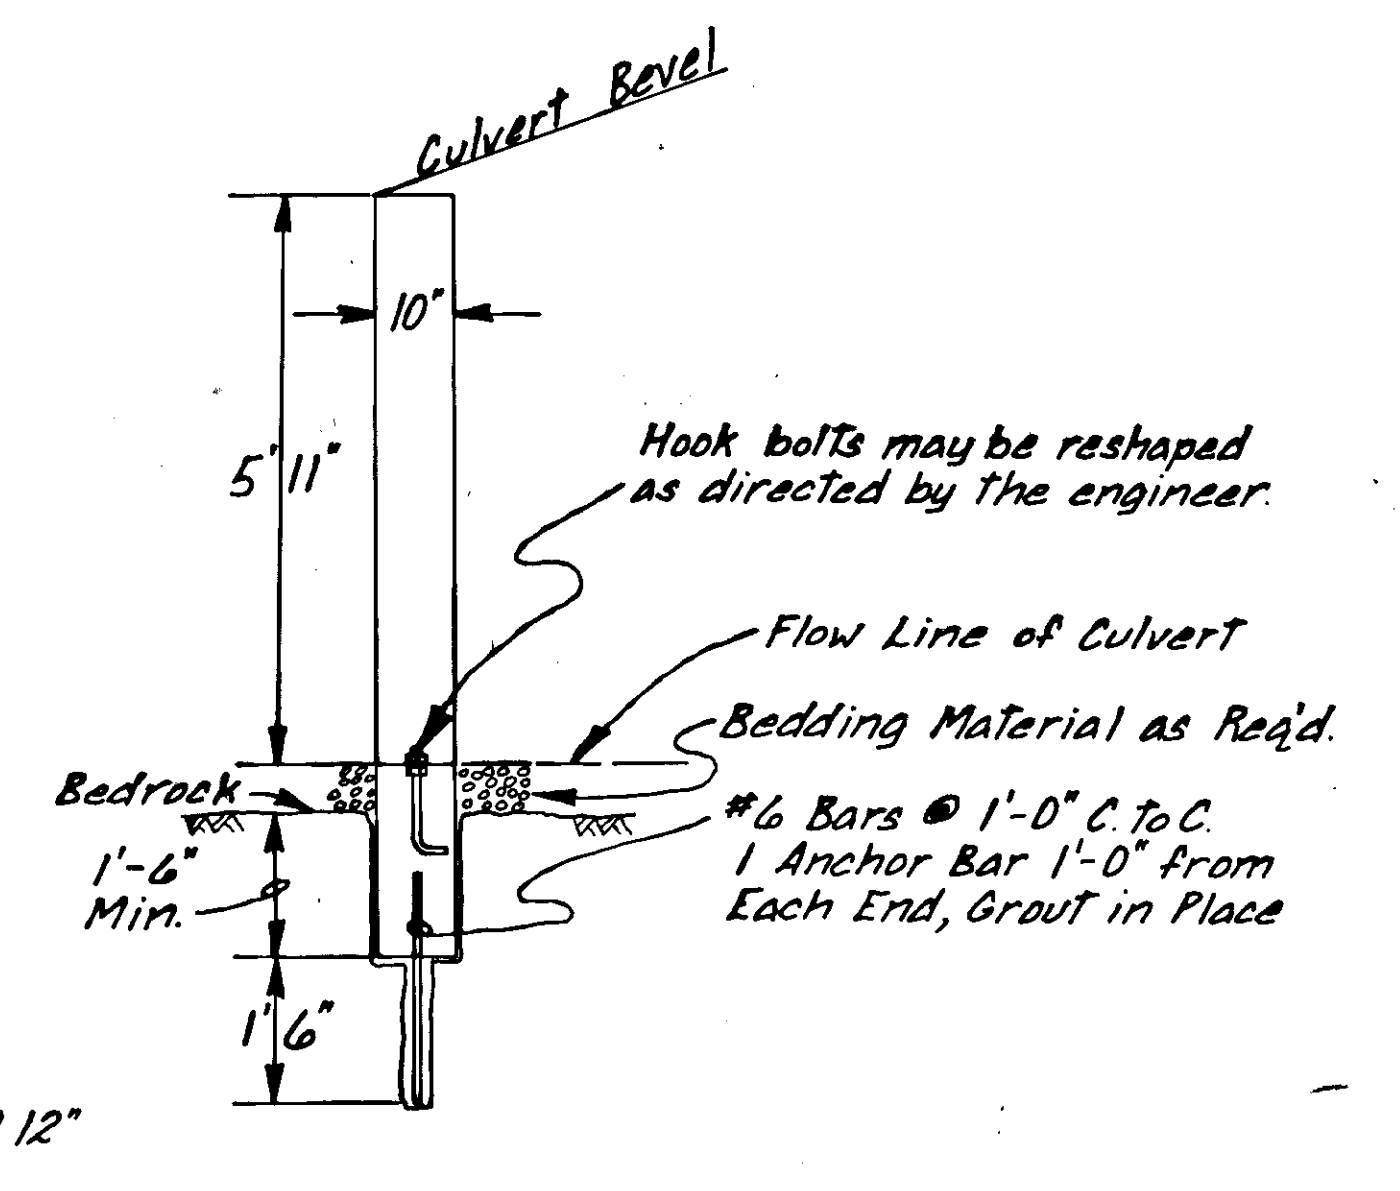

**ALTERNATE METHOD OF ANCHORING  
HEAD & WING WALLS IF BEDROCK IS  
ENCOUNTERED.**

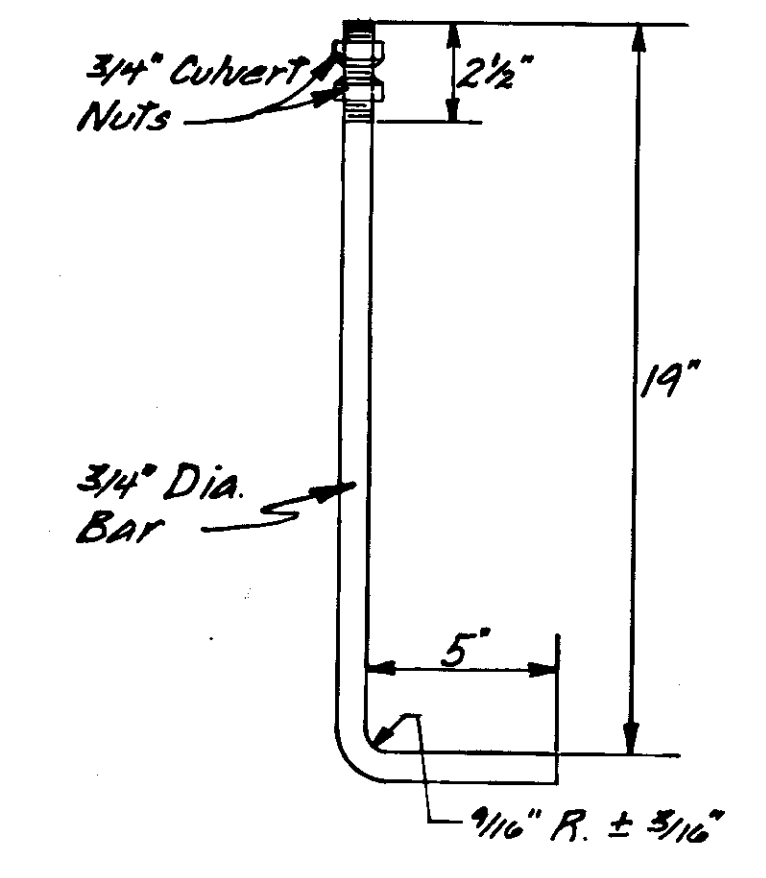

**HOOK BOLT DETAIL**

