

State of Alaska

Department of Transportation
and Public Facilities
Southcoast Region

February 18, 2016

KAKE FERRY TERMINAL PASSENGER FACILITY KAKE, ALASKA

PROJECT No. SAMHS00002/0939008

PROJECT SUMMARY



The undersigned hereby certifies that this duplicated document is an exact and true copy of the original.

Cody Sutter

As-BUILT PLANS

Contractor: DAWSON Construction Inc.
Project Engineer: VAL BEAN
BEGIN WORK: APRIL 18, 2016
END WORK: SEPTEMBER 11, 2017

PROJECT INDEX PROJECT SUMMARY

TITLE & ESTIMATE OF QUANTITIES (2 SHEETS)

PLANSETS

PLANSET A - UPLANDS (11 SHEETS)

PLANSET B - WAITING BUILDING & ELECTRICAL (35 SHEETS)

THE FOLLOWING STANDARD DRAWINGS APPLY TO THIS PROJECT


D-23.01	G-10.01
D-26.02	G-13.00
F-01.02	G-20.11
F-03.01	I-20.15
G-00.02	I-21.03
G-04.10S OR G-04.10W	I-30.10

TIDAL DATA

HTL	+18.1'
MHW	+13.2'
MLLW	0.0'
ELW	-4.6'




SITE MAP

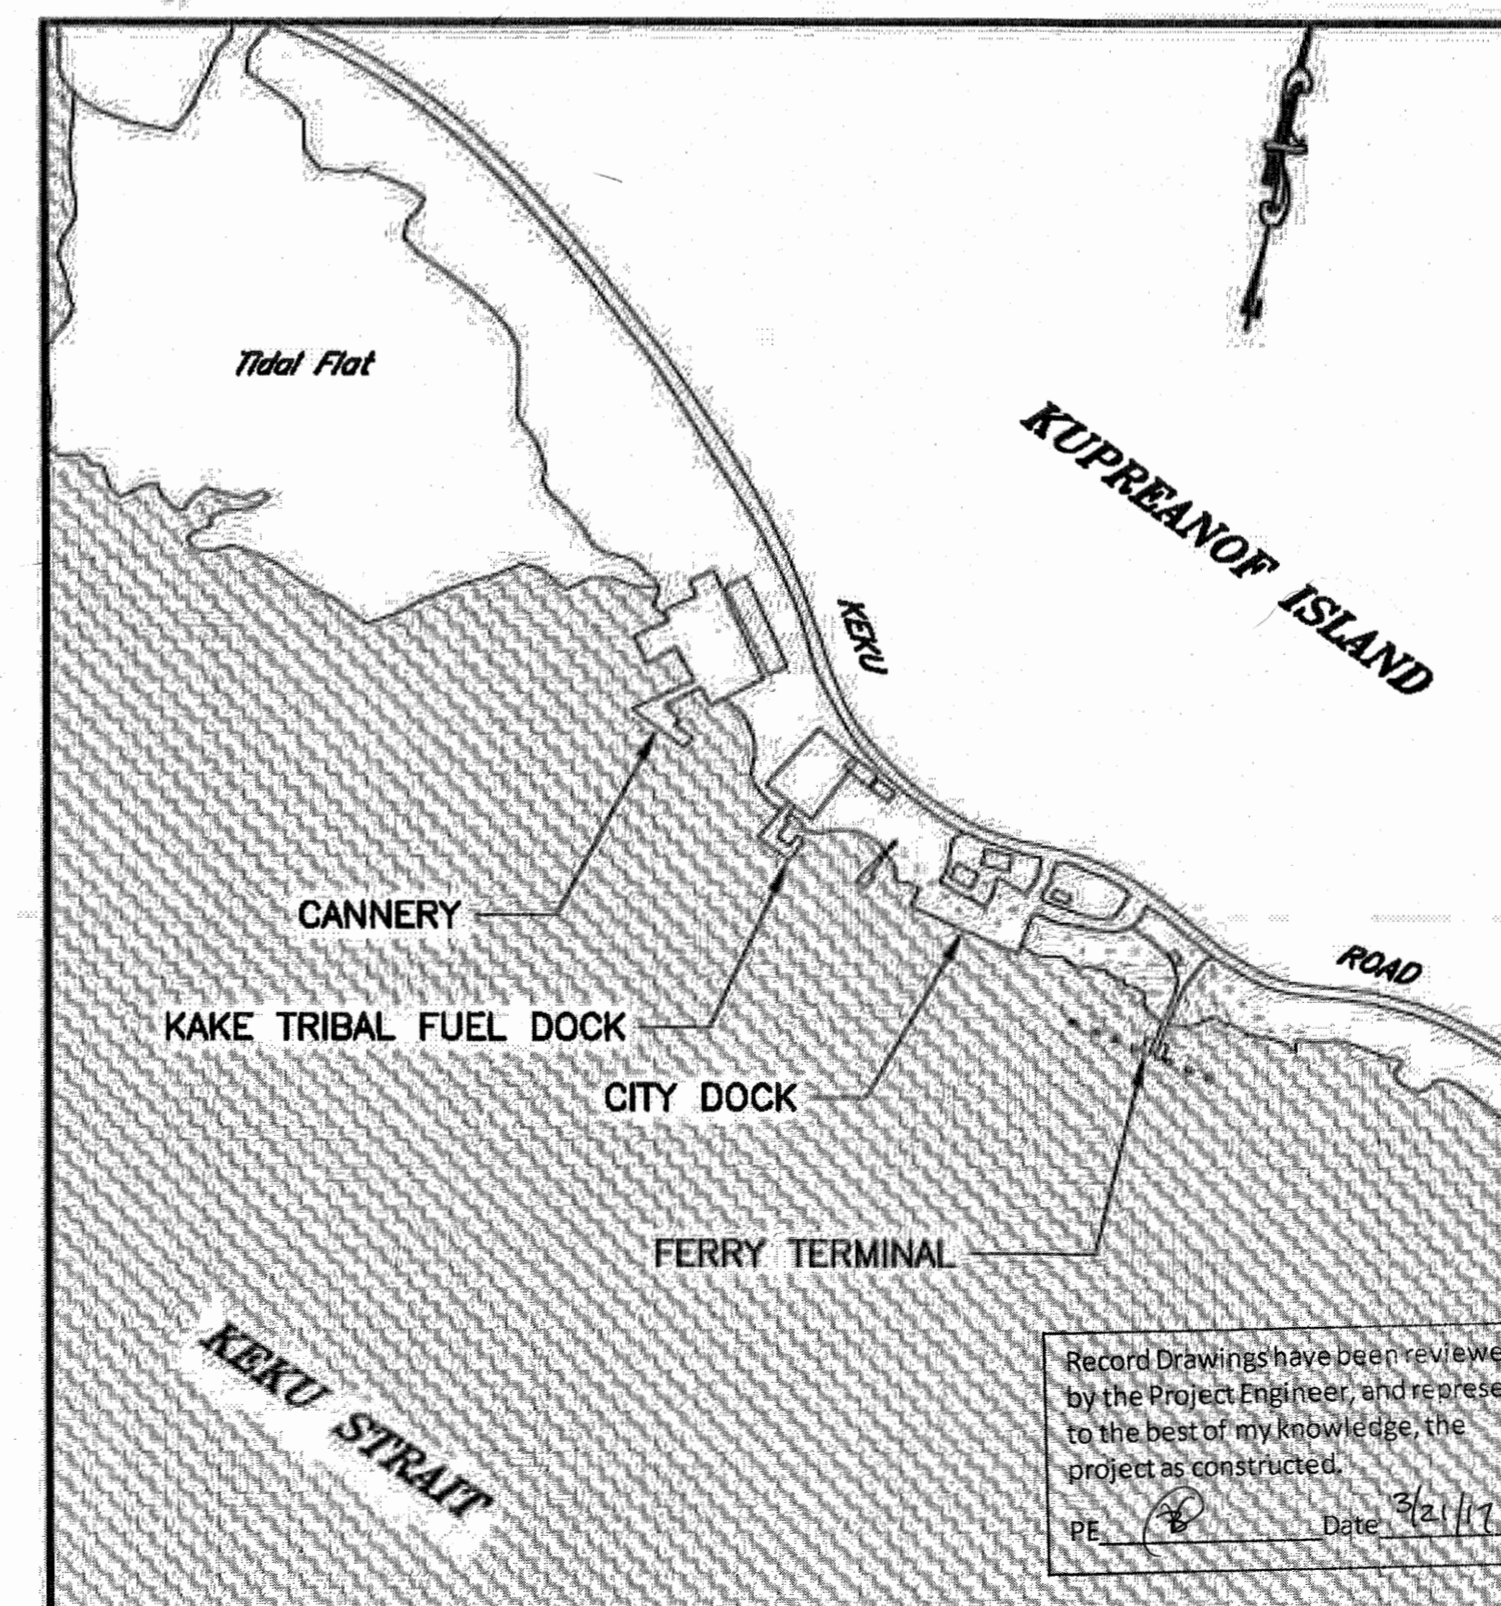

VICINITY MAP

PATH: \\DOTSERFS02\PROJECTS\KAE\69446\PLANSET\MF\SUMMARY\1_TITLE SHEET.DWG
TAB:1
Monday, August 24, 2015 7:50:30 AM
PLOT: PSPACE OR MSPACE: 1=1(F)

STATE OF ALASKA
DEPARTMENT OF TRANSPORTATION
& PUBLIC FACILITIES
SOUTHCOAST REGION

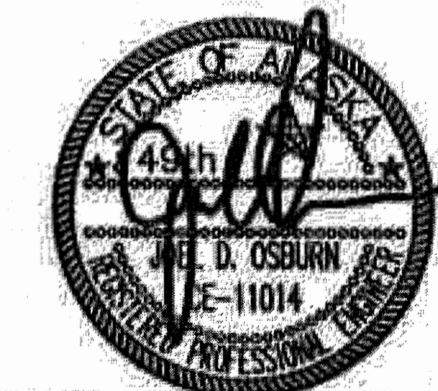

APPROVED: [Signature] 11/6/15
DATE
FOR REGIONAL PRE-CONSTRUCTION ENGINEER
L. PAT CARROLL, P.E.

APPROVED: [Signature] 11/06/15
DATE
DIRECTOR OF DESIGN & CONSTRUCTION
SOUTHCOAST REGION
CHUCK CORREA, P.E.

CERTIFIED TRUE & CORRECT AS-BUILT OF ACTUAL FIELD CONDITION:

CONSTRUCTION PROJECT MANAGER DATE

STATE	PROJECT DESIGNATION	YEAR	SHEET NO.	TOTAL SHEETS
ALASKA	SAMHS00002	2015	1	2

ESTIMATE OF QUANTITIES			
ITEM #	ITEM DESCRIPTION	PAY UNIT	QTY.
BASIC BID			
201(3B)	CLEARING AND GRUBBING	LUMP SUM	ALL REQ'D
201(9)	INVASIVE SPECIES CONTROL, REMOVAL, AND DISPOSAL	CONTINGENT SUM	ALL REQ'D
202(1)	REMOVAL OF STRUCTURES AND OBSTRUCTIONS	LUMP SUM	ALL REQ'D
202(13)	TERMINAL CLOSURE PRICE WITHHOLDING	CONTINGENT SUM	ALL REQ'D
203(7)	BORROW	CYVM	75 80
203(19)	UPLAND IMPROVEMENTS	LUMP SUM	ALL REQ'D
603(21-18)	18 INCH CORRUGATED POLYETHYLENE PIPE	LINEAR FOOT	25 34
604(5)	INLET, TYPE A	EACH	1
606(1)	W-BEAM GUARDRAIL	LINEAR FOOT	100 5
606(13)	PARALLEL GUARDRAIL TERMINAL (ET-PLUS) DELETED CO 1	EACH	2 0
607(3)	CHAIN LINK FENCE	LINEAR FOOT	8
607(6)	WALK GATE	EACH	1
608(1A)	CONCRETE SIDEWALK, 4-INCHES THICK	SQUARE YARD	200 203
608(6)	CURB RAMP	EACH	2
609(2A)	CURB AND GUTTER TYPE A	LINEAR FOOT	235 249
609(2B)	CURB AND GUTTER TYPE B	LINEAR FOOT	103 87
609(2C)	CURB AND GUTTER TYPE C	LINEAR FOOT	55 45
615(1)	STANDARD SIGN	SQUARE FOOT	4.34
626(1)	SANITARY SEWER CONDUIT, 4 INCH	LINEAR FOOT	55
626(2)	SEWER SERVICE CONNECTION	EACH	1
626(3)	SANITARY SEWER CLEANOUT	EACH	1
627(1)	COPPER WATER CONDUIT, 2-INCH	LINEAR FOOT	85 120
627(2)	DUCTILE IRON WATER CONDUIT, 6-INCH	LINEAR FOOT	120 142
627(3)	WATER SERVICE CONNECTION	EACH	1
627(4)	FIRE HYDRANT INSTALLATION	EACH	1
627(5)	INSTALL GATE VALVE, 2-INCH	EACH	1
635(1)	INSULATION BOARD	SQUARE FOOT	24
640(1)	MOBILIZATION AND DEMOBILIZATION	LUMP SUM	ALL REQ'D
640(4)	WORKER MEALS AND LODGING, OR PER DIEM	LUMP SUM	ALL REQ'D
641(1)	EROSION, SEDIMENT AND POLLUTION CONTROL ADMINISTRATION	LUMP SUM	ALL REQ'D
641(3)	TEMPORARY EROSION, SEDIMENT AND POLLUTION CONTROL	LUMP SUM	ALL REQ'D
641(5)	TEMPORARY EROSION, SEDIMENT AND POLLUTION CONTROL BY DIRECTIVE	CONTINGENT SUM	ALL REQ'D
641(6)	WITHHOLDING	CONTINGENT SUM	ALL REQ'D
642(1)	CONSTRUCTION SURVEYING	LUMP SUM	ALL REQ'D
643(2)	TRAFFIC MAINTENANCE	LUMP SUM	ALL REQ'D
644(1)	FIELD OFFICE	LUMP SUM	ALL REQ'D
662(1)	ELECTRICAL POWER AND LIGHTING SYSTEMS	LUMP SUM	ALL REQ'D
695(1)	WAITING BUILDING	LUMP SUM	ALL REQ'D
695(2)	PURSERS SHELTER	LUMP SUM	ALL REQ'D
ALTERNATE A			
625(1)	HANDRAIL	LINEAR FOOT	230
611(1)	RIPRAP SLOPE REPAIR, CO 1	CYVM	150
662(1a)	Inside Passage Electrical Cooperative Fee, CO 1	LUMP SUM	ALL REQ'D
662(1b)	Rowing Type E2, E21 and X2 Light fixtures, CO 5	LUMP SUM	ALL REQ'D

GENERAL NOTES

- AMHS FERRY SERVICE SCHEDULE, LOADING AND UNLOADING OPERATIONS SHALL BE UNINTERRUPTED BY CONSTRUCTION WORK.
- TYPICAL SECTIONS AND TRANSITIONS MAY BE MODIFIED BY THE ENGINEER WHERE REQUIRED TO ACCOMMODATE EXISTING FIELD CONDITIONS.
- DRAINAGE INLETS, PIPE LENGTHS AND LOCATIONS ARE SUBJECT TO FIELD VERIFICATIONS AND REVISIONS BY THE ENGINEER.
- REFER TO STANDARD DRAWINGS FOR DETAILS NOT SHOWN.
- REFERENCE APPENDIX B AND SECTION 641 OF THE SPECIFICATIONS FOR ALL PERTINENT ENVIRONMENTAL WORK RESTRICTIONS.
- LOCATION OF NEW SEWER AND WATER UTILITIES MAY VARY FROM LOCATIONS SHOWN ON THE PLANS. THE CONTRACTOR SHALL FIELD VERIFY AND COORDINATE EXACT LOCATIONS OF NEW UTILITY FEATURES (ANGLE POINTS, VALVES, ETC.) WITH THE ENGINEER AND THE CITY OF KAKE.

695(3)	Ice & Water Shield, CO 1	LUMP SUM	ALL REQ'D
695(4)	Flashing Support at Exterior Slab to Sidewalk, CO 5	LUMP SUM	ALL REQ'D
695(5)	Vandal Covers and Square D Core Switch, CO 5	LUMP SUM	ALL REQ'D

CONSTRUCTION CONSIDERATIONS

- THE CONTRACTOR SHALL STAGE/SCHEDULE THE PROJECT SUCH THAT VEHICLE PARKING (8 VEHICLE SPACES) AND STAGING AREAS (10 VEHICLE SPACES), EITHER EXISTING, PERMANENT OR TEMPORARY ARE PROVIDED AT ALL TIMES. THE CONTRACTOR SHALL ALSO PREPARE A TEMPORARY STAGING/PARKING AREA PLAN, PER SECTION 690, WHEN EXISTING OPERATIONAL FACILITIES WILL BE CLOSED DURING CONSTRUCTION ACTIVITIES.
- THE CONTRACTOR MAY STAGE EQUIPMENT ON ANY PART OF STATE OF ALASKA PROPERTY SO AS LONG IT DOES NOT IMPACT TEMPORARY OR PERMANENT STAGING AND PARKING AREAS FOR AMHS PASSENGERS.
- REFER TO PROJECT #68238 PLANS FOR EXISTING ELECTRICAL DETAILS. COORDINATE ALL POWER DISRUPTIONS TO THE RAMP/APRON LIFT SYSTEM WHEN VESSELS ARE NOT SCHEDULED TO BE IN PORT. INSURE THAT PERMANENT OR TEMPORARY POWER IS RESTORED TO THE RAMP/APRON LIFT MOTORS AND THAT THE TRANSFER BRIDGE IS FULLY FUNCTIONAL A MINIMUM OF ONE-HOUR BEFORE SCHEDULED VESSEL ARRIVALS.


BASIS OF ESTIMATE

ITEM NO.	ITEM	UNIT	QUANTITY	FACTOR
203 (19)	UPLAND IMPROVEMENTS - INCLUDES THE FOLLOWING:			
	AGGREGATE BASE COURSE, GRADING D1	CUBIC YARD	120	
	SEED	SQUARE YARD	225	
	TOPSOIL	SQUARE YARD	225	
695(2A)	PURSERS SHELTER HATCHER, CO 6	LUMP SUM	ALL REQ'D	
695(6)	PANEL A SWITCH KEY, CO 5	LUMP SUM	ALL REQ'D	
695(7)	SURFACE MOUNT RACEWAY, CO 5	LUMP SUM	ALL REQ'D	
695(9)	HEAVY DUTY WEATHER STRAPING, CO 6	LUMP SUM	ALL REQ'D	
695(10)	WIND BREAKER, CO 6	LUMP SUM	ALL REQ'D	

ABBREVIATIONS

CL	CENTER LINE	MIN	MINIMUM
CYVM	CUBIC YARD VEHICLE MEASURE	MLLW	MEAN LOWER LOW WATER
BLDG	BUILDING	N	NORTHING
BP	BUILDING PIPE	NTS	NOT TO SCALE
CB	CATCH BASIN	OC	ON CENTER
CPP	CORRUGATED POLYETHYLENE PIPE	PC	POINT OF CURVATURE
CY	CUBIC YARD	PCC	POINT OF COMPOUND CURVE
DIA	DIAMETER	PL	PLATE
D.I.	DUCTILE IRON	PRC	POINT OF REVERSE CURVATURE
DWG	DRAWING	PT	POINT OF TANGENCY
E	EASTING	PVC	POLYVINYL CHLORIDE
ELEV	ELEVATION	R	RADIUS
Δ	DELTA	RT	RIGHT
GAL	GALLON	SHT	SHEET
HTL	HIGH TIDE LINE	STA	STATION (100 FT.)
L	LENGTH	SY	SQUARE YARD
LBS	POUNDS	T	TANGENT
LF	LINEAR FEET	TEL	TELEPHONE
LT	LEFT	TYP	TYPICAL
MAX	MAXIMUM		

REFERENCE LEGEND

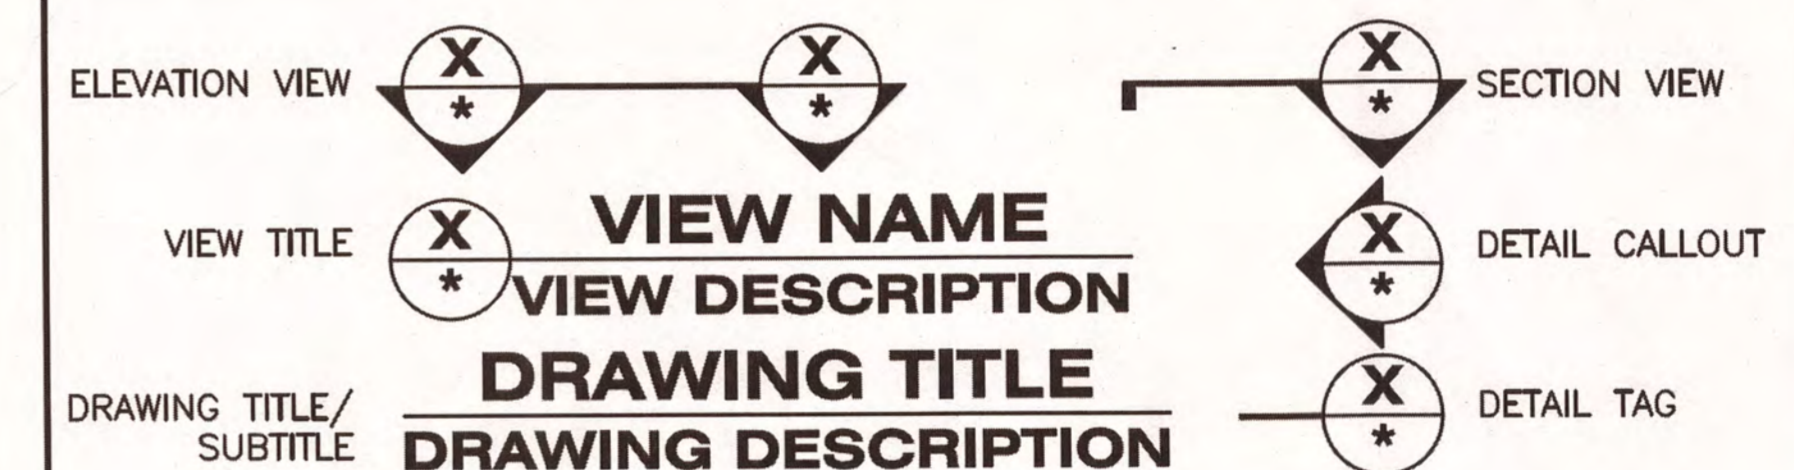

NOTES:
* SHEET NUMBER WHERE REFERENCE IS LOCATED WHEN ON A DIFFERENT SHEET OR DASH MARK WHEN REFERENCE IS ON THE SAME SHEET

Record Drawings have been reviewed by the Project Engineer, and represent to the best of my knowledge, the project as constructed.


PE Date 3/21/17

DO NOT SCALE FROM THESE DRAWINGS USE DIMENSIONS

DESIGNED BY: J. OSBURN	STATE OF ALASKA DEPARTMENT OF TRANSPORTATION & PUBLIC FACILITIES SOUTHCOST REGION		
	KAKE FERRY TERMINAL PASSENGER FACILITY		
ESTIMATE OF QUANTITIES AND GENERAL NOTES			
CHECKED BY: STAFF	PROJECT DESIGNATION		
DRAWN BY: STAFF	YEAR		
PATH: \\DOTSERFS02\PROJECTS\KAE\69446\PLANSET\MF\SUMMARY\2_ESTIMATE.DWG			
TAB: 2 Friday, November 06, 2015 8:47:01 AM OSBURN, JOEL D (DOT)			
REVISIONS		YEAR	SHEET
NO.	DATE	DESCRIPTION	TOTAL SHEETS
			2
SFHMS00002		2015	2

State of Alaska

Department of Transportation
and Public Facilities
Southcoast Region

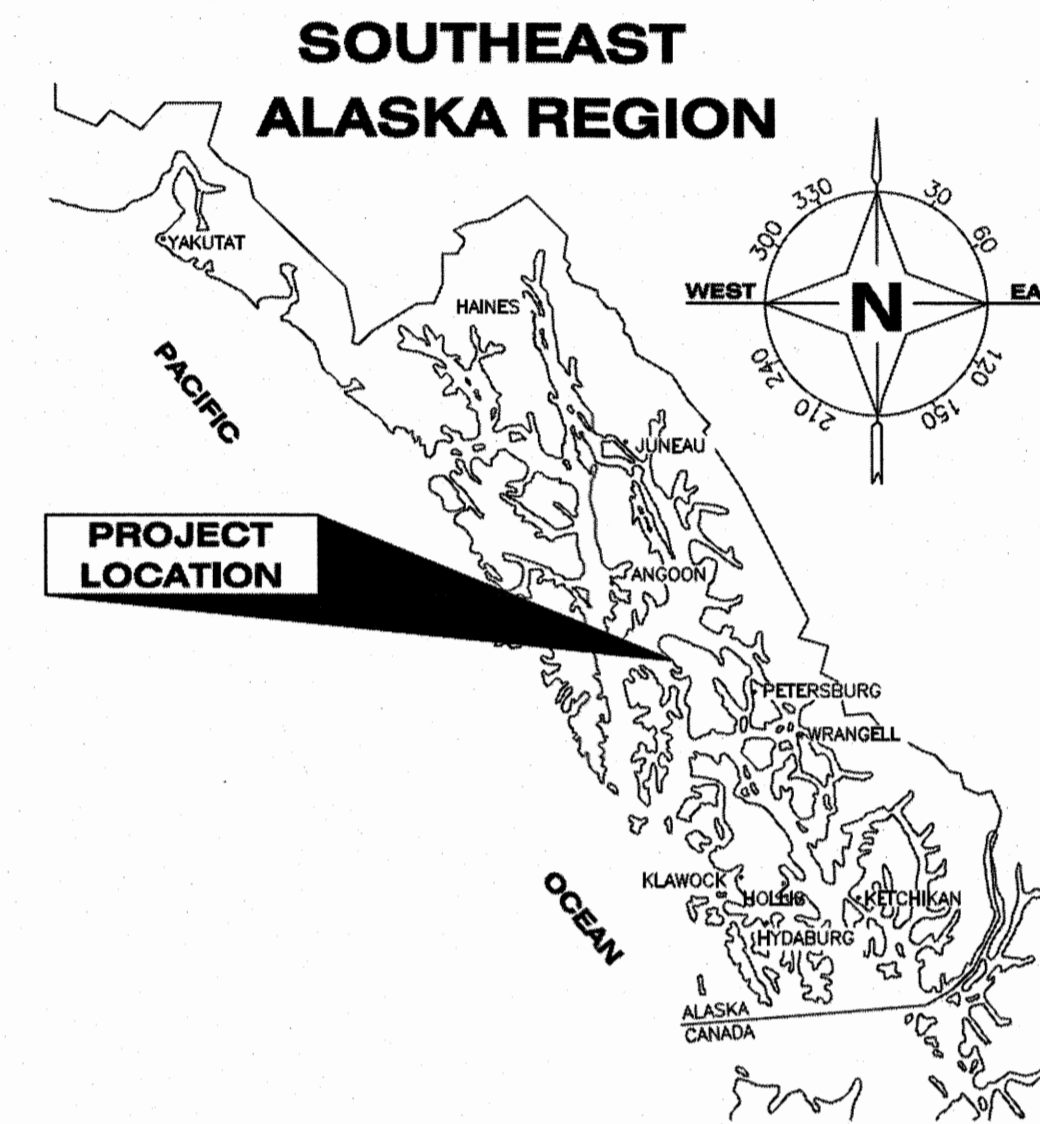

SHEET INDEX	
SHEET NO.	DESCRIPTION
1	TITLE SHEET
2	SURVEY CONTROL SHEET
3	EXISTING SITE & DEMOLITION PLAN
4	PROPOSED SITE PLAN
5	SITE LAYOUT PLAN
6	LAYOUT POINTS
7	TYPICAL SECTIONS
8	MISCELLANEOUS DETAILS
9-10	UTILITY DETAILS
11	PURSEERS SHELTER

KAKE FERRY TERMINAL PASSENGER FACILITY

KAKE, ALASKA

PROJECT No. SAMHS00002

PLANSET A: UPLANDS

Record Drawings have been reviewed by the Project Engineer, and represent to the best of my knowledge, the project as constructed.
PE: [Signature] Date: 3/21/17

DO NOT SCALE FROM THESE DRAWINGS USE DIMENSIONS

CHECKED BY: J. OSBURN 	STATE OF ALASKA DEPARTMENT OF TRANSPORTATION & PUBLIC FACILITIES SOUTHCOAST REGION KAKE FERRY TERMINAL PASSENGER FACILITY PLANSET A TITLE SHEET																					
DESIGNED BY: STAFF DRAWN BY: STAFF	PATH: \\DOTSERFS02\PROJECTS\KAE\69446\PLANSET\MF\PLANSET A\1_TITLE SHEET.DWG TAB: 1 Monday, November 02, 2015 11:15:58 AM J. OSBURN, JOEL D (DOT)																					
<table border="1"> <thead> <tr> <th colspan="3">REVISIONS</th> <th>PROJECT DESIGNATION</th> <th>YEAR</th> <th>SHEET NO.</th> <th>TOTAL SHEETS</th> </tr> <tr> <th>NO.</th> <th>DATE</th> <th>DESCRIPTION</th> <th></th> <th></th> <th></th> <th></th> </tr> </thead> <tbody> <tr> <td></td> <td></td> <td></td> <td>SAMHS00002</td> <td>2015</td> <td>1</td> <td>11</td> </tr> </tbody> </table>	REVISIONS			PROJECT DESIGNATION	YEAR	SHEET NO.	TOTAL SHEETS	NO.	DATE	DESCRIPTION								SAMHS00002	2015	1	11	
REVISIONS			PROJECT DESIGNATION	YEAR	SHEET NO.	TOTAL SHEETS																
NO.	DATE	DESCRIPTION																				
			SAMHS00002	2015	1	11																

LOCAL SYSTEM COORDINATES				
Point #	Northing	Easting	Elevation	Description
47	503210.95	295115.48	66.52	GPS_ALCTRL2_47
48	502170.18	295364.82	30.18	GPS_ALCTRL2_48
49	501747.37	295915.69	30.90	GPS_ALCTRL2_49

NAD83(92) GEOGRAPHIC			
Point #	Latitude	Longitude	Description
47	N56° 57' 50.6114"	W133° 55' 31.0274"	GPS_ALCTRL2_47
48	N56° 57' 40.4444"	W133° 55' 26.4592"	GPS_ALCTRL2_48
49	N56° 57' 44.2198"	W133° 55' 16.4939"	GPS_ALCTRL2_49

All **SURVEY CONTROL** monuments in this table are provided strictly for survey control. Should any of them be destroyed during construction they **shall NOT** be replaced.

HORIZONTAL CONTROL

Horizontal Control for this project is based on the AK DOT/PF Kake Grid.

It relates to AKSPC Zone 1 NAD83 (92) through the following parameters:

Grid Scale = 0.99990134

Rotation = 0.0000

Translation about DOT/PF control point 49 as follows:

AKSPC Northing = 1873115.82 FT US

AKSPC Easting = 2635136.37 FT US

Local Northing = 501747.38 FT US

Local Easting = 295915.69 FT US

Project Specific Basis of Horizontal Control



47 - 2" Aluminum cap on rebar. Stamped "AK DOT & PF 47"

48 - 2" Aluminum cap on rebar set 0.4ft from edge of pavement at the top of wood stairs opposite fuel farm at cannery. Stamped "AK DOT & PF 48"

49 - 2" Aluminum cap on rebar set 1.8ft from edge of pavement at NW side of apron to ferry terminal entrance. Stamped "AK DOT & PF 49"

VERTICAL CONTROL

The Vertical Datum for Kake Grid is Mean Lower Low Water = 0.00 ft based on National Ocean Service Benchmark Tidal Benchmark series 9451528. See <http://www.co-ops.nos.noaa.gov/stations.html?type=Bench+Mark+Data+Sheets> for details.

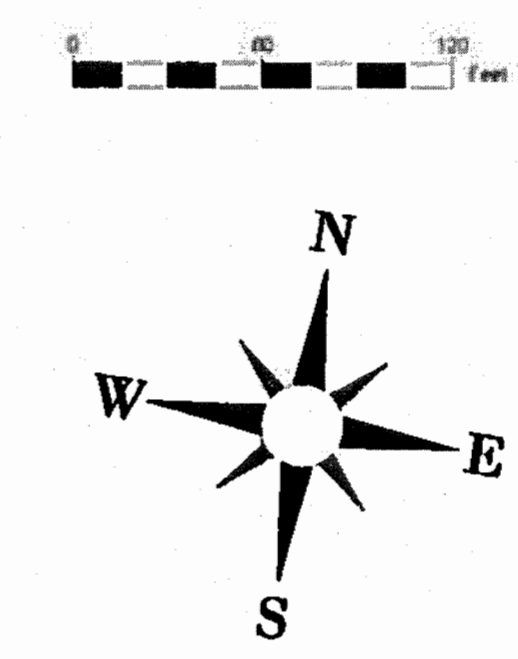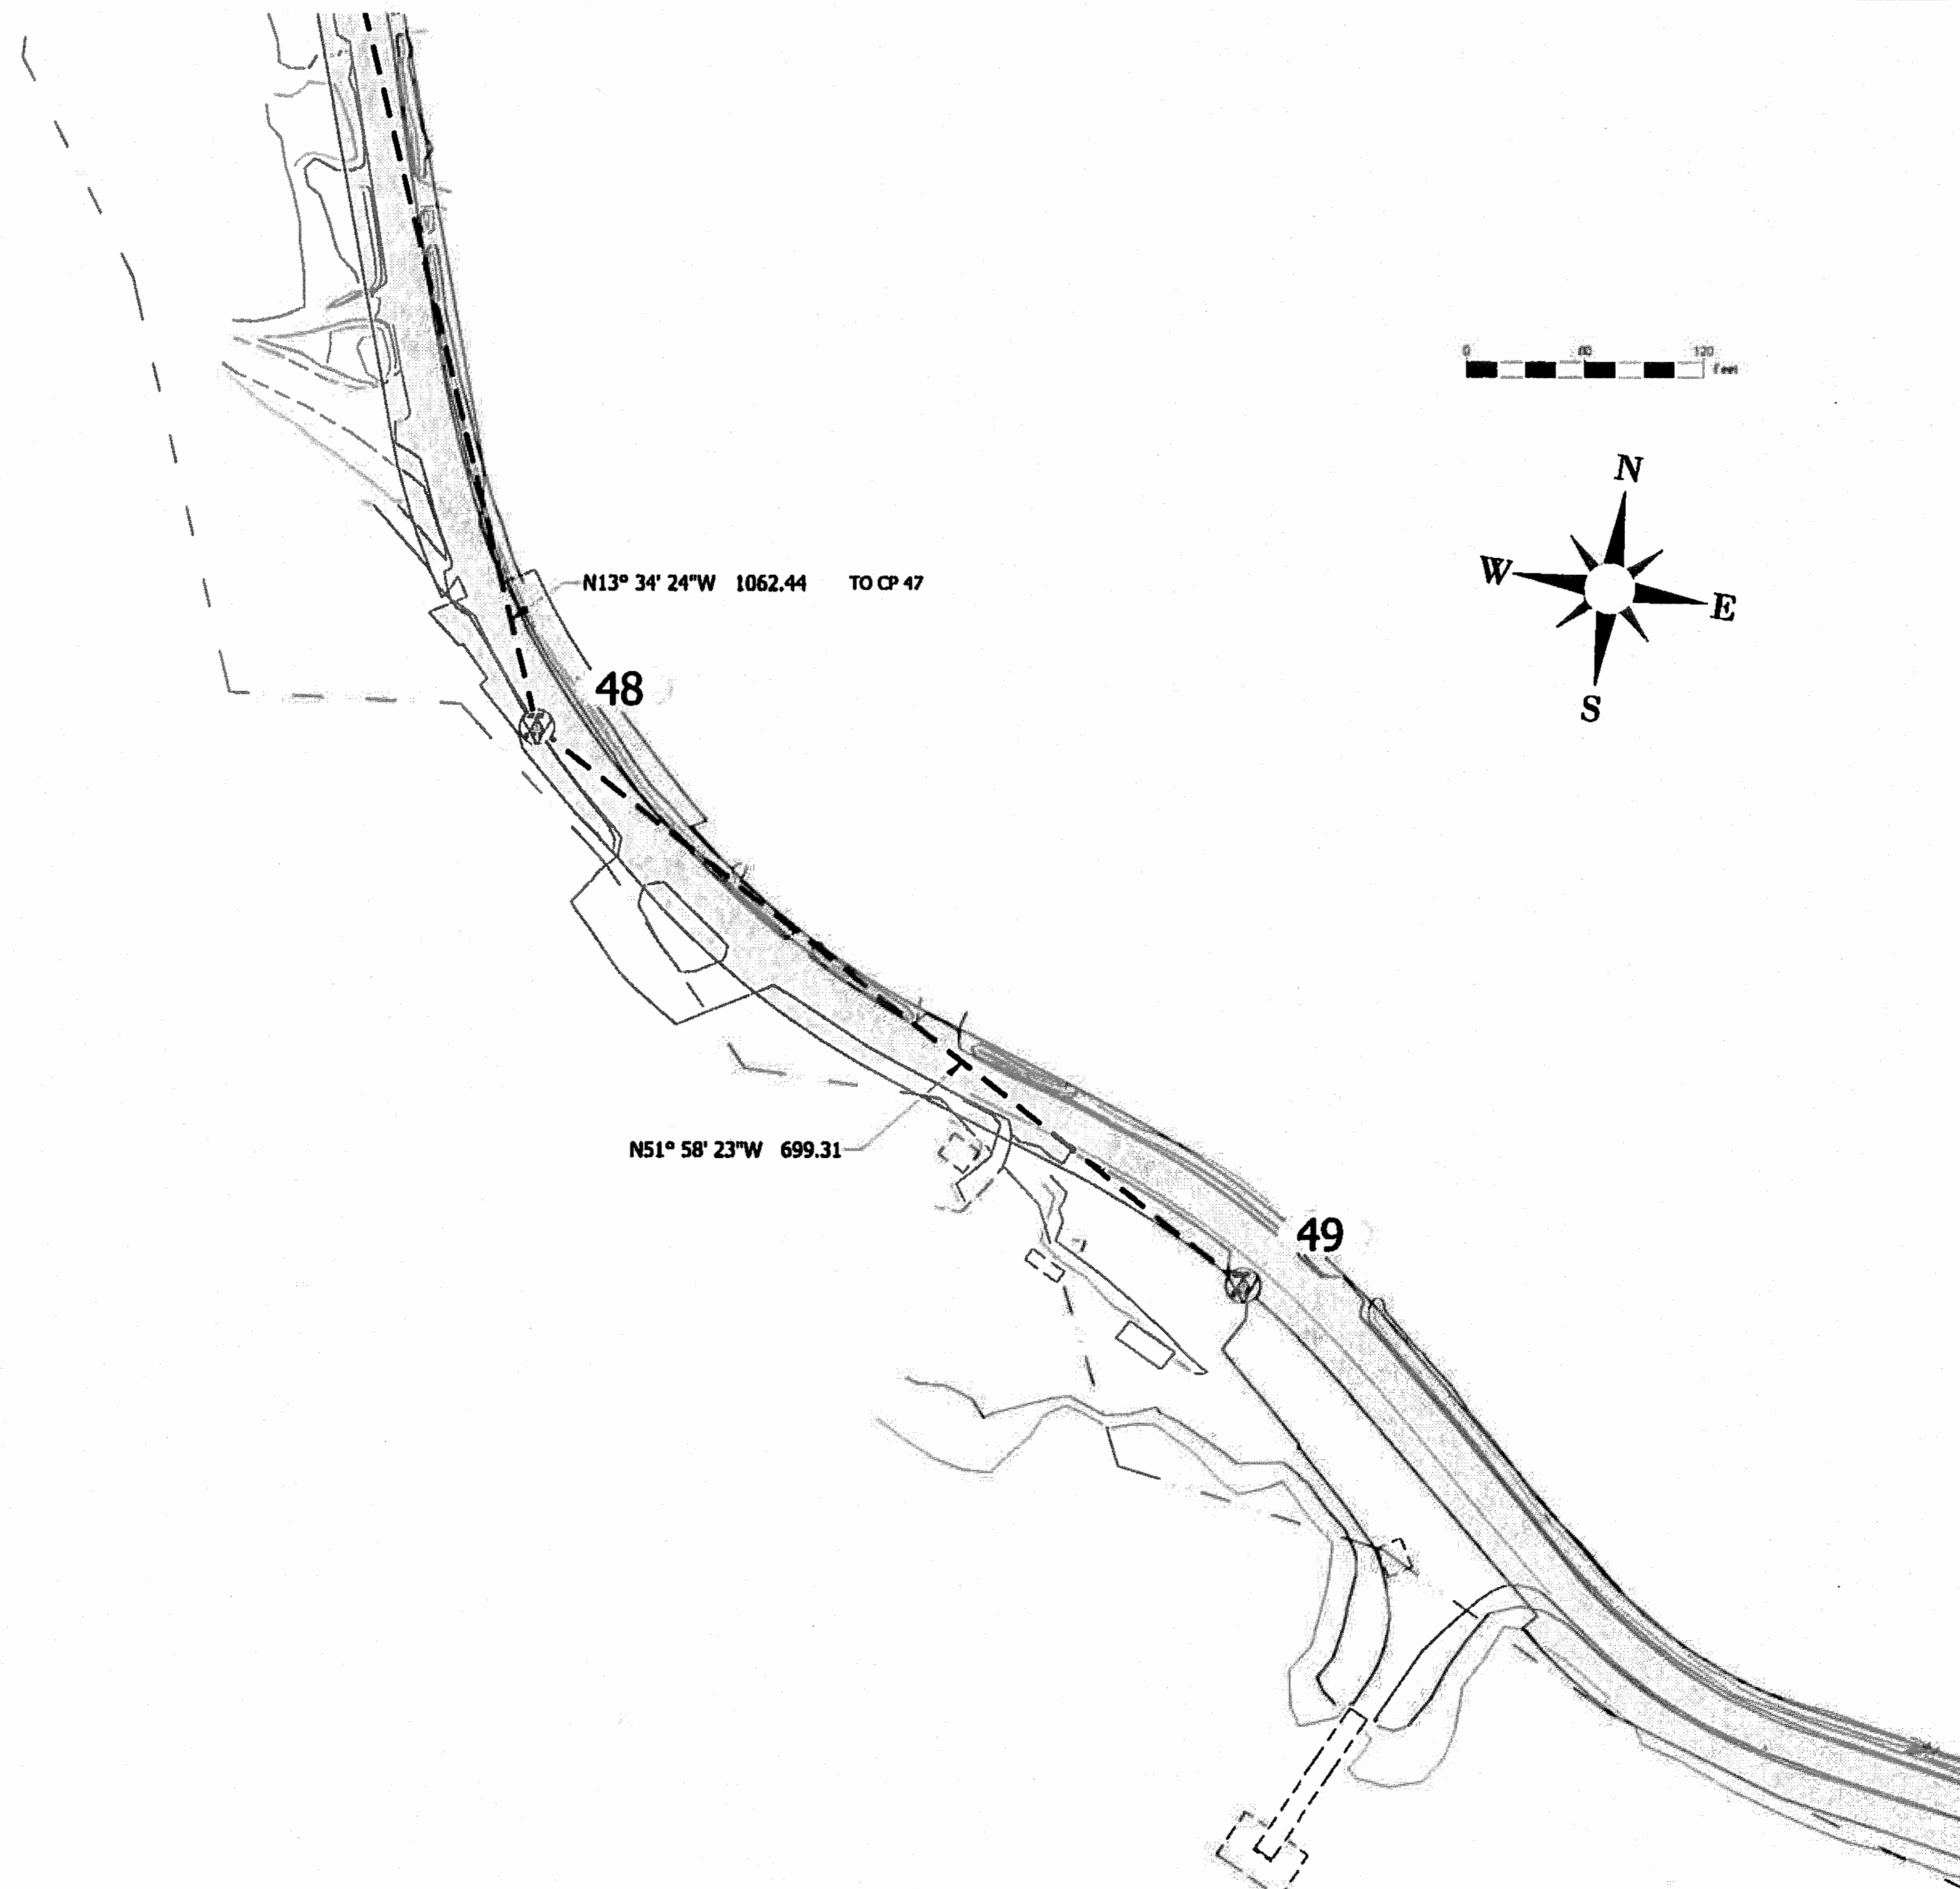

MONUMENT NOTES:




1. If any pair of control points disagrees by more than 1:10,000 horizontally or vertically then a third network point must be tied to ascertain which point is in error or has been disturbed.
2. Whether listed or not, all monuments, property markers, or accessories that will be disturbed or buried shall be referenced prior to being disturbed, and re-established in their original position and a record of monument form in accordance with A.S.34.65.040 shall be submitted to the construction engineer for review prior to recording. Coordinate values listed are for informational purposes and should be used to reset monuments only as a last resort.

KAKE FERRY TERMINAL

Record Drawings have been reviewed by the Project Engineer, and represent to the best of my knowledge, the project as constructed.
 PE: [Signature] Date: 3/21/17


CHECKED BY: DMI DESIGNED BY: DMI DRAWN BY: DMI	STATE OF ALASKA DEPARTMENT OF TRANSPORTATION & PUBLIC FACILITIES SOUTHCOAST REGION KAKE FERRY TERMINAL PASSENGER FACILITY PLANSET A SURVEY CONTROL SHEET										
	PATH: Q:\KAE\69446\SV\69446_A2.DWG TAB: A2 Thursday, August 20, 2015 11:02:46 AM IGNOTOV, DANIEL M (DOT)		PROJECT DESIGNATION	YEAR	SHEET NO.	TOTAL SHEETS					
<table border="1"> <thead> <tr> <th>NO.</th> <th>DATE</th> <th>DESCRIPTION</th> </tr> </thead> <tbody> <tr> <td> </td> <td> </td> <td> </td> </tr> </tbody> </table>		NO.	DATE	DESCRIPTION				SAHMS0002 2015 2		11	
NO.	DATE	DESCRIPTION									

DO NOT SCALE FROM THESE DRAWINGS USE DIMENSIONS

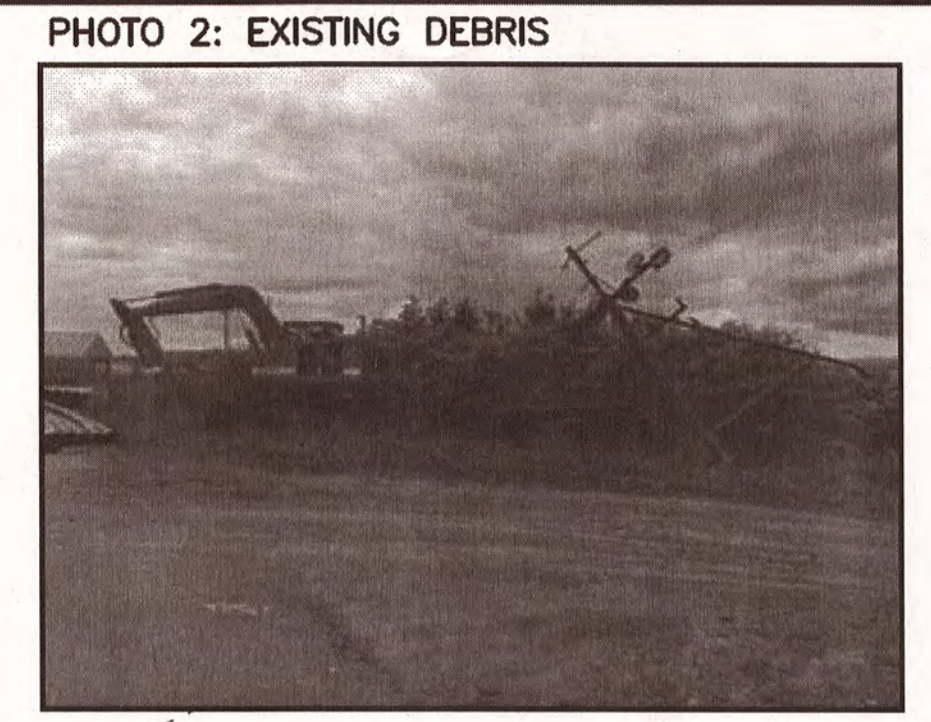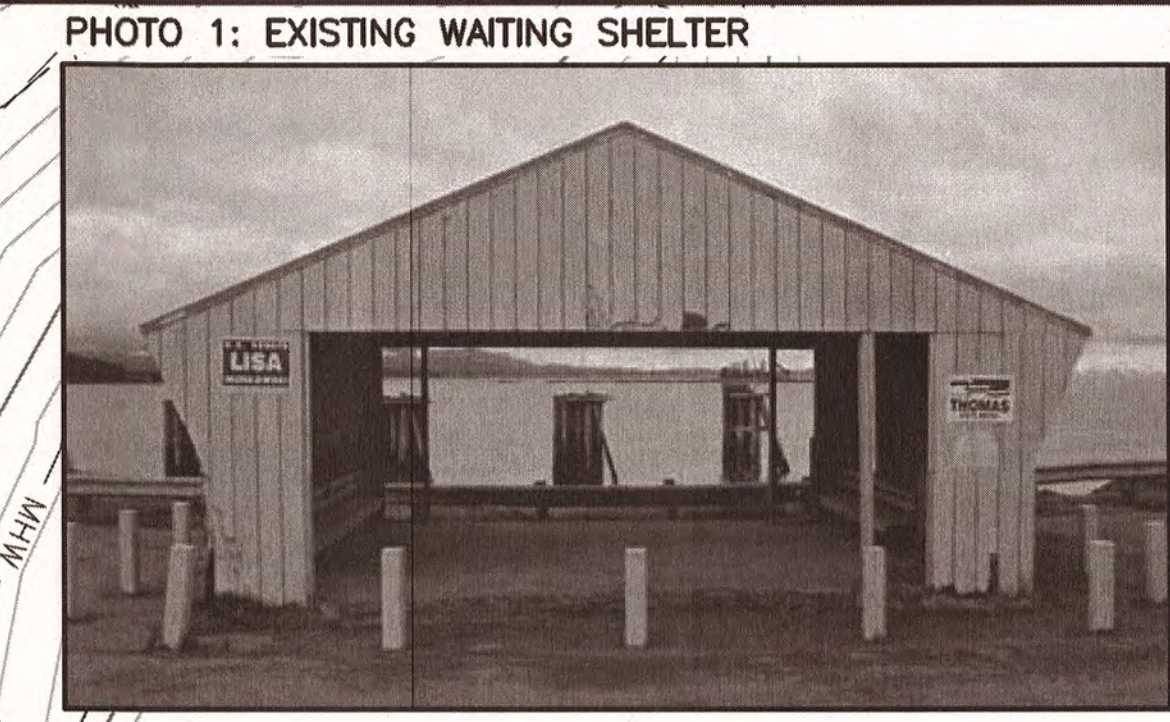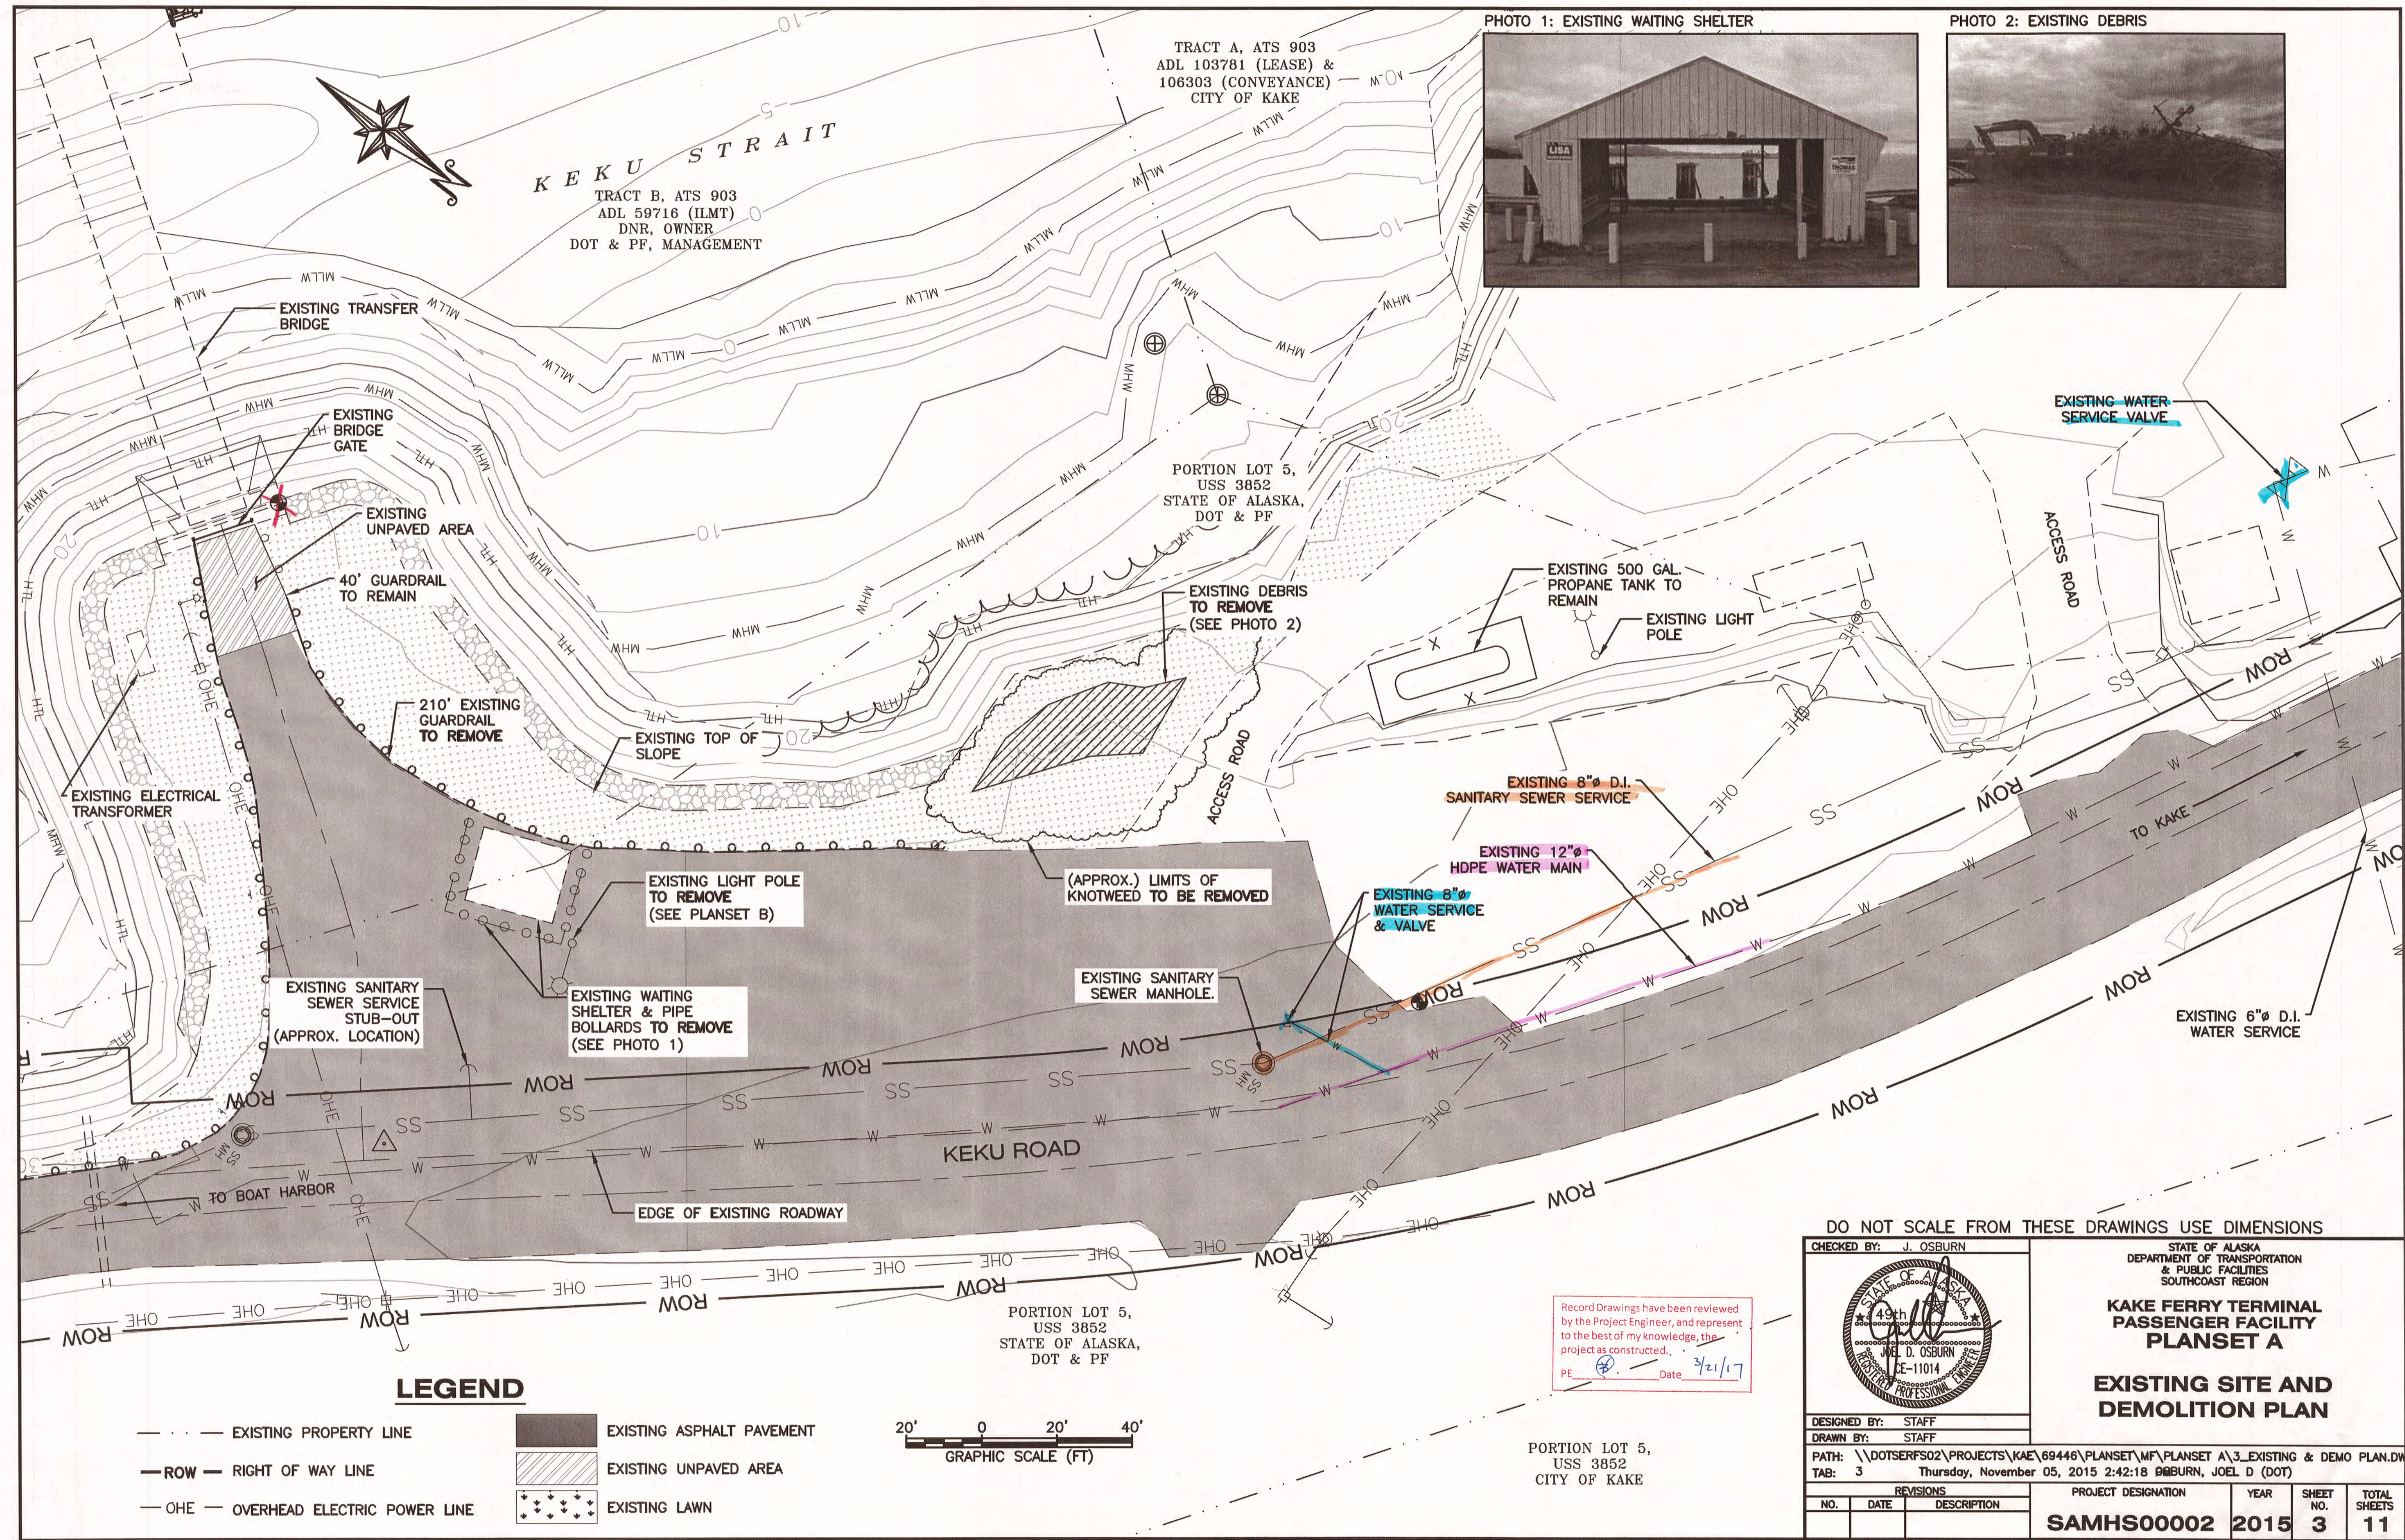

LEGEND

- EXISTING PROPERTY LINE
- ROW --- RIGHT OF WAY LINE
- OHE --- OVERHEAD ELECTRIC POWER LINE
- EXISTING ASPHALT PAVEMENT
- EXISTING UNPAVED AREA
- EXISTING LAWN

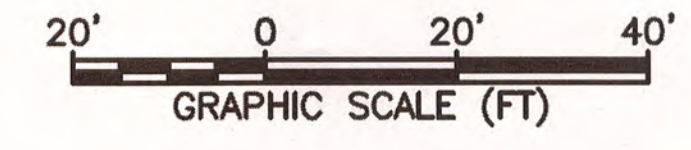

Record Drawings have been reviewed by the Project Engineer, and represent to the best of my knowledge, the project as constructed.
 PE Date 3/1/17

PORTION LOT 5,
 USS 3852
 CITY OF KAKE


DO NOT SCALE FROM THESE DRAWINGS USE DIMENSIONS

CHECKED BY: J. OSBURN

DESIGNED BY: STAFF
 DRAWN BY: STAFF

PATH: \\DOTSERFS02\PROJECTS\KAE\69446\PLANSET\MF\PLANSET A\3_EXISTING & DEMO PLAN.DWG
 TAB: 3 Thursday, November 05, 2015 2:42:18 PM BURN, JOEL D (DOT)


PROJECT DESIGNATION: SAMHS00002
 YEAR: 2015
 SHEET NO.: 3
 TOTAL SHEETS: 11

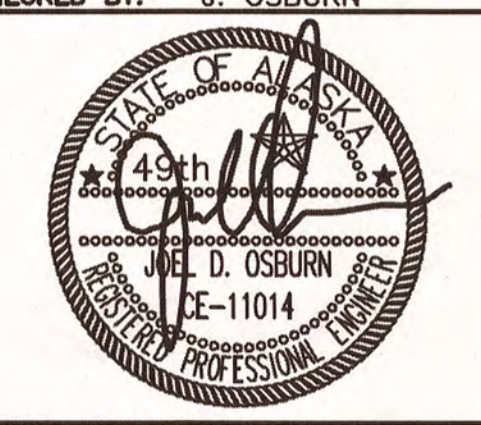

STATE OF ALASKA
 DEPARTMENT OF TRANSPORTATION
 & PUBLIC FACILITIES
 SOUTHCOAST REGION

**KAKE FERRY TERMINAL
 PASSENGER FACILITY
 PLANSET A**

**EXISTING SITE AND
 DEMOLITION PLAN**

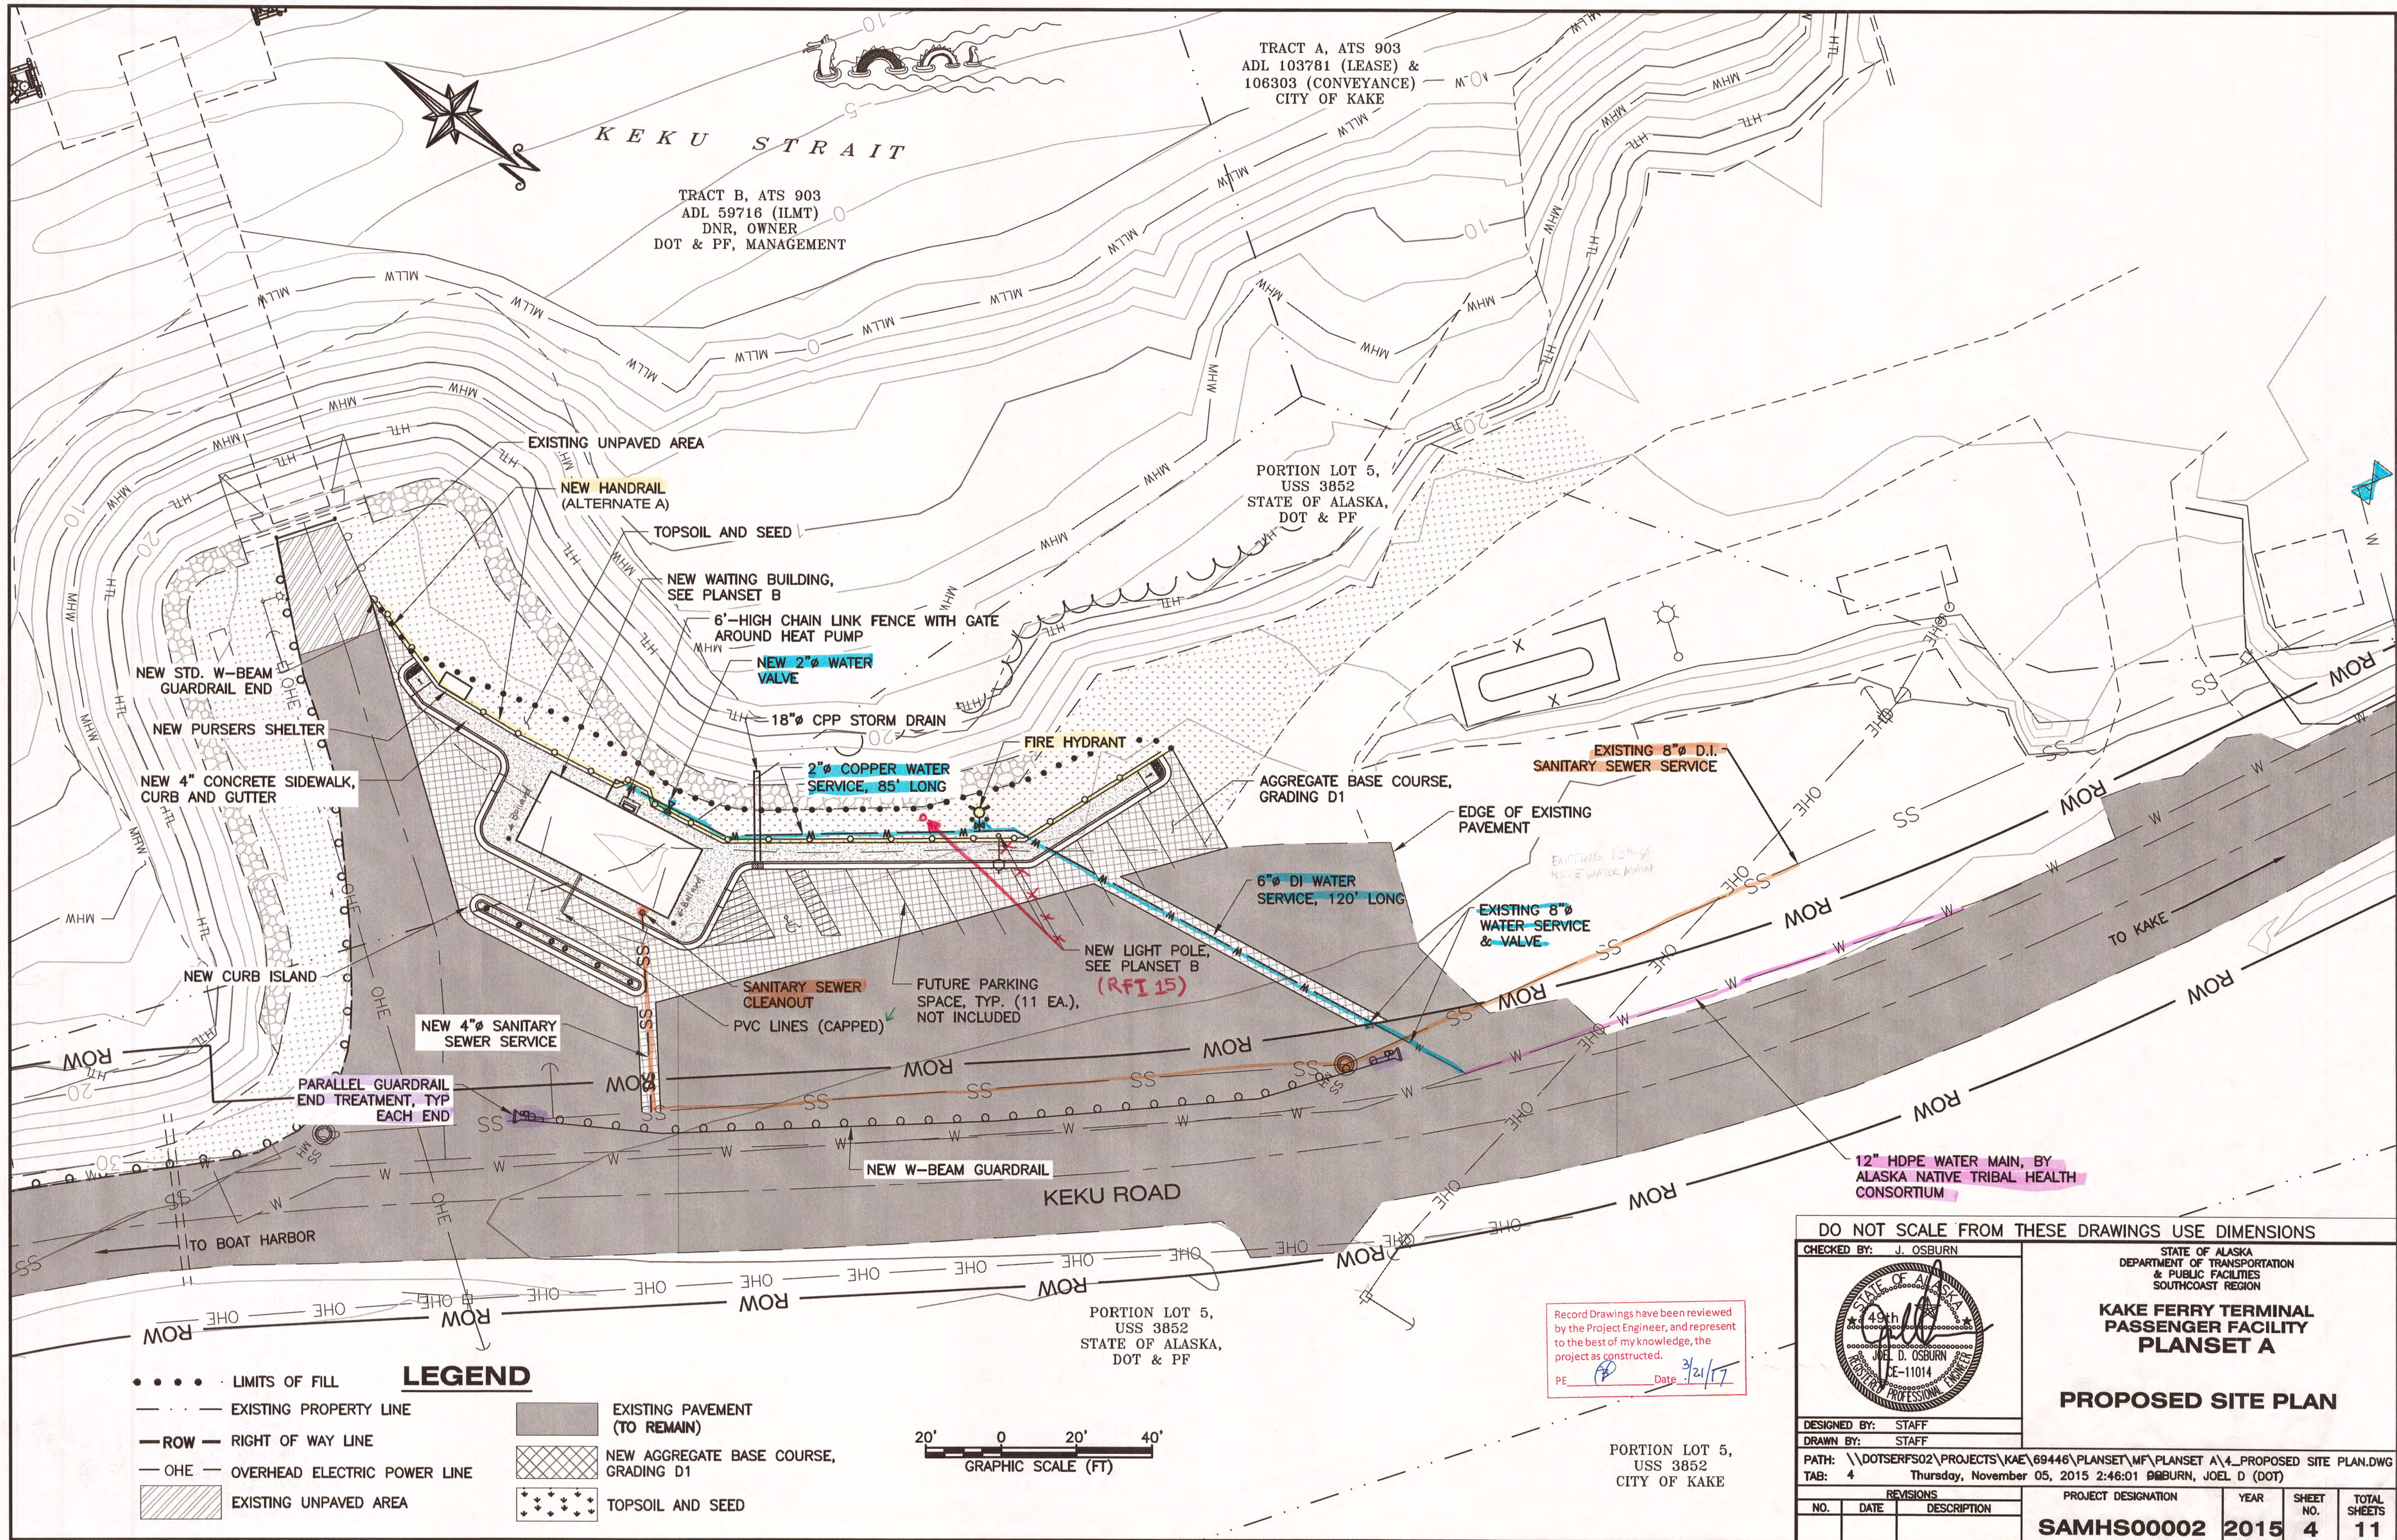

TRACT A, ATS 903
ADL 103781 (LEASE) &
106303 (CONVEYANCE)
CITY OF KAKE


TRACT B, ATS 903
ADL 59716 (ILMT)
DNR, OWNER
DOT & PF, MANAGEMENT

PORTION LOT 5,
USS 3852
STATE OF ALASKA,
DOT & PF

PORTION LOT 5,
USS 3852
STATE OF ALASKA,
DOT & PF

LEGEND

- LIMITS OF FILL
- - - - - EXISTING PROPERTY LINE
- - - - - ROW - RIGHT OF WAY LINE
- - - - - OHE - OVERHEAD ELECTRIC POWER LINE
- ▨ EXISTING UNPAVED AREA
- ▨ EXISTING PAVEMENT (TO REMAIN)
- ▨ NEW AGGREGATE BASE COURSE, GRADING D1
- ▨ TOPSOIL AND SEED

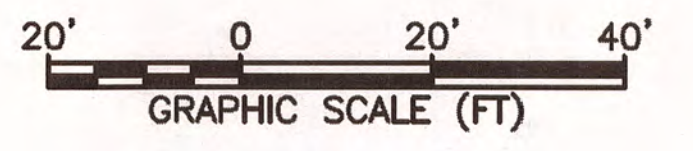

Record Drawings have been reviewed by the Project Engineer, and represent to the best of my knowledge, the project as constructed.
PE [Signature] Date 3/21/17

PORTION LOT 5,
USS 3852
CITY OF KAKE

DO NOT SCALE FROM THESE DRAWINGS USE DIMENSIONS

CHECKED BY: J. OSBURN


DESIGNED BY: STAFF
DRAWN BY: STAFF


PATH: \\DOTSERFS02\PROJECTS\KAE\69446\PLANSET\MF\PLANSET A\4_PROPOSED SITE PLAN.DWG
TAB: 4 Thursday, November 05, 2015 2:46:01 PM BURN, JOEL D (DOT)

PROJECT DESIGNATION: SAMHS00002
YEAR: 2015
SHEET NO.: 4
TOTAL SHEETS: 11

KAKE FERRY TERMINAL PASSENGER FACILITY PLANSET A

PROPOSED SITE PLAN

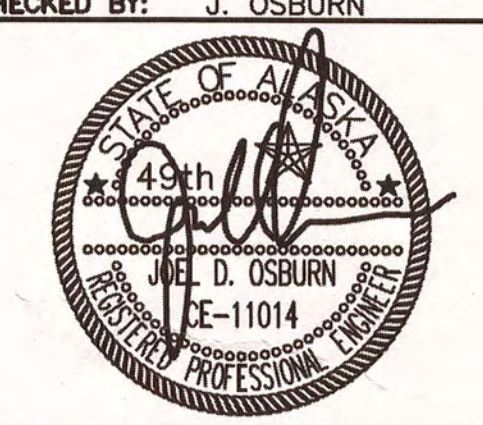

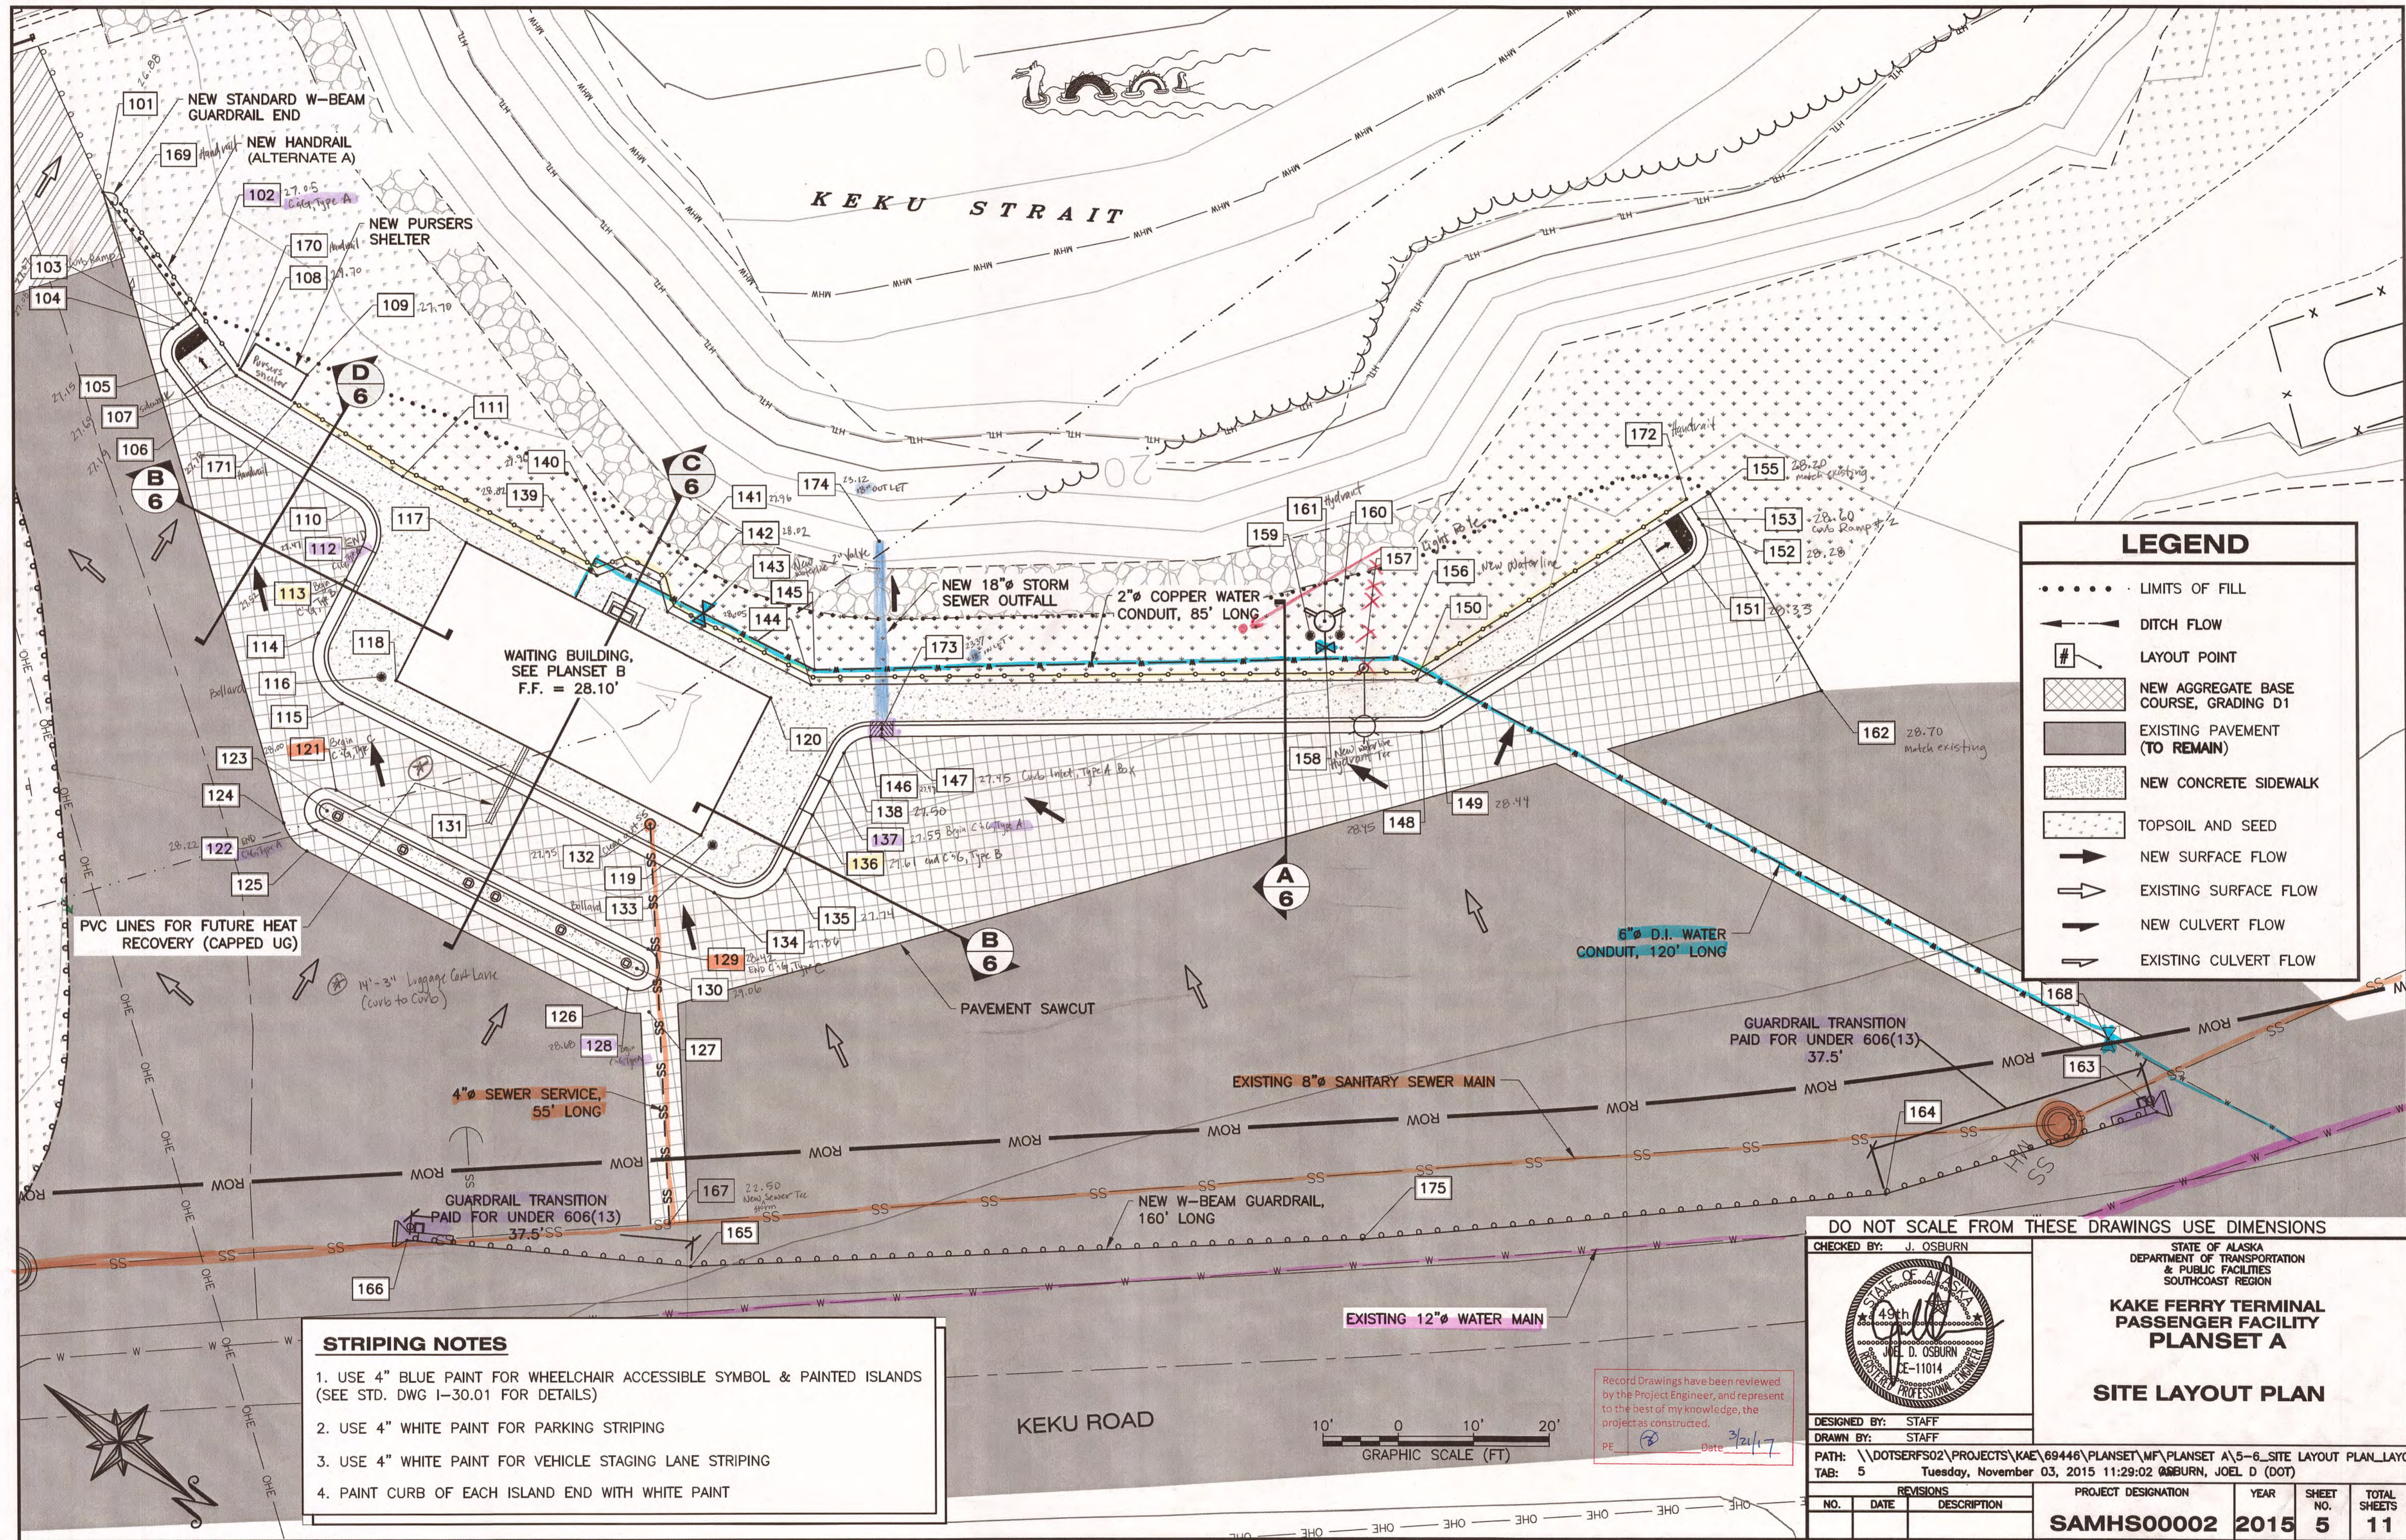

LEGEND

- LIMITS OF FILL
- ← DITCH FLOW
- # LAYOUT POINT
- [Cross-hatched box] NEW AGGREGATE BASE COURSE, GRADING D1
- [Solid grey box] EXISTING PAVEMENT (TO REMAIN)
- [Dotted box] NEW CONCRETE SIDEWALK
- [Stippled box] TOPSOIL AND SEED
- NEW SURFACE FLOW
- ⇨ EXISTING SURFACE FLOW
- ⇩ NEW CULVERT FLOW
- ⇨ EXISTING CULVERT FLOW

STRIPING NOTES

- USE 4" BLUE PAINT FOR WHEELCHAIR ACCESSIBLE SYMBOL & PAINTED ISLANDS (SEE STD. DWG I-30.01 FOR DETAILS)
- USE 4" WHITE PAINT FOR PARKING STRIPING
- USE 4" WHITE PAINT FOR VEHICLE STAGING LANE STRIPING
- PAINT CURB OF EACH ISLAND END WITH WHITE PAINT

DO NOT SCALE FROM THESE DRAWINGS USE DIMENSIONS

CHECKED BY: J. OSBURN

DESIGNED BY: STAFF
DRAWN BY: STAFF

STATE OF ALASKA
DEPARTMENT OF TRANSPORTATION & PUBLIC FACILITIES
SOUTHCOST REGION

KAKE FERRY TERMINAL PASSENGER FACILITY PLANSET A


SITE LAYOUT PLAN

DESIGNED BY: STAFF
DRAWN BY: STAFF

PATH: \\DOTSERFS02\PROJECTS\KAKE\69446\PLANSET\MF\PLANSET A\5-6_SITE LAYOUT PLAN_LAYOUT.PO
TAB: 5 Tuesday, November 03, 2015 11:29:02 OSBURN, JOEL D (DOT)

REVISIONS		PROJECT DESIGNATION	YEAR	SHEET NO.	TOTAL SHEETS
NO.	DATE	DESCRIPTION			
			2015	5	11

Record Drawings have been reviewed by the Project Engineer, and represent to the best of my knowledge, the project as constructed.
PE [Signature] Date 3/21/17

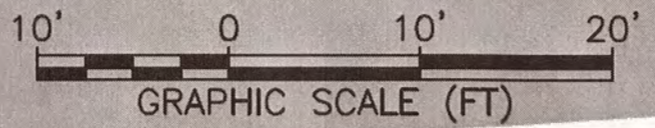

LAYOUT POINT TABLE				
#	NORTH	EAST	ELEV	DESCRIPTION
101	501443.20	296013.61	26.88	GRDRL_BREAK
102	501462.32	296019.45	27.05	BEGIN C&G TYPE A
103	501461.75	296021.47	27.07	CURB RAMP #1
104	501461.50	296022.34	27.08	C&G_PC_R=4
105	501464.25	296027.28	27.15	C&G_PT
106	501471.46	296029.34	27.19	C&G_PT
107	501472.03	296022.22	27.69	SDWK_PI
108	501471.92	296021.23	27.70	PURSERS SHELTER
109	501479.44	296016.39	27.70	PURSERS SHELTER
110	501494.71	296026.80	27.41	C&G_PC_R=4
111	501497.68	296019.45	27.95	SDWK_PI
112	501499.08	296030.05	27.47	END C&G TYPE A_PT
113	501499.98	296034.96	27.52	BEGIN C&G TYPE B
114	501501.43	296042.72	27.61	C&G_PC_R=5
115	501509.58	296048.33	27.64	C&G_PT
116	501511.57	296042.30	-	BOLLARD
117	501509.67	296021.30	28.10	SDWK_BLDG CORNER
118	501513.41	296041.52	27.88	SDWK_BLDG CORNER
119	501557.98	296033.27	28.10	SDWK_BLDG CORNER
120	501554.24	296013.05	28.10	SDWK_BLDG CORNER
121	501515.97	296058.00	28.00	BEGIN C&G TYPE C_PT
122	501517.07	296063.90	28.22	END C&G TYPE A_PC_R=3
123	501516.66	296060.93	28.60	ISLAND_RP=3'
124	501513.08	296065.74	28.19	MATCH EXISTING_PC_R=6
125	501517.76	296066.83	28.17	MATCH EXISTING
126	501562.98	296058.46	28.71	MATCH EXISTING_PC_R=6
127	501566.67	296056.18	28.74	MATCH EXISTING
128	501562.58	296055.48	28.68	BEGIN C&G TYPE A_PT
129	501561.49	296049.58	28.42	END C&G TYPE C_PC_R=3
130	501561.89	296052.56	29.06	ISLAND_RP=3'
131	501534.62	296049.12	-	PVC_CAPPED
132	501551.69	296036.23	27.95	SS_CLEANOUT
133	501559.98	296033.34	-	BOLLARD
134	501563.99	296038.26	27.86	C&G_PC_R=5
135	501569.60	296030.10	27.74	C&G_PT
136	501568.12	296022.09	27.61	END C&G TYPE B
137	501567.21	296017.17	27.55	BEGIN C&G TYPE A


LAYOUT POINT TABLE				
#	NORTH	EAST	ELEV	DESCRIPTION
138	501566.43	296012.98	27.50	C&G_PC_R=4
139	501526.06	296014.20	28.02	SDWK
140	501528.22	296010.75	27.96	SDWK
141	501533.14	296009.84	27.96	SDWK
142	501536.39	296012.29	28.02	SDWK
143	501540.35	296009.52	-	NEW WATERLINE_2" VALVE
144	501557.44	296008.39	28.05	SDWK_PI
145	501556.59	296006.51	-	NEW WATERLINE_PI
146	501567.91	296009.10	27.47	C&G_PT
147	501569.08	296008.17	27.45	CURB INLET_TYPE A BOX
148	501625.59	295964.10	28.45	C&G_PC_R=5
149	501627.21	295961.87	28.44	C&G_PT
150	501620.83	295958.93	28.95	SDWK_PI
151	501640.88	295924.47	28.33	C&G_PC_R=4
152	501638.50	295919.34	28.28	C&G_PT
153	501637.62	295919.02	28.26	CURB RAMP #2
154	501635.68	295918.31	28.24	C&G_END
155	501636.72	295915.49	28.22	MATCH EXISTING
156	501616.91	295958.18	-	NEW WATERLINE_PI
157	501614.30	295961.97	-	LIGHT POLE
158	501609.55	295964.08	-	NEW WATERLINE_HYDRANT TEE
159	501606.03	295962.84	-	BOLLARD
160	501609.11	295960.38	-	BOLLARD
161	501606.42	295960.18	-	HYDRANT
162	501664.35	295927.30	28.70	MATCH EXISTING
163	501733.64	295944.79	-	BEGIN GRDRL_END TREATMENT
164	501711.65	295975.42	-	END GRDRL_END TREATMENT_BEGIN GRDRL R=734'
165	501591.61	296079.72	-	END GRDRL_BEGIN GRDRL_END TREATMENT
166	501559.59	296099.88	-	END GRDRL_END TREATMENT
167	501585.83	296076.87	22.50	NEW S. SEWER TEE
168	501722.64	295941.01	-	EXISTING WATERLINE_VALVE
169	501446.05	296013.42	-	HANDRAIL
170	501471.39	296020.99	-	HANDRAIL
171	501480.37	296020.32	27.78	HANDRAIL
172	501634.74	295917.97	-	HANDRAIL
173	501568.47	296007.39	23.37	PIPE 18_INLET
174	501553.07	295987.69	23.12	PIPE 18_OUTLET
175	501660.18	296022.60	-	PT GRDRL
176	501620.71	295951.87	-	HYDRANT




GENERAL NOTES:

1. USE PLAN LOCATION INFORMATION ONLY WHERE "-" IS SHOWN FOR ELEVATION.

Record Drawings have been reviewed by the Project Engineer, and represent to the best of my knowledge, the project as constructed.
 PE [Signature] Date 3/21/17


DO NOT SCALE FROM THESE DRAWINGS USE DIMENSIONS

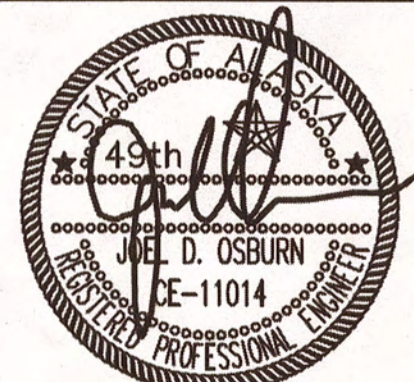CHECKED BY: J. OSBURN 		STATE OF ALASKA DEPARTMENT OF TRANSPORTATION & PUBLIC FACILITIES SOUTHCOAST REGION KAKE FERRY TERMINAL PASSENGER FACILITY PLANSET A LAYOUT POINTS	
DESIGNED BY: STAFF DRAWN BY: STAFF		PROJECT DESIGNATION: SAMHS00002 YEAR: 2015 SHEET NO.: 6 TOTAL SHEETS: 11	
PATH: \\DOTSERFS02\PROJECTS\KAE\69446\PLANSET\MF\PLANSET A\5-6_SITE LAYOUT PLAN_LAYOUT PO TAB: 6 Monday, November 02, 2015 2:51:57 PM OSBURN, JOEL D (DOT)			
NO.	DATE	DESCRIPTION	

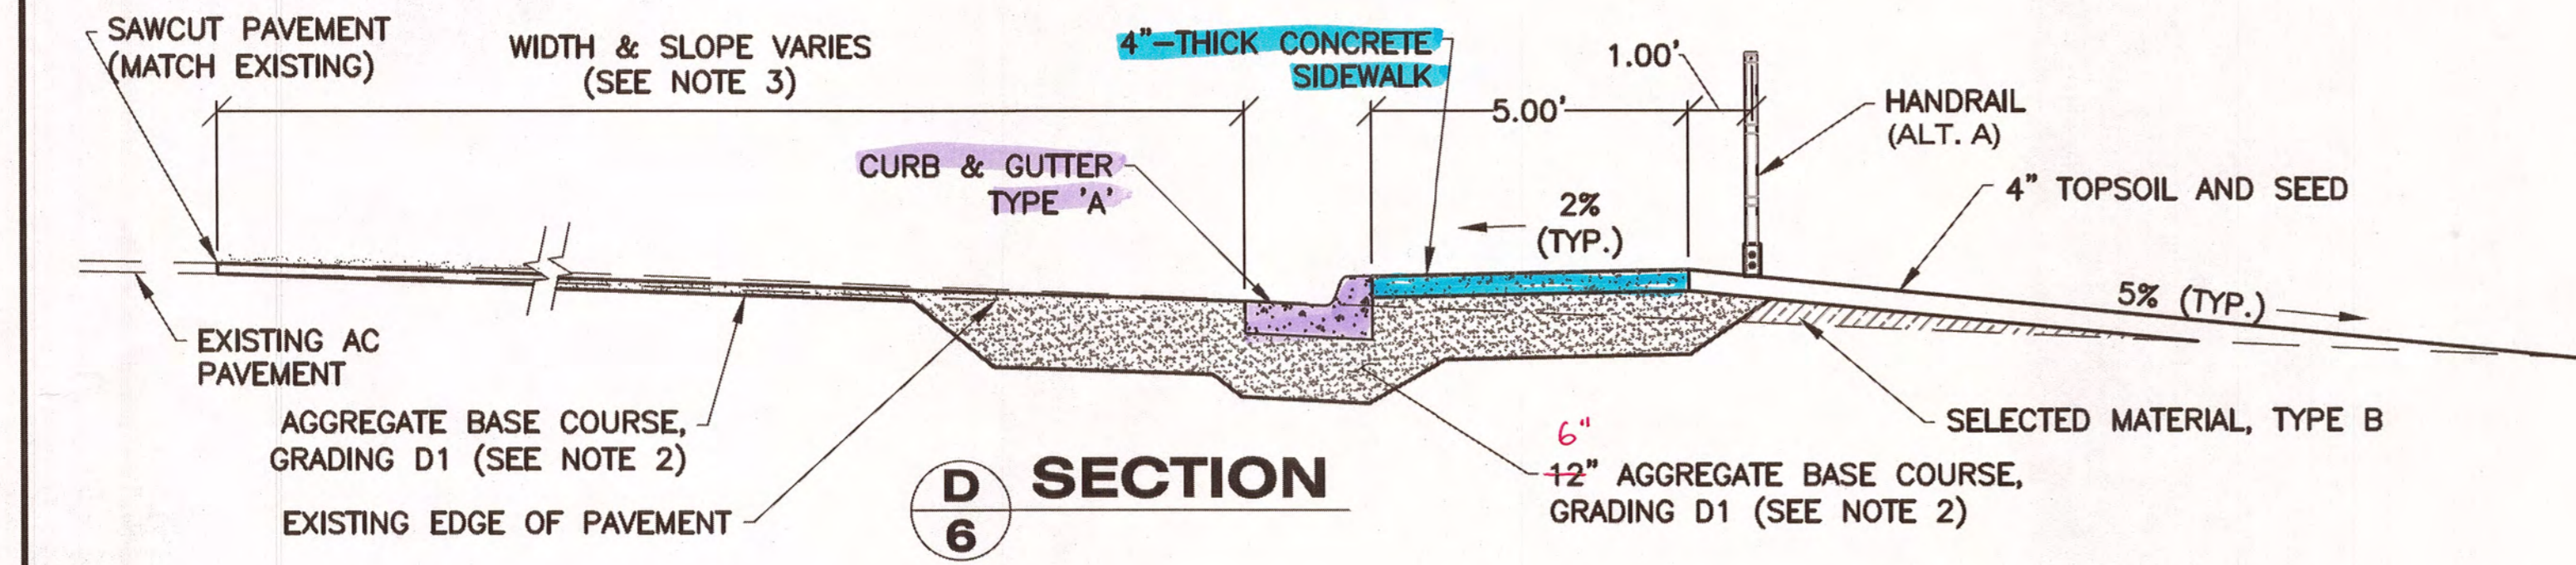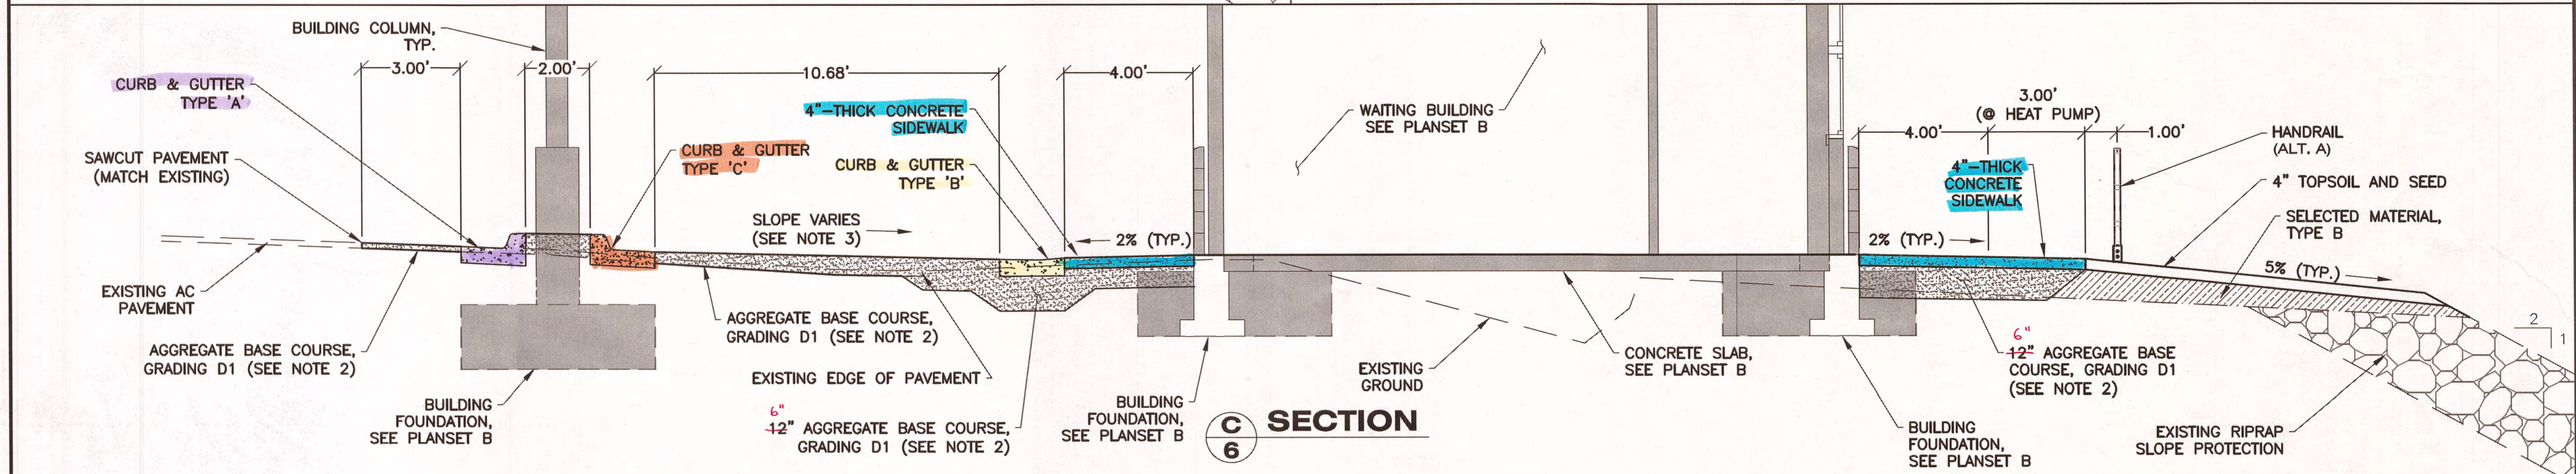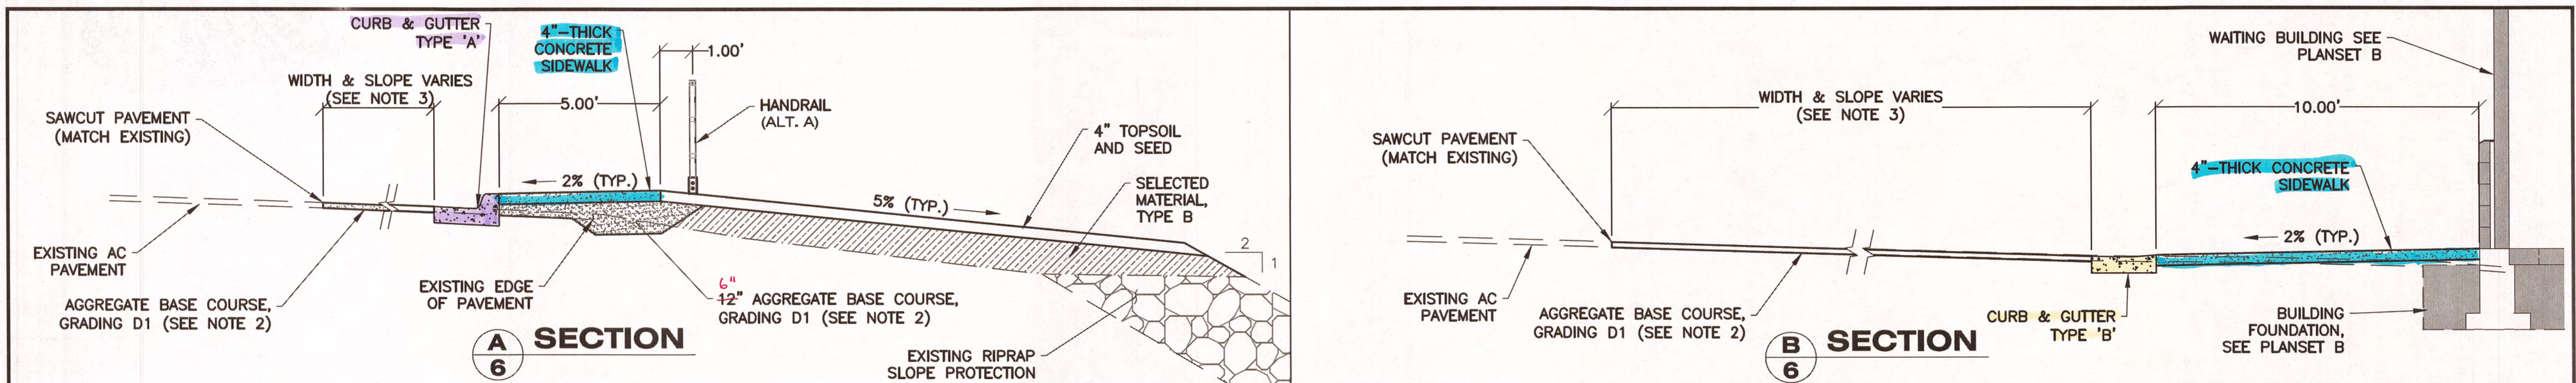

GENERAL TYPICAL SECTION NOTES:

1. THE EXISTING ASPHALT PAVEMENT THICKNESS IS 2-INCHES.
2. REGRADE EXISTING BASE COURSE AFTER REMOVING ASPHALT PAVEMENT AND ADD NEW D-1 BASE COURSE TO LINE AND GRADE PROVIDED ON LAYOUT PLAN. CONSTRUCT 6-12" THICK NEW BASE COURSE OUTSIDE OF THE EXISTING PAVEMENT LIMITS, AS NECESSARY BASED ON THESE TYPICAL SECTIONS.
REFER TO PLANSET B FOR BUILDING FOUNDATION DETAILS.
3. REFER TO THE SITE LAYOUT PLAN FOR SURFACE GRADING INFORMATION. PAVEMENT SLOPE VARIES DEPENDING ON EDGE LAYOUT POINTS.

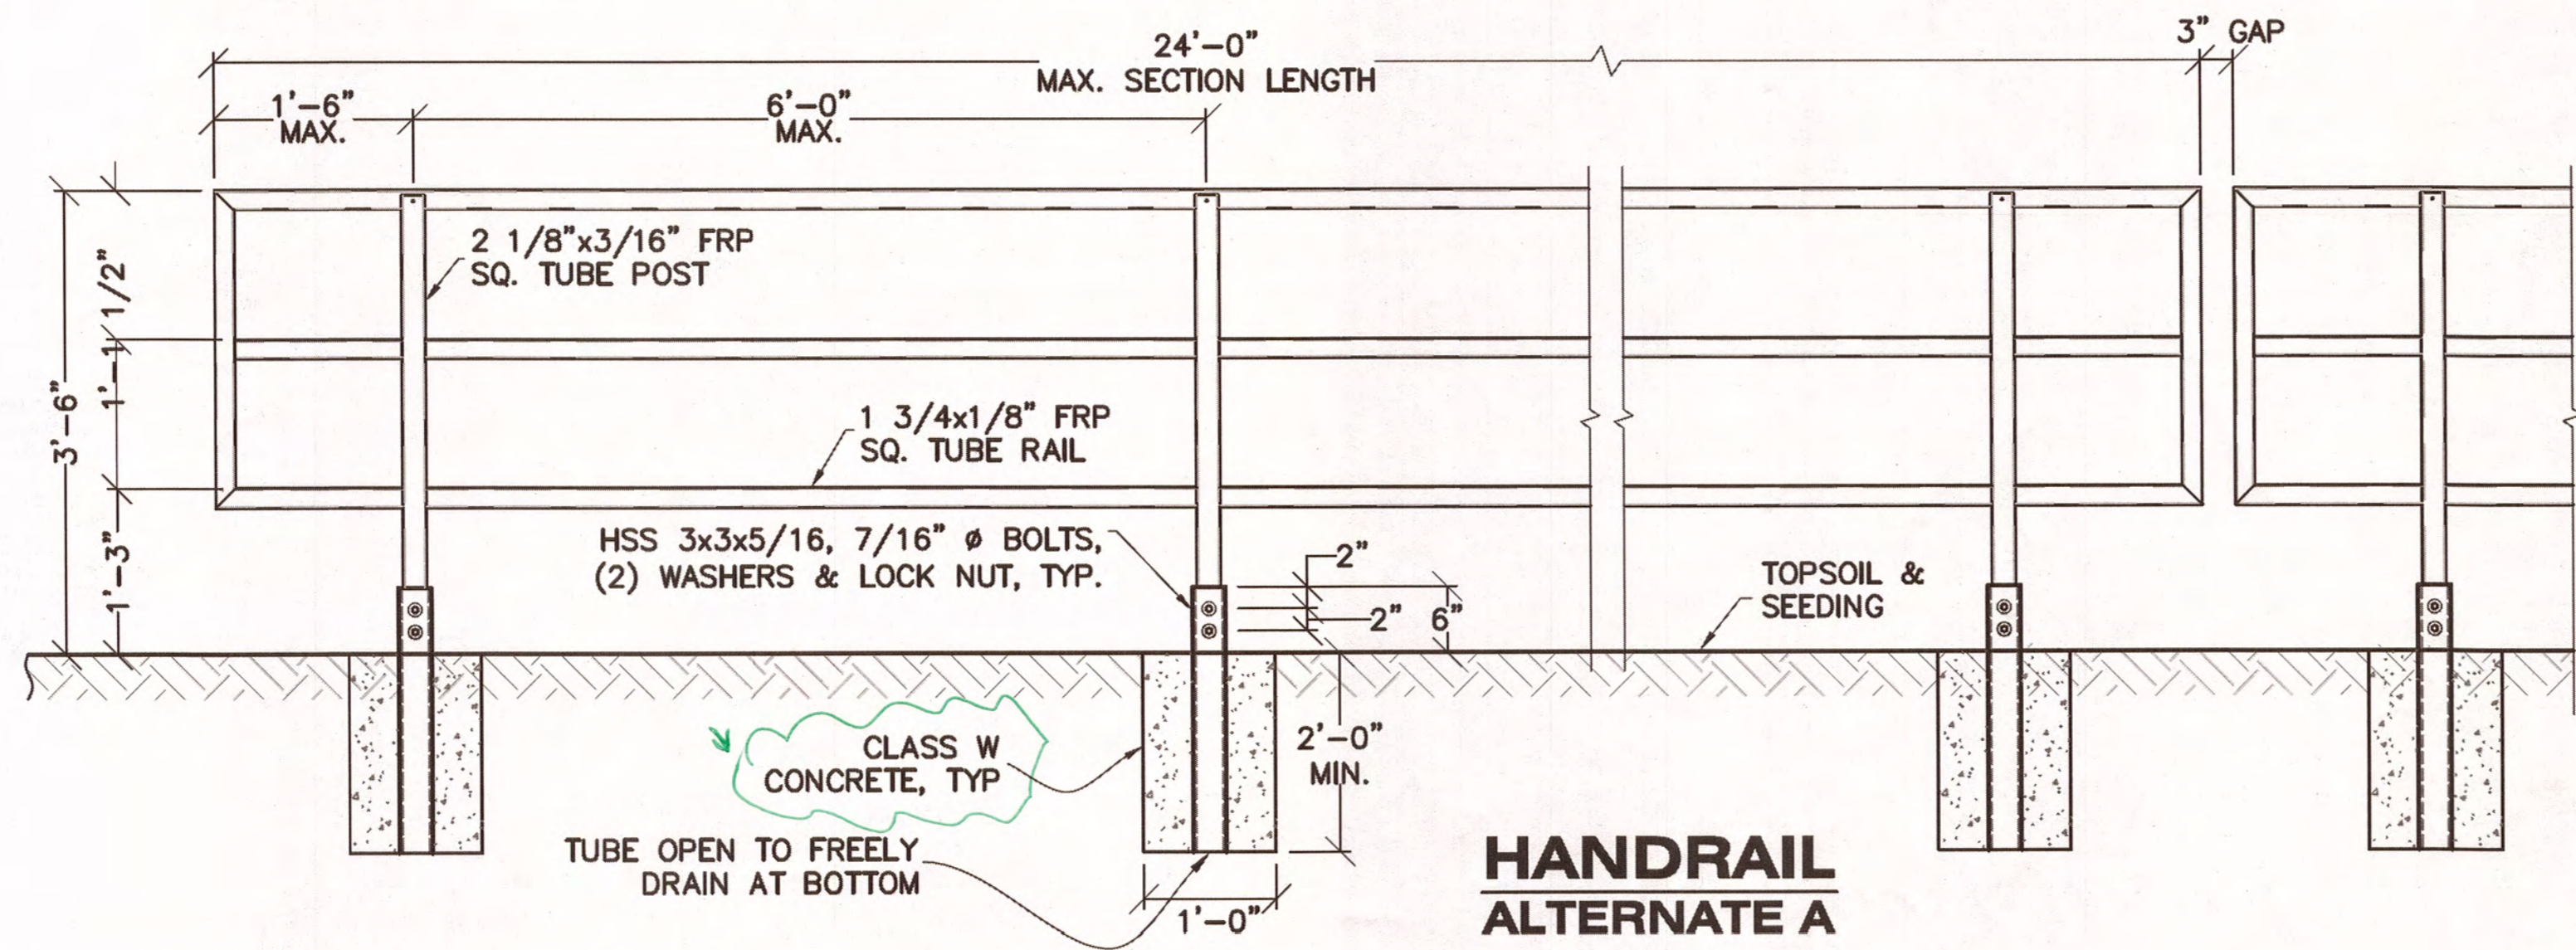

Record Drawings have been reviewed by the Project Engineer, and represent to the best of my knowledge, the project as constructed.
PE [Signature] Date 3/21/17

DO NOT SCALE FROM THESE DRAWINGS USE DIMENSIONS

CHECKED BY: J. OSBURN


DESIGNED BY: STAFF
DRAWN BY: STAFF

PATH: \\DOTSERFS02\PROJECTS\KAE\69446\PLANSET\WF\PLANSET A\7-8_TYP SECS & MISC DETS.DWG
TAB: 7 Monday, November 02, 2015 11:44:23 AM OSBURN, JOEL D (DOT)

REVISIONS

NO.	DATE	DESCRIPTION


PROJECT DESIGNATION: SAMHS00002
YEAR: 2015
SHEET NO.: 7
TOTAL SHEETS: 11

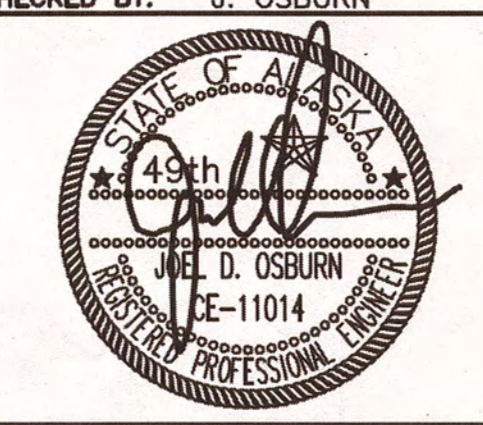

STATE OF ALASKA
DEPARTMENT OF TRANSPORTATION & PUBLIC FACILITIES
SOUTHCOST REGION

KAKE FERRY TERMINAL PASSENGER FACILITY PLANSET A


TYPICAL SECTIONS

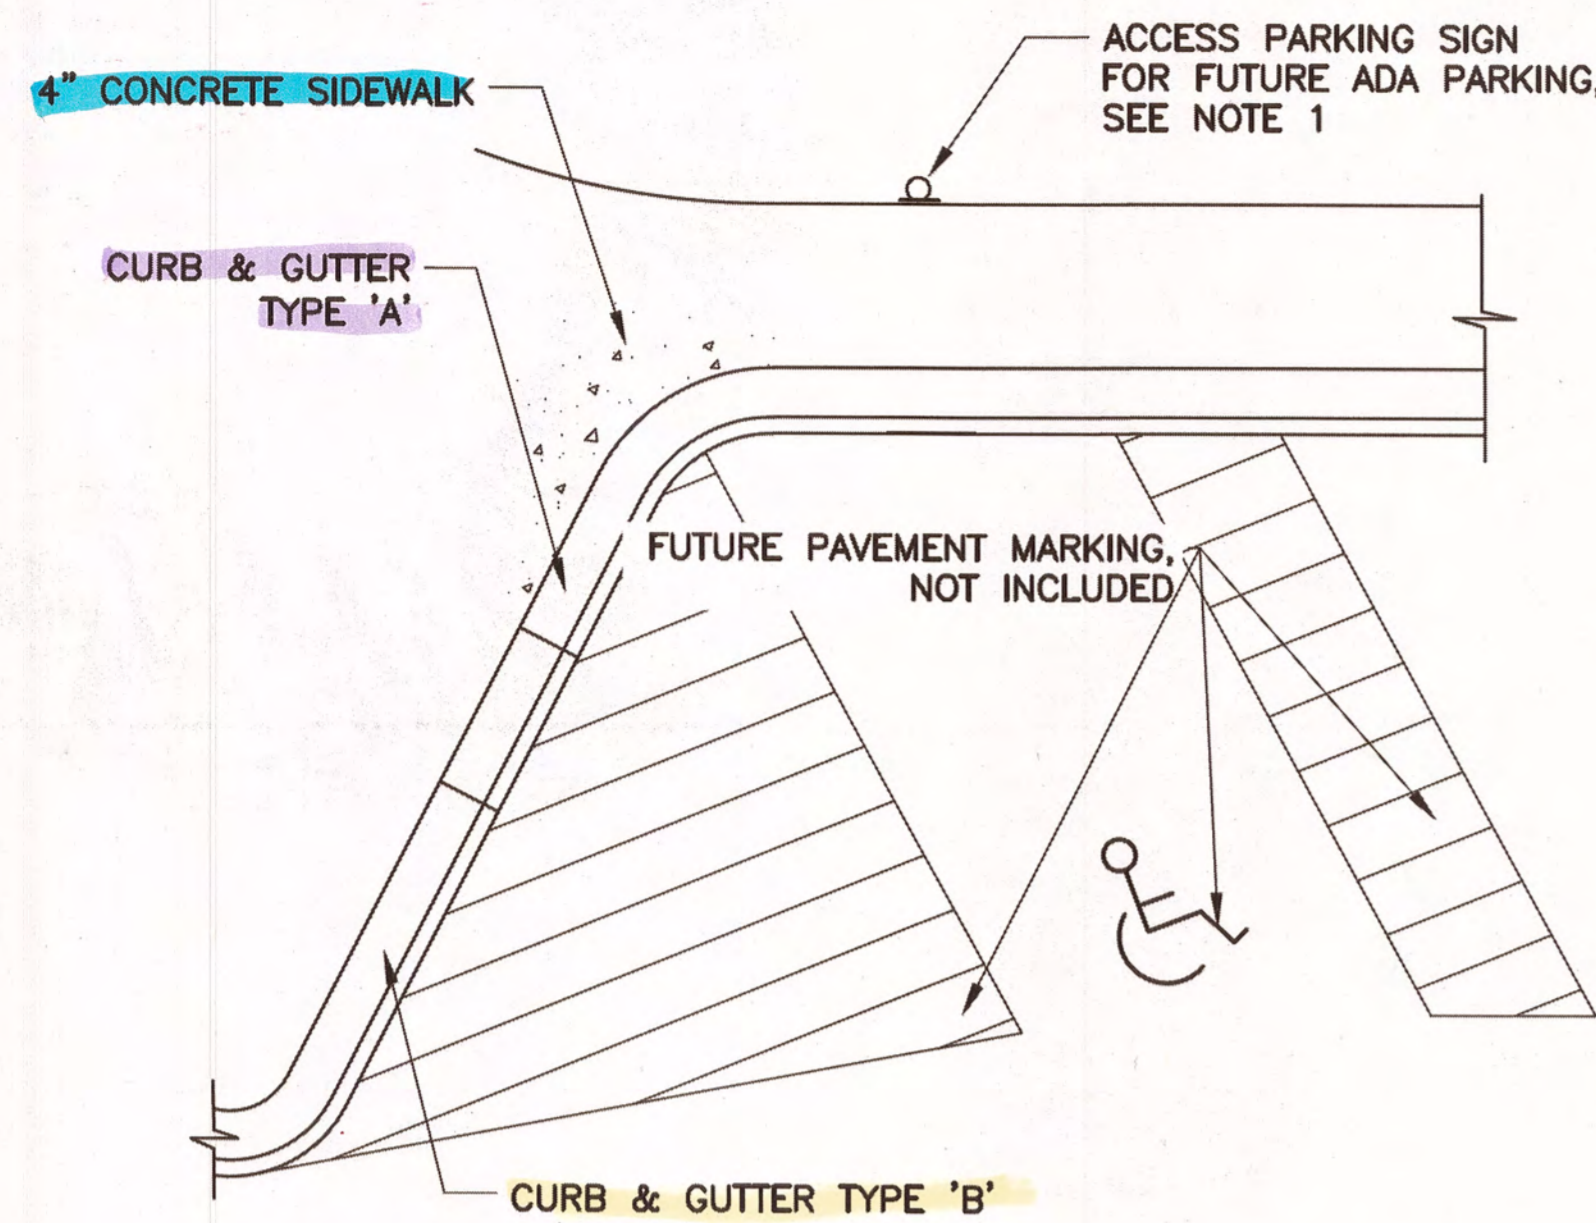

ACCESSIBLE PARKING

ACCESSIBILITY NOTE:

1. USE R7-8 SIGN WITH R7-8A PLAQUE FOR ACCESS PARKING, IN ACCORDANCE WITH ASDS. REFER TO STD. DWG S-00.11 AND STD DWG S-05.01 FOR POST HEIGHT AND SIGN FRAMING. REFER TO STD. DWG S-20.10 FOR SIGN TO POST CONNECTION AND S-30.03 FOR SLEEVE-TYPE CONCRETE FOUNDATION.

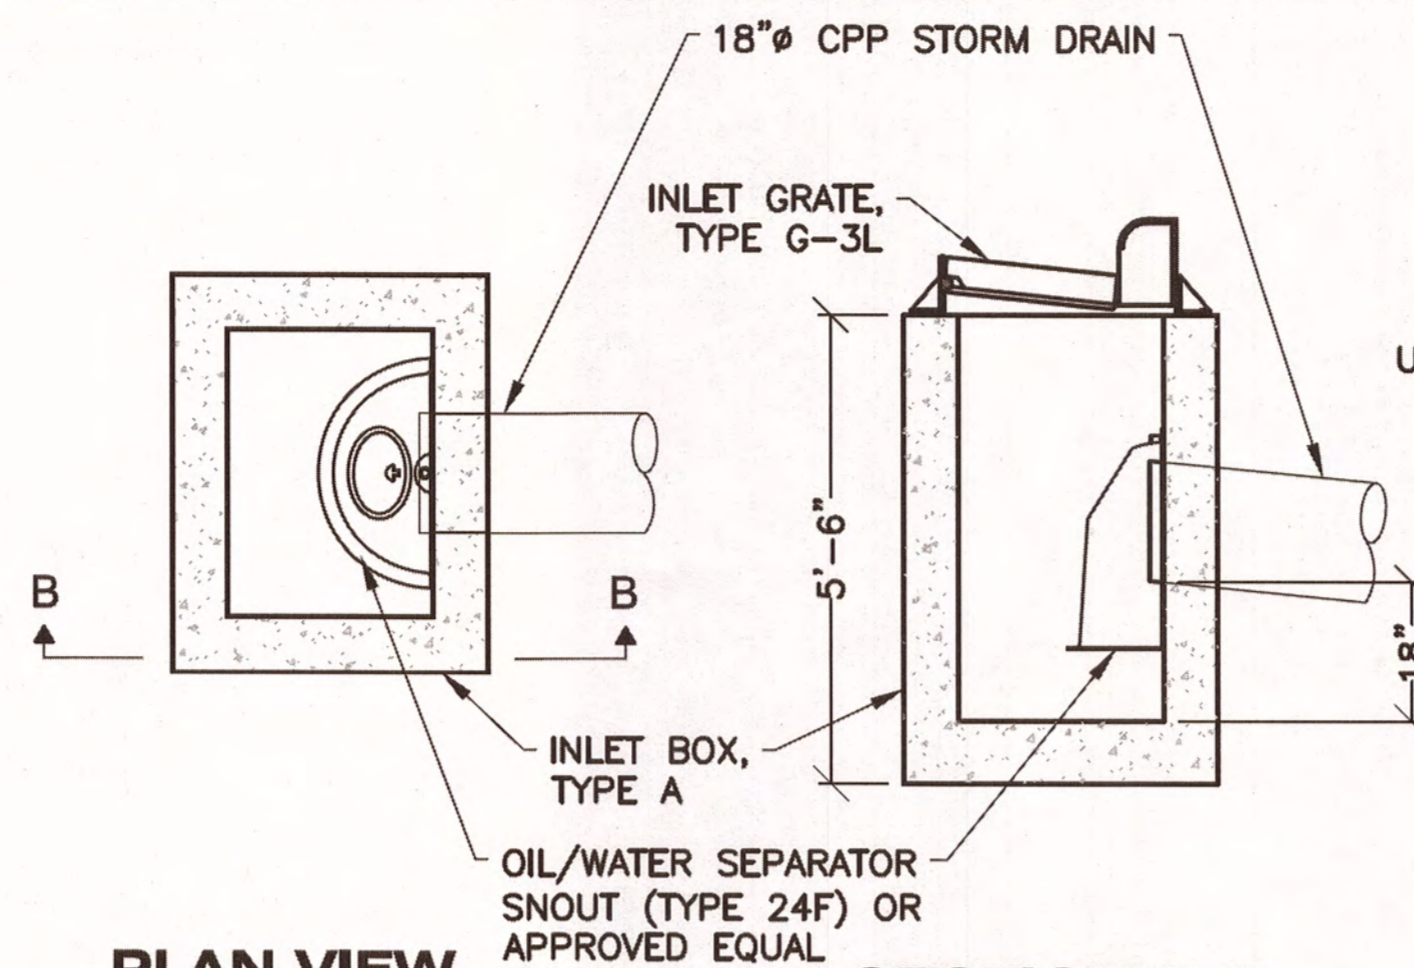


PLAN VIEW


SECTION B-B

NOTE: INLET GRATE AND FRAME NOT SHOWN FOR CLARITY


STANDARD CURB INLET

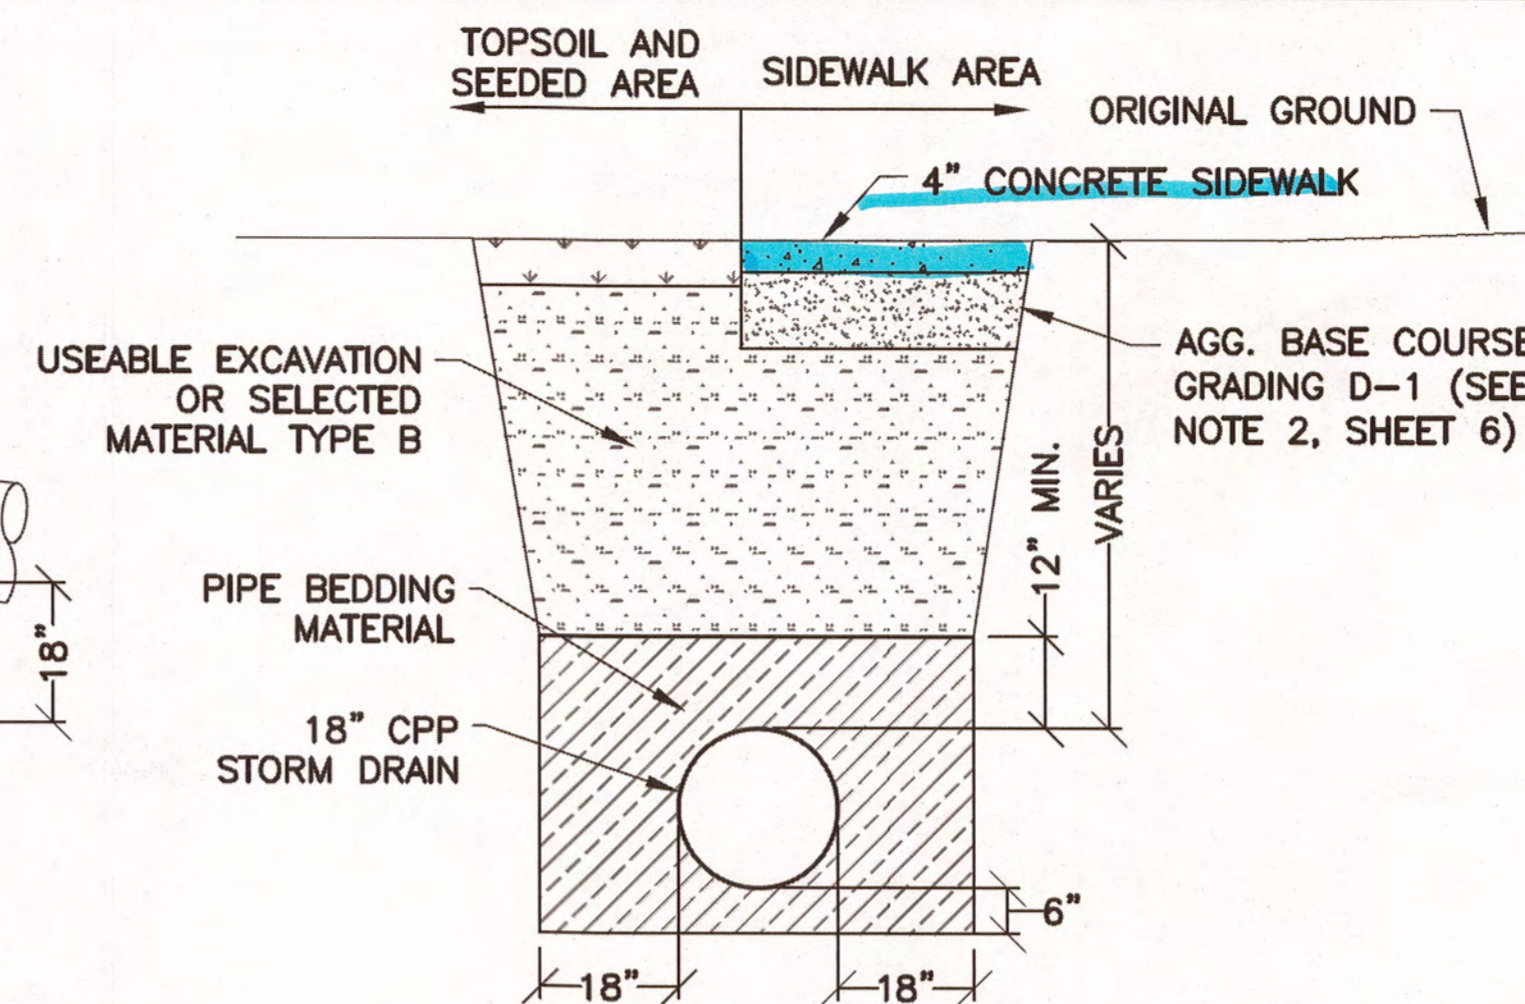

STORM DRAIN TYPICAL

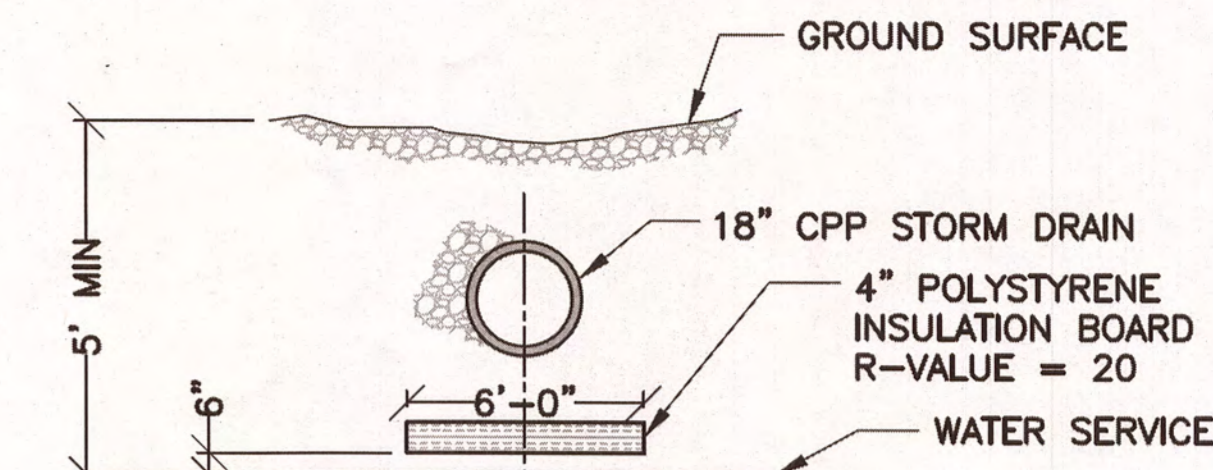


ELEVATION

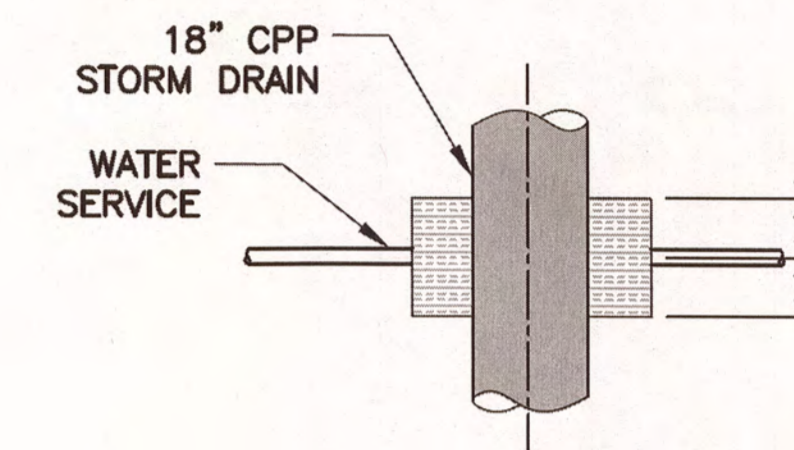


PLAN

PIPE CROSSING


NOTE: WRAP AROUND INSULATION WITH R-VALUE EQUAL TO 20 MAY BE SUBSTITUTED FOR BOARD INSULATION IF APPROVED BY THE ENGINEER

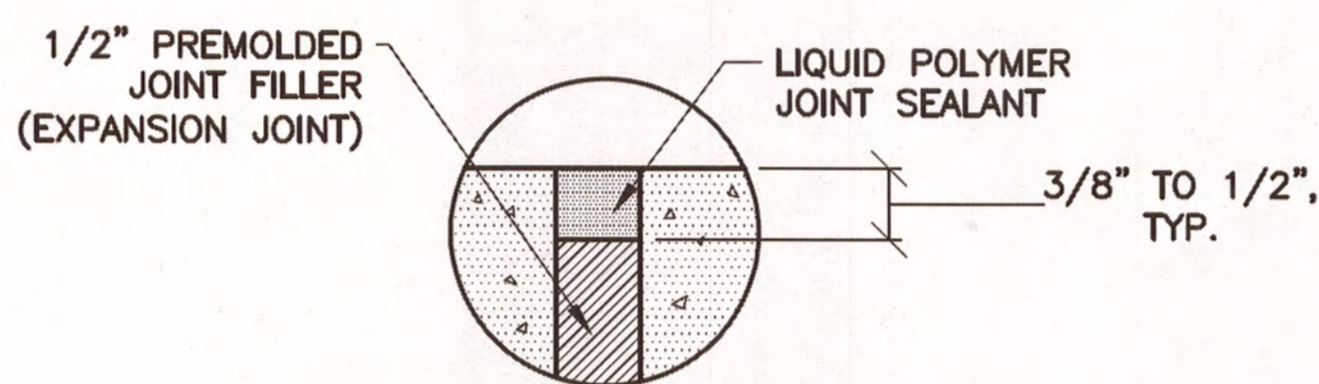


**SECTION A-A
EXPANSION JOINT**

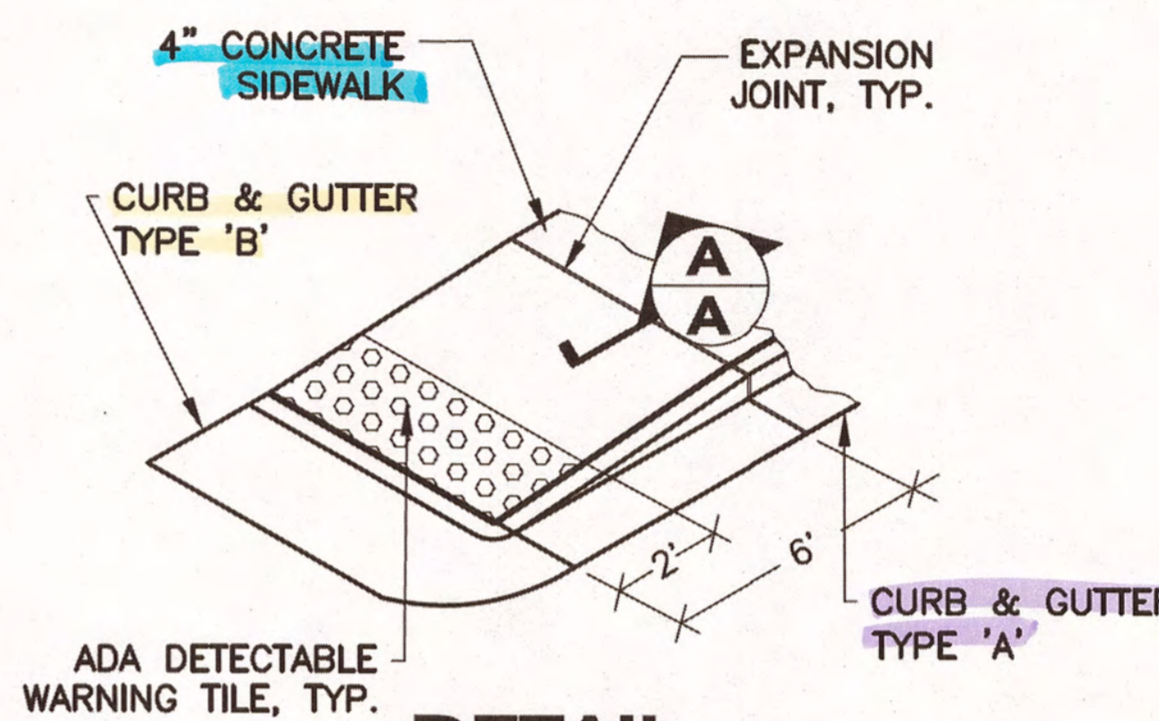

**DETAIL
SIDEWALK END RAMP**

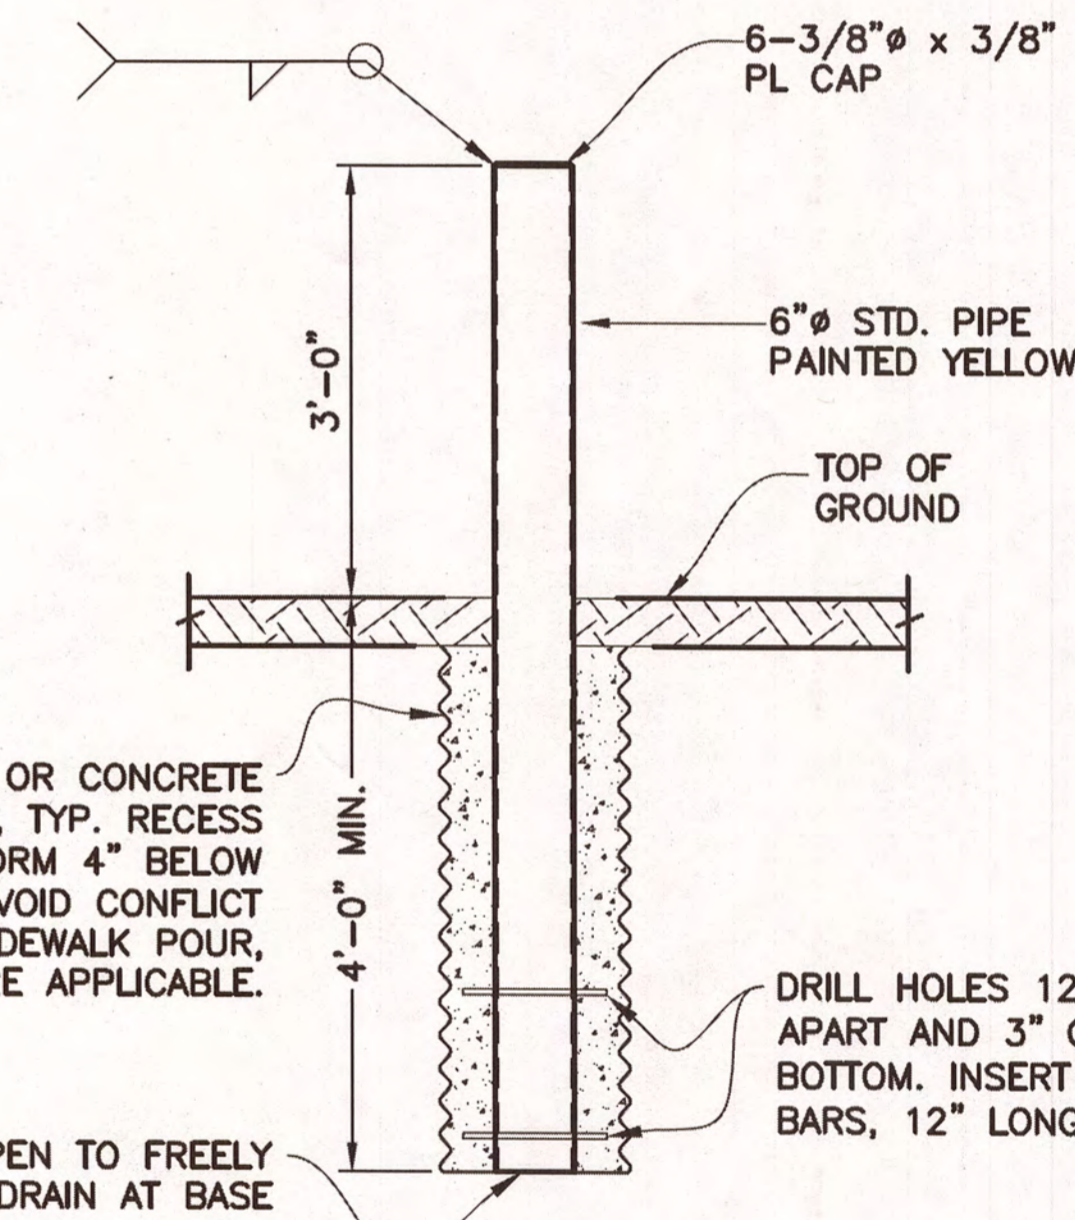


BOLLARD DETAIL

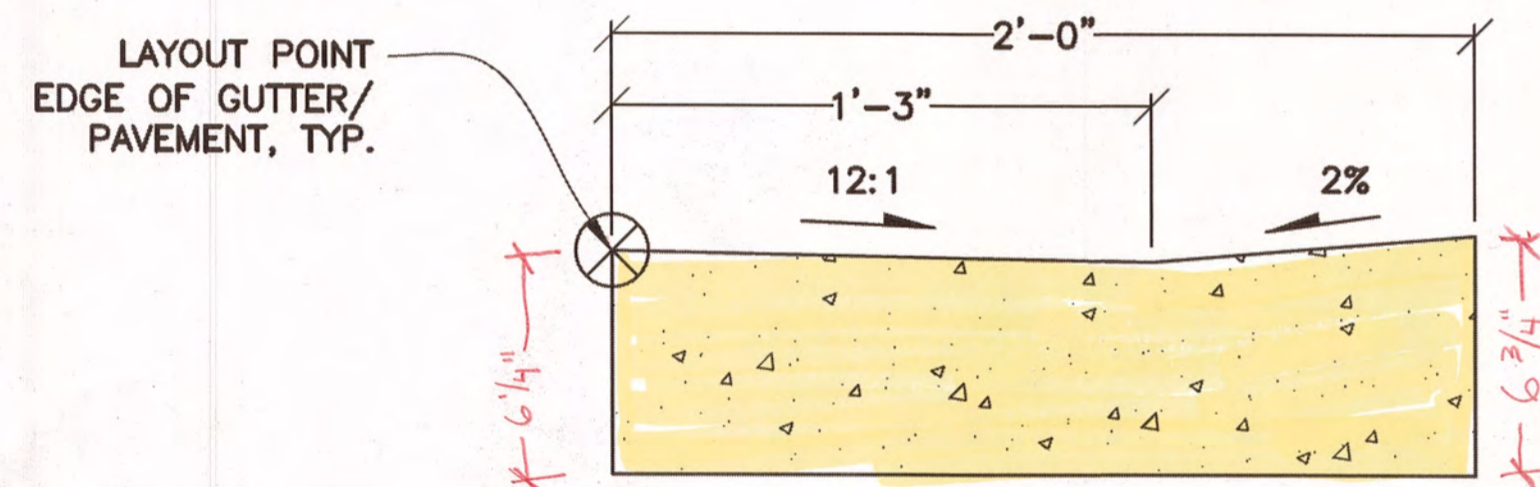


**DETAIL
TYPE B - CURB & GUTTER**

SIDEWALK, CURB AND GUTTER NOTES

1. TYPE 'A' CURB AND GUTTER IS "STANDARD" PER STD. DWG. I-20.15. TYPES 'B' AND 'C' ARE PER DETAILS THIS SHEET.
2. REFER TO SHEET S1.1 IN PLANSET B FOR CRACK CONTROL AND EXPANSION JOINT LAYOUT IN THE SIDEWALKS.
3. BOTH FRONT AND BACK TOP EDGES OF THE CURB & GUTTER SHALL BE TROWELED TO A RADIUS OF ONE-HALF (1/2) INCH. ALL JOINTS AND SEAMS SHALL BE EDGED. STEEL TROWELING FINISH REQUIRED PRIOR TO BROOM FINISHING ON ALL SURFACES. CURING COMPOUND SHALL BE APPLIED TO THE CONCRETE. APPLICATION SHALL CONFORM TO THE MANUFACTURER'S RECOMMENDATIONS.
4. ALL CURB & GUTTER LOCATIONS ARE REFERENCED TO THE EDGE OF PAVEMENT/EDGE OF GUTTER PAN. LOCATIONS FOR CURB INLETS ARE REFERENCED TO THE EDGE OF PAVEMENT. INLET ELEVATIONS ARE REFERENCED TO THE EDGE OF PAVEMENT WITHOUT THE STANDARD DEPRESSION.

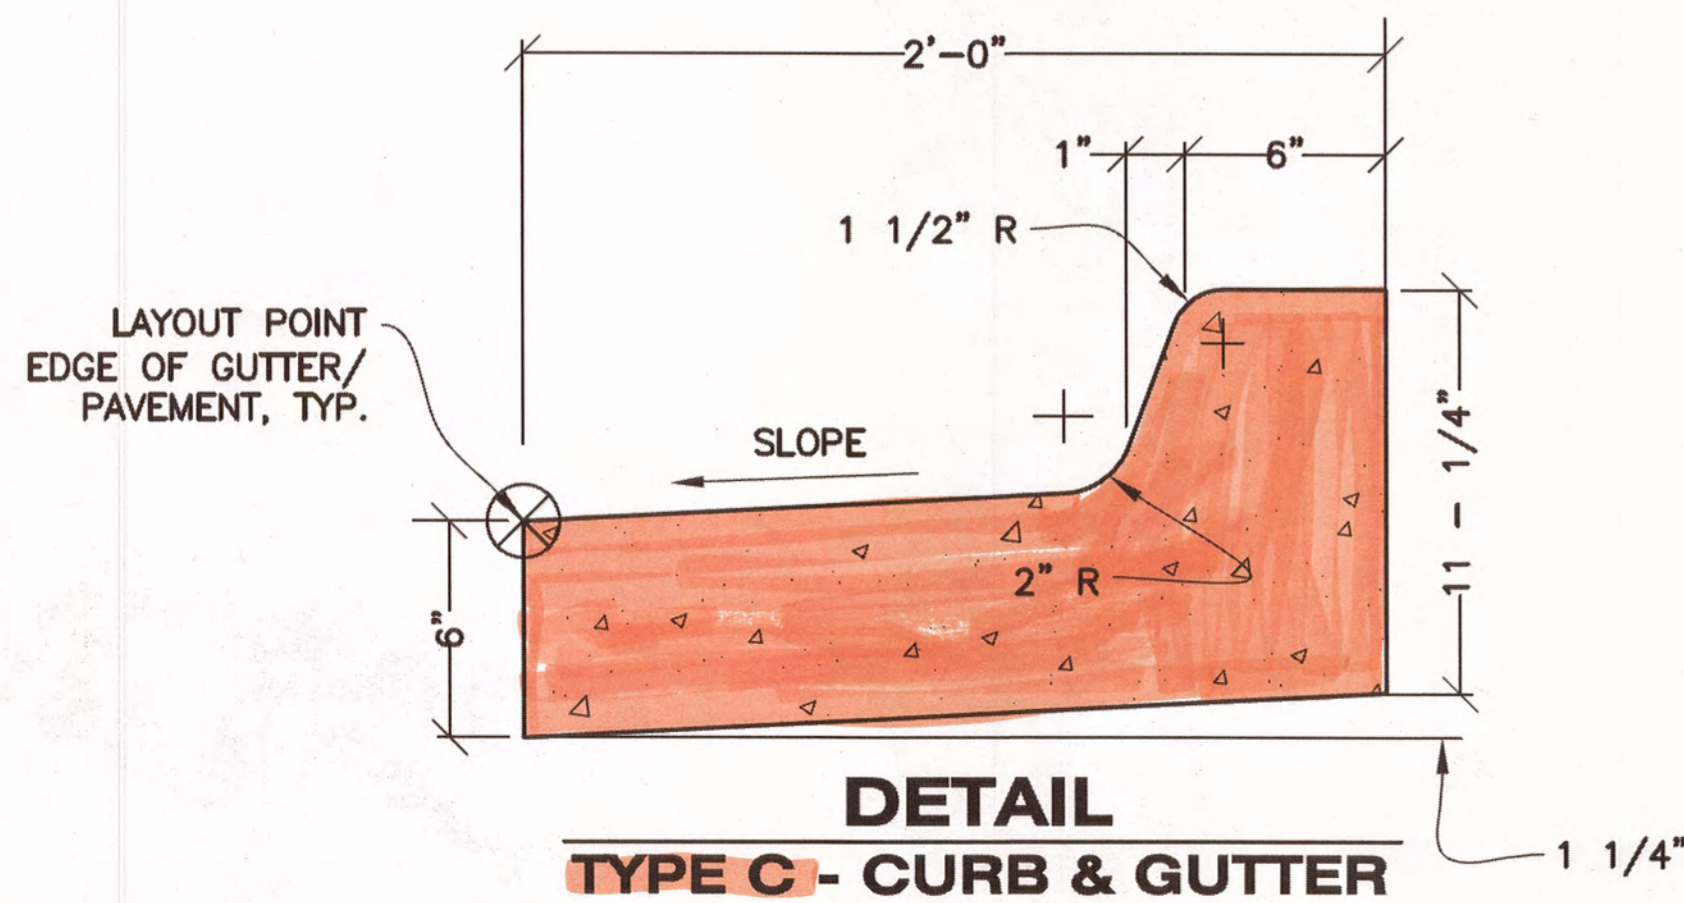

**DETAIL
TYPE C - CURB & GUTTER**

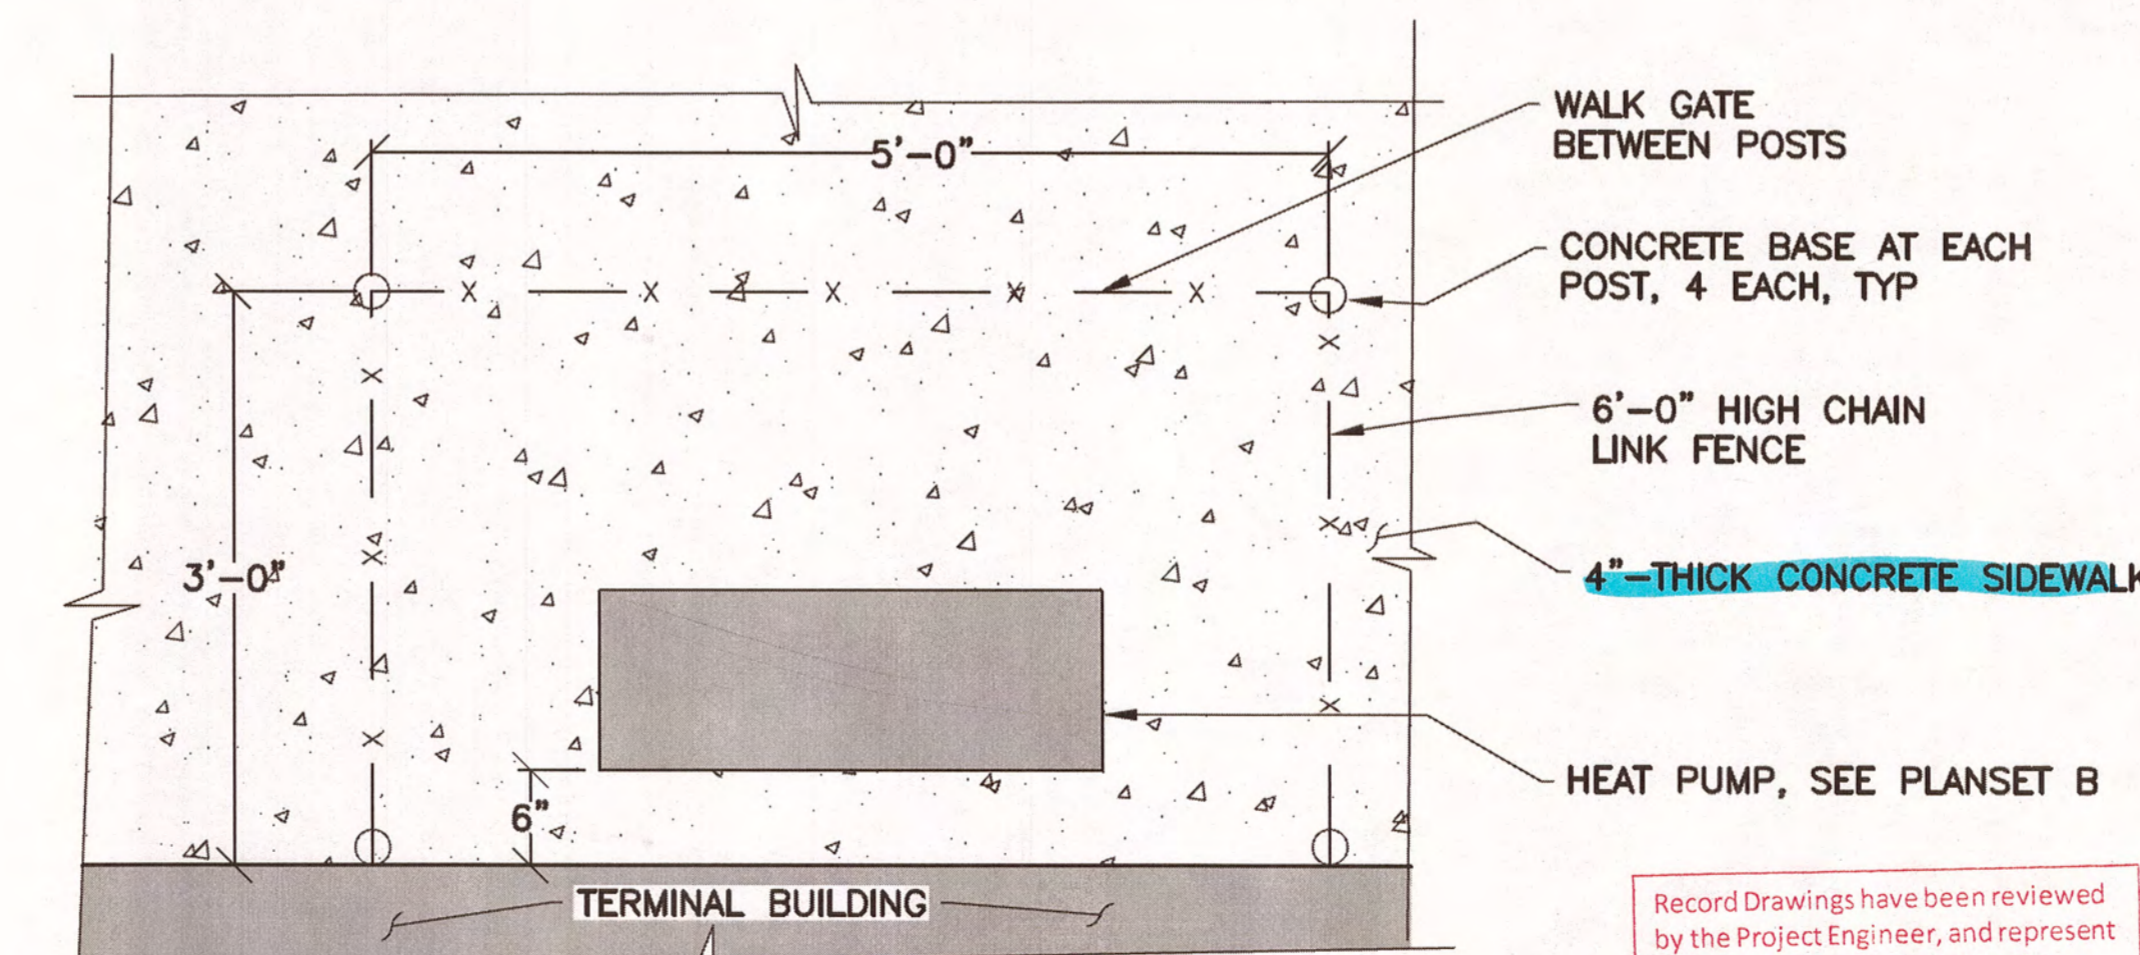


CHAIN LINK FENCE LAYOUT

Record Drawings have been reviewed by the Project Engineer, and represent to the best of my knowledge, the project as constructed.
PE [Signature] Date 3/21/17


DO NOT SCALE FROM THESE DRAWINGS USE DIMENSIONS

CHECKED BY: J. OSBURN		STATE OF ALASKA DEPARTMENT OF TRANSPORTATION & PUBLIC FACILITIES SOUTHCOST REGION	
DESIGNED BY: STAFF		KAKE FERRY TERMINAL PASSENGER FACILITY PLANSET A	
DRAWN BY: STAFF		MISCELLANEOUS DETAILS	
PATH: \\DOTSERFS02\PROJECTS\KAE\69446\PLANSET\MF\PLANSET A\7-8_TYP SECS & MISC DETS.DWG TAB: 8 Tuesday, November 03, 2015 11:52:50 AM OSBURN, JOEL D (DOT)			
REVISIONS		PROJECT DESIGNATION	YEAR
NO.	DATE	DESCRIPTION	SHEET NO.
			TOTAL SHEETS
		SAMHS00002	2015 8 11

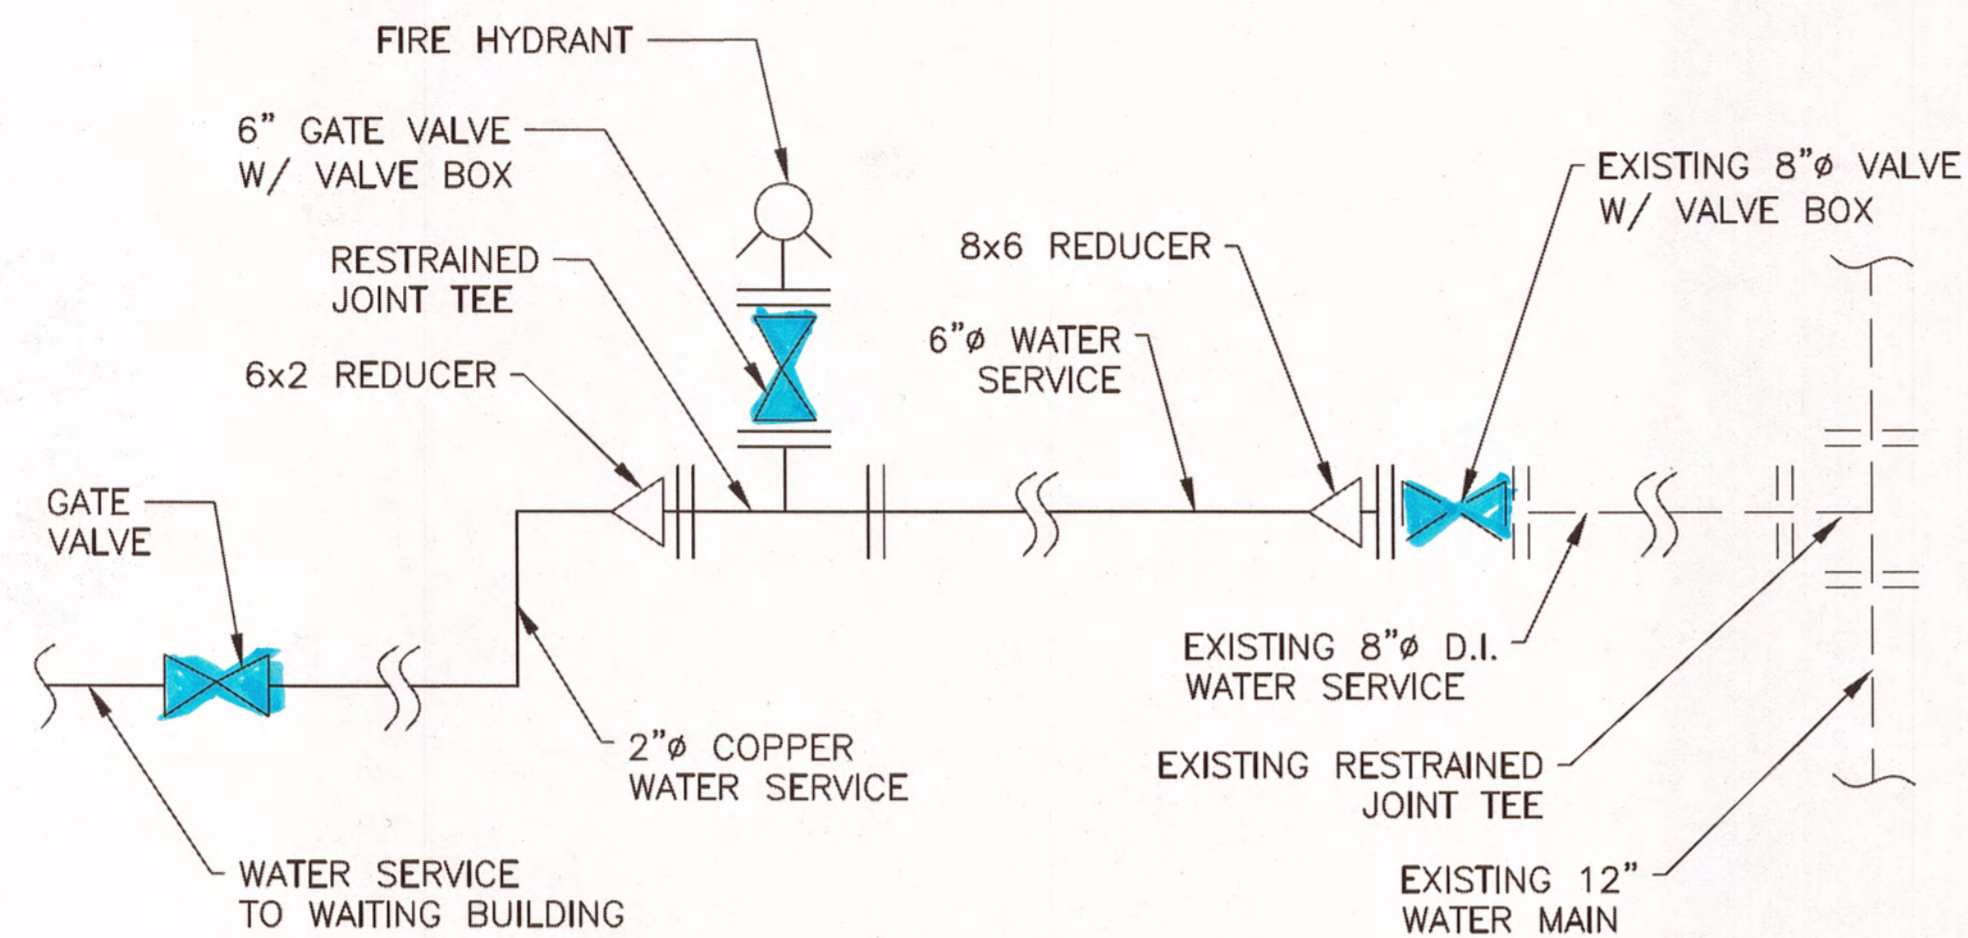

WATER SERVICE CONNECTION

Layout Points: 143, 158, 161

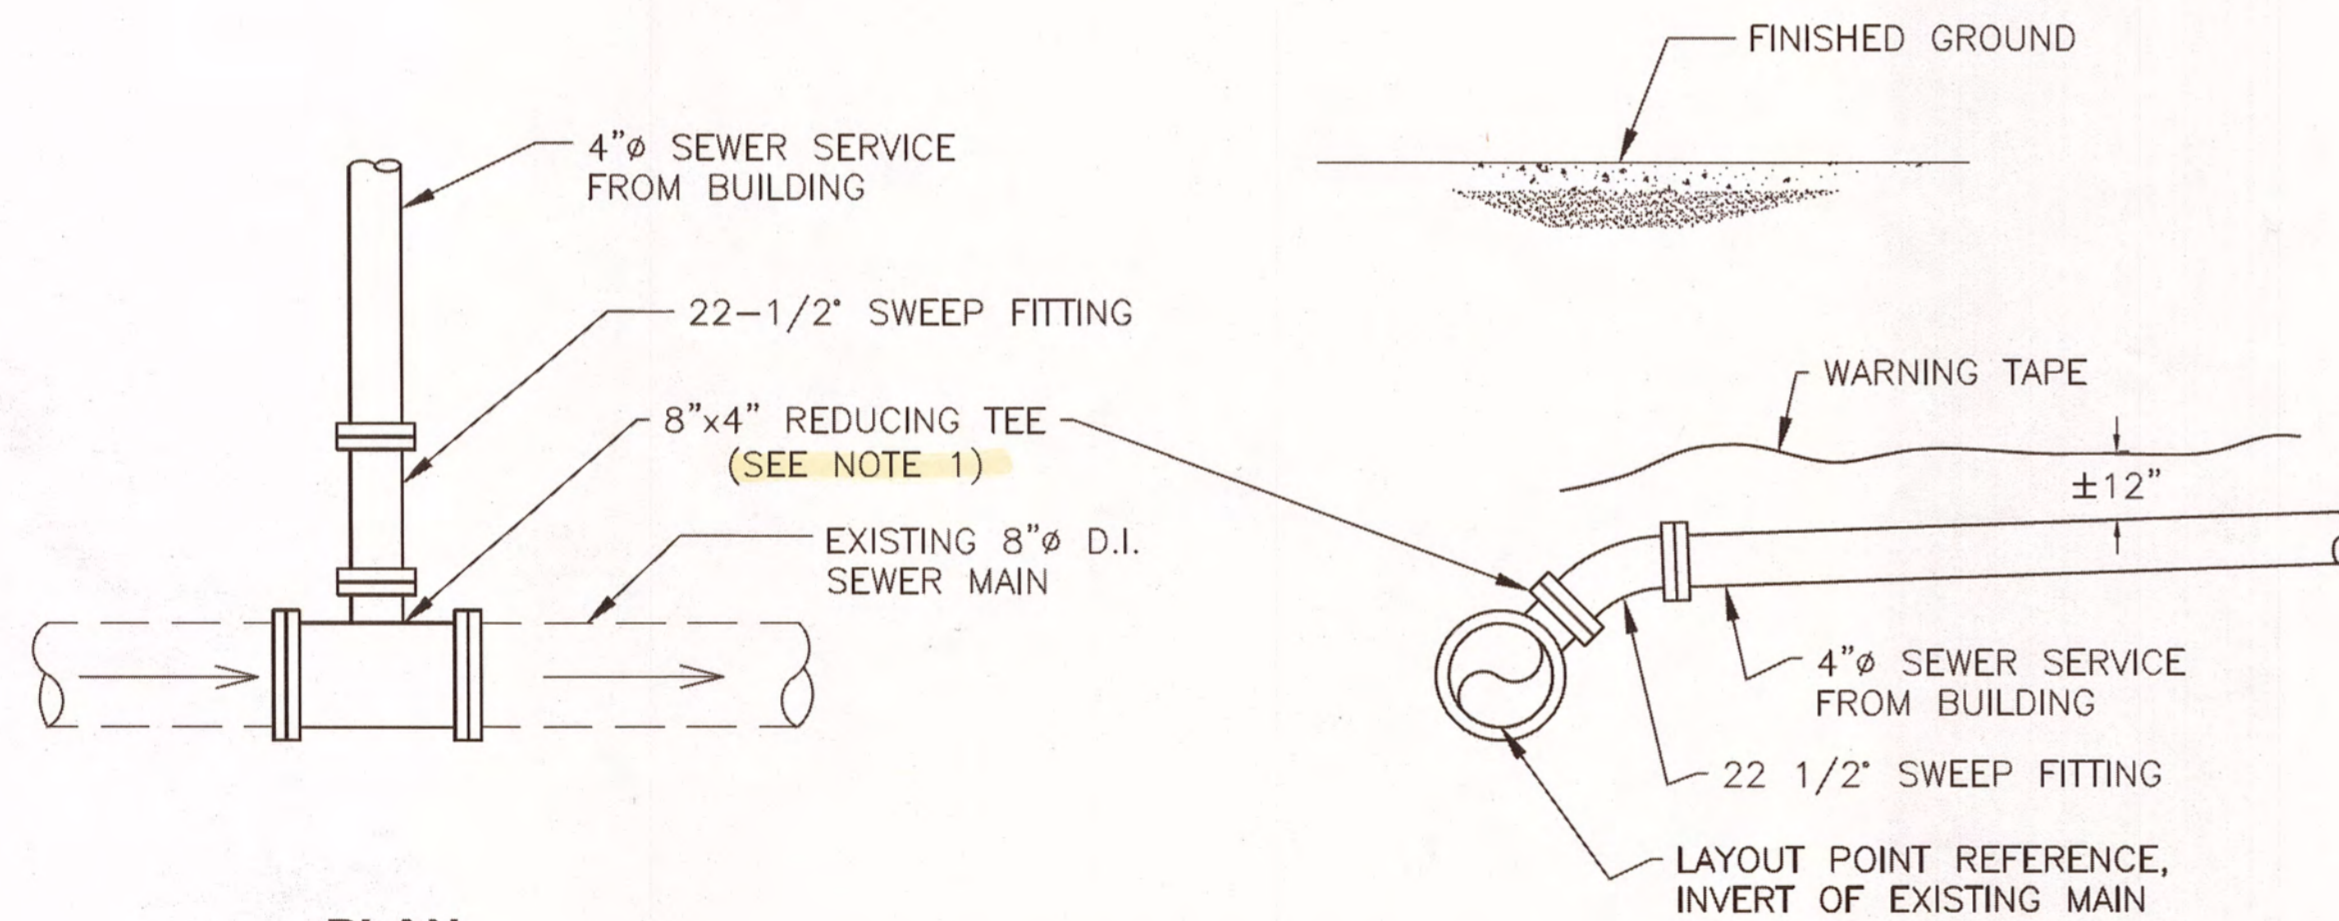


PLAN

ELEVATION

SEWER SERVICE CONNECTION

SEWER SERVICE CONNECTION NOTES:

- 8" DOUBLE STRAP SERVICE SADDLE OR EQUAL MAY BE SUBSTITUTED FOR A REDUCING TEE (SEE DETAIL 1). SADDLE TEE SHALL BE A ROMAC CB SEWER SADDLE OR AN APPROVED EQUAL.
- DISTANCE FROM TEE TO MANHOLE, AND TWO MEASURED DISTANCES FROM END OF SERVICE PIPE TO PERMANENT OBJECTS, SHALL BE NOTED ON AS-BUILT PLANS.
- DIAMETER OF HOLE CUT IN SEWER MAIN SHALL NOT EXCEED 0.25" LARGER THAN THE SADDLE TEE CONNECTION. TEE SHALL BE CENTERED OVER CUT IN PIPE AND CLAMPED WITH METAL BAND SO TEE GASKET FORMS A WATER-TIGHT SEAL.
- WATER AND DEBRIS SHALL NOT BE ALLOWED TO ENTER THE SEWER MAIN DURING THE TAPPING OPERATION.

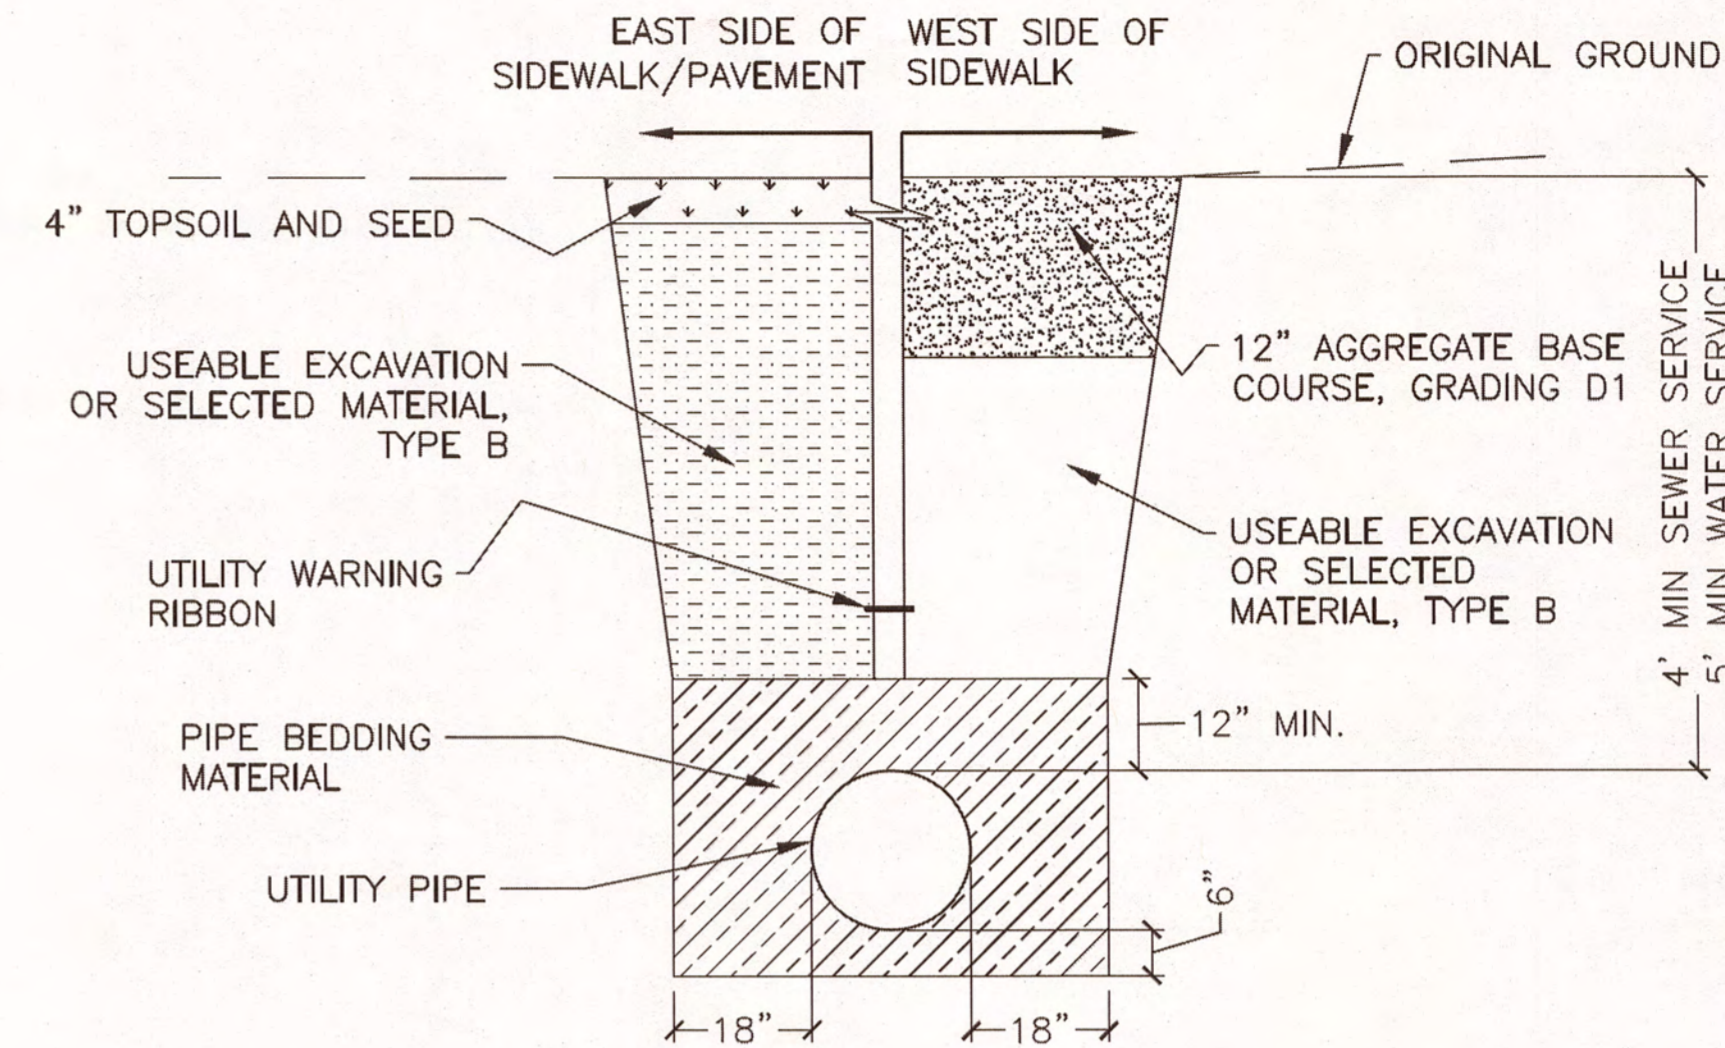


TYPICAL SECTION UTILITY TRENCH

Layout Points: 173, 174

TRENCHING NOTES:

- EXPECT TO ENCOUNTER BEDROCK IN TRENCH EXCAVATION.
- PLACE D-1 BASE COURSE SURFACING WITHIN 24 HOURS OF PAVEMENT REMOVAL. MAINTAIN DRIVING SURFACES TO THE SATISFACTION OF THE ENGINEER.
- CONTRACTOR SHALL INCORPORATE USEABLE EXCAVATED MATERIALS IN TRENCH BACKFILL EXCEPT WHERE EXISTING MATERIALS ARE DETERMINED TO BE UNSUITABLE BY THE ENGINEER FOR RE-USE. IMPORT OF SELECTED MATERIALS FOR TRENCH BACKFILL SHALL ONLY BE UTILIZED AND PAID FOR WHEN AUTHORIZED BY THE ENGINEER. TRENCH BACKFILL SHALL MEET GRADATION REQUIREMENTS FOR SELECTED MATERIAL, TYPE B.

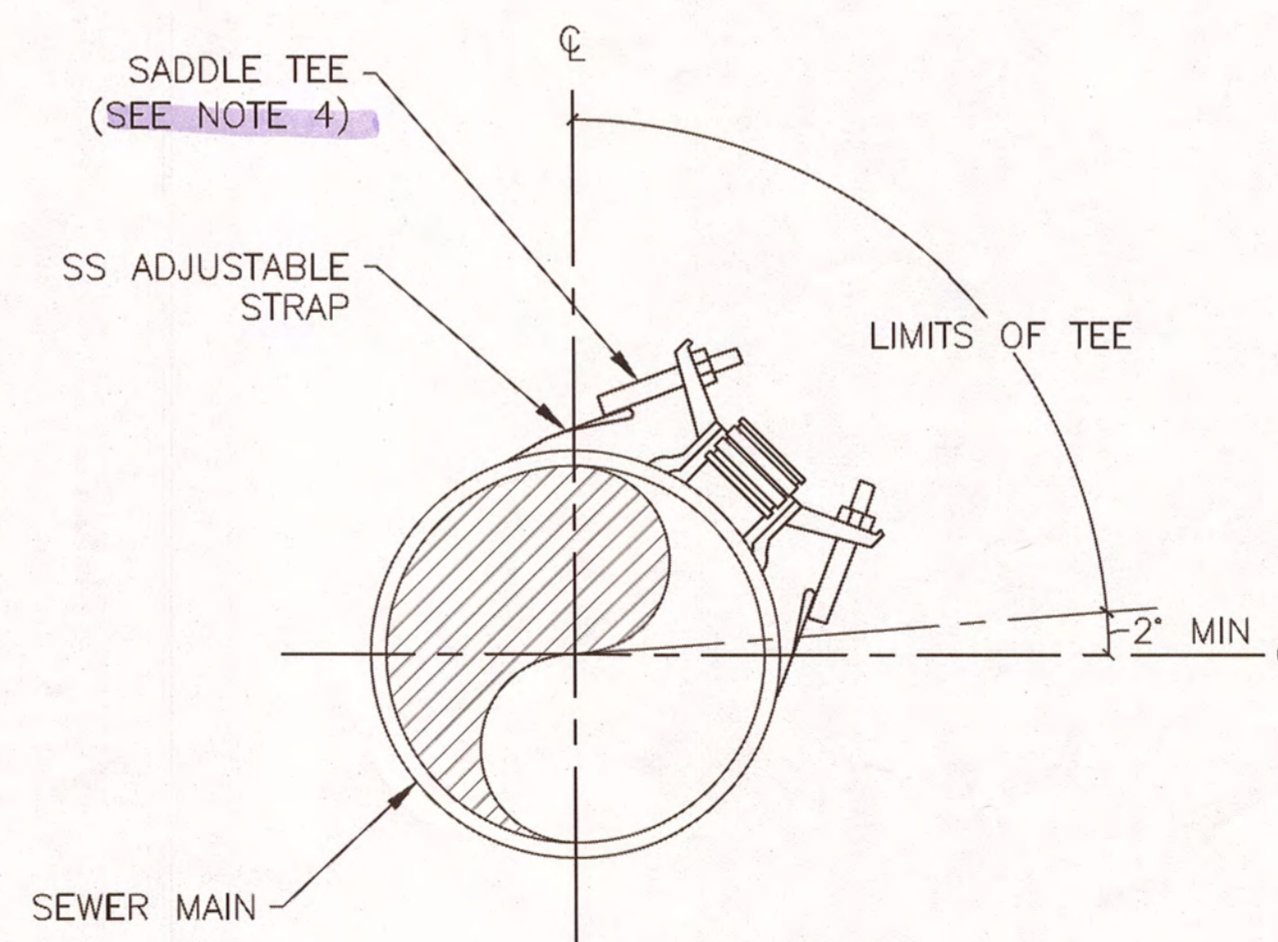


1 SANITARY SEWER SADDLE TEE

Layout Points: 167


Record Drawings have been reviewed by the Project Engineer, and represent to the best of my knowledge, the project as constructed.
PE [Signature] Date 3/21/17

DO NOT SCALE FROM THESE DRAWINGS USE DIMENSIONS


CHECKED BY: J. OSBURN		STATE OF ALASKA DEPARTMENT OF TRANSPORTATION & PUBLIC FACILITIES SOUTHCOST REGION	
DESIGNED BY: STAFF		KAKE FERRY TERMINAL PASSENGER FACILITY PLANSET A UTILITY DETAILS	
DRAWN BY: STAFF			
PATH: \\DOTSERFS02\PROJECTS\KAE\69446\PLANSET\MF\PLANSET A\9-10_UTILITY DETAILS.DWG TAB: 9 Wednesday, November 04, 2015 4:15:05 PM, JOEL D (DOT)			
REVISIONS		PROJECT DESIGNATION	YEAR
NO.	DATE	DESCRIPTION	SHEET NO.
			9
		SAMHS00002	2015
			11

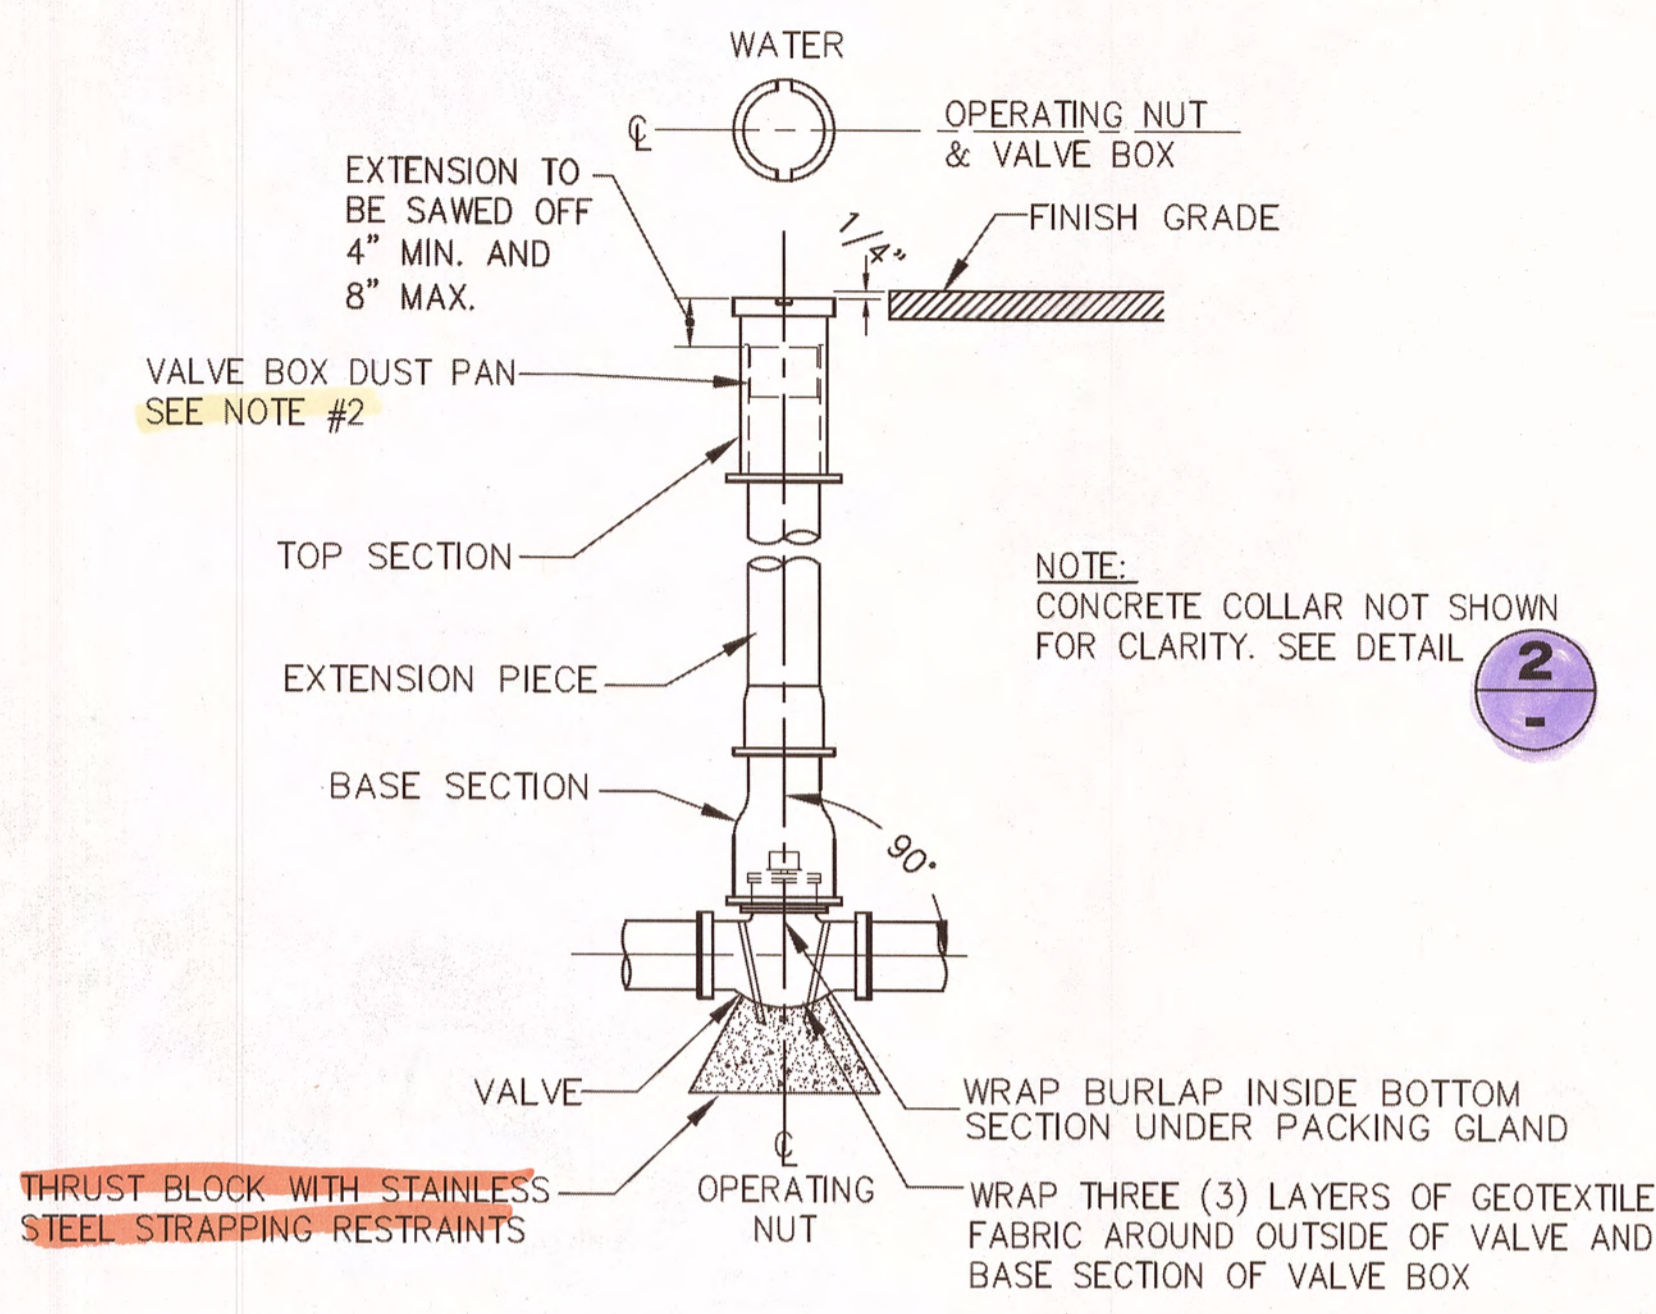


1
-
**DETAIL
MAINLINE VALVE**

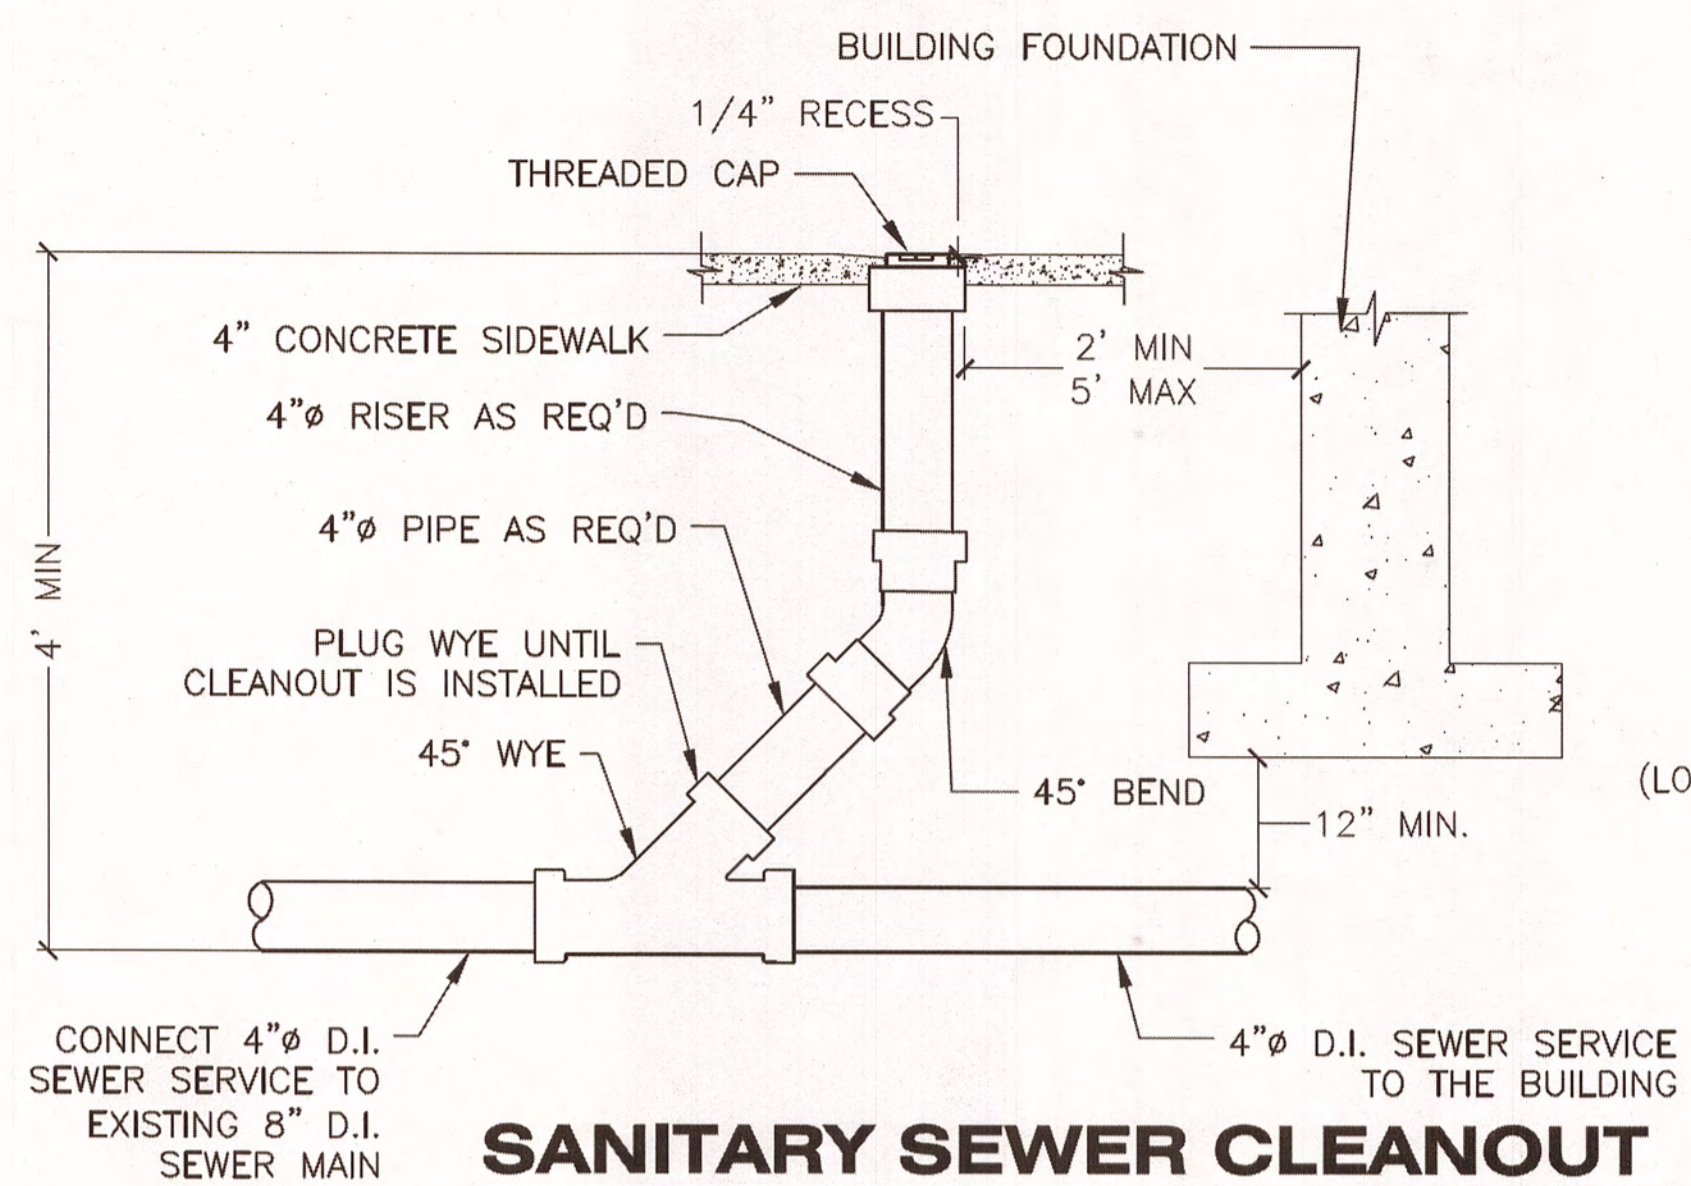

SANITARY SEWER CLEANOUT

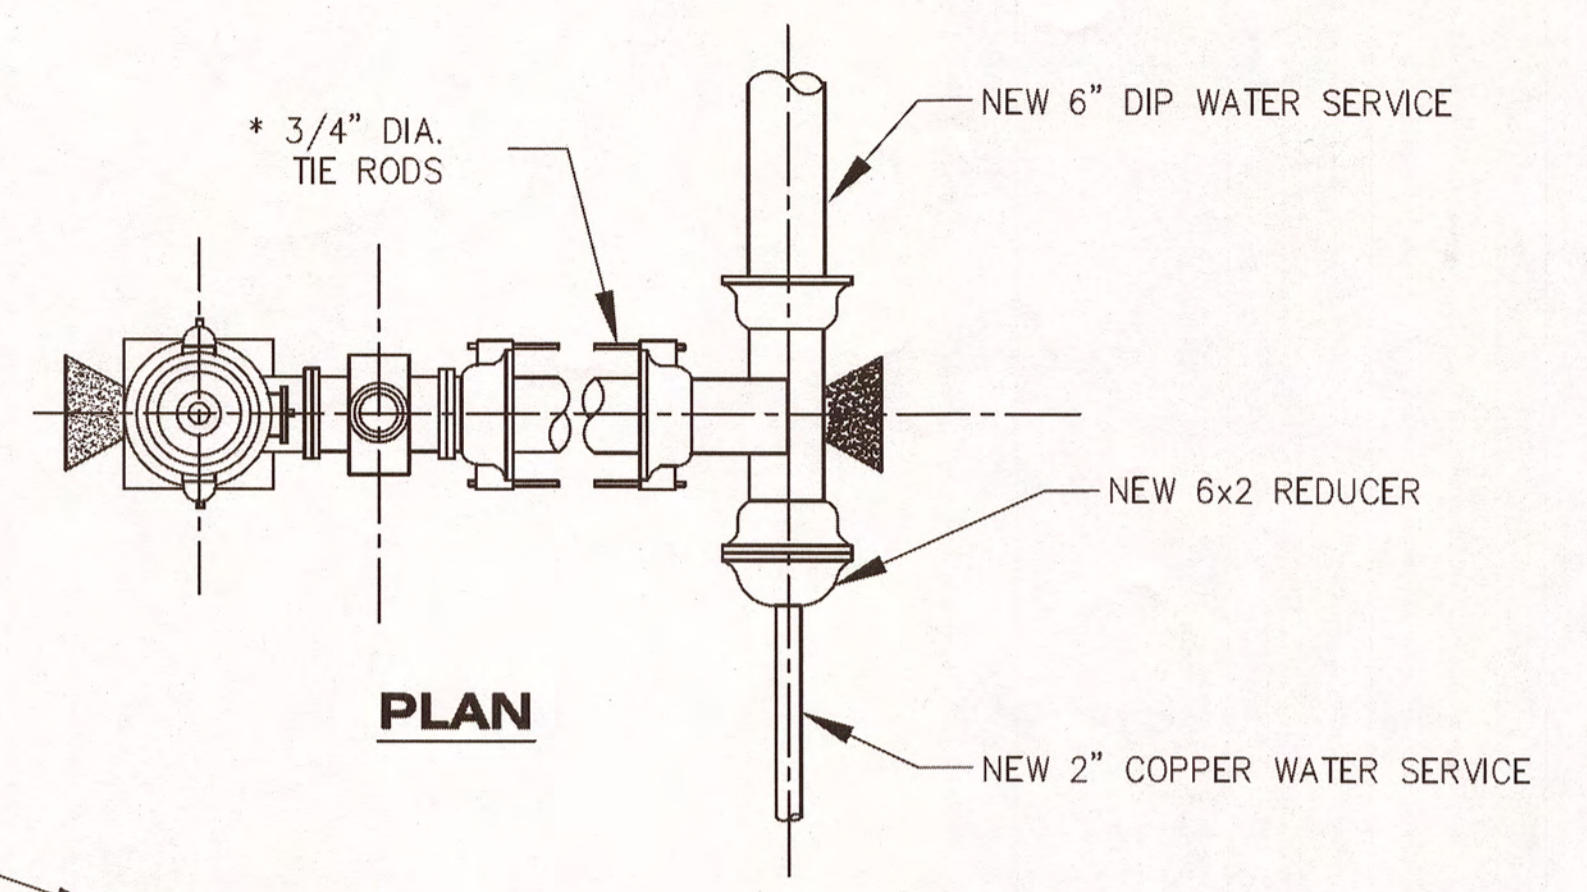

PLAN

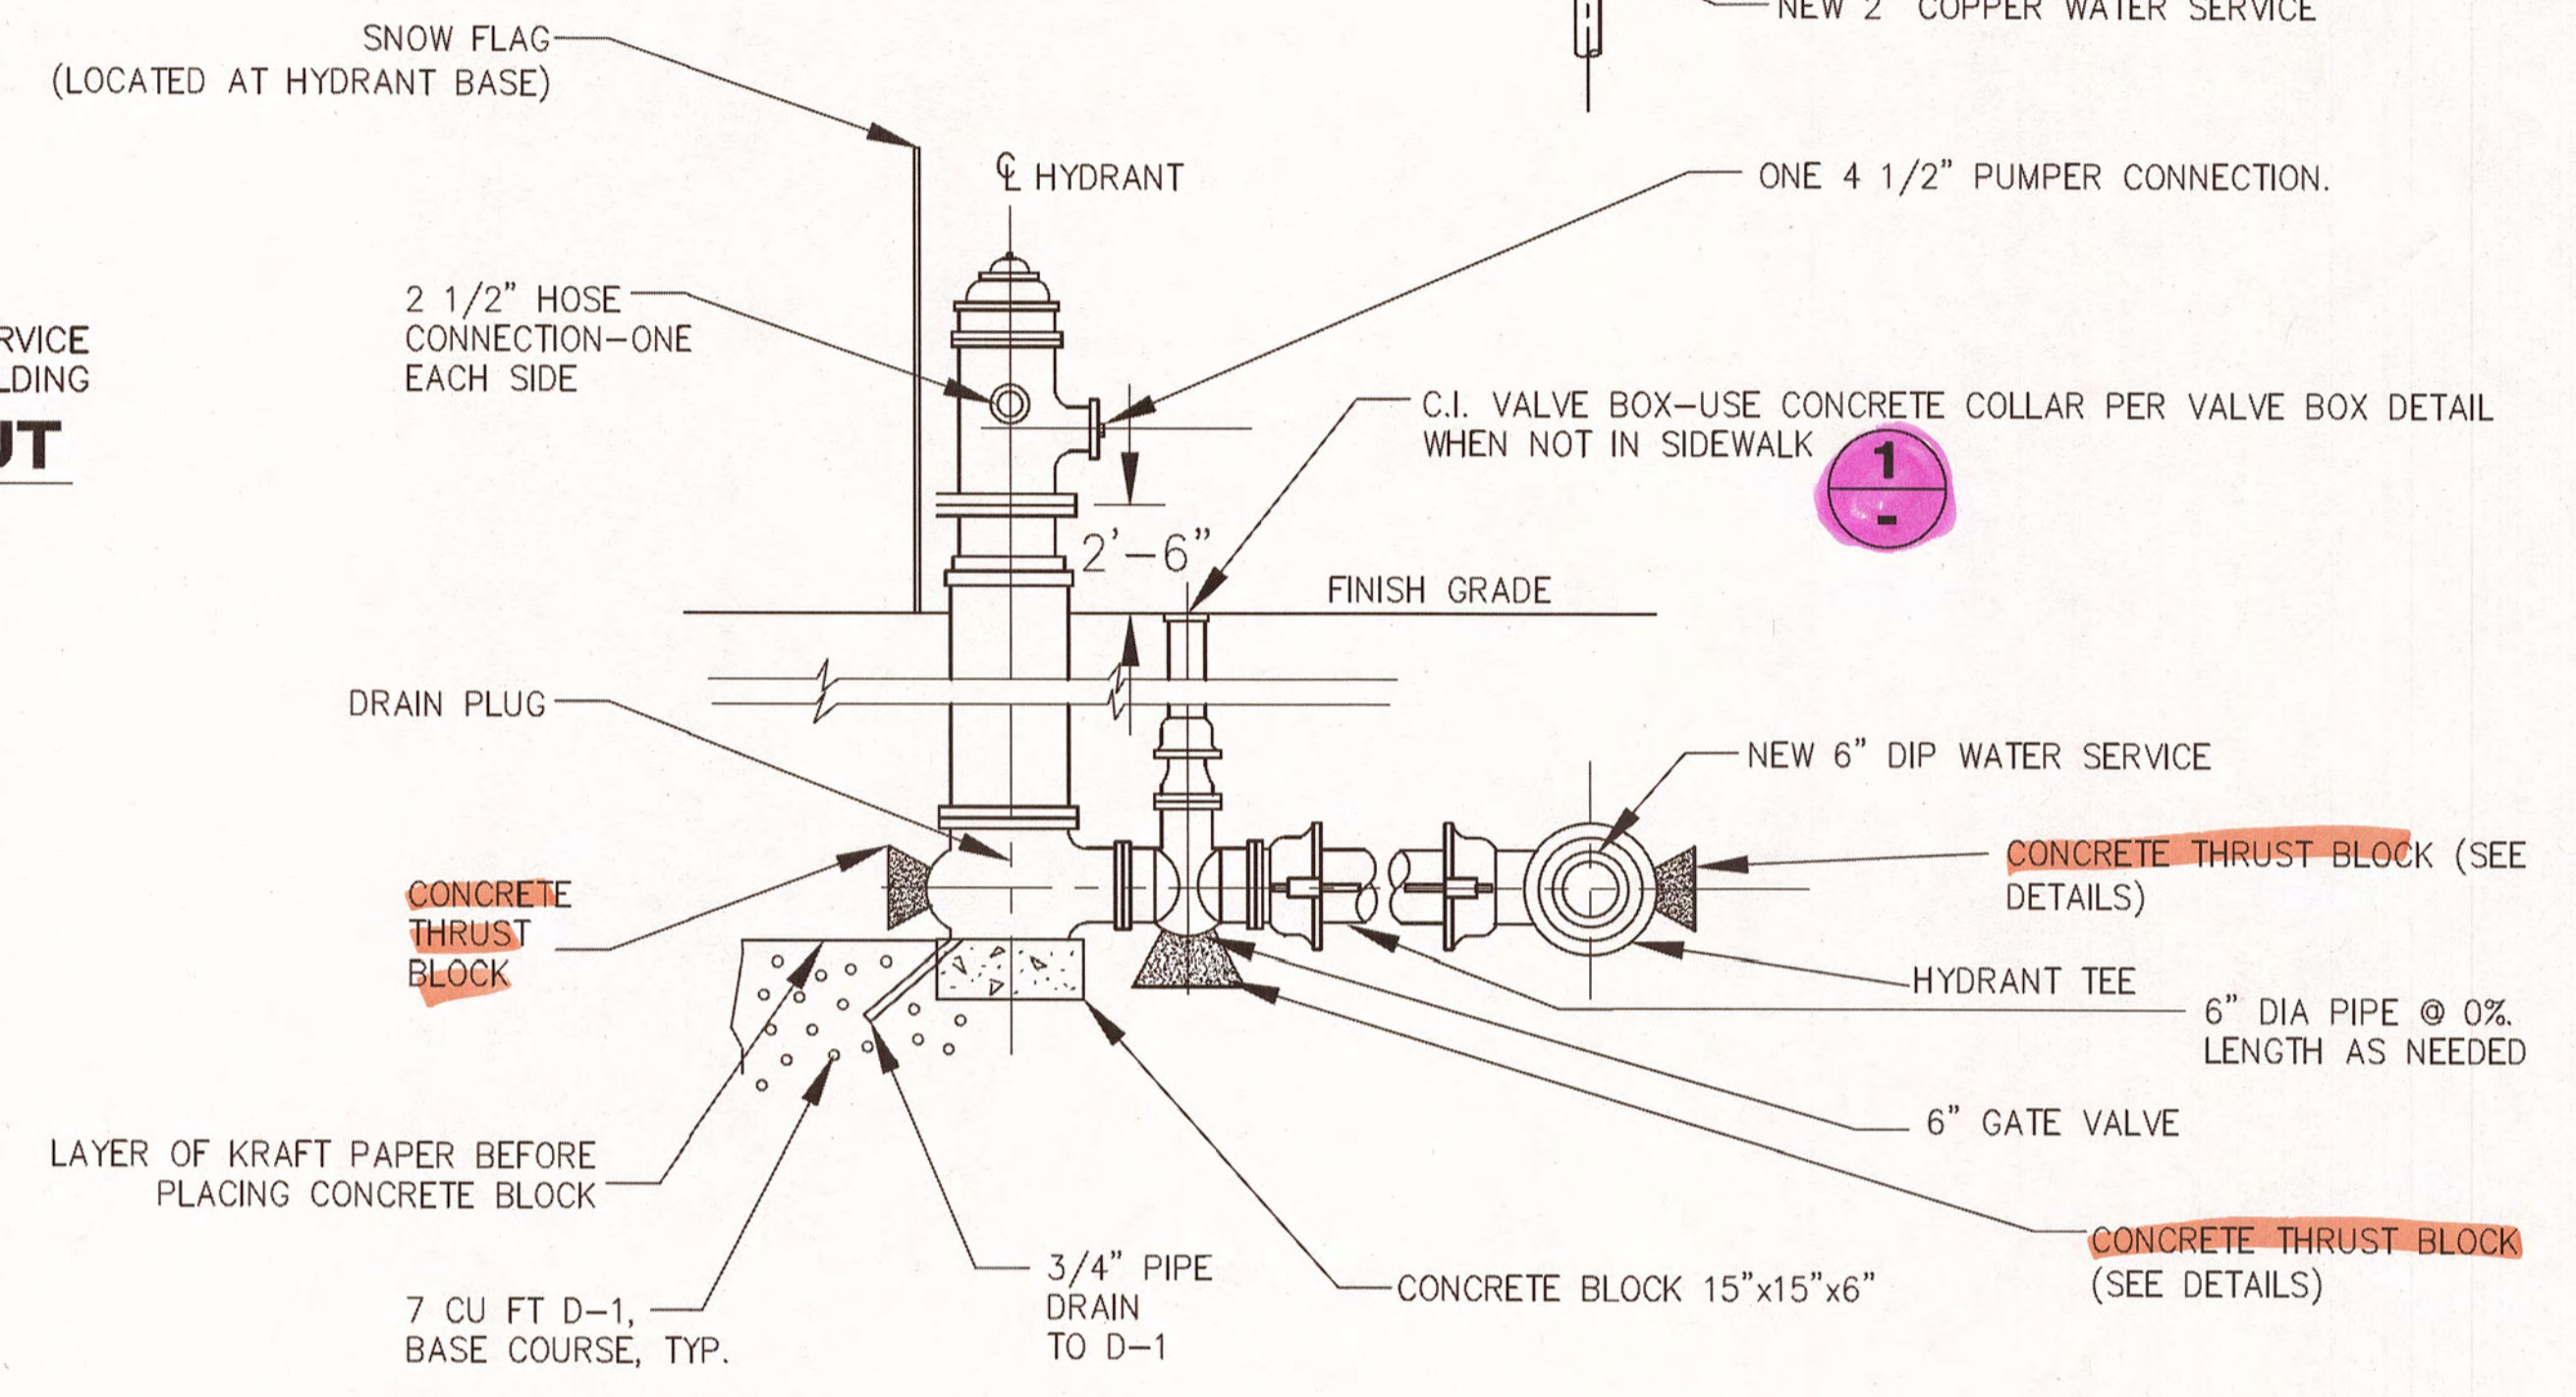


ELEVATION

* THRUST BLOCKS MAY BE INSTALLED IN LIEU OF TIE RODS


**DETAIL
FIRE HYDRANT**

- VALVE & HYDRANT NOTES:**
1. AS-BUILT ALL UNDERGROUND UTILITIES AND PROVIDE LOCATIONS TO THE ENGINEER PRIOR TO FINAL TESTING, BACKFILLING.
 2. VALVE LID AND TOP SECTION TO BE OLYMPIC FOUNDRY TYPE C OR EQUAL. EXTENSION PIECE TO BE OLYMPIC FOUNDRY TYPE A 10 FOOT SECTION OR 5" DIA. SINGLE HUB SOIL PIPE OR APPROVED EQUAL. BASE SECTION TO BE OLYMPIC FOUNDRY TYPE B OR EQUAL. VALVE BOX DUST PAN MADE OF 14 GAUGE HOT ROLLED ELECTRIC RESISTANCE WELDED (HREW) TUBE.
 3. IN AREAS OUTSIDE THE TRAVELED WAY & REGULAR VEHICULAR TRAFFIC, VALVE BOXES SHALL BE EXTENDED 6" TO 12" ABOVE GRADE.
 4. VALVE BOX LOCATIONS SHALL BE CLEARED OF ALL OBSTRUCTIONS BY A MINIMUM OF 3' IN ALL DIRECTIONS.
 5. BENDS BETWEEN THE HYDRANT AND THE MAIN SHALL NOT EXCEED 11 1/4' UNLESS APPROVED BY THE ENGINEER.
 6. ALL HYDRANTS SHALL BE PAINTED CATERPILLAR YELLOW. PORT CAPS SHALL BE COLOR CODED PER NFPA STANDARD 291.
 7. HYDRANT SHALL BE MUELLER CENTURION 200 OR 250 WITH INTEGRAL STORZ PUMPER CONNECTION OR APPROVED EQUAL.

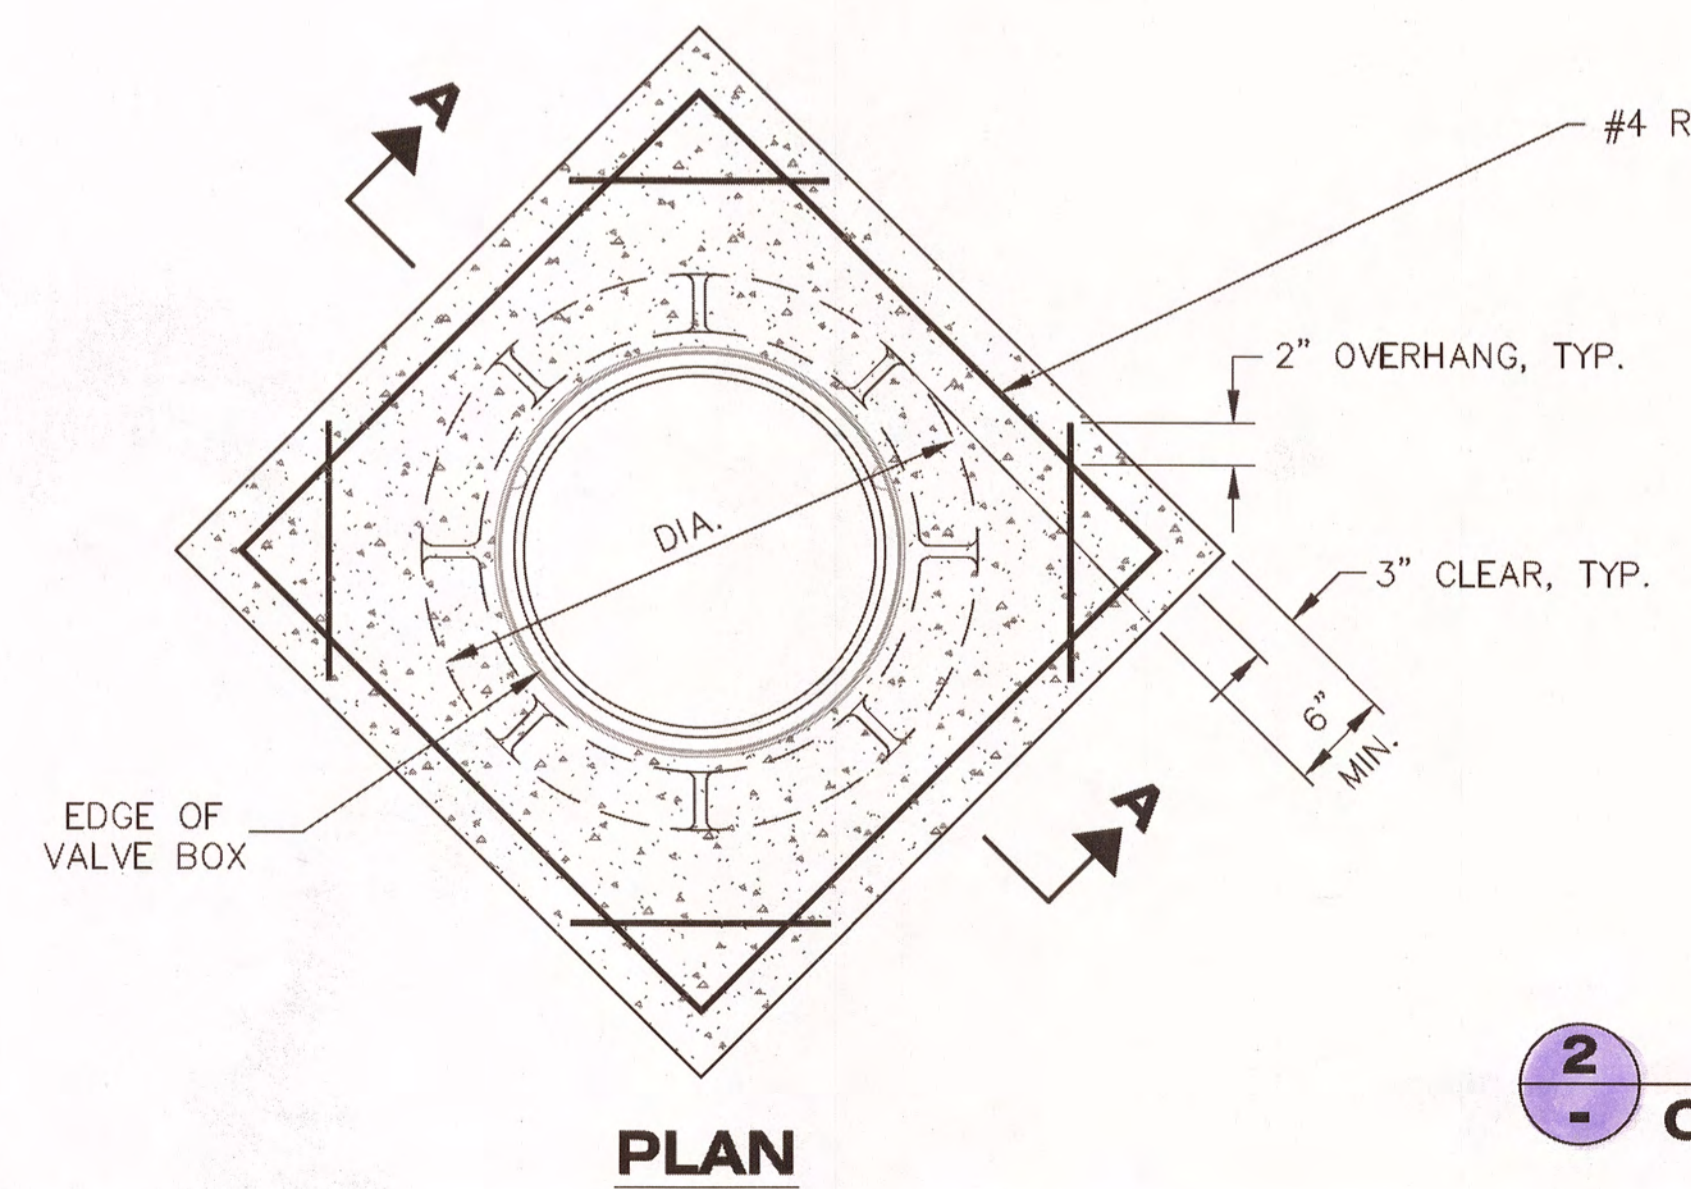

PLAN

2
-
**DETAIL
CONCRETE COLLAR**




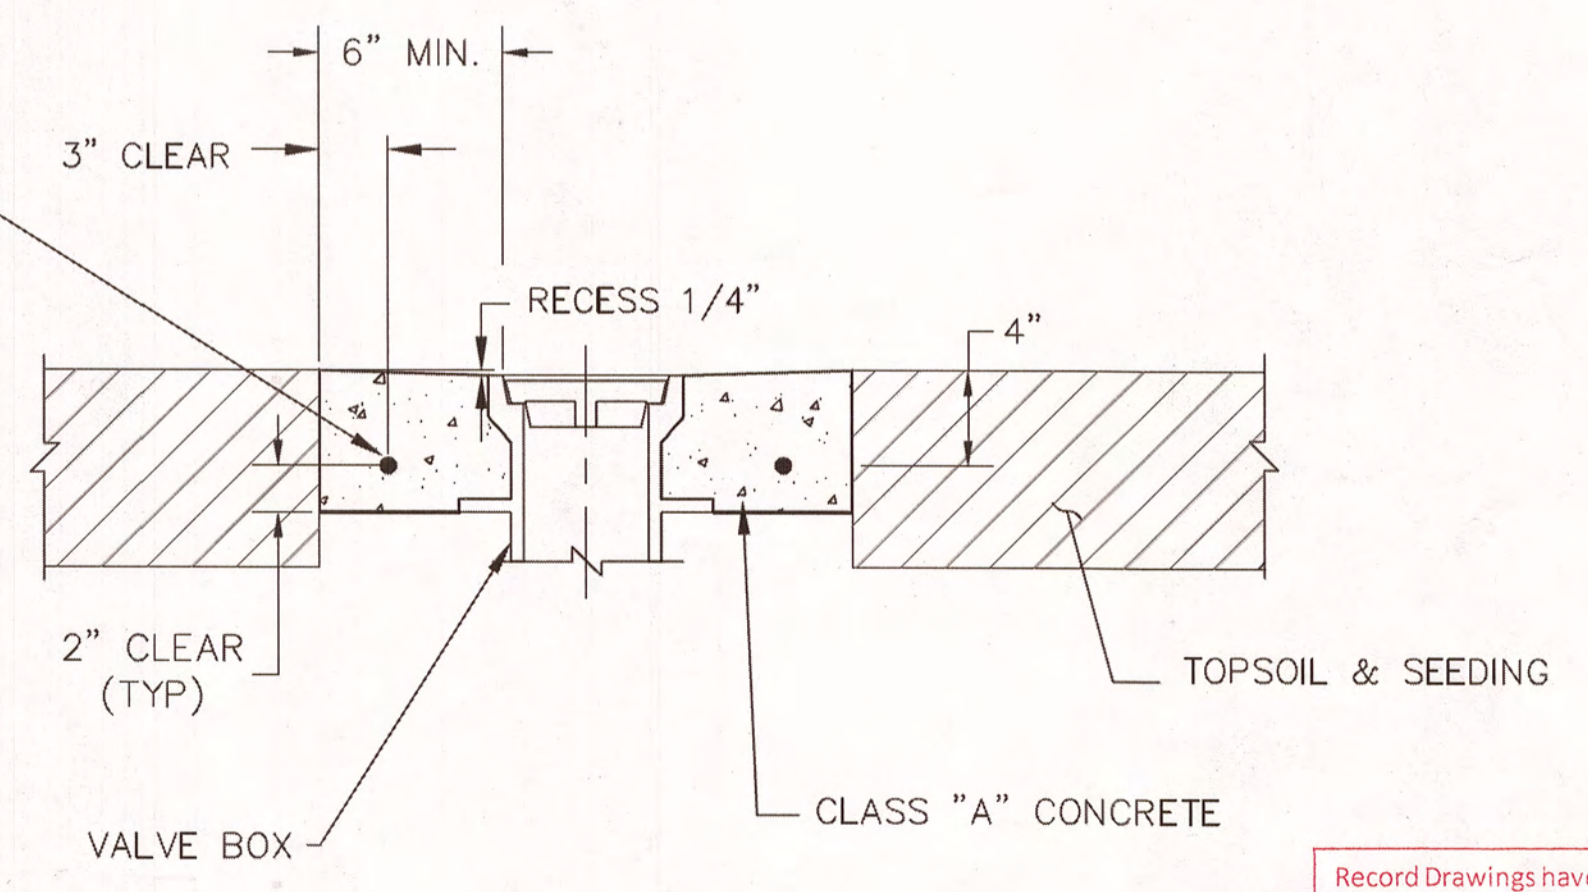


SECTION A-A

Record Drawings have been reviewed by the Project Engineer, and represent to the best of my knowledge, the project as constructed.
PE [Signature] Date 3/21/17

DO NOT SCALE FROM THESE DRAWINGS USE DIMENSIONS

CHECKED BY: J. OSBURN		STATE OF ALASKA DEPARTMENT OF TRANSPORTATION & PUBLIC FACILITIES SOUTHCOST REGION	
DESIGNED BY: STAFF		KAKE FERRY TERMINAL PASSENGER FACILITY PLANSET A UTILITY DETAILS	
DRAWN BY: STAFF			
PATH: \\DOTSERFS02\PROJECTS\KAE\69446\PLANSET\MF\PLANSET A\9-10_UTILITY DETAILS.DWG TAB: 10 Monday, November 02, 2015 11:44:45 AM OSBURN, JOEL D (DOT)			
REVISIONS		PROJECT DESIGNATION	YEAR
NO.	DATE	DESCRIPTION	SHEET NO.
			11
		SAMHS00002	2015 10

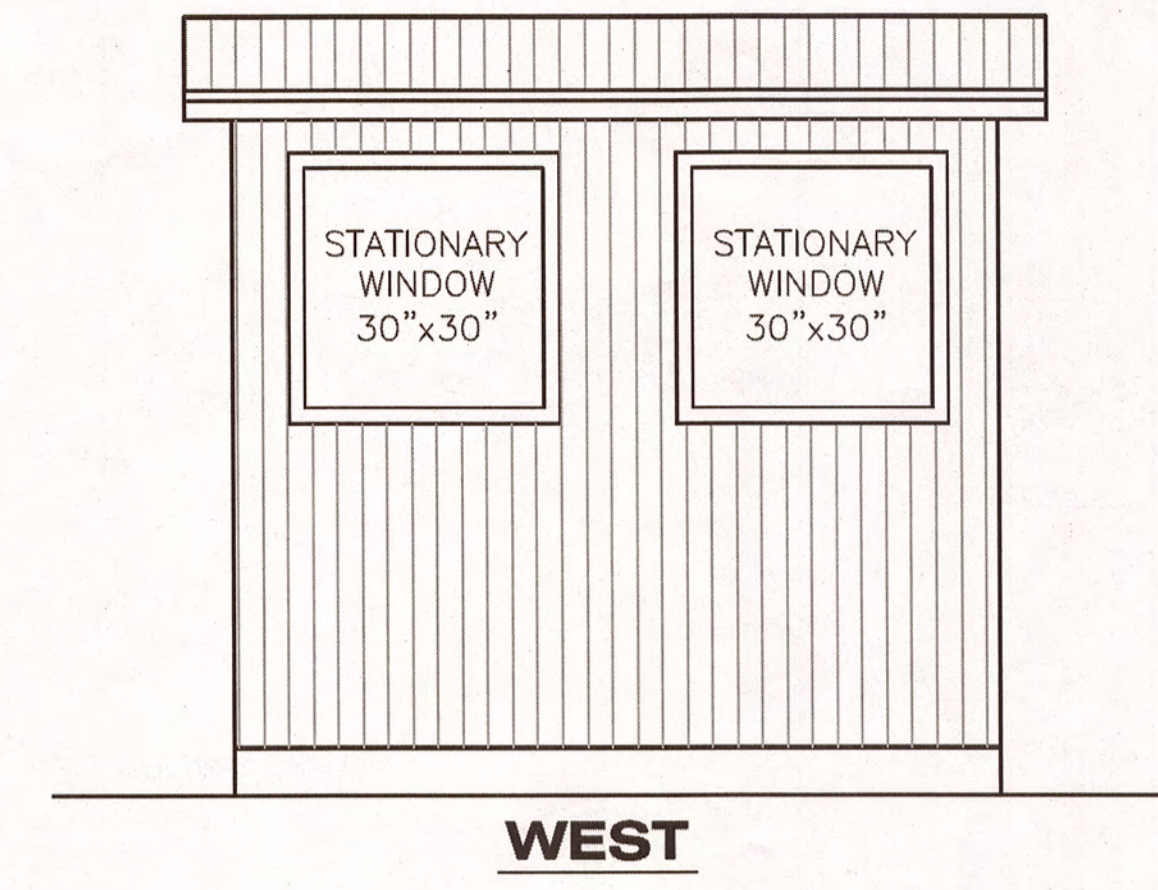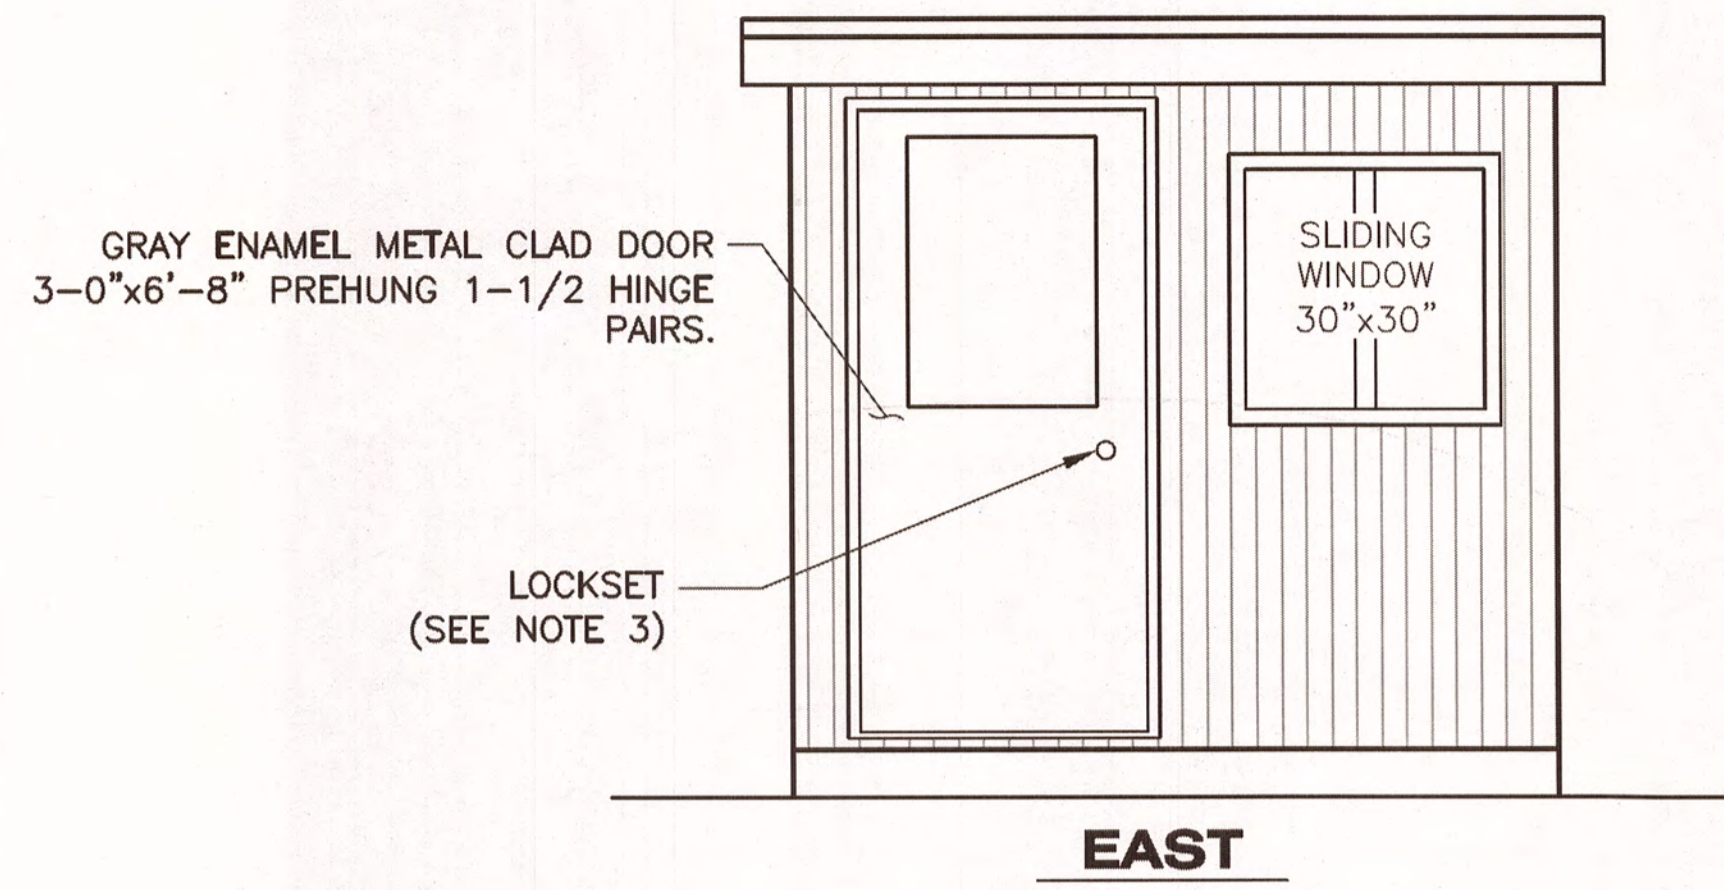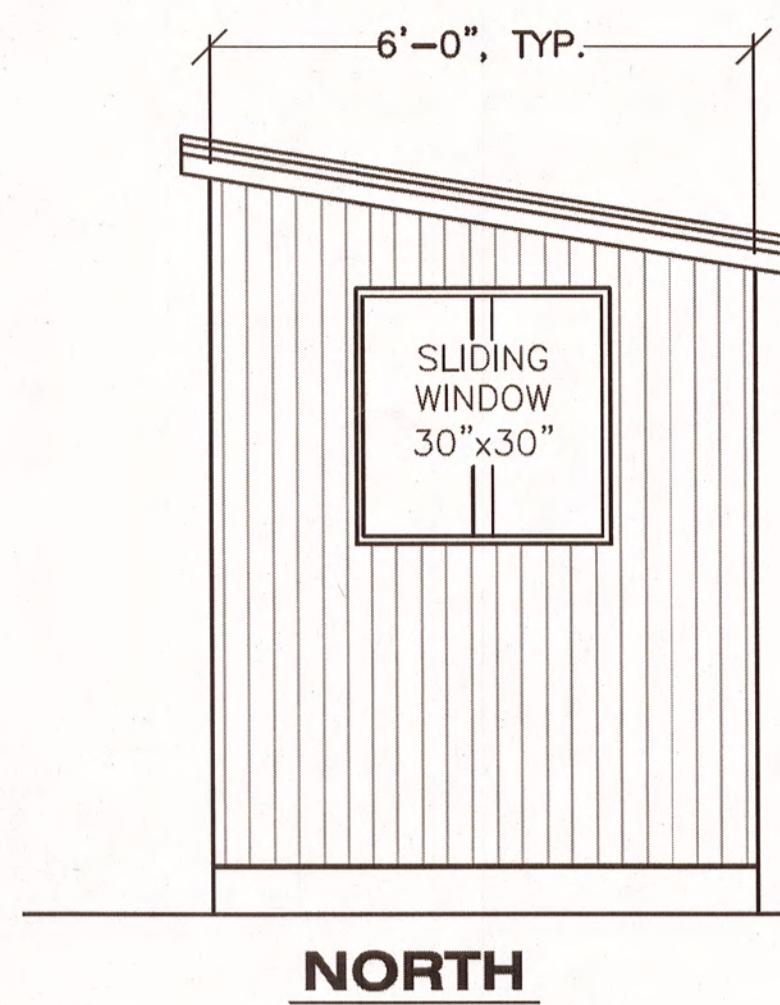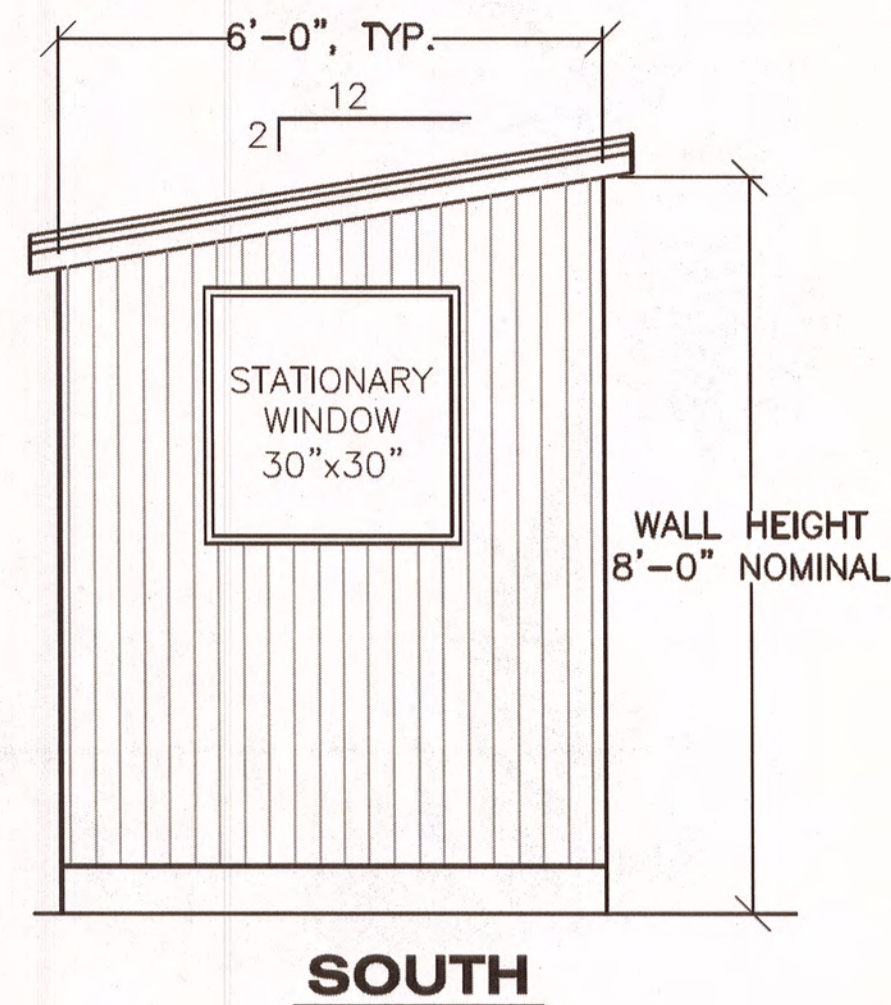


ELEVATION VIEWS


NOTES:

1. CONTRACTOR'S OPTION TO CONSTRUCT PURSER SHELTER SHOWN OR SUPPLY PRE-MANUFACTURED PARKUT STANDARD BOOTH MODEL 84, B.I.G. INTERNATIONAL STANDARD STEEL BOOTH MODEL DC46A, OR APPROVED EQUAL.
2. BUILDING SHALL BE EQUIPPED IN ELECTRIC LIGHT AND POWER RECEPTACLE. SEE PLANSET B FOR ELECTRICAL DRAWINGS.
3. DOOR LOCKSETS SHALL BE THE TYPE AND STYLE PER SECTION 087100, VOLUME II OF THE SPECIFICATIONS, AND SHALL BE KEyed TO THE AMHS MASTER-KEY SYSTEM.
4. WINDOWS AND DOORS SHALL MEET THE DIMENSIONS SHOWN AND SHALL BE INSTALLED PER DETAILS ON SHEET A5.4 AND AS SPECIFIED IN VOLUME II OF THE SPECIFICATIONS.
5. INSTALL HURRICANE TIES AT RAFTERS. FLASHING TO BE INSTALLED ON ALL EDGES OF ROOF & BASE OF WALLS.


6. DOOR FRAME - 2x4 FRAMING.
7. SHEETROCK RETURN ON THE INTERIOR.

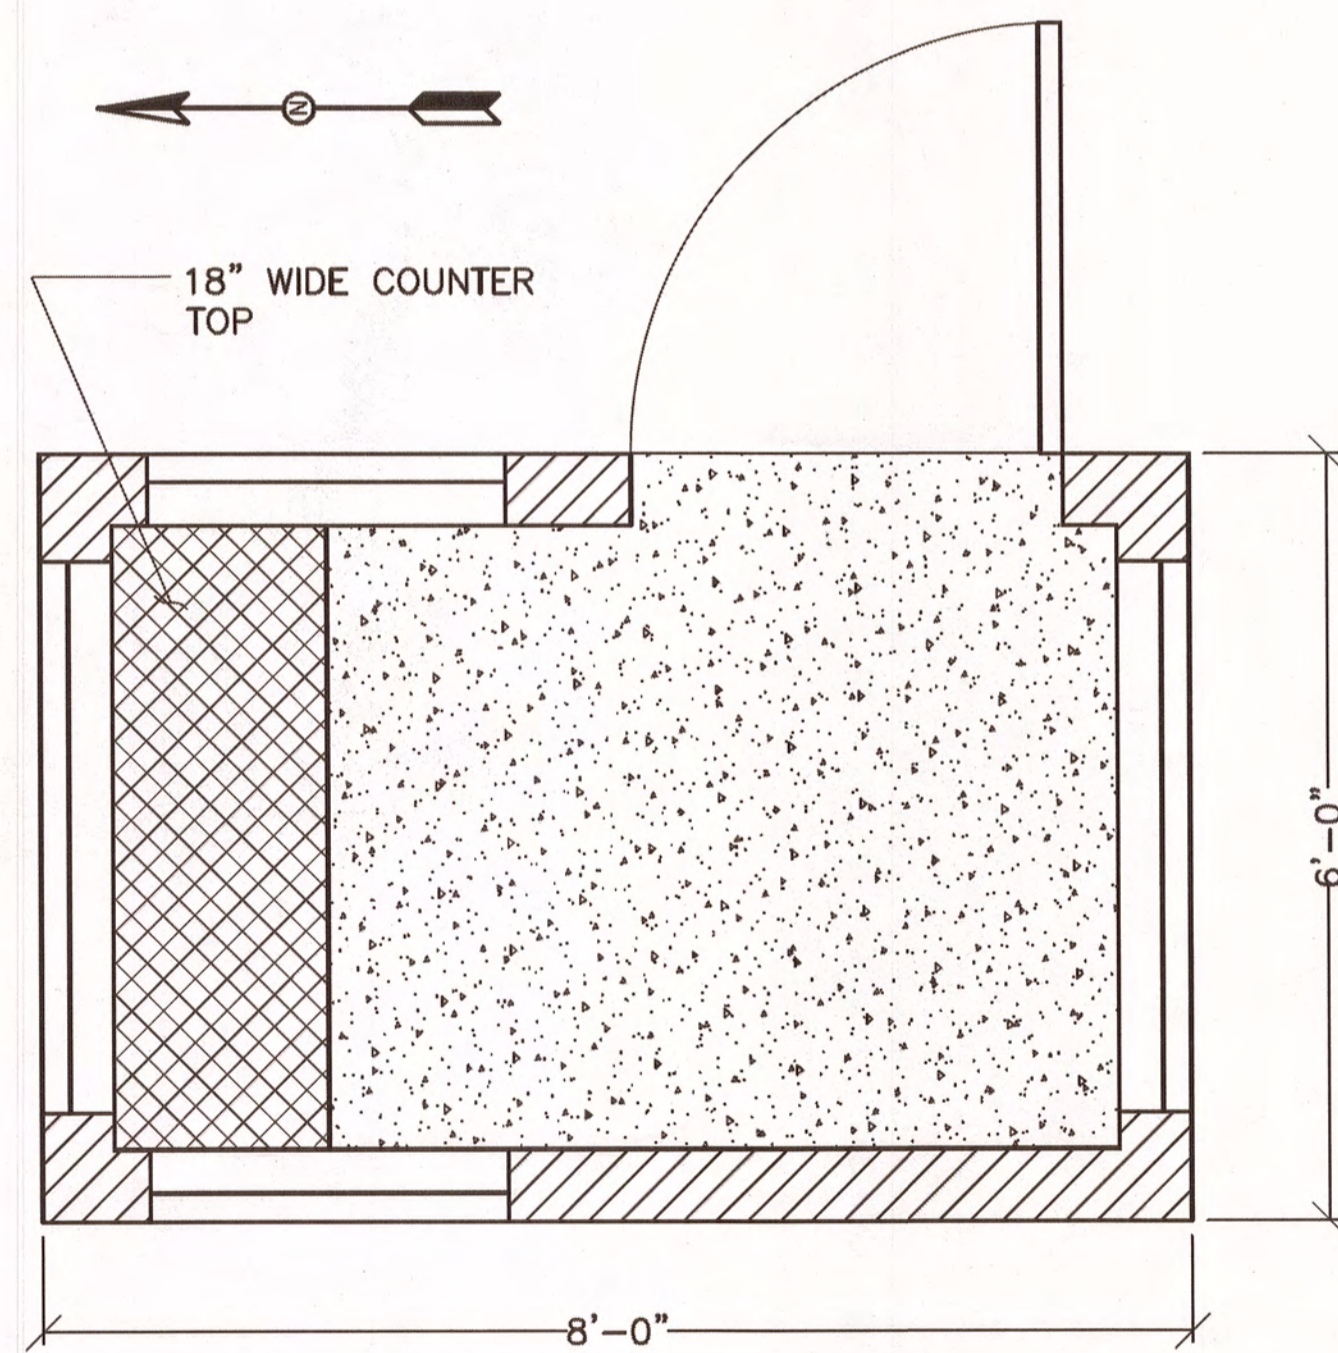

FLOOR PLAN

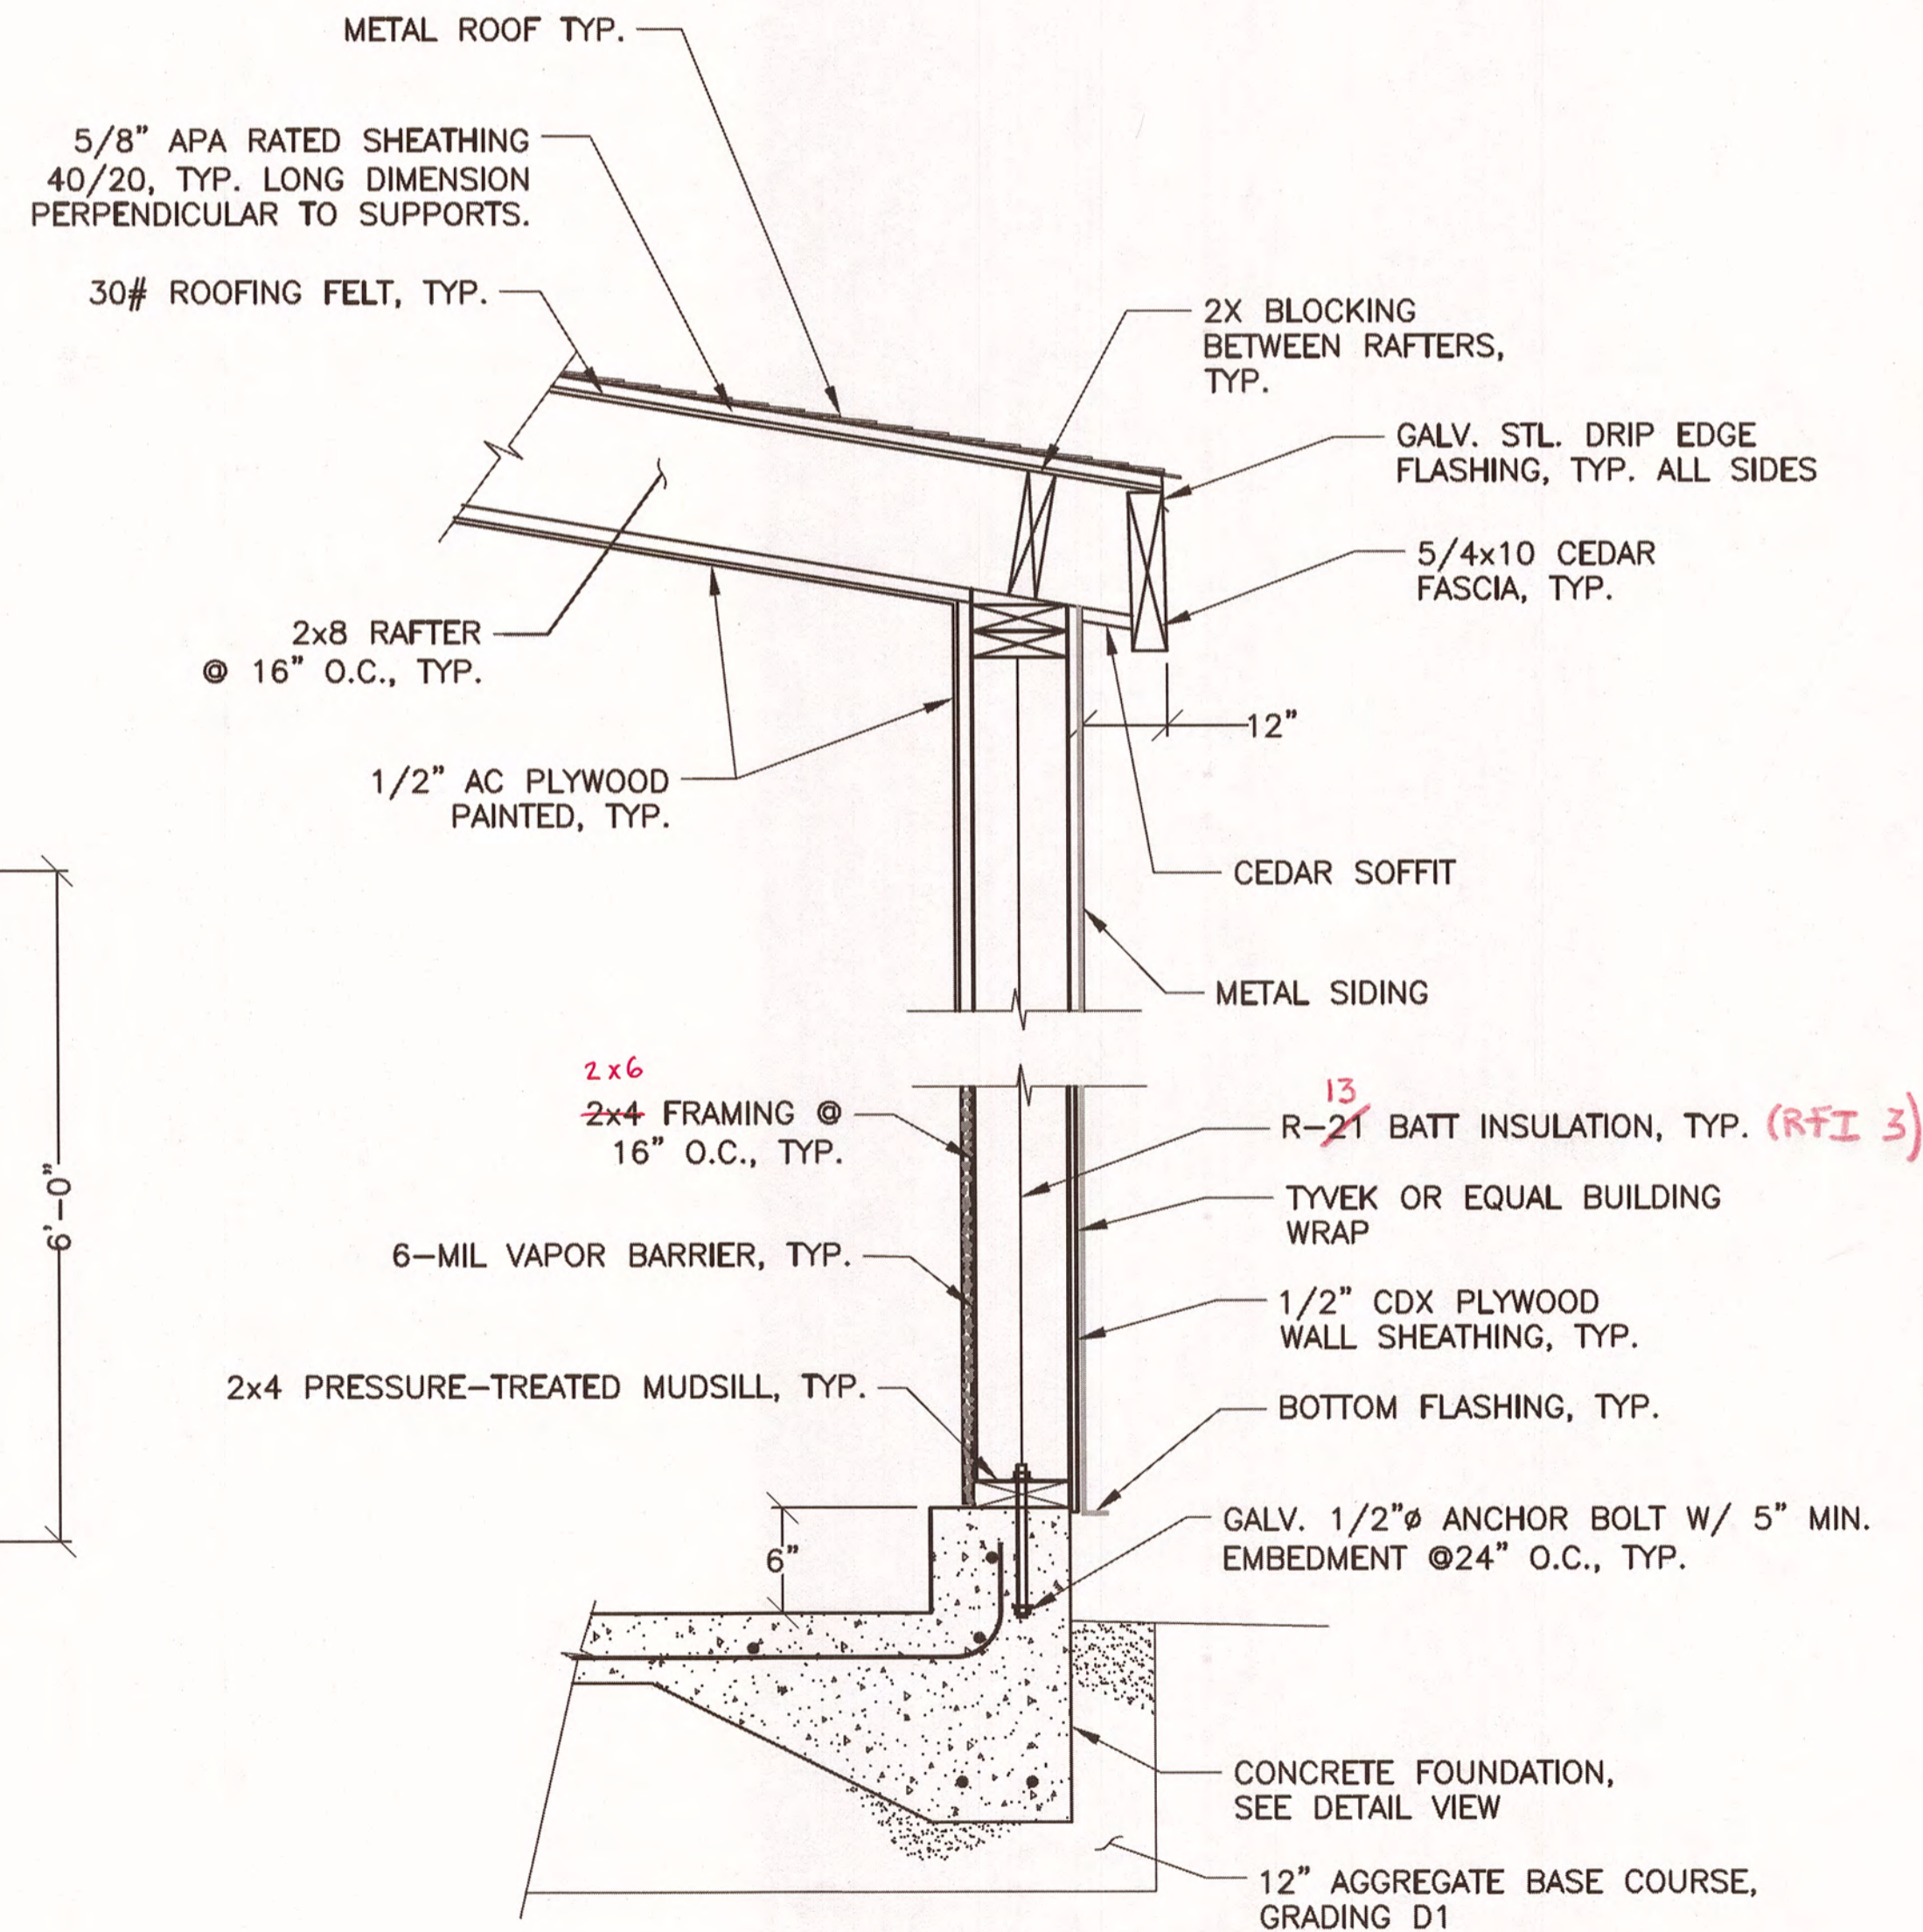

TYPICAL WALL SECTION

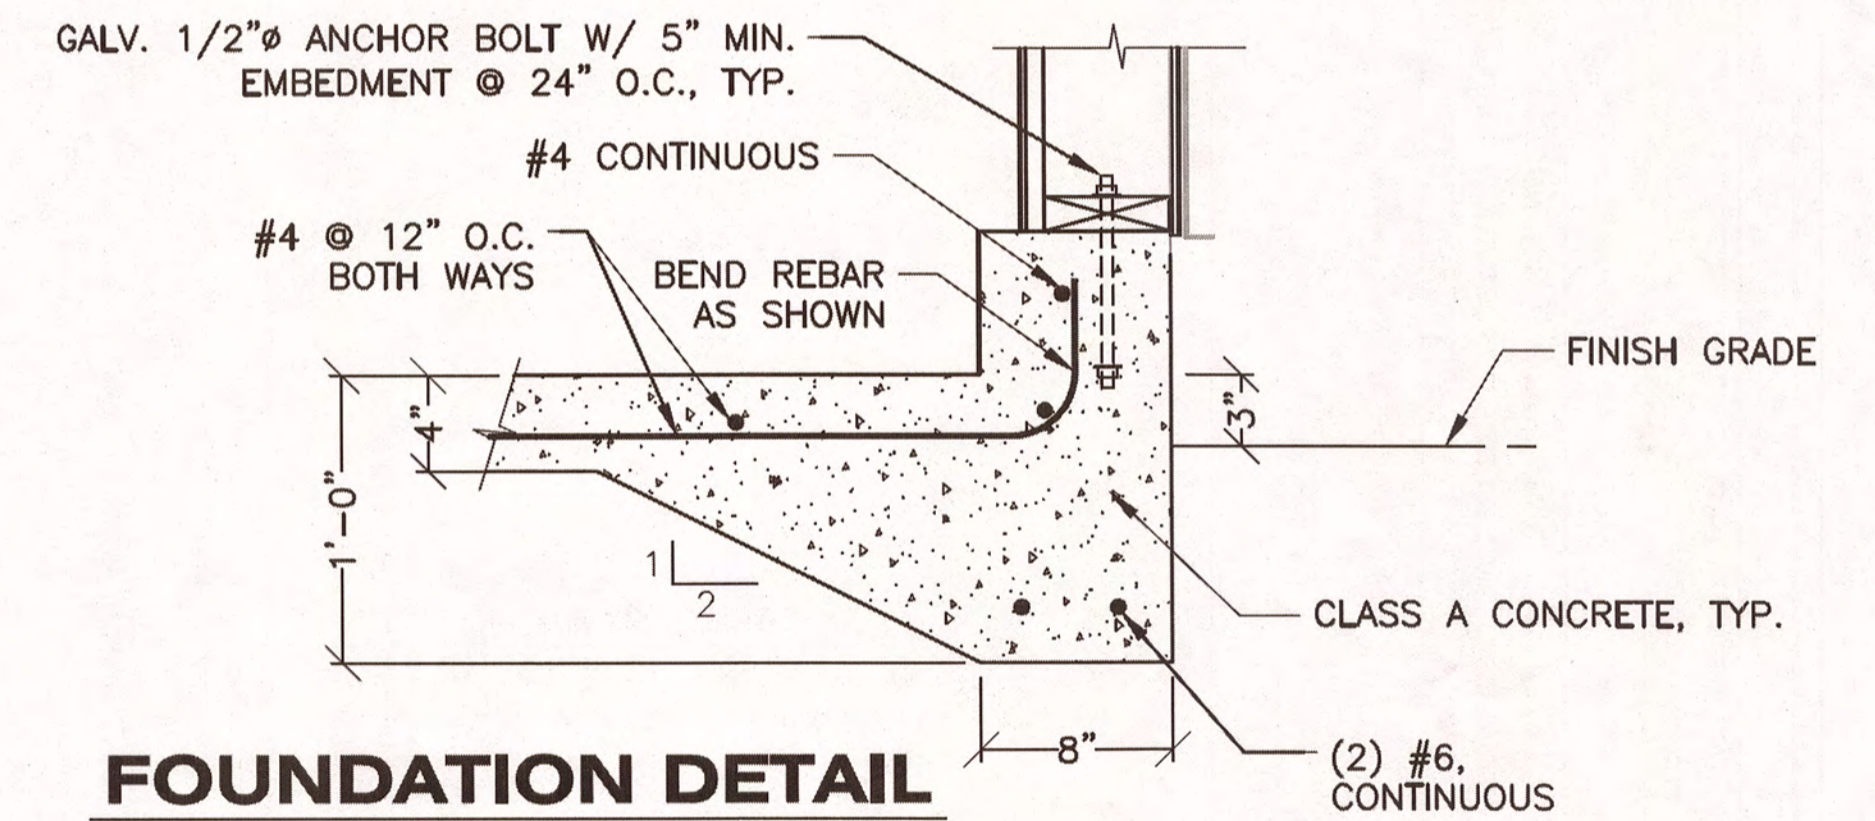

FOUNDATION DETAIL


Record Drawings have been reviewed by the Project Engineer, and represent to the best of my knowledge, the project as constructed.
 PE [Signature] Date 3/21/17

DO NOT SCALE FROM THESE DRAWINGS USE DIMENSIONS

CHECKED BY: J. OSBURN		STATE OF ALASKA DEPARTMENT OF TRANSPORTATION & PUBLIC FACILITIES SOUTHCOST REGION	
DESIGNED BY: STAFF		KAKE FERRY TERMINAL PASSENGER FACILITY PLANSET A PURSER'S SHELTER	
DRAWN BY: STAFF			
PATH: \\DOTSERFS02\PROJECTS\KAE\69446\PLANSET\MF\PLANSET A\11_PURSER'S SHELTER.DWG TAB: 11 Thursday, November 05, 2015 2:58:43 PM J. OSBURN, JOEL D (DOT)			
REVISIONS		PROJECT DESIGNATION	YEAR
NO.	DATE	DESCRIPTION	SHEET NO.
			11
		SAMHS00002	2015
			11

State of Alaska

Department of Transportation
and Public Facilities
Southcoast Region

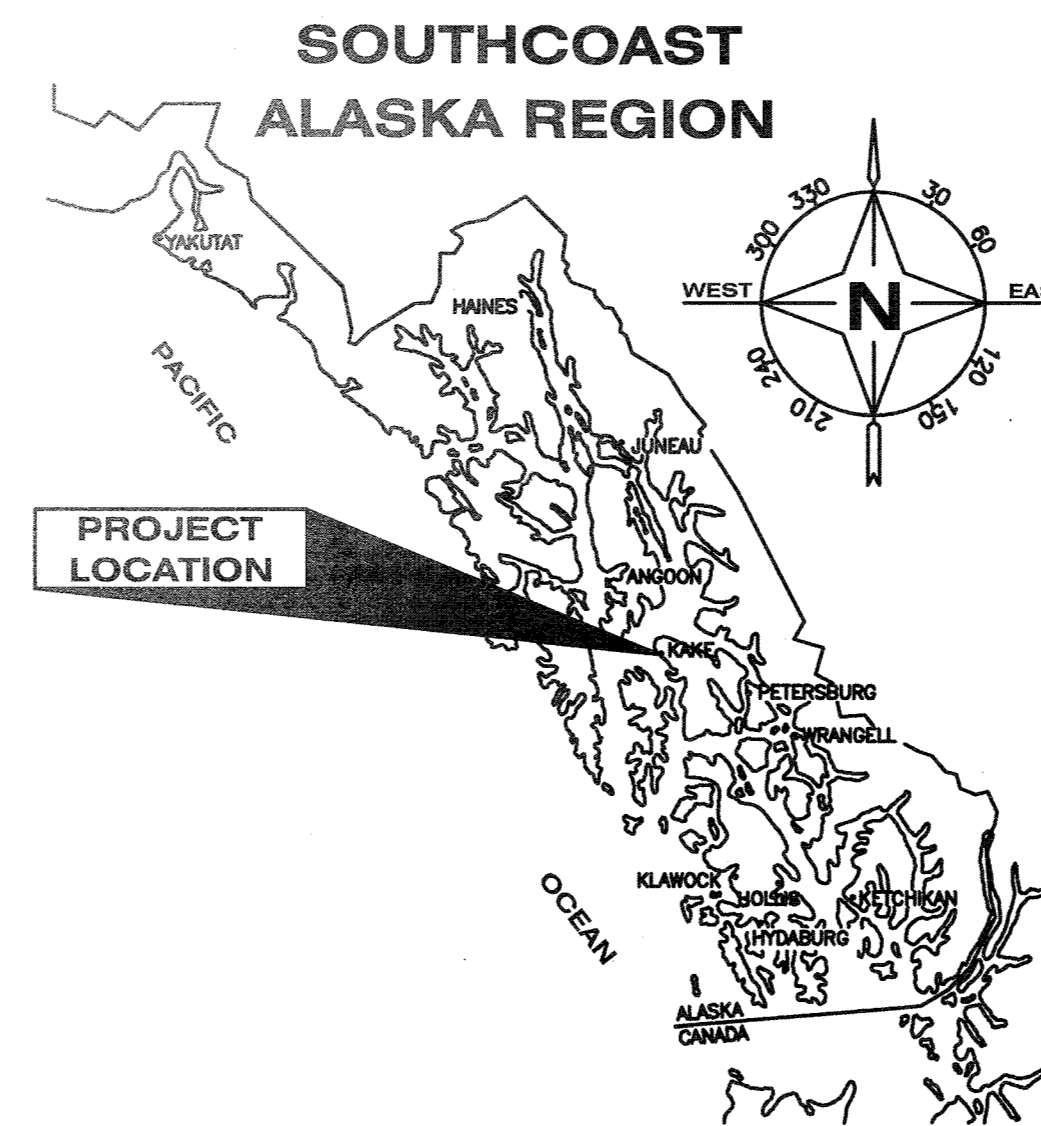

SHEET INDEX	
SHEET NO.	DESCRIPTION
1	TITLE SHEET
A0.1-A5.5	ARCHITECTURAL (13 SHEETS)
S0.1-S4.3	STRUCTURAL (11 SHEETS)
M1.0-M3.1	MECHANICAL (3 SHEET)
E1-E6.1	ELECTRICAL (10 SHEETS)

KAKE FERRY TERMINAL PASSENGER FACILITY KAKE, ALASKA

PROJECT No. SAMHS00002

PLANSET B: WAITING BUILDING & ELECTRICAL

RECORD DRAWINGS


THESE DRAWINGS HAVE BEEN PREPARED FROM INFORMATION PROVIDED BY THE CONTRACTOR. THERE IS NO GUARANTEE TO THE ACCURACY OF THE INFORMATION CONTAINED HEREIN, EITHER EXPRESSED OR IMPLIED.

October 27, 2017


WELSHWHITELEYARCHITECT, LLC

DO NOT SCALE FROM THESE DRAWINGS USE DIMENSIONS

Drawings Prepared By:

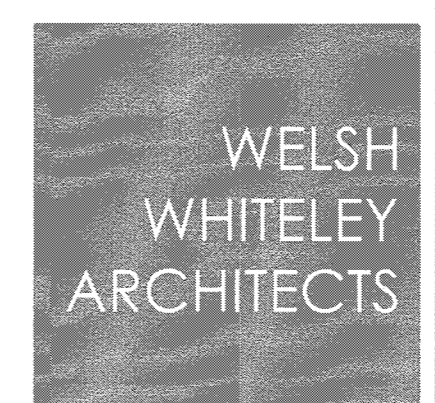

327 Bawden Street
Ketchikan, Alaska 99901
(907) 225-2412 Voice
(907) 225-2422 Fax

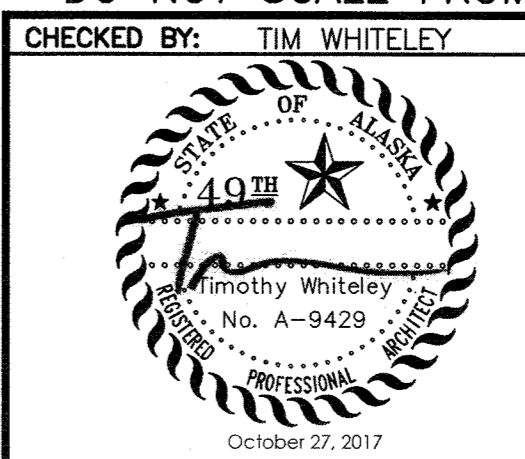

CHECKED BY: TIM WHITELEY
DESIGNED BY: TIM WHITELEY
DRAWN BY: AL, AR

STATE OF ALASKA
DEPARTMENT OF TRANSPORTATION
& PUBLIC FACILITIES
SOUTHCOAST REGION
**KAKE FERRY TERMINAL
PASSENGER FACILITY
PLANSET B
TITLE SHEET**

PATH: Y:\2011 PROJECTS\1121_ANGOON & KAKE FERRY TERMINALS\10 DRAWINGS\2-KAKE SHEETS\1121-KAK
TAB: 1 Friday, October 27, 2017 12:04:13 PM AMANDA ROBINSON

REVISIONS		PROJECT DESIGNATION SAMHS00002	YEAR 2015	SHEET NO. 1	TOTAL SHEETS 35
NO.	DATE				

DRAWING SYMBOLS

Grid Lines

Detail Bubble
Drawing Number
Sheet Number

Building Section
Direction of View
Drawing Number
Sheet Number

Partial Building Section
Direction of View
Drawing Number
Sheet Number

Wall Type

Window Type

Door Type

Datum Point, Elevation

Match Line

Equipment Symbol

Revision Number & Cloud

Centerline

Property Line

Room Number

Wall Construction

New Wall Construction (1-Hr. Fire Resistive)

Electric Wall Heater

Electrical Panel

Illuminated Exit Sign Surface Mounted - Ceiling.

Illuminated Exit Sign Surface Mounted - Wall

Illuminated Exit Sign W/ Emergency Light

Point of Vertical Dimension

Wall Mounted Dry-Chem. Fire Extinguisher Cabinet

Wall Mounted Dry-Chem. Fire Extinguisher

Thermostat

ARCHITECTURAL NOTES

- All work shall be done in accordance with the International Building Code - 2009 (IBC), International Fire Code - 2009 (IFC), International Mechanical Code - 2009 (IMC), 2009 Uniform Plumbing Code (UPC), and National Electrical Code - 2011 (NEC), as amended by the State of Alaska; and the Americans with Disabilities Act (ADA). See Project Code Analysis for more information.
- Contractor shall verify all site conditions and dimensions prior to proceeding with the Work. Any variation from the Conditions and Dimensions shown on the drawings shall be reported to the Architect for resolution prior to construction. This shall include any conflict between lighting, ventilation fixtures and grills located in the suspended acoustic ceiling tile grid and in conflict with new walls or in a space formed by a new wall where ventilation or lighting may need to be added.
- Written dimensions shall take precedence over scaled dimensions. Dimensions are to the centerline of columns, and to the face of framing on new wall construction, unless otherwise noted.
- Provide safety glazing in locations specified in Section 2403. Glazing in doors and any glazing located within 2 feet of door jambs to be safety glass.

ABBREVIATIONS

AB	ANCHOR BOLT	FOC	FACE OF COLUMN OR CONCRETE	R	RISER
ACOUS	ACOUSTICAL	FOF	FACE OF FINISH	RAD	RADIUS
ACT	ACOUSTICAL TILE	FOS	FACE OF STUDS	RD	ROOF DRAIN
ADA	AMERICANS WITH DISABILITIES ACT	FRP	FIBERGLASS REINFORCED PANEL	RBR	RUBBER
ADJ	ADJUSTABLE	FT	FOOT OR FEET	REF	REFERENCE, REFRIGERATOR
AFF	ABOVE FINISHED FLOOR	FTG	FOOTING	REFL	REFLECTED
AGGR	AGGREGATE			RGRTR	REGISTER
AL, ALUM	ALUMINUM	GA	GAUGE	REINF	REINFORCED
ANOD	ANODIZED	GALV	GALVANIZED	REQ	REQUIRED
APPROX	APPROXIMATE	GLU-LAM	GLUE-LAMINATED	RESIL	RESILIENT
ARCH	ARCHITECTURAL	GL	GLASS, GLAZING	RH	RIGHT HAND
		GWB	GYP-SUM WALL BOARD	RM	ROOM
		GYP	GYP-SUM	RO	ROUGH OPENING
				ROW	RIGHT OF WAY
BD	BOARD			RT	RESILIENT TILE
BTWN	BETWEEN	HB	HOSE BIB	S	SOUTH
BITUM	BITUMINOUS	HC	HOLLOW CORE	SC	SOLID CORE
BLDG	BUILDING	HD	HEAD	SCHED	SCHEDULE
BLK	BLOCK	HDR	HEADER	SEAL	SEALANT
BLKG	BLOCKING	HM	HOLLOW METAL	SECT	SECTION
BM	BEAM	HORIZ	HORIZONTAL	SHR	SHOWER
BOT	BOTTOM	HR	HOUR	SHT	SHEET
BUR	BUILT-UP ROOFING	HT	HEIGHT	SIM	SIMILAR
		HTG	HEATING	SPEC	SPECIFICATION
CAB	CABINET	HVAC	HEAT/VENTILATION/AIR	SQ	SQUARE
CHAMF	CHAMFER	COND	CONDITIONING	SQ FT	SQUARE FOOT (FEET)
CIP	CAST IN PLACE	HW	HOT WATER	SQ IN	SQUARE INCH (ES)
CLG	CEILING	HWT	HOT WATER TANK	SST	STAINLESS STEEL
CLO	CLOSET	ID	INSIDE DIAMETER	STA	STATION
CLR	CLEAR	IHM	INSULATED HOLLOW METAL	STD	STANDARD
COL	COLUMN	IN	INCH	STL	STEEL
CONC	CONCRETE	INC	INCLUDING	STOR	STORAGE
CONN	CONNECTION	INCL	INCLUDING	STRUCT	STRUCTURAL, STRUCTURE
CONSTR	CONSTRUCTION	INSUL	INSULATION	SUSP	SUSPENDED
CONT	CONTINUOUS	INT	INTERIOR	SYM	SYMMETRICAL
CORR	CORRIDOR			SV	SHEET VINYL
CPT	CARPET	JB	JUNCTION BOX	T, TRD	TREAD
CTSK	COUNTERSINK	JC	JANITORS CLOSET	T&G	TONGUE AND GROOVE
CT	CERAMIC TILE	KIT	KITCHEN	TEL	TELEPHONE
CTR	CENTER	L	LENGTH, LONG	TEMP	TEMPERED
		LAM	LAMINATE, LAMINATED	TER	TERRAZZO
DTL	DETAIL	LAV	LAVATORY	THRESH	THRESHOLD
DEMO	DEMOLITION	LF	LINEAL FEET	T JT	TOOLED JOINT
DF	DRINKING FOUNTAIN	LH	LEFT HAND	TOS	TOP OF SLAB
DIA	DIAMETER	LT	LIGHT	TYP	TYPICAL
DIAG	DIAGONAL	MATL	MATERIAL	UL	UNDERWRITERS' LABORATORIES UNFINISHED UNLESS OTHERWISE NOTED
DIM	DIMENSION	MAX	MAXIMUM	UNFIN	UNFINISHED
DISP	DISPENSER	MB	MACHINE BOLT	UON	UNLESS OTHERWISE NOTED
DN	DOWN	MECH	MECHANICAL	VT	VINYL TILE
DR	DOOR	MEMB	MEMBRANE	VERT	VERTICAL
DS	DOWN SPOUT	MEZZ	MEZZANINE	VTR	VENT THROUGH ROOF
DW	DISH WASHER	MTL	METAL	W	WEST
DWG	DRAWING	MFR	MANUFACTURER	W/	WITH
		MIN	MINIMUM	WC	WATER CLOSET
E	EAST	MIR	MIRROR	WD	WOOD
EA	EACH	MISC	MISCELLANEOUS	WDO	WINDOW
EXP JT	EXPANSION JOINT	MTD	MOUNTED	W/O	WITHOUT
ELEC	ELECTRICAL	N	NORTH	WL	WATER LINE
ELEV	ELEVATOR, ELEVATION	NIC	NOT IN CONTRACT	WRB	WATER-RESISTANT BARRIER
EMER	EMERGENCY	NO, (H)	NUMBER	WT	WEIGHT
ENCL	ENCLOSURE	NTS	NOT TO SCALE	WWW	WELDED WIRE FABRIC
EQ	EQUAL	OC	ON CENTER	WWW	WELDING WIRE MESH
EQUIP	EQUIPMENT	OD	OUTSIDE DIAMETER		
EXIST	EXISTING	OFF	OFFICE		
EXP	EXPANDED, EXPANSION	OH	OVERHANG		
EXT	EXTERIOR	OPNG	OPENING		
		OPP	OPPOSITE		
FA	FIRE ALARM	OTS	OPEN TO STRUCTURE		
FD	FLOOR DRAIN	PBD	PARTICLE BOARD		
FDN	FOUNDATION	PERF	PERFORATED		
FE	FIRE EXTINGUISHER	PL	PROPERTY LINE/PLATE		
FEC	FIRE EXTINGUISHER CABINET	P-LAM	PLASTIC LAMINATE		
		PLYWD	PLYWOOD		
FF	FACTORY FINISH	PNL	PANEL		
FIN	FINISH	PR	PAIR		
FLR	FLOOR	PSF	POUNDS PER SQUARE FOOT		
FLASH	FLASHING	PSI	POUNDS PER SQUARE INCH		
FLUOR	FLUORESCENT	PT	PRESSURE TREATED		

CODE ANALYSIS

CODE: International Building Code - 2009, 2009 Uniform Plumbing Code, State of Alaska Amendments

PROJECT DESCRIPTION: Construction of a New 810 Gross Square Foot Ferry Passenger Waiting Terminal.

A. USE AND OCCUPANCY CLASSIFICATION (Chapter 3):

Proposed: A-3 Area = 400 GSF
400 GSF / 7 Occupants Per GSF = 57 Occupants

B. TYPE OF CONSTRUCTION (Chapter 6):

Proposed: VB

Type V-B Description: Structural Elements, Exterior Walls and Interior Walls may be of Any Material Permitted by Code. (Section 602.5 & Table 601).

Fire Resistive Rating for Building Elements (Table 601):

Structural Frame: 0
Bearing Walls: 0
Exterior: 0
Interior: 0
Floor Construction: 0
Roof Construction: 0

C. HEIGHT (Table 503):

Allowable: 1 Story / 40 feet
Proposed: 1 Story / 18'-11"

D. FLOOR AREA (Table 503):

Allowable: 6,000 Square Feet
Proposed: 2,346 Gross Square Feet Beneath Roof
810 Building Square Feet per 502 "Area . . ."

E. OTHER:

CODE NOTES:

303.1 Occupancy Type: A-3 (Passenger Ferry Terminal)

Table 1004.1.1 - A3: 7 net SF. per occupant / max. with no fixed chairs
Approximately 400 SF / 7 SF = 57 occupants

1008.1.2 Doors must swing in the direction of egress travel with an occupant load of 50 or more persons

1997 Uniform Plumbing Code Chapter 29

Plumbing Fixture Count:

Table A29 - Group A (conference rooms, exhibit spaces, lounges): 30 net SF. per occupant / max. with no fixed chairs
Approximately 400 SF / 30 SF = 13 occupants

2011 NEC / NFPA 70: National Electrical Code / International Electrical Code Series

110.26 Spaces About Electrical Equipment. Space requirements for equipment operating at equal to or less than 150 volts shall have 36" deep by a minimum of 30" wide or the width of the equipment whichever is wider by 78" high. Storage of materials is not allowed in this space.

2010 ADA Standards for Accessible Design

203.5 Machinery Spaces. Machinery Spaces are exempt from the scoping requirements of the 2010 ADAAG, including the requirements to be on an accessible route. These requirements include mechanical and electrical rooms.

203.9 Employee Work Areas. Employee Work Areas shall be designed so that individuals can approach, enter and exit the employee work area. No turning space required in a Janitorial Closet. No turning radius required if a wheelchair clear space cannot move 48" beyond the swing of the door.

213.3.1 Toilet compartments. Where toilet compartments are provided, at least one shall comply with 604.8.1. At least one compartment shall comply with 604.8.2 where six or more compartments are provided.

213.3.2 Water Closets. Where water closets are provided at least one shall meet the requirements of 604.

213.3.3 Urinals. Where more than one urinal is provided, at least one shall comply with 605.

213.3.4 Lavatories. Where lavatories are provided, at least one shall comply with 606 and not be located within the toilet compartment.

404.2.4.3 Recessed Doors and Gates. Maneuvering clearances for forward approach shall be provided when any obstruction is more than 8" deep measured perpendicular to the face of the door and within 18 inches of the latch side of the door. This requires 18" clear of the latch on the pull side and 12" on the push side when provided with closer and latch when provided with both closer and latch.

602 Drinking Fountains

602.1 General. Drinking fountains shall comply with 307 and 602.

602.2 Clear Floor Space. Units shall have a clear floor or ground space complying with 305 positioned for a forward approach and centered on the unit. Knee and toe clearance complying with 306 shall be provided.

602.3 Operable Parts. Operable parts shall comply with 309.

602.4 Spout Height. Spout outlets shall be 36 inches (915 mm) maximum above the finish floor or ground.

602.5 Spout Location. The spout shall be located 15 inches (380 mm) minimum from the vertical support and 5 inches (125 mm) maximum from the front edge of the unit, including bumpers.

604.3.1 Clearance - Size: Clearance around a water closet shall be 60 inches minimum measured perpendicular from the side wall and 56 inches minimum measured perpendicular from the rear wall.

RECORD DRAWINGS

THESE DRAWINGS HAVE BEEN PREPARED FROM INFORMATION PROVIDED BY THE CONTRACTOR. THERE IS NO GUARANTEE TO THE ACCURACY OF THE INFORMATION CONTAINED HEREIN, EITHER EXPRESSED OR IMPLIED.

October 27, 2017

WELSHWHITELEYARCHITECT, LLC

DO NOT SCALE FROM THESE DRAWINGS USE DIMENSIONS

Drawings Prepared By:

WELSH WHITELEY ARCHITECTS

327 Bawden Street
Ketchikan, Alaska 99901
(907) 225-2412 Voice
(907) 225-2422 Fax

CHECKED BY: TIM WHITELEY

DESIGNED BY: TIM WHITELEY

DRAWN BY: AL, AR


October 27, 2017

STATE OF ALASKA
DEPARTMENT OF TRANSPORTATION & PUBLIC FACILITIES
SOUTHCOST REGION

KAKE FERRY TERMINAL PASSENGER FACILITY PLANSET B

General Notes


PATH: Y:\2011 PROJECTS\1121_ANGOOON & KAKE FERRY TERMINALS\10 DRAWINGS\2-KAKE SHEETS	PROJECT DESIGNATION	YEAR	SHEET NO.	TOTAL SHEETS
TAB: A0.1 Friday, October 27, 2017 12:03:45 PM AMANDA ROBINSON	SAMHS00002	2015	A0.1	35

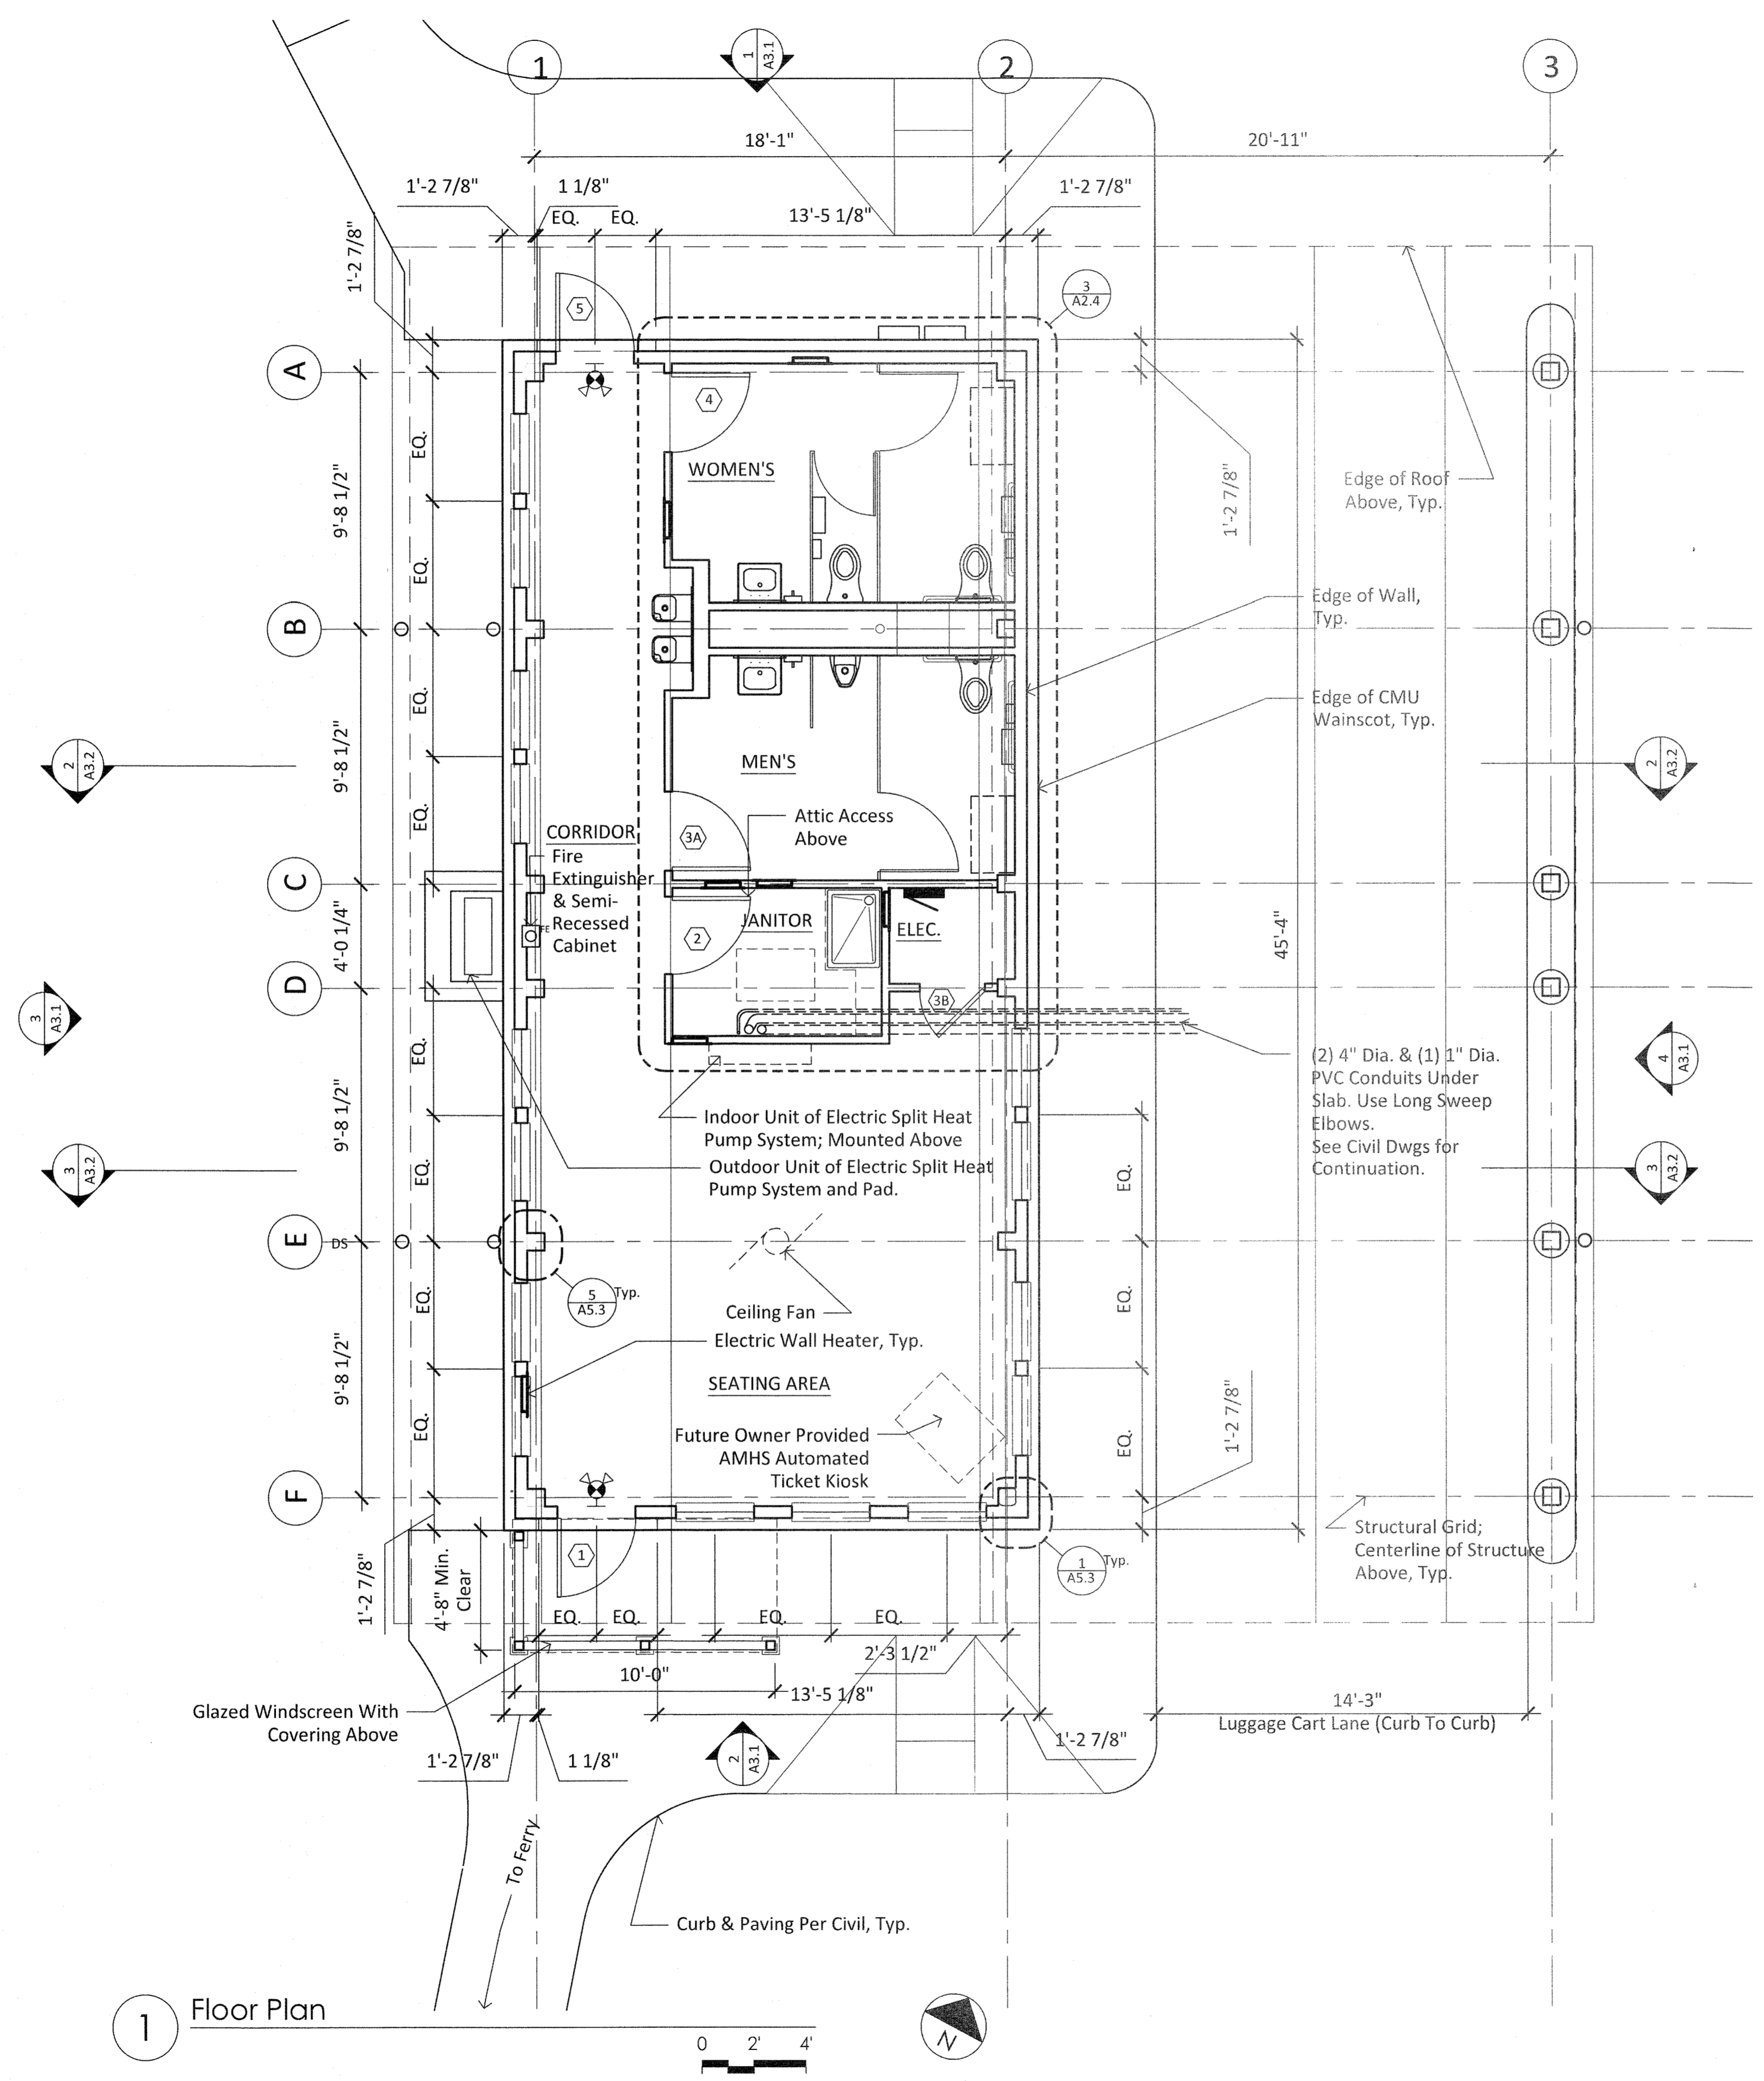

DOOR SCHEDULE (See A2.1 For Locations)

Symbol	Size (W x H)	Type	Construction					Remarks
			Thick	Door	Frame	Fire Rating	Hardware Group	
①	3'-0" X 7'-0"	A	1-3/4"	Alum.	Alum.	0	1	Storefront Entry
②	3'-0" X 7'-0"	B	1-3/4"	WD	HM	0	3	Janitor
③A	3'-0" X 7'-0"	B	1-3/4"	WD	HM	0	2	Men's Room
③B	3'-0" X 7'-0"	B	1-3/4"	WD	HM	0	4	Elec. Closet
④	3'-0" X 7'-0"	B	1-3/4"	WD	HM	0	2	Women's Room
⑤	3'-0" X 7'-0"	A	1-3/4"	Alum.	Alum.	0	1	Storefront Entry

DOOR TYPES

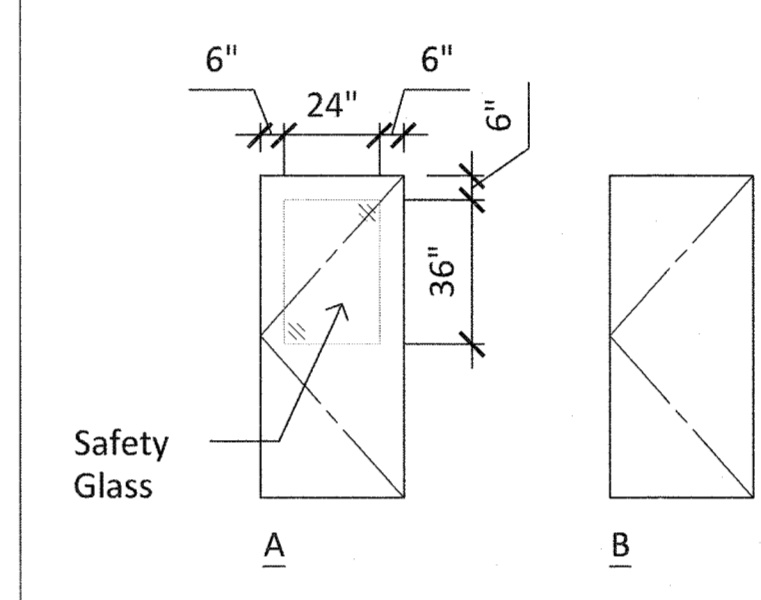

NOTES:

- 1. Clear Finish Wood Doors.

WINDOW SCHEDULE (See A3.1 For Locations)

Symbol	Size (W x H)	Construction				Details			Remarks
		Frame	Safety Glass	Operation	Fire Rating	Head	Sill		
A	7'-0" x 5'-6"	Vinyl	No	Fixed/ Awning	0	4/A5.3	3/A5.3		
B	3'-4" x 5'-6"	Vinyl	Yes	Fixed	0	4/A5.3	3/A5.3		
C	3'-4" x 1'-10"	Vinyl	Yes	Fixed	0	4/A5.3			

NOTES:

- 1. See Drawing 6/A5.3 For Interior Window Trim

RECORD DRAWINGS

THESE DRAWINGS HAVE BEEN PREPARED FROM INFORMATION PROVIDED BY THE CONTRACTOR. THERE IS NO GUARANTEE TO THE ACCURACY OF THE INFORMATION CONTAINED HEREIN, EITHER EXPRESSED OR IMPLIED.

October 27, 2017


WELSHWHITELEYARCHITECT, LLC

DO NOT SCALE FROM THESE DRAWINGS USE DIMENSIONS

Drawings Prepared By:



CHECKED BY: TIM WHITELEY

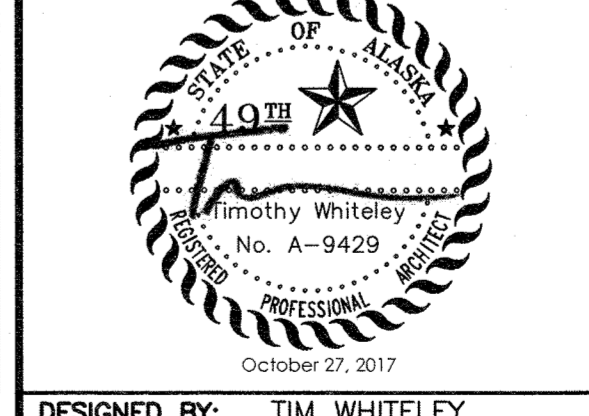

STATE OF ALASKA
DEPARTMENT OF TRANSPORTATION
& PUBLIC FACILITIES
SOUTHCOST REGION
**KAKE FERRY TERMINAL
PASSENGER FACILITY
PLANSET B**

Plan

DESIGNED BY: TIM WHITELEY


DRAWN BY: AL, AR

PATH: Y:\2011 PROJECTS\1121_ANGOOK & KAKE FERRY TERMINALS\10 DRAWINGS\2-KAKE SHEETS\1121-K

TAB: A2.1 Friday, October 27, 2017 12:03:10 PM AMANDA ROBINSON

REVISIONS		PROJECT DESIGNATION	YEAR	SHEET NO.	TOTAL SHEETS
NO.	DATE	DESCRIPTION			

SAMHS0002 2015 **A2.1** **35**

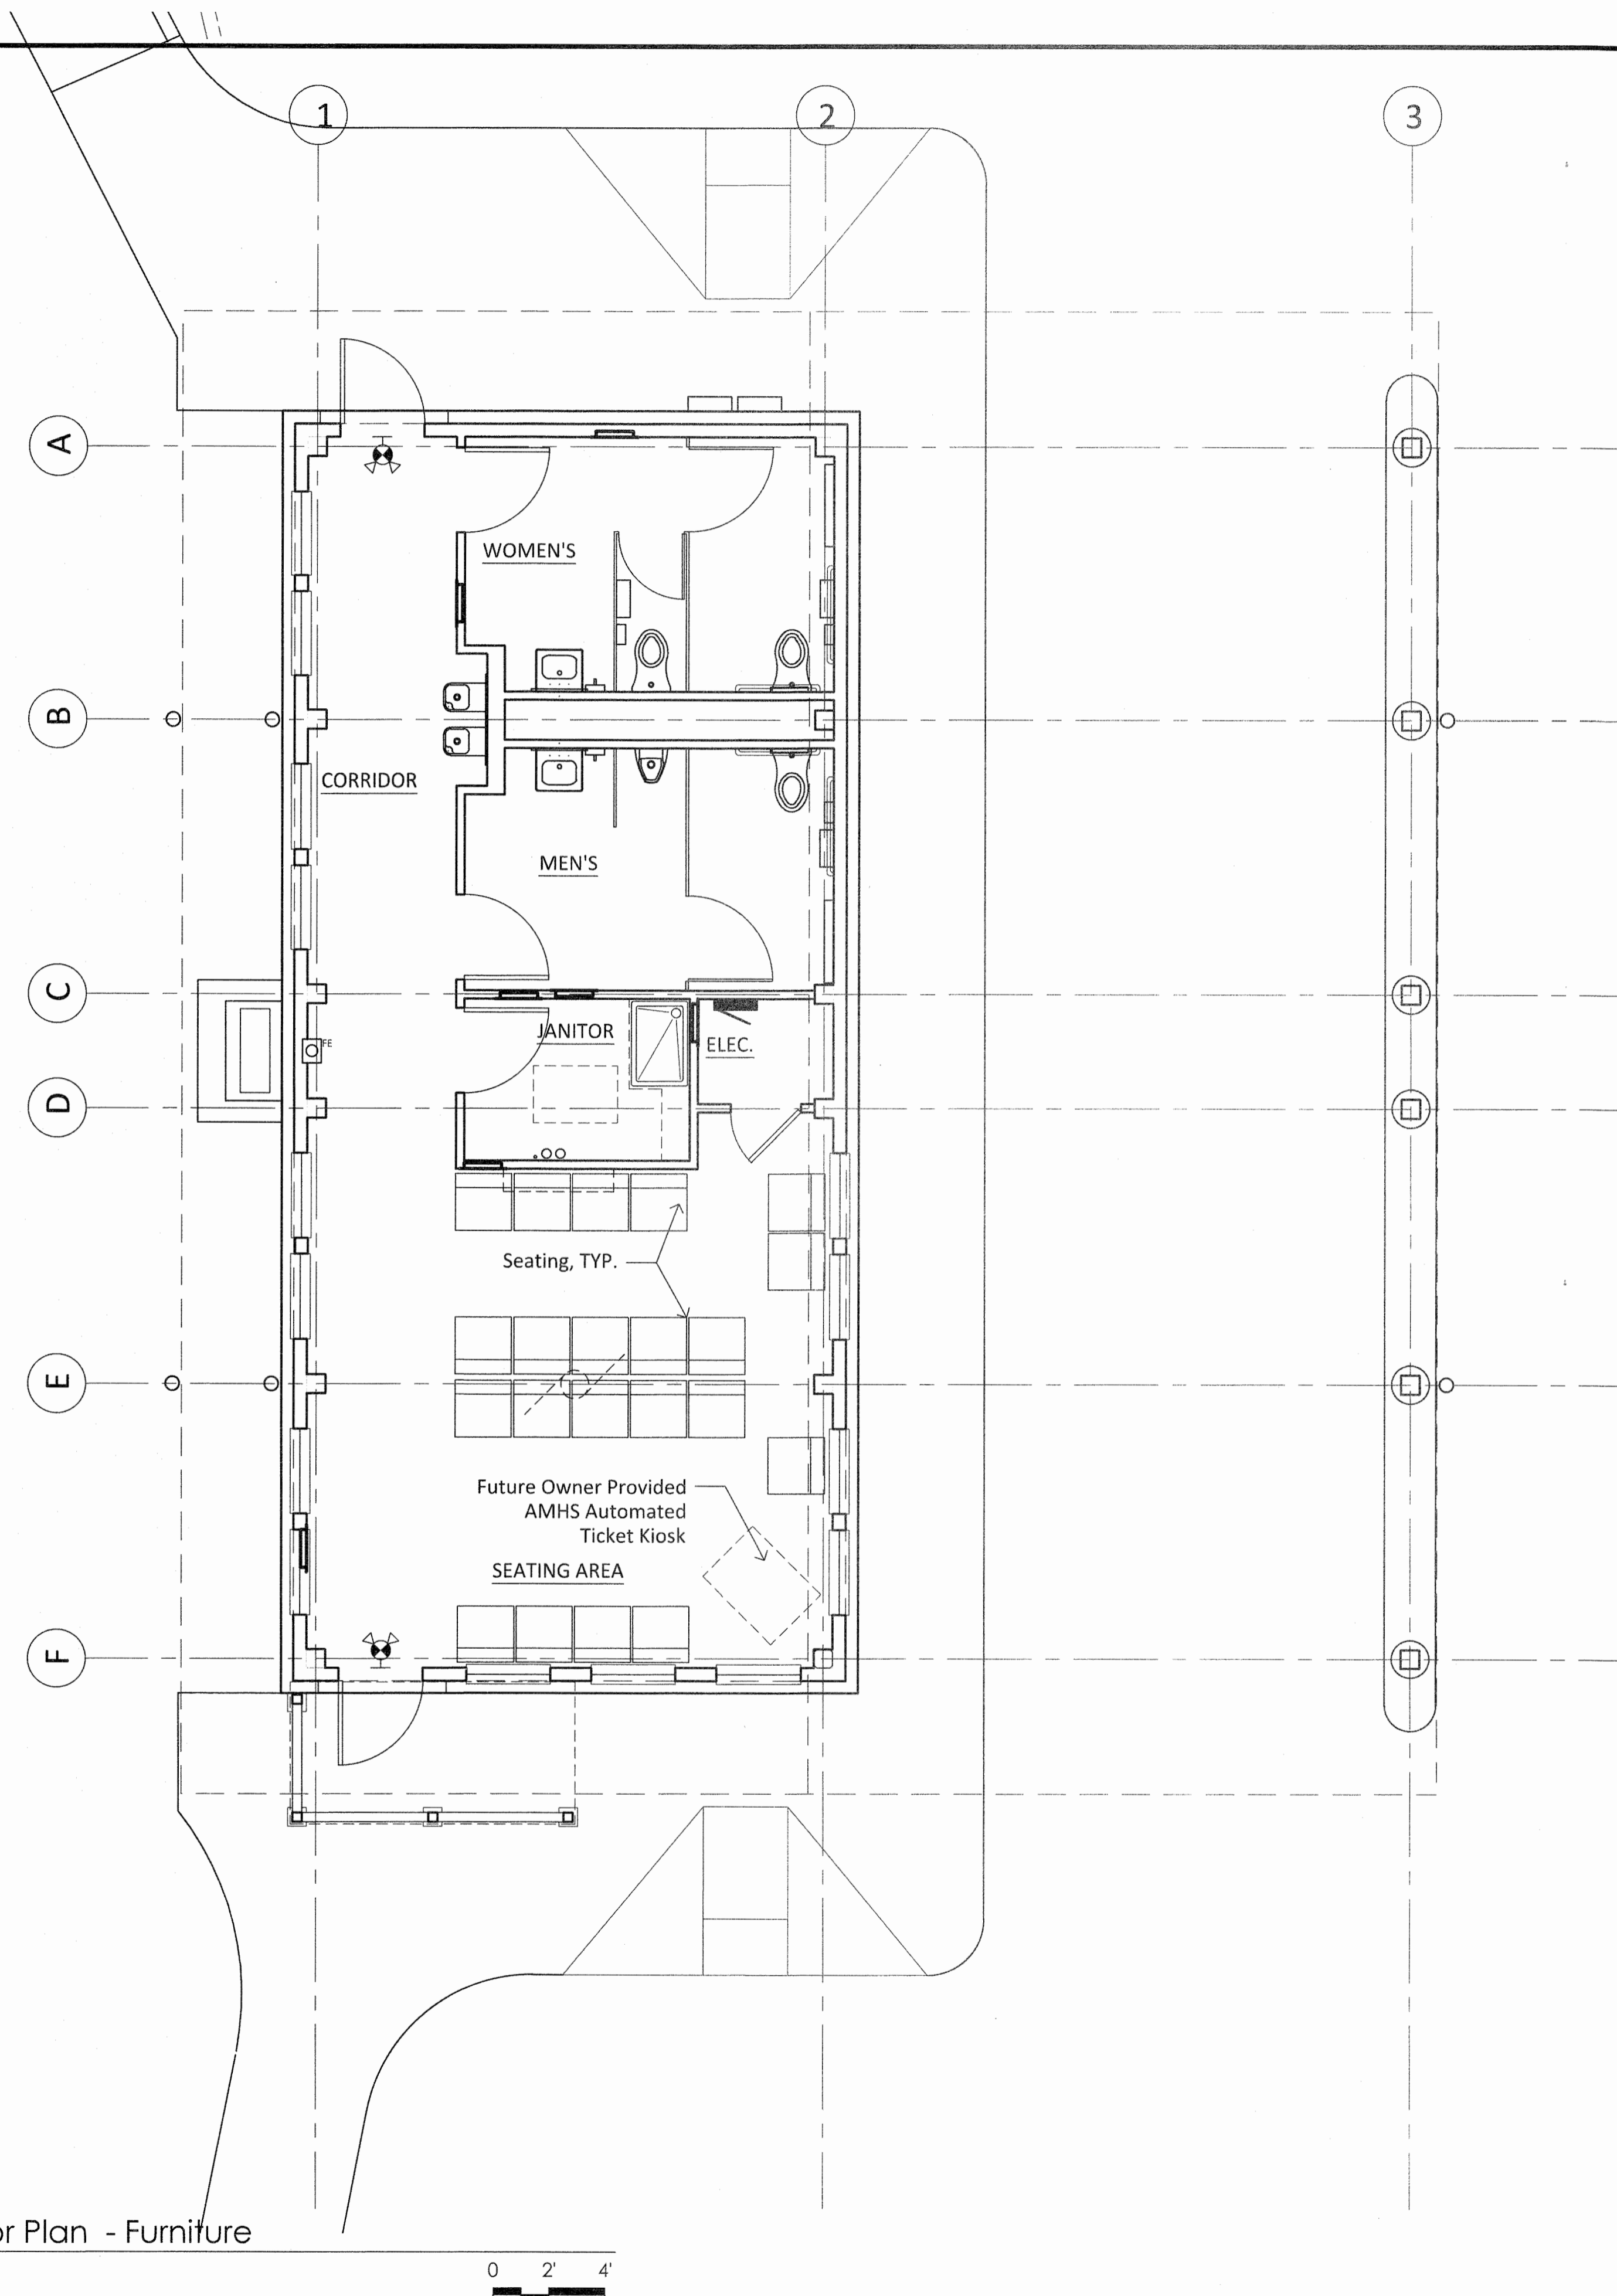

1 Floor Plan - Furniture

ROOM FINISH SCHEDULE

Room Name	Floor	Finish	Base	Finish	Walls	Finish	Ceiling	Finish	Remarks
Waiting	Concrete	Seal	Rub.	FF	5/8" Gyp. Wall Board W/ Vapor Barrier Primer	Paint	1x6 T&G Over 5/8" Gyp. Wall Board W/ Vapor Barrier Primer	Clear Finish	
Corridor	Concrete	Seal	Rub.	FF	5/8" Gyp. Wall Board W/ Vapor Barrier Primer	Paint	1x6 T&G Over 5/8" Gyp. Wall Board W/ Vapor Barrier Primer	Clear Finish	
Janitor	Concrete	Seal	Rub.	FF	5/8" Gyp. Wall Board W/ Vapor Barrier Primer	Paint	5/8" Gyp. Wall Board W/ Vapor Barrier Primer	Paint	
Electrical	Concrete	Seal	Rub.	FF	5/8" Gyp. Wall Board W/ Vapor Barrier Primer	Paint	5/8" Gyp. Wall Board W/ Vapor Barrier Primer	Paint	
Men's	Sheet Vinyl	FF	Rub.	FF	FRP W/ Vapor Barrier Primer	FF	5/8" Gyp. Wall Board W/ Vapor Barrier Primer	Paint	
Women's	Sheet Vinyl	FF	Rub.	FF	FRP W/ Vapor Barrier Primer	FF	5/8" Gyp. Wall Board W/ Vapor Barrier Primer	Paint	

RECORD DRAWINGS

THESE DRAWINGS HAVE BEEN PREPARED FROM INFORMATION PROVIDED BY THE CONTRACTOR. THERE IS NO GUARANTEE TO THE ACCURACY OF THE INFORMATION CONTAINED HEREIN, EITHER EXPRESSED OR IMPLIED.

October 27, 2017

WELSHWHITELEYARCHITECT, LLC

Drawings Prepared By:

WELSH WHITELEY ARCHITECTS

327 Bawden Street
Ketchikan, Alaska 99901
(907) 225-2412 Voice
(907) 225-2422 Fax

DO NOT SCALE FROM THESE DRAWINGS USE DIMENSIONS

CHECKED BY: TIM WHITELEY

DESIGNED BY: TIM WHITELEY
DRAWN BY: AL, AR


PATH: Y:\2011 PROJECTS\1121_ANGOOK & KAKE FERRY TERMINALS\10 DRAWINGS\2-KAKE SHEETS\1121-K
TAB: A2.2 Friday, October 27, 2017 12:02:51 PM AMANDA ROBINSON

STATE OF ALASKA
DEPARTMENT OF TRANSPORTATION
& PUBLIC FACILITIES
SOUTHCOST REGION

**KAKE FERRY TERMINAL
PASSENGER FACILITY
PLANSET B**


Furniture Plan

REVISIONS			PROJECT DESIGNATION	YEAR	SHEET NO.	TOTAL SHEETS
NO.	DATE	DESCRIPTION	SAMHS0002	2015	A2.2	35

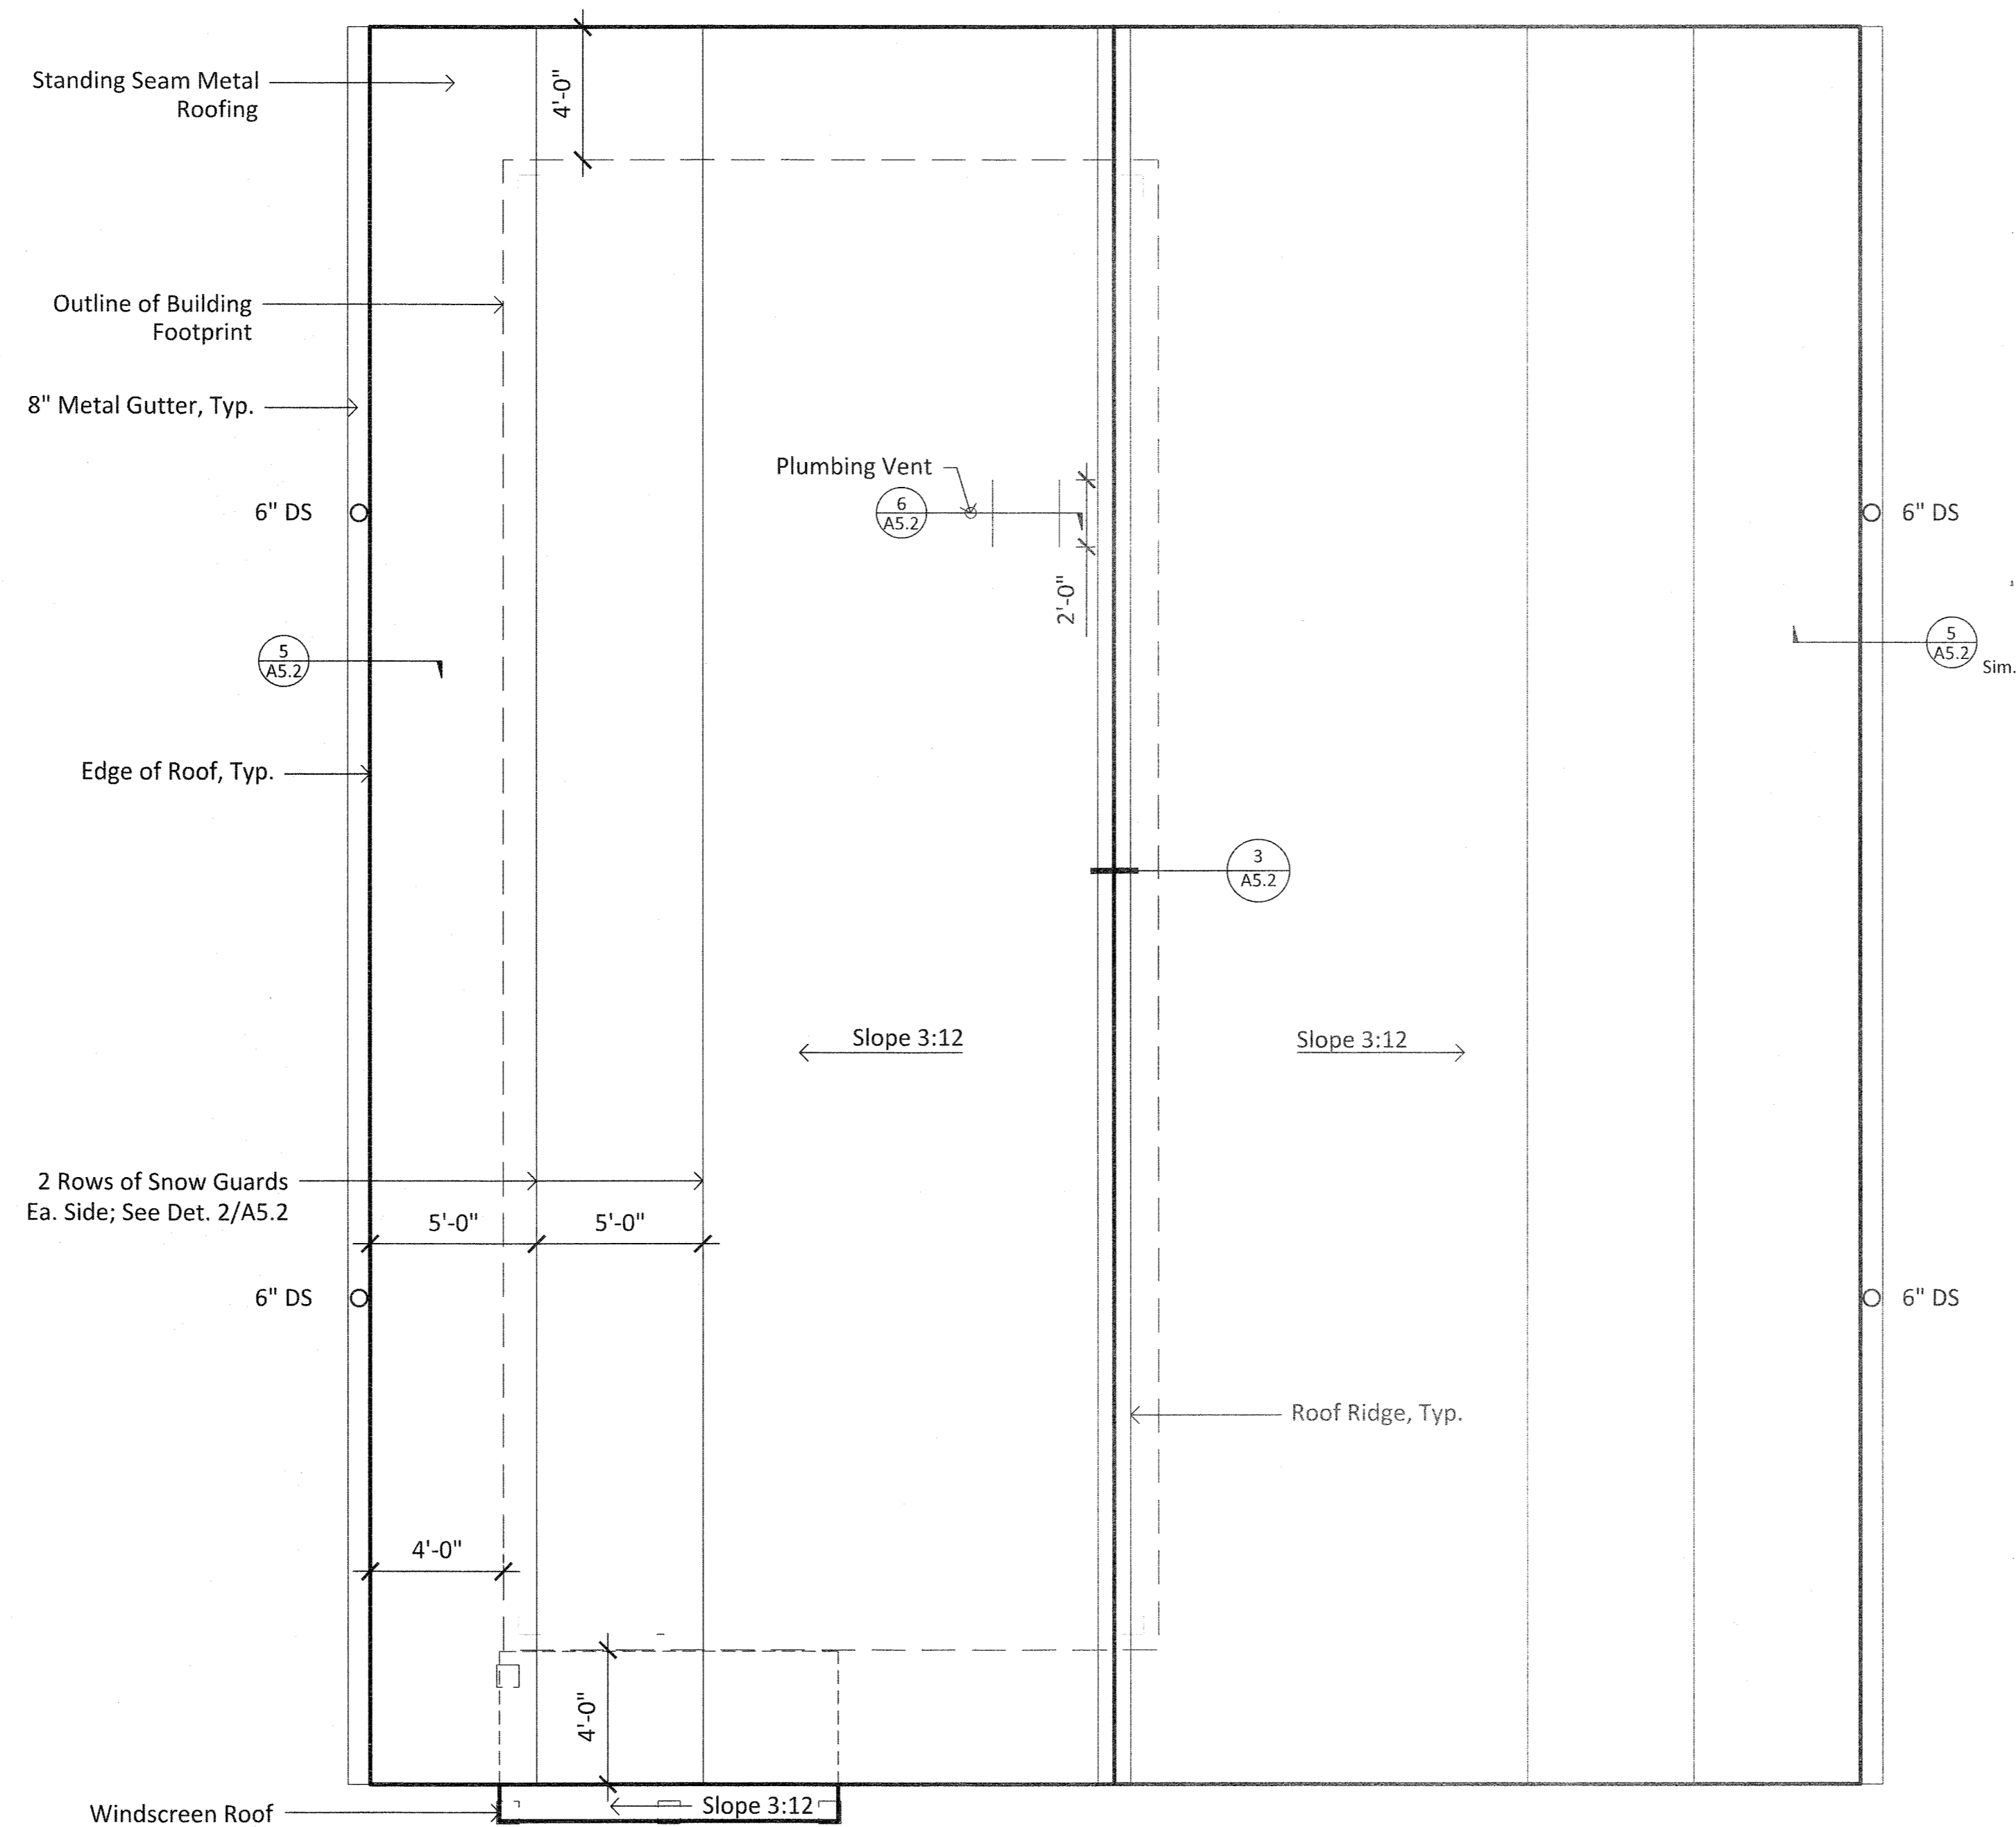

1 Roof Plan

0 2' 4'

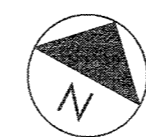

RECORD DRAWINGS

THESE DRAWINGS HAVE BEEN PREPARED FROM INFORMATION PROVIDED BY THE CONTRACTOR. THERE IS NO GUARANTEE TO THE ACCURACY OF THE INFORMATION CONTAINED HEREIN, EITHER EXPRESSED OR IMPLIED.

October 27, 2017

WELSHWHITELEYARCHITECT, LLC

Drawings Prepared By: **WELSH WHITELEY ARCHITECTS**

327 Bowden Street
Ketchikan, Alaska 99901
(907) 225-2412 Voice
(907) 225-2422 Fax

DO NOT SCALE FROM THESE DRAWINGS USE DIMENSIONS

CHECKED BY: **TIM WHITELEY**

STATE OF ALASKA
DEPARTMENT OF TRANSPORTATION & PUBLIC FACILITIES
SOUTHCOST REGION

KAKE FERRY TERMINAL PASSENGER FACILITY PLANSET B

Roof Plan


DESIGNED BY: **TIM WHITELEY**

DRAWN BY: **AL, AR**

PROFESSIONAL ARCHITECT
No. A-9429
October 27, 2017

PATH: Y:\2011 PROJECTS\1121_ANGOOK & KAKE FERRY TERMINALS\10 DRAWINGS\2-KAKE SHEETS\1121-K
TAB: A2.3 Friday, October 27, 2017 12:02:18 PM AMANDA ROBINSON


REVISIONS			PROJECT DESIGNATION	YEAR	SHEET NO.	TOTAL SHEETS
NO.	DATE	DESCRIPTION	SAMHS00002	2015	A2.3	35

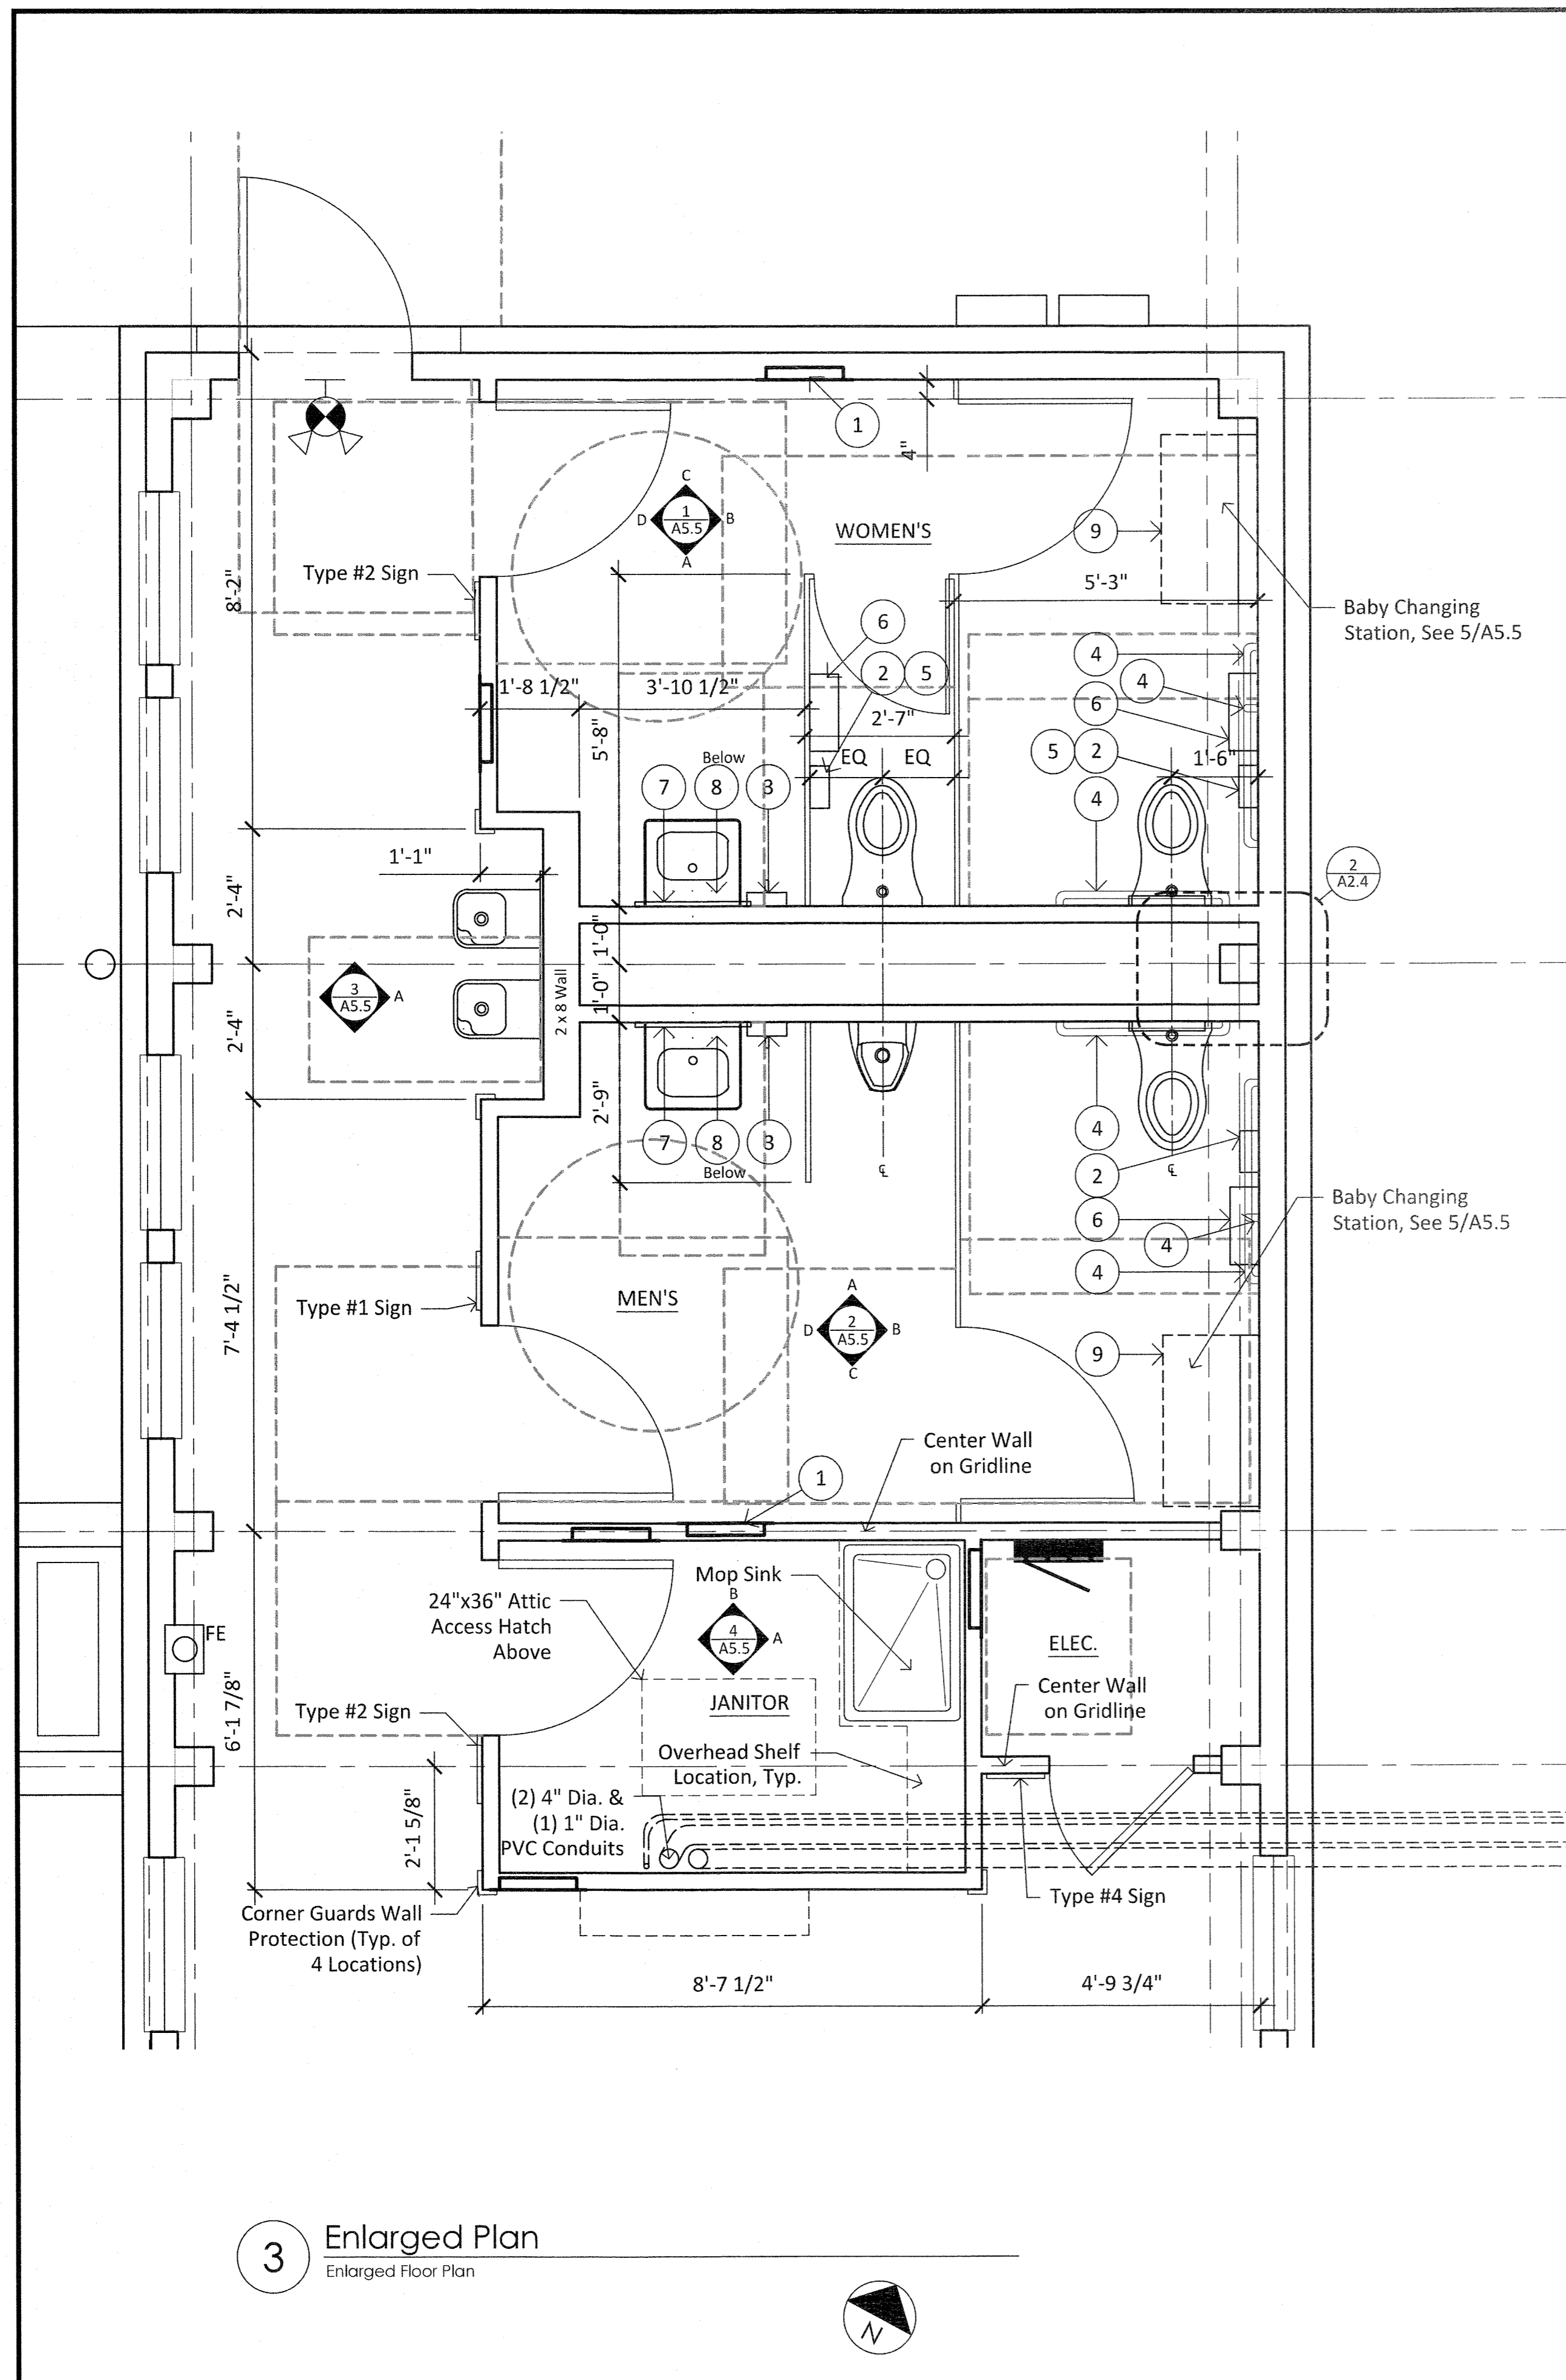

3 Enlarged Plan
Enlarged Floor Plan

TOILET ACCESSORIES SCHEDULE	
Number	Accessory
①	Paper Towel Dispenser/ Waste Receptical
②	Toilet Tissue Dispenser
③	Liquid Soap Dispenser
④	Grab Bar
⑤	Sanitary Napkin Disposal
⑥	Seat Cover Dispenser
⑦	Mirror
⑧	Under Lavatory Guard
⑨	Baby Changing Station

SHEET NOTE:
1) All Interior Walls to be Constructed of 2x4 Framing Unless Otherwise Noted.

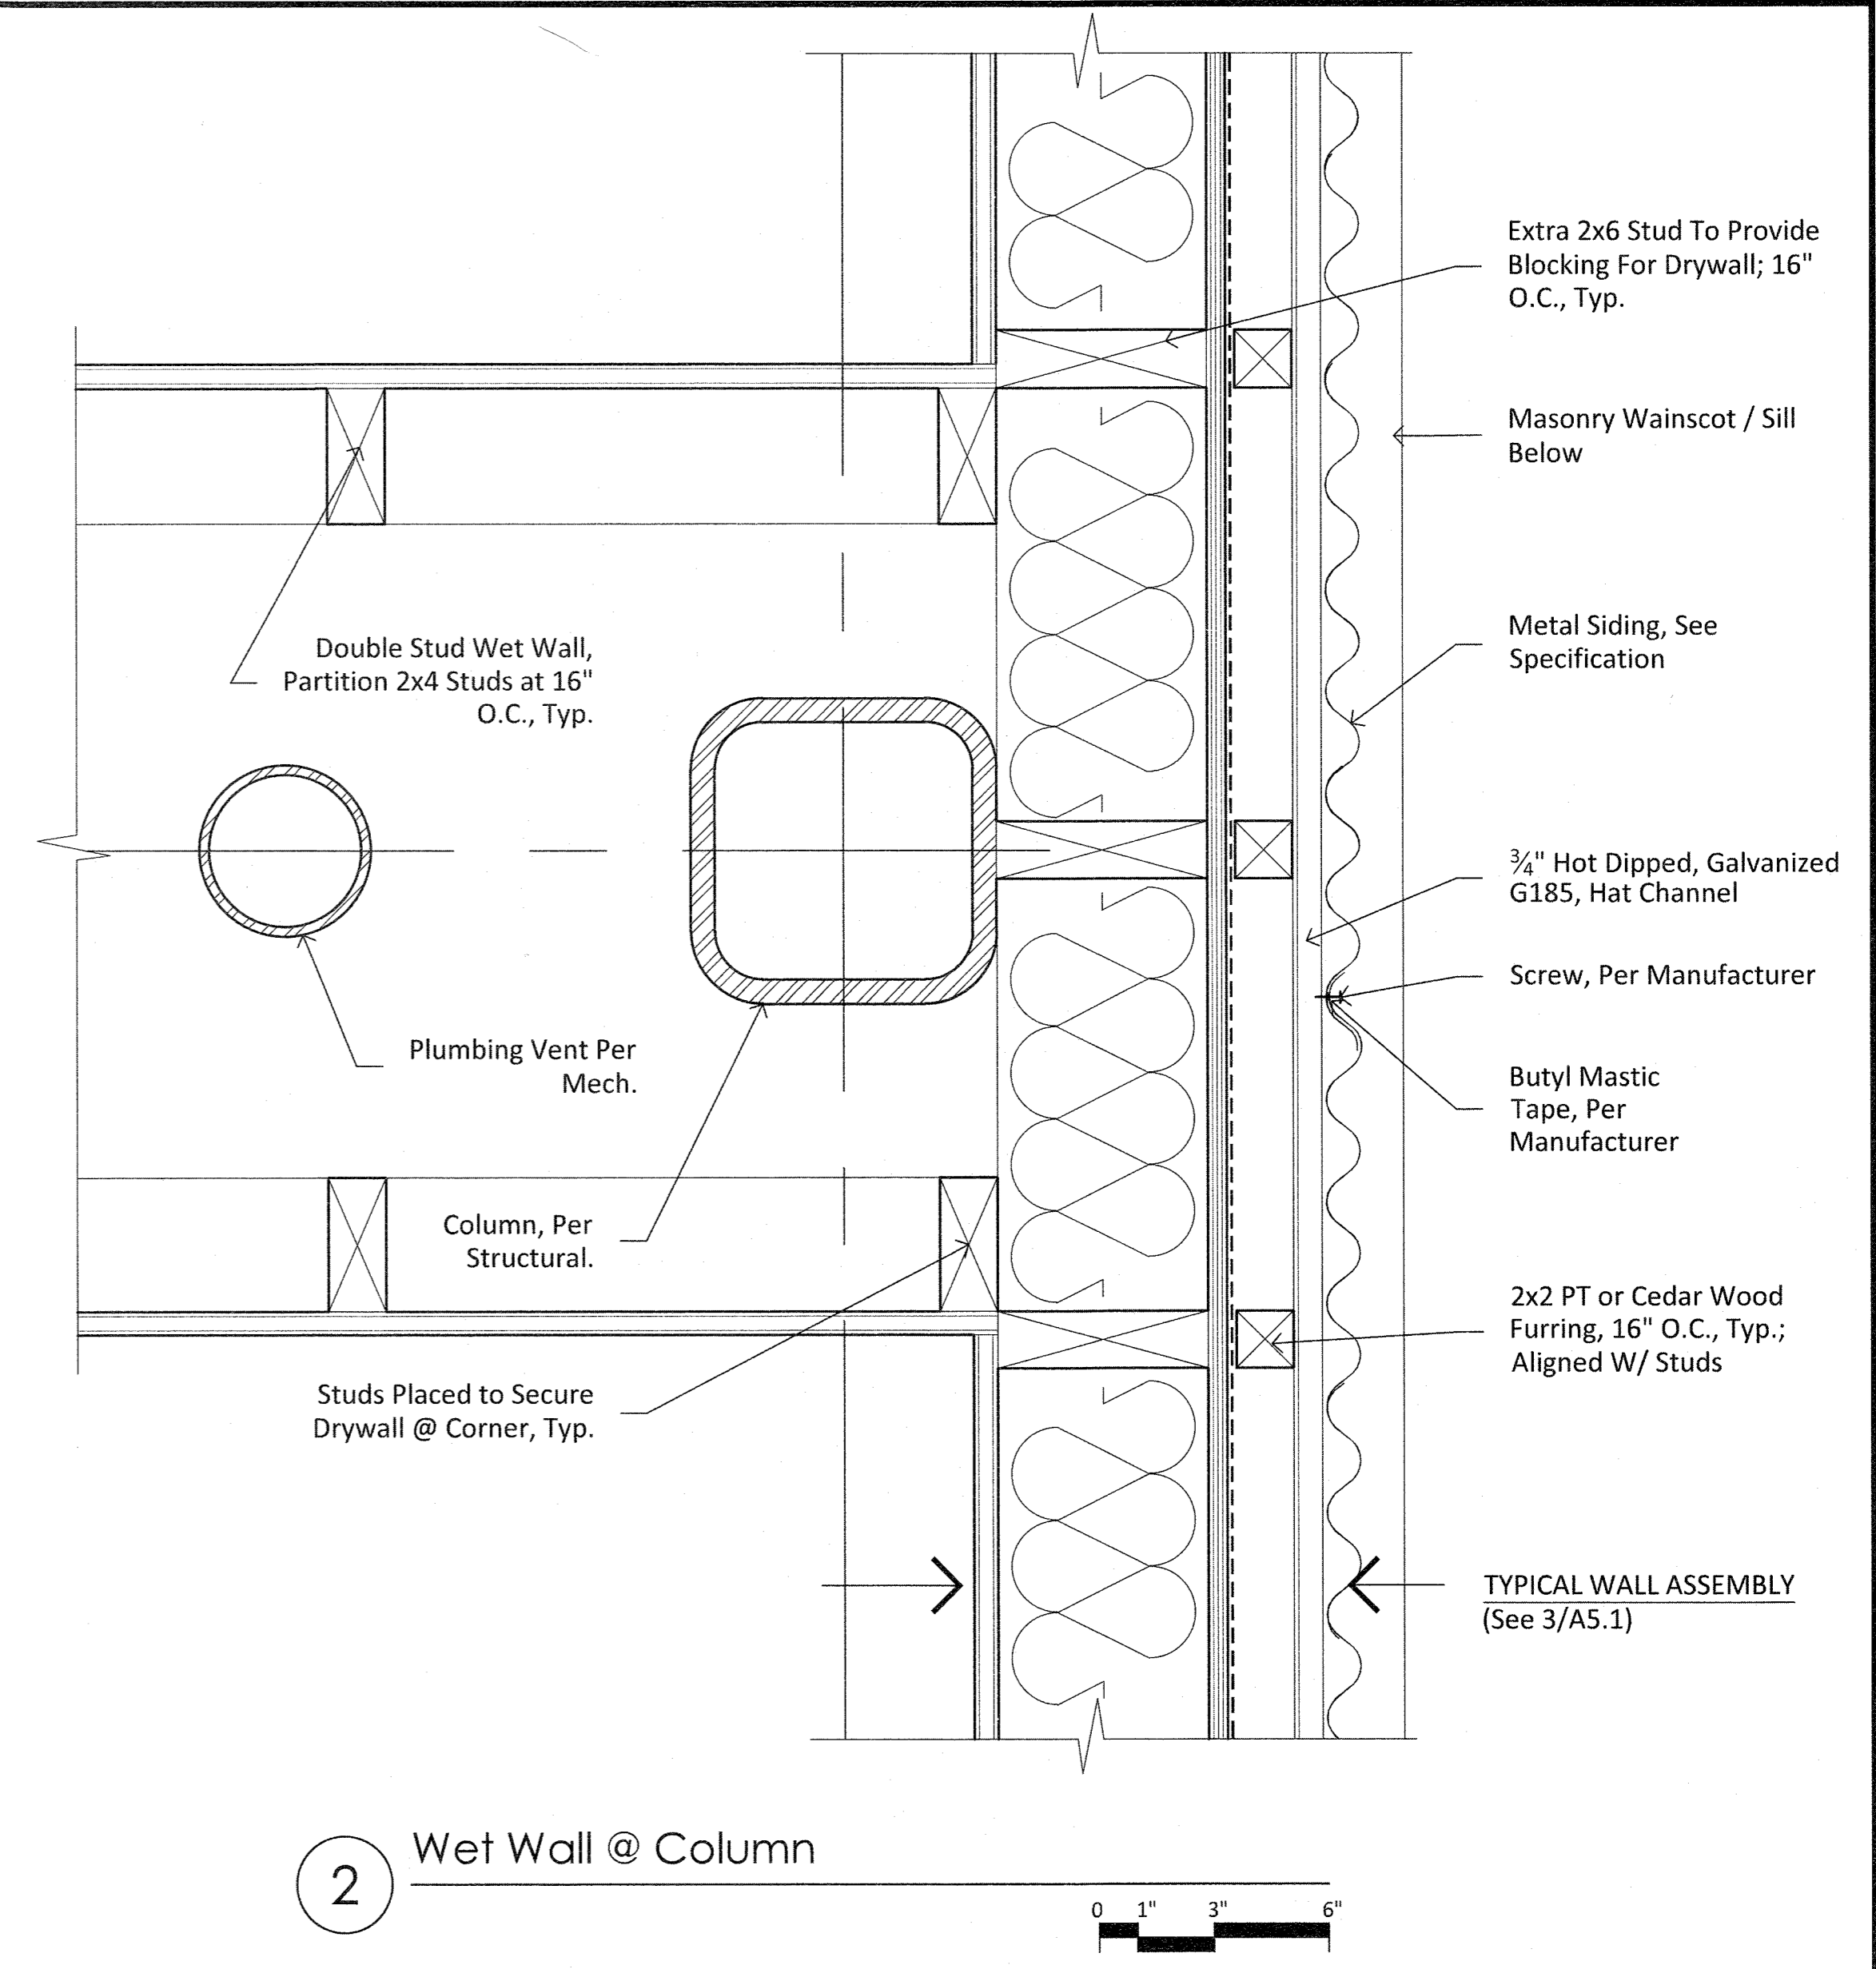

2 Wet Wall @ Column

RECORD DRAWINGS
THESE DRAWINGS HAVE BEEN PREPARED FROM INFORMATION PROVIDED BY THE CONTRACTOR. THERE IS NO GUARANTEE TO THE ACCURACY OF THE INFORMATION CONTAINED HEREIN, EITHER EXPRESSED OR IMPLIED.
October 27, 2017
WELSHWHITELEYARCHITECT, LLC

DO NOT SCALE FROM THESE DRAWINGS USE DIMENSIONS

Drawings Prepared By: **WELSH WHITELEY ARCHITECTS**

327 Bawden Street
Ketchikan, Alaska 99901
(907) 225-2412 Voice
(907) 225-2422 Fax

CHECKED BY: **TIM WHITELEY**

STATE OF ALASKA
DEPARTMENT OF TRANSPORTATION & PUBLIC FACILITIES
SOUTHCOST REGION

KAKE FERRY TERMINAL PASSENGER FACILITY PLANSET B

Enlarged Plans


DESIGNED BY: **TIM WHITELEY**
DRAWN BY: **AL, AR**

PROFESSIONAL ARCHITECT
No. A-9429
October 27, 2017

PROJECT DESIGNATION: **SAMHS00002**
YEAR: **2015**
SHEET NO.: **A2.4**
TOTAL SHEETS: **35**


PATH: Y:\2011 PROJECTS\1121_ANGOOON & KAKE FERRY TERMINALS\10 DRAWINGS\2-KAKE SHEETS\1121-K
TAB: A2.4 Friday, October 27, 2017 12:01:00 PM AMANDA ROBINSON

REVISIONS		
NO.	DATE	DESCRIPTION

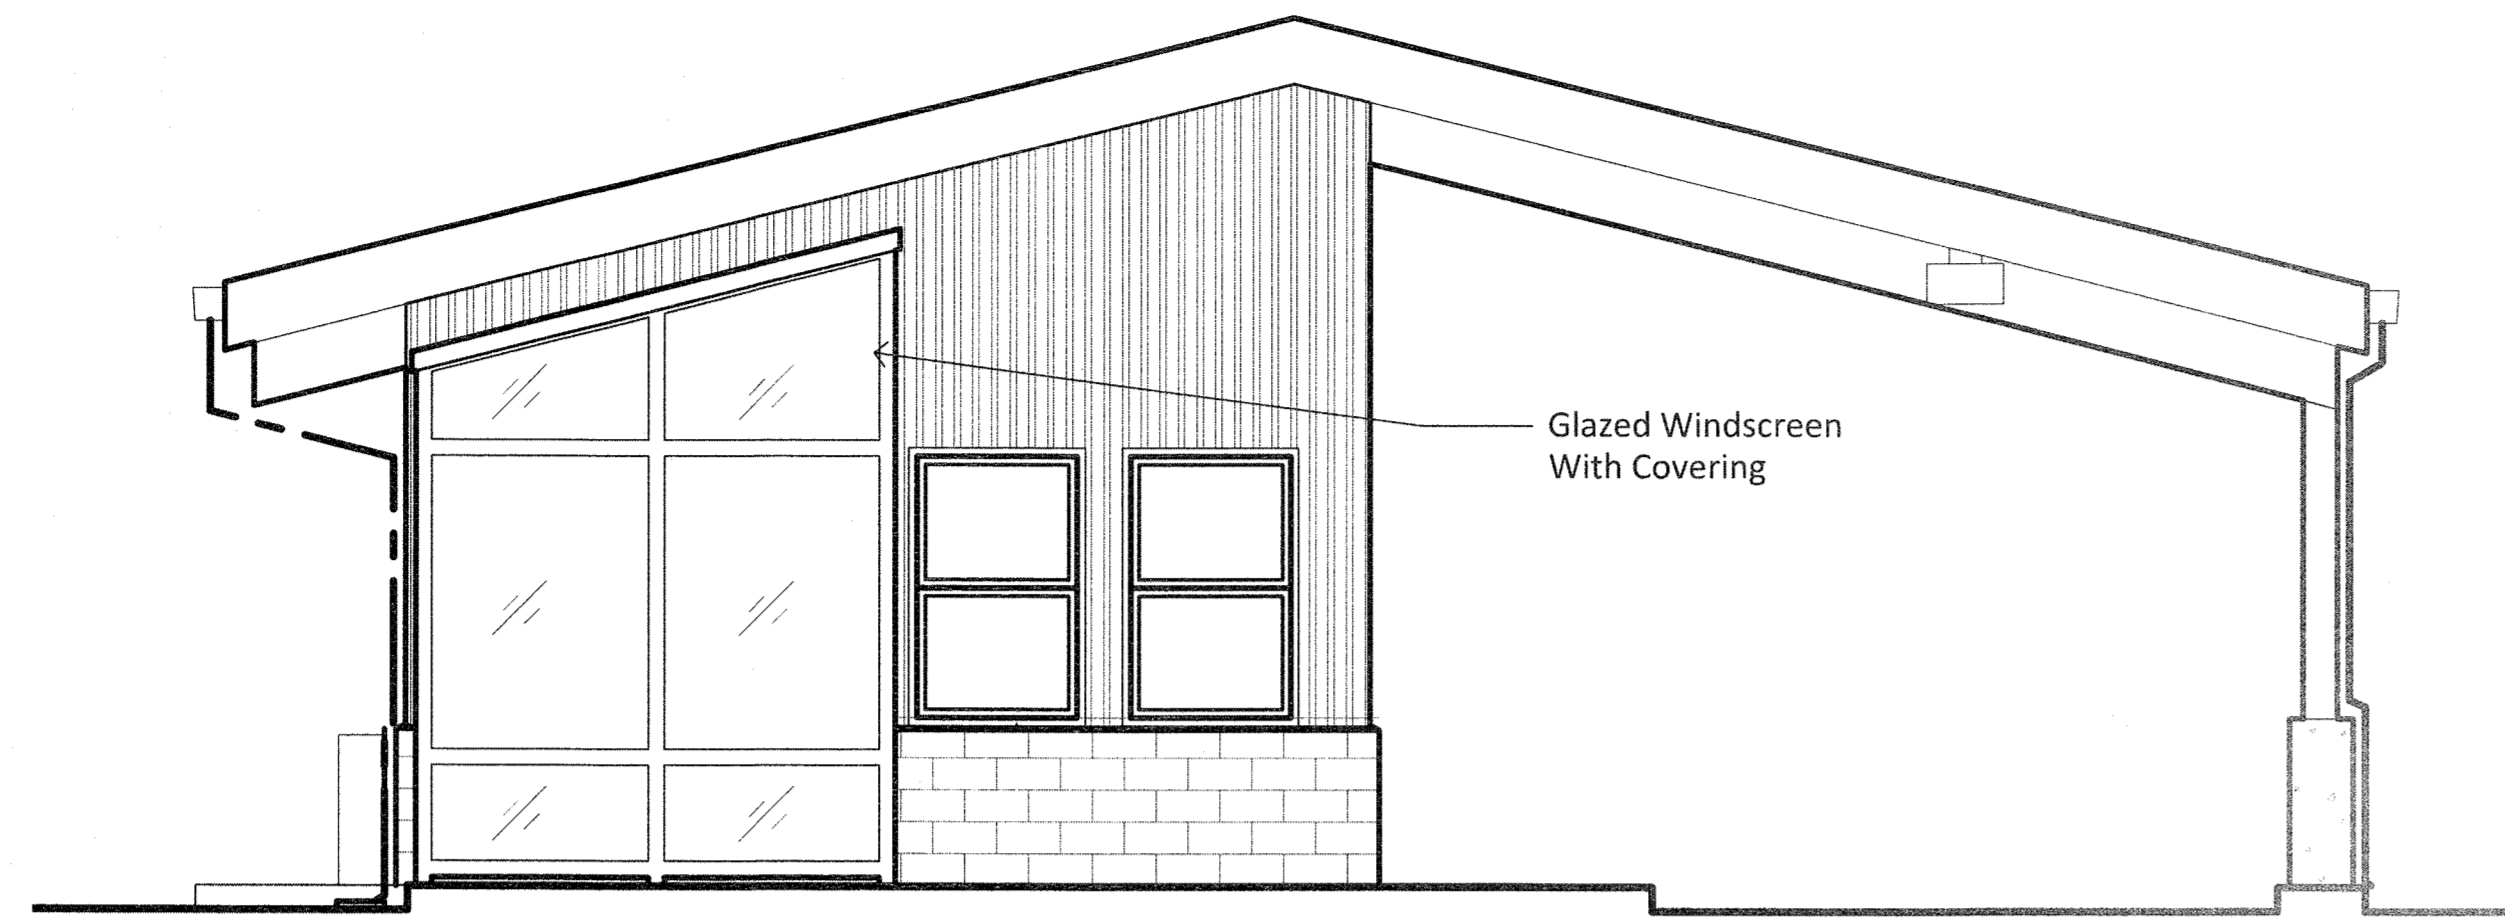


5 South Elevation - Windscreen

0 2' 4'

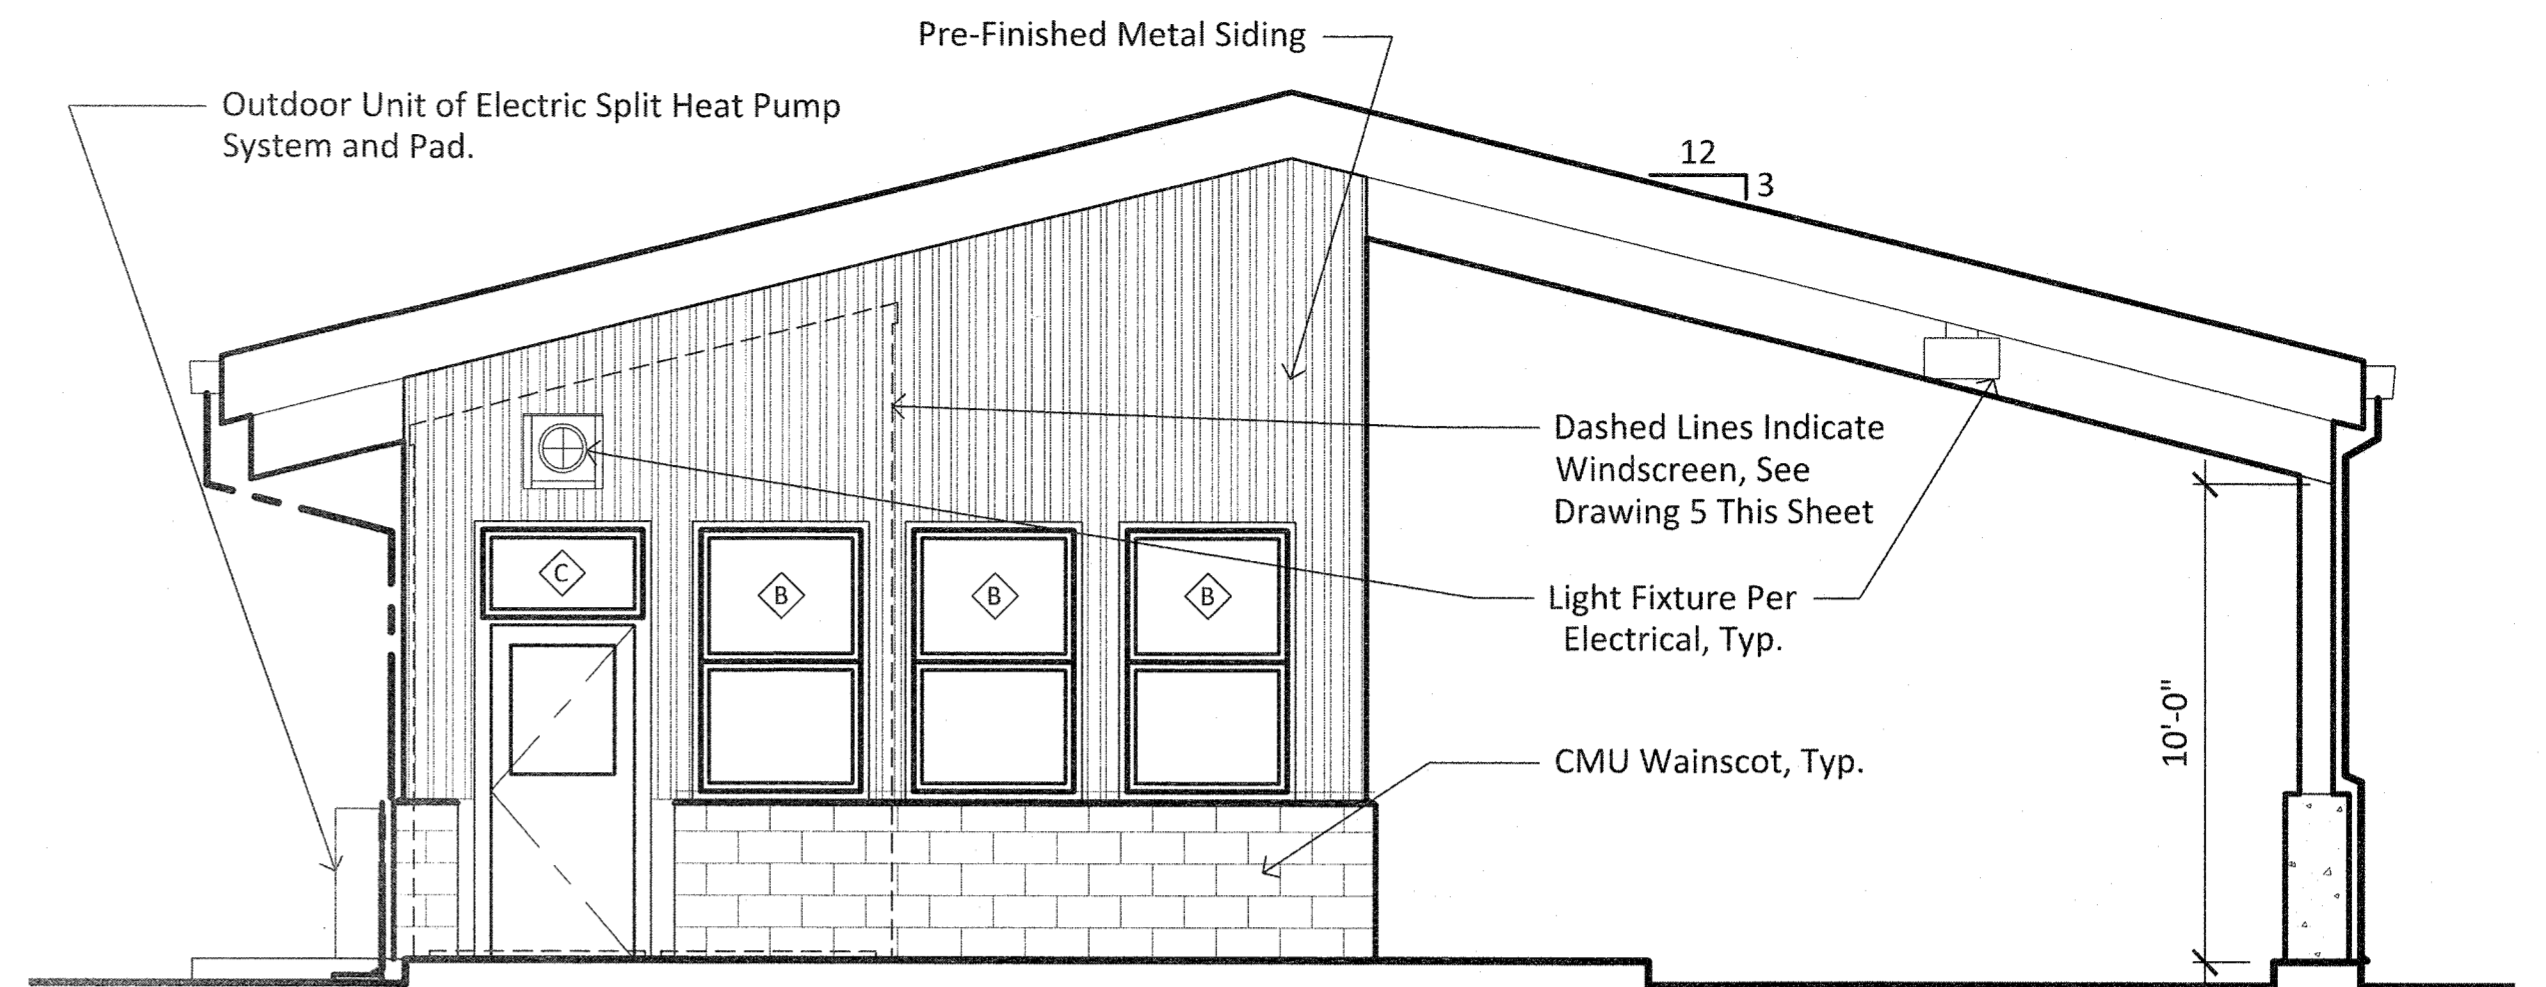


2 South Elevation

0 2' 4'

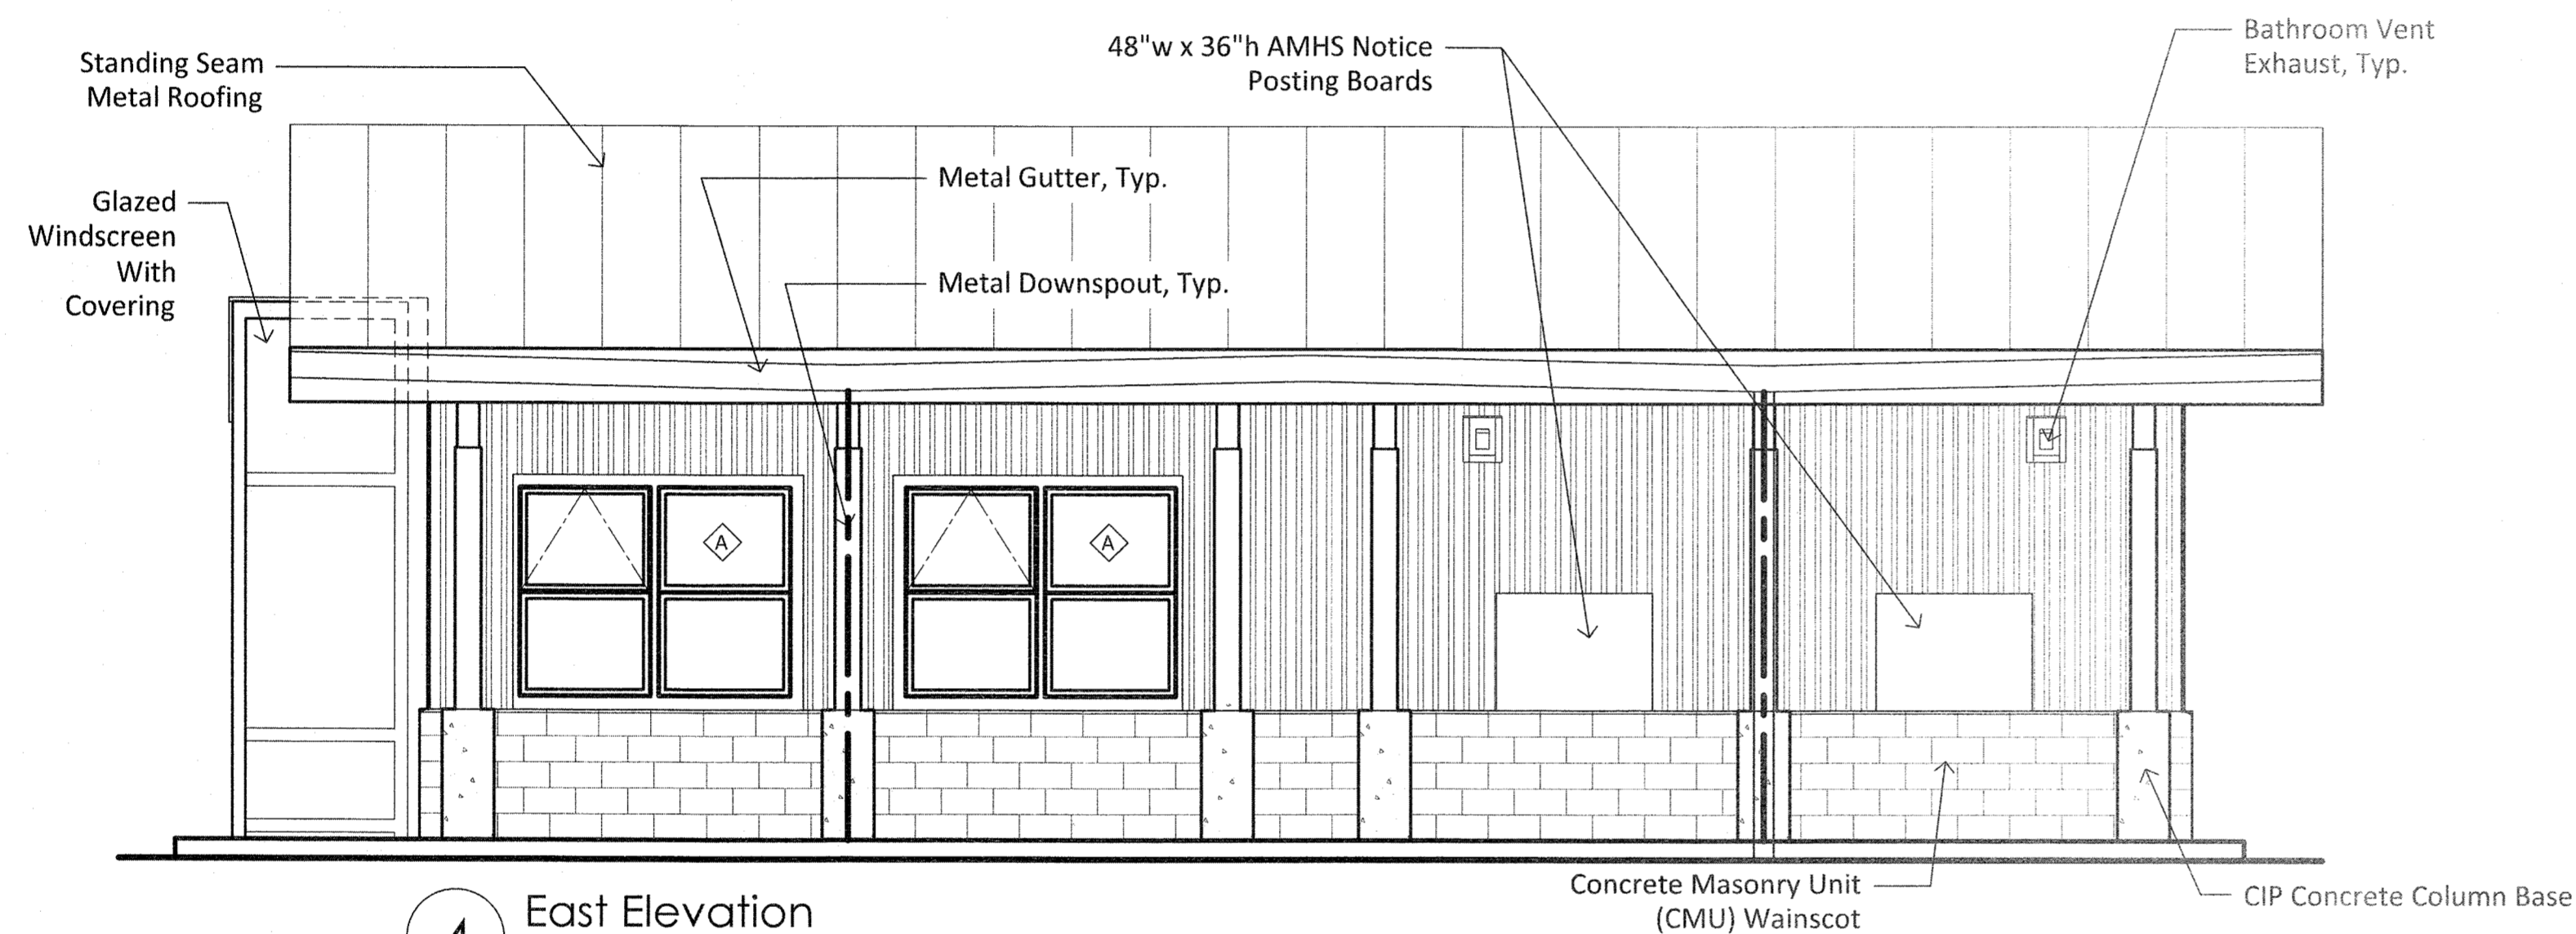

4 East Elevation


0 2' 4'

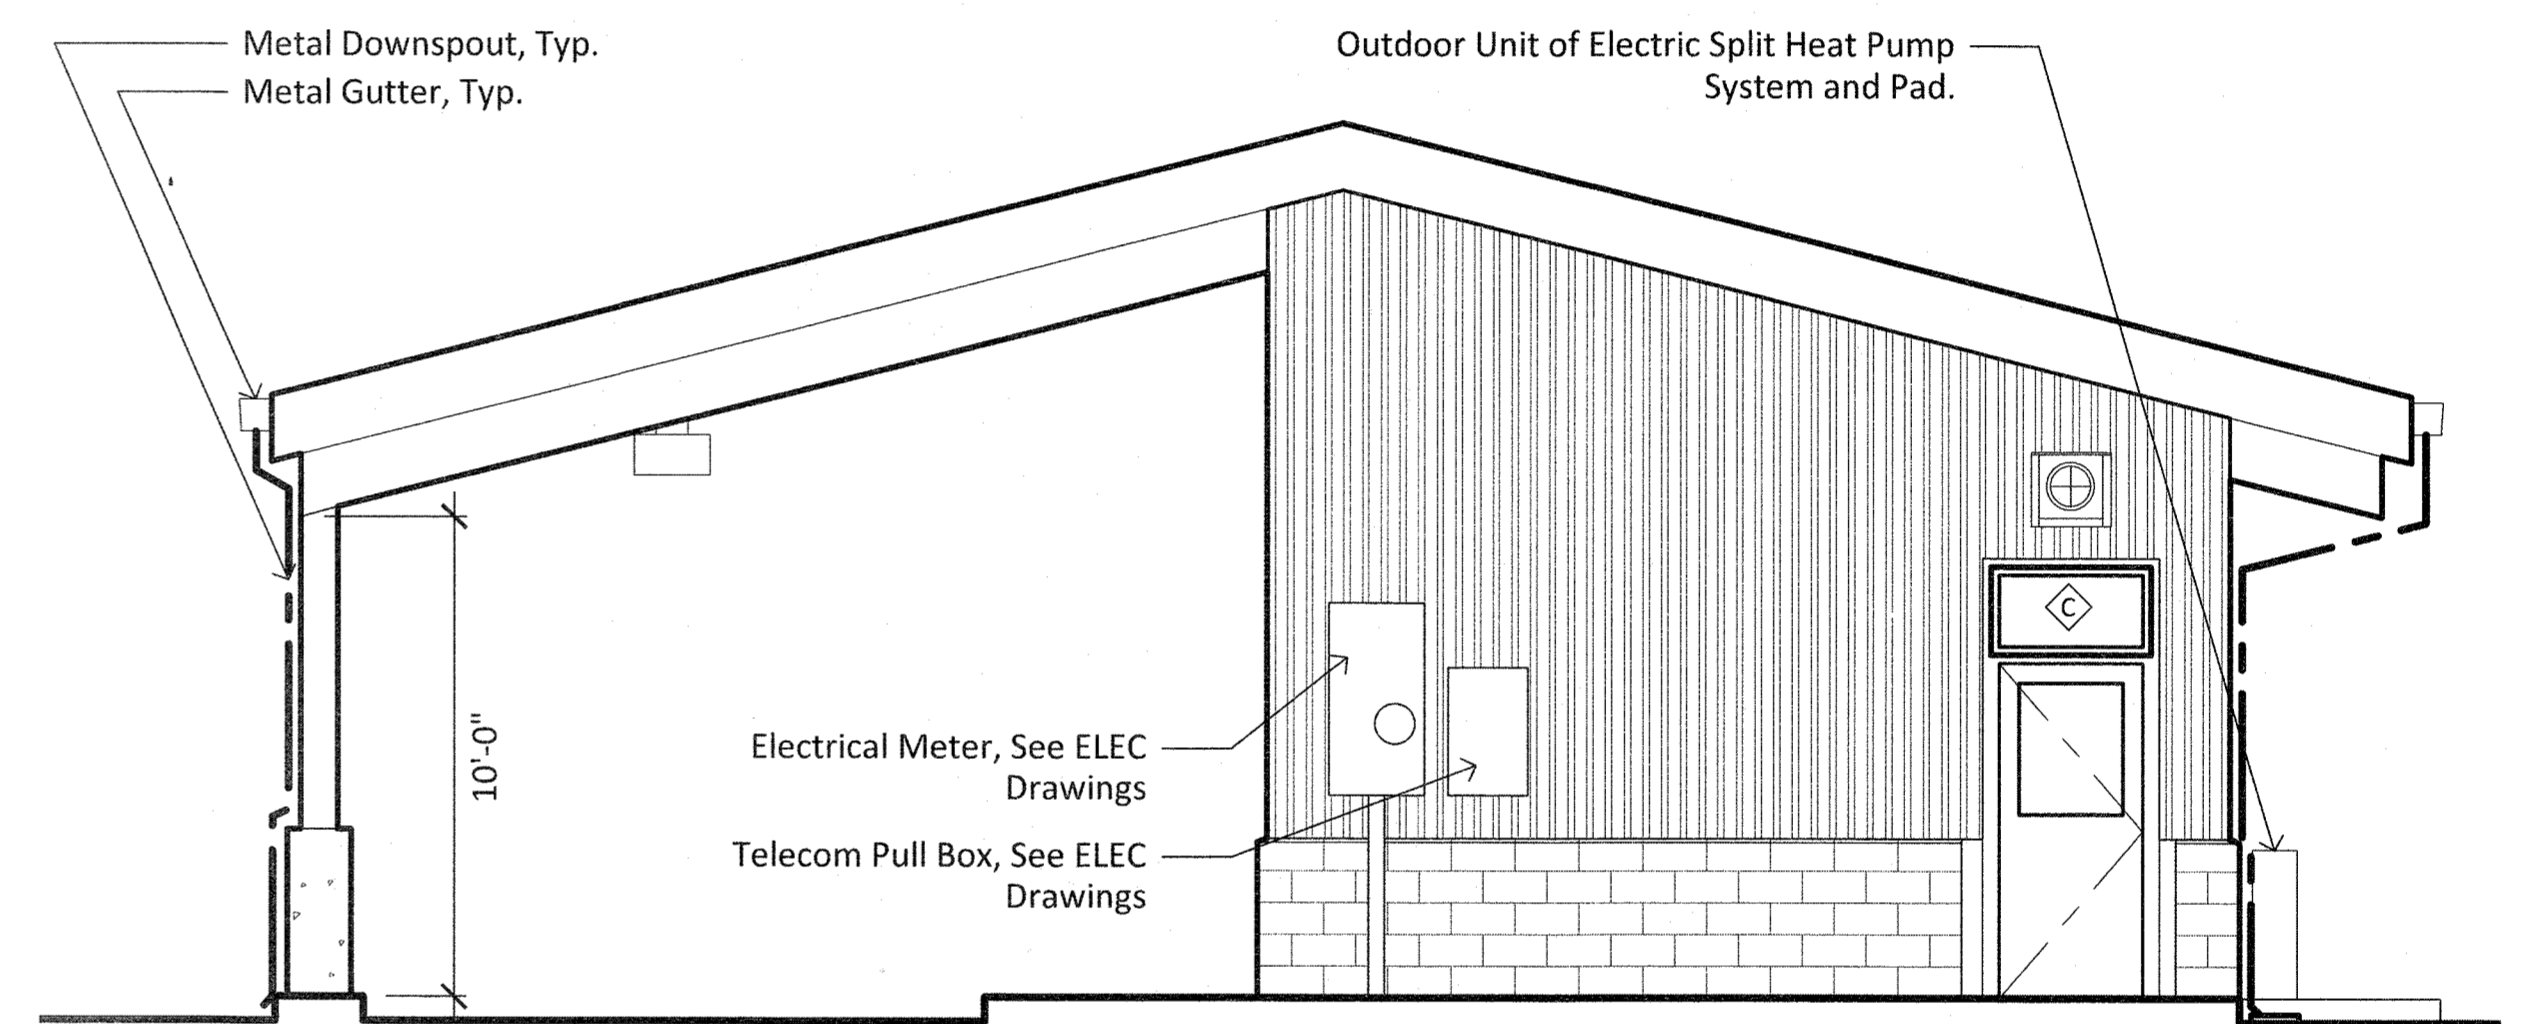

1 North Elevation

1/4" = 1'-0"

0 2' 4'

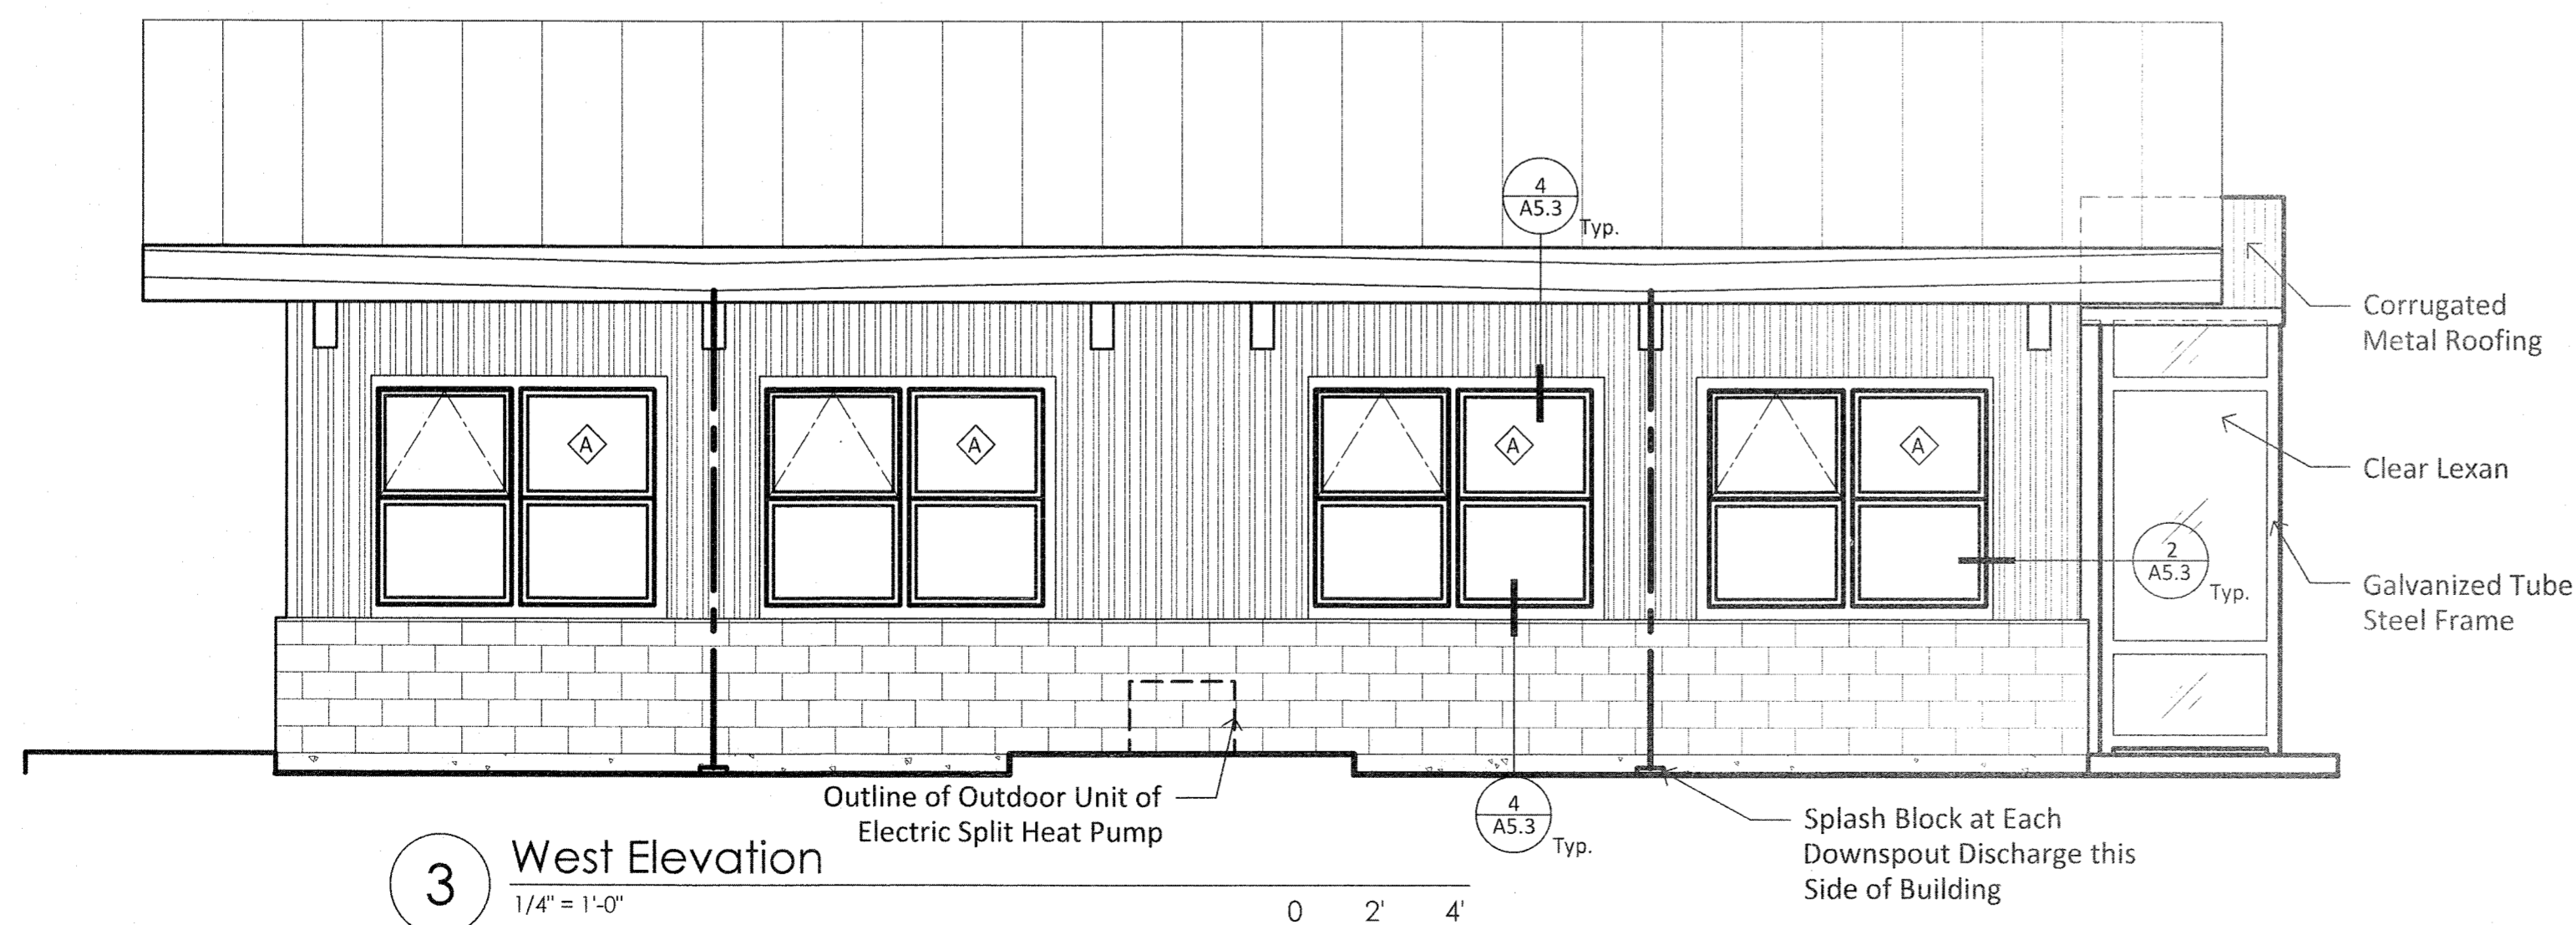

3 West Elevation

1/4" = 1'-0"

0 2' 4'

RECORD DRAWINGS

THESE DRAWINGS HAVE BEEN PREPARED FROM INFORMATION PROVIDED BY THE CONTRACTOR. THERE IS NO GUARANTEE TO THE ACCURACY OF THE INFORMATION CONTAINED HEREIN, EITHER EXPRESSED OR IMPLIED.

October 27, 2017

WELSHWHITELEYARCHITECT, LLC


Drawings Prepared By:



327 Bawden Street
Ketchikan, Alaska 99901
(907) 225-2412 Voice
(907) 225-2422 Fax

DO NOT SCALE FROM THESE DRAWINGS USE DIMENSIONS

CHECKED BY: TIM WHITELEY

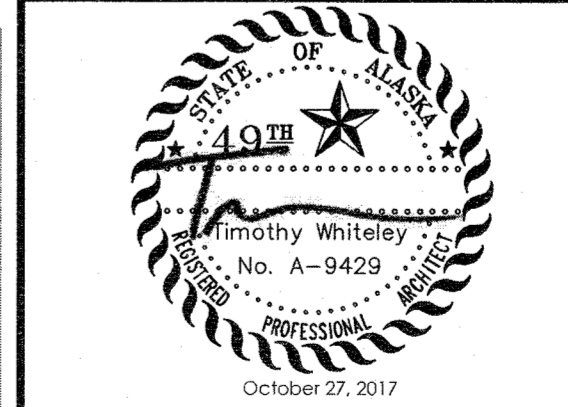

DESIGNED BY: TIM WHITELEY

DRAWN BY: AL, AR

PATH: Y:\2011 PROJECTS\1121_ANGOOK & KAKE FERRY TERMINALS\10 DRAWINGS\2-KAKE SHEETS\1121-K


TAB: A3.1 Friday, October 27, 2017 11:59:53 AM AMANDA ROBINSON

REVISIONS		
NO.	DATE	DESCRIPTION


STATE OF ALASKA
DEPARTMENT OF TRANSPORTATION
& PUBLIC FACILITIES
SOUTHCOST REGION
**KAKE FERRY TERMINAL
PASSENGER FACILITY
PLANSET B**

Elevations


PROJECT DESIGNATION	YEAR	SHEET NO.	TOTAL SHEETS
SAMHS0002	2015	A3.1	35

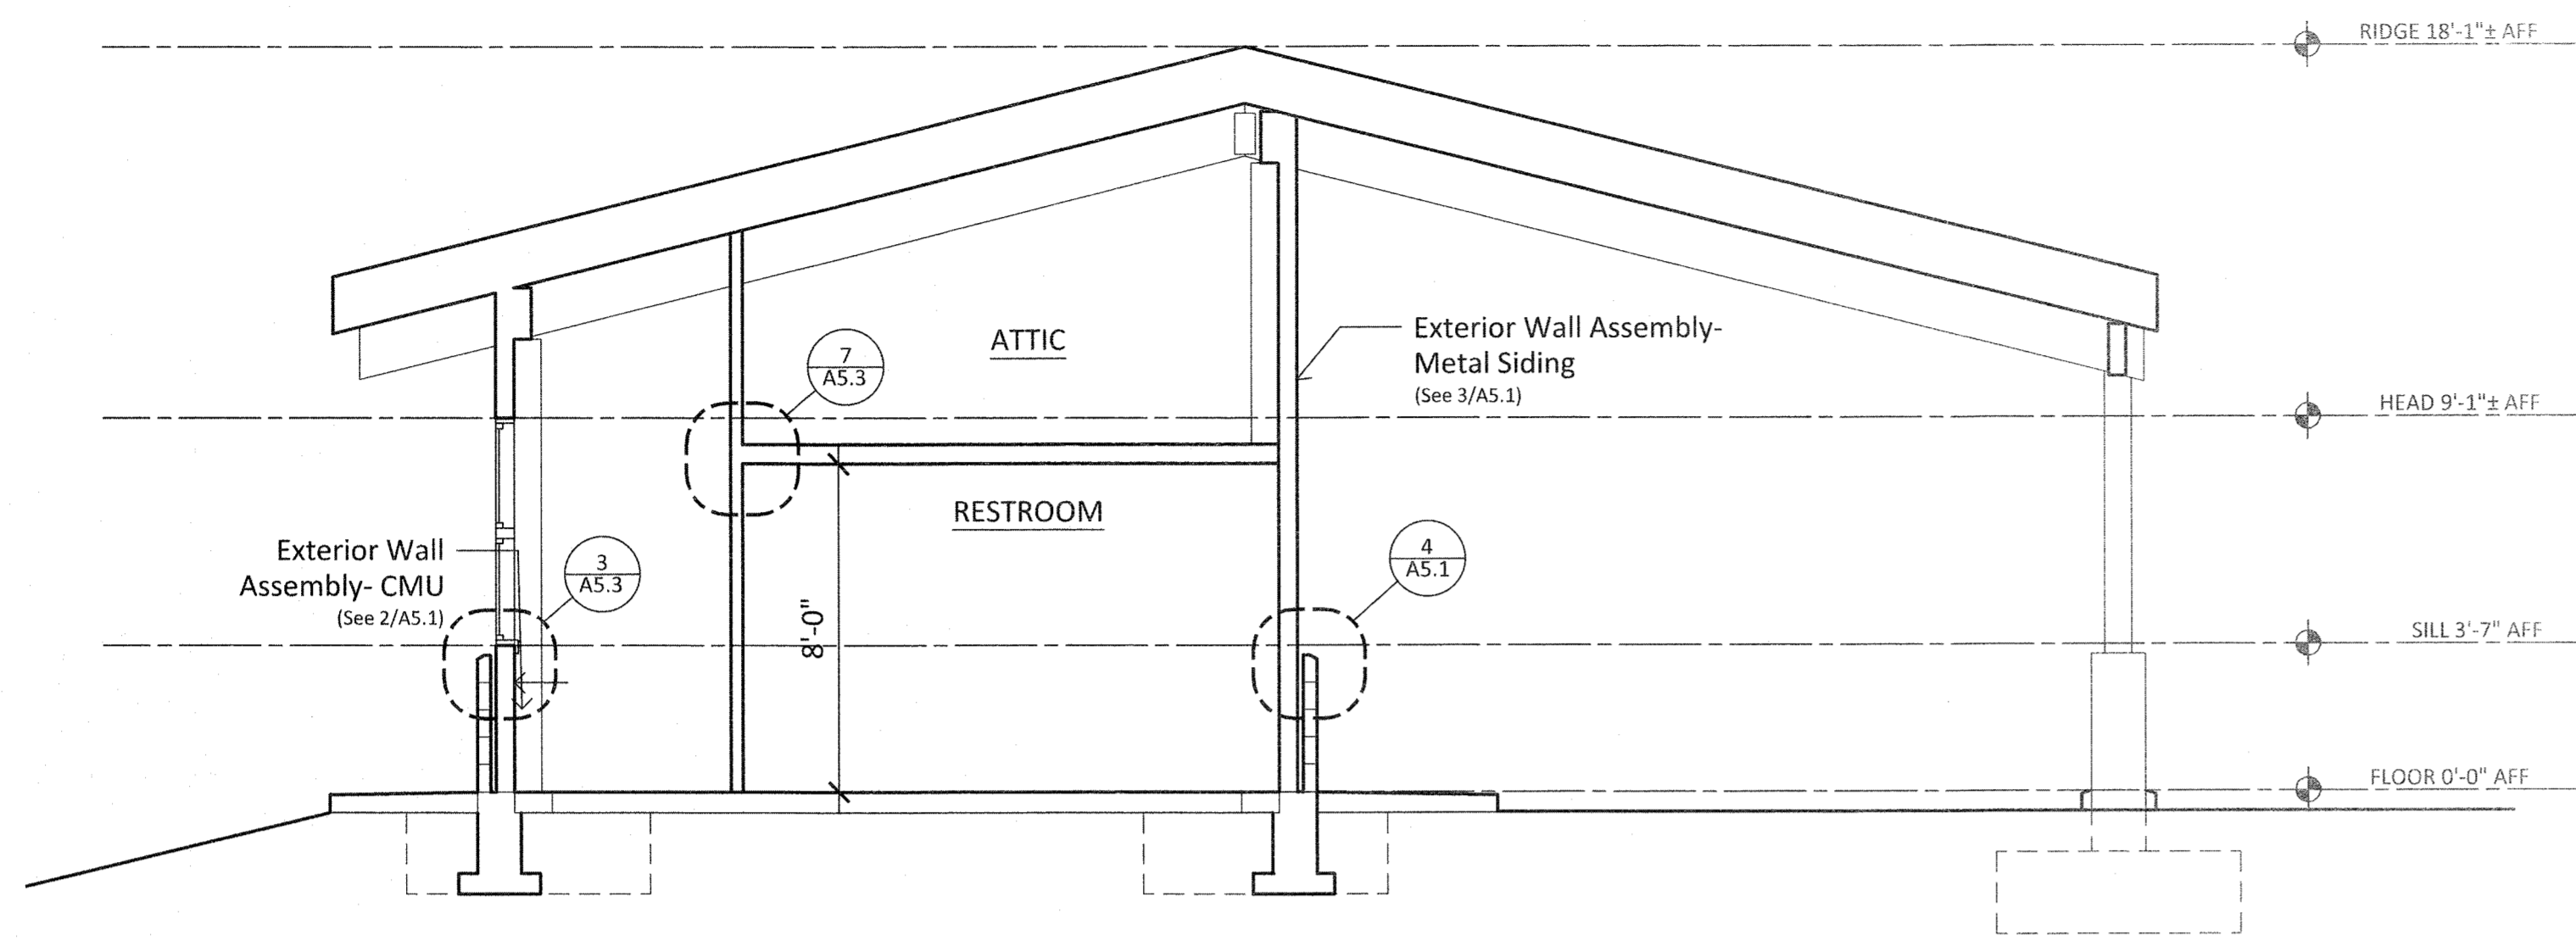


2 Section Thru Restroom 0 2' 4'

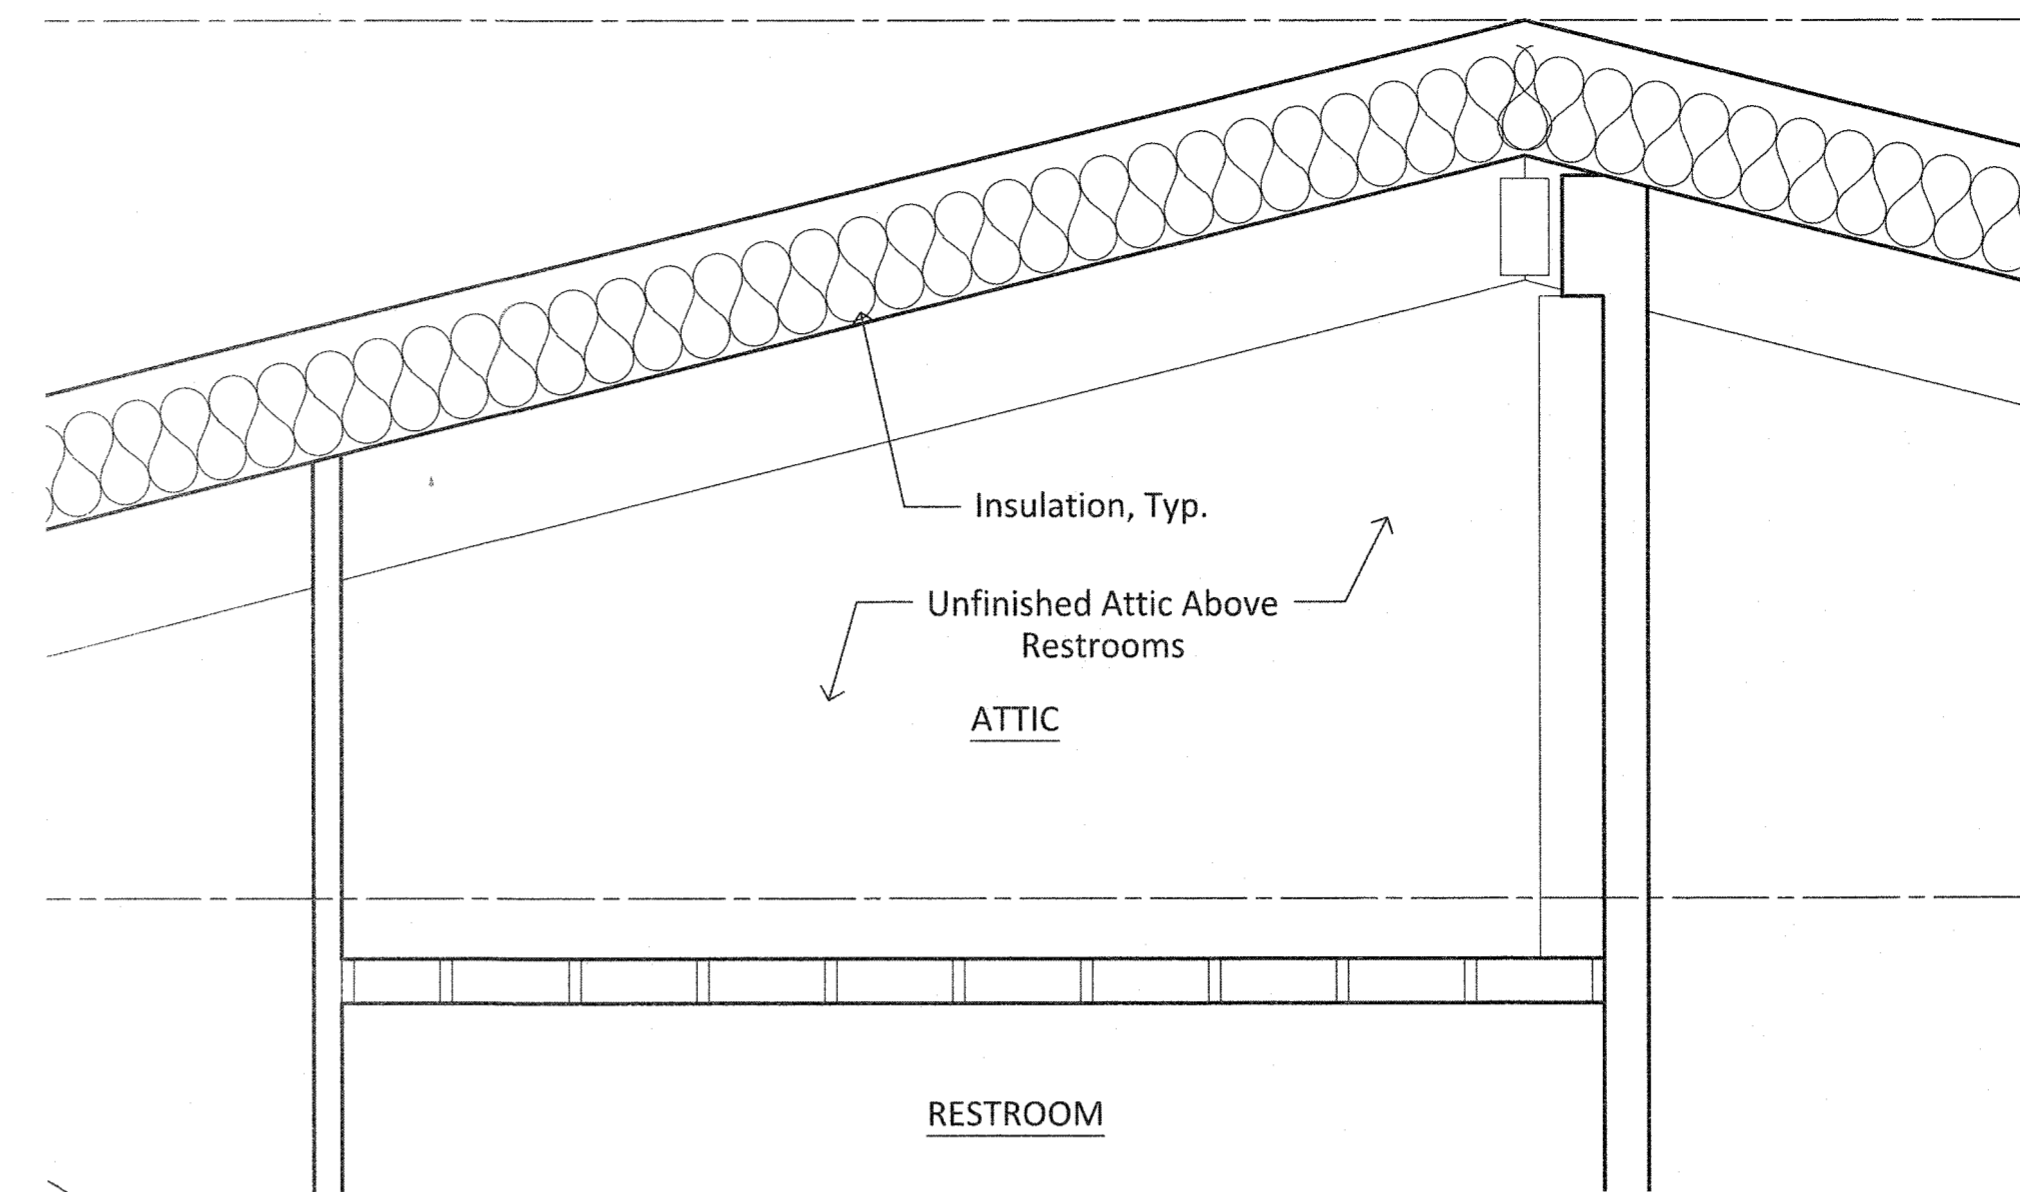

1 Not Used

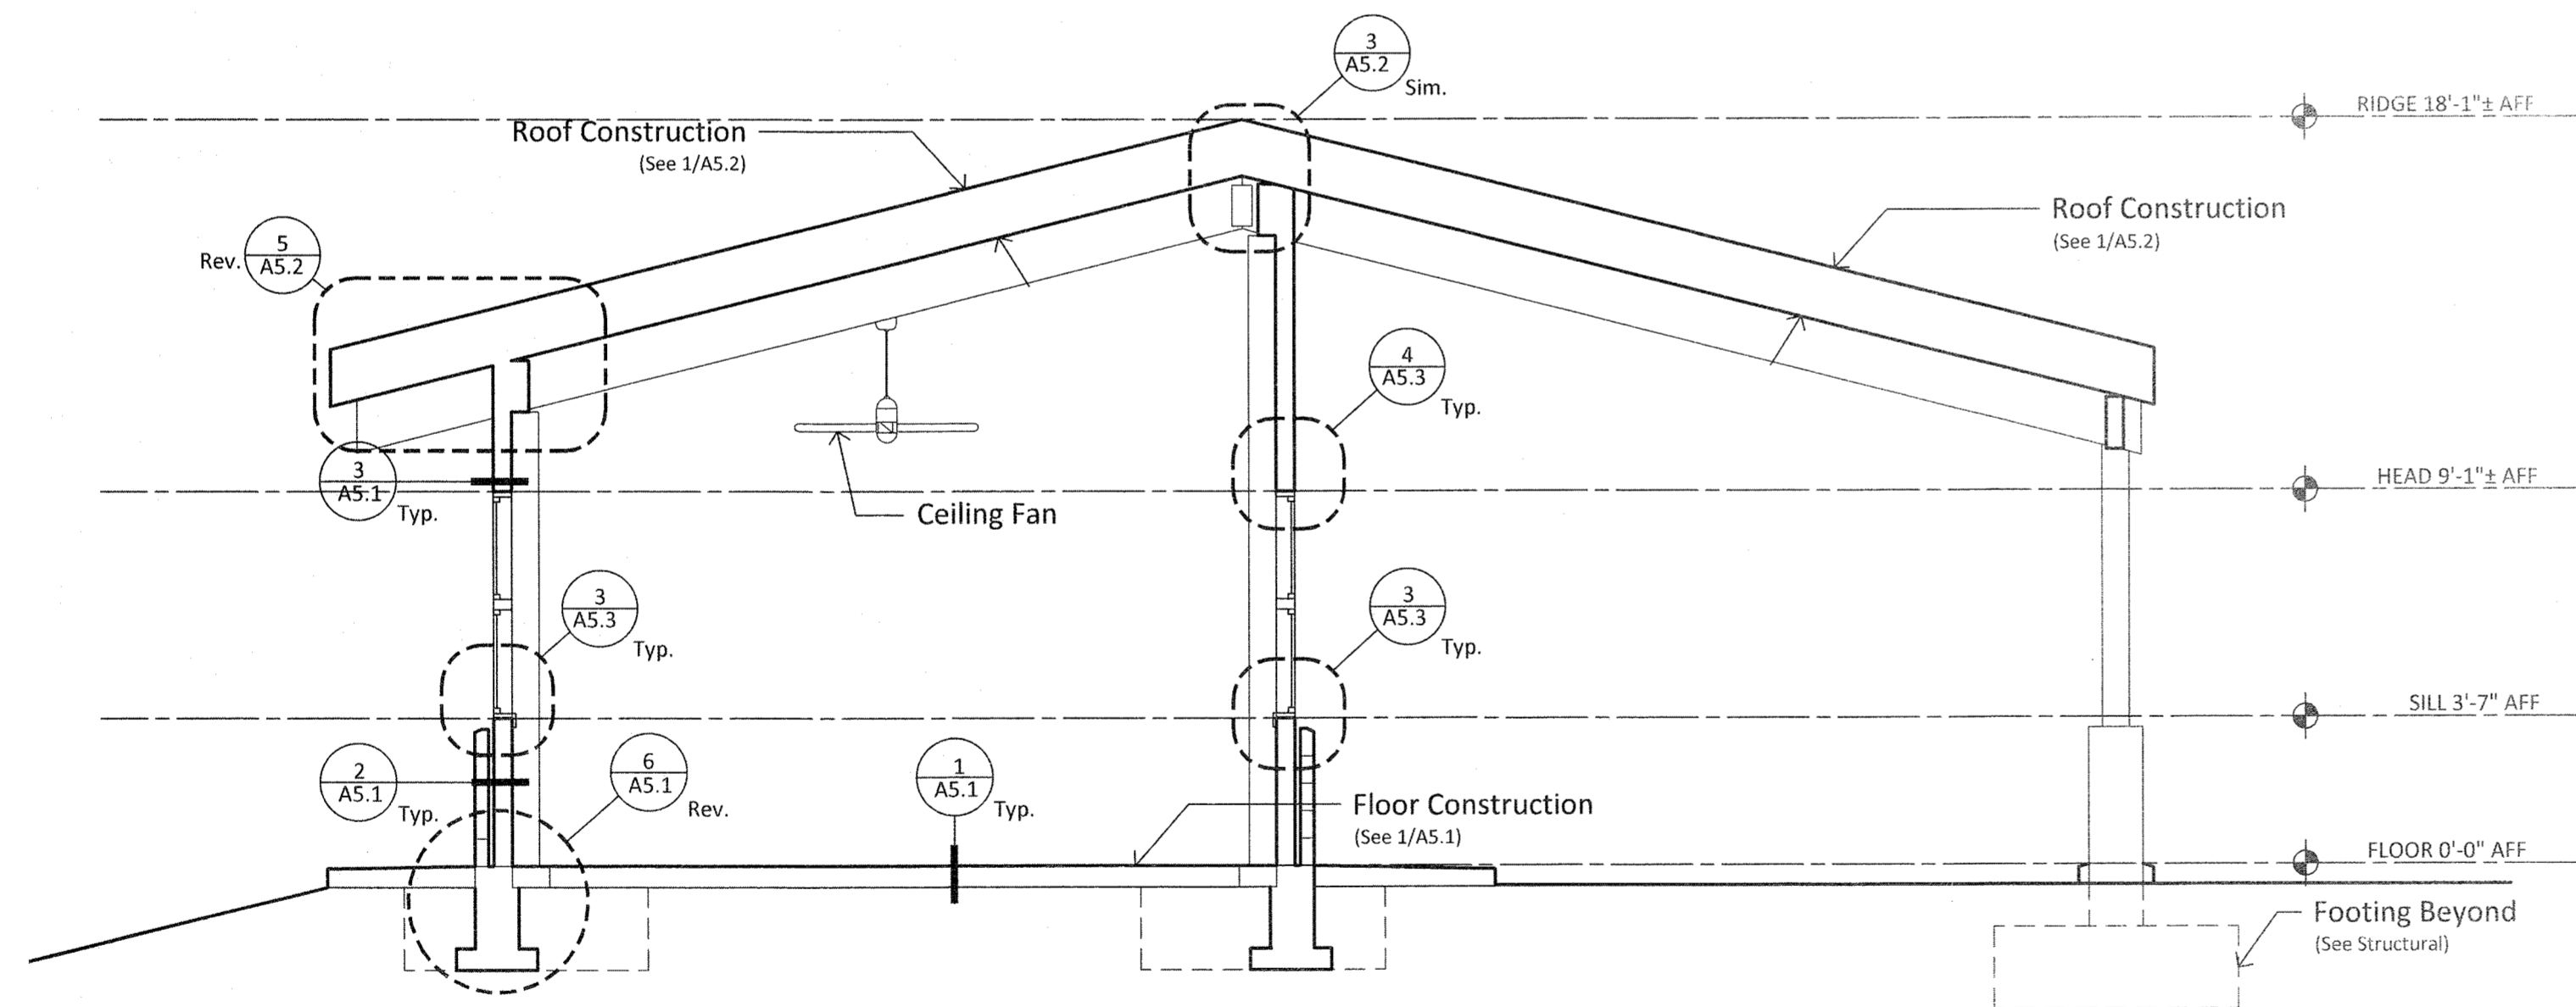


3 Section Thru Seating Area 0 2' 4'

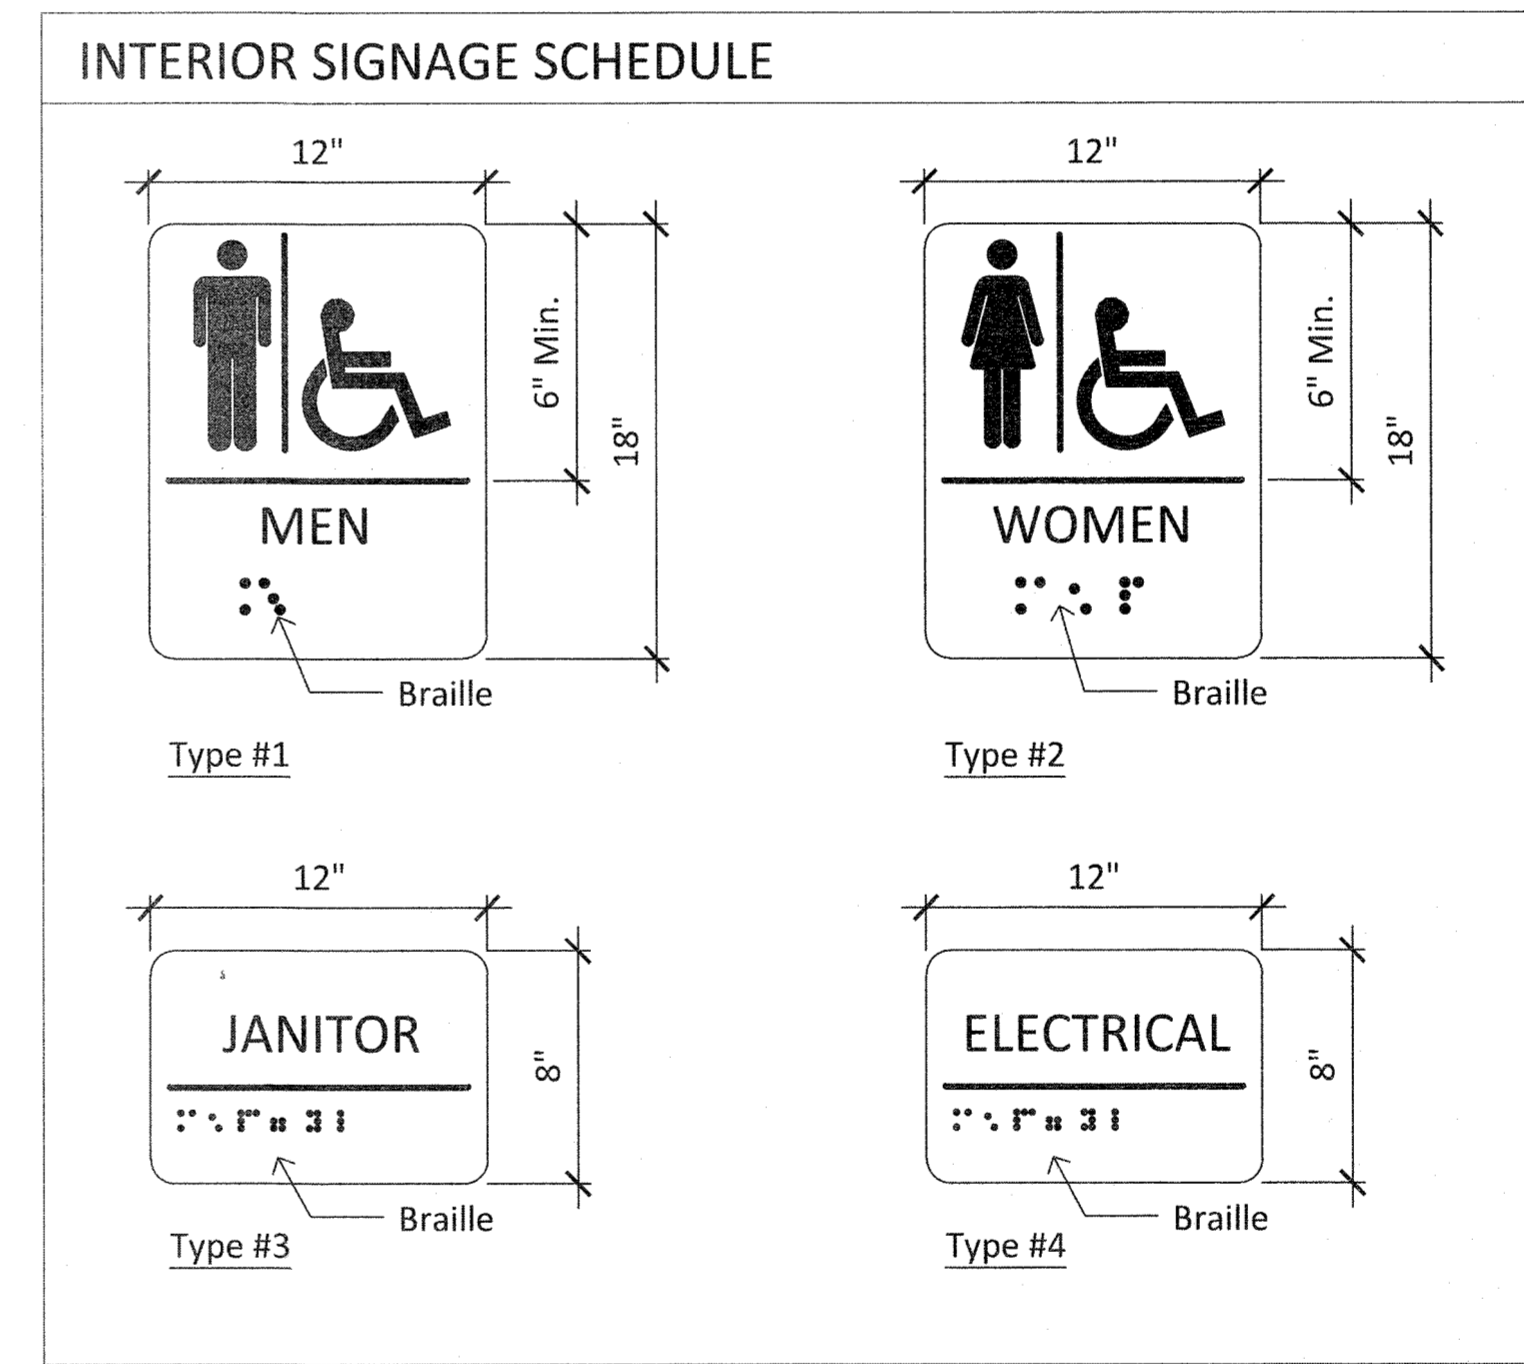

RECORD DRAWINGS
 THESE DRAWINGS HAVE BEEN PREPARED FROM INFORMATION PROVIDED BY THE CONTRACTOR. THERE IS NO GUARANTEE TO THE ACCURACY OF THE INFORMATION CONTAINED HEREIN, EITHER EXPRESSED OR IMPLIED.
 October 27, 2017
 WELSHWHITELEYARCHITECT, LLC


Drawings Prepared By:
WELSH WHITELEY ARCHITECTS
 327 Bowden Street
 Ketchikan, Alaska 99901
 (907) 225-2412 Voice
 (907) 225-2422 Fax

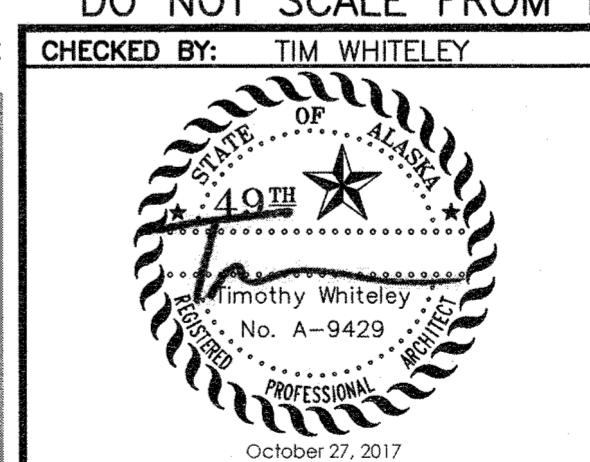


DESIGNED BY: TIM WHITELEY
 DRAWN BY: AL, AR
 PATH: Y:\2011 PROJECTS\1121_ANGOOON & KAKE FERRY TERMINALS\10 DRAWINGS\2-KAKE SHEETS\1121-K
 TAB: A3.2 Friday, October 27, 2017 11:59:29 AM AMANDA ROBINSON

DO NOT SCALE FROM THESE DRAWINGS USE DIMENSIONS
 STATE OF ALASKA
 DEPARTMENT OF TRANSPORTATION
 & PUBLIC FACILITIES
 SOUTHCOST REGION
**KAKE FERRY TERMINAL
 PASSENGER FACILITY
 PLANSET B**
 Sections


REVISIONS			PROJECT DESIGNATION	YEAR	SHEET NO.	TOTAL SHEETS
NO.	DATE	DESCRIPTION	SAMHS00002	2015	A3.2	35

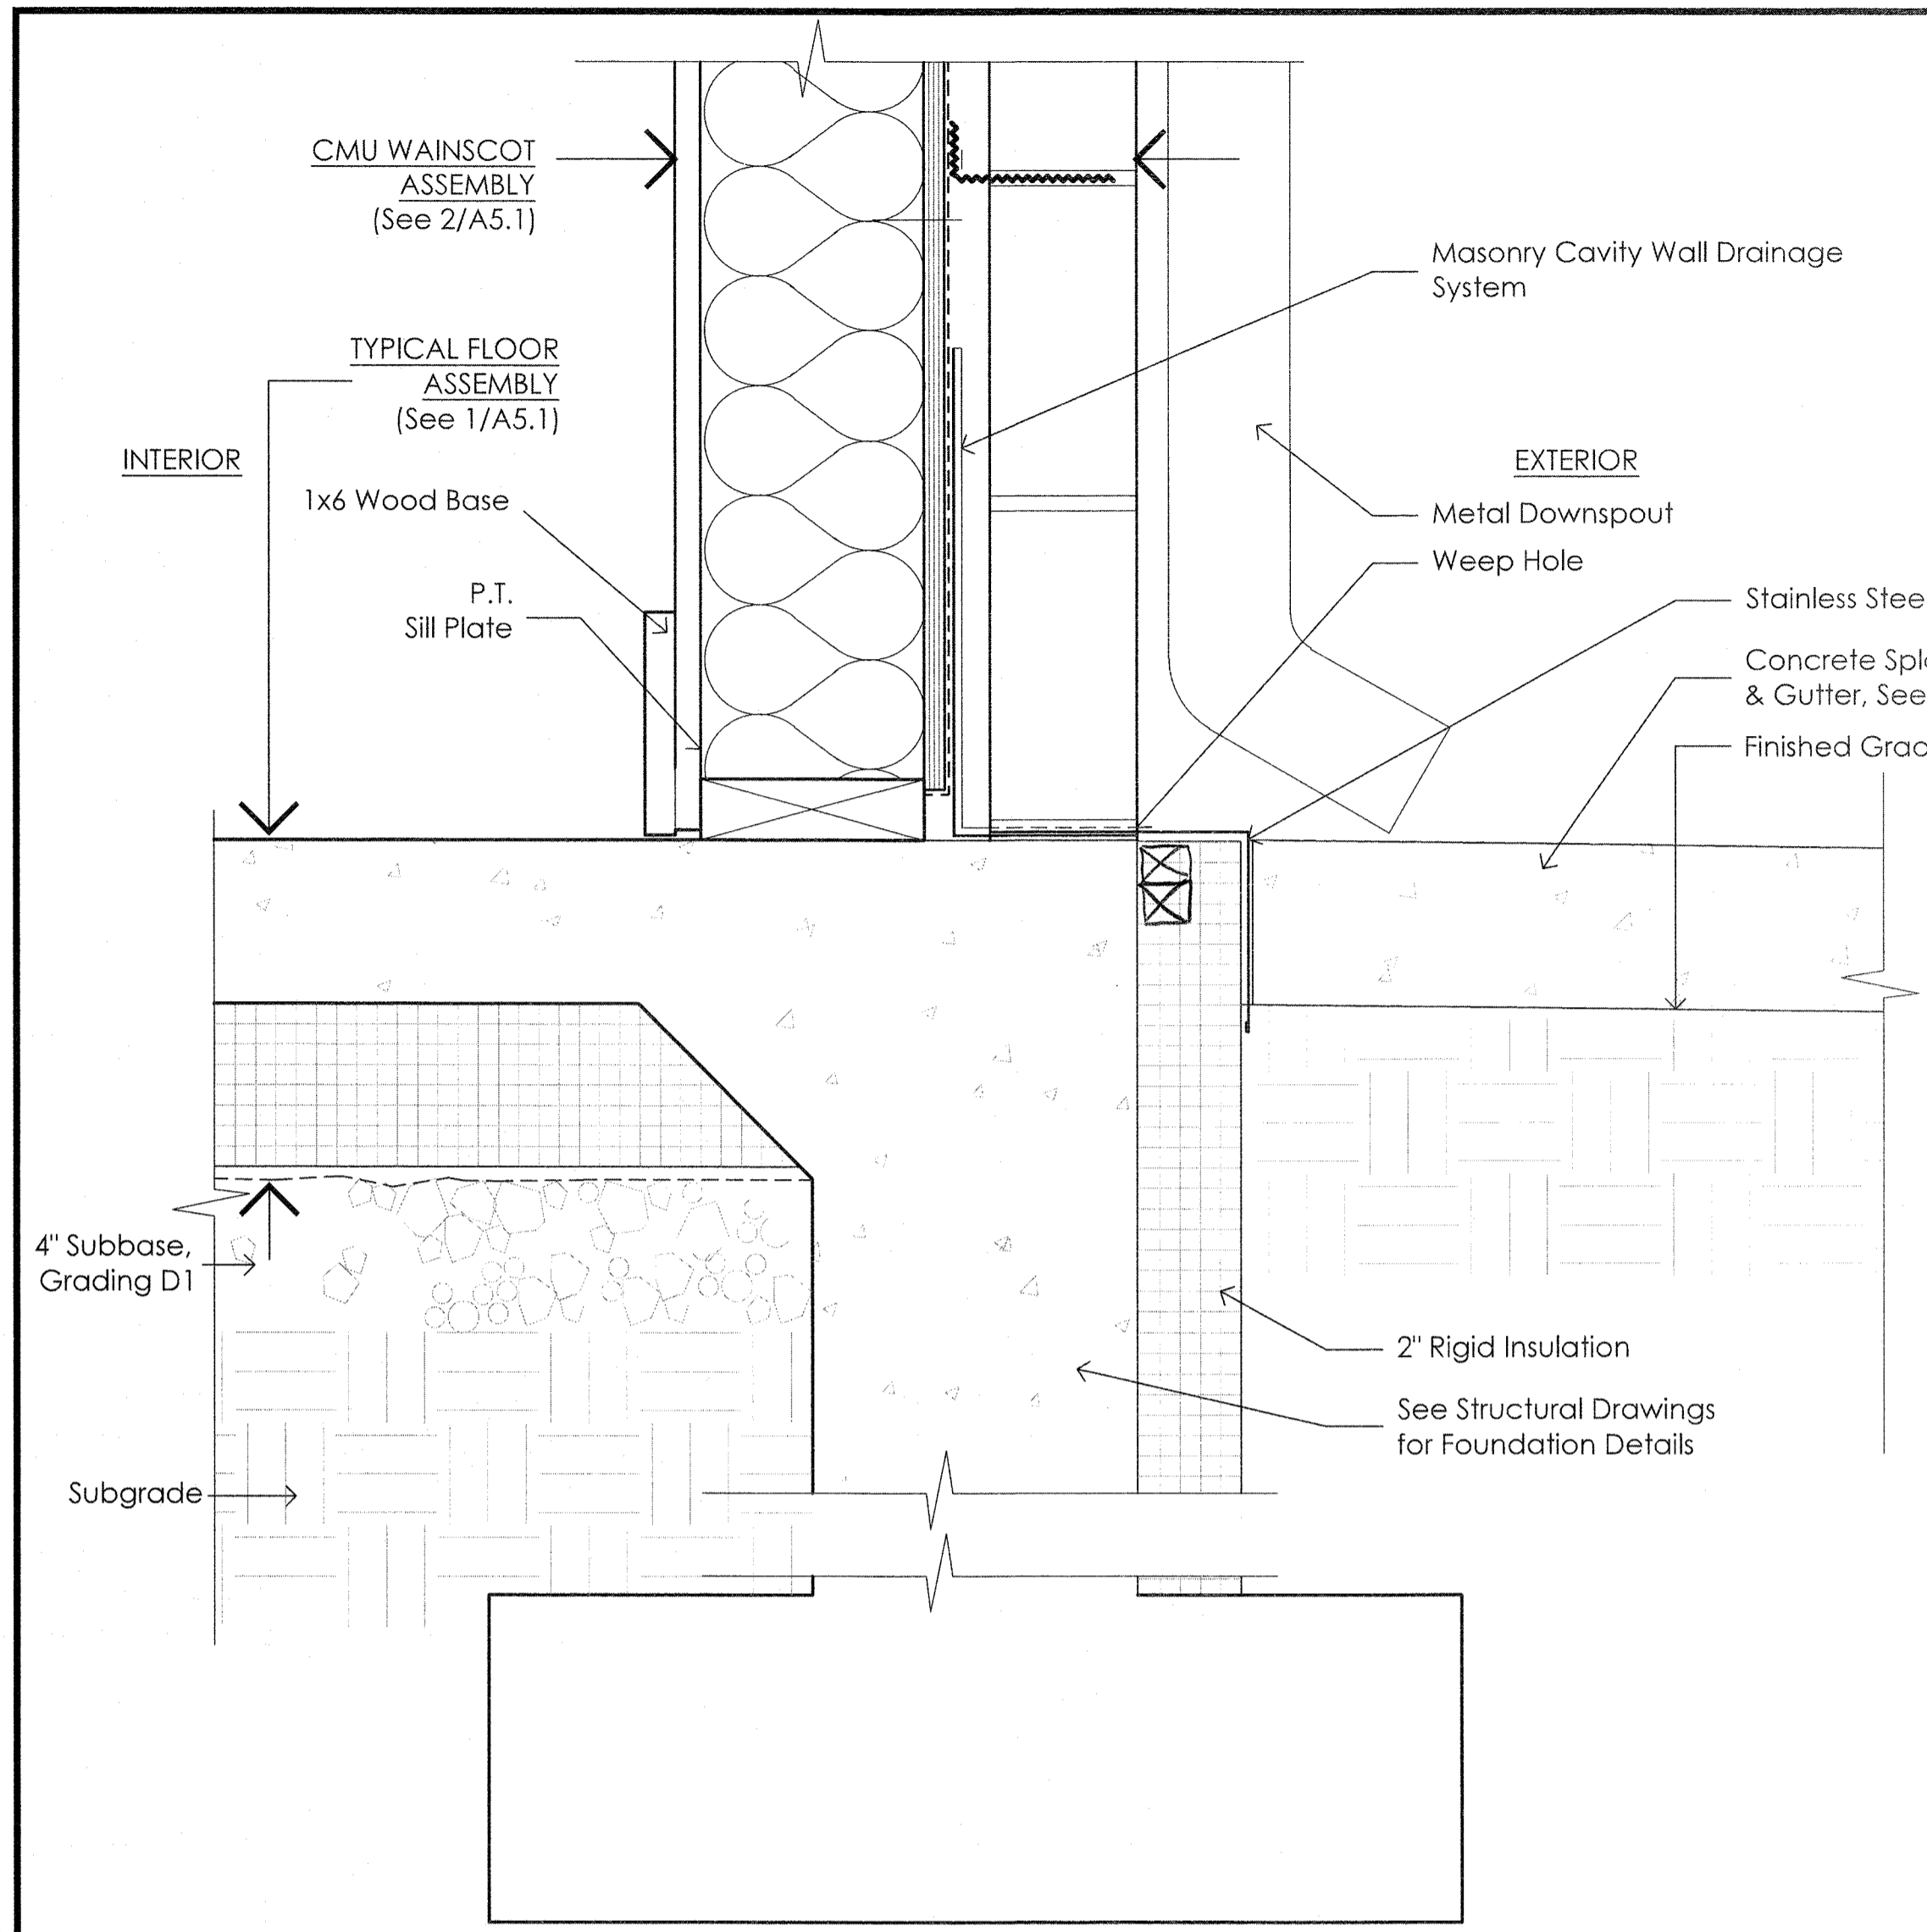


6 Wall and Floor at Foundation

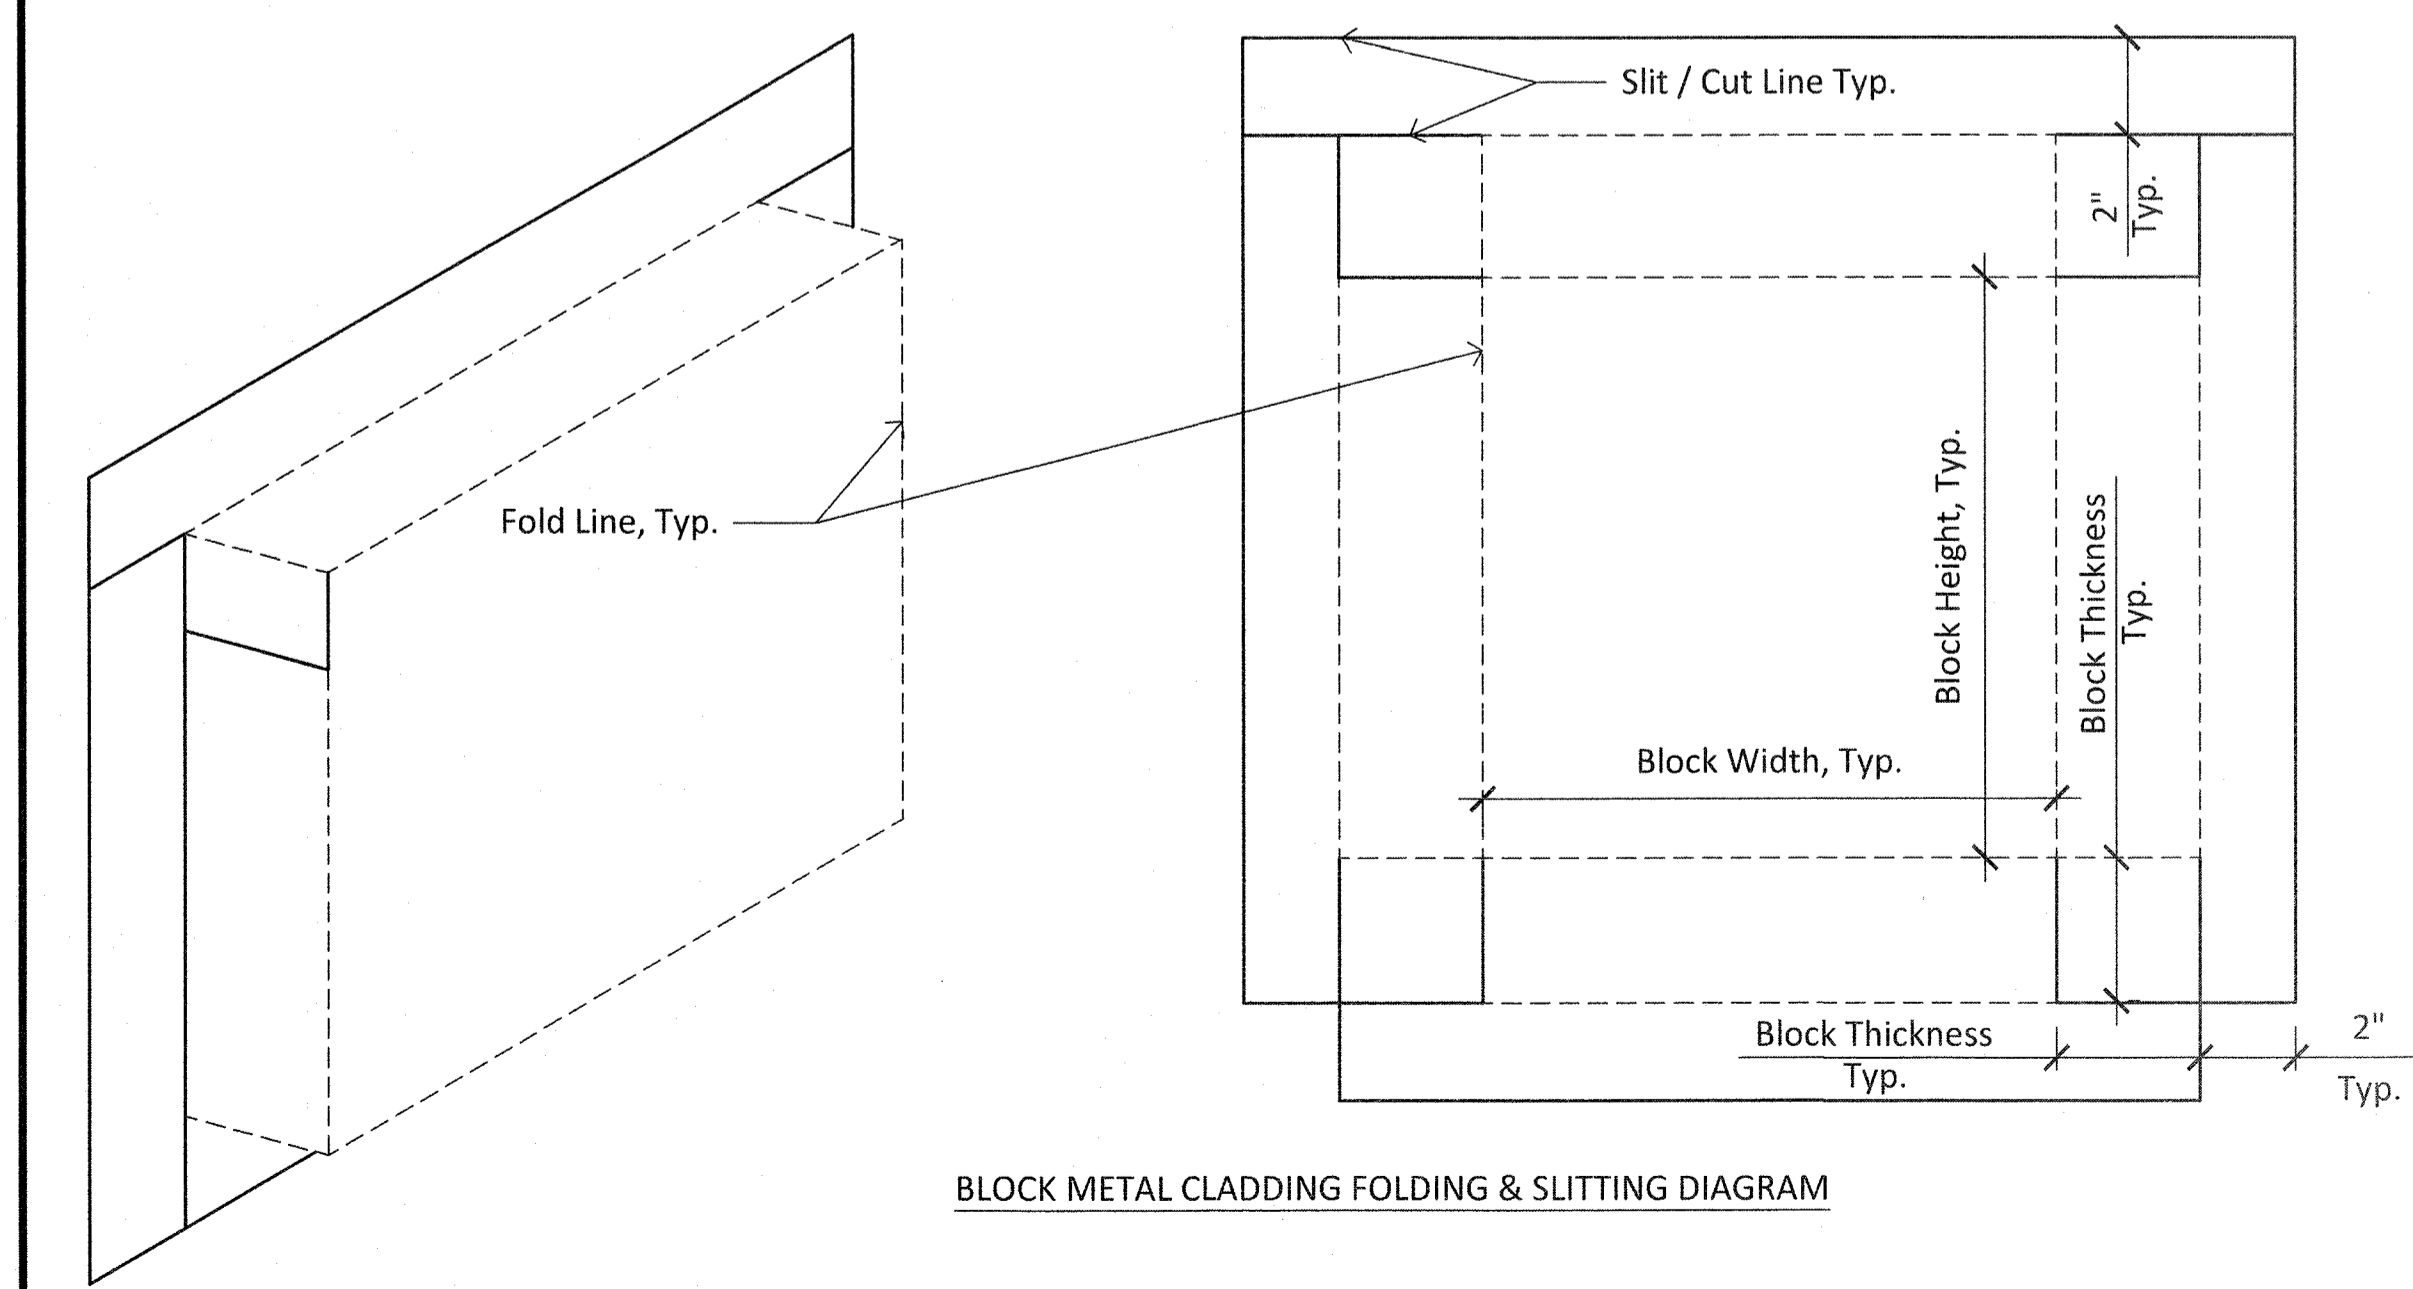


BLOCK METAL CLADDING FOLDING & SLITTING DIAGRAM

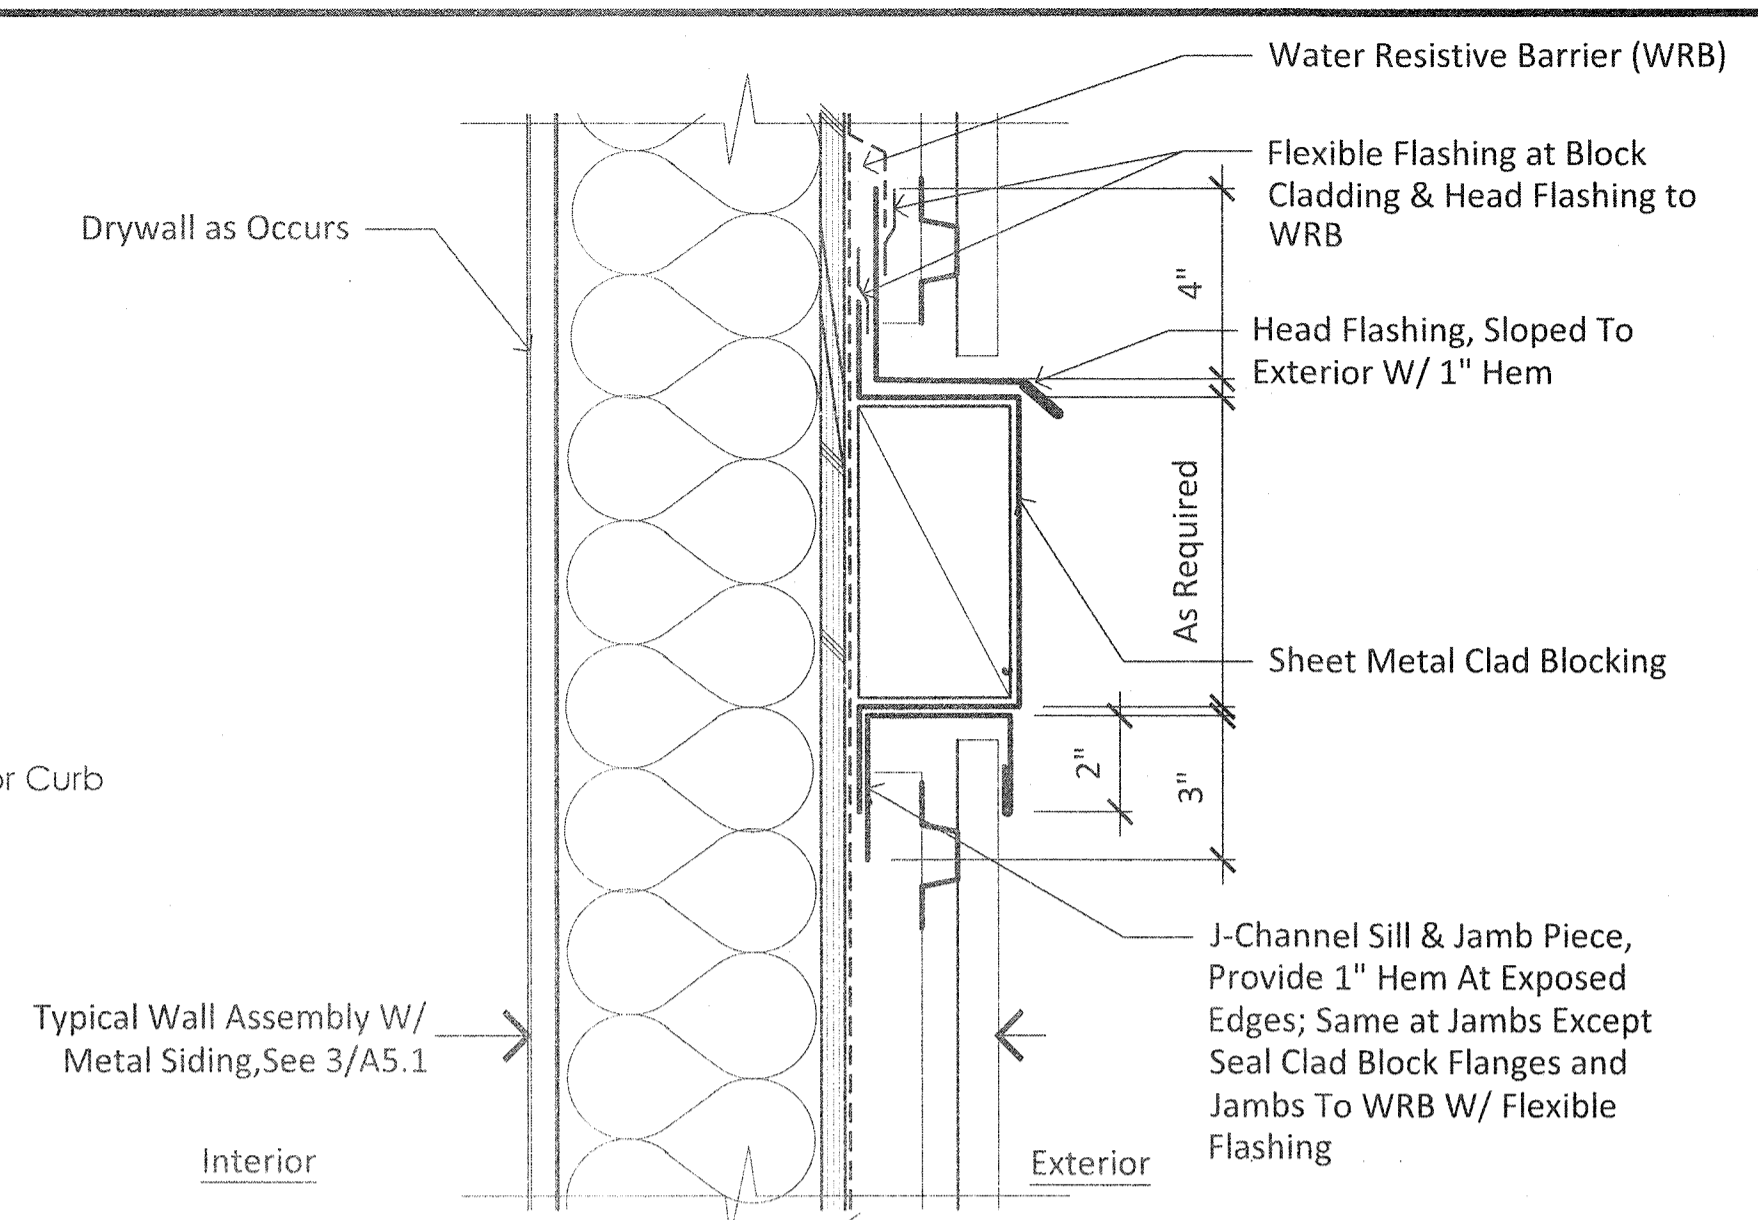


5 Exterior Mounting Block

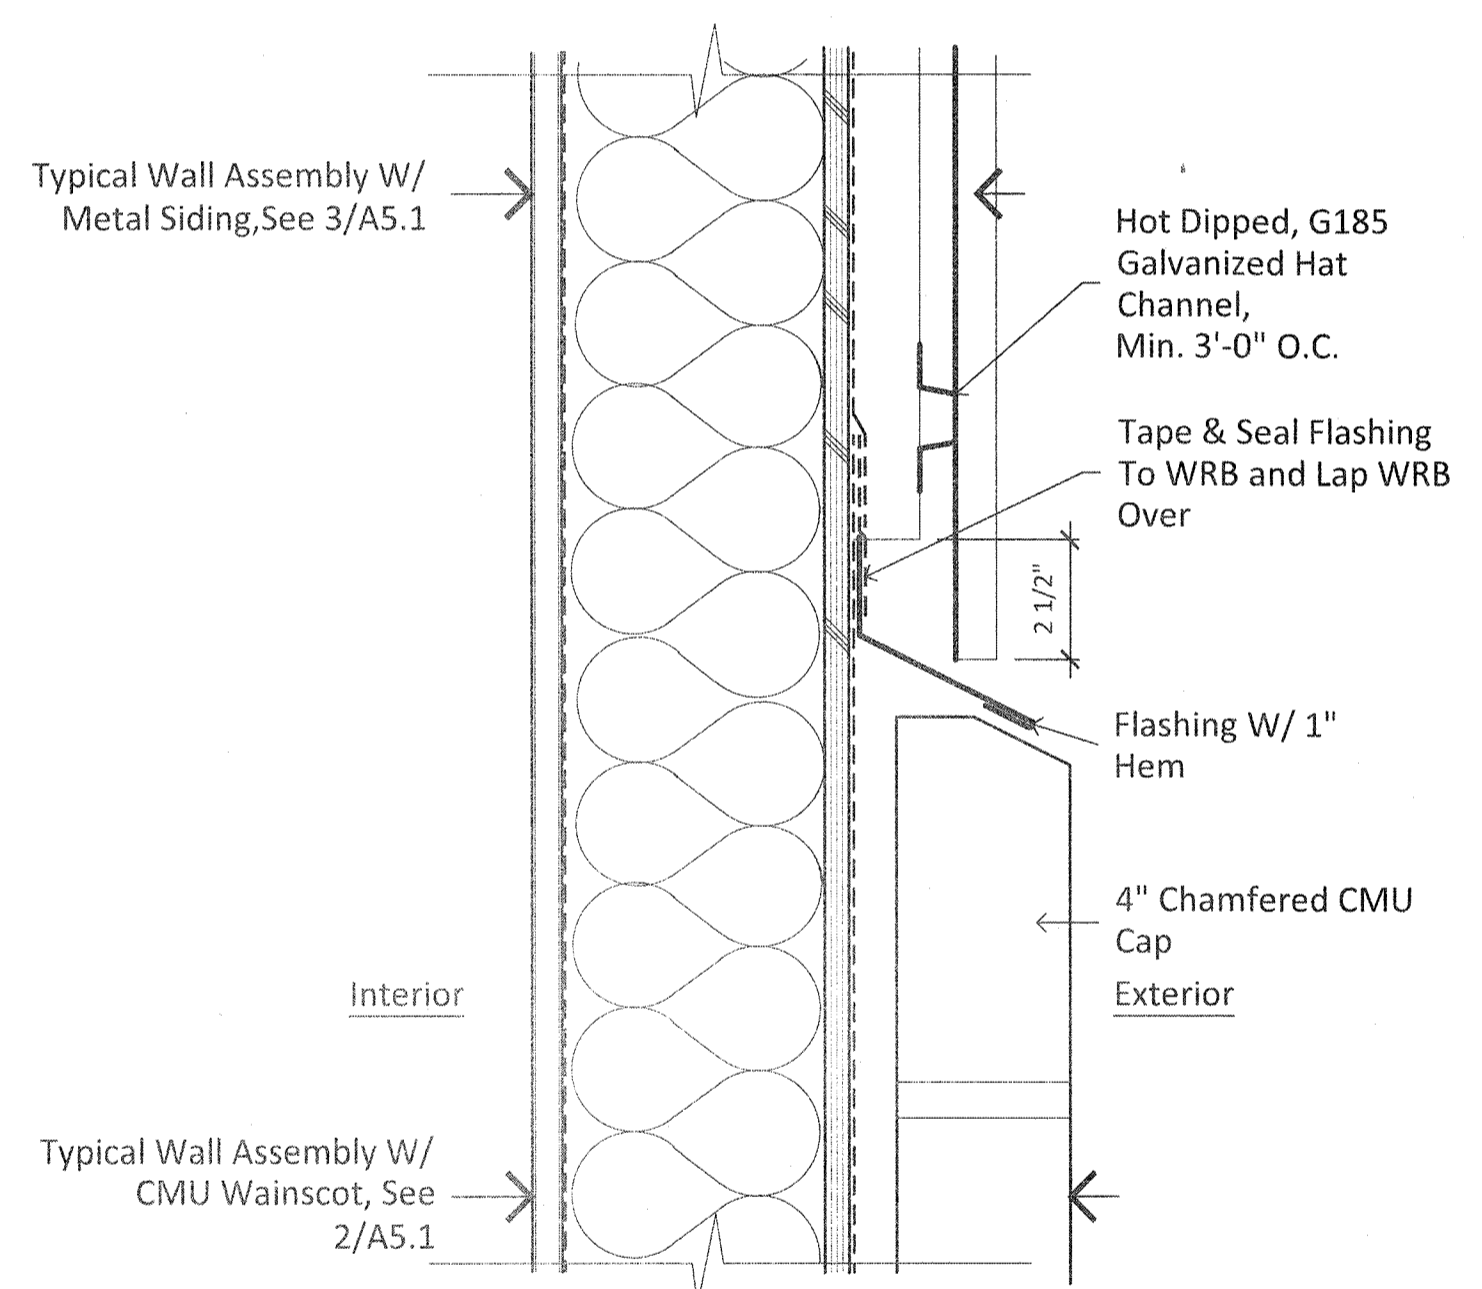


4 Metal Siding to CMU Wainscot Joint

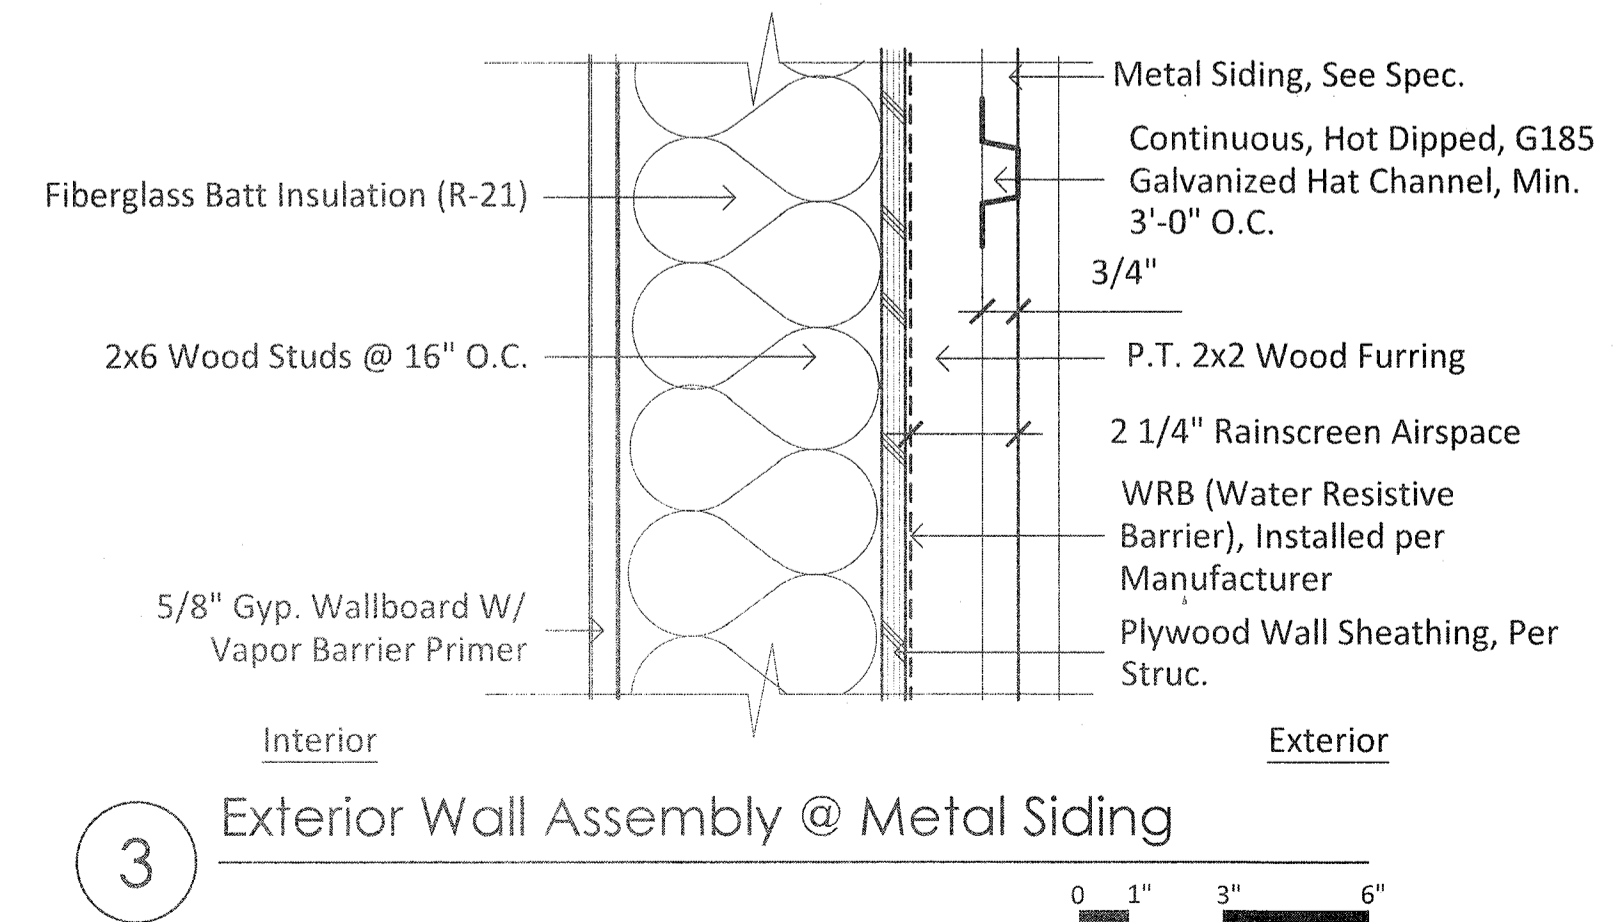

3 Exterior Wall Assembly @ Metal Siding

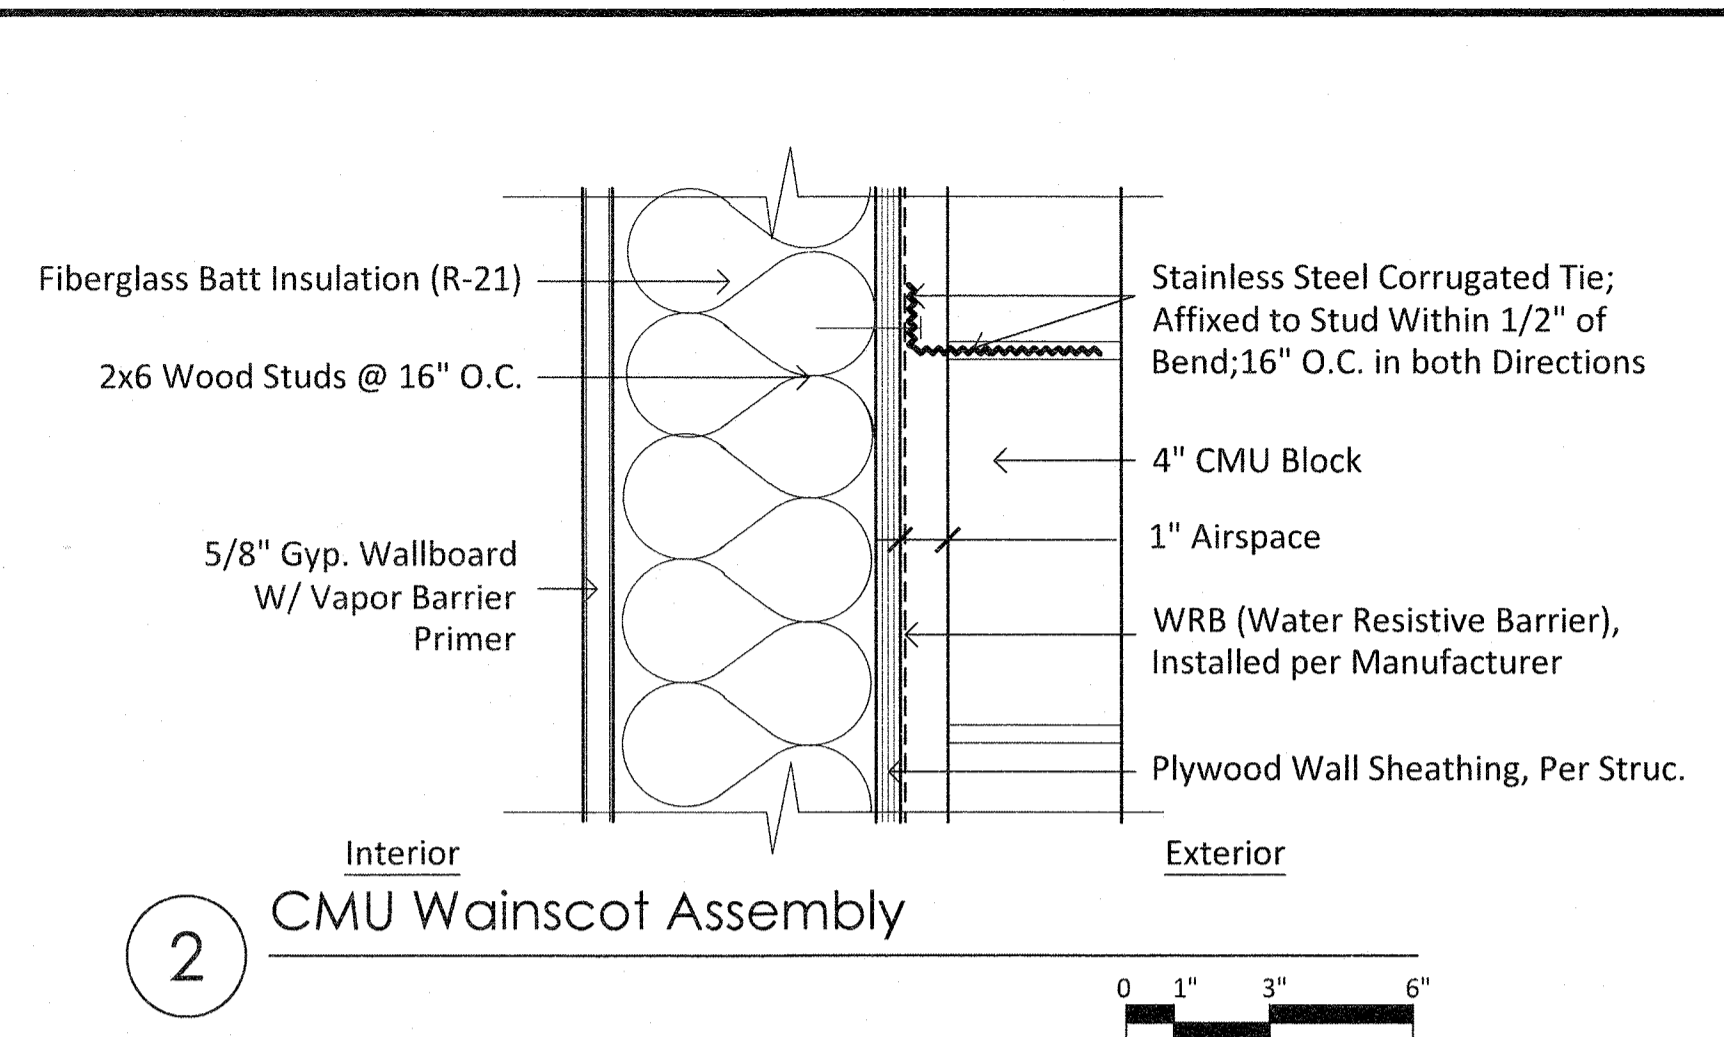

2 CMU Wainscot Assembly

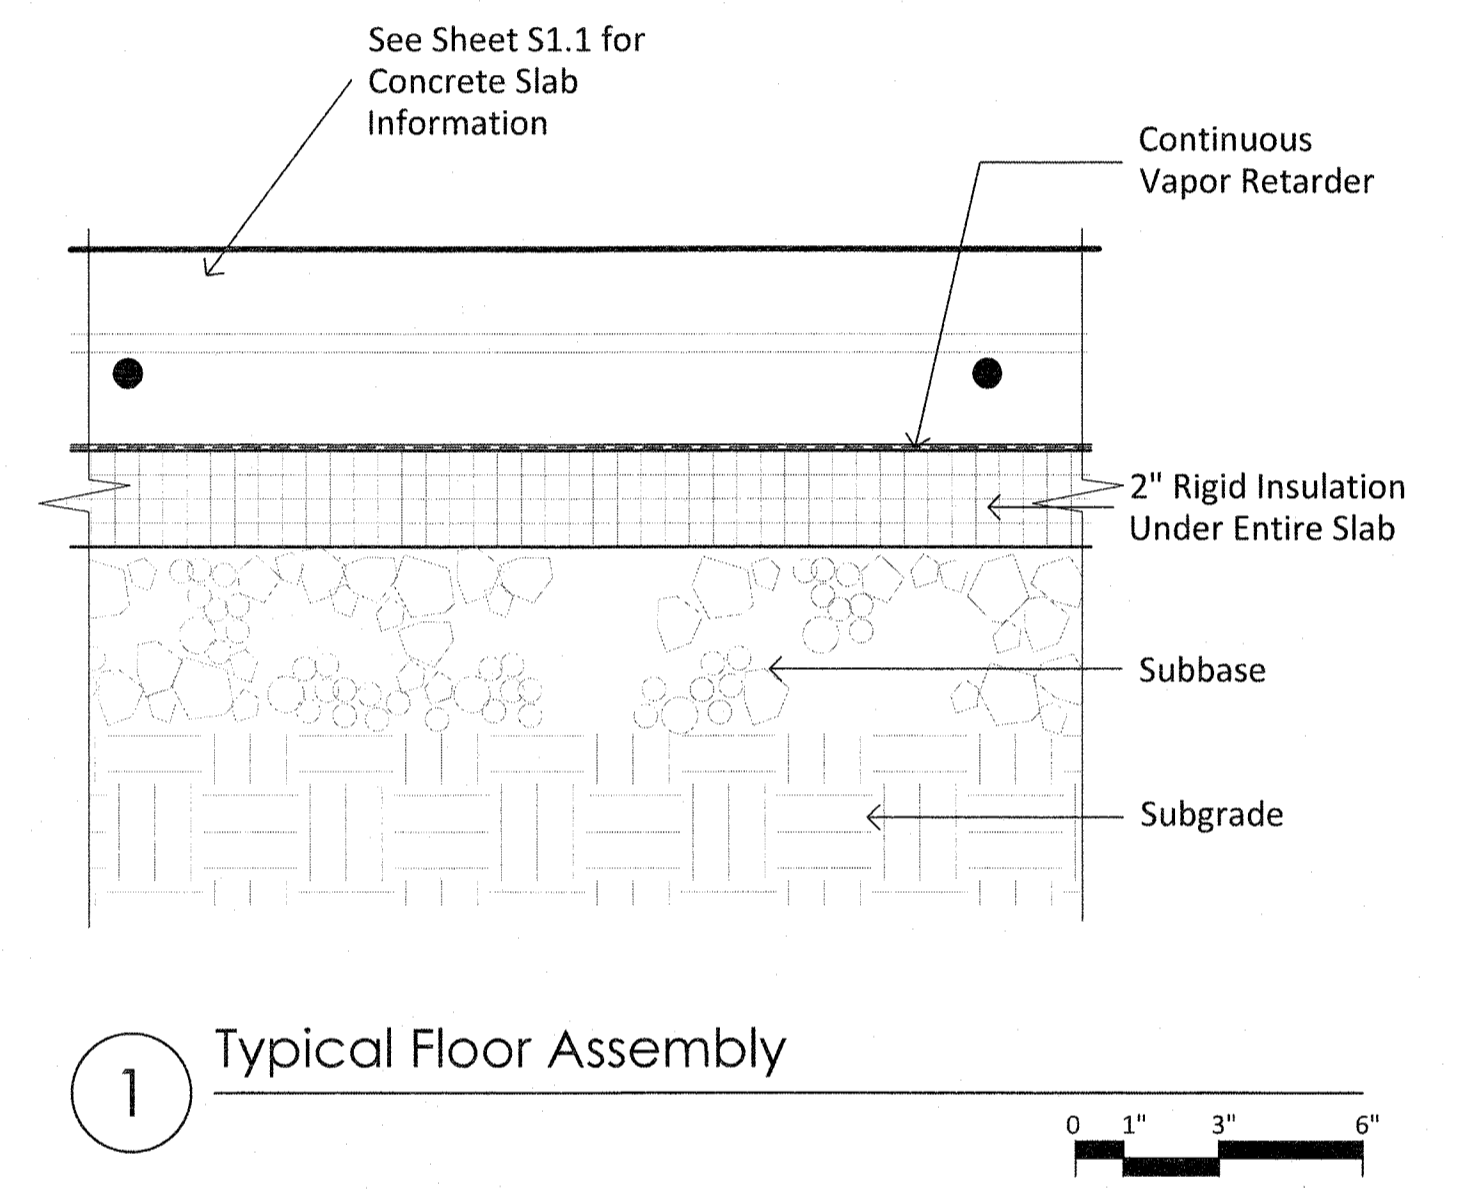

1 Typical Floor Assembly

RECORD DRAWINGS
 THESE DRAWINGS HAVE BEEN PREPARED FROM INFORMATION PROVIDED BY THE CONTRACTOR. THERE IS NO GUARANTEE TO THE ACCURACY OF THE INFORMATION CONTAINED HEREIN, EITHER EXPRESSED OR IMPLIED.
 October 27, 2017
 WELSHWHITELEYARCHITECT, LLC

DO NOT SCALE FROM THESE DRAWINGS USE DIMENSIONS

Drawings Prepared By: **WELSH WHITELEY ARCHITECTS**

327 Bawden Street
 Ketchikan, Alaska 99901
 (907) 225-2412 Voice
 (907) 225-2422 Fax

CHECKED BY: TIM WHITELEY
 DRAWN BY: AL, AR


DESIGNED BY: TIM WHITELEY
 DRAWN BY: AL, AR

STATE OF ALASKA
 DEPARTMENT OF TRANSPORTATION & PUBLIC FACILITIES
 SOUTHCOAST REGION
KAKE FERRY TERMINAL PASSENGER FACILITY PLANSET B
 Details

October 27, 2017

PATH: Y:\2011 PROJECTS\1121_ANGOOON & KAKE FERRY TERMINALS\10 DRAWINGS\2-KAKE SHEETS\1121-K
 TAB: A5.1 Friday, October 27, 2017 11:59:06 AM AMANDA ROBINSON

REVISIONS			PROJECT DESIGNATION	YEAR	SHEET NO.	TOTAL SHEETS
NO.	DATE	DESCRIPTION	SAMHS0002	2015	A5.1	35

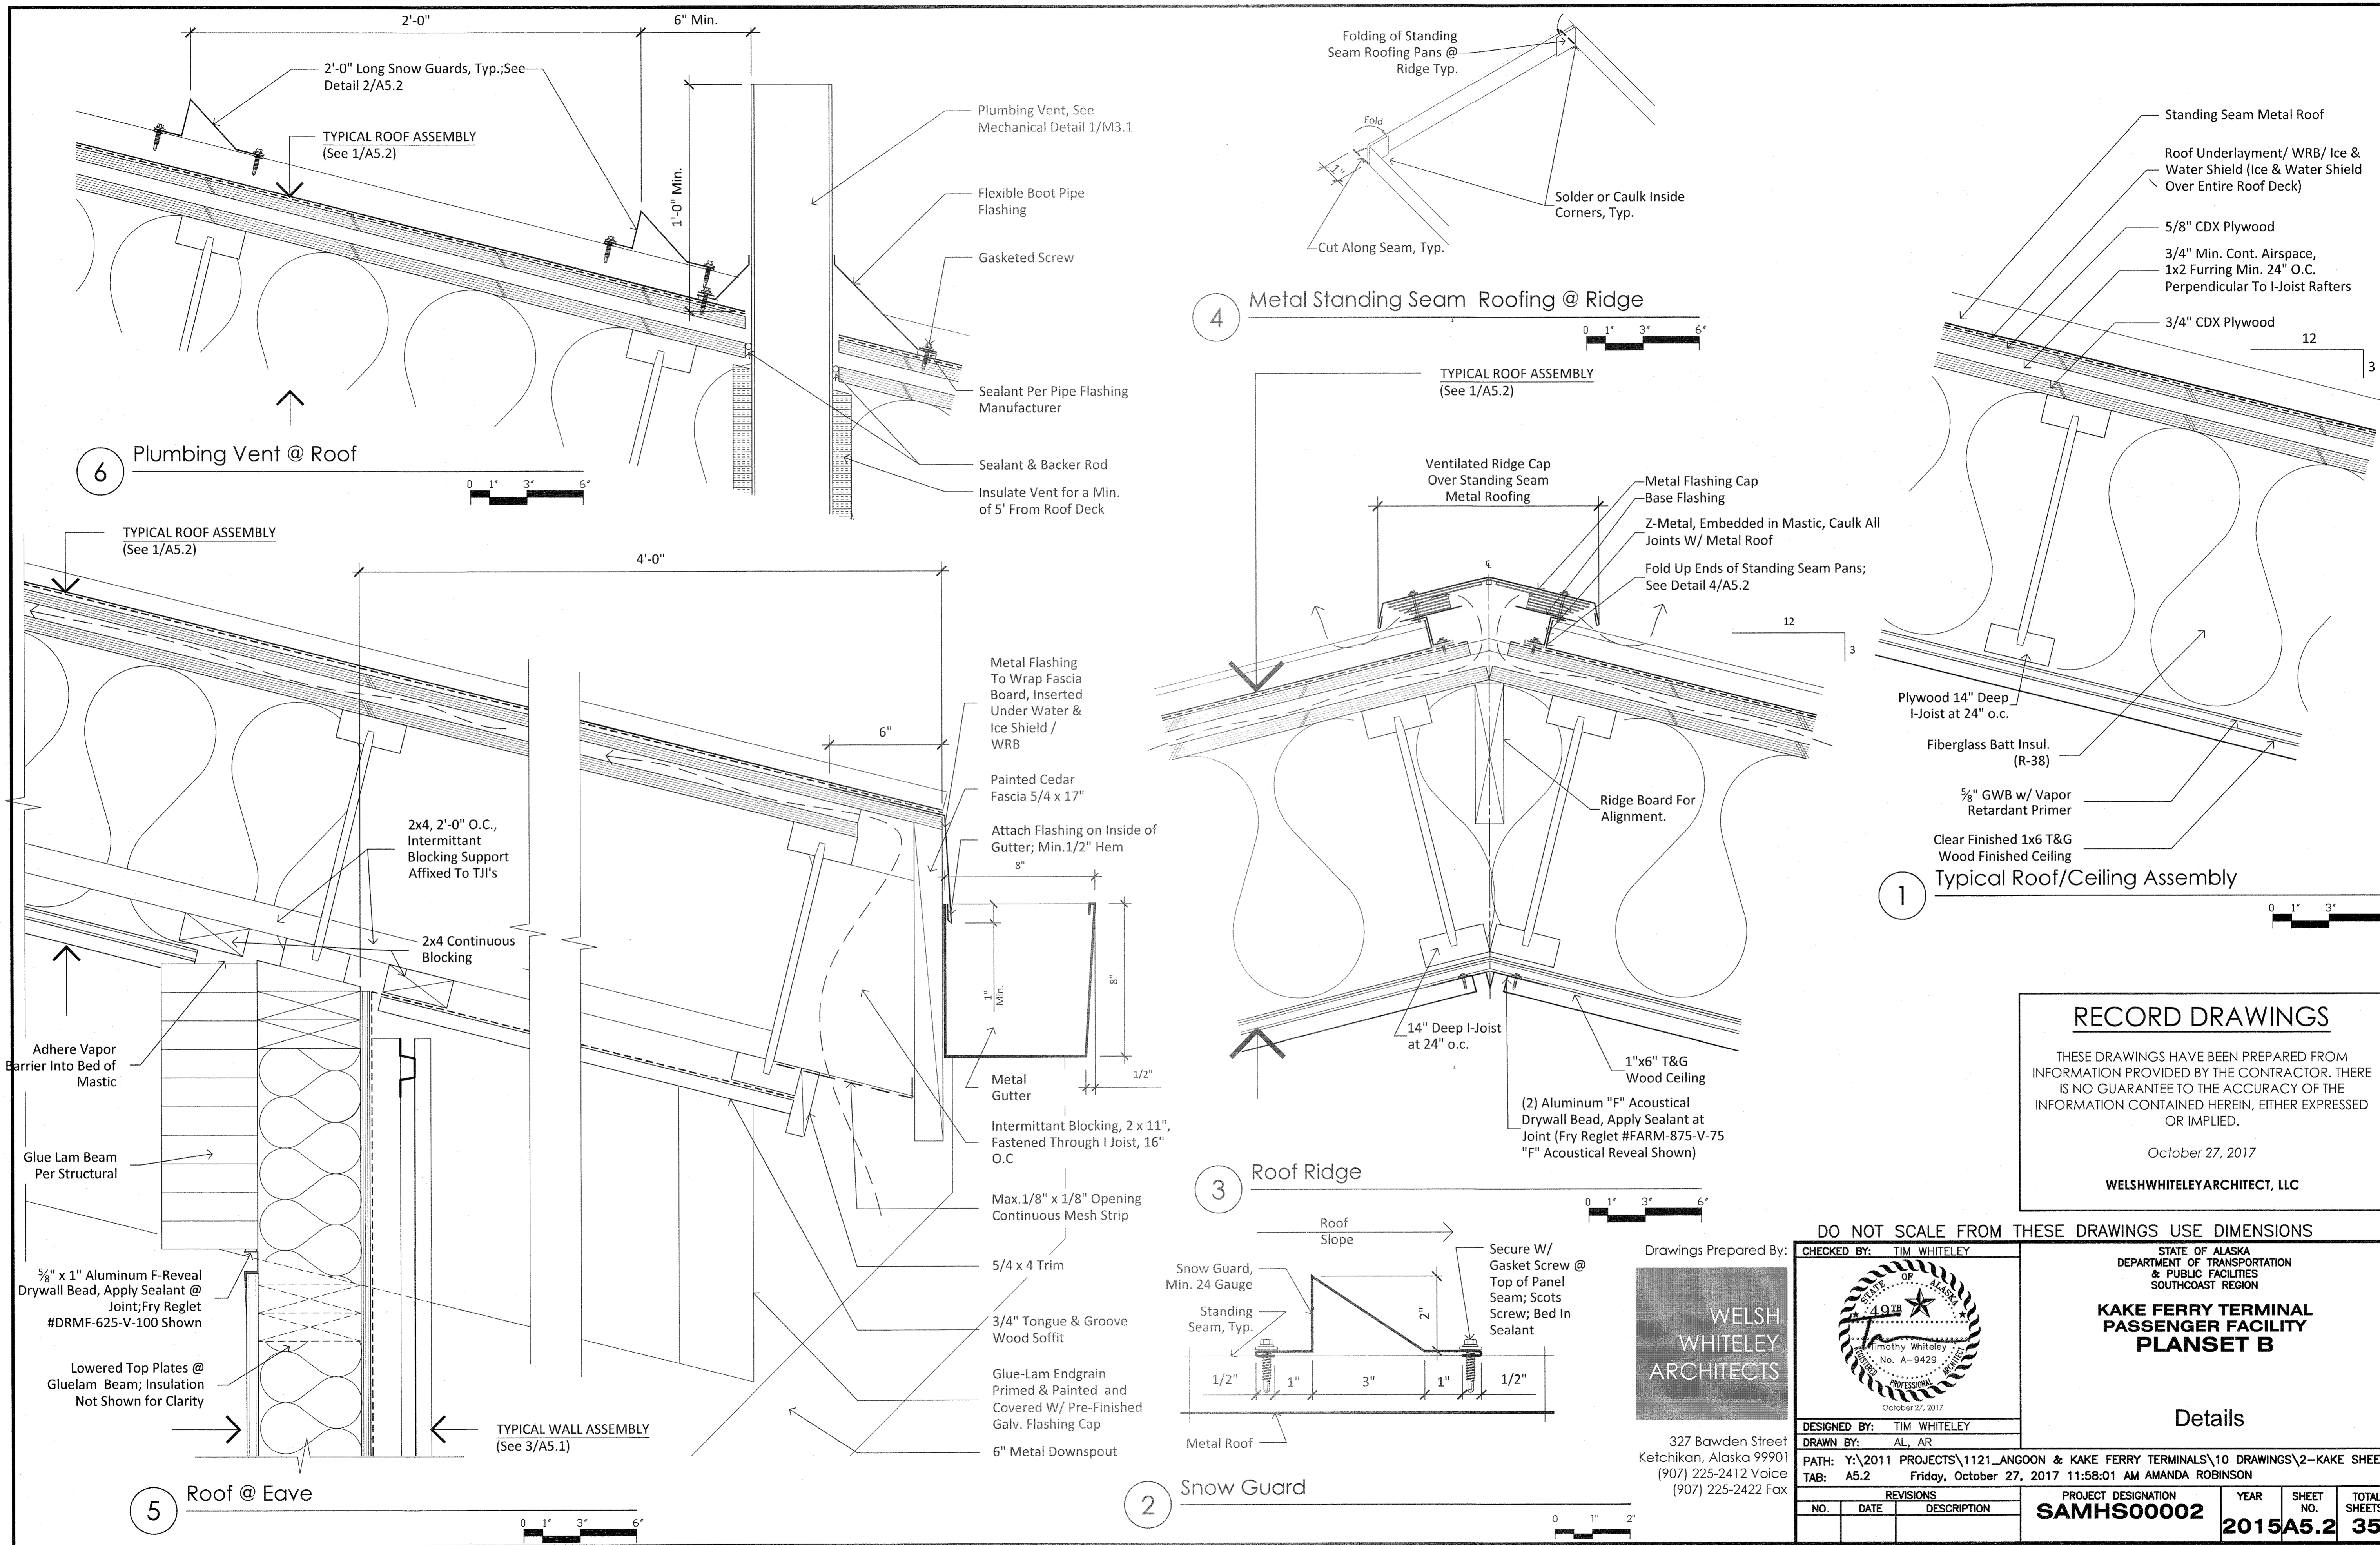

RECORD DRAWINGS
 THESE DRAWINGS HAVE BEEN PREPARED FROM INFORMATION PROVIDED BY THE CONTRACTOR. THERE IS NO GUARANTEE TO THE ACCURACY OF THE INFORMATION CONTAINED HEREIN, EITHER EXPRESSED OR IMPLIED.
 October 27, 2017
 WELSHWHITELEYARCHITECT, LLC

Drawings Prepared By:
WELSH WHITELEY ARCHITECTS
 327 Bawden Street
 Ketchikan, Alaska 99901
 (907) 225-2412 Voice
 (907) 225-2422 Fax

DO NOT SCALE FROM THESE DRAWINGS USE DIMENSIONS

CHECKED BY: TIM WHITELEY
 DRAWN BY: AL, AR
 DESIGNED BY: TIM WHITELEY
 October 27, 2017

REVISIONS		
NO.	DATE	DESCRIPTION


STATE OF ALASKA
 DEPARTMENT OF TRANSPORTATION & PUBLIC FACILITIES
 SOUTHCOAST REGION

KAKE FERRY TERMINAL PASSENGER FACILITY PLANSET B


Details

PROJECT DESIGNATION	YEAR	SHEET NO.	TOTAL SHEETS
SAMHS00002	2015	A5.2	35


PATH: Y:\2011 PROJECTS\1121_ANGOOK & KAKE FERRY TERMINALS\10 DRAWINGS\2-KAKE SHEETS\1121-K
 TAB: A5.2 Friday, October 27, 2017 11:58:01 AM AMANDA ROBINSON

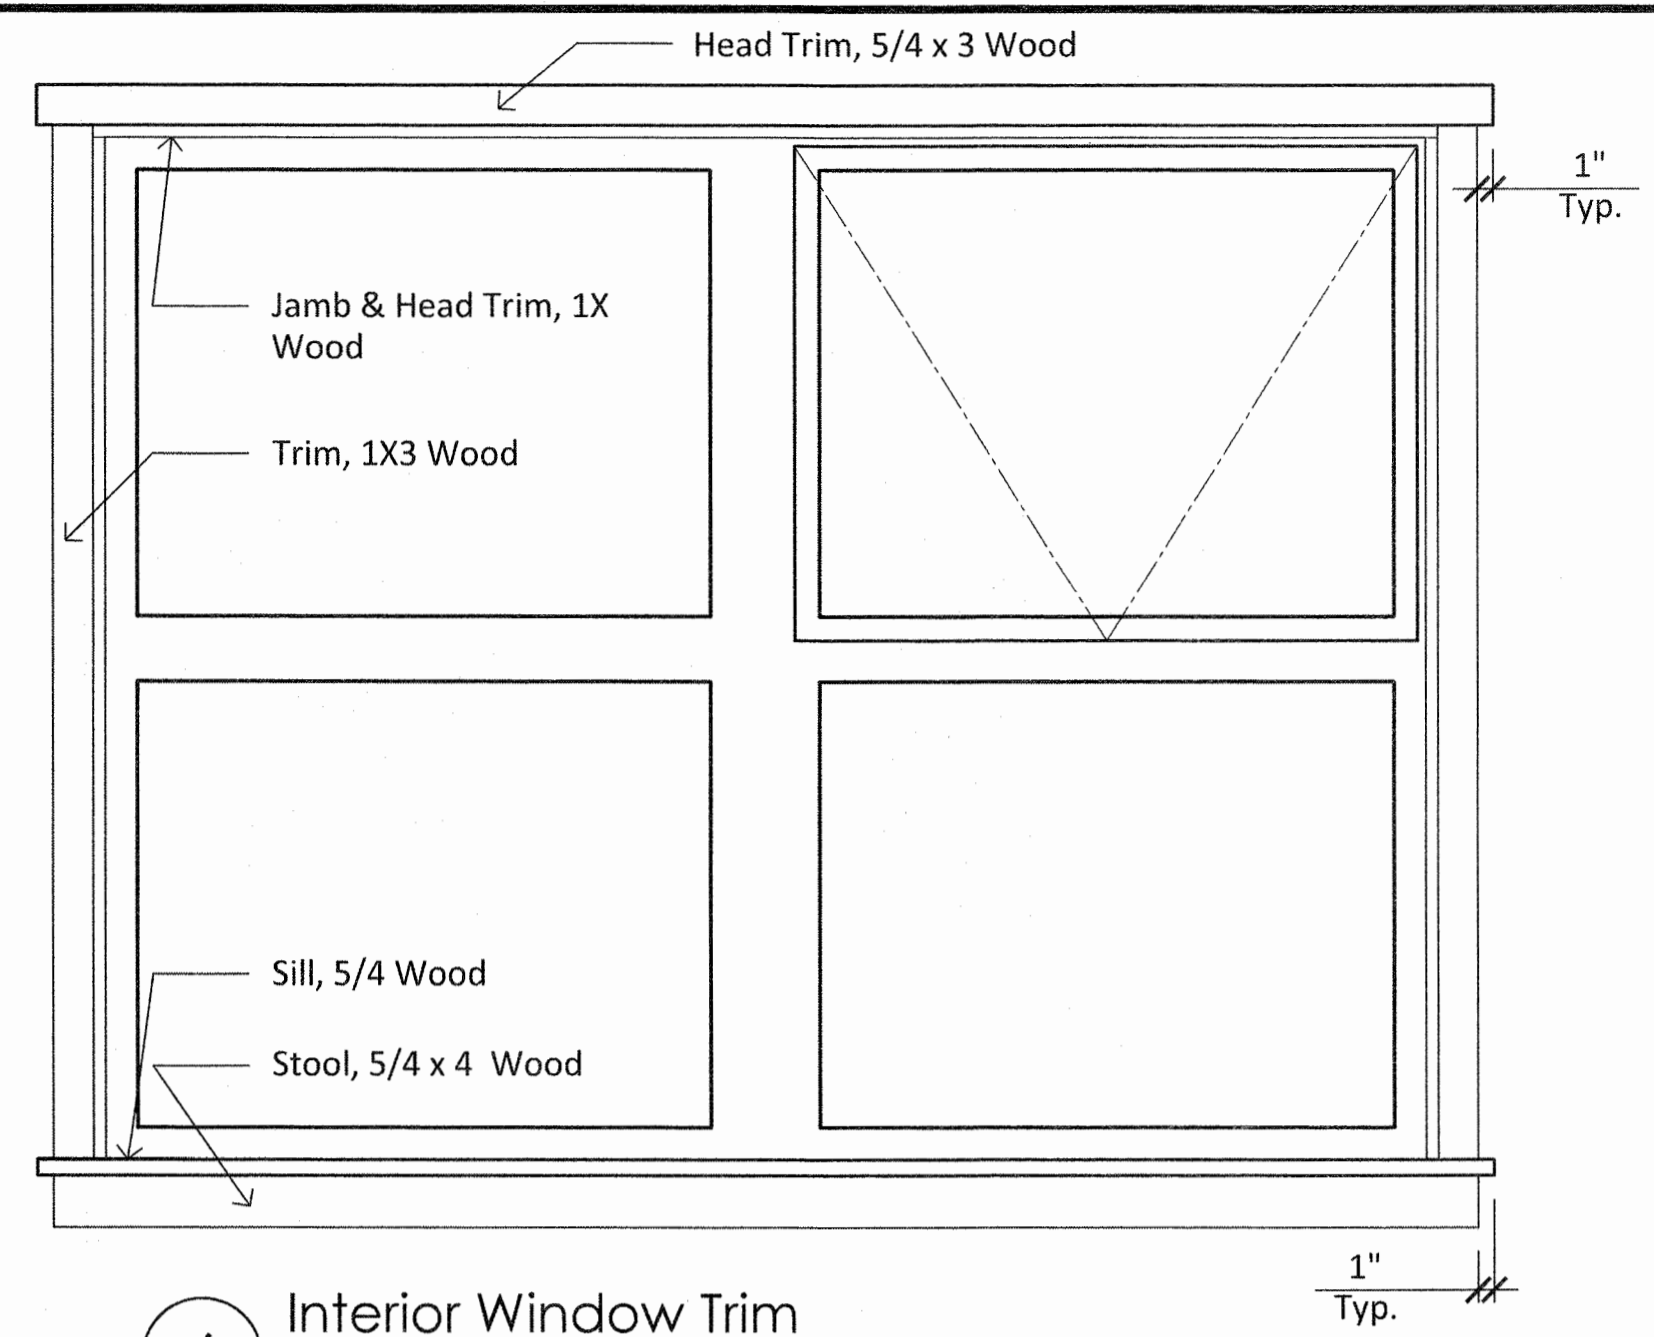


6 Interior Window Trim

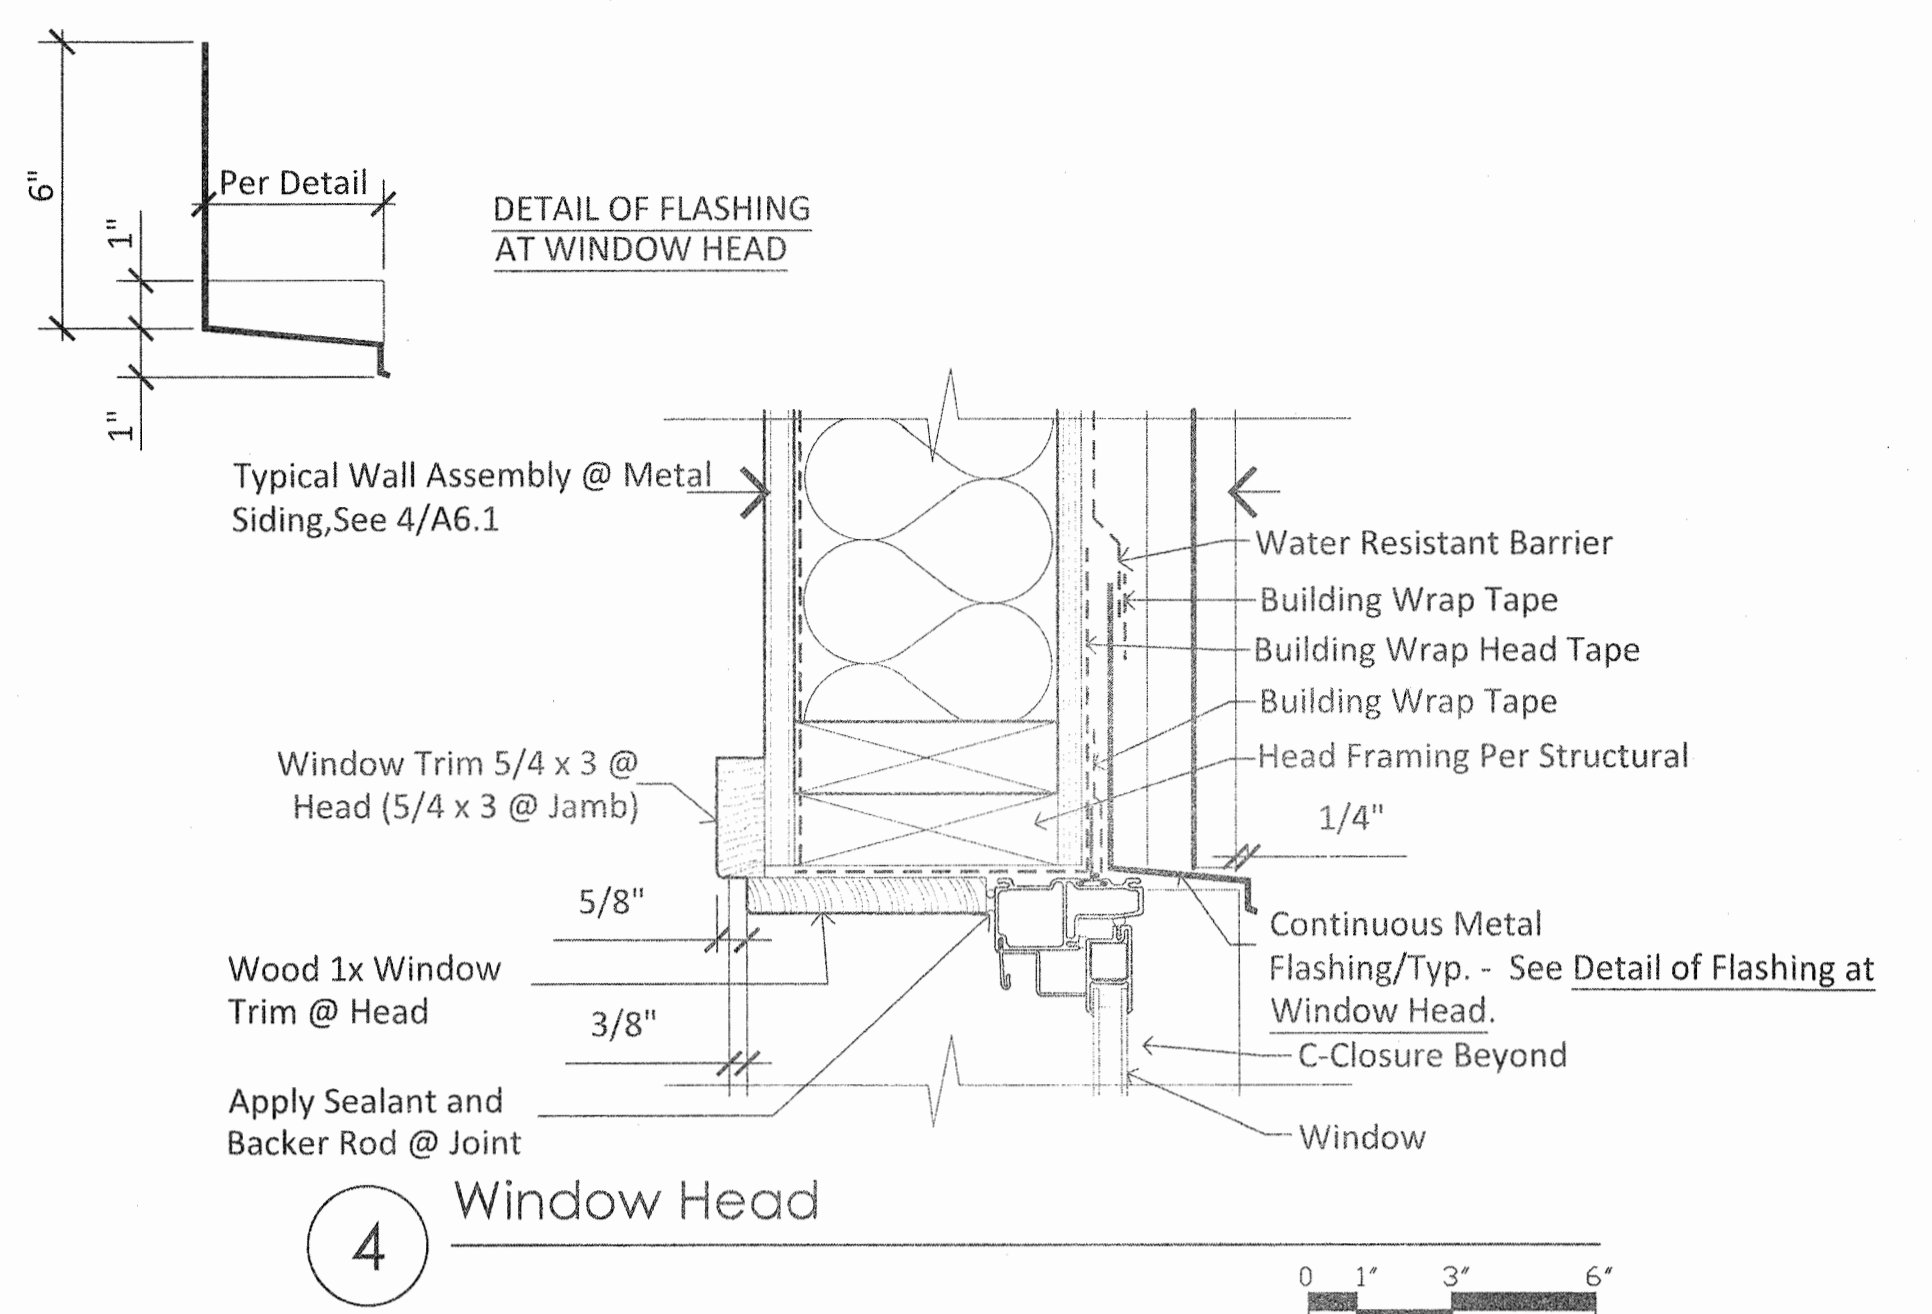


4 Window Head

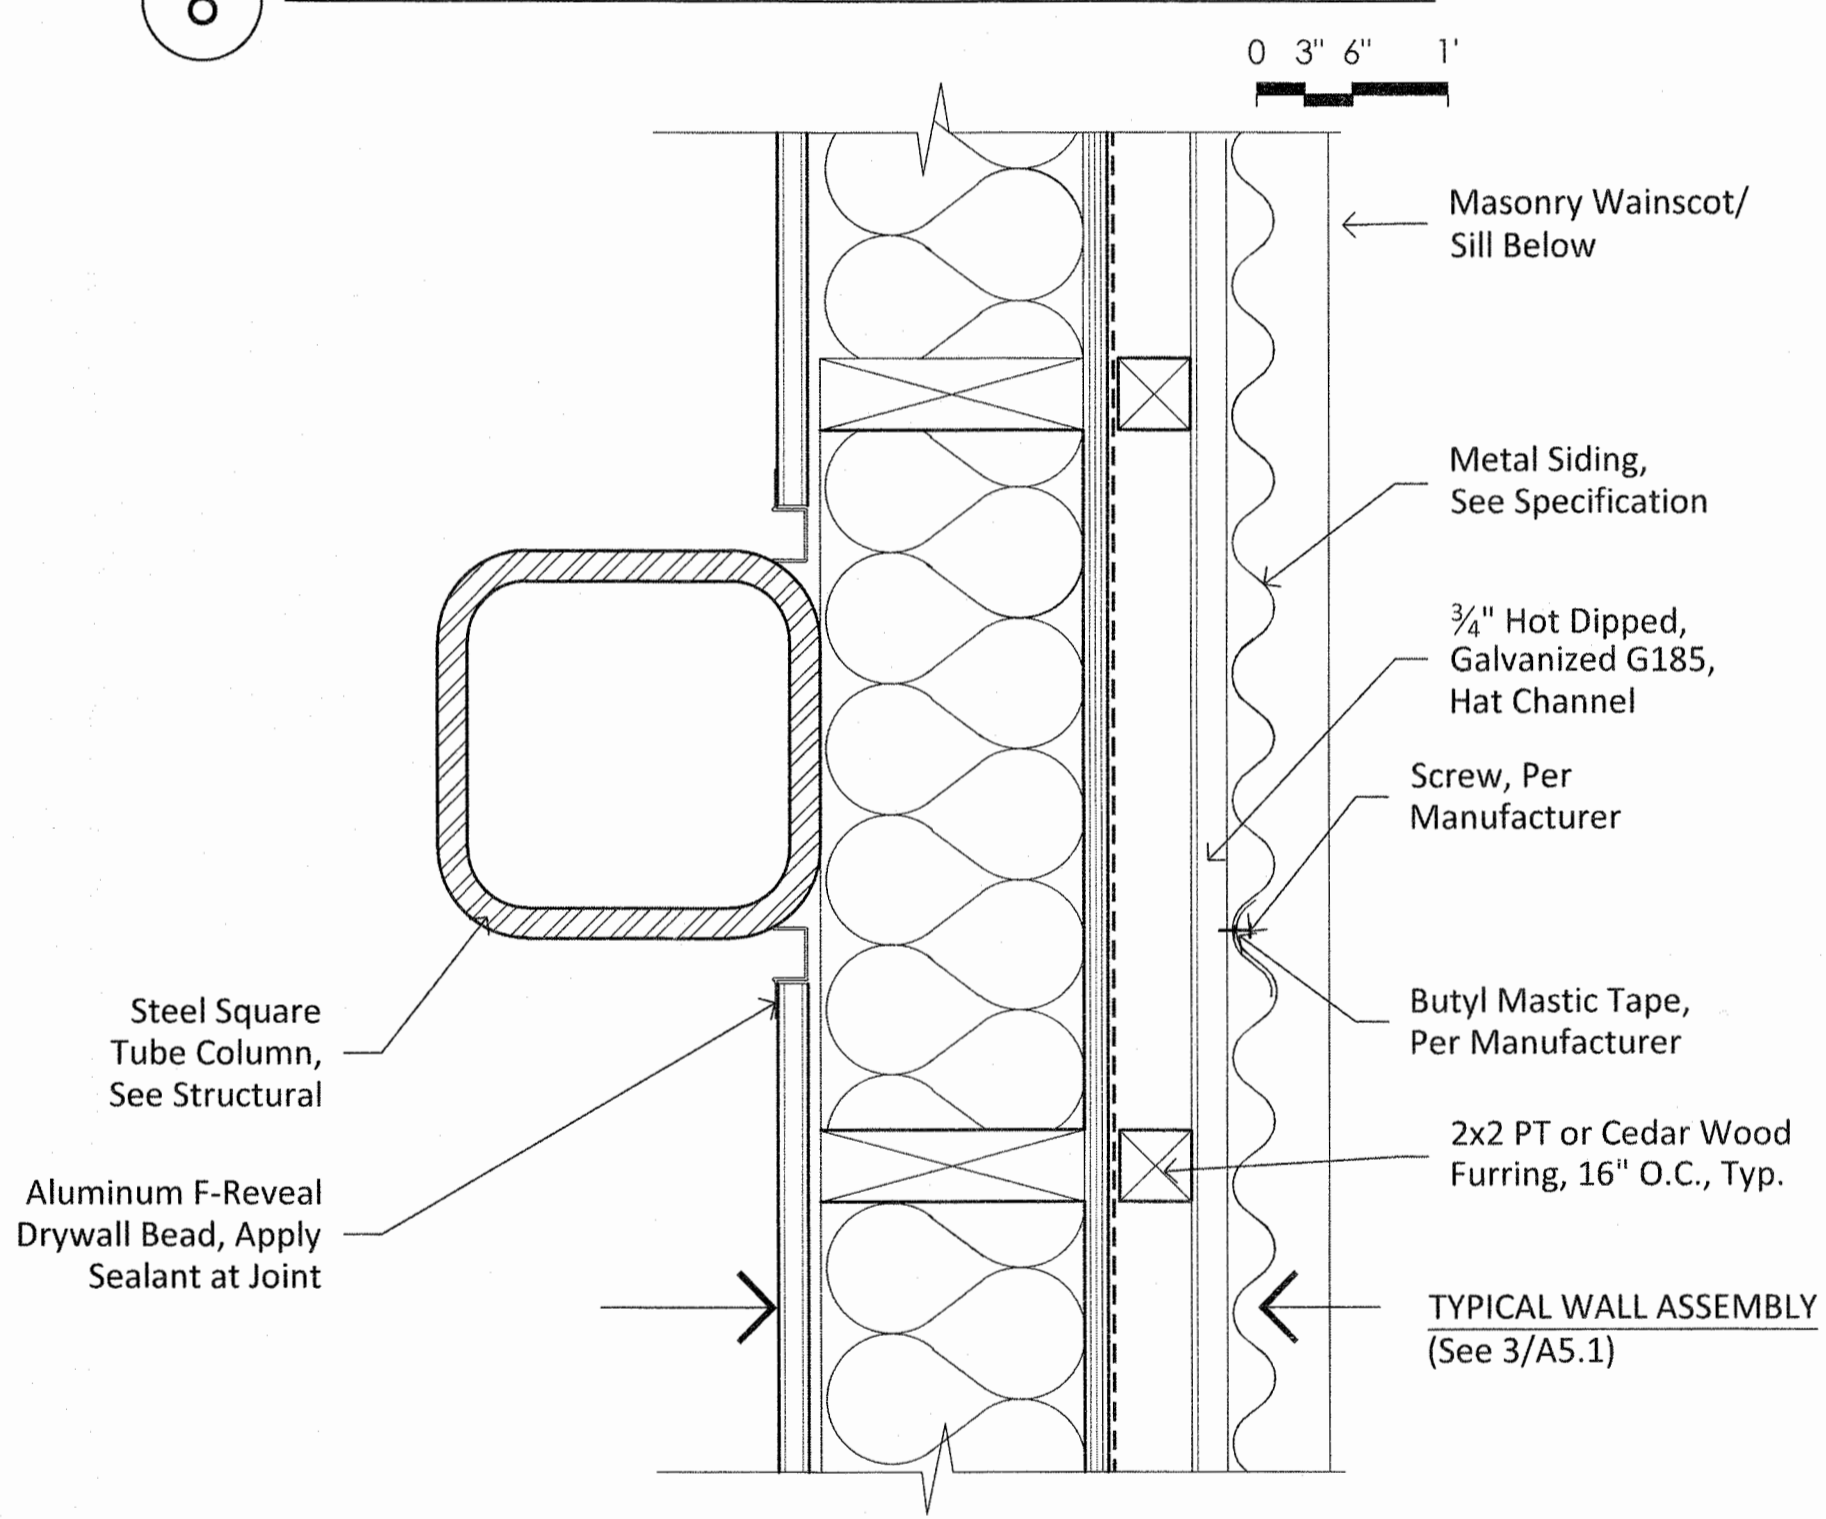


5 Wall @ Column

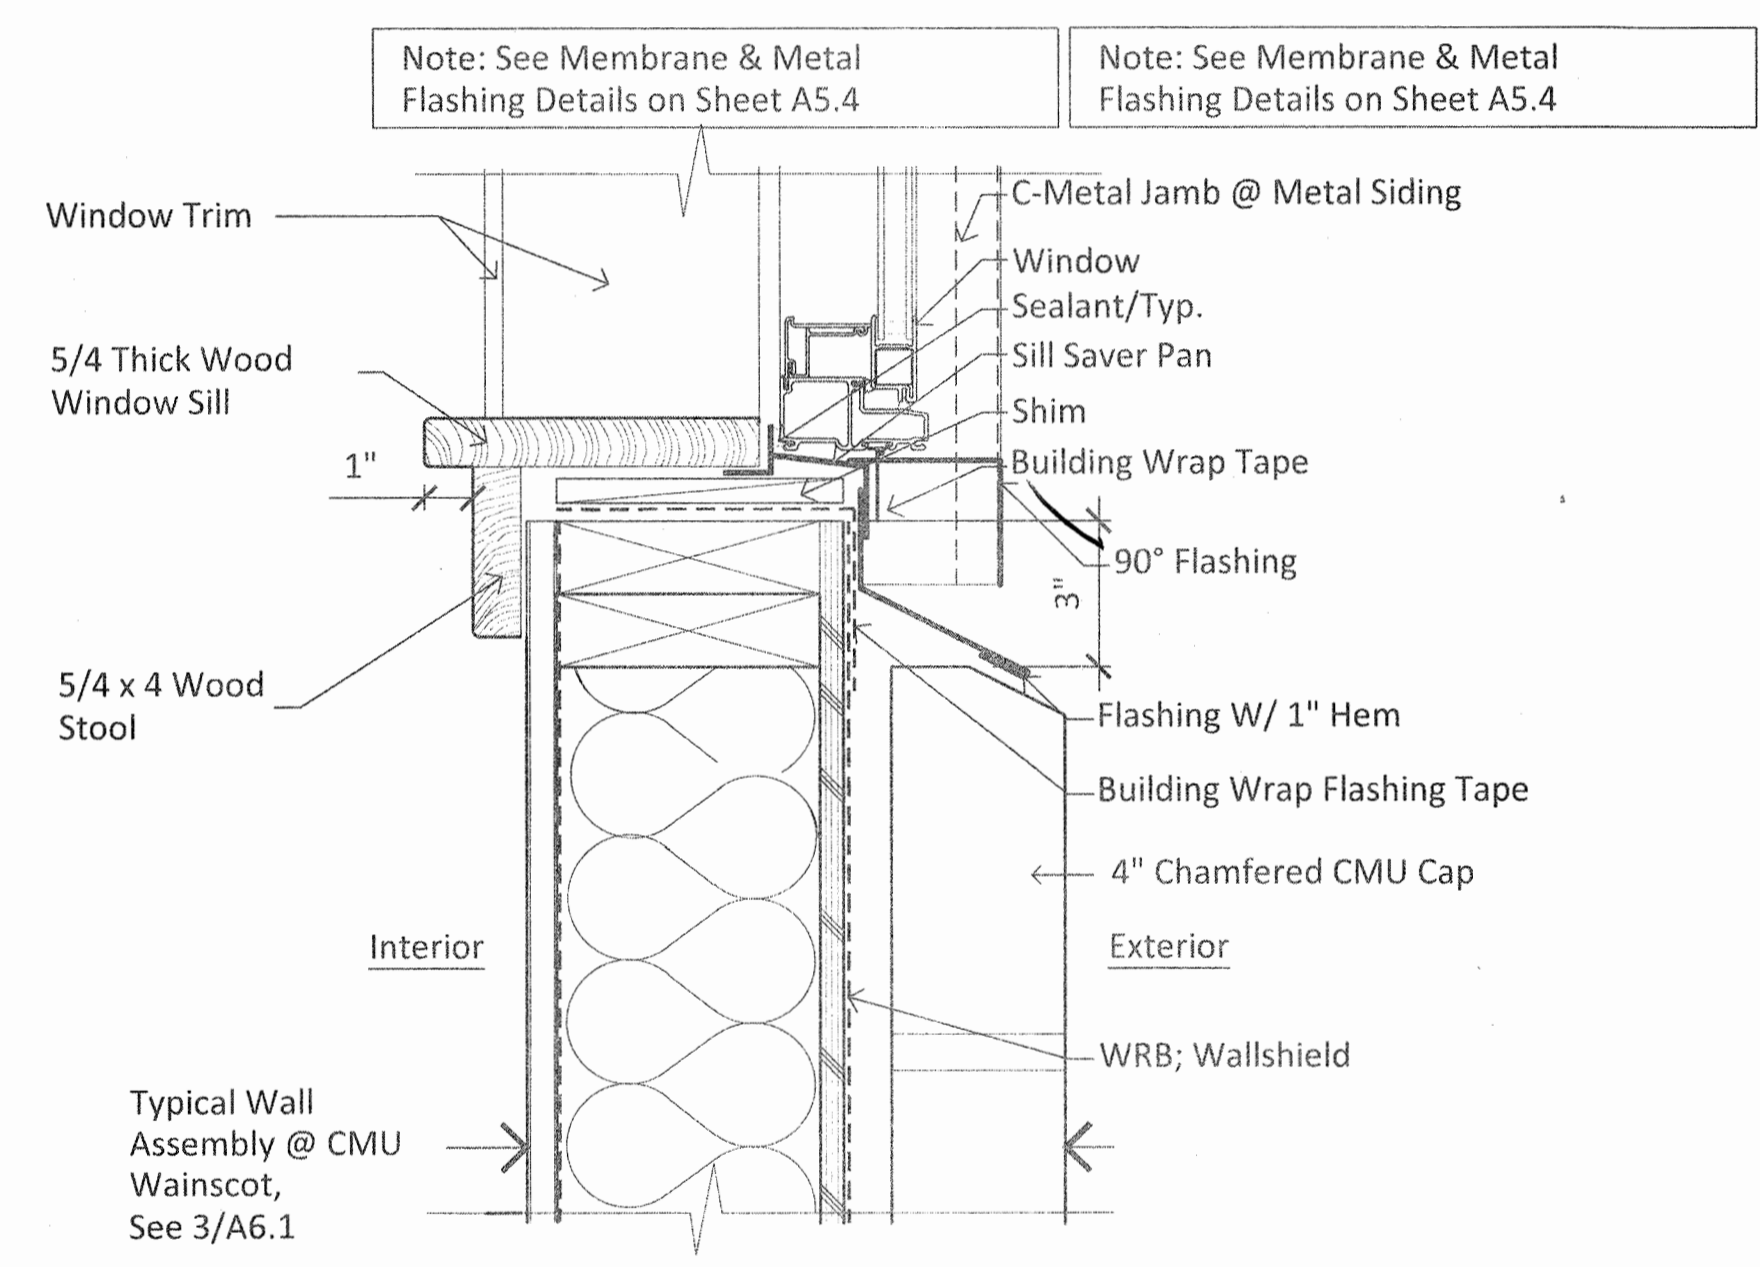


3 Window Sill

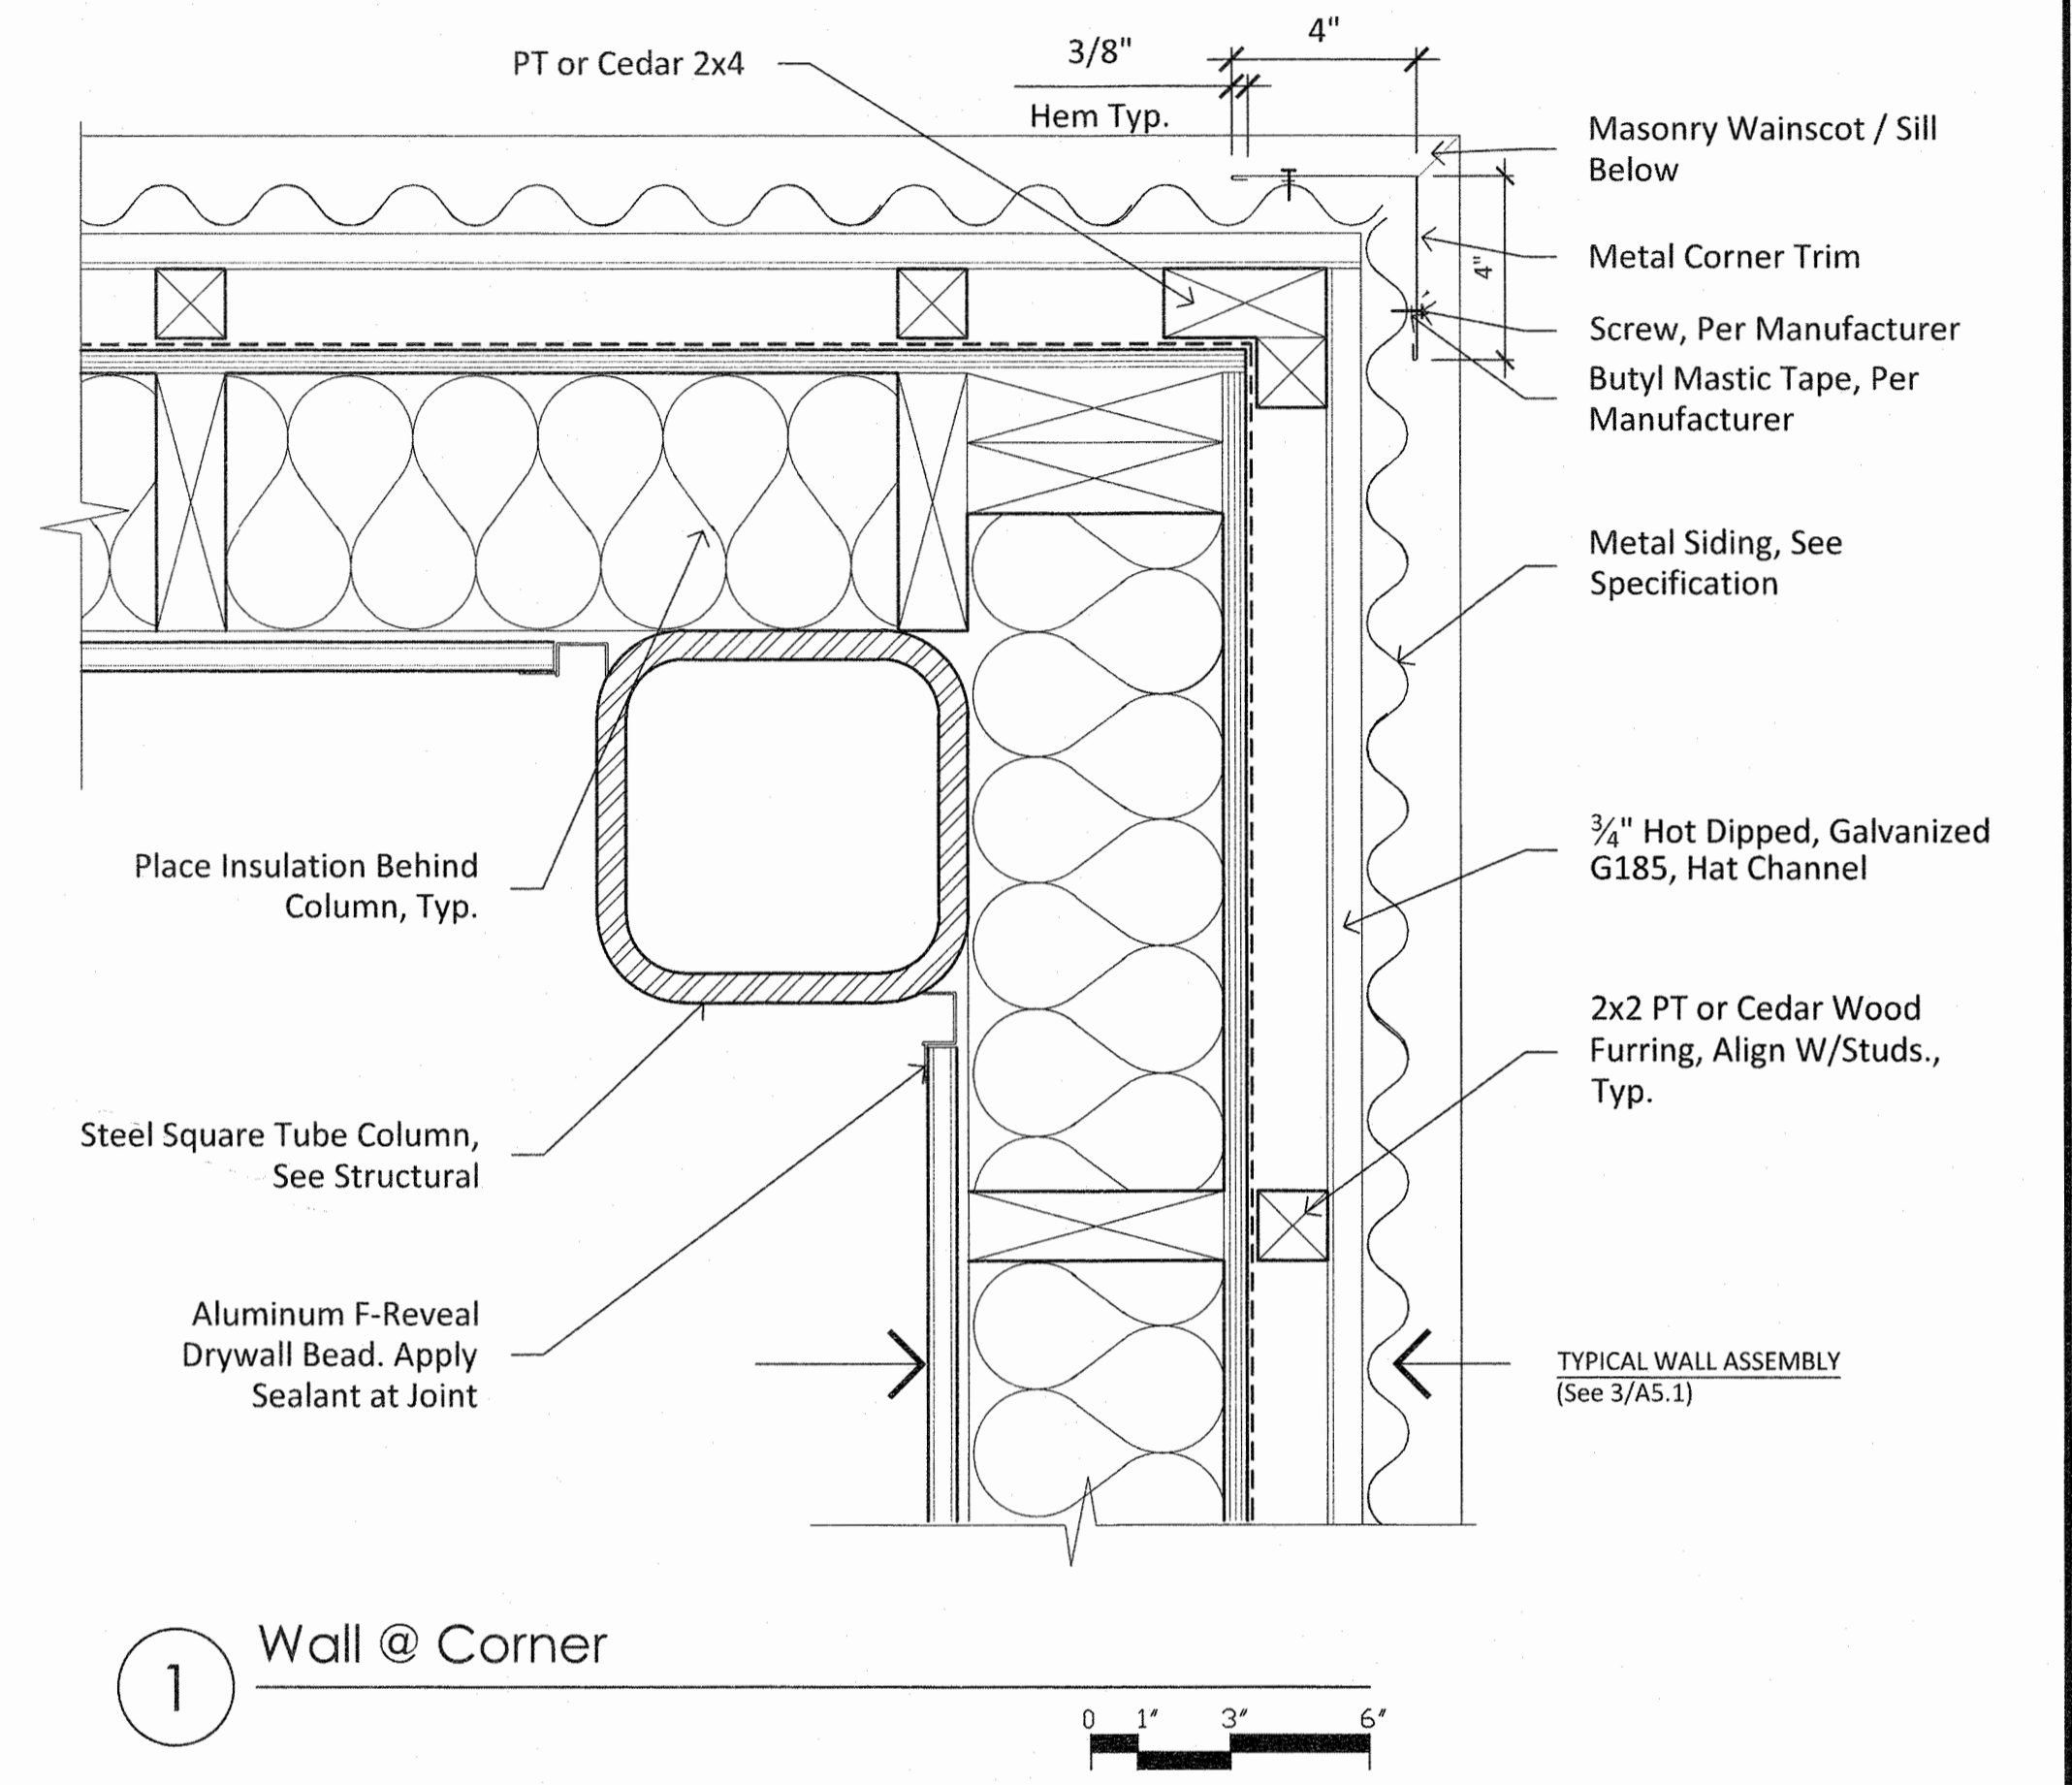

1 Wall @ Corner

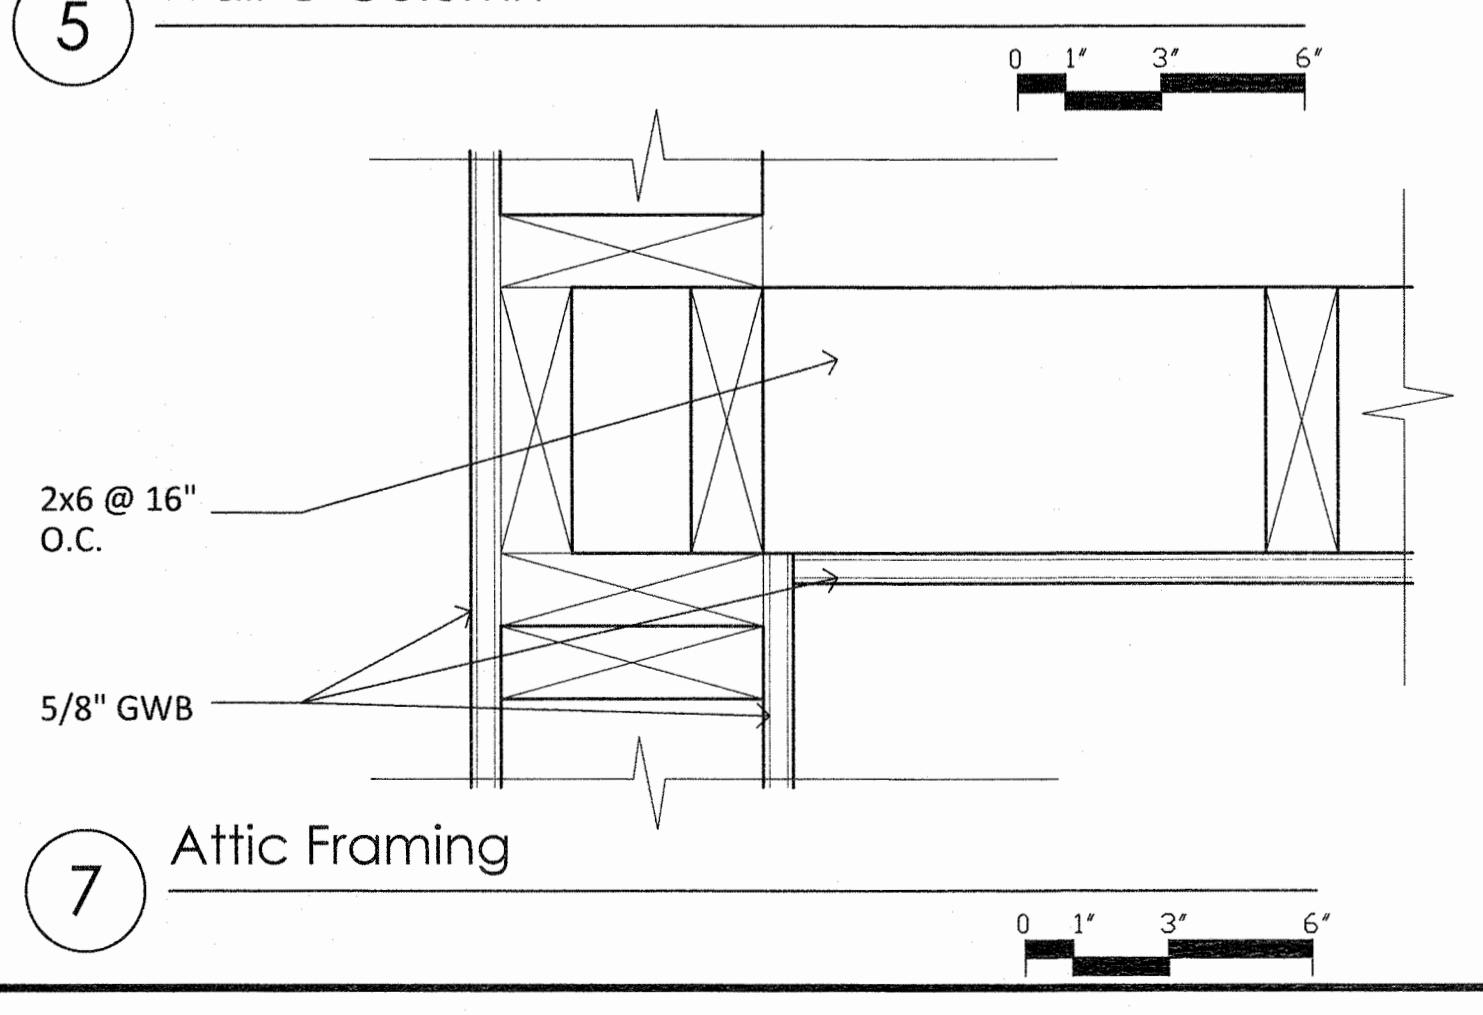

7 Attic Framing

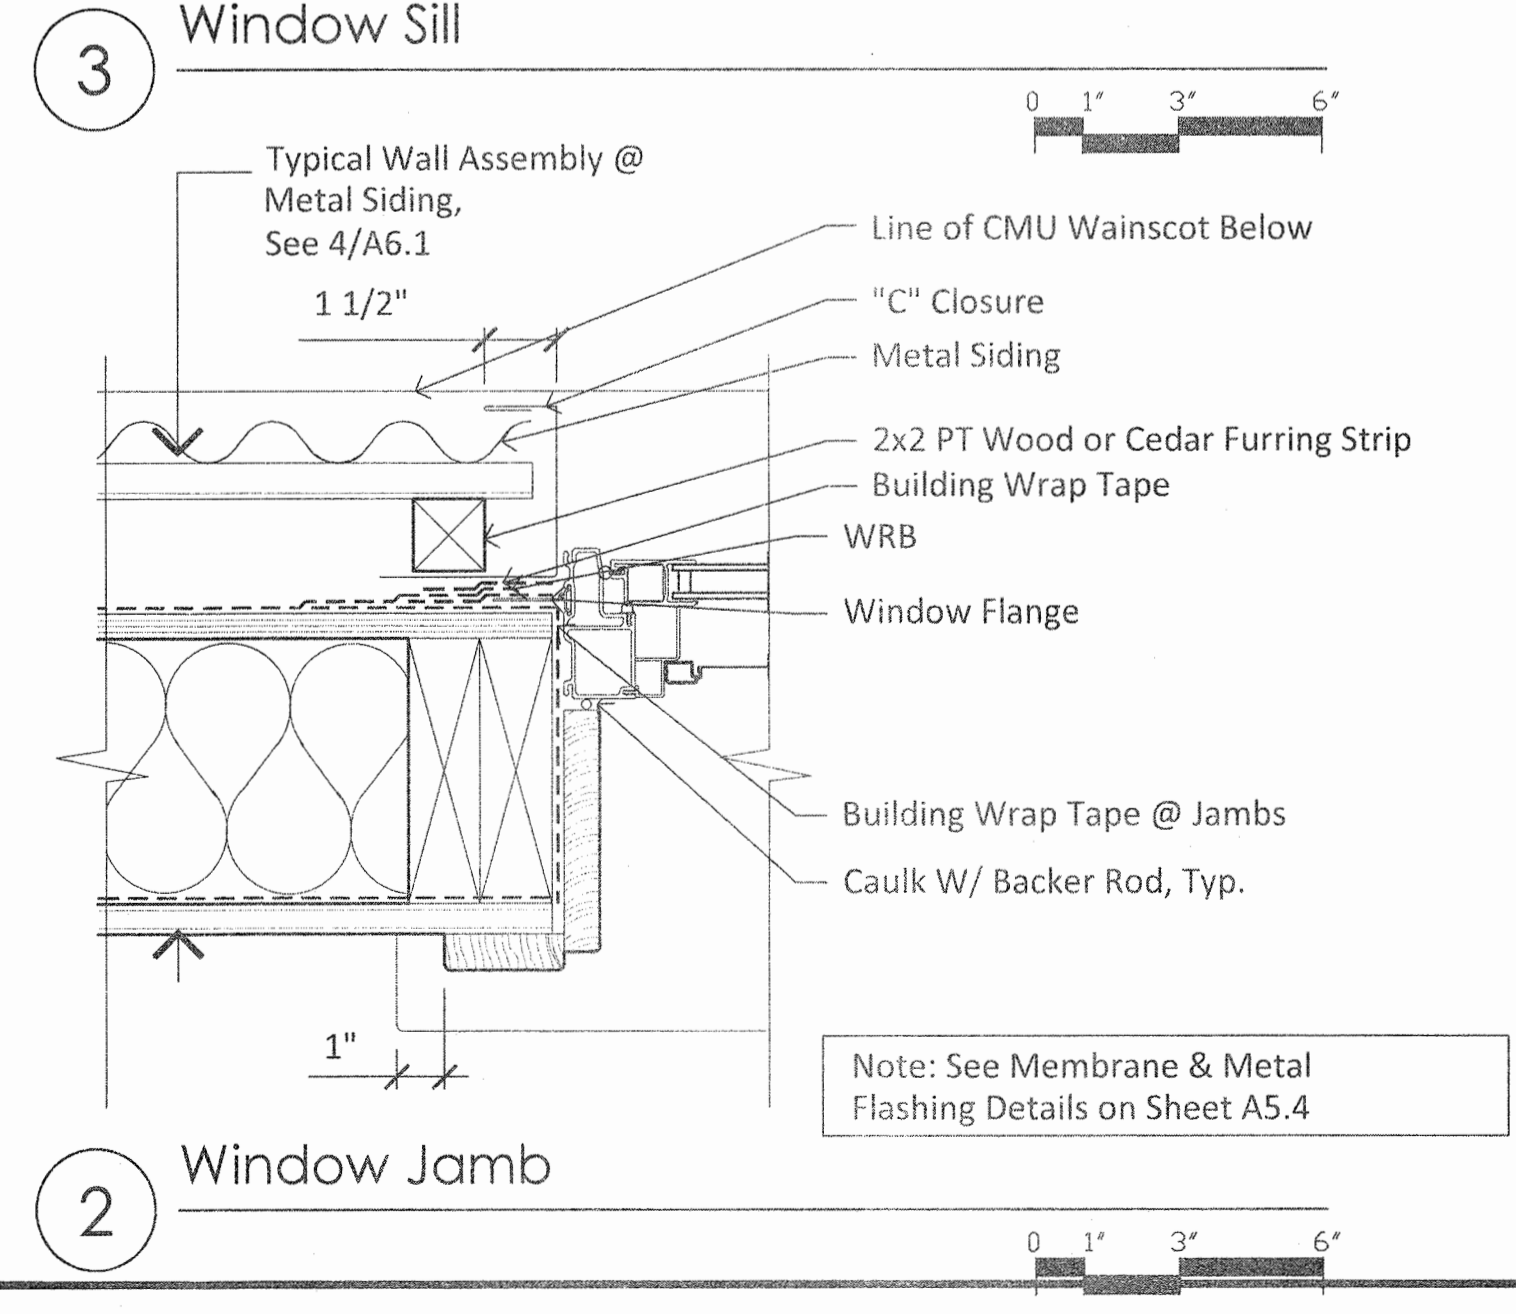

2 Window Jamb

RECORD DRAWINGS
 THESE DRAWINGS HAVE BEEN PREPARED FROM INFORMATION PROVIDED BY THE CONTRACTOR. THERE IS NO GUARANTEE TO THE ACCURACY OF THE INFORMATION CONTAINED HEREIN, EITHER EXPRESSED OR IMPLIED.
 October 27, 2017
 WELSHWHITELEYARCHITECT, LLC

DO NOT SCALE FROM THESE DRAWINGS USE DIMENSIONS

Drawings Prepared By: **WELSH WHITELEY ARCHITECTS**

327 Bawden Street
 Ketchikan, Alaska 99901
 (907) 225-2412 Voice
 (907) 225-2422 Fax

CHECKED BY: TIM WHITELEY
 DRAWN BY: AL, AR

STATE OF ALASKA
 DEPARTMENT OF TRANSPORTATION
 & PUBLIC FACILITIES
 SOUTHCOST REGION

**KAKE FERRY TERMINAL
 PASSENGER FACILITY
 PLANSET B**


Details

DESIGNED BY: TIM WHITELEY
 DRAWN BY: AL, AR


PATH: Y:\2011 PROJECTS\1121_ANGOOON & KAKE FERRY TERMINALS\10 DRAWINGS\2-KAKE SHEETS\1121-K
 TAB: A5.3 Friday, October 27, 2017 11:57:45 AM AMANDA ROBINSON

REVISIONS			PROJECT DESIGNATION	YEAR	SHEET NO.	TOTAL SHEETS
NO.	DATE	DESCRIPTION	SAMHS00002	2015A5.3	35	35


- GENERAL NOTES:**
1. INSTALLATION TO BE COMPLETED IN ACCORDANCE WITH MANUFACTURER'S SPECIFICATIONS.
 2. ALL DIMENSIONS ARE CONSIDERED TRUE AND REFLECT MANUFACTURER'S SPECIFICATIONS.
 3. ALL WINDOW MATERIALS MUST BE COMPATIBLE WITH WATER-RESISTANT PRODUCTS.
 4. FOR AIR BARRIER DESIGN, USE WATER-RESISTANT BARRIER WITH WATER-RESISTANT BARRIER TAPE @ ALL MEMBRANE JOINTS. (HORIZONTAL AND VERTICAL)

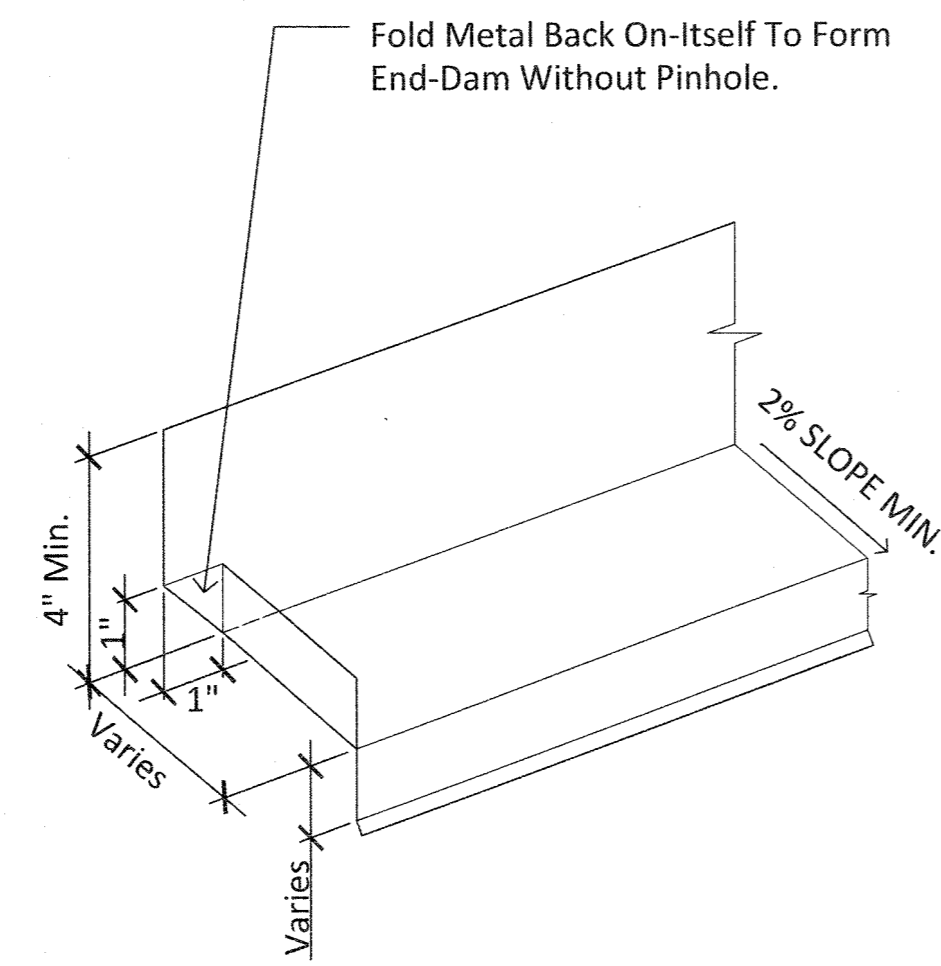


Typical Metal Head Flashing With Folded End Dams, (By Others).
10 Window Flashing Application
 Step 9b of 10

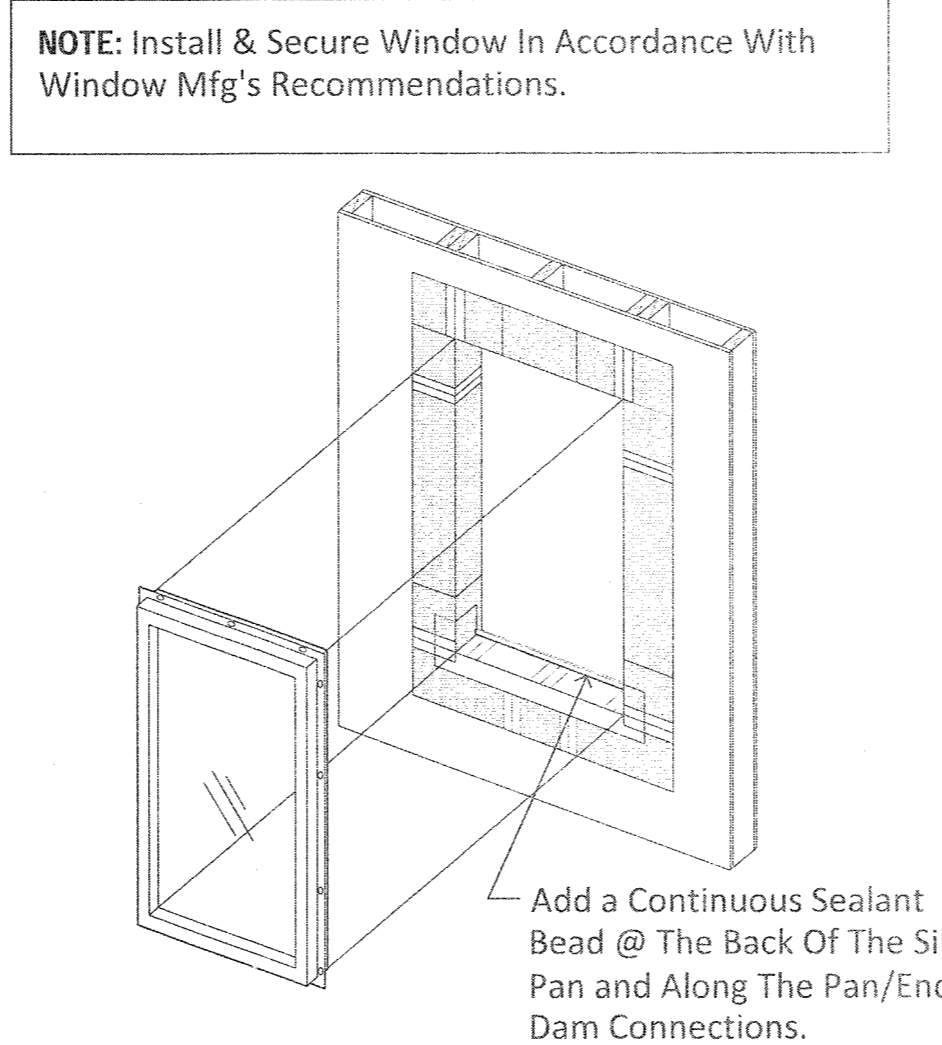


7 Window Flashing Application
 Step 7 of 10

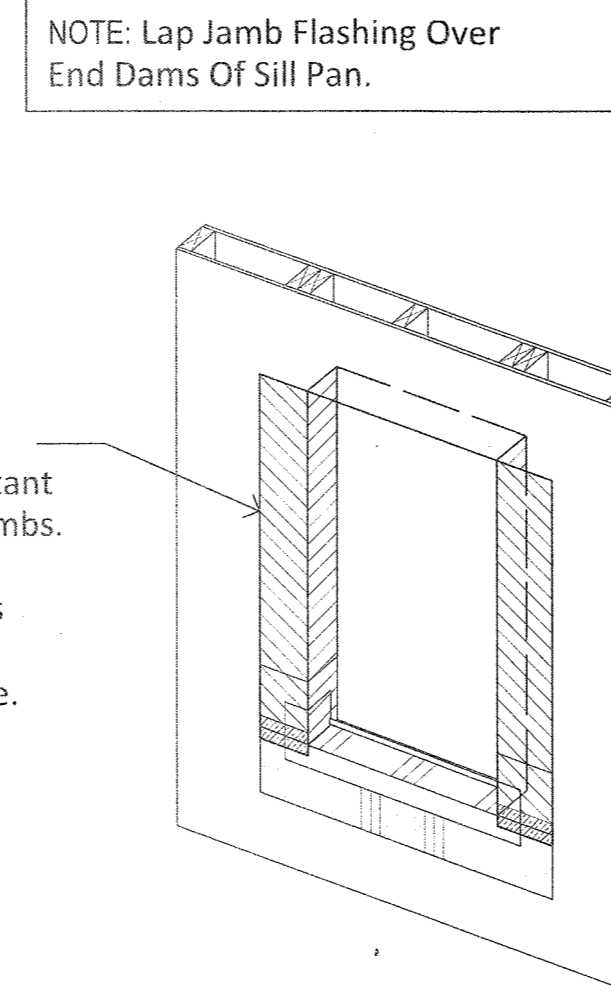


4 Window Flashing Application
 Step 4 of 10

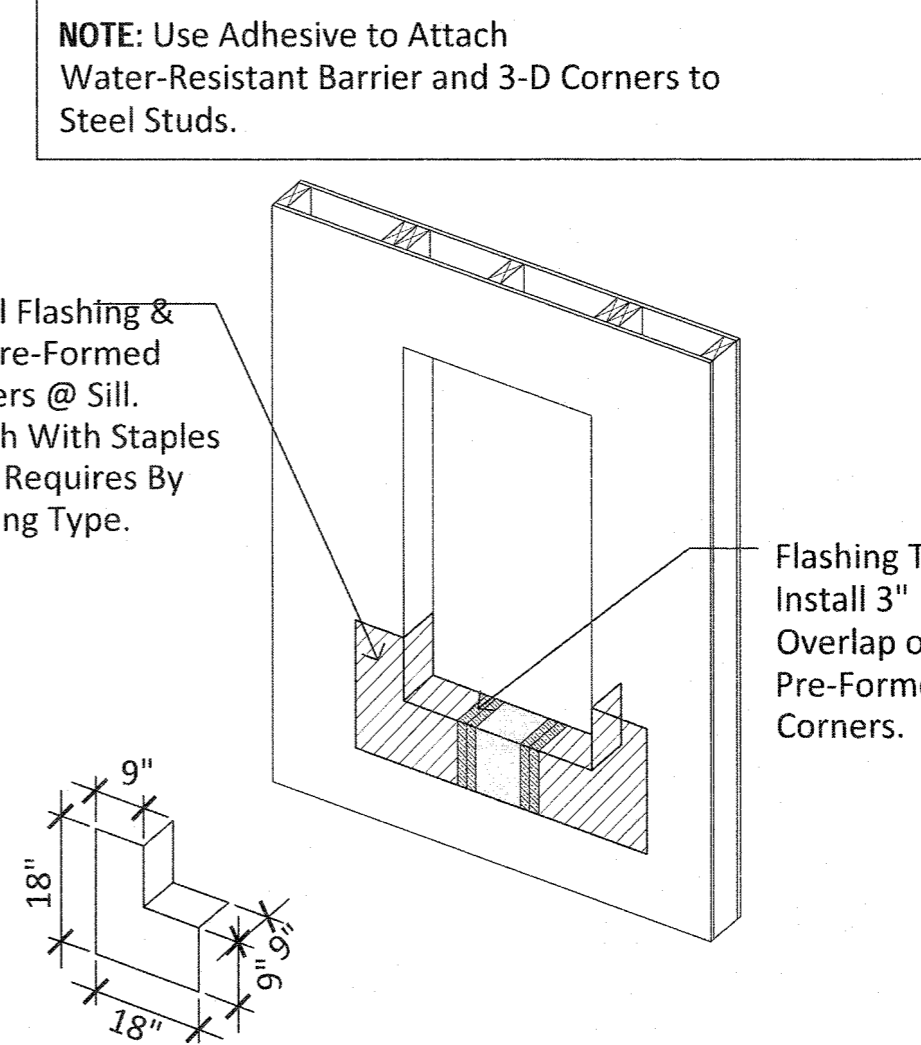


2 Window Flashing Application
 Step 2 of 10

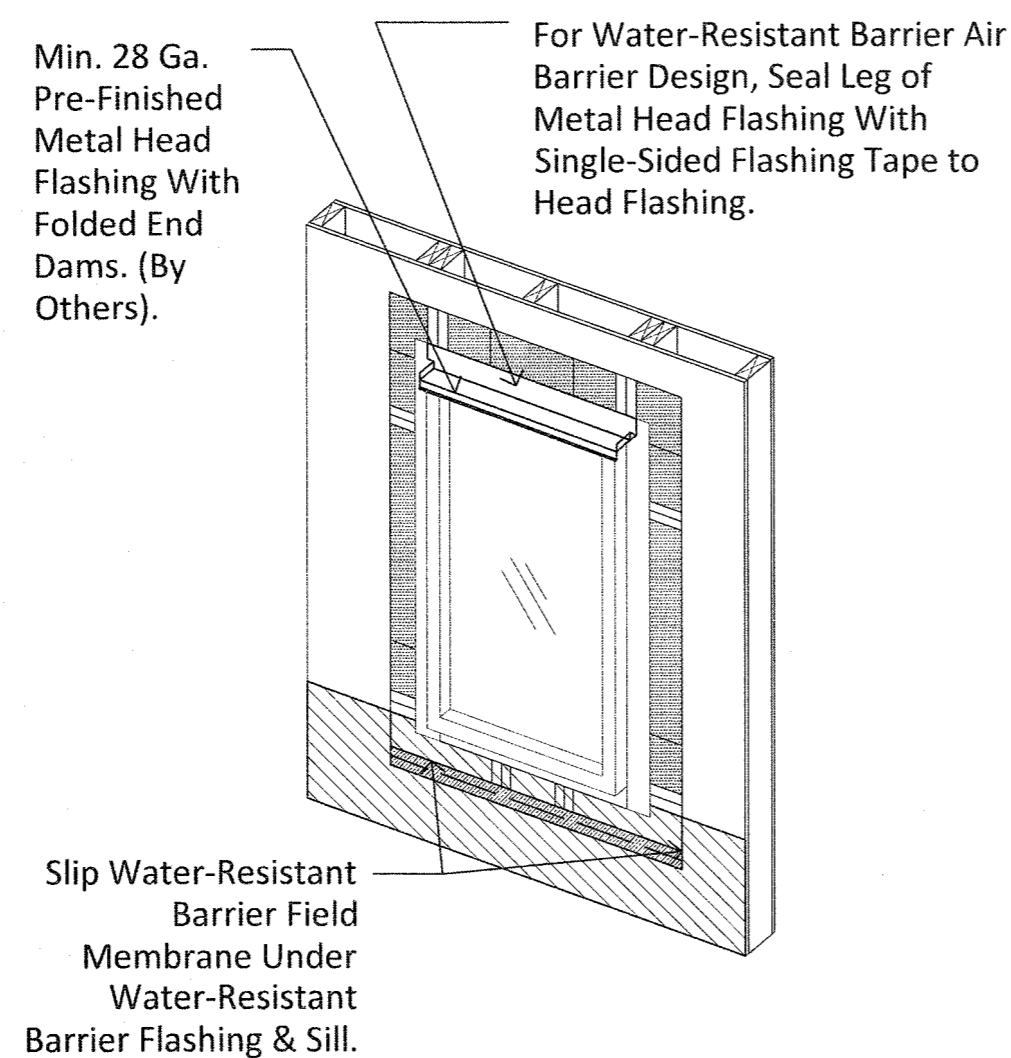


9 Window Flashing Application
 Step 9a of 10

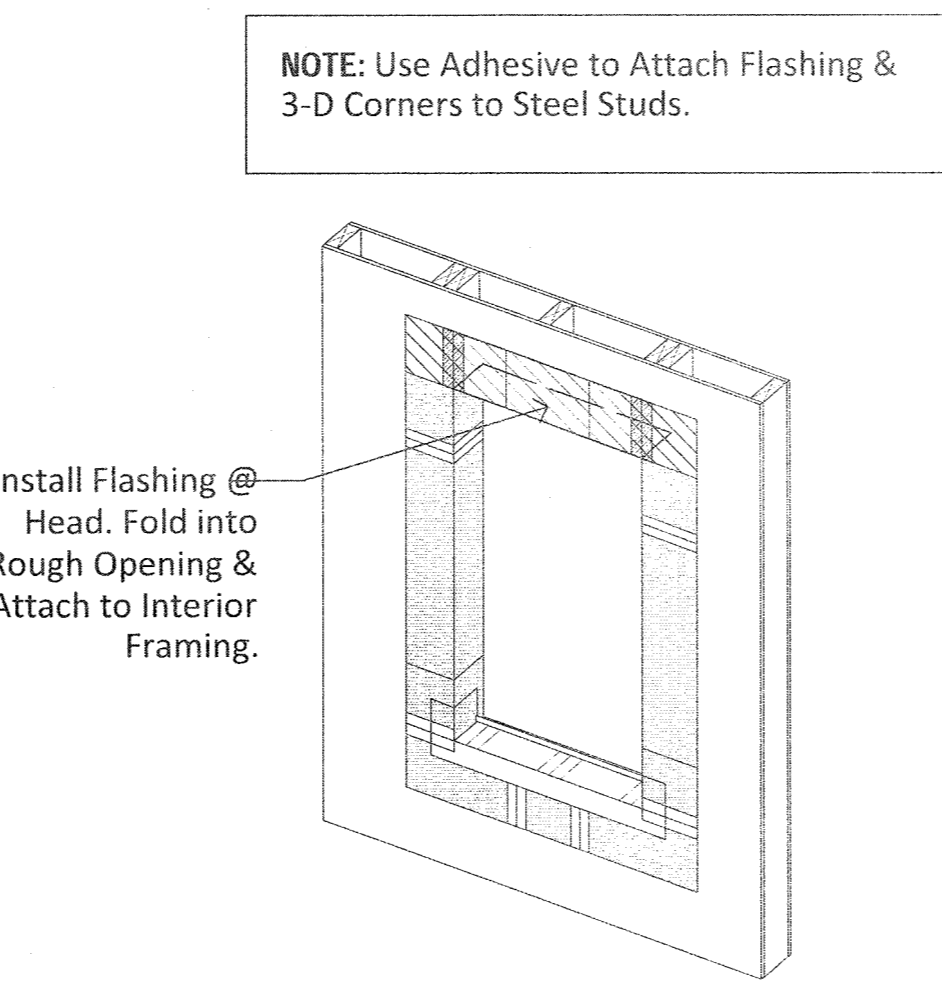

6 Window Flashing Application
 Step 6 of 10

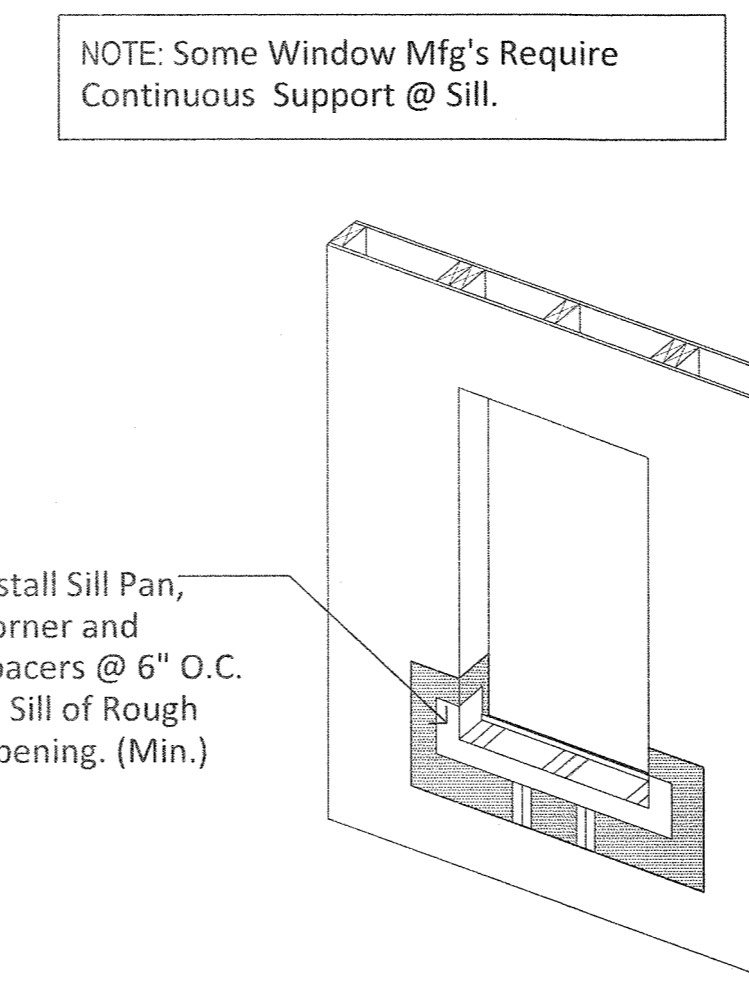

3 Window Flashing Application
 Step 3 of 10

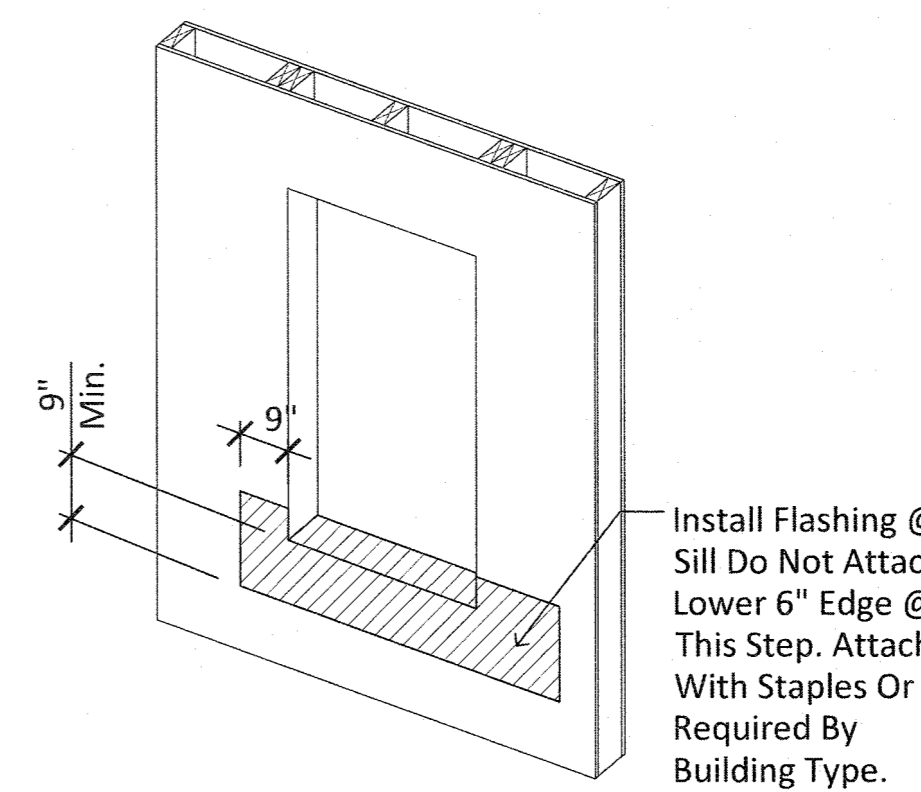

1 Window Flashing Application
 Step 1 of 10


RECORD DRAWINGS

THESE DRAWINGS HAVE BEEN PREPARED FROM INFORMATION PROVIDED BY THE CONTRACTOR. THERE IS NO GUARANTEE TO THE ACCURACY OF THE INFORMATION CONTAINED HEREIN, EITHER EXPRESSED OR IMPLIED.


October 27, 2017

WELSHWHITELEYARCHITECT, LLC


NOTE: Upper Water-Resistant Barrier Field Membrane Must Lap Over Lower Membranes, Shingle Fashion.

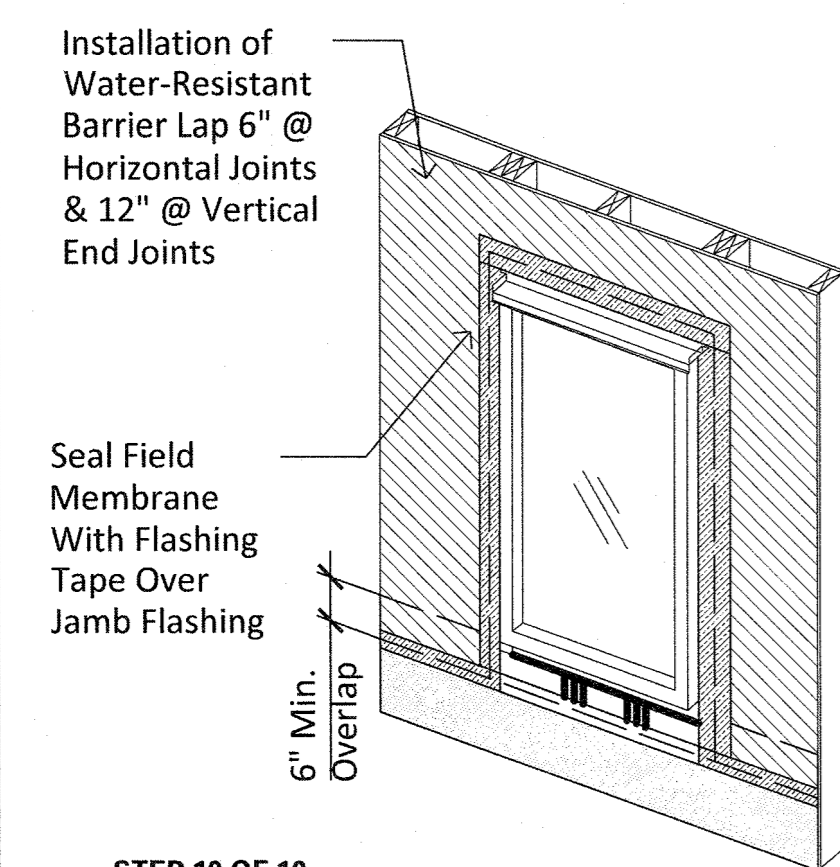

11 Window Flashing Application
 Step 10 of 10

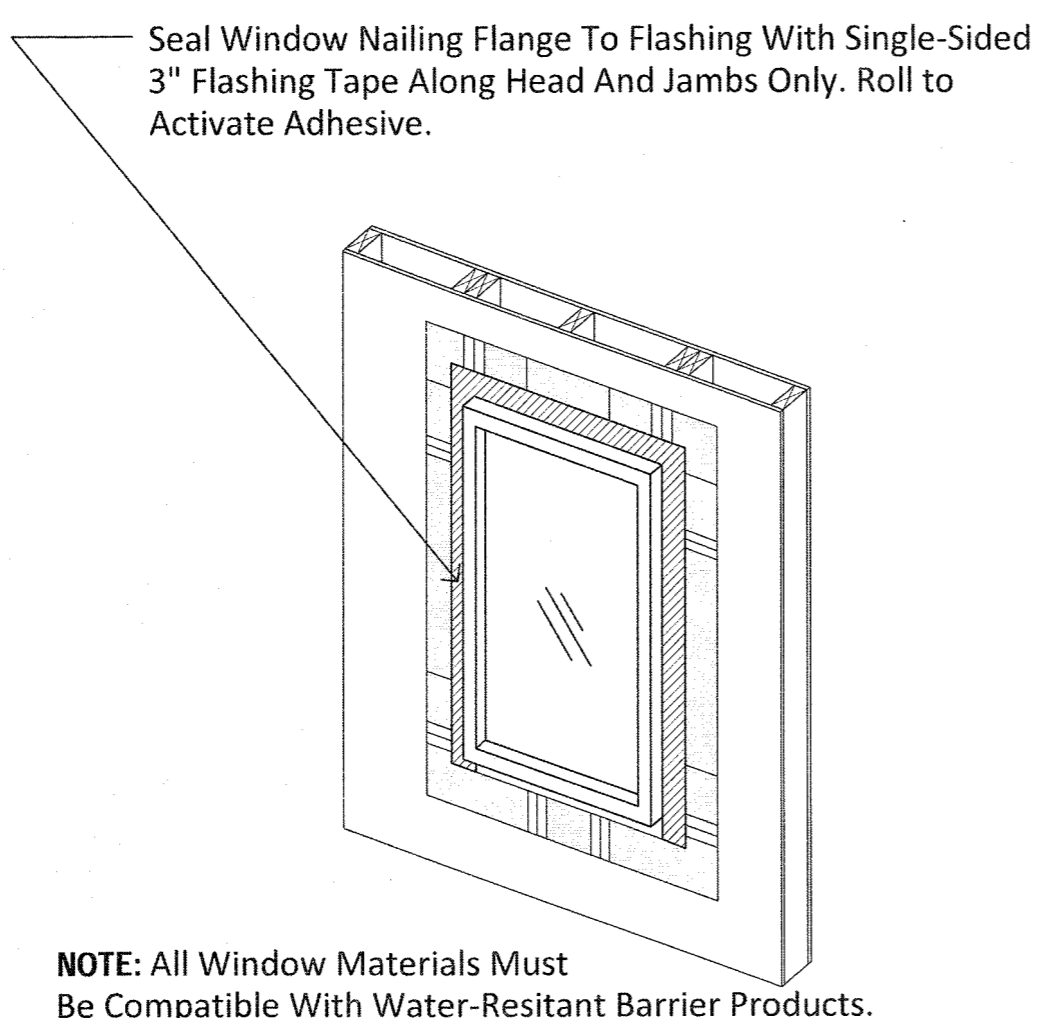

8 Window Flashing Application
 Step 8 of 10

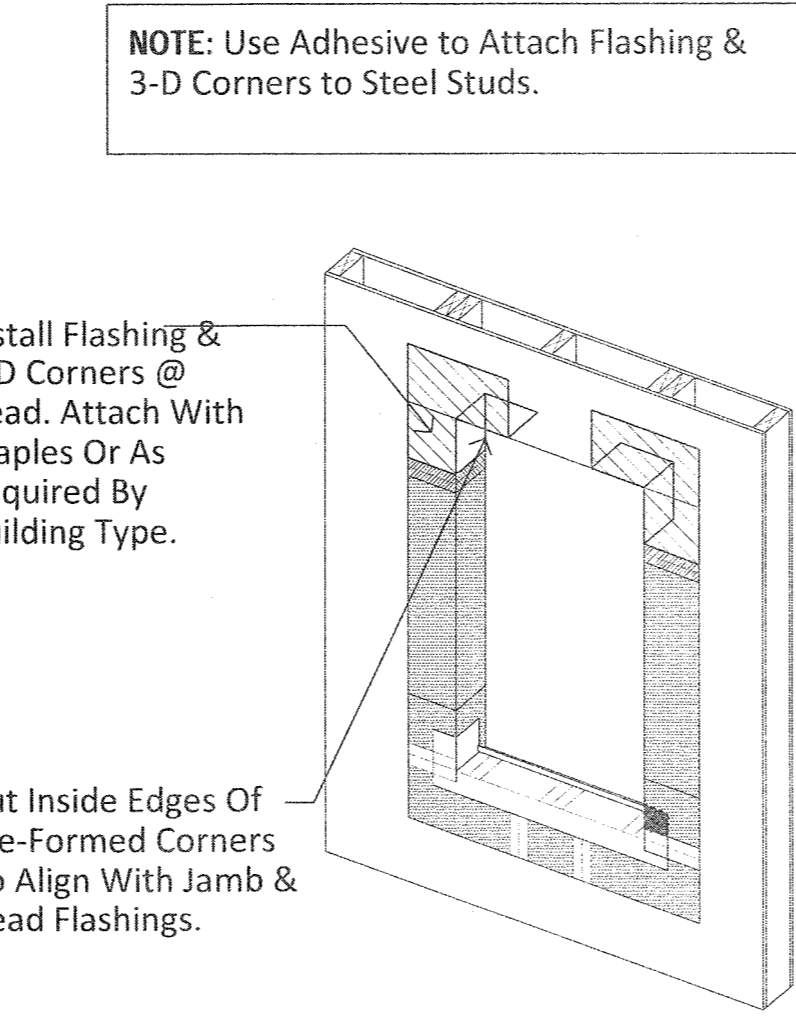

5 Window Flashing Application
 Step 5 of 10

Drawings Prepared By: **WELSH WHITELEY ARCHITECTS**

327 Bawden Street
 Ketchikan, Alaska 99901
 (907) 225-2412 Voice
 (907) 225-2422 Fax

DO NOT SCALE FROM THESE DRAWINGS USE DIMENSIONS

CHECKED BY: TIM WHITELEY
 STATE OF ALASKA
 DEPARTMENT OF TRANSPORTATION & PUBLIC FACILITIES
 SOUTHCOST REGION
 KAKE FERRY TERMINAL PASSENGER FACILITY
 PLANSET B

DESIGNED BY: TIM WHITELEY
 DRAWN BY: AL, AR
 October 27, 2017

REVISIONS


NO.	DATE	DESCRIPTION

PROJECT DESIGNATION: **SAMHS00002**


YEAR: **2015**

SHEET NO.: **A5.4**


TOTAL SHEETS: **35**

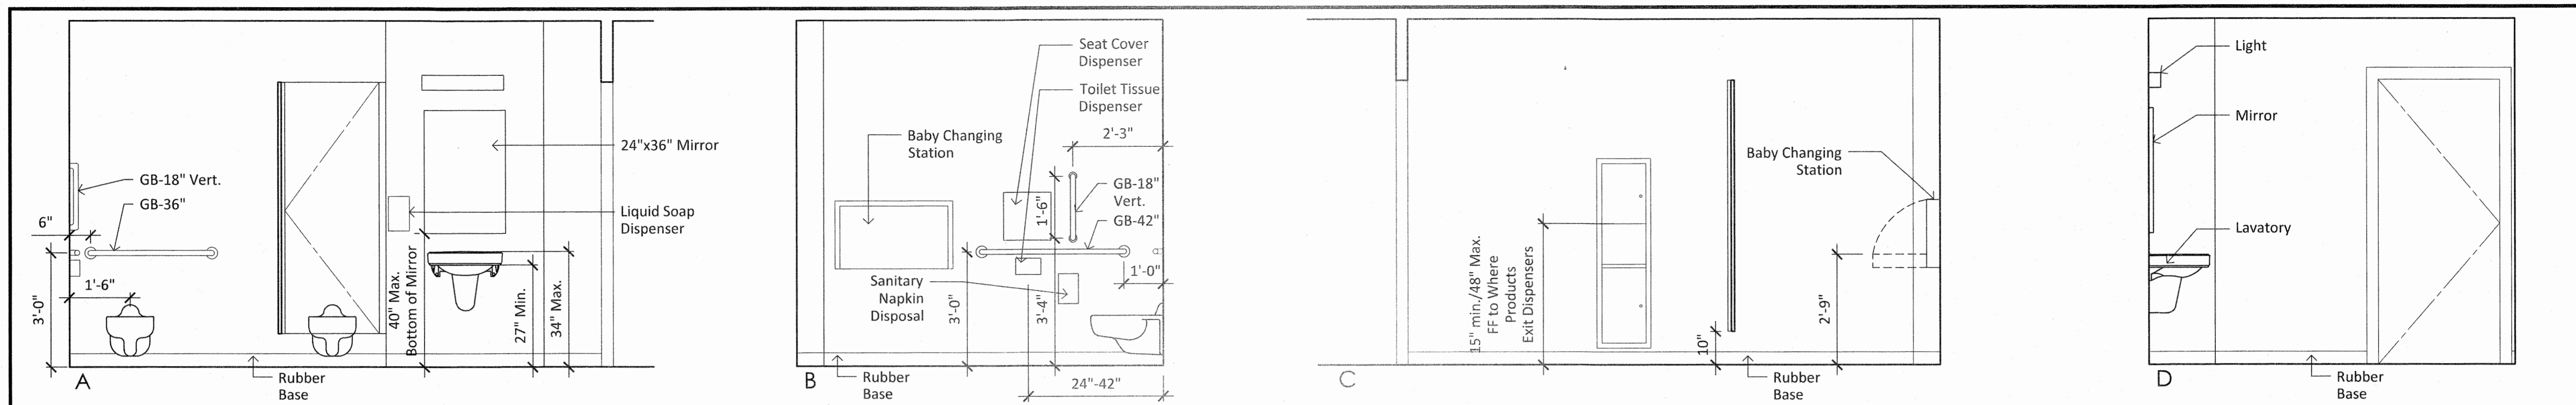

1 Women's Restroom 0 6" 1' 2'

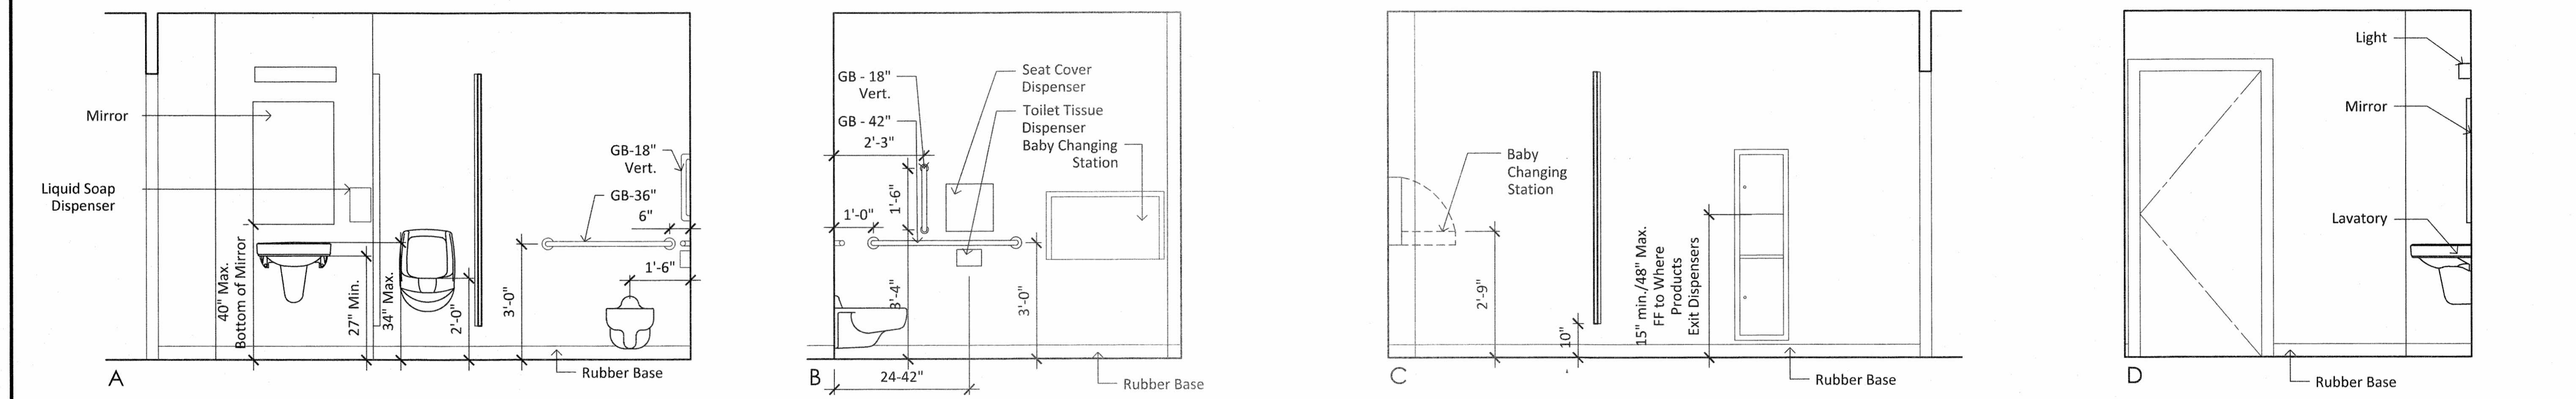

2 Men's Restroom 0 6" 1' 2'

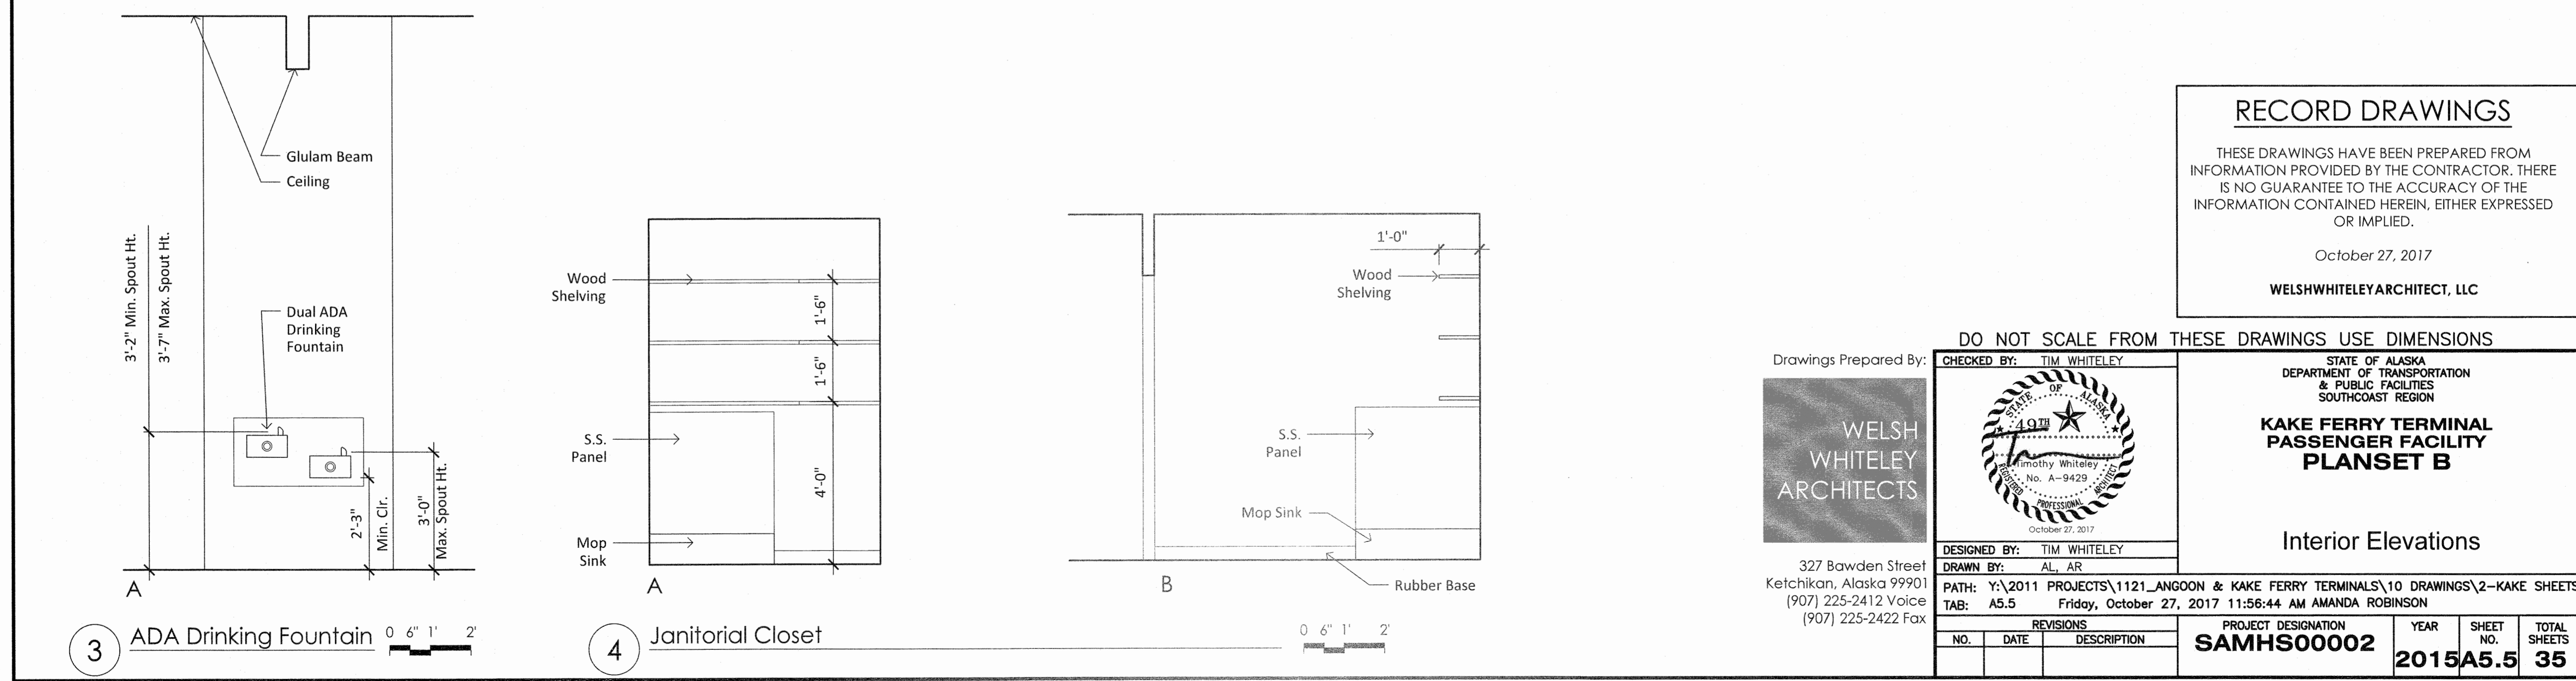

3 ADA Drinking Fountain 0 6" 1' 2'

4 Janitorial Closet 0 6" 1' 2'

RECORD DRAWINGS
 THESE DRAWINGS HAVE BEEN PREPARED FROM INFORMATION PROVIDED BY THE CONTRACTOR. THERE IS NO GUARANTEE TO THE ACCURACY OF THE INFORMATION CONTAINED HEREIN, EITHER EXPRESSED OR IMPLIED.
 October 27, 2017
 WELSHWHITELEYARCHITECT, LLC

DO NOT SCALE FROM THESE DRAWINGS USE DIMENSIONS

Drawings Prepared By: **WELSH WHITELEY ARCHITECTS**
 327 Bawden Street
 Ketchikan, Alaska 99901
 (907) 225-2412 Voice
 (907) 225-2422 Fax

DESIGNED BY: TIM WHITELEY
 DRAWN BY: AL, AR
 October 27, 2017

STATE OF ALASKA
 DEPARTMENT OF TRANSPORTATION
 & PUBLIC FACILITIES
 SOUTHCOST REGION

**KAKE FERRY TERMINAL
 PASSENGER FACILITY
 PLANSET B**

Interior Elevations

REVISIONS			PROJECT DESIGNATION	YEAR	SHEET NO.	TOTAL SHEETS
NO.	DATE	DESCRIPTION	SAMHS00002	2015	A5.5	35

PATH: Y:\2011 PROJECTS\1121_ANGOOON & KAKE FERRY TERMINALS\10 DRAWINGS\2-KAKE SHEETS\1121-K
 TAB: A5.5 Friday, October 27, 2017 11:56:44 AM AMANDA ROBINSON

STRUCTURAL GENERAL NOTES

CRITERIA:

CODE:

CONSTRUCTION SHALL BE IN CONFORMANCE WITH THE INTERNATIONAL BUILDING CODE (IBC), 2009 EDITION, AS AMENDED BY THE STATE OF ALASKA.

GROUND SNOW LOAD: 85 PSF
 ROOF SNOW LOAD: AT HEATED BUILDING ROOF= 60 PSF
 AT UNHEATED ROOF STRUCTURE= 65 PSF

WIND: 110 MPH (3 SECOND GUST), EXPOSURE D, I= 1.0

SEISMIC: SITE CLASSIFICATION D
 Ss= 0.32g Fo= 1.55 Sds= 0.33g
 S1= 0.23g Fv= 1.94 Sd1= 0.30g
 R= 1.25, CANTILEVERED COLUMN SYSTEM, ORDINARY STEEL
 MOMENT FRAME
 IMPORTANCE, I = 1.0
 Cd= 1.25
 Ω0= 1.25
 Cs= 0.26g

FOUNDATION:

FOUNDATION HAS BEEN DESIGNED FOR AN ASSUMED ALLOWABLE SOIL PRESSURE OF 3000 PSF BASED ON THE ANTICIPATION OF ENCOUNTERING TYPE 3 SOILS (SANDY GRAVEL OR GRAVEL, FIRM) AS DESCRIBED IN TABLE 1806.2 OF THE IBC. VERIFY CONDITIONS AT THE LIMIT OF EXCAVATION IN THE PRESENCE OF THE PROJECT ENGINEER.

FOUNDATION SHALL BEAR ON A COMPACTED BASE COURSE OVER COMPACTED NATIVE MATERIAL. EXCAVATE TO A MINIMUM OF 4 INCHES BELOW BOTTOM OF SLAB AND FOOTINGS. COMPACT NATIVE MATERIAL WITH A MINIMUM EFFORT OF 6 PASSES WITH A DOUBLE DRUM ROLLER OR VIBRATORY PLATE COMPACTOR WITH A MINIMUM CENTRIFUGAL FORCE OF 15,000 POUNDS.

BASE COURSE SHALL BE COMPACTED WITH A MINIMUM EFFORT OF 6 PASSES OF A DOUBLE DRUM ROLLER OR VIBRATORY PLATE COMPACTOR WITH A MINIMUM CENTRIFUGAL FORCE OF 15,000 POUNDS. BASE COURSE SHALL MEET BASE COURSE C-1 REQUIREMENTS ACCORDING TO ALASKA DEPARTMENT OF TRANSPORTATION AND PUBLIC FACILITIES STANDARD SPECIFICATIONS FOR HIGHWAY CONSTRUCTION, 2015 EDITION.

CONCRETE:

CONCRETE SHALL MEET CLASS A REQUIREMENTS ACCORDING TO ALASKA DEPARTMENT OF TRANSPORTATION AND PUBLIC FACILITIES STANDARD SPECIFICATIONS FOR HIGHWAY CONSTRUCTION, 2015 EDITION WITH 28 DAY STRENGTH $f_c = 4,000$ PSI. FOR CONSTRUCTION REQUIREMENTS AND REQUIRED SUBMITTALS SEE SPECIFICATIONS REFERENCED ABOVE.

CONCRETE REINFORCING SHALL CONFORM TO ASTM A615 GRADE 60. FABRICATE AND PLACE STEEL REINFORCEMENT IN ACCORDANCE WITH CRSI'S "MANUAL OF STANDARD PRACTICE". REINFORCING SHALL BE SUPPORTED ON WELL-CURED BLOCKS OR APPROVED METAL ACCESSORIES. WELDING OF REINFORCING IS PROHIBITED. SUBMIT FABRICATION SHOP DRAWINGS FOR REVIEW AND APPROVAL PRIOR TO COMMENCING FABRICATION.

PROVIDE MINIMUM COVER AT REINFORCING BARS AS FOLLOWS: EXCEPT AT SLABS-ON-GRADE FOR CAST AGAINST EARTH - 3"; EXPOSED TO EARTH OR WEATHER - 2"; INTERIOR SLABS-ON-GRADE - 1.5".

AT WALL CORNERS AND INTERSECTING WALLS PROVIDE EITHER CORNER BARS, WITH THE SAME SIZE AND SPACING AS THE HORIZONTAL WALL STEEL, WITH A 50 DIAMETER LAP IN THE OUTSIDE FACE OF THE WALL, OR EXTEND HORIZONTAL STEEL WITH 90 DEGREE HOOK AND 50 BAR DIAMETER LAP SPLICE.

FINISH INTERIOR SLABS WITH A SMOOTH STEEL TROWEL FINISH AFTER BULLFLOAT. APPLY 1ST TROWEL AND CONSOLIDATE CONCRETE BY HAND OR MACHINE TROWEL. CONTINUE TROWEL PASSES UNTIL SURFACE IS FREE OF TROWEL MARKS AND UNIFORM IN TEXTURE AND APPEARANCE GRIND SMOOTH ANY SURFACE DEFECTS. SEAL SURFACE WITH PENETRATING SILANE OR SILOXANE SEALER.

STRUCTURAL STEEL:

ALL STEEL SHALL CONFORM TO THE FOLLOWING:

HOLLOW RECTANGULAR SECTIONS: ASTM A500, GRADE B
 PLATES: ASTM A36
 ANCHOR BOLTS: ASTM A307, HEADED BOLTS, GALVANIZED
 OTHER BOLTS: ASTM A307, GALVANIZED

ALL STEEL SHALL BE FABRICATED IN ACCORDANCE WITH THE AISC CODE OF STANDARD PRACTICE, LATEST EDITION. SUBMIT FABRICATION SHOP DRAWINGS FOR REVIEW AND APPROVAL PRIOR TO COMMENCING FABRICATION.

ALL WELDING SHALL BE IN ACCORDANCE WITH AWS D1.1 "STRUCTURAL WELDING CODE", AND BE PERFORMED BY WELDERS QUALIFIED IN ACCORDANCE WITH D1.1. SMAW SHALL UTILIZE E70XX ELECTRODES. SUBMIT WELDER QUALIFICATIONS AND WELDING PROCEDURES FOR REVIEW AND APPROVAL.

STRUCTURAL STEEL INSIDE THE BUILDING ENVELOPE SHALL BE SHOP PAINTED WITH THE FABRICATOR'S STANDARD LEAD AND CHROMATE FREE, NONASPHALTIC, RUST-INHIBITING PRIMER COMPLYING WITH MPI#79 AND COMPATIBLE WITH TOPCOAT.

STRUCTURAL STEEL OUTSIDE THE BUILDING ENVELOPE OR DESIGNATED AS (GALV) SHALL BE HOT-DIP GALVANIZED PER ASTM A153. CLEAN AREAS WHERE GALVANIZING IS DAMAGED OR MISSING AND REPAIR GALVANIZING TO COMPLY WITH ASTM A780 USING ZINC ALLOY STICK METHOD AND TOP COATED WITH BRUSH APPLIED COLD GALVANIZING PAINT.

GROUT:

NONMETALLIC, NONCORROSIVE, NONSTAINING, SHRINKAGE-RESISTANT GROUT MEETING ASTM C1107. GROUT SHALL BE FACTORY-PACKAGED AND MIXED WITH WATER TO CONSISTENCY SUITABLE FOR APPLICATION AND A MINIMUM 30-MINUTE WORKING TIME.

PLYWOOD:

ALL SHEATHING SHALL BE STANDARD PLYWOOD AS GRADED BY THE AMERICAN PLYWOOD ASSOCIATION CONFORM TO APA PS1 AND BEAR THAT QUALITY MARK. ALL PLYWOOD SHALL BE MADE WITH EXTERIOR TYPE GLUE. FLAT BLOCKING SHALL BE USED AT ALL PLYWOOD EDGES AS NOTED ON THE TYPICAL DETAILS OR SHOWN IN THE PLANS. ALL PLYWOOD IN CONTACT WITH OR WITHIN 6 INCHES OF SOIL OR DESIGNATED AS (P/T) SHALL BE PRESSURE TREATED IN ACCORDANCE WITH AWWA C-9, WITH ACZA TO A NET RETENTION OF 0.40 PCF.

LUMBER:

ALL WORKMANSHIP AND CONSTRUCTION SHALL CONFORM TO IBC, CHAPTER 23. ALL SAWN LUMBER SHALL BE VISUALLY GRADED IN ACCORDANCE WITH THE W.W.P.A. GRADING RULES. SAWN LUMBER AT THE FOLLOWING LOCATIONS SHALL MEET THE FOLLOWING GRADES, UNLESS NOTED OTHERWISE:

ALL TIMBER GREATER THAN 5.5 INCHES THICK : DOUG FIR NO. 1
 ALL OTHER TIMBER 2 TO 4 INCHES THICK : DOUG FIR NO. 2

LAMINATED VENEER LUMBER:

LAMINATED VENEER LUMBER SHALL HAVE THE FOLLOWING PROPERTIES =

MODULES OR ELASTICITY, E = 2.0x10⁶ PSI
 ALLOWABLE FLEXURAL STRESS, Fb = 2900 PSI
 ALLOWABLE COMPRESSION PERPENDICULAR TO GRAIN, Fc = 750 PSI
 ALLOWABLE SHEAR PARALLEL TO GRAIN = 285 PSI

TREATED LUMBER:

ALL TIMBER IN CONTACT WITH CONCRETE, EXPOSED TO WEATHER, OR AS INDICATED AS (P/T) ON THE PLANS SHALL BE PRESSURE TREATED IN ACCORDANCE WITH AWWA C2. FIELD TREAT CUTS, HOLES OR DAMAGE TO TREATMENT WITH CUPRINOL IN ACCORDANCE WITH AWWA M4.

GLUED LAMINATED TIMBERS:

GLUED LAMINATED TIMBER BEAMS SHALL COMPLY WITH ANSI A190.1 COMBINATION 24F-V4 FOR SINGLE SPANS AND 24F-V8 FOR MULTISPANS AND BE ARCHITECTURAL APPEARANCE GRADE. MULTIPLE SPAN BEAMS SHALL BE MADE WITH NO CAMBER.

MANUFACTURED WOOD ROOF AND FLOOR TRUSSES AND JOISTS:

ALL WOOD MANUFACTURED JOISTS SHALL BE FACTORY MANUFACTURED WITH MATERIAL DESIGNED TO SUPPORT THE LOADING SHOWN ON THE DRAWINGS. JOIST SHALL HAVE CAPACITIES AND PROPERTIES AS LISTED. SUBMIT DETAILED SHOP DRAWINGS AND DESIGN CALCULATIONS OF ALL TRUSSES AND MANUFACTURED JOISTS TO THE ENGINEER FOR REVIEW AND APPROVAL PRIOR TO SHIPPING.

WOOD CONNECTIONS AND FRAMING:

ALL FRAMING NAILING SHALL CONFORM TO TABLE 2304.9.1 OF THE IBC UNLESS OTHERWISE SHOWN. STANDARD WASHERS SHALL BE UNDER ALL BOLT HEADS AND NUTS CONTACTING WOOD. PROVIDE STEEL STRAPS AT PIPES IN STUD WALLS AS REQUIRED BY IBC. BOLTS SHALL BE STANDARD ASTM A307, GALVANIZED. ALL NAILS SHALL BE COMMON WIRE OR BOX NAILS AND SHALL BE HOT-DIP GALVANIZED PER ASTM A153. ALL WOOD SCREWS AND LAG SCREWS SHALL BE HOT-DIP GALVANIZED PER ASTM A153.

INSTALL FIRE BLOCKING WHERE REQUIRED BY IBC 717.2.2.

LAG SCREWS SHALL BE INSTALLED IN ACCORDANCE WITH NDS PART 11.

- A. LEAD HOLES FOR LAG SCREWS SHALL BE BORED AS FOLLOWS:
1. THE CLEARANCE HOLE FOR THE SHANK SHALL HAVE THE SAME DIAMETER AS THE SHANK, AND THE SAME DEPTH OF PENETRATION AS THE LENGTH OF UNTHREADED SHANK.
 2. THE LEAD HOLE FOR THE THREADED PORTION SHALL HAVE A DIAMETER EQUAL TO 40% TO 70% OF THE SHANK DIAMETER IN WOOD WITH $G \leq 0.5$ AND A LENGTH EQUAL TO AT LEAST THE LENGTH OF THE THREADED PORTION. THE LARGER PERCENTILE IN EACH RANGE SHALL APPLY TO LAG SCREWS OF GREATER DIAMETER.
- B. THE THREADED PORTION OF THE LAG SCREW SHALL BE INSERTED IN ITS LEAD HOLE BY TURNING WITH A WRENCH, NOT BY DRIVING WITH A HAMMER.
- C. LUBRICANT SHALL BE USED ON THE LAG SCREWS OR IN THE LEAD HOLES TO FACILITATE INSERTION AND PREVENT DAMAGE TO THE LAG SCREW.

MISCELLANEOUS:

REFER TO ARCHITECTURAL PLANS FOR WALL OPENINGS, ARCHITECTURAL TREATMENT AND DIMENSIONS NOT SHOWN, CONSULT MECHANICAL PLANS FOR SIZE AND LOCATION OF ALL OPENINGS FOR DUCTS, PIPING, ETC. NOT SHOWN. COORDINATE WITH ARCHITECTURAL FOR DETAILED INFORMATION. PROVIDE AND INSTALL BLOCKING BETWEEN STUDS AT MECHANICAL EQUIPMENT AND SEISMIC RESTRAINT PER MECHANICAL.

ABBREVIATIONS

AITC	AMERICAN INSTITUTE FOR TIMBER CONSTRUCTION	FND	FOUNDATION
APA	AMERICAN PLYWOOD ASSOCIATION	FT	FEET
APP	APPROXIMATELY	FTG	FOOTING
ARCH	ARCHITECT	G	SPECIFIC GRAVITY OF WOOD
ASTM	AMERICAN SOCIETY FOR TESTING AND MATERIALS	GALV	GALVANIZED
AWPA	AMERICAN WOOD PRESERVER'S ASSOCIATION	GLB	GLU LAM BEAM
BLDG	BUILDING	HSS	HOLLOW STRUCTURAL STEEL
BLKG	BLOCKING	IBC	INTERNATIONAL BUILDING CODE
BN	BOUNDARY NAILING	ICC	INTERNATIONAL CODE COUNCIL
BTWN	BETWEEN	MAX.	MAXIMUM
⊕	CENTERLINE	MIN.	MINIMUM
CLR	CLEAR	NDS	NATIONAL DESIGN SPECIFICATION
COL	COLUMN	NO.	NUMBER
CONC	CONCRETE	O.C.	ON CENTER
CP	COMPLETE PENETRATION	Ⓟ	PLATE
CRSI	CONCRETE REINFORCING STEEL INSTITUTE	P/T	PRESSURE TREATED
CY	CUBIC YARD	PSI	POUNDS PER SQUARE INCH
DBL	DOUBLE	REINF	REINFORCING
EA	EACH	REQ'D	REQUIRED
EMBED	EMBEDMENT	SIM	SIMILAR
EN	EDGE NAILING	STD	STANDARD
ER	EVALUATION REPORT	STR	STRUCTURAL
EW	EACH WAY	TYP.	TYPICAL
		W/C	WATER/CEMENT
		W.P.	WORK POINT
		U.N.O.	UNLESS NOTED OTHERWISE

DO NOT SCALE FROM THESE DRAWINGS USE DIMENSIONS

CHECKED BY: CMG		STATE OF ALASKA DEPARTMENT OF TRANSPORTATION & PUBLIC FACILITIES SOUTHCOST REGION		
DESIGNED BY: CMG		KAKE FERRY TERMINAL PASSENGER FACILITY		
DRAWN BY: DRD		PLANSET B		
PATH: N:\12XXX\122068 AMHS KAKE TERMINAL\E1 DRAWINGS\PND\2017-9-29\S0.1.DWG		STRUCTURAL GENERAL NOTES		
TAB: S0.1 Monday, October 09, 2017 8:15:19 AM DANIELLE DUNIWIN				
REVISIONS		PROJECT DESIGNATION	YEAR	SHEET NO.
NO.	DATE	DESCRIPTION	SAMHS00002	2015
				S0.1
				35

PLANS PREPARED BY:
 PND ENGINEERS, INC.
 9360 GLACIER HWY
 JUNEAU, AK 99801

RECORD DRAWINGS


THESE DRAWINGS HAVE BEEN PREPARED FROM INFORMATION PROVIDED BY THE CONTRACTOR. THERE IS NO GUARANTEE TO THE ACCURACY OF THE INFORMATION CONTAINED HEREIN, EITHER EXPRESSED OR IMPLIED.

October 9, 2017


WELSHWHITELEYARCHITECT, LLC

NOTE:


1. DOUBLE 2x6 KING STUDS WHERE STUD HEIGHT < 11FT
TRIPLE 2x6 KING STUDS HEIGHT > 11FT
2. FULL HEIGHT STUDS AT EACH END WALL WITH NO INTERMEDIATE P

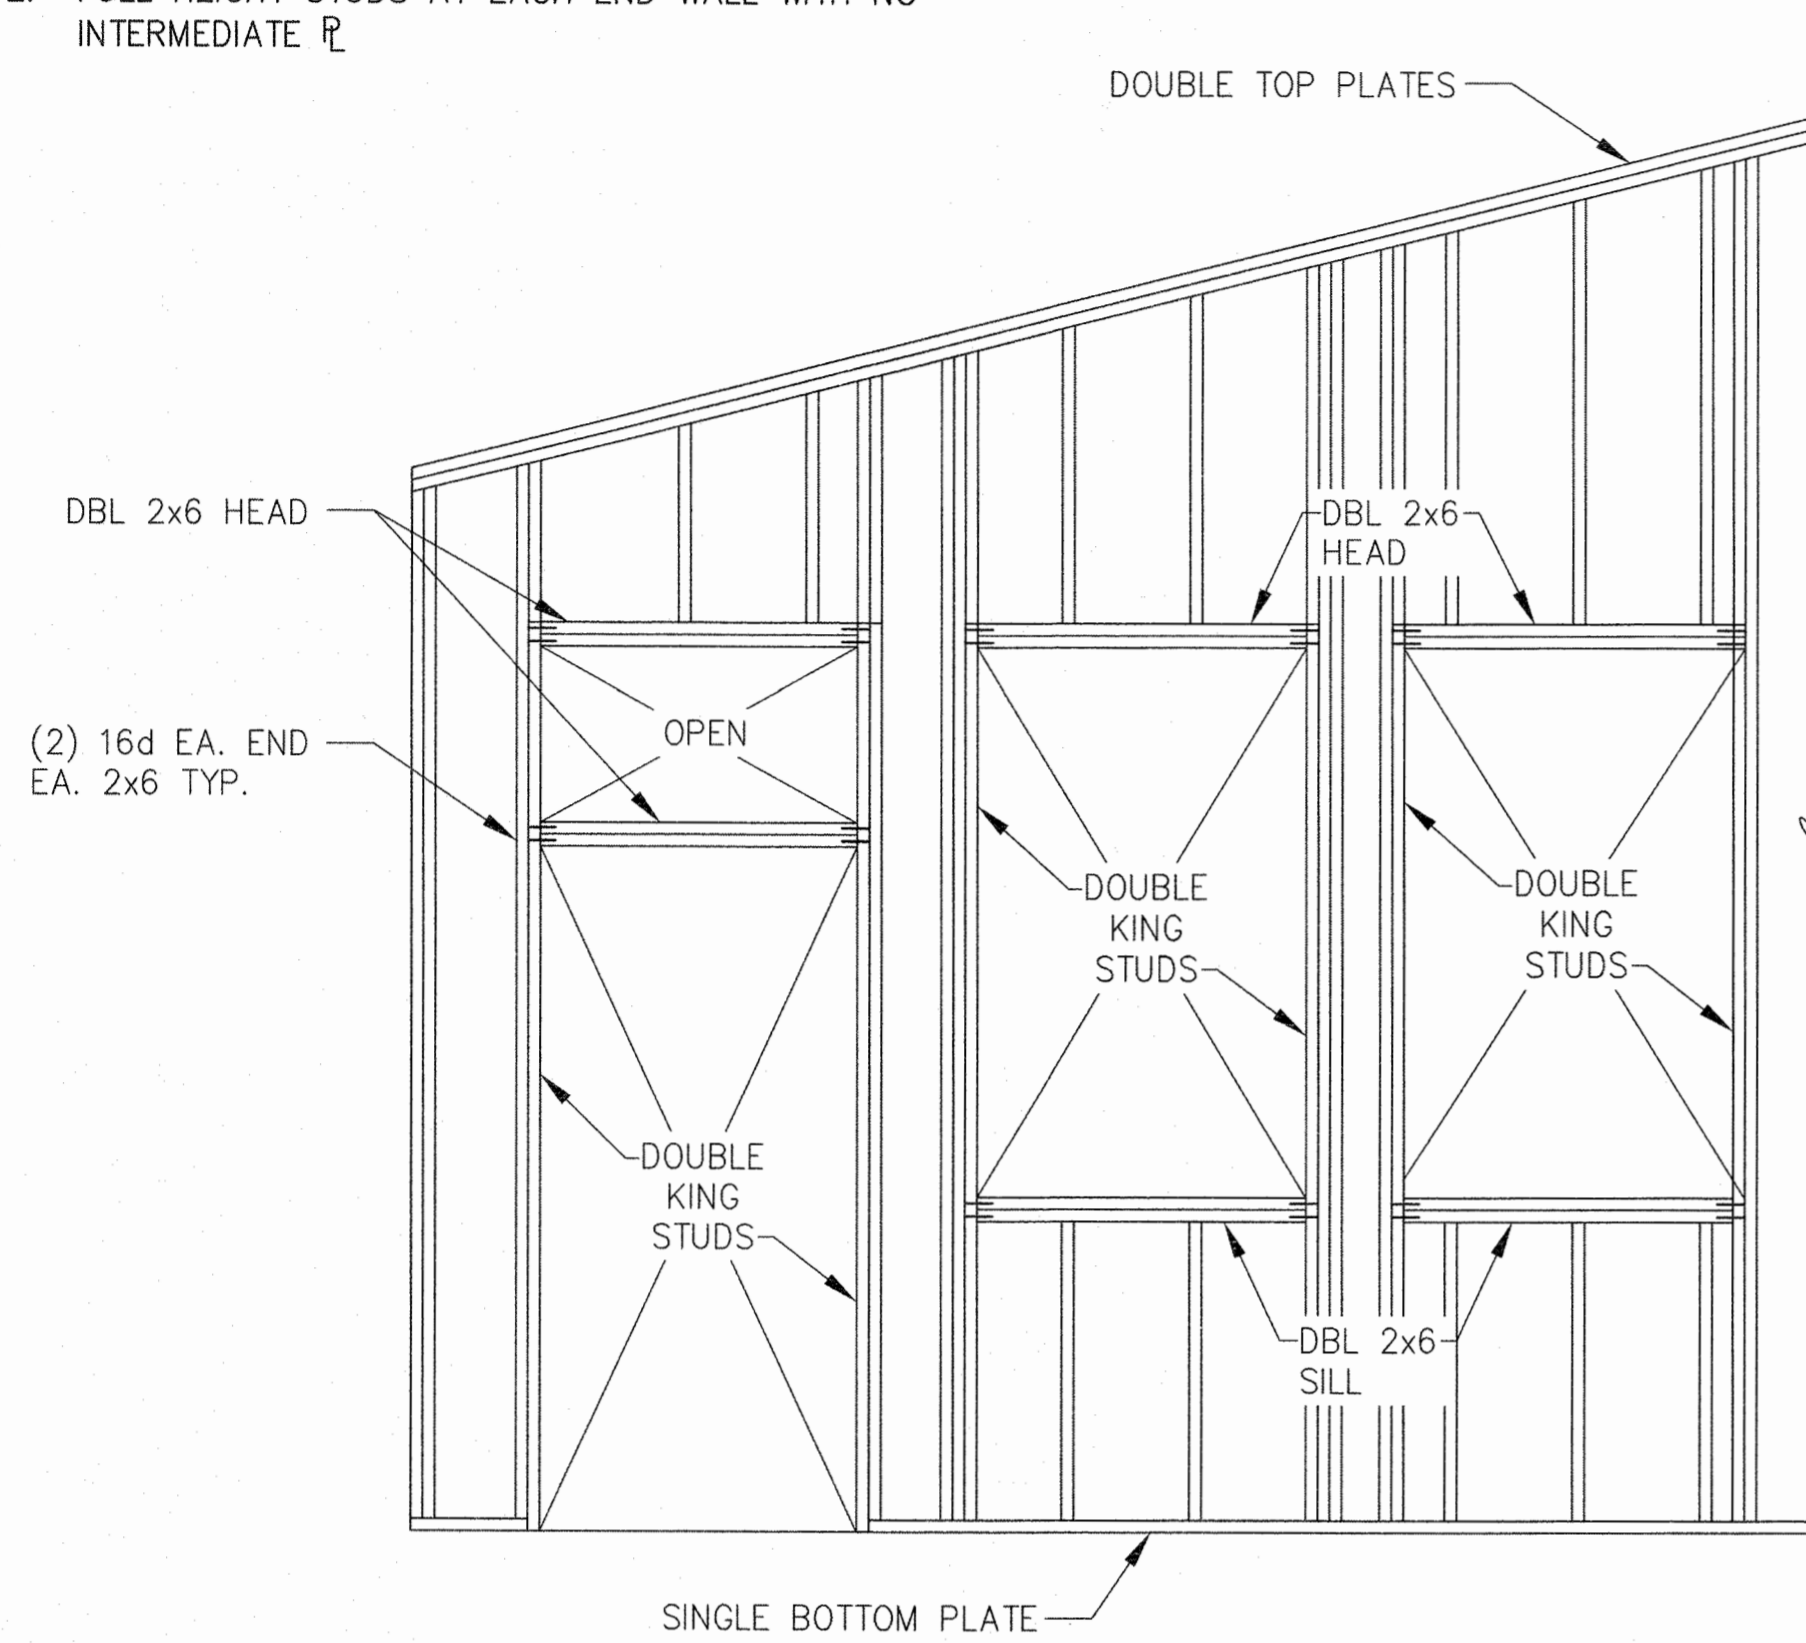

A TYPICAL END WALL FRAMING AT OPENINGS

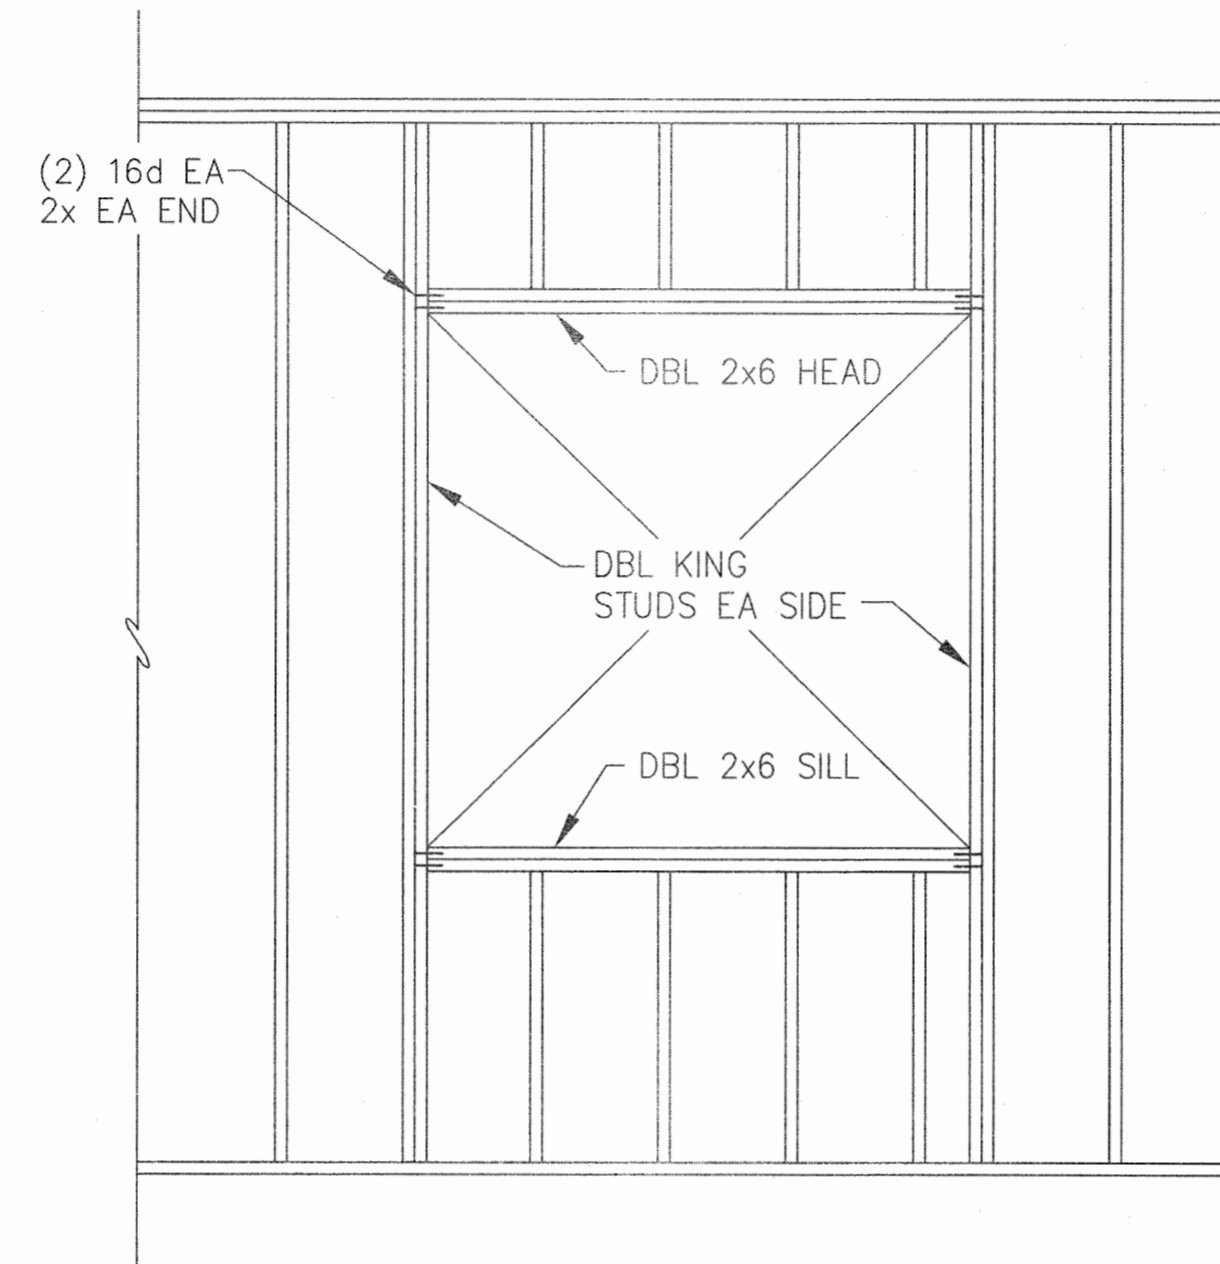

B SIDEWALL WINDOW TYPICAL FRAMING

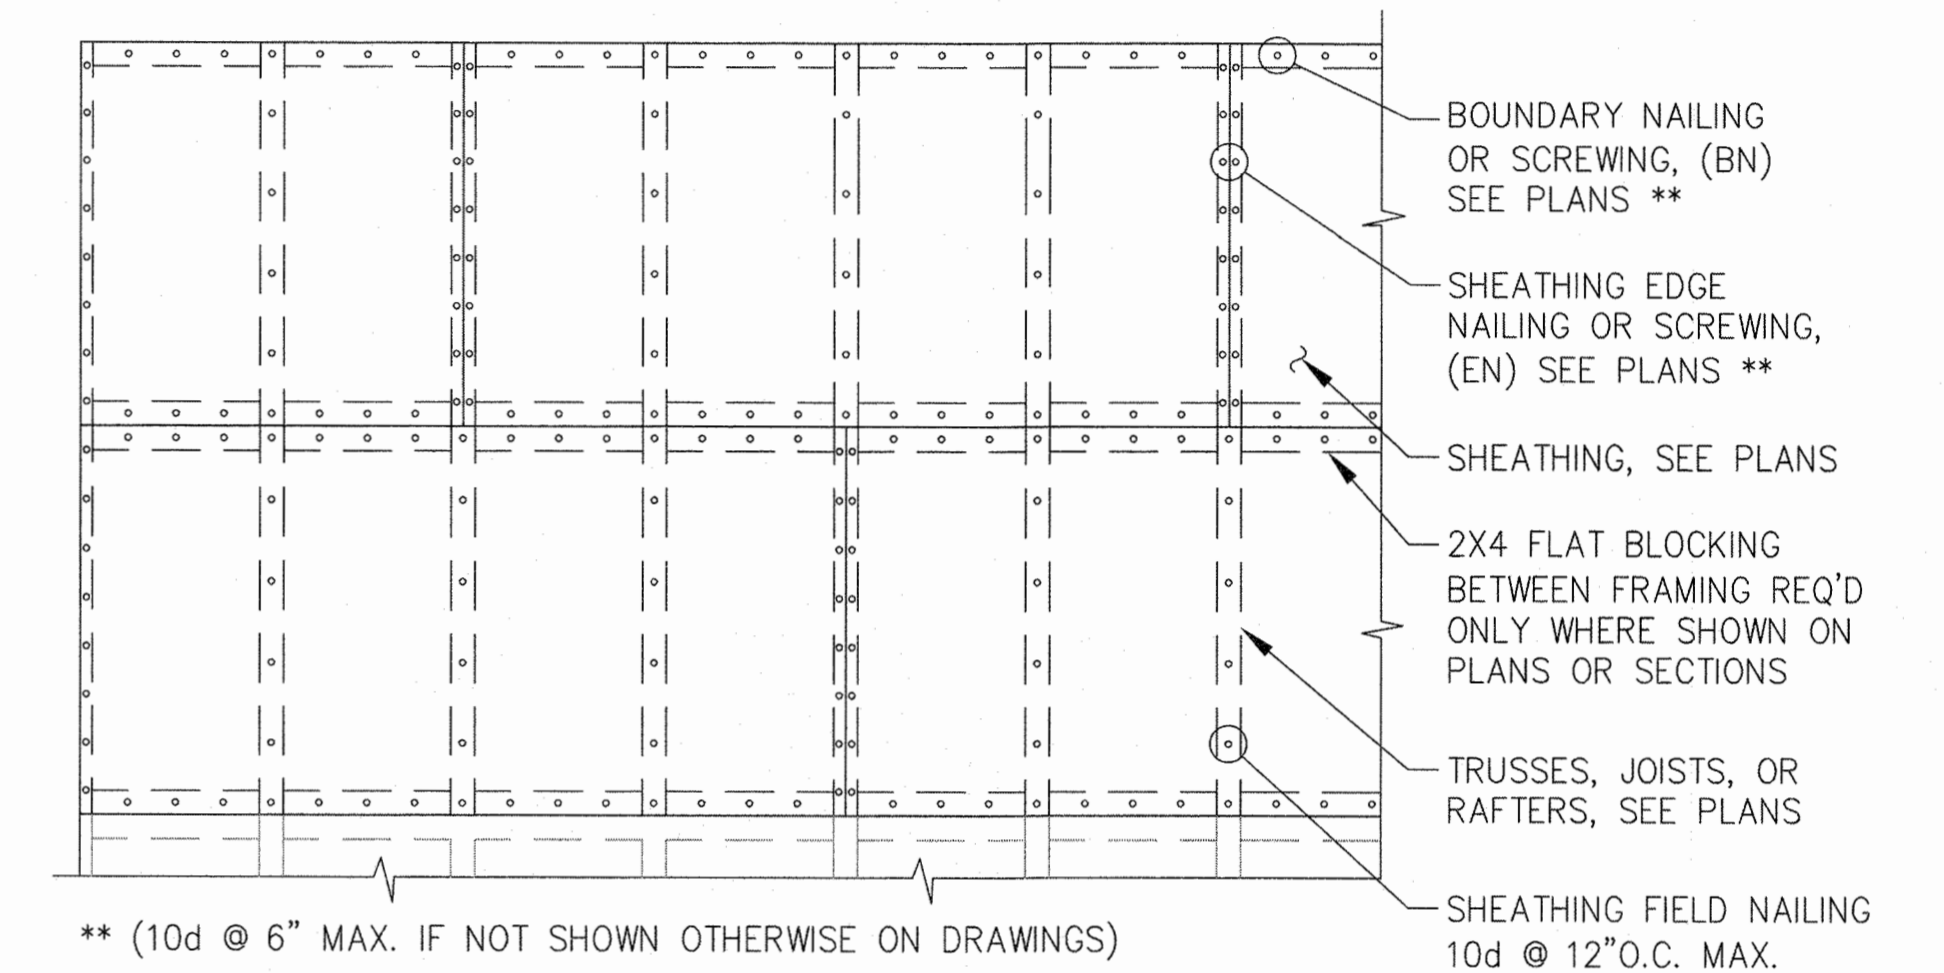

** (10d @ 6" MAX. IF NOT SHOWN OTHERWISE ON DRAWINGS)

PLAN

NOTE:

1. STAGGER SHEATHING JOINTS A MINIMUM OF TWO JOIST SPACES
2. NAILS AT ABUTTING SHEATHING EDGES MUST PENETRATE THE SAME PIECE OF FRAMING OR BLOCKING.

C TYPICAL PLYWOOD ROOF DIAPHRAGM

RECORD DRAWINGS

THESE DRAWINGS HAVE BEEN PREPARED FROM INFORMATION PROVIDED BY THE CONTRACTOR. THERE IS NO GUARANTEE TO THE ACCURACY OF THE INFORMATION CONTAINED HEREIN, EITHER EXPRESSED OR IMPLIED.


October 9, 2017

WELSHWHITELEYARCHITECT, LLC


DO NOT SCALE FROM THESE DRAWINGS USE DIMENSIONS

CHECKED BY: CMG		STATE OF ALASKA DEPARTMENT OF TRANSPORTATION & PUBLIC FACILITIES SOUTHCOST REGION				
DESIGNED BY: CMG		KAKE FERRY TERMINAL PASSENGER FACILITY PLANSET B				
DRAWN BY: DRD						
PATH: N:\12XXX\122068 AMHS KAKE TERMINAL\E1 DRAWINGS\PND\2017-9-29\S0.2.DWG		STRUCTURAL FRAMING DETAILS				
TAB: S0.2 Monday, October 09, 2017 8:15:21 AM DANIELLE DUNIVIN						
REVISIONS		PROJECT DESIGNATION	YEAR	SHEET NO.	TOTAL SHEETS	
NO.	DATE	DESCRIPTION	SAMHS00002	2015	S0.2	35

PLANS PREPARED BY:
PND ENGINEERS, INC.
9360 GLACIER HWY
JUNEAU, AK 99801

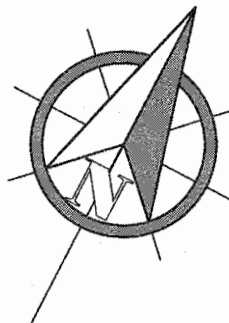

4" SLAB ON GRADE WITH #4 AT 1'-6" O.C. EACH WAY OVER RIGID INSULATION OVER VAPOR BARRIER OVER 4" BASE COURSE. SEE S1.1 FOR SLAB JOINTS.

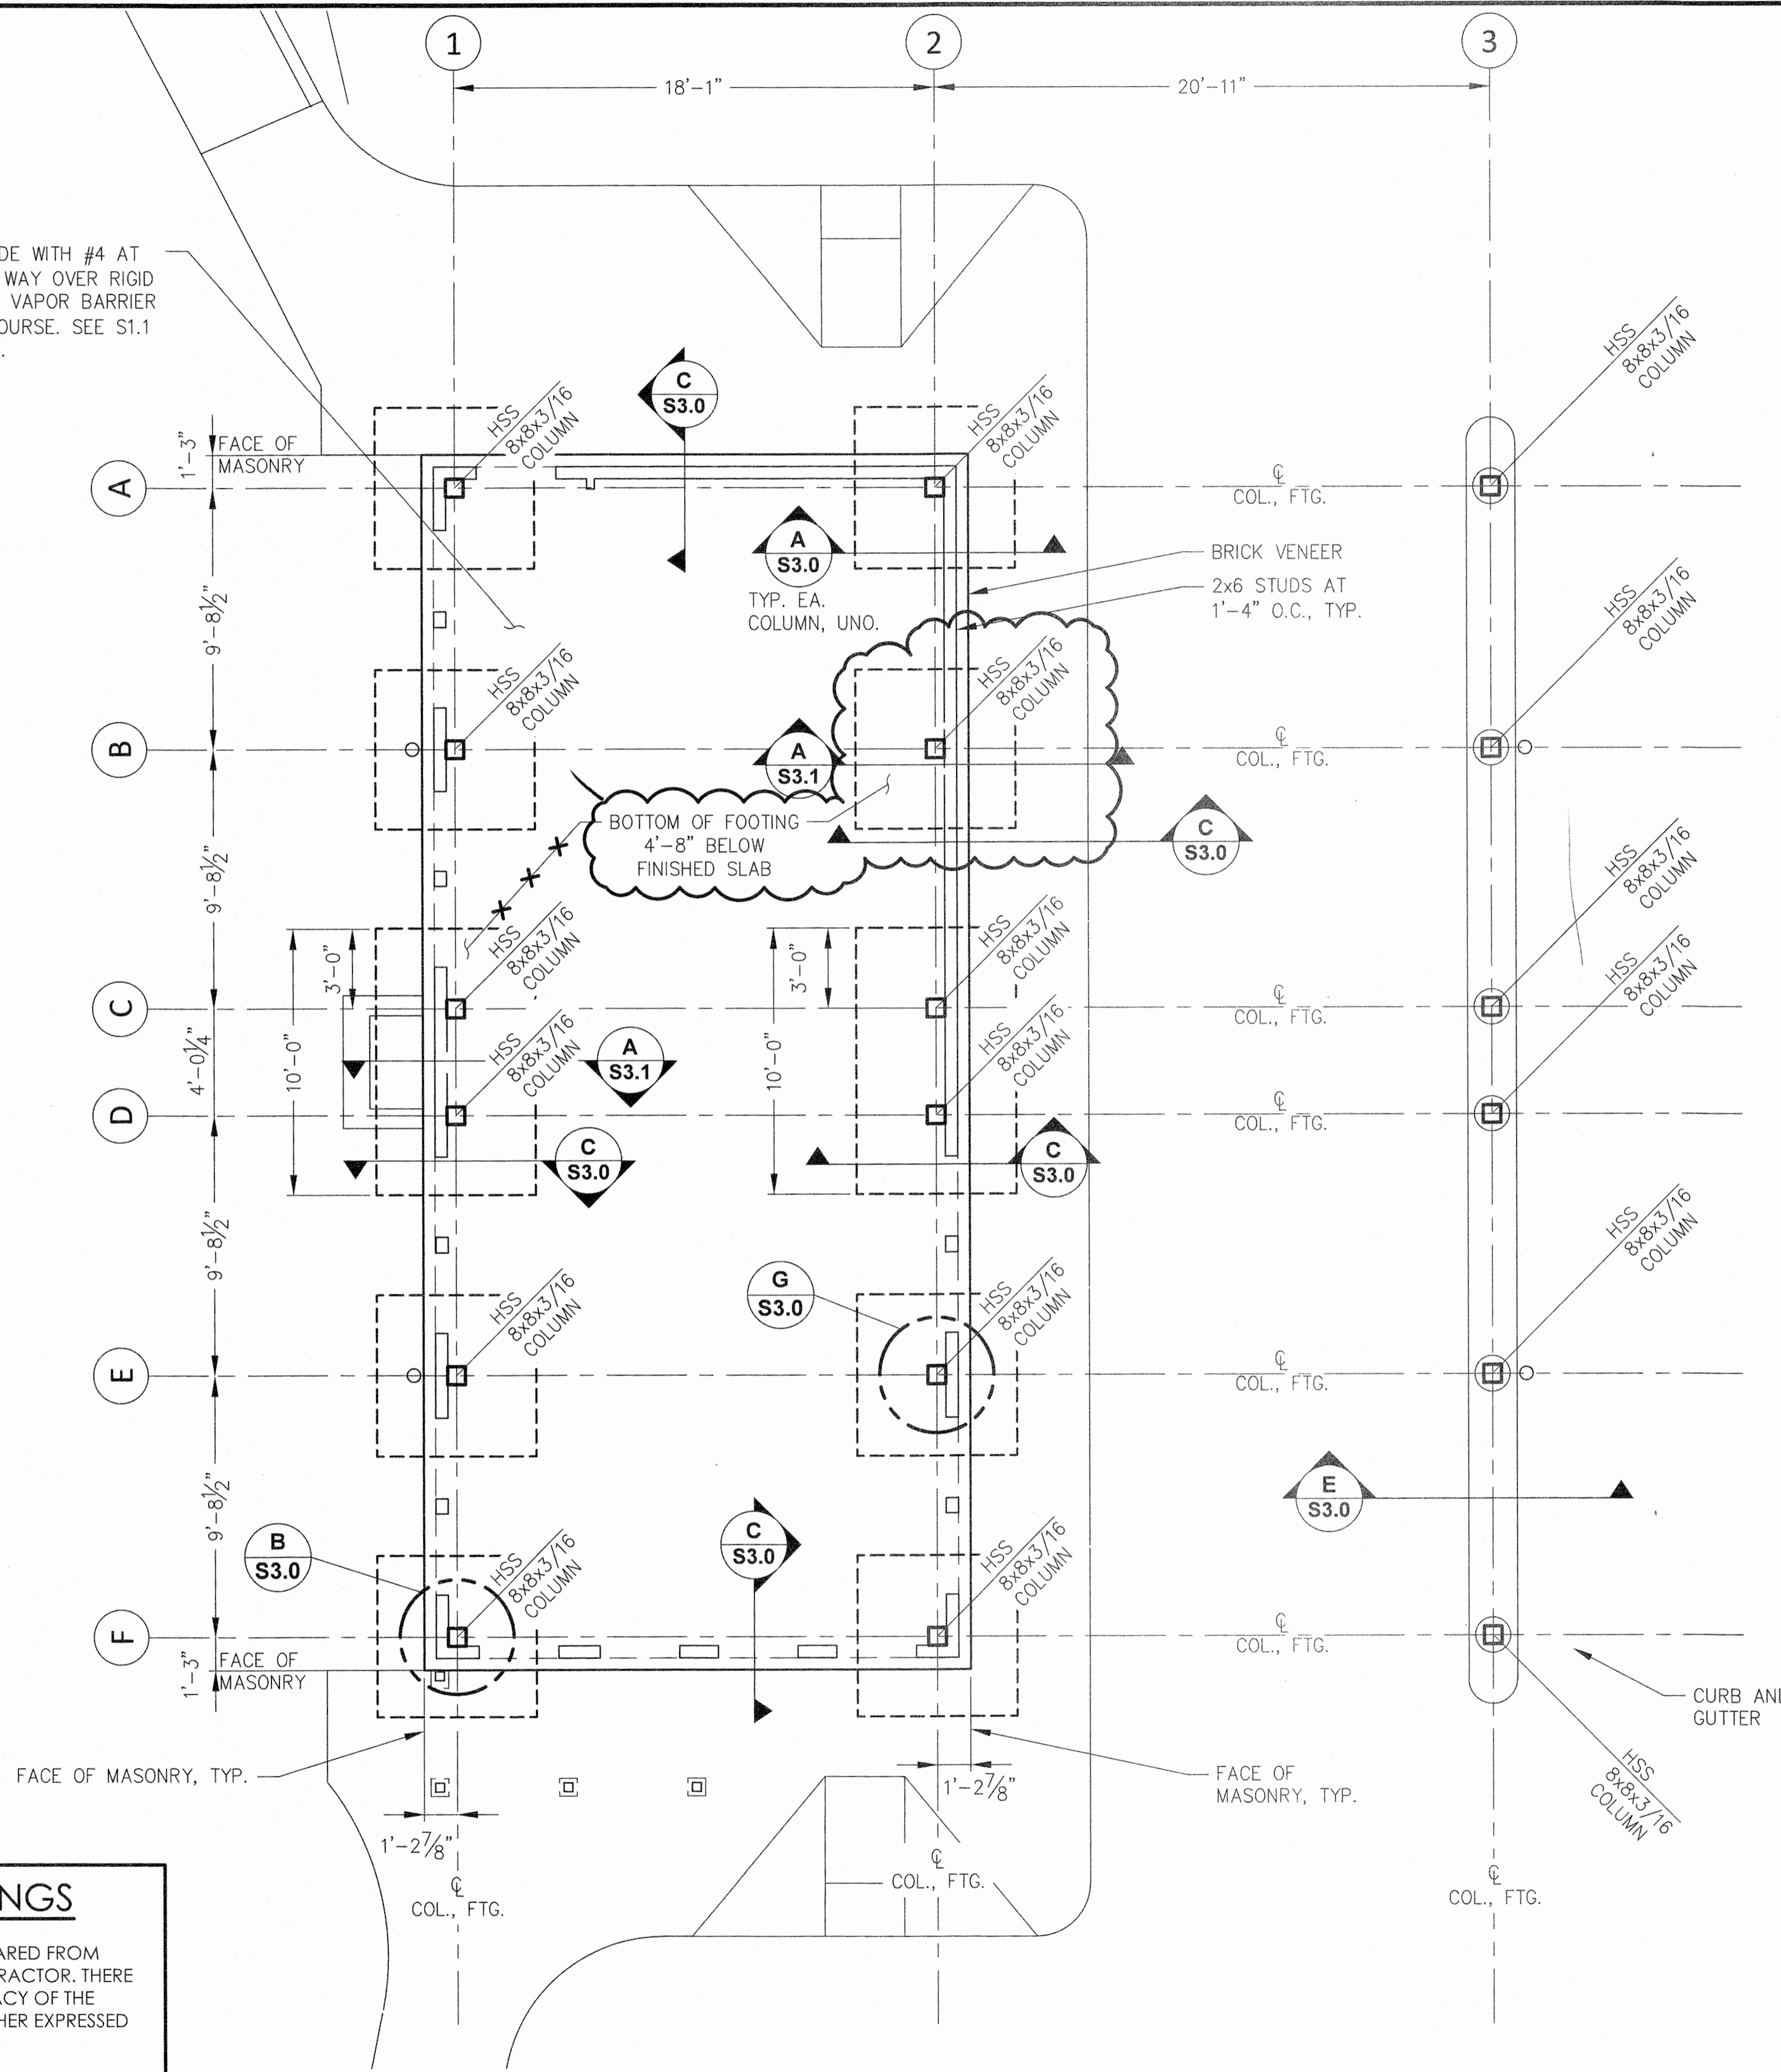

NOTE:
 1. BOTTOM OF COLUMN FOOTINGS 2'-8" BELOW FINISHED FLOOR UNLESS NOTED OTHERWISE.
 2. REFER TO CIVIL DRAWINGS FOR LAYOUT OF EXTERIOR SIDEWALK, CURB, AND GUTTER.
 3. THE BOTTOM OF THE COLUMN FOOTINGS AND THE BOTTOM OF THE PERIMETER FOOTINGS ARE AT THE SAME ELEVATION AND THE DISTANCE FROM TOP OF SLAB TO BOTTOM OF FOOTING IS 2'-8". THERE IS 4" BETWEEN BOTTOM OF SLAB AND TOP OF COLUMN FOOTING. THE 4" IS 4" OS INSULATION OR 2" OF INSULATION AND 2" OF COMPACTED GRAVEL.

RECORD DRAWINGS
 THESE DRAWINGS HAVE BEEN PREPARED FROM INFORMATION PROVIDED BY THE CONTRACTOR. THERE IS NO GUARANTEE TO THE ACCURACY OF THE INFORMATION CONTAINED HEREIN, EITHER EXPRESSED OR IMPLIED.
 October 9, 2017
 WELSHWHITELEYARCHITECT, LLC


1 FOUNDATION AND FLOOR FRAMING PLAN



PLANS PREPARED BY:
 PND ENGINEERS, INC.
 9360 GLACIER HWY
 JUNEAU, AK 99801

DO NOT SCALE FROM THESE DRAWINGS USE DIMENSIONS

CHECKED BY: CMG	STATE OF ALASKA DEPARTMENT OF TRANSPORTATION & PUBLIC FACILITIES SOUTHCOST REGION
DESIGNED BY: CMG	KAKE FERRY TERMINAL PASSENGER FACILITY PLANSET B
DRAWN BY: DRD	FOUNDATION AND FLOOR FRAMING PLAN ADD #1
PATH: N:\12XXX\122068 AMHS KAKE TERMINAL\E1 DRAWINGS\PND\2017-9-29\S1.0.DWG	PROJECT DESIGNATION SAMHS00002
TAB: S1.0 Monday, October 09, 2017 8:15:29 AM DANIELLE DUNWIN	YEAR 2015
REVISIONS	SHEET NO. S1.0
NO. DATE DESCRIPTION	TOTAL SHEETS 35

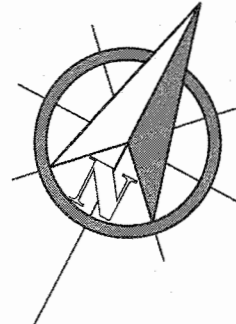

TOOLED CRACK CONTROL JOINT AT 6'-0" O.C.

TOOLED CRACK CONTROL JOINT AT TANGENT PT AND BACK OF WALK EXTENSION

INDICATES SLAB PLACEMENT SEQUENCE

TOOLED CRACK CONTROL JOINT AT COLUMNS, TYP.

TOOLED JOINT AT C JOINT, TYP.

TOOLED CRACK CONTROL JOINT, TYP.

B S3.0

E S3.0

D S3.0

RECORD DRAWINGS

THESE DRAWINGS HAVE BEEN PREPARED FROM INFORMATION PROVIDED BY THE CONTRACTOR. THERE IS NO GUARANTEE TO THE ACCURACY OF THE INFORMATION CONTAINED HEREIN, EITHER EXPRESSED OR IMPLIED.

October 9, 2017

WELSHWHITELEYARCHITECT, LLC


1 SLAB PLAN




NOTE:

- CONTRACTOR SHALL PLACE INTERIOR SLAB IN CHECKERBOARD FASHION WITH ALTERNATE AREAS PLACED IN ALTERNATE DAYS OF SEQUENCE OF CONSTRUCTION NOTED ON THE PLAN.
- USE CONSTRUCTION JOINTS PER DETAIL 4, THIS SHEET.
- POUR ENTIRE SLAB IN ONE (1) POUR.**


PLANS PREPARED BY:
PND ENGINEERS, INC.
9360 GLACIER HWY
JUNEAU, AK 99801

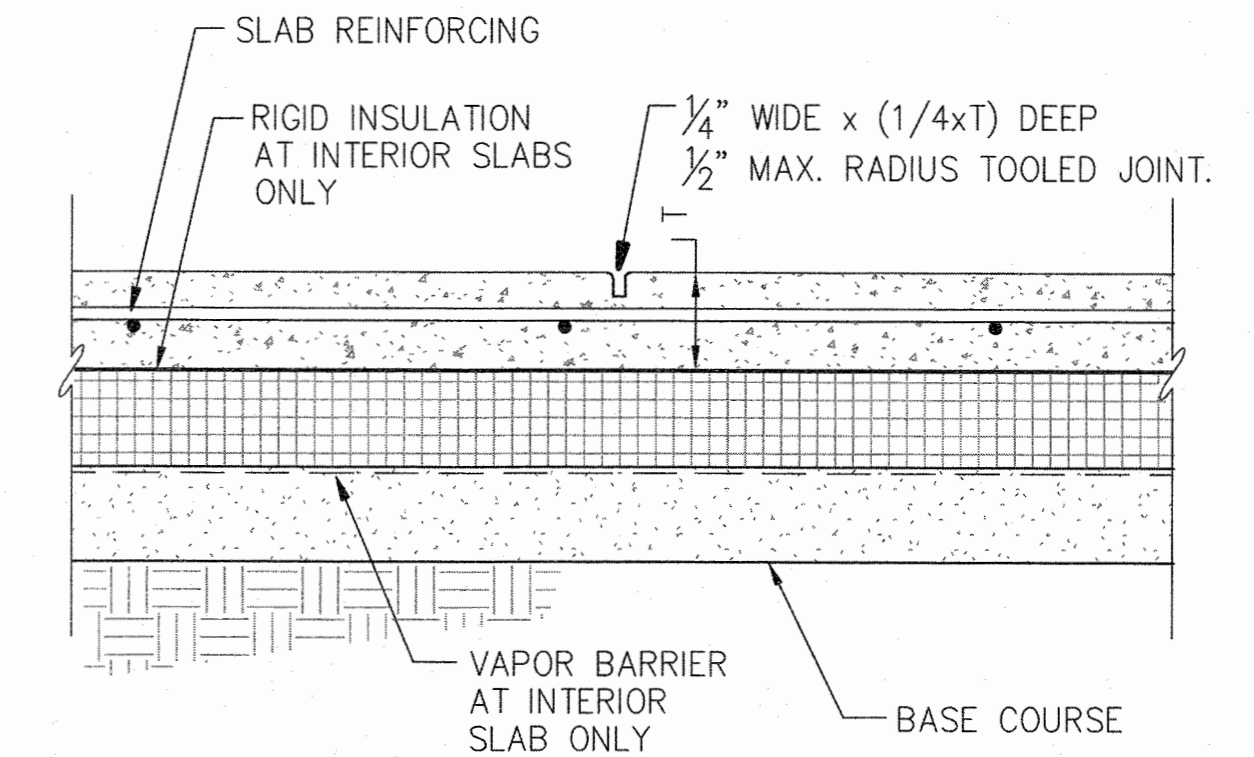

2 TYPICAL SLAB CONTROL JOINT

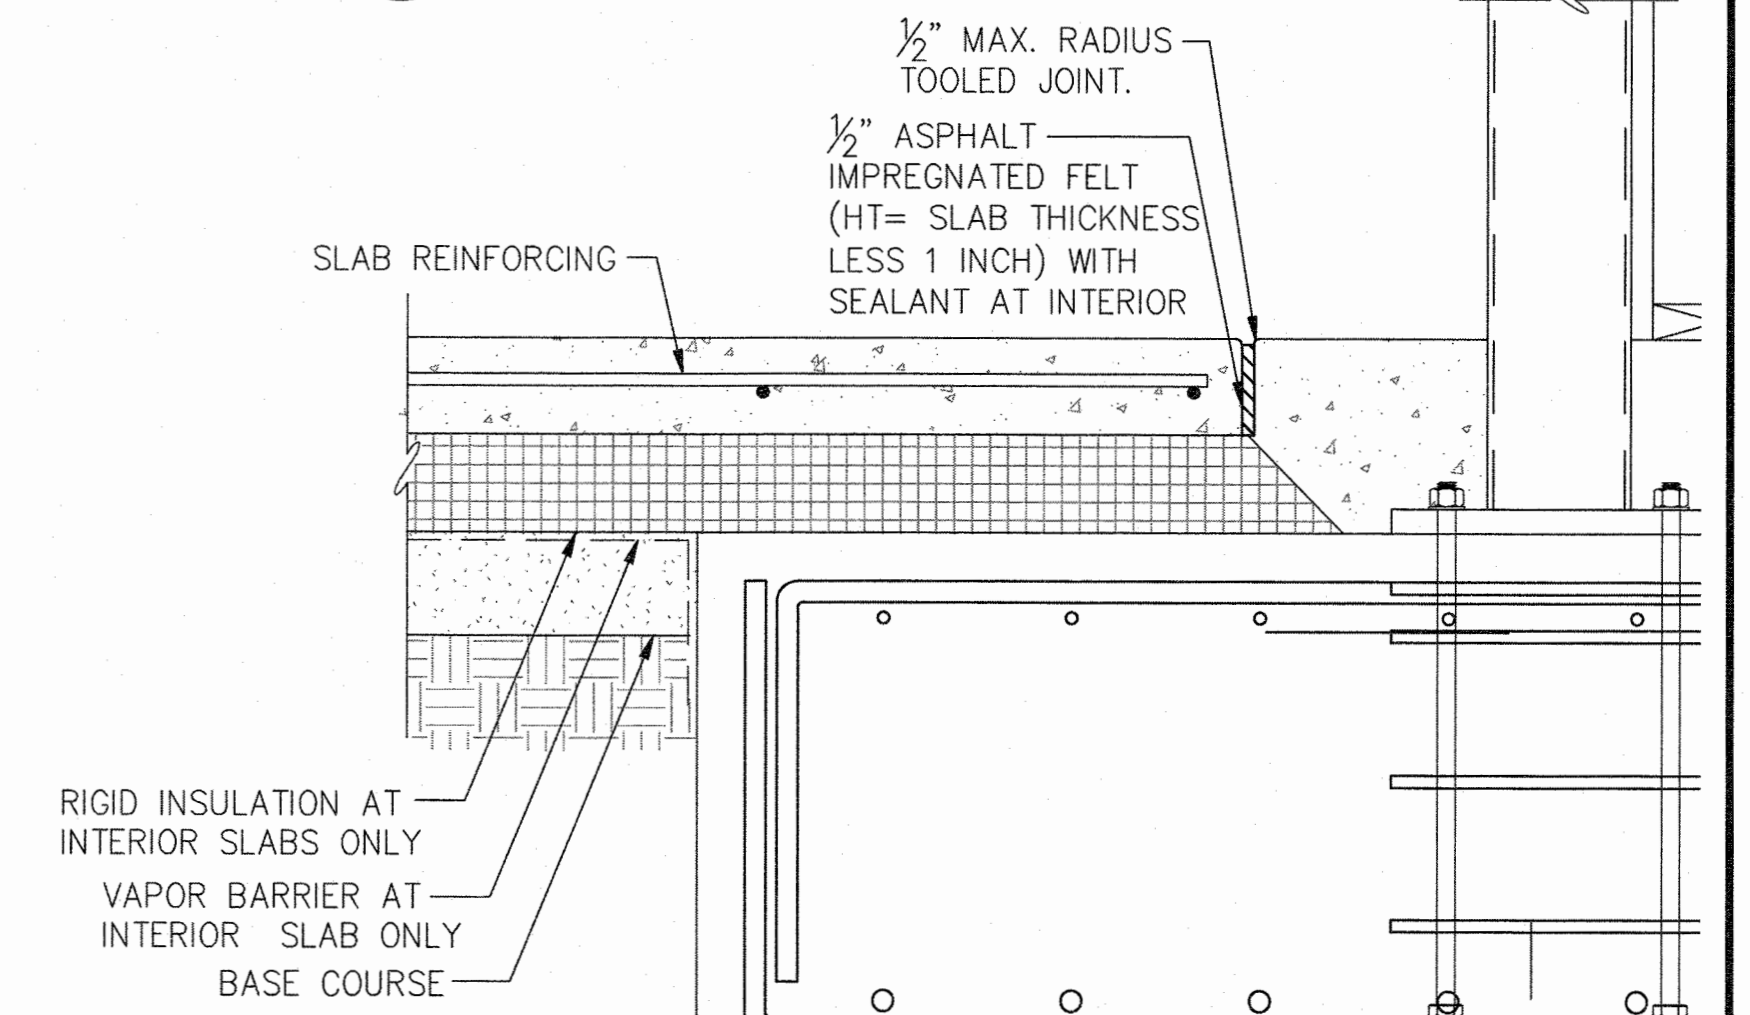

3 TYPICAL SLAB ISOLATION JOINT


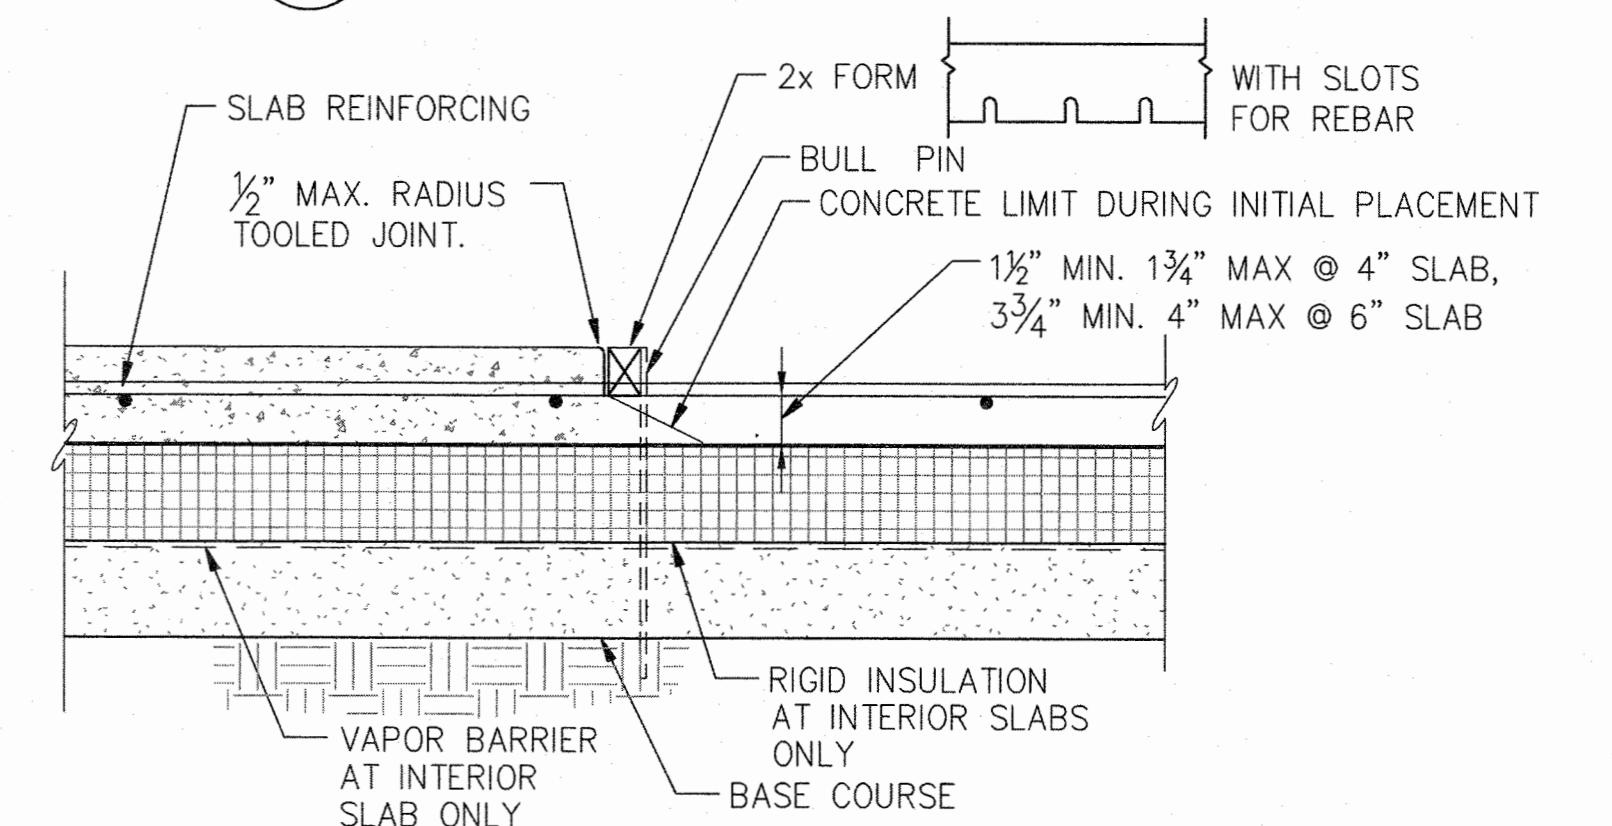


4 CONSTRUCTION JOINTS - LOCATE AT SLAB CONTROL JOINTS

DO NOT SCALE FROM THESE DRAWINGS USE DIMENSIONS

CHECKED BY: CMG		STATE OF ALASKA DEPARTMENT OF TRANSPORTATION & PUBLIC FACILITIES SOUTHCOST REGION			
		KAKE FERRY TERMINAL PASSENGER FACILITY PLANSET B			
		SLAB PLAN ADD #1			
DESIGNED BY: CMG					
DRAWN BY: DRD					
PATH: N:\12XXX\122068 AMHS KAKE TERMINAL\E1 DRAWINGS\PND\2017-9-29\S1.0.DWG					
TAB: S1.1	Monday, October 09, 2017 8:15:30 AM	DANIELLE DUNIVIN			
REVISIONS		PROJECT DESIGNATION	YEAR	SHEET NO.	TOTAL SHEETS
NO.	DATE	DESCRIPTION	SAMHS00002	2015	S1.1
					35

ADDENDUM #1; ATTACHMENT #1

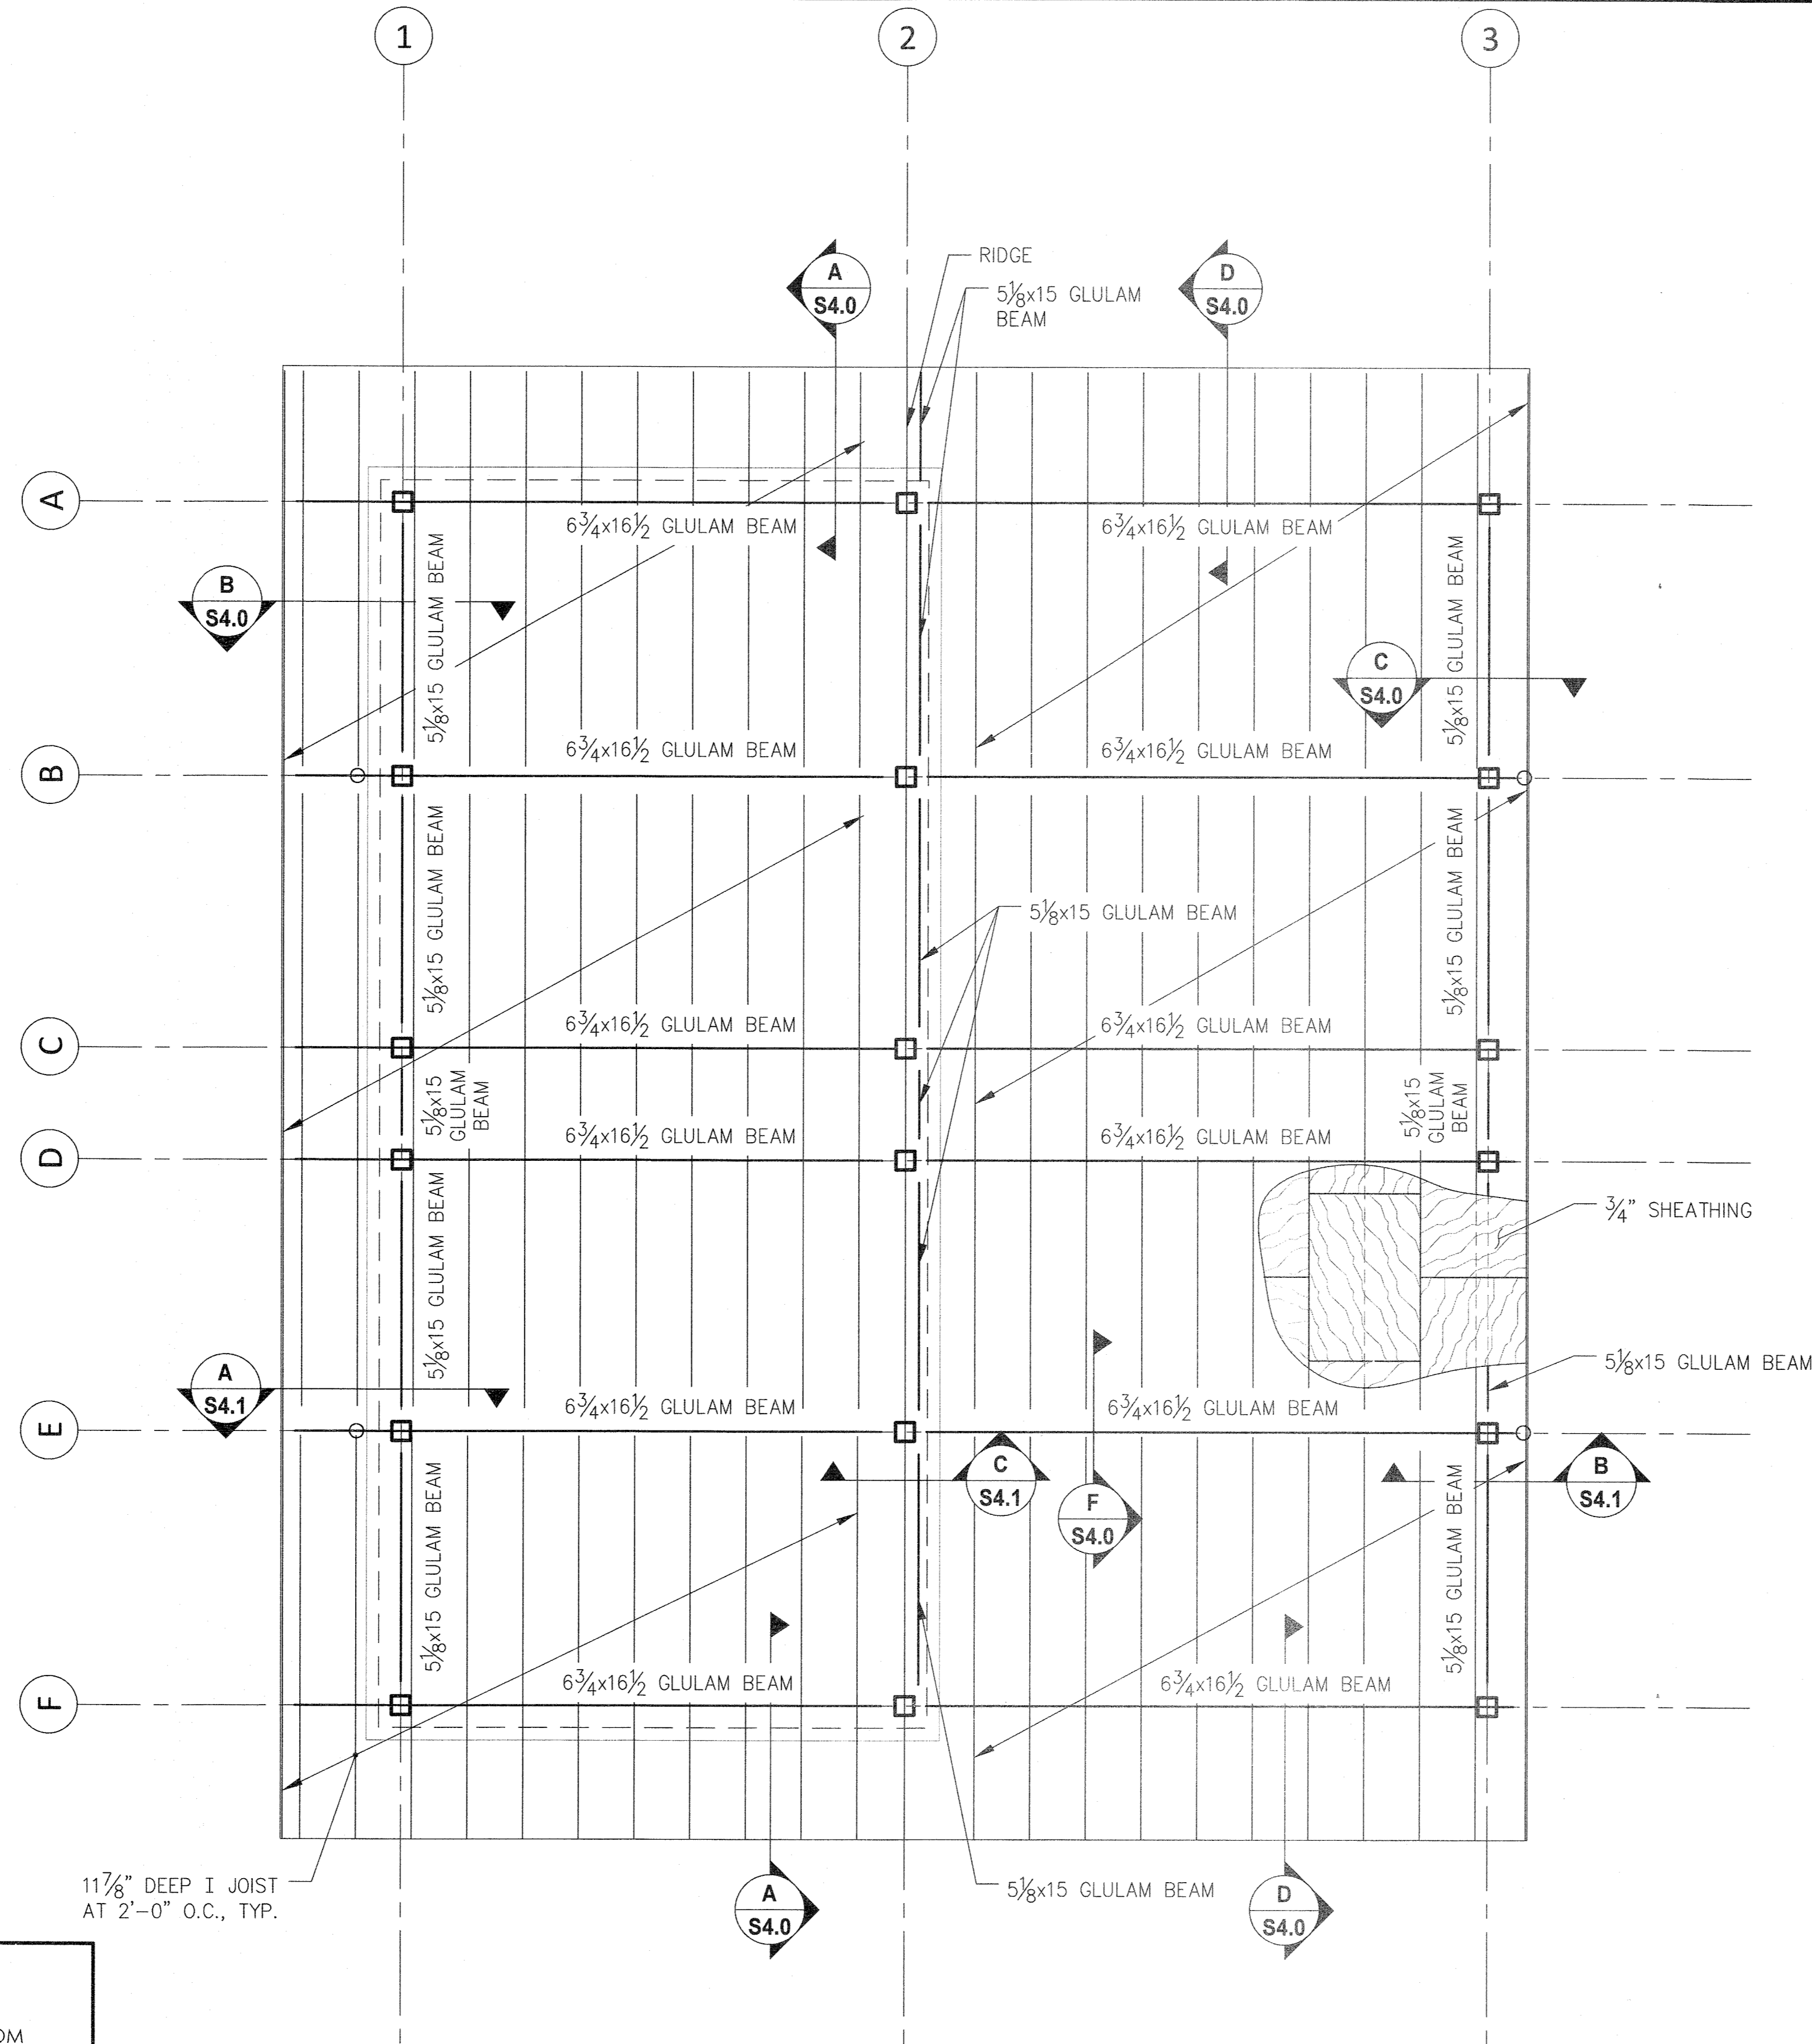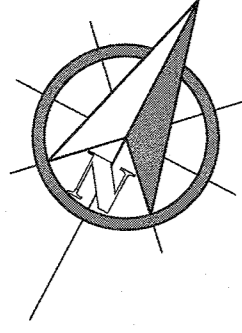

1 1/8" DEEP I JOIST
AT 2'-0" O.C., TYP.


NOTE:
 1. I JOISTS SHALL HAVE 7/16" WIDE PLYWOOD OR OSB WEB WITH 1 1/2" HIGH BY 2 1/2" WIDE LVL FLANGES WITH THE FOLLOWING CAPACITY/CHARACTERISTICS =
 MOMENT CAPACITY = 6,750 FOOT POUNDS
 SHEAR CAPACITY = 2,255 POUNDS
 EI = 450x10 IN²-POUNDS

RECORD DRAWINGS
 THESE DRAWINGS HAVE BEEN PREPARED FROM INFORMATION PROVIDED BY THE CONTRACTOR. THERE IS NO GUARANTEE TO THE ACCURACY OF THE INFORMATION CONTAINED HEREIN, EITHER EXPRESSED OR IMPLIED.
 October 9, 2017
 WELSHWHITELEYARCHITECT, LLC


1 FOUNDATION AND FLOOR FRAMMING PLAN

PLANS PREPARED BY:
 PND ENGINEERS, INC.
 9360 GLACIER HWY
 JUNEAU, AK 99801


DO NOT SCALE FROM THESE DRAWINGS USE DIMENSIONS			
CHECKED BY: CMG	STATE OF ALASKA DEPARTMENT OF TRANSPORTATION & PUBLIC FACILITIES SOUTHCOST REGION		
KAKE FERRY TERMINAL PASSENGER FACILITY PLANSET B			
ROOF FRAMMING PLAN			
DESIGNED BY: CMG	PROJECT DESIGNATION		
DRAWN BY: DRD	SAMHS00002		
PATH: N:\12XXX\122068 AMHS KAKE TERMINAL\E1 DRAWINGS\PND\2017-9-29\S1.0.DWG		YEAR	TOTAL SHEETS
TAB: S2.0 Monday, October 09, 2017 8:15:35 AM DANIELLE DUNIVIN		2015	35
REVISIONS		SHEET NO.	
NO.	DATE	DESCRIPTION	

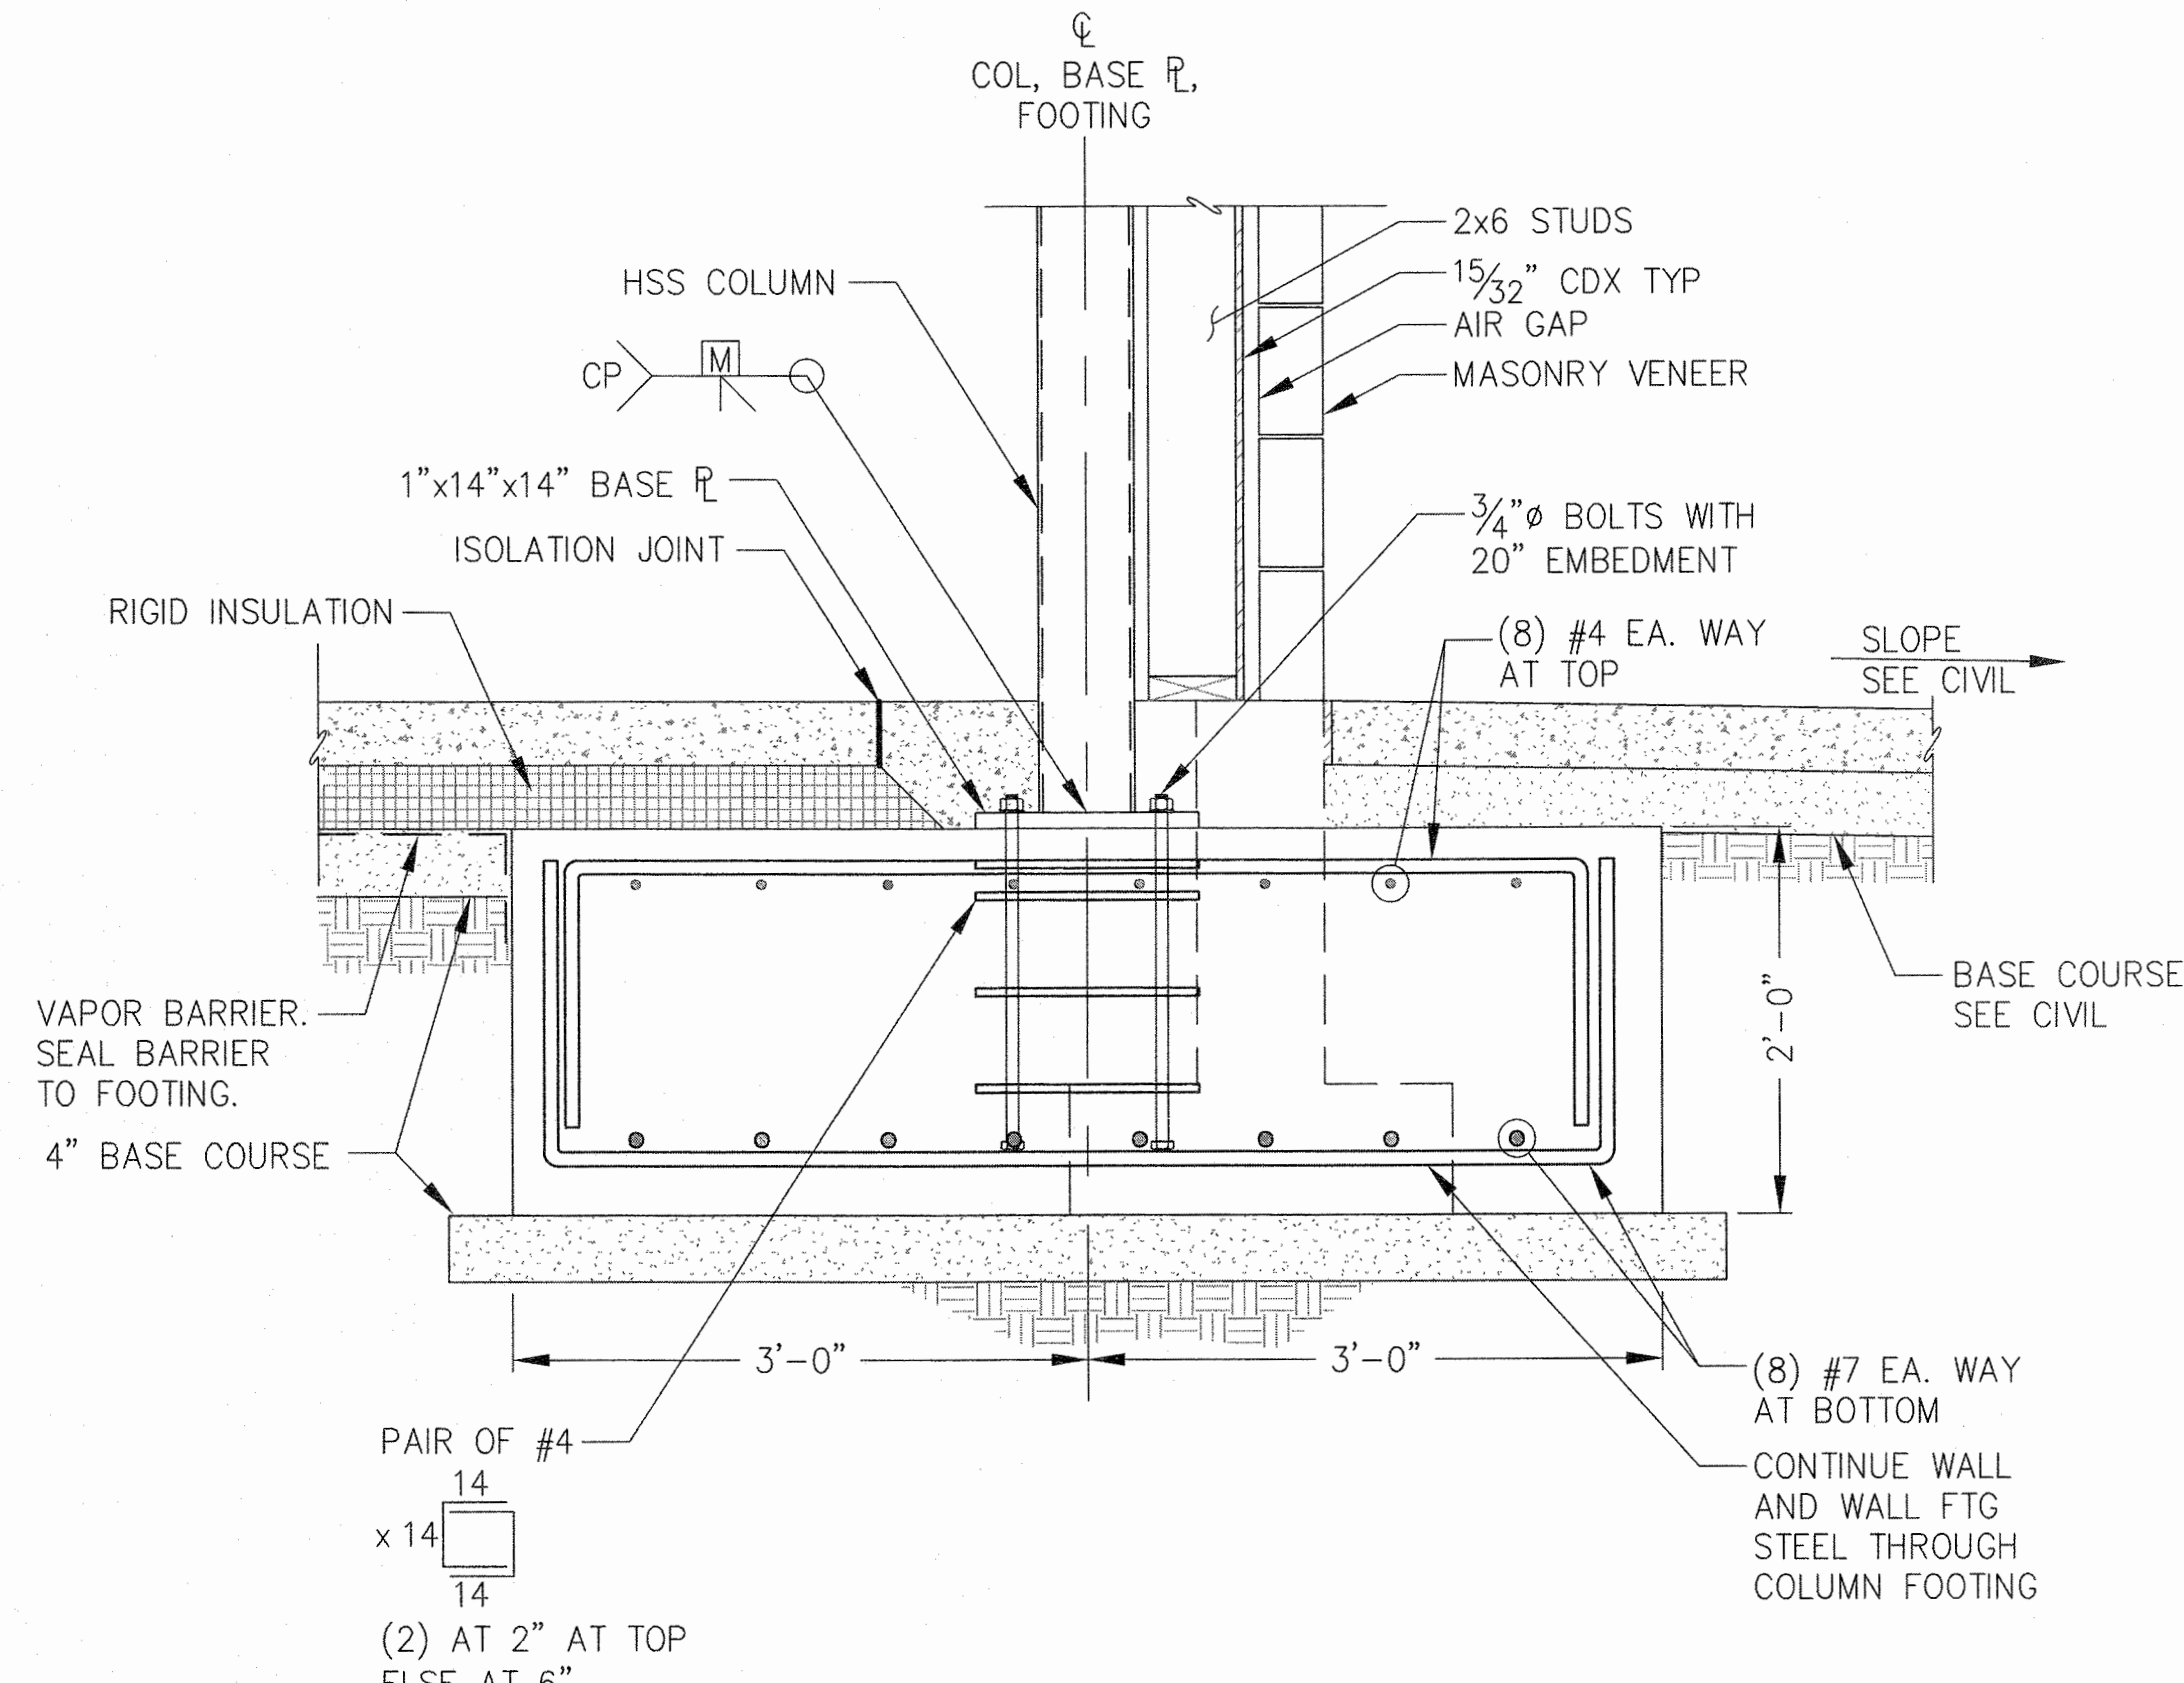


A TYPICAL COLUMN FOOTING DETAIL

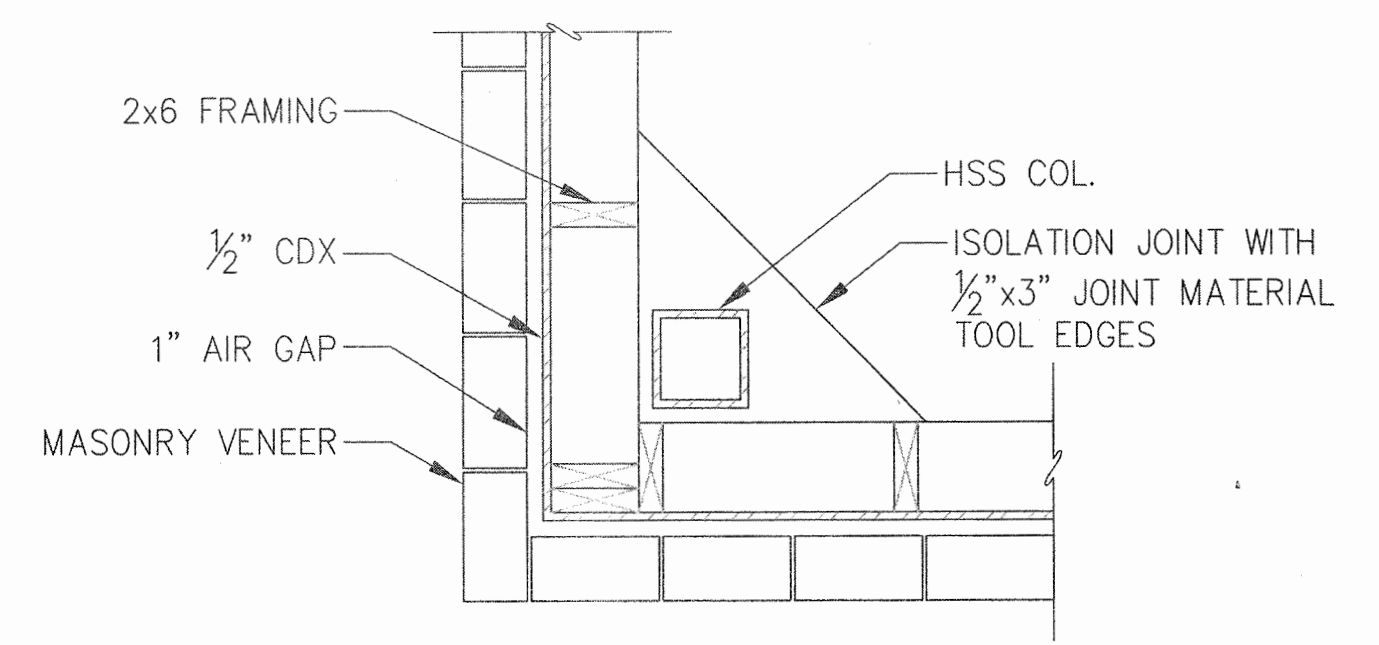


B TYPICAL CORNER COLUMN/ SLAB DETAIL

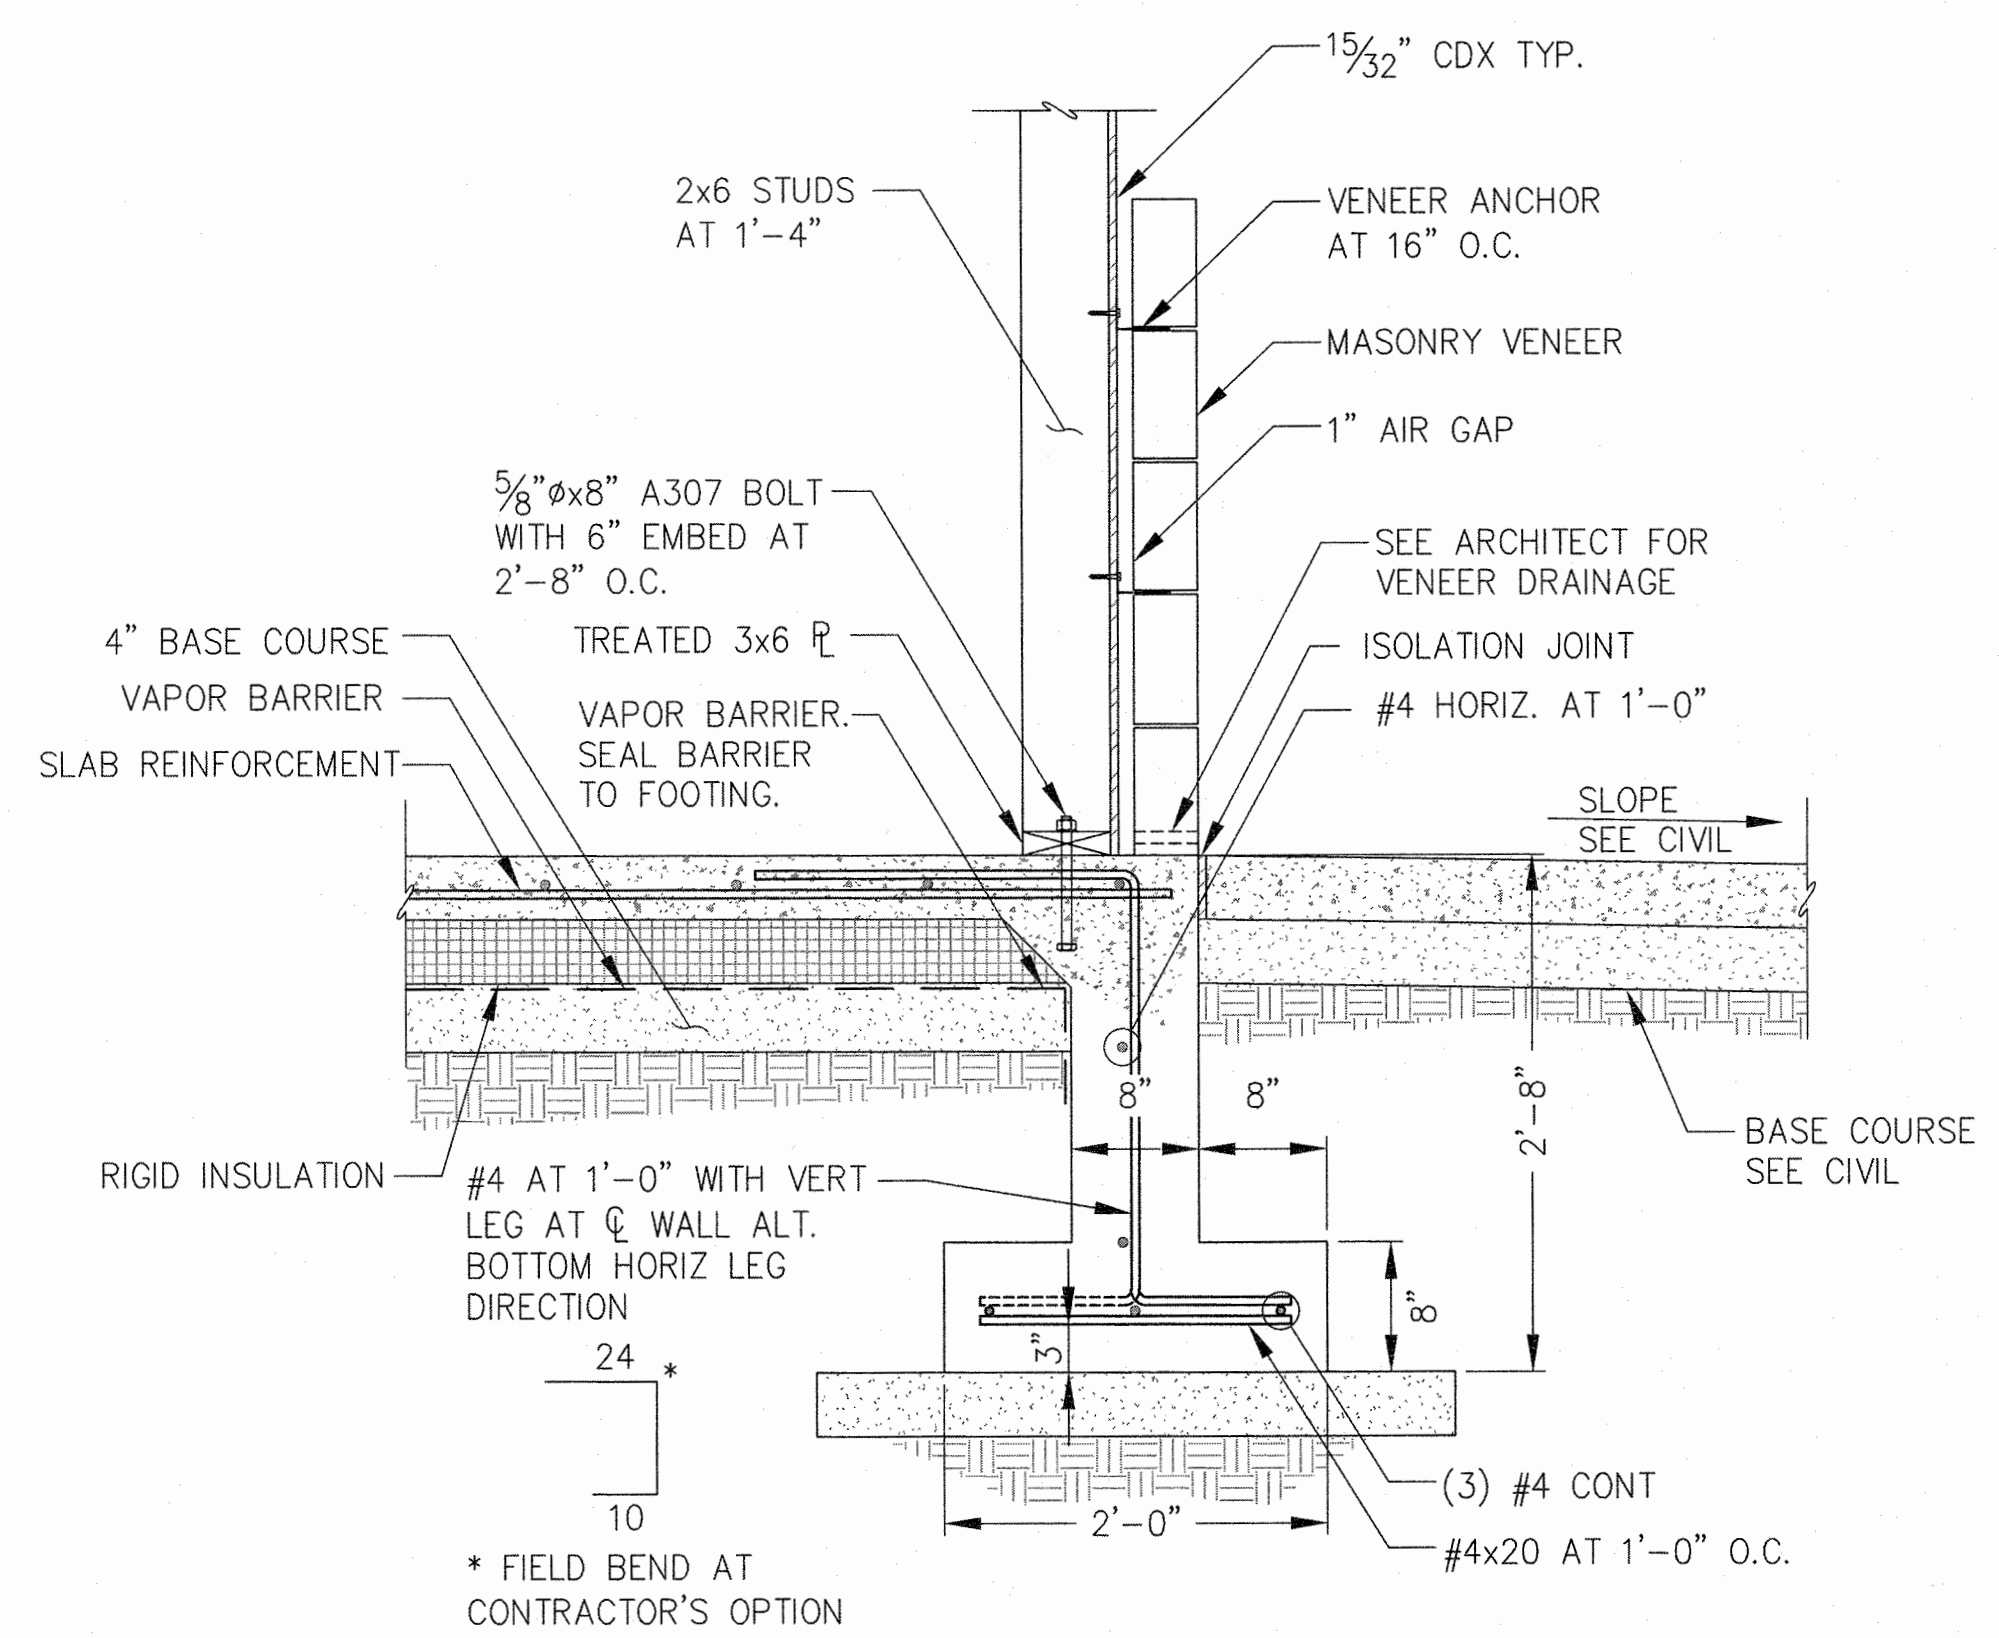


C TYPICAL PERIMETER WALL DETAIL

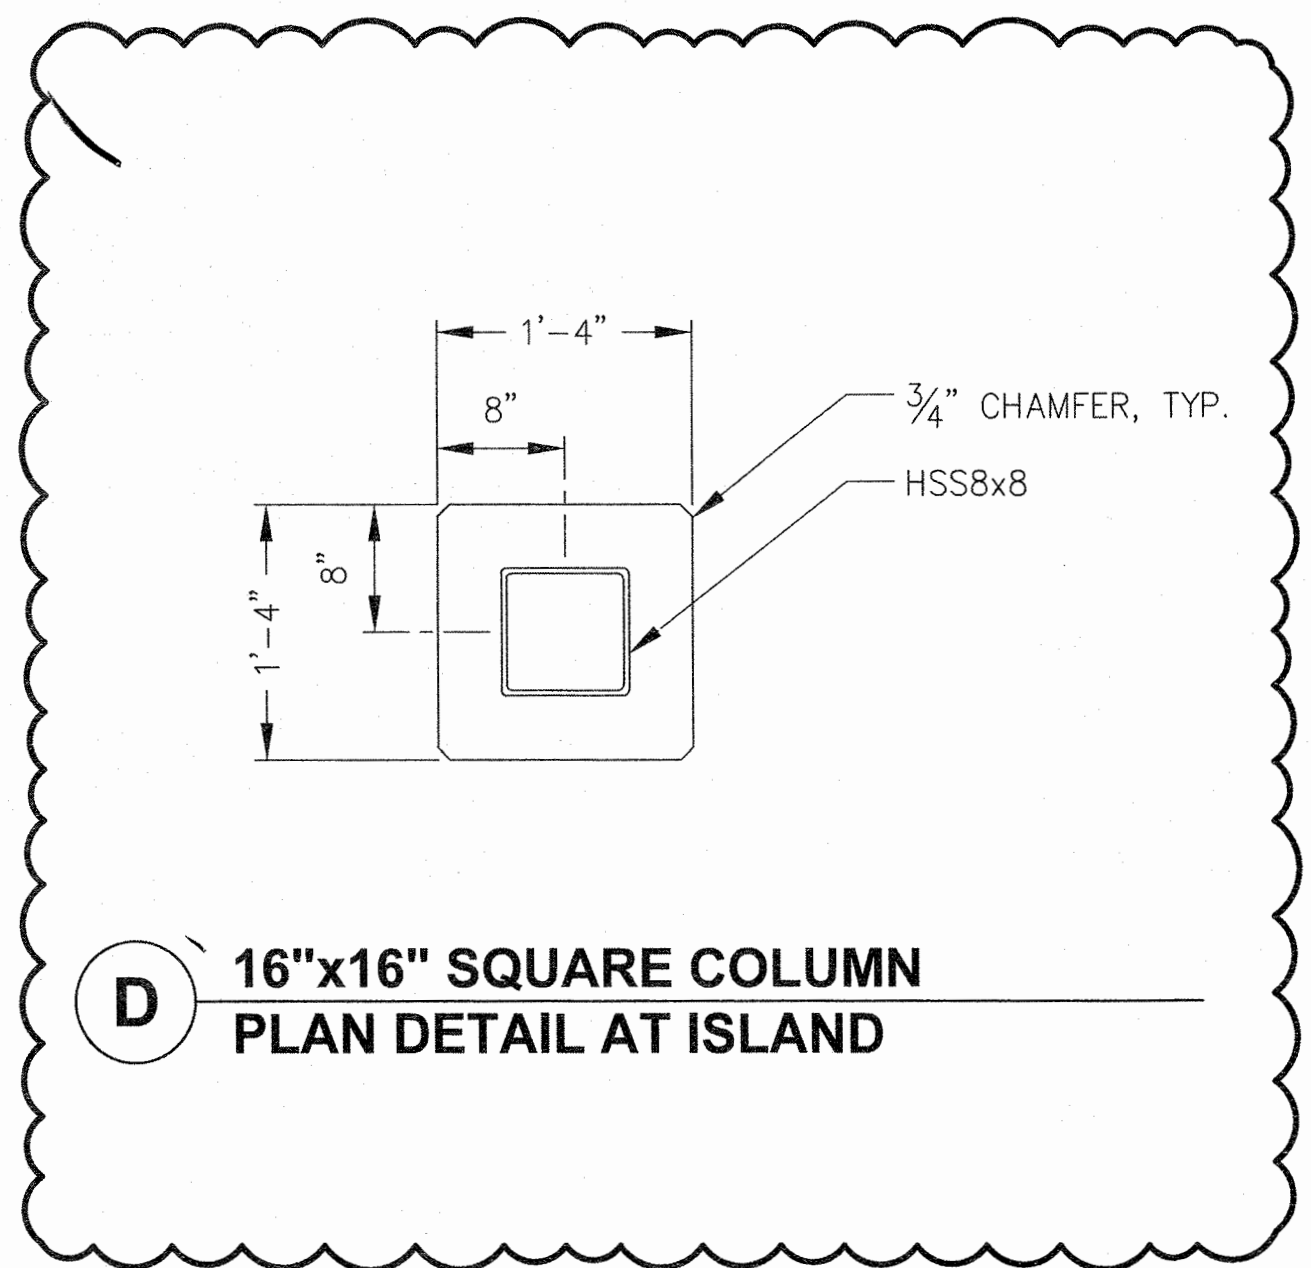


D 16"x16" SQUARE COLUMN PLAN DETAIL AT ISLAND

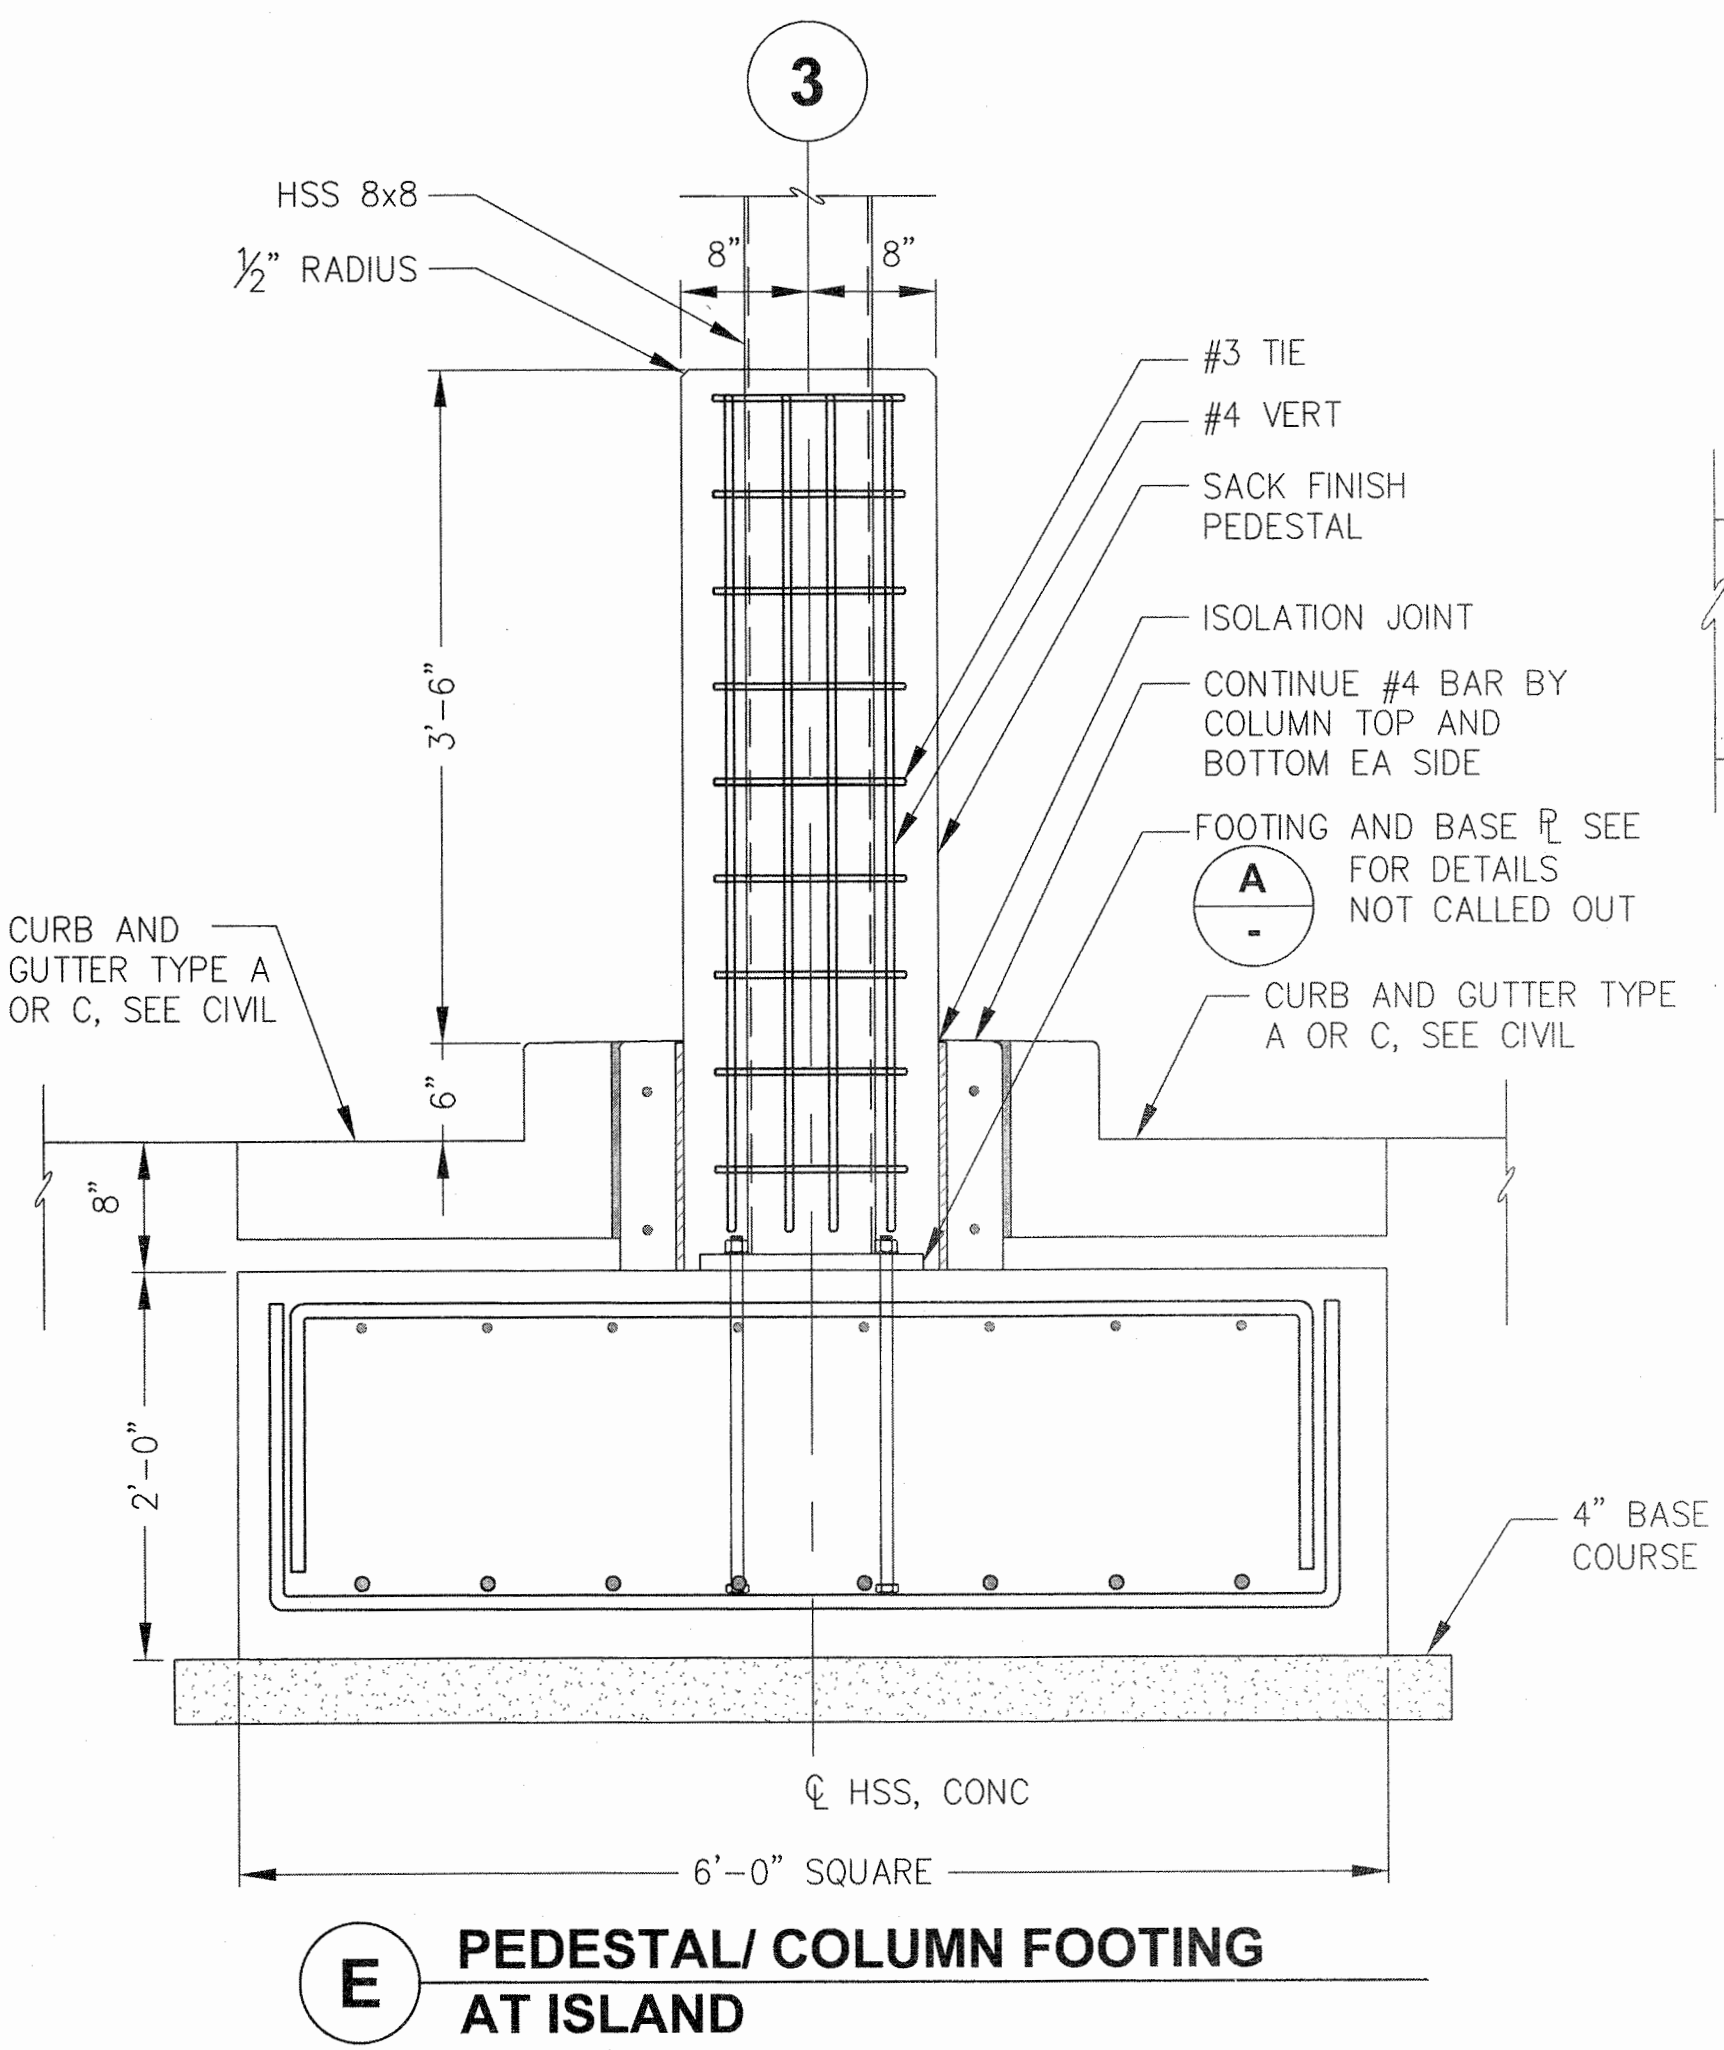

E PEDESTAL/ COLUMN FOOTING AT ISLAND

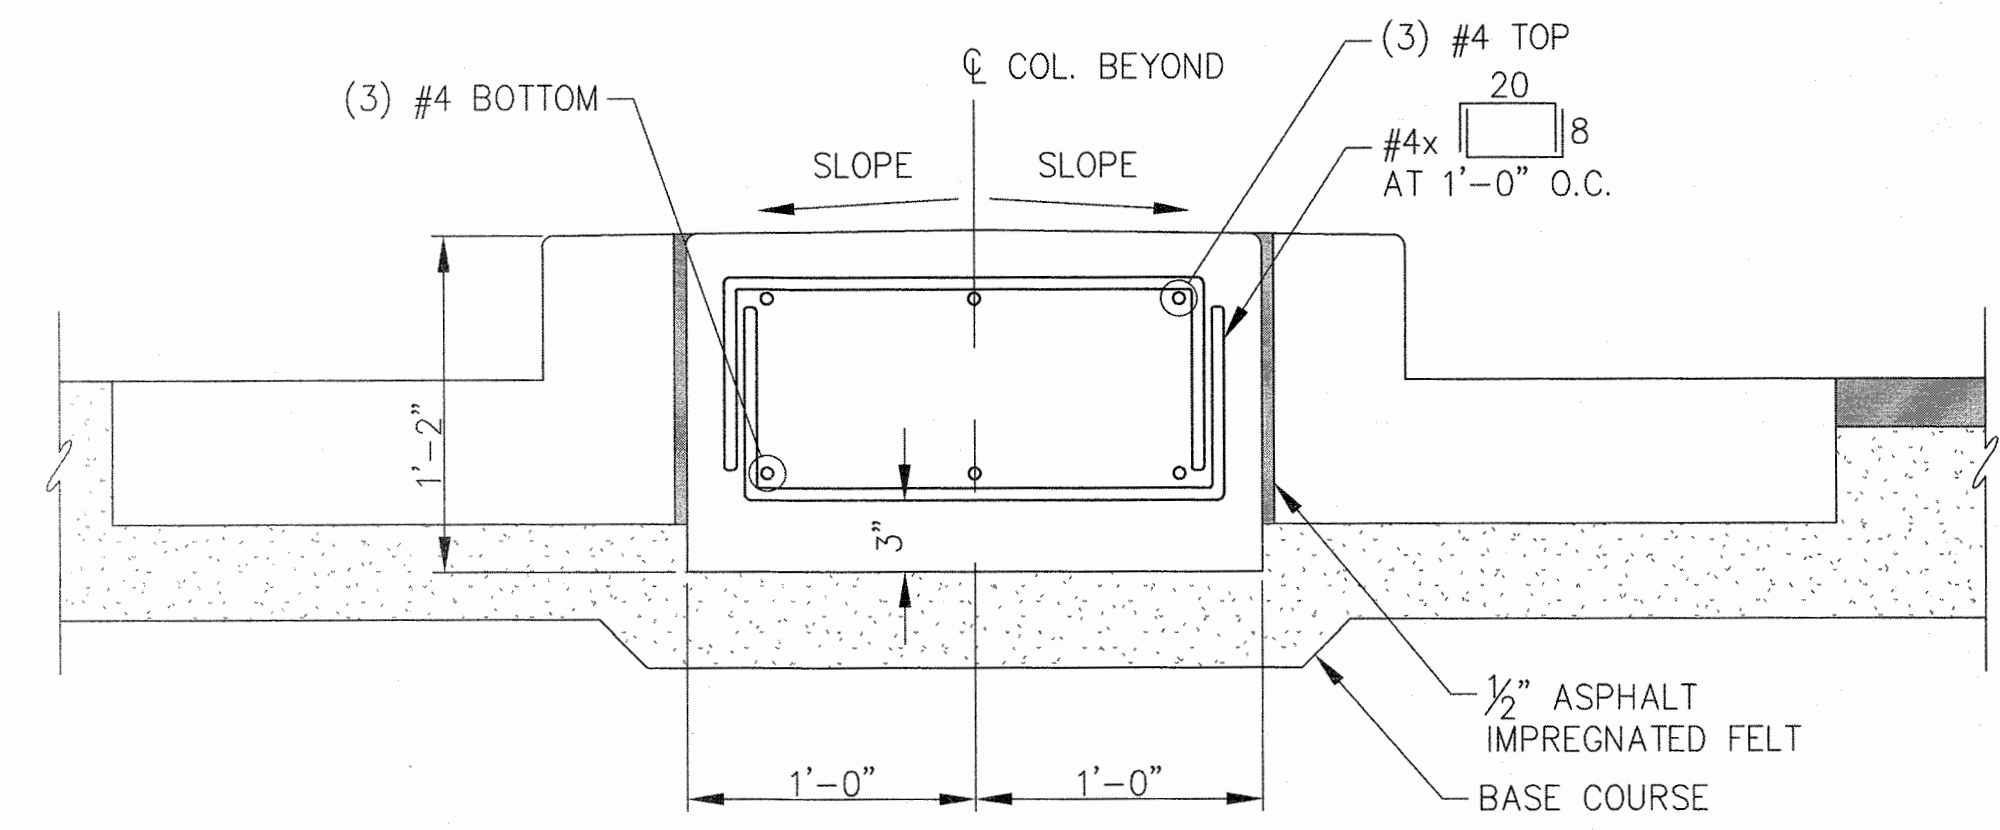

F ISLAND SECTION

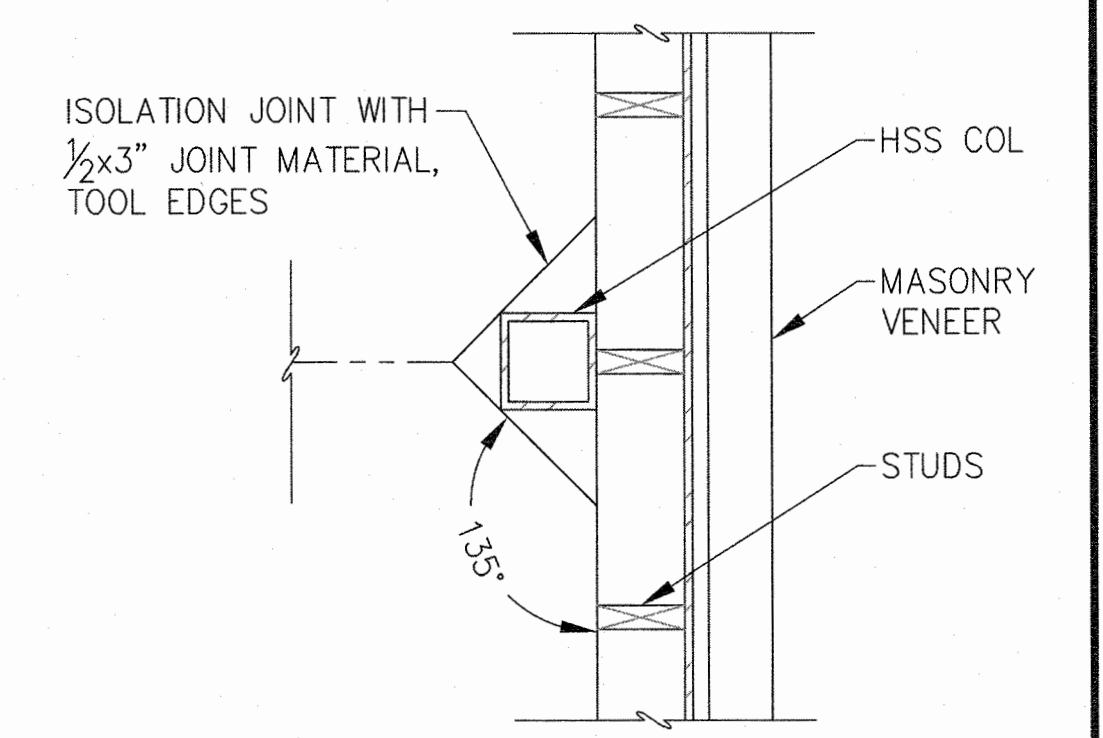

G COLUMN AND SLAB DETAIL

RECORD DRAWINGS

THESE DRAWINGS HAVE BEEN PREPARED FROM INFORMATION PROVIDED BY THE CONTRACTOR. THERE IS NO GUARANTEE TO THE ACCURACY OF THE INFORMATION CONTAINED HEREIN, EITHER EXPRESSED OR IMPLIED.


October 9, 2017

WELSHWHITELEYARCHITECT, LLC


PLANS PREPARED BY:
PND ENGINEERS, INC.
9360 GLACIER HWY
JUNEAU, AK 99801

DO NOT SCALE FROM THESE DRAWINGS USE DIMENSIONS

CHECKED BY: CMG	STATE OF ALASKA DEPARTMENT OF TRANSPORTATION & PUBLIC FACILITIES SOUTHCOST REGION									
DESIGNED BY: CMG	KAKE FERRY TERMINAL PASSENGER FACILITY PLANSET B									
DRAWN BY: DRD	FOUNDATION SECTIONS AND DETAILS ADD #1									
PATH: N:\12XXX\122068 AMHS KAKE TERMINAL\E1 DRAWINGS\PND\2017-9-29\S3.0.DWG	PROJECT DESIGNATION SAMHS00002									
TAB: S3.0 Monday, October 09, 2017 8:15:46 AM DANIELLE DUNIVIN	YEAR SHEET TOTAL 2015 S3.0 35									
<table border="1"> <thead> <tr> <th colspan="3">REVISIONS</th> </tr> <tr> <th>NO.</th> <th>DATE</th> <th>DESCRIPTION</th> </tr> </thead> <tbody> <tr> <td> </td> <td> </td> <td> </td> </tr> </tbody> </table>		REVISIONS			NO.	DATE	DESCRIPTION			
REVISIONS										
NO.	DATE	DESCRIPTION								

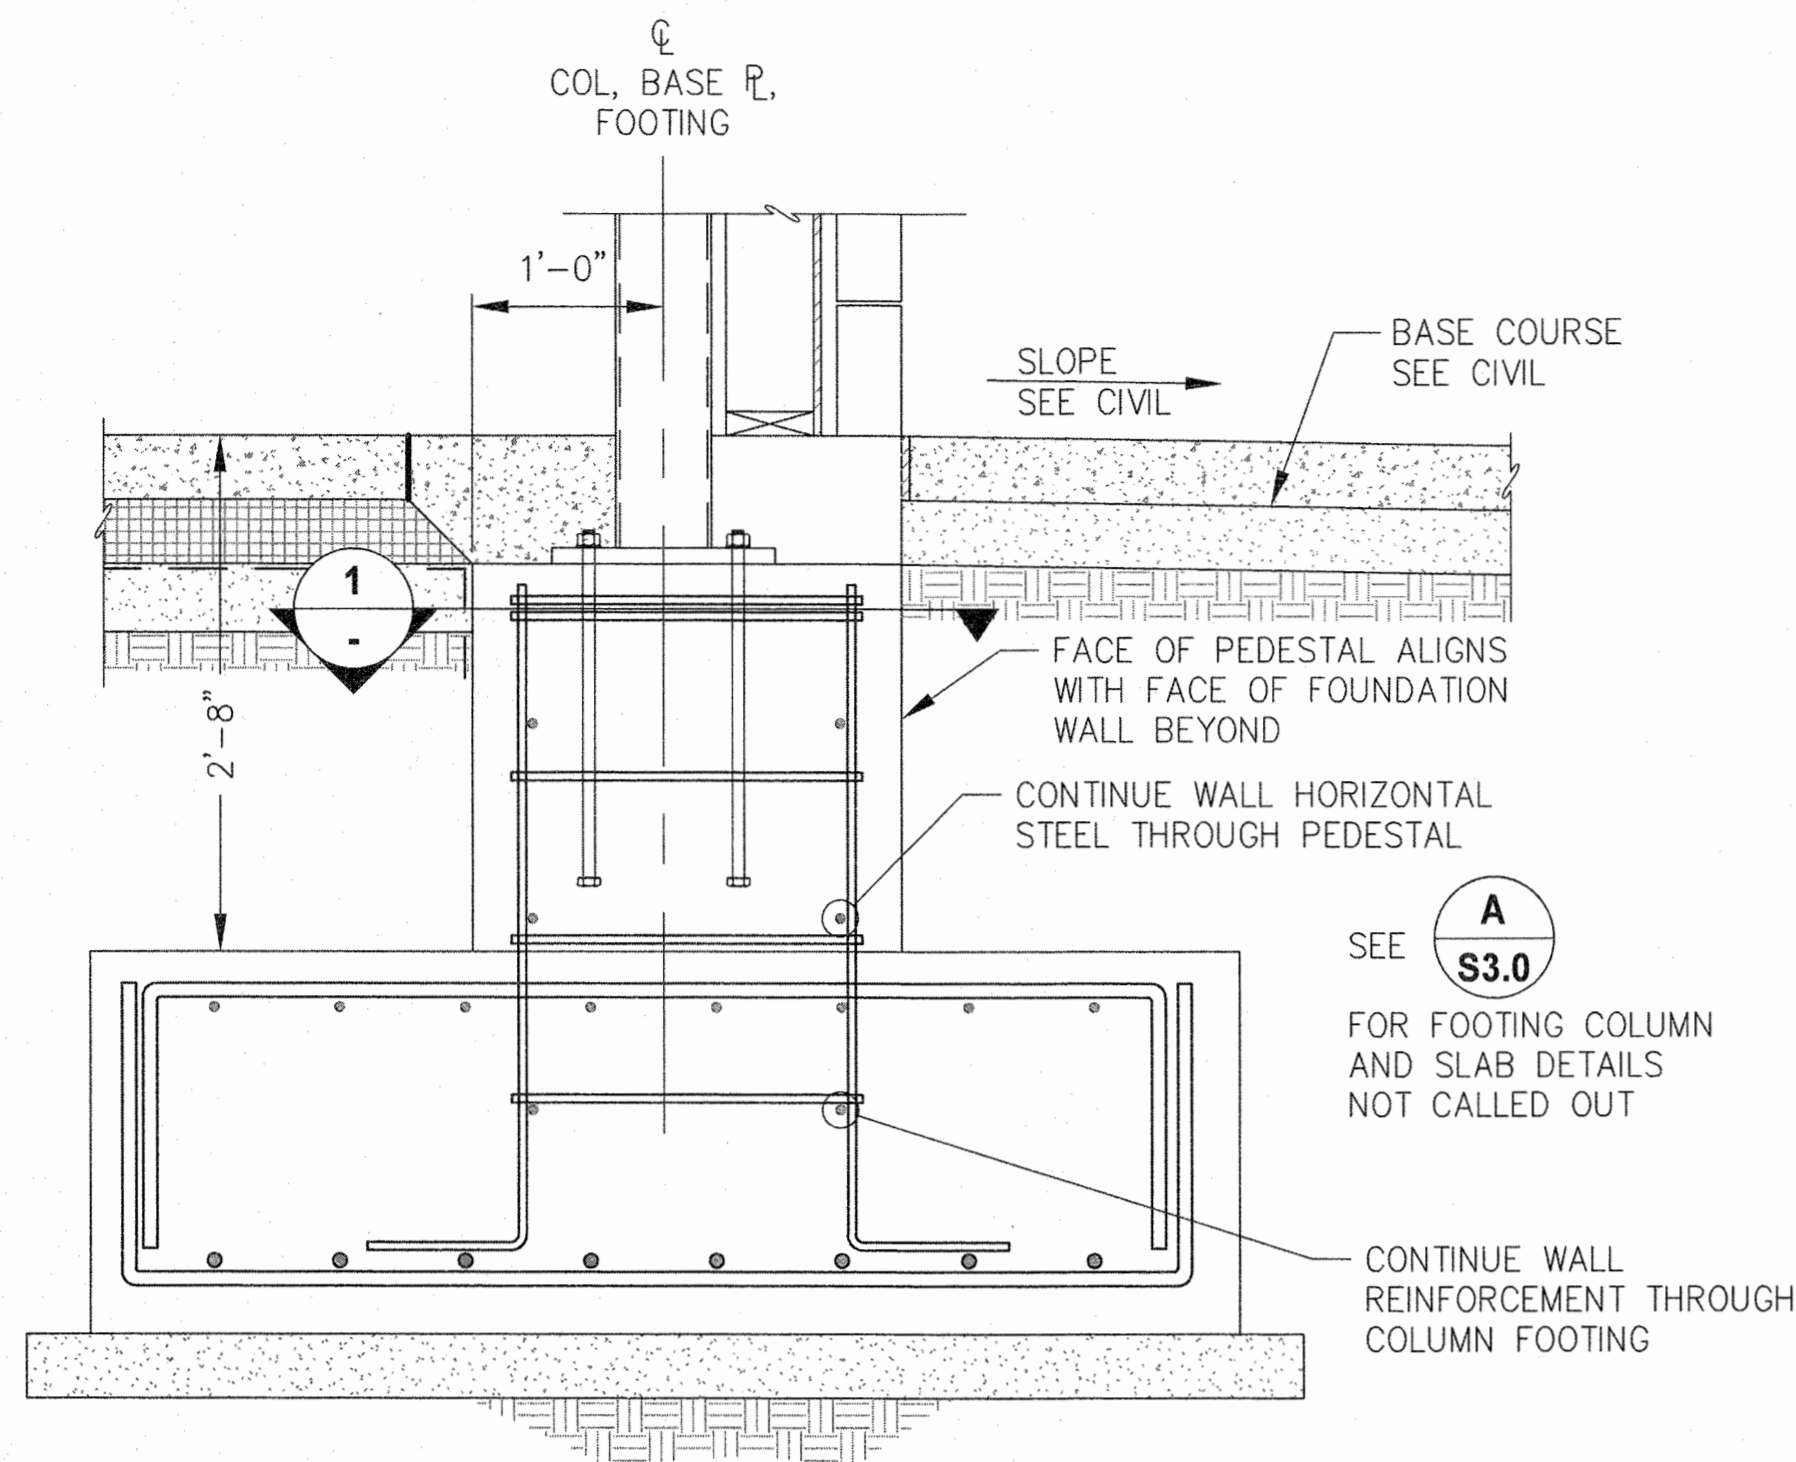

A DEPRESSED COLUMN FOOTING DETAIL

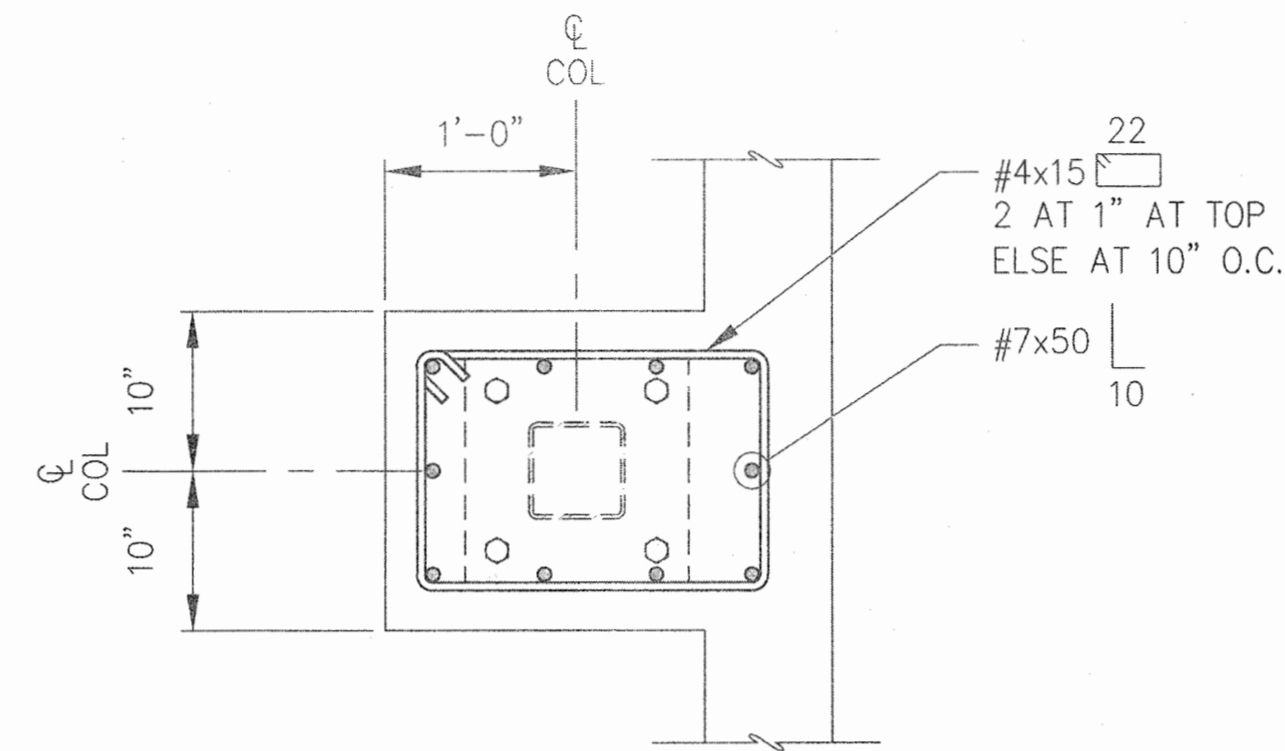

1 PEDESTAL SECTION

RECORD DRAWINGS

THESE DRAWINGS HAVE BEEN PREPARED FROM INFORMATION PROVIDED BY THE CONTRACTOR. THERE IS NO GUARANTEE TO THE ACCURACY OF THE INFORMATION CONTAINED HEREIN, EITHER EXPRESSED OR IMPLIED.


October 9, 2017

WELSHWHITELEYARCHITECT, LLC


DO NOT SCALE FROM THESE DRAWINGS USE DIMENSIONS

CHECKED BY: CMG		STATE OF ALASKA DEPARTMENT OF TRANSPORTATION & PUBLIC FACILITIES SOUTHCOST REGION				
DESIGNED BY: CMG		KAKE FERRY TERMINAL PASSENGER FACILITY PLANSET B				
DRAWN BY: DRD						
PATH: N:\12XXX\122068 AMHS KAKE TERMINAL\E1 DRAWINGS\PND\2017-9-29\S3.0.DWG		FOUNDATION SECTIONS AND DETAILS ADD #1				
TAB: S3.1 Monday, October 09, 2017 8:15:51 AM DANIELLE DUNIVIN						
REVISIONS		PROJECT DESIGNATION	YEAR	SHEET NO.	TOTAL SHEETS	
NO.	DATE	DESCRIPTION	SAMHS00002	2015	S3.1	35


PLANS PREPARED BY:
PND ENGINEERS, INC.
9360 GLACIER HWY
JUNEAU, AK 99801

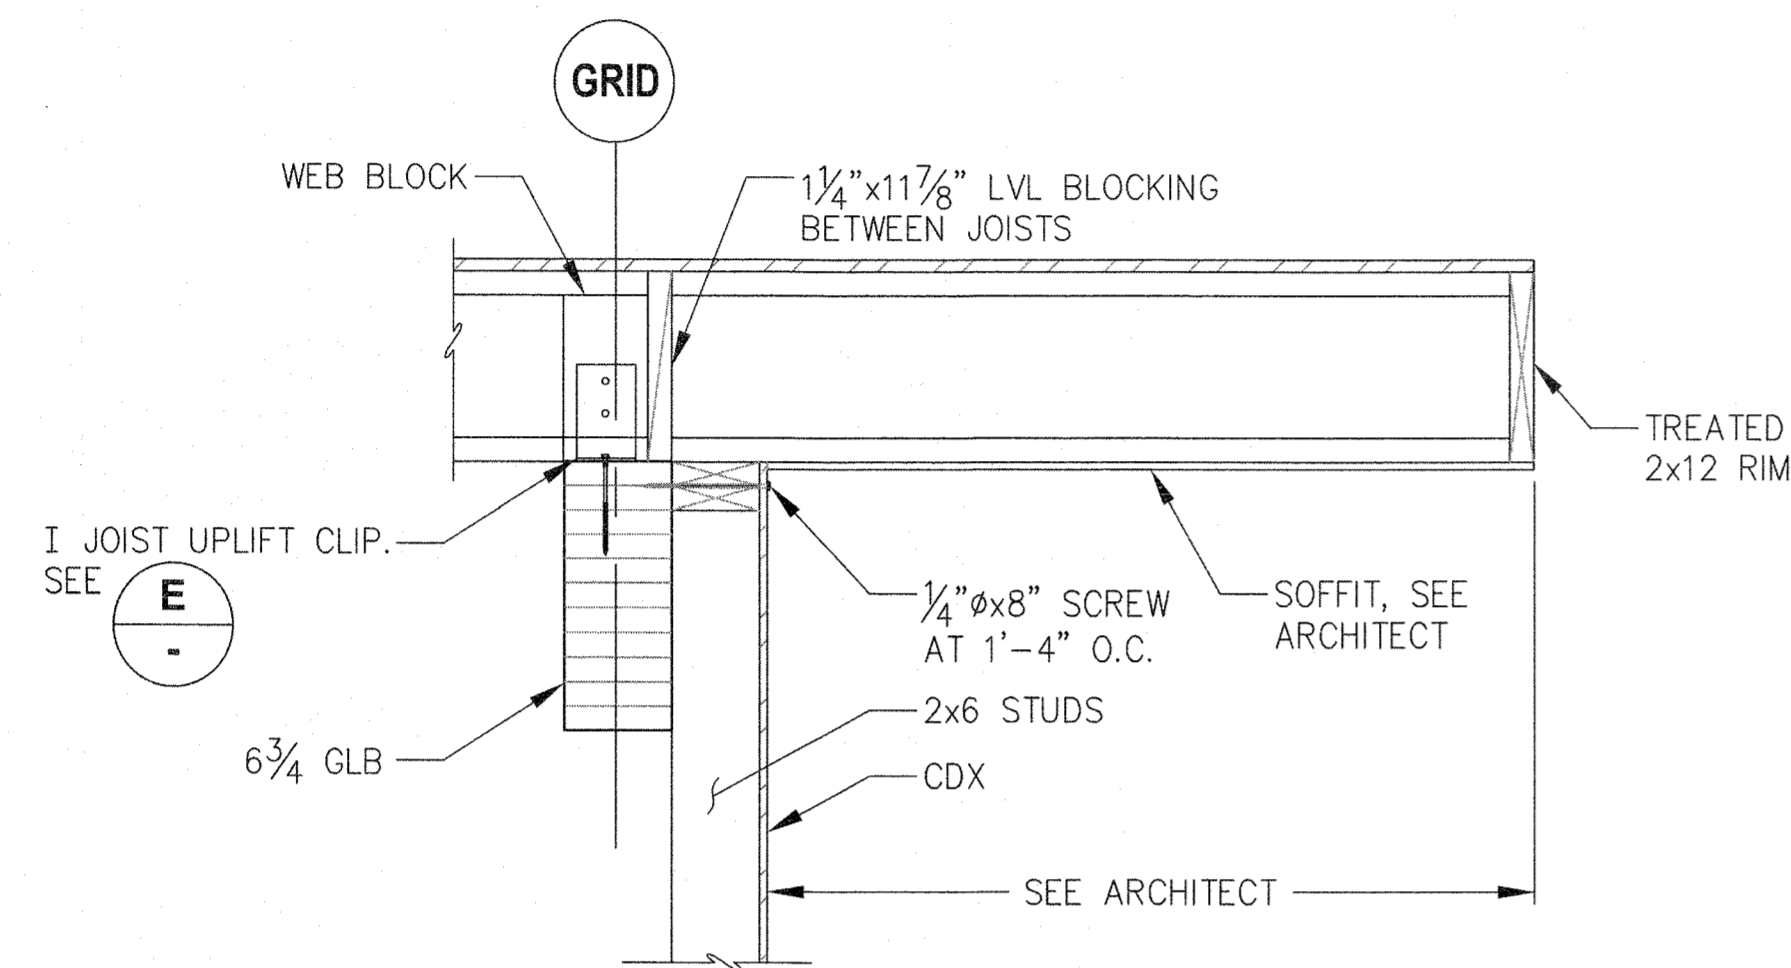


A END WALL DETAIL

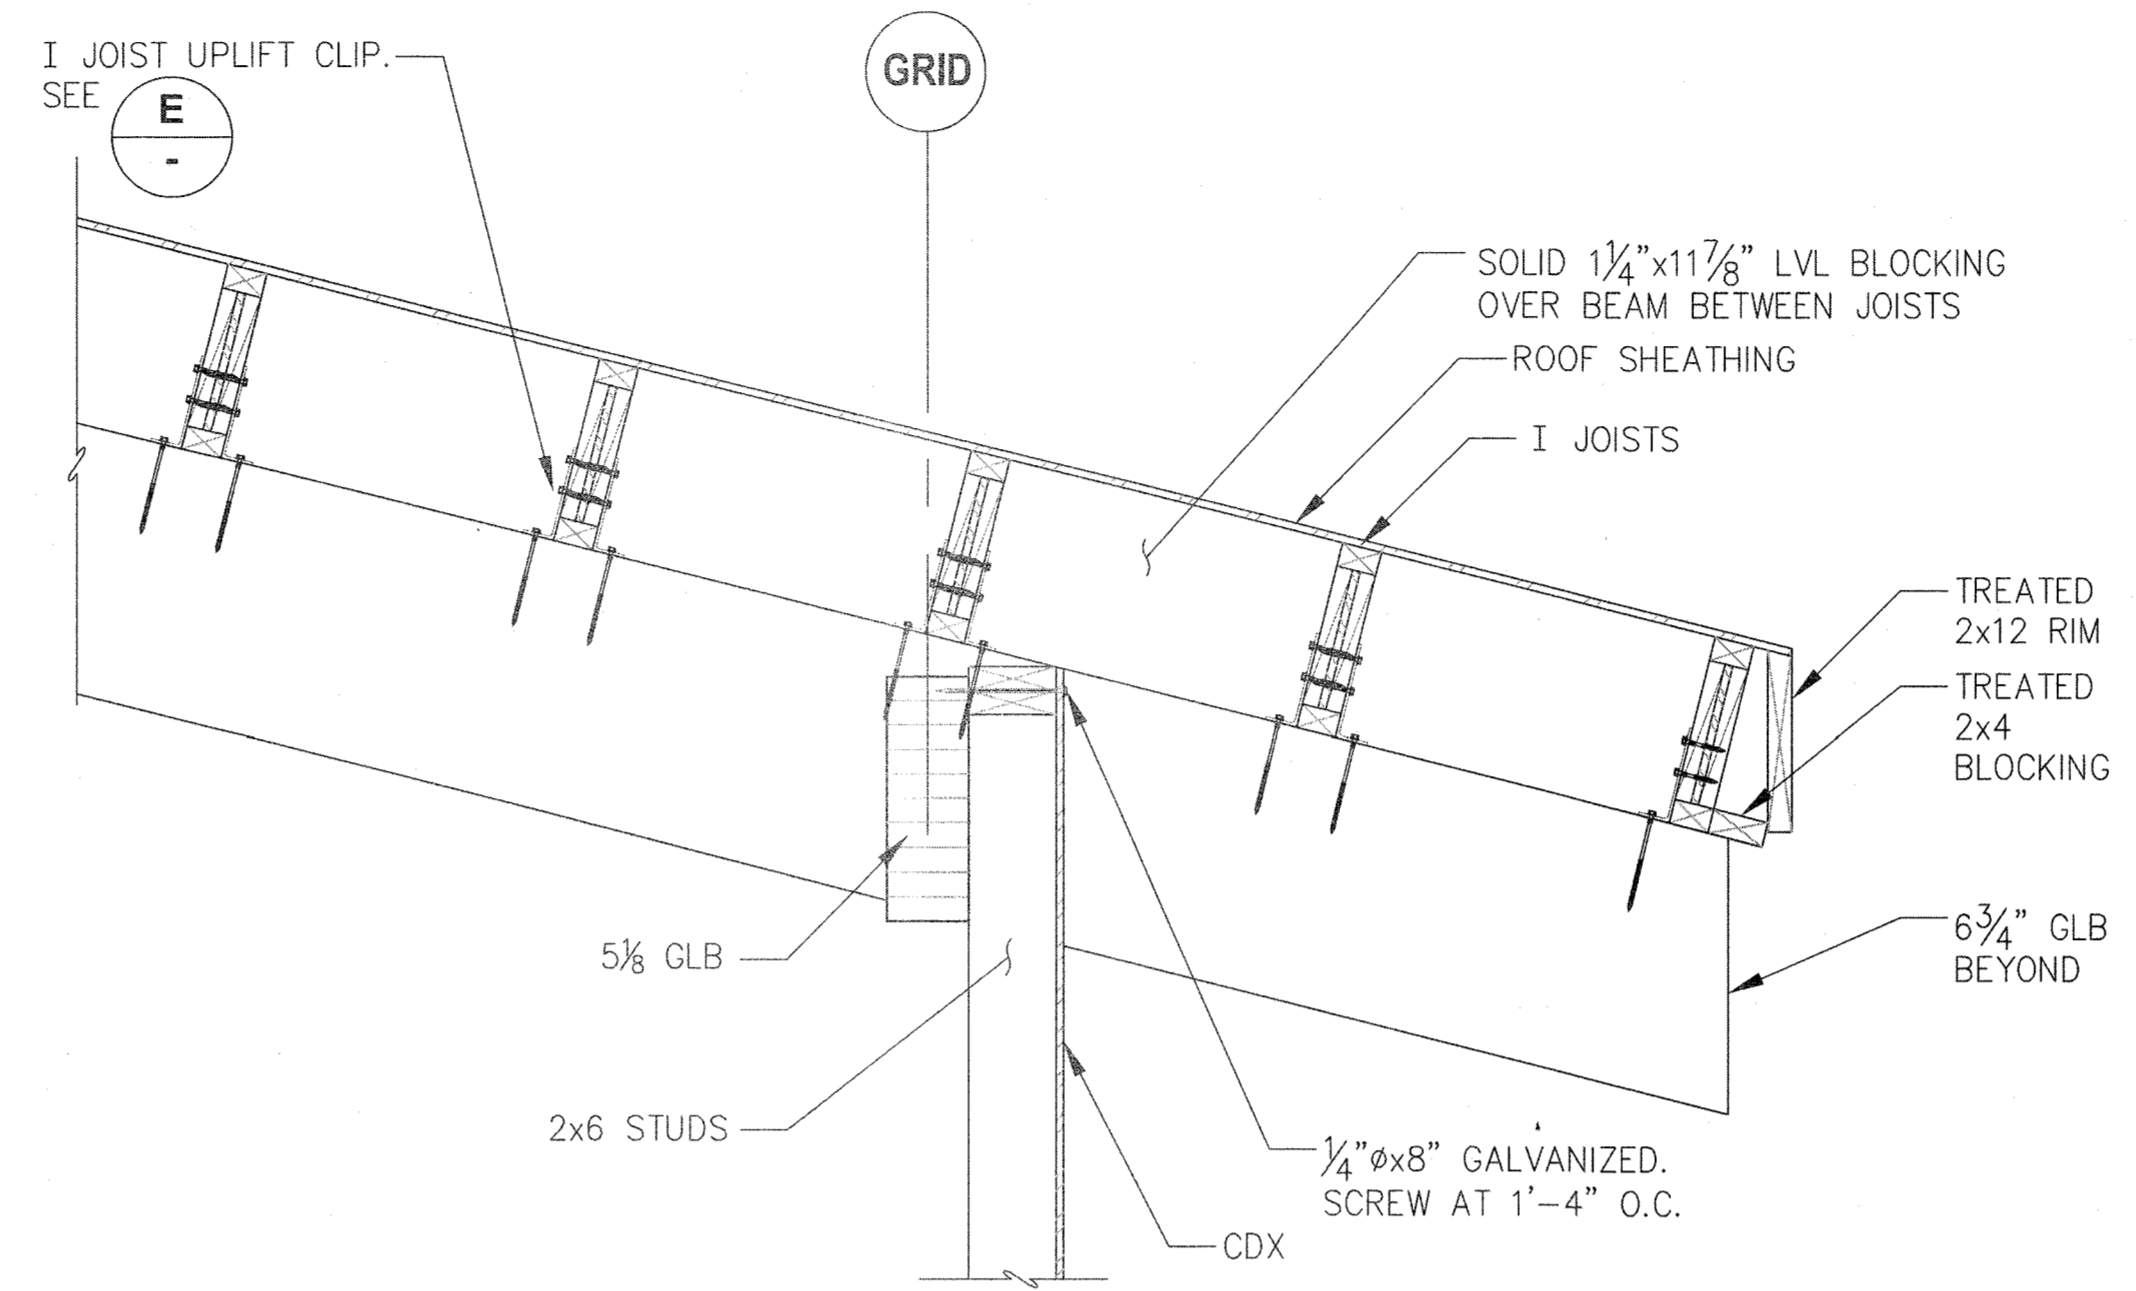


B EAVE DETAIL

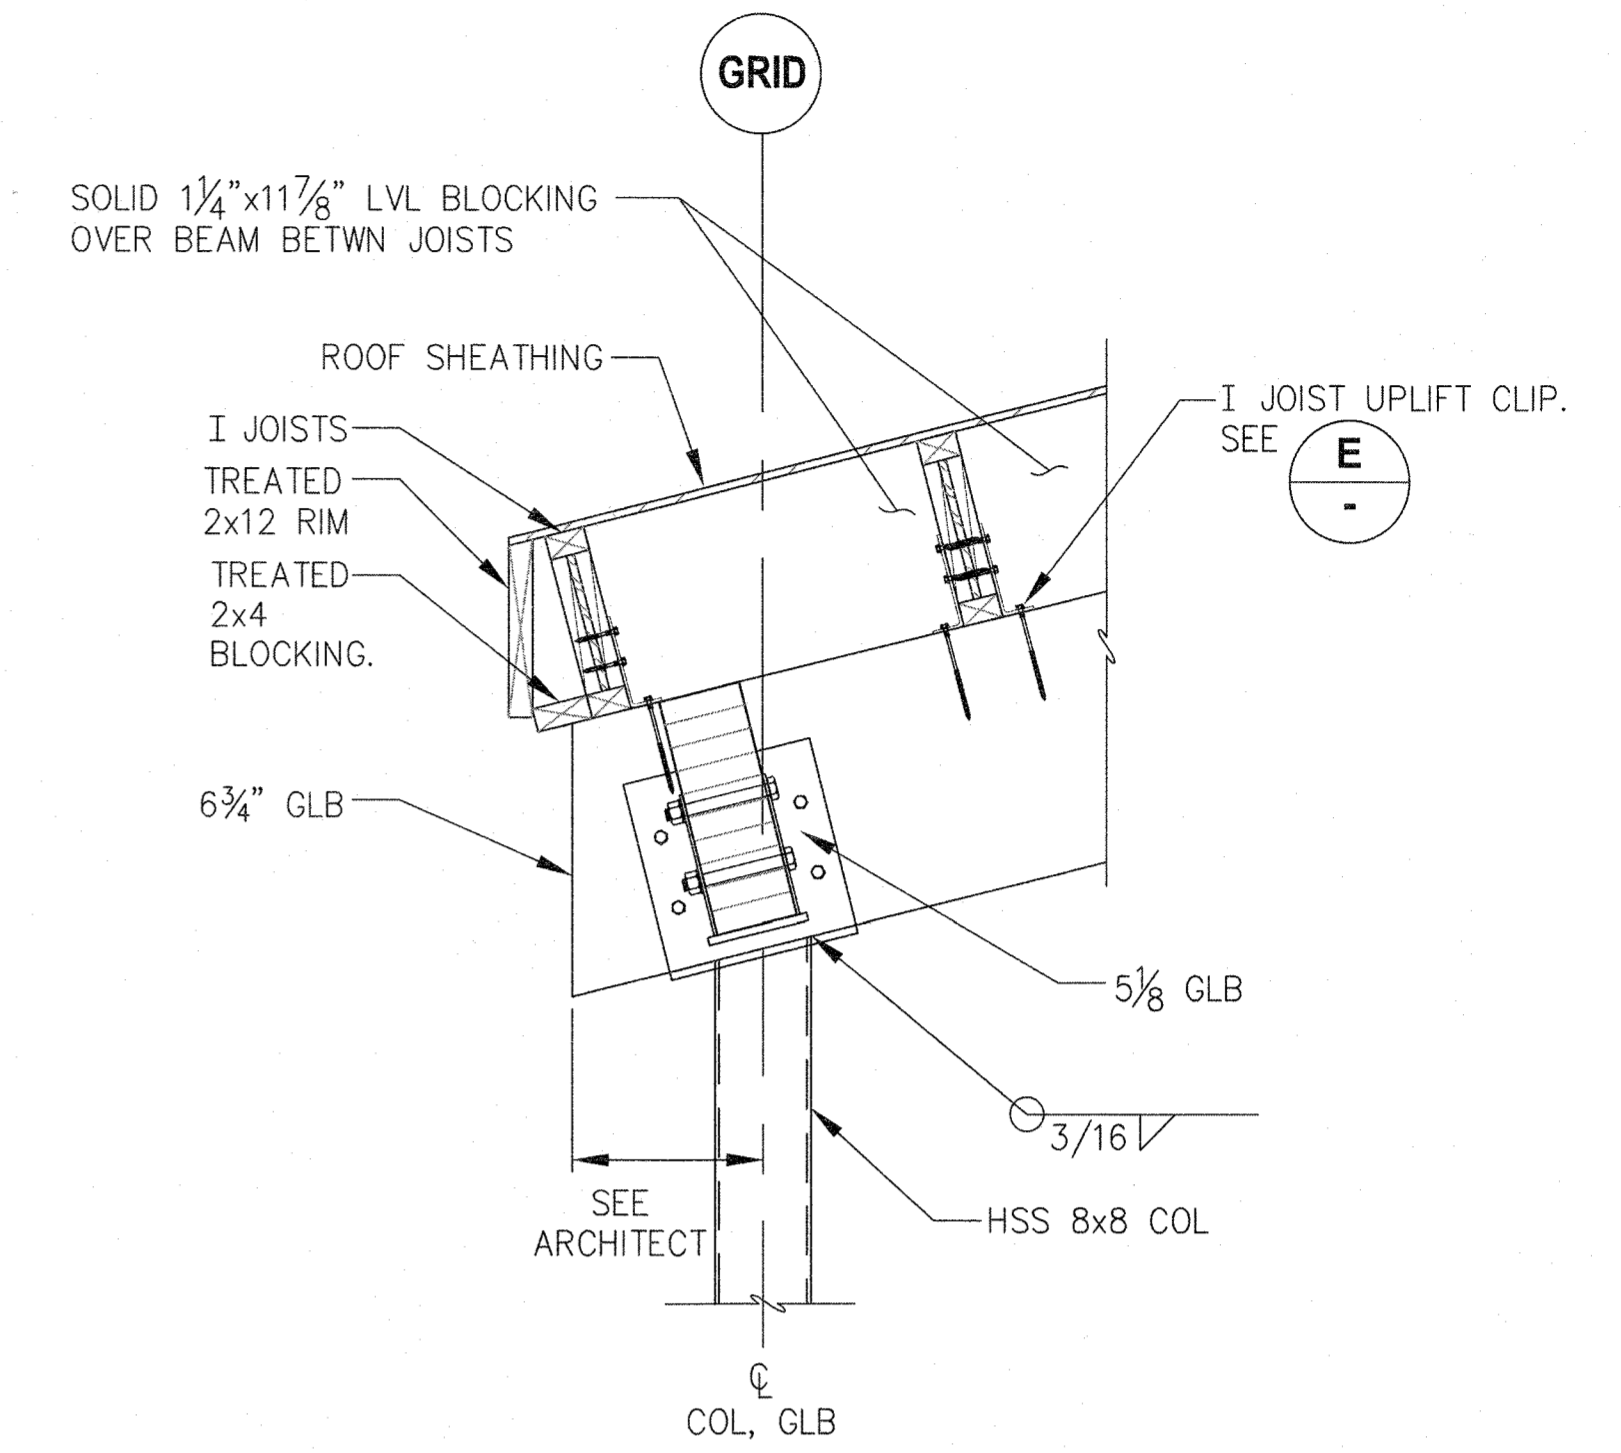


C SECTION AT DRIVE- EAVE

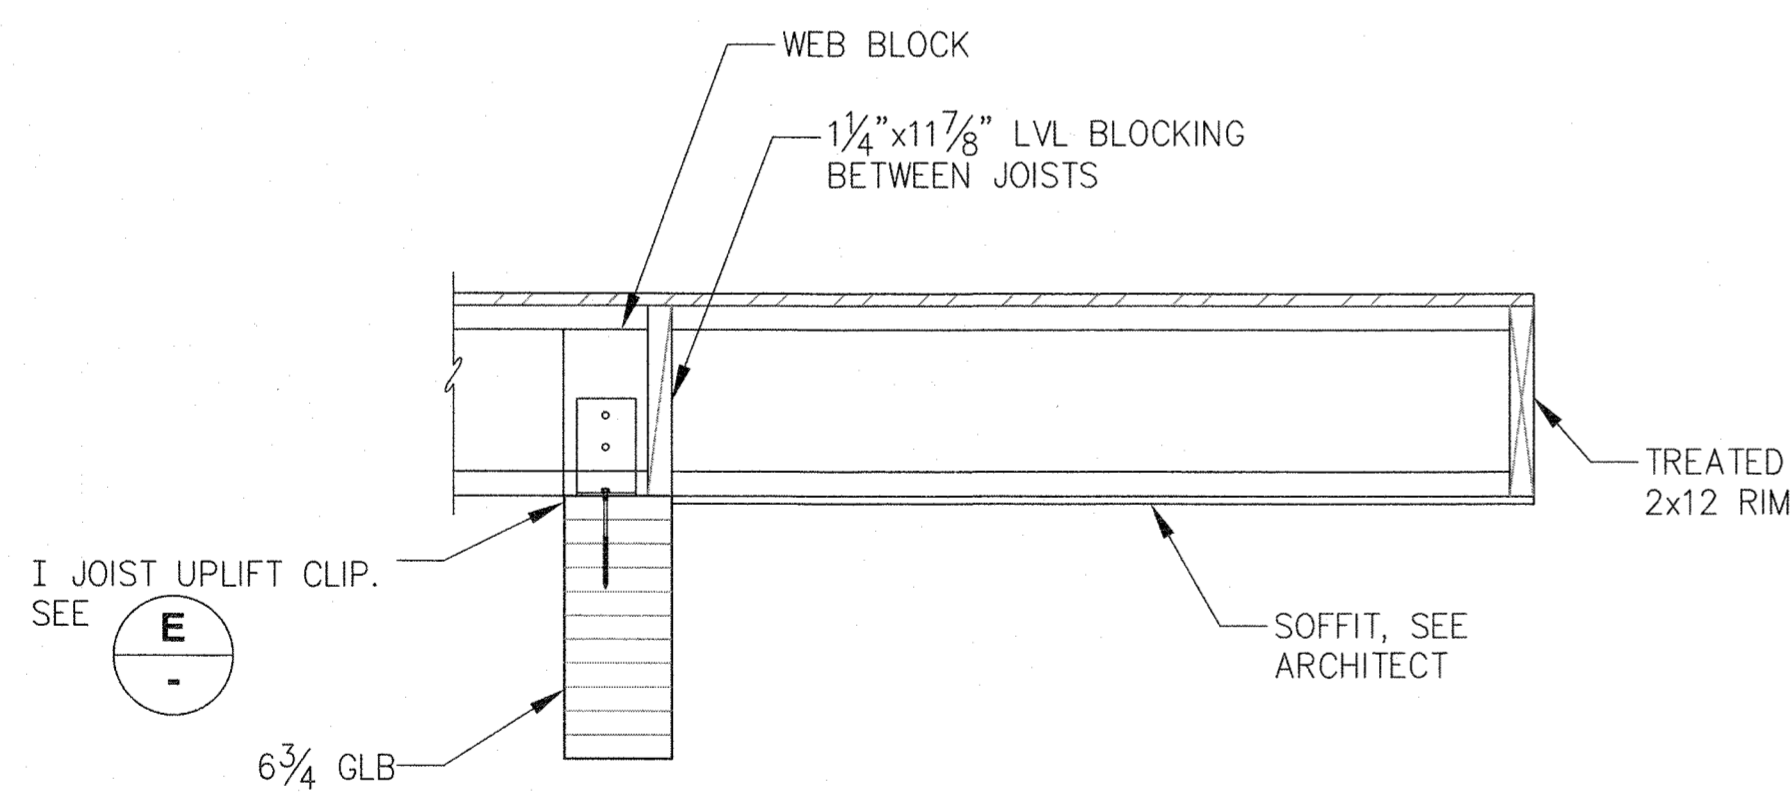

D SECTION AT DRIVE- EAVE

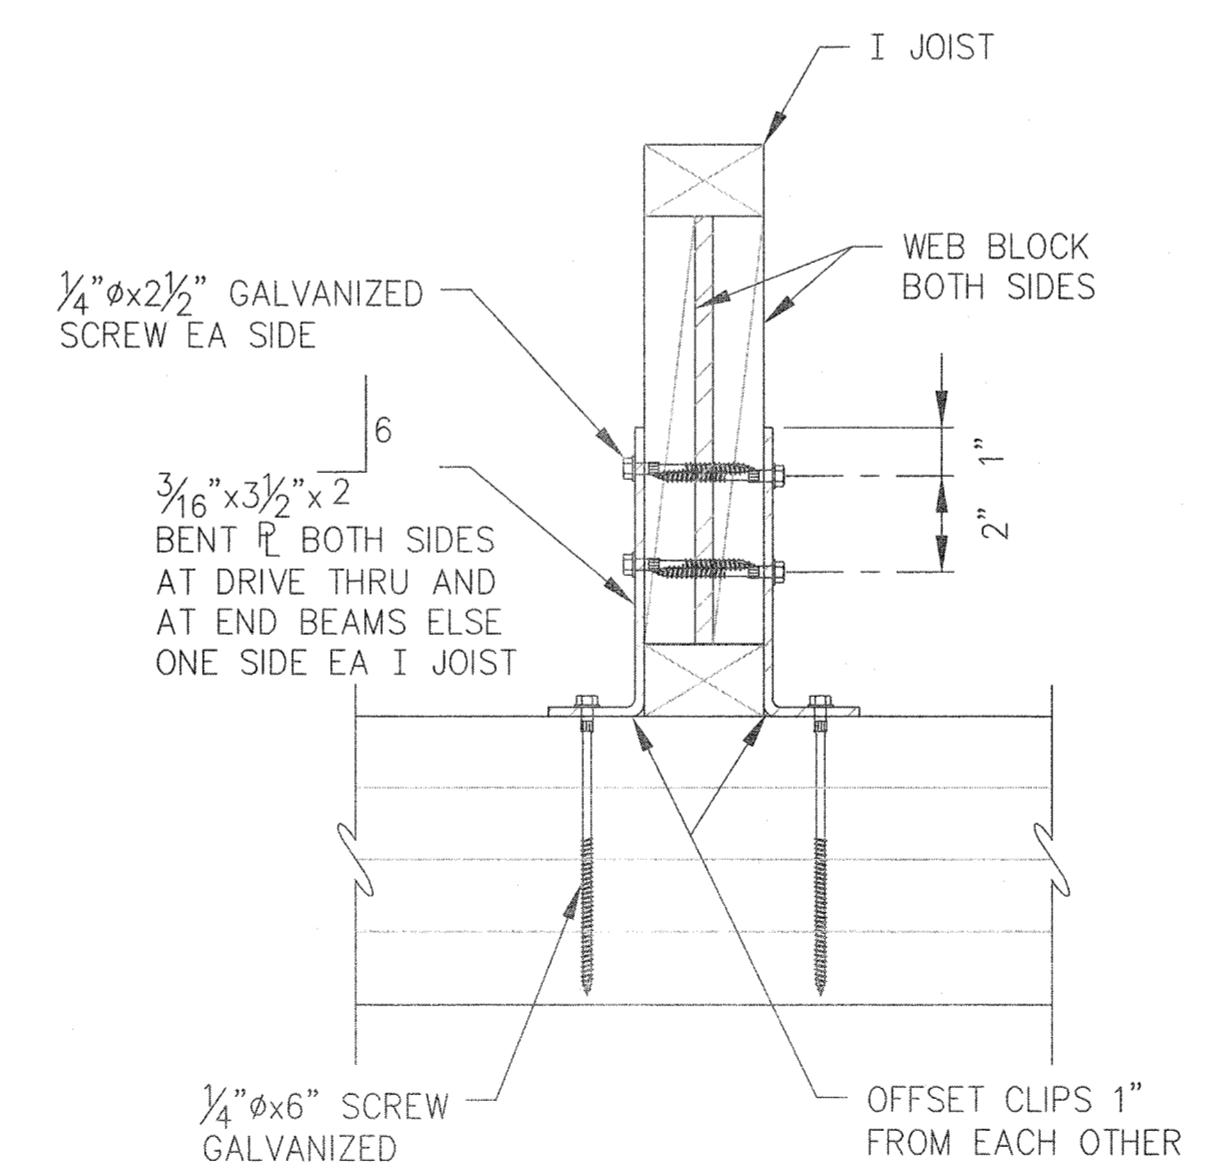

E I JOIST UPLIFT CLIP DETAIL

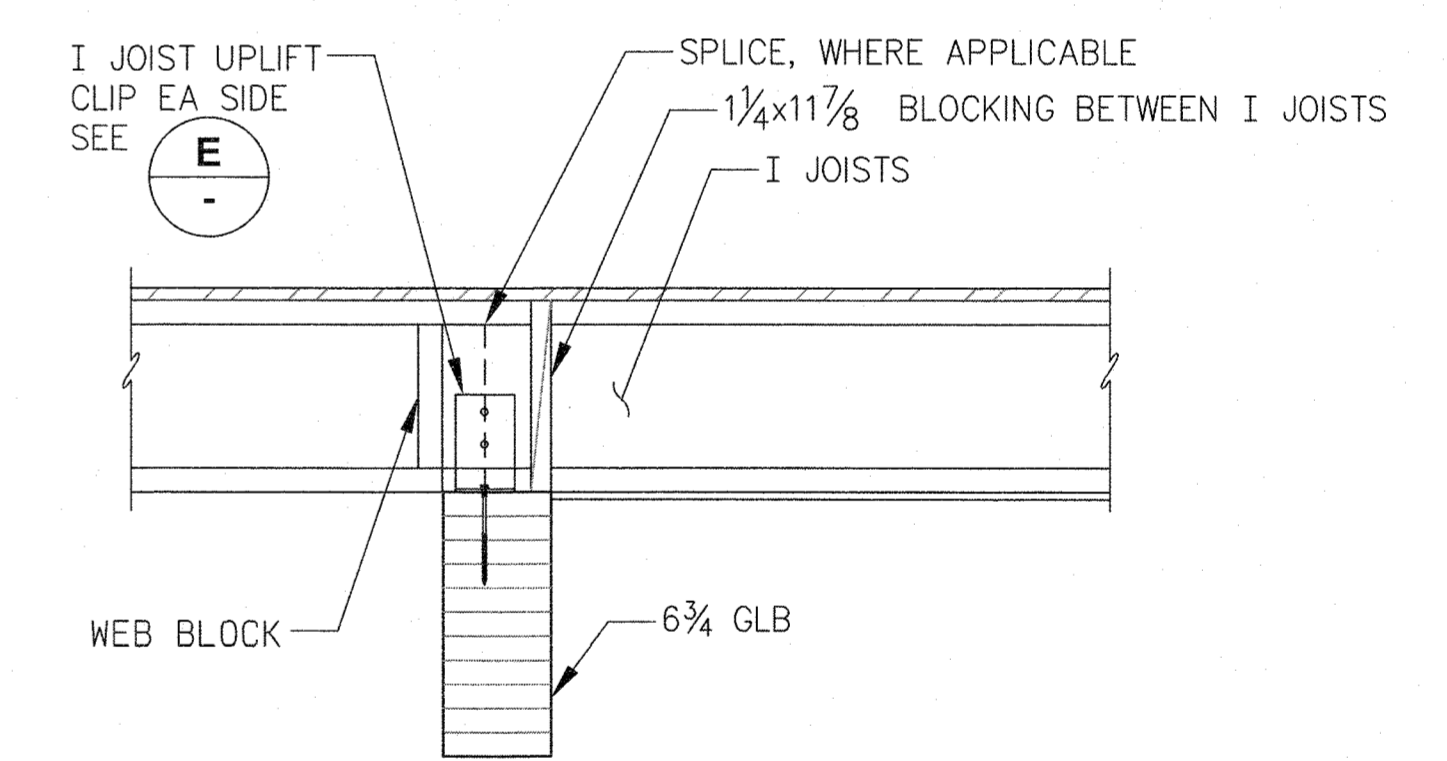

F INTERIOR I JOIST TO GLU-LAM BEAM

DO NOT SCALE FROM THESE DRAWINGS USE DIMENSIONS

CHECKED BY: CMG		STATE OF ALASKA DEPARTMENT OF TRANSPORTATION & PUBLIC FACILITIES SOUTHCOST REGION				
DESIGNED BY: CMG		KAKE FERRY TERMINAL PASSENGER FACILITY PLANSET B				
DRAWN BY: DRD		ROOF SECTIONS AND DETAILS ADD #1				
PATH: N:\12XXX\122068 AMHS KAKE TERMINAL\E1 DRAWINGS\PND\2017-9-29\S4.0.DWG						
TAB: S4.0 Monday, October 09, 2017 8:15:59 AM DANIELLE DUNIVIN						
REVISIONS		PROJECT DESIGNATION	YEAR	SHEET NO.	TOTAL SHEETS	
NO.	DATE	DESCRIPTION	SAMHS00002	2015	S4.0	35


RECORD DRAWINGS

THESE DRAWINGS HAVE BEEN PREPARED FROM INFORMATION PROVIDED BY THE CONTRACTOR. THERE IS NO GUARANTEE TO THE ACCURACY OF THE INFORMATION CONTAINED HEREIN, EITHER EXPRESSED OR IMPLIED.


October 9, 2017

WELSHWHITELEYARCHITECT, LLC


PLANS PREPARED BY:
PND ENGINEERS, INC.
9360 GLACIER HWY
JUNEAU, AK 99801

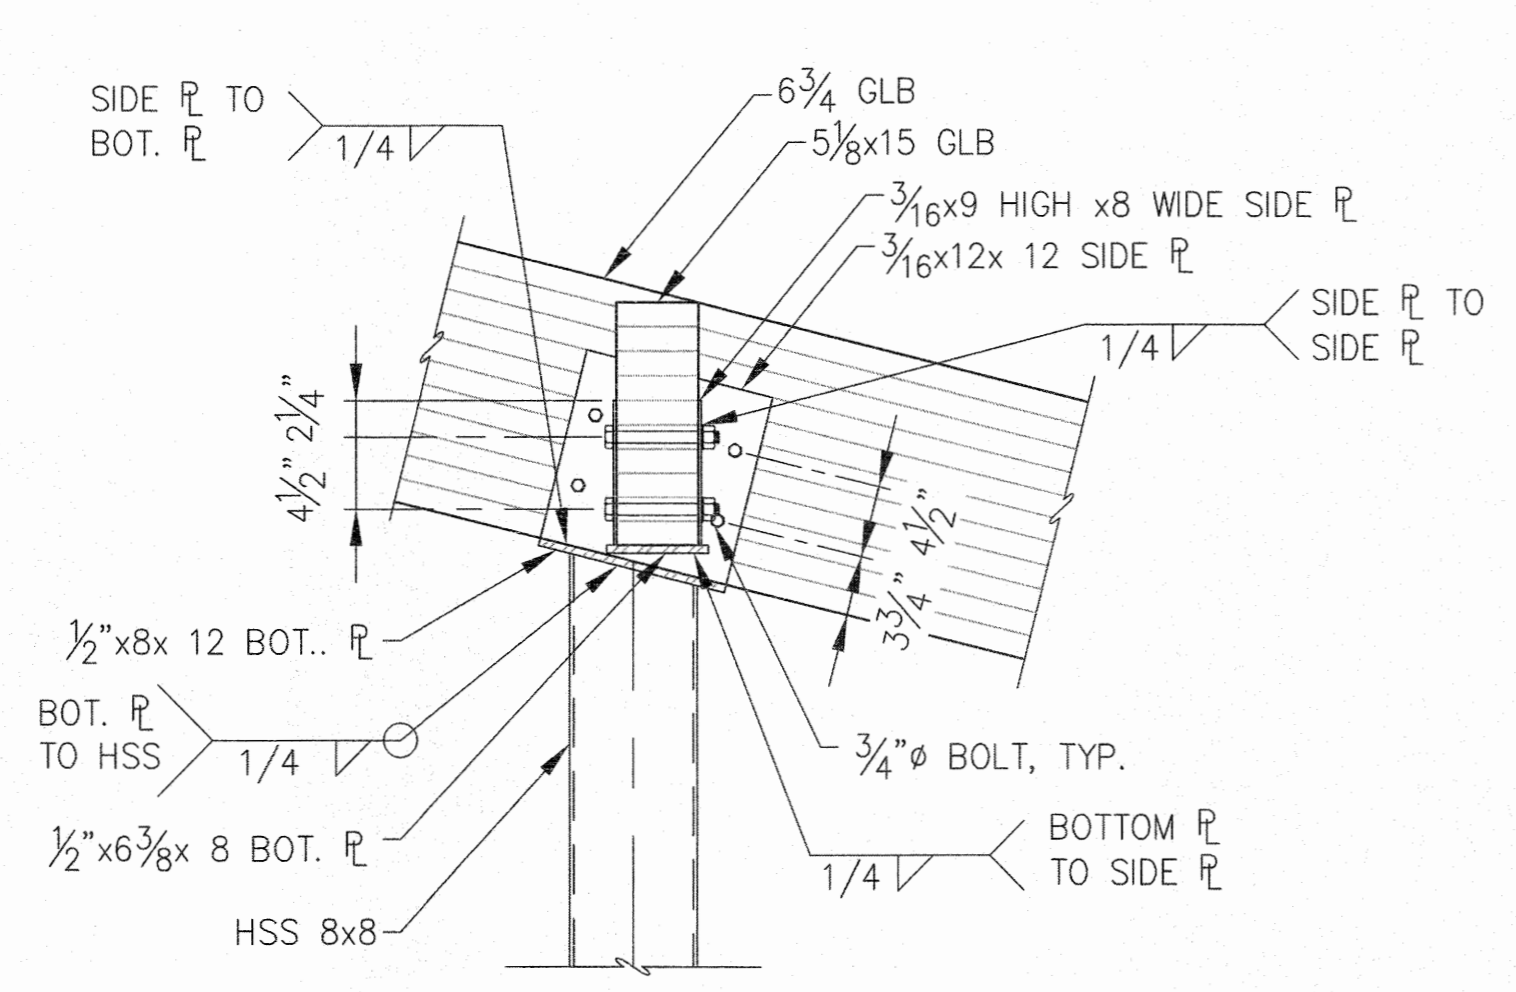

A BEAM TO COLUMN AND BEAM TO BEAM AT EAVE

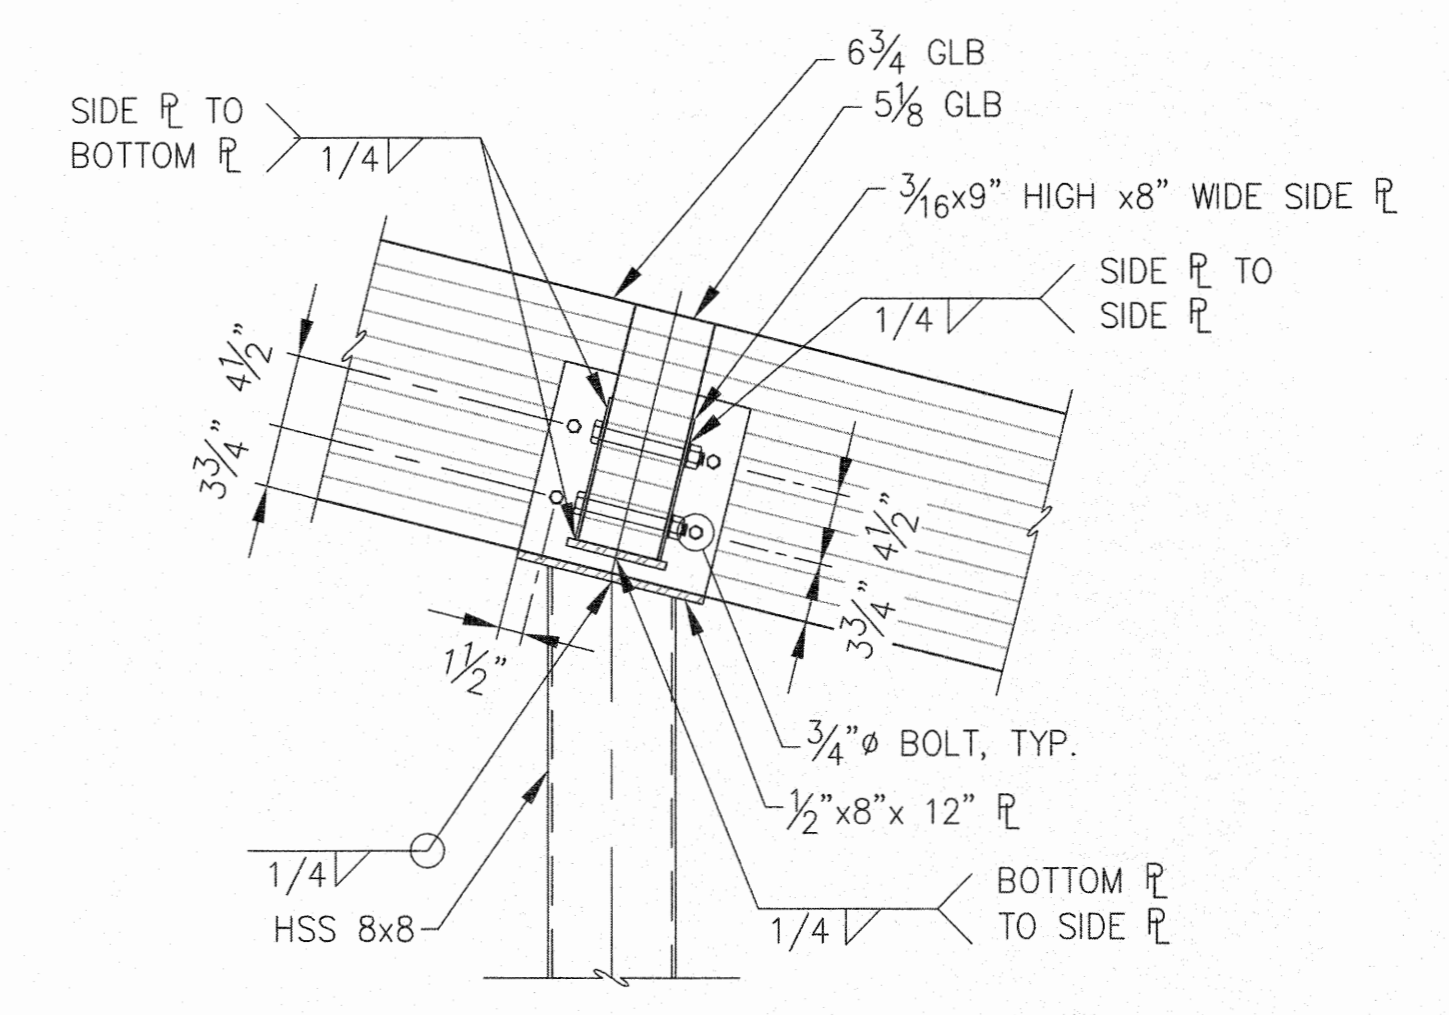

B BEAM TO COLUMN AND BEAM TO BEAM AT DRIVE

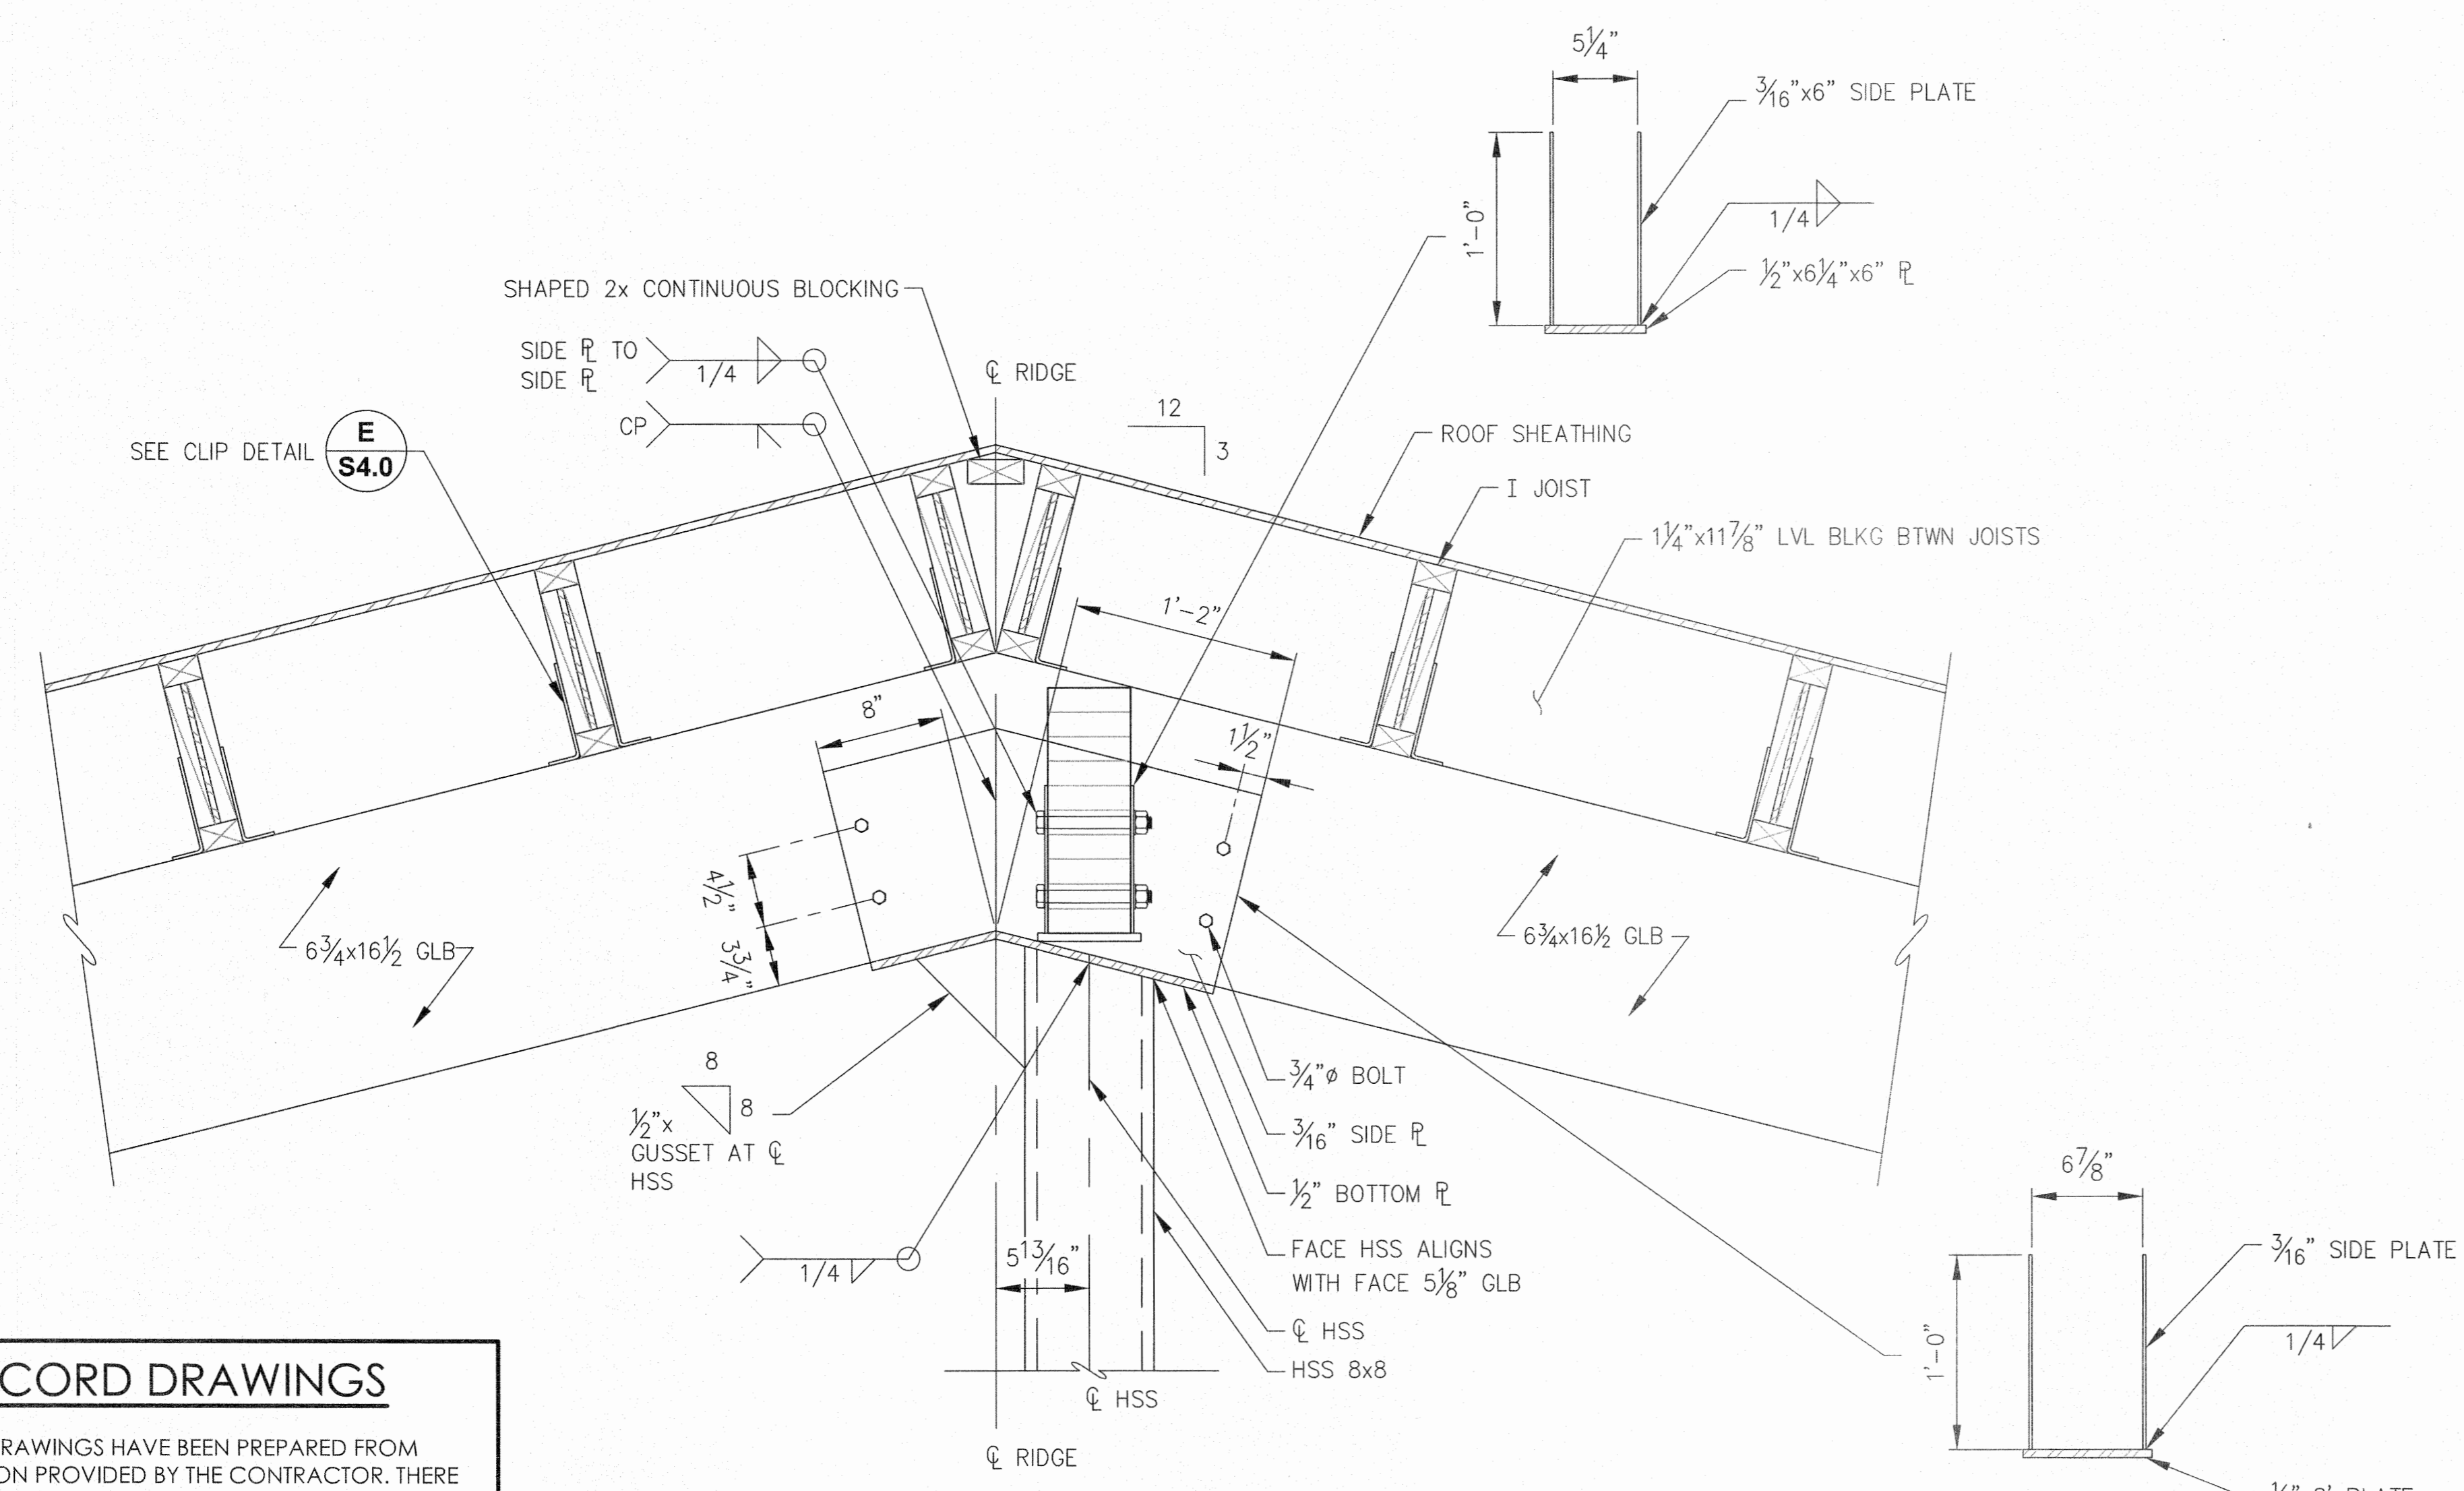


C BEAM TO COLUMN AT RIDGE

RECORD DRAWINGS
 THESE DRAWINGS HAVE BEEN PREPARED FROM INFORMATION PROVIDED BY THE CONTRACTOR. THERE IS NO GUARANTEE TO THE ACCURACY OF THE INFORMATION CONTAINED HEREIN, EITHER EXPRESSED OR IMPLIED.
 October 9, 2017
 WELSHWHITELEYARCHITECT, LLC


DO NOT SCALE FROM THESE DRAWINGS USE DIMENSIONS

CHECKED BY: CMG	STATE OF ALASKA DEPARTMENT OF TRANSPORTATION & PUBLIC FACILITIES SOUTHCOST REGION		
DESIGNED BY: CMG	KAKE FERRY TERMINAL PASSENGER FACILITY PLANSET B		
DRAWN BY: DRD	ROOF SECTIONS AND DETAILS ADD #1		
PATH: N:\12XXX\122068 AMHS KAKE TERMINAL\E1 DRAWINGS\PND\2017-9-29\S4.1.DWG			
TAB: S4.1 Monday, October 09, 2017 8:16:01 AM DANIELLE DUNNIN			
REVISIONS		PROJECT DESIGNATION	YEAR
NO.	DATE	DESCRIPTION	SHEET NO.
			2015
			S4.1
			TOTAL SHEETS
			35


PLANS PREPARED BY:
 PND ENGINEERS, INC.
 9360 GLACIER HWY
 JUNEAU, AK 99801

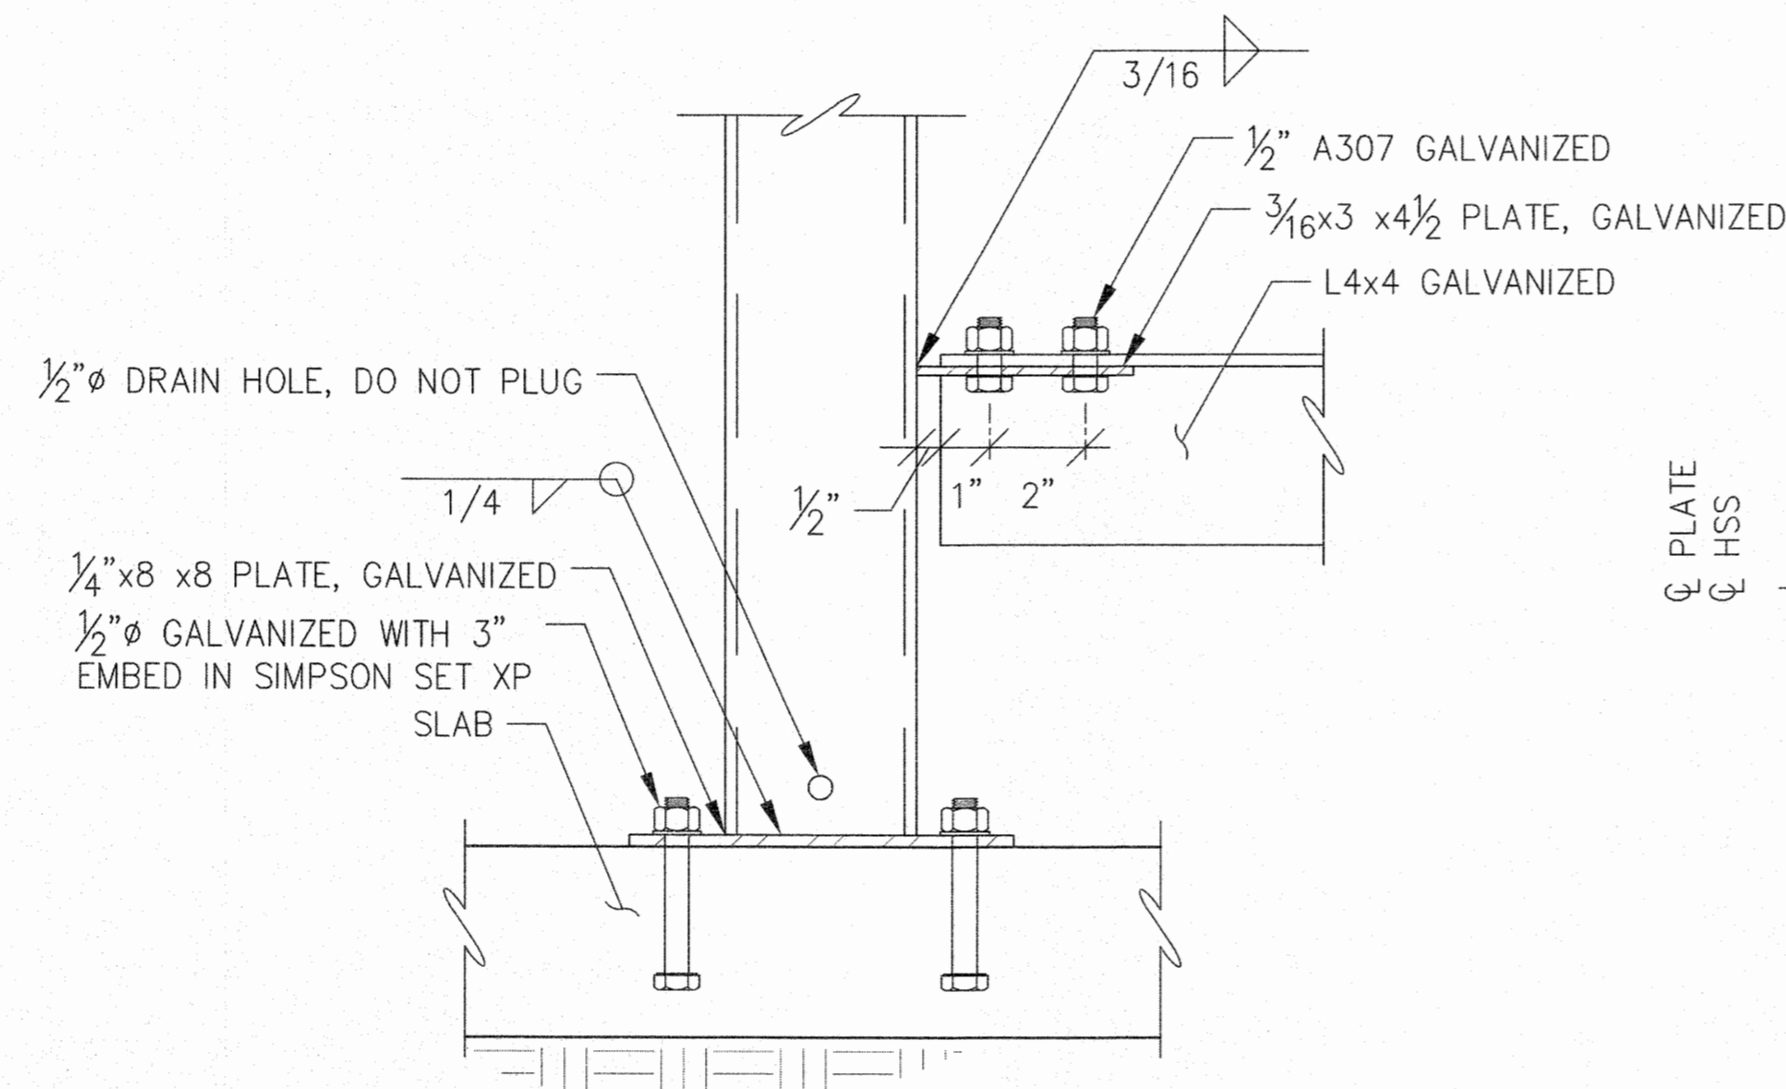


1 HSS BASE DETAIL

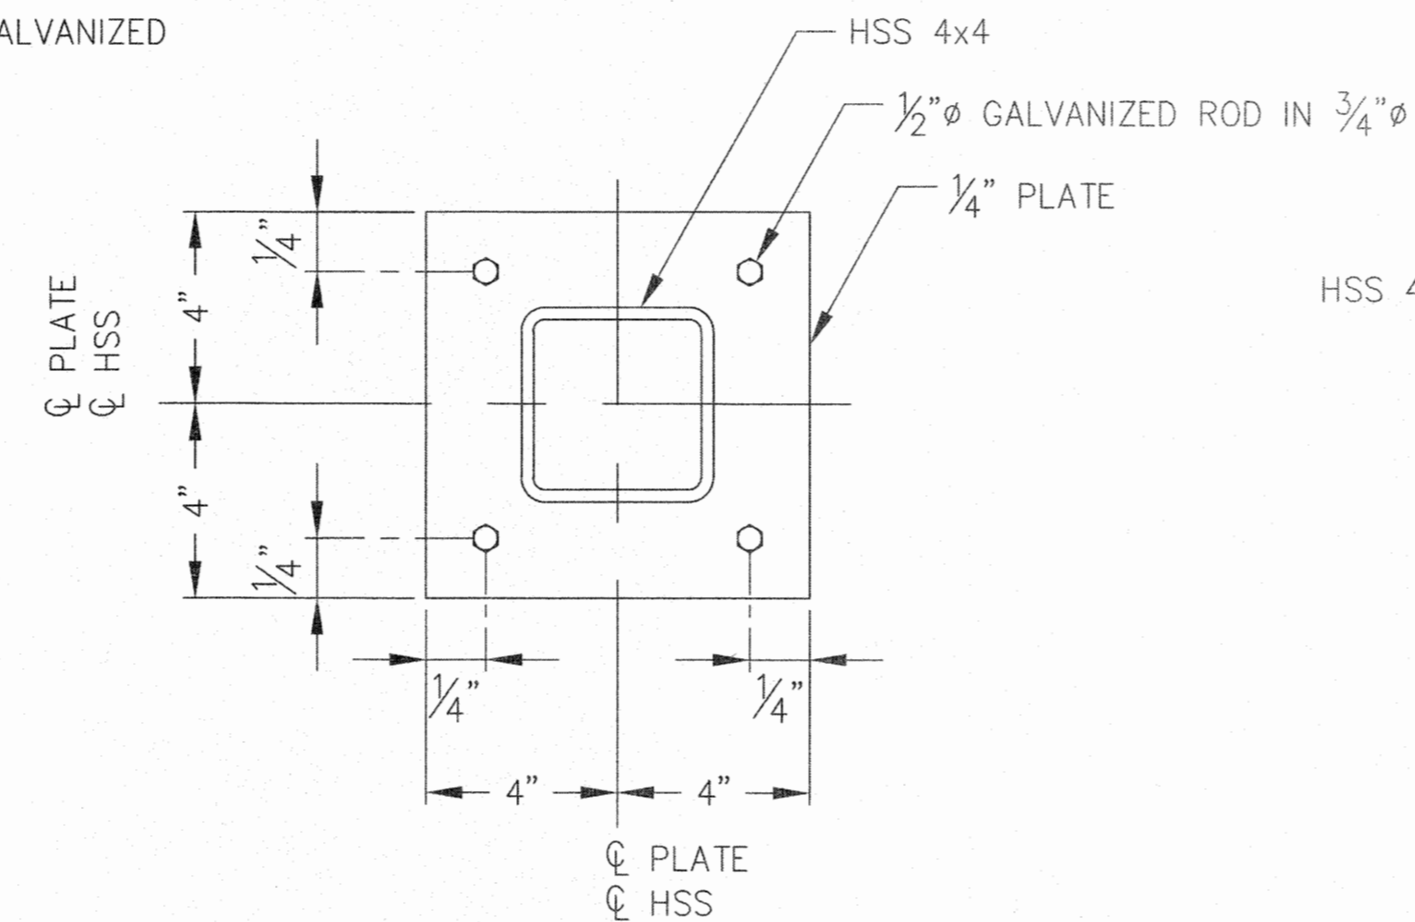


2 HSS BASE PLATE

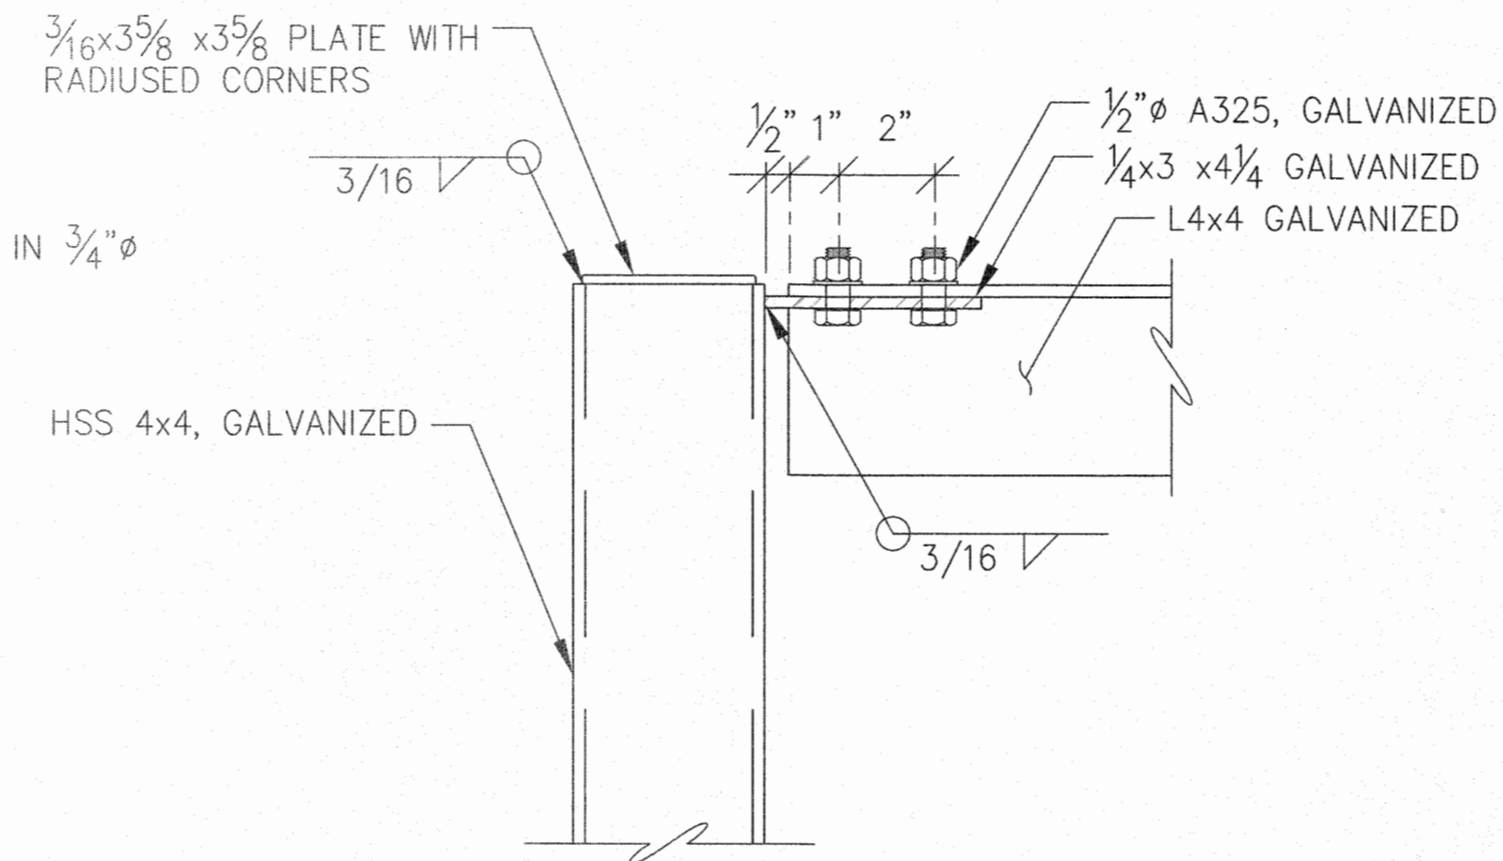


3 TOP HSS TO L4x4, TYPICAL

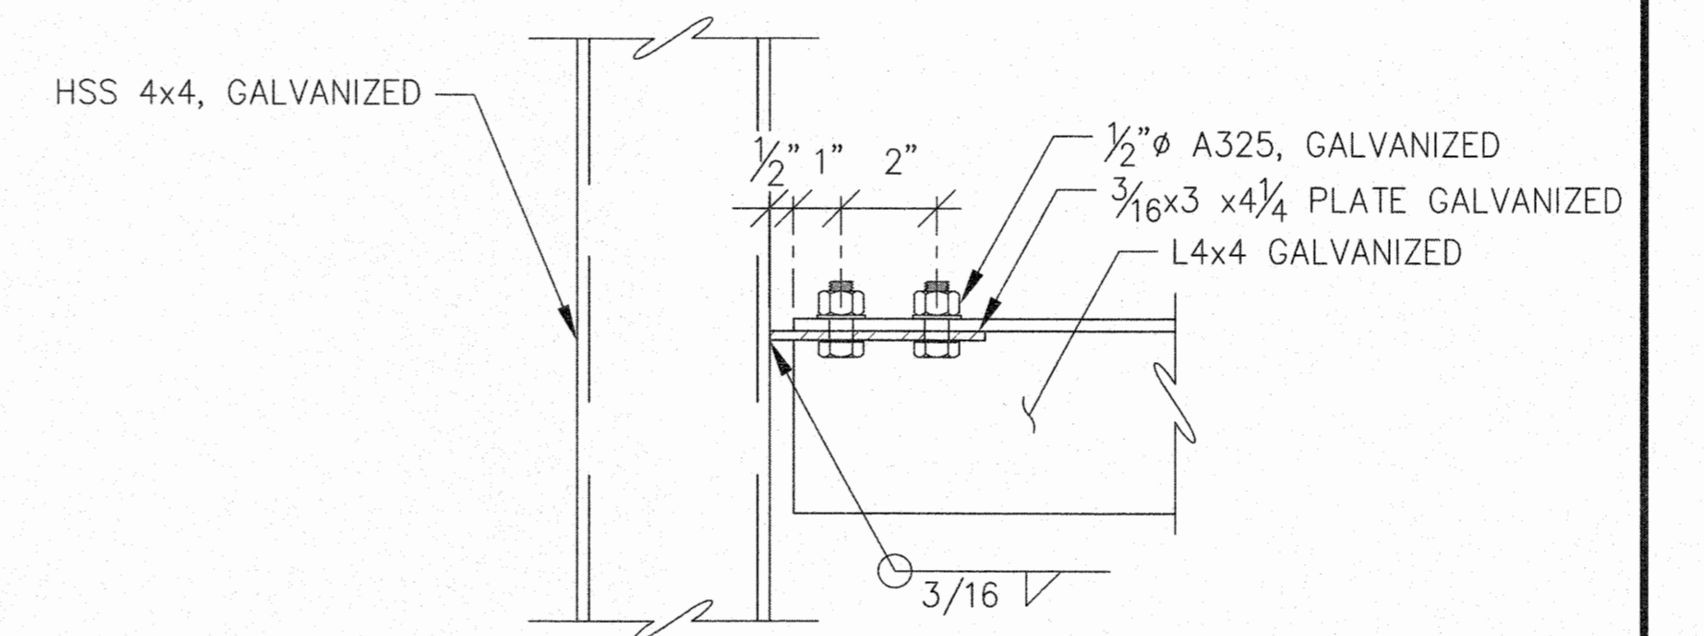


4 L4x4 TO HSS, TYPICAL

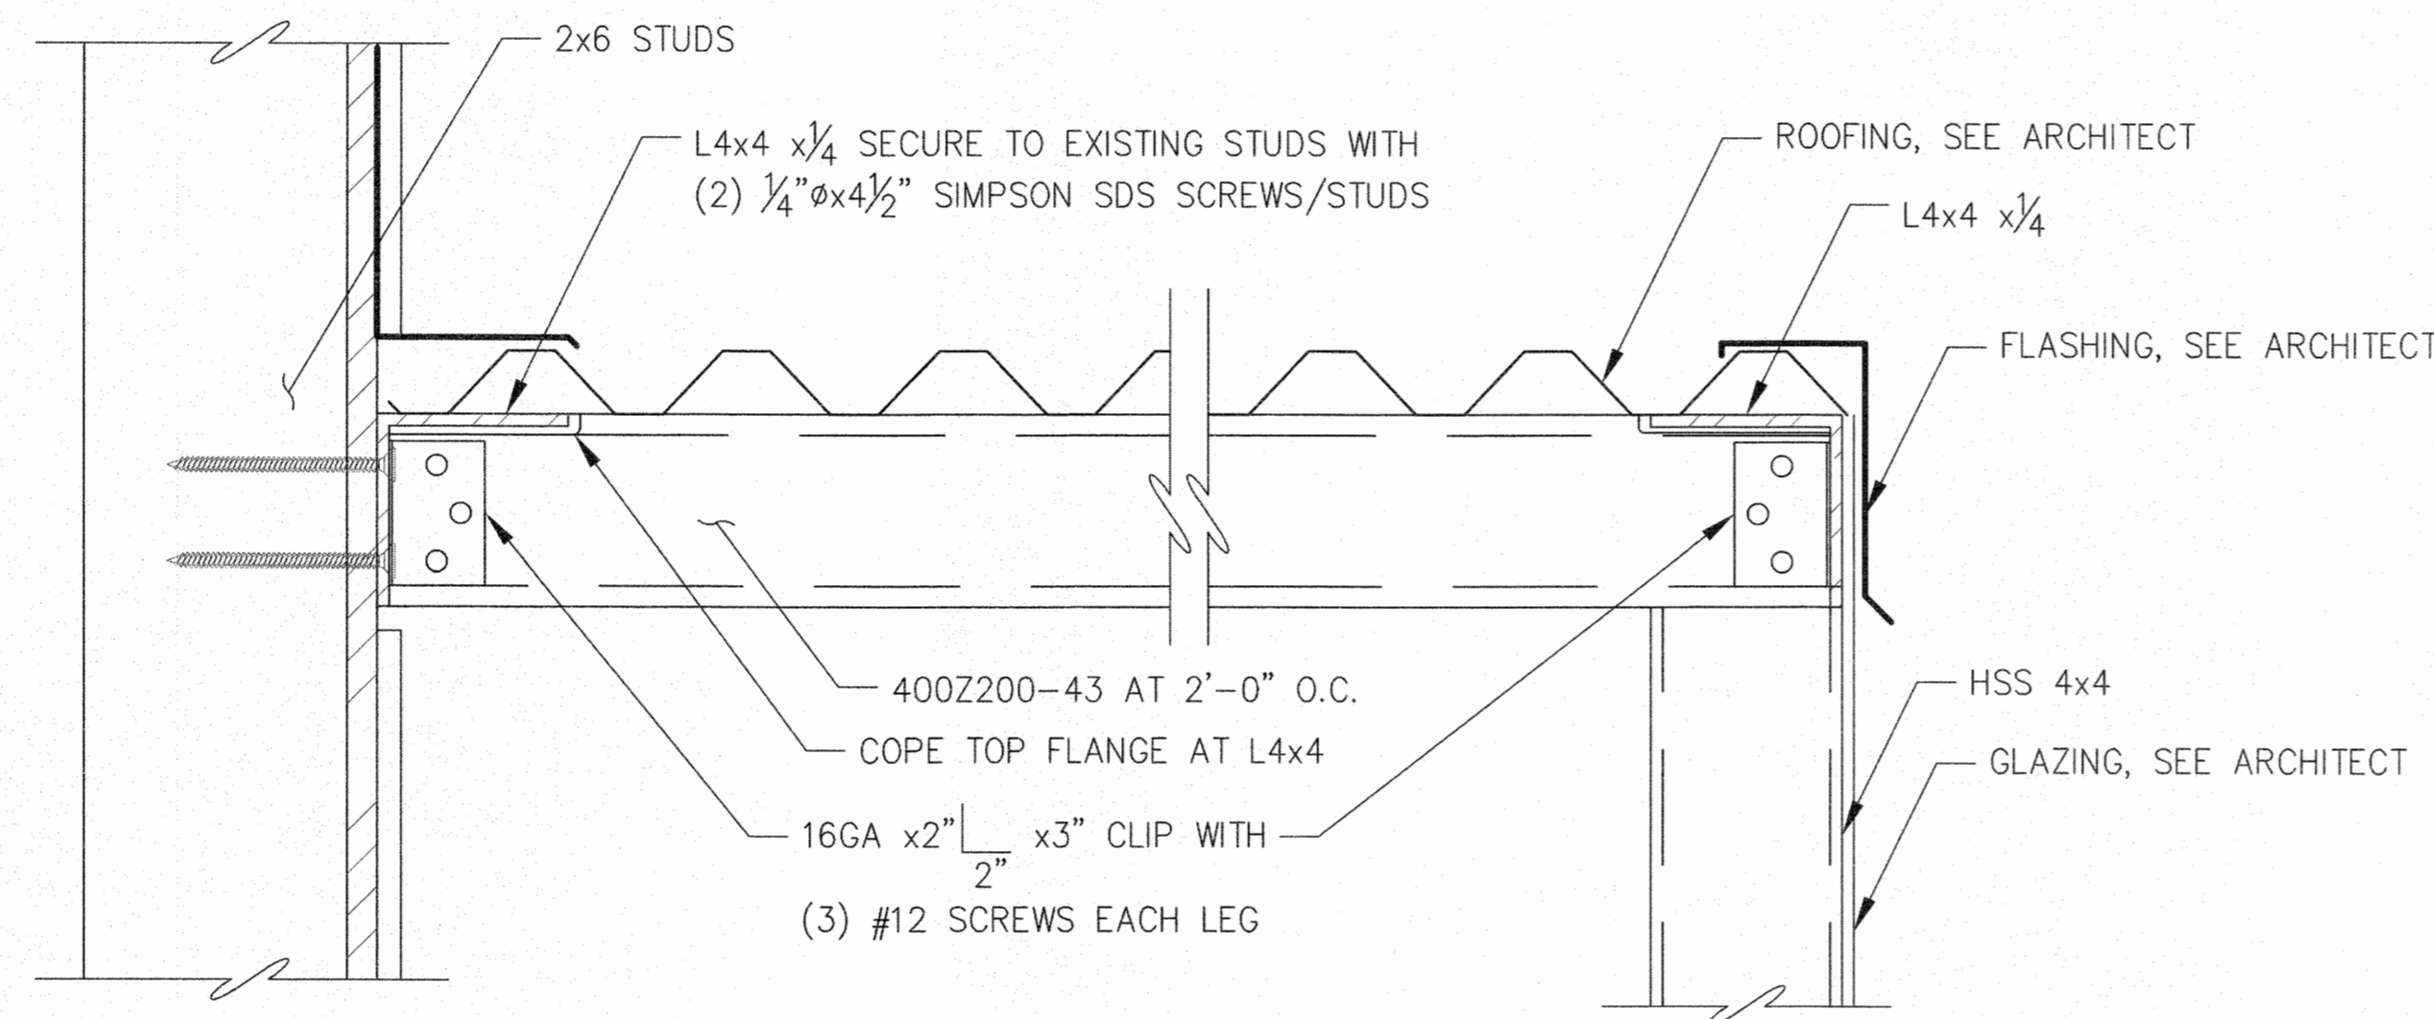

5 ROOF SECTION

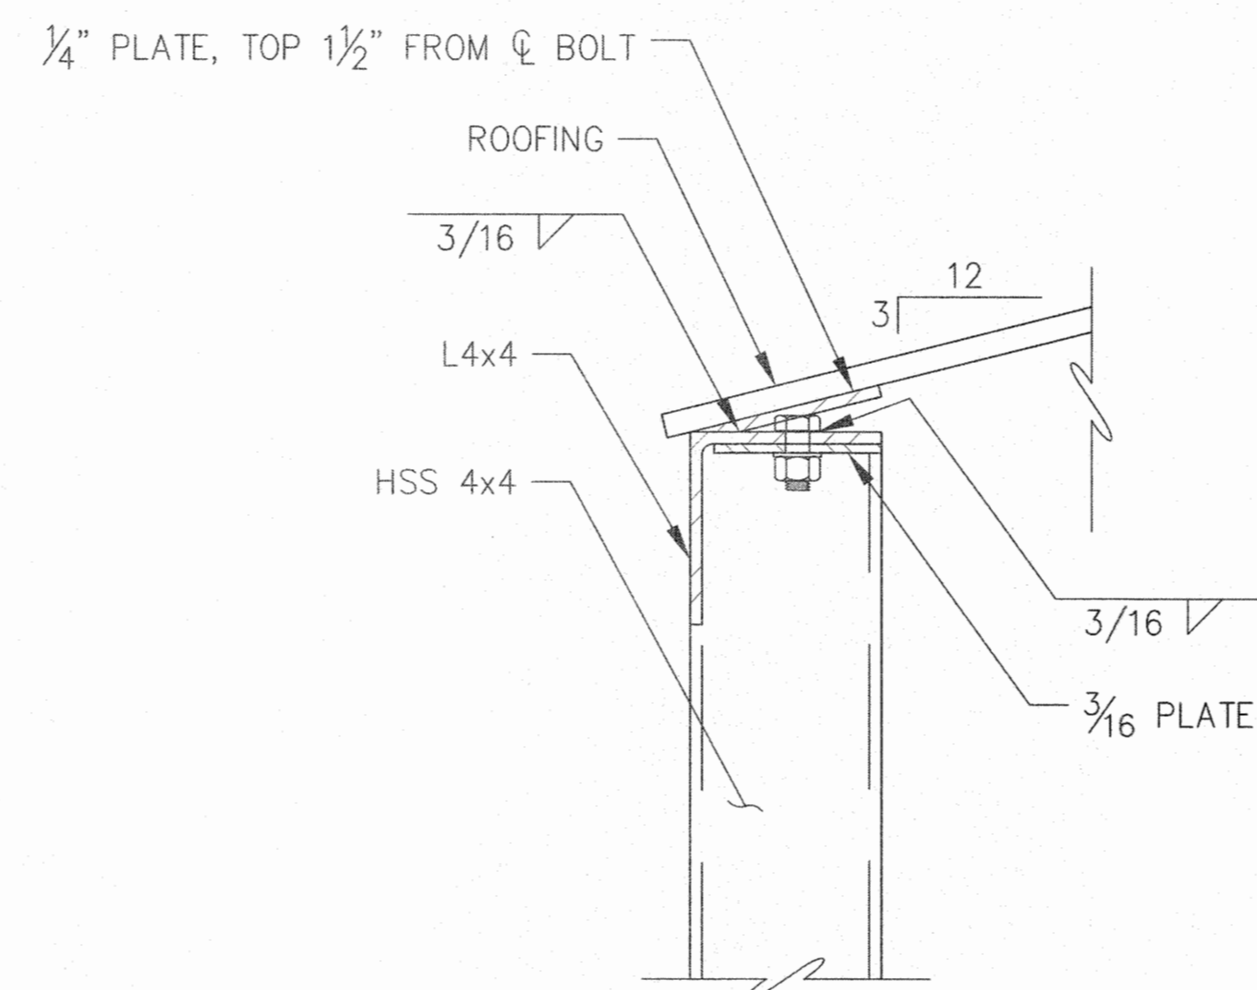

6 ROOFING TO L4x4 BOTTOM OF SLOPE

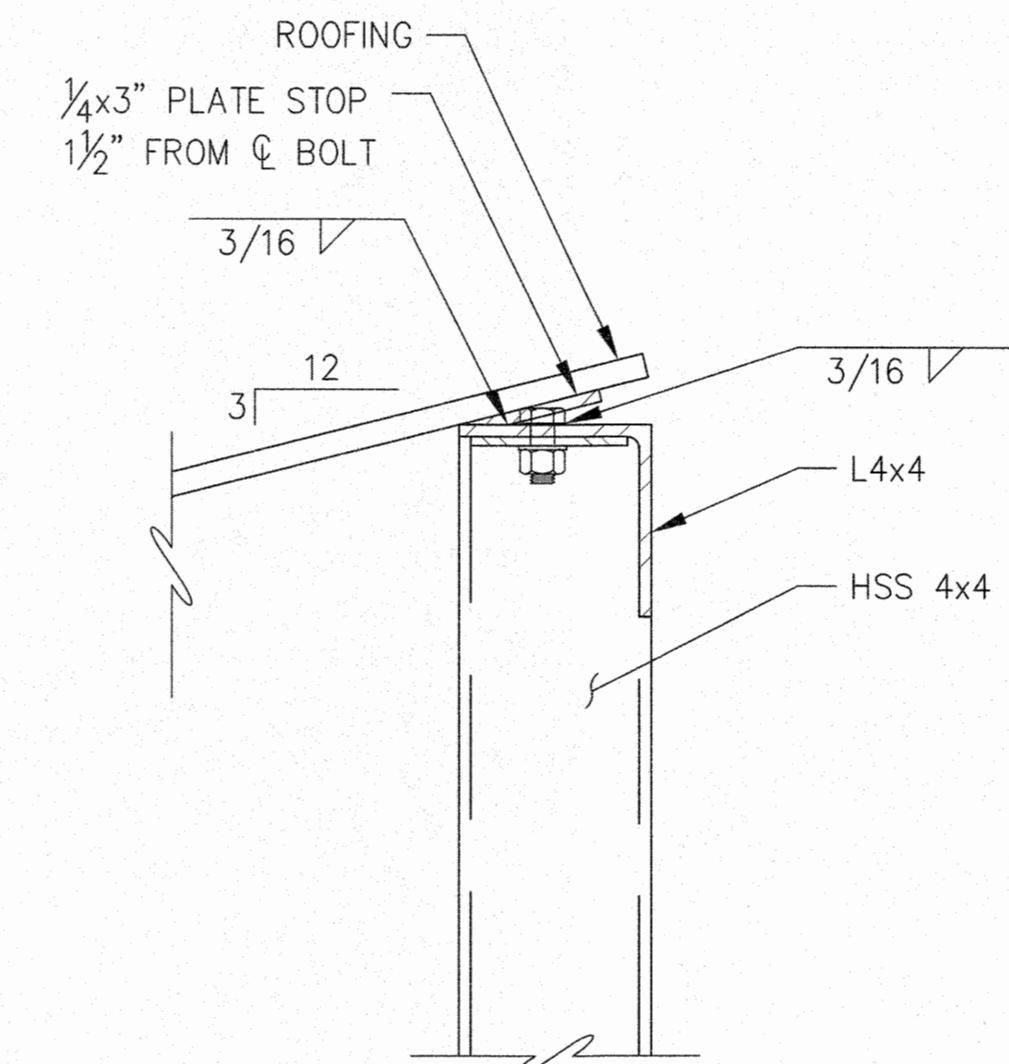

7 ROOFING TO L4x4 TOP OF SLOPE

RECORD DRAWINGS

THESE DRAWINGS HAVE BEEN PREPARED FROM INFORMATION PROVIDED BY THE CONTRACTOR. THERE IS NO GUARANTEE TO THE ACCURACY OF THE INFORMATION CONTAINED HEREIN, EITHER EXPRESSED OR IMPLIED.


October 9, 2017

WELSHWHITELEYARCHITECT, LLC


PLANS PREPARED BY:
PND ENGINEERS, INC.
9380 GLACIER HWY
JUNEAU, AK 99801

DO NOT SCALE FROM THESE DRAWINGS USE DIMENSIONS


CHECKED BY: CMG	STATE OF ALASKA DEPARTMENT OF TRANSPORTATION & PUBLIC FACILITIES SOUTHCOST REGION		
DESIGNED BY: CMG	KAKE FERRY TERMINAL PASSENGER FACILITY PLANSET B		
DRAWN BY: DRD	WINDBREAK SECTIONS AND DETAILS		
PATH: N:\12XXX\122068 AMHS KAKE TERMINAL\E1 DRAWINGS\PND\2017-9-29\S4.2.DWG			
TAB: S4.2 Monday, October 09, 2017 8:16:09 AM DANIELLE DUNIVIN			
REVISIONS		PROJECT DESIGNATION	YEAR
NO.	DATE	DESCRIPTION	SHEET NO.
			2015
			S4.2
			TOTAL SHEETS
			35

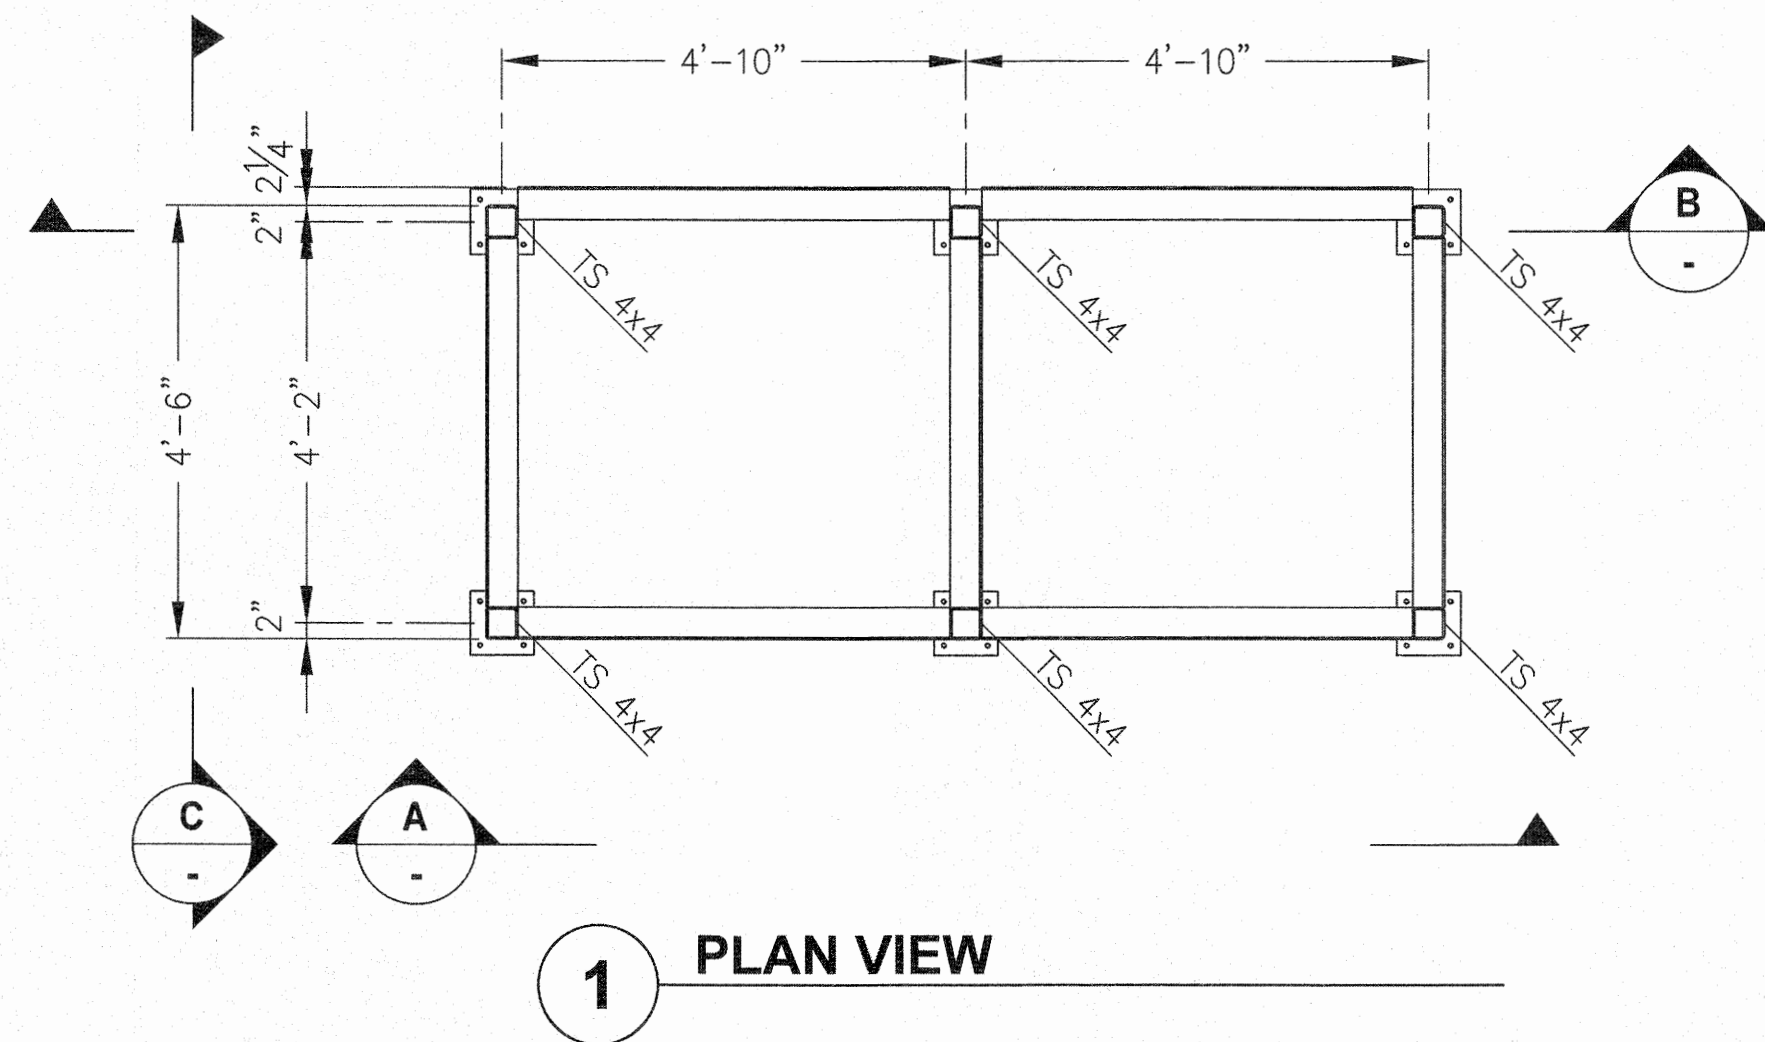


1 PLAN VIEW

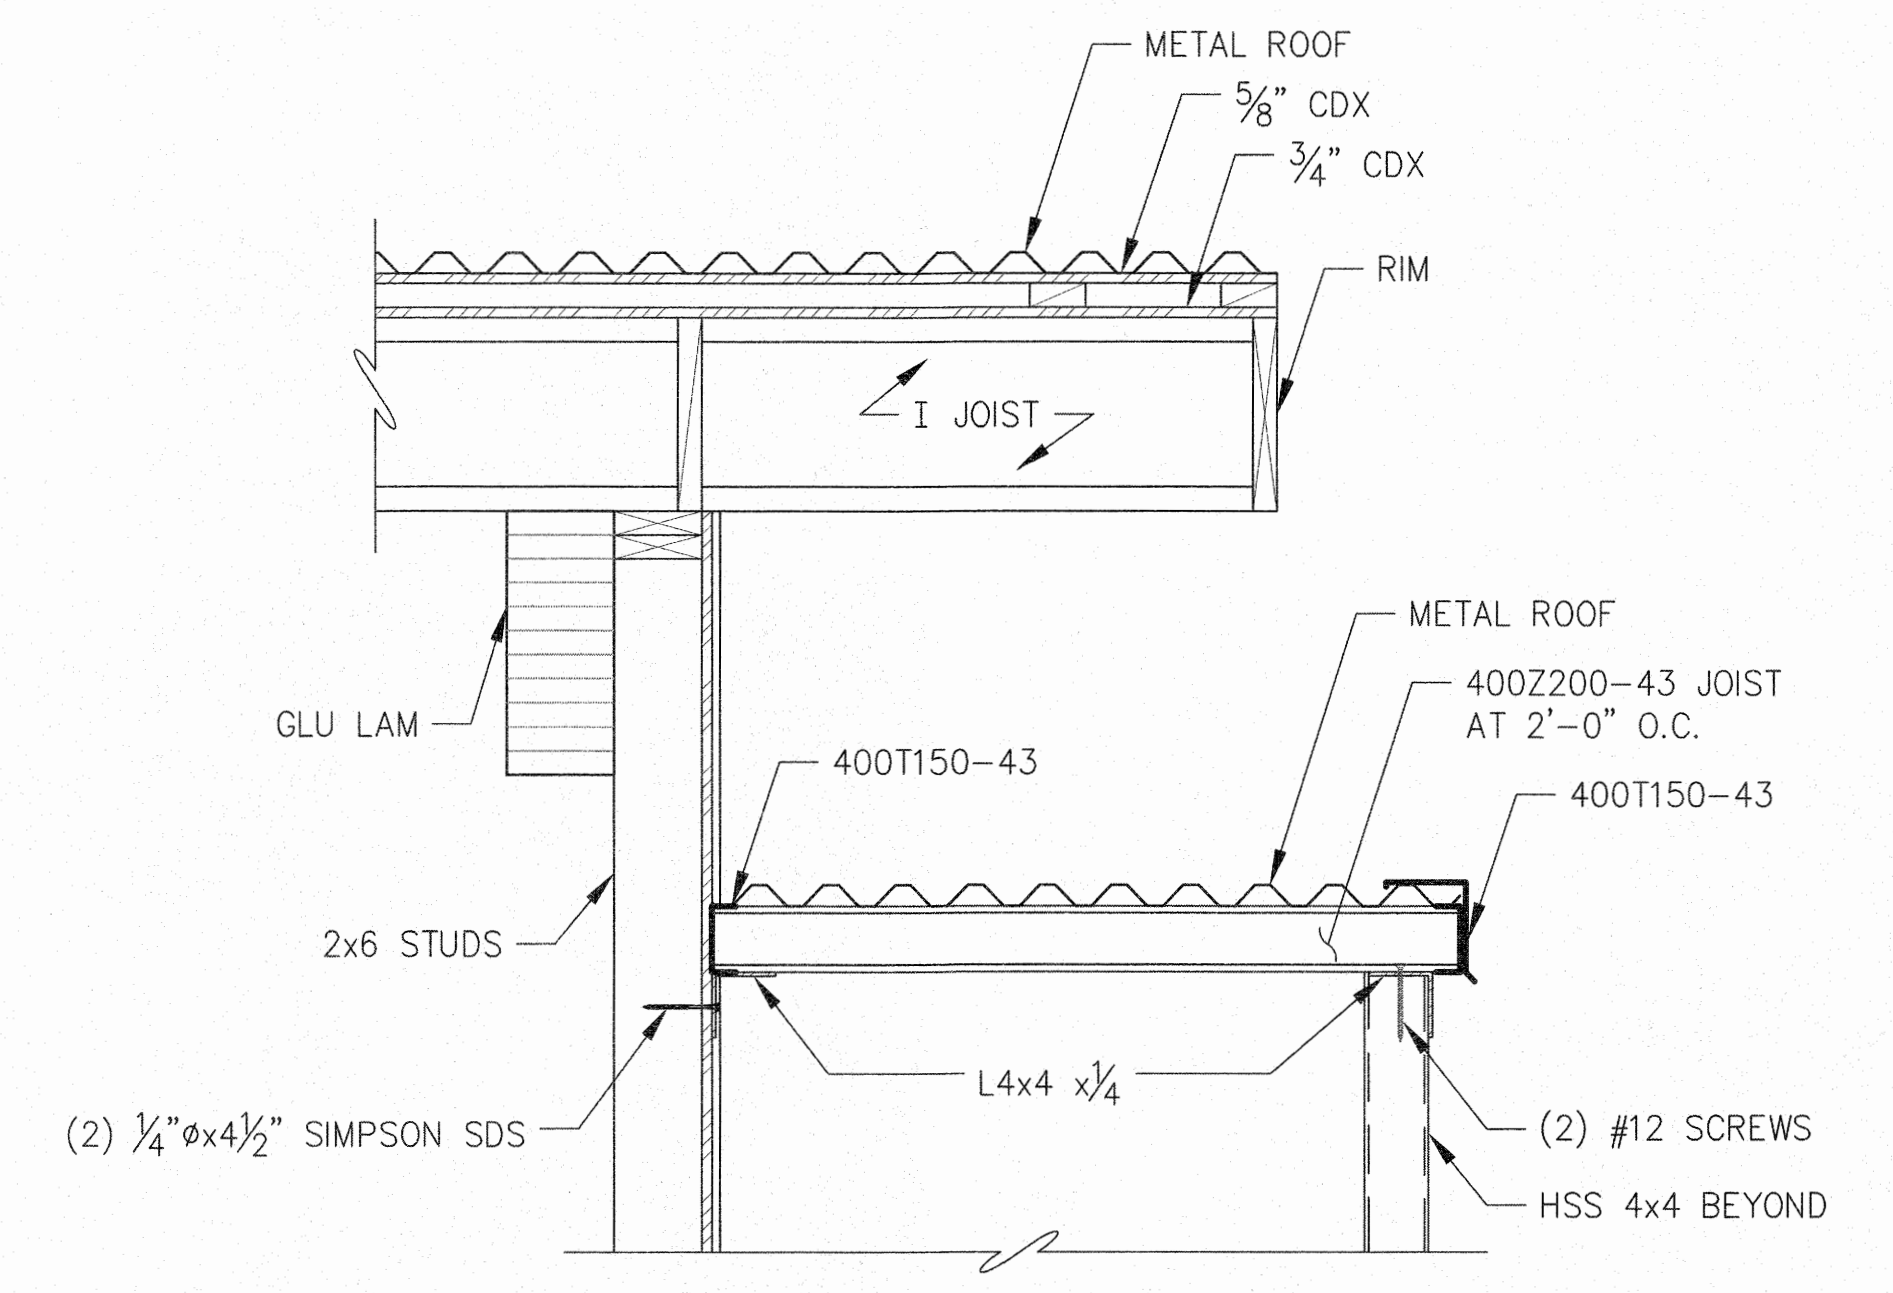


WINDBREAK ROOF SECTION

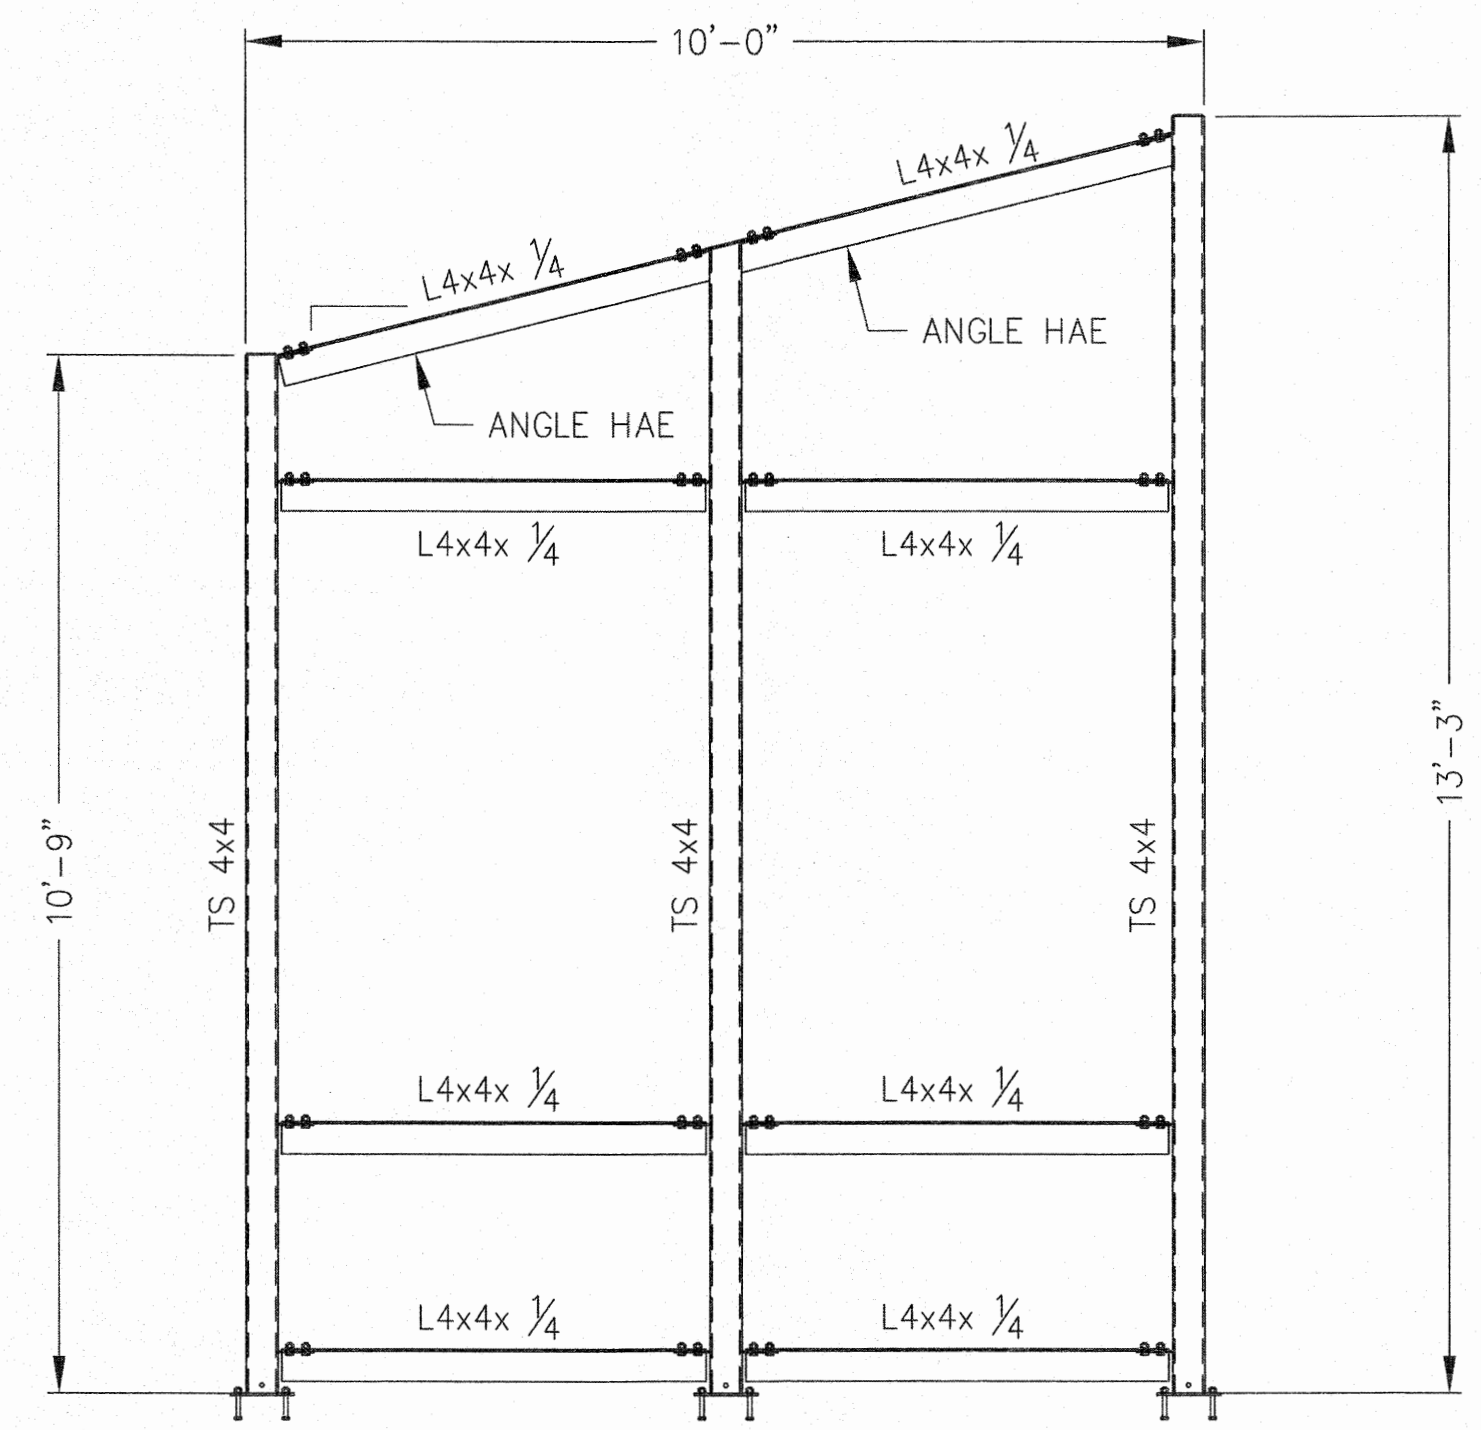

A ELEVATION VIEW

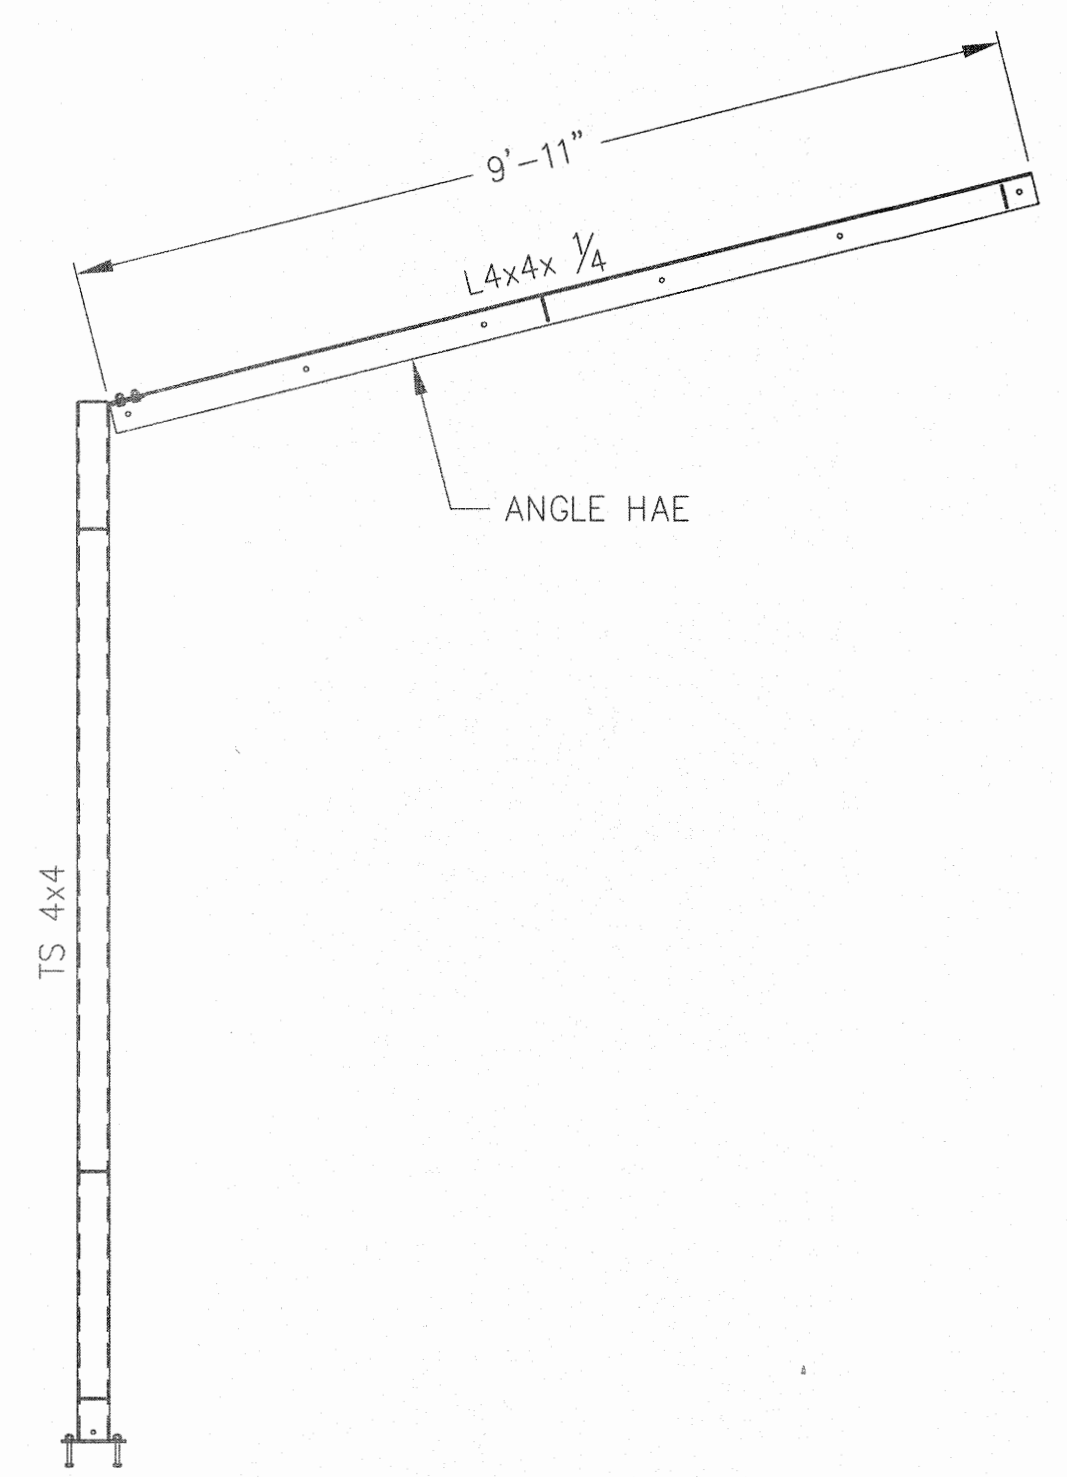

B ELEVATION VIEW

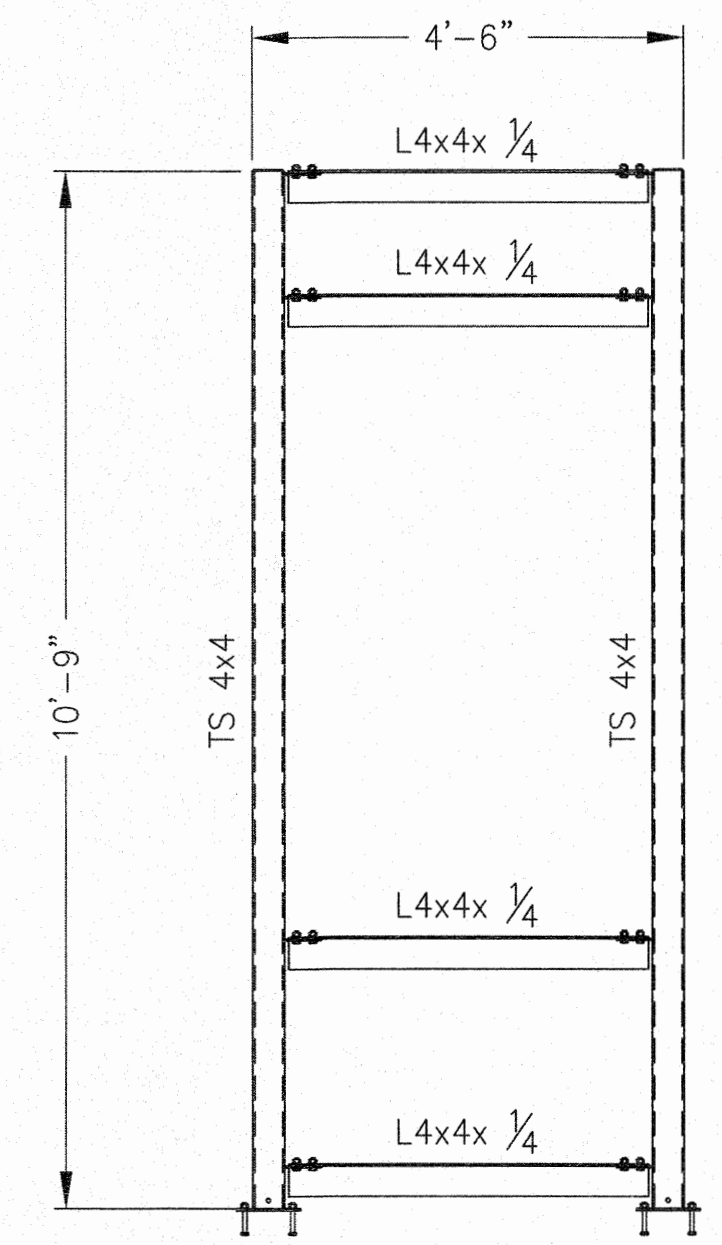

C ELEVATION VIEW

RECORD DRAWINGS

THESE DRAWINGS HAVE BEEN PREPARED FROM INFORMATION PROVIDED BY THE CONTRACTOR. THERE IS NO GUARANTEE TO THE ACCURACY OF THE INFORMATION CONTAINED HEREIN, EITHER EXPRESSED OR IMPLIED.

October 9, 2017

WELSHWHITELEYARCHITECT, LLC

DO NOT SCALE FROM THESE DRAWINGS USE DIMENSIONS

CHECKED BY: CMG	STATE OF ALASKA DEPARTMENT OF TRANSPORTATION & PUBLIC FACILITIES SOUTHCOST REGION				
DESIGNED BY: CMG	KAKE FERRY TERMINAL PASSENGER FACILITY PLANSET B				
DRAWN BY: DRD	WINDBREAK SECTIONS AND DETAILS				
PATH: N:\12XXX\122068 AMHS KAKE TERMINAL\E1 DRAWINGS\PND\2017-9-29\S4.2.DWG					
TAB: S4.3 Monday, October 09, 2017 8:16:11 AM DANIELLE DUNIVIN					
REVISIONS		PROJECT DESIGNATION	YEAR	SHEET NO.	TOTAL SHEETS
NO.	DATE	DESCRIPTION	SAMHS00002	2015	S4.3
					35

PLANS PREPARED BY:
PND ENGINEERS, INC.
9380 GLACIER HWY
JUNEAU, AK 99801

HEAT PUMP/AIR CONDITIONING UNITS SCHEDULE

EQUIPMENT	LOCATION SERVED	DESIGN MANUFACTURER AND MODEL	REFRIGERANT PIPING - INCHES	CONDENSATE PIPING - INCHES	FEATURES/OPTIONS
HP-1	BUILDING	DAIKIN FTXS36LVJU	5/8 RS; 3/8 RL	1"	HEAT PUMP: INDOOR FAN COIL UNIT; NOMINAL SENSIBLE COOLING CAPACITY OF 36,000 BTU/HR, RATED HEATING CAPACITY 38,000 BTU/HR WALL MOUNTED UNIT. 4-WAY DISCHARGE, INTEGRAL CONDENSATE PUMP. PROVIDE OPTIONAL REMOTE THERMOSTAT WITH TIME CLOCK. MOUNT BEHIND VANDAL PROOF, LOCKABLE, CLEAR PLASTIC GUARD. POWER FOR INDOOR UNIT FROM CCU-1.
CCU-1	BUILDING	DAIKIN RXS36LVJU	5/8 RS; 3/8 RL	--	COMPRESSOR/CONDENSER UNIT, OUTDOOR UNIT. RATED COOLING CAPACITY 36,000 BTU/HR, RATED HEATING CAPACITY 38,000 BTU/HR. 208-230V, SINGLE PHASE. PROVIDE LEVEL MOUNTING BASE. SECURE TO CONCRETE PAD WITH ASTM F593-316 AUSTENITIC STAINLESS STEEL ANCHOR BOLTS.

PLUMBING FIXTURE AND EQUIPMENT SCHEDULE

EQUIPMENT	DESCRIPTION	MANUFACTURE AND MODEL	FEATURES
WC-1	WATER CLOSET	AMERICAN STANDARD, AFWALL MILLENIUM	WALL MOUNTED, SIPHON JET, VITREOUS CHINA BOWL, WITH ELONGATED RIM, 1-1/2 INCH TOP SPUD. EXPOSED MANUAL FLUSH VALVE W/SEAT BUMPER. 1.6 GALLON FLUSH VOLUME. SOLID WHITE PLASTIC SEAT, OPEN FRONT, SELF-SUSTAINING HINGE. COORDINATE WITH ARCHITECTURAL FOR MOUNTING HEIGHTS. PROVIDE WALL CARRIER.
WC-2	WATER CLOSET	AMERICAN STANDARD, AFWALL MILLENIUM	WALL MOUNTED, SIPHON JET, VITREOUS CHINA BOWL, WITH ELONGATED RIM, 1-1/2 INCH TOP SPUD. EXPOSED BATTERY OPERATED AUTOMATIC FLUSH VALVE W/ MANUAL FLUSH OVERRIDE. 1.6 GALLON FLUSH VOLUME. SOLID WHITE PLASTIC SEAT, OPEN FRONT, SELF-SUSTAINING HINGE. RIM HEIGHT FOR ADA COMPLIANCE. COORDINATE WITH ARCHITECTURAL FOR MOUNTING HEIGHTS. PROVIDE WALL CARRIER.
U-1	URINAL	AMERICAN STANDARD, WASHBROOK	VITREOUS CHINA, WALL HUNG, SIPHON JET URINAL WITH SHIELDS, INTEGRAL TRAP, ELONGATED RIM, REMOVABLE STAINLESS STEEL STRAINER, ONE-INCH TOP SPUD, STEEL SUPPORTING HANGER. EXPOSED ELECTRONIC BATTERY POWERED FLUSH VALVE. SIMILAR TO SLOAN 8186 1.0 GALLON FLUSH. ADA COMPATIBLE.
SS-1	SERVICE SINK	AMERICAN STANDARD, FLORWELL	FLOOR MOUNTED SINK. 28"x28" ENAMELED CAST IRON, CORNER DESIGN WITH VINYL BUMP GUARD AND 3-INCH DRAIN. STAINLESS STEEL STRAINER. EXPOSED WALL TYPE SUPPLY WITH LEVER HANDLES, SPOUT AND WALL BRACE WITH 3/4" HOSE THREAD, INTEGRAL VACUUM BREAKER. FIVE FEET OF 1/2-INCH DIAMETER PLAIN END REINFORCED RUBBER HOSE, HOSE CLAMP HANGER, AND MOP HANGER.
L-1	LAVATORY FAUCET	AMERICAN STANDARD, LUCERNE SLOAN OPTIMA EAF-350	VITREOUS CHINA WALL MOUNTED BASIN, 20x18 INCHES WITH DRILLINGS ON 4-INCH CENTERS, FRONT OVERFLOW. WALL MOUNTED CARRIER ARMS. CHROME PLATED FAUCET, HANDS FREE FAUCET W/ ELECTRONIC TEMPERING VALVE. ADA COMPLIANT MANUFACTURED INSULATION SHIELDS AS REQUIRED. QUARTER TURN BALL VALVE STOPS. INFRARED SENSOR AND LITHIUM BATTERY. VANDAL RESISTANT SPRAY OUTLET, 0.5 GPM.
WHA	WATER HAMMER ARRESTOR	ZURN Z-1700 WHA-1: SIZE 100 WHA-2: SIZE 200	HOT WATER WITH 3/4-INCH AND COLD WATER WITH 1-INCH THREADED CONNECTIONS. ISOLATING VALVE INSTALLED FOR WHA.
TP	TRAP PRIMER	WATTS T20 PRECISION PR-500	ALL BRASS, 1/2-INCH IPS, SPRING-LOADED. UNION CONNECTIONS AT INLET AND OUTLET. WITH VACUUM BREAKING MEANS.
FD-1	FLOOR DRAIN	ZURN Z-415	6" DIAMETER TOP.
DF-1	DRINKING FOUNTAIN	ELKAY EHW217C	DUAL DRINKING FOUNTAIN, HEAVY DUTY, ADA COMPATIBLE WITH OPTIONAL APRON, IN WALL MOUNTING PLATE AND SUPPORT LEGS. 14 GAGE STAINLESS STEEL, BOTTOM COVER PLATES.
TV-1	THERMOSTATIC MIXING VALVE	POWERS LFMM430	TEMPERATURE LIMITING THERMOSTATIC MIXING VALVE. 1/2" INLETS, 3/4" OUTLET. STRAINER/CHECK STOPS.
HHW-1	HOT WATER HEATER	EEMAX EX95T ML	ELECTRIC TANKLESS WATER HEATER. 9.5 KW 240V AT 1.0 GPM WITH 50F EWT. UNIT SHALL BE UL RATED. ELEMENT SHALL HAVE REPLACABLE CARTRIDGE INSERT, REPLACEABLE FILTER. IRON FREE ELEMENT, NICKEL CHROME MATERIAL. MAXIMUM OPERATING PRESSURE 150 PSI.
WH-1	WALL HYDRANT	ZURN 1300	3/4" NON-FREEZE TYPE IN RECESSED BOX WITH INTERNAL VACUUM BREAKER. NICKEL BRONZE FACE. 2-INCH SIZE.
	WATER METER	SENSUS OMNI C2	THERMOPLASTIC ROTOR, MAGNETIC DRIVE, BRONZE CASE. 10GPM NOMINAL FLOW AT 1 PSI PRESSURE DROP.
ET-1	EXPANSION TANK	AMTROL THERM-X-TROL ST-12C	ASME RATED. POTABLE WATER USE. PRE-PRESSURIZED BUTYL DIAPHRAGM THERMAL EXPANSION CHAMBER. TOTAL NOMINAL VOLUME 6.4 GALLONS.

PLUMBING FIXTURE CONNECTION SCHEDULE

FIXTURE	HOT WATER	COLD WATER	WASTE	VENT
WATER CLOSET, FLUSH VALVE	-	1-1/2	4	2
URINAL	-	1	2	2
LAVATORY	1/2	1/2	1-1/2	1-1/2
FLOOR DRAIN	-	-	2 OR 3	1-1/2
DRINKING FOUNTAIN	-	1/2	1-1/2	1-1/4
PRIMING LINE	-	1/2	-	-
SERVICE SINK	1/2	1/2	3	2

FAN SCHEDULE

EQUIPMENT	AREA SERVED	CFM	TSP. INCHES OF WATER	DESIGN MANUFACTURER AND MODEL	MINIMUM HORSEPOWER ELECTRICAL CHARACTERISTICS	FEATURES AND ACCESSORIES
TEF-1	WOMEN'S TOILET ROOM	150	0.20	PANASONIC FV-11-15VK1	42W, 120-V, 1-PHASE	CEILING MOUNTED, CABINET EXHAUST FAN WITH INTEGRAL INLET GRILLE, DUCT CONNECTION. TO OPERATE AT COMMAND OF OCCUPANCY SENSOR PROVIDE BY ELECTRICAL.
TEF-2	MEN'S TOILET ROOM	150	0.20	PANASONIC FV-11-15VK1	42W, 120-V, 1-PHASE	CEILING MOUNTED, CABINET EXHAUST FAN WITH INTEGRAL INLET GRILLE, DUCT CONNECTION. TO OPERATE AT COMMAND OF OCCUPANCY SENSOR PROVIDE BY ELECTRICAL.
TEF-3	JANITOR	70	0.25	PANASONIC FV-05-11VK1	20.1W, 120-V, 1-PHASE	CEILING MOUNTED, CABINET EXHAUST FAN WITH INTEGRAL INLET GRILLE, DUCT CONNECTION. TO OPERATE CONTINUOUS BY WALL-SWITCH.
TF (2)	TOILET ROOM TRANSFER FAN	180	-	BROAN MODEL 511	0.9 AMPS, 120-V, 1-PHASE	DIRECT DRIVE DUAL FAN TRANSFER FAN, IN-THE-WALL MOUNTED. STEEL GRILLE, BOTH ENDS. SOLID STATE RECESSED SPEED CONTROLLER.
CEILING FAN, CF-1	LOBBY	5000 HIGH SPEED	-	HUNTER LOW PROFILE III MODEL 20807	66 WATTS HIGH SPEED 120-V, 1-PHASE	PROPELLER TYPE CEILING FAN. 52" DIA. CEILING FAN WITH MAPLE/CHERRY VENEER BLADES (5), ANTIQUE PEWTER FINISH, 36" DOWNROD. MULTIPLE SPEED FAN CONTROL.

SYMBOLS

	CW	COLD WATER		2	CONSTRUCTION NOTE
	HW	HOT WATER			THERMOSTAT OR THERMOSTATIC SENSOR - IMMERSION, ROOM
	RL	REFRIGERANT LIQUID			THERMOMETER
	RS	REFRIGERANT SUCTION			CONTROL SWITCH
	W	WASTE			DIAMETER
	V	VENT			ACCESS DOOR
		EXISTING			RELOCATE
		REMOVE			CONNECTION POINT, REMOVAL POINT
	AV	AUTOMATIC VALVE			CLEANOUT
	DV	DRAIN VALVE			UNION
		PITCHED DOWN			REDUCER
		GATED OR PLUGGED			GATE VALVE OR BALL VALVE
		STRAINER		5	FLOW SETTER W/NO.
		TEST PORT/PLUG		FCO	FLOOR CLEANOUT
		CHECK VALVE			GLOBE VALVE OR ISOLATING BALL VALVE
	AFF	ABOVE FINISHED FLOOR		CCU	COMPRESSOR-CONDENSER UNIT
	CFM	CUBIC FEET PER MINUTE		CI	CAST IRON
	CO	CLEANOUT		DI	DUCTILE IRON
	DU	DIELECTRIC UNION		DV	DRAIN VALVE
	ESP	EXTERNAL STATIC PRESSURE		EWT	ENTERING WATER TEMPERATURE
	FCO	FLOOR CLEANOUT		FD	FLOOR DRAIN
	HB	HOSE BIBB		HP	HEAT PUMP
	HHW	HOT WATER HEATER		IAW	IN ARCHITECTURAL WORK
	IEW	IN ELECTRICAL WORK		ICW	IN CIVIL WORK
	IPS	IRON PIPE SIZE		L-1	LAVATORY
	MBH	1,000 BTU PER HOUR		NIC	NOT IN CONTRACT
	NIM	NOT IN MECHANICAL		NO	NORMALLY OPEN
	PSI	POUNDS PER SQUARE INCH		SS	SERVICE SINK
	TEF	TOILET EXHAUST FAN		TF	TRANSFER FAN
	TP	TRAP PRIMER		T&P	TEMPERATURE AND PRESSURE RELIEF VALVE
	TSP	TOTAL STATIC PRESSURE		TYP.	TYPICAL
	U	URINAL		VI	VIBRATION ISOLATORS
	VTR	VENT THROUGH ROOF		WCO	WALL CLEAN OUT
	WHA	WATER HAMMER ARRESTOR		YCO	YARD CLEANOUT

SHEET NOTES:

- SEE SPECIFICATIONS FOR ADDITIONAL MANUFACTURER'S INFORMATION ON EQUIPMENT AND SYSTEMS REQUIREMENTS.
- CODES & REGULATIONS: ALL WORK HEREUNDER SHALL BE STRICTLY IN CONFORMANCE WITH APPLICABLE CODES AND REGULATIONS. ALL WORK SHALL BE IN ACCORDANCE WITH THE 2009 INTERNATIONAL FIRE CODE, 2009 INTERNATIONAL MECHANICAL CODE, 2009 UNIFORM PLUMBING CODE, NFPA, AND STATE OF ALASKA MODIFICATIONS INSOFAR AS MINIMUM REQUIREMENTS ARE CONCERNED, BUT THE DRAWINGS AND SPECIFICATIONS SHALL GOVERN IN CASE THE MINIMUM REQUIREMENTS ARE EXCEEDED. ALL ELECTRICAL EQUIPMENT SHALL BEAR THE UL LABEL.

MECHANICAL SHEET LIST


NUMBER	TITLE
M1.0	SCHEDULES - SYMBOLS
M2.1	FLOOR PLAN - FOUNDATION & MAIN FLOOR
M3.1	DETAILS & DIAGRAMS

DO NOT SCALE FROM THESE DRAWINGS USE DIMENSIONS


RECORD DRAWINGS
THESE DRAWINGS HAVE BEEN PREPARED FROM INFORMATION PROVIDED BY THE CONTRACTOR. THERE IS NO GUARANTEE TO THE ACCURACY OF THE INFORMATION CONTAINED HEREIN, EITHER EXPRESSED OR IMPLIED.
09-25-2017
WELSHWHITELEYARCHITECT, LLC

DRAWINGS PREPARED BY:
PDC ENGINEERS
FORMERLY MURRAY & ASSOCIATES, P.C.
CONSULTING ENGINEERS
P O BOX 21081
JUNEAU, ALASKA 99802
TEL: 907 780-6151

CHECKED BY: DOUG MURRAY	STATE OF ALASKA DEPARTMENT OF TRANSPORTATION & PUBLIC FACILITIES SOUTHCOST REGION					
DRAWN BY: KB	KAKE FERRY TERMINAL PASSENGER FACILITY PLANSET B					
DESIGNED BY: DOUG MURRAY	SCHEDULES - SYMBOLS					
PATH: Z:\CURRENT PROJECTS\70\70-14\DRAWINGS\AS-BUILT\M1.0.DWG						
TAB: M1.0 Tuesday, September 26, 2017 2:03:05 PM	DOMINIC I. MCGONEGAL					
NO.	DATE	DESCRIPTION	PROJECT DESIGNATION	YEAR	SHEET NO.	TOTAL SHEETS
			SAMHS00002	2015	M1.0	35

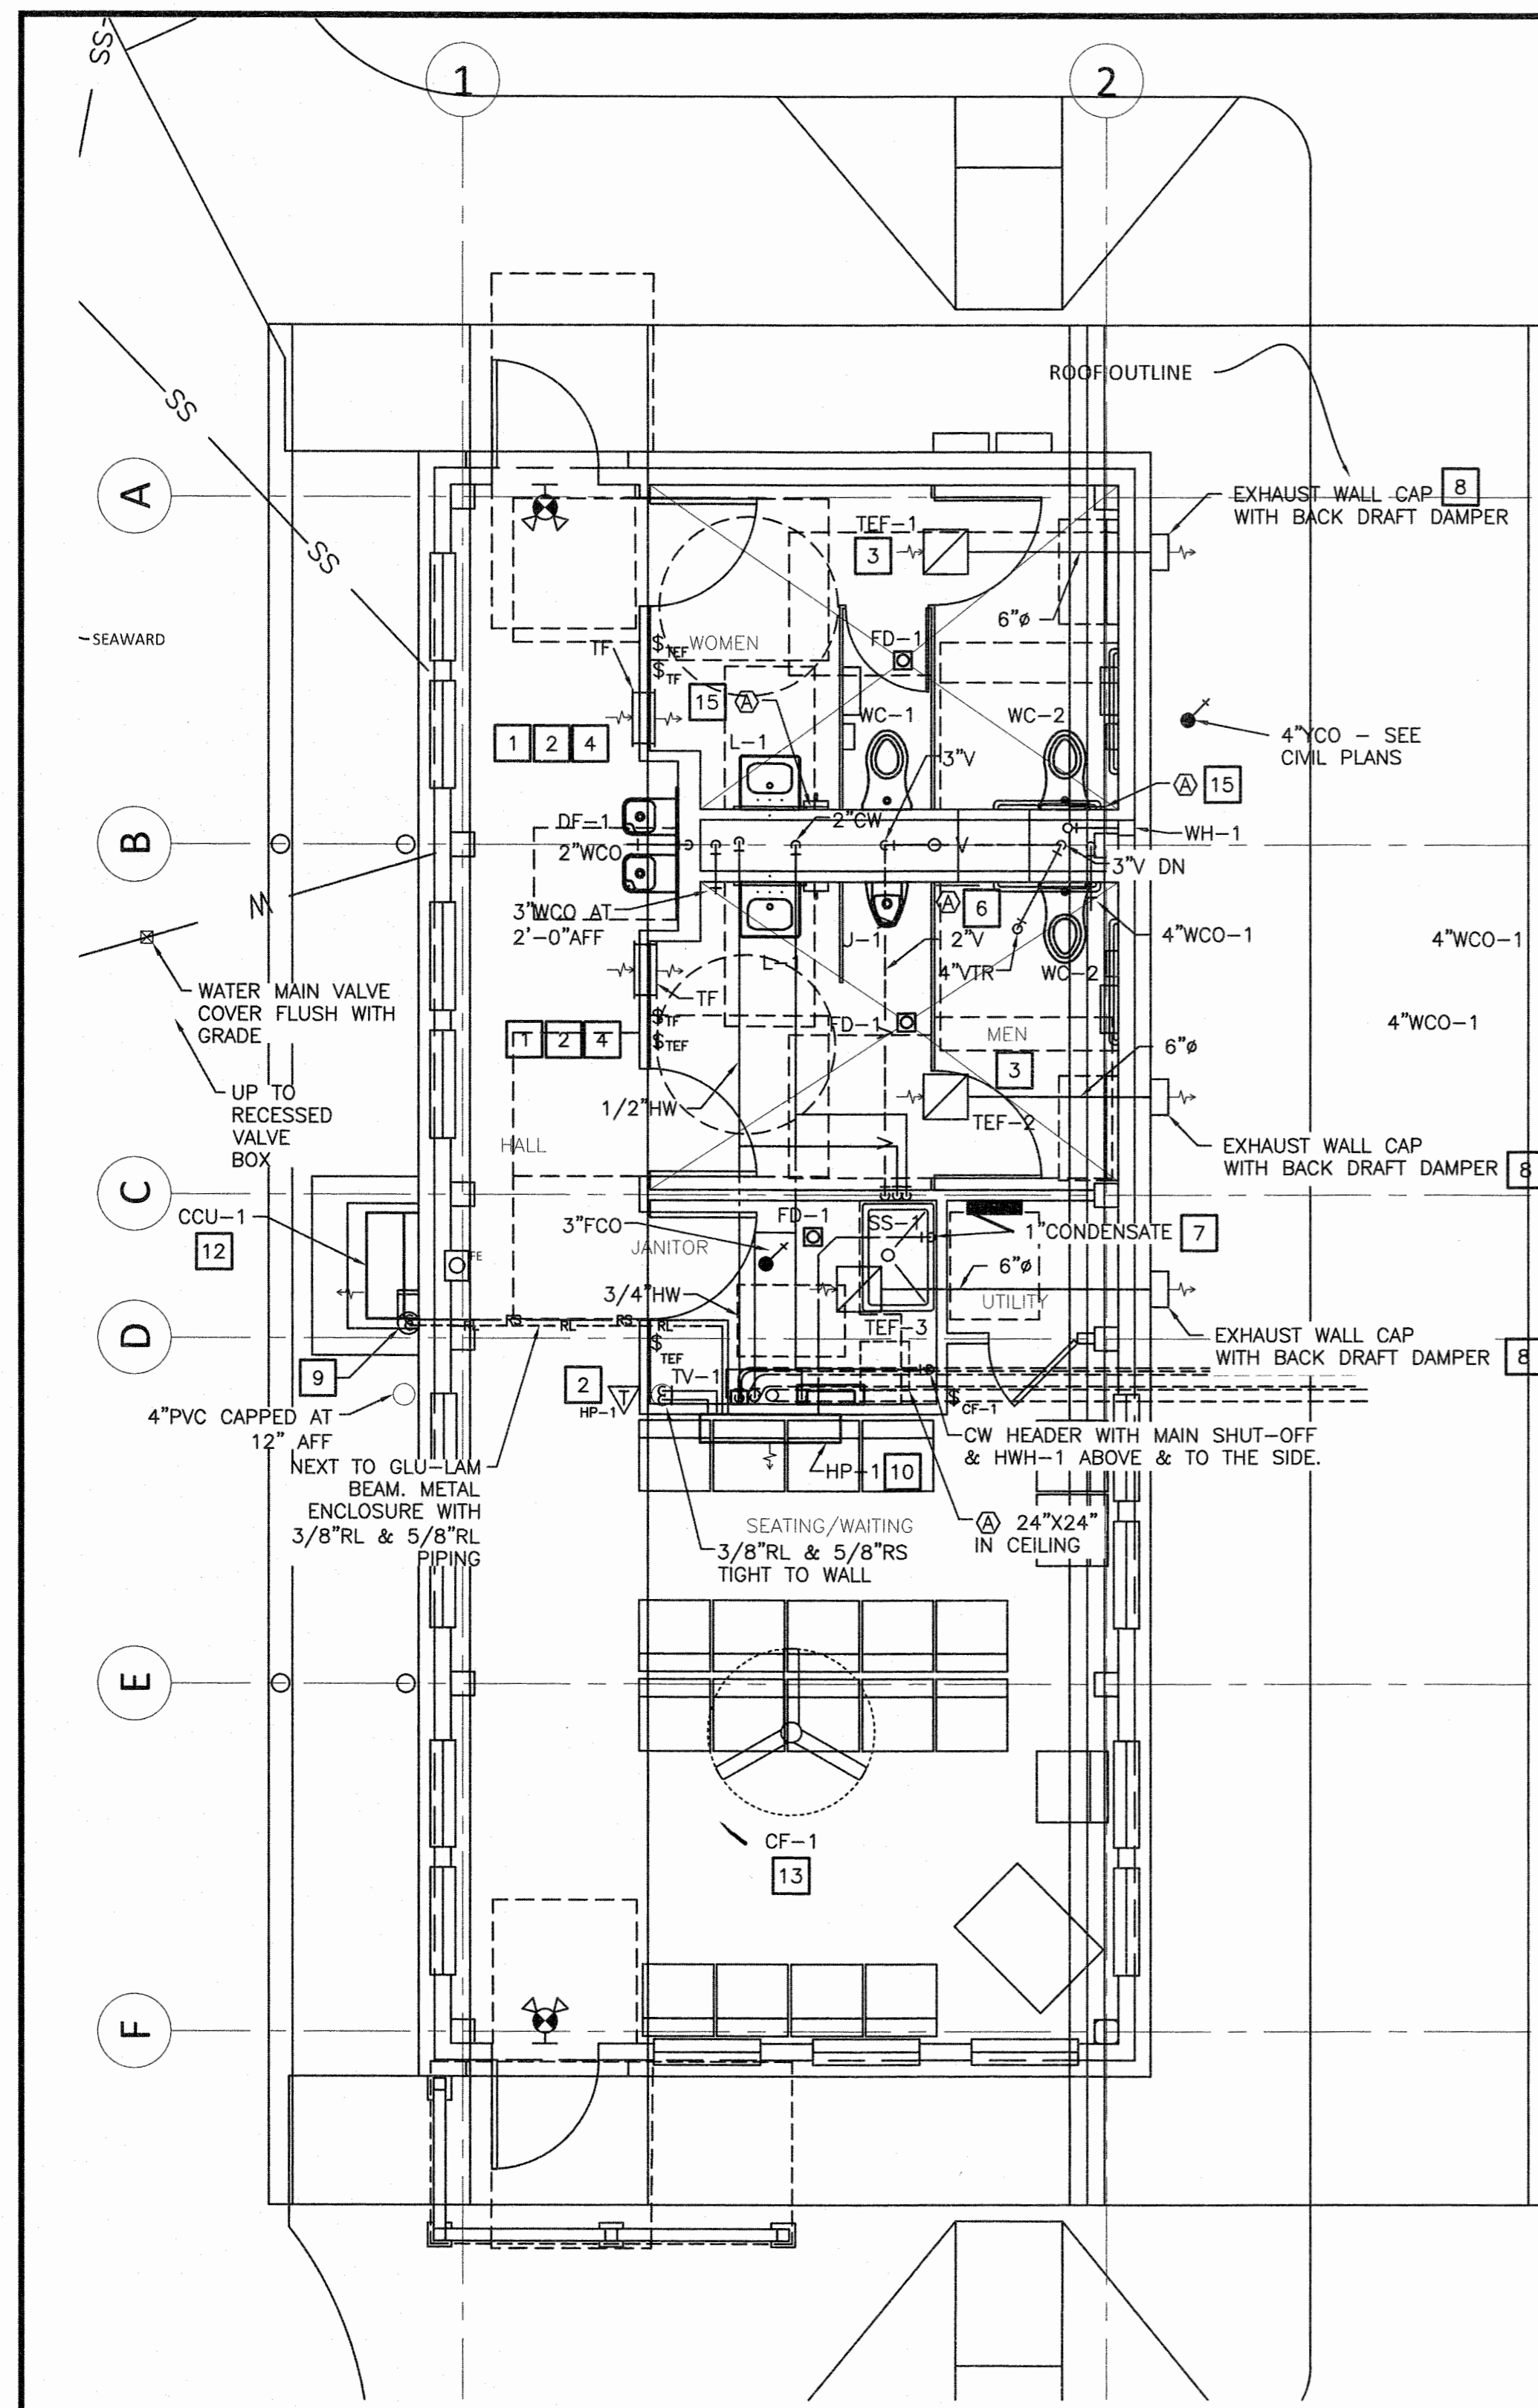

1 FLOOR PLAN-PIPING
 SCALE: 0 2' 4' 8' 16'

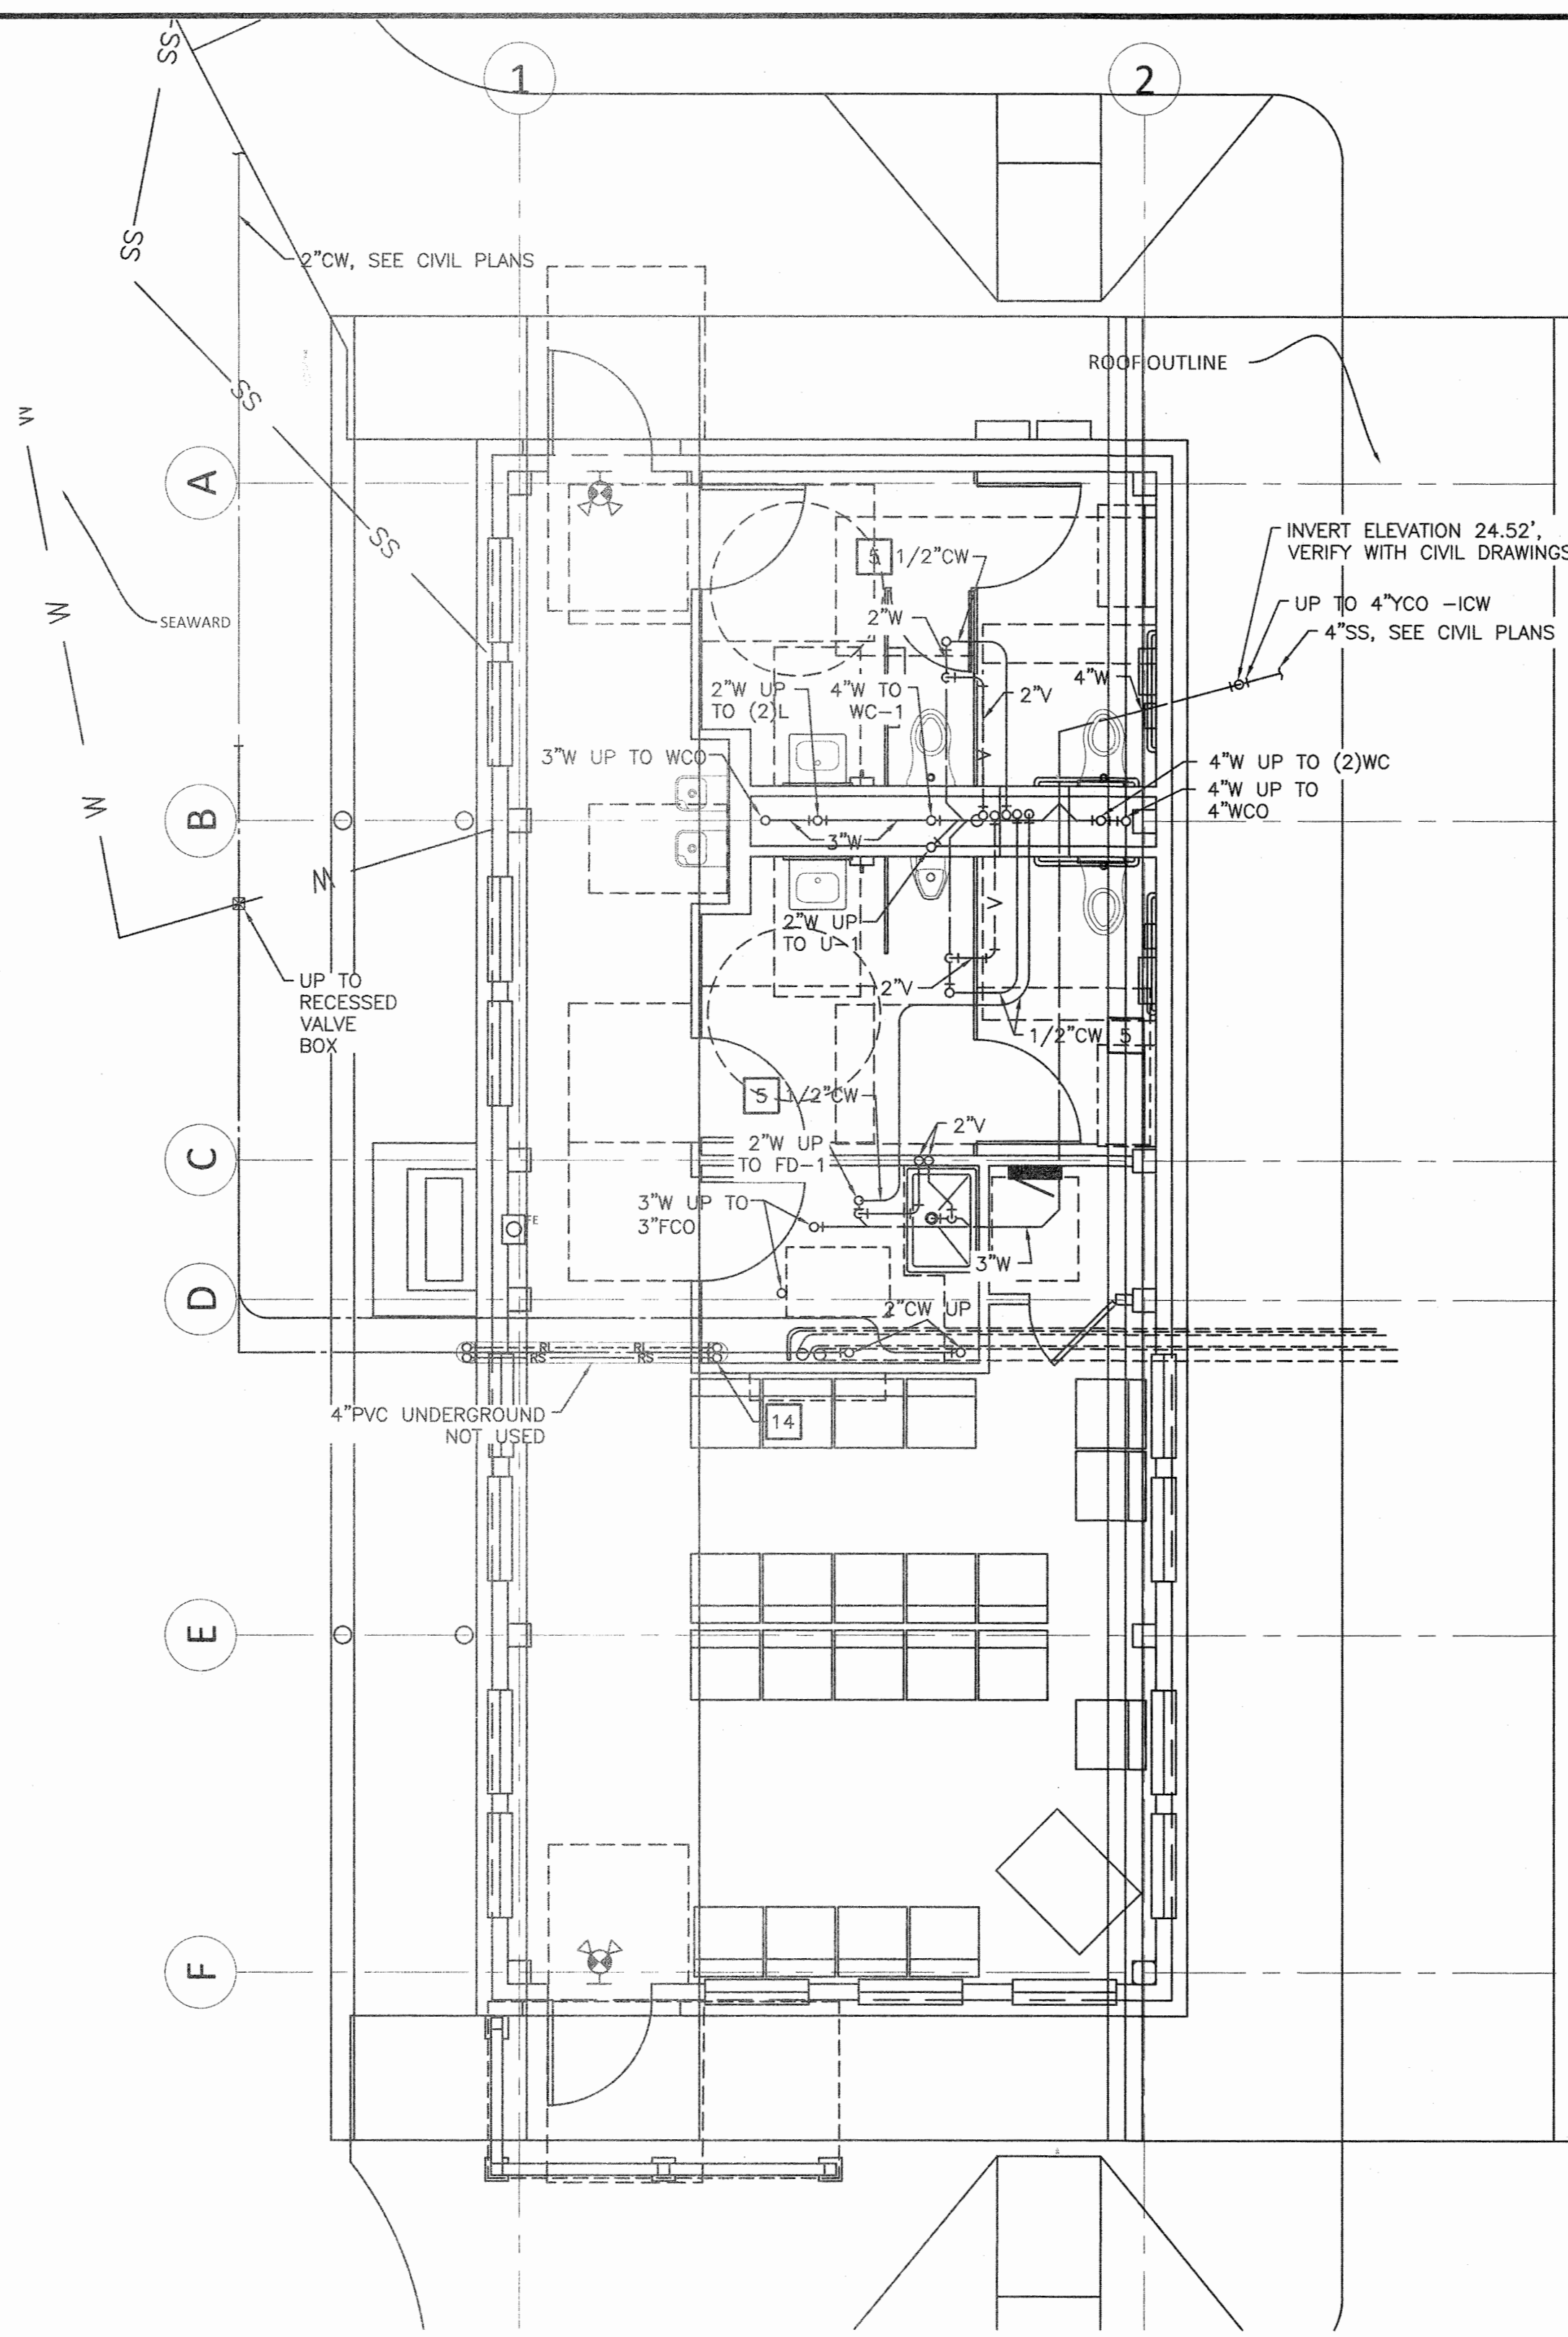

2 FOUNDATION PLAN-PIPING
 SCALE: 0 2' 4' 8' 16'

GENERAL NOTES:

1. INSULATE RL, RS, AND CONDENSATE DRAIN PIPE WITH A MINIMUM OF 3/4 INCH THICK FLEXIBLE ELASTOMERIC CELLULAR INSULATION. PROVIDE ALUMINUM SHEET METAL COVER ON ALL INTERIOR AND EXTERIOR INSULATED PIPING.
2. SEE DETAILS AND DIAGRAMS ON SHEET M3.1 FOR ADDITIONAL INFORMATION AND CONFIGURATION OF PIPING.

CONSTRUCTION NOTES:

- 1 FAN SPEED CONTROLLER. LOCATE ADJACENT TO LIGHT SWITCH.
- 2 PROVIDE CLEAR PLASTIC LOCKABLE COVER OVER THERMOSTAT/CONTROLLER.
- 3 OPERATION OF TEF-1 BY OCCUPANCY SENSOR, SEE ELECTRICAL.
- 4 MOUNT TRANSFER FAN AT 9'-0" ABOVE FLOOR. FAN CONTROLLED BY SPEED CONTROL SWITCH LOCATED WHERE SHOWN.
- 5 1/2" TYPE K COPPER TO FD-1 TRAP PRIMER CONNECTION.
- 6 WATER HAMMER ARRESTORS AND VALVES ACCESSIBLE IN ATTIC SPACE.
- 7 INDIRECT WASTE CONDENSATE PIPING INTO SS-1. ROUTE DRAIN CONCEALED IN WALL TO JUST ABOVE SPLASH PANEL. FINISH WITH ELBOW DOWN AND ESCUTCHEON.
- 8 MOUNT EXHAUST WALL CAP AS HIGH AS POSSIBLE. SEAL PENETRATION WATER TIGHT. SEE DETAIL ON SHEET M3.1.
- 9 REFRIGERANT PIPING INSTALLED IN METAL ENCLOSURE ON OUTSIDE OF BUILDING TO THE 9'-0" LEVEL, PENETRATE TO INTERIOR.
- 10 MOUNT HP-1 AS HIGH AS POSSIBLE. APPROXIMATELY 9'-1" ABOVE FINISHED FLOOR TO BOTTOM OF UNIT.
- 11 NOT USED
- 12 OUTDOOR UNIT MOUNTED ON TREATED TIMBERS SECURED TO CONCRETE SIDEWALK.
- 13 SUPPORT AND SECURE CF-1 BASE TO STRUCTURE PER MANUFACTURER'S REQUIREMENTS.
- 14 CAPPED ABOVE FLOOR.
- 15 WALL ACCESS DOOR.

RECORD DRAWINGS
 THESE DRAWINGS HAVE BEEN PREPARED FROM INFORMATION PROVIDED BY THE CONTRACTOR. THERE IS NO GUARANTEE TO THE ACCURACY OF THE INFORMATION CONTAINED HEREIN, EITHER EXPRESSED OR IMPLIED.
 09-25-2017
 WELSHWHITELEYARCHITECT, LLC

DRAWINGS PREPARED BY:
 PDC ENGINEERS
 FORMERLY MURRAY & ASSOCIATES, P.C.
 CONSULTING ENGINEERS
 P O BOX 21081
 JUNEAU, ALASKA 99802
 TEL: 907 780-6151

DO NOT SCALE FROM THESE DRAWINGS USE DIMENSIONS

CHECKED BY: DOUG MURRAY		STATE OF ALASKA DEPARTMENT OF TRANSPORTATION & PUBLIC FACILITIES SOUTHCOST REGION	
		KAKE FERRY TERMINAL PASSENGER FACILITY PLANSET B	
		FLOOR PLAN - FOUNDATION & MAIN FLOOR, ADD #1	
DESIGNED BY: DOUG MURRAY		PROJECT DESIGNATION	YEAR
DRAWN BY: KB		SAMHS00002	2015
PATH: Z:\CURRENT PROJECTS\70\70-14\DRAWINGS\AS-BUILT\M2.1.DWG		SHEET NO.	TOTAL SHEETS
TAB: M2.1 Tuesday, September 26, 2017 2:03:08 PM		M2.1	35
DOMINIC I. MCGONEGAL			
REVISIONS			
NO.	DATE	DESCRIPTION	


SYMBOLS AND MOUNTING HEIGHTS

MOUNTING HEIGHTS ARE TO BE AS LISTED BELOW UNLESS OTHERWISE INDICATED ON PLAN.

<p>SWITCHES, 3 WAY, KEYED, TIMER 48" AFF</p> <p>MOTOR SWITCH W/ PILOT LIGHT HAND-OFF-AUTO SWITCH LITGHT SWITCH W/ MOTION SENSOR FAN SPEED CONTROL SWITCH, BY MECH DIMMER SWITCH</p> <p>DUPLEX RECEPTACLE B = BLUE DEVICE, CKT ON 24/7 TAMPERPROOF DUPLEX RECEPT QUADPLEX RECEPT (2 DUPLEX) GFI - GROUND FAULT RECEPT SPLIT WIRED DUPLEX RECEPT SPECIAL RECEPTACLE D = NEMA 14-30R R = NEMA 14-50R</p> <p>TELEPHONE OUTLET, W=WALL @48" DATA / TELEPHONE OUTLET</p> <p>PUSHBUTTON 48" AFF PHOTOCELL SECURITY SYSTEM OUTLET (CAMERA) 1' ABOVE WINDOW HEADER THERMOSTAT-LINE VOLTAGE 54" TO TOP MAX L = LOW VOLTAGE TSTAT</p> <p>FLUORESCENT FIXTURES SEE FIXTURE SCHEDULE EMERGENCY LIGHT - BATTERY PACK NIGHT LIGHT, UNSWITCHED MISC LIGHT FIXTURES DOWNLIGHT, FLOODS AND WALL PACKS HPS LIGHT FIXTURES POLE MOUNTED INCANDESCENT FIXTURE</p> <p>EMERGENCY BATTERY PACK FIXTURE REMOTE EMERG LIGHT HEAD EXIT LIGHT, W/ EMERG LIGHT HEADS GUY EXISTING UTILITY POLE & GUY NEW WOOD UTILITY POLE & GUY</p> <p>LOCAL TEL CO ARC FAULT CIRCUIT INTERRUPTER AUTOMATIC TRANSFER SWITCH COMPUTER PATCH PANEL COMPUTER TERMINAL CABINET FIRE ALARM CONTROL PANEL GROUNDING ELECTRODE CONDUCTOR GROUND FAULT CIRCUIT INTERRUPTER LOCAL ELECTRIC CO LIQUIDTIGHT FLEXIBLE CONDUIT NETWORK INTERFACE DEVICE SHORT CIRCUIT CURRENT RATING SERVICE ENTRANCE TELEPHONE PATCH PANEL TELEPHONE TERMINAL BOARD WEATHERPROOF EXPLOSIONPROOF - CLASS I HAZARDOUS LOCATION</p>	<p>DISCONNECT COMBINATION MAGNETIC STARTER/DISCONNECT MOTOR MOTOR STARTER CONTACTOR FLOAT SWITCH (PROVIDED BY OTHERS) TIME CLOCK RELAY</p> <p>ELECTRIC BASEBOARD HEATER, SEE SPEC FOR WATTAGES ECH, ELECTRIC CABINET HEATER, 12" AFF SEE SPEC FOR WATTAGES PANELBOARD - RECESSED PANELBOARD - SURFACE TRANSFORMER 6'-6" AFF TOP JUNCTION BOX C=CAMERA PS=PURSER SHELTER R=RAMP (POWER) H = HANDHOLE, CONCRETE SIDEWALK BOX MOTION SENSOR</p> <p>GROUND, NEUTRAL, HOT CONDUCTORS - #12 UNLESS OTHERWISE NOTED. INSTALL EQUIPMENT GROUNDING CONDUCTOR IN EACH BRANCH CIRCUIT. MINIMUM CIRCUITING IS 2#12 W/ #12G. EACH BRANCH CIRCUIT SHALL HAVE ITS OWN NEUTRAL, NO SHARED NEUTRAL. INDOOR BRANCH CIRCUITS CAN BE TYPE MC OR TYPE THHN/THWN RUN IN EMT. 3/4" MINIMUM HOMERUN SIZE. WHERE WIRE SIZE IS SHOWN BY HOMERUN THAT SIZE WIRE SHALL BE USED FOR THE ENTIRE CIRCUIT WITH THE CONDUIT SIZED PER THE WIRE COUNT.</p> <p>DASHED EQUIPMENT INDICATES EXISTING OR FUTURE EQUIPMENT. REFER TO DRAWING NOTE.</p> <p>OVERHEAD LINE OHE = OVHD PRIMARY LINE S = SECONDARY LINE T = TELEPHONE LINE L = PARKING LOT LIGHTING C = SECURITY CAMERA P = POWER PS=PURSER SHELTER POWER R = FUTURE RAMP POWER</p> <p>UNDERGROUND CIRCUIT OR EXISTING CIRCUIT</p> <p>-X = REMOVE LINE -U = UNDERGROUND</p>
--	---

PROJECT GENERAL NOTES


- A THE PROJECT IS DESIGNED TO THE 2014 NEC AND 2009 IBC, IFC & IMC.
- B COORDINATE HEATER INSTALLATION TO AVOID CASEWORK AND FURNITURE. MOUNT DEVICES CLEAR OF THE HEATER PER ELECTRIC HEATER MFR REQUIREMENTS (MIN OF 12" ABOVE AND 6" FROM THE SIDE OF THE HEATERS).
- C IN GENERAL THE ELECTRICAL DEVICES IN THE ENTIRE BUILDING SHALL BE INSTALLED RECESS MOUNTED. PRIOR TO INSTALLATION COORDINATE THE LIGHTING, SWITCHES, RECEPTACLES, SECURITY CAMERA AND TELEPHONE/DATA OUTLETS LAYOUT WITH THE PROJECT ENGINEER.
- D REFERENCES TO THE MECHANICAL CONTRACTOR INCLUDES PLUMBING, HVAC, CONTROL AND SHEET METAL CONTRACTORS.
- E IBC OCCUPANCY TYPES - 1ST FLOOR = B.
- F THE ELECTRICAL SET CONSISTS OF 10 SHEETS: E1, E2.1, E3.1-3.3, E4.1-4.2, E5.1-5.2, E6.1.
- G SEE 16010 FOR THE SCOPE OF WORK INVOLVED WITH SECTIONS 662 AND 695.

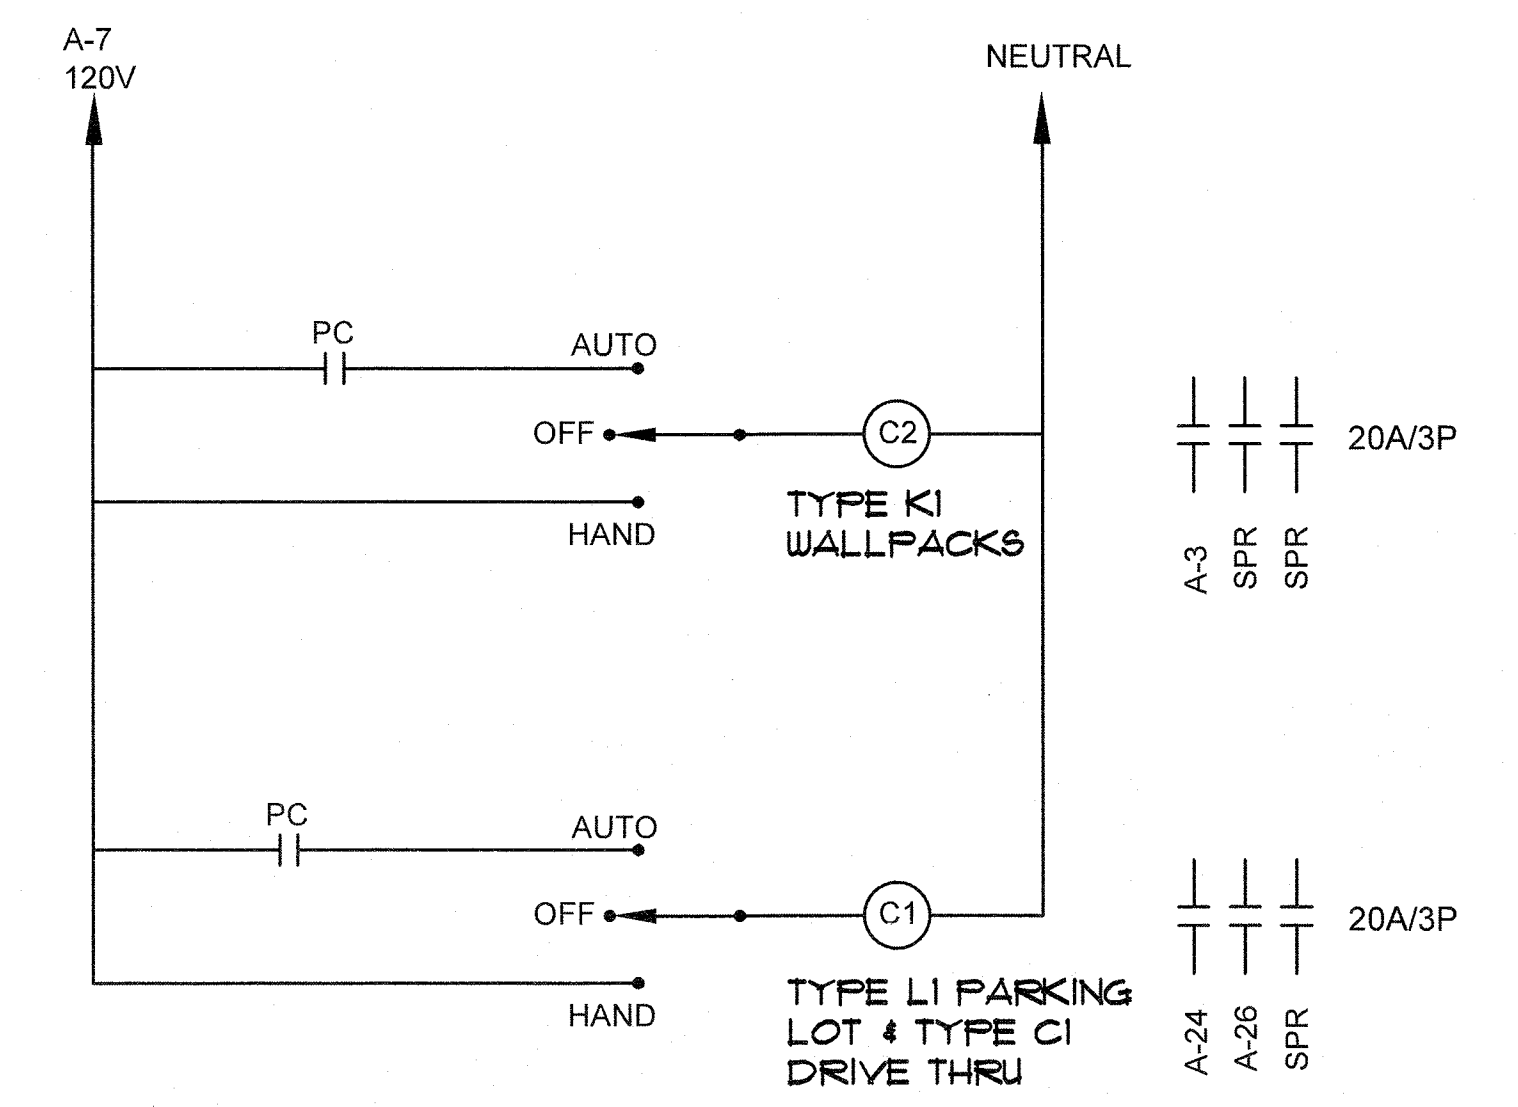

C# CONTACTOR
PC PHOTOCELL CONTROL
HOA HAND-OFF-AUTO SWITCH

1 EXTERIOR LIGHTING CONTROL DETAIL

- NO SCALE
- NOTES:**
- A IN THE AUTO MODE, THE FIXTURES SHALL BE CONTROLLED BY PHOTOCELL AND BY SPLIT BUS PANEL A:
-THE TYPE C1 CANOPY LIGHTS AND TYPE L1 PARKING LOT LIGHT ARE ON ONLY WHEN THE BUILDING IS OPERATING IN THE OCCUPIED MODE.
-THE TYPE K1 WALL PACK FIXTURES SHALL BE ON WHENEVER IT IS DARK (WITH THE BUILDING UNOCCUPIED OR OCCUPIED.)
 - B IN THE HAND MODE ALL FIXTURES ON (BYPASS PHOTOCELL/CONTROL CIRCUITING).
 - C HOA SWITCH CAN BE INTEGRAL WITH CONTACTOR.
 - D COORDINATE THE EXTERIOR LIGHTING FIXTURE LOCATIONS, MOUNTING HEIGHTS, LAYOUT AND CONTROL WITH THE ENGINEER PRIOR TO INSTALLATION.

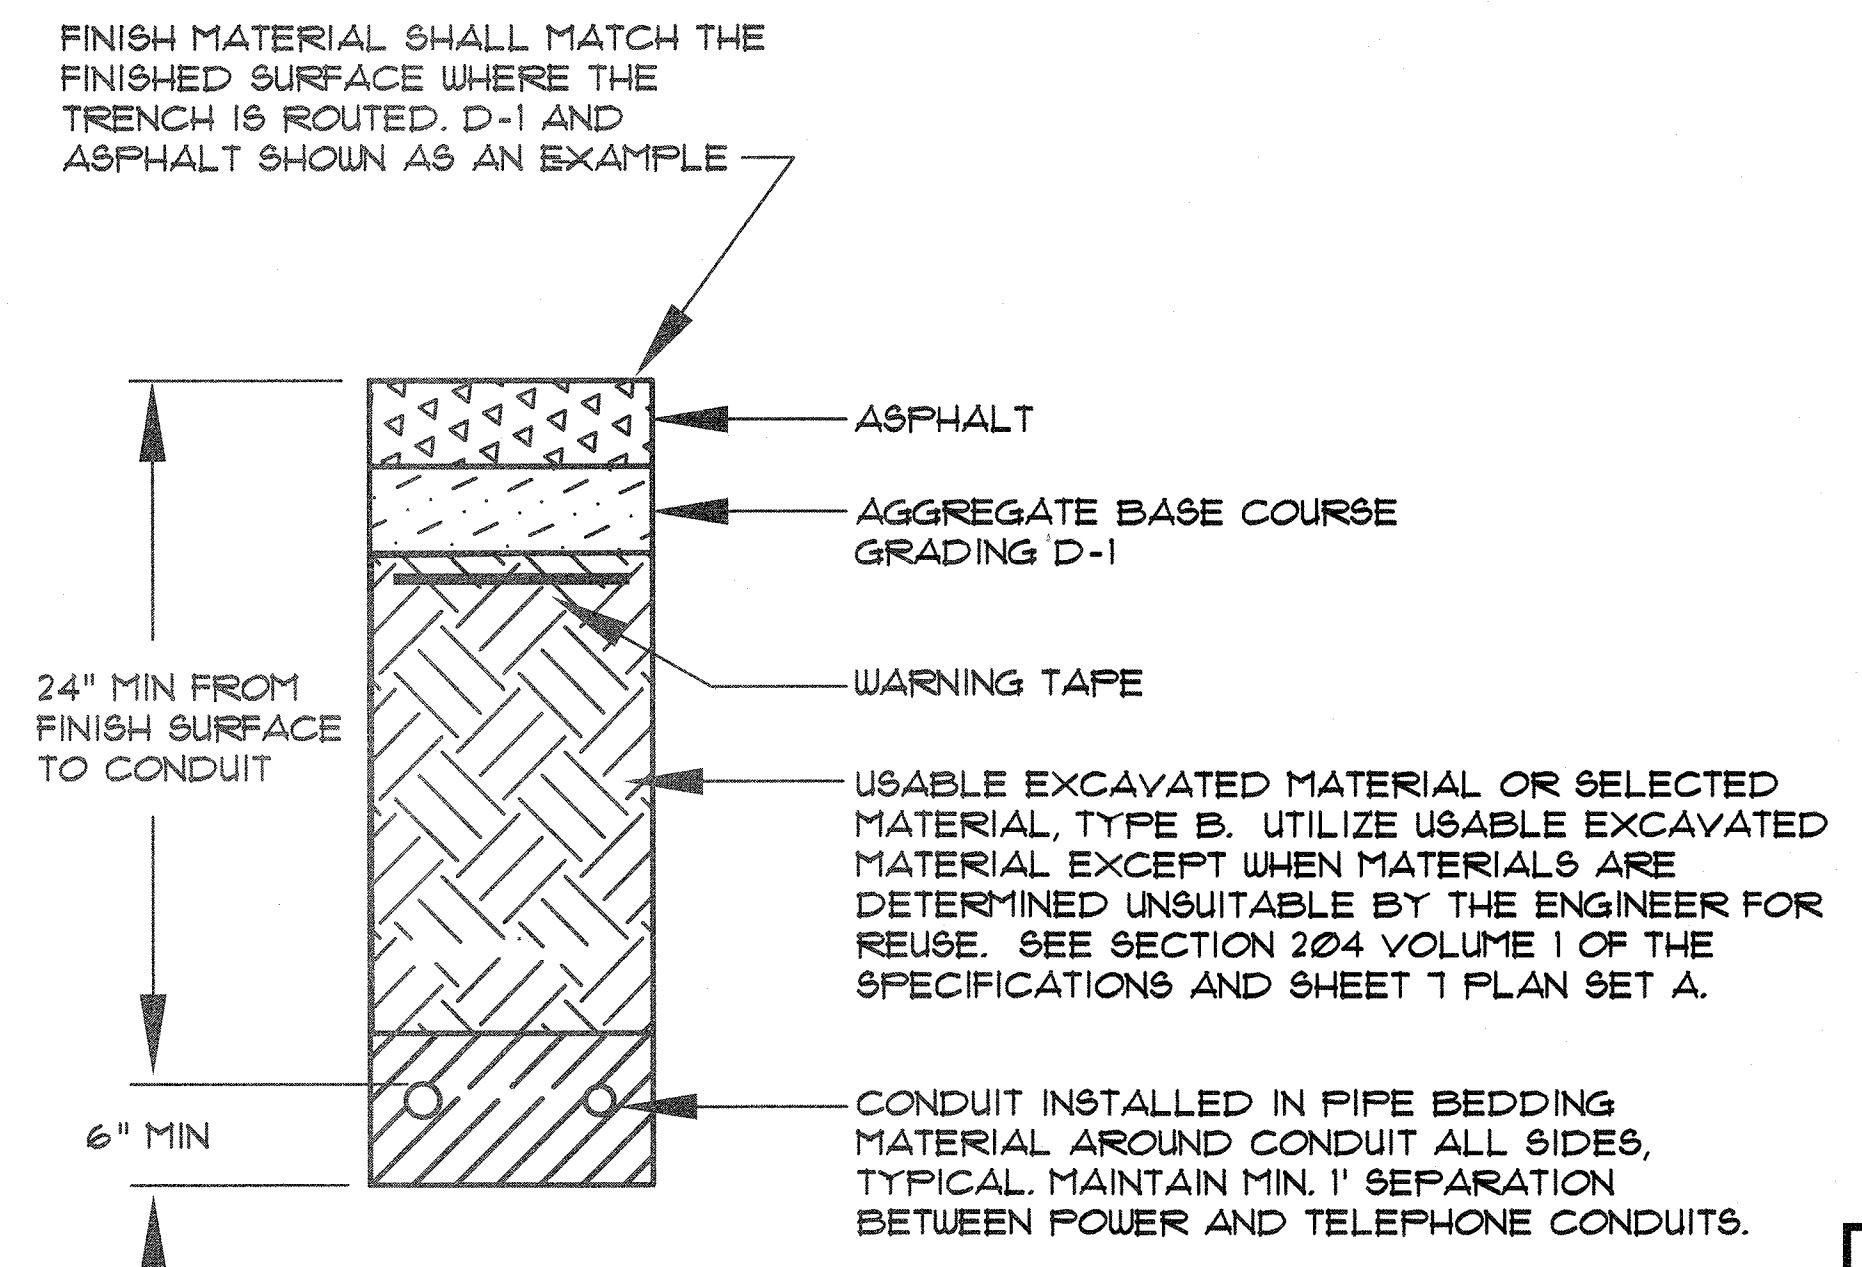

2 TRENCH DETAIL

- NO SCALE
- GENERAL NOTES:**
- A SEE CIVIL FOR SPECIFICATIONS ON TYPES OF MATERIALS. COORDINATE INSTALLATION WITH ENGINEER
 - B MAINTAIN MIN. 1' SEPARATION BETWEEN CONDUITS AND THE DRY PIPES (WATER, SANITARY SEWER) AND BETWEEN THE POWER & TELE CONDUITS.


RECORD DRAWINGS

THESE DRAWINGS HAVE BEEN PREPARED FROM INFORMATION PROVIDED BY THE CONTRACTOR. THERE IS NO GUARANTEE TO THE ACCURACY OF THE INFORMATION CONTAINED HEREIN, EITHER EXPRESSED OR IMPLIED.

August 31, 2017

WELSHWHITELEYARCHITECT, LLC
NELSON ELECTRICAL ENGINEERING

<p>CHECKED BY: TED</p>		<p>STATE OF ALASKA DEPARTMENT OF TRANSPORTATION & PUBLIC FACILITIES SOUTHCOST REGION</p> <p>KAKE FERRY TERMINAL PASSENGER FACILITY PLANSET B</p> <p>ELECTRICAL SYMBOLS & MISC. DETAILS</p>									
<p>DESIGNED BY: KCN DRAWN BY: KCN</p> <p>PATH: G:\FILEHISTORY\KNEE\LAPTOP-DUMKBOBA\DATA\C\USERS\KNEE\DOCUMENTS\0-KNEE\2011\ANGOOON-KAKE.DWG\16-KAK TAB: E1</p>		<p>PROJECT DESIGNATION SAMHS00002</p>	<p>YEAR 2015</p>	<p>SHEET NO. E1</p>	<p>TOTAL SHEETS 35</p>						
<p>REVISIONS</p> <table border="1"> <thead> <tr> <th>NO.</th> <th>DATE</th> <th>DESCRIPTION</th> </tr> </thead> <tbody> <tr> <td> </td> <td> </td> <td> </td> </tr> </tbody> </table>		NO.	DATE	DESCRIPTION				<p>PROJECT DESIGNATION SAMHS00002</p>			
NO.	DATE	DESCRIPTION									

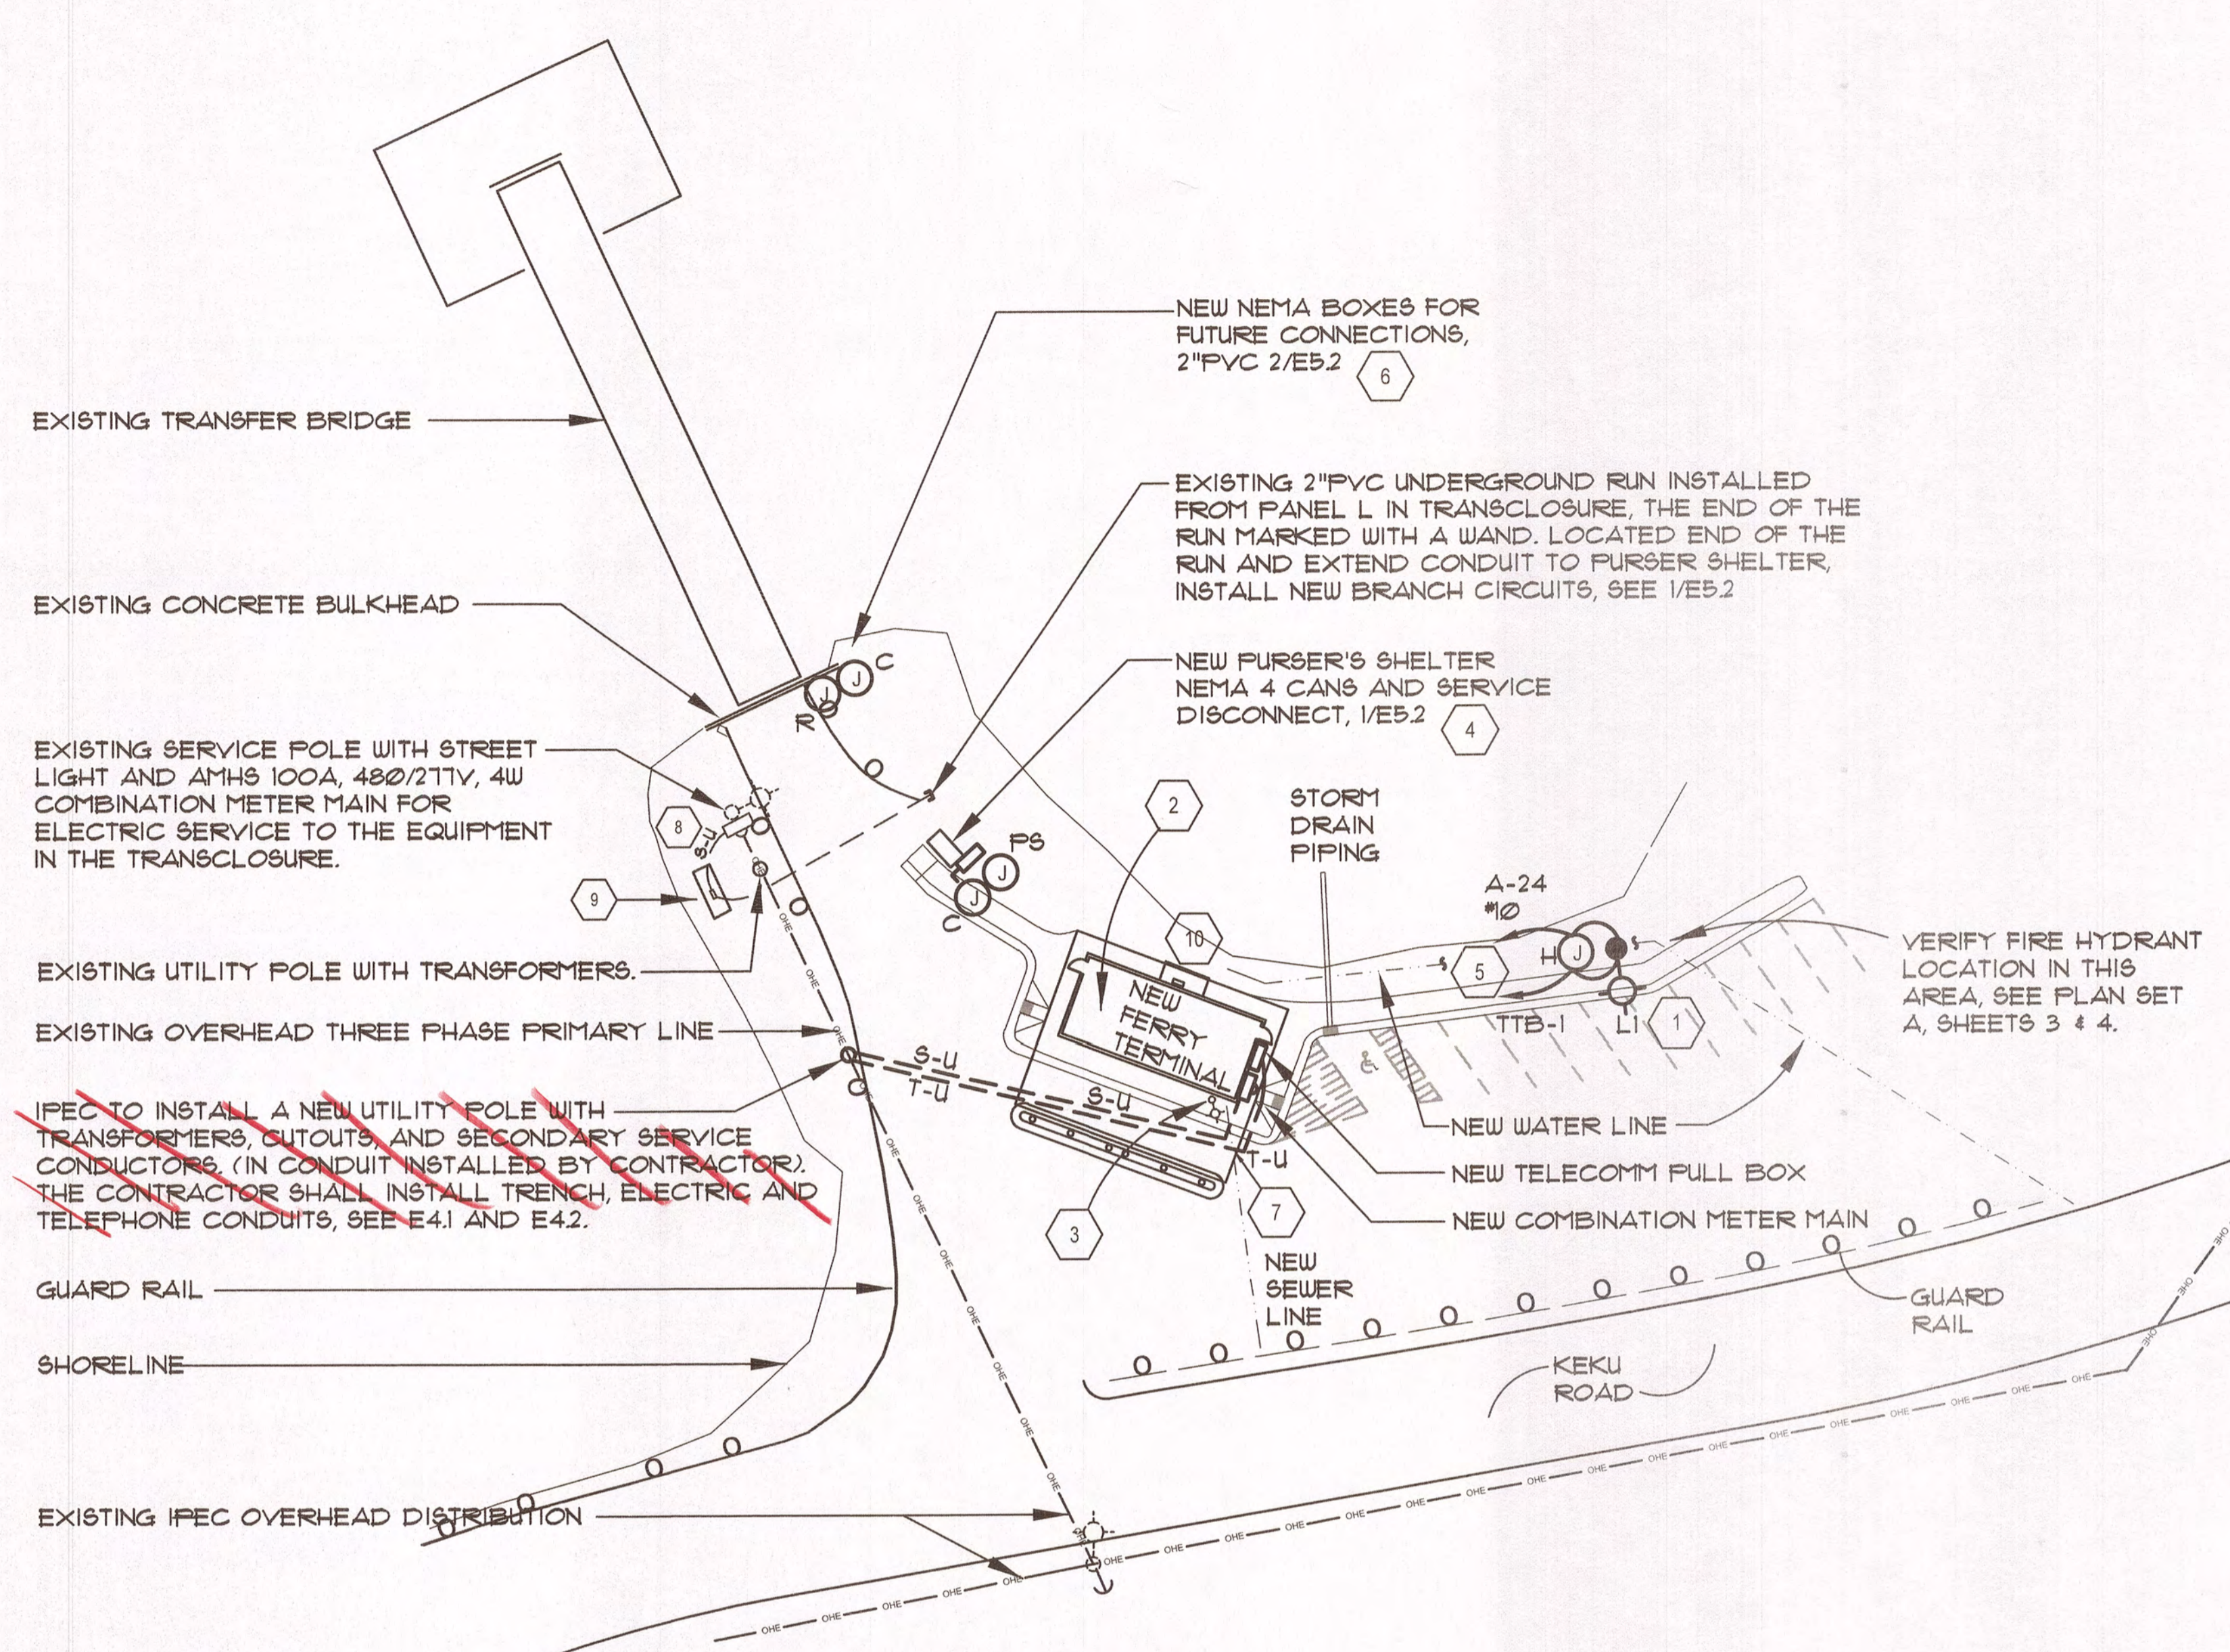

1 ELECTRICAL SITE PLAN
SCALE: 1" = 60'



2 EXISTING FERRY SHELTER PHOTO
NO SCALE

ELECTRICAL NOTES

- 1 LIGHT POLE WITH PROVISIONS FOR FUTURE SECURITY CAMERA SYSTEM. INSTALL SIDEWALK BOX WITH (2) 1-1/4" RSC FROM BOX UP INTO THE POLE BASE. ONE CONDUIT IS FOR LIGHTING CIRCUIT. THE OTHER CONDUIT IS FOR FUTURE SECURITY CAMERA WITH FULL STRING FOR FUTURE SECURITY CAMERA. LOCATE SIDEWALK BOX AND POLE NORTH OF SIDEWALK. SEE E5.1
- 2 AN EXISTING WAITING SHELTER IS LOCATED IN THE FOOTPRINT OF THE NEW BUILDING. THE EXISTING WAITING SHELTER SHALL BE DEMOLISHED. REMOVE ALL EXISTING ELECTRICAL CIRCUITS. SEE 2/E2.1.
- 3 DISCONNECT AND REMOVE EXISTING WOOD POLE WITH STREET LIGHT, POLE MOUNTED DISCONNECT AND CIRCUITING.
- 4 SEE 1/E5.2 FOR PURSER'S SHELTER ELECTRICAL PLAN & CONDUIT PLAN ON 2/E3.1
- 5 1" PVC W/ #10 LIGHTING CIRCUIT TO PANEL A VIA LIGHTING CONTACTORS IN STORAGE ROOM, SEE 1/E1.1 & E3.1. 2" PVC FOR FUTURE SECURITY CAMERA TO TTB-1 LOCATED IN STORAGE ROOM, SEE E4.2. SEE CONDUIT PLAN ON 2/E3.1
- 6 INSTALL (2) NEW 24X24X6 NEMA 4 HINGE COVER CANS FOR FUTURE CONNECTIONS TO RAMP POWER (R) AND SECURITY CAMERA (C). MOUNT THE CANS AT BULKHEAD WITH GALVANIZED STRUT, SEE 2/E5.2. INSTALL (2) 2" PVC80 FROM SECURITY CAMERA SYSTEM CAN TO THE CAN MOUNTED ON PURSER SHELTER, SEE 1/E5.2 AND E4.2. INSTALL 2" PVC80 FROM RAMP POWER CAN TO THE "PS" NEMA 4 CAN AT THE PURSER SHELTER FOR FUTURE POWER CONNECTIONS.
- 7 COORDINATE THE SERVICE CONDUITS TO CROSS ABOVE THE SEWER LINE WHICH RUNS AT 4' DEEP. MAINTAIN 1' FOOT CLEARANCE FROM SEWER PIPING.
- 8 EXISTING UNDERGROUND SERVICE FROM POLE TO EXISTING AMHS TRANSCLUSURE TO REMAIN, SEE E4.1.
- 9 EXISTING AMHS TRANSCLUSURE WITH PANEL L (TRANSCLUSURE LOCATION SHOWN IS BASED ON WORK BEING DONE IN SUMMER 2015) - REMOVE AND REPLACE TRANSFORMER, BREAKERS AND INSTALL NEW CIRCUITS FOR NEW PURSER'S SHELTER, SEE 2/E3.3, E4.1 & 1/E5.2. THERE IS AN EXISTING 2" C STUBBED UP AT PANEL L. EXTEND THIS CONDUIT FOR THE PURSER SHELTER BRANCH CIRCUITS.
- 10 TO HANDHOLE LOCATED AT TYPE LI LIGHT POLE.

GENERAL NOTES

- A SEE PLAN SET A CIVIL DRAWINGS FOR EXISTING AND NEW SITE WORK. SEE C3.0 FOR EXTENT OF NEW PAVING
- B COORDINATE THE LOCATION OF THE SANITARY SEWER, AND WATER LINES WITH PLAN SET A SHEET 3.
- C SEE 2/E1 FOR TRENCHING. SEE E5.1 - E5.2 FOR LIGHT POLE INSTALLATION, SIDEWALK BOX DETAILS. MAINTAIN MIN. 1' SEPARATION BETWEEN THESE 'WET' PIPES AND THE ELECTRICAL AND TELEPHONE SERVICE CONDUITS.
- D COORDINATE THE EXACT LOCATION OF EACH NEMA 4 CAN, LIGHTING POLE BASE AND SIDEWALK BOX WITH THE ENGINEER PRIOR TO INSTALLATION.
- E INSTALL THE LONG DIMENSION OF THE SIDEWALK BOX PARALLEL TO THE CURB OR SIDEWALK.
- F ALL WORK SHOWN ON THE SITE PLAN OUTSIDE OF A 5' PERIMETER OF THE WAITING SHELTER AND PURSER'S SHELTER SHALL BE BID AS WORK ITEM 662(1). SEE SECTION 16010-1.03 FOR ADDITIONAL INFO ON THE WORK WITHIN 5' PERIMETER OF THE BUILDINGS.


PCS # 1
PLANSSET B SHEET NO. E2.1, ELECTRICAL SITE PLAN. Replace leader note "IPEC TO INSTALL A NEW UTILITY POLE WITH TRANSFORMERS, CUTOUPS, AND SECONDARY SERVICE CONDUCTORS. (IN CONDUIT INSTALLED BY CONTRACTOR). THE CONTRACTOR SHALL INSTALL TRENCH, ELECTRIC AND TELEPHONE CONDUITS, SEE E4.1 AND E4.2." with "IPEC TO INSTALL A NEW UTILITY POLE WITH TRANSFORMERS, CUTOUPS, AND SECONDARY SERVICE CONDUCTORS. IPEC TO INSTALL TRENCH, ELECTRIC AND TELEPHONE CONDUITS, SEE E4.1 AND E4.2. THE CONTRACTOR SHALL COORDINATE CONSTRUCTION SEQUENCING WITH IPEC."


RECORD DRAWINGS

THESE DRAWINGS HAVE BEEN PREPARED FROM INFORMATION PROVIDED BY THE CONTRACTOR. THERE IS NO GUARANTEE TO THE ACCURACY OF THE INFORMATION CONTAINED HEREIN, EITHER EXPRESSED OR IMPLIED.

August 31, 2017

WELSHWHITELEYARCHITECT, LLC
NELSON ELECTRICAL ENGINEERING

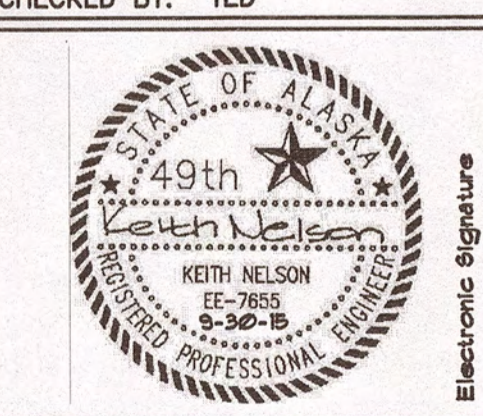CHECKED BY: TED		STATE OF ALASKA DEPARTMENT OF TRANSPORTATION & PUBLIC FACILITIES SOUTHCOST REGION															
		KAKE FERRY TERMINAL PASSENGER FACILITY PLANSSET B															
DESIGNED BY: KCN DRAWN BY: KCN		ELECTRICAL SITE PLAN															
PATH: C:\USERS\KNEE\DOCUMENTS\0-KAKE AS-BLT\KAK E1 CA 171010.DWG																	
TAB: E2.1																	
<table border="1" style="width: 100%; border-collapse: collapse;"> <thead> <tr> <th colspan="2">REVISIONS</th> </tr> <tr> <th>NO.</th> <th>DESCRIPTION</th> </tr> </thead> <tbody> <tr> <td> </td> <td> </td> </tr> </tbody> </table>		REVISIONS		NO.	DESCRIPTION			<table border="1" style="width: 100%; border-collapse: collapse;"> <tr> <td>PROJECT DESIGNATION</td> <td>YEAR</td> <td>SHEET NO.</td> <td>TOTAL SHEETS</td> </tr> <tr> <td style="text-align: center;">SAMHS00002</td> <td style="text-align: center;">2015</td> <td style="text-align: center;">E2.1</td> <td style="text-align: center;">35</td> </tr> </table>		PROJECT DESIGNATION	YEAR	SHEET NO.	TOTAL SHEETS	SAMHS00002	2015	E2.1	35
REVISIONS																	
NO.	DESCRIPTION																
PROJECT DESIGNATION	YEAR	SHEET NO.	TOTAL SHEETS														
SAMHS00002	2015	E2.1	35														

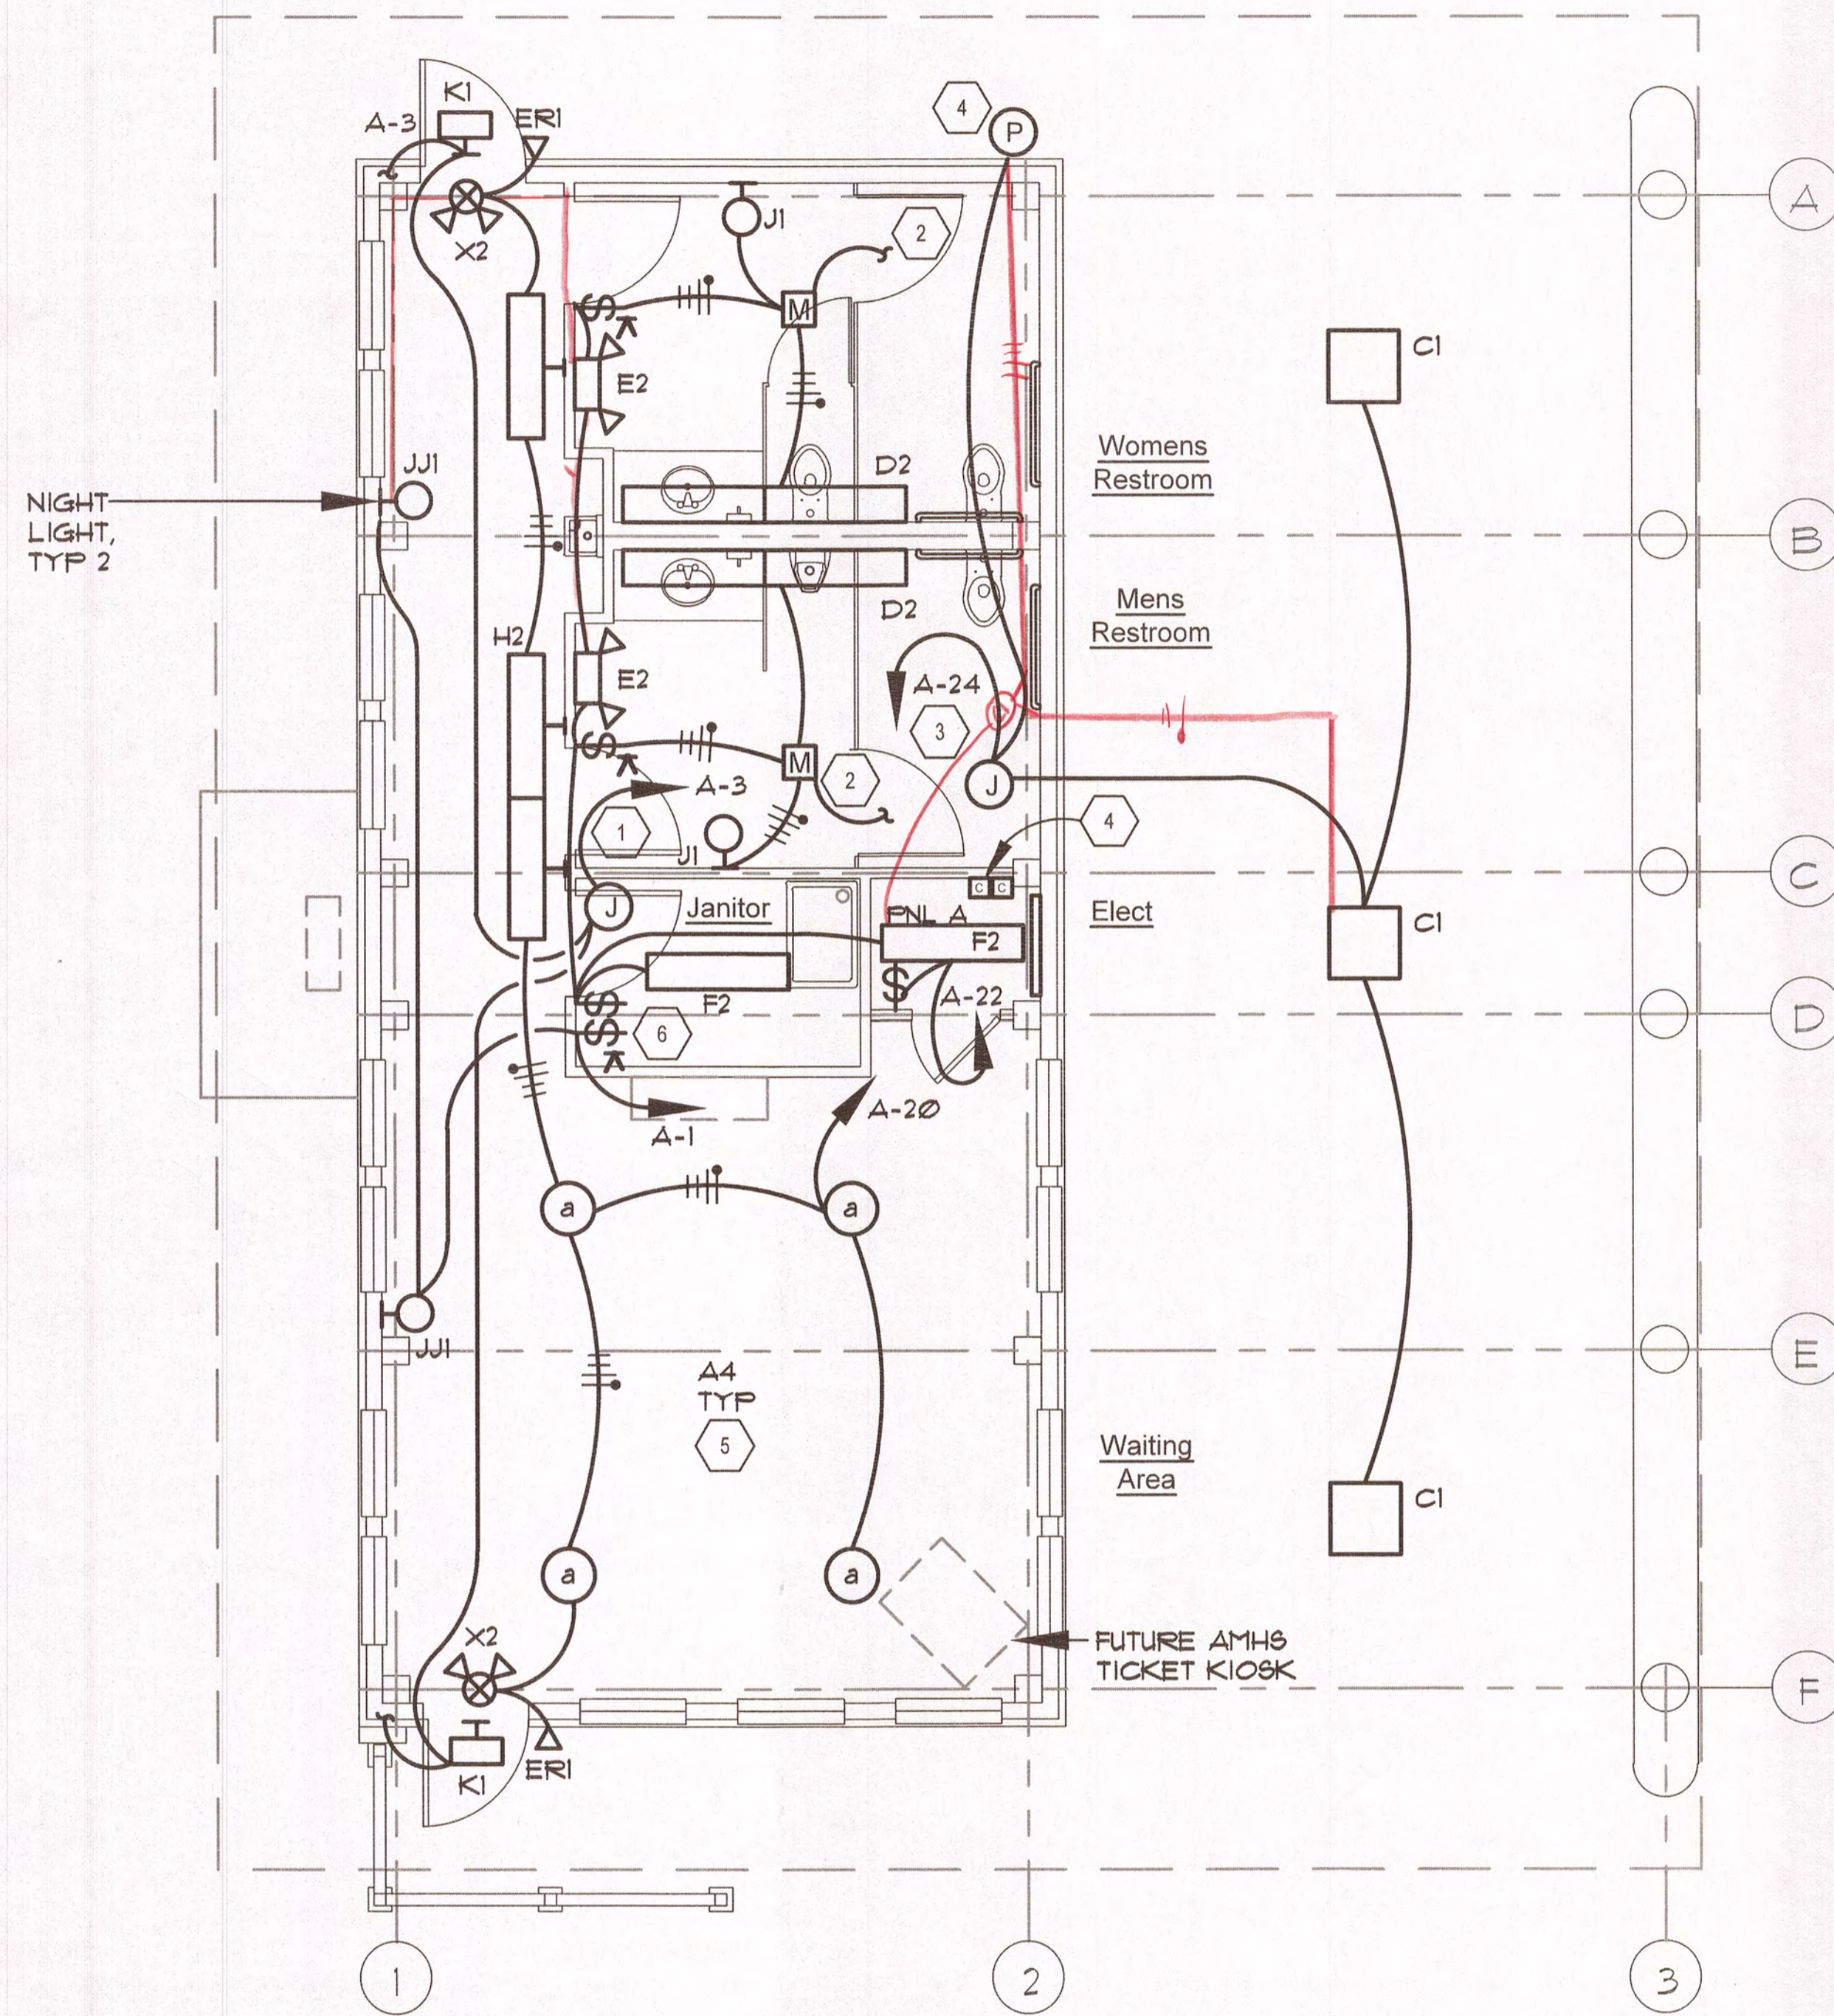


ELECTRICAL NOTES:

- 1 HOMERUN VIA WALLPACK LIGHTING CONTACTOR IN STORAGE ROOM. SEE I/E1. JBOX LOCATED IN CEILING SPACE.
- 2 CONNECT TO EXH FAN IN BATHROOM. SEE E3.2. MOTION SENSOR ONE RELAY/CONTACT CONTROLS THE TYPE D2 & J2 FIXTURES AND THE OTHER RELAY/CONTACT CONTROLS THE EXHAUST FAN. AFTER NO MOTION IS DETECTED, PROGRAM THE SENSOR TIME DELAY: LIGHTS OFF = 1 MINUTE, FAN OFF = 15 MINUTES.
- 3 HOMERUN VIA PARKING LOT LIGHTING CONTACTOR IN STORAGE ROOM. SEE I/E1. CONNECT CIRCUIT FOR THE TYPE C1 FIXTURES TO THE PARKING LOT TYPE L1 FIXTURES. JBOX LOCATED IN CEILING SPACE.
- 4 EXTERIOR LIGHTING CONTROLS - (2) CONTACTORS, TIME CLOCK, PHOTOCELL, SEE I/E1.1.
- 5 CEILING IS WOOD, SLOPED, TONGUE AND GROOVE WITH SPACE ABOVE TO INSTALL CONDUIT. PENDANT MOUNT FIXTURES SO THE BOTTOM OF ALL FIXTURES ARE SAME HEIGHT ABOVE FLOOR AT 9'-6".
- 6 NIGHT LIGHTING HOMERUN VIA KEYED SWITCH IN JANITOR'S CLOSET. INSTALL LABEL ON SWITCH. "E LIGHTS ADDED TO CIRCUIT A-1 OF KEYED SWITCH LINE SIDE."

GENERAL NOTES:

- A SEE E6.1 FOR PANELBOARD SCHEDULES
- B STEEL COLUMNS CARRY GLU-LAM BEAMS. SEE ARCHITECTURAL AND STRUCTURAL DRAWINGS - COORDINATE RACEWAY INSTALLATION.

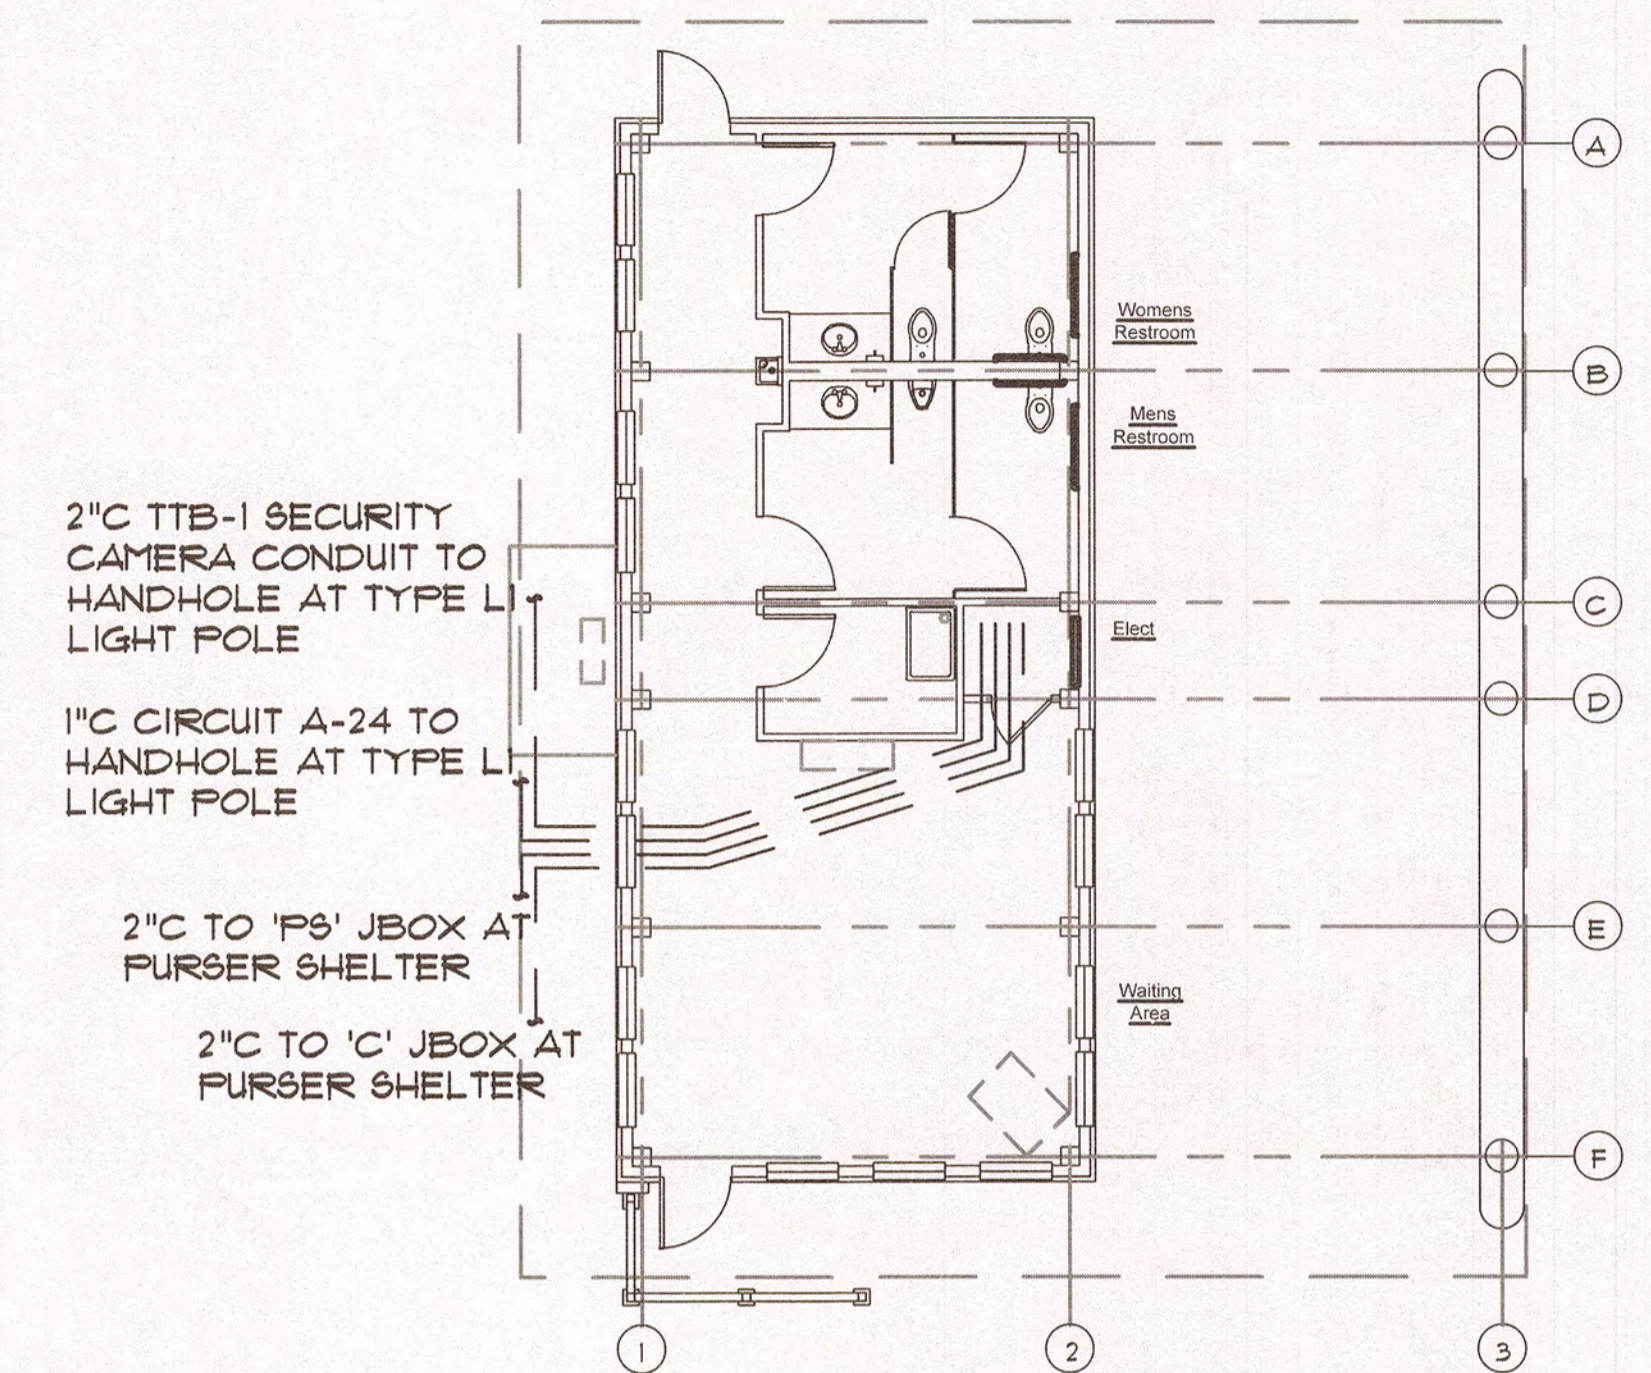

2 SITE PLAN BURIED CONDUITS
SCALE: 1/8" = 1' - 0"

GENERAL NOTES:

- A SEE I/E2.1 FOR ADDITION INFO

1 LIGHTING PLAN
SCALE: 1/4" = 1' - 0"


RECORD DRAWINGS

THESE DRAWINGS HAVE BEEN PREPARED FROM INFORMATION PROVIDED BY THE CONTRACTOR. THERE IS NO GUARANTEE TO THE ACCURACY OF THE INFORMATION CONTAINED HEREIN, EITHER EXPRESSED OR IMPLIED.

August 31, 2017

WELSHWHITELEYARCHITECT, LLC
NELSON ELECTRICAL ENGINEERING

CHECKED BY: TED		STATE OF ALASKA DEPARTMENT OF TRANSPORTATION & PUBLIC FACILITIES SOUTHCOST REGION												
		KAKE FERRY TERMINAL PASSENGER FACILITY PLANSET B												
		ELECTRICAL LIGHTING PLAN												
DESIGNED BY: KCN		PROJECT DESIGNATION												
DRAWN BY: KCN		YEAR												
PATH: C:\USERS\KNEE\DOCUMENTS\0-KAKE AS-BLT\KAK E1 CA 171010.DWG		SHEET NO.												
TAB: E3.1		TOTAL SHEETS												
<table border="1"> <thead> <tr> <th>NO.</th> <th>DATE</th> <th>DESCRIPTION</th> </tr> </thead> <tbody> <tr> <td> </td> <td> </td> <td> </td> </tr> </tbody> </table>		NO.	DATE	DESCRIPTION				<table border="1"> <tr> <td>SAMHS00002</td> <td>2015</td> <td>E3.1</td> <td>35</td> </tr> </table>			SAMHS00002	2015	E3.1	35
NO.	DATE	DESCRIPTION												
SAMHS00002	2015	E3.1	35											

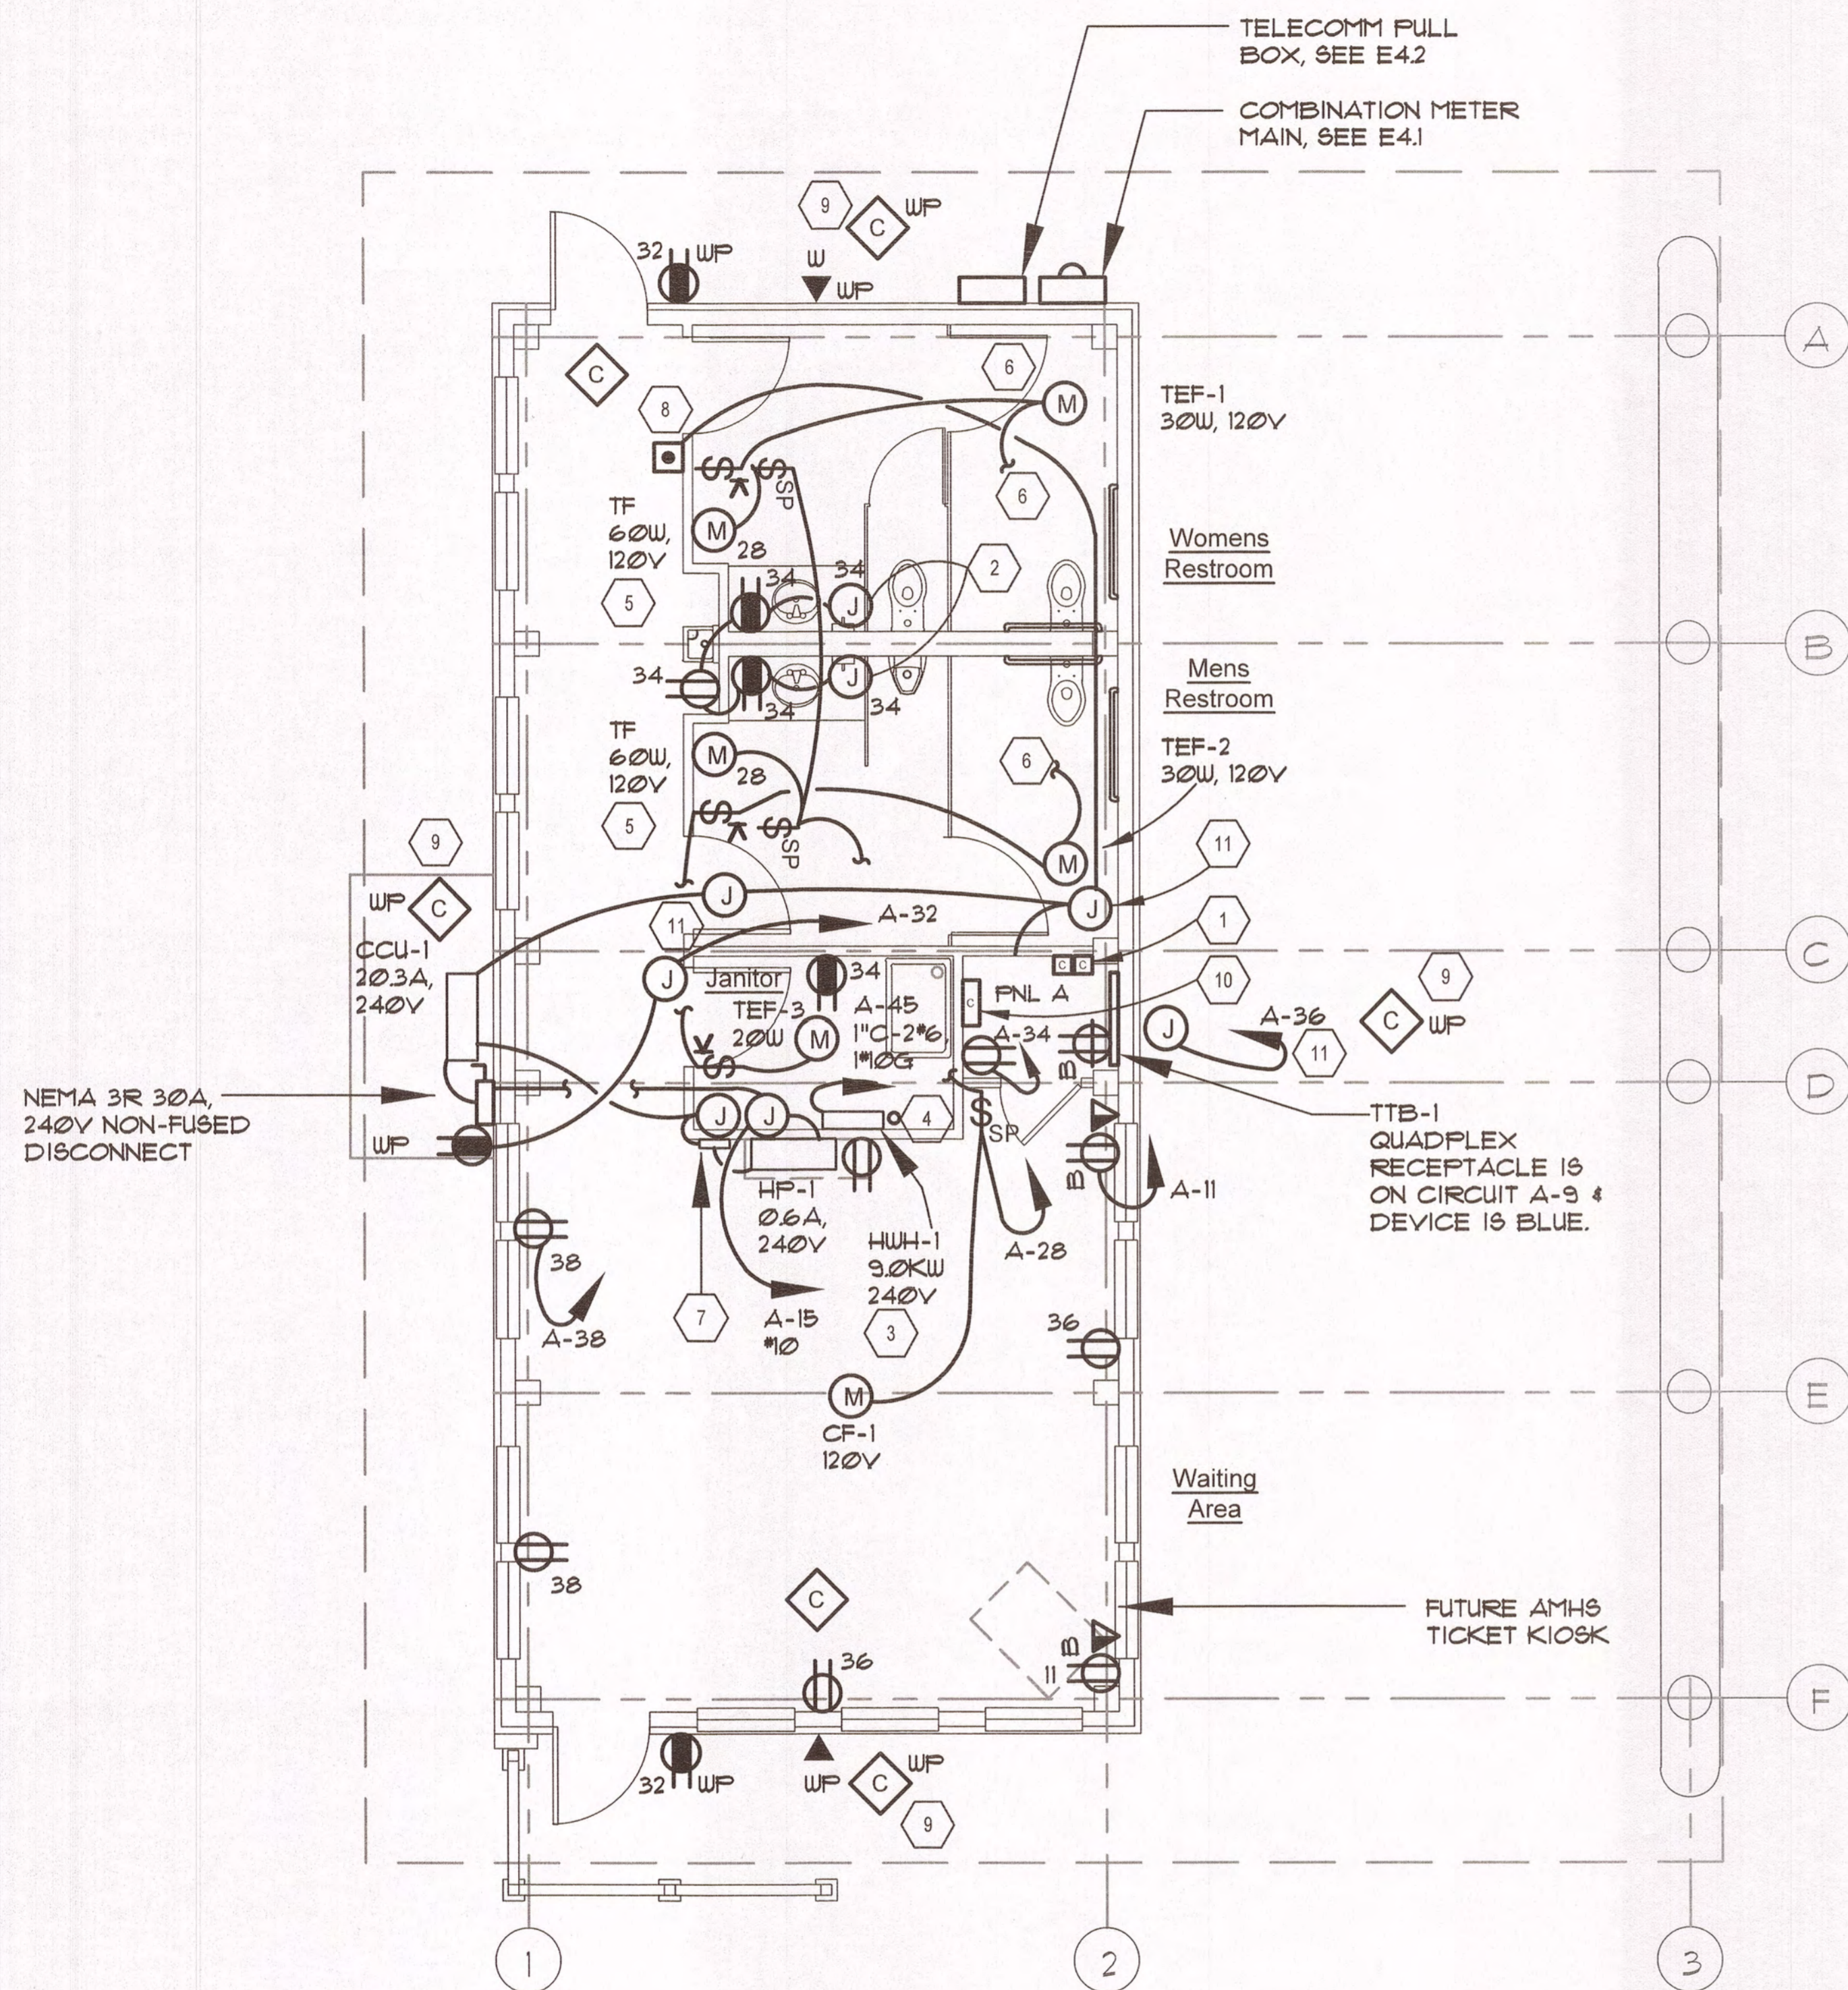

1 POWER & SYSTEMS PLAN

SCALE: 1/4" = 1' - 0"
 0 4' 8' 12'




ELECTRICAL NOTES:

- 1 TIME CLOCK AND CONTACTORS FOR EXTERIOR BUILDING AND PARKING LOT LIGHTING. SEE 1/E1. CONTACTOR FOR SPLIT BUS, SEE E4.1
- 2 INSTALL JBOX FOR 120V CONNECTION TO LOW VOLTAGE TRANSFORMER FOR LAV FAUCETS, TOILET AND URINAL VALVE CONTROLS. TRANSFORMERS PROVIDED BY MECH. COORDINATE W/ MECH AND MAKE COMPLETE CONNECTIONS. Boxes in Power installed to Bathroom stall by Mecon, mechanical equipment provided by Subcontractor. 2 Gang blank cover was installed.
- 3 MAKE COMPLETE CONNECTIONS TO 9.000W, 240V WATER HEATER PROVIDED BY MECHANICAL. COORDINATE LOCATION OF WATER HEATER WITH OWNER AND MECH.
- 4 WATER SERVICE METAL PIPE. MAKE CONNECTION TO GROUNDING ELECTRODE SYSTEM, SEE E4.1
- 5 SPEED SWITCH IS FOR THE TRANSFER FAN, TF. SWITCH IS PROVIDED BY MECHANICAL. MAKE COMPLETE CONNECTIONS.
- 6 TOILET EXHAUST FAN, TEF. INSTALL SWITCH AND MAKE CONNECTIONS TO THE MOTION SENSOR CONTROLLED LIGHTING CIRCUIT IN THE BATHROOM, SEE E3.1.
- 7 HARDWIRED CONTROLLER FOR HEAT PUMP BY MECH. MAKE COMPLETE CONTROL CONNECTIONS PER MFR REQUIREMENTS WITH MIN. #16/BC CONTROL CABLE BETWEEN CCU-1 AND HP-1. CONFIRM FINAL LOCATION WITH MECH ENGINEER. POWER & CONTROL JBOXES ARE LOCATED IN CEILING SPACE.
- 8 FLUSH MOUNT PUSHBUTTON FOR PANEL A CONTACTOR WHICH CONTROLS THE BOTTOM PANEL SECTION IN PANEL A (CKTS 19-48), COMPLETE WITH LABEL. JBOX IS LOCATED IN CEILING SPACE.
- 9 MOUNT BOX FLUSH IN SOFFIT.
- 10 100A CONTACTOR, SEE E4.1
- 11 JBOX LOCATED IN CEILING SPACE

GENERAL NOTES:

- A SEE E4.2 FOR TTB-1 TELEPHONE/DATA AND SECURITY CAMERA OUTLETS
- B SEE M-1 MECHANICAL DRAWING FOR MOTOR NAMES & INFO.
- C SEE E6.1 FOR PANELBOARD SCHEDULES.
- D STEEL COLUMNS CARRY GLU-LAM BEAMS. SEE ARCHITECTURAL AND STRUCTURAL DRAWINGS - COORDINATE RACEWAY INSTALLATION.

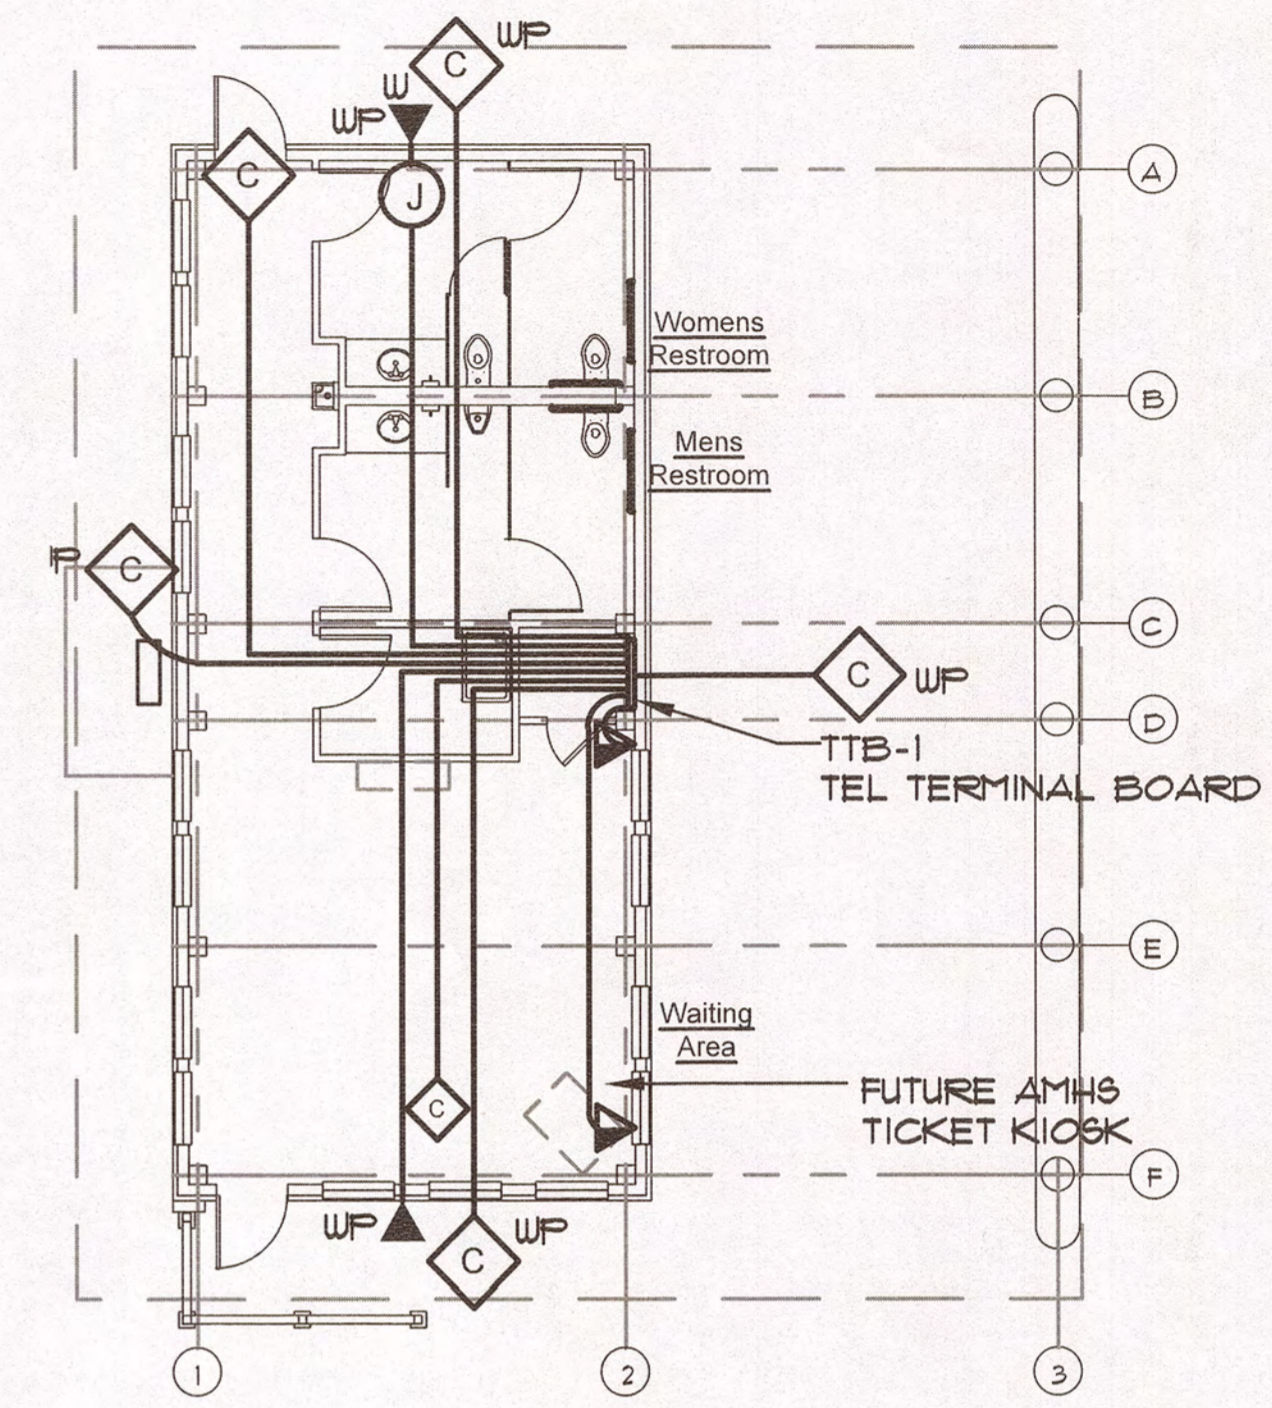

2 CAMERA & TELECOMM CONDUIT PLAN

SCALE: 1/8" = 1' - 0"

GENERAL NOTES:


- A SEE 1/E3.2 FOR ADDITION INFO


RECORD DRAWINGS

THESE DRAWINGS HAVE BEEN PREPARED FROM INFORMATION PROVIDED BY THE CONTRACTOR. THERE IS NO GUARANTEE TO THE ACCURACY OF THE INFORMATION CONTAINED HEREIN, EITHER EXPRESSED OR IMPLIED.

August 31, 2017

WELSHWHITELEYARCHITECT, LLC
NELSON ELECTRICAL ENGINEERING

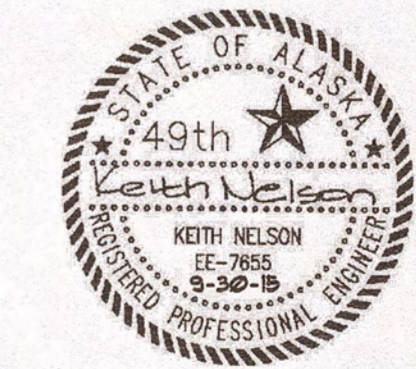CHECKED BY: TED  Electronic Signature	STATE OF ALASKA DEPARTMENT OF TRANSPORTATION & PUBLIC FACILITIES SOUTHCOAST REGION KAKE FERRY TERMINAL PASSENGER FACILITY PLANSET B ELECTRICAL POWER & SYSTEMS PLAN														
DESIGNED BY: KCN DRAWN BY: KCN PATH: C:\USERS\KNEE\DOCUMENTS\0-KAKE AS-BLT\KAK E1 CA 171010.DWG TAB: E3.2	<table border="1" style="width: 100%; border-collapse: collapse;"> <thead> <tr> <th>NO.</th> <th>DATE</th> <th>REVISIONS DESCRIPTION</th> <th>PROJECT DESIGNATION</th> <th>YEAR</th> <th>SHEET NO.</th> <th>TOTAL SHEETS</th> </tr> </thead> <tbody> <tr> <td></td> <td></td> <td></td> <td style="text-align: center;">SAMHS00002</td> <td style="text-align: center;">2015</td> <td style="text-align: center;">E3.2</td> <td style="text-align: center;">35</td> </tr> </tbody> </table>	NO.	DATE	REVISIONS DESCRIPTION	PROJECT DESIGNATION	YEAR	SHEET NO.	TOTAL SHEETS				SAMHS00002	2015	E3.2	35
NO.	DATE	REVISIONS DESCRIPTION	PROJECT DESIGNATION	YEAR	SHEET NO.	TOTAL SHEETS									
			SAMHS00002	2015	E3.2	35									

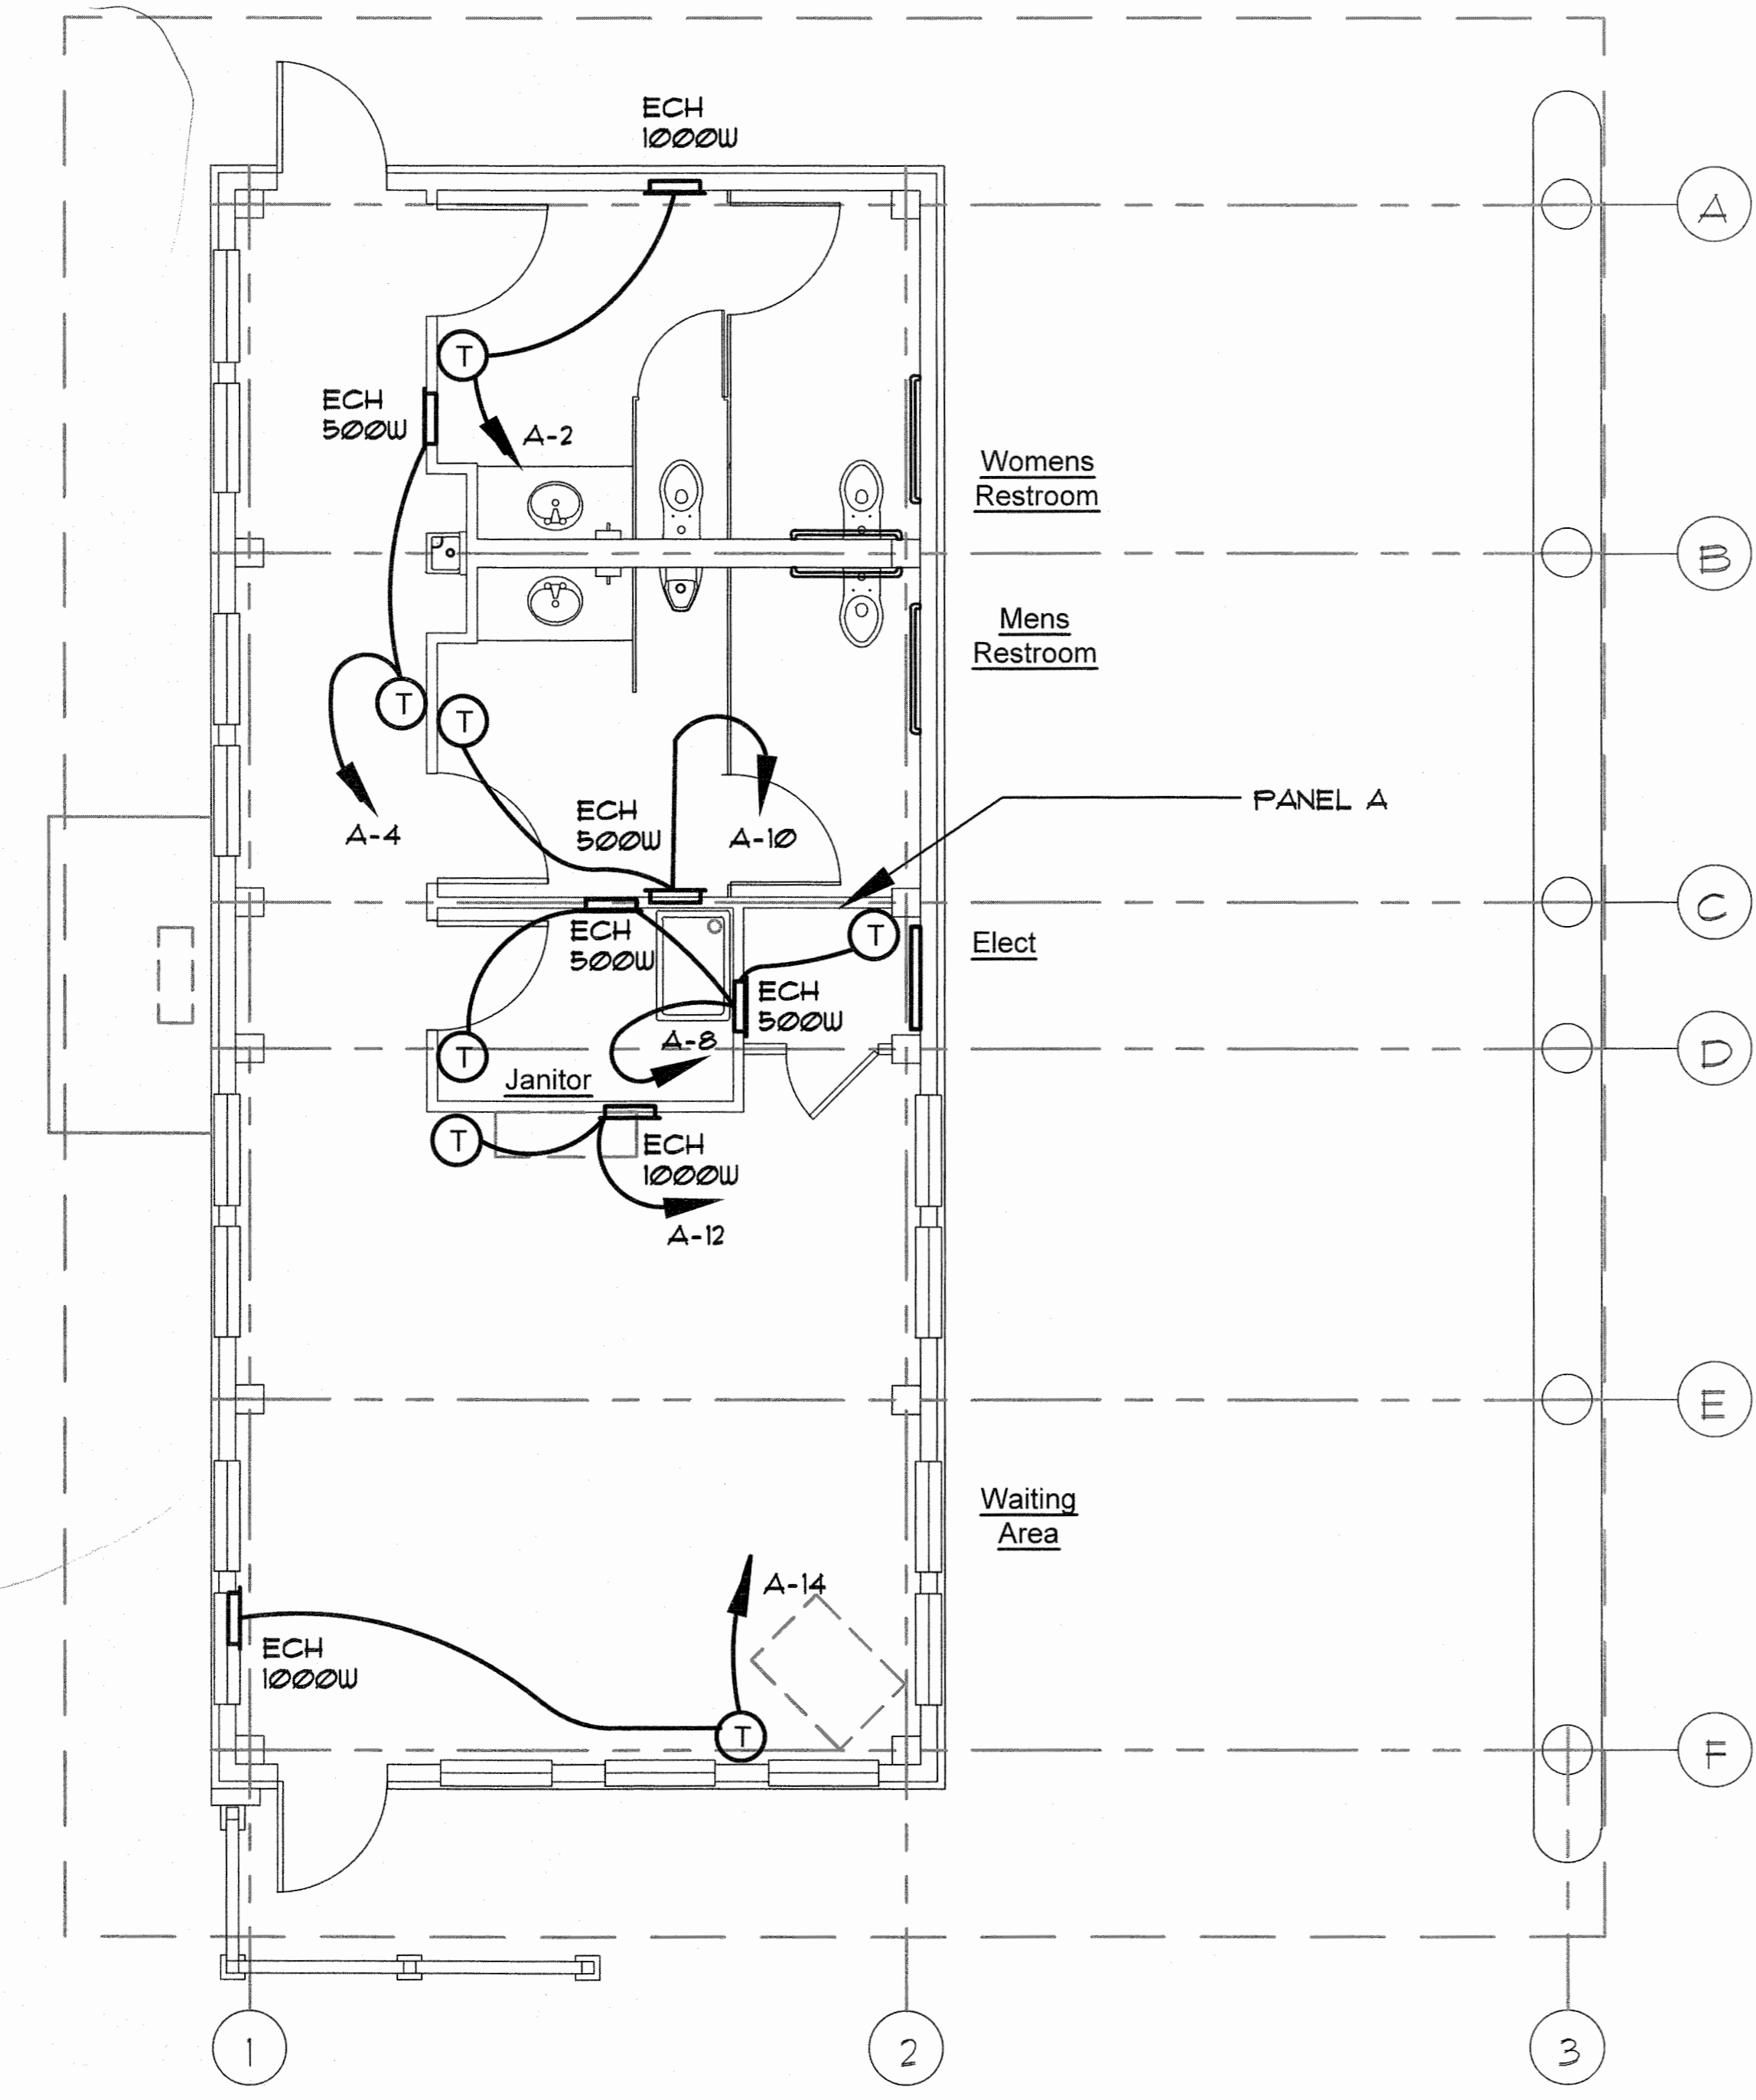


1 HEATING PLAN
 SCALE: 1/4" = 1' - 0"
 0 4' 8' 12'

GENERAL NOTES:

A SEE ARCHITECTURAL DRAWINGS FOR STEEL COLUMN LOCATIONS AND COORDINATE RACEWAY/WIRING INSTALLATION.

B SET THERMOSTATS OF ALL ELECTRIC HEATERS TO 50°F

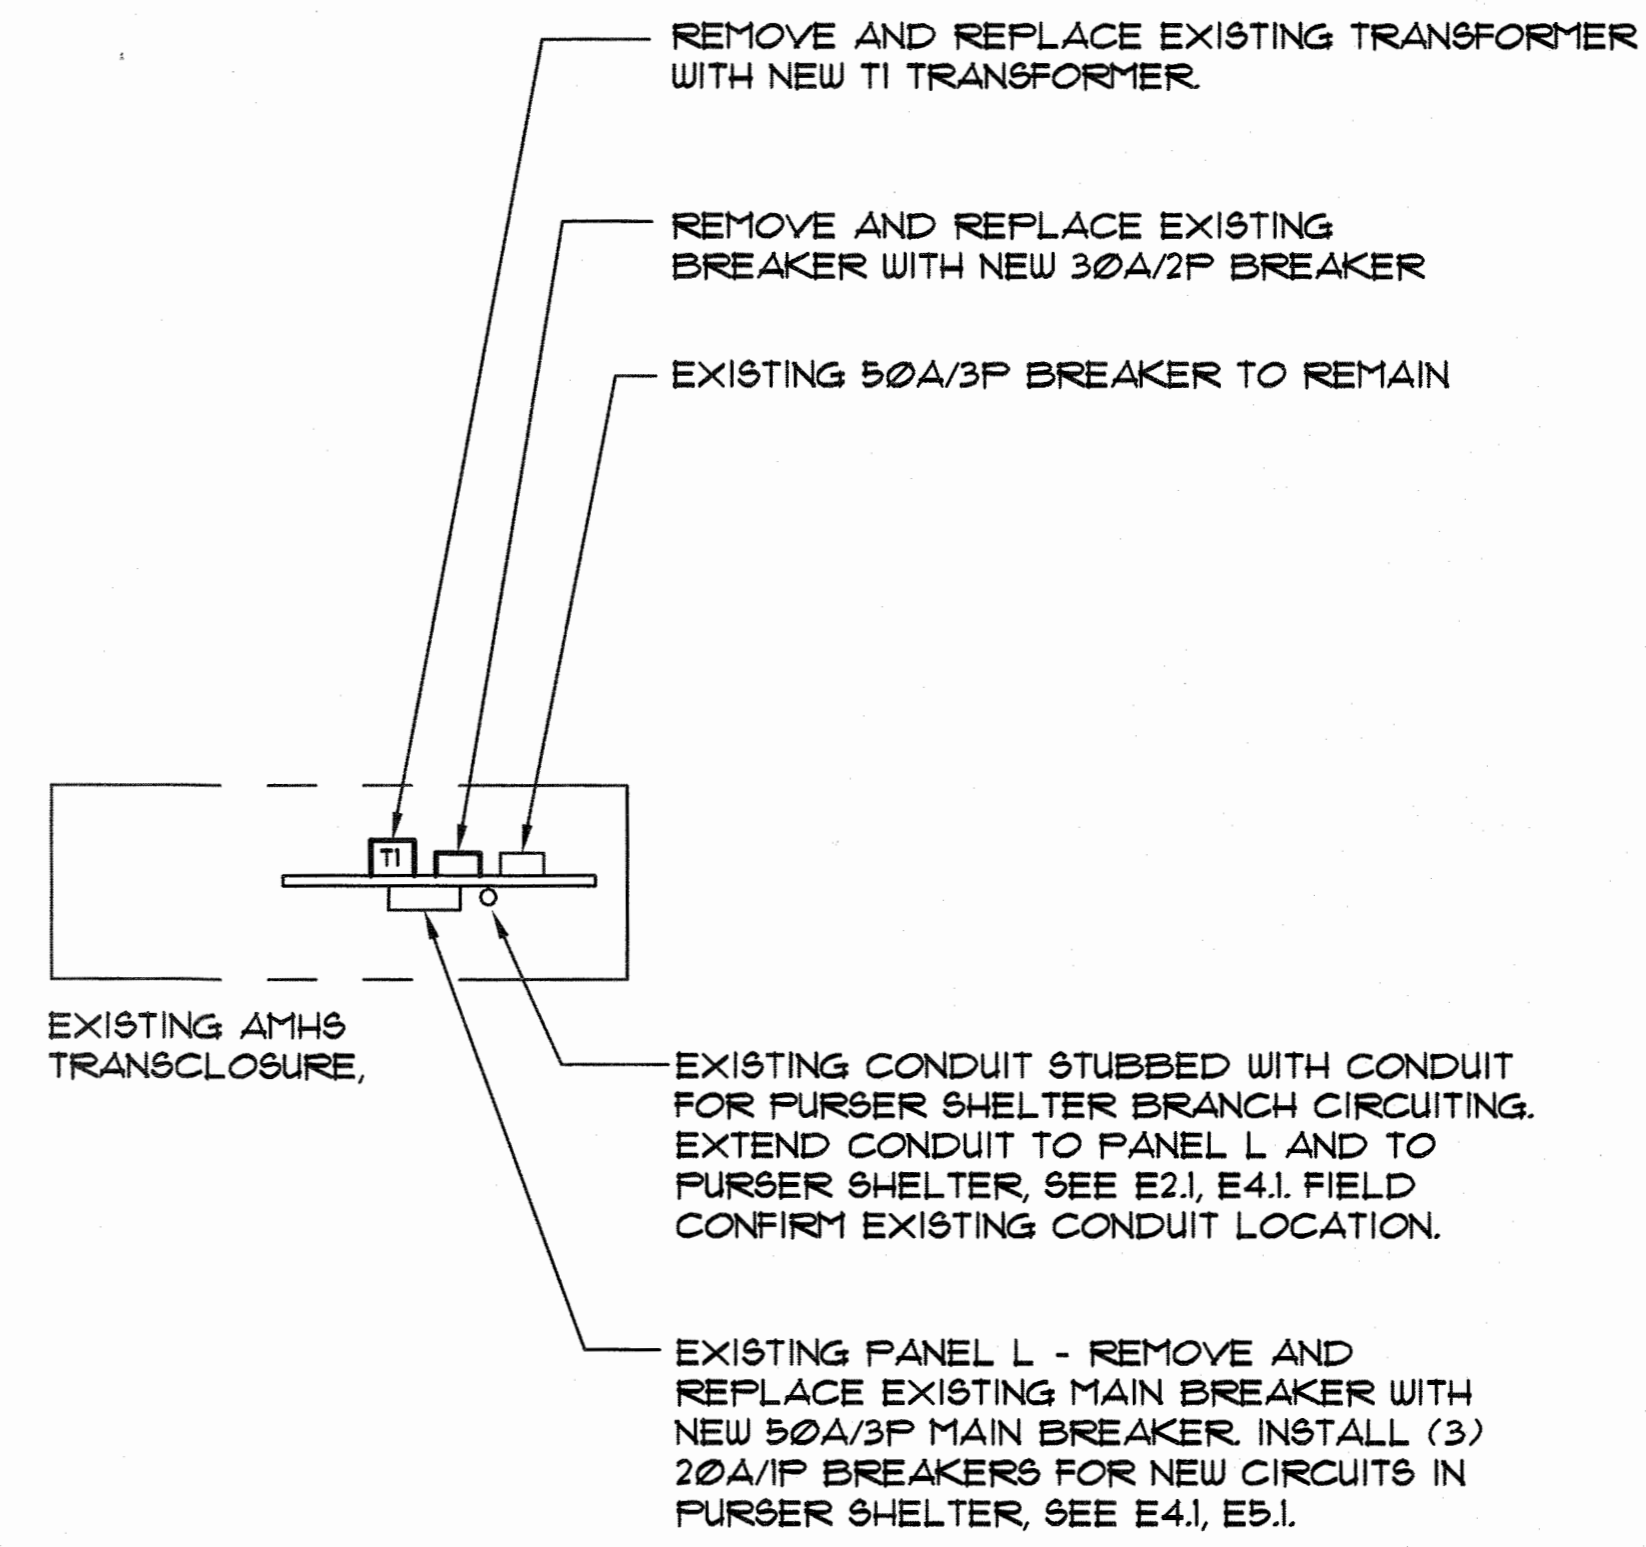

2 AMHS TRANSCLASURE PLAN
 NO SCALE

GENERAL NOTES:

A DETAIL IS BASED ON AS-BUILT DRAWINGS. NOT ALL EQUIPMENT IS SHOWN. FIELD CONFIRM EXISTING CONDITIONS.

B SEE E2.1 FOR TRANSCLASURE LOCATION AND RAMP POWER CONDUIT, E4.1 FOR ONE LINE, 1/E5.1 FOR FURSER SHELTER CIRCUITING.

RECORD DRAWINGS

THESE DRAWINGS HAVE BEEN PREPARED FROM INFORMATION PROVIDED BY THE CONTRACTOR. THERE IS NO GUARANTEE TO THE ACCURACY OF THE INFORMATION CONTAINED HEREIN, EITHER EXPRESSED OR IMPLIED.

August 31, 2017

WELSHWHITELEYARCHITECT, LLC
 NELSON ELECTRICAL ENGINEERING

CHECKED BY: TED		STATE OF ALASKA DEPARTMENT OF TRANSPORTATION & PUBLIC FACILITIES SOUTHCOST REGION			
		KAKE FERRY TERMINAL PASSENGER FACILITY PLANSET B			
		ELECTRICAL HEATING PLAN & TRANSCLASURE DETAIL			
DESIGNED BY: KCN		PATH: C:\USERS\KNEE\DOCUMENTS\0-KAKE AS-BLT\KAK E1 CA 171010.DWG			
DRAWN BY: KCN		TAB: E3.3			
REVISIONS		PROJECT DESIGNATION		YEAR	SHEET NO.
NO.	DATE	DESCRIPTION	SAMHS00002	2015	E3.3
					TOTAL SHEETS
					35

INSIDE PASSAGE ELECTRIC CO, IPEC, EXISTING OVERHEAD PRIMARY DISTRIBUTION

NEW IPEC POLE MOUNTED CUTOUT SWITCHES & TRANSFORMER FOR 120/240V, 1PH, 3W SERVICE

INSTALL NEW RISER CONDUIT ON STANDOFF BRACKETS MOUNTED TO NEW IPEC INTERMEDIATE POLE. ALSO, INSTALL NEW TEL SERVICE CONDUIT, SEE E42

EXISTING IPEC OVERHEAD PRIMARY DISTRIBUTION

EXISTING IPEC POLE MOUNTED CUTOUT SWITCHES & TRANSFORMER FOR 480/277V, 3PH, 4W SERVICE

EXISTING RISER POLE WITH EXISTING COMBINATION METER MAIN, 100A/3P, 480/277V, 3 PHASE, 4W

NEW COMBINATION METER MAIN, 225A, 120/240V, 1 PHASE, 3E

PANEL 'A' W/ SPLIT BUS

100/2

FERRY TERMINAL BLDG

CONTACTOR 100A, 240V, 2P, NEMA 1 SURFACE MOUNT

SHORT CIRCUIT CURRENT INFO:
120/240 VOLT DISTRIBUTION SHORT CIRCUIT CURRENT:
200 AMP METER MAIN @ FERRY TERMINAL BLDG: 8,310 AMPS
STANDARD 10,000 AIC RATING IS SUITABLE FOR ALL DISTRIBUTION EQUIPMENT.

PRELIMINARY ARC FLASH ANALYSIS INFO:
120/240V VOLT DISTRIBUTION SYSTEM EQUIPMENT:
FLASH PROTECTION BOUNDARY 4' - 0"
LIMITED APPROACH BOUNDARY 3' - 6"
RESTRICTED APPROACH BOUNDARY 1' - 0"
PROHIBITED APPROACH BOUNDARY 0' - 1"
SHOCK HAZARD 240VAC

GROUNDING ELECTRODE SYSTEM
- (2) - 3/4" DIA X 10' DRIVEN COPPER GROUND ROD
- CONNECTION TO 20' OF REBAR IN FOOTING
- STRUCTURAL STEEL AT COLUMN NEAR METER MAIN
- WATER PIPING, IF METAL. CONNECTION IN JANITOR CLOSET

BOND THE FOLLOWING TO THE GROUNDING ELECTRODE SYSTEM (GES) WITH MIN. #6:
- TELEPHONE SYSTEM GROUNDING BUS, SEE E42

FEEDER NUMBER	CONDUIT AND WIRE SIZE
1	3" C BY CONTRACTOR, 3" x 3/8" BY IPEC
2	2" C W/ 3" x 3/8", 1" x 4G
3	1-1/4" C W/ 3" x 2, 1" x 2G
4	1-1/4" C W/ 3" x 2, 1" x 2G
5	1/2" C W/ 2" x 2, 1" x 2G
6	1" BARE CU GEC
7	1" C W/ 3" x 2, 1" x 2G
8	2" C W/ 3" x 2, 1" x 2G
9	1" BARE CU GEC

NEC LOAD CALCULATION - NEW PANEL A

LOAD TYPE	VA
LIGHTING @ 1.25	3,040
MOTORS	310
RECEPTACLES	2,880
HEATING	9,872
HOT WATER	9,000
FUTURE WASTE HEAT SYSTEM	2,500
LARGEST MOTOR @ 0.25	1,086
TOTAL CONNECTED LOAD	28,648

119 AMPS

THE 200A, 120/240V, 1PH, 3W PANEL AND FEEDER WILL HANDLE THE CONNECTED LOAD


TRANSFORMER SCHEDULE

NAME	KVA	PRIMARY	SECONDARY	GROUNDING	NOTES
T1	10	480V, 1PH, 3W	120/240V, 1PH, 3W	8	6
EXIST	3	480V, 1PH, 3W	120/240V, 1PH, 3W		REMOVE

1 ELECTRICAL ONE LINE DIAGRAM
NO SCALE

- ELECTRICAL NOTES:**
- INSTALL CONTACTOR AND PUSHBUTTON. PUSHBUTTON SHALL CONTROL THE CONTACTOR WHICH SWITCHES THE LOWER PORTION OF PANEL A (CKTS 18-48) ON AND OFF. THE FERRY TERMINAL MANAGER SHALL TURN THESE CIRCUITS ON WHENEVER THE BUILDING IS OCCUPIED AND OFF WHENEVER THE BUILDING IS UNOCCUPIED.
 - PUSHBUTTON IS LOCATED IN THE CORRIDOR, SEE E3.2.
 - REARRANGE EXISTING BREAKERS AND INSTALL NEW CIRCUIT BREAKERS IN EXISTING PANEL LOCATED IN AMHS TRANSCLASURE. THE NEW CIRCUITS FEED THE NEW FURGER'S SHELTER. THE EXISTING PANEL IS A SQUARE D LOAD CENTER, 18 CKT, 120/240V, 1PH, 3W. SEE E2.1 & 2/E3.3.
 - IPEC INSTALLATION INCLUDES INSTALLING SERVICE TRANSFORMER, SERVICE CONDUCTORS FROM TRANSFORMER TO METER MAIN, AND MAKING CONNECTIONS AT TRANSFORMER AND COMBINATION METER MAIN. THE TRENCH AND SERVICE CONDUIT FOR THE UNDERGROUND SERVICE IS INSTALLED BY THE CONTRACTOR IN THIS CONTRACT. COORDINATE W/ IPEC THEIR SERVICE REQUIREMENTS INCLUDING THEIR MOB/DEMOS TO THE SITE, THE TRENCH ROUTE AND THEIR EQUIPMENT LOCATIONS. THE CONTRACTOR SHALL ALSO INSTALL EMPTY TELEPHONE SERVICE CONDUIT IN THE TRENCH, SEE E4.2.
 - TAKE PHOTOGRAPHS OF ALL CONCEALED CONNECTIONS OF THE GROUNDING ELECTRODE SYSTEM CONNECTIONS AND ROUTE OF CONDUCTORS, INCLUDE THEM IN O/M MANUALS.
 - CONNECT NEW GEC TO EXISTING GROUNDING ELECTRODE SYSTEM
 - REMOVE EXISTING 3" x 2 CONDUCTORS EXTEND CONDUITS AS REQUIRED TO FEED NEW BREAKER, INSTALL NEW 2" x 2, 1" x 2G.

- GENERAL NOTES:**
- ALL SERVICE WORK SHALL COMPLY WITH LOCAL UTILITY CO REQUIREMENTS.
 - PROVIDE NEW TYPED CIRCUIT DIRECTORY FOR NEW PANELS & EXISTING PANELS THAT HAVE NEW WORK. FIELD CONFIRM EXISTING CIRCUITS IN EXISTING PANEL L.
 - TAPE THE OUTLINE OF THE NEC 110.16 CLEARANCES ON THE FLOOR IN FRONT OF EACH NEW PANELBOARD.
 - PER THE DOT: PANEL L WORK: THE ELECTRICAL DISTRIBUTION INFO FOR THE AMHS TRANSCLASURE IS BASED ON AS-BUILT INFO AND THE CONTRACTOR SHALL BID ON THIS INFO. PRIOR TO ORDERING THE NEW EQUIPMENT, THE CONTRACTOR SHALL FIELD CONFIRM THE INSTALLATION REQUIREMENTS AND NOTE THE DIFFERENCES BETWEEN AS-BUILT AND FIELD CONDITIONS FOR DISCUSSION AS A POSSIBLE CHANGE ORDER.

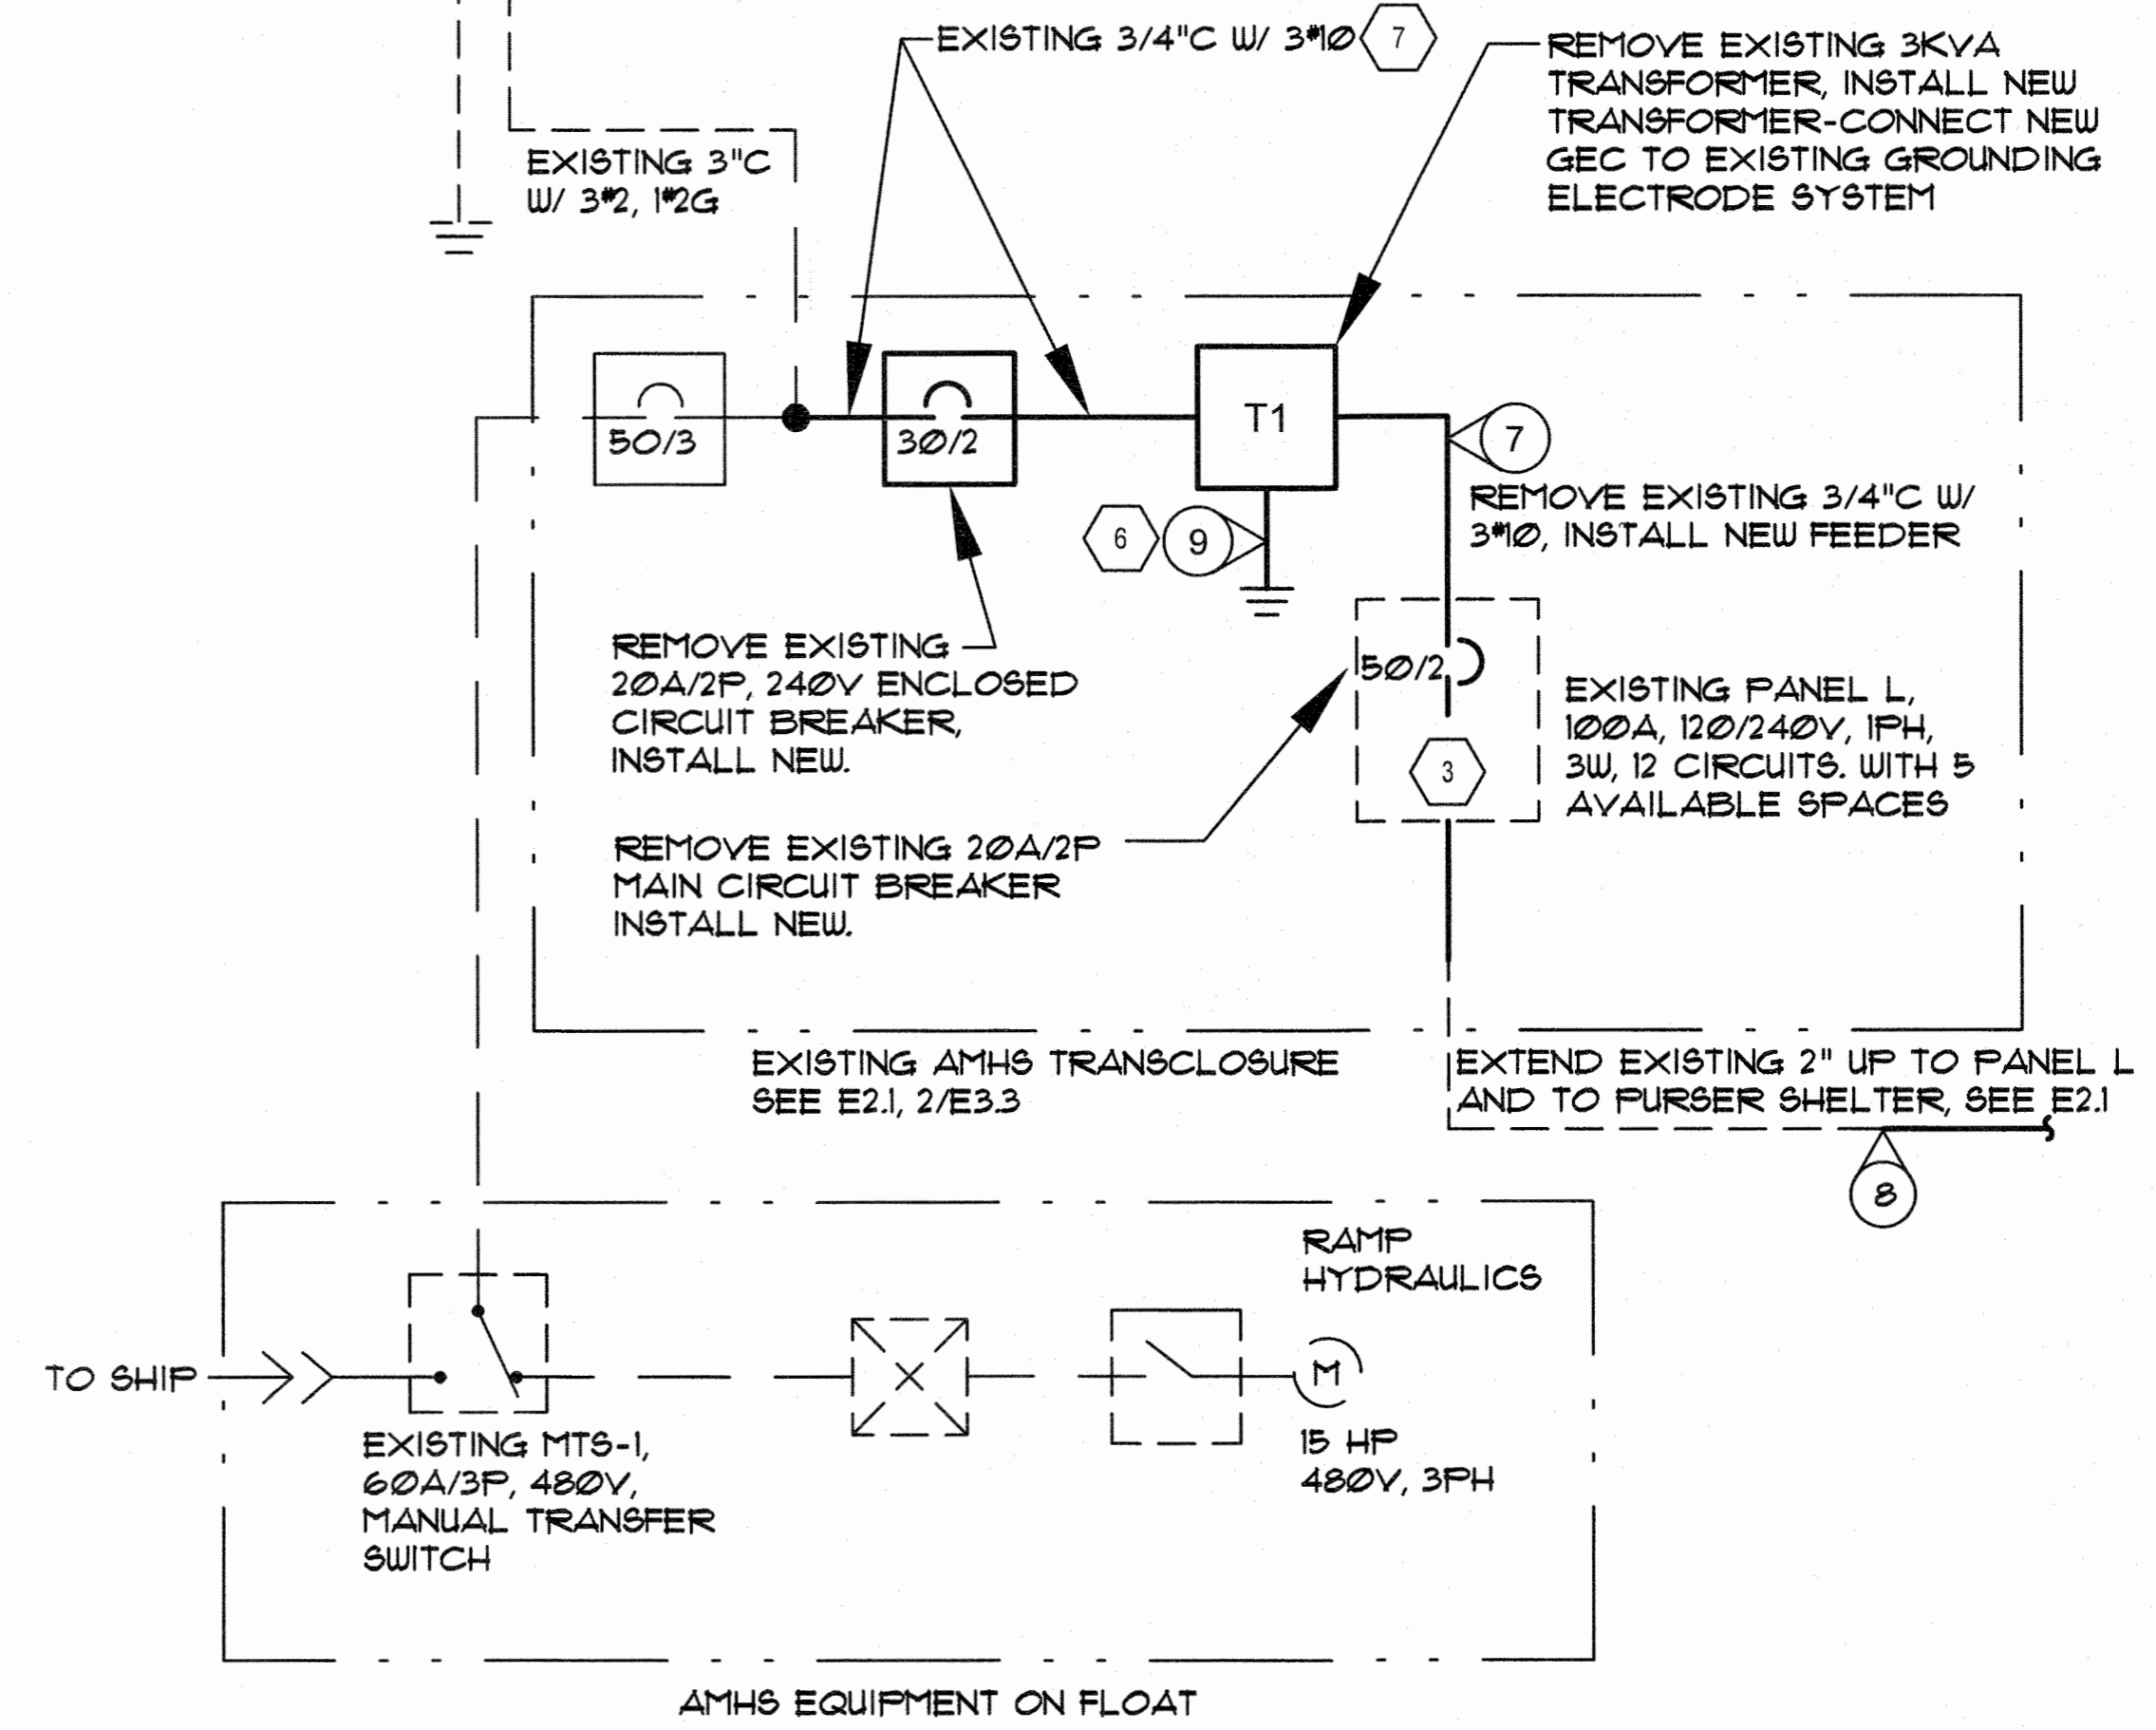

RECORD DRAWINGS

THESE DRAWINGS HAVE BEEN PREPARED FROM INFORMATION PROVIDED BY THE CONTRACTOR. THERE IS NO GUARANTEE TO THE ACCURACY OF THE INFORMATION CONTAINED HEREIN, EITHER EXPRESSED OR IMPLIED.

August 31, 2017

WELSHWHITELEYARCHITECT, LLC
NELSON ELECTRICAL ENGINEERING

CHECKED BY: TED

STATE OF ALASKA
DEPARTMENT OF TRANSPORTATION & PUBLIC FACILITIES
SOUTHCOST REGION

KAKE FERRY TERMINAL PASSENGER FACILITY PLANSET B

ELECTRICAL ONE LINE DIAGRAM

DESIGNED BY: KCN
DRAWN BY: KCN

PATH: C:\USERS\KNEE\DOCUMENTS\0-KAKE AS-BLT\KAK E1 CA 171010.DWG
TAB: E4.1

NO.	DATE	REVISIONS DESCRIPTION	PROJECT DESIGNATION	YEAR	SHEET NO.	TOTAL SHEETS
			SAMHS00002	2015	E4.1	35

ROOF DECK

NEW FERRY TERMINAL BUILDING

CEILING - 1ST FLOOR
ABOVE BATHROOM, JANITOR & ELEC RMs.

NEW TELEPHONE TERMINAL BOARD, TTB-1, 4'X4'X3/4" PAINTED PLYWOOD BACKBOARD, LOCATED IN ELEC ROOM.


FUTURE NETWORK INTERFACE DEVICE BY LOCAL TELCO

QUADPLEX RECEPTACLE MOUNTED ON THE BACKBOARD.

BUSHING ON ALL CONDUITS, TYP.

TELECOMM EQUIPMENT GROUND BUS. LEAVE 6' COILED #6 FOR ACS TELE CONNECTION.

1ST FLOOR

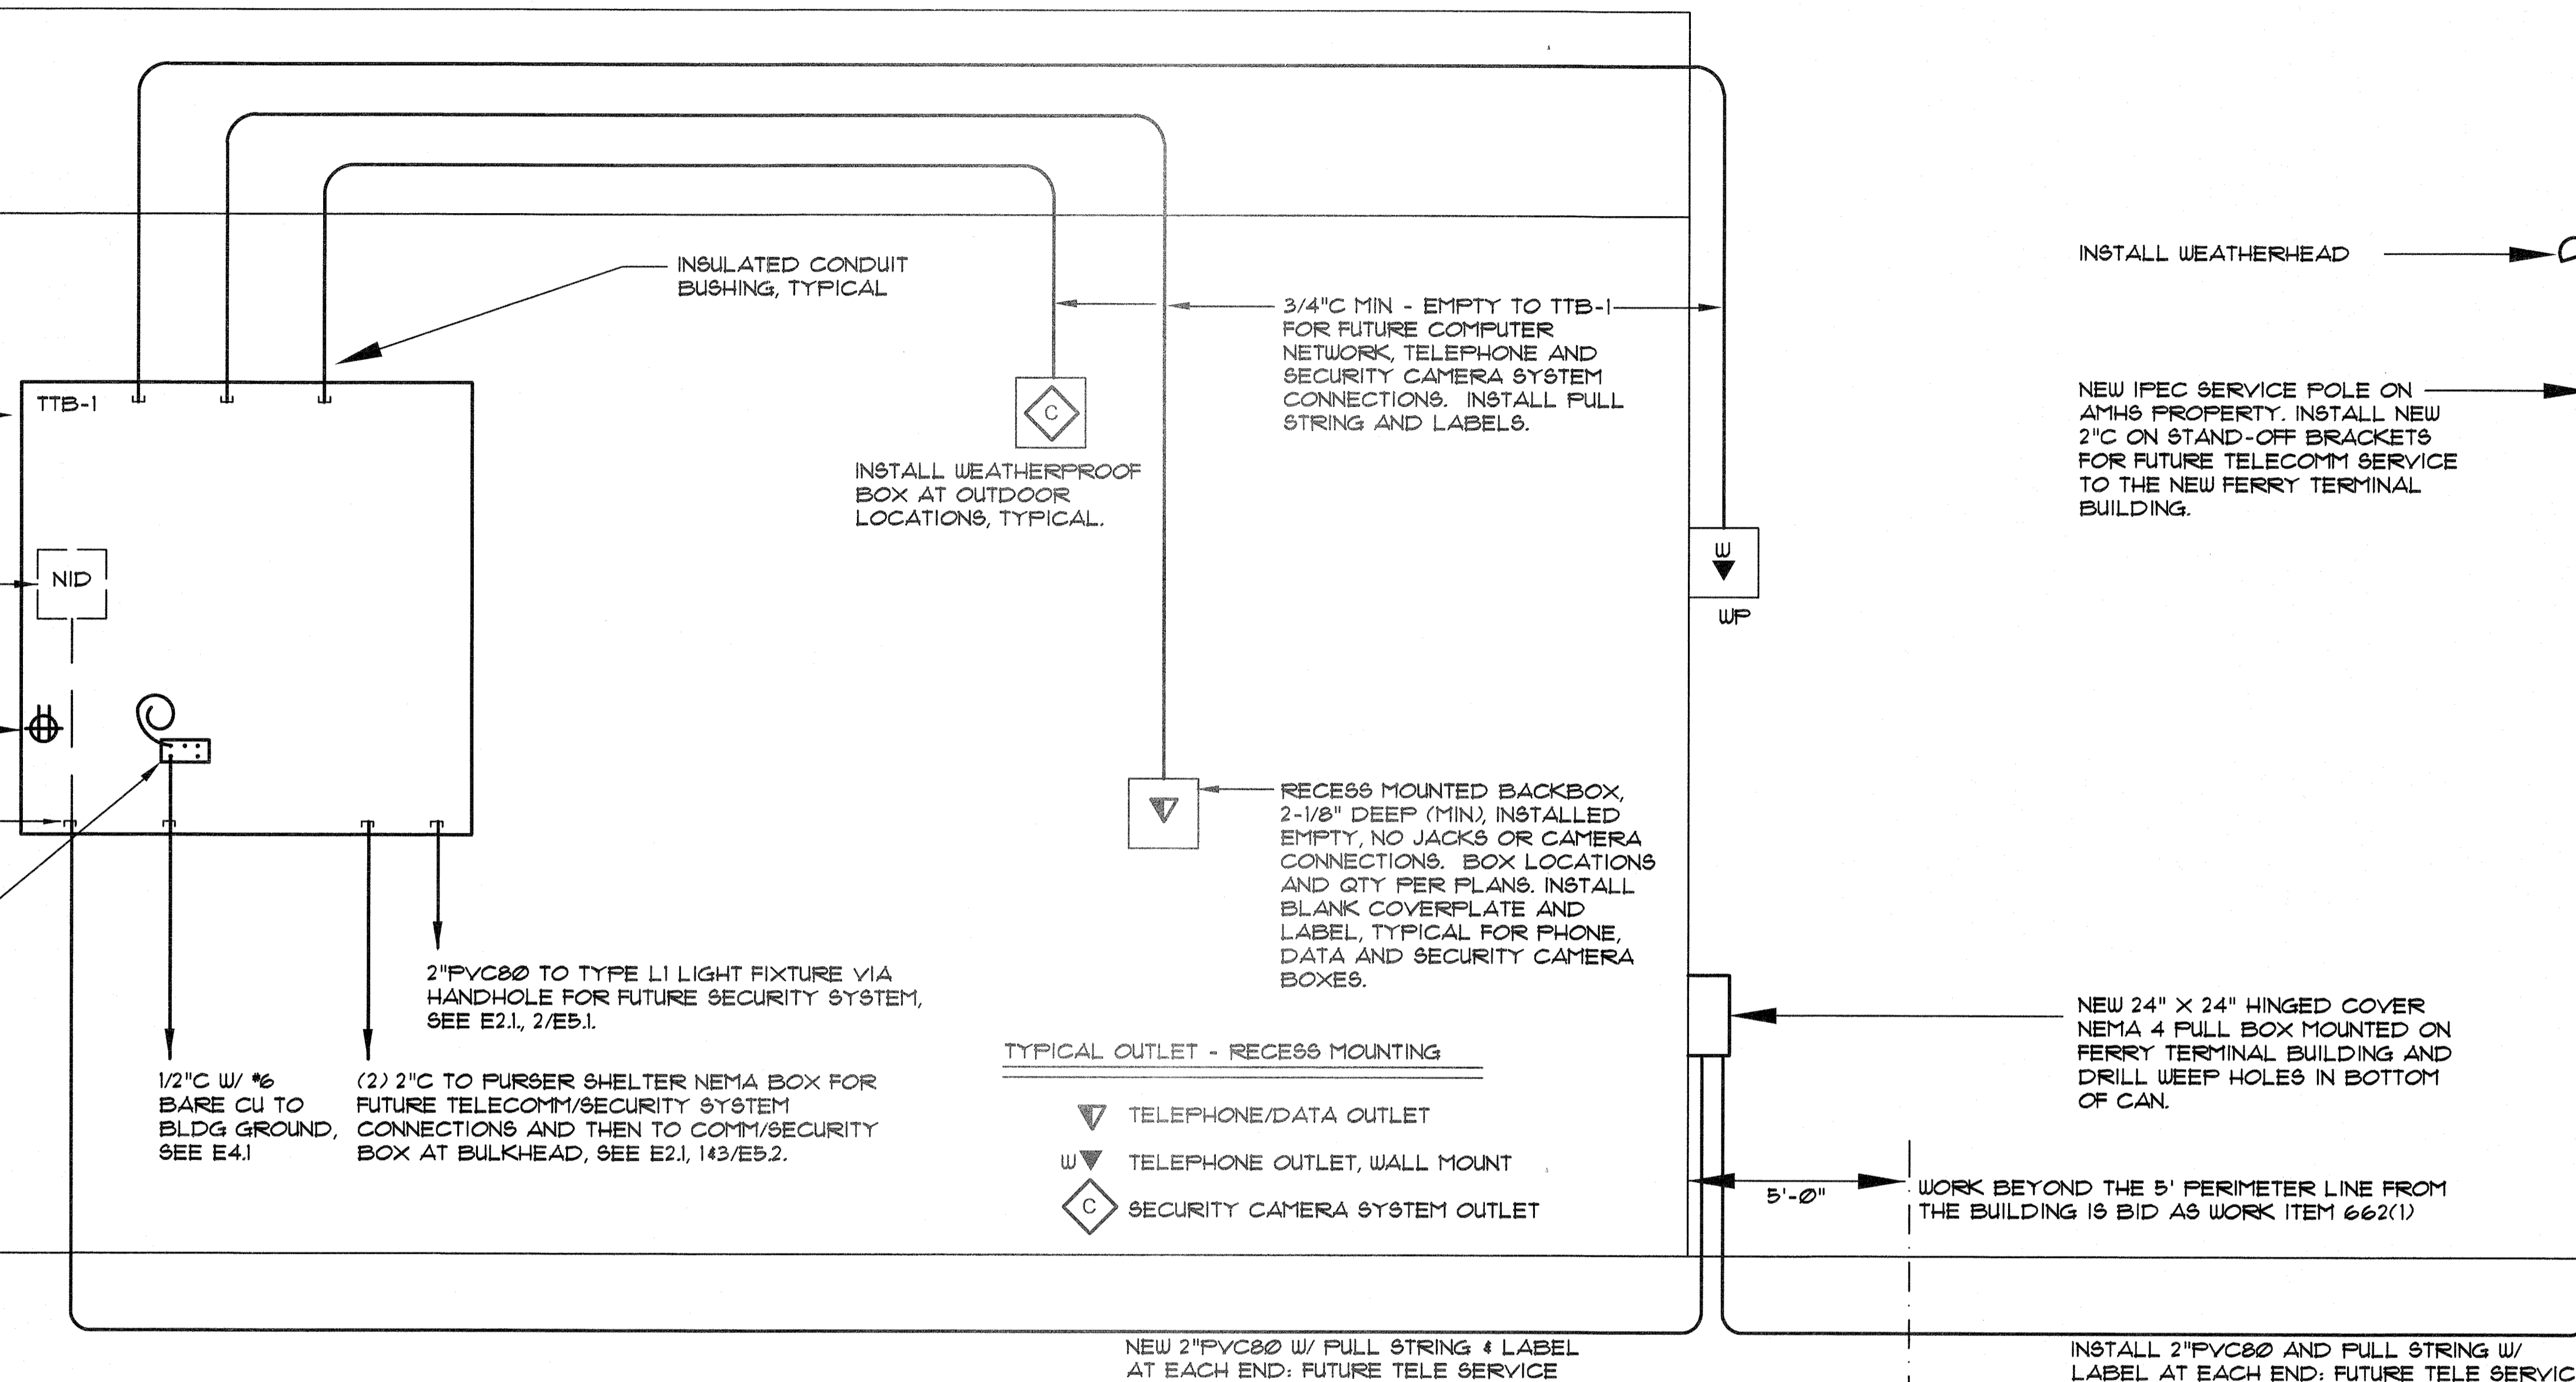

1 TELECOMMUNICATION & SECURITY SYSTEM ONE LINE DIAGRAM
NO SCALE

GENERAL NOTES:

- A THIS DIAGRAM DOES NOT SHOW ALL DEVICES. THE INTENT OF THIS DETAIL IS TO SHOW THE TELECOMMUNICATION AND SECURITY SYSTEMS INSTALLATION METHODS. COORDINATE QUANTITIES AND LOCATIONS W/ THE OWNER. SEE SPECIFICATIONS E6 SERIES SHEETS FOR ADDITIONAL INFORMATION.
- B THE TELECOMMUNICATIONS AND SECURITY SYSTEMS ARE EMPTY RACEWAY SYSTEMS. INSTALL COMPLETE RACEWAY CONCEALED FROM OUTLET TO TELEPHONE TERMINAL PANEL TTB-1. INSTALL FULL STRING IN EACH RACEWAY AND LABEL AT EACH END. LABEL SHALL IDENTIFY THE OUTLET LOCATION AND END POINT OF THE RACEWAY.
- C OUTLET BOXES SHALL BE INSTALLED WITH BLANK COVERPLATE. BOXES SHALL BE INSTALLED CONCEALED. INSTALL LABEL ON COVERPLATE: TELE/DATA OR SECURITY CAMERA.
- D COORDINATE THE INSTALLATION REQUIREMENTS WITH THE LOCAL TELCO (TELEPHONE) AND AMHS IT DEPARTMENT (SECURITY CAMERA AND DATA).
- E FIRE CAULK AROUND ALL CONDUIT PENETRATIONS THRU THE GYP BOARD.


RECORD DRAWINGS

THESE DRAWINGS HAVE BEEN PREPARED FROM INFORMATION PROVIDED BY THE CONTRACTOR. THERE IS NO GUARANTEE TO THE ACCURACY OF THE INFORMATION CONTAINED HEREIN, EITHER EXPRESSED OR IMPLIED.


August 31, 2017

WELSHWHITELEYARCHITECT, LLC
NELSON ELECTRICAL ENGINEERING

CHECKED BY: TED		STATE OF ALASKA DEPARTMENT OF TRANSPORTATION & PUBLIC FACILITIES SOUTHCOST REGION							
		KAKE FERRY TERMINAL PASSENGER FACILITY PLANSET B							
		ELECTRICAL TELECOMM ONE LINE DIAGRAM							
DESIGNED BY: KCN		PROJECT DESIGNATION							
DRAWN BY: KCN		YEAR							
PATH: C:\USERS\KNEE\DOCUMENTS\0-KAKE AS-BLT\KAK E1 CA 171010.DWG		SHEET NO.							
TAB: E4.2		TOTAL SHEETS							
<table border="1"> <thead> <tr> <th>NO.</th> <th>DATE</th> <th>REVISIONS DESCRIPTION</th> </tr> </thead> <tbody> <tr> <td> </td> <td> </td> <td> </td> </tr> </tbody> </table>		NO.	DATE	REVISIONS DESCRIPTION				SAMHS00002 2015 E4.2 35	
NO.	DATE	REVISIONS DESCRIPTION							

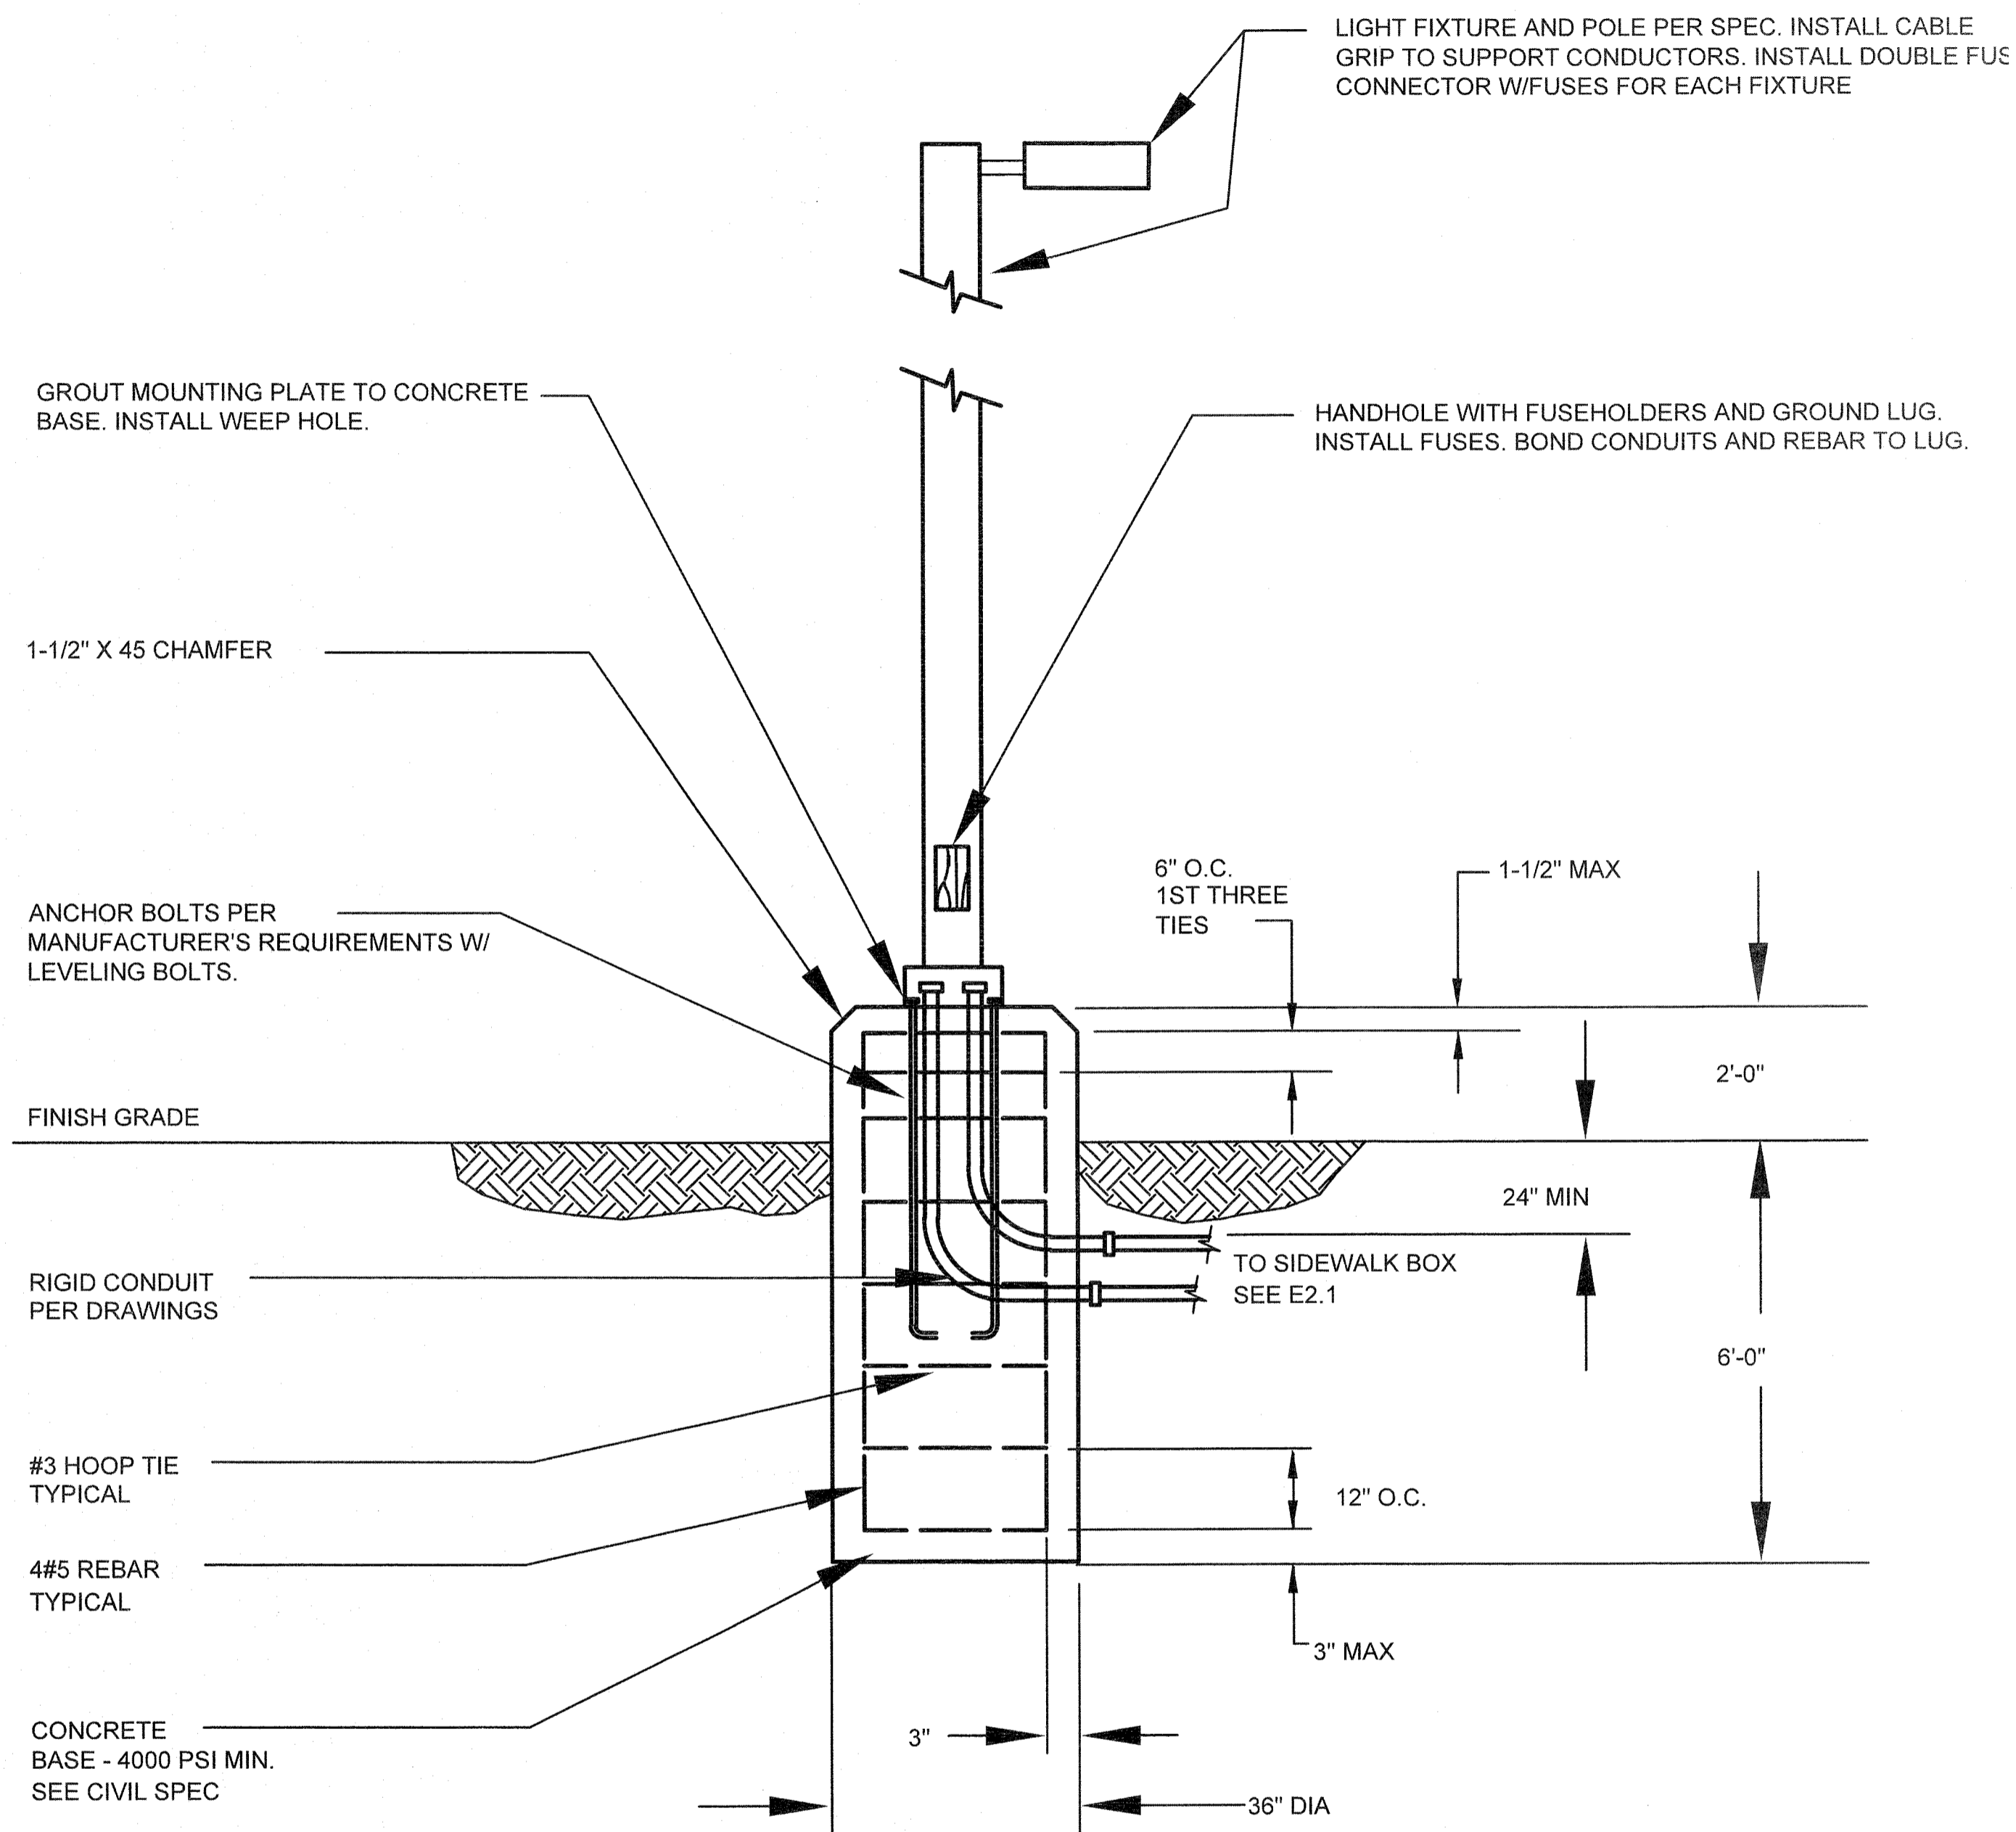


1 LIGHT POLE STANDARD DETAIL
 NO SCALE
 A. ALSO SEE DETAIL 2/E5.2 FOR ADDITIONAL INFO.
 B. BID AS WORK ITEM 662(1)

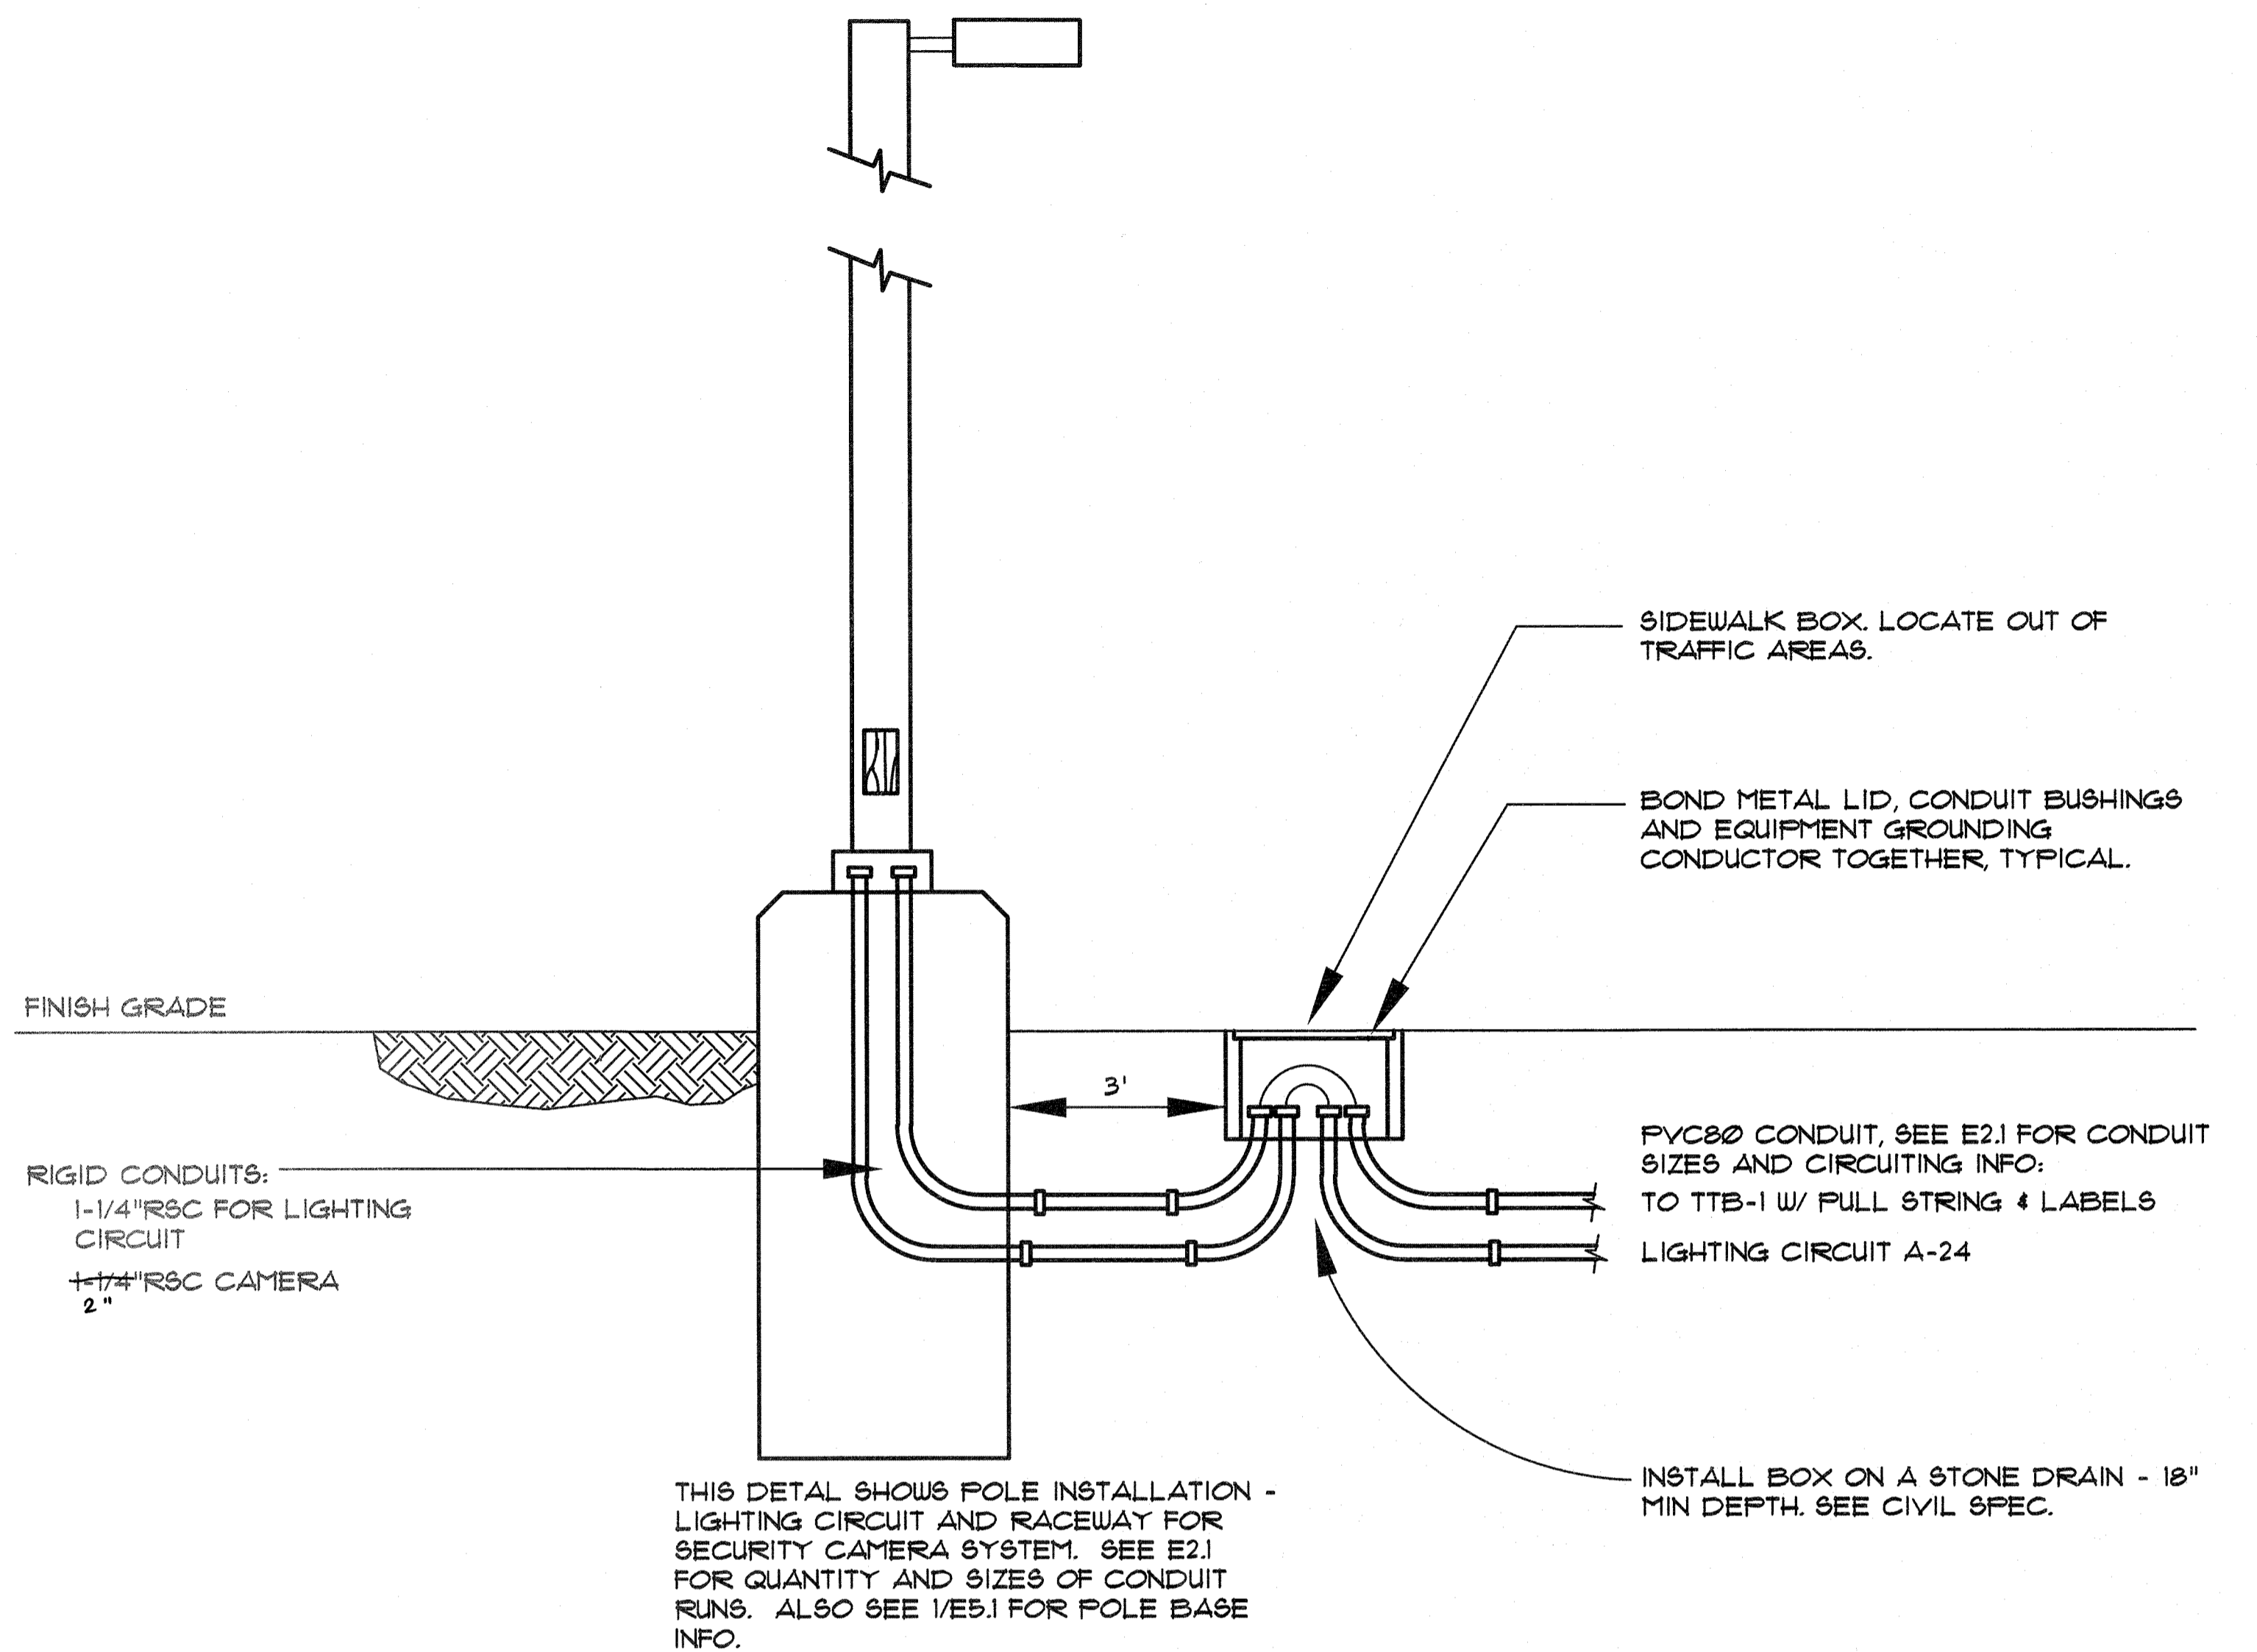


2 LIGHT POLE INSTALLATION DETAIL
 NO SCALE
 A. ALSO SEE DETAIL 1/E5.2 FOR ADDITIONAL INFO.

RECORD DRAWINGS
 THESE DRAWINGS HAVE BEEN PREPARED FROM INFORMATION PROVIDED BY THE CONTRACTOR. THERE IS NO GUARANTEE TO THE ACCURACY OF THE INFORMATION CONTAINED HEREIN, EITHER EXPRESSED OR IMPLIED.
 August 31, 2017
 WELSHWHITELEYARCHITECT, LLC
 NELSON ELECTRICAL ENGINEERING

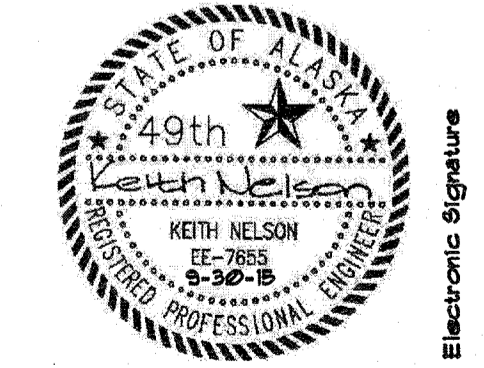CHECKED BY: TED		STATE OF ALASKA DEPARTMENT OF TRANSPORTATION & PUBLIC FACILITIES SOUTHCOST REGION																				
		KAKE FERRY TERMINAL PASSENGER FACILITY PLANSET B																				
		MISC. ELECTRICAL DETAILS																				
DESIGNED BY: KCN DRAWN BY: KCN		PATH: C:\USERS\KNEE\DOCUMENTS\0-KAKE AS-BLT\KAK E1 CA 171010.DWG																				
TAB: E5.1																						
<table border="1"> <thead> <tr> <th colspan="2">REVISIONS</th> <th rowspan="2">PROJECT DESIGNATION</th> <th rowspan="2">YEAR</th> <th rowspan="2">SHEET NO.</th> <th rowspan="2">TOTAL SHEETS</th> </tr> <tr> <th>NO.</th> <th>DATE</th> <th>DESCRIPTION</th> </tr> </thead> <tbody> <tr> <td> </td> <td> </td> <td> </td> <td> </td> <td> </td> <td> </td> </tr> </tbody> </table>		REVISIONS		PROJECT DESIGNATION	YEAR	SHEET NO.	TOTAL SHEETS	NO.	DATE	DESCRIPTION							<table border="1"> <tr> <td style="text-align: center;">SAMHS00002</td> <td style="text-align: center;">2015</td> <td style="text-align: center;">E5.1</td> <td style="text-align: center;">35</td> </tr> </table>		SAMHS00002	2015	E5.1	35
REVISIONS		PROJECT DESIGNATION	YEAR					SHEET NO.	TOTAL SHEETS													
NO.	DATE			DESCRIPTION																		
SAMHS00002	2015	E5.1	35																			


BID THE WORK IN THE PURSER SHELTER AS
WORK ITEM 695(2), SEE SPECIFICATIONS

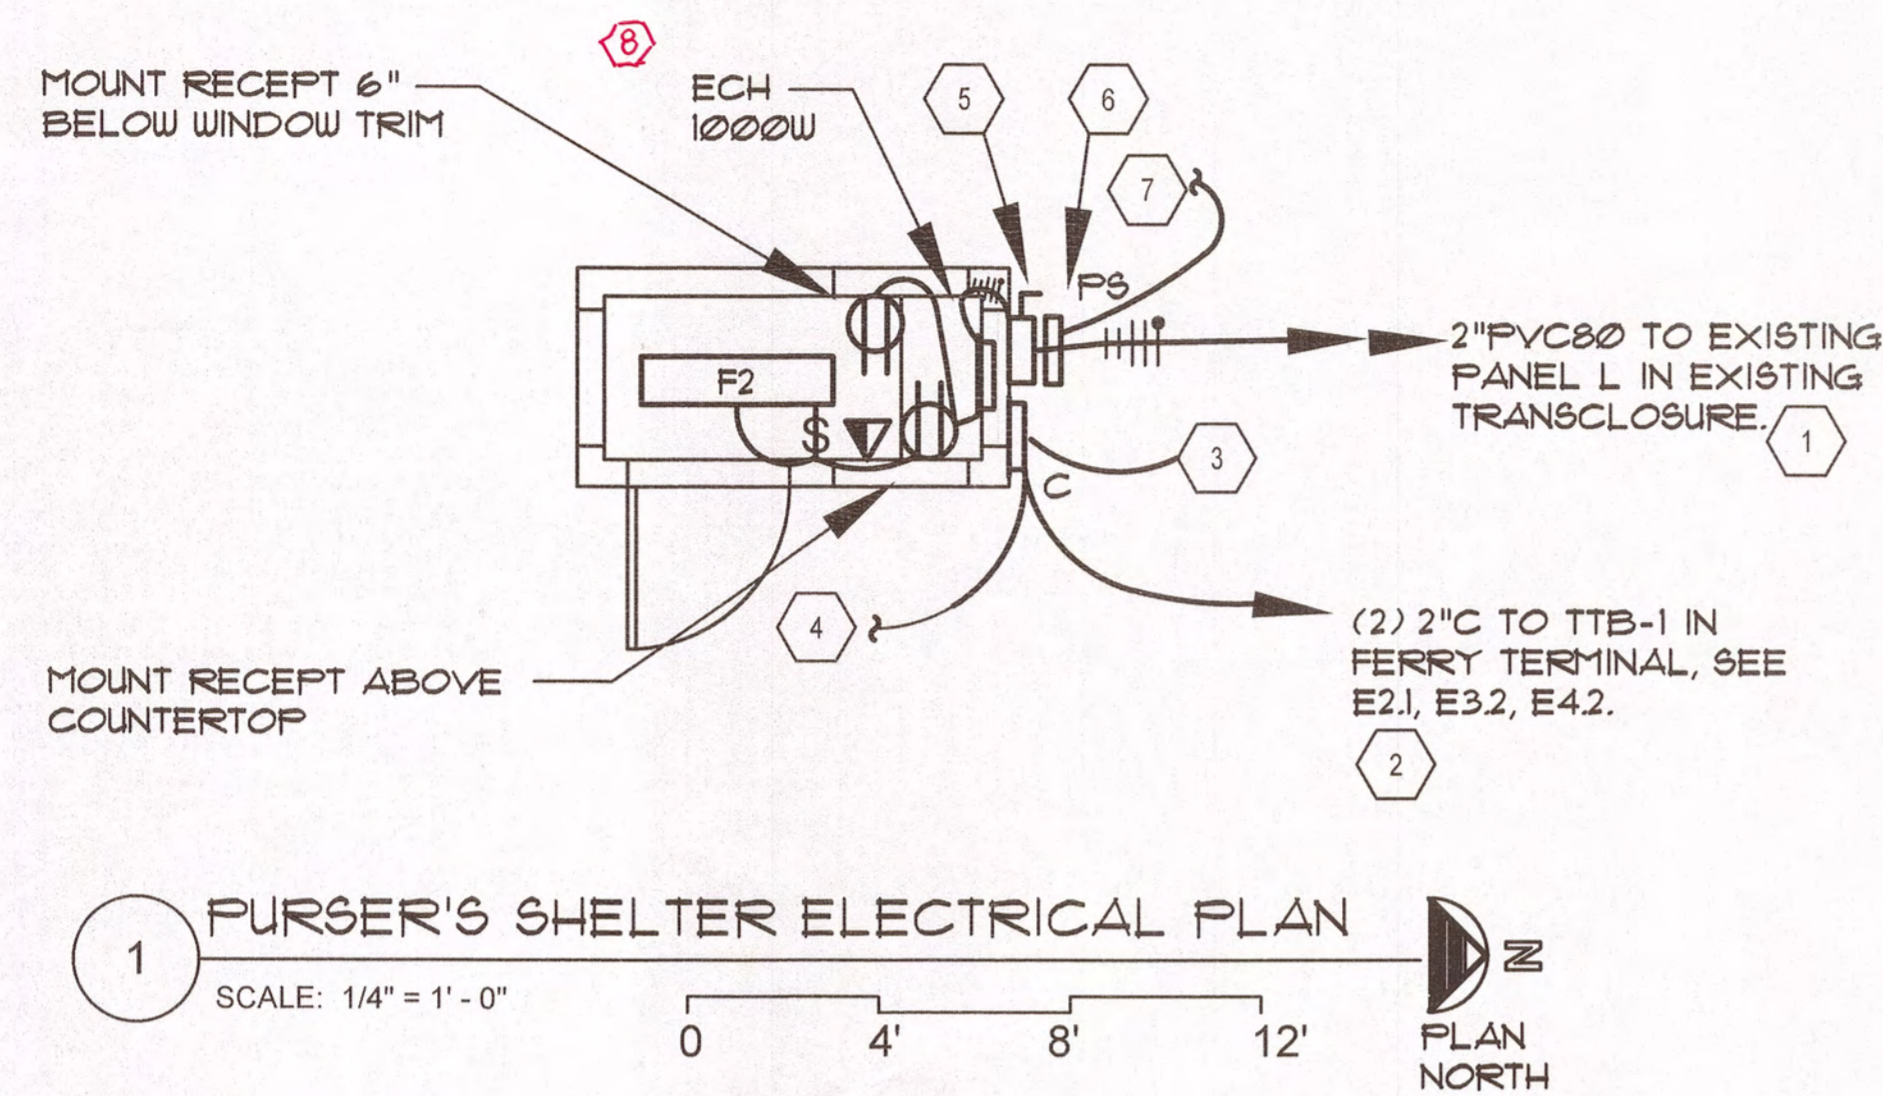

1 PURSER'S SHELTER ELECTRICAL PLAN
SCALE: 1/4" = 1' - 0"
PLAN NORTH

ELECTRICAL NOTES:

- 1 INSTALL NEW 20A/2P BREAKER IN AVAILABLE SPACES IN EXISTING PANEL L SQUARE D LOAD CENTER - ONE CIRCUIT FOR LIGHTS, RECEPT, AND ONE FOR HEATER. CONFIRM AVAILABLE SPACE W/ DOT/AMHS. REARRANGE EXISTING BREAKERS AS REQUIRED TO OBTAIN 2 CONSECUTIVE SPACES.
- 2 ONE CONDUIT FOR FUTURE COMM, ONE CONDUIT FOR FUTURE SECURITY-CAMERA SYSTEM.
- 3 24X24X4 NEMA 4 HINGED COVER CAN FOR FUTURE COMMUNICATIONS/SECURITY CAMERA SYSTEMS. INSTALL FULL STRINGS, LABELS IN ALL CONDUITS & WIRING DIAGRAM IN THE ENCLOSURE PER SPECIFICATIONS
- 4 (2) 2" C TO NEW NEMA 4 CAN (COMMUNICATIONS/SECURITY CAMERA SYSTEMS) MOUNTED ON BULKHEAD-ONE CONDUIT FOR FUTURE COMM, ONE CONDUIT FOR FOR SECURITY CAMERA SYSTEM, SEE E2.1, 2/E5.2
- 5 30/3P, 240V, 9E, NEMA 3R, NON-FUSED DISCONNECT. DO NOT CONNECT THE NEUTRAL TO THE GROUND BUS PER NEC 250.32. NO GROUND ROD REQUIRED PER NEC 250.32A EXCEPTION. INSTALL LABEL PER IDENTIFICATION SPEC.
- 6 24X24X4 NEMA 4 HINGED COVER CAN FOR PURSER SHELTER POWER MOUNTED BELOW DISCONNECT, ROUTE BRANCH CIRCUITING FROM PANEL L TO BOX THEN TO DISCONNECT.
- 7 2" PVC80 TO RAMP "C" NEMA 4 BOX, SEE E2.1, 2/E5.2
- 8 HEATER MOUNTED T-START

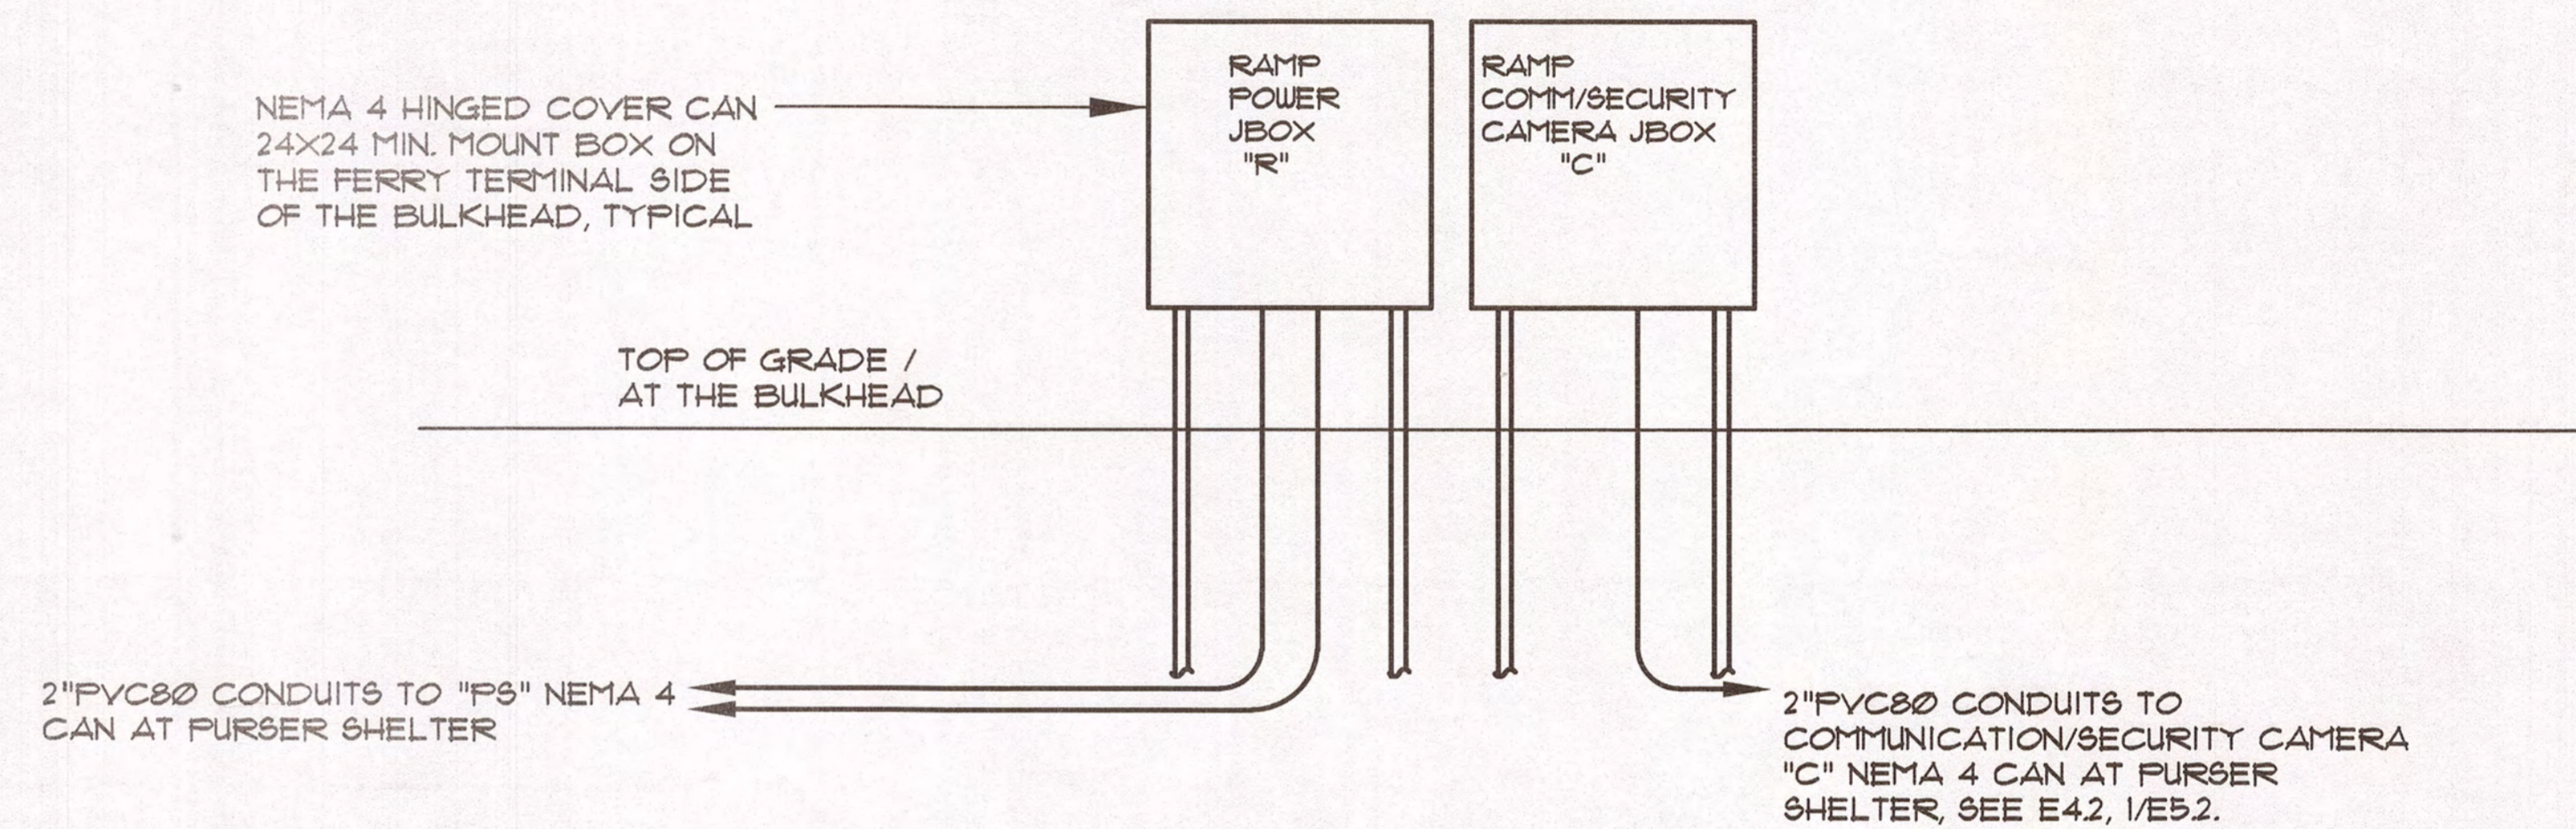

2 BULKHEAD BOX DETAIL
SCALE: 1/4" = 1' - 0"

GENERAL NOTES:


- A DETAIL IS DIAGRAMMATIC IN NATURE AND IS INTENDED TO SHOWS THE RACEWAY TRANSITION FROM THE UNDERGROUND RUN NEAR THE BULKHEAD. NOT ALL COMPONENTS ARE SHOWN. SEE E2.1, E4.2 & 1/E5.2.
- B LABEL COVER OF BOX AND INSTALL AS-BUILT DRAWING PER SPECIFICATIONS
- C COORDINATE LOCATION OF THE JBOXES AND INSTALLATION METHODS WITH THE ENGINEER PRIOR TO COMMENCING WITH THE ROUGH-IN WORK.
- D BID AS WORK ITEM 662(1)

RECORD DRAWINGS

THESE DRAWINGS HAVE BEEN PREPARED FROM INFORMATION PROVIDED BY THE CONTRACTOR. THERE IS NO GUARANTEE TO THE ACCURACY OF THE INFORMATION CONTAINED HEREIN, EITHER EXPRESSED OR IMPLIED.

August 31, 2017

WELSHWHITELEY ARCHITECT, LLC
NELSON ELECTRICAL ENGINEERING

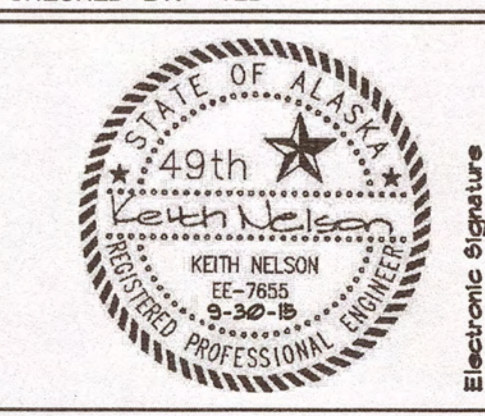CHECKED BY: TED  DESIGNED BY: KCN DRAWN BY: KCN		STATE OF ALASKA DEPARTMENT OF TRANSPORTATION & PUBLIC FACILITIES SOUTHCOAST REGION KAKE FERRY TERMINAL PASSENGER FACILITY PLANSET B MISC. ELECTRICAL DETAILS			
PATH: G:\FILEHISTORY\KNEE\LAPTOP-DUMKBOBA\DATA\C\USERS\KNEE\DOCUMENTS\0-KNEE\2011\ANGOON-KAKE\DWG\16-KAK TAB: E5.2		PROJECT DESIGNATION SAMHS00002	YEAR 2015	SHEET NO. E5.2	TOTAL SHEETS 35

KAKE FERRY TERMINAL LIGHTING FIXTURE SCHEDULE

TYPE	LAMPS	MOUNTING	DESCRIPTION	MANUFACTURER
A4	4-42TRT SP35	PENDANT, 9'-6" TO BOTTOM OF FIXTURE, SLOPED WOOD CEILING 3:12	PENDANT MOUNTED, CONICAL COMPACT FLUORESCENT, 27" DIA, MATTE WHITE, SLOPE ADAPTER, METAL SIDES, 120V,	SHAPER 444 SERIES
C1	90W LED 3000K	PENDANT, FIXTURE WITHIN GLU-LAM SPACE, SLOPED WOOD CEILING 3:12	LED SQUARE CANOPY FIXTURE FLAT TEMPERED GLASS LENS, IP65, GASKETED, WET LABEL, TYPE III DISTRIB, NATURAL ALUM, 240V	GARDCO SLENDERFORM SFC SERIES
D2	2-F32T8/735	SURFACE, CENTER CENTERED ABOVE MIRROR & PARTITIONS	4' FLUORESCENT INDIRECT, ASYMMETRIC DISTRIBUTION,	CORELITE AW-SP-T28 SERIES PERFORATED SHIELD,
E2	2 - 8 WATT HALOGEN BY MFR	SURFACE WALL, 6" ABOVE DOOR HEADER HEIGHT	EMERGENCY BATTERY PACK 2 HALOGEN LAMPS, CHARGER, TEST SWITCH, 6 VOLT BATTERY, 24 WATT MIN, 120/277V ADJUST LAMPS FOR MAX. LIGHT DISTRIBUTION	LITHONIA 6ELM2P SERIES
ER1	1 - 6 WATT HALOGEN SEALED	SURFACE WALL SAME AS E2	EMERGENCY FIXTURE, REMOTE METAL HEAD, 1 LAMP, 6V, WET LOCATION, CONNECT TO X2 OR E2	LITHONIA ELA-NX SERIES SERIES
F2	2-F32T8/735	SURFACE	4' FLUORESCENT WRAPAROUND, ACRYLIC LENS, WHITE TRIM, 120V	METALUX SA-232 SERIES
H2	2-28T5HO/735 SP35	SURFACE GYP BOARD 8'AFF	4' INDIRECT ASYMMETRIC WALL MOUNT WHITE ACRYLIC LENS, END CAPS, ROUND PERFERATIONS, 120V	NEO-RAY NUMBUS 601 SERIES
J1	19W LED 3500K	SURFACE, WALL, 6'AFF	LED CURVED WALL SCONCE, 14"WIDE PERFORATED CURVED SHIELD, ALUMINUM, 1900 LUMENS, 120V	SHAPER 635 SERIES
JJ1	16W LED	SURFACE, WALL, 7'AFF	WALL SCONCE, LED NIGHT LIGHT, SIM TO J1 EXCEPT 1600 LUMENS, 16 WATT	SHAPER 635 SERIES
K1	30W LED	SURFACE, WALL 1' ABOVE HEADER	ROUND LED WALLPACK, SOLID UPPER HALF, RIBS, PRISMED LEN, DRIVERS FOR 1800 LUMEN OUTPUT, DARK BRONZE TGIC POWDER COAT FINISH, IP66 RATED, 120V	KIM WF SERIES
L1	255W LED DUAL ARRAY 3000K	POLE MOUNT 25' POLE	LED PARKING LOT FIXTURE, TYPE II DISTRIBUTION, WET LABEL GASKETED, DARK BRONZE TGIC POWDER COAT FINISH, FLAT GLASS, LENS MOUNTING ARM, DOUBLE FUSES & HOLDERS, EXTNL HOUSE SIDE SHIELD FOR WATERSIDE OF FIXTURE, IP66 RATED, 240V	GARDCO GULLWING GL18 SERIES
X2	LED & 2-5.4W HALOGEN HEADS	WALL, BACKMOUNT, 6" ABOVE DOOR HEADER HEIGHT	25 FOOT, ROUND TAPERED STEEL GALVANIZED POLE W/ HANDHOLE, SIDE ARM MOUNT, BASE COVER, AASHTO 120MPH W/ 3 SEC. WIND GUST. COMBO LED EXIT FIXTURE WITH 2- EMERG LIGHT, GREEN LETTERING, CHARGER, TEST, HIGH OUTPUT BATTERY, ARROWS PER PLAN, WHITE HOUSING, EMERGENCY HALOGEN LAMPS, 120V, UNIT SHALL POWER 2 - ER1 REMOTE LAMPS	VALMONT RTS SERIES

NOTES:

- MANUFACTURER'S LISTED ARE TO ESTABLISH QUALITY AND TYPE OF LIGHTING FIXTURE. PRIOR TO ORDERING THE FIXTURES THE OWNER AND ELECTRICAL CONTRACTOR SHALL SELECT THE TYPES OF FIXTURES, MOUNTING TYPES/ACCESSORIES, COLORS AND FINISHES.
- PROVIDE LAMPS AND ALL MOUNTING AND OPERATING ACCESSORIES REQUIRED FOR A COMPLETE INSTALLATION. ALL FIXTURES SHALL HAVE AN EQUIPMENT GROUNDING CONDUCTOR INSTALLED FROM ITS JBOX TO THE FIXTURE GROUND. FIXTURES SHALL BE SUPPORTED FROM THE BUILDING STRUCTURE PER IBC REQUIREMENTS.
- INDOOR BALLASTS SHALL BE HIGH POWER FACTOR, CLASS P, SOUND RATED 'A'. FLUORESCENT BALLASTS SHALL BE ELECTRONIC, 10% MAX. TOTAL HARMONIC DISTORTION, RAPID START, FULL LIGHT OUTPUT TYPE.
- EXTERIOR HID FIXTURE BALLAST SHALL BE SUITABLE FOR OUTDOOR INSTALLATION. CONSTANT WATTAGE AUTOTRANSFORMER TYPE BALLAST AND RATED FOR -20F STARTING. BEAR THE SEAL OF THE CERTIFIED BALLAST MANUFACTURERS AND UNDERWRITERS' LABORATORIES, INC. IN ACCORDANCE WITH UL 1029, CLASS C SOUND RATING.
- LED FIXTURES SHALL BE TESTED PER IESNA LM-79 STANDARDS.
- PROVIDE THE OWNER WITH THE TOOLS FOR EACH TYPE OF TAMPERPROOF HARDWARE SYSTEM USED. (FOR EXAMPLE, TORX TX20 SCREWDRIVER) PROVIDE TWO SPARE KEYS FOR LOCKS.
- PROVIDE SPARE PARTS:
 FLUORESCENT:
 28T5HO/735 SP35: EIGHT LAMPS AND TWO BALLASTS
 F32T8/735: EIGHT LAMPS AND TWO BALLASTS
 CFL:
 42TRT: EIGHT LAMPS AND TWO BALLASTS
 LED:
 TYPE C1, J1, JJ1, K1 & L1 FIXTURES: (1) OPTICAL SYSTEM FOR EACH FIXTURE TYPE (LED LAMPS & DRIVER ASSEMBLY)

PANEL 'A' SCHEDULE

CKT. NO.	P	TRIP	LOAD SERVED	LOAD WATTS A	LOAD WATTS B	LOAD TYPE	CKT. NO.	P	TRIP	LOAD SERVED	LOAD WATTS A	LOAD WATTS B	LOAD TYPE
1	1	20	EMERGENCY LIGHT - Night Light - Corridor	40		L	2	1	20	Heat - Womens	1000		H
3	1	20	Lts - Wallpacks		96	L	4	1	20	Heat - Corridor		500	H
5	1	20	Spare	0		S	6	1	20	Spare	0		S
7	1	20	Control Ckt		50	A	8	1	20	Heat - Janitor/Storage		1000	H
9	1	20	Rec - TTB-1	360		G	10	1	20	Heat - Men	500		H
11	1	20	Rec - 24/7		360	G	12	1	20	Heat - Waiting		1000	H
13	1	20	Spare	0		S	14	1	20	Heat - Waiting	1000		H
15	2	30	CCU-1, HP-1		2436	H	16	2	100	Split Bus Main CB		0	F
17			" "	2436		H	18			" "	0		F
Circuits 1-18 are not switched. They are energized 24/7.							SPLIT BUS		Circuits 19-48 are switched on & off by the contactor.				
19	1	20	Spare		0	S	20	1	20	Lts - Corridor, Waiting		804	L
21	1	20	Spare	0		S	22	1	20	Lts - Bathm, Jan, TEF1-3, Storage	562		L
23	1	20	Spare		0	S	24	2	20	Lts - Parking Lot, Drive Thru		465	L
25	1	20	Spare	0		S	26			" "	465		L
27	1	20	Spare		0	S	28	1	20	TF-1&2, CF-1		220	M
29	1	20	Space	0		S	30	1	20	Space	0		S
31	1	20	Space		0	S	32	1	20	Rec - Exterior		540	G
33	1	20	Space	0		S	34	1	20	Rec - Bathrm, Jan, Storage	720		G
35	1	20	Space		0	S	36	1	20	Rec - Waiting		540	G
37	1	20	Space	0		S	38	1	20	Rec - Waiting	360		G
39	1	20	Space		0	S	40	1	20	Space		0	S
41	1	20	Space	0		S	42	1	20	Space		0	S
43	1	20	Space		0	S	44	1	20	Space		0	S
45	2	50	* HWH-1	4500		C	46	1	20	Space		0	S
47			* "		4500	C	48	1	20	Space		0	S

225 AMP PANEL -MLO, 120/240, 1 PH, 3W
 10,000 AIC, SURFACE MOUNTED, NEMA 1
 SPLIT BUS 30 & 18 CKTS, GROUND BUS
 TOP SECTION IS ON 24/7.

BOTTOM SECTION CONTROLLED BY PUSHBUTTON/CONTACTOR
 OFF WHEN BUILDING IS UNOCCUPIED
 ON WHEN BUILDING IS OCCUPIED WHILE FERRY IS IN PORT.


* = LOCKABLE HASP

RECORD DRAWINGS

THESE DRAWINGS HAVE BEEN PREPARED FROM INFORMATION PROVIDED BY THE CONTRACTOR. THERE IS NO GUARANTEE TO THE ACCURACY OF THE INFORMATION CONTAINED HEREIN, EITHER EXPRESSED OR IMPLIED.

August 31, 2017

WELSHWHITELEYARCHITECT, LLC
 NELSON ELECTRICAL ENGINEERING

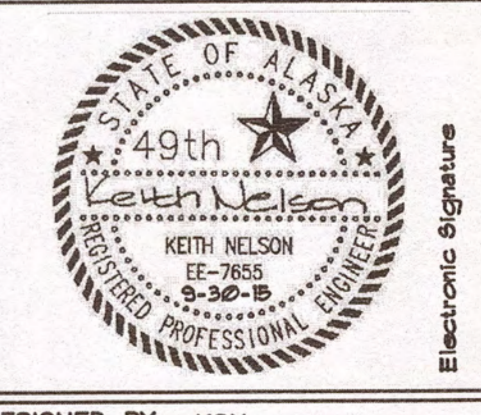CHECKED BY: TED		STATE OF ALASKA DEPARTMENT OF TRANSPORTATION & PUBLIC FACILITIES SOUTHCOST REGION				
 Electronic Signature		KAKE FERRY TERMINAL PASSENGER FACILITY PLANSET B ELECTRICAL SPECIFICATIONS				
						DESIGNED BY: KCN
DRAWN BY: KCN		PATH: C:\USERS\KNEE\DOCUMENTS\0-KAKE AS-BLT\KAK E1 CA 171010.DWG		YEAR	SHEET NO.	TOTAL SHEETS
TAB: E6.1		REVISIONS		2015	E6.1	35
NO.	DATE	DESCRIPTION		SAMHS00002		

800 P2 P0 / 50000 2HMA2
 JAWNET 19957
 SHAS