

PROPOSED AIRPORT PROJECT

The undersigned hereby certifies that this duplicated document is an exact and true copy of the original.

*Jessica Dinkale*

KAKE AIRPORT  
KAKE, ALASKA

October 22, 2018

KAKE AIRPORT RUNWAY  
REHABILITATION

**FINAL PS&E**

PROJECT NO. SFAPT00078  
AIP NO. 3-02-0398-~~XX~~-2018  
007

2018



**AS-BUILTS**  
Contractor - SECON  
Project Engineer - VAL BEAN  
Begin Date - MAY 23, 2019  
End Date - SEPTEMBER 4, 2019

SPONSORED BY THE STATE OF ALASKA  
DEPARTMENT OF TRANSPORTATION AND PUBLIC FACILITIES  
SOUTHCOAST REGION

APPROVED BY:

*L. Pat Carroll*

DATE

7/17/18

L. PAT CARROLL, P.E., PRECONSTRUCTION ENGINEER, SOUTHCOAST REGION


ACCEPTED FOR CONSTRUCTION:

*D. Lance Mearig*


DATE

24 Jul 2018

D. LANCE MEARIG, P.E., REGIONAL DIRECTOR, SOUTHCOAST REGION

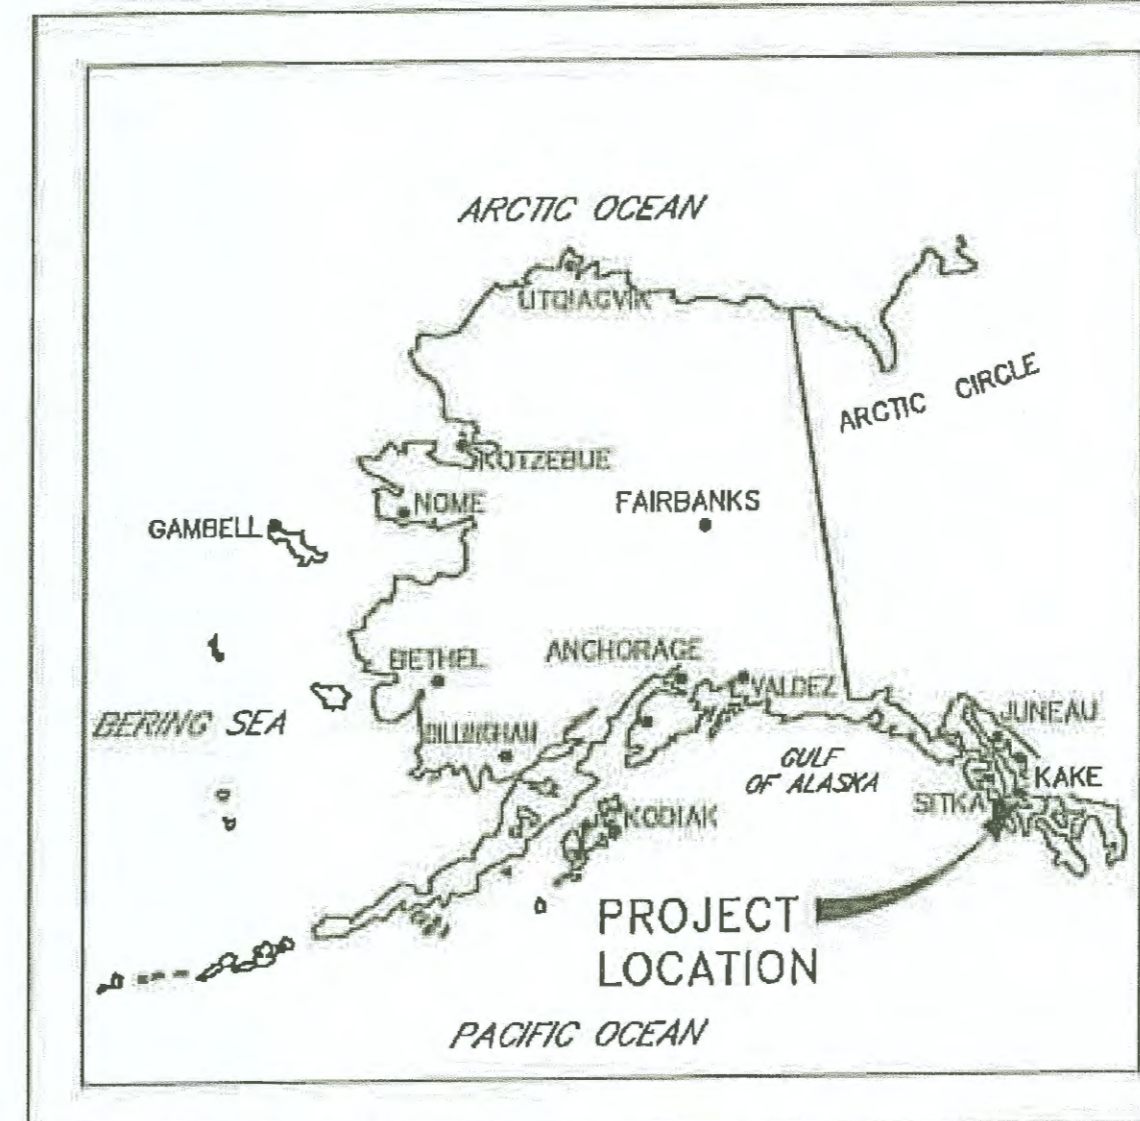

LOCATION MAP

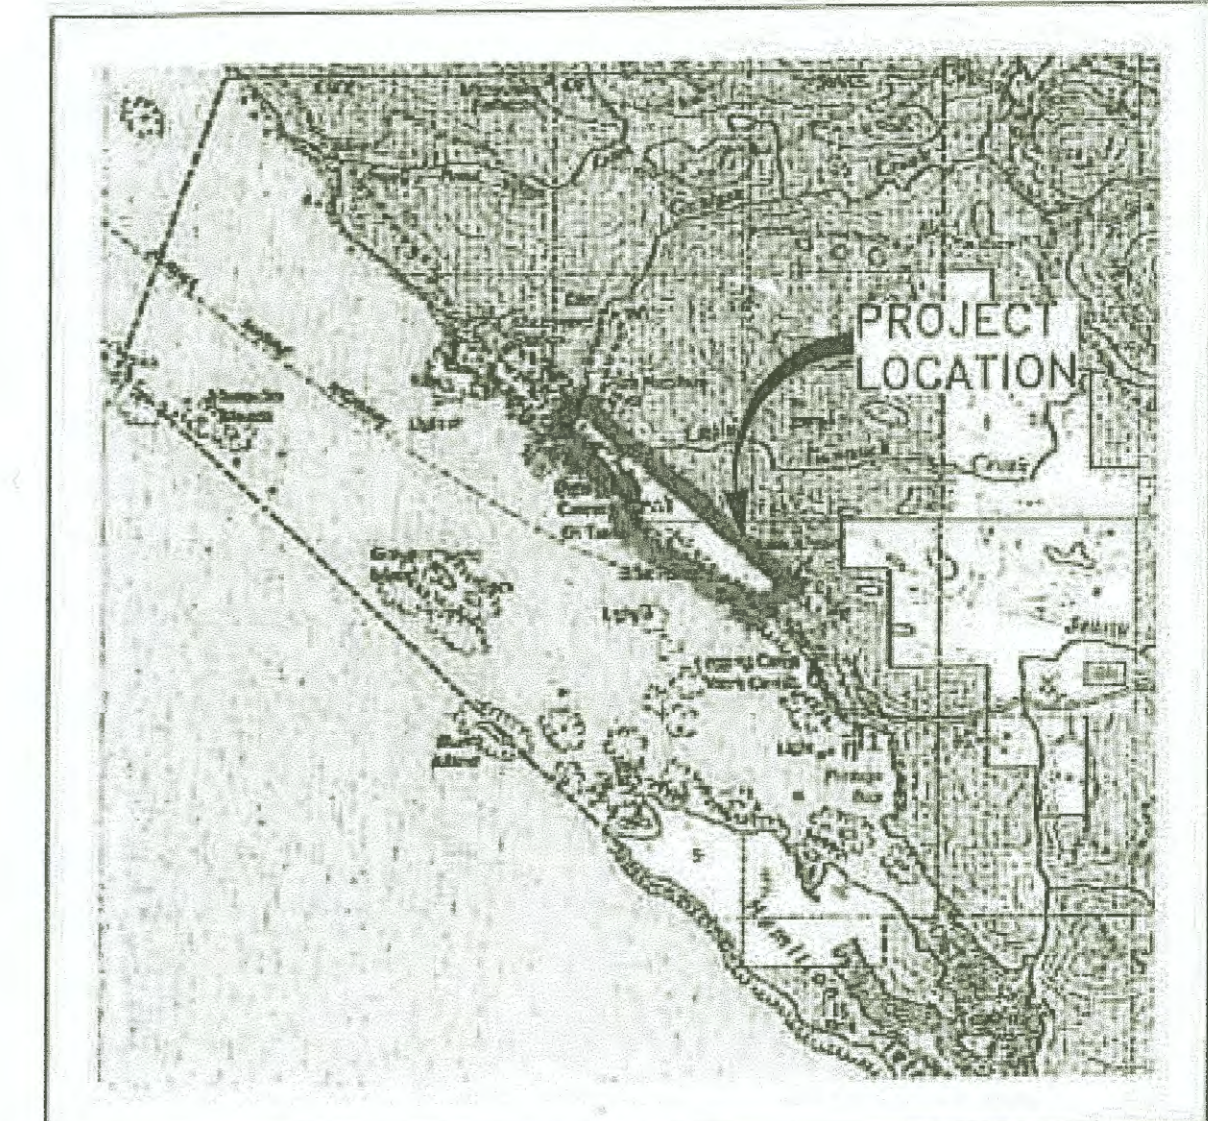

VICINITY MAP

PROJECT DRAWINGS

SHEET NO.	SHEET TITLE
CIVIL	
1	COVER
2	ESTIMATED QUANTITIES AND ESTIMATING FACTORS
3	PROJECT LAYOUT
4	TYPICAL SECTIONS I
5	TYPICAL SECTIONS II
6	RUNWAY 11-29 PLAN AND PROFILE STA 10+00 TO 21+00
7	RUNWAY 11-29 PLAN AND PROFILE STA 21+00 TO 33+00
8	RUNWAY 11-29 PLAN AND PROFILE STA 33+00 TO 45+00
9	RUNWAY 11-29 PLAN AND PROFILE STA 45+00 TO 56+00
10	TEMPORARY RUNWAY 11-29 MARKING PLANS
11	TEMPORARY THRESHOLD MARKINGS
12	TEMPORARY MARKING DETAILS
13	PERMANENT RUNWAY 11-29 MARKING PLAN
14	PERMANENT MARKING DETAILS
ELECTRICAL	
E1	ELECTRICAL LEGEND
E2	ELECTRICAL SITE PLAN -- DEMOLITION
E3	ELECTRICAL SITE PLAN -- NEW WORK
E4	ELECTRICAL SITE PLAN -- APRON ENLARGED PLANS
E5	ELECTRICAL DETAILS I
E6	ELECTRICAL DETAILS II
E7	ELECTRICAL DETAILS III
E8	ROTATING BEACON DETAILS

PROJECT DRAWINGS

SHEET NO.	SHEET TITLE
E9	EQUIPMENT BUILDING DETAILS I
E10	EQUIPMENT BUILDING DETAILS II
E11	CONTROL PANEL DETAILS
E12	FOUNDATION DETAILS
E13	ELECTRICAL SCHEDULES

APPENDIX DRAWINGS

SHEET NO.	SHEET TITLE
APPENDIX: APPENDIX A	
AA1	ESCP PROJECT LAYOUT PLAN
AA2	ESCP PROJECT PHASING
APPENDIX: APPENDIX B	
AB1	SURVEY CONTROL
APPENDIX: APPENDIX D	
AD1	CONSTRUCTION SAFETY AND PHASING PLAN OVERVIEW
AD2	CONSTRUCTION SAFETY AND PHASING PLAN PHASE 1 PLAN
AD3	CONSTRUCTION SAFETY AND PHASING PLAN PHASE 2 PLAN
AD4	CONSTRUCTION SAFETY AND PHASING PLAN PHASE 2 TURNAROUND PLAN
AD5	CONSTRUCTION SAFETY AND PHASING PLAN PHASE 3
AD6	CONSTRUCTION SAFETY AND PHASING PLAN PHASE 3 CROSSOVER PLAN
AD7	CONSTRUCTION SAFETY AND PHASING DETAILS I
AD8	CONSTRUCTION SAFETY AND PHASING DETAILS II

DAVID PYEATT, P.E., PROJECT MANAGER  
STATE OF ALASKA  
DEPARTMENT OF TRANSPORTATION & PUBLIC FACILITIES  
SOUTHCOAST REGION  
6860 GLACIER HIGHWAY  
JUNEAU, AK 99811  
(907)465-4490

ESTIMATED QUANTITIES

ITEM NO.	SSAC 2018 ITEM NO.	PAY ITEM	PAY UNIT	QUANTITY
G100.010.0000	G-100a	MOBILIZATION AND DEMOBILIZATION	LUMP SUM	ALL REQUIRED
G115.010.0000	G-115a	WORKER MEALS AND LODGING, OR PER DIEM	LUMP SUM	ALL REQUIRED
G130.010.0000	G-130a	FIELD OFFICE	LUMP SUM	ALL REQUIRED
G130.020.0000	G-130b	FIELD LABORATORY	LUMP SUM	ALL REQUIRED
G130.060.0000	G-130g	NUCLEAR TESTING EQUIPMENT STORAGE SHED	EACH	1
G131.010.0000	G-131a	ENGINEERING TRANSPORTATION (TRUCK)	EACH	2
G131.020.0000	G-131b	ENGINEERING TRANSPORTATION (ATV)	EACH	1
G135.010.0000	G-135a	CONSTRUCTION SURVEYING BY THE CONTRACTOR	LUMP SUM	ALL REQUIRED
G135.020.0000	G-135b	EXTRA THREE PERSON SURVEY PARTY	HOUR	<del>80</del> 0
G135.200.0000	G-135g	MONUMENT CASE	EACH	2
G135.210.0000	G-135h	ADJUST EXISTING MONUMENT CASE	EACH	2
G700.010.0000	G-700a	AIRPORT FLAGGER	CONTINGENT SUM	ALL REQUIRED
G710.010.0000	G-710a	HIGHWAY TRAFFIC MAINTENANCE	LUMP SUM	ALL REQUIRED
L100.020.0000	L-100b	REGULATOR, L-828	EACH	1
L100.030.0000	L-100d	MEDIUM INTENSITY RUNWAY EDGE AND THRESHOLD LIGHT, L-861 AND L-861E	EACH	63
L100.040.0000	L-100e	TAXIWAY EDGE LIGHT, L-861T	EACH	16
L100.070.0000	L-100h	REMOVE RUNWAY AND TAXIWAY LIGHT	EACH	<del>69</del> 70
L100.130.0000	L-100n	AIRPORT SIGN, L-858	EACH	1
L100.150.0000	L-100p	HANDHOLE, L-867, SIZE B	EACH	12
L100.180.0000	L-100r	TEMPORARY RUNWAY LIGHTING SYSTEM	LUMP SUM	ALL REQUIRED
L100.170.0000	L-100ap	SPARE PARTS	CONTINGENT SUM	ALL REQUIRED
L101.020.0000	L-101b	ROTATING BEACON, MEDIUM INTENSITY, L-801A	EACH	1
L103.010.0030	L-103a	30-FOOT HINGED POLE BEACON TOWER	EACH	1
L107.010.0008	L-107a	8-FOOT LIGHTED WIND CONE, IN PLACE	EACH	2
L108.010.2008	L-108a	UNDERGROUND CABLE #8 AWG, COPPER, 5KV FAA TYPE C, L-824	LINEAR FOOT	<del>9,800</del> 9,953
L108.030.0006	L-108c-06	#6 BARE COPPER GROUND CONDUCTOR	LINEAR FOOT	<del>13,000</del> 13,092
L108.050.1008	L-108e	UNDERGROUND CABLE #8 AWG, COPPER, 600V, TYPE C, L-824	LINEAR FOOT	<del>6,900</del> 6,903
L108.070.0000	L-108g	GROUND ROD	EACH	17

ESTIMATED QUANTITIES

ITEM NO.	SSAC 2018 ITEM NO.	PAY ITEM	PAY UNIT	QUANTITY
L109.030.0000	L-109c	ELECTRICAL ENCLOSURE AND FOUNDATION IN PLACE	EACH	1
L109.040.0000	L-109d	INSTALLATION OF ELECTRICAL EQUIPMENT IN NEW OR EXISTING STRUCTURE	EACH	1
L109.080.0000	L-109e	DEMOLITION OF ELECTRICAL EQUIPMENT	LUMP SUM	1
L110.030.1002	L-110a-2	RIGID STEEL CONDUIT, 2-INCH	LINEAR FOOT	430
L110.110.1002	L-110g-2	PE CONDUIT, 2-INCH	LINEAR FOOT	<del>12,570</del> 11,569
P152.010.0000	P-152a	UNCLASSIFIED EXCAVATION	CUBIC YARD	<del>12,400</del> 22,039 .83
P153.200.0000	P-153a	GEOFOAM FILL	LUMP SUM	ALL REQUIRED
P154.020.0000	P-154b	SUBBASE COURSE	TON	<del>3,750</del> 4,018.30
P156.010.0000	P-156a	EROSION, SEDIMENT AND POLLUTION CONTROL ADMINISTRATION	LUMP SUM	ALL REQUIRED
P156.030.0000	P-156b	TEMPORARY AIR AND WATER POLLUTION, SOIL EROSION, AND SILTATION CONTROL	LUMP SUM	ALL REQUIRED
P156.050.0000	P-156d	TEMPORARY AIR AND WATER POLLUTION, SOIL EROSION, AND SILTATION CONTROL BY DIRECTIVE	CONTINGENT SUM	ALL REQUIRED
P156.060.0000	P-156f	WITHHOLDING	CONTINGENT SUM	ALL REQUIRED
P161.010.0000	P-161a	RECYCLED ASPHALT PAVEMENT	SQUARE YARD	<del>44,600</del> 44,018 .95
P209.020.0000	P-209b	CRUSHED AGGREGATE BASE COURSE	TON	<del>7,000</del> 10,299.78
P401.010.0040	P-401a-2B	HOT MIX ASPHALT TYPE II, CLASS B	TON	<del>7,900</del> 8,102.95
P401.080.0000	P-401b	HOT MIX ASPHALT PRICE ADJUSTMENT	CONTINGENT SUM	ALL REQUIRED
P401.020.5828	P-401c	ASPHALT BINDER, PG 58-28	TON	<del>482</del> 441.00
P620.020.0000	P-620c	RUNWAY AND TAXIWAY PAINTING	LUMP SUM	ALL REQUIRED
P620.070.0000	P-620g	TEMPORARY RUNWAY & TAXIWAY PAINTING	LUMP SUM	ALL REQUIRED
P660.030.0000	P-660b	REFLECTIVE MARKER, TYPE II	EACH	12

ESTIMATING FACTORS

ITEM NO.	ITEM	FACTOR/QUANTITY
P-154b	SUBBASE COURSE	1.95 TON/CY
P-209b	CRUSHED AGGREGATE BASE COURSE	1.95 TON/CY
P-401a	HOT MIX ASPHALT, TYPE II, CLASS B	118 LBS/SY/ INCH
P-401c	ASPHALT BINDER PG 58-28	6.10% OF P-401a

Record Drawings have been reviewed by the Project Engineer, and represent to the best of my knowledge, the project as constructed.  
 PE [Signature] Date 10.24.19

8/13/2018, 1:10 PM

PLANS DEVELOPED BY: STANTEC CONSULTING SERVICES, INC. 725 EAST FIREWEED LANE, SUITE 200, ANCHORAGE, AK 99503-2245 CERTIFICATE OF AUTHORIZATION #126386  
 U:\2047059100\Drawing\C\Sheets\2047059100\_ESTM.dwg

DESIGN RPK  
 DRAWN ADC  
 CHECKED JGL


STATE OF ALASKA  
 DEPARTMENT OF TRANSPORTATION AND PUBLIC FACILITIES  
 SOUTHCOAST REGION-DESIGN AND CONSTRUCTION-AVIATION



BY	DATE	REVISIONS
RPK	7/9/2018	ADDED AASHTOWARE ITEM NUMBERS TO THE ESTIMATE.
RPK	8/13/2018	CHANGED L-109e PAY UNIT $\Delta$ ADDENDUM 2

KAKE AIRPORT  
 KAKE, ALASKA  
 RUNWAY REHABILITATION  
 AIP 3-02-0398-XX-2018/SFAPT00078  
 ESTIMATED QUANTITIES AND ESTIMATING FACTORS

SHEET 2 OF 27

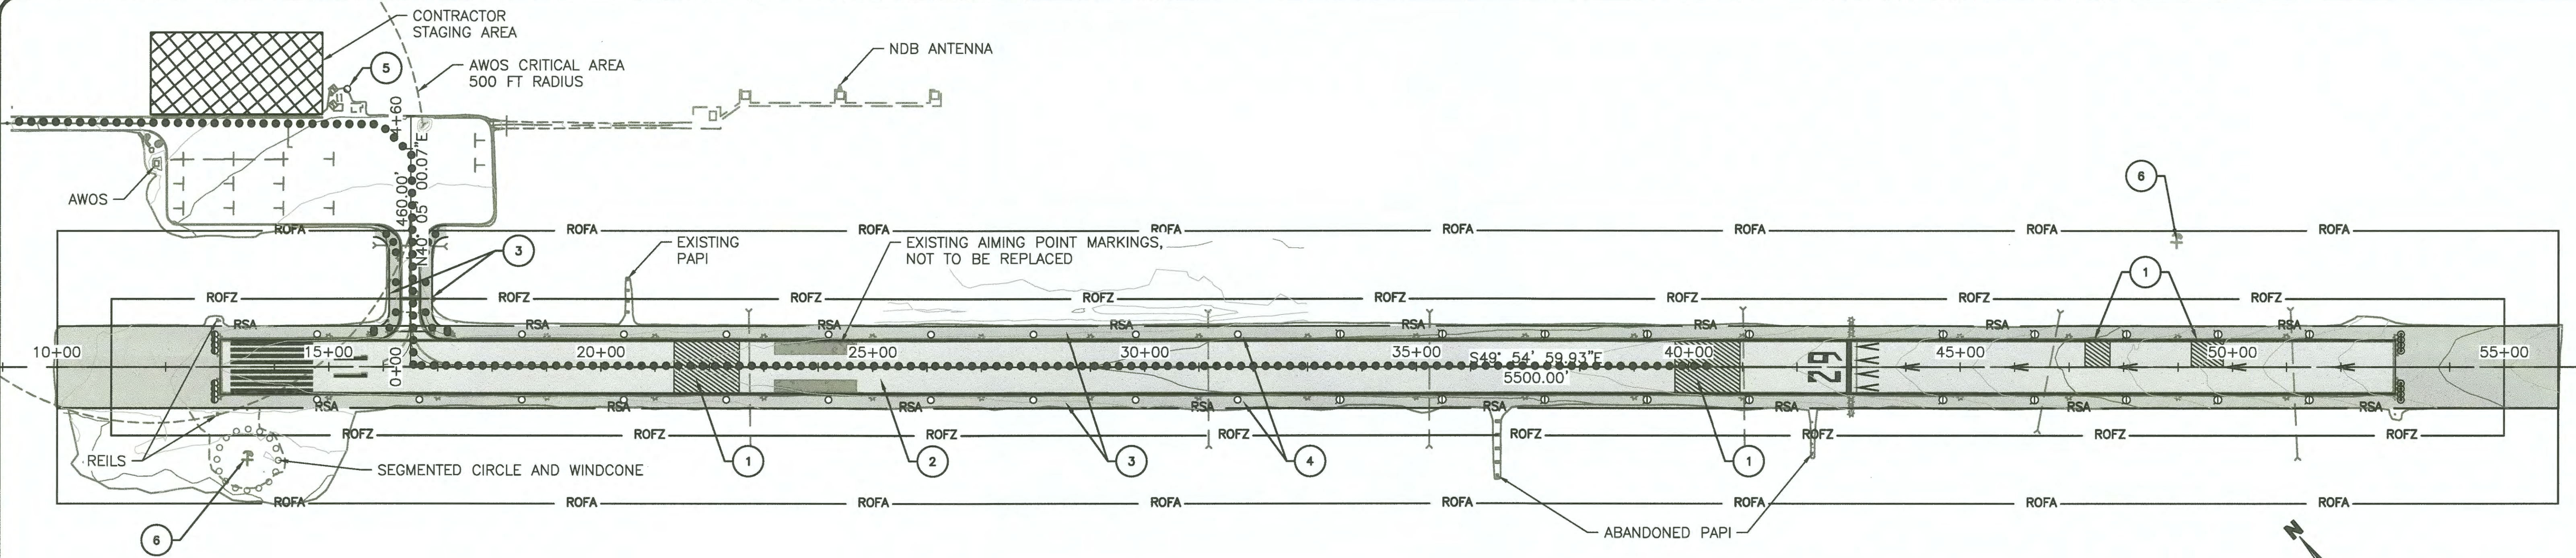

**LEGEND:**

DEMOLITION	EXISTING	NEW	
---	---	---	PROPERTY LINE
---	---	---	UNDERGROUND ELECTRIC
---	---	---	UTILITY POLE
---	---	---	TAXIWAY/RUNWAY LIGHT
---	---	●	TAXIWAY LIGHT
---	---	○	RUNWAY LIGHT - OMNI-DIRECTIONAL
---	---	⊕	RUNWAY LIGHT - BI-DIRECTIONAL
---	---	⊙	THRESHOLD LIGHT
---	---	⊙	RUNWAY END LIGHT
---	---	⊙	ANTENNA
---	---	---	REIL
---	---	---	HMA
---	---	---	GRAVEL EDGE
---	---	---	SIGN
---	---	---	CULVERT
---	---	---	DRAINAGE/SWALE
---	---	---	CONTOUR LINES
---	---	---	RUNWAY OBJECT FREE AREA
---	---	---	RUNWAY OBJECT FREE ZONE
---	---	---	RUNWAY SAFETY AREA
---	---	---	TAXIWAY OBJECT FREE AREA
---	---	---	TAXIWAY SAFETY AREA
---	---	---	WIND CONE
---	---	---	SEGMENTED CIRCLE AND WIND CONE
---	---	---	FILL
---	---	---	CUT
---	---	---	HAUL ROUTE
---	---	---	BOREHOLE
---	---	---	CONSTRUCTION PHASE/WORK LIMITS

**LEGEND:**

	CONTRACTOR STAGING AREA
	RUNWAY REPAIR
	RAP
	HMA

**ABBREVIATIONS:**

AC	ADVISORY CIRCULAR	LS	LUMP SUM
AIP	AIRPORT IMPROVEMENT PROGRAM	LVC	LENGTH OF VERTICAL CURVE
AWOS	AUTOMATED WEATHER OBSERVATION SYSTEM	MAX	MAXIMUM
BVCE	BEGIN VERTICAL CURVE ELEVATION	MIN	MINIMUM
BVCS	BEGIN VERTICAL CURVE STATION	N	NORTHING
CABC	CRUSHED AGGREGATE BASE COURSE	NDB	NON-DIRECTIONAL BEACON
CL	CENTERLINE	O.C.	ON CENTER
CF	CUBIC FOOT	OFF	OFFSET
CS	CONTINGENT SUM	PAPI	PRECISION APPROACH PATH INDICATOR
CSPP	CONSTRUCTION SAFETY AND PHASING PLAN	PC	POINT OF CURVATURE
CTAF	COMMON TRAFFIC ADVISORY FREQUENCY (122.9 MHz)	PT	POINT OF TANGENCY
CY	CUBIC YARD	PVI	POINT OF VERTICAL INTERSECTION
E	EAST	R	RADIUS
E	EASTING	RAP	RECYCLED ASPHALT PAVEMENT
ELEV	ELEVATION	REIL	RUNWAY END IDENTIFICATION LIGHT(S)
EG	EXISTING GROUND	ROFA	RUNWAY OBJECT FREE AREA
EPS	EXPANDED POLYSTYRENE (GEOFOAM)	ROFZ	RUNWAY OBSTACLE FREE ZONE
EVCE	END VERTICAL CURVE ELEVATION	RP	RADIUS POINT
EVCS	END VERTICAL CURVE STATION	RSA	RUNWAY SAFETY AREA
FAA	FEDERAL AVIATION ADMINISTRATION	RT	RIGHT
FG	FINISHED GRADE	RW	RUNWAY
FOD	FOREIGN OBJECTS & DEBRIS	S	SOUTH
FT	FEET	SCS	SURVEY CONTROL SHEET
HMA	HOT MIX ASPHALT	STA	STATION
K	RATE OF VERTICAL CURVATURE	SY	SQUARE YARD
LB	POUND	TOFA	TAXIWAY OBJECT FREE AREA
L	LENGTH	TSA	TAXIWAY SAFETY AREA
LT	LEFT	TYP	TYPICAL
LF	LINEAR FEET	TW	TAXIWAY



**GENERAL PROJECT NOTES:**

- NO UNCOVERED, STOCKPILED MATERIAL WILL BE PERMITTED WITHIN THE AIRPORT PROPERTY.
- REFER TO THE CSPP AND PROJECT SPECIFICATIONS FOR CONSTRUCTION PHASING, AND SEQUENCING INFORMATION FOR LIMITATIONS ON CONSTRUCTION.
- SEE SURVEY CONTROL FOR HORIZONTAL AND VERTICAL CONTROL, INCLUDED AS SUPPLEMENTAL INFORMATION.
- CONTRACTOR IS RESPONSIBLE FOR PREPARING STAGING AREA.

**PROJECT TASKS: #**

- REPAIR RUNWAY DEPRESSIONS WITH GEOFOAM
- REHABILITATE RUNWAY PAVEMENT.
- RECONSTRUCT RSA AND TSA GRADES.
- REPLACE RUNWAY AND TAXIWAY LIGHTING SYSTEM.
- CONSTRUCT AIRPORT BEACON AND ELECTRICAL EQUIPMENT ENCLOSURE.
- REPLACE LIGHTED WIND CONES.

Record Drawings have been reviewed by the Project Engineer, and represent to the best of my knowledge, the project as constructed.  
 PE [Signature] Date 10.24.19

DESIGN RPK  
 DRAWN ADC  
 CHECKED JGL

STATE OF ALASKA  
 DEPARTMENT OF TRANSPORTATION AND PUBLIC FACILITIES  
 SOUTHCOAST REGION-DESIGN AND CONSTRUCTION-AVIATION




BY	DATE	REVISIONS


KAKE AIRPORT  
 KAKE, ALASKA  
 RUNWAY REHABILITATION  
 AIP 3-02-0398-XX-2018/SFAPT00078  
 PROJECT LAYOUT

SHEET  
 3  
 OF  
 27


PLANS DEVELOPED BY: STANTEC CONSULTING SERVICES, INC. 725 EAST FIREWEED LANE, SUITE 200, ANCHORAGE, AK 99503-2245 907-276-4245 CERTIFICATE OF AUTHORIZATION #126386  
 U:\2047059100\drawing\C\Sheets\2047059100\_SECT.dwg 6/25/2018, 3:52 PM

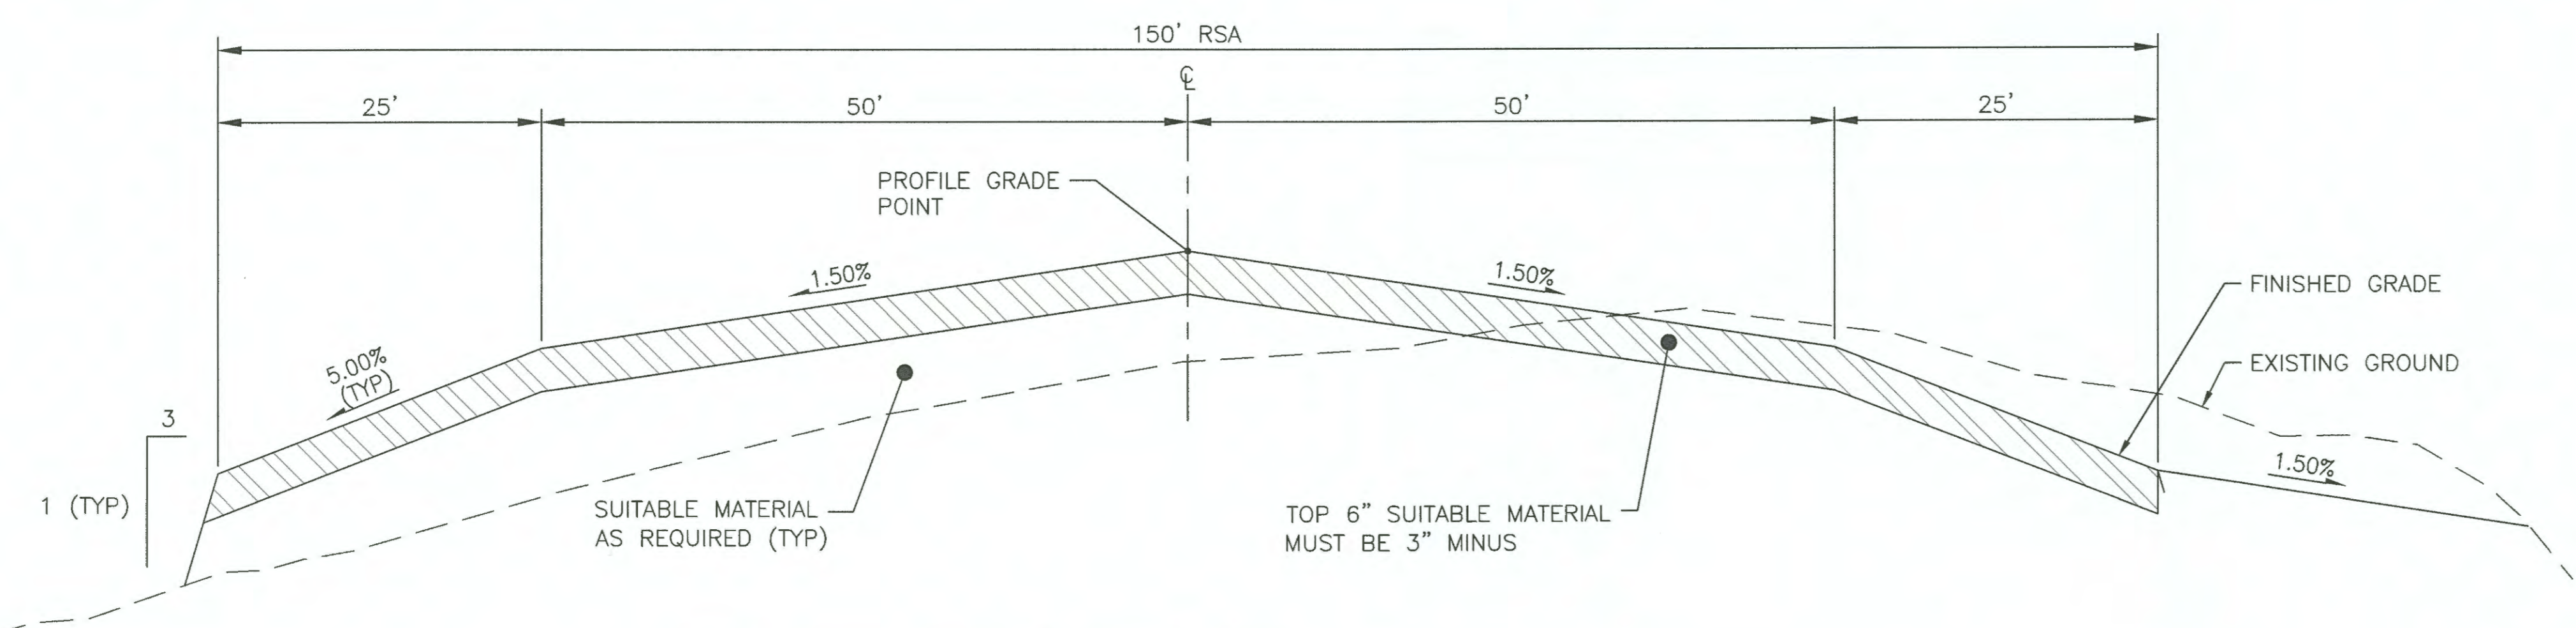

1  
 4 **RSA TYPICAL SECTION**  
 STA. 10+00 TO 13+00  
 STA 53+00 TO 56+00

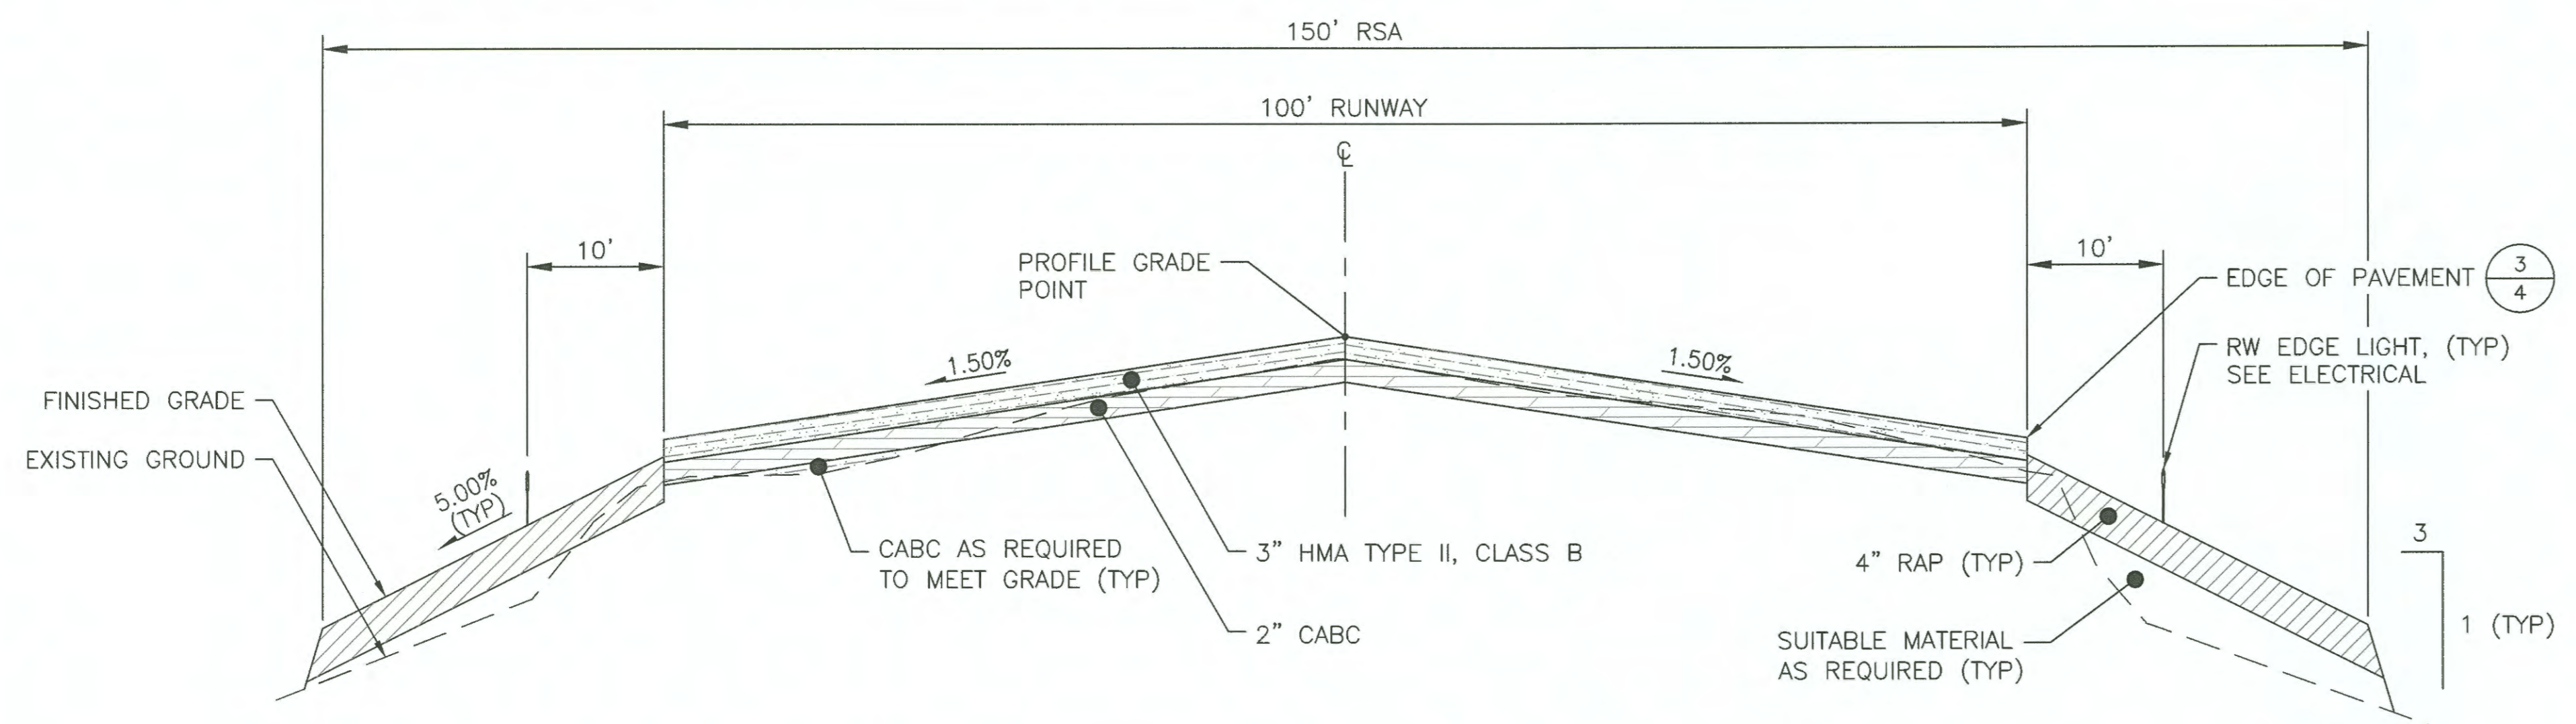

2  
 4 **RUNWAY TYPICAL PAVEMENT SECTION**  
 STA. 13+00 TO STA 53+00 (EXCEPT FOR EPS REPAIR SECTIONS)

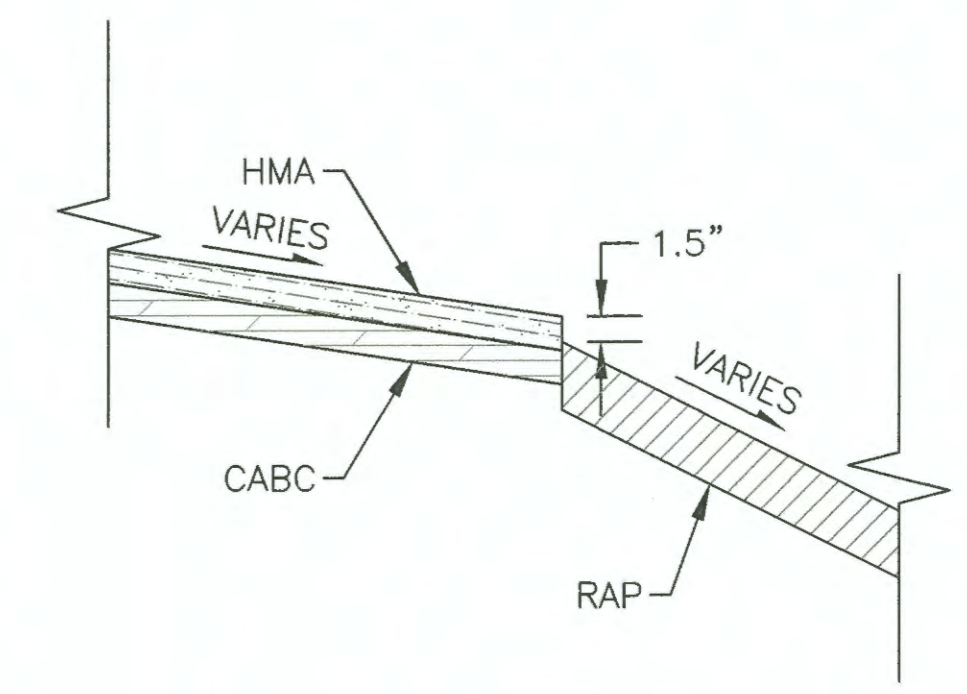

3  
 4 **EDGE OF PAVEMENT**  
 NTS

Record Drawings have been reviewed by the Project Engineer, and represent to the best of my knowledge, the project as constructed.  
 PE [Signature] Date 10.24.19

DESIGN RPK  
 DRAWN ADC  
 CHECKED JGL



**STATE OF ALASKA**  
 DEPARTMENT OF TRANSPORTATION AND PUBLIC FACILITIES  
 SOUTHCOAST REGION-DESIGN AND CONSTRUCTION-AVIATION



BY	DATE	REVISIONS


**KAKE AIRPORT**  
 KAKE, ALASKA  
 RUNWAY REHABILITATION  
 AIP 3-02-0398-XX-2018/SFAPT00078  
 TYPICAL SECTIONS I

SHEET  
**4**  
 OF  
**27**

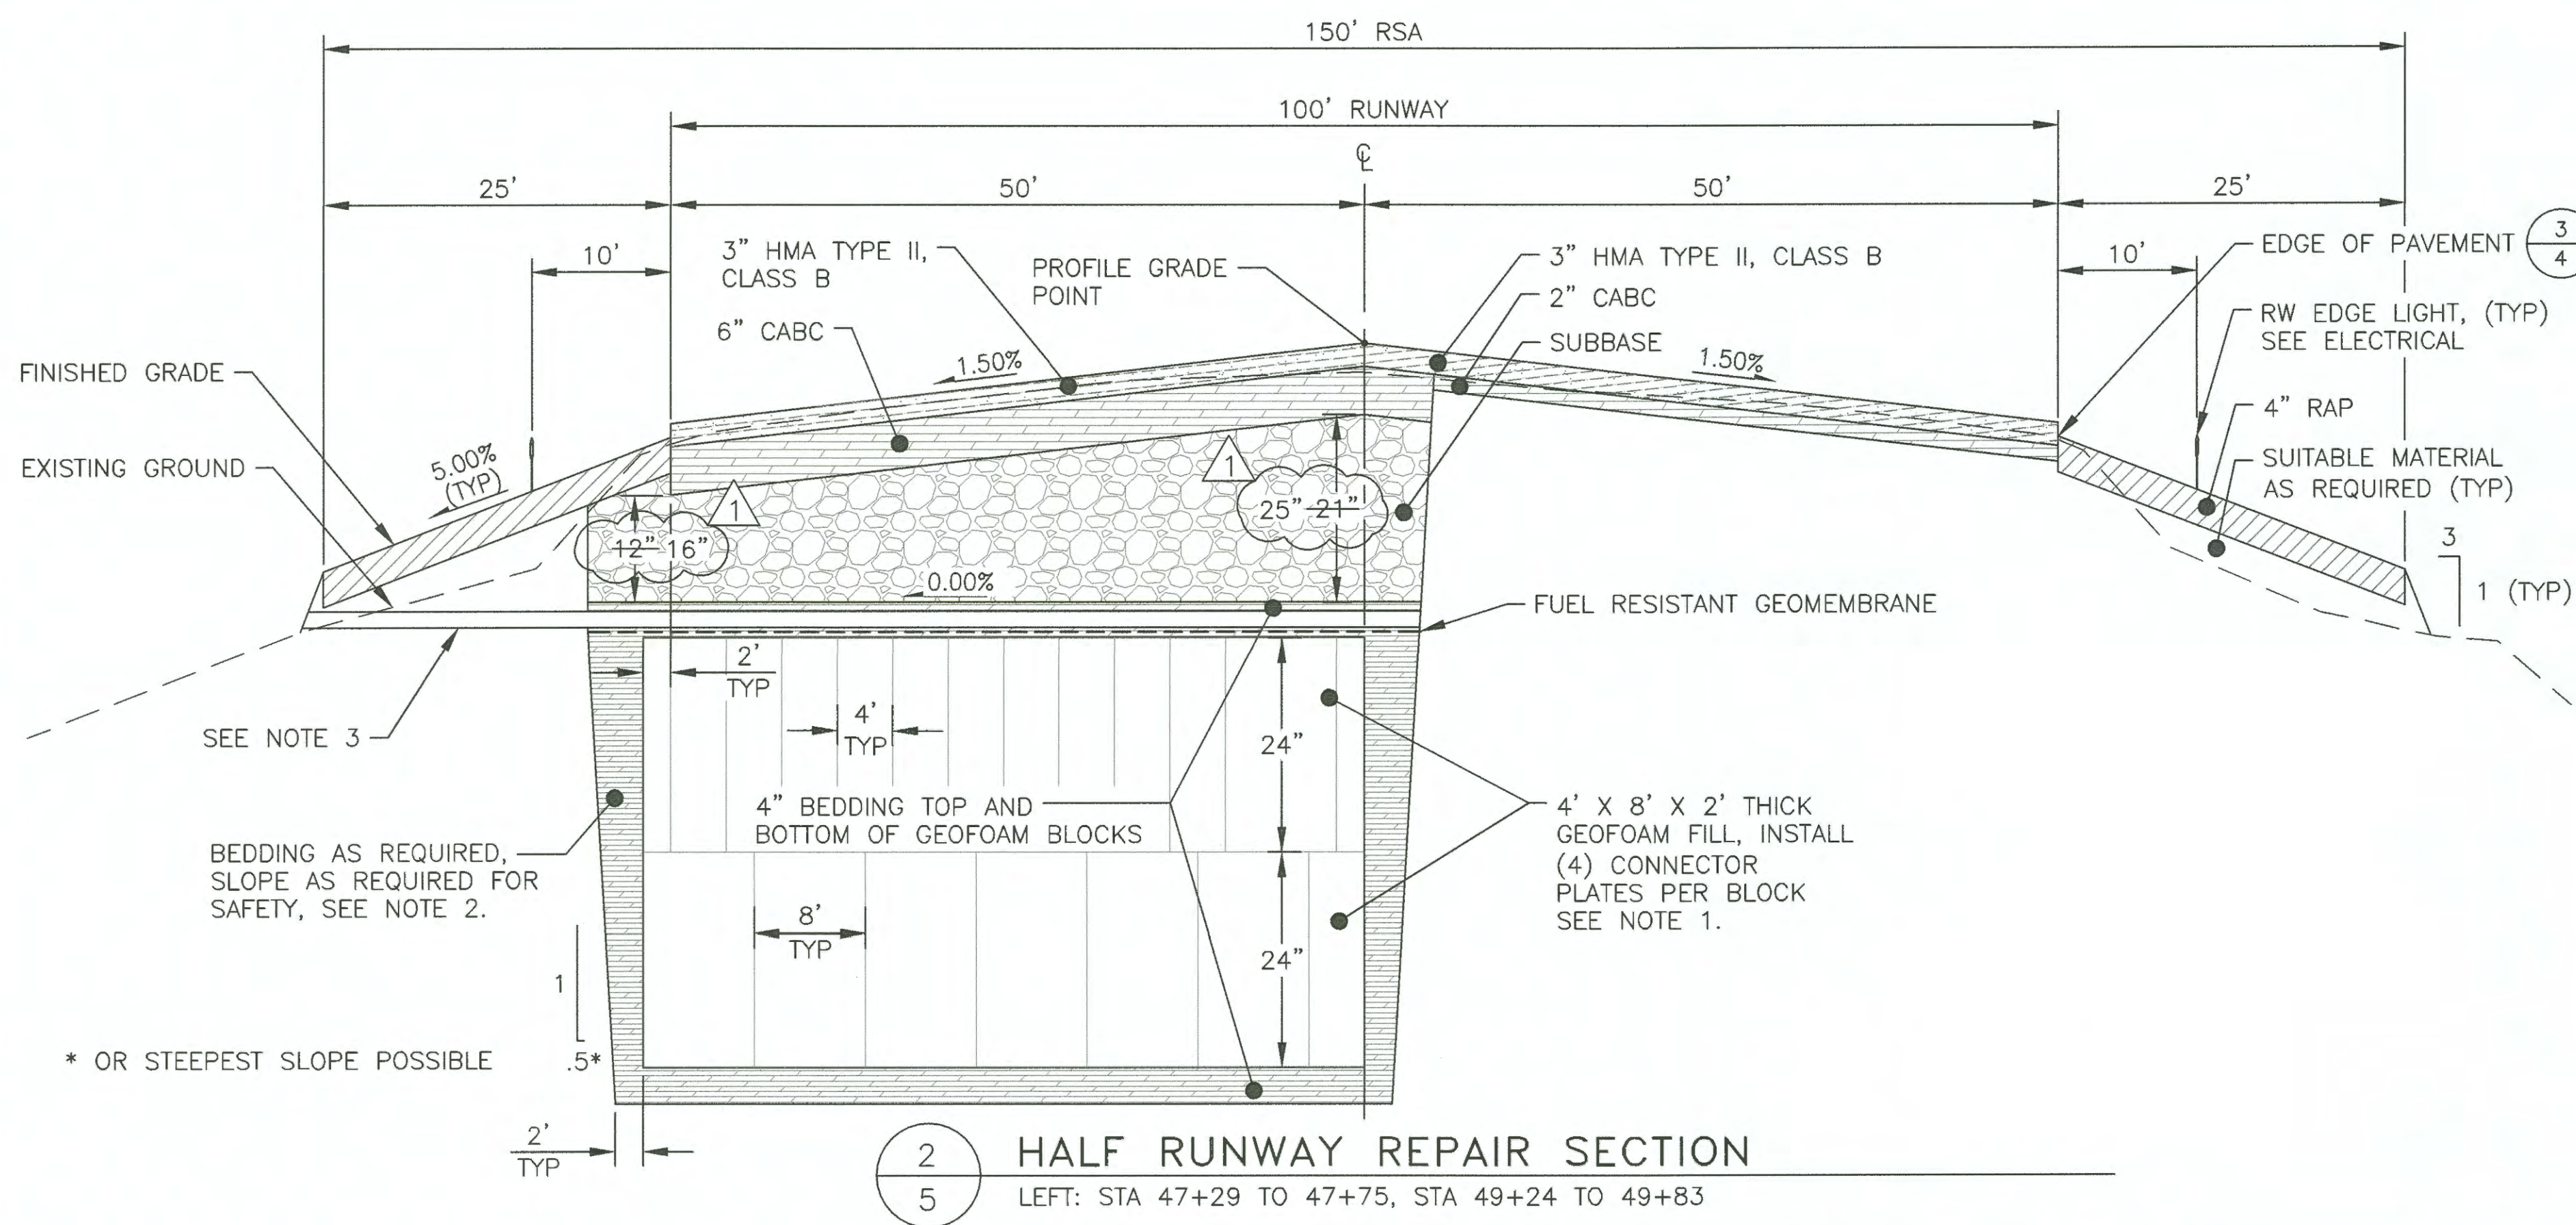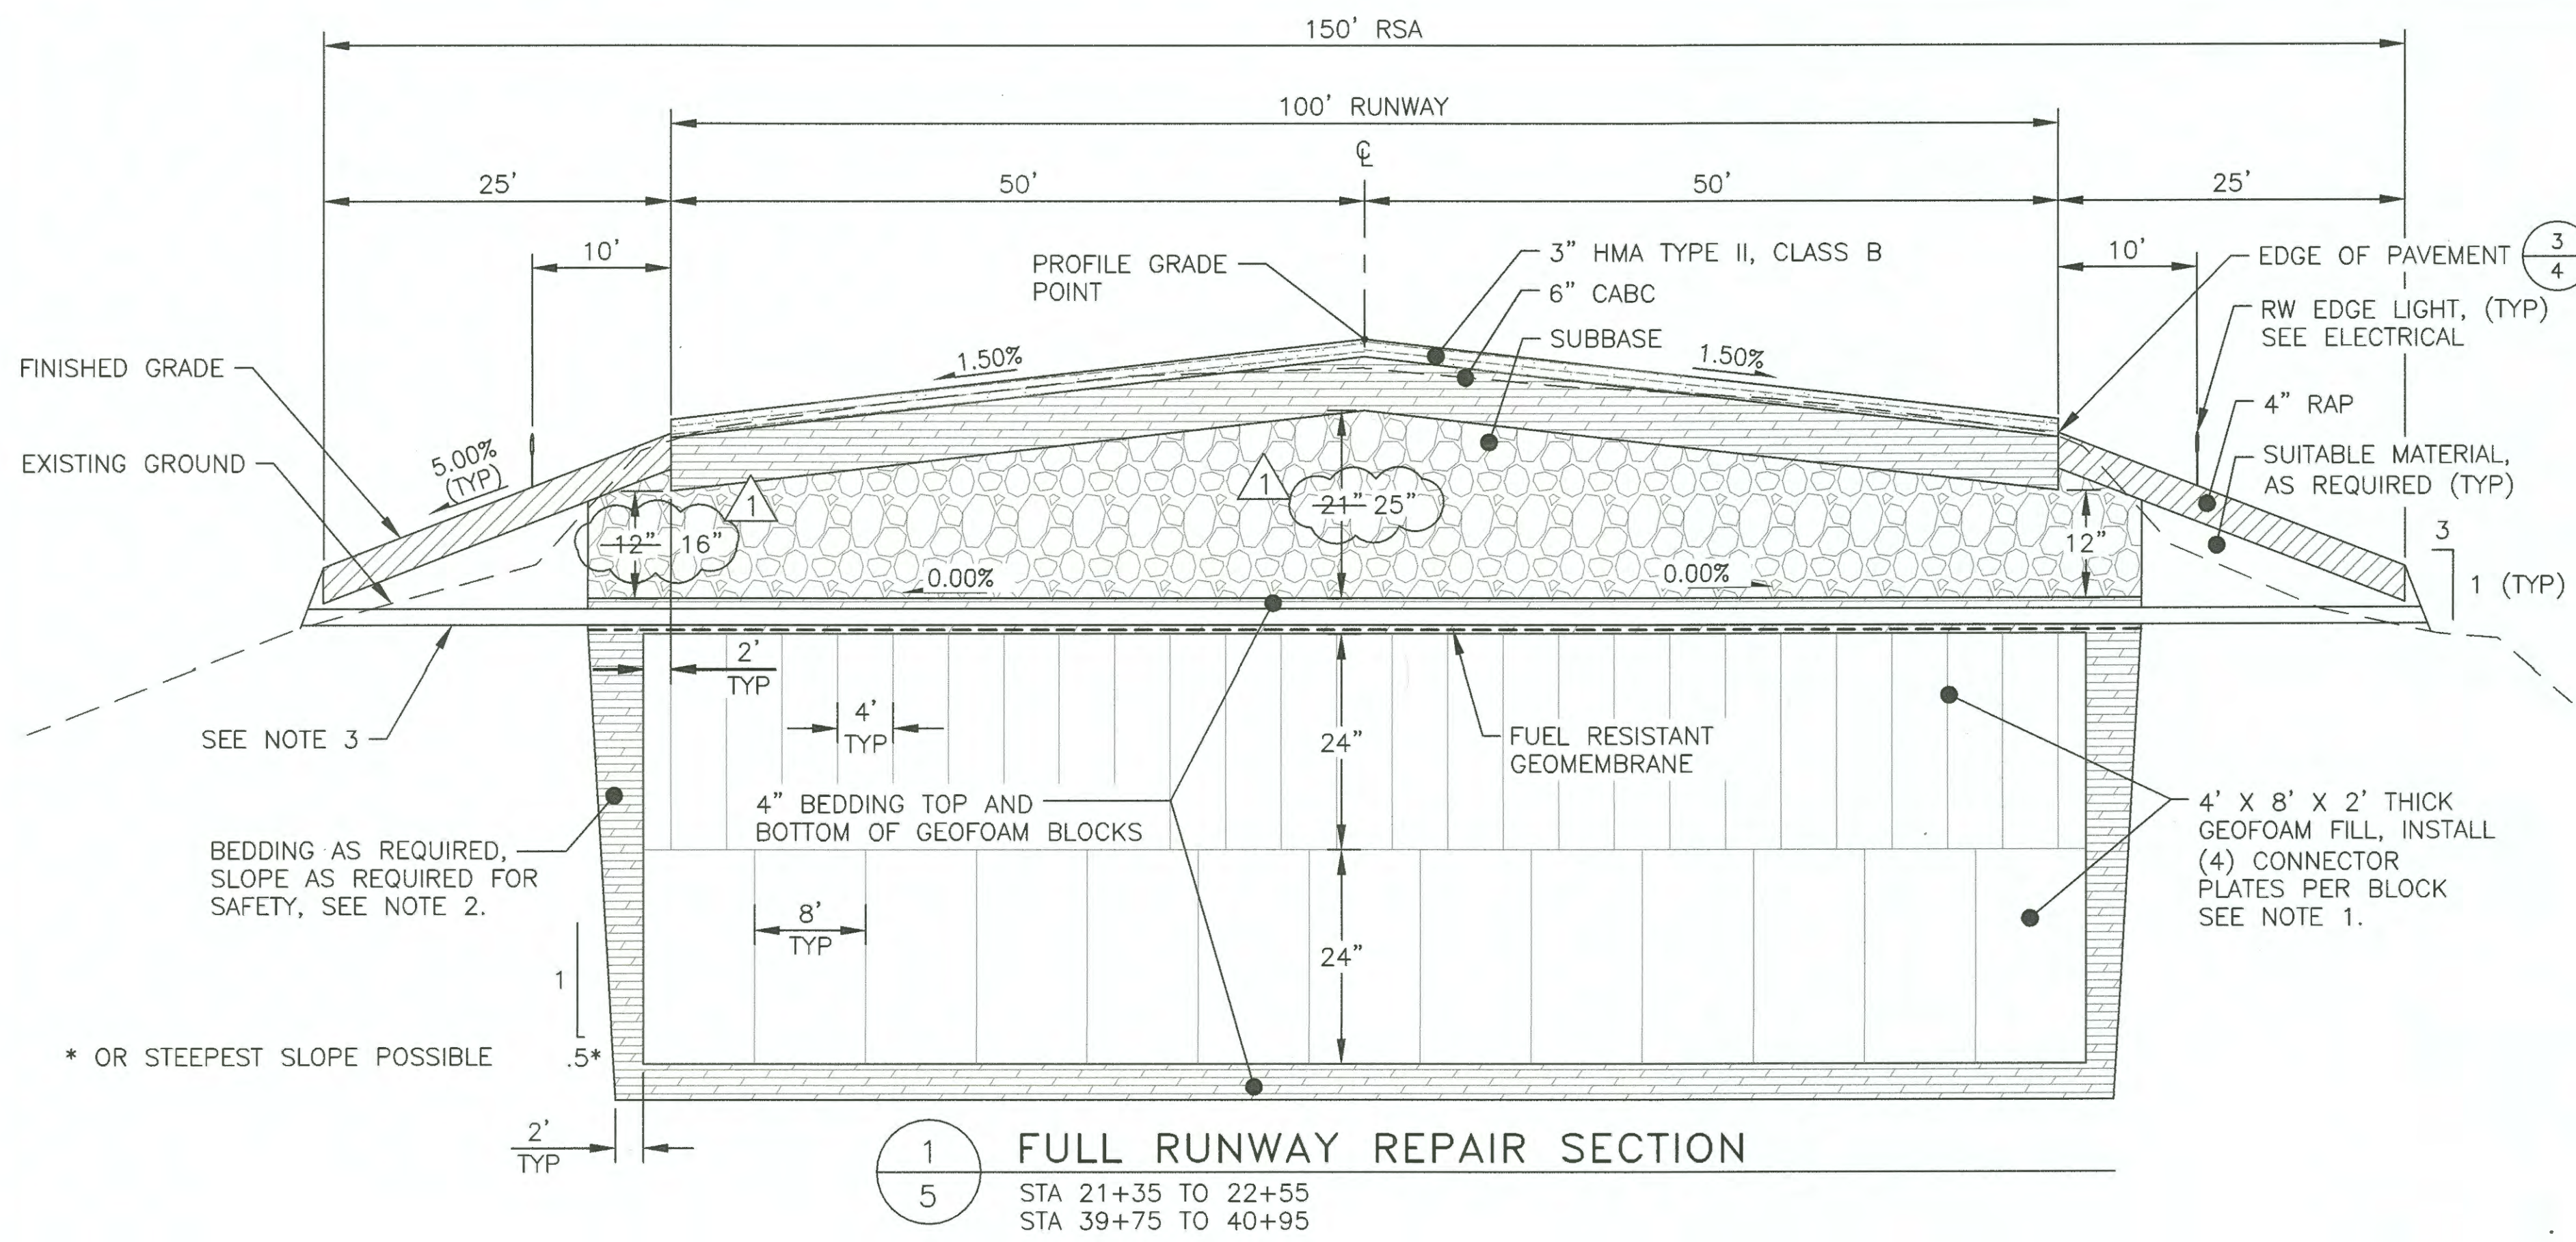

**RUNWAY REPAIR SECTION NOTES:**

1. ORIENT SECOND LAYER OF GEOFOAM BLOCK 90° AND TO STAGGER JOINTS WITH A 50% OFFSET.
2. DO NOT USE RAP OR CABC MIXED WITH RAP AS BEDDING AGAINST THE GEOFOAM BLOCKS.
3. TRANSVERSE RUNS OF 2"Ø PERFORATED PVC PIPE AT 15' O.C. DAYLIGHT TO EDGE OF EMBANKMENT.

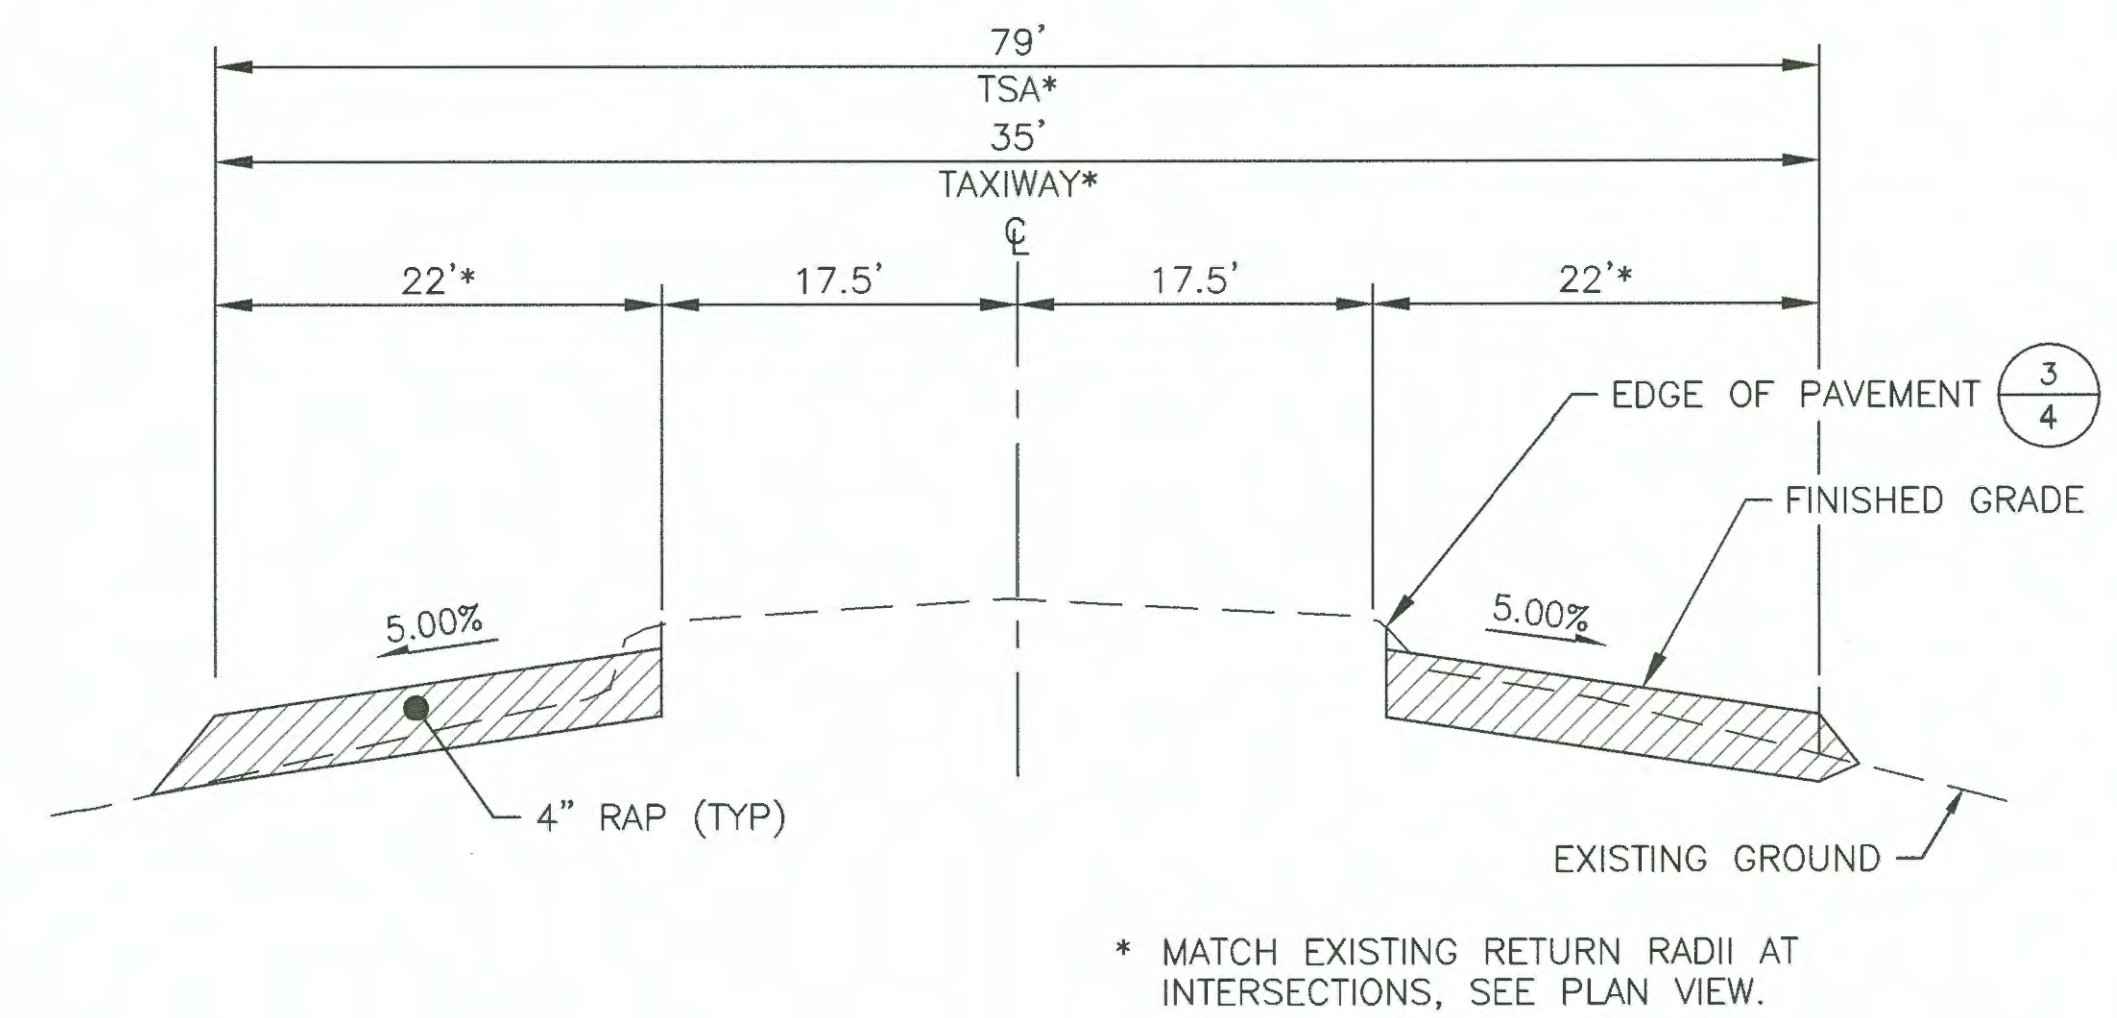

Record Drawings have been reviewed by the Project Engineer, and represent to the best of my knowledge, the project as constructed.  
 PE [Signature] Date 3.6.20



DESIGN	RPK
DRAWN	ADC
CHECKED	JGL

STATE OF ALASKA  
 DEPARTMENT OF TRANSPORTATION AND PUBLIC FACILITIES  
 SOUTHCOAST REGION-DESIGN AND CONSTRUCTION-AVIATION





BY	DATE	REVISIONS
JGL	04/05/19	△ REVISED DEPTH OF GEOFOAM BELOW FG

KAKE AIRPORT  
 KAKE, ALASKA  
 RUNWAY REHABILITATION  
 AIP 3-02-0398-XX-2018/SFAPT00078  
 TYPICAL SECTIONS II

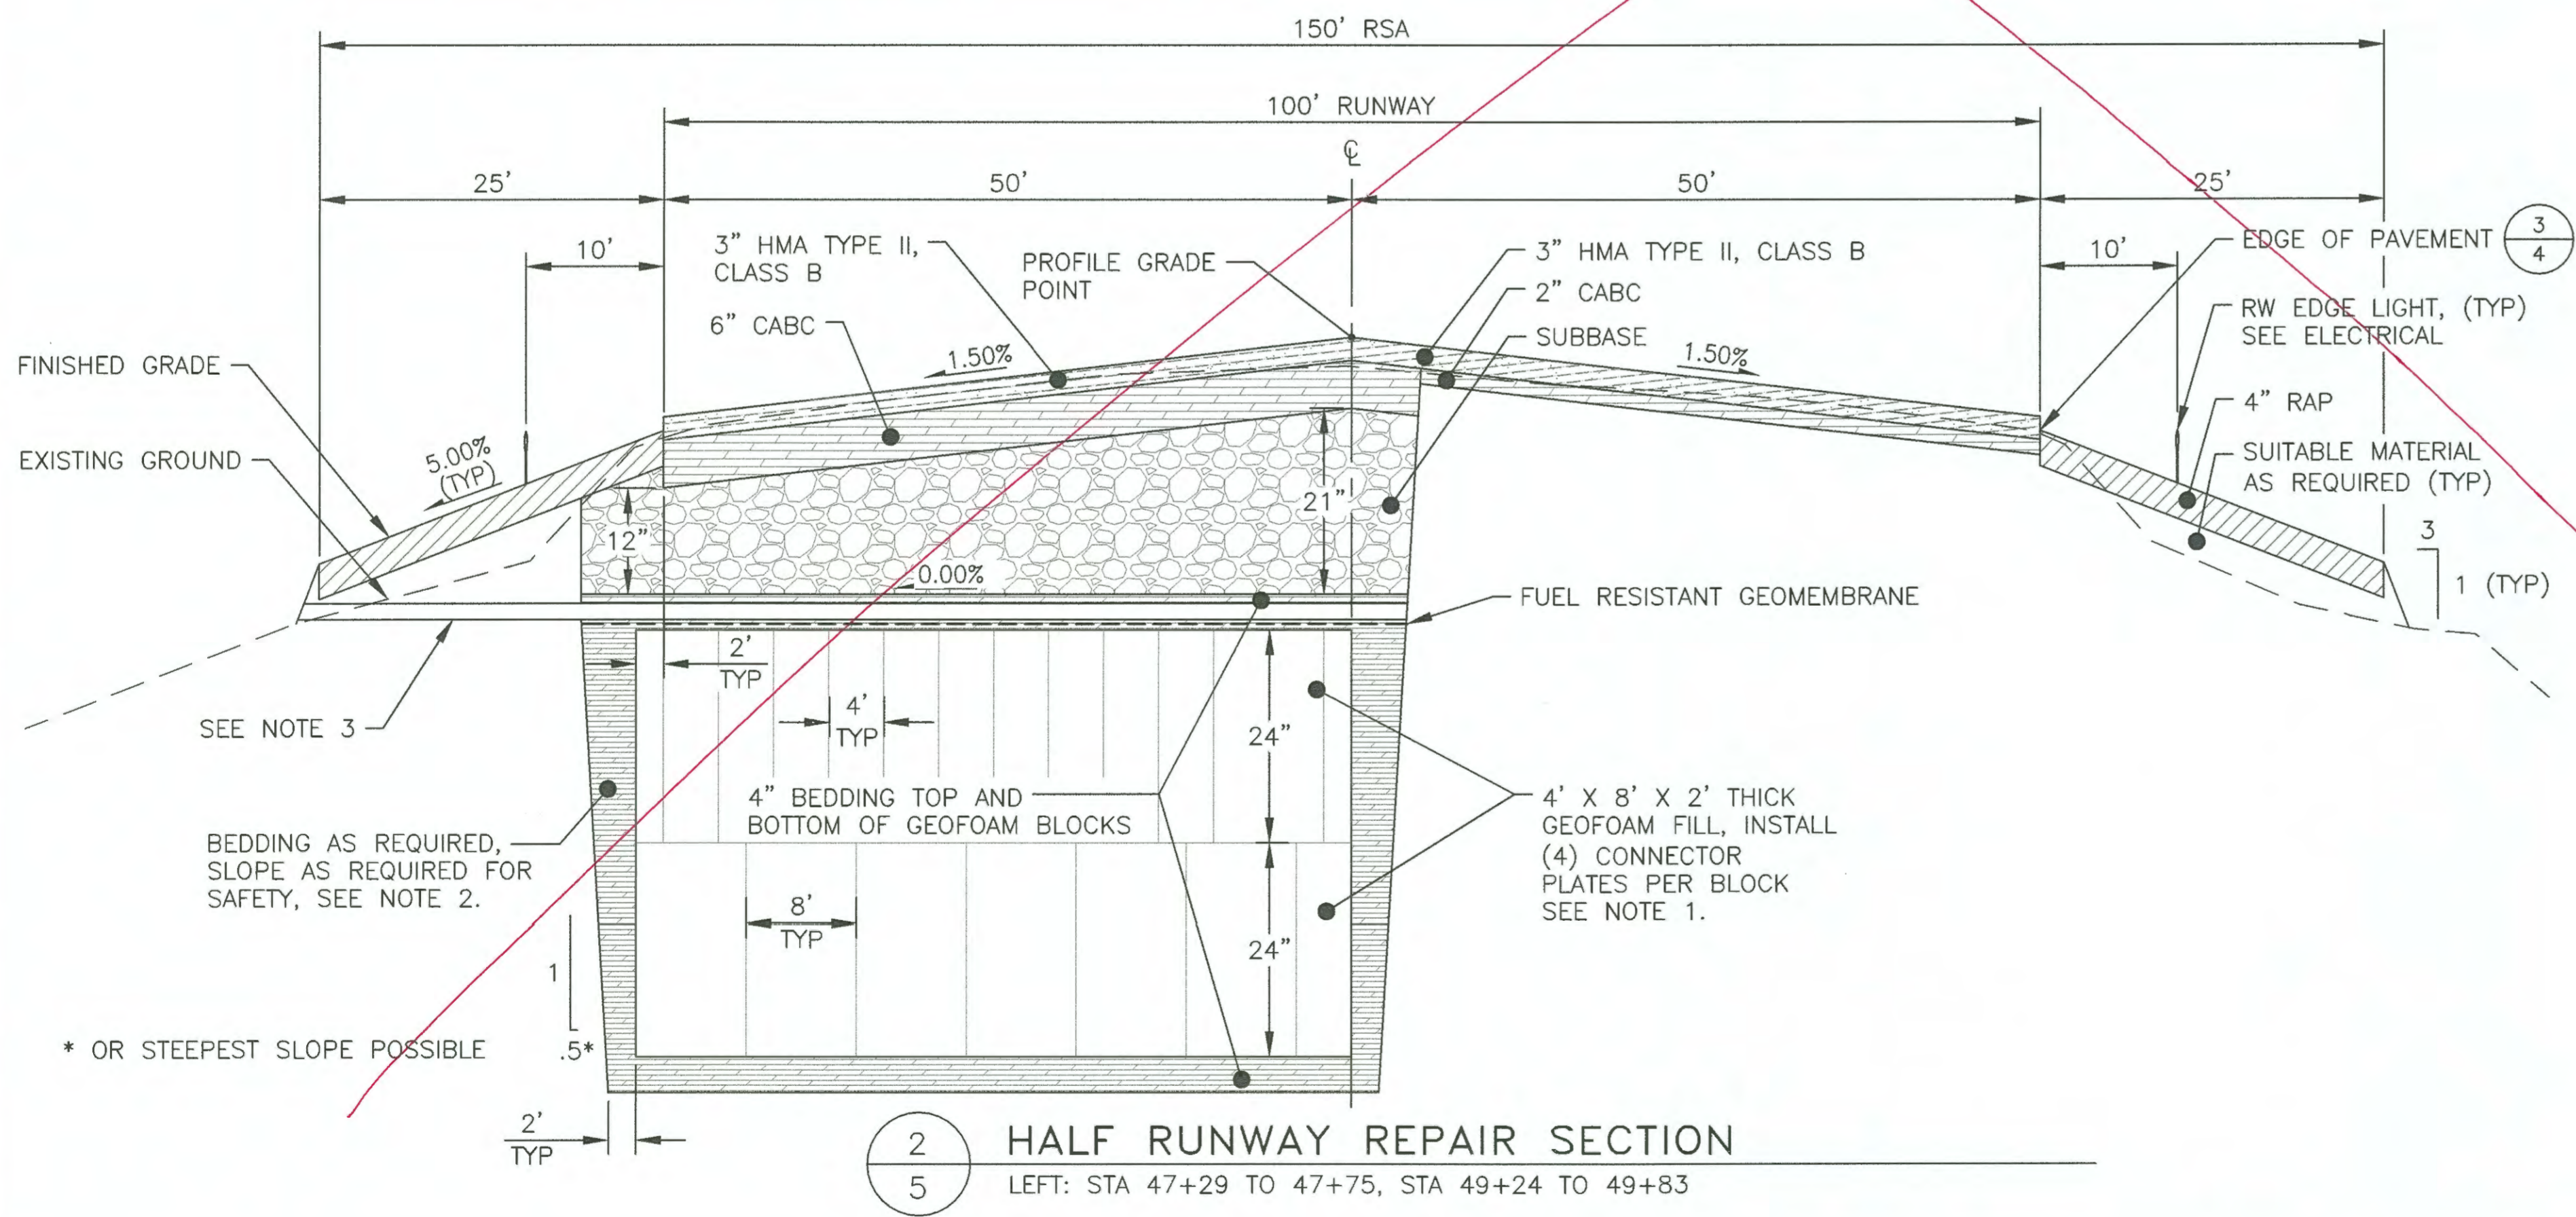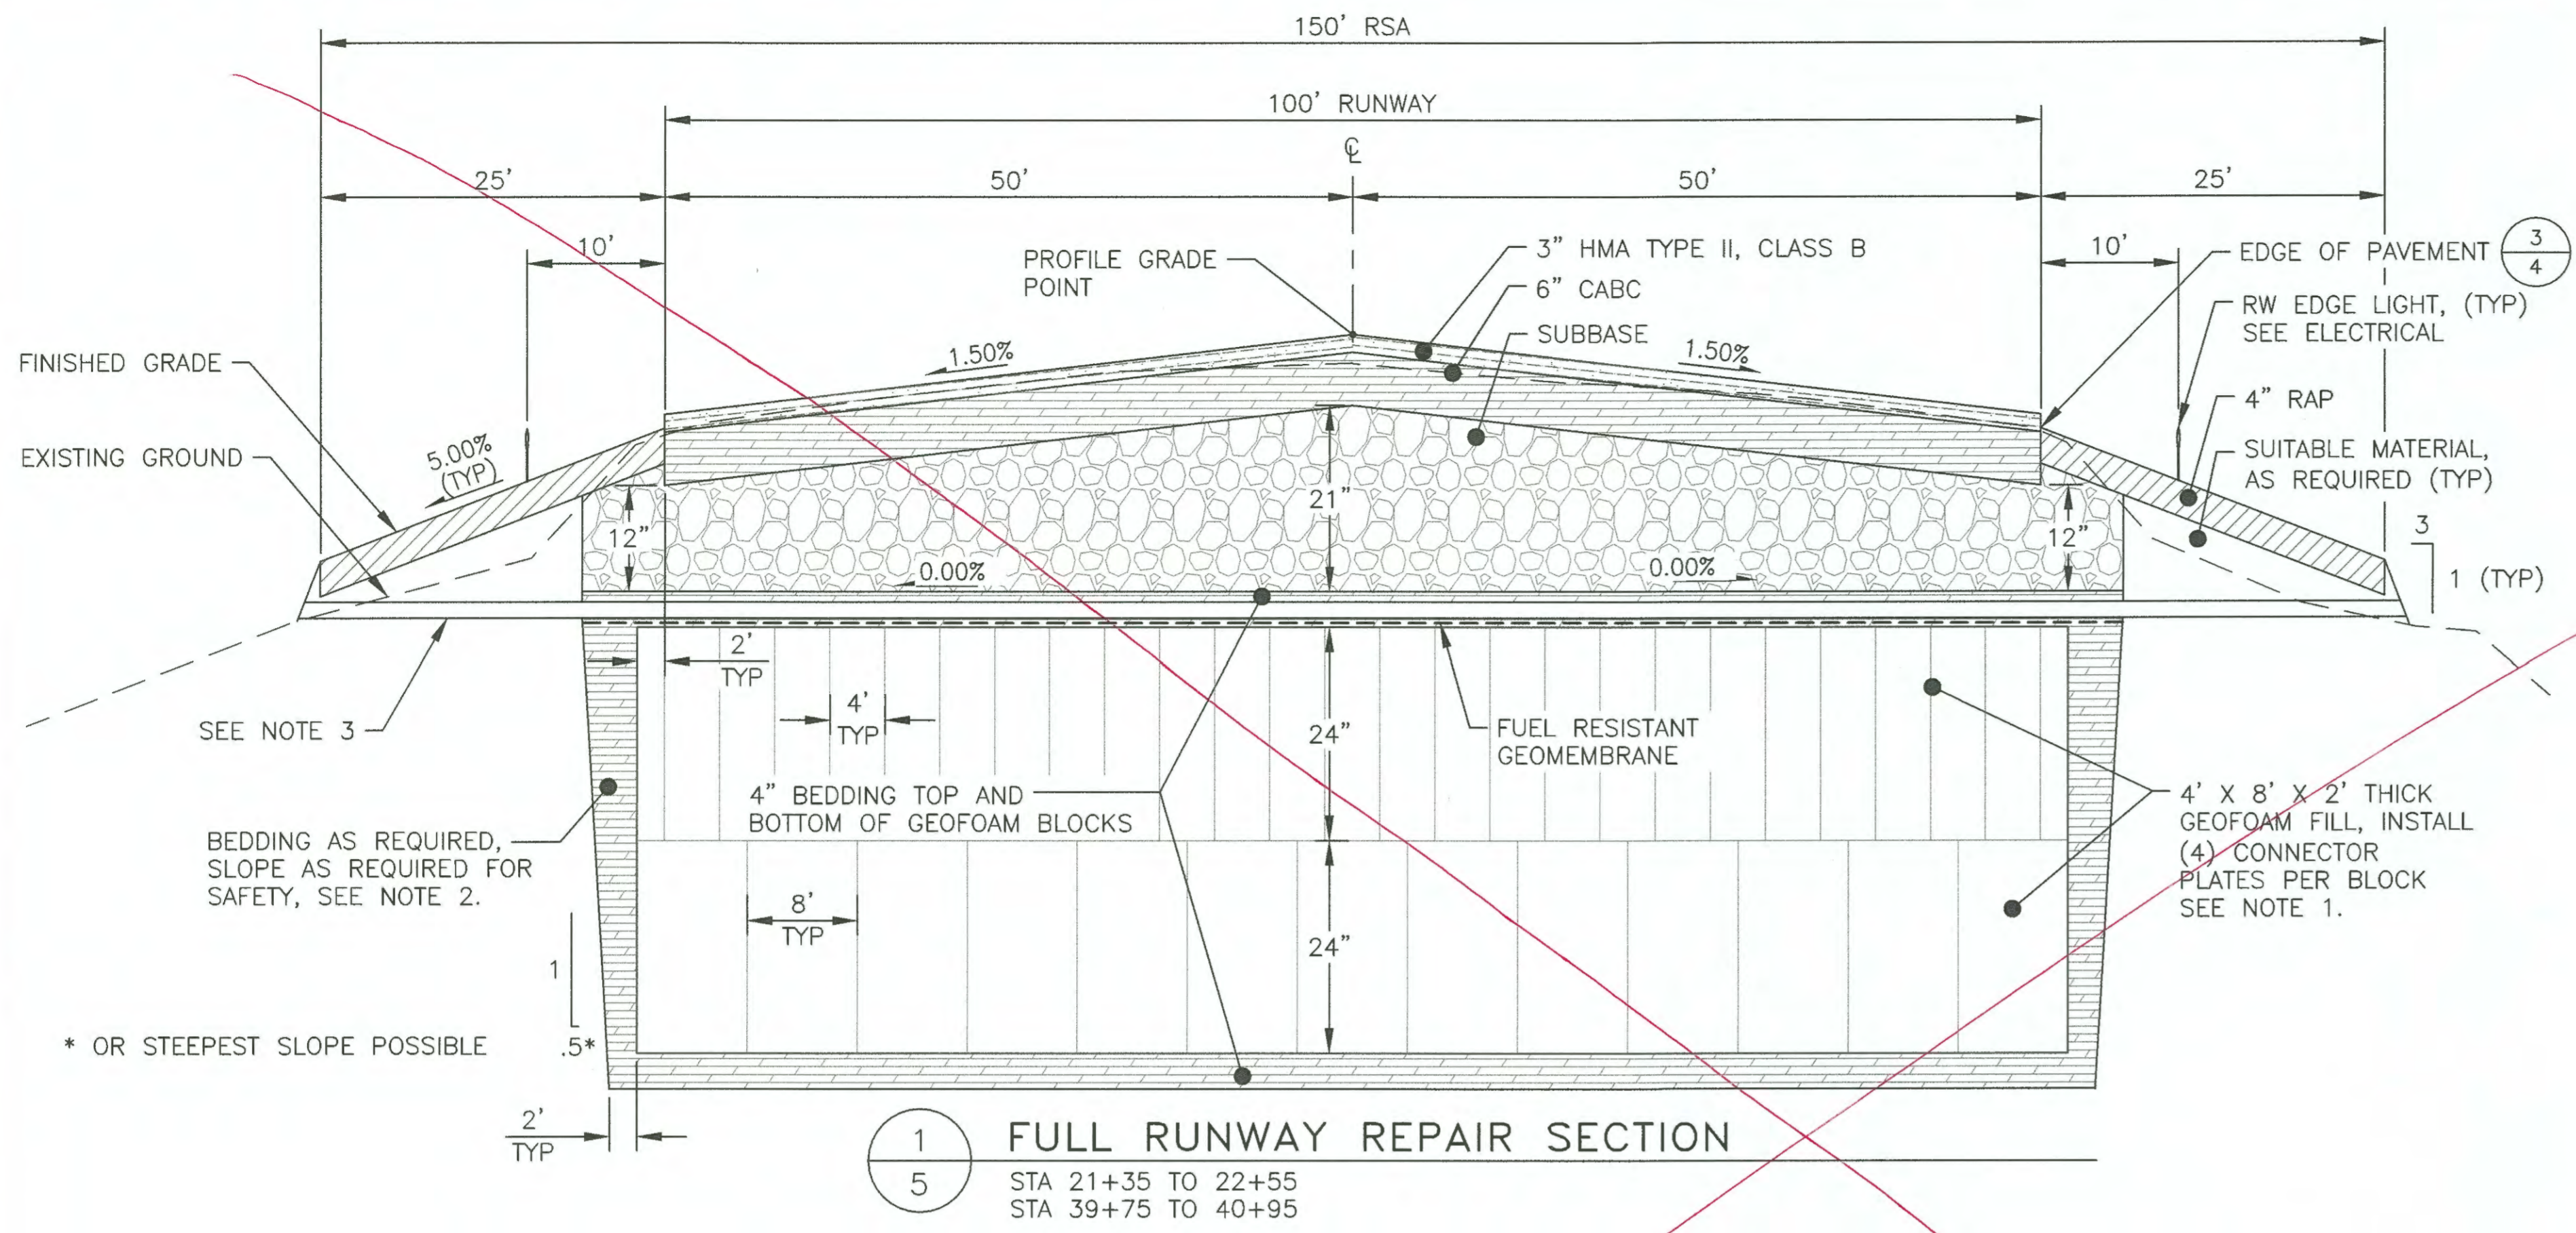

**RUNWAY REPAIR SECTION NOTES:**

1. ORIENT SECOND LAYER OF GEOFOAM BLOCK 90° AND TO STAGGER JOINTS WITH A 50% OFFSET.
2. DO NOT USE RAP OR CABC MIXED WITH RAP AS BEDDING AGAINST THE GEOFOAM BLOCKS.
3. TRANSVERSE RUNS OF 2"Ø PERFORATED PVC PIPE AT 15' O.C. DAYLIGHT TO EDGE OF EMBANKMENT.

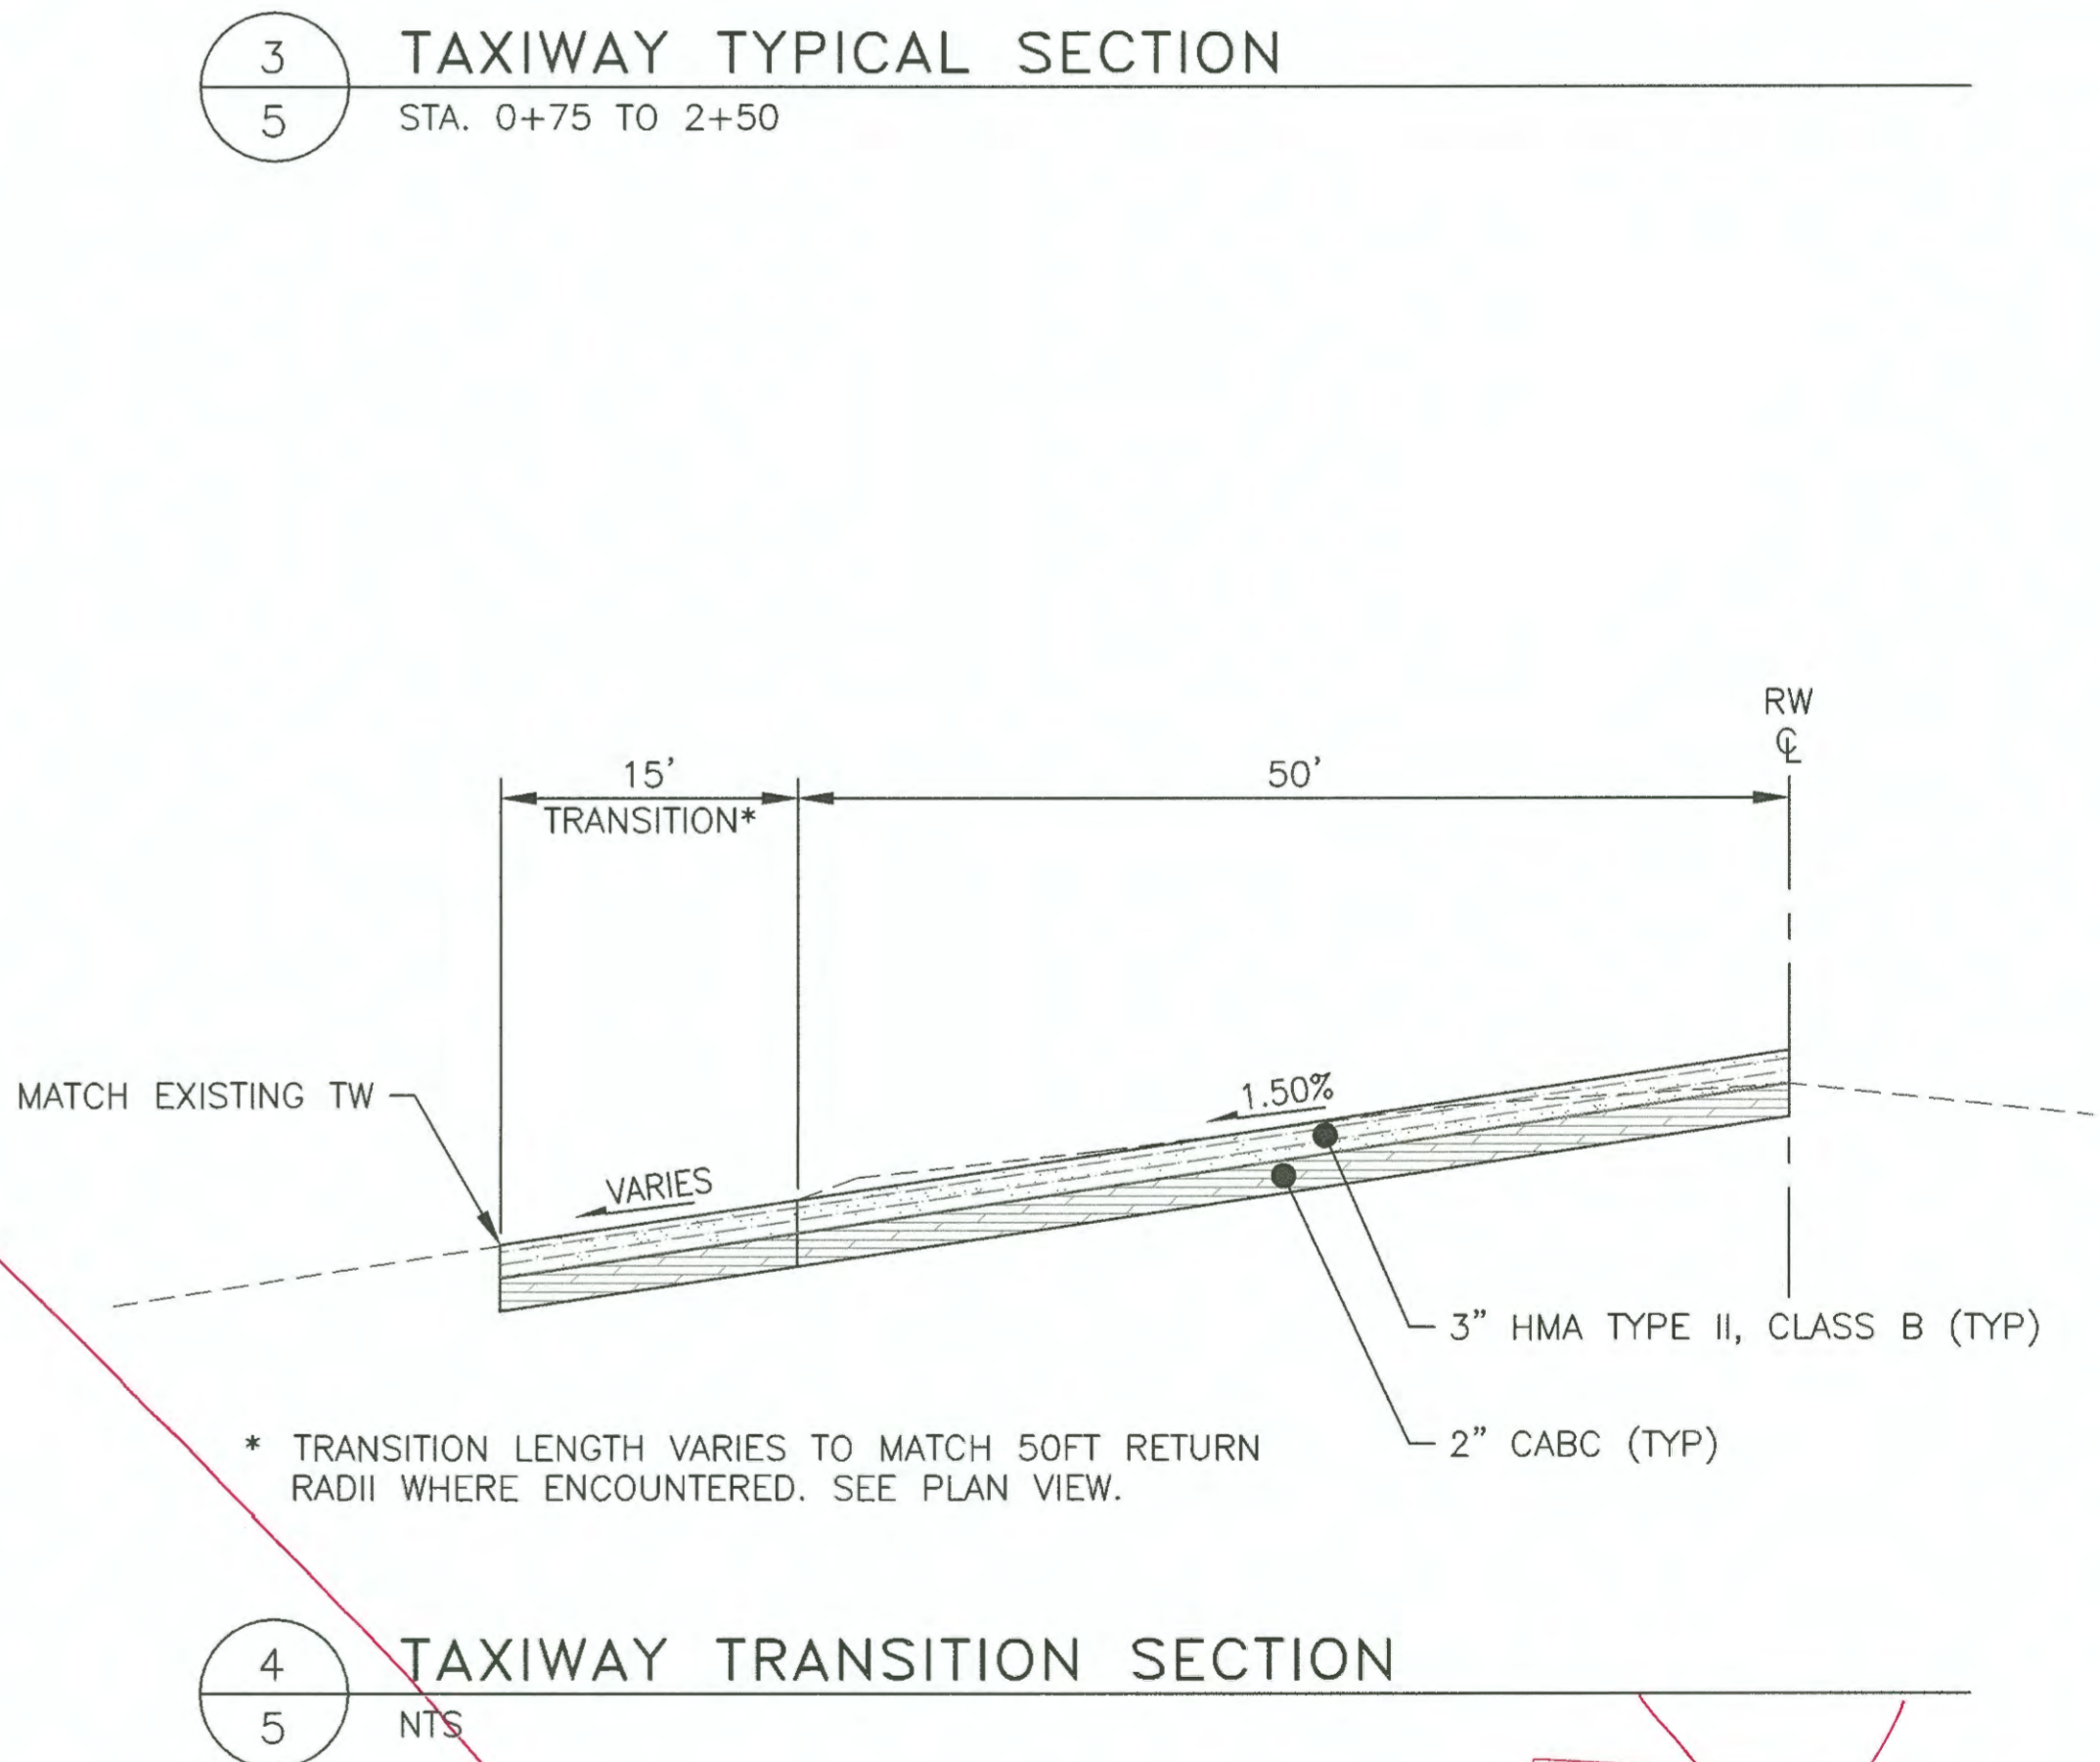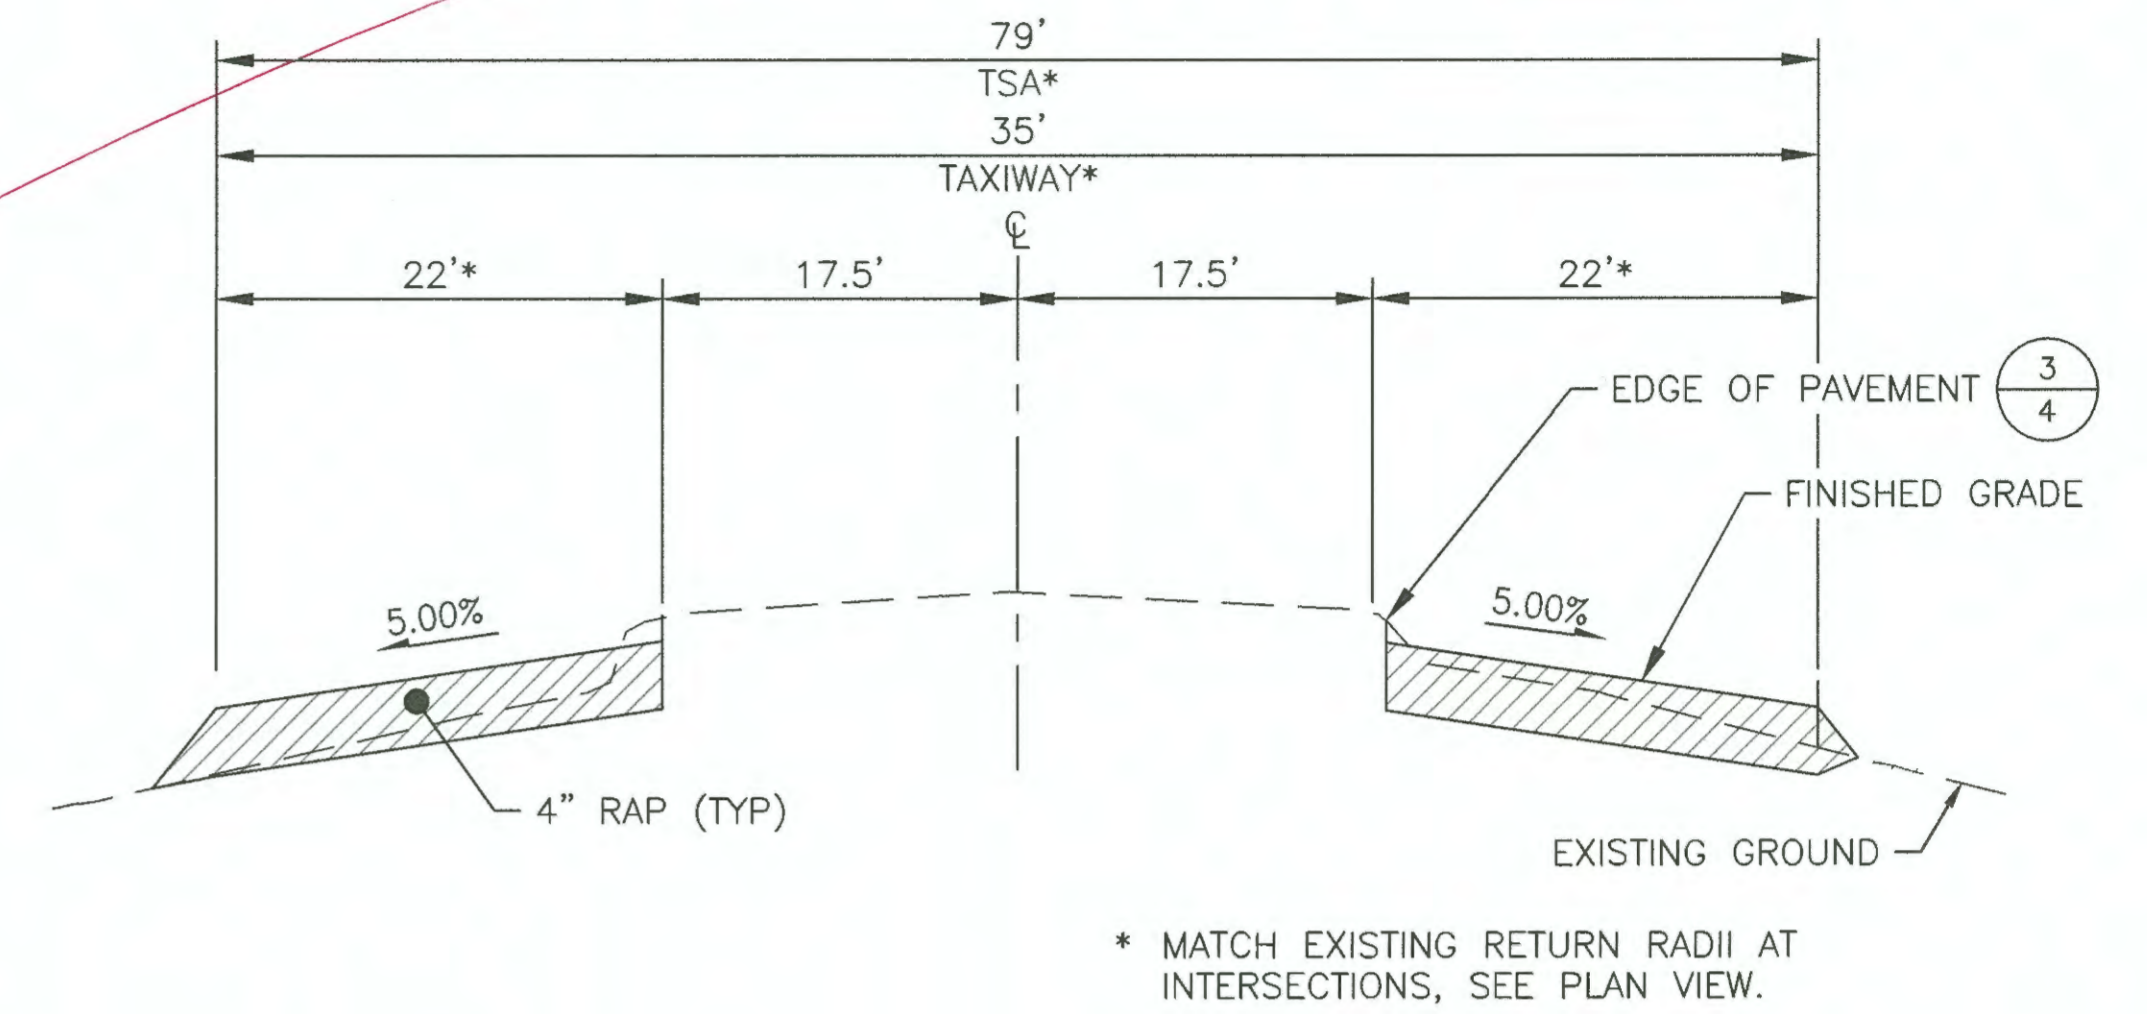

Record Drawings have been reviewed by the Project Engineer, and represent to the best of my knowledge, the project as constructed.  
PE [Signature] Date 10.24.19


DESIGN	RPK
DRAWN	ADC
CHECKED	JGL

STATE OF ALASKA  
DEPARTMENT OF TRANSPORTATION AND PUBLIC FACILITIES  
SOUTHCOAST REGION-DESIGN AND CONSTRUCTION-AVIATION





NO.	BY	DATE	REVISIONS

KAKE AIRPORT  
KAKE, ALASKA  
RUNWAY REHABILITATION  
AIP 3-02-0398-XX-2018/SFAPT00078  
TYPICAL SECTIONS II

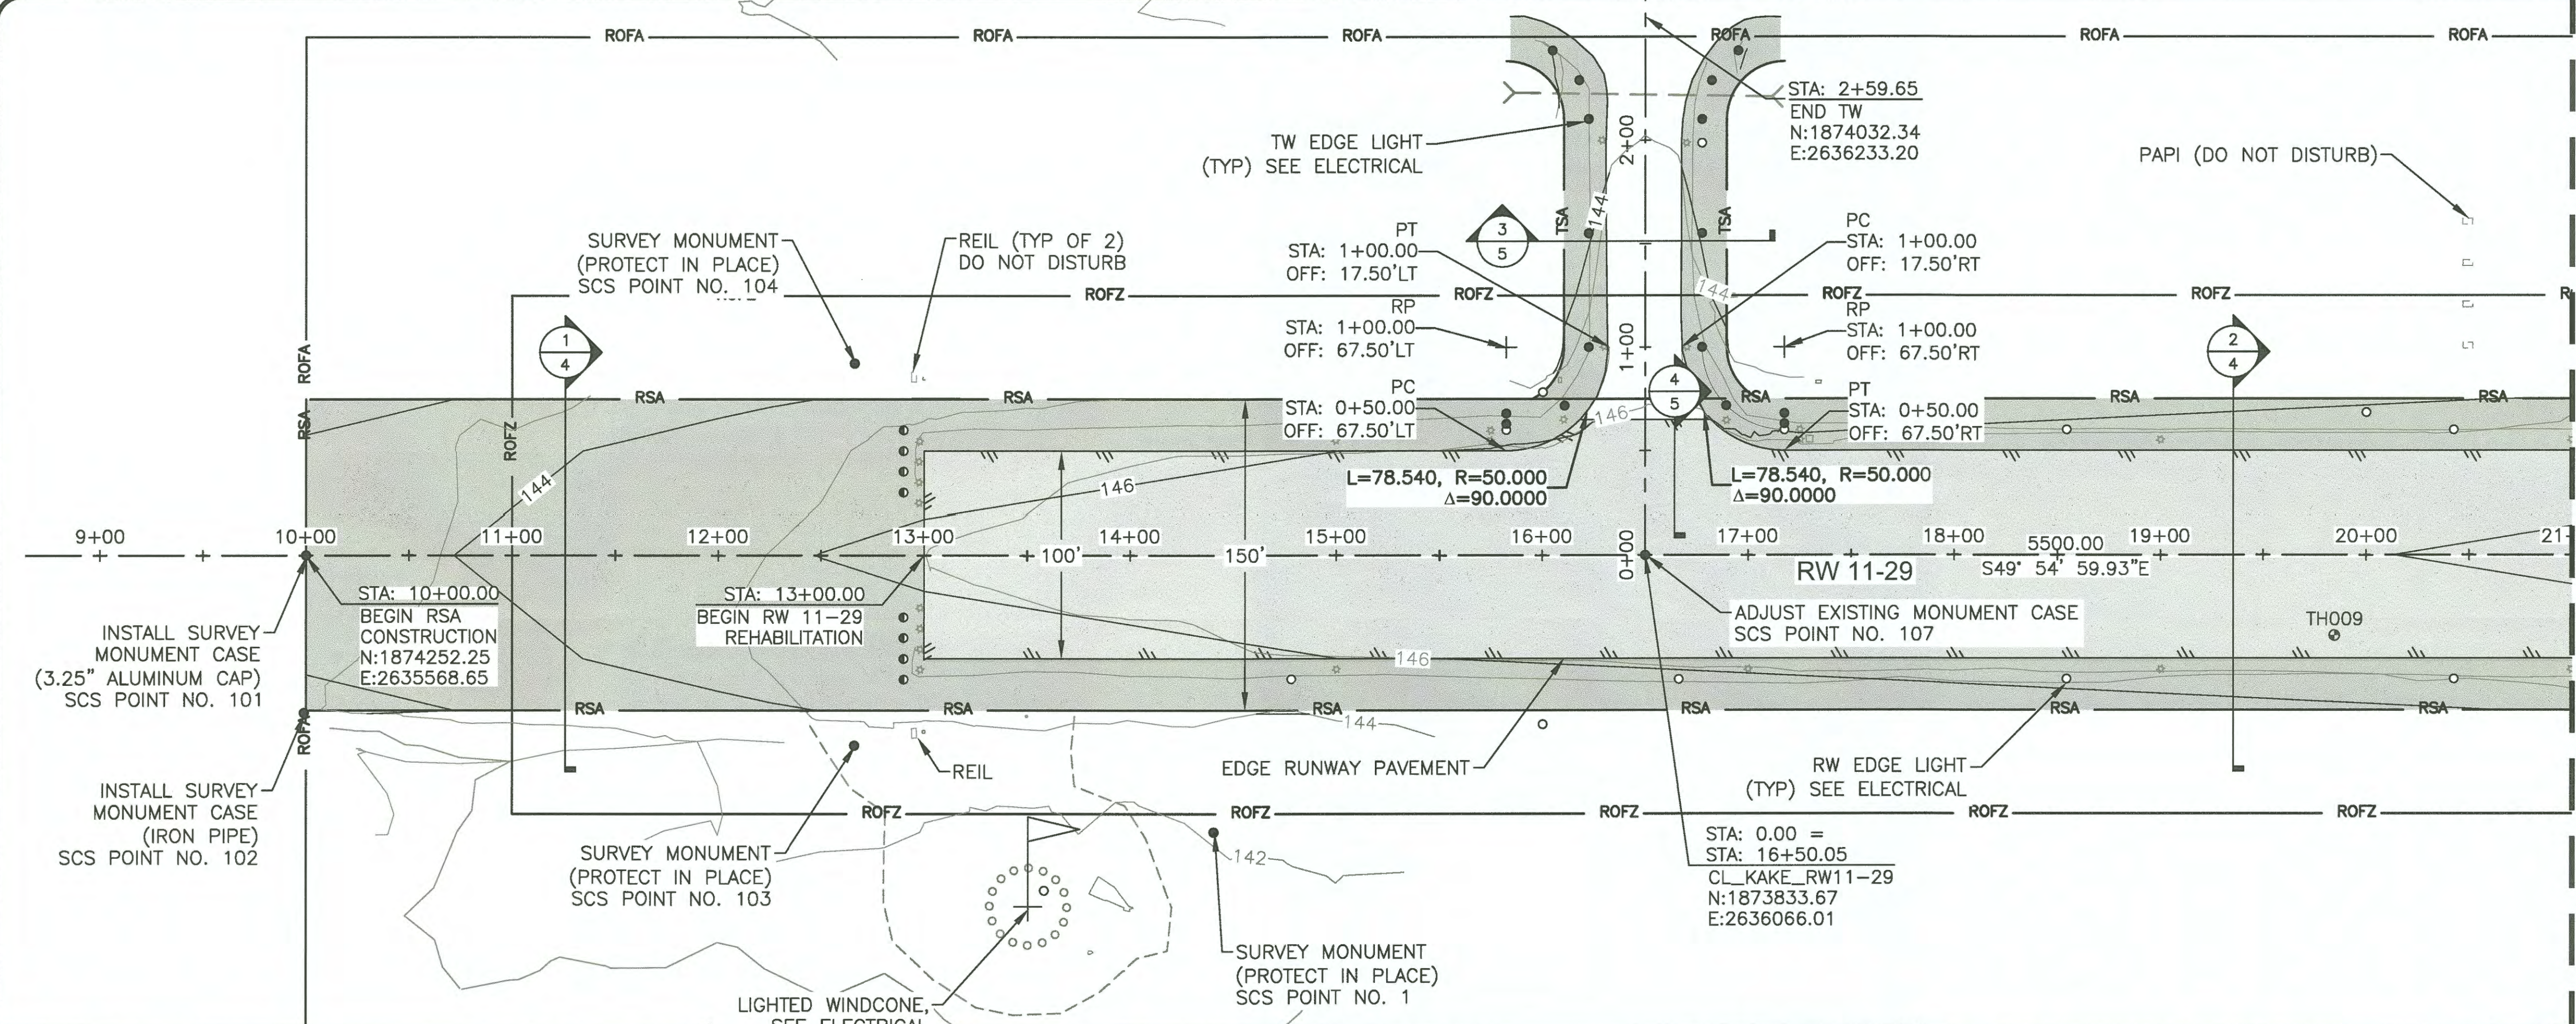

MATCH LINE STA. 21+00.00  
SEE SHEET 7

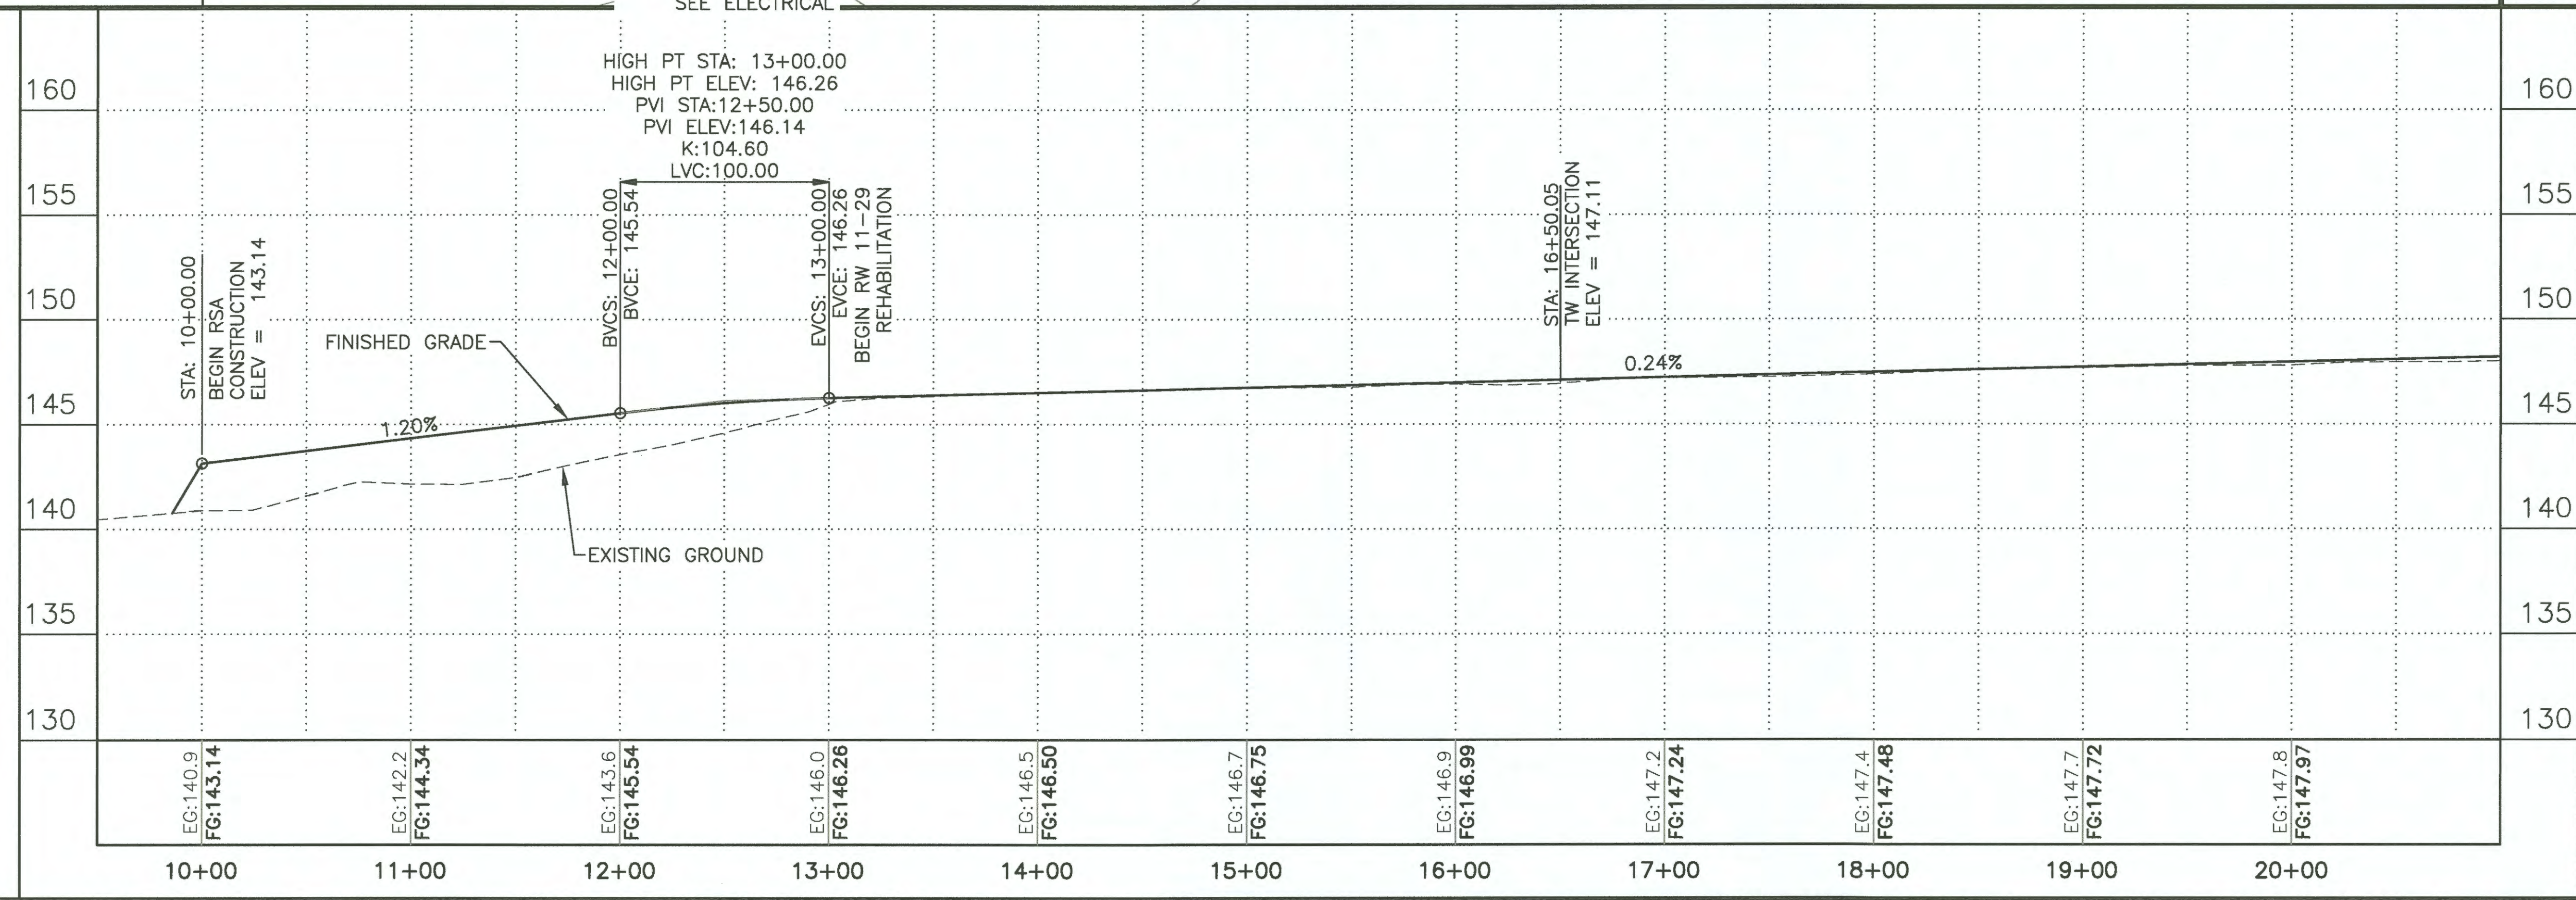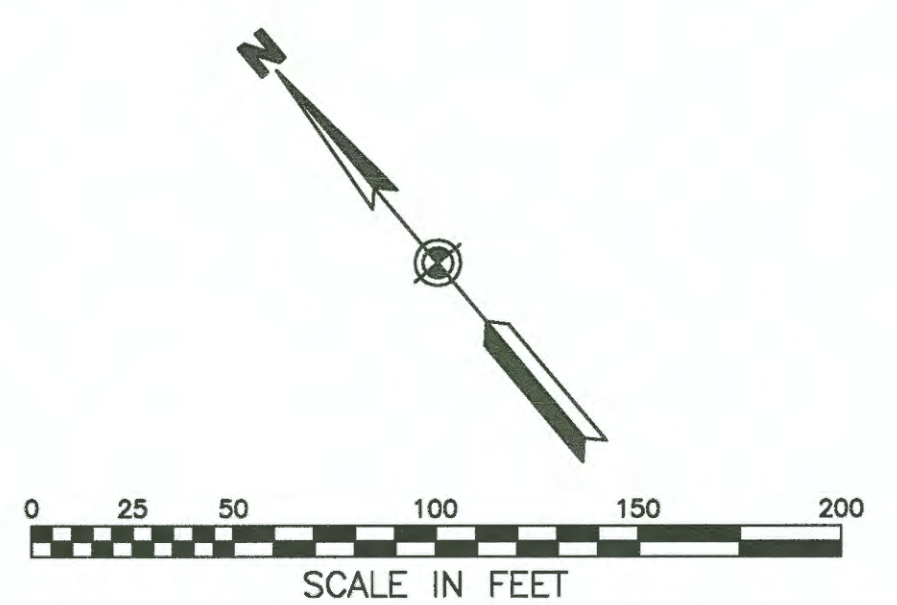

Record Drawings have been reviewed by the Project Engineer, and represent to the best of my knowledge, the project as constructed.  
 PE [Signature] Date: 06.24.19

DESIGN RPK  
 DRAWN ADC  
 CHECKED JGL

STATE OF ALASKA  
 DEPARTMENT OF TRANSPORTATION AND PUBLIC FACILITIES  
 SOUTHCOAST REGION-DESIGN AND CONSTRUCTION-AVIATION






BY	DATE	REVISIONS

KAKE AIRPORT  
 KAKE, ALASKA  
 RUNWAY REHABILITATION  
 AIP 3-02-0398-XX-2018/SFAPT00078  
 RUNWAY 11-29 PLAN AND PROFILE  
 STA 10+00 TO 21+00

SHEET  
 6  
 OF  
 27

6/25/2018, 3:52 PM  
 PLANS DEVELOPED BY: STANTEC CONSULTING SERVICES, INC. 725 EAST FIREWEED LANE, SUITE 200, ANCHORAGE, AK 99503-2245 907-276-4245 CERTIFICATE OF AUTHORIZATION #126386  
 U:\2047059100\drawing\C\Sheets\2047059100\_PNP.dwg

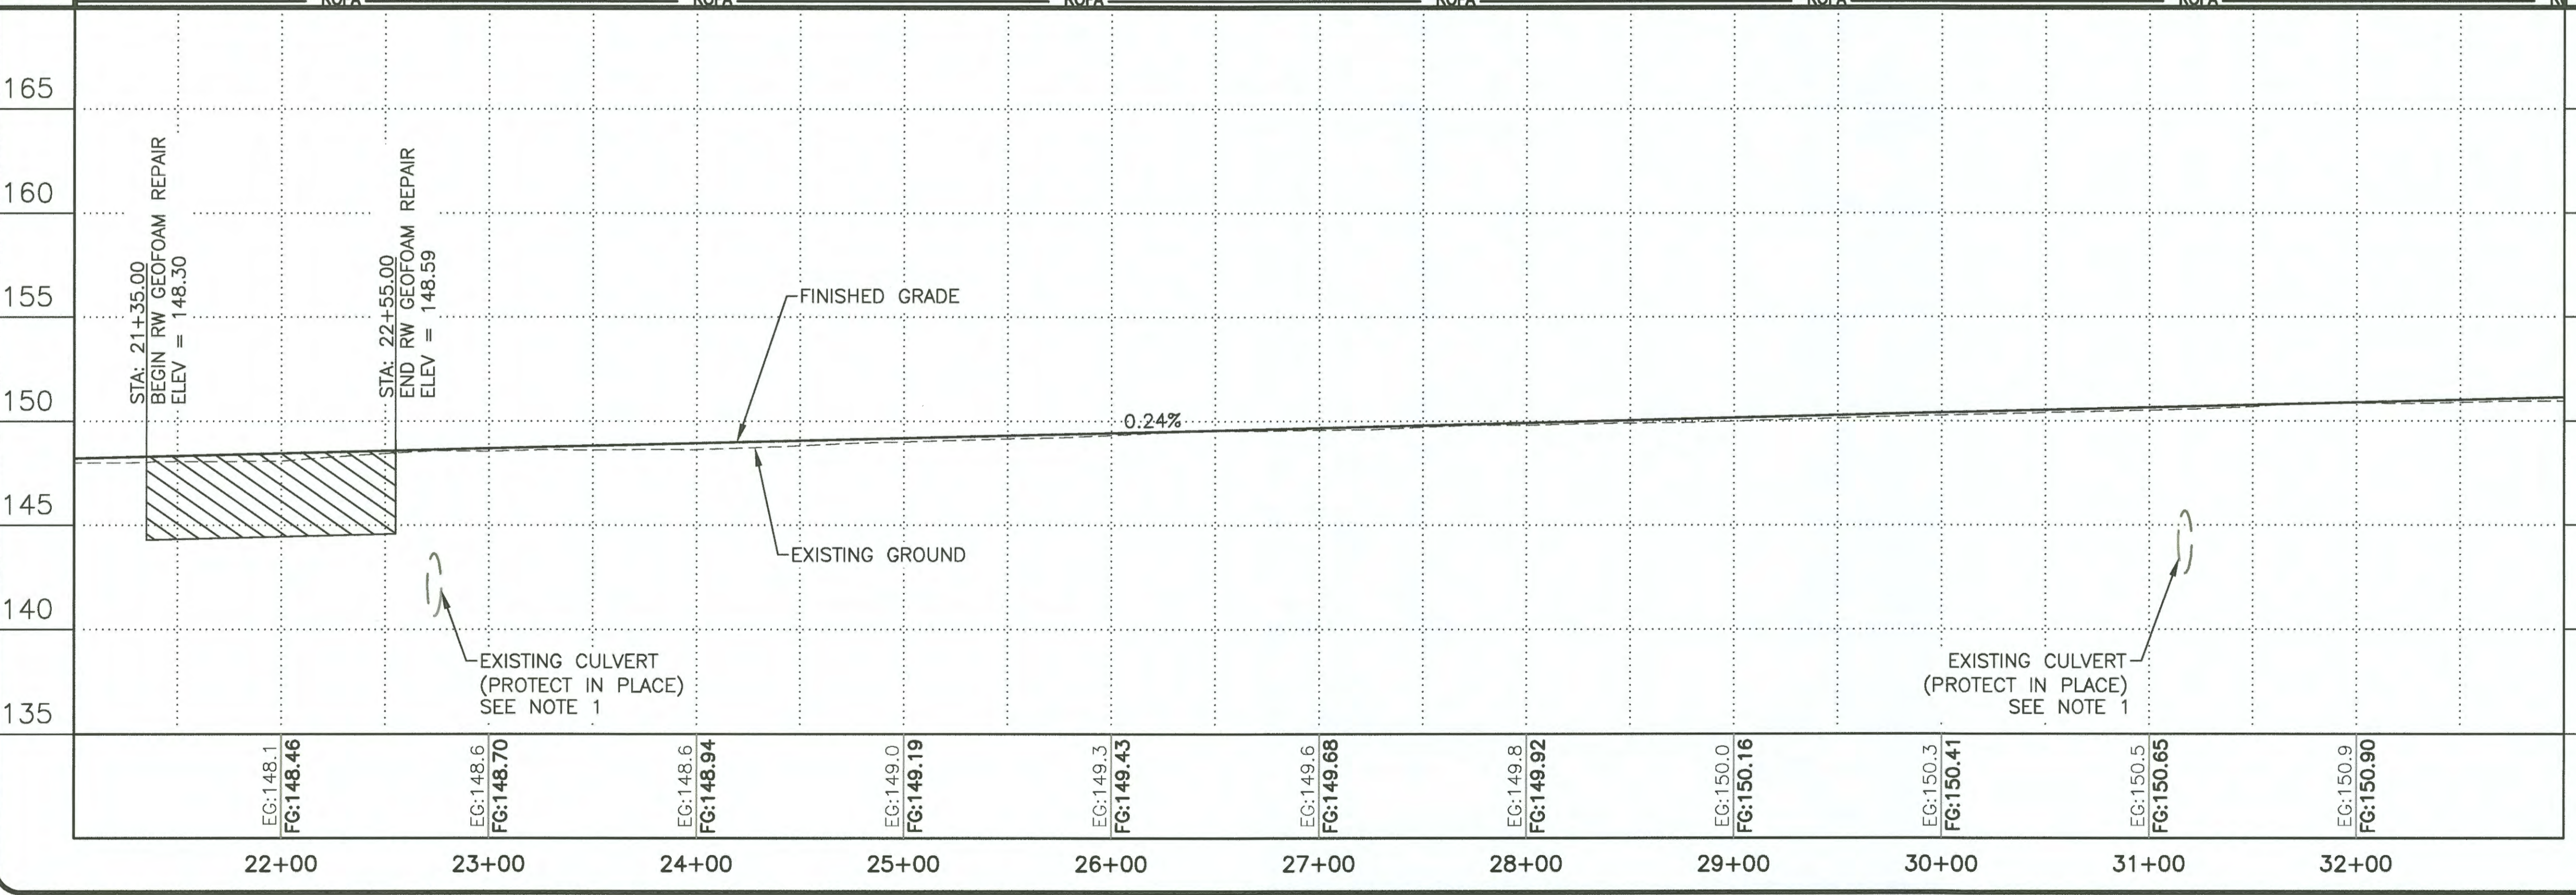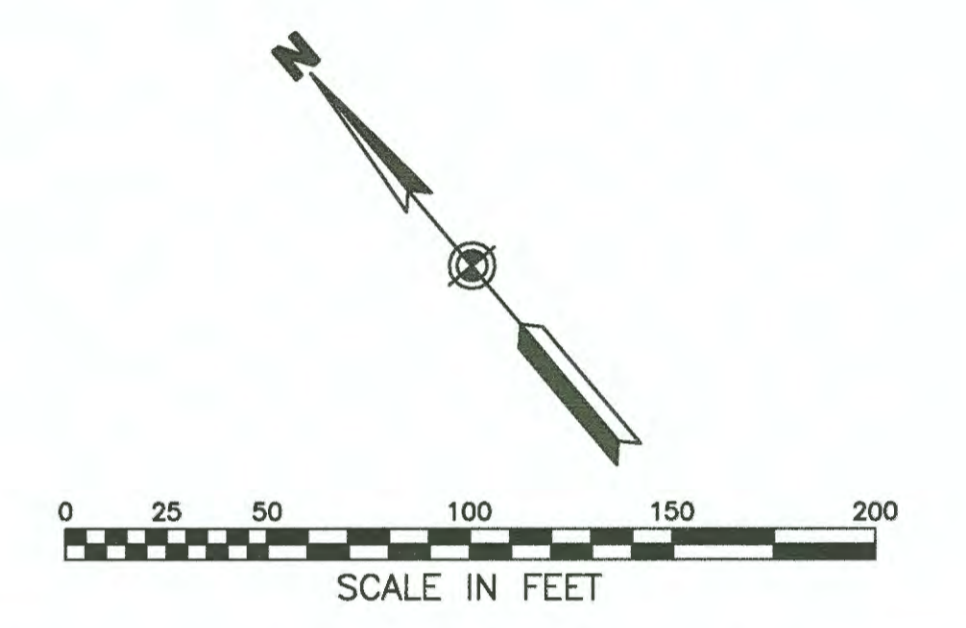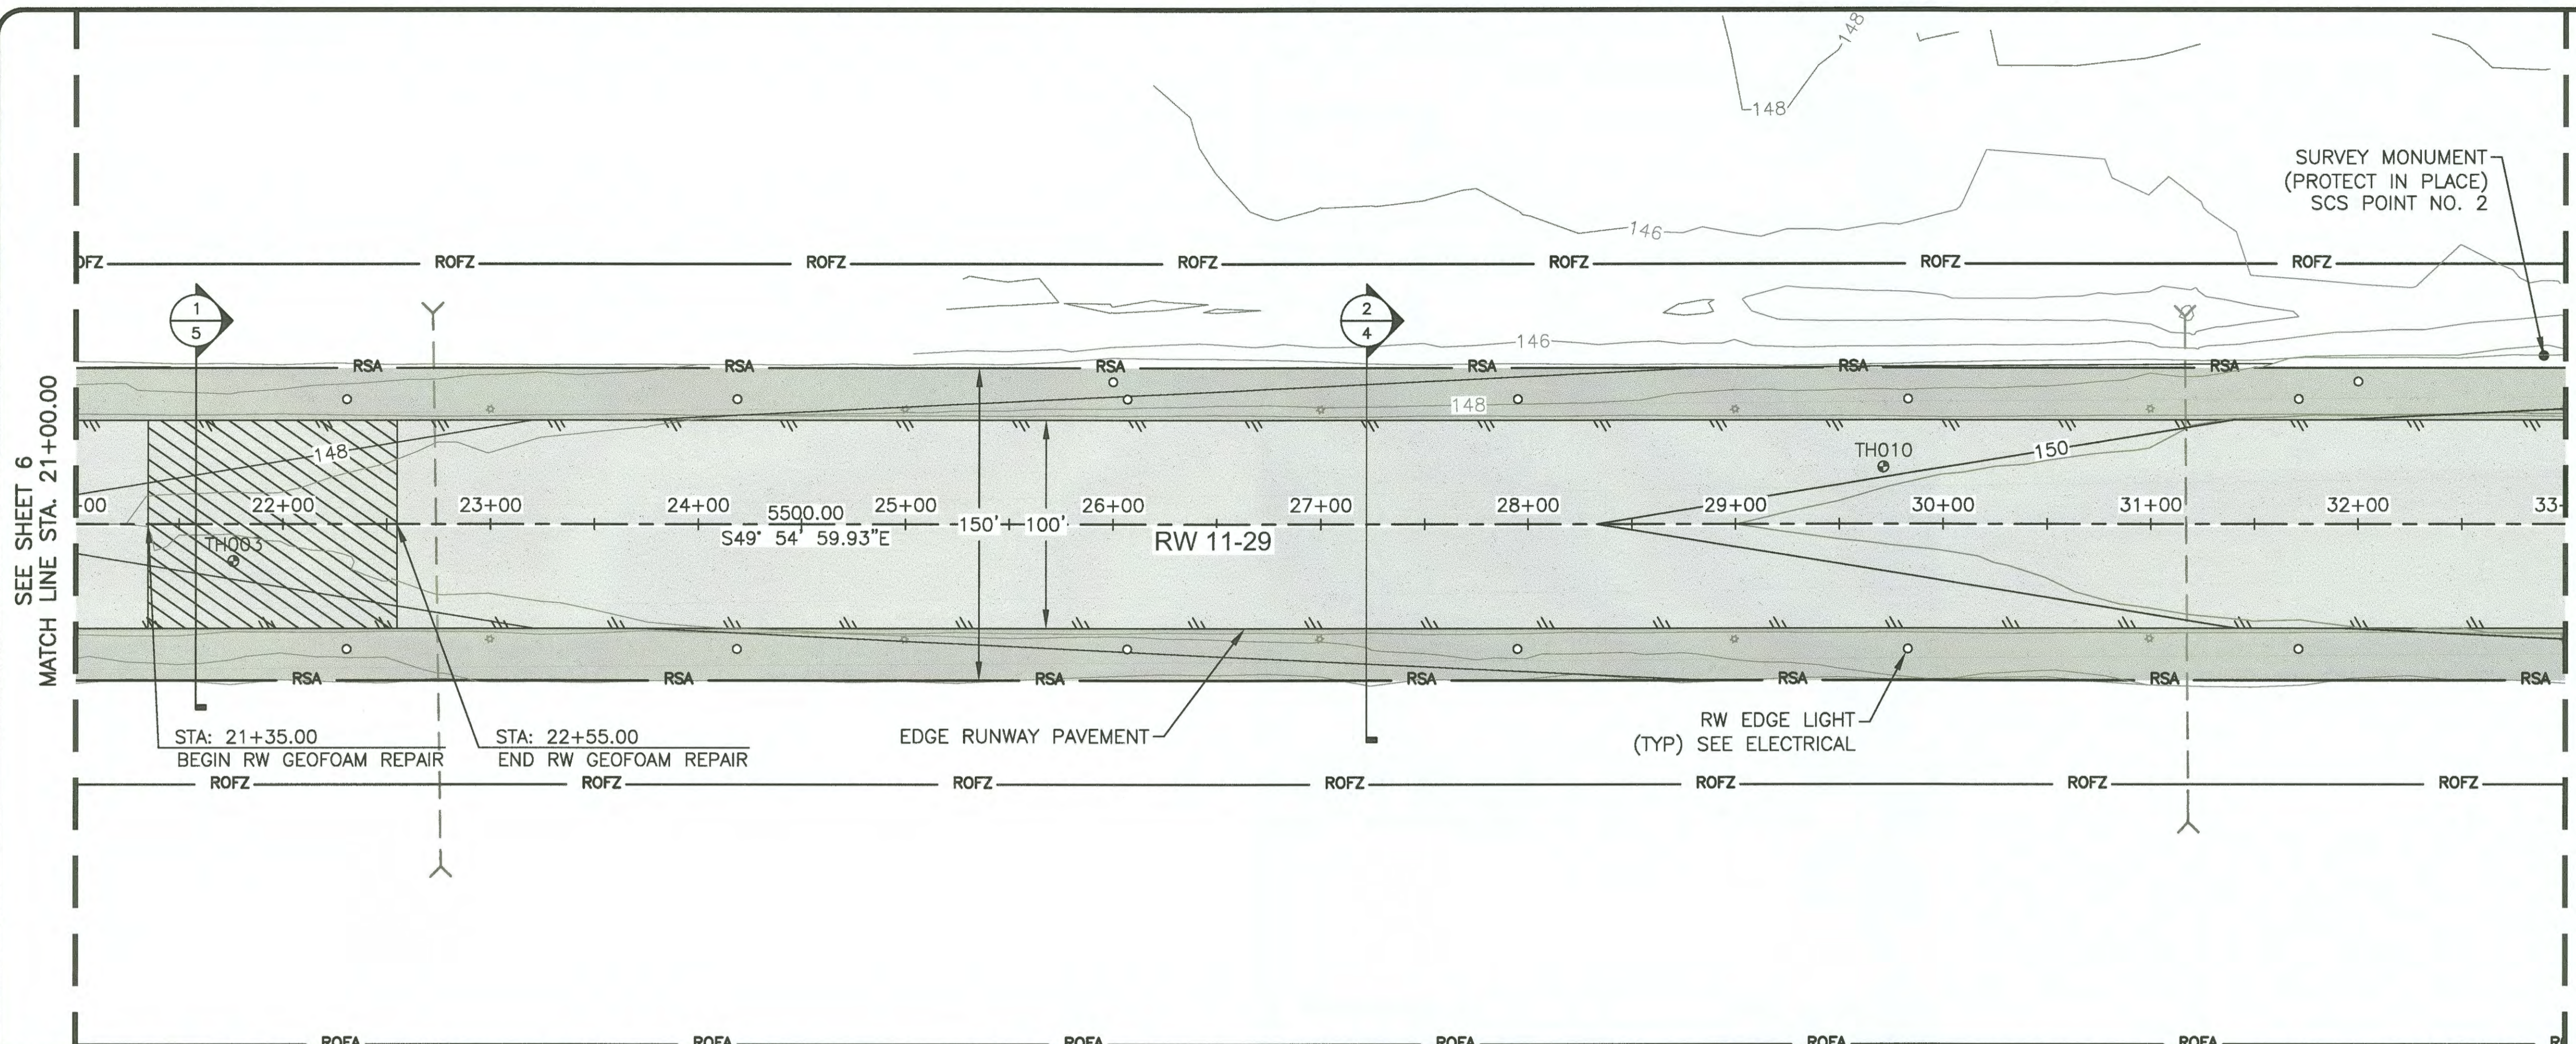

**NOTES:**  
 1. CULVERT INFORMATION IS FROM AS-BUILTS, FIELD VERIFY DEPTH AND LOCATION.

Record Drawings have been reviewed by the Project Engineer, and represent to the best of my knowledge, the project as constructed.  
 PE [Signature] Date 10.24.19

DESIGN RPK  
 DRAWN ADC  
 CHECKED JGL




STATE OF ALASKA  
 DEPARTMENT OF TRANSPORTATION AND PUBLIC FACILITIES  
 SOUTHCOAST REGION-DESIGN AND CONSTRUCTION-AVIATION



BY	DATE	REVISIONS

KAKE AIRPORT  
 KAKE, ALASKA  
 RUNWAY REHABILITATION  
 AIP 3-02-0398-XX-2018/SFAPT00078  
 RUNWAY 11-29 PLAN AND PROFILE  
 STA 21+00 TO 33+00

SHEET 7 OF 27

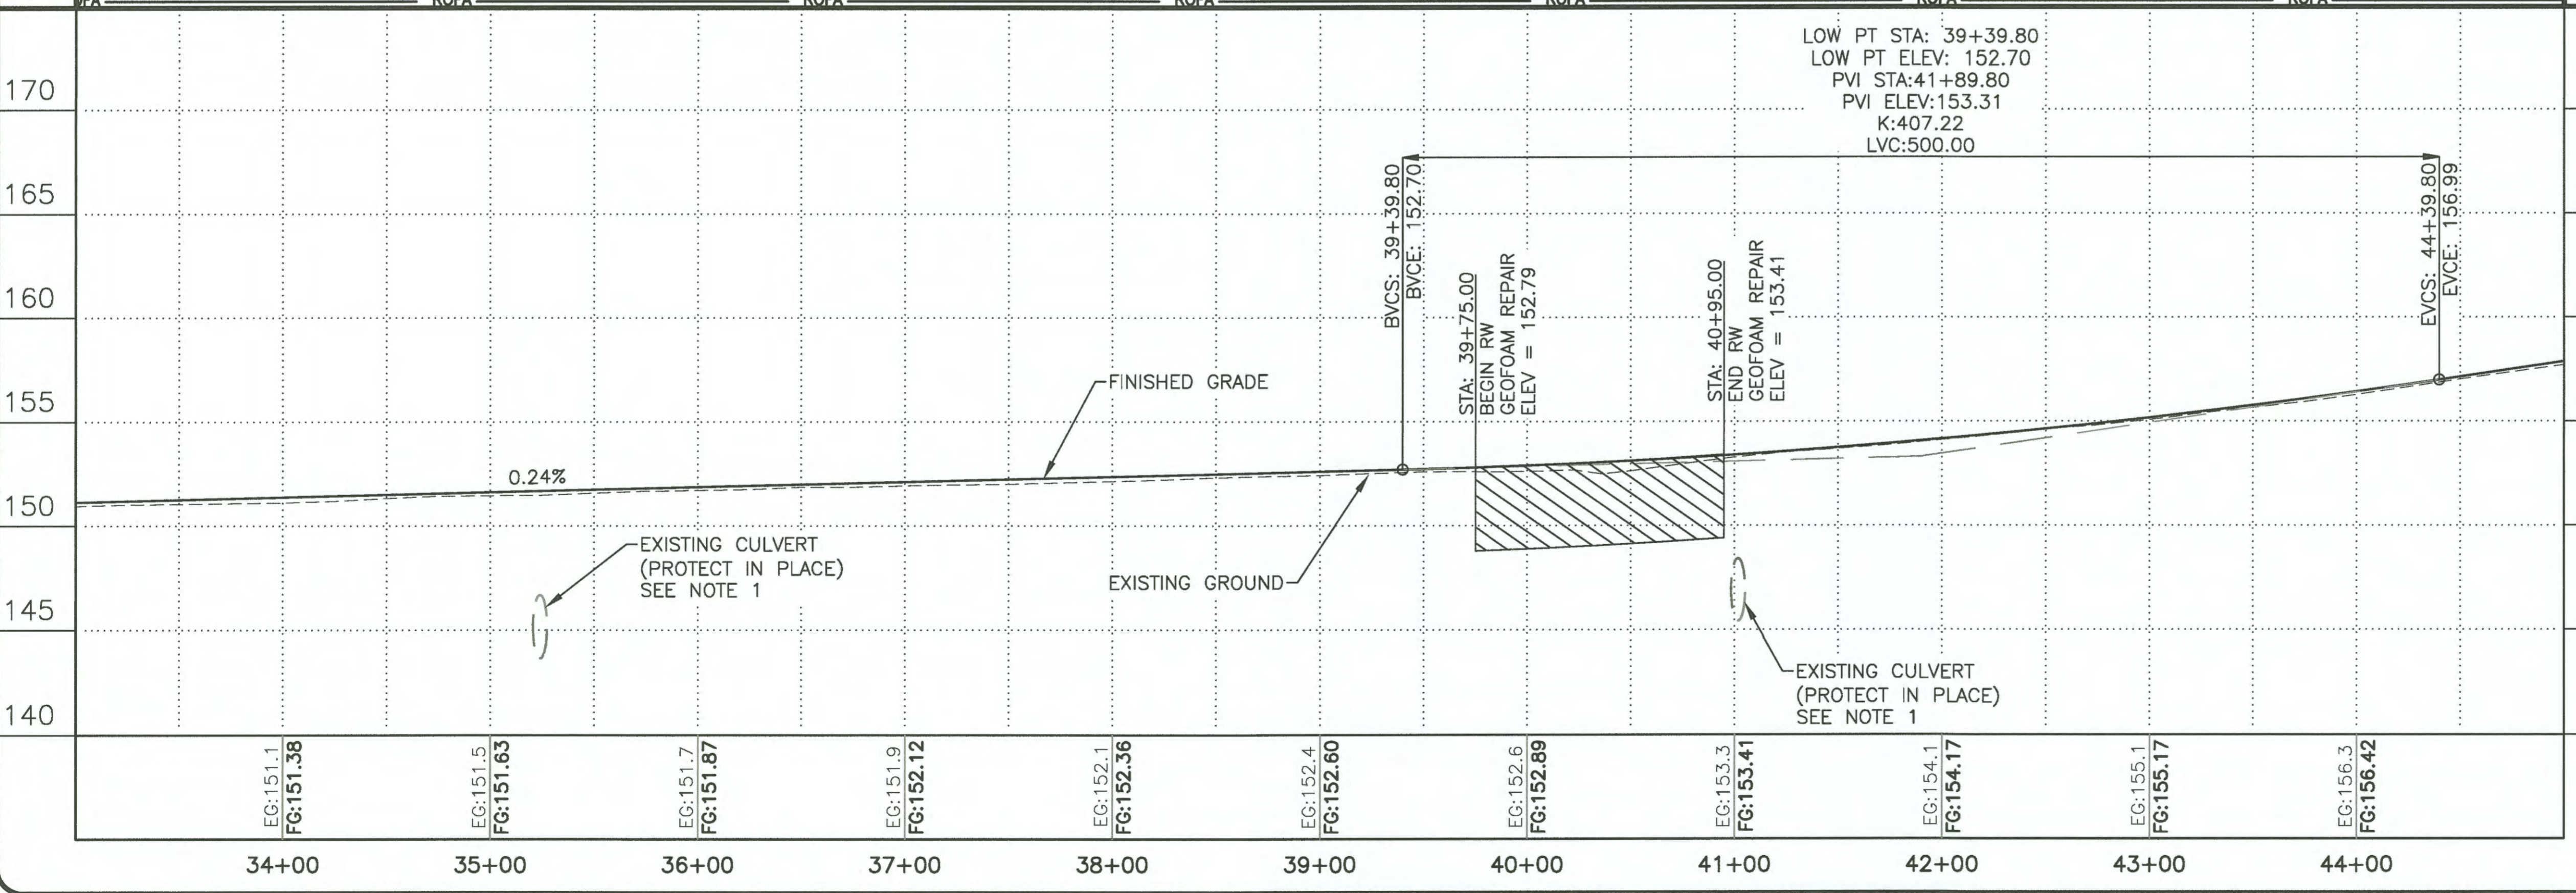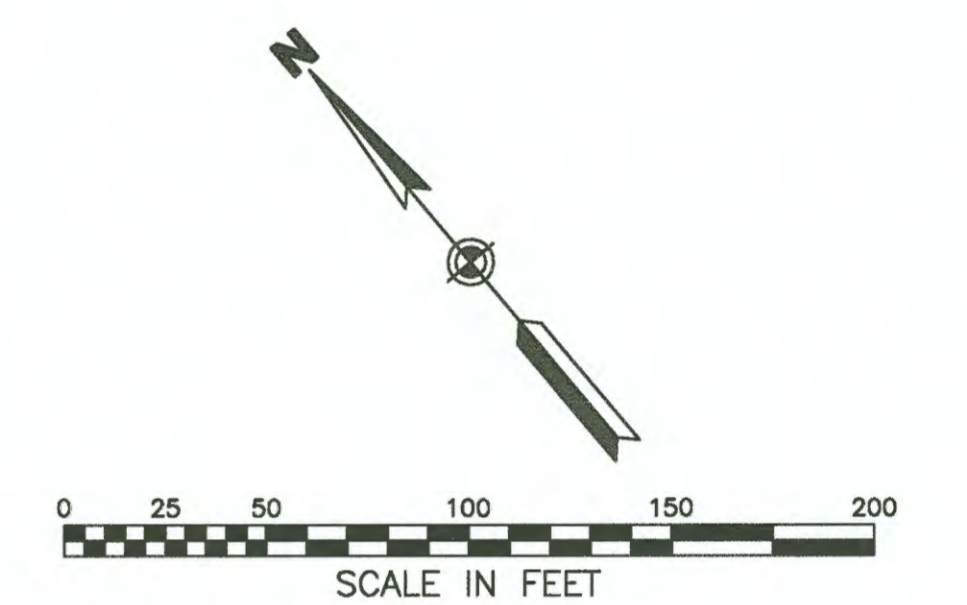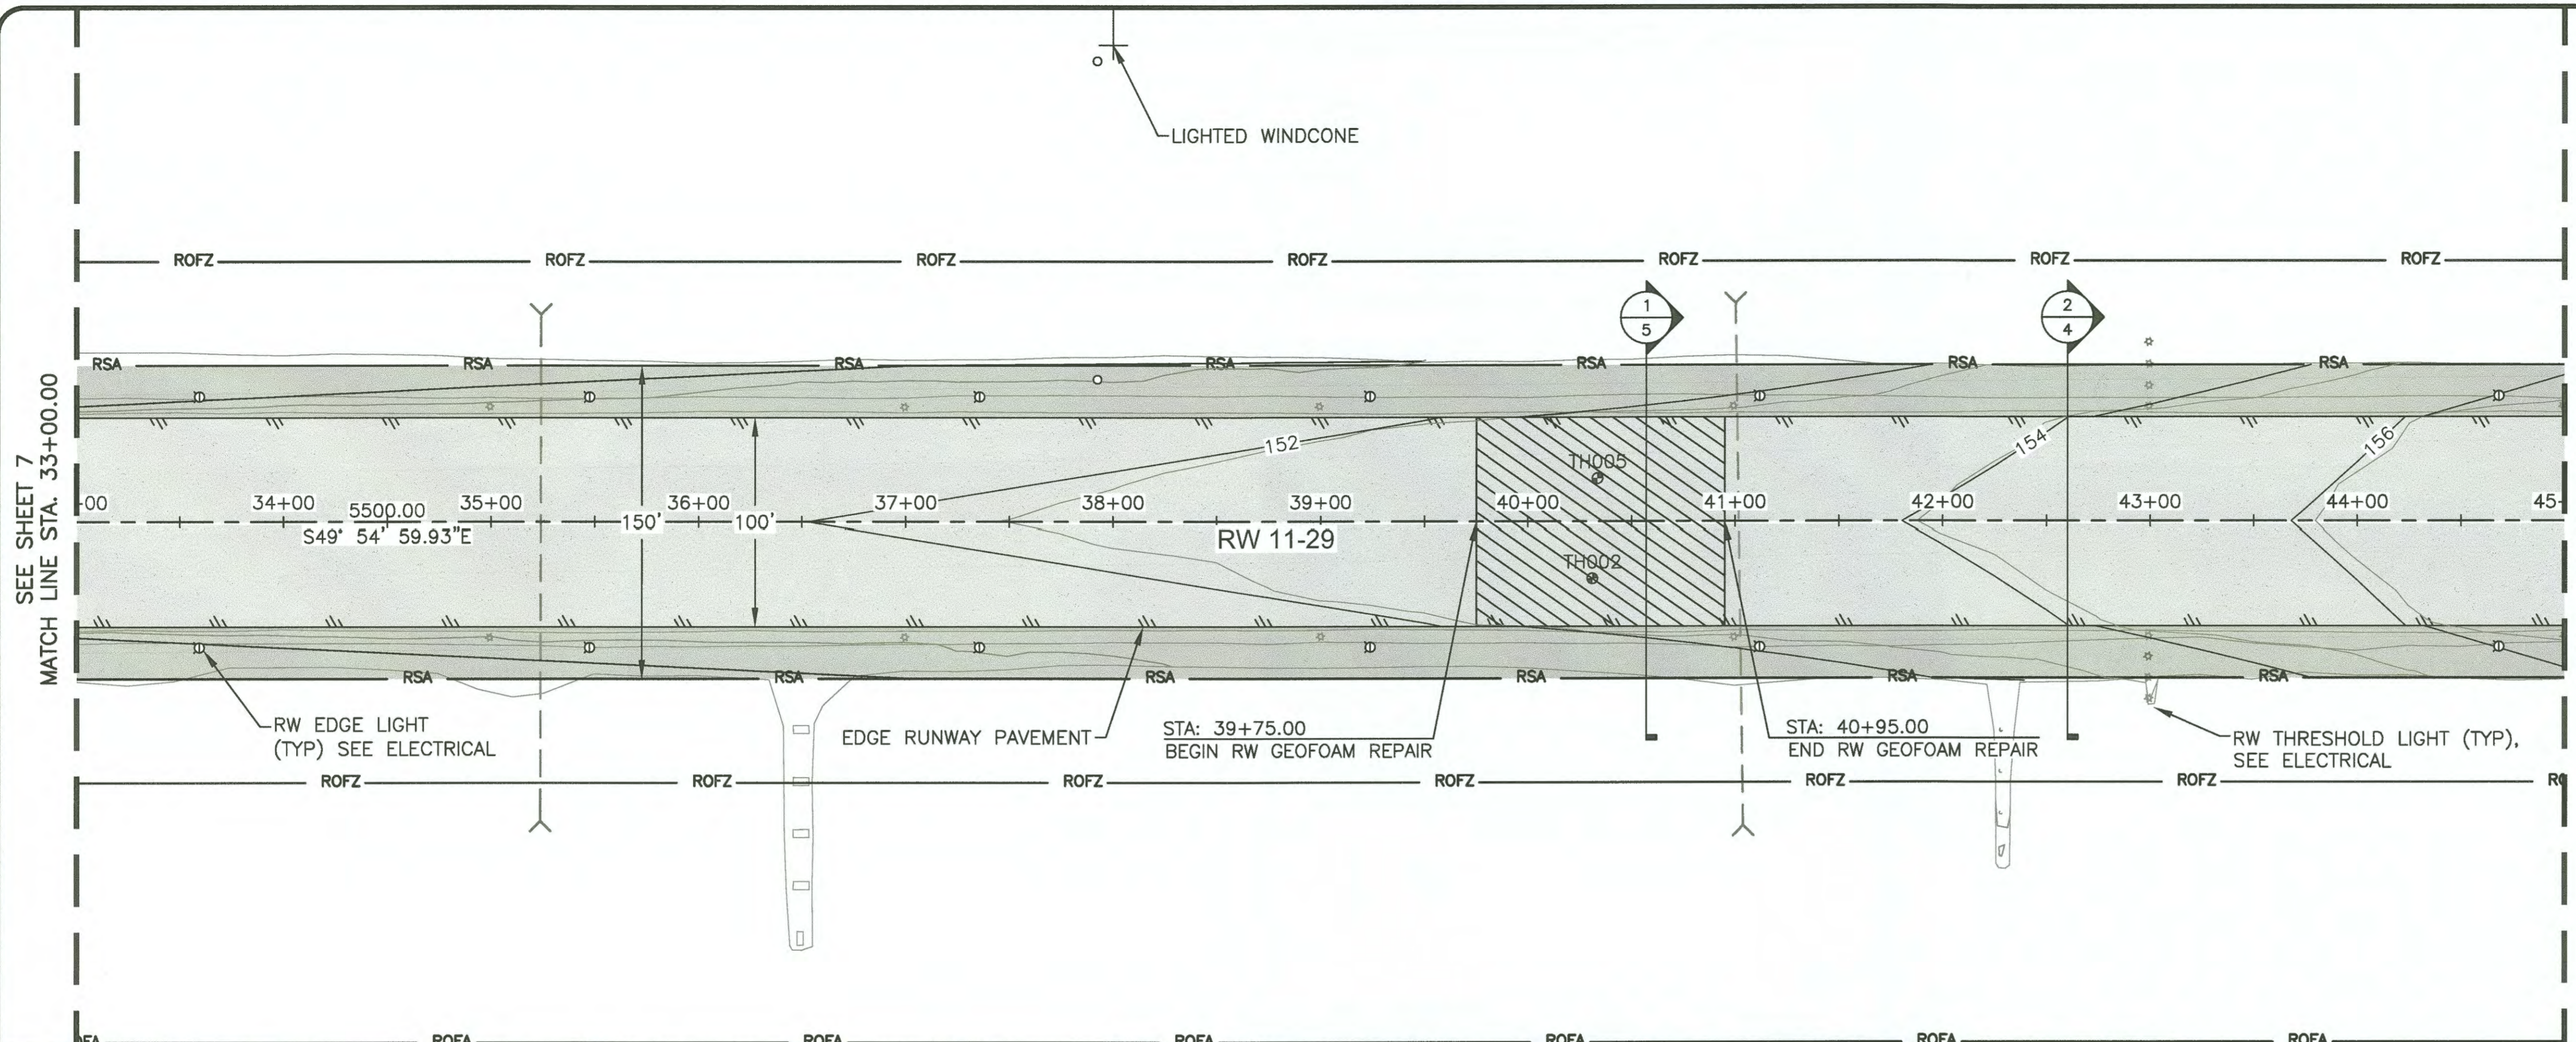

**NOTES:**  
 1. CULVERT INFORMATION IS FROM AS-BUILTS, FIELD VERIFY DEPTH AND LOCATION.

Record Drawings have been reviewed by the Project Engineer, and represent to the best of my knowledge, the project as constructed.  
 PE [Signature] Date 10.24.19

DESIGN RPK  
 DRAWN ADC  
 CHECKED JGL

STATE OF ALASKA  
 DEPARTMENT OF TRANSPORTATION AND PUBLIC FACILITIES  
 SOUTHCOAST REGION-DESIGN AND CONSTRUCTION-AVIATION




BY	DATE	REVISIONS

**KAKE AIRPORT**  
 KAKE, ALASKA  
 RUNWAY REHABILITATION  
 AIP 3-02-0398-XX-2018/SFAPT00078  
 RUNWAY 11-29 PLAN AND PROFILE  
 STA 33+00 TO 45+00


SHEET **8** OF **27**



6/25/2018, 3: 3: 53 PM  
 PLANS DEVELOPED BY: STANTEC CONSULTING SERVICES, INC. 725 EAST FIREWEED LANE, SUITE 200, ANCHORAGE, AK 99503-2245 907-276-4245 CERTIFICATE OF AUTHORIZATION #126386  
 U:\2047059100\drawing\C\Sheets\2047059100\_MRKG\_TEMP.dwg

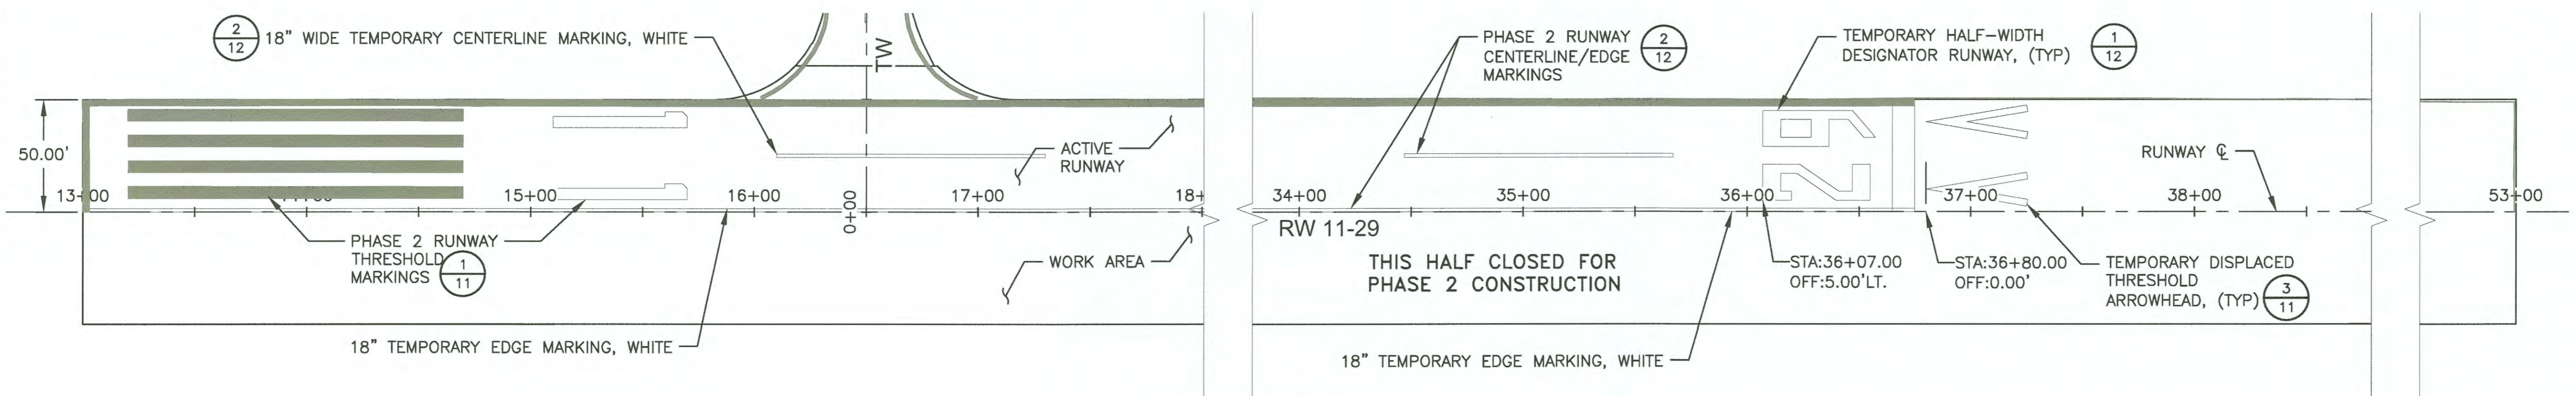

**1**  
**10** TEMPORARY HALF WIDTH RUNWAY MARKING - PHASE 2  
 SCALE: N.T.S.

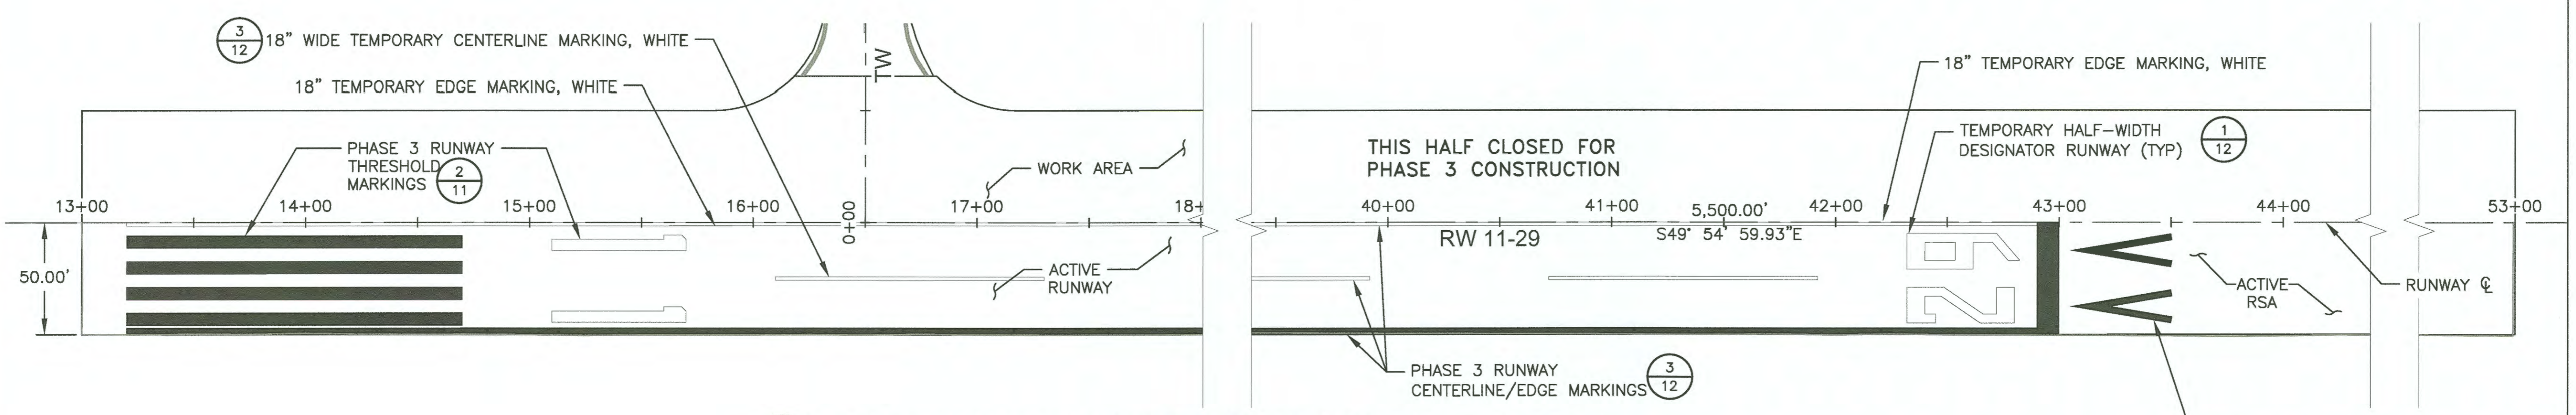


**2**  
**10** TEMPORARY HALF WIDTH RUNWAY MARKING - PHASE 3  
 SCALE: N.T.S.

**MARKING NOTES**

- TEMPORARY MARKINGS ARE SHOWN AS OUTLINED WHILE NEW PERMANENT MARKINGS TO REMAIN AFTER WORK IS COMPLETED ARE SHOWN AS SOLID BLACK ON THE TEMPORARY MARKING SHEETS. EXISTING STRIPES TO REMAIN DURING PHASE 2 ARE SHOWN AS DARK GRAY.
- EXISTING RUNWAY AND TAXIWAY MARKINGS THAT CONFLICT WITH TEMPORARY RUNWAY MARKINGS OR ARE NOT SHOWN IN THE DETAILS SHALL BE REMOVED PRIOR TO OPENING THE HALF WIDTH RUNWAY TO AIRCRAFT OPERATIONS.
- ALL TEMPORARY RUNWAY MARKINGS SHALL BE WHITE UNLESS OTHERWISE NOTED. TEMPORARY MARKINGS SHALL BE REMOVED AS PROJECT PHASING PROCEEDS.
- THRESHOLD MARKINGS ARE INSTALLED AS IF THE FULL RUNWAY WERE OPEN, BUT ONLY HALF AT A TIME.
- ALL TEMPORARY AND EXISTING MARKINGS SHALL BE REMOVED USING HIGH PRESSURE WATER IN RECTANGULAR BLOCKS TO OBSCURE ORIGINAL MARKING PATTERN.
- OBLITERATE ALL MARKINGS BEYOND THE DISPLACED THRESHOLD ARROWHEADS SHOWN.

**TEMPORARY MARKING LEGEND**

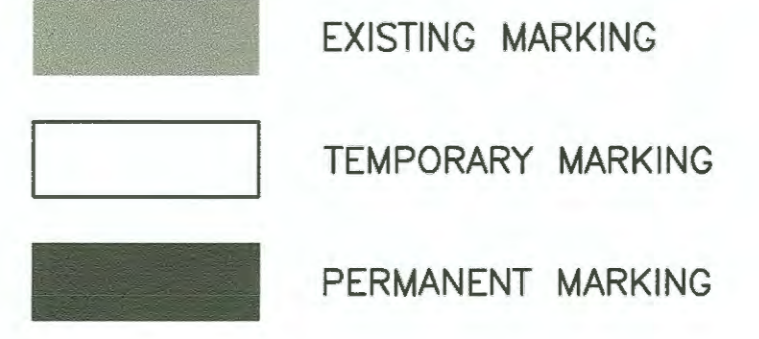

Record Drawings have been reviewed by the Project Engineer, and represent to the best of my knowledge, the project as constructed.  
 PE [Signature] Date 10.24.19



DESIGN RPK  
 DRAWN ADC  
 CHECKED JGL

STATE OF ALASKA  
 DEPARTMENT OF TRANSPORTATION AND PUBLIC FACILITIES  
 SOUTHCOAST REGION-DESIGN AND CONSTRUCTION-AVIATION



BY	DATE	REVISIONS

**KAKE AIRPORT**  
 KAKE, ALASKA  
 RUNWAY REHABILITATION  
 AIP 3-02-0398-XX-2018/SFAPT00078  
 TEMPORARY RUNWAY 11-29 MARKING PLANS


SHEET  
**10**  
 OF  
**27**




6/25/2018, 3:53 PM  
 PLANS DEVELOPED BY: STANTEC CONSULTING SERVICES, INC. 725 EAST FIREWEED LANE, SUITE 200, ANCHORAGE, AK 99503-2245 907-276-4245 CERTIFICATE OF AUTHORIZATION #126386  
 U:\2047059100\drawing\C\Sheets\2047059100\_MRKG\_TEMP.dwg

**NOTE:**


SEE DETAIL 2 ON SHEET 14 FOR  
11 RUNWAY DESIGNATOR.

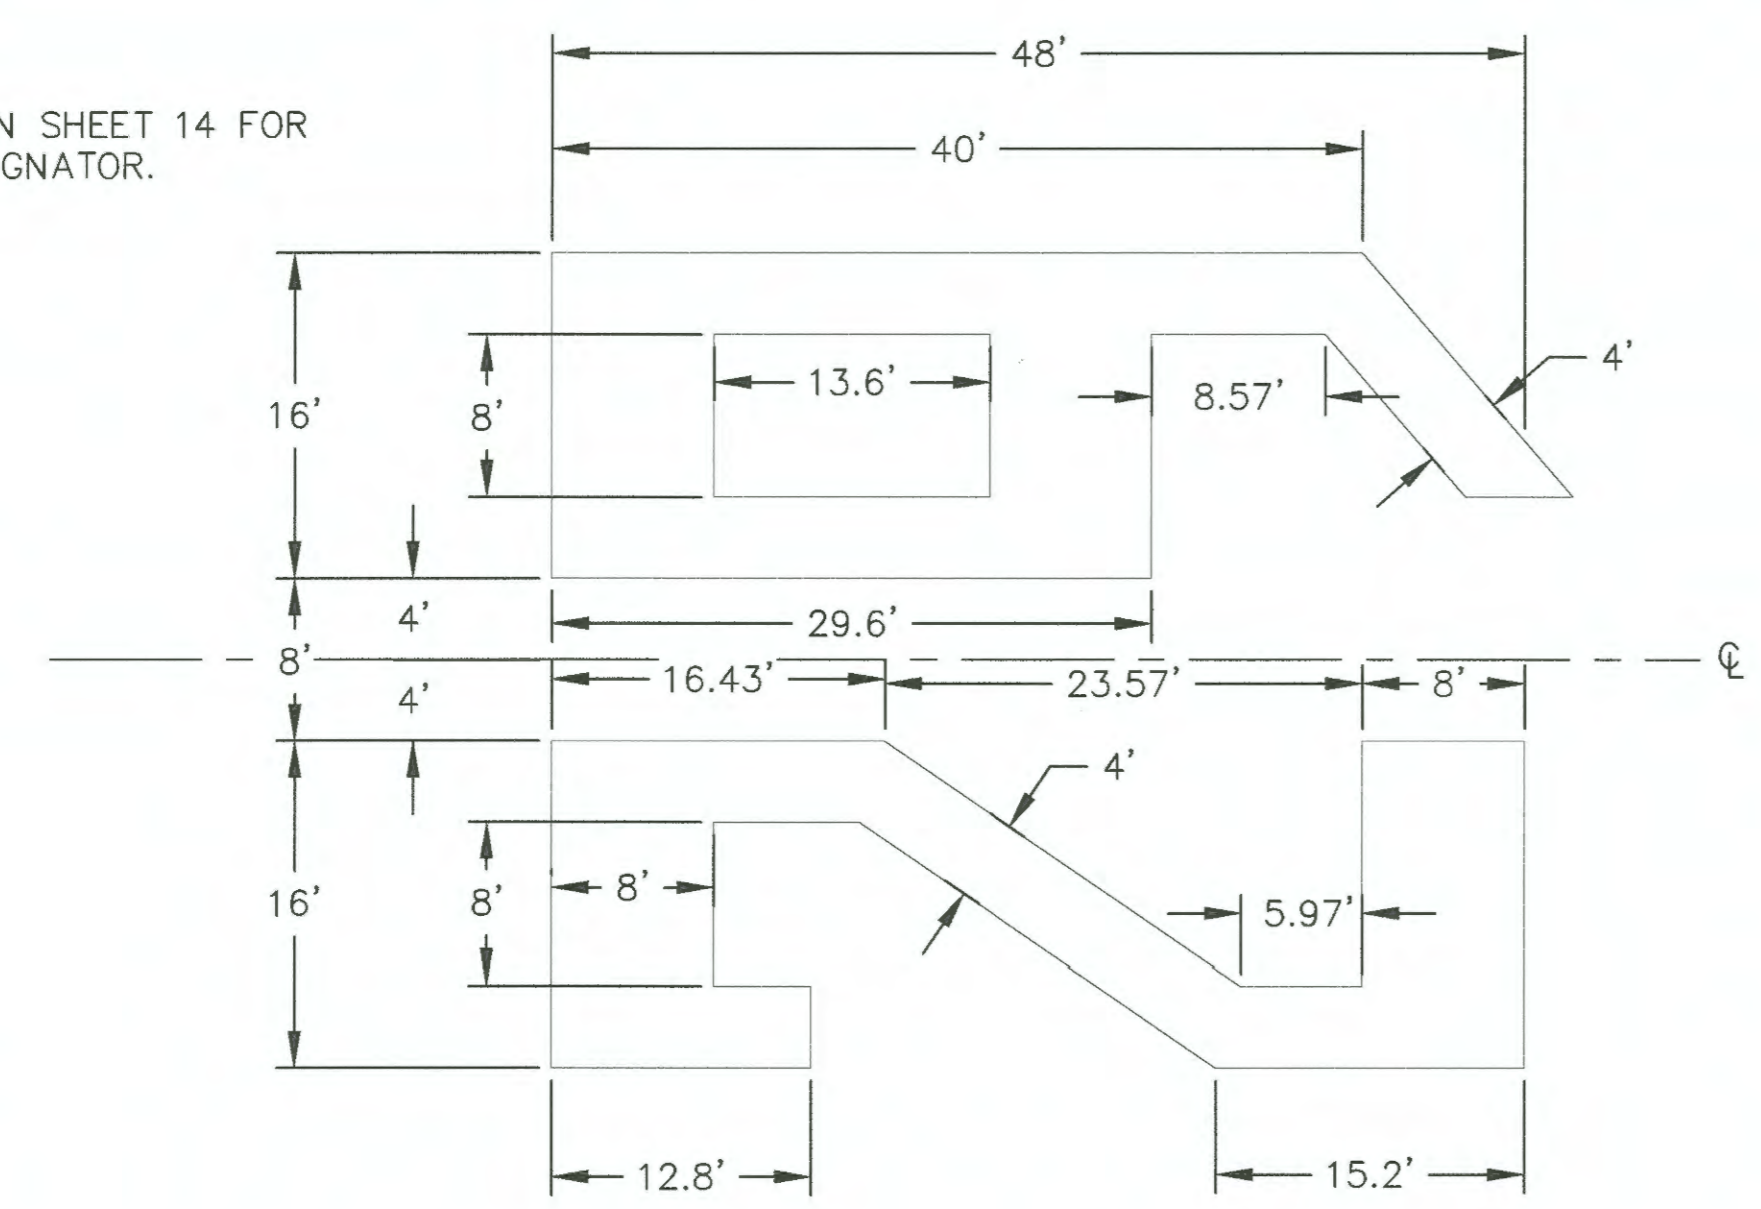

1 TEMPORARY HALF WIDTH RUNWAY DESIGNATOR DETAIL  
12 NTS

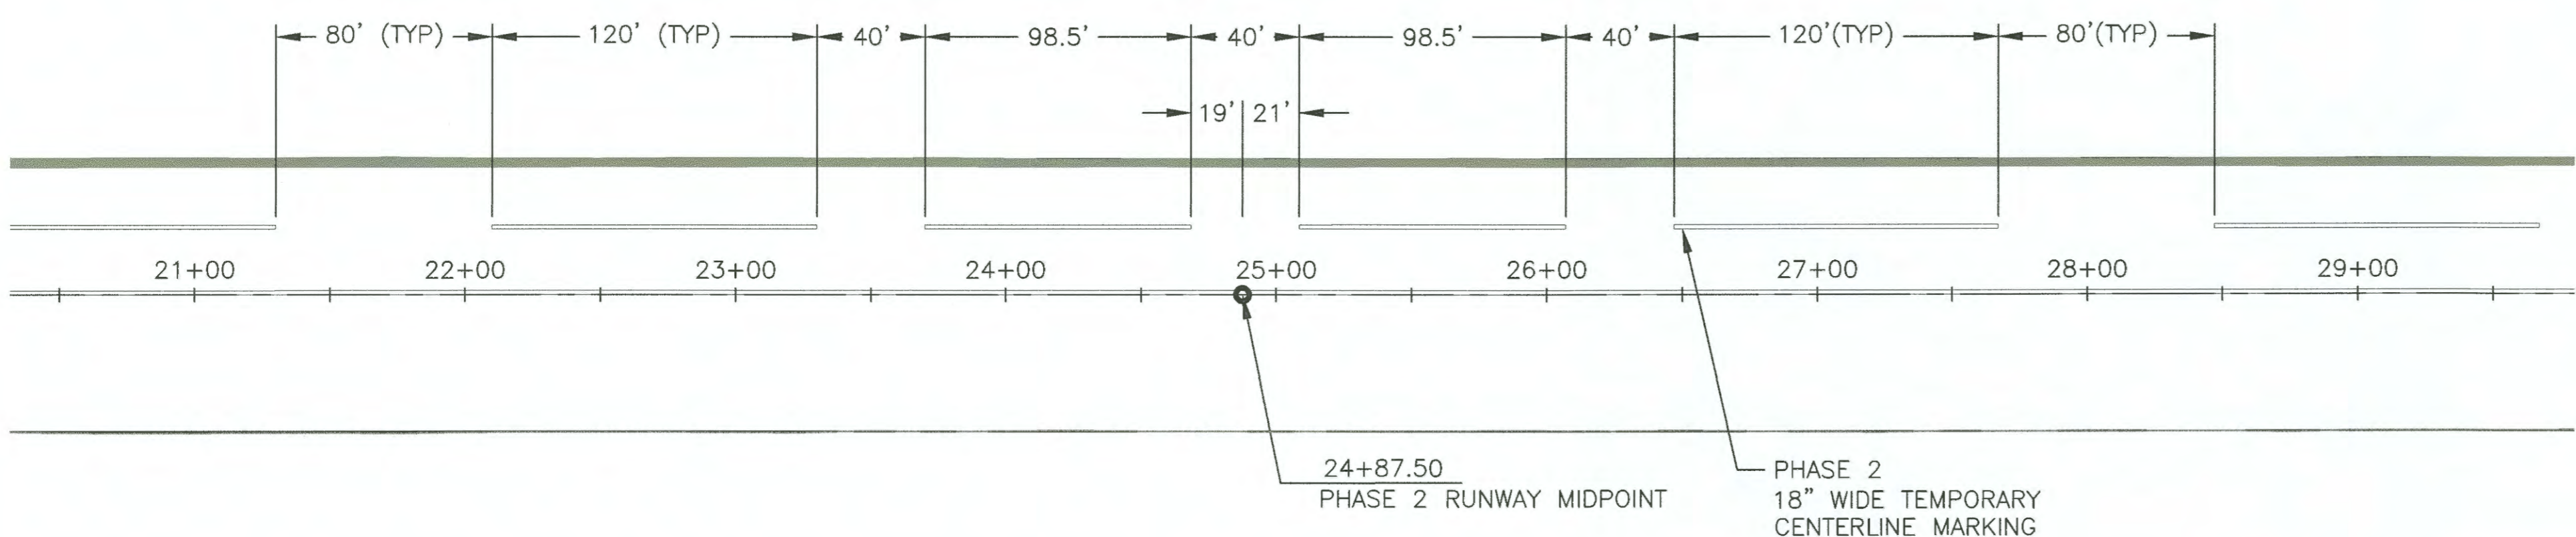

2 PHASE 2 TEMPORARY HALF WIDTH CENTERLINE MARKING DIMENSION LAYOUT  
12 NTS

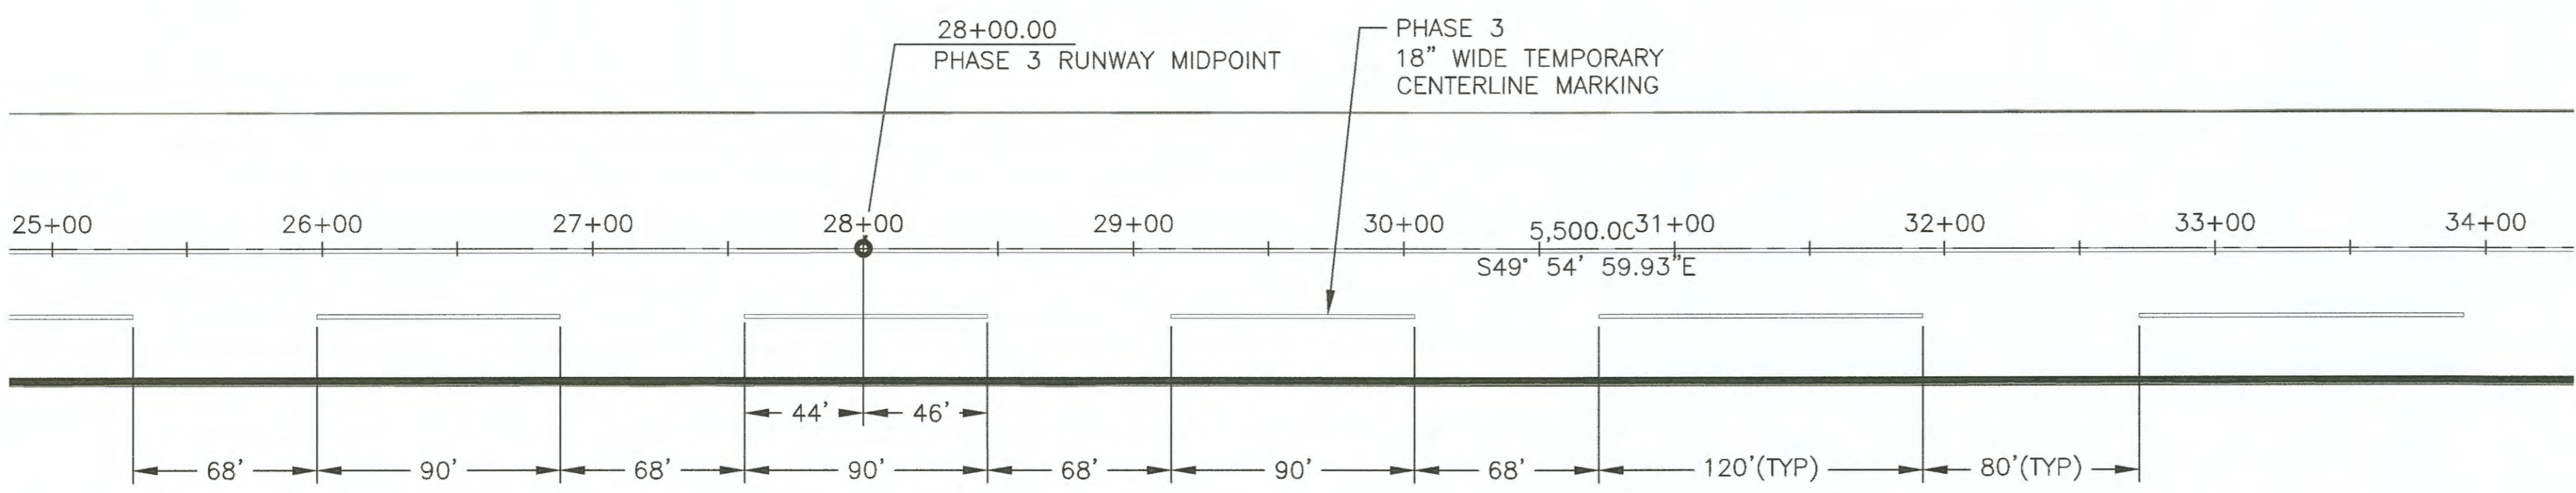

3 PHASE 3 TEMPORARY HALF WIDTH CENTERLINE MARKING DIMENSION LAYOUT  
12 NTS

**NOTE:**

1. THE TEMPORARY CENTERLINE MARKINGS ARE 120 FT LONG SPACED 80 FT APART EXCEPT WHERE SHOWN.

Record Drawings have been reviewed  
 by the Project Engineer, and represent  
 to the best of my knowledge, the  
 project as constructed.  
 PE [Signature] Date 10.24.19

DESIGN RPK  
 DRAWN ADC  
 CHECKED JGL





**STATE OF ALASKA**  
 DEPARTMENT OF TRANSPORTATION AND PUBLIC FACILITIES  
 SOUTHCOAST REGION-DESIGN AND CONSTRUCTION-AVIATION



BY	DATE	REVISIONS

**KAKE AIRPORT**  
 KAKE, ALASKA  
 RUNWAY REHABILITATION  
 AIP 3-02-0398-XX-2018/SFAPT00078  
 TEMPORARY MARKING DETAILS

SHEET  
**12**  
 OF  
**27**

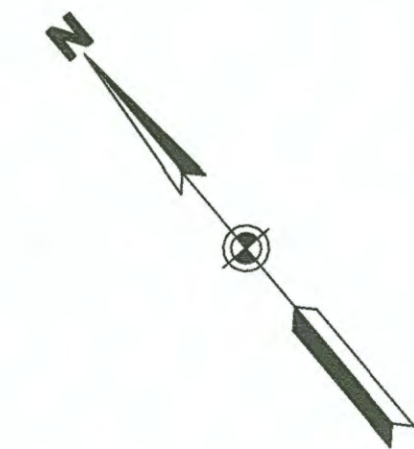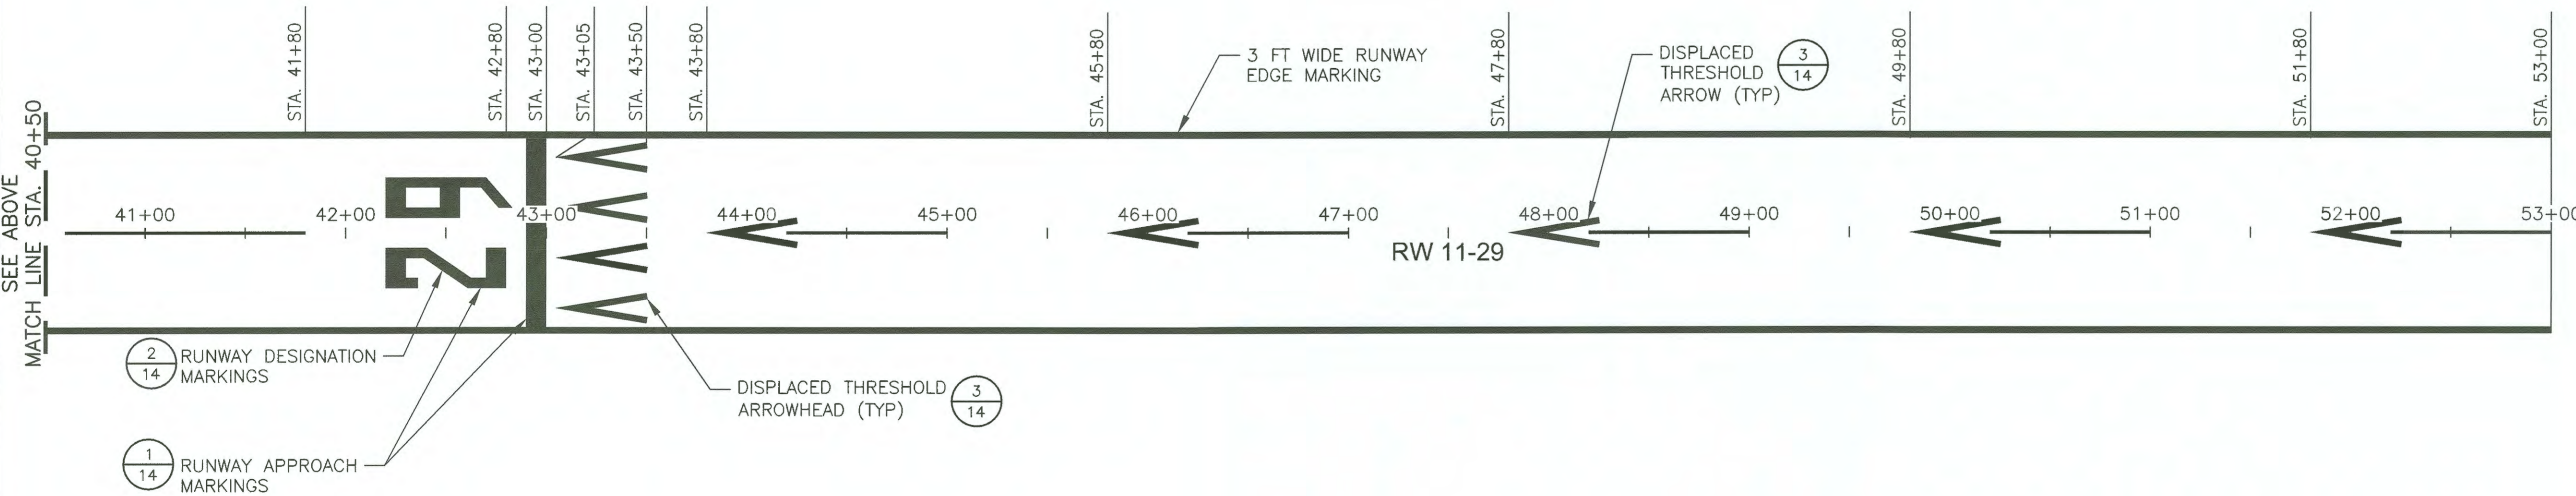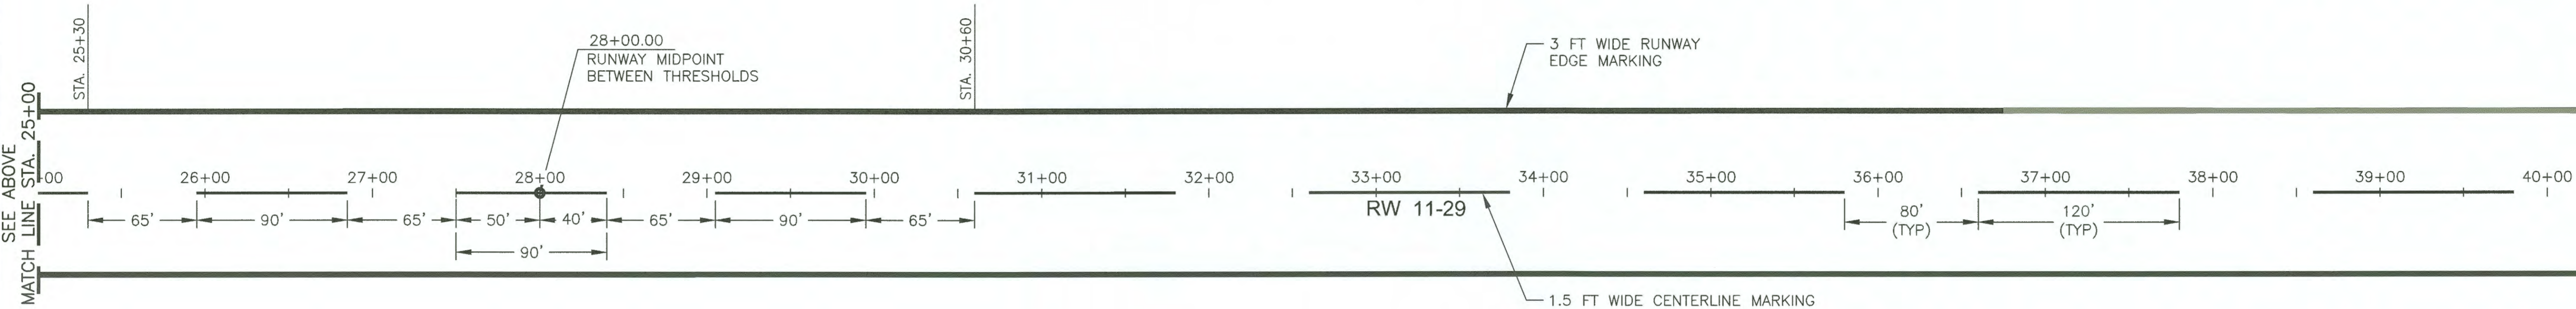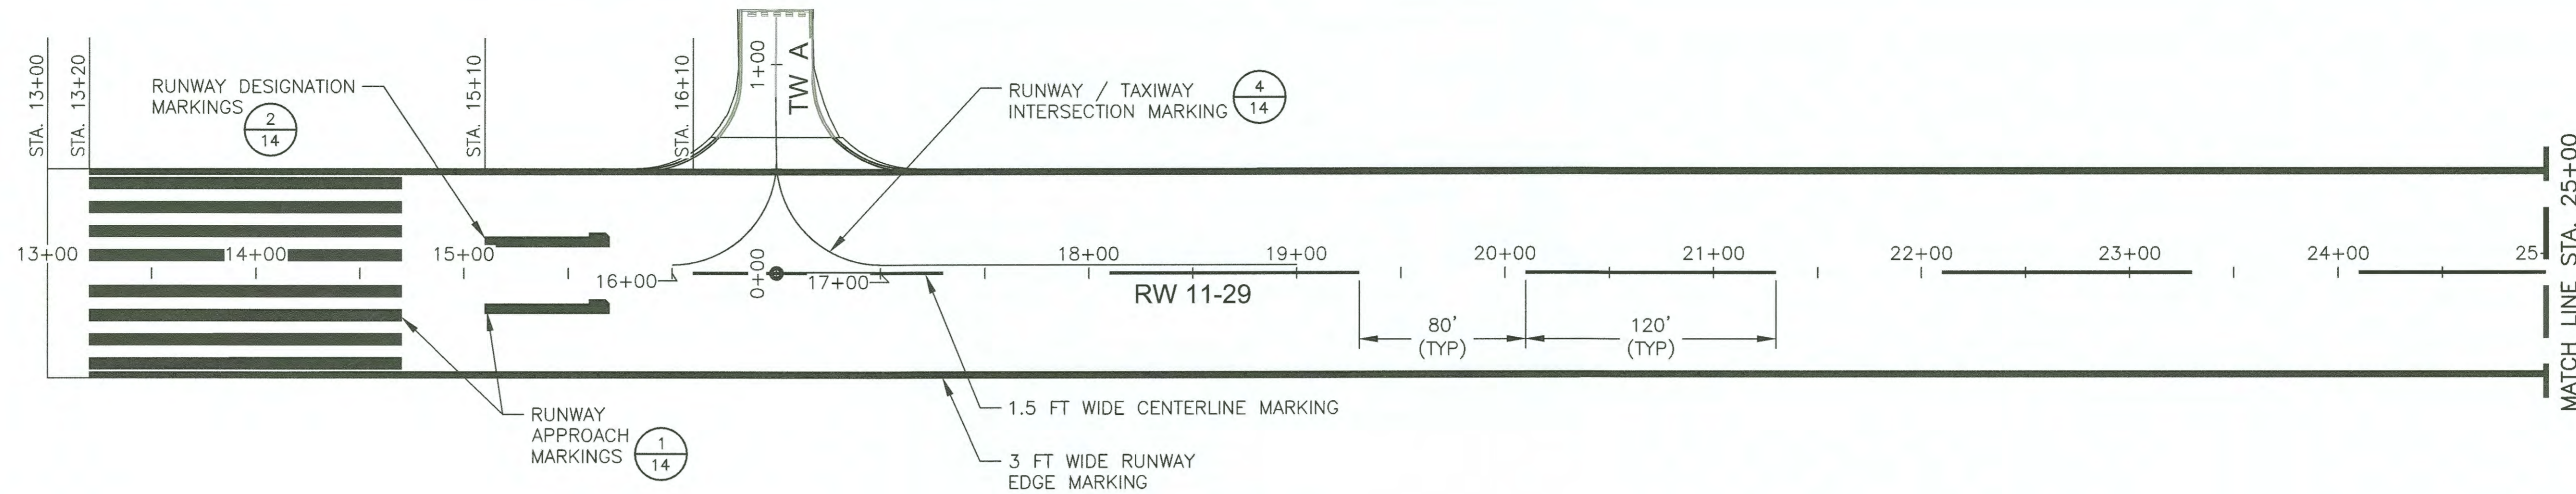

Record Drawings have been reviewed by the Project Engineer, and represent to the best of my knowledge, the project as constructed.  
PE [Signature] Date 10-24-19



DESIGN RPK  
DRAWN ADC  
CHECKED JGL


STATE OF ALASKA  
DEPARTMENT OF TRANSPORTATION AND PUBLIC FACILITIES  
SOUTHCOAST REGION-DESIGN AND CONSTRUCTION-AVIATION



BY	DATE	REVISIONS

KAKE AIRPORT  
KAKE, ALASKA  
RUNWAY REHABILITATION  
AIP 3-02-0398-XX-2018/SFAPT00078  
PERMANENT RUNWAY 11-29 MARKING PLAN


SHEET  
13  
OF  
27

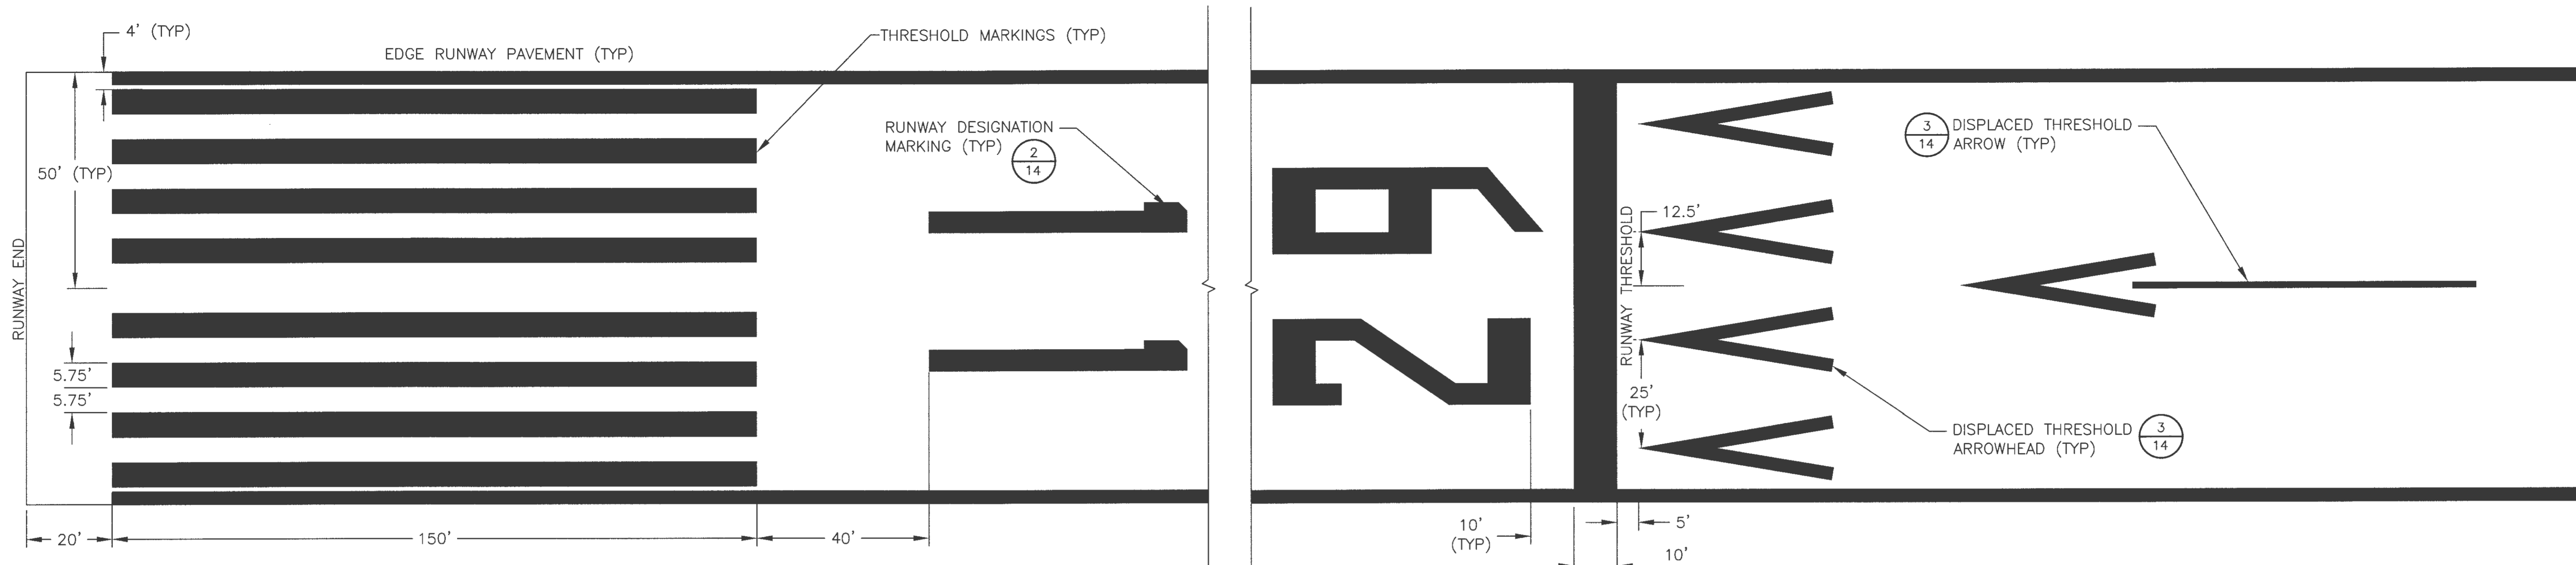


1 RUNWAY APPROACH END MARKINGS  
14 NTS

NOTES:


1. SEE PLAN VIEW FOR LOCATION OF MARKINGS BY STATION.
2. OUTER EDGE OF RUNWAY EDGE STRIPE IS 50' FROM RUNWAY CENTERLINE.
3. ALL RUNWAY MARKINGS ARE WHITE. ALL TAXIWAY & APRON MARKINGS ARE YELLOW UNLESS NOTED OTHERWISE.
4. LAYOUT TAXIWAY CENTERLINE TO CLEAR 3 FEET INSIDE EDGE TO INSIDE EDGE.
5. RUNWAY MARKINGS TAKE PRECEDENCE OVER TAXIWAY MARKINGS. BREAK TAXIWAY MARKINGS, OR PAINT RUNWAY MARKINGS OVER THE TOP OF TAXIWAY MARKINGS.

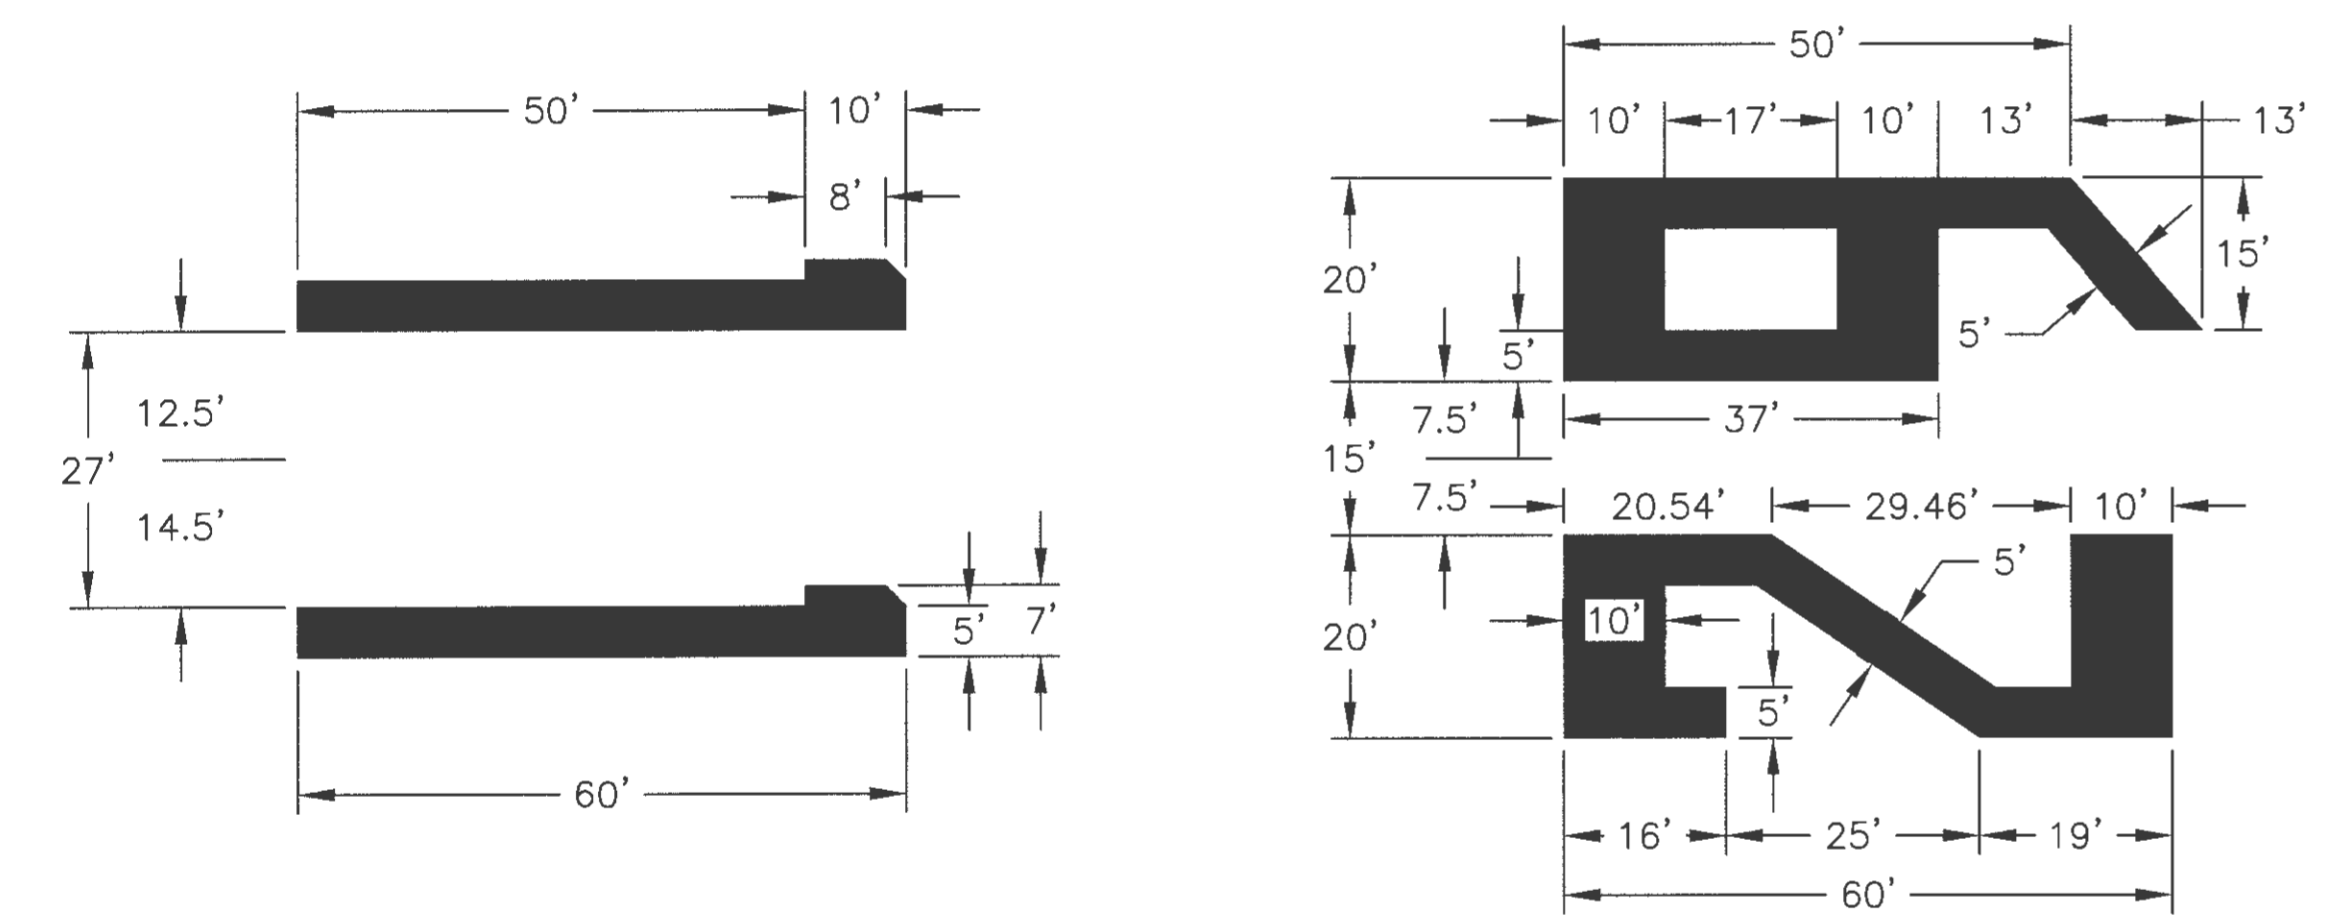

2 RUNWAY DESIGNATOR DETAIL  
14 NTS

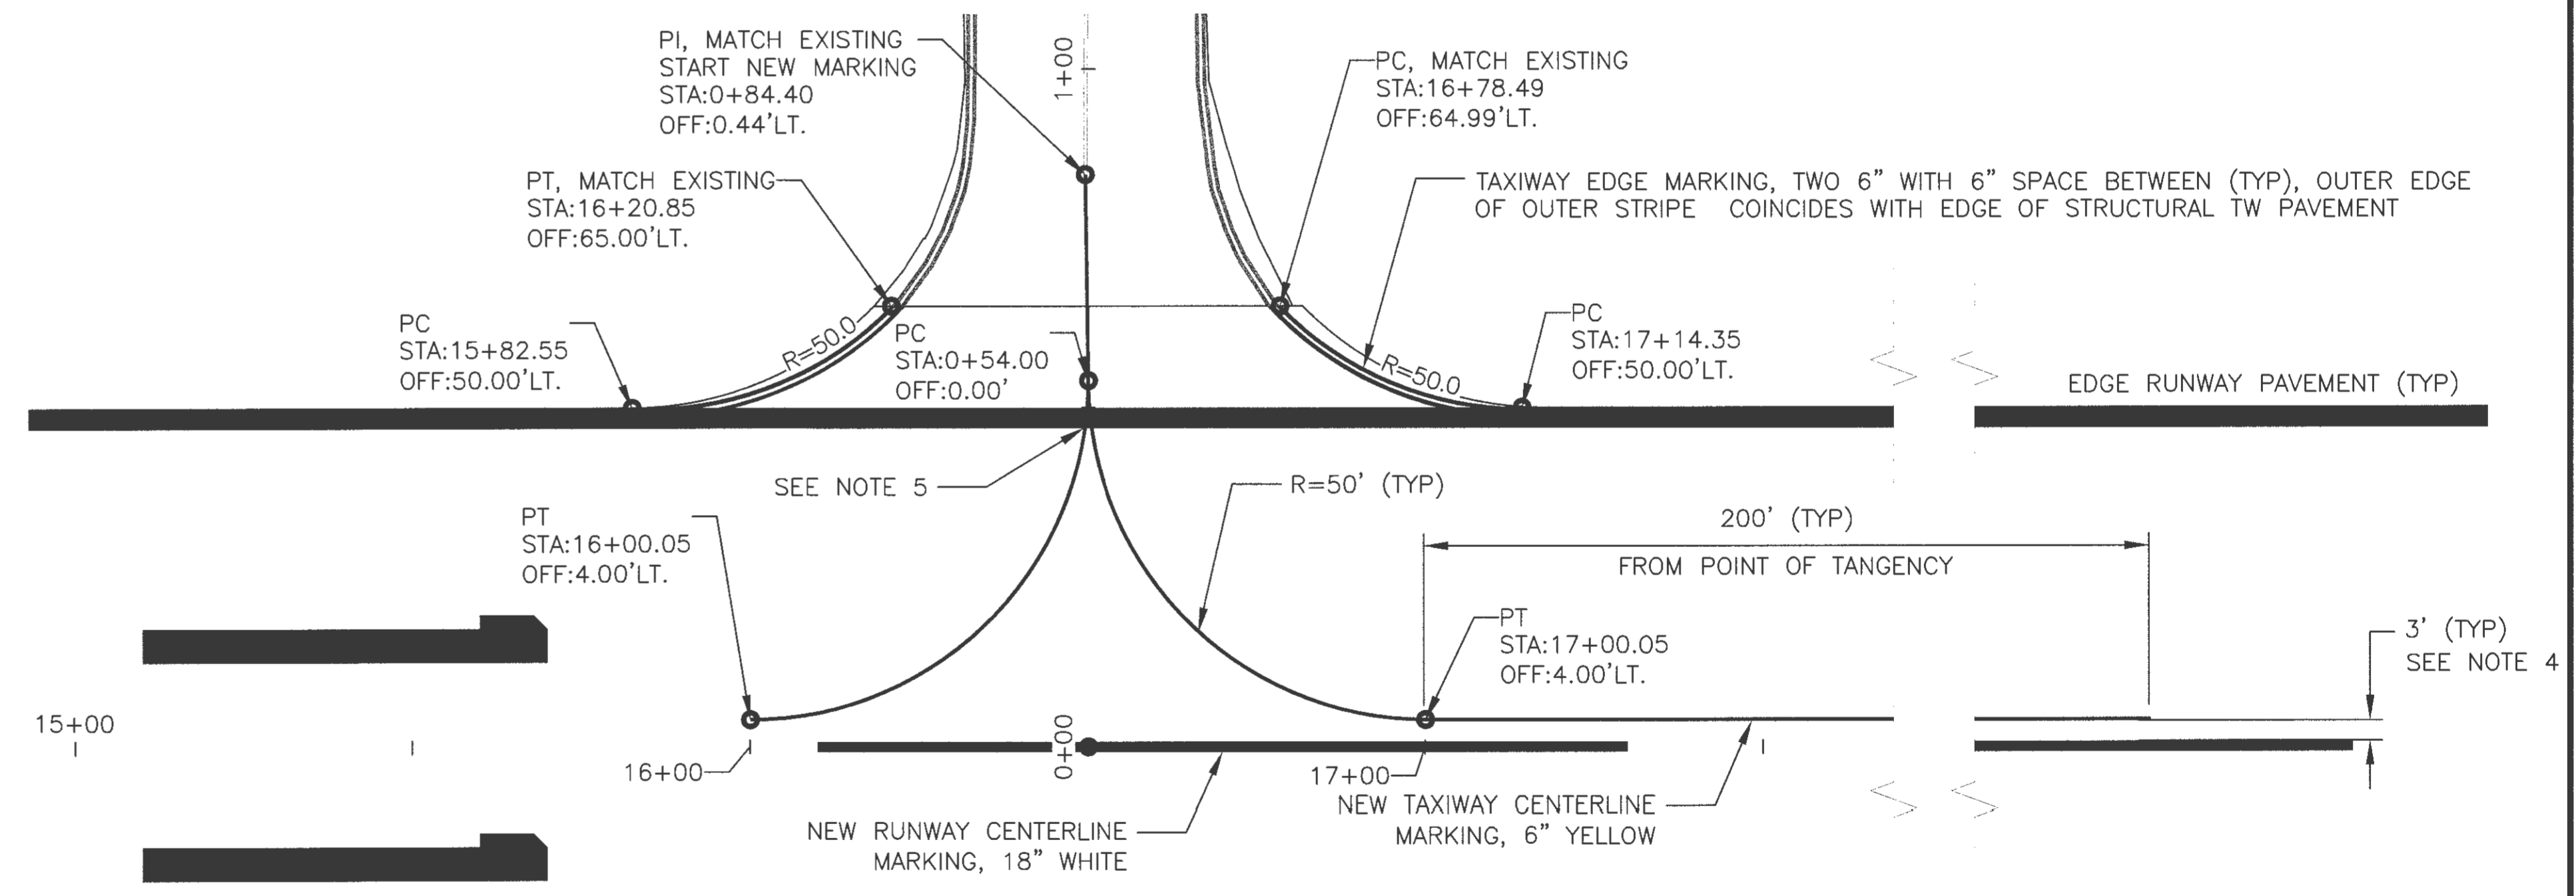

4 RUNWAY / TAXIWAY INTERSECTION MARKINGS  
14 NTS

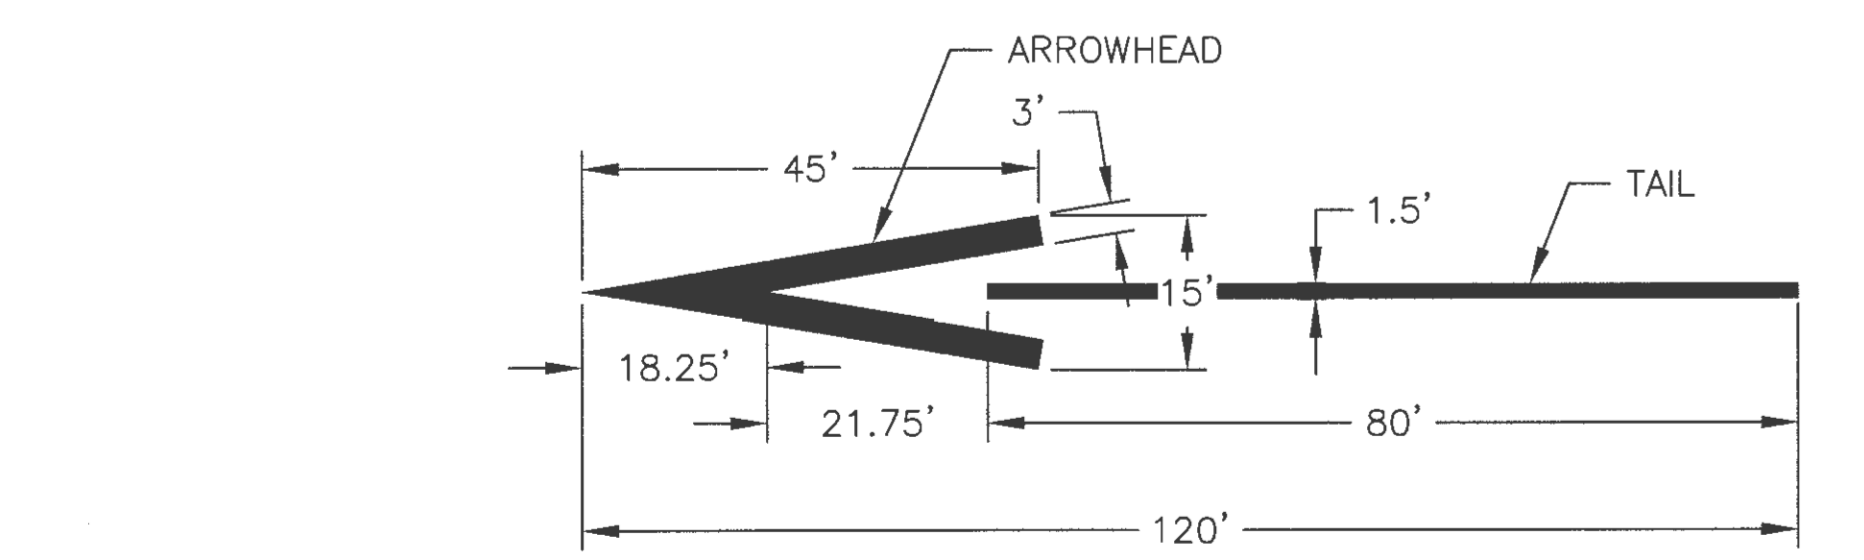

3 DISPLACED THRESHOLD ARROW AND ARROWHEAD  
14 NTS

Record Drawings have been reviewed by the Project Engineer, and represent to the best of my knowledge, the project as constructed.  
 PE [Signature] Date: 07-19

DESIGN RPK  
 DRAWN ADC  
 CHECKED JGL

STATE OF ALASKA  
 DEPARTMENT OF TRANSPORTATION AND PUBLIC FACILITIES  
 SOUTHCOAST REGION-DESIGN AND CONSTRUCTION-AVIATION





BY	DATE	REVISIONS

KAKE AIRPORT  
 KAKE, ALASKA  
 RUNWAY REHABILITATION  
 AIP 3-02-0398-XX-2018/SFAPT00078  
 PERMANENT MARKING DETAILS

SHEET  
 14  
 OF  
 27



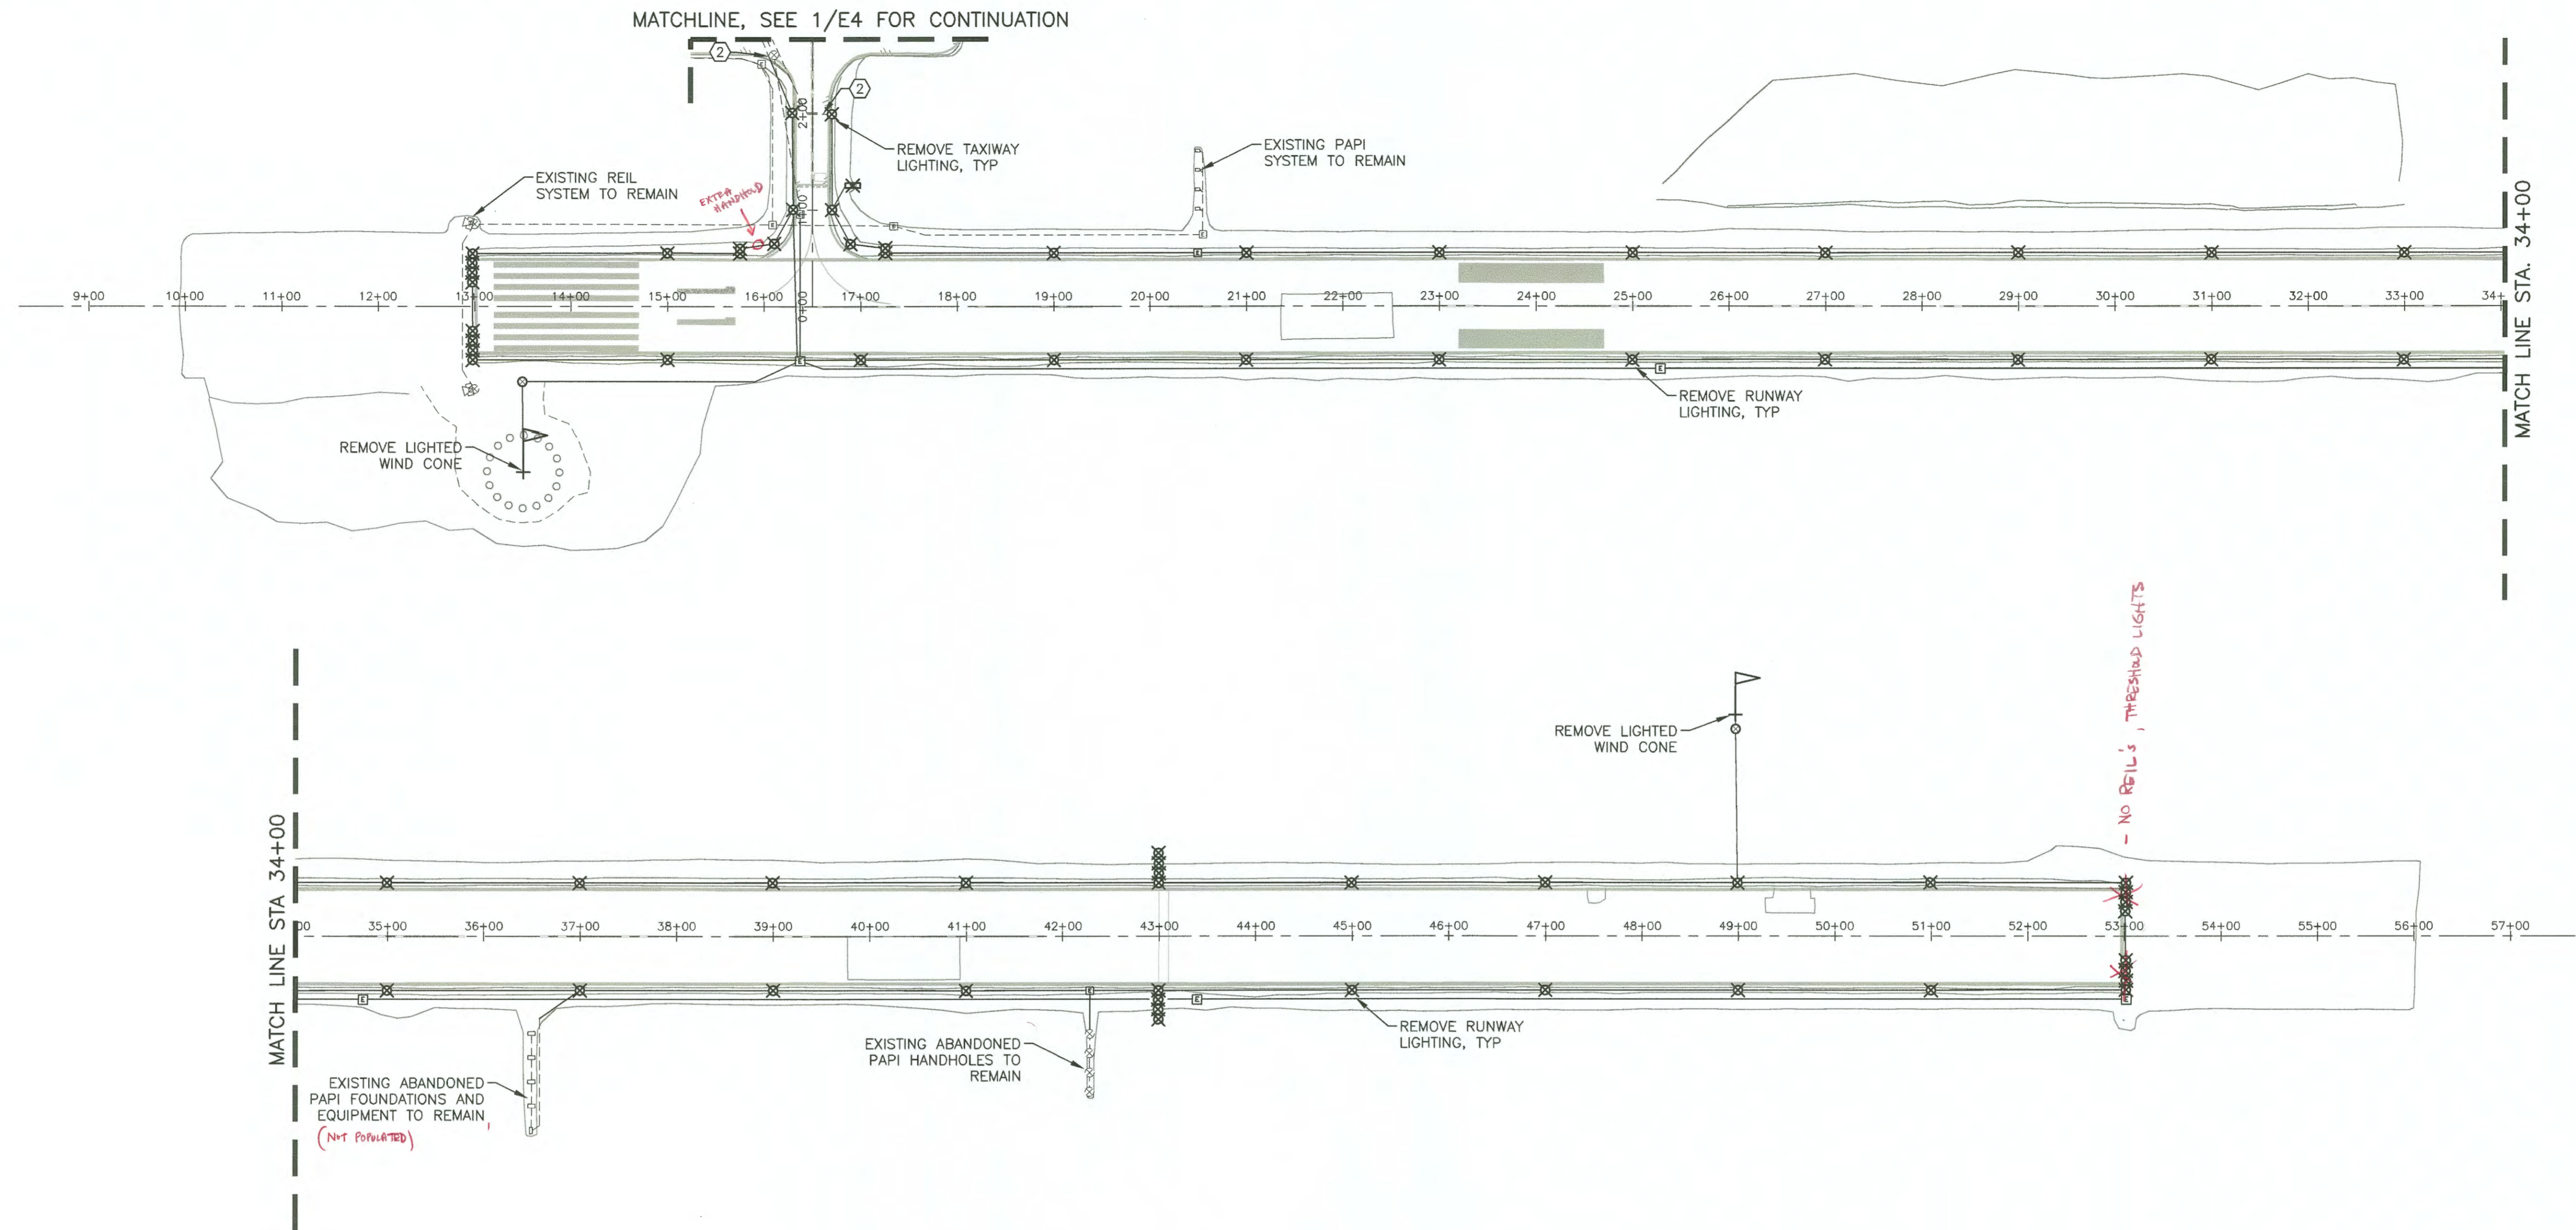

Record Drawings have been reviewed by the Project Engineer, and represent to the best of my knowledge, the project as constructed.  
 PE  Date 10.24.19

DESIGN LPS  
 DRAWN LPS,JCA  
 CHECKED MXS




STATE OF ALASKA  
 DEPARTMENT OF TRANSPORTATION AND PUBLIC FACILITIES  
 SOUTHCOAST REGION-DESIGN AND CONSTRUCTION-AVIATION



BY	DATE	REVISIONS

KAKE AIRPORT  
 KAKE, ALASKA  
 RUNWAY REHABILITATION  
 AIP 3-02-0398-XX-2018/SFAPT00078  
 ELECTRICAL SITE PLAN - DEMOLITION

SHEET **E2** OF 27

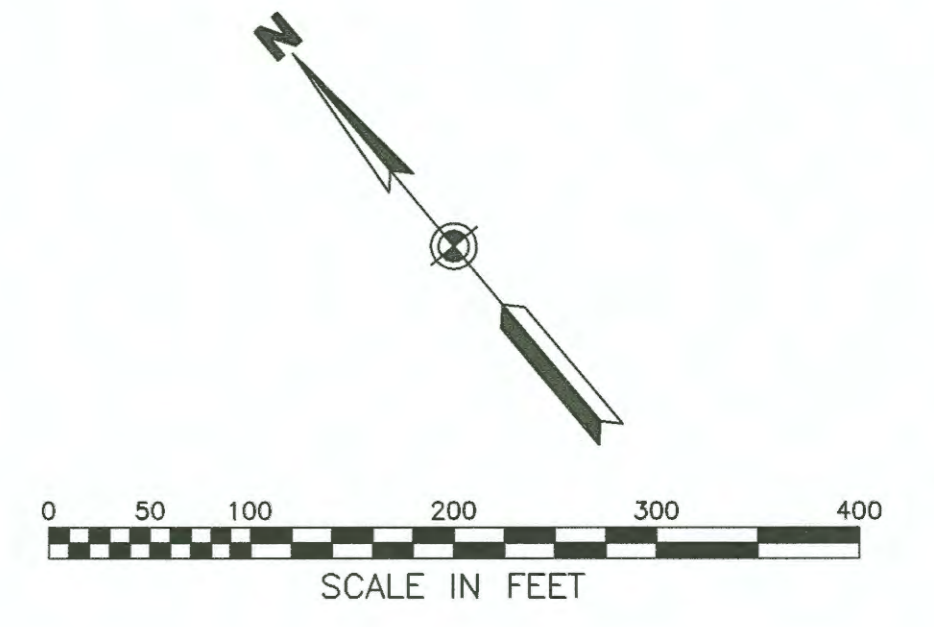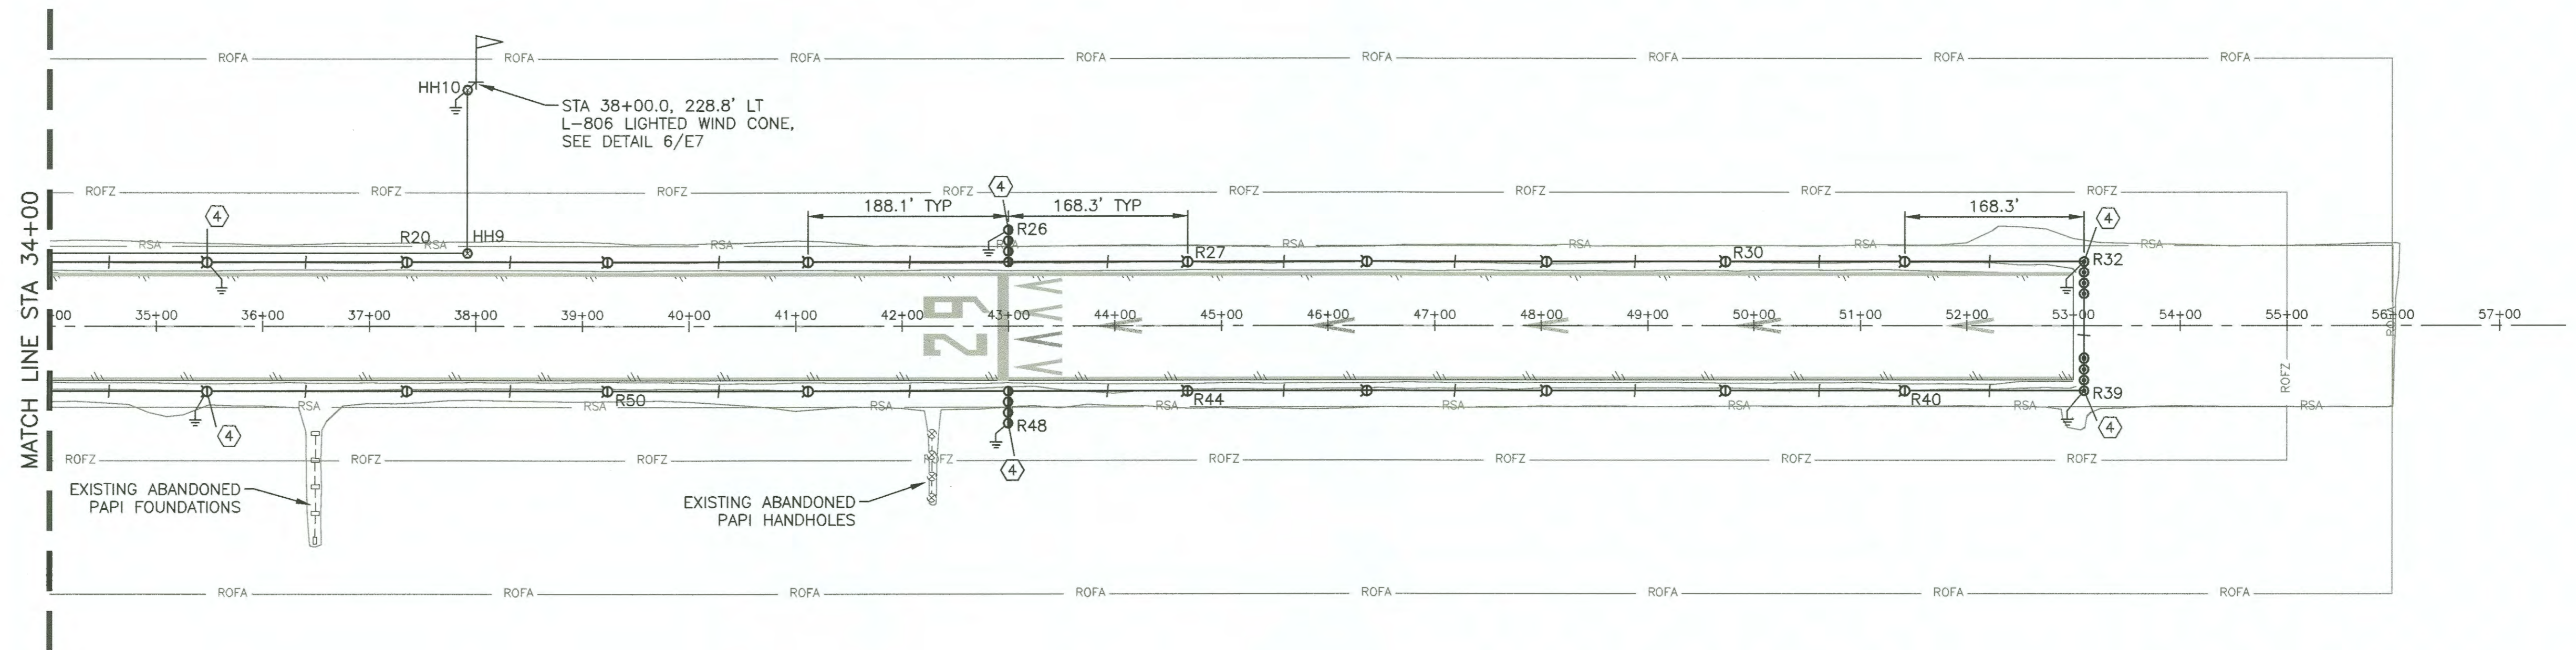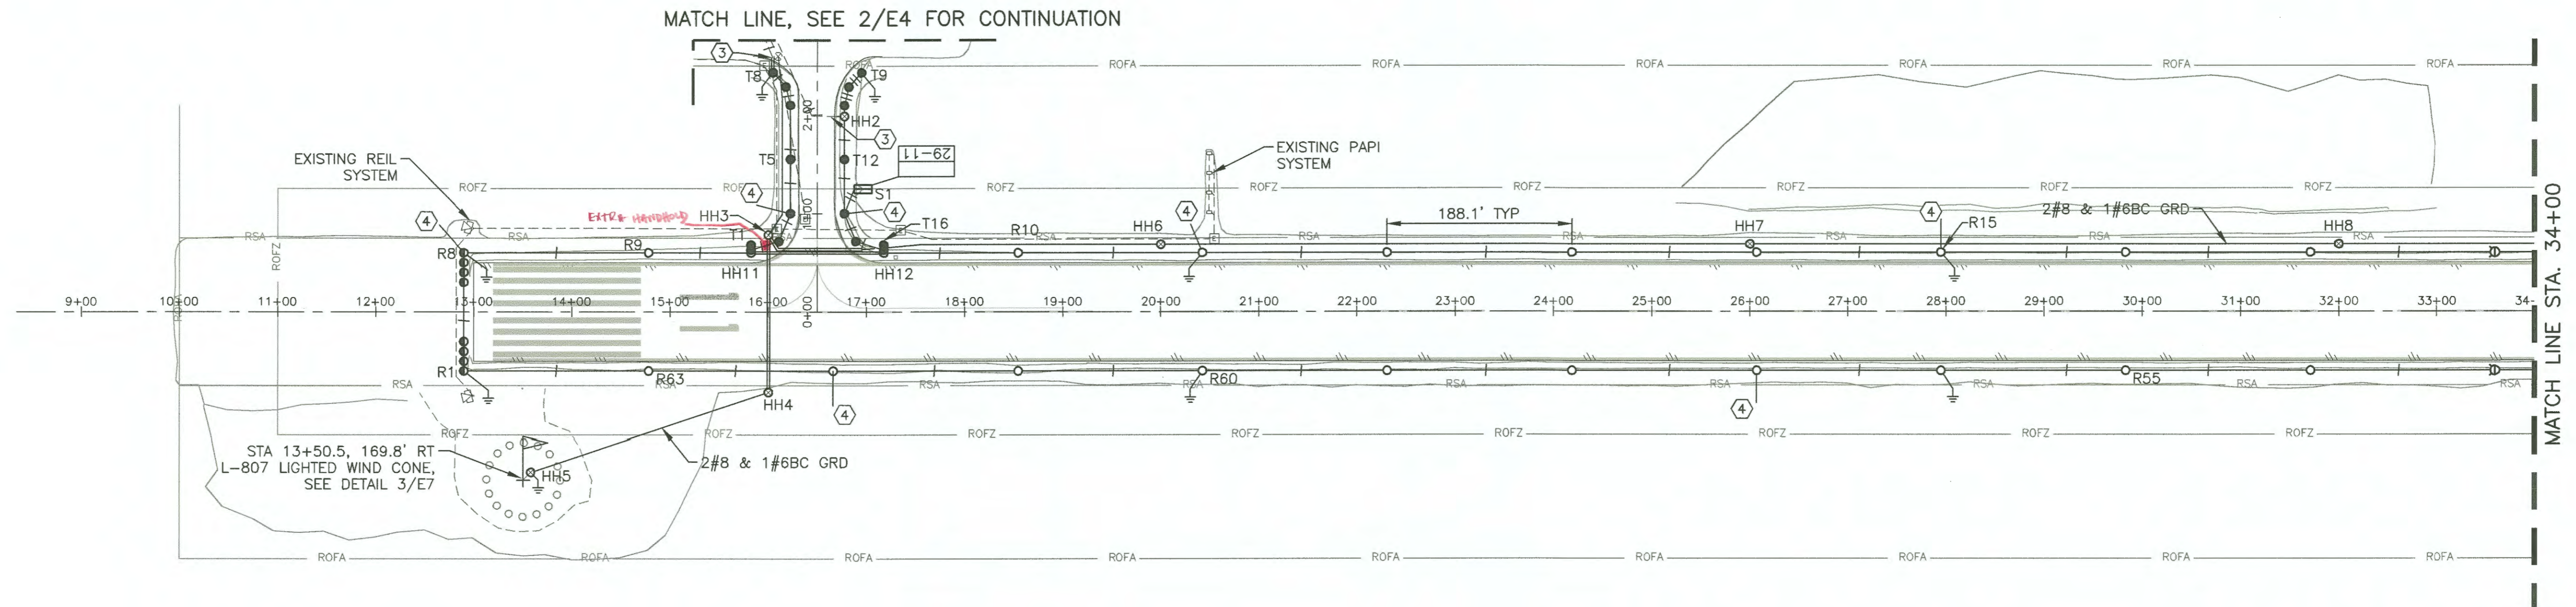

Record Drawings have been reviewed by the Project Engineer, and represent to the best of my knowledge, the project as constructed.  
 PE [Signature] Date 10.24.19

DESIGN LPS  
 DRAWN LPS,JCA  
 CHECKED MXS

STATE OF ALASKA  
 DEPARTMENT OF TRANSPORTATION AND PUBLIC FACILITIES  
 SOUTHCOAST REGION-DESIGN AND CONSTRUCTION-AVIATION




BY	DATE	REVISIONS


KAKE AIRPORT  
 KAKE, ALASKA  
 RUNWAY REHABILITATION  
 AIP 3-02-0398-XX-2018/SFAPT00078  
 ELECTRICAL SITE PLAN - NEW WORK

SHEET  
**E3**  
 OF  
 27


7/25/2018, 12:46 PM  
 PLANS DEVELOPED BY: STANTEC CONSULTING SERVICES, INC. 725 EAST FIREWEED LANE, SUITE 200, ANCHORAGE, AK 99503-2245 907-276-4245 CERTIFICATE OF AUTHORIZATION #126386  
 U:\2047059100\drawing\E\_sheets\2047059100\_E4\_e-site-apron.dwg

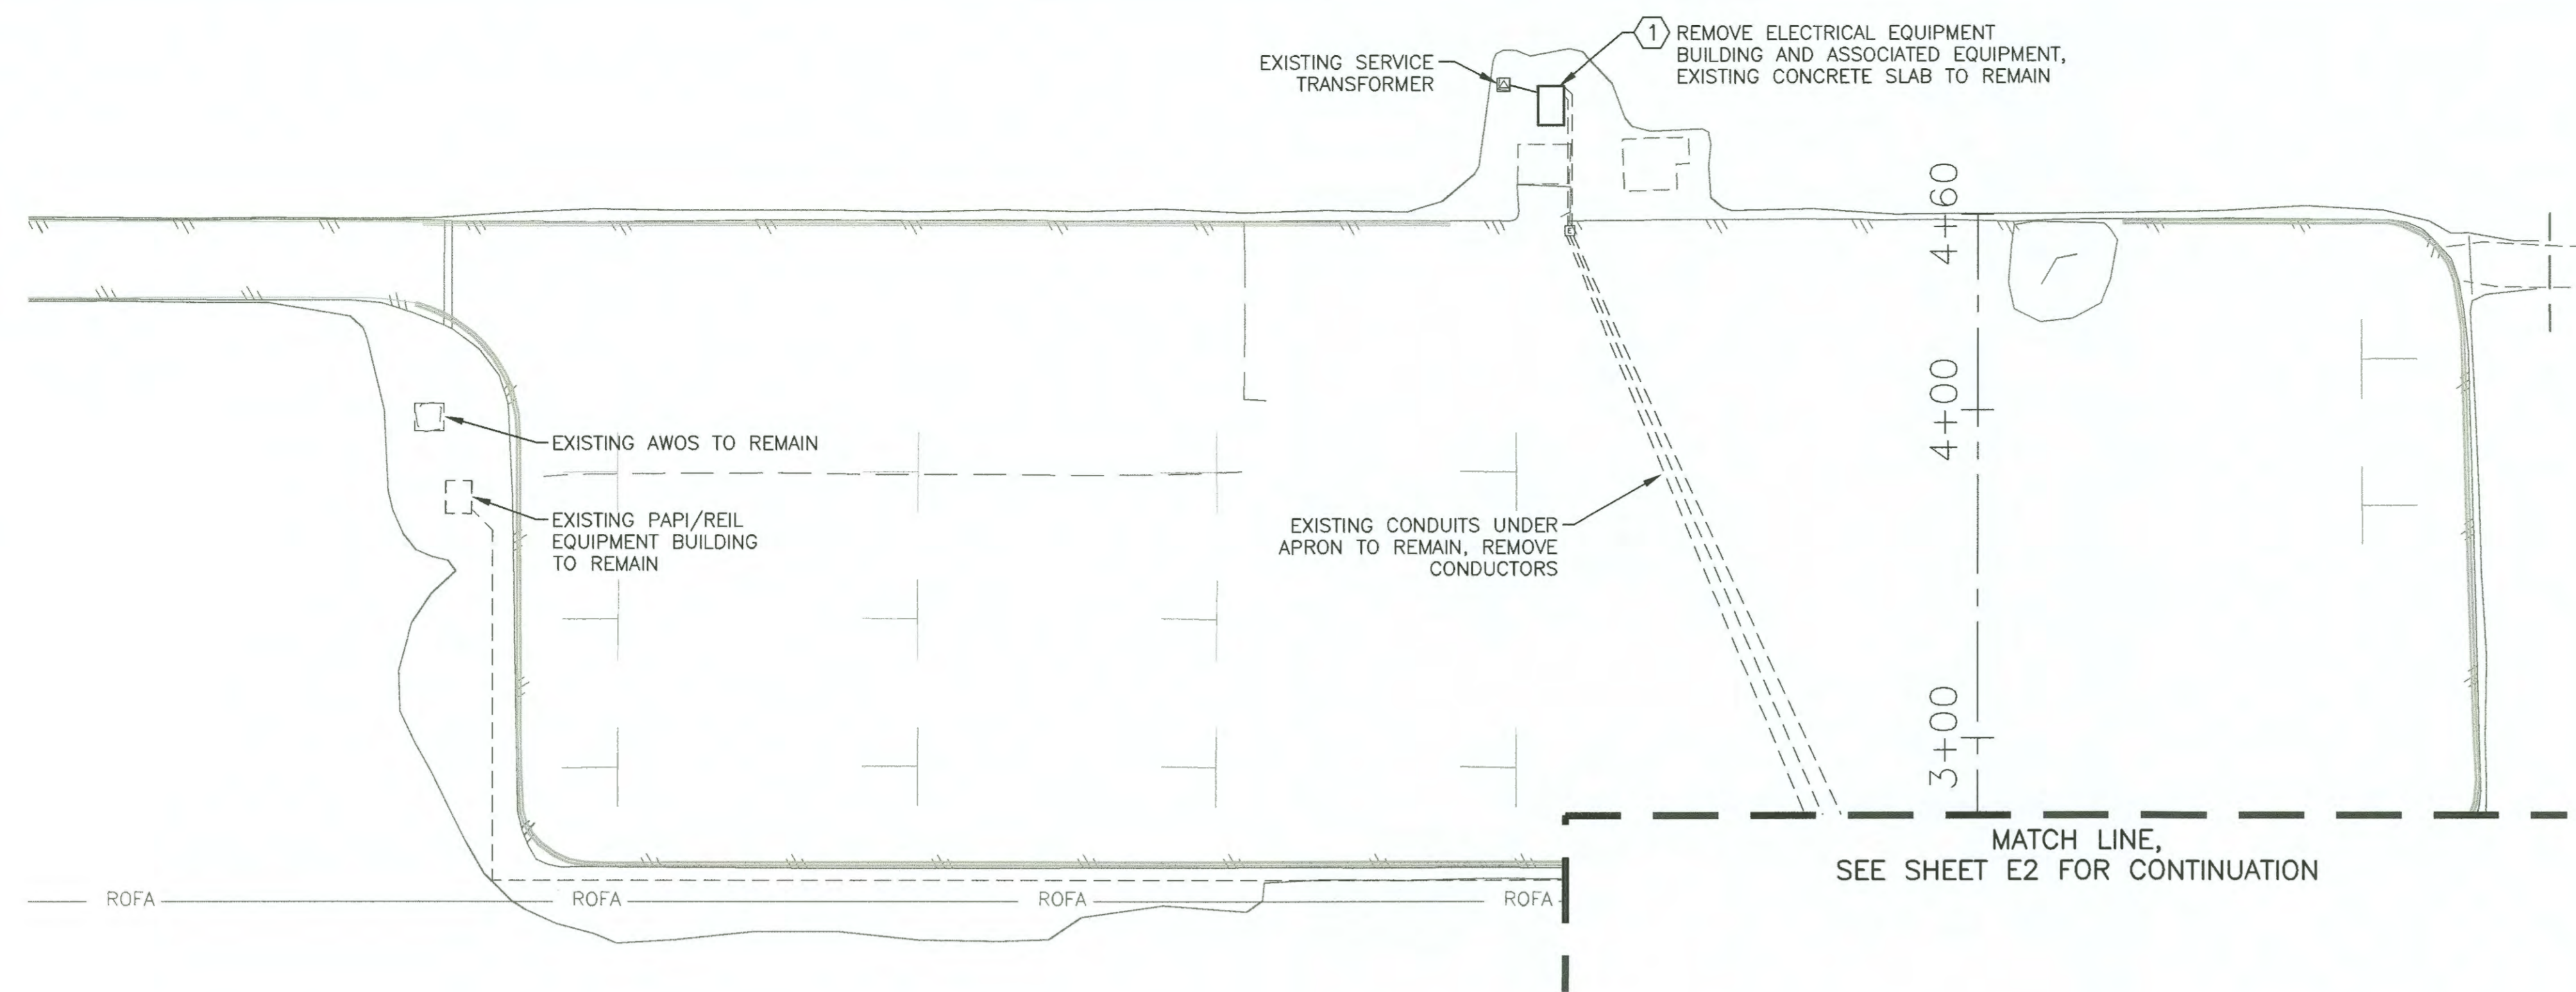

1  
E4  
APRON ELECTRICAL PLAN - DEMOLITION

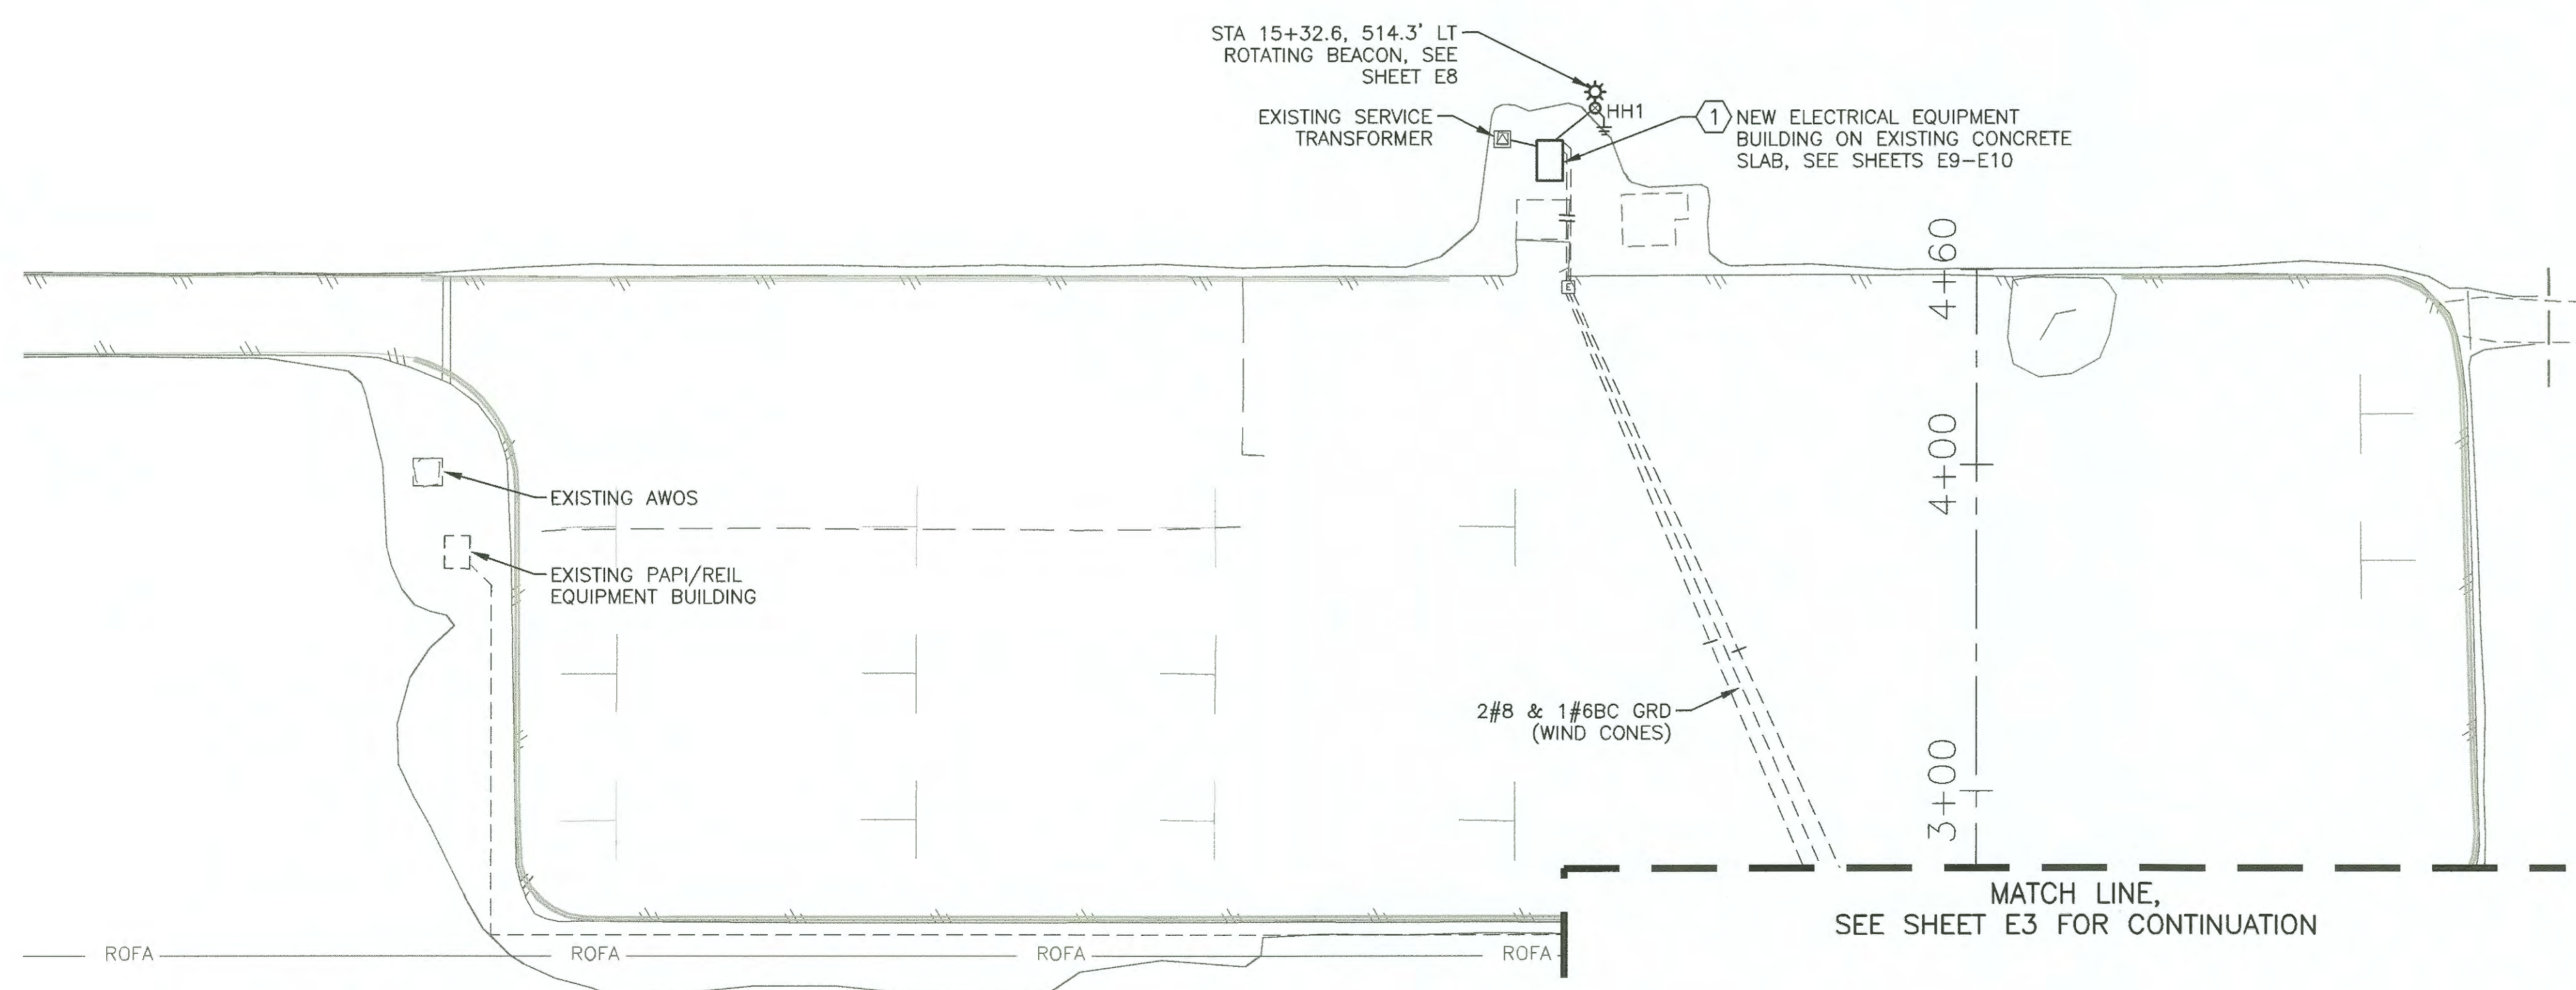

2  
E4  
APRON ELECTRICAL PLAN - NEW WORK

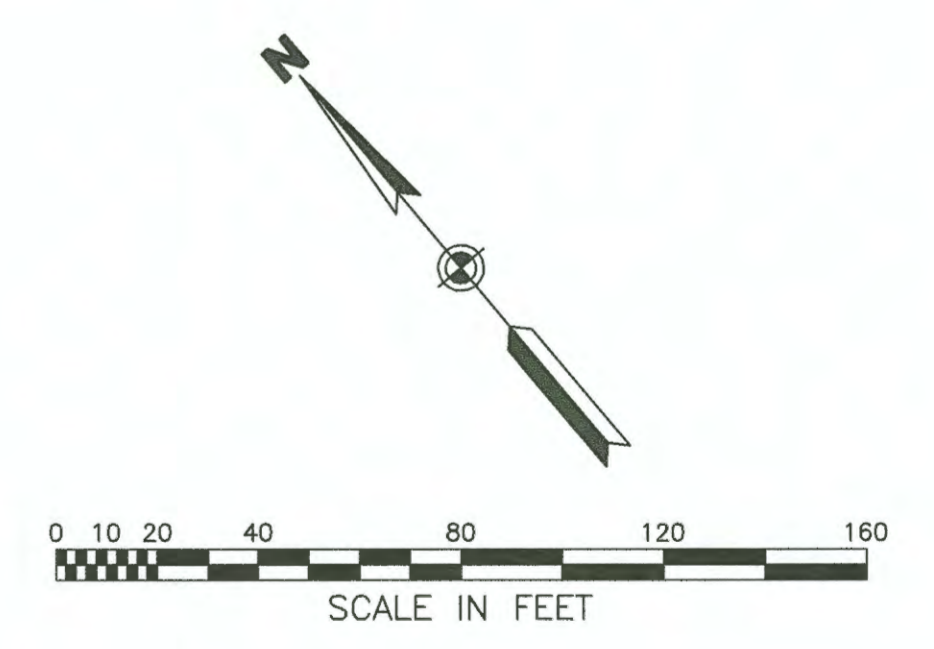

Record Drawings have been reviewed by the Project Engineer, and represent to the best of my knowledge, the project as constructed.  
 PE Date 10.24.19

DESIGN LPS  
 DRAWN LPS,JCA  
 CHECKED MXS


**STATE OF ALASKA**  
 DEPARTMENT OF TRANSPORTATION AND PUBLIC FACILITIES  
 SOUTHCOAST REGION-DESIGN AND CONSTRUCTION-AVIATION




BY	DATE	REVISIONS

**KAKE AIRPORT**  
 KAKE, ALASKA  
 RUNWAY REHABILITATION  
 AIP 3-02-0398-XX-2018/SFAPT00078  
 ELECTRICAL SITE PLAN - APRON  
 ENLARGED PLANS


SHEET  
**E4**  
 OF  
**27**

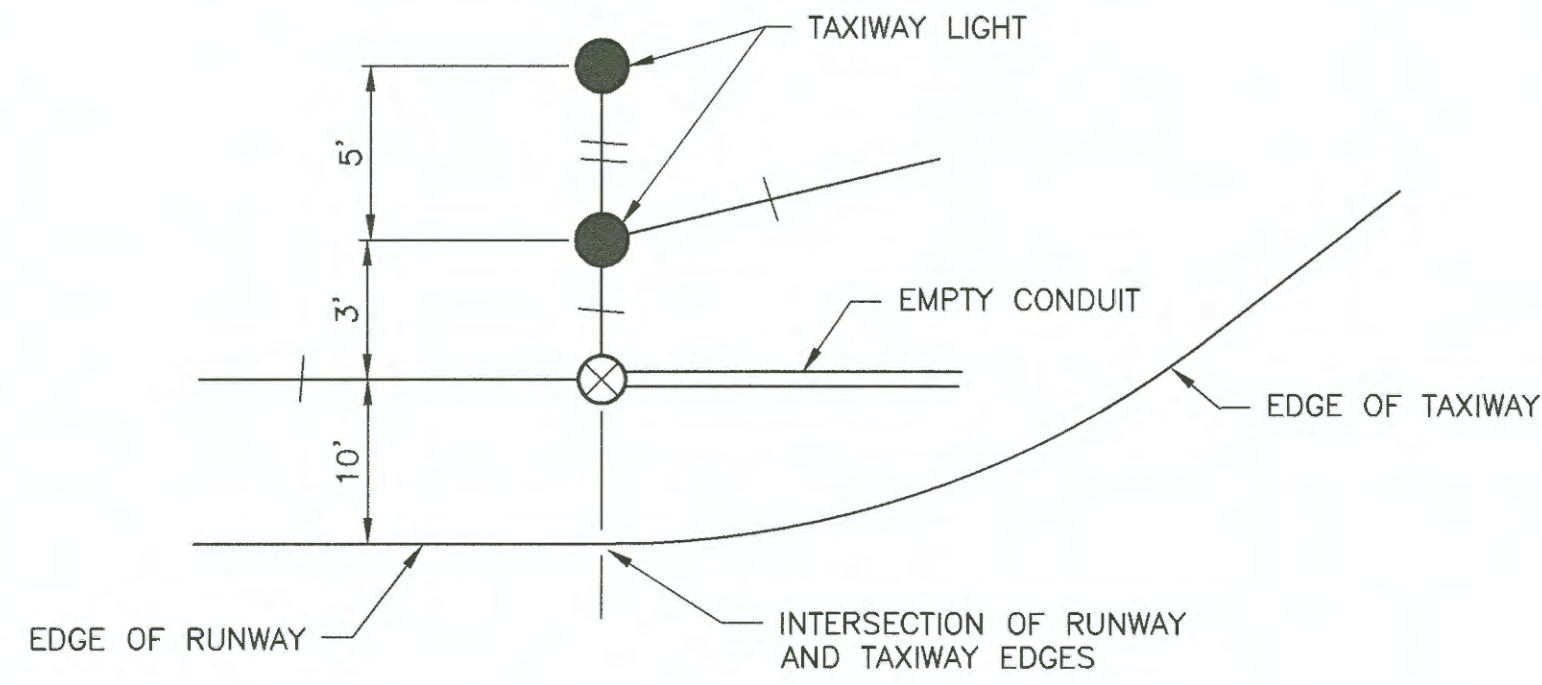

**3** TYPICAL TAXIWAY ENTRANCE LIGHTS  
E5 SCALE: N.T.S.

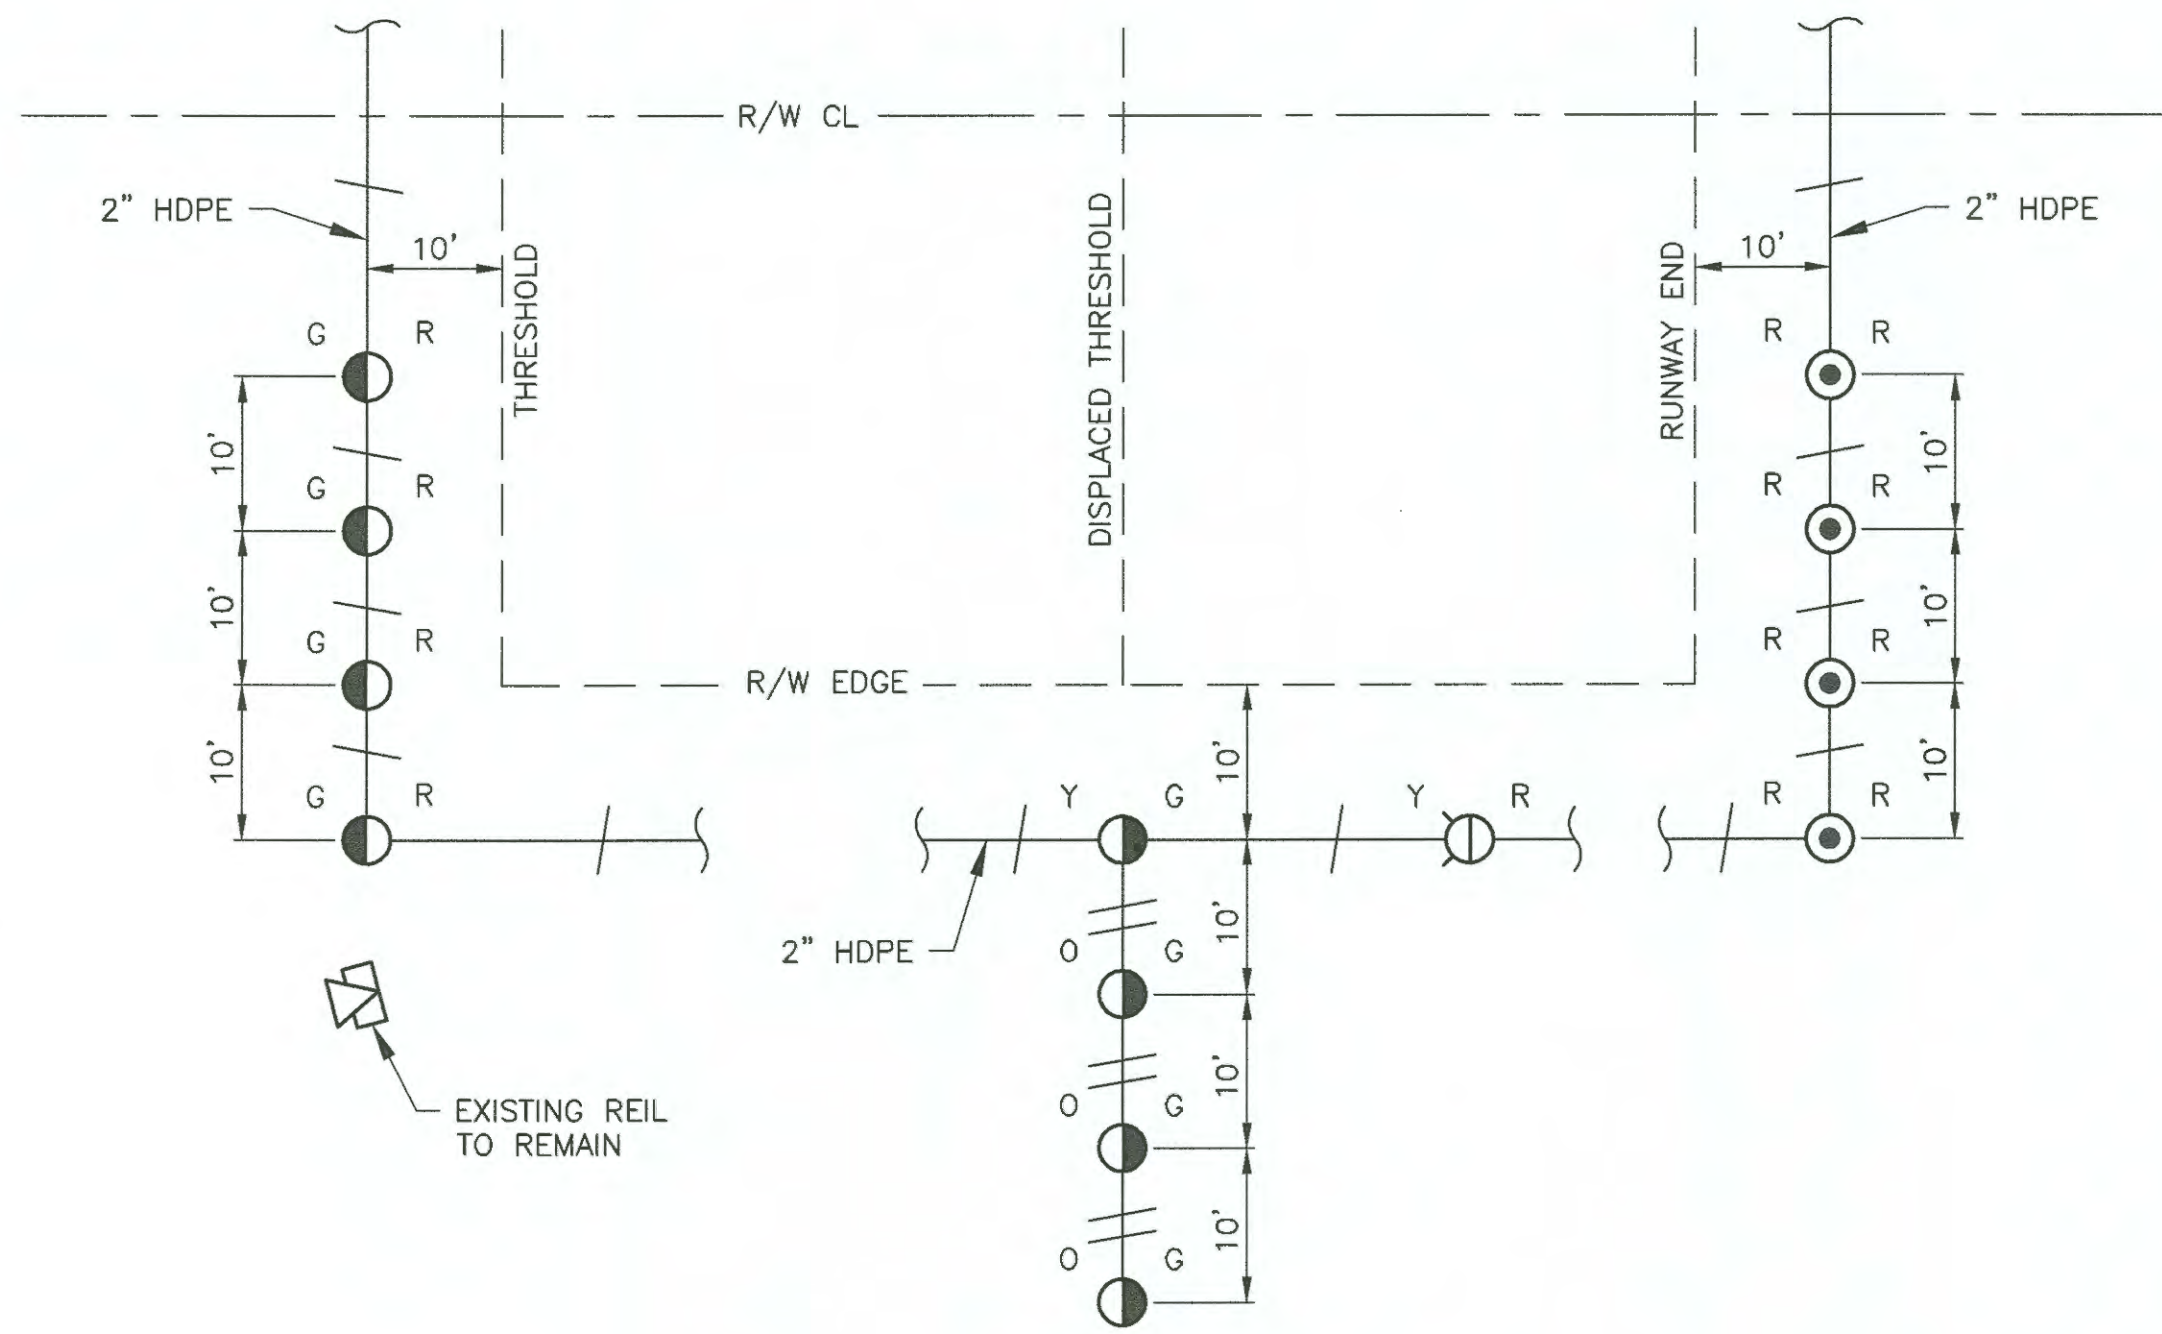

**2** THRESHOLD LIGHTING DETAIL  
E5 SCALE: N.T.S.

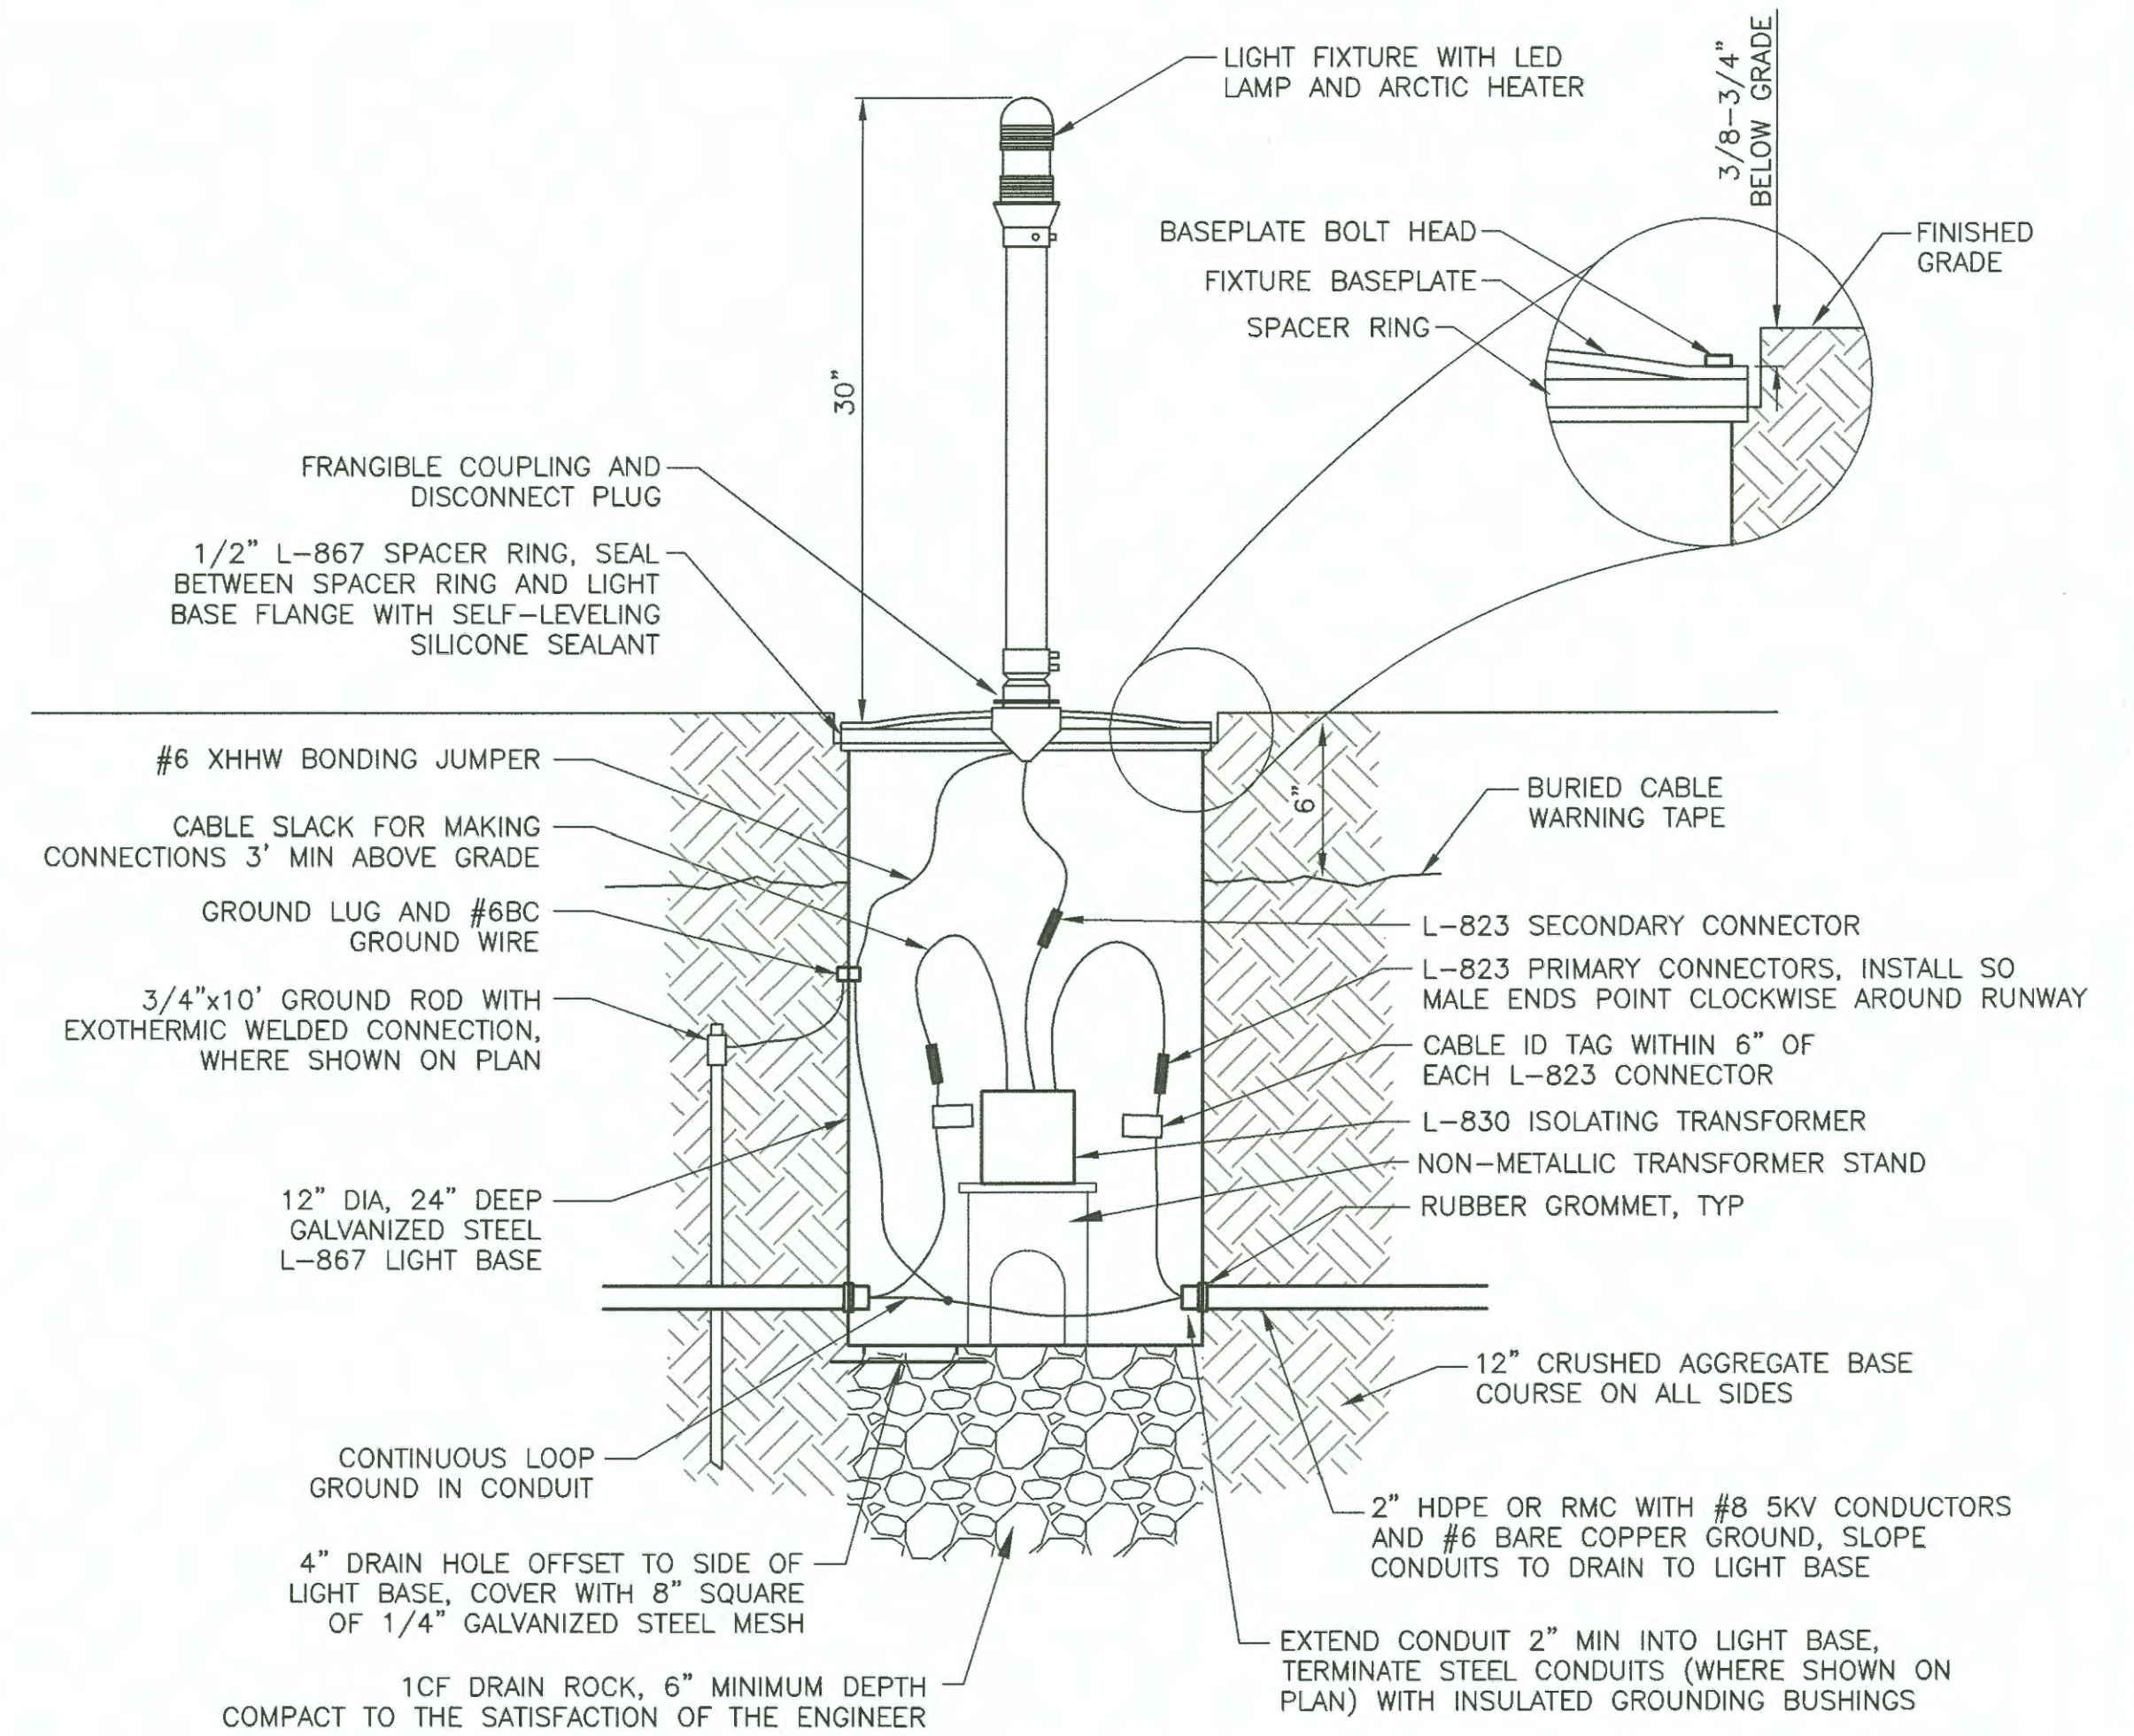

**1** BASE MOUNTED LIGHT DETAIL  
E5 SCALE: N.T.S.

**NOTE:**  
CIRCUIT GROUND WIRE ROUTED IN CONDUIT SHALL BE CONTINUOUS THROUGH LIGHT BASE OR JOINED USING IRREVERSIBLE COMPRESSION CONNECTORS AND SHALL NOT RELY ON LIGHT BASE GROUND LUG FOR CONTINUITY

Record Drawings have been reviewed by the Project Engineer, and represent to the best of my knowledge, the project as constructed.  
PE [Signature] Date 10.24.19

DESIGN LPS  
DRAWN LPS,JCA  
CHECKED MXS


STATE OF ALASKA  
DEPARTMENT OF TRANSPORTATION AND PUBLIC FACILITIES  
SOUTHCOAST REGION-DESIGN AND CONSTRUCTION-AVIATION



BY	DATE	REVISIONS


KAKE AIRPORT  
KAKE, ALASKA  
RUNWAY REHABILITATION  
AIP 3-02-0398-XX-2018/SFAPT00078  
ELECTRICAL DETAILS I

SHEET  
E5  
OF  
27

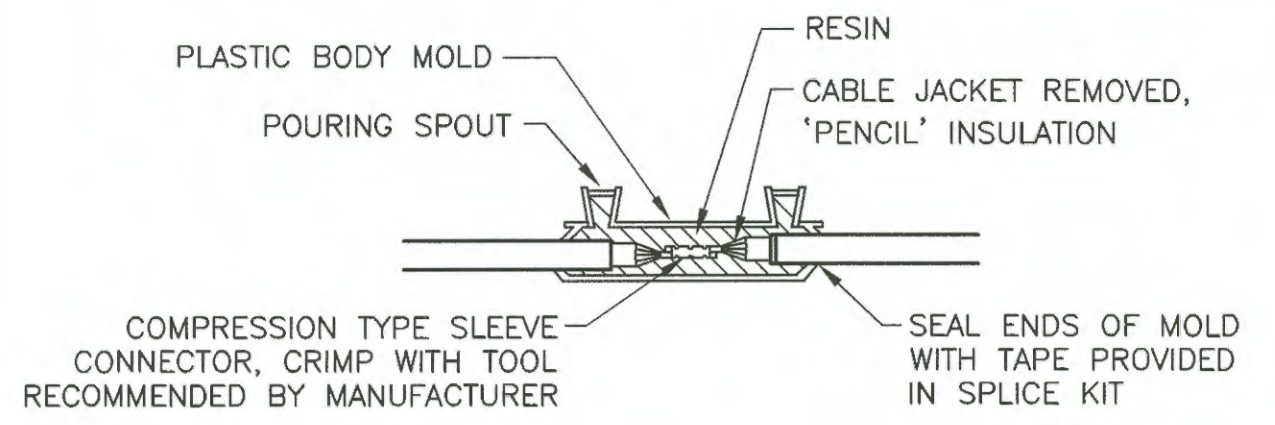

TYPE A


FOR SPLICES IN HOMERUNS AND FOR EXTENSIONS TO EXISTING CABLES ONLY

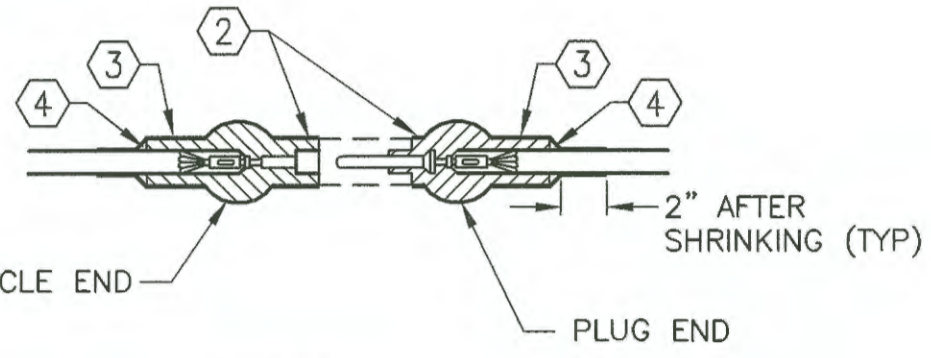

TYPE B

FOR SPLICES FOR USE AT JUNCTION OF HOMERUN WITH LOOP CIRCUIT

- NOTES:
1. CABLE SHALL MEET SPECIFICATION L-824. INSIDE DIAMETER OF CONNECTOR SHALL PROPERLY MATCH THE OUTSIDE DIAMETER OF CABLE. CONNECTOR SHALL BE SUPPLIED TO MATCH CABLE PER MANUFACTURER'S INSTRUCTIONS.
  2. WRAP WITH A MINIMUM OF ONE LAYER PLASTIC TAPE, ONE-HALF LAPPED, EXTENDING AT LEAST 1.5" ON EACH SIDE OF JOINT. COVER WITH HEAT SHRINK, SEE NOTE 3.
  3. HEAT SHRINKABLE TUBING WITH INTERNAL ADHESIVE AT ENDS ONLY. CENTER PORTION AT SEPARABLE CONNECTOR POINT SHALL NOT HAVE INTERNAL ADHESIVE.
  4. INSTALL ADDITIONAL ADHESIVE COMPOUND FILLER

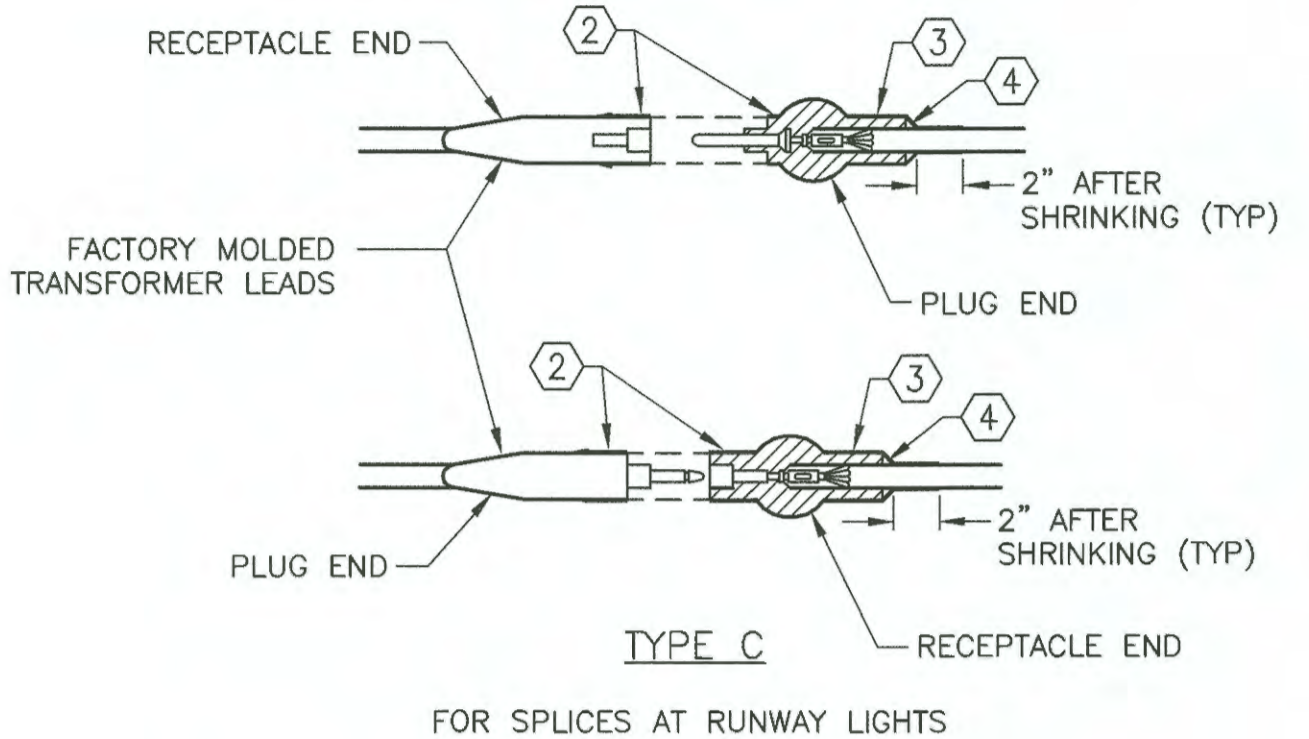


TYPE C

FOR SPLICES AT RUNWAY LIGHTS

2 TYPICAL SPLICE DETAILS


E6 SCALE: N.T.S.

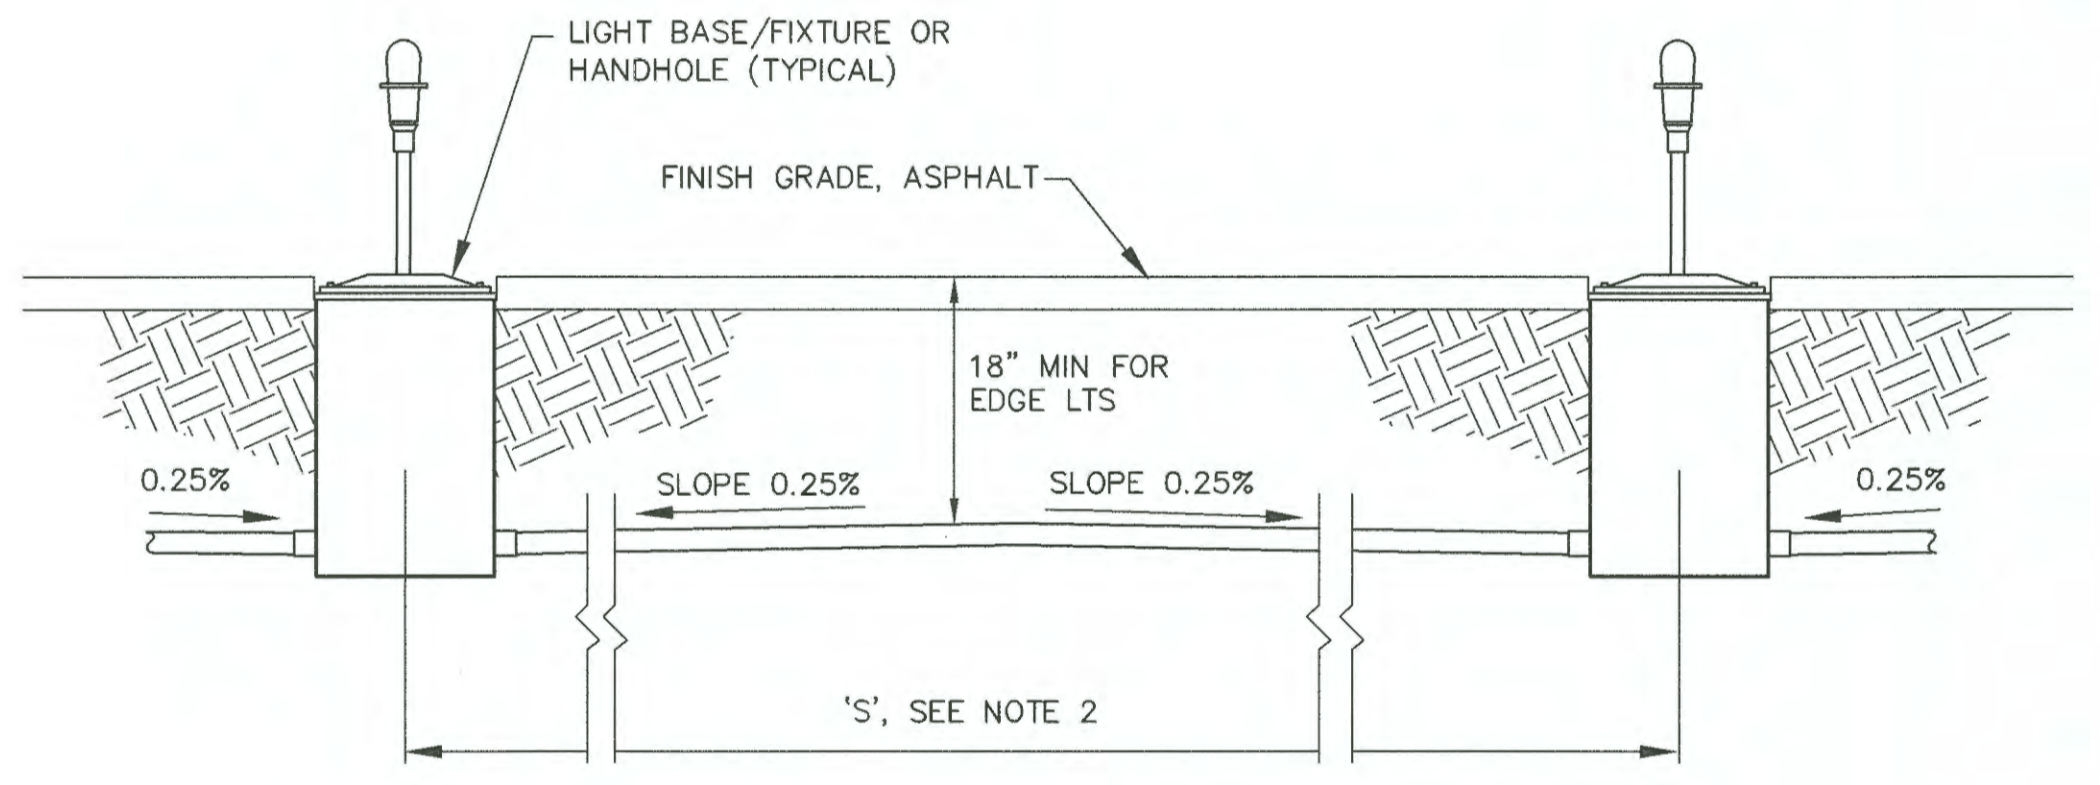

- NOTES:
1. CONDUIT SHALL BE INSTALLED WITH CROWN TO DRAIN TO LIGHT BASES AS SHOWN.
  2. IF 'S' IS LESS THAN 20', OR IF 0.25% SLOPE CAN BE MAINTAINED IN ONE DIRECTION DUE TO SLOPE OF GRADE, LAY CONDUIT STRAIGHT WITHOUT CROWN BETWEEN BASES/HANDHOLES. DUE TO GRADE OF RUNWAY AND TAXIWAY, THIS CONDITION WILL BE PRESENT AT NUMEROUS LOCATIONS, SEE PROFILE SHEETS FOR GENERAL GRADES.


5 TYPICAL INTERCONNECTION DETAIL

E6 SCALE: N.T.S.

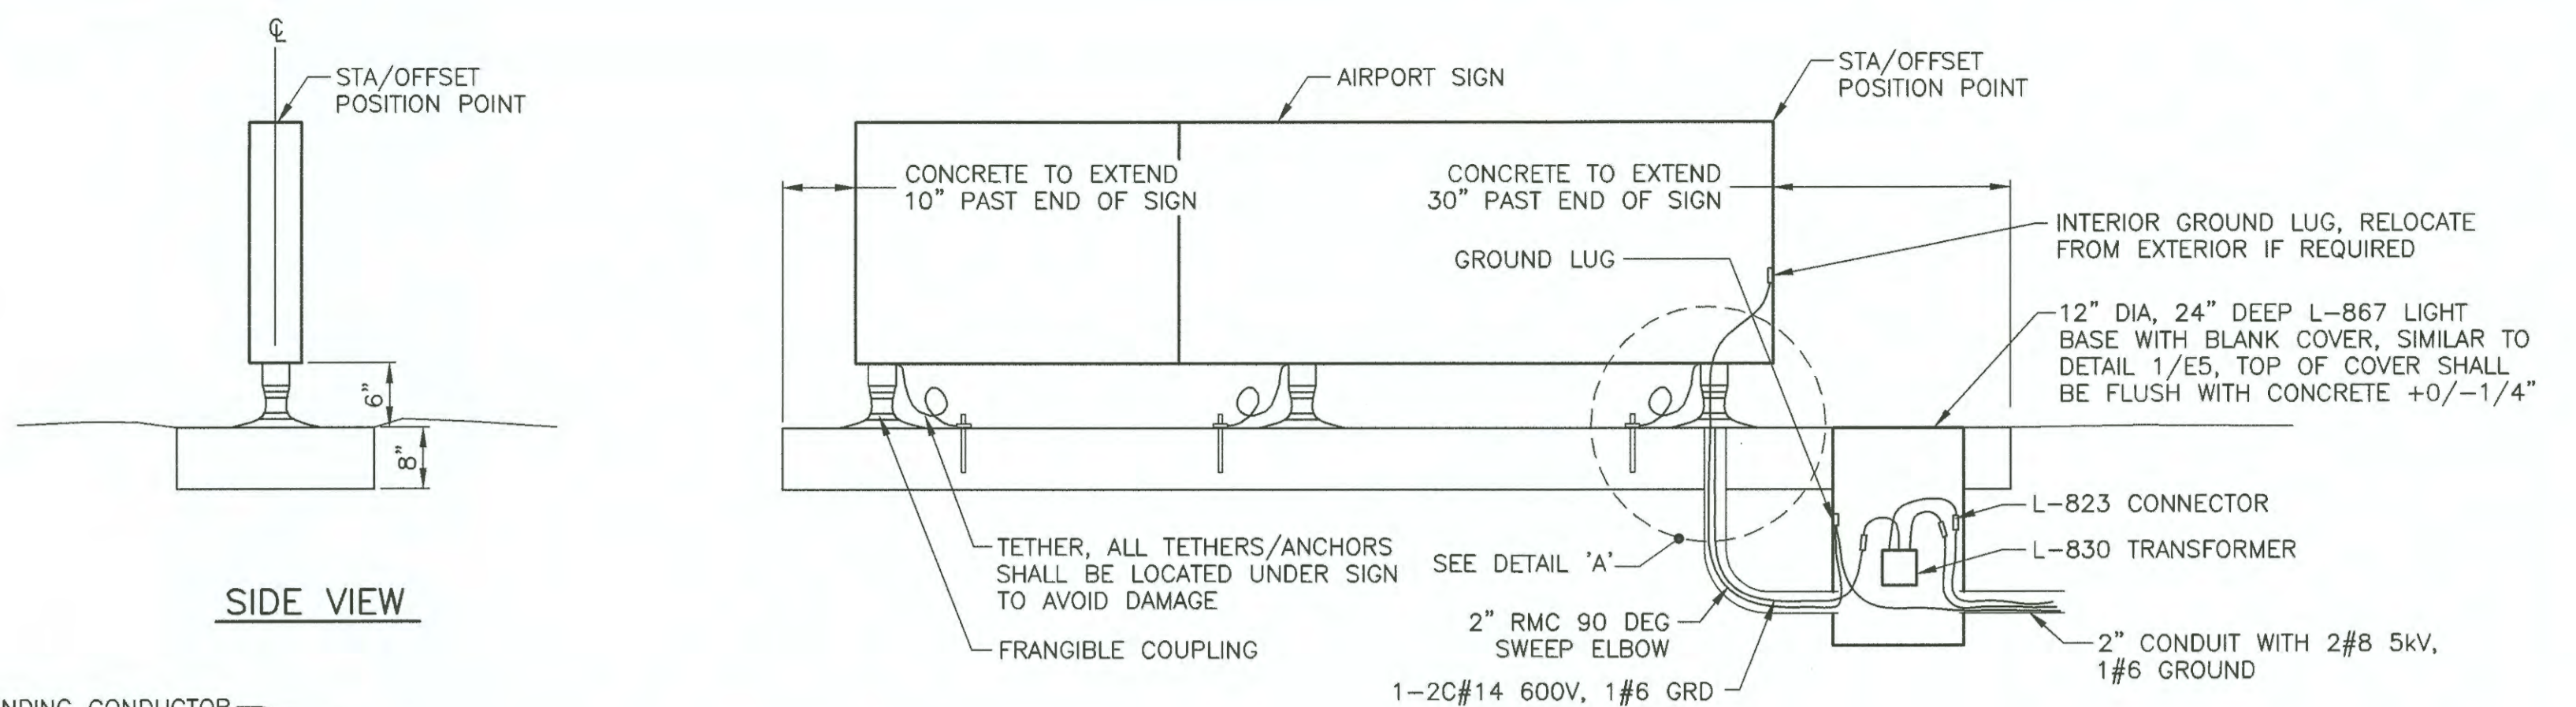

SIDE VIEW


FRONT VIEW

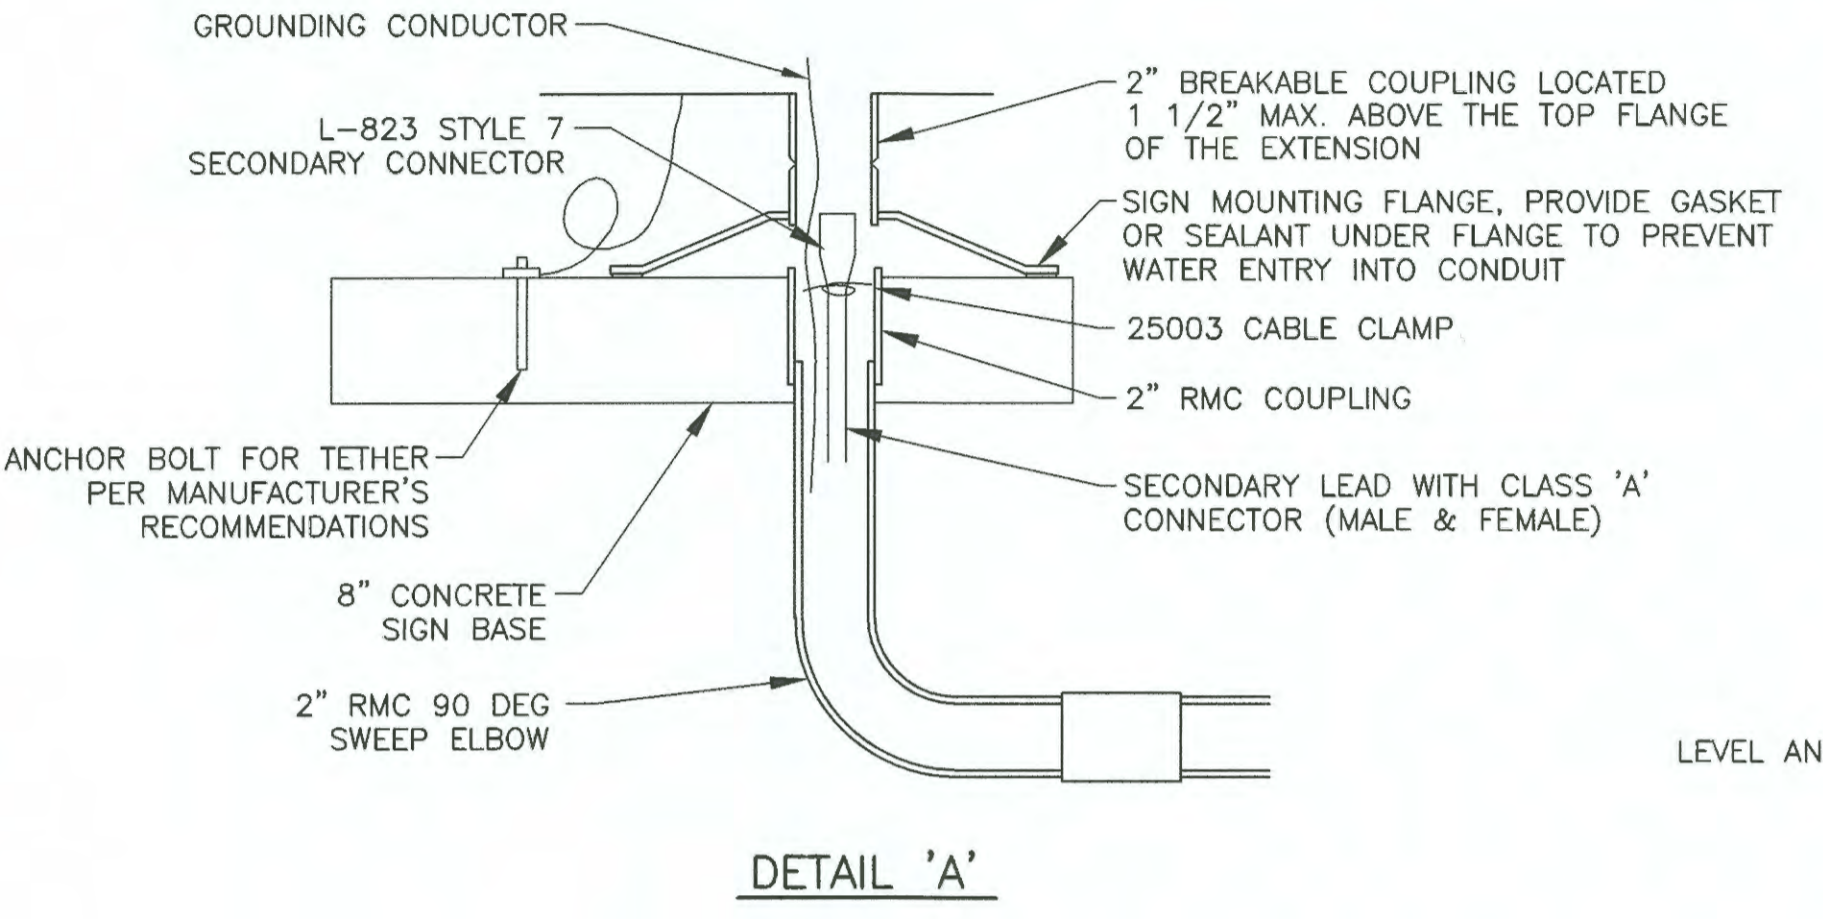

DETAIL 'A'

1 AIRPORT SIGN DETAILS

E6 SCALE: N.T.S.

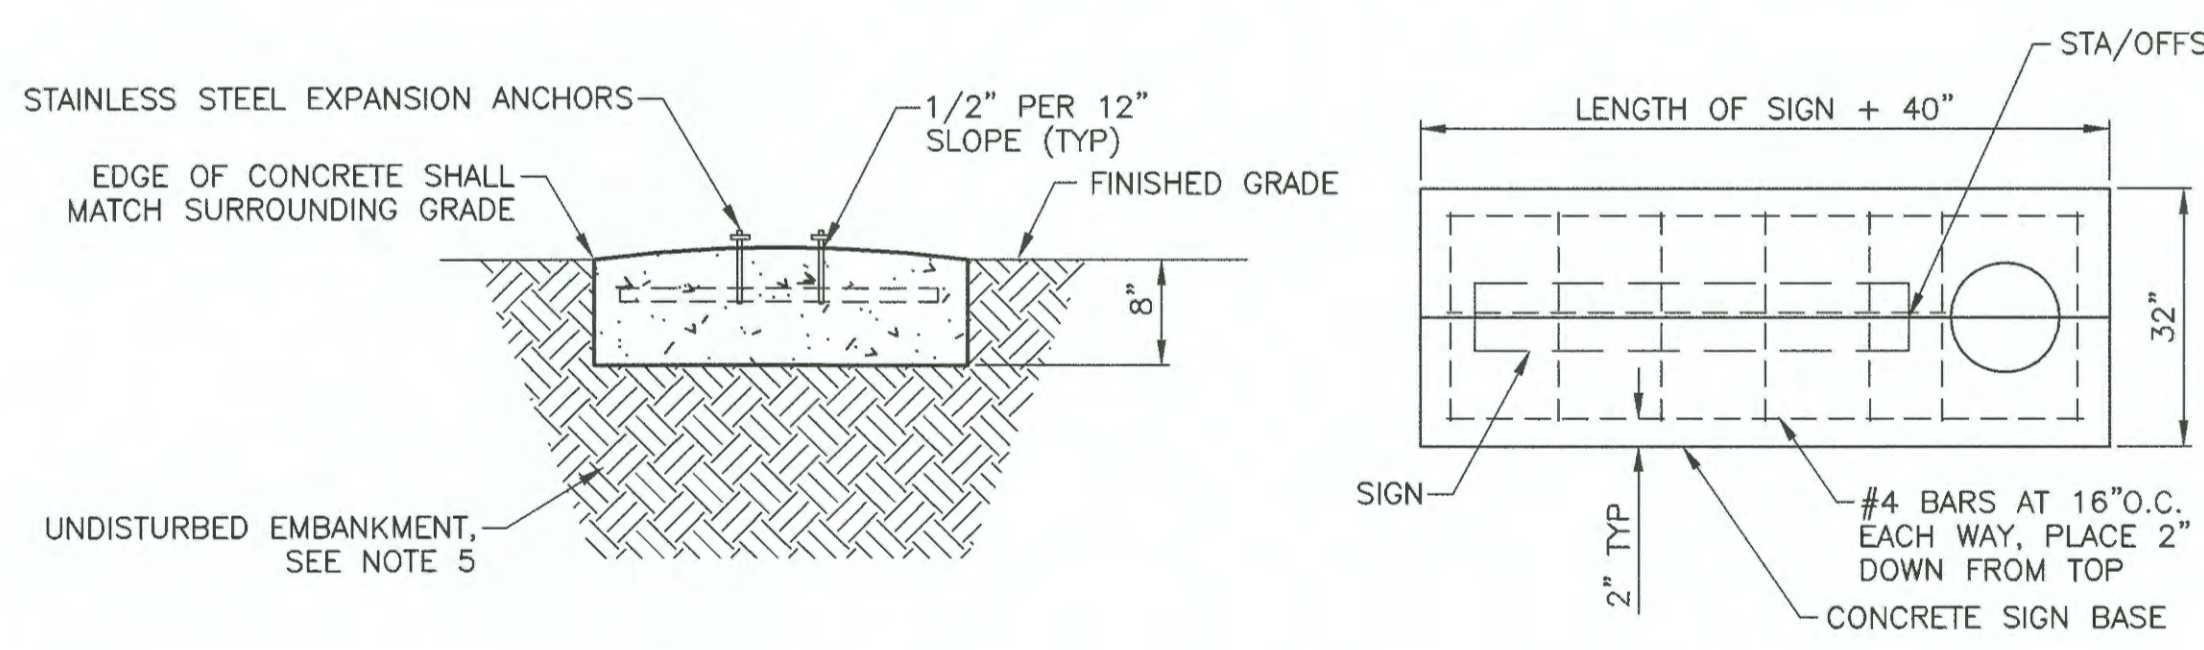

SIDE VIEW

PLAN VIEW

- NOTES:
1. MINOR GRADING OR FILL MAY BE REQUIRED AT SIGN LOCATION. THE GRADING AND EARTHWORK SHALL BE SUBSIDIARY TO OTHER PAY ITEMS AND NO SEPARATE PAYMENT WILL BE MADE.
  2. ATTACH SIGN TO CONCRETE BASE USING STAINLESS STEEL EXPANSION ANCHORS IN ACCORDANCE WITH MANUFACTURER'S INSTRUCTIONS.
  3. CONCRETE SHALL MEET THE REQUIREMENTS OF SECTION P-610.
  4. SET SIGN BASE ELEVATION AT FINISH GRADE ELEVATION AT END CLOSEST TO RUNWAY OR TAXIWAY EDGE. SIGN BASE SHALL BE LEVEL. ADJUST EMBANKMENT GRADING TO MEET EDGE OF OTHER SIDES OF FOUNDATION.
  5. IF EXISTING EMBANKMENT MATERIAL IS DEEMED UNSUITABLE BY THE ENGINEER, REMOVE TO A DEPTH OF 24" BELOW FOUNDATION AND REPLACE WITH COMPACTED SUBBASE.

3 CONCRETE SIGN BASE DETAIL

E6 SCALE: N.T.S.

Record Drawings have been reviewed by the Project Engineer, and represent to the best of my knowledge, the project as constructed.  
PE [Signature] Date 10.24.19

DESIGN LPS  
DRAWN LPS,JCA  
CHECKED MXS

STATE OF ALASKA  
DEPARTMENT OF TRANSPORTATION AND PUBLIC FACILITIES  
SOUTHCOAST REGION-DESIGN AND CONSTRUCTION-AVIATION



NO.	DATE	REVISIONS


KAKE AIRPORT  
KAKE, ALASKA  
RUNWAY REHABILITATION  
AIP 3-02-0398-XX-2018/SFAPT00078  
ELECTRICAL DETAILS II

SHEET E6 OF 27




ROTATING BEACON, L-801A, CLASS II, WITH ONE WHITE AND ONE GREEN METAL HALIDE LAMP, PHOTOCELL CONTROLLED WITH TELLTALE RELAY, THERMOSTATICALLY CONTROLLED HEATER FOR MOVING PARTS ON SEPARATE CIRCUIT

CENTER OF LIGHT BEAM  
HORIZONTAL LINE

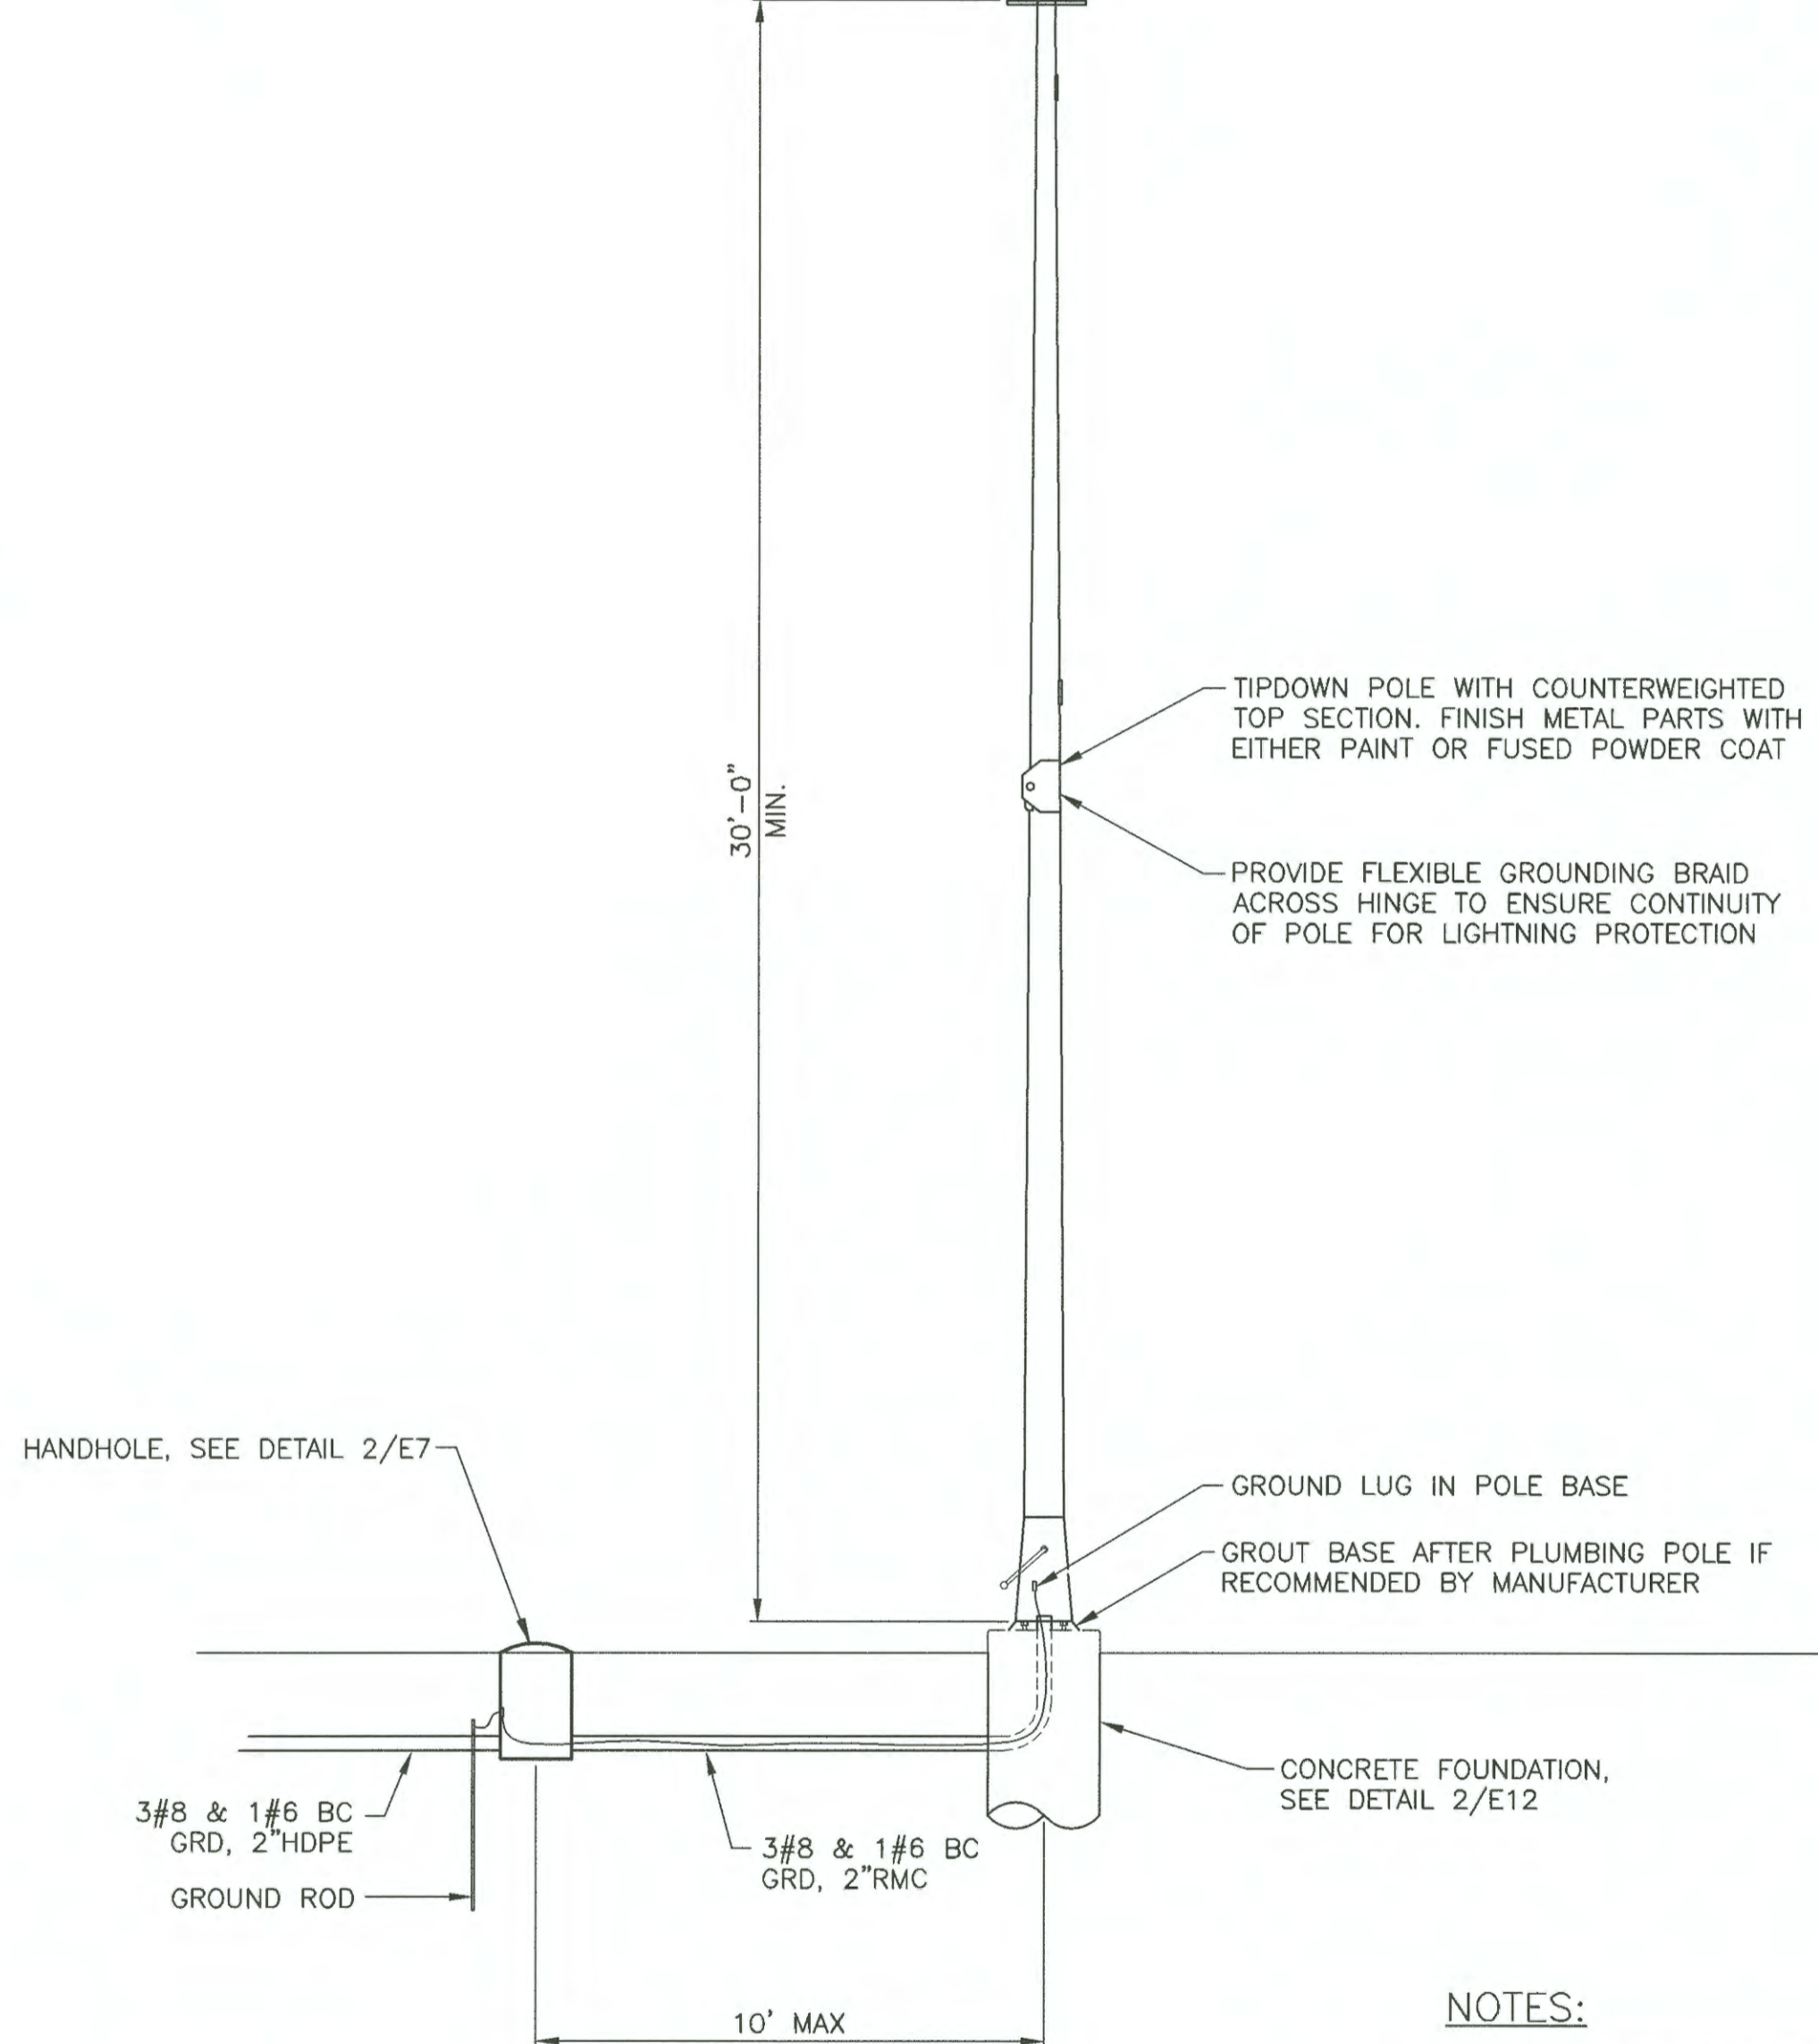


3 BEACON POLE ASSEMBLY  
E8 SCALE: N.T.S.


- NOTES:
- 1. COMPONENTS AND ASSEMBLIES SHALL BE RATED FOR 120 MPH WINDS.
  - 2. BEAM DEFLECTION AT 45 MPH SHALL BE LESS THAN 2 DEGREES.

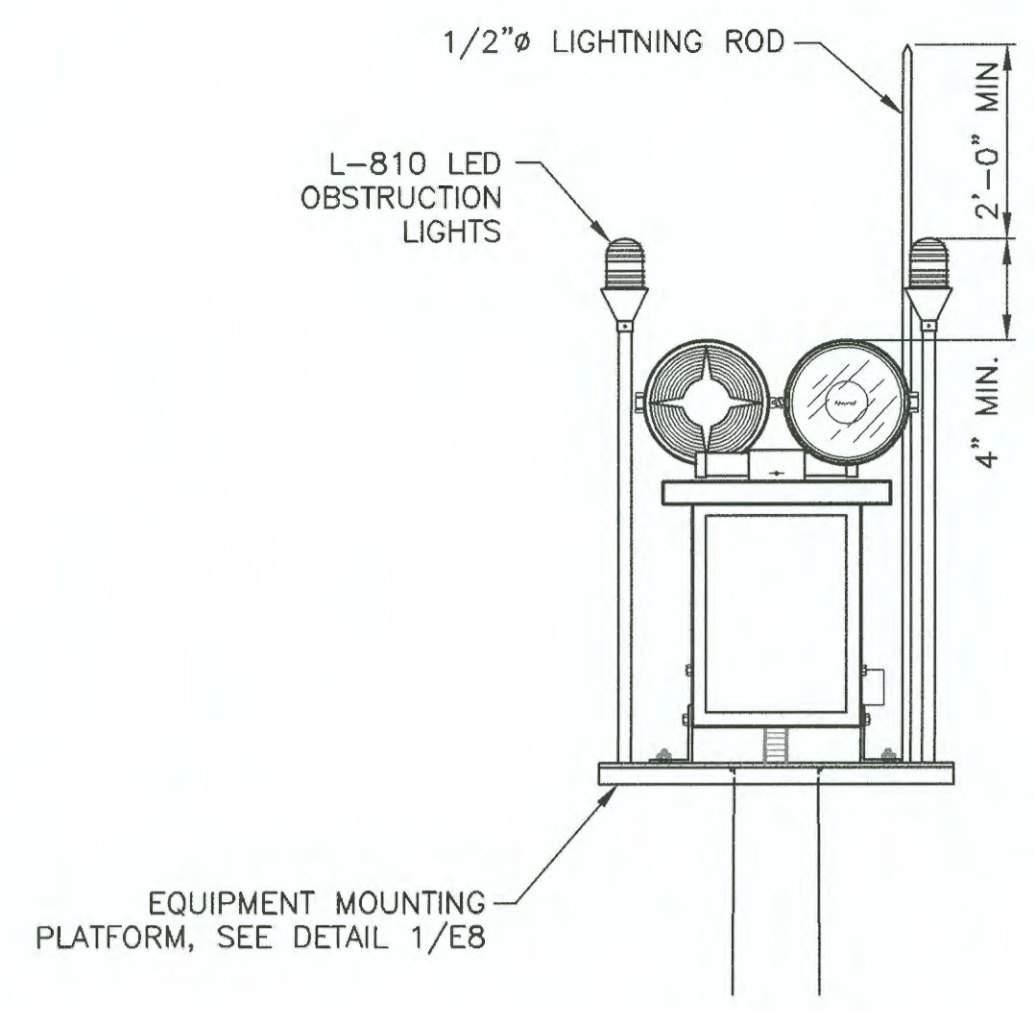

2 BEACON ASSEMBLY DETAILS  
E8 SCALE: N.T.S.

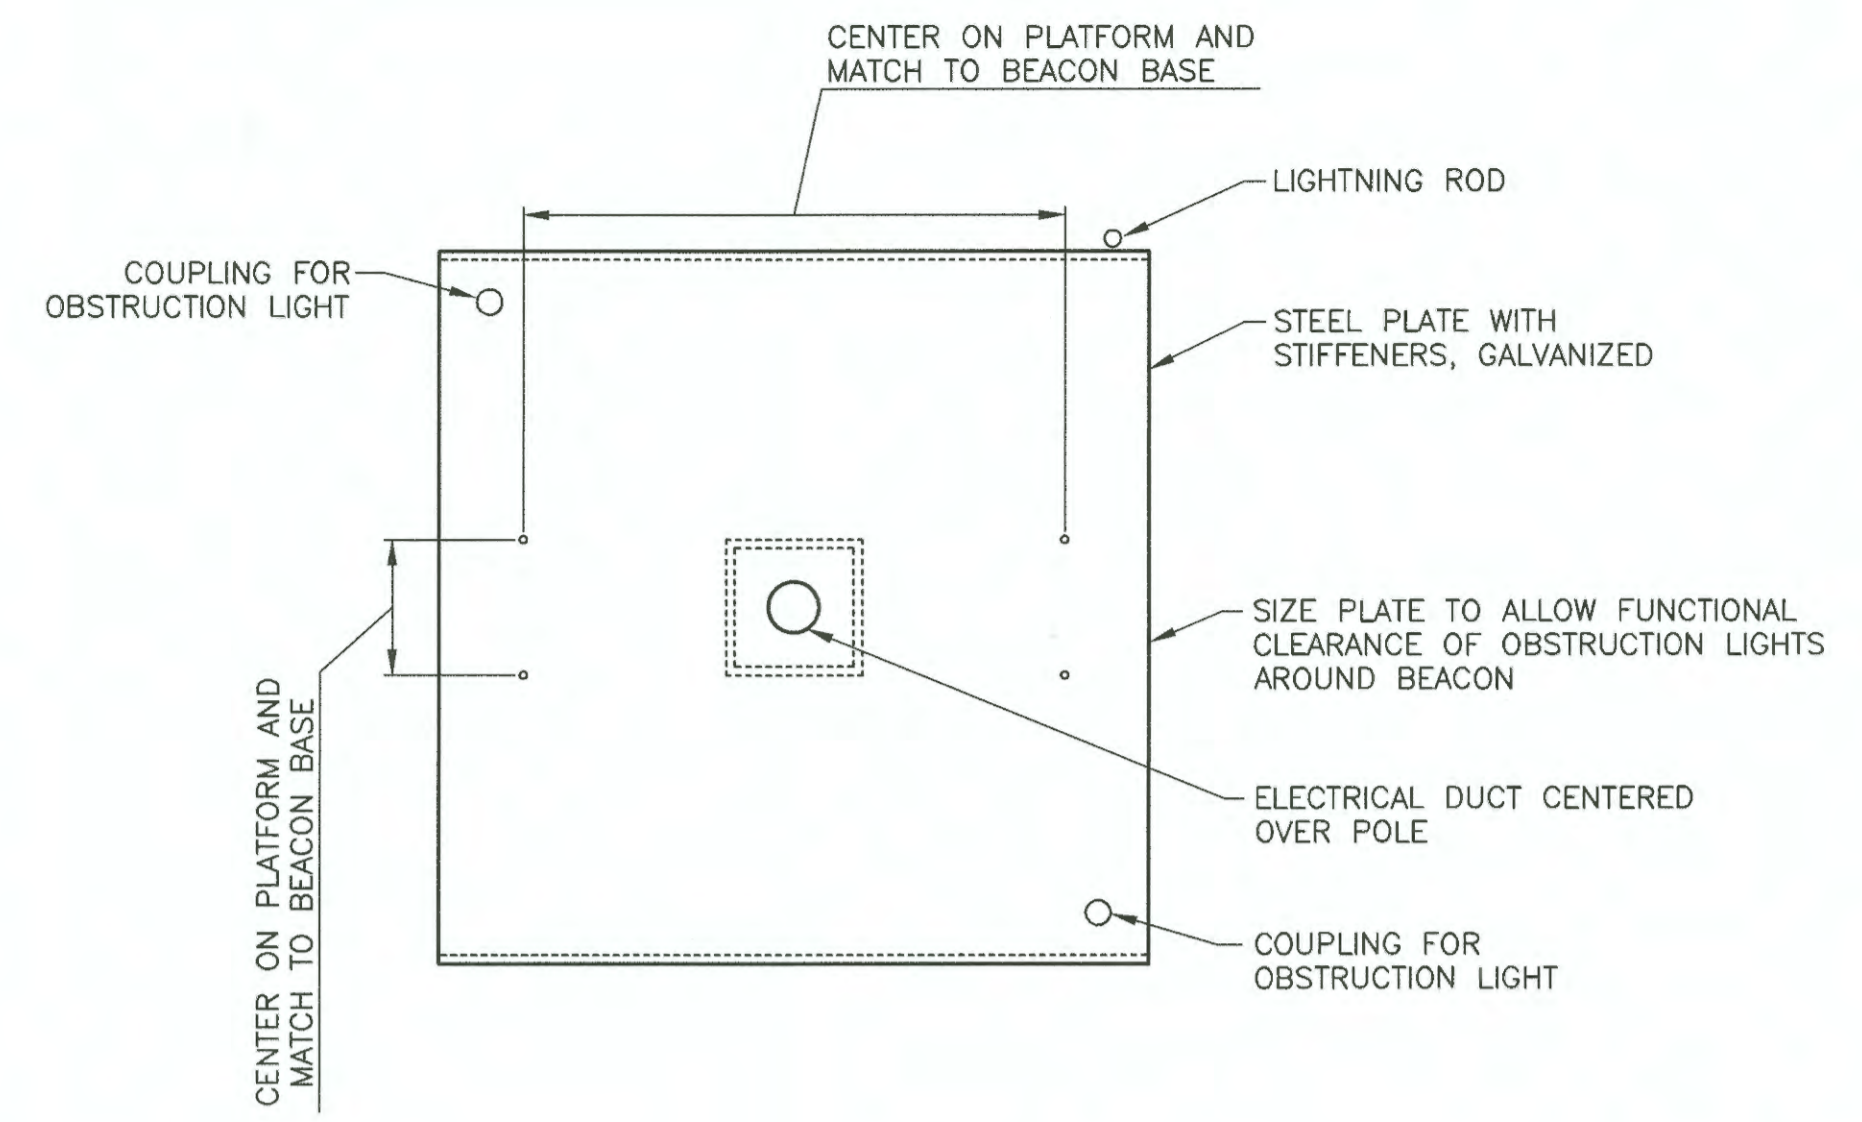

1 EQUIPMENT MOUNTING PLATFORM DETAIL  
E8 SCALE: N.T.S.

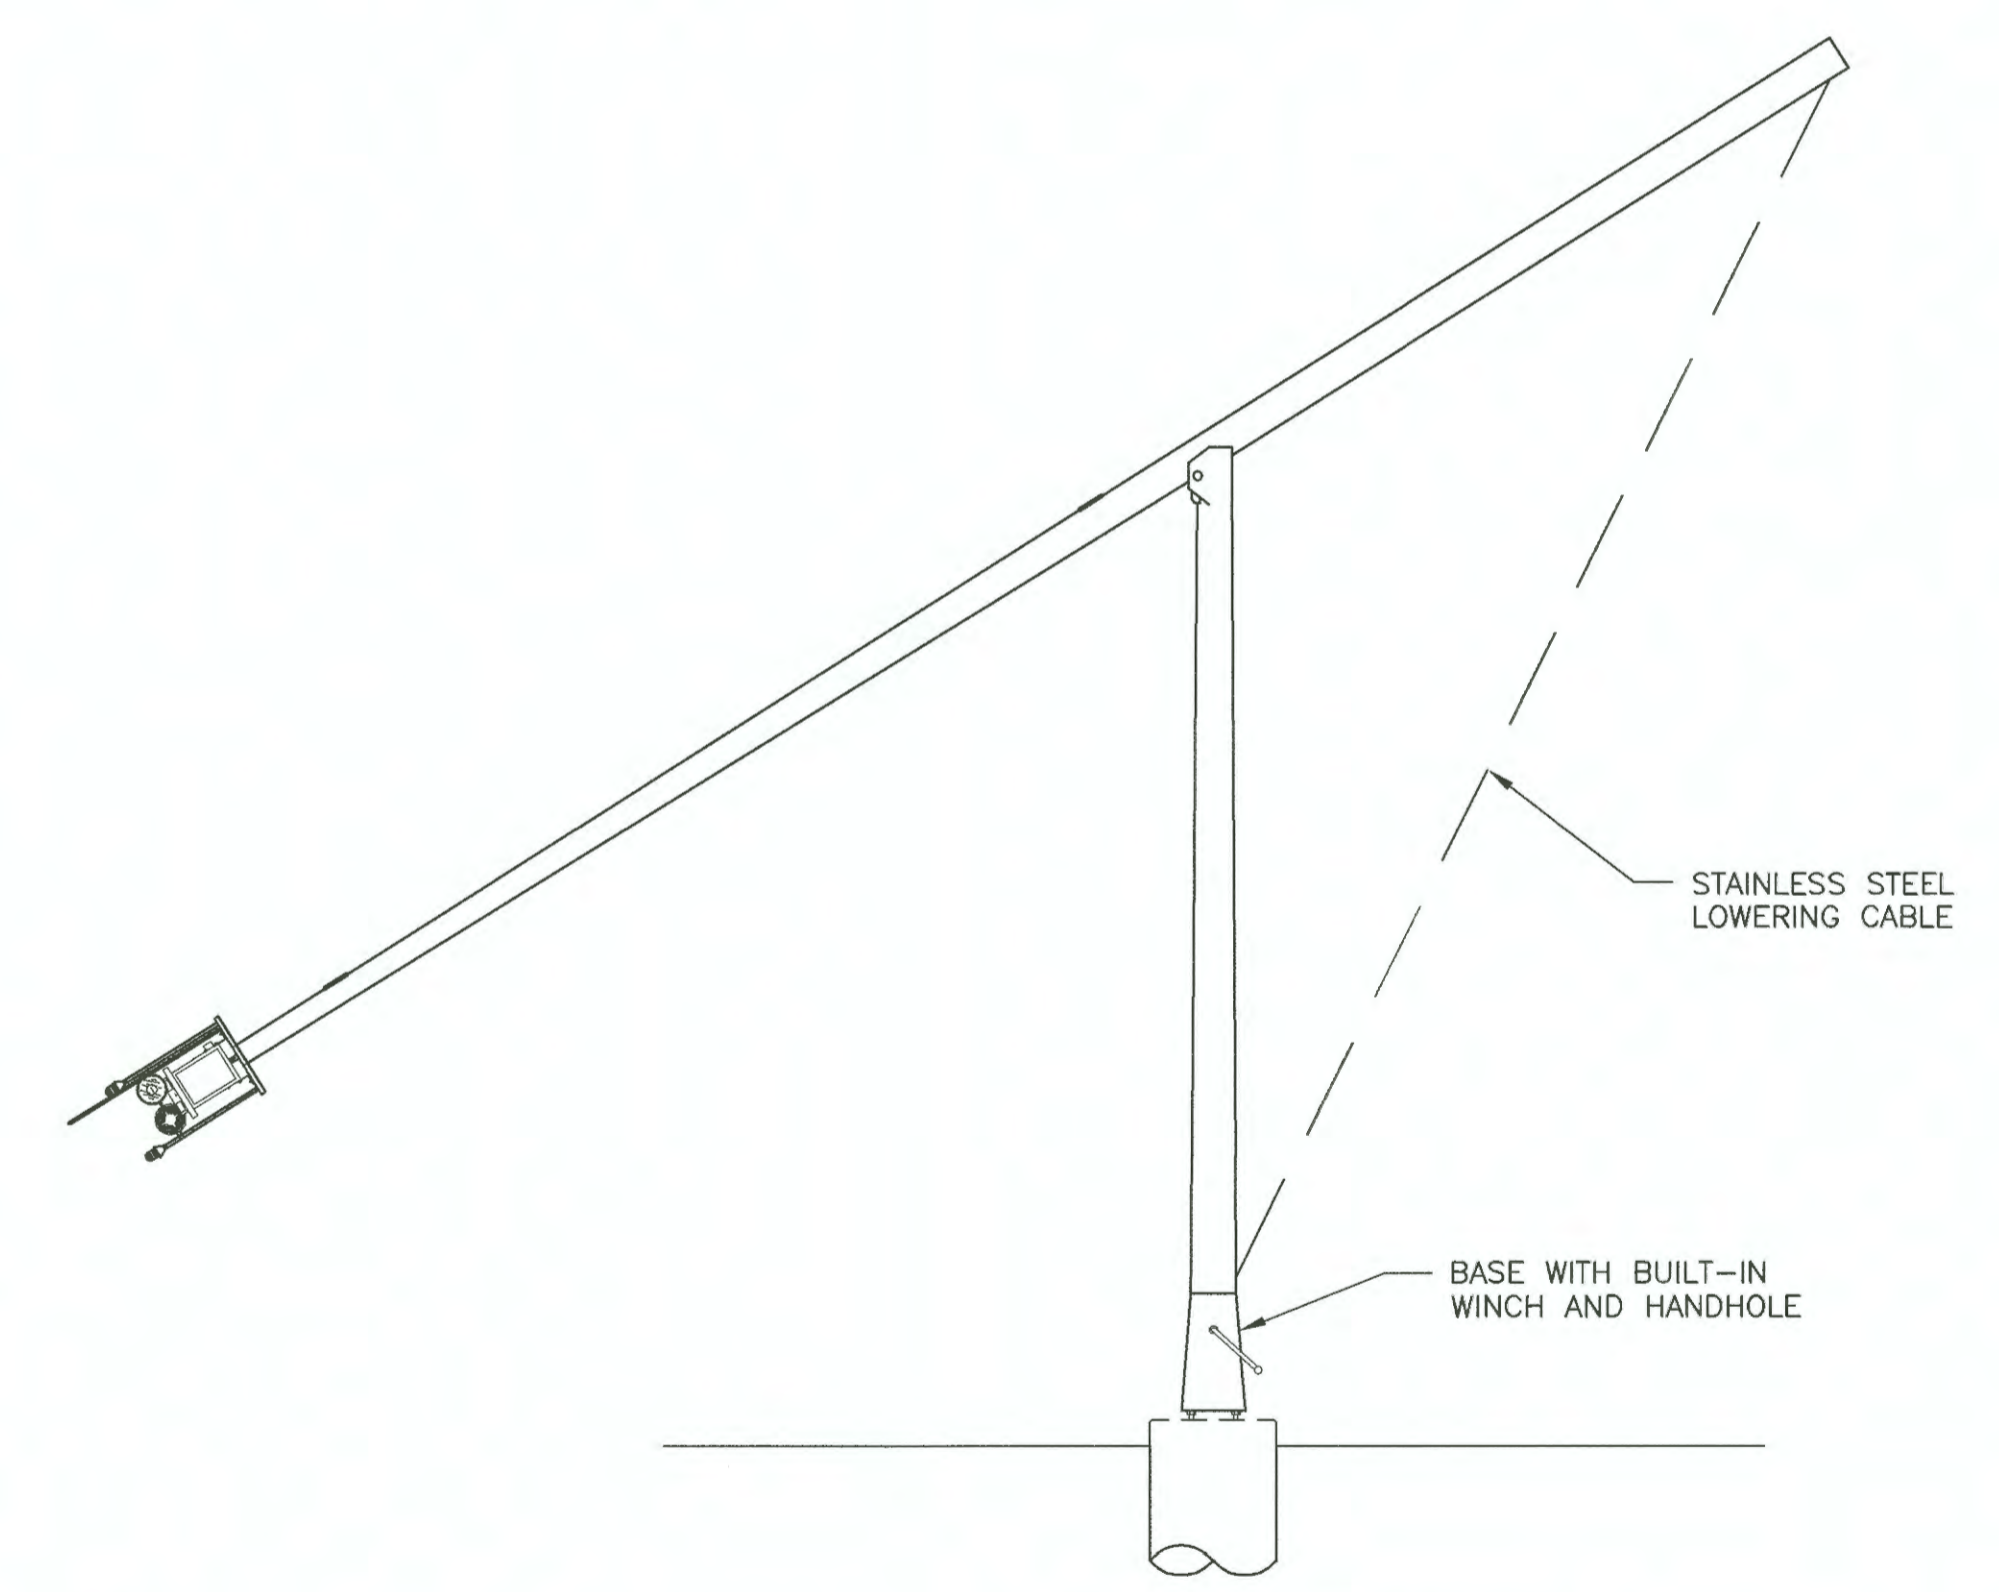

4 BEACON POLE ASSEMBLY, SERVICE POSITION  
E8 SCALE: N.T.S.

Record Drawings have been reviewed by the Project Engineer, and represent to the best of my knowledge, the project as constructed.  
PE [Signature] Date 10.24.19

DESIGN LPS  
DRAWN LPS,JCA  
CHECKED MXS

STATE OF ALASKA  
DEPARTMENT OF TRANSPORTATION AND PUBLIC FACILITIES  
SOUTHCOAST REGION-DESIGN AND CONSTRUCTION-AVIATION




NO.	DATE	REVISIONS

KAKE AIRPORT  
KAKE, ALASKA  
RUNWAY REHABILITATION  
AIP 3-02-0398-XX-2018/SFAPT00078  
ROTATING BEACON DETAILS


SHEET  
E8  
OF  
27

8/02/2018, 10:50 AM


PLANS DEVELOPED BY: STANTEC CONSULTING SERVICES, INC. 725 EAST FIREWEED LANE, SUITE 200, ANCHORAGE, AK 99503-2245 907-276-4245 CERTIFICATE OF AUTHORIZATION #126386 U:\2047059100\Drawing\E\_Sheets\2047059100\_E3-E12\_details.dwg

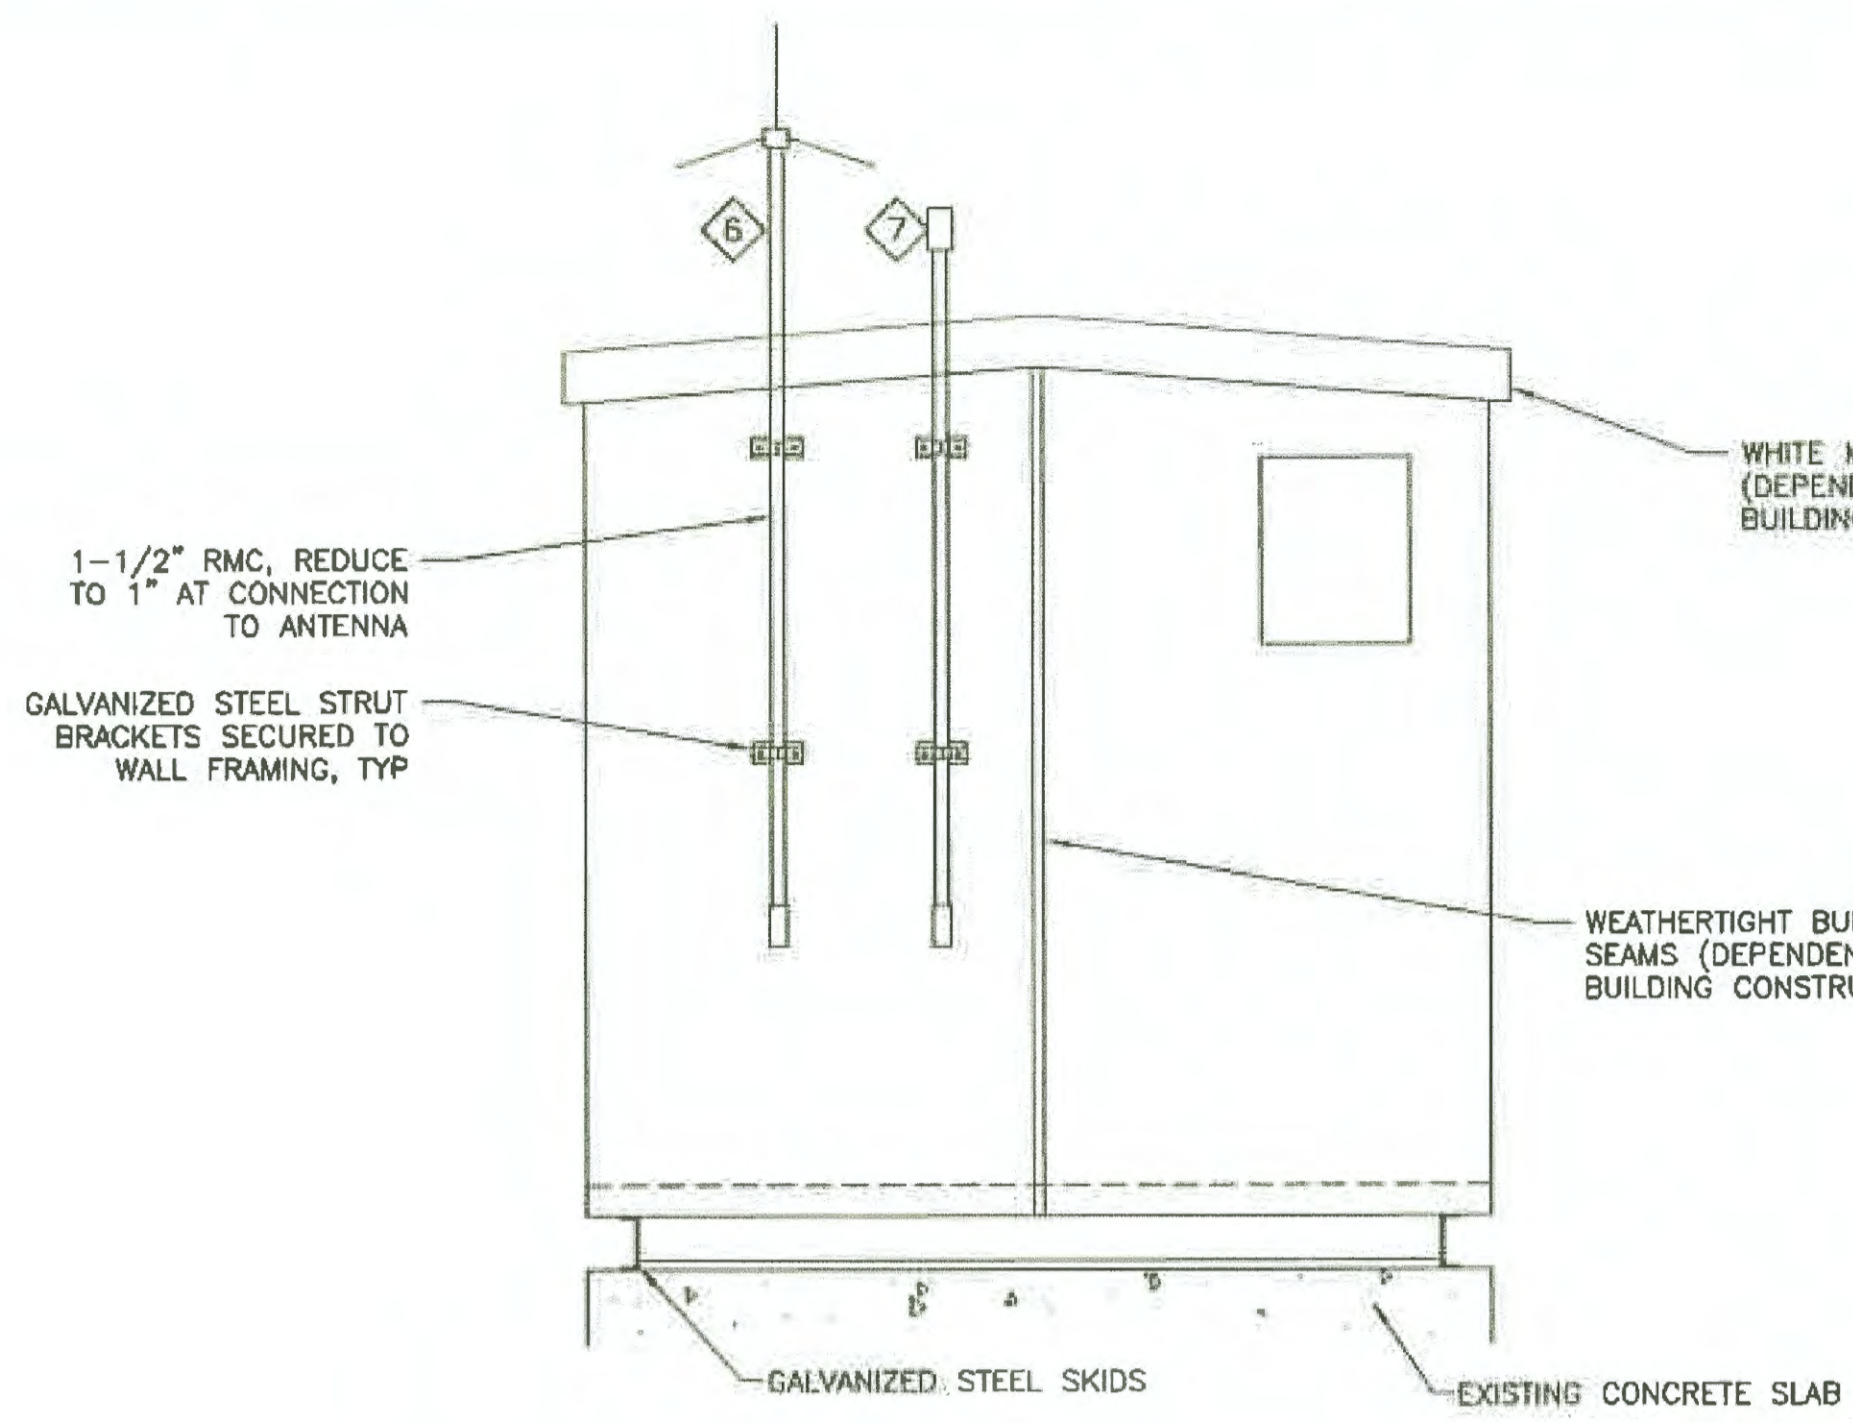

3 TYPICAL BUILDING END ELEVATION  
E9 SCALE: N.T.S.

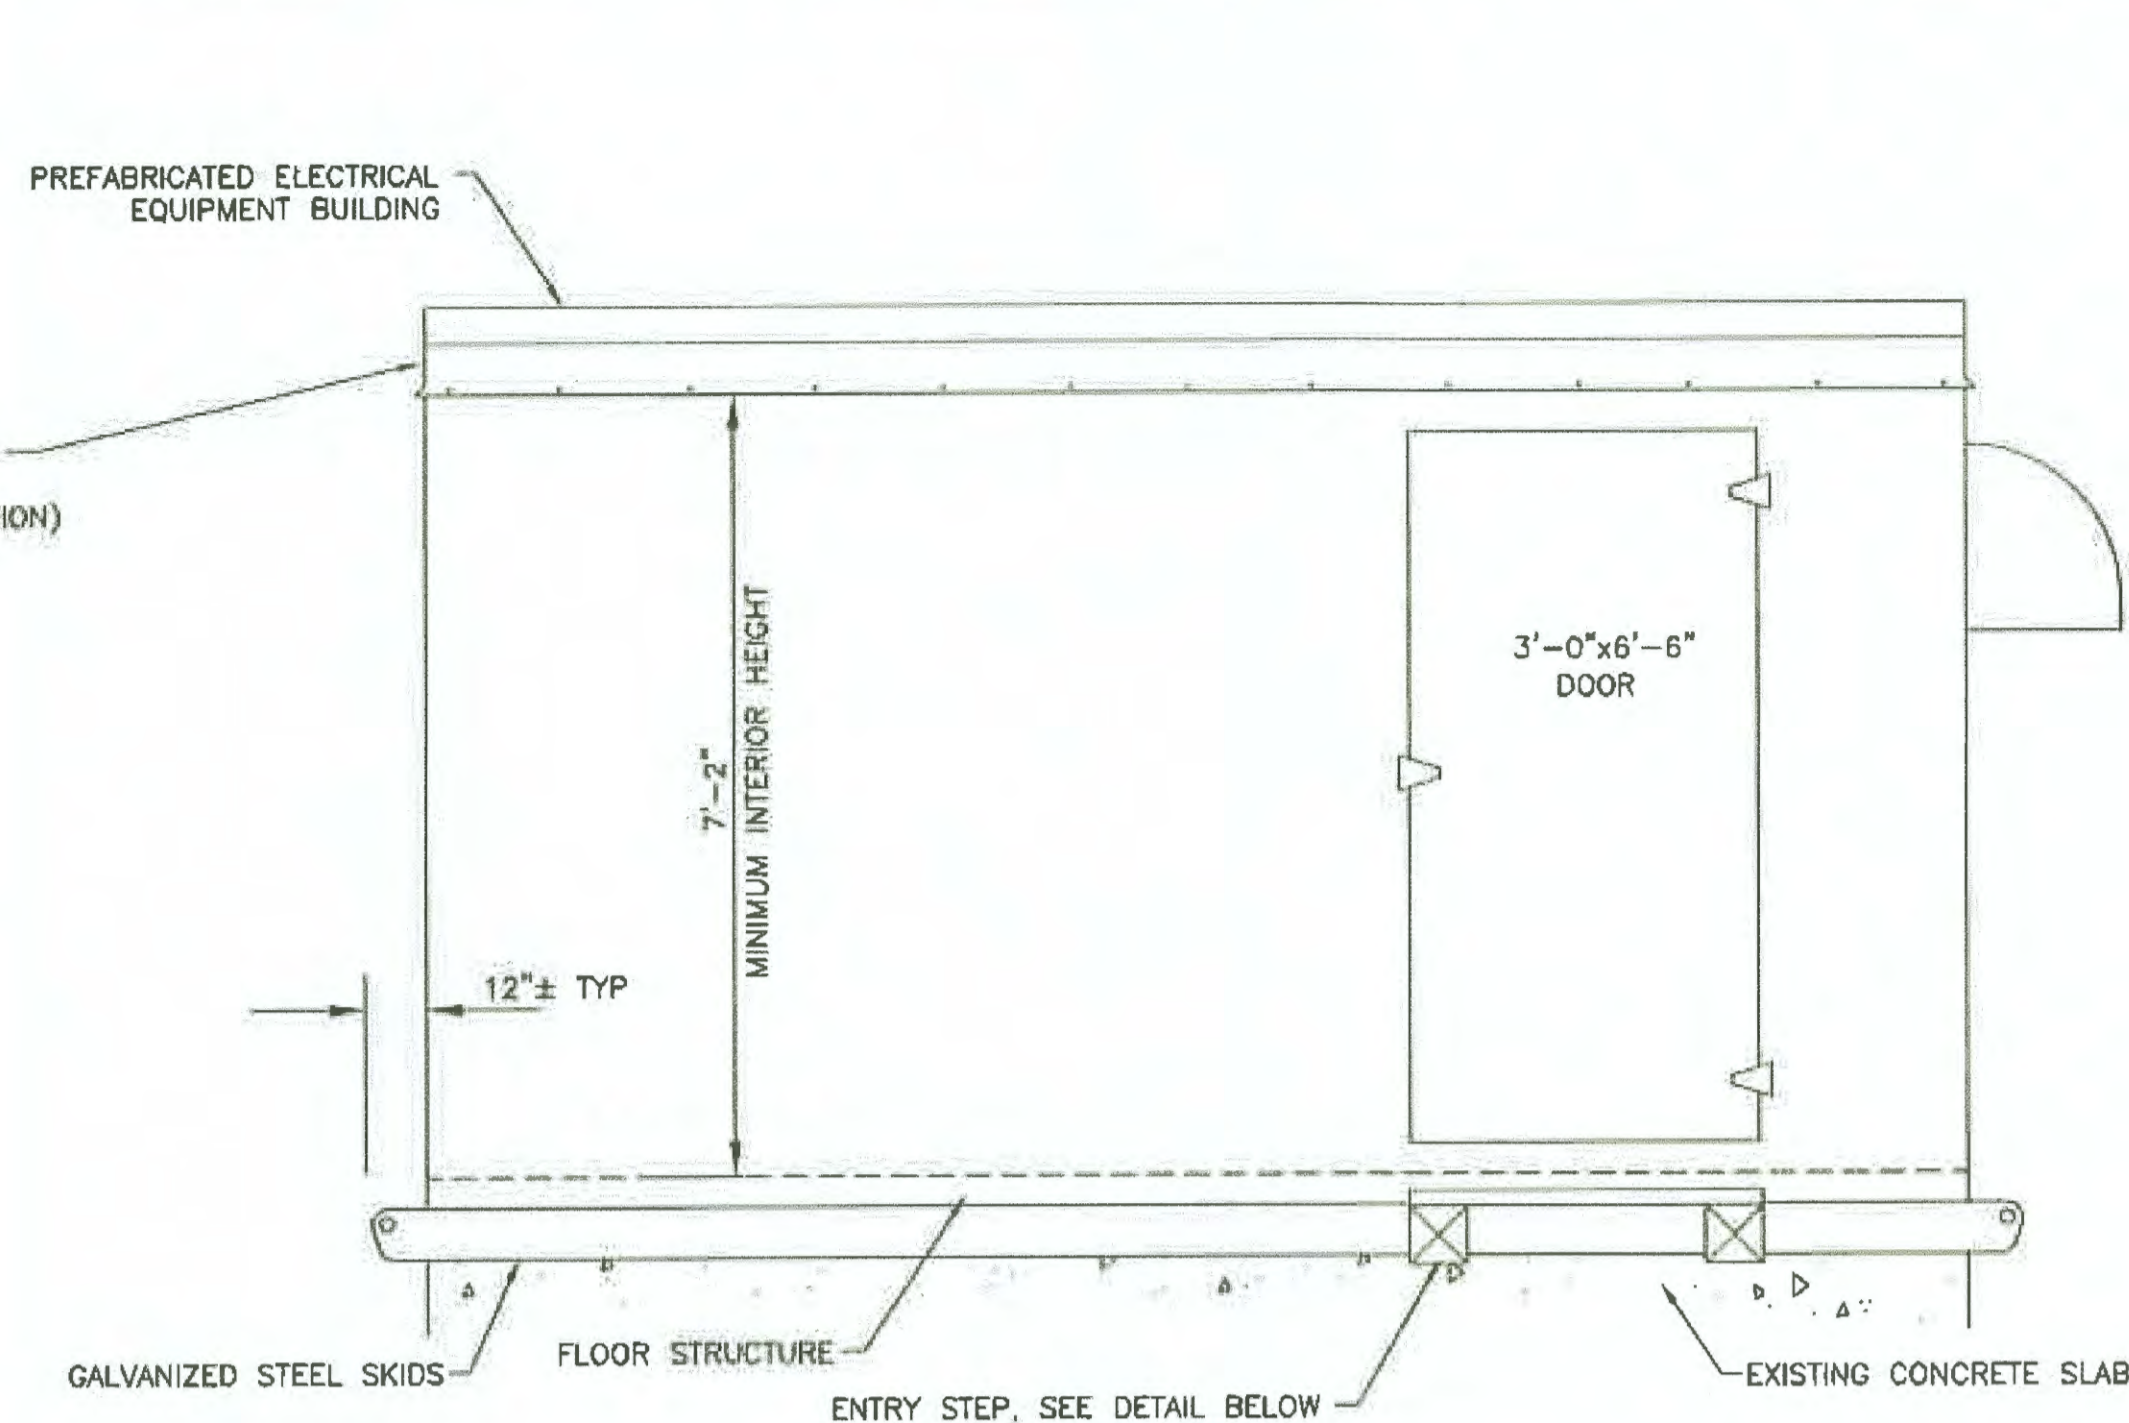


2 TYPICAL BUILDING SIDE ELEVATION  
E9 SCALE: N.T.S.

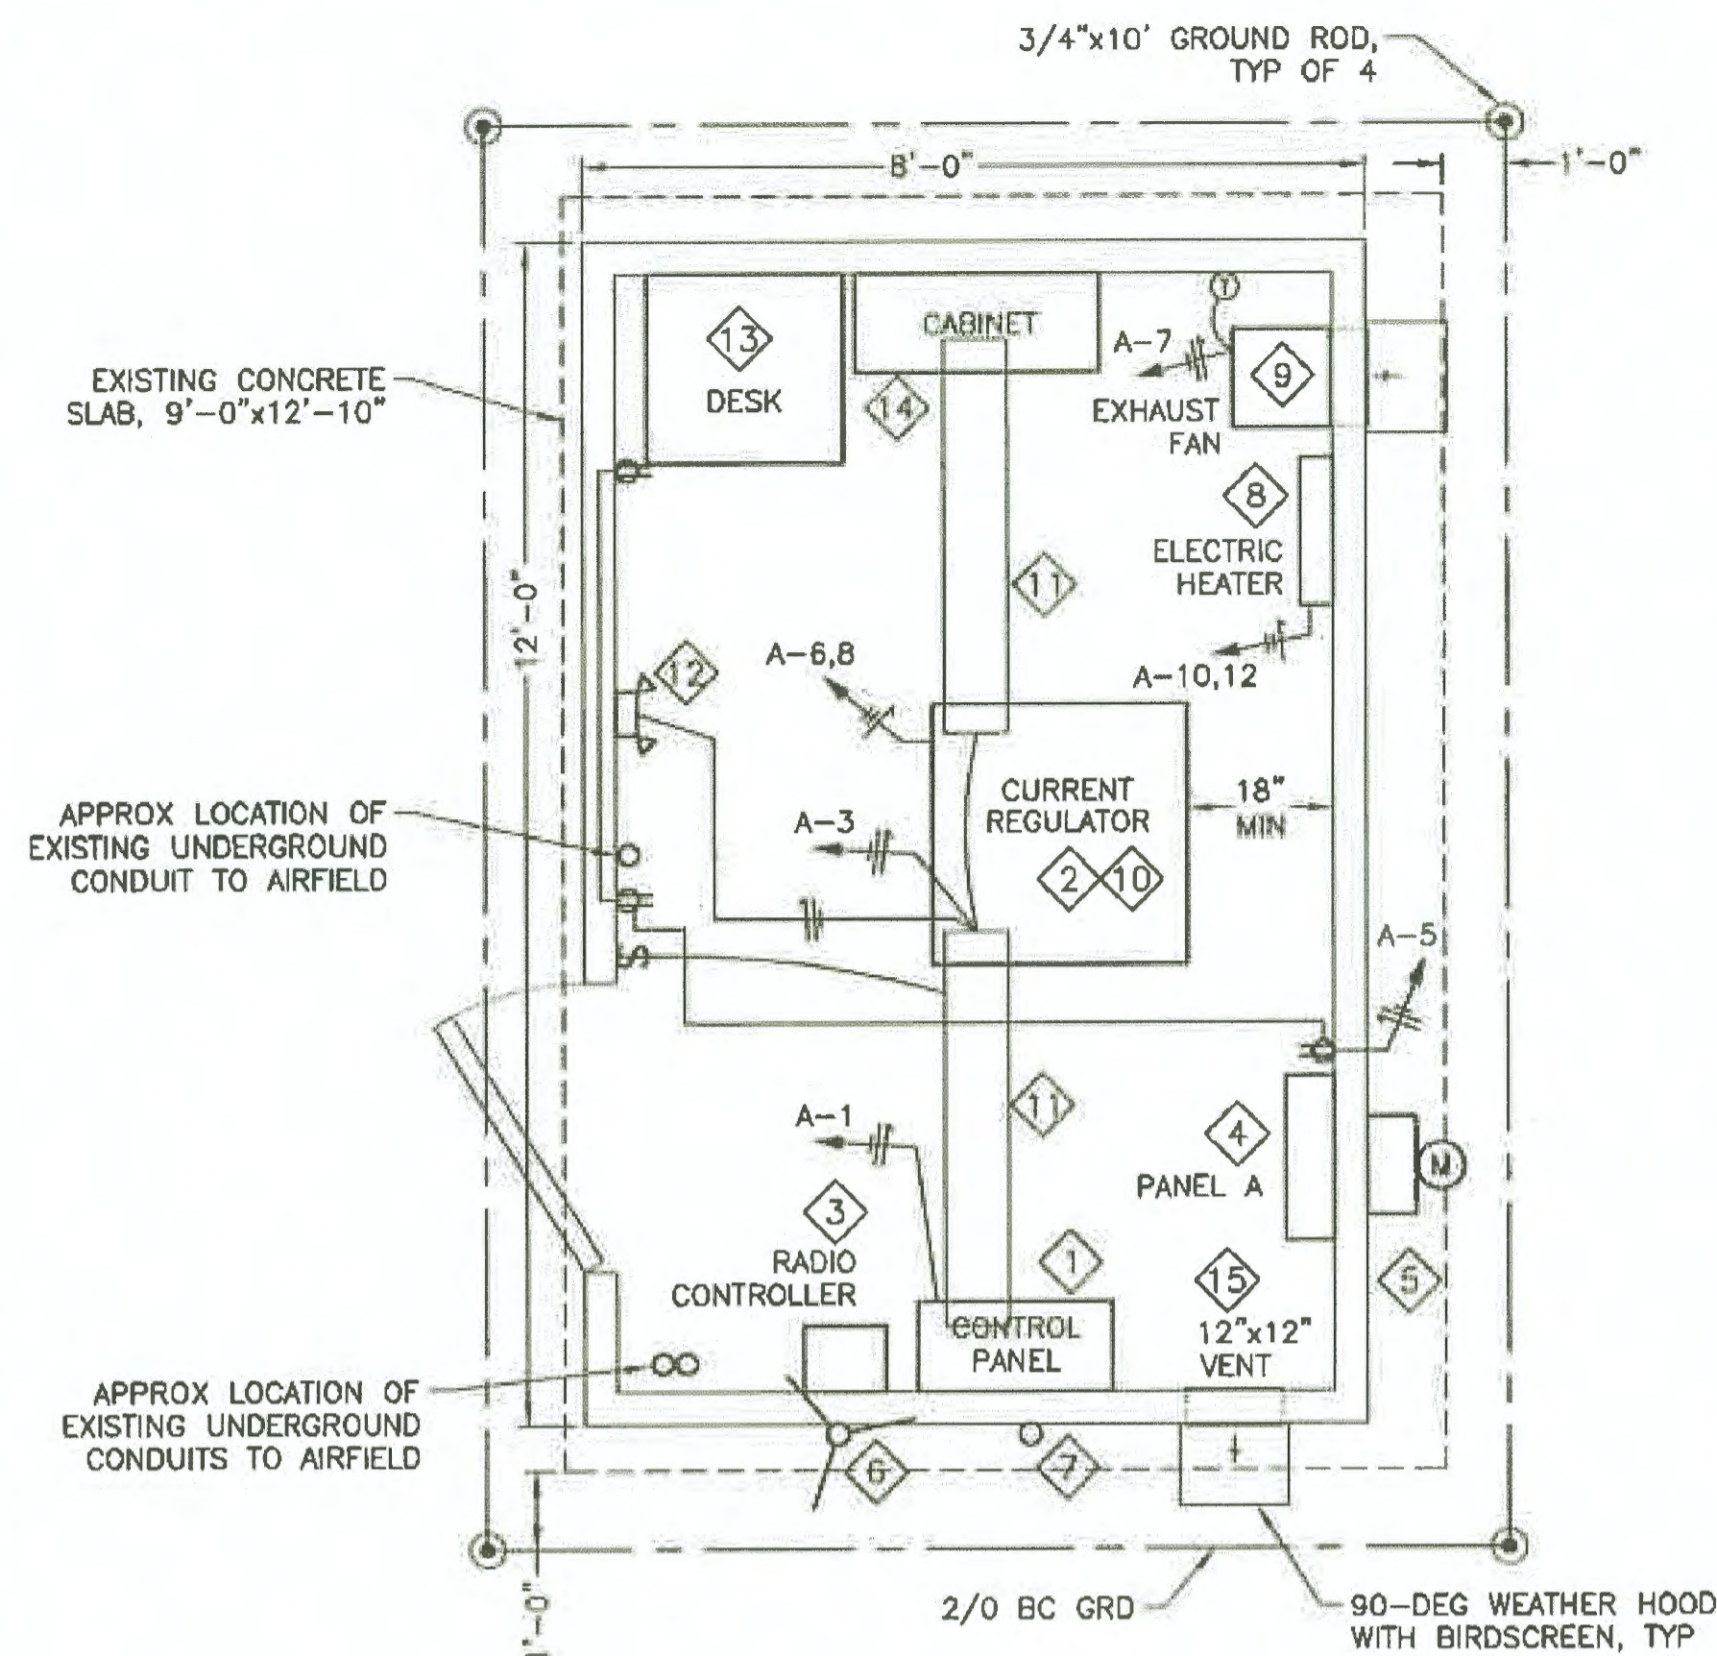


1 ELECTRICAL EQUIPMENT BUILDING PLAN  
E9 SCALE: N.T.S.

EQUIPMENT LIST		
NO.	DESCRIPTION	NOTES
1	LIGHTING CONTROL PANEL	SEE SPECIFICATION L-109 AND SHEET E11
2	5KW REGULATOR, 3-STEP 240V INPUT, 6.6A OUTPUT	FERRORESONANT TYPE WITH DIGITAL METER AND INTEGRAL SERIES CUTOUT
3	ADJUSTABLE FREQUENCY RADIO CONTROLLER	SET FREQUENCY TO CTAF: 122.9MHZ, RELAYS SHALL OPERATE CUMULATIVELY
4	PANELBOARD	BOLT-ON CIRCUIT BREAKERS, SEE PANEL SCHEDULE FOR ADDITIONAL INFORMATION
5	METER/MAIN	100A/2-POLE MAIN BREAKER, KILOWATT-HOUR METER PROVIDED BY UTILITY
6	RADIO ANTENNA	
7	PHOTOELECTRIC CONTROL	
8	2000W ELECTRIC HEATER	INTEGRAL 40-85 DEG F THERMOSTAT
9	EXHAUST FAN, 150CFM MINIMUM AT 0.2 IN WG	WITH BACKDRAFT DAMPER AND WALL-MOUNTED 40-85 DEG F THERMOSTAT
10	PLUG CUTOUT, 5KV	MOUNT INTEGRAL TO REGULATOR, PROVIDE WITH SEPARATE GROUNDING COVER FOR TROUBLESHOOTING
11	INTERIOR LIGHT FIXTURE	4000LM OUTPUT, FROSTED LENS, 120V
12	EMERGENCY LIGHT	
13	METAL WALL DESK 24"x23"x12"	MOUNT TOP OF DESK AT 36" AFF
14	LOCKABLE WALL CABINET 30"x12"x26"	
15	12"x12" RELIEF AIR VENT	WITH WEIGHTED DAMPER AND DUST FILTER

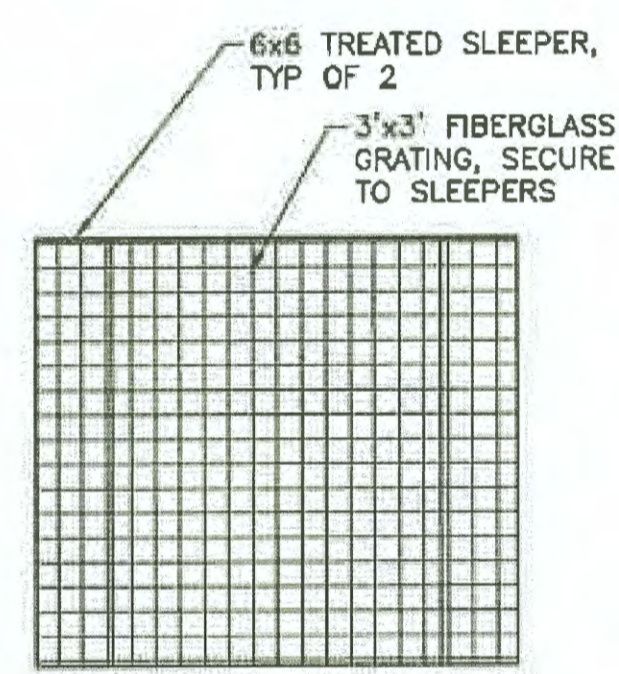

NOTE:  
INSTALL STEP IN FRONT OF DOOR TO ELECTRICAL EQUIPMENT BUILDING. GRADE AREA AS REQUIRED TO PROVIDE LEVEL, STABLE STEP APPROXIMATELY 7" HIGH.

5 ENTRY STEP DETAIL  
E9 SCALE: N.T.S.

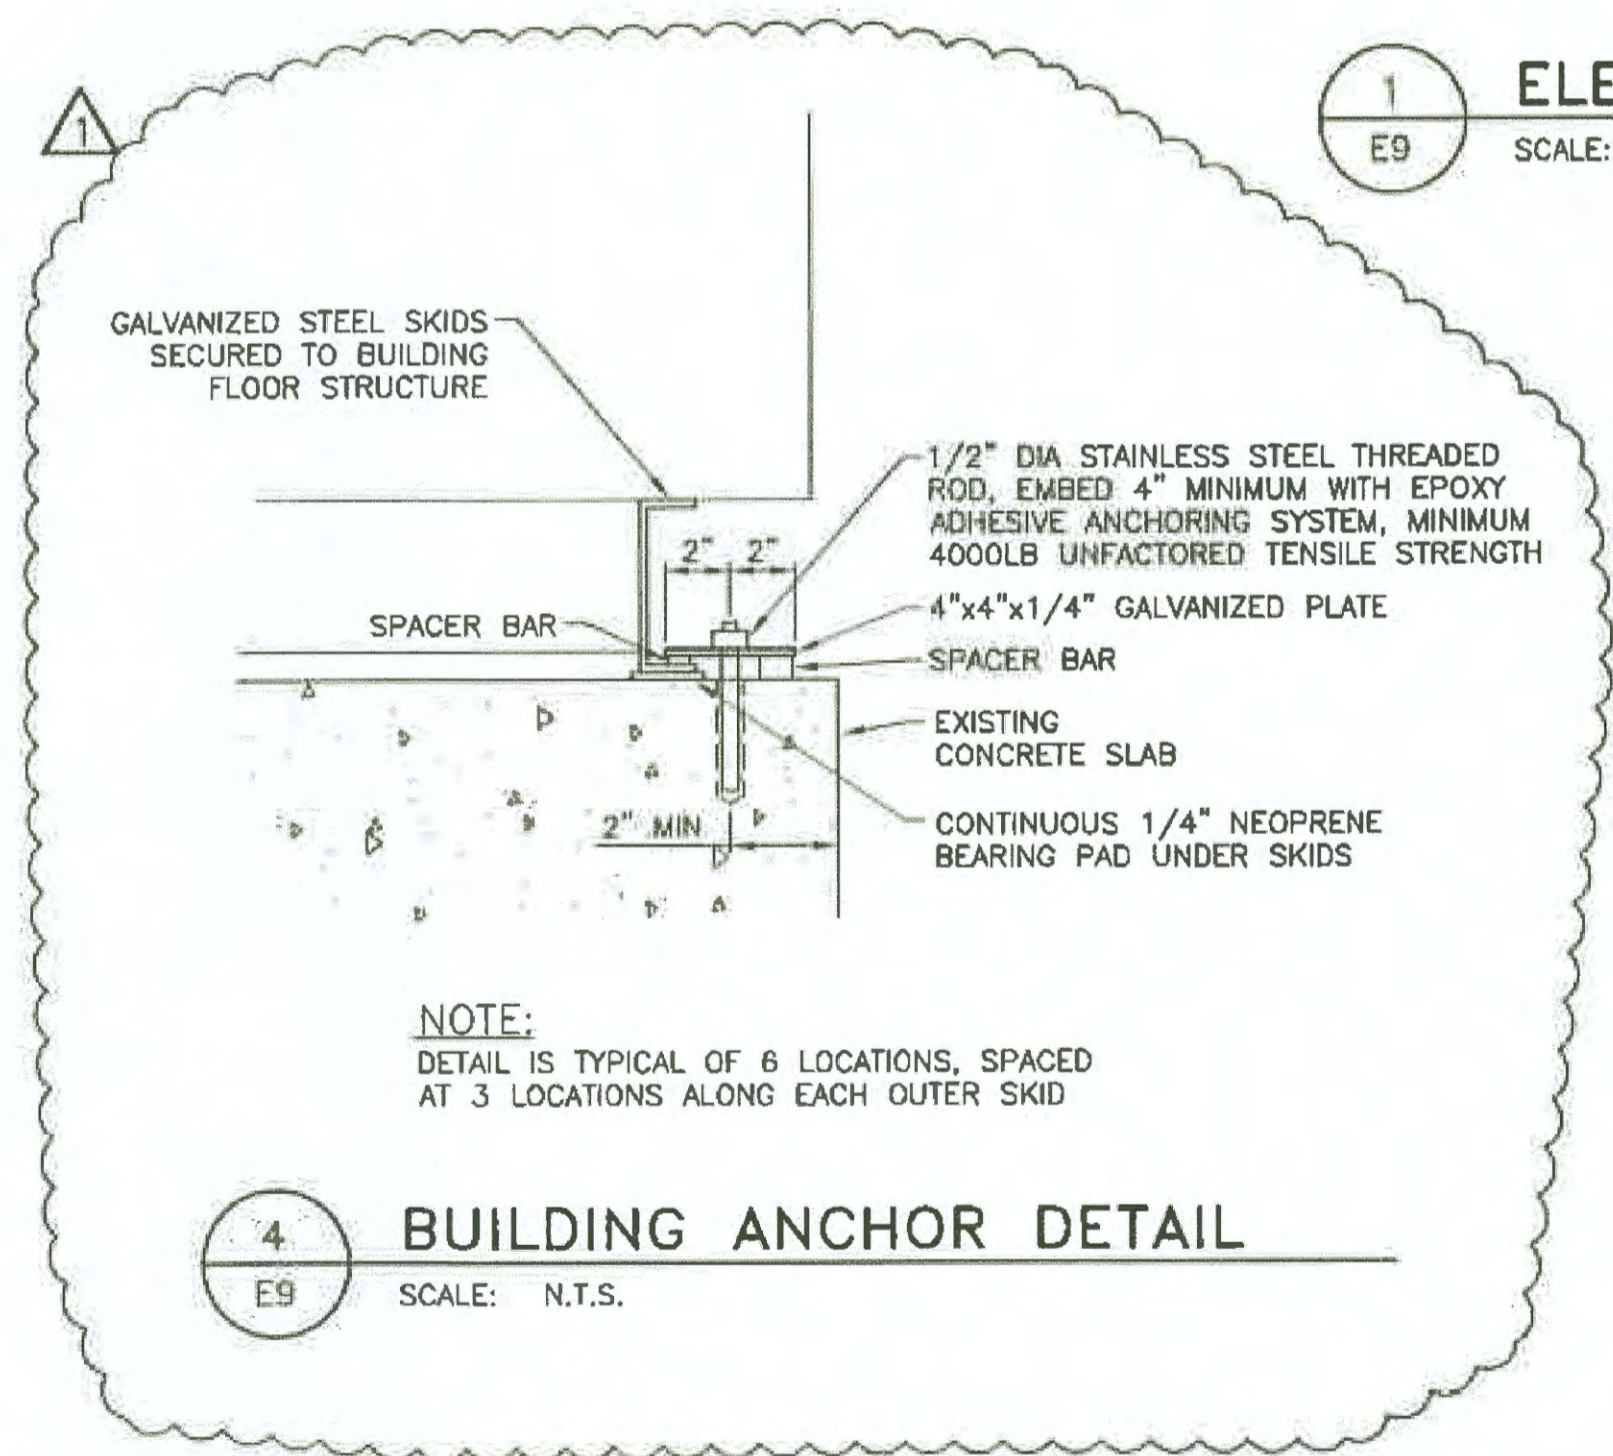

NOTE:  
DETAIL IS TYPICAL OF 6 LOCATIONS, SPACED AT 3 LOCATIONS ALONG EACH OUTER SKID

4 BUILDING ANCHOR DETAIL  
E9 SCALE: N.T.S.

ELECTRICAL EQUIPMENT BUILDING NOTES:

- COORDINATE BUILDING CONSTRUCTION AND PLACEMENT WITH EXISTING CONDUITS TO ALLOW PENETRATION THROUGH THE FLOOR OR CUT AND REPAIR CONCRETE SLAB AS REQUIRED TO RELOCATE CONDUIT STUB UPS FOR FLOOR PENETRATION.
- EXISTING EQUIPMENT BUILDING AND EQUIPMENT SHALL BE REMOVED AND SALVAGED OR DISPOSED OF IN ACCORDANCE WITH GENERAL NOTE 2 ON SHEET E1. REMOVAL IS PAID FOR UNDER ITEM L-109a AND INCLUDES ASSOCIATED UNDERGROUND CONDUIT AND ELECTRICAL SERVICE FEEDER.

BUILDING PLAN LEGEND	
	DUPLEX RECEPTACLE
	SINGLE POLE SWITCH
	CEILING MOUNTED LIGHT FIXTURE
	EMERGENCY LIGHT WITH BATTERY BACKUP
	THERMOSTAT
	SEE EQUIPMENT LIST

Record Drawings have been reviewed by the Project Engineer, and represent to the best of my knowledge, the project as constructed.  
PE [Signature] Date 10/24/19

DESIGN LPS  
DRAWN LPS,JCA  
CHECKED MXS


STATE OF ALASKA  
DEPARTMENT OF TRANSPORTATION AND PUBLIC FACILITIES  
SOUTHCOAST REGION-DESIGN AND CONSTRUCTION-AVIATION



BY	DATE	REVISIONS
LPS	8/1/18	ADDENDUM 1

KAKE AIRPORT  
KAKE, ALASKA  
RUNWAY REHABILITATION  
AIP 3-02-0398-XX-2018/SFAPT00078  
EQUIPMENT BUILDING DETAILS I

SHEET E9 OF 27

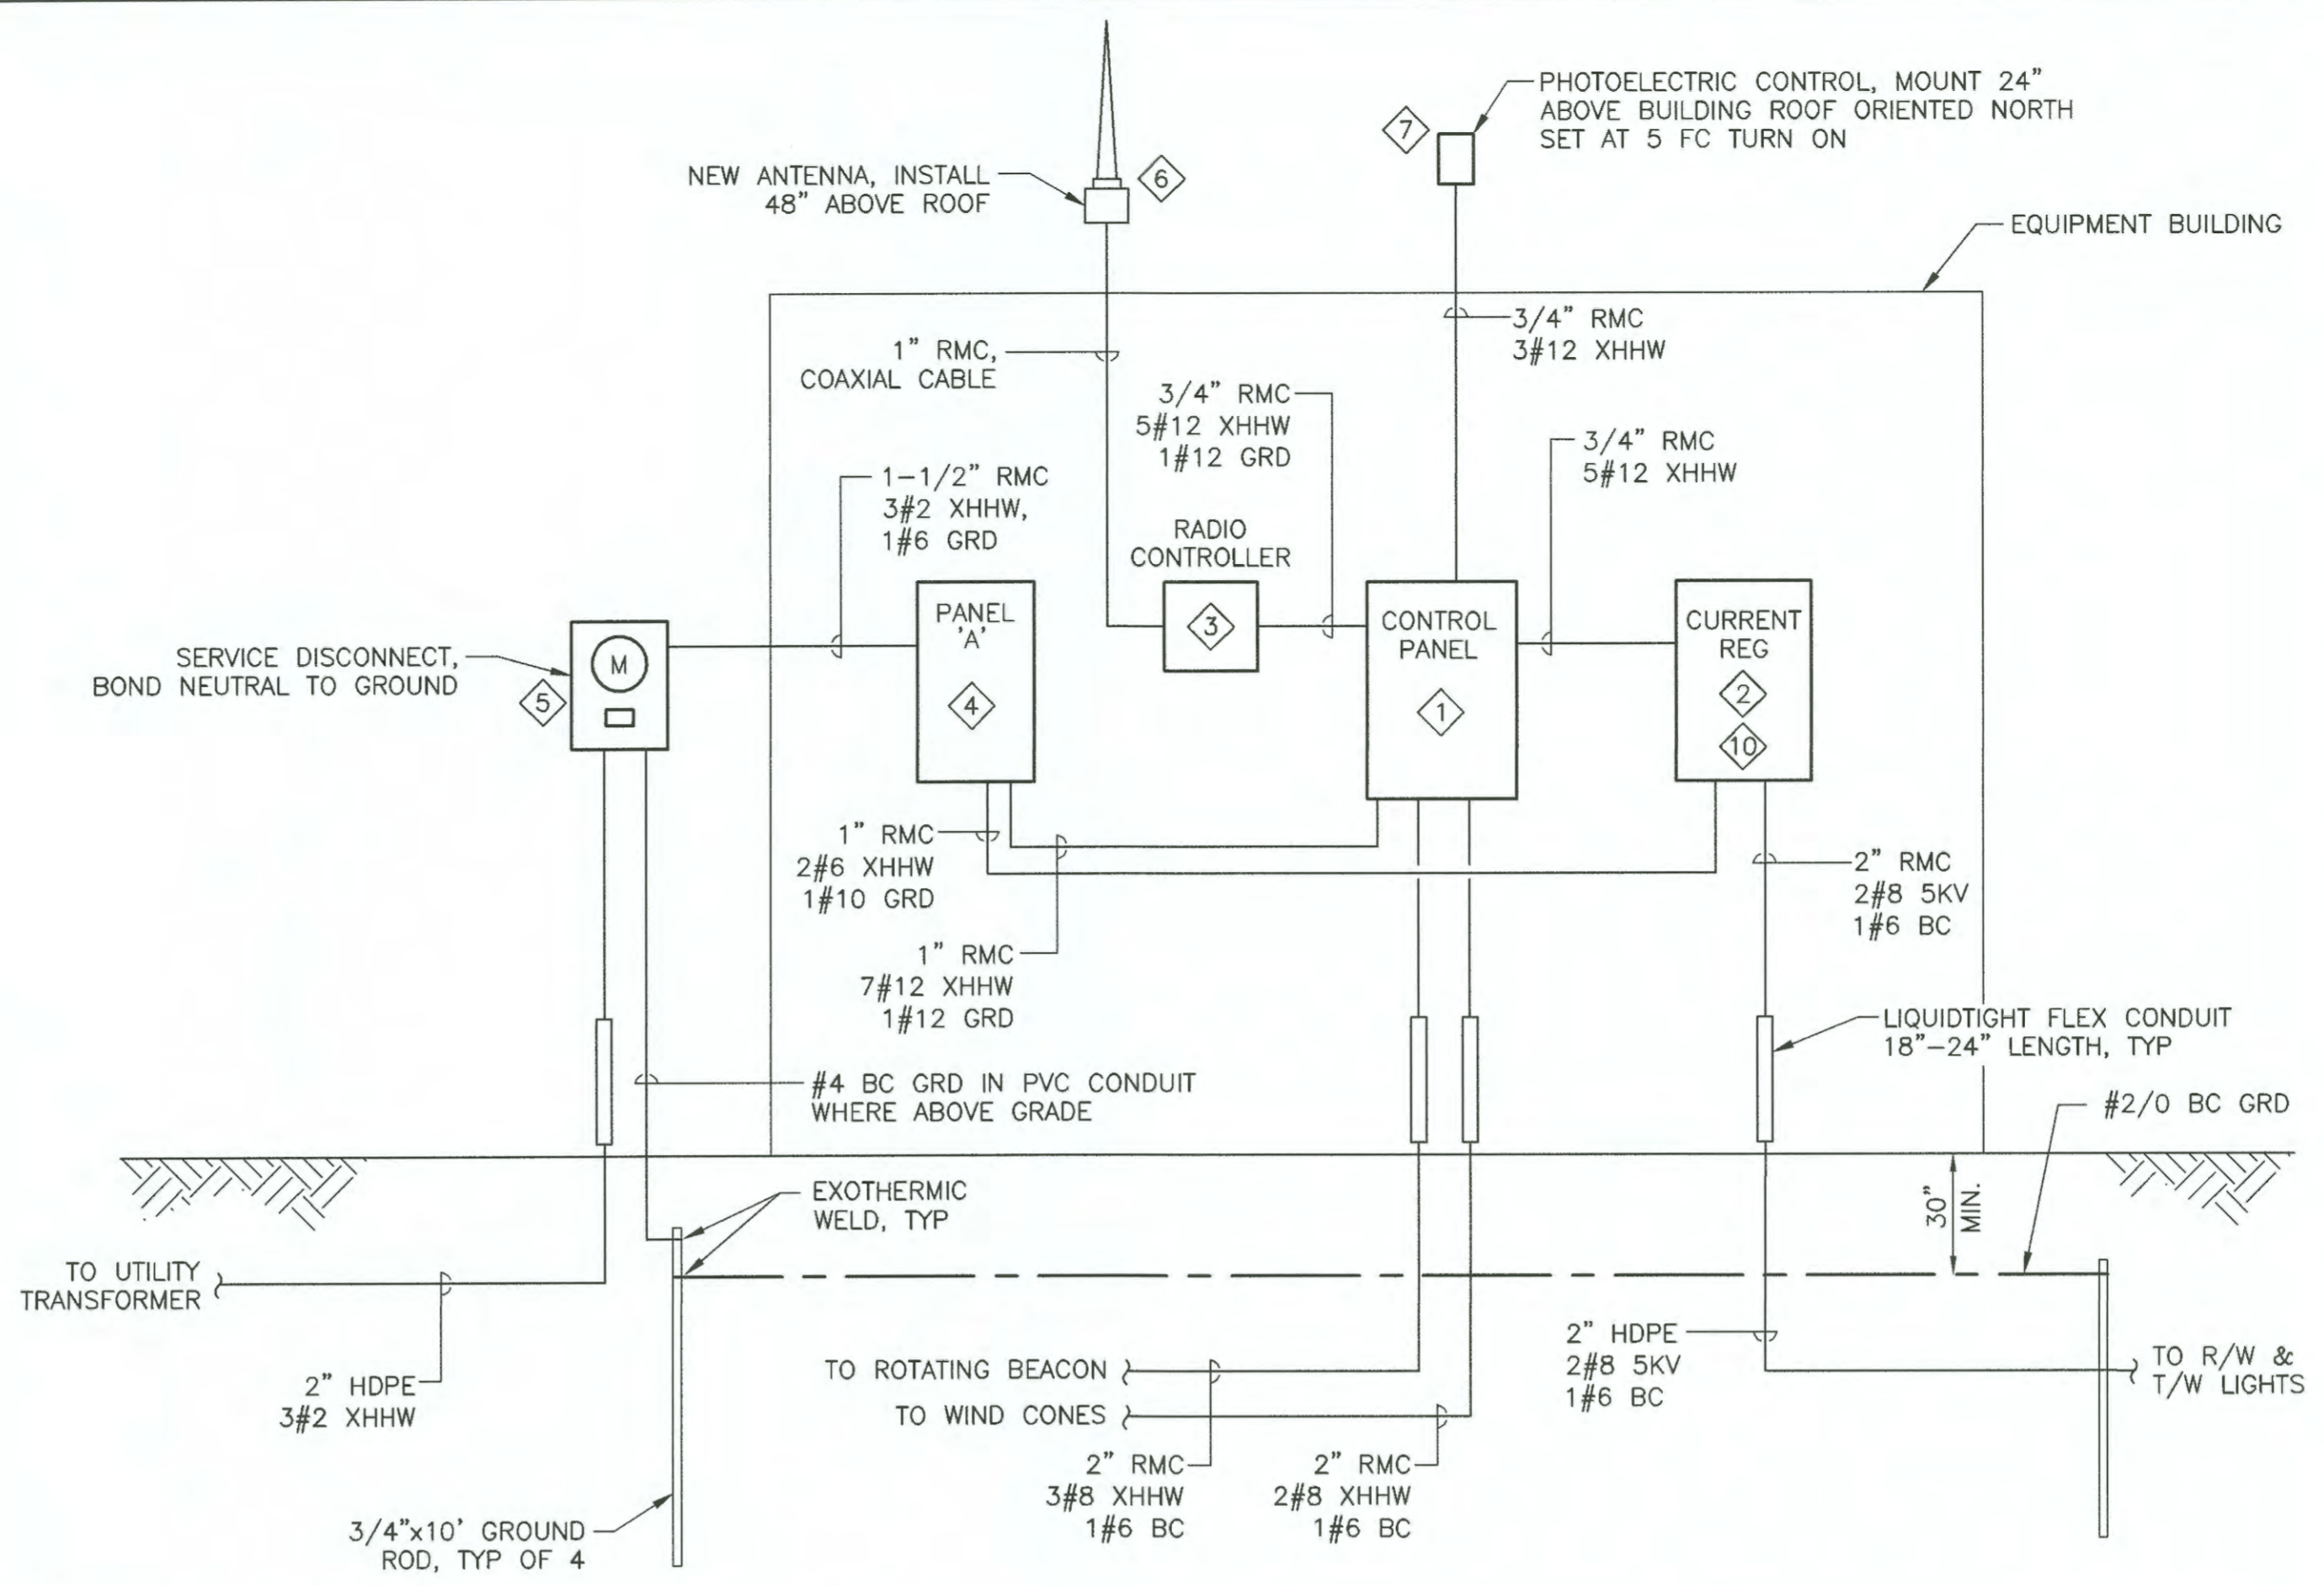

**ONE-LINE DIAGRAM**  
 SCALE: N.T.S.

- ELECTRICAL EQUIPMENT BUILDING NOTES:**
- ALL BUILDING PENETRATIONS SHALL GO THROUGH THE FLOOR OR WALLS. WALL PENETRATIONS SHALL BE MADE BELOW THE LEVEL OF THE INTERIOR EQUIPMENT THEY SERVE.
  - NO PENETRATIONS SHALL BE MADE THROUGH THE ROOF.
  - ALL PENETRATIONS SHALL BE SEALED WEATHERTIGHT WITH SILICONE SEALANT.
  - IMC OR EMT MAY BE USED FOR CONDUIT SECTIONS LOCATED ENTIRELY INTERIOR TO THE EQUIPMENT BUILDING.
  - GROUND RING AND RODS ARE SUBSIDIARY TO EQUIPMENT BUILDING INSTALLATION.

PANEL 'A'									
CKT	LOAD	BRANCH		CONN KVA		BRANCH		LOAD	CKT
		BKR	VA	A	B	VA	BKR		
1	LIGHTING CONTROL PANEL	20/1	600	1.1		470	20/2	ROTATING BEACON	2
3	ENCLOSURE LIGHTS	20/1	139		0.5	400		BEACON STRIP HEATER	4
5	RECEPTACLES - SEE NOTE 1	20/1	540	4.0		3504	40/2	5KW REGULATOR	6
7	EXHAUST FAN	20/1	75		3.6	3504		SEE NOTE 2	8
9				1.0		1000	20/2	ELECTRIC HEATER	10
11					1.0	1000			12
13				0.1		64	20/1	WIND CONES	14
15					0.0				16
17					0.0				18
19					0.0				20
21					0.0				22
23					0.0				24
25					0.0				26
27					0.0				28
29					0.0				30
CONNECTED LOAD			11.3 KVA	6.2	5.1	PANEL SPECIFICATIONS			
NEC DEMAND			47 AMPS	51	43	MAINS RATING AMPS - 100			
			13.4 KVA			MAIN CIRCUIT BREAKER AMPERES - MLO			
			56 AMPS			CAPACITY ONE-POLE CIRCUITS - 30			
PANEL NOTES		SYSTEM VOLTAGE - 240/120							
1. GFI CIRCUIT BREAKER		PHASE, NO. OF WIRES - 1 PH, 3 W							
2. MAXIMUM INPUT LOAD SHOWN. ACTUAL LOAD WILL BE LESS.		AIC RATING - 10,000							
		MOUNTING - SURFACE							

EQUIPMENT LIST		
NO.	DESCRIPTION	NOTES
1	LIGHTING CONTROL PANEL	SEE SPECIFICATION L-109 AND SHEET E11
2	5KW REGULATOR, 3-STEP 240V INPUT, 6.6A OUTPUT	FERRERSONANT TYPE WITH DIGITAL METER AND INTEGRAL SERIES CUTOFF
3	ADJUSTABLE FREQUENCY RADIO CONTROLLER	SET FREQUENCY TO CTAF: 122.9MHZ, RELAYS SHALL OPERATE CUMULATIVELY
4	PANELBOARD	BOLT-ON CIRCUIT BREAKERS, SEE PANEL SCHEDULE FOR ADDITIONAL INFORMATION
5	METER/MAIN	100A/2-POLE MAIN BREAKER, KILOWATT-HOUR METER PROVIDED BY UTILITY
6	RADIO ANTENNA	
7	PHOTOELECTRIC CONTROL	
8	2000W ELECTRIC HEATER	INTEGRAL 40-85 DEG F THERMOSTAT
9	EXHAUST FAN, 150CFM MINIMUM AT 0.2 IN WG	WITH BACKDRAFT DAMPER AND WALL-MOUNTED 40-85 DEG F THERMOSTAT
10	PLUG CUTOFF, 5KV	MOUNT INTEGRAL TO REGULATOR, PROVIDE WITH SEPARATE GROUNDING COVER FOR TROUBLESHOOTING
11	INTERIOR LIGHT FIXTURE	4000LM OUTPUT, FROSTED LENS, 120V
12	EMERGENCY LIGHT	
13	METAL WALL DESK 24"x23"x12"	MOUNT TOP OF DESK AT 36" AFF
14	LOCKABLE WALL CABINET 30"x12"x26"	
15	12"x12" RELIEF AIR VENT	WITH WEIGHTED DAMPER AND DUST FILTER

Record Drawings have been reviewed by the Project Engineer, and represent to the best of my knowledge, the project as constructed.  
 PE [Signature] Date 10.24.19

DESIGN LPS  
 DRAWN LPS,JCA  
 CHECKED MXS




STATE OF ALASKA  
 DEPARTMENT OF TRANSPORTATION AND PUBLIC FACILITIES  
 SOUTHCOAST REGION-DESIGN AND CONSTRUCTION-AVIATION



BY	DATE	REVISIONS

KAKE AIRPORT  
 KAKE, ALASKA  
 RUNWAY REHABILITATION  
 AIP 3-02-0398-XX-2018/SFAPT00078  
 EQUIPMENT BUILDING DETAILS II

SHEET E10 OF 27

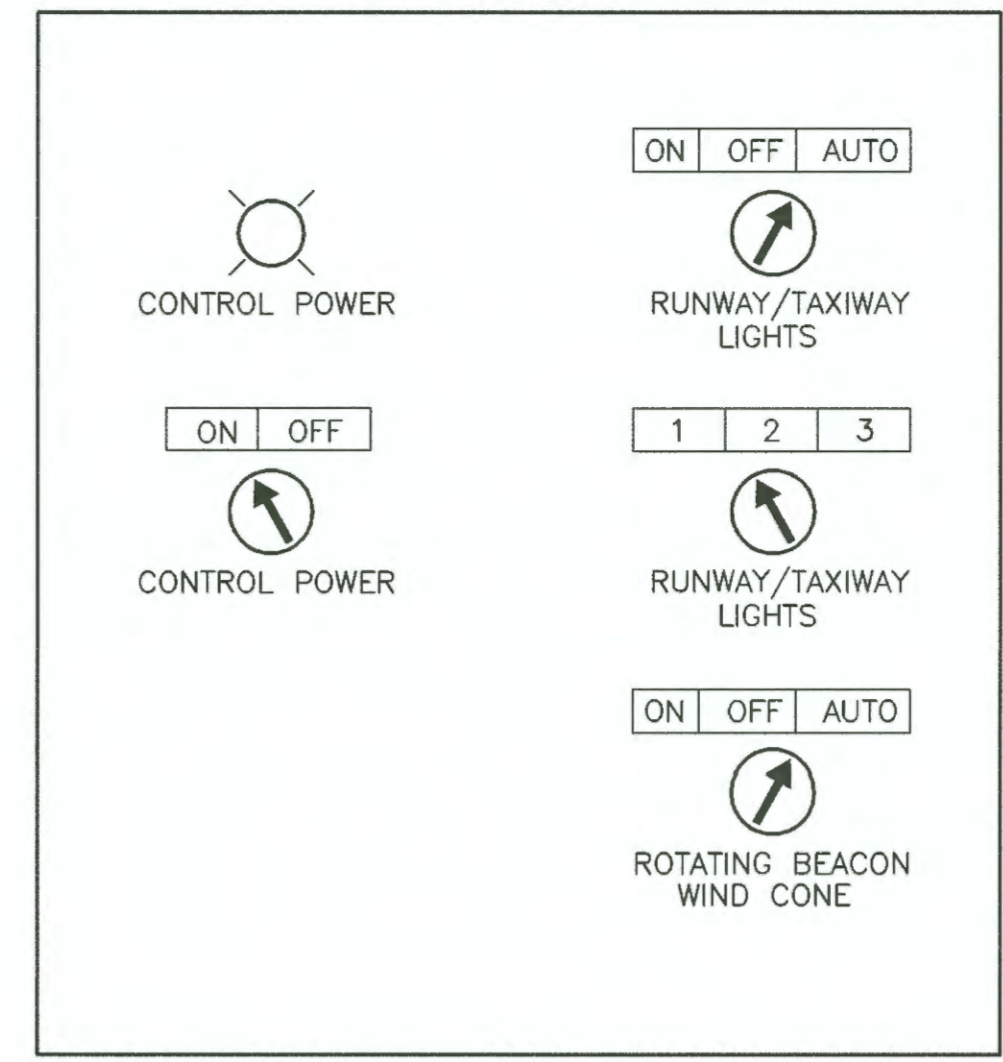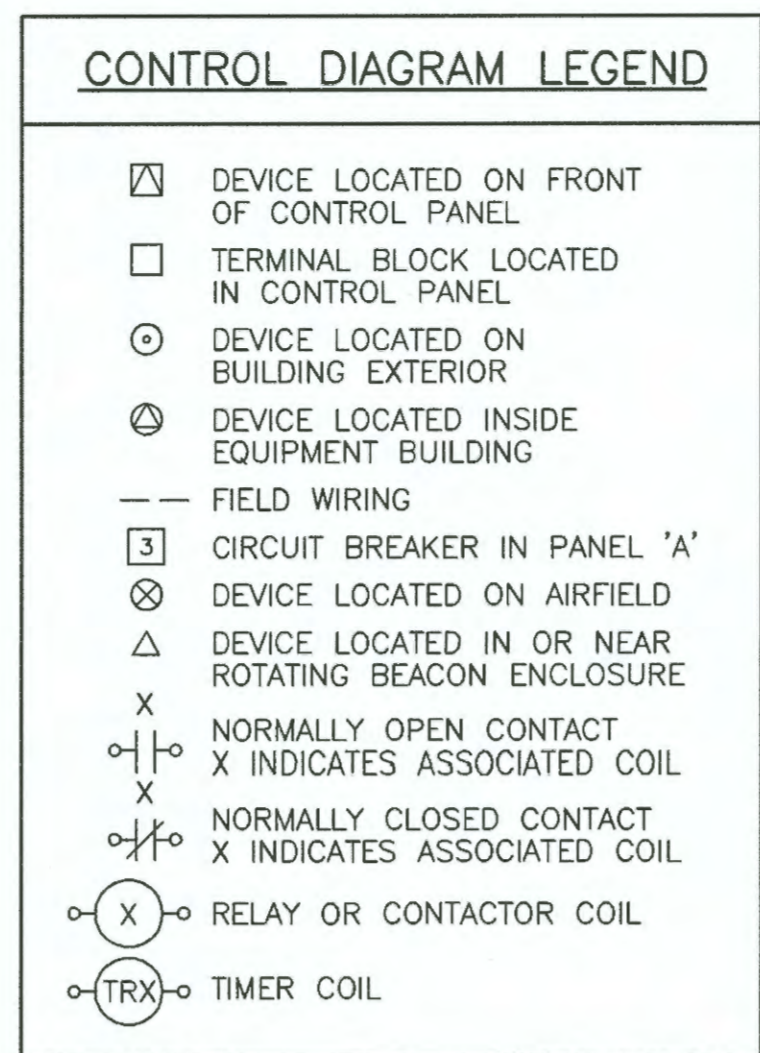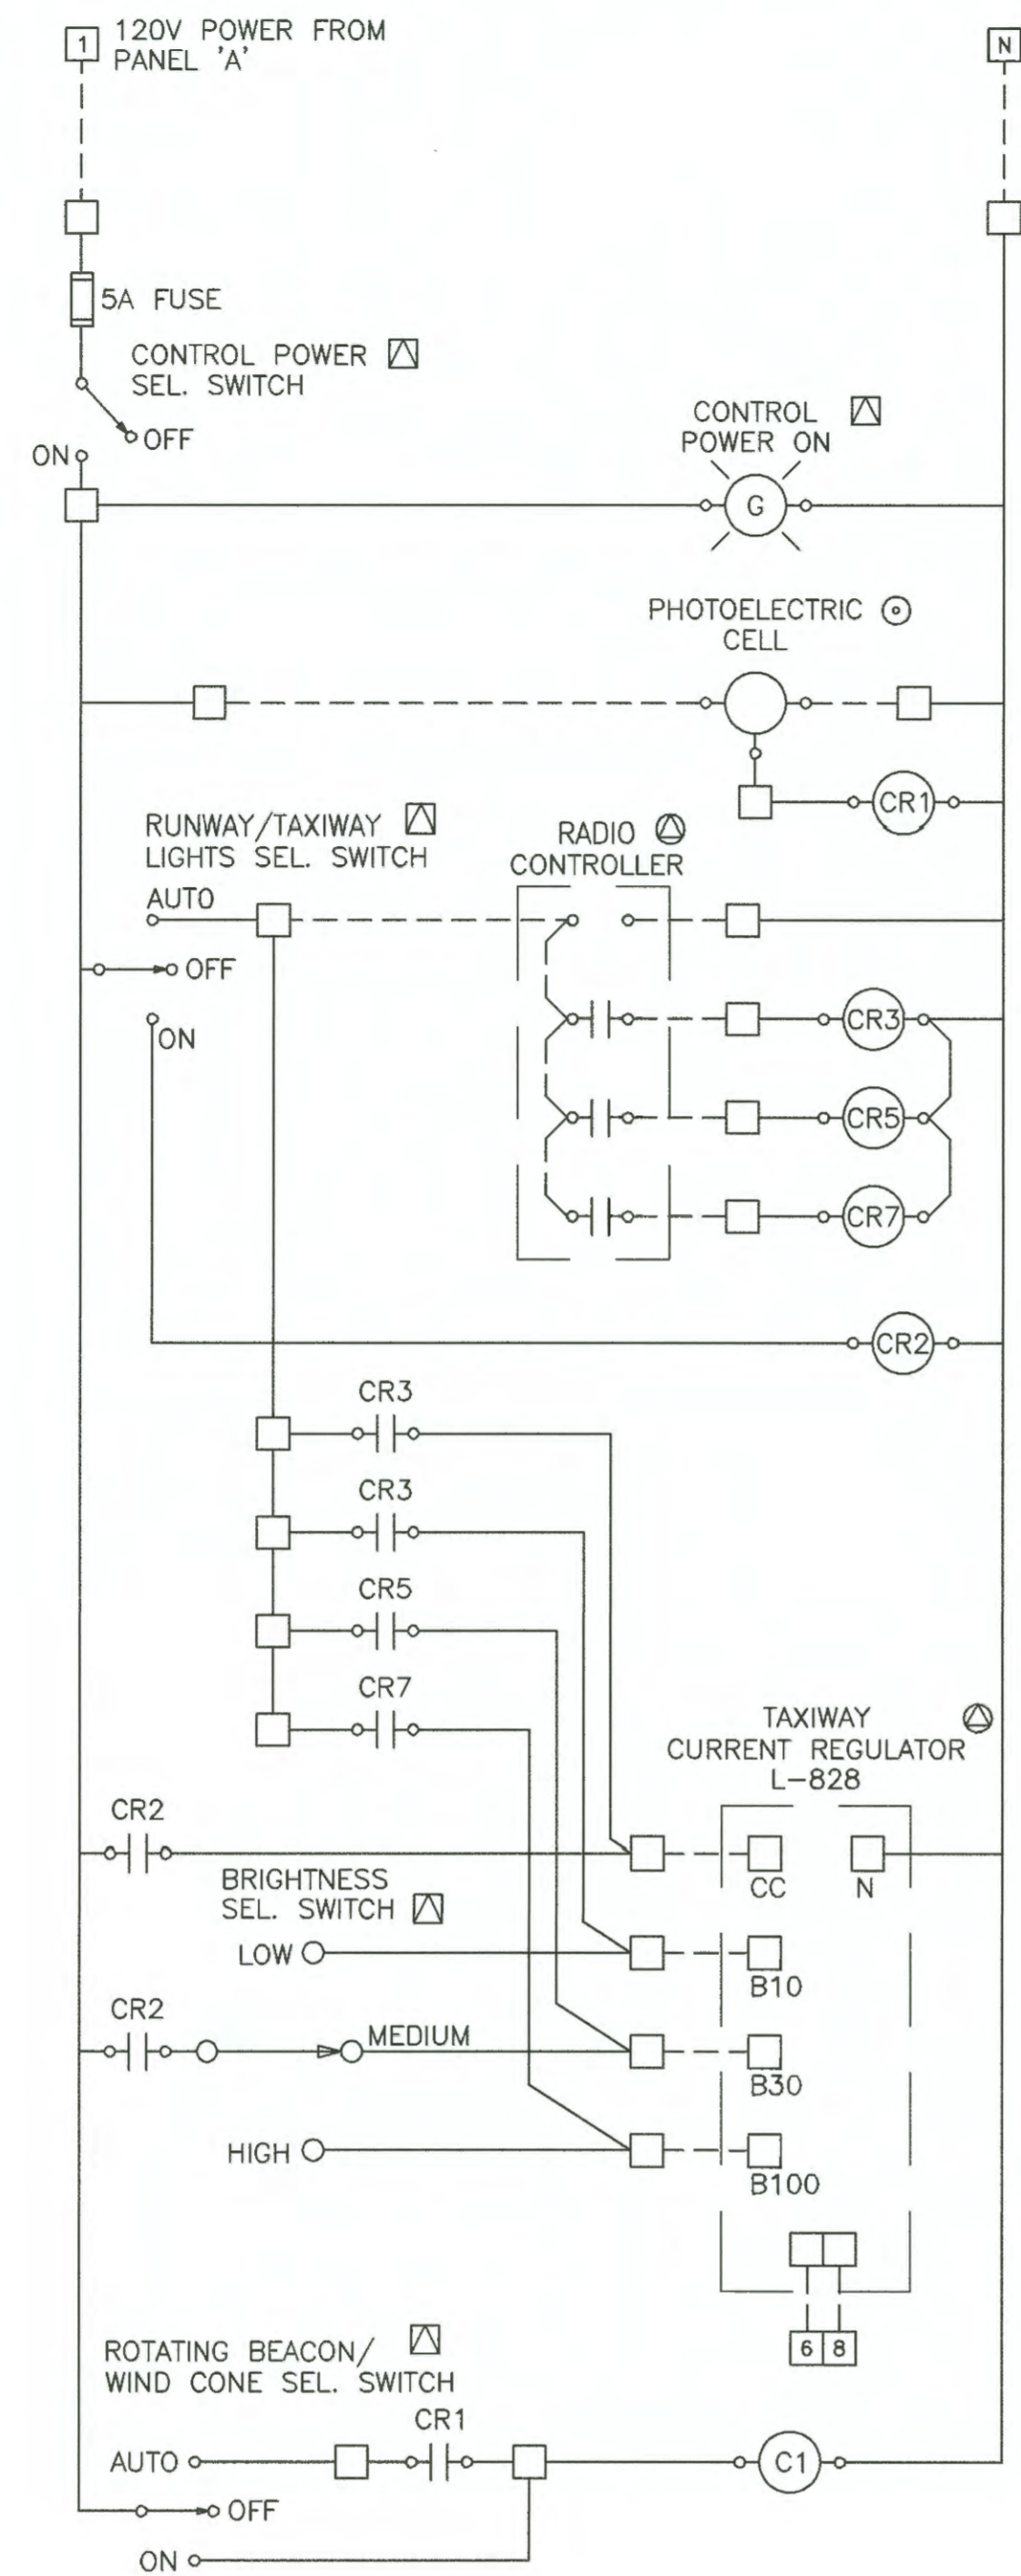

**CONTROL SEQUENCE DESCRIPTION**

**RUNWAY & TAXIWAY LIGHTS**

ON - LIGHTS ON AT BRIGHTNESS SET BY MANUAL BRIGHTNESS SWITCH

OFF - LIGHTS OFF

AUTO - RADIO CONTROLLER ENABLED  
 3 CLICKS OF MIC TURNS ON RW/TW LIGHTS AT STEP 1,  
 2 ADDITIONAL CLICKS OF MIC TURNS RW/TW LIGHTS TO STEP 2,  
 2 ADDITIONAL CLICKS OF MIC TURNS RW/TW LIGHTS TO STEP 3,  
 LIGHTS REMAIN ON FOR 15 MINUTES AFTER LAST CLICK


**ROTATING BEACON/WIND CONE**

ON - BEACON ON

OFF - BEACON OFF

AUTO - PHOTOELECTRIC CONTROL ENABLED

**1 CONTROL PANEL DETAIL**  
SCALE: N.T.S.

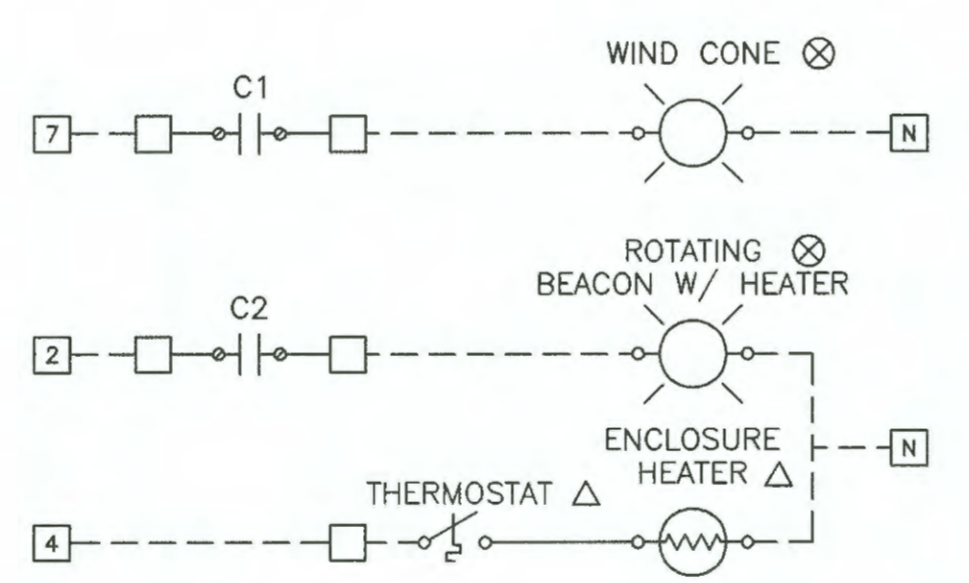

**2 CONTROL PANEL LADDER DIAGRAM**  
SCALE: N.T.S.

Record Drawings have been reviewed by the Project Engineer, and represent to the best of my knowledge, the project as constructed.  
 PE [Signature] Date 10.24.19

DESIGN LPS  
 DRAWN LPS,JCA  
 CHECKED MXS

STATE OF ALASKA  
 DEPARTMENT OF TRANSPORTATION AND PUBLIC FACILITIES  
 SOUTHCOAST REGION-DESIGN AND CONSTRUCTION-AVIATION




BY	DATE	REVISIONS

KAKE AIRPORT  
 KAKE, ALASKA  
 RUNWAY REHABILITATION  
 AIP 3-02-0398-XX-2018/SFAPT00078  
 CONTROL PANEL DETAILS


SHEET  
**E11**  
 OF  
 27

8/01/2018, 4:03 PM

PLANS DEVELOPED BY: STANTEC CONSULTING SERVICES, INC. 725 EAST FIREWEED LANE, SUITE 200, ANCHORAGE, AK 99503-2245 907-276-4245 CERTIFICATE OF AUTHORIZATION #126386  
 U:\2047059100\Drawing\K. Sheets\2047059100\_E3-E12\_details.dwg

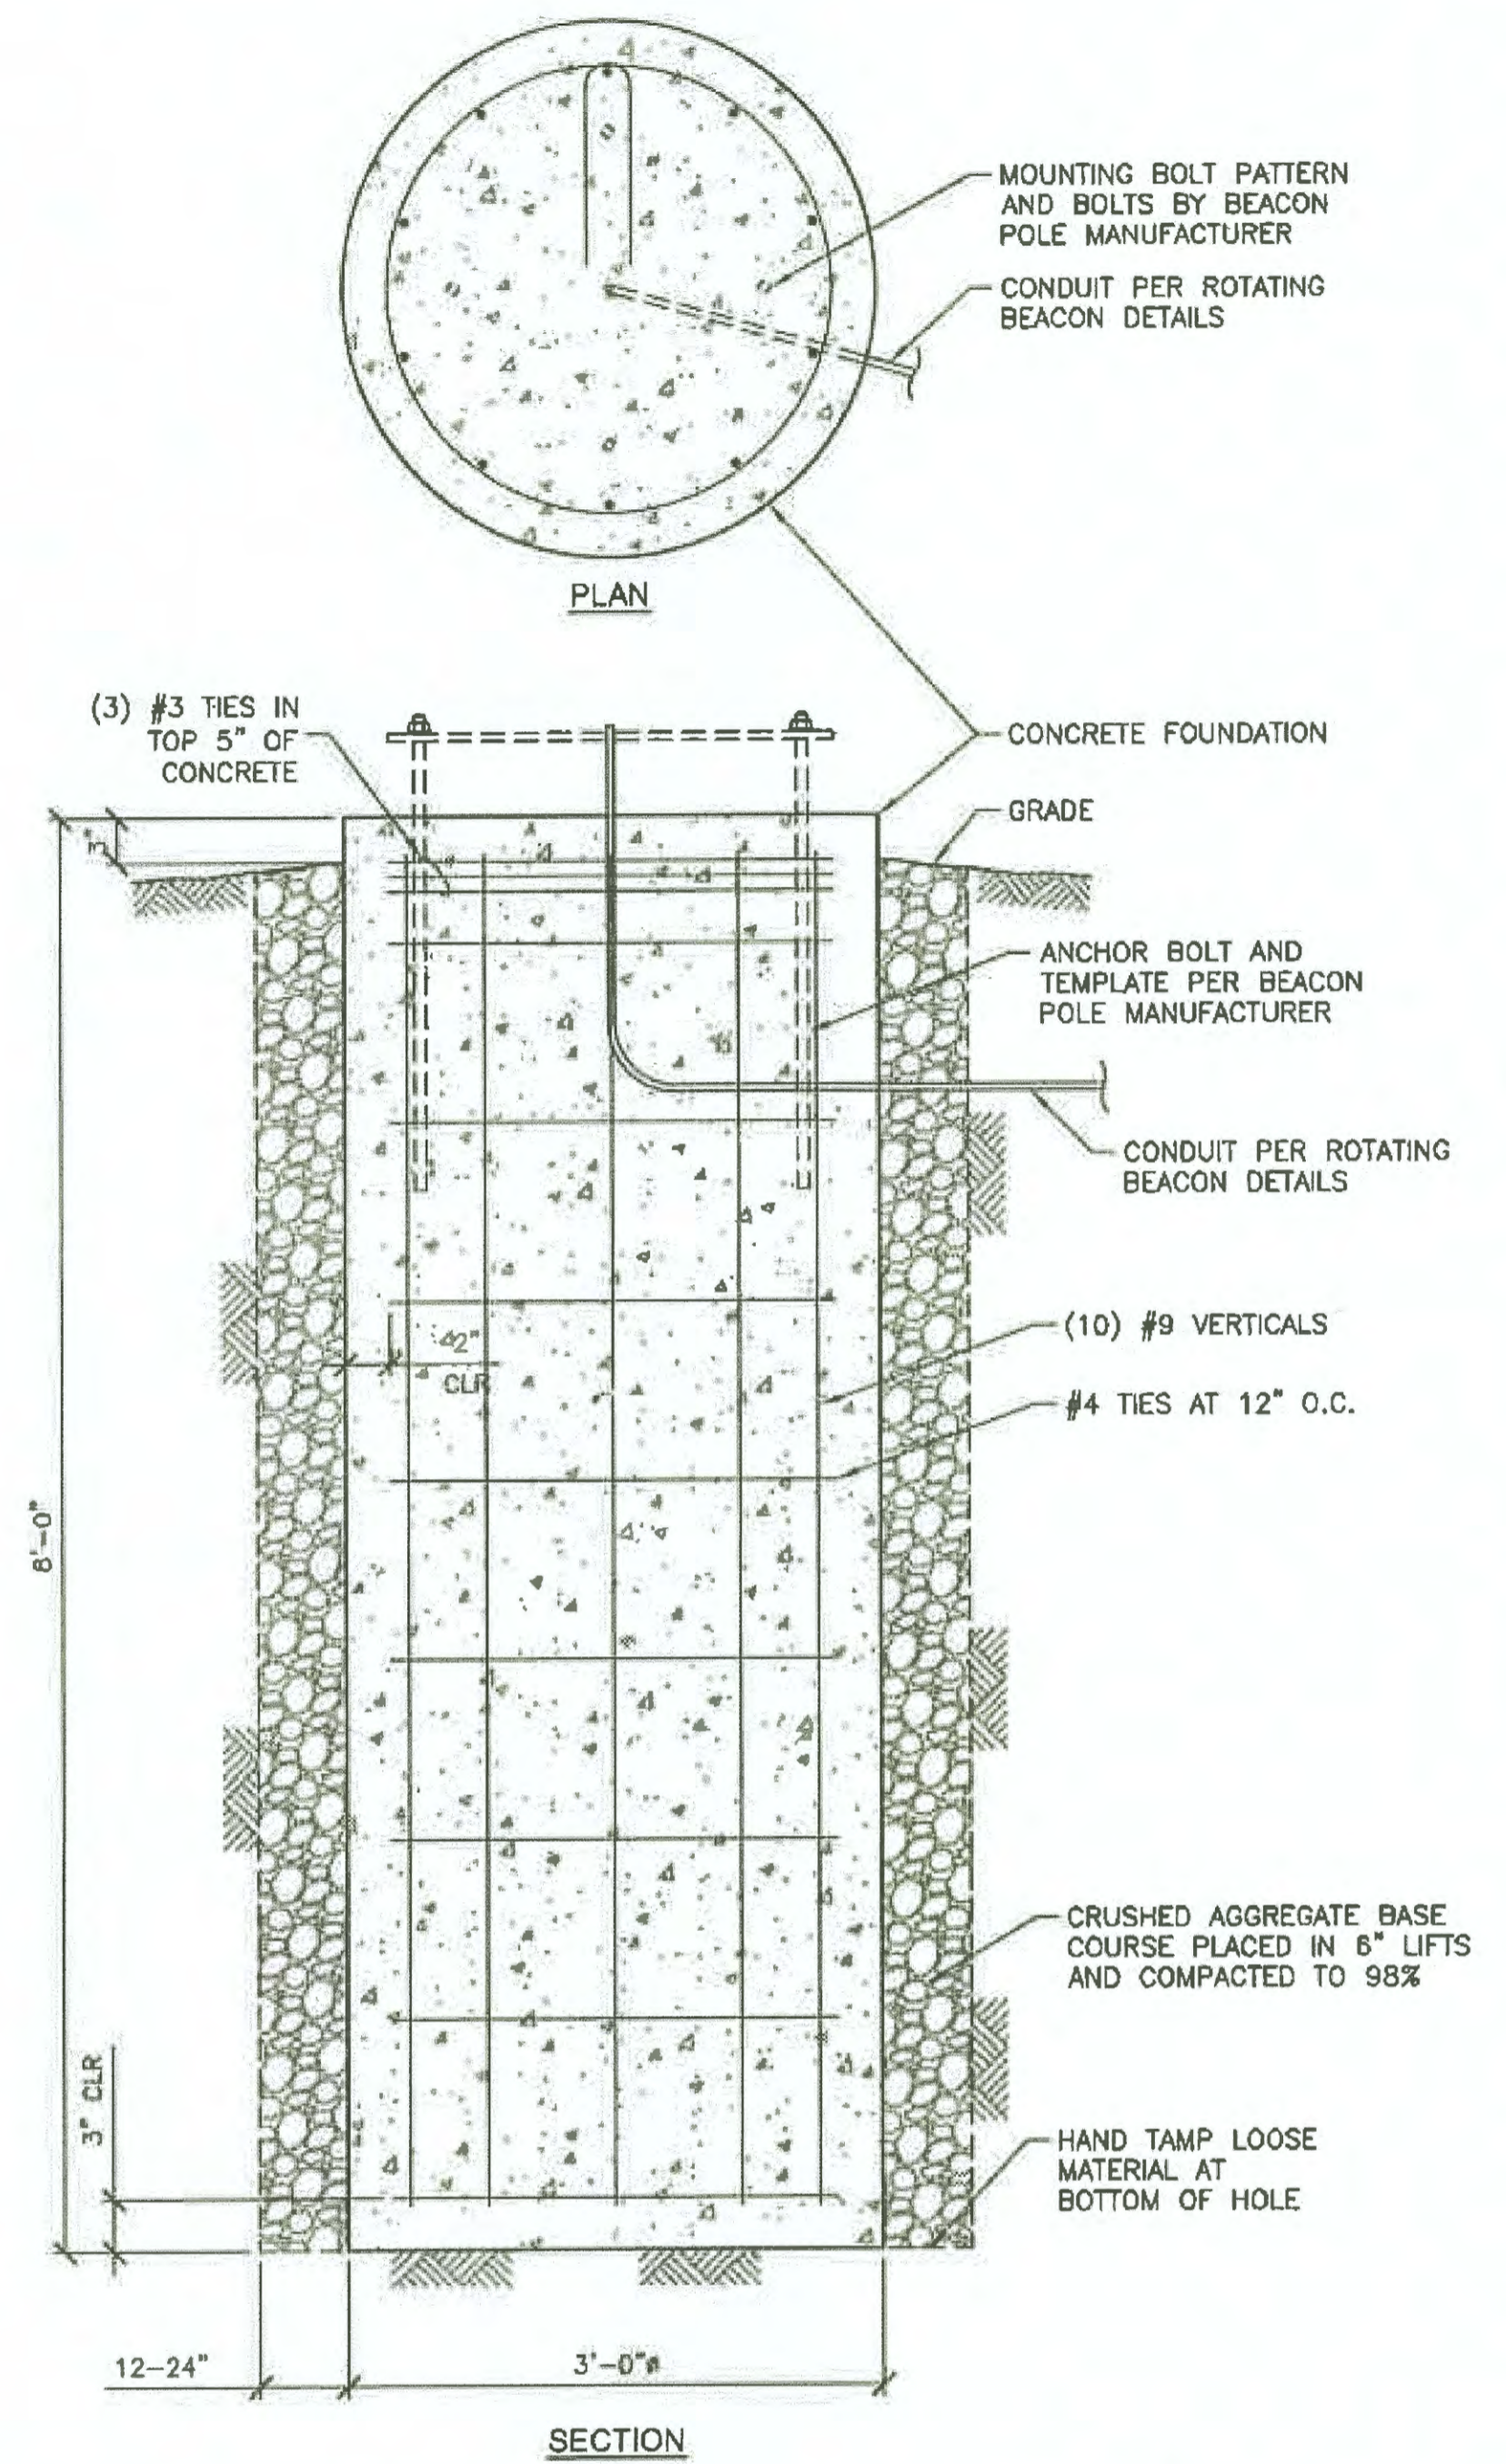

**2 ROTATING BEACON FOUNDATION DETAIL**  
 E12 SCALE: N.T.S.

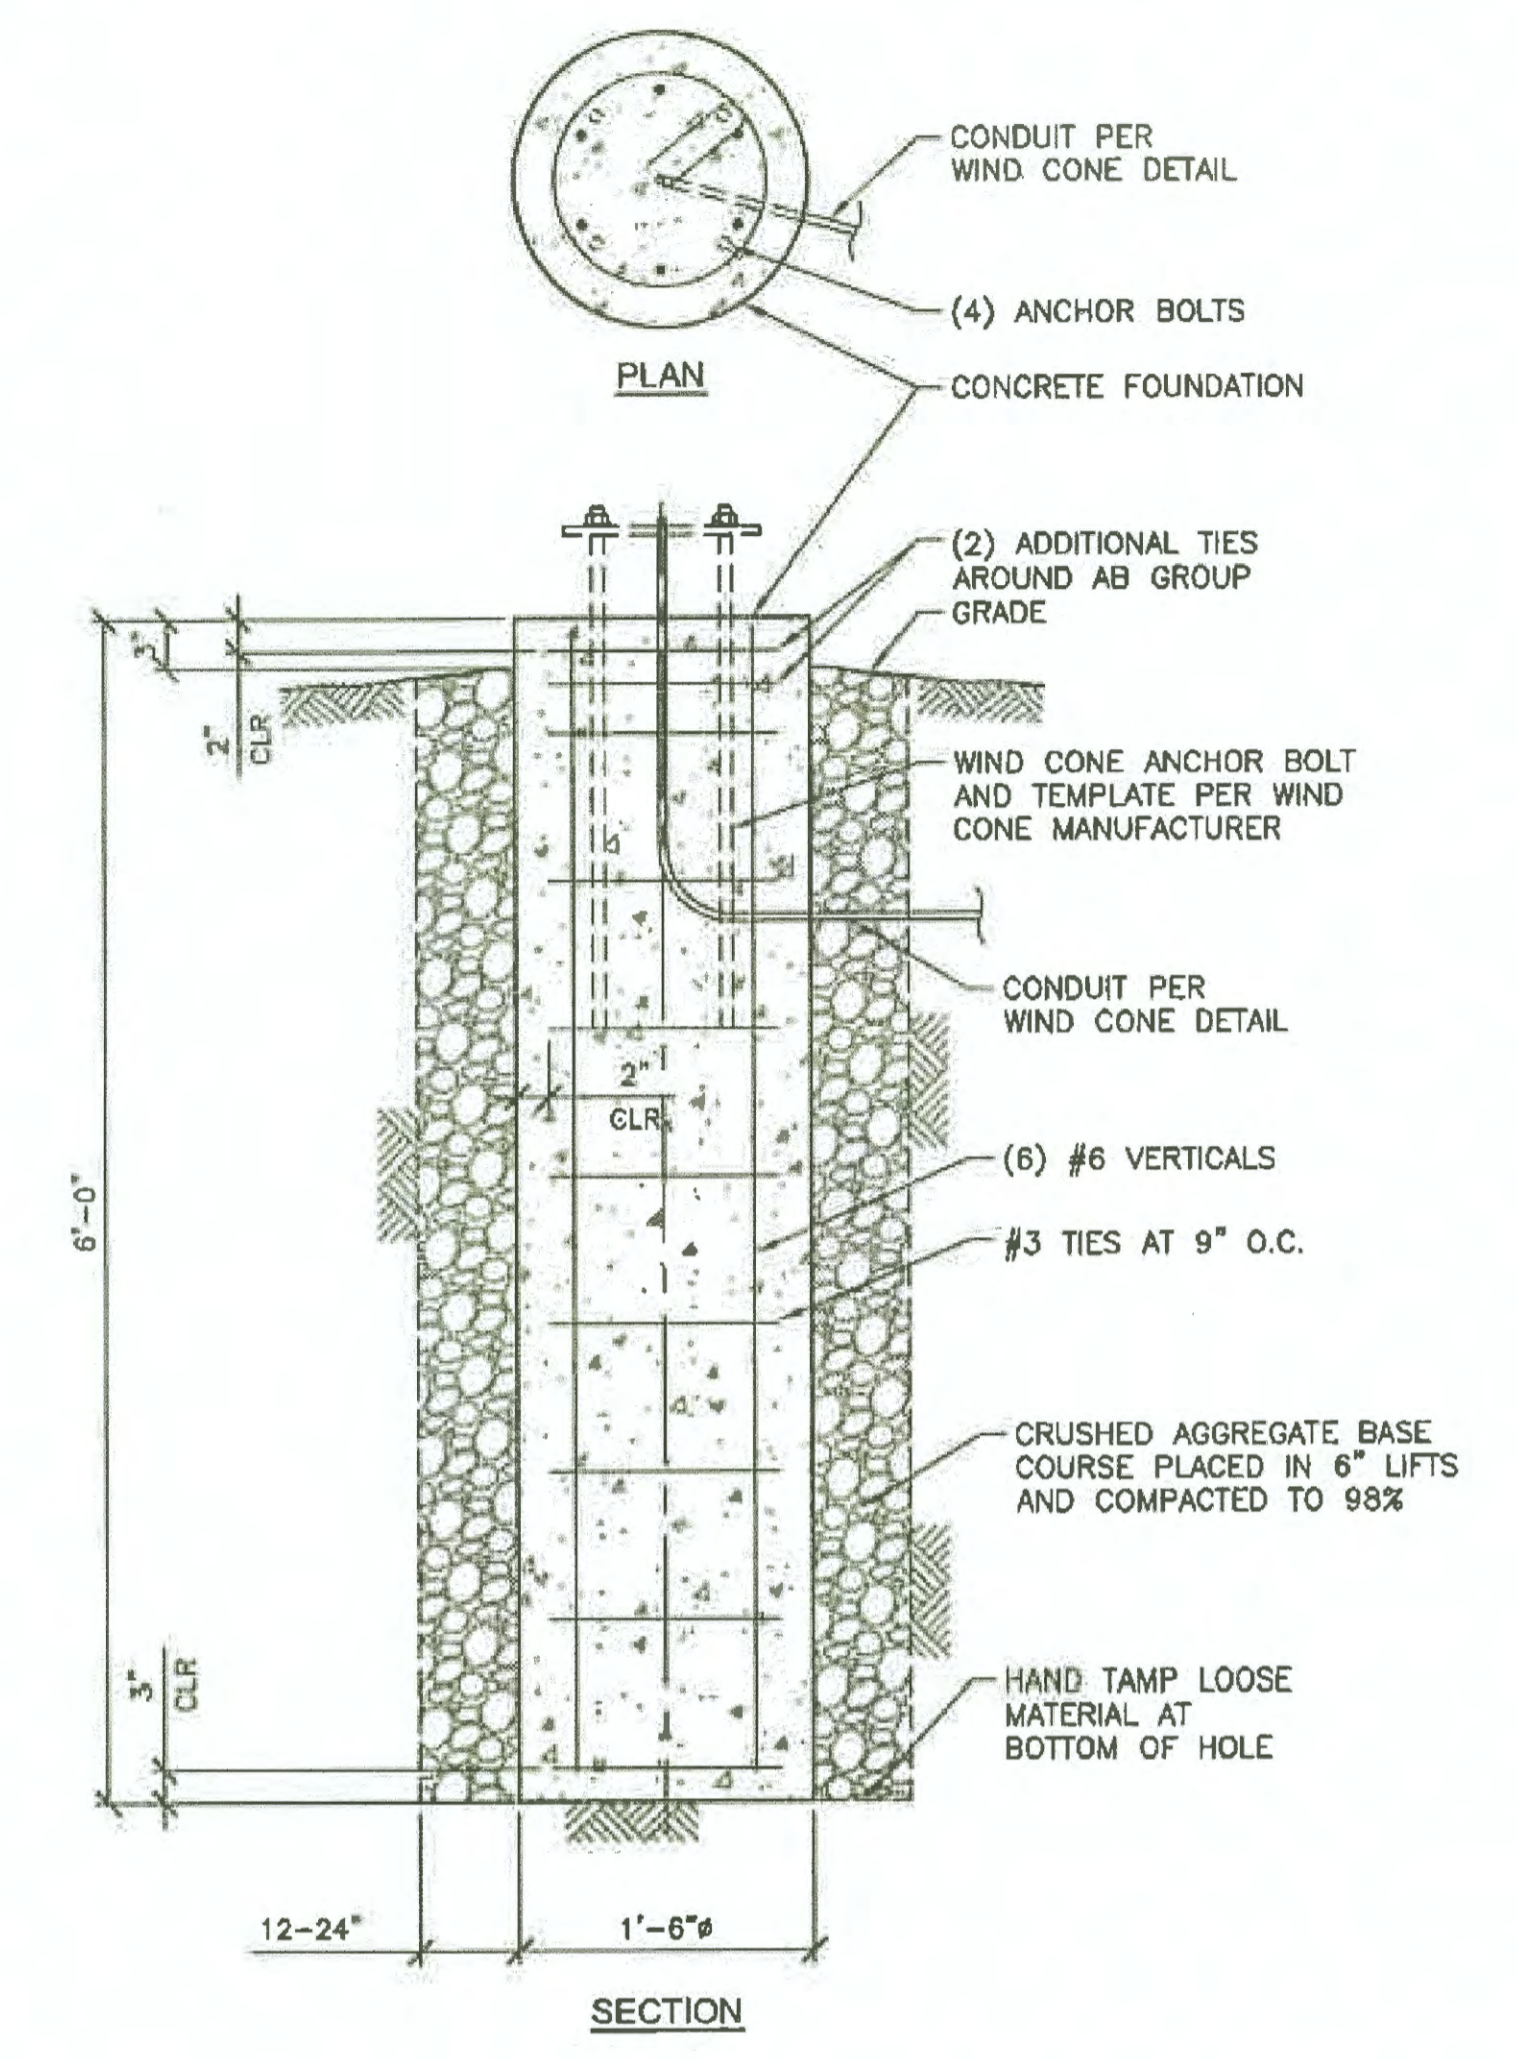

**1 WIND CONE FOUNDATION DETAIL**  
 E12 SCALE: N.T.S.

**NOTE:**  
 IF BEDROCK IS ENCOUNTERED WITHIN THE DEPTH OF THE FOUNDATION AND IS DEEMED STRUCTURALLY ADEQUATE BY THE ENGINEER, THE FOUNDATION MAY BE PINNED OR DOWELED INTO THE BEDROCK FOR STABILITY AS DIRECTED BY THE ENGINEER AND EXTENDED ABOVE GRADE AS DETAILED

Record Drawings have been reviewed by the Project Engineer, and represent to the best of my knowledge, the project as constructed.  
 PE [Signature] Date 10.24.19

DESIGN SC  
 DRAWN LPS  
 CHECKED KR

STATE OF ALASKA  
 DEPARTMENT OF TRANSPORTATION AND PUBLIC FACILITIES  
 SOUTHCOAST REGION-DESIGN AND CONSTRUCTION-AVIATION









BY	DATE	REVISIONS
KR	8/1/18	ADDENDUM 1 - ADD SHEET

KAKE AIRPORT  
 KAKE, ALASKA  
 RUNWAY REHABILITATION  
 AIP 3-02-0398-XX-2018/SFAPT00078  
 FOUNDATION DETAILS

SHEET  
**E12**  
 OF  
 27





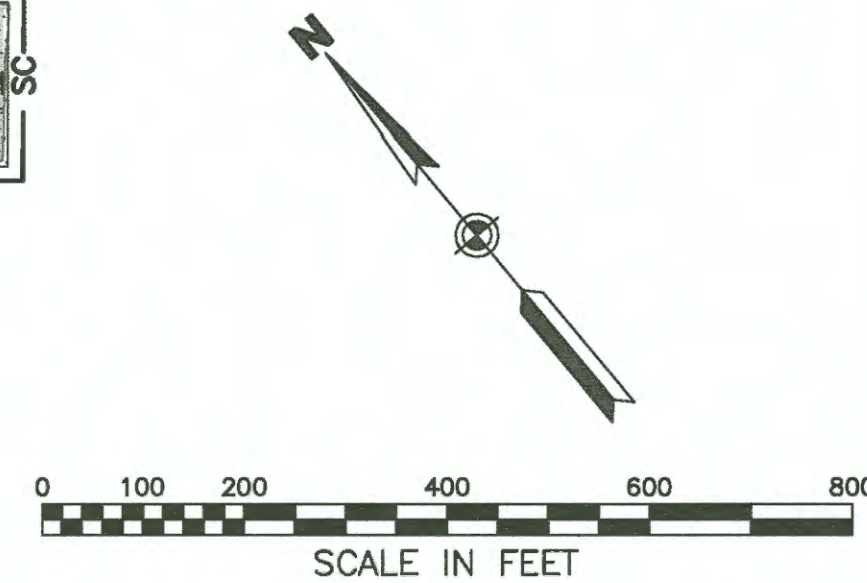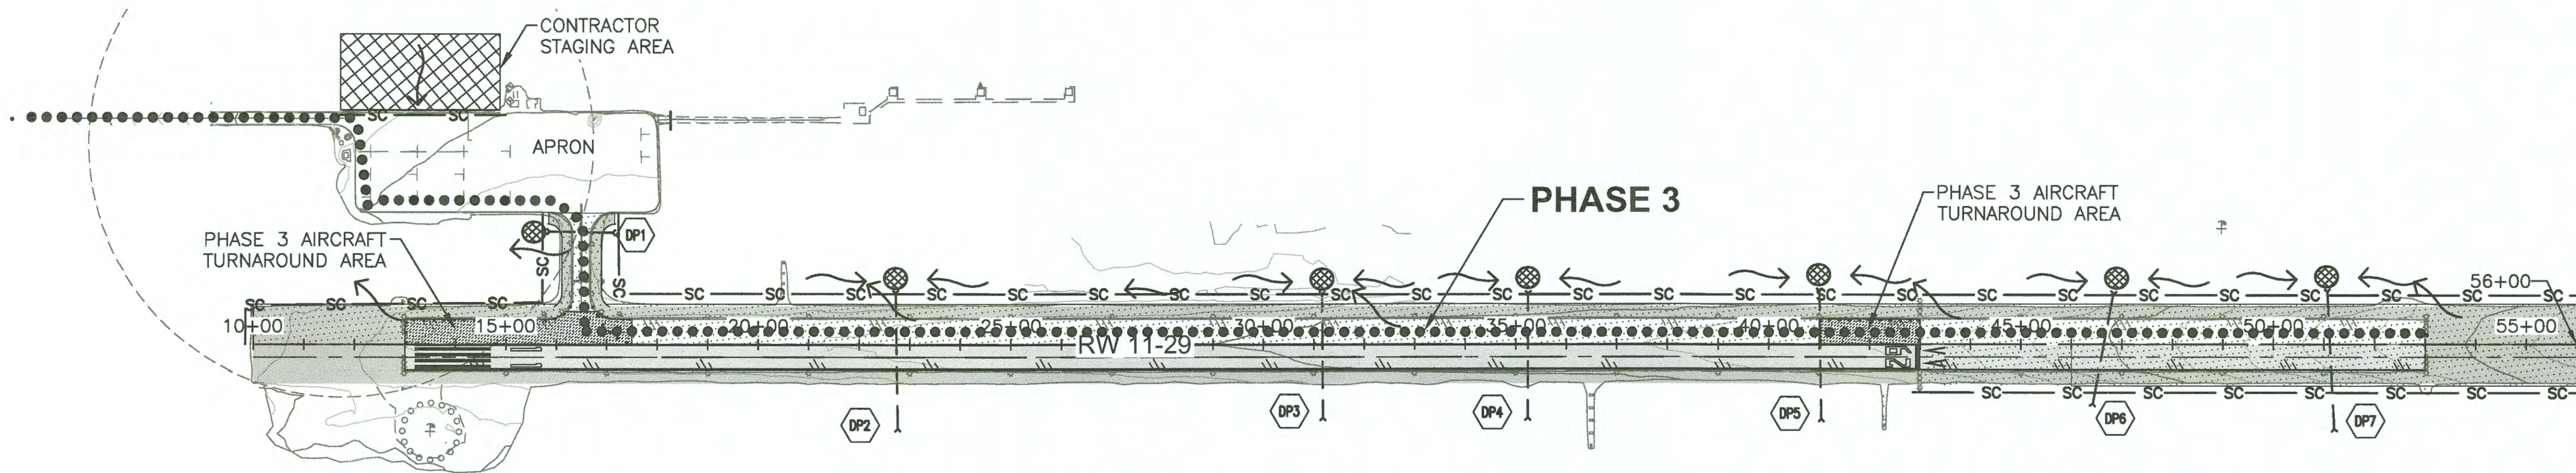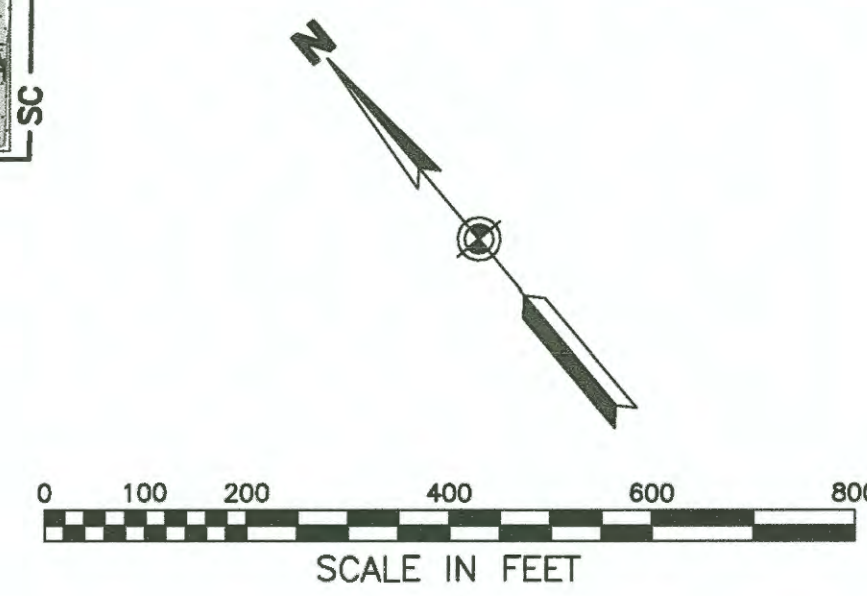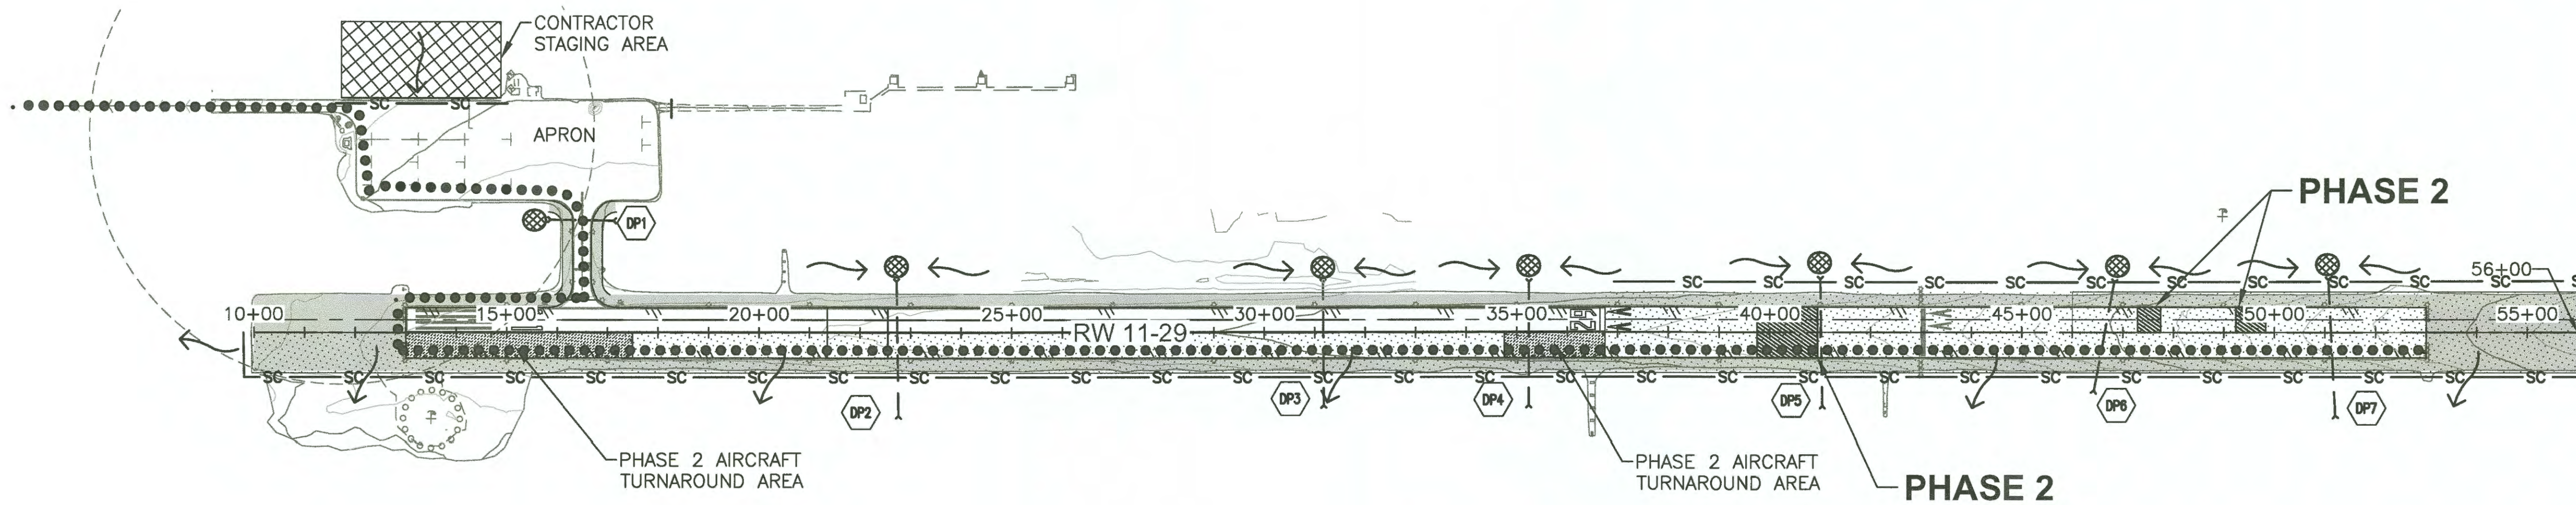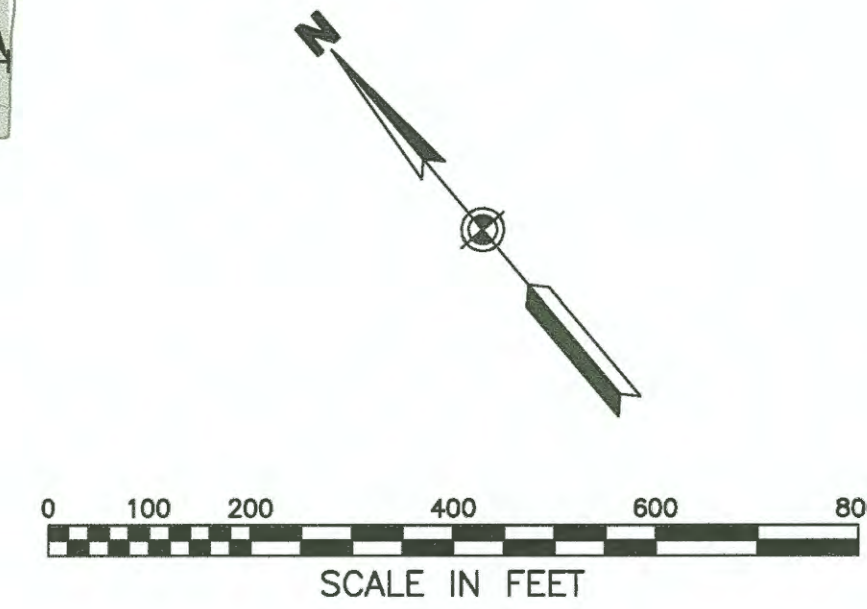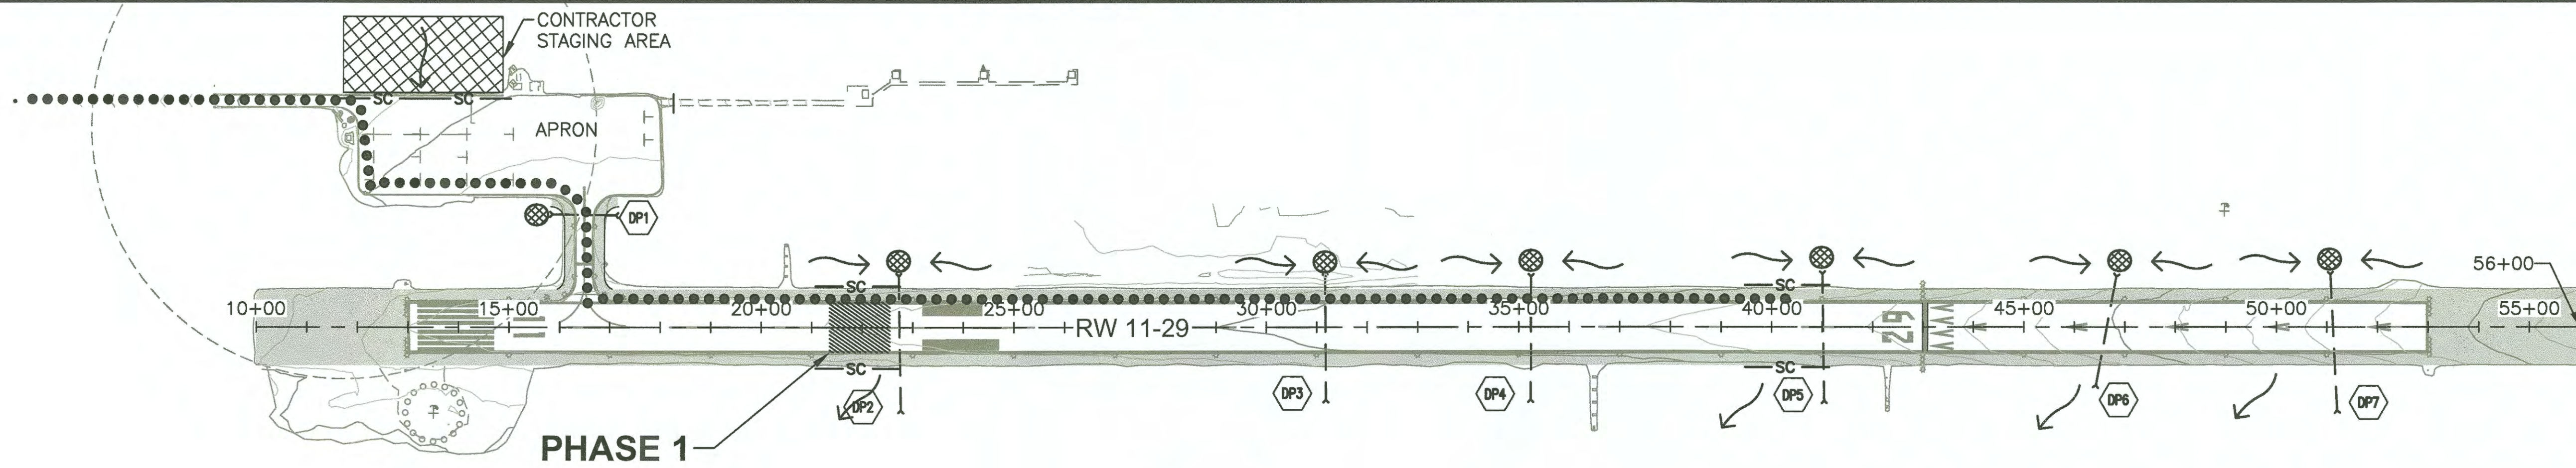

Record Drawings have been reviewed by the Project Engineer, and represent to the best of my knowledge, the project as constructed.  
PE [Signature] Date 10.24.19

DESIGN RPK  
DRAWN ADC  
CHECKED JGL

STATE OF ALASKA  
DEPARTMENT OF TRANSPORTATION AND PUBLIC FACILITIES  
SOUTHCOAST REGION-DESIGN AND CONSTRUCTION-AVIATION


BY	DATE	REVISIONS

KAKE AIRPORT  
KAKE, ALASKA  
RUNWAY REHABILITATION  
AIP 3-02-0398-XX-2018/SFAPT00078  
ESCP PROJECT PHASING

SHEET  
AA2  
OF  
AA2

NO.	DATE	REVISION	STATE	PROJECT DESIGNATION	YEAR	SHEET NO.	TOTAL SHEETS
			ALASKA	SFAPT00087	2015	AB-1	XX

DRAWING LOCATION: C:\Users\jv\OneDrive\Documents\Projects\AK\SFAPT00087\Drawings\KAKE\KAKE\_SCS\_2-2018\_Rev1.dwg  
 DATE: 2/13/2018 16:16  
 LAYOUT: SCS  
 SCALE: AS SHOWN  
 SHEETS: 1 OF 1

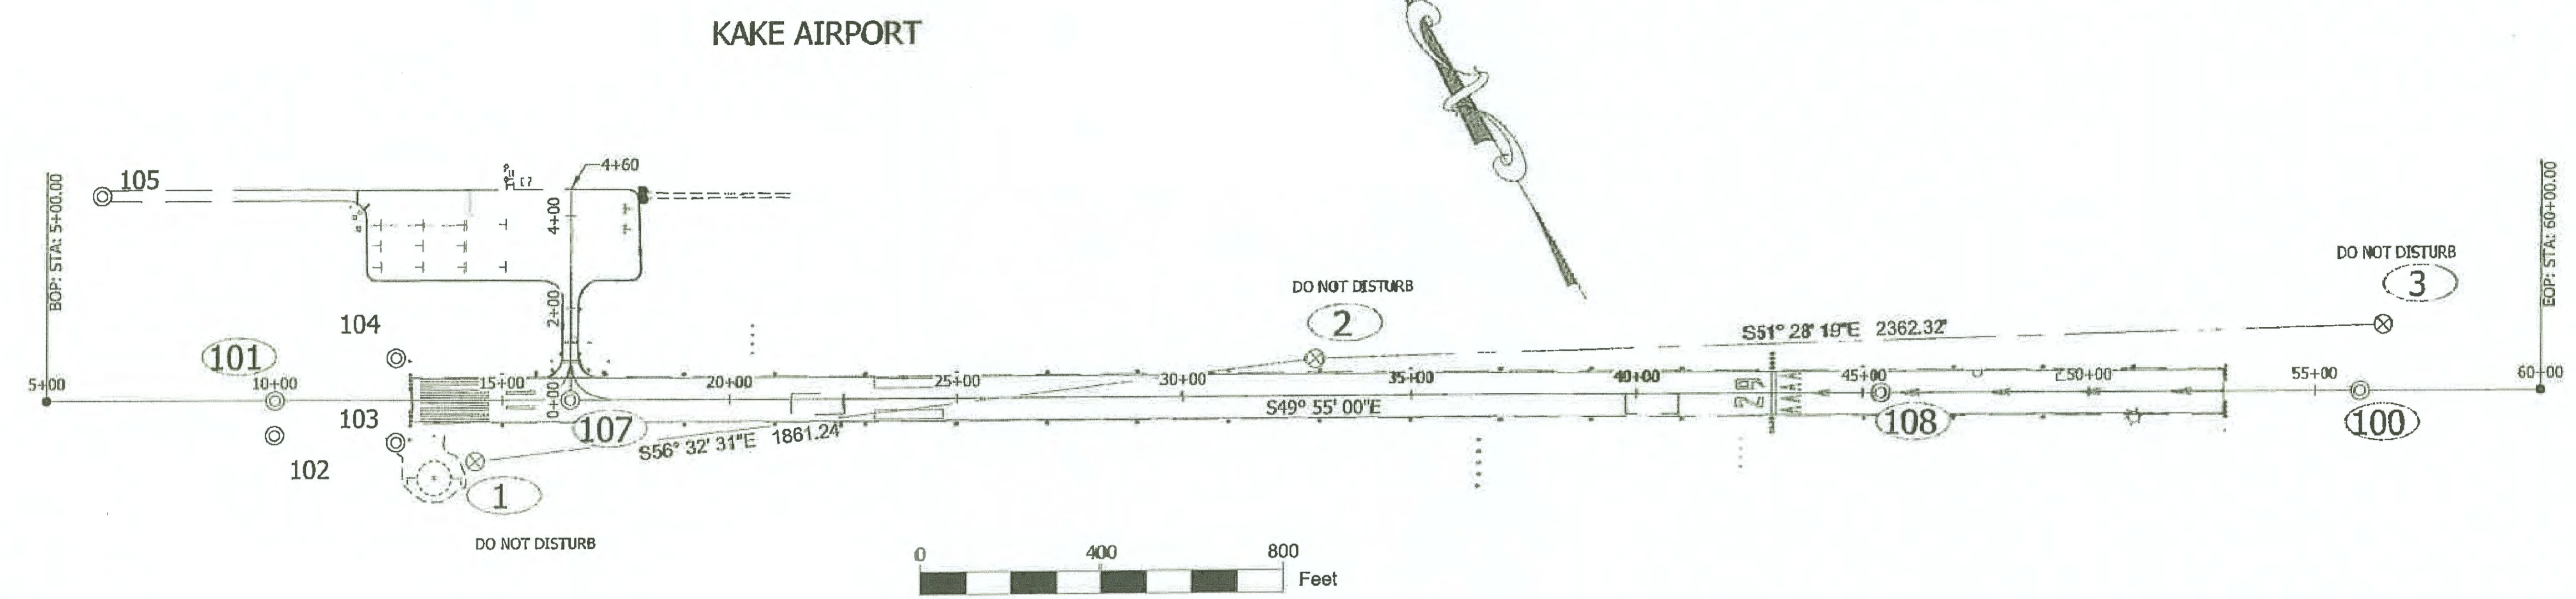

**PROPERTY & CENTERLINE MONUMENTS** in these tables shall be **preserved** in their original horizontal positions. If absolutely necessary then they will be referenced and then replaced in their original horizontal position and a corner monument record form shall be prepared and submitted to DOT for review by the contracting professional land surveyor prior to recordation.

**CONTROL MONUMENTS** labeled 1-3 in this table are **high precision Primary and Secondary Airport control maintained by the FAA and shall be preserved in their original horizontal and vertical positions. They shall NOT be disturbed or destroyed.**

**SURVEY CONTROL STATEMENT**

This survey was performed in NAD83(2011) AK State Plane Zone 1 GRID. Elevations shown are referenced to NAVD88 using published ellipsoidal heights on PACS/SACS AFE A-C (Control Points 1-3) and Geoid 12B. Refer to National Geodetic Survey PID A14909, A14910, and A14911. These monuments were re-tied this survey and were in good condition and fit well with each other.

All bearings and distances as shown are GRID. Convergence at Control Point 2 (AFE B) is -0° 12' 15". Combined Scale Factor is 0.99989555. To convert GRID distances to ground distances multiply by 1.00010446.

**MONUMENT NOTES:**


- If any pair of control points disagrees from published value by more than 1:10,000 horizontally or vertically then a third network point must be tied to ascertain which point is in error or has been disturbed.
- Whether listed or not, all monuments, property markers, or accessories that will be disturbed or buried shall be referenced prior to being disturbed, and re-established in their original position and a record of monument form in accordance with A.S.34.65.040 shall be submitted to the construction engineer for review prior to recording. Coordinate values listed are for informational purposes and should be used to reset monuments only as a last resort.

PROPERTY MONUMENTS TO BE PRESERVED					
Point #	Northing	Easting	Description	Station	Offset
102	1874194.56	2635518.73	IP	9+98.95	76.28R
103	1874010.53	2635713.03	SPINHOLE_5/8"REBAR	12+66.11	91.97R
104	1874151.35	2635831.76	SPINHOLE_5/8"REBAR	12+66.28	92.22L
105	1874837.97	2635565.37	ALCAP_3.25" _IN-MON-CASE	6+20.34	446.03L
106	1874761.08	2634565.03	ALCAP_3.25" _IN-MON-CASE	N\A	N\A

NGS CONTROL NOT TO BE DISTURBED						
Point #	Northing	Easting	Elevation	Description	Station	Offset
1	1873966.07	2635819.54	142.68	BC_3.25" _AFE-A	14+40.62	133.92R
2	1872839.92	2637372.35	148.71	BC_3.25" _AFE-B	32+89.43	80.62L
3	1871368.43	2639220.40	175.07	BC_3.25" _AFE-C	56+50.88	144.94L


CENTERLINE MONUMENTS TO BE PRESERVED					
Point #	Northing	Easting	Description	Station	Offset
100	1871290.61	2639087.77	ALCAP_2" -DOT/PF-CL_1994	55+99.51	0.00R
101	1874252.25	2635568.65	ALCAP_3.25" -DOT-CL_1986	10+00.00	0.00R
107	1873833.58	2636065.93	ALCAP_3.25" _IN-MON-CASE	16+50.05	0.12R
108	1871973.07	2638276.92	ALCAP_3.25" _IN-MON-CASE	45+39.69	0.04L

Record Drawings have been reviewed by the Project Engineer, and represent to the best of my knowledge, the project as constructed.  
 PE: [Signature] Date: 10.24.17

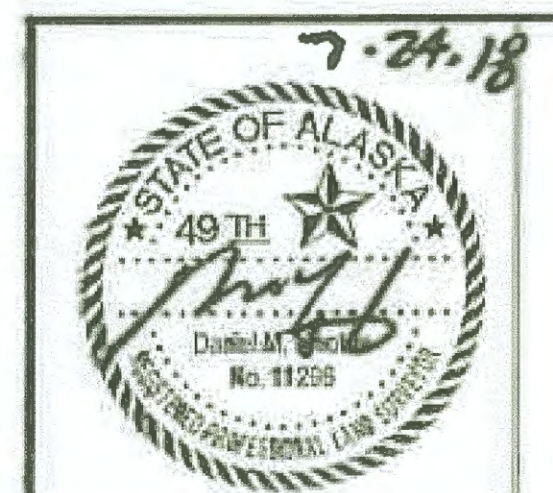


STATE OF ALASKA  
 DEPARTMENT OF TRANSPORTATION  
 AND PUBLIC FACILITIES  
**KAKE AIRPORT RUNWAY  
 REHABILITATION  
 SFAPT00087**

6/25/2018, 3:54 PM

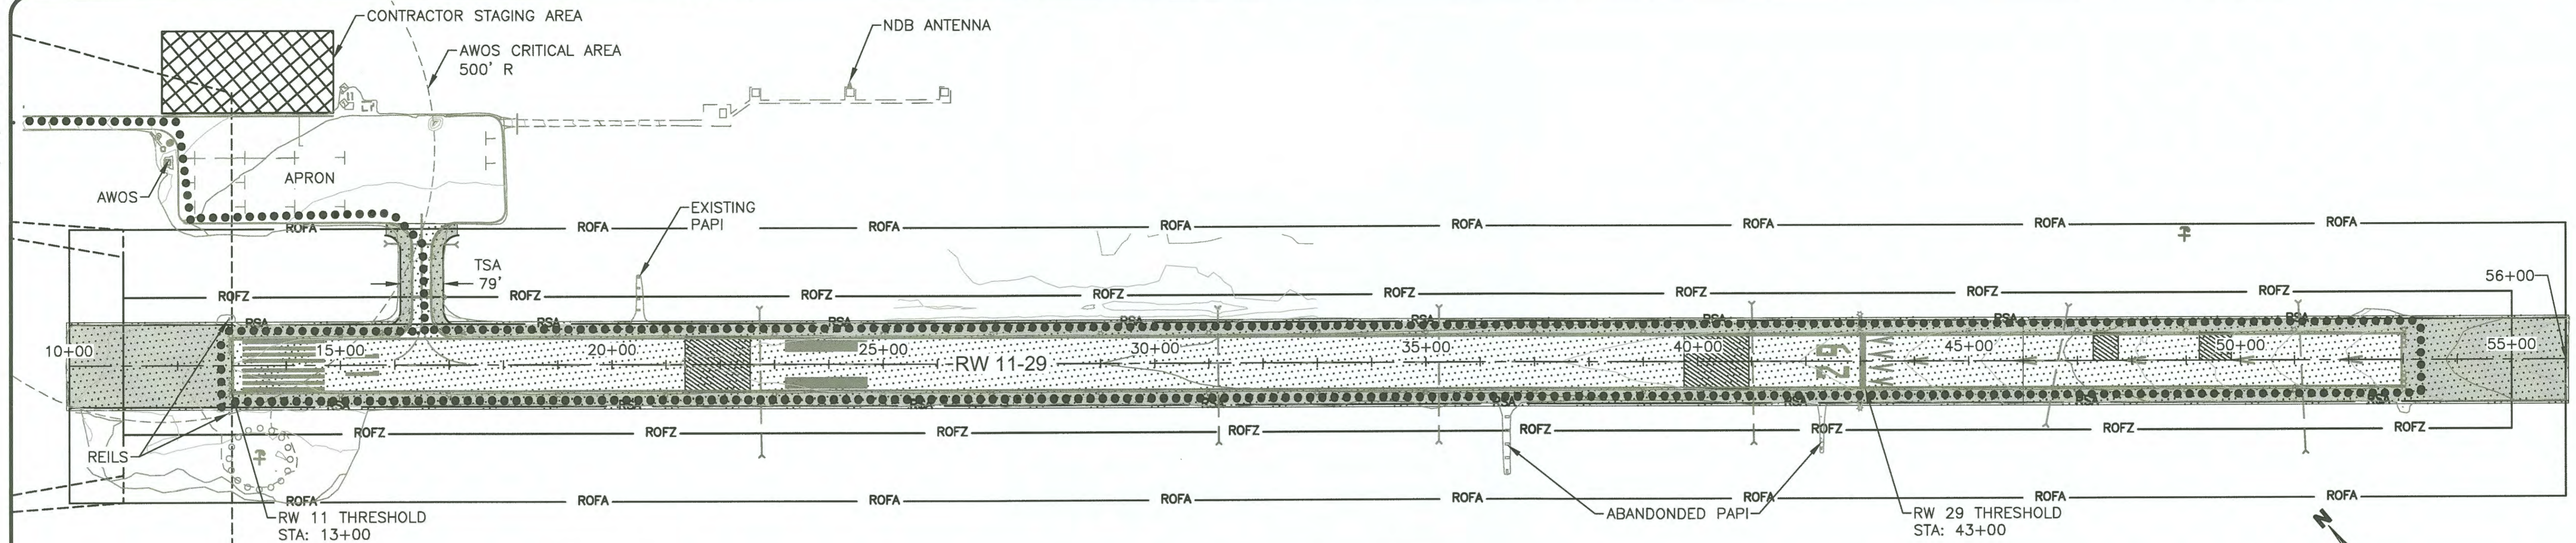

KAKE AIRPORT (B-II) RUNWAY SAFETY DIMENSIONS										
OPERATIONAL CONDITIONS	WIDTH (FEET)					RW 11/29 DECLARED DISTANCES				NOTES
	RSA	ROFA	ROFZ	TSA	TOFA	TORA	TODA	ASDA	LDA	
FULL WIDTH RW	150	500	400	79	131	4000/4000	4000/4000	4000/4000	4000/3000	AS SHOWN ON THIS SHEET
PHASE 2	100	500	250	79	131	2375/2375	2375/2375	2375/2375	2375/2375	RSA LIMITED BY TOP OF EMBANKMENT - FULL WIDTH DISPLACED THRESHOLD IS CLOSED.
PHASE 3	100	500	250	79	131	3000/3000	3000/3000	3000/3000	3000/3000	RSA LIMITED BY TOP OF EMBANKMENT - FULL WIDTH DISPLACED THRESHOLD IS CLOSED.

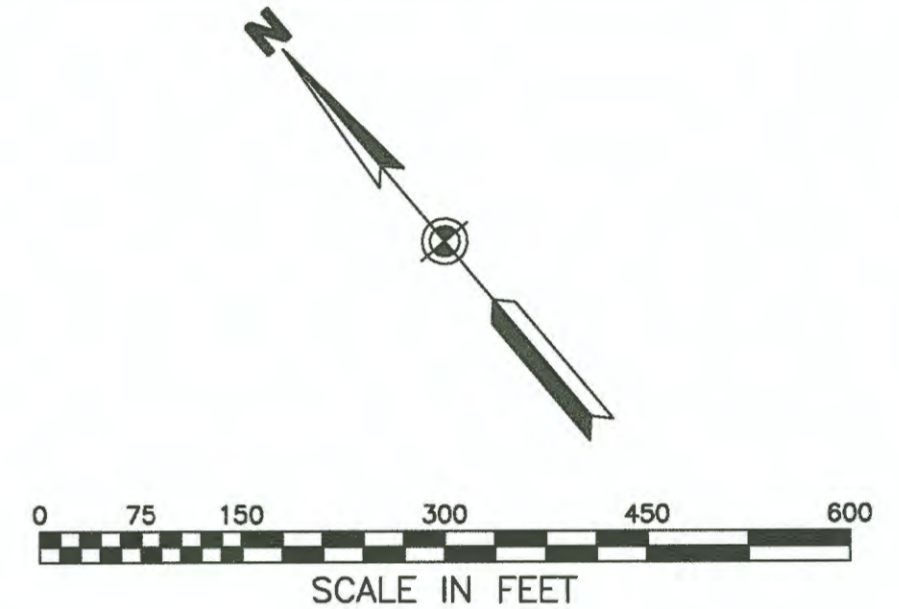

- NOTES:**
- SUBMIT A SAFETY PLAN COMPLIANCE DOCUMENT (SPCD) TO THE ENGINEER FOR REVIEW. DO NOT BEGIN CONSTRUCTION ACTIVITIES UNTIL THE ENGINEER APPROVES SPCD IN WRITING. ALLOW 30 DAYS FOR INITIAL REVIEW. INCLUDE CONSTRUCTION SEQUENCING AND HALF-WIDTH RUNWAY OPERATIONS. IF PLAN DIFFERS FROM WHAT IS SHOWN, OR IF SUBSEQUENT CHANGES ARE MADE, SUBMIT A REVISION TO THE ENGINEER FOR REVIEW AND APPROVAL. ALLOW 5 DAYS FOR REVIEW OF REVISED SAFETY AND SEQUENCING PLANS.
  - DEVELOP A CONSTRUCTION SCHEDULE BASED ON SEQUENCING SHOWN, OR SUBMIT AN ALTERNATE WORK SEQUENCE FOR APPROVAL. PROVIDE SUFFICIENT DETAIL TO ADDRESS REQUIRED SUBMITTALS, REVIEW PERIODS, PROCUREMENT OF MATERIALS, WORK, AND COORDINATION REQUIREMENTS.
  - THE CSPP AND SAFETY PLAN DRAWINGS DESCRIBE THE GENERAL SCOPE OF WORK FOR EACH PHASE. THIS SHEET SHOWS THE AIRPORT LAYOUT IN ITS EXISTING CONDITION. PARTICULAR RESTRICTIONS ARE NOTED ON THE SAFETY AND PHASING PLAN FOR EACH PHASE. ANY STATION AND OFFSETS REFERENCE THE RUNWAY ALIGNMENT AS DEFINED.
  - DURING CONSTRUCTION, THE ROFZ AND ROFA ARE CENTERED ON THE ACTIVE RUNWAY. THE RSA VARIES DEPENDING ON THE ACTUAL SURFACE AVAILABLE FOR EACH PHASE.
  - ALL WORK AND MATERIALS REQUIRED TO ADDRESS DIRECTIONS OR CONDITIONS OF THE CSPP, SPCD, CONSTRUCTION SAFETY PLAN DRAWINGS, AND OTHER REQUIREMENTS INCLUDING DIRECTION OF THE ENGINEER TO MAINTAIN THE SAFETY AND SECURITY OF THE AIRPORT, GENERAL PUBLIC, DOT&PF EMPLOYEES, CONTRACTOR, AND SUBCONTRACTOR EMPLOYEES WILL BE SUBSIDIARY AS SPECIFIED UNDER THE GENERAL CONTRACT PROVISIONS. REVIEW THE GENERAL CONTRACT PROVISIONS IN THEIR ENTIRETY AND NOTICE THE FOLLOWING GCP SECTIONS: 40-05, 40-07, 50-05, 50-13, 70-09, 70-11, AND SECTION 80.
  - CLEAR SAFETY AREAS OF PERSONNEL AND EQUIPMENT WHEN DIRECTED BY THE ENGINEER OR BY AIRPORT PERSONNEL.
  - DURING AIRCRAFT OPERATIONS, KEEP PERSONNEL AND EQUIPMENT OUTSIDE OF THE RSA AND ROFZ. KEEP CLEAR 15 MINUTES PRIOR TO ARRIVAL, AND AFTER DEPARTURE.
  - WORK OUTSIDE 200 FT OF EXISTING RUNWAY CENTERLINE AND BEYOND 300 FT OF RUNWAY ENDS MAY BE PERFORMED AT ANY TIME DURING THE CONTRACT, SUBJECT TO APPROVED SAFETY PLAN CONDITIONS, LIMITATIONS DESCRIBED IN GCP SECTION 80 OF THE GENERAL CONTRACT PROVISIONS, AND PERMIT CONDITIONS, IF ANY EXIST.
  - DO NOT STORE MATERIALS OR PARK EQUIPMENT WITHIN 250 FT OF ACTIVE RUNWAY CENTERLINE. USE THE CONTRACTOR STAGING AREA SHOWN TO STORE MATERIALS OR PARK EQUIPMENT.
  - SEE SHEET AD7 FOR ROFA VERTICAL CLEARANCES.
  - MARK OPEN TRENCHES WITH HAZARD MARKER BARRIERS. LIGHT WITH RED LIGHTS DURING HOURS OF RESTRICTED VISIBILITY OR DARKNESS. OPEN TRENCHES OR EXCAVATIONS ARE NOT PERMITTED WITHIN 200 FT OF THE RUNWAY CENTERLINE AND 300 FT OF THE RUNWAY THRESHOLDS WHILE THE RUNWAY IS OPEN. COVER OR BACKFILL OPEN TRENCHES OR EXCAVATIONS PRIOR TO OPENING RUNWAY TO AIRCRAFT. COVERS FOR TRENCHES OR EXCAVATIONS MUST BE OF SUFFICIENT STRENGTH TO SUPPORT THE WEIGHT OF THE HEAVIEST AIRCRAFT OPERATING ON THE RUNWAY.
  - ACCESS ROUTES AND HAULING ARE NOT ALLOWED TO CROSS AN ACTIVE RUNWAY, TAXIWAY, OR APRON. ACCESS AND HAUL ROUTES MUST USE THE UNPAVED RUNWAY AND TAXIWAY SAFETY AREAS AS SHOWN.
  - KEEP ALL ACTIVE HAUL ROUTES AND AIRPORT SURFACES CLEAN OF MATERIAL. REMOVE SPILLED OR TRACKED MATERIALS IMMEDIATELY TO AVOID DAMAGING AIRCRAFT.
  - CLEAN AIRPORT SURFACES AND CONDUCT FOD INSPECTION AT THE END OF EVERY WORK SHIFT. CLEANING IS SUBSIDIARY TO RELATED WORK. SEE GCP SECTION 40-05.
  - DURING APPROVED RUNWAY CLOSURES USE LIGHTED RUNWAY CLOSURE MARKERS AT THE LOCATIONS SHOWN, OR AS OTHERWISE DIRECTED. COORDINATE WITH AIRPORT MANAGEMENT TO REMOVE THE RUNWAY EDGE LIGHTS AND RUNWAY THRESHOLD LIGHTS FROM SERVICE DURING CLOSURES. SEE GCP SECTION 70-09.
  - HALF-WIDTH CLOSURES ARE REQUIRED TO COMPLETE THE PROJECT. REFER TO GUIDELINES IN THE DRAWINGS FOR IMPLEMENTING CLOSURES.
  - DURING HALF-WIDTH OPERATIONS, INSPECT TEMPORARY MARKINGS, BARRIERS, AND LIGHTING AT THE START AND END OF EACH WORK SHIFT. TAKE ACTION TO CORRECT DEFICIENCIES IMMEDIATELY UPON DISCOVERY OR NOTIFICATION.
  - PROVIDE SUFFICIENT BALLAST OR ANCHORING OF TEMPORARY LIGHTING AND BARRICADES TO WITHSTAND PROPELLER WASH. SAND BAGS OR OTHER BALLAST MATERIALS MUST MATCH COLOR OF PAVEMENT TO A SUFFICIENT DEGREE AS TO NOT INTERFERE WITH THE AIRPORT MARKING SYSTEM. WHITE OR YELLOW COLORED SAND BAGS WILL NOT BE ALLOWED.
  - MAINTAIN AIRCRAFT ACCESS TO TAXIWAY AND APRON DURING AIR OPERATIONS.
  - COORDINATE NAVAID OUTAGES WITH THE FAA THROUGH THE ENGINEER, AT LEAST 45 DAYS PRIOR TO OUT OF SERVICE DATE.
  - DAMAGE TO FAA FACILITIES INCLUDING POWER DISRUPTION MUST BE IMMEDIATELY REPAIRED IN A MANNER ACCEPTABLE TO THE FAA AND AT THE CONTRACTOR'S EXPENSE.
  - KAKE IS A UTILITY AIRPORT WITH AN APPROACH CATEGORY B, DESIGN GROUP II-SMALL WITH APPROACH VISIBILITY MINIMUMS NOT LESS THAN 1 MILE. AIRCRAFT OPERATING AT KAKE ARE 12,500 LBS OR LESS.
  - THE SPEED LIMIT WITHIN THE AIRPORT PROPERTY IS 25 M.P.H. SEE GCP SECTION 80-05, THIRD PARAGRAPH.

**LEGEND:**

- HAUL ROUTE
- CONSTRUCTION PHASE/WORK LIMITS
- ▨ CONSTRUCTION WORK AREA
- ▩ CONTRACTOR STAGING AREA
- ▧ RUNWAY EXCAVATION AREA
- ▦ TURNAROUND AREA
- ⊗ TEMPORARY RUNWAY CLOSURE MARKING
- CONE

Record Drawings have been reviewed by the Project Engineer, and represent to the best of my knowledge, the project as constructed.  
 PE [Signature] Date 10-24-19

U:\2047059100\drawing\C\Sheets\2047059100\_CSPP.dwg

DESIGN RPK  
 DRAWN ADC  
 CHECKED JGL


**STATE OF ALASKA**  
 DEPARTMENT OF TRANSPORTATION AND PUBLIC FACILITIES  
 SOUTHCOAST REGION-DESIGN AND CONSTRUCTION-AVIATION

BY	DATE	REVISIONS

**KAKE AIRPORT**  
 KAKE, ALASKA  
 RUNWAY REHABILITATION  
 AIP 3-02-0398-XX-2018/SFAPT00078  
 CONSTRUCTION SAFETY AND PHASING PLAN  
 OVERVIEW

SHEET  
**AD1**  
 OF  
**AD8**

6/25/2018, 3:54 PM

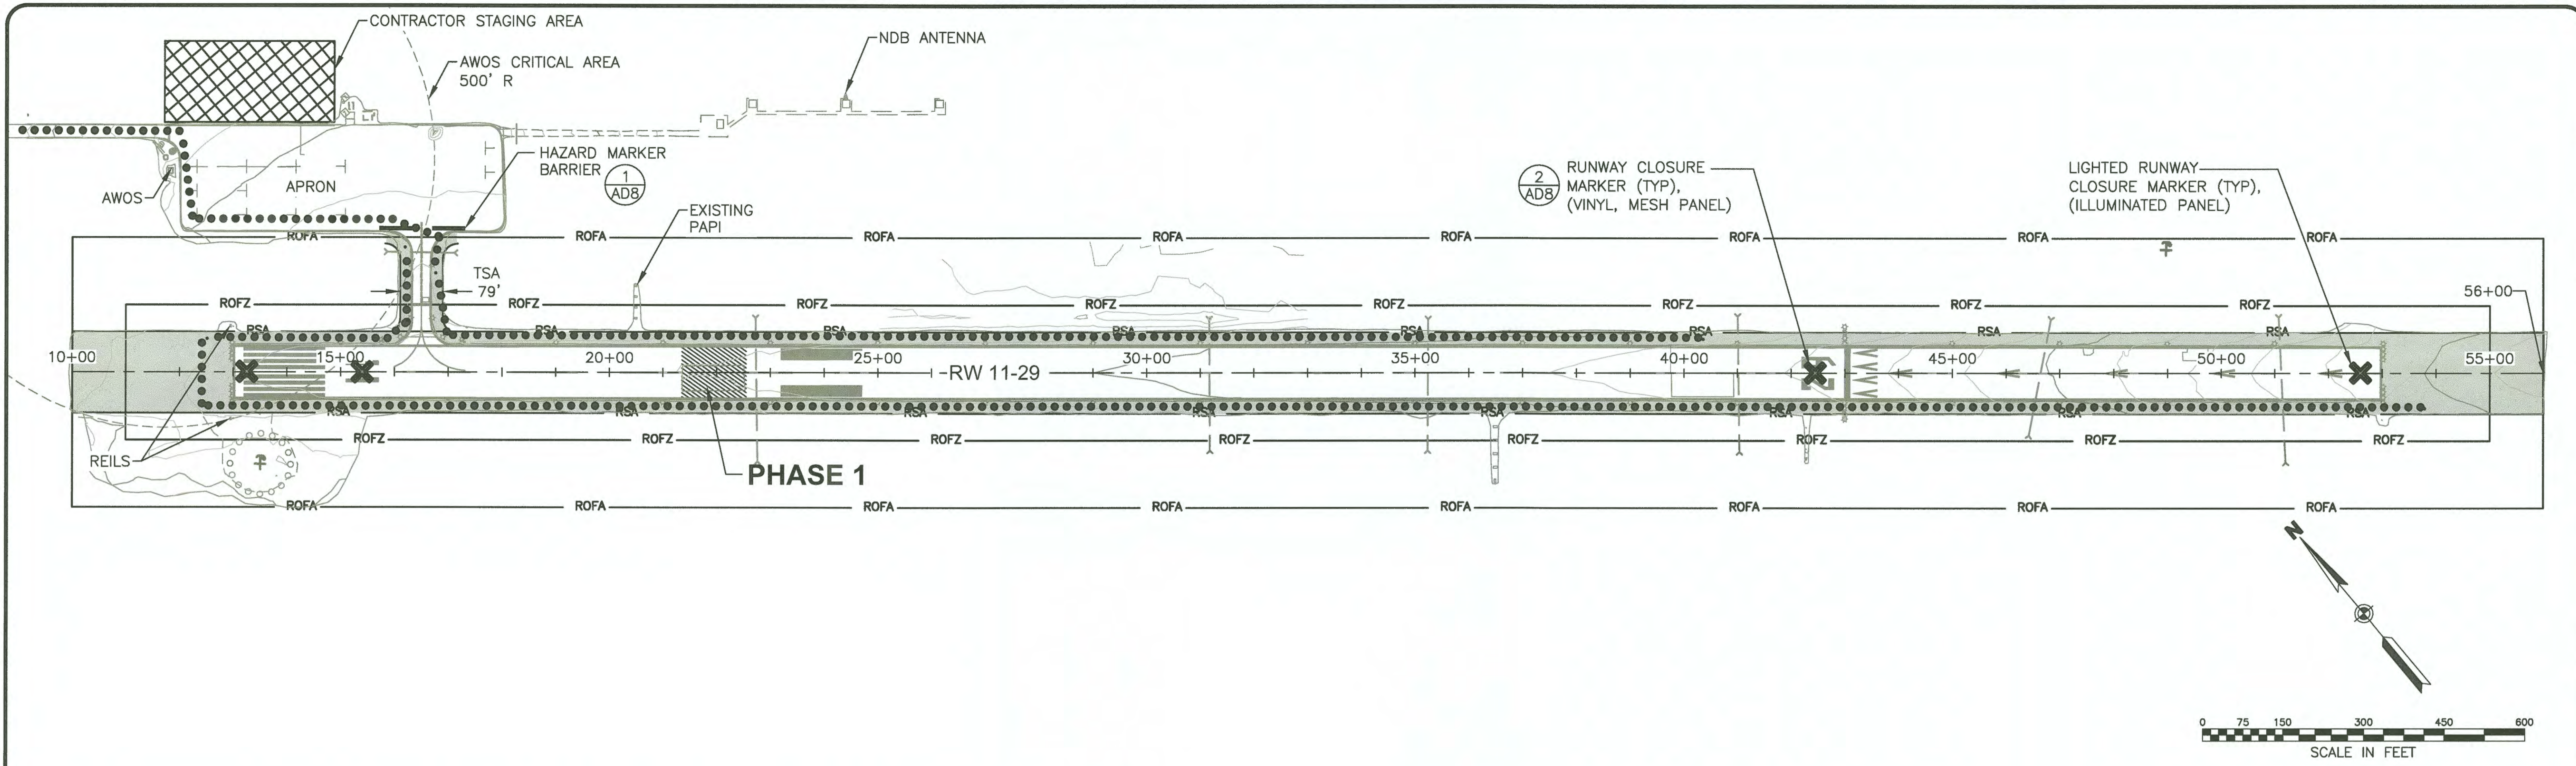

**PHASE 1 SAFETY PLAN NOTES:**

1. CLEANING OF THE HAUL ROUTES MUST BE CONTINUOUS TO PREVENT THE ACCUMULATION OR SPREAD OF FOD. AIRCRAFT DECLARING AN EMERGENCY MUST BE ALLOWED TO LAND. BE PREPARED TO EVACUATE THE ROFZ ON SHORT NOTICE. MONITOR THE CTAF RADIO FREQUENCY DURING ALL WORK SHIFTS, EVEN WHEN THE RUNWAY IS CLOSED.
2. NIGHTTIME CLOSURES OF THE RUNWAY WILL BE REQUIRED FOR PHASE 1 WITH COORDINATION MEASURES AS SPECIFIED IN THE CSPP DOCUMENT. A SINGLE 1-WEEK RUNWAY CLOSURE (AIRPORT CLOSURE) WILL BE ALLOWED FOR REPAIRING THE RUNWAY USING GEOFOAM.
3. DURING THE AIRPORT CLOSURE THE ROFA, ROFZ, RSA AND TSA RESTRICTIONS DO NOT EXIST. HOWEVER, HAUL ROUTES WILL STILL BE ENFORCED TO LIMIT DAMAGE TO AIRPORT SURFACES. DO NOT HAUL ACROSS PAVED SURFACES EXCEPT AS SHOWN ON THE APPROVED CSPP AND SPCD DOCUMENTS AND DRAWINGS. REPAIR ANY RUTTING OR OTHER DAMAGE TO AIRPORT SURFACES DUE TO HAULING AT THE CONTRACTOR'S EXPENSE. SEE SECTIONS 50-13, 70-11(B) & (G), AND 70-15.
4. LEAVE CLOSURE MARKERS IN PLACE AT ALL TIMES DURING AIRPORT CLOSURE. RELOCATE MARKERS AS REQUIRED OR AS DIRECTED.
5. MAINTAIN TAXIWAY EDGE LIGHTING FOR OPEN TAXIWAY. COVER OR OTHERWISE DISABLE EDGE LIGHTS FOR CLOSED AREAS. COORDINATE CLOSING AND OPENING OF AIR OPERATIONS AREAS WITH AIRPORT MANAGEMENT THROUGH THE ENGINEER. ALLOW FOR ISSUANCE OF NOTAMS BY AIRPORT MANAGEMENT TO KEEP ALL AIRPORT USERS INFORMED OF CLOSED AREAS AND APRON, TAXIWAY, AND RUNWAY STATUS.
6. CONDUCT AN INSPECTION WITH THE ENGINEER OF THE RUNWAY SURFACE, MARKINGS, AND LIGHTING SYSTEM PRIOR TO BEGINNING PHASE 2. CLEAN, REPAIR, AND REPLACE AIRPORT FACILITIES AS DIRECTED.

**PHASE 1 WORK ITEMS:**

1. CONSTRUCT ALL EROSION AND SEDIMENT CONTROL BMPs REQUIRED FOR THIS PHASE.
2. PLACE RW CLOSURE MARKERS AND TURN OFF AIRPORT LIGHTING SYSTEMS IMMEDIATELY AFTER BEING NOTIFIED BY THE ENGINEER THAT THE RUNWAY IS CLOSED.
3. SCOPE OF CONSTRUCTION FOR THIS PHASE:
  - REPAIR THE RUNWAY USING GEOFOAM AT THE LOCATION SHOWN.
  - REPLACE THE ELECTRICAL ENCLOSURE AND OTHER CRITICAL AIRPORT ELECTRICAL SYSTEMS.
  - PLACE TEMPORARY HOT MIX ASPHALT OR COLD PATCH OVER RUNWAY REPAIR LOCATIONS THAT WILL OPEN FOR AIRCRAFT OPERATIONS IN PHASE 2.
4. AT THE CONTRACTOR'S OPTION, THE FOLLOWING WORK CAN BEGIN IN PHASE 1 AND BE COMPLETED IN PHASE 2, WITH THE CONDITION THAT THIS WORK NOT EFFECT THE SCHEDULE OF, OR INTERFERE WITH THE WORK LISTED ABOVE.
  - REMOVAL AND REPLACEMENT OF EXISTING RUNWAY EDGE LIGHTS AND PAVEMENT REMOVAL ON THE SIDE TO BE CLOSED DURING PHASE 2.
  - RSA IMPROVEMENTS TO THE SIDE OF THE RUNWAY THAT WILL REMAIN CLOSED IN PHASE 2.
  - TSA IMPROVEMENTS. THIS WORK MAY BE CONDUCTED DURING ANY PHASE AT ANYTIME WHEN AIRCRAFT ARE NOT PRESENT. WORK WITHIN THE ROFZ IS LIMITED TO NIGHT TIME RUNWAY CLOSURES. THE CONTRACTOR MUST EVACUATE EQUIPMENT AND PERSONNEL FROM THE TOFA FOR ANY AIRCRAFT OPERATIONS AT ANY TIME.
5. PREPARE THE RUNWAY FOR TRANSITION TO PHASE 2 WHILE THE RUNWAY IS FULLY CLOSED IN PHASE 1. APPLY TEMPORARY MARKINGS AND INSTALL TEMPORARY LIGHTING SYSTEM. MAINTAIN RUNWAY CLOSURE MARKINGS AS DIRECTED.

Record Drawings have been reviewed by the Project Engineer, and represent to the best of my knowledge, the project as constructed.  
 PE [Signature] Date 10.24.19

U:\2047059100\drawing\C\Sheets\2047059100\_CSPP.dwg

DESIGN RPK  
 DRAWN ADC  
 CHECKED JGL


**STATE OF ALASKA**  
 DEPARTMENT OF TRANSPORTATION AND PUBLIC FACILITIES  
 SOUTHCOAST REGION-DESIGN AND CONSTRUCTION-AVIATION

BY	DATE	REVISIONS

**KAKE AIRPORT**  
 KAKE, ALASKA  
 RUNWAY REHABILITATION  
 AIP 3-02-0398-XX-2018/SFAPT00078  
 CONSTRUCTION SAFETY AND PHASING PLAN  
 PHASE 1 PLAN

SHEET  
**AD2**  
 OF  
**AD8**

6/25/2018, 3:54 PM

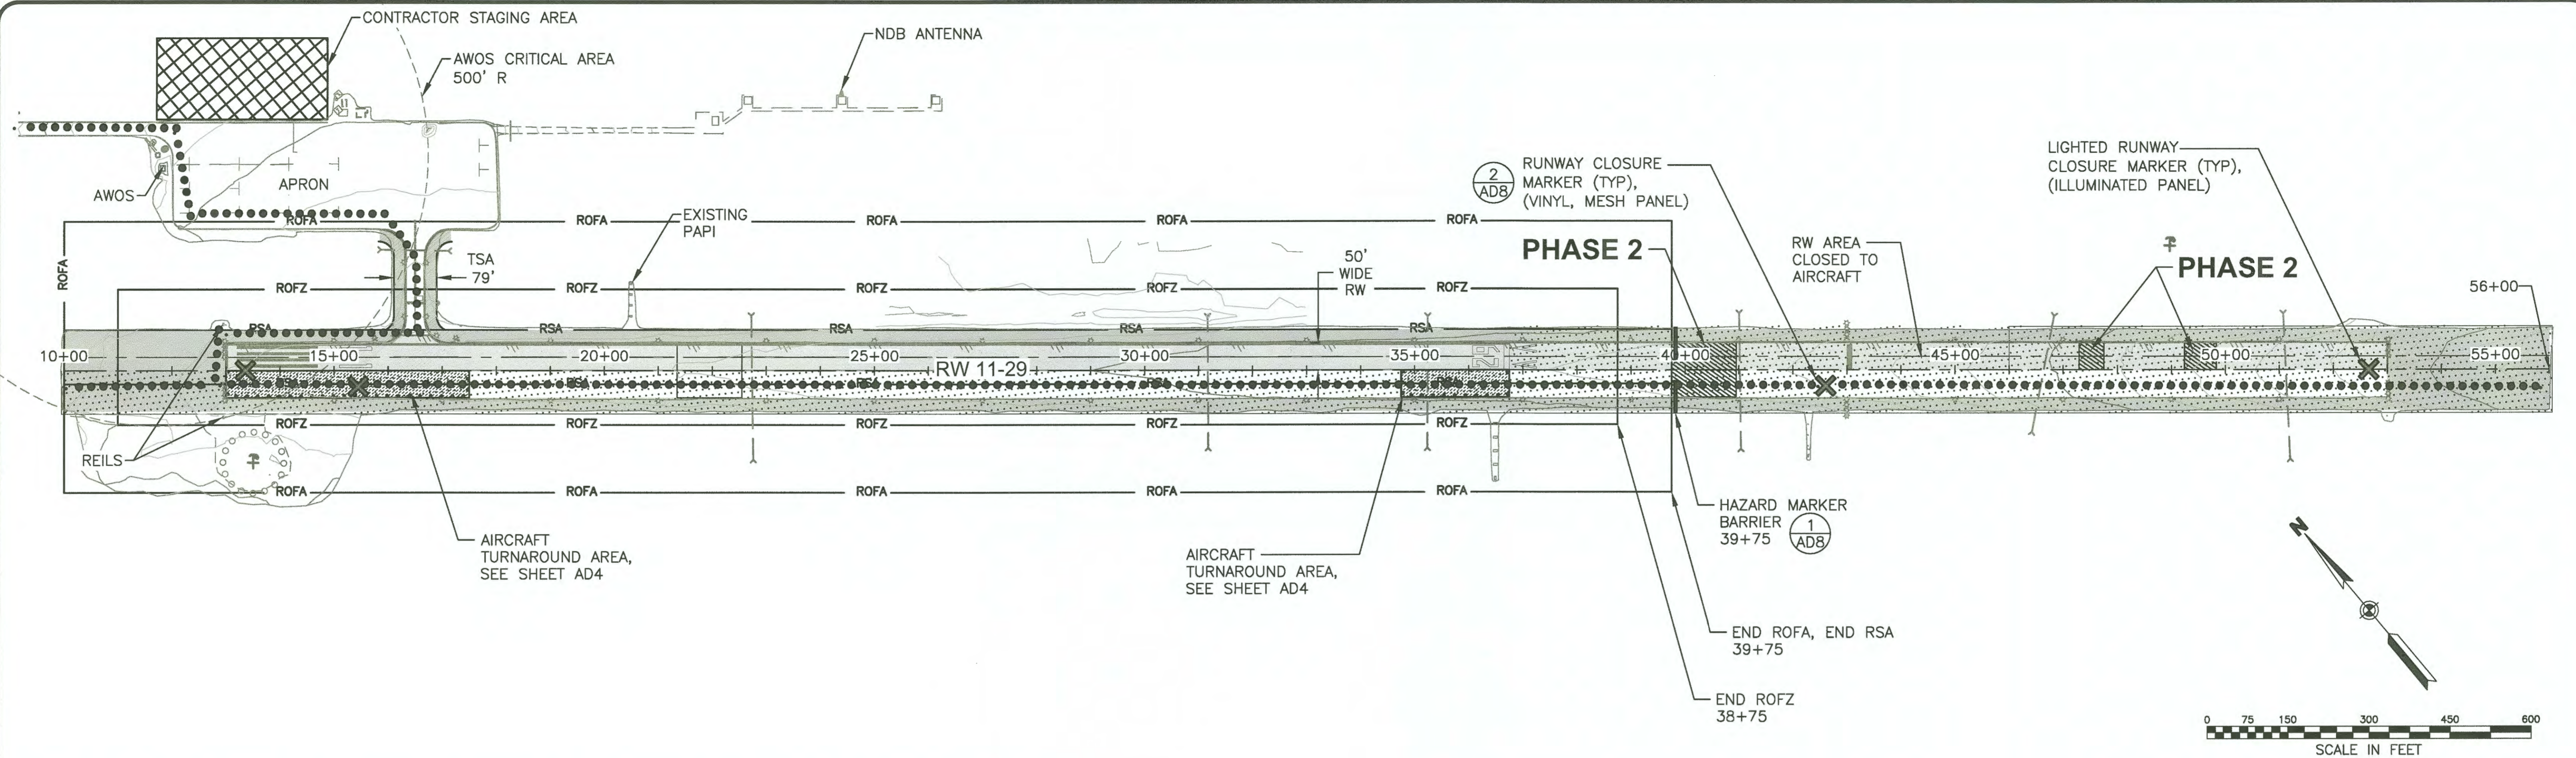

**PHASE 2 SAFETY PLAN NOTES:**

1. ALL HAULING MUST TAKE PLACE ON THE CLOSED PORTION OF THE RUNWAY. CLEANING OF THE HAUL ROUTES MUST BE CONTINUOUS TO PREVENT THE ACCUMULATION OR SPREAD OF FOD.
2. NIGHT TIME CLOSURE OF THE RUNWAY WILL BE REQUIRED FOR PHASE 2 WITH PROPER COORDINATION AS SPECIFIED.
3. PROVIDE TEMPORARY RUNWAY EDGE LIGHTING FOR THE HALF WIDTH OPERATION OF RUNWAY 11-29, INCLUDING THRESHOLD LIGHTING. PROVIDE POWER, CABLING, AND ALL OTHER WORK REQUIRED FOR TEMPORARY LIGHTING. A COMBINATION OF TEMPORARY AND EXISTING LIGHTING MAY BE USED TO PROVIDE THE LIGHTING REQUIRED. RELOCATE TEMPORARY LIGHTING DURING NIGHT TIME CLOSURES TO ACCOMMODATE CONSTRUCTION, REPOSITION AND INSPECT TEMPORARY LIGHTING PRIOR TO DAILY OPENING OF HALF WIDTH RUNWAY FOR AIRCRAFT OPERATIONS.
4. THE WIDTH OF RUNWAY 11-29 WITH THE TEMPORARY EDGE LIGHTING IN PLACE IS 50 FEET FOR THIS PHASE. SEE DETAIL 1 ON SHEET AD7.
5. LEAVE PANEL TYPE CLOSURE MARKERS ON PORTION OF THE CLOSED HALF OF RUNWAY NOT ACTIVELY BEING WORKED ON IN PLACE AT ALL TIMES DURING PHASE 2.
6. PROVIDE AIRCRAFT TURNAROUNDS FOR THE DURATION OF THIS PHASE WHEN THE RUNWAY IS OPEN TO OPERATIONS. ACCOMPLISH WORK WITHIN THESE LIMITS DURING NIGHT TIME CLOSURES, AND RE-OPEN FOR AIRCRAFT OPERATIONS EVERY DAY, SEE SHEET AD4.
7. MAINTAIN TAXIWAY EDGE LIGHTING FOR OPEN TAXIWAY. COVER OR OTHERWISE DISABLE EDGE LIGHTS FOR CLOSED AREAS. COORDINATE CLOSING AND OPENING OF AIR OPERATIONS AREAS WITH AIRPORT MANAGEMENT THROUGH THE ENGINEER. ALLOW FOR ISSUANCE OF NOTAMS BY AIRPORT MANAGEMENT TO KEEP ALL AIRPORT USERS INFORMED OF CLOSED AREAS AND APRON, TAXIWAY, AND RUNWAY STATUS.
8. CONDUCT AN INSPECTION WITH THE ENGINEER OF THE RUNWAY SURFACE, MARKINGS, AND LIGHTING SYSTEM PRIOR TO BEGINNING PHASE 3. CLEAN, REPAIR, AND REPLACE AIRPORT FACILITIES AS DIRECTED.

**PHASE 2 WORK ITEMS:**

1. OPEN THE HALF WIDTH RUNWAY TO DAYTIME OPERATIONS AND BEGIN PHASE 2 ONLY WHEN APPROVED BY THE ENGINEER.
2. CONSTRUCT ALL EROSION AND SEDIMENT CONTROL BMPs REQUIRED FOR THIS PHASE.
3. SCOPE OF CONSTRUCTION FOR THIS PHASE:
  - REPAIR THE RUNWAY USING GEOFOAM AT THE THREE LOCATIONS SHOWN.
  - REMOVE EXISTING ASPHALT – HALF WIDTH OF RUNWAY
  - CONSTRUCT RSA EMBANKMENT IMPROVEMENTS
  - CONSTRUCT RUNWAY EDGE LIGHTS WITHIN PHASE LIMITS
  - PLACE NEW HOT MIX ASPHALT
  - APPLY TEMPORARY MARKINGS AND INSTALL TEMPORARY LIGHTING SYSTEM IN PREPARATION FOR PHASE 3.

Record Drawings have been reviewed by the Project Engineer, and represent to the best of my knowledge, the project as constructed.  
 PE Date 10.24.19

U:\2047059100\drawing\C\Sheets\2047059100\_CSP.dwg



DESIGN RPK  
 DRAWN ADC  
 CHECKED JGL

STATE OF ALASKA  
 DEPARTMENT OF TRANSPORTATION AND PUBLIC FACILITIES  
 SOUTHCOAST REGION-DESIGN AND CONSTRUCTION-AVIATION

BY	DATE	REVISIONS

KAKE AIRPORT  
 KAKE, ALASKA  
 RUNWAY REHABILITATION  
 AIP 3-02-0398-XX-2018/SFAPT00078  
 CONSTRUCTION SAFETY AND PHASING PLAN  
 PHASE 2 PLAN

SHEET  
**AD3**  
 OF  
**AD8**

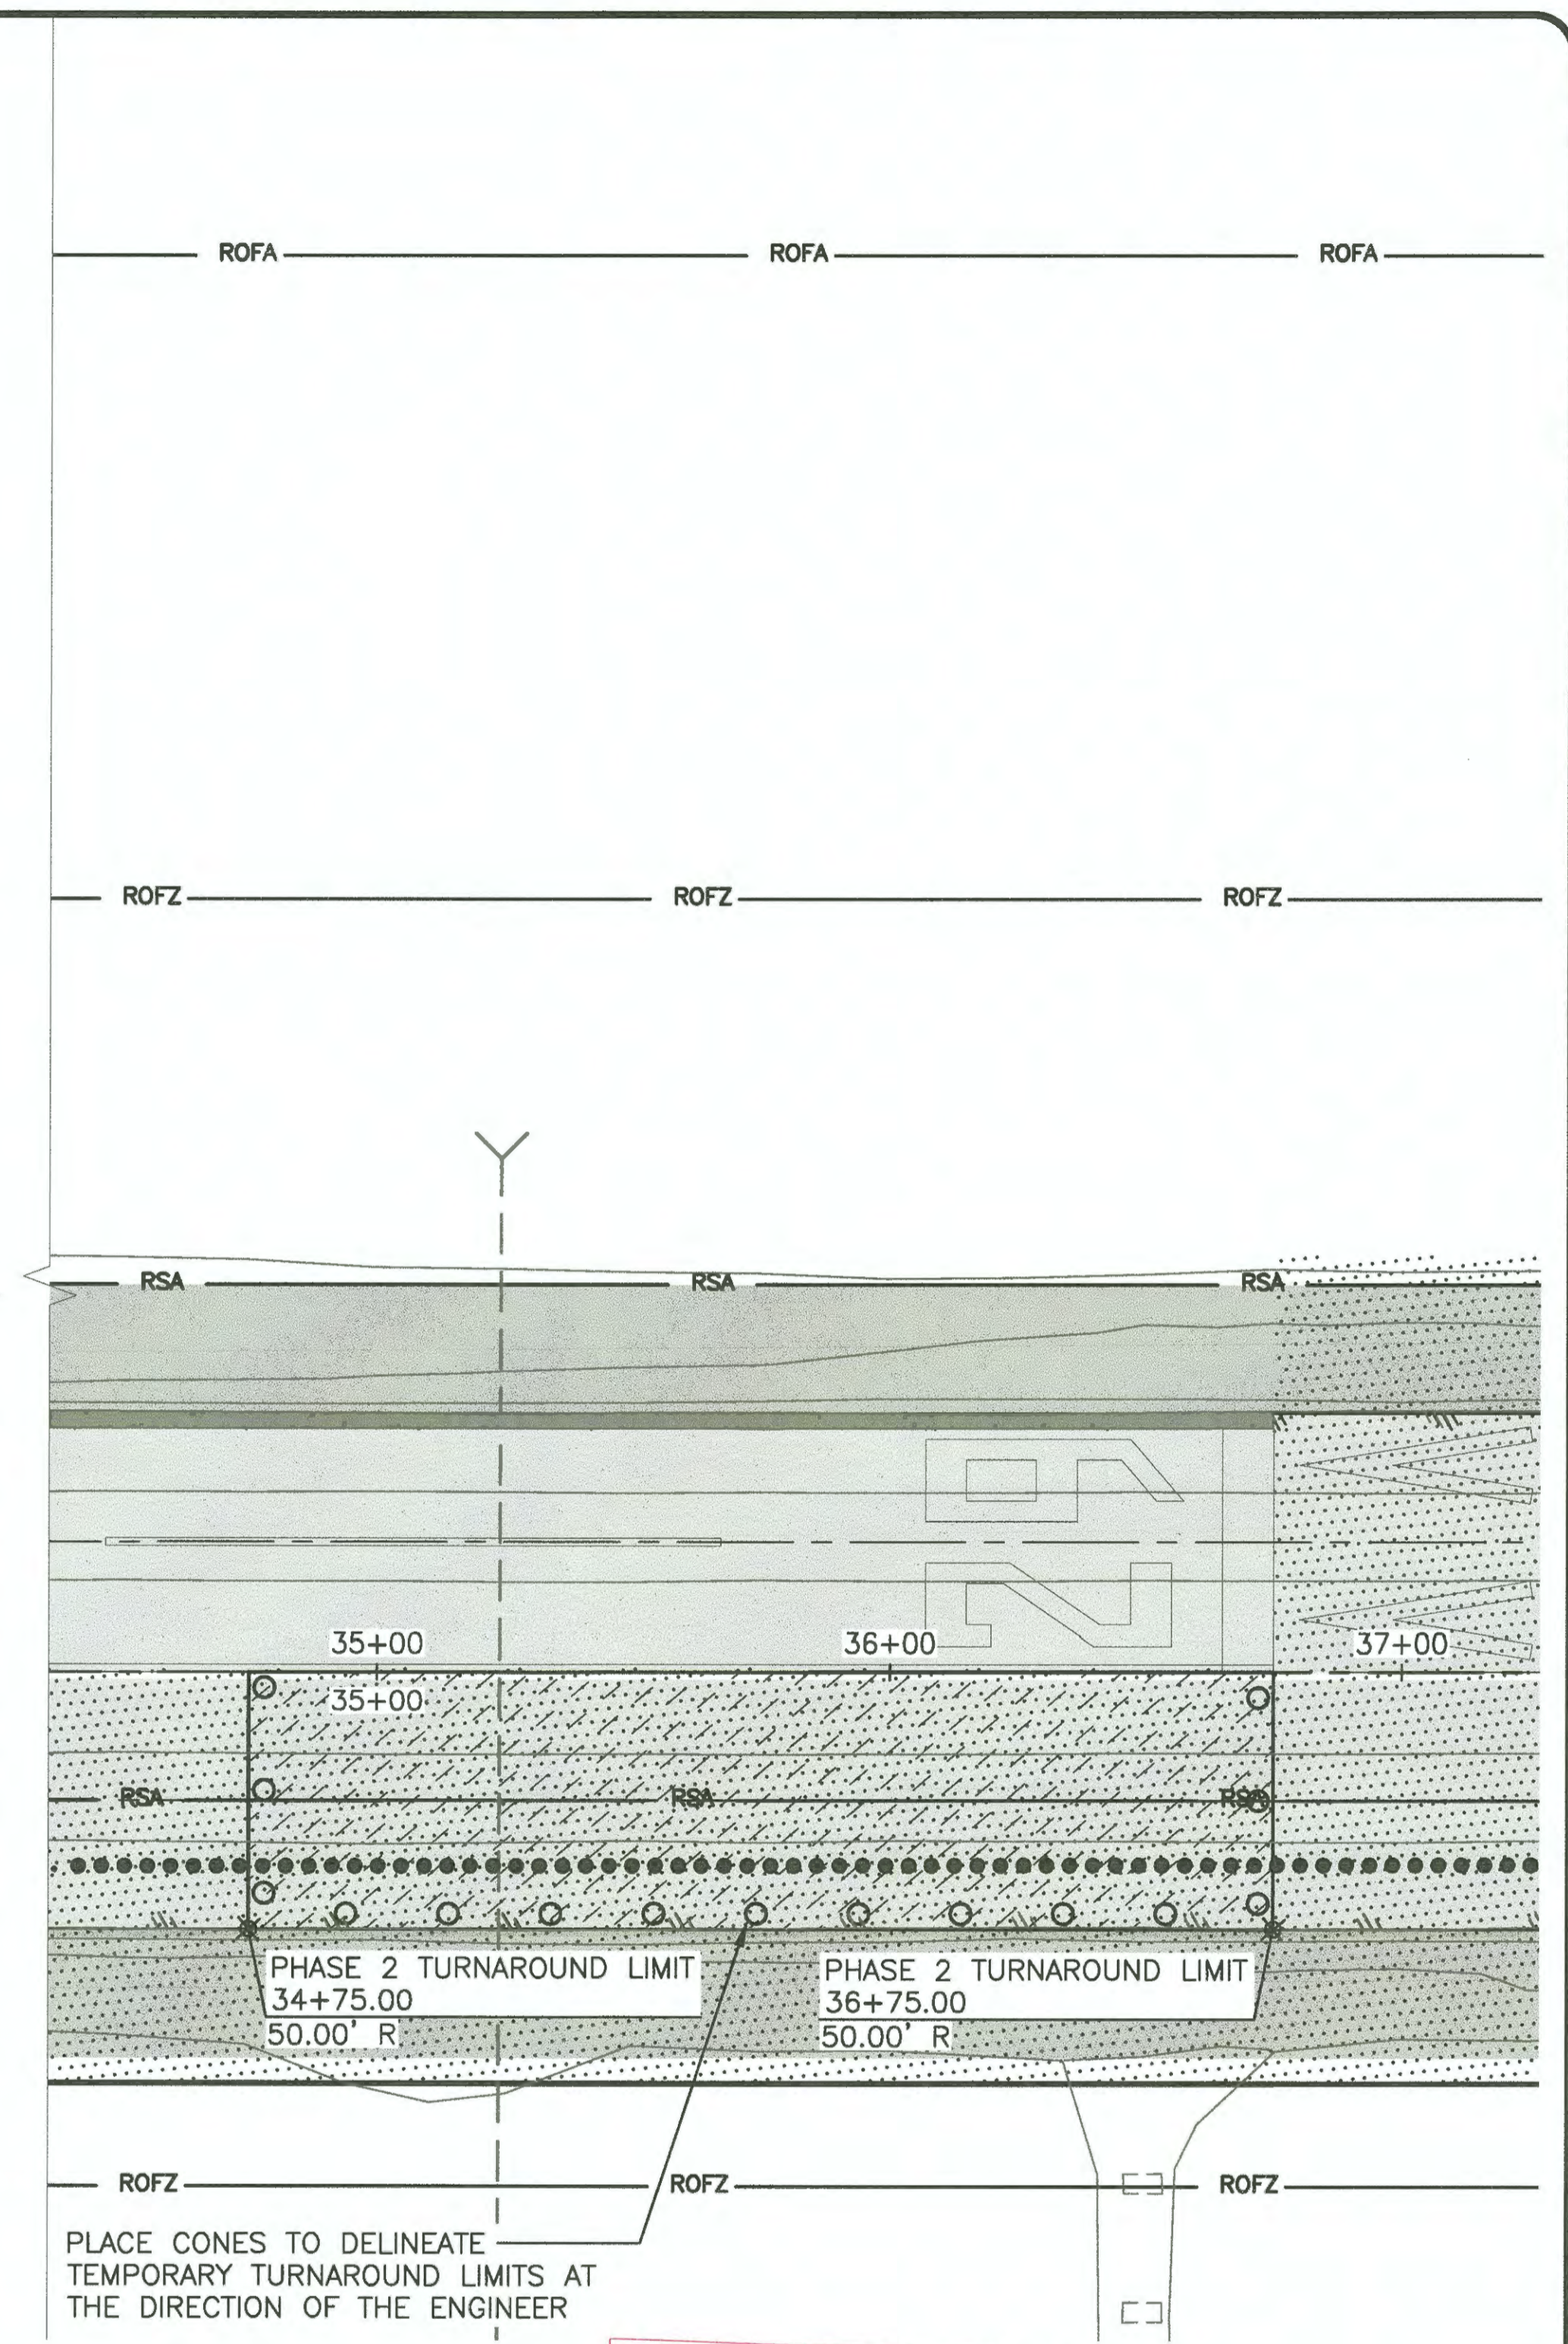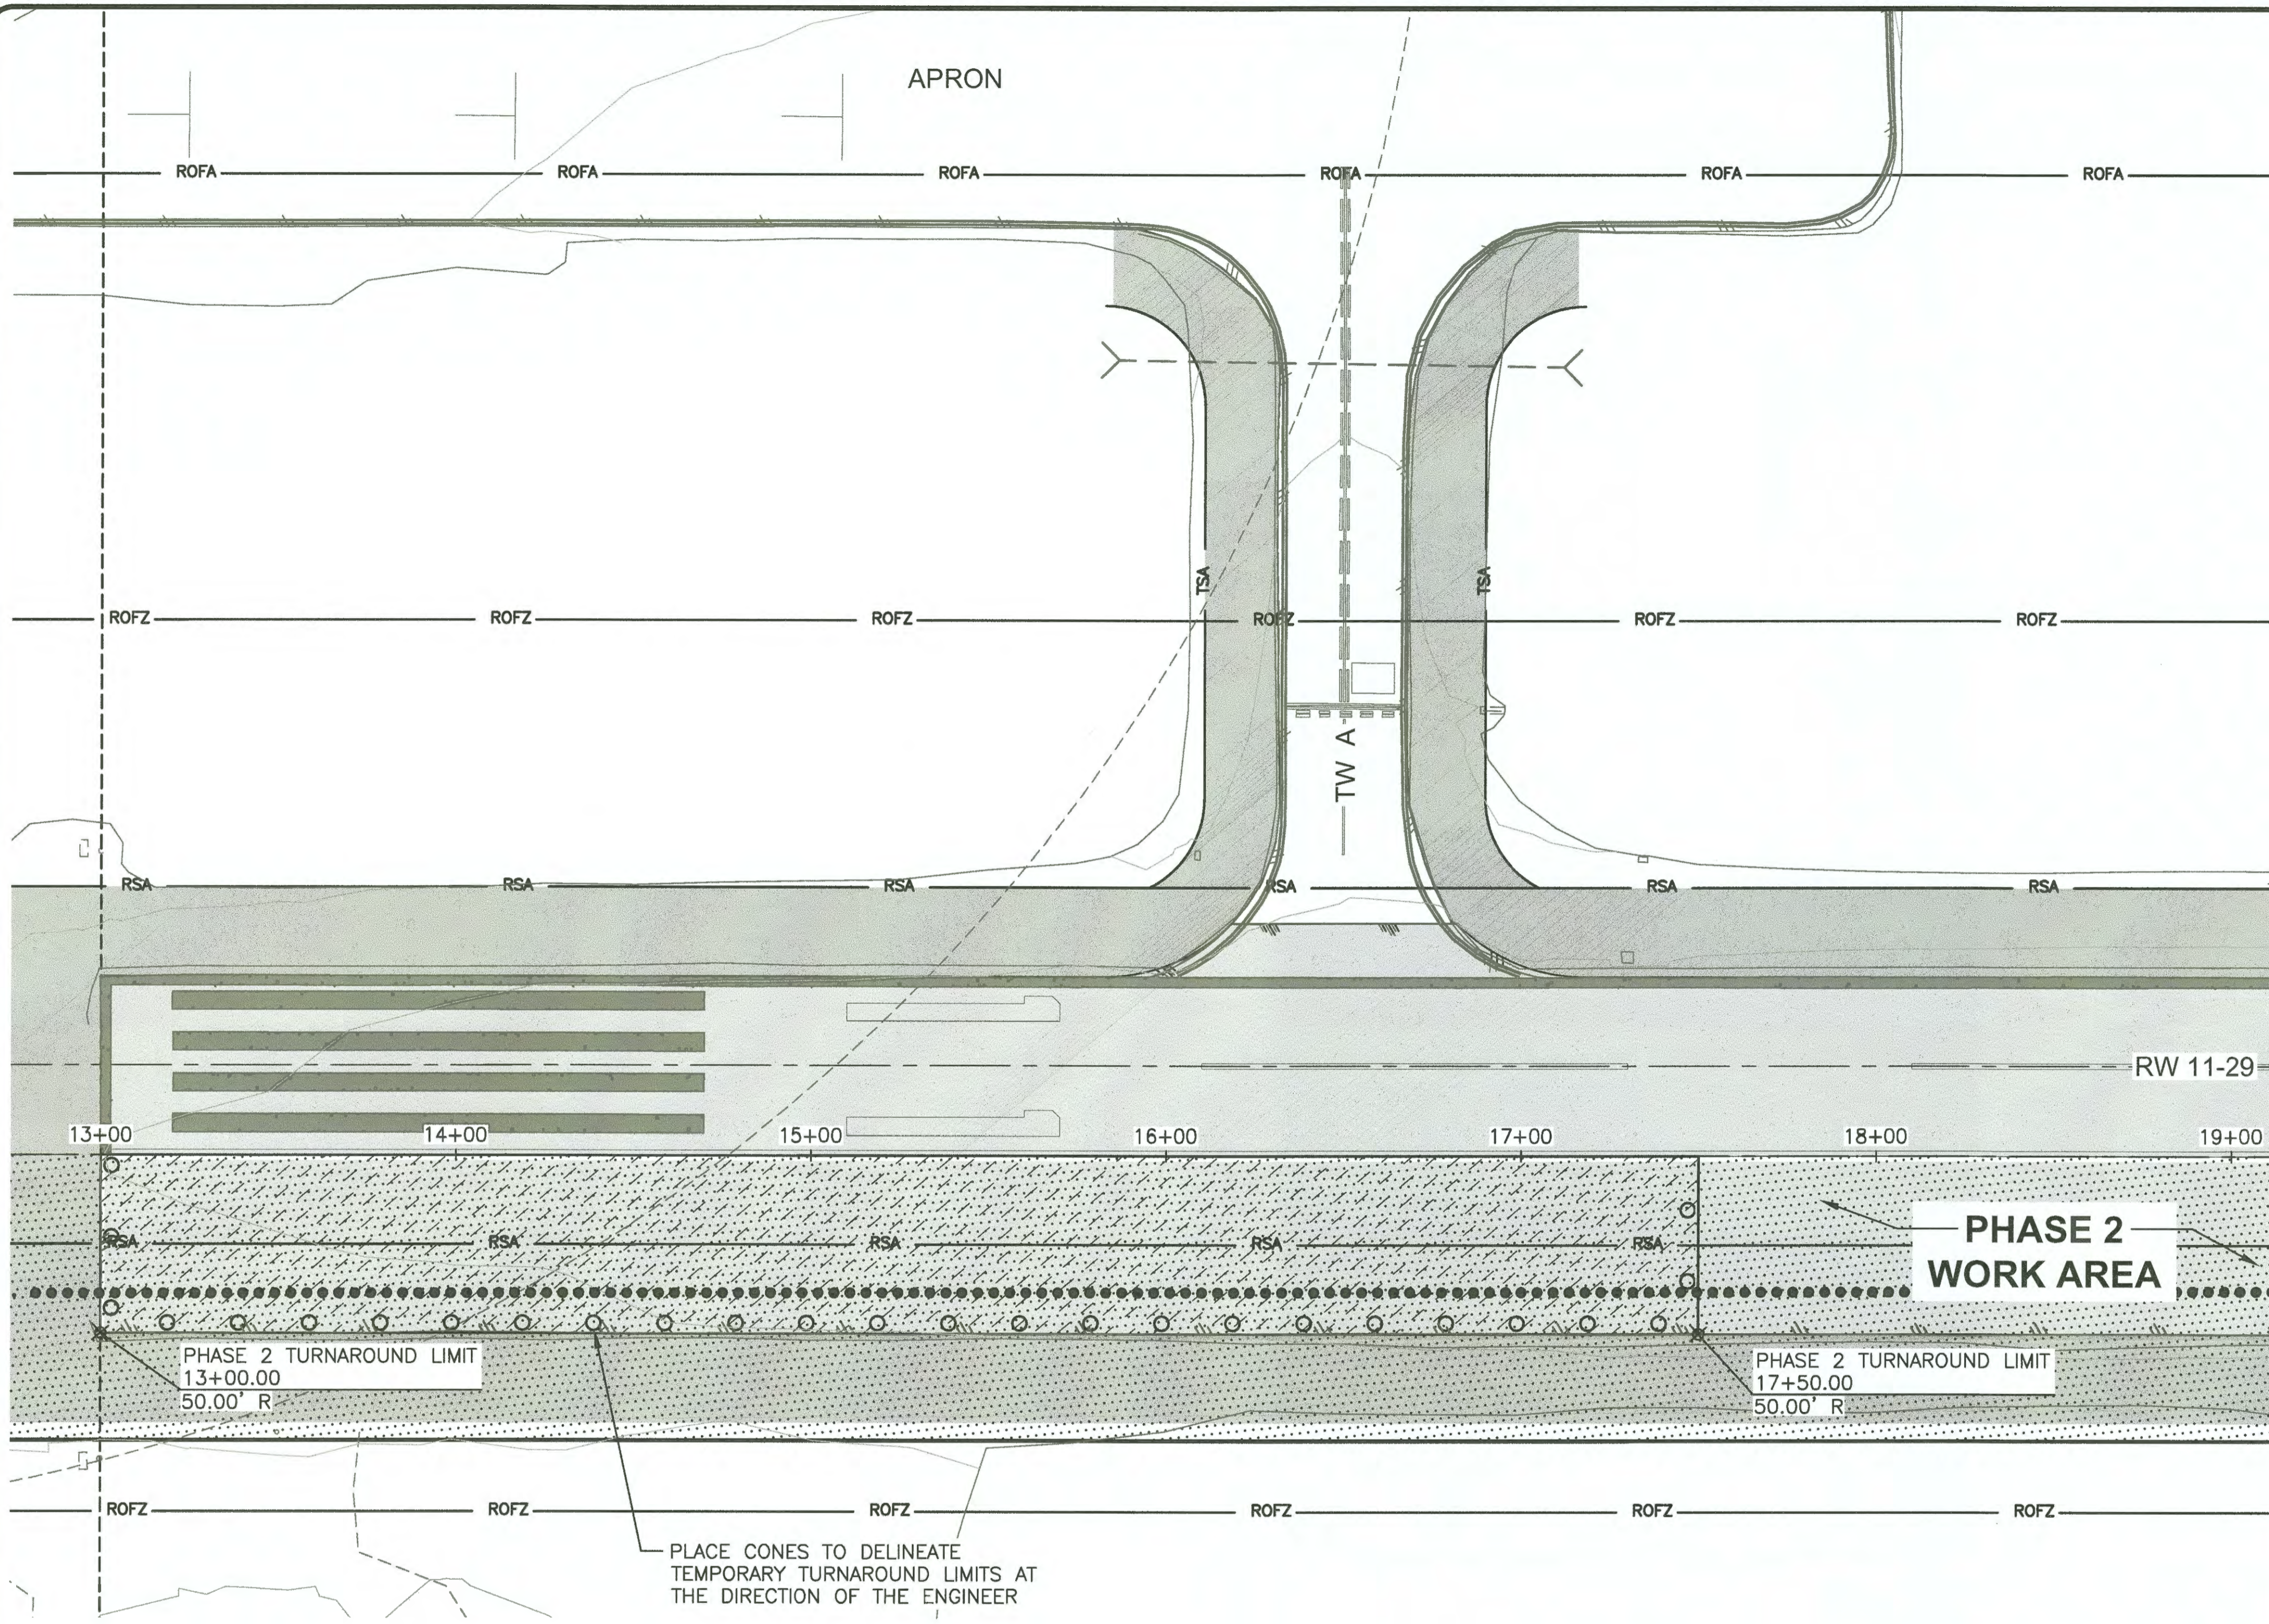


PLACE CONES TO DELINEATE  
TEMPORARY TURNAROUND LIMITS AT  
THE DIRECTION OF THE ENGINEER

PLACE CONES TO DELINEATE  
TEMPORARY TURNAROUND LIMITS AT  
THE DIRECTION OF THE ENGINEER

Record Drawings have been reviewed  
by the Project Engineer, and represent  
to the best of my knowledge, the  
project as constructed.  
PE [Signature] Date 10.24.19

**NOTES:**

1. TURNAROUND SURFACE MUST BE COMPACTED CABG CAPABLE OF SUPPORTING AIRCRAFT DURING ALL WEATHER CONDITIONS, OR HMA. CONSTRUCT PAVEMENT TRANSITION WEDGE AS REQUIRED. SEE DETAIL 3 ON SHEET AD7.
2. TURNAROUND AREA MUST BE OPEN TO AIRCRAFT WHEN THE RUNWAY IS ACTIVE.

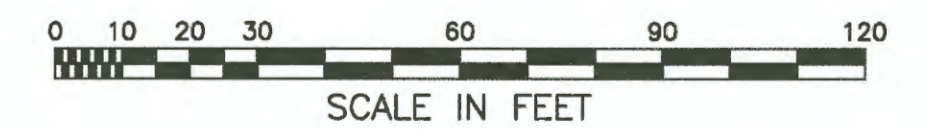

DESIGN RPK  
DRAWN ADC  
CHECKED JGL


STATE OF ALASKA  
DEPARTMENT OF TRANSPORTATION AND PUBLIC FACILITIES  
SOUTHCOAST REGION-DESIGN AND CONSTRUCTION-AVIATION

BY	DATE	REVISIONS

KAKE AIRPORT  
KAKE, ALASKA  
RUNWAY REHABILITATION  
AIP 3-02-0398-XX-2018/SFAPT00078  
CONSTRUCTION SAFETY AND PHASING PLAN  
PHASE 2 TURNAROUND PLAN

SHEET  
AD4  
OF  
AD8

6/25/2018, 3:54 PM

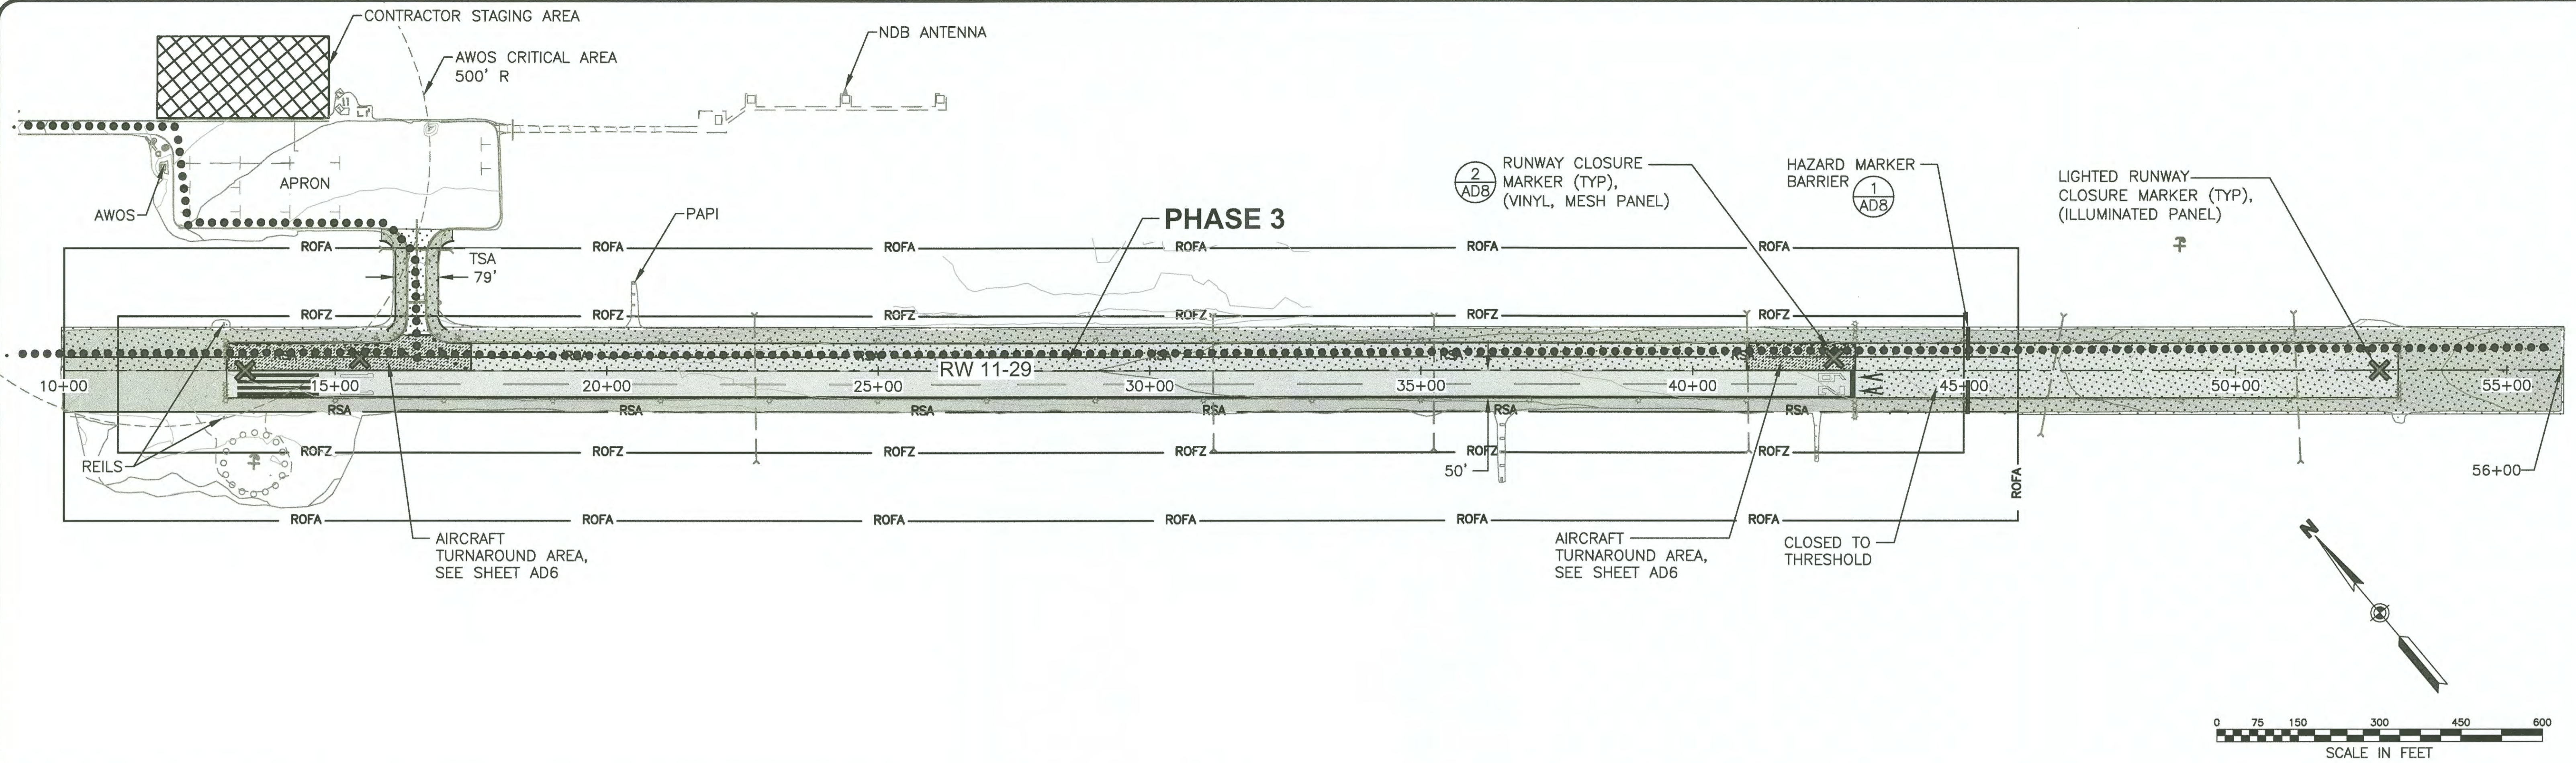

**PHASE 3 SAFETY PLAN NOTES:**

1. ALL HAULING MUST TAKE PLACE ON THE CLOSED PORTION OF THE RUNWAY. CLEANING OF THE HAUL ROUTES MUST BE CONTINUOUS TO PREVENT THE ACCUMULATION OR SPREAD OF FOD.
2. NIGHT TIME CLOSURE OF THE RUNWAY WILL BE REQUIRED FOR PHASE 3 WITH PROPER COORDINATION AS SPECIFIED.
3. PROVIDE TEMPORARY RUNWAY EDGE LIGHTING FOR THE HALF WIDTH OPERATION OF RUNWAY 11-29, INCLUDING THRESHOLD LIGHTING. PROVIDE POWER, CABLING, AND ALL OTHER WORK REQUIRED FOR TEMPORARY LIGHTING. A COMBINATION OF TEMPORARY AND EXISTING LIGHTING MAY BE USED TO PROVIDE THE LIGHTING REQUIRED. RELOCATE TEMPORARY LIGHTING DURING NIGHT TIME CLOSURES TO ACCOMMODATE CONSTRUCTION, REPOSITION AND INSPECT TEMPORARY LIGHTING PRIOR TO DAILY OPENING OF HALF WIDTH RUNWAY FOR AIRCRAFT OPERATIONS.
4. THE WIDTH OF RUNWAY 11-29 WITH THE TEMPORARY EDGE LIGHTING IN PLACE IS 50 FEET FOR THIS PHASE. SEE DETAIL 1 ON SHEET AD7.
5. LEAVE PANEL TYPE CLOSURE MARKERS ON PORTION OF THE CLOSED HALF RUNWAY NOT ACTIVELY BEING WORKED ON IN PLACE AT ALL TIMES DURING PHASE.
6. PROVIDE AIRCRAFT TURNAROUNDS FOR THE DURATION OF THIS PHASE WHEN THE RUNWAY IS OPEN TO OPERATIONS. ACCOMPLISH WORK WITHIN THESE LIMITS DURING NIGHT TIME CLOSURES, AND RE-OPEN FOR AIRCRAFT OPERATIONS EVERY DAY, SEE SHEET AD6.
7. MAINTAIN TAXIWAY EDGE LIGHTING FOR OPEN TAXIWAY. COVER OR OTHERWISE DISABLE EDGE LIGHTS FOR CLOSED AREAS. COORDINATE CLOSING AND OPENING OF AIR OPERATIONS AREAS WITH AIRPORT MANAGEMENT THROUGH THE ENGINEER. ALLOW FOR ISSUANCE OF NOTAMS BY AIRPORT MANAGEMENT TO KEEP ALL AIRPORT USERS INFORMED OF CLOSED AREAS AND APRON, TAXIWAY, AND RUNWAY STATUS.

**PHASE 3 WORK ITEMS:**

1. OPEN THE HALF WIDTH RUNWAY TO DAYTIME OPERATIONS AND BEGIN PHASE 3 ONLY WHEN APPROVED BY THE ENGINEER.
2. CONSTRUCT ALL EROSION AND SEDIMENT CONTROL BMPs REQUIRED FOR THIS PHASE.
3. SCOPE OF CONSTRUCTION FOR THIS PHASE:
  - REMOVE REMAINING EXISTING ASPHALT WITHIN THE LIMITS SPECIFIED
  - COMPLETE RSA EMBANKMENT IMPROVEMENTS
  - COMPLETE TSA EMBANKMENT IMPROVEMENTS
  - PLACE NEW HOT MIX ASPHALT
  - COMPLETE RUNWAY EDGE LIGHTS
  - COMPLETE TAXIWAY EDGE LIGHTS AND AIRPORT SIGNS
  - COMPLETE ROTATING BEACON
  - COMPLETE LIGHTED WIND CONES
3. PREPARE THE RUNWAY FOR THE TRANSITION BACK TO FULL WIDTH OPERATIONS.
4. OPEN THE RUNWAY TO FULL WIDTH OPERATIONS WHEN APPROVED BY THE ENGINEER.
5. COMPLETE THE FULL WIDTH RUNWAY MARKINGS DURING SUBSEQUENT NIGHT TIME CLOSURES.

Record Drawings have been reviewed by the Project Engineer, and represent to the best of my knowledge, the project as constructed.  
 PE: [Signature] Date 10.24.19

U:\2047059100\drawing\C\Sheets\2047059100\_CSP.dwg


DESIGN RPK  
 DRAWN ADC  
 CHECKED JGL

STATE OF ALASKA  
 DEPARTMENT OF TRANSPORTATION AND PUBLIC FACILITIES  
 SOUTHCOAST REGION-DESIGN AND CONSTRUCTION-AVIATION

BY	DATE	REVISIONS

KAKE AIRPORT  
 KAKE, ALASKA  
 RUNWAY REHABILITATION  
 AIP 3-02-0398-XX-2018/SFAPT00078  
 CONSTRUCTION SAFETY AND PHASING PLAN  
 PHASE 3


SHEET  
**AD5**  
 OF  
**AD8**

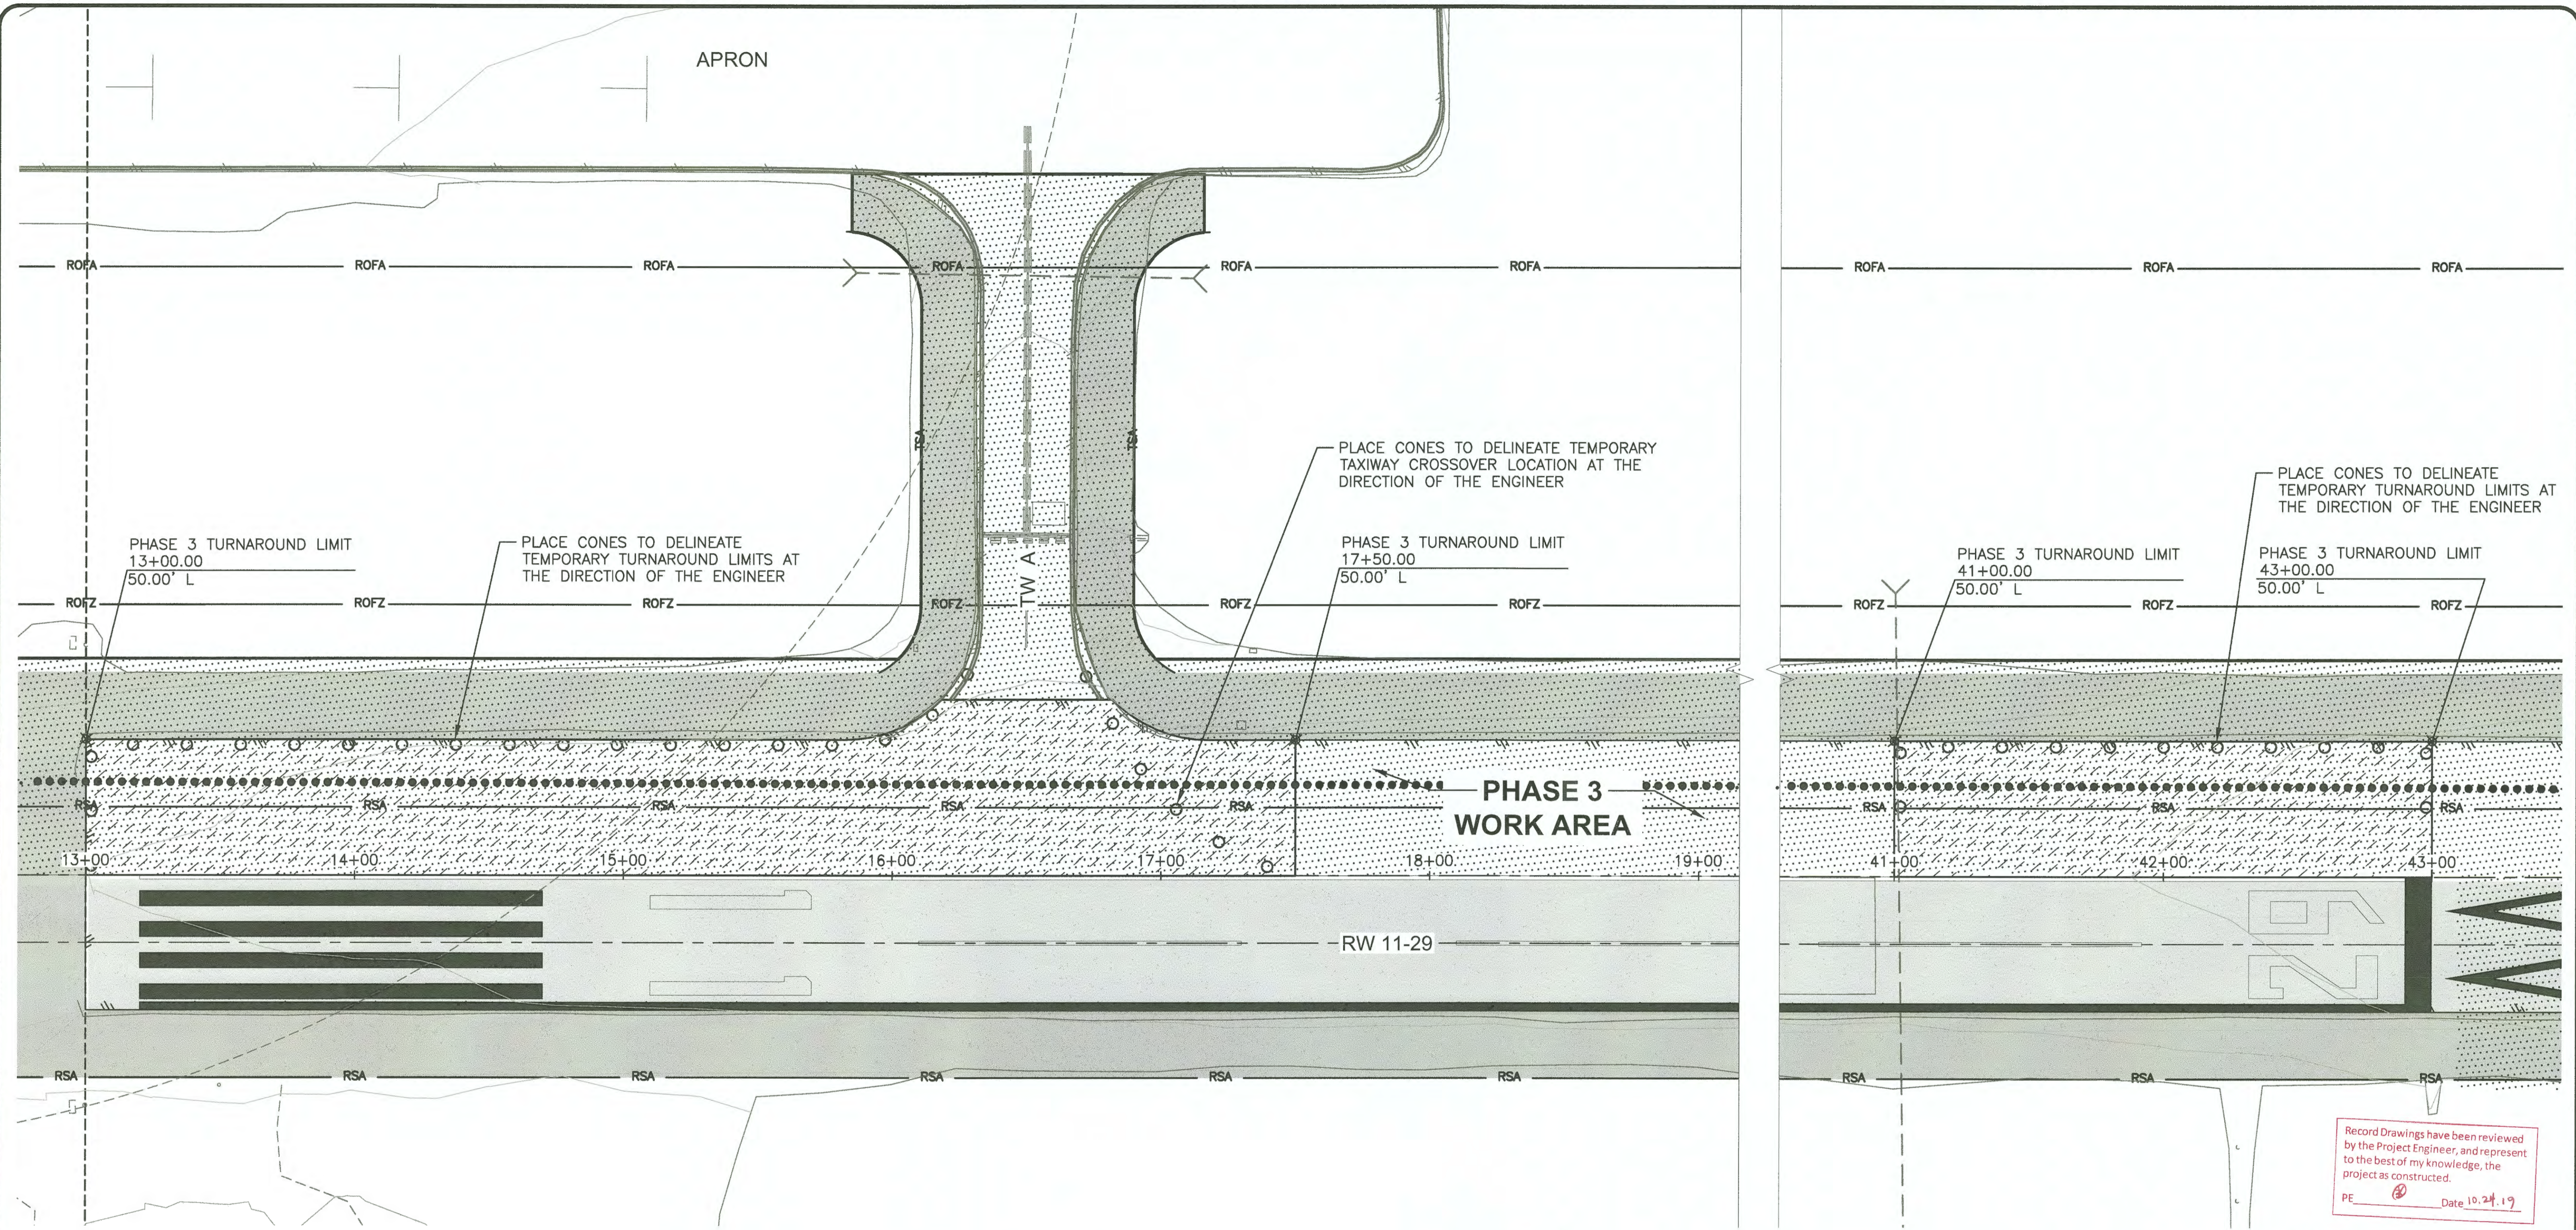

Record Drawings have been reviewed by the Project Engineer, and represent to the best of my knowledge, the project as constructed.  
 PE [Signature] Date 10.24.19

**NOTES:**

1. MAINTAIN ACCESS FROM THE RUNWAY TO THE TAXIWAY WHENEVER THE RUNWAY IS OPEN TO AIRCRAFT OPERATIONS.
2. CROSSOVER TAXIWAY AND TURNAROUND SURFACE MUST BE COMPACTED CABC CAPABLE OF SUPPORTING AIRCRAFT DURING ALL WEATHER CONDITIONS, OR HMA. CONSTRUCT PAVEMENT TRANSITION WEDGE AS REQUIRED. SEE DETAIL 3 ON SHEET AD7.
3. TURNAROUND AREA MUST BE OPEN TO AIRCRAFT WHEN THE RUNWAY IS ACTIVE.

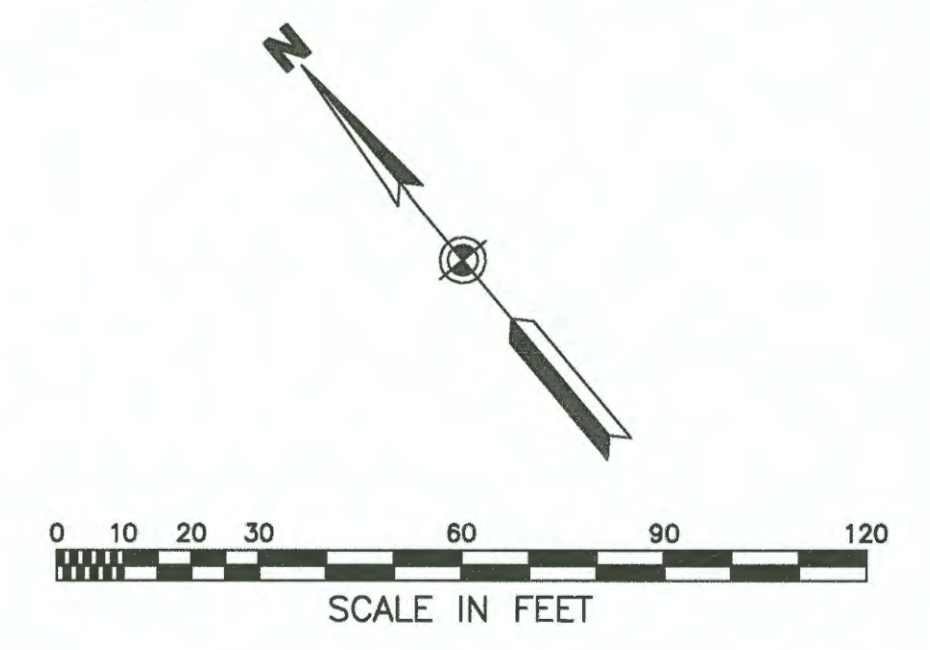

U:\2047059100\drawing\C\Sheets\2047059100\_CSPP.dwg


DESIGN RPK  
 DRAWN ADC  
 CHECKED JGL

STATE OF ALASKA  
 DEPARTMENT OF TRANSPORTATION AND PUBLIC FACILITIES  
 SOUTHCOAST REGION-DESIGN AND CONSTRUCTION-AVIATION

BY	DATE	REVISIONS

KAKE AIRPORT  
 KAKE, ALASKA  
 RUNWAY REHABILITATION  
 AIP 3-02-0398-XX-2018/SFAPT00078  
 CONSTRUCTION SAFETY AND PHASING PLAN  
 PHASE 3 CROSSOVER PLAN


SHEET  
 AD6  
 OF  
 AD8

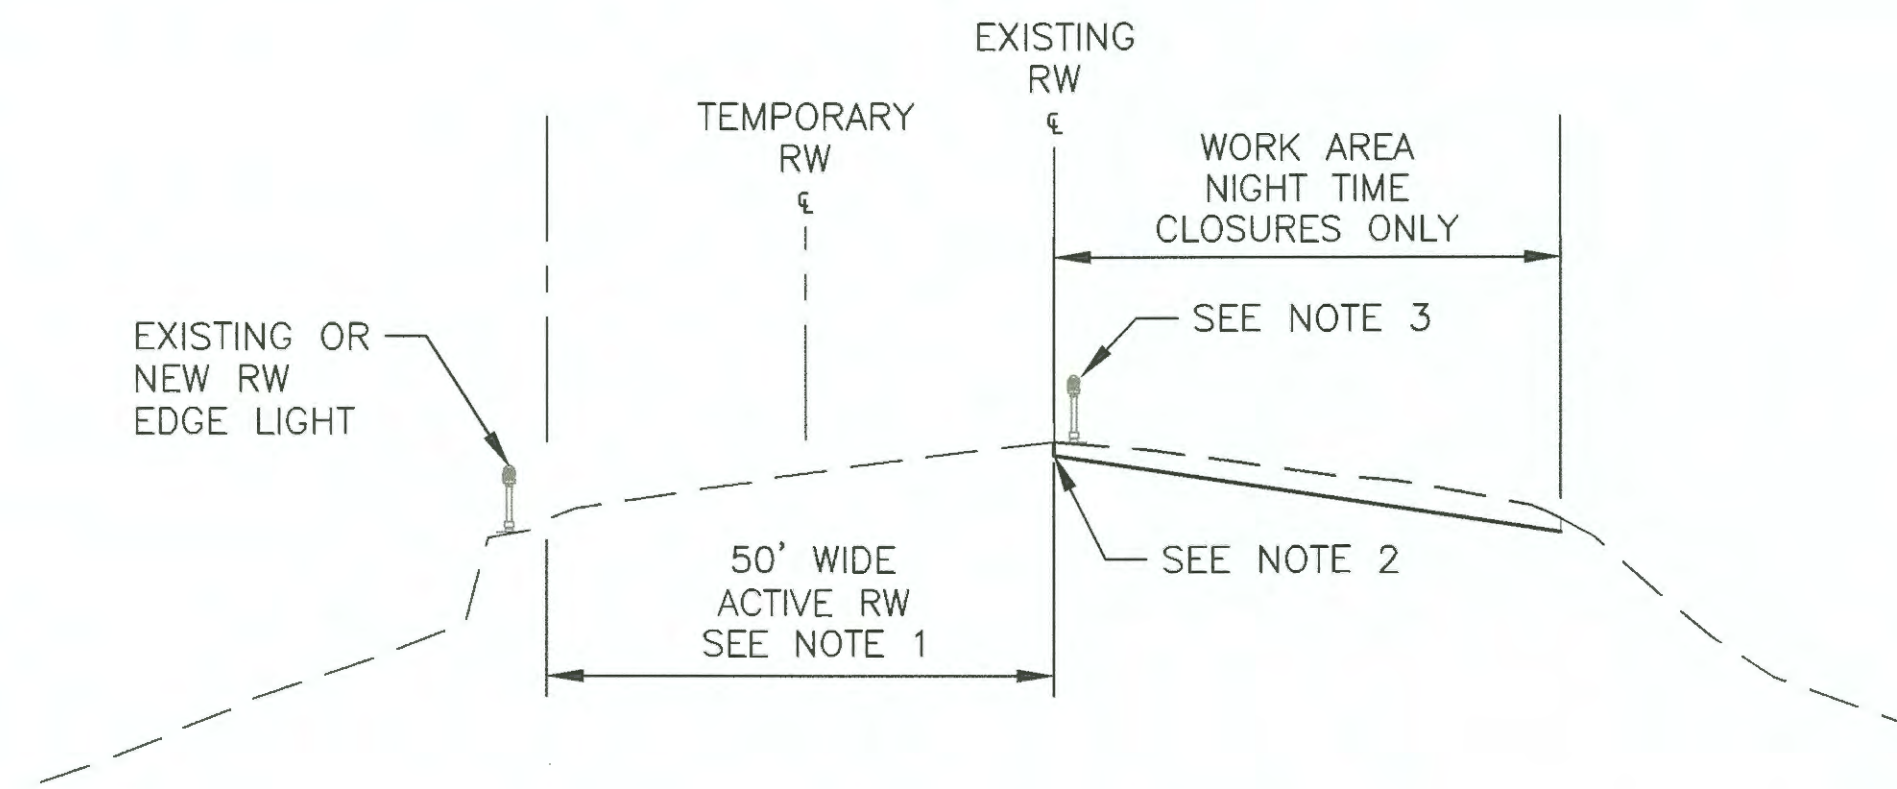


**NOTES:**

1. SECTION DEPICTS RW CONDITIONS WHEN HALF WIDTH RW IS ACTIVE DURING PHASE 2. COMPLETE WORK IN ACCORDANCE WITH THE APPROVED SAFETY AND STAGING PLANS. SECTION IS MIRRORED ABOUT EXISTING CENTERLINE FOR THE PHASE 3 HALF WIDTH RW CLOSURE.
2. ALL EXCAVATIONS MUST BE FILLED AND COMPACTED PRIOR TO THE END OF EACH SHIFT – VERTICAL FACE MUST NOT EXCEED 6 INCHES DURING AIRCRAFT OPERATIONS. CONSTRUCT PAVEMENT TRANSITION WEDGE WHERE AIRCRAFT MUST CROSS. SEE DETAIL 3 SHEET AD7.
3. TEMPORARY LIGHTING MUST BE PLACED A MINIMUM OF 2 FEET INSIDE THE WORK AREA DURING AIRCRAFT OPERATIONS. RELOCATE THE TEMPORARY LIGHTING DURING THE NIGHT TIME CLOSURES AS REQUIRED TO ACCOMMODATE CONSTRUCTION. REPLACE LIGHTING AND INSPECT PRIOR TO THE END OF EACH WORK SHIFT AND PRIOR TO OPENING RW TO AIRCRAFT OPERATIONS.

**1**  
AD7 HALF WIDTH RW TYPICAL SECTION  
SCALE: N.T.S.

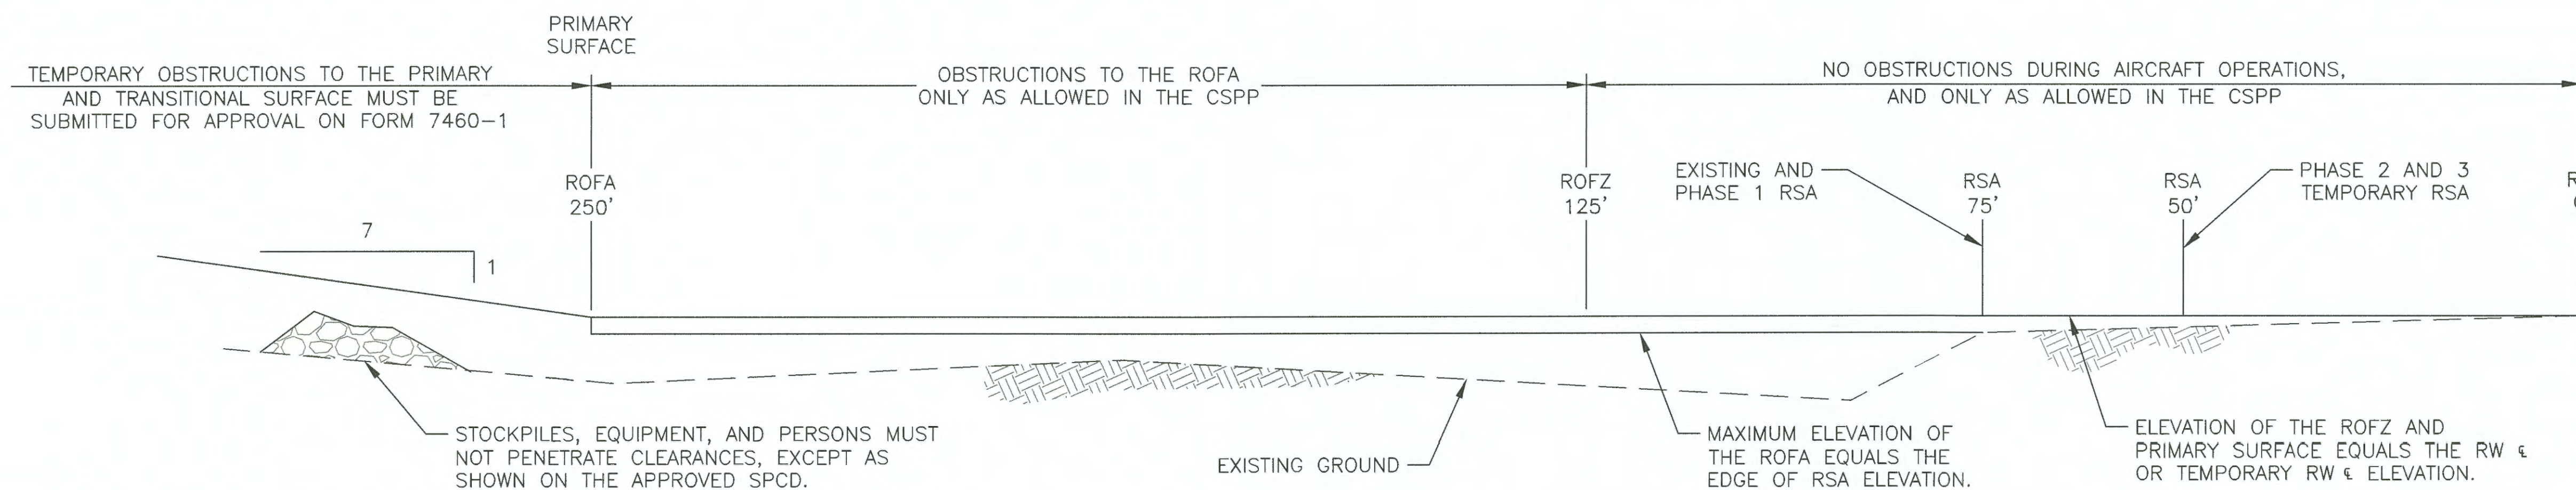

**2**  
AD7 VERTICAL RELATION OF THE RSA, ROFZ, AND ROFA  
SCALE: N.T.S.

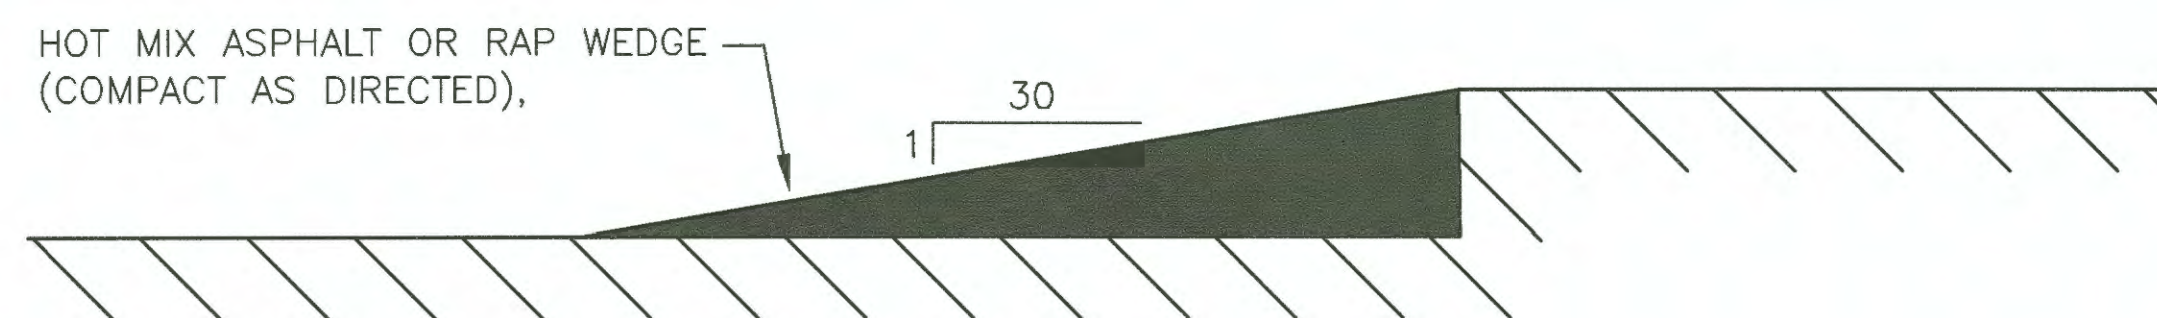

**3**  
AD7 TRANSITION WEDGE DETAIL  
SCALE: N.T.S.

Record Drawings have been reviewed by the Project Engineer, and represent to the best of my knowledge, the project as constructed.  
PE *[Signature]* Date 10/24/19


DESIGN	RPK
DRAWN	ADC
CHECKED	JGL

**STATE OF ALASKA**  
DEPARTMENT OF TRANSPORTATION AND PUBLIC FACILITIES  
SOUTHCOAST REGION-DESIGN AND CONSTRUCTION-AVIATION



BY	DATE	REVISIONS

**KAKE AIRPORT**  
KAKE, ALASKA  
RUNWAY REHABILITATION  
AIP 3-02-0398-XX-2018/SFAPT00078  
CONSTRUCTION SAFETY AND PHASING  
DETAILS I

SHEET  
**AD7**  
OF  
**AD8**

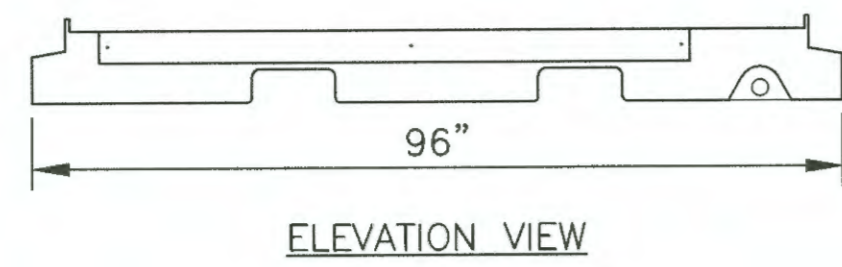


ELEVATION VIEW

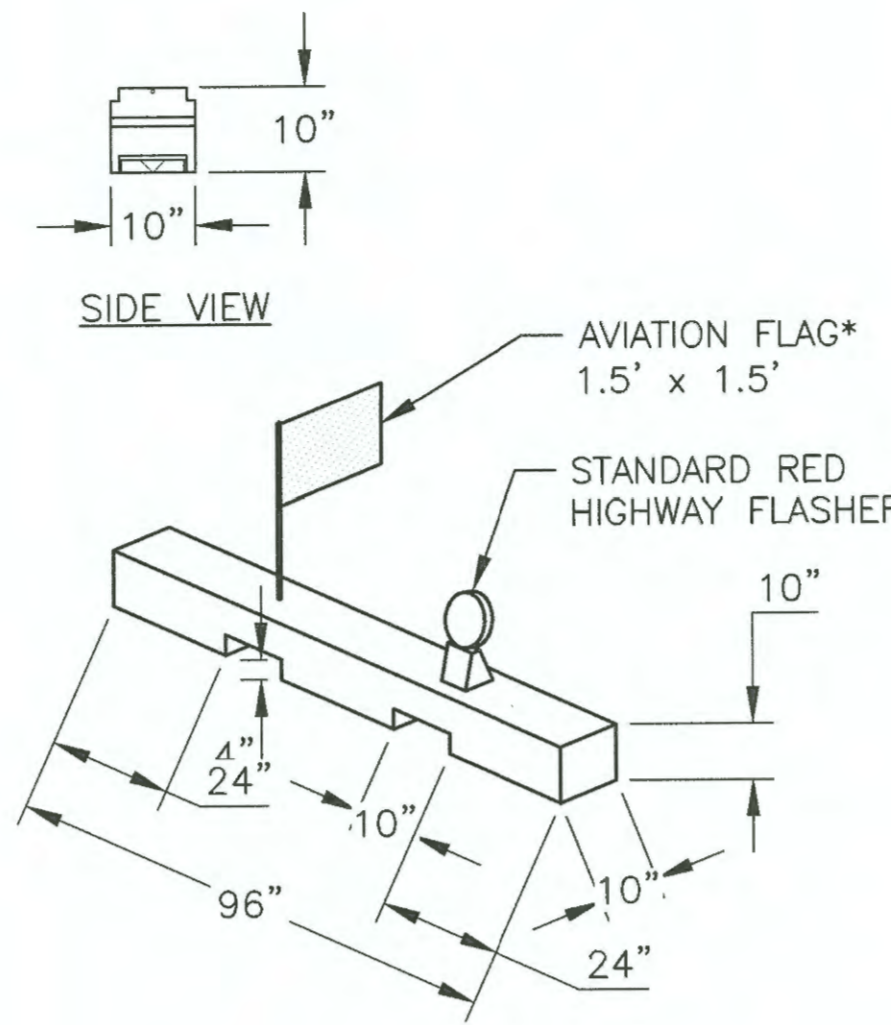

PREPARATION OF FLAG & FLASHER MOUNT DETAIL

\* FLAGS SHALL ALTERNATE COLOR (ORANGE/WHITE) ON EACH BARRIER AS THEY ARE PLACED IN THE AIRPORT OPERATIONS AREA.

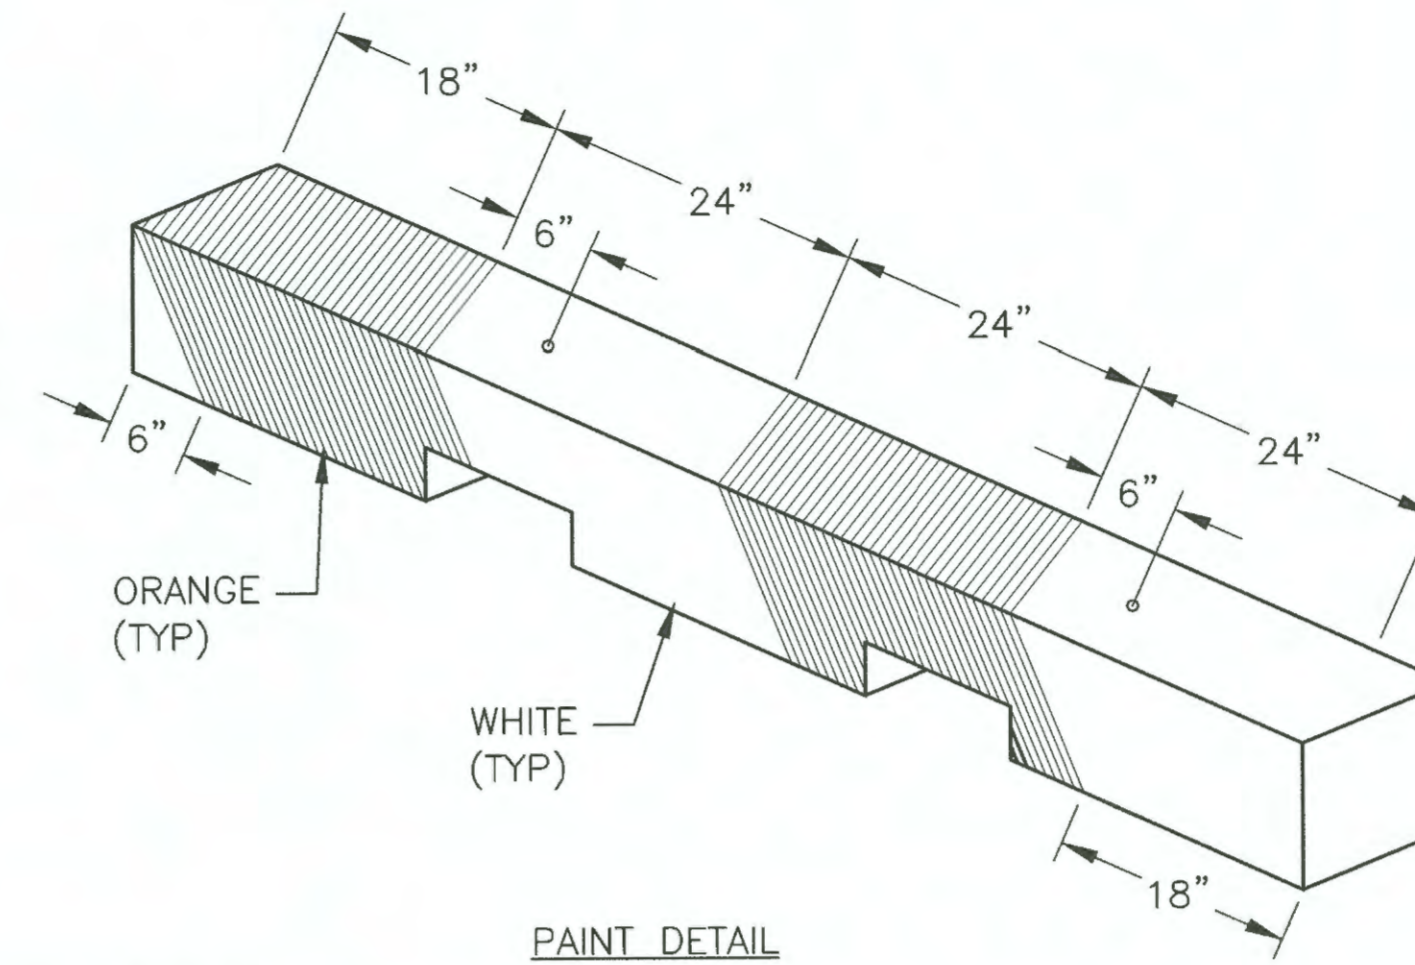

PAINT DETAIL


**HAZARD MARKER BARRIER NOTES**

1. PLACE BARRIERS TO LIMIT ACCESS TO THE CLOSED RUNWAY. USE LOW STYLE BARRIERS (LESS THAN 12 INCHES HIGH) WHEN ADJACENT TO AN ACTIVE MOVEMENT AREA.
2. DISABLE AND PREVENT THE OPERATION OF RUNWAY EDGE LIGHTS AND RUNWAY THRESHOLD LIGHTS DURING CLOSURE OF THE RUNWAY.
3. HAZARD MARKER BARRIERS ARE NOT TO BE PLACED WITHIN THE OFZ OF THE ACTIVE RUNWAY. CONSIDER PROPELLER WASH WHEN PLACING BARRIERS.
4. SEE CSPP SECTION 16 FOR SPACING REQUIREMENTS.

1  
AD8

**HAZARD MARKER BARRIER DETAIL**

SCALE: N.T.S. CONCEPTUAL DETAIL, SUBMIT ALTERNATE DESIGN OR COMMERCIAL PRODUCT FOR APPROVAL. COLOR MUST BE ALTERNATING ORANGE AND WHITE SIMILAR AS SHOWN.

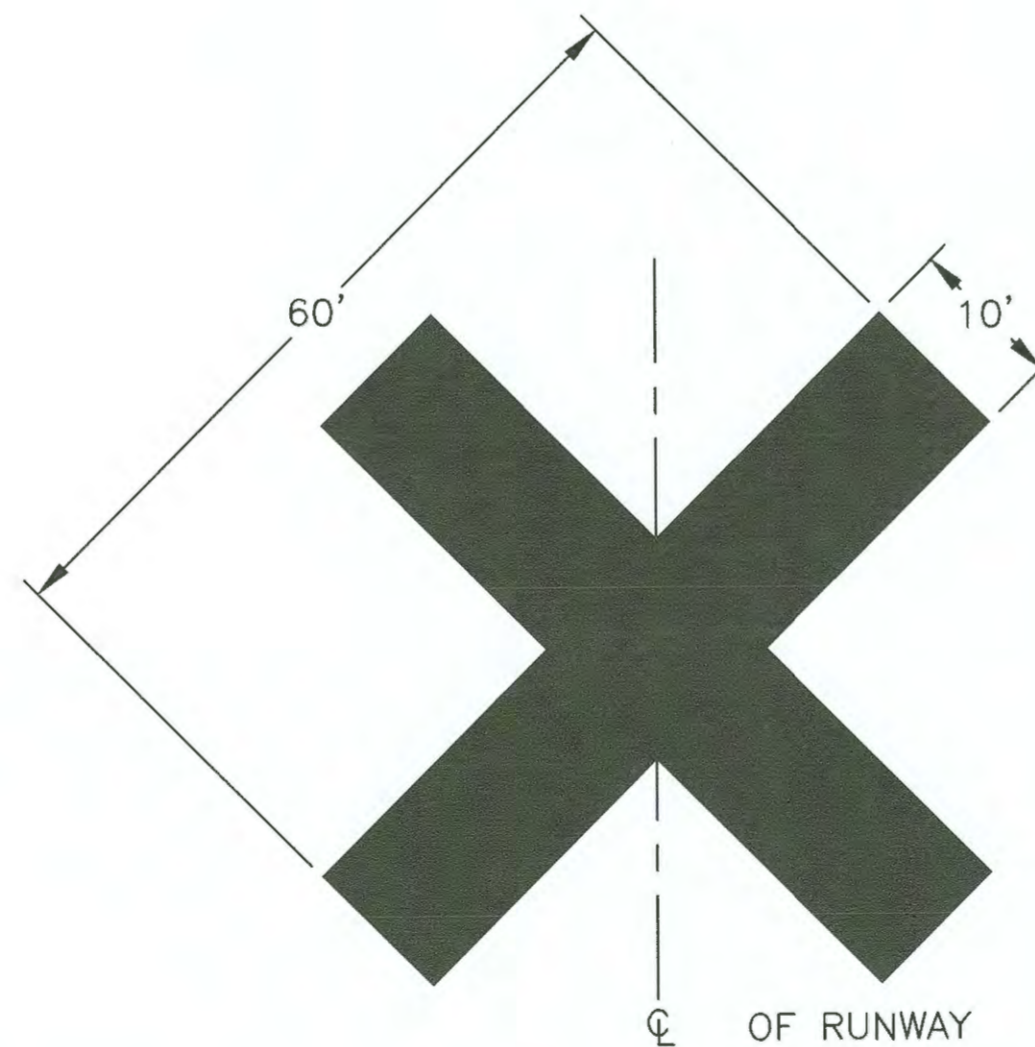

CL OF RUNWAY

**RUNWAY CLOSURE MARKER NOTES**

1. RUNWAY CLOSURE MARKER SHALL BE POSITIONED OVER RUNWAY DESIGNATION NUMERALS TO DENOTE A TEMPORARY CLOSED RUNWAY, OR AS DIRECTED.
2. RUNWAY CLOSURE MARKERS SHALL BE CONSTRUCTED OF VINYL MESH AND SHALL BE YELLOW IN COLOR.
3. PLACE LIGHTED RUNWAY CLOSURE MARKER AT EACH END OF THE CLOSED RUNWAY. ALIGN ON THE EXTENDED CENTERLINE, AND POSITION ON THE RSA EMBANKMENT TO AVOID CONFLICT WITH CONSTRUCTION ACTIVITY, OR AS OTHERWISE DIRECTED. SEE AC 150/5345-53, AND AC 150/5345-55 FOR ADDITIONAL REQUIREMENTS AND GUIDANCE FOR LIGHTED CLOSURE MARKERS.

2  
AD8

**CLOSURE MARKER DETAIL**

SCALE: N.T.S.

Record Drawings have been reviewed by the Project Engineer, and represent to the best of my knowledge, the project as constructed.  
PE *[Signature]* Date 10/24/19

DESIGN RPK  
DRAWN ADC  
CHECKED JGL

STATE OF ALASKA  
DEPARTMENT OF TRANSPORTATION AND PUBLIC FACILITIES  
SOUTHCOAST REGION-DESIGN AND CONSTRUCTION-AVIATION

BY	DATE	REVISIONS

KAKE AIRPORT  
KAKE, ALASKA  
RUNWAY REHABILITATION  
AIP 3-02-0398-XX-2018/SFAPT00078  
CONSTRUCTION SAFETY AND PHASING  
DETAILS II

SHEET  
AD8  
OF  
AD8