

CONSTRUCTION PLANS FOR

# KLAWOCK AIRPORT LIGHTING KLAWOCK, ALASKA

## AIRPORT LIGHTING

A.I.P. NO. 3-02-0154-05


70388

1992

SPONSORED BY THE STATE OF ALASKA

STATE OF ALASKA

DEPARTMENT OF TRANSPORTATION AND PUBLIC FACILITIES  
SOUTHEAST REGION DESIGN & CONSTRUCTION

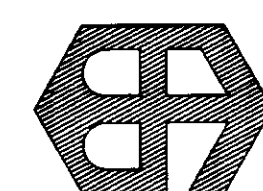


RAJ BHARGAVA ASSOCIATES  
ENGINEERING IN ALASKA

301 E. Fireweed Lane, Anchorage, Alaska 99503 (907) 276-3768

APPROVED \_\_\_\_\_ DATE \_\_\_\_\_

D.D. DIECKMEYER, DIRECTOR, SOUTH EAST REGION, DESIGN & CONSTRUCTION

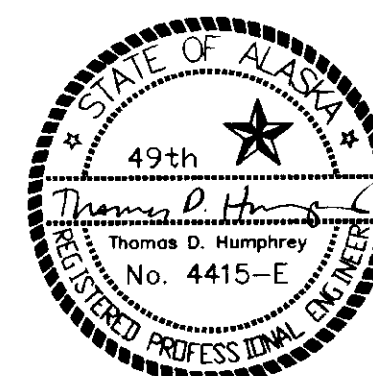


### ESTIMATED QUANTITIES


NO.	ITEM	UNIT	QUANTITY
100	MOBILIZATION AND DEMOBILIZATION	L.S.	ALL REQ'D
120	DBE ADJUSTMENT	C.S.	ALL REQ'D
125	ENGINEERING TRANSPORTATION	L.S.	ALL REQ'D
330	UNCLASSIFIED EXCAVATION	L.S.	ALL REQ'D
1000a	REGULATOR, L-828 (15KW)	EACH	1
1000d	THRESHOLD LIGHT, L861E	EACH	12
1000e	MEDIUM INTENSITY RUNWAY MARKER LIGHT, L-861	EACH	49
1000f	TAXIWAY MARKER LIGHT, L-861T	EACH	28
1000g	HANDHOLE, L-867	EACH	110
1000i	2" RIGID STEEL CONDUIT	L.F.	30
1000k	2" PVC CONDUIT	L.F.	12,695
1000l	UNDERGROUND CABLE #8 AWG, COPPER, 5KV TYPE "B", L-824	L.F.	25,000
1000m	#6 BARE COPPER GROUND CONDUCTOR	L.F.	13,200
1000p	UNDERGROUND CABLE, COPPER 600 VOLT, TYPE "B", L-824	L.F.	680
1000q	GROUND ROD	EACH	27
1000r	TAXIWAY LOCATION & HOLD LINE SIGNS L-858L & L-858R	EACH	2
1005a	ELECTRICAL EQUIPMENT ENCLOSURE	L.S.	ALL REQ'D
1005b	STANDBY GENERATOR	L.S.	ALL REQ'D
1005c	ELECTRICAL EQUIPMENT INSTALLATION	L.S.	ALL REQ'D
1005d	APRON LIGHTS	L.S.	ALL REQ'D
1007	PRECISION APPROACH PATH INDICATOR (PAPI) SYSTEM (SET OF 4) L-880B	SET	2
1008	RUNWAY END IDENTIFIER LIGHTS (REIL) L-849A	PAIR	2
1010	8-FOOT LIGHTED WIND CONE L-807 STYLE 1 SIZE 1	L.S.	ALL REQ'D
1020	AIRPORT LIGHT BEACON L-801	L.S.	ALL REQ'D
1025	ELECTRICAL POWER AND TELEPHONE SERVICE	L.S.	ALL REQ'D

### INDEX

SHEET TITLE	SHEET NO.
TITLE SHEET	1
OVERALL PROJECT PLAN	2
LIGHTING PLAN (NORTH)	3
LIGHTING PLAN (SOUTH)	4
ELECTRICAL DETAILS	5
ELECTRICAL DETAILS	6
ELECTRICAL DETAILS	7
CONTROL WIRING DIAGRAMS	8
ENCLOSURE DETAILS	9
LIGHTED WIND CONE	10
PAPI	11
REIL, THRESHOLD & BEACON DETAILS	12

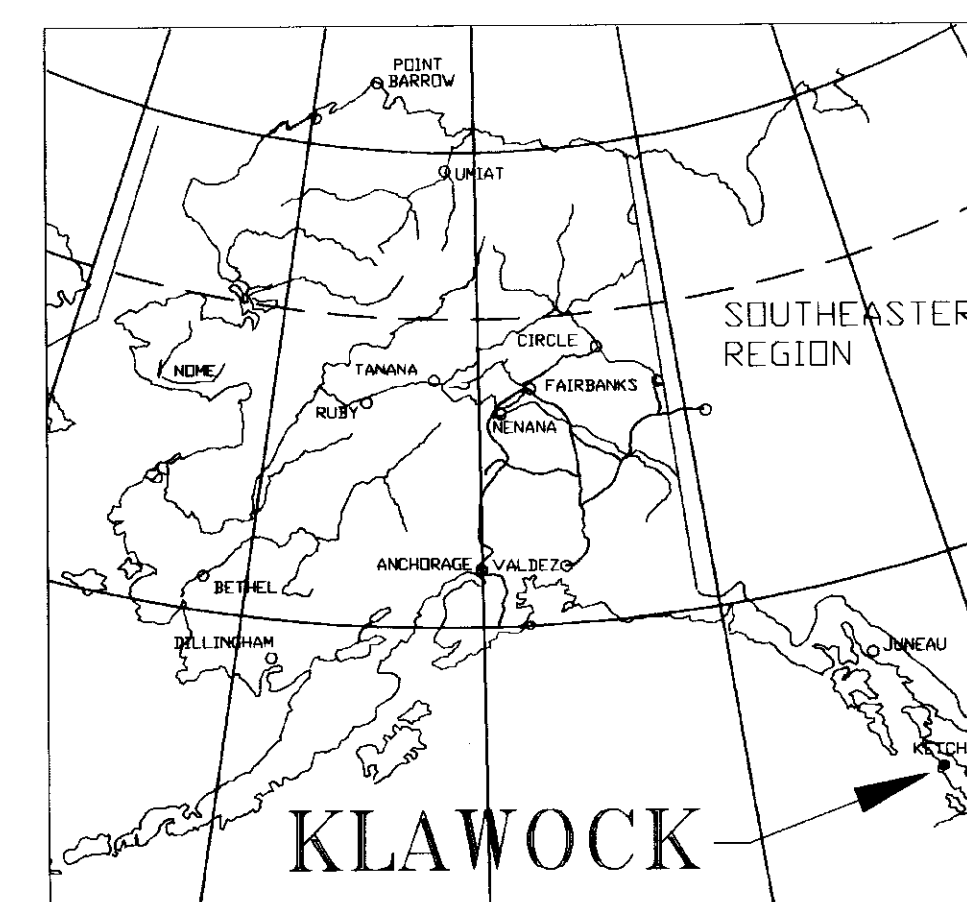


LOCATION MAP  
NO SCALE

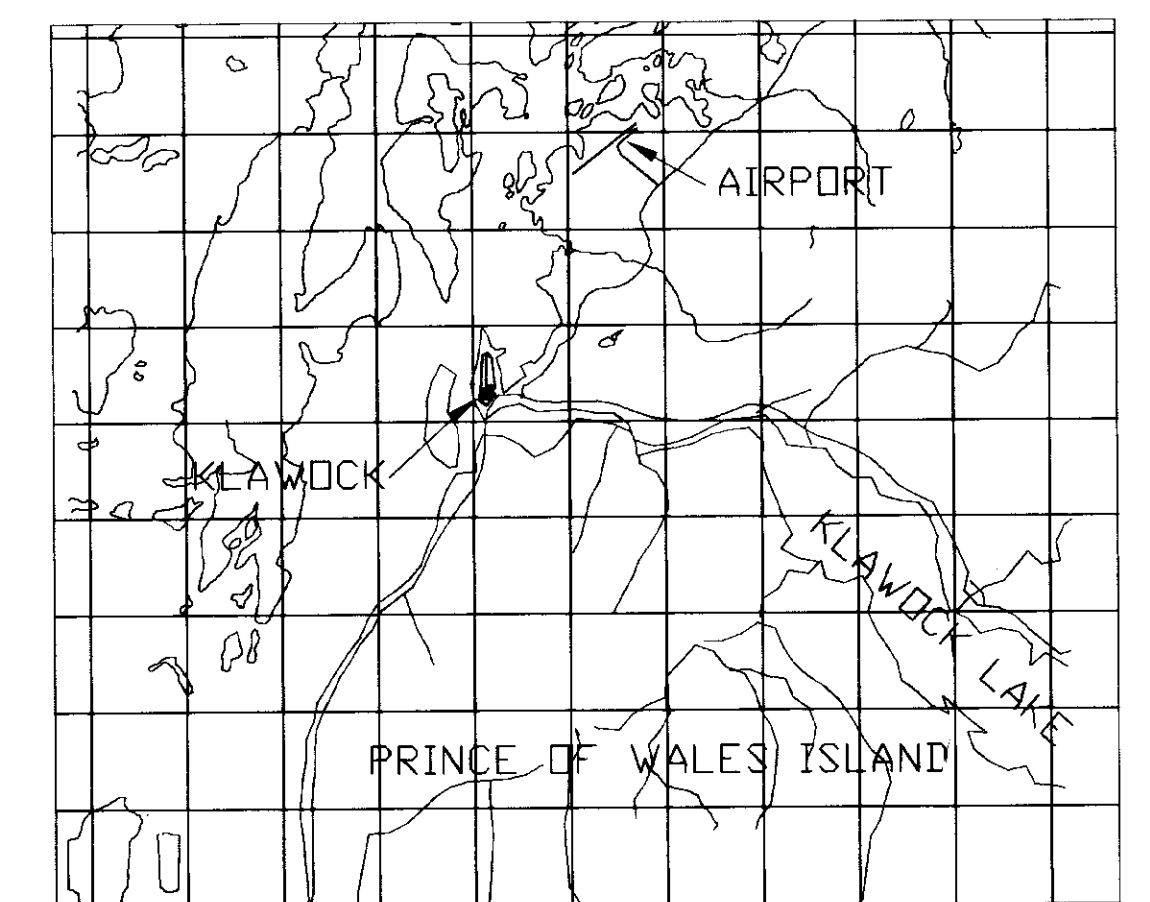

VICINITY MAP  
NO SCALE



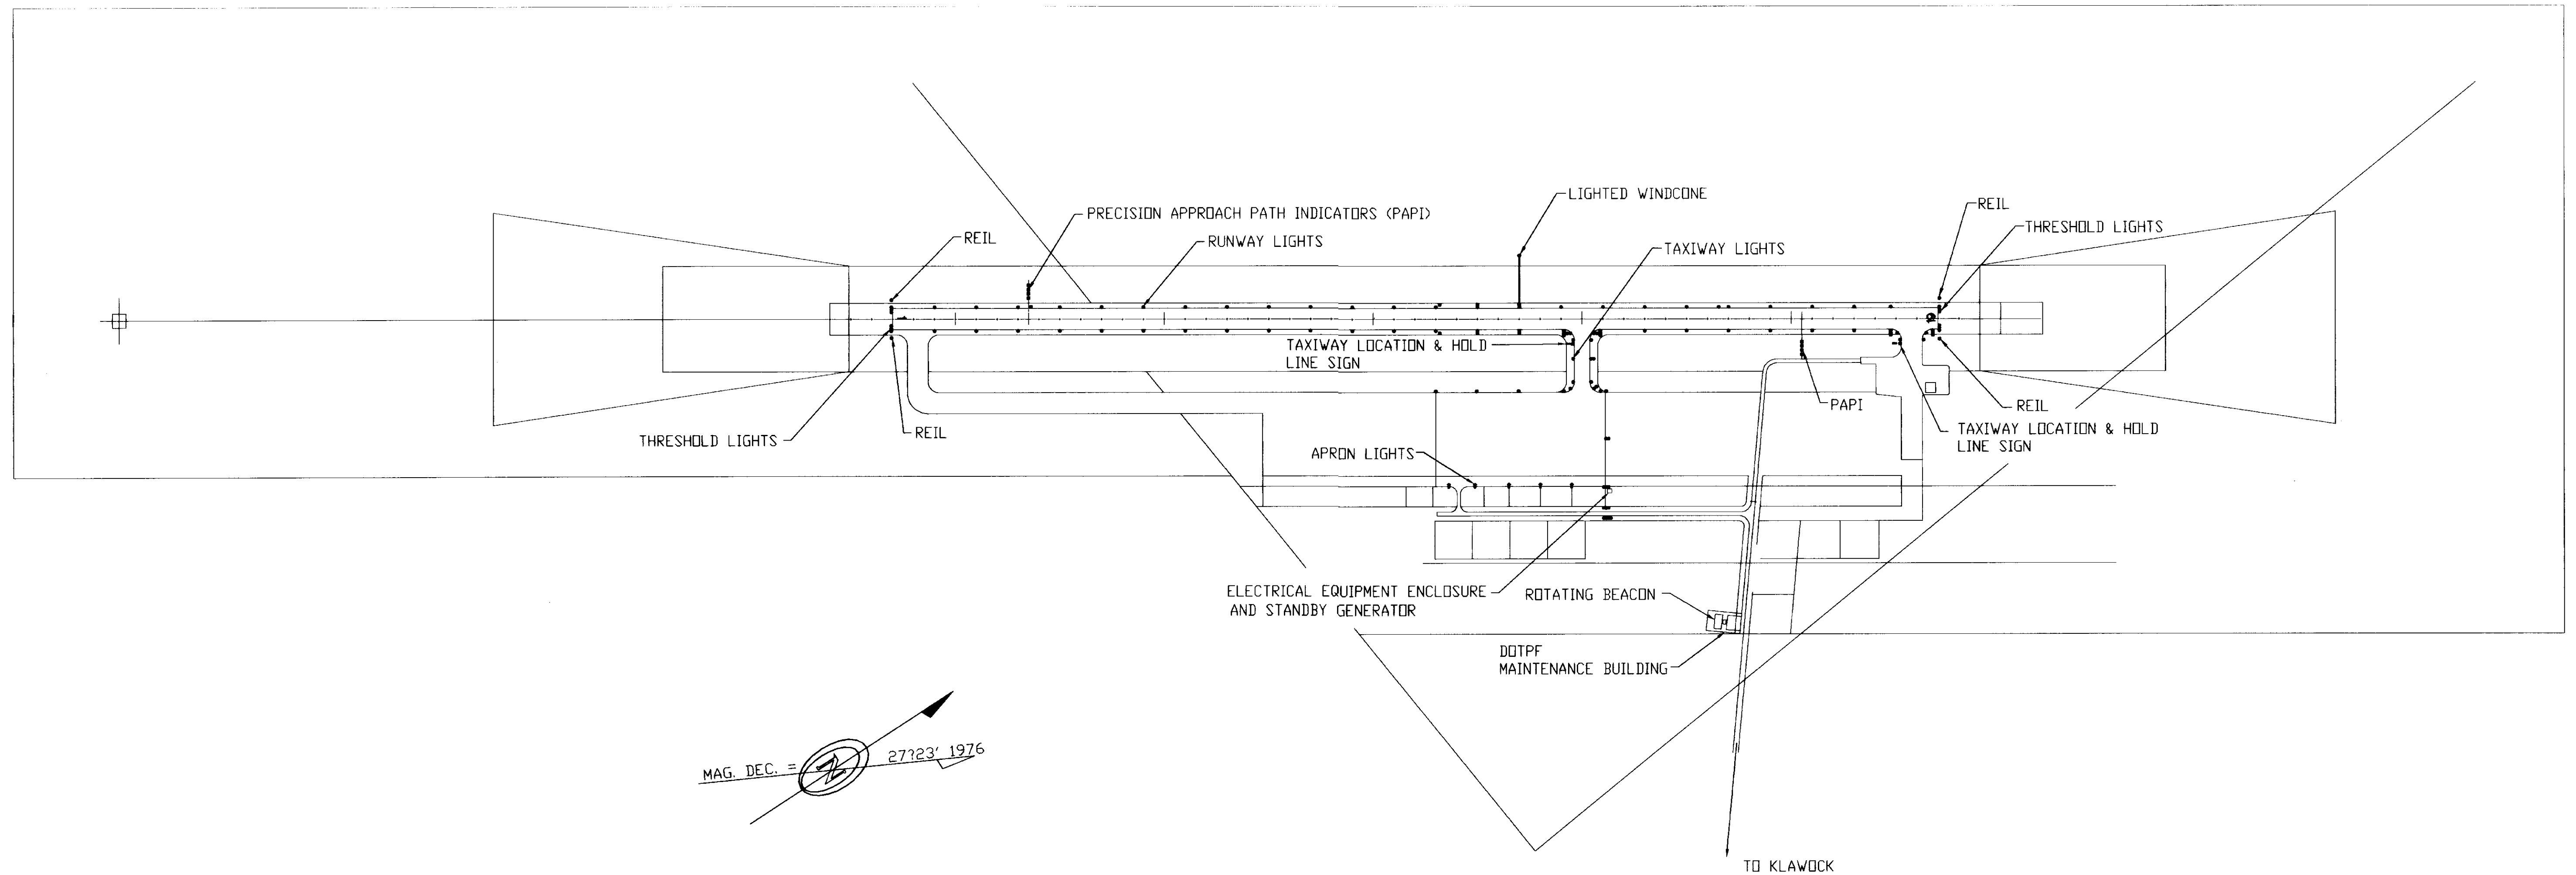

NOTE: DO NOT SCALE FROM THESE PLANS—USE DIMENSIONS


ENGINEER'S SEAL









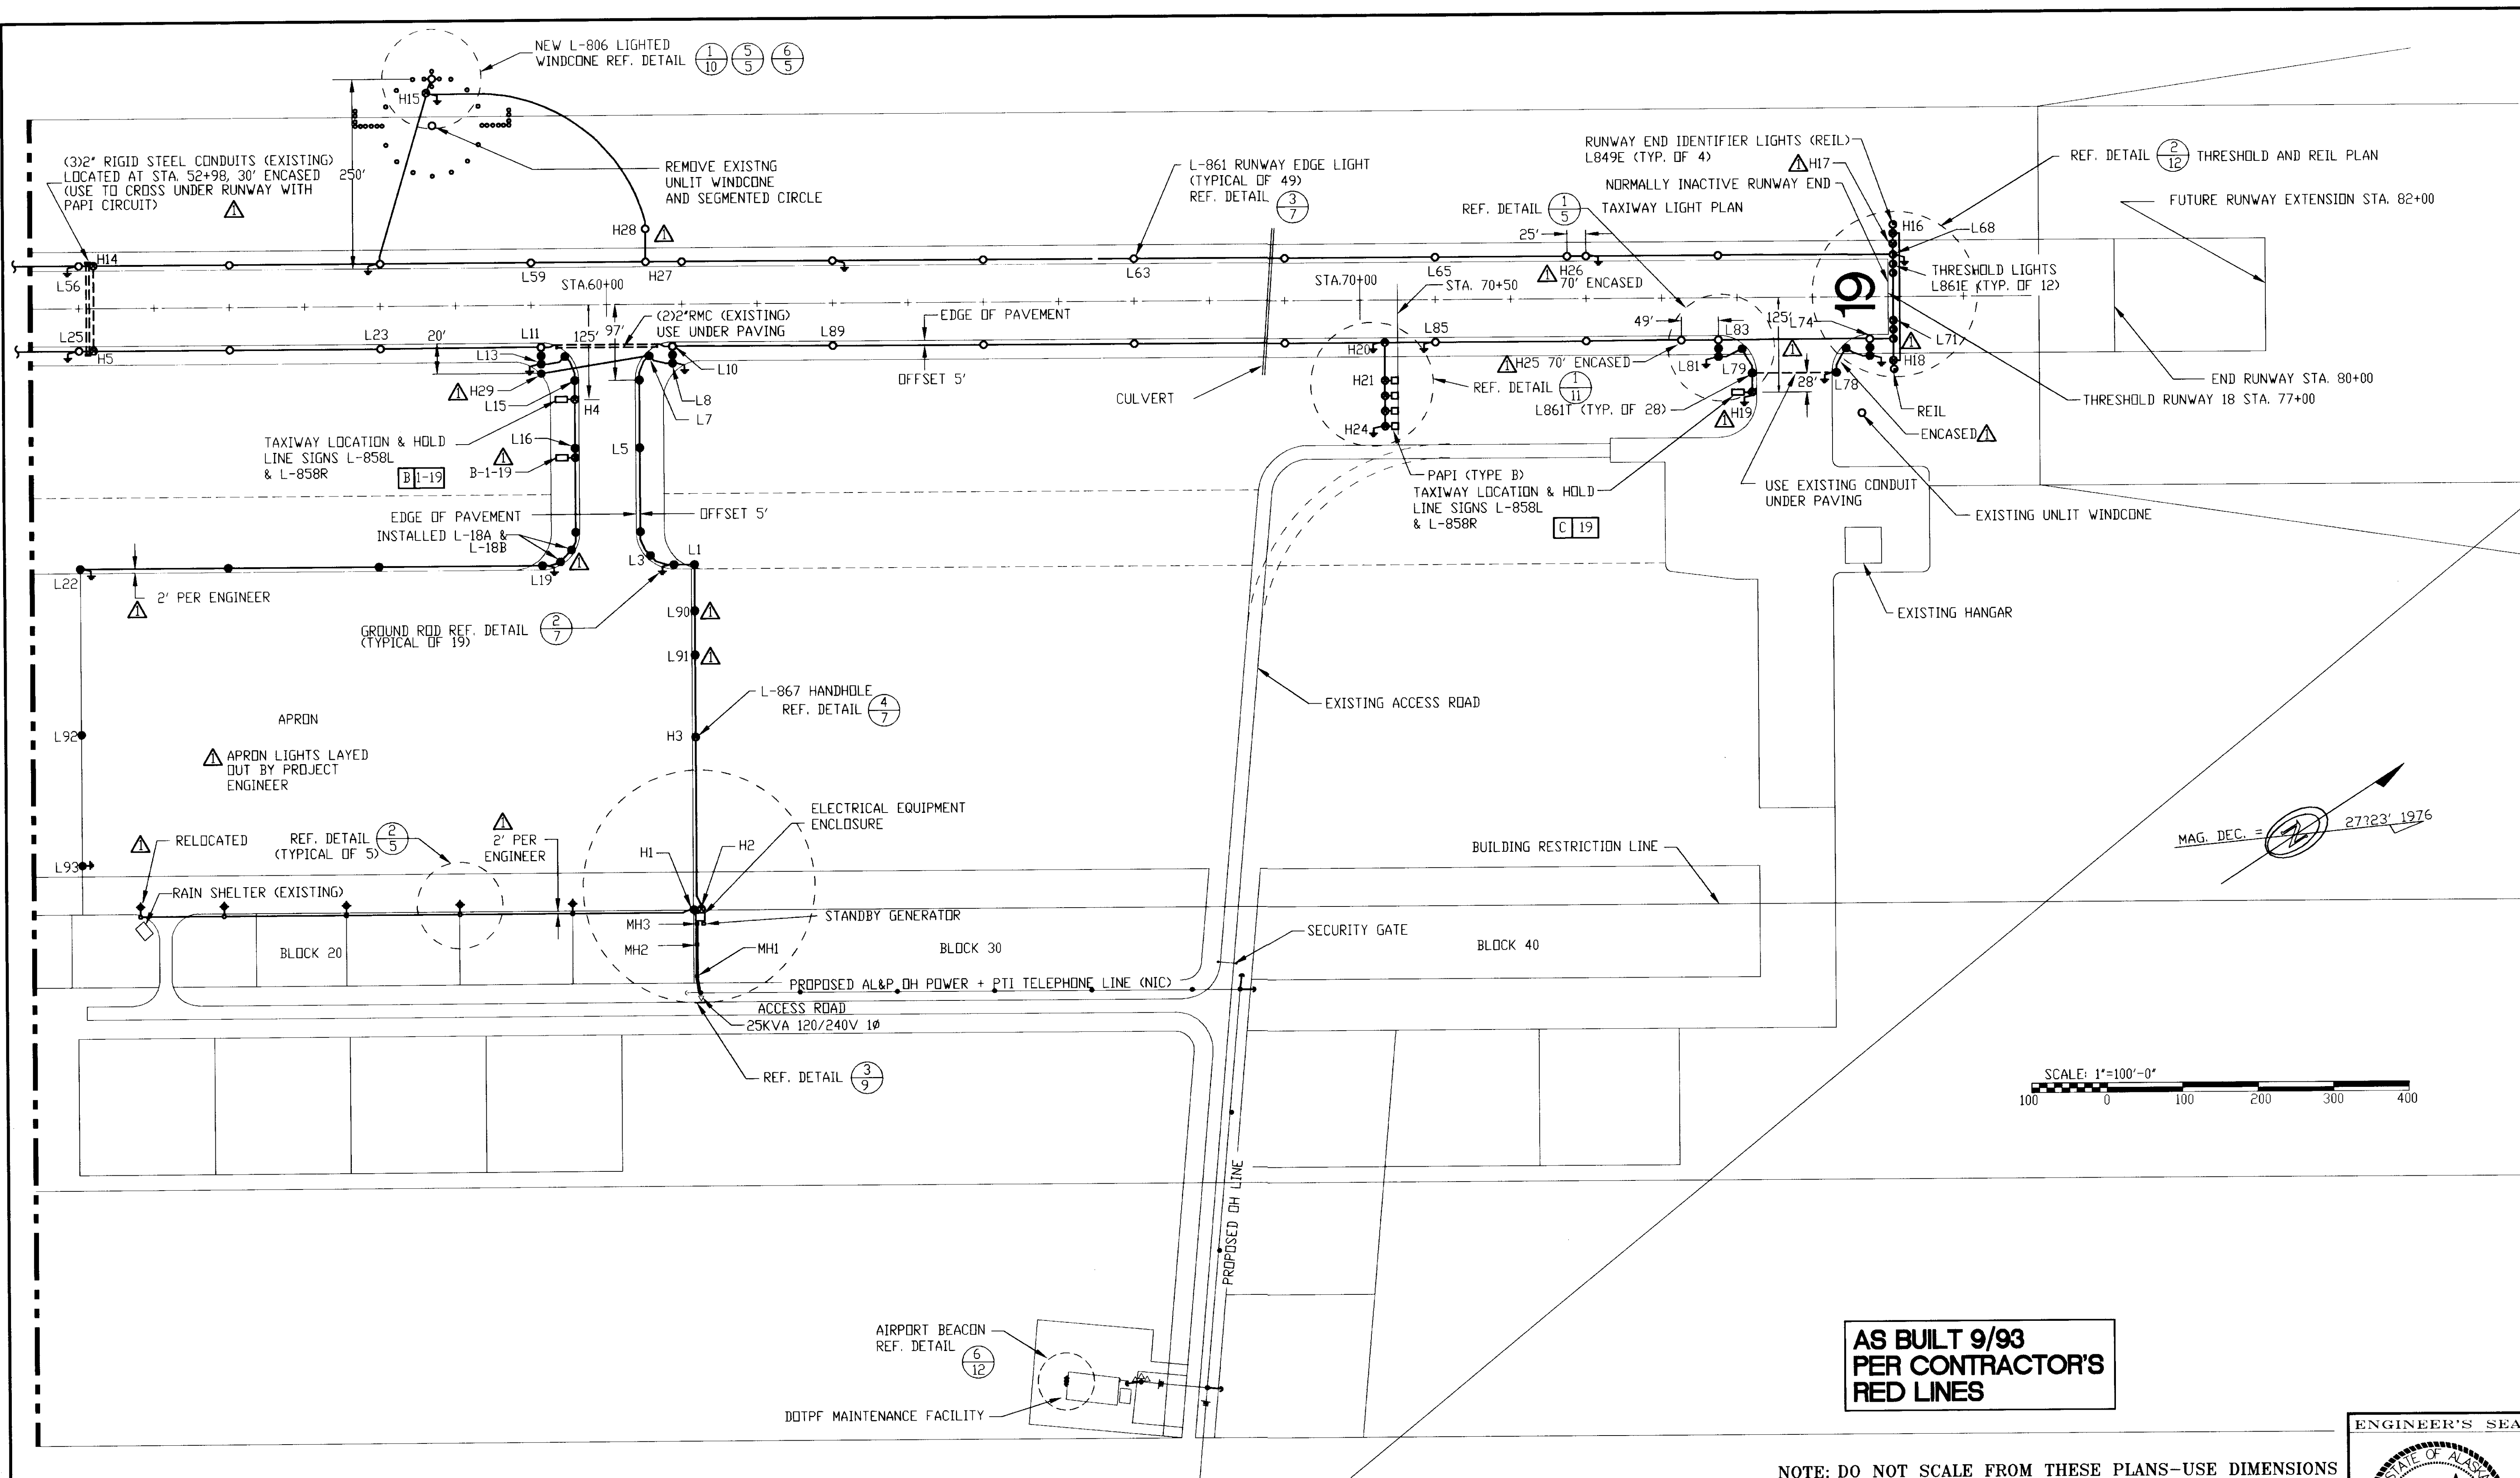


**AS BUILT 9/93  
PER CONTRACTOR'S  
RED LINES**

NOTE: DO NOT SCALE FROM THESE PLANS—USE DIMENSIONS


ENGINEER'S SEAL






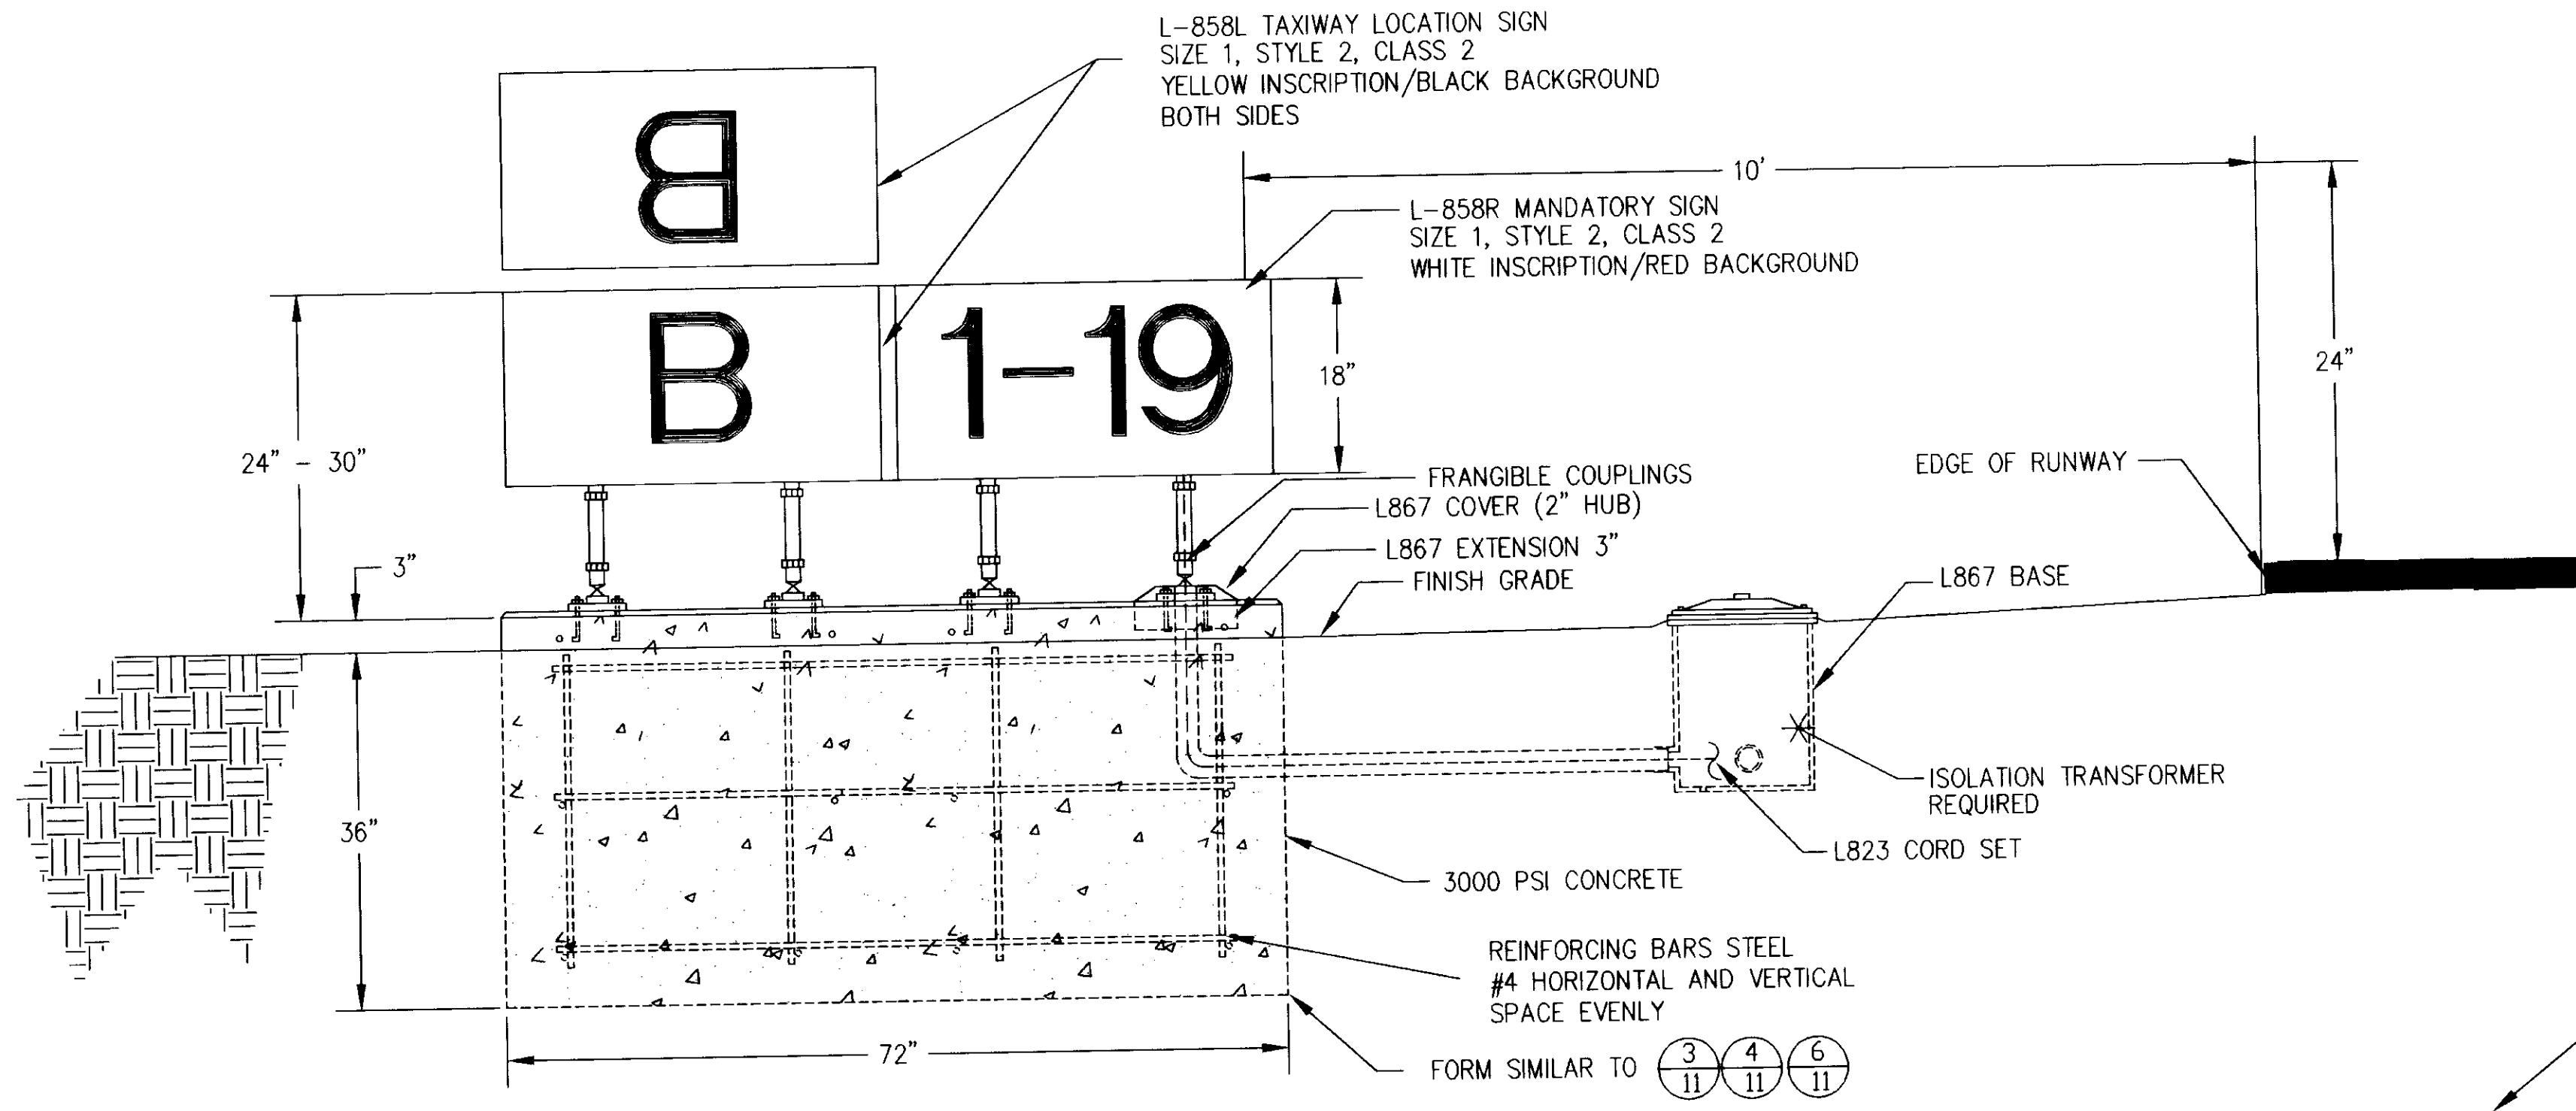


**4 TAXIWAY LOCATION + HOLD LINE SIGN**  
NOT TO SCALE (C19 SIMILAR)

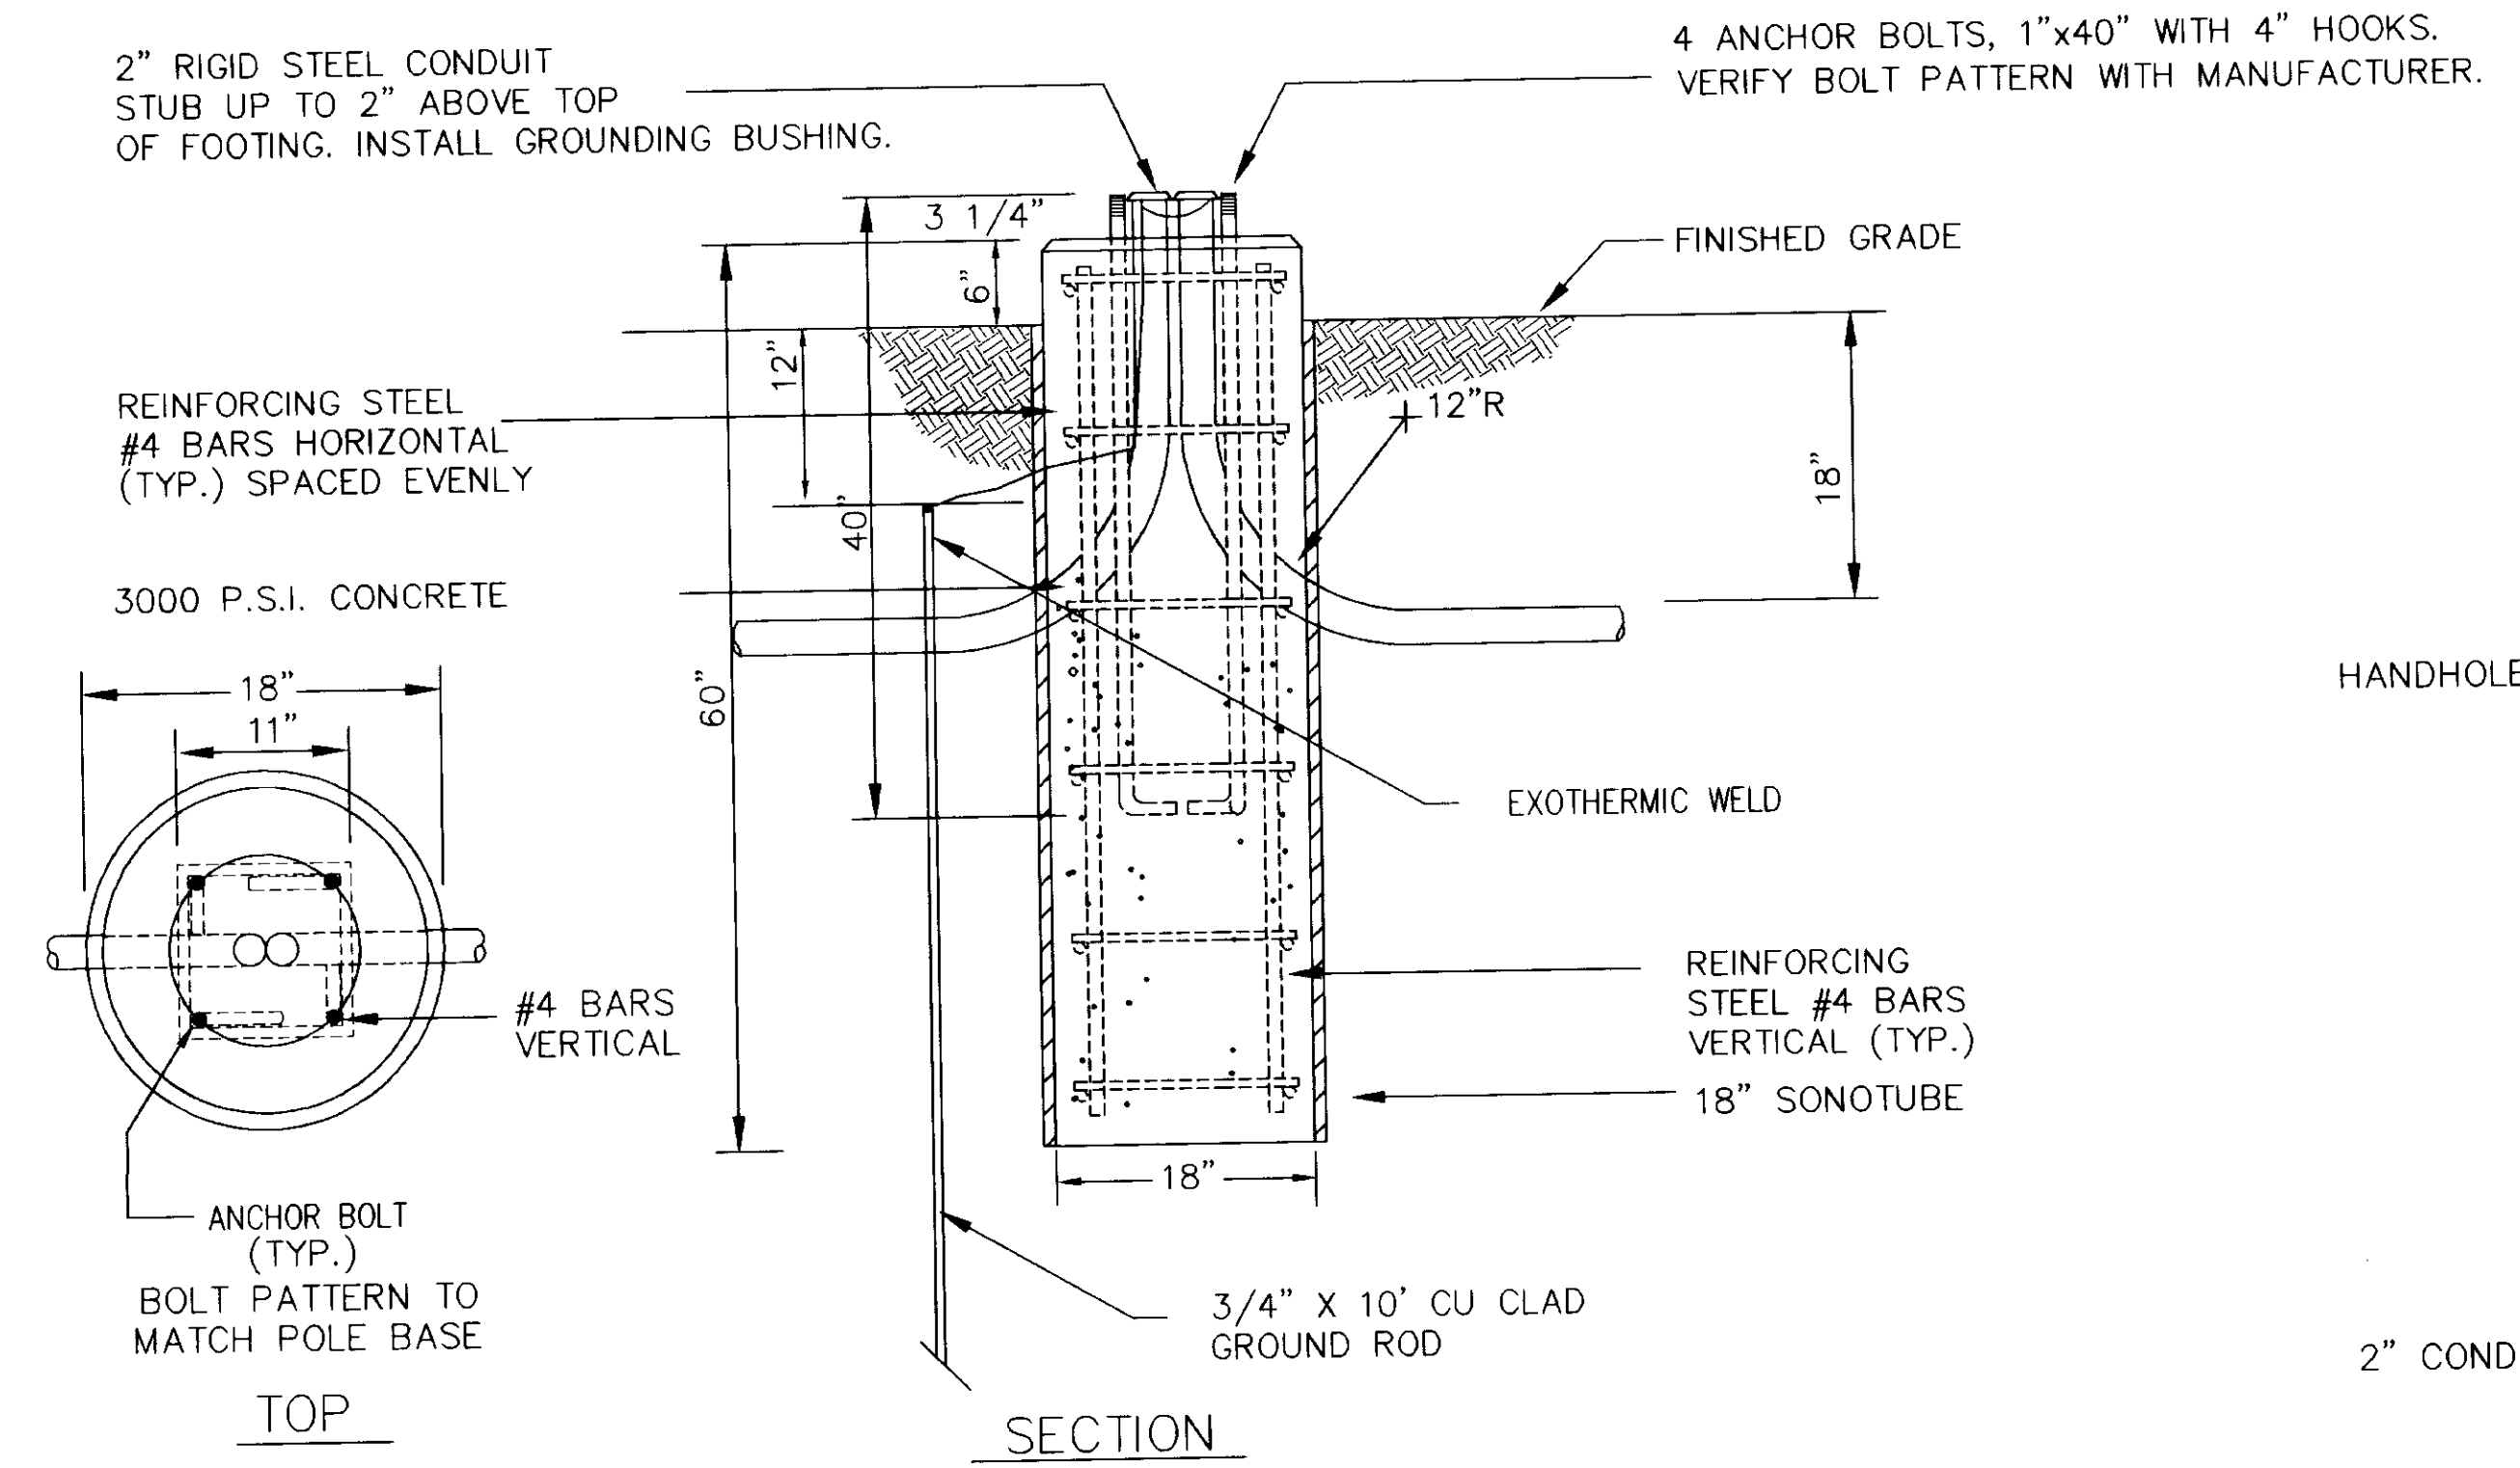


**3 LIGHT POLE FOUNDATION DETAIL**  
NOT TO SCALE

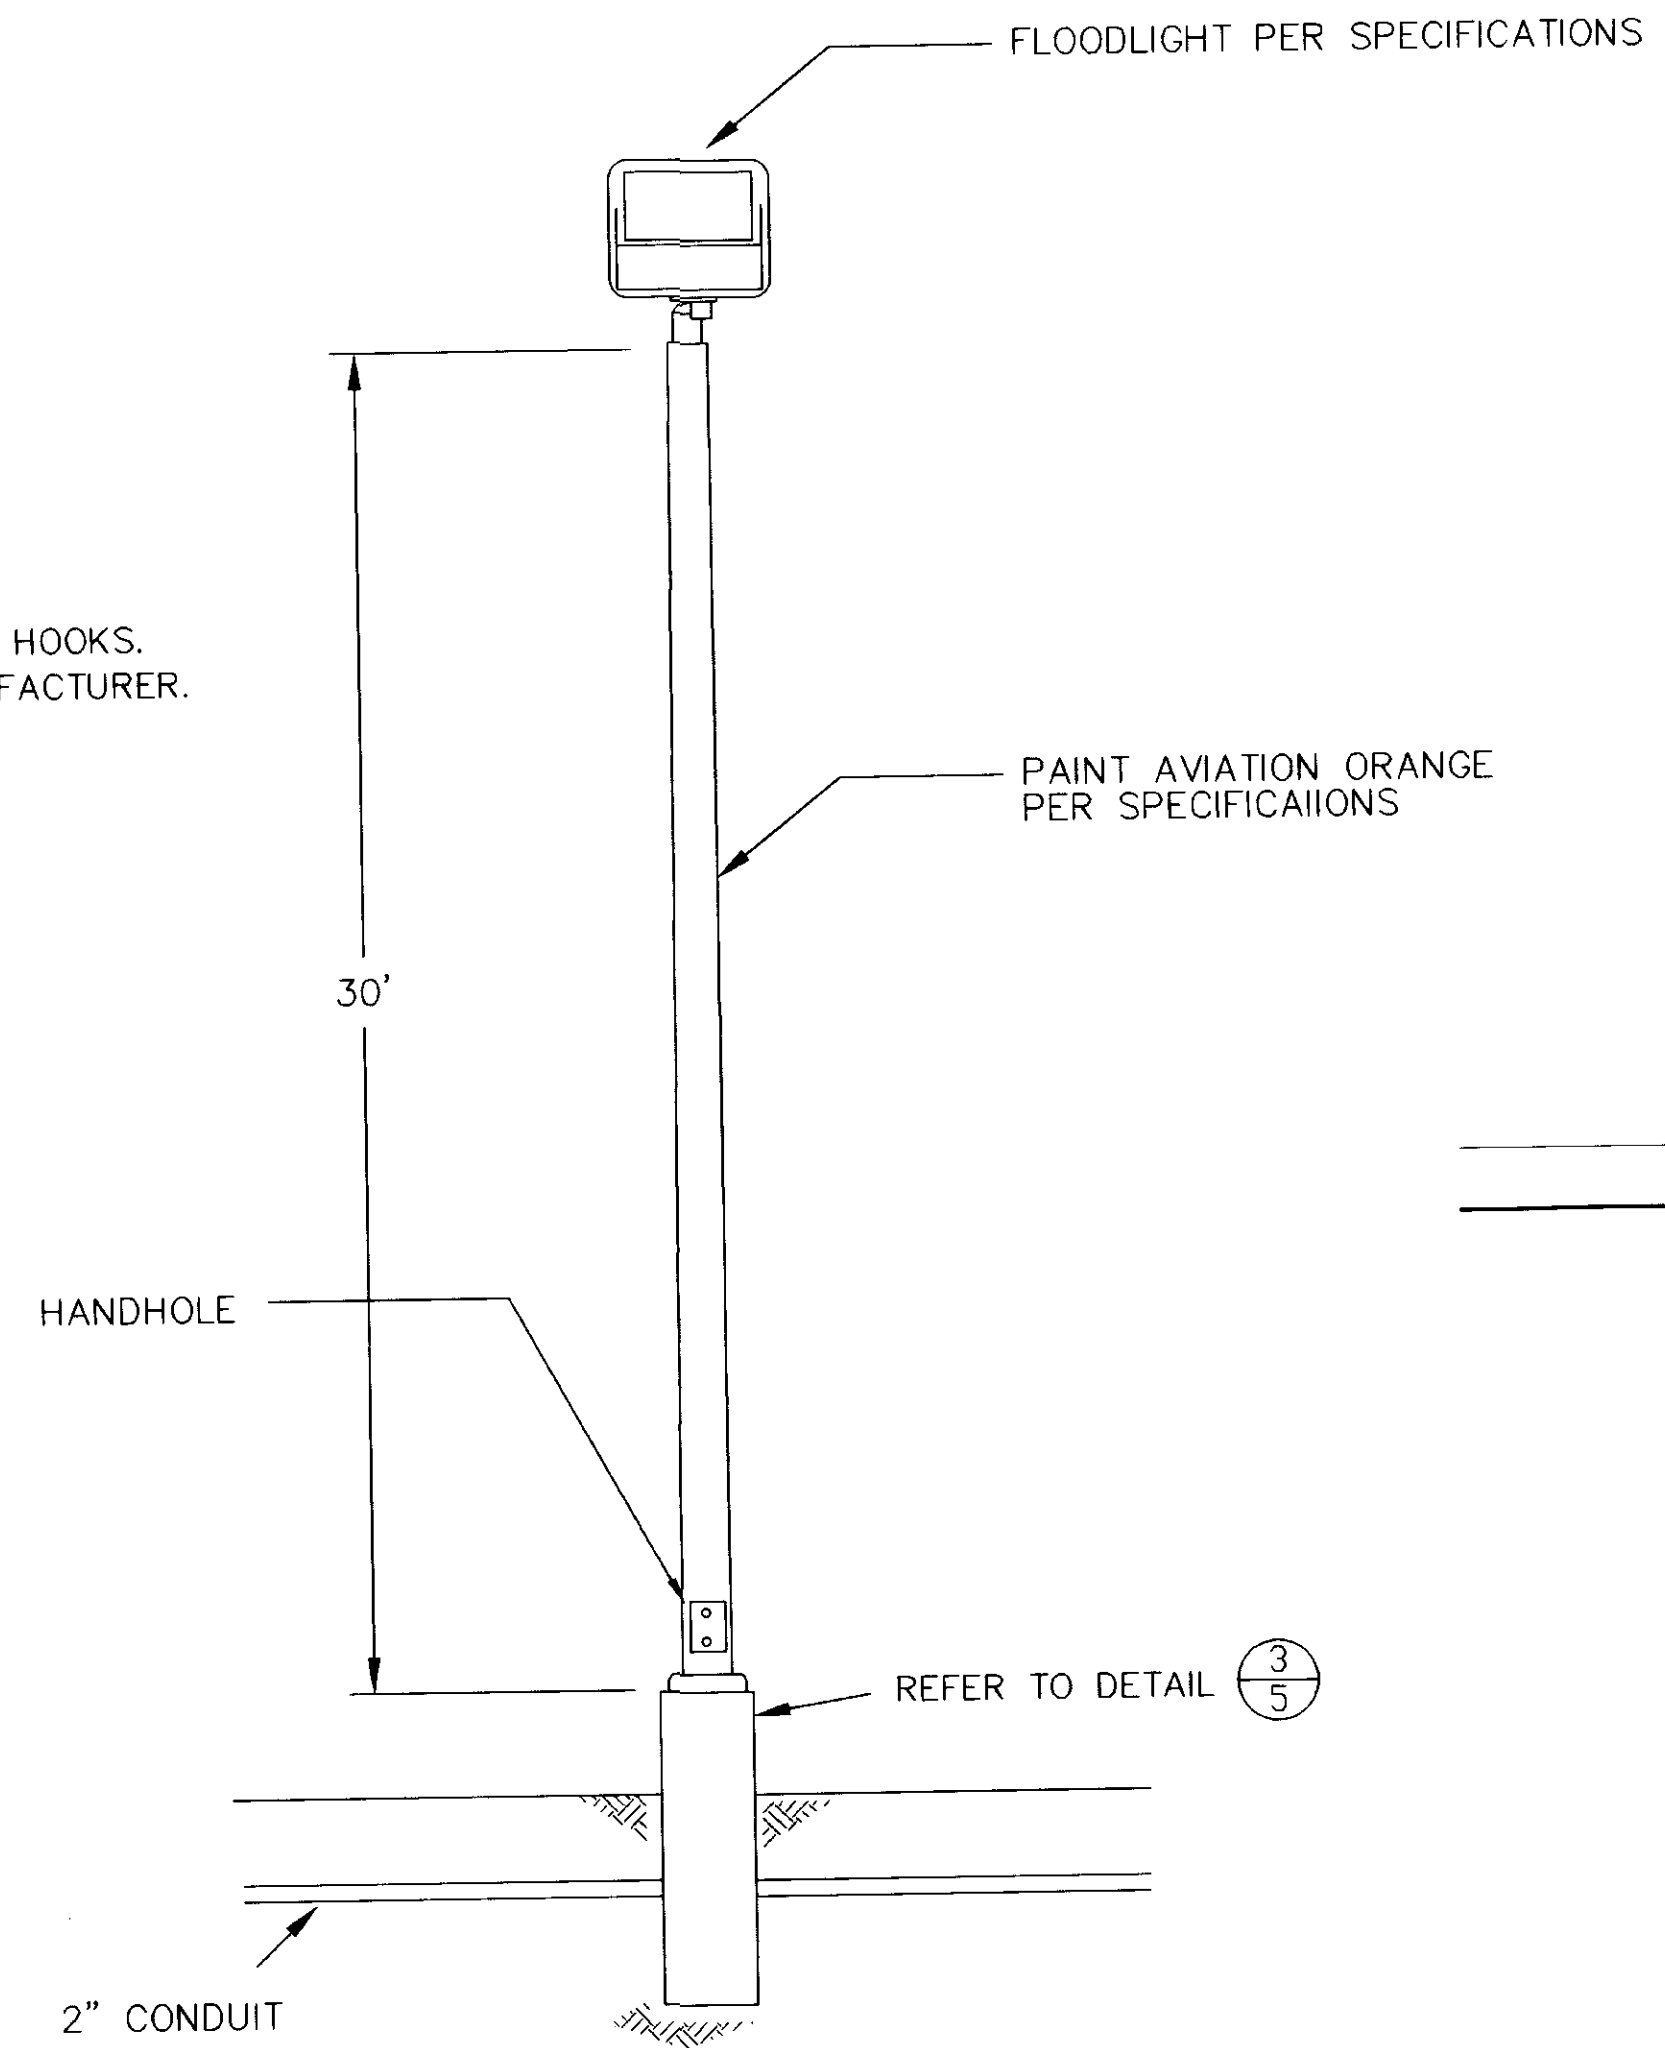


**2 APRON LIGHTING**  
NOT TO SCALE

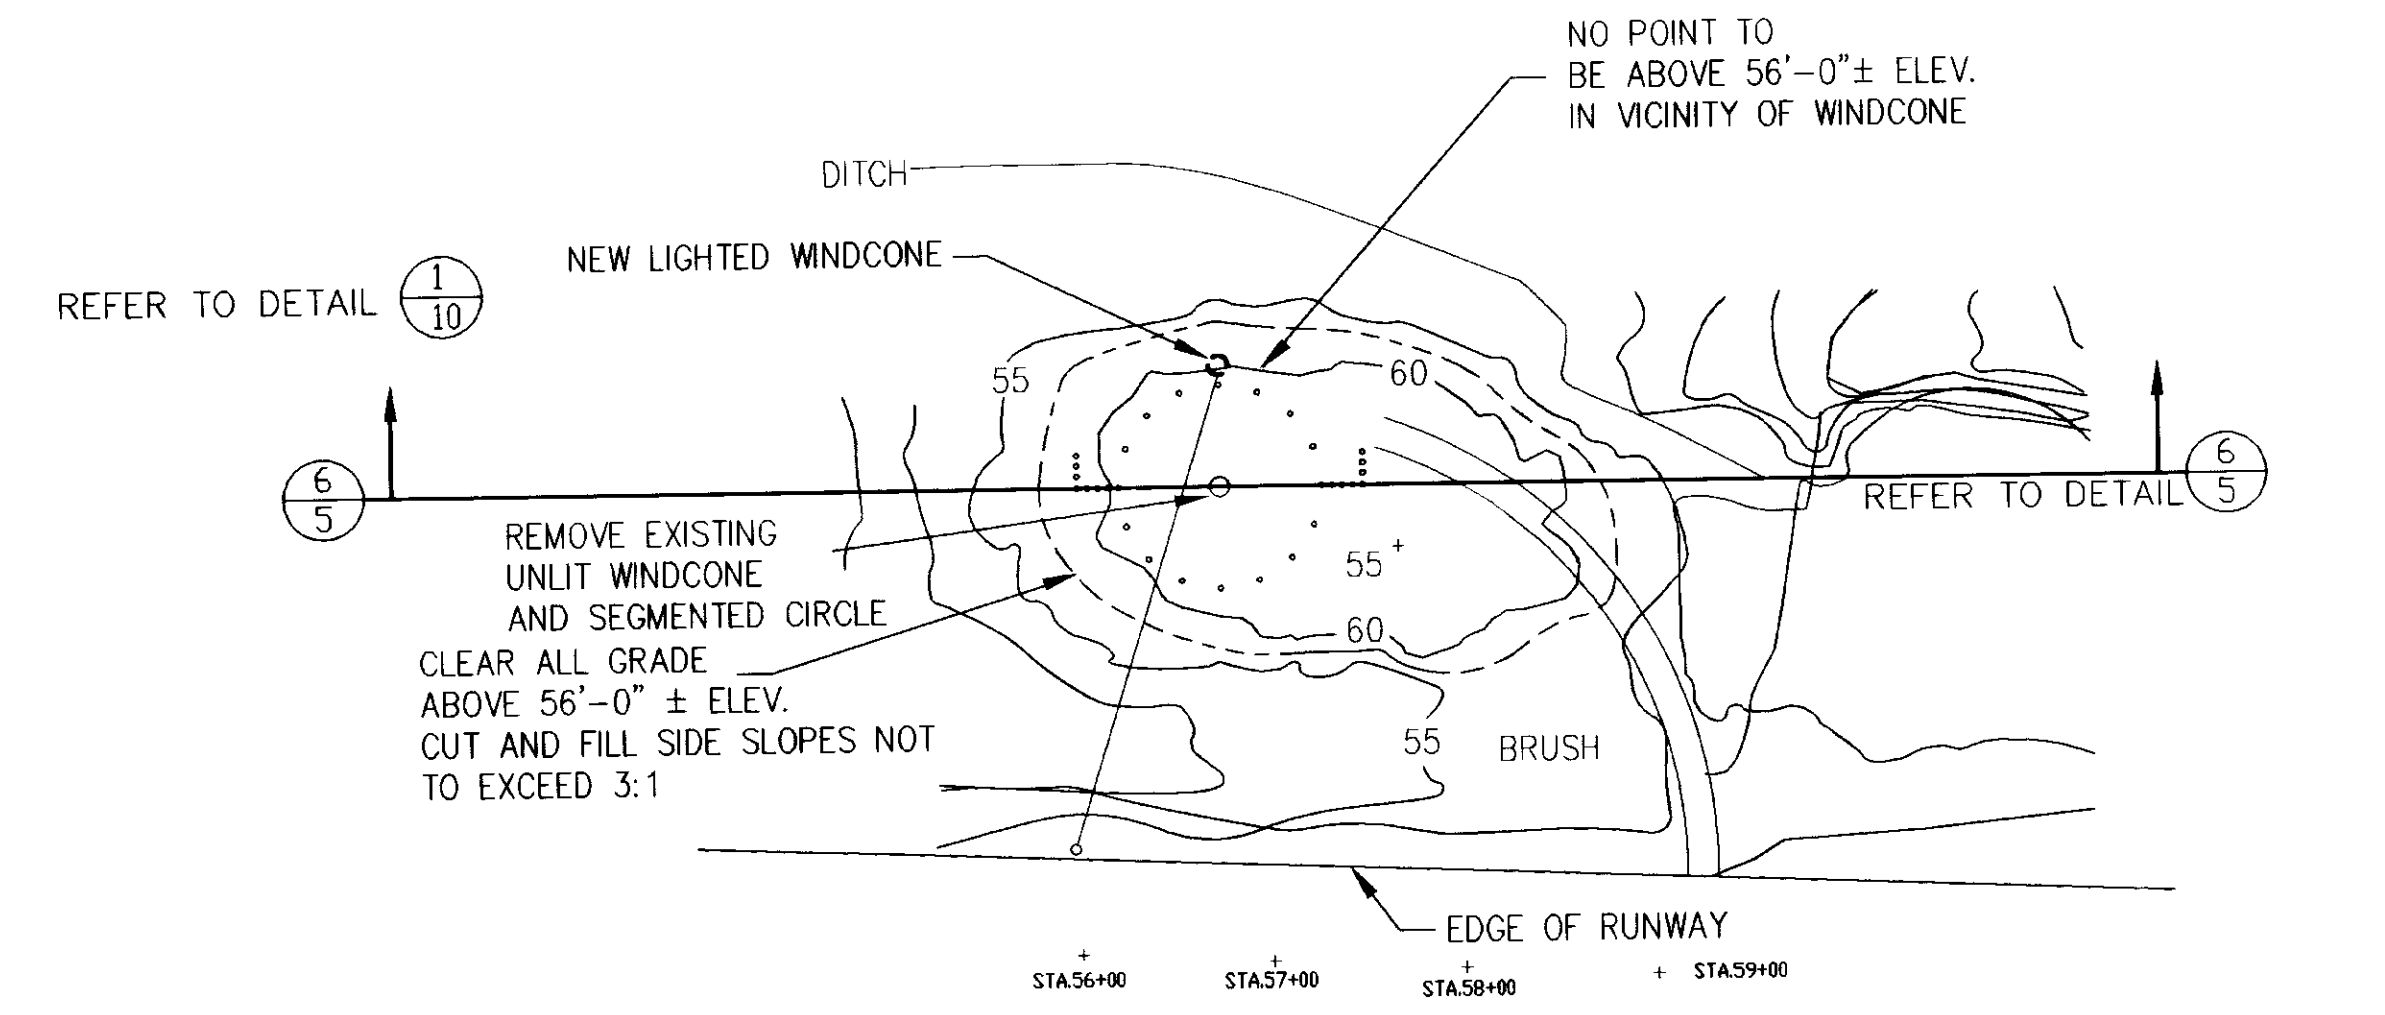

**5 WINDCONE GRADING PLAN**  
SCALE: 1"=100' CONTOUR INTERVAL= 5'

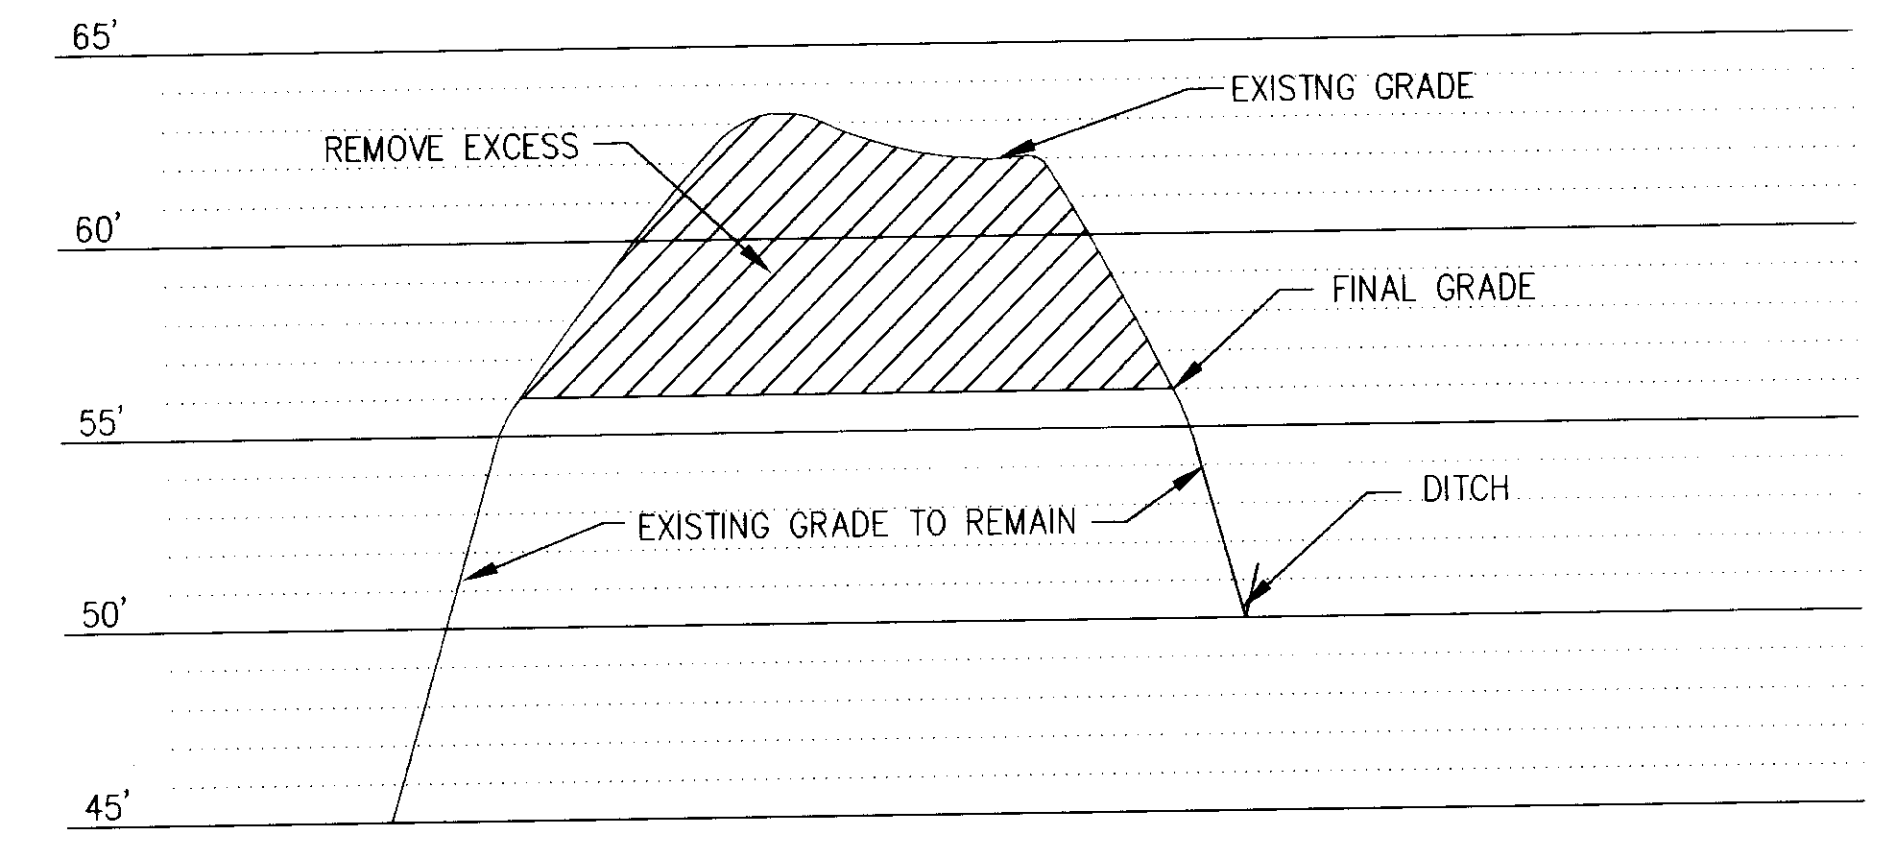


**6 WINDCONE PROFILE**  
SCALE: 1"=100' HOR. 1"=5'-0" VERT.

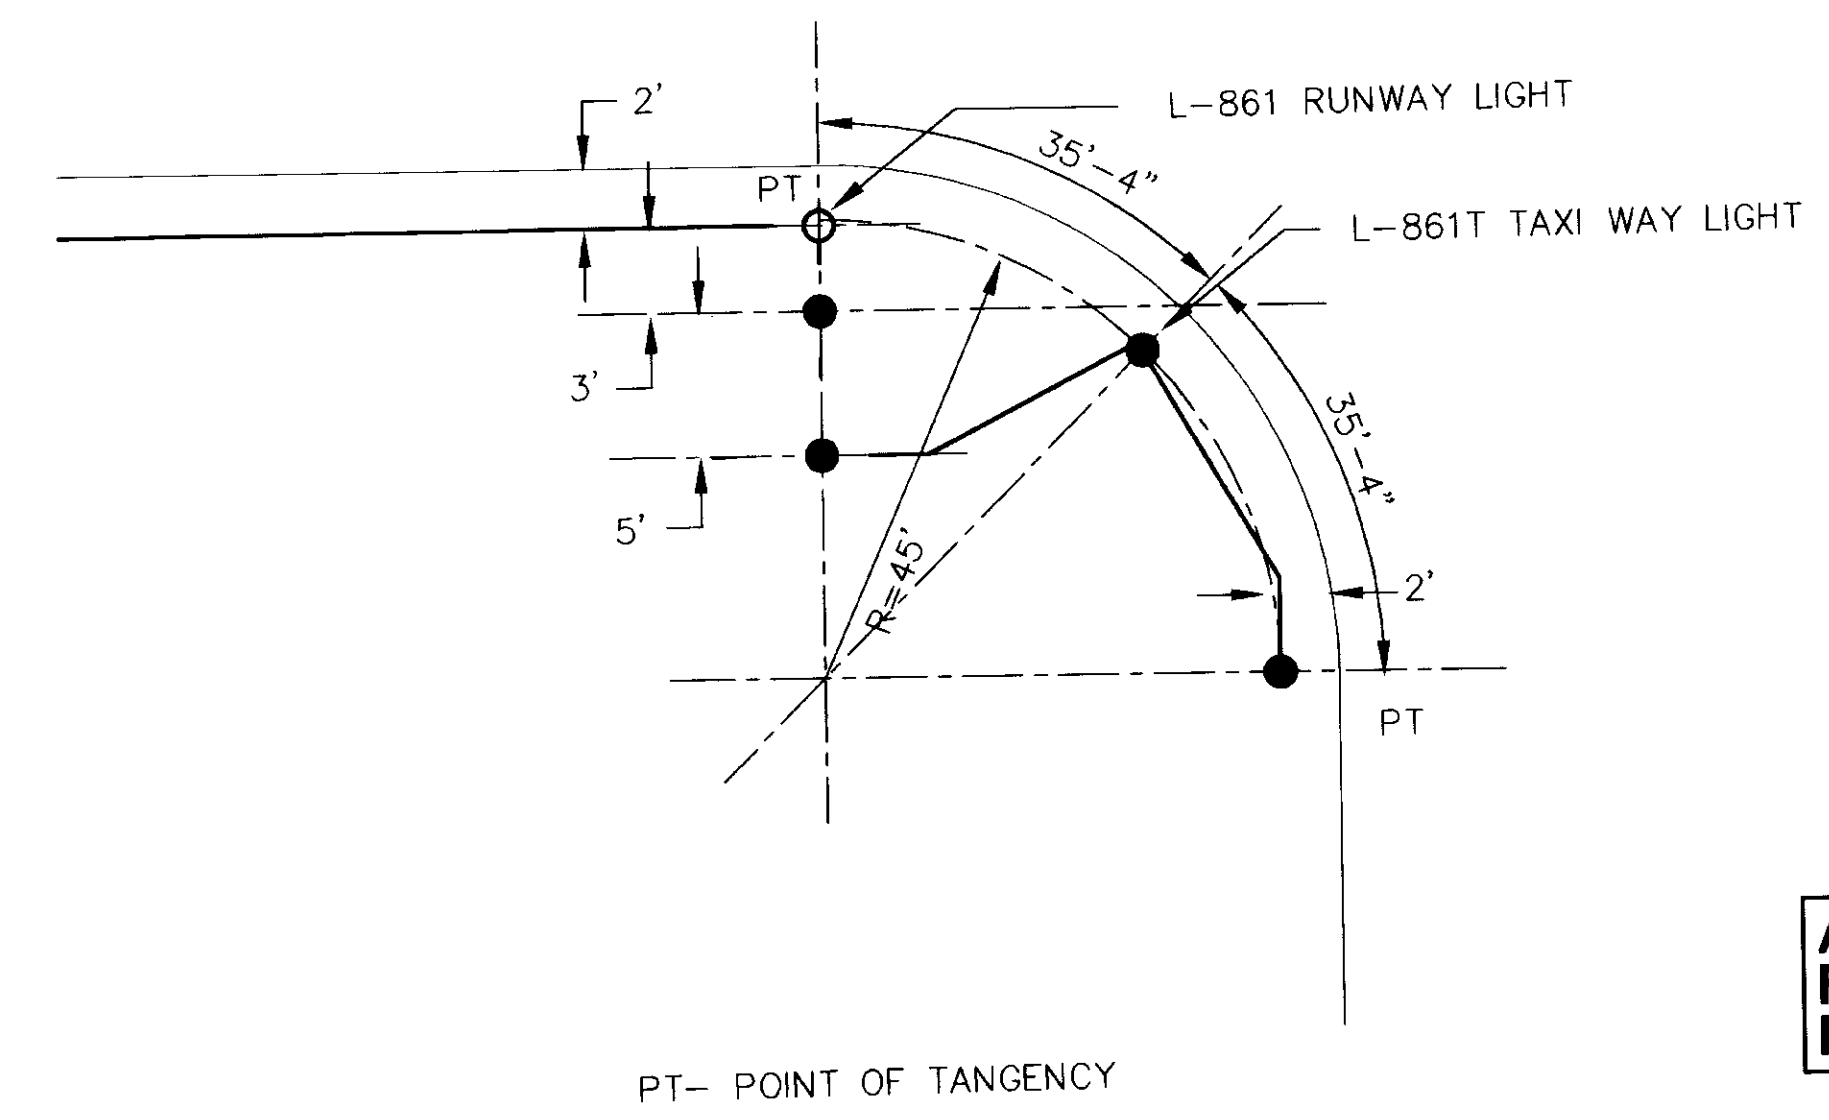


**1 ENTRANCE-EXIT LIGHTS LOCATION DETAIL**  
NOT TO SCALE

NOTE: DO NOT SCALE FROM THESE PLANS-USE DIMENSIONS

AS BUILT 9/93  
PER CONTRACTOR'S  
RED LINES

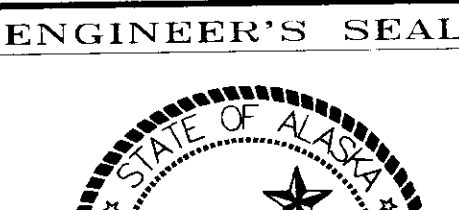




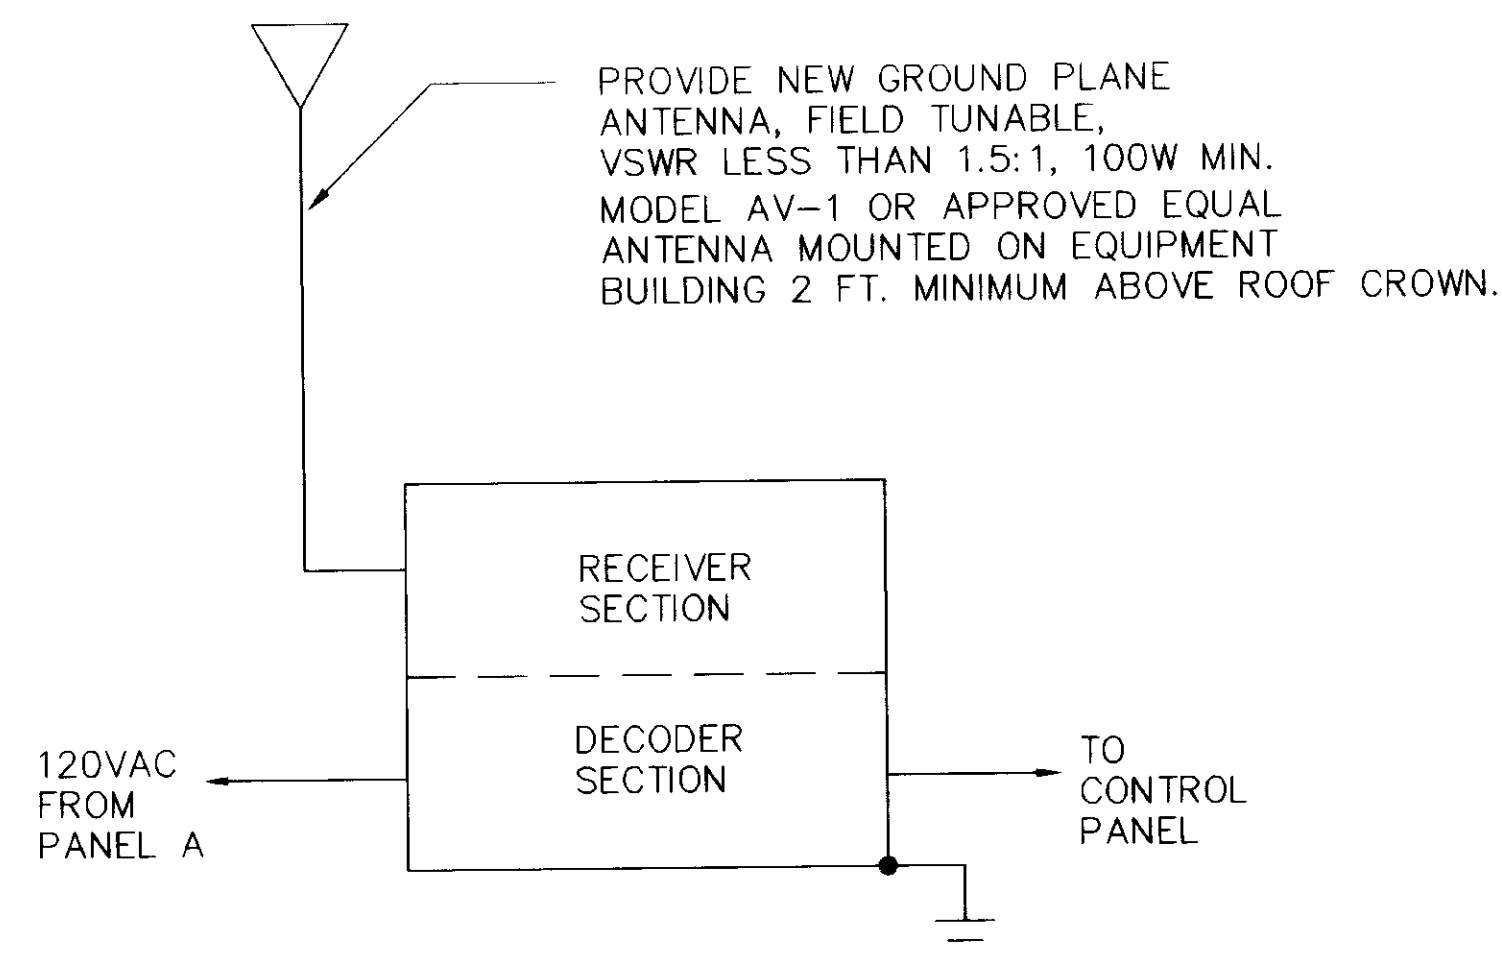

- NOTES: 1. VHF RADIO CONTROLLER TO BE FAA TYPE L-854  
2. FAA ASSIGNED FREQUENCY-122.9 MHZ  
3. CONTROLLER TO SENSE 3.5, OR 7 PULSES WITHIN 5 SEC., ACTIVATE APPROPRIATE RELAYS AND SHUT DOWN AFTER 15 MIN. TIME INTERVAL.

# 1 RADIO CONTROLLER NOT TO SCALE

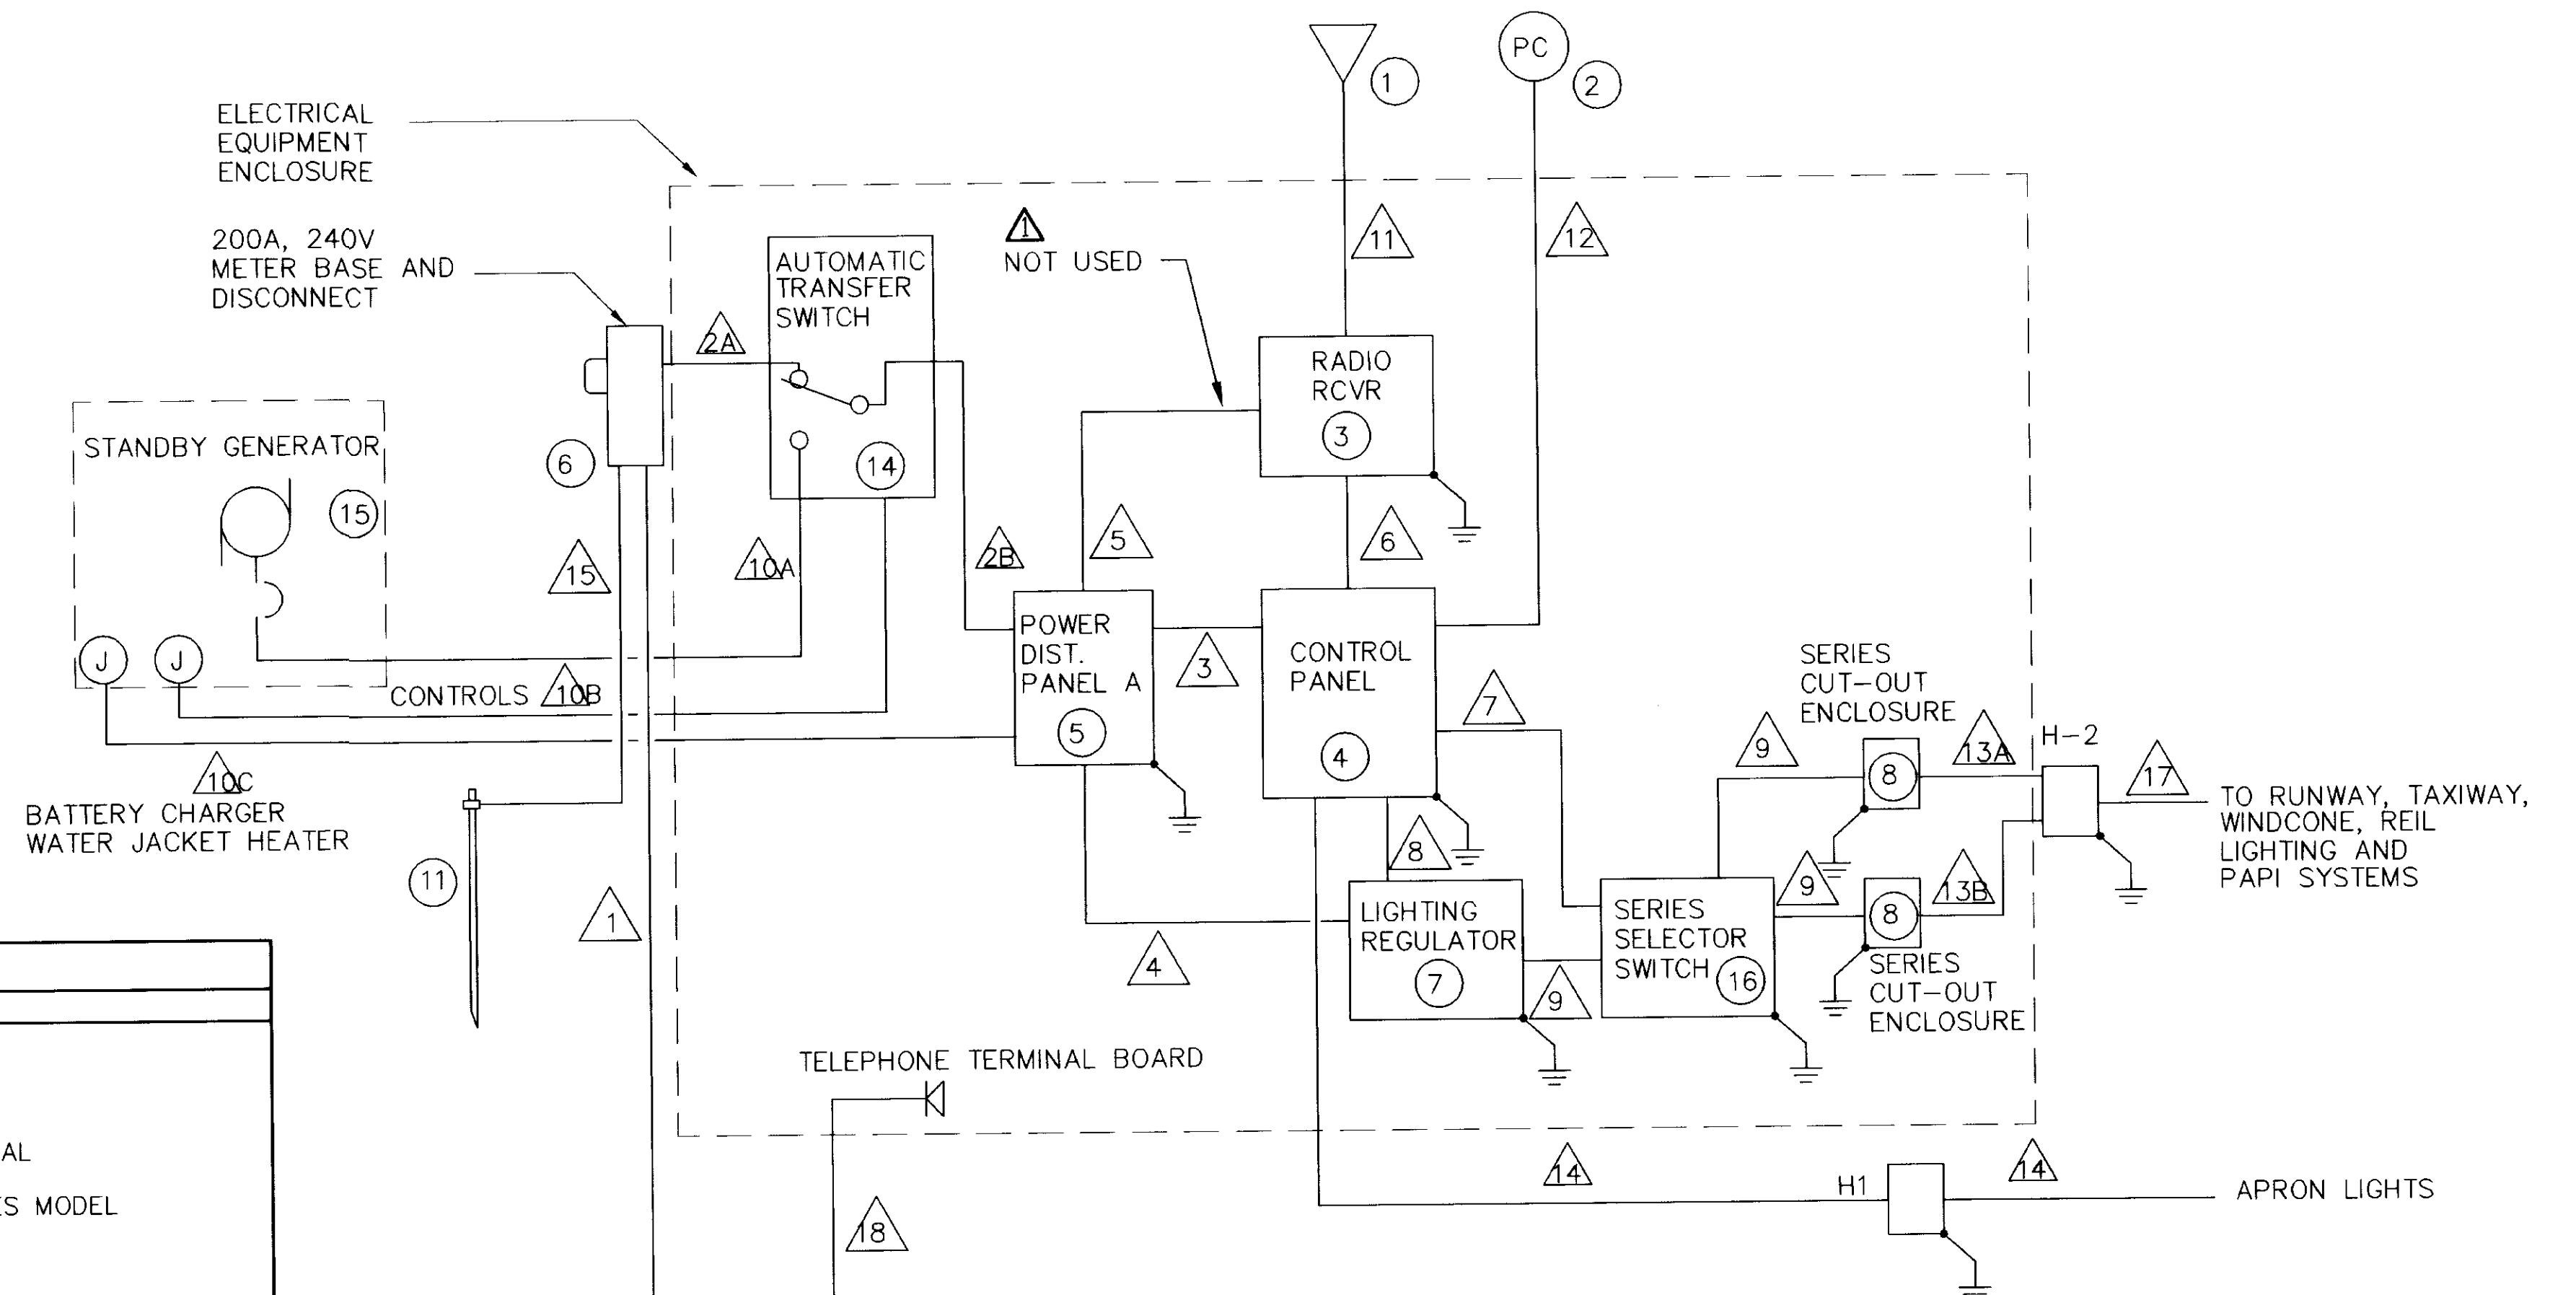


- NOTES: 1. (NO) INDICATES EQUIPMENT REFERENCE NO. SEE SCHEDULE.  
2. (NO) INDICATES CONDUIT/CONDUCTOR REFERENCE NUMBER. SEE SCHEDULE.  
3. INSTALL 2" GRMC SWEEP AT BASE OF POLE, EXTEND CONDUIT AT LEAST 24" ABOVE GRADE, CAP AND COVER WITH U-GUARD.  
4. INSTALL 3" GRMC SWEEP AT BASE OF POLE, EXTEND CONDUIT UP INTO U-GUARD, COMPLETE INSTALLATION PER REA ASSEMBLY UNIT 'UM5', FOR FINAL CONNECTION BY AP&T.

## 2 RUNWAY LIGHTING SCHEMATIC DIAGRAM NOT TO SCALE

AS BUILT 9/93  
PER CONTRACTOR'S  
RED LINES

ENGINEER'S SEAL

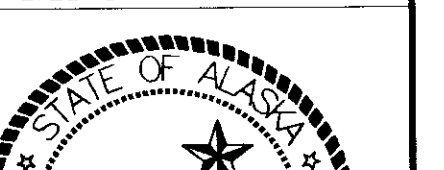

NOTE: DO NOT SCALE FROM THESE PLANS-USE DIMENSIONS

### CONDUIT/CONDUCTOR SCHEDULE


REF. NO.	CONDUIT SIZE IN.	TYPE	NO. OF COND.	TYPE	FROM	TO
1	3	RSC	4	NO. 3/0 (2)	POLE	METER BASE
2A	3	RSC	4	NO. 3/0	METER BASE	XFER SWITCH
2B	2	RSC	4	NO. 3/0	XFER SWITCH	PANEL A
3	3/4	RSC	8	NO. 12	PANEL A	CONT. PNL
4	1	RSC	2	NO. 4	PANEL A	LTG. REG.
5	3/4	RSC	2	NO. 12	PANEL A	RADIO CONT.
6	3/4	RSC	5	NO. 12	CONT. PNL	RADIO CONT.
7	3/4	RSC	4	NO. 12	CONT. PNL	CIRC SEL SW
8	3/4	RSC	5	NO. 12	CONT. PNL	LTG. REG.
9	1-1/2	RSC	2	NO. 8	LTG. REG.	CO ENCL
			1	NO. 6G		
10A	3	RSC	4	NO. 2/0	GENERATOR	XFER SWITCH
10B	3/4	RSC	2	NO. 12	XFER SWITCH	GENERATOR
10C	3/4	RSC	4	NO. 12	PANEL A	GENERATOR
11	3/4	RSC	1	RG58/AU	RADIO CONT.	ANTENNA
12	3/4	RSC	3	NO. 12	CONT. PNL	PHOTOCELL
13A&B	2	RSC	2	NO. 8 5 KV	CO. ENCL	H6
			1	NO. 6G		
14	1-1/2	RSC	4	NO. 10	CONT. PNL	APRON LTG
15	3/4	RSC	1	NO. 2G	METER BASE	GND. ROD
17	2	PVC	4	NO. 8 5KV	H6	RUNWAY LTG
			1	NO. 6G		PAPI SYSTEMS
18	2	RSC	1	PULL WIRE	POLE	TEL. TERM. BD

- NOTES: 1. ALL CONDUCTORS 600V COPPER XHHW UNLESS NOTED OTHERWISE  
2. ONE CONDUCTOR TAPE OFF SPARE FOR FUTURE THREE PHASE SERVICE  
3. IMC MAY BE USED INSTEAD OF RSC ABOVE GRADE INSIDE OF ENCLOSURE

### EQUIPMENT LIST

REF. NO.	DESCRIPTION
1	RADIO CONTROL ANTENNA, ANTENNA SPECIALISTS MODEL VA1 OR EQUAL
2	PHOTOELECTRIC CONTROL, TORK NO. 2101 OR EQUAL
3	RADIO RECEIVER/CONTROLLER, CONTROL INDUSTRIES MODEL NOL RC-IT51A OR FAA APPROVED EQUAL
4	CONTROL PANEL, SEE SPECIFICATIONS,
5	CIRCUIT BREAKER PANEL, 225A 120/240V 3Ø 4W SQ.D CL1630 NQOD OR EQUAL
6	COMBINATION METER BASE/DISCONNECT SQ.D CL 4125 UGC200QR, 120/240V 3Ø 200A WITH 200A SELF CONTAINED KWHR METER (125A MAIN CIRCUIT BREAKER)
7	CONSTANT CURRENT REGULATOR, 15.0KW
8	5KV SERIES CUT-OUTS, SEPSCO NO. 30196. 14 X 12 X 18 NEMA 1 ENCLOSURE
9	HEATER, ELECTRIC, 240V, 2000 W WALL MOUNTED MARKEL H3422 OR EQUAL
10	THERMOSTAT, LINE VOLTAGE, 40 TO 90°F, WITH OFF POSITION, WALL SURFACE MOUNTED
11	GROUND ROD 5/8" X 8' COPPER CLAD
12	HID LIGHT FIXTURE, 50W, 120V, HPS. CEILING MOUNTED WITH PRISMATIC POLYCARBONATE LENS, -40°F BALLAST HUBBELL NRG-401 OR EQUAL
13	HID EXTERIOR LIGHT FIXTURE, 70W, 120V, HPS WITH INTEGRAL PHOTOCELL CONTROL, WALL MOUNTED, -40°F BALLAST HUBBELL NRG-307 OR EQUAL
14	AUTOMATIC TRANSFER SWITCH, SEE SPECIFICATIONS
15	STANDBY GENERATOR, SEE SPECIFICATIONS
16	CIRCUIT SELECTOR SWITCH (L-847, 2 CIRCUIT)




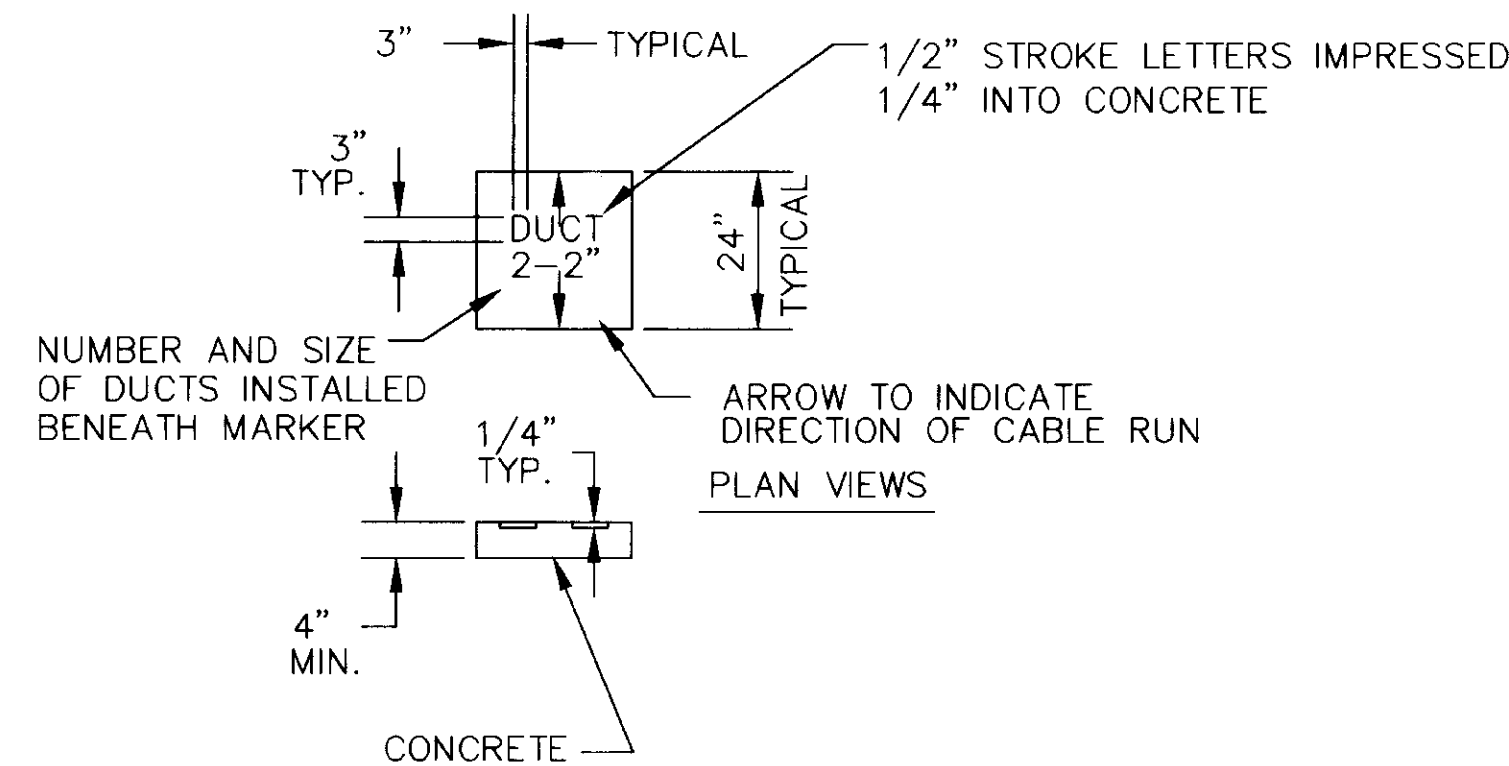


**NOTES:**

1. MARKERS SHALL BE PLACED ON EACH SIDE OF ALL PAVED OVER CROSSINGS, CORNER POINTS AND EVERY 1000' MIN.
2. COST OF CONCRETE MARKERS IS INCIDENTAL TO THE ASSOCIATED ITEMS OF DUCT OR CABLE.
3. EDGE EXPOSED CONCRETE WITH A 1/4" RADIUS TOOL.
4. WHERE ADDITIONAL SPACE TO FIT THE LEGEND IS REQUIRED, THE FOLLOWING METHODS SHALL BE EMPLOYED.
  - A. REDUCE LETTER SIZE TO 3" HIGH, 2" WIDE.
  - B. INCREASE THE MARKER SIZE TO 30" x 30" MAX.
  - C. PROVIDE ADDITIONAL MARKERS PLACED SIDE BY SIDE

**1 CABLE AND DUCT MARKERS**  
NOT TO SCALE

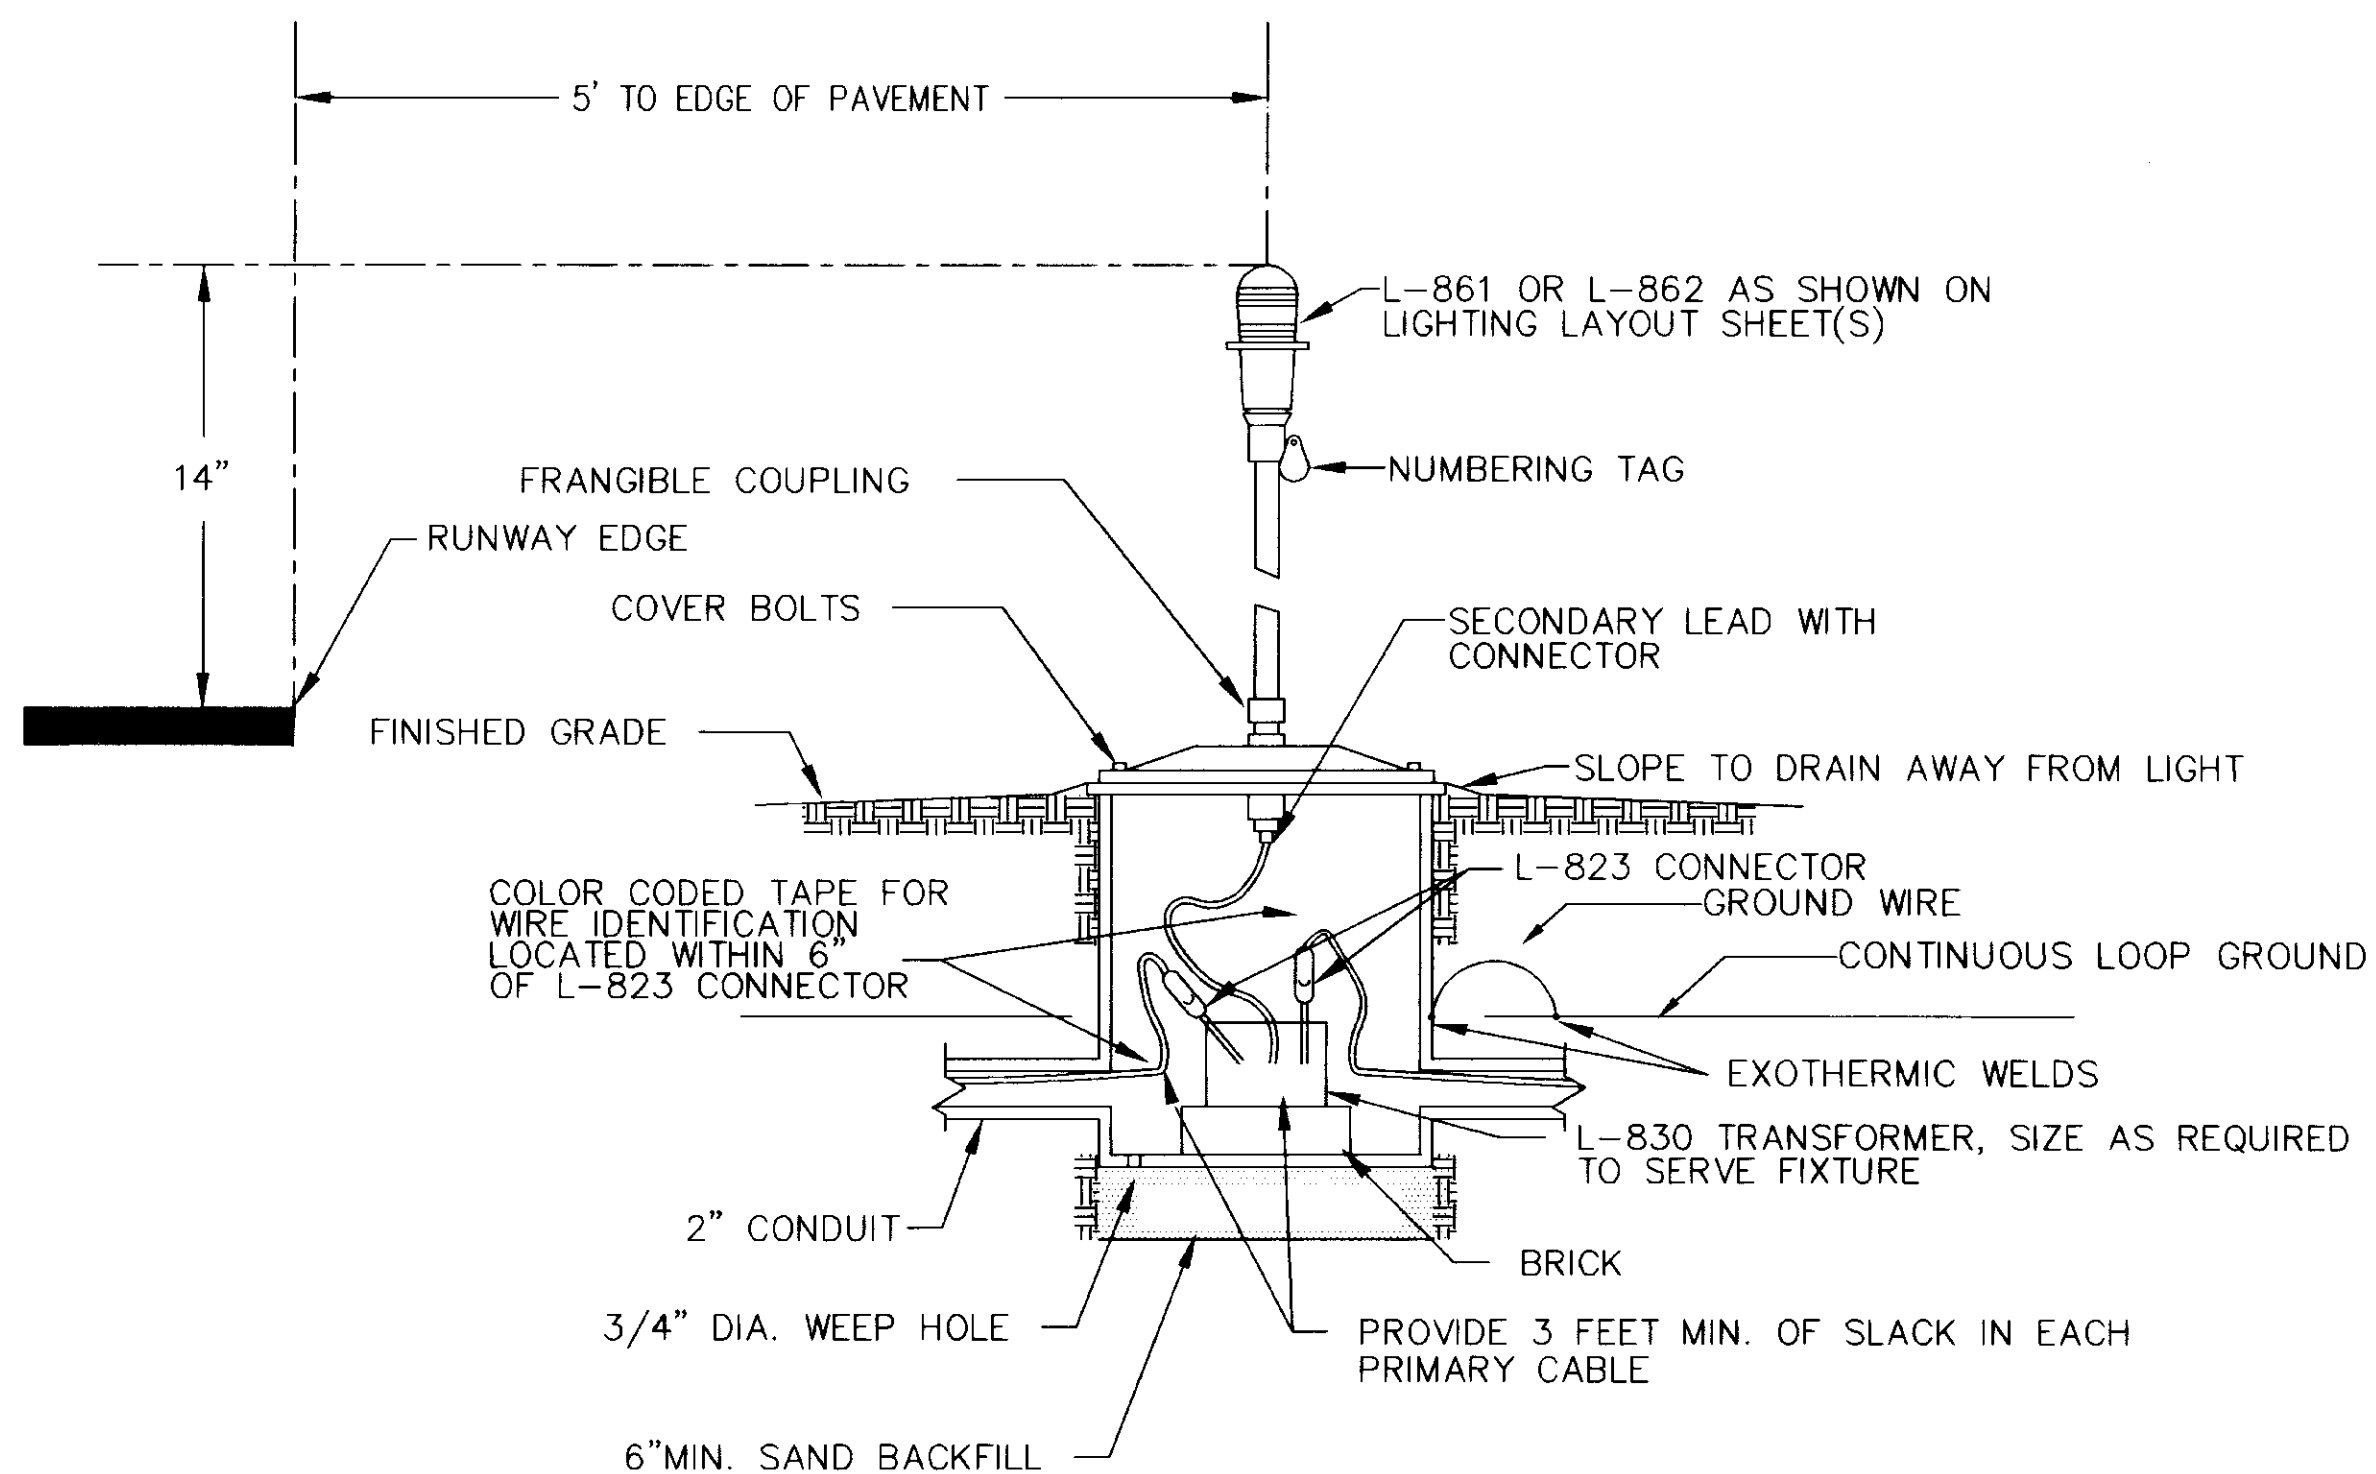


**3 MEDIUM / HIGH INTENSITY LIGHT - BASE MOUNTED**  
VIEW IS PARALLEL TO RWY. EDGE

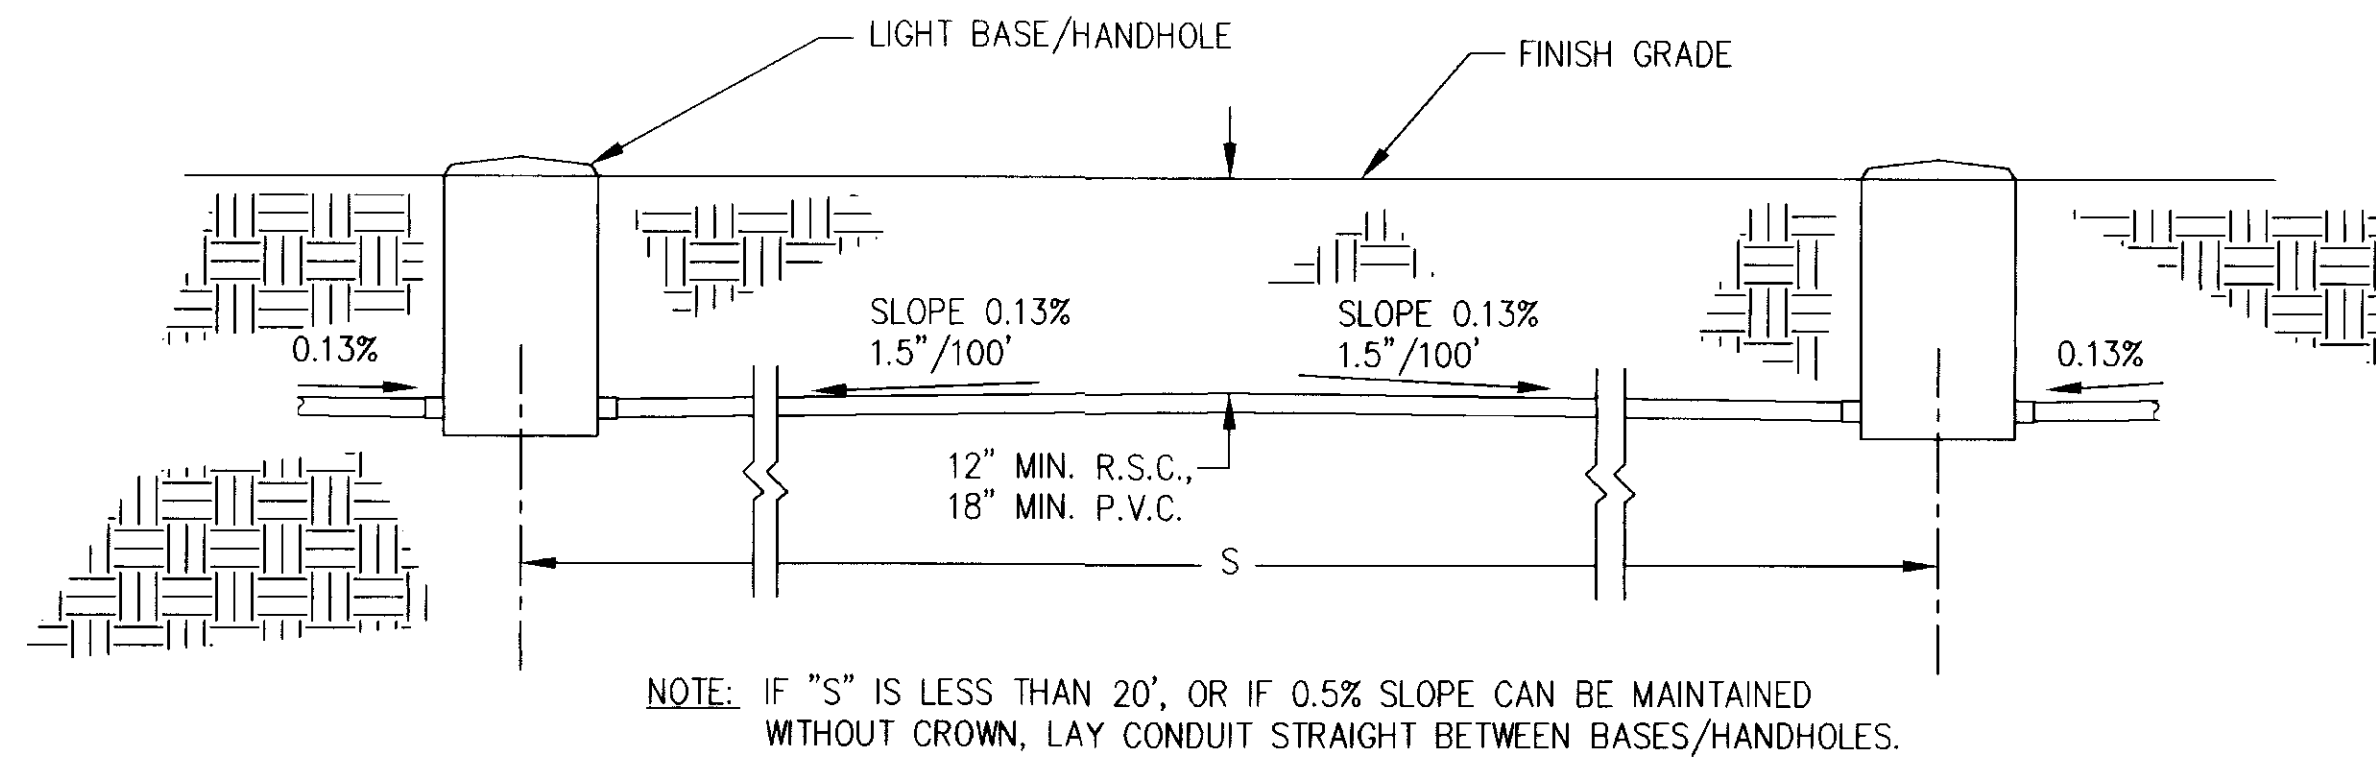

NOTE: IF "S" IS LESS THAN 20', OR IF 0.5% SLOPE CAN BE MAINTAINED WITHOUT CROWN, LAY CONDUIT STRAIGHT BETWEEN BASES/HANDHOLES.


**7 CONDUIT INSTALLATION DETAIL**  
NOT TO SCALE

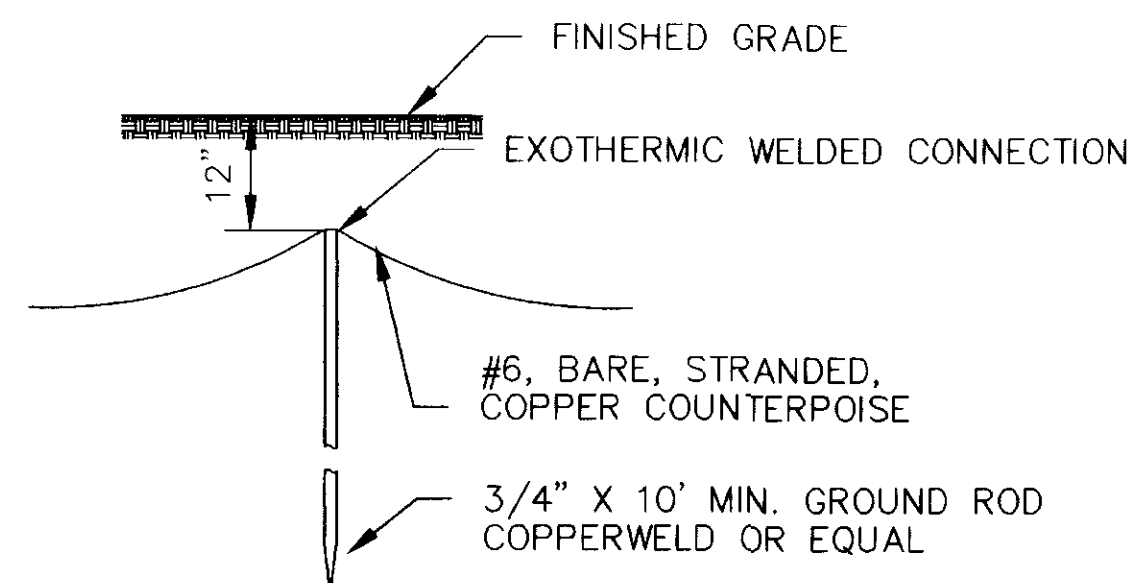


**NOTES:**

1. TYPE AND MINIMUM NUMBER OF GROUND RODS SHALL BE AS SPECIFIED ON THE PLAN.
2. THE RESISTANCE TO GROUND OF THE COUNTERPOISE GROUNDING SYSTEM SHALL NOT EXCEED 25 OHMS.
3. COST OF GROUND RODS IS INCIDENTAL TO THE ASSOCIATED ITEMS REQUIRING GROUNDING UNLESS OTHERWISE SPECIFIED.


**2 GROUND ROD**  
NOT TO SCALE

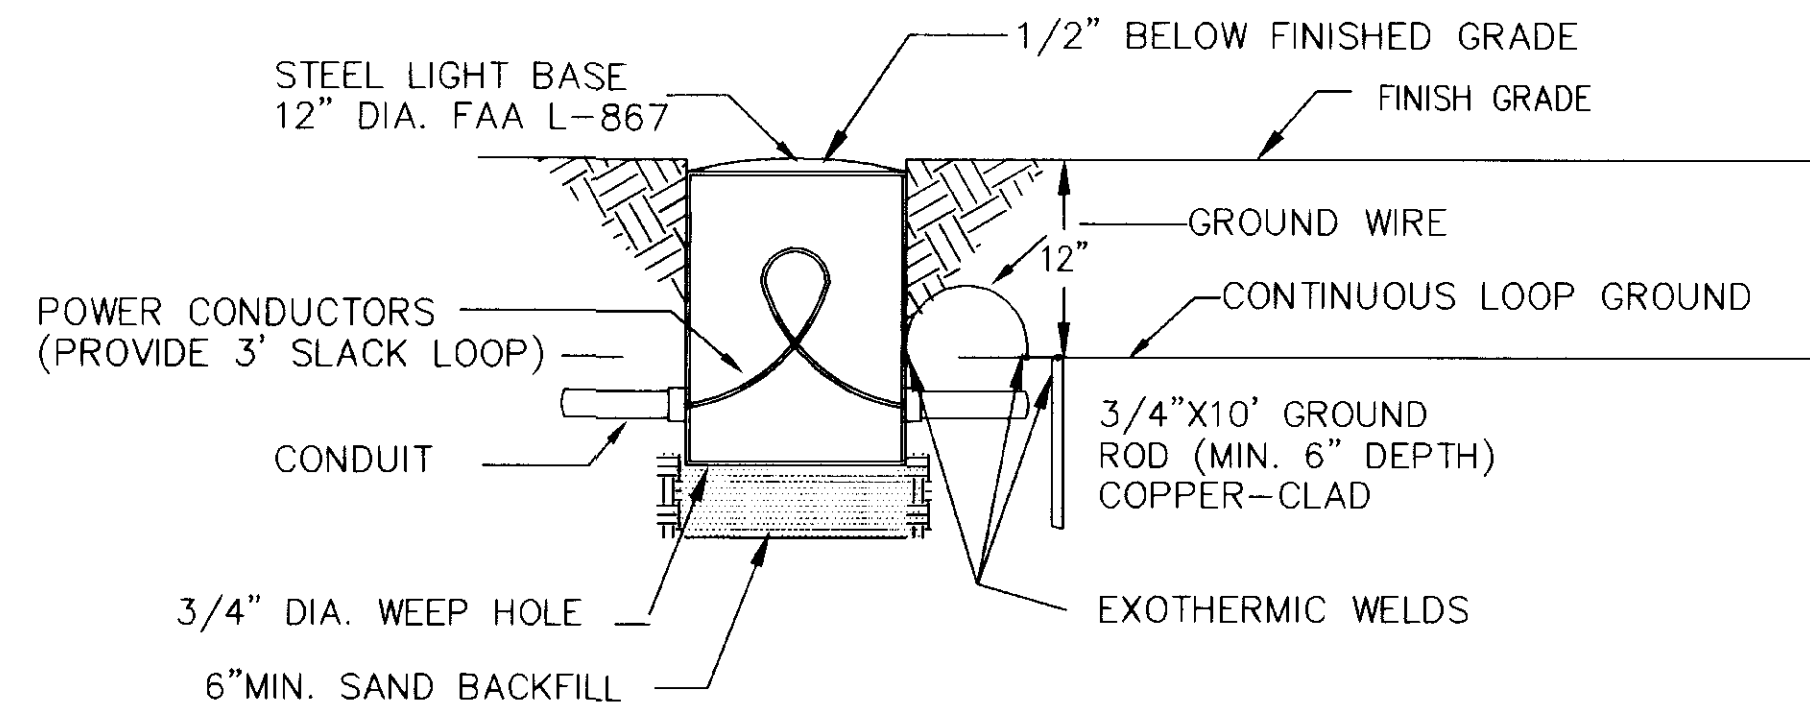

**4 HAND HOLE DETAIL**  
NOT TO SCALE

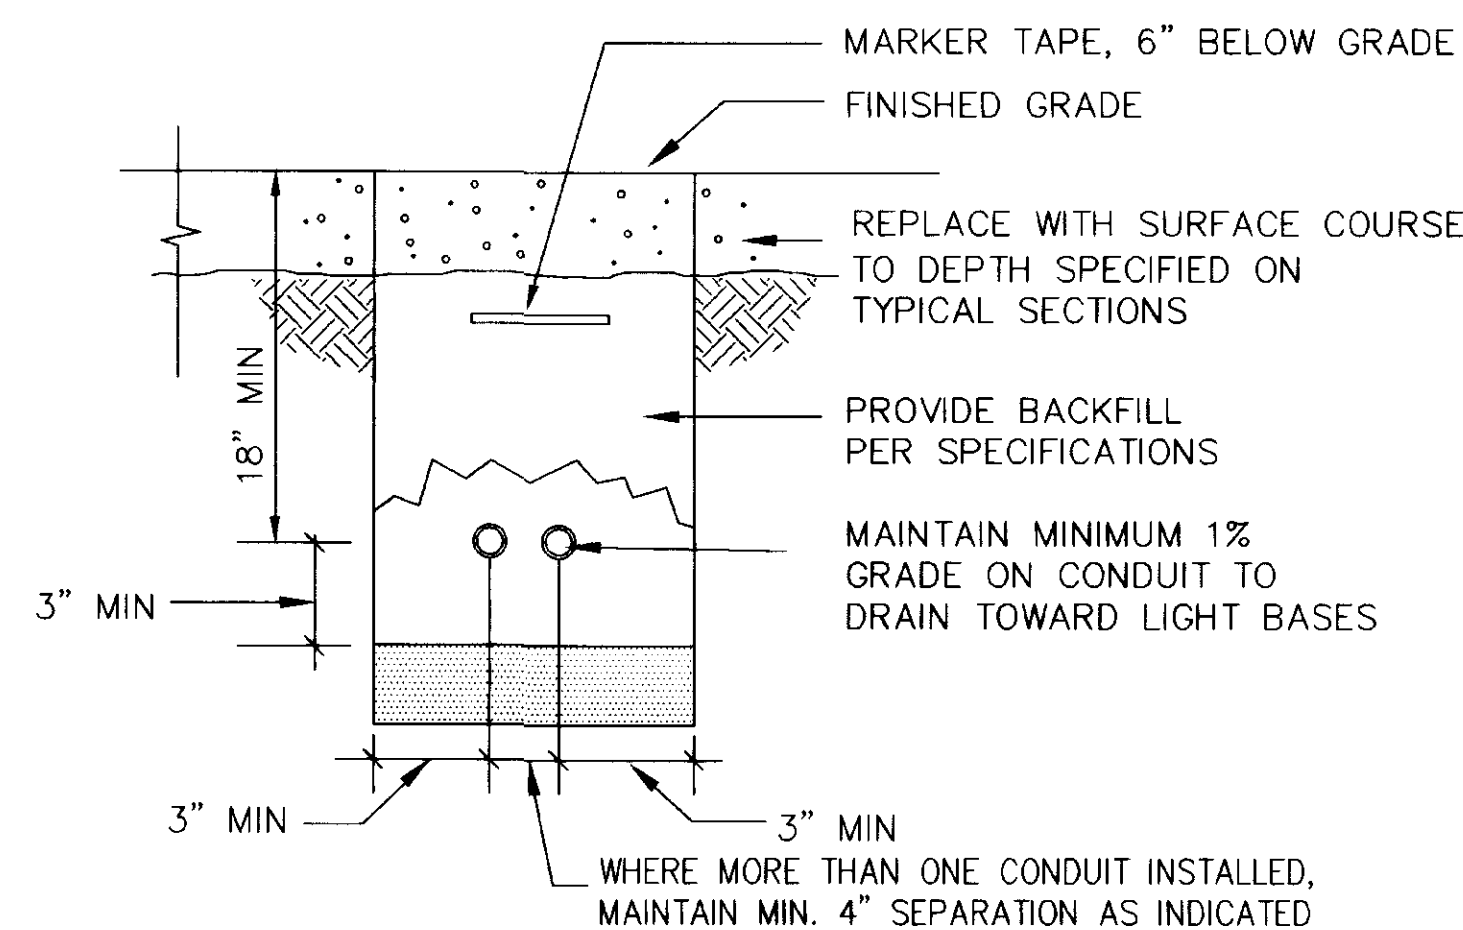


**5 TRENCH DETAIL**  
NOT TO SCALE

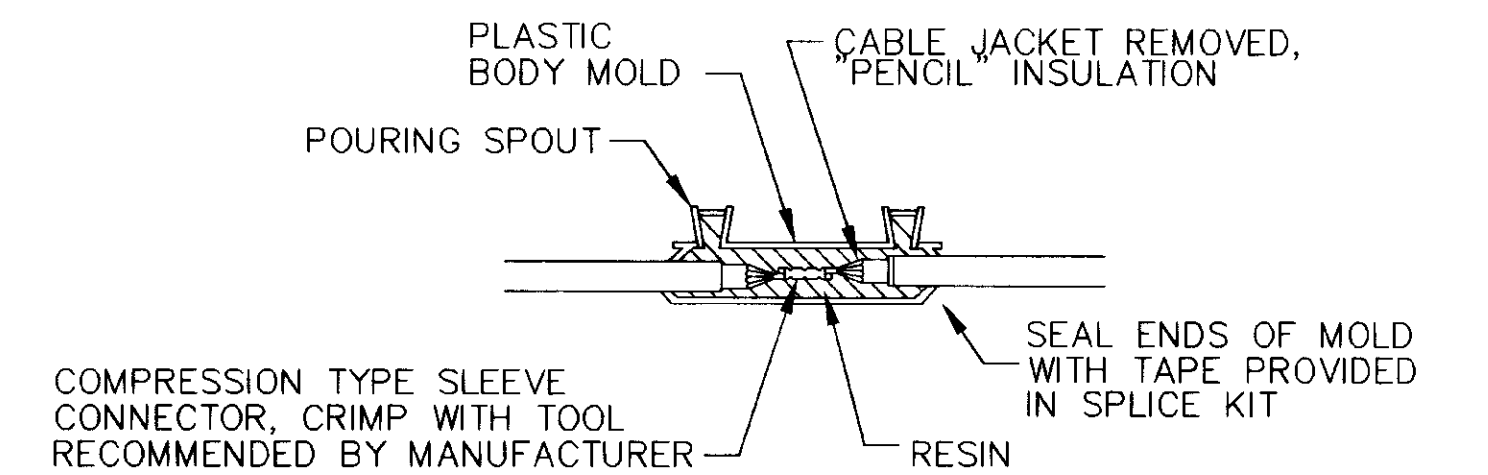

**TYPE A**

FOR SPLICES IN HOMERUNS AND FOR EXTENSIONS TO EXISTING CABLES ONLY


WRAP WITH AT LEAST ONE LAYER OF RUNNER OR SYNTHETIC RUBBER TAPE AND ONE LAYER OF PLASTIC TAPE, ONE-HALF LAPPED, EXTENDING AT LEAST 1 1/2 INCHES ON EACH SIDE OF JOINT.

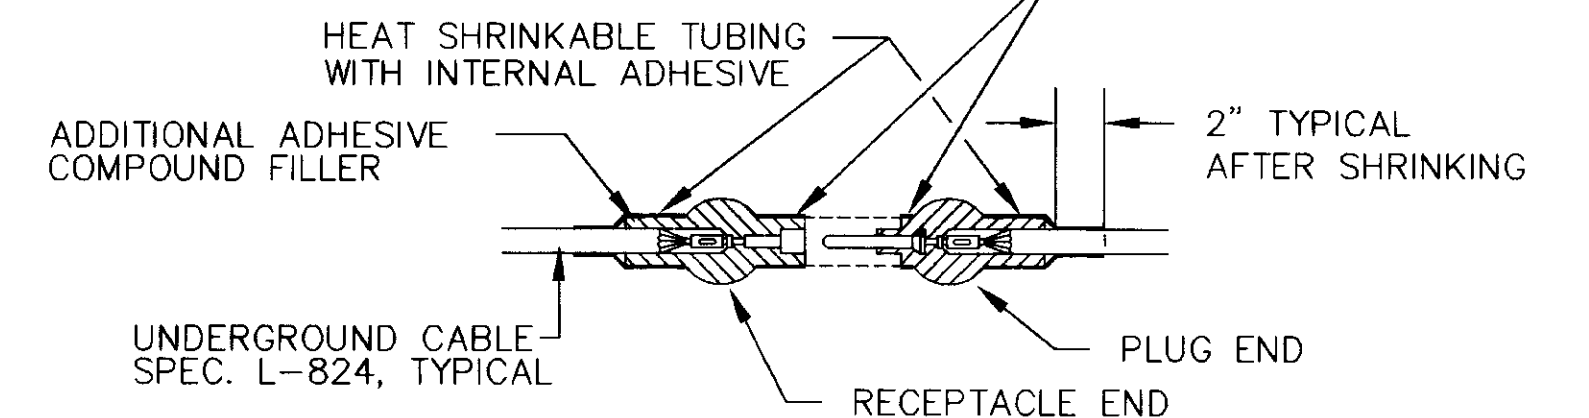

**TYPE B**

FOR SPLICES FOR USE AT JUNCTION OF HOMERUN WITH LOOP CIRCUIT

WRAP WITH AT LEAST ONE LAYER OF RUNNER OR SYNTHETIC RUBBER TAPE AND ONE LAYER OF PLASTIC TAPE, ONE-HALF LAPPED, EXTENDING AT LEAST 1 1/2 INCHES ON EACH SIDE OF JOINT.

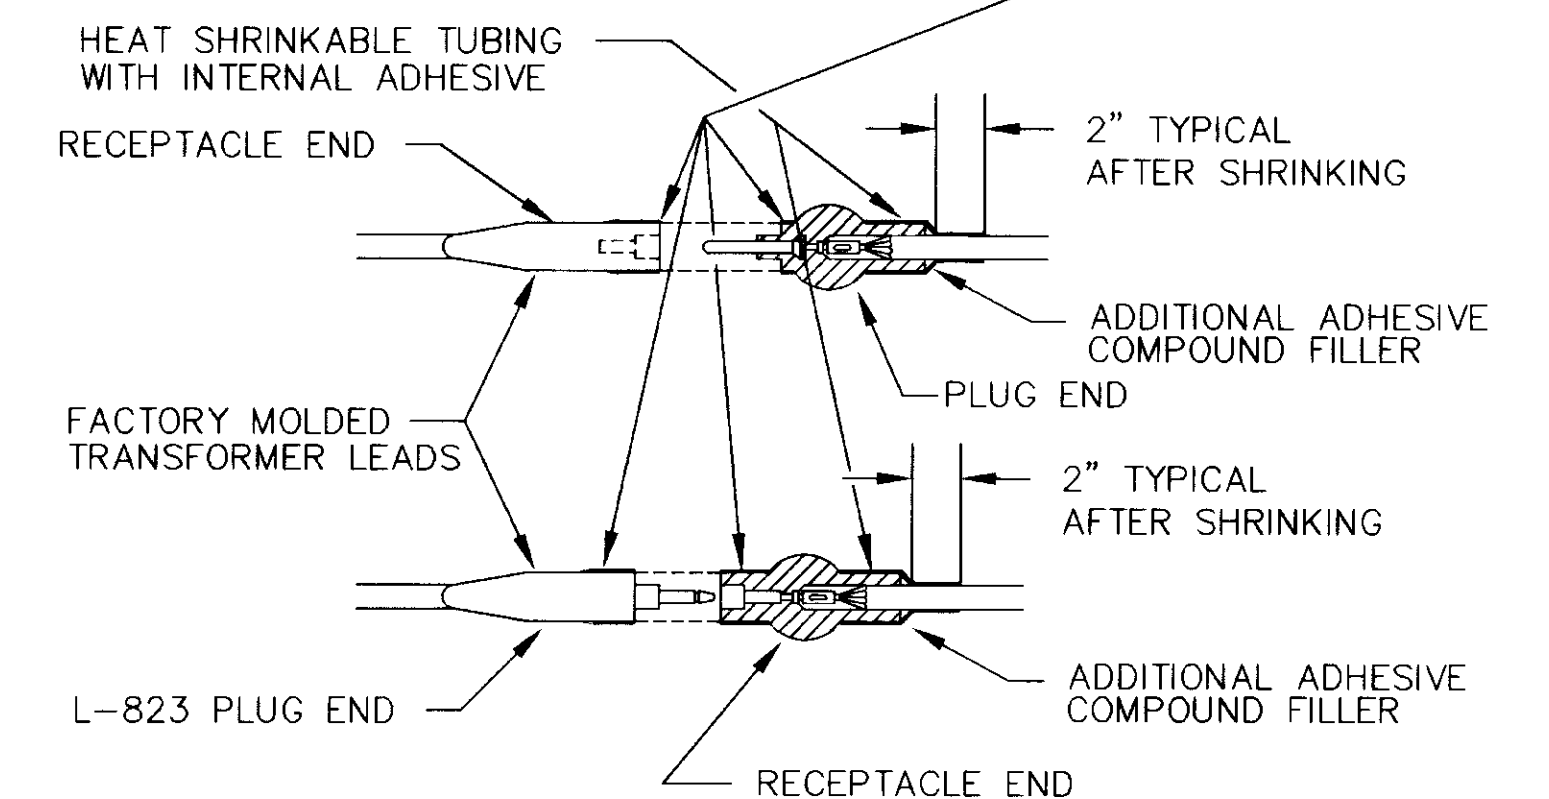

**TYPE C**

FOR SPLICES AT RUNWAY LIGHTS

**NOTES:**

1. SEE LIGHTING LAYOUT SHEET(S) FOR SPLICE TYPE (TYPE C SPLICES IN HANDHOLES ONLY FOR THIS PROJECT.)
2. INSIDE DIAMETER OF CONNECTOR SHALL PROPERLY MATCH THE OUTSIDE DIAMETER OF CABLE

**6 CABLE SPLICES**  
NOT TO SCALE

AS BUILT 9/93  
PER CONTRACTOR'S  
RED LINES


ENGINEER'S SEAL

NOTE: DO NOT SCALE FROM THESE PLANS-USE DIMENSIONS





### 1 LIGHTING CIRCUIT DIAGRAM

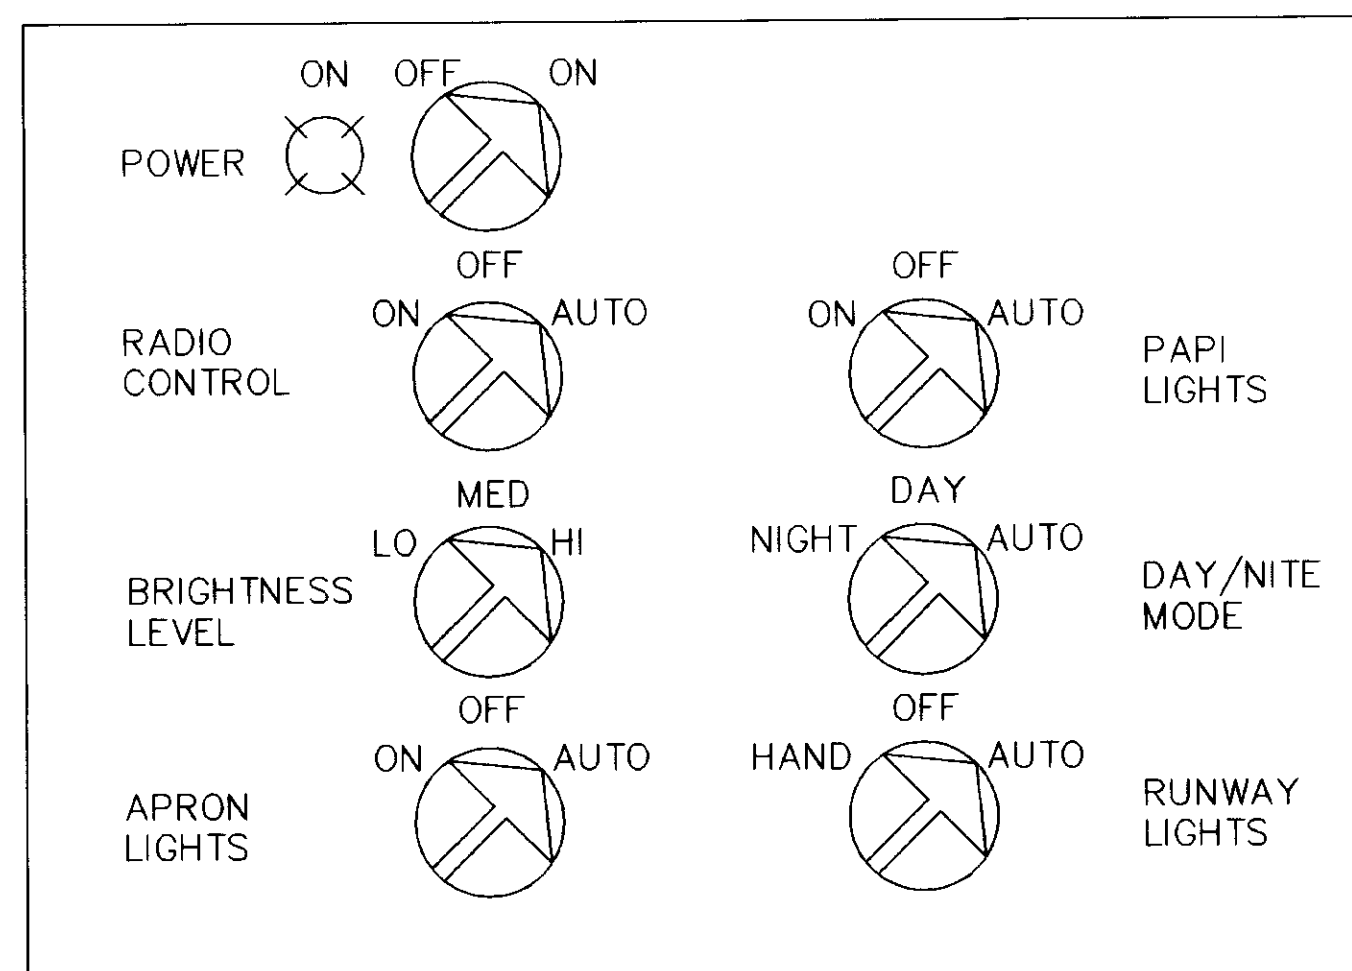

NOTES: 1. MOUNT CONTROL DEVICES ON CABINET FACE AS SHOWN.  
2. PROVIDE NEMA 12 STEEL CABINET WITH HINGED DOOR AND NEOPRENE GASKET, WITH INNER HINGED PANEL.

**2 CONTROL PANEL DETAIL**  
NOT TO SCALE



### 3 LIGHTING CONTROL DIAGRAM

RELAYS AND/OR CONTACTORS C1, C2, C3 TO BE SIZED APPROPRIATE TO LOAD REQUIREMENTS.

**AS BUILT 9/93  
PER CONTRACTOR'S  
RED LINES**


NOTE: DO NOT SCALE FROM THESE PLANS—USE DIMENSIONS











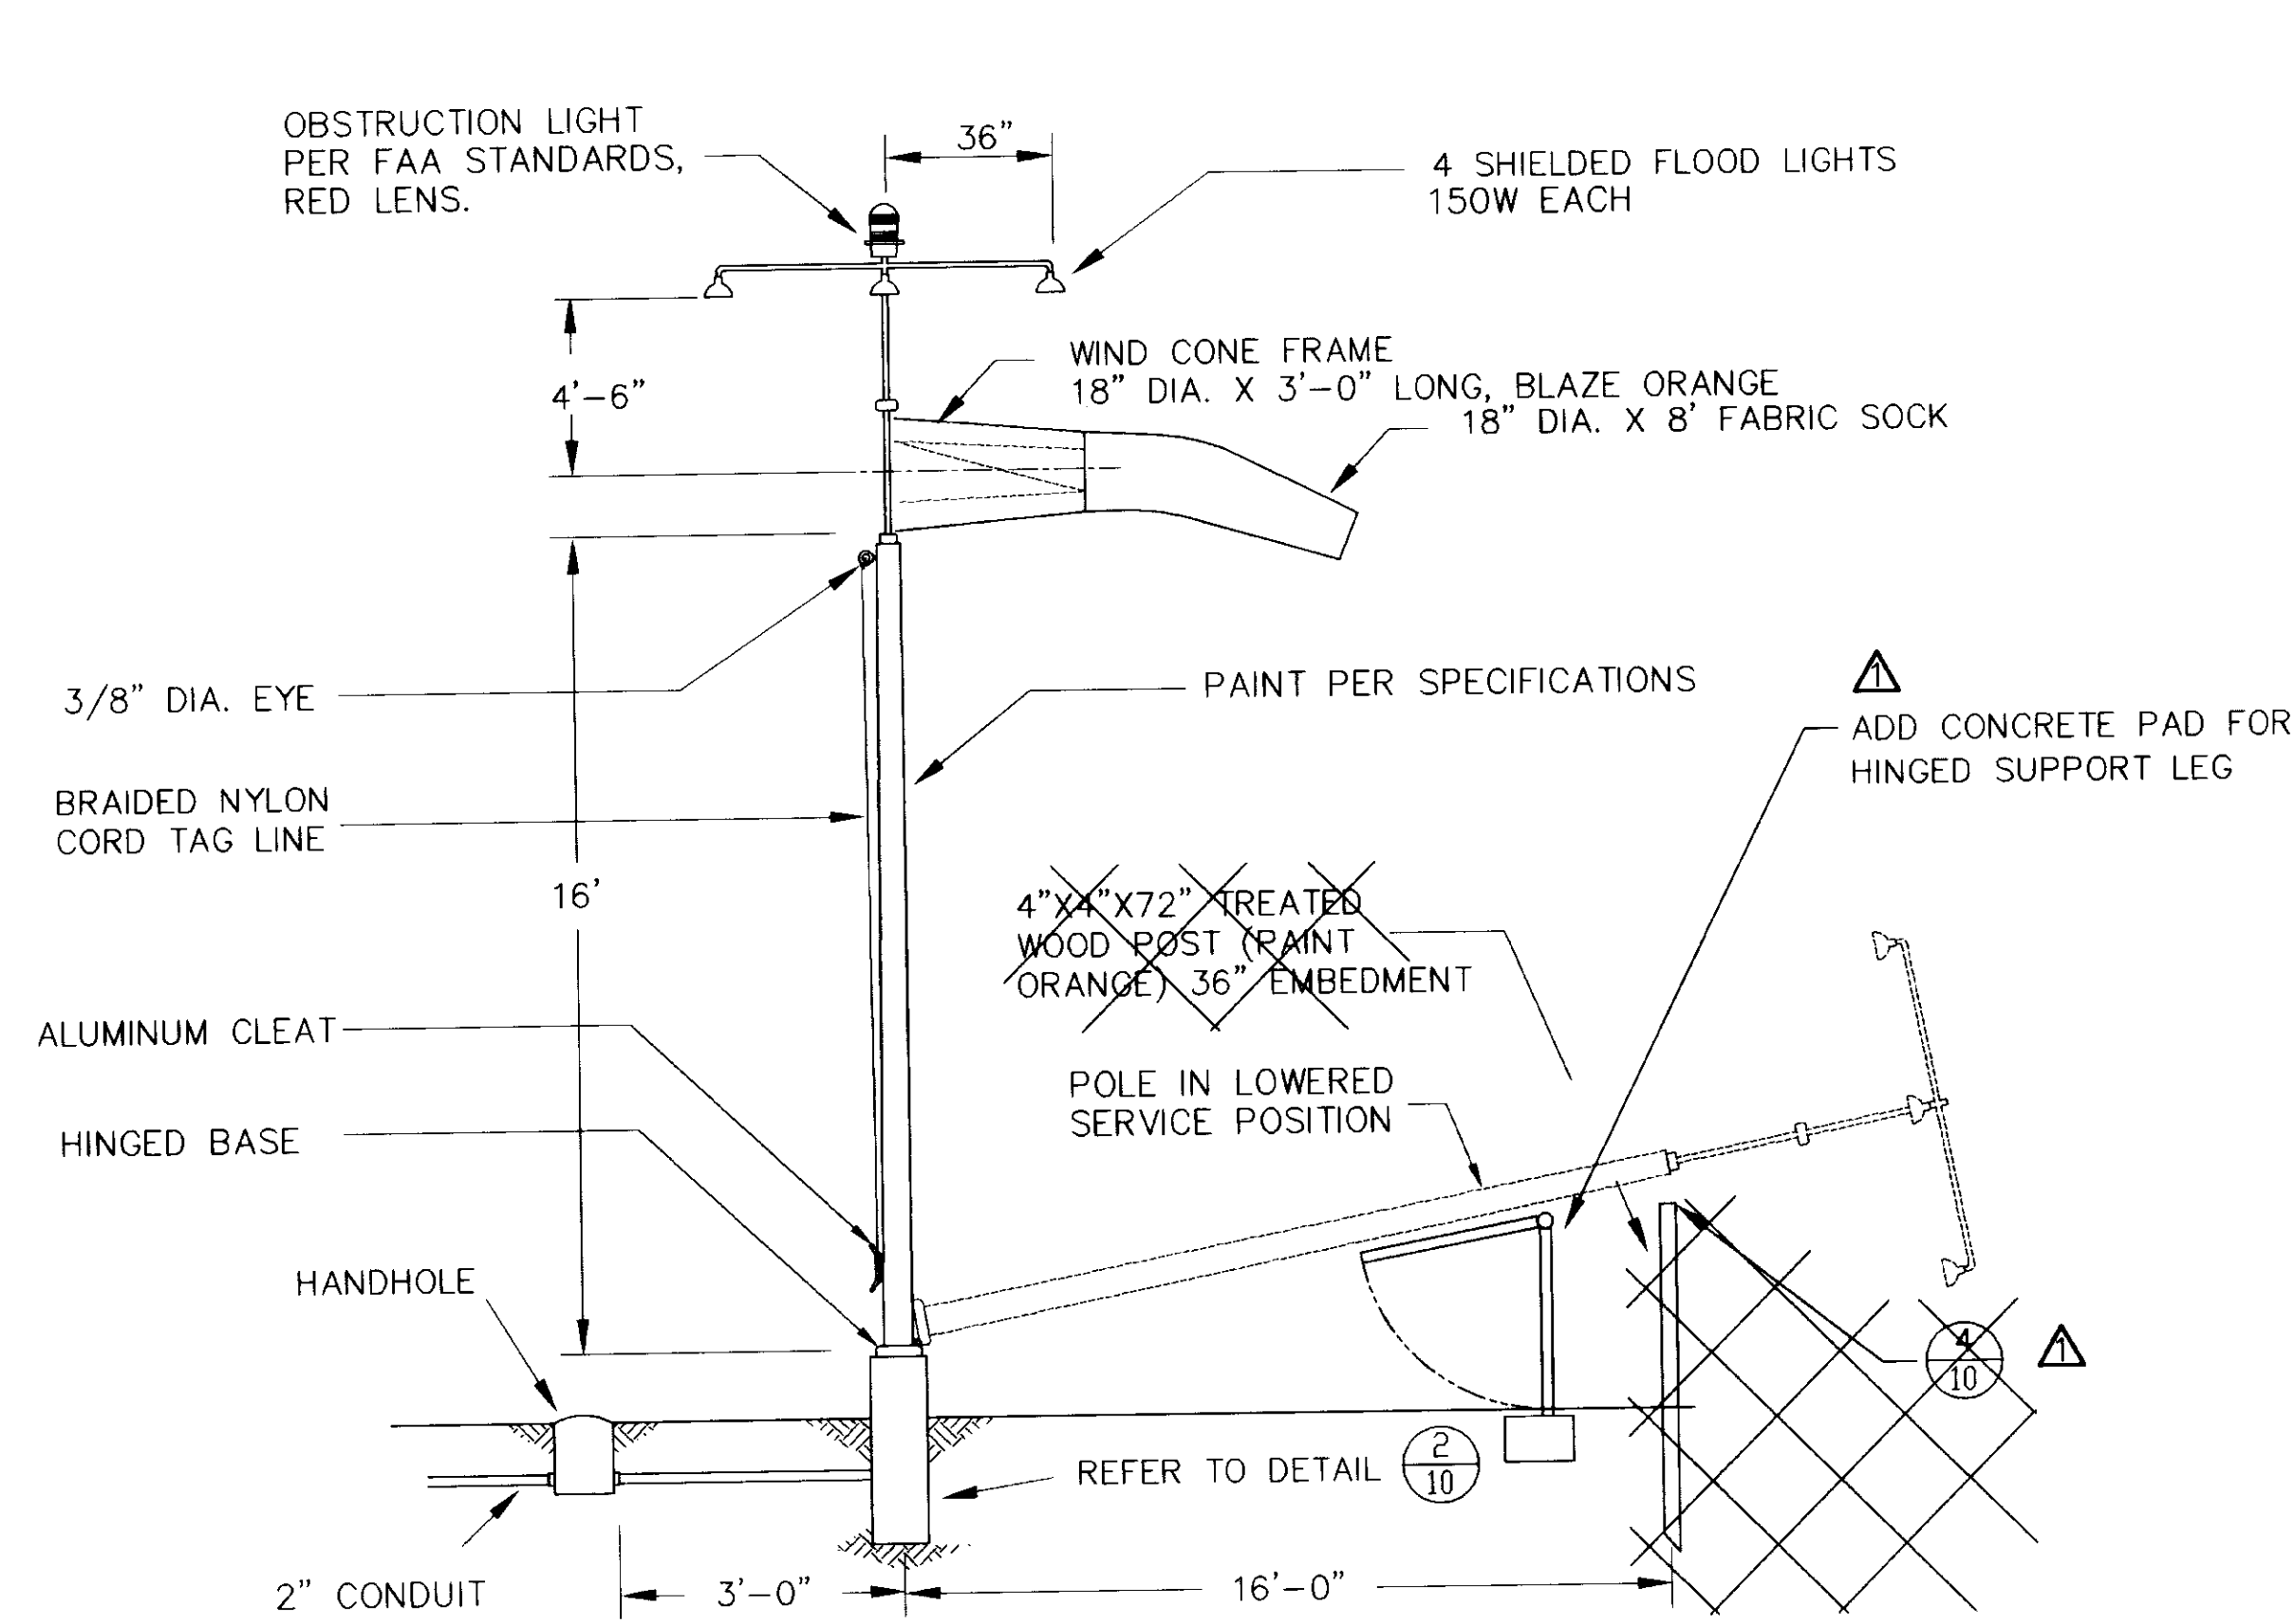


1 LIGHTED WINDCONE  
NOT TO SCALE

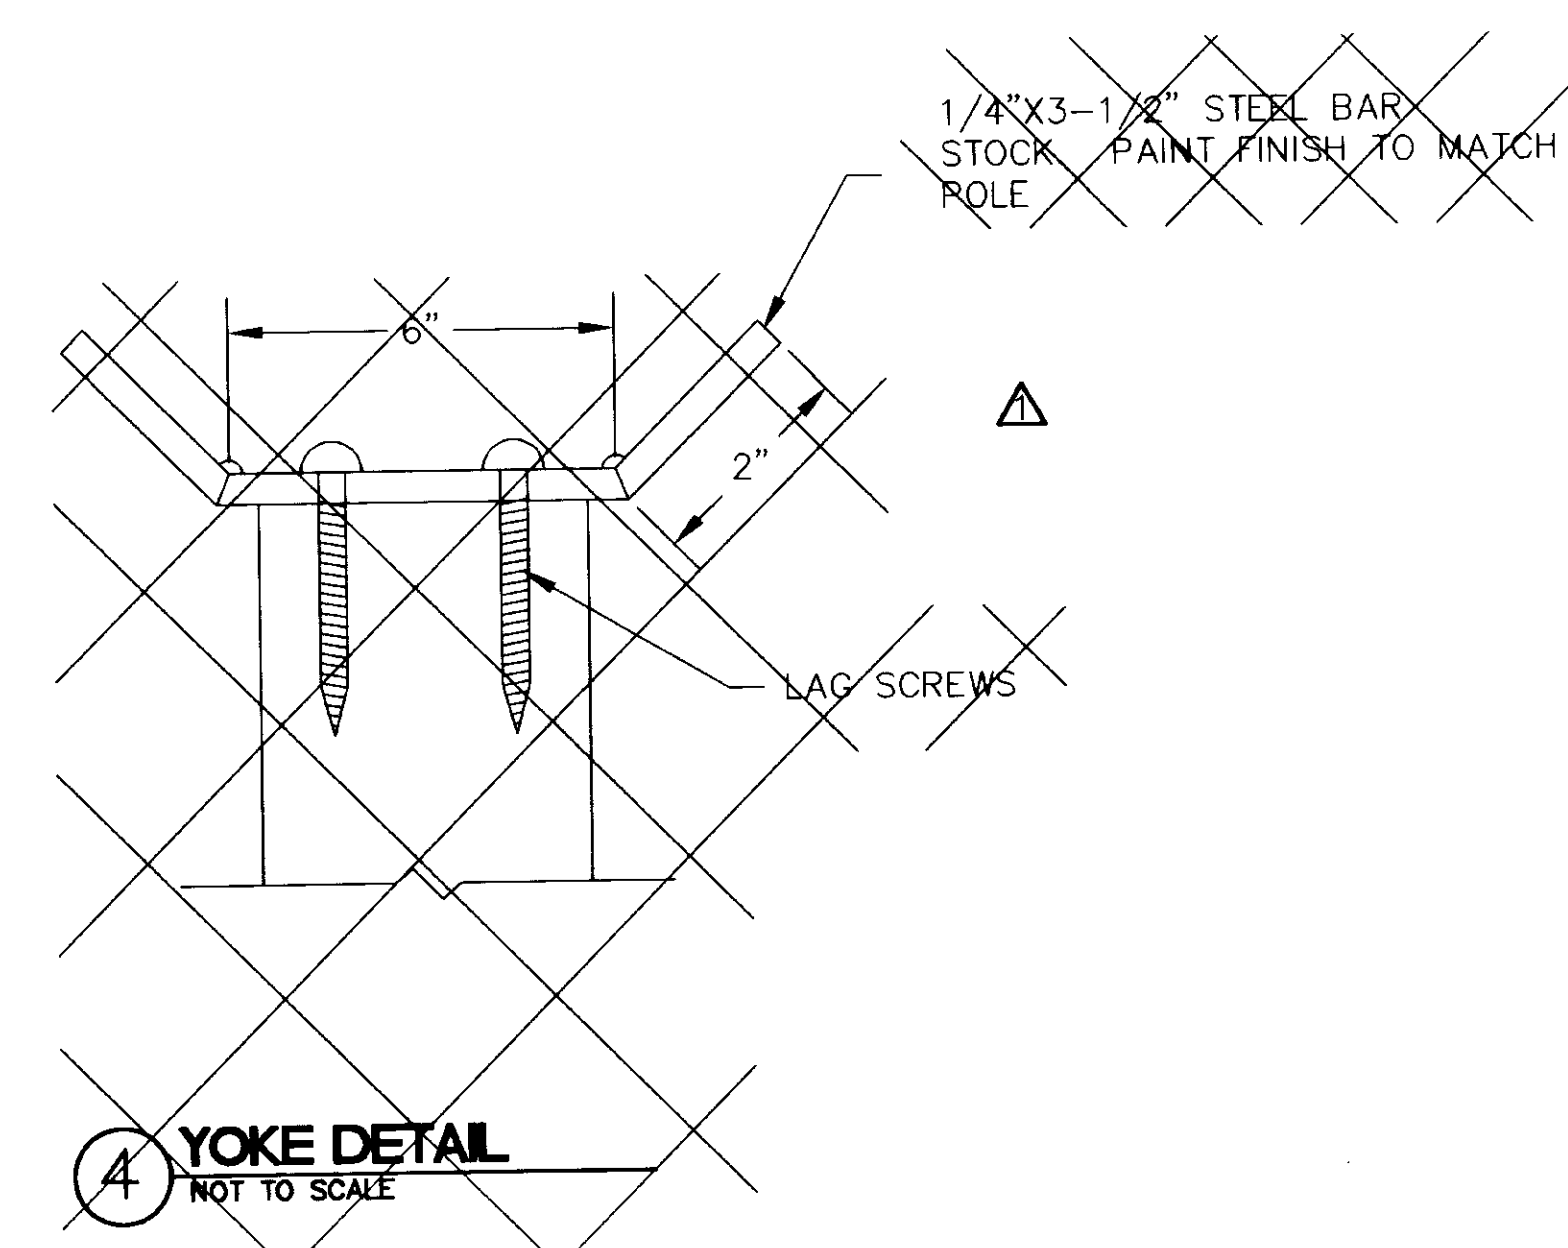

4 YOKE DETAIL  
NOT TO SCALE

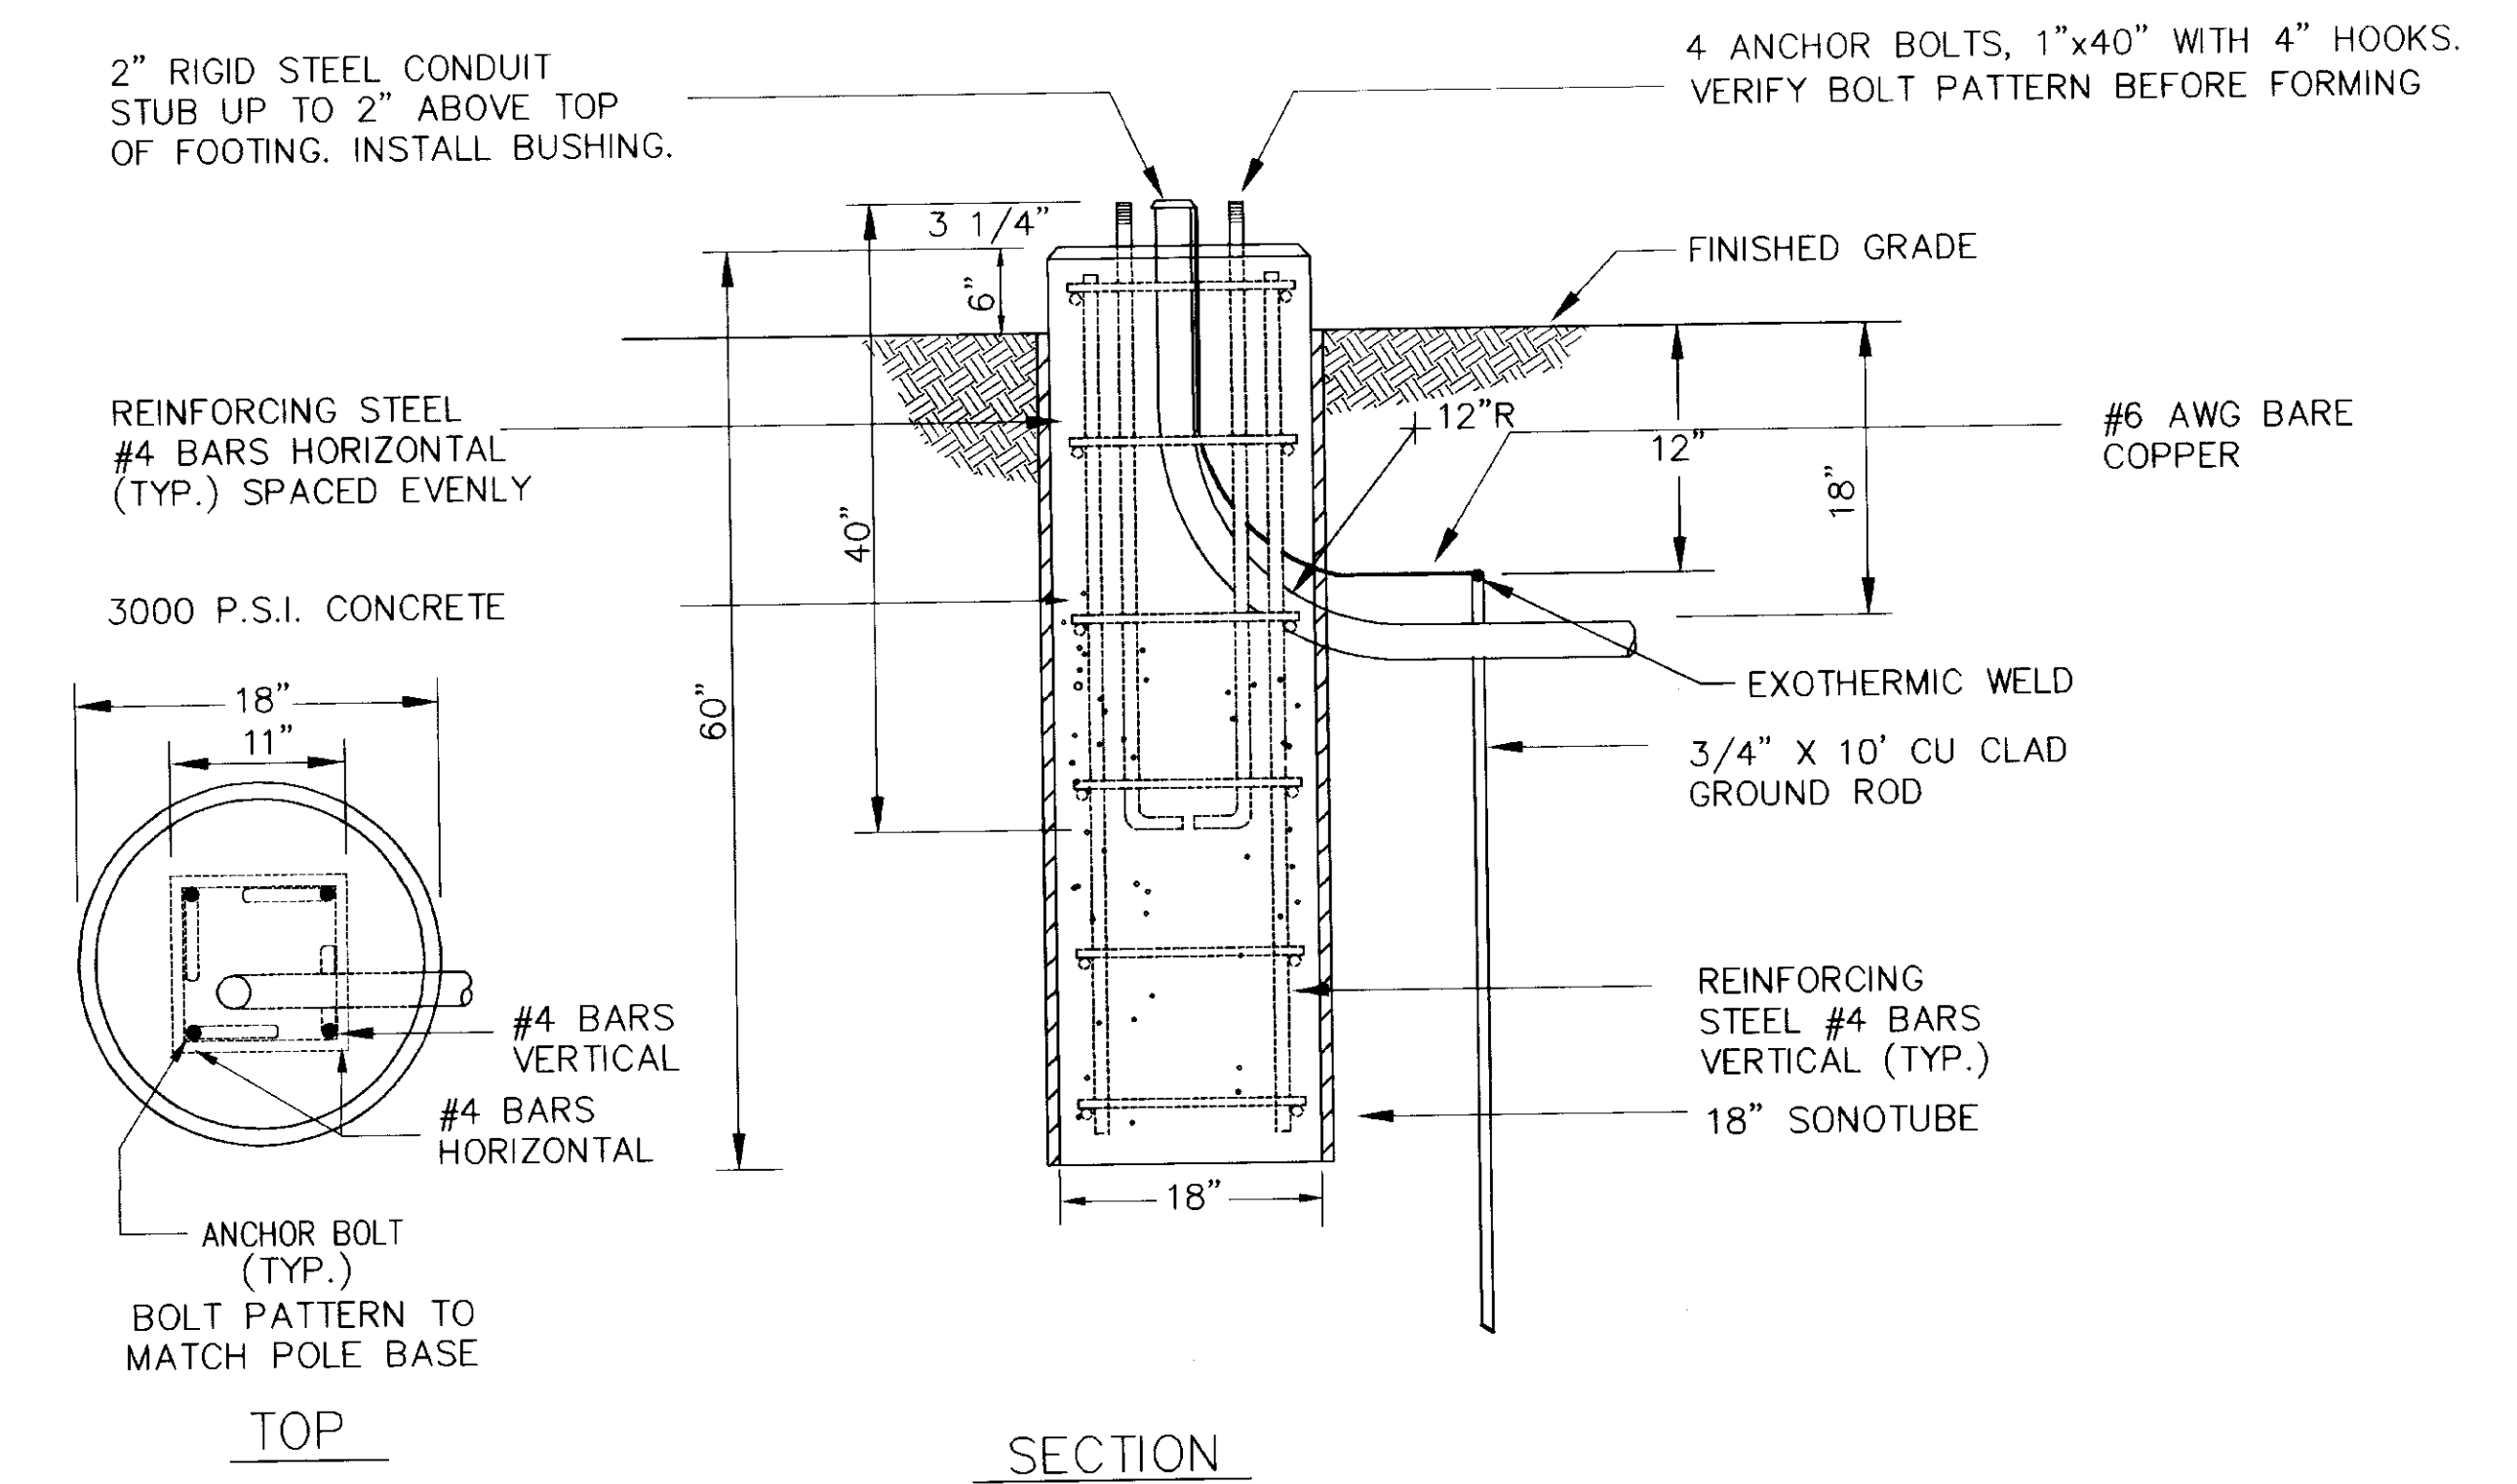

2 WINDCONE FOUNDATION DETAIL  
NOT TO SCALE

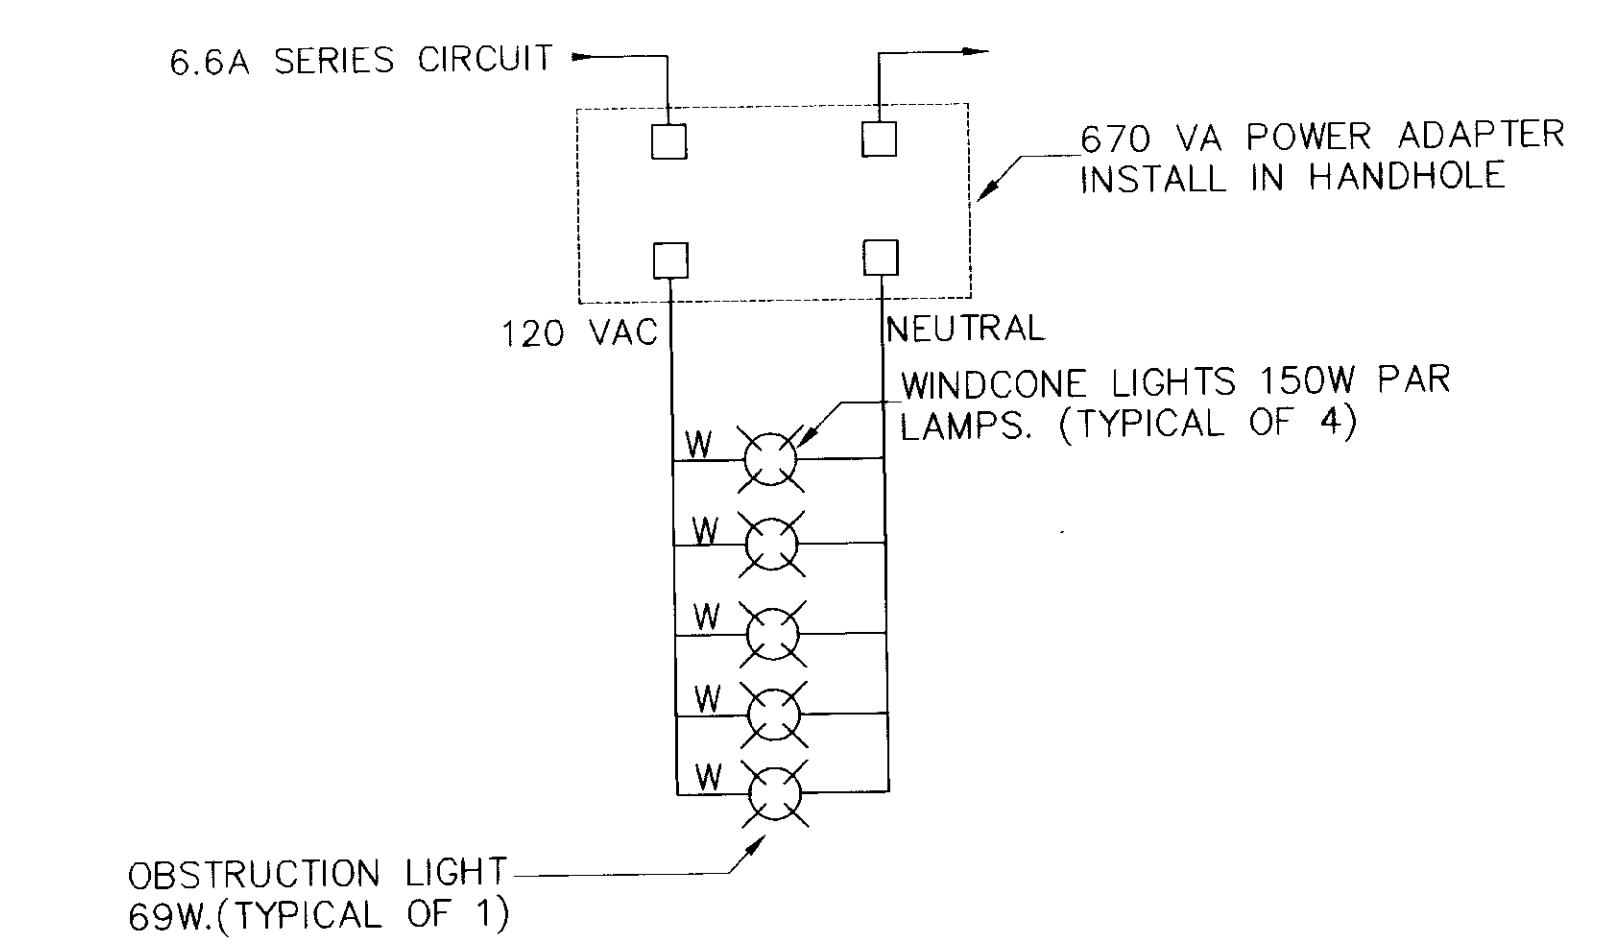


NOTE: 1. PROVIDE NEW LIGHTED WINDCONE PER DETAILS THIS SHEET AND OTHERS.








3 WINDCONE LIGHTING DIAGRAM  
NOT TO SCALE

AS BUILT 9/93  
PER CONTRACTOR'S  
RED LINES


NOTE: DO NOT SCALE FROM THESE PLANS—USE DIMENSIONS

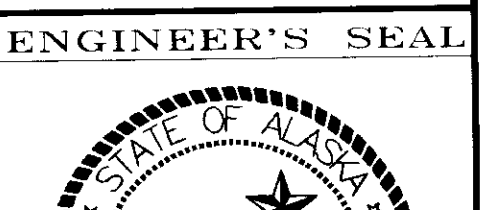



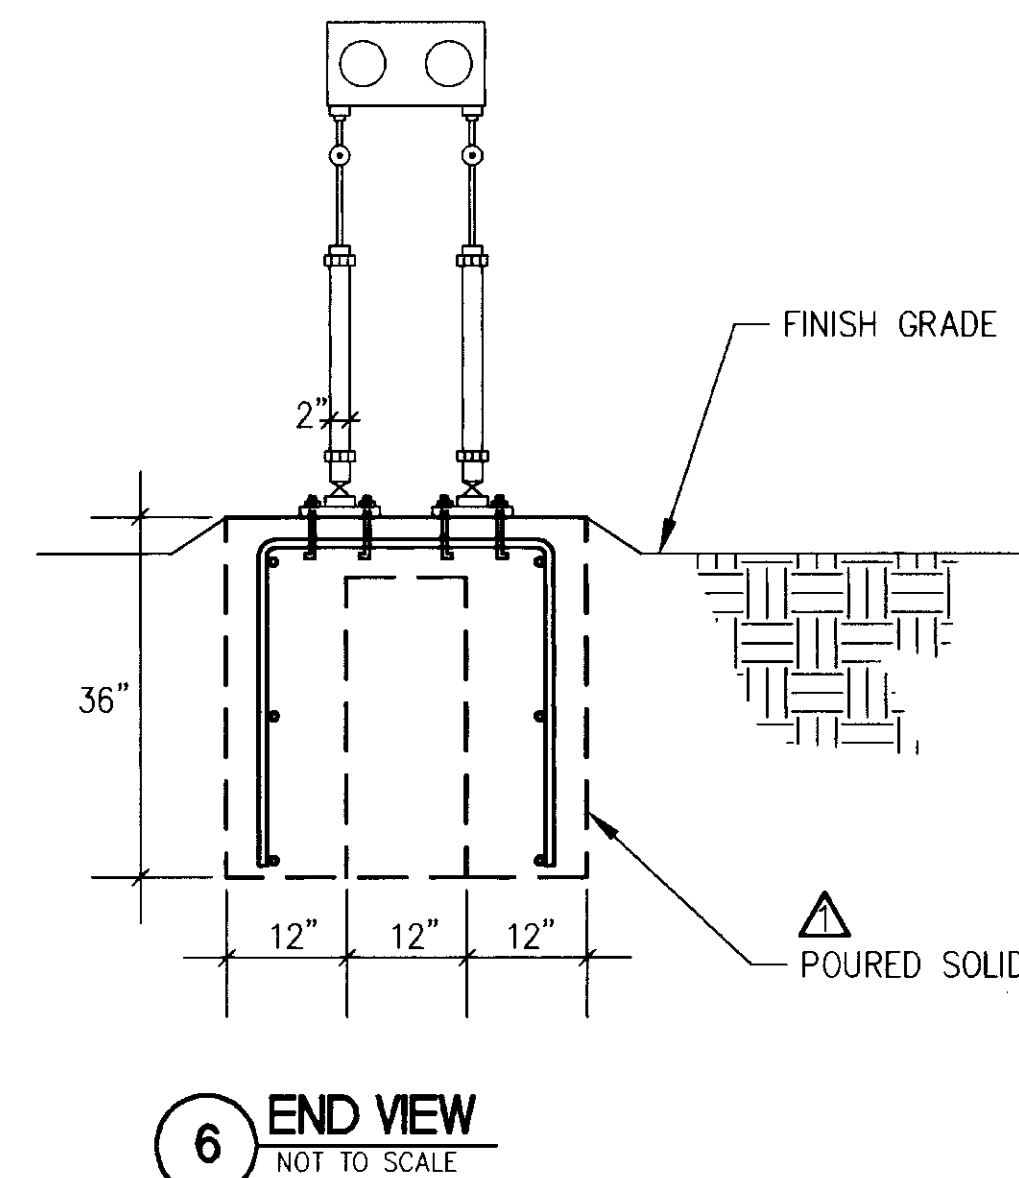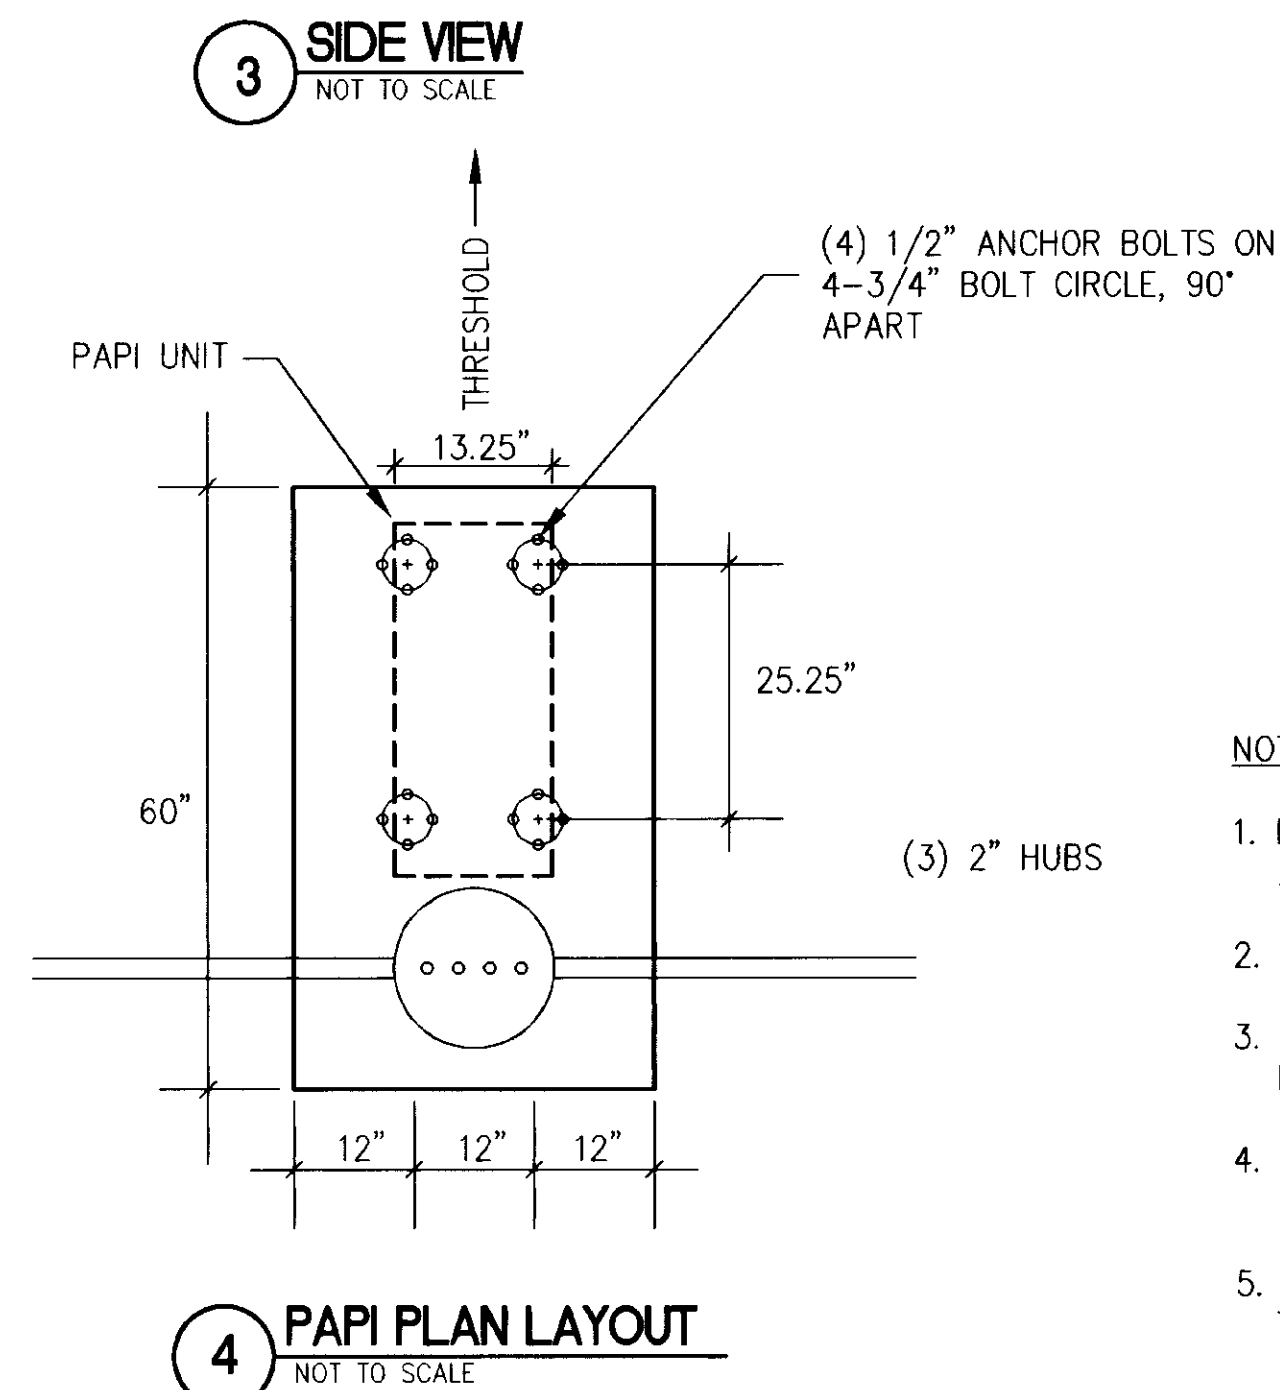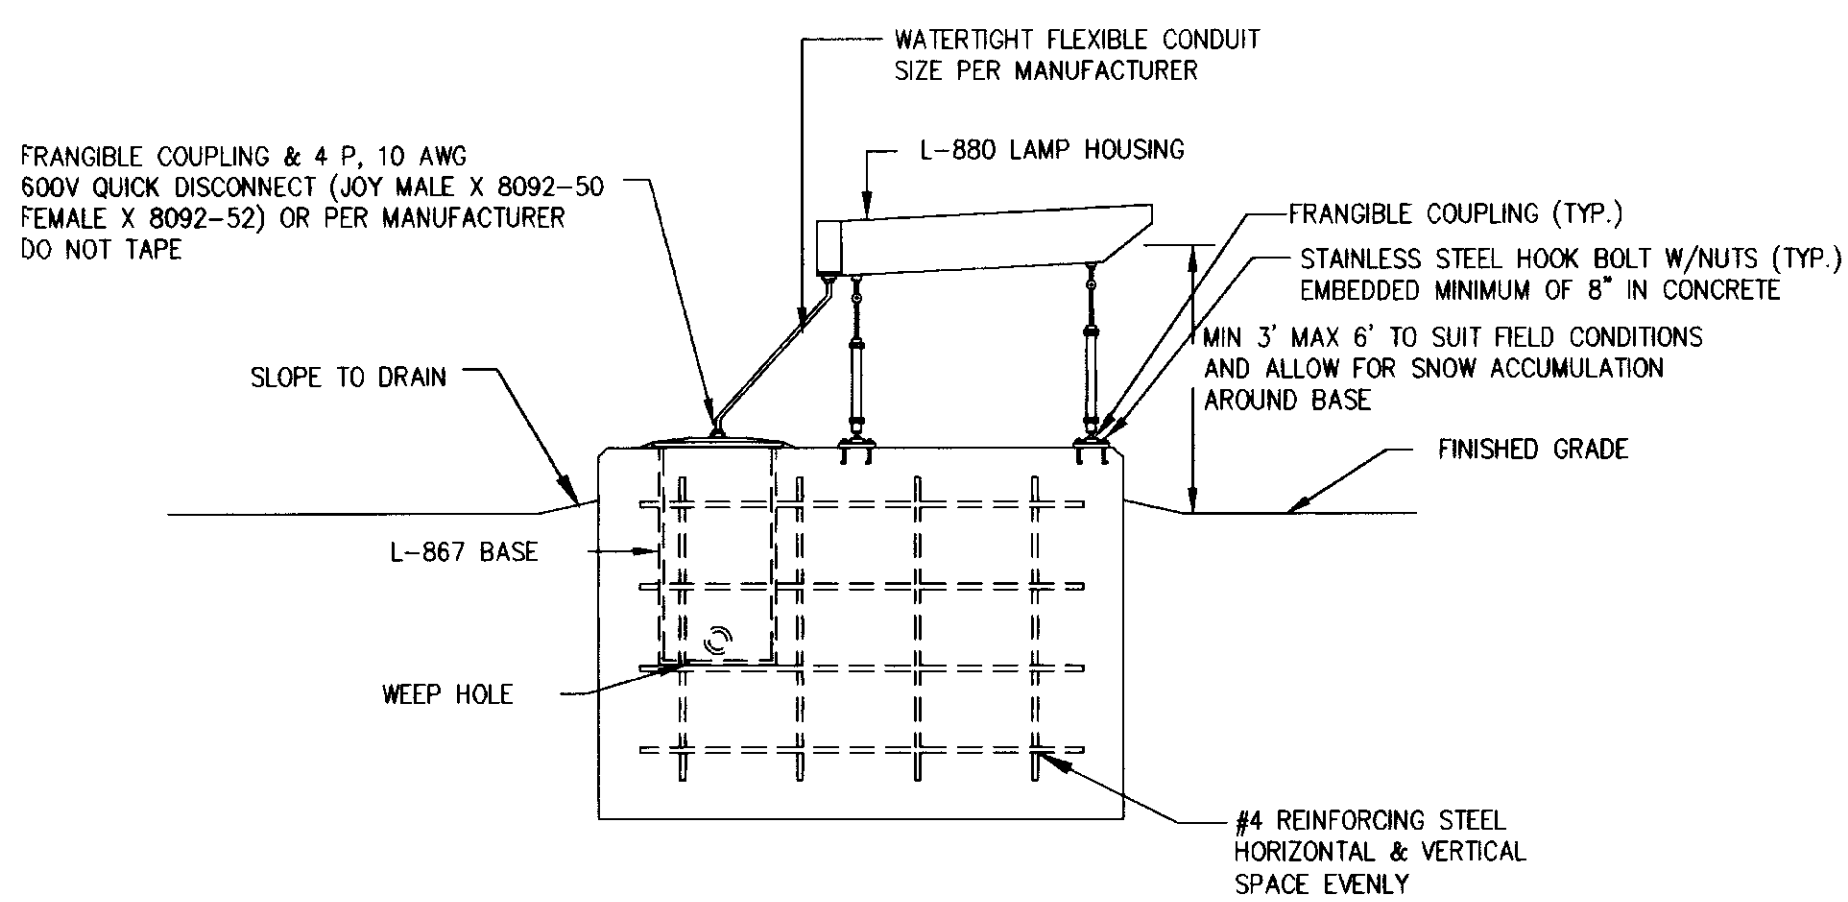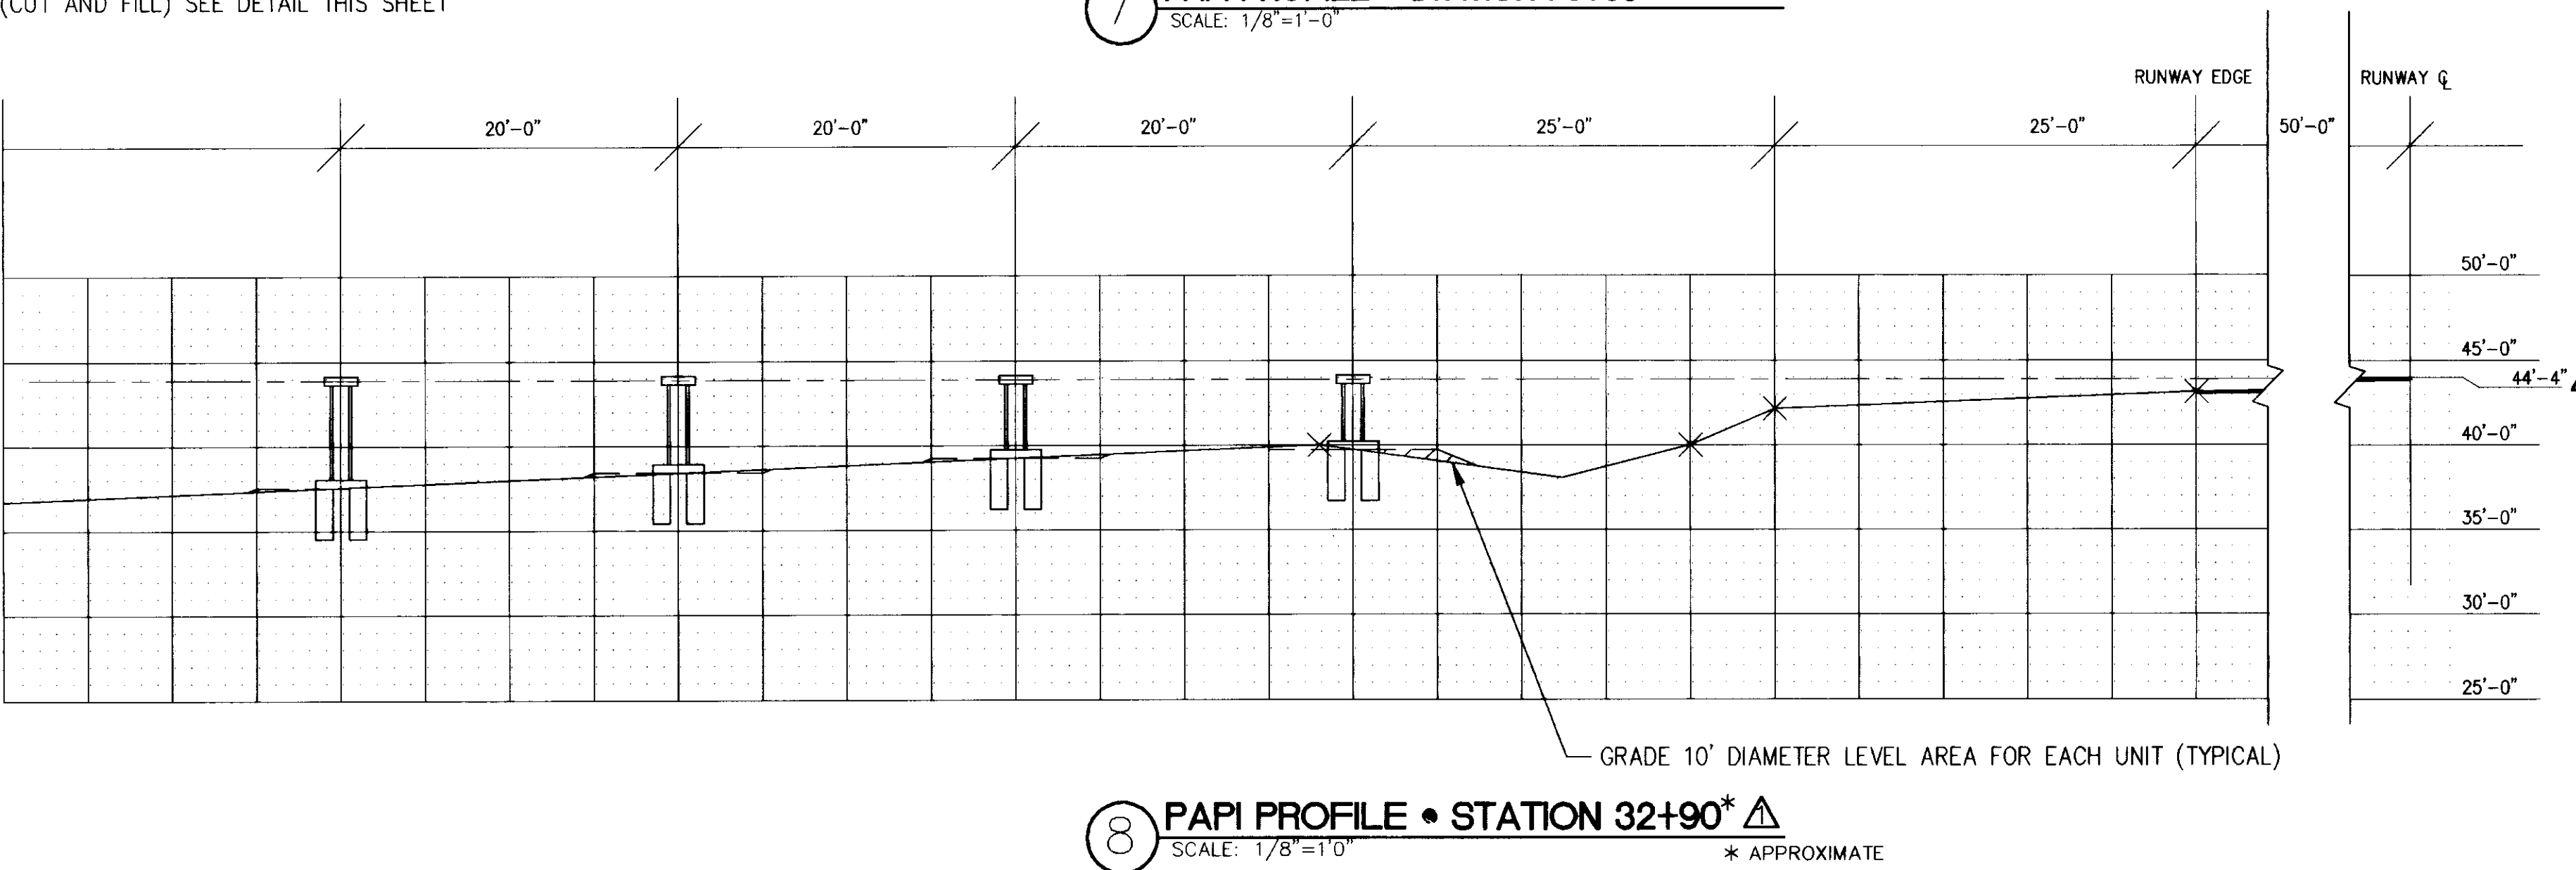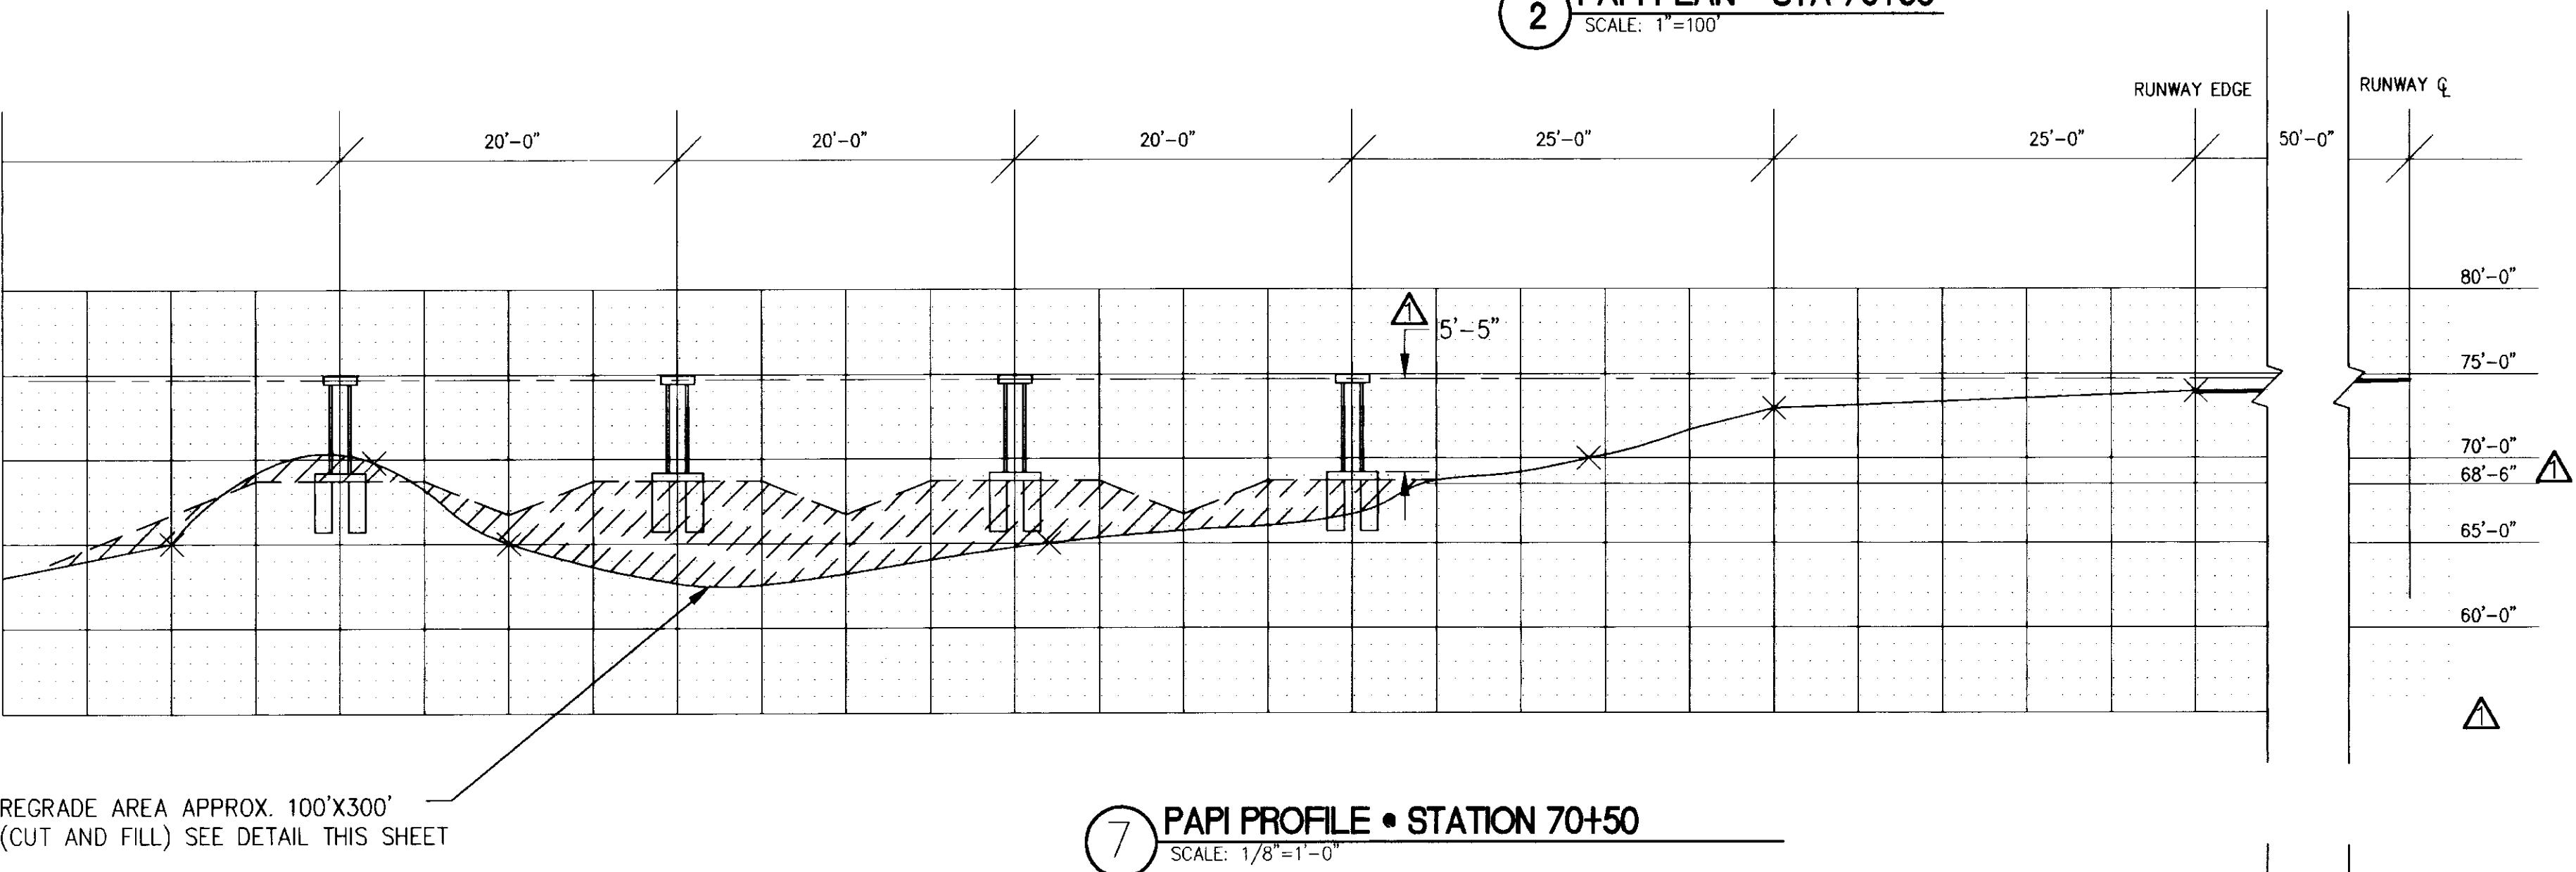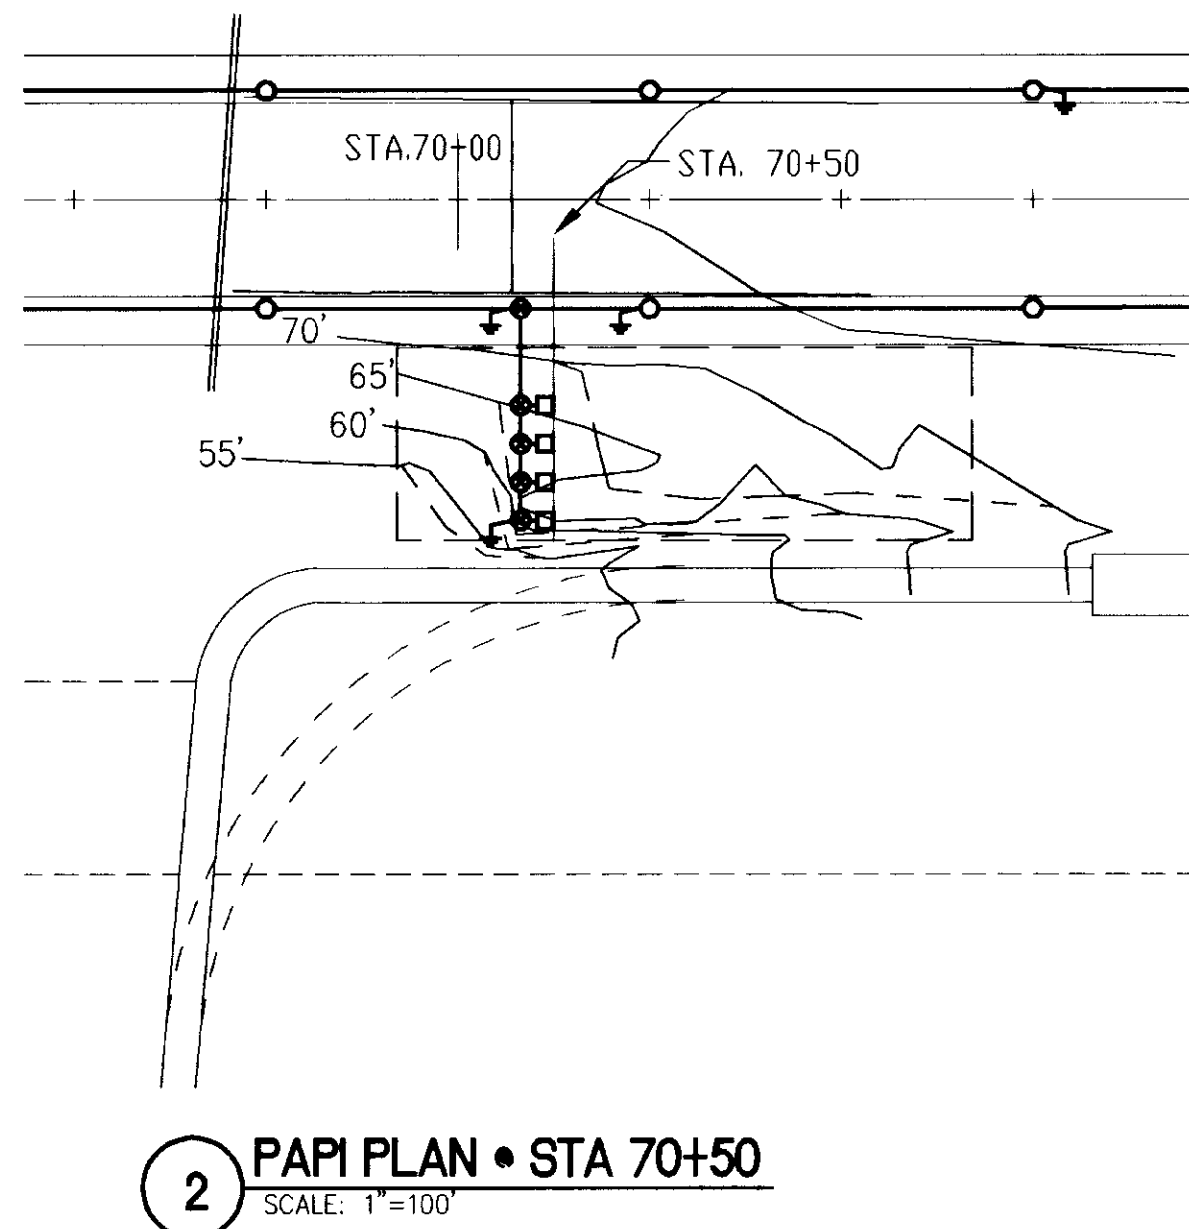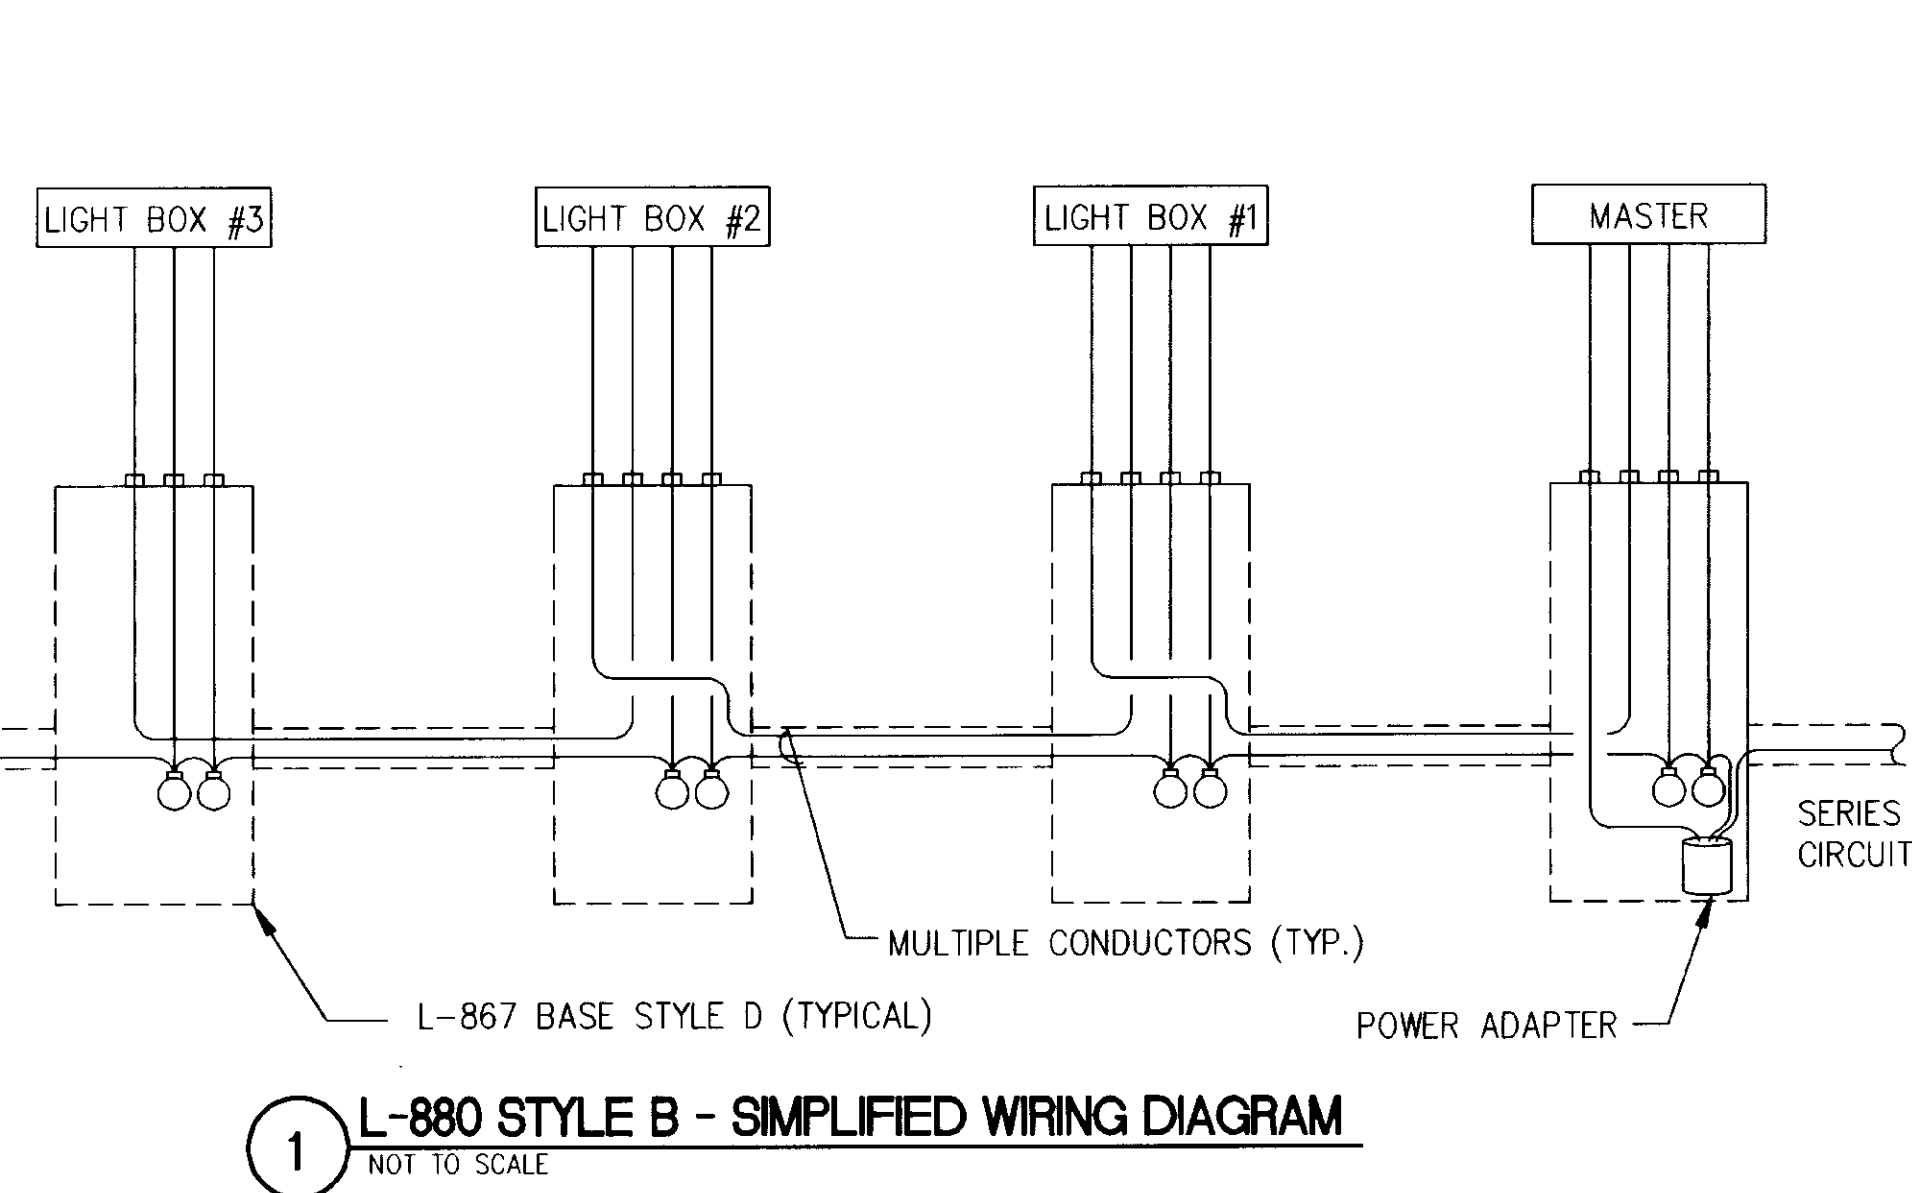

DESCRIPTION	RUNWAY END 1	RUNWAY END 19
DIMENSION A	686'	1034'
DIMENSION B	50'	50'
DIMENSION C	20'	20'
THRESHOLD ELEVATION	39.3	79.9
THRESHOLD CLEARANCE HEIGHT	32.0'±	28.0'±
APERTURE ELEVATION UNIT 1	44.4	68.6
APERTURE ELEVATION UNIT 2	44.4	68.6
APERTURE ELEVATION UNIT 3	44.4	68.6
APERTURE ELEVATION UNIT 4	44.4	68.6
AIMING ANGLE UNIT 1	3'30"	3'30"
AIMING ANGLE UNIT 2	3'10"	3'10"
AIMING ANGLE UNIT 3	2'50"	2'50"
AIMING ANGLE UNIT 4	2'30"	2'30"

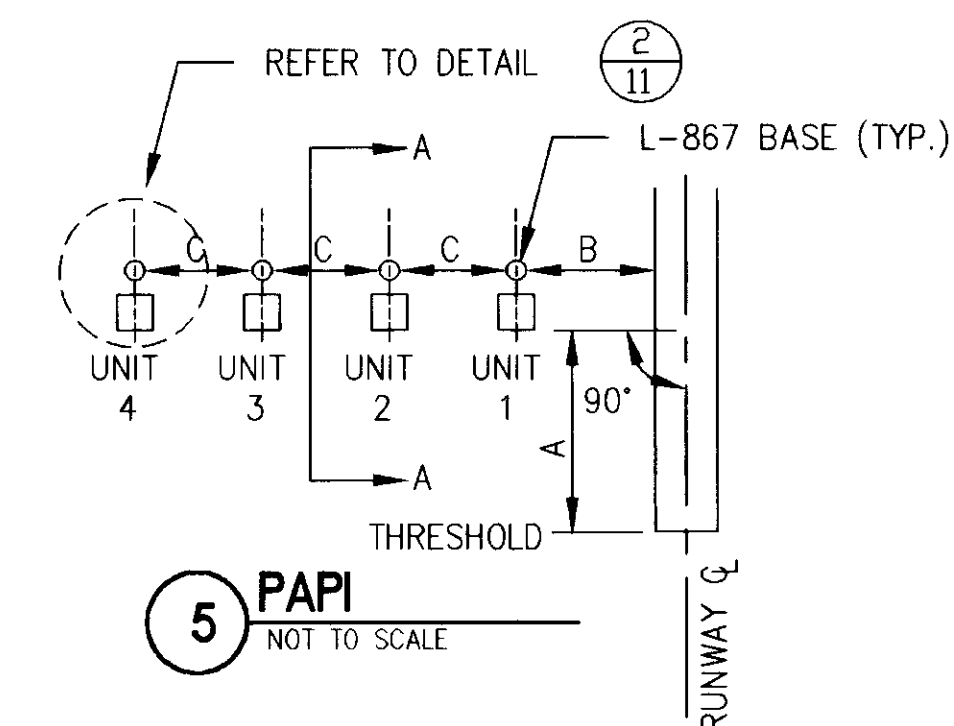

#### NOTES:

- PROVIDE FRANGIBLE MOUNTINGS FOR ALL LIGHT UNITS AND POWER ADAPTERS.
- NUMBER AND CONFIGURATION OF LEGS PER MANUFACTURER.
- QUICK DISCONNECTS ARE NOT REQUIRED IN CABLES ENTERING/LEAVING THE POWER ADAPTER.
- GROUND EACH LAMP HOUSING AND POWER ADAPTER PER MANUFACTURER.
- APPLY "NEVER SEEZ" OR APPROVED EQUAL TO ALL THREADED BOLTS AND CONNECTIONS.
- AZIMUTHAL AIMING. EACH LIGHT UNIT SHALL BE AIMED OUTWARD INTO APPROACH ZONE ON A LINE PARALLEL TO THE RUNWAY CENTERLINE WITHIN A TOLERANCE OF  $\pm 1/2$  DEGREE.
- MOUNTING HEIGHT TOLERANCES. THE BEAM CENTERS OF ALL LIGHT UNITS SHALL BE WITHIN 1 INCH OF HORIZONTAL PLANE, THIS HORIZONTAL PLANE SHALL BE WITHIN  $\pm 1$  FOOT (0.3 M) OF THE ELEVATION OF THE RUNWAY CENTERLINE AT THE INTERCEPT POINT OF THE VISUAL GLIDEPATH WITH THE RUNWAY.
- TOLERANCE ALONG LINE PERPENDICULAR TO RUNWAY. THE FRONT FACE OF EACH LIGHT UNIT IN A BAR SHALL BE LOCATED ON A LINE PERPENDICULAR TO THE RUNWAY CENTERLINE WITHIN  $\pm 6$  INCHES.
- FURNISH, INSTALL, AND WIRE POWER ADAPTERS, ETC. PER MANUFACTURER'S INSTRUCTION'S.
- THE DIFFERENCE IN LATERAL SPACING BETWEEN THE LIGHT UNITS SHALL NOT EXCEED ONE FOOT.
- CONTRACTOR SHALL EXCAVATE TO LEVEL SITE FOR PAPI INSTALLATION AS REQUIRED. PAPI DIMENSION A MAY BE ADJUSTED  $\pm 50'$  WITH ENGINEER'S PERMISSION TO BETTER SUIT FIELD CONDITIONS (TO MINIMIZE EXCAVATION) AND OBTAIN NECESSARY OBSTACLE CLEARANCE SURFACE.
- ALL UNCLASSIFIED EXCAVATION, GRADING, AND SEEDING FOR PAPI SITE PREPARATION IS INCIDENTAL TO PAPI INSTALLATION.
- RESEED ALL DISTURBED AREAS PER SPECIFICATIONS.

NOTE: DO NOT SCALE FROM THESE DRAWINGS - USE DIMENSIONS


DATE:	DESCRIPTION OF CHANGE:
9/93	AS BUILT PER CONTRACTOR'S RED LINES

STATE OF ALASKA  
DEPARTMENT OF TRANSPORTATION  
AND PUBLIC FACILITIES  
SOUTHEAST REGION DESIGN & CONSTRUCTION

**RAJ BHARGAVA ASSOCIATES**  
ENGINEERING IN ALASKA

**PAPI**  
KLAWOCK AIRPORT LIGHTING  
A.I.P. No. 3-02-0154-05


DESIGNED BY:	T.D.H.	PROJECT NO.	70388
DRAWN BY:	E.RAEL	DATE:	8/9/92
CHECKED BY:			

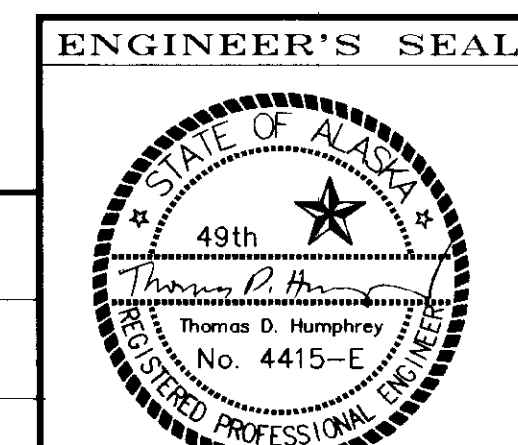




# GENERAL NOTES


1. NUMBER OF MOUNTS PER MANUFACTURER. ONE OF THE LEGS SHALL BE USED AS WIREWAY.
2. OPTICAL HEAD MAY BE ALSO MOUNTED ON FRONT OR SIDE OF THE POWER & CONTROL UNIT.
3. ADJUSTABLE CURRENT SENSING ON/OFF CONTROL CIRCUIT SHALL BE PROVIDED.
4. NUMBER, SIZE AND TYPE OF CONDUCTORS BETWEEN THE POWER SUPPLY/CONTROL TRANSFORMERS, AND THE MASTER POWER AND CONTROL UNIT SHALL BE PER MANUFACTURER. SAME SHALL APPLY TO WIRING BETWEEN THE MASTER AND THE SLAVE UNITS, EXCEPT THAT THE CABLE SHALL BE L-824, TYPE C.
5. COLOR CODED WIRE IDENTIFICATION TAPE AS FOLLOWS:  
WHEN FACING LIGHT WITH BACK TO PAVEMENT, CABLE TO LEFT IS CODED RED AND CABLE TO THE RIGHT IS CODED BLUE.

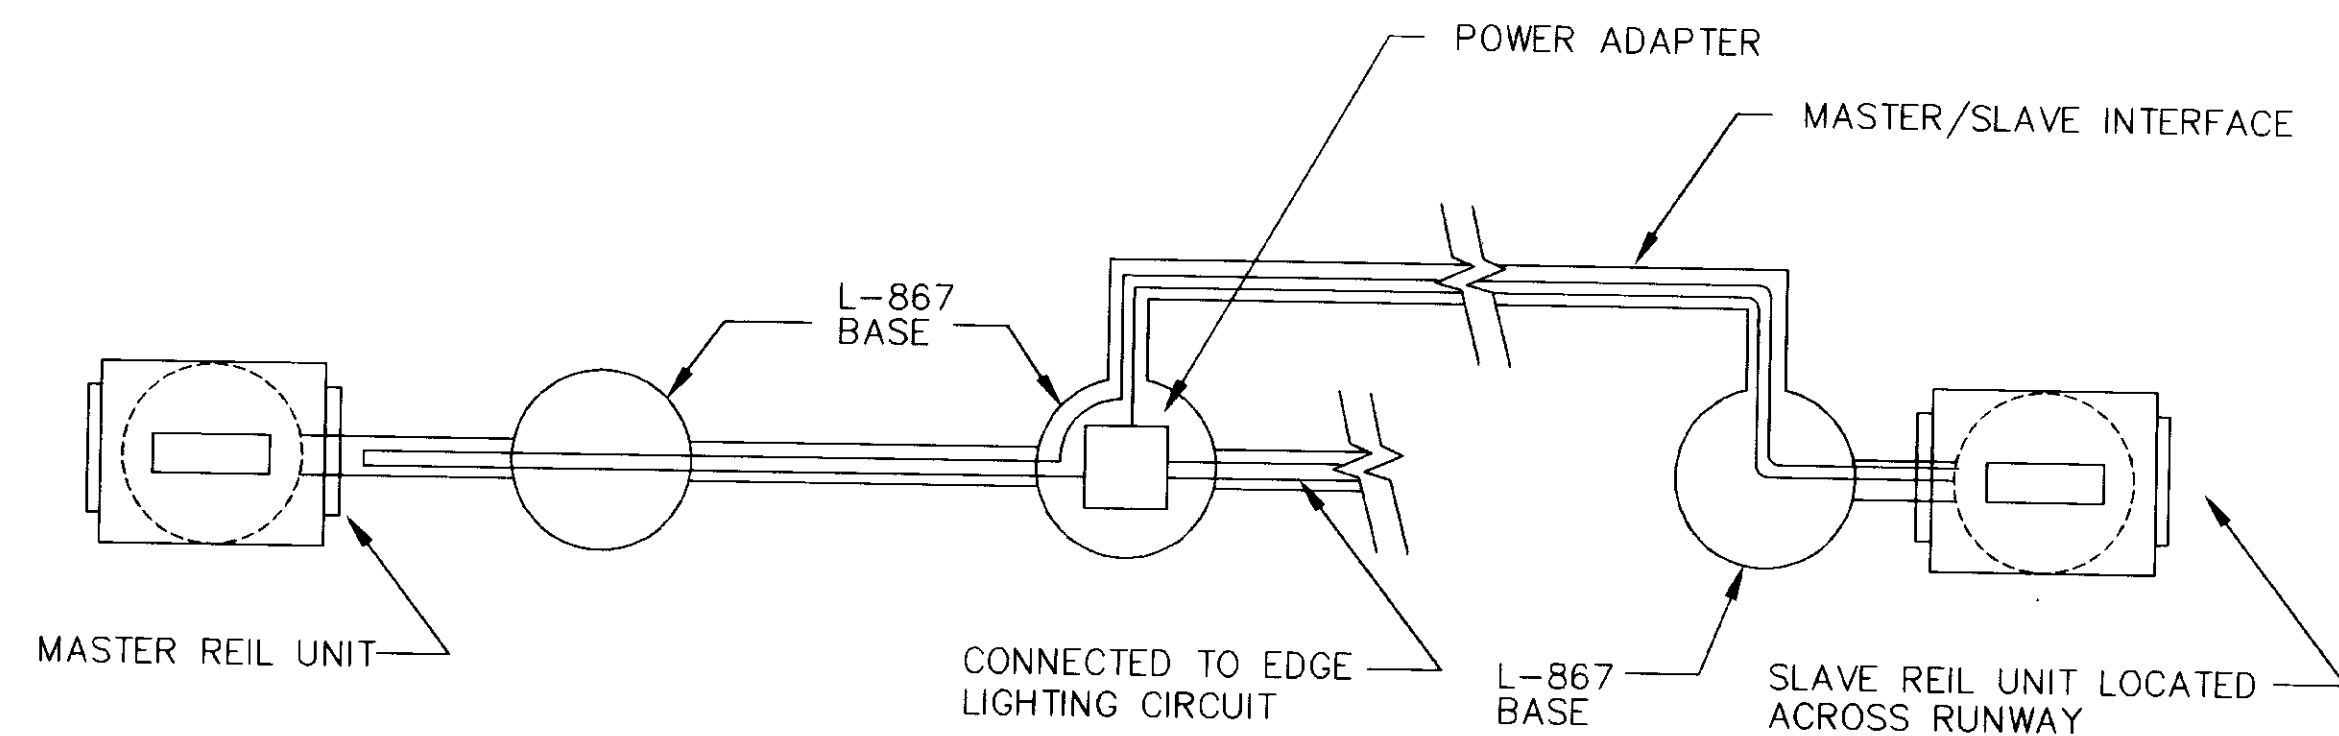


**7 REIL WIRING DETAIL**  
NOT TO SCALE

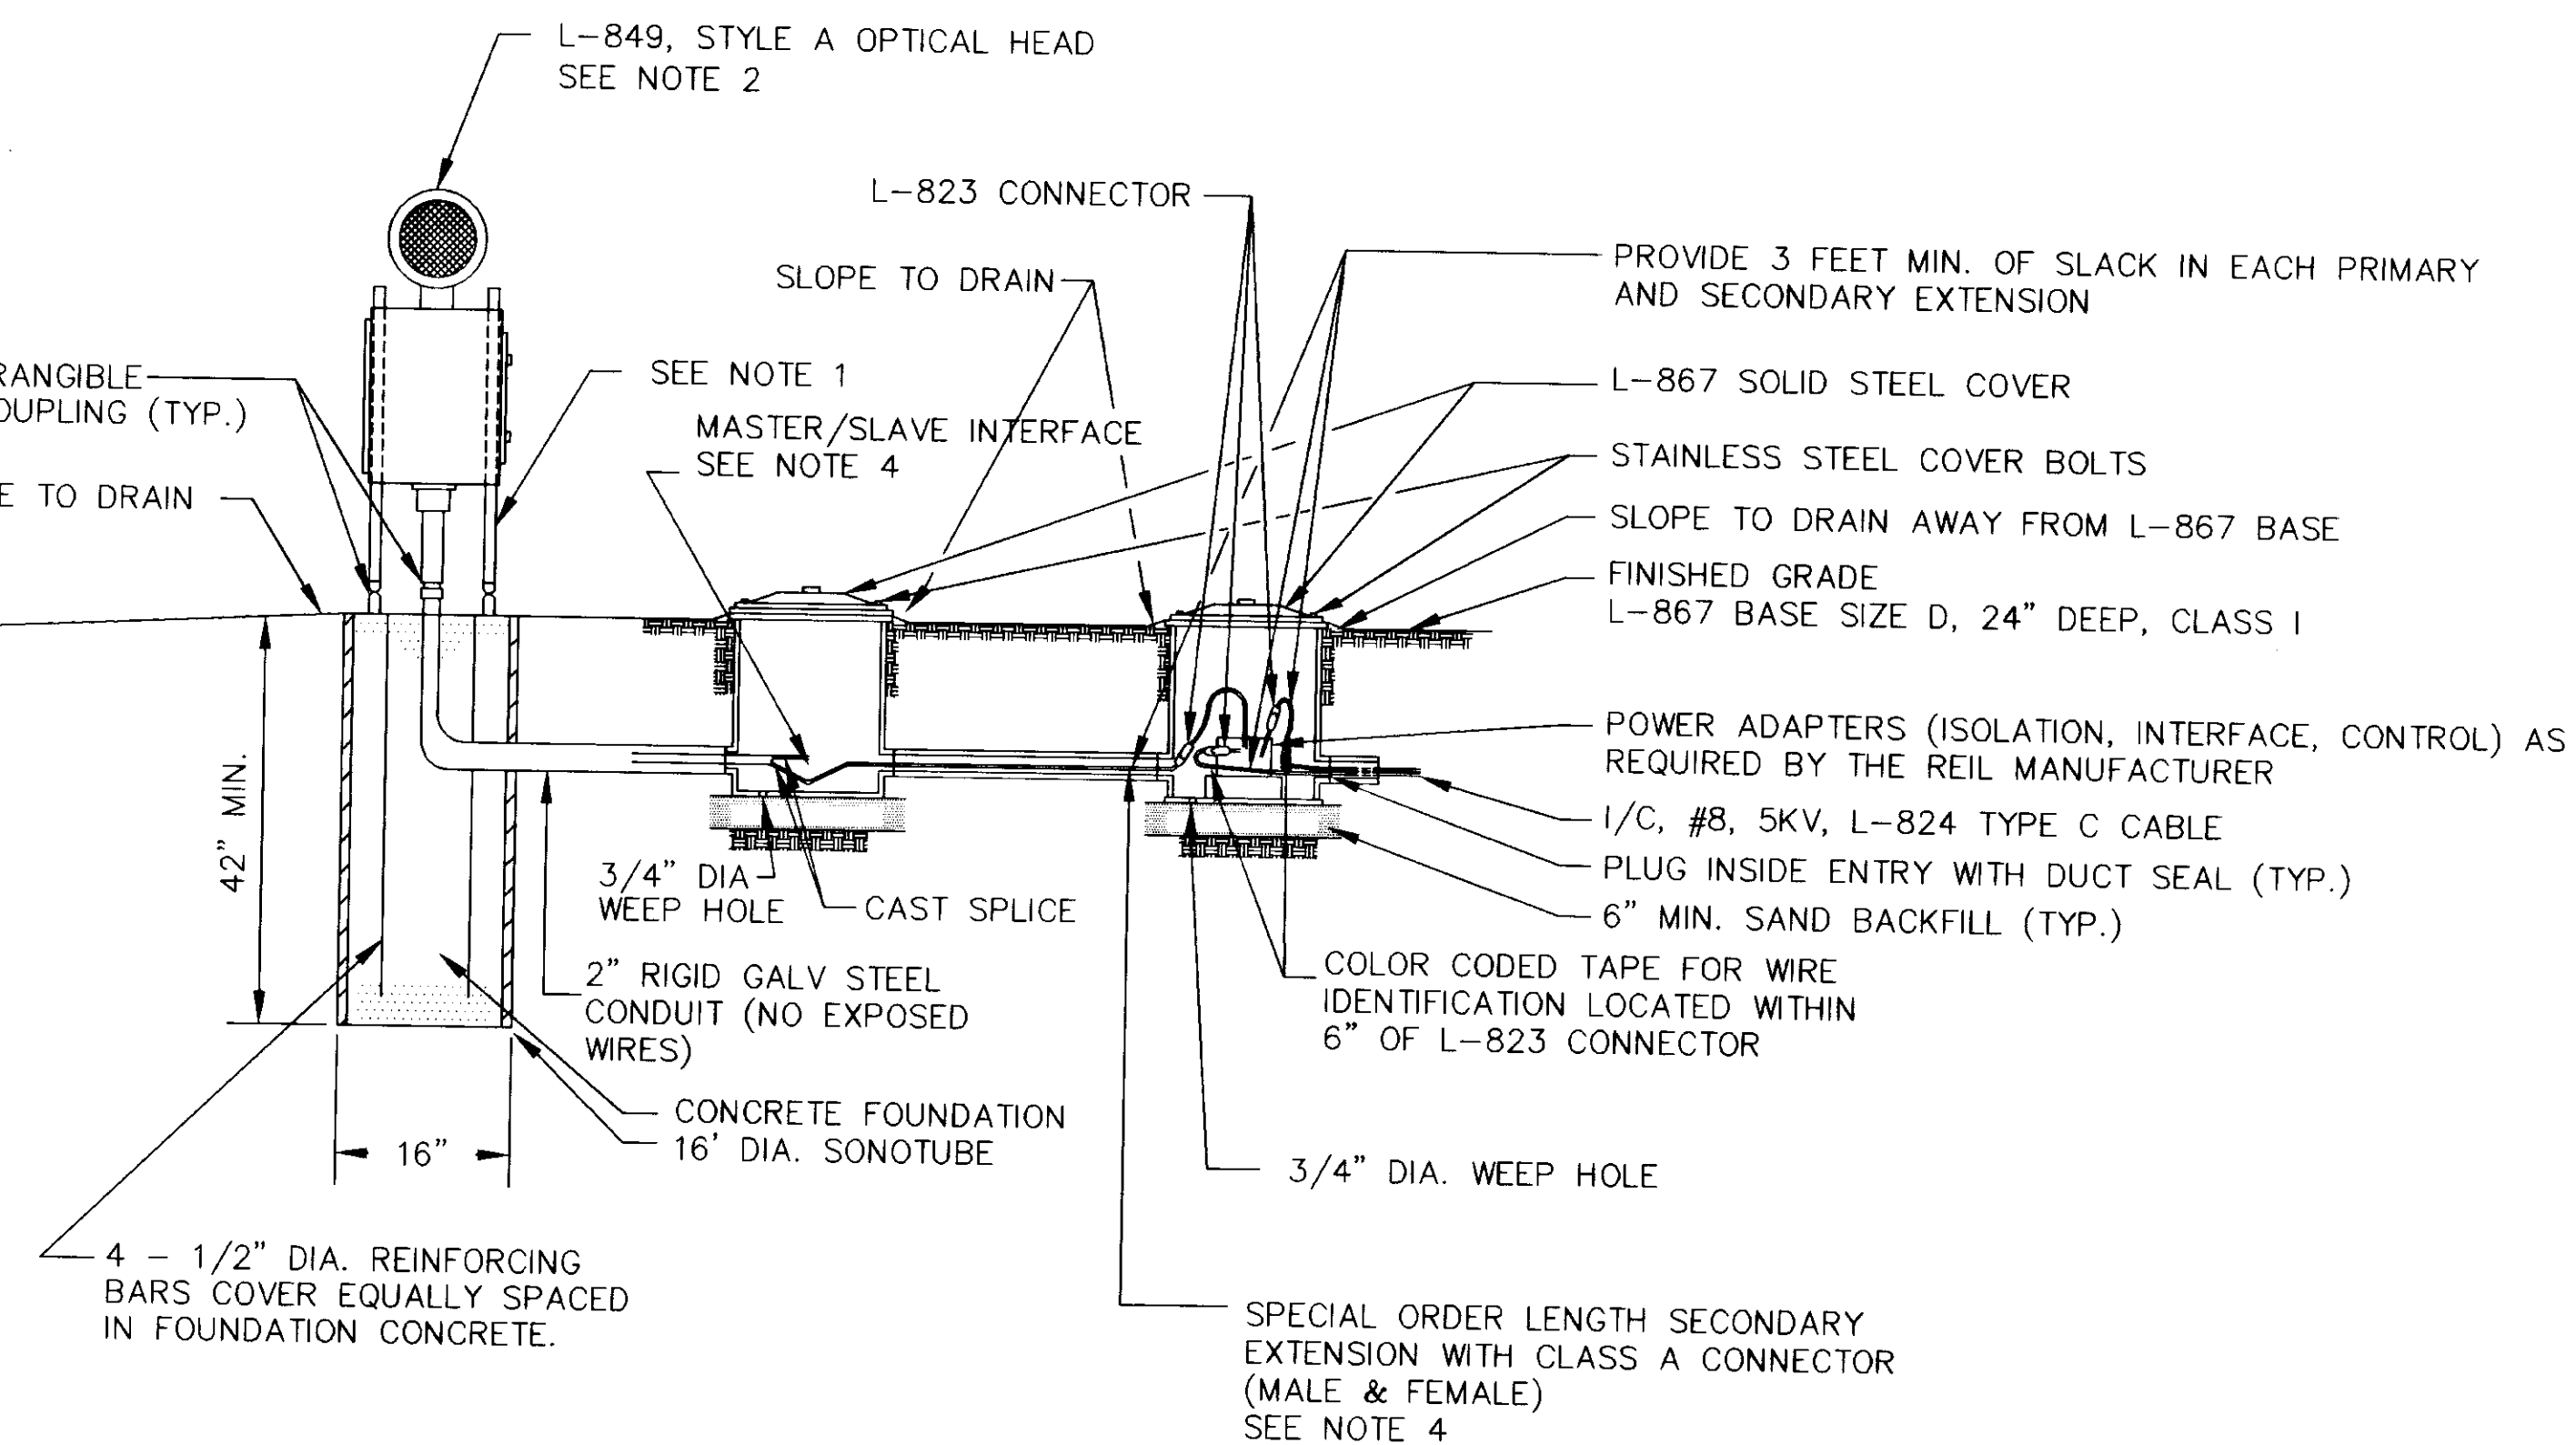


**1 REIL LIGHT DETAIL**  
NOT TO SCALE

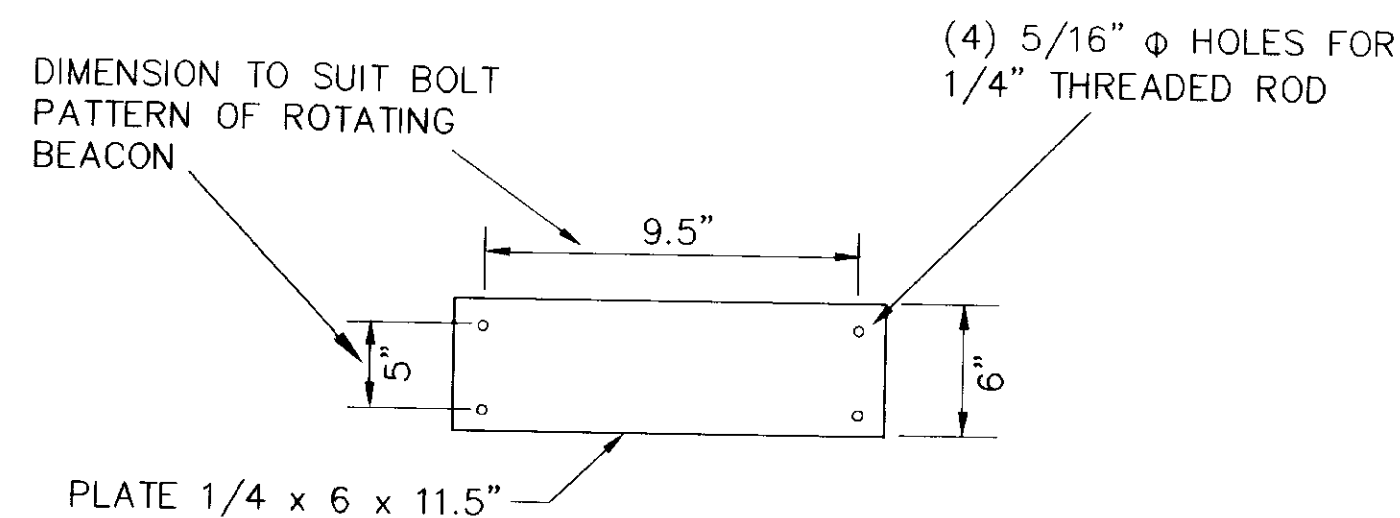

**3 MAST DETAILS**  
NOT TO SCALE

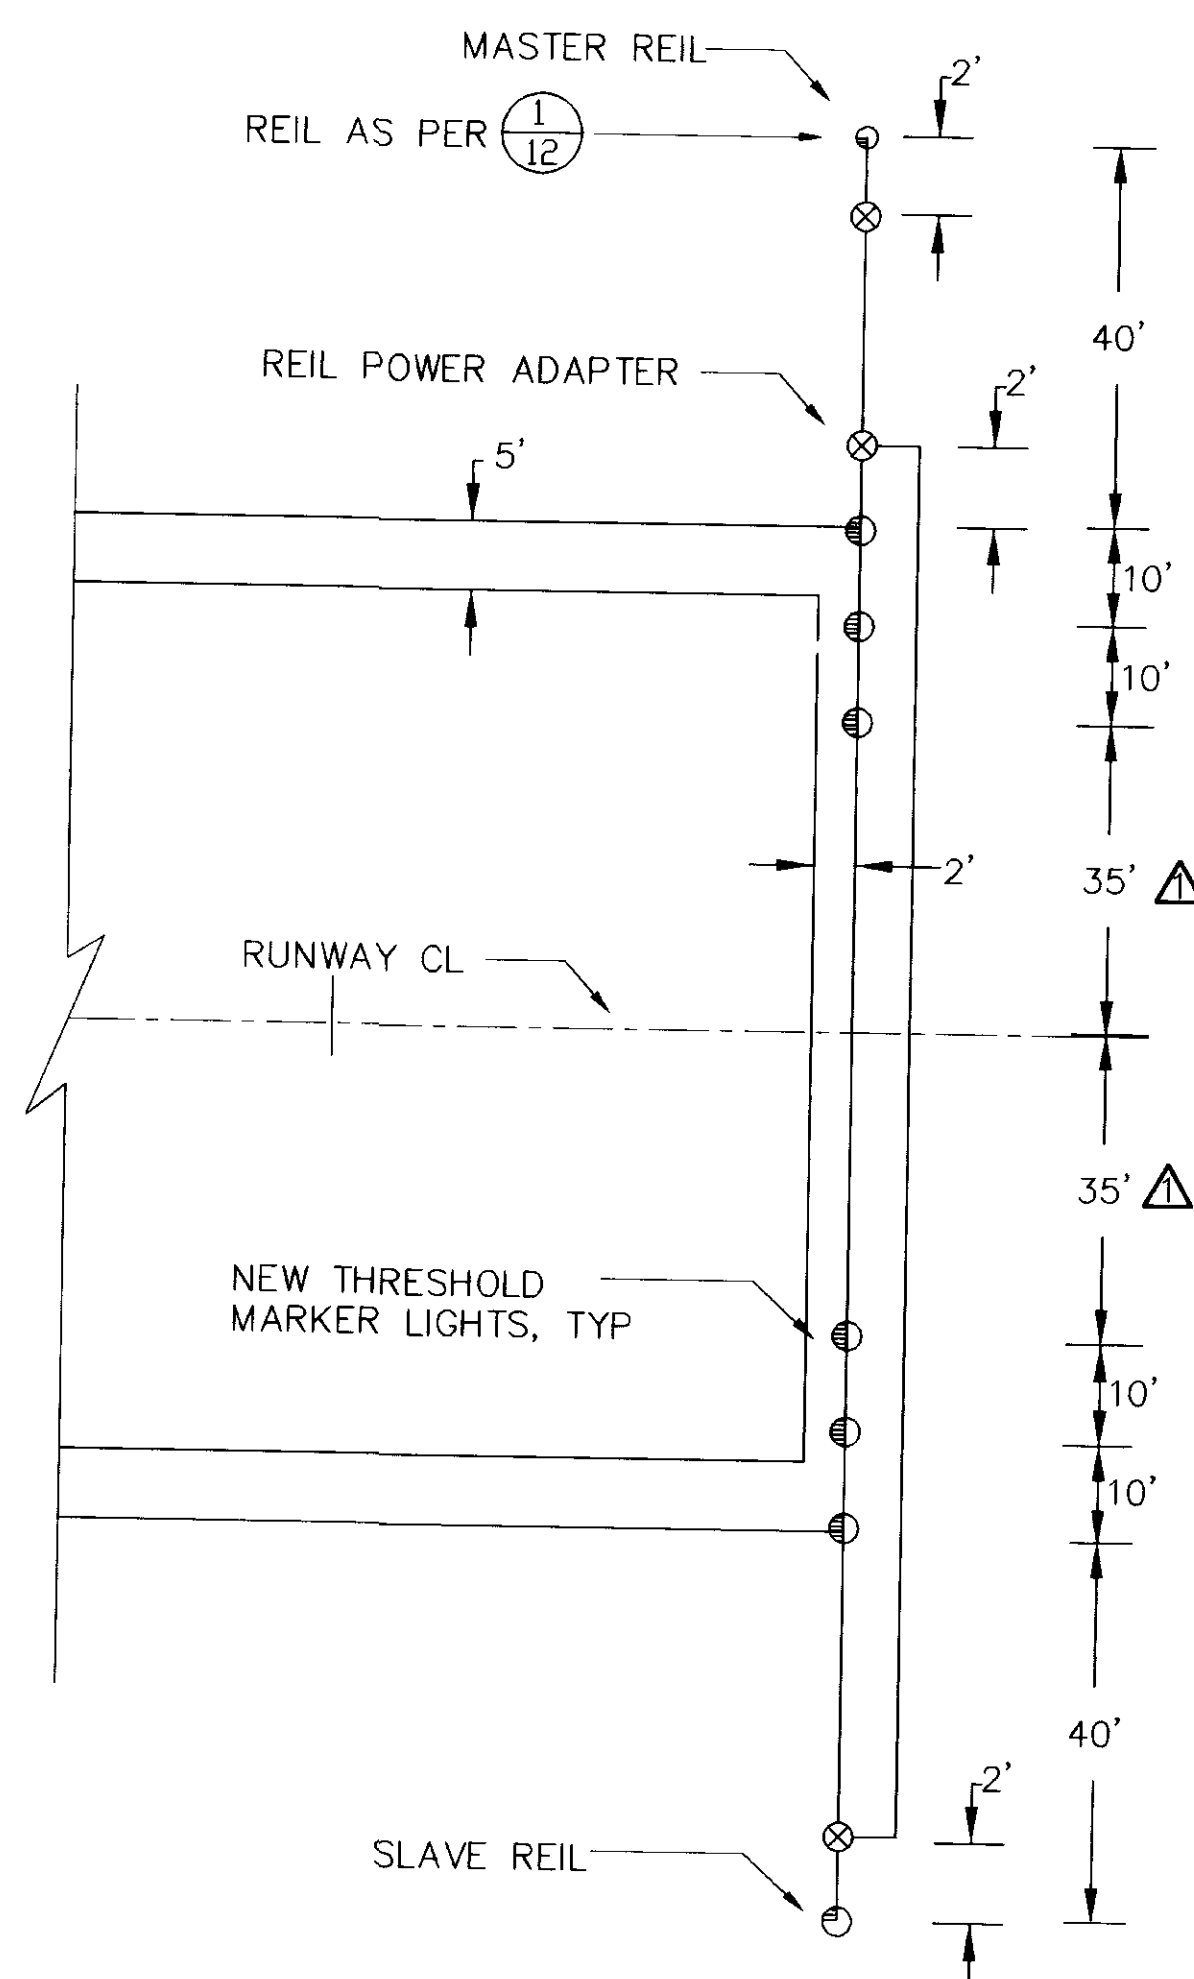


**2 REIL AND THRESHOLD LIGHT CONFIGURATION**  
NOT TO SCALE

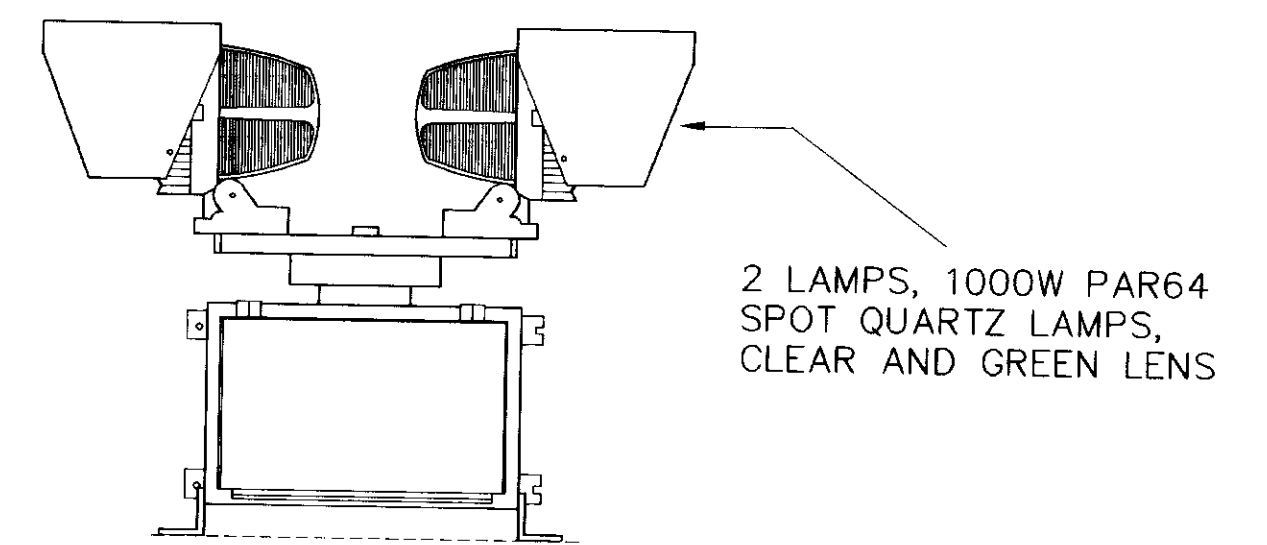


- NOTES:
1. BEACON ROTATION SPEED TO BE 11.4 RPM
  2. BEACON TO BE FAA TYPE L801.

**4 BEACON DETAIL**  
NOT TO SCALE

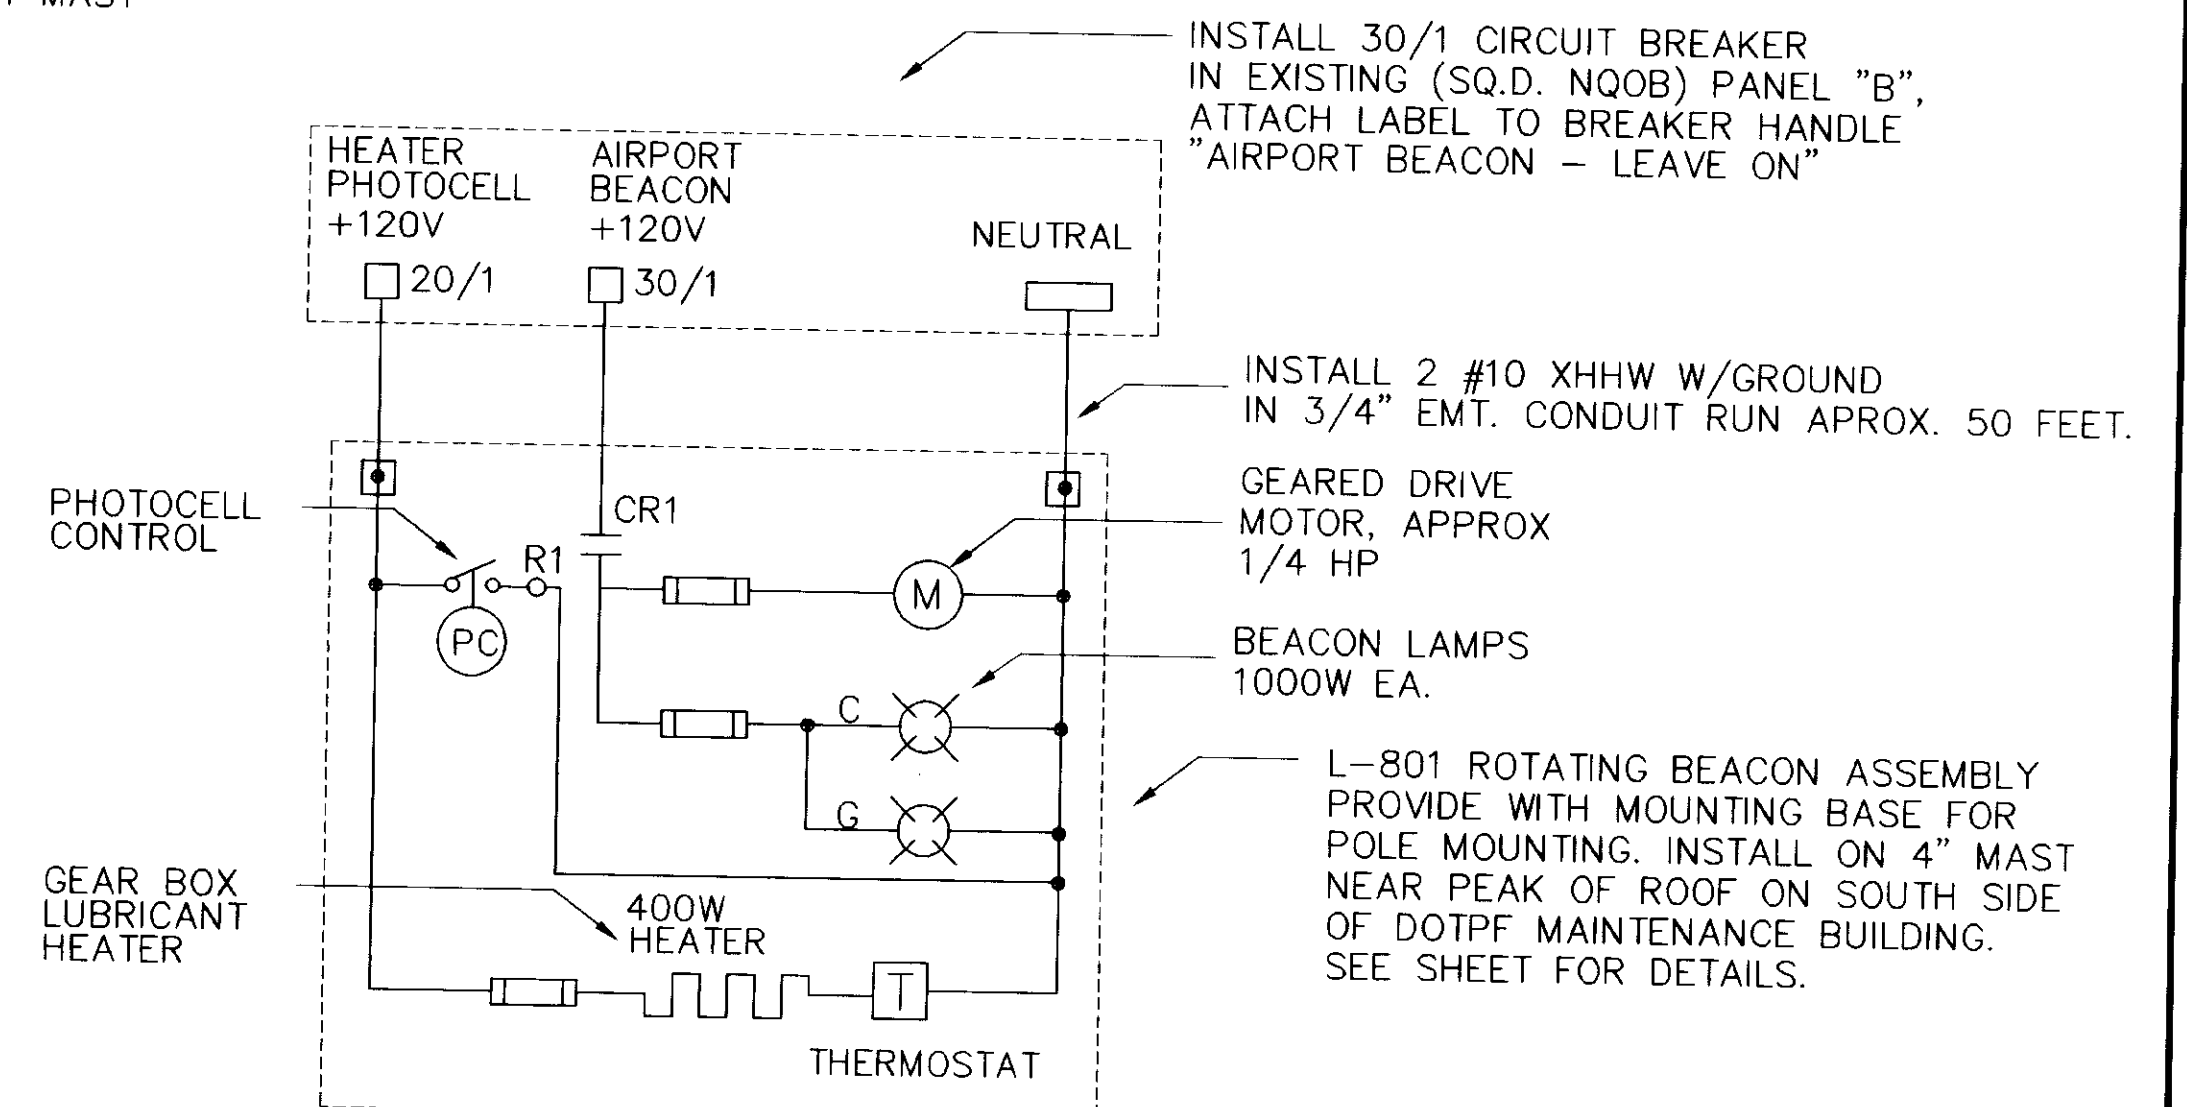

**5 BEACON WIRING DIAGRAM**  
NOT TO SCALE

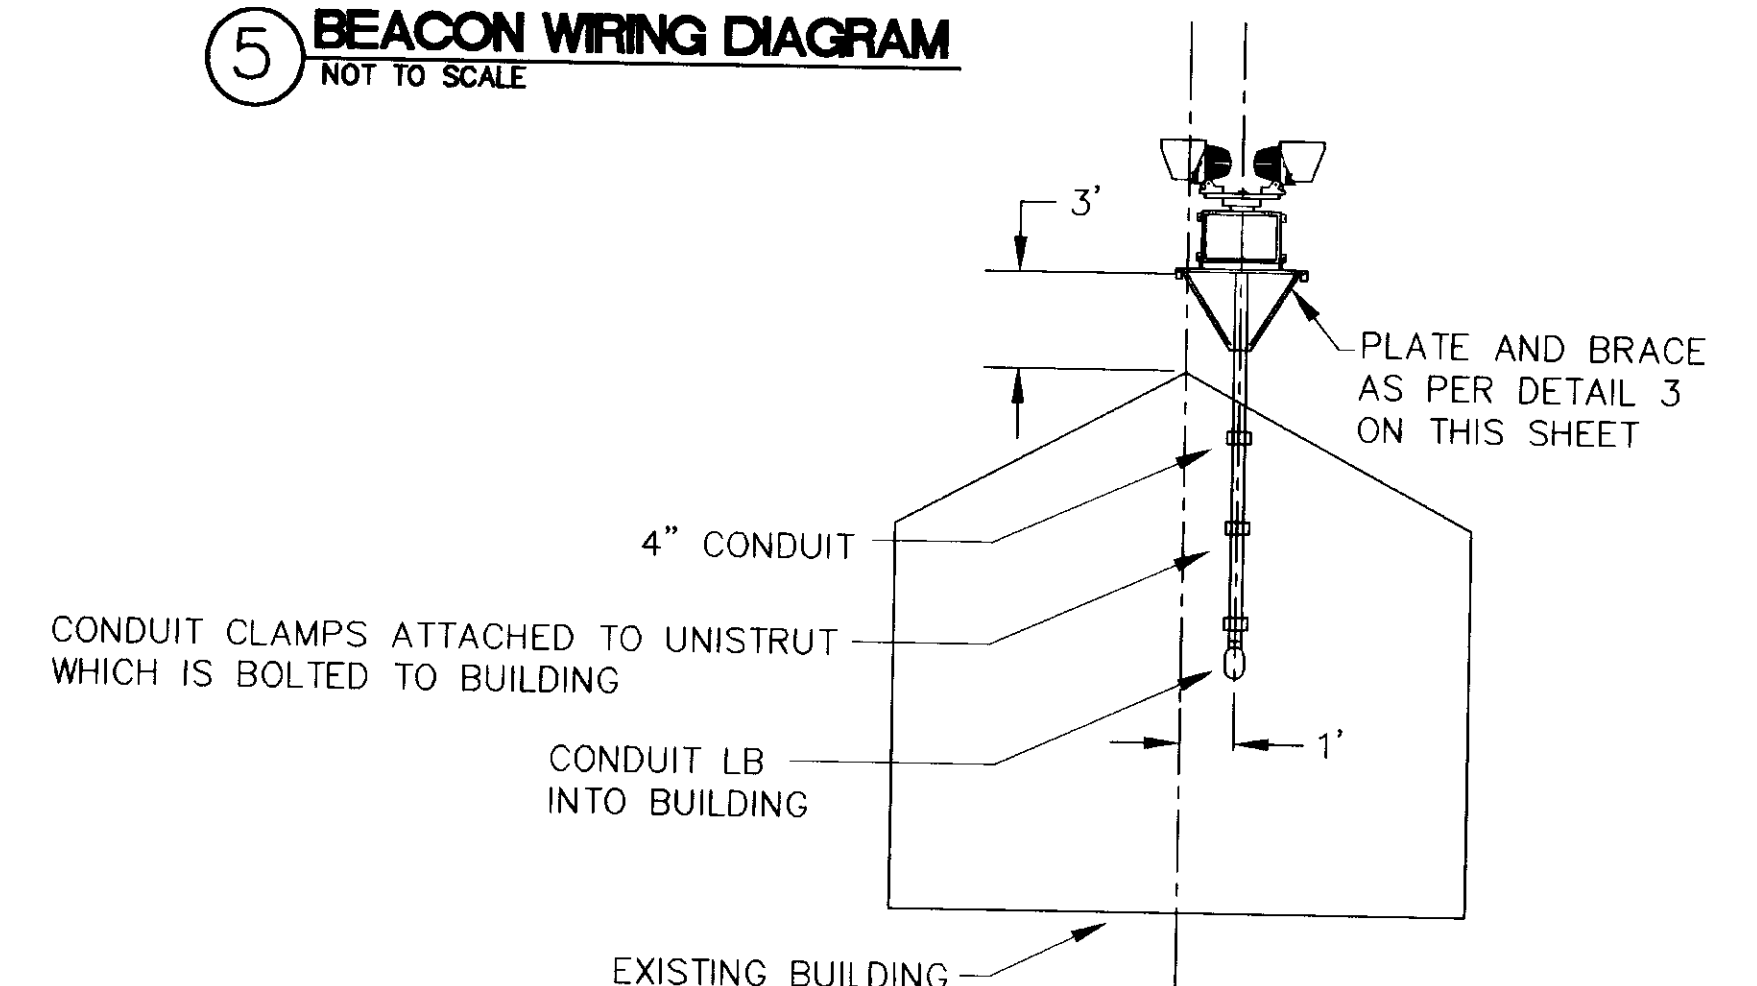

**6 BEACON BUILDING DETAIL**  
NOT TO SCALE

AS BUILT 9/93  
PER CONTRACTOR'S  
RED LINES

ENGINEER'S SEAL