

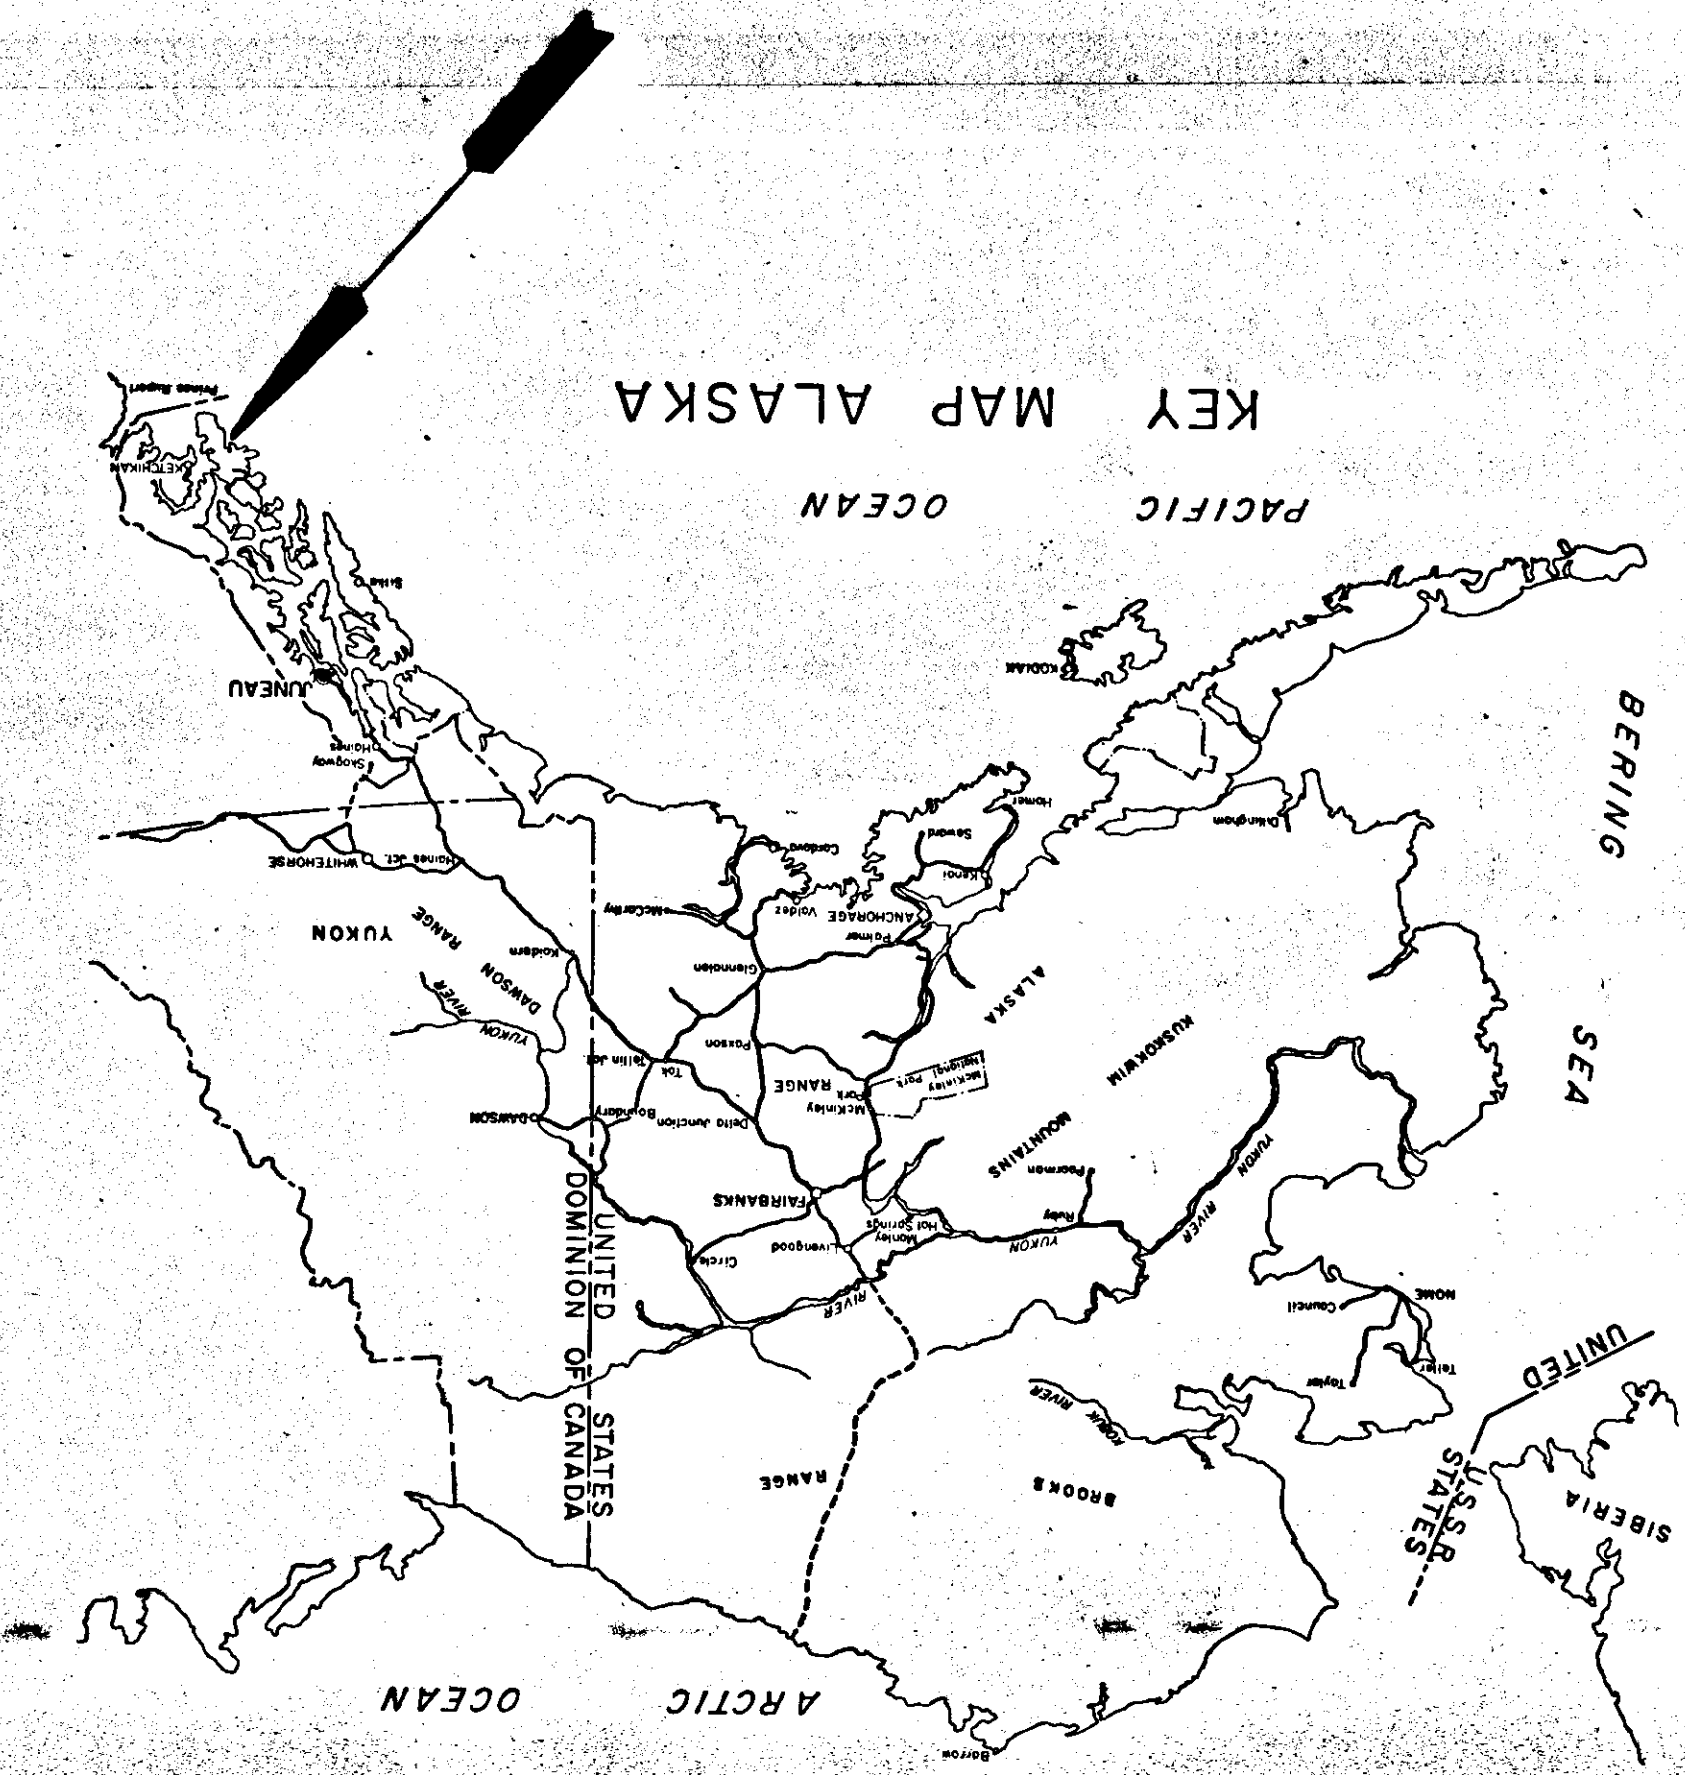


AS CONSTRUCTED PLANS

U.S. DEPARTMENT OF TRANSPORTATION
FEDERAL HIGHWAY ADMINISTRATION
WESTERN DIRECT FEDERAL DIVISION
ALASKA FOREST HIGHWAY PROJECT 9-1(I)
BIG SALT HIGHWAY
CLASS 2
LENGTH 4.348 MILES
TONGASS NATIONAL FOREST
ALASKA

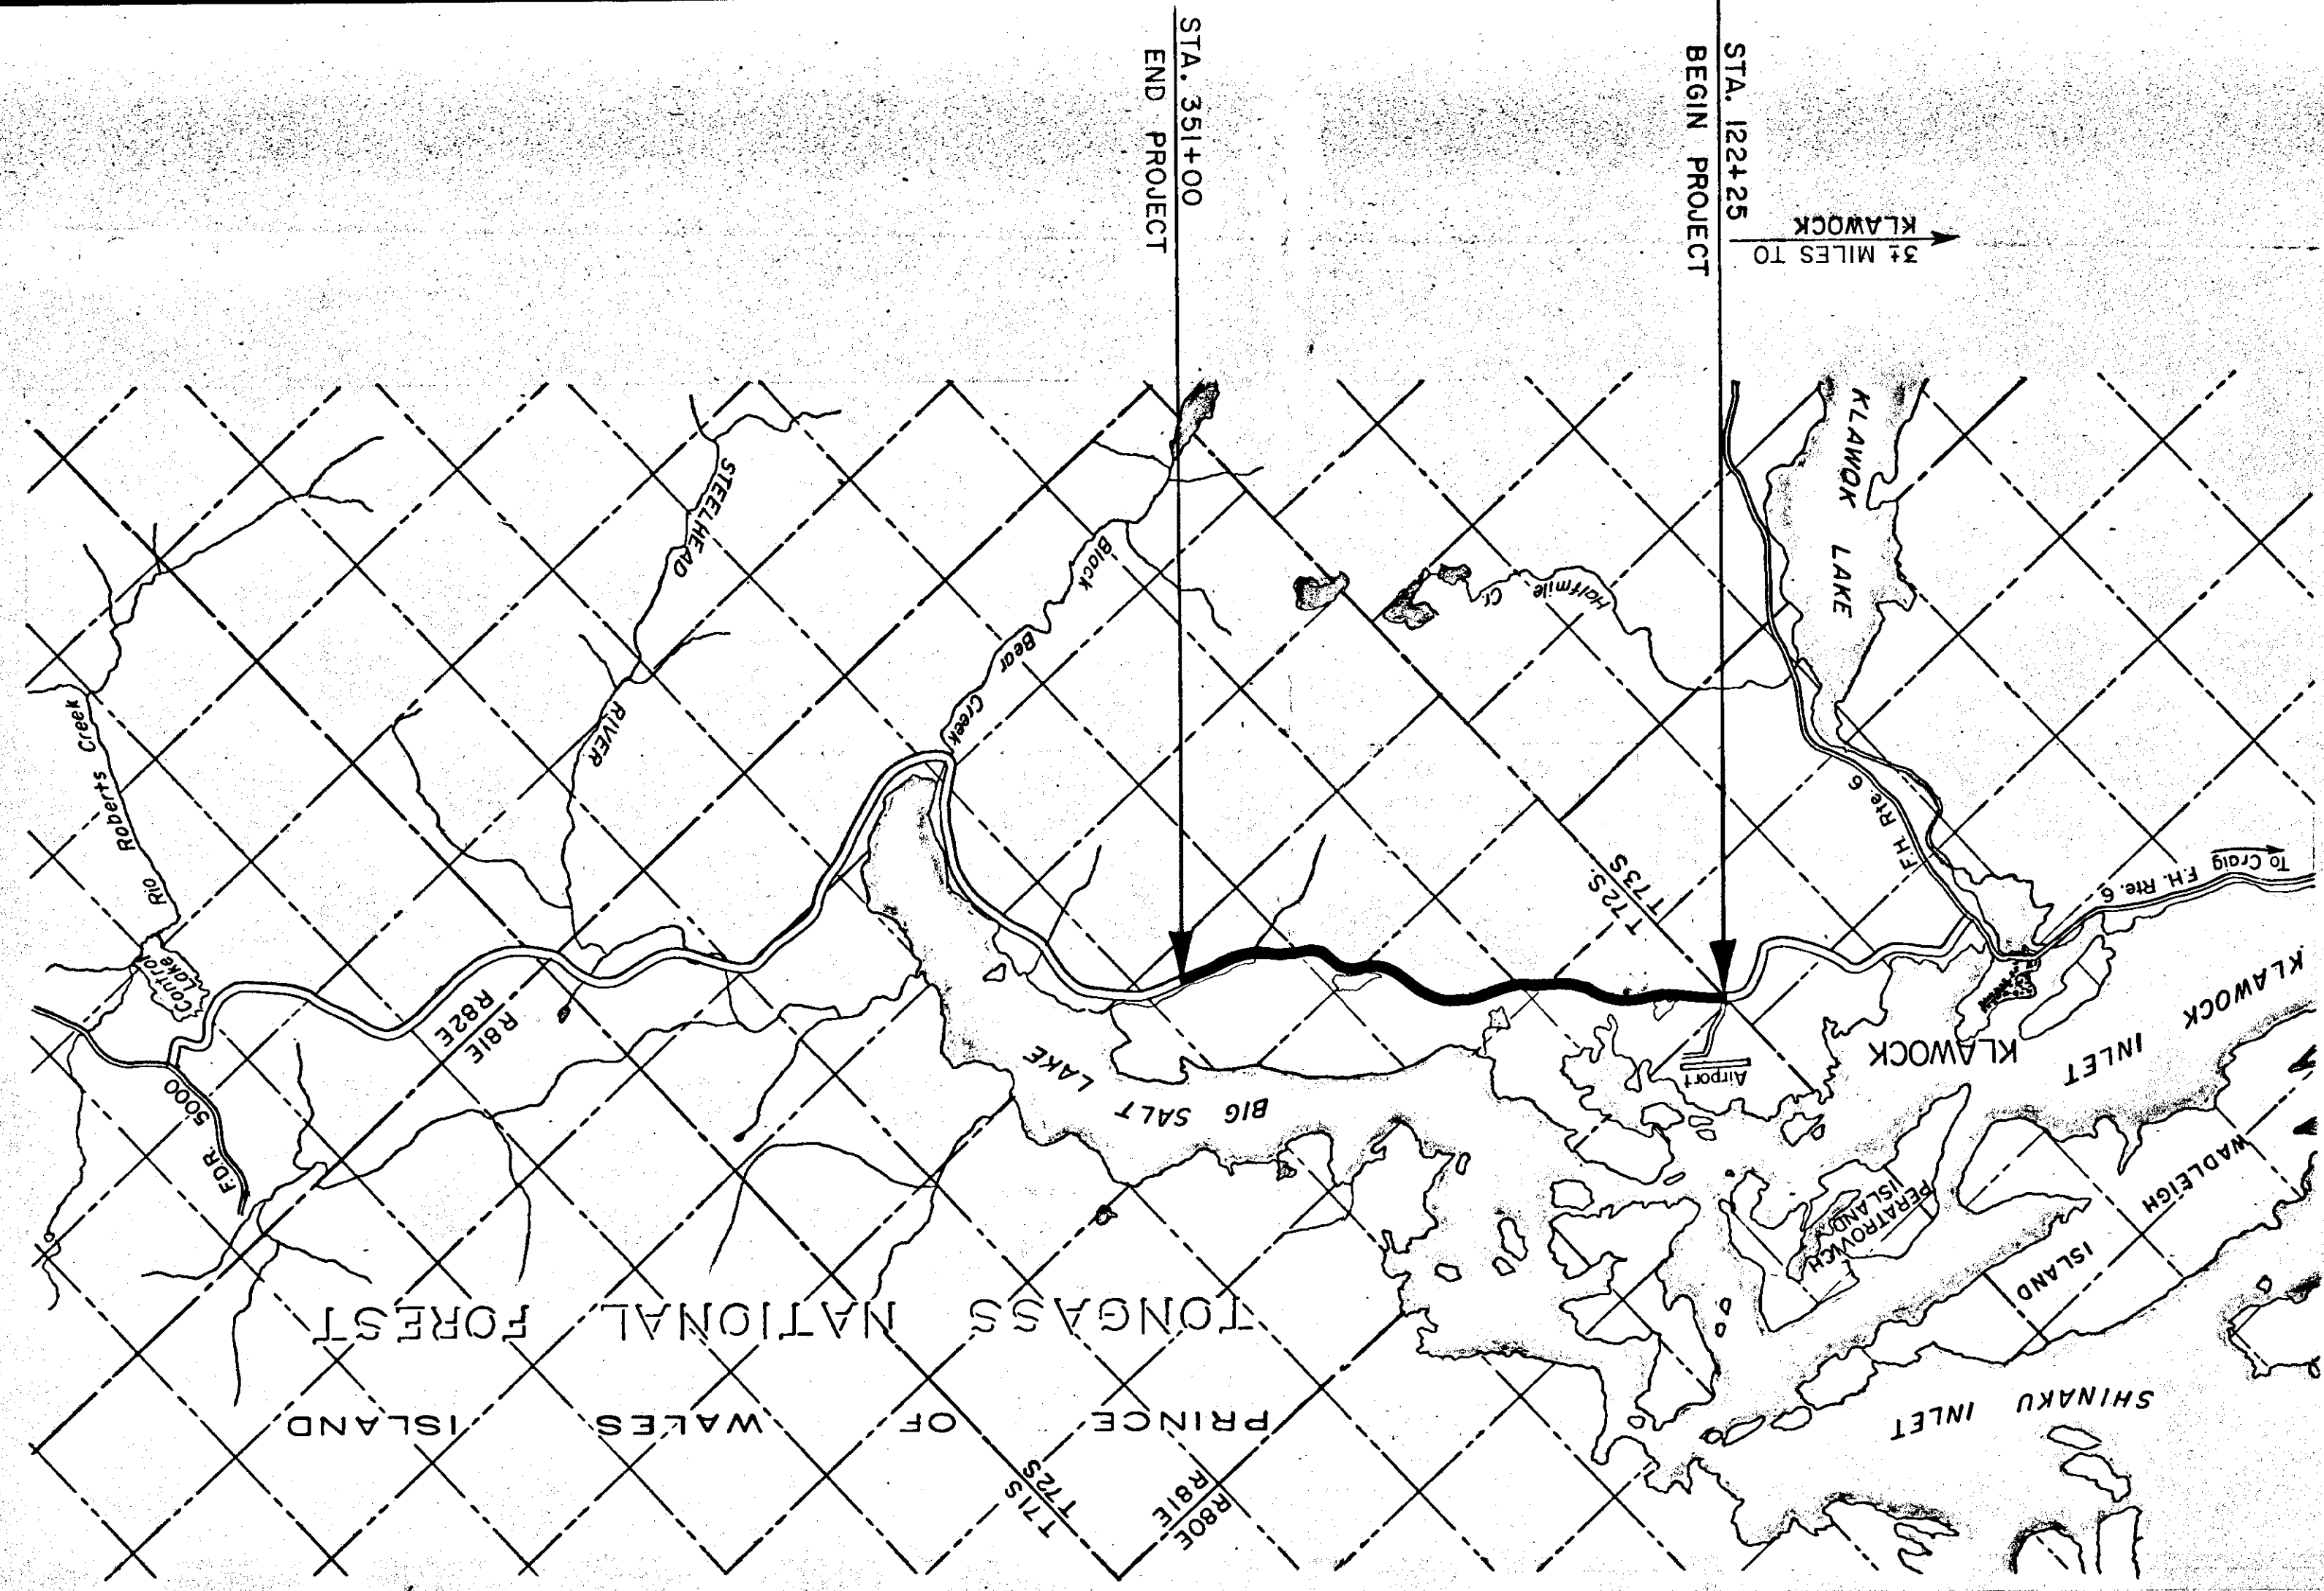


- CONVENTIONAL SYMBOLS
- COUNTY LINE
 - TOWNSHIP OR RANGE LINE
 - SECTION LINE
 - QUARTER SECTION LINE
 - SIXTEENTH LINE
 - NATIONAL PARK OR FOREST BOUNDARY
 - LINE TO BE CONSTRUCTED
 - LIMIT OF SLOPE LINE, TOP OF CUT
 - LIMIT OF SLOPE LINE, TOE OF FILL
 - PROPOSED RIGHT OF WAY LINE
 - EXISTING RIGHT OF WAY LINE
 - LIMITED ACCESS RIGHT OF WAY
 - RAILROAD
 - EXISTING FENCE
 - EXISTING CULVERT
 - CULVERT TO BE CONSTRUCTED
 - EXISTING BRIDGE
 - PROPOSED BRIDGE
 - POWER POLES (EXISTING & PROPOSED)
 - TELEPHONE/TELEGRAPH POLES (EXIST & PROPOSED)
 - JOINT USE POLES (EXISTING & PROPOSED)

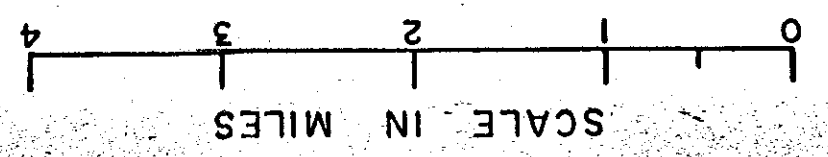

Description of Project
Improvement: Grading
Roadbed Width: 22' at Profile Grade
Project Begin: 9/28/81
Project Completed: 11/30/81
Project Engineer: J.B. Arriaga

Plans
Prepared M. Eastman
Checked J. B. Arriaga 10/21/82
Reviewed J. B. Arriaga 10/22/82

INDEX TO SHEETS			SHEET NO.
1	TITLE SHEET		
2	TYPICAL SECTION		
3 - 6	PLAN SHEETS		

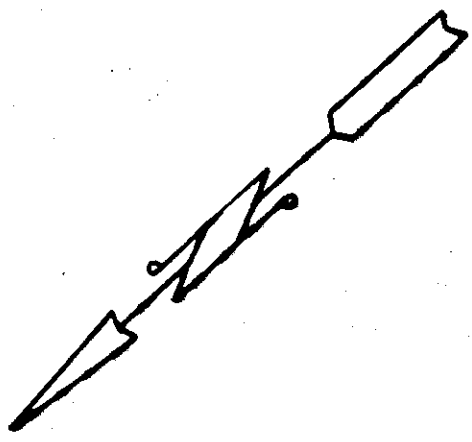

122+25 Airport Road
26' Wide

07.123+41.3 BK
123+28.7 AH.

EQUATION

+ 120

-125

N. 42.42

N. 42.42.30"E.

130

134+37 18" CSP
Extended 4' Lt.

135

137+88 24' CSP
Extended 2' Right

140+22 18" CSP
Extended 4' Lt.

142+67 18" CSP
Extended 2' Lt.

145

149+04 18" CSP
Extended 4' Right

BIG SALT HIGHWAY

SSANGS

EQUATION

$$\frac{P.T. 160 + 46.0 BK.}{160 + 69.0 AH.}$$
$$D = 5.2 \text{ L} \\ e = 0.040$$

N.56 / 3 L.

R.R. 040

N. 42.72

P.T. 153 + 60.3

LEGEND
CSP = Galvanized Corrugated
Steel Pipe
CAP = Corrugated Aluminum Pipe

P.C. 161 + 81.8

EQUATION

166+34 24" CSP
Extended 8' Left

168+63 18" CSP
Extended 2' Left

P.C./69*89.5

170+77 18" CSP
Extended 8' Left

P.C. 172+24.5

$D = 10^{\circ} \text{C.R.}$
 $e = 0.050$



4-32 18" CSP
Extended 8 Left

N. 88.02.E.


176*91
Extend

PT. 179 x 18 + 37.9


TONGASS NATIONAL FOREST

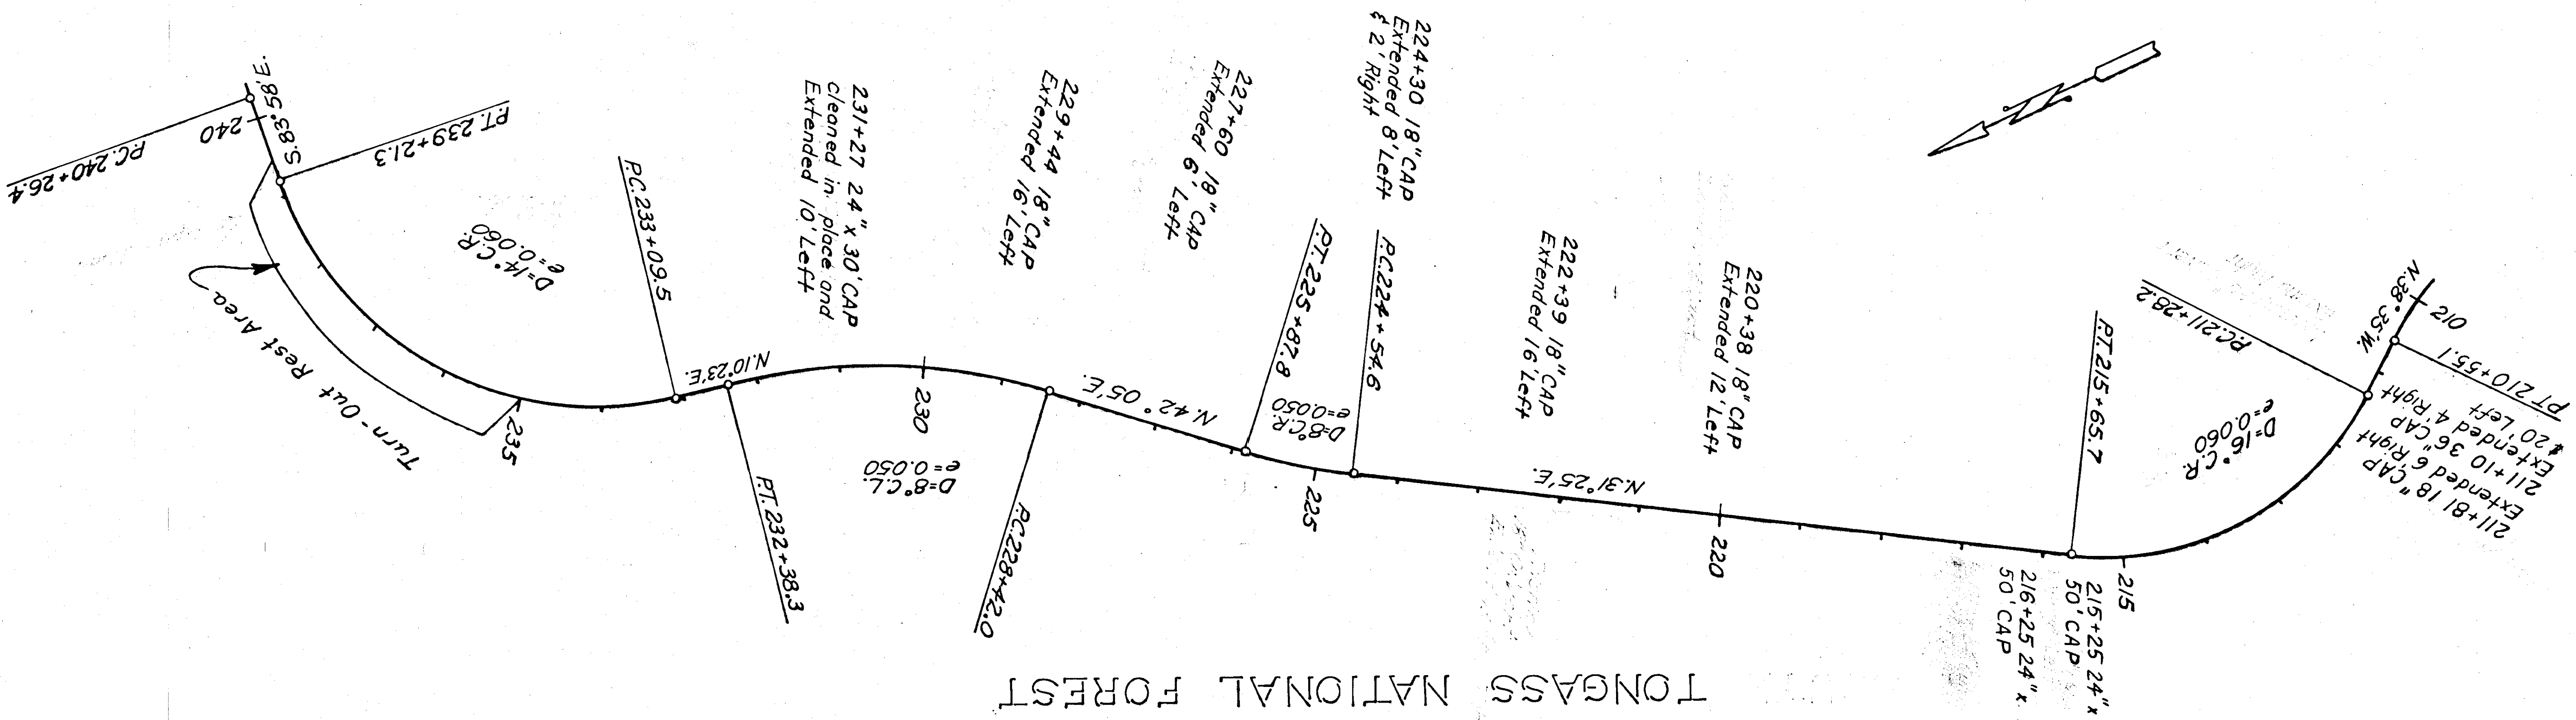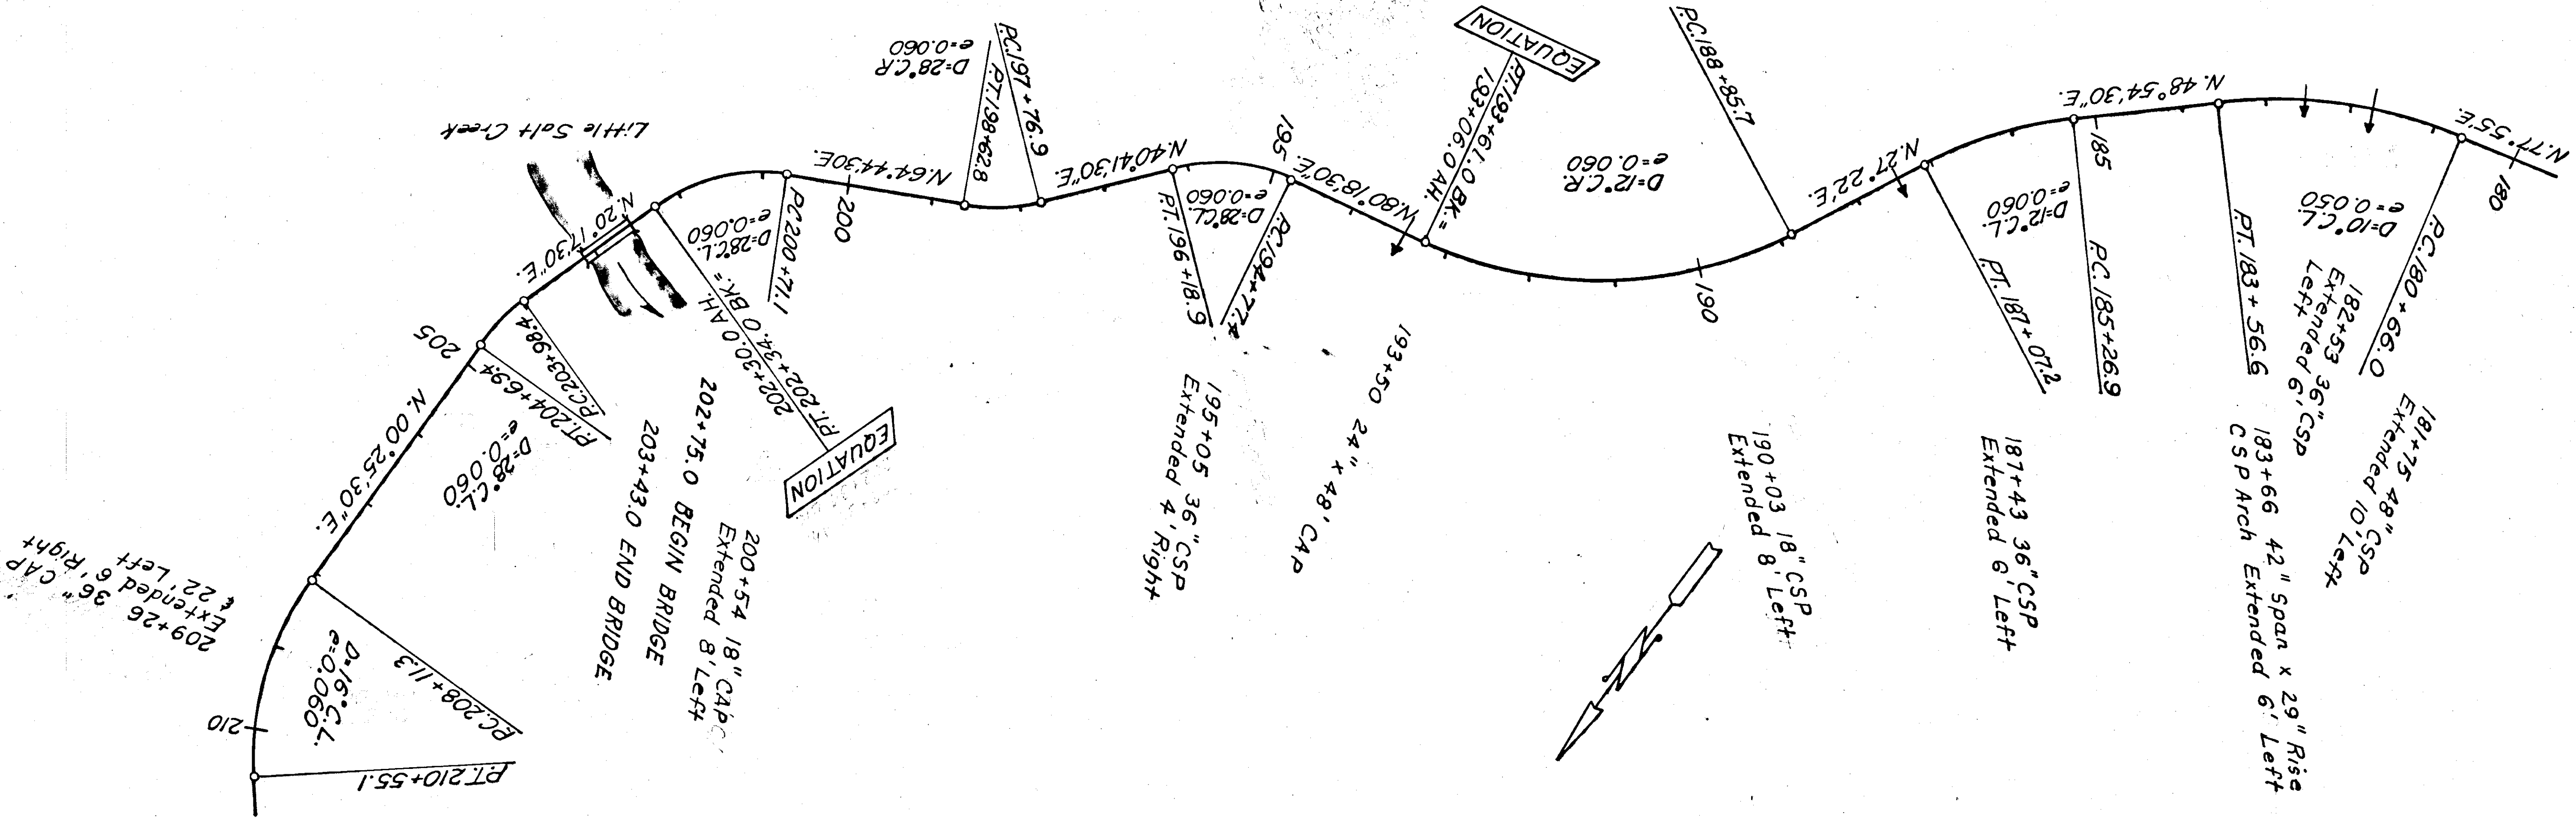


TONGASS NATIONAL FOREST

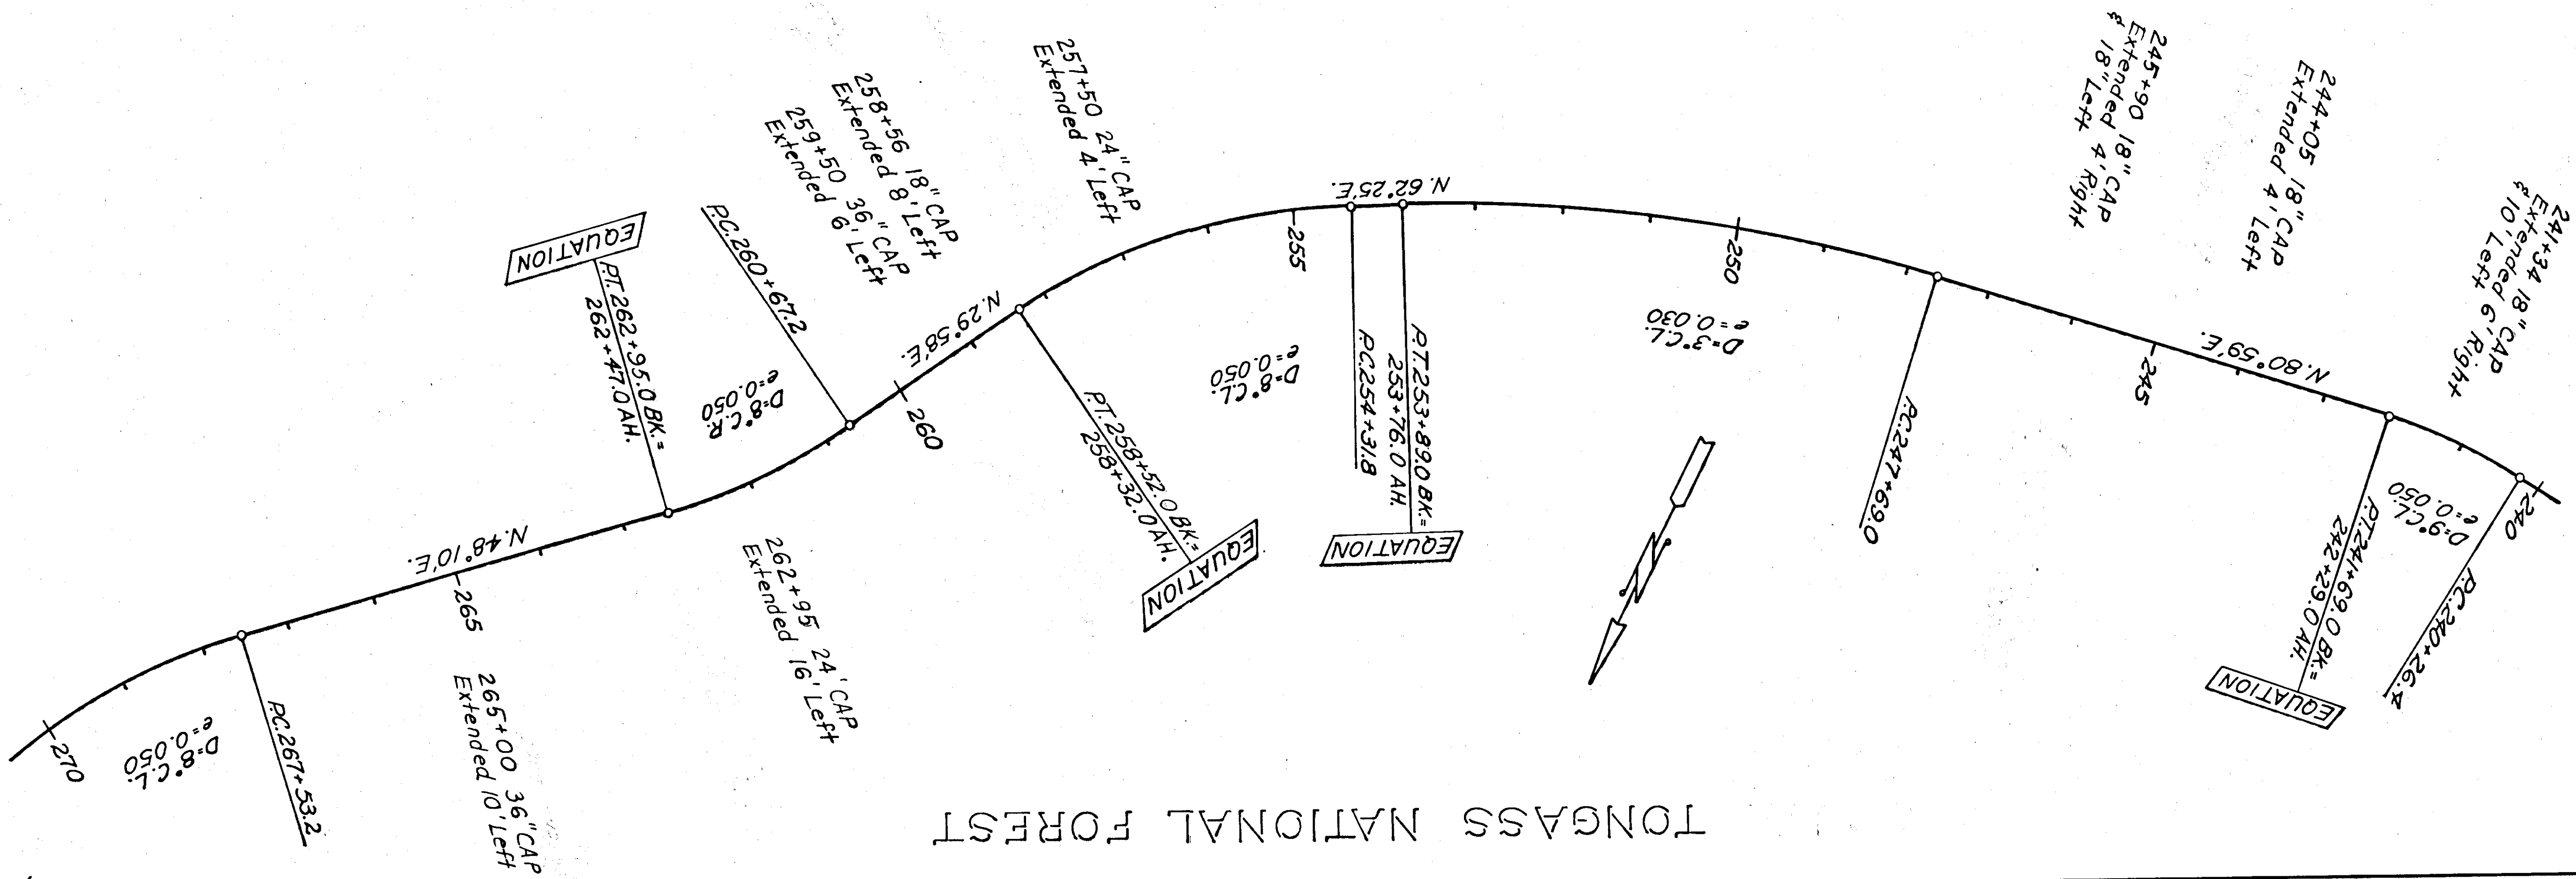


NATIONAL FOREST

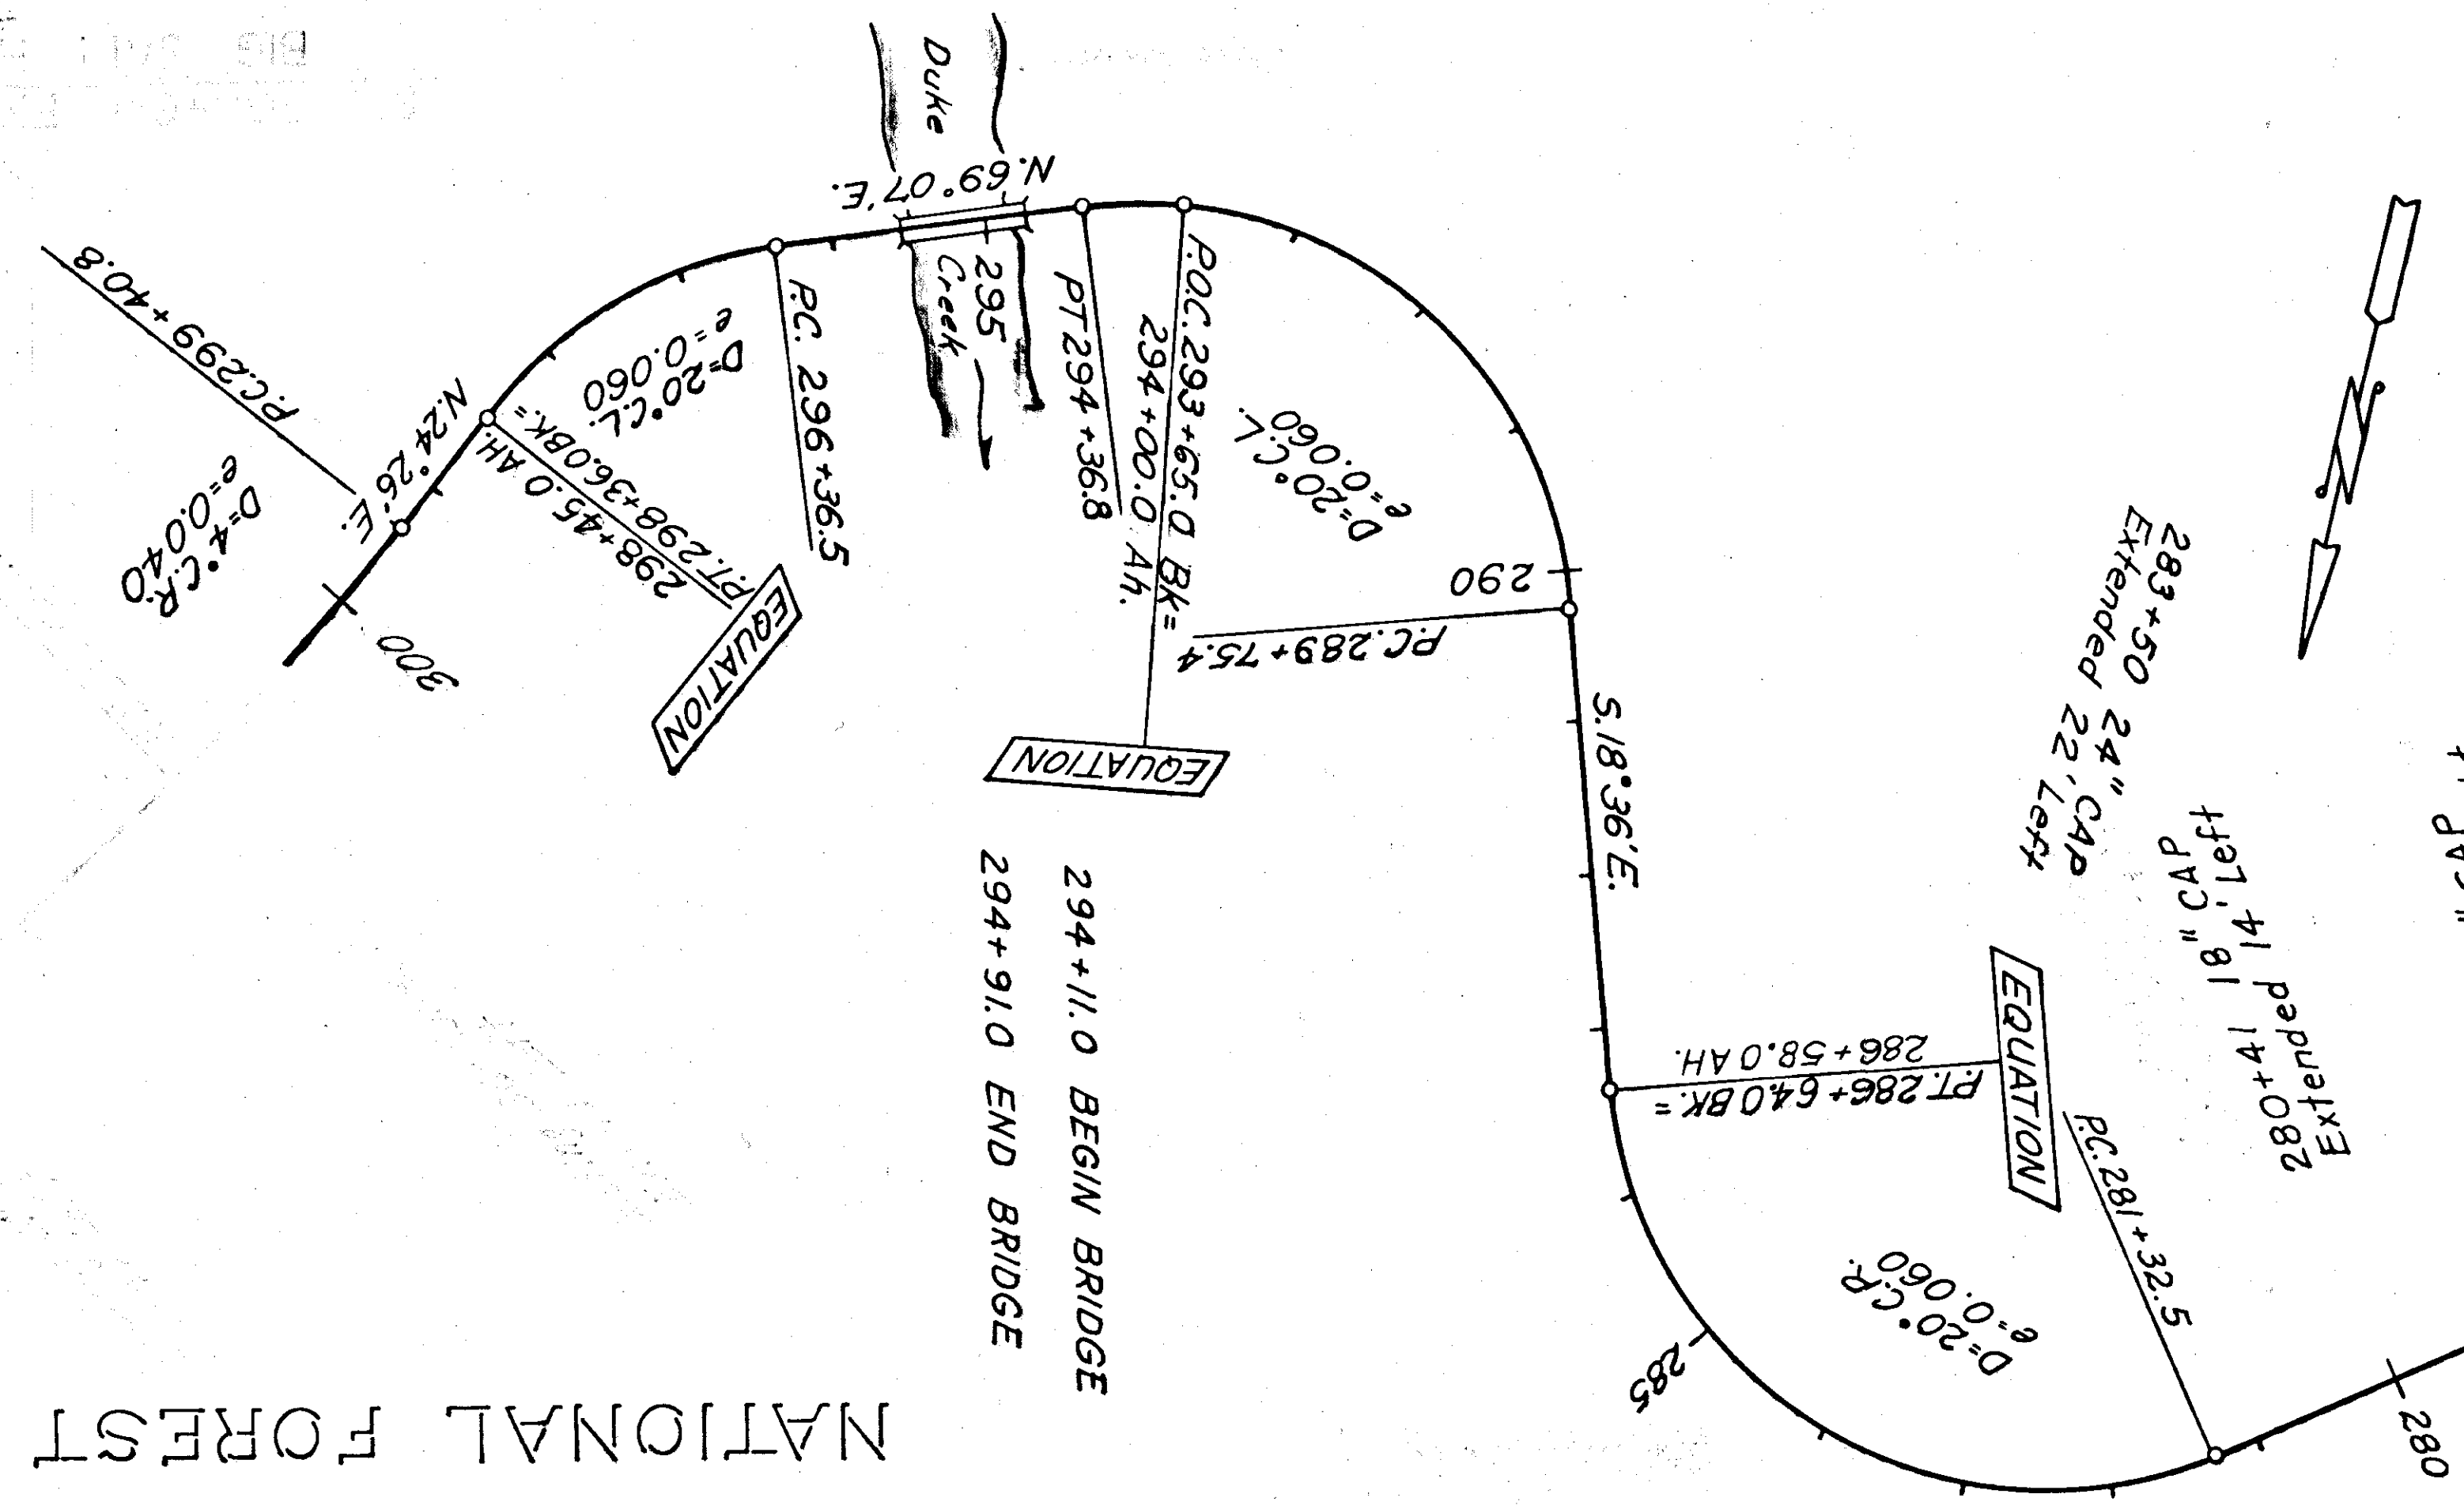

TONGASS

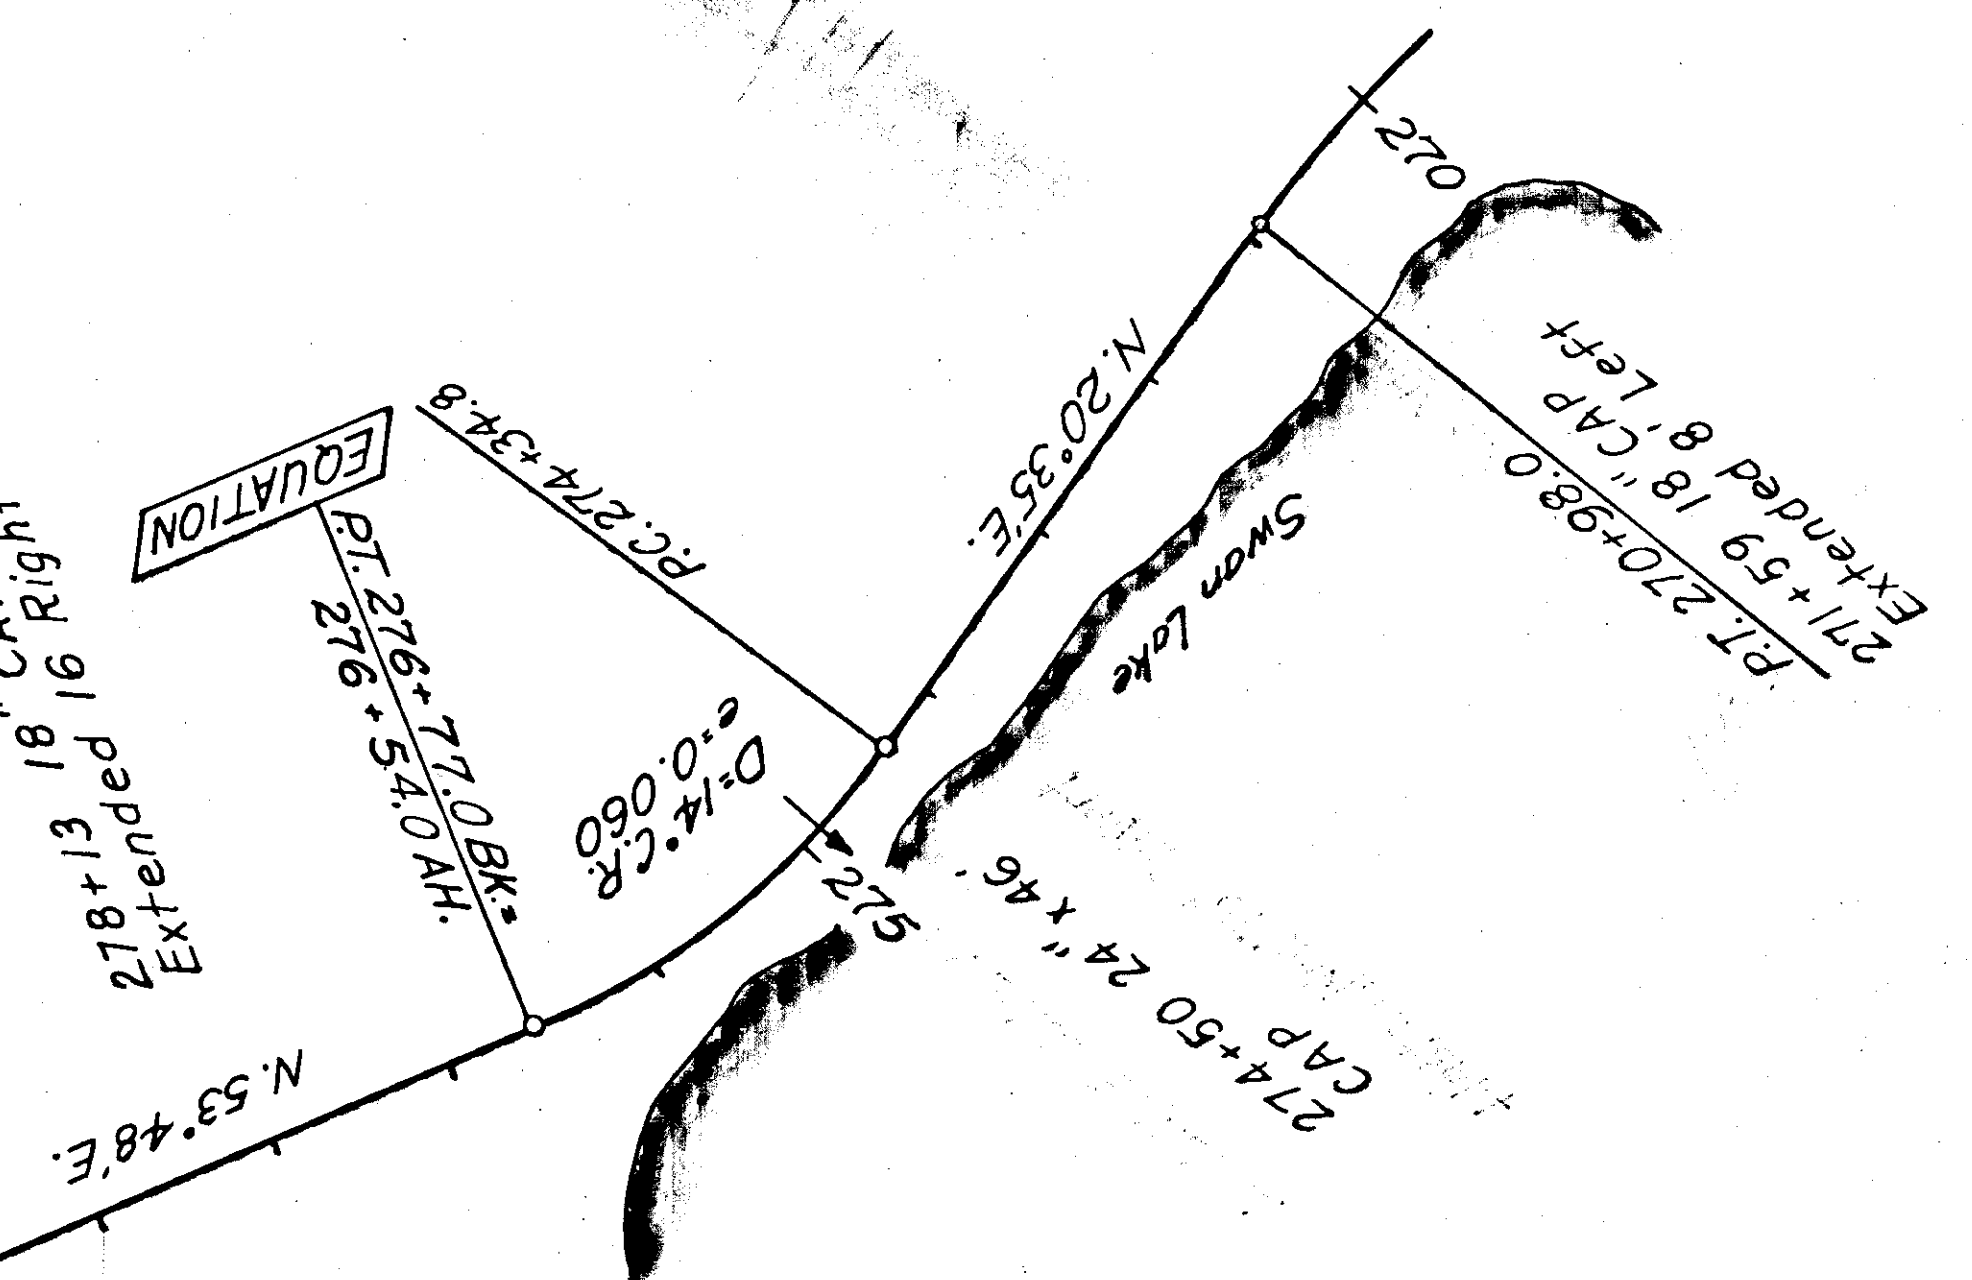

TONGASS NATIONAL FOREST

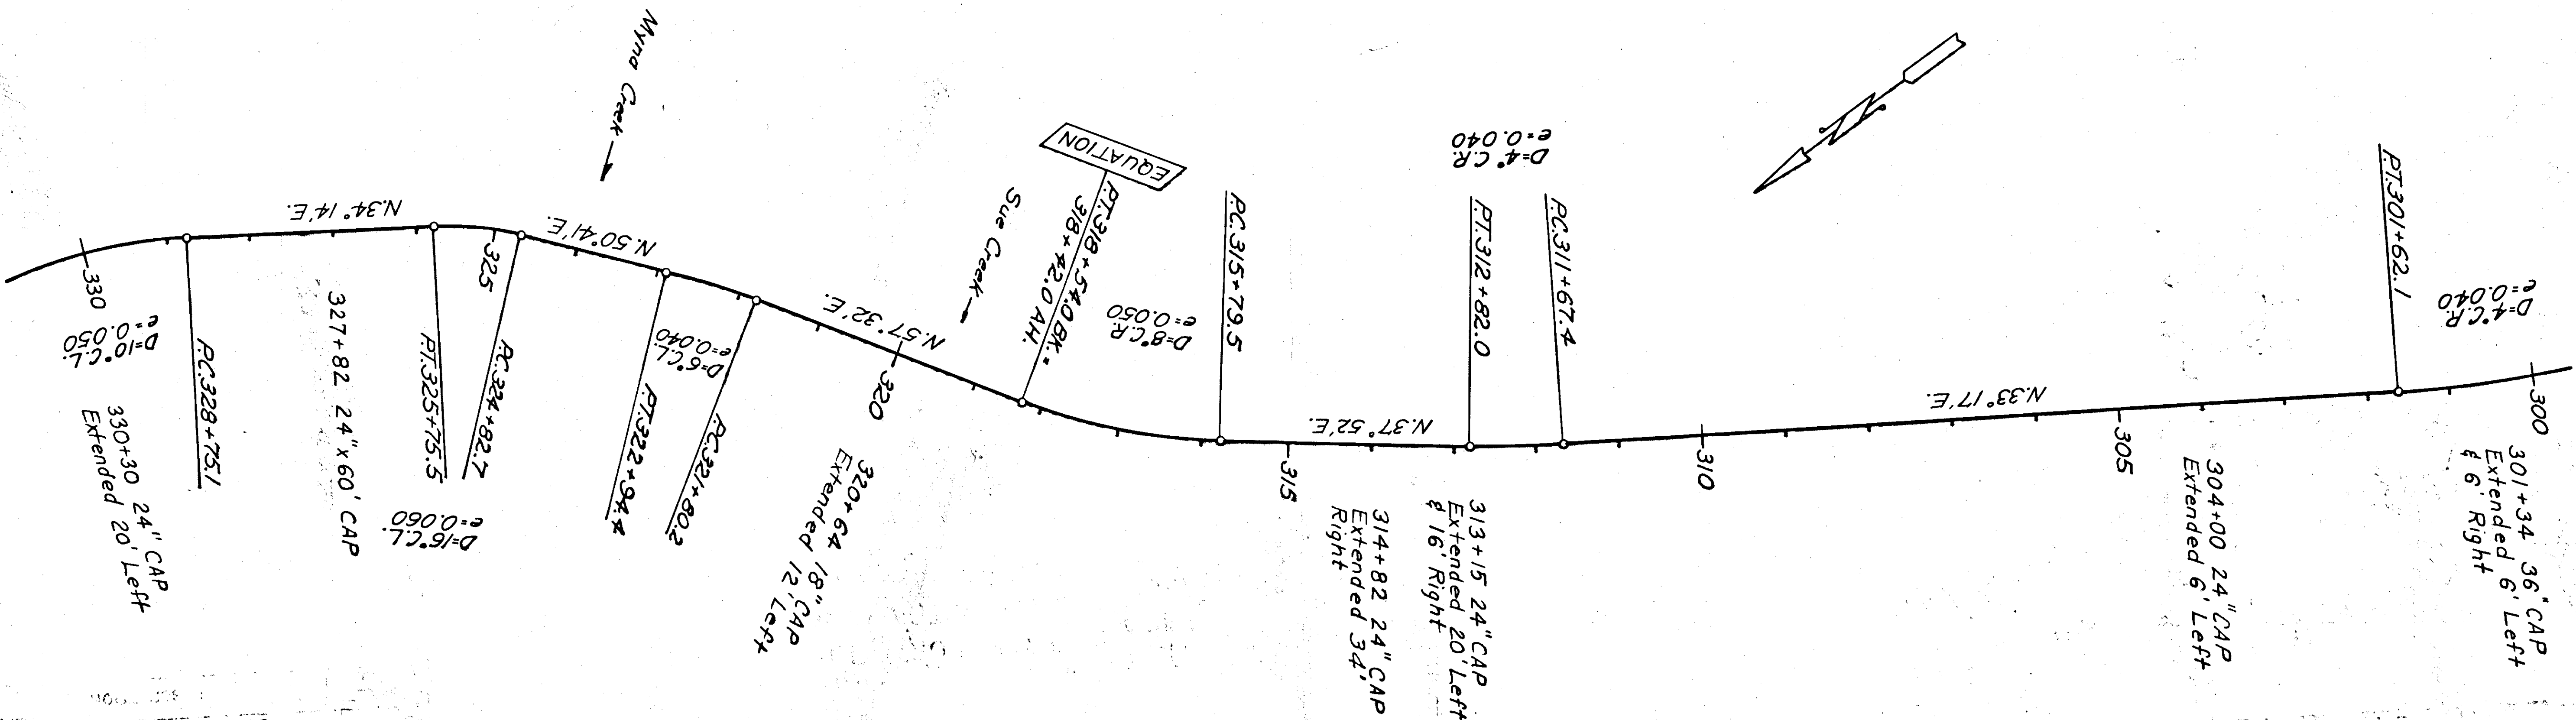

TONGASS NATIONAL FOREST

