



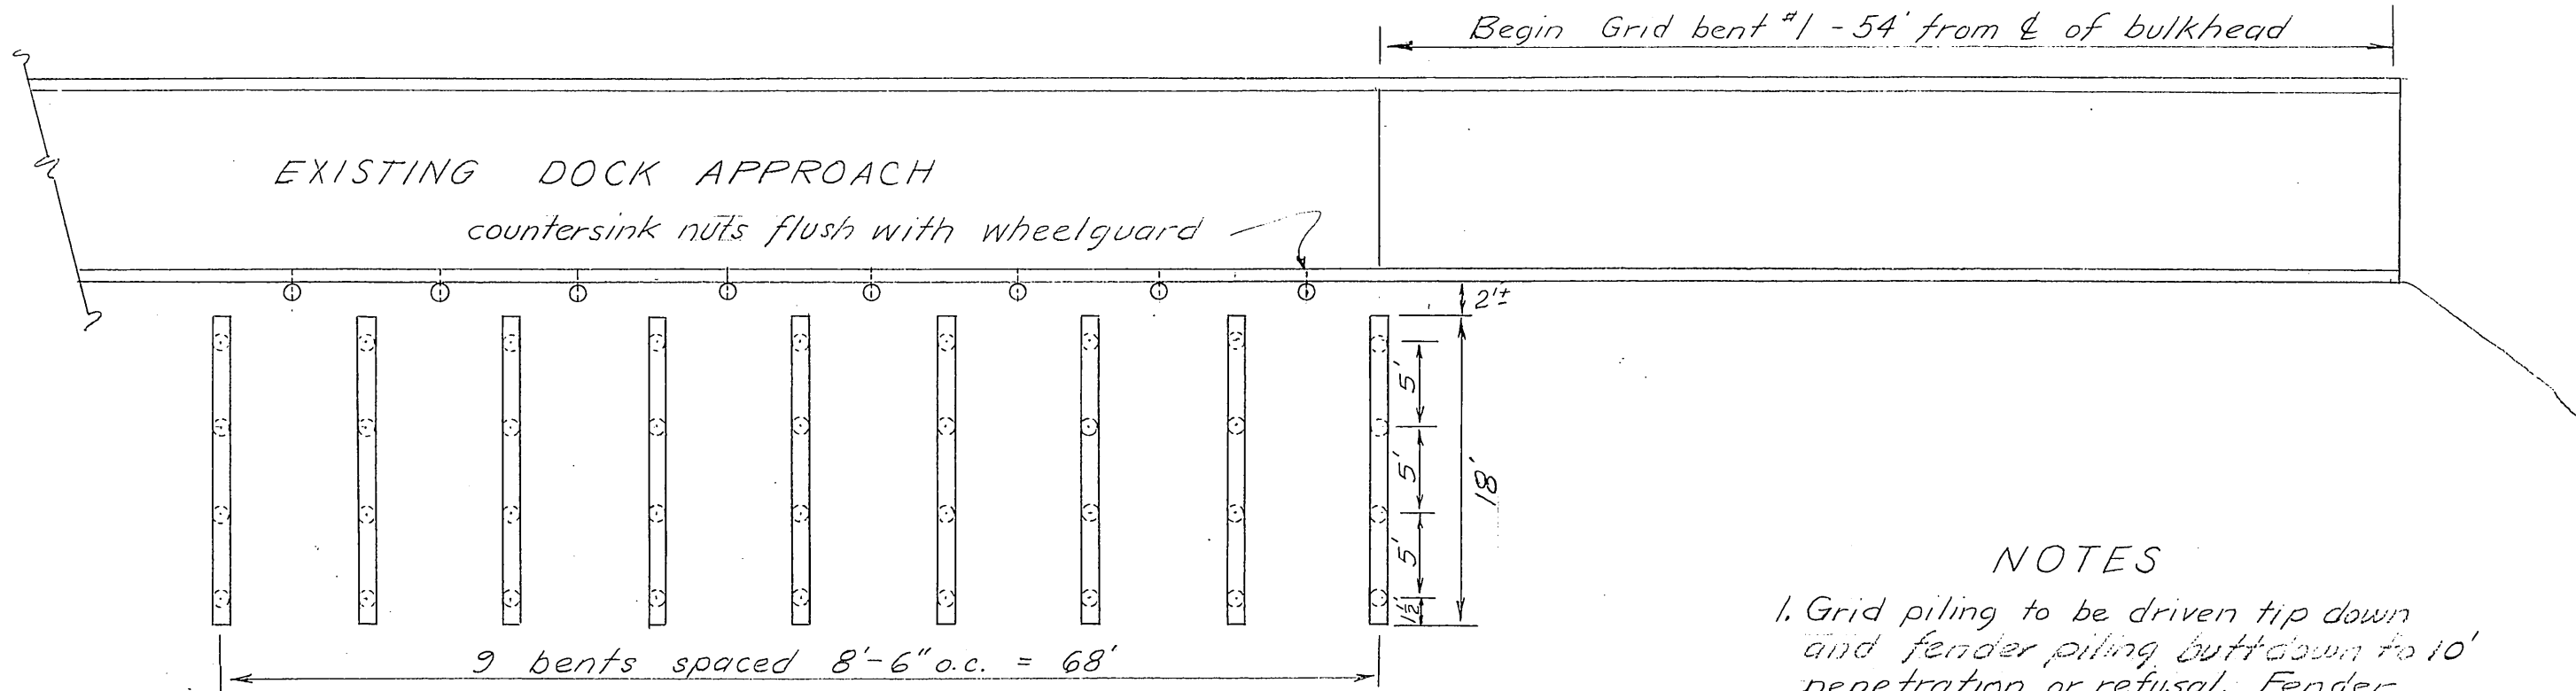

PLAN VIEW
1" = 10'

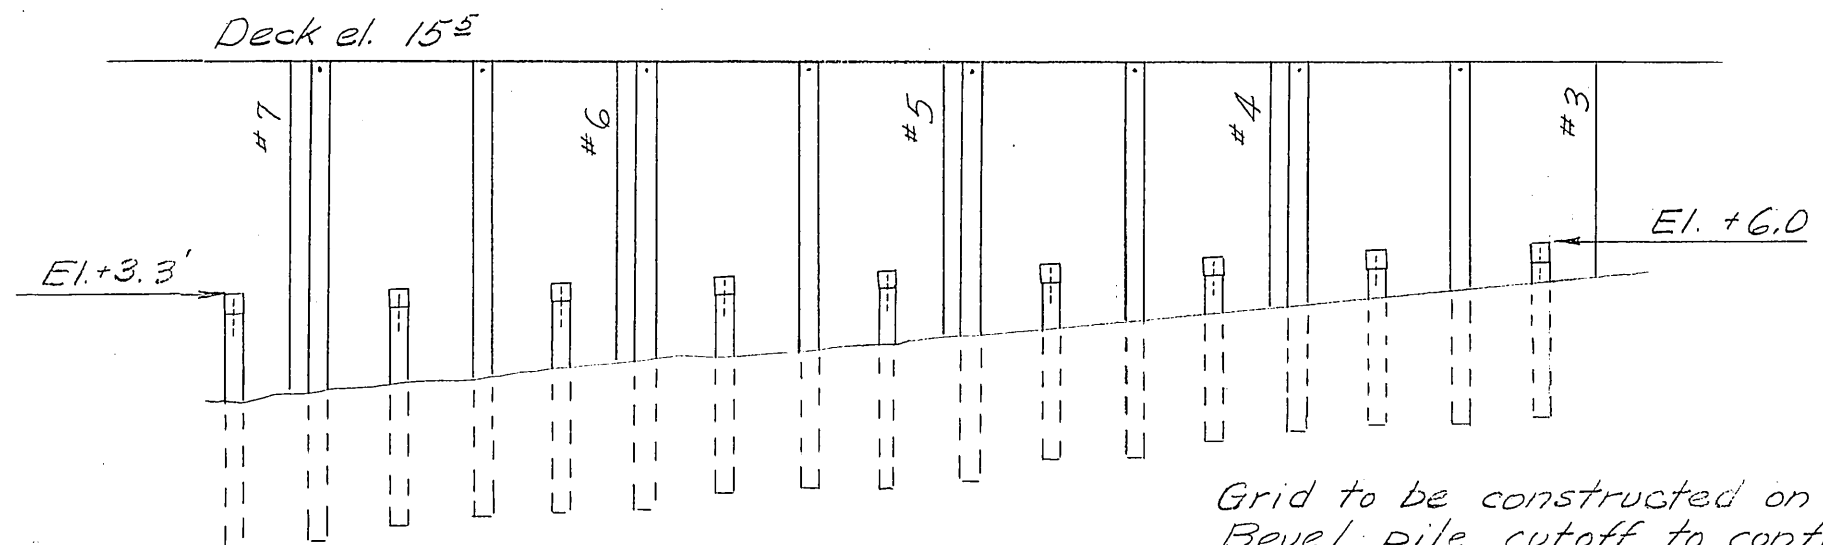

PROFILE VIEW
1" = 10'

Grid to be constructed on 4% grade.
Bevel pile cutoff to conform to grade.

NOTES

1. Grid piling to be driven tip down and fender piling butt down to 10' penetration or refusal. Fender piling to be fastened to approach wheelguard with $\frac{3}{4}$ " bolts.
2. Used creosote caps & piling will be acceptable. Caps to be 12' x 12' x 18' minimum dimension.
3. Secure caps to piles with $\frac{3}{4}$ " x 30" drift bolts w/ clinch rings. Treat pile tops with 2 applications of hot creosote oil followed by a $\frac{1}{4}$ " coat of asphaltic roofing compound.
4. All hardware to be galvanized.

AS BUILT

STATE OF ALASKA DEPARTMENT OF PUBLIC WORKS DIVISION OF WATER AND HARBORS		
Klawock Grid		
SCALE <u>1" = 10'</u>	APPROVED _____	
DATE <u>July 22, '64</u>	COMMISSIONER	
PROJ. NO. <u>W-65175</u>	SURVEYED BY <u>DS</u>	DRAWN BY <u>DM</u>