
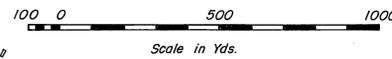
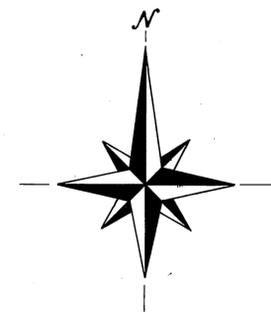


STATE OF ALASKA  
DEPARTMENT OF PUBLIC WORKS  
**DIVISION OF WATER & HARBORS**

KETCHIKAN BAR HARBOR - PHASE No. 7  
PROJECT No. 3-69153  
KETCHIKAN THOMAS BASIN - PHASE No. 2  
PROJECT No. 3-69167

AS BUILT

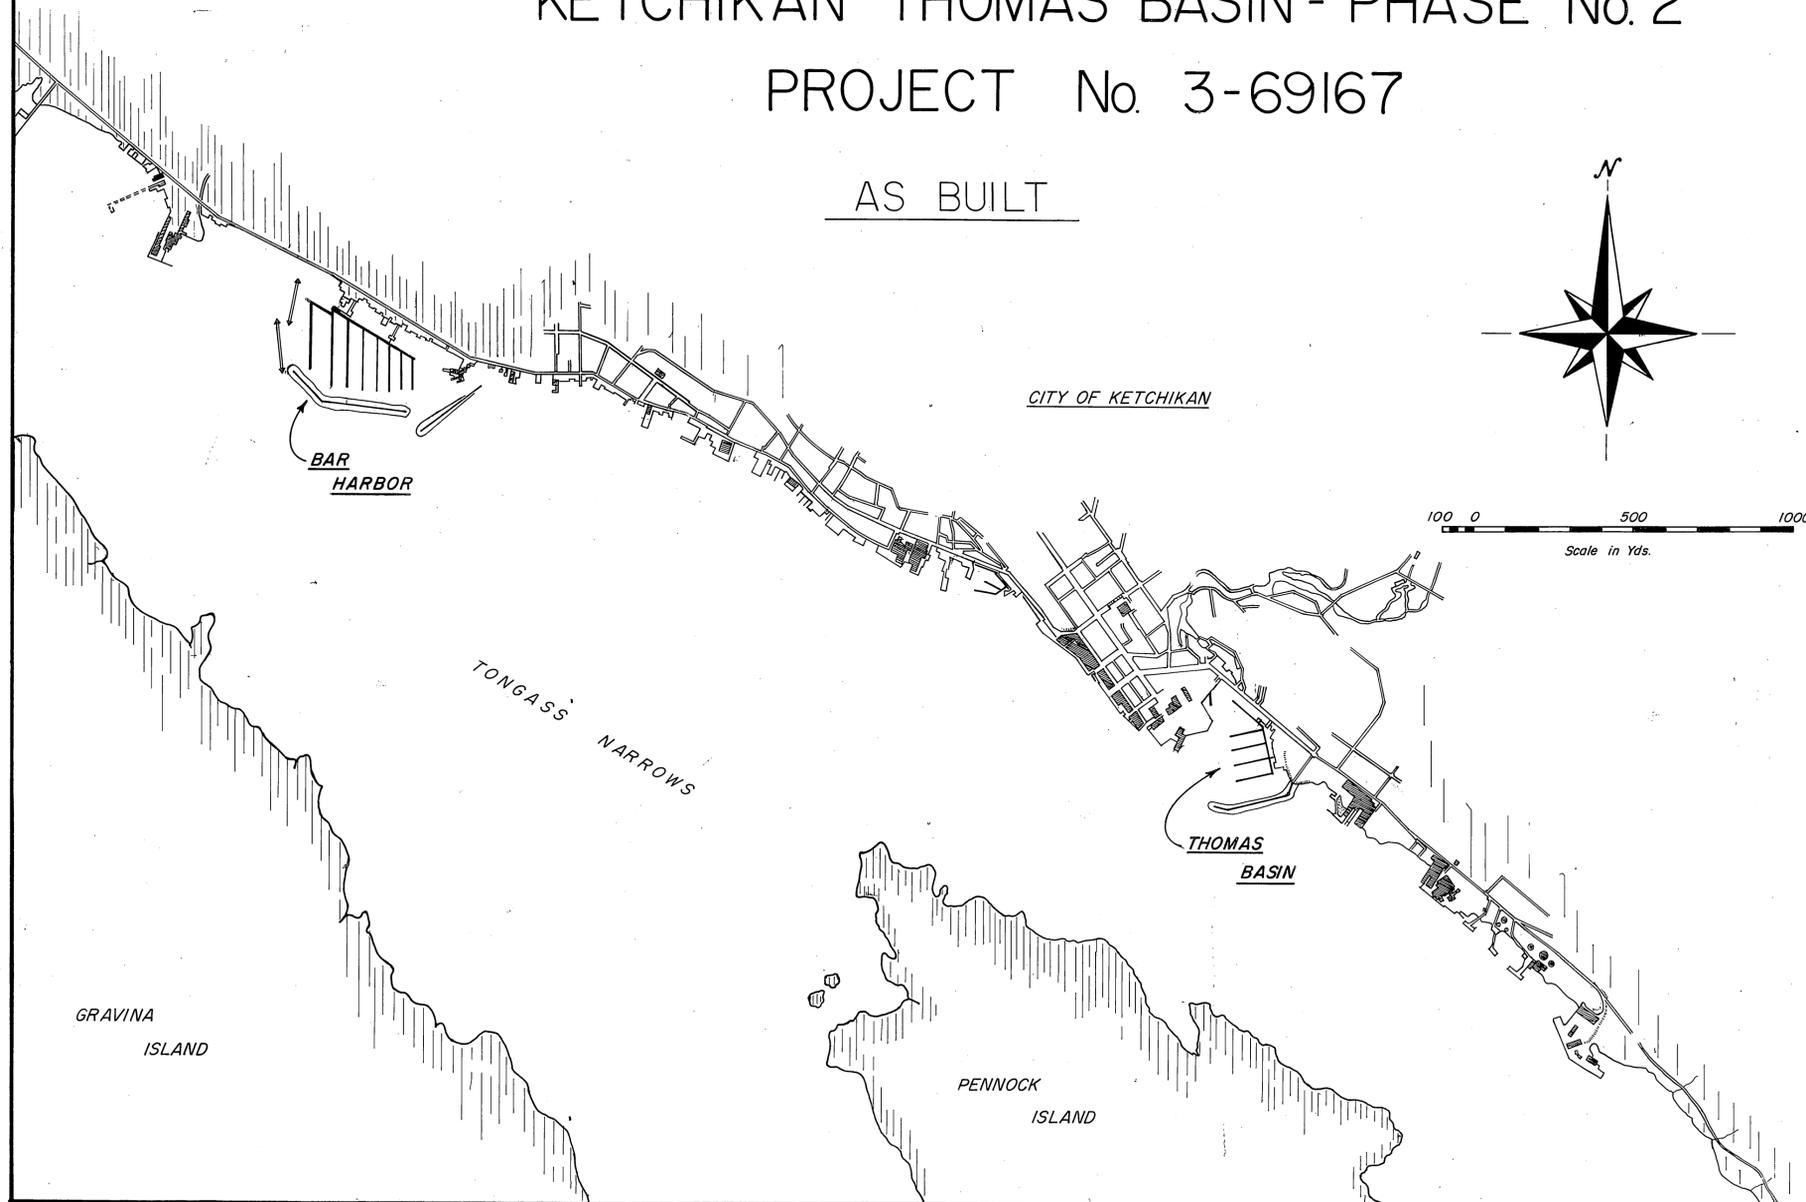

**WORK SUMMARY**

**THOMAS BASIN:** Major units of this project shall consist of the construction & installation of 23-17'x2'-4 1/2" stall floats (929 S.F.), seven (7) firestops (420 S.F.), and performing misc. repairs to existing floats.

**BAR HARBOR:** Major units of this project shall consist of the construction & installation of 8-75'x6' stall floats (3516 S.F.), ~~on 18x24~~ ~~pile~~, drilling eight (8) pile holes (80 L.F.), placing eight (8) float piling (544 L.F.), installation of eleven (11) firestops (624 S.F.), performing misc. float repairs, and furnishing 60 additional flotation billets.










**Alternate No. 1:** Consists of reconstruction of 5875 S.F. of float superstructure, and replacement of approx. 15 flotation billets.

**INDEX TO SHEETS**




TITLE & LOCATION	SHEET
BAR HARBOR FLOAT PLAN	2
GRID DETAILS	3
THOMAS BASIN FLOAT PLAN	4
TYPICAL FLOATS	5
TYPICAL STALL FLOATS	6

DATE 8-16-68 APPROVED *Lynn O. Forrest, Jr.*  
COMMISSIONER



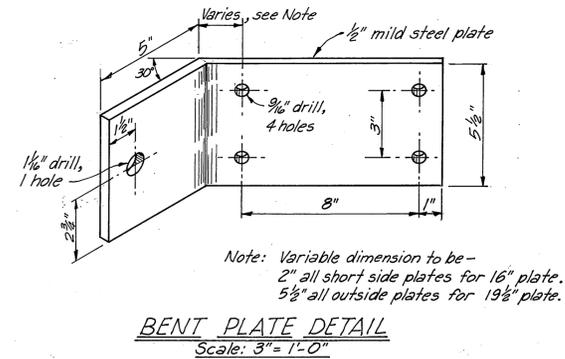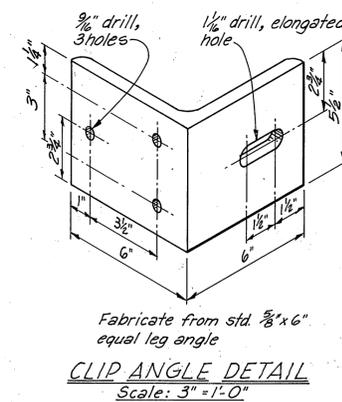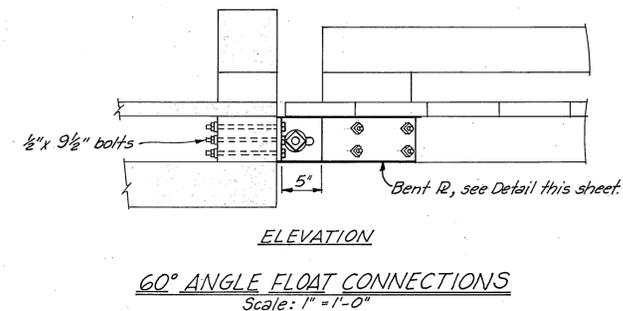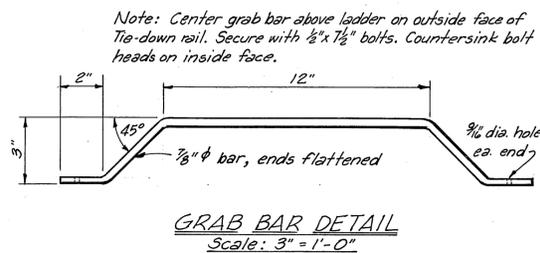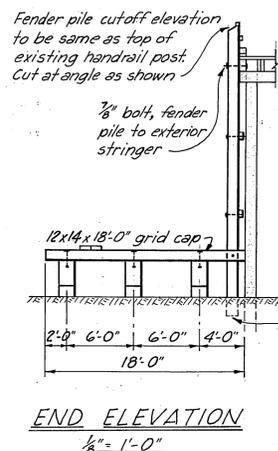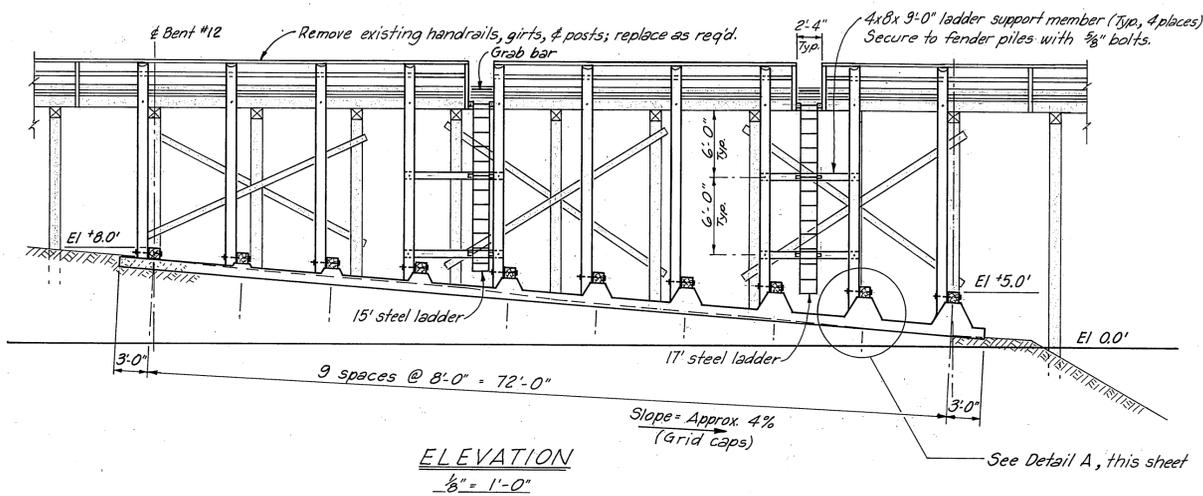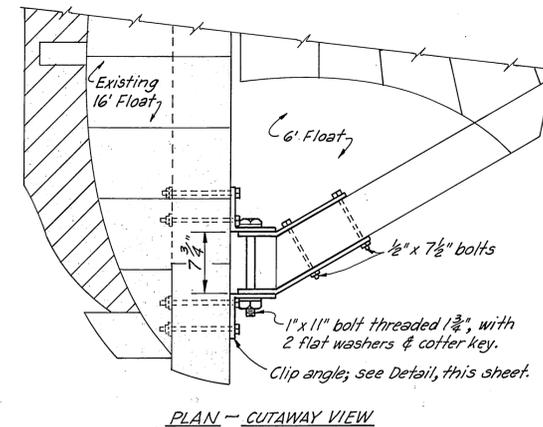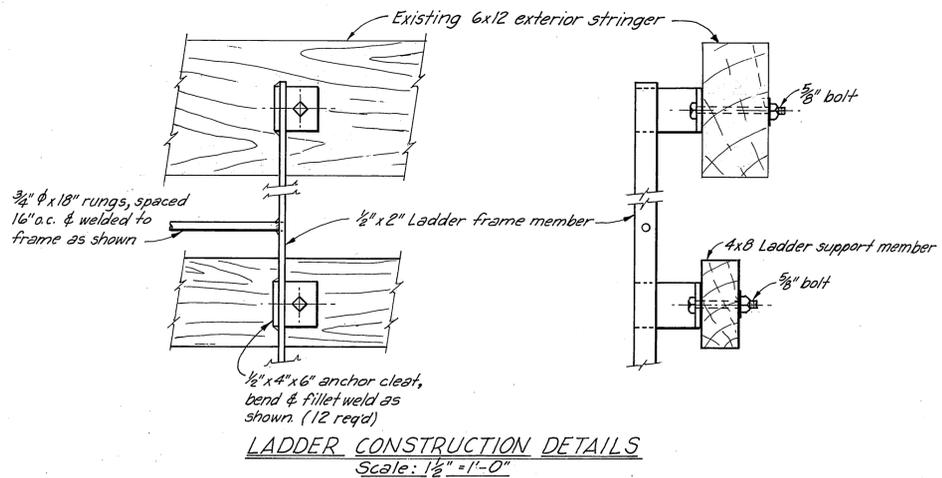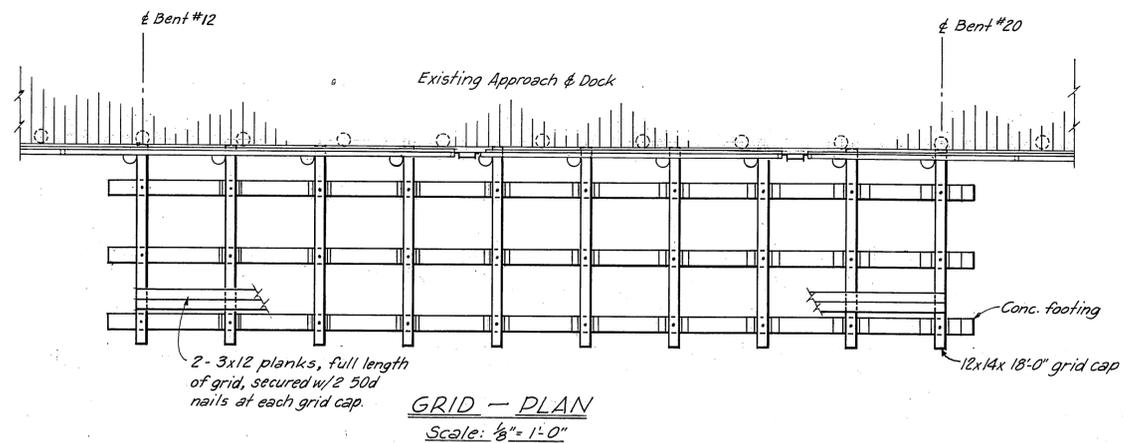

NOTE: GRID CONSTRUCTION NOT PART OF THIS CONTRACT.

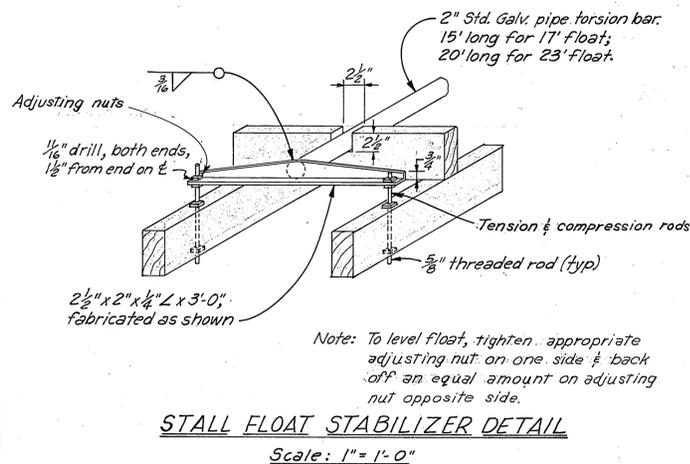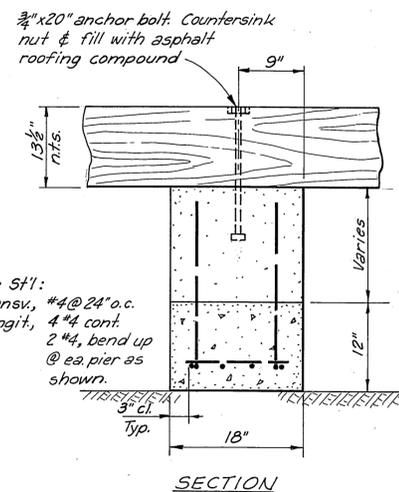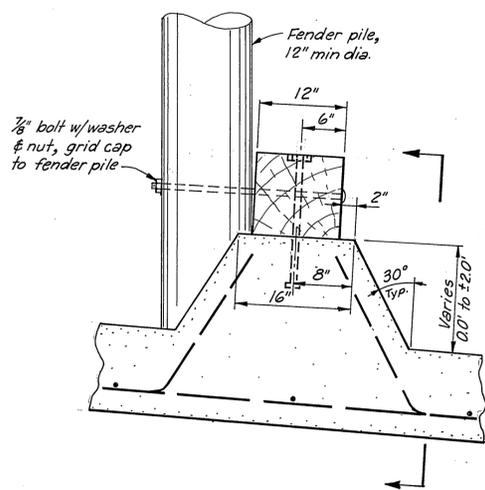

- Notes:
1. All hardware except Re SH1 to be hot dip galvanized.
  2. A malleable iron washer shall be placed between all nut & wood surfaces.
  3. All bolts to be of the economy headed type, except as noted.
  4. All bolt holes shall be drilled true size; field drilled holes in creosote treated members shall be treated with hot creosote oil.
  5. Pressure treated creosote material shall be cut to size prior to treatment.
  6. All timber material to be constr. grade Douglas fir.
  7. All 12 lb. ret. creos. treatment to be full cell; all 8 lb. ret. creos. treatment to be empty cell.

MATERIALS		
ITEM	DRESSING	TREATMENT
Piling	Class A	12# creos. ret.
Caps	SZE	" " "
Grid decking	Rough	8# creos. ret.
Ladder support	Rough	" " "



STATE OF ALASKA  
DEPARTMENT OF PUBLIC WORKS  
DIVISION OF WATER AND HARBORS

**GRID & MISCELLANEOUS  
CONSTRUCTION DETAILS**


As noted  
7-31-68  
NO. 3-69153

APPROVED Don Statter  
DIRECTOR

DRAWN BY JET CHECKED BY DW

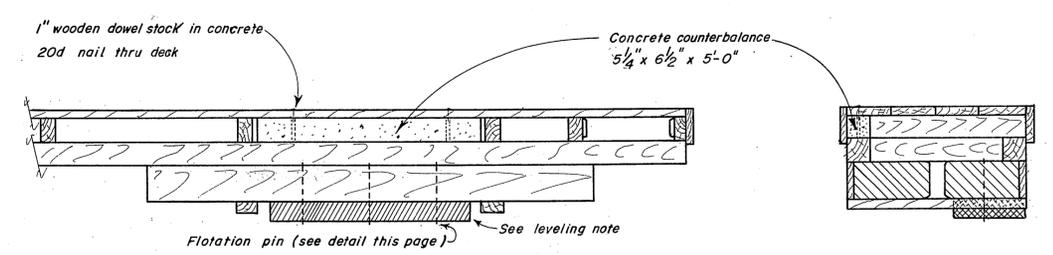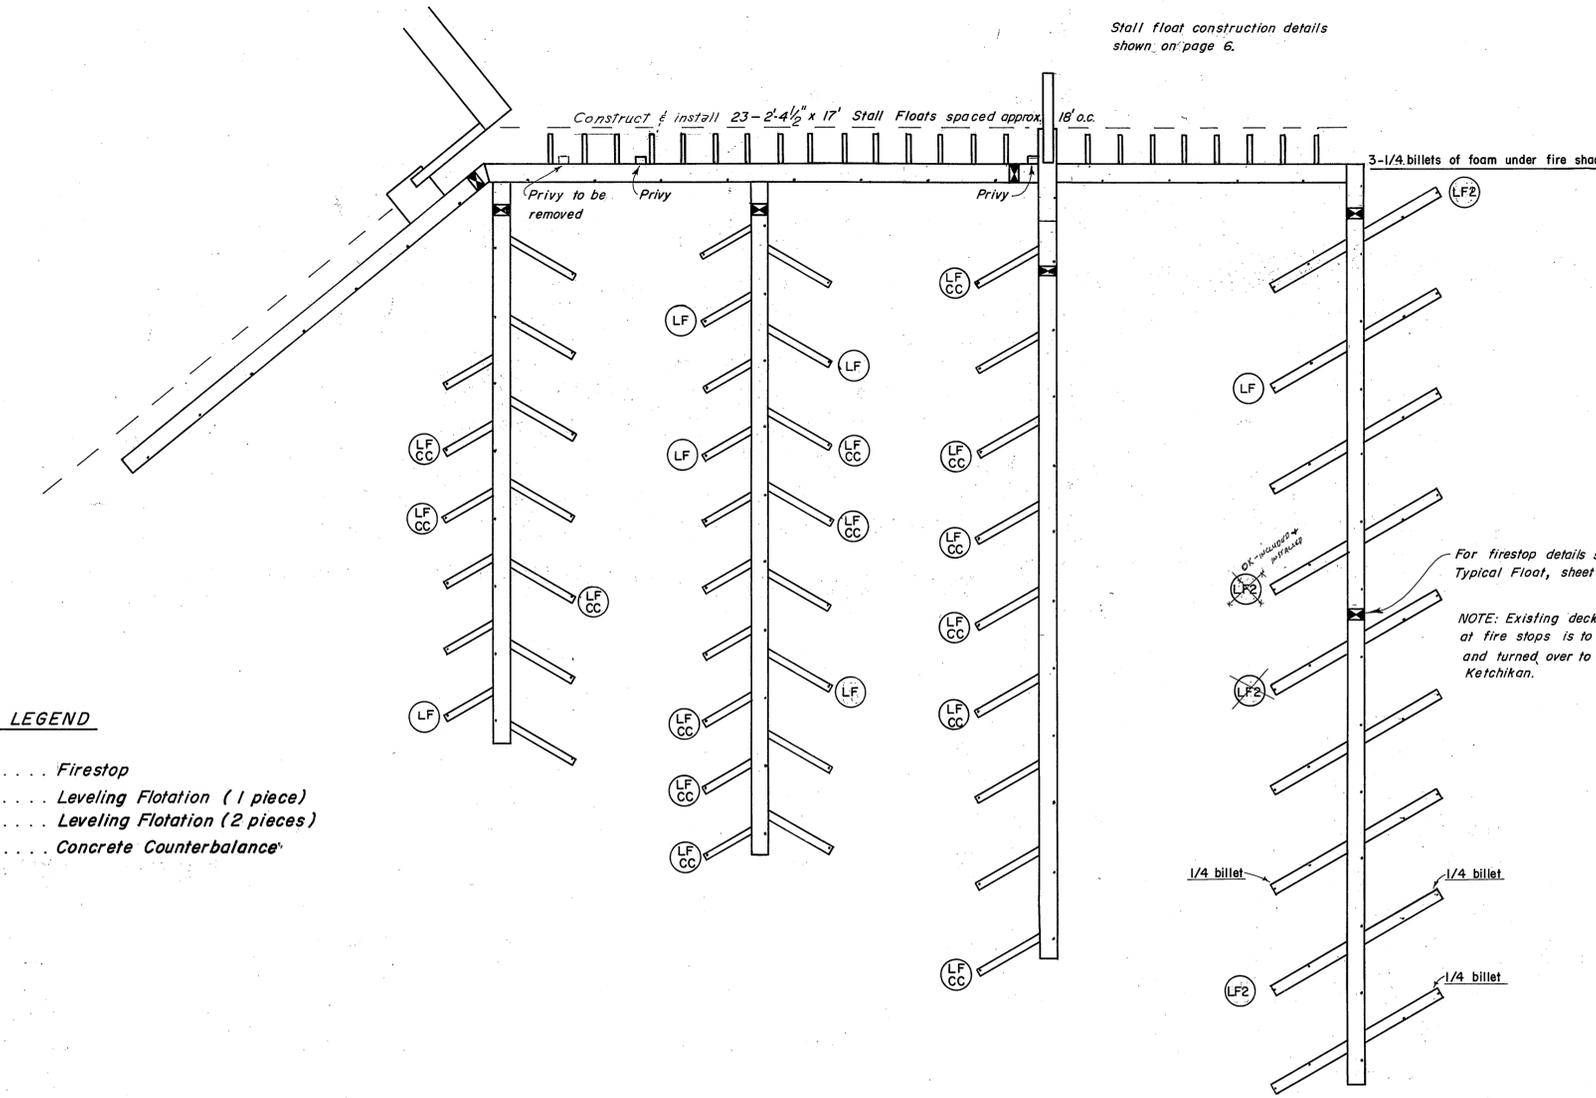

**4' FLOAT SECTION**  
(Showing leveling flotation & concrete ballast)  
Scale 1/2" = 1'-0"

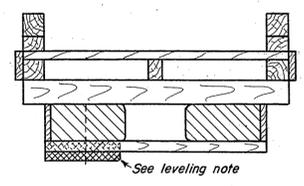


**6' FLOAT SECTION**  
(Showing leveling flotation)  
Scale 1/2" = 1'-0"

**Leveling Note:**  
5" x 20" x 4'-6" leveling flotation shall be installed at the locations indicated on float plan layout (this sheet). Place flotation between lower sill members with the outer edge bearing on side members (cut side up). Pin flotation together with 3/8" x 20" "ell" pin (see detail), 3 places approx. equally spaced.

- LEGEND**
- Firestop
  - LF ..... Leveling Flotation (1 piece)
  - LF2 ..... Leveling Flotation (2 pieces)
  - CC ..... Concrete Counterbalance

**KETCHIKAN - THOMAS BASIN FLOAT FACILITIES**  
Scale 1" = 50'

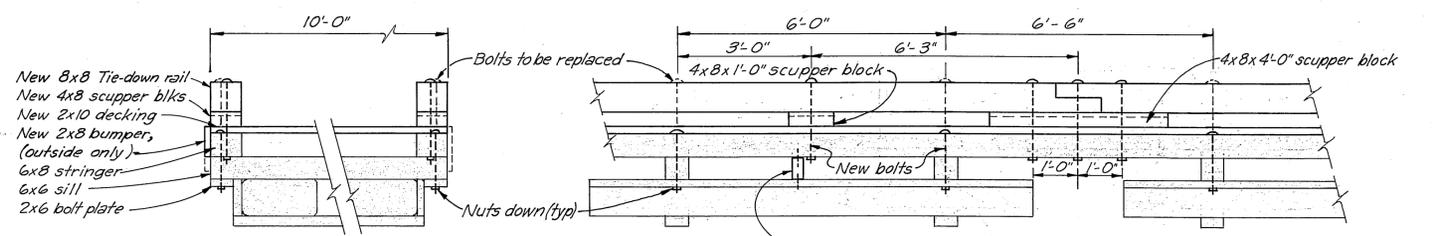

**NOTES:**  
Existing Tie-down Rails, Scupper Blocks, Decking and Bumpers to be removed. Replace with 8x8 S4S TDR's, 4x8 S4S Scupper blocks, 2x10 S1S2E decking & 2x8 S4S bumper member (one side only). Long bolts to be replaced with short bolts securing sill, stringer & bolt plate. New TDR to be secured w/ 3/4" bolts as shown. All bolts to be 3/4" econ. hd type w/ M.I. washers. All timber mat'l to be Const. grade Doug. fir, 8" creo. retention, empty cell process.

**10' FLOAT RECONSTRUCTION DETAIL (ALT. No. 1)**  
Scale: 1/2" = 1'-0"

**FLOTATION PIN DETAIL**  
Scale 3" = 1'-0"


STATE OF ALASKA  
DEPARTMENT OF PUBLIC WORKS  
DIVISION OF WATER AND HARBORS

**THOMAS BASIN PLAN & MISCELLANEOUS DETAILS**

SCALE As Shown  
DATE July 25, 1968  
PROJ. NO. 367/67  
SURVEYED BY  
DRAWN BY JEB  
CHECKED BY JVA

APPROVED Don Statter  
DIRECTOR


Sheet 4 of 6 sheets

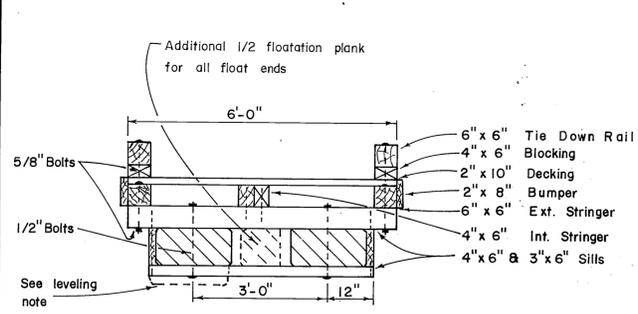

**6' FLOAT SECTION**  
1/2" = 1'-0"


**NOTE**  
6' Float construction shall conform to 10' float constr. except as noted.

**Leveling note**  
5" x 20" x 4" to 5" leveling floatation shall be installed as directed by the Engr. (required on approx. 20% of the stall floats including 6' stall floats). Place floatation between lower sill members with the outer edge bearing on siding members (cut side up). Pin floatation together with 3/8" x 20" "ell" pin (see detail, this sheet), 3 places, approx. equally spaced.



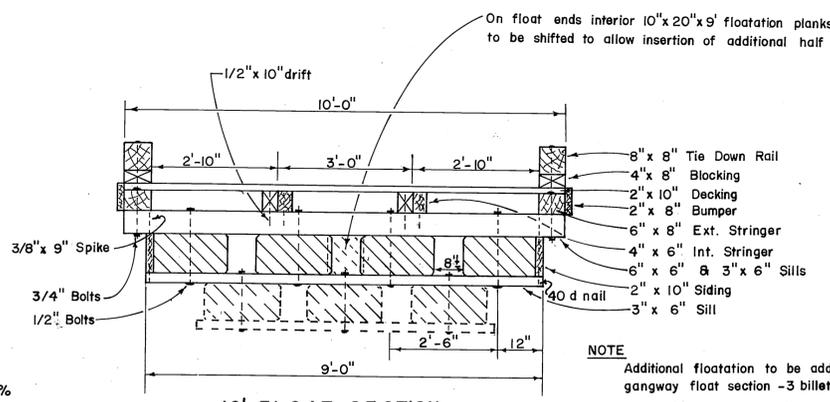


**10' FLOAT SECTION**  
1/2" = 1'-0"


**NOTE**  
Additional floatation to be added on gangway float section - 3 billets as shown timber gangway - 2 for steel gangway.

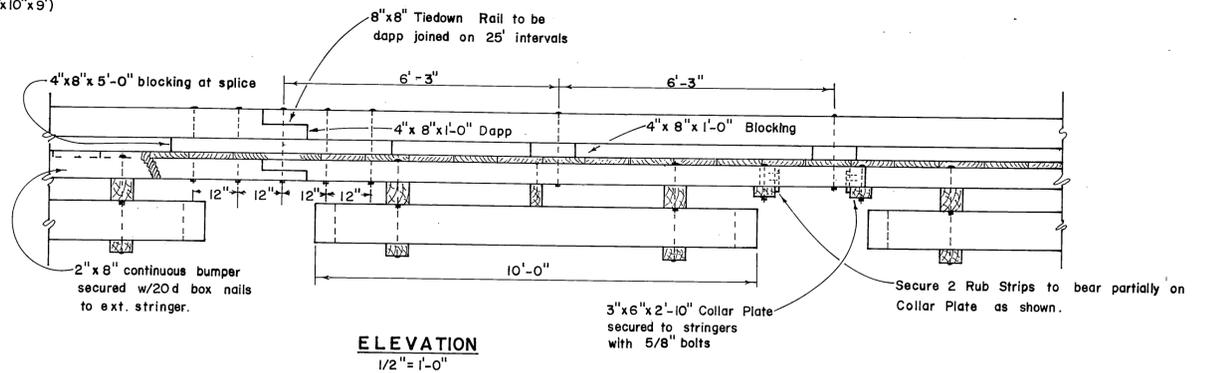


**ELEVATION**  
1/2" = 1'-0"

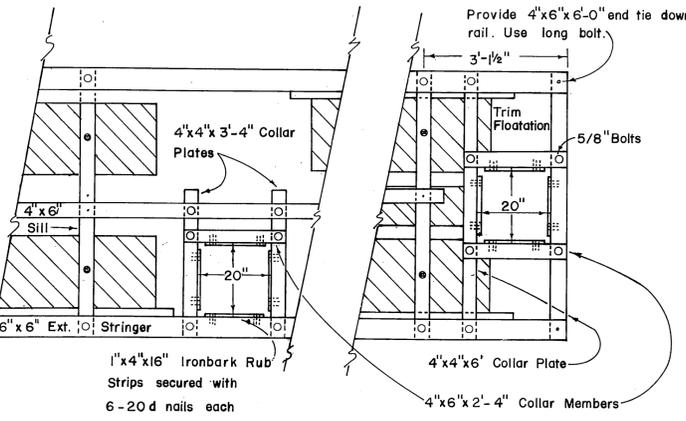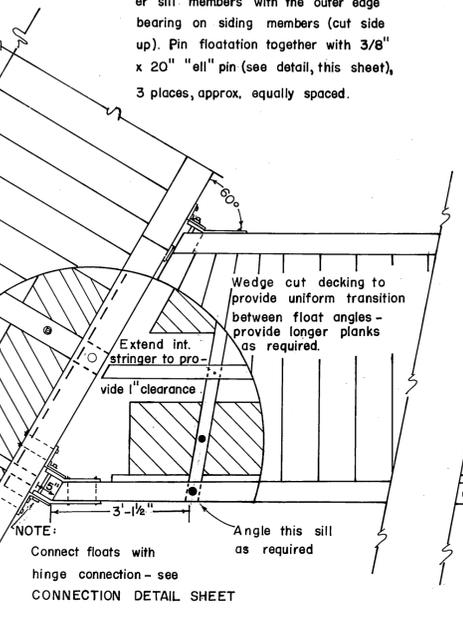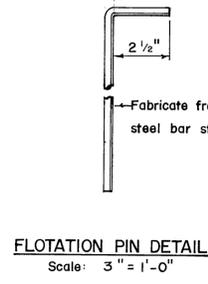


**CONNECTION & COLLAR DETAIL**  
6' STALL FLOAT  
1/2" = 1'-0"

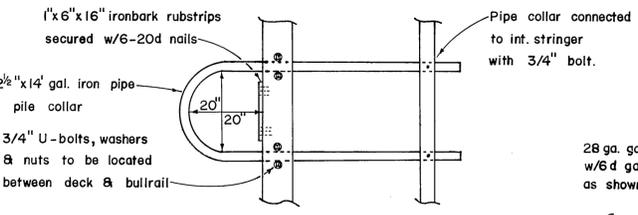

**PIPE PILE COLLAR DETAIL**  
1/2" = 1'-0"

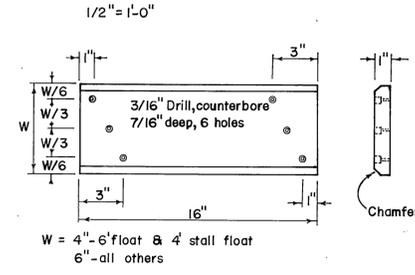


**IRONBARK RUB STRIP**  
1" = 6"

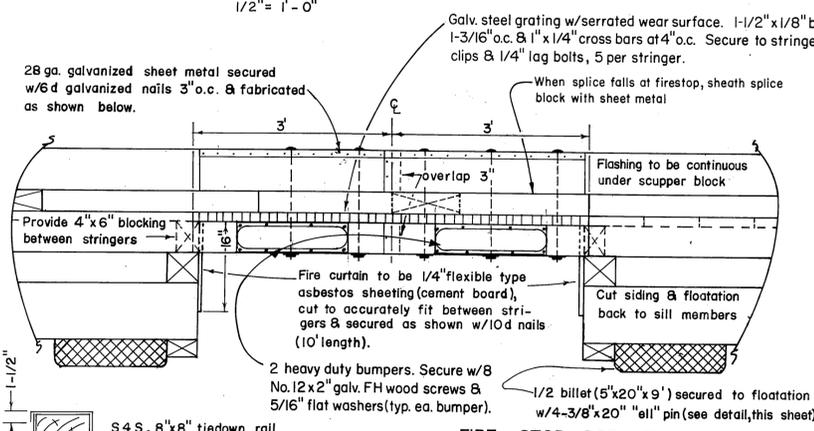

**FLASHING FABRICATION**  
Scale 1" to 1'-0"

**NOTES:**  
Secure grating to stringers with saddle clips & 1/4" lag bolts - 5 at each stringer per 6' width

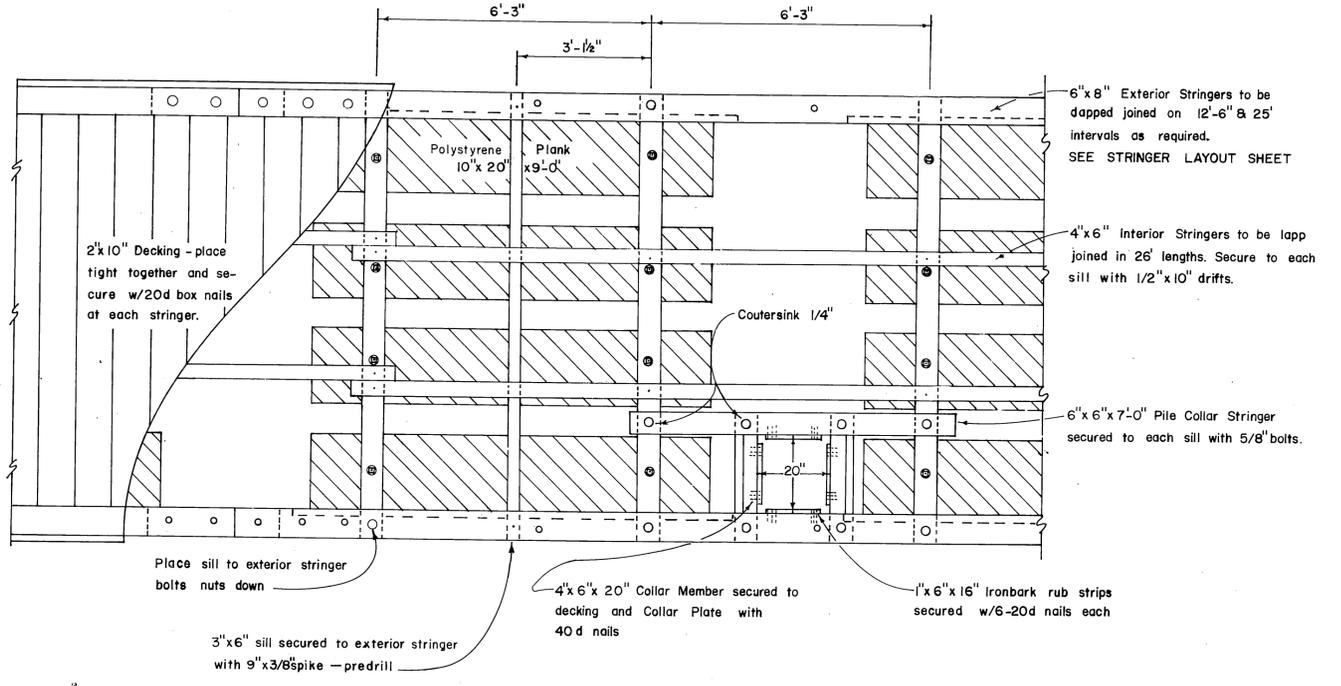

**PLAN VIEW 10' FLOAT**  
1/2" = 1'-0"

\* Exact width to conform to width of floatation material

MATERIALS		
ITEM	DRESSING	TREATMENT
3" x 6" - 4" x 6" & 6" x 6" upper sill	S-1-E 1/8" off	12 lbs. ref.
2" x 10" Siding	"	"
3" x 6" Lower Sill	Rough	"
4" x 4" & 3" x 6" Collar Plates	Rough	8 lbs. ref.
4" x 6" Collar Members	S-2-E	"
4" x 6" Interior Stringers	"	"
6" x 6" & 6" x 8" Ext. Stringers	S-4-S	"
2" x 8" Bumpers	"	"
6" x 6" Collar Stringers	"	"
2" x 10" Decking	S-1-S-2-E	"
4" x 6" & 4" x 8" Blocking	S-4-S	"
6" x 6" & 8" x 8" Rail	"	"

**PRE-DRILLED BOLT HOLES**

**COLLAR MEMBERS** - all holes  
**SILLS** - holes for floatation plank bolts  
**STRINGERS** - 1. holes for stringer to sill bolts

**TIE DOWN RAIL** - all holes

**PILE COLLAR STRINGER - 10' FLOAT** - all holes

**FIELD DRILLED BOLT HOLES**

**SILLS** - 1. holes for stringer to sill bolts  
2. pile collar stringer to sill  
**PILE COLLAR INT. STRINGER - 6' FLOAT** - all holes  
**RAIL BLOCKING** - all holes  
**COLLAR PLATES** - all holes  
**EXT. STRINGER** - 1. holes for tiedown rail bolts  
2. " " pile collar plate bolt

**NOTES**

All hardware to be hot-dipped galvanized. A malleable iron washer shall be placed between all nut and wood surfaces. All bolts to be of the economy headed type. Bolt holes to be drilled 1/16" oversize except sill bolt holes for floatation planks 1/8" oversize. Drift holes to be drilled 1/16" undersize. All field drill holes shall be treated with hot creosote oil. All pressure treated creosote material shall be cut to size prior to treatment. Tie down rails shall extend across all float ends except under gangway. All bolt heads facing decking shall be countersunk 1/4" previous to treatment. Field drill all drift bolt holes. A barrier of 6 mil black polyethylene shall be placed between the contact surfaces of all creosote timber and floatation material (except float siding members).

All material to be construction grade Douglas Fir  
All piling will be Class A creosoted to 12 lbs. retention  
All 12 lb. ref. creosoted treatment to be Full Cell  
All 8 " " " " " Empty "

STATE OF ALASKA  
DEPARTMENT OF PUBLIC WORKS  
DIVISION OF WATER AND HARBORS

**TYPICAL FLOATS**

SCALE As Shown  
DATE April 1968  
PROJ. NO. APPROVED DON STATTER  
DIRECTOR

DESIGNED BY RPH-DS DRAWN BY MH CHECKED BY DS

SHEET 6 of 6 SHEETS

