


KETCHIKAN HARBOR FACILITIES

PROJECT NO. 3-74153

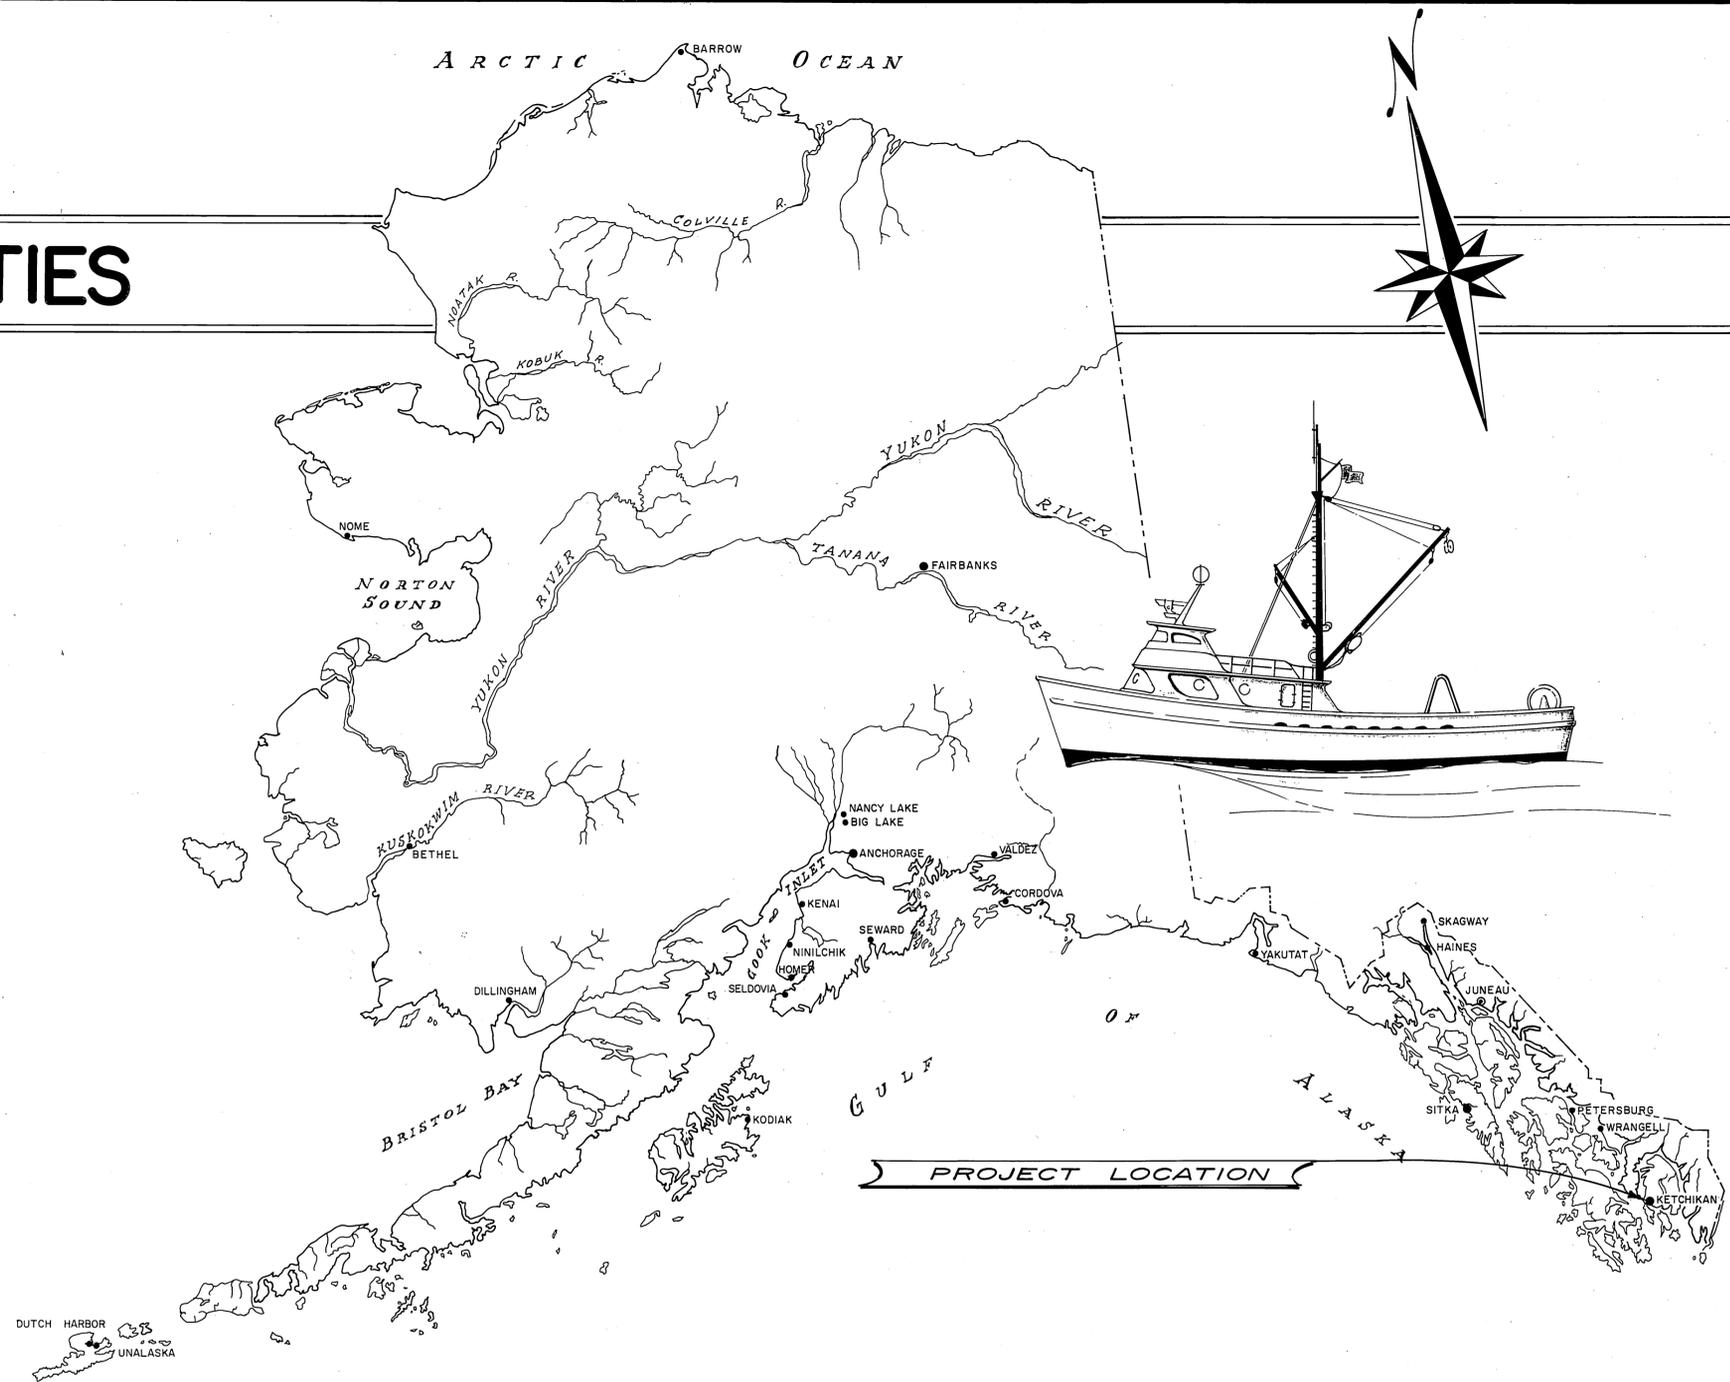

WORK SUMMARY

BAR HARBOR: Construction & installation of 2976 S.F. of concrete floats, furnishing & driving approx. 835 L.F. of 12" dia. steel piles, reconstructing the superstructure of a 10' x 512' timber float and replacing 32 flotation billets.


THOMAS BASIN: Reconstructing the superstructure of a 10' x 412' timber float, replacing 16 flotation billets and performing other misc. repairs.

As - built 12/74

STATE OF ALASKA DEPARTMENT OF PUBLIC WORKS
DIVISION OF WATER & HARBORS

INDEX TO SHEETS	
1	TITLE
2	PROJECT LAYOUT
3	FLOAT RECONSTRUCTION
4	STANDARD FLOAT DET'LS.
5	STALL FLOAT DET'LS.

APPROVED
Jan Stetter
 DIRECTOR
 DATE: 3/19/74
 SHEET 1 OF 5

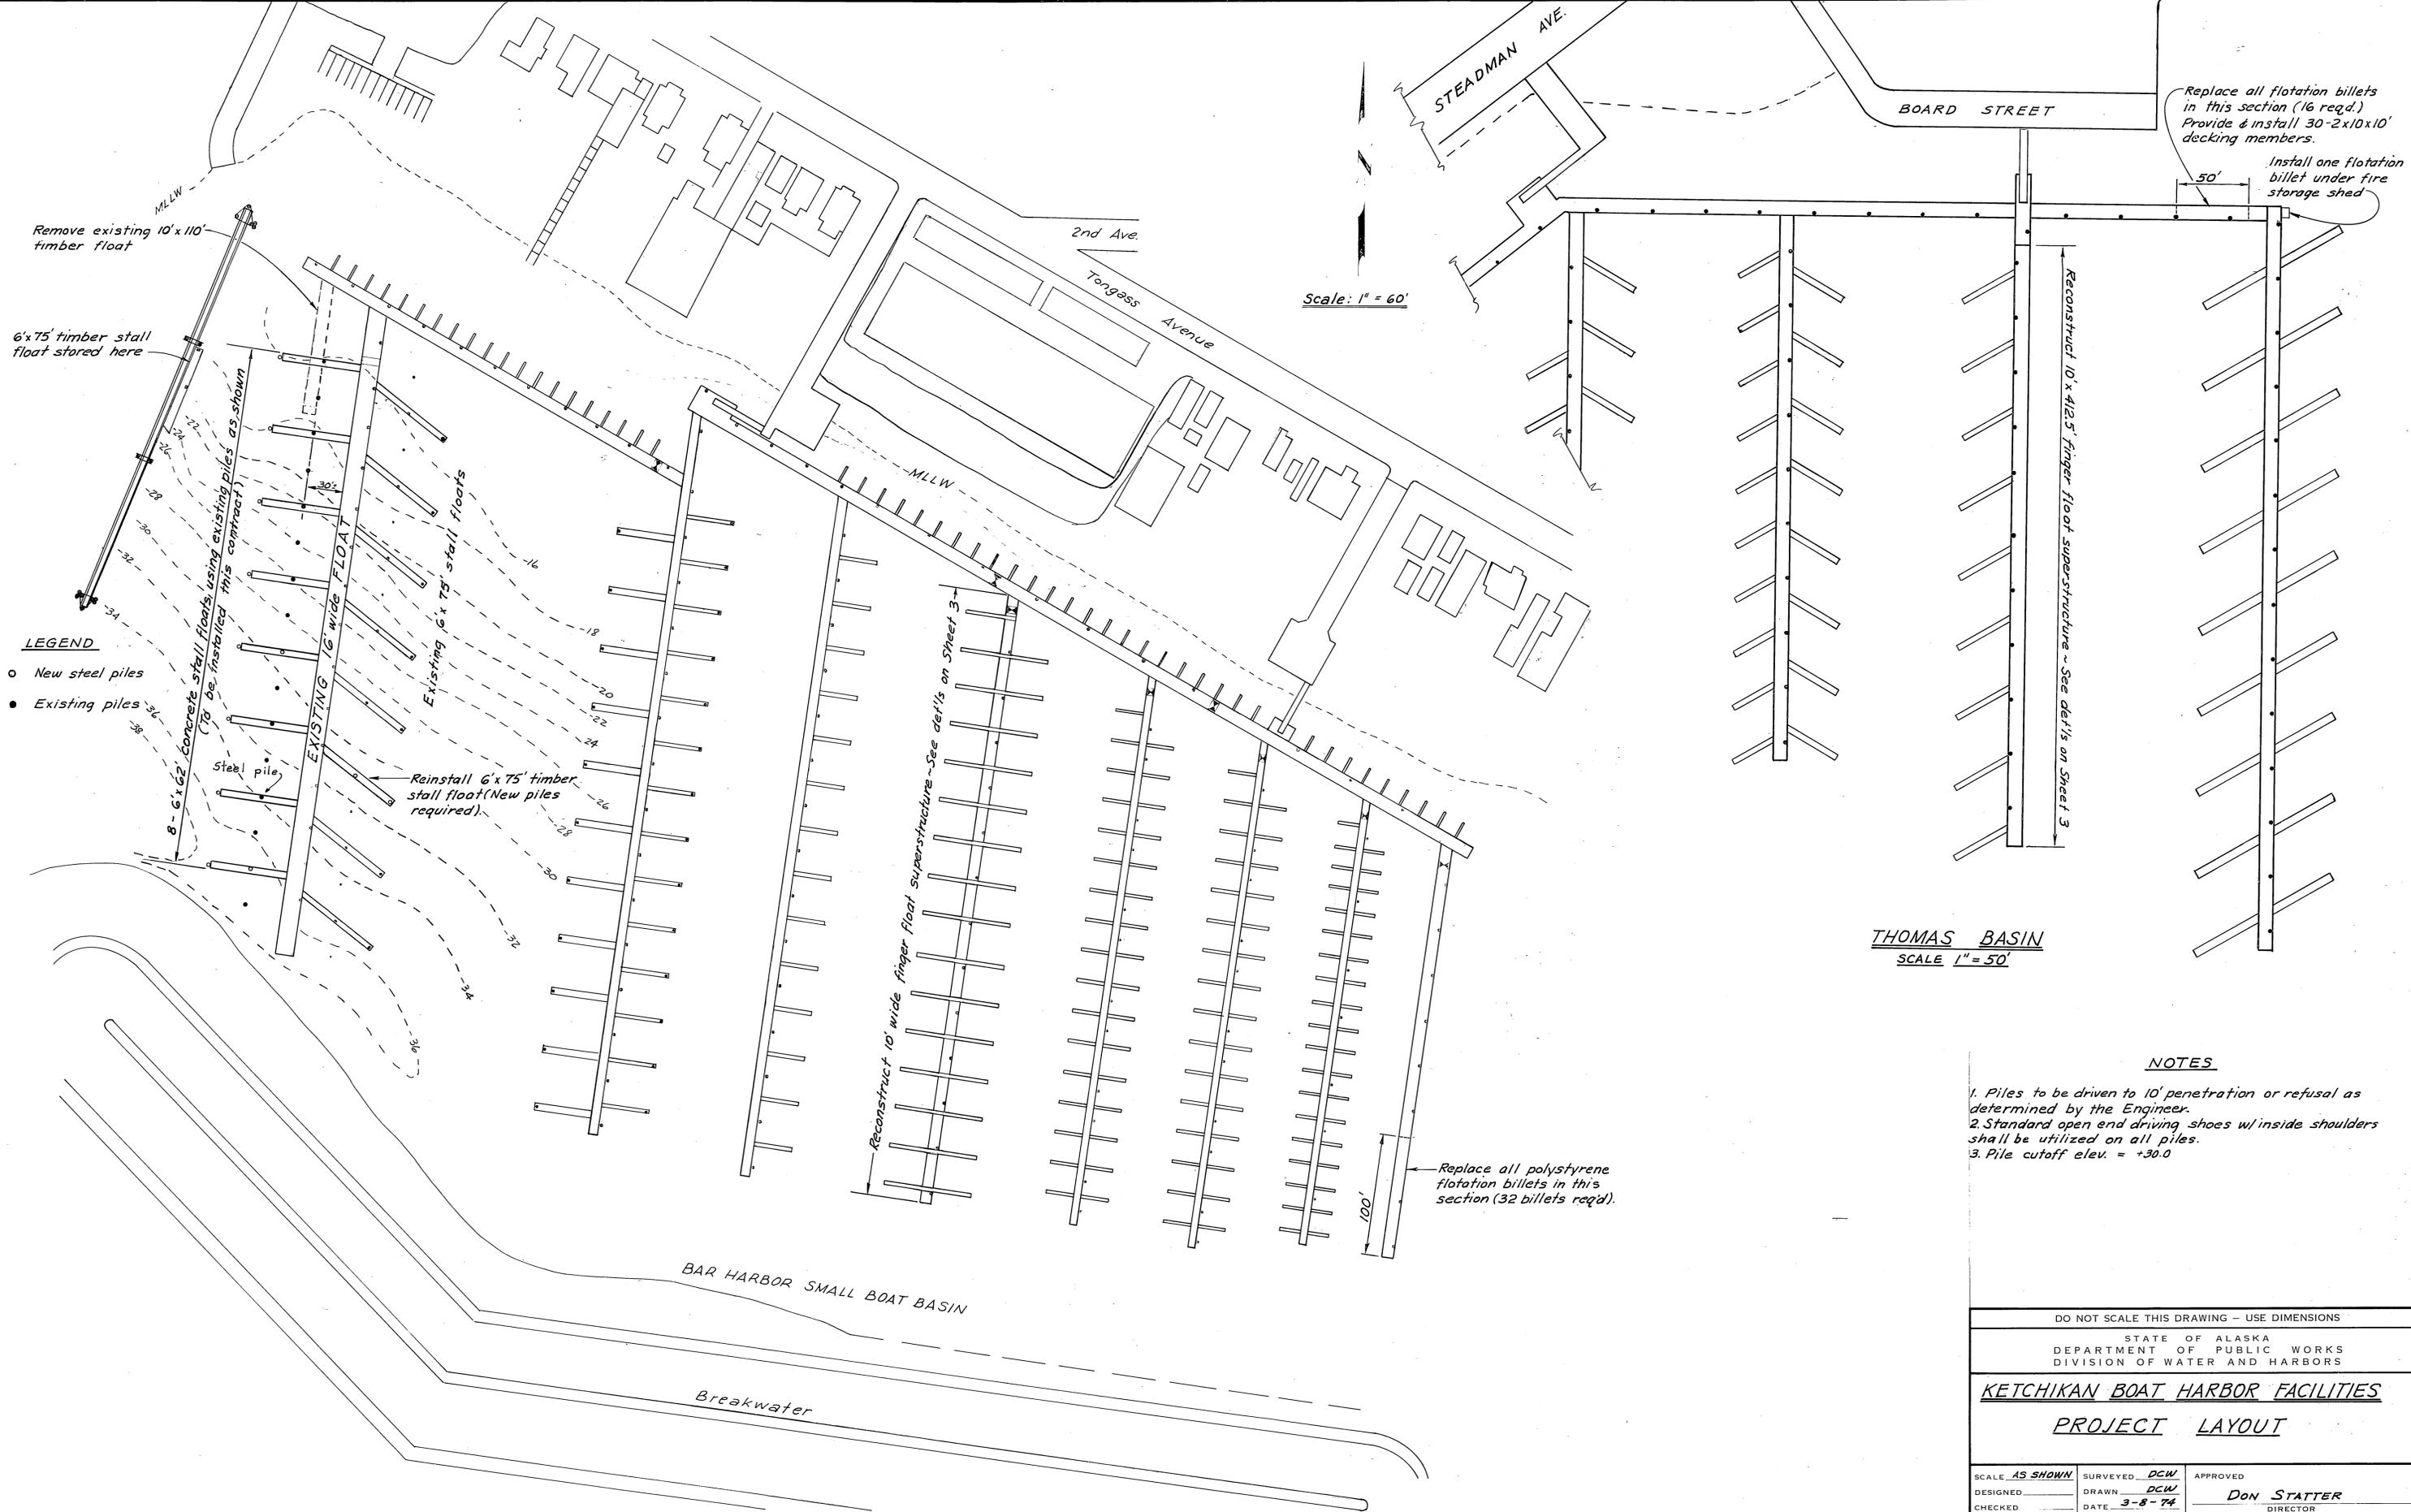

LEGEND
 ○ New steel piles
 ● Existing piles

Replace all flotation billets in this section (16 reqd.)
 Provide & install 30-2x10x10' decking members.


Install one flotation billet under fire storage shed

THOMAS BASIN
 SCALE 1" = 50'

NOTES


1. Piles to be driven to 10' penetration or refusal as determined by the Engineer.
2. Standard open end driving shoes w/inside shoulders shall be utilized on all piles.
3. Pile cutoff elev. = +30.0

DO NOT SCALE THIS DRAWING - USE DIMENSIONS		
STATE OF ALASKA DEPARTMENT OF PUBLIC WORKS DIVISION OF WATER AND HARBORS		
KETCHIKAN BOAT HARBOR FACILITIES		
PROJECT LAYOUT		
SCALE AS SHOWN	SURVEYED DCW	APPROVED
DESIGNED	DRAWN DCW	Don Statter DIRECTOR
CHECKED	DATE 3-8-74	
PROJECT NUMBER	3-74153	SHEET 2 OF 5

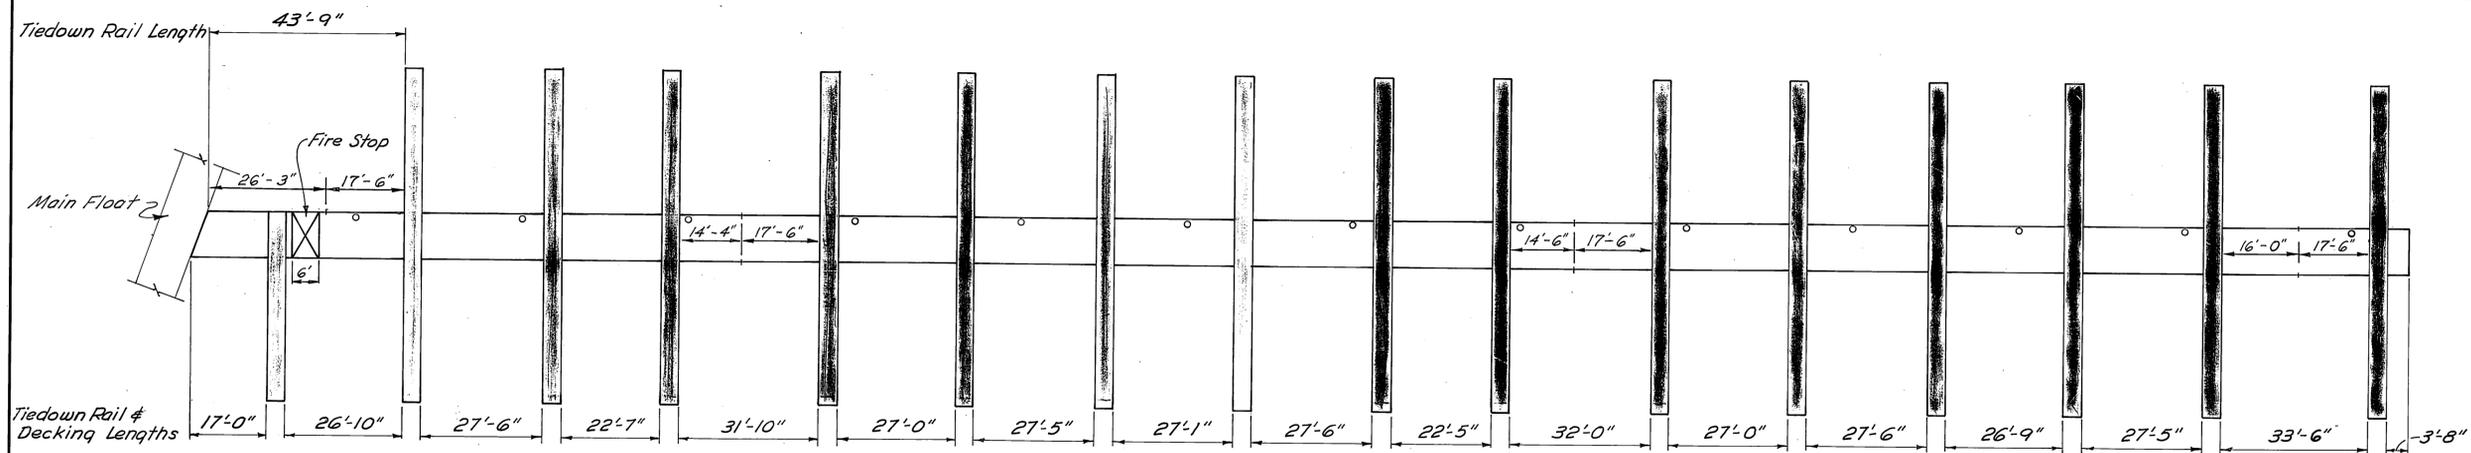


TDR's between stalls to be in one length except where distance exceeds 28'

BAR HARBOR
 10x500' Finger Float 4/31 ~ 4x32' Stall Floats
 1" = 20'

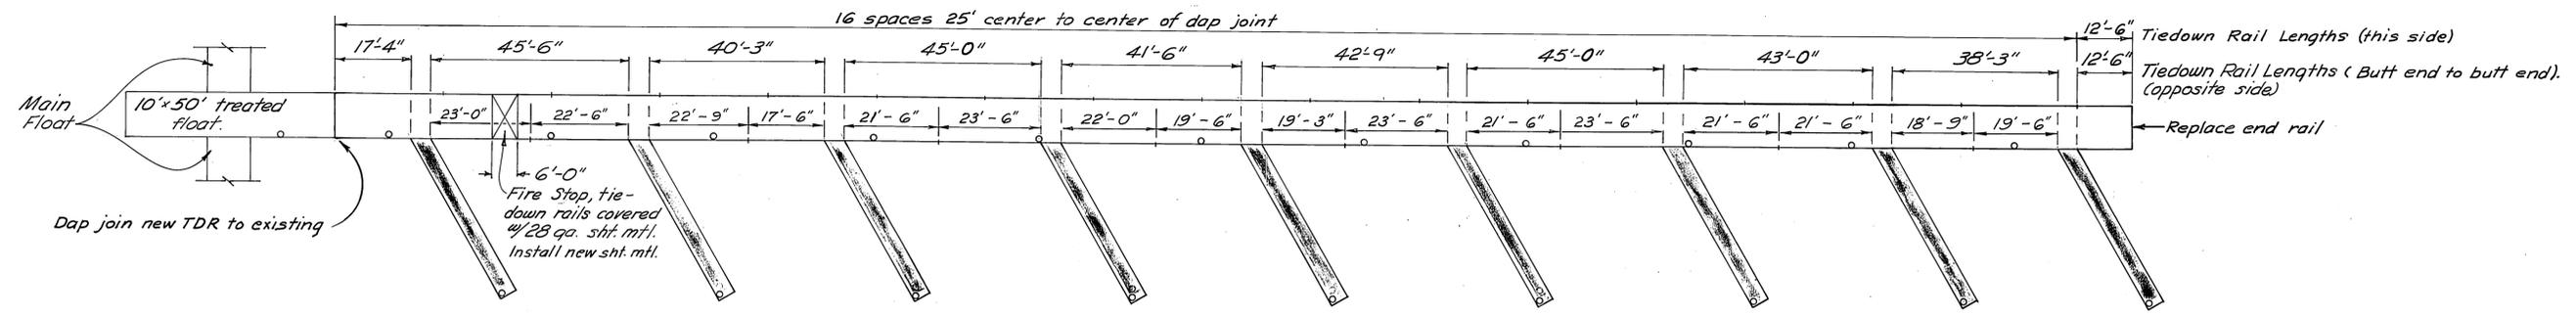

THOMAS BASIN
 10x412'-6" Finger Float 4/9 ~ 4x42' Stall Floats
 1" = 20'


Note: Shaded areas represent existing portion of facilities to remain intact.

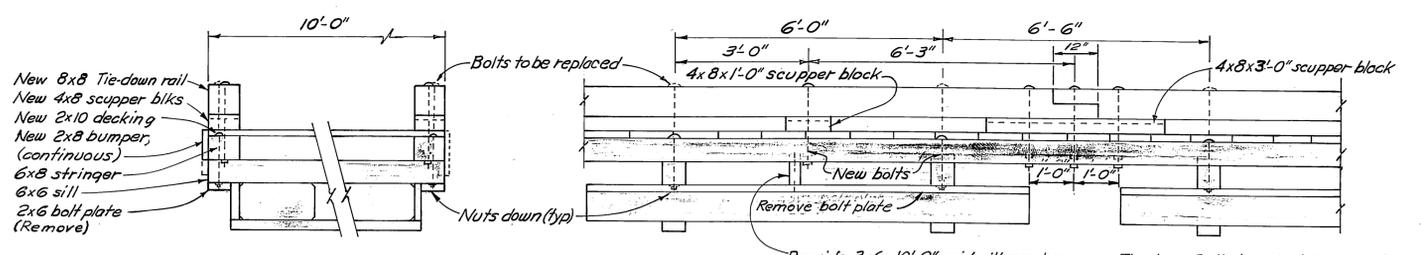

NOTES:
 Existing Tie-down Rails, Scupper Blocks, Decking and Bumpers to be removed. Replace with 8x8 S4S TDR's, 4x8 S4S Scupper blocks, 2x10 milled decking & 2x8 S4S bumper member. Long bolts to be replaced with short bolts securing sill to stringer. New TDR to be secured w/ 3/4" bolts as shown. All bolts to be 3/4" econ. hd. type w/ M.I. washers. All timber mat'l to be No. 1 structural Doug. Fir penta: treated, 0.6# retent.


10' FLOAT RECONSTRUCTION DETAIL
 1/2" = 1'-0"

Tie-down Rails to be 25' from c. to c. of dap joints except where stall openings occur. TDR's between stalls may have one splice where distance exceeds 28'. Place 4x8 x 1'-0" blocks @ all TDR ends

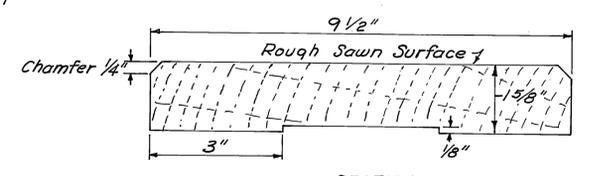


MILLED DECKING DETAIL
 SECTION
 1/2 Size


DO NOT SCALE THIS DRAWING - USE DIMENSIONS		
STATE OF ALASKA DEPARTMENT OF PUBLIC WORKS DIVISION OF WATER AND HARBORS		
KETCHIKAN BOAT HARBOR FACILITIES FLOAT RECONSTRUCTION		
SCALE <i>As Shown</i>	SURVEYED <i>D.C.W.</i>	APPROVED
DESIGNED _____	DRAWN <i>ES</i>	<i>Don Statter</i>
CHECKED _____	DATE <i>2-74</i>	DIRECTOR
PROJECT NUMBER <i>3-74153</i>	SHEET <i>3</i> OF <i>5</i>	

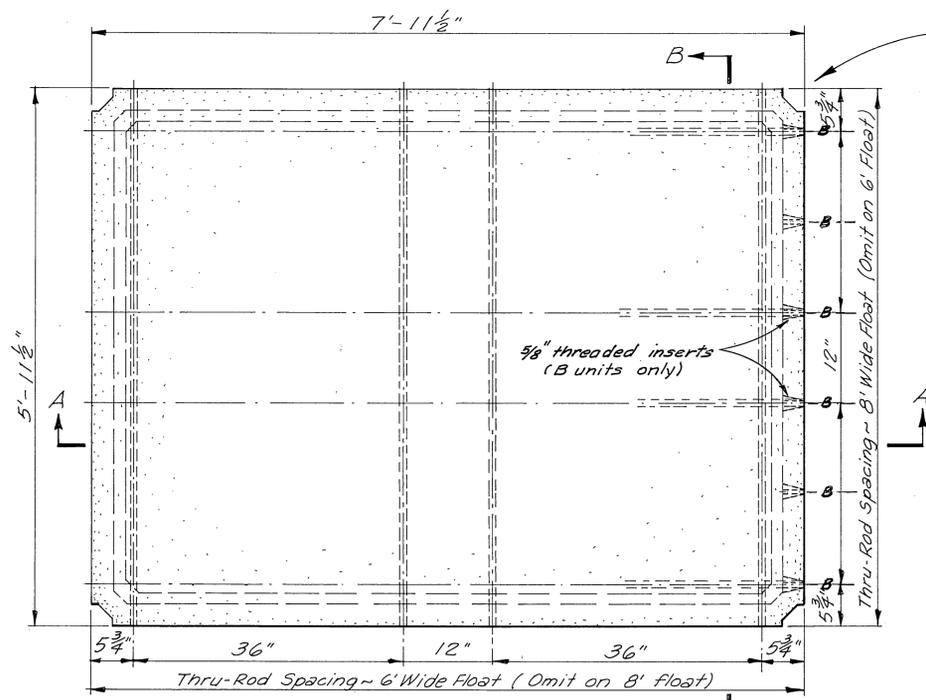


PLAN

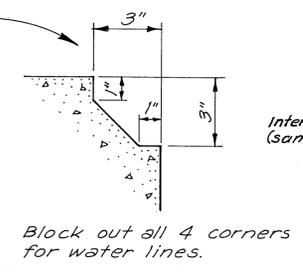

Interior wale dim. (same both sides)
Exterior wale dim. (same both sides)

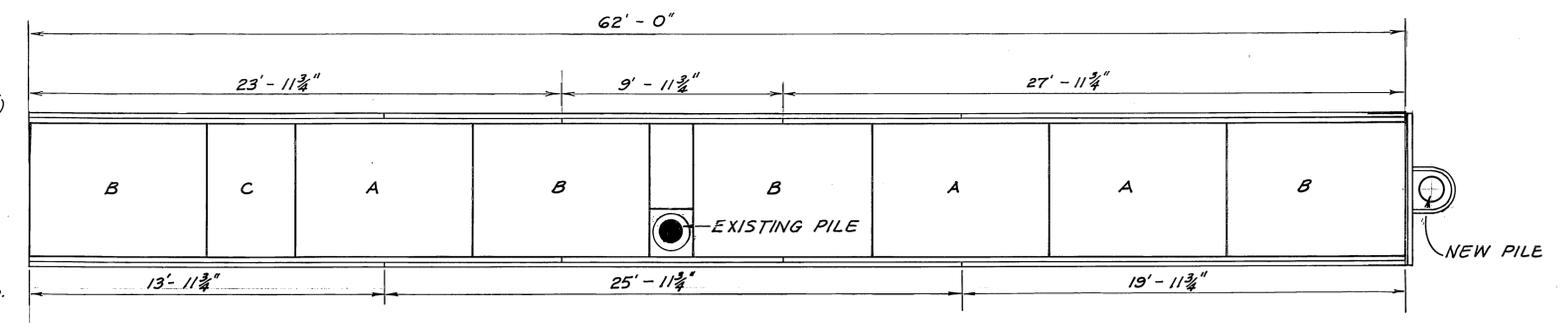


CONCRETE UNIT & WALER LAYOUT

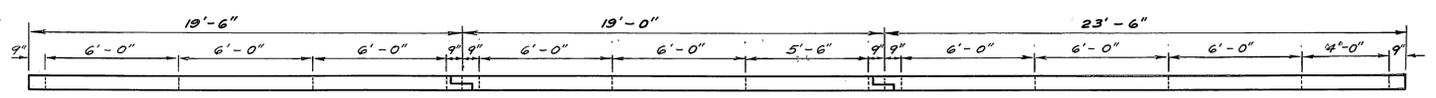


TIEDOWN RAIL LAYOUT
(Typ. for both sides)

6' x 62' STALL FLOAT ASSEMBLY
1/4" = 1'-0"

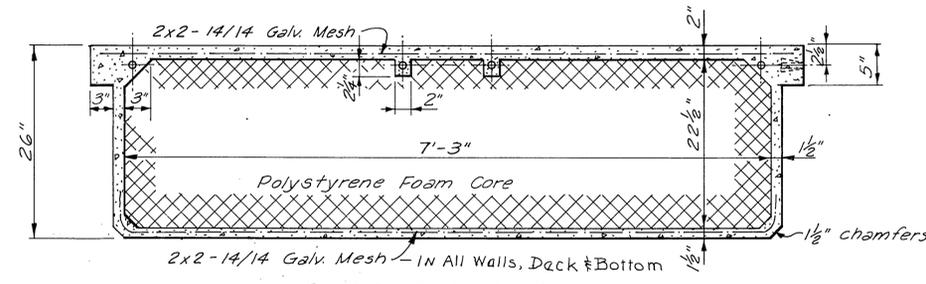

SECTION A-A

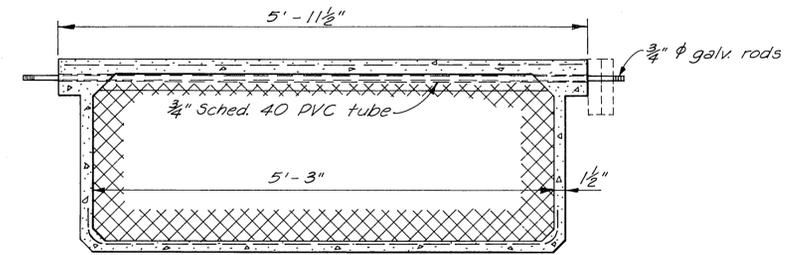


SECTION B-B

6' x 8' FLOAT
1" = 1'-0"


NOTES

1. Float units to be cast of lightweight concrete 100^{pcf} max. w/ min comp. strength 3000 psi @ 7days.
2. Inner core to be 1.1^{pcf} polystyrene foam per ASTM designation D-1621-59T
3. Portland cement shall comply with ASTM des. C-150 for Type III.
4. Expanded shale shall comply with ASTM des. C-330.
5. Galv. wire mesh shall comply with ASTM des. A-185.
6. Unit A is same as unit B w/o inserts.

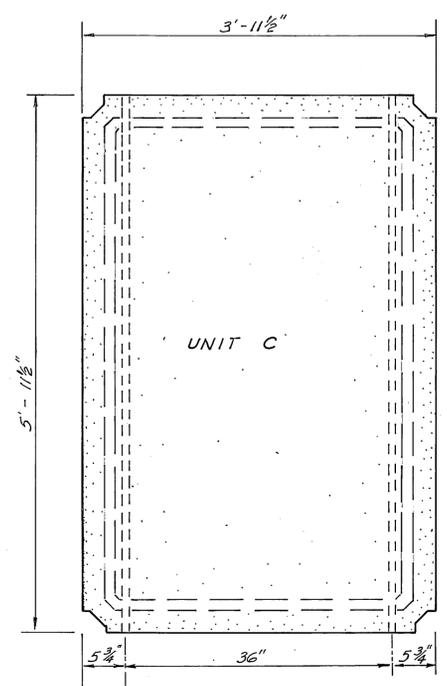


PLAN

4' x 6' FLOAT UNIT
1" = 1'-0"

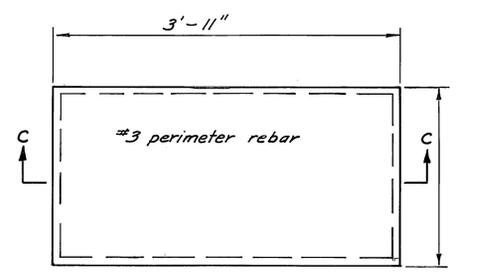


PLAN

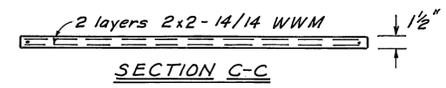

SECTION C-C

CONC. SLAB ~ PILE COLLAR WELDMENT
1" = 1'-0"

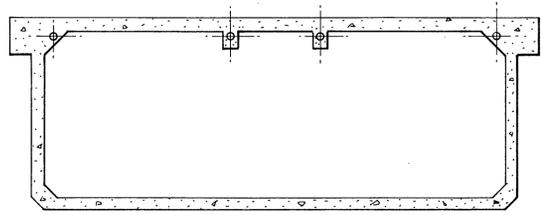

ALT. SECTION B-B
(8'-WIDE FLOAT)

NOTES

1. Timber walers to be 3x8, S4S, select structural grade Douglas Fir, pressure treated w/ pentachlorophenol to D.G.T.C.F. ref. & predrilled for thru-rods. Butt joints to be made @ center of float units.
2. Bumper strips & Tie-down rails to be No.1 & Dense No.1 grade, respectively, Doug. Fir, pressure treated as above & predrilled as detailed. Bumper strips may be random lgths.
3. Framing & predrilling to be completed prior to pressure treatment.


DO NOT SCALE THIS DRAWING - USE DIMENSIONS

STATE OF ALASKA
DEPARTMENT OF PUBLIC WORKS
DIVISION OF WATER AND HARBORS


KETCHIKAN BAR HARBOR FACILITIES

CONCRETE FLOAT STANDARD DETLS


SCALE AS SHOWN	SURVEYED DCW	APPROVED
DESIGNED	DRAWN DCW	Don STATTER DIRECTOR
CHECKED DS-DM	DATE FEB. 28, 1974	
PROJECT NUMBER	3-74153	SHEET 4 OF 5

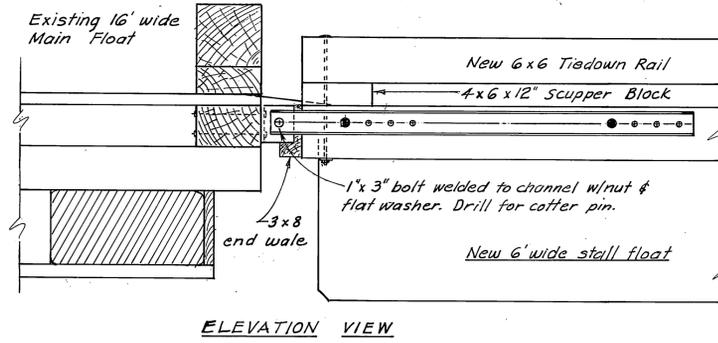


ELEVATION VIEW

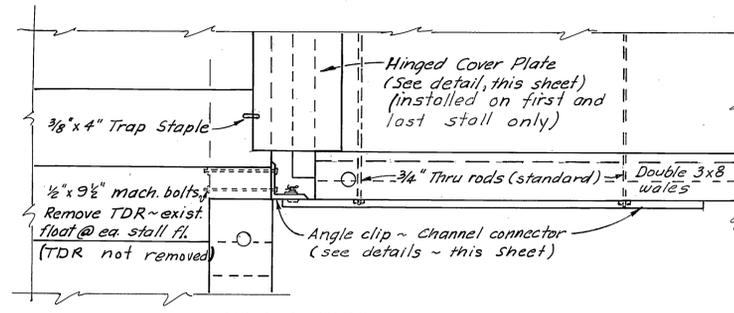


PLAN VIEW
STALL FLOAT to FINGER FLOAT CONNECTION
Scale: 1"=1'-0"

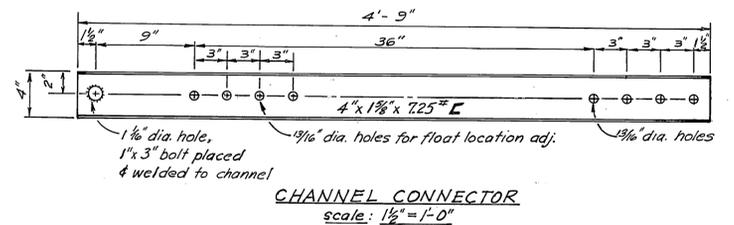


CHANNEL CONNECTOR
scale: 1 1/2"=1'-0"

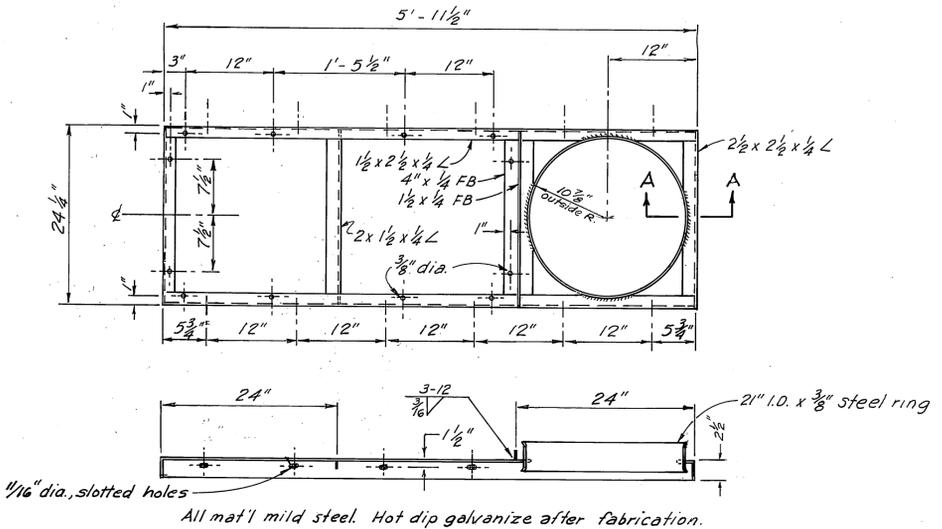



PILE COLLAR WELDMENT DETL.
SCALE: 1"=1'-0"

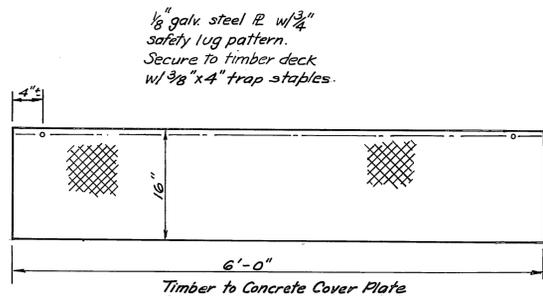


COVER PLATE DETAILS
Scale: 1"=1'-0"

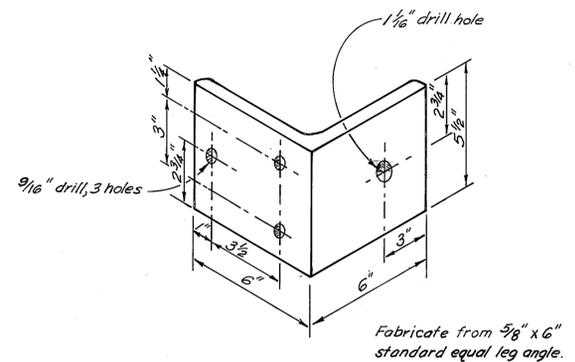


ANGLE CLIP DETAILS
Scale 3"=1'-0"

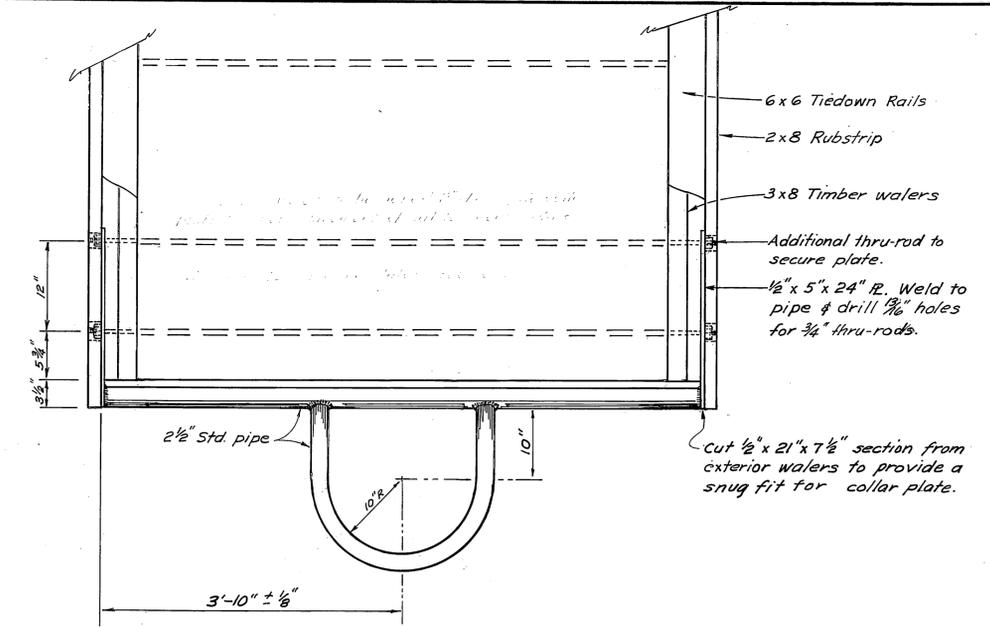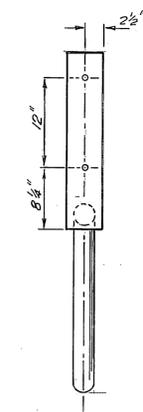


END PILE COLLAR - 6' STALL FLOAT
Scale: 1"=1'-0"

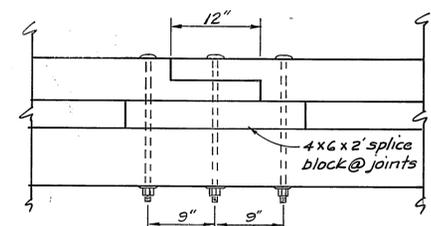


SPLICE DETAILS

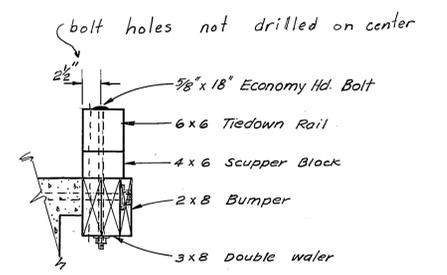

TIE-DOWN RAIL DETAILS
1"=1'-0"

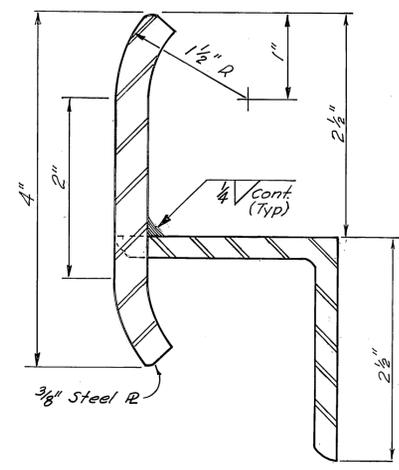

SECTION A-A
FULL SIZE

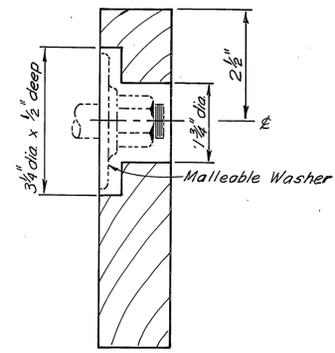

2x8 BUMPER MEMBER
one-half size

DO NOT SCALE THIS DRAWING - USE DIMENSIONS		
STATE OF ALASKA DEPARTMENT OF PUBLIC WORKS DIVISION OF WATER AND HARBORS		
KETCHIKAN BAR HARBOR FACILITIES		
STALL FLOAT CONSTRUCTION DET'LS		
SCALE AS SHOWN	SURVEYED DCW	APPROVED
DESIGNED _____	DRAWN DCW	DON STATTER DIRECTOR
CHECKED _____	DATE 2-20-74	
PROJECT NUMBER	3-74153	SHEET 5 OF 5