


# KNUDSON COVE HARBOR FACILITY

## PROJECT NO 3-75117

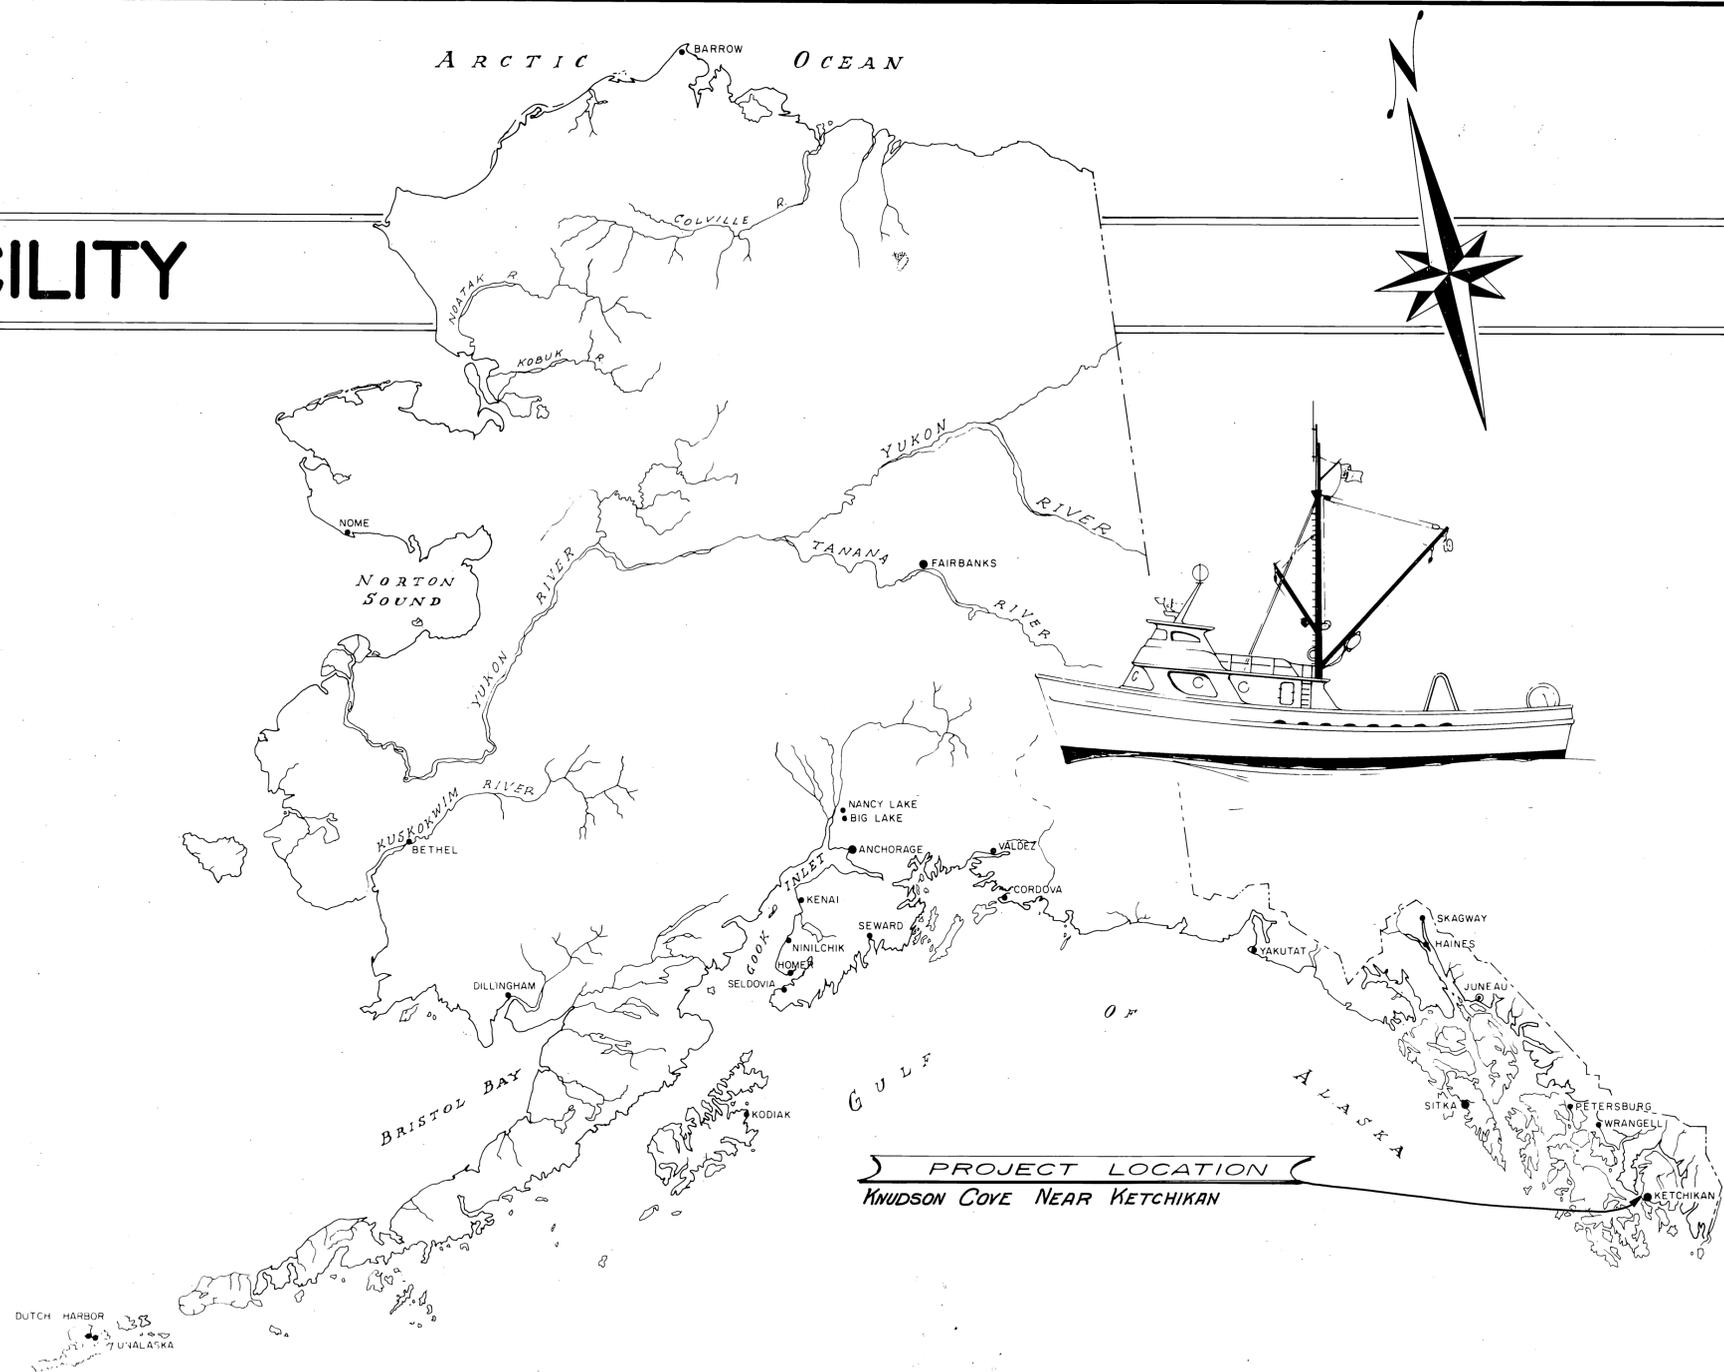

PROJECT LOCATION  
KNUDSON COVE NEAR KETCHIKAN

### WORK SUMMARY


This project consists of dredging 4,636 c.y., clearing and grubbing for a new parking area, 4,670 c.y. of unclassified excavation, furnishing and installing 105 precast concrete launching ramp planks, constructing 1,080 sq. ft of sectional floats, furnishing and driving 3 float piles, reconstructing 2,272 sq. ft of timber approach, and placing 1,306 cy. of riprap slope protection.



STATE OF ALASKA DEPARTMENT OF PUBLIC WORKS  
**DIVISION OF WATER & HARBORS**

INDEX TO SHEETS			
1	TITLE SHEET	4	6' SECTIONAL FLOAT
2	DREDGING PLAN	5	16' WIDE BOAT LAUNCHING RAMP
3	PARKING AREA & LAUNCHING RAMP PLAN	6	APPROACH RECONSTRUCTION

APPROVED  
*David Ward*  
 DIRECTOR  
 DATE 8-12-74  
 SHEET 1 OF 6

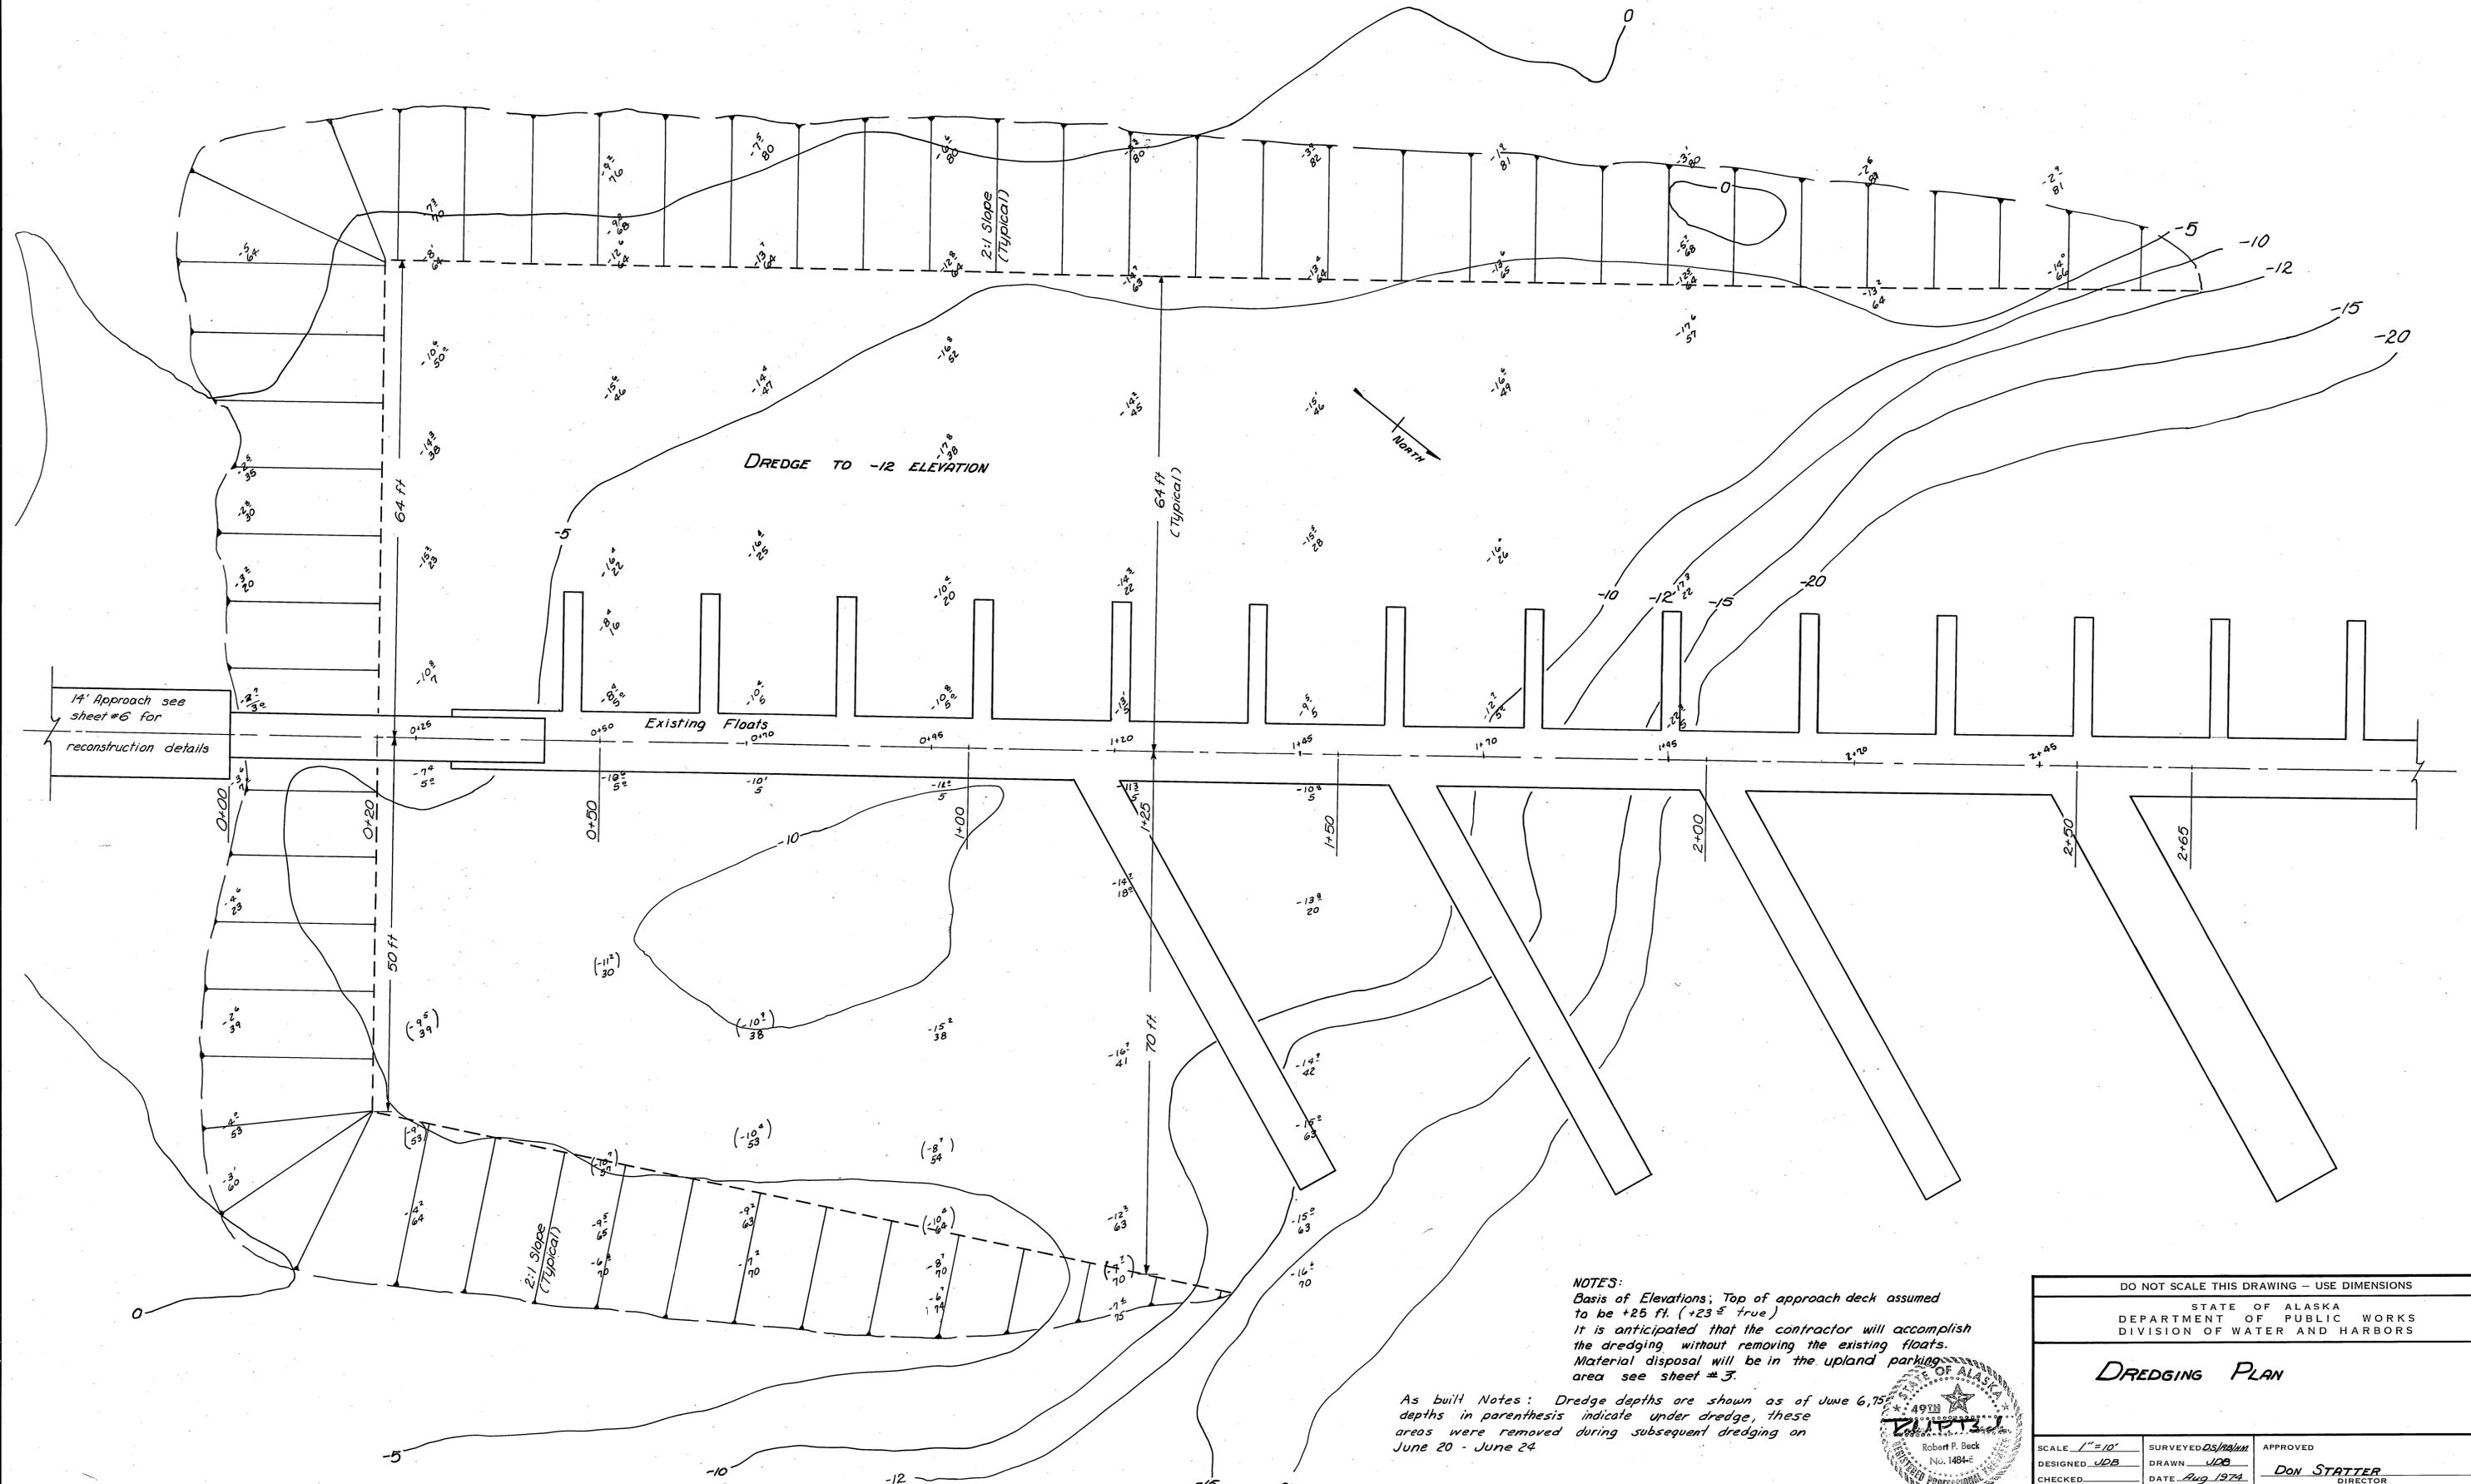

**NOTES:**  
 Basis of Elevations; Top of approach deck assumed to be +25 ft. (+23 ± true)  
 It is anticipated that the contractor will accomplish the dredging without removing the existing floats.  
 Material disposal will be in the upland parking area see sheet #3.

As built Notes: Dredge depths are shown as of June 6, 75. depths in parenthesis indicate under dredge, these areas were removed during subsequent dredging on June 20 - June 24



DO NOT SCALE THIS DRAWING - USE DIMENSIONS		
STATE OF ALASKA DEPARTMENT OF PUBLIC WORKS DIVISION OF WATER AND HARBORS		
<b>DREDGING PLAN</b>		
SCALE 1" = 10'	SURVEYED <i>Os/ma/m</i>	APPROVED
DESIGNED <i>UDB</i>	DRAWN <i>UDB</i>	<b>DON STATER</b> DIRECTOR
CHECKED	DATE <i>Aug 1974</i>	
PROJECT NUMBER <b>3-75117</b>	SHEET <b>2</b> OF <b>6</b>	