

State of Alaska

Department of Transportation
and Public Facilities
Southeast Region


KETCHIKAN, ALASKA SOUTH TONGASS PAVING STP-NH-0902(040)~67674

COLLINS ROAD GUARDRAIL HSIP PROJECT NO. 0902041 ~ 68412


The undersigned hereby
certifies that this duplicated
document is an exact and
true copy of the original.

Cody Sullivan


January 20, 2015

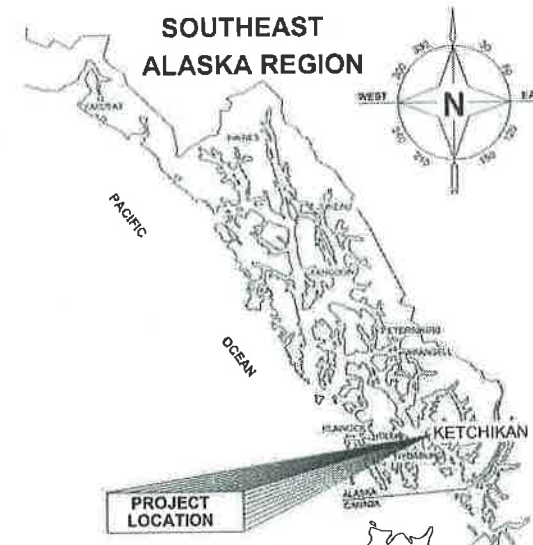

As-Built Plans
Project Engineer: Mandi Bolshakoff
Contractor: Secon, Inc
Begin Work: March 23, 2015
End Work: June 26, 2016

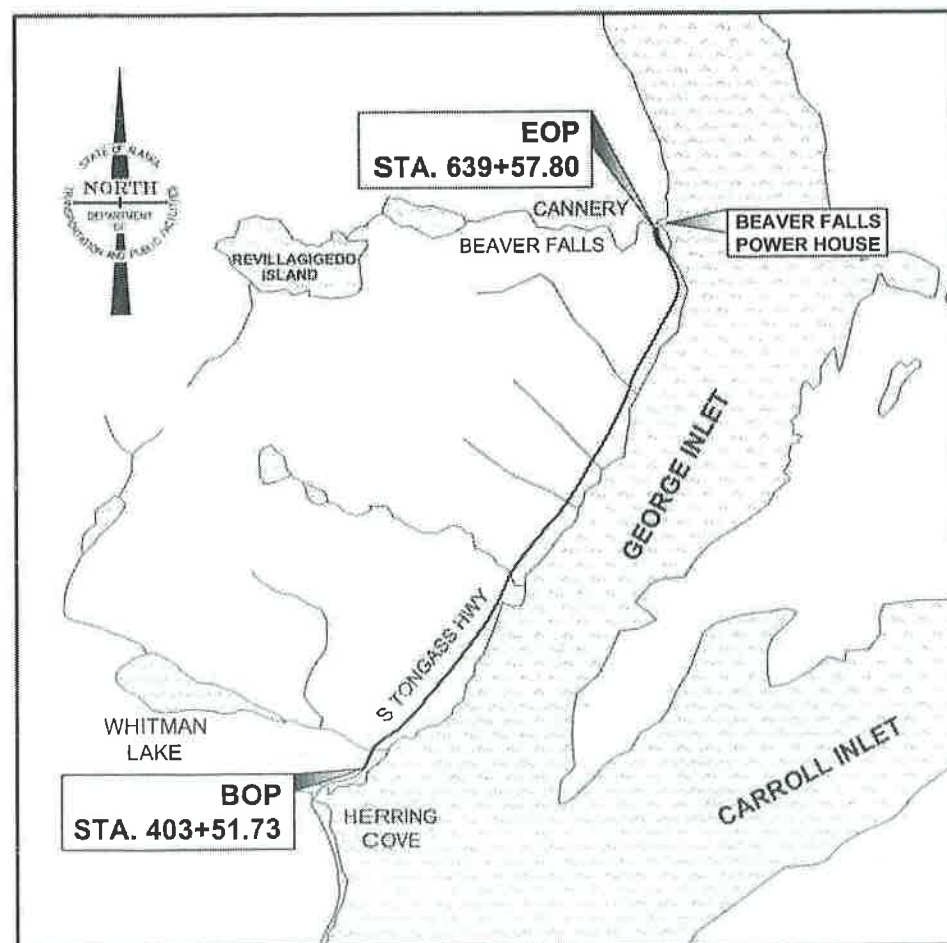

VICINITY MAP

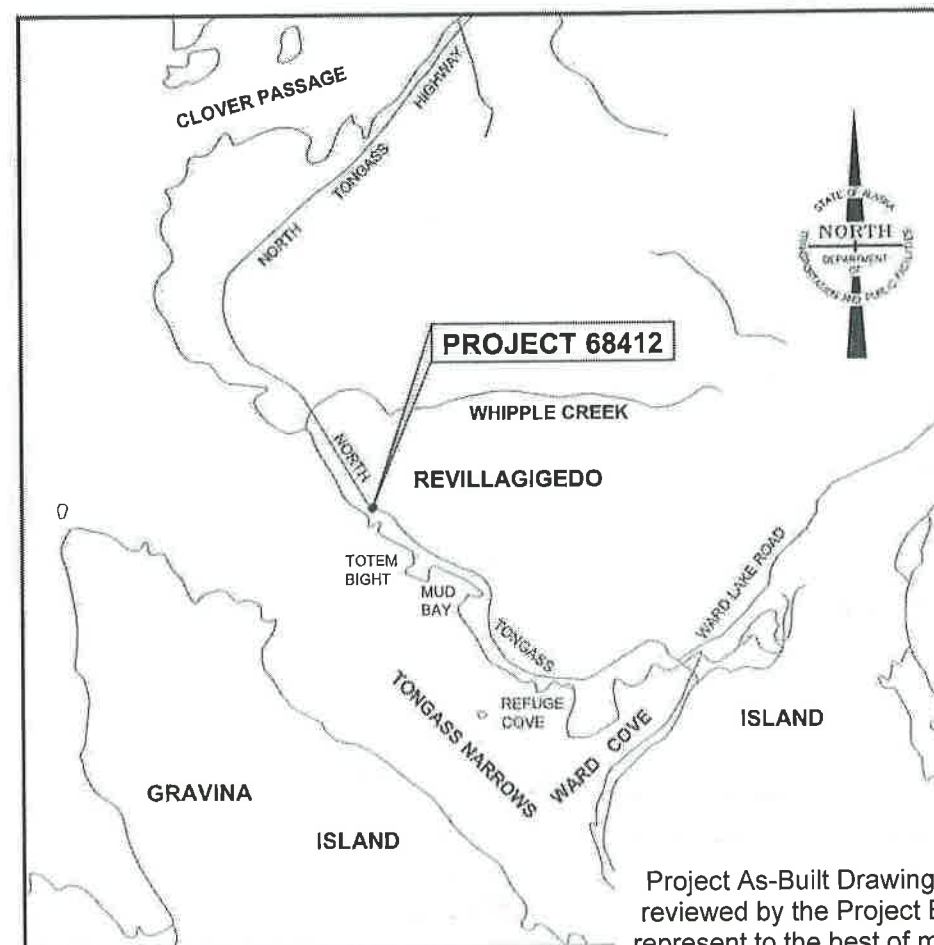

VICINITY MAP

Project As-Built Drawings have been
reviewed by the Project Engineer and
represent to the best of my knowledge,
the project as constructed.

PE *MS* Date *12/11/14*

INDEX

SHEET NO.	DESCRIPTION
AA1	COMBINED TITLE SHEET
BB1	COMBINED ESTIMATE OF QUANTITIES
SOUTH TONGASS PAVING	
A1	TITLE SHEET
A2-A8	SURVEY CONTROL
A9	LAYOUT PLAN
B1-B2	TYPICAL SECTIONS & DETAILS
C1	ESTIMATE OF QUANTITIES
D1-D4	SUMMARIES
F1-F15	PLAN VIEW
G1-G4	SUPERELEVATION PROFILE
H1-H15	SIGNING & STRIPING
P1-P15	EROSION & SEDIMENT CONTROL PLAN
T1	TRAFFIC CONTROL
COLLINS ROAD GUARDRAIL HSIP	
A1	TITLE SHEET
B1	TYPICAL SECTION
C1	ESTIMATE OF QUANTITIES
E1	PARALLEL GUARDRAIL TERMINAL DETAILS
F1	PLAN VIEW
S1	TRAFFIC CONTROL
Asbuilts	

ROUTE: 291400 MILEPOINT: 10.5 TO 15.14

PATH: Q:\KTN\67674\PLANSET\67674_AA1_TSHT.DWG TAB:A1

Wednesday, October 01, 2014 8:07:14 AM

PLOT: PSPACE OR MSPACE: 1=1(F)

STATE OF ALASKA
DEPARTMENT OF TRANSPORTATION
& PUBLIC FACILITIES
SOUTHEAST REGION



APPROVED:

REGIONAL PRE-CONSTRUCTION ENGINEER
L. PAT CARROLL, P.E.

APPROVED:

DIRECTOR OF DESIGN & CONSTRUCTION
CHUCK CORREA, P.E.

CERTIFIED TRUE & CORRECT AS-BUILT OF ACTUAL FIELD
CONDITION:

CONSTRUCTION PROJECT MANAGER DATE

STATE	PROJECT DESIGNATION	YEAR	SHEET	TOTAL
ALASKA	STP-NH-0902(040)~67674	2014	AA1	74
ALASKA	0902041~68412	2014		

Items added by Change Order:

610(1)	Ditch Lining	Lump Sum	All Required
--------	--------------	----------	--------------

642(3)	Three Person Survey	Hour	36.2
--------	---------------------	------	------

CHECKED BY: M. VAN ALSTINE



1/26/14 11/25/14

DESIGNED BY: L. SEIFERT		
DRAWN BY: R. GRANTHAM		
PATH: Q:\KTNIG674\PLANSET\ADDENDUM 167674_BB1_EST.DWG		
TAB: BB1	Wednesday, November 25, 2014 11:46:49 AM	
REVISIONS		
NO.	DATE	DESCRIPTION

STATE OF ALASKA
DEPARTMENT OF TRANSPORTATION
& PUBLIC FACILITIES
SOUTHEAST REGION

KTN-SOUTH TONGASS PAVING
PROJECT #67674


**ADDENDUM 2
COMBINED
ESTIMATE OF QUANTITIES**

State of Alaska

Department of Transportation
and Public Facilities
Southeast Region

KETCHIKAN, ALASKA SOUTH TONGASS PAVING

STP-NH-0902(040)~67674

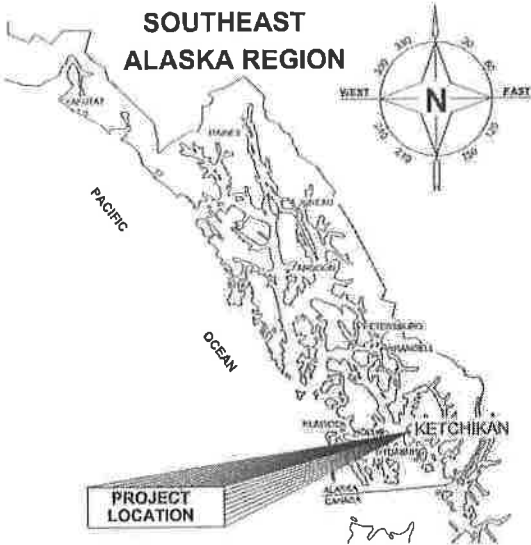

As Advertised:

November 7, 2014

DESIGN DESIGNATION

PROJECT TYPE		GRAVEL TO BLACK
A.D.T. 2010		130
A.D.T. 2025		140
D.H.V. (10.7%) 2010		10
D.H.V. (10.7%) 2025		50
% T		6.2
V		50 MPH
E.A.L.		50,000

PROJECT SUMMARY

LENGTH OF PROJECT		23,606 FT
LENGTH OF PAVING		23,433 FT
WIDTH OF PAVING		25 FT

Project As-Built Drawings have been reviewed by the Project Engineer and represent to the best of my knowledge, the project as constructed.
PE *MD* Date *12/11/15*

THE FOLLOWING STANDARD DRAWINGS APPLY TO THIS PROJECT:

A-1	G-00.02	I-81.00	M-13.01	S-00.11	T-06.00
C-04.12	G-04.10W		M-16.01	S-01.00	T-21.03
C-05.20	G-10.01			S-05.01	
E-13.00	G-15.10			S-20.10	
	G-20.11				

INDEX

SHEET NO.	DESCRIPTION
A1	TITLE SHEET
A2-A8	SURVEY CONTROL
A9	LAYOUT PLAN
B1-B2	TYPICAL SECTIONS & DETAILS
C1	ESTIMATE OF QUANTITIES
D1-D4	SUMMARIES
F1-F15	PLAN VIEW
G1-G4	SUPERELEVATION PROFILE
H1-H15	SIGNING & STRIPING
P1-P15	EROSION & SEDIMENT CONTROL PLAN
T1	TRAFFIC CONTROL

ROUTE: 291400 MILEPOINT: 10.5 TO 15.14

PATH: Q:\KTN\67674\PLANSET\67674_A1 TSHT.DWG TAB:A1
Wednesday, July 30, 2014 1:37:29 PM
PLOT: PSPACE OR MSPACE: 1=1(F)

STATE OF ALASKA
DEPARTMENT OF TRANSPORTATION
& PUBLIC FACILITIES
SOUTHEAST REGION



APPROVED: *Pat Carroll* 11/6/14
REGIONAL PRE-CONSTRUCTION ENGINEER
L. PAT CARROLL, P.E. DATE

APPROVED: *Chuck Correa* 11/6/14
DIRECTOR OF DESIGN & CONSTRUCTION
CHUCK CORREA, P.E. DATE

CERTIFIED TRUE & CORRECT AS-BUILT OF ACTUAL FIELD
CONDITION:

CONSTRUCTION PROJECT MANAGER DATE

STATE	PROJECT DESIGNATION	YEAR	SHEET NO.	TOTAL SHEETS
ALASKA	STP-NH-0902(040)~67674	2014	A1	66

HORIZONTAL CONTROL

Horizontal Control for this project is based on the DOT/PF South Tongass Grid 2000. The intent of this local ground distance based coordinate system is to relate it to Alaska State Plane while preserving ground distances.

The DOT/PF Ketchikan South Tongass Grid -2000 System is a local ground coordinate system based at DOT/PF GPS control station 95-K-4 (#36). It relates to AKSPC zone 1 NAD83 (92) through the following parameters:
Zone = NAD83 AKSPC ZONE 1
Grid Scale = 0.999900264
Convergence = +1°44'48"
Translation about DOT/PF control point 95-K-4 as follows:
AKSPC Northing = 1277612.22594 FT US
AKSPC Easting = 3117379.86890 FT US
Local Northing = 328083.33333 FT US
Local Easting = 656166.66667 FT US

Project Specific Basis of Horizontal Control

95-K-4 : 2” Brass Cap located in the breakwater of Saxman harbor.

NAD83(1992) Lat 55°18'51.8820” N Lon 131°35'43.1545”W
KTN_S-Tongass-Grid N 328083.3333' E 656166.6667'
AKSPC N=1277612.22594' E=3117379.86890'

95-K-6 : 2” Brass Cap in bedrock on beach located adjacent to 2976 S. Tongass

NAD83(1992) Lat 55°18'49.0933” N Lon 131°35'23.7309”W
KTN_S-Tongass-Grid N 327799.9386' E 657290.4836'
AKSPC N 1277363.2420' E 3118511.6888'

VERTICAL CONTROL

The Vertical Datum for Ketchikan South Tongass Grid 2000 is Mean Lower Low Water based on levels from the National Ocean Service Benchmark NO. 37. The record elevation for NO. 37 is 35.09' above MLLW based on the 1960-1978 tidal epoch for tide station 9450460. The project specific basis of vertical control is point #36 “95-K-4” with an observed elevation of 22.21' above MLLW.

See Change Order 1

A2 Survey Control						
Point #	Northing	Easting	Elevation	Description	Station	Offset
240	332404.81	670699.64	31.14	BC_SH_MON	N\A	N\A
241	332628.35	670965.08	32.52	BC_SH_MON	N\A	N\A
242	332706.20	671653.12	47.50	BC_SH_MON	405+08.90	12.12R
470	334097.16	672870.79	76.31	REBAR_FND	423+81.21	32.99L
501	333394.06	672363.44	80.03	REBAR_SET	415+10.61	21.13L
505	334997.63	674704.48	112.20	PLASCAP_FND_885	444+71.32	24.13R
506	335304.36	675020.29	105.39	REBAR_SET	449+05.64	17.97R
510	336651.27	675664.87	100.09	ALCAP2" _472	464+38.46	21.21R
512	337672.98	676036.15	126.80	ALCAP2" _473	475+32.82	34.02L
516	339597.26	676925.23	124.16	REBAR_474	496+94.17	17.38L
517	340436.70	677426.06	156.71	ALCAP2" _475	506+70.67	19.42L
518	341066.79	678209.11	143.58	ALCAP2" _476	516+71.75	15.46R
519	341861.45	678701.94	100.19	ALCAP2" _477	526+03.49	16.15L
520	342400.66	679240.27	87.89	REBAR_FND	533+63.72	18.70R
529	346790.03	681139.39	69.04	ALCAP2" _482	583+64.72	21.46L
530	347547.23	681632.57	69.78	ALCAP2" _483	592+62.73	26.57R
531	348328.93	681857.76	78.58	ALCAP2" _484	600+70.94	18.12L
532	348866.80	682376.82	93.20	ALCAP2" _485	608+16.26	16.84R
533	349590.69	682572.92	105.08	ALCAP2" _486	615+30.90	14.09R
534	350097.64	682770.59	122.92	ALCAP2" _487	621+15.39	4.90R
535	350478.95	682741.41	127.40	ALCAP2" _488	624+96.51	15.56R
536	351056.40	682518.86	121.66	ALCAP2" _489	631+13.65	15.69R
537	351626.69	682094.27	86.02	ALCAP2" _SET	638+20.61	24.15L

Project As-Built Drawings have been reviewed by the Project Engineer and represent to the best of my knowledge, the project as constructed.
PE mg Date 12/11/15

All SURVEY CONTROL monuments in this table are provided strictly for survey control. Should any of them be destroyed during construction they SHALL NOT be replaced.

EXCEPT 240,241 & 242 WHICH ARE EXISTING SHOULDER MONUMENTS AND NEED TO BE PRESERVED. IF SAID MONUMENTS ARE TO BE DISTURBED THEY NEED TO REFERENCED AND REPLACED IN THEIR ORIGINAL HORIZONTAL POSITION AFTER CONSTRUCTION

PATH:Q:\KTN\67674\PLANSET\67674_A2-A8_SV
CNTL.DWG

SEIFERT, LOLITA T (DOT)
TAB: A2 Wednesday, November 05, 2014 7:53

ADDENDUM NUMBER

ATTACHMENT NUMBER

RECORD OF REVISIONS

No.	DATE	DESCRIPTION

MONUMENT NOTES:
1. If any pair of control points disagrees from published value by more than 1:10,000 horizontally or vertically then a third network point must be tied to ascertain which point is in error or has been disturbed.

2. Whether listed or not, all monuments, property markers, or accessories that will be disturbed or buried shall be referenced prior to being disturbed, and re-established in their original position and a record of monument form in accordance with A.S.34.65.040 shall be submitted to the construction engineer for review prior to recording. Coordinate values listed are for informational purposes and should be used to reset monuments only as a last resort.

CHECKED BY: DIGNOTOV



DESIGNED BY: J.PAPOI

DRAWN BY: J.PAPOI

STATE OF ALASKA
DEPARTMENT OF TRANSPORTATION
& PUBLIC FACILITIES
SOUTHEAST REGION



KTN-SOUTH TONGASS PAVING
PROJECT #67674

SURVEY
CONTROL

PROJECT DESIGNATION

STP-NH-0902(040)-67674

STATE	YEAR
ALASKA	2014
SHEET NUMBER	TOTAL SHEETS
A2	66

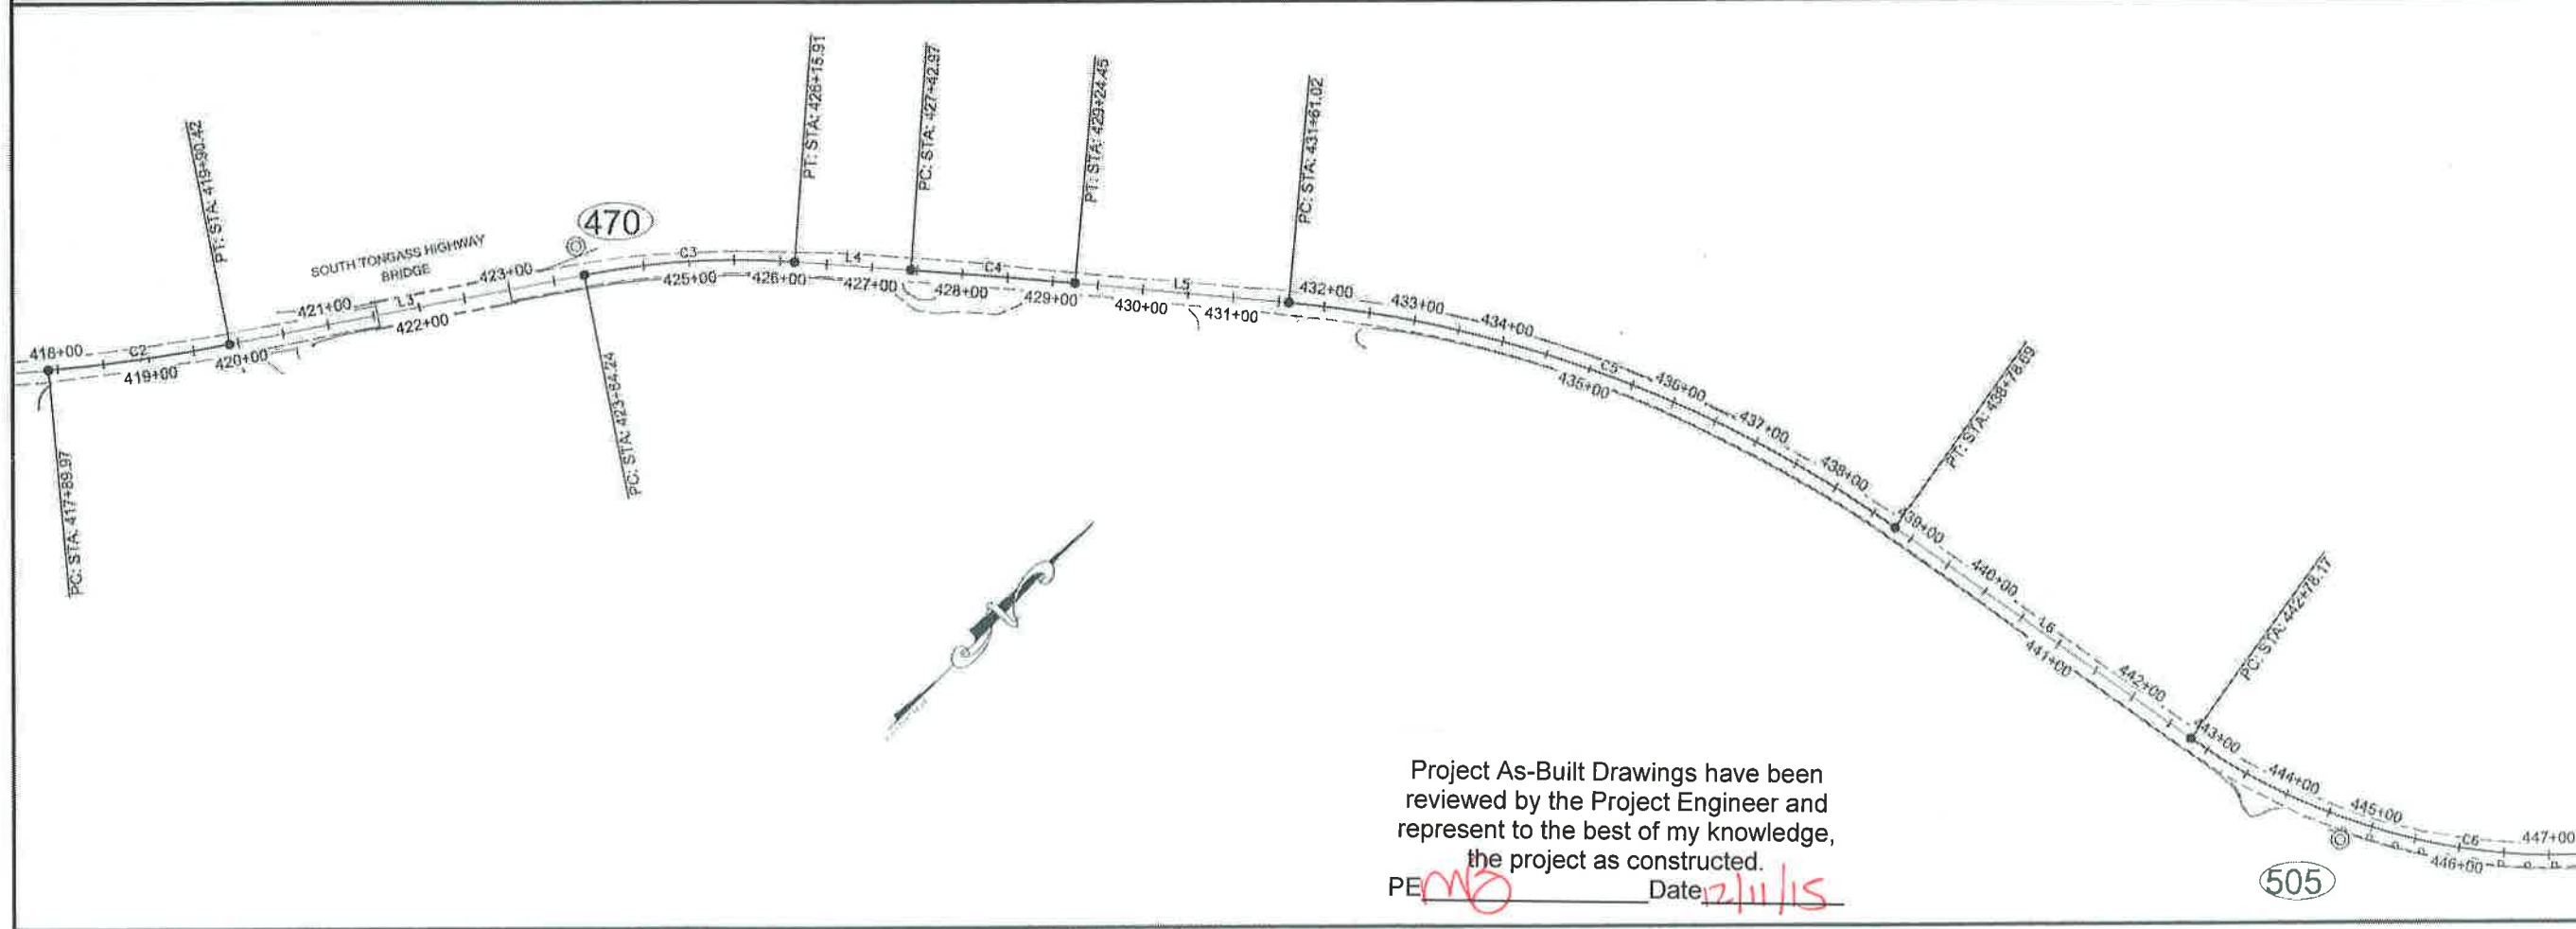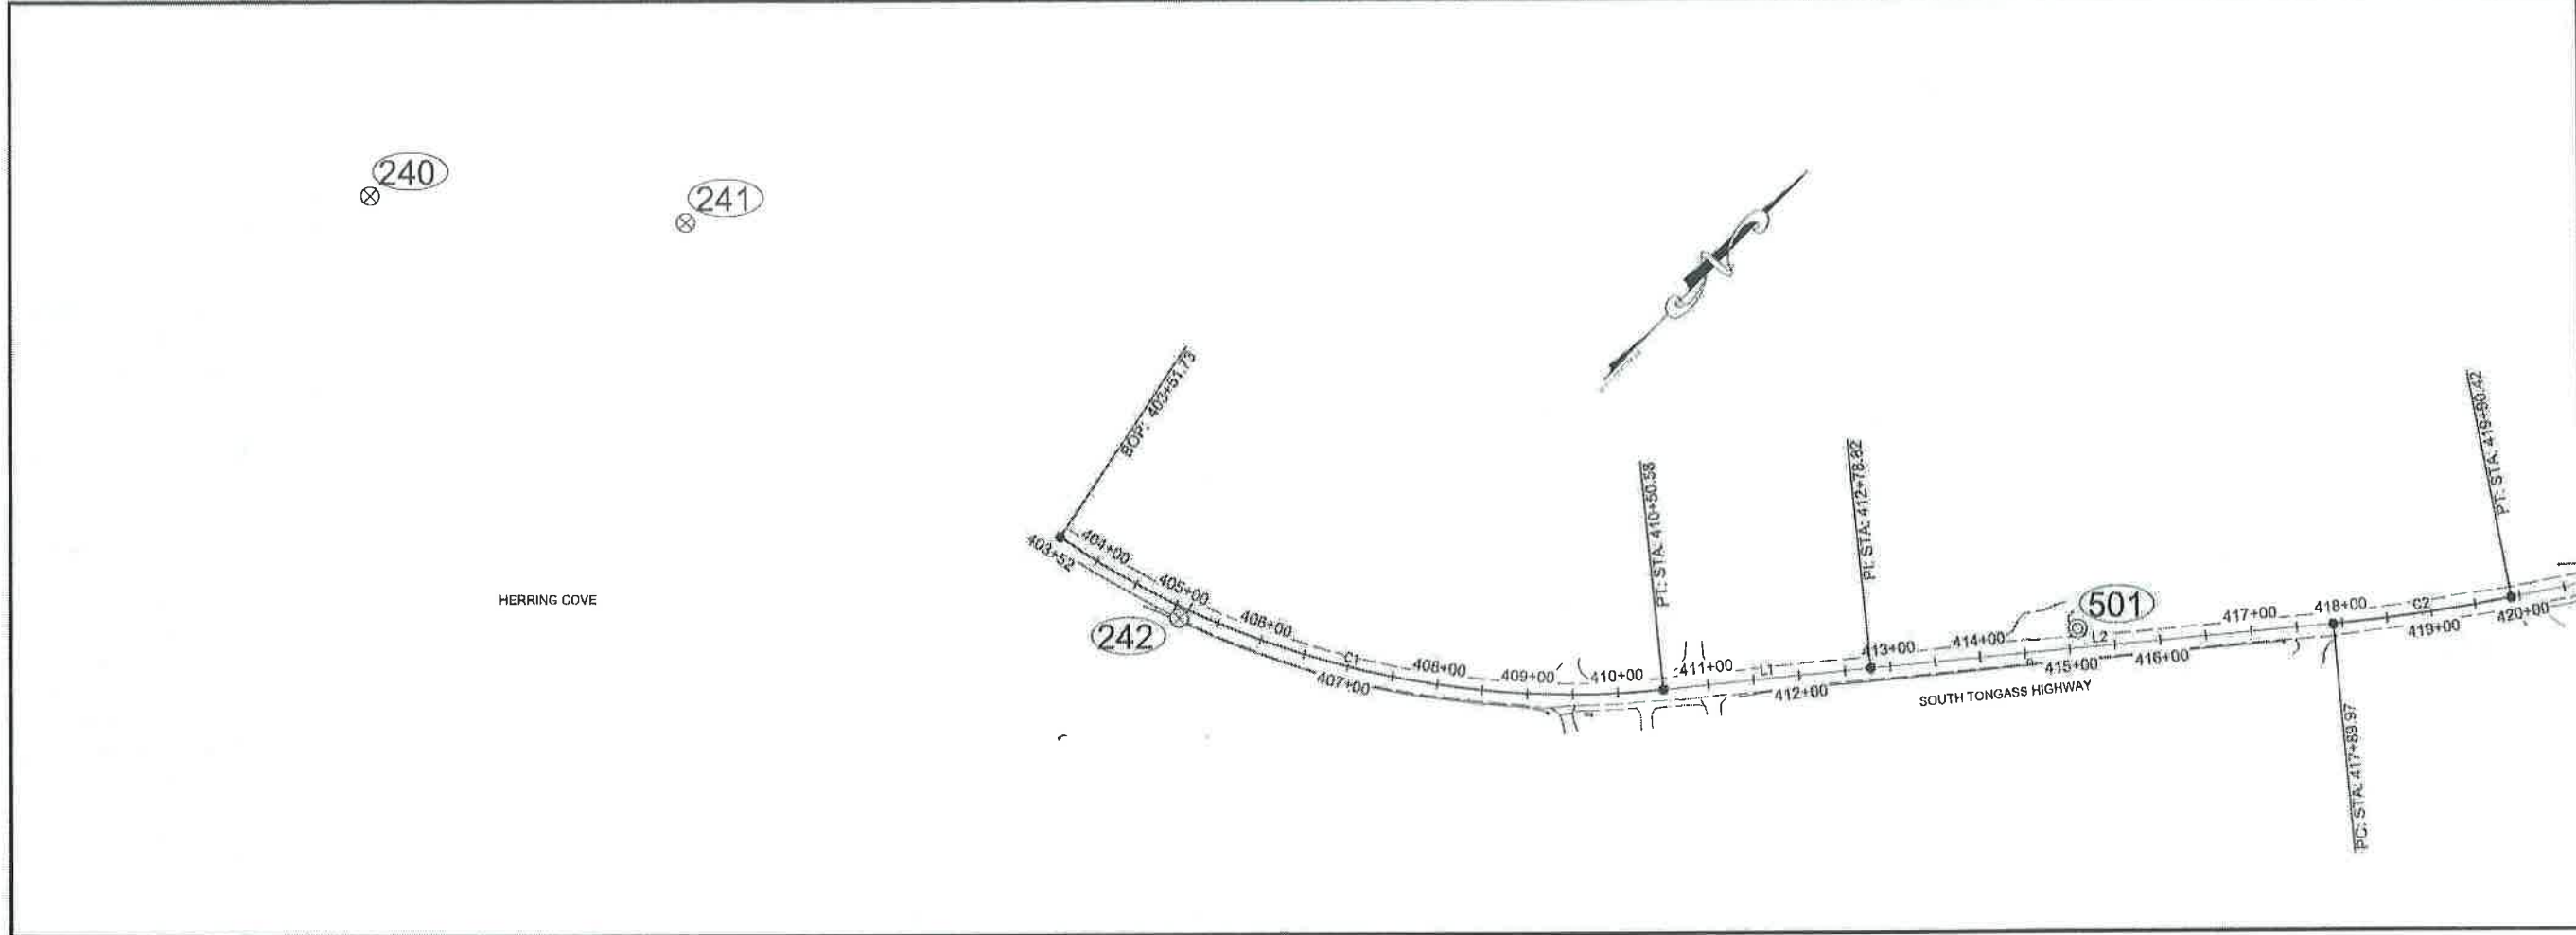

Project As-Built Drawings have been reviewed by the Project Engineer and represent to the best of my knowledge, the project as constructed.

PE *[Signature]* Date *2/11/15*

PATH: Q:\KTN\67674\PLANSET\07674_A2-A8_SV
 CNTL.DWG

SEIFERT, LOLITA T (DOT)
 TAB: A3 Wednesday, November 05, 2014 7:23

ADDENDUM NUMBER

ATTACHMENT NUMBER

RECORD OF REVISIONS

No.	DATE	DESCRIPTION

MONUMENT NOTES:
 1. If any pair of control points disagrees from published value by more than 1:10,000 horizontally or vertically then a third network point must be tied to ascertain which point is in error or has been disturbed.

 2. Whether listed or not, all monuments, property markers, or accessories that will be disturbed or buried shall be referenced prior to being disturbed, and re-established in their original position and a record of monument form in accordance with A.S.34.65.040 shall be submitted to the construction engineer for review prior to recording. Coordinate values listed are for informational purposes and should be used to reset monuments only as a last resort.

CHECKED BY: D.IGNOTOV

DESIGNED BY: J.PAPOI
 DRAWN BY: J.PAPOI



STATE OF ALASKA
 DEPARTMENT OF TRANSPORTATION
 A PUBLIC FACILITIES
 SOUTHEAST REGION

 KTN-SOUTH TONGASS PAVING
 PROJECT #67674

SURVEY CONTROL

PROJECT DESIGNATION
STP-NH-0902(040)-67674

STATE	YEAR
ALASKA	2014
SHEET NUMBER	TOTAL SHEETS
A3	66

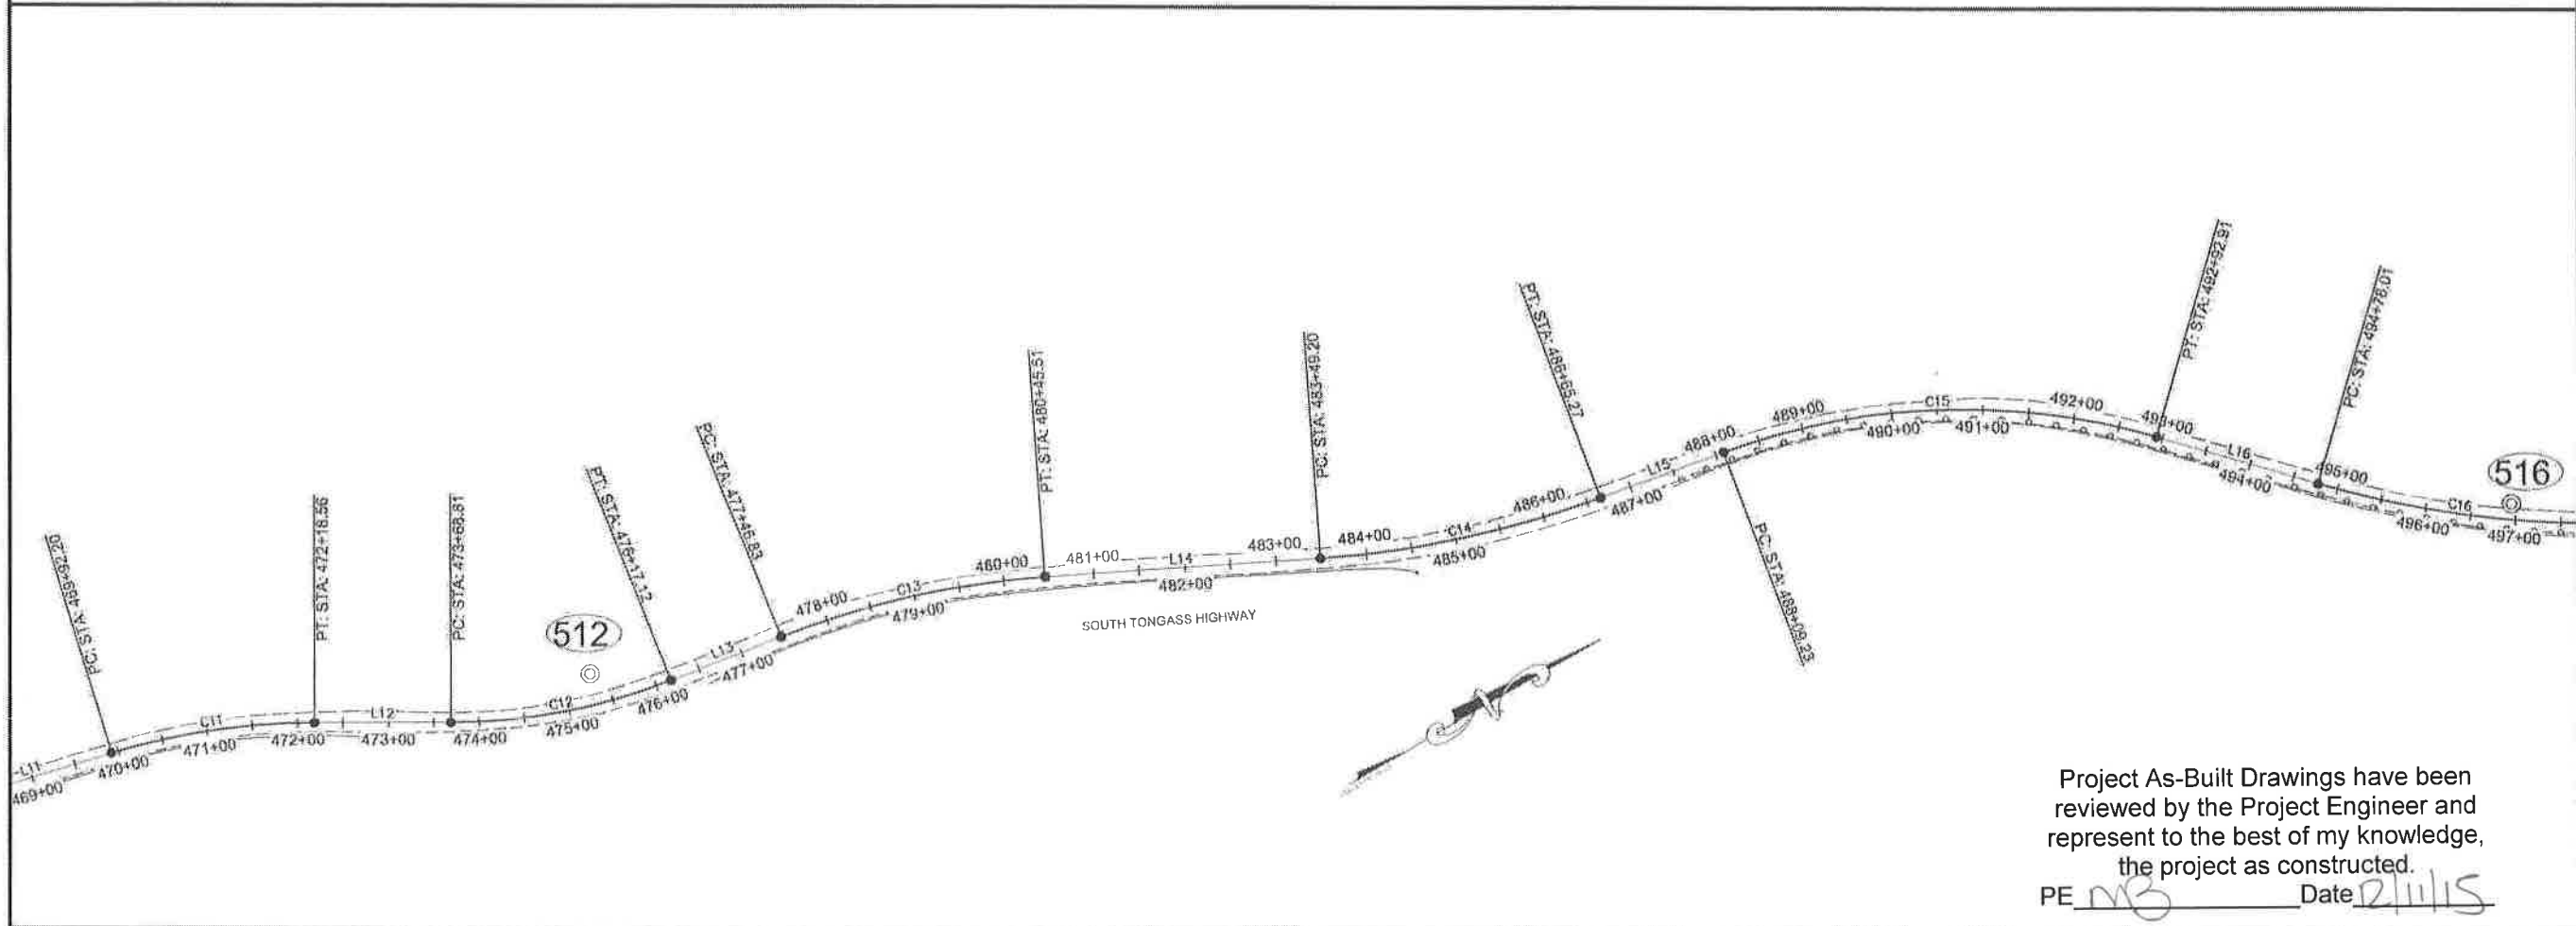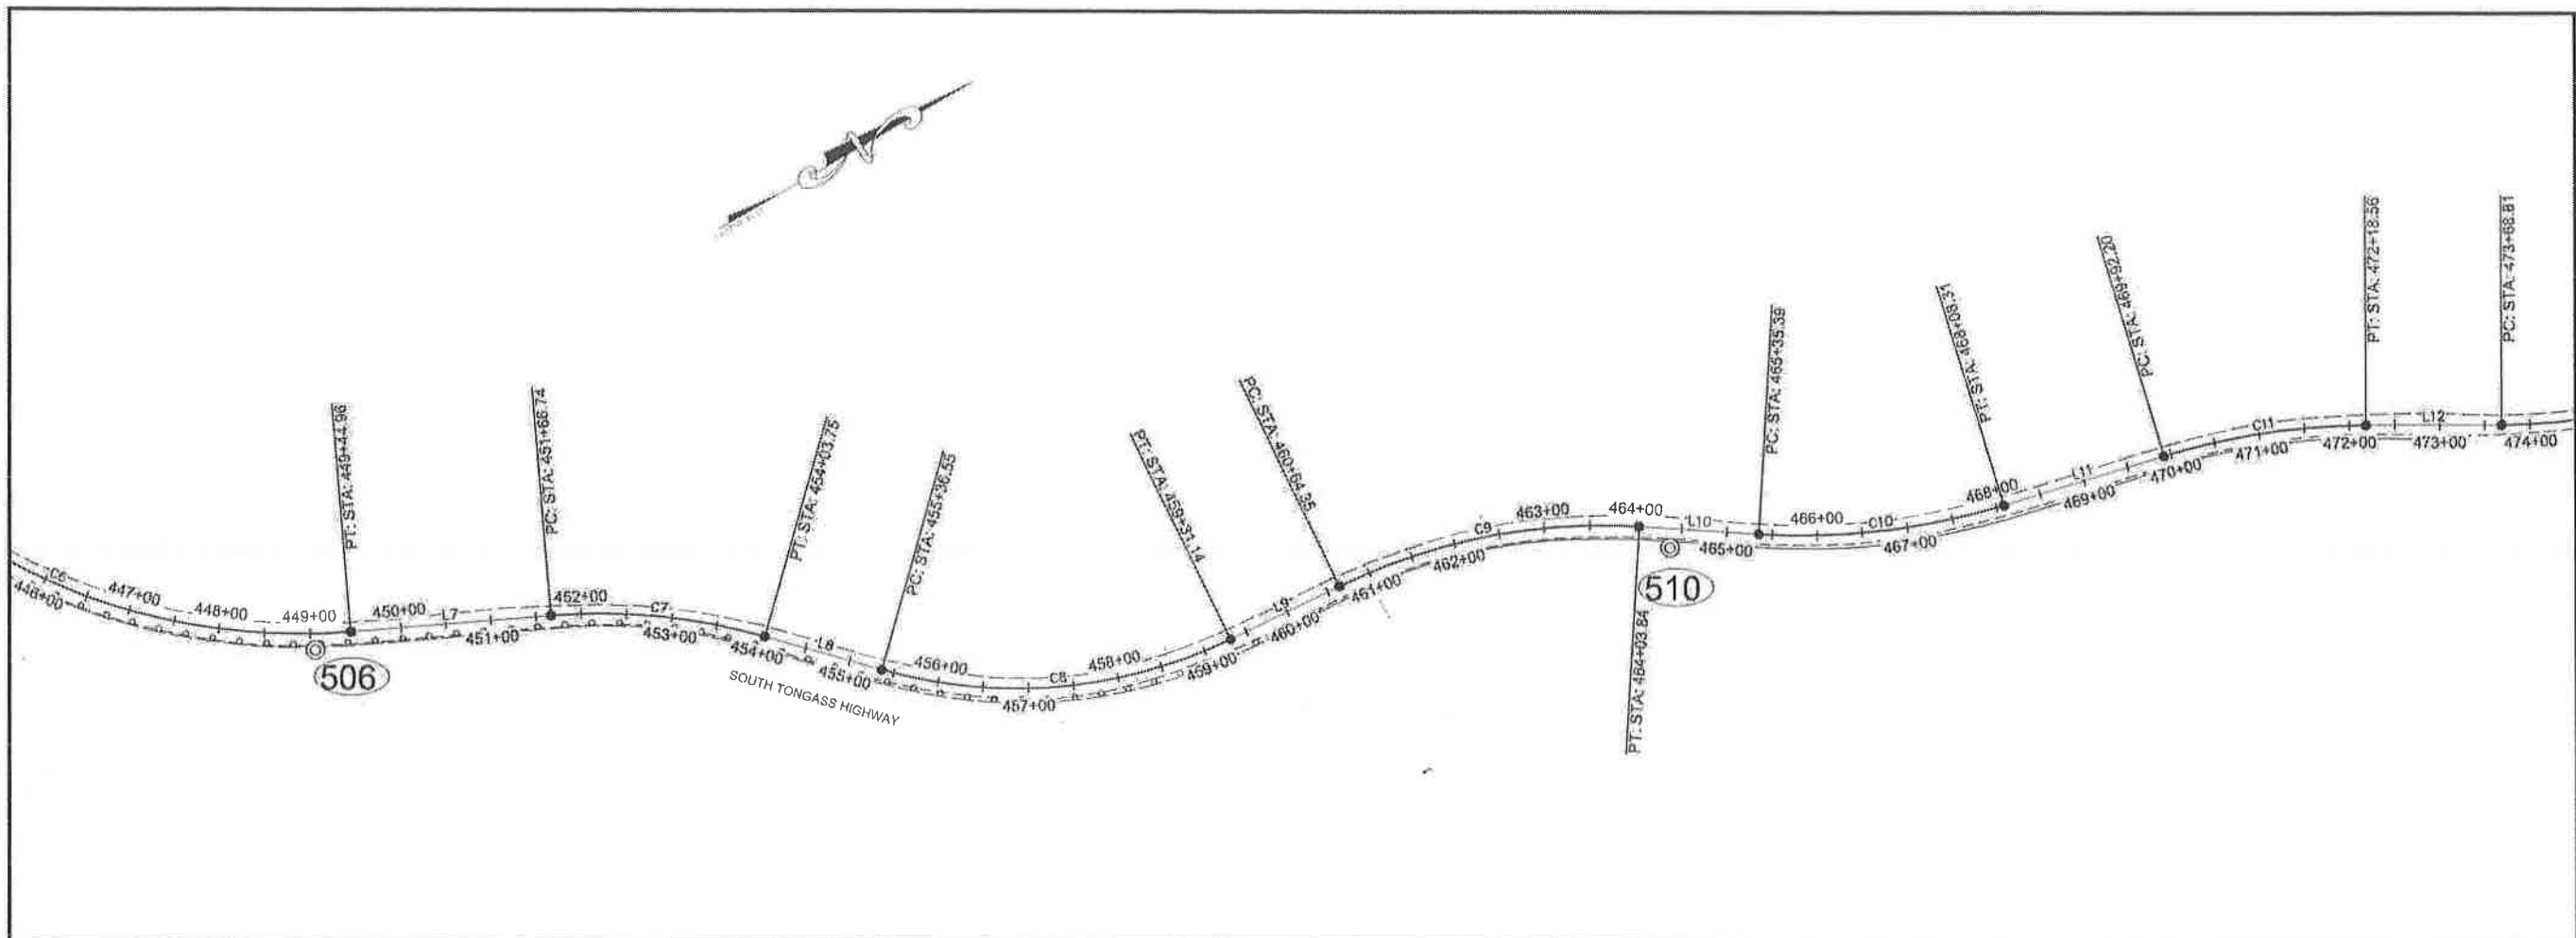

Project As-Built Drawings have been reviewed by the Project Engineer and represent to the best of my knowledge, the project as constructed.

PE MB Date 2/11/15

PATH: Q:\KTN\67674\PLANSET\67674_A2-A8_SV
CNTL.DWG

SEIFERT, LOLITA T (DOT)
TAB: A4 Wednesday, November 05, 2014 7:23

RECORD OF REVISIONS		
No.	DATE	DESCRIPTION

MONUMENT NOTES:

1. If any pair of control points disagrees from published value by more than 1:10,000 horizontally or vertically then a third network point must be tied to ascertain which point is in error or has been disturbed.

2. Whether listed or not, all monuments, property markers, or accessories that will be disturbed or buried shall be referenced prior to being disturbed, and re-established in their original position and a record of monument form in accordance with A.S.34.65.040 shall be submitted to the construction engineer for review prior to recording. Coordinate values listed are for informational purposes and should be used to reset monuments only as a last resort.

CHECKED BY: D.IGNOTOV





DESIGNED BY: J.PAPOI
DRAWN BY: J.PAPOI

STATE OF ALASKA
DEPARTMENT OF TRANSPORTATION
& PUBLIC FACILITIES
SOUTHEAST REGION

KTN-SOUTH TONGASS PAVING
PROJECT #67674

SURVEY CONTROL

PROJECT DESIGNATION	
STP-NH-0902(040)-67674	
STATE	YEAR
ALASKA	2014
SHEET NUMBER	TOTAL SHEETS
A4	66

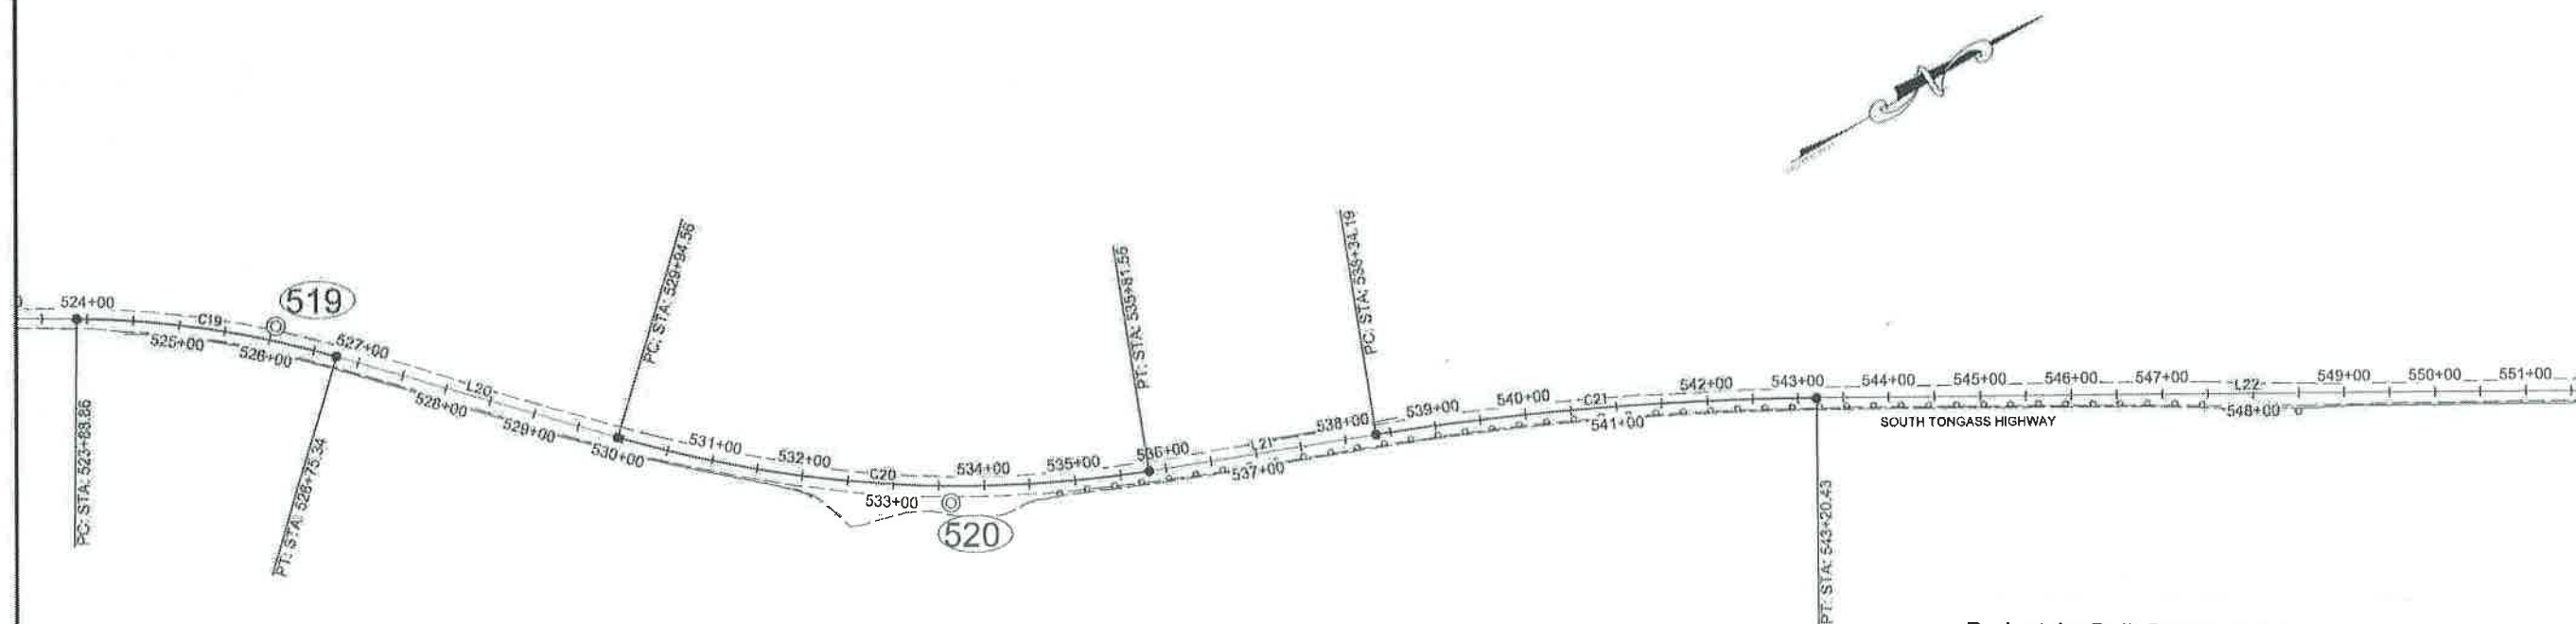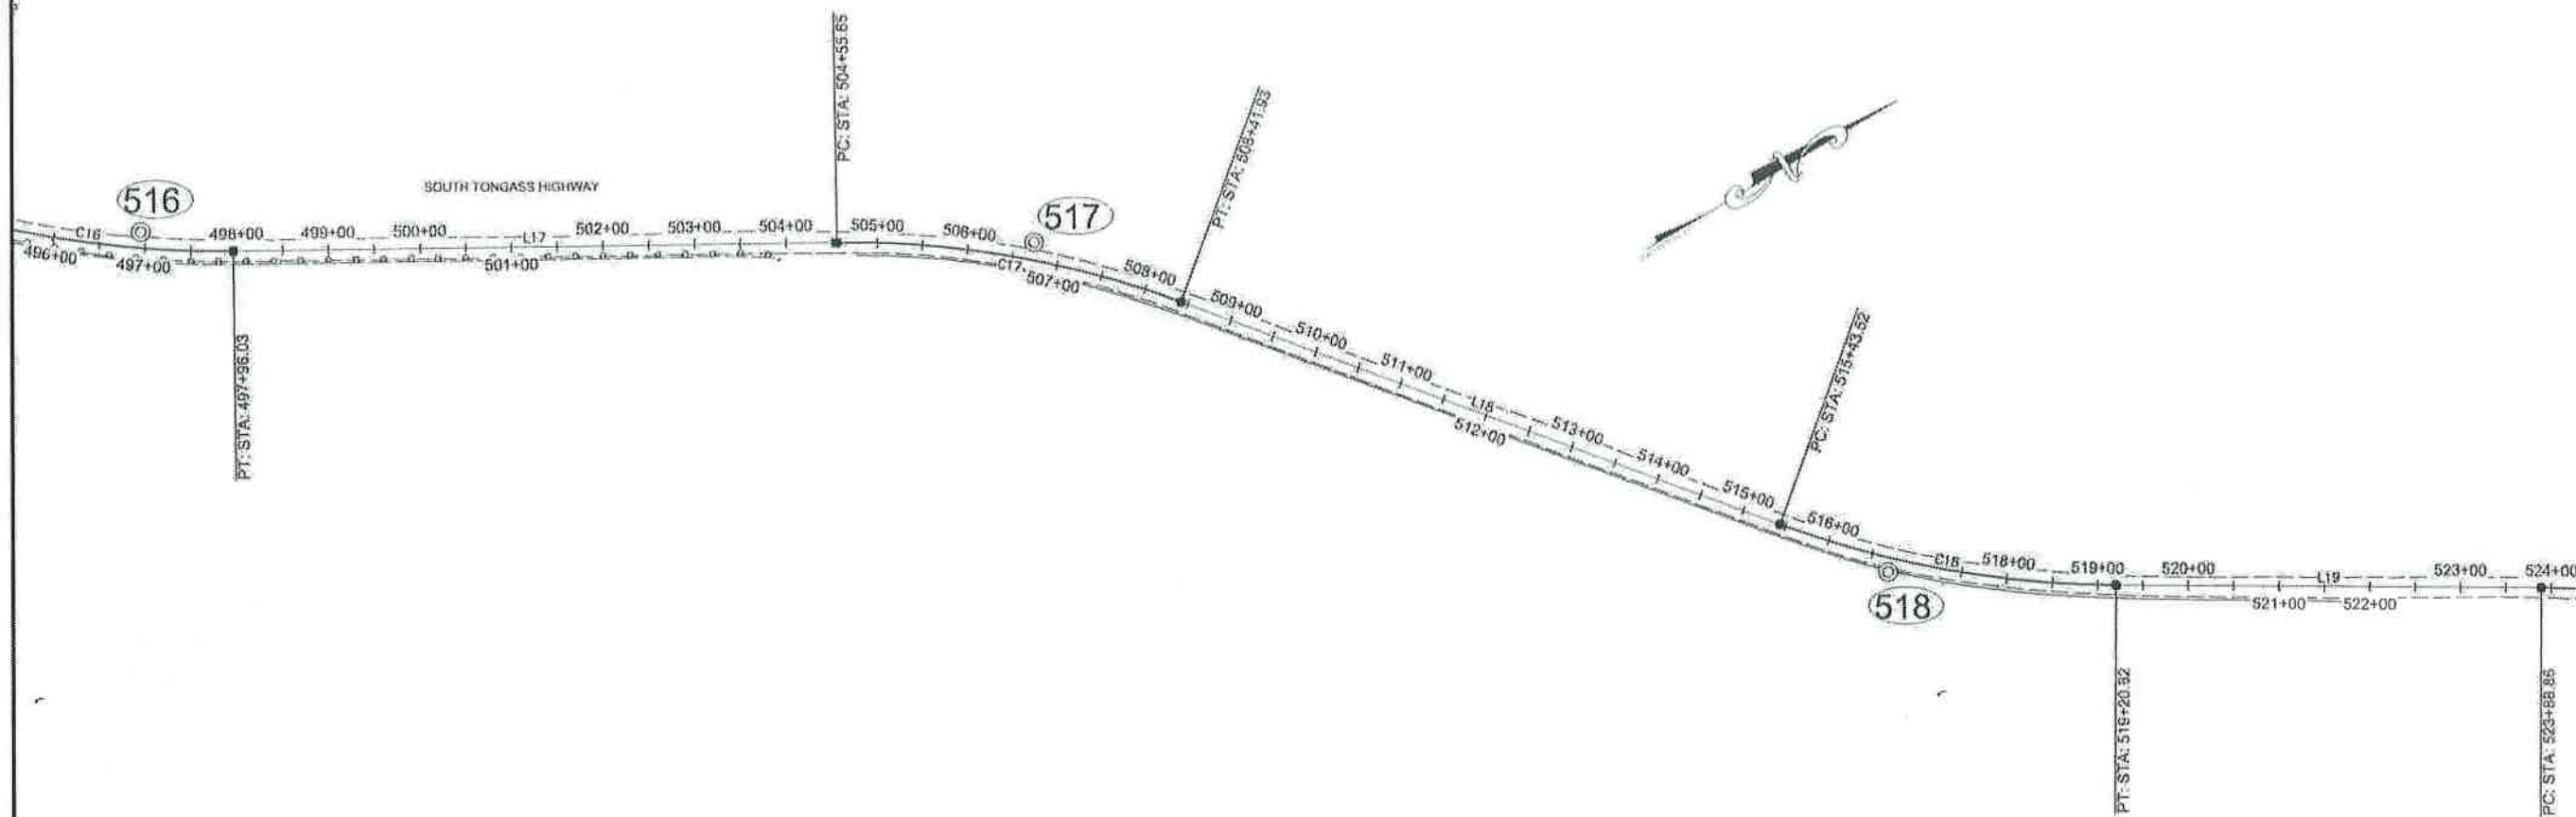

Project As-Built Drawings have been reviewed by the Project Engineer and represent to the best of my knowledge, the project as constructed.

PE mg Date 12/11/15

PATH:Q:\KTN\67674\PLANSET\67674_A2-A8_SV
CNTL.DWG

SEIFERT, LOLITA T (DOT)
TAB: A5 Wednesday, November 05, 2014 7:3

ADDENDUM NUMBER

ATTACHMENT NUMBER

RECORD OF REVISIONS

No.	DATE	DESCRIPTION

MONUMENT NOTES:

1. If any pair of control points disagrees from published value by more than 1:10,000 horizontally or vertically then a third network point must be tied to ascertain which point is in error or has been disturbed.

2. Whether listed or not, all monuments, property markers, or accessories that will be disturbed or buried shall be referenced prior to being disturbed, and re-established in their original position and a record of monument form in accordance with A.S.34.65.040 shall be submitted to the construction engineer for review prior to recording. Coordinate values listed are for informational purposes and should be used to reset monuments only as a last resort.

CHECKED BY: D.ISNOTOV



DESIGNED BY: J.PAPOI

DRAWN BY: J.PAPOI

STATE OF ALASKA
DEPARTMENT OF TRANSPORTATION
& PUBLIC FACILITIES
SOUTHEAST REGION

KTN-SOUTH TONGASS PAVING
PROJECT #67674

SURVEY CONTROL

PROJECT DESIGNATION


STP-NH-0902(040)-67674

STATE YEAR

ALASKA 2014



SHEET NUMBER TOTAL SHEETS

A5 66

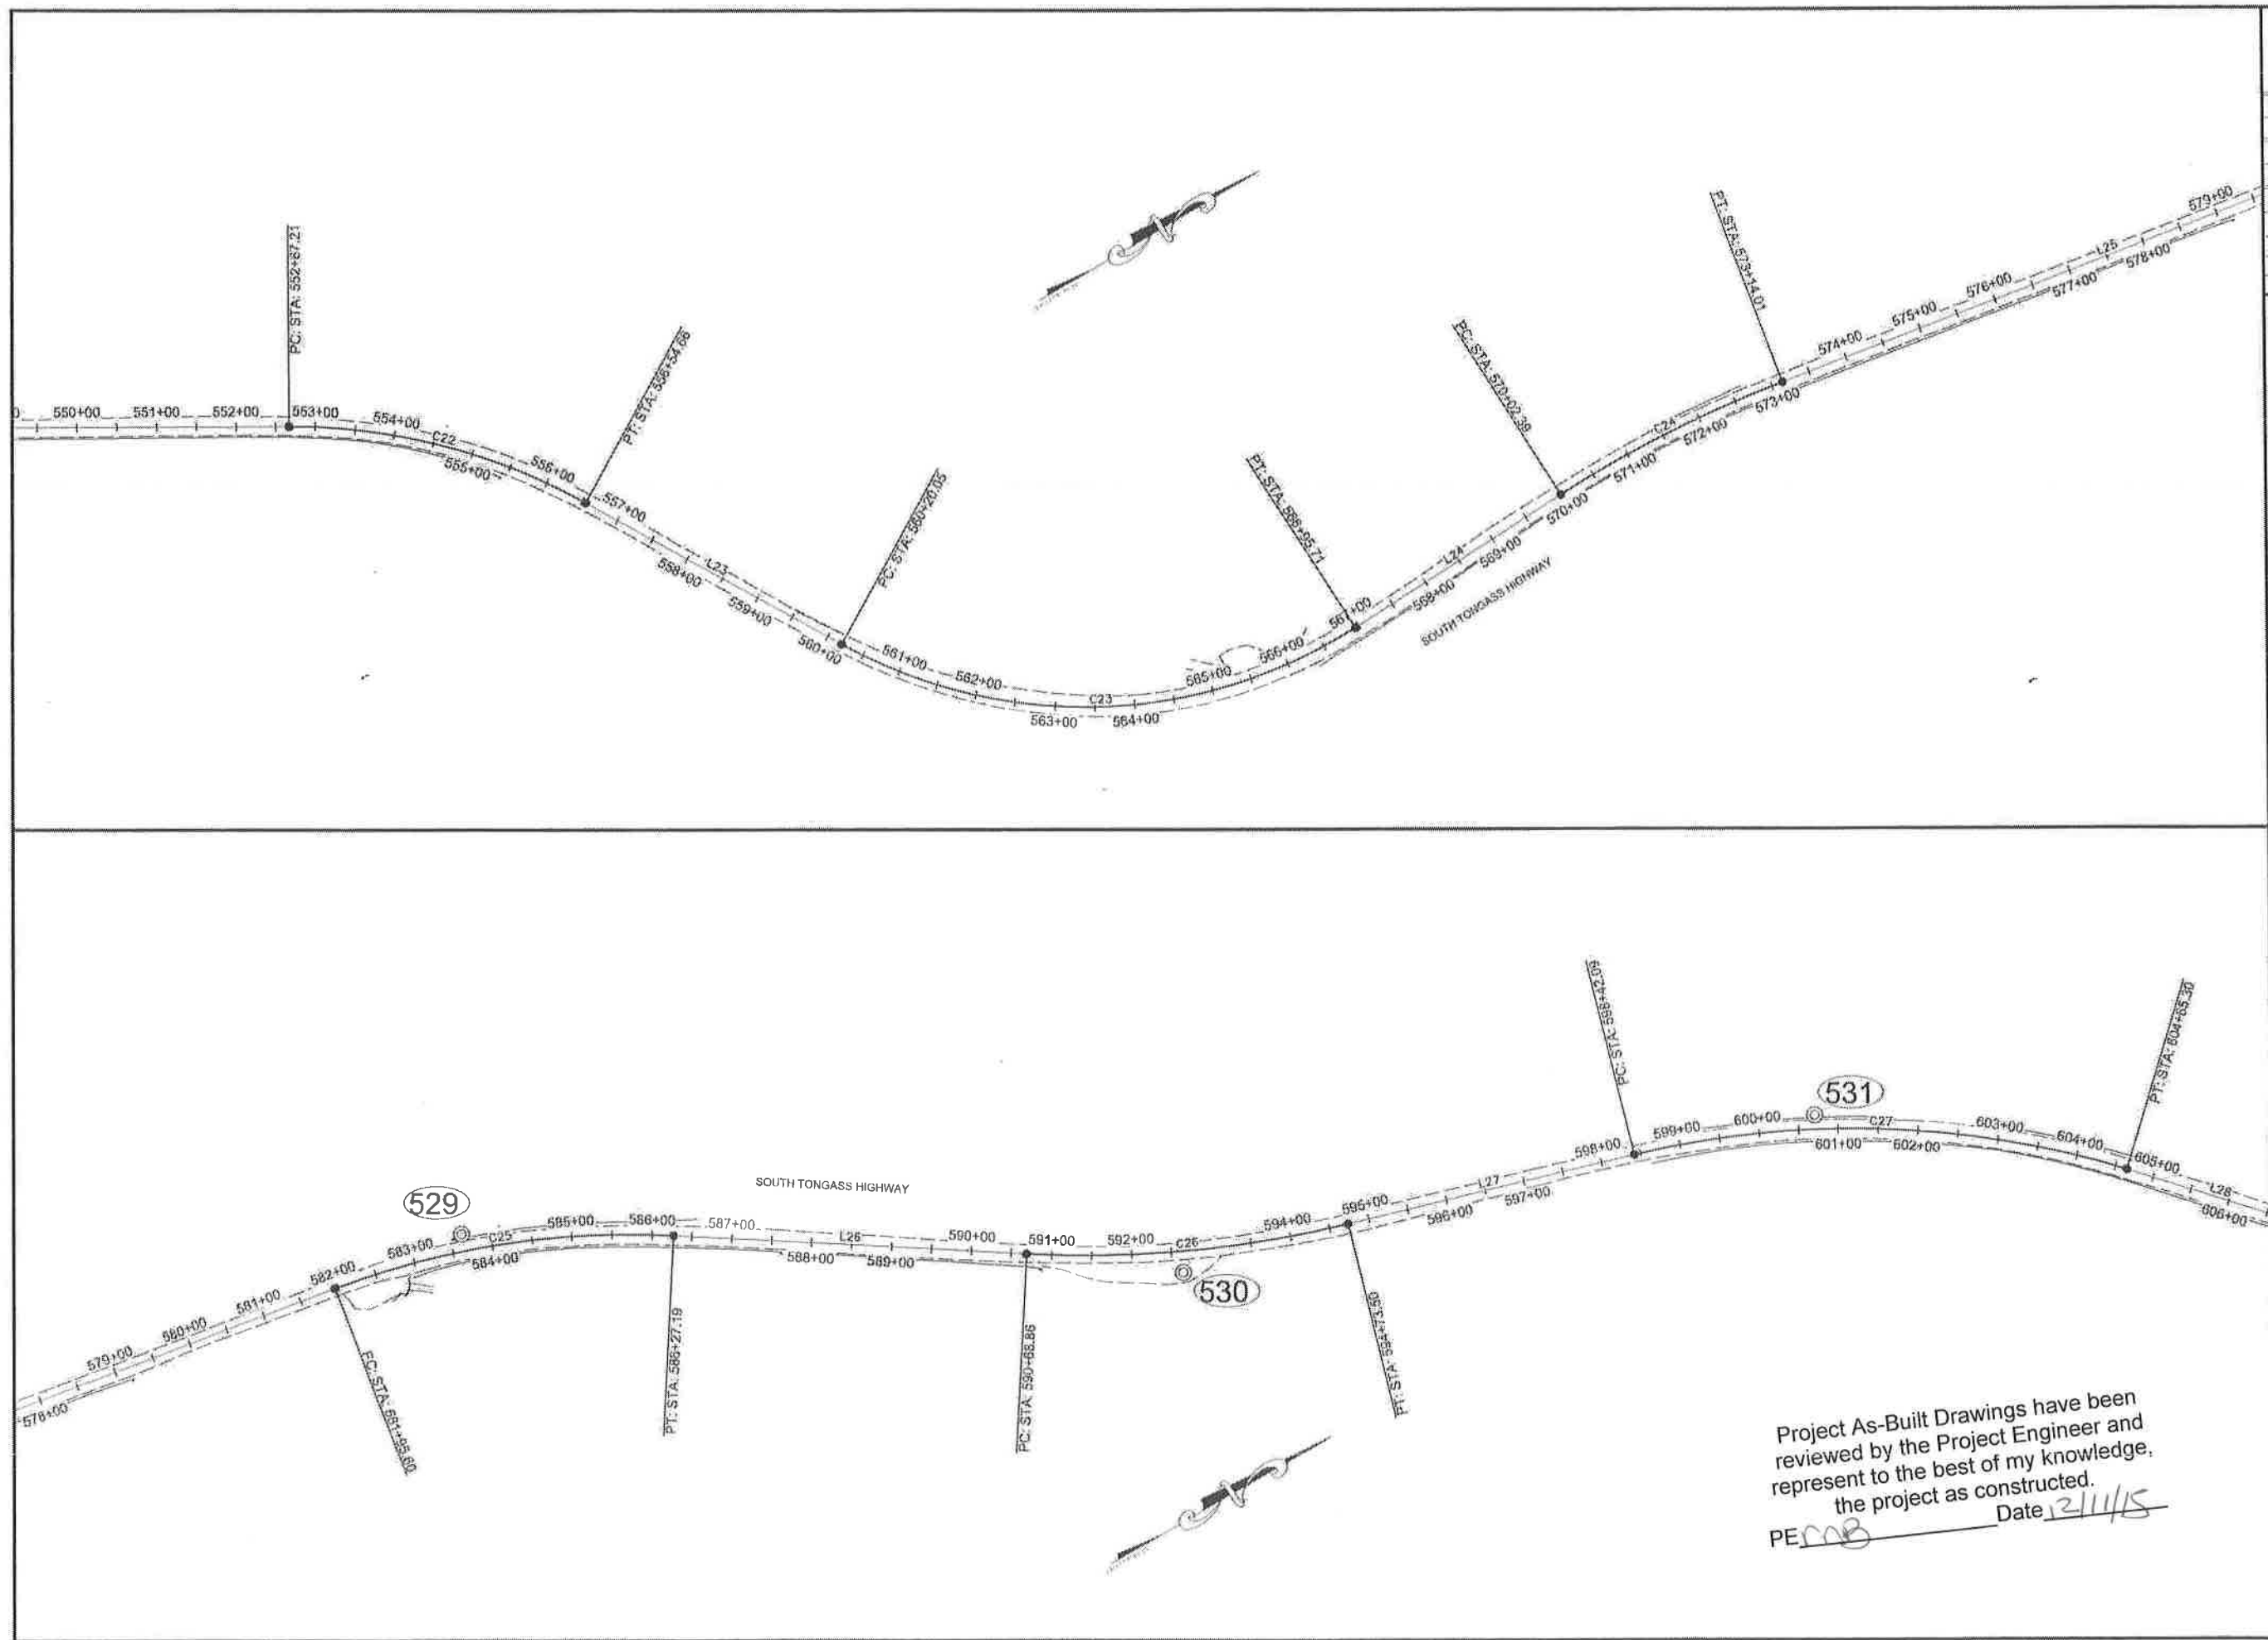

Project As-Built Drawings have been reviewed by the Project Engineer and represent to the best of my knowledge, the project as constructed.
PE DOB Date 12/11/15

PATH: Q:\KTN\67674\PLANSET\67674_A2-A6_SV CNTL.DWG		
SEIFERT, LOLITA T (DOT)		
TAB: A6 Wednesday, November 04, 2014 7:2		
ADDENDUM NUMBER		
ATTACHMENT NUMBER		
RECORD OF REVISIONS		
No.	DATE	DESCRIPTION
MONUMENT NOTES:		
1. If any pair of control points disagrees from published value by more than 1:10,000 horizontally or vertically then a third network point must be tied to ascertain which point is in error or has been disturbed.		
2. Whether listed or not, all monuments, property markers, or accessories that will be disturbed or buried shall be referenced prior to being disturbed, and re-established in their original position and a record of monument form in accordance with A.S.34.65.040 shall be submitted to the construction engineer for review prior to recording. Coordinate values listed are for informational purposes and should be used to reset monuments only as a last resort.		
CHECKED BY: D.IGNOTOV		
		
DESIGNED BY: J.PAPOI		
DRAWN BY: J.PAPOI		
STATE OF ALASKA DEPARTMENT OF TRANSPORTATION & PUBLIC FACILITIES SOUTHEAST REGION		
KTN-SOUTH TONGASS PAVING PROJECT #67674		
SURVEY CONTROL		
PROJECT DESIGNATION		
STP-NH-0902(040)-67674		
STATE	YEAR	
ALASKA	2014	
SHEET NUMBER	TOTAL SHEETS	
A6	66	

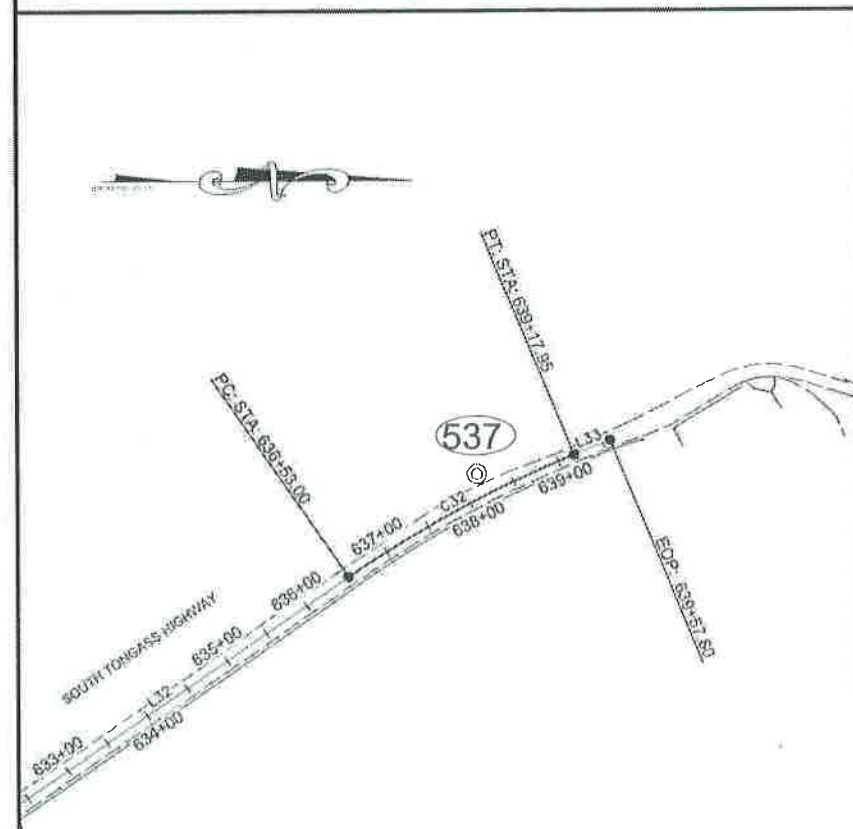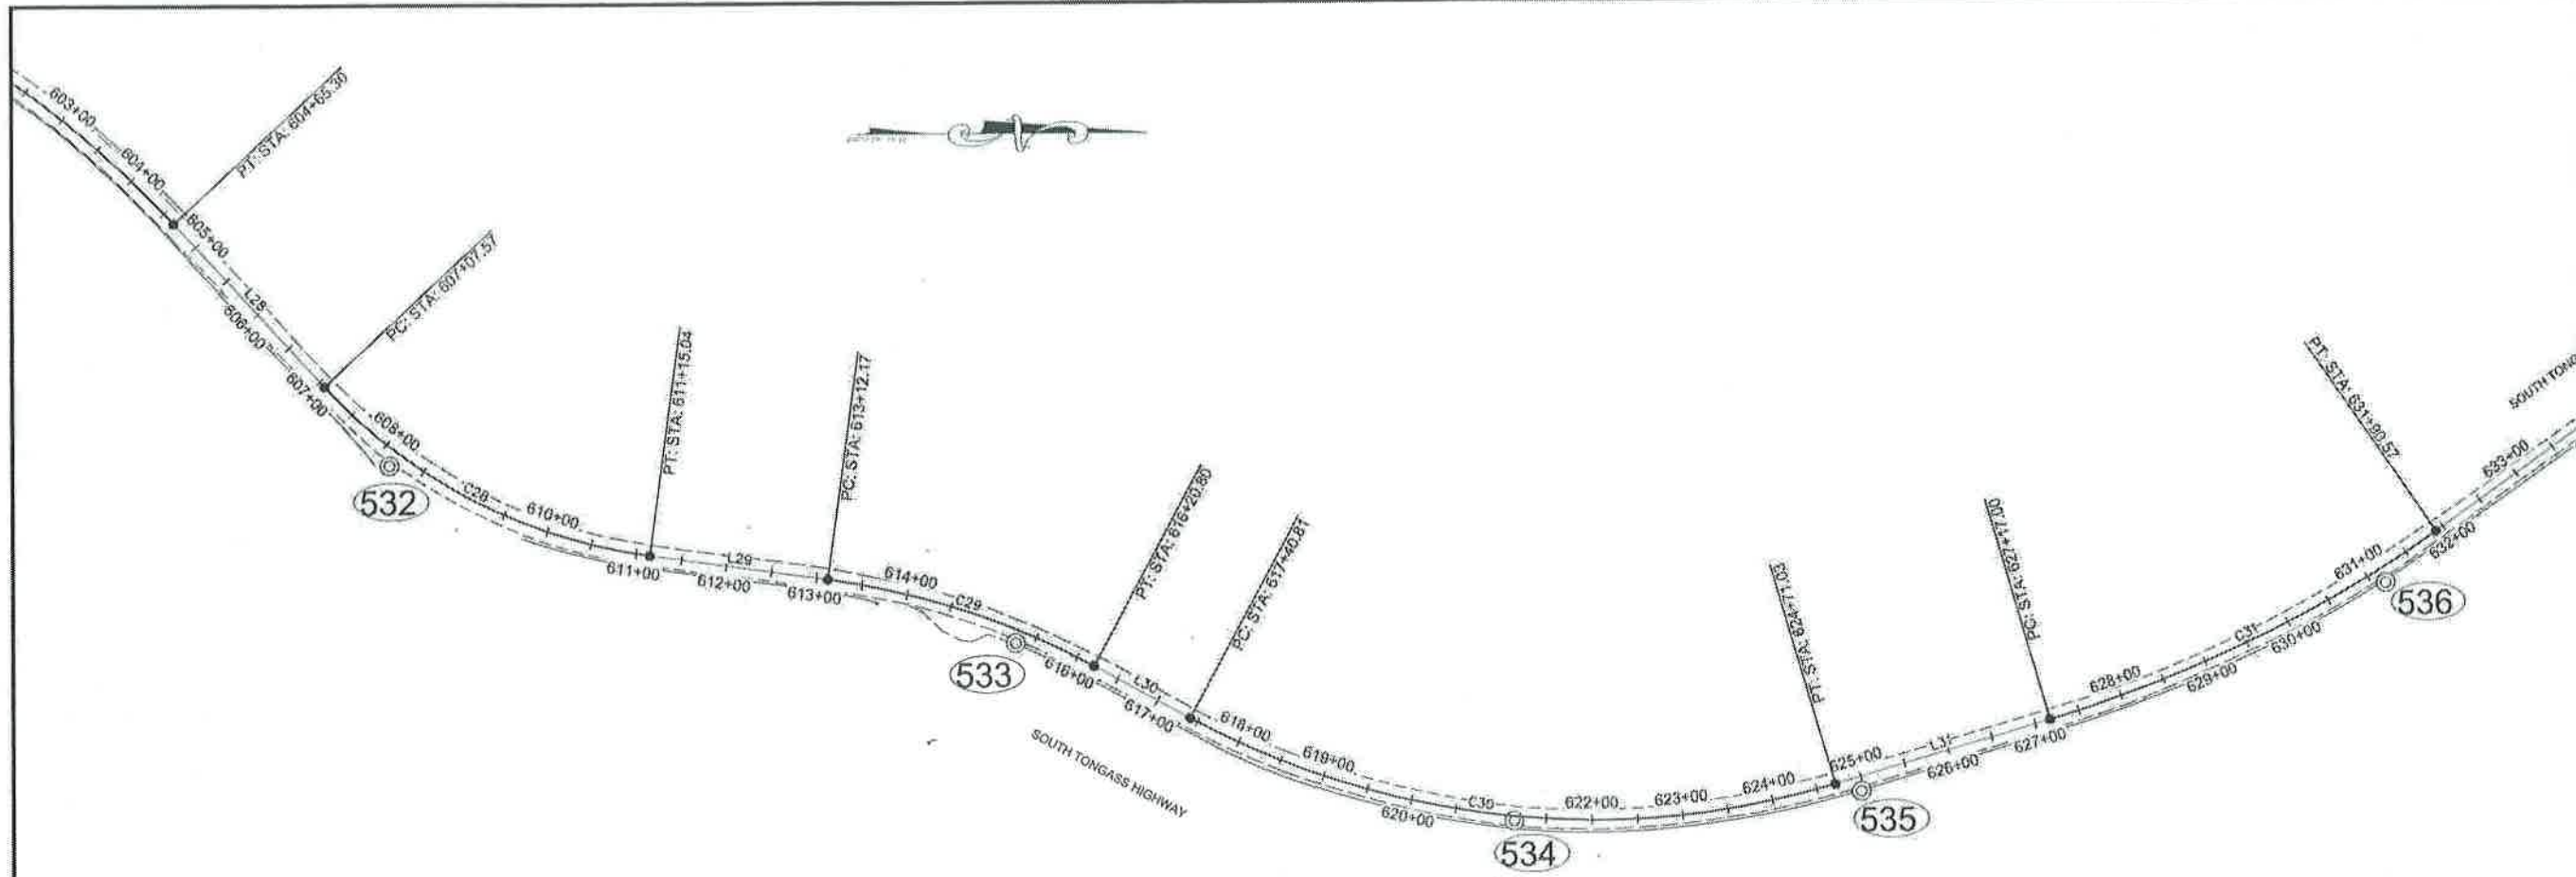

All **SURVEY CONTROL** monuments in this table are provided strictly for survey control. Should any of them be destroyed during construction they **SHALL NOT** be replaced.

EXCEPT 240, 241 & 242 WHICH ARE EXISTING SHOULDER MONUMENTS AND NEED TO BE PRESERVED. IF SAID MONUMENTS ARE TO BE DISTURBED THEY NEED TO BE REFERENCED AND REPLACED IN THEIR ORIGINAL HORIZONTAL POSITION AFTER CONSTRUCTION

Project As-Built Drawings have been reviewed by the Project Engineer and represent to the best of my knowledge, the project as constructed.
PE *[Signature]* Date 12/11/15

See change order 1

A2 Survey Control						
Point #	Northing	Easting	Elevation	Description	Station	Offset
240	332404.81	670699.64	31.14	BC_SH_MON	N/A	N/A
241	332628.35	670965.08	32.52	BC_SH_MON	N/A	N/A
242	332706.20	671653.12	47.50	BC_SH_MON	408+08.90	12.12R
470	334097.16	672870.79	76.31	REBAR_FND	423+81.21	32.99L
501	333394.06	672363.44	80.03	REBAR_SET	415+10.61	21.13L
505	334997.63	674704.48	112.20	PLASCAP_FND	444+71.32	24.13R
506	335304.36	675020.29	105.39	REBAR_SET	449+05.64	17.97R
510	336651.27	675664.87	100.09	ALCAP2" _472	464+38.46	21.21R
512	337672.98	676036.15	126.90	ALCAP2" _473	475+32.82	34.02L
516	339597.26	676925.23	124.16	REBAR_474	496+94.17	17.38L
517	340436.70	677426.06	156.71	ALCAP2" _475	506+70.67	19.42L
518	341066.79	678209.11	143.38	ALCAP2" _476	516+71.75	15.46R
519	341861.45	678701.94	100.19	ALCAP2" _477	526+03.49	16.15L
520	342400.66	679240.27	87.89	REBAR_FND	533+63.72	18.70R
529	346790.03	681138.39	69.04	ALCAP2" _482	583+64.72	21.46L
530	347547.23	681532.57	69.78	ALCAP2" _483	592+62.73	26.57R
531	348328.93	681857.76	78.58	ALCAP2" _484	600+70.94	18.12L
532	348866.00	682376.82	93.20	ALCAP2" _485	608+16.26	16.84R
533	349550.69	682572.92	105.08	ALCAP2" _486	615+30.90	14.09R
534	350097.64	682770.59	122.92	ALCAP2" _487	621+15.39	4.90R
535	350478.95	682741.41	127.40	ALCAP2" _488	624+96.51	15.56R
536	351056.40	682518.86	121.66	ALCAP2" _489	631+13.65	15.69R
537	351526.69	682094.27	86.02	ALCAP2" _SET	638+20.61	24.15L

PATH: Q:\KTN\67674\PLANSET\67674_A2-A8_SV
CNTL.DWG

SEIFERT, LOLITA T (DOT)
TAB: A7
Wednesday, November 05, 2014 7:30

ADDENDUM NUMBER

ATTACHMENT NUMBER

RECORD OF REVISIONS

No.	DATE	DESCRIPTION
-----	------	-------------

MONUMENT NOTES:
1. If any pair of control points disagrees from published value by more than 1:10,000 horizontally or vertically then a third network point must be tied to ascertain which point is in error or has been disturbed.
2. Whether listed or not, all monuments, property markers, or accessories that will be disturbed or buried shall be referenced prior to being disturbed, and re-established in their original position and a record of monument form in accordance with A.S.34.65.040 shall be submitted to the construction engineer for review prior to recording. Coordinate values listed are for informational purposes and should be used to reset monuments only as a last resort.

CHECKED BY: D.IGNOTOV


DESIGNED BY: J.PAPOI
DRAWN BY: J.PAPOI

STATE OF ALASKA
DEPARTMENT OF TRANSPORTATION
& PUBLIC FACILITIES
SOUTHEAST REGION
KTN-SOUTH TONGASS PAVING
PROJECT #67674

SURVEY CONTROL

PROJECT DESIGNATION
STP-NH-0902(040)-67674

STATE	YEAR
ALASKA	2014
SHEET NUMBER	TOTAL SHEETS
A7	66

* See Change Order #1

SOUTH TONGASS DESIGN ALIGNMENT

TAG	STATION	NORTHING	EASTING	DISTANCE	BEARING	STATION	RADIUS	LENGTH	DELTA
C1	403+51.73	332676.20	671497.57			410+50.58	1005.00	698.85	39°50'30"
L1	410+50.58	333026.20	672086.23	228.25	N39° 20' 39"E	412+78.82			
C2	417+89.97	333594.78	672558.88			419+90.42	1955.00	200.45	5°52'29"
L3	419+90.42	333754.85	672679.40	393.83	N34° 02' 14"E	423+84.24			
C3	423+84.24	334081.20	672899.83			426+15.91	880.00	231.67	15°05'01"
L4	426+15.91	334254.00	673053.14	127.06	N49° 07' 16"E	427+42.97			
C4	427+42.97	334337.16	673149.20			429+24.45	8000.00	181.48	1°17'59"
L5	429+24.45	334454.36	673287.76	236.57	N50° 25' 15"E	431+61.02			
C5	431+61.02	334605.09	673470.09			438+78.69	1355.00	717.67	30°20'47"
L6	438+78.69	334898.17	674116.02	399.49	N80° 46' 02"E	442+78.17			
C6	442+78.17	334962.27	674510.33			449+44.96	688.00	666.79	55°31'45"
L7	449+44.96	335348.01	675022.27	221.78	N25° 14' 17"E	451+66.74			
C7	451+66.74	335548.62	675116.83			454+03.75	660.00	237.01	20°34'31"
L8	454+03.75	335740.47	675253.81	132.80	N45° 48' 48"E	455+36.55			
C8	455+36.55	335833.03	675349.04			459+31.14	540.00	394.59	41°52'02"
L9	459+31.14	336183.09	675511.38	133.21	N3° 56' 46"E	460+64.35			
C9	460+64.35	336315.98	675520.54			464+03.84	660.00	339.49	29°28'19"
L10	464+03.84	336834.05	675628.10	131.56	N33° 25' 05"E	465+35.39			
C10	465+35.39	336743.86	675700.55			468+08.31	765.00	272.92	20°26'27"
L11	468+08.31	336993.39	675807.48	183.88	N12° 58' 38"E	469+92.20			
C11	469+92.20	337172.58	675848.78			472+18.56	770.00	226.36	16°50'37"
L12	472+18.56	337382.57	675931.07	150.25	N29° 49' 15"E	473+68.81			
C12	473+68.81	337512.83	676005.79			476+17.12	660.00	248.31	21°33'23"
L13	476+17.12	337746.27	676086.33	129.70	N8° 15' 52"E	477+46.83			
C13	477+46.83	337874.83	676104.97			480+45.51	970.00	298.68	17°38'33"
L14	480+45.51	338159.00	676192.38	303.69	N25° 54' 24"E	483+49.20			
C14	483+49.20	338432.18	676325.07			486+65.27	1100.00	316.07	16°27'47"
L15	486+65.27	338732.29	676420.70	143.96	N9° 26' 37"E	488+09.23			
C15	488+09.23	338874.30	676444.32			492+92.91	755.00	483.68	36°42'20"
L16	492+92.91	339294.88	676666.04	185.10	N46° 08' 57"E	494+78.01			
C16	494+78.01	339423.12	676799.53			497+96.03	1085.00	318.01	16°47'36"
L17	497+96.03	339673.67	676993.53	659.62	N28° 21' 20"E	504+55.65			

SOUTH TONGASS DESIGN ALIGNMENT

TAG	STATION	NORTHING	EASTING	DISTANCE	BEARING	STATION	RADIUS	LENGTH	DELTA
C17	504+55.65	340248.58	677316.90			508+41.93	1050.00	386.28	21°04'42"
L18	508+41.93	340543.28	677563.26	701.60	N50° 26' 03"E	515+43.52			
C18	515+43.52	340990.17	678104.11			519+20.62	1090.00	377.09	19°49'19"
L19	519+20.62	341275.39	678347.91	468.25	N30° 36' 44"E	523+88.86			
C19	523+88.86	341678.38	678586.35			526+75.34	1040.00	286.48	15°46'57"
L20	526+75.34	341901.86	678764.14	319.22	N46° 23' 41"E	529+94.56			
C20	529+94.56	342122.02	678995.29			535+81.56	1333.00	587.00	25°13'51"
L21	535+81.56	342606.00	679319.03	252.62	N21° 09' 49"E	538+34.19			
C21	538+34.19	342841.58	679410.23			543+20.43	3262.00	486.24	8°32'26"
L22	543+20.43	343280.29	679618.87	946.78	N29° 42' 16"E	552+67.21			
C22	552+67.21	344102.66	680088.02			556+54.66	758.00	387.45	29°17'13"
L23	556+54.66	344376.72	680355.92	365.39	N58° 59' 28"E	560+20.05			
C23	560+20.05	344564.96	680669.08			566+95.71	628.90	675.66	61°33'22"
L24	566+95.71	345132.12	680973.36	306.69	N2° 33' 53"W	570+02.39			
C24	570+02.39	345438.50	680959.64			573+14.01	1513.50	311.62	11°47'48"
L25	573+14.01	345749.04	680977.73	881.59	N9° 13' 55"E	581+95.60			
C25	581+95.60	346619.21	681119.16			586+27.19	1039.00	431.59	23°48'01"
L26	586+27.19	347018.89	681273.64	441.66	N33° 01' 56"E	590+68.86			
C26	590+68.86	347389.17	681514.40			594+73.50	1400.00	404.65	16°33'38"
L27	594+73.50	347755.36	681683.23	368.58	N16° 28' 18"E	598+42.09			
C27	598+42.09	348108.82	681787.74			604+65.30	1160.00	623.22	30°46'57"
L28	604+65.30	348631.78	682112.79	242.27	N47° 15' 15"E	607+07.57			
C28	607+07.57	348796.22	682290.70			611+15.04	593.00	407.46	39°22'09"
L29	611+15.04	349150.35	682475.60	197.14	N7° 53' 06"E	613+12.17			
C29	613+12.17	349345.63	682502.64			616+20.80	854.00	308.62	20°42'21"
L30	616+20.80	349637.15	682598.71	120.02	N28° 35' 27"E	617+40.81			
C30	617+40.81	349742.53	682656.14			624+71.03	936.00	730.22	44°41'58"
L31	624+71.03	350450.16	682733.53	245.96	N16° 06' 31"W	627+17.00			
C31	627+17.00	350686.46	682665.28			631+90.57	1471.00	473.58	18°26'45"
L32	631+90.57	351112.66	682463.53	462.42	N34° 33' 16"W	636+53.00			
C32	636+53.00	351493.51	682201.25			639+17.95	1235.00	264.95	12°17'31"
L33	639+17.95	351726.10	682075.44	39.85	N22° 15' 45"W	639+57.80			

PATH:Q:\KTN\67674\PLANSET\67674_A2-A8_SV
CNTL.DWG

SEIFERT, LOLITA T (DOT)
TAB: A8 Wednesday, November 05, 2014 7:3

ADDENDUM NUMBER

ATTACHMENT NUMBER

RECORD OF REVISIONS

No.	DATE	DESCRIPTION

MONUMENT NOTES:
1. If any pair of control points disagrees from published value by more than 1:10,000 horizontally or vertically then a third network point must be tied to ascertain which point is in error or has been disturbed.

2. Whether listed or not, all monuments, property markers, or accessories that will be disturbed or buried shall be referenced prior to being disturbed, and re-established in their original position and a record of monument form in accordance with A.S.34.65.040 shall be submitted to the construction engineer for review prior to recording. Coordinate values listed are for informational purposes and should be used to reset monuments only as a last resort.

CHECKED BY: D.IGNOTOV



DESIGNED BY: J.PAPOI
DRAWN BY: J.PAPOI

STATE OF ALASKA
DEPARTMENT OF TRANSPORTATION
& PUBLIC FACILITIES
SOUTHEAST REGION

KTN-SOUTH TONGASS PAVING
PROJECT #67674

**SURVEY
CONTROL**


PROJECT DESIGNATION

STP-NH-0902(040)-67674

STATE	YEAR
ALASKA	2014
SHEET NUMBER	TOTAL SHEETS
A8	66

Project As-Built Drawings have been reviewed by the Project Engineer and represent to the best of my knowledge, the project as constructed.

PE *me* Date *2/11/15*

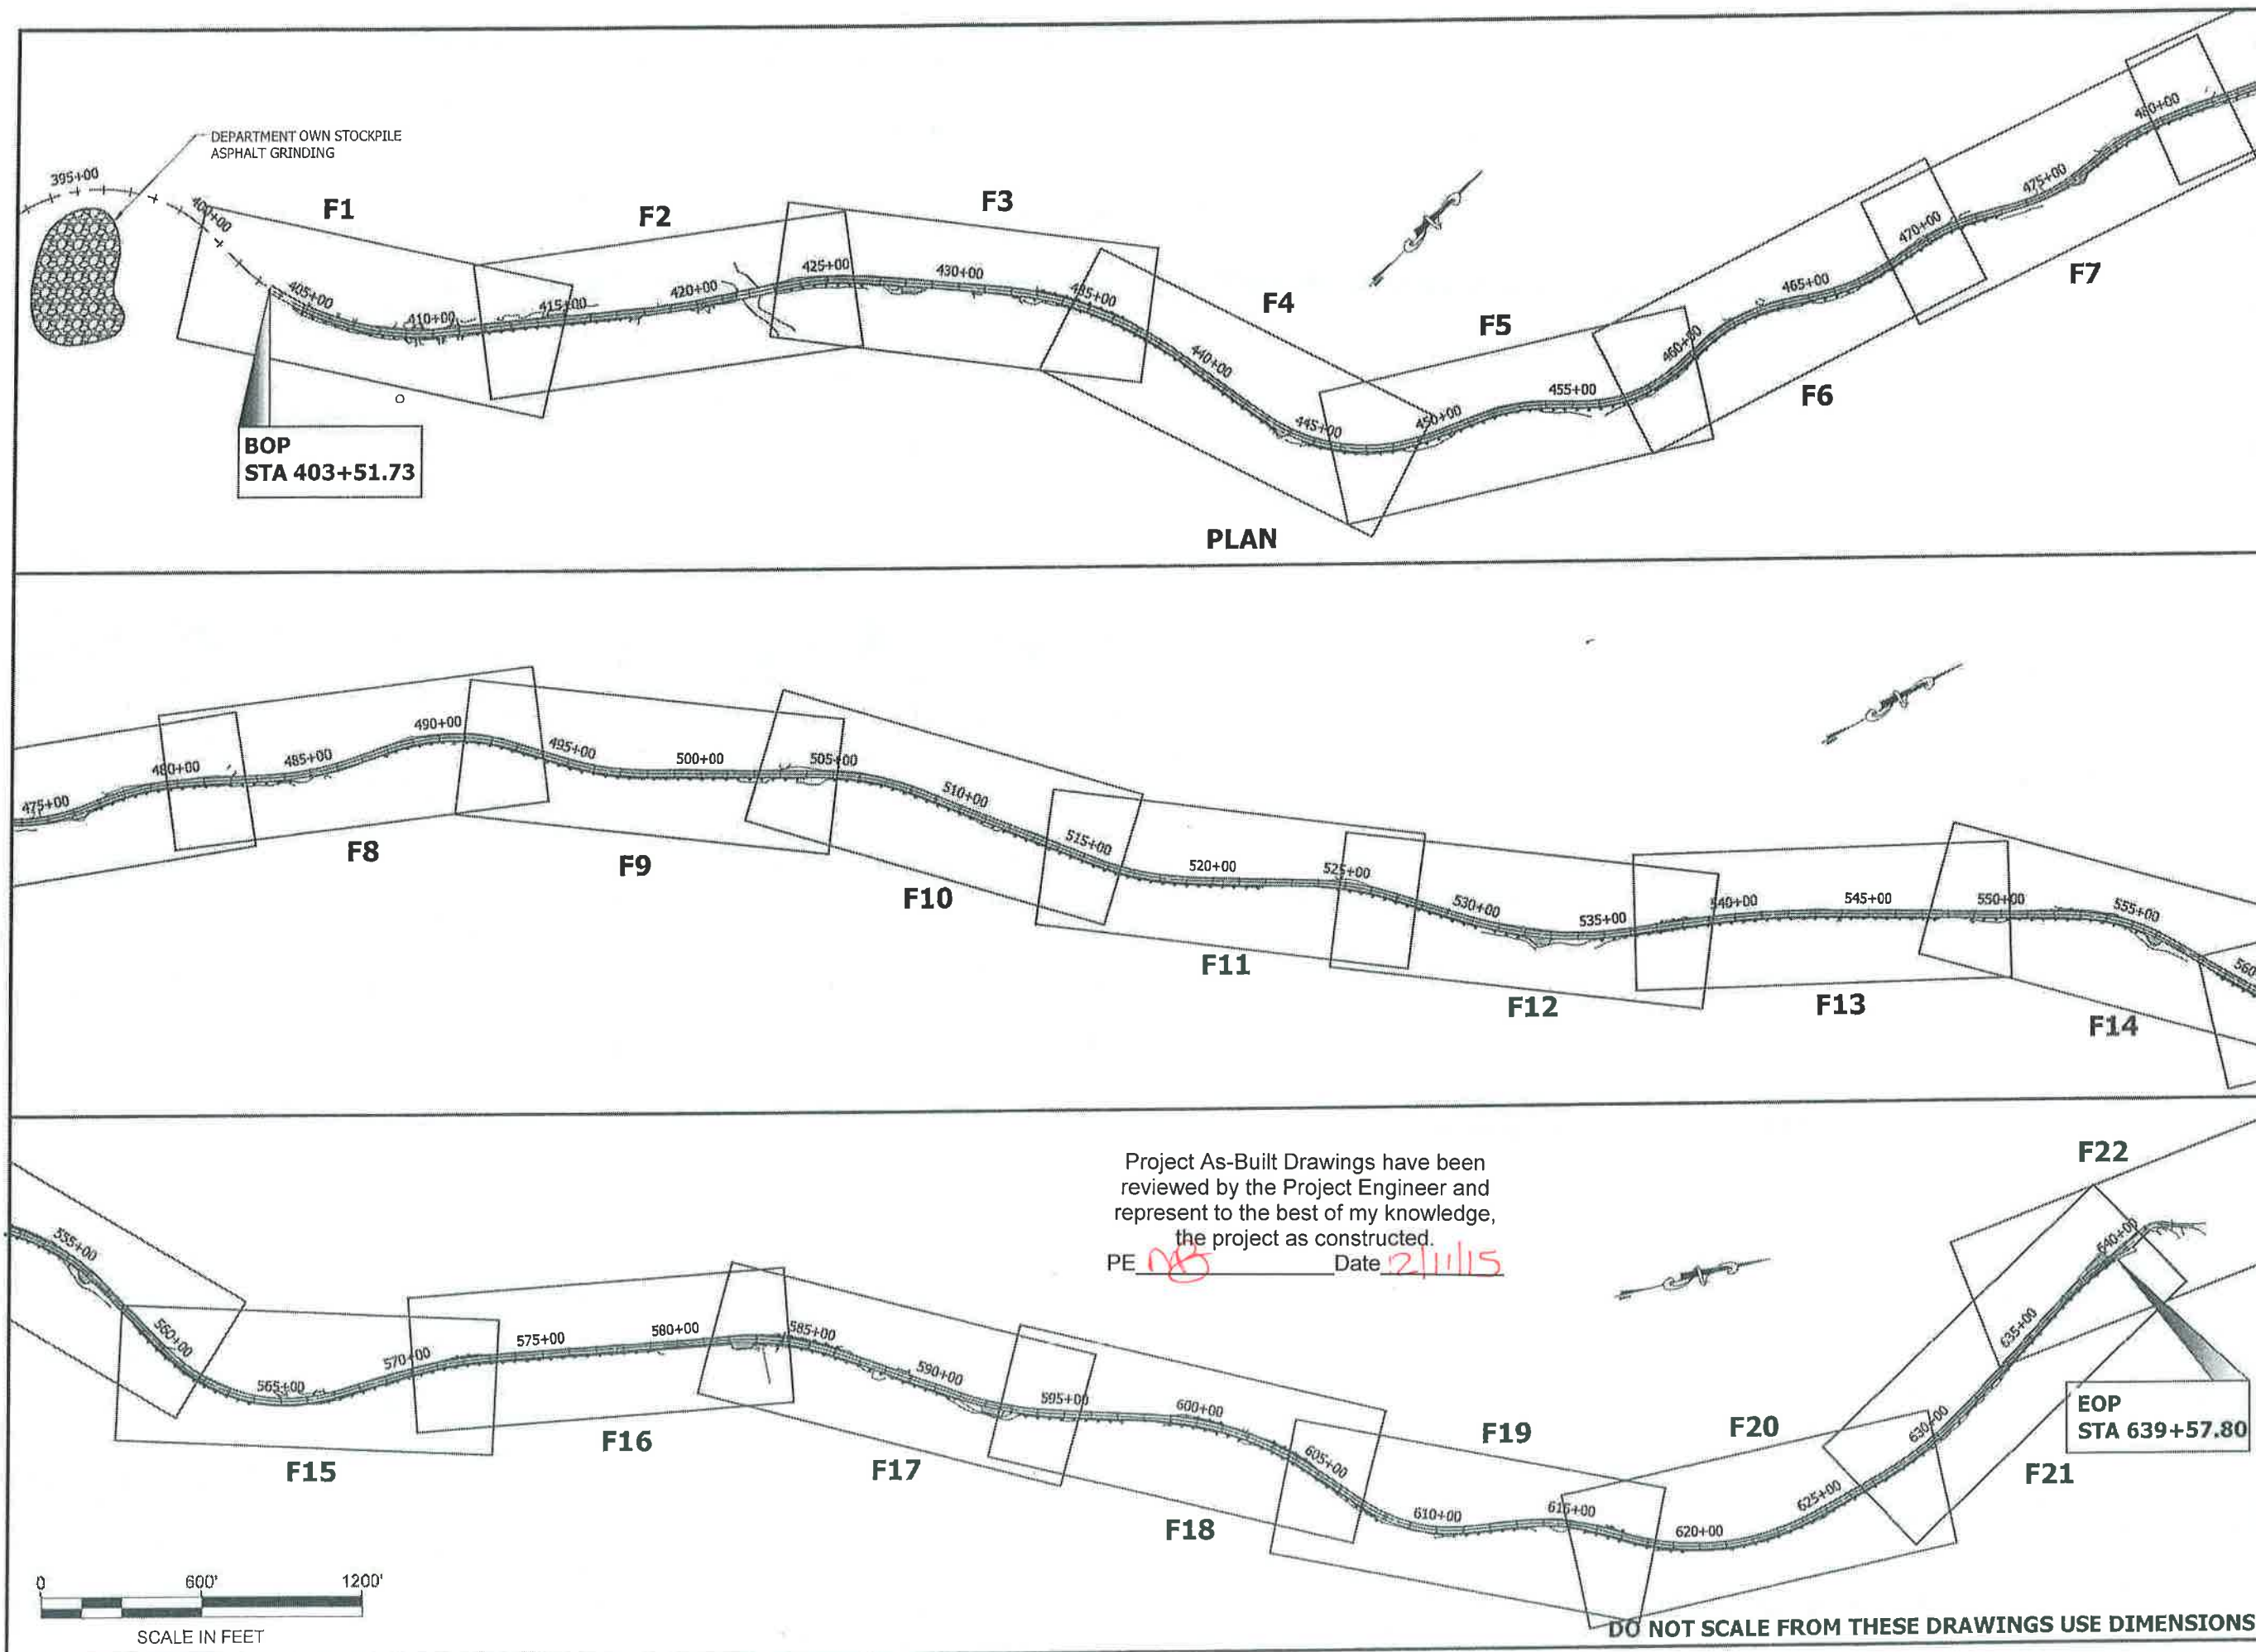

PLAN

PATH: Q:\KTN\67674\PLANSET\67674_A9_LAYOUT.DWG
 TAB: A9
 GRANHAM, RICK L (DOT)
 Wednesday, November 05, 2014 9:09:31 AM

ADDENDUM NUMBER

ATTACHMENT NUMBER

RECORD OF REVISIONS

No.	DATE	DESCRIPTION

PLAN LEGEND

CHECKED BY: M. VAN ALSTINE

DESIGNED BY: L. SEIFERT

DRAWN BY: R. GRANHAM

STATE OF ALASKA
 DEPARTMENT OF TRANSPORTATION
 & PUBLIC FACILITIES
 SOUTHEAST REGION

KTN-SOUTH TONGASS PAVING
 PROJECT #67674

LAYOUT PLAN



PROJECT DESIGNATION
 STP-NH-0902(040)-67674

STATE	YEAR
ALASKA	2014

SHEET NUMBER	TOTAL SHEETS
A9	66

Project As-Built Drawings have been reviewed by the Project Engineer and represent to the best of my knowledge, the project as constructed.
 PE MS Date 2/11/15

EOP
 STA 639+57.80

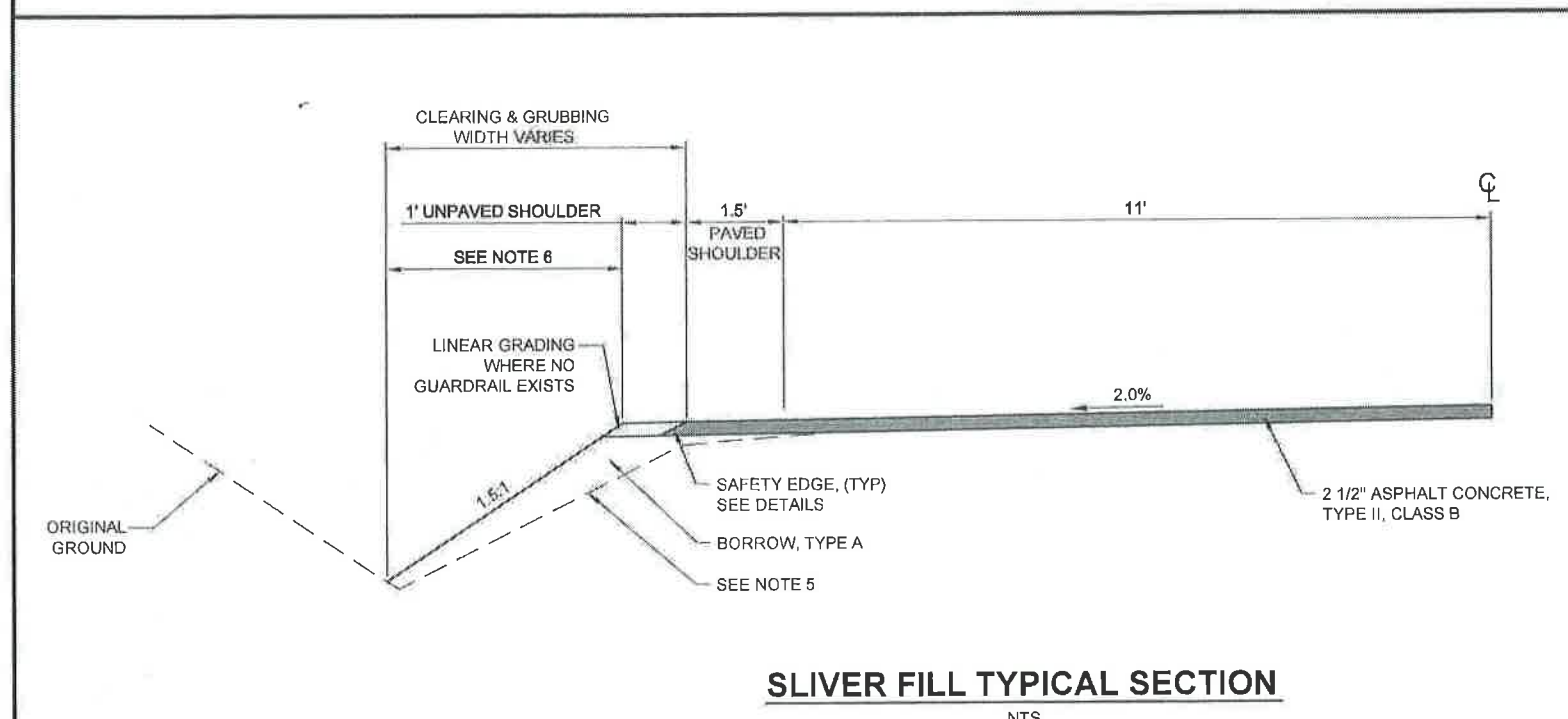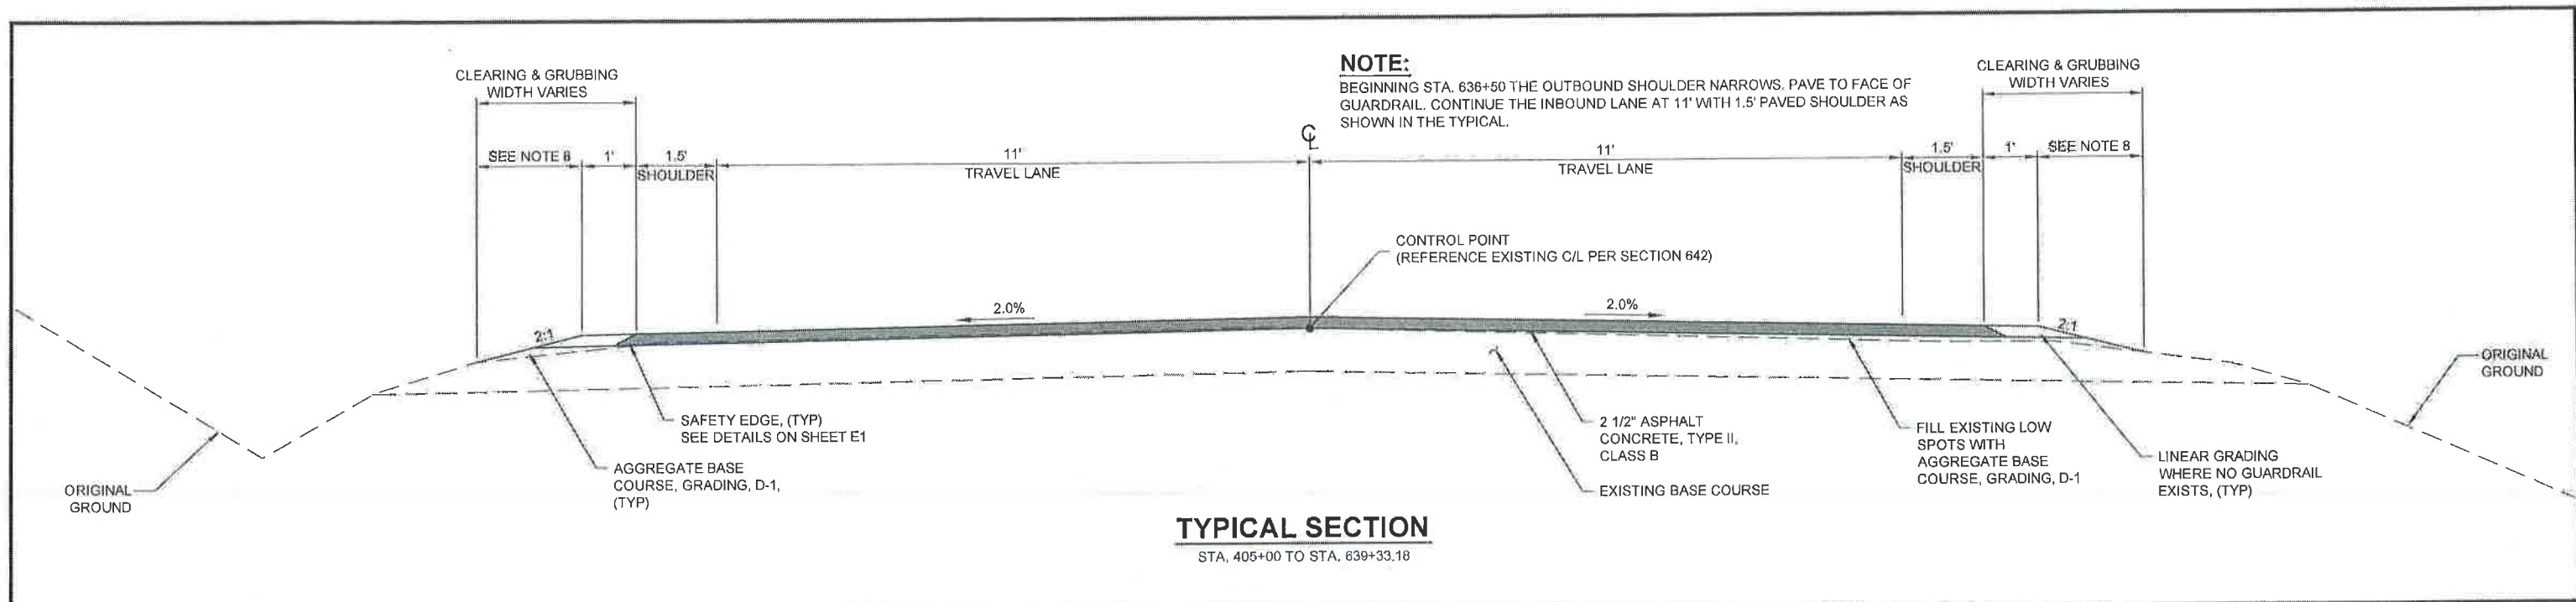

SLIVER FILL LOCATIONS TABLE					
STATION		OFF SET	STATION		OFF SET
FROM	TO		FROM	TO	
436+88	437+13	LT	459+38	459+63	LT
437+13	437+38	LT	459+63	459+88	LT
437+63	437+88	LT	459+88	460+13	LT
438+63	438+88	LT	460+13	460+38	LT
441+63	441+88	LT	464+13	464+38	LT
443+65	444+13	LT	464+63	464+88	LT
444+13	444+38	LT	464+88	465+13	LT
444+38	444+63	LT	465+13	465+38	LT
444+63	444+88	LT	475+13	475+38	LT
444+88	445+13	LT	476+00	477+25	LT
450+50	450+63	LT	492+88	493+13	LT
454+38	454+63	LT	526+13	526+38	LT
454+88	455+13	LT	528+63	528+88	LT
455+00	455+50	LT	541+13	541+38	LT
456+63	456+88	LT	575+38	575+63	LT
456+88	457+13	LT	575+63	575+88	LT
457+13	457+38	LT	575+88	576+13	LT
457+38	457+63	LT	576+13	576+75	LT
457+63	457+88	LT	590+13	590+38	LT
457+88	458+13	LT	627+63	627+88	LT
459+13	459+38	LT	629+13	629+38	LT

SLOPE EXCEPTIONS TABLE					
STATION		OFF SET	STATION		OFF SET
FROM	TO		FROM	TO	
409+50	410+25	LT	523+50	523+75	RT
417+75	420+50	RT	525+75	527+00	LT
424+50	426+00	LT	528+25	528+63	LT
438+25	438+50	LT	528+88	530+00	LT
442+00	442+75	LT	538+75	541+13	LT
444+13	445+75	LT	541+38	543+50	LT
449+75	450+50	LT	567+00	568+00	LT
451+50	452+00	LT	589+25	590+13	LT
455+00	455+50	LT	590+38	593+50	LT
457+50	457+75	LT	593+75	595+50	RT
460+38	462+00	LT	608+50	610+50	LT
468+75	469+50	LT	617+25	619+00	LT
474+00	476+25	RT	620+00	623+00	LT
477+25	482+50	LT	626+00	627+63	LT
483+50	484+00	LT	627+88	630+00	LT
484+88	487+50	RT	632+00	633+00	LT
487+00	490+50	LT	636+50	638+25	LT

NOTES:

- EXISTING ROADWAY IS UNPAVED.
- REFER TO G-SHEETS FOR SUPERELEVATION PROFILE DATA.
- FILLS ARE LOW AND DO NOT REQUIRE BENCHING. CLEAR SURFACE VEGETATION PRIOR TO PLACING FILL AGAINST THE EXISTING EMBANKMENT.
- WATER LINES EXIST IN THE LEFT HAND SIDE OF THE ROAD AND UPHILL DITCH BETWEEN THE BOP AND WHITMAN CREEK BRIDGE. CONTACT KETCHIKAN GATEWAY BOROUGH TO REQUEST UTILITY LOCATIONS.
- FILLS ARE LOW AND DO NOT REQUIRE BENCHING. CLEAR SURFACE VEGETATION PRIOR TO PLACING FILL AGAINST THE EXISTING EMBANKMENT (SEE SLIVER FILL LOCATIONS TABLE).
- BONDED FABRIC MATRIX AND SEEDING LIMITS.
- THE INTENT IS NOT TO RAISE OR LOWER THE CENTERLINE GRADE OF THE ROAD. THE INTENT IS TO PREPARE THE EXISTING ROADWAY SURFACE BY REGRADING TO ESTABLISH THE ROADWAY CROSS SLOPE AND SUPERELEVATION. SUPPLEMENT WITH BASE COURSE AS DIRECTED.
- SLOPE EXCEPTIONS TABLE IS FOR AREAS WHERE SLOPES SHALL BE STEEPENED TO 1.5:1. THESE AREAS REQUIRE BONDED FIBER MATRIX AND SEEDING. **Rock LIME (IWA #1)**

Project As-Built Drawings have been reviewed by the Project Engineer and represent to the best of my knowledge, the project as constructed.
PE **MB** Date **2/11/15**

DO NOT SCALE FROM THESE DRAWINGS USE DIMENSIONS

CHECKED BY: M. VAN ALSTINE

DESIGNED BY: L. SEIFERT

DRAWN BY: R. GRANTHAM

PATH: Q:\KTN67674\PLANSET\067674_B1-B2_TYP.DWG

TAB: B1 Wednesday, November 05, 2014 7:38:26 AM GRANTHAM, RICK L (DOT)

NO. DATE DESCRIPTION

STATE OF ALASKA
DEPARTMENT OF TRANSPORTATION
& PUBLIC FACILITIES
SOUTHEAST REGION

**KTN-SOUTH TONGASS PAVING
PROJECT #67674**

TYPICAL SECTIONS


STP-NH-0902(040)-67674 2014 **B1** 66

BASIC BID - ESTIMATE OF QUANTITIES			
ITEM NO	ITEM DESCRIPTION	PAY UNIT	QUANTITY
201 (3B)	CLEARING AND GRUBBING	LUMP SUM	ALL REQUIRED
201 (7)	INVASIVE SPECIES CONTROL, REMOVAL, AND DISPOSAL	SQUARE YARD	6,487.62
202 (2)	REMOVAL OF PAVEMENT	SQUARE YARD	66.74
202 (13)	ABANDON AND FILL EXISTING PIPE	EACH	1
203 (6A)	BORROW, TYPE A	TON	5,149
301 (1)	AGGREGATE BASE COURSE, GRADING D-1	TON	11,723.27
303 (3)	LINEAR GRADING	STATION	265
401 (1)	ASPHALT CONCRETE, TYPE II; CLASS B	TON	9,754.78
401 (2)	ASPHALT CEMENT, GRADE PG 58-28	TON	487.74
401 (6)	ASPHALT PRICE ADJUSTMENT	CONTINGENT SUM	ALL REQUIRED
401(10)	ASPHALT MATERIAL PRICE ADJUSTMENT	CONTINGENT SUM	ALL REQUIRED
603 (22-15)	14 INCH LINER PIPE	LINEAR FOOT	119.3
606 (1)	W-BEAM GUARDRAIL	LINEAR FOOT	381.75
606 (6)	REMOVING AND DISPOSING GUARDRAIL	LINEAR FOOT	482.5
606 (13)	PARALLEL GUARDRAIL TERMINAL	EACH	2
606 (15)	ADJUST EXISTING GUARDRAIL	LINEAR FOOT	20,267.0
615 (1)	STANDARD SIGN	SQUARE FOOT	382.28
618 (2)	SEEDING	ACRE	0
619 (3)	BONDED FIBER MATRIX (BFM)	POUND	0
639 (3)	APPROACH	EACH	21
640 (1)	MOBILIZATION AND DEMOBILIZATION	LUMP SUM	ALL REQUIRED
640 (4)	WORKER MEALS AND LODGING, PER DIEM	LUMP SUM	ALL REQUIRED
641 (1)	EROSION, SEDIMENT AND POLLUTION CONTROL ADMINISTRATION	LUMP SUM	ALL REQUIRED
641 (3)	TEMPORARY EROSION, SEDIMENT AND POLLUTION CONTROL	LUMP SUM	ALL REQUIRED
641 (4)	TEMPORARY EROSION, SEDIMENT AND POLLUTION CONTROL ADDITIVES	CONTINGENT SUM	ALL REQUIRED
641 (6)	WITHHOLDING	CONTINGENT SUM	ALL REQUIRED
642 (1)	CONSTRUCTION SURVEYING	LUMP SUM	ALL REQUIRED
642 (8)	ADJUST EXISTING MONUMENT	EACH	0
642 (11)	ADJUST EXISTING MONUMENT CASE	EACH	1
643 (2)	TRAFFIC MAINTENANCE	LUMP SUM	ALL REQUIRED
643 (3)	PERMANENT CONSTRUCTION SIGNS	LUMP SUM	ALL REQUIRED
643 (15)	FLAGGING	CONTINGENT SUM	ALL REQUIRED
643 (23)	TRAFFIC PRICE ADJUSTMENT	CONTINGENT SUM	ALL REQUIRED
643 (25)	TRAFFIC CONTROL	CONTINGENT SUM	ALL REQUIRED
644 (1)	FIELD OFFICE Deleted CO #3	LUMP SUM	ALL REQUIRED
644 (2)	FIELD LABORATORY Deleted CO #3	LUMP SUM	ALL REQUIRED
644 (6)	VEHICLES	LUMP SUM	ALL REQUIRED
644 (15)	NUCLEAR TESTING EQUIPMENT STORAGE SHED Deleted CO #3	LUMP SUM	ALL REQUIRED
646 (1)	CPM SCHEDULING	LUMP SUM	ALL REQUIRED
670 (1)	PAINTED TRAFFIC MARKINGS	LUMP SUM	ALL REQUIRED
670 (8)	RECESSED PAVEMENT MARKER	EACH	433

Items added by Change Order
401(9) Asphalt Price Reduction For Unacceptable Asphalt
610(1) Ditch Lining
642(3) Three Person Survey

Lumpsum All Required
Lumpsum All Required
Hour 36.2

BASIC BID - BASIS OF ESTIMATE		
ITEM NO.	ITEM	ESTIMATING FACTOR
201 (7)	INVASIVE SPECIES CONTROL, REMOVAL, AND DISPOSAL	REED CANARY GRASS = 1860 SY
		OXEYE DAISY = 3180 SY
		CHEAT GRASS = 370 SY
		ORANGE HAWKWEED = 40 SY
		TOTAL = 5450 SY
201 (3B)	CLEARING AND GRUBBING	3.5' WIDE STRIP ON AVERAGE FOR BOTH SIDES OF THE ROAD.
203 (6A)	BORROW, TYPE A	1.7 TON/CY
301 (1)	AGGREGATE BASE COURSE, GRADING D-1	1.95 TON/CY
401 (1)	ASPHALT CONCRETE, TYPE II; CLASS B	120 LBS/SY/IN
401 (2)	ASPHALT CEMENT, GRADE PG 58-28	6.0% OF ITEM 401(1)

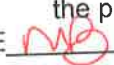Project As-Built Drawings have been reviewed by the Project Engineer and represent to the best of my knowledge, the project as constructed.
PE  Date 12/11/15

DO NOT SCALE FROM THESE DRAWINGS USE DIMENSIONS



CHECKED BY: M. VAN ALSTINE
DESIGNED BY: L. SEIFERT
DRAWN BY: R. GRANTHAM

STATE OF ALASKA
DEPARTMENT OF TRANSPORTATION
& PUBLIC FACILITIES
SOUTHEAST REGION

KTN-SOUTH TONGASS PAVING
PROJECT #67674

ADDENDUM 2
ESTIMATE OF QUANTITIES

PATH: Q:\KTN\67674\PLANSET\ADDENDUM 1\67674_C1_EST.DWG
TAB: C1
Wednesday, November 26, 2014 11:48:15 AM
GRANTHAM, RICK L (DOT)


REVISIONS
NO. DATE DESCRIPTION

PROJECT DESIGNATION
STP-NH-0902(040)-67674


YEAR
2014

SHEET NO.
C1


TOTAL SHEETS
66

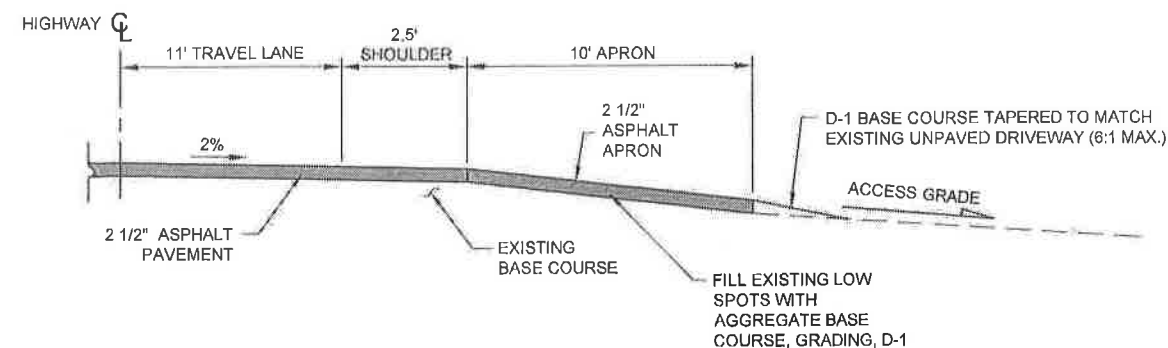

DRIVEWAY APRON TYPICAL
NTS

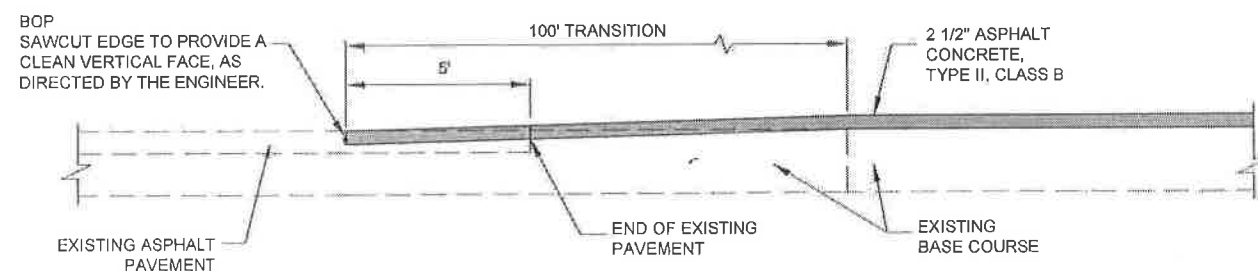


PAVEMENT TRANSITION DETAIL
BOP (STA. 405+00)

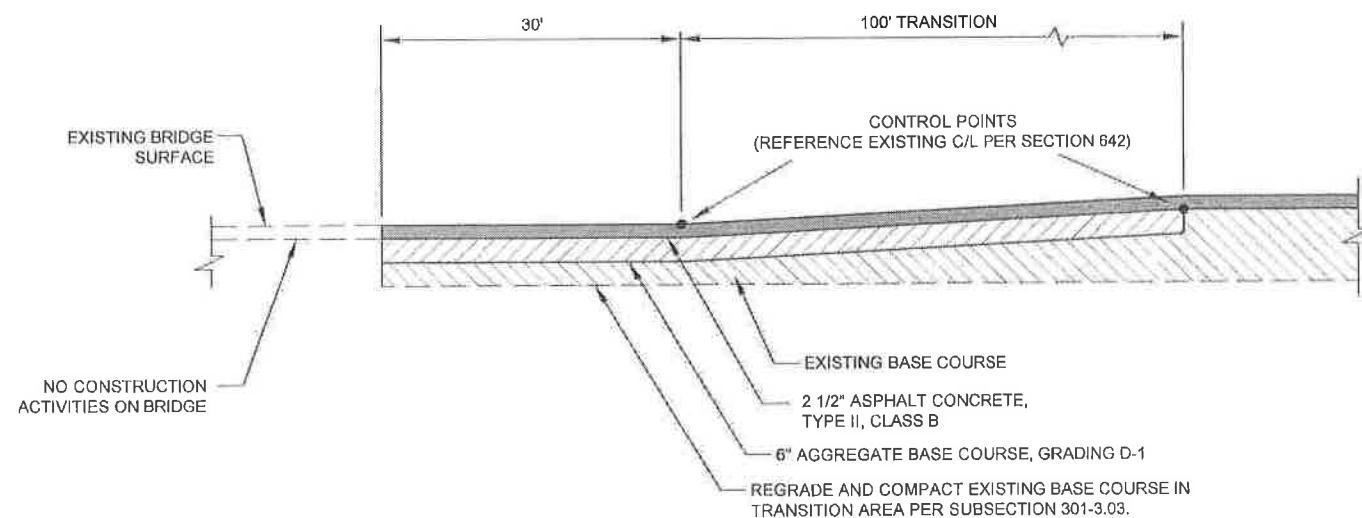


BRIDGE TRANSITION DETAIL
(TYP. UP STATION & DOWN STATION OF EXISTING BRIDGE)
N.T.S.

*** NOTE:**
EXISTING PULLOUTS ARE UNPAVED. GRADE AT 2% MIN. TO MATCH GRADE AT EDGE OF SHOULDER PAVEMENT OR AS DIRECTED BY THE PROJECT ENGINEER.

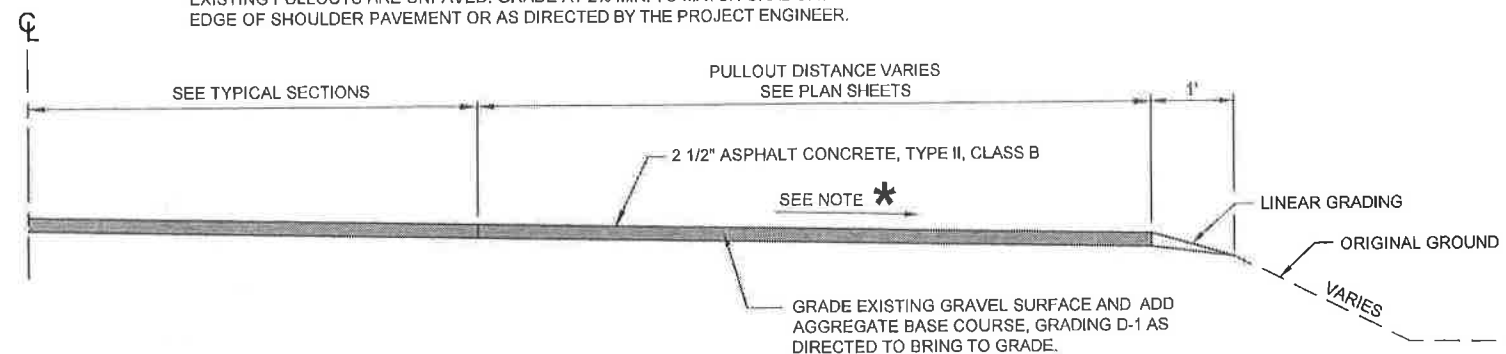


PULLOUT TYPICAL SECTION
NTS

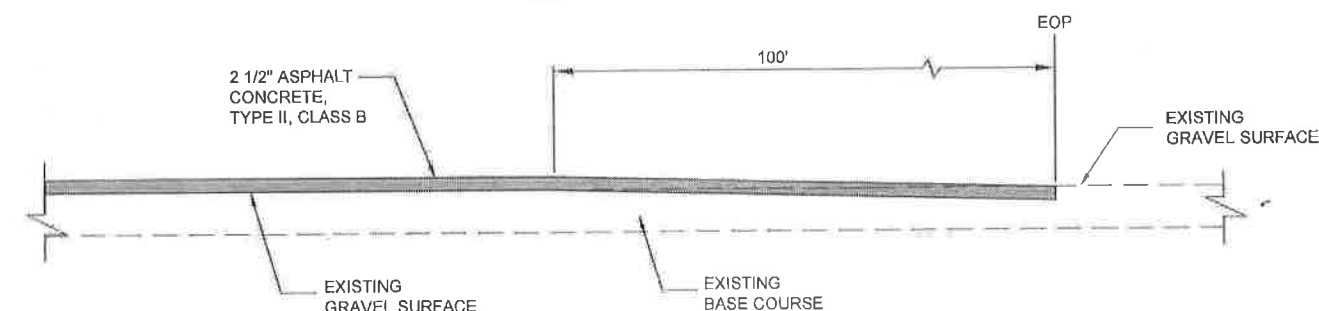


PAVEMENT TO GRAVEL TRANSITION DETAIL
EOP (STA. 639+33.18)

Project As-Built Drawings have been reviewed by the Project Engineer and represent to the best of my knowledge, the project as constructed.
PE *[Signature]* Date *12/11/15*

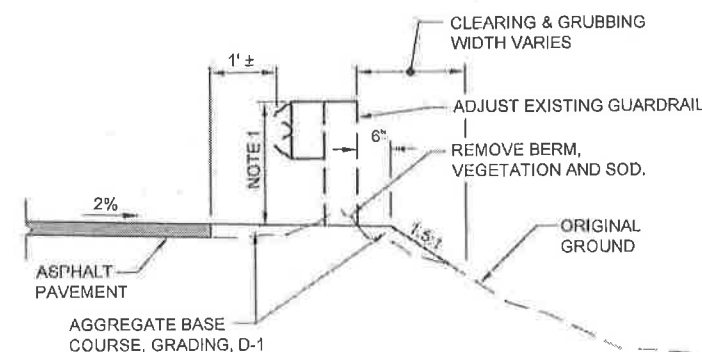

GUARDRAIL TYPICAL SECTION
NTS

NOTE:
1. GUARDRAIL HEIGHT 28" AFTER ADJUSTMENT.

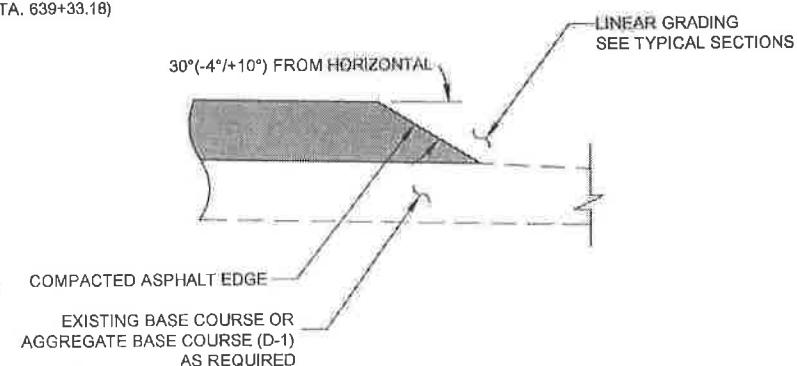

SAFETY EDGE DETAIL

NOTE: DO NOT USE A SAFETY EDGE WHERE THERE WILL BE A JOINT (CENTERLINE, INTERSECTIONS, DRIVEWAYS, ETC.).

DO NOT SCALE FROM THESE DRAWINGS USE DIMENSIONS

CHECKED BY: M. VANALSTINE STATE OF ALASKA DEPARTMENT OF TRANSPORTATION & PUBLIC FACILITIES SOUTHEAST REGION		KTN-SOUTH TONGASS PAVING PROJECT #67674	
DESIGNED BY: L. SEIFERT DRAWN BY: R. GRANTHAM		TYPICAL SECTIONS & DETAILS	
PATH: Q:\KTN\67674\PLANSET\67674_B1-B2_TYP.DWG TAB: B2 Wednesday, November 05, 2014 7:38:32 AM GRANTHAM, RICK L (DOT)		PROJECT DESIGNATION STP-NH-0902(040)-67674	
NO.	DATE	DESCRIPTION	TOTAL SHEETS
			66

303(3) LINEAR GRADING						
STATION		OFFSET		LENGTH	STATION	REMARKS
FROM	TO	LEFT	RIGHT	(FT)	LENGTH	
403+52	420+46	X		1695	17	
403+52	404+66		X	114	1	
409+23	411+31		X	208	2	
417+34	420+78		X	344	3	
424+01	432+91	X		890	9	
427+15	432+55		X	540	5	
436+77	536+93	X		10016	100	
443+53	444+54		X	102	1	
472+96	476+54		X	357	4	
484+50	487+40		X	290	3	
521+88	524+39		X	251	3	
532+10	534+58		X	248	2	
538+59	551+85	X		1326	13	
554+22	571+59	X		1737	17	
555+41	558+56		X	315	3	
564+12	566+33		X	221	2	
572+61	583+50	X		1089	11	
579+16	582+93		X	377	4	
586+54	599+24	X		1270	13	
587+62	588+22		X	60	1	
590+87	598+60		X	774	8	
601+38	602+73	X		135	1	
604+74	642+17	X		3743	37	
608+02	609+76		X	174	2	
613+69	615+21		X	152	2	

606 (1) W-BEAM GUARDRAIL INSTALLATION				
STATION		OFFSET	LENGTH	REMARKS
FROM	TO			
421+29.50	421+35.75	RT	6.25	
423+19.00	423+56.50	LT	37.50	
423+19.00	426+66.00	RT	347.00	REPLACE THREE SECTIONS DAMAGED RAIL & HARDWARE. POSTS TO REMAIN.

606 (6) REMOVING AND DISPOSING GUARDRAIL				
STATION		OFFSET	LENGTH	REMARKS
FROM	TO			
420+79.50	421+35.75	RT	56.25	WHITMAN CREEK - S TONGASS
423+19.00	423+56.50	LT	37.50	REMOVE THREE SECTIONS DAMAGED RAIL & HARDWARE. POSTS TO REMAIN
423+19.00	427+16.00	RT	397.00	WHITMAN CREEK - S TONGASS

603(22) LINER PIPE											
PIPE	INLET			OUTLET			LENGTH (FT)	SIZE (INCH)	TYPE	GRADE	REMARKS
	STATION	OFFSET	INVERT	STATION	OFFSET	INVERT					
P1	407+00.00	24' LT	50.97	406+97.00	34' RT	43.96	58	18	CMP	12.62%	60.0 59.3
P2	416+27.00	25' LT	73.72	416+30.00	34' RT	68.12	59	18	CMP	9.53%	INSTALL PIPE LINER / USE 15" SMOOTH WALL HDPE

606 (13) PARALLEL GUARDRAIL TERMINAL					
STATION		OFFSET		LENGTH	REMARKS
FROM	TO	LEFT	RIGHT		
420+79.50	421+29.50		X	50.00	WHITMAN CREEK
426+66.00	427+16.00		X	50.00	WHITMAN CREEK

606 (15) ADJUST EXISTING GUARDRAIL						
FROM STA	TO STA	LEFT	RIGHT	PLAN LENGTH	Measured Length	Remarks
404+80	409+25		x	457	457	Actual station
411+15	417+50		x	603	607	Actual station
432+50	433+59		x	1098	1085	Actual station
432+90	436+80	x		386	395	Actual station
444+13	472+96		x	2842	2883	Actual station
476+41	484+50		x	796	809	Actual station
487+42	503+82		x	1649	1658	Actual station
504+75	521+00		x	1713	1725	Actual station
524+39	532+15		x	771	776	Actual station
534+58	547+62		x	1309	1304	Actual station
536+99	538+59	x		166	169	Actual station
548+67	555+41		x	773	674	Actual station
566+81	579+60			1283	1257	Actual station
571+59	572+61	x		102	102	Actual station
582+97	587+53		x	469	456	Actual station
583+50	586+54	x		304	304	Actual station
588+31	590+87		x	265	256	Actual station
599+13	608+36		x	942	923	Actual station
599+24	601+32	x		201	208	Actual station
602+73	604+72	x		200	199	Actual station
609+76	613+64		x	393	388	Actual station
615+21	639+57		x	2436	2436	Actual station
552+20	554+54	x			239	Not listed on plans
558+97	564+51		x		548	Not listed on plans
593+61	597+60		x		399	Not listed on plans

Project As-Built Drawings have been reviewed by the Project Engineer and represent to the best of my knowledge, the project as constructed.

PE M3 Date 12/11/15

DO NOT SCALE FROM THESE DRAWINGS USE DIMENSIONS

CHECKED BY: M. VAN ALSTINE



DESIGNED BY: L. SEIFERT
DRAWN BY: R. GRANTHAM

STATE OF ALASKA
DEPARTMENT OF TRANSPORTATION
& PUBLIC FACILITIES
SOUTHEAST REGION

KTN-SOUTH TONGASS PAVING
PROJECT #67674

ADDENDUM 2
SUMMARIES

PATH: Q:\KTN67674\PLANS\SET1\ADDENDUM 1\67674_D1_SUMS.DWG
TAB: D1
Wednesday, November 26, 2014 11:50:03 AM
GRANTHAM, RICK L (DOT)

REVISIONS			PROJECT DESIGNATION	YEAR	SHEET NO.	TOTAL SHEETS
NO.	DATE	DESCRIPTION				
			STP-NH-0902(040)-67674	2014	D1	66

615(1) STANDARD SIGN										
NUMBER	STATION	OFFSET	DESCRIPTION	ASDS CODE	WIDTH (IN)	HEIGHT (IN)	AREA (SF)	POST MATERIAL	SIGN FACING	REMARKS
1	404+25	RT	SPEED LIMIT 50	R2-1	30	36	7.50	2.5 PST	NB	
2	404+30	LT	SPEED LIMIT 25	R2-1	30	36			SB	DO NOT REMOVE
3	407+00	RT	EMERGENCY PARKING ONLY	R8-4	30	24	5.00	2.5 PST	NB	
4	409+10	LT	SPEED LIMIT 25	W3-5	36	36			SB	DO NOT REMOVE
5	417+40	LT	SPEED LIMIT 35	R2-1	30	36			SB	DO NOT REMOVE
6	421+55	RT	WHITMAN CREEK	I-3	42	36	10.50	2.5 PST	NB	8" UC/ 6" LC B FONT
7	422+98	LT	WHITMAN CREEK	I-3	42	36	10.50	2.5 PST	SB	8" UC/ 6" LC B FONT
8	425+75	LT	SPEED LIMIT 35	W3-5	36	36			SB	DO NOT REMOVE
9	427+00	RT	\$1000 FINE FOR LITTERING	R16-106	42	42	12.25	2.5 PST	NB	
10	429+80	RT	WINDING ROAD (ARROW) (SYMBOL)	W1-5R	36	36	9.00	2.5 PST	NB	
11	429+80	RT	40 MPH (ADVISORY SPEED PLATE)	W13-1	24	24	4.00		NB	MOUNT BELOW SIGN #10
12	438+45	RT	SINGLE FACED 1 DIGIT MILE MARKER (9)	D10-1	10	18	1.25	2.5 PST	NB	
13	438+45	RT	SINGLE FACED 1 DIGIT MILE MARKER (9)	D10-1	10	18	1.25		SB	MOUNT DIRECTLY BEHIND SIGN #12
14	441+78	RT	CURVE (SYMBOL)	W1-2L	30	30	6.25	2.5 PST	NB	
15	441+78	RT	45 MPH (ADVISORY SPEED PLATE)	W13-1	24	24	4.00		NB	MOUNT BELOW SIGN #14
16	450+72	RT	CURVE (SYMBOL)	W1-2R	30	30	6.25	2.5 PST	NB	
17	450+72	RT	45 MPH (ADVISORY SPEED PLATE)	W13-1	24	24	4.00		NB	MOUNT BELOW SIGN #16
18	454+38	RT	CURVE (SYMBOL)	W1-2L	30	30	6.25	2.5 PST	NB	
19	454+38	RT	40 MPH (ADVISORY SPEED PLATE)	W13-1	24	24	4.00		NB	MOUNT BELOW SIGN #18
20	455+04	LT	REVERSE CURVE (ARROW) (SYMBOL)	W1-4L	36	36	9.00	2.5 PST	SB	
21	455+04	LT	45 MPH (ADVISORY SPEED PLATE)	W13-1	24	24	4.00		SB	MOUNT BELOW SIGN #20
22	459+65	RT	WINDING ROAD (ARROW) (SYMBOL)	W1-5R	36	36	9.00	2.5 PST	NB	
23	459+65	RT	45 MPH (ADVISORY SPEED PLATE)	W13-1	24	24	4.00		NB	MOUNT BELOW SIGN #22
24	460+28	LT	CURVE (SYMBOL)	W1-2R	30	30	6.25	2.5 PST	SB	
25	460+28	LT	40 MPH (ADVISORY SPEED PLATE)	W13-1	24	24	4.00		SB	MOUNT BELOW SIGN #24
26	472+78	RT	CURVE (SYMBOL)	W1-2L	30	30	6.25	2.5 PST	NB	
27	472+78	RT	40 MPH (ADVISORY SPEED PLATE)	W13-1	24	24	4.00		NB	MOUNT BELOW SIGN #26
28	473+16	LT	WINDING ROAD (ARROW) (SYMBOL)	W1-5R	36	36	9.00	2.5 PST	SB	
29	473+16	LT	45 MPH (ADVISORY SPEED PLATE)	W13-1	24	24	4.00		SB	MOUNT BELOW SIGN #28
30	477+06	LT	CURVE (SYMBOL)	W1-2R	30	30	6.25	2.5 PST	SB	
31	477+06	LT	40 MPH (ADVISORY SPEED PLATE)	W13-1	24	24	4.00		SB	MOUNT BELOW SIGN #30
32	487+11	RT	CURVE (SYMBOL)	W1-2R	30	30	6.25	2.5 PST	NB	
33	487+11	RT	45 MPH (ADVISORY SPEED PLATE)	W13-1	24	24	4.00		NB	MOUNT BELOW SIGN #32

Project As-Built Drawings have been reviewed by the Project Engineer and represent to the best of my knowledge, the project as constructed.

PE MB

Date 12/11/15

DO NOT SCALE FROM THESE DRAWINGS USE DIMENSIONS				
CHECKED BY: M. VAN ALSTINE		STATE OF ALASKA DEPARTMENT OF TRANSPORTATION A PUBLIC FACILITIES SOUTHEAST REGION		
		KTN-SOUTH TONGASS PAVING PROJECT #67674		
DESIGNED BY: L. SEIFERT DRAWN BY: R. GRANTHAM		SUMMARIES		
PATH: Q:\KTN\67674\PLANSET\67674_01-04_SUMS.DWG TAB: 02		Wednesday, November 05, 2014 7:39:04 AM SEIFERT, LOLITA T (DOT)		
REVISIONS		PROJECT DESIGNATION		
NO.	DATE	DESCRIPTION	YEAR	SHEET NO.
			2014	D2
STP-NH-0902(040)-67674			TOTAL SHEETS 66	

615(1) STANDARD SIGN										
NUMBER	STATION	OFFSET	DESCRIPTION	ASDS CODE	WIDTH (IN)	HEIGHT (IN)	AREA (SF)	POST MATERIAL	SIGN FACING	REMARKS
34	491+25	RT	SINGLE FACED 2 DIGIT MILE MARKER (10)	D10-2	10	27	1.88	2.5 PST	NB	
35	491+25	RT	SINGLE FACED 2 DIGIT MILE MARKER (10)	D10-2	10	27	1.88		SB	MOUNT DIRECTLY BEHIND SIGN #34
36	493+91	LT	CURVE (SYMBOL)	W1-2L	30	30	6.25	2.5 PST	SB	
37	493+91	LT	45 MPH (ADVISORY SPEED PLATE)	W13-1	24	24	4.00		SB	MOUNT BELOW SIGN #36
38	543+50	RT	SINGLE FACED 2 DIGIT MILE MARKER (11)	D10-2	10	27	1.88	2.5 PST	NB	
39	543+50	RT	SINGLE FACED 2 DIGIT MILE MARKER (11)	D10-2	10	27	1.88		SB	MOUNT DIRECTLY BEHIND SIGN #38
40	547+50	RT	REVERSE CURVE (ARROW) (SYMBOL)	W1-4R	36	36	9.00	2.5 PST	NB	
41	547+50	RT	45 MPH (ADVISORY SPEED PLATE)	W13-1	24	24	4.00		NB	MOUNT DIRECTLY BELOW SIGN #40
42	551+65	RT	CURVE (SYMBOL)	W1-2R	30	30	6.25	2.5 PST	NB	
43	551+65	RT	45 MPH (ADVISORY SPEED PLATE)	W13-1	24	24	4.00		NB	MOUNT BELOW SIGN #42
44	556+35	RT	EMERGENCY PARKING ONLY	R8-4	30	24	5.00	2.5 PST	NB	
45	556+75	LT	EMERGENCY PARKING ONLY	R8-4	30	24	5.00	2.5 PST	SB	
46	557+53	LT	CURVE (SYMBOL)	W1-2L	30	30	6.25	2.5 PST	SB	
47	557+53	LT	45 MPH (ADVISORY SPEED PLATE)	W13-1	24	24	4.00		SB	MOUNT BELOW SIGN #46
48	559+18	RT	CURVE (SYMBOL)	W1-2L	30	30	6.25	2.5 PST	NB	
49	559+18	RT	40 MPH (ADVISORY SPEED PLATE)	W13-1	24	24	4.00		NB	MOUNT BELOW SIGN #48
50	567+93	LT	CURVE (SYMBOL)	W1-2R	30	30	6.25	2.5 PST	SB	
51	567+93	LT	40 MPH (ADVISORY SPEED PLATE)	W13-1	24	24	4.00		SB	MOUNT BELOW SIGN #50
52	596+30	RT	SINGLE FACED 2 DIGIT MILE MARKER (12)	D10-2	10	27	1.88	2.5 PST	NB	
53	596+30	RT	SINGLE FACED 2 DIGIT MILE MARKER (12)	D10-2	10	27	1.88		SB	MOUNT DIRECTLY BEHIND SIGN #52
54	606+06	RT	CURVE (SYMBOL)	W1-2L	30	30	6.25	2.5 PST	NB	
55	606+06	RT	40 MPH (ADVISORY SPEED PLATE)	W13-1	24	24	4.00		NB	MOUNT BELOW SIGN #54
56	612+13	LT	CURVE (SYMBOL)	W1-2R	30	30	6.25	2.5 PST	SB	
57	612+13	LT	40 MPH (ADVISORY SPEED PLATE)	W13-1	24	24	4.00		SB	MOUNT BELOW SIGN #56
58	613+95	RT	SPEED LIMIT 35	W3-5	36	36	9.00	2.5 PST	NB	
59	622+80	RT	SPEED LIMIT 35	R2-1	30	36	7.50	2.5 PST	NB	
60	629+25	RT	END ROAD 1000 FT	W14-101	36	36	9.00	2.5 PST	NB	
61	630+35	RT	SPEED LIMIT 20	W3-5	36	36	9.00	2.5 PST	NB	
62	636+00	RT	SPEED LIMIT 20	R2-1	30	36	7.50	2.5 PST	NB	
63	636+00	LT	SPEED LIMIT 50	R2-1	30	36	7.50	2.5 PST	SB	
64	636+80	RT	PAVEMENT ENDS	W8-3	36	36	9.00	2.5 PST	NB	
65	637+00	LT	HEADLIGHTS ON AT ALL TIMES	R16-110	42	30	8.75	2.5 PST	SB	
66	637+00	RT	HEADLIGHTS ON AT ALL TIMES	R16-110	42	30	8.75	2.5 PST	NB	
67	637+00	RT	END ENFORCMENT	R16-116	36	18	4.50		NB	MOUNT BELOW SIGN #66
68	638+00	LT	EMERGENCY PARKING ONLY	R8-4	30	24	5.00	2.5 PST	SB	
69	639+11	LT	END	W14-100	30	30	6.25	2.5 PST	NB	
70	639+11	LT	OBJECT MARKER TYPE 4	OM4-1	18	18	2.25		NB	MOUNT BELOW SIGN #69
71	639+56	RT	CURVE (SYMBOL)	W1-2R	30	30	6.25	2.5 PST	NB	
72	639+56	RT	15 MPH (ADVISORY SPEED PLATE)	W13-1	24	24	4.00		NB	MOUNT BELOW SIGN #71

Project As-Built Drawings have been reviewed by the Project Engineer and represent to the best of my knowledge, the project as constructed.
PE *ma3* Date *12/11/15*

DO NOT SCALE FROM THESE DRAWINGS USE DIMENSIONS

CHECKED BY: M. VAN ALSTINE		STATE OF ALASKA DEPARTMENT OF TRANSPORTATION & PUBLIC FACILITIES SOUTHEAST REGION				
		KTN-SOUTH TONGASS PAVING PROJECT #67674				
DESIGNED BY: L. SEIFERT DRAWN BY: R. GRANTHAM		SUMMARIES				
PATH: Q:\KTN\67674\PLANSET\67674_D1-D4_SUMS.DWG TAB: D3		SEIFERT, LOLITA T (DOT)				
NO.	DATE	DESCRIPTION	PROJECT DESIGNATION	YEAR	SHEET NO.	TOTAL SHEETS
			STP-NH-0902(040)-67674	2014	D3	66

639(3) APPROACH					
STATION	OFFSET	RADIUS		DRIVEWAY WIDTH	REMARKS
		R1*	R2*		
409+43	RT	10	5	14	DRIVEWAY
409+44	LT	5	5	34	DRIVEWAY
410+30	RT	12	10	16	DRIVEWAY
410+87	LT	8	8	32	DRIVEWAY
411+00	RT	8	10	16	DRIVEWAY
414+73	LT	20	10	56	DRIVEWAY
417+65	RT	6	8	32	DRIVEWAY
420+05	RT	15	8	30	DRIVEWAY
428+22	RT	20	20	64	PULLOUT
430+75	RT	8	8	30	DRIVEWAY
432+26	RT	8	10	30	DRIVEWAY
443+73	RT	20	20	30	PULLOUT
476+17	RT	20	20	42	PULLOUT
532+68	RT	20	20	50	PULLOUT
556+00	RT	10	10	34	PULLOUT
565+10	LT	5	5	30	DRIVEWAY
566+50	LT	10	10	34	DRIVEWAY
582+50	RT	10	10	60	PULLOUT
588+70	LT	8	8	44	DRIVEWAY
592+33	RT	15	15	80	PULLOUT
638+70	LT	15	15	80	PULLOUT

642 (8) ADJUST EXISTING MONUMENT			
STATION	OFFSET	PAVED AREA (Y/N)	REMARKS
405+07.12	11' RT	Y	242 BC_SH_MON


642 (11) ADJUST EXISTING MONUMENT CASE		
STATION	OFFSET	REMARKS
405+07.12	11' RT	242 BC_SH_MON

Project As-Built Drawings have been reviewed by the Project Engineer and represent to the best of my knowledge, the project as constructed.

PE MS Date 12/11/15

DO NOT SCALE FROM THESE DRAWINGS USE DIMENSIONS

CHECKED BY: M. VAN ALSTINE		STATE OF ALASKA DEPARTMENT OF TRANSPORTATION & PUBLIC FACILITIES SOUTHEAST REGION			
		KTN-SOUTH TONGASS PAVING PROJECT #67674			
DESIGNED BY: L. SEIFERT		SUMMARIES			
DRAWN BY: H. GRANITZMAN					
PATH: Q:\KTN\67674\PLANSET\67674_D1-D4_SUMS.DWG					
TAB: D4		Wednesday, November 05, 2014 7:39:34 AM		SEIFERT, LOLITA T (DOT)	
REVISIONS		PROJECT DESIGNATION		YEAR	SHEET NO.
NO.	DATE	DESCRIPTION			TOTAL SHEETS
		STP-NH-0902(040)-67674		2014	D4 66

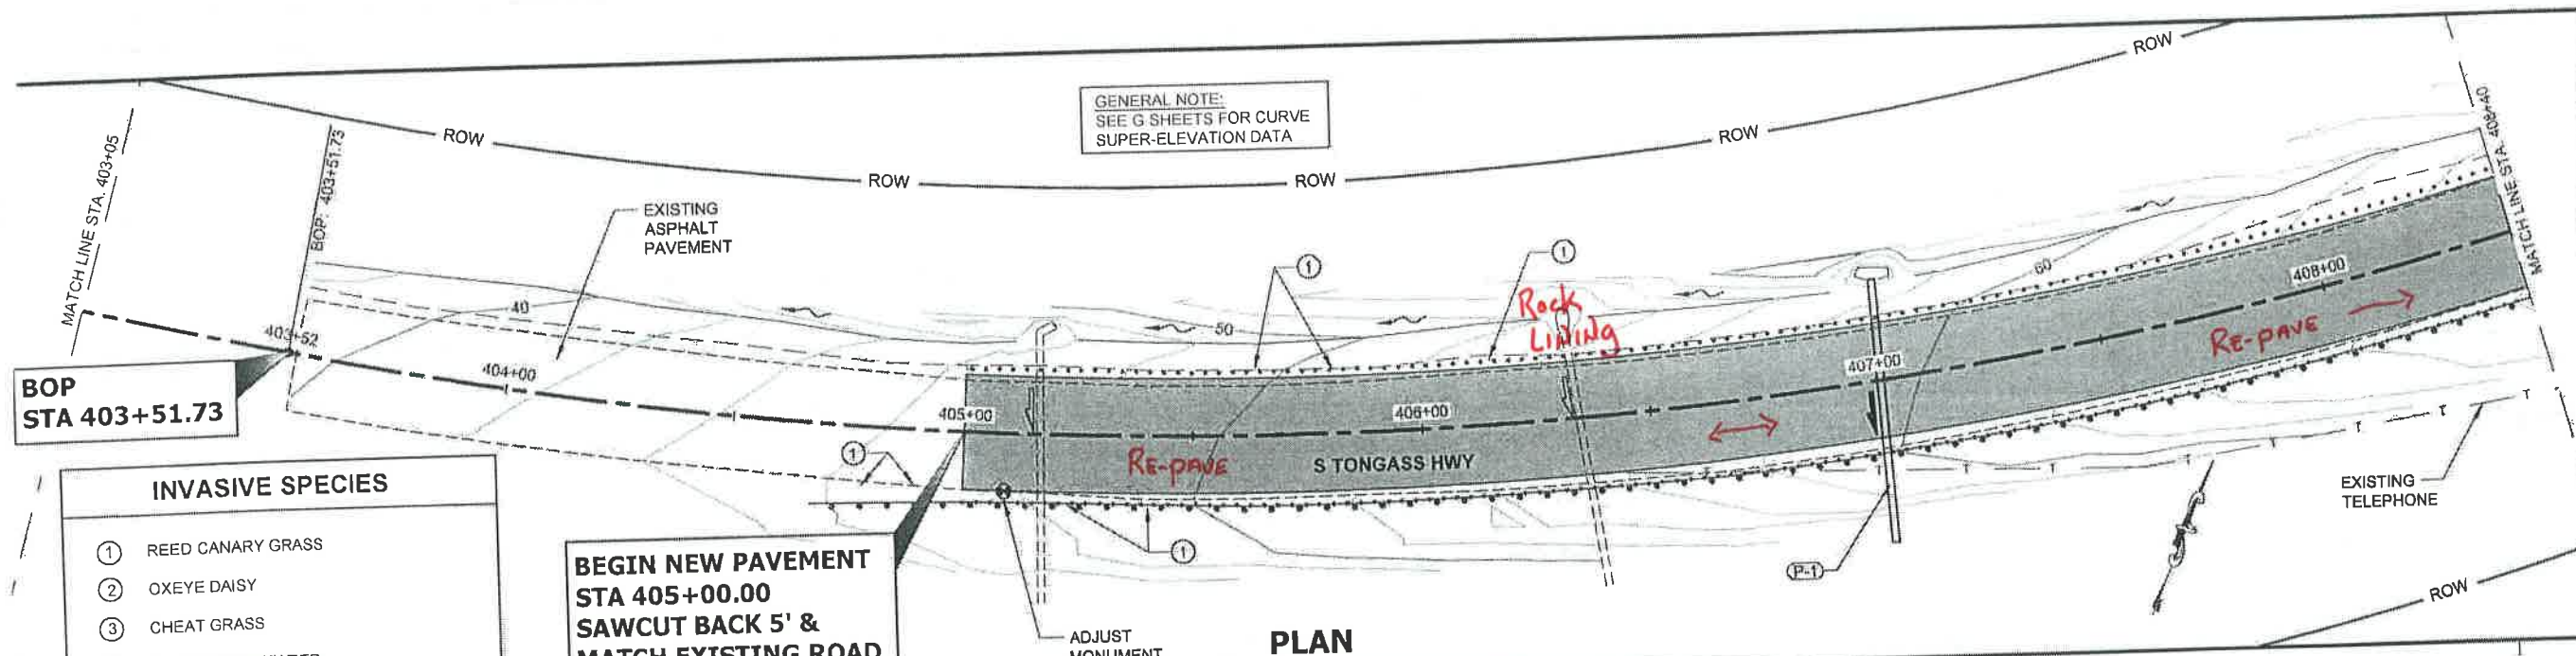


GENERAL NOTE:
SEE G SHEETS FOR CURVE
SUPER-ELEVATION DATA

BEGIN NEW PAVEMENT
STA 405+00.00
SAWCUT BACK 5' &
MATCH EXISTING ROAD


PLAN

- INVASIVE SPECIES**
- ① REED CANARY GRASS
 - ② OXEYE DAISY
 - ③ CHEAT GRASS
 - ④ ORANGE HAWKWEED
 - INVASIVE SPECIES - REMOVE & DISPOSE
 - (---) INVASIVE SPECIES OUTSIDE OF PROJECT LIMITS DO NOT DISTURB

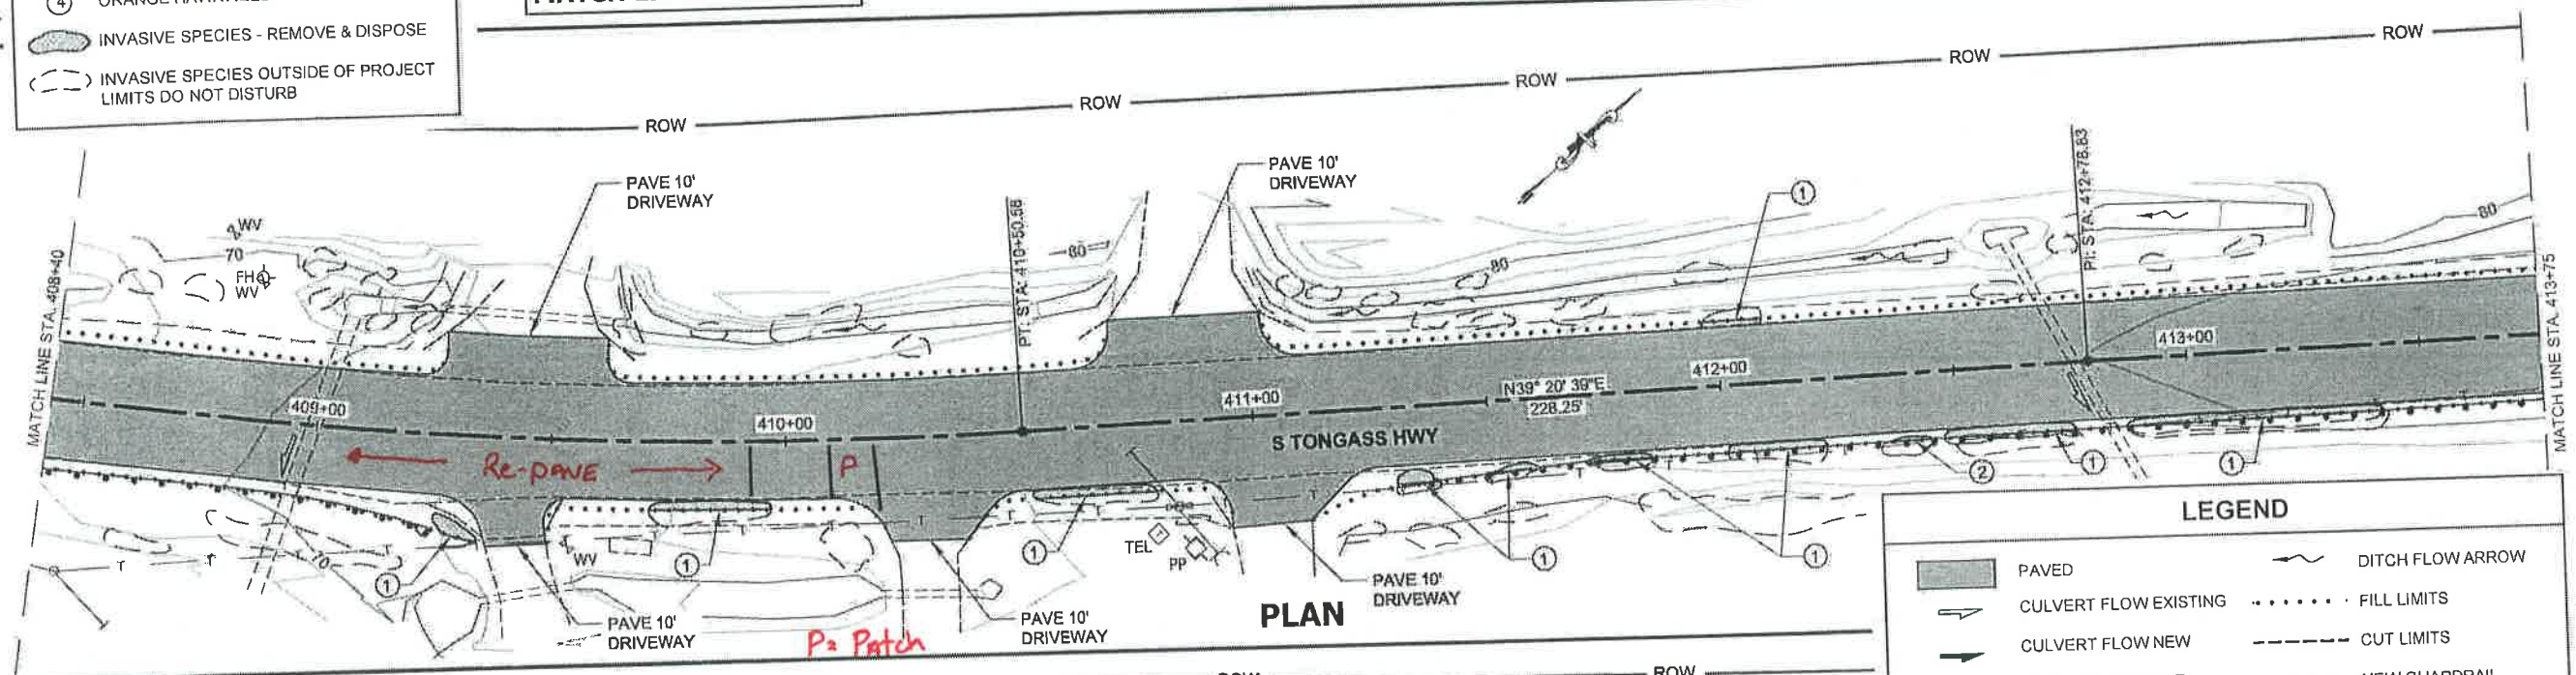

PLAN

- LEGEND**
- [Solid Grey] PAVED
 - [Dashed Line] CULVERT FLOW EXISTING
 - [Solid Arrow] CULVERT FLOW NEW
 - [Circle with dot] ADJUST MONUMENT
 - [Wavy Line] DITCH FLOW ARROW
 - [Dotted Line] FILL LIMITS
 - [Long Dashed Line] CUT LIMITS
 - [Line with triangles] NEW GUARDRAIL

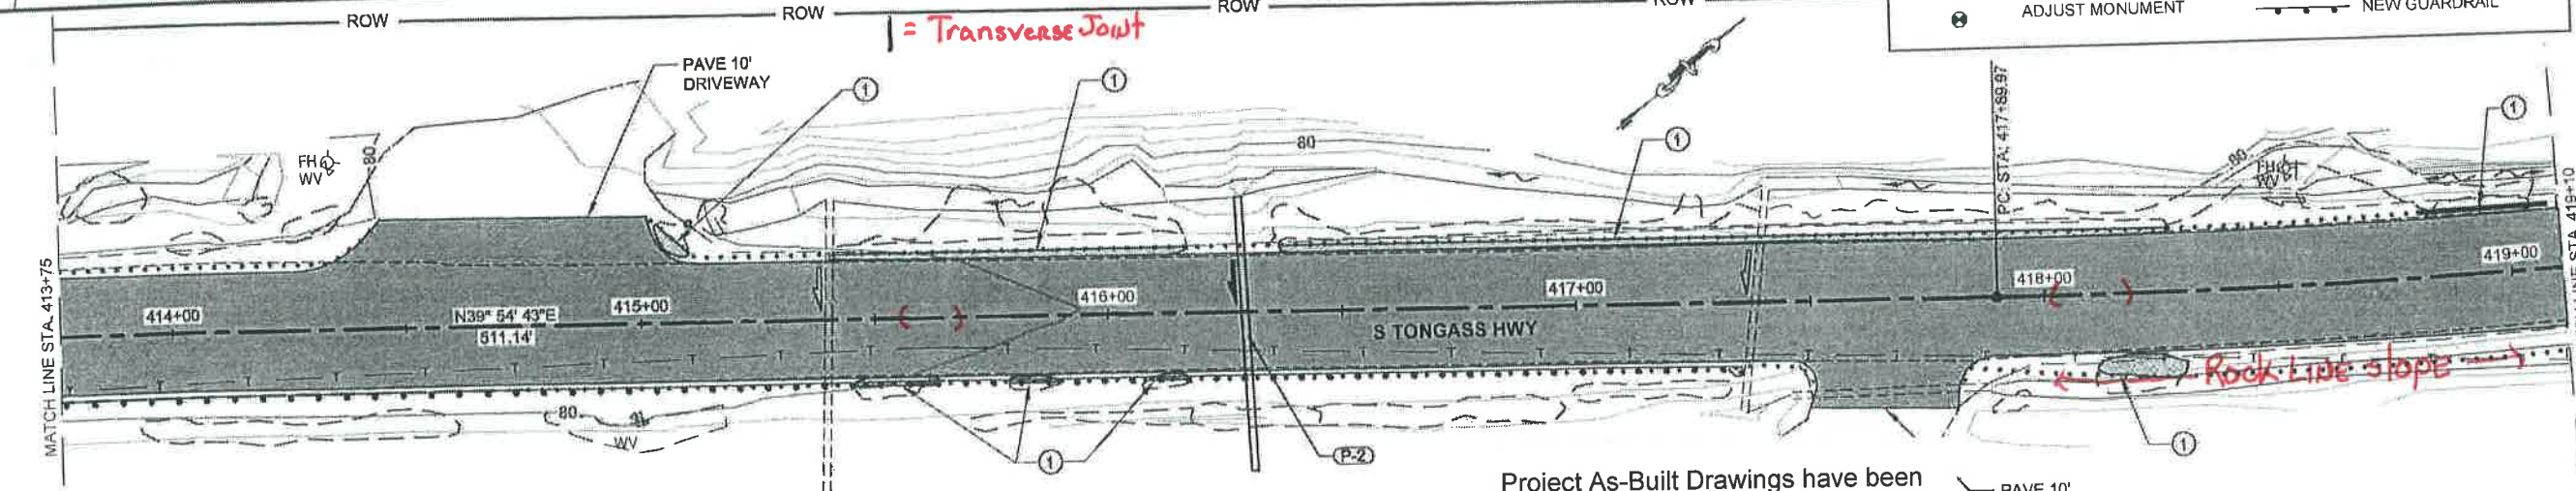

PLAN



Project As-Built Drawings have been reviewed by the Project Engineer and represent to the best of my knowledge, the project as constructed.
PE *[Signature]* Date 12/11/15

SCALE FROM THESE DRAWINGS USE DIMENSIONS

PATH:
Q:\KTN\67674\PLANSET\67674_F1-F15_PLAN.DWG
TAB: F1
GRANTHAM, RICK L (DOT)
Thursday, November 06, 2014 6:59:24 AM
ADDENDUM NUMBER
ATTACHMENT NUMBER
RECORD OF REVISIONS
No DATE DESCRIPTION


PLAN LEGEND

CHECKED BY: M. VAN ALSTINE

DESIGNED BY: L. SEIFERT
DRAWN BY: R. GRANTHAM
STATE OF ALASKA
DEPARTMENT OF TRANSPORTATION & PUBLIC FACILITIES
SOUTHEAST REGION
KTN-SOUTH TONGASS PAVING
PROJECT #67674

PLAN VIEW
PROJECT DESIGNATION
STP-NH-0902(040)~67674

STATE	YEAR
ALASKA	2014
SHEET NUMBER	TOTAL SHEETS
F1	66

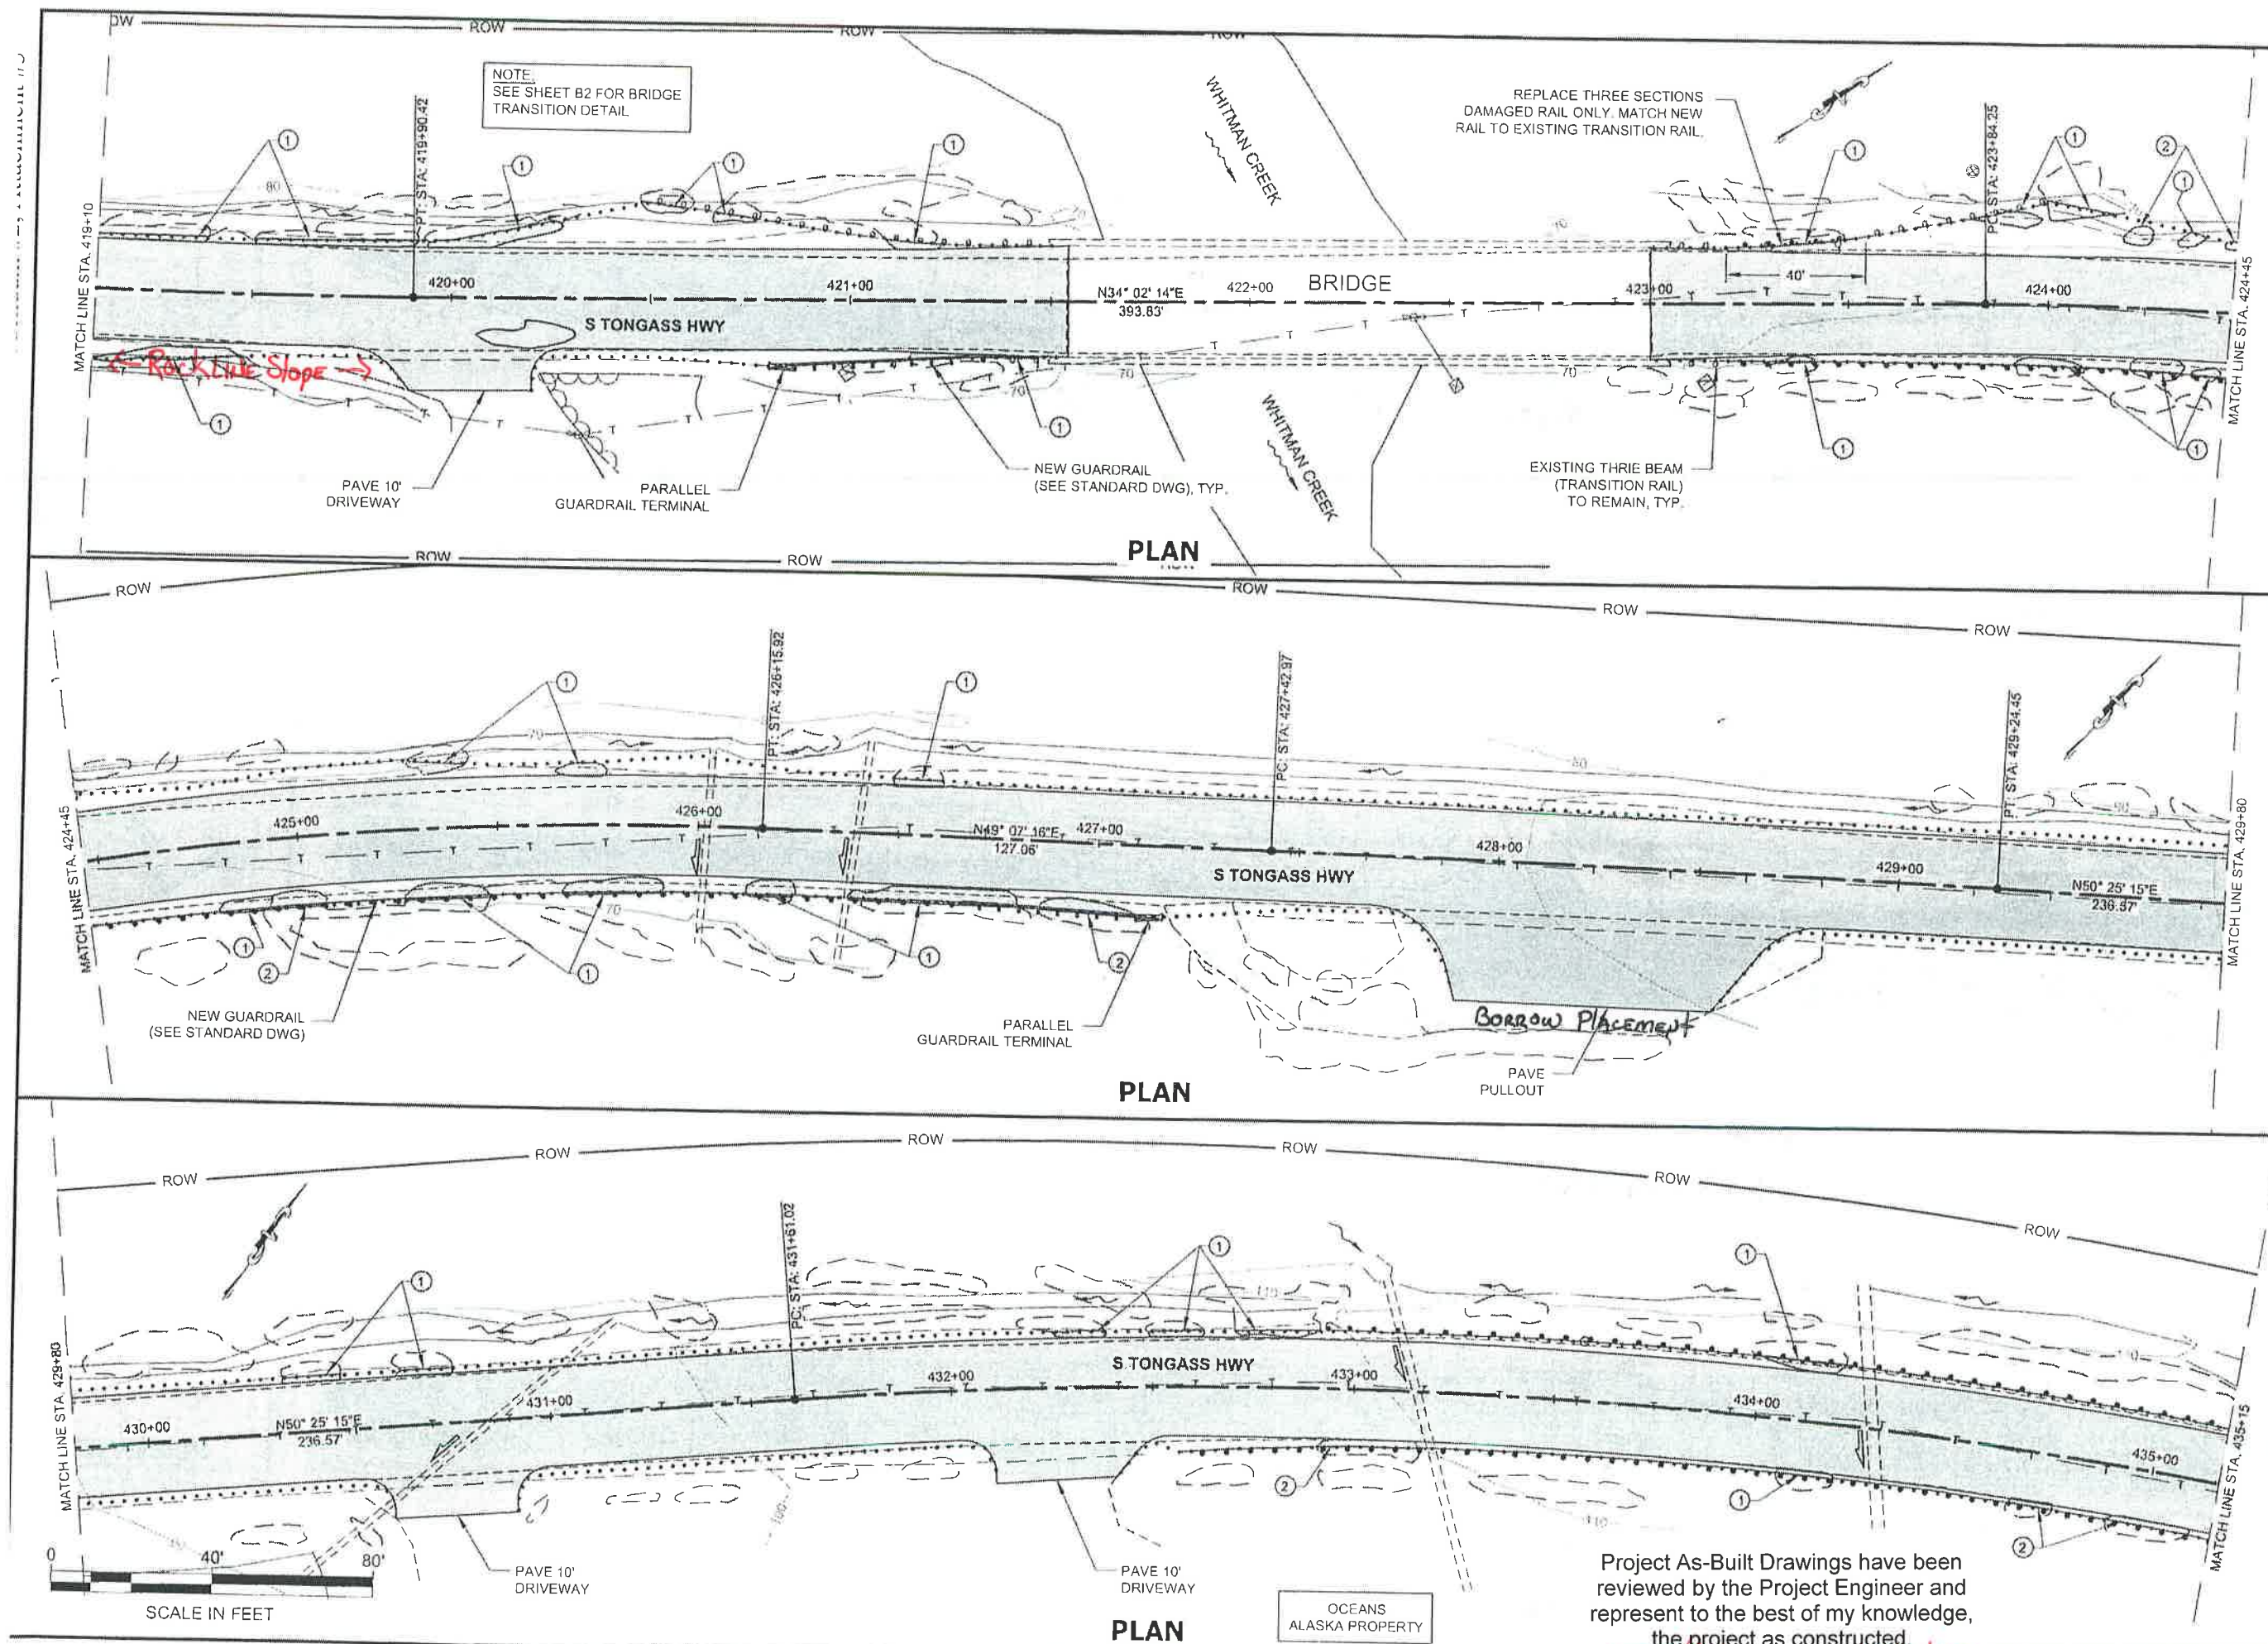

PATH: Q:\KTN\67674\PLANSET\ADDENDUM 1\67674_F2_F11.DWG
 GRANTHAM, RICK L (DOT)
 Wednesday, November 26, 2014 1:00:25 PM

ADDENDUM NUMBER		2
ATTACHMENT NUMBER		5
RECORD OF REVISIONS		
No.	DATE	DESCRIPTION

PLAN LEGEND

CHECKED BY: M. VAN ALSTINE

DESIGNED BY: L. SEIFERT

DRAWN BY: R. GRANTHAM

STATE OF ALASKA
 DEPARTMENT OF TRANSPORTATION
 & PUBLIC FACILITIES
 SOUTHEAST REGION

KTN-SOUTH TONGASS PAVING
 PROJECT #67674


**ADDENDUM 2
 PLAN VIEW**

PROJECT DESIGNATION
 STP-NH-0902(040)~67674


STATE	YEAR
ALASKA	2014
SHEET NUMBER	TOTAL SHEETS
F2	66

Project As-Built Drawings have been reviewed by the Project Engineer and represent to the best of my knowledge, the project as constructed.


PE *KMB* Date *12/1/15* WINGS USE DIMENSIONS

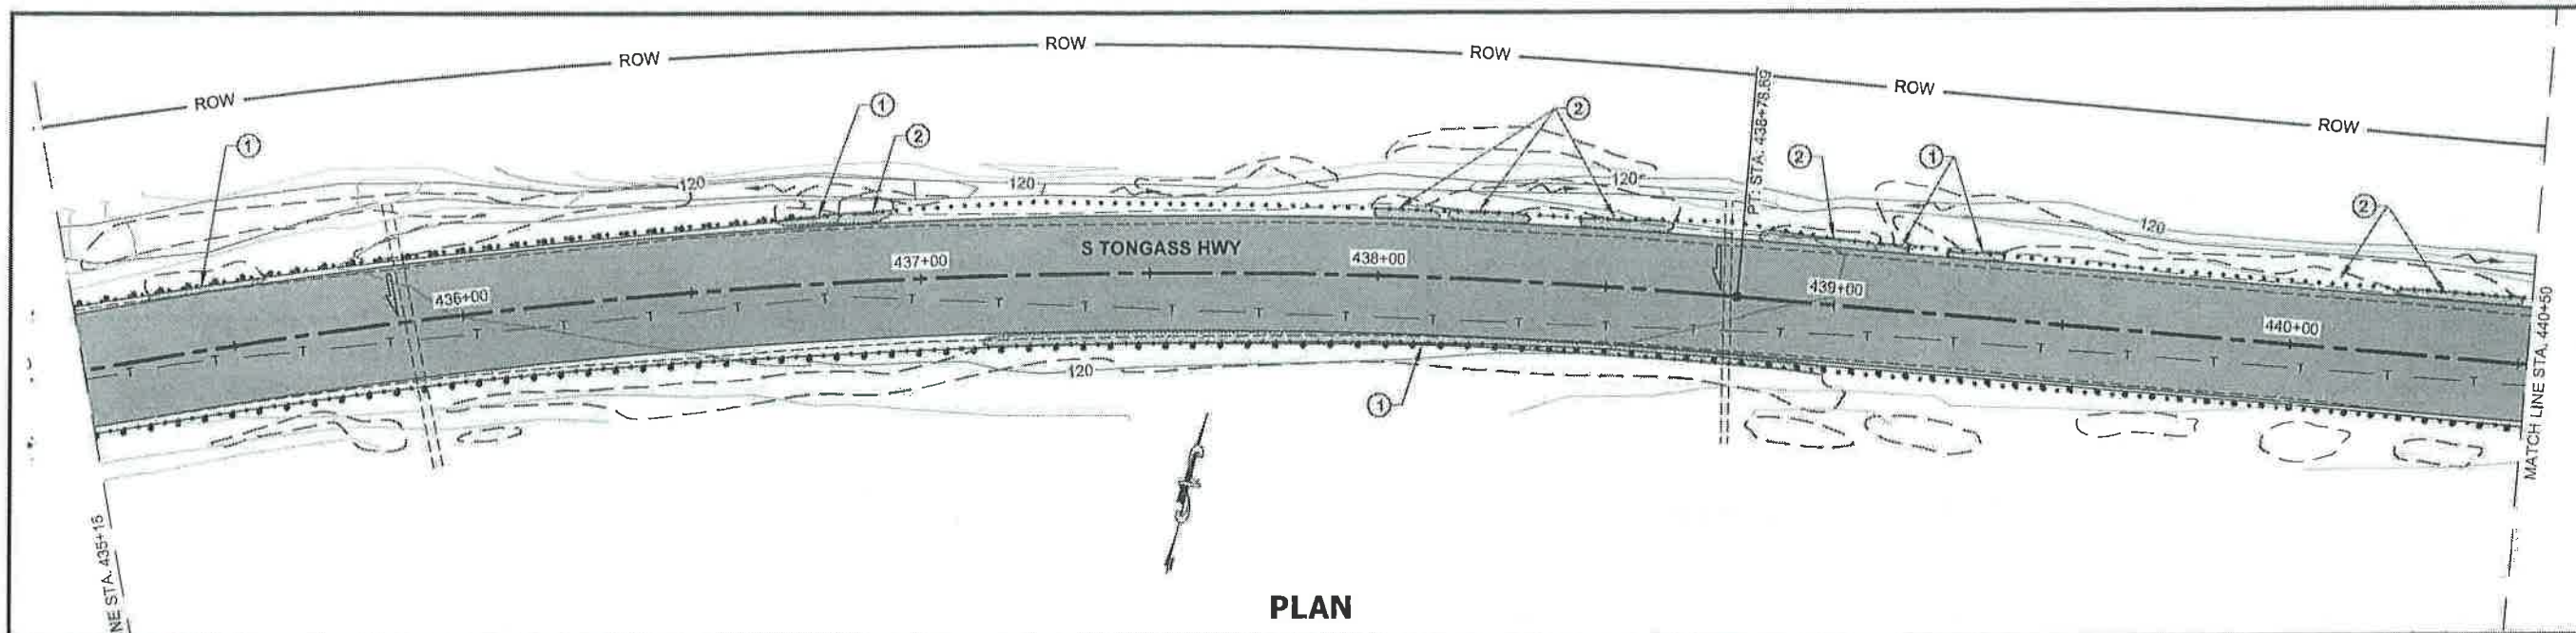

PLAN

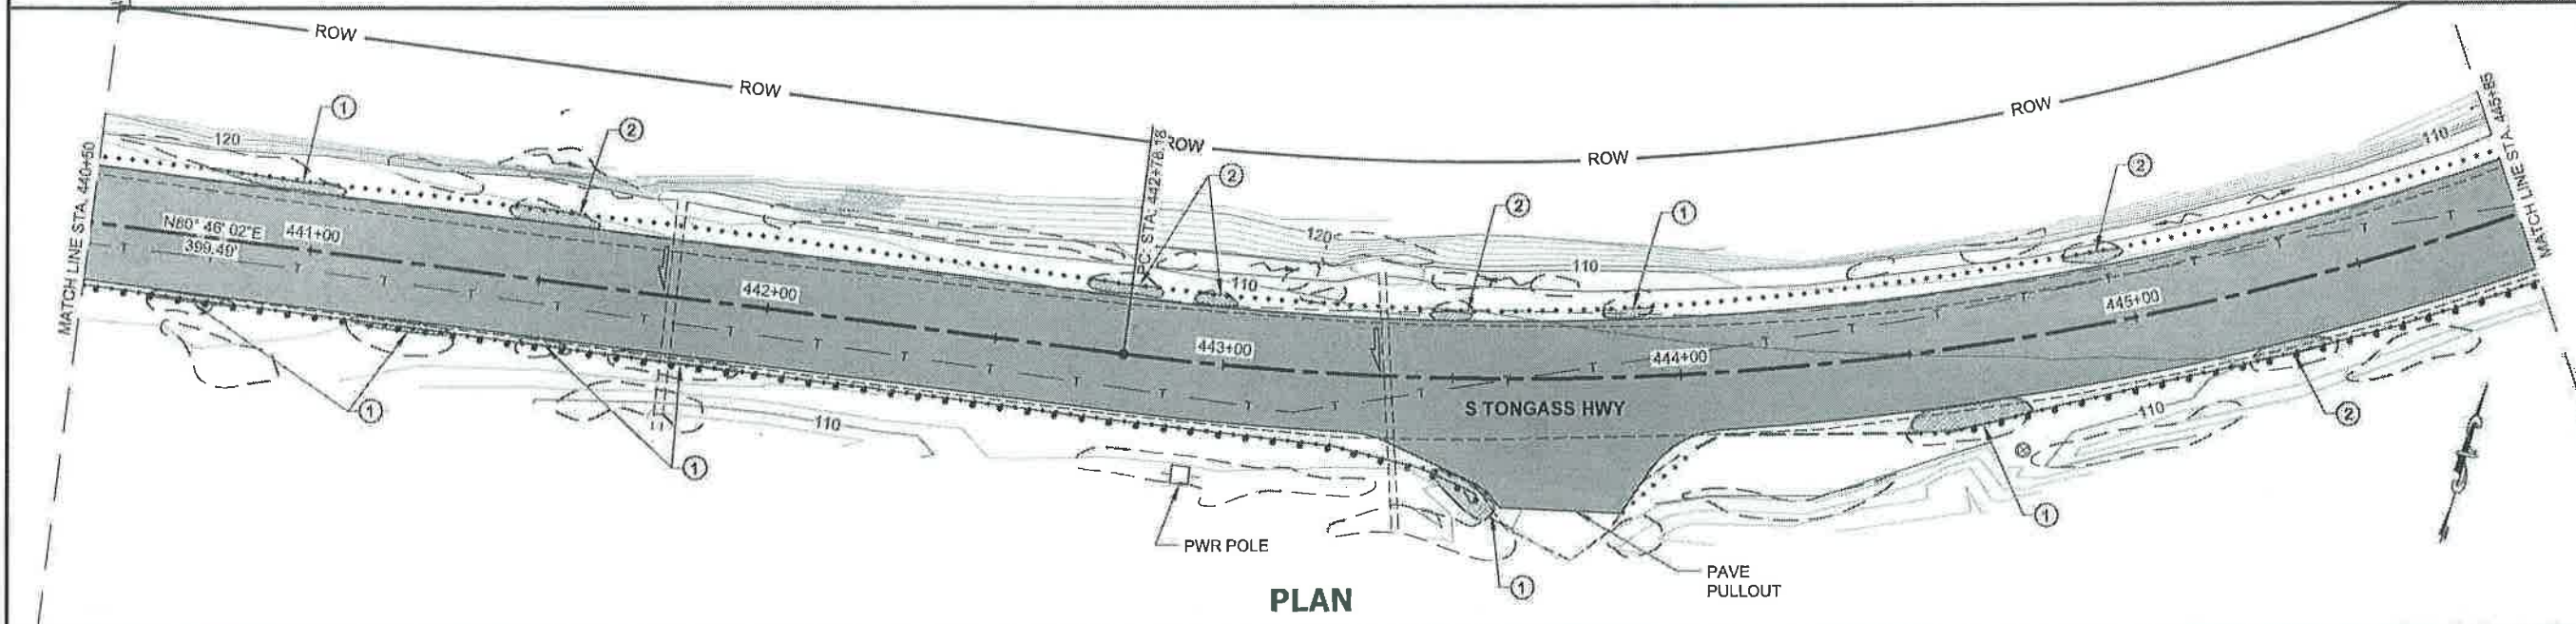

PLAN

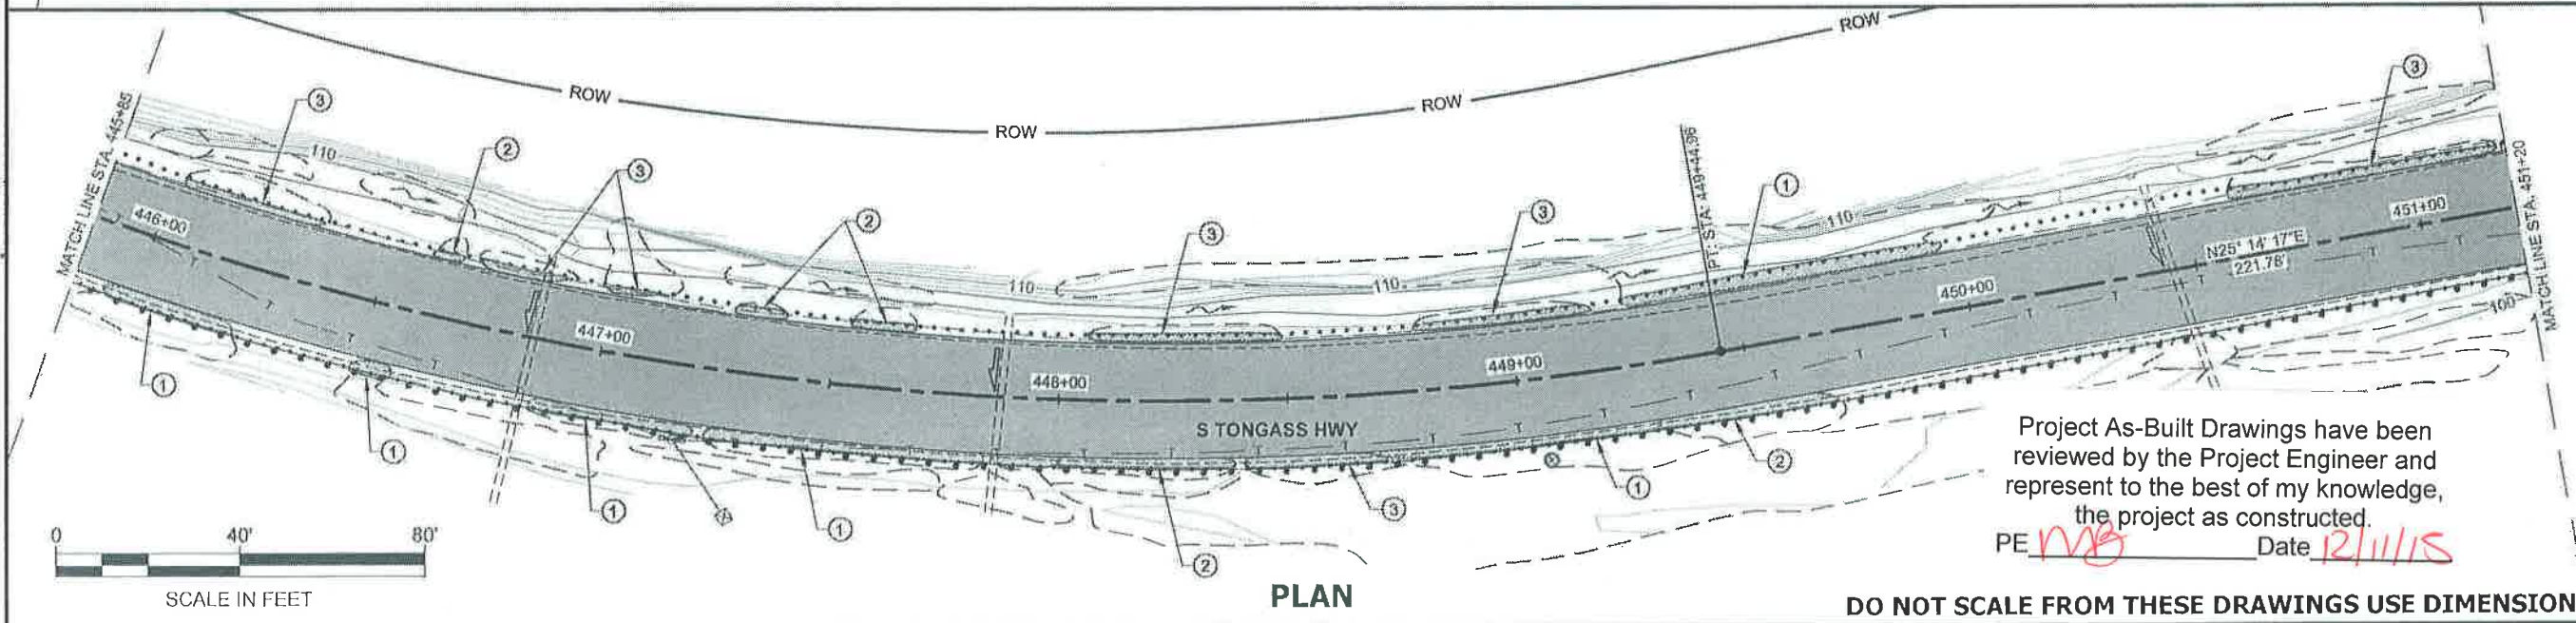

PLAN

Project As-Built Drawings have been reviewed by the Project Engineer and represent to the best of my knowledge, the project as constructed.
 PE *MB* Date *12/11/15*

DO NOT SCALE FROM THESE DRAWINGS USE DIMENSIONS

PATH: Q:\KTN\67674\PLANSET\67674_F1-F15_PLAN.DWG
 TAB: F3
 GRANHAM, RICK L (DOT)
 Thursday, November 06, 2014 7:00:05 AM

ADDENDUM NUMBER

ATTACHMENT NUMBER

RECORD OF REVISIONS

No.	DATE	DESCRIPTION

PLAN LEGEND

CHECKED BY: M. VAN ALSTINE

DESIGNED BY: L. SEIFERT

DRAWN BY: R. GRANHAM

STATE OF ALASKA
 DEPARTMENT OF TRANSPORTATION & PUBLIC FACILITIES
 SOUTHEAST REGION

KTN-SOUTH TONGASS PAVING PROJECT #67674


PLAN VIEW

PROJECT DESIGNATION


STP-NH-0902(040)~67674

STATE	YEAR
ALASKA	2014


SHEET NUMBER	TOTAL SHEETS
F3	66

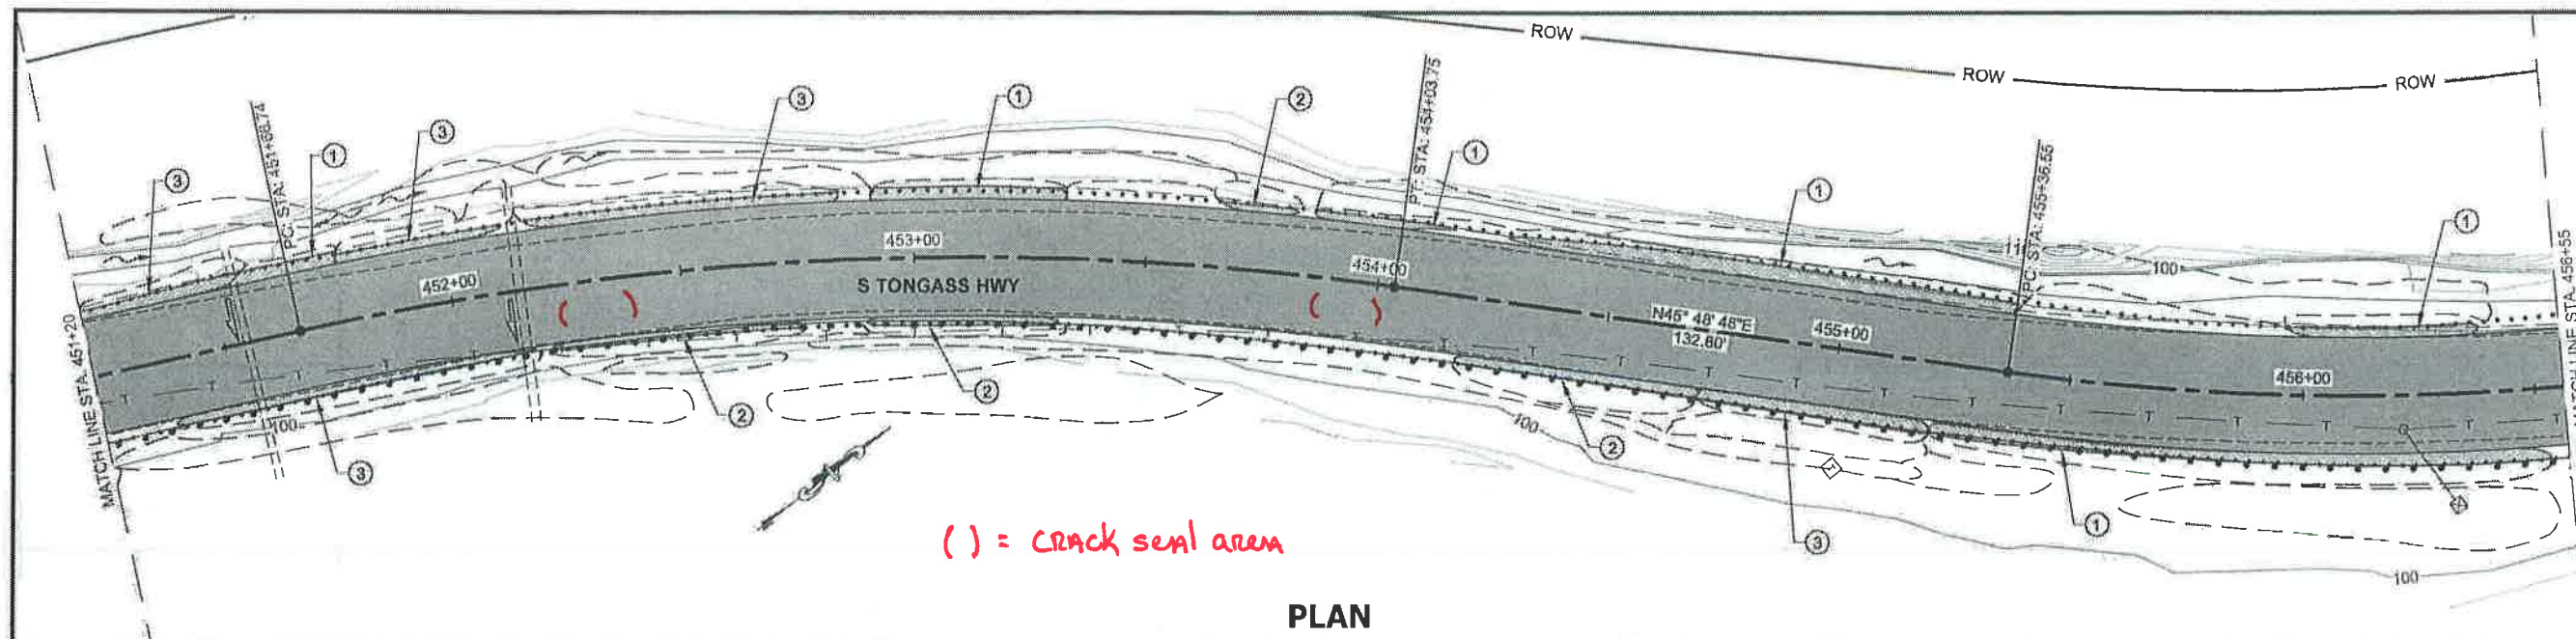

PLAN

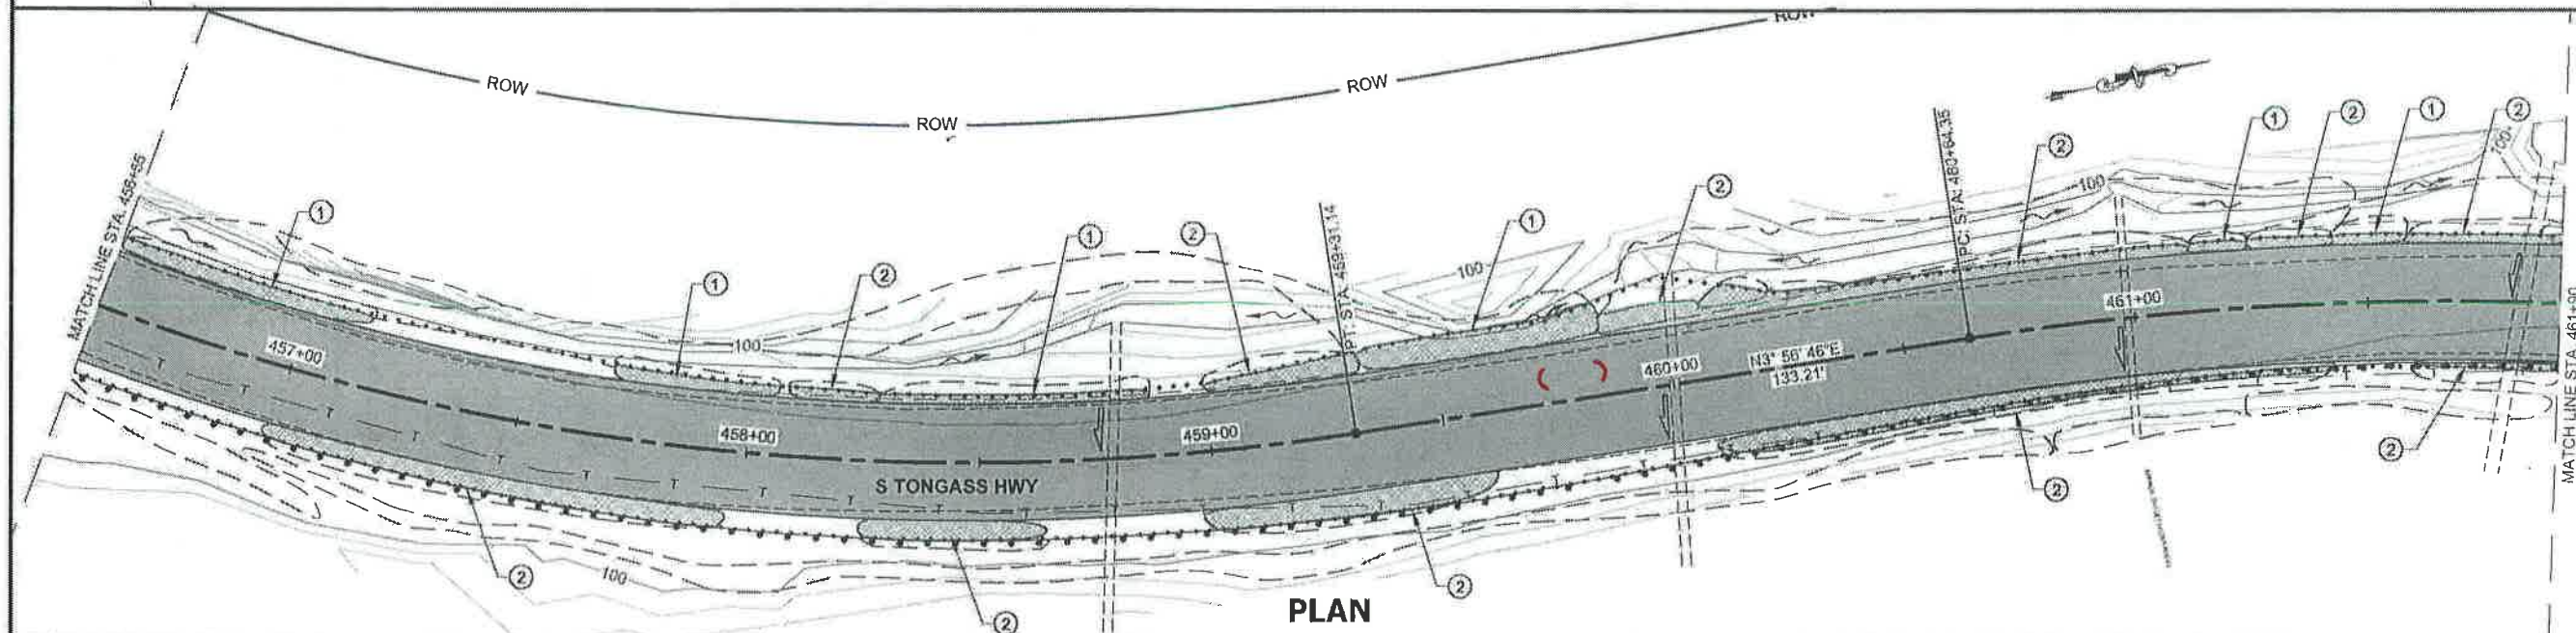

PLAN

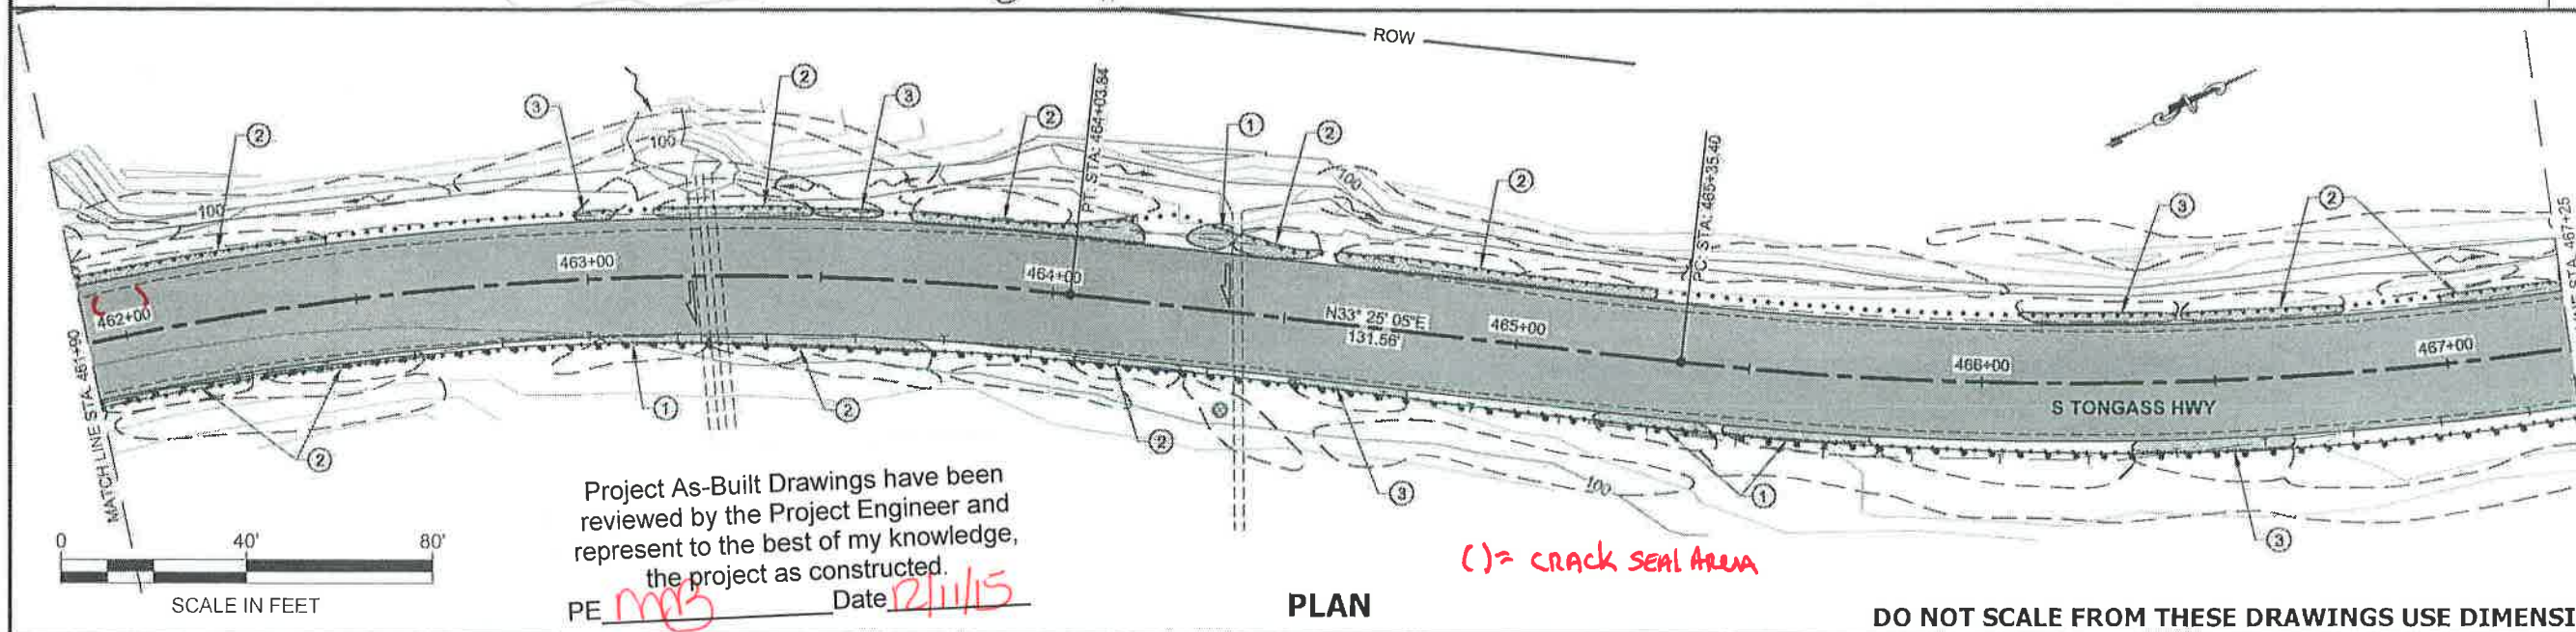

PLAN



SCALE IN FEET


Project As-Built Drawings have been reviewed by the Project Engineer and represent to the best of my knowledge, the project as constructed.

PE *MB* Date *12/1/15*

() = crack seal area


DO NOT SCALE FROM THESE DRAWINGS USE DIMENSIONS

PATH: Q:\KTN\67674\PLANSET\67674_F1-F15_PLAN.DWG		
TAB: F4		
GRANTHAM, RICK L (DOT)		
Thursday, November 06, 2014 7:00:22 AM		
ADDENDUM NUMBER		
ATTACHMENT NUMBER		
RECORD OF REVISIONS		
No.	DATE	DESCRIPTION

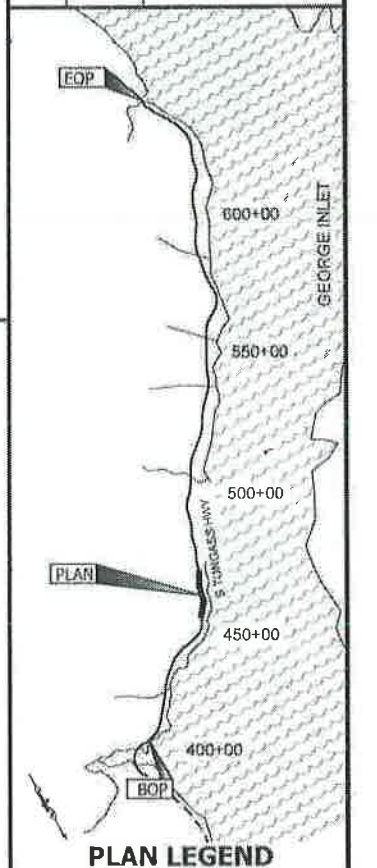


CHECKED BY: M. VAN ALSTINE	
DESIGNED BY: L. SEIFERT	
DRAWN BY: R. GRANTHAM	
STATE OF ALASKA DEPARTMENT OF TRANSPORTATION & PUBLIC FACILITIES SOUTHEAST REGION	
KTN-SOUTH TONGASS PAVING PROJECT #67674	


PROJECT DESIGNATION	
STP-NH-0902(040)~67674	
STATE	YEAR
ALASKA	2014
SHEET NUMBER	TOTAL SHEETS
F4	66

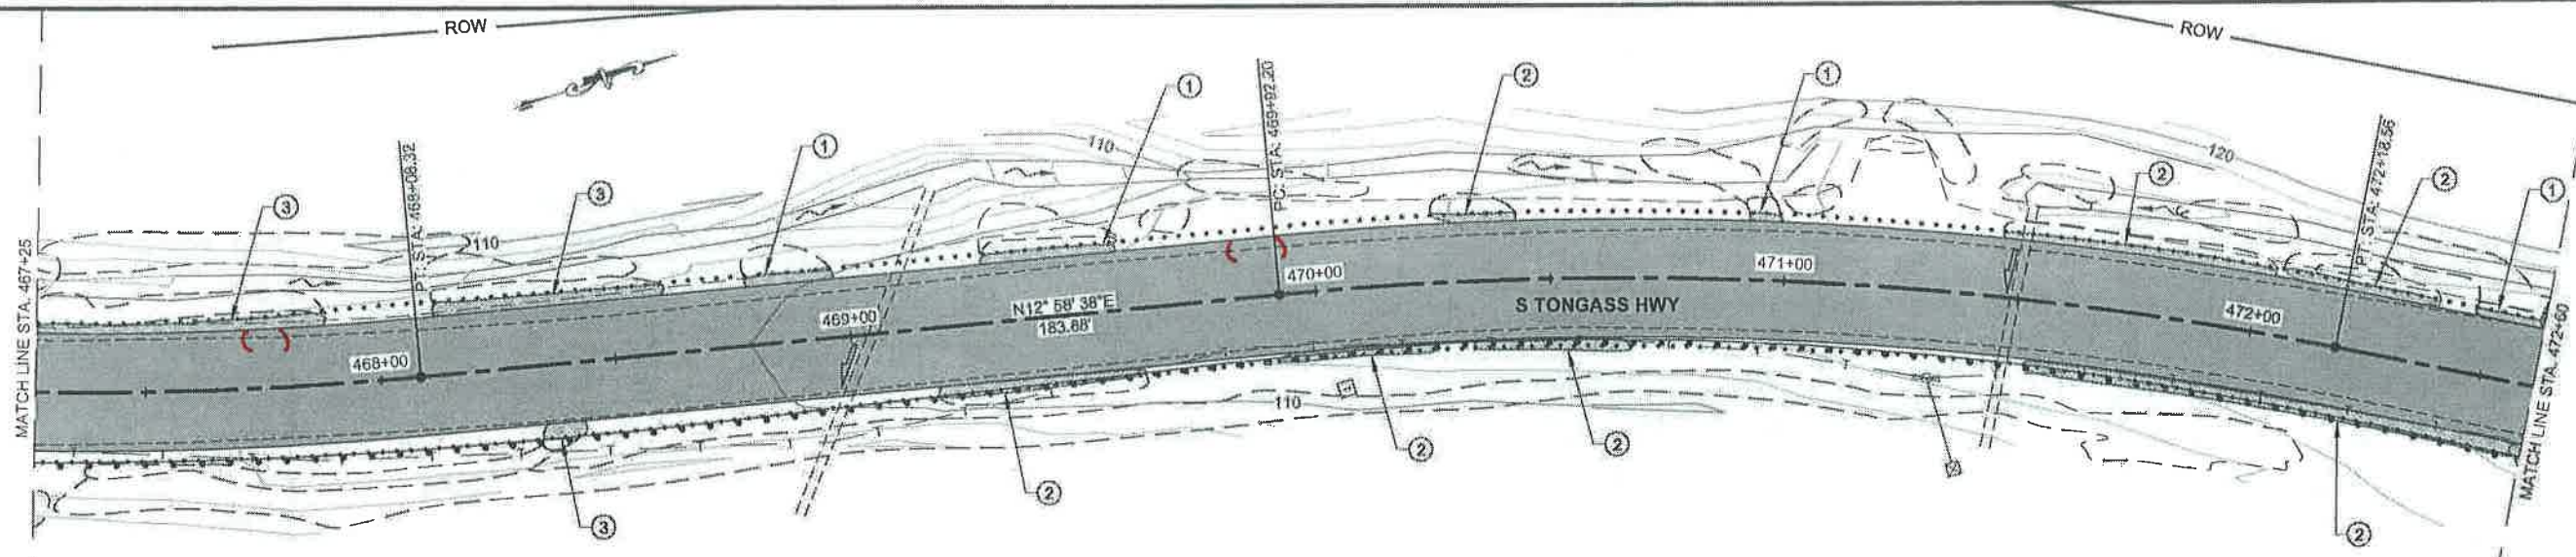

() = crack seal Area
PLAN

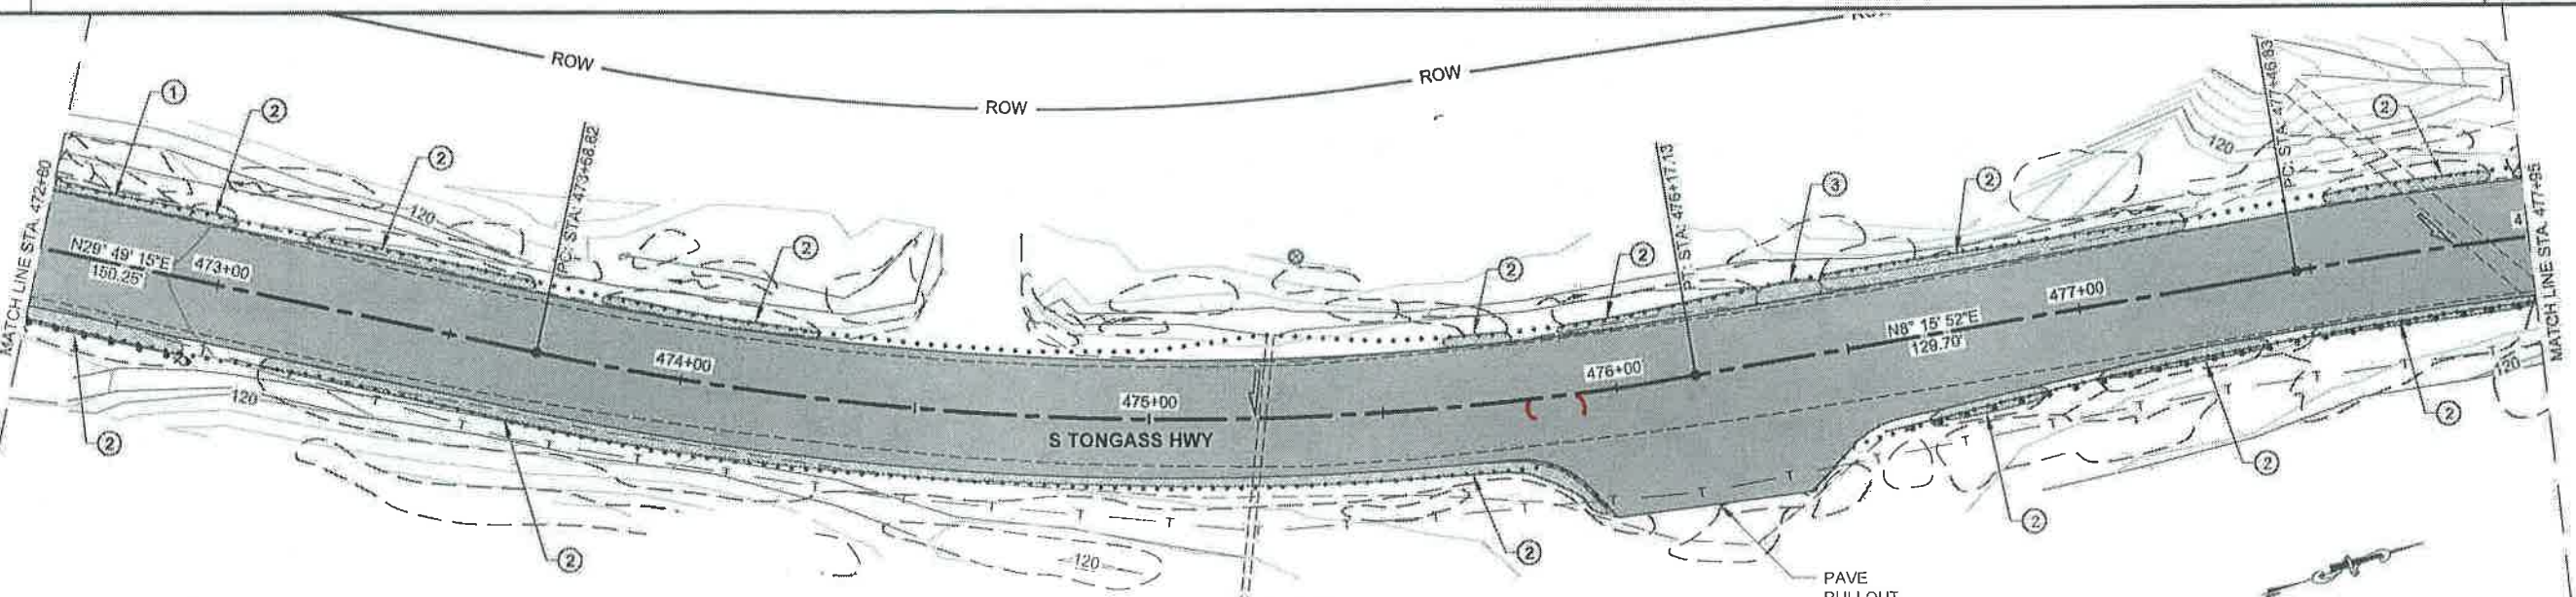

PLAN

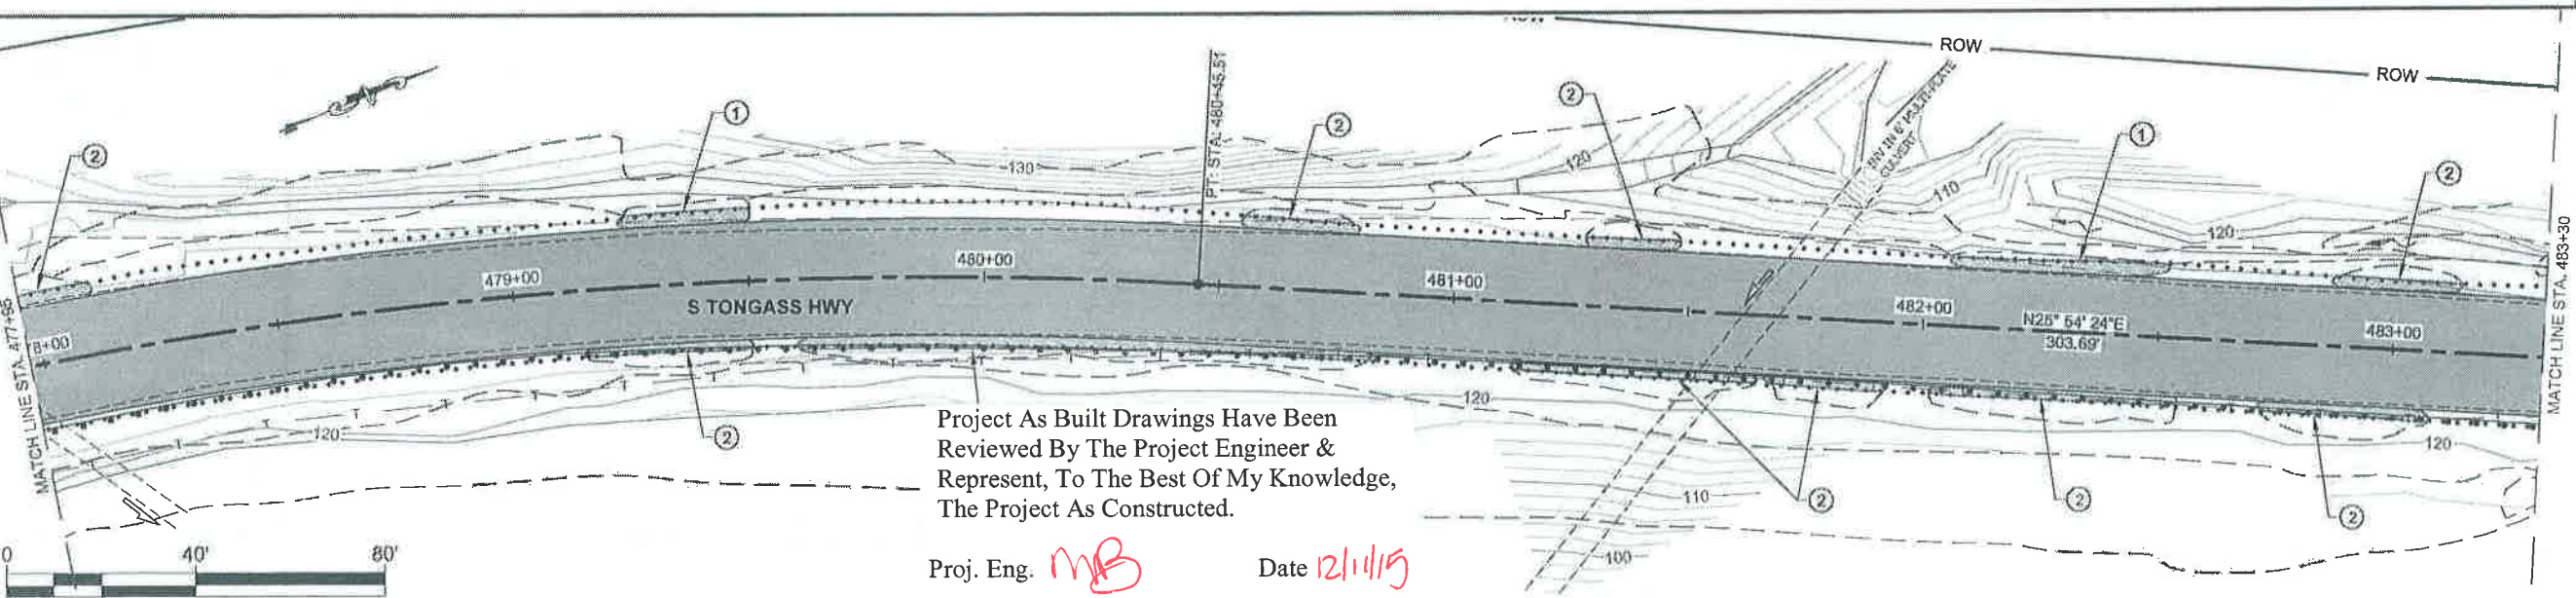

Project As Built Drawings Have Been Reviewed By The Project Engineer & Represent, To The Best Of My Knowledge, The Project As Constructed.

Proj. Eng. *MB* Date *12/1/15*
PLAN



DO NOT SCALE FROM THESE DRAWINGS USE DIMENSIONS

PATH:
Q:\KTN\67674\PLANSET\67674_F1-F15_PLAN.D

TAB: F5

GRANTHAM, RICK L (DOT)

Thursday, November 06, 2014 7:00:44 AM

ADDENDUM NUMBER

ATTACHMENT NUMBER

RECORD OF REVISIONS

No.	DATE	DESCRIPTION

PLAN LEGEND

CHECKED BY: M. VAN ALSTINE

DESIGNED BY: L. SEIFERT

DRAWN BY: R. GRANTHAM

STATE OF ALASKA
DEPARTMENT OF TRANSPORTATION
& PUBLIC FACILITIES
SOUTHEAST REGION

KTN-SOUTH TONGASS PAVING
PROJECT #67674


PLAN VIEW

PROJECT DESIGNATION


STP-NH-0902(040)~67674

STATE	YEAR
ALASKA	2014


SHEET NUMBER	TOTAL SHEETS
F5	66

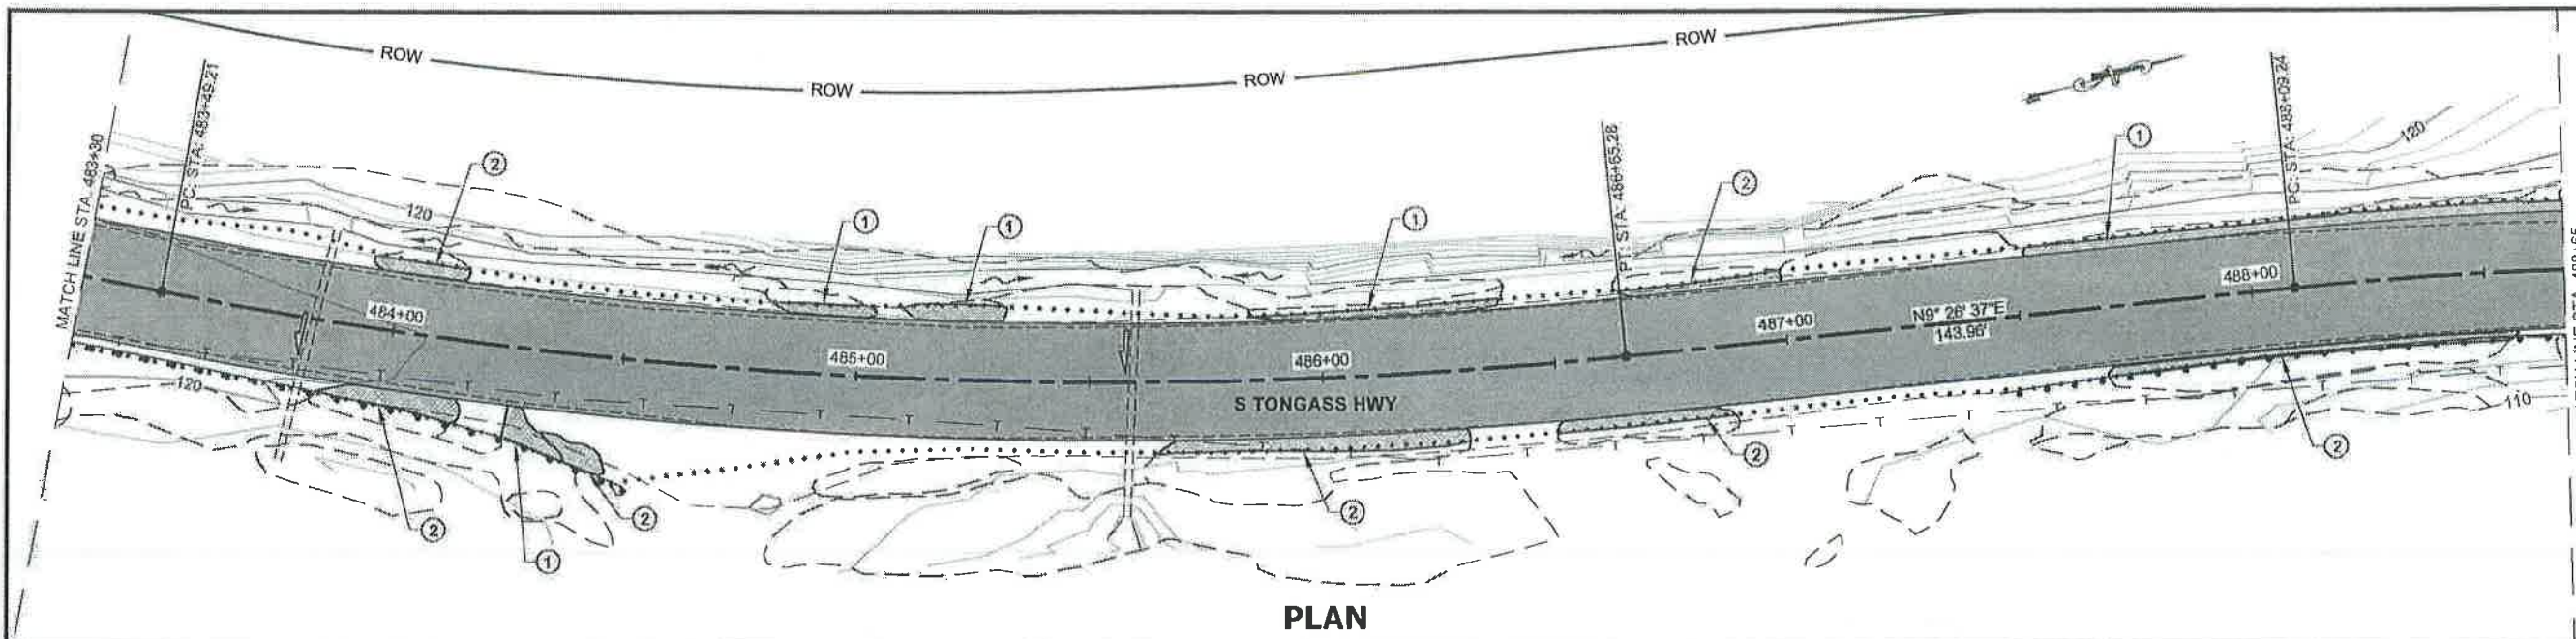

PLAN

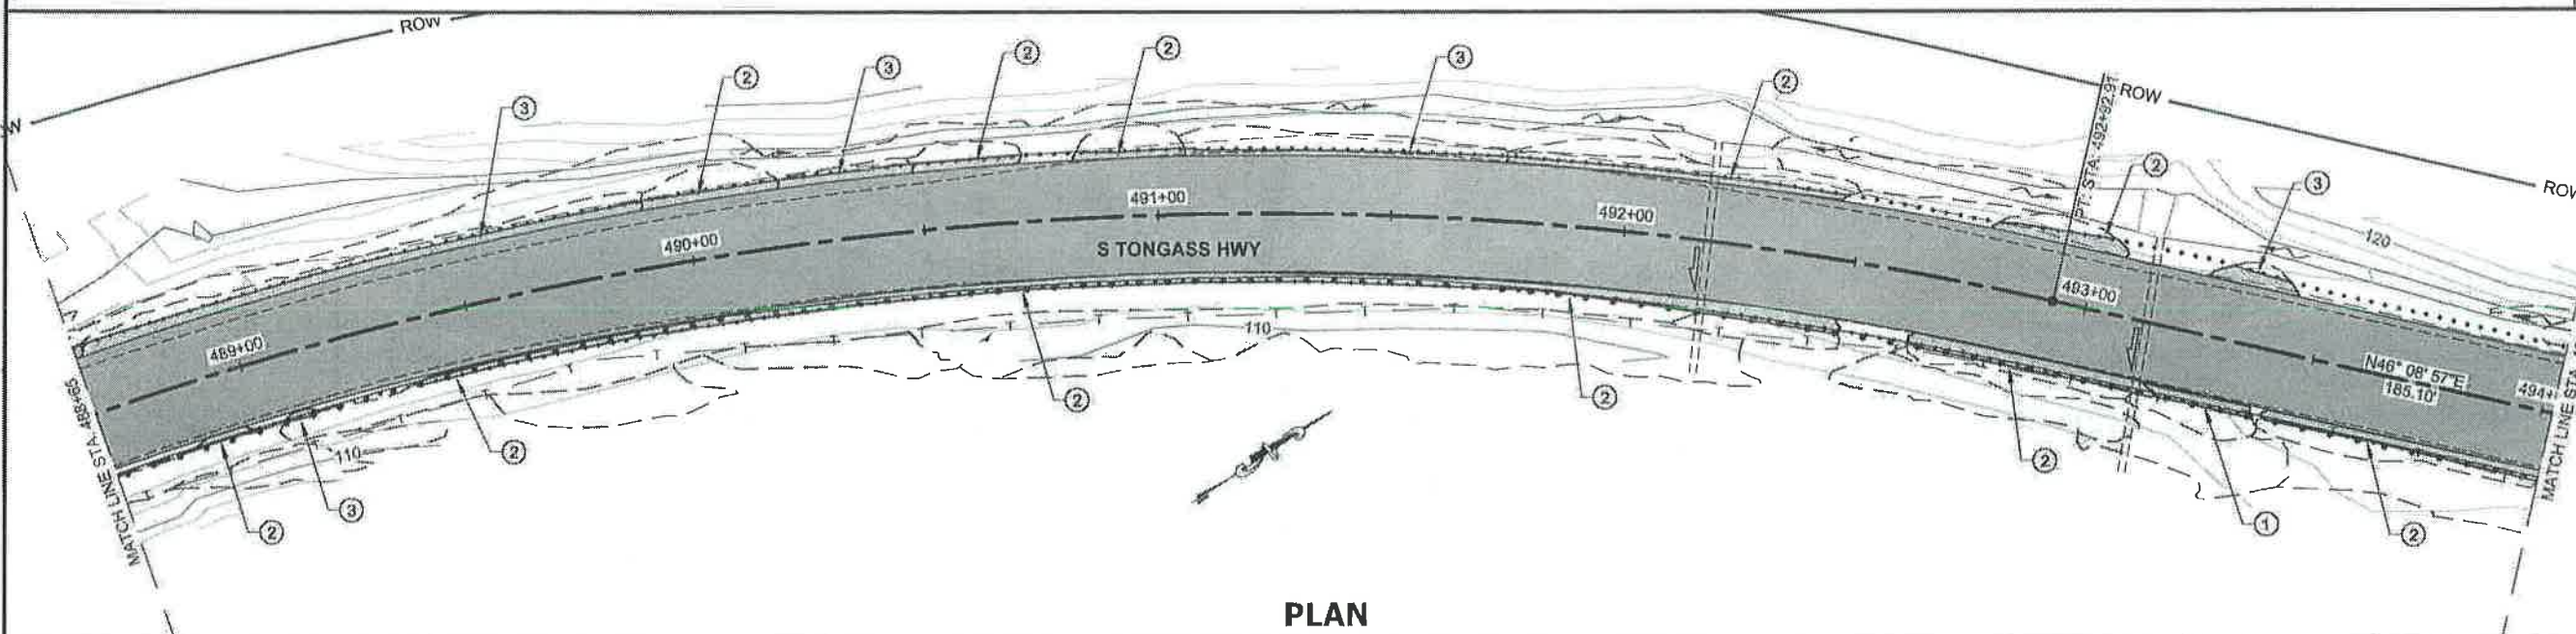

PLAN

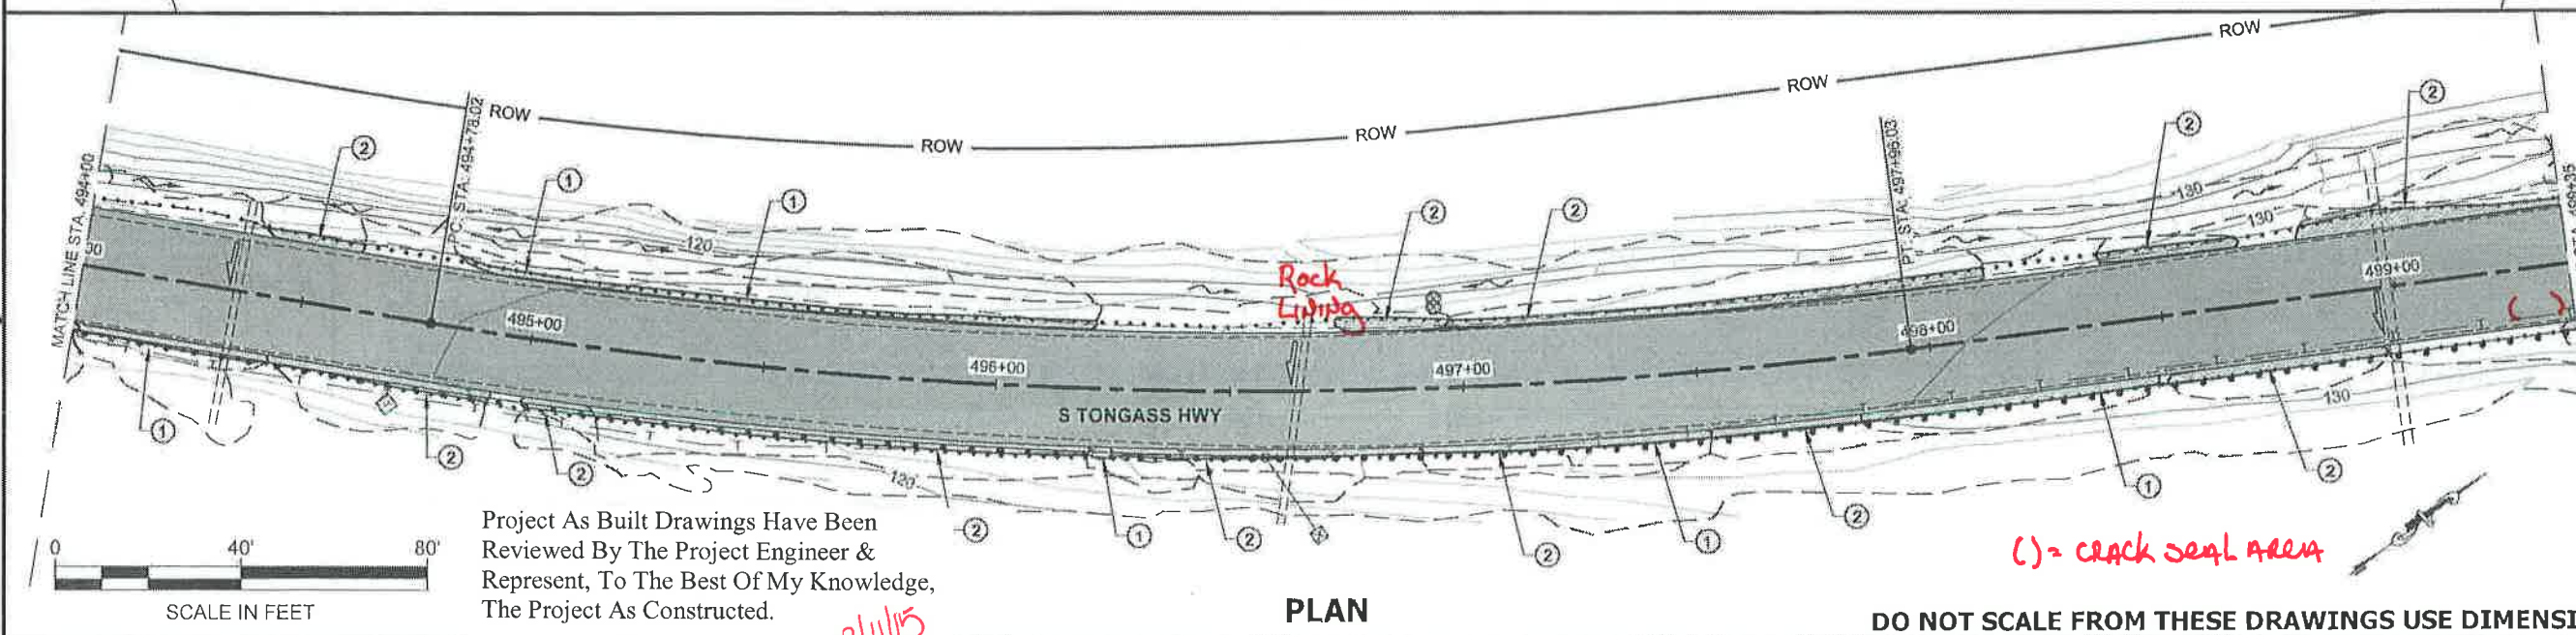

PLAN



Project As Built Drawings Have Been Reviewed By The Project Engineer & Represent, To The Best Of My Knowledge, The Project As Constructed.

Proj. Eng. MB Date 12/11/15

DO NOT SCALE FROM THESE DRAWINGS USE DIMENSIONS

PATH:
Q:\KTN\67674\PLANSET\67674_F1-F15_PLAN.DWG
TAB: F6

GRANTHAM, RICK L (DOT)
Thursday, November 06, 2014 7:00:58 AM

ADDENDUM NUMBER

ATTACHMENT NUMBER

RECORD OF REVISIONS

No	DATE	DESCRIPTION

PLAN LEGEND

CHECKED BY: M. VAN ALSTINE

DESIGNED BY: L. SEIFERT
DRAWN BY: R. GRANTHAM

STATE OF ALASKA
DEPARTMENT OF TRANSPORTATION
& PUBLIC FACILITIES
SOUTHEAST REGION


KTN-SOUTH TONGASS PAVING
PROJECT #67674

PLAN VIEW


PROJECT DESIGNATION
STP-NH-0902(040)~67674

STATE	YEAR
ALASKA	2014


SHEET NUMBER	TOTAL SHEETS
F6	66

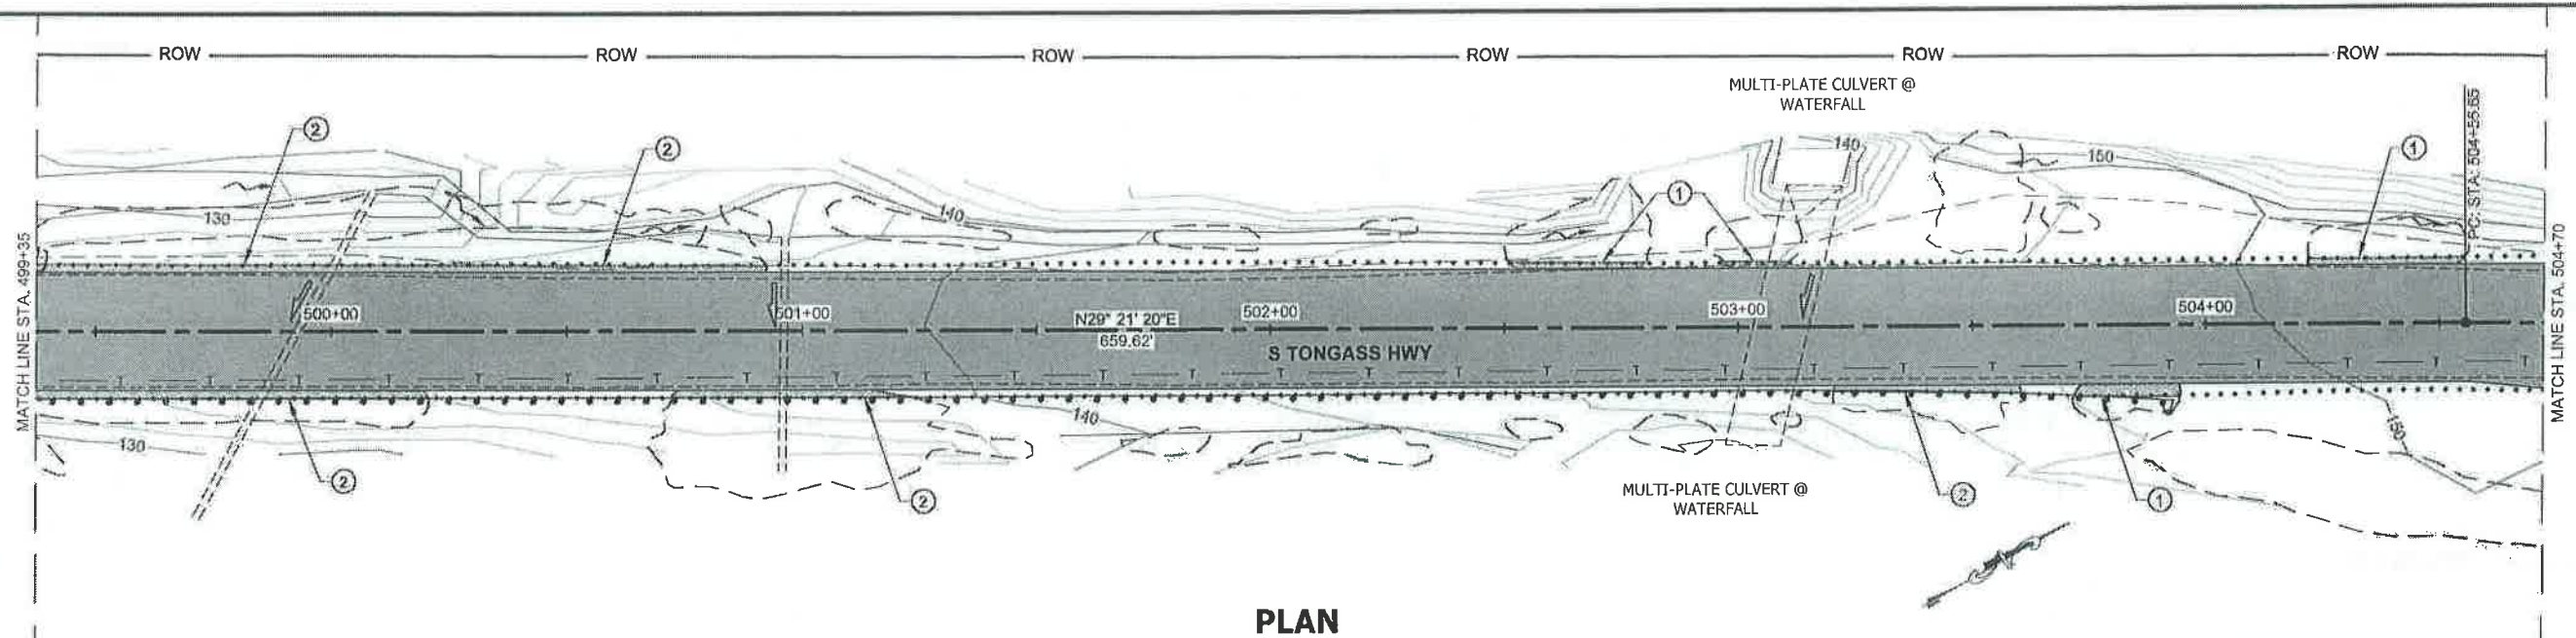

PLAN

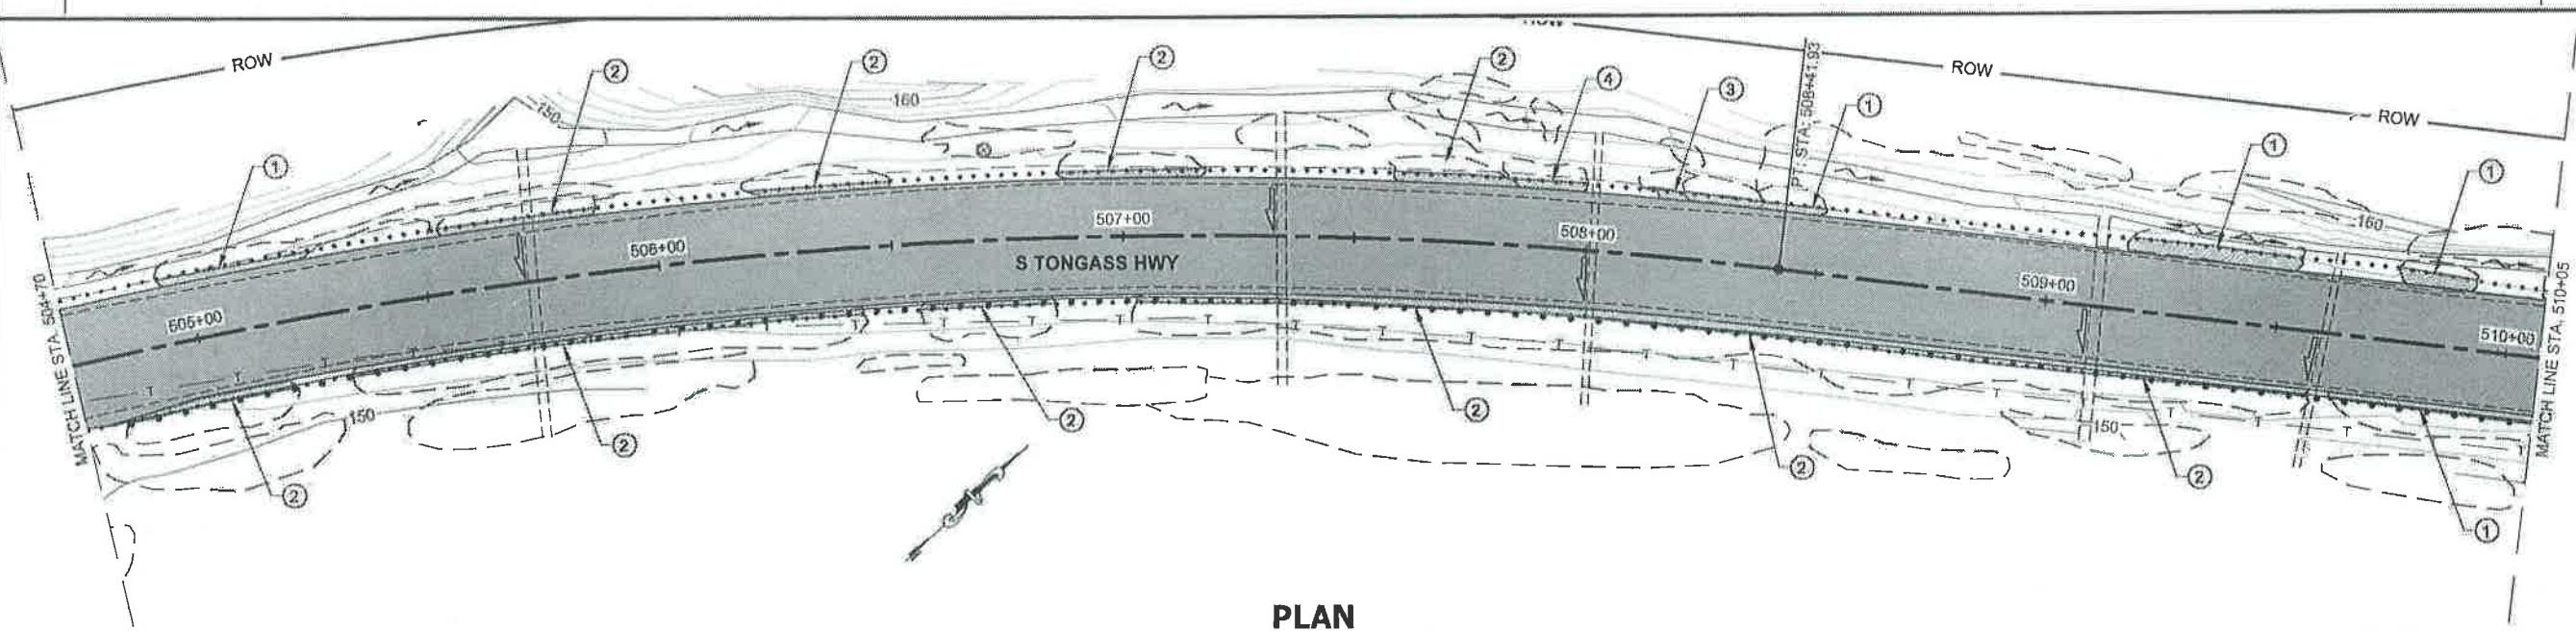

PLAN

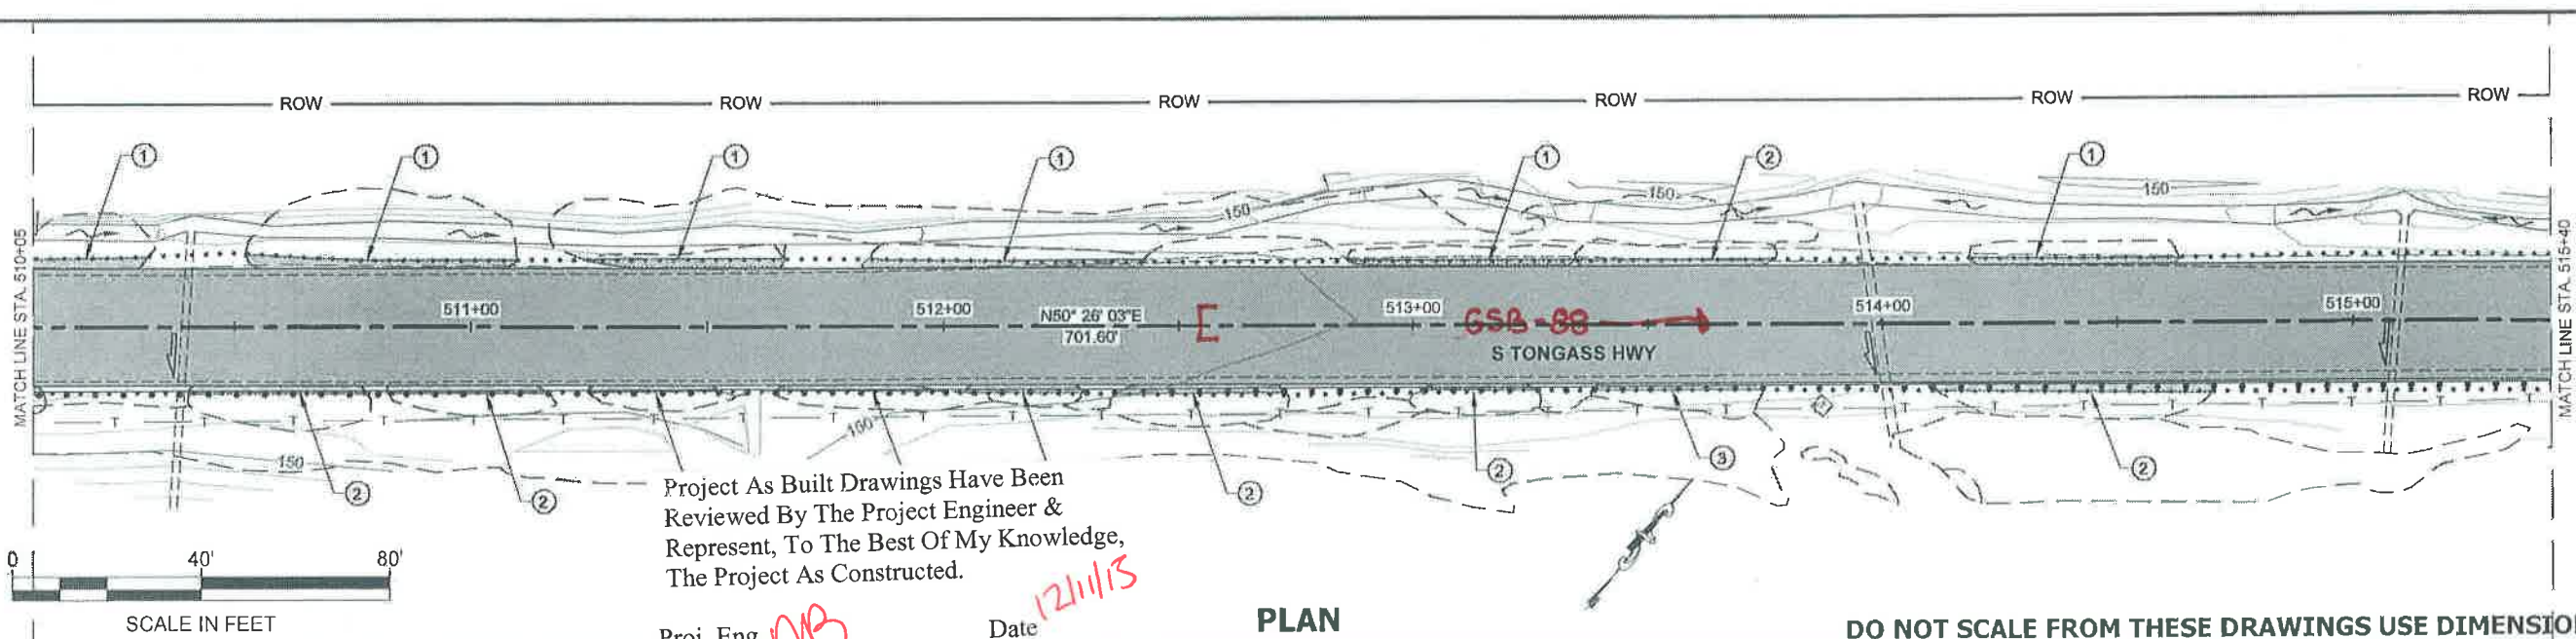

PLAN



Project As Built Drawings Have Been Reviewed By The Project Engineer & Represent, To The Best Of My Knowledge, The Project As Constructed.

Proj. Eng. *MB*

Date *12/11/13*

DO NOT SCALE FROM THESE DRAWINGS USE DIMENSIONS

PATH:
Q:\KTN\67674\PLANSET\67674_F1-F15_PLAN.DWG
TAB: F7

GRANTHAM, RICK L (DOT)
Thursday, November 06, 2014 7:01:22 AM

ADDENDUM NUMBER

ATTACHMENT NUMBER

RECORD OF REVISIONS

No	DATE	DESCRIPTION

PLAN LEGEND

CHECKED BY: M. VAN ALSTINE

DESIGNED BY: L. SEIFERT
DRAWN BY: R. GRANTHAM

STATE OF ALASKA
DEPARTMENT OF TRANSPORTATION
& PUBLIC FACILITIES
SOUTHEAST REGION

KTN-SOUTH TONGASS PAVING
PROJECT #67674

11/6/14


PLAN VIEW

PROJECT DESIGNATION


STP-NH-0902(040)~67674

STATE	YEAR
ALASKA	2014


SHEET NUMBER	TOTAL SHEETS
F7	66

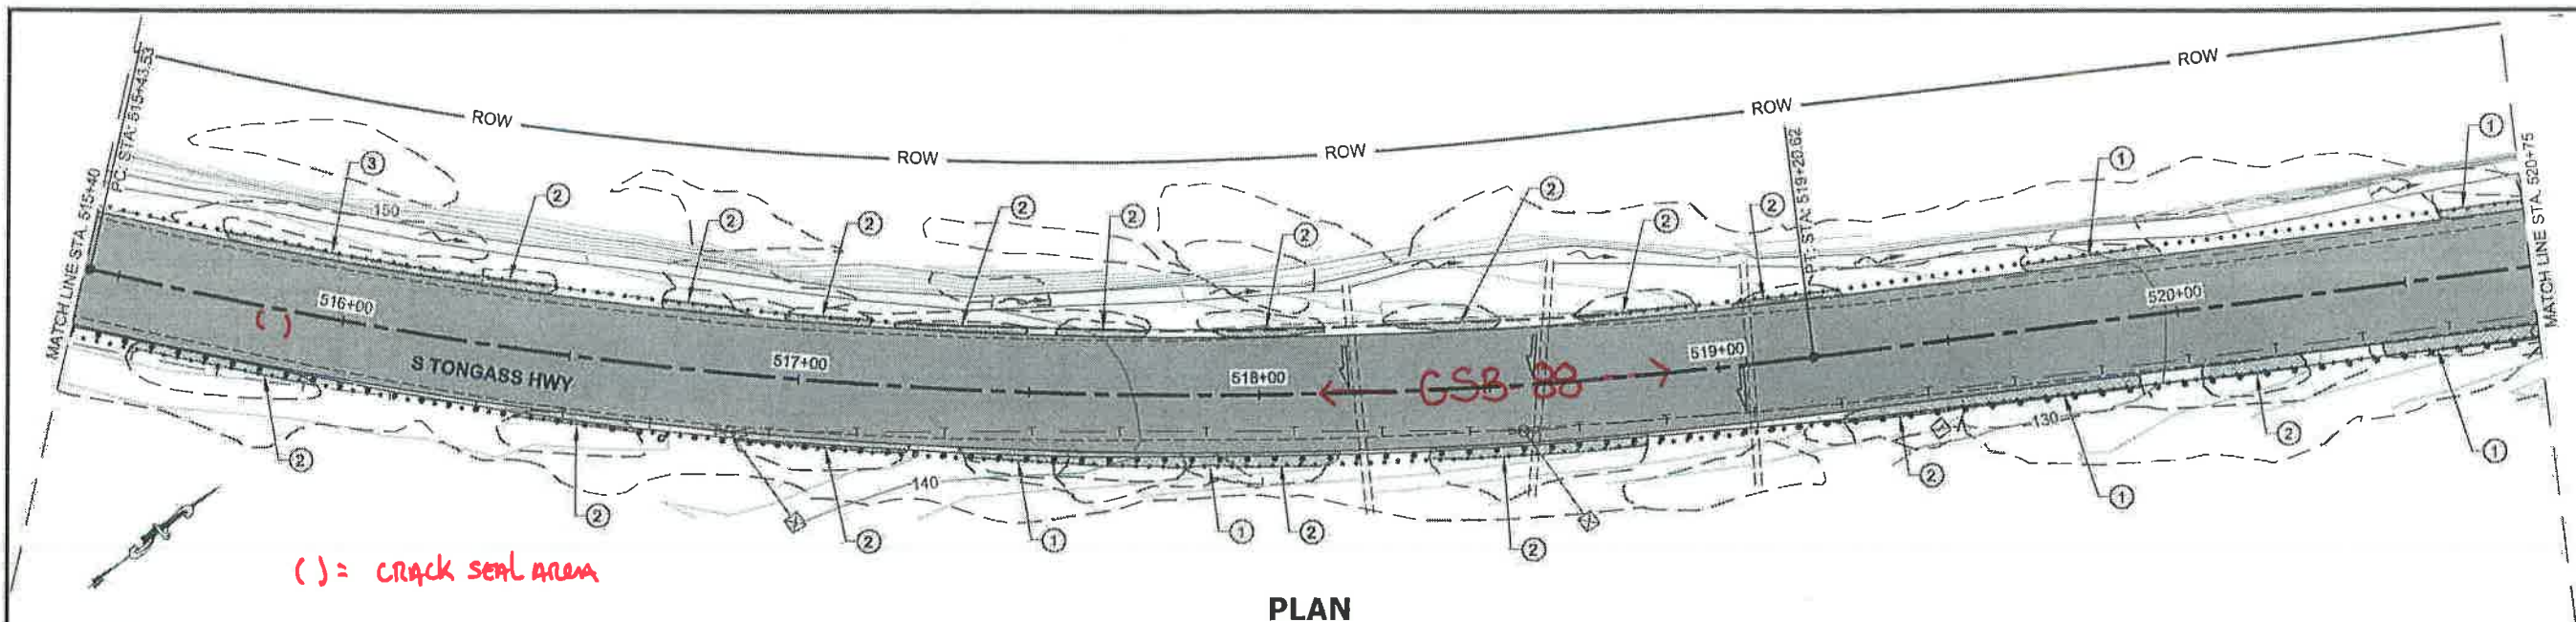

PLAN

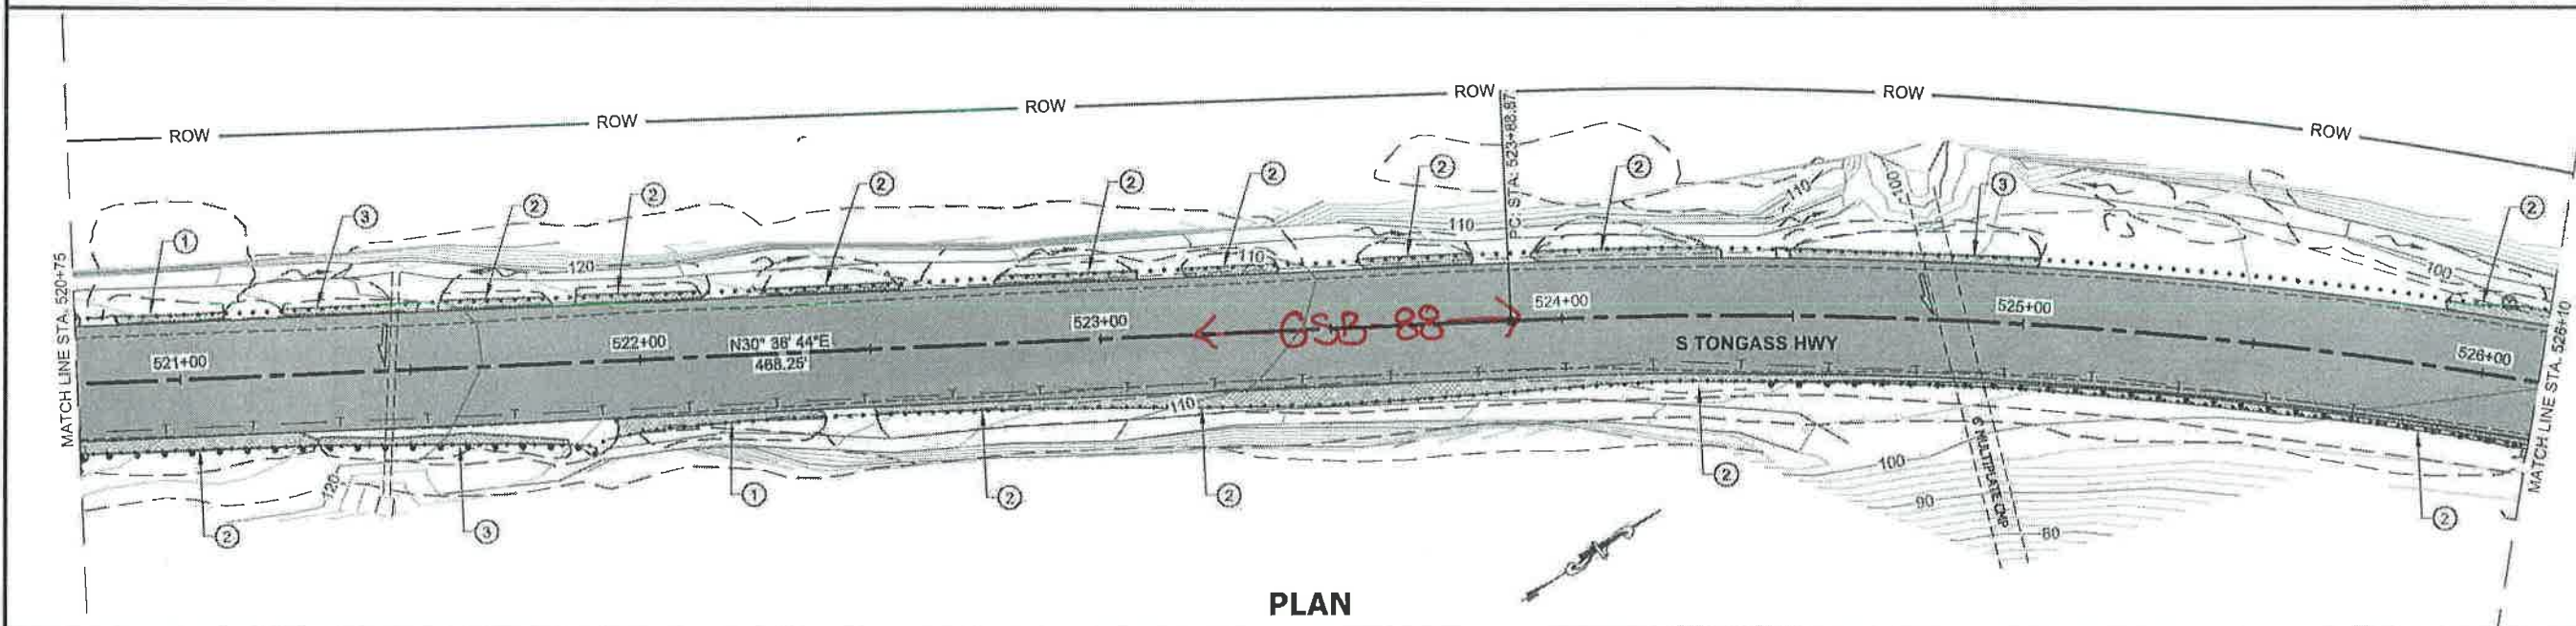

PLAN

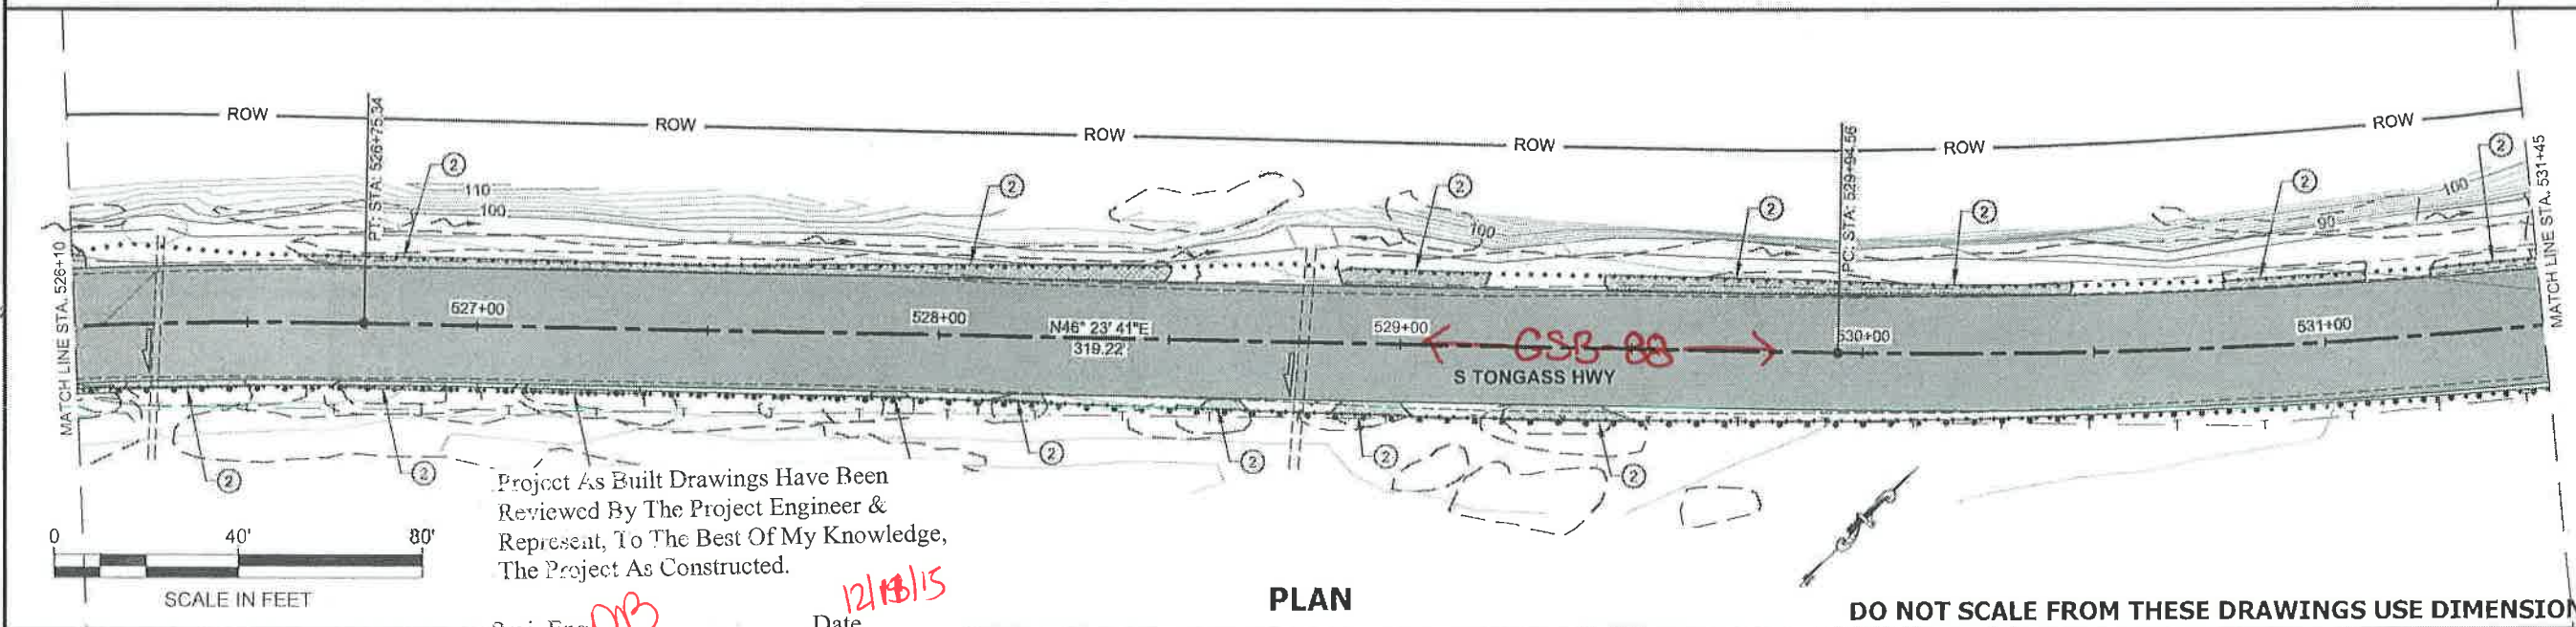

PLAN

Project As Built Drawings Have Been Reviewed By The Project Engineer & Represent, To The Best Of My Knowledge, The Project As Constructed.

Proj. Eng. *MB* Date *12/13/15*

DO NOT SCALE FROM THESE DRAWINGS USE DIMENSIONS

PATH
Q:\KTN\67674\PLANSET\67674_F1-F15_PLAN.DWG
TAB: F8

GRANTHAM, RICK L (DOT)
Thursday, November 06, 2014 7:01:35 AM

ADDENDUM NUMBER

ATTACHMENT NUMBER

RECORD OF REVISIONS

No.	DATE	DESCRIPTION

PLAN LEGEND

CHECKED BY: M. VAN ALSTINE

DESIGNED BY: L. SEIFERT

DRAWN BY: R. GRANTHAM

STATE OF ALASKA
DEPARTMENT OF TRANSPORTATION
& PUBLIC FACILITIES
SOUTHEAST REGION




KTN-SOUTH TONGASS PAVING
PROJECT #67674

PLAN VIEW

PROJECT DESIGNATION
STP-NH-0902(040)~67674

STATE	YEAR
ALASKA	2014

SHEET NUMBER	TOTAL SHEETS
F8	66

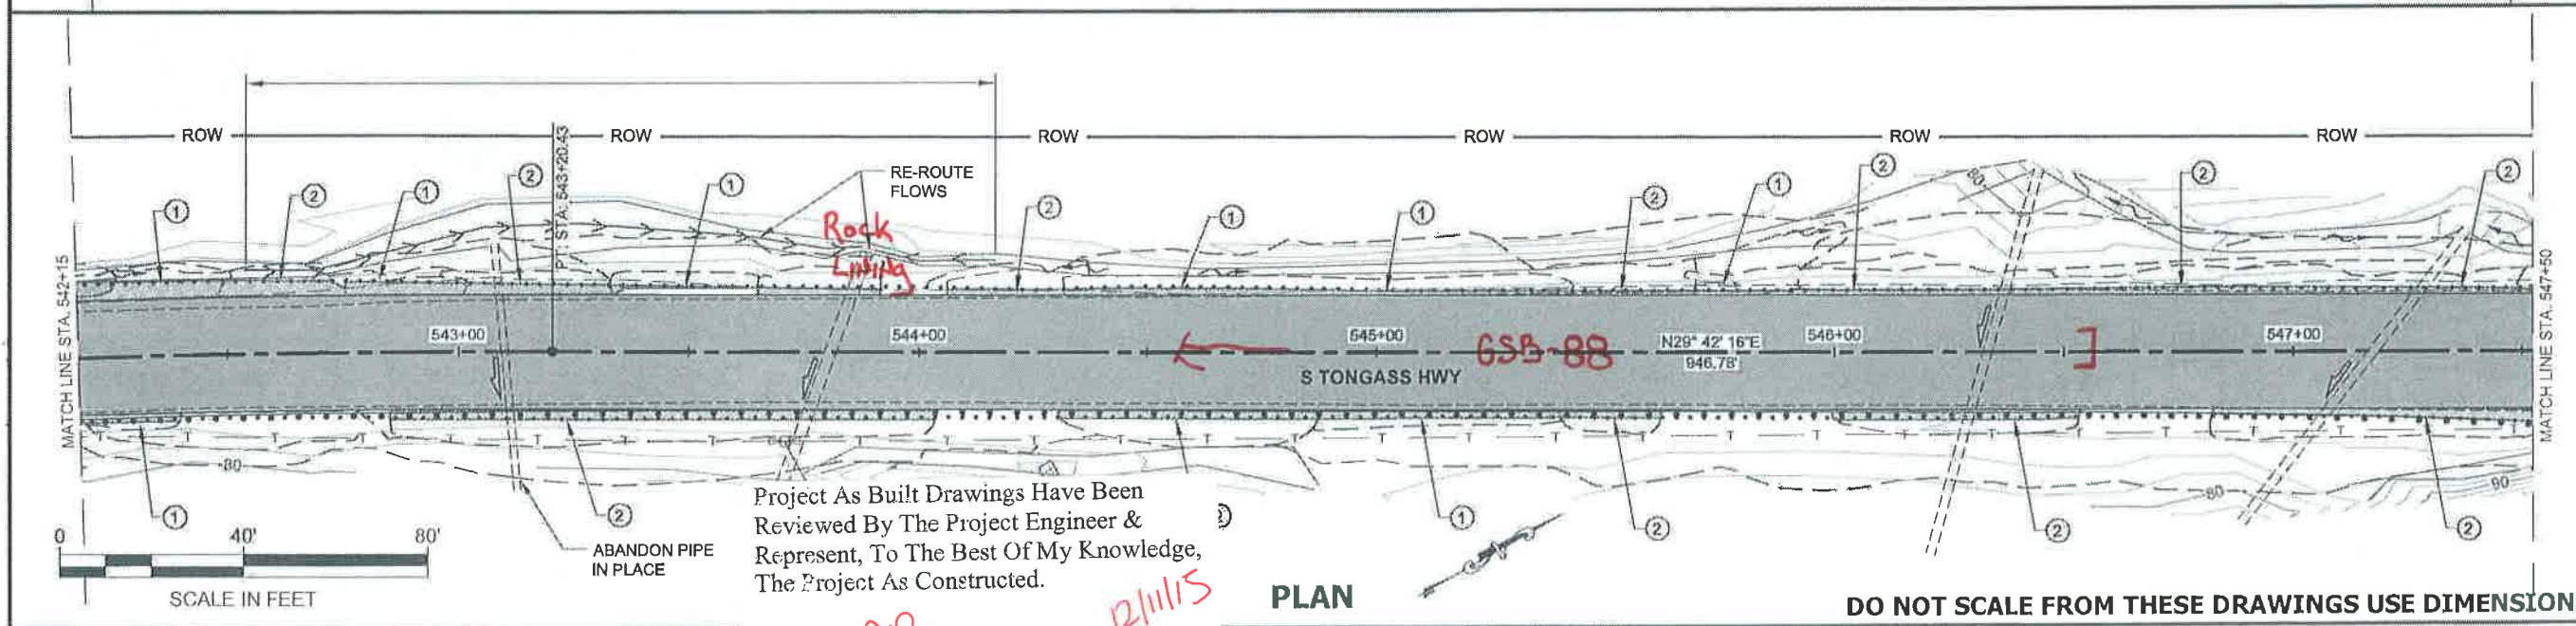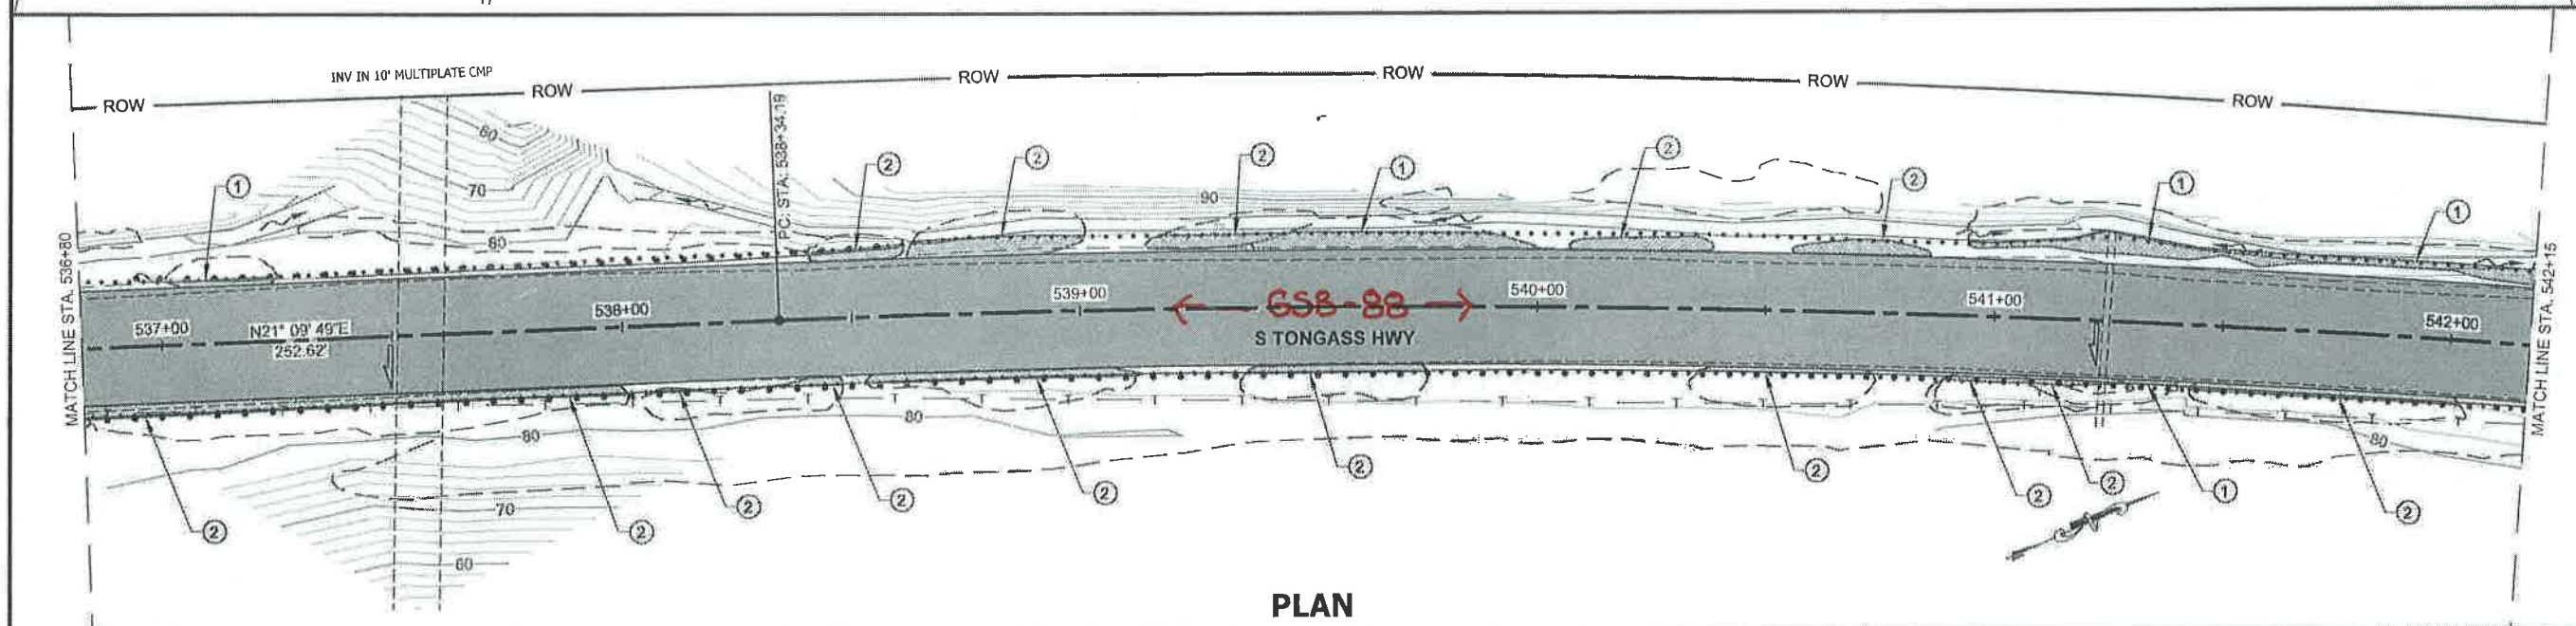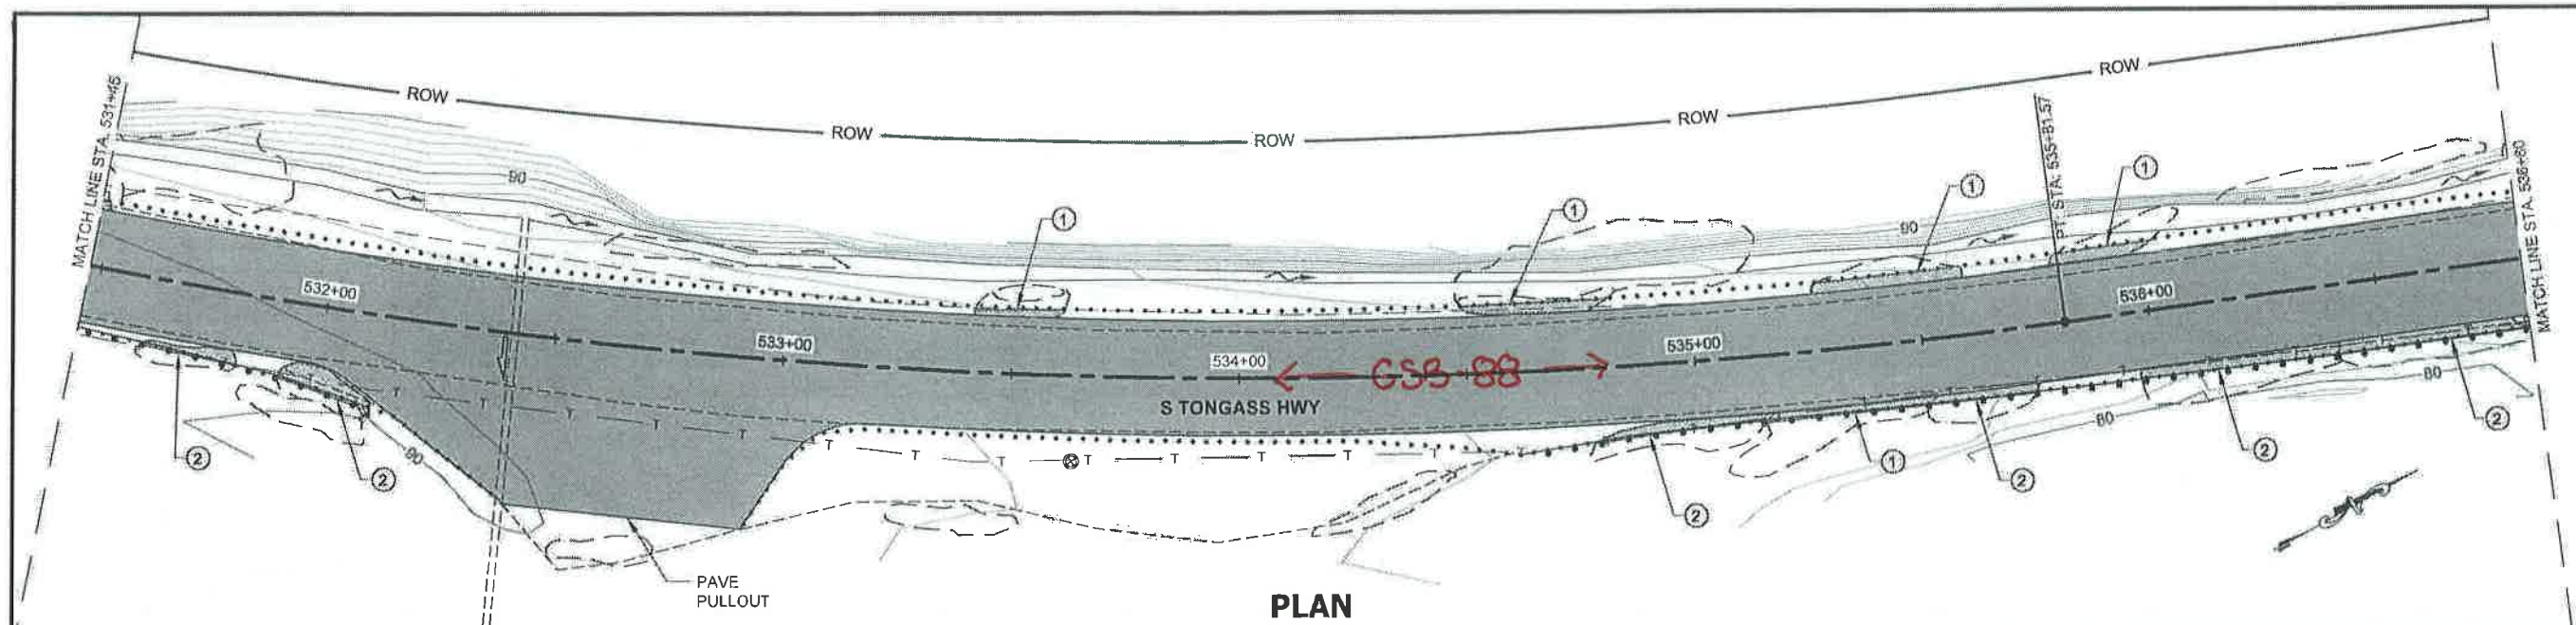

Project As Built Drawings Have Been Reviewed By The Project Engineer & Represent, To The Best Of My Knowledge, The Project As Constructed.

Proj. Eng. MB

Date 12/11/15

PATH: Q:\KTN\67674\PLANSET\67674_F1-F15_PLAN.DWG

TAB: F9

GRANTHAM, RICK L (DOT)




Thursday, November 06, 2014 7:01:49 AM

ADDENDUM NUMBER

ATTACHMENT NUMBER

RECORD OF REVISIONS

No. DATE DESCRIPTION

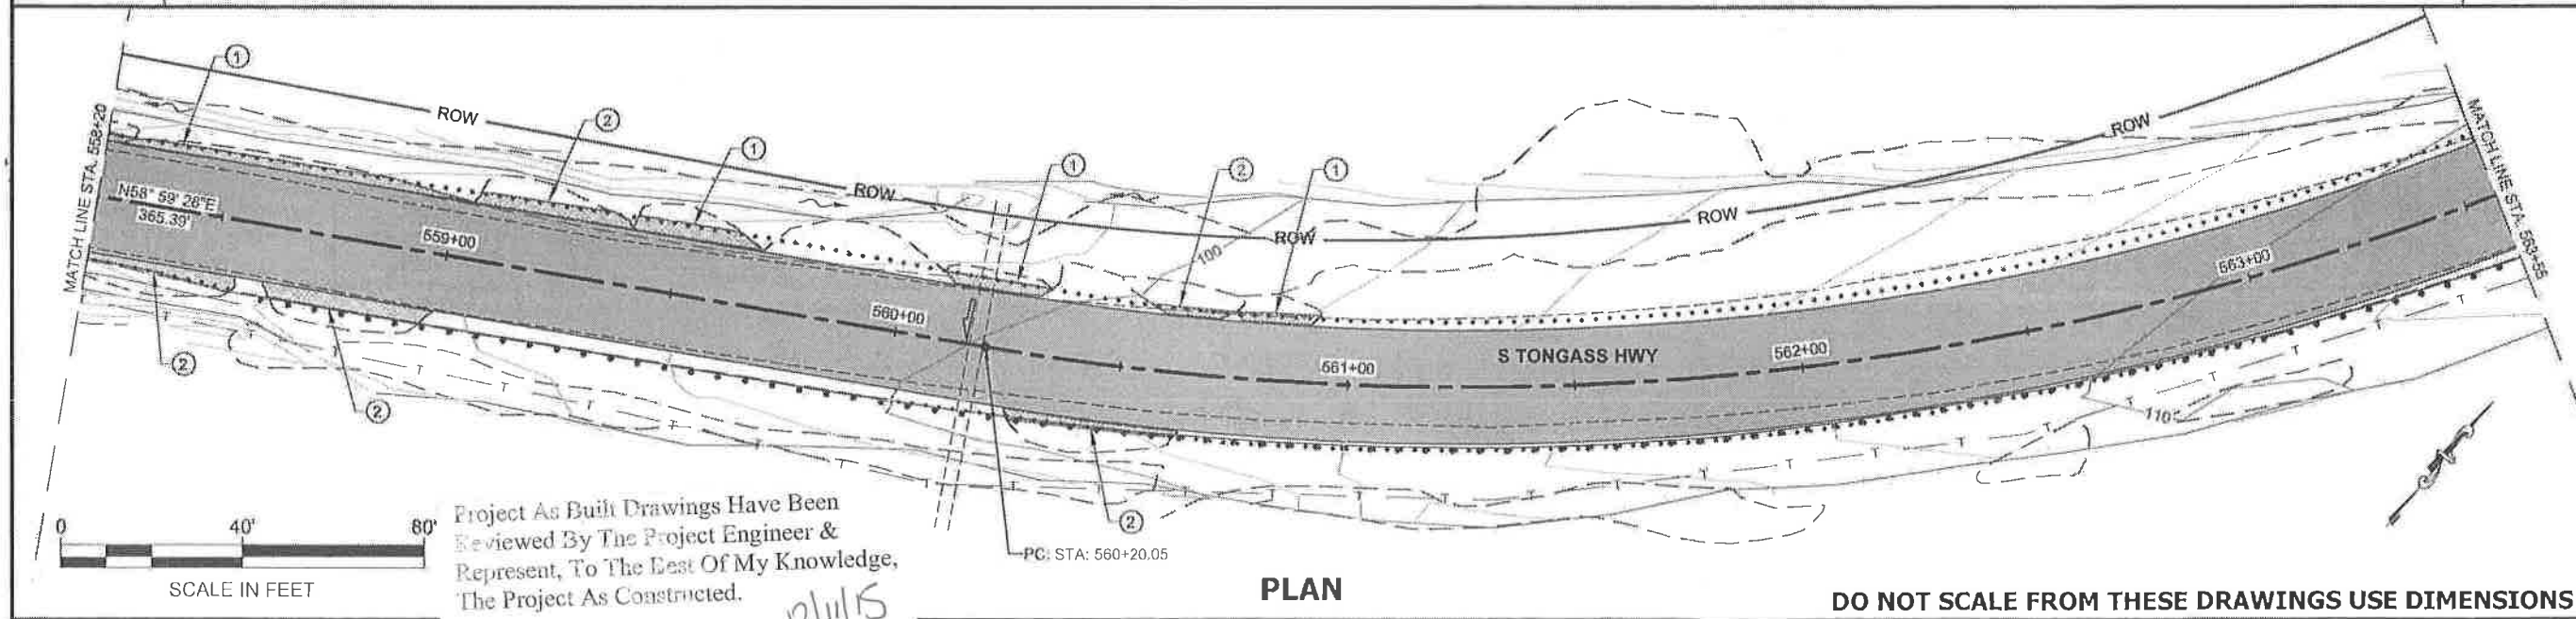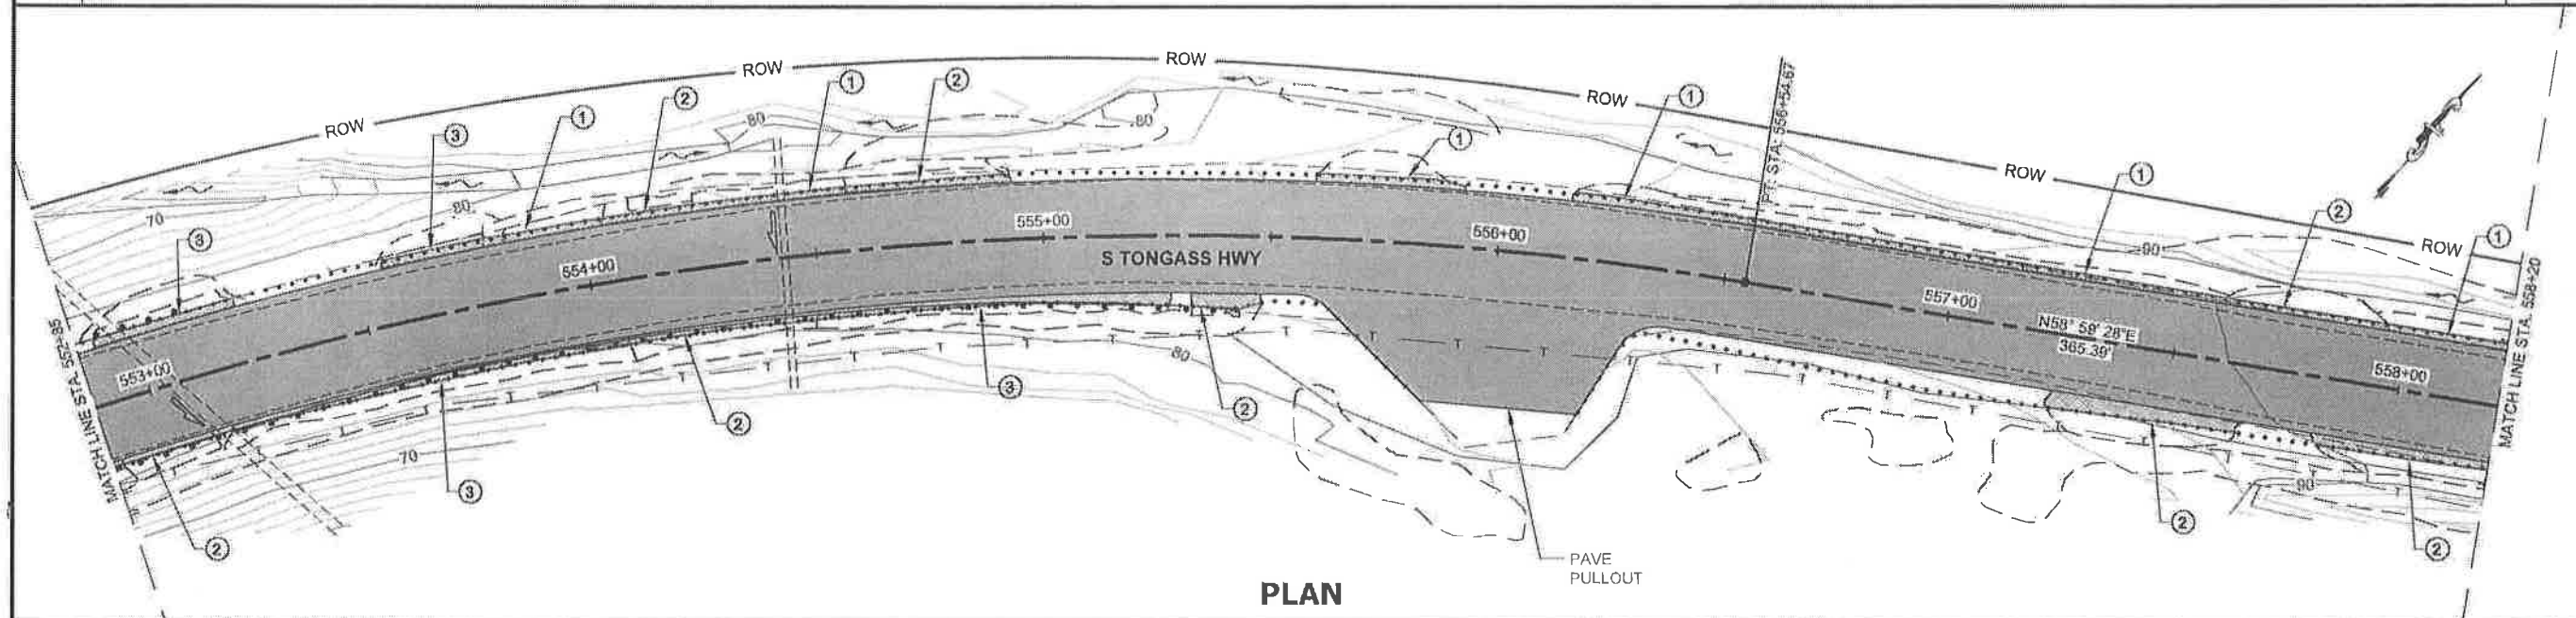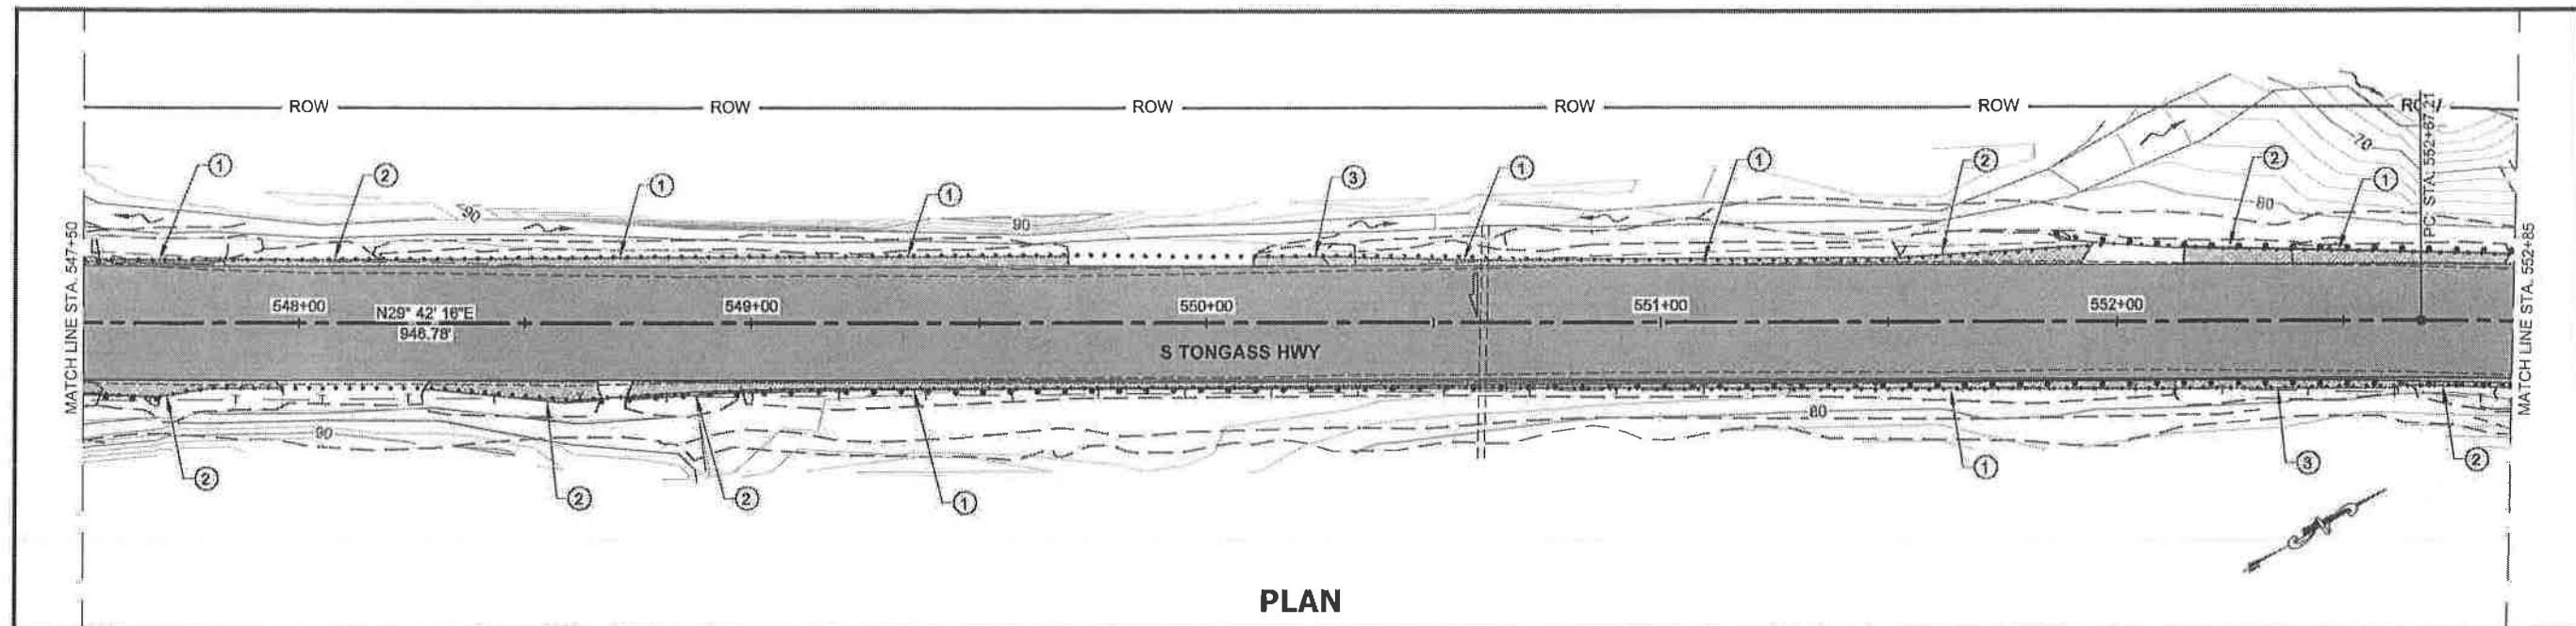


Project As Built Drawings Have Been Reviewed By The Project Engineer & Represent, To The Best Of My Knowledge, The Project As Constructed.

Proj. Eng. MB


Date 12/1/15

DO NOT SCALE FROM THESE DRAWINGS USE DIMENSIONS

PATH: Q:\KTN\67674\PLANSET\67674_F1-F15_PLAN.DWG
 TAB: F10
 GRANHAM, RICK L (DOT)
 Thursday, November 06, 2014 7:02:02 AM
 ADDENDUM NUMBER
 ATTACHMENT NUMBER
 RECORD OF REVISIONS
 No. DATE DESCRIPTION
 PLAN LEGEND
 CHECKED BY: M. VAN ALSTINE
 DESIGNED BY: L. SEIFERT
 DRAWN BY: R. GRANHAM
 STATE OF ALASKA
 DEPARTMENT OF TRANSPORTATION
 & PUBLIC FACILITIES
 SOUTHEAST REGION
 KTN-SOUTH TONGASS PAVING
 PROJECT #67674
 PLAN VIEW
 PROJECT DESIGNATION
 STP-NH-0902(040)~67674
 STATE ALASKA
 YEAR 2014
 SHEET NUMBER F10
 TOTAL SHEETS 66

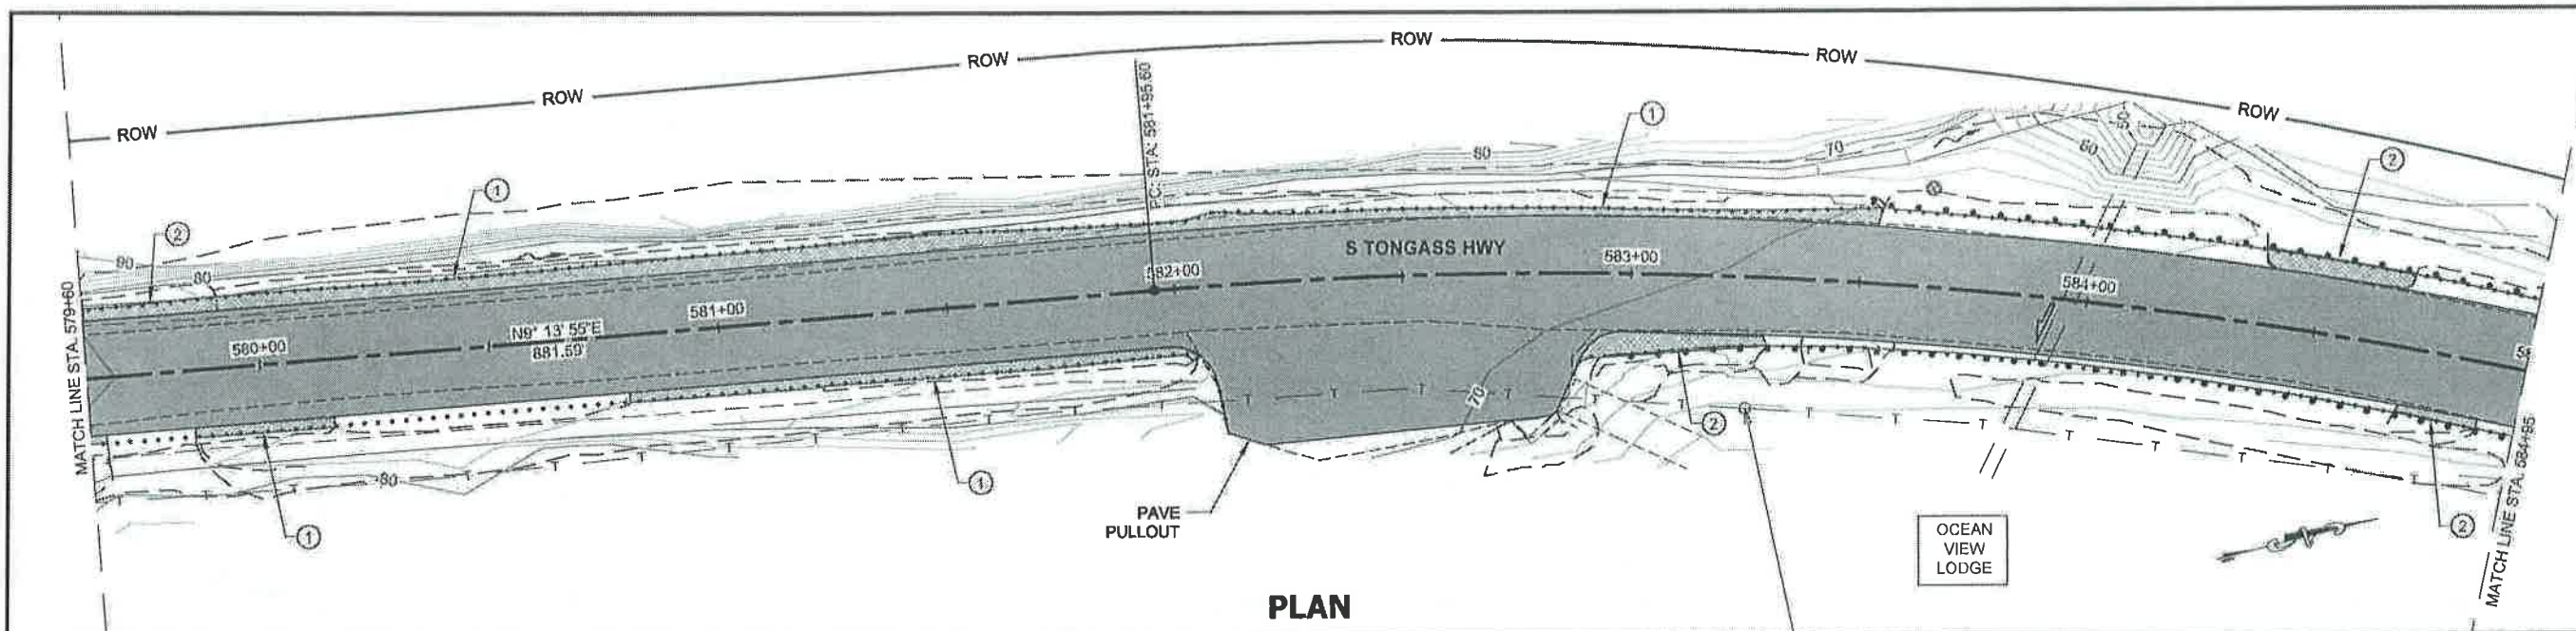

PLAN

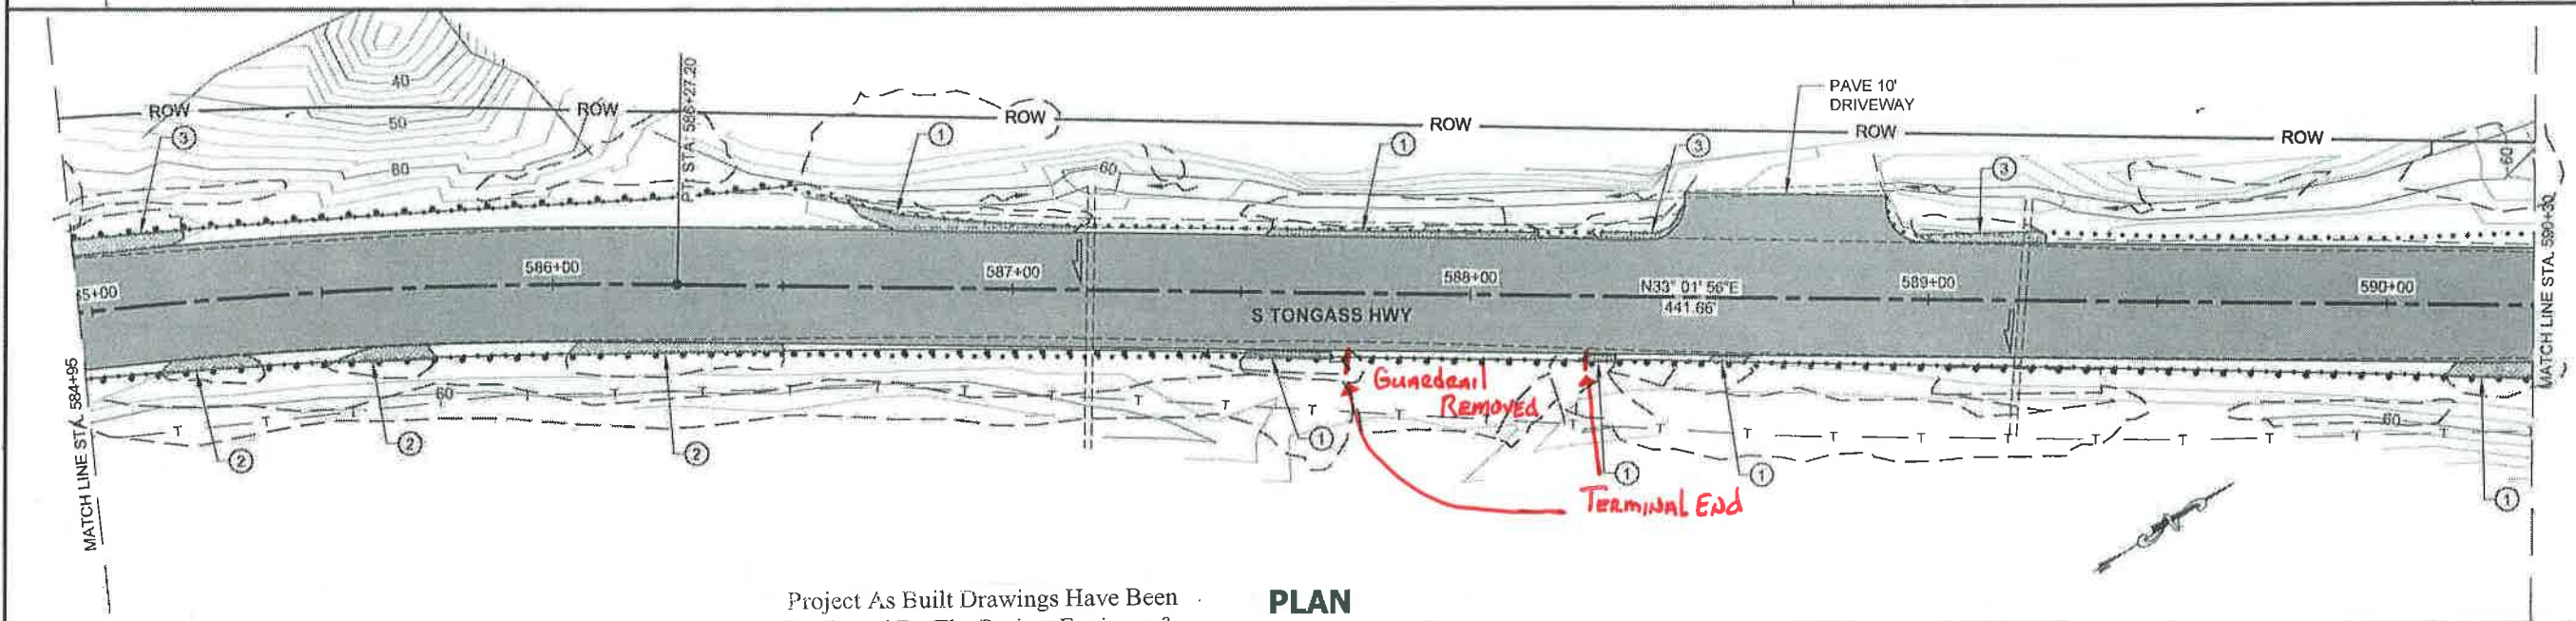


PLAN

Project As Built Drawings Have Been Reviewed By The Project Engineer & Represent, To The Best Of My Knowledge, The Project As Constructed.

Proj. Eng. *MB*


Date *12/1/15*

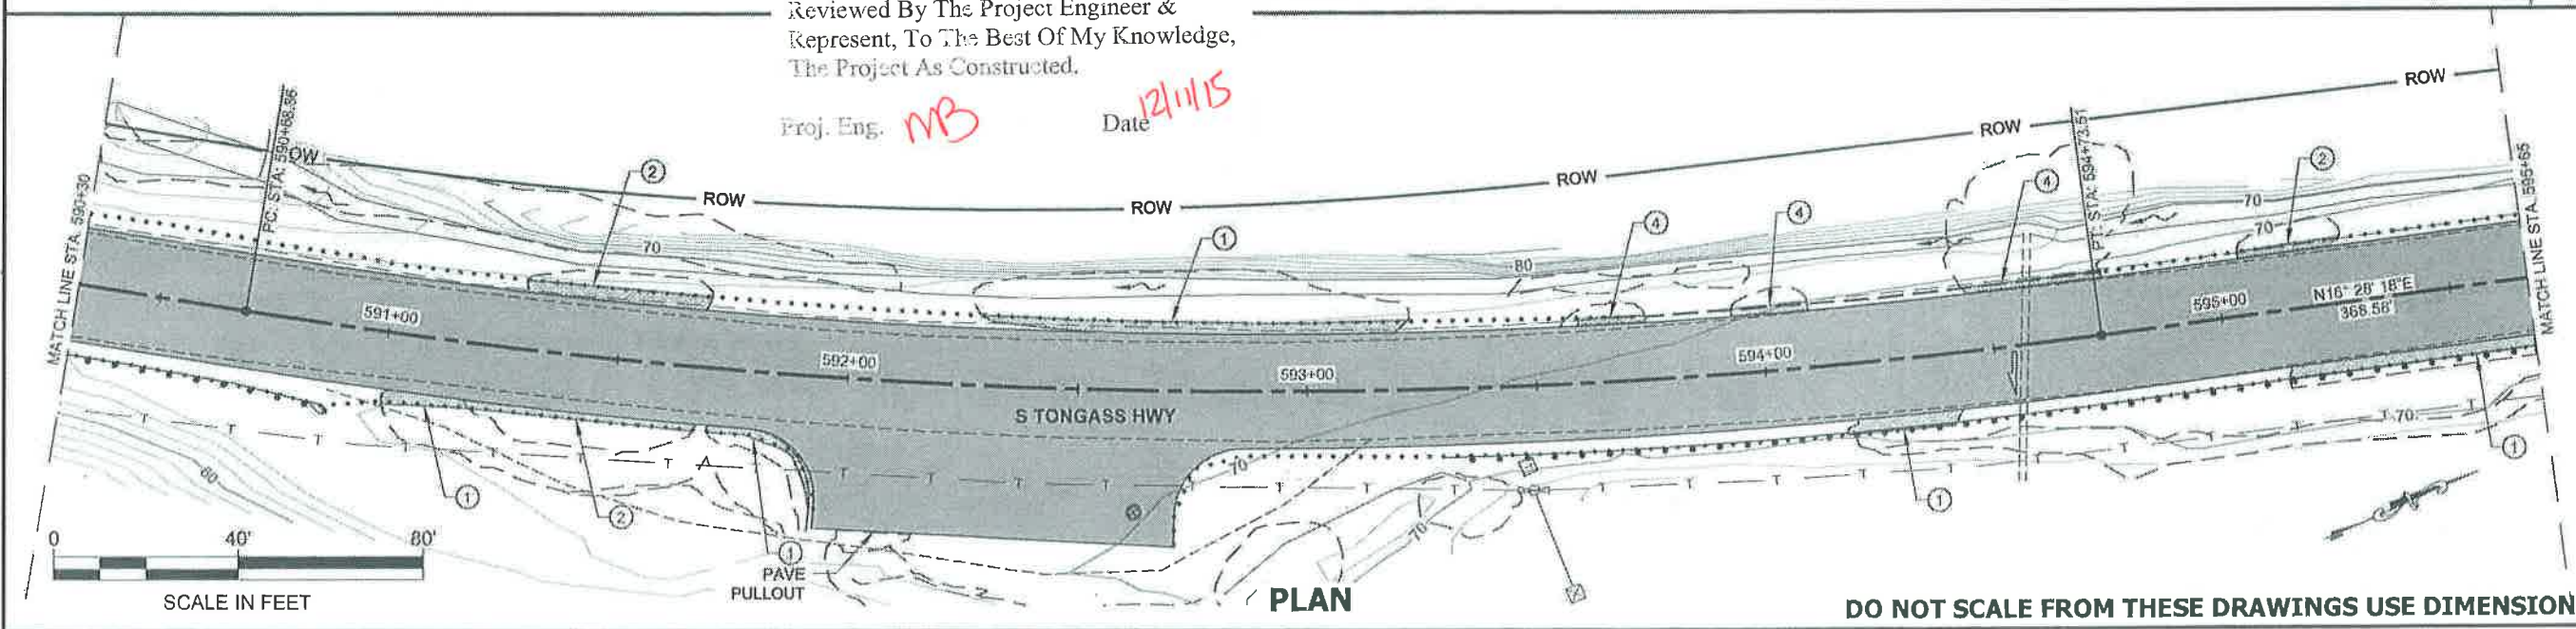

PLAN

SCALE IN FEET

DO NOT SCALE FROM THESE DRAWINGS USE DIMENSIONS

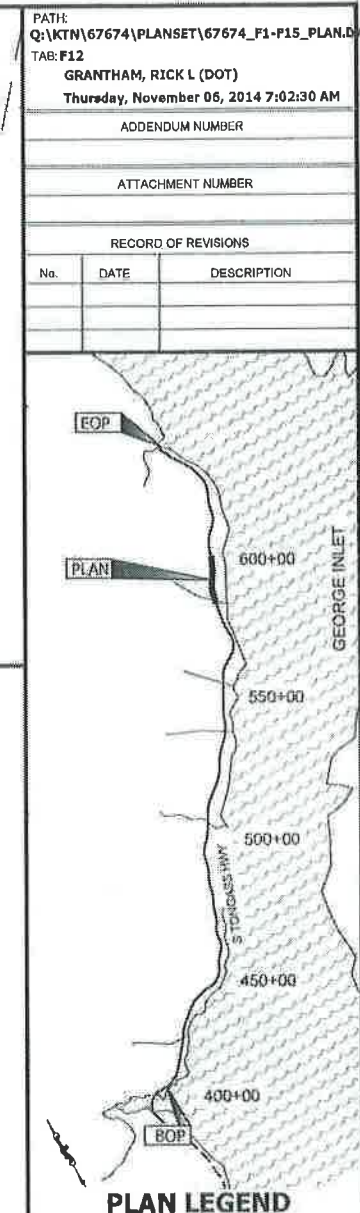

CHECKED BY: M. VAN ALSTINE



DESIGNED BY: L. SEIFERT

DRAWN BY: R. GRANTHAM


STATE OF ALASKA
DEPARTMENT OF TRANSPORTATION
& PUBLIC FACILITIES
SOUTHEAST REGION

KTN-SOUTH TONGASS PAVING
PROJECT #67674

PLAN VIEW


PROJECT DESIGNATION
STP-NH-0902(040)~67674

STATE	YEAR
ALASKA	2014
SHEET NUMBER	TOTAL SHEETS
F12	66

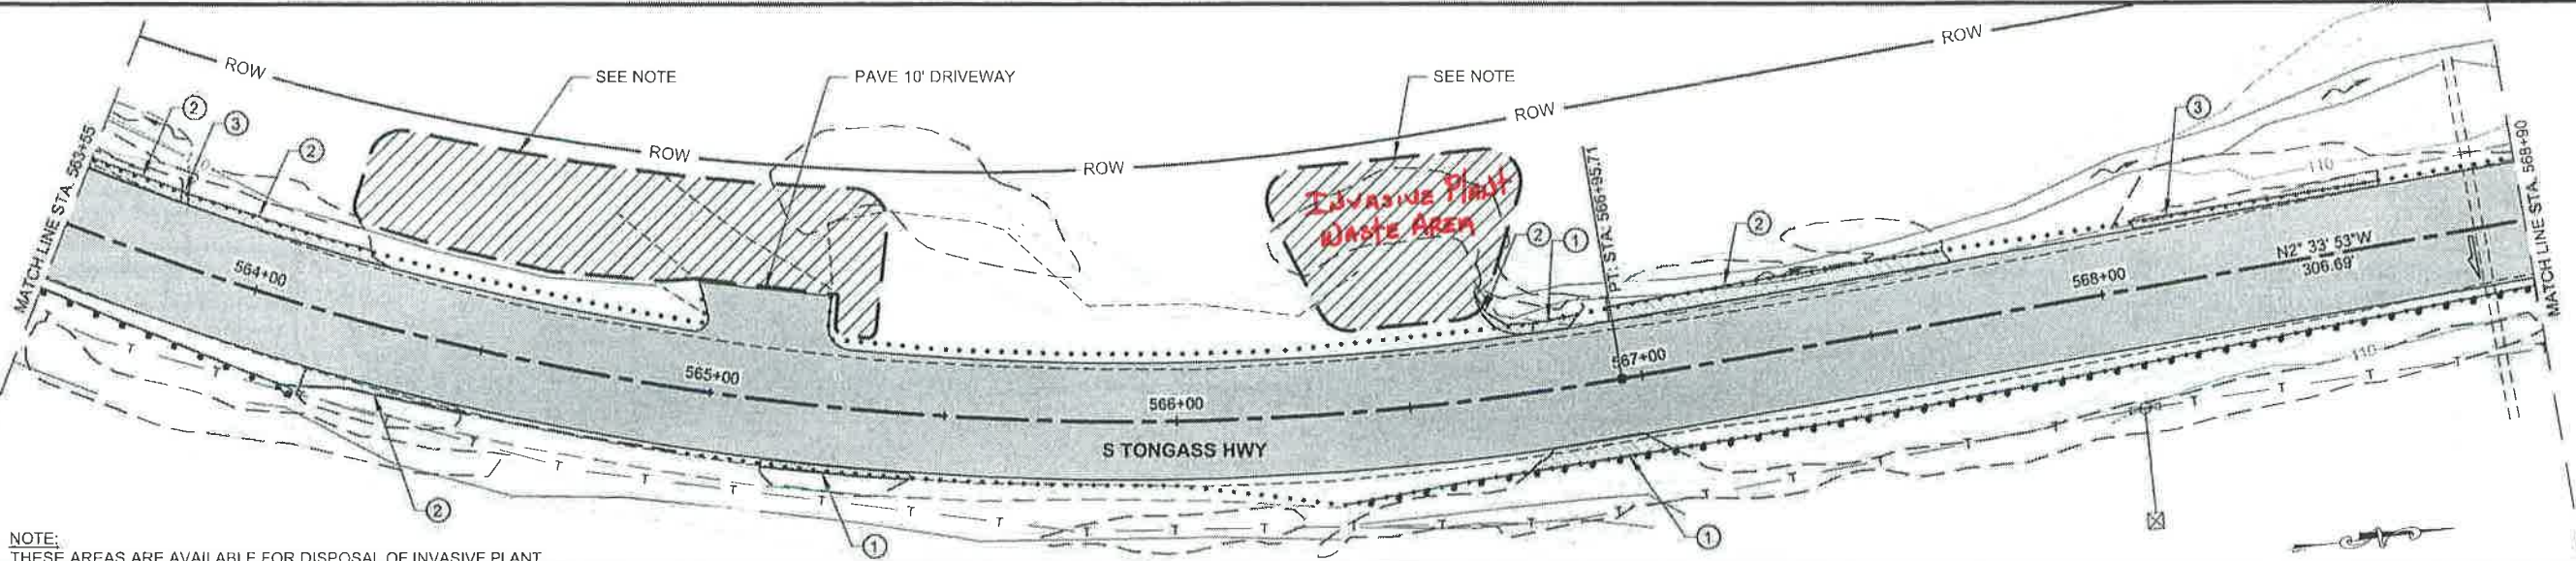


NOTE:
 THESE AREAS ARE AVAILABLE FOR DISPOSAL OF INVASIVE PLANT SPECIES. CONTRACTOR SHALL PROVIDE SURVEY AND FLAGGING OF THESE AREAS IN ACCORDANCE WITH SECTION 642 OF THE SPECIFICATIONS AND TO SATISFACTION OF THE PROJECT ENGINEER.

PLAN

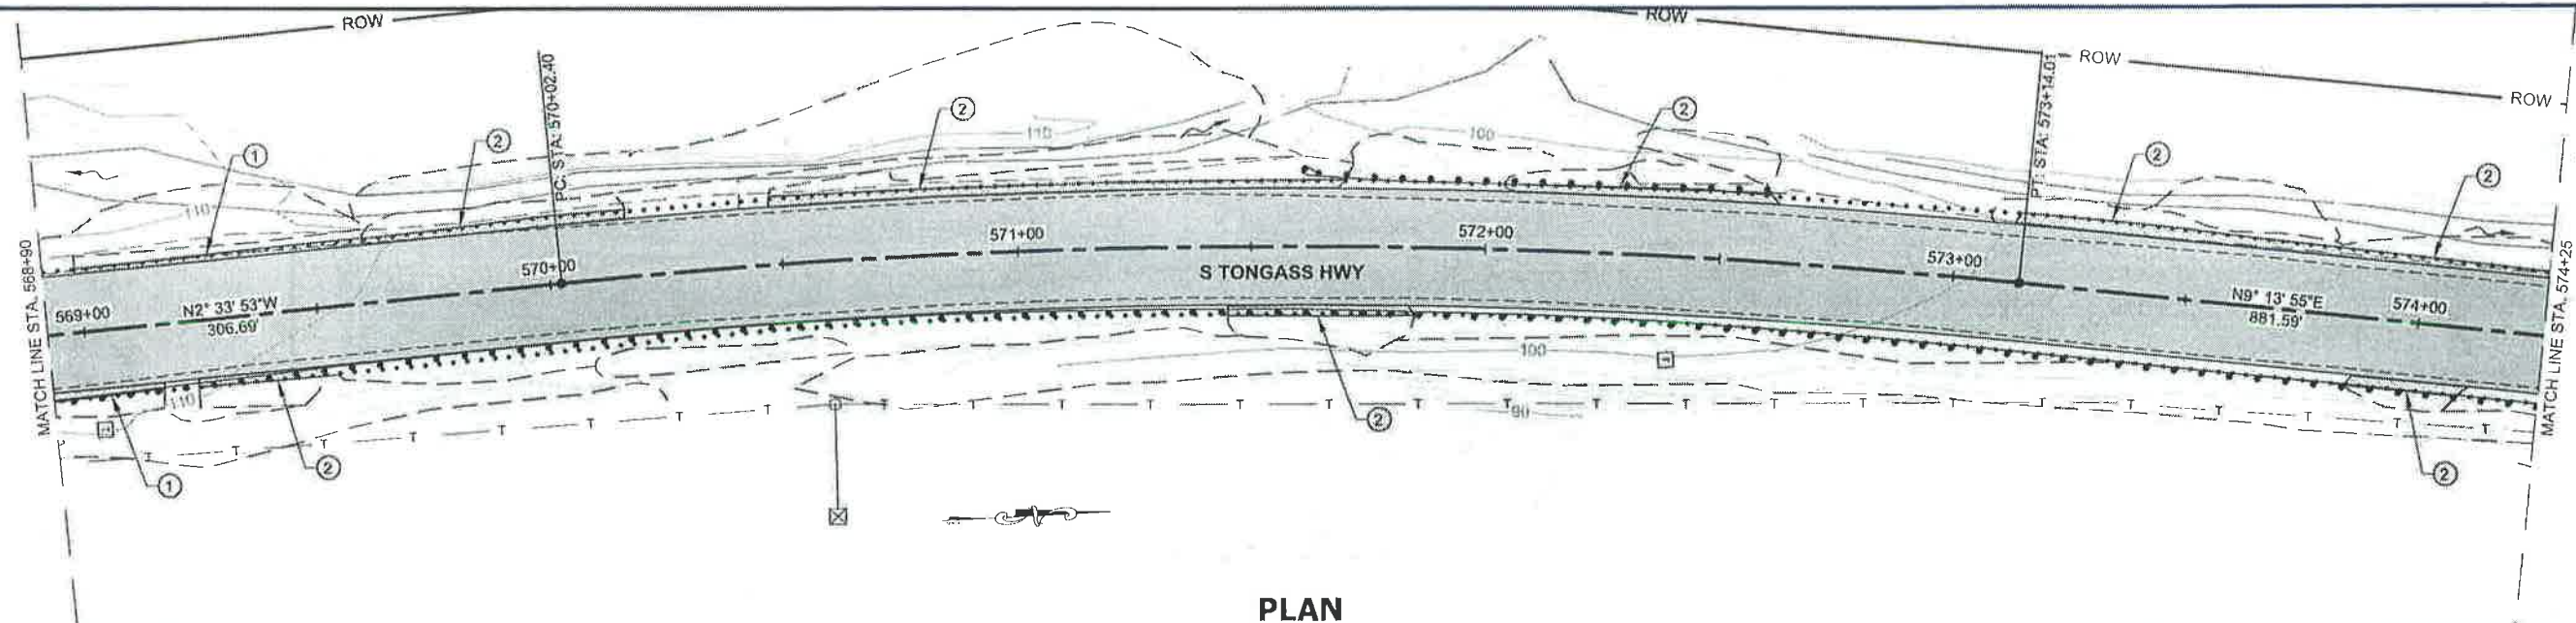

PLAN

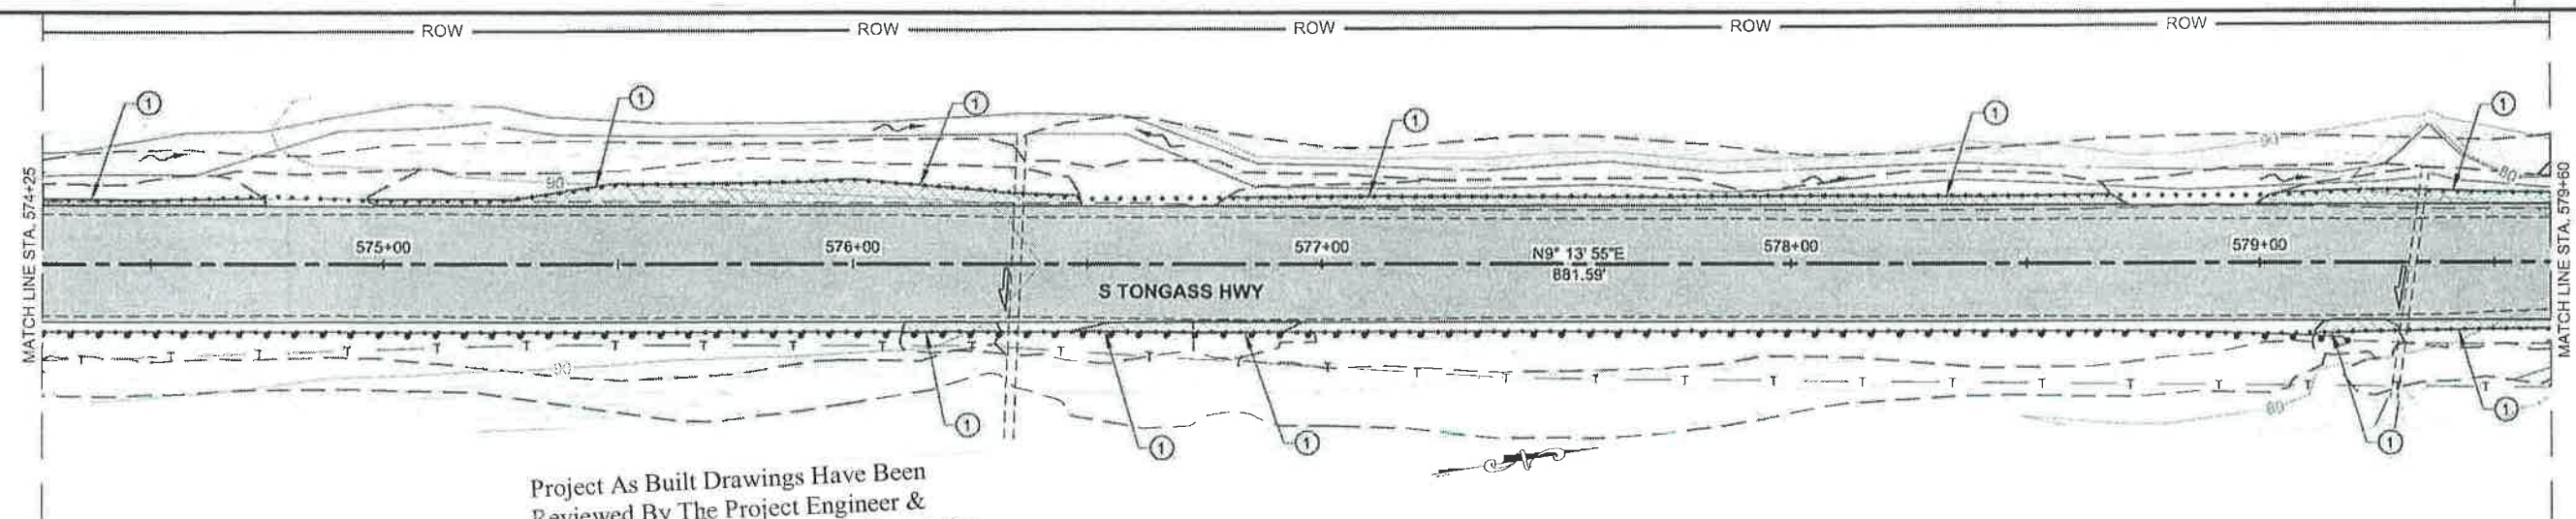

PLAN




Project As Built Drawings Have Been Reviewed By The Project Engineer & Represent, To The Best Of My Knowledge, The Project As Constructed.

Proj. Eng. *MB*

Date *12/11/15*

DO NOT SCALE FROM THESE DRAWINGS USE DIMENSIONS

PATH: Q:\KTN\67674\PLANSET\ADDENDUM 1\67674_F2_F11.DWG GRANHAM, RICK L (DOT) Wednesday, November 26, 2014 1:10:57 PM		
ADDENDUM NUMBER		
2		
ATTACHMENT NUMBER		
6		
RECORD OF REVISIONS		
No.	DATE	DESCRIPTION

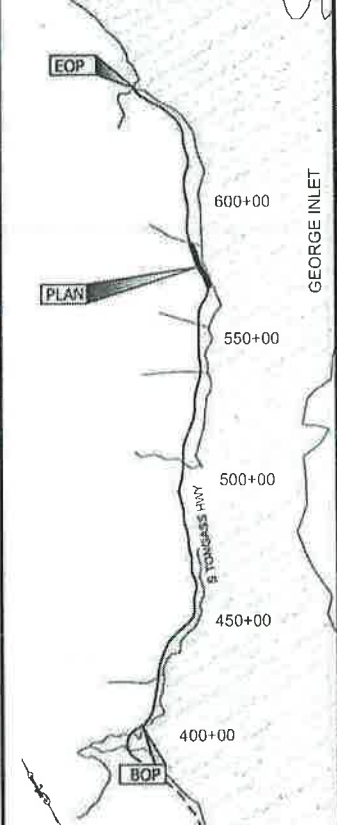


PLAN LEGEND

CHECKED BY: M. VAN ALSTINE




DESIGNED BY: L. SEIFERT
 DRAWN BY: R. GRANHAM
 STATE OF ALASKA
 DEPARTMENT OF TRANSPORTATION
 & PUBLIC FACILITIES
 SOUTHEAST REGION
 KTN-SOUTH TONGASS PAVING
 PROJECT #67674


PROJECT DESIGNATION	
STP-NH-0902(040)~67674	
STATE	YEAR
ALASKA	2014
SHEET NUMBER	TOTAL SHEETS
F11	66

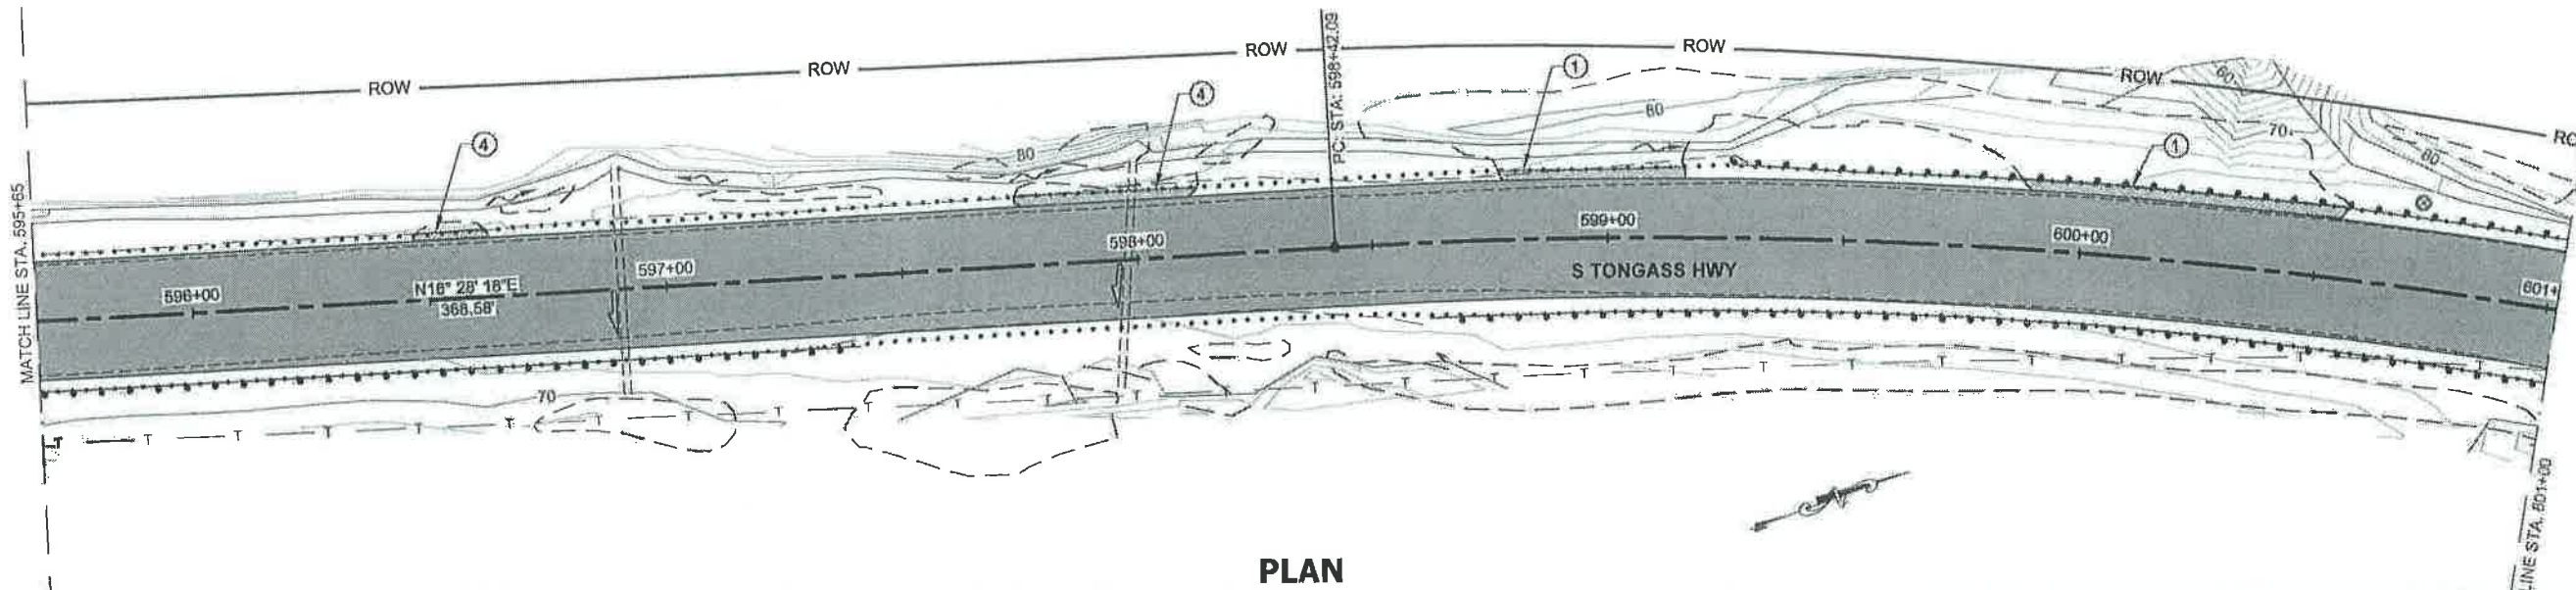

PLAN

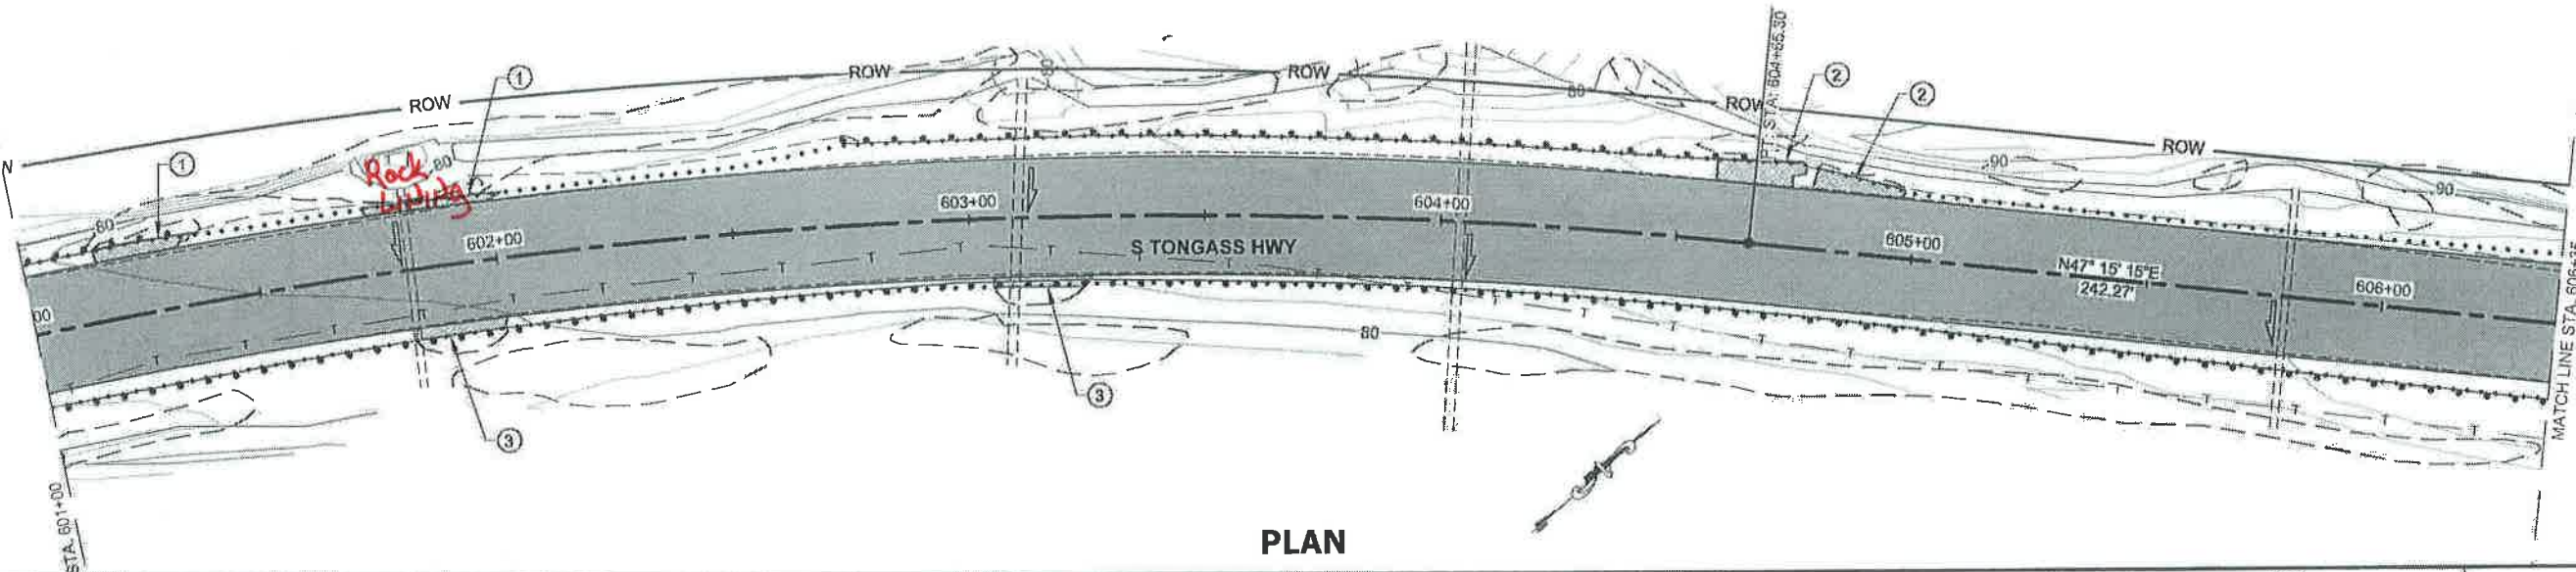

PLAN

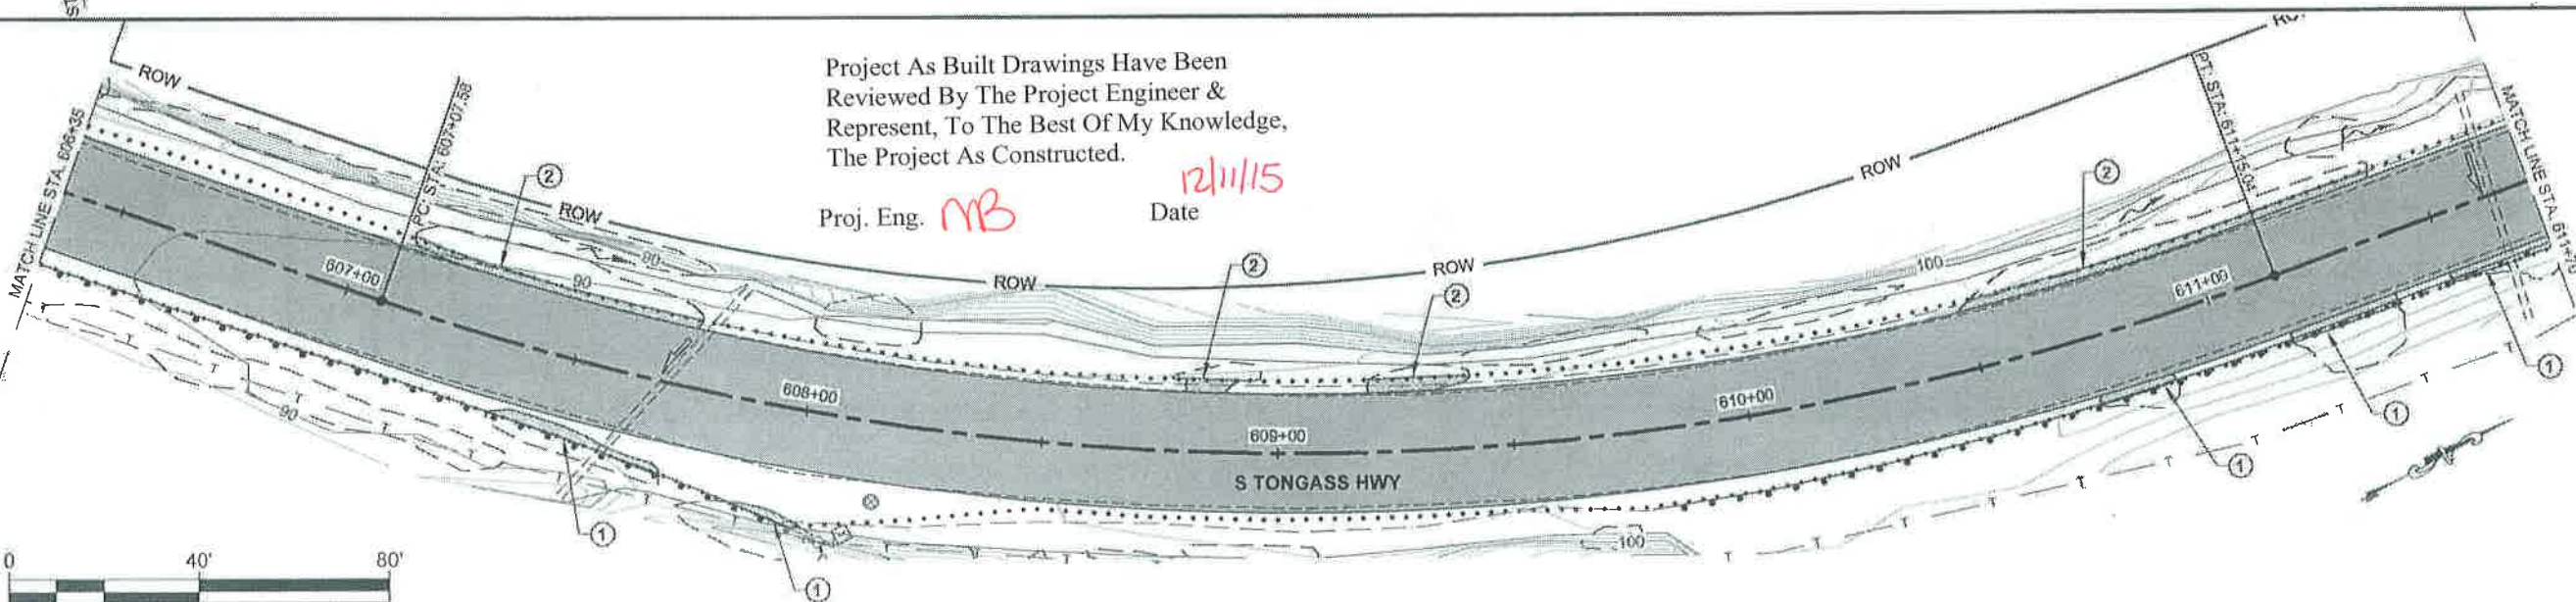

PLAN

Project As Built Drawings Have Been Reviewed By The Project Engineer & Represent, To The Best Of My Knowledge, The Project As Constructed.

Proj. Eng. MB

Date

12/11/15

PATH: Q:\KTN\67674\PLANSET\67674_F1-F15_PLAN.DWG

TAB F13


GRANTHAM, RICK L (DOT)

Thursday, November 06, 2014 7:02:44 AM

ATTACHMENT NUMBER

RECORD OF REVISIONS

No	DATE	DESCRIPTION

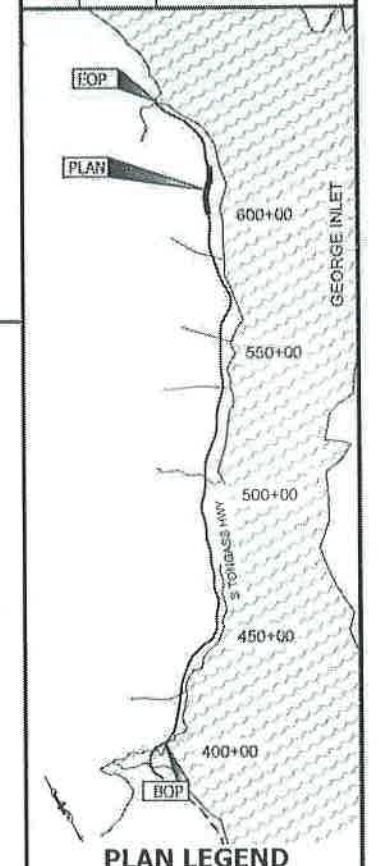

CHECKED BY: M. VAN ALSTINE



DESIGNED BY: L. SEIFERT

DRAWN BY: R. GRANTHAM

STATE OF ALASKA
DEPARTMENT OF TRANSPORTATION
& PUBLIC FACILITIES
SOUTHEAST REGION


KTN-SOUTH TONGASS PAVING
PROJECT #67674

PLAN VIEW


PROJECT DESIGNATION
STP-NH-0902(040)~67674

STATE	YEAR
ALASKA	2014
SHEET NUMBER	TOTAL SHEETS
F13	66


DO NOT SCALE FROM THESE DRAWINGS USE DIMENSIONS

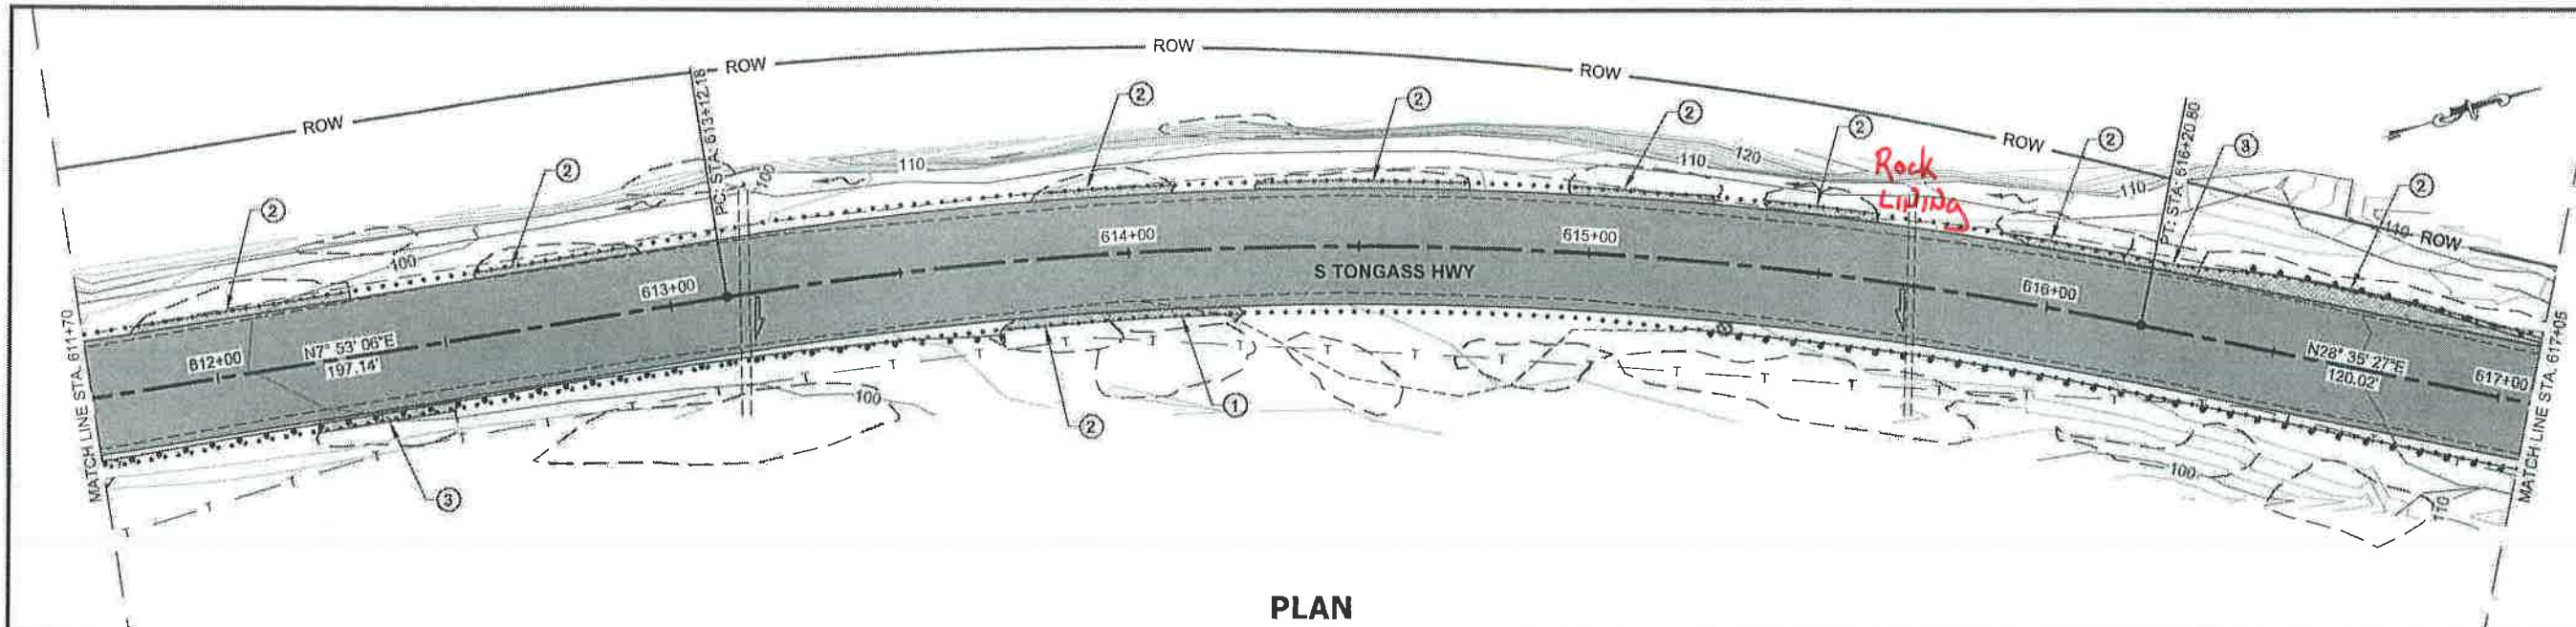

PLAN

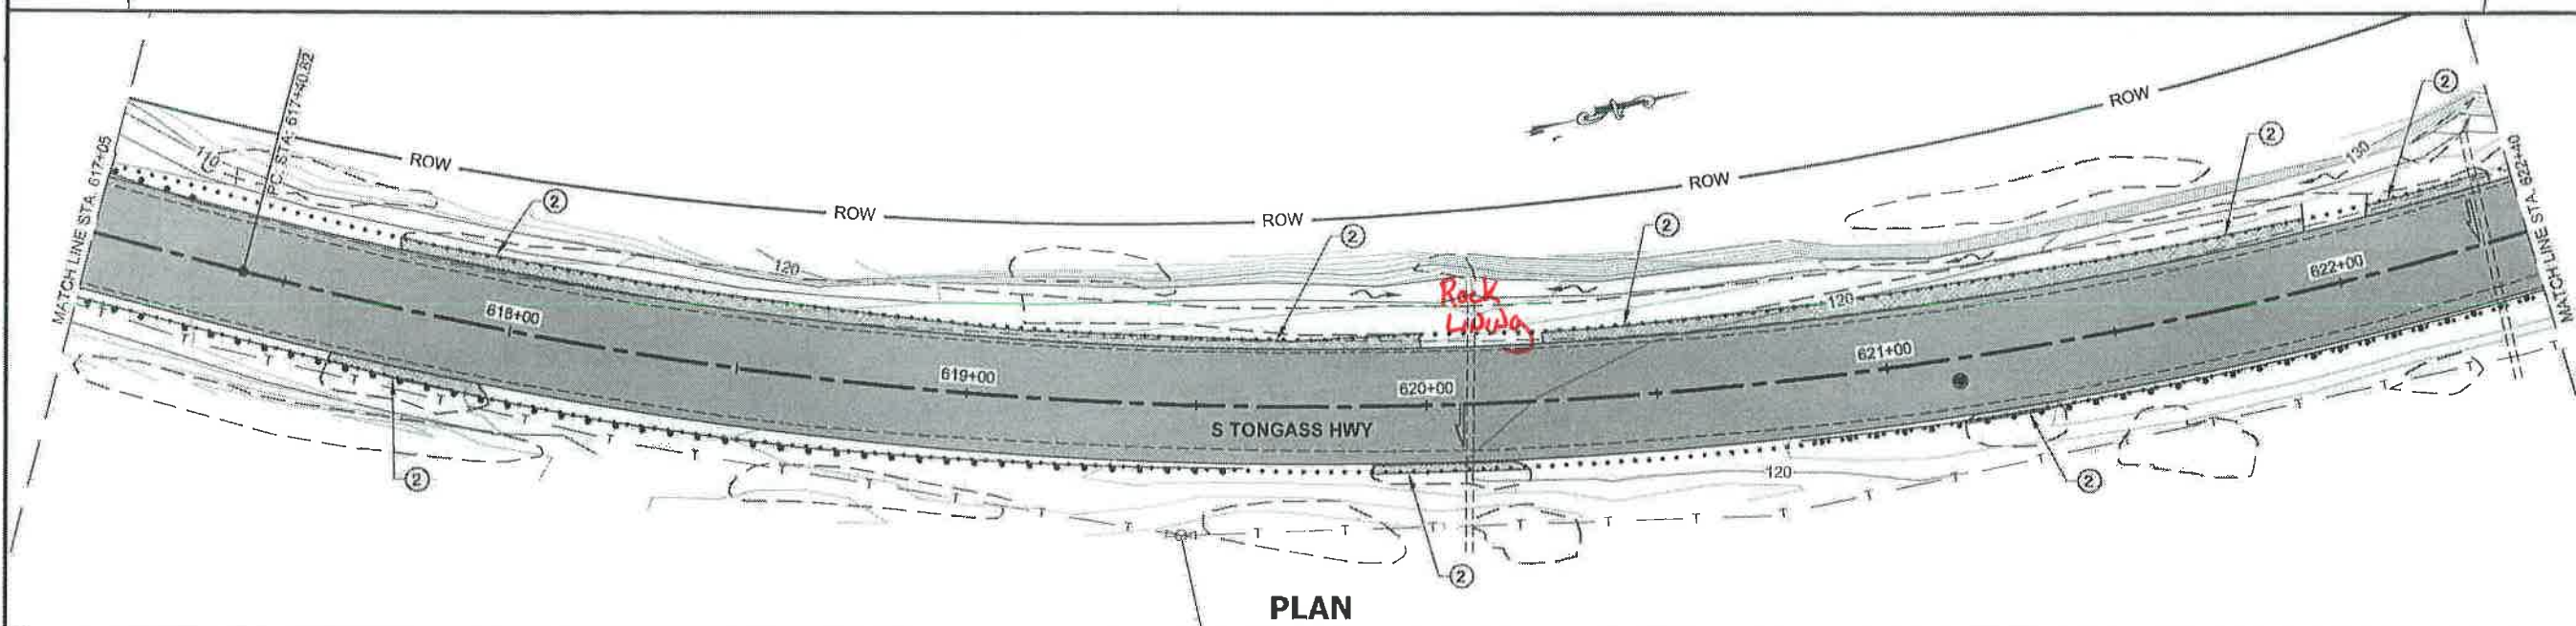

PLAN

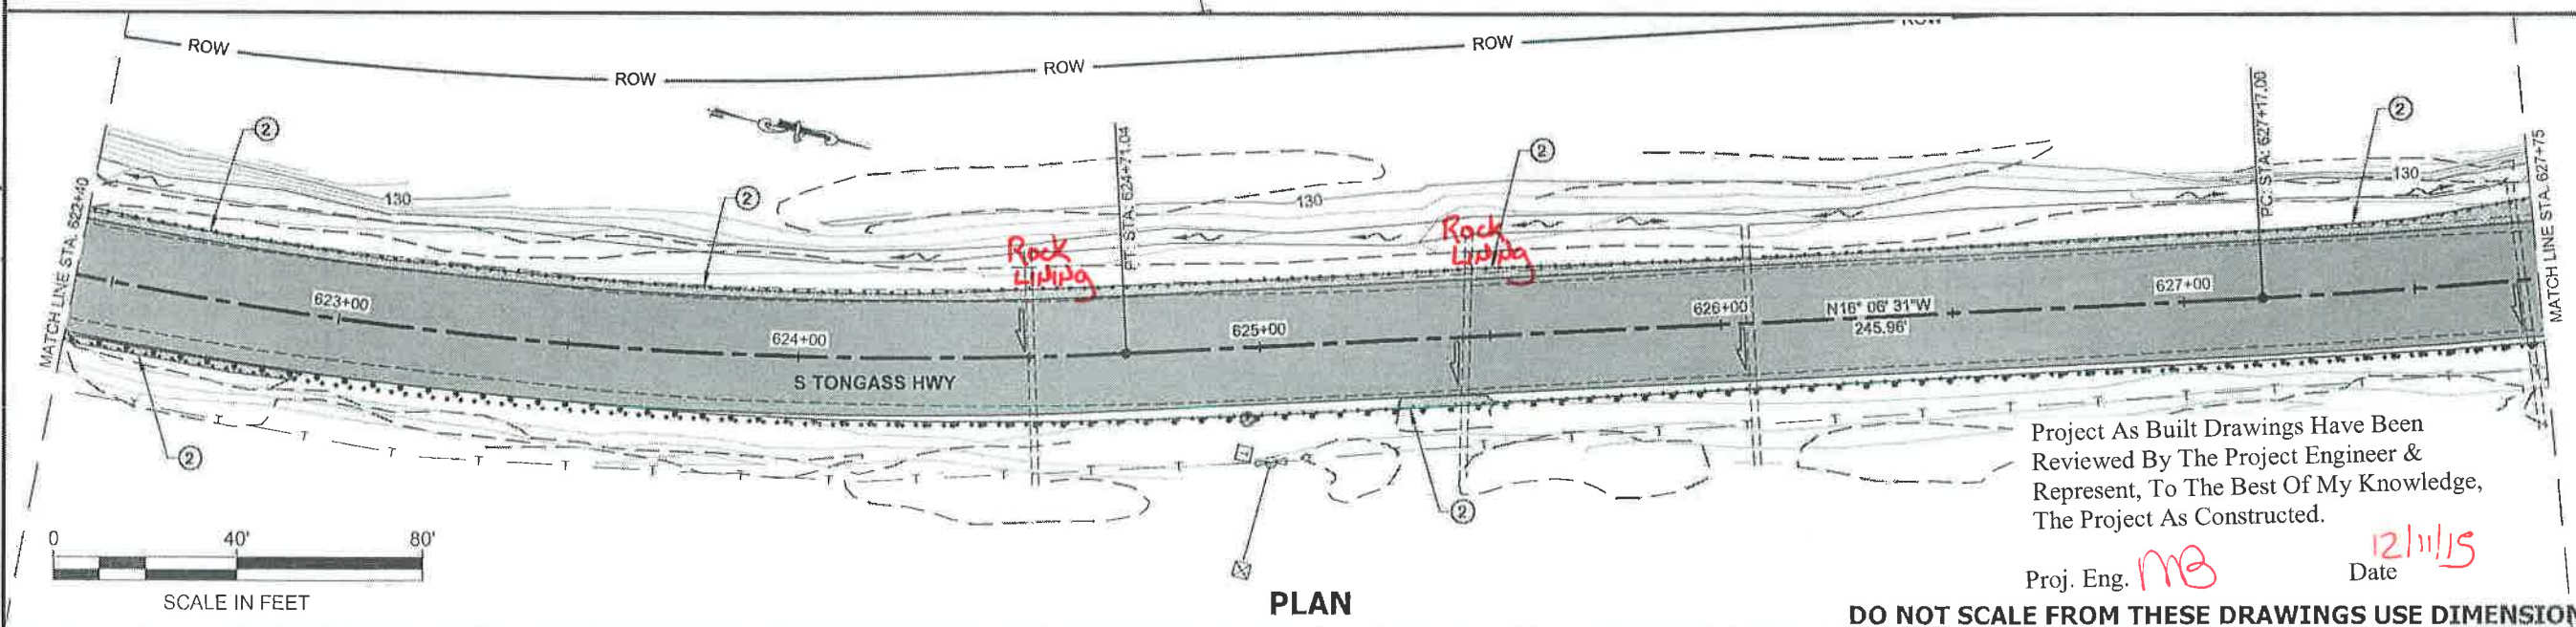

PLAN



Project As Built Drawings Have Been Reviewed By The Project Engineer & Represent, To The Best Of My Knowledge, The Project As Constructed.

Proj. Eng. *me* Date *12/11/15*

DO NOT SCALE FROM THESE DRAWINGS USE DIMENSIONS

PATH:
Q:\KTN\67674\PLANSET\67674_F1-F15_PLAN.DWG

TAB: F14

GRANTHAM, RICK L (DOT)

Thursday, November 06, 2014 7:02:58 AM

ADDENDUM NUMBER

ATTACHMENT NUMBER

RECORD OF REVISIONS

No.	DATE	DESCRIPTION

PLAN LEGEND

CHECKED BY: M. VAN ALSTINE

DESIGNED BY: L. SEIFERT

DRAWN BY: R. GRANTHAM

STATE OF ALASKA
DEPARTMENT OF TRANSPORTATION
& PUBLIC FACILITIES
SOUTHEAST REGION

KTN-SOUTH TONGASS PAVING
PROJECT #67674




11/6/14

PLAN VIEW

PROJECT DESIGNATION
STP-NH-0902(040)~67674

STATE	YEAR
ALASKA	2014

SHEET NUMBER	TOTAL SHEETS
F14	66

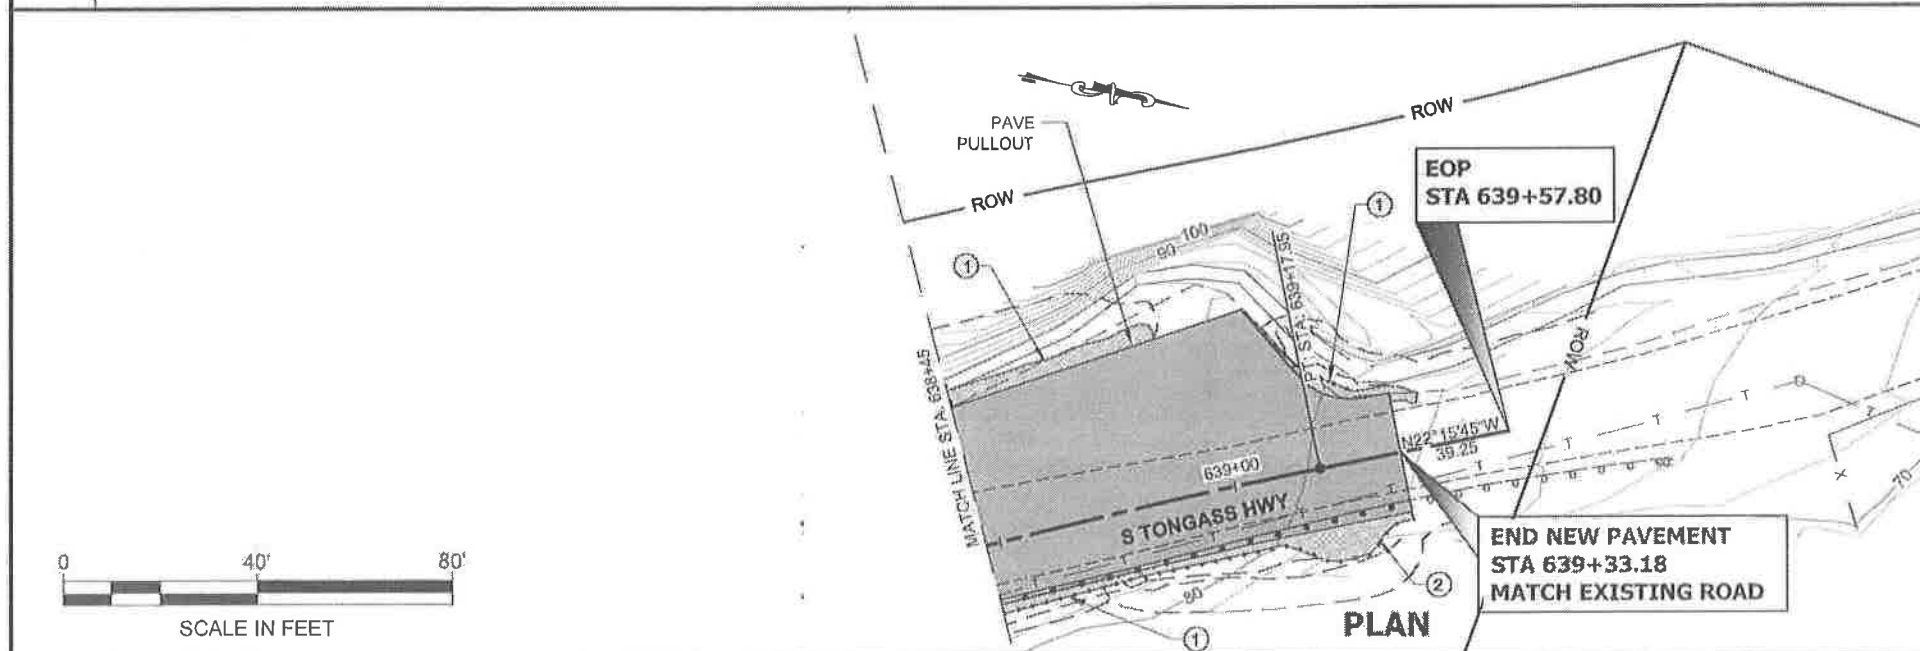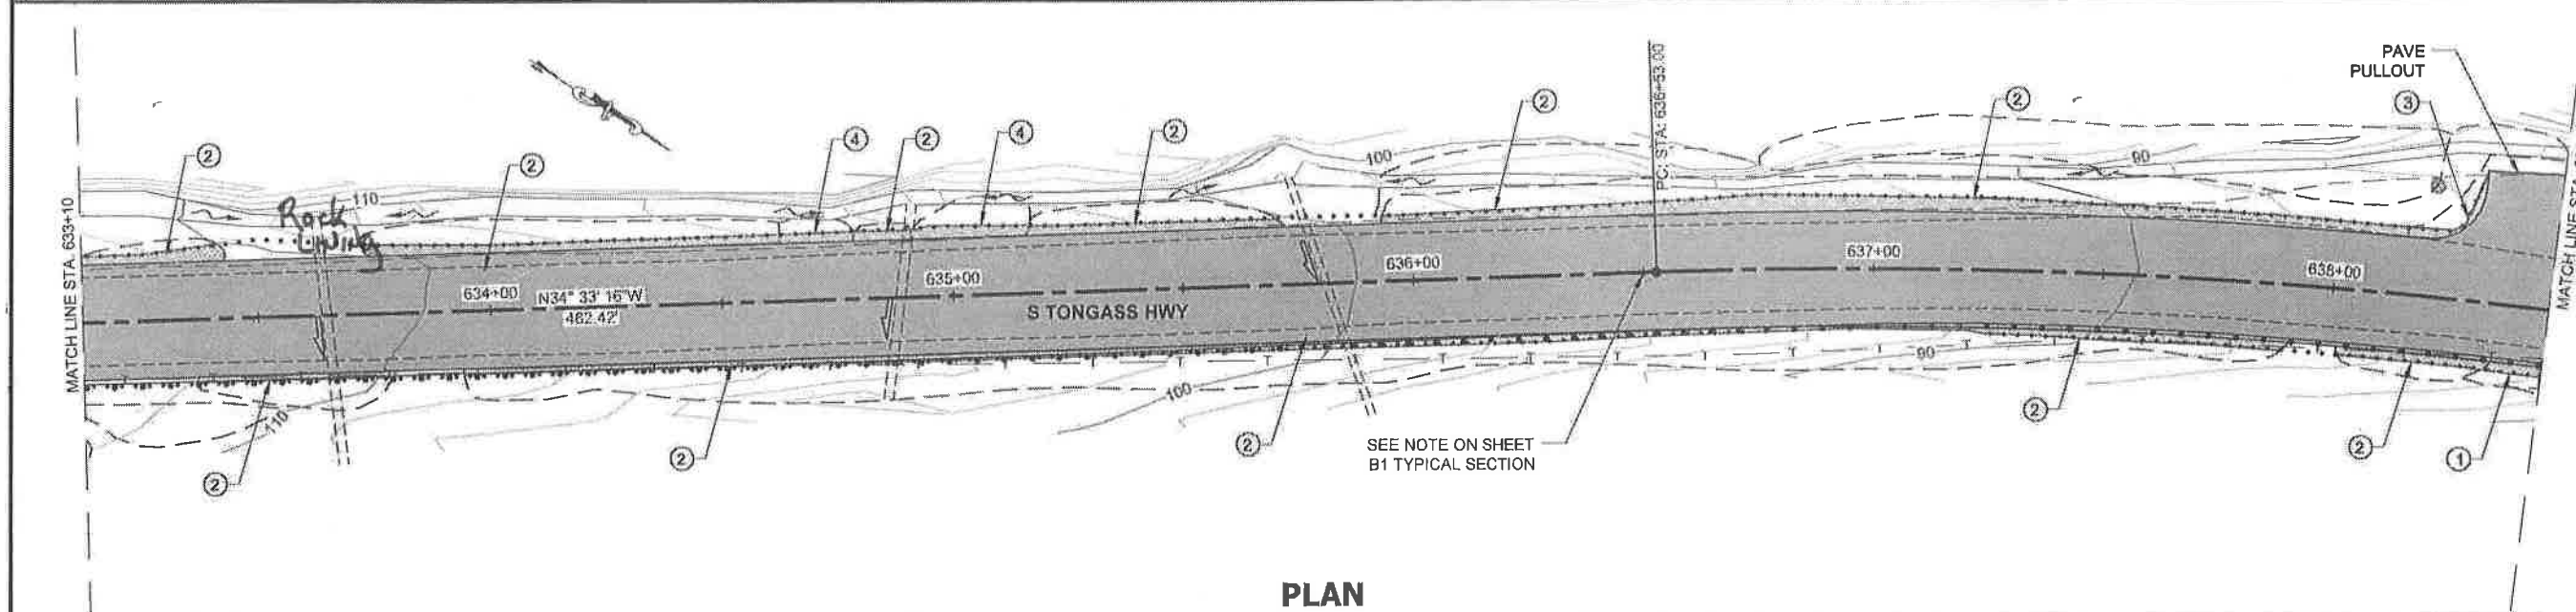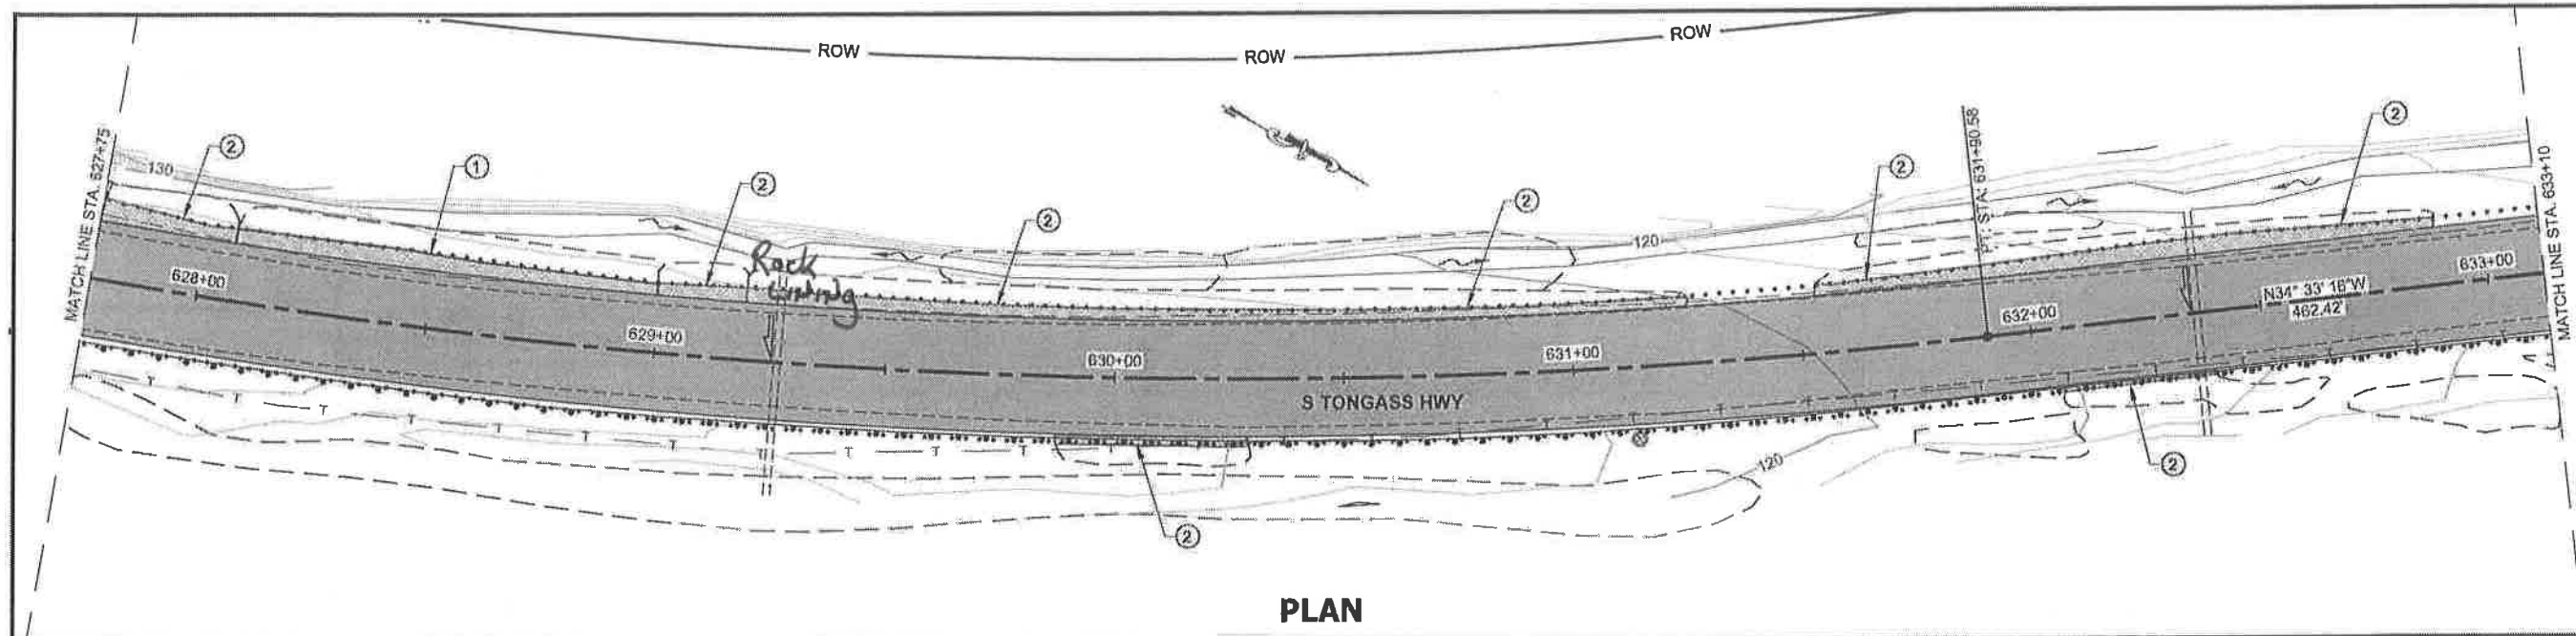

Project As Built Drawings Have Been Reviewed By The Project Engineer & Represent, To The Best Of My Knowledge, The Project As Constructed.


Proj. Eng. MB

Date 12/1/15

DO NOT SCALE FROM THESE DRAWINGS USE DIMENSIONS

PATH: Q:\KTN\67674\PLANSET\67674_F1-F15_PLAN.DWG
TAB: F15
GRANTHAM, RICK I (DOT)
Thursday, November 06, 2014 7:03:13 AM

ADDENDUM NUMBER		
ATTACHMENT NUMBER		
RECORD OF REVISIONS		
No	DATE	DESCRIPTION

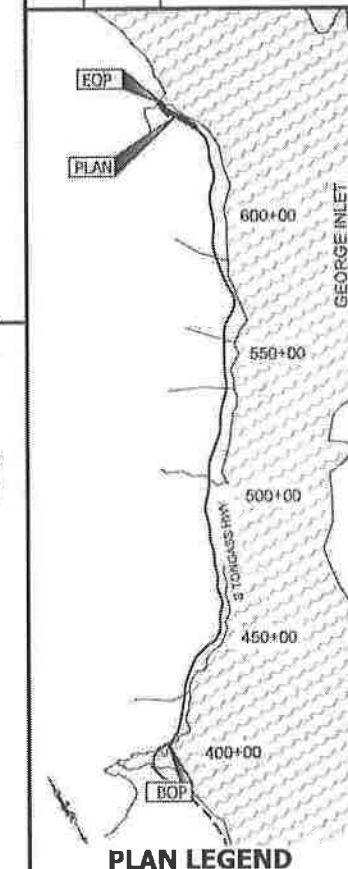

CHECKED BY: M. VAN ALSTINE




DESIGNED BY: L. SEIFERT

DRAWN BY: R. GRANTHAM

STATE OF ALASKA
DEPARTMENT OF TRANSPORTATION
& PUBLIC FACILITIES
SOUTHEAST REGION

KTN-SOUTH TONGASS PAVING
PROJECT #67674

PROJECT DESIGNATION	
STP-NH-0902(040)~67674	
STATE	YEAR
ALASKA	2014
SHEET NUMBER	TOTAL SHEETS
F15	66

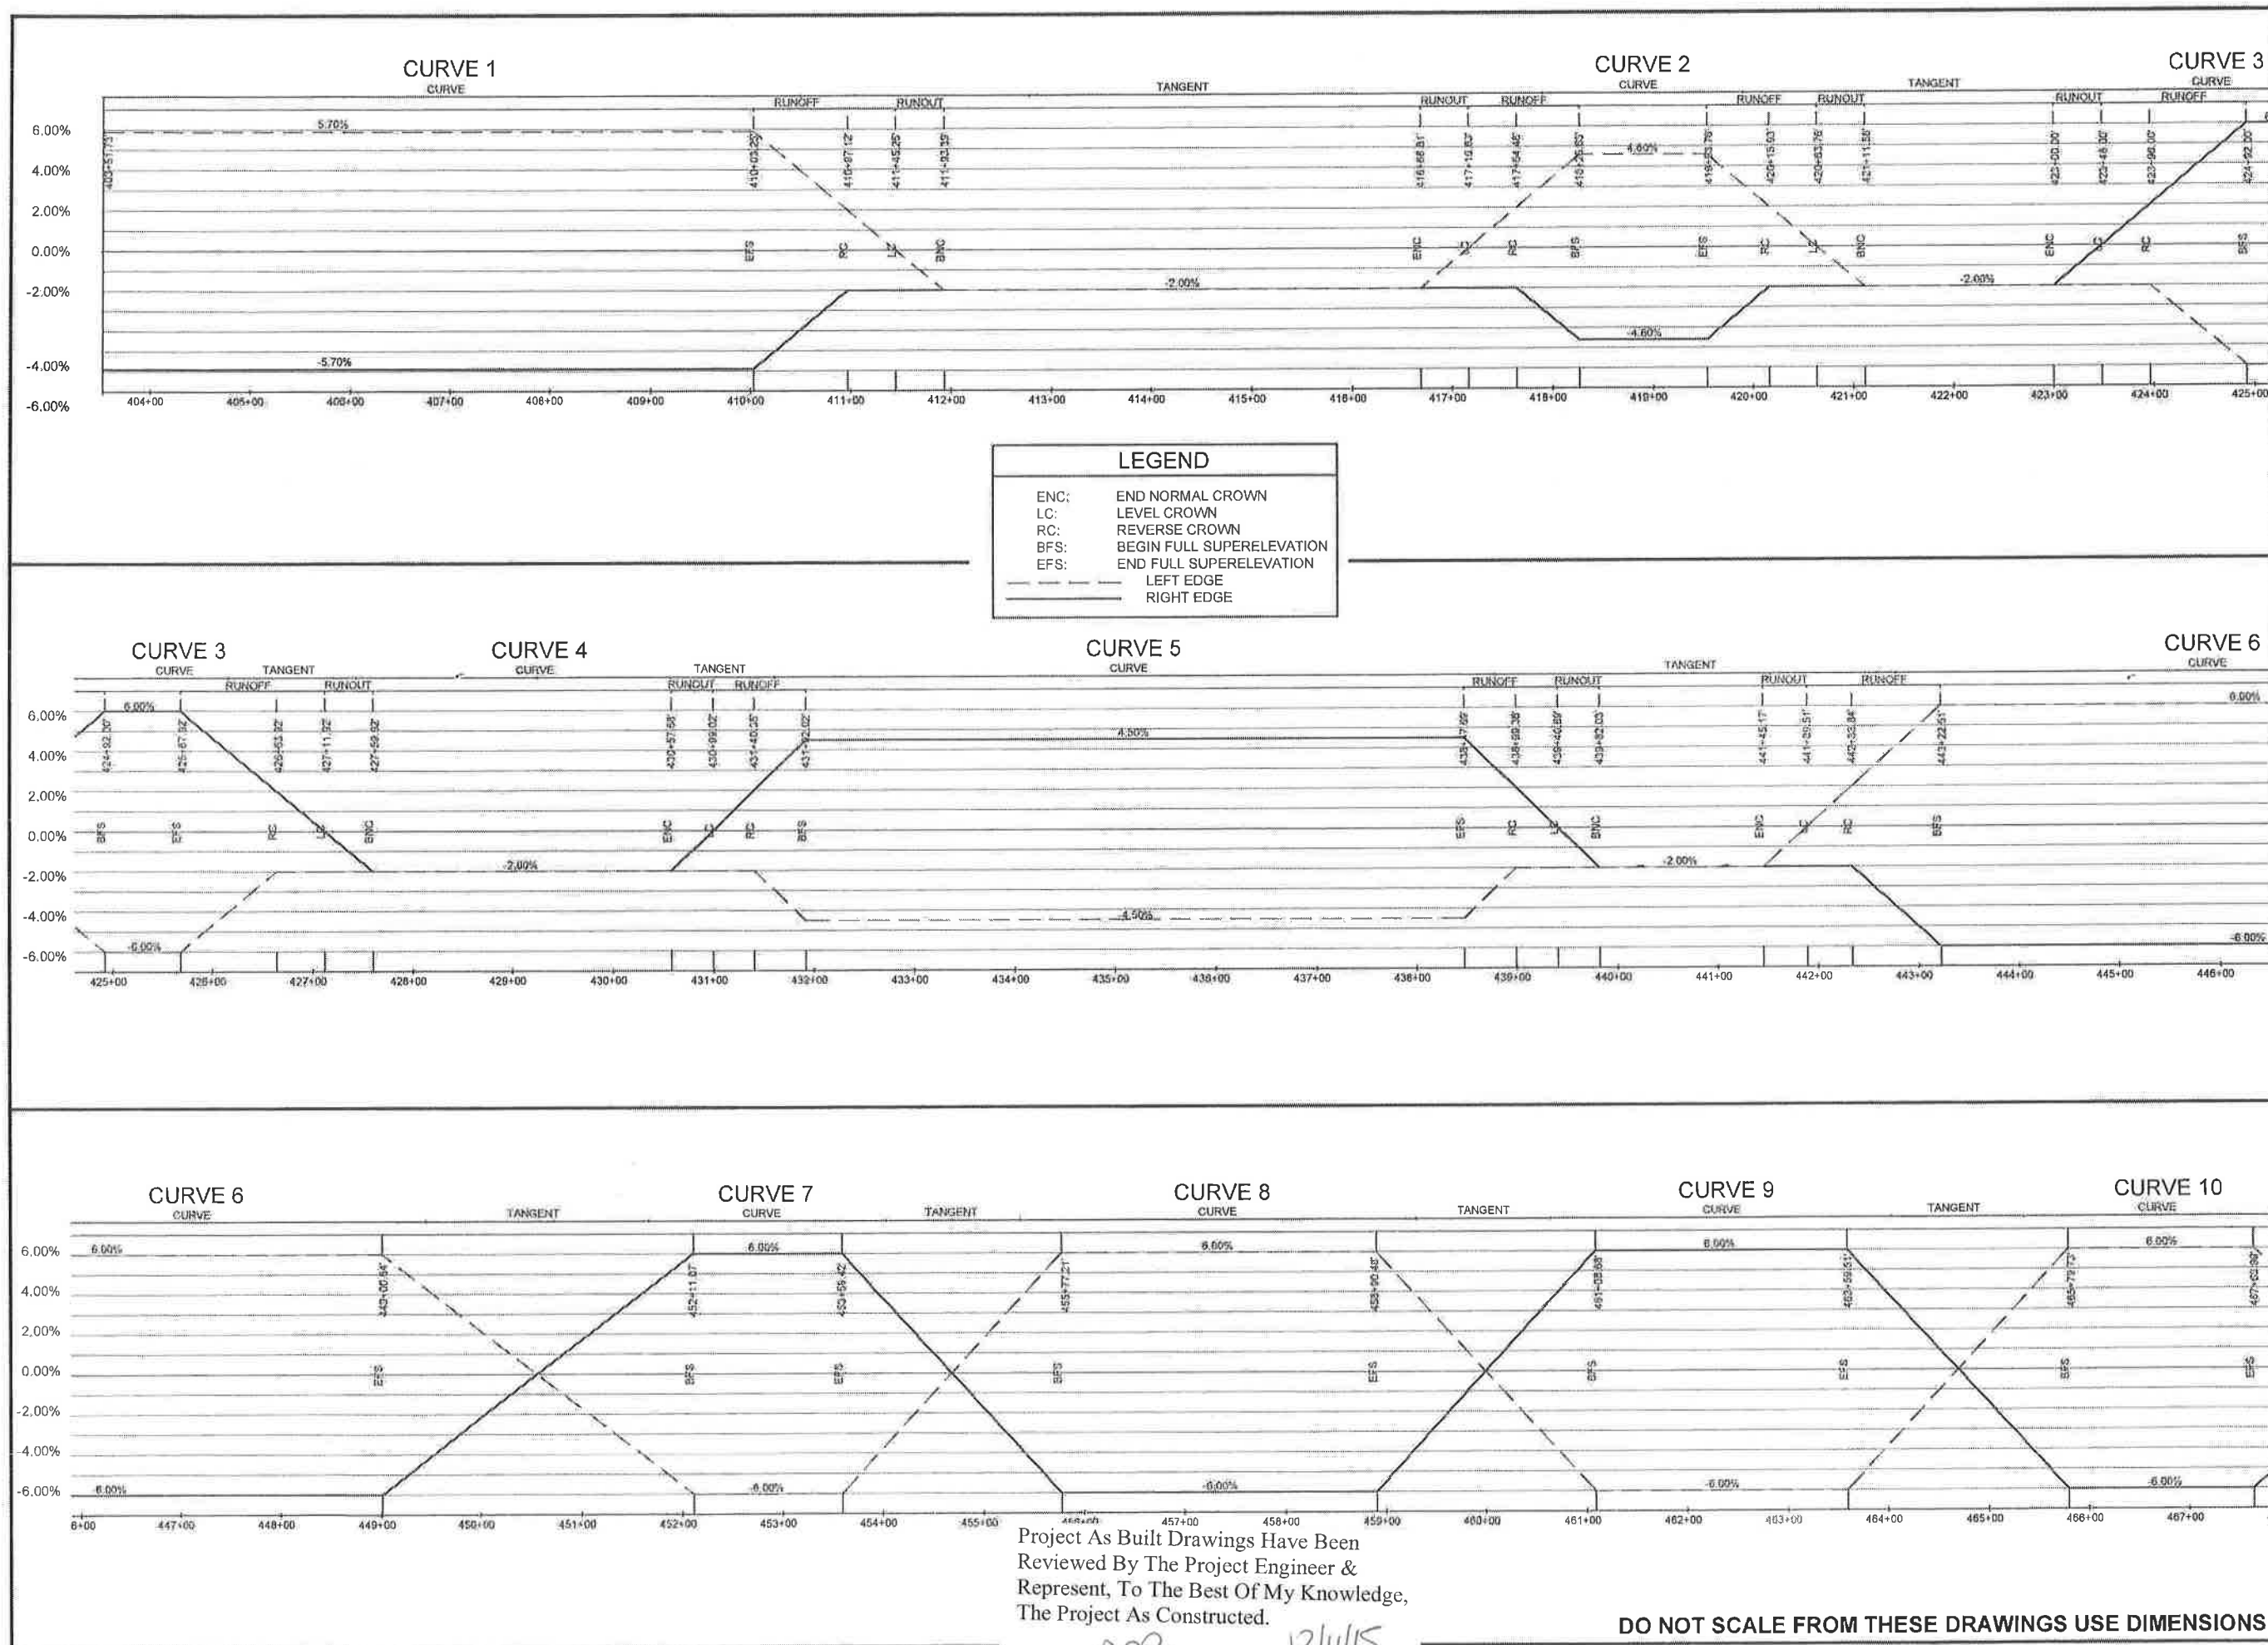

PATH: Q:\KTN\97674\PLANSET\97674_G1-G4_SUPER.DWG
TAB: G1
GRANTHAM, RICK L (DOT)
Wednesday, November 05, 2014 7:47:37 AM

ADDENDUM NUMBER

ATTACHMENT NUMBER

RECORD OF REVISIONS

No	DATE	DESCRIPTION

CHECKED BY: M. VAN ALSTINE

DESIGNED BY: L. SEIFERT
DRAWN BY: R. GRANTHAM

STATE OF ALASKA
DEPARTMENT OF TRANSPORTATION
& PUBLIC FACILITIES
SOUTHEAST REGION

KTN-SOUTH TONGASS PAVING
PROJECT #67674

**SUPERELEVATION
PROFILE**

PROJECT DESIGNATION
STP-NH-0902(040)-67674


STATE	YEAR
ALASKA	2014

SHEET NUMBER	TOTAL SHEETS
G1	66



Project As Built Drawings Have Been Reviewed By The Project Engineer & Represent, To The Best Of My Knowledge, The Project As Constructed.

Proj. Eng. *MB* 12/11/15
Date

DO NOT SCALE FROM THESE DRAWINGS USE DIMENSIONS

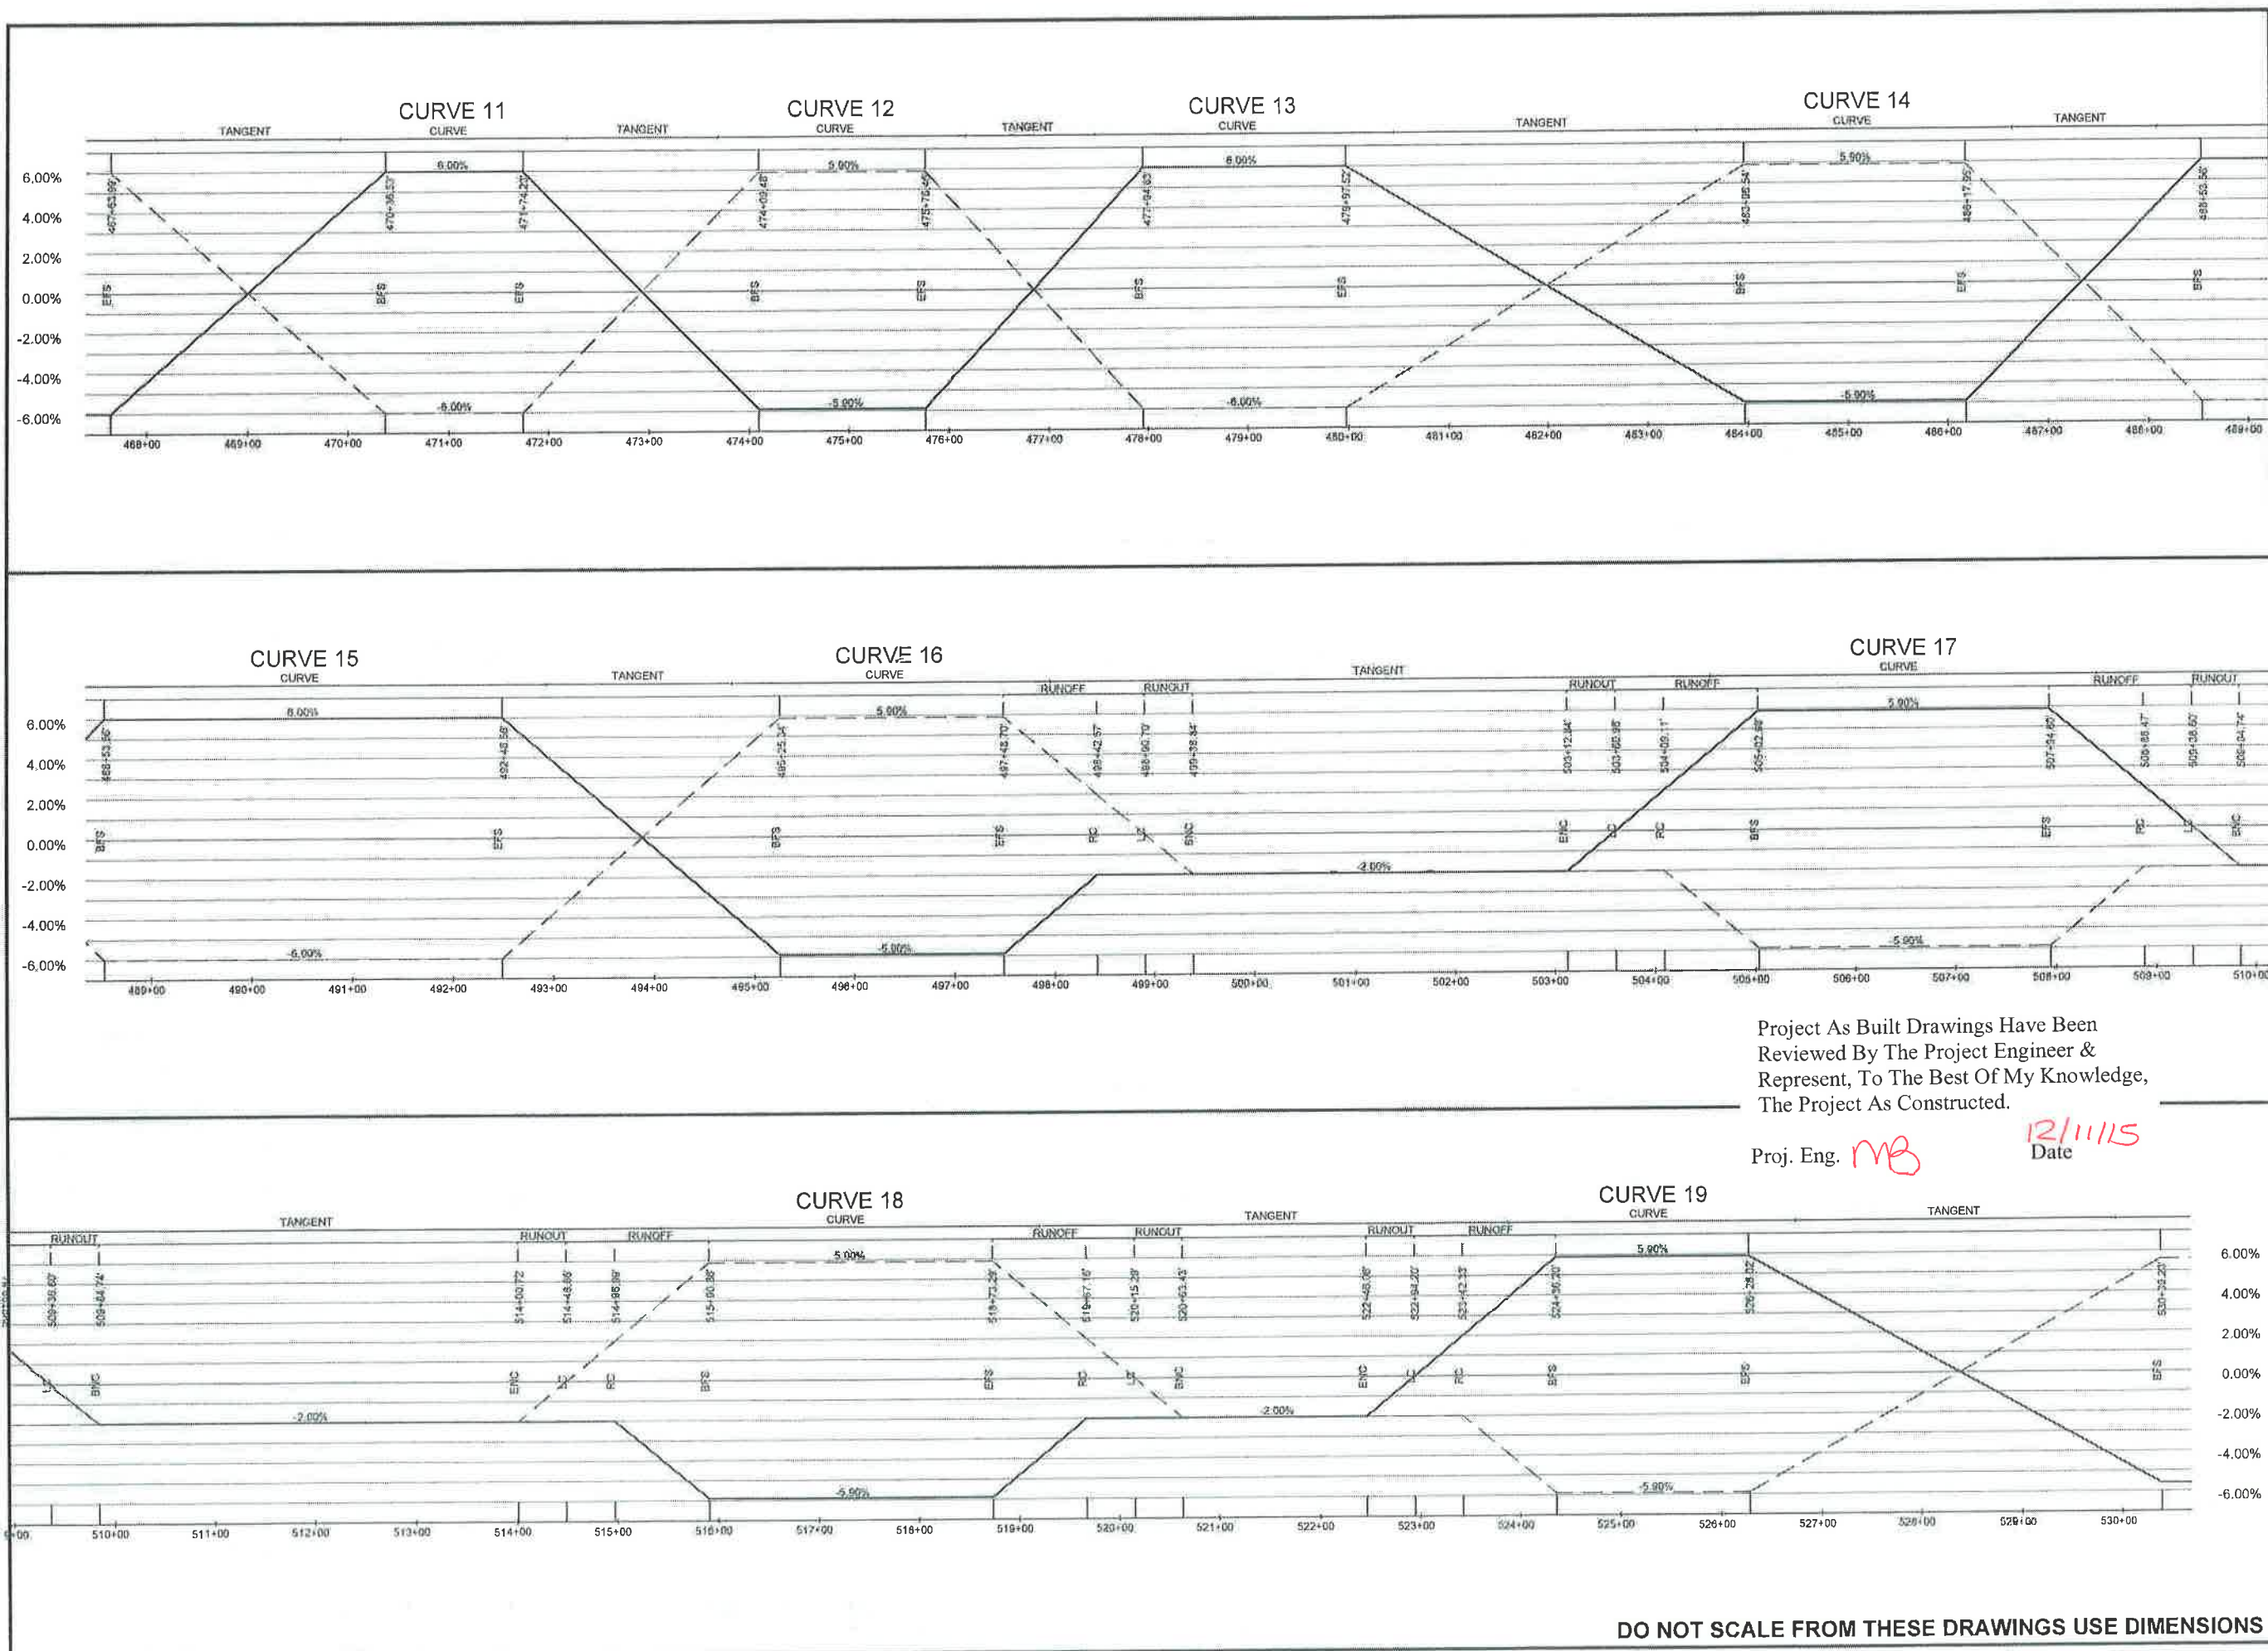


PATH: Q:\KTM67674\PLANSET\67674_G1-G4_SUPER.DWG TAB: G2 GRANTHAM, RICK L (DOT) Wednesday, November 05, 2014 7:47:56 AM		
ADDENDUM NUMBER		
ATTACHMENT NUMBER		
RECORD OF REVISIONS		
No.	DATE	DESCRIPTION
CHECKED BY: M. VAN ALSTINE		
		
DESIGNED BY: L. SEIFERT		
DRAWN BY: R. GRANTHAM		
STATE OF ALASKA DEPARTMENT OF TRANSPORTATION & PUBLIC FACILITIES SOUTHEAST REGION		
KTN-SOUTH TONGASS PAVING PROJECT #67674		
SUPERELEVATION PROFILE		
PROJECT DESIGNATION STP-NH-0902(040)-67674		
STATE ALASKA	YEAR 2014	
SHEET NUMBER G2	TOTAL SHEETS 66	

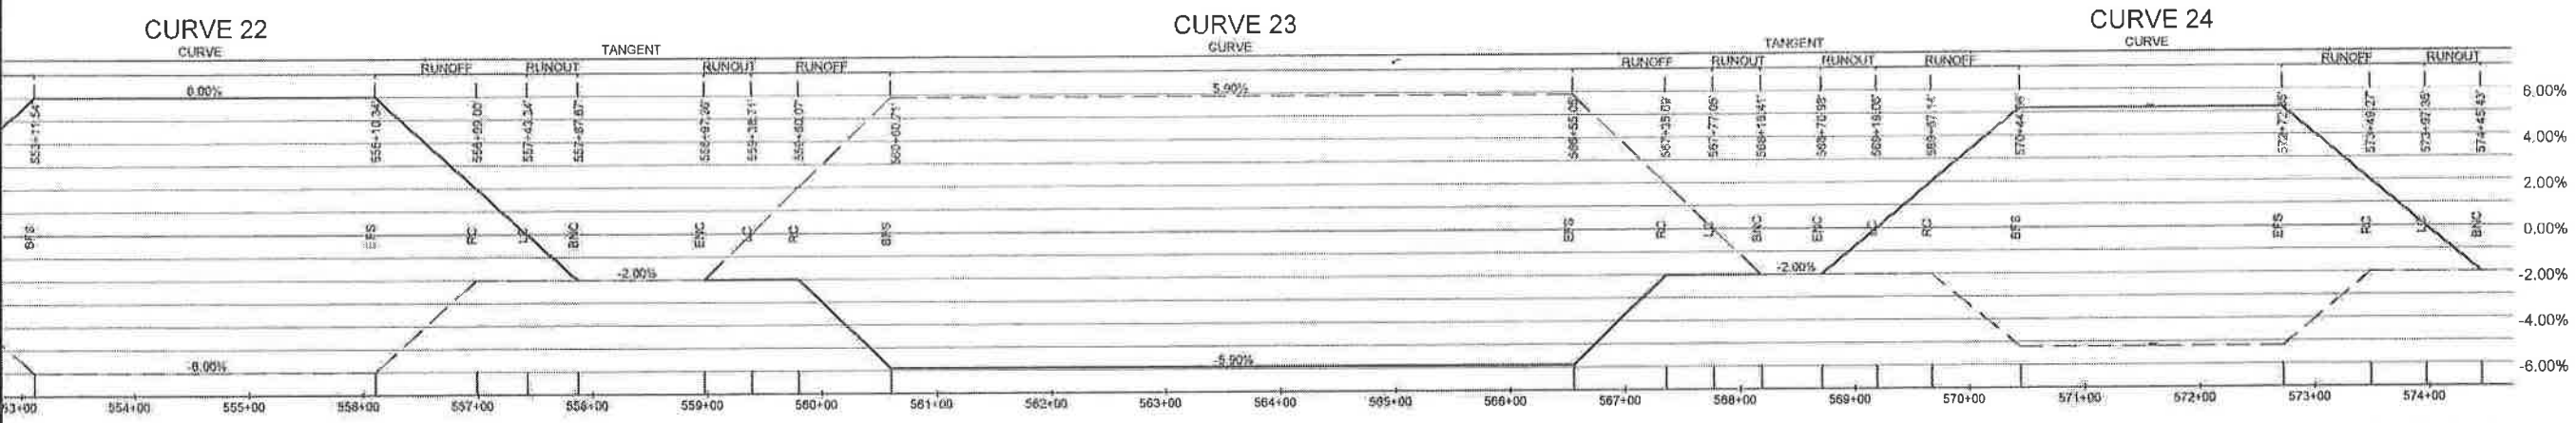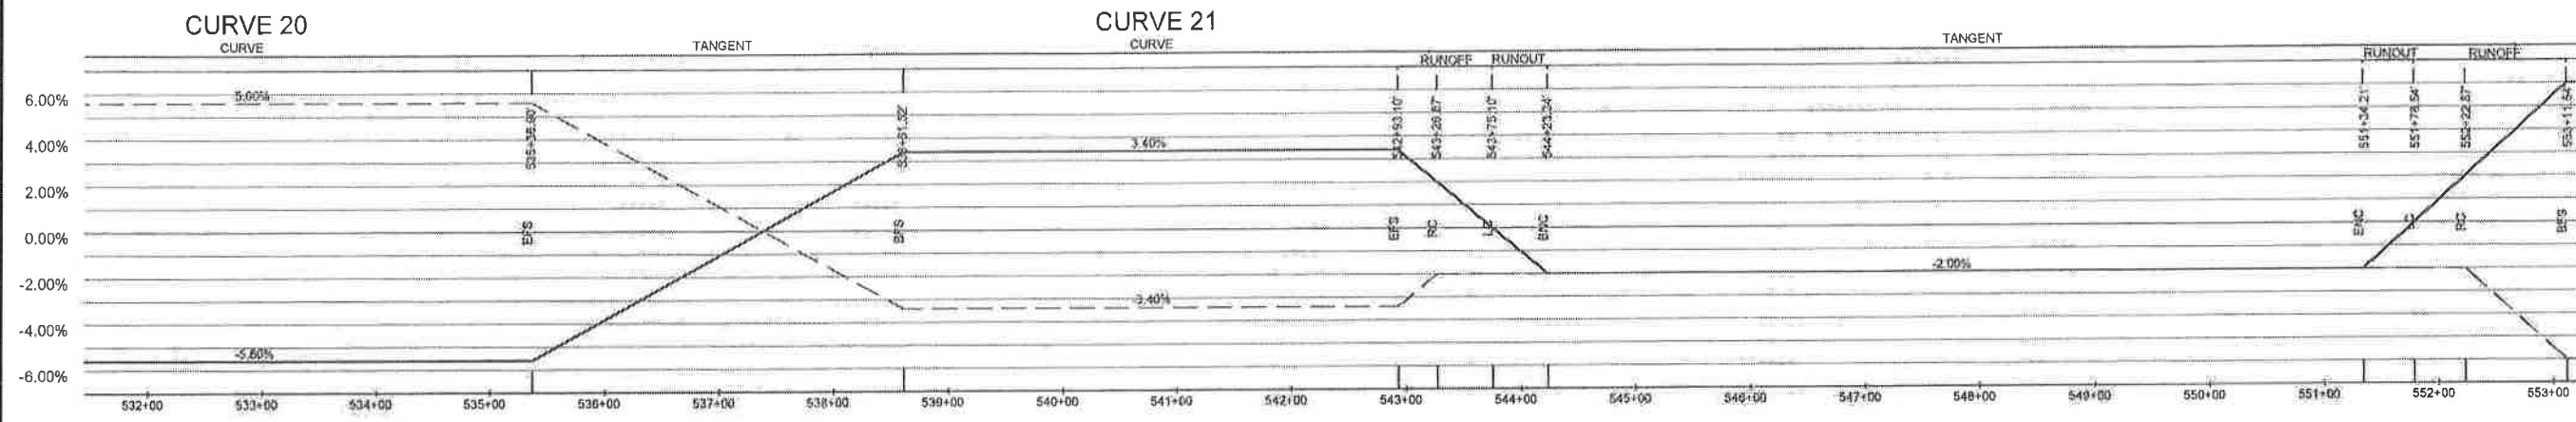

Project As Built Drawings Have Been
 Reviewed By The Project Engineer &
 Represent, To The Best Of My Knowledge,
 The Project As Constructed.



Proj. Eng. *MB* Date *12/11/15*

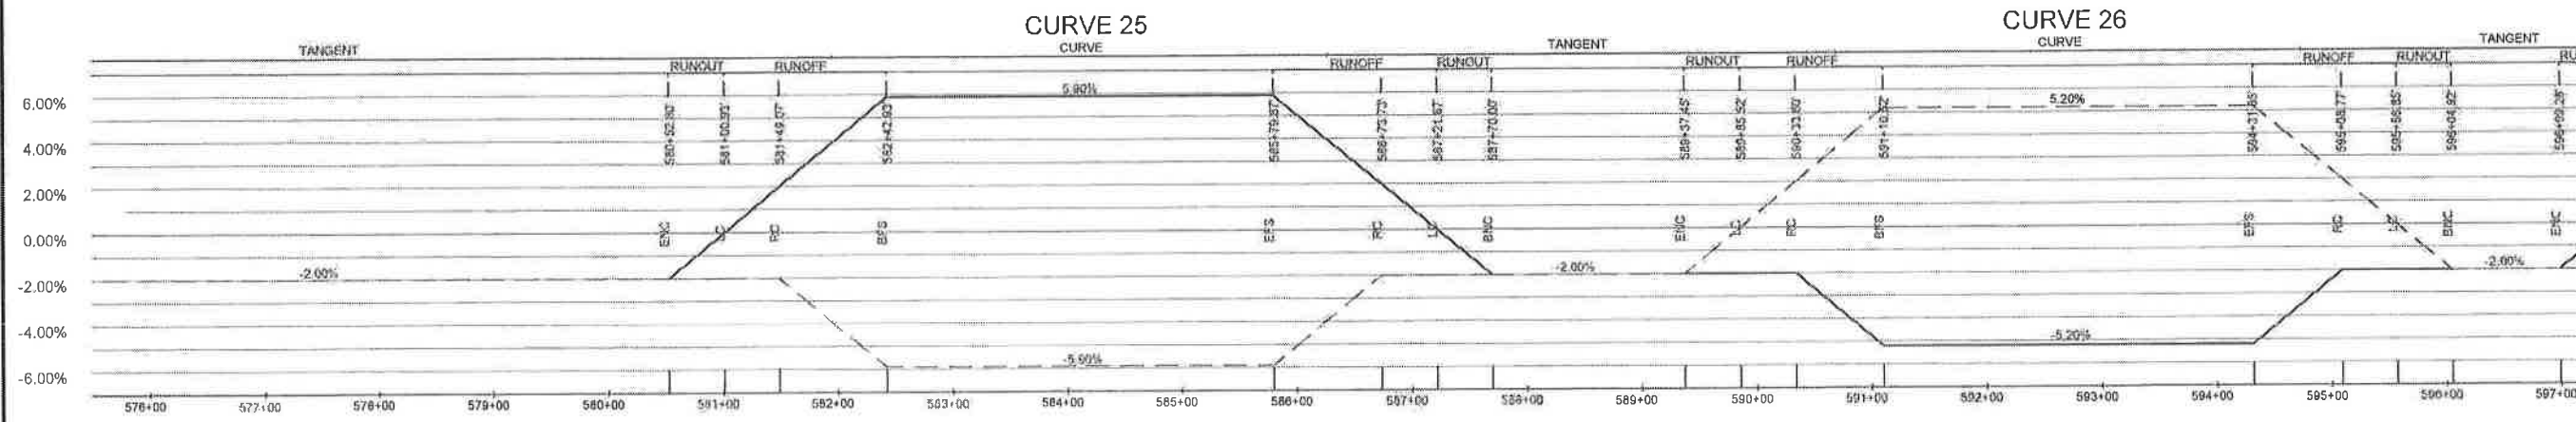

CHECKED BY: M. VAN ALSTINE

DESIGNED BY: L. SEIFERT
 DRAWN BY: R. GRANTHAM
 STATE OF ALASKA
 DEPARTMENT OF TRANSPORTATION
 & PUBLIC FACILITIES
 SOUTHEAST REGION
 KTN-SOUTH TONGASS PAVING
 PROJECT #87674
**SUPERELEVATION
 PROFILE**
 PROJECT DESIGNATION
STP-NH-0902(040)-67674

STATE	YEAR
ALASKA	2014
SHEET NUMBER	TOTAL SHEETS
G3	66

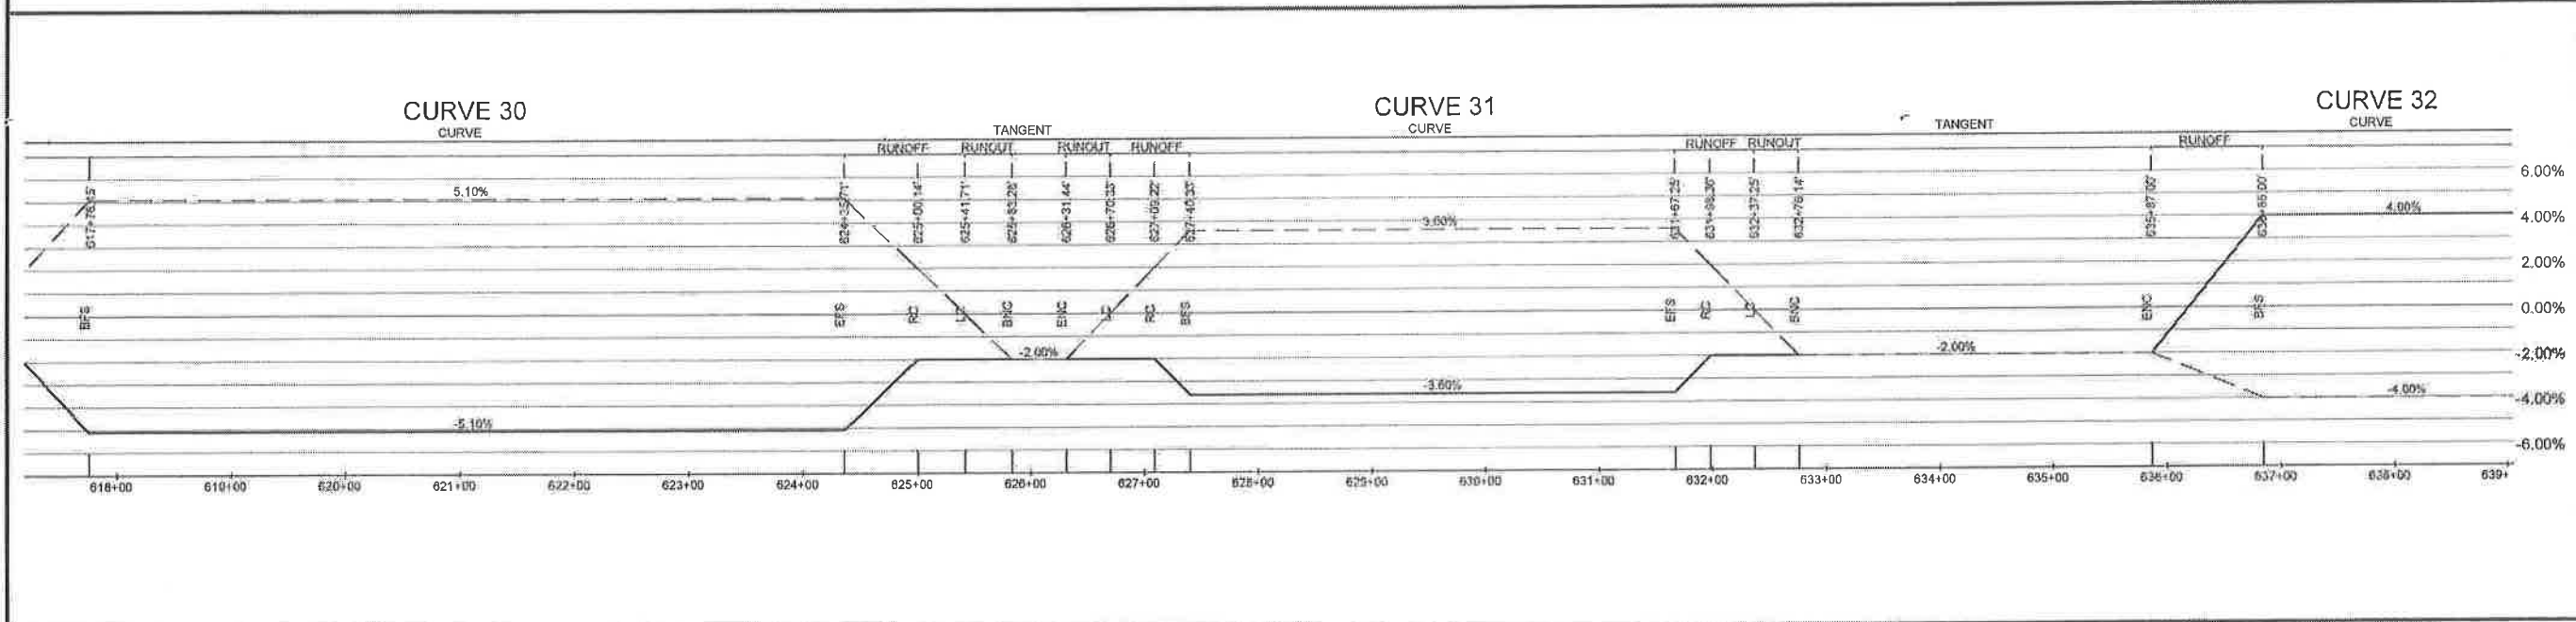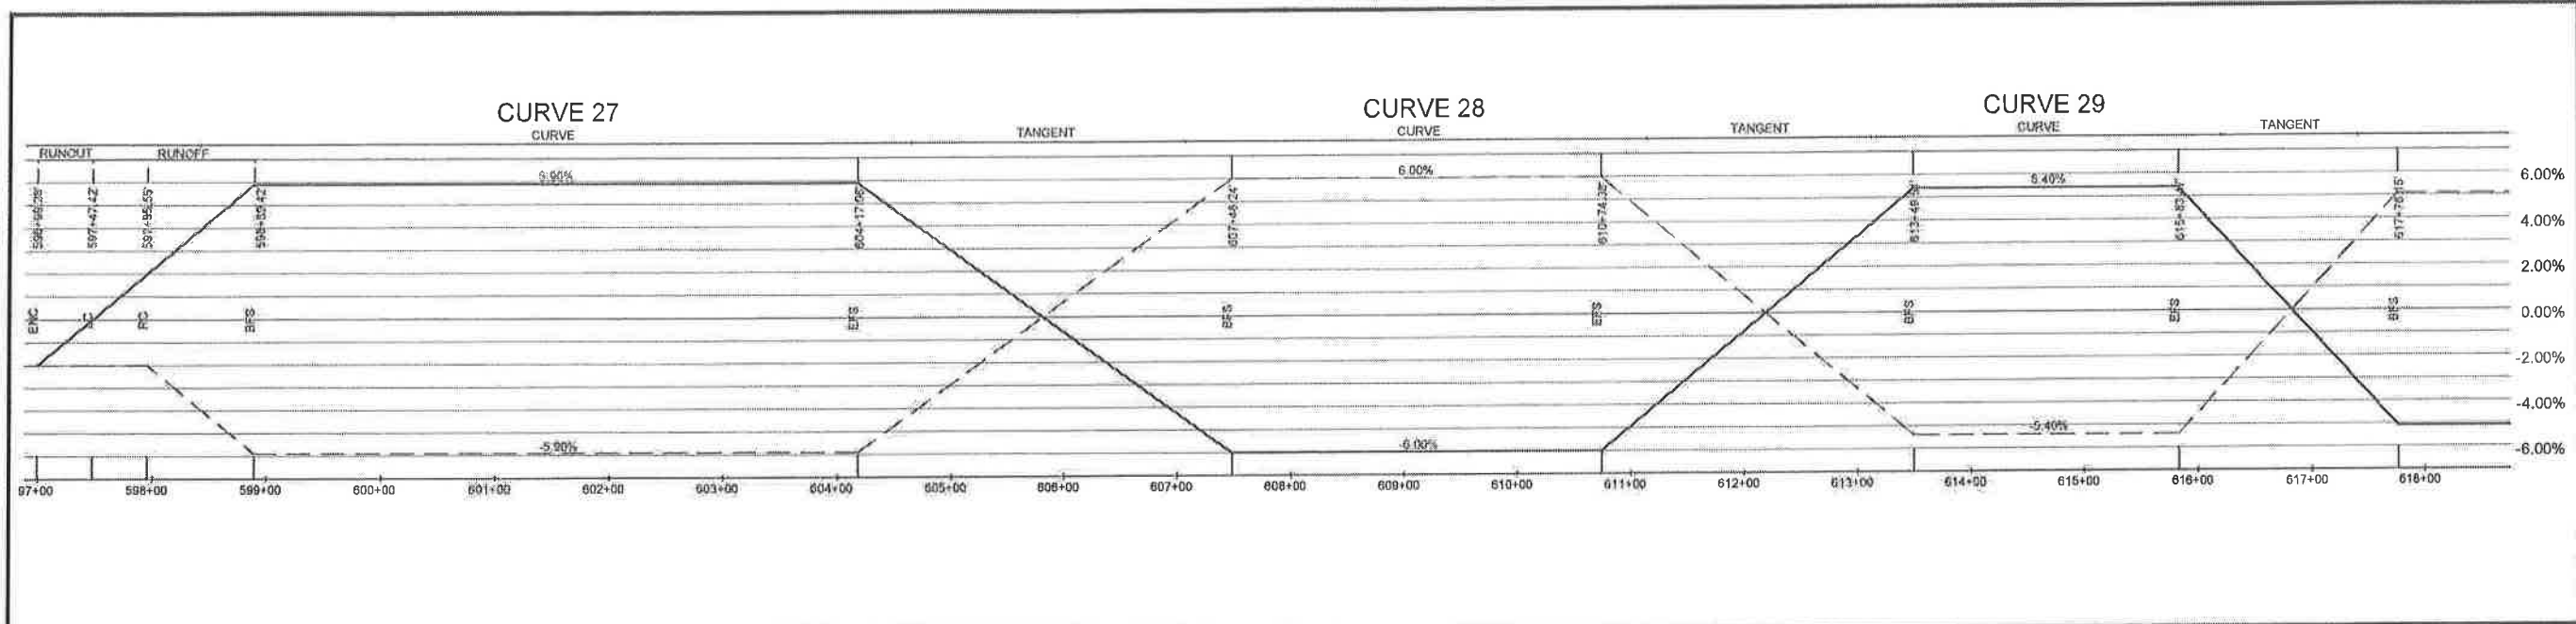

Project As Built Drawings Have Been Reviewed By The Project Engineer & Represent, To The Best Of My Knowledge, The Project As Constructed.

Proj. Eng. *W3* 12/11/15
Date

PATH: Q:\KTN\67674\PLAN\SET\67674_G1-G4_SUPER.DWG		
TAB: G4		
GRANTHAM, RICK L (DOT)		
Wednesday, November 05, 2014 7:48:12 AM		
ADDENDUM NUMBER		
ATTACHMENT NUMBER		
RECORD OF REVISIONS		
No.	DATE	DESCRIPTION



CHECKED BY: M. VAN ALSTINE

DESIGNED BY: L. SEIFERT

DRAWN BY: R. GRANTHAM


STATE OF ALASKA
DEPARTMENT OF TRANSPORTATION
& PUBLIC FACILITIES
SOUTHEAST REGION

KTN-SOUTH TONGASS PAVING
PROJECT #67674

SUPERELEVATION PROFILE

PROJECT DESIGNATION	
STP-NH-0902(040)~67674	
STATE	YEAR
ALASKA	2014
SHEET NUMBER	TOTAL SHEETS
G4	66

DO NOT SCALE FROM THESE DRAWINGS USE DIMENSIONS

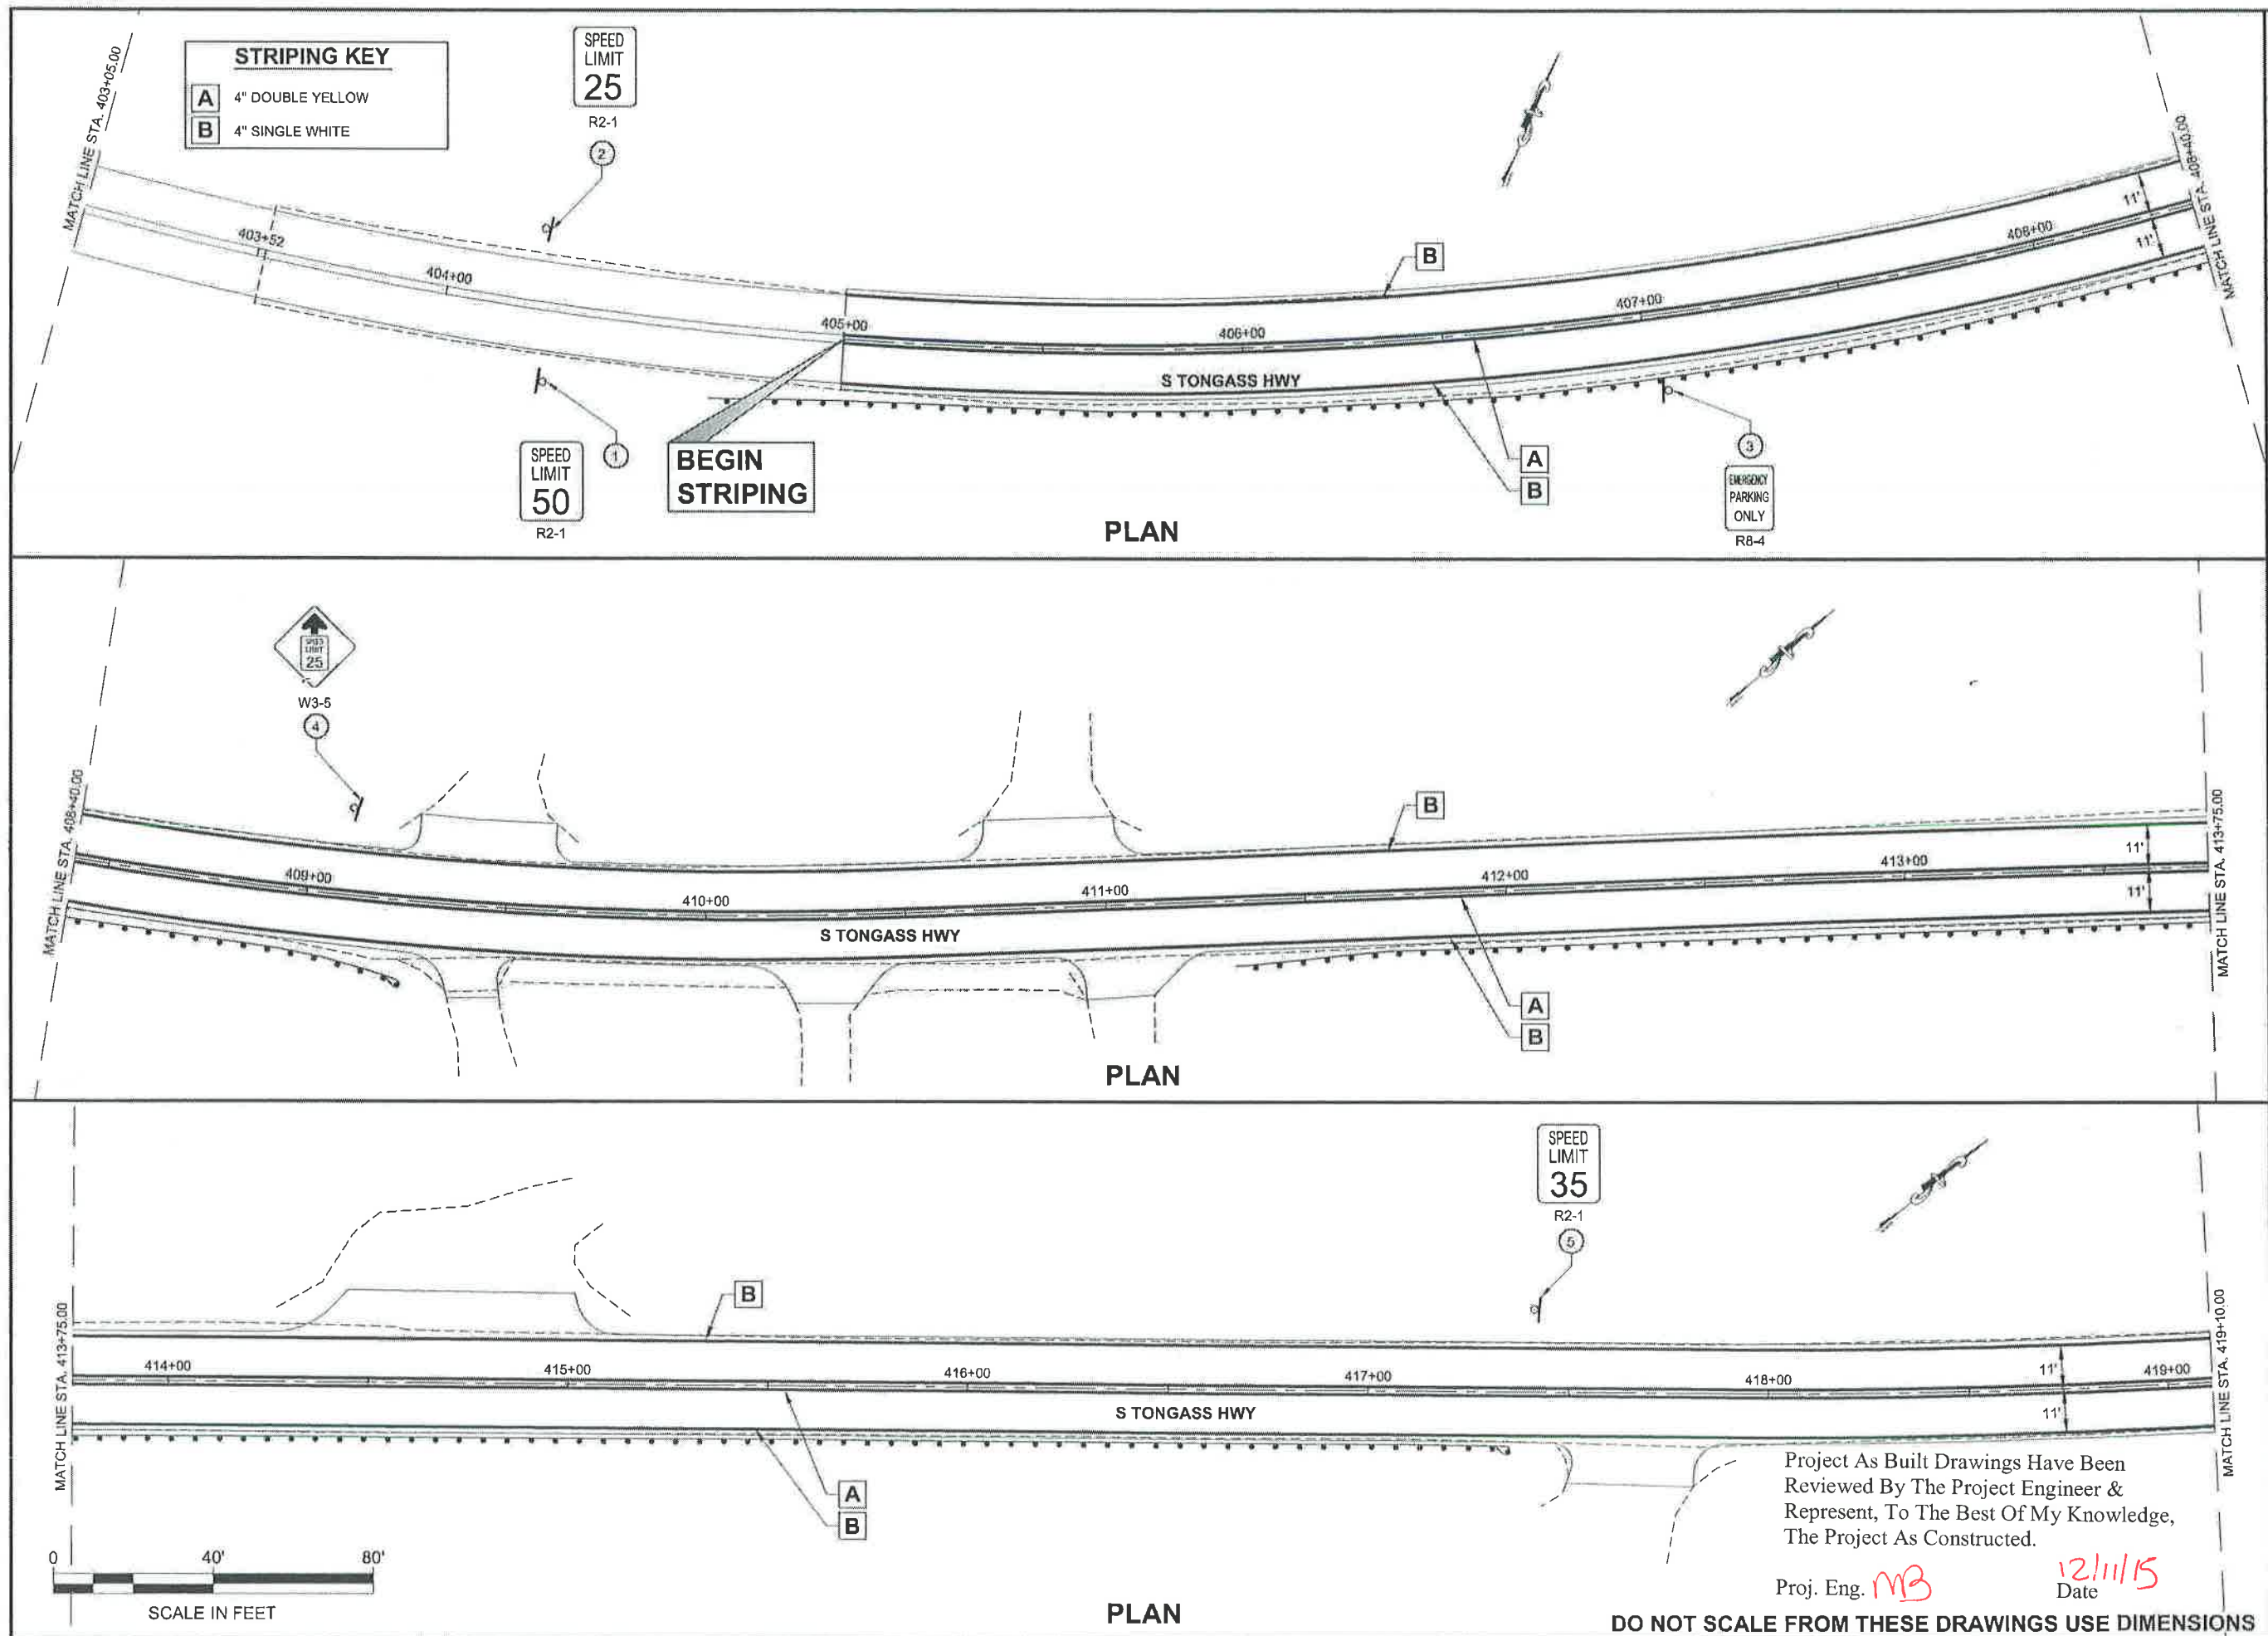

PATH:
Q:\KTN\67674\PLANSET\67674_H1-H15_STRIPE.DWG

TAB: H1

SEIFERT, LOLITA T (DOT)

Wednesday, November 05, 2014 7:43:12 AM

ADDENDUM NUMBER

ATTACHMENT NUMBER

RECORD OF REVISIONS

No.	DATE	DESCRIPTION

PLAN LEGEND

CHECKED BY: D. EPSTEIN

DESIGNED BY: L. SEIFERT

DRAWN BY: R. GRANTHAM

STATE OF ALASKA
DEPARTMENT OF TRANSPORTATION
& PUBLIC FACILITIES
SOUTHEAST REGION

**KTN-SOUTH TONGASS PAVING
PROJECT #67674**


**SIGNING
&
STRIPING**

PROJECT DESIGNATION


STP-NH-0902(040)-67674

STATE	YEAR
ALASKA	2014


SHEET NUMBER	TOTAL SHEETS
H1	66

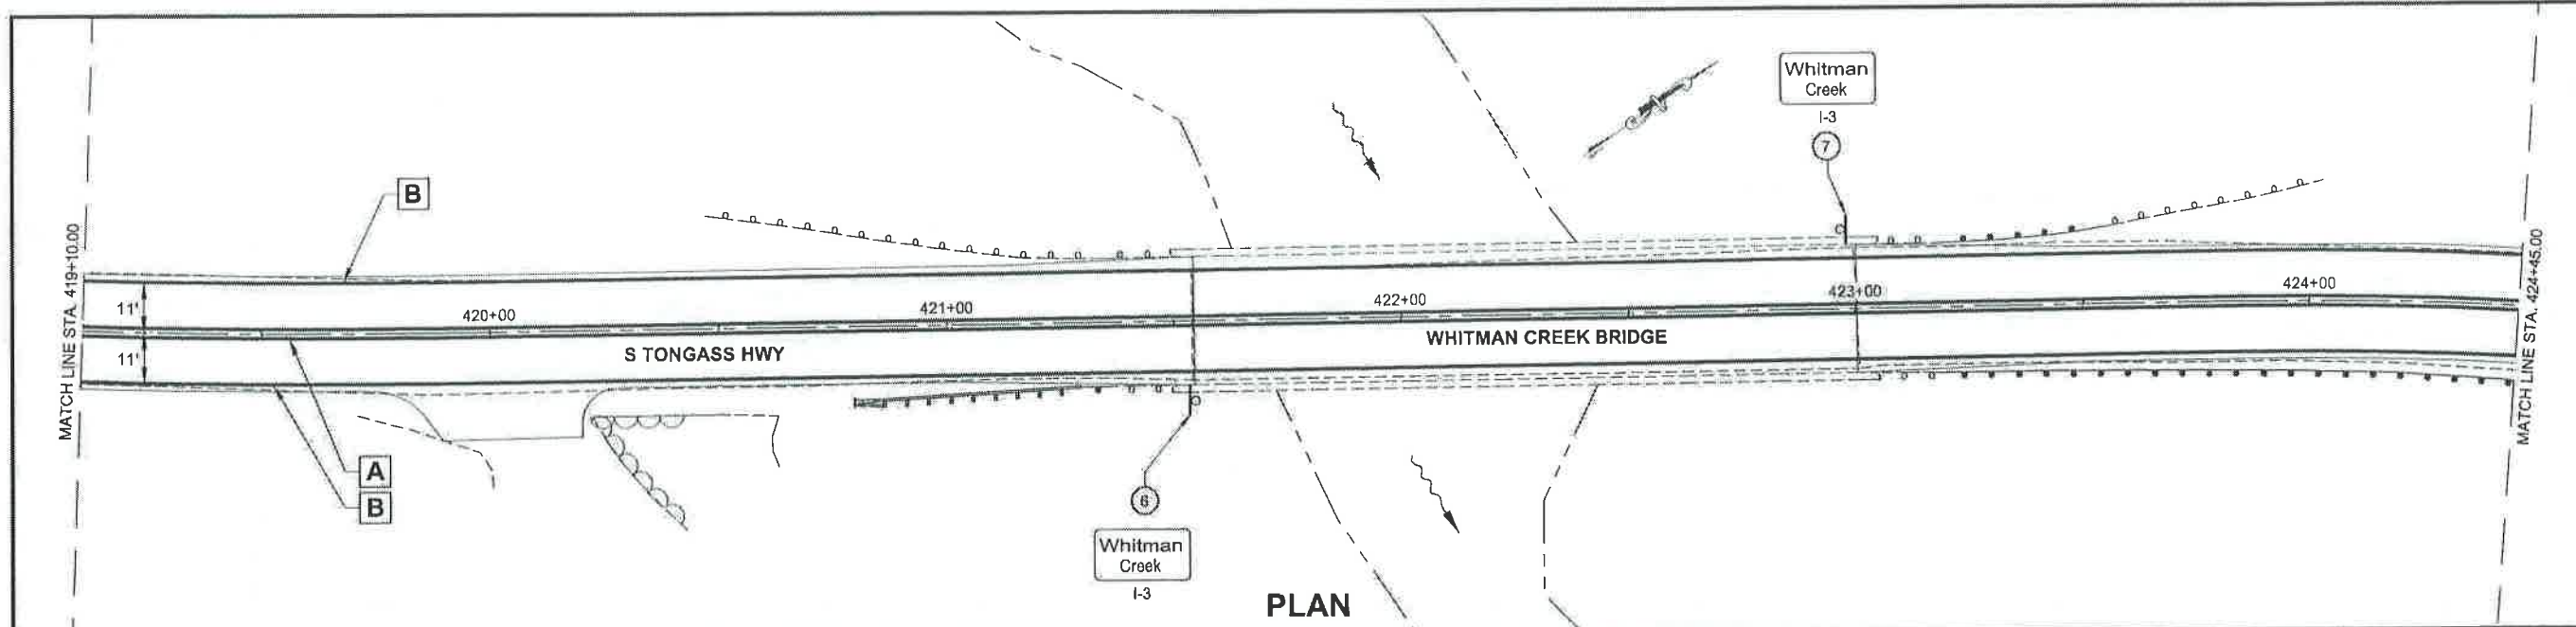

PLAN

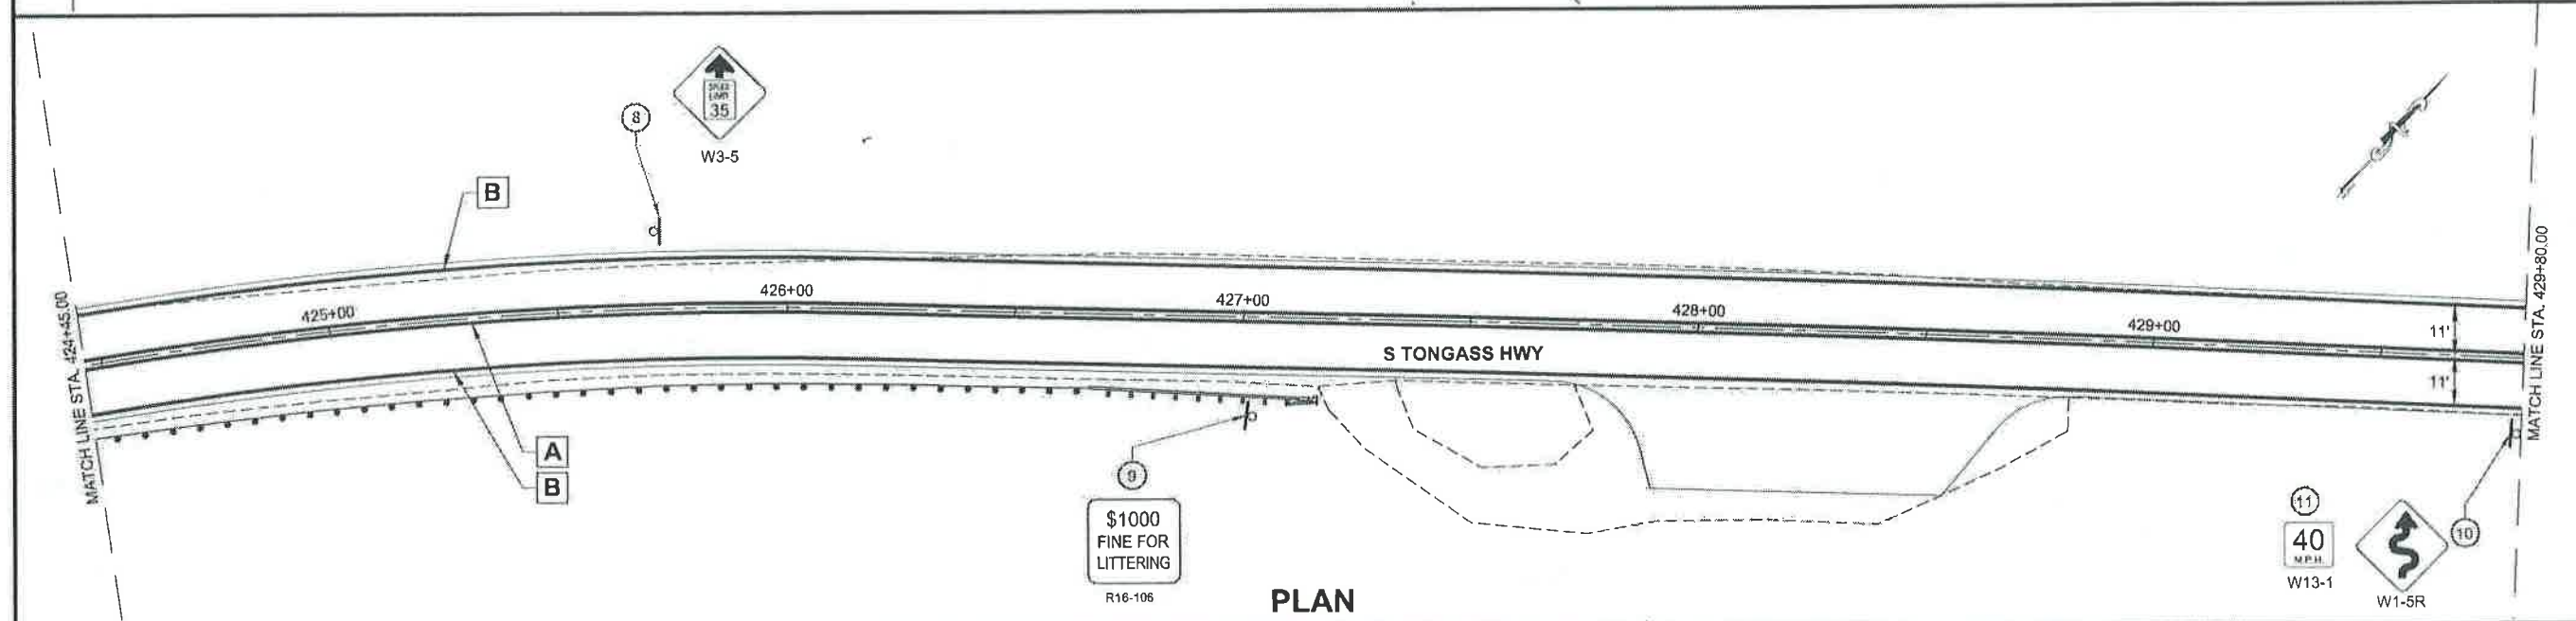

PLAN

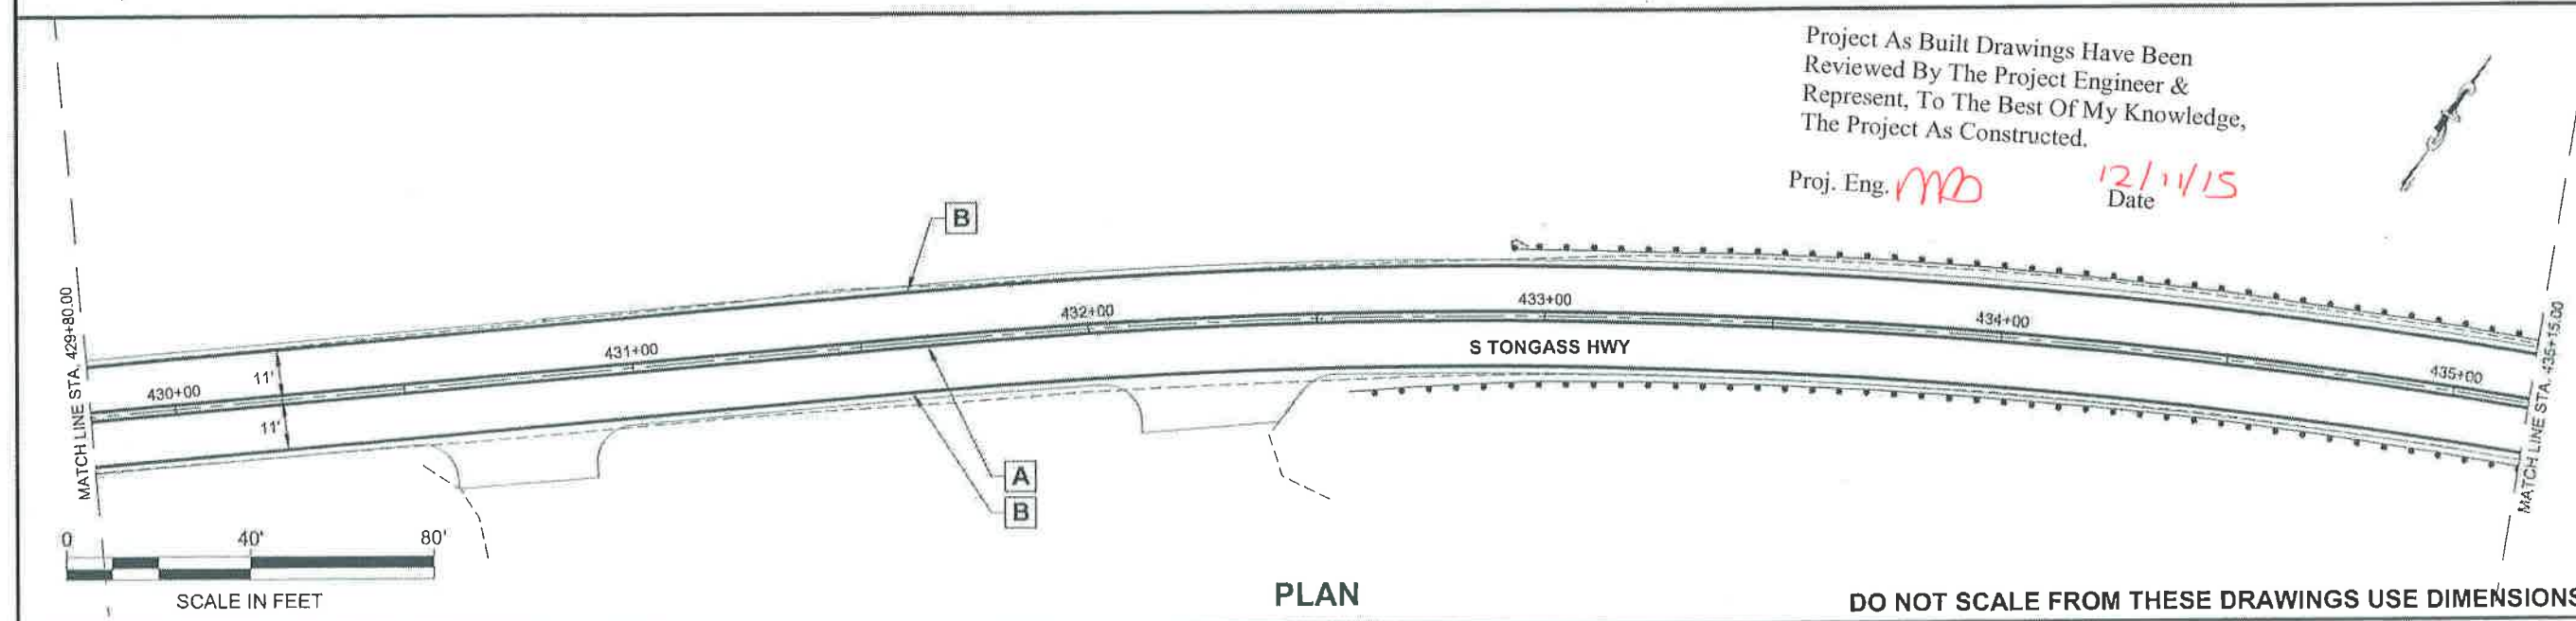


PLAN

Project As Built Drawings Have Been Reviewed By The Project Engineer & Represent, To The Best Of My Knowledge, The Project As Constructed.
 Proj. Eng. *MD* Date *12/1/15*

PATH: Q:\KTN\67674\PLAN\SET167674_H1-H13_STRIPES.DWG
 TAB: H2
 SEIFERT, LOLITA T (DOT)
 Wednesday, November 05, 2014 7:43:44 AM

RECORD OF REVISIONS		
No.	DATE	DESCRIPTION

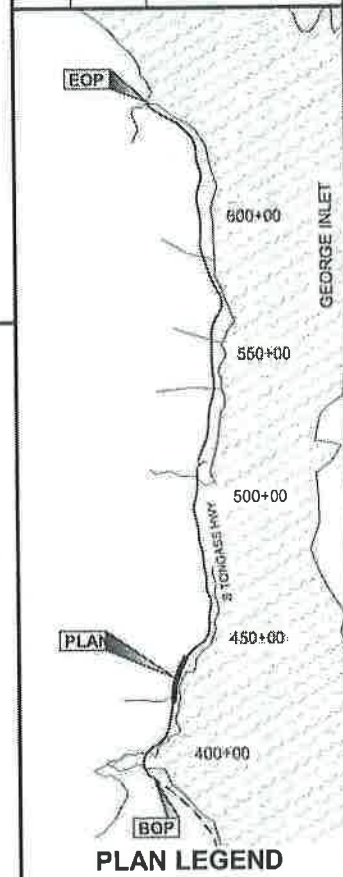

CHECKED BY: D. EPSTEIN

DESIGNED BY: L. SEIFERT
 DRAWN BY: R. GRANTHAM

STATE OF ALASKA
 DEPARTMENT OF TRANSPORTATION
 & PUBLIC FACILITIES
 SOUTHEAST REGION


KTN-SOUTH TONGASS PAVING
 PROJECT #67674

**SIGNING
 &
 STRIPING**


PROJECT DESIGNATION
STP-NH-0902(040)-67674

STATE ALASKA	YEAR 2014
SHEET NUMBER H2	TOTAL SHEETS 66


DO NOT SCALE FROM THESE DRAWINGS USE DIMENSIONS

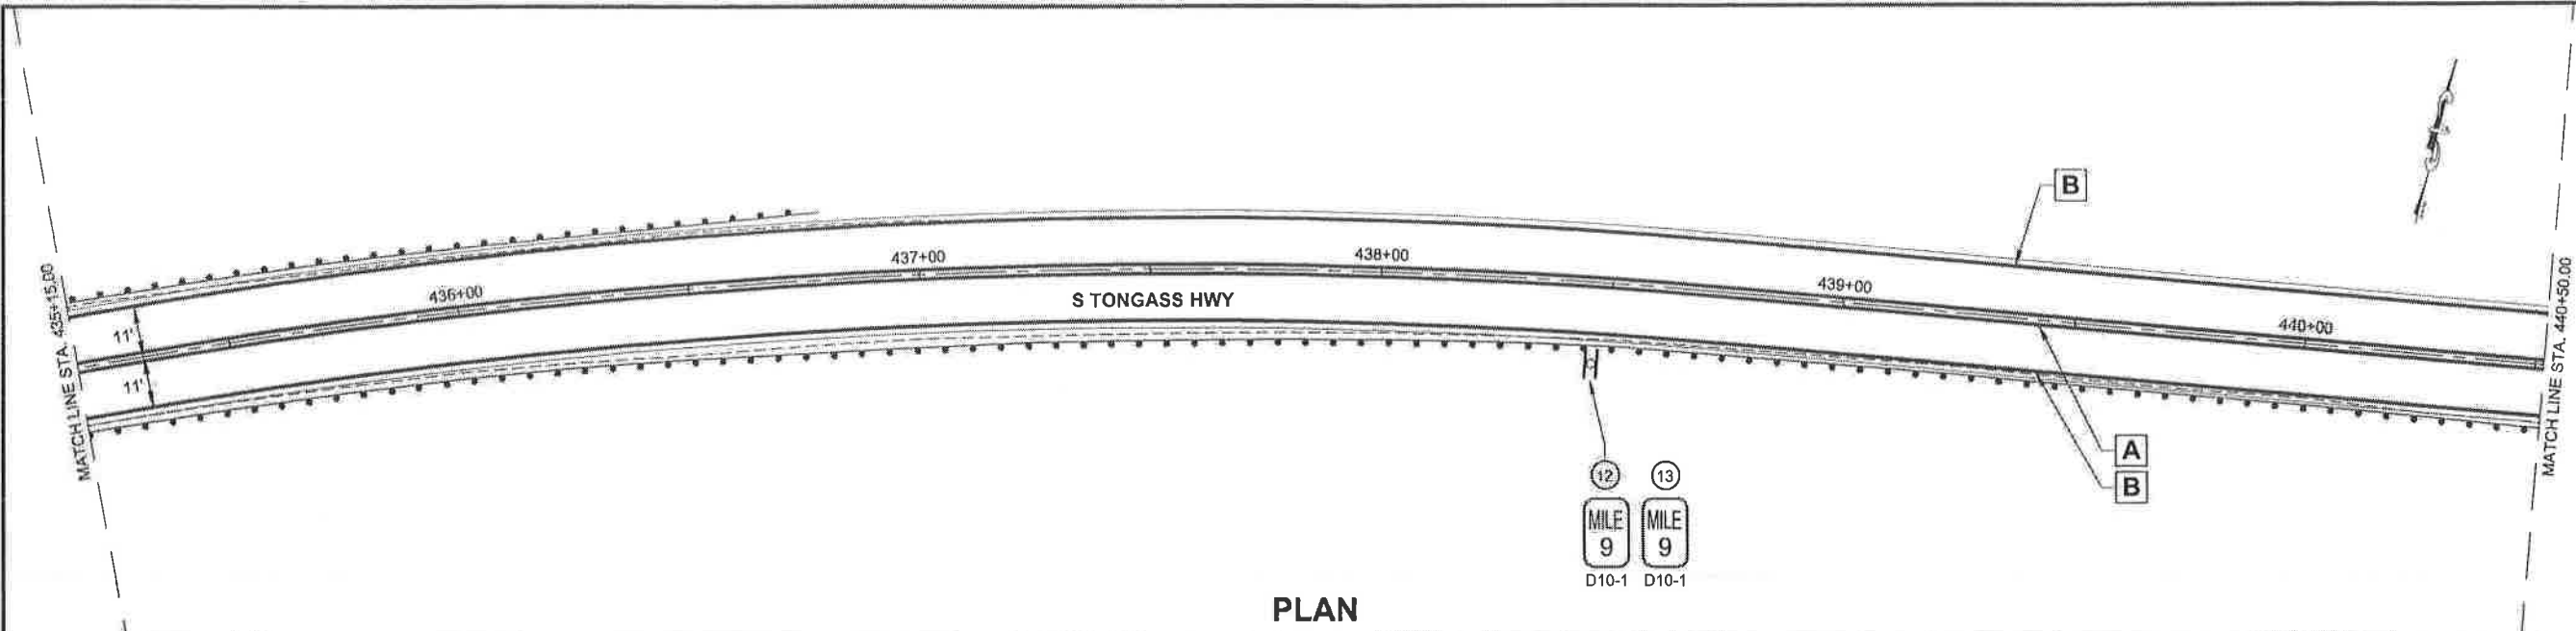

PLAN

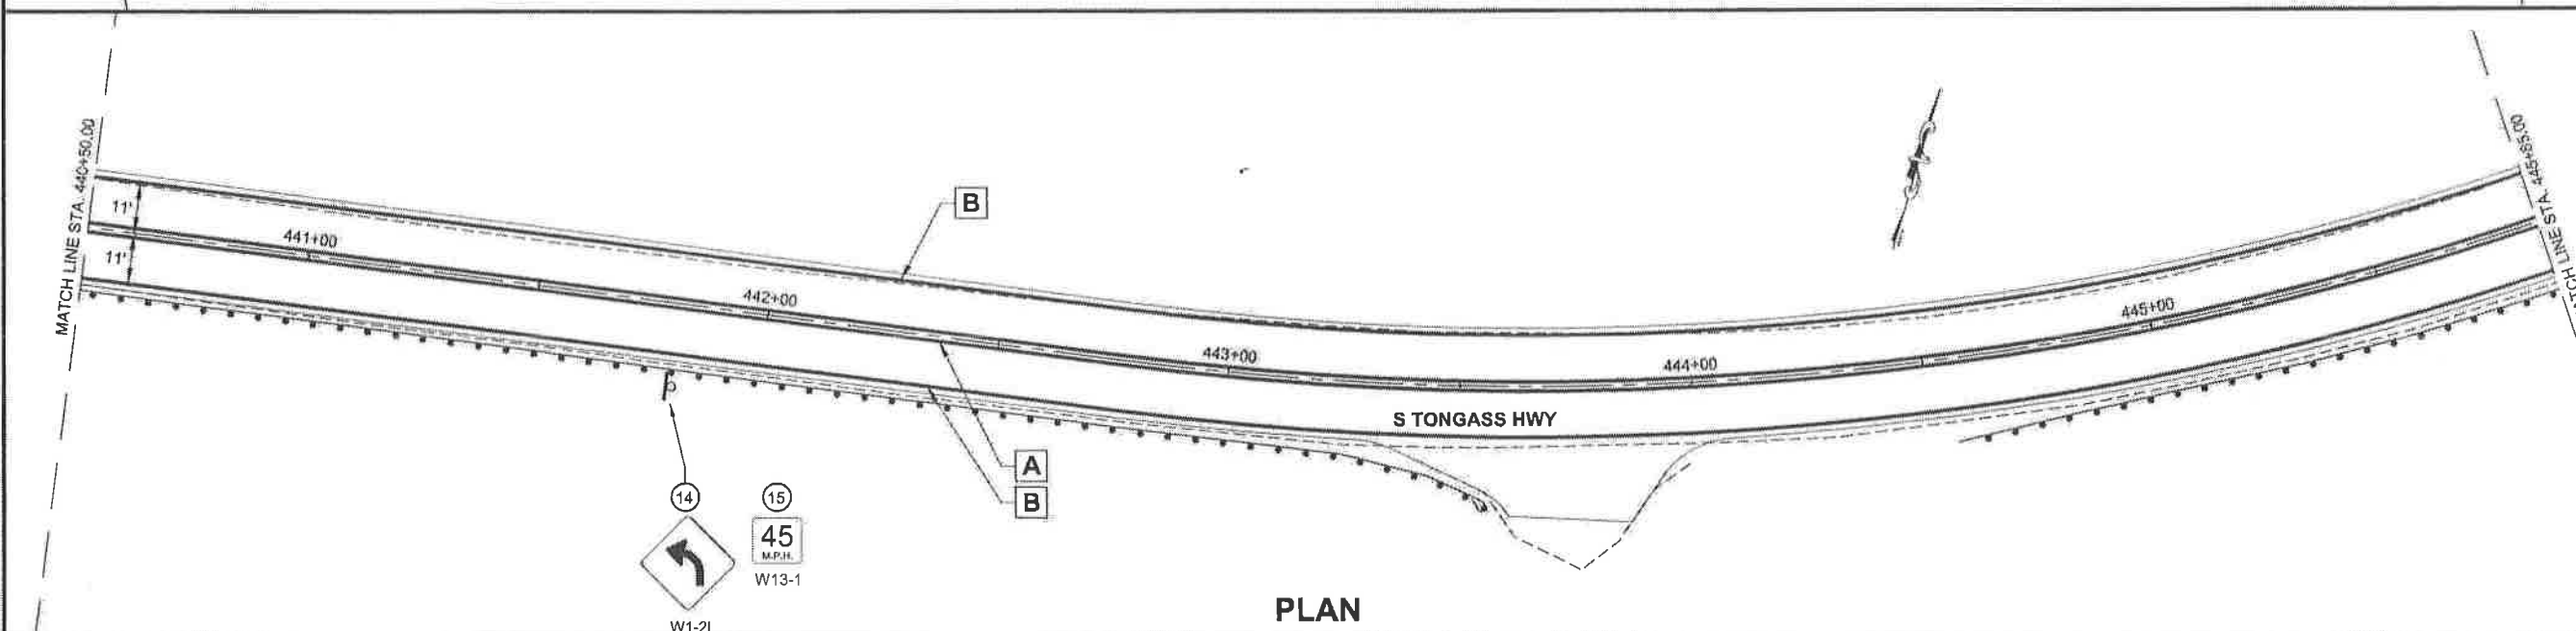

PLAN

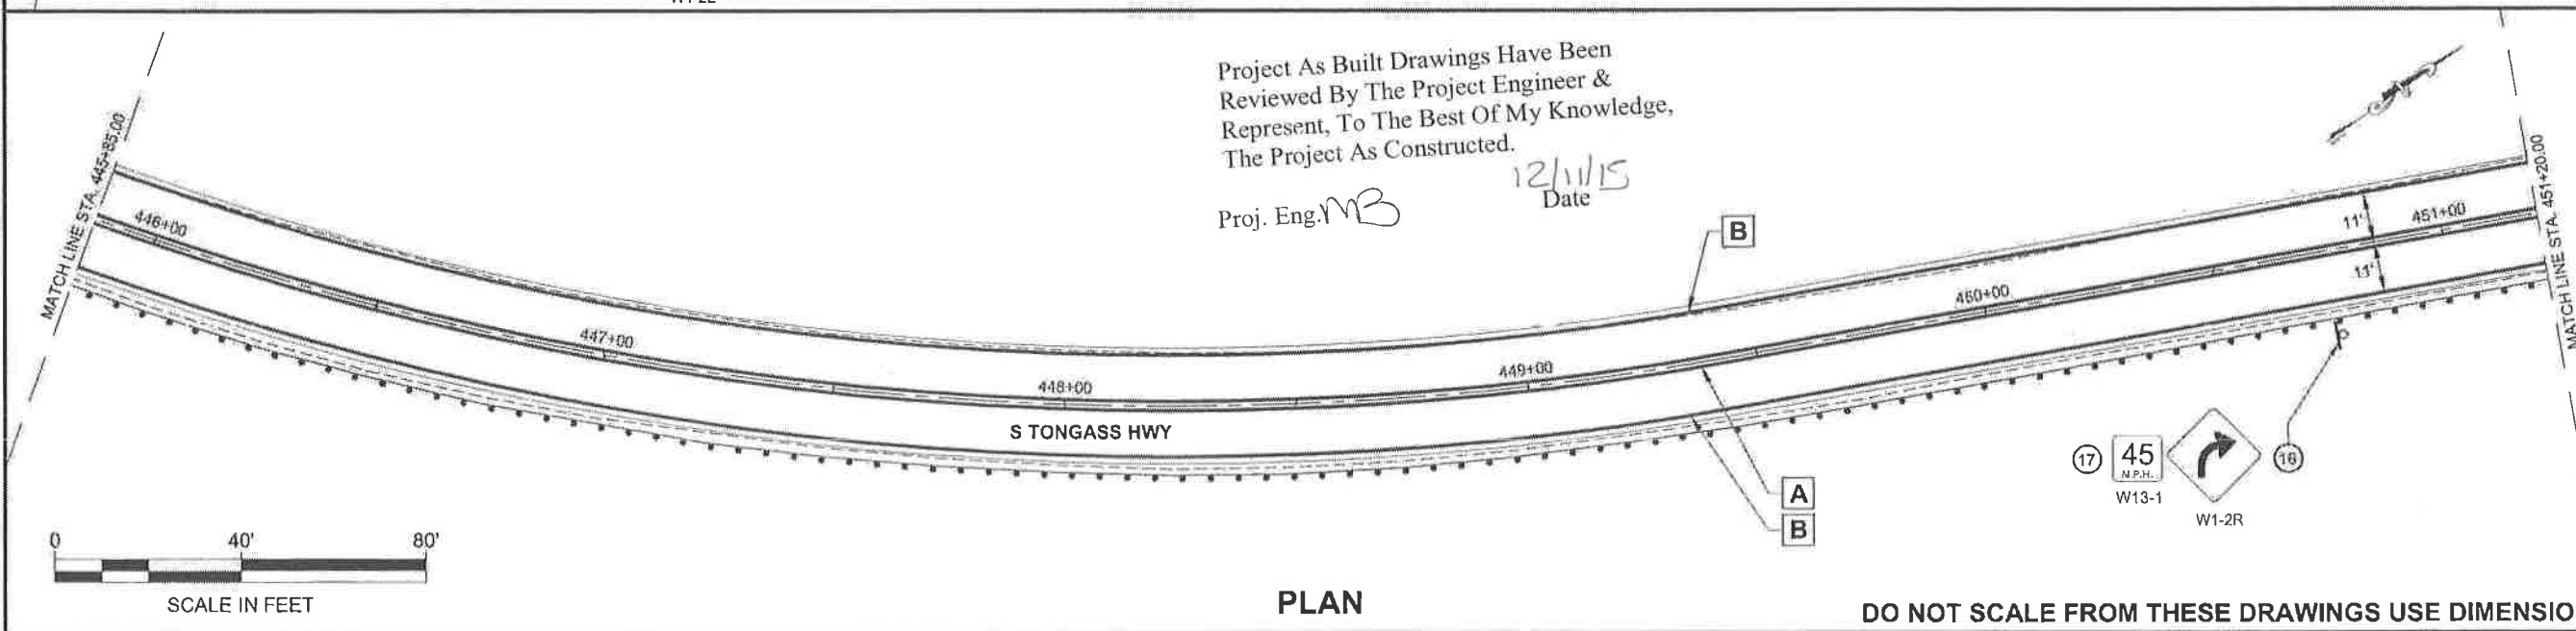

PLAN


Project As Built Drawings Have Been Reviewed By The Project Engineer & Represent, To The Best Of My Knowledge, The Project As Constructed.

Proj. Eng. MB Date 12/11/15

DO NOT SCALE FROM THESE DRAWINGS USE DIMENSIONS

PATH: Q:\KTN\67674\PLANSET\67674_H1-H15_STRIPE.DWG
 TAB: H3
 SEIFERT, LOLITA T (DOT)
 Wednesday, November 05, 2014 7:44:34 AM

RECORD OF REVISIONS		
No.	DATE	DESCRIPTION

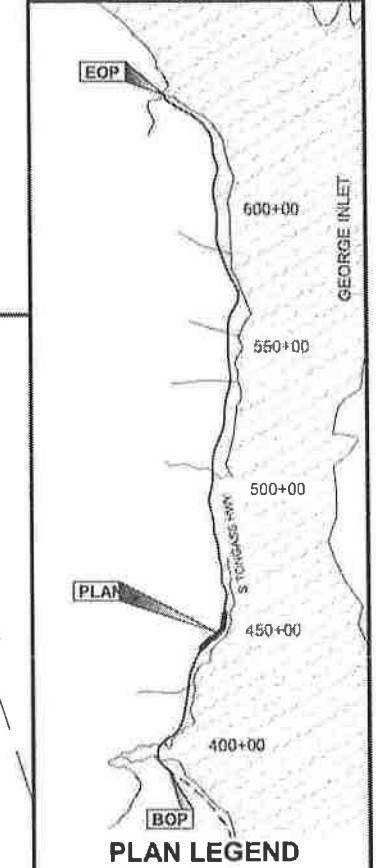

CHECKED BY: D. EPSTEIN

DESIGNED BY: L. SEIFERT
 DRAWN BY: R. GRANTHAM


STATE OF ALASKA
 DEPARTMENT OF TRANSPORTATION
 & PUBLIC FACILITIES
 SOUTHEAST REGION

KTN-SOUTH TONGASS PAVING
 PROJECT #67674


**SIGNING
&
STRIPING**

PROJECT DESIGNATION
STP-NH-0902(040)-67674


STATE	YEAR
ALASKA	2014
SHEET NUMBER	TOTAL SHEETS
H3	66

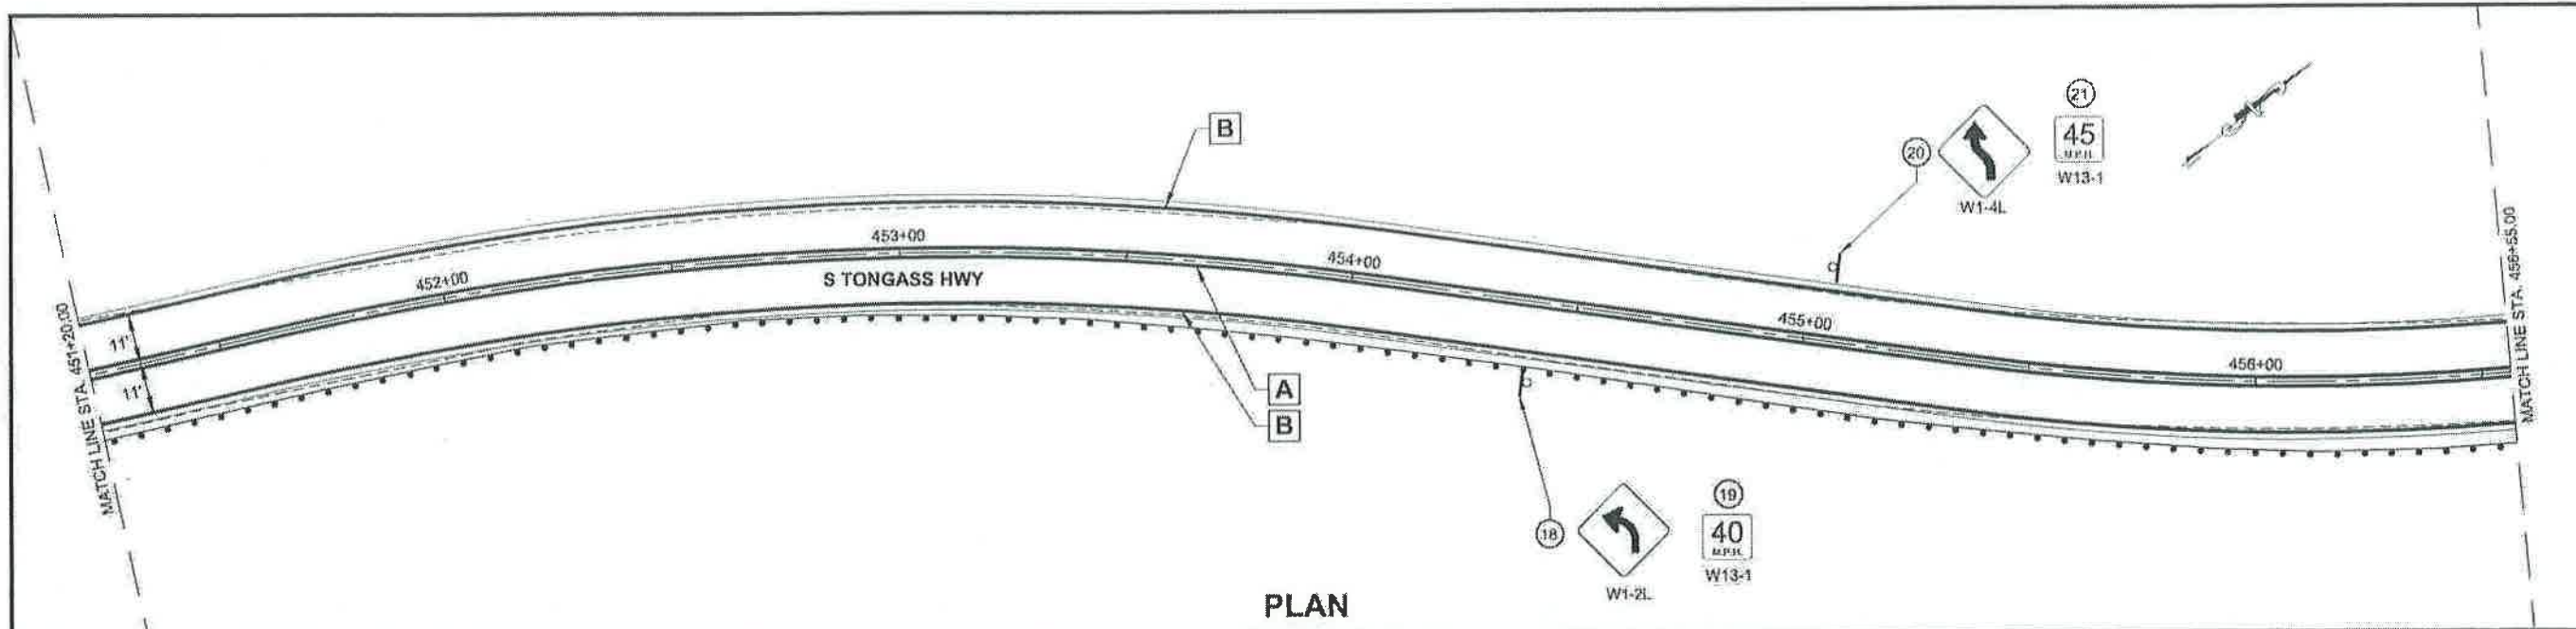

PLAN

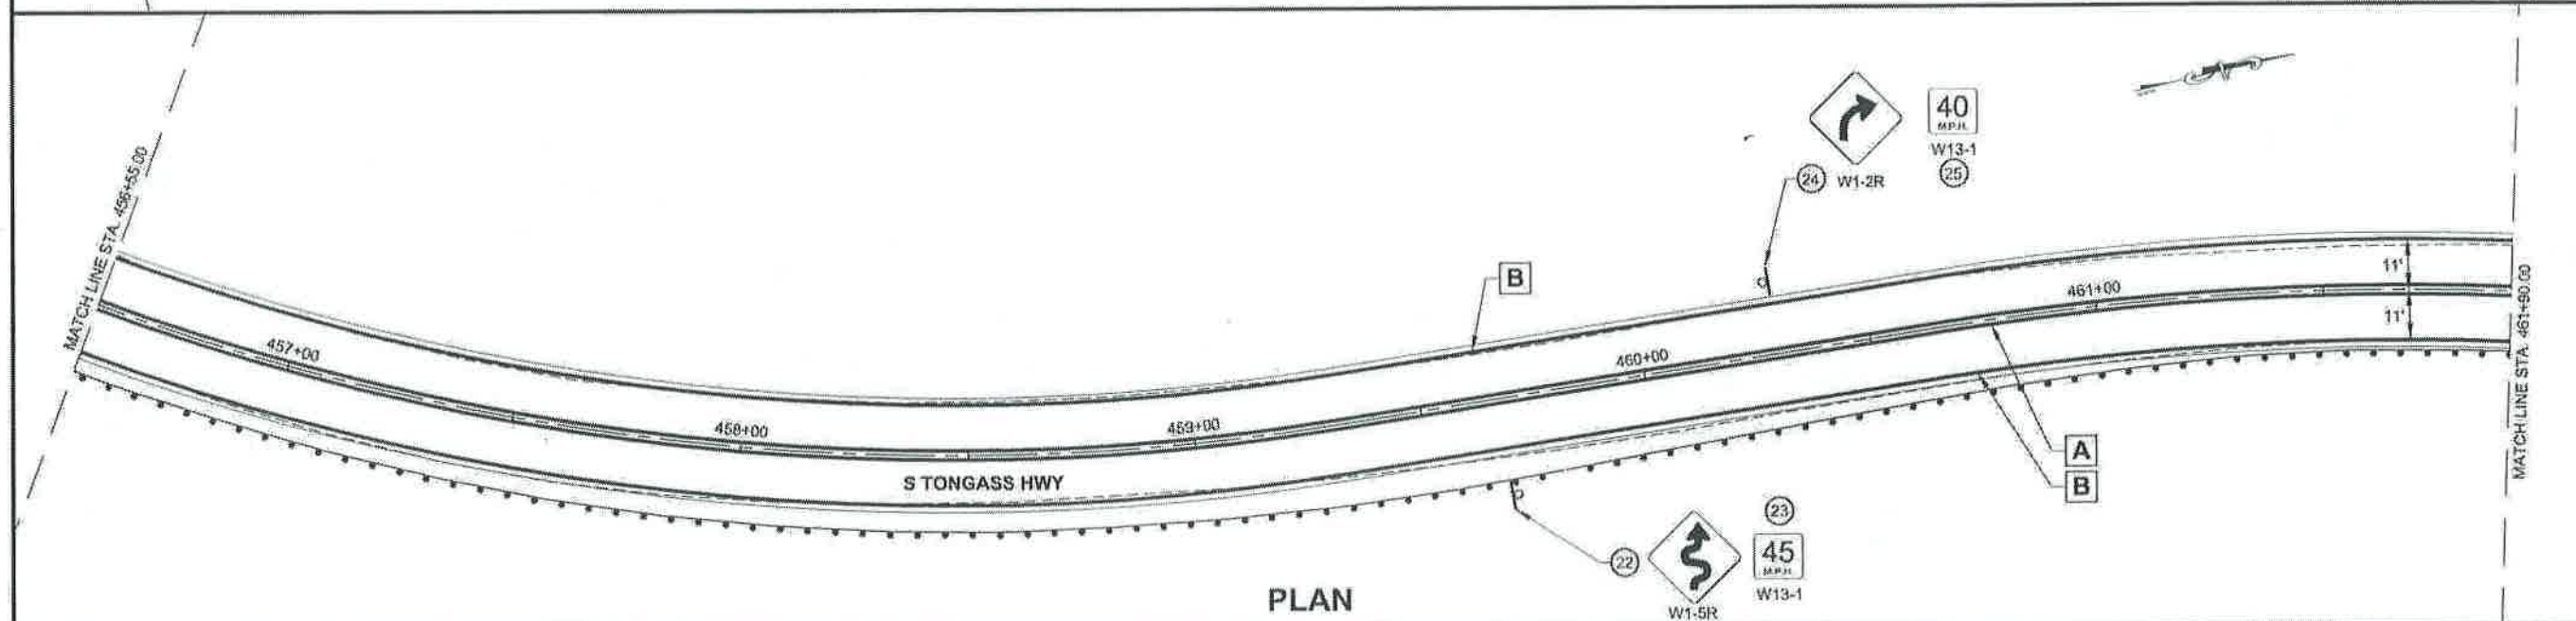

PLAN

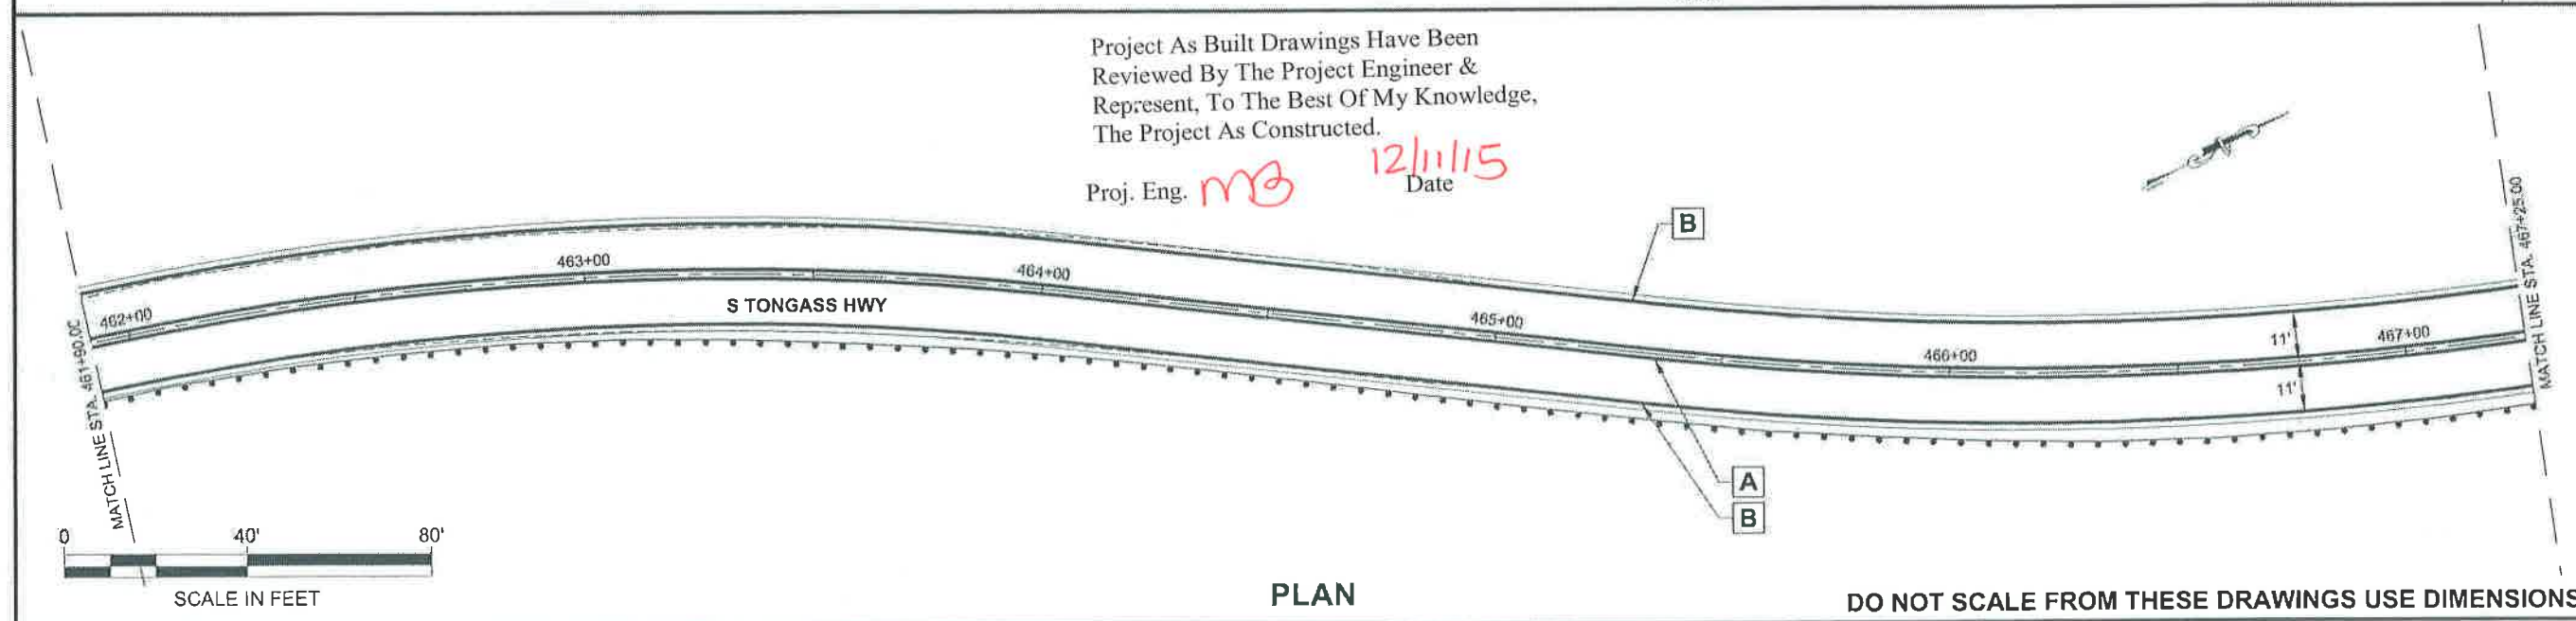

PLAN

Project As Built Drawings Have Been Reviewed By The Project Engineer & Represent, To The Best Of My Knowledge, The Project As Constructed.

Proj. Eng. *mb*

12/11/15
Date

DO NOT SCALE FROM THESE DRAWINGS USE DIMENSIONS

PATH: Q:\KTN\67674\PLANSET\67674_H1-H15_STRIPE.DWG
TAB: H4
SEIFERT, LOLITA T (DOT)
Wednesday, November 05, 2014 7:44:55 AM

ADDENDUM NUMBER

ATTACHMENT NUMBER

RECORD OF REVISIONS

No.	DATE	DESCRIPTION

EOP

600+00

550+00

500+00

450+00

400+00

BOP

PLAN

GEORGE INLET

PLAN LEGEND

CHECKED BY: D. EPSTEIN

DESIGNED BY: L. SEIFERT

DRAWN BY: R. GRANTHAM

STATE OF ALASKA
DEPARTMENT OF TRANSPORTATION
& PUBLIC FACILITIES
SOUTHEAST REGION

KTN-SOUTH TONGASS PAVING
PROJECT #67674

**SIGNING
&
STRIPING**


PROJECT DESIGNATION

STP-NH-0902(040)-67674

STATE	YEAR
ALASKA	2014


SHEET NUMBER	TOTAL SHEETS
H4	66

MATCH LINE STA. 467+25.00

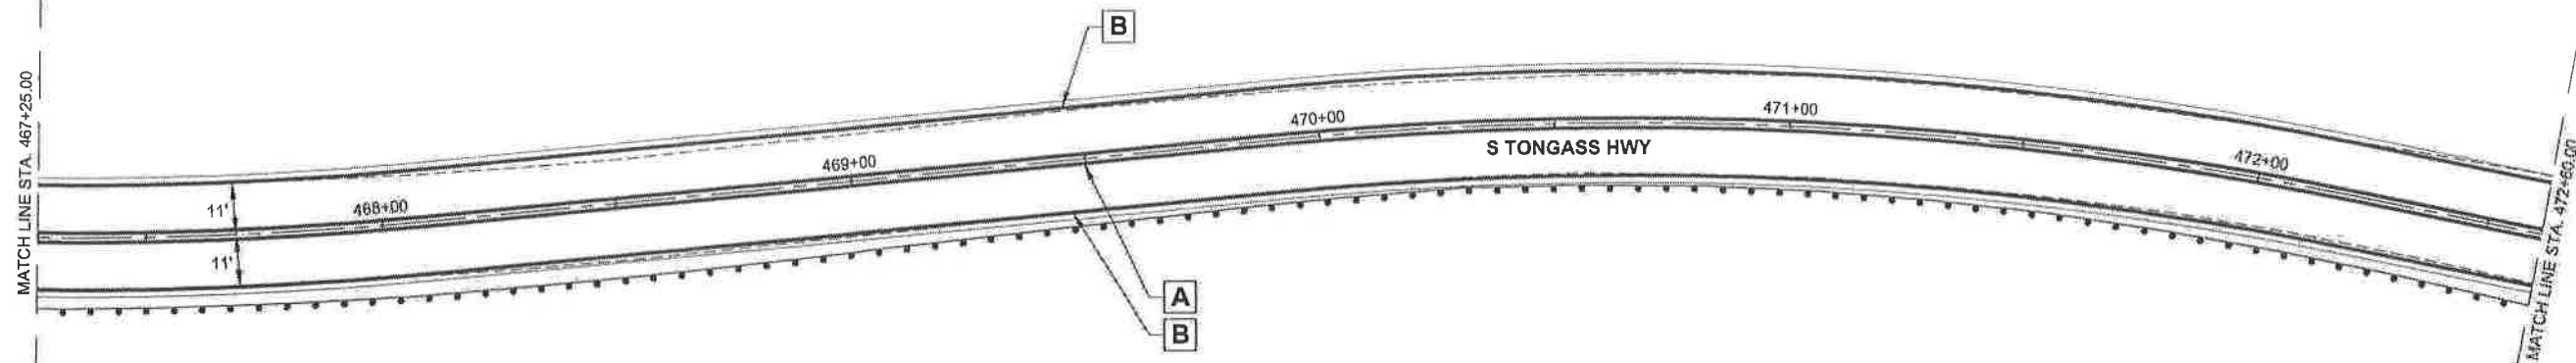


PLAN

MATCH LINE STA. 472+80.00

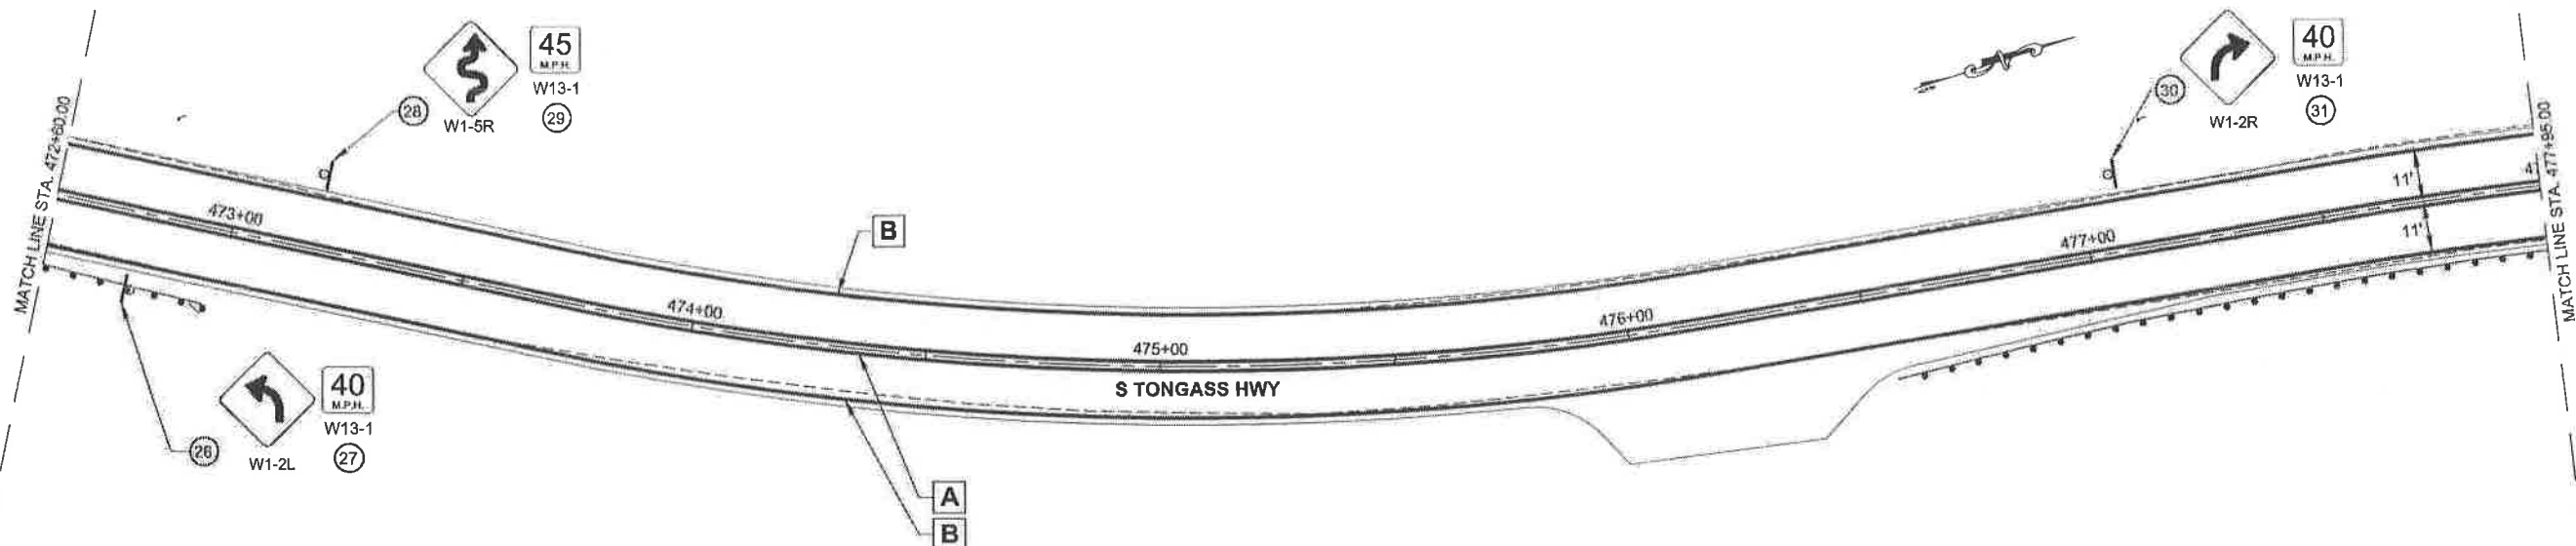

PLAN

MATCH LINE STA. 477+95.00

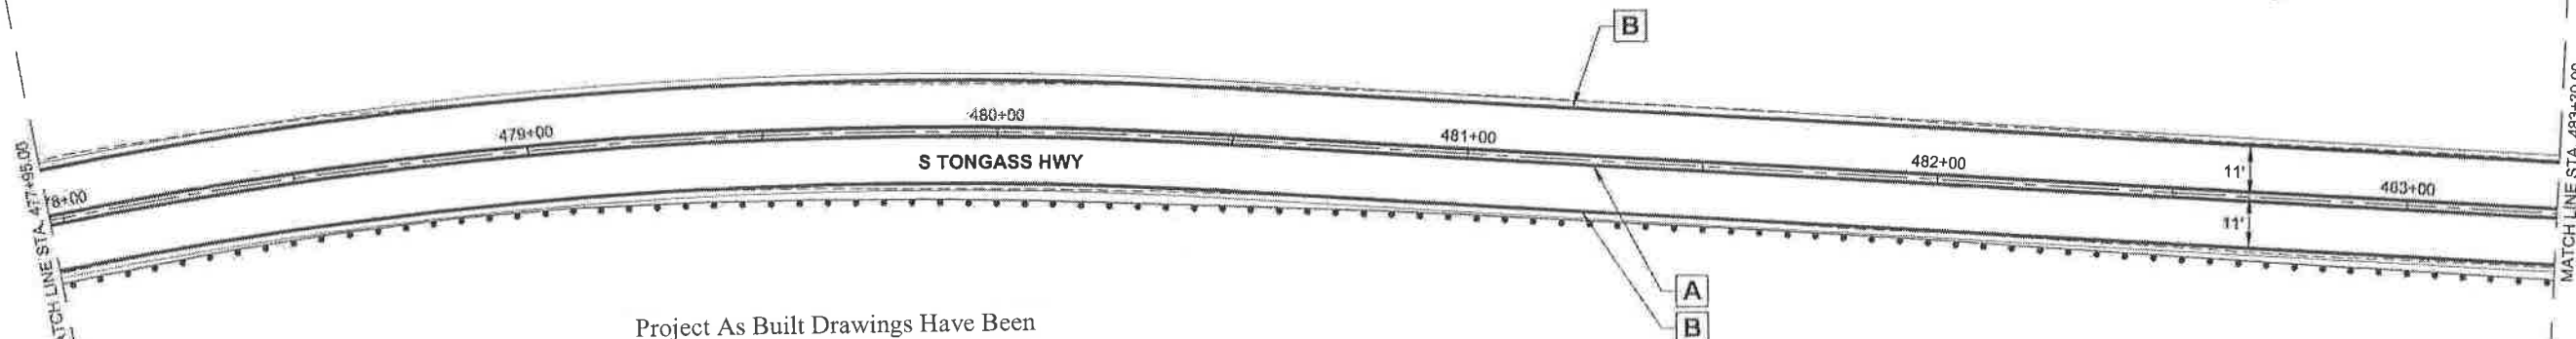

PLAN




Project As Built Drawings Have Been Reviewed By The Project Engineer & Represent, To The Best Of My Knowledge, The Project As Constructed.

Proj. Eng. *mb* Date 12/11/15

DO NOT SCALE FROM THESE DRAWINGS USE DIMENSIONS

PATH: Q:\KTN\67674\PLANSET\67674_H5-H15_STRIPES.DWG
TAB: H5
SEIFERT, LOLITA T (DOT)
Wednesday, November 05, 2014 7:45:23 AM

ADDENDUM NUMBER		
ATTACHMENT NUMBER		
RECORD OF REVISIONS		
No.	DATE	DESCRIPTION

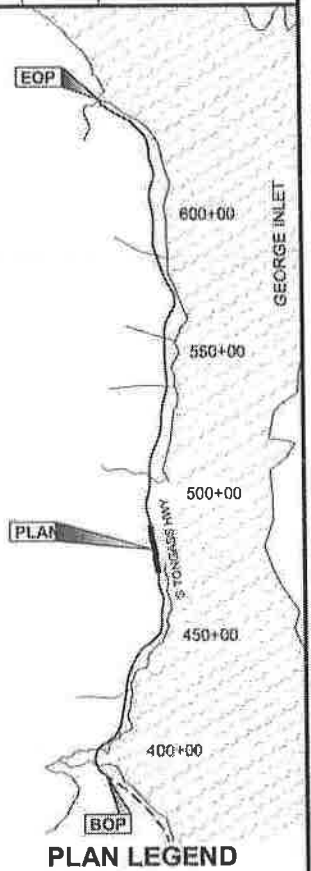

CHECKED BY: D. EPSTEIN

STATE OF ALASKA
DEPARTMENT OF TRANSPORTATION & PUBLIC FACILITIES
SOUTHEAST REGION
David Bruce Epstein
Professional Engineer
11-6-14

DESIGNED BY: L. SEIFERT
DRAWN BY: R. GRANTHAM

STATE OF ALASKA
DEPARTMENT OF TRANSPORTATION & PUBLIC FACILITIES
SOUTHEAST REGION


KTN-SOUTH TONGASS PAVING PROJECT #67674

SIGNING & STRIPING


PROJECT DESIGNATION

STP-NH-0902(040)-67674


STATE	YEAR
ALASKA	2014
SHEET NUMBER	TOTAL SHEETS
H5	66

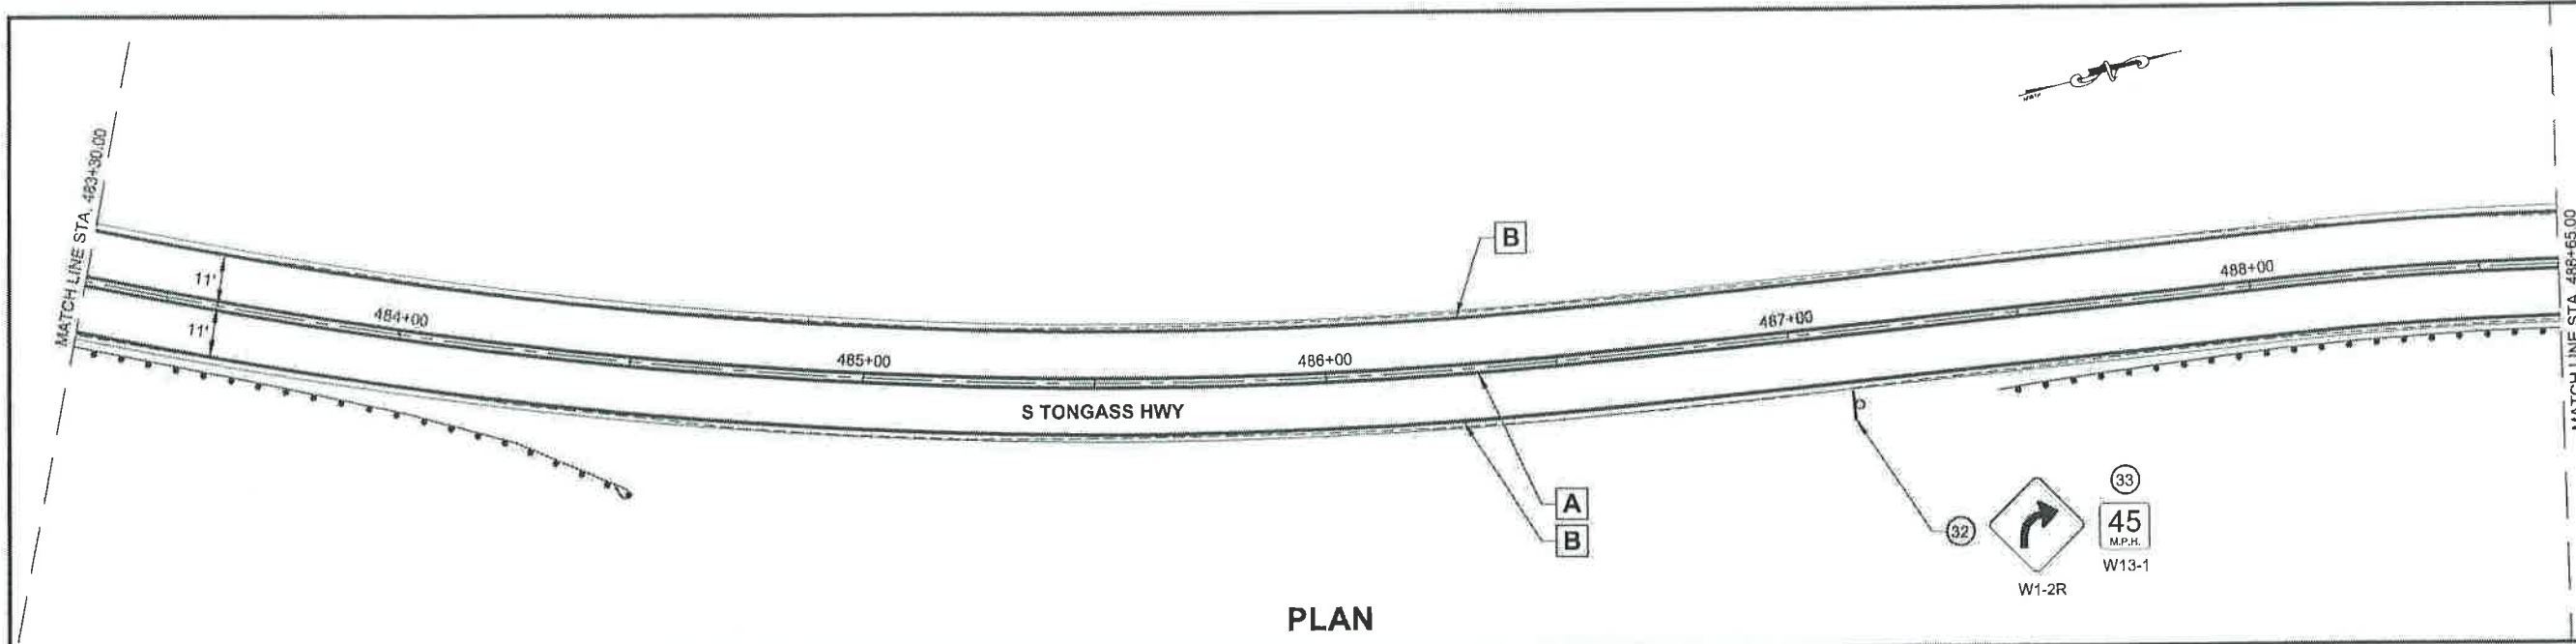

PLAN

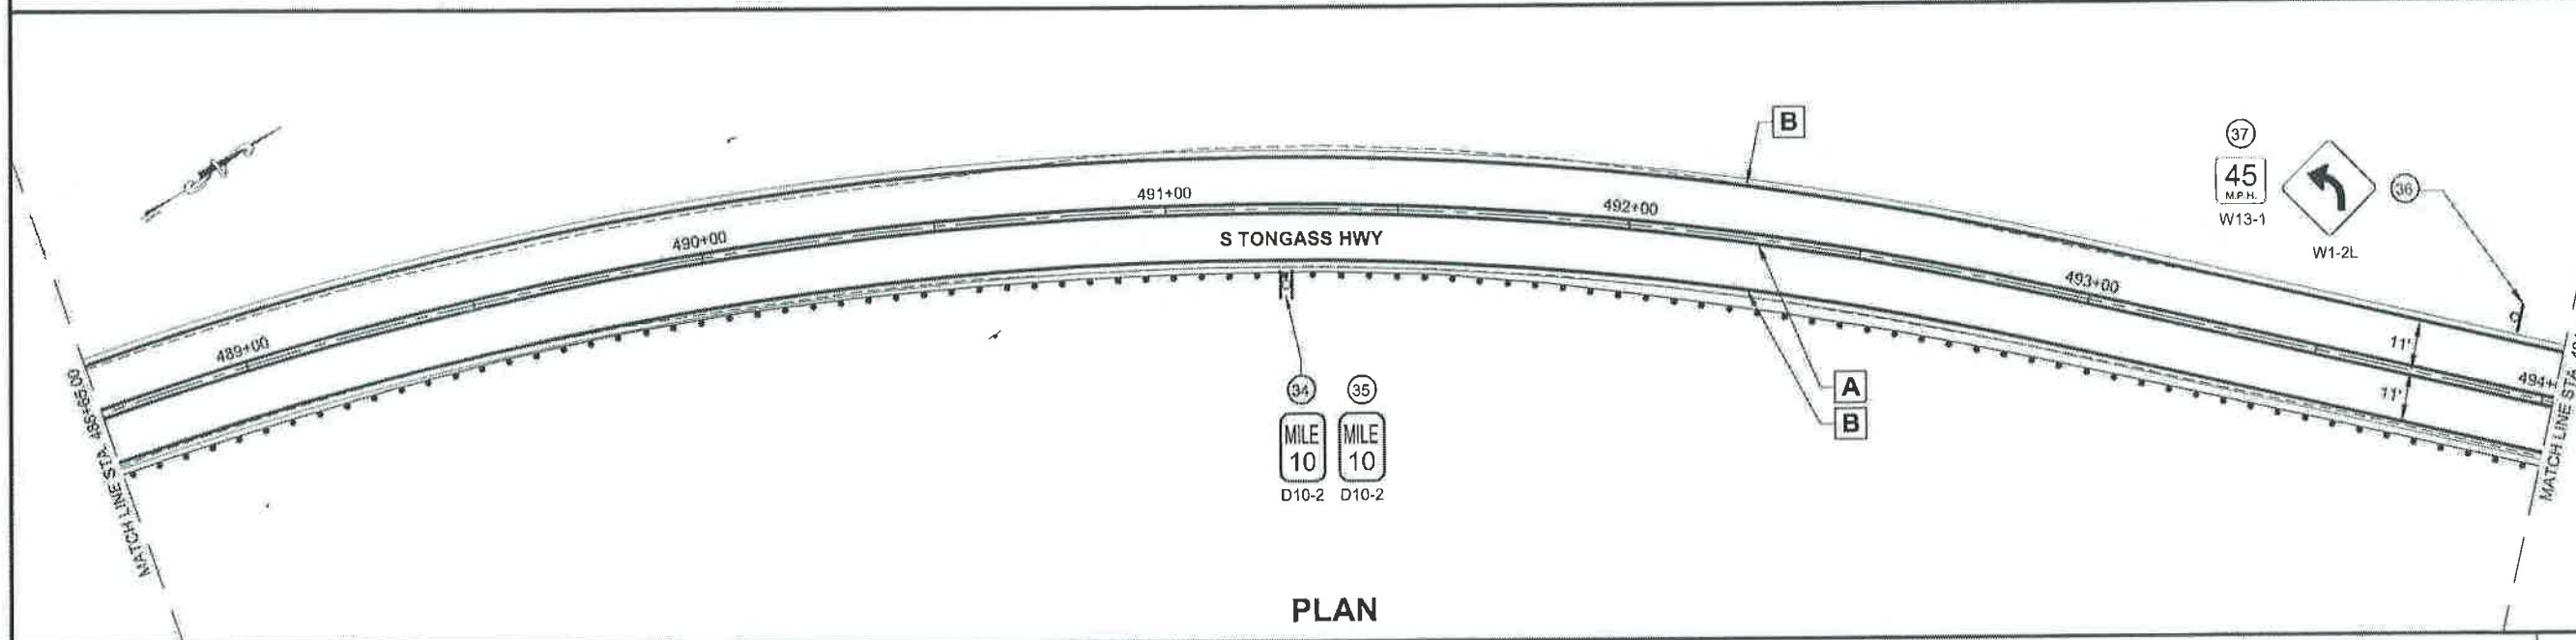


PLAN

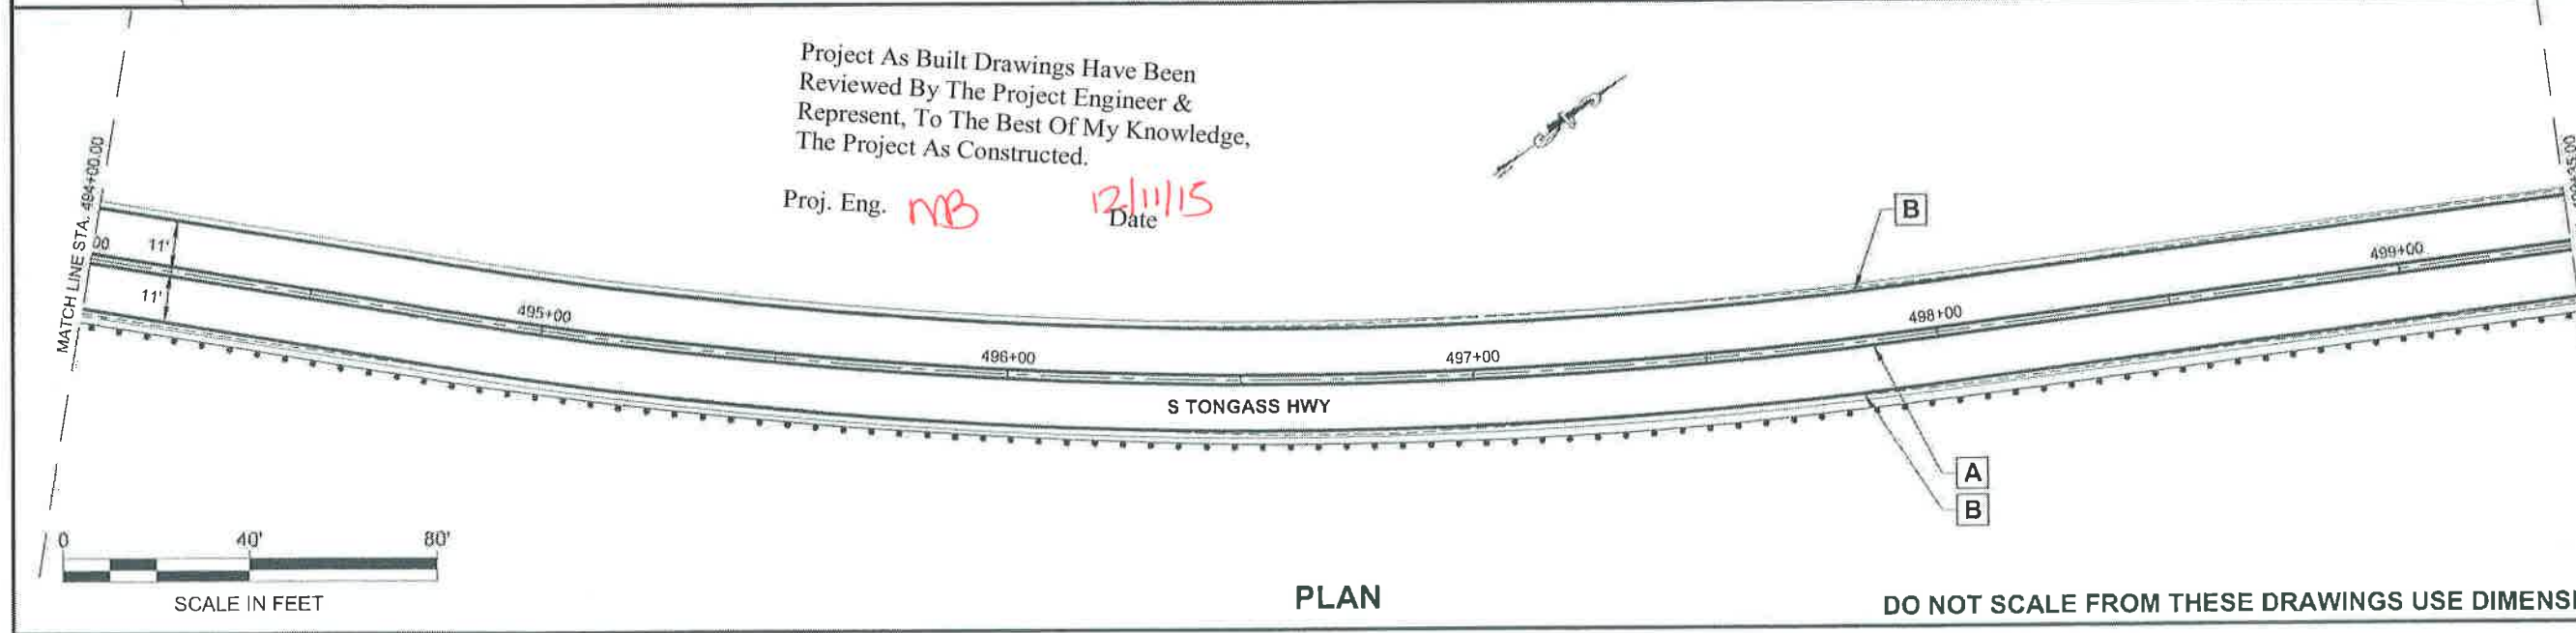

PLAN

PATH: Q:\KTN\67674\PLANSET\67674_H1-H15_STRIPS.DWG
 TAB: H6
 SEIFERT, LOLITA T (DOT)
 Wednesday, November 05, 2014 7:45:45 AM

ADDENDUM NUMBER		
ATTACHMENT NUMBER		
RECORD OF REVISIONS		
No.	DATE	DESCRIPTION

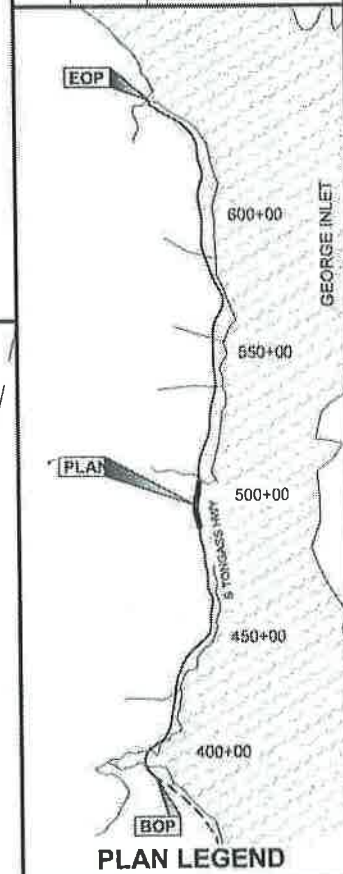

CHECKED BY: D. EPSTEIN

DESIGNED BY: L. SEIFERT
 DRAWN BY: R. GRANTHAM

STATE OF ALASKA
 DEPARTMENT OF TRANSPORTATION
 & PUBLIC FACILITIES
 SOUTHEAST REGION

KTN-SOUTH TONGASS PAVING
 PROJECT #67674

**SIGNING
 &
 STRIPING**

PROJECT DESIGNATION
 STP-NH-0902(040)-67674

STATE	YEAR
ALASKA	2014
SHEET NUMBER	TOTAL SHEETS
H6	66

MATCH LINE STA. 499+35.00

11'
11'

500+00

501+00

502+00

503+00

504+00

S TONGASS HWY

MATCH LINE STA. 504+70.00

PLAN

MATCH LINE STA. 504+70.00

505+00

11'
11'

506+00

507+00

S TONGASS HWY

508+00

509+00

510+00

MATCH LINE STA. 510+05.00

PLAN

MATCH LINE STA. 510+05.00

11'
11'

511+00

512+00

513+00

514+00

515+00

S TONGASS HWY

MATCH LINE STA. 515+40.00

PLAN

Project As Built Drawings Have Been
Reviewed By The Project Engineer &
Represent, To The Best Of My Knowledge,
The Project As Constructed.

Proj. Eng. MB


12/11/15
Date



SCALE IN FEET

DO NOT SCALE FROM THESE DRAWINGS USE DIMENSIONS

PATH: Q:\KTN\67674\PLANSET\67674_H1-H15_STRIPED.DWG		
TAB: H7		
SEIFERT, LOLITA T (DOT)		
Wednesday, November 05, 2014 7:46:04 AM		
ADDENDUM NUMBER		
ATTACHMENT NUMBER		
RECORD OF REVISIONS		
No.	DATE	DESCRIPTION

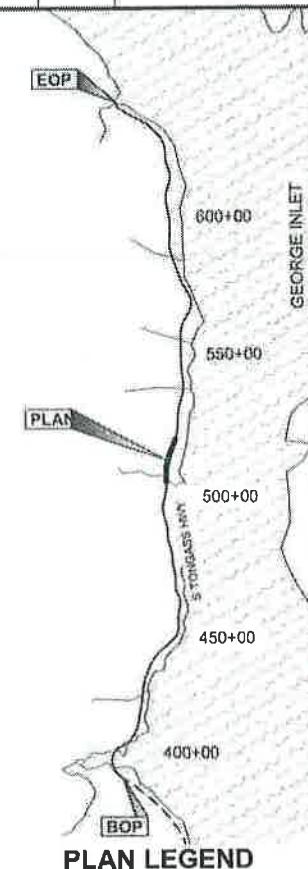

CHECKED BY: D. EPSTEIN



DESIGNED BY: L. SEIFERT

DRAWN BY: R. GRANTHAM

STATE OF ALASKA
DEPARTMENT OF TRANSPORTATION
& PUBLIC FACILITIES
SOUTHEAST REGION


KTN-SOUTH TONGASS PAVING
PROJECT #67674

**SIGNING
&
STRIPING**


PROJECT DESIGNATION

STP-NH-0902(040)-67674


STATE	YEAR
ALASKA	2014
SHEET NUMBER	TOTAL SHEETS
H7	66

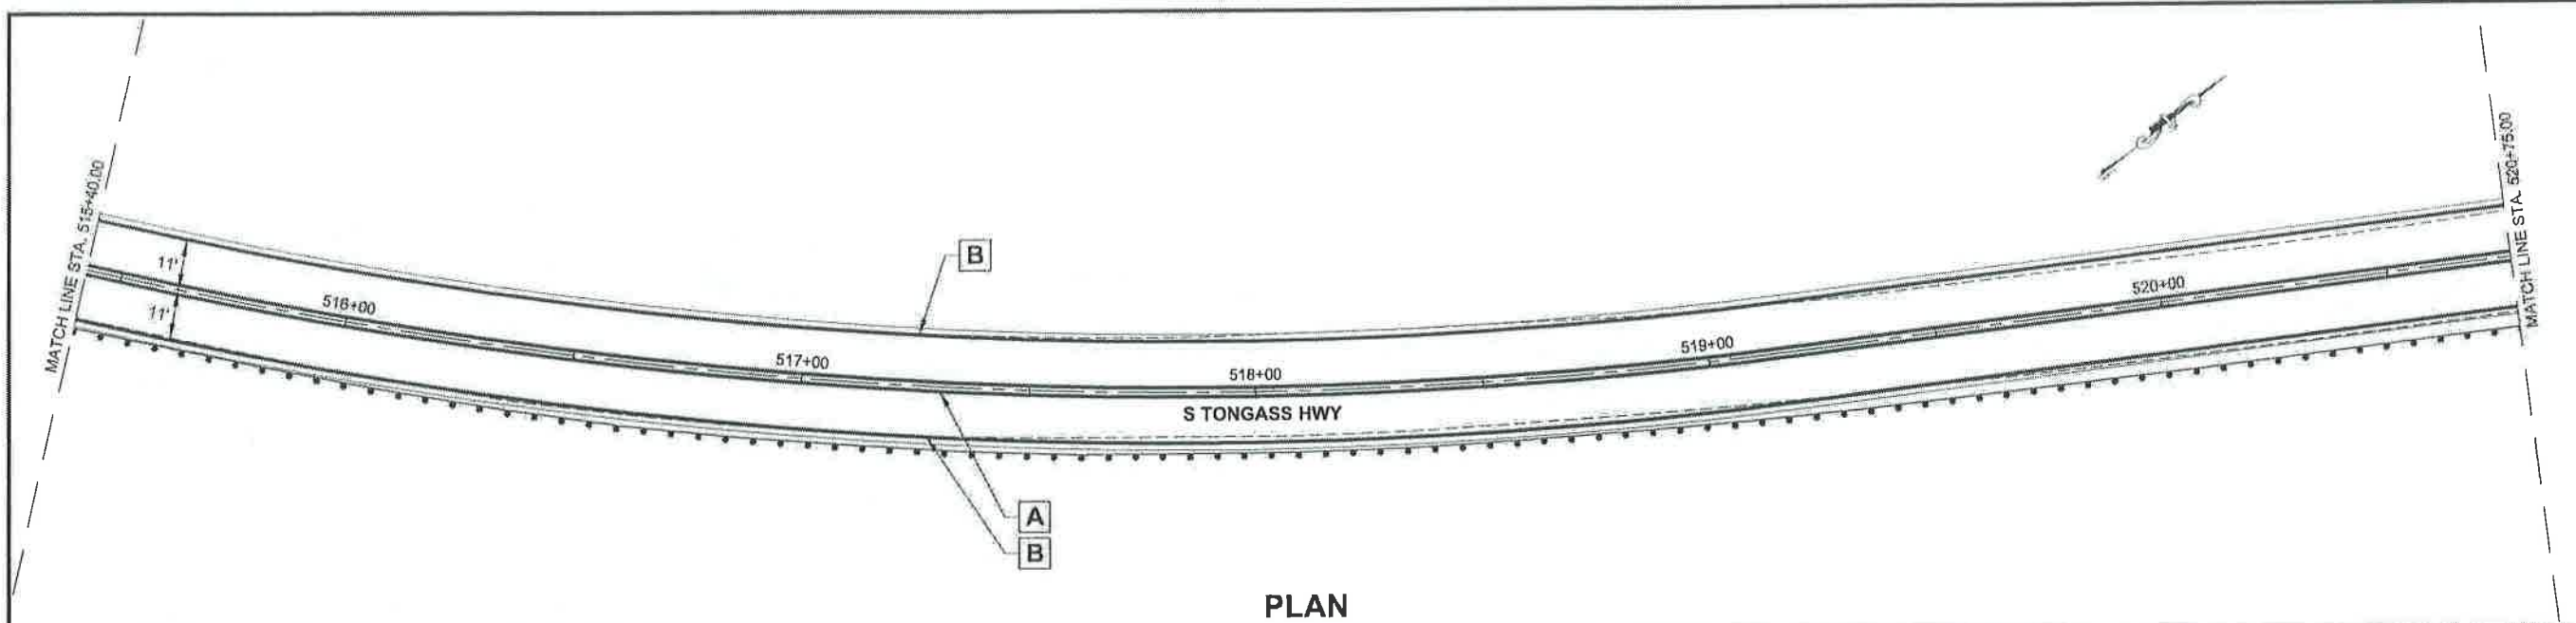

PLAN

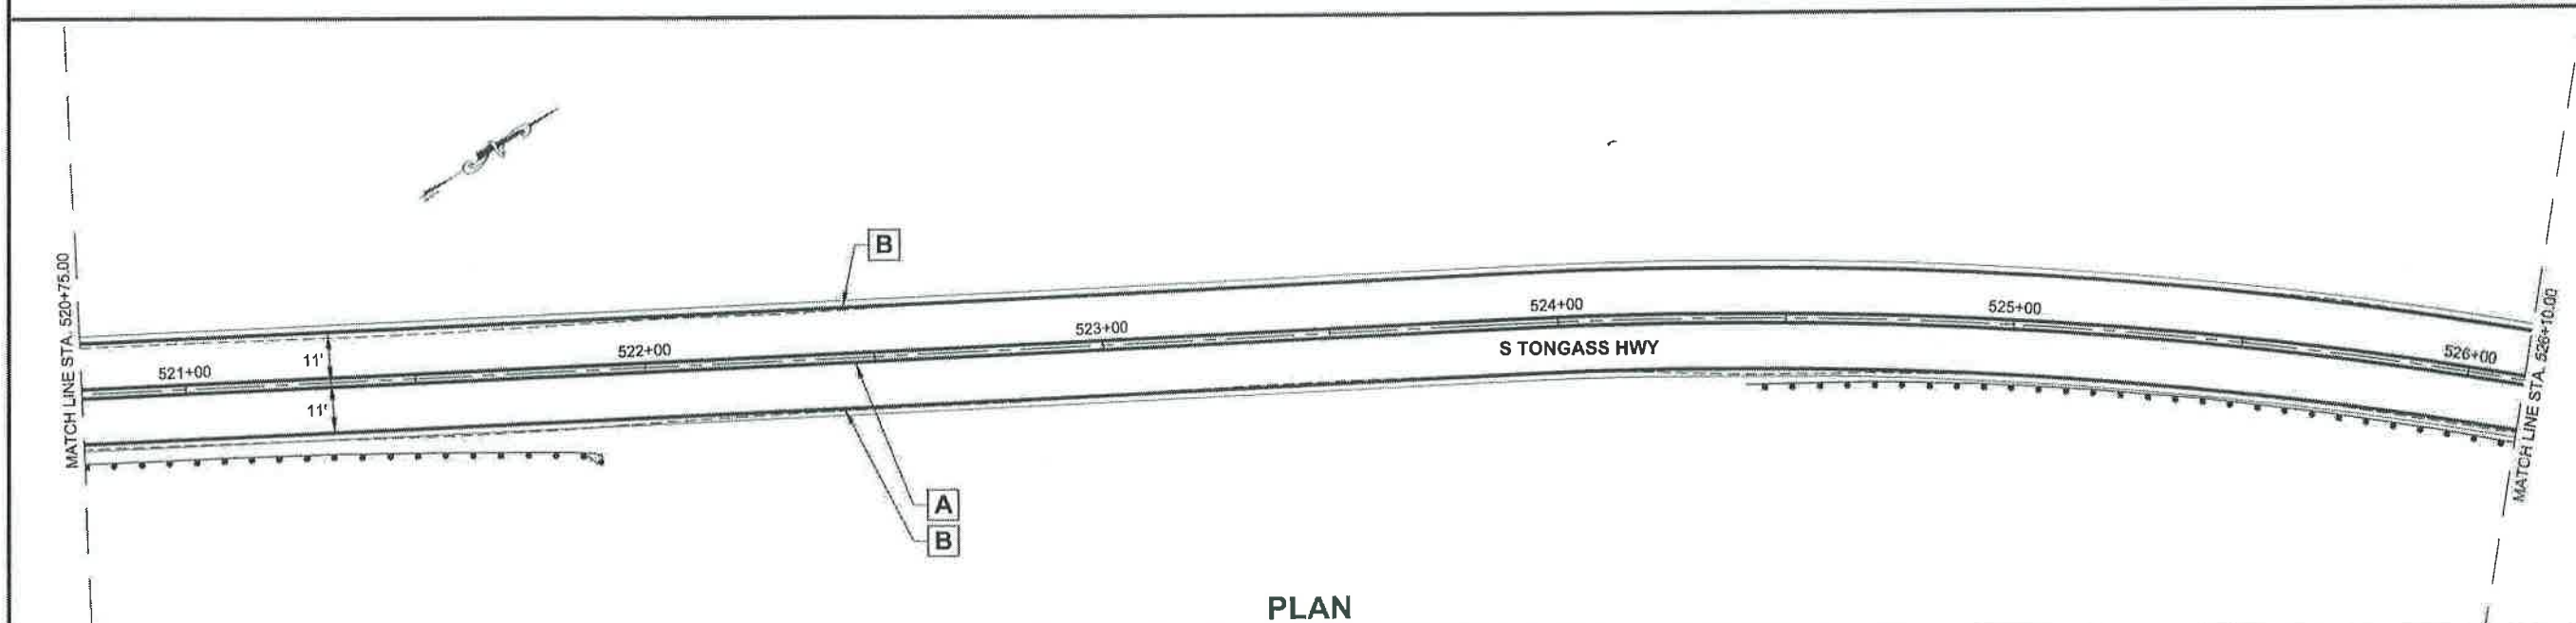

PLAN

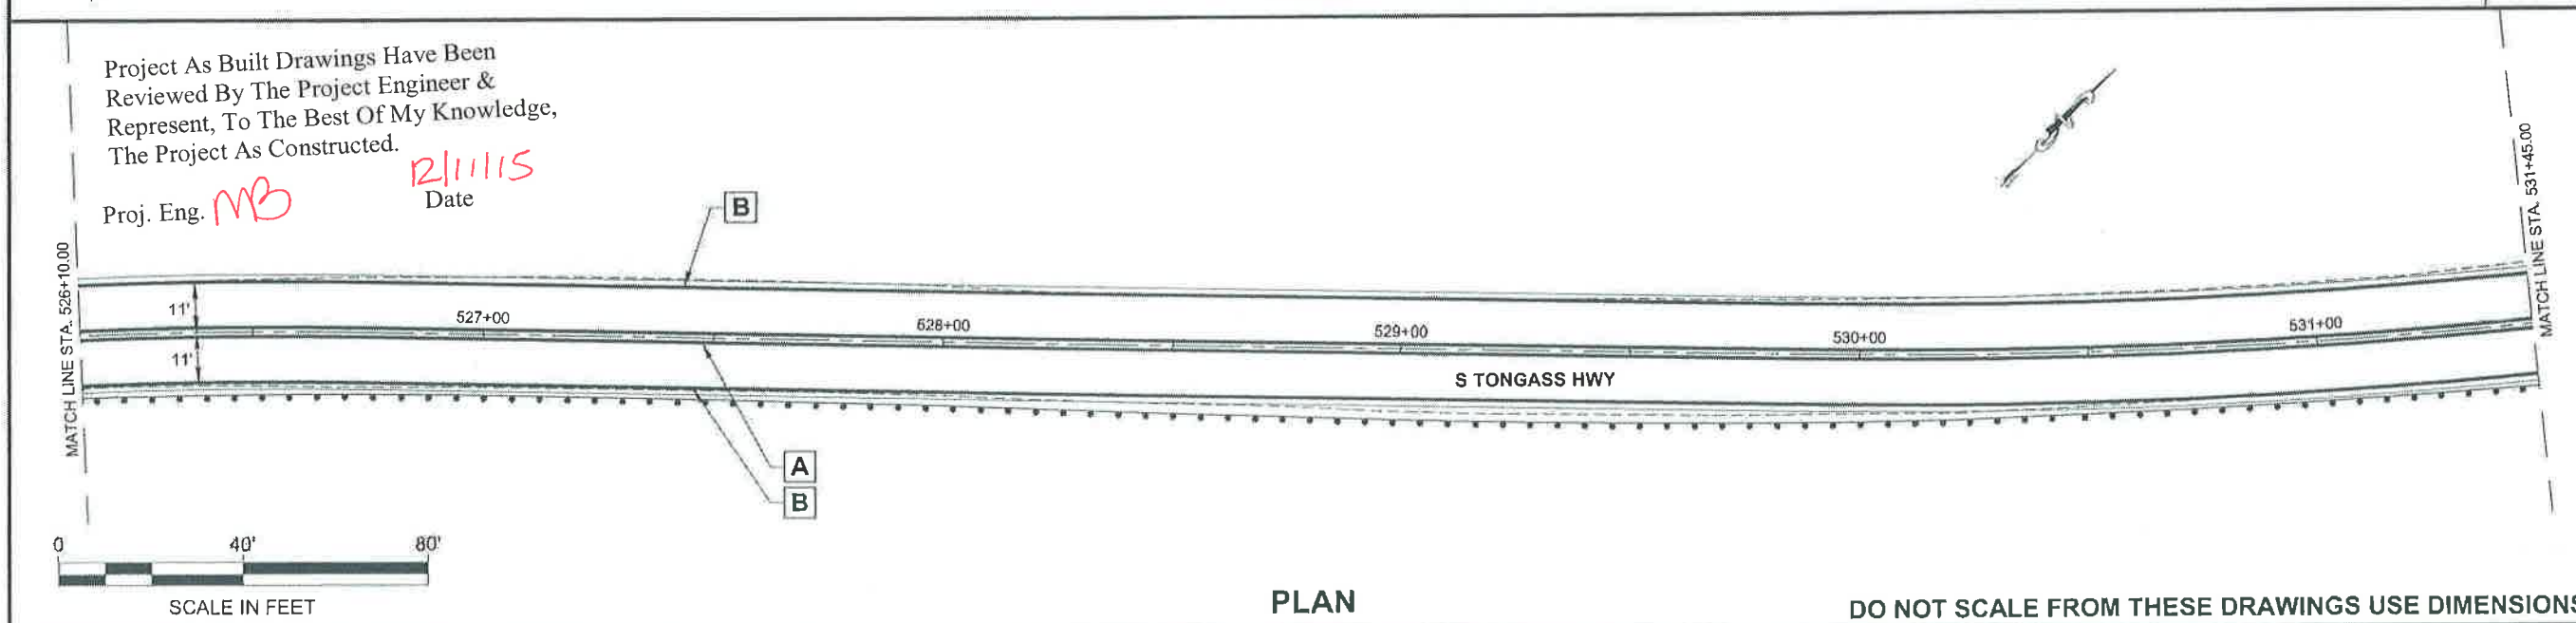

PLAN


DO NOT SCALE FROM THESE DRAWINGS USE DIMENSIONS

Project As Built Drawings Have Been Reviewed By The Project Engineer & Represent, To The Best Of My Knowledge, The Project As Constructed.

Proj. Eng. MB

Date 12/11/15

PATH: Q:\KTN\67674\PLANSET\67674_H1-H15_STRIPE.DWG		
TAB: H8		
SEIFERT, LOLITA T (DOT)		
Wednesday, November 05, 2014 7:46:20 AM		
ADDENDUM NUMBER		
ATTACHMENT NUMBER		
RECORD OF REVISIONS		
No.	DATE	DESCRIPTION

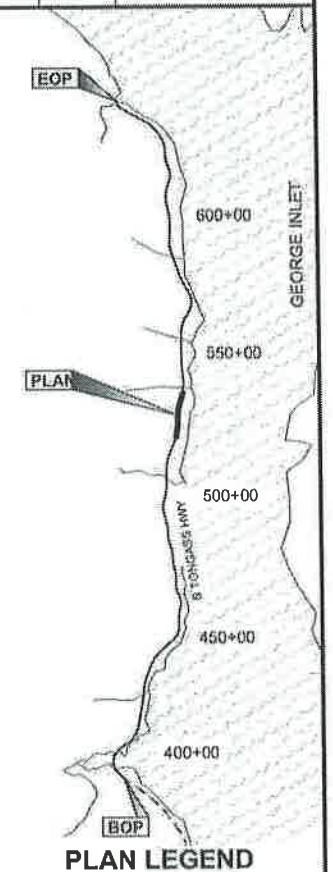

CHECKED BY: D. EPSTEIN



DESIGNED BY: L. SEIFERT

DRAWN BY: R. GRANTHAM

STATE OF ALASKA
DEPARTMENT OF TRANSPORTATION
& PUBLIC FACILITIES
SOUTHEAST REGION


KTN-SOUTH TONGASS PAVING
PROJECT #67674

**SIGNING
&
STRIPING**


PROJECT DESIGNATION

STP-NH-0902(040)-67674


STATE	YEAR
ALASKA	2014
SHEET NUMBER	TOTAL SHEETS
H8	66

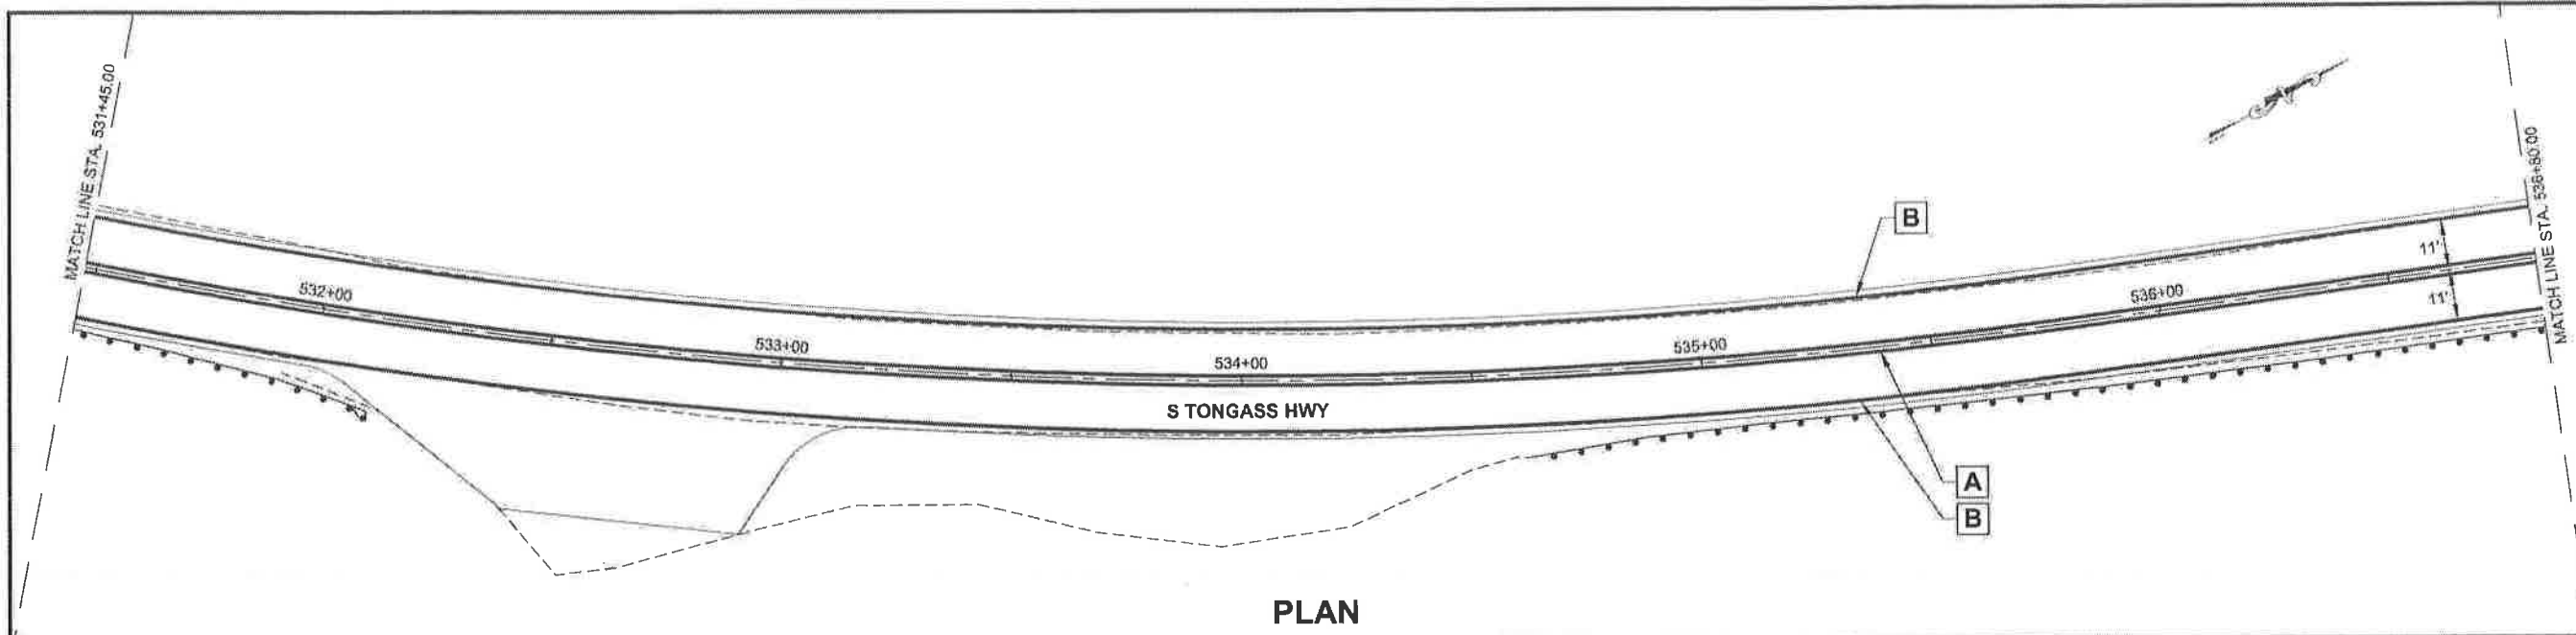

PLAN

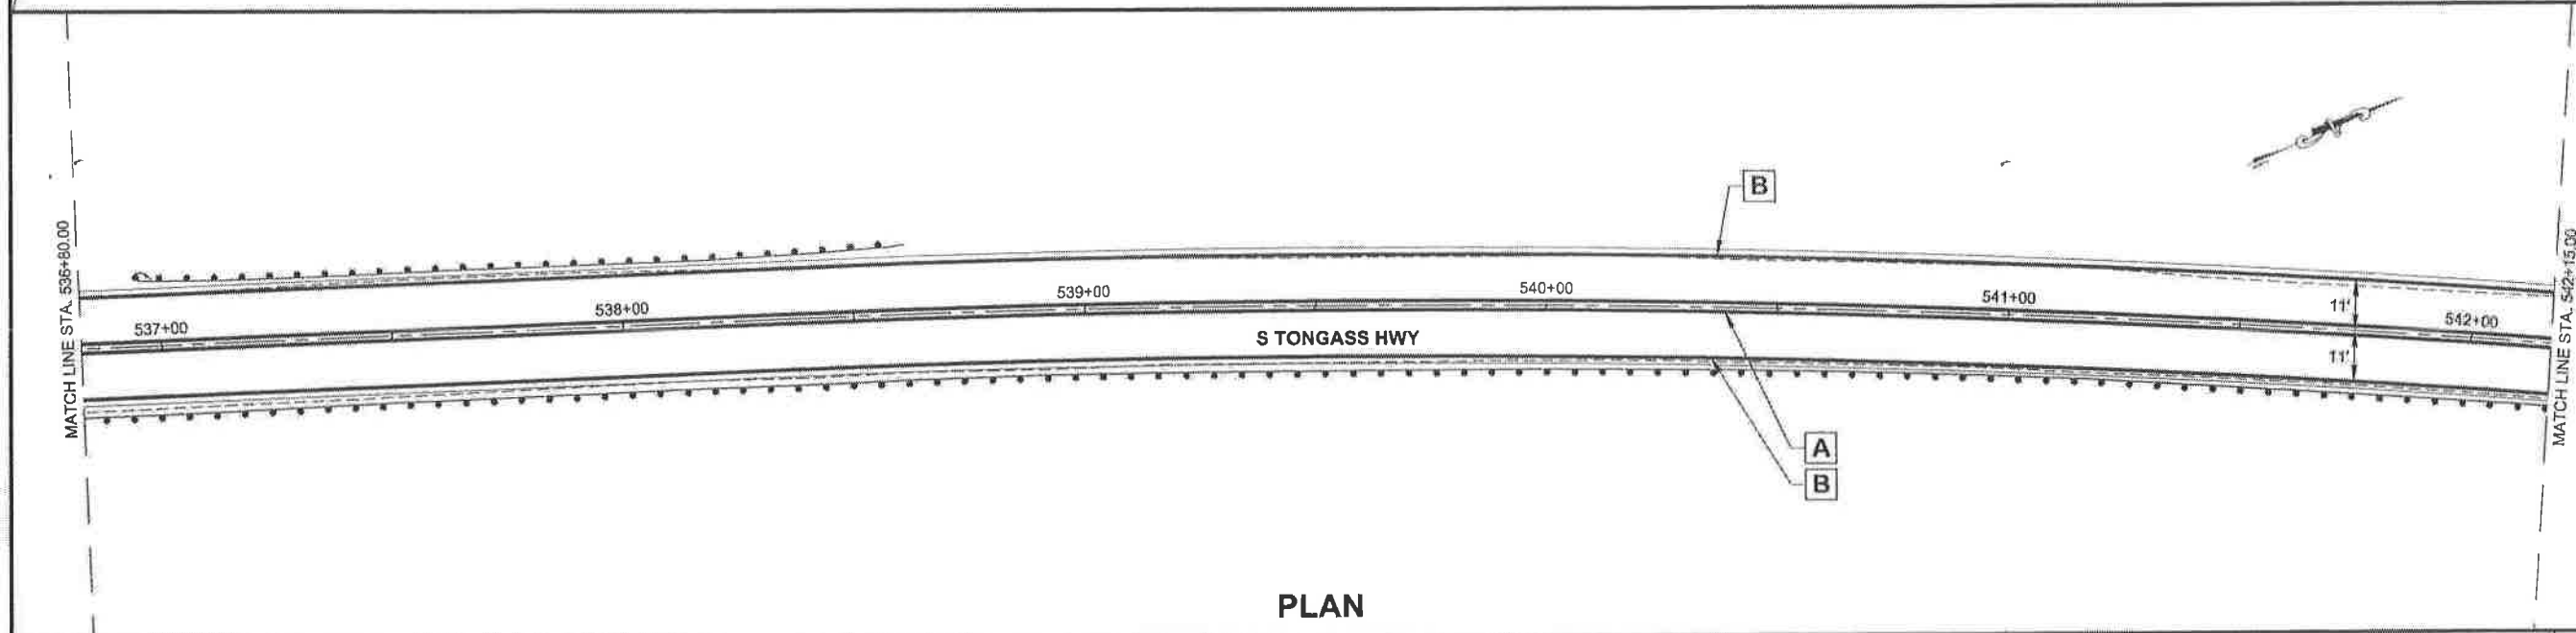


PLAN

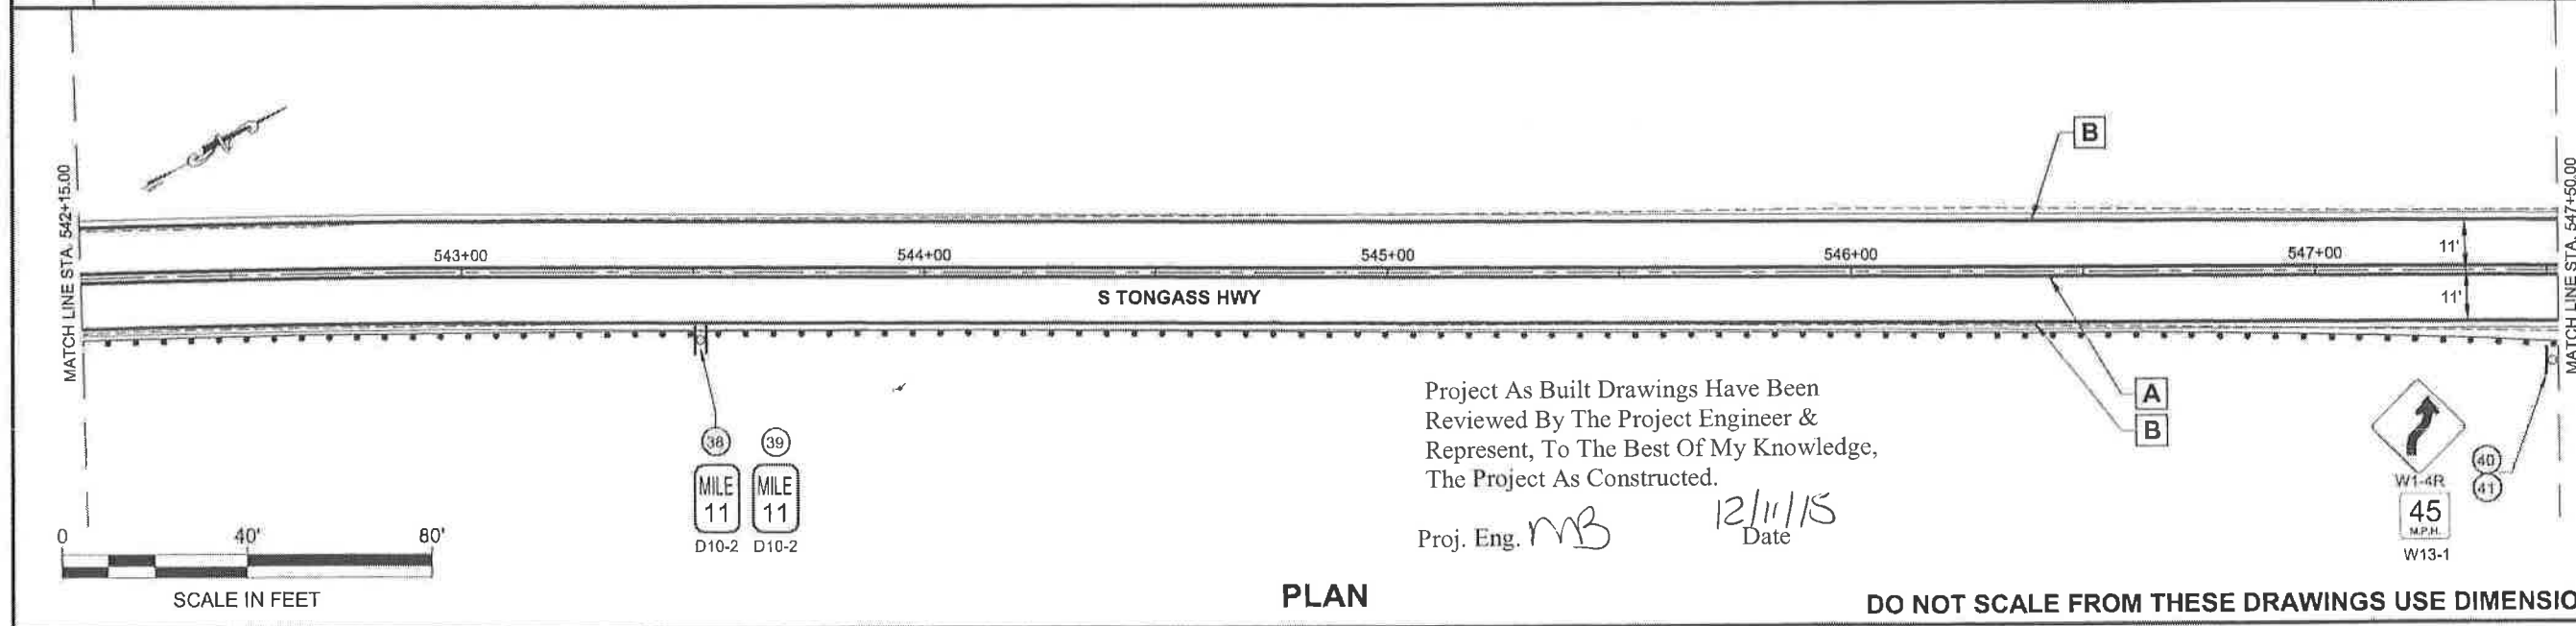

PLAN

DO NOT SCALE FROM THESE DRAWINGS USE DIMENSIONS

PATH: Q:\KTN\07674\PLANS ET\07674_H1-H15_STRIP.DWG		
TAB: H9		
SEIFERT, LOLITA T (DOT)		
Wednesday, November 05, 2014 7:46:45 AM		
ADDENDUM NUMBER		
ATTACHMENT NUMBER		
RECORD OF REVISIONS		
No.	DATE	DESCRIPTION

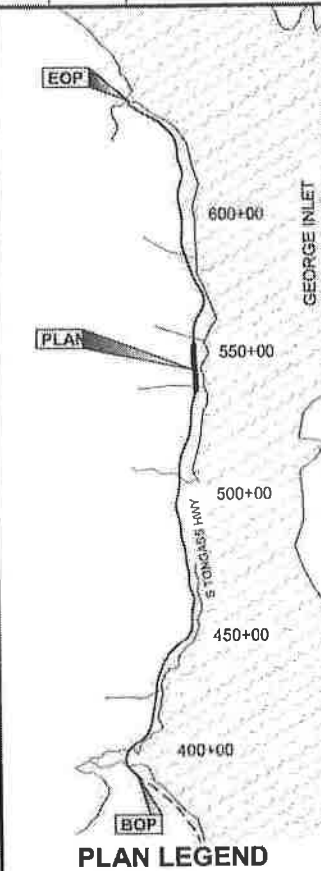

CHECKED BY: D. EPSTEIN

11.6.14

DESIGNED BY: L. SEIFERT




DRAWN BY: R. GRANTHAM

STATE OF ALASKA
DEPARTMENT OF TRANSPORTATION
& PUBLIC FACILITIES
SOUTHEAST REGION

KTN-SOUTH TONGASS PAVING
PROJECT #67674

**SIGNING
&
STRIPING**

PROJECT DESIGNATION	
STP-NH-0902(040)-67674	
STATE	YEAR
ALASKA	2014
SHEET NUMBER	TOTAL SHEETS
H9	66

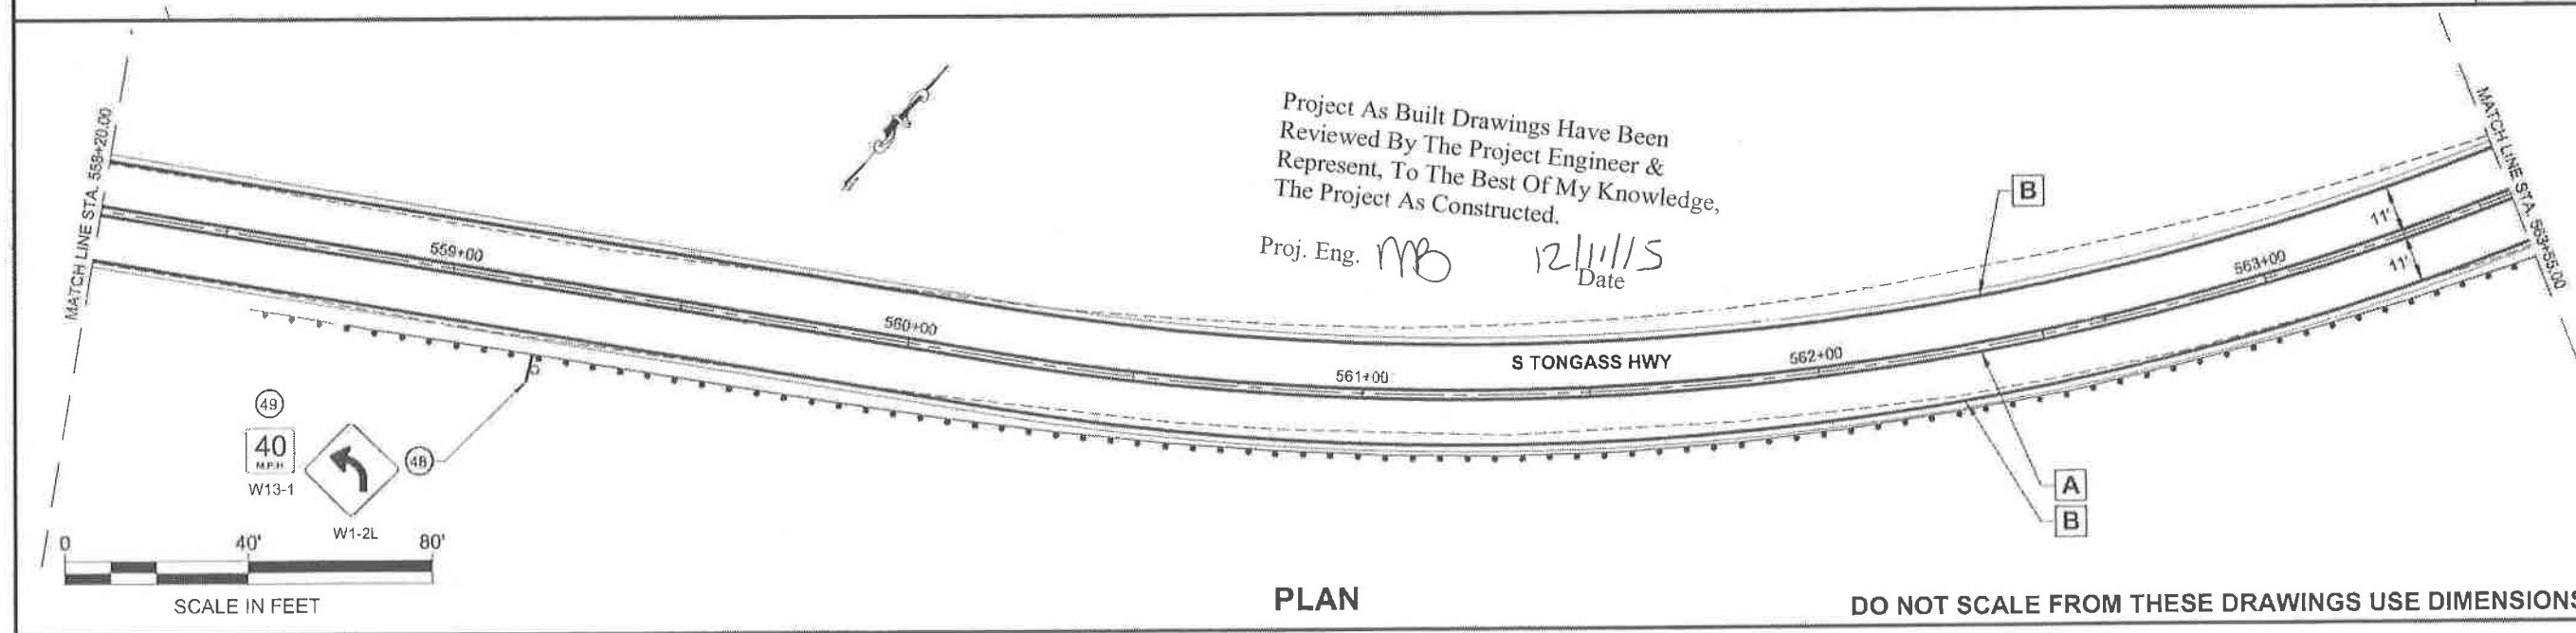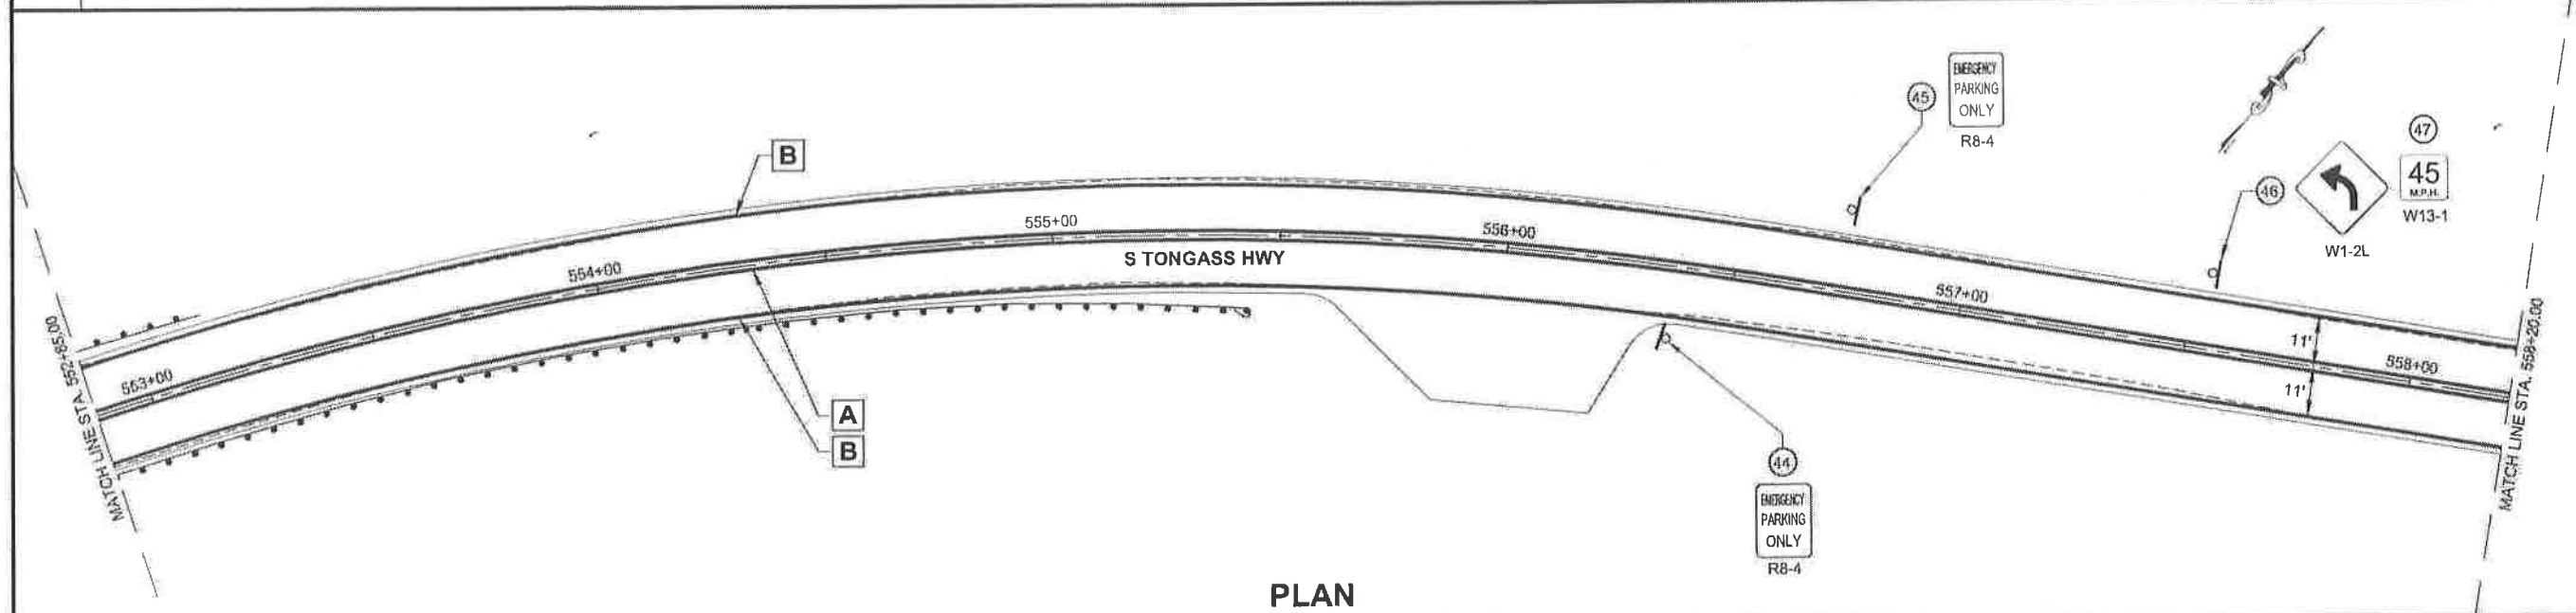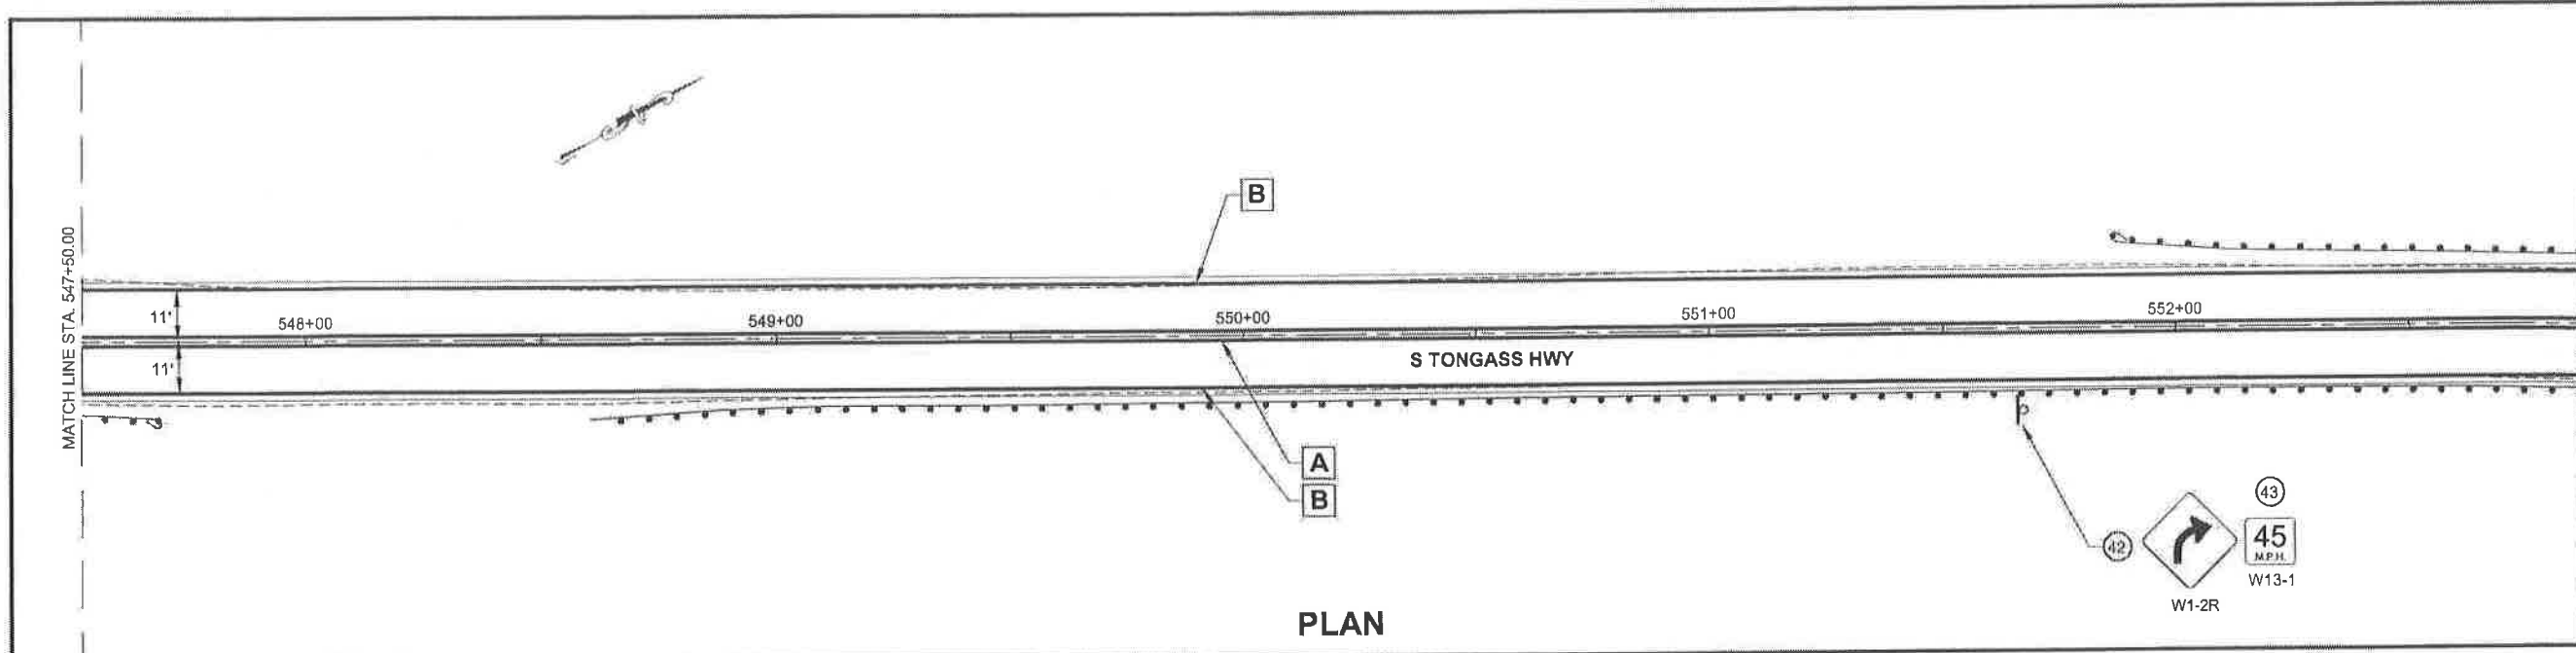

PATH: Q:\KTN\67674\PLANSET\67674_H1-H15_STRIPES.DWG
 TAB: H10
 SEIFERT, LOLITA T (DOT)
 Wednesday, November 05, 2014 7:47:03 AM

ADDENDUM NUMBER

ATTACHMENT NUMBER

RECORD OF REVISIONS

No.	DATE	DESCRIPTION

PLAN LEGEND

CHECKED BY: D. EPSTEIN

DESIGNED BY: L. SEIFERT

DRAWN BY: R. GRANTHAM

STATE OF ALASKA
 DEPARTMENT OF TRANSPORTATION
 & PUBLIC FACILITIES
 SOUTHEAST REGION

KTN-SOUTH TONGASS PAVING
 PROJECT #67674


**SIGNING
 &
 STRIPING**

PROJECT DESIGNATION


STP-NH-0902(040)-67674

STATE	YEAR
ALASKA	2014


SHEET NUMBER	TOTAL SHEETS
H10	66

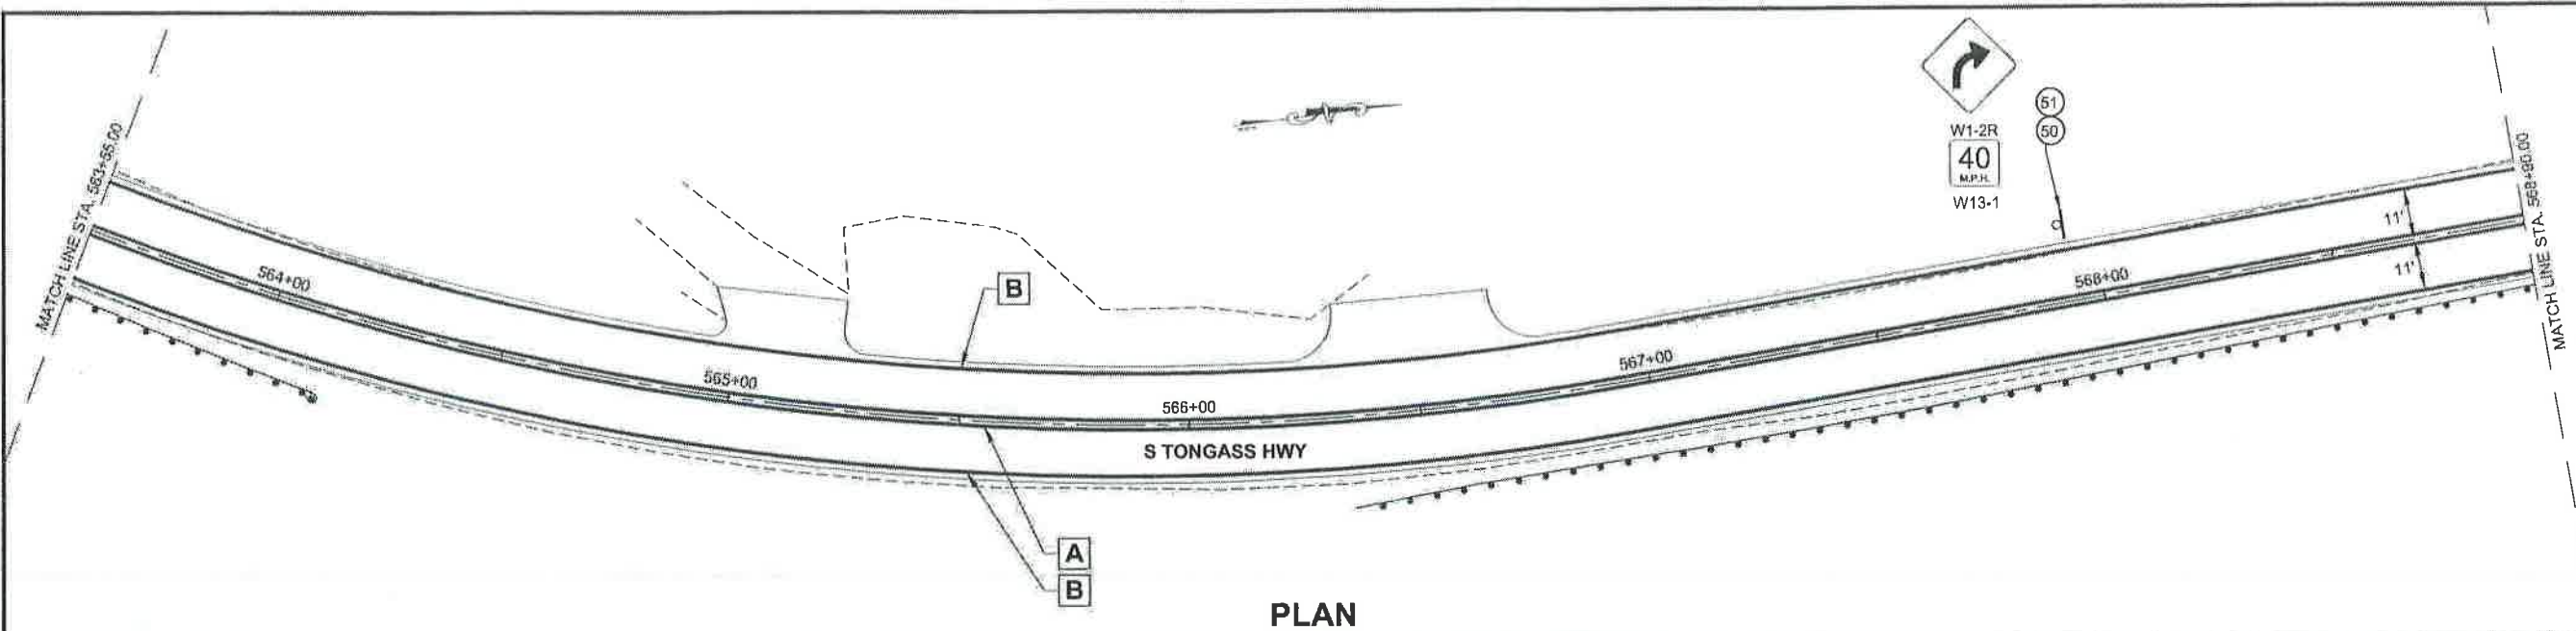

PLAN

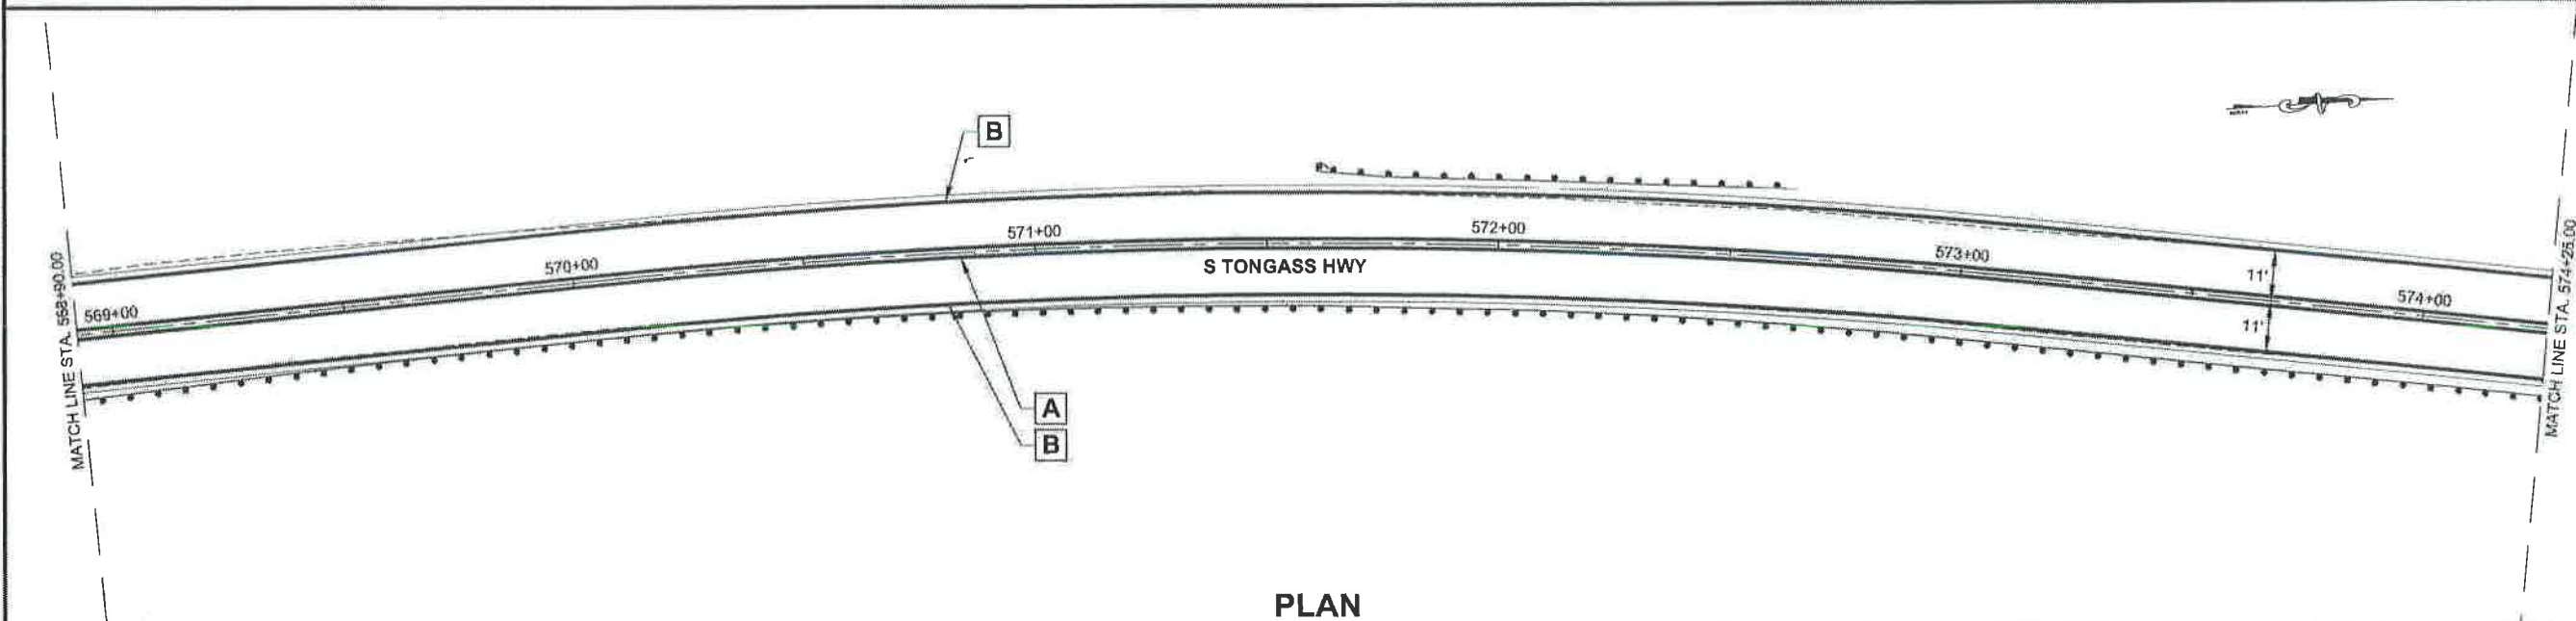

PLAN

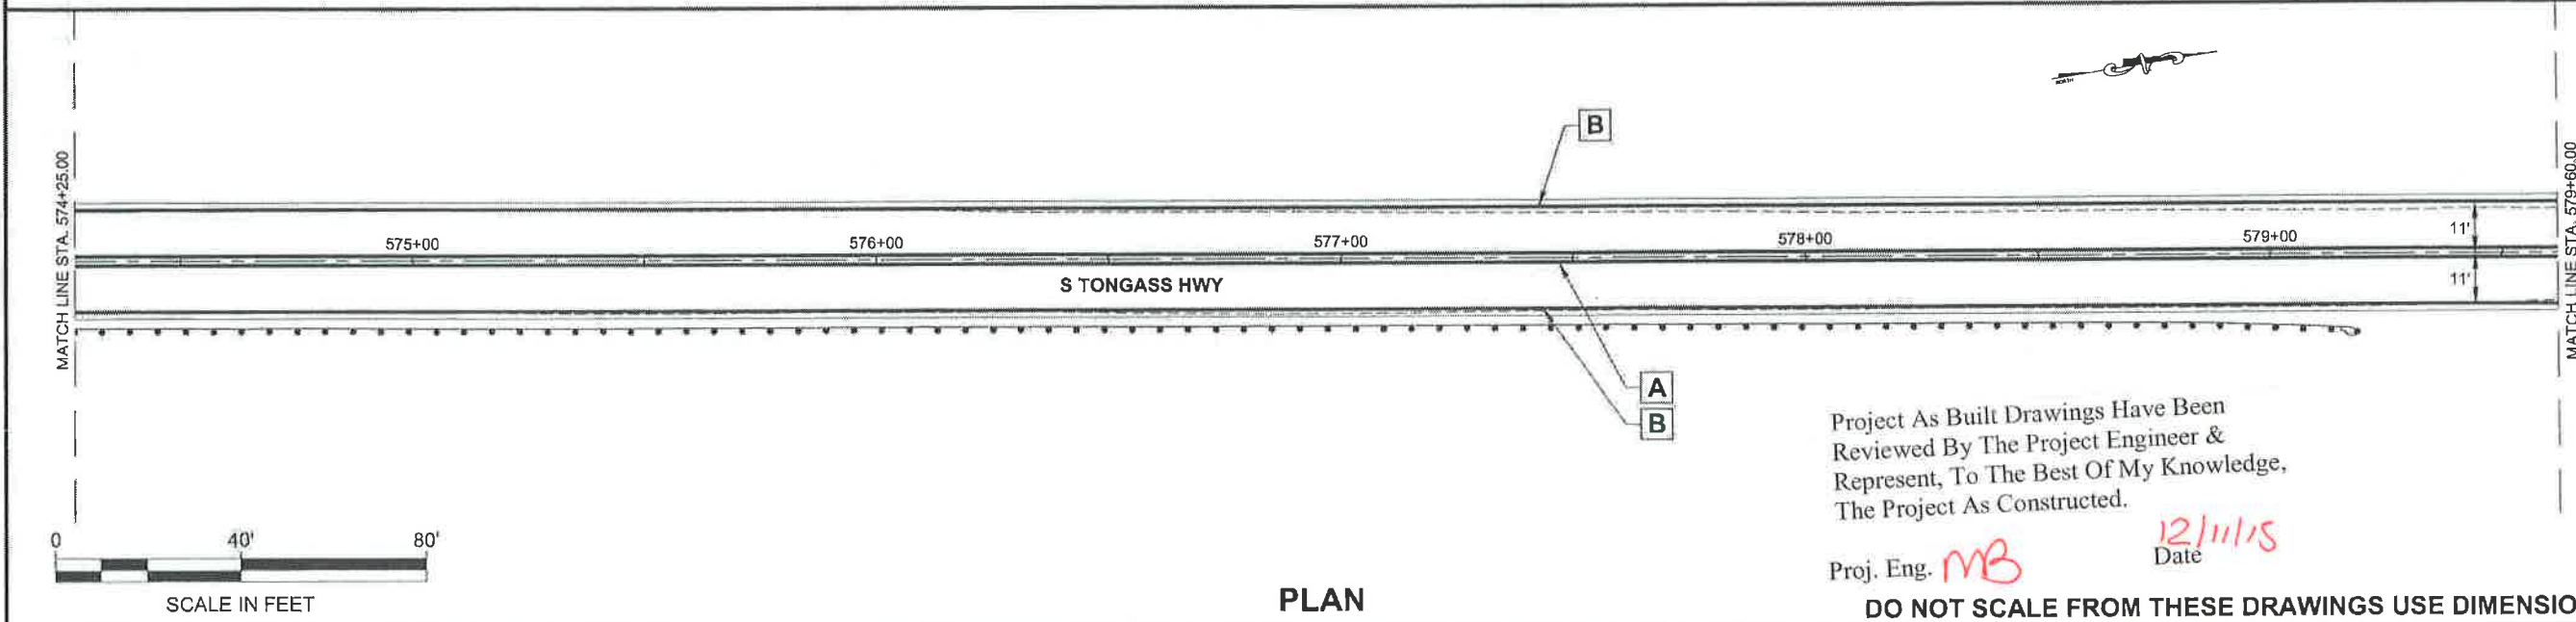

PLAN




Project As Built Drawings Have Been Reviewed By The Project Engineer & Represent, To The Best Of My Knowledge, The Project As Constructed.

Proj. Eng. *MB* Date *12/11/15*

DO NOT SCALE FROM THESE DRAWINGS USE DIMENSIONS

PATH: Q:\KTN\67674\PLANSET\67674_H11-H15_STRIPE.DWG
 TAB: H11
 SEIFERT, LOLITA T (DOT)
 Wednesday, November 05, 2014 7:47:35 AM

RECORD OF REVISIONS		
No.	DATE	DESCRIPTION

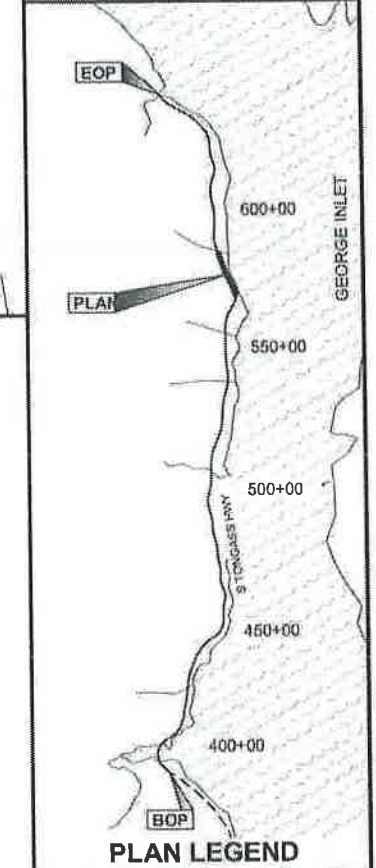

CHECKED BY: D. EPSTEIN


DESIGNED BY: L. SEIFERT
 DRAWN BY: R. GRANTHAM

STATE OF ALASKA
 DEPARTMENT OF TRANSPORTATION
 & PUBLIC FACILITIES
 SOUTHEAST REGION


KTN-SOUTH TONGASS PAVING
 PROJECT #67674

**SIGNING
&
STRIPING**


PROJECT DESIGNATION	
STP-NH-0902(040)-67674	
STATE	YEAR
ALASKA	2014
SHEET NUMBER	TOTAL SHEETS
H11	66

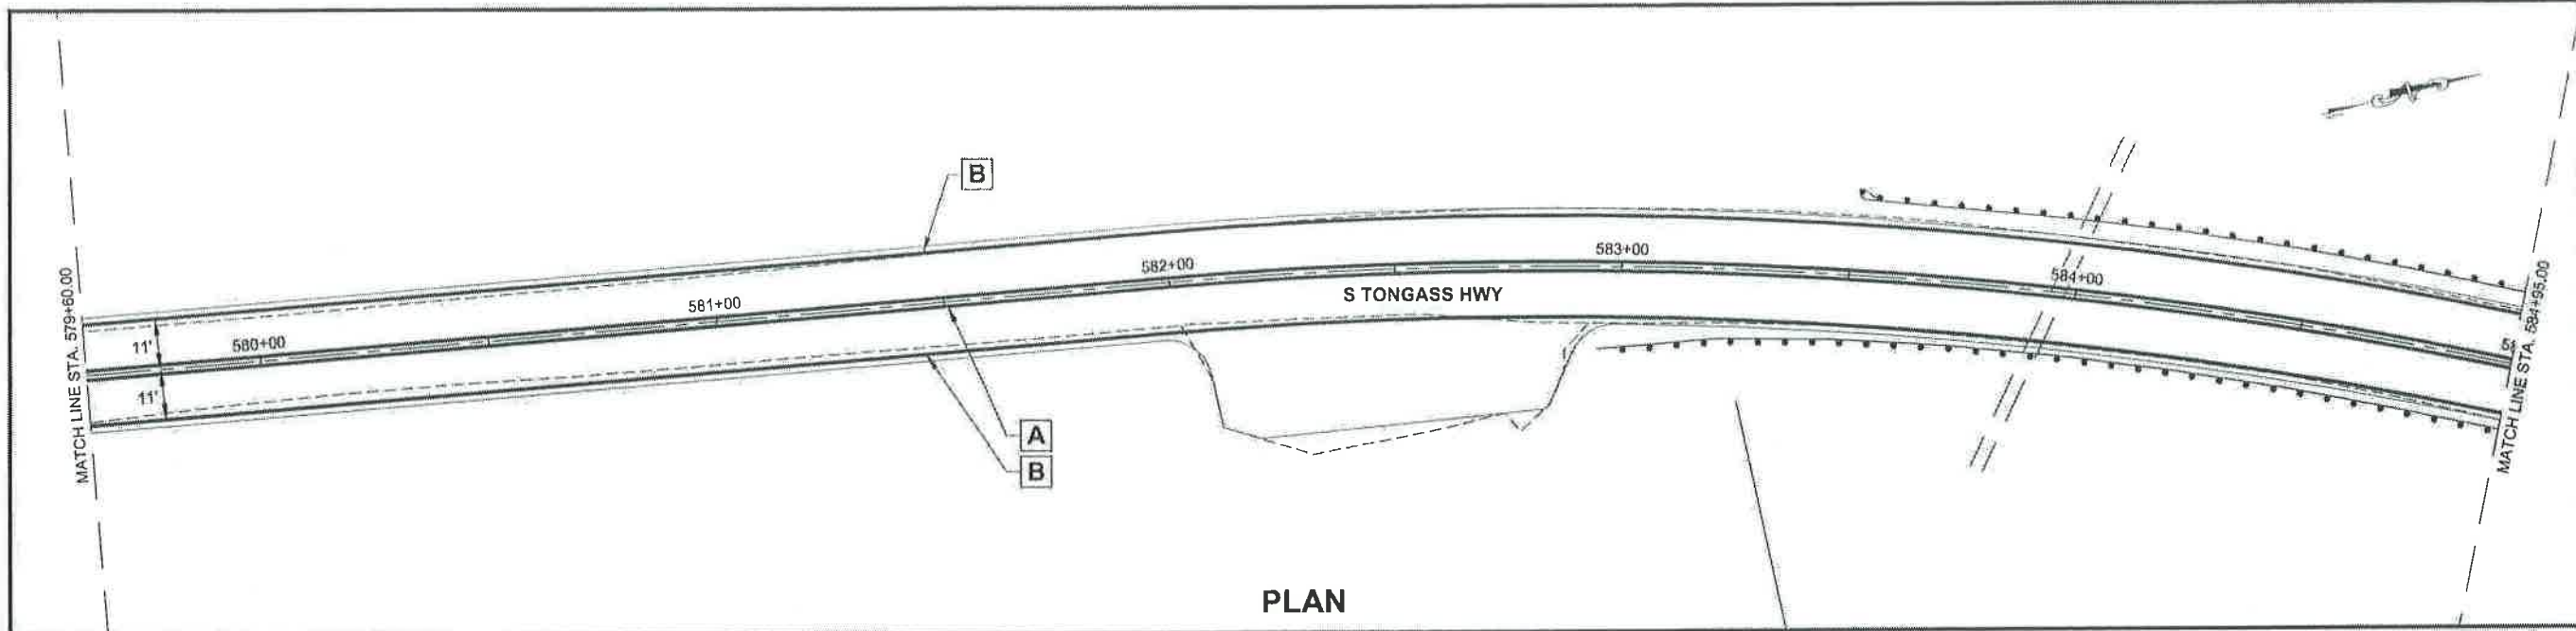

PLAN

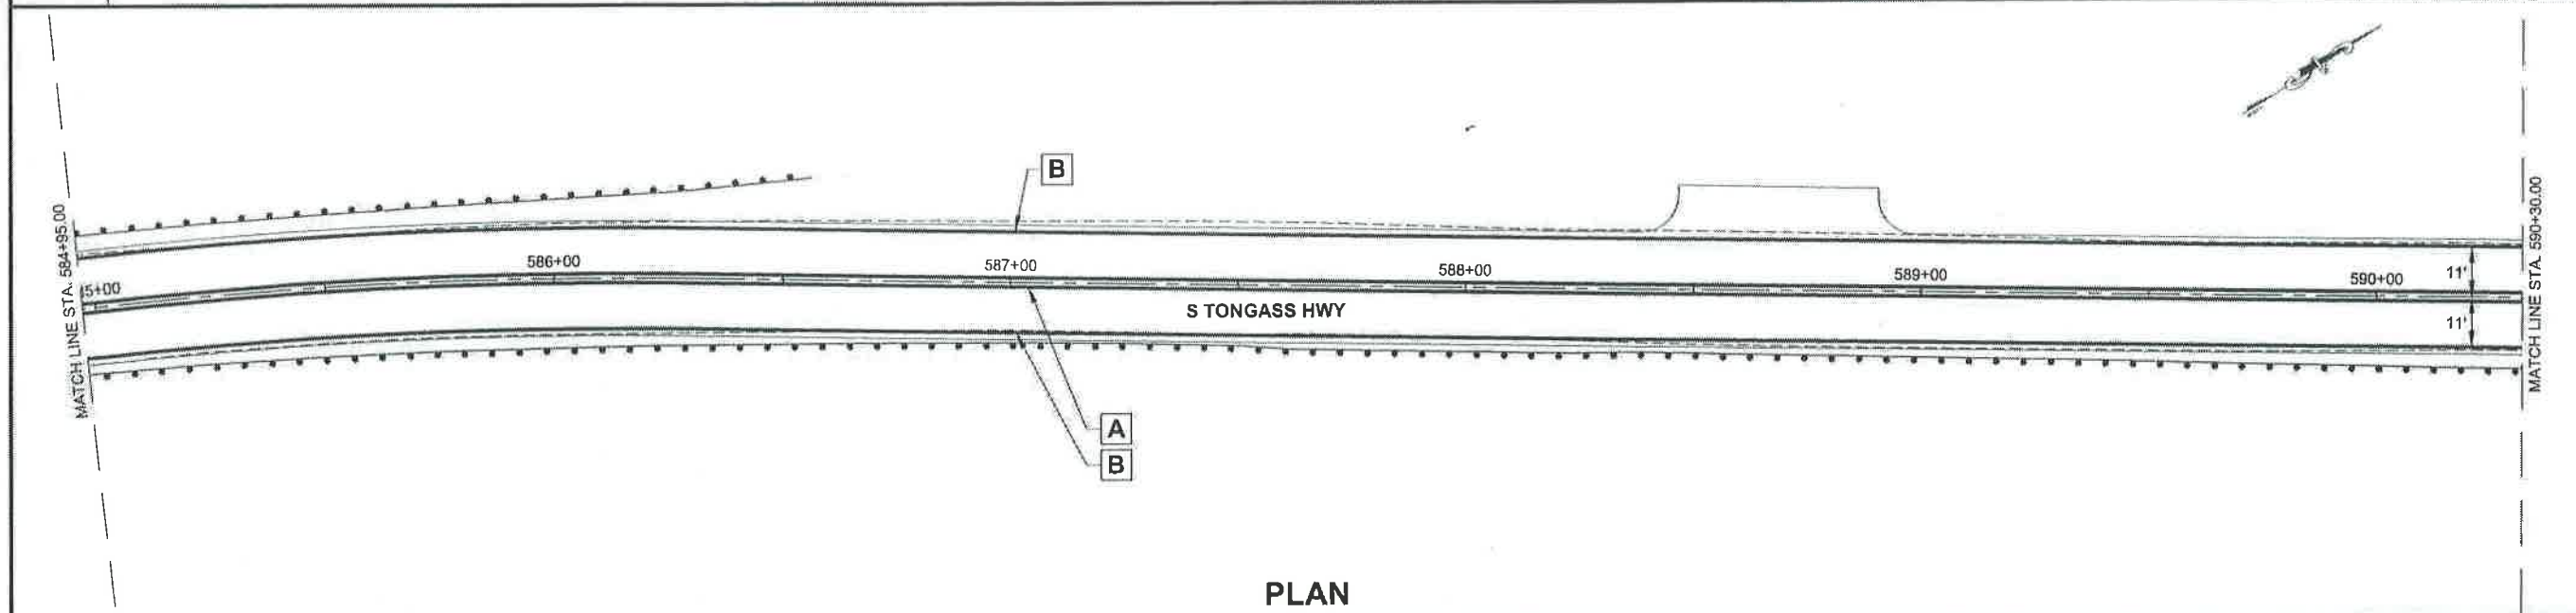

PLAN

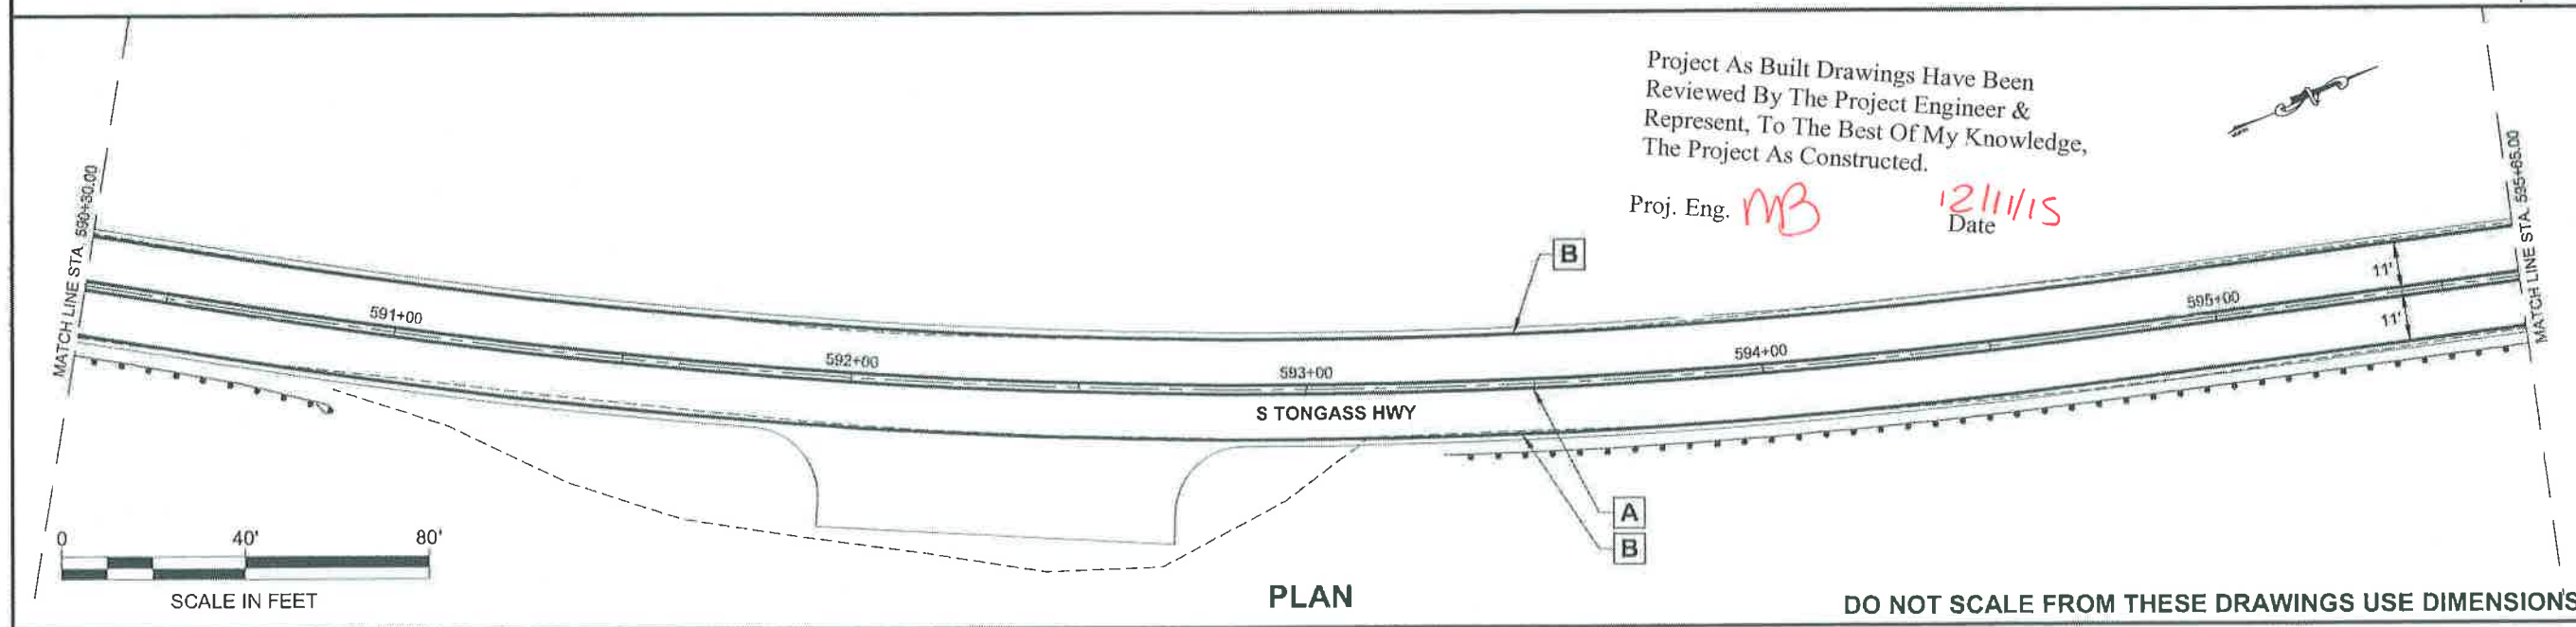

PLAN

PATH: Q:\KTN\67674\PLANSET\67674_H1-H15_STRIPES.DWG
 TAB: H12
 SEIFERT, LOLITA T (DOT)
 Wednesday, November 05, 2014 7:47:48 AM

ADDENDUM NUMBER

ATTACHMENT NUMBER

RECORD OF REVISIONS

No.	DATE	DESCRIPTION

EOP

PLAN

600+00

550+00

500+00

450+00

400+00

BOP

GEORGE INLET

PLAN LEGEND

CHECKED BY: D. EPSTEIN

DESIGNED BY: L. SEIFERT

DRAWN BY: R. GRANTHAM

STATE OF ALASKA
 DEPARTMENT OF TRANSPORTATION
 & PUBLIC FACILITIES
 SOUTHEAST REGION

KTN-SOUTH TONGASS PAVING
 PROJECT #67674


**SIGNING
 &
 STRIPING**

PROJECT DESIGNATION


STP-NH-0902(040)-67674

STATE	YEAR
ALASKA	2014


SHEET NUMBER	TOTAL SHEETS
H12	66

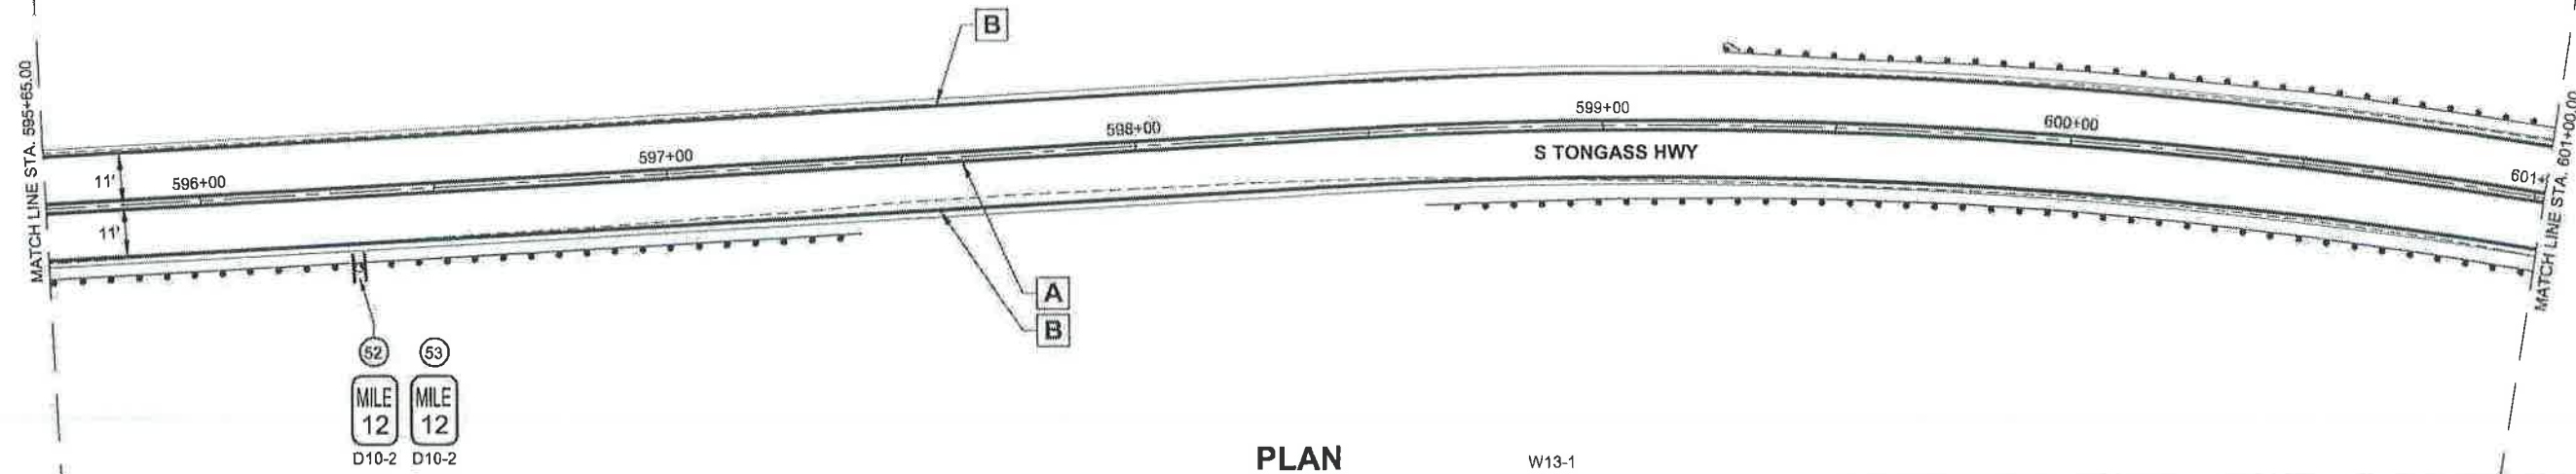

PLAN W13-1

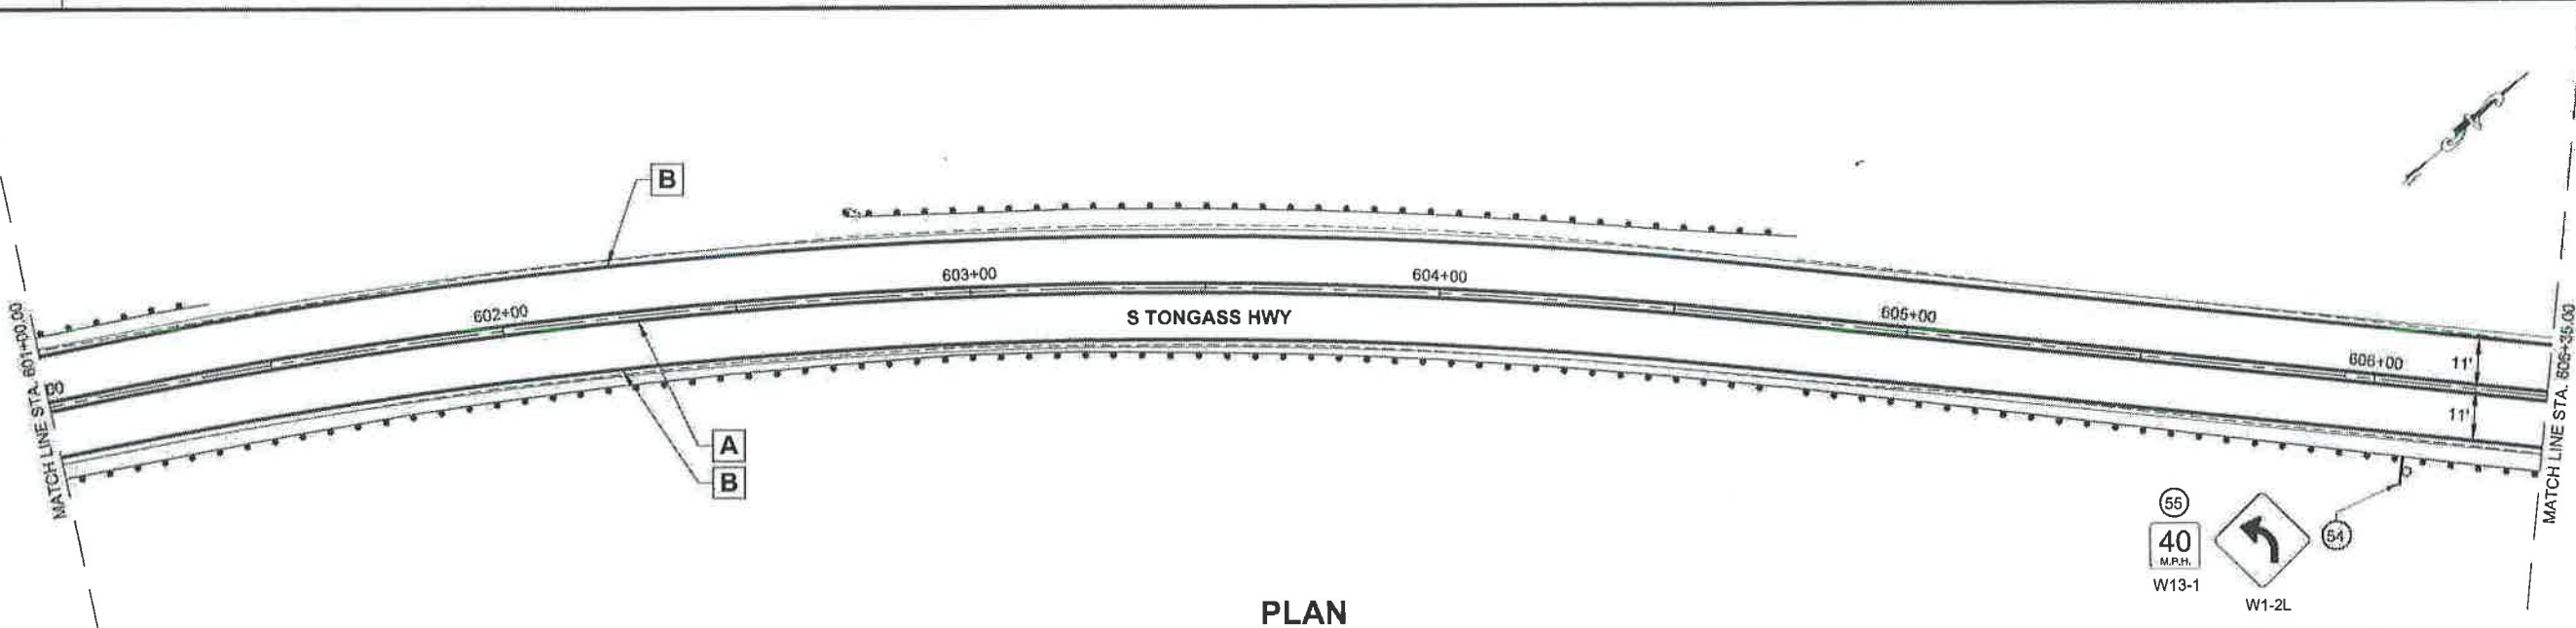

PLAN W13-1

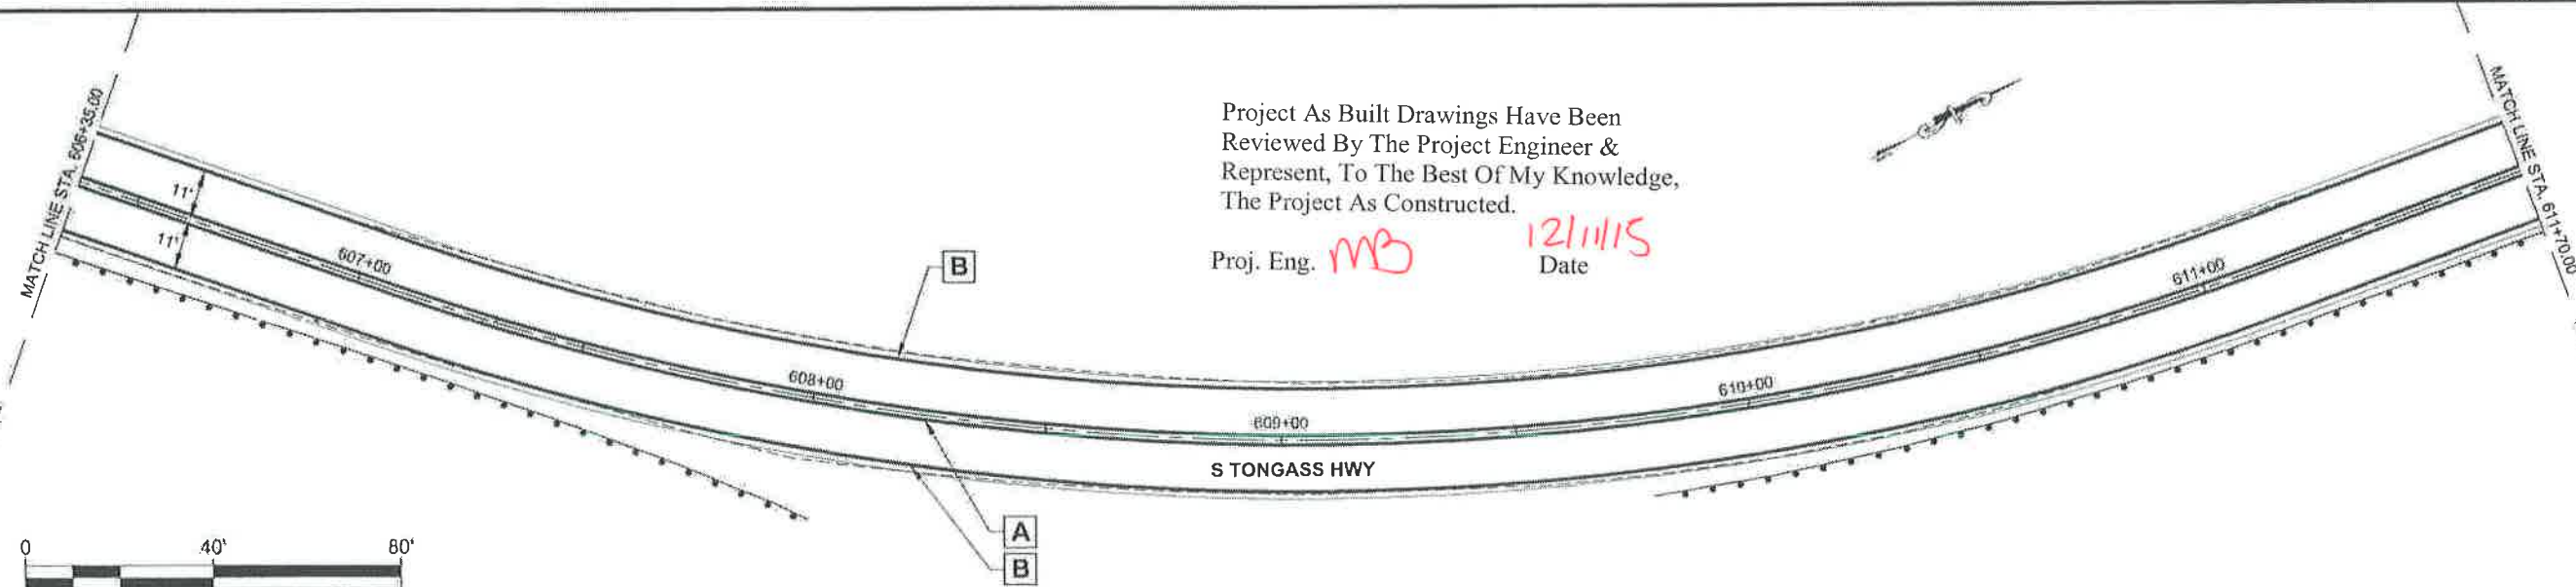

PLAN


Project As Built Drawings Have Been Reviewed By The Project Engineer & Represent, To The Best Of My Knowledge, The Project As Constructed.

Proj. Eng. *MB* Date *12/11/15*

DO NOT SCALE FROM THESE DRAWINGS USE DIMENSIONS

PATH: Q:\KTN\67674\PLANSET\67674_H1-H15_STRIPE.DWG
 TAB: H13
 SEIFERT, LOLITA T (DOT)
 Wednesday, November 05, 2014 7:48:15 AM

RECORD OF REVISIONS		
No.	DATE	DESCRIPTION

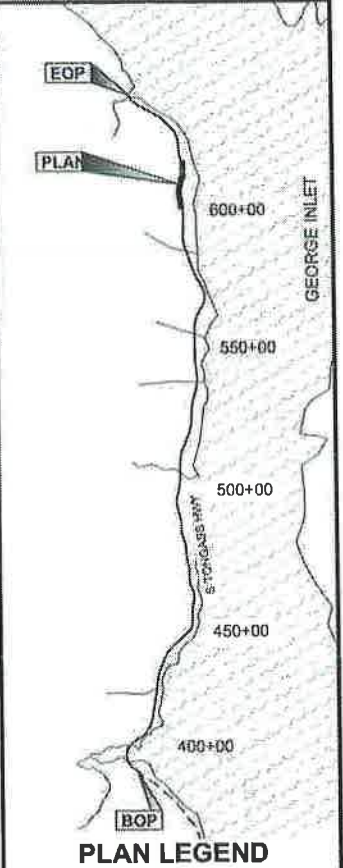


CHECKED BY: D. EPSTEIN

DESIGNED BY: L. SEIFERT
 DRAWN BY: R. GRANTHAM


STATE OF ALASKA
 DEPARTMENT OF TRANSPORTATION
 & PUBLIC FACILITIES
 SOUTHEAST REGION

KTN-SOUTH TONGASS PAVING
 PROJECT #67674


SIGNING & STRIPING	
PROJECT DESIGNATION	
STP-NH-0902(040)-67674	
STATE	YEAR
ALASKA	2014
SHEET NUMBER	TOTAL SHEETS
H13	66

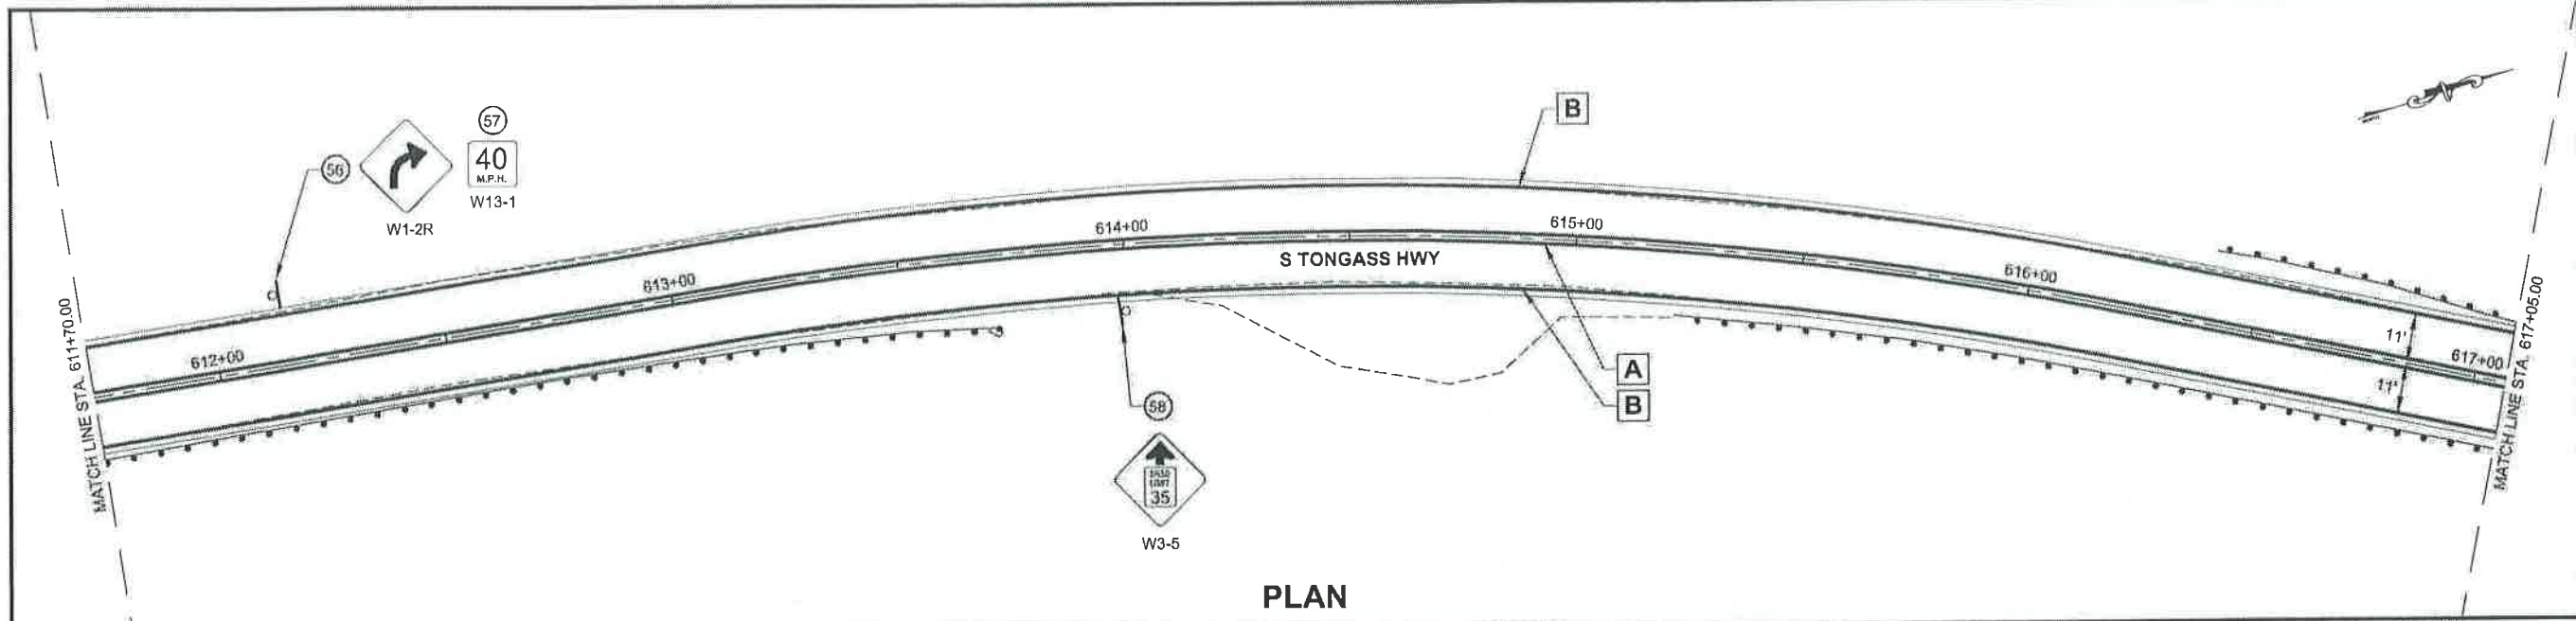

PLAN

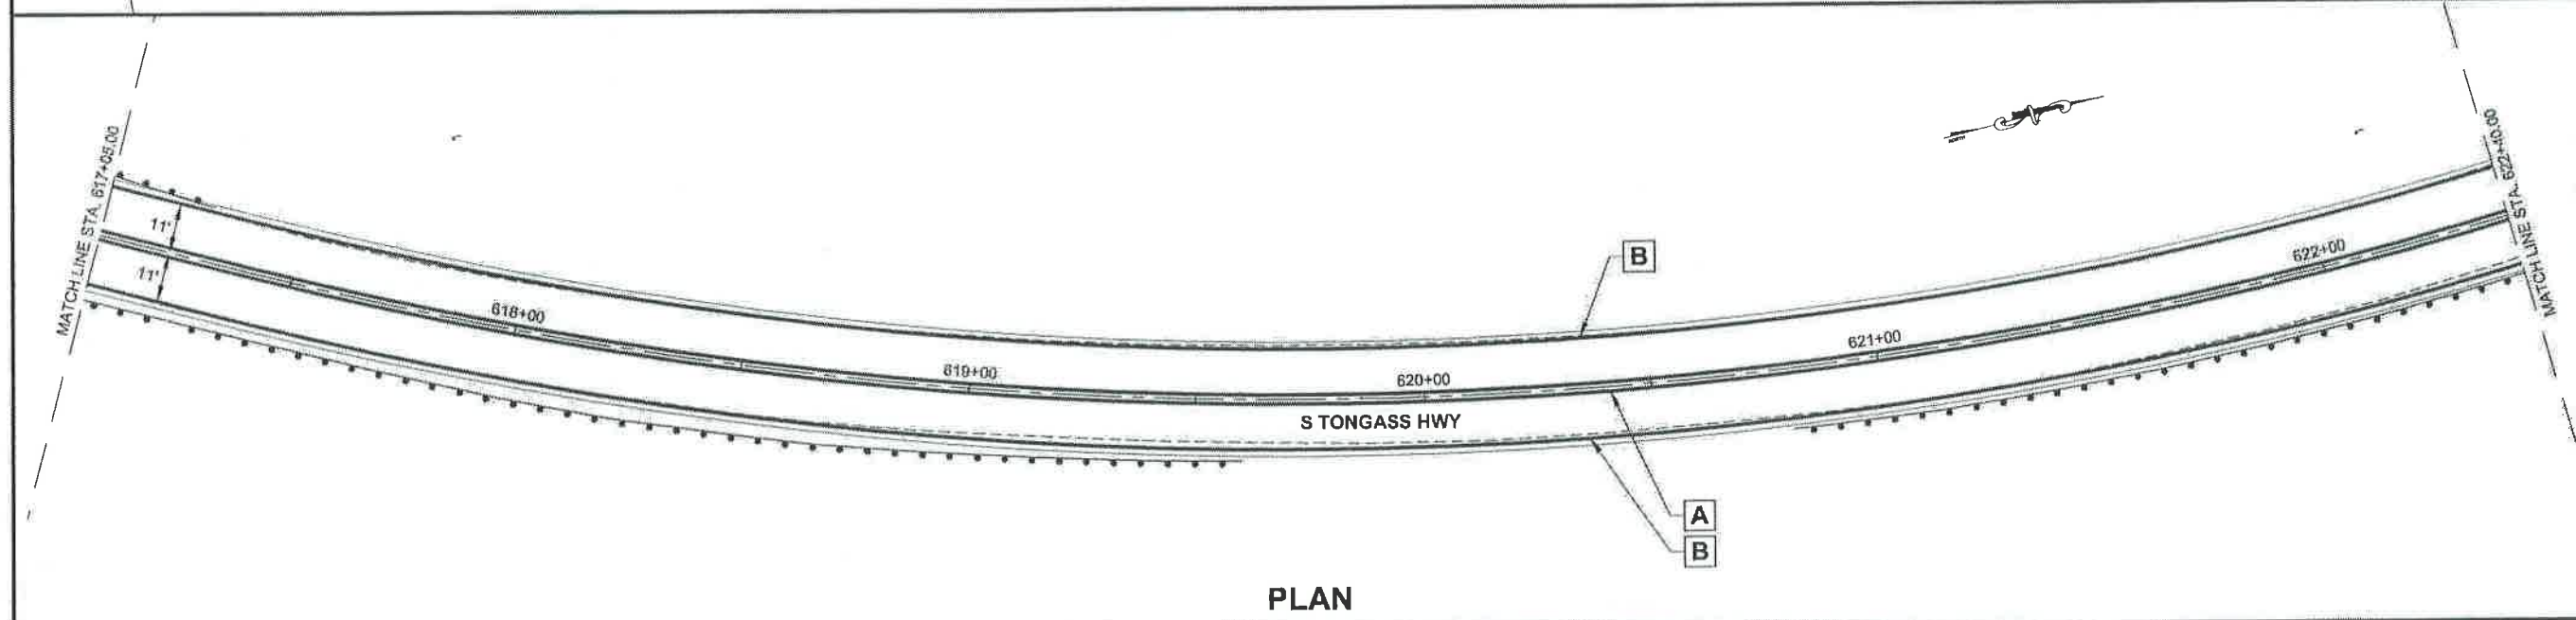

PLAN

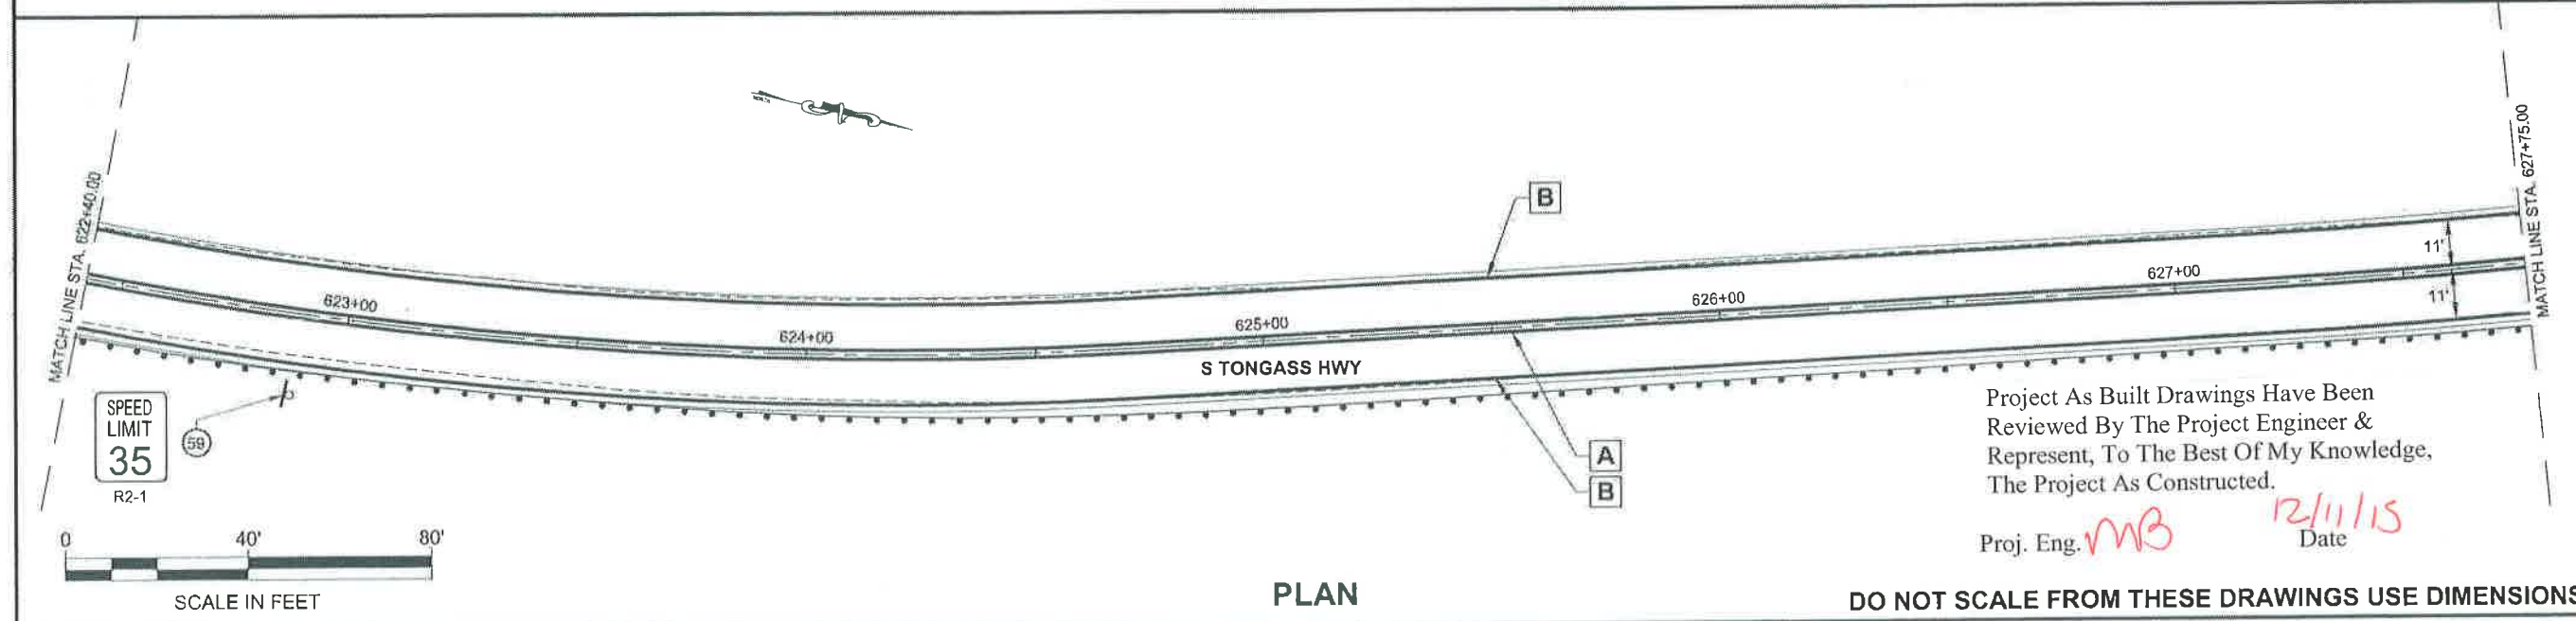

PLAN

Project As Built Drawings Have Been Reviewed By The Project Engineer & Represent, To The Best Of My Knowledge, The Project As Constructed.

Proj. Eng. *MB* Date *12/11/15*

DO NOT SCALE FROM THESE DRAWINGS USE DIMENSIONS

PATH: Q:\KTN\67674\PLANSET\67674_H14\H15_STRIPE.DWG
 TAB: H14
 SEIFERT, LOLITA T (DOT)
 Wednesday, November 05, 2014 7:48:33 AM

ADDENDUM NUMBER

ATTACHMENT NUMBER

RECORD OF REVISIONS

No.	DATE	DESCRIPTION

EOP
 PLAN
 600+00
 550+00
 500+00
 450+00
 400+00
 BOP
 GEORGE INLET

PLAN LEGEND

CHECKED BY: D. EPSTEIN

DESIGNED BY: L. SEIFERT

DRAWN BY: R. GRANTHAM

STATE OF ALASKA
 DEPARTMENT OF TRANSPORTATION
 & PUBLIC FACILITIES
 SOUTHEAST REGION

KTN-SOUTH TONGASS PAVING
 PROJECT #67674


**SIGNING
 &
 STRIPING**

PROJECT DESIGNATION


STP-NH-0902(040)-67674

STATE	YEAR
ALASKA	2014


SHEET NUMBER	TOTAL SHEETS
H14	66

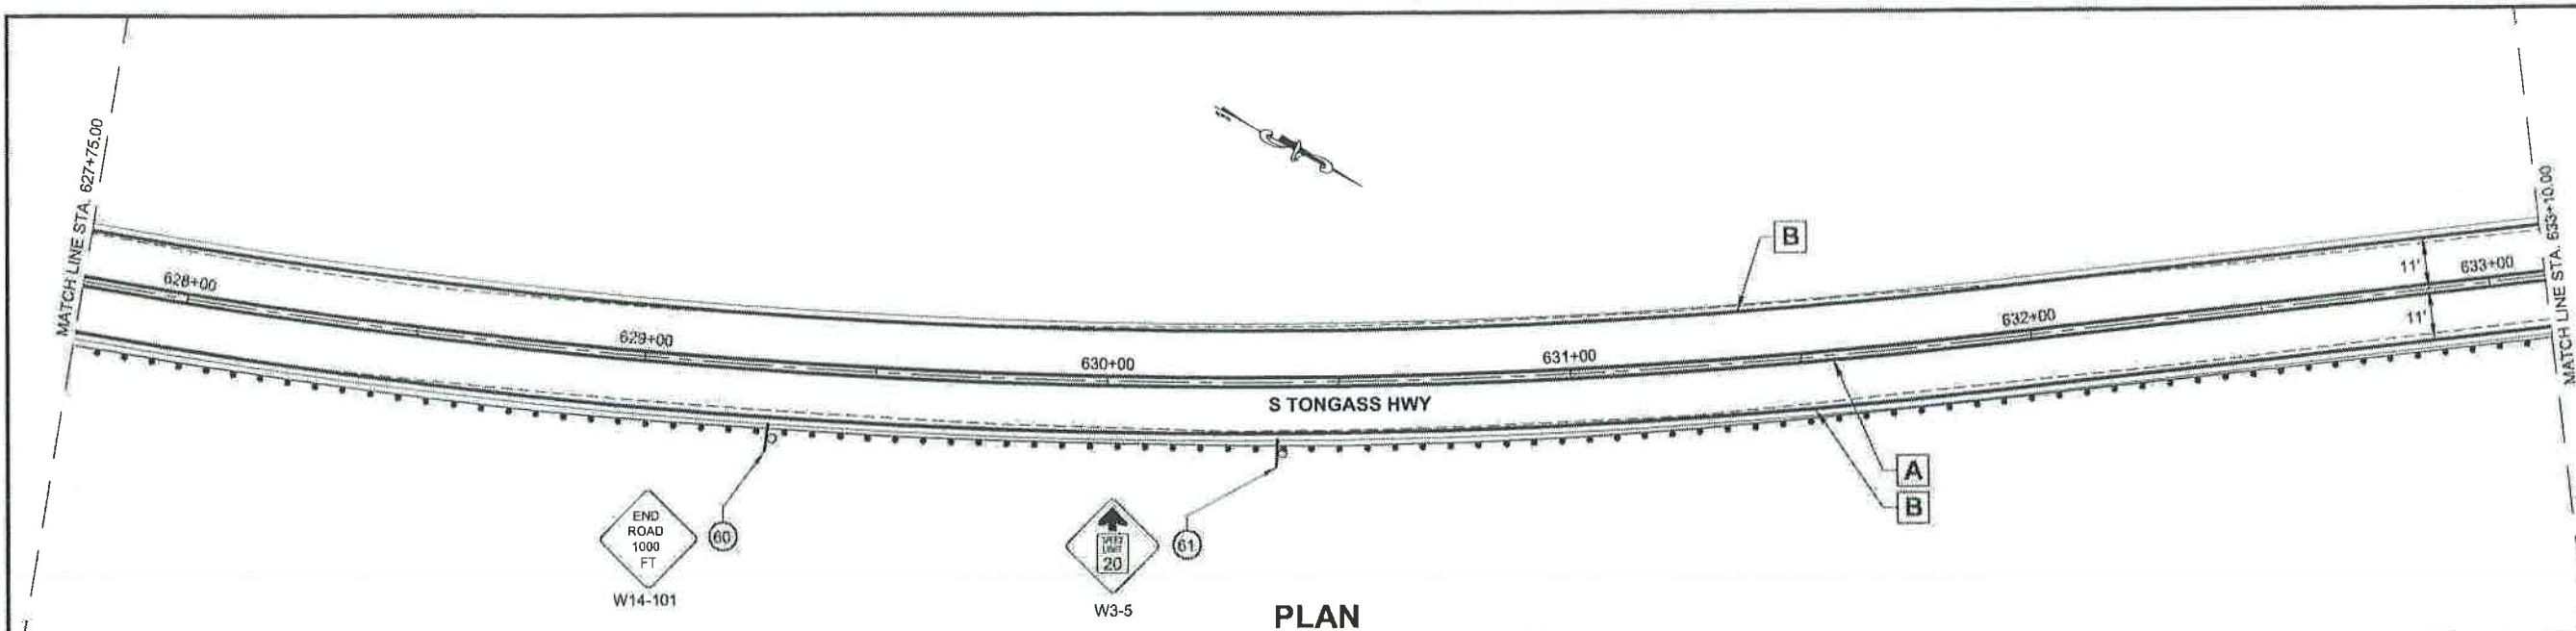

PLAN

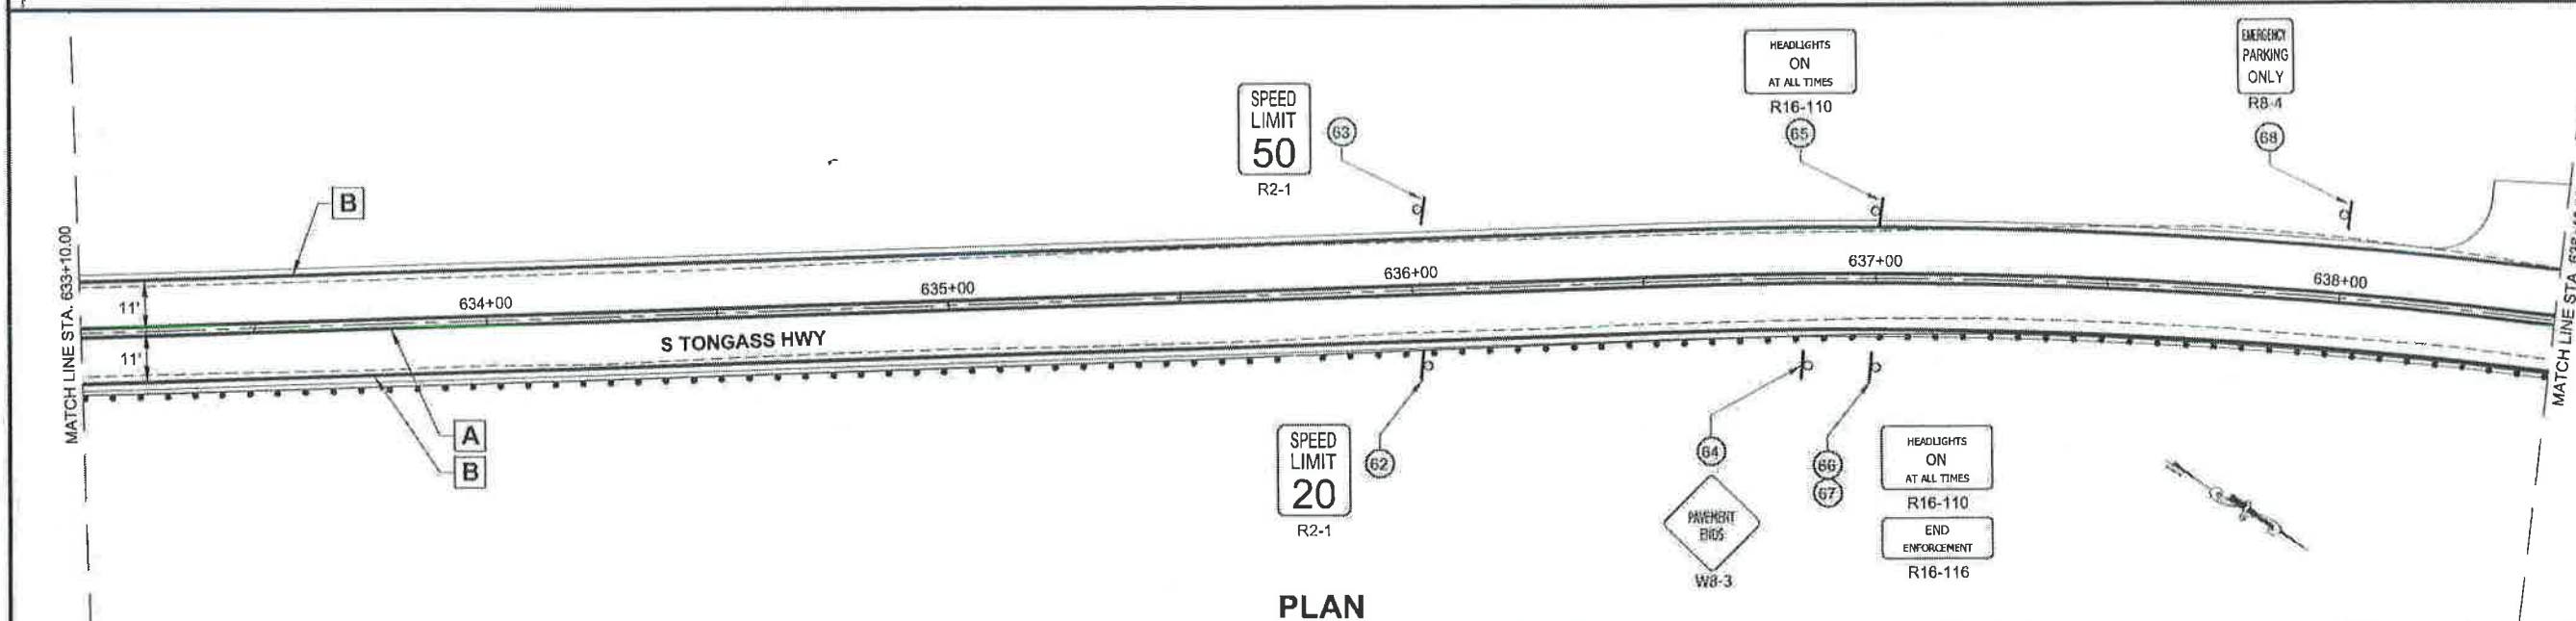

PLAN

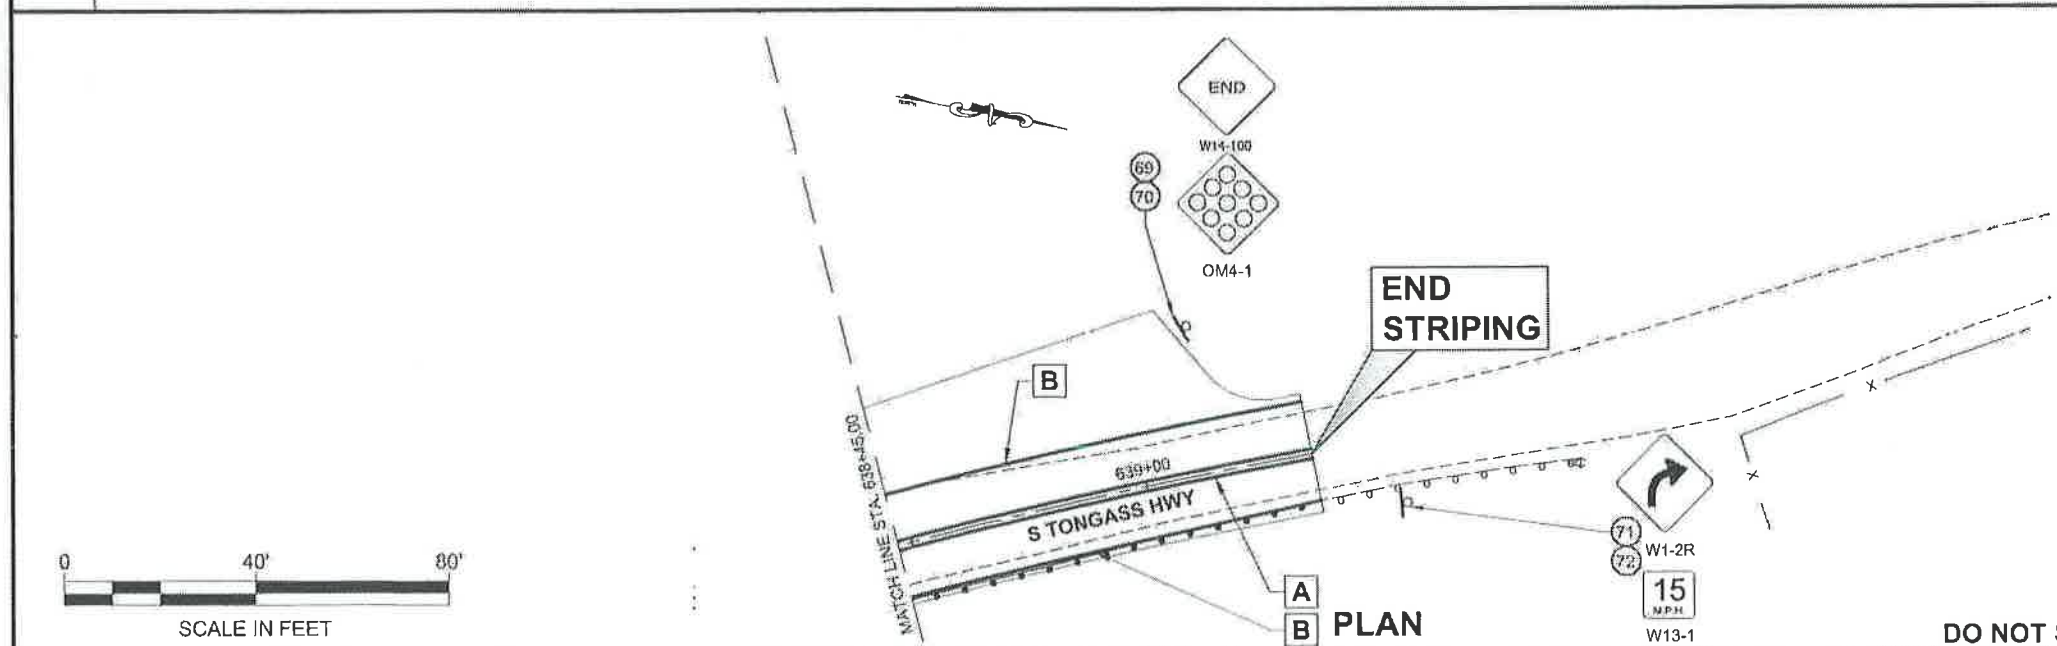

PLAN




Project As Built Drawings Have Been Reviewed By The Project Engineer & Represent, To The Best Of My Knowledge, The Project As Constructed.

Proj. Eng. **MR** Date **12/15/15**

DO NOT SCALE FROM THESE DRAWINGS USE DIMENSIONS

PATH: Q:\KTN\67674\PLANS\KTN67674_H1-H15_STRIPES.DWG
TAB: H15
SEIFERT, LOLITA T (DOT)
Wednesday, November 05, 2014 7:48:48 AM

RECORD OF REVISIONS		
No.	DATE	DESCRIPTION

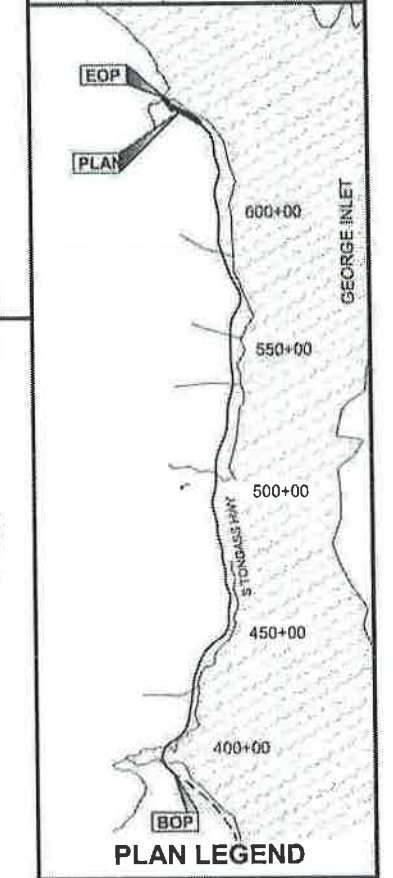

CHECKED BY: D. EPSTEIN




DESIGNED BY: L. SEIFERT
DRAWN BY: R. GRANTHAM

STATE OF ALASKA
DEPARTMENT OF TRANSPORTATION
& PUBLIC FACILITIES
SOUTHEAST REGION
KTN-SOUTH TONGASS PAVING
PROJECT #67674



SIGNING & STRIPING

PROJECT DESIGNATION	
STP-NH-0902(040)-67674	
STATE	YEAR
ALASKA	2014
SHEET NUMBER	TOTAL SHEETS
H15	66

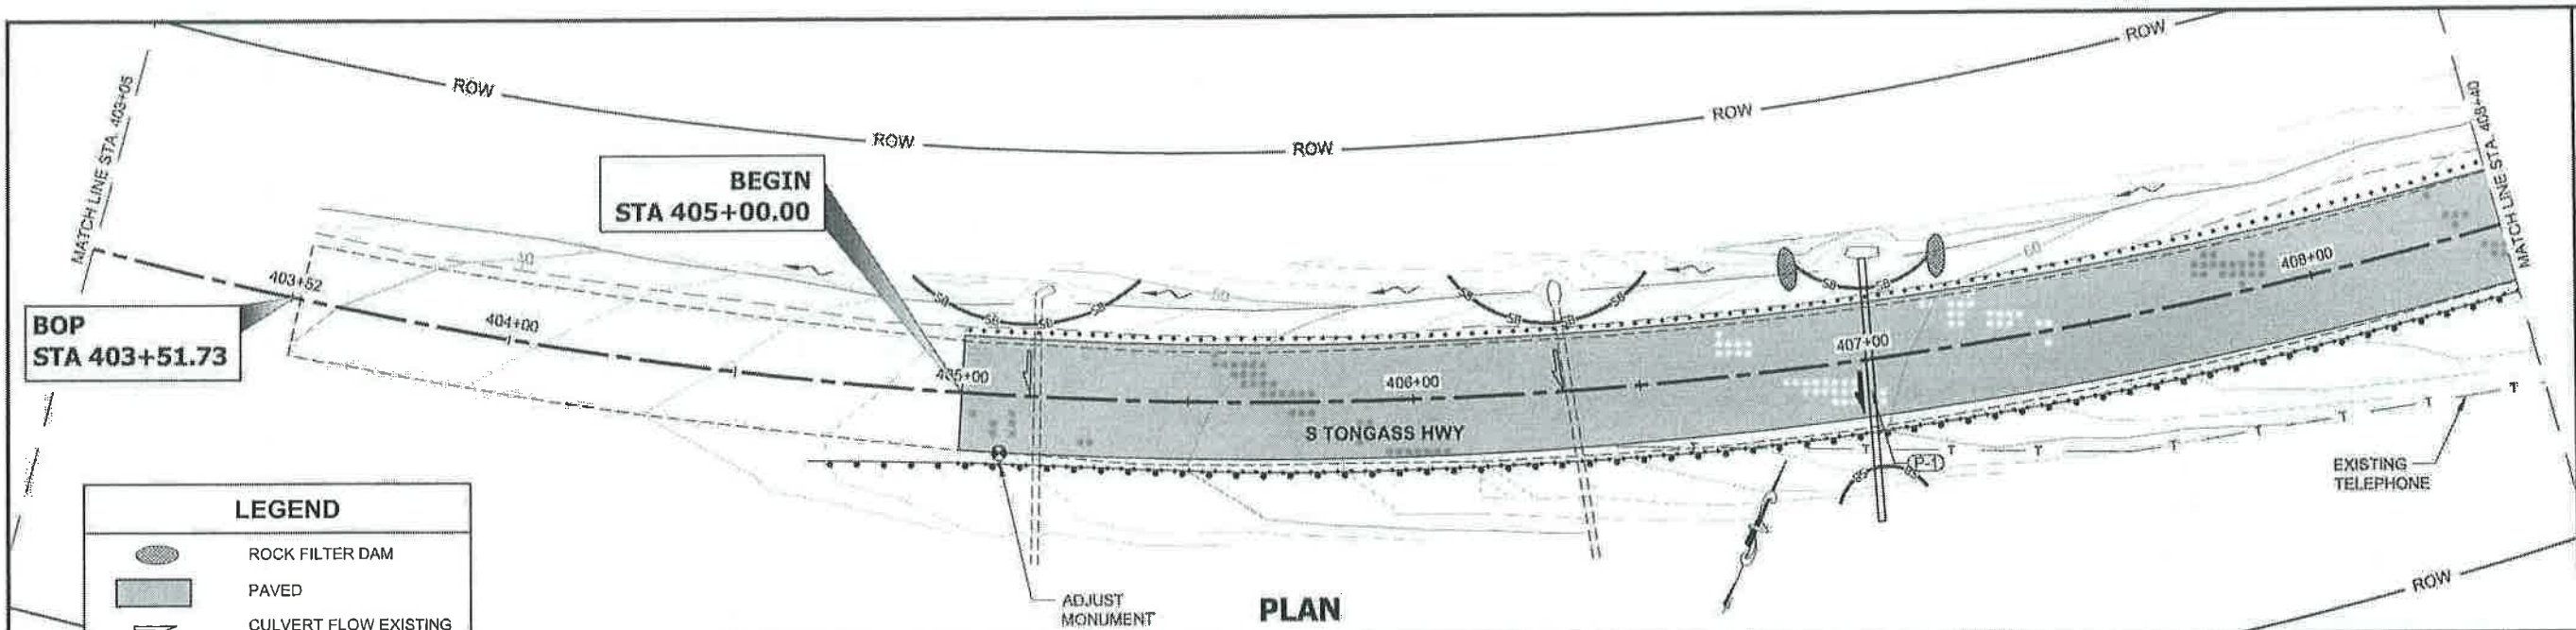

LEGEND

- ROCK FILTER DAM
- PAVED
- CULVERT FLOW EXISTING
- CULVERT FLOW NEW
- ADJUST MONUMENT
- SEDIMENT BARRIER
- DITCH FLOW ARROW

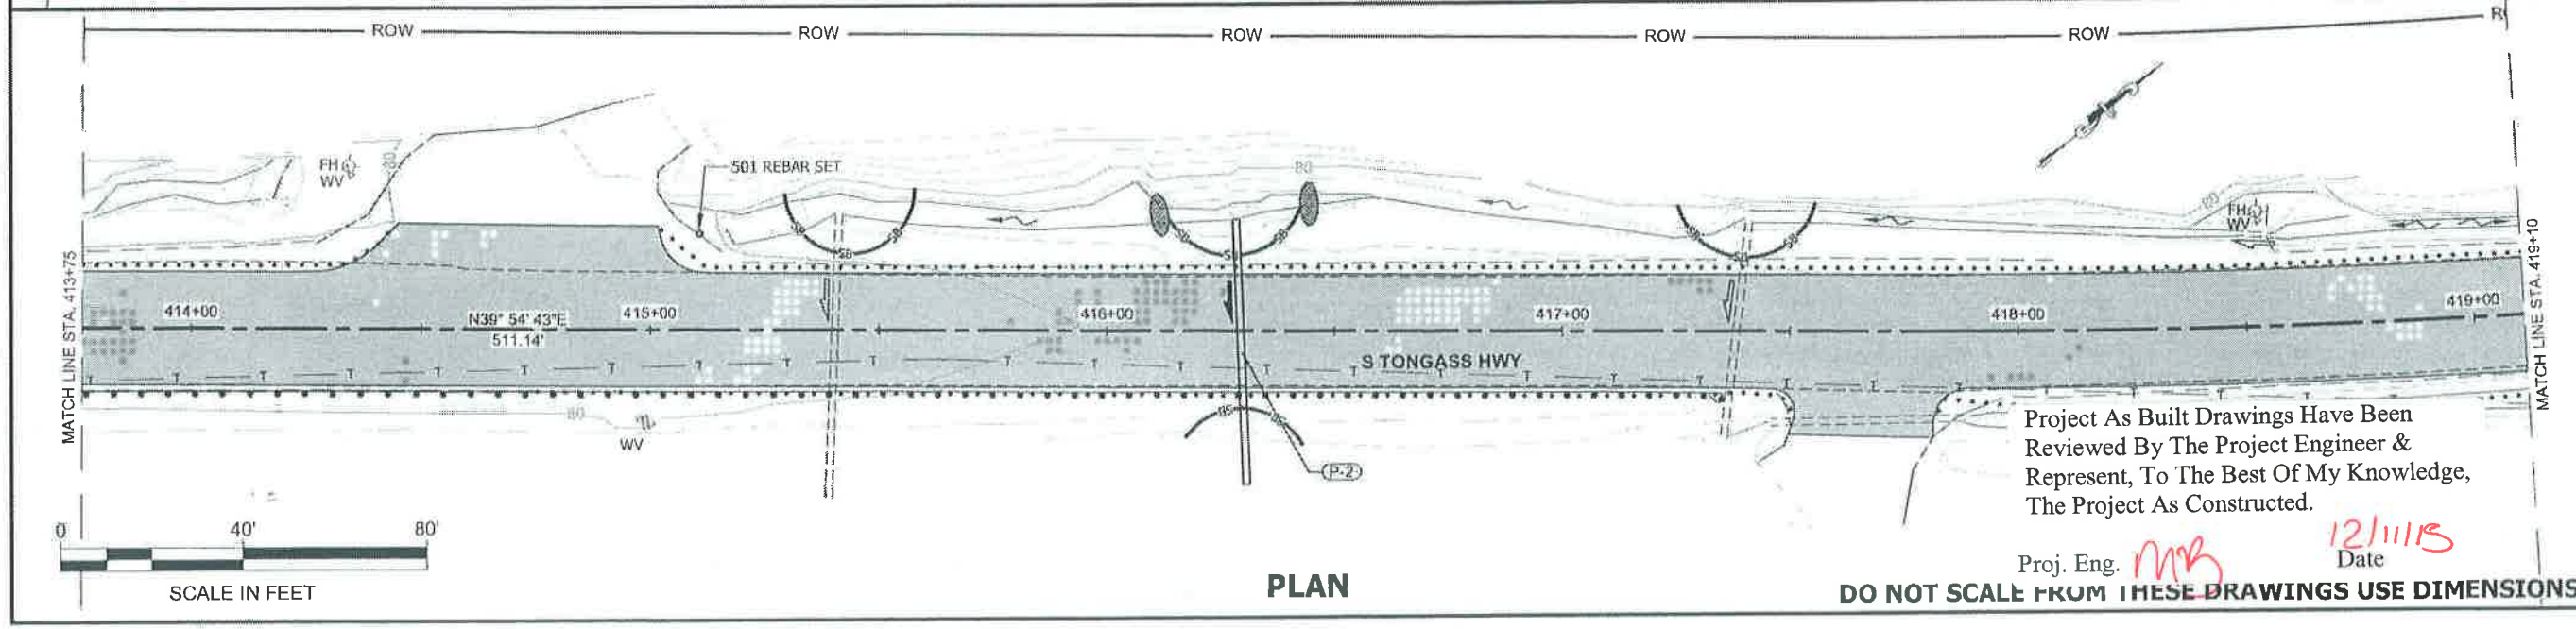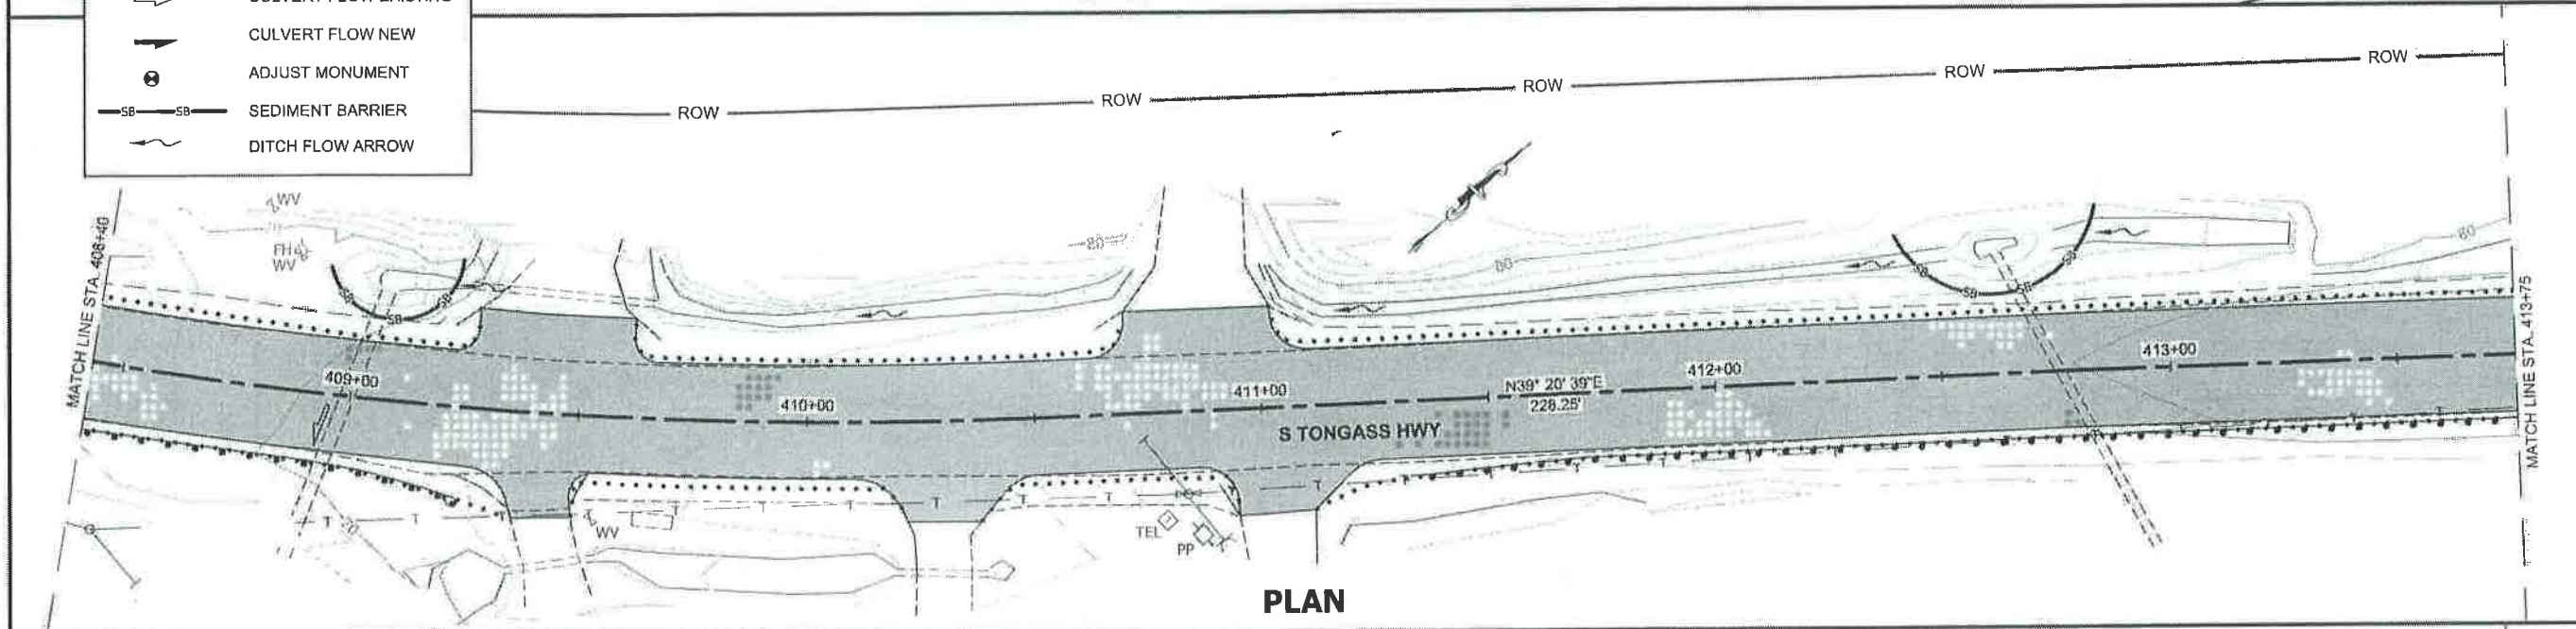

PATH: Q:\KTN\67674\PLANSET\67674_P1-P15
 55CB.DWG
 SEIFERT, LOLITA T (DOT)
 Wednesday, November 05, 2014 7:58:41 AM

ADDENDUM NUMBER

ATTACHMENT NUMBER

RECORD OF REVISIONS

No.	DATE	DESCRIPTION

PLAN LEGEND

CHECKED BY: M. VAN ALSTINE

ESCP NOT SEALED IN ACCORDANCE WITH ALASKA HIGHWAY PRECONSTRUCTION MANUAL SECTION 1120.7.3 DATED NOVEMBER 15, 2013

DESIGNED BY: L. SEIFERT

DRAWN BY: R. GRANTHAM

STATE OF ALASKA
 DEPARTMENT OF TRANSPORTATION & PUBLIC FACILITIES
 SOUTHEAST REGION

KTN-SOUTH TONGASS PAVING PROJECT #67674

ESCP

PROJECT DESIGNATION

STP-NH-0902(040)~67674


STATE	YEAR
ALASKA	2014

SHEET NUMBER	TOTAL SHEETS
P1	66


Project As Built Drawings Have Been Reviewed By The Project Engineer & Represent, To The Best Of My Knowledge, The Project As Constructed.

Proj. Eng. *MRB* Date *12/11/15*


DO NOT SCALE FROM THESE DRAWINGS USE DIMENSIONS

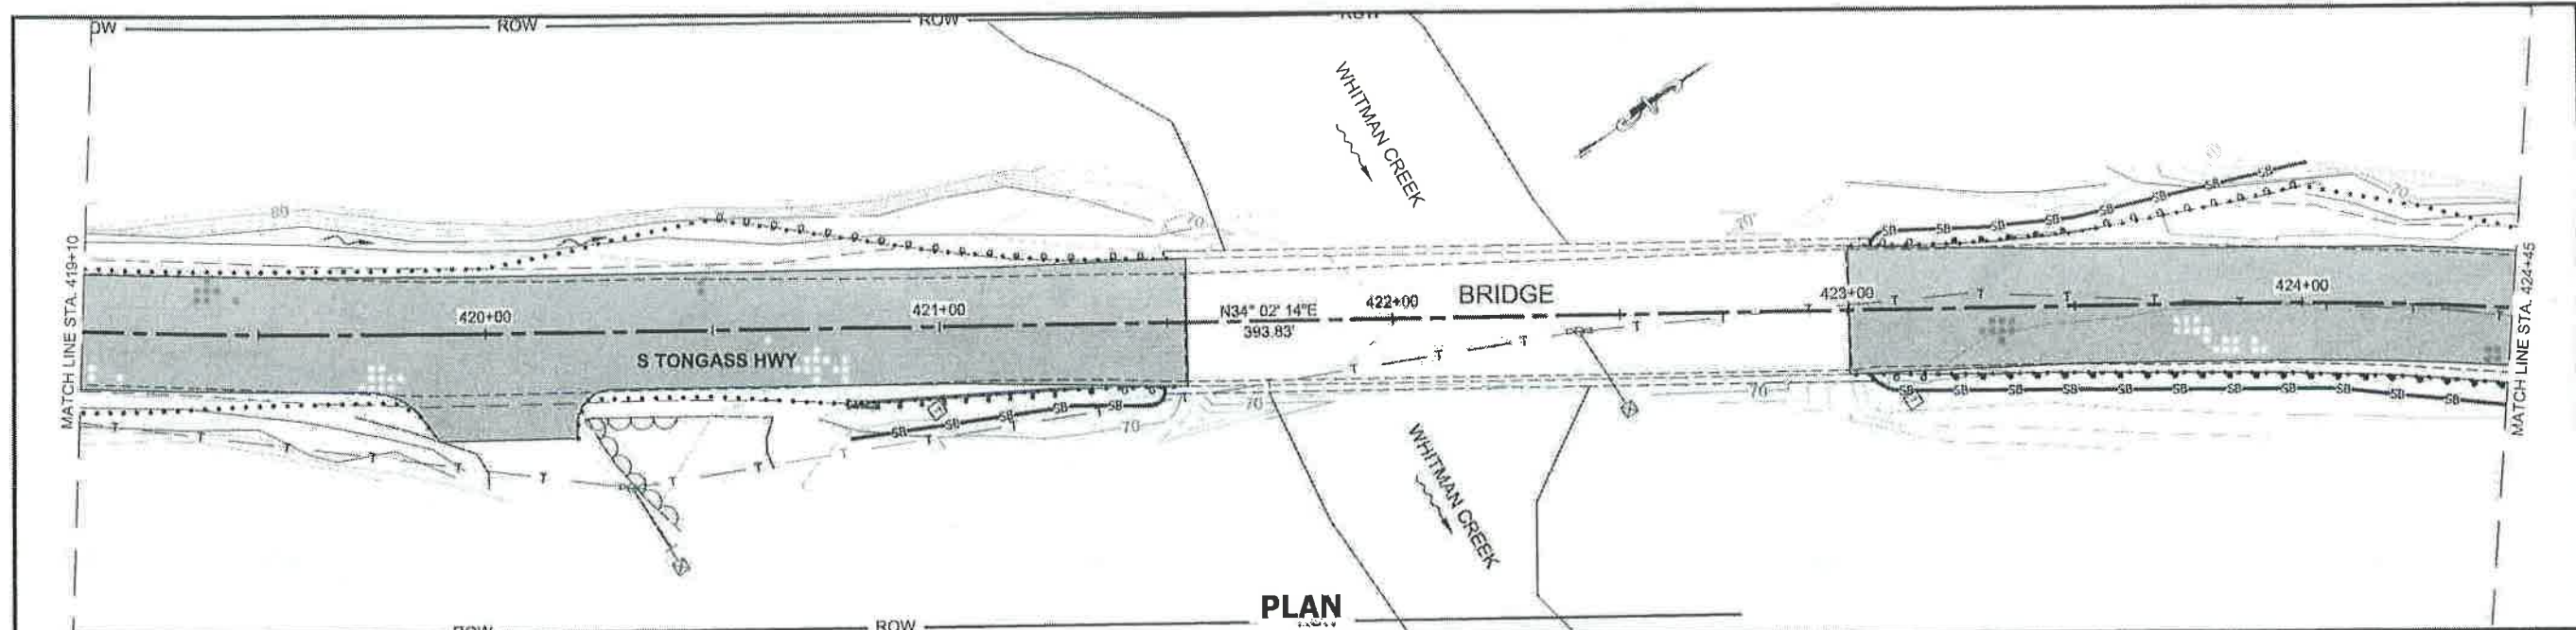

PLAN

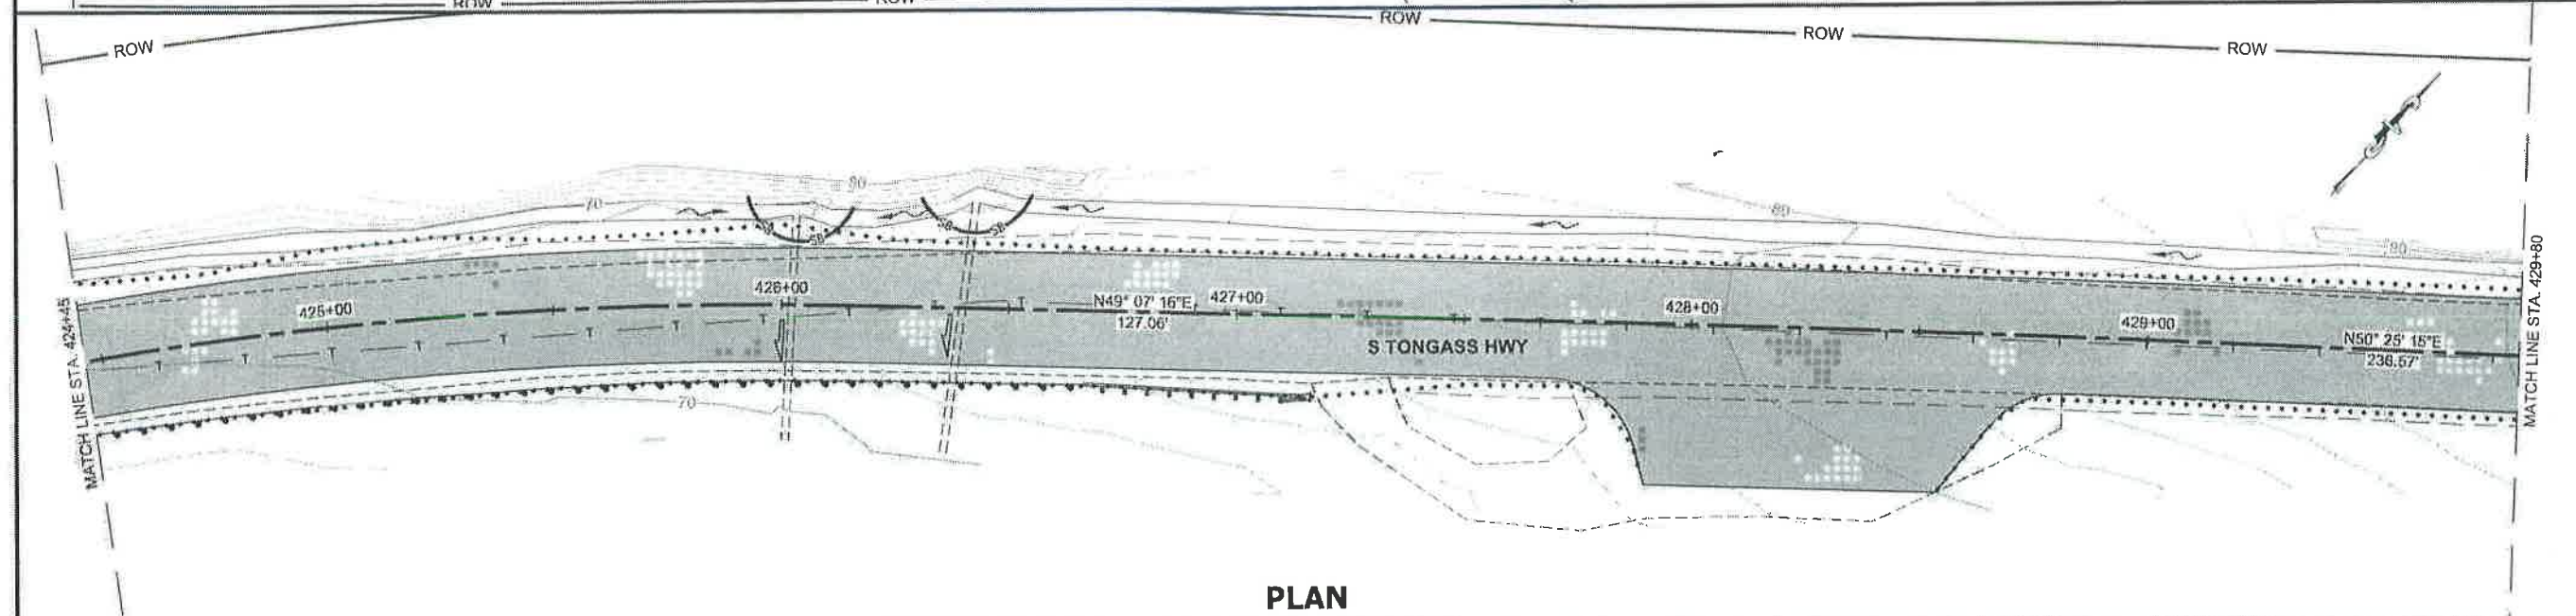

PLAN

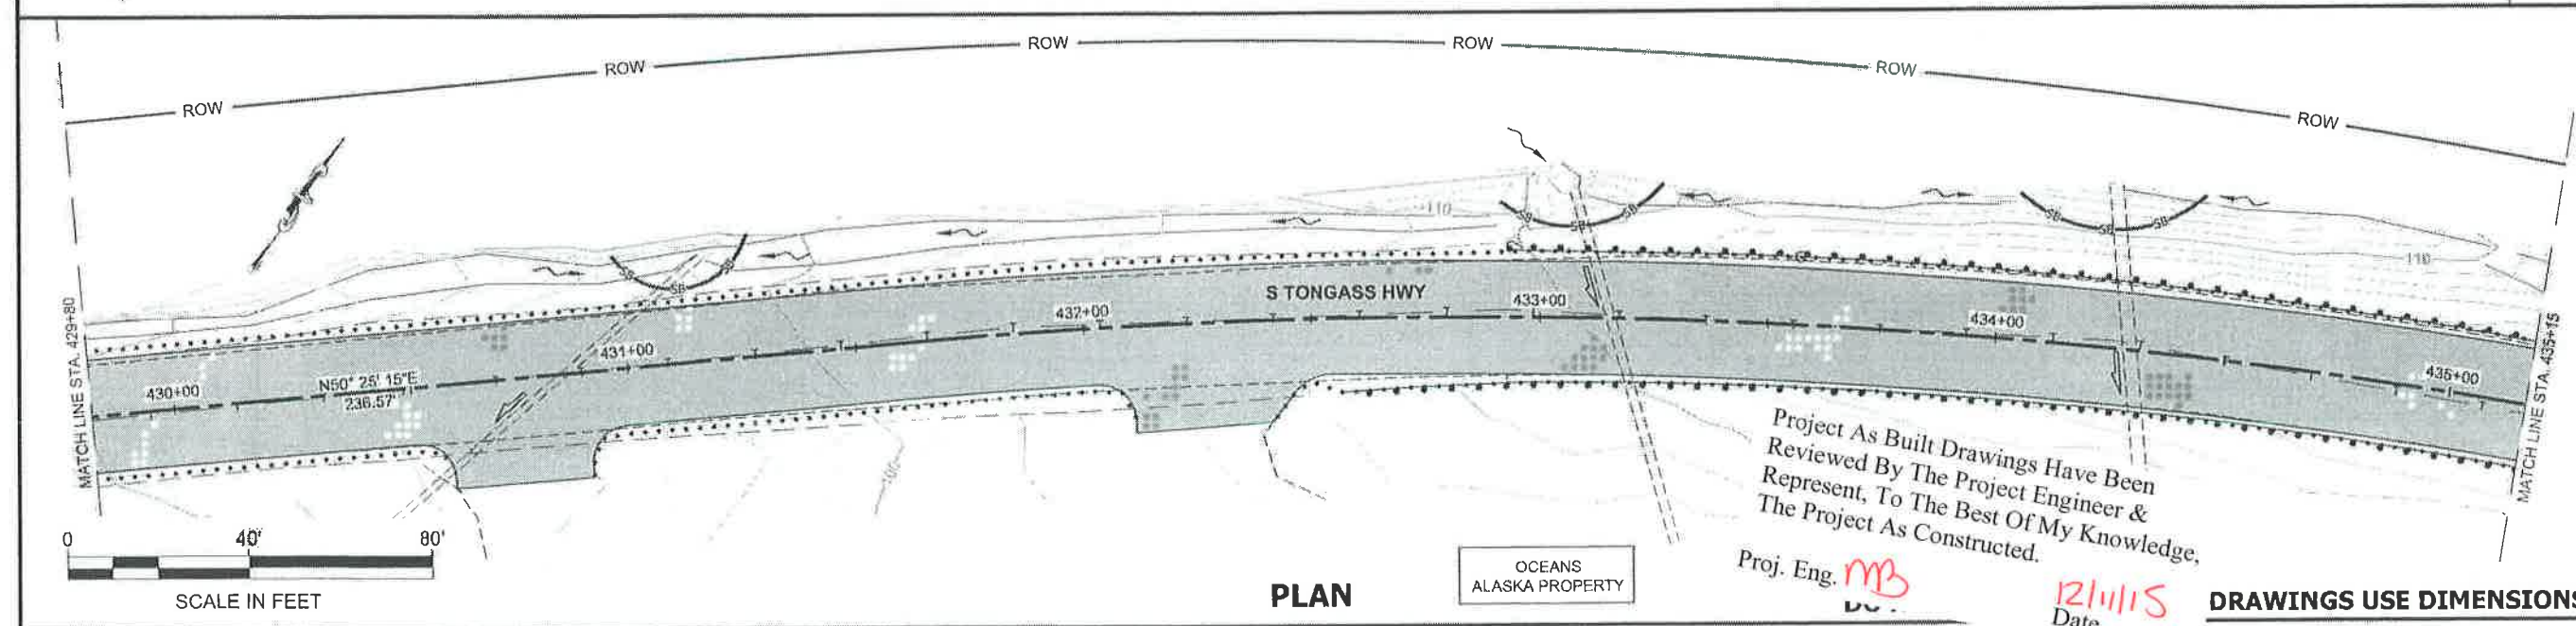

PLAN

OCEANS
ALASKA PROPERTY


Project As Built Drawings Have Been
Reviewed By The Project Engineer &
Represent, To The Best Of My Knowledge,
The Project As Constructed.

Proj. Eng. *MB*

12/11/15
Date

DRAWINGS USE DIMENSIONS

PATH: Q:\KTN\67674\PLANSET\67674_P1-P15 556.DWG		
SEIFERT, LOLITA T (DOT)		
Wednesday, November 05, 2014 7:58:24 AM		
ADDENDUM NUMBER		
ATTACHMENT NUMBER		
RECORD OF REVISIONS		
No.	DATE	DESCRIPTION

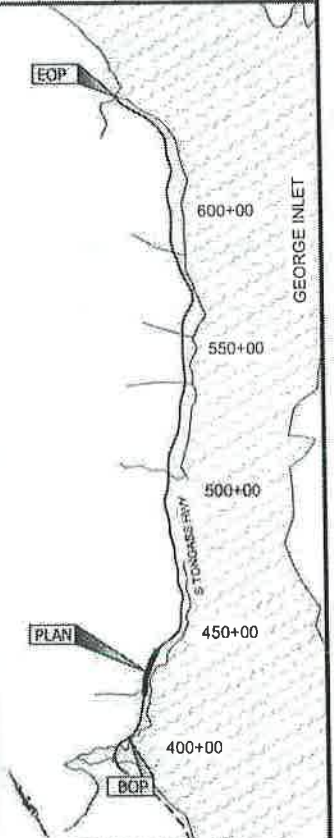

PLAN LEGEND

CHECKED BY: M. VAN ALSTINE

ESCP NOT SEALED IN ACCORDANCE
WITH ALASKA HIGHWAY
PRECONSTRUCTION MANUAL
SECTION 1120.7.3
DATED NOVEMBER 15, 2013

DESIGNED BY: L. SEIFERT

DRAWN BY: R. GRANTHAM

STATE OF ALASKA
DEPARTMENT OF TRANSPORTATION
& PUBLIC FACILITIES
SOUTHEAST REGION


KTN-SOUTH TONGASS PAVING
PROJECT #67674

ESCP


PROJECT DESIGNATION

STP-NH-0902(040)~67674


STATE	YEAR
ALASKA	2014
SHEET NUMBER	TOTAL SHEETS
P2	66

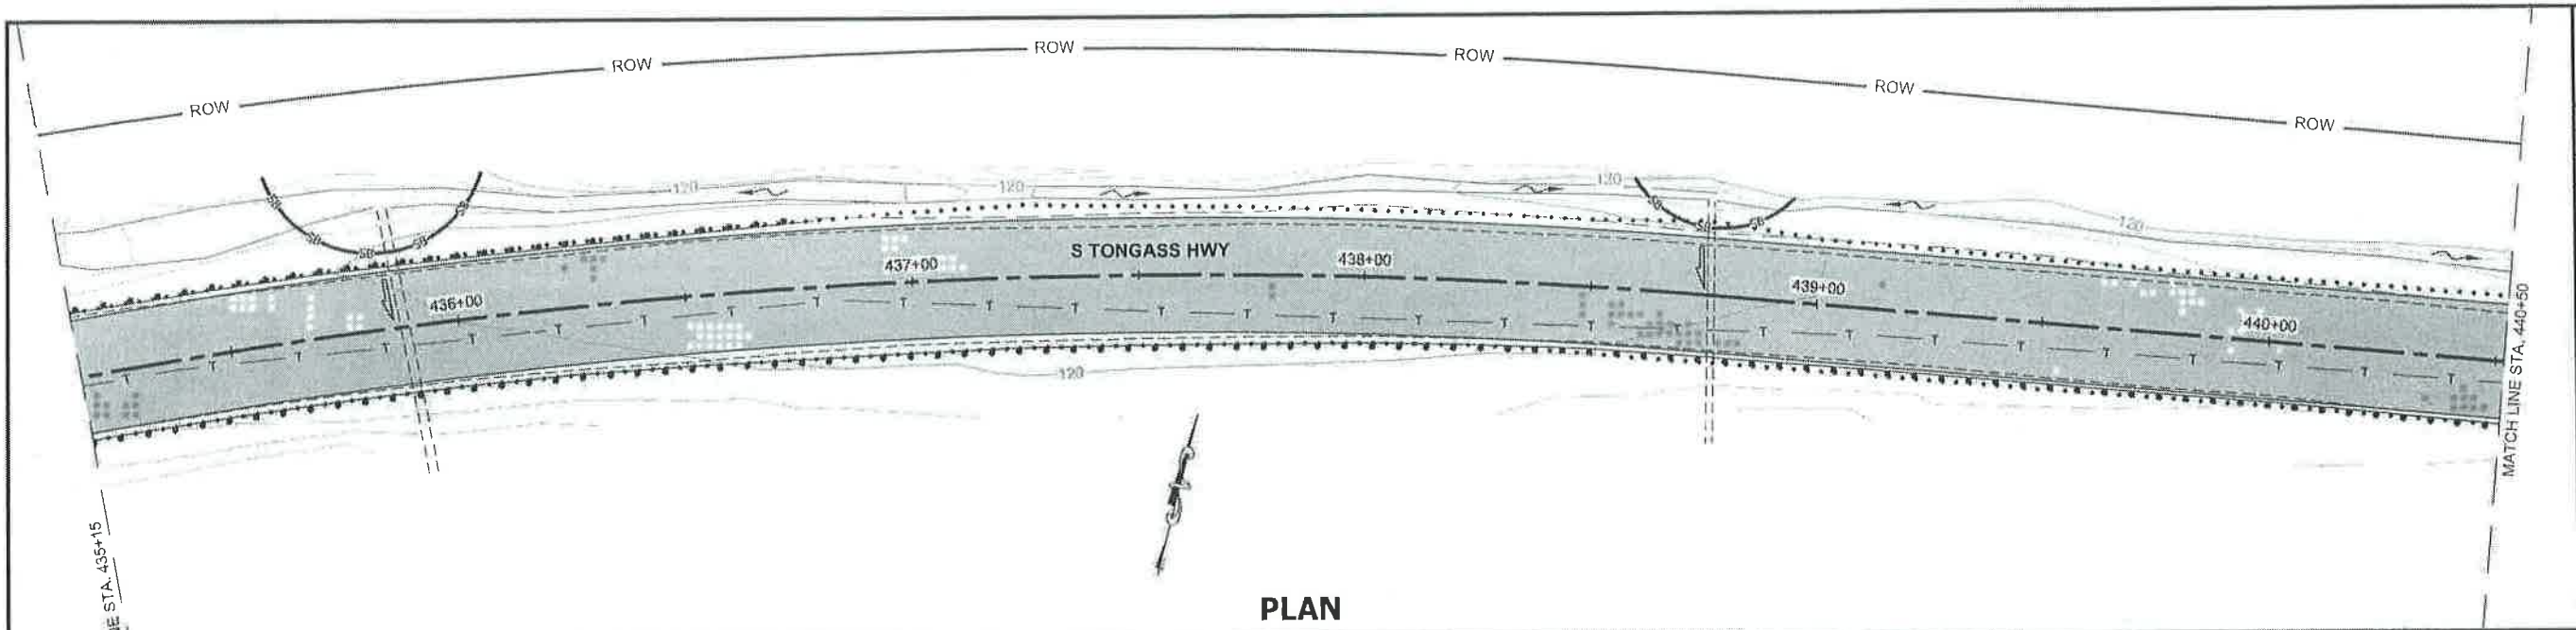

PLAN

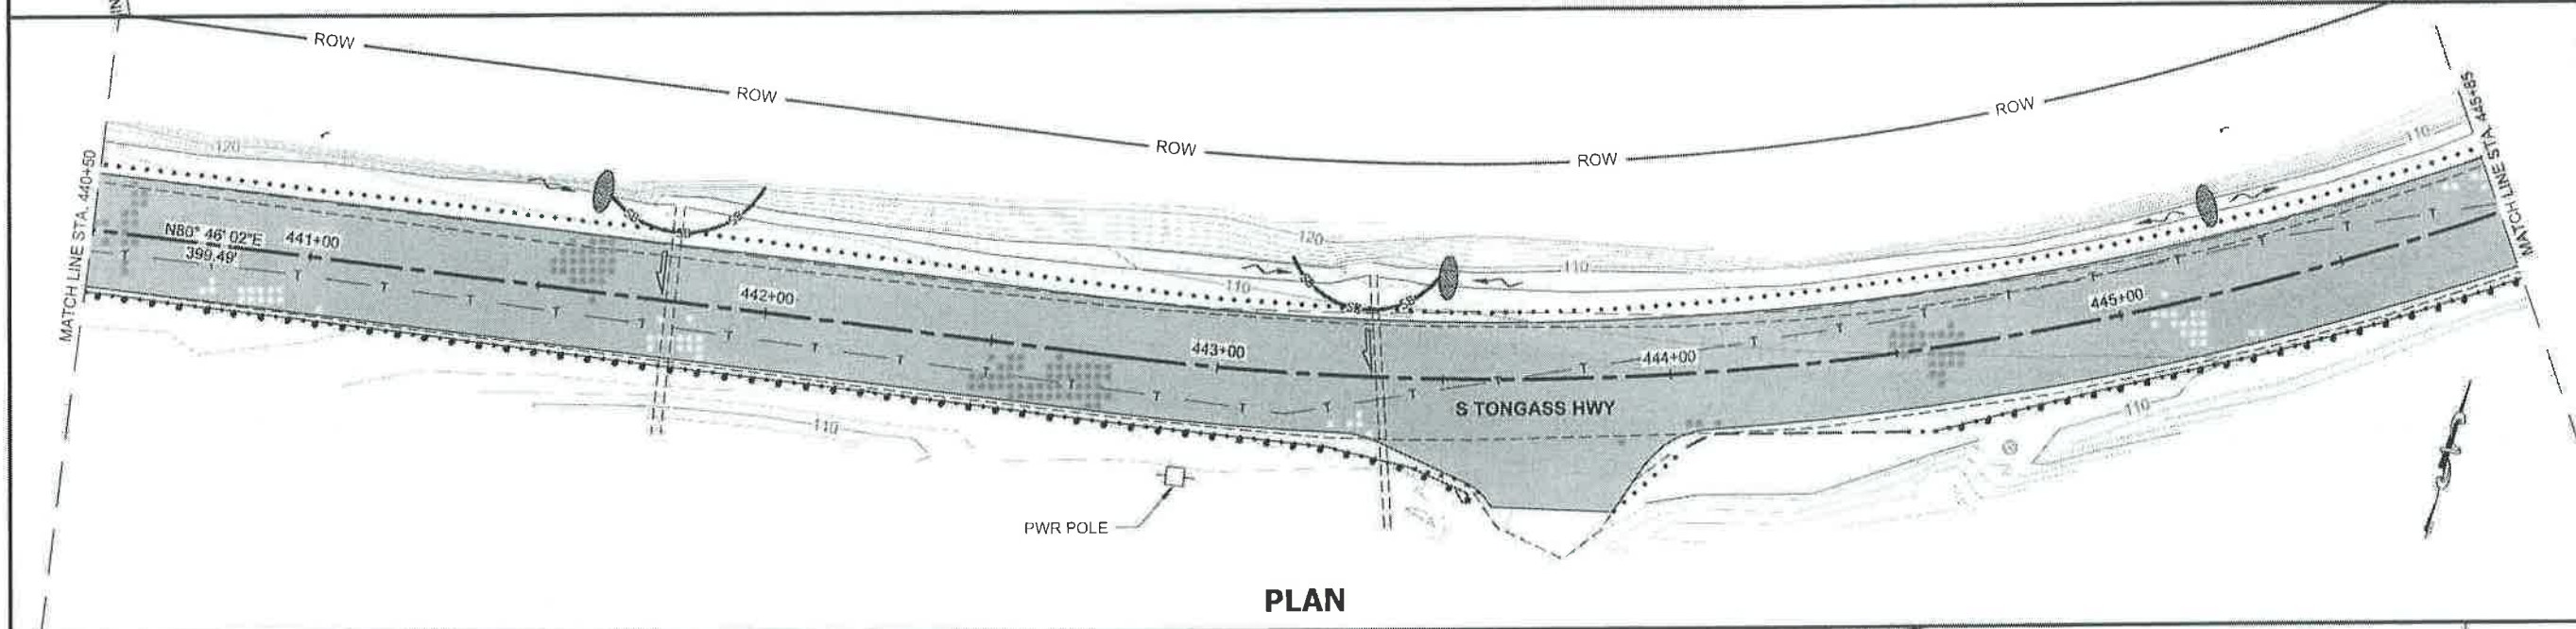

PLAN

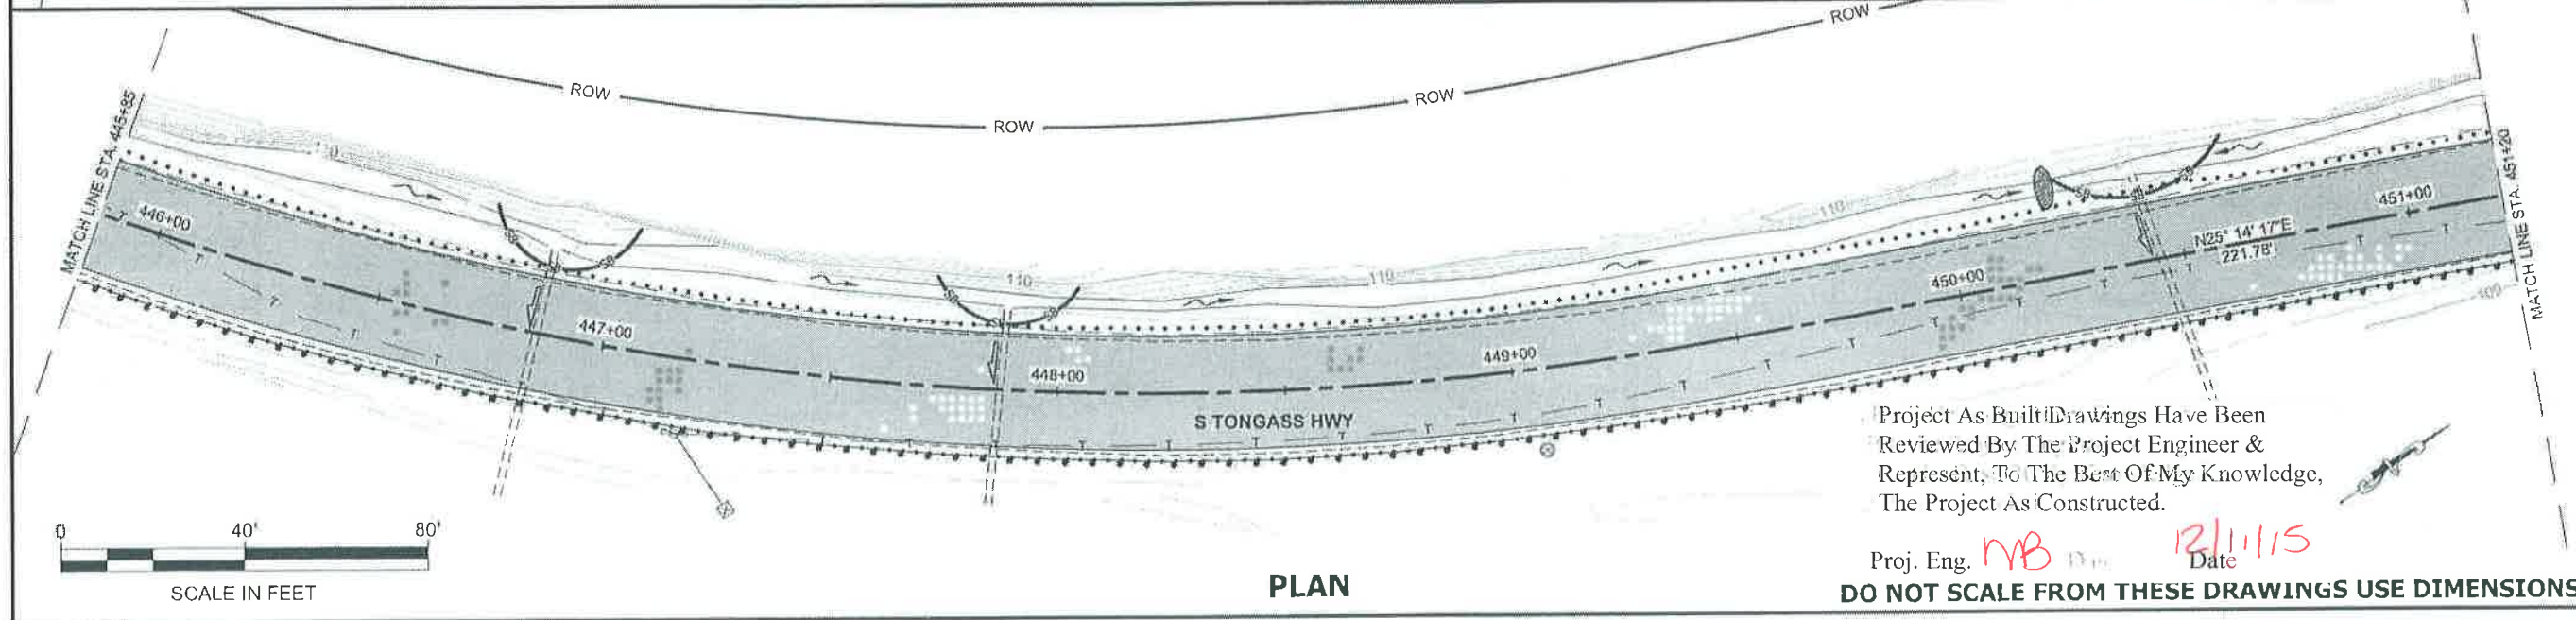

PLAN

Project As Built Drawings Have Been Reviewed By The Project Engineer & Represent, To The Best Of My Knowledge, The Project As Constructed.

Proj. Eng. *MB* Date *12/11/15*
DO NOT SCALE FROM THESE DRAWINGS USE DIMENSIONS

PATH: Q:\KTN\67674\PLANSET\67674_P1-P15
55589WG
SEIFERT, LOLITA T (DOT)
Wednesday, November 05, 2014 7:58:08 AM

ADDENDUM NUMBER

ATTACHMENT NUMBER

RECORD OF REVISIONS

No.	DATE	DESCRIPTION

PLAN LEGEND

CHECKED BY: M. VAN ALSTINE

ESCP NOT SEALED IN ACCORDANCE WITH ALASKA HIGHWAY PRECONSTRUCTION MANUAL SECTION 1120.7.3 DATED NOVEMBER 15, 2013

DESIGNED BY: L. SEIFERT
DRAWN BY: R. GRANTHAM

STATE OF ALASKA
DEPARTMENT OF TRANSPORTATION & PUBLIC FACILITIES
SOUTHEAST REGION

KTN-SOUTH TONGASS PAVING PROJECT #67674


ESCP

PROJECT DESIGNATION

STP-NH-0902(040)~67674

STATE	YEAR
ALASKA	2014

SHEET NUMBER	TOTAL SHEETS
P3	66

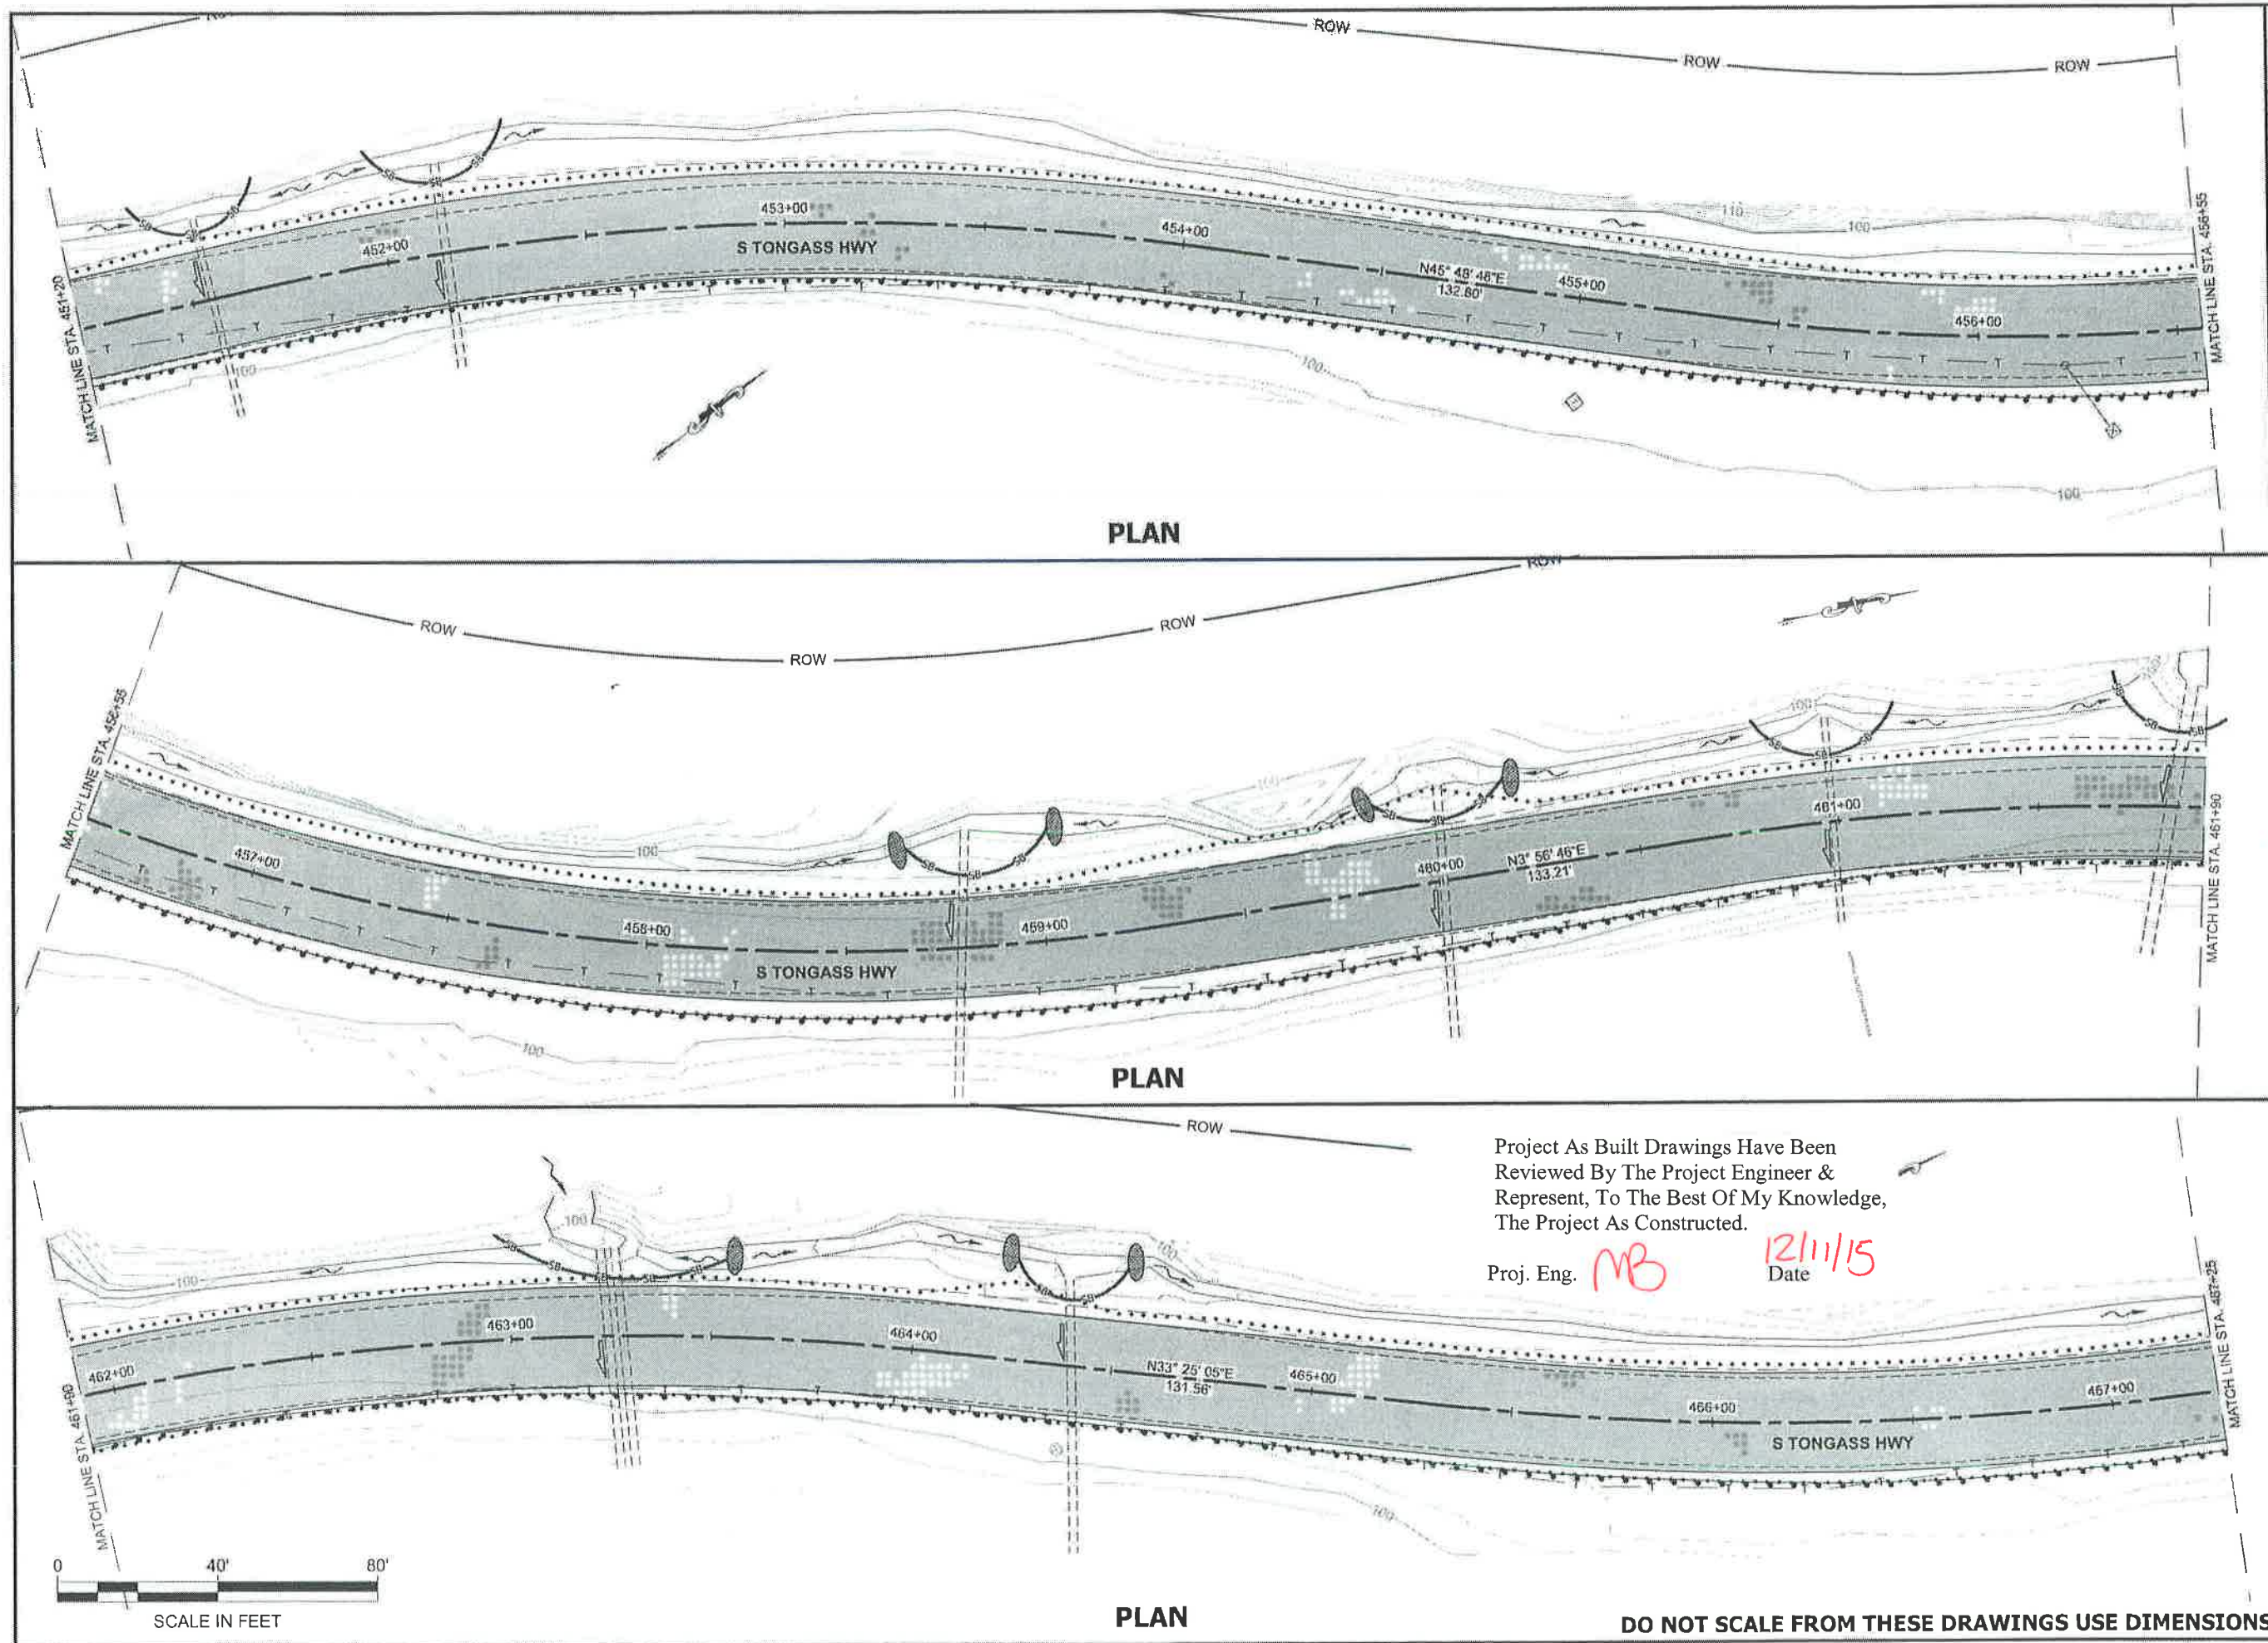

PATH: Q:\KTN\67674\PLANSET\67674_P1-P15
 ESCP.DWG
 SEIFERT, LOLITA T (DOT)
 Wednesday, November 05, 2014 7:57:49 AM

ADDENDUM NUMBER

ATTACHMENT NUMBER

RECORD OF REVISIONS

No.	DATE	DESCRIPTION

PLAN LEGEND

CHECKED BY: M. VAN ALSTINE

ESCP NOT SEALED IN ACCORDANCE WITH ALASKA HIGHWAY PRECONSTRUCTION MANUAL SECTION 1120.7.3 DATED NOVEMBER 15, 2013

DESIGNED BY: L. SEIFERT

DRAWN BY: R. GRANTHAM

STATE OF ALASKA
 DEPARTMENT OF TRANSPORTATION & PUBLIC FACILITIES
 SOUTHEAST REGION

KTN-SOUTH TONGASS PAVING PROJECT #67674


ESCP

PROJECT DESIGNATION


STP-NH-0902(040)~67674

STATE	YEAR
ALASKA	2014


SHEET NUMBER	TOTAL SHEETS
P4	66

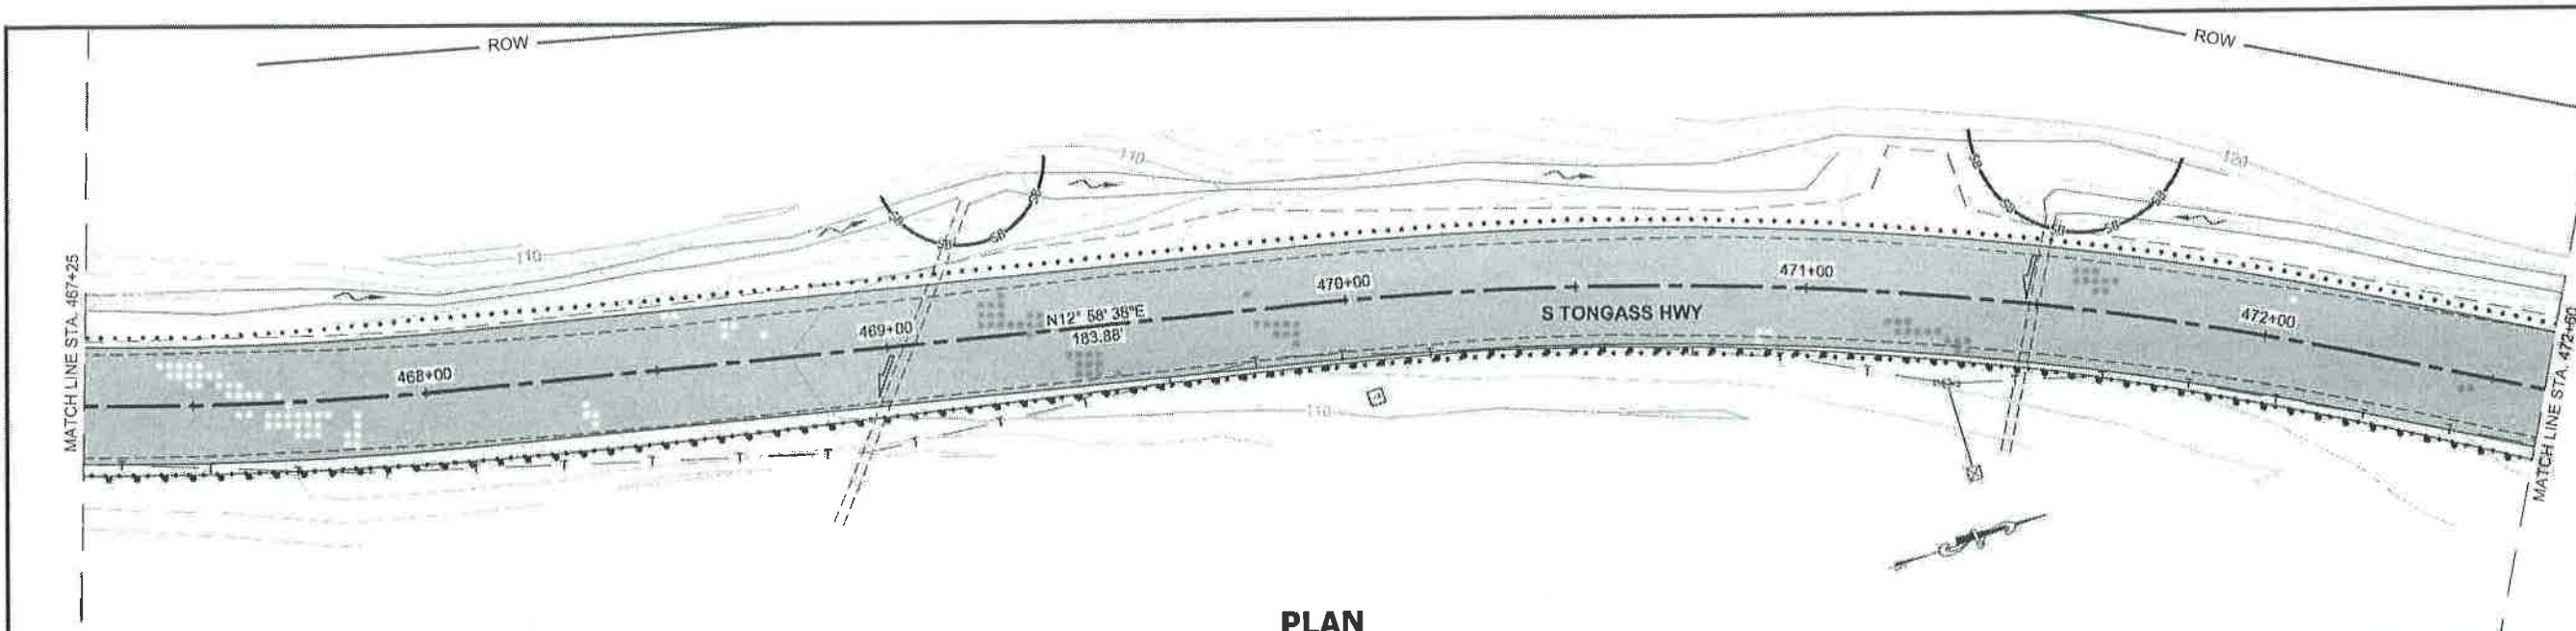

PLAN

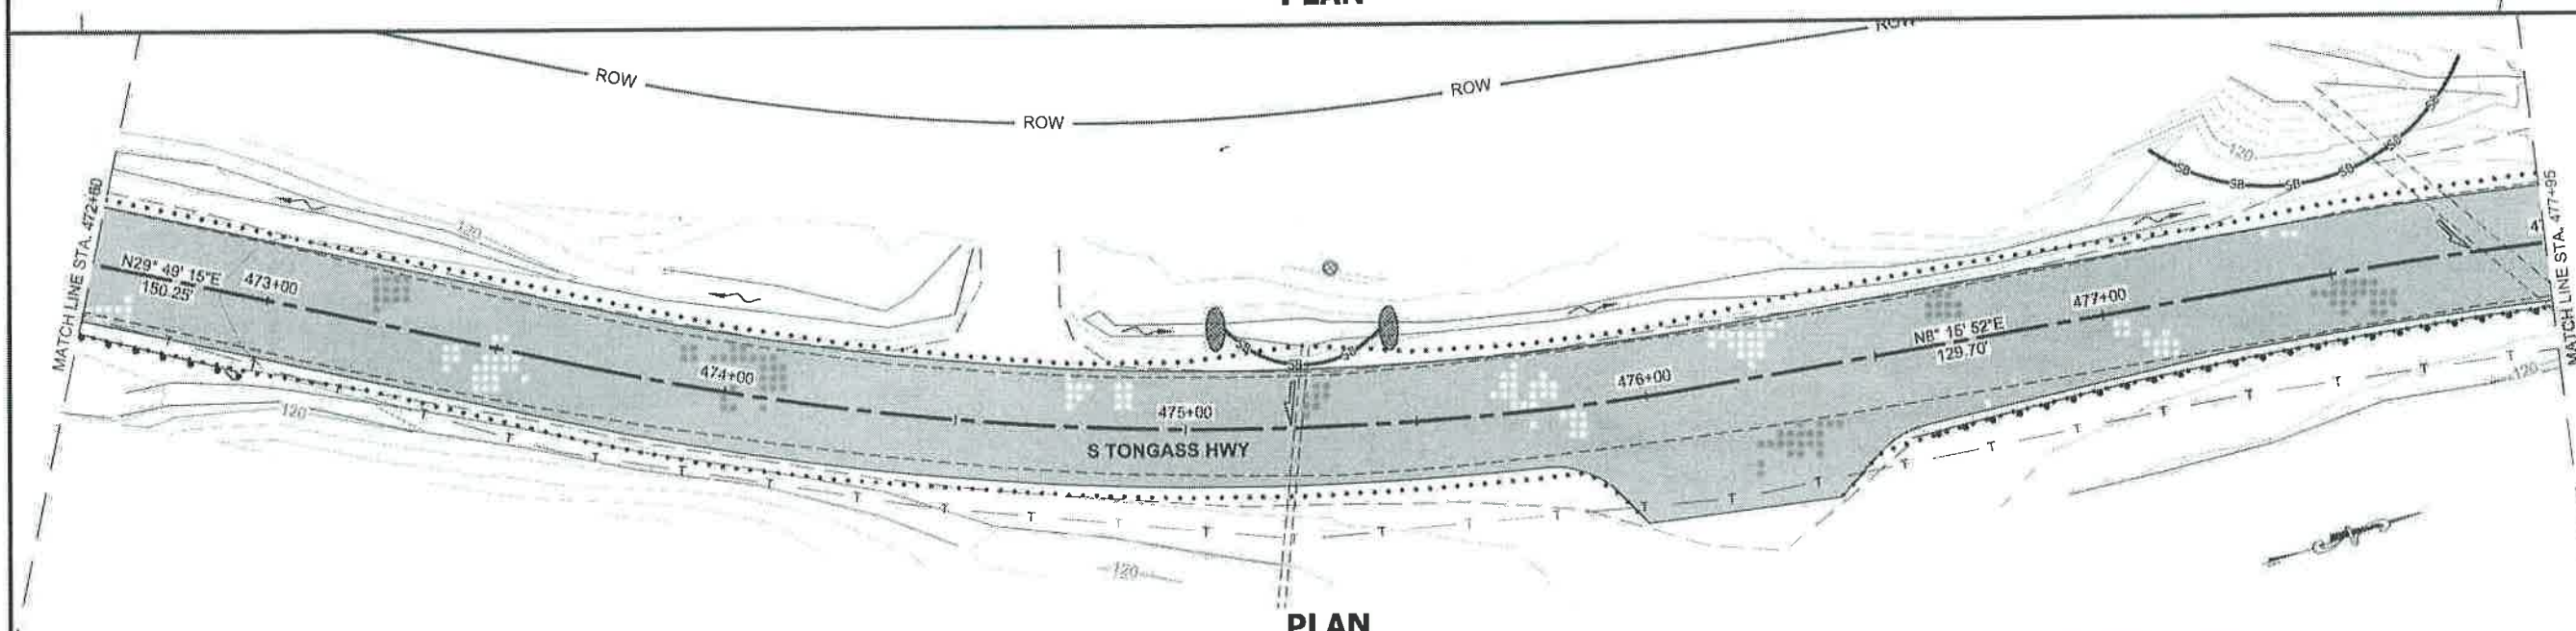

PLAN

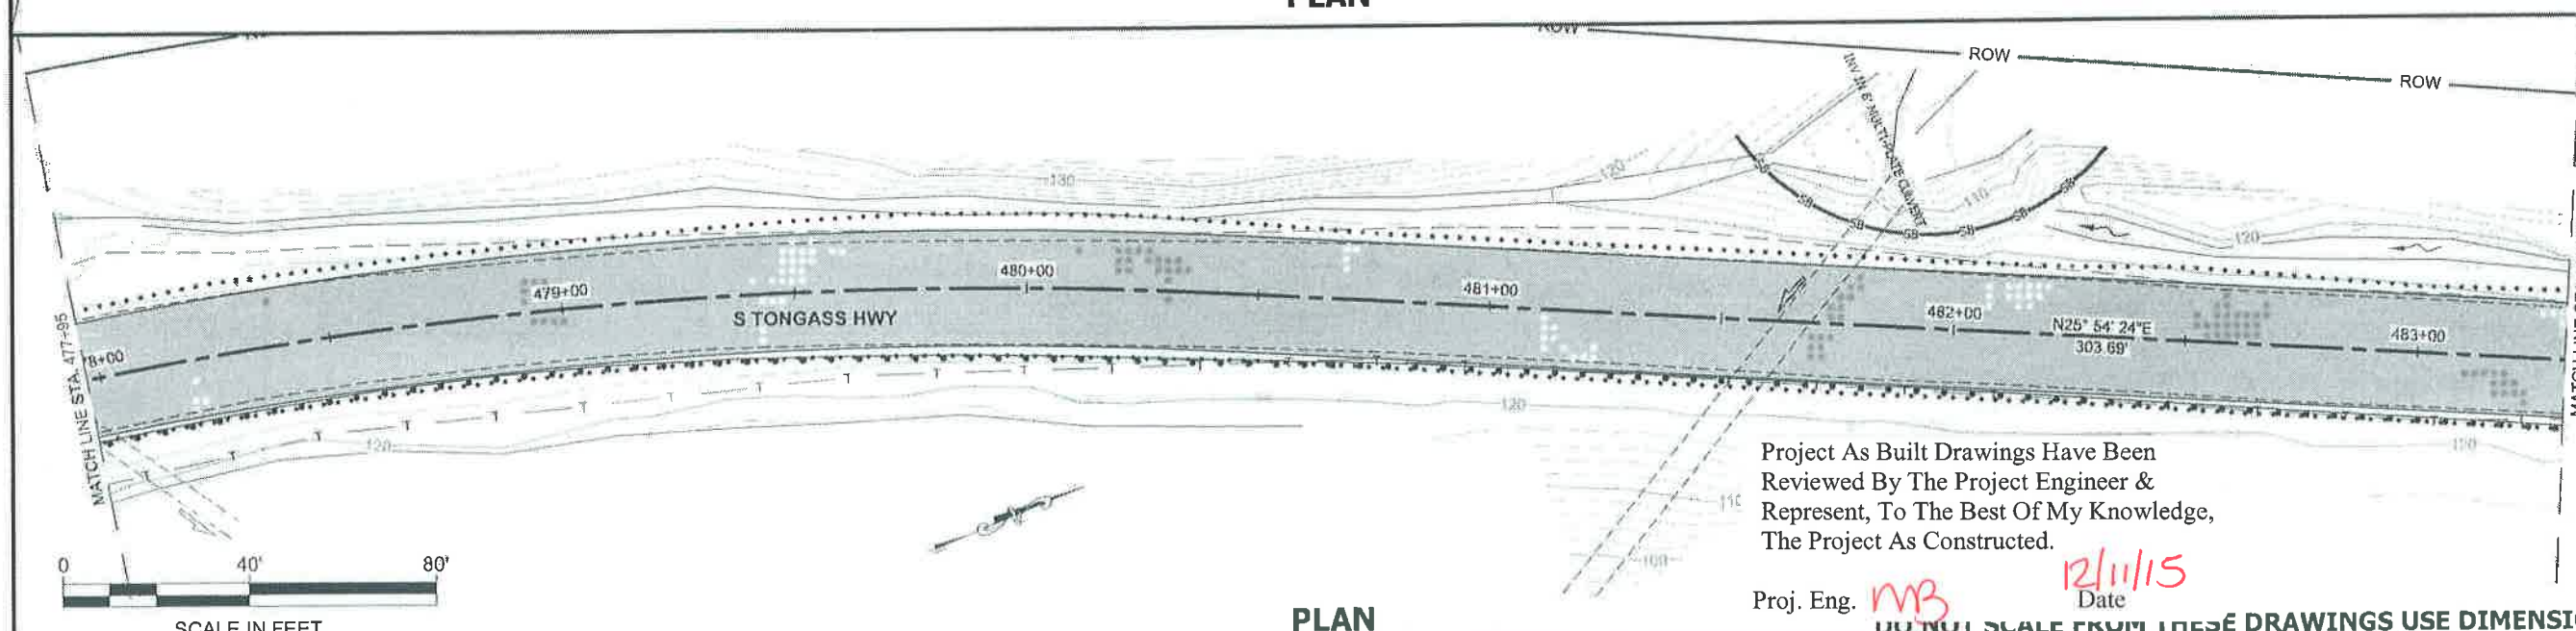

PLAN



Project As Built Drawings Have Been Reviewed By The Project Engineer & Represent, To The Best Of My Knowledge, The Project As Constructed.

Proj. Eng. *MB* Date *12/11/15*

DO NOT SCALE FROM THESE DRAWINGS USE DIMENSIONS

PATH:
Q:\KTN\67674\PLANSET\67674_P1-P15
55689.WG

SEIFERT, LOLITA T (DOT)
Wednesday, November 05, 2014 7:57:20 AM

ADDENDUM NUMBER

ATTACHMENT NUMBER

RECORD OF REVISIONS

No.	DATE	DESCRIPTION

PLAN LEGEND

CHECKED BY: M. VAN ALSTINE

ESCP NOT SEALED IN ACCORDANCE WITH ALASKA HIGHWAY PRECONSTRUCTION MANUAL SECTION 1120.7.3 DATED NOVEMBER 15, 2013

DESIGNED BY: L. SEIFERT

DRAWN BY: R. GRANTHAM

STATE OF ALASKA
DEPARTMENT OF TRANSPORTATION & PUBLIC FACILITIES
SOUTHEAST REGION

KTN-SOUTH TONGASS PAVING PROJECT #67674


ESCP

PROJECT DESIGNATION


STP-NH-0902(040)~67674

STATE	YEAR
ALASKA	2014


SHEET NUMBER	TOTAL SHEETS
P5	66

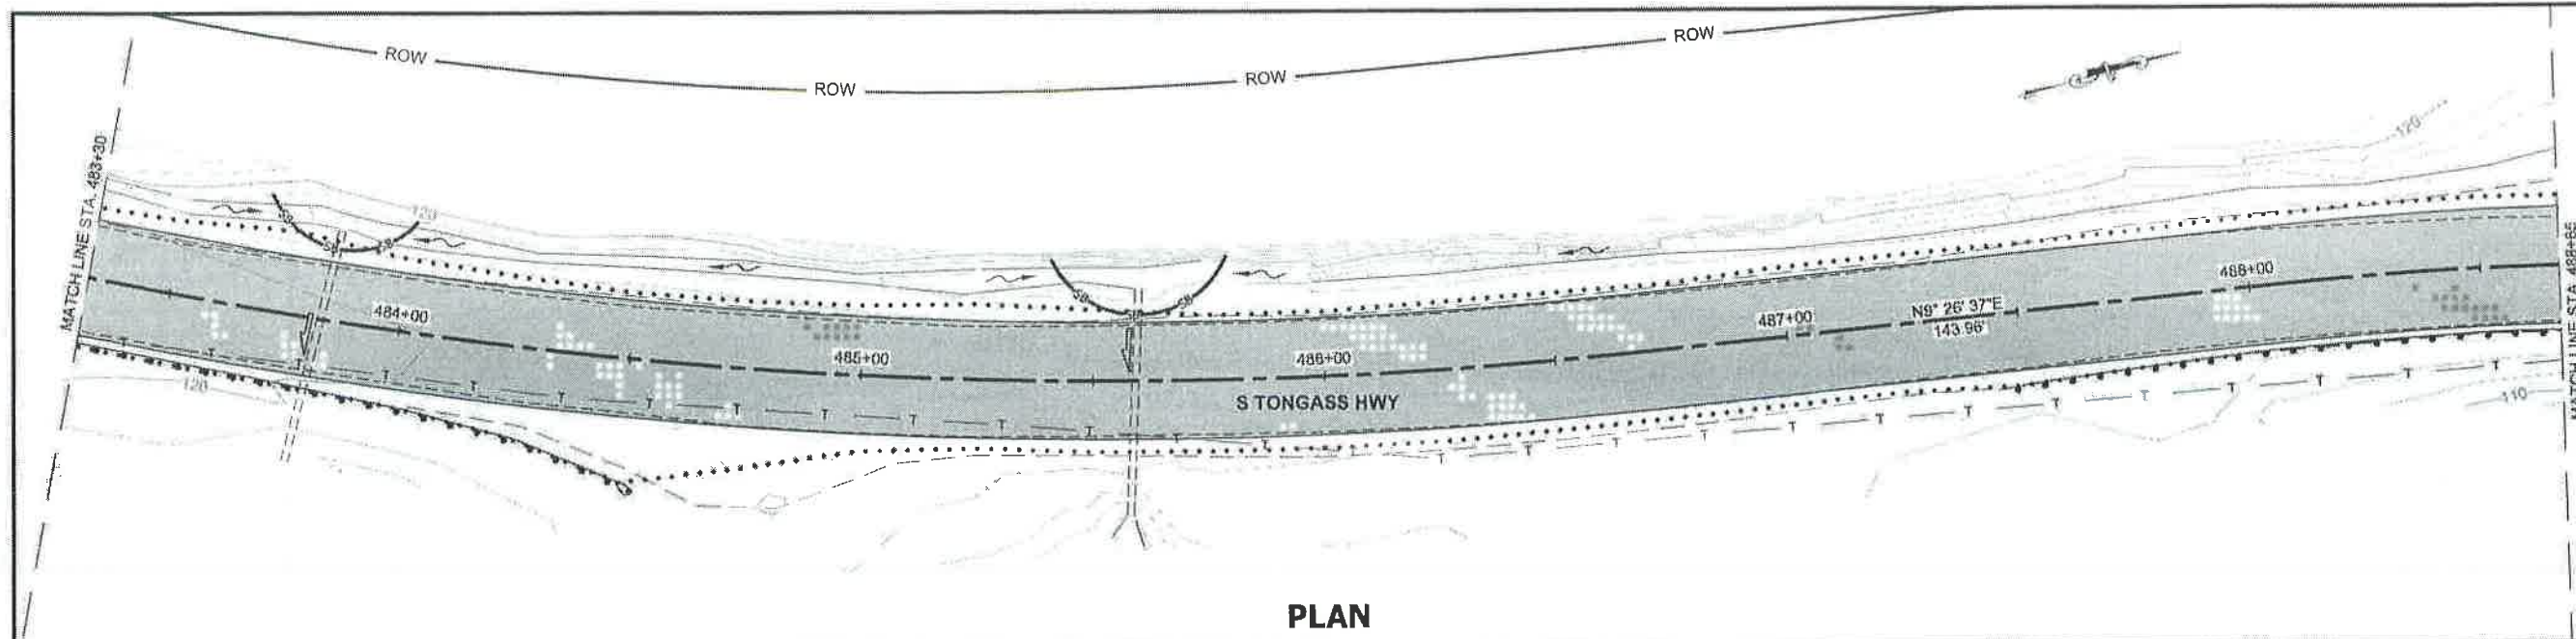

PLAN

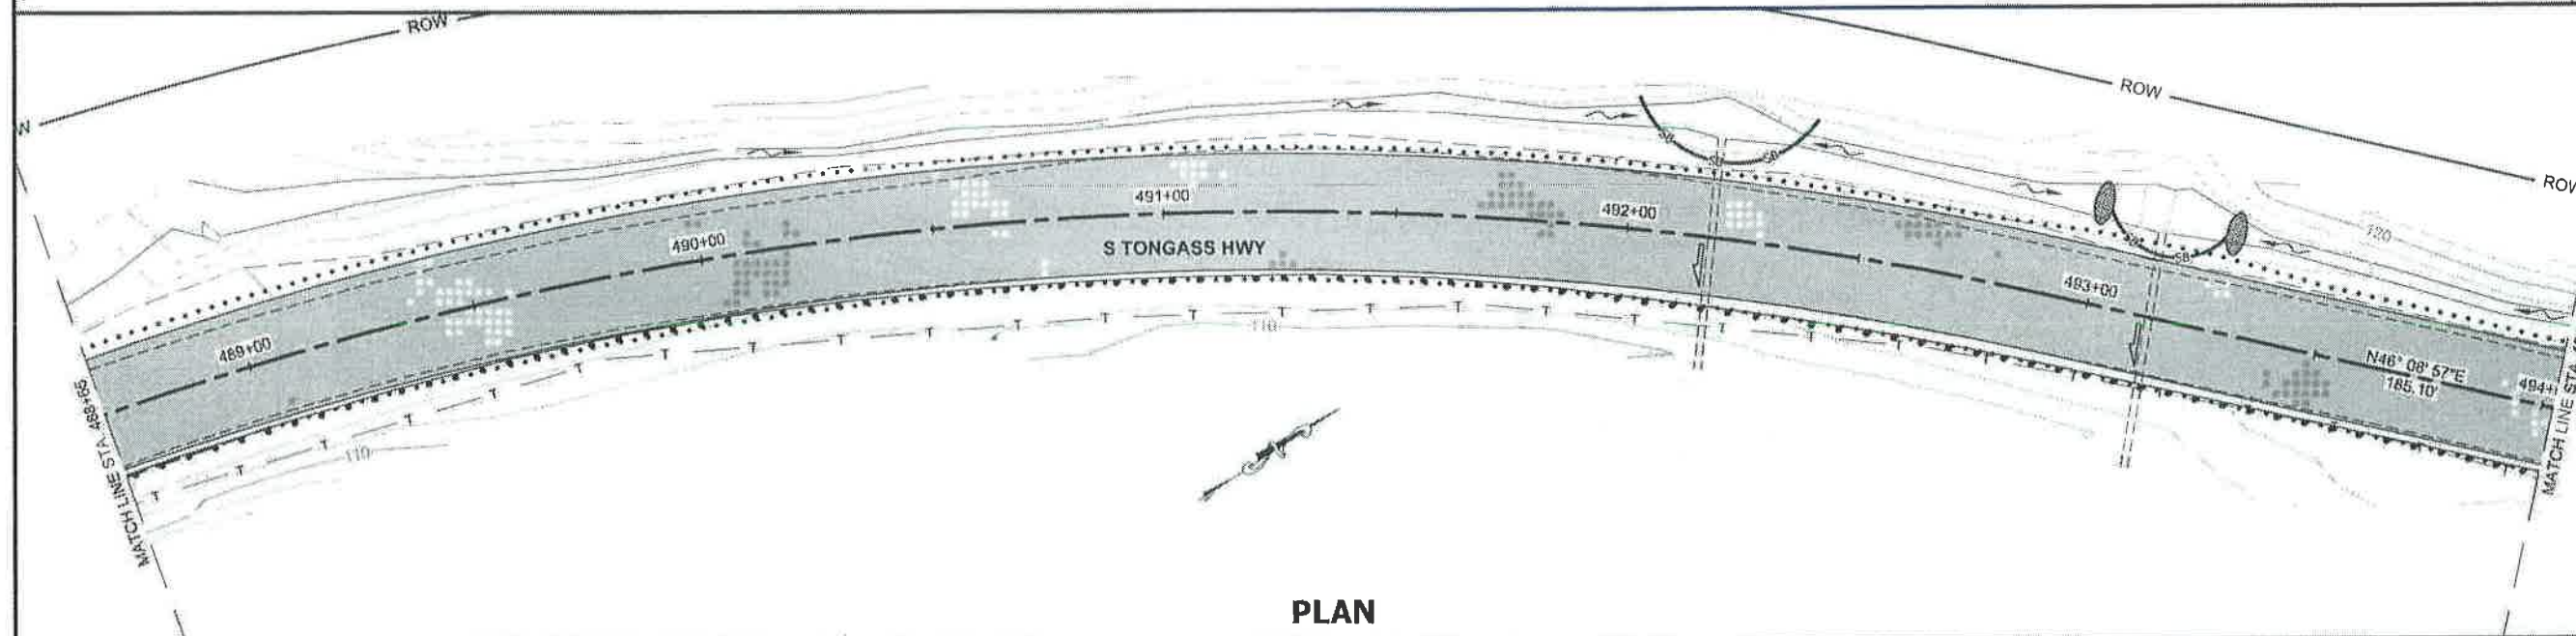

PLAN

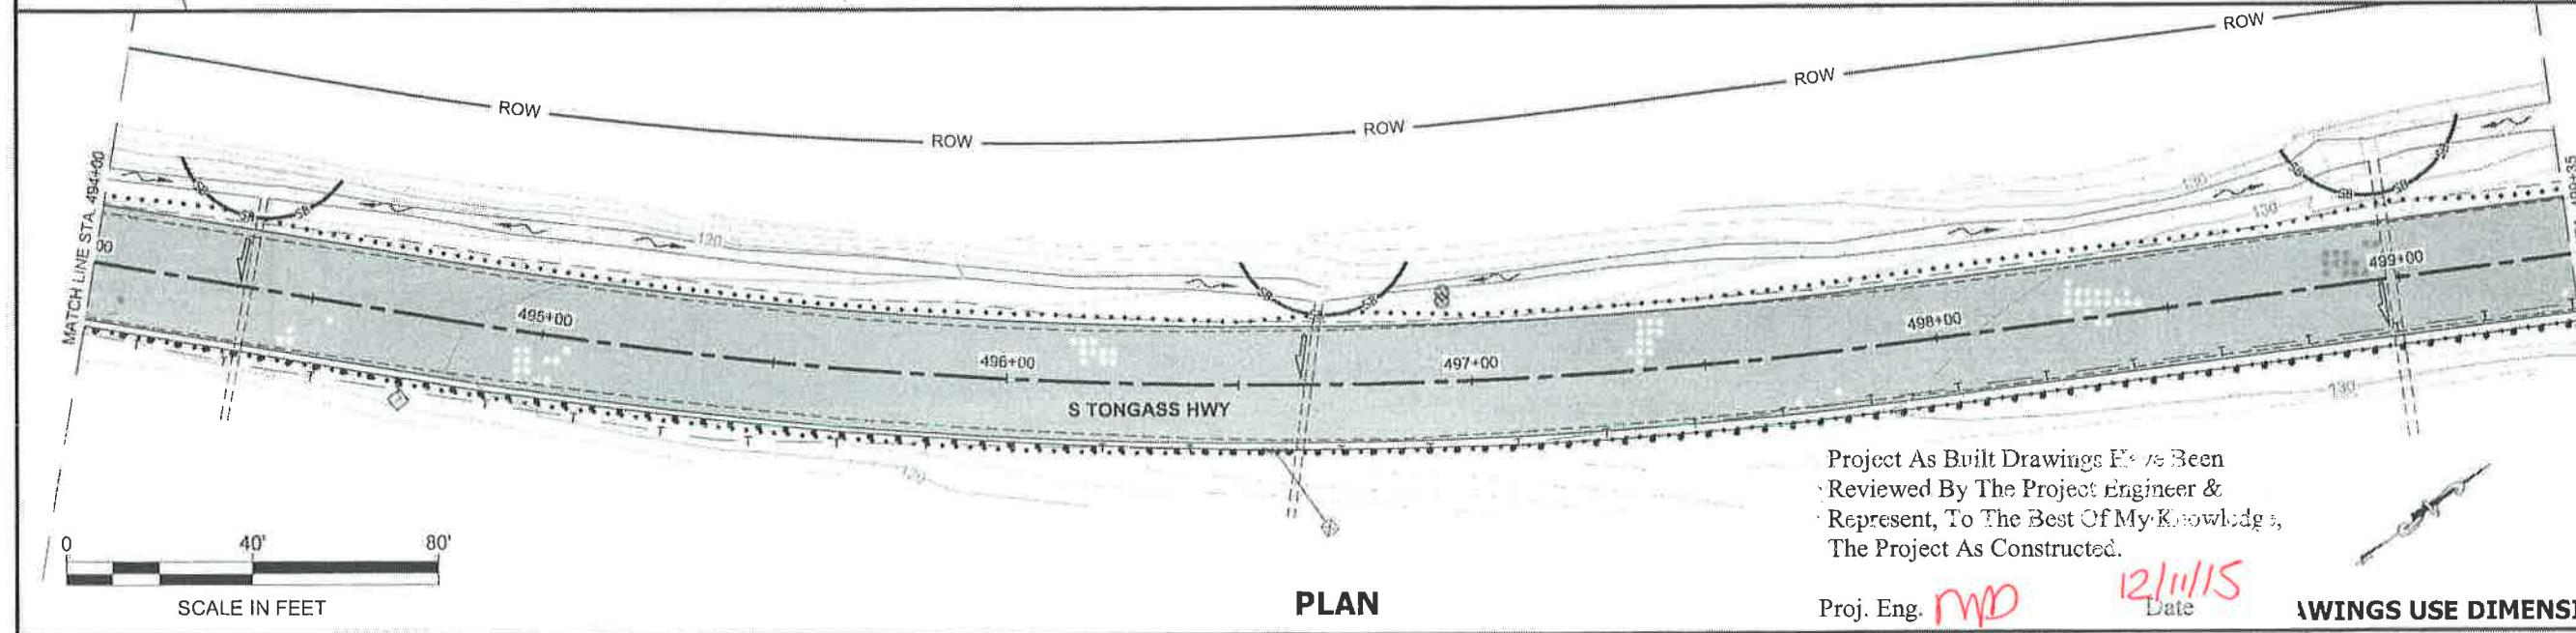

PLAN



Project As Built Drawings Have Been
Reviewed By The Project Engineer &
Represent, To The Best Of My Knowledge,
The Project As Constructed.

Proj. Eng. *MD*


12/11/15
Date

WINGS USE DIMENSIONS

PATH:
Q:\KTN\67674\PLANSET\67674_P1-P15
ESCP.BWG

SEIFERT, LOLITA T (DOT)
Wednesday, November 05, 2014 7:57:04 AM

ADDENDUM NUMBER		
ATTACHMENT NUMBER		
RECORD OF REVISIONS		
No.	DATE	DESCRIPTION

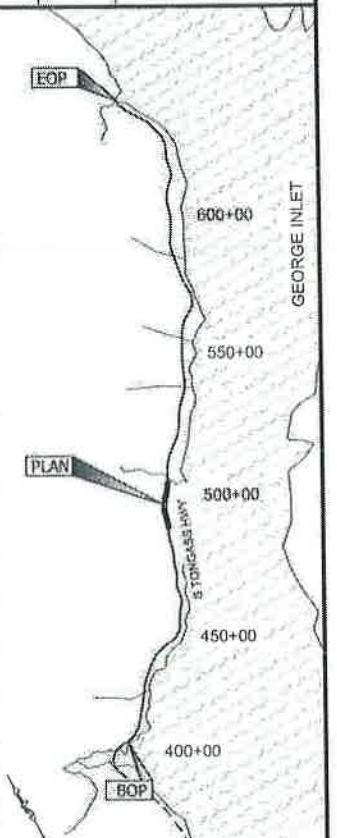

PLAN LEGEND

CHECKED BY: M. VAN ALSTINE

ESCP NOT SEALED IN ACCORDANCE
WITH ALASKA HIGHWAY
PRECONSTRUCTION MANUAL
SECTION 1120.7.3
DATED NOVEMBER 15, 2013

DESIGNED BY: L. SEIFERT

DRAWN BY: R. GRANTHAM

STATE OF ALASKA
DEPARTMENT OF TRANSPORTATION
& PUBLIC FACILITIES
SOUTHEAST REGION


KTN-SOUTH TONGASS PAVING
PROJECT #67674

ESCP


PROJECT DESIGNATION

STP-NH-0902(040)~67674


STATE	YEAR
ALASKA	2014
SHEET NUMBER	TOTAL SHEETS
P6	66

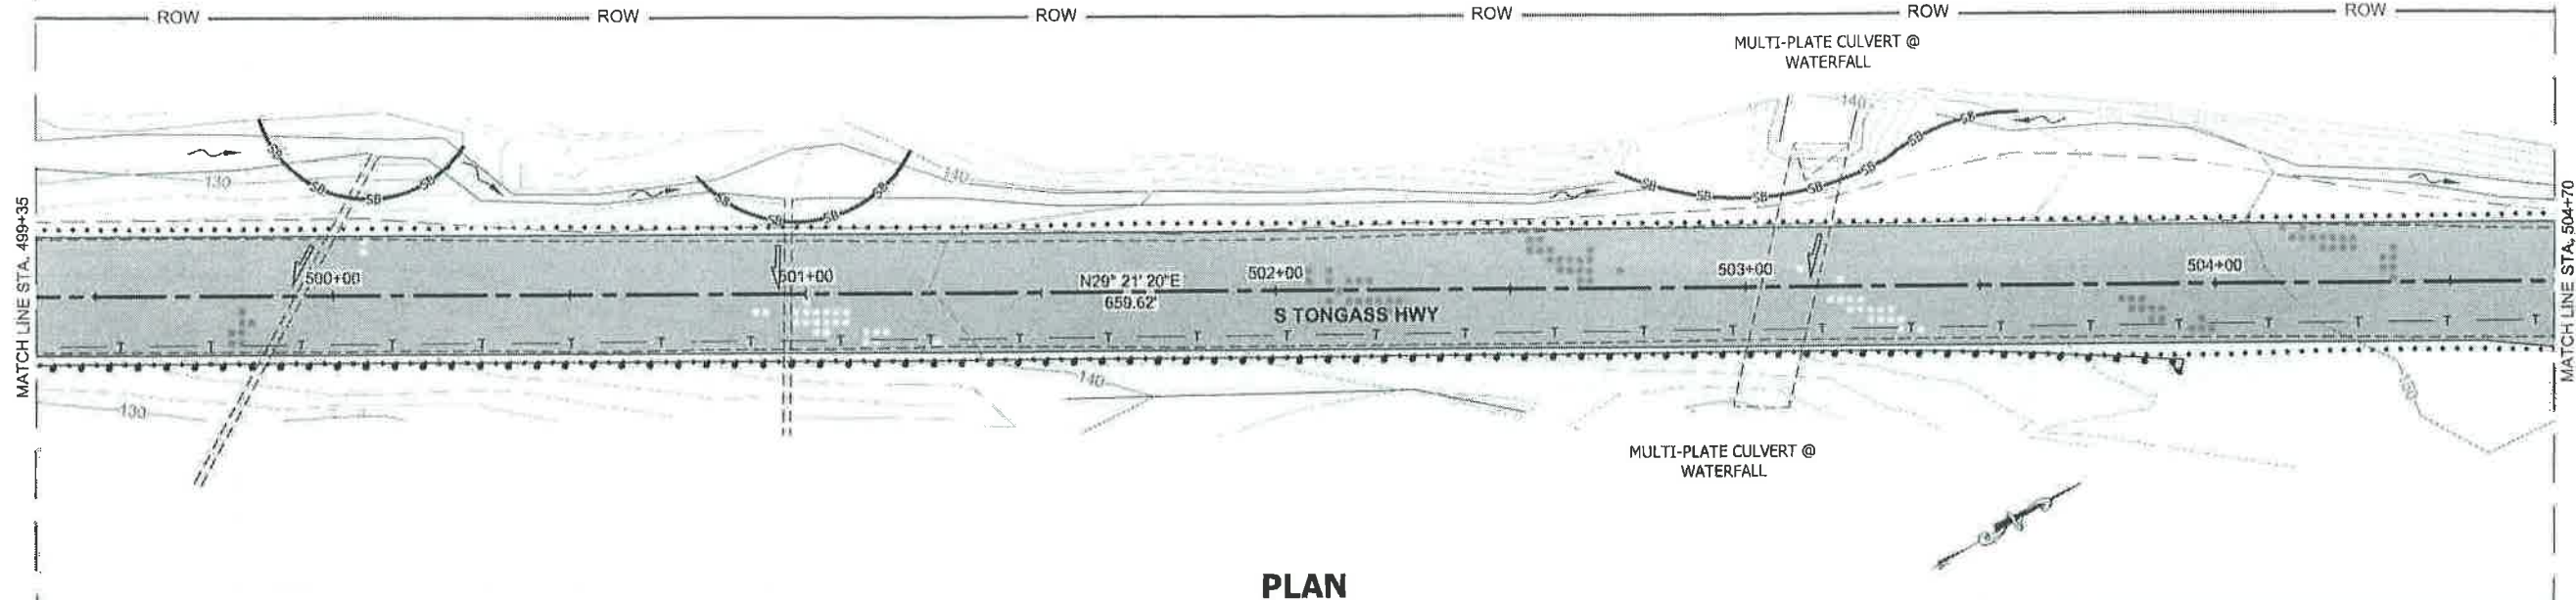

PLAN

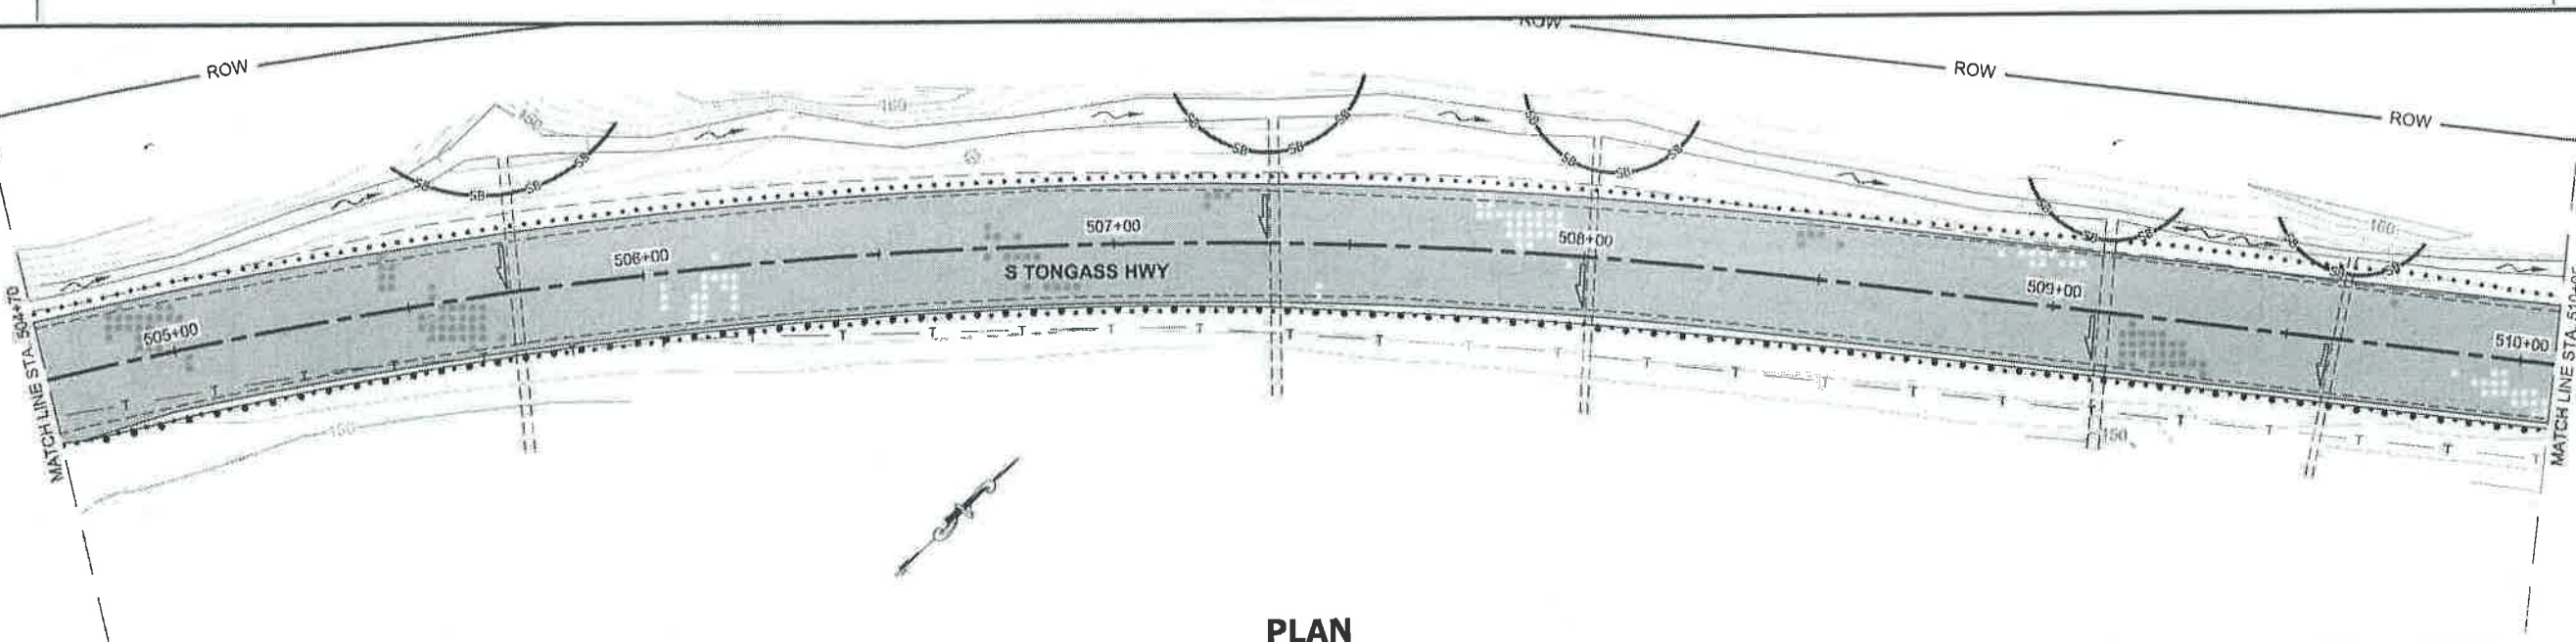

PLAN

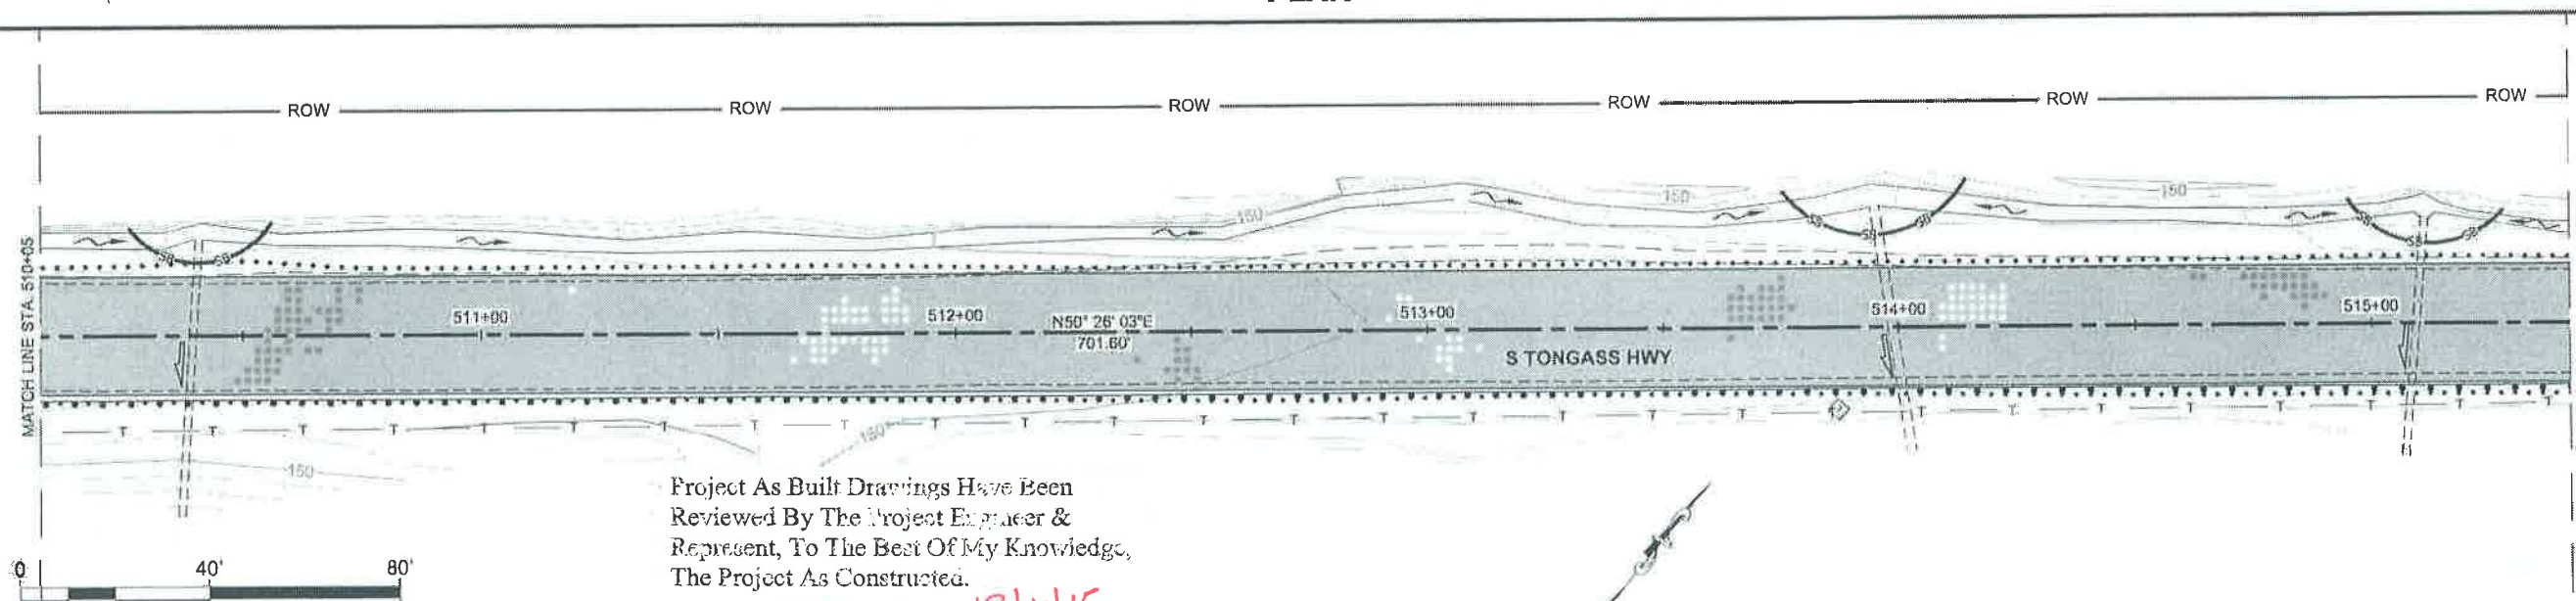

PLAN



Project As Built Drawings Have Been Reviewed By The Project Engineer & Represent, To The Best Of My Knowledge, The Project As Constructed.


Proj. Eng.

MD


12/11/15
Date

DO NOT SCALE FROM THESE DRAWINGS USE DIMENSIONS


PATH: Q:\KTN\67674\PLANSET\67674_P1-P15 4568.DWG SEIFERT, LOLITA T (DOT) Wednesday, November 05, 2014 7:59:59 AM		
ADDENDUM NUMBER		
ATTACHMENT NUMBER		
RECORD OF REVISIONS		
No.	DATE	DESCRIPTION
CHECKED BY: M. VAN ALSTINE		
ESCP NOT SEALED IN ACCORDANCE WITH ALASKA HIGHWAY PRECONSTRUCTION MANUAL SECTION 1120.7.3 DATED NOVEMBER 15, 2013		
DESIGNED BY: L. SEIFERT		
DRAWN BY: R. GRANTHAM		
STATE OF ALASKA DEPARTMENT OF TRANSPORTATION & PUBLIC FACILITIES SOUTHEAST REGION		
KTN-SOUTH TONGASS PAVING PROJECT #67674		
ESCP PROJECT DESIGNATION STP-NH-0902(040)~67674		
STATE	YEAR	
ALASKA	2014	
SHEET NUMBER	TOTAL SHEETS	
P7	66	

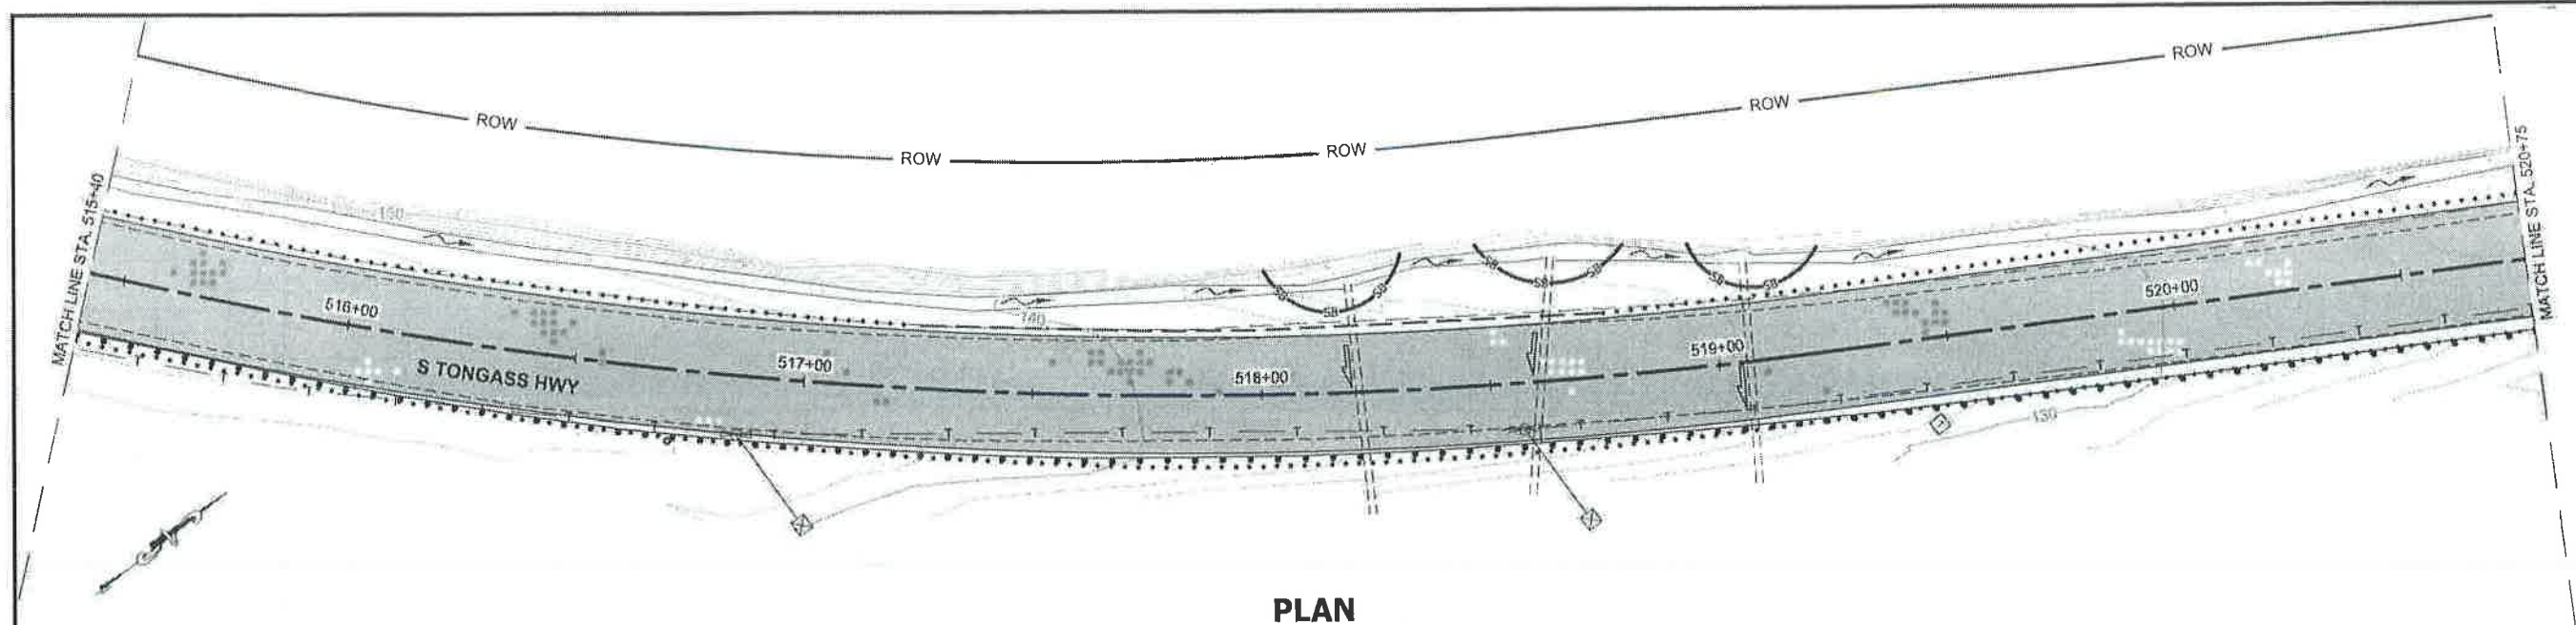

PLAN

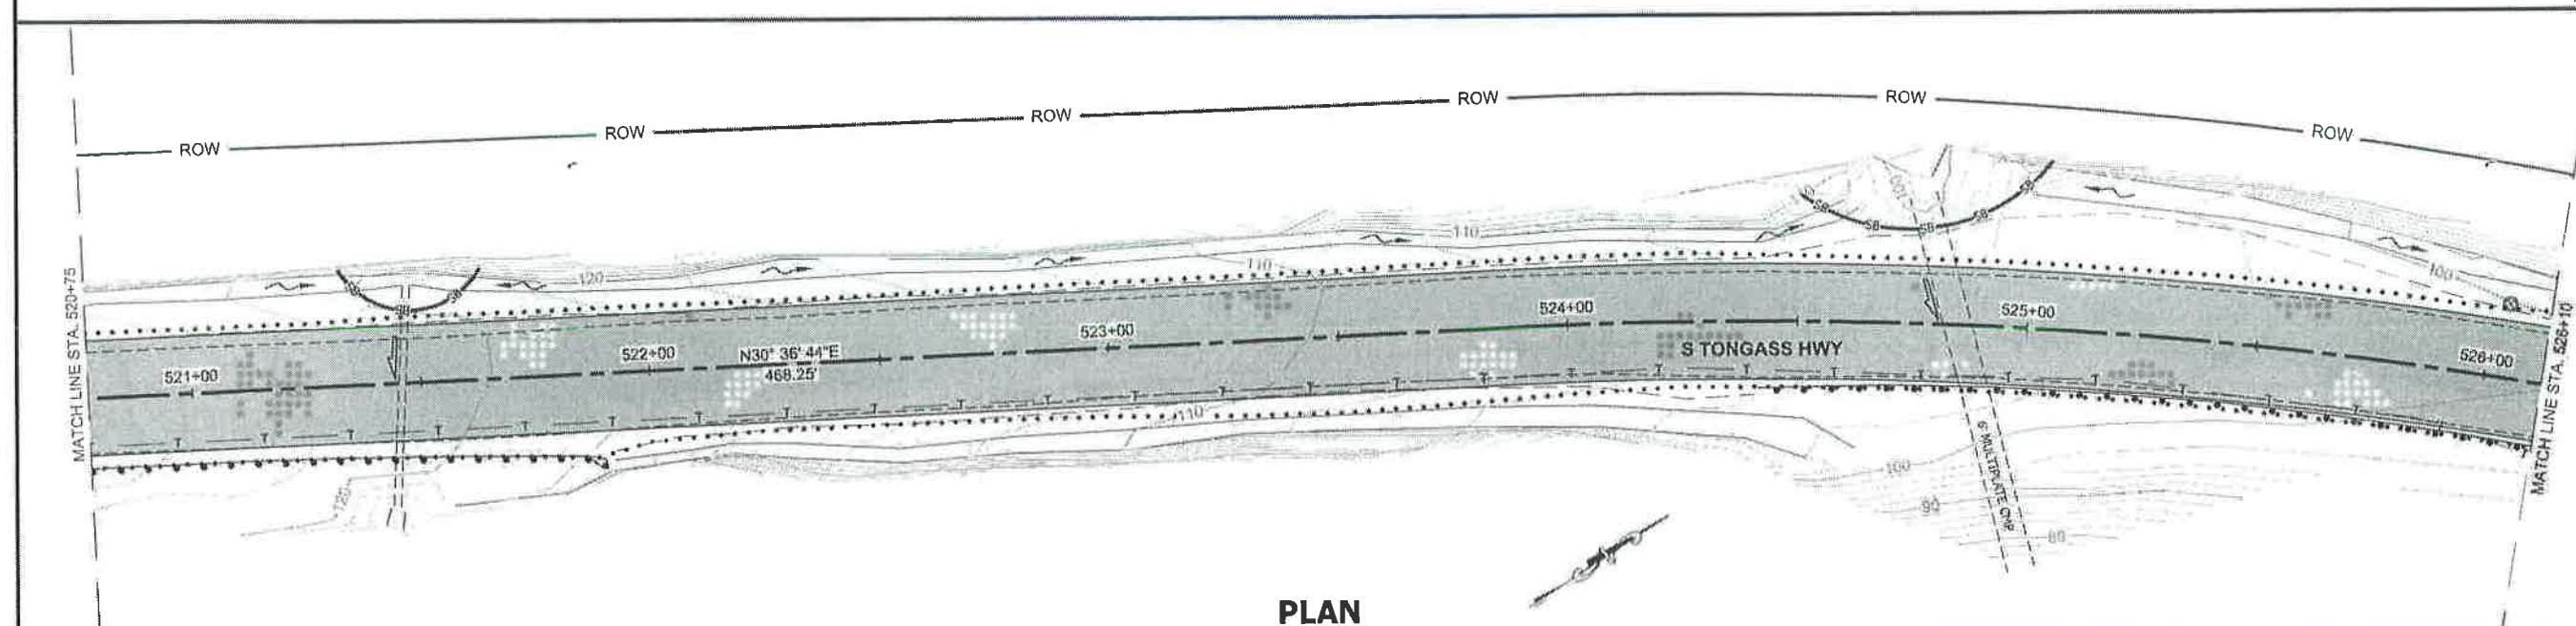

PLAN

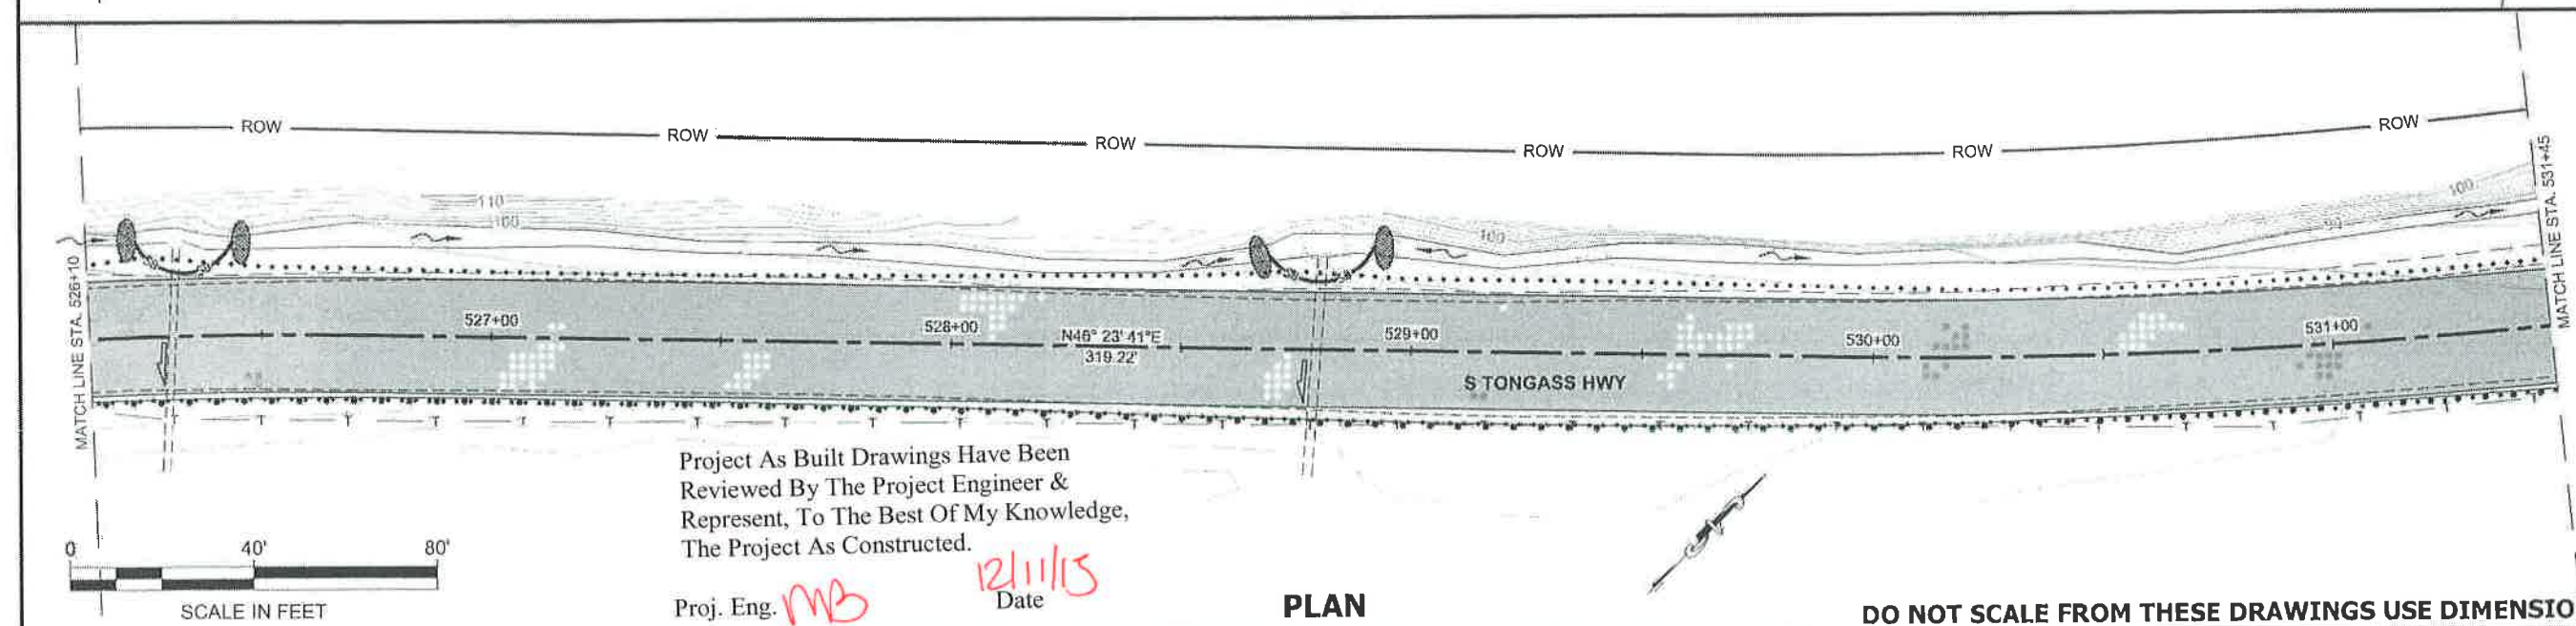

PLAN

Project As Built Drawings Have Been
Reviewed By The Project Engineer &
Represent, To The Best Of My Knowledge,
The Project As Constructed.


Proj. Eng. MB

Date 12/11/15



DO NOT SCALE FROM THESE DRAWINGS USE DIMENSIONS

PATH: Q:\KTN\67674\PLANSET\67674_P1-P15 ESCP.DWG		
SEIFERT, LOLITA T (DOT)		
Wednesday, November 05, 2014 7:55:37 AM		
ADDENDUM NUMBER		
ATTACHMENT NUMBER		
RECORD OF REVISIONS		
No.	DATE	DESCRIPTION

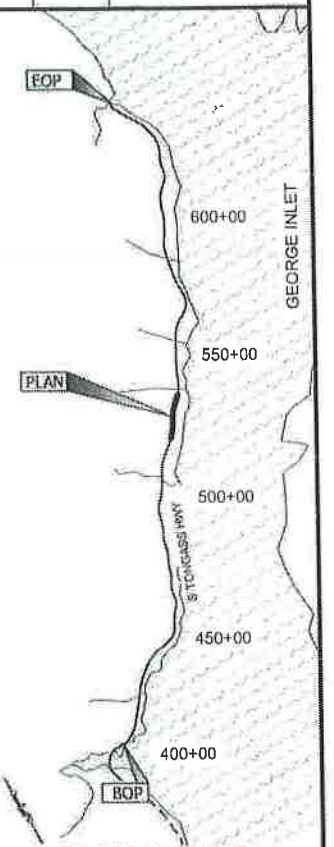

PLAN LEGEND

CHECKED BY: M. VAN ALSTINE

ESCP NOT SEALED IN ACCORDANCE
WITH ALASKA HIGHWAY
PRECONSTRUCTION MANUAL
SECTION 1120.7.3
DATED NOVEMBER 15, 2013

DESIGNED BY: L. SEIFERT

DRAWN BY: R. GRANTHAM

STATE OF ALASKA
DEPARTMENT OF TRANSPORTATION
& PUBLIC FACILITIES
SOUTHEAST REGION


KTN-SOUTH TONGASS PAVING
PROJECT #67674

ESCP


PROJECT DESIGNATION

STP-NH-0902(040)~67674


STATE	YEAR
ALASKA	2014
SHEET NUMBER	TOTAL SHEETS
P8	66

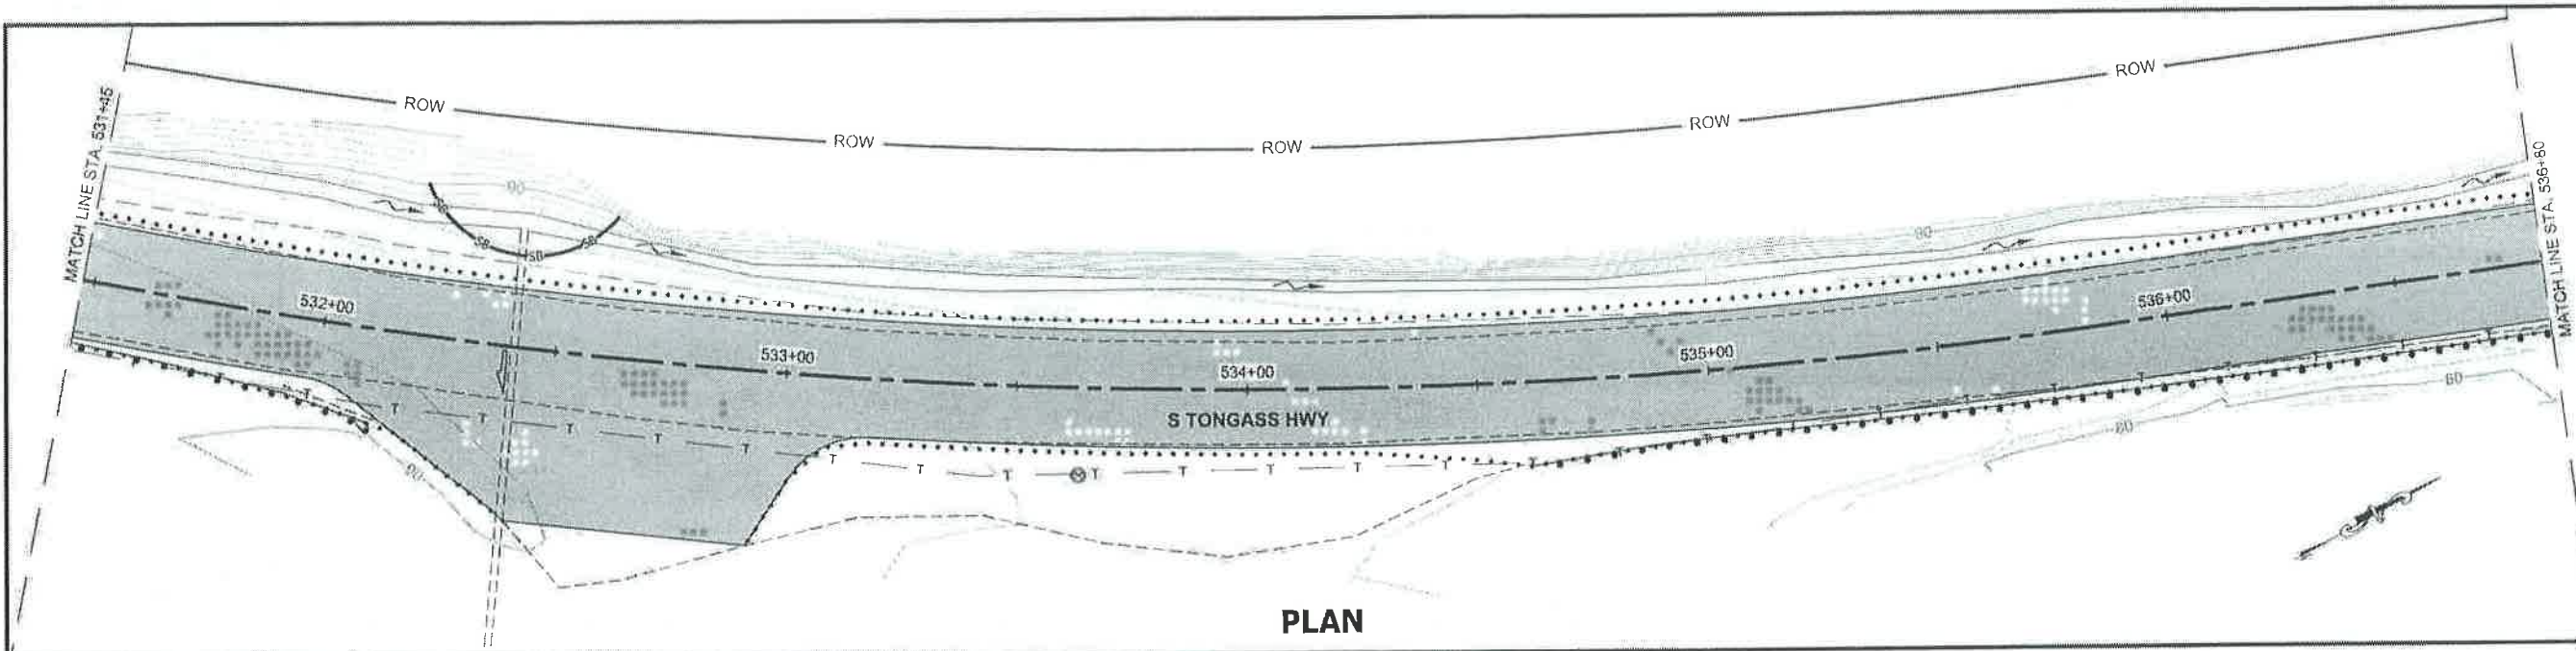

PLAN

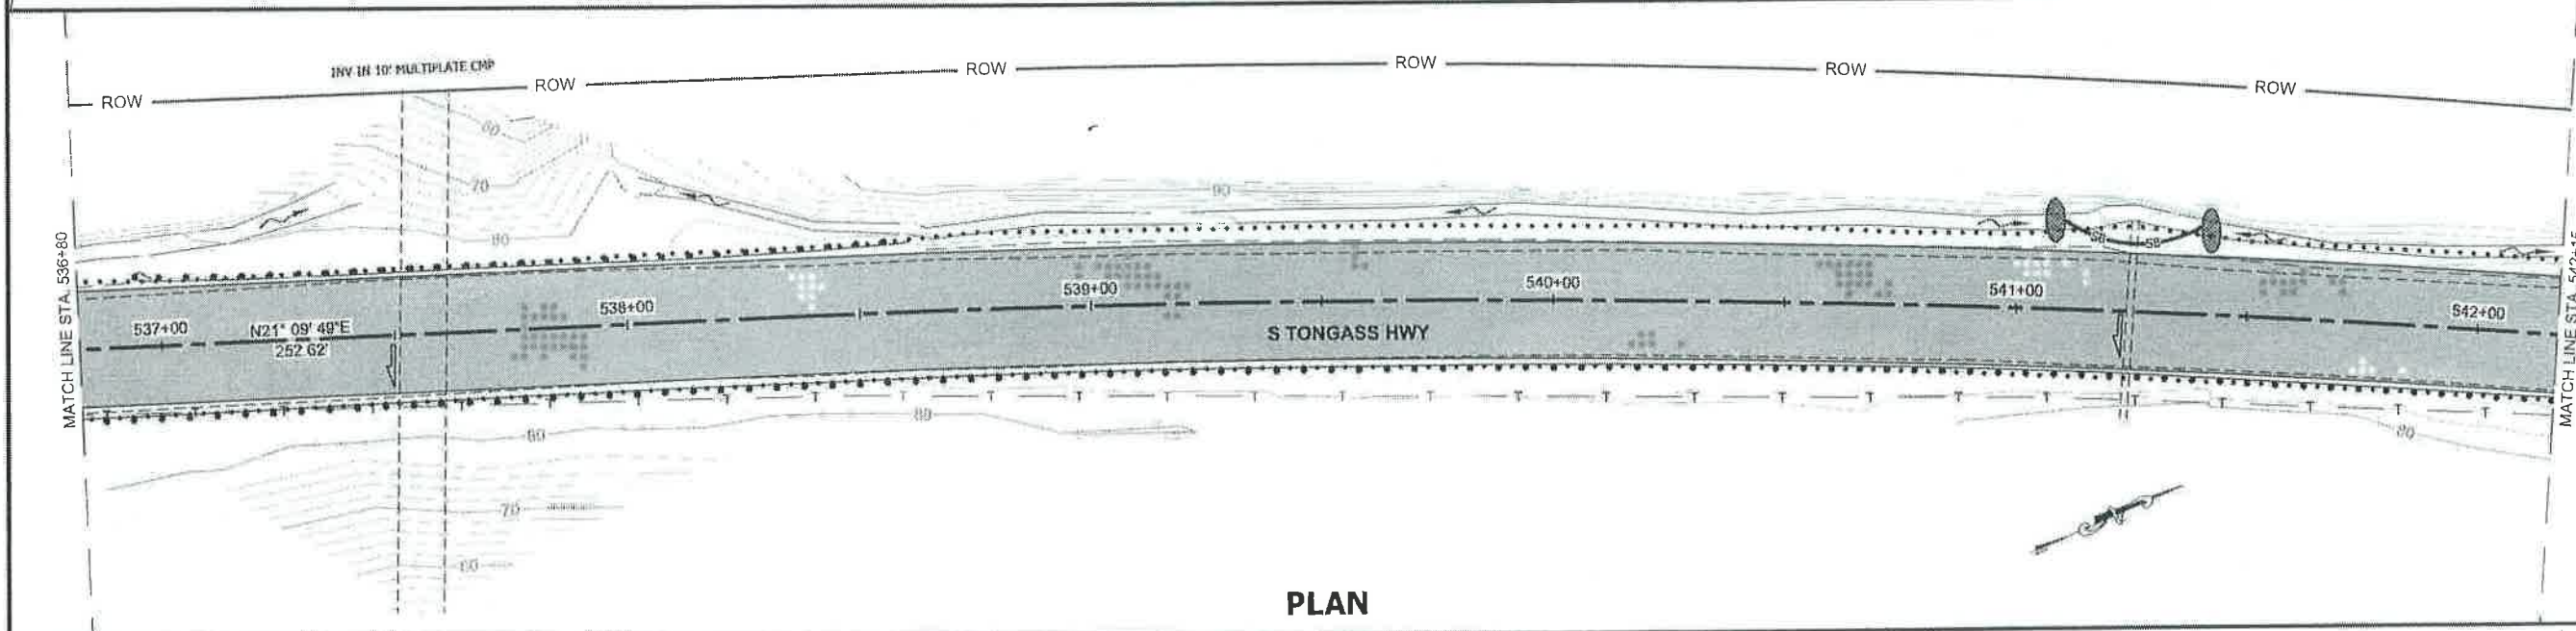

PLAN

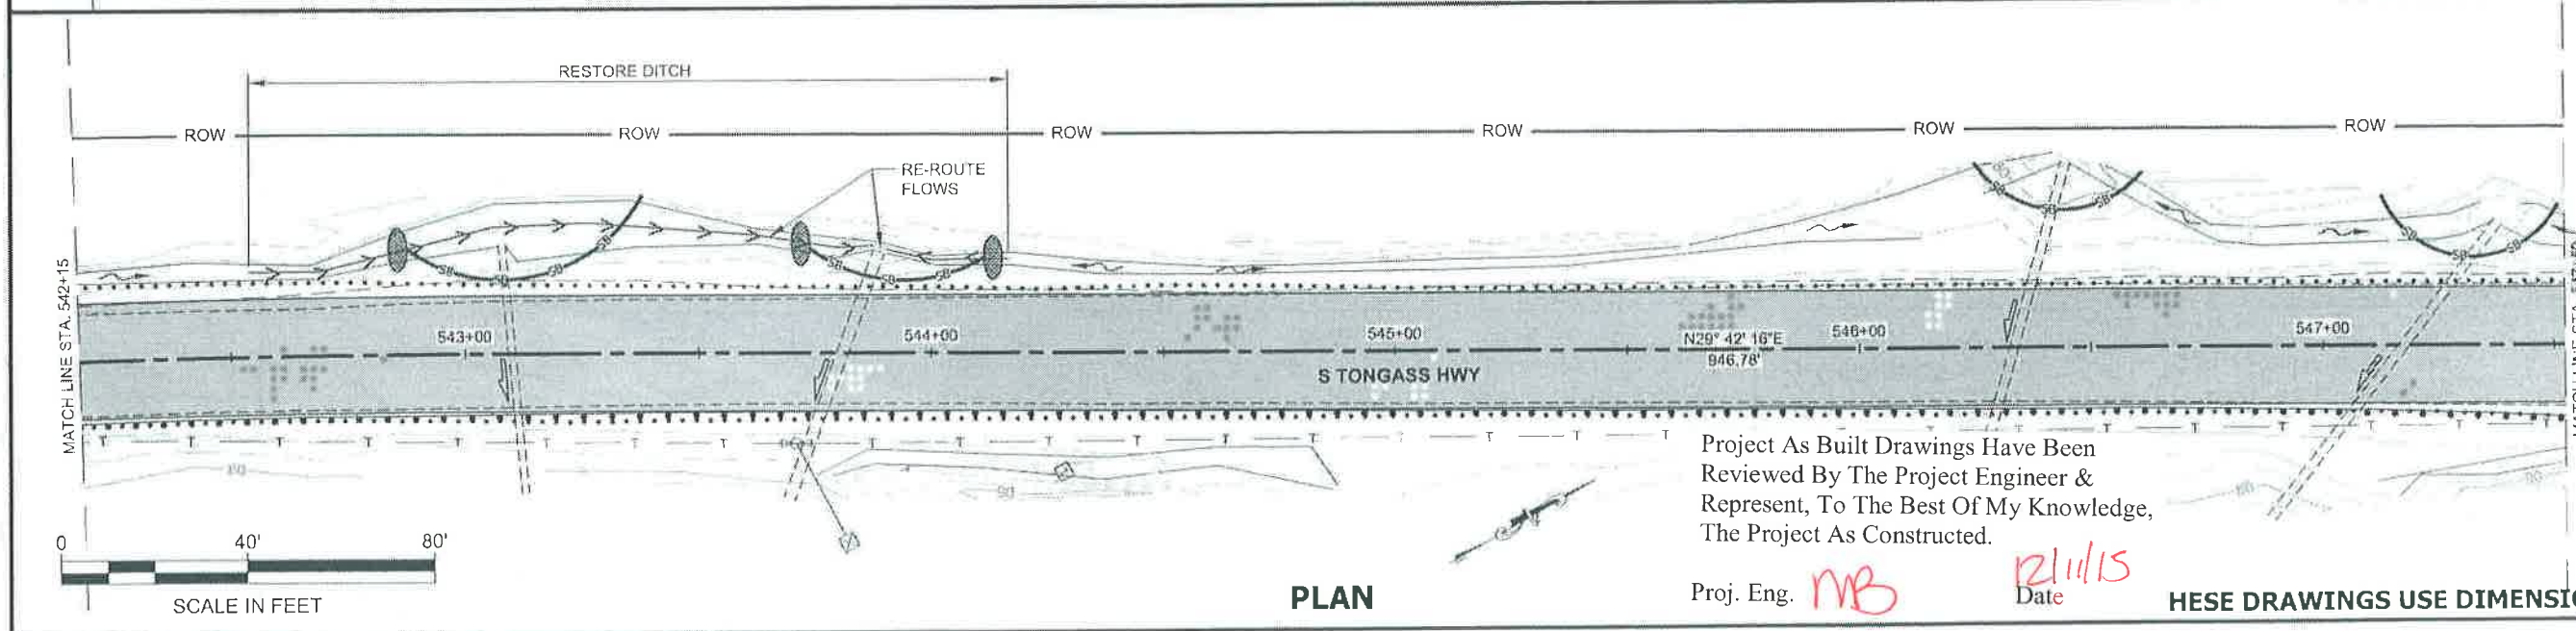

PLAN



Project As Built Drawings Have Been Reviewed By The Project Engineer & Represent, To The Best Of My Knowledge, The Project As Constructed.

Proj. Eng. *MB*

Date *12/11/15*

HESE DRAWINGS USE DIMENSIONS

PATH:
Q:\KTN\67674\PLANSET\67674_P1-P15
ESC.PDWG

SEIFERT, LOLITA T (DOT)
Wednesday, November 05, 2014 7:54:52 AM

ADDENDUM NUMBER

ATTACHMENT NUMBER

RECORD OF REVISIONS

No.	DATE	DESCRIPTION

PLAN LEGEND

CHECKED BY: M. VAN ALSTINE

ESC NOT SEALED IN ACCORDANCE WITH ALASKA HIGHWAY PRECONSTRUCTION MANUAL SECTION 1129.7.3 DATED NOVEMBER 15, 2013

DESIGNED BY: L. SEIFERT

DRAWN BY: R. GRANTHAM

STATE OF ALASKA
DEPARTMENT OF TRANSPORTATION
& PUBLIC FACILITIES
SOUTHEAST REGION

KTN-SOUTH TONGASS PAVING
PROJECT #67674




ESC

PROJECT DESIGNATION

STP-NH-0902(040)~67674

STATE	YEAR
ALASKA	2014

SHEET NUMBER	TOTAL SHEETS
P9	66

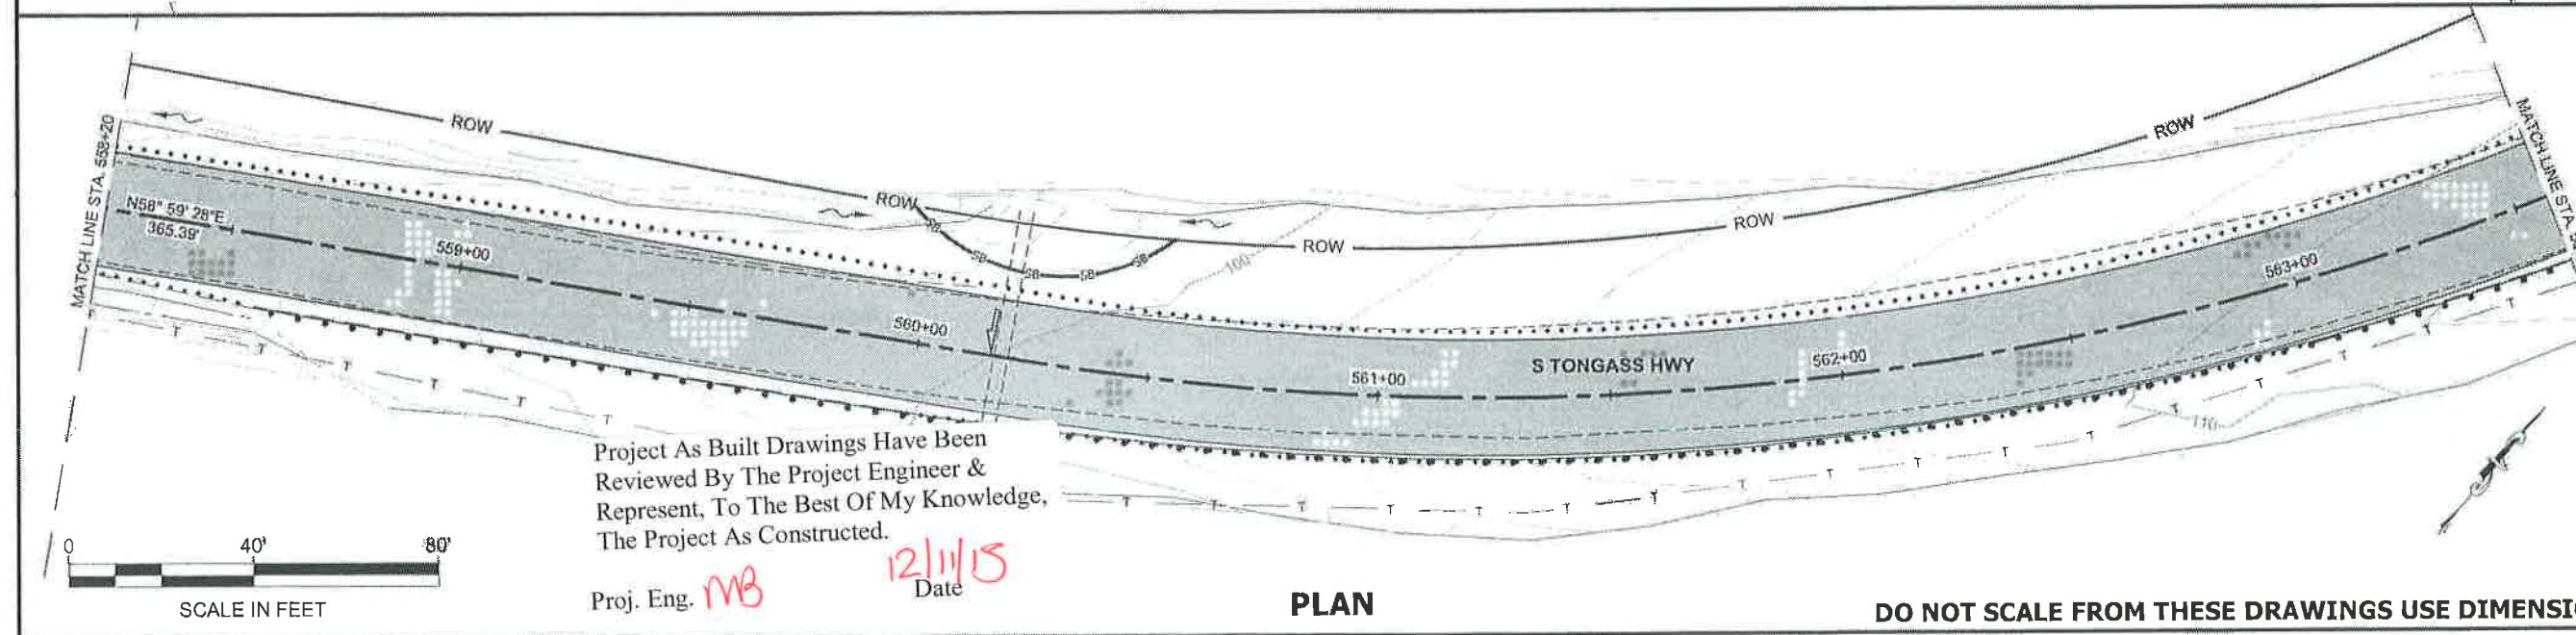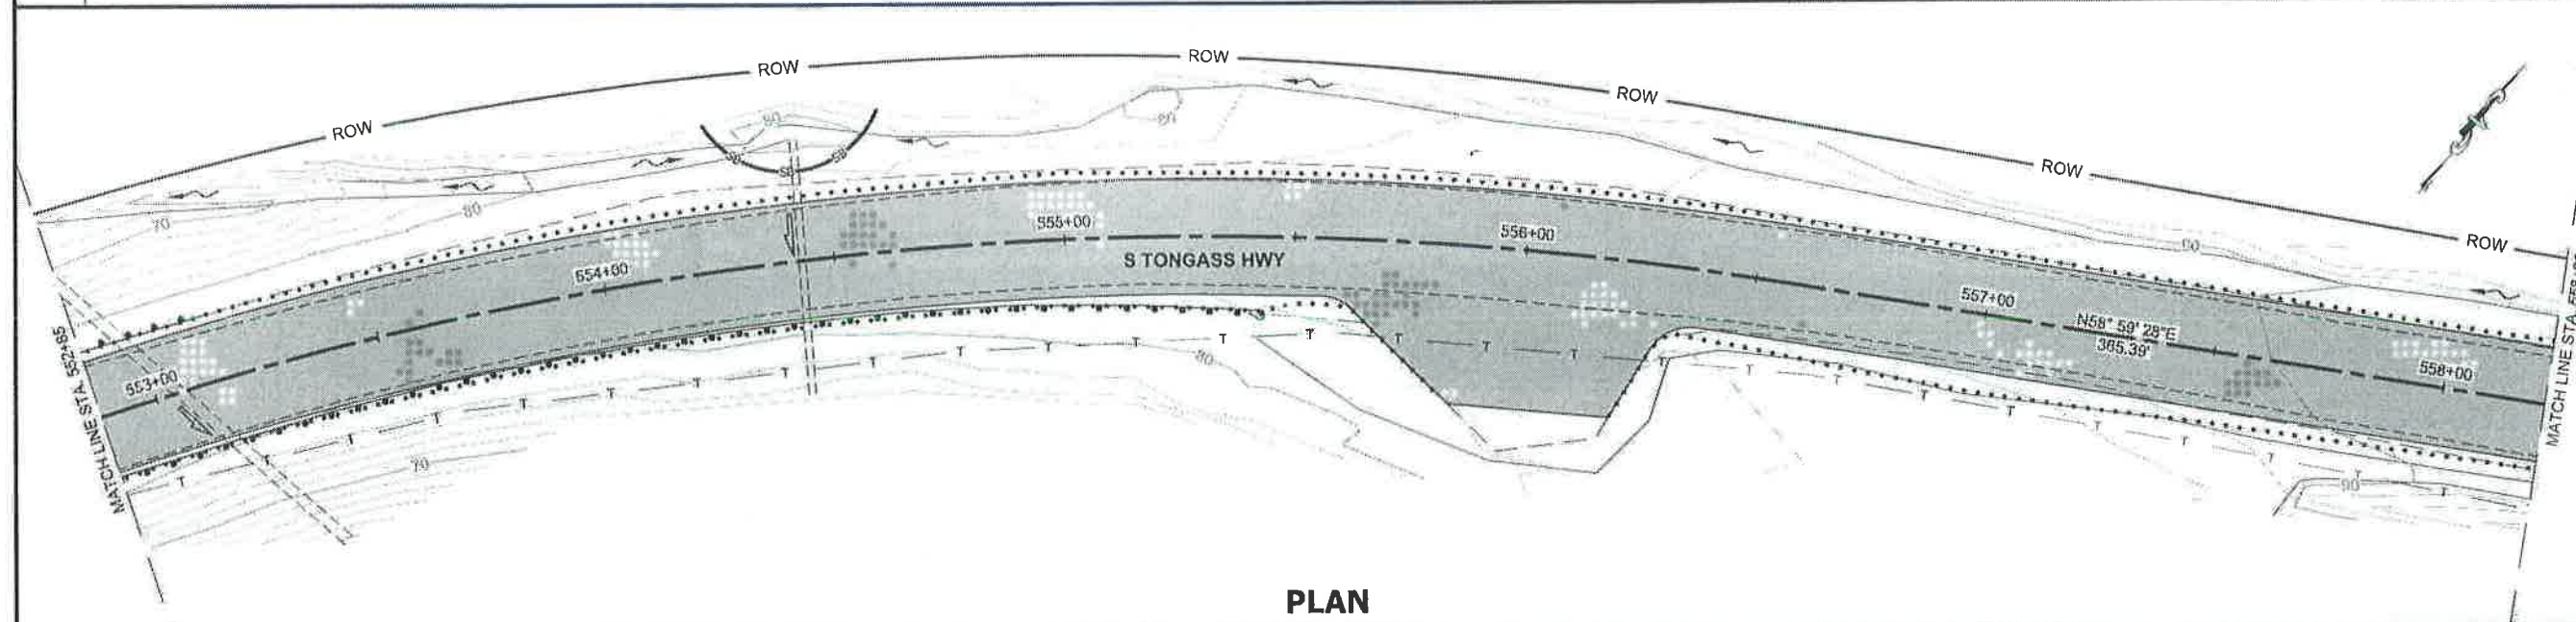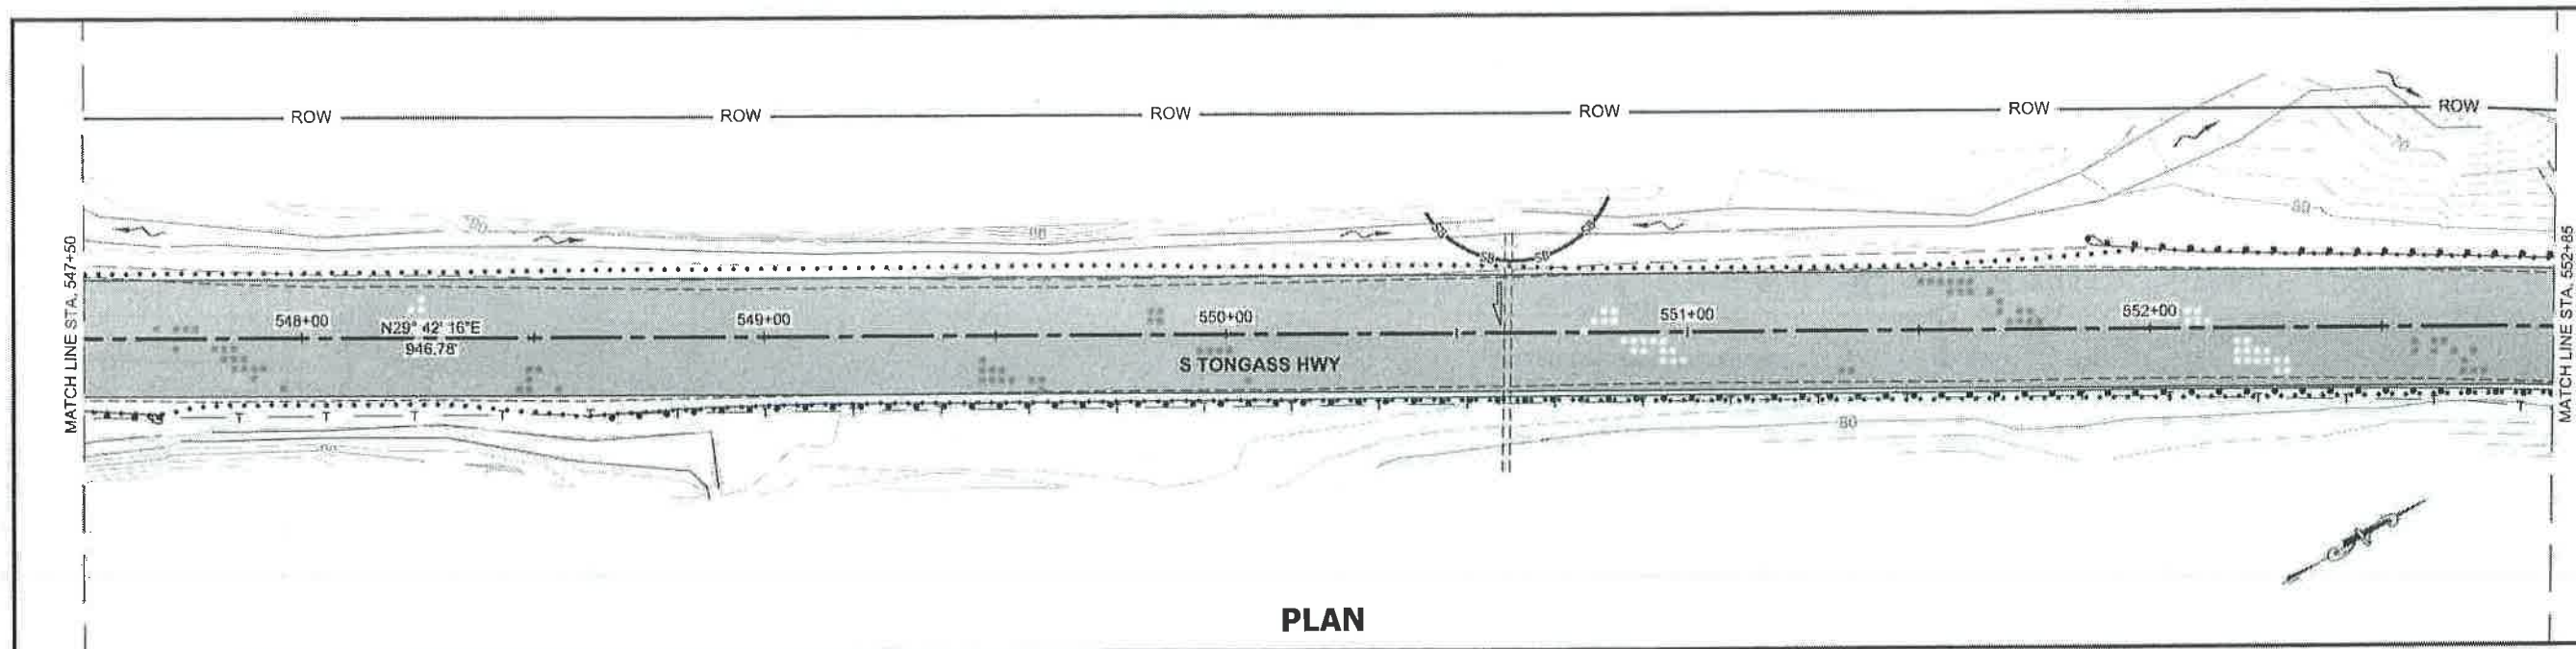

Project As Built Drawings Have Been Reviewed By The Project Engineer & Represent, To The Best Of My Knowledge, The Project As Constructed.


Proj. Eng. *MB*

12/11/15
Date

PLAN

DO NOT SCALE FROM THESE DRAWINGS USE DIMENSIONS

PATH: Q:\KTN\67674\PLANSET\67674_P1-P15 ESCP.DWG		
SEIFERT, LOLITA T (DOT)		
Wednesday, November 05, 2014 7:53:13 AM		
ADDENDUM NUMBER		
ATTACHMENT NUMBER		
RECORD OF REVISIONS		
No.	DATE	DESCRIPTION

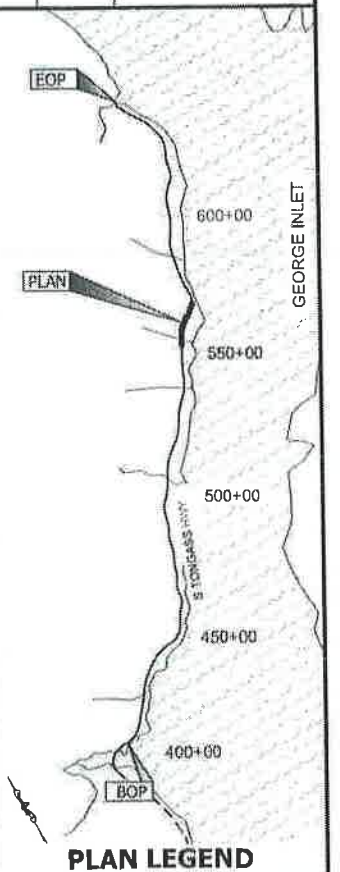

CHECKED BY: M, VAN ALSTINE

ESCP NOT SEALED IN ACCORDANCE
WITH ALASKA HIGHWAY
PRECONSTRUCTION MANUAL
SECTION 1120.7.3
DATED NOVEMBER 15, 2013

DESIGNED BY: L, SEIFERT

DRAWN BY: R, GRANTHAM

STATE OF ALASKA
DEPARTMENT OF TRANSPORTATION
& PUBLIC FACILITIES
SOUTHEAST REGION

KTN-SOUTH TONGASS PAVING
PROJECT #67674


ESCP

PROJECT DESIGNATION


STP-NH-0902(040)~67674

STATE	YEAR
ALASKA	2014


SHEET NUMBER	TOTAL SHEETS
P10	66

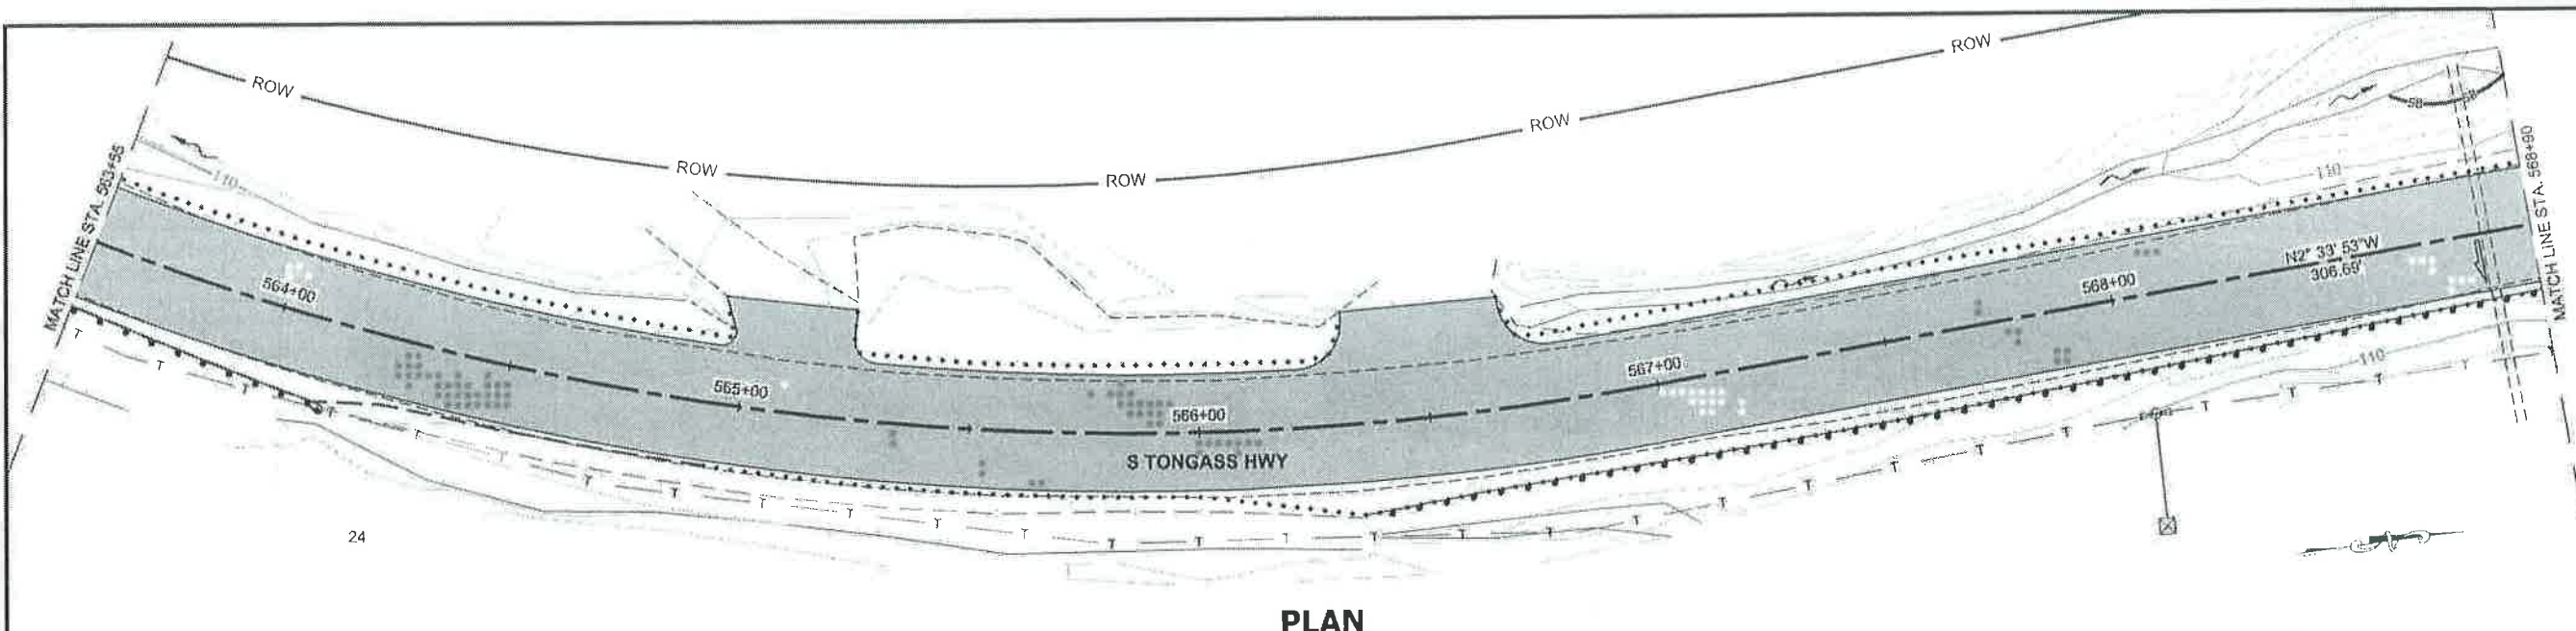

PLAN

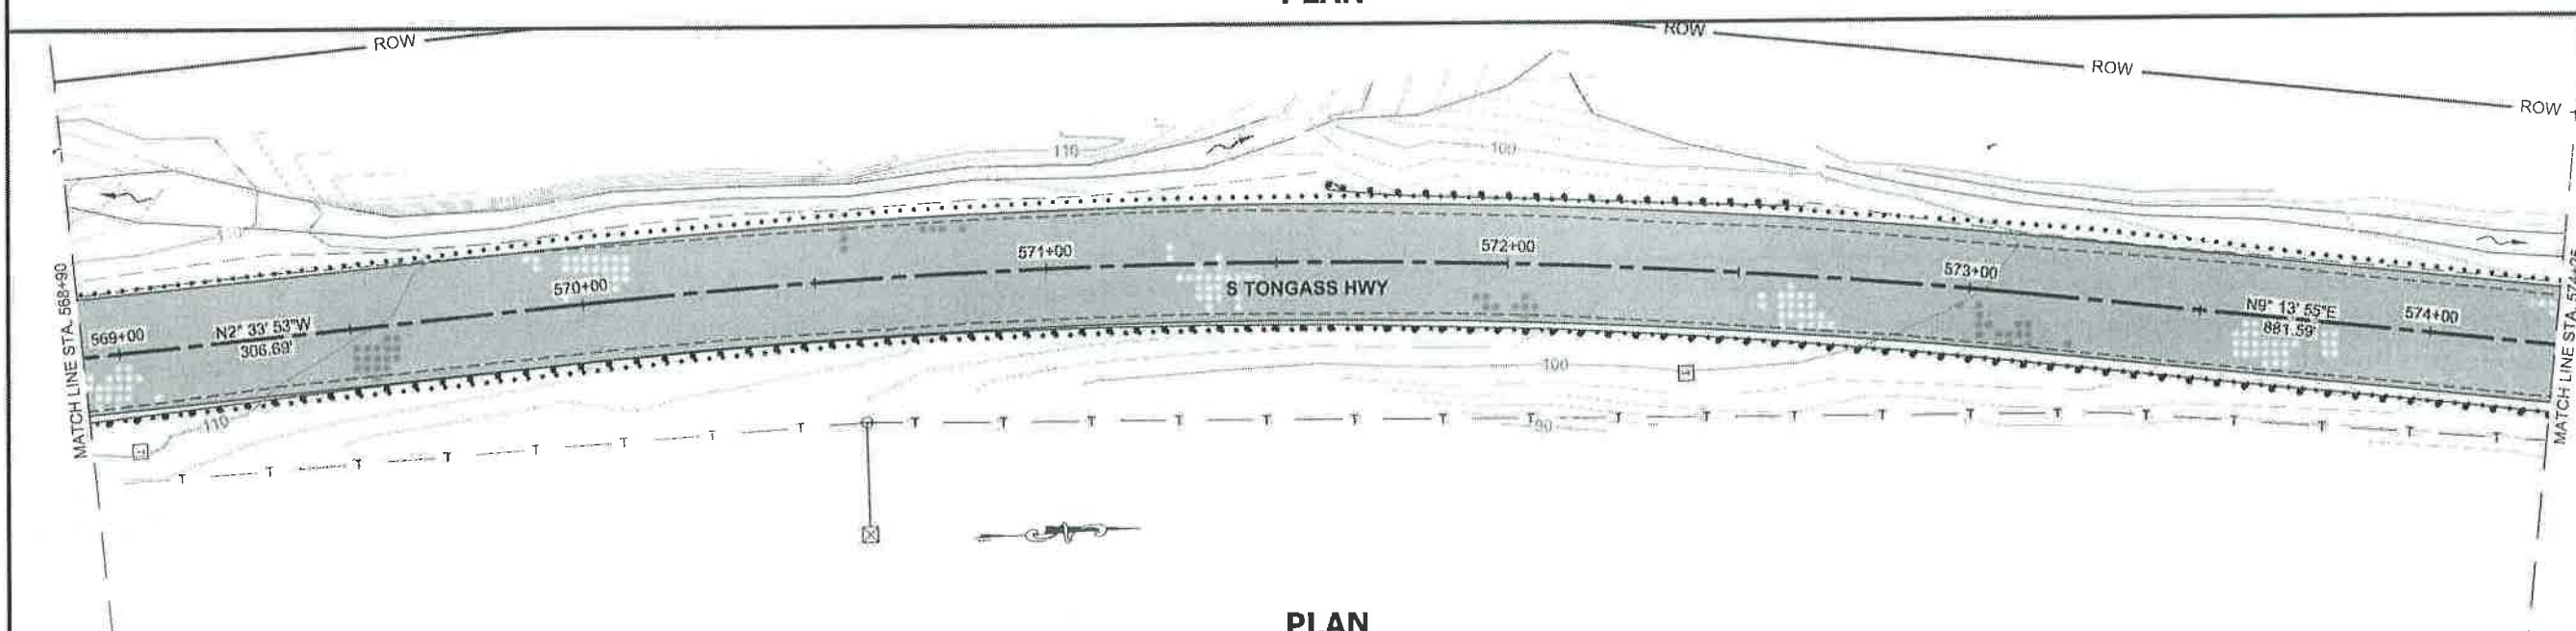

PLAN

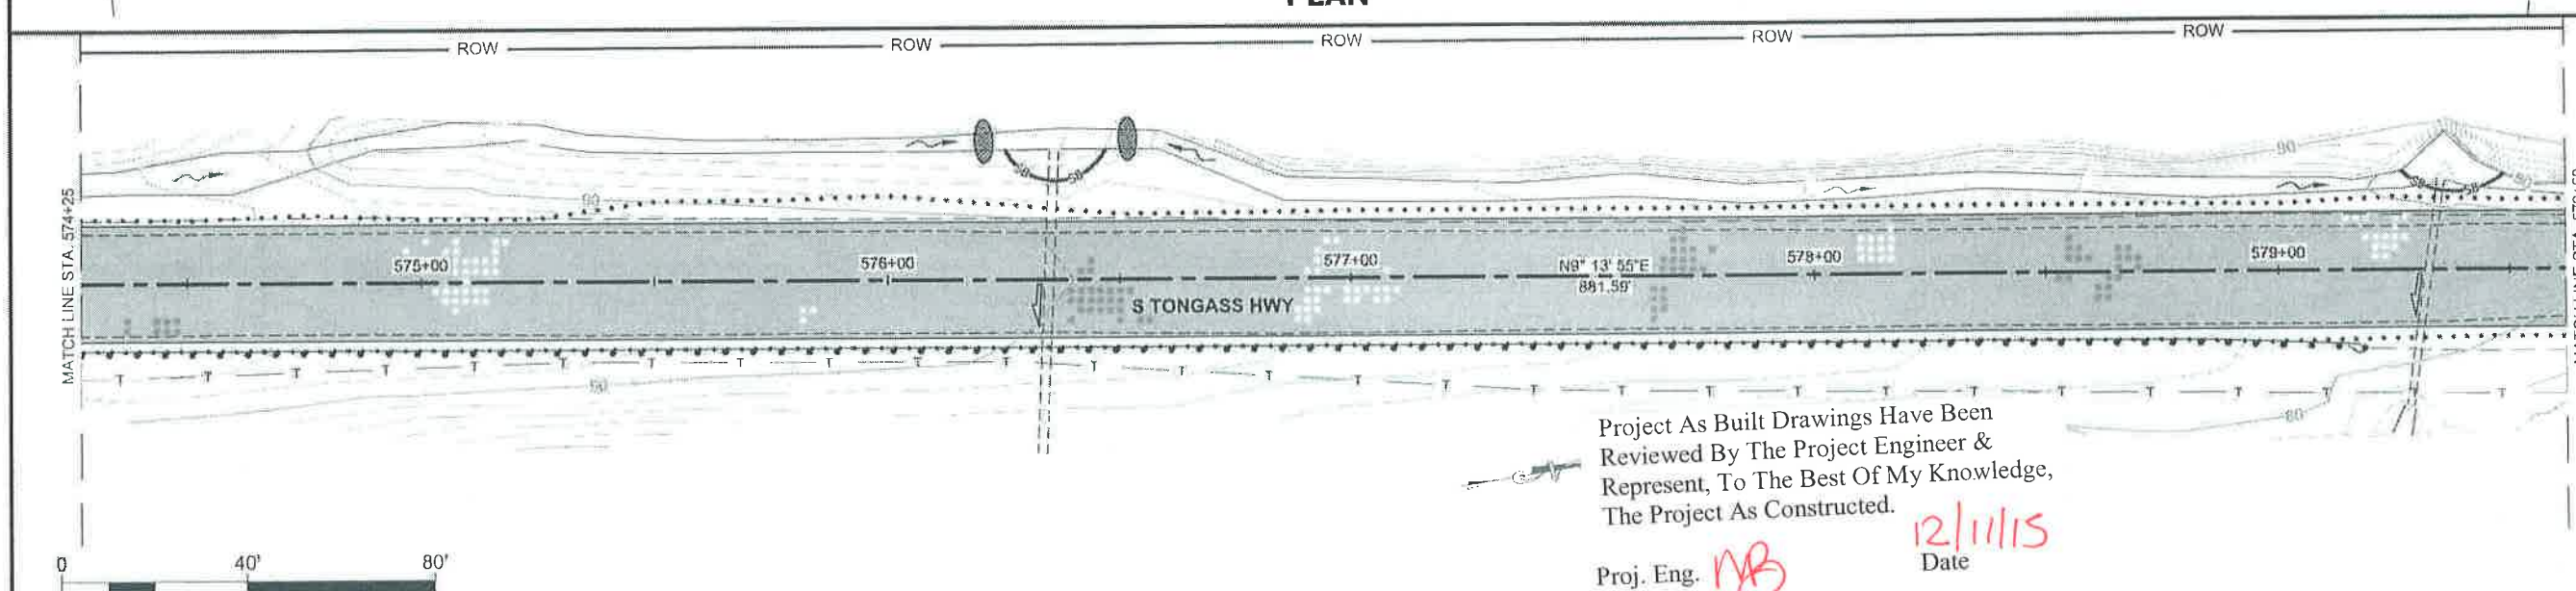

PLAN



Project As Built Drawings Have Been
Reviewed By The Project Engineer &
Represent, To The Best Of My Knowledge,
The Project As Constructed.

Proj. Eng. *MB*

12/11/15
Date

DO NOT SCALE FROM THESE DRAWINGS USE DIMENSIONS

PATH:
Q:\KTN\67674\PLANSET\67674_P1-P15
556.DWG

SEIFERT, LOLITA T (DOT)
Wednesday, November 05, 2014 7:52:32 AM

ADDENDUM NUMBER

ATTACHMENT NUMBER

RECORD OF REVISIONS

No.	DATE	DESCRIPTION

PLAN LEGEND

CHECKED BY: M. VAN ALSTINE

ESCP NOT SEALED IN ACCORDANCE
WITH ALASKA HIGHWAY
PRECONSTRUCTION MANUAL
SECTION 1120.7.3
DATED NOVEMBER 15, 2013

DESIGNED BY: L. SEIFERT
DRAWN BY: R. GRANTHAM

STATE OF ALASKA
DEPARTMENT OF TRANSPORTATION
& PUBLIC FACILITIES
SOUTHEAST REGION

KTN-SOUTH TONGASS PAVING
PROJECT #67674


ESCP

PROJECT DESIGNATION


STP-NH-0902(040)~67674

STATE	YEAR
ALASKA	2014


SHEET NUMBER	TOTAL SHEETS
P11	66

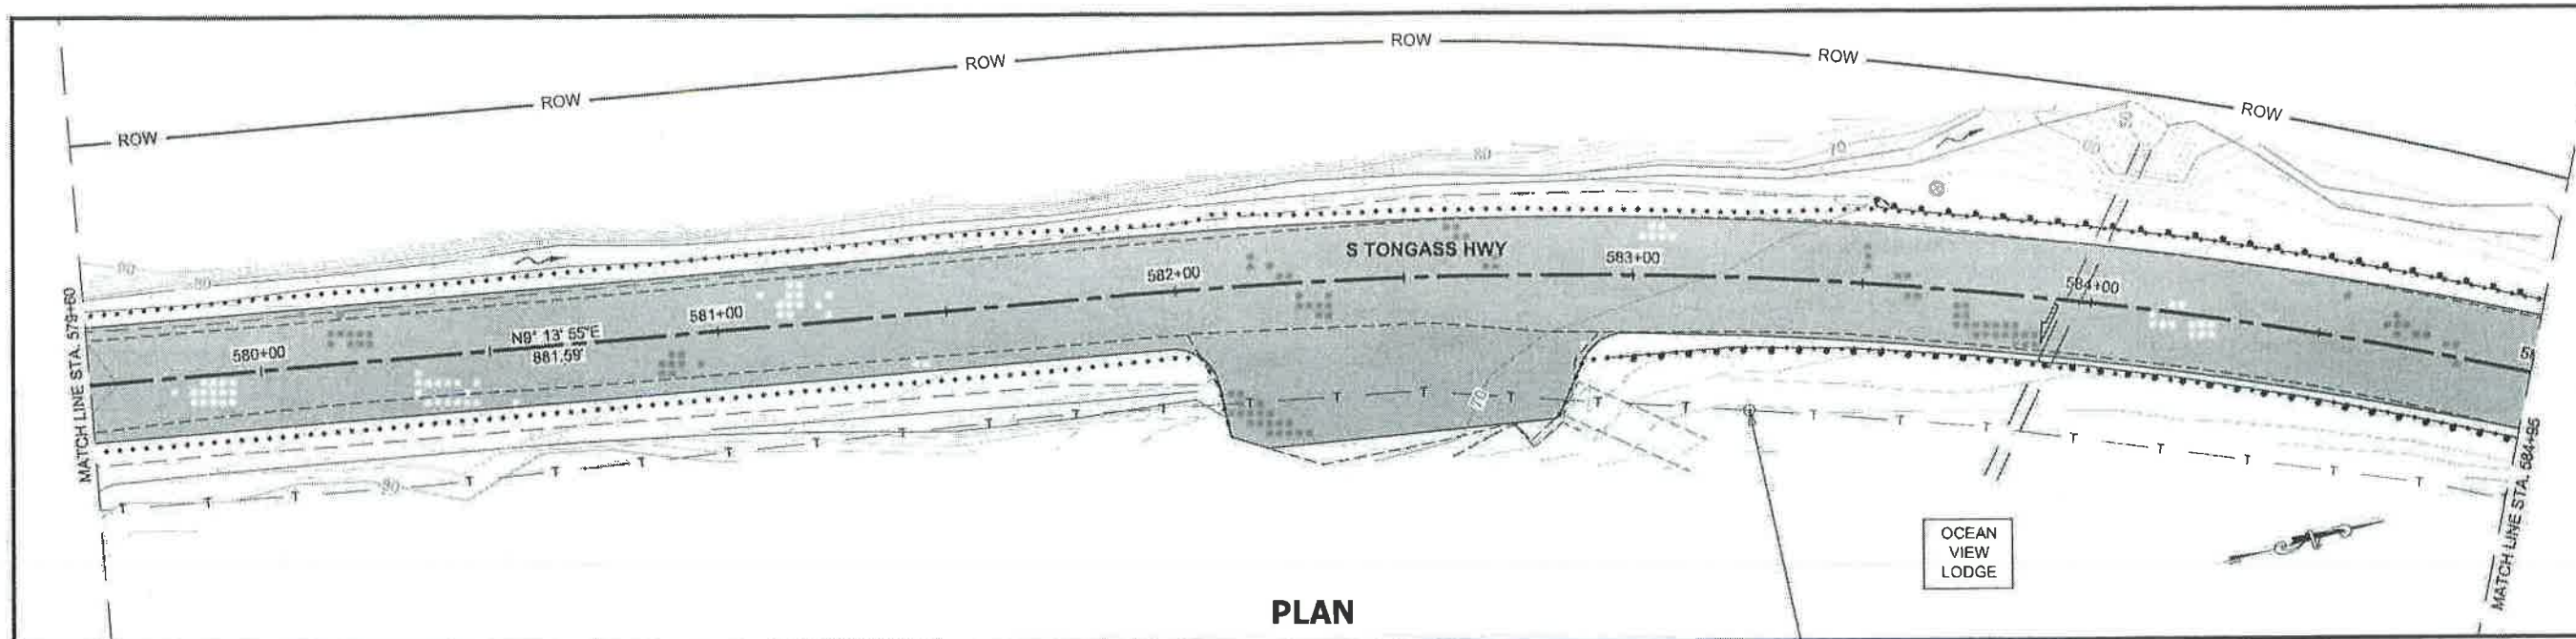

PLAN

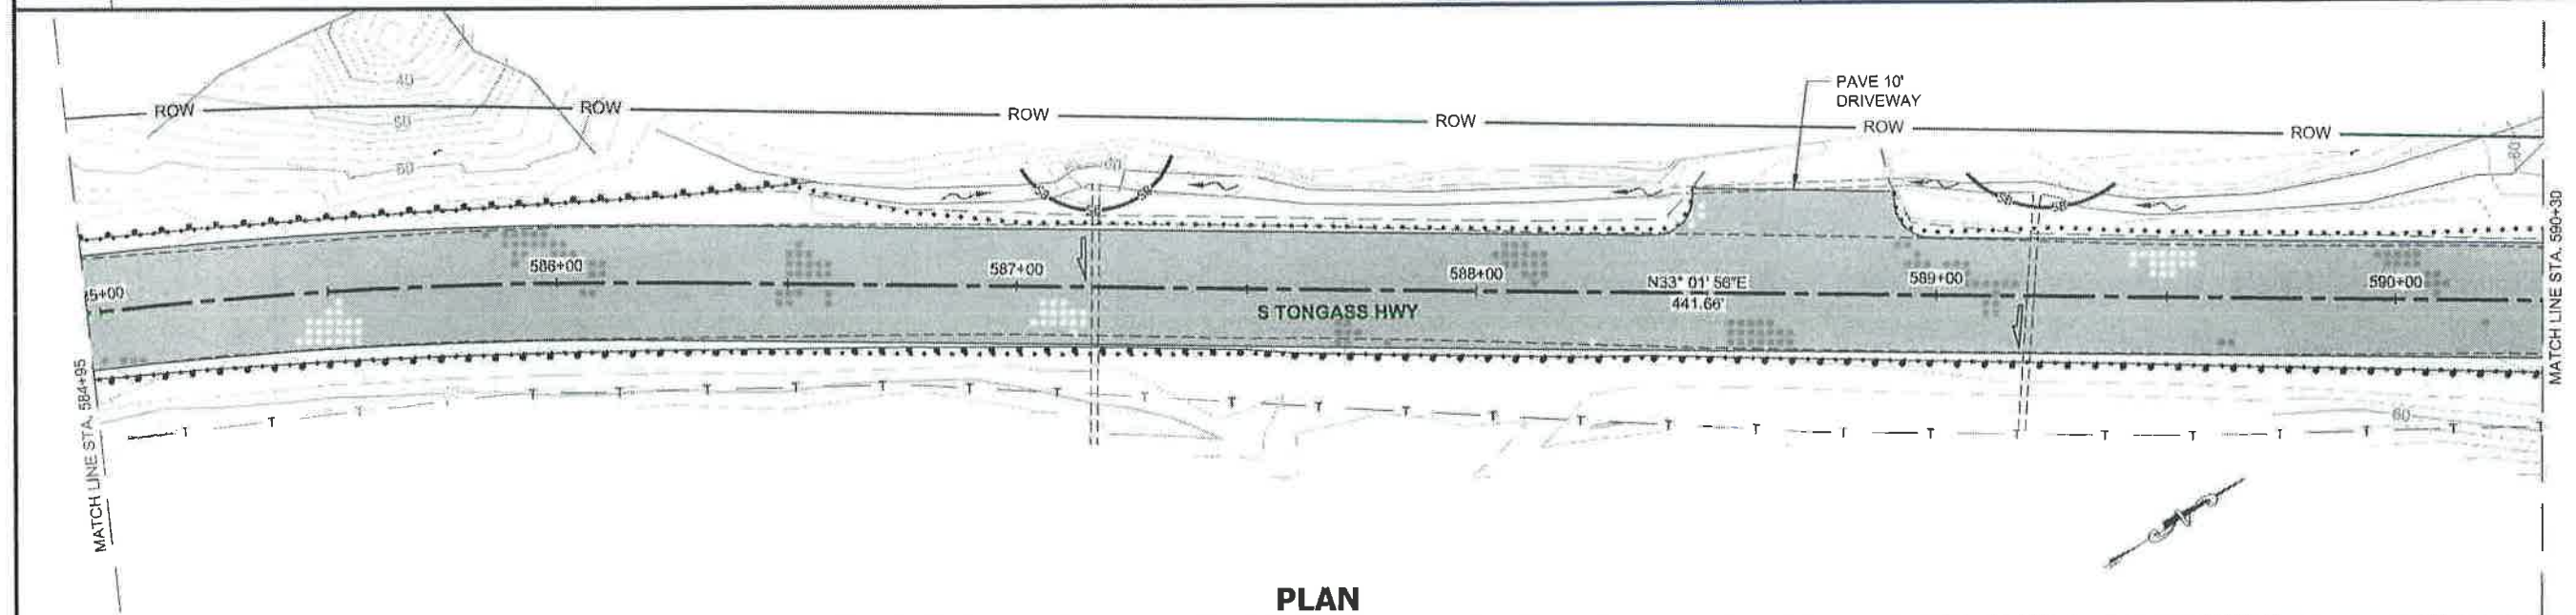

PLAN

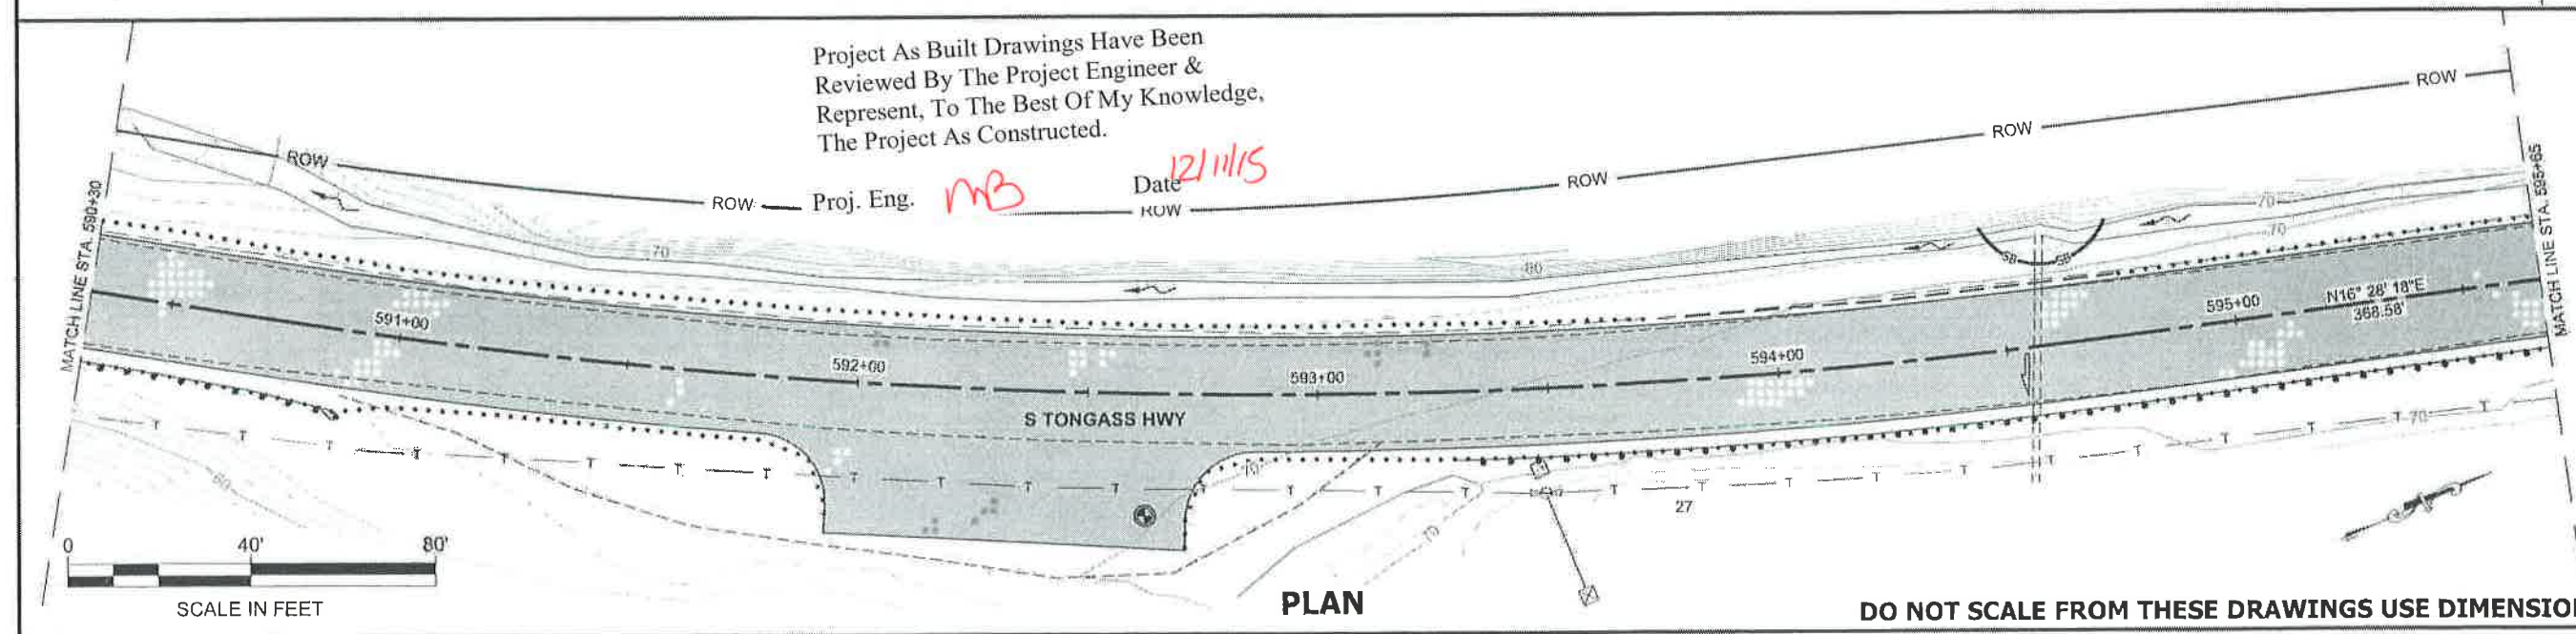

PLAN

DO NOT SCALE FROM THESE DRAWINGS USE DIMENSIONS

PATH:
Q:\KTN\67674\PLANSET\67674_P1-P15
ESCP.DWG
SEIFERT, LOLITA T (DOT)
Wednesday, November 05, 2014 7:51:45 AM

ADDENDUM NUMBER

ATTACHMENT NUMBER

RECORD OF REVISIONS		
No.	DATE	DESCRIPTION

PLAN LEGEND

CHECKED BY: M. VAN ALSTINE

ESCP NOT SEALED IN ACCORDANCE
WITH ALASKA HIGHWAY
PRECONSTRUCTION MANUAL
SECTION 1120.7.3
DATED NOVEMBER 15, 2013

DESIGNED BY: L. SEIFERT
DRAWN BY: R. GRANTHAM

STATE OF ALASKA
DEPARTMENT OF TRANSPORTATION
& PUBLIC FACILITIES
SOUTHEAST REGION


KTN-SOUTH TONGASS PAVING
PROJECT #67674

ESCP


PROJECT DESIGNATION
STP-NH-0902(040)~67674

STATE	YEAR
ALASKA	2014


SHEET NUMBER	TOTAL SHEETS
P12	66

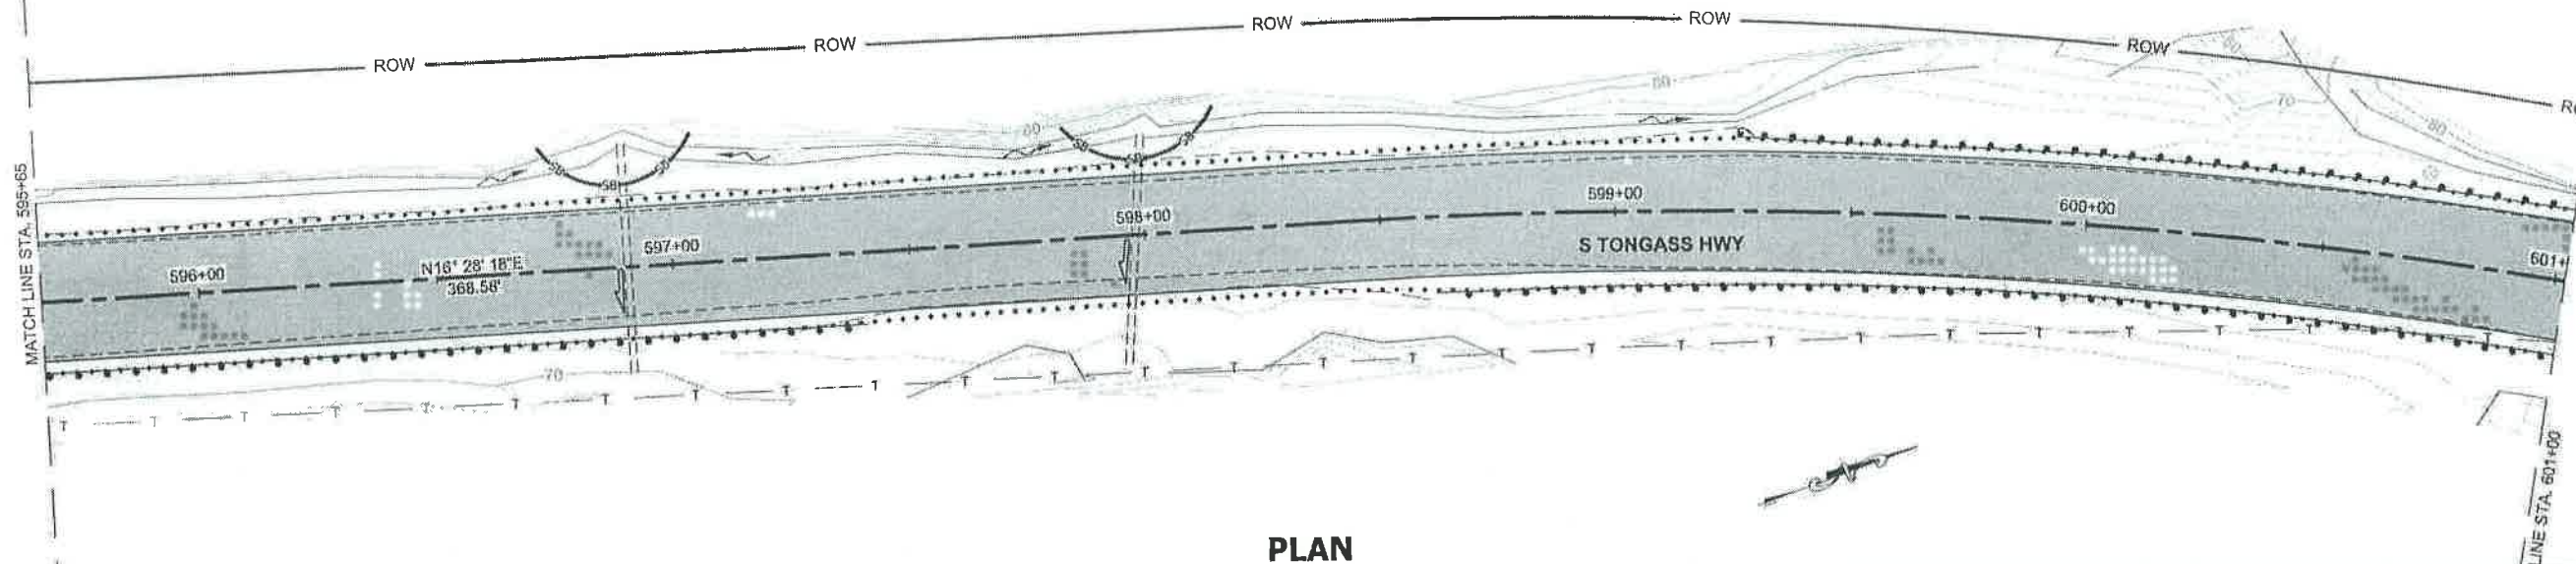

PLAN

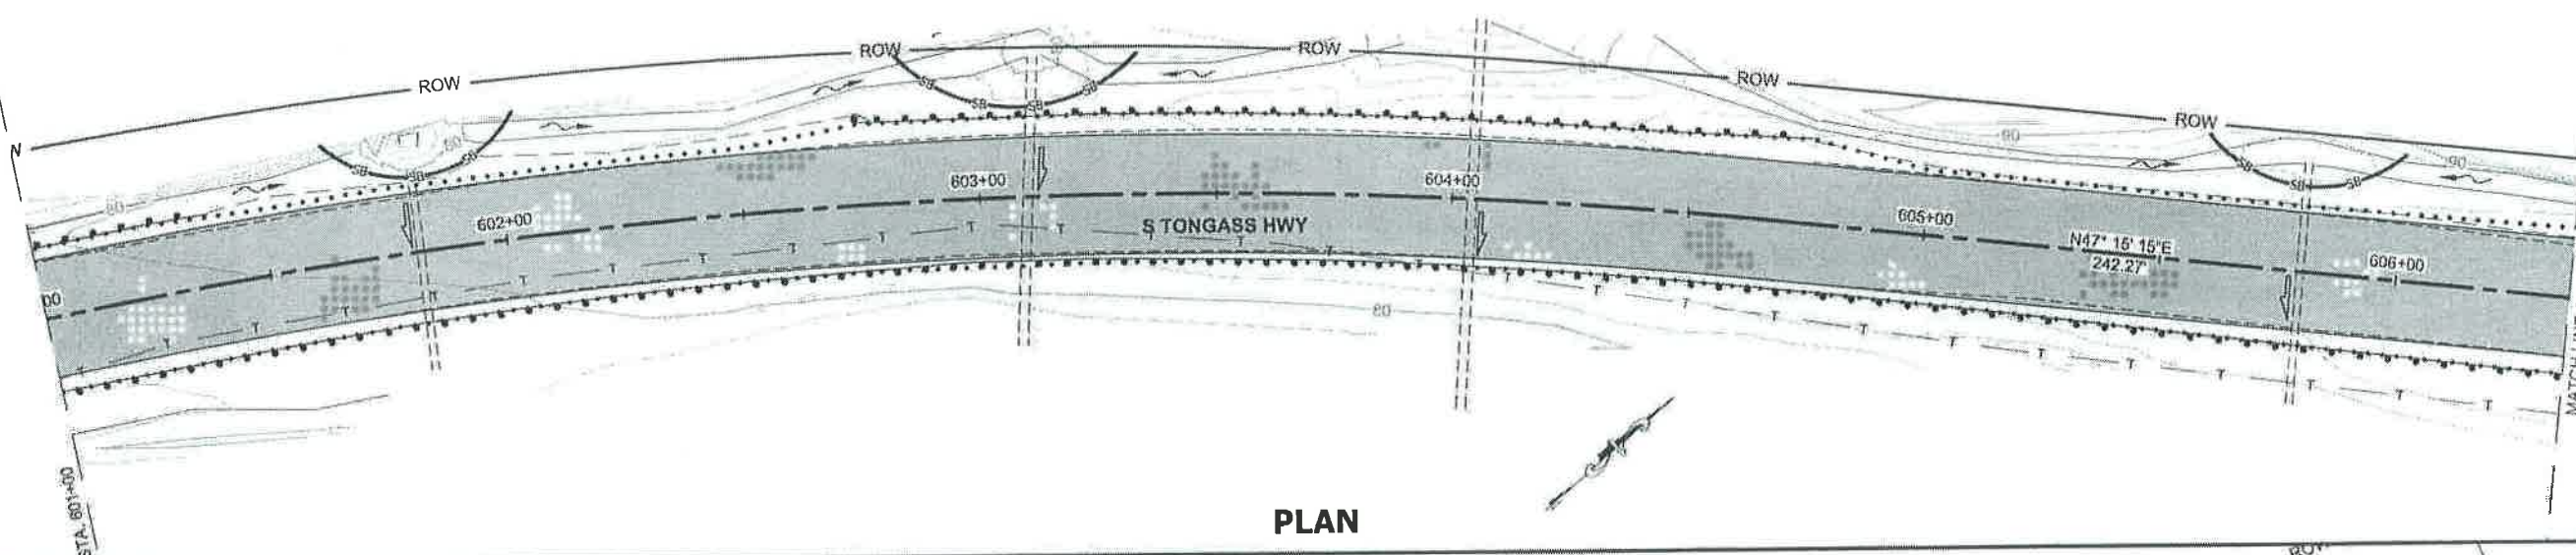

PLAN

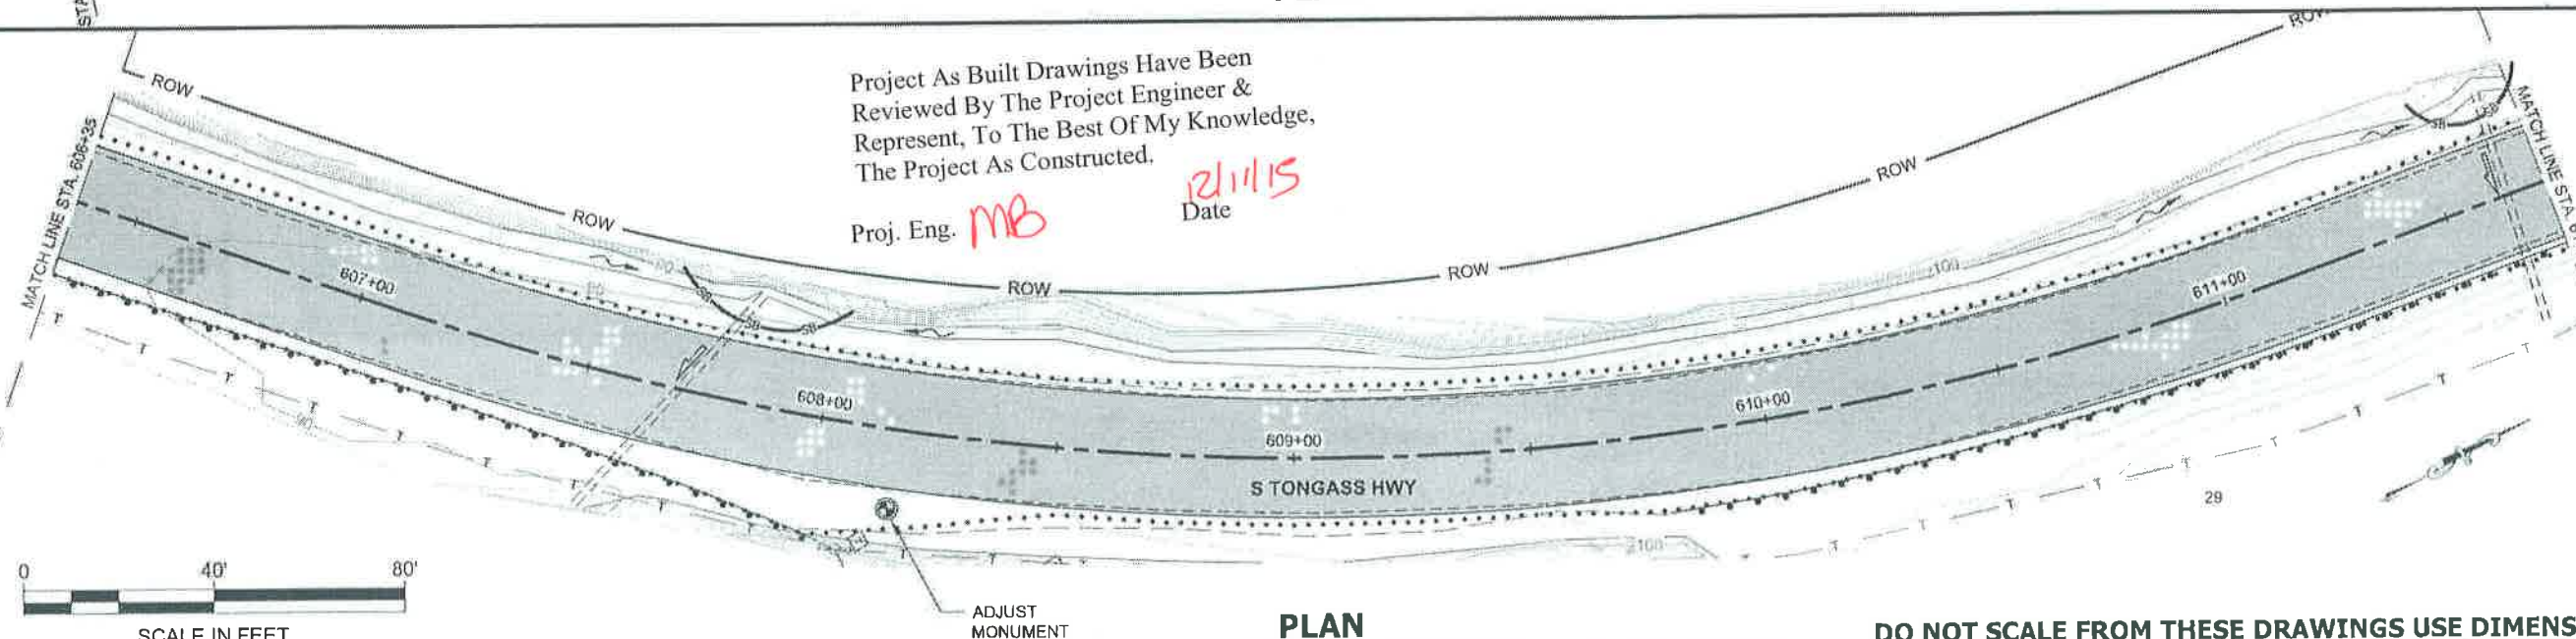

PLAN



Project As Built Drawings Have Been
Reviewed By The Project Engineer &
Represent, To The Best Of My Knowledge,
The Project As Constructed.

Proj. Eng. **MB**


Date **12/11/15**

DO NOT SCALE FROM THESE DRAWINGS USE DIMENSIONS

PATH:
Q:\KTN\67674\PLANSET\67674_P1-P15
ESCP.DWG

SEIFERT, LOLITA T (DOT)
Wednesday, November 05, 2014 7:51:04 AM

ADDENDUM NUMBER		
ATTACHMENT NUMBER		
RECORD OF REVISIONS		
No.	DATE	DESCRIPTION

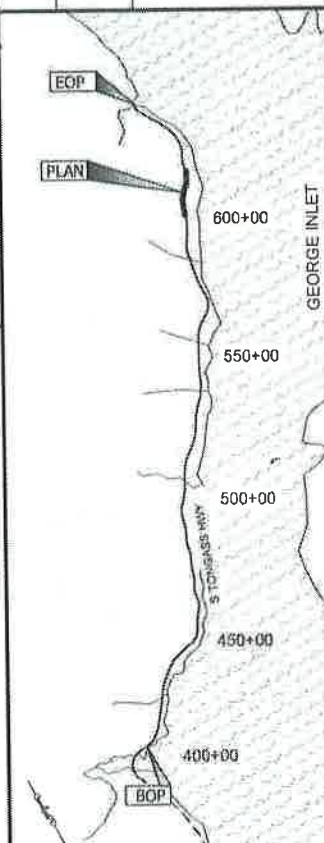

PLAN LEGEND

CHECKED BY: M. VAN ALSTINE

ESCP NOT SEALED IN ACCORDANCE
WITH ALASKA HIGHWAY
PRECONSTRUCTION MANUAL
SECTION 1120.7.3
DATED NOVEMBER 15, 2013

DESIGNED BY: L. SEIFERT

DRAWN BY: R. GRANTHAM


STATE OF ALASKA
DEPARTMENT OF TRANSPORTATION
& PUBLIC FACILITIES
SOUTHEAST REGION

KTN-SOUTH TONGASS PAVING
PROJECT #67674


ESCP

PROJECT DESIGNATION
STP-NH-0902(040)~67674


STATE	YEAR
ALASKA	2014
SHEET NUMBER	TOTAL SHEETS
P13	66

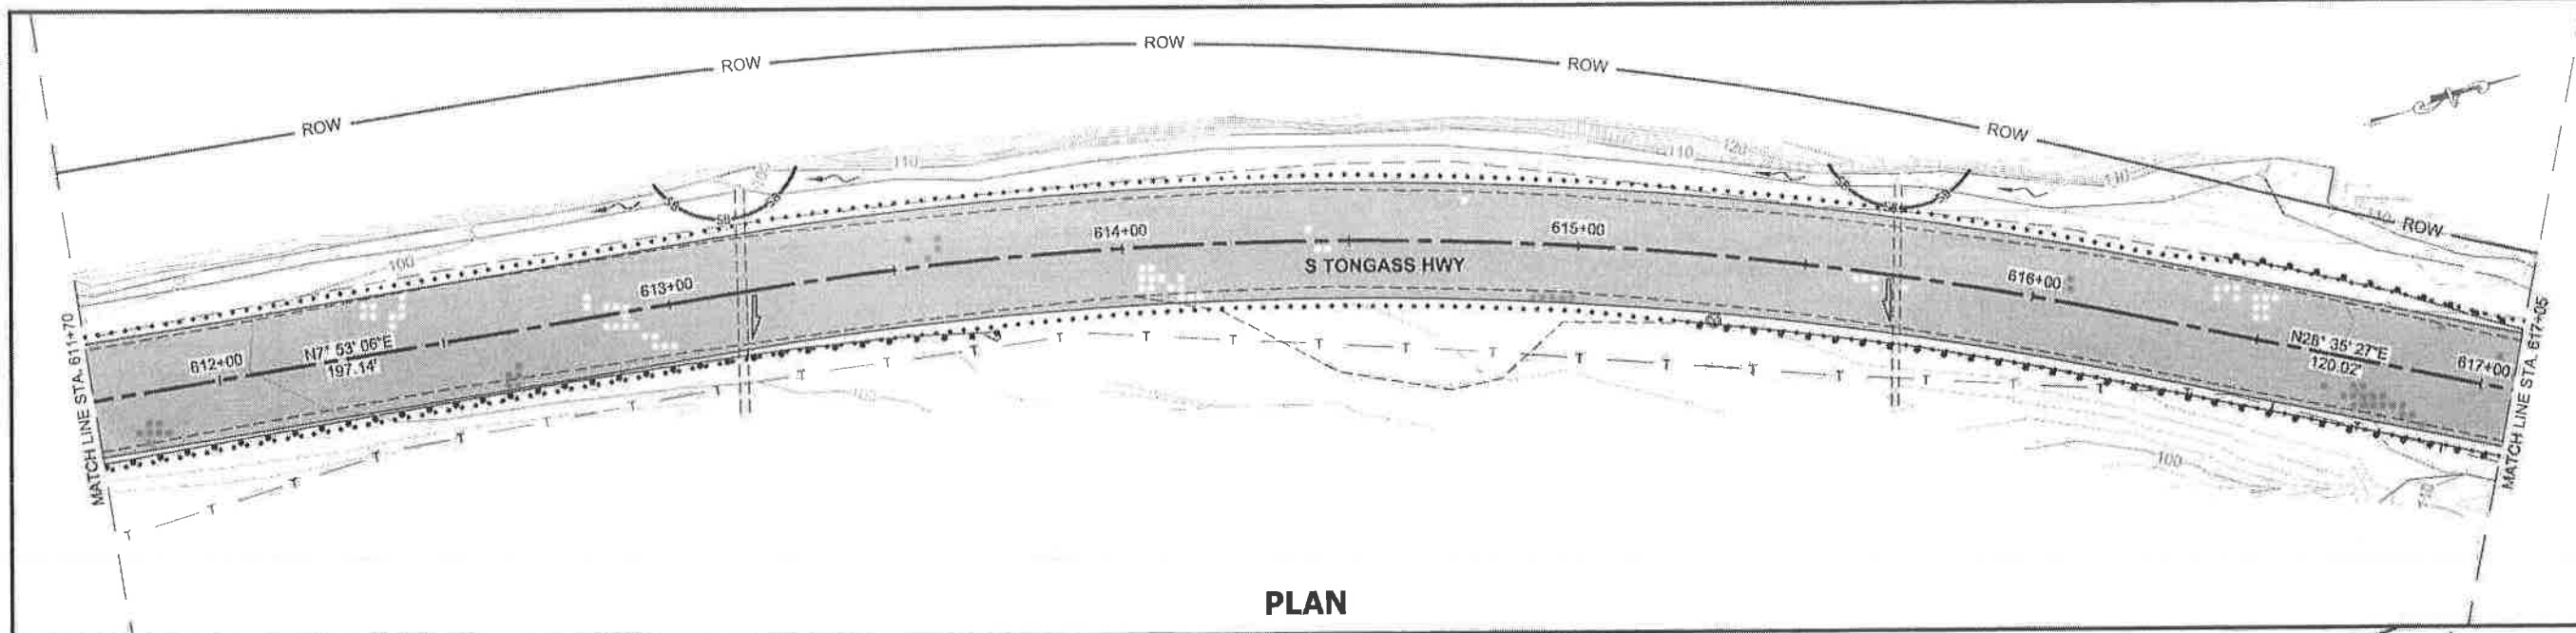

PLAN

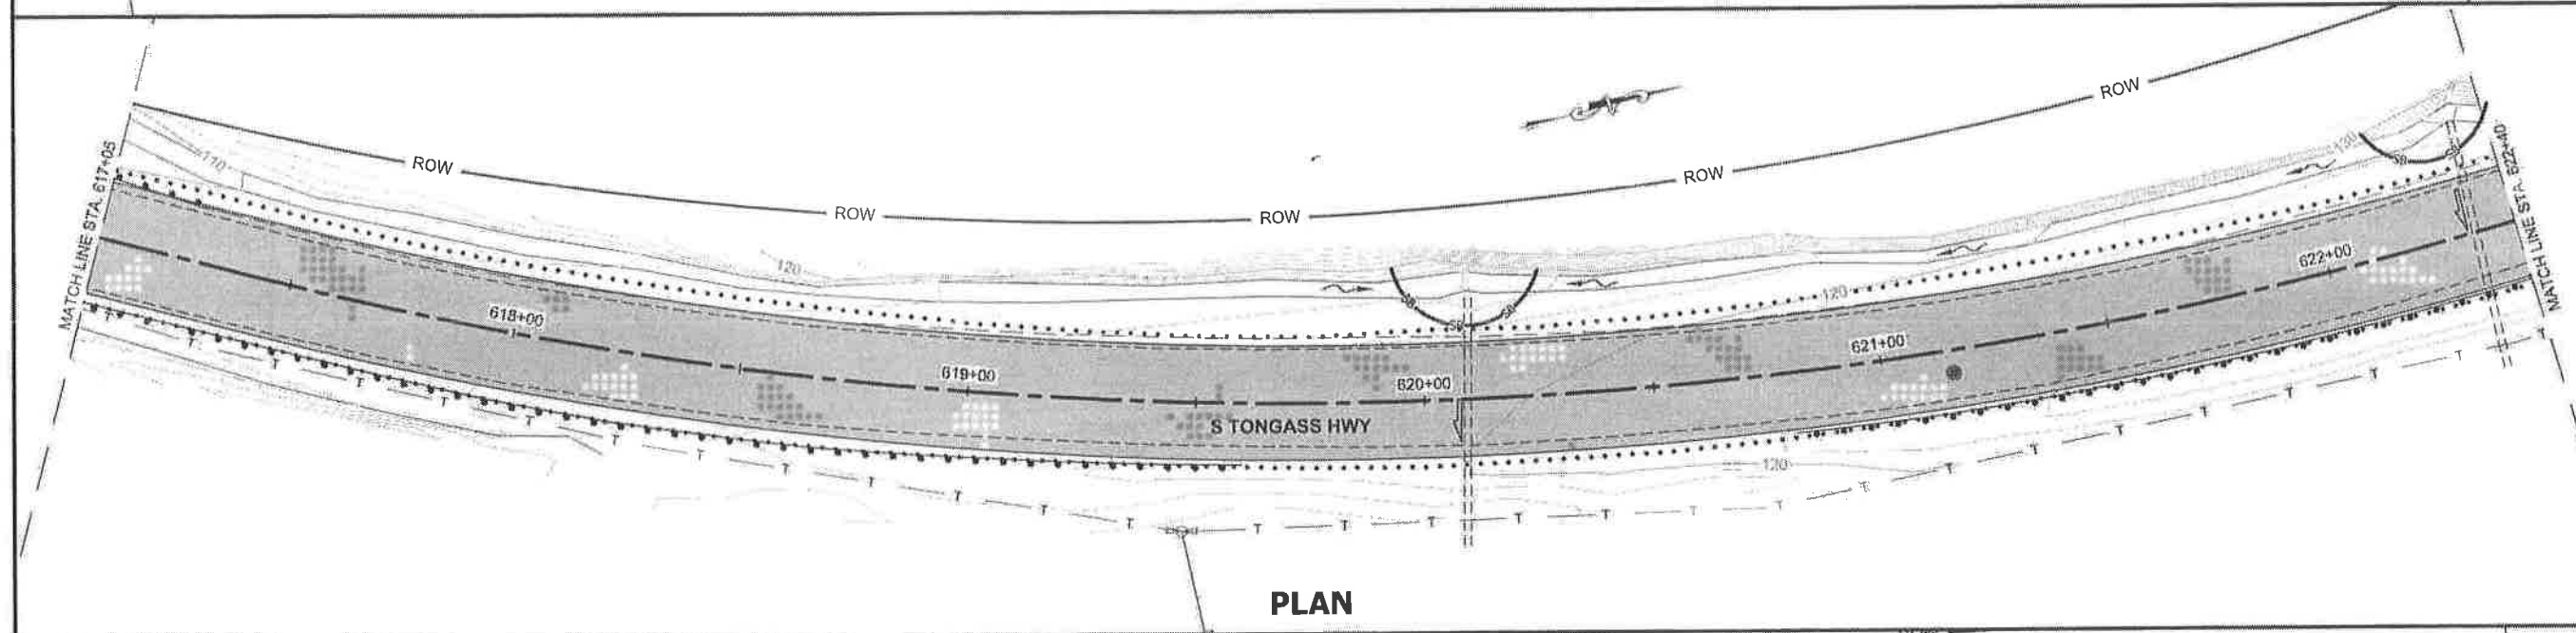

PLAN

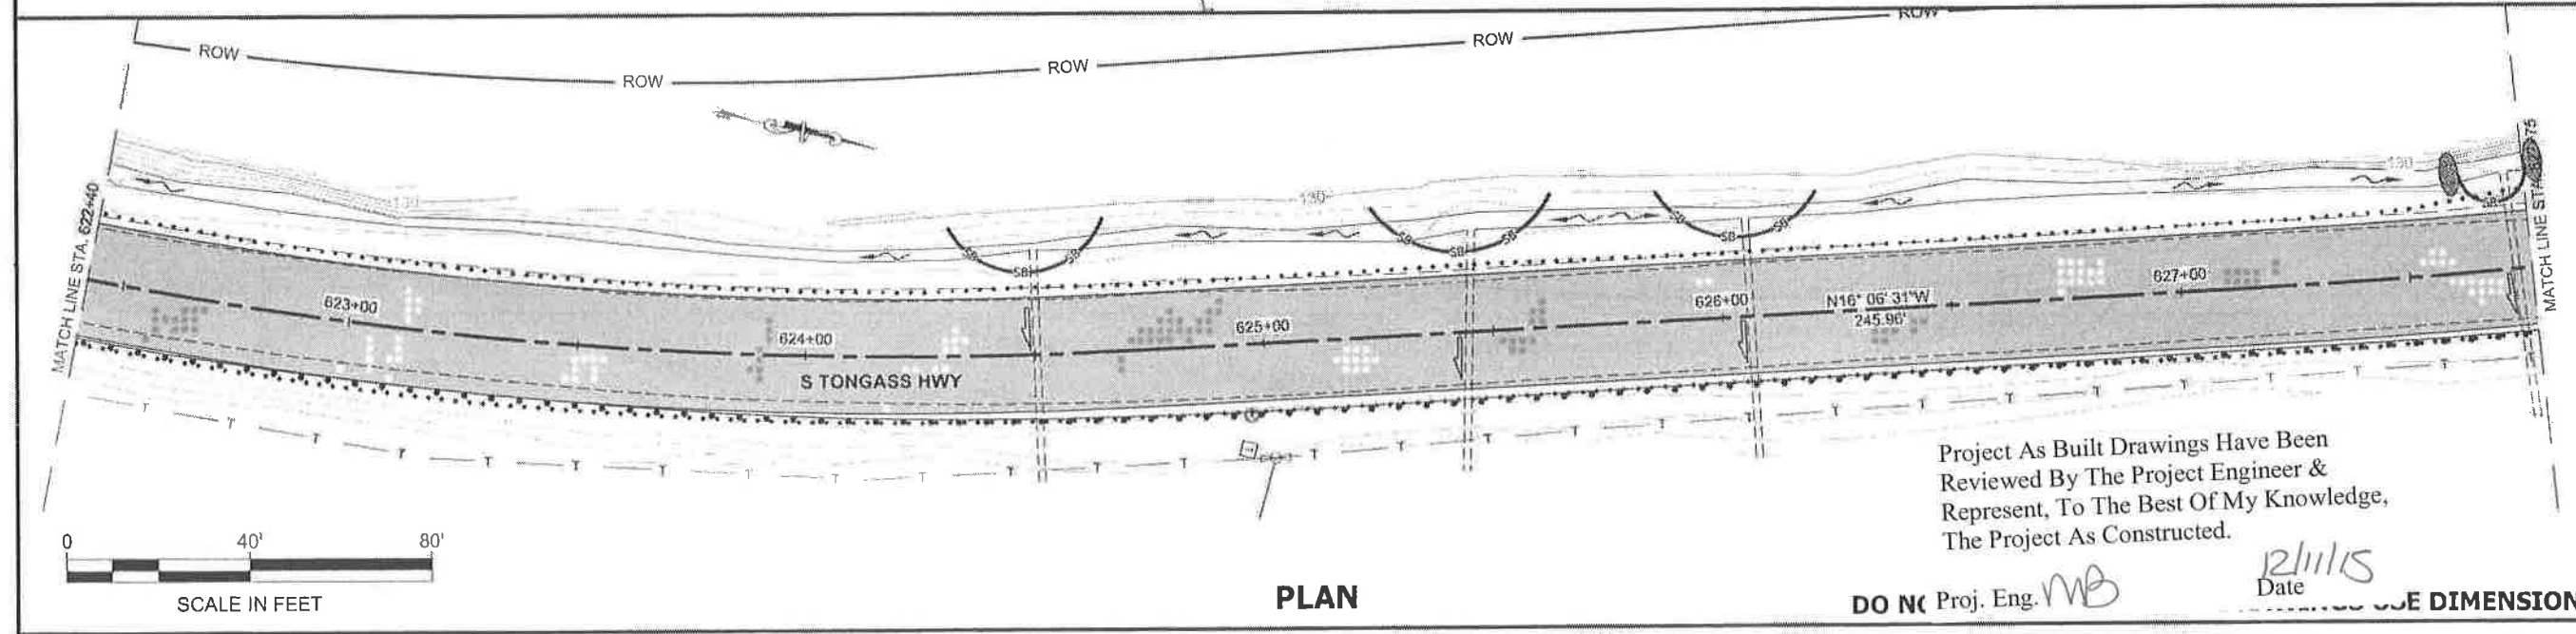

PLAN



Project As Built Drawings Have Been
Reviewed By The Project Engineer &
Represent, To The Best Of My Knowledge,
The Project As Constructed.

DO NOT Proj. Eng. MB

Date 12/11/15

USE DIMENSIONS

PATH:
Q:\KTN\67674\PLANSET\67674_P1-P15
ESCP.DWG

SEIFERT, LOLITA T (DOT)
Wednesday, November 05, 2014 7:50:45 AM

ADDENDUM NUMBER

ATTACHMENT NUMBER

RECORD OF REVISIONS

No.	DATE	DESCRIPTION

EOP

PLAN

600+00

550+00

500+00

450+00

400+00

GEORGE INLET

BOP

PLAN LEGEND

CHECKED BY: M. VAN ALSTINE

ESCP NOT SEALED IN ACCORDANCE
WITH ALASKA HIGHWAY
PRECONSTRUCTION MANUAL
SECTION 1120.7.3
DATED NOVEMBER 15, 2013

DESIGNED BY: L. SEIFERT

DRAWN BY: R. GRANTHAM

STATE OF ALASKA
DEPARTMENT OF TRANSPORTATION
& PUBLIC FACILITIES
SOUTHEAST REGION

KTN-SOUTH TONGASS PAVING
PROJECT #67674


ESCP

PROJECT DESIGNATION


STP-NH-0902(040)~67674

STATE	YEAR
ALASKA	2014

SHEET NUMBER	TOTAL SHEETS
P14	66

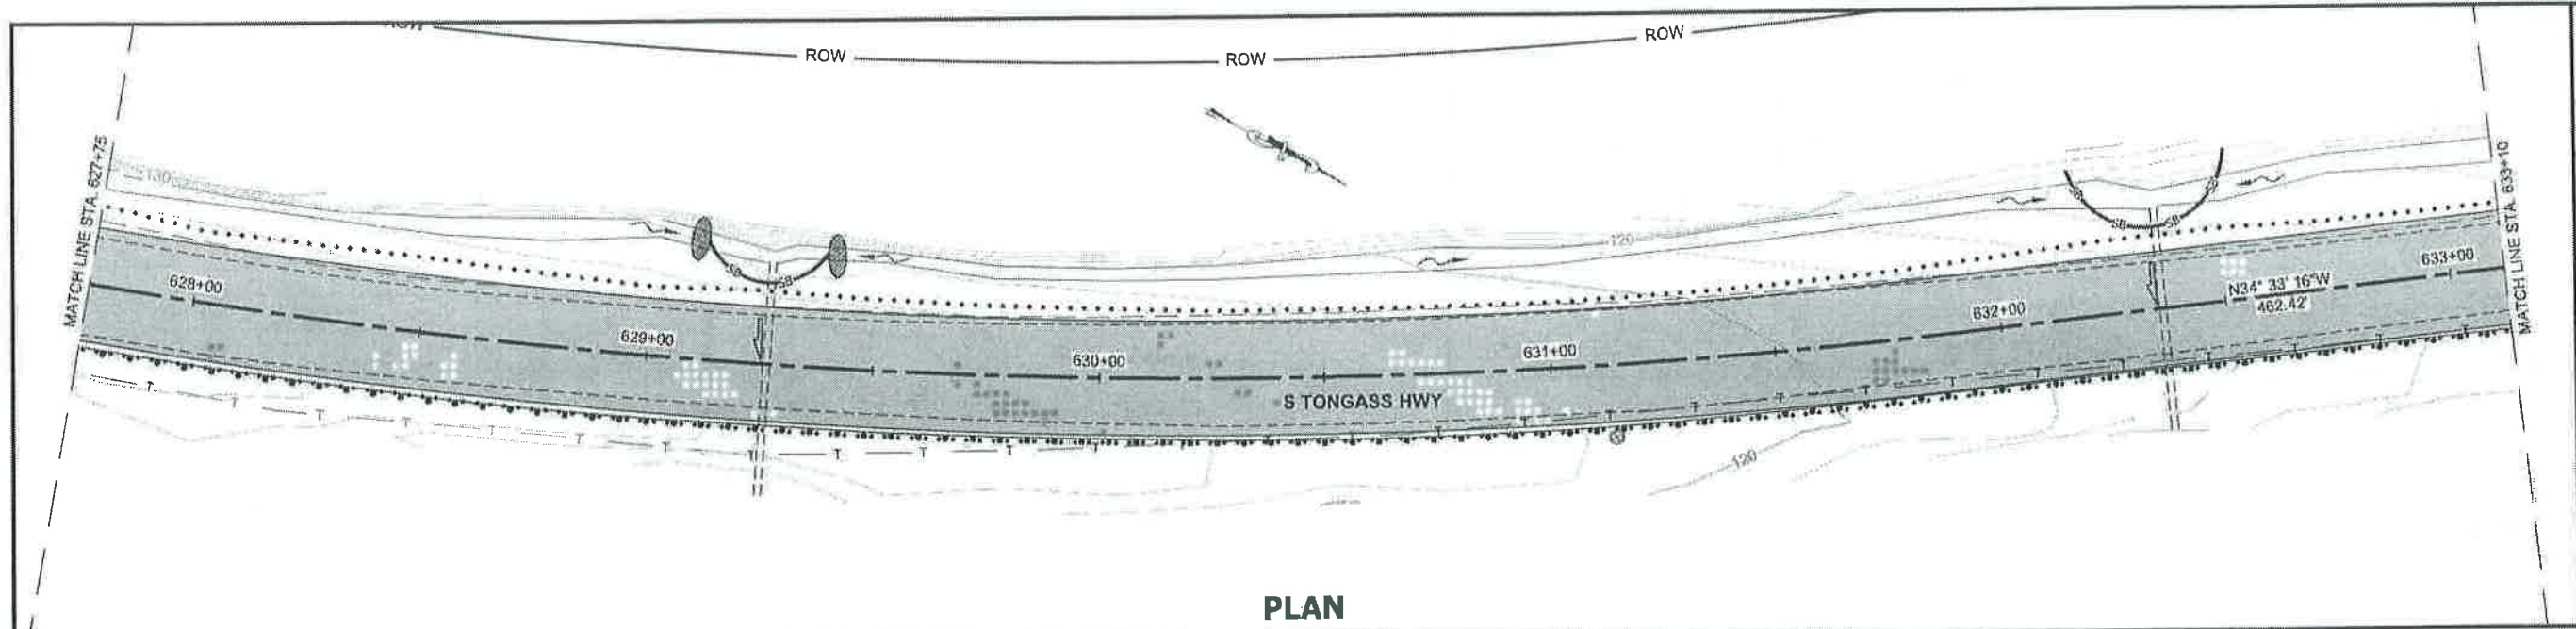


PLAN

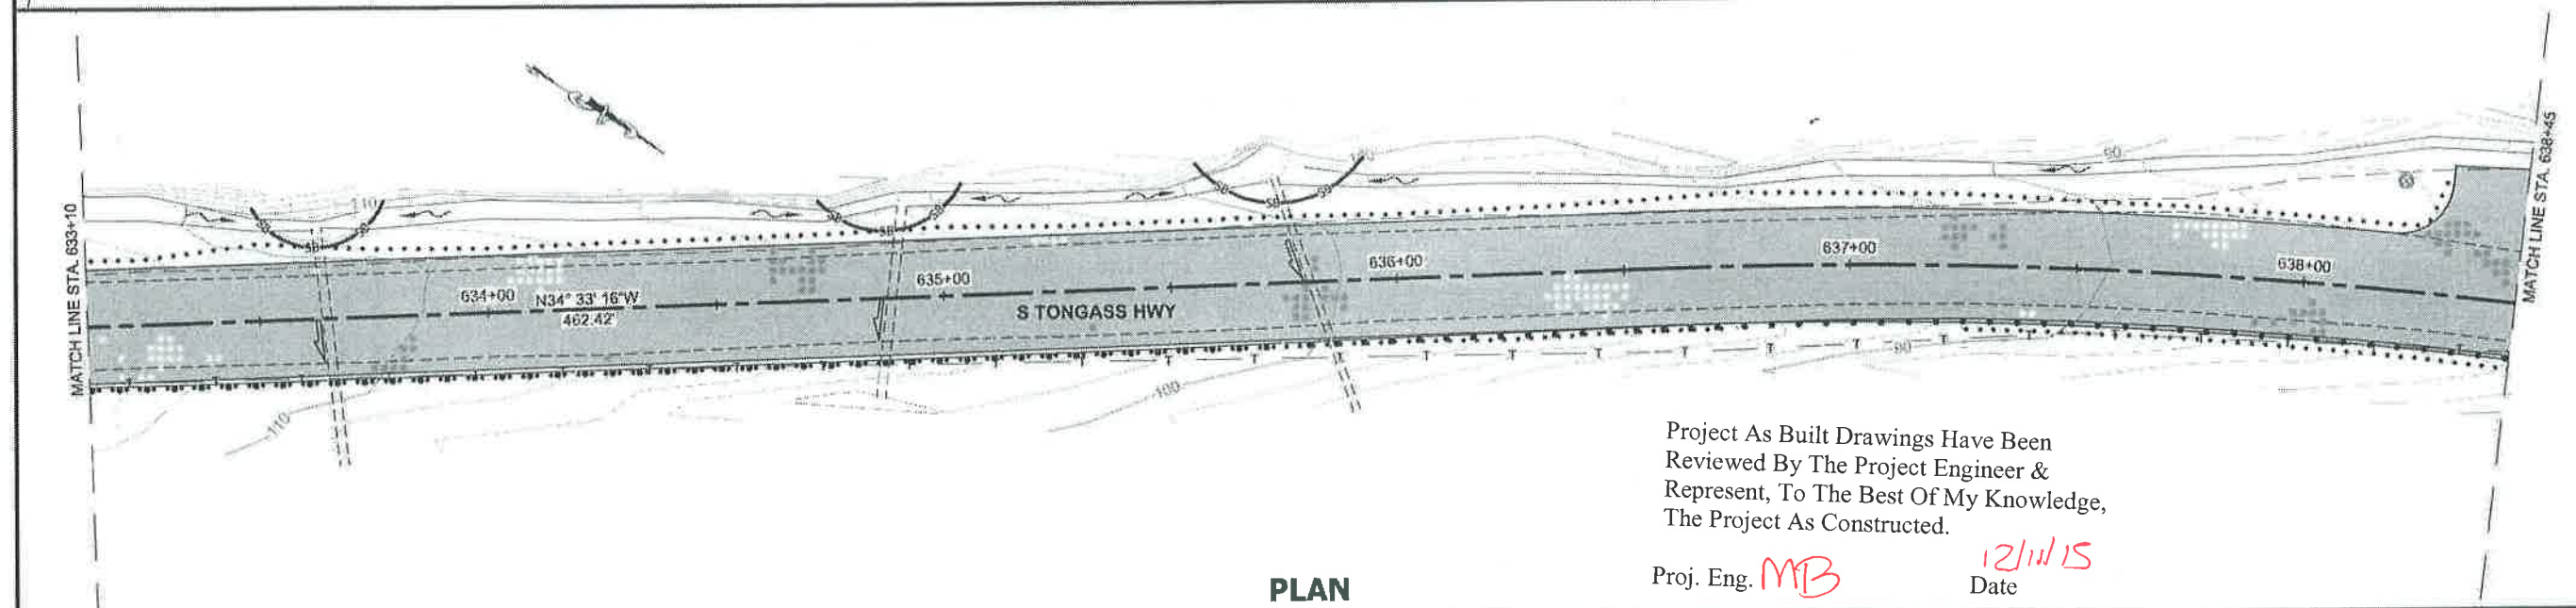

PLAN

Project As Built Drawings Have Been Reviewed By The Project Engineer & Represent, To The Best Of My Knowledge, The Project As Constructed.

Proj. Eng. *MB* Date *12/11/15*

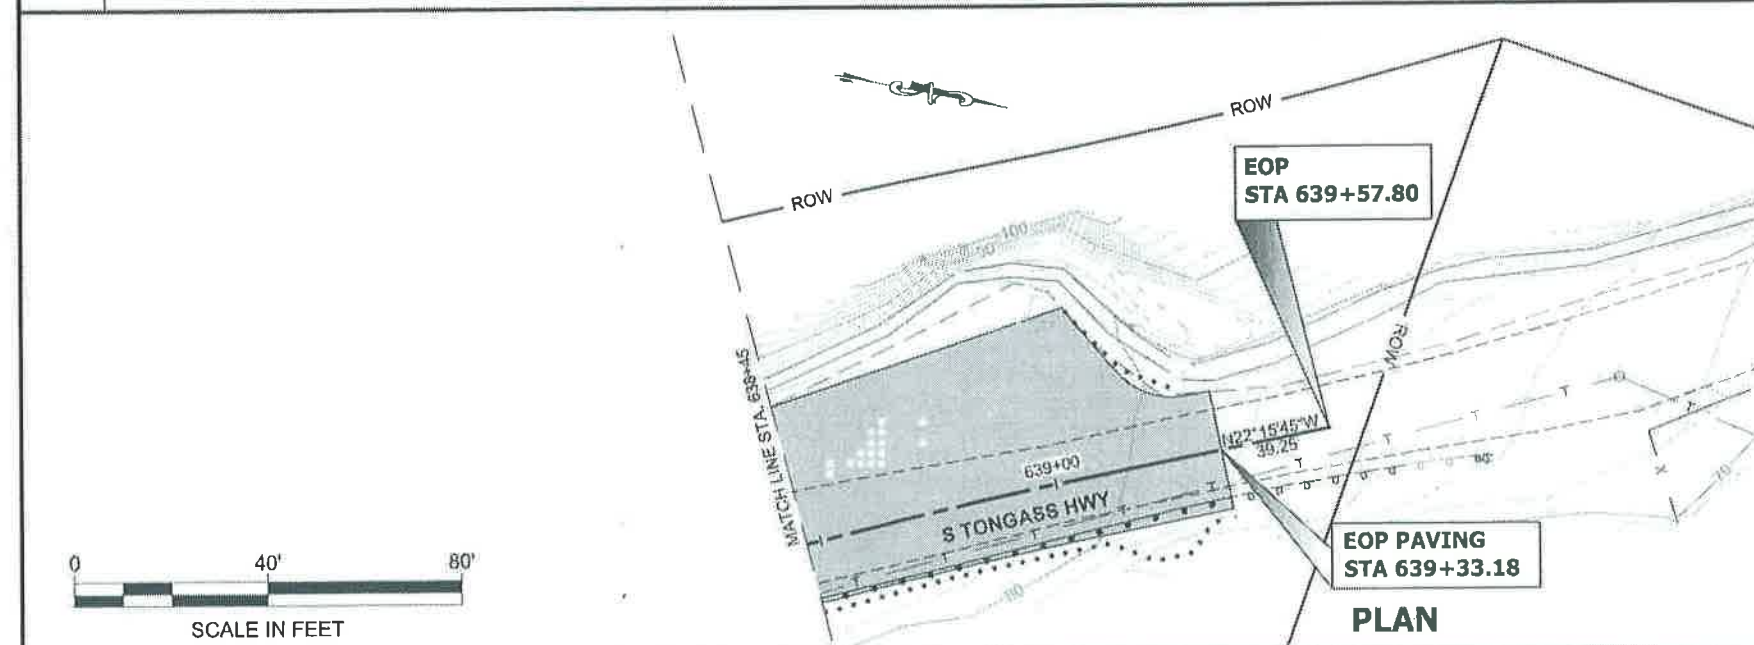

PLAN



NOTES:

1. REFER TO APPENDIX B OF SPECIAL PROVISIONS FOR ENVIRONMENTAL COMMITMENTS.
2. THE LOCATION OF TEMPORARY EROSION & SEDIMENT POLLUTION CONTROLS ARE RECOMMENDATIONS. IT IS THE RESPONSIBILITY OF THE CONTRACTOR TO PREPARE & IMPLEMENT A SWPPP ACCORDING TO SECTION 641 OF THE SPECIFICATIONS.
3. INSTALL EROSION & SEDIMENT CONTROL DEVICES BEFORE BEGINNING PAVEMENT PULVERIZING ACTIVITIES OR AS SPECIFIED ELSEWHERE.
4. EROSION CONTROL MEASURERS WILL BE EVALUATED BY THE ENGINEER BASED ON EFFECTIVENESS. THOSE FOUND IN EFFECTIVE MUST BE REPLACED OR REPAVED WITHIN 24 HOURS FOLLOWING A NOTIFICATION.
5. MAINTAIN DEVICES. MONITOR DAILY.
6. LOCATION & LENGTH OF FIBER ROLLS IS DEPENDANT ON CONDITIONS OF THE SITE. LAP ADJACENT FIBER ROLLS TO PREVENT SEDIMENT BYPASS.

DO NOT SCALE FROM THESE DRAWINGS USE DIMENSIONS

PATH:
Q:\KTN\67674\PLANSET\67674_P1-P15
ESCP.DWG

SEIFERT, LOLITA T (DOT)
Wednesday, November 05, 2014 7:50:25 AM

ADDENDUM NUMBER

ATTACHMENT NUMBER

RECORD OF REVISIONS

No.	DATE	DESCRIPTION

600+00
550+00
500+00
450+00
400+00

GEORGE INLET

PLAN LEGEND

CHECKED BY: M. VAN ALSTINE

ESCP NOT SEALED IN ACCORDANCE WITH ALASKA HIGHWAY PRECONSTRUCTION MANUAL SECTION 1120.7.3 DATED NOVEMBER 15, 2013

DESIGNED BY: L. SEIFERT

DRAWN BY: R. GRANTHAM

STATE OF ALASKA
DEPARTMENT OF TRANSPORTATION & PUBLIC FACILITIES
SOUTHEAST REGION


KTN-SOUTH TONGASS PAVING PROJECT #67674

ESCP


PROJECT DESIGNATION
STP-NH-0902(040)~67674

STATE	YEAR
ALASKA	2014

SHEET NUMBER	TOTAL SHEETS
P15	66

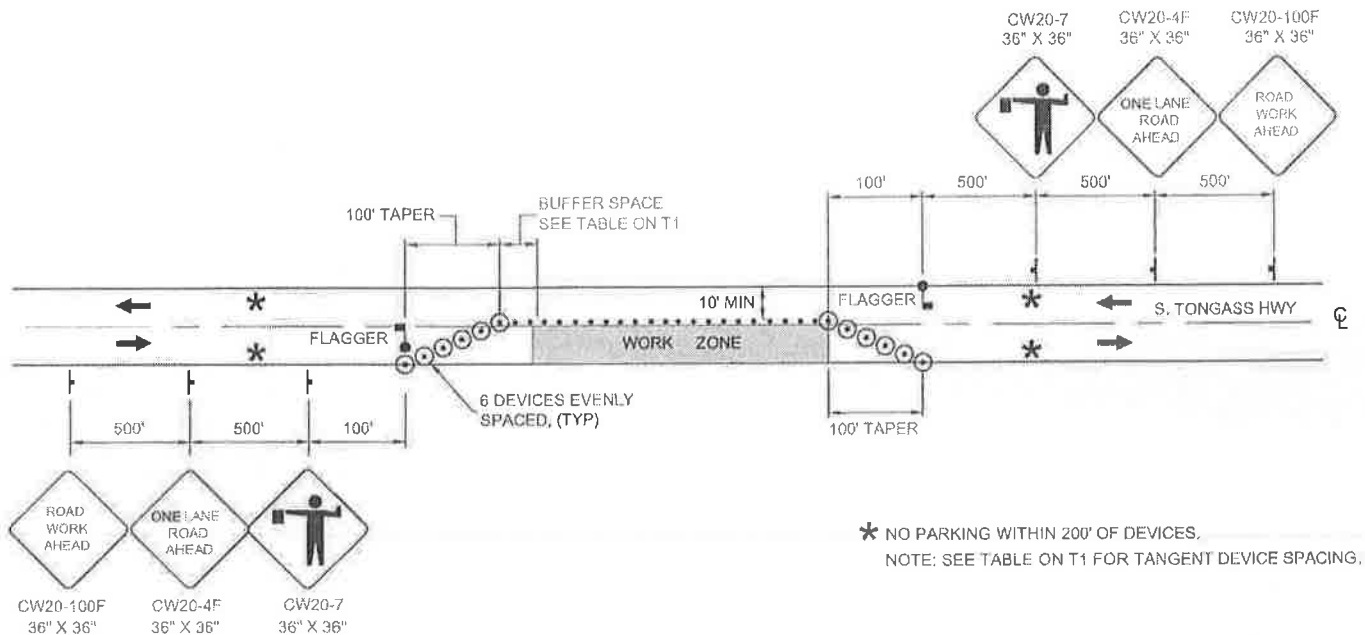


TWO LANE ROADWAY-SINGLE LANE CLOSURE

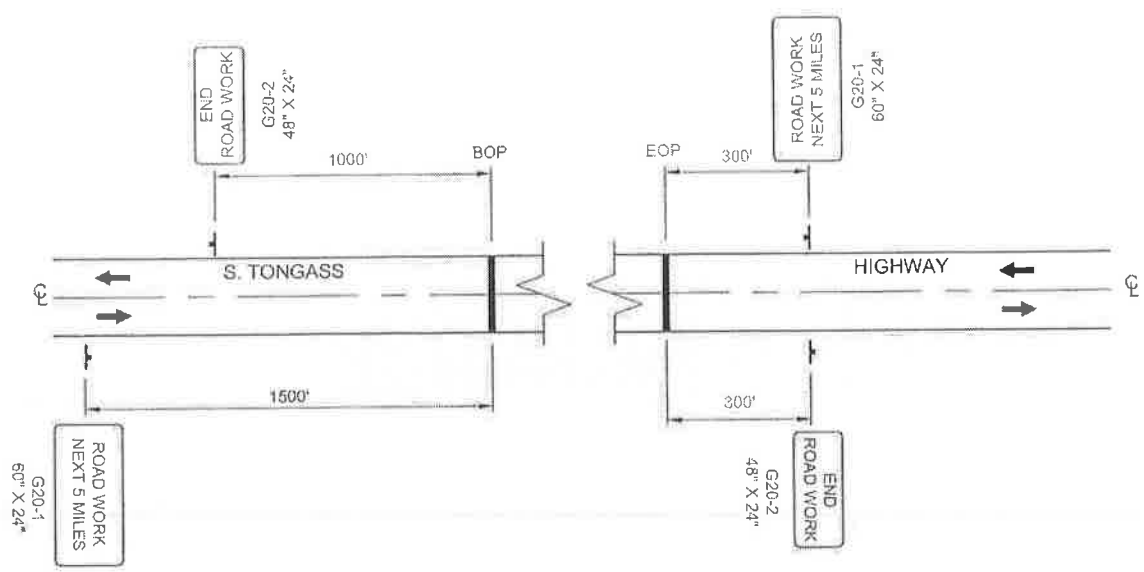

PERMANENT CONSTRUCTION SIGNING

SEE STANDARD DRAWING C-04.12 FOR DOUBLE TRAFFIC FINE SIGNS

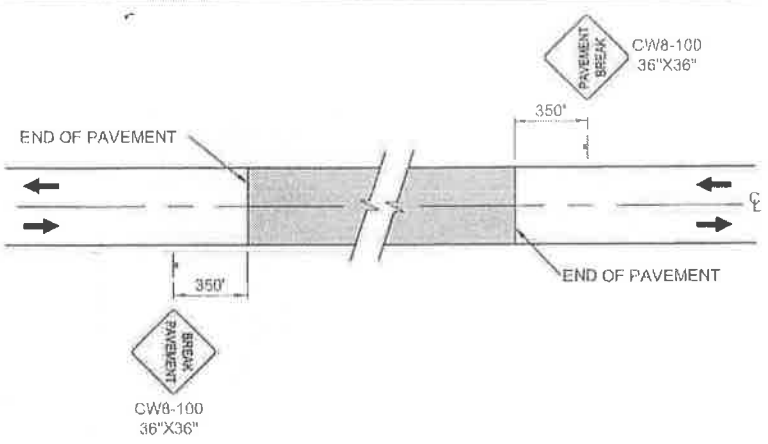

SIGNING FOR UNPAVED AREA


TRAFFIC CONTROL NOTES:

1. IT IS THE INTENT OF THIS TRAFFIC CONTROL PLAN (TCP) TO ILLUSTRATE SOME BUT NOT ALL OF THE TRAFFIC CONTROL CONFIGURATIONS THAT WILL BE REQUIRED BY THIS PROJECT. ALL TRAFFIC CONTROL PLANS SHALL BE DEVELOPED AND SUBMITTED FOR APPROVAL PRIOR TO USE.
2. A MINIMUM OF ONE LANE SHALL BE MAINTAINED AT ALL TIMES, THROUGH ALL WORK AREAS.
3. TWO LANES SHALL BE MAINTAINED AT ALL TIMES IN NON-WORK AREAS AND DURING NON-WORKING HOURS.
4. TRAFFIC LANES SHALL BE A MINIMUM OF 10' WIDE.
5. CONSTRUCTION SIGNING SHALL BE IN PLACE ONLY WHEN THE CONDITIONS EXIST FOR WHICH THE SIGNS ARE INTENDED.
6. CHANNELIZATION DEVICES SHALL BE LIT IN ACCORDANCE WITH THE ALASKA TRAFFIC MANUAL IF USED AT NIGHT.
7. KEEP THE PUBLIC INFORMED OF CONSTRUCTION ACTIVITIES THROUGH THE USE OF THE LOCAL NEWS MEDIA. NEWS RELEASES SHALL BE APPROVED PRIOR TO THEIR RELEASE. NEWS RELEASES WILL BE REQUIRED BUT NOT LIMITED TO, THE ONSET OF WORK, PAVING, AND CHANGES IN THE LANE CONFIGURATIONS.
8. TRAFFIC DELAYS SHALL NOT EXCEED 10 MINUTES.
9. FLAGGERS SHALL BE IN RADIO CONTACT WITH ONE ANOTHER.

LEGEND	
	SIGN
	CONE
	DRUM
	TYPE III BARRICADE
	FLAGGING STATION

Project As Built Drawings Have Been Reviewed By The Project Engineer & Represent, To The Best Of My Knowledge, The Project As Constructed.

Proj. Eng. *MB* Date 12/11/15

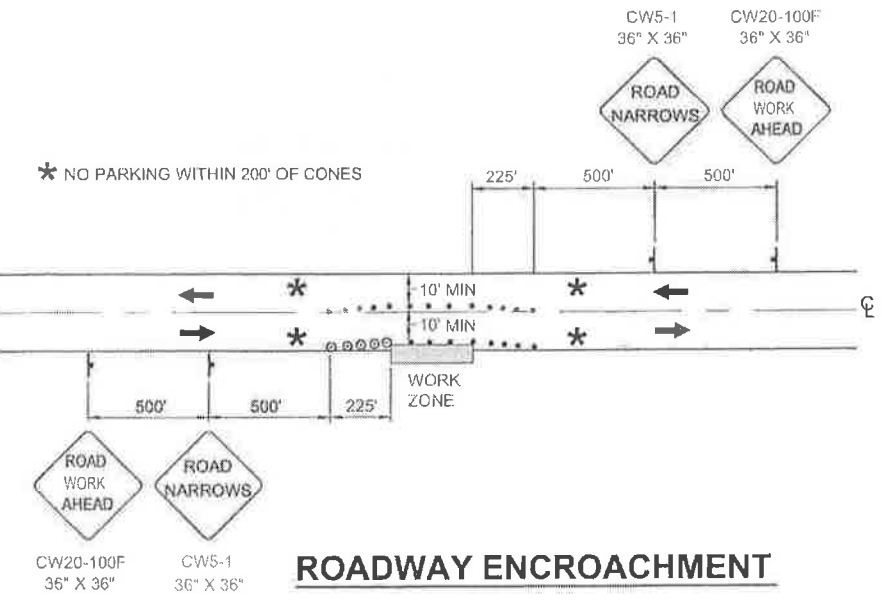

ROADWAY ENCROACHMENT

TCP SETUP TABLE									
SPEED (MPH)	MIN MERGING TAPER LENGTH (L) IN FEET			MIN NUMBER OF DEVICES WIDTH OF OFFSET (W) IN FEET			MAX DEVICE SPACING IN FEET		BUFFER SPACE (FT)
	10'	11'	12'	10'	11'	12'	ALONG TAPER	ALONG TANGENT	
25 OR BELOW	105	115	125	6	6	6	25	50	155
30	150	165	180	6	7	7	30	60	200
35	205	225	245	7	8	8	35	70	250
40	270	295	320	8	9	9	40	80	305
45	450	495	540	11	12	13	45	90	360
50	500	550	600	11	12	13	50	100	425
55	550	605	660	11	12	13	55	110	495
60	600	660	720	11	12	13	60	120	570

DO NOT SCALE FROM THESE DRAWINGS USE DIMENSIONS

CHECKED BY: M. VAN ALSTINE	STATE OF ALASKA DEPARTMENT OF TRANSPORTATION & PUBLIC FACILITIES SOUTHEAST REGION
TCP NOT SEALED IN ACCORDANCE WITH ALASKA HIGHWAY PRECONSTRUCTION MANUAL SECTION 1400.3.5 DATED JANUARY 30, 2012.	KTN-SOUTH TONGASS PAVING PROJECT #67674
DESIGNED BY: L. SEIFERT DRAWN BY: R. GRANTHAM	ADDENDUM TRAFFIC CONTROL PLAN
PATH: Q:\KTN67674\PLANS\ADDENDUM\67674_T1 TRAFFIC.DWG TAB: T1 Wednesday, November 26, 2014 1:08:37 PM GRANTHAM, RICK L (DOT)	PROJECT DESIGNATION STP-NH-0902(040)-67674
REVISIONS NO. DATE DESCRIPTION	YEAR 2014
	SHEET NO. T1
	TOTAL SHEETS 66


State of Alaska

Department of Transportation and Public Facilities

Southeast Region


KETCHIKAN, ALASKA

COLLINS ROAD GUARDRAIL HSIP PROJECT NO. 0902041 ~ 68412

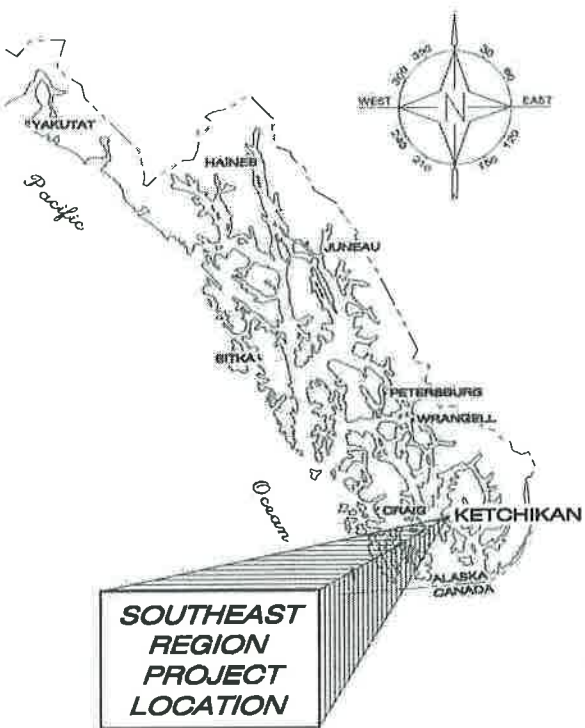

As Advertised:

November 7, 2014

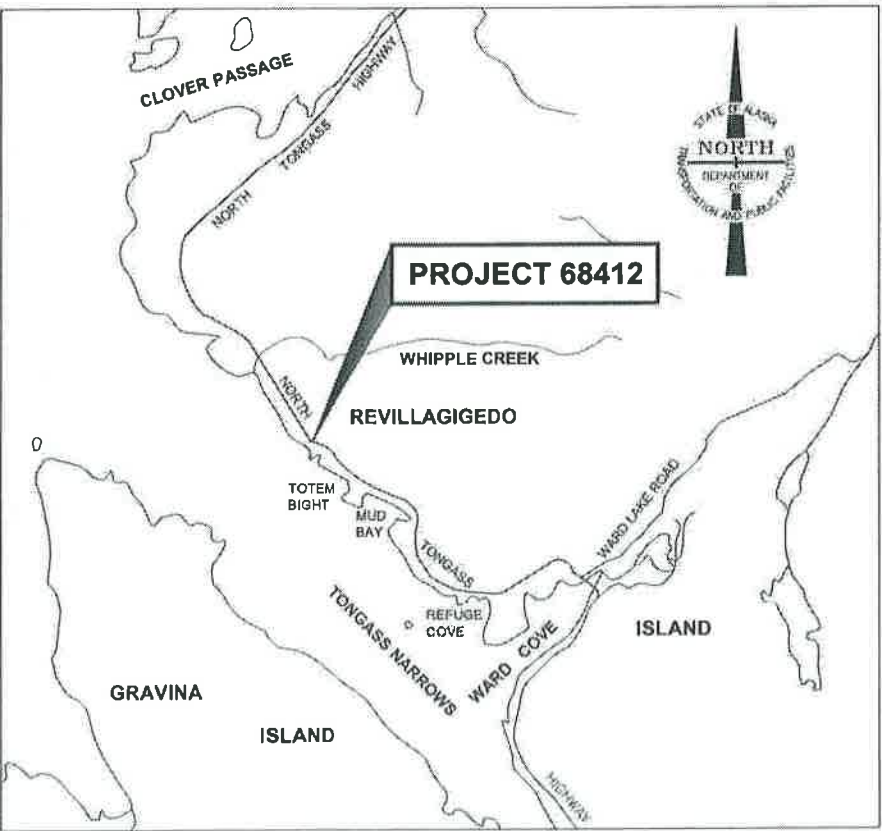

VICINITY MAP

DESIGN DESIGNATION

	2015	2035
AVERAGE DAILY TRAFFIC	4580	5080
DESIGN HOURLY VOLUME (10%)	490	540
DESIGN SPEED (MPH)	50	60
PEAK HOURLY FACTOR	0.9	0.9
DIRECTIONAL DISTRIBUTION (ENTERING/LEAVING)	55/45	55/45
PERCENT TRUCK TRAFFIC	13.1%	13.1%
EQUIVALENT AXLE LOAD		1,300,000
TURNING VEHICLE: WB-50		
VEHICLE LOADING: HS25		

THE FOLLOWING STANDARD DRAWINGS APPLY TO THIS PROJECT:

A-1 G-10.01
G-00.02 G-20.11
G-04.10

Project As Built Drawings Have Been
Reviewed By The Project Engineer &
Represent, To The Best Of My Knowledge,
The Project As Constructed.

Proj. Eng. *MB* Date *12/11/13*

INDEX

SHEET NO.	DESCRIPTION
A1	TITLE SHEET
B1	TYPICAL SECTION
C1	ESTIMATE OF QUANTITIES
E1	PARALLEL GUARDRAIL TERMINAL DETAILS
F1	PLAN VIEW
S1	TRAFFIC CONTROL PLAN

Asbuilt's

ROUTE: 291500 MILEPOINT: 8.263 - 8.362
PATH: Q:\Ktn\68412\Planset\688412_A1_Ttl.dwg
Tue, 12/Aug/14 07:00AM dastevens
PLOT: PSPACE OR MSPACE: 1000mm=1m(F) TAB: TSHT


STATE OF ALASKA
DEPARTMENT OF TRANSPORTATION & PUBLIC FACILITIES
SOUTHEAST REGION



RECOMMENDED FOR APPROVAL: *L. Pat Carroll* 8/19/14
L. PAT CARROLL, P.E.
REGIONAL PRE-CONSTRUCTION ENGINEER
DATE
APPROVED: *Chuck Correa* FOR 8/19/14
CHUCK CORREA, P.E.
DIRECTOR OF DESIGN & CONSTRUCTION
DATE
CERTIFIED TRUE & CORRECT AS-BUILT OF ACTUAL FIELD CONDITION:

CONSTRUCTION PROJECT MANAGER DATE

STATE	PROJECT DESIGNATION	YEAR	SHEET NO.	TOTAL SHEETS
ALASKA	0902041~68412	2014	A1	6

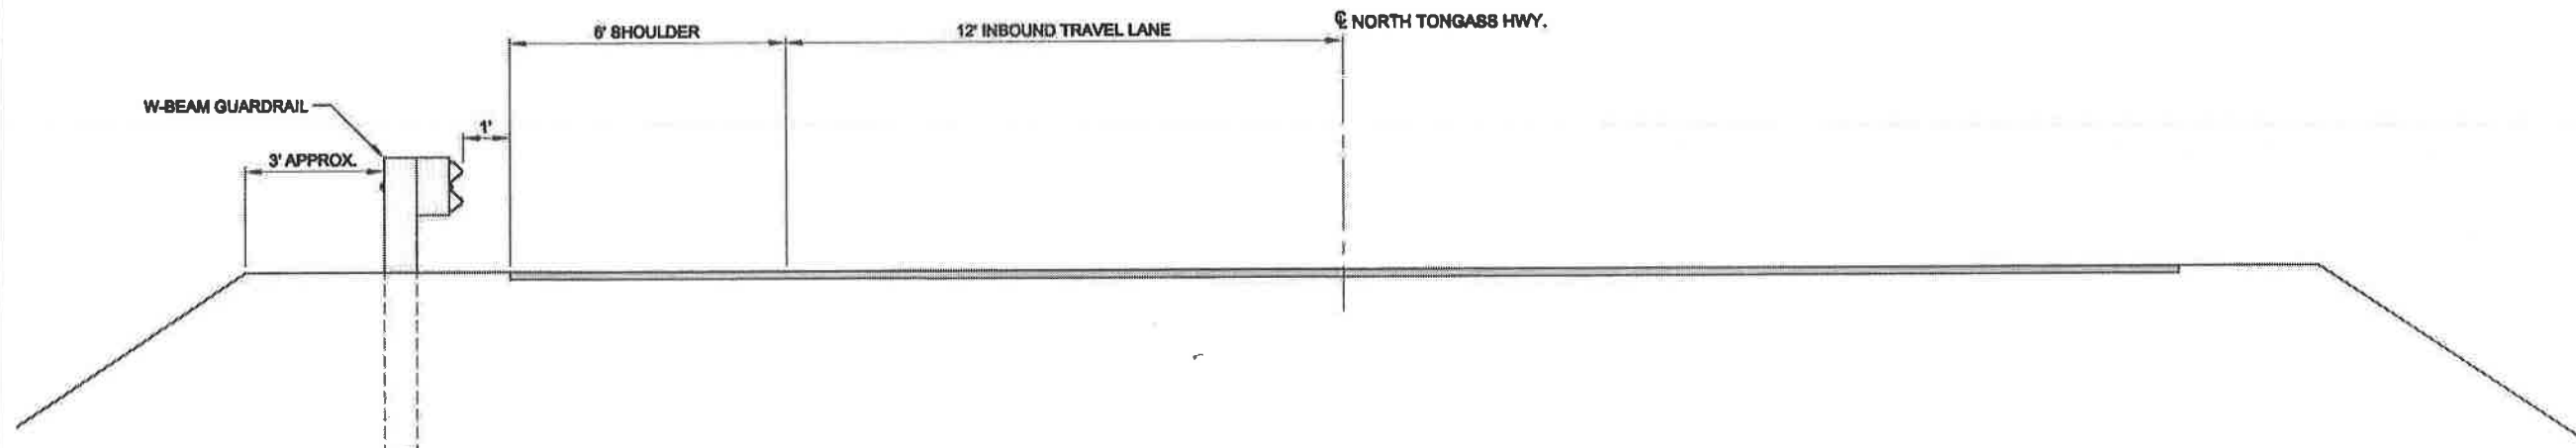

**TYPICAL SECTION
W-BEAM GUARDRAIL**
NTS

NOTE:
INSTALL GUARDRAIL POST PER STD. DWG. G-10.01.

Project As Built Drawings Have Been
Reviewed By The Project Engineer &
Represent, To The Best Of My Knowledge,
The Project As Constructed.

Proj. Eng. *MB* 12/11/15
Date

DO NOT SCALE FROM THESE DRAWINGS USE DIMENSIONS

PATH:
Q:\KTM\68412\PLAN\SET\09412_B1_TYPICAL
SECTION.DWG

TAB: B1 STEVENS, DAVID

ADDENDUM NUMBER

ATTACHMENT NUMBER

RECORD OF REVISIONS

No.	DATE	DESCRIPTION

KTN: COLLINS ROAD
GUARDRAIL HSIP

TYPICAL SECTION

CHECKED BY: D. EPSTEIN



DESIGNED BY: D. EPSTEIN

DRAWN BY: D. STEVENS

STATE OF ALASKA
DEPARTMENT OF TRANSPORTATION
& PUBLIC FACILITIES
SOUTHEAST REGION

**KTN - COLLINS ROAD
GUARDRAIL HSIP**

TYPICAL SECTION

PROJECT DESIGNATION	
0902041 - 68412	
STATE	YEAR
ALASKA	2014
SHEET NUMBER	TOTAL SHEETS
B1	6

BASIC BID - ESTIMATE OF QUANTITIES			
ITEM NO	ITEM DESCRIPTION	PAY UNIT	QUANTITY
606 (1)	W-BEAM GUARDRAIL	LINEAR FOOT	256
606 (13)	PARALLEL GUARDRAIL TERMINAL	EACH	2
640 (1)	MOBILIZATION AND DEMOBILIZATION	LUMP SUM	ALL REQUIRED
640 (4)	WORKER MEALS AND LODGING, PER DIEM	LUMP SUM	ALL REQUIRED
641 (1)	EROSION, SEDIMENT AND POLLUTION CONTROL ADMINISTRATION	LUMP SUM	ALL REQUIRED
641 (3)	TEMPORARY EROSION, SEDIMENT AND POLLUTION CONTROL	LUMP SUM	ALL REQUIRED
641 (4)	TEMPORARY EROSION, SEDIMENT AND POLLUTION CONTROL ADDITIVES	CONTINGENT SUM	ALL REQUIRED
643 (2)	TRAFFIC MAINTENANCE	LUMP SUM	ALL REQUIRED
643 (15)	FLAGGING	CONTINGENT SUM	ALL REQUIRED
643 (23)	TRAFFIC PRICE ADJUSTMENT	CONTINGENT SUM	ALL REQUIRED
643 (25)	TRAFFIC CONTROL	CONTINGENT SUM	ALL REQUIRED

Project As Built Drawings Have Been
Reviewed By The Project Engineer &
Represent, To The Best Of My Knowledge,
The Project As Constructed.

Proj. Eng. MB Date 12/11/15

DO NOT SCALE FROM THESE DRAWINGS USE DIMENSIONS

PATH:
Q:\KTN\67674\PLANSET\ADDENDUM
1168412_C1.DWG

TAB: C1GRANTHAM, RICHARD

ADDENDUM NUMBER
2

ATTACHMENT NUMBER
8

RECORD OF REVISIONS

No.	DATE	DESCRIPTION

KTN: COLLINS ROAD
GUARDRAIL HSIP

ESTIMATE OF QUANTITIES

CHECKED BY: D. EPSTEIN



DESIGNED BY: D. EPSTEIN

DRAWN BY: D. STEVENS


STATE OF ALASKA
DEPARTMENT OF TRANSPORTATION
& PUBLIC FACILITIES
SOUTHEAST REGION

KTN - COLLINS ROAD
GUARDRAIL HSIP

ADDENDUM 2
ESTIMATE OF
QUANTITIES

PROJECT DESIGNATION
0902041 - 68412


STATE	YEAR
ALASKA	2014
SHEET NUMBER	TOTAL SHEETS
C1	6

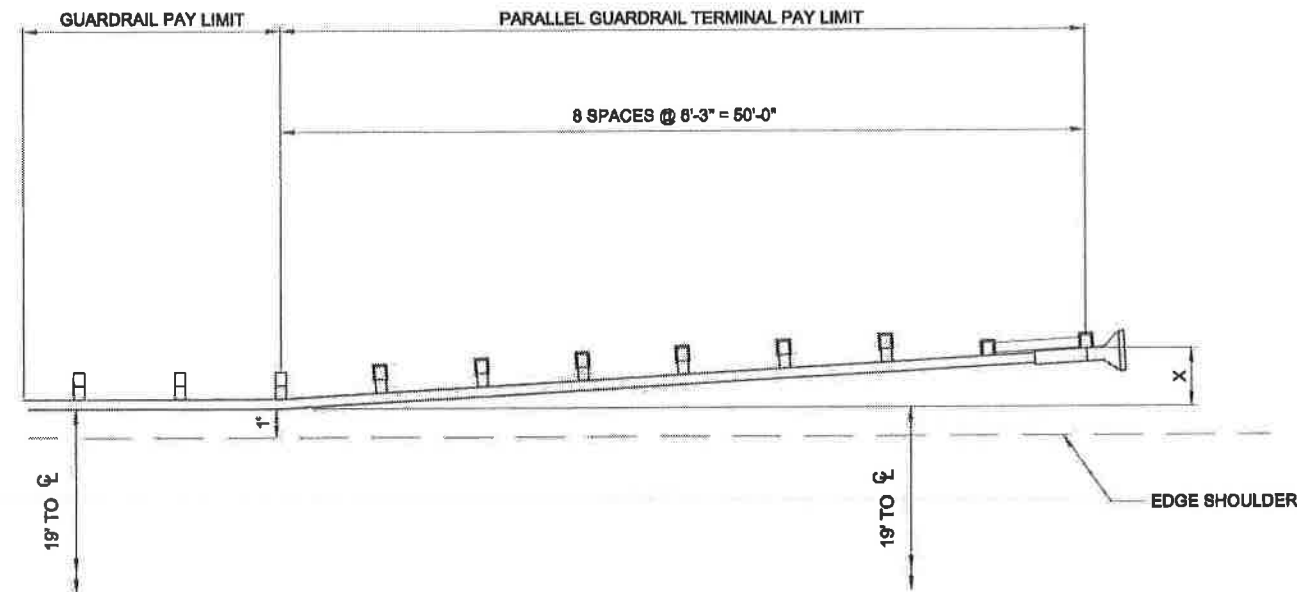

PARALLEL GUARDRAIL TERMINAL LAYOUT PLAN
NO SCALE

NOTES:

1. INSTALLATION AND MATERIALS PER PARALLEL GUARDRAIL TERMINAL MANUFACTURER RECOMMENDATION, DIRECTION, AND SUPPLY.
2. SEE STANDARD DRAWING G-20.10 FOR ADDITIONAL INFORMATION.
3. END OFFSET "X" IS 2 FEET FOR THE UPSTREAM TERMINAL AND 0 FEET FOR THE DOWNSTREAM TERMINAL.

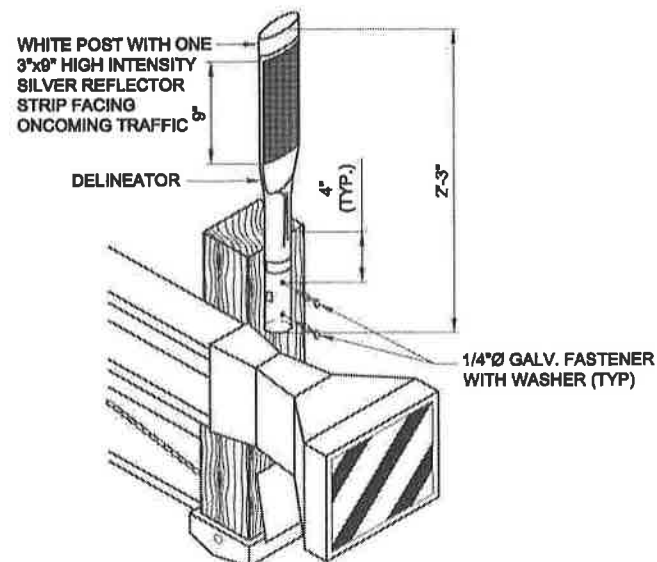

FLEXIBLE GUARDRAIL DELINEATOR
NO SCALE

DELINEATOR NOTES:

1. EACH PARALLEL GUARDRAIL TERMINAL END SHALL HAVE ONE DELINEATOR.

Project As Built Drawings Have Been
Reviewed By The Project Engineer &
Represent, To The Best Of My Knowledge,
The Project As Constructed.

Proj. Eng. MB

Date 12/11/15

DO NOT SCALE FROM THESE DRAWINGS USE DIMENSIONS

PATH:
Q:\KTN\08412\PLANSET\08412_E1
DET8.DWG

TAB: E1 STEVENS, DAVID

ADDENDUM NUMBER

ATTACHMENT NUMBER

RECORD OF REVISIONS

No.	DATE	DESCRIPTION

KTN: COLLINS ROAD
GUARDRAIL HSIP

PARALLEL GUARDRAIL
TERMINAL DETAILS

CHECKED BY: D. EPSTEIN



DESIGNED BY: D. EPSTEIN

DRAWN BY: D. STEVENS

STATE OF ALASKA
DEPARTMENT OF TRANSPORTATION
& PUBLIC FACILITIES
SOUTHEAST REGION


KTN - COLLINS ROAD
GUARDRAIL HSIP

**PARALLEL GUARDRAIL
TERMINAL DETAILS**

PROJECT DESIGNATION

0902041 - 68412

STATE	YEAR
ALASKA	2014
SHEET NUMBER	TOTAL SHEETS
E1	6

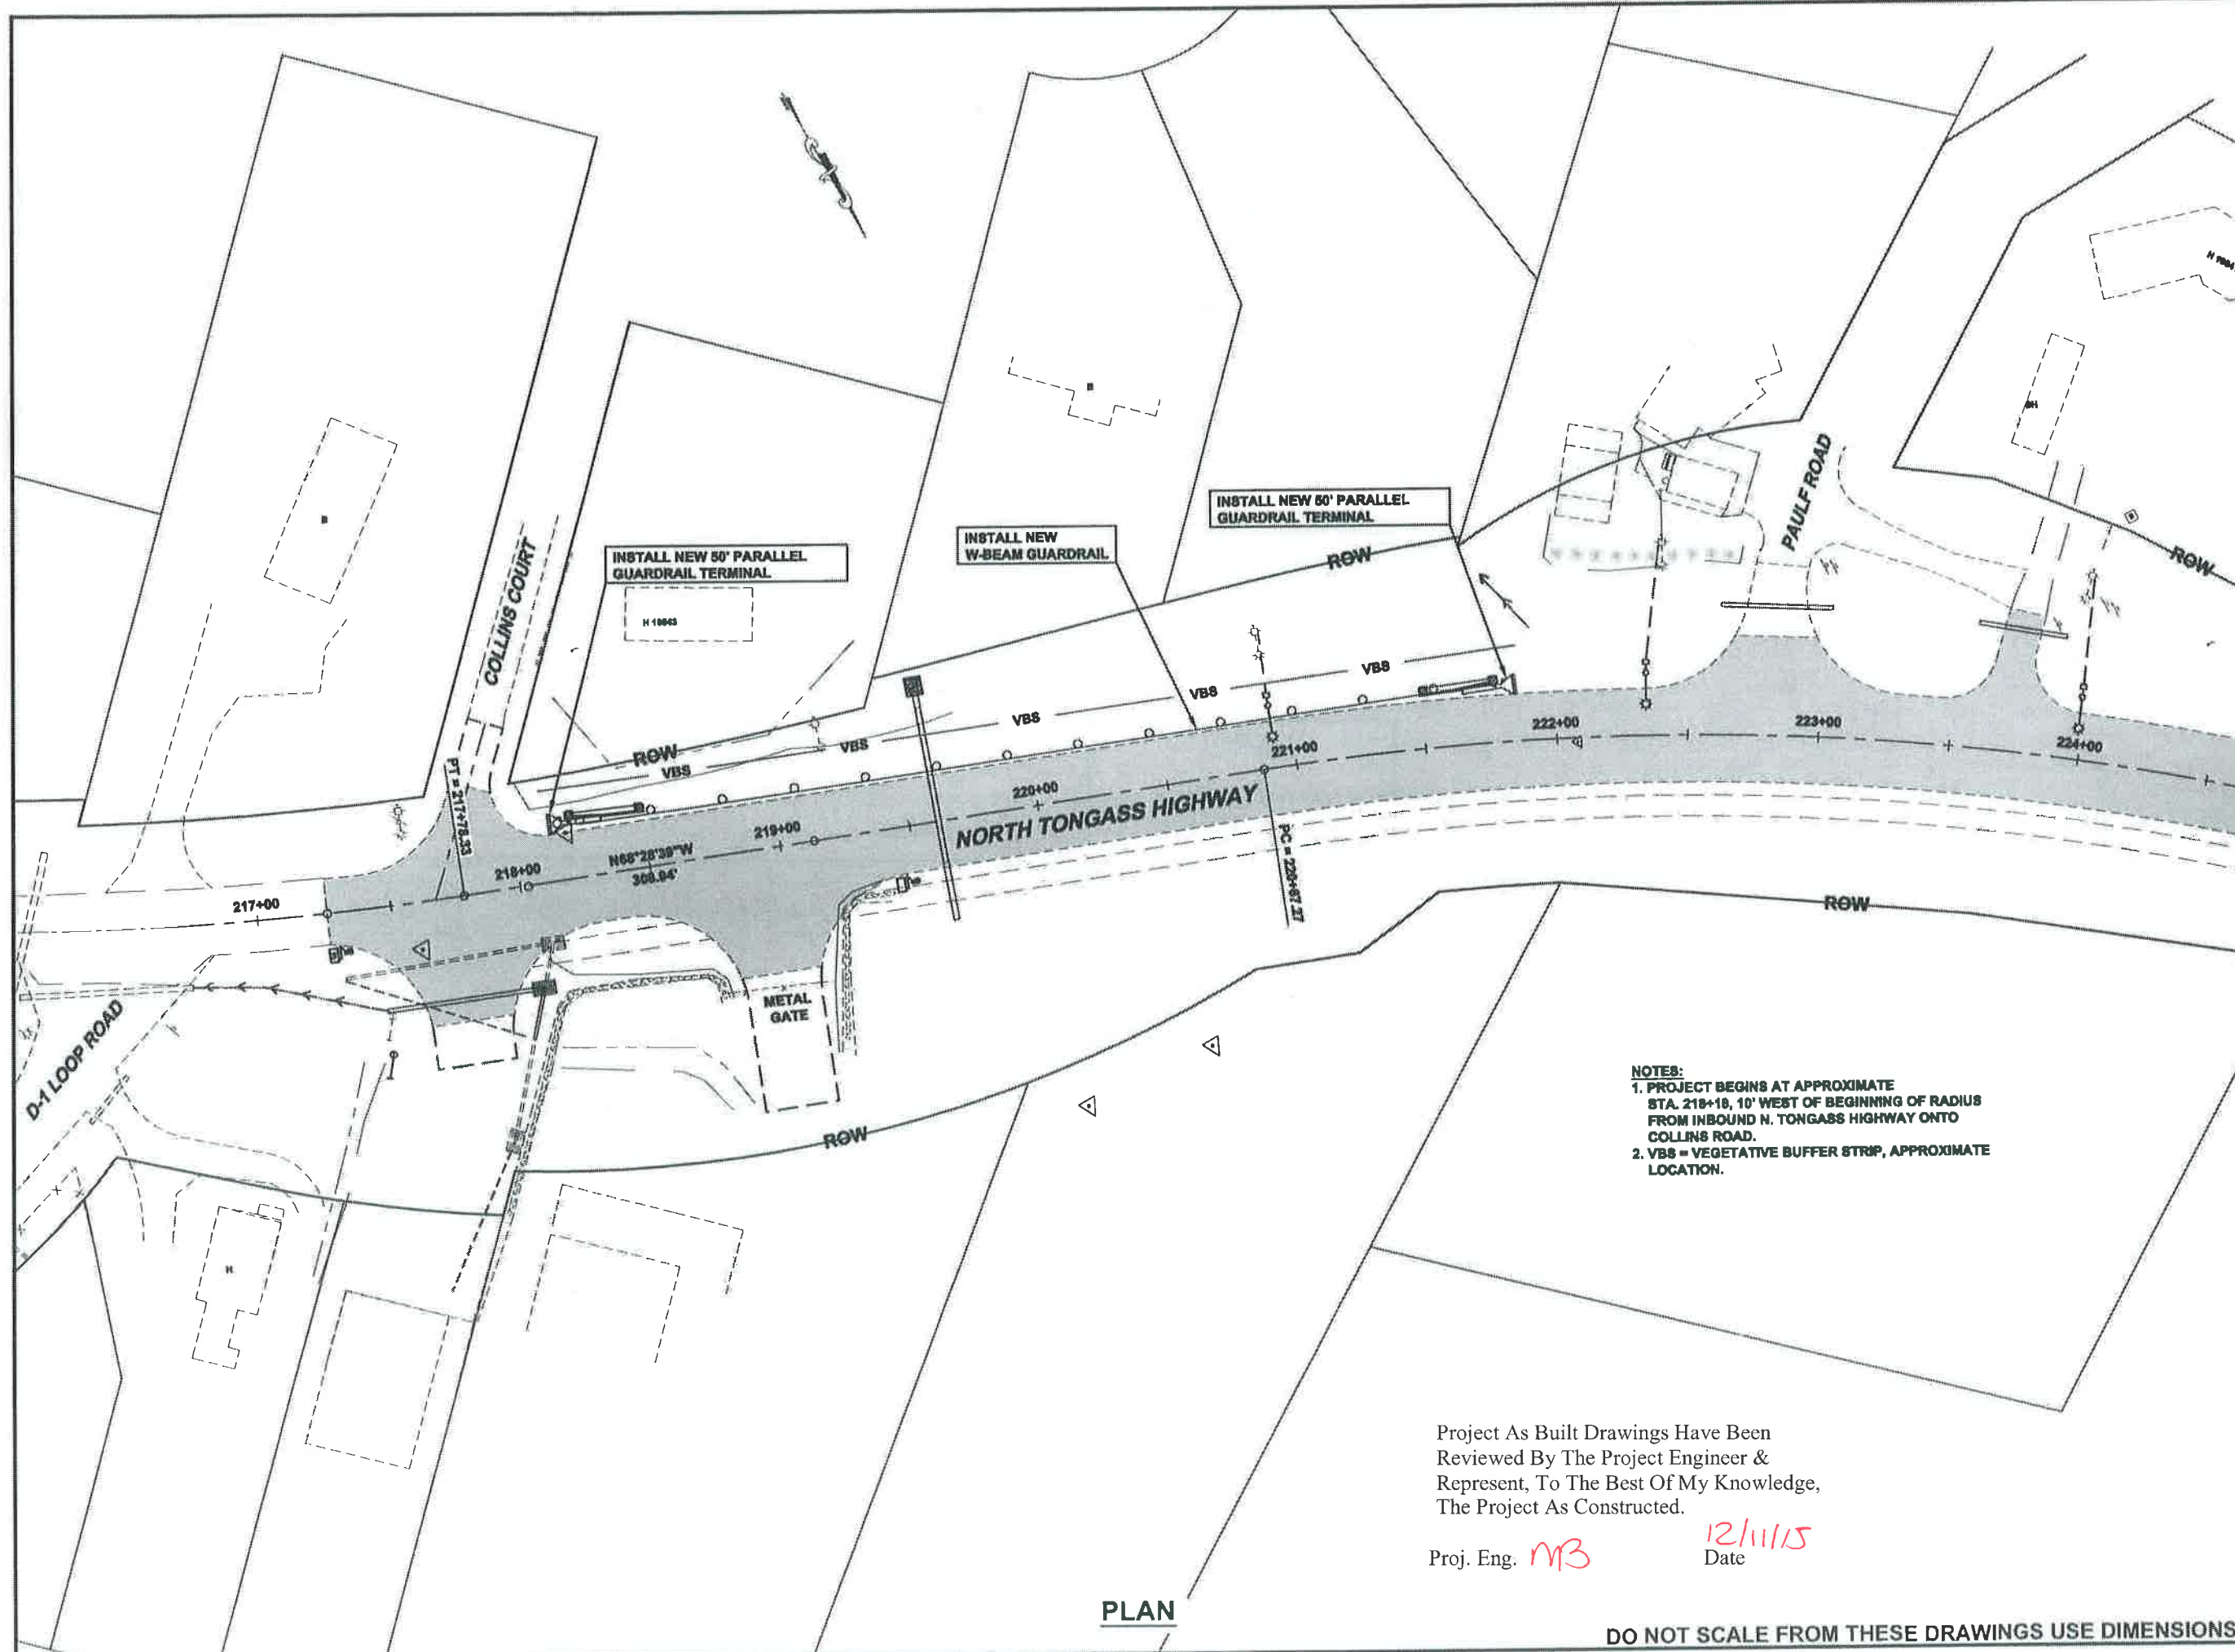

NOTES:
 1. PROJECT BEGINS AT APPROXIMATE STA. 218+18, 10' WEST OF BEGINNING OF RADIUS FROM INBOUND N. TONGASS HIGHWAY ONTO COLLINS ROAD.
 2. VBS = VEGETATIVE BUFFER STRIP, APPROXIMATE LOCATION.

Project As Built Drawings Have Been Reviewed By The Project Engineer & Represent, To The Best Of My Knowledge, The Project As Constructed.

Proj. Eng. *MB* Date *12/11/15*

PLAN

DO NOT SCALE FROM THESE DRAWINGS USE DIMENSIONS

PATH: Q:\KTN\68412\PLANSET\68412_F1_PLAN.DWG
 TAB: F1 STEVENS, DAVID
 ADDENDUM NUMBER
 ATTACHMENT NUMBER
 RECORD OF REVISIONS

No.	DATE	DESCRIPTION

PLAN LEGEND

CHECKED BY: D. EPSTEIN

DESIGNED BY: D. EPSTEIN
 DRAWN BY: D. STEVENS

STATE OF ALASKA
 DEPARTMENT OF TRANSPORTATION
 & PUBLIC FACILITIES
 SOUTHEAST REGION


**KTN - COLLINS ROAD
 GUARDRAIL HSIP**

PLAN VIEW

PROJECT DESIGNATION
0902041 - 68412

STATE	YEAR
ALASKA	2014

SHEET NUMBER	TOTAL SHEETS
F1	6

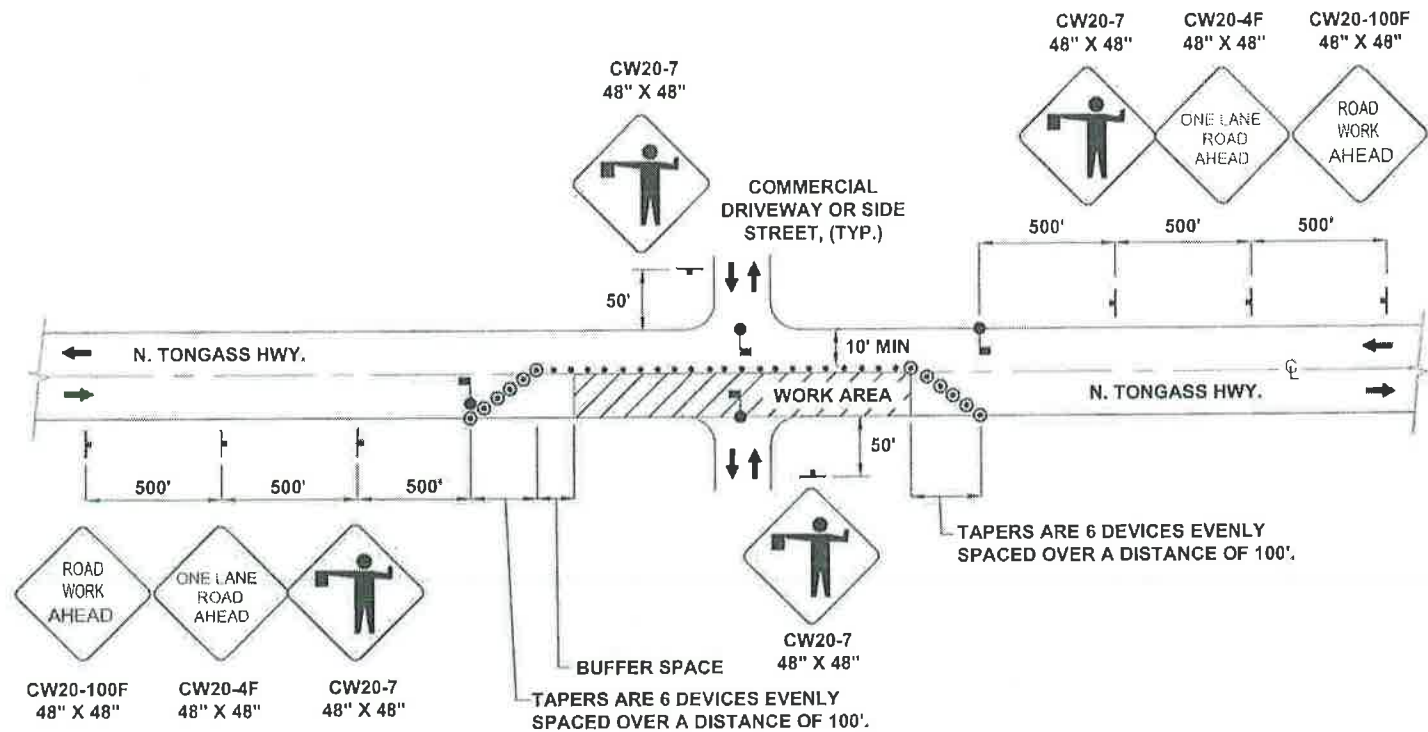

TWO LANE ROADWAY-SINGLE LANE CLOSURE

LEGEND

- SIGN
- CONE
- DRUM
- TYPE III BARRICADE
- FLAGGER

Project As Built Drawings Have Been Reviewed By The Project Engineer & Represent, To The Best Of My Knowledge, The Project As Constructed.

Proj. Eng: MB Date 12/11/15

TCP SETUP TABLE									
SPEED (MPH)	MIN MERGING TAPER LENGTH (L) IN FEET			MIN NUMBER OF DEVICES			MAX DEVICE SPACING IN FEET		BUFFER SPACE (FT)
	WIDTH OF OFFSET (W) IN FEET			WIDTH OF OFFSET (W) IN FEET			ALONG TAPER	ALONG TANGENT	
45	450	495	540	11	12	13	45	90	360
50	500	550	600	11	12	13	50	100	425
55	550	605	660	11	12	13	55	110	495
60	600	660	720	11	12	13	60	120	570

TRAFFIC CONTROL NOTES:

- IT IS THE INTENT OF THIS TRAFFIC CONTROL PLAN (TCP) TO ILLUSTRATE SOME BUT NOT ALL OF THE TRAFFIC CONTROL CONFIGURATIONS THAT WILL BE REQUIRED BY THIS PROJECT. ALL TRAFFIC CONTROL PLANS SHALL BE DEVELOPED BY THE CONTRACTOR AND SUBMITTED TO THE ENGINEER FOR APPROVAL PRIOR TO USE.
- A MINIMUM OF ONE LANE SHALL BE MAINTAINED AT ALL TIMES IN WORK AREAS.
- TWO LANES SHALL BE MAINTAINED AT ALL TIMES WITHIN THE PROJECT LIMITS IN NON-WORK AREAS AND DURING NON-WORKING HOURS.
- DRIVING LANES SHALL BE A MINIMUM WIDTH OF 10'.
- TRAFFIC DELAYS SHALL NOT EXCEED 5 MINUTES.
- WORK SHALL BE ACCOMPLISHED ONLY BETWEEN THE HOURS OF 9AM AND 4PM.
- SEE TCP SETUP TABLE FOR TAPER AND BUFFER SPACE DIMENSIONS.

DO NOT SCALE FROM THESE DRAWINGS USE DIMENSIONS

PATH:
Q:\KTN\67674\PLANSET\ADDENDUM
1168412_S1.DWG

TAB: S1

GRANTHAM, RICH

ADDENDUM NUMBER
2

ATTACHMENT NUMBER
9

RECORD OF REVISIONS

No.	DATE	DESCRIPTION

KTN: COLLINS ROAD
GUARDRAIL HSIP

TRAFFIC CONTROL PLAN

CHECKED BY:

DESIGNED BY:

DRAWN BY:


STATE OF ALASKA
DEPARTMENT OF TRANSPORTATION
& PUBLIC FACILITIES
SOUTHEAST REGION

KTN - COLLINS ROAD
GUARDRAIL HSIP

ADDENDUM 2
TRAFFIC CONTROL
PLAN

PROJECT DESIGNATION
0902041 - 68412

STATE	YEAR
ALASKA	2014
SHEET NUMBER	TOTAL SHEETS
S1	6

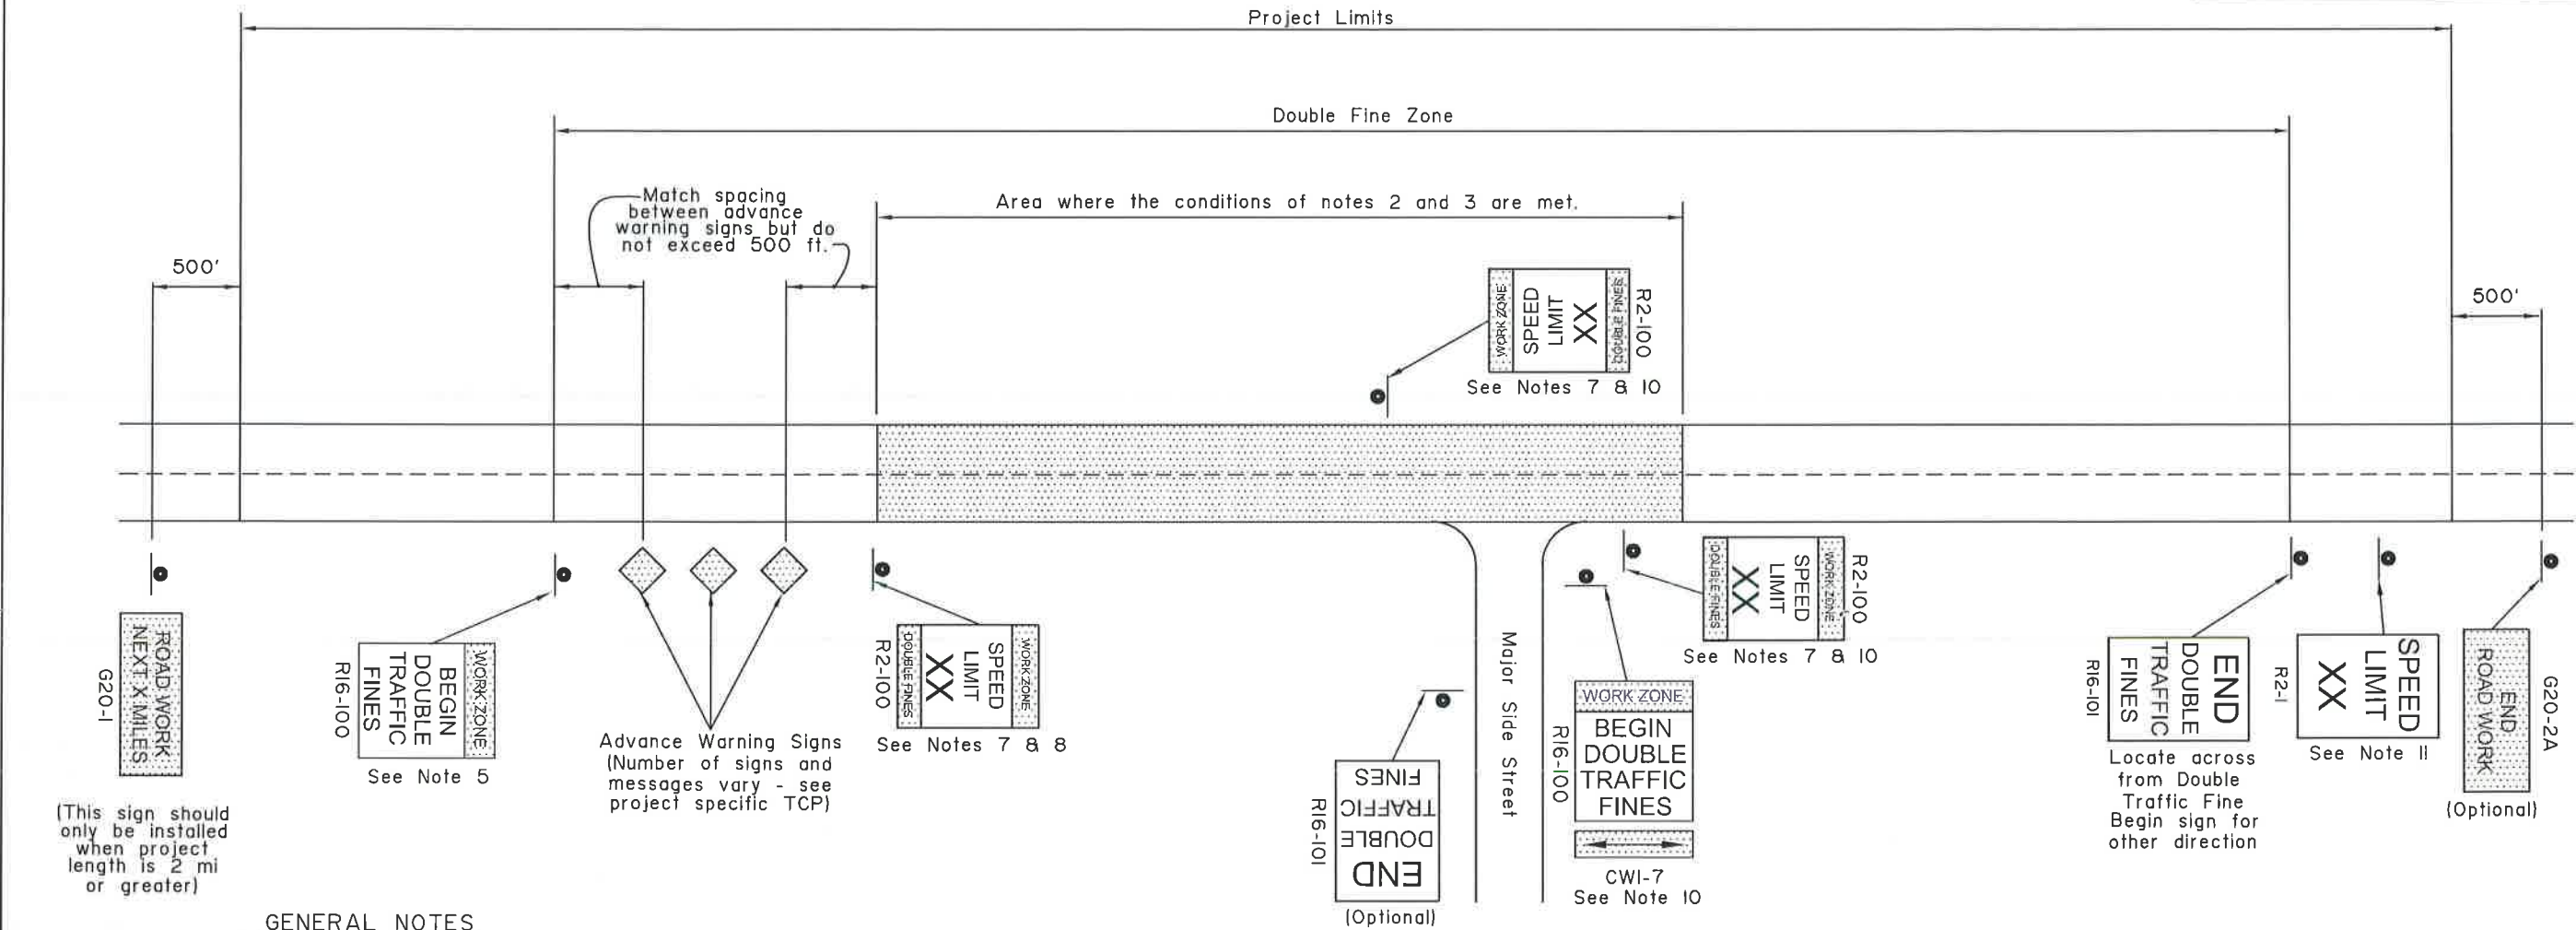

GENERAL NOTES

1. Signs are shown for one direction only (with one exception). Signs for the other direction mirror those shown.

2. Double fine signs shall be used only where one or more of the following conditions exist:

a. Active work areas (where road workers and/or machines are presently working on or adjacent to a road)

b. Detours on new temporary roads built for that purpose (this does not include detours on existing streets)

c. Sections of paved roads where pavement has been removed.

d. Roads being paved where unmatched asphalt lifts result in a vertical lip between lanes.

3. Double fine signs shall be confined to the areas where the above conditions exist, with the following exceptions:

a. If the project is 2 miles or shorter in length, the entire project may be posted for double fines when the above conditions exist on any part of the project.

b. When the above conditions exist at multiple locations separated by less than 2 miles, the locations and the intervening segments may be posted as a single double fine zone.

4. Double fine signs shall be removed or covered when work activity ceases for more than two days and conditions b, c, or d of note 2 are not met.

5. The R16-100 "BEGIN" sign may be used in place of the first advance warning sign. However, when this is done, the appropriate advance warning sign must be reinstalled when the double fine sign is taken down or covered.

6. When a double fine zone is longer than 2 miles, work zone speed limit signs shall be posted at spacings not greater than 2 miles within the double fine zone.

7. "Work zone speed limit signs", as used here, refer either to 1) R2-100 signs or 2) standard R2-1 regulatory speed limit signs with CW20-102 "DOUBLE FINES" plates mounted below.

8. The limit shown on work zone speed limit signs shall be either the existing limit before construction or, if a work zone speed limit order has been approved in accordance with ADOT&PF Procedure 05.05.020 PDR, a reduced limit.

9. All existing regulatory speed limit signs within double fine zones shall either be replaced with R2-100 signs or supplemented with CW20-102 plates.

10. Signs shall be installed at major intersections within the double fine zone to warn entering drivers of double fines. This may be done with a R16-100 sign with a CWI-7 arrow panel on the side street or with two work zone speed limit signs on the main street on either side of the intersection. Use of R16-100 signs on side streets eliminates the need for "Road Work Ahead" signs on those streets. If the speed limit has been reduced, the two work zone speed limit signs are mandatory.

11. At the end of each double fine zone, install an R2-1 sign showing the speed limit for the road beyond the double fine zone.

Project As Built Drawings Have Been
Reviewed By The Project Engineer &
Represent, To The Best Of My Knowledge,
The Project As Constructed.

Proj. Eng. *MB* Date *12/11/15*

REVISIONS		
Date	Description	By
6/11/99	Revised Notes	KJS
2/28/03	Rev. Notes & Sign No's	KJS

State of Alaska
Department of Transportation
& Public Facilities

LOCATION OF
DOUBLE TRAFFIC
FINE SIGNS

APPROVED
[Signature]
3/31/99


49th
State of Alaska
Department of Transportation
& Public Facilities

Date

C-04.12


GENERAL NOTES:

- Final pavement markings conforming to Part 3 of the Alaska Traffic Manual should be installed before paved roads are open to public travel. If that is not practical, install interim pavement markings as shown on this drawing. Maintain interim pavement markings until final pavement markings are installed.
- No interim pavement markings are required:
 - on projects that will not have permanent markings when finished.
 - in work zones that are open to public travel for no more than one work shift during daytime or for no more than one hour at night.
 - where DO NOT PASS and PASS WITH CARE signs are installed on two lane roads as shown in Detail C, no pavement markings are required:
 - for 3 days if seasonal ADT is above 2000, or
 - for 1 month if seasonal ADT is below 2000.
- Interim pavement markings should not be in place longer than 14 calendar days before being replaced with permanent markings conforming to Part 3 of the Alaska Traffic Manual unless the Engineer provides written approval.
- Where R4-1 DO NOT PASS signs are used, install at the beginning of no passing zones and at no more than 1500' spacings within no passing zones.
- Install high level warning devices on all DO NOT PASS and PASS WITH CARE signs.
- Offset temporary markings 8"-12" from the future location of permanent markings if applied on the same lift of pavement.
- Dimensions in parenthesis apply to curves with a radius of 1000 feet or less or where posted speed limit is 30 mph or less.

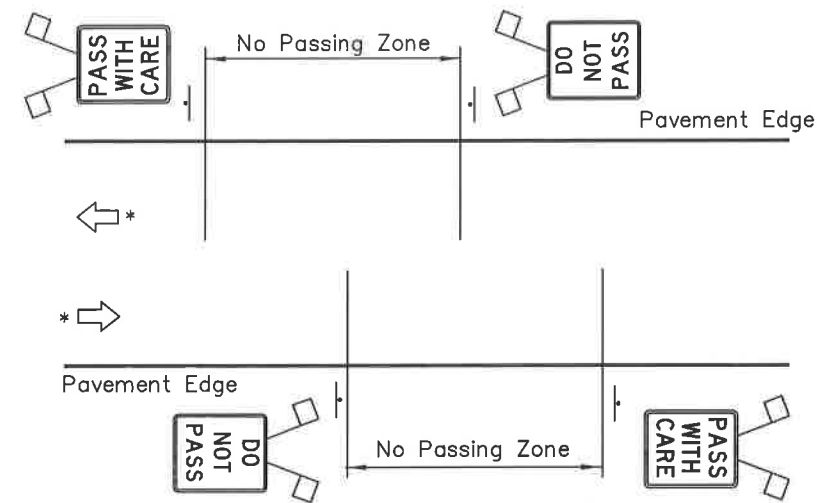

DETAIL C


Two-lane road: No Passing Zones indicated by signs only (see Note 2c). No centerline delineation.

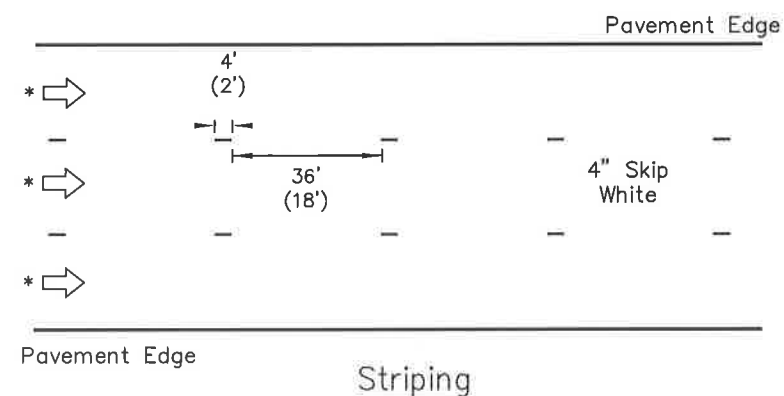

DETAIL D


Multilane one-way road: Lane dividing lines

* Direction of Travel

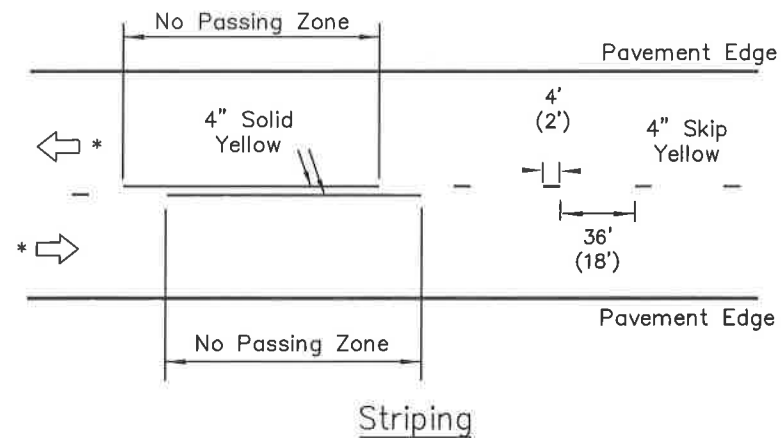


DETAIL A

Two-lane road: No Passing Zones indicated with pavement markings.

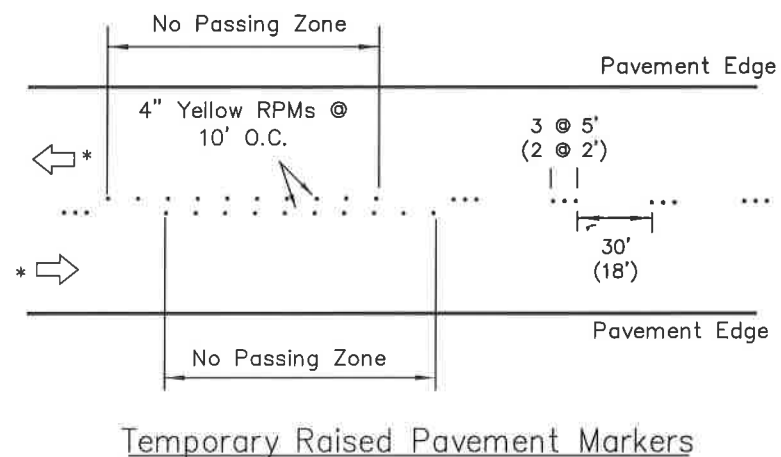

DETAIL B

Two-lane road: No Passing Zones indicated by signs only. Raised pavement markers for centerline delineation.

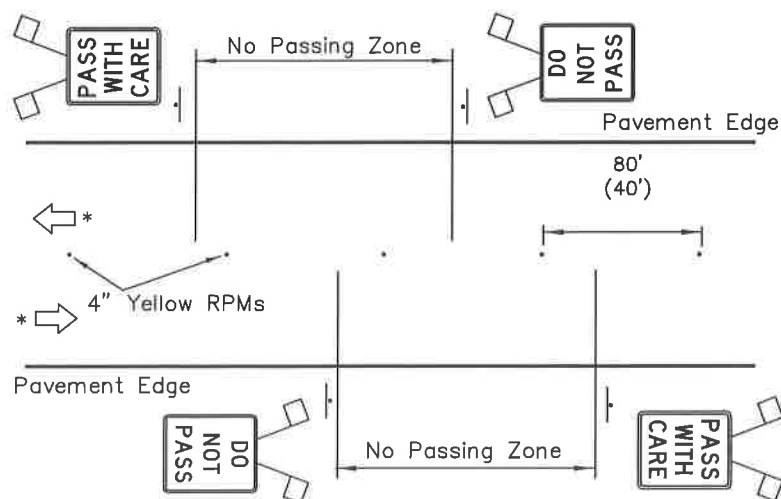

REVISIONS		
Date	Description	By
4/28/10	RPM spacing, signs	KJS

Sheet 1 of 1

State of Alaska
Department of Transportation
& Public Facilities

**INTERIM
PAVEMENT MARKINGS**

APPROVED



Project As Built Drawings Have Been Reviewed By The Project Engineer & Represent, To The Best Of My Knowledge, The Project As Constructed.



Proj. Eng. MB

12/11/15
Date


Date 5/31/12

GENERAL NOTES:

1. Silt Fence Supports shall be 2-inch PVC pipe reinforced with iron pipe or No. 6 rebar, wood posts, or as approved.
2. For Water Installations, secure the ends of the silt fence to the stream bank by staking.
3. Use approved Wire Support Mesh to keep filter fabric in place in water installations.
4. For Land Installations, fence shall be placed at the toe of embankment or excavation areas, or as directed.
5. Fence anchored in standing water shall have the bottom anchored with sandbags or equivalent to prevent gaps.
6. Installation and application shall be in accordance with the practices as outlined in the Erosion and Sediment Control Plan.
7. Filter fabric shall be overlapped 6 inches at fence supports.
8. Filter fabric shall be hung taut, not loose or folded.

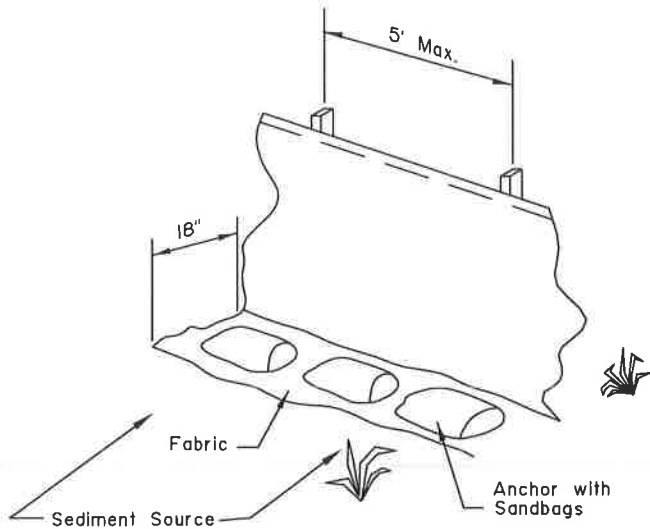
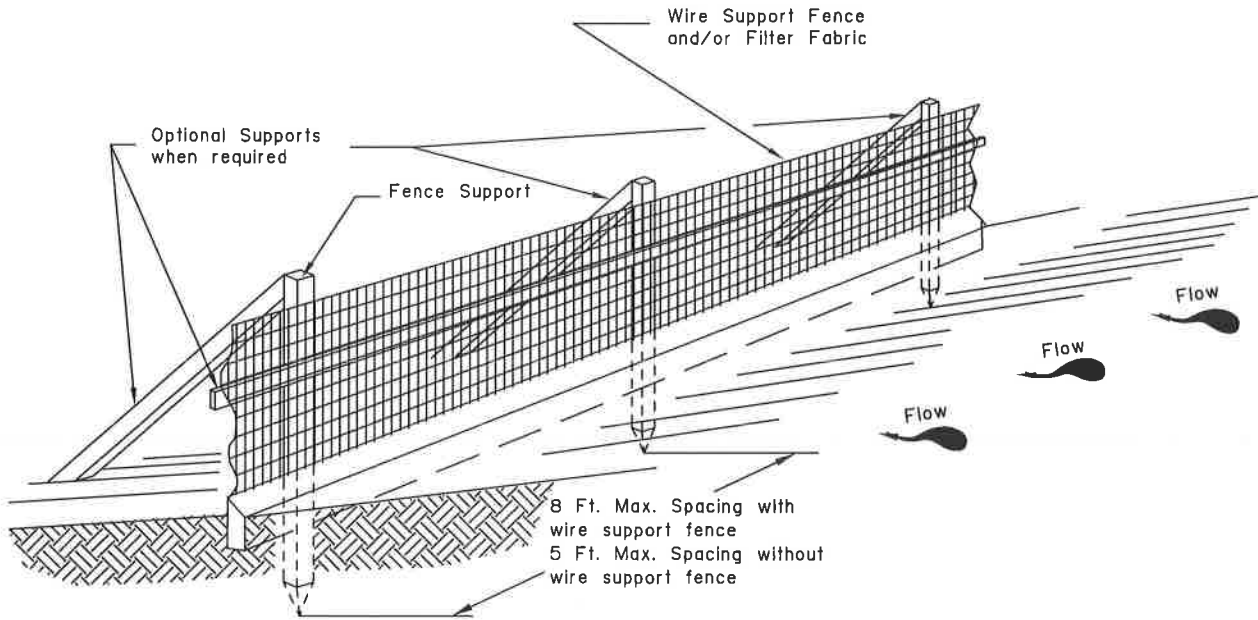


SANDBAG SUPPORT DETAIL

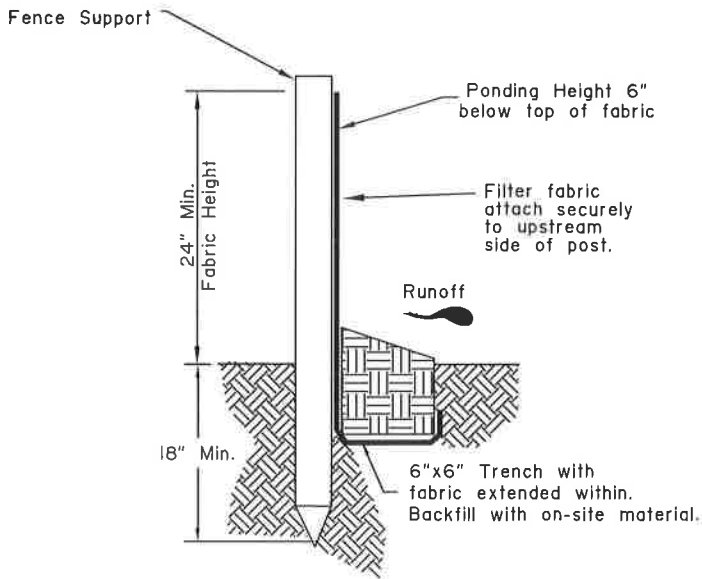

TRENCH SUPPORT DETAIL

TYPICAL LAND INSTALLATION

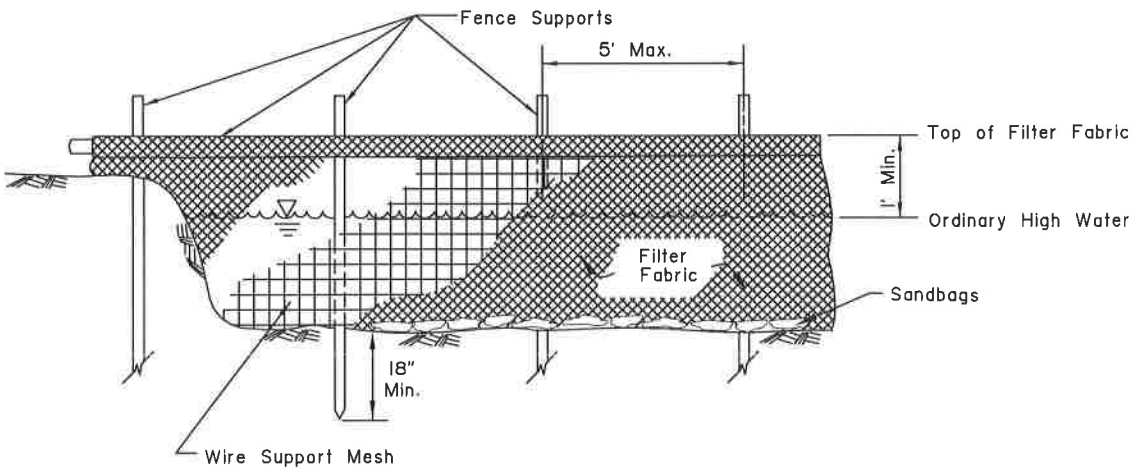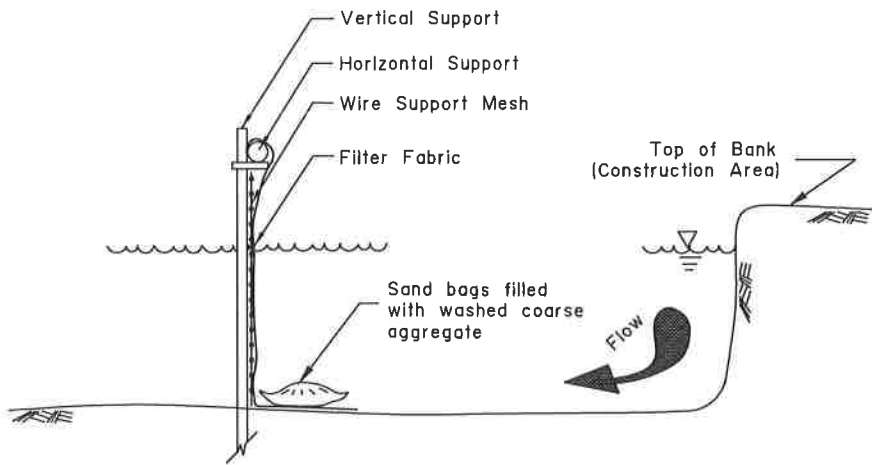

TYPICAL WATER INSTALLATION

Project As Built Drawings Have Been Reviewed By The Project Engineer & Represent, To The Best Of My Knowledge, The Project As Constructed.

Proj. Eng. MB 12/11/15 Date

REVISIONS		
Date	Description	By

State of Alaska
Department of Transportation
& Public Facilities


SEDIMENT CONTROL
SYSTEM
(SILT FENCE)

APPROVED
1/1/96

Date


GENERAL NOTES:

1. All covered hardware shall comply with the AASHTO/AGC/ARTBA "A Guide to Standardized Highway Barrier Hardware", latest edition.

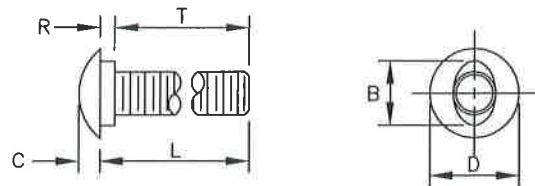


B	C	D	L (Length)	R	T (Thread Length)
15/16"	5/16"	1 5/16" or 1 7/16"	As Required	7/32"	As Required

5/8" BUTTONHEAD BOLT

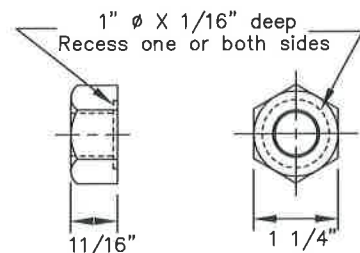


5/8" Dia. RECESSED HEX NUT

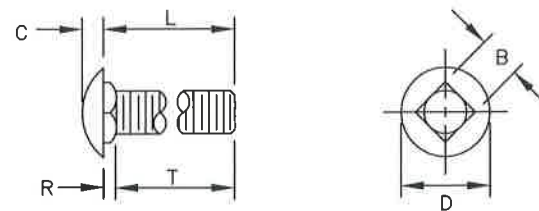


B	C	D	L (Length)	R	T (Thread Length)
5/8"	5/16"	1 5/16"	As Required	3/16"	As Required

5/8" Dia. CARRIAGE BOLT

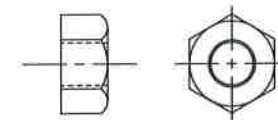


STANDARD HEX NUT

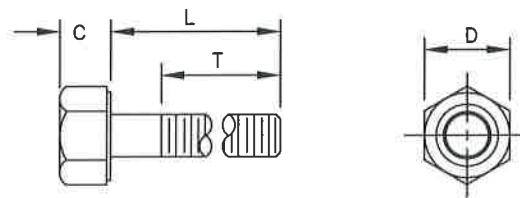


Bolt Size	C	D	L (Length)	T (Thread Length)
5/16"	—	—	1 1/2"	7/8"
5/16"	—	—	1"	1"
3/8"	—	—	7 1/2"	1 1/2"
1/2"	—	—	1 1/2"	1 1/2"
1/2"	—	—	1 1/4"	1 1/4"
5/8" H.S.	5/16"	7/8"	8"	1 1/2"
5/8"-11	—	—	1 1/2"	1 1/2"
3/4"	—	—	1 1/2"	1 1/2"
3/4"	—	—	As Required	2"
3/4" H.S.	15/32"	1 1/4"	2"	1 1/2"

STANDARD HEX BOLTS

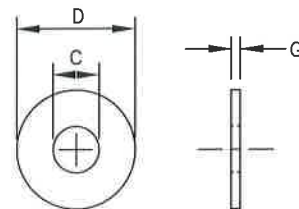


For Bolt Ø	C	D	G
3/8"	7/16"	1"	5/64"
1/2"	17/32"	1 1/16"	3/32"
1/2" H.S.	17/32"	1 1/16"	3/32"
5/8"	11/16"	1 3/4"	9/64"
3/4"	13/16"	1 15/32"	9/64"
3/4" H.S.	13/16"	2"	5/32"
1"	1 1/16"	2"	9/64"


STANDARD STEEL WASHERS

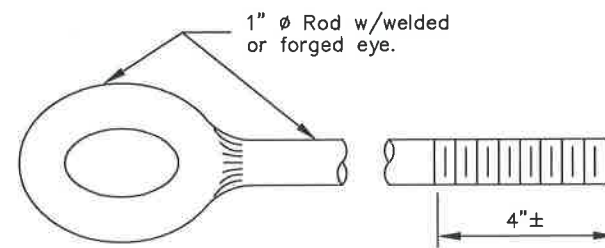


EYE BOLT

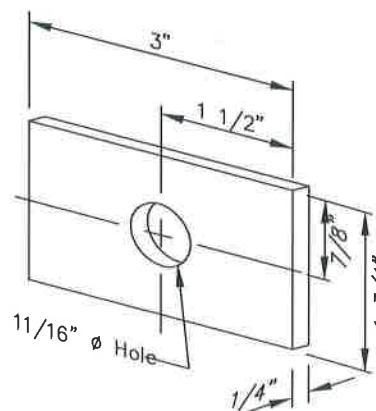

FLAT PLATE WASHER

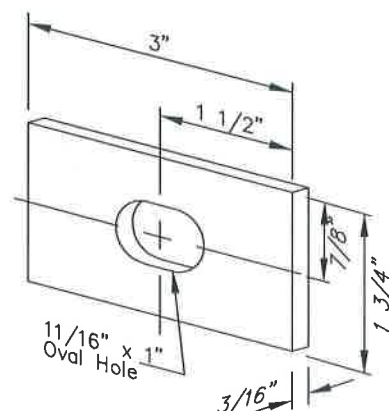

RECTANGULAR POST BOLT WASHER

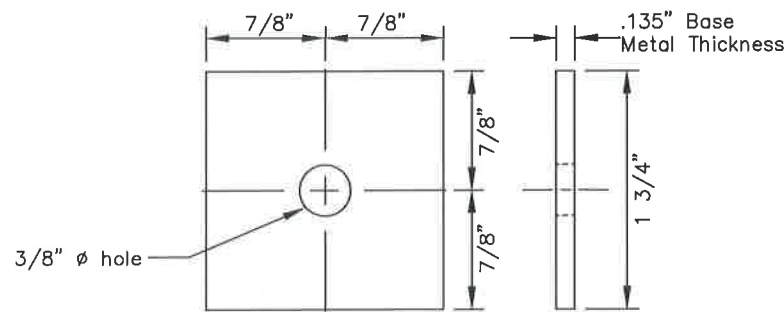

SQUARE STEEL WASHER

Project As Built Drawings Have Been Reviewed By The Project Engineer & Represent, To The Best Of My Knowledge, The Project As Constructed.

Proj. Eng. MB

12/11/15
Date

REVISIONS		
Date	Description	By
3/15/99	Delete BCT Hardware	KJS

State of Alaska
Department of Transportation
& Public Facilities
**STANDARD GUARDRAIL
HARDWARE
(NUTS, BOLTS, WASHERS)**

APPROVED



Date 5/31/12

GENERAL NOTES:

- Provide hardware compliant with the AASHTO/AGC/ARTBA "A Guide to Standardized Highway Barrier Hardware, latest edition.
- Install back-up plates between blockouts and w-beam or thrie-beam rail at intermediate (non-splice) posts when steel blockouts are used but not with wood, rubber, plastic, or other approved blockouts.
- Provide Thrie beam and W-beam compliant with AASHTO M180A. Use 12 gauge (0.105") thick steel for both.








Project As Built Drawings Have Been Reviewed By The Project Engineer & Represent, To The Best Of My Knowledge, The Project As Constructed.

Proj. Eng. *NB*

12/11/15
Date


REVISIONS		
Date	Description	By
4/28/10	Revise General Notes	KJS

State of Alaska
Department of Transportation
& Public Facilities
**STANDARD GUARDRAIL
HARDWARE
(RAILS AND SPLICES)**

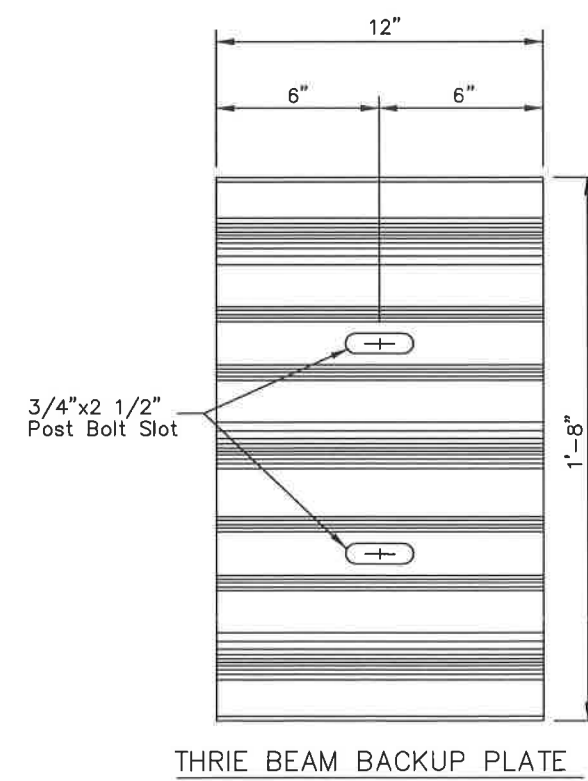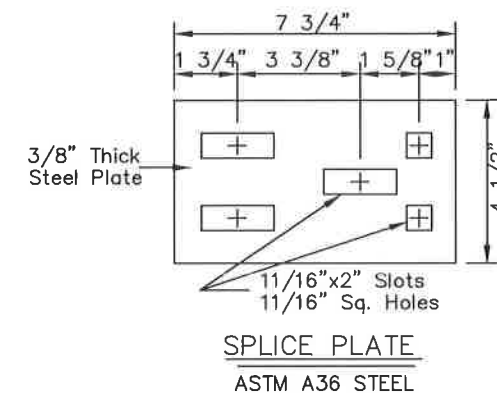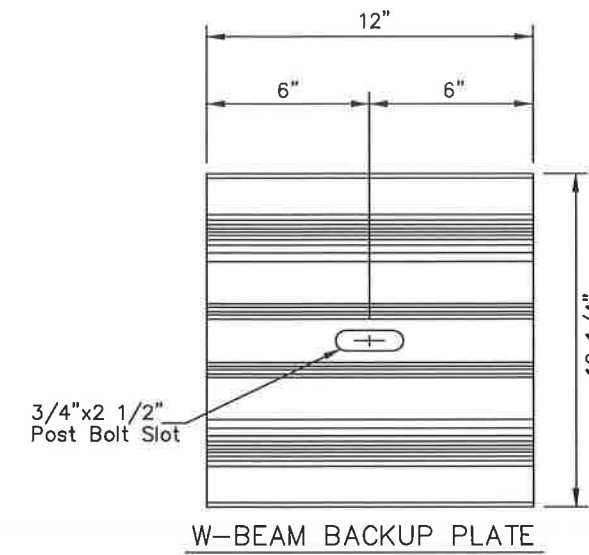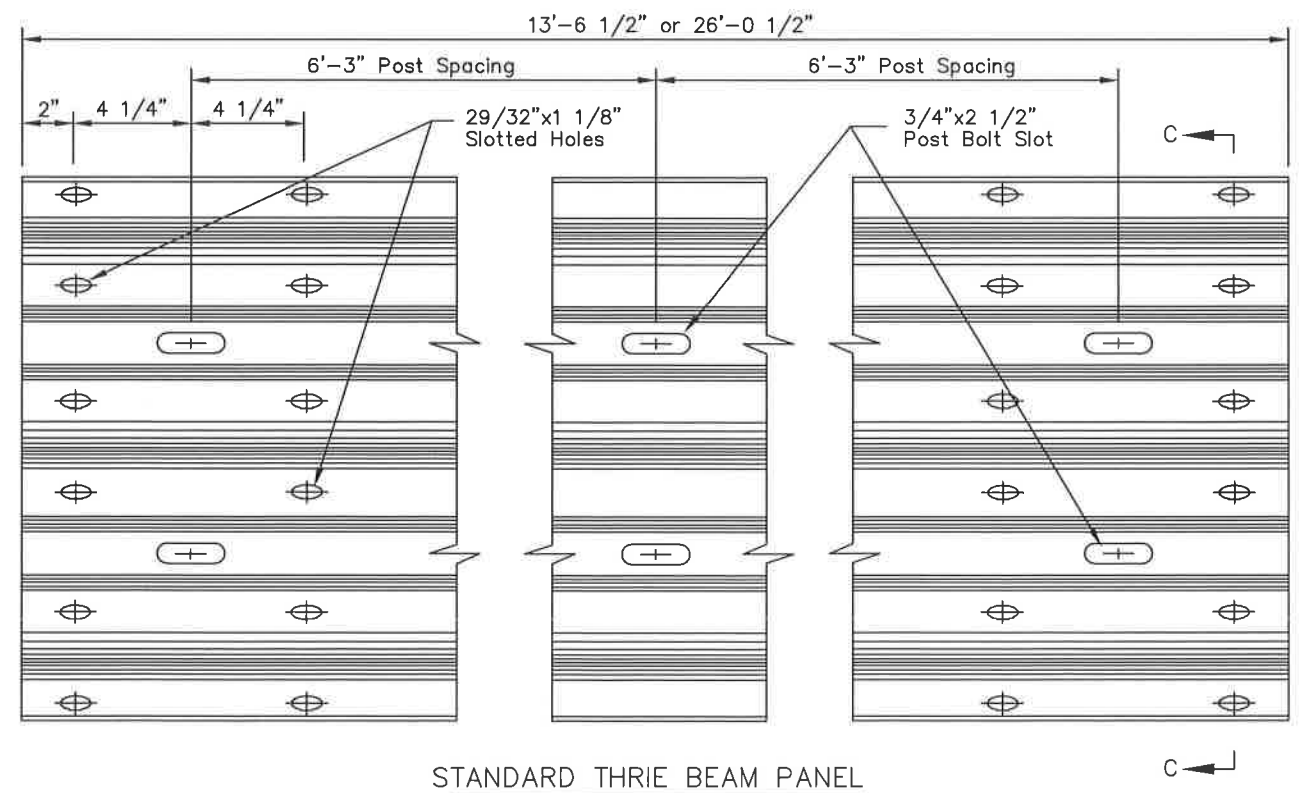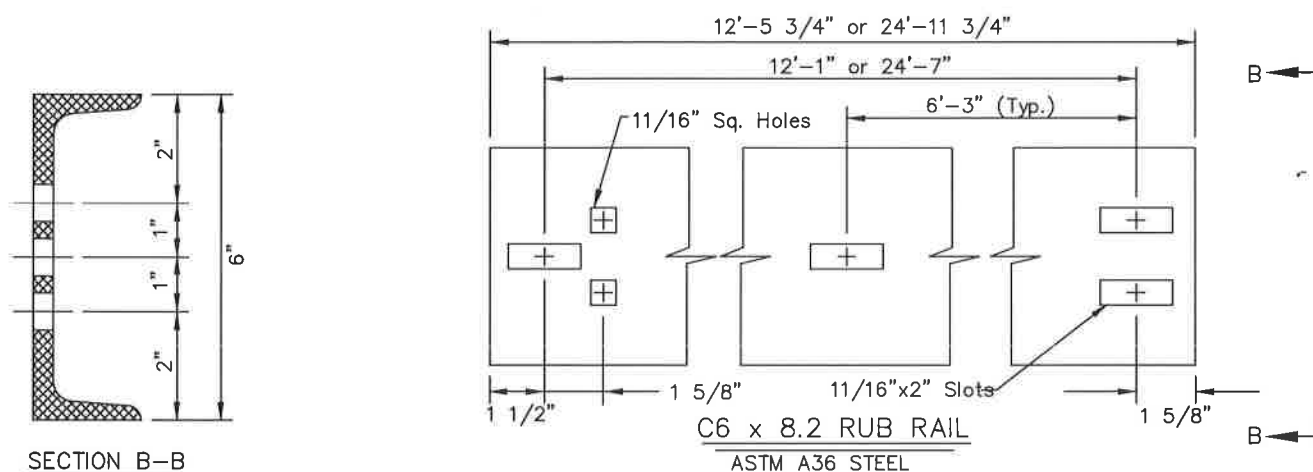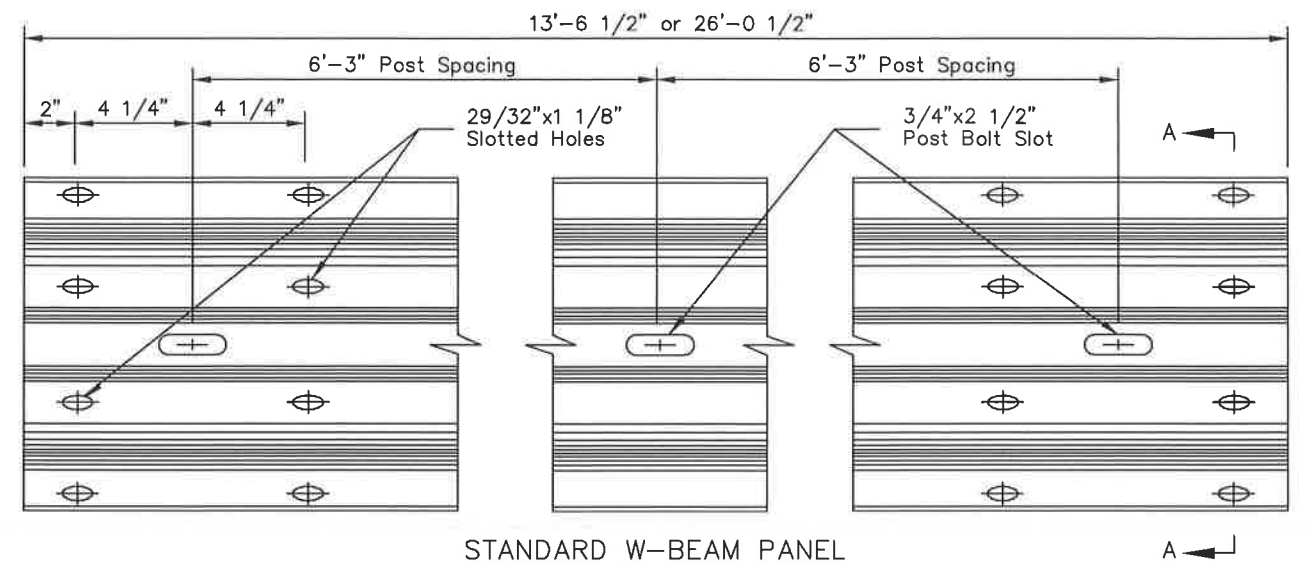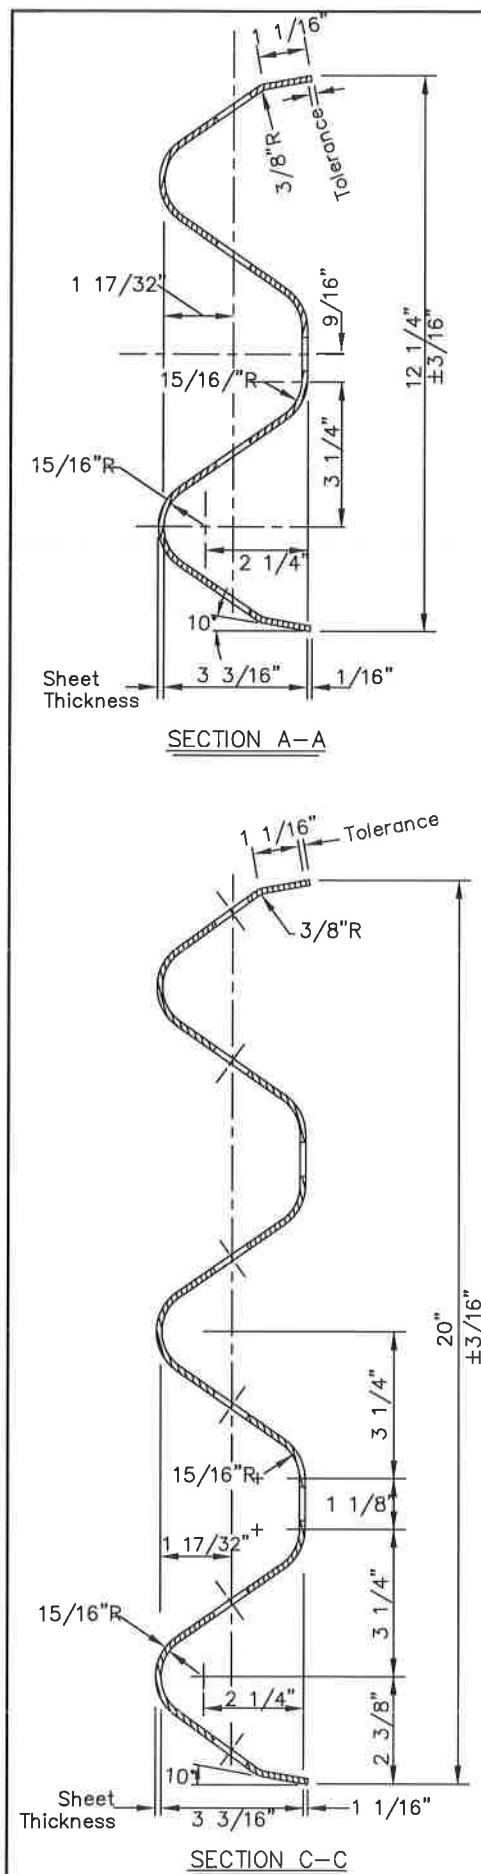


GENERAL NOTES:


1. W-Beam and Thrie Beam Terminal Connectors shall conform to AASHTO M180, Class B, Type 2.
2. W-Beam end sections shall conform to AASHTO M180, Class A, Type 2.
3. All covered hardware shall comply with the AASHTO/AGC/ARTBA "A Guide to Standardized Highway Barrier Hardware", latest edition.

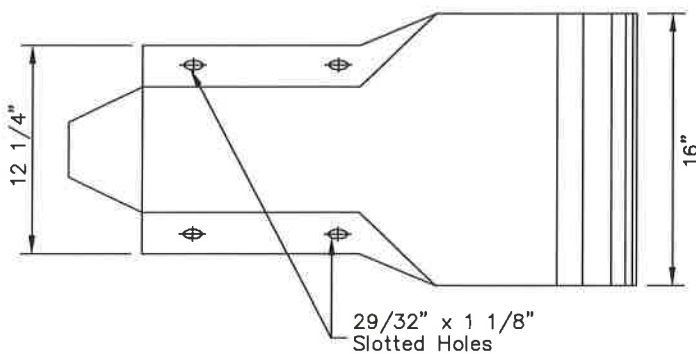

PROFILE

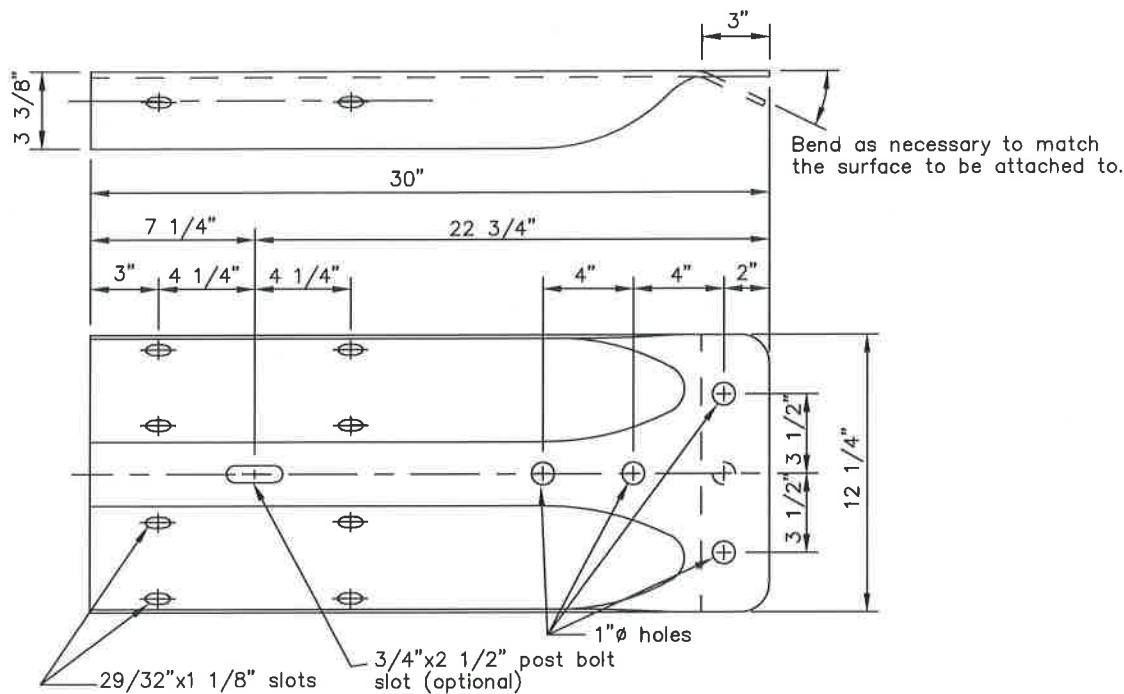


STANDARD W-BEAM TERMINAL CONNECTOR

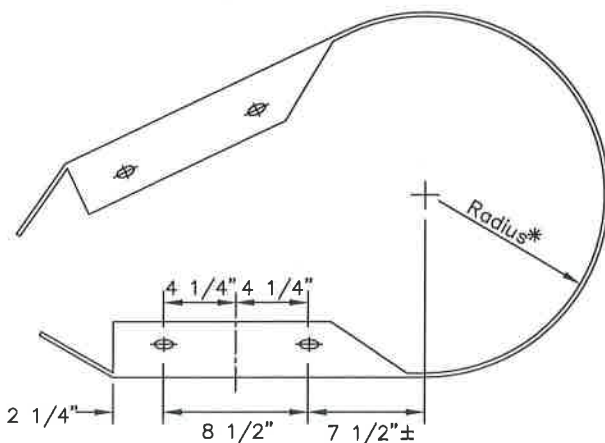

W-BEAM PLAN VIEW

*Radius to be specified on the plans

STANDARD W-BEAM END SECTION

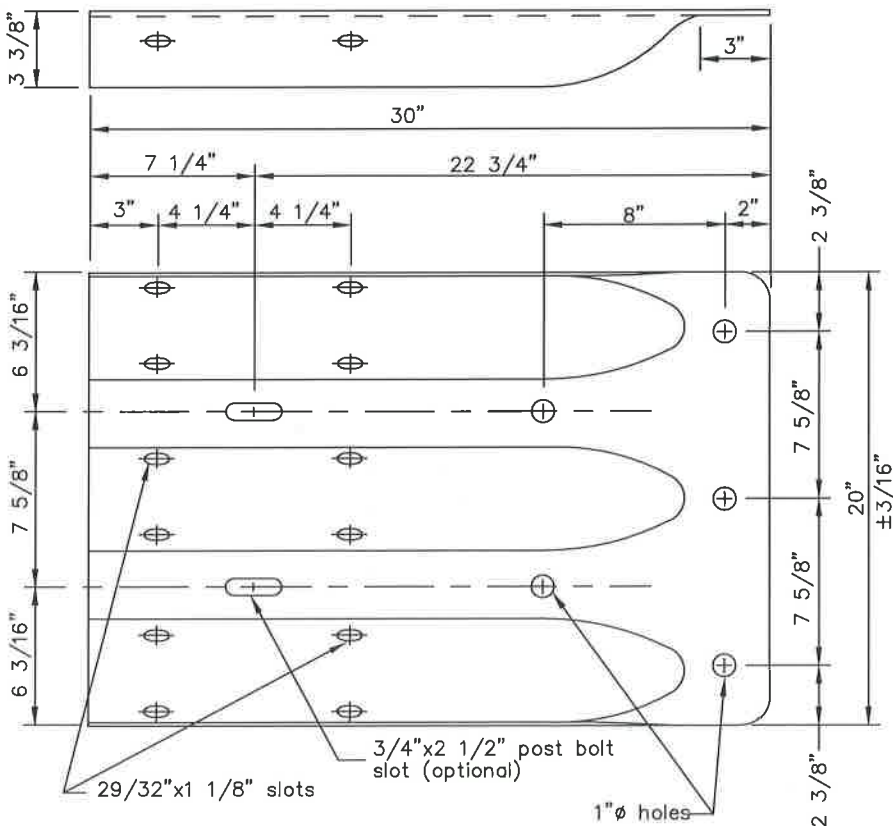

STANDARD THRIE BEAM TERMINAL CONNECTOR

Project As Built Drawings Have Been Reviewed By The Project Engineer & Represent, To The Best Of My Knowledge, The Project As Constructed.

Proj. Eng. MB

Date

12/11/15

REVISIONS		
Date	Description	By
3/15/99	Delete Thrie End Sect.	KJS

State of Alaska
Department of Transportation
& Public Facilities

STANDARD GUARDRAIL
HARDWARE
(TERMINAL CONNECTORS)



Date 5/31/12

1. Cable Anchor Plate may be formed in single unit or welded fabrication.
2. Anchor Cable Assembly shall conform to AASHTO M-30 with Type II Wire Rope.
3. Sleeve for Wood Posts shall conform to the requirements of ASTM A120 and shall be of 2-inch galvanized standard pipe. Sleeve shall be a tight, pressed fit in post.
4. Bolts, nuts and washers shall conform to ASTM A-325 and galvanized in accordance with ASTM A-153.
5. Radius ID plates shall be attached to all shop-bent guardrail sections. They shall be bolted to the back side of the guardrail panel with the lower splice bolt nearest the P.C. of the radius.
6. Rail bend radius in feet shall be shown as "XX" on the radius ID plate. Digits shall be etched or stamped and have a min. height of 1 1/2" and a max. width of 3/4". The plate shall be galvanized after digits are marked.
7. All covered hardware shall comply with the AASHTO/AGC/ARTBA "A Guide to Standardized Highway Barrier Hardware", latest edition.

Proj. Eng. **NR**

Date _____

REVISIONS		
Date	Description	By
3/15/99	Delete BCT Hardware	KJS

STANDARD GUARDRAIL HARDWARE (MISCELLANEOUS)

A
B
C
D
E
F
G
H
I
J
K
L
M
N
O
P
Q
R
S
T
U
V
W
X
Y
Z
[
\
]
^_`~Date 5/31/12


G-00 02.




CONTROLLED RELEASE TERMINAL HARDWARE DETAILS



Type	Guardrail Color	Reflectors ReflectORIZED
A	White	Front & Rear
B	White	Front
C	Yellow	Front
D	Yellow	Front & Rear

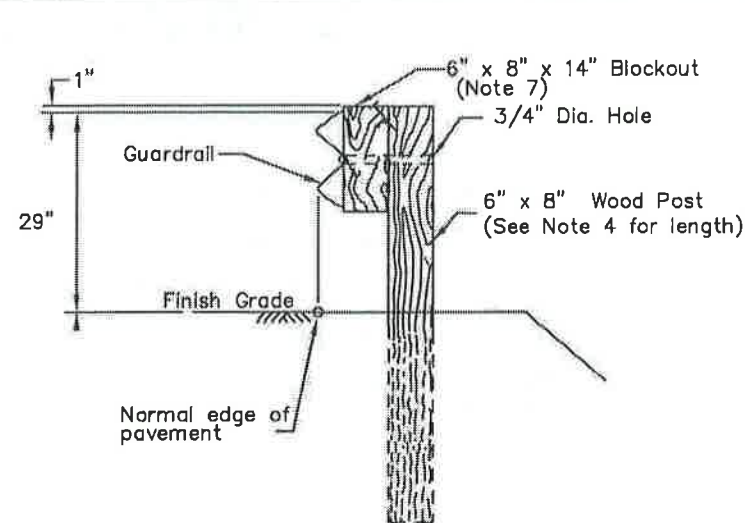


TYPE I POST INSTALLATION

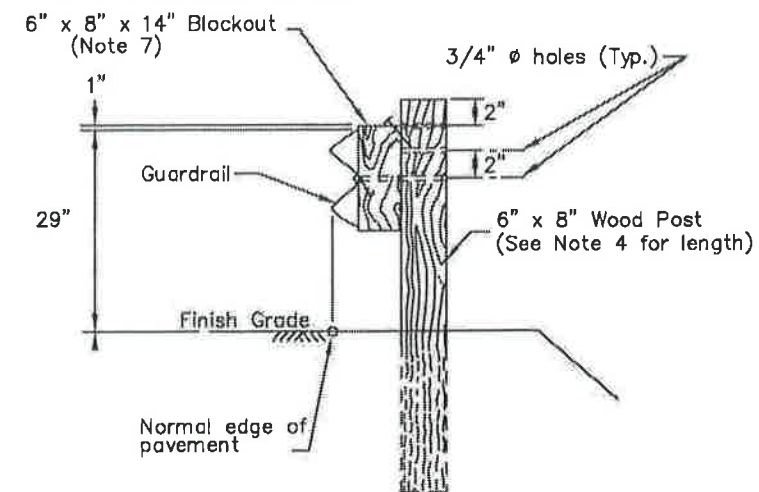

TYPE II POST INSTALLATION


(Facilitates raising rail for future overlays.)

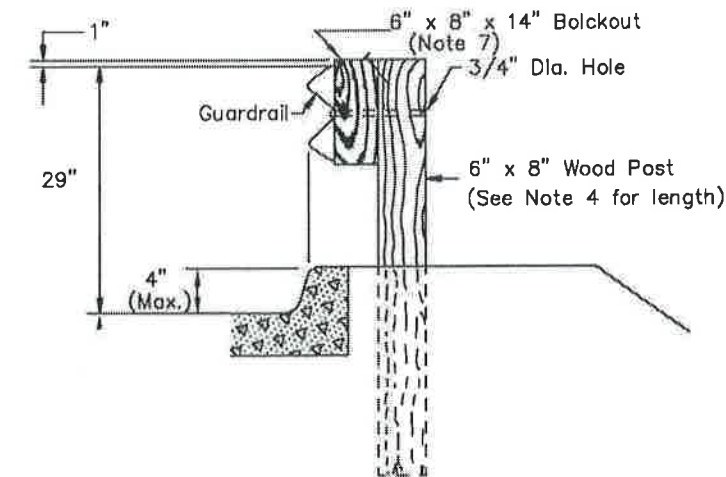


CURB DETAIL

TYPE III POST INSTALLATION

NOTE: Curb should not be installed with guardrail when the speed limit exceeds 40 mph.

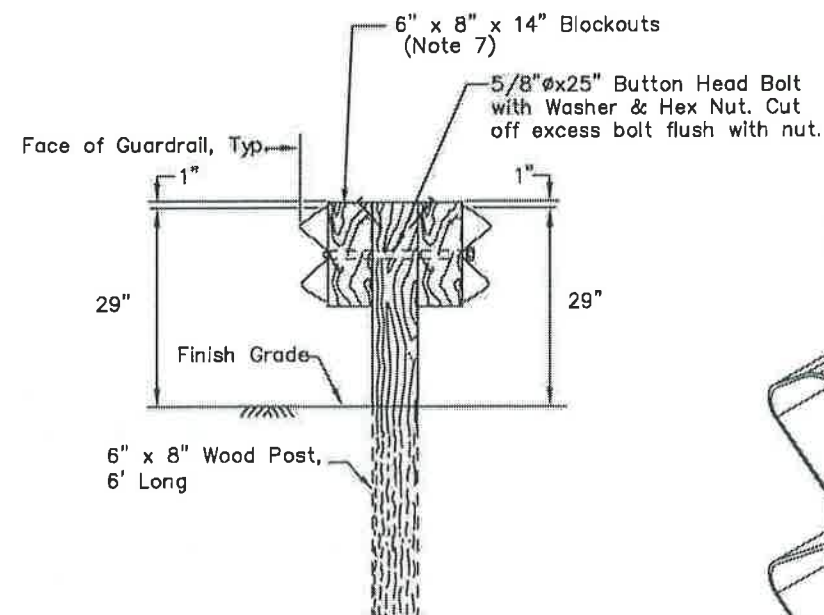

TYPE IV DOUBLE SIDED INSTALLATION

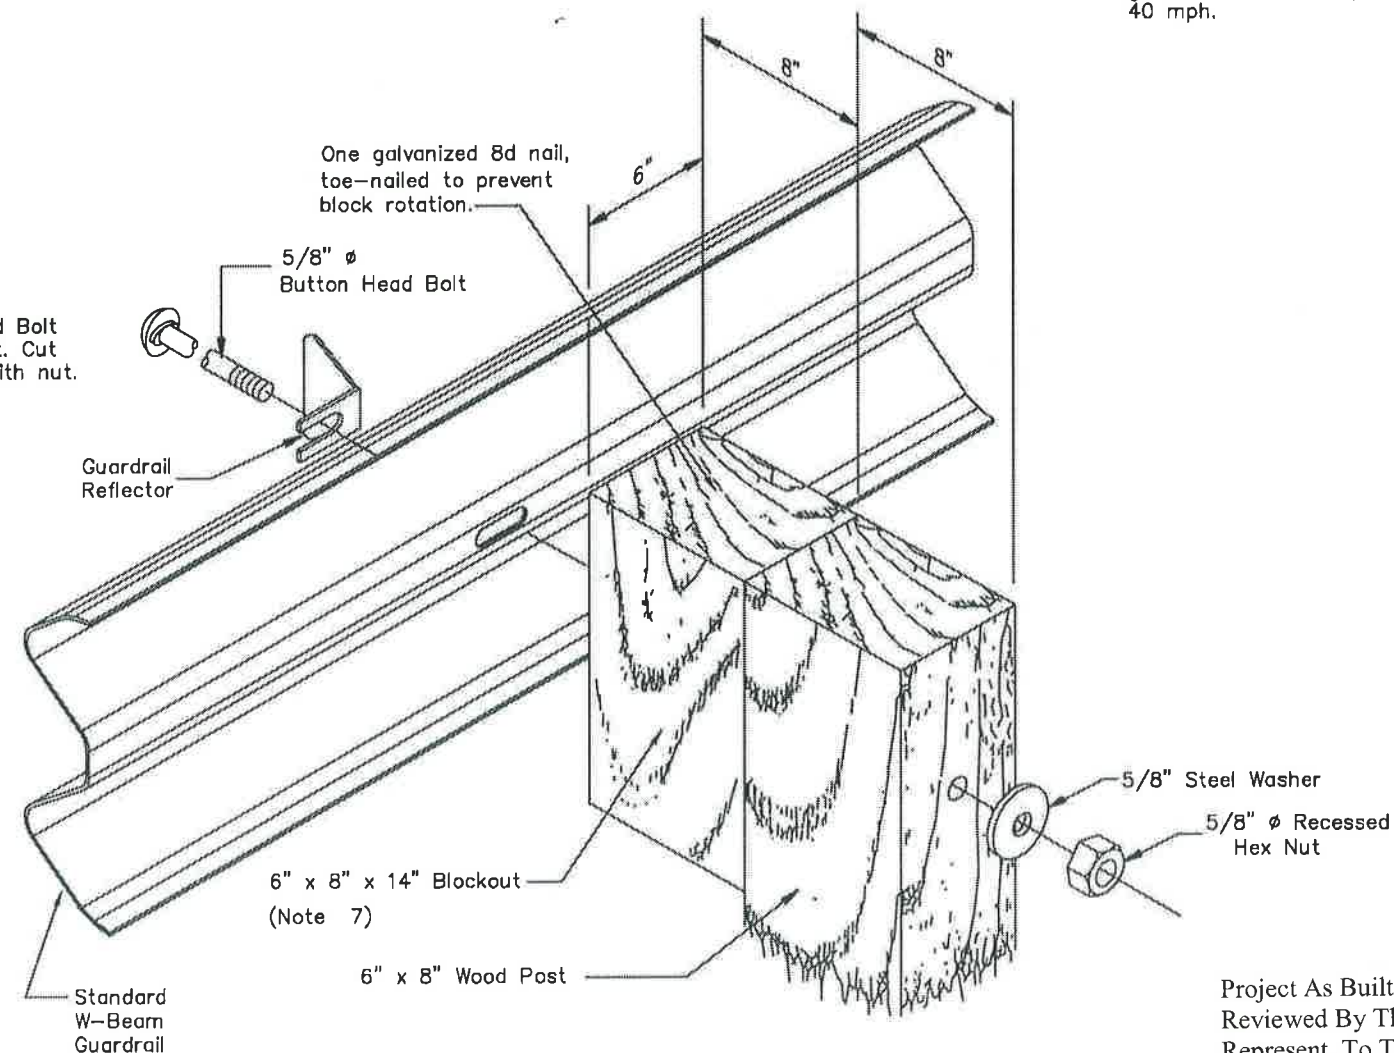

ASSEMBLY DETAIL

(Type I post shown)

GENERAL NOTES:

1. Attach guardrail reflectors at 50' centers beginning with the first post. Use Type A reflectors unless specified otherwise.
2. Provide hardware compliant with the AASHTO/AGC/ARTBA "A Guide to Standardized Highway Barrier Hardware," latest edition.
3. See Standard Drawing G-00 for hardware details.
4. See Standard Drawing G-10 for post lengths corresponding to different combinations of slope and behind-post embankment width.
5. Typical post spacing is 6'-3" center to center.
6. This barrier is acceptable under NCHRP 350, TL-3.
7. Use wood, rubber, plastic, or other NCHRP 350 or MASH approved blockouts designed to be used with wood posts.
8. Use 25 linear foot transition to match height of existing or new rail elements and end treatments.

REVISIONS		
Date	Description	By
12/1/87	2'-0" behind post	Gdo
5/15/89	Ref S4S to rough sawn	Gdo
4/1/93	Hinge point note	Gdo
1/1/96	Del. hardware/ add type II	Gdo
3/15/99	Post length and misc	Gdo
4/1/13	Double-sided detail and increase g.r. height	JCJ


State of Alaska
Department of Transportation
& Public FacilitiesWOOD POST
W-BEAM GUARDRAIL

Date 05/15/13


Project As Built Drawings Have Been
Reviewed By The Project Engineer &
Represent, To The Best Of My Knowledge,
The Project As Constructed.

Proj. Eng. MB

Date 12/11/13

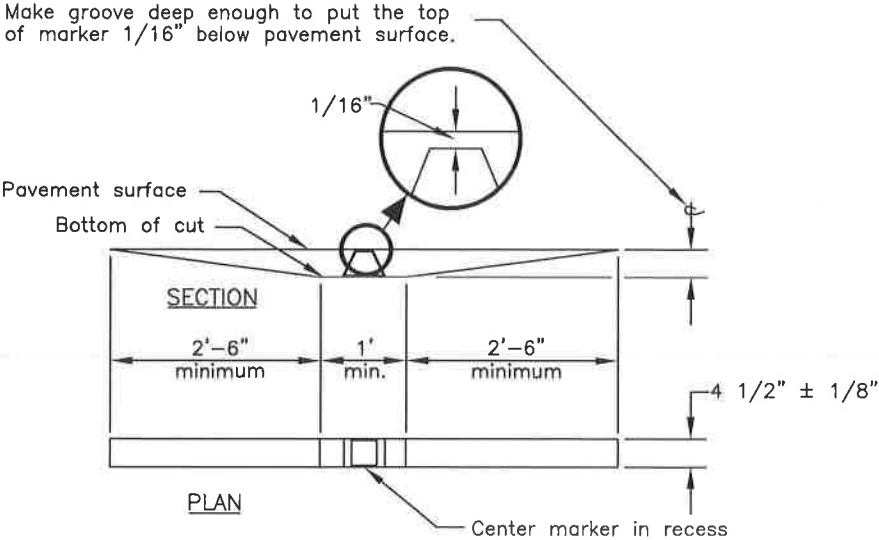


RECESSED PAVEMENT MARKER SLOT

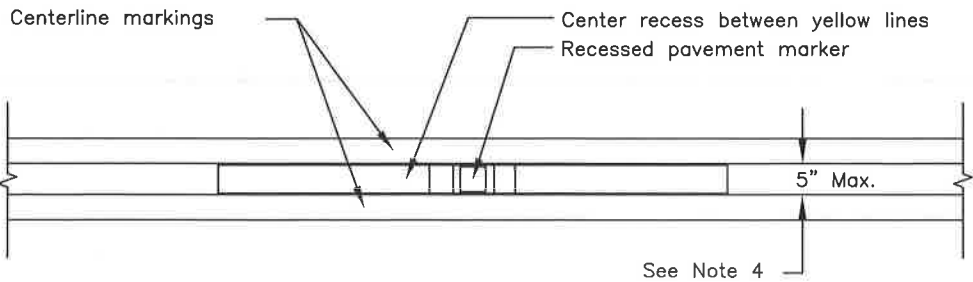


RECESSED PAVEMENT MARKERS WITH DOUBLE CENTERLINE INSTALLATION

GENERAL NOTES

1. Install recessed pavement markers spaced at 80' on tangent sections of roadway and on curves with a radius greater than 1,600'.
2. Install recessed pavement markers spaced at 40' on curves with a radius 1,600' or less.
3. Install recessed pavement markers between the lines on sections with double lines (either broken or solid.)
4. Increase the distance between yellow painted lines from the standard 3" up to a maximum of 5" to minimize paint overspray onto the marker.
5. Install recessed pavement markers on the centerline of the line, midpoint between stripe segments on sections with single broken lines.
6. Install reflectors of the same color as the pavement markings they supplement, except when red reflectors are specified on the departure side of markers on one-way roads to warn motorists they are going the wrong way.
7. Unless otherwise specified on one-way roads, reflectors are required only on the approaching traffic side of markers. In these cases, the 2'-6" taper may be omitted on the departure side.

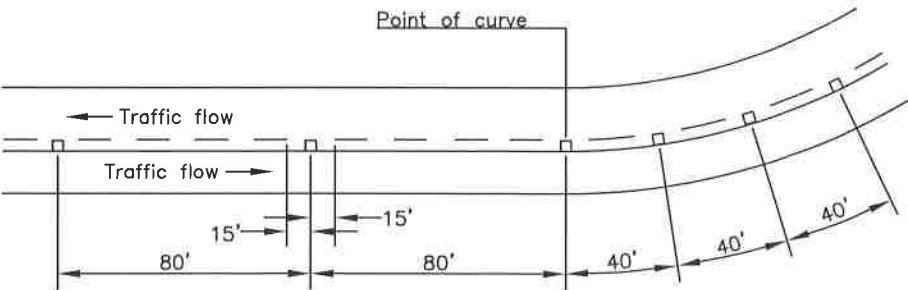

RECESSED PAVEMENT MARKERS ON CURVES WITH A RADIUS LESS THAN 1,600'

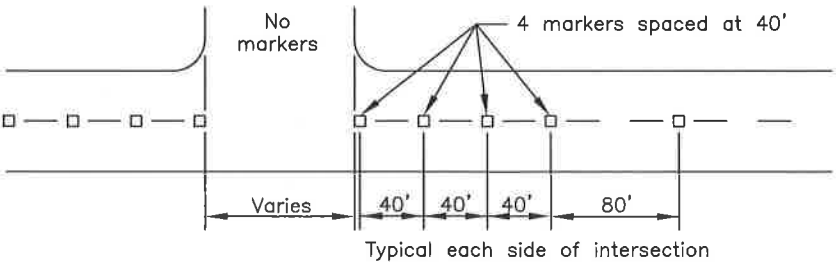

RECESSED PAVEMENT MARKERS AT INTERSECTION APPRO.

Project As Built Drawings Have Been Reviewed By The Project Engineer & Represent, To The Best Of My Knowledge, The Project As Constructed.

Proj. Eng. MB

Date

12/11/15

REVISIONS		
Date	Description	By

Sheet 1 of 1

State of Alaska
Department of Transportation
& Public Facilities



RECESSED PAVEMENT MARKERS

APPROVED


49th

3/28/03


Date

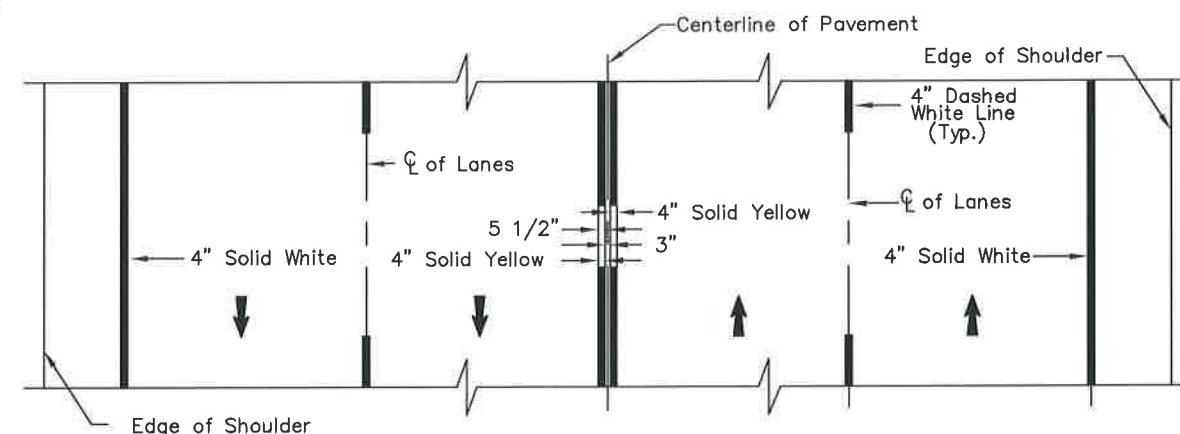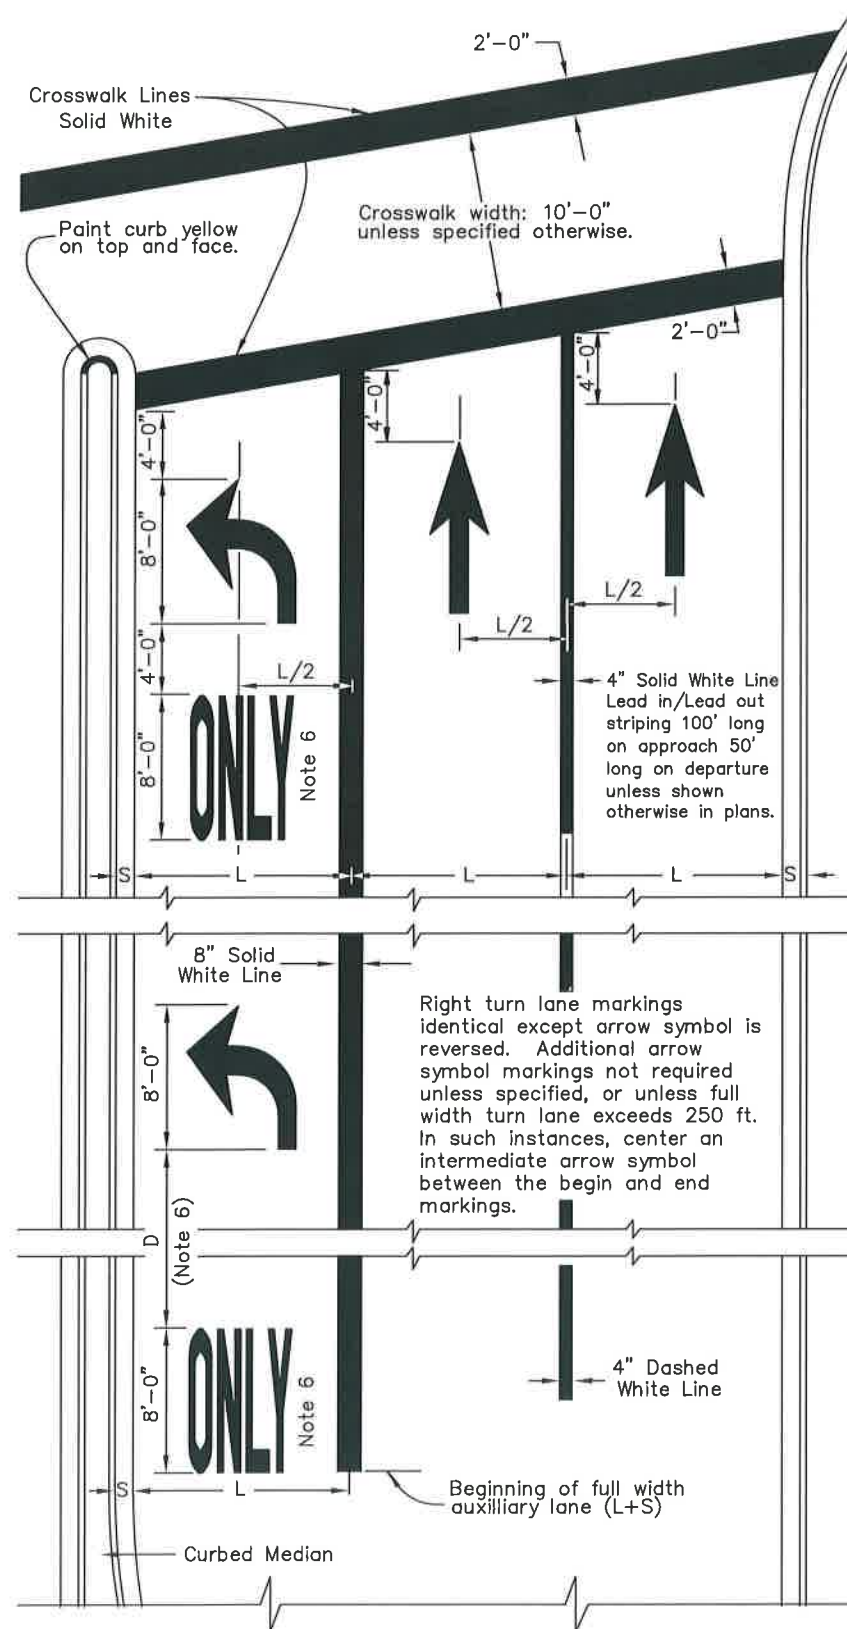


FOUR LANE TWO WAY

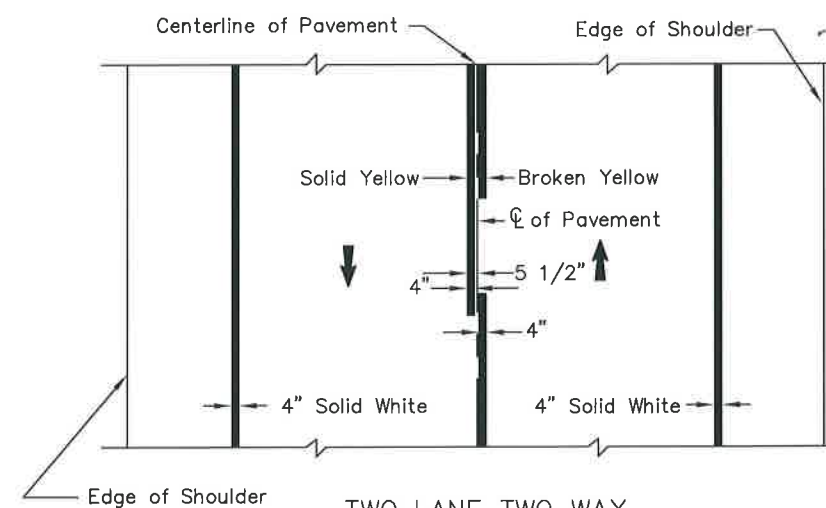

TWO LANE TWO WAY

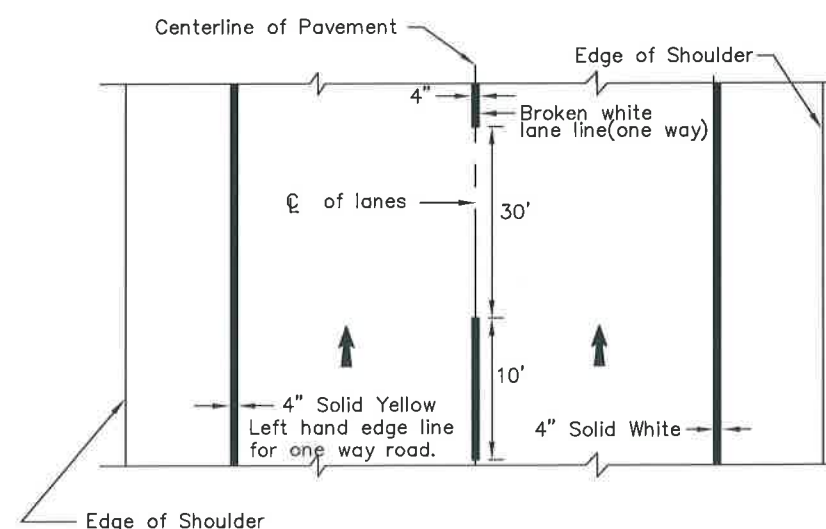

TWO LANE ONE WAY

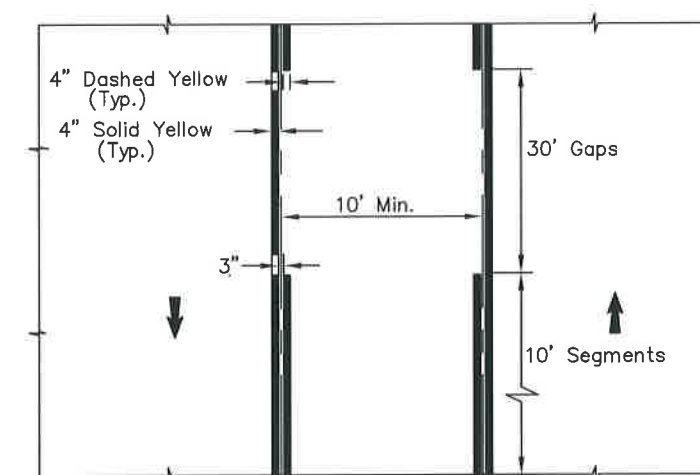

TWO-WAY LEFT TURN LANE

SPEED	D
25 or less	35
30	45
35	50
40	60
45	65
50	75
55 or more	80

- GENERAL NOTES:

1. All markings white unless indicated otherwise.
2. Lengths of stripe and gap for lane and center lines identical.
3. Lane lines for auxiliary lanes are unbroken solid lines.
4. "L" = driving lane width.
5. "S" = shy distance as shown on plans, otherwise 1 to 2 feet.
6. ONLY markings are required where through lanes change to turn lanes. In other cases, apply ONLY markings as indicated on plans.
7. See ALASKA TRAFFIC MANUAL for additional instruction on the use of TRAFFIC CONTROL DEVICES.
8. 6. Adjust distance D between ONLY and Turn Arrow based on SPEED vs. D table.

REVISIONS		
Date	Description	By
1/1/86	Arrow Dimension	Gdo
1/1/96	Intersect. Note	Gdo
4/28/10	Details, labels, notes	KJS

State of Alaska
Department of Transportation
& Public Facilities

PAVEMENT MARKING APPLICATIONS

A
E
E
E
C
V
E
IDate 5/31/12

Project As Built Drawings Have Been
Reviewed By The Project Engineer &
Represent, To The Best Of My Knowledge,
The Project As Constructed.

Proj. Eng. MK

Date

