





REVISIONS			STATE	PROJECT DESIGNATION	YEAR	SHEET NO.	TOTAL SHEETS
No.	DATE	DESCRIPTION	ALASKA	ACH PRL-0003(123)/67818	2007	A2	A5

RECOVERED	TO BE SET THIS PROJECT
GOV'T SECTION CORNER	
GOV'T 1/4 SECTION CORNER	
GOV'T 1/16 SECTION CORNER	
GOV'T SURVEY MONUMENT	
GOV'T CONTROL STA.	
PRIMARY MON. [BRASS/AL CAP]	
SECONDARY CORNER	
PRIMARY CENTERLINE MONUMENT	
SECONDARY CENTERLINE MONUMENT	
SURVEY CONTROL POINT	
SECONDARY SURVEY CONT. POINT	
GPS CONTROL POINT	
BENCH MARK	
TEMPORARY BENCH MARK	
ROCK MONUMENT	
INTERNATIONAL BOUNDARY LINE	ALASKA CANADA
TOWNSHIP & RANGE LINE	T. 13 N. R. 3 W. T. 12 N. R. 2 W.
SECTION LINE	
1/4 SECTION LINE	
1/16 SECTION LINE	
CORPORATE or CITY LIMITS	
EXISTING RIGHT-OF-WAY	
RIGHT-OF-WAY REQUIRED	
PROJECT RIGHT-OF-WAY LINE	R/W
EXISTING PROPERTY LINE	
CONTROLLED ACCESS LINE	C/A
PERMIT LINE	
EXISTING EASEMENT LINE	
STATION EQUATION	STA. 14+33.22 BK. STA. 16+90.17 AHD. 27+00
PROJECT CENTERLINE	
EXISTING CENTERLINE	
RAILROAD CENTERLINE	
HIGHWAY MILEPOST	6.5 25+17.50
RAILROAD MILEPOST	R.R. 2580+60 HWY. 126+33 842
MATERIAL WASTE AREA	AS-BUILT

CLEARING LIMITS	TEMPORARY STAGING	LIMIT OF CUT SLOPE	LIMIT OF FILL SLOPE	PROPOSED ROADWAY	EXISTING ROADWAY	NOISE BARRIER	FENCE	STONE FENCE	HEAD & WINGWALLS	GUARD RAIL EXISTING	GUARD RAIL PROPOSED	RETAINING WALL	TUNNEL	INTERMITTENT DRAINAGE	INTERCEPTOR DITCH	MARSHLAND	CREEK	RIVER	LAKE	RESERVOIR	CHANNEL CHANGE	PLANTER	VENT	TANK VENT	WELL	SEPTIC TANKS	Above Ground	Below Ground	SATELLITE DISH	PRIVATE SIGN	GAS PUMP	POST	BOULDER OR BOULDERS	LANDSCAPE LIGHT	DECIDUOUS TREE	CONIFER TREE	SHRUB OR SHRUBS	FISH STREAM	CULVERT NO.

PIPELINES:	EXISTING	PROPOSED
(BELLS INDICATE DIRECTION OF FLOW)		
SANITARY SEWER		
OIL		
GAS		
WATER		
STORM DRAIN		
SIDEWALK		
CONCRETE CURB		
CONCRETE CURB & GUTTER		
DRIVEWAY, APPROACH, & SIDEDRAIN		
BRIDGE		
RIPRAP		
TELEPHONE	OVERHEAD: OT DIRECT BURY: UT	OVERHEAD: OT DIRECT BURY: UT
ELECTRIC	OVERHEAD: OE DIRECT BURY: UE	OVERHEAD: OE DIRECT BURY: UE
FIBER OPTIC		FO
CABLE TV	OVERHEAD: OT DIRECT BURY: UT	
U.G. DUCT		
TELEPHONE MANHOLE		
ELECTRIC MANHOLE		
FOUNDATION		
BUILDING		
MANHOLE	M.H.	M.H.
FIRE HYDRANT		
METER		
VALVE		
PIPE CULVERT w/ END SECT.		
UTILITY POLE		
ELECTROLIER		
UTILITY POLE WITH LUMINAIRE		
POLE ANCHOR /w GUY		
TRANSMISSION TOWER [WOOD]		
TRANSMISSION TOWER [STEEL]		
ELECTRICAL OUTLET		
ELECTRICAL PEDESTAL		
TELEPHONE PEDESTAL		
CABLE T.V. PEDESTAL		

	EXISTING	PROPOSED
MAILBOX		
SIGN (FACING →)		
DELINEATOR (FACING →)		
PVC CONDUIT	PVC	PVC
RMC CONDUIT	RMC	RMC
SIGNAL FACE, VEHICULAR		
SIGNAL FACE, LEFT TURN		
SIGNAL FACE, PEDESTRIAN		
JUNCTION BOX, TYPE IA		
JUNCTION BOX, TYPE II		
JUNCTION BOX, TYPE III		
DETECTOR, LOOP		
DETECTOR, OPTICOM		
PEDESTRIAN PUSH BUTTON (DIRECTION →)		
SIGNAL CONTROLLER		
LOAD CENTER		
SIGNAL POLE		
SIGNAL POLE w/MASTARM		
SOLID WHITE STRIPE	W	W
SOLID YELLOW STRIPE	Y	Y
BROKEN WHITE or YELLOW STRIPE	W	Y
DASH YELLOW STRIPE	Y	Y
SOLID YELLOW STRIPE with BROKEN YELLOW STRIPE	Y	Y

X = ACTUAL NUMBER


PND ENGINEERS, INC.  
1508 W. 36th Ave. Anchorage, AK 99503  
907-561-1011 engineering@pndengineers.com

STATE OF ALASKA  
DEPARTMENT OF TRANSPORTATION  
AND  
PUBLIC FACILITIES

GRAVINA ISLAND HIGHWAY  
GRADING, DRAINAGE, AND BRIDGES

SYMBOLS

REVISIONS			STATE	PROJECT DESIGNATION	YEAR	SHEET NO.	TOTAL SHEETS
No.	DATE	DESCRIPTION	ALASKA	ACH PRL-0003(123)/67818	2007	A3	A5

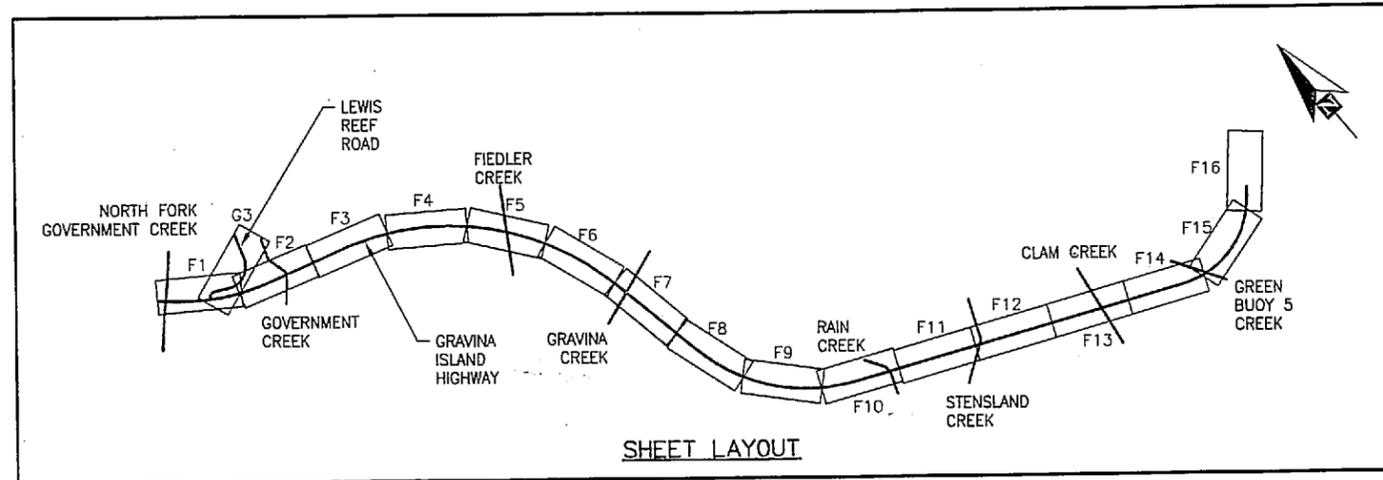

ABBREVIATIONS			
	DEFINITION		DEFINITION
BOP	BEGINING OF PROJECT	PGL	PROFILE GRADE LINE
CAP	CORRUGATED ALUMINUM PIPE	PI	POINT OF INTERSECTION
CFS	CUBIC FEET PER SECOND	PT	POINT OF TANGENCY
CL	CENTERLINE	PVC	POINT OF VERTICAL CURVE
CPEP	CORRUGATED POLYETHYLENE PIPE	PVI	POINT OF VERTICAL INTERSECTION
D, DIA	DIAMETER	PVT	POINT OF VERTICAL
DF	DEEP FILL	R	RADIUS
E	EASTING	R/W	RIGHT OF WAY
EL, ELEV	ELEVATION	RC	ROCK CUT
EOP	END OF PROJECT	RO	RUNOFF
FPS	FEET PER SECOND	RT	RIGHT
FT	FEET	S	SUPERELEVATION
HDPE	HIGH DENSITY POYETHYLENE	SHT	SHEET
INV	INVERT	SQ MI	SQUARE MILE
KET	KETCHIKAN	STA	STATION
L	LENGTH	STD	STANDARD
LT	LEFT	T	TANGENT
MAX	MAXIMUM	TYP	TYPICAL
MIN	MINIMUM	VC	VERTICAL CURVE
MLLW	MEAN LOWER LOW WATER		
N	NORTHING, NORTH		
NIC	NOT IN CONTRACT		
DHW	ORDINARY HIGH WATER		
PC	POINT OF CURVATURE		

PND ENGINEERS, INC.  
1506 W. 36th Ave. Anchorage, AK 99503  
907-561-1011 engineering@pndengineers.com





STATE OF ALASKA  
DEPARTMENT OF TRANSPORTATION  
AND  
PUBLIC FACILITIES

GRAVINA ISLAND HIGHWAY  
GRADING, DRAINAGE, AND BRIDGES

ABBREVIATIONS

REVISIONS			STATE	PROJECT DESIGNATION	YEAR	SHEET NO.	TOTAL SHEETS
No.	DATE	DESCRIPTION	ALASKA	ACH PRL-0003(123)/67818	2007	A4	A5

NOTE:  
1. RIGHT OF WAY NOT SHOWN ON PLANS. ROW WAS NOT FINALIZED AT COMPLETION OF AS-BUILT PLANS AND WAS OMITTED TO AVOID CONFUSION.

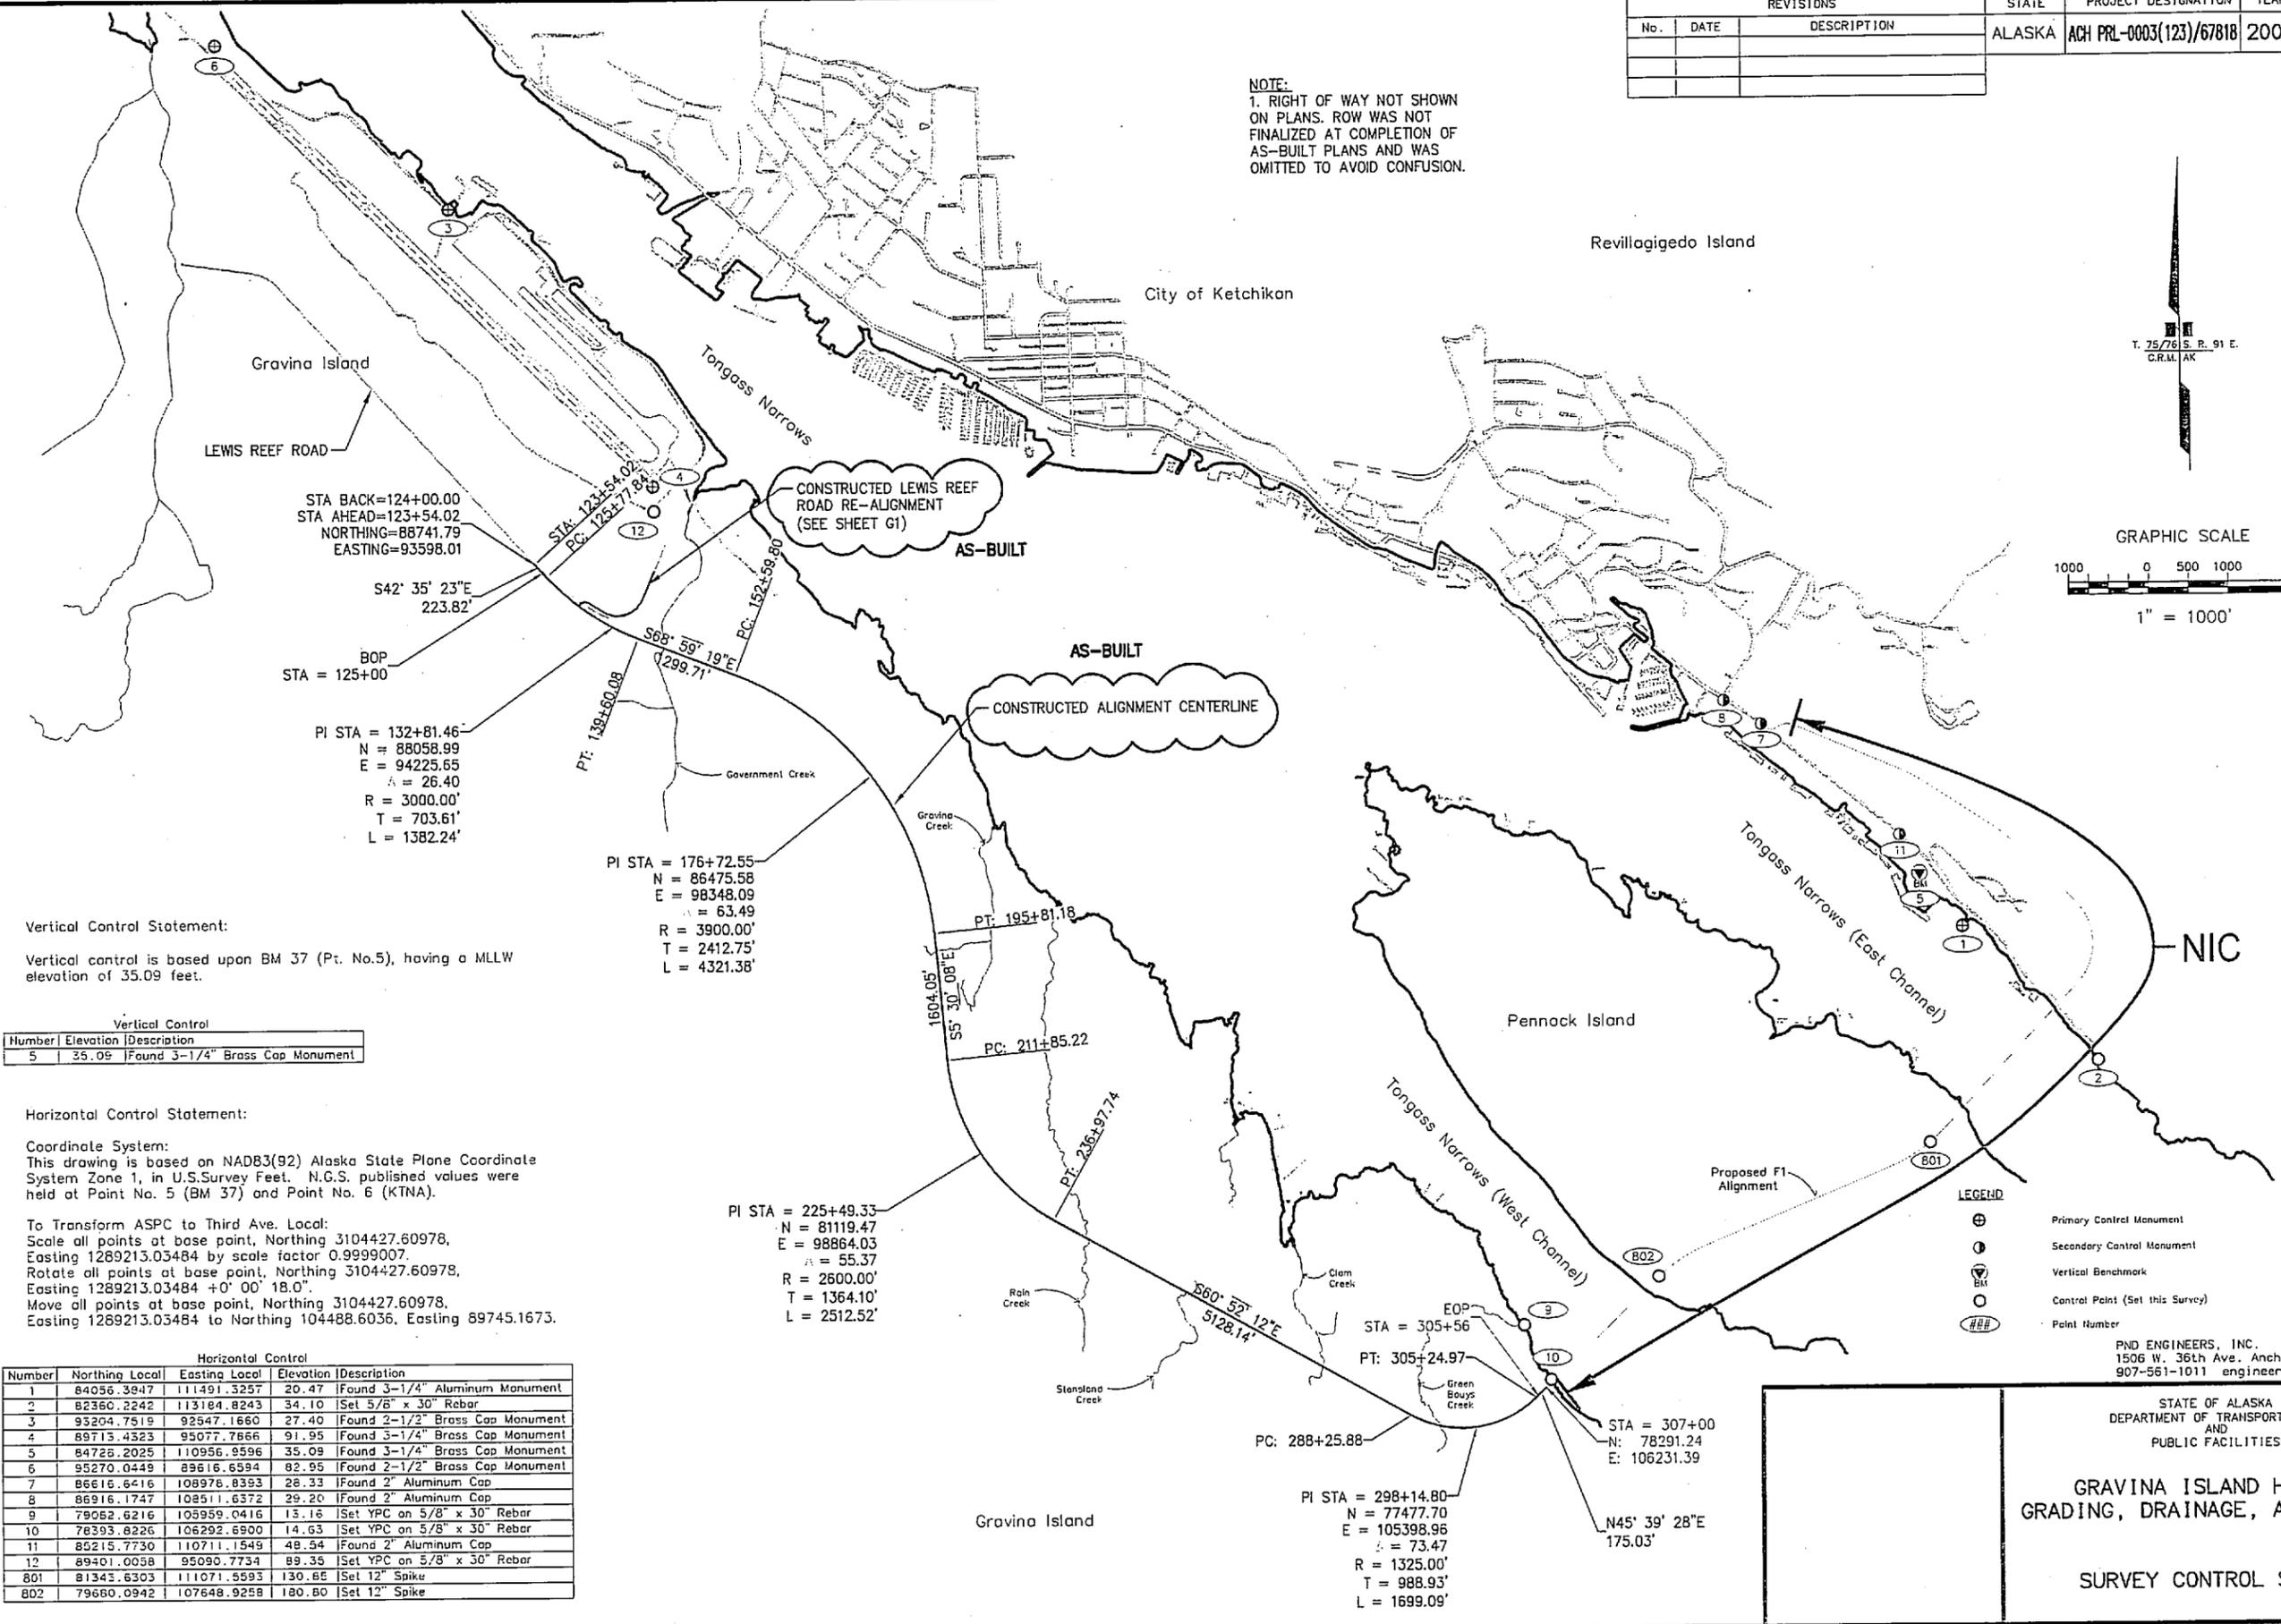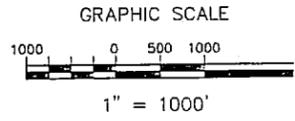

Vertical Control Statement:  
Vertical control is based upon BM 37 (Pt. No.5), having a MLLW elevation of 35.09 feet.

Number	Elevation	Description
5	35.09	Found 3-1/4" Brass Cap Monument

Horizontal Control Statement:  
Coordinate System:  
This drawing is based on NAD83(92) Alaska State Plane Coordinate System Zone 1, in U.S. Survey Feet. N.G.S. published values were held at Point No. 5 (BM 37) and Point No. 6 (KTNA).

To Transform ASPC to Third Ave. Local:  
Scale all points at base point, Northing 3104427.60978, Easting 1289213.03484 by scale factor 0.9999007.  
Rotate all points at base point, Northing 3104427.60978, Easting 1289213.03484 +0' 00' 18.0"  
Move all points at base point, Northing 3104427.60978, Easting 1289213.03484 to Northing 104488.6036, Easting 89745.1673.

Number	Northing Local	Easting Local	Elevation	Description
1	84056.3947	111491.3257	20.47	Found 3-1/4" Aluminum Monument
2	82360.2242	113184.8243	34.10	Set 5/8" x 30" Rebar
3	93204.7515	92547.1660	27.40	Found 2-1/2" Brass Cap Monument
4	89715.4323	95077.7666	91.95	Found 3-1/4" Brass Cap Monument
5	84725.2025	110956.9596	35.09	Found 3-1/4" Brass Cap Monument
6	95270.0449	89616.6594	82.95	Found 2-1/2" Brass Cap Monument
7	86616.6416	108976.8393	28.33	Found 2" Aluminum Cap
8	86916.1747	108511.6372	29.20	Found 2" Aluminum Cap
9	79052.6216	109959.0416	13.16	Set YPC on 5/8" x 30" Rebar
10	78393.8226	106292.6900	14.63	Set YPC on 5/8" x 30" Rebar
11	85215.7730	110711.1549	48.54	Found 2" Aluminum Cap
12	89401.0058	95090.7734	89.35	Set YPC on 5/8" x 30" Rebar
801	81343.6303	111071.5593	130.85	Set 12" Spike
802	79660.0942	107648.9258	180.80	Set 12" Spike

- LEGEND
- ⊕ Primary Control Monument
  - ⊙ Secondary Control Monument
  - ⊕ Vertical Benchmark
  - ⊕ Control Point (Set this Survey)
  - ### Point Number


PND ENGINEERS, INC.  
1506 W. 36th Ave. Anchorage, AK 99503  
907-561-1011 engineer@pndengineers.com

STATE OF ALASKA  
DEPARTMENT OF TRANSPORTATION  
AND  
PUBLIC FACILITIES


GRAVINA ISLAND HIGHWAY  
GRADING, DRAINAGE, AND BRIDGES

SURVEY CONTROL SHEET

REVISIONS			STATE	PROJECT DESIGNATION	YEAR	SHEET NO.	TOTAL SHEETS
No.	DATE	DESCRIPTION	ALASKA	ACH PRL-0003(123)/67818	2007	A5	A5

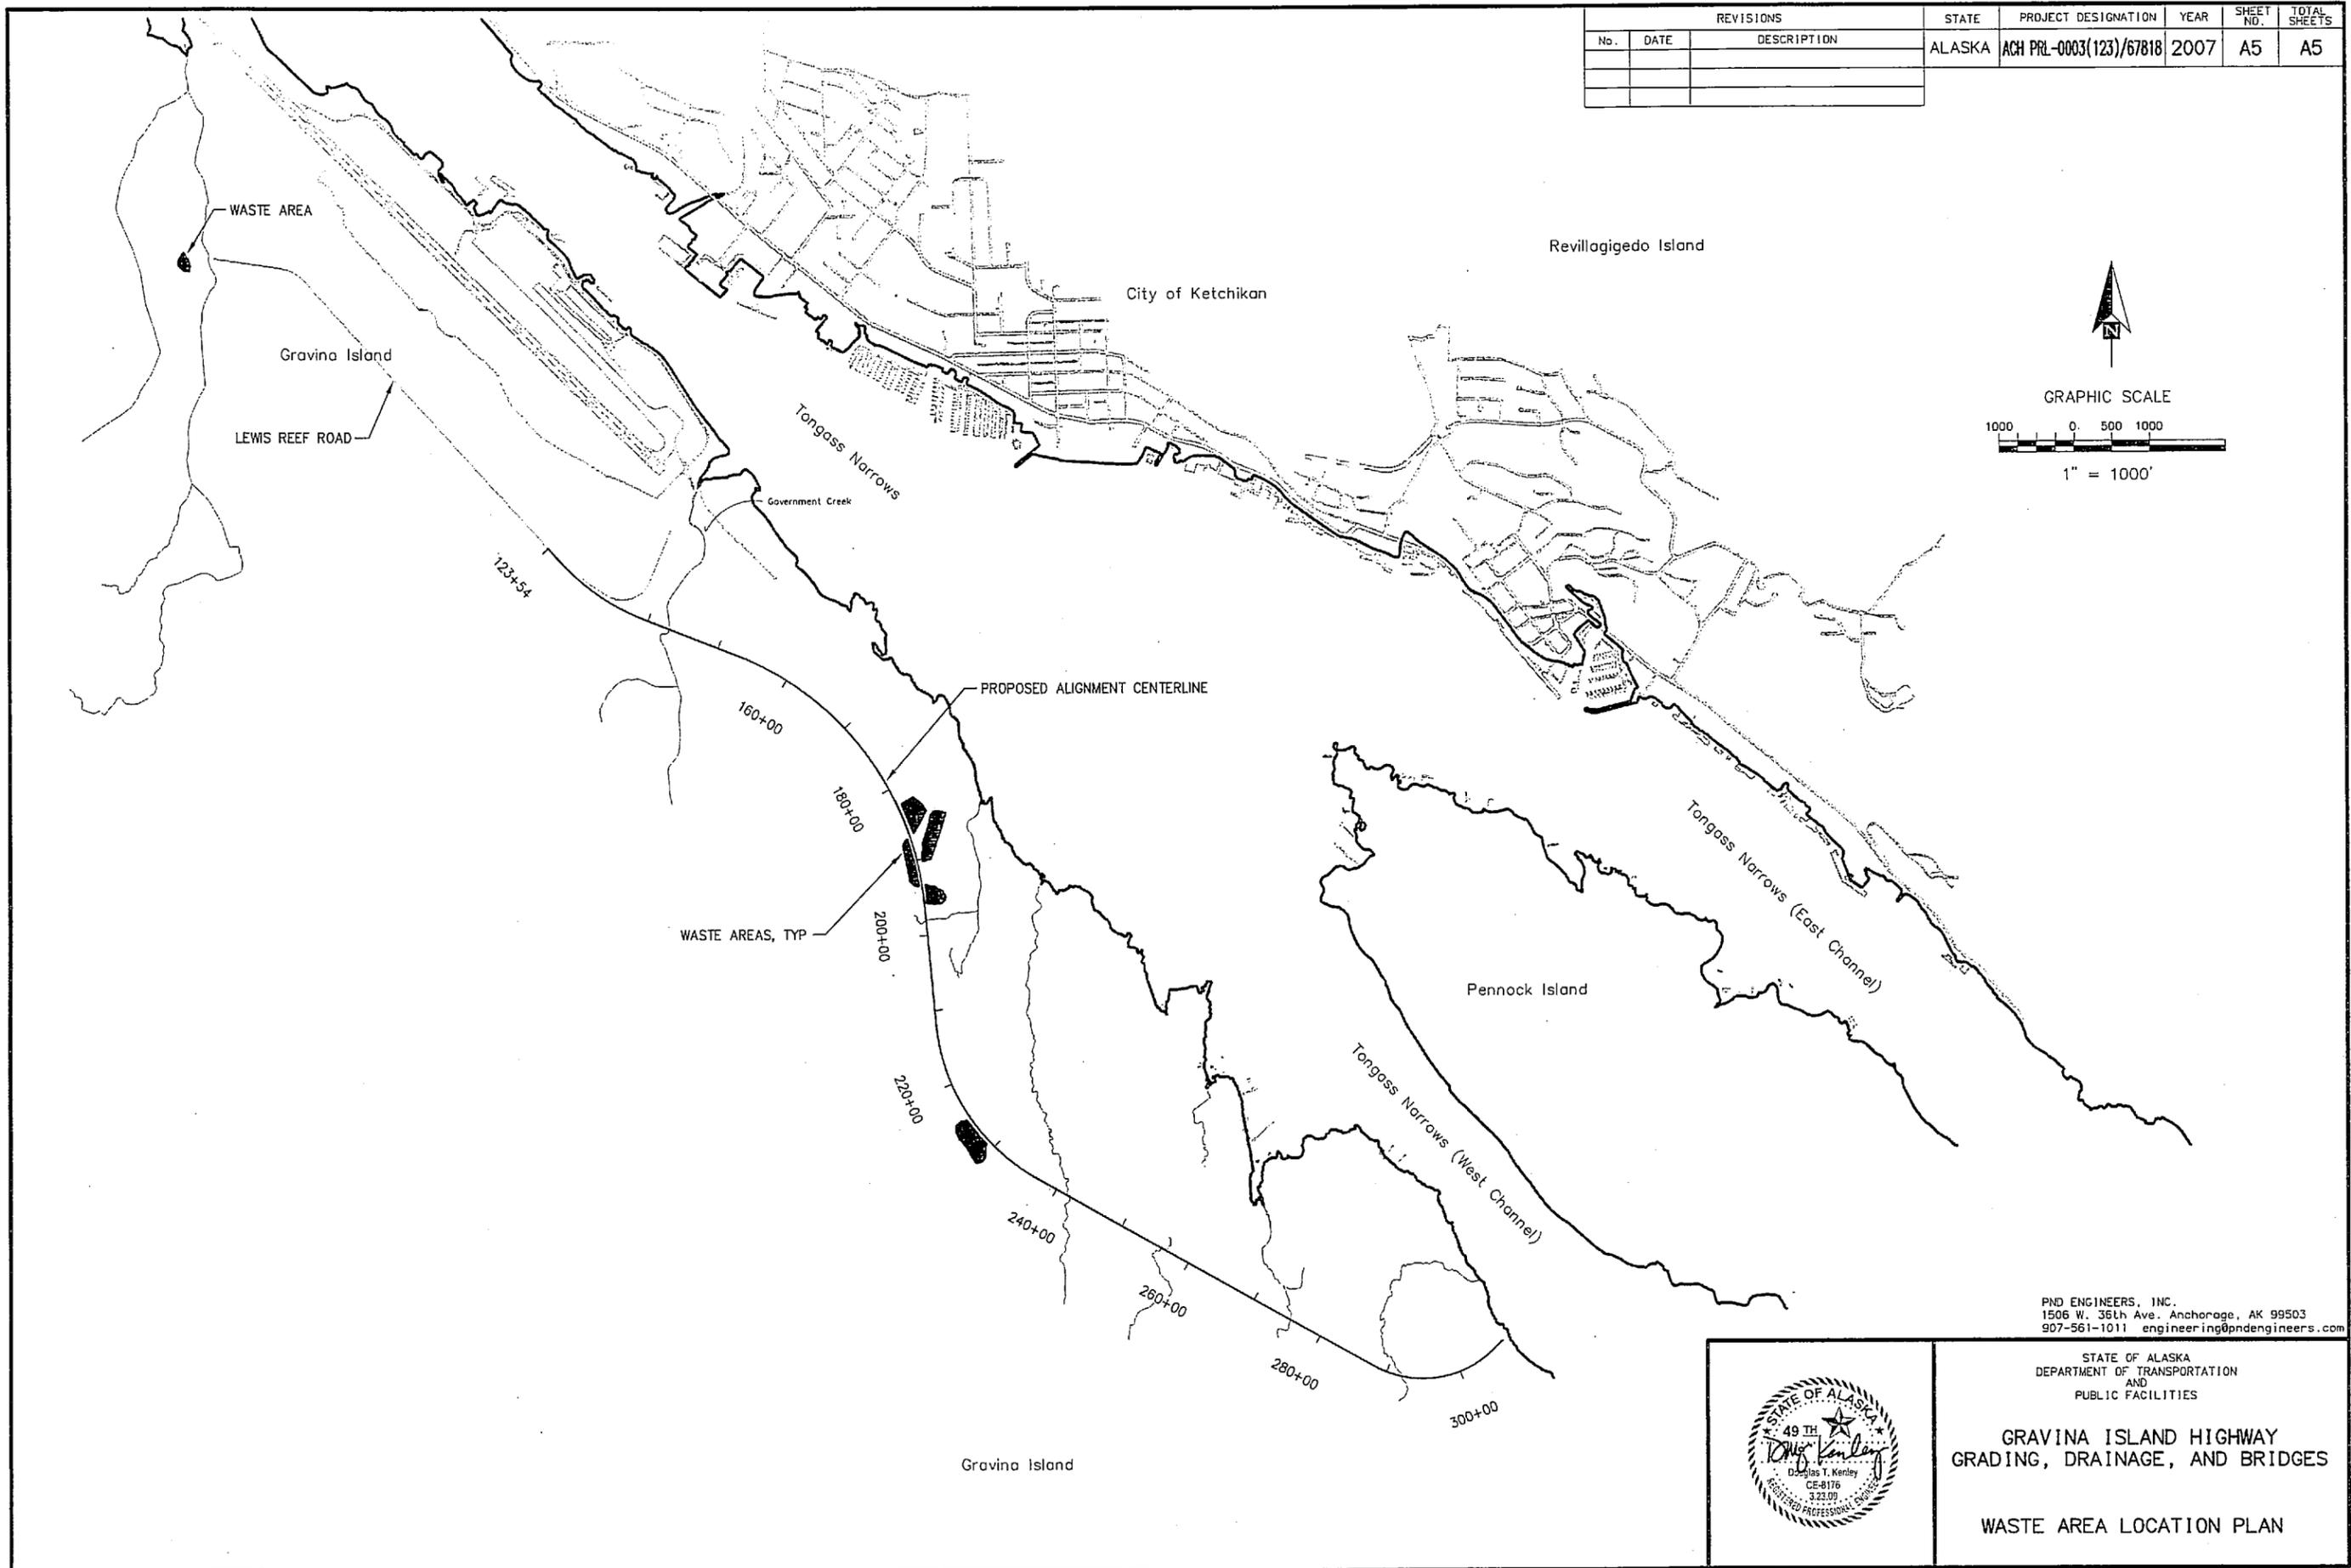

PND ENGINEERS, INC.  
 1506 W. 36th Ave. Anchorage, AK 99503  
 907-561-1011 engineering@pndengineers.com

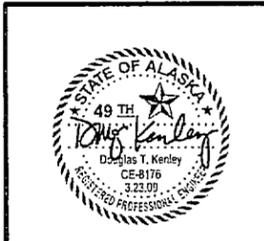

STATE OF ALASKA  
 DEPARTMENT OF TRANSPORTATION  
 AND  
 PUBLIC FACILITIES



**GRAVINA ISLAND HIGHWAY  
 GRADING, DRAINAGE, AND BRIDGES**

WASTE AREA LOCATION PLAN


REVISIONS		STATE	PROJECT DESIGNATION	YEAR	SHEET NO.	TOTAL SHEETS
No.	DATE	ALASKA	ACH PRL-0003(123)/67818	2007	B1	B3

**NOTES:**


1. LOCATIONS FOR TYPICAL SECTIONS SHOWN ON PLAN & PROFILE SHEETS.
2. DITCH LINING SHALL BE PLACED AGAINST ERODIBLE, NON-ROCK SLOPES. CONSTRUCT DITCH LINING AS REQUIRED BY FIELD CONDITIONS. SHOW INSTALLED LOCATIONS ON AS-BUILT DRAWINGS.
3. ALL GROUND DISTURBED BY NEW CONSTRUCTION SHALL BE SEEDING, OR OTHERWISE STABILIZED, AS SHOWN ON PLANS.
4. SLOPE FLATTENING ALONG SECTION "DF" SHALL BE AT CONTRACTOR'S DISCRETION. TOTAL INCREASE OF FOOTPRINT SHALL NOT EXCEED PERMITTED FOOTPRINT.

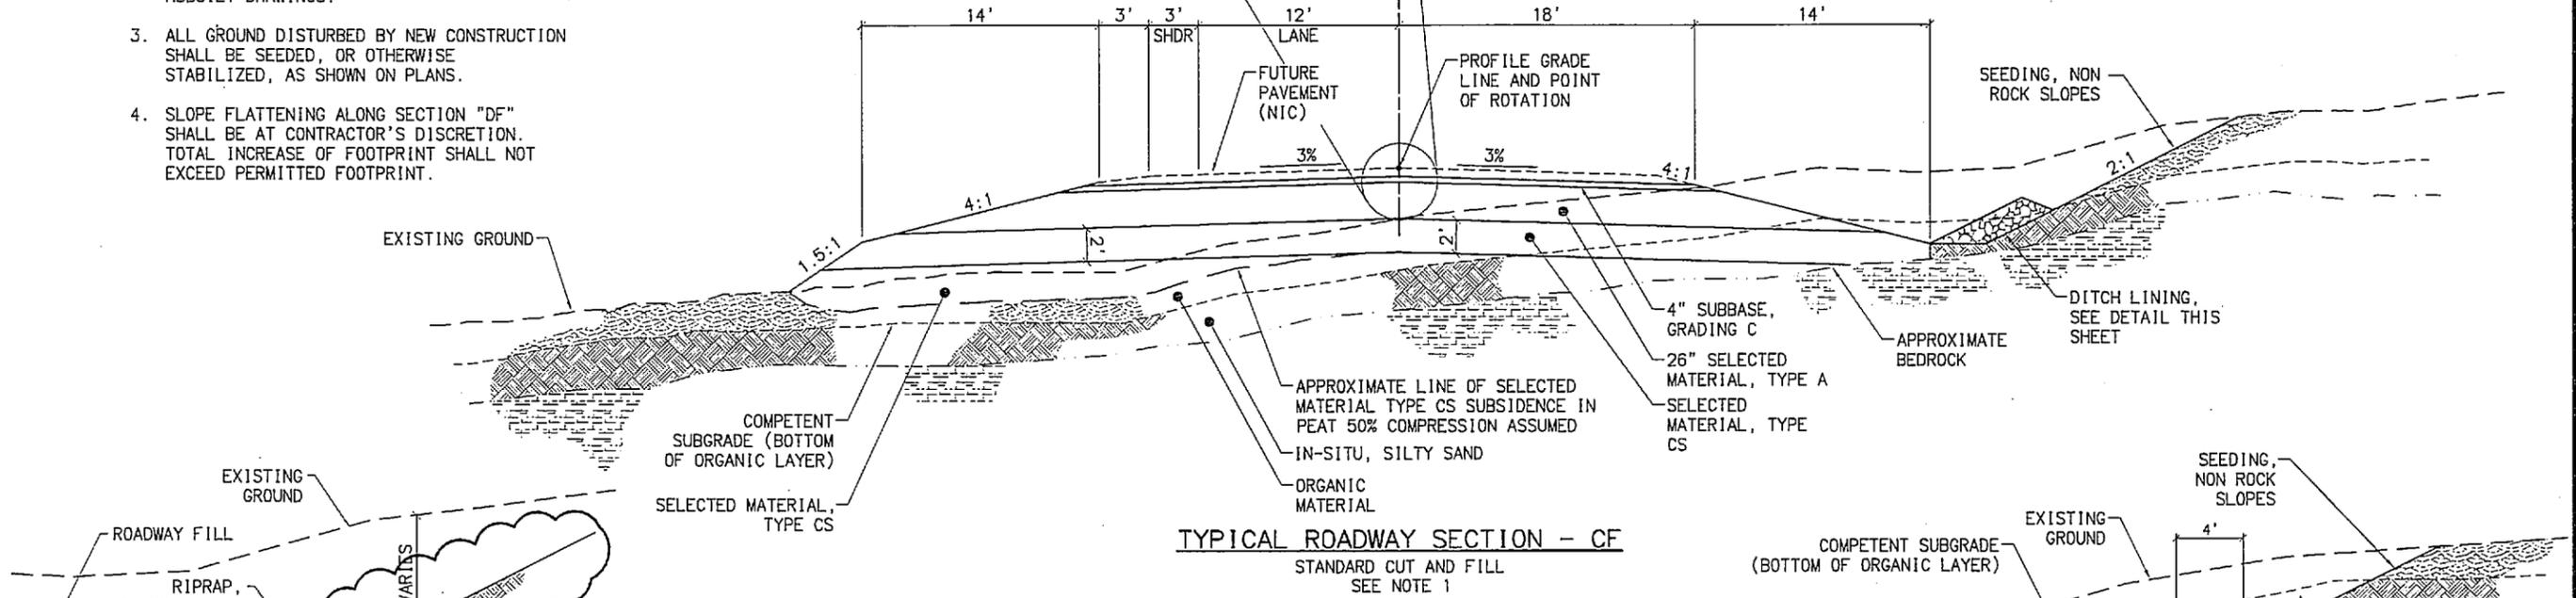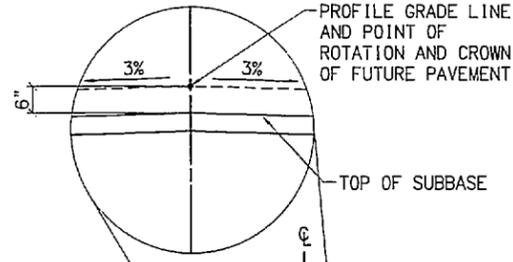

**TYPICAL ROADWAY SECTION - CF**  
STANDARD CUT AND FILL  
SEE NOTE 1

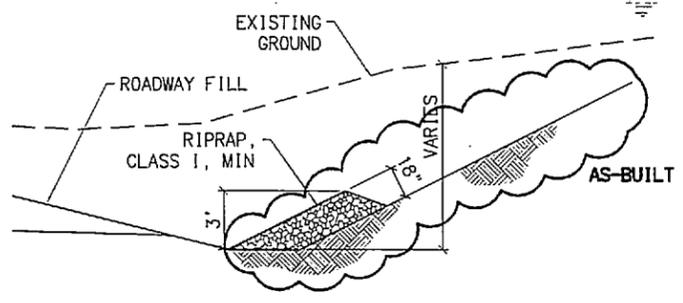


**DITCH LINING - D1**  
SEE NOTE 2

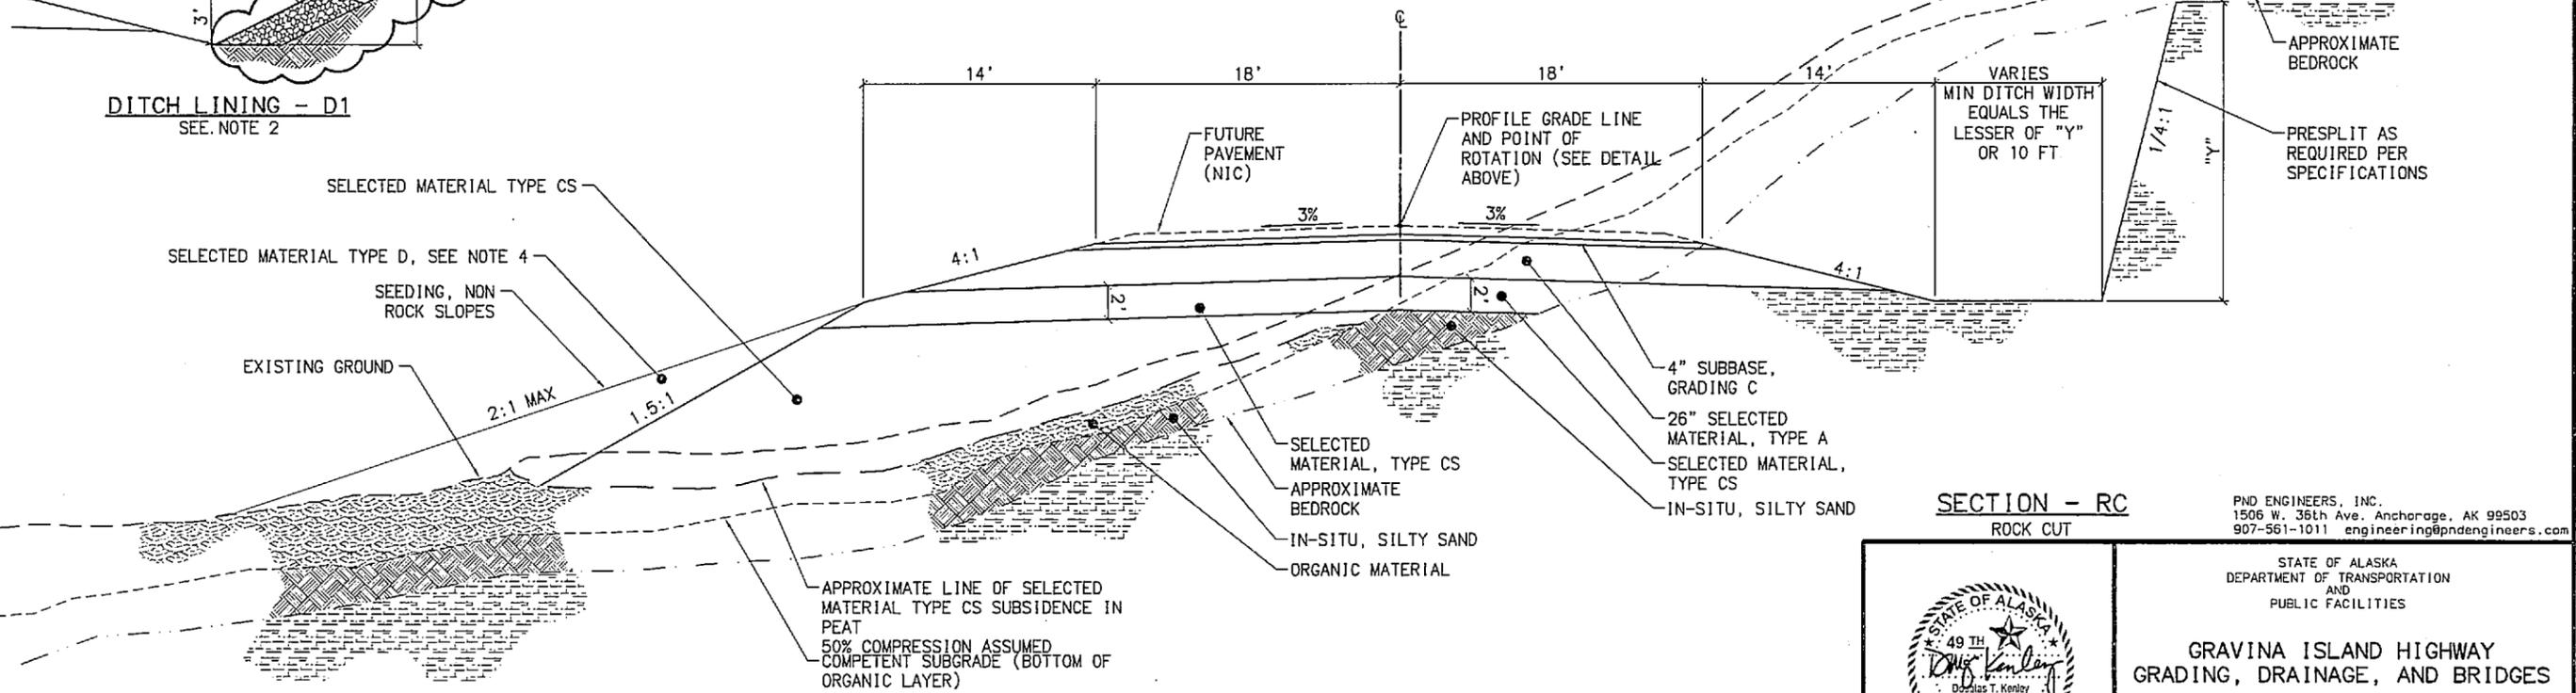

**SECTION - RC**  
ROCK CUT

PND ENGINEERS, INC.  
1506 W. 36th Ave. Anchorage, AK 99503  
907-561-1011 engineering@pndengineers.com

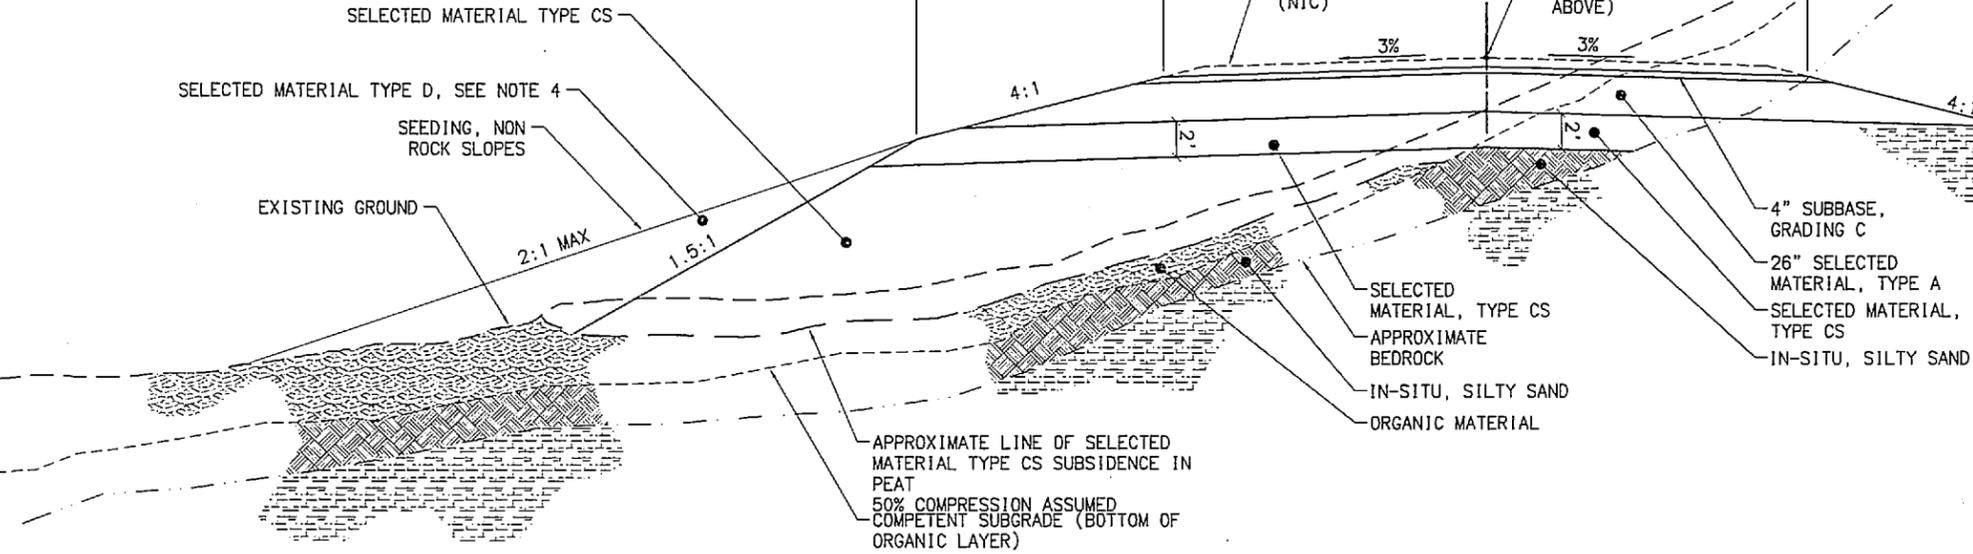

**SECTION - DF**  
DEEP FILL

**TYPICAL ROADWAY SECTION**  
DEEP FILLS AND ROCK CUTS  
SEE NOTE 1



STATE OF ALASKA  
DEPARTMENT OF TRANSPORTATION  
AND  
PUBLIC FACILITIES


GRAVINA ISLAND HIGHWAY  
GRADING, DRAINAGE, AND BRIDGES

TYPICAL SECTIONS


REVISIONS			STATE	PROJECT DESIGNATION	YEAR	SHEET NO.	TOTAL SHEETS
No.	DATE	DESCRIPTION	ALASKA	ACH PRL-0003(123)/67818	2007	B2	B3

**NOTE:**

1. ALL TEMPORARY FILL PLACED DURING CONSTRUCTION SHALL HAVE A LAYER OF SEPARATION GEOTEXTILE FABRIC PLACED OVER THE ORIGINAL GROUND SURFACE FOR PROTECTION.
2. ALL TEMPORARY FILL SHALL BE REMOVED TO THE EXTENT PRACTICABLE WHEN NO LONGER REQUIRED FOR CONSTRUCTION. NO NATURAL EARTHEN MATERIAL SHALL BE REMOVED FROM UNDER GEOTEXTILE.
3. MAINTAIN ROAD DRAINAGE AND NATURAL DRAINAGE THROUGH STAGING AREAS.
4. CLEARING LIMITS SHALL BE NO MORE THAN 20FT FROM CUT/FILL LIMITS AND SHALL NOT EXTEND OUTSIDE OF THE RIGHT OF WAY.

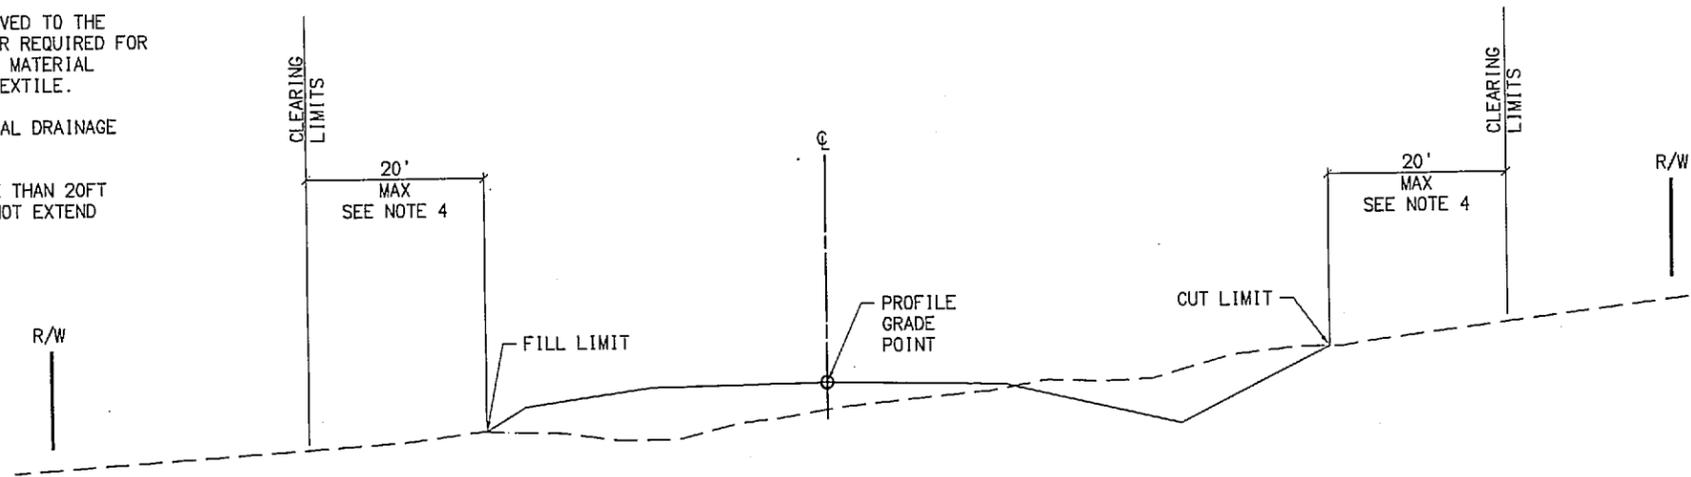

**TYPICAL CLEARING LIMIT SECTION**

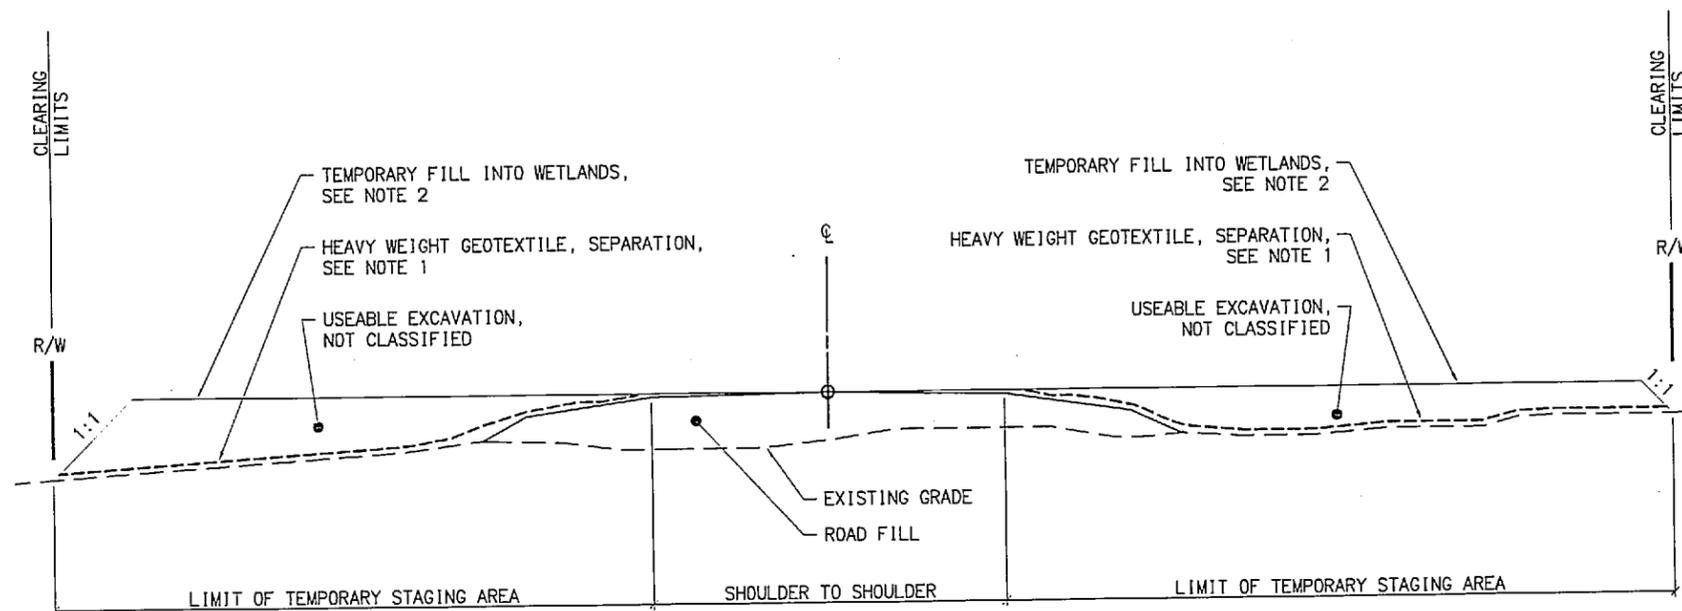

**TYPICAL ROADWAY SECTION AT TEMPORARY STAGING AREAS**

PND ENGINEERS, INC.  
1506 W. 36th Ave. Anchorage, AK 99503  
907-551-1011 engineering@pndengineers.com




STATE OF ALASKA  
DEPARTMENT OF TRANSPORTATION  
AND  
PUBLIC FACILITIES

**GRAVINA ISLAND HIGHWAY  
GRADING, DRAINAGE, AND BRIDGES**

TYPICAL SECTIONS


REVISIONS			STATE	PROJECT DESIGNATION	YEAR	SHEET NO.	TOTAL SHEETS
No.	DATE	DESCRIPTION	ALASKA	ACH PRL-0003(123)/67818	2007	B3	B3

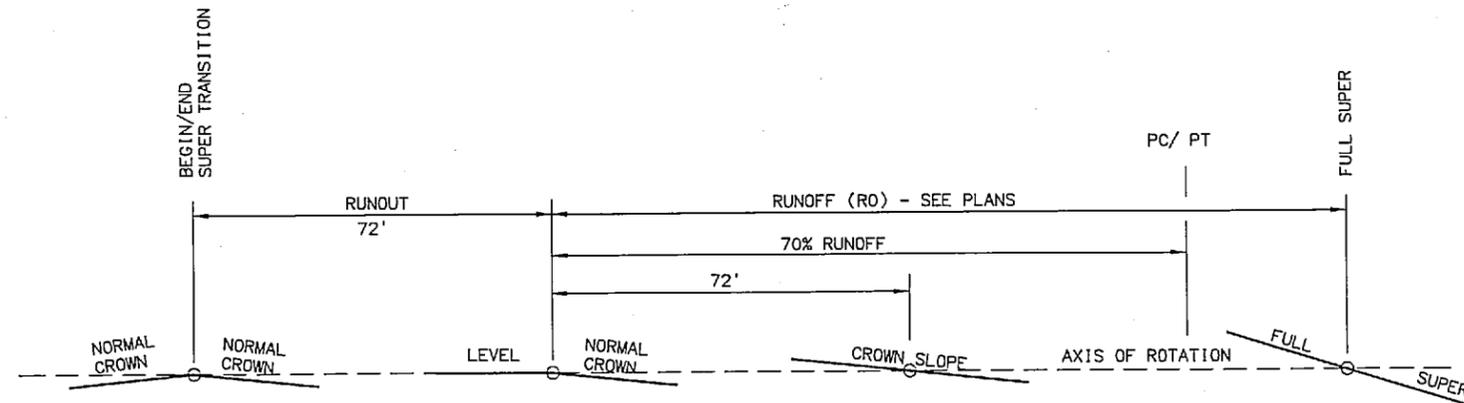

SUPERELEVATION TRANSITION

NOTES

1. TRANSITION THE ROADWAY TO A SUPERELEVATED CROSS SLOPE BY ROTATING THE TRAVELED WAY AND SHOULDER ABOUT THE CENTERLINE OF THE ALIGNMENT.
2. BUILD SUPERELEVATION INTO SUBGRADE AND CARRY THROUGH SHOULDERS.
3. % RUNOFF = PORTION OF RUNOFF ON TANGENT
4. WIDENING FOR GUARDRAIL OR CURVATURE DOES NOT CHANGE THE LOCATION OF THE AXIS OF ROTATION.
5. SEE PLAN FOR DEGREE OF SUPERELEVATION.

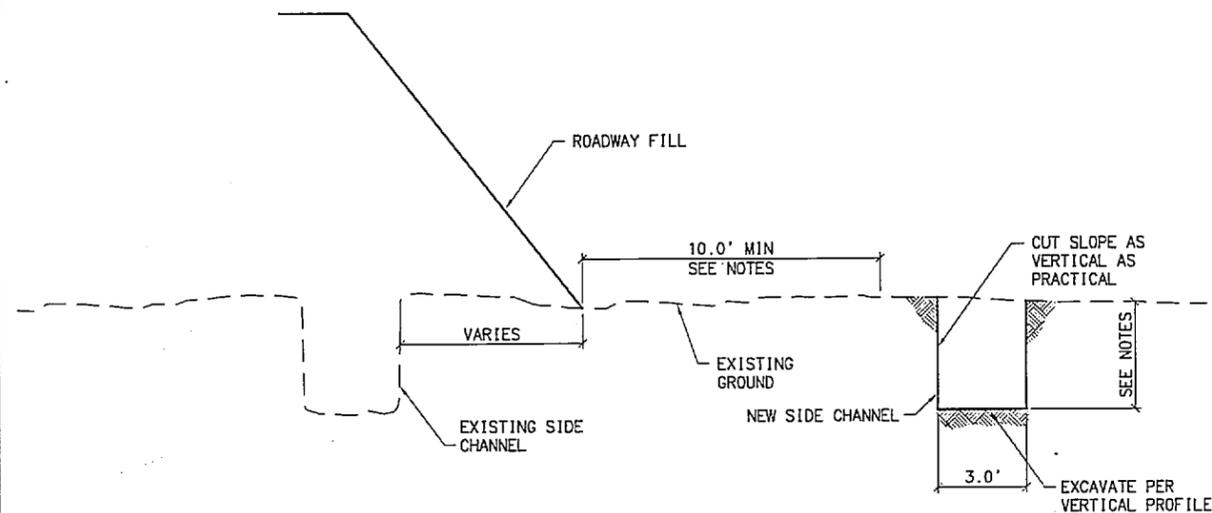

SIDE CHANNEL NOTES:

1. CONSTRUCT NEW SIDE CHANNEL BEFORE DISTURBING EXISTING CHANNEL.
2. WHERE PROPOSED CHANNEL IS GREATER THAN 3' DEEP OR OTHERWISE NECESSARY, SIDE SLOPES MAY BE BUILT AT 2:1 SLOPE AND STABILIZED AS DIRECTED BY THE ENGINEER.
3. SURVEY EXISTING CHANNEL LOCATION AND DEPTH PRIOR TO PLACING ROADWAY FILL.
4. MAINTAIN 10' MIN VEGETATED BUFFER BETWEEN ROADWAY FILL AND NEW CHANNEL TO REDUCE SEDIMENTATION.

STENSLAND CREEK SIDE CHANNEL

STA 251+00 TO 252+80

PND ENGINEERS, INC.  
1508 W. 36th Ave. Anchorage, AK 99503  
907-561-1011 engineering@pndengineers.com



STATE OF ALASKA  
DEPARTMENT OF TRANSPORTATION  
AND  
PUBLIC FACILITIES

GRAVINA ISLAND HIGHWAY  
GRADING, DRAINAGE, AND BRIDGES

TYPICAL SECTIONS

REVISIONS			STATE	PROJECT DESIGNATION	YEAR	NO.	SHEETS
No.	DATE	DESCRIPTION	ALASKA	ACH PRL-0003(123)/67818	2007	D1	D1

### CULVERT INSTALLATION SUMMARY

PIPE NAME	SIZE	MATERIAL	SLOPE LENGTH	Go.	Corrugation	START STATION	START OFFSET	START INVERT	END STATION	END OFFSET	END INVERT	SLOPE	RIPRAP INLET	RIPRAP OUTLET	FISH STREAM	REMARKS
C1	42"	CPEP	154.60'	TYPE S		155+03.30	40.70' R	94.67	156+21.32	58.48' L	84.40	6.66%	YES	REMARKS		ENERGY DISSIPATER, DTL SHT E1
C2	36"	CPEP	99.64'	TYPE S		158+28.50	38.30' R	94.83	158+48.00	58.64' L	83.44	11.52%	YES	REMARKS		ENERGY DISSIPATER, DTL SHT E2
C3	36"	CAP	89.47'	0.06	3X1	162+41.00	30.46' R	93.76	162+49.40	58.40' L	89.34	4.95%		CLASS I		CHECK DAM, SHALLOW BEDROCK
C4	36"	CPEP	127.57'	TYPE S		167+02.70	46.20' R	88.07	166+42.00	65.80' L	83.56	3.54%	YES	CLASS II		
C5	24"	CPEP	82.34'	TYPE S		169+25.70	38.50' R	89.42	169+42.10	42.08' L	88.51	1.11%	YES	CLASS I		
C6	36"	CPEP	99.79'	TYPE S		173+47.50	38.80' R	83.96	173+63.80	59.50' L	80.77	3.20%		CLASS II		
C7	78"	CAP	132.56'	0.075	3X1	177+81.50	60.27' R	70.23	177+36.40	64.23' L	66.68	2.68%	YES	CLASS I	FIEDLER	NOTE 1
C8	36"	CPEP	86.42'	TYPE S		199+82.60	36.86' R	101.20	200+16.00	42.72' L	99.34	2.16%	YES	CLASS I		SHALLOW BEDROCK
C9	42"	CPEP	104.98'	TYPE S		222+78.24	47.93' R	94.80	222+32.77	46.58' L	93.84	0.92%	YES	CLASS II		DITCH TO INLET
C10	36"	CPEP	119.67'	TYPE S		230+89.50	53.53' R	103.91	231+42.60	53.60' L	103.00	0.76%		CLASS II		SHALLOW BEDROCK
C11	36"	CPEP	99.75'	TYPE S		238+84.23	40.92' R	100.68	238+55.33	54.27' L	94.91	5.80%		CLASS II		SHALLOW BEDROCK
C12	66"	CAP	96.06'	0.06	3X1	242+22.54	43.63' R	89.18	241+90.37	46.78' L	87.47	1.78%	YES	CLASS I	RAIN	CHECK DAM, NOTE 1
C13	36"	CPEP	133.61'	TYPE S		250+43.40	58.38' L	34.31	251+03.82	60.67' R	33.34	0.73%		CLASS II		
C14	96"	CAP	142.03'	0.105	3X1	255+87.38	57.02' R	20.30	256+68.97	59.11' L	19.87	0.30%	YES	CLASS I	STENSLAND	NOTE 1
C15	36"	CPEP	114.22'	TYPE S		259+73.41	48.41' R	37.94	259+09.93	46.43' L	37.53	0.36%	YES	CLASS I		
C16	24"	CPEP	93.61'	TYPE S		267+66.78	43.48' R	69.55	267+35.10	44.50' L	68.78	0.82%	YES	CLASS I		CHECK DAM
C17	108"	CAP	139.70'	0.135		275+64.91	62.19' R	59.20	275+12.83	67.33' L	58.58	0.44%	YES	CLASS I	CLAM	NOTE 1
C17A	36"	CPEP	79.97'	0.06	3X1	272+15.38	38.10' R	77.71	272+14.35	41.74' L	75.65	2.58%	YES	CLASS I		
C18	36"	CAP	119.14'	0.06	3X1	286+93.44	37.03' R	74.80	286+01.25	38.26' L	73.46	1.13%		CLASS I		CHECK DAM, DITCH TO INLET
C19	102"	CAP	142.07'	0.135	3X1	292+50.12	52.27' R	62.79	291+54.96	53.08' L	59.44	2.36%	YES	CLASS I	GREEN BUOY	NOTE 1
C20	36"	CPEP	167.40'	TYPE S		299+51.85	50.19' L	76.70	300+74.32	65.07' R	68.25	5.07%	YES	CLASS II		
C21	24"	CAP	92.85'	0.06	2-2/3X1/2	303+25.82	34.45' L	82.66	303+58.05	51.83' R	71.61	12.00%		CLASS I		
C22A	24"	CAP	71.24'	0.06	2-2/3X1/2	141+01.60	33.47' L	108.59	141+22.37	34.57' R	108.08	0.72%		CLASS I		CHECK DAM, SHALLOW BEDROCK
C22B	24"	CAP	71.37'	0.06	2-2/3X1/2	141+07.41	33.22' L	108.53	141+28.44	34.87' R	108.03	0.70%		CLASS I		CHECK DAM, SHALLOW BEDROCK
C23	24"	CPEP	101.50'	TYPE S		217+27.34	38.43' R	102.80	216+61.78	38.92' L	101.80	0.99%		CLASS I		
C24	24"	CPEP	101.67'	TYPE S		234+91.87	37.96' R	112.01	234+25.80	39.19' L	110.35	1.63%	YES	CLASS I		
C25	24"	CPEP	96.29'	TYPE S		246+62.55	41.93' R	67.02	246+59.91	53.98' L	60.22	7.09%	YES	CLASS II		SHALLOW BEDROCK
C26	24"	CPEP	98.49'	TYPE S		273+57.27	43.01' R	76.81	273+30.81	51.60' L	71.39	5.52%	YES	CLASS I		SHALLOW BEDROCK

CPEP = CORRUGATED POLYETHYLENE PIPE  
CAP = CORRUGATED ALUMINUM PIPE

#### AS-BUILT NOTES

1. INVERTS OF FISH STREAMS ARE BASED ON SURVEY ELEVATION OF STREAM BED AT INLET/OUTLET MINUS 40% OF PIPE DIAMETER.
2. ALL CULVERTS UPDATED PER AS-BUILT SURVEY.

### GUARDRAIL INSTALLATION SUMMARY

STATION TO STATION		OFFSET		W BEAM	REMARKS	
TO	FROM	LT	RT			
139+75.50	TO	142+06.73		18'	175.0'	ET-2000 END TERMINAL
141+25.50	TO	142+06.73	18'		62.5'	W-BEAM DOWNSTREAM ANCHOR
143+91.73	TO	144+73.00		18'	62.5'	W-BEAM DOWNSTREAM ANCHOR
143+91.73	TO	146+35.50	18'		187.5'	ET-2000 END TERMINAL
194+61.50	TO	197+42.73		18'	225.0'	ET-2000 END TERMINAL
196+61.50	TO	197+42.73	18'		62.5'	W-BEAM DOWNSTREAM ANCHOR
198+45.73	TO	199+27.00		18'	62.5'	W-BEAM DOWNSTREAM ANCHOR
198+45.73	TO	200+89.50	18'		187.5'	ET-2000 END TERMINAL
TOTALS				1,025'		

1. OFFSET IS TO FACE OF W-BEAM GUARDRAIL, OFFSET AT BRIDGE TRANSITION AND END TERMINAL WILL VARY.
2. W BEAM LENGTHS DOES NOT INCLUDE GUARDRAIL TO BRIDGE TRANSITION LENGTH NOR THE ET-2000 END TERMINAL LENGTH.

#### NOTES:

1. FIELD VERIFY INLET ELEVATION, OUTLET ELEVATION, AND REQUIRED SLOPE PER DETAILS SHOWN ON SHEET E1.
2. WHERE NON-FISH STREAM CULVERT OUTLETS ARE SEATED ON BEDROCK, RIPRAP MAY BE OMITTED.

PND ENGINEERS, INC.  
1506 W. 36th Ave. Anchorage, AK 99503  
907-561-1011 engineering@pndengineers.com




STATE OF ALASKA  
DEPARTMENT OF TRANSPORTATION  
AND  
PUBLIC FACILITIES

GRAVINA ISLAND HIGHWAY  
GRADING, DRAINAGE, AND BRIDGES


SUMMARY SHEET

REVISIONS			STATE	PROJECT DESIGNATION	YEAR	SHEET NO.	TOTAL SHEETS
No.	DATE	DESCRIPTION	ALASKA	ACH PRL-0003(123)/67818	2007	E1	E11

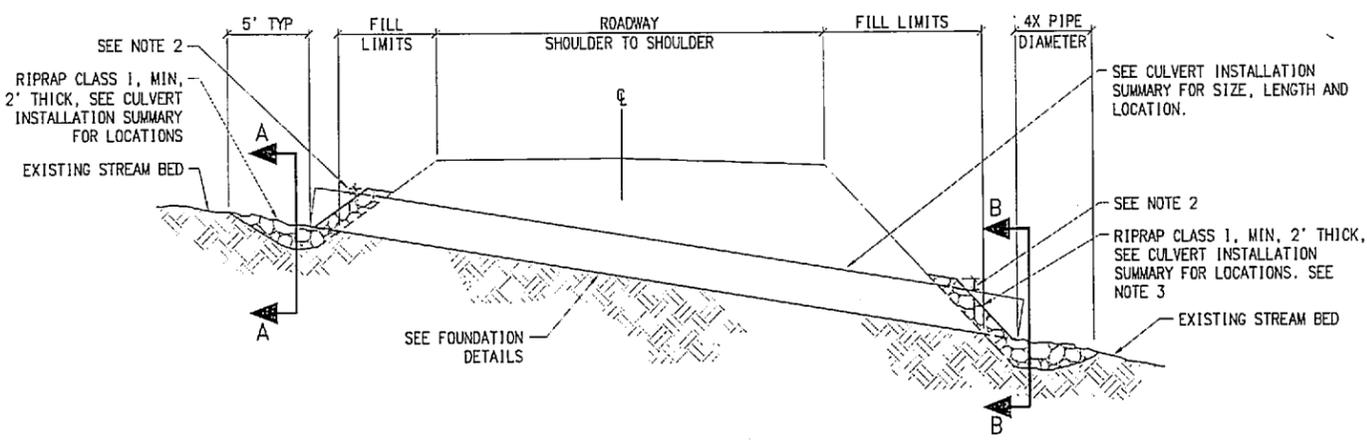


**TYPICAL PIPE CULVERT INSTALLATION - NON-FISH STREAMS**


- NOTES:**
- SEE SHT E11 FOR DRAINAGE SWALE DETAILS AT ABUTMENTS.
  - EXTEND RIPRAP 1' ABOVE CULVERT OR TO THE Q50 FLOOD ELEVATION, WHICHEVER IS GREATER. SEE DETAIL AND PLAN SHEETS FOR Q50 ELEVATION.
  - WHERE NON-FISH STREAM CULVERT OUTLET IS SEATED ON BEDROCK, RIPRAP APRON MAY BE OMITTED

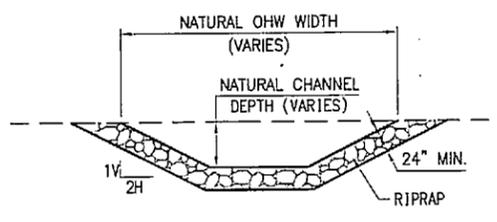

**SECTION A-A**

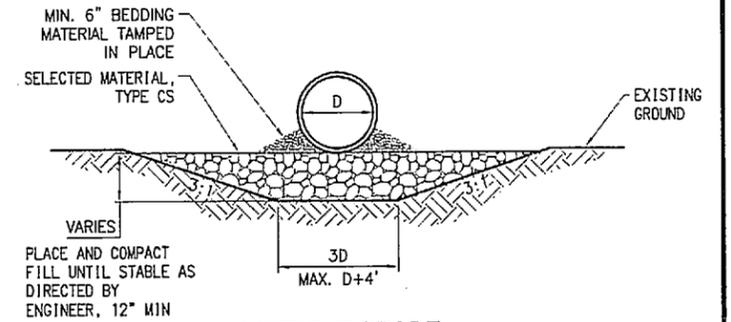


**SOFT SUBGRADE**  
TO BE USED IN UNSTABLE AREAS AS DIRECTED BY THE ENGINEER.

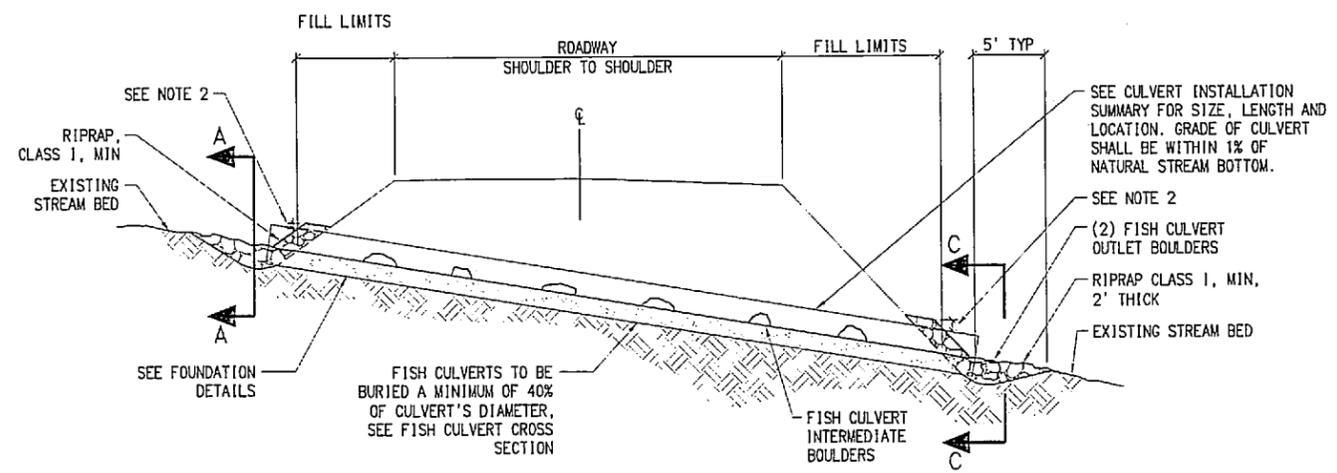


**TYPICAL PIPE CULVERT INSTALLATION - FISH STREAMS**


NOTE: SEE SHEETS E5-E9 FOR INDIVIDUAL FISH STREAMS PLAN AND PROFILE

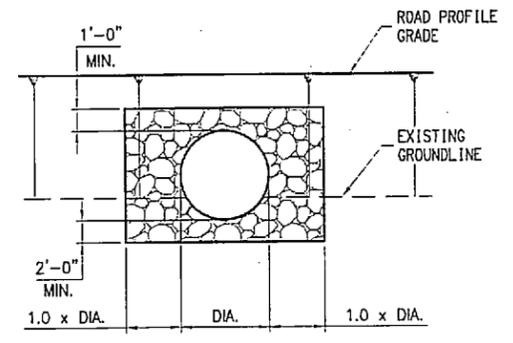


**ELEVATION B-B**

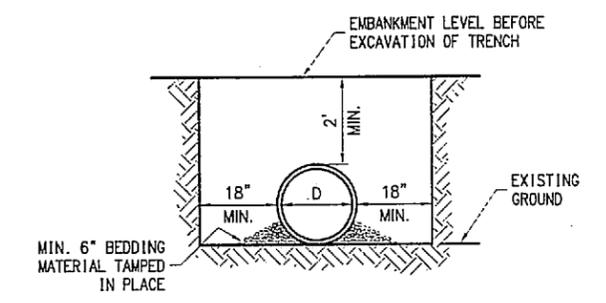


**STABLE SUBGRADE**  
FOR USE ON EXISTING GROUND

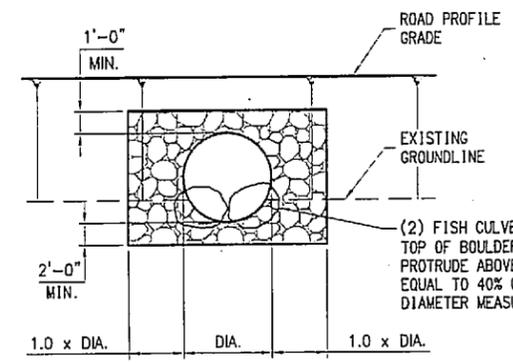


**ELEVATION C-C**

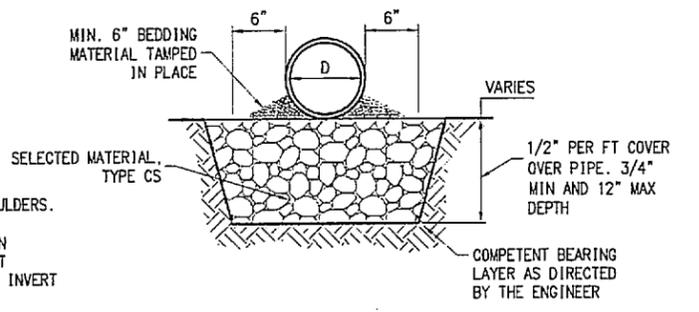

**STABLE SUBGRADE (UNYIELDING MATERIAL)**  
SUBEXCAVATION REQUIRED

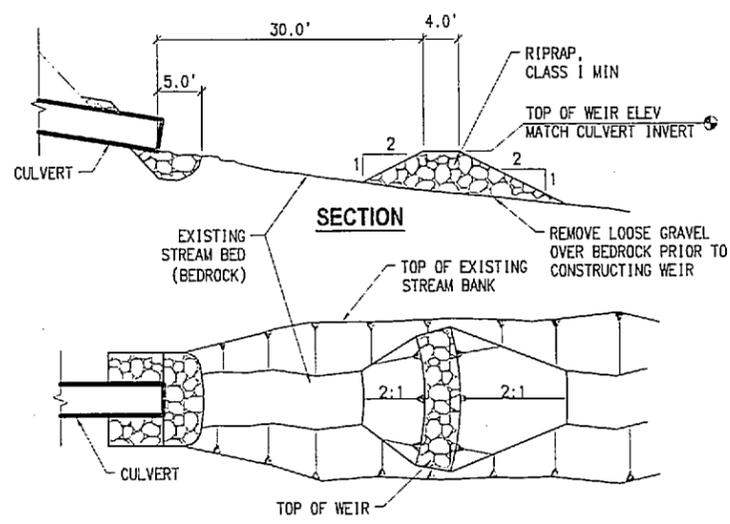

**CULVERT C1 ENERGY DISSIPATER**

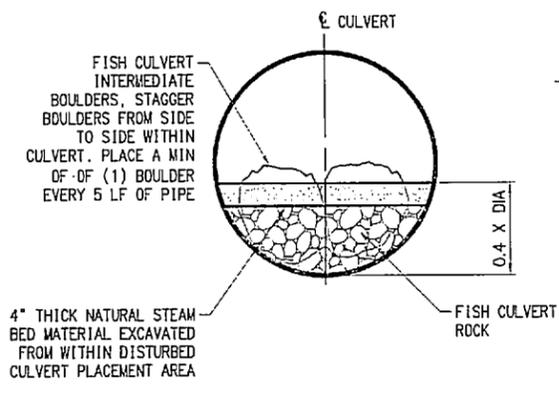

**FISH CULVERT CROSS SECTION**

(FOUNDATION TYPE TO BE DETERMINED IN THE FIELD)

PND ENGINEERS, INC.  
1508 W. 35th Ave., Anchorage, AK 99503  
907-561-1011 engineering@pndengineers.com




STATE OF ALASKA  
DEPARTMENT OF TRANSPORTATION  
AND  
PUBLIC FACILITIES

GRAVINA ISLAND HIGHWAY  
GRADING, DRAINAGE, AND BRIDGES

CULVERT DETAILS

REVISIONS			STATE	PROJECT DESIGNATION	YEAR	SHEET NO.	TOTAL SHEETS
No.	DATE	DESCRIPTION	ALASKA	ACH PRL-0003(123)/67818	2007	E2	E11

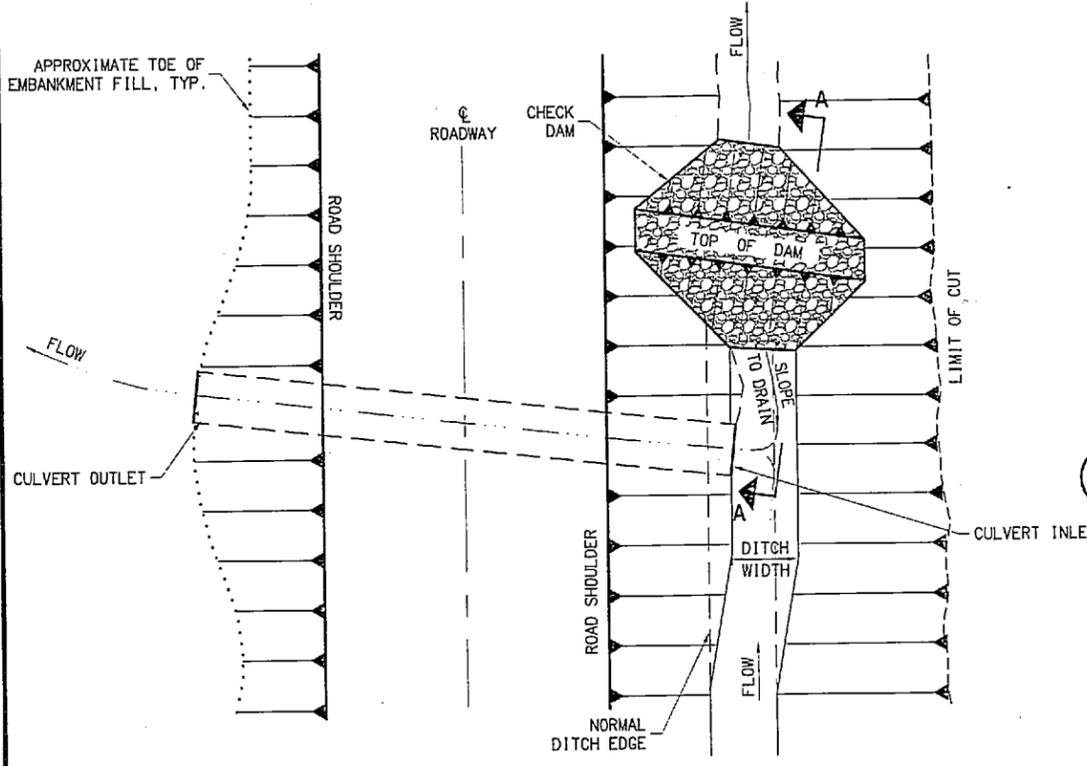


**CULVERT WITH PERMANENT CHECK DAM**  
SEE PLANS FOR LOCATION

DRAINAGE FLUME SUMMARY	
STATION	OFFSET
154+50	LT
154+50	RT
158+40	RT
165+75	RT
177+90	LT
178+50	RT
216+05	RT
221+50	LT
222+75	RT
241+25	RT
242+15	LT
246+50	LT
248+75	RT
284+50	LT
287+00	RT
291+00	LT
291+90	RT
LRR 12+25	LT
LRR 15+00	LT


AS-BUILT

**NOTES:**


1. FLUME SUMMARY LOCATIONS ARE APPROXIMATE. ACTUAL LOCATION AND LENGTH SHALL BE AS SHOWN ON THE PLANS OR AS REQUIRED PER FIELD CONDITIONS.
2. WHERE BEDROCK IS ENCOUNTERED, RIP THICKNESS MAY BE DECREASED.

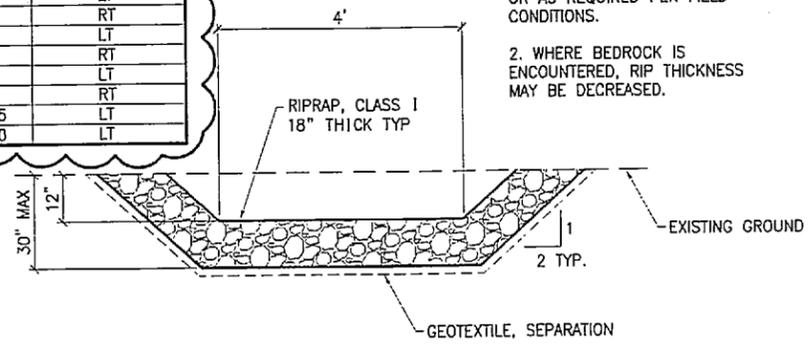


**DRAINAGE FLUME AT CUT/FILL TRANSITIONS**

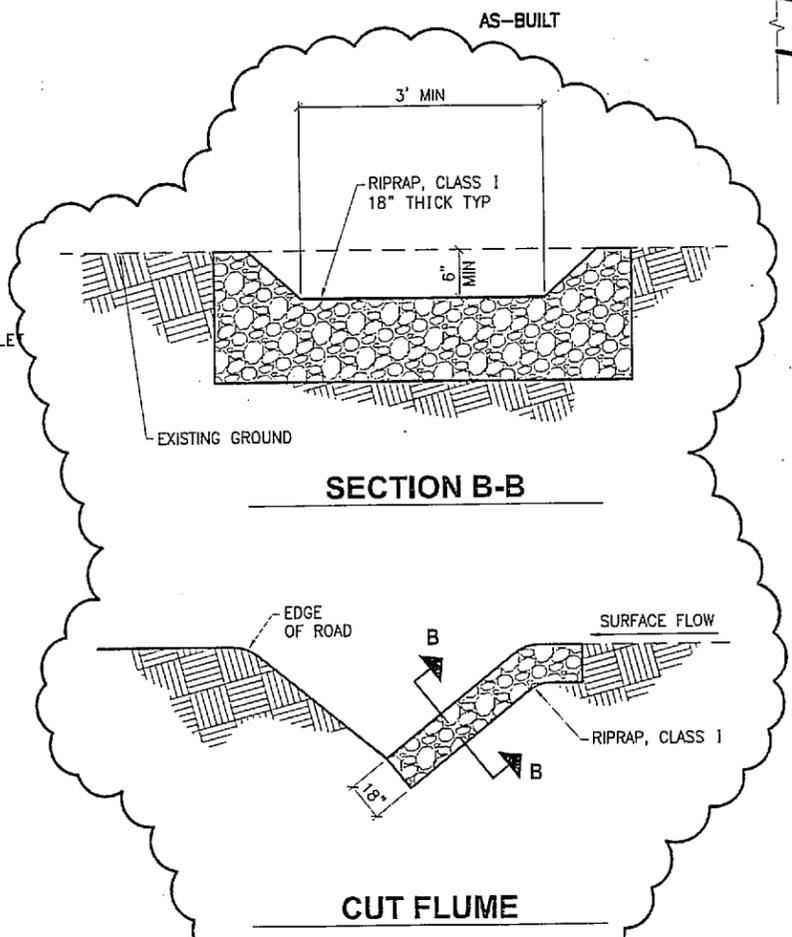


**CUT FLUME**

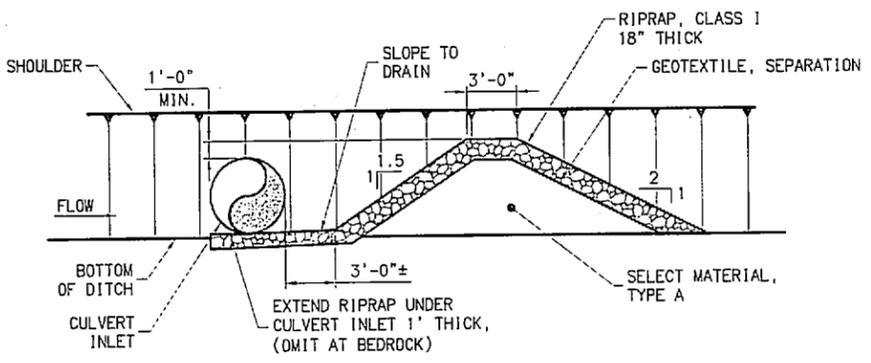

**SECTION A-A**

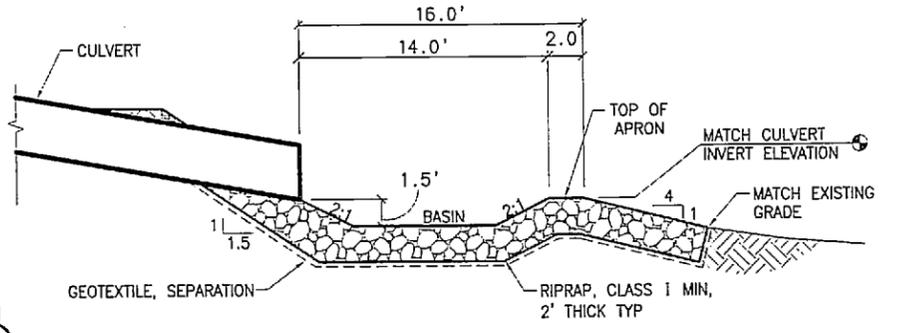

**SECTION**

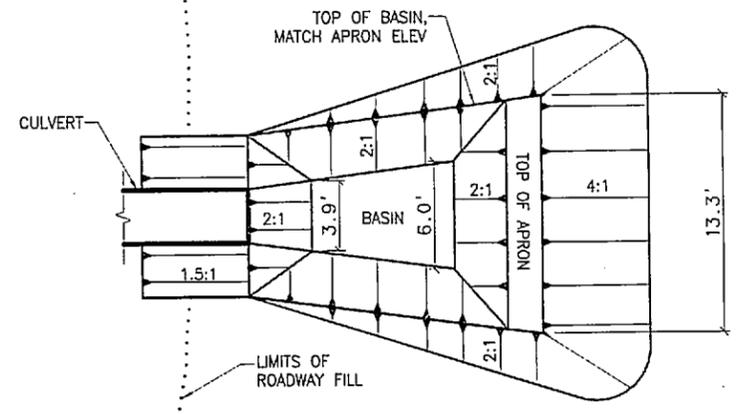

**PLAN**

**CULVERT C2 ENERGY DISSIPATOR**

PND ENGINEERS, INC.  
1506 W. 36th Ave. Anchorage, AK 99503  
907-561-1011 engineering@pndengineers.com




STATE OF ALASKA  
DEPARTMENT OF TRANSPORTATION  
AND  
PUBLIC FACILITIES


GRAVINA ISLAND HIGHWAY  
GRADING, DRAINAGE, AND BRIDGES

DETAILS


REVISIONS			STATE	PROJECT DESIGNATION	YEAR	SHEET NO.	TOTAL SHEETS
No.	DATE	DESCRIPTION	ALASKA	ACH PRL-0003(123)/67818	2007	E3	E11

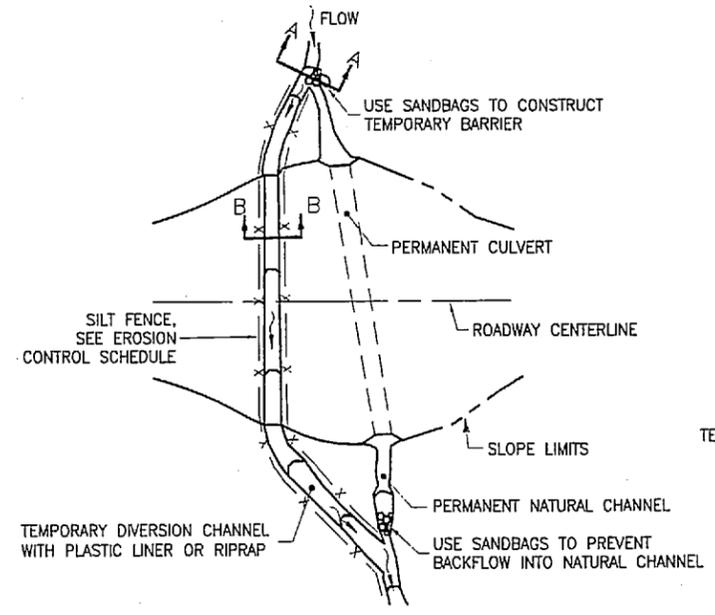


**DIVERSION CHANNEL**

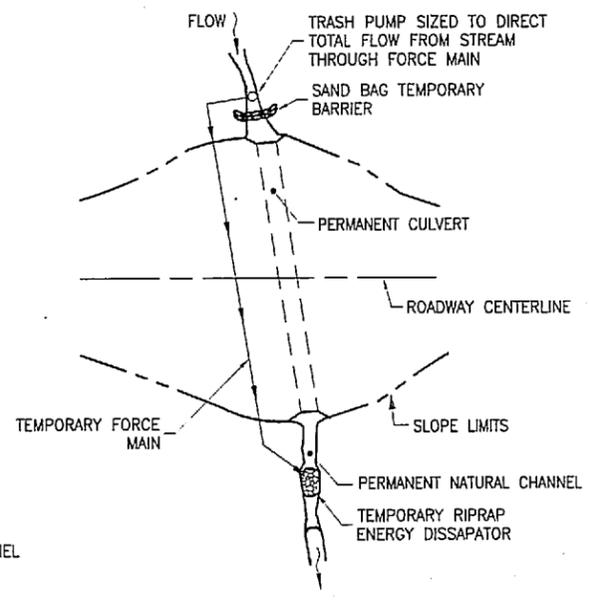

**DIVERSION PUMP**  
SEE NOTE 5

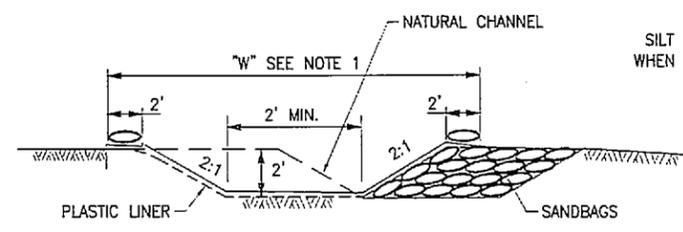


SECTION A-A

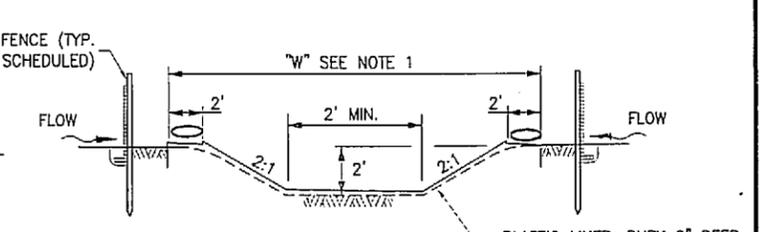


SECTION B-B

**PLASTIC LINED DIVERSION CHANNEL**

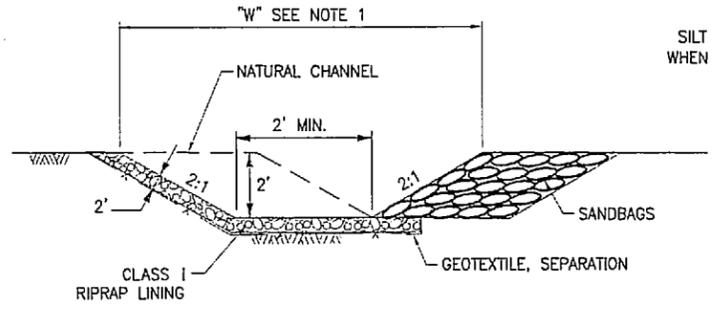


SECTION A-A

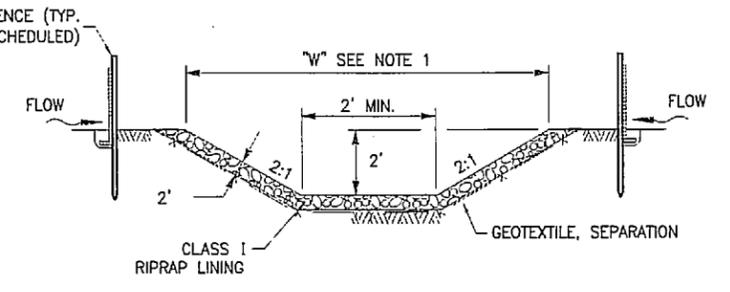

SECTION B-B

**RIPRAP LINED DIVERSION CHANNEL**

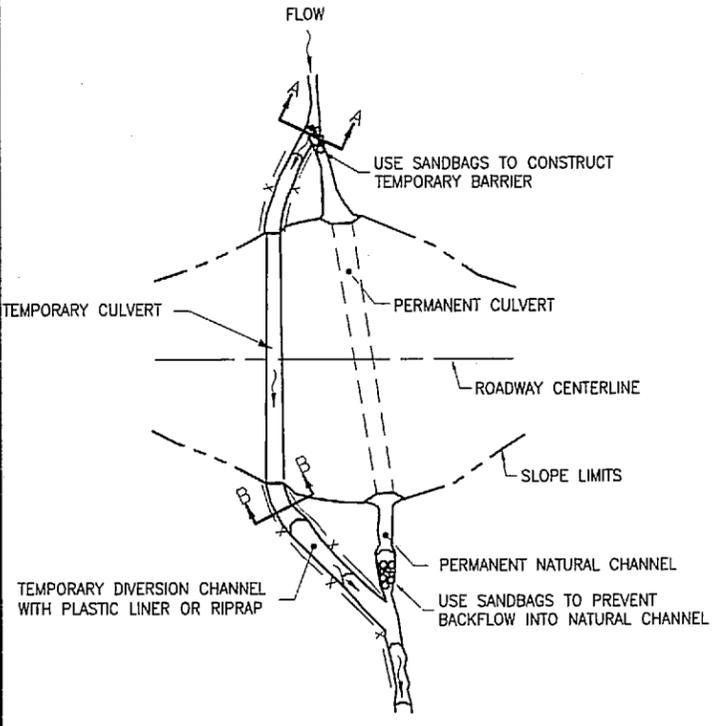

**TEMPORARY CULVERT DIVERSION**

**NOTES:**

1. "W" - MATCH CHANNEL WIDTH TO EXISTING STREAM WIDTH.
2. USE PLASTIC LINER OR RIPRAP ALONG THE ENTIRE LENGTH AND WIDTH OF THE TEMPORARY DIVERSION CHANNEL.
3. CONSTRUCT CHANNEL TO MAINTAIN POSITIVE DRAINAGE. PROVIDE A MINIMUM GRADE OF 0.5 PERCENT WHERE POSSIBLE.
4. DO NOT CONSTRUCT WITH LONGITUDINAL JOINTS IF USING A PLASTIC LINER. BURY THE UPSTREAM EDGE OF THE LINER A MINIMUM OF 6" DEEP AND SECURE WITH RIPRAP OR SANDBAGS.
5. IF A TRASH PUMP IS USED DURING CONSTRUCTION THE INTAKE MUST BE OPERATED, AND MAINTAINED TO PREVENT FISH ENTRAPMENT, ENTRAINMENT, OR INJURY WITH THE USE OF PERFORATED PLATE AND WOVEN WIRE HAVING A MESH SIZE NOT GREATER THAN 3/32 INCHES OR PROFILE BAR AND WEDGEWIRE HAVING OPENINGS NOT GREATER THAN 1/16 INCHES. APPROACH VELOCITIES SHALL NOT EXCEED A PASSIVE VELOCITY OF 0.2 FEET PER SECOND (FPS) OR AN ACTIVE VELOCITY OF 0.4 FPS

PND ENGINEERS, INC.  
1506 W. 36th Ave., Anchorage, AK 99503  
907-561-1011 engineering@pndengineers.com





STATE OF ALASKA  
DEPARTMENT OF TRANSPORTATION  
AND  
PUBLIC FACILITIES


GRAVINA ISLAND HIGHWAY  
GRADING, DRAINAGE, AND BRIDGES

DETAILS

REVISIONS			STATE	PROJECT DESIGNATION	YEAR	SHEET NO.	TOTAL SHEETS
No.	DATE	DESCRIPTION	ALASKA	ACH PRL-0003(123)/67818	2007	E4	E11

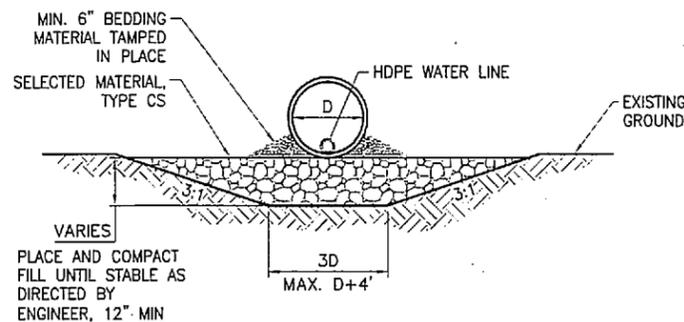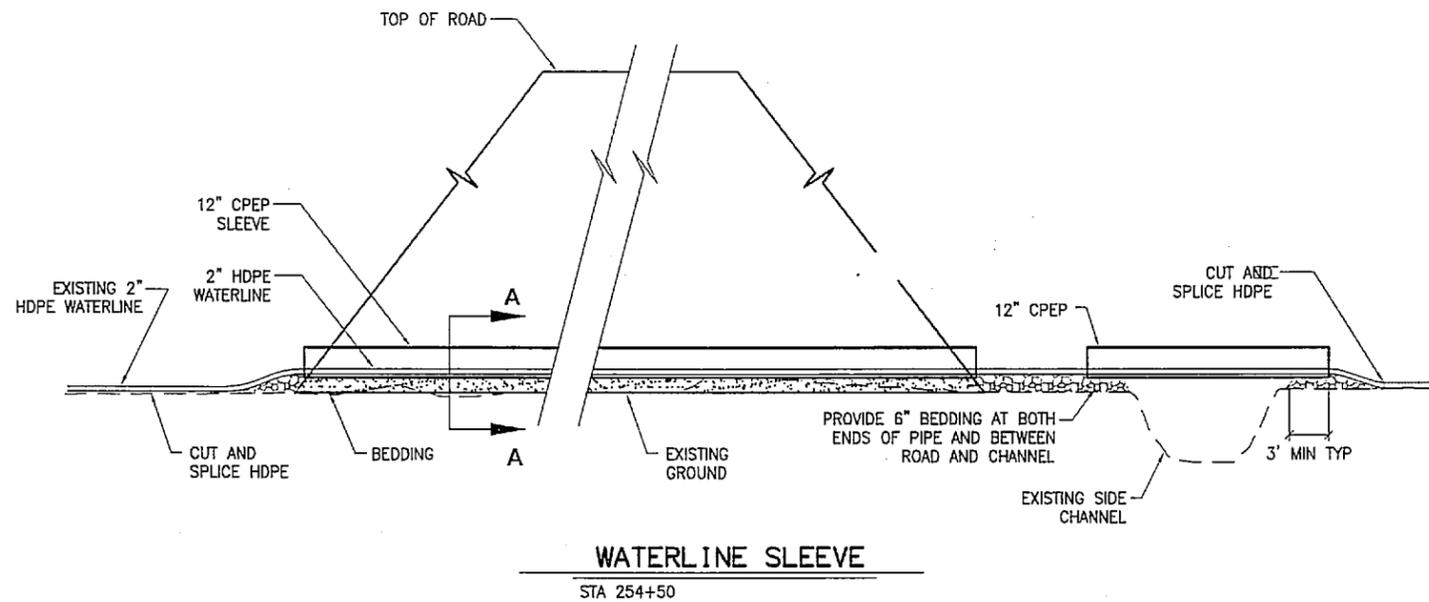


**SECTION A-A**

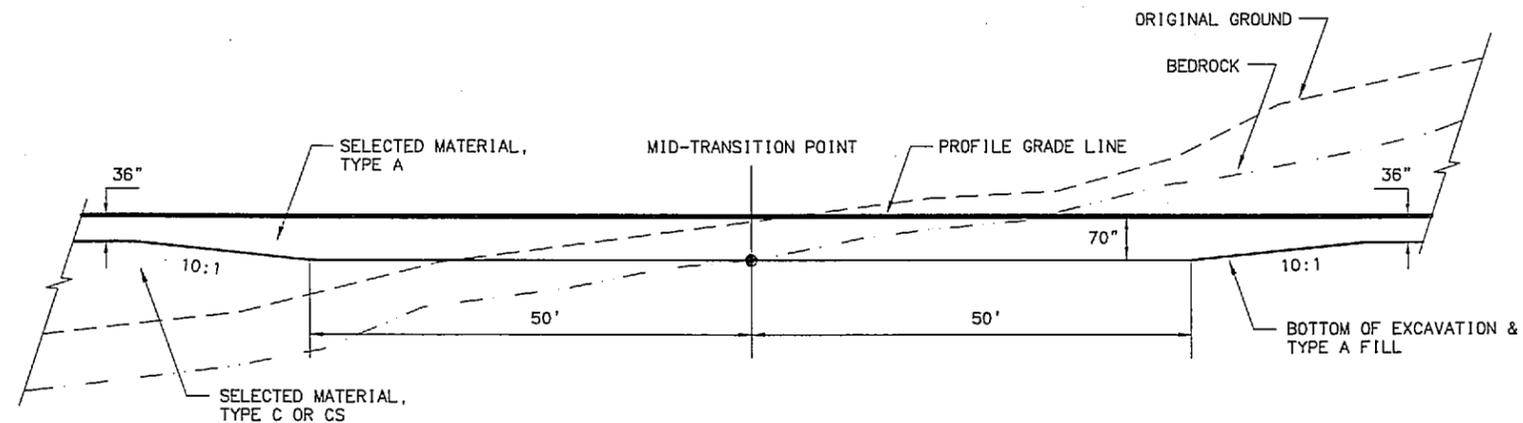


**CUT-FILL LONGITUDINAL TRANSITION - CASE 2**

TO BE USED WHERE DIFFERENCE BETWEEN BEDROCK SLOPE AND PROPOSED GRADE IS GREATER THAN 10%.

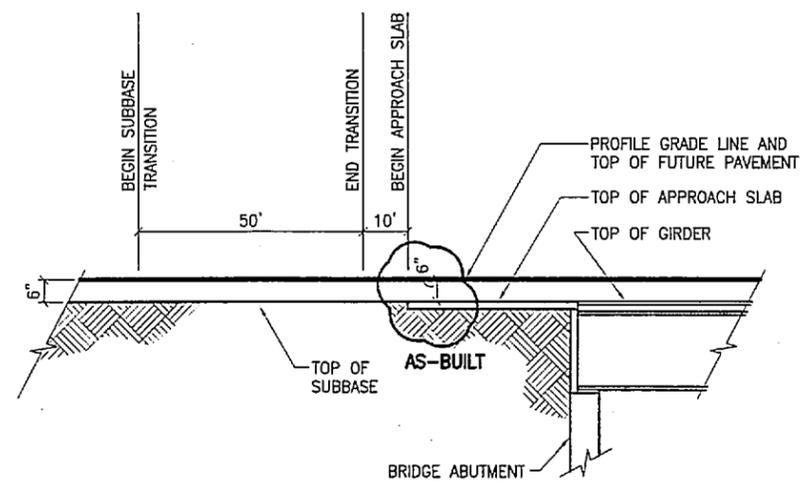

**SUBBASE PROFILE TRANSITION AT BRIDGES**

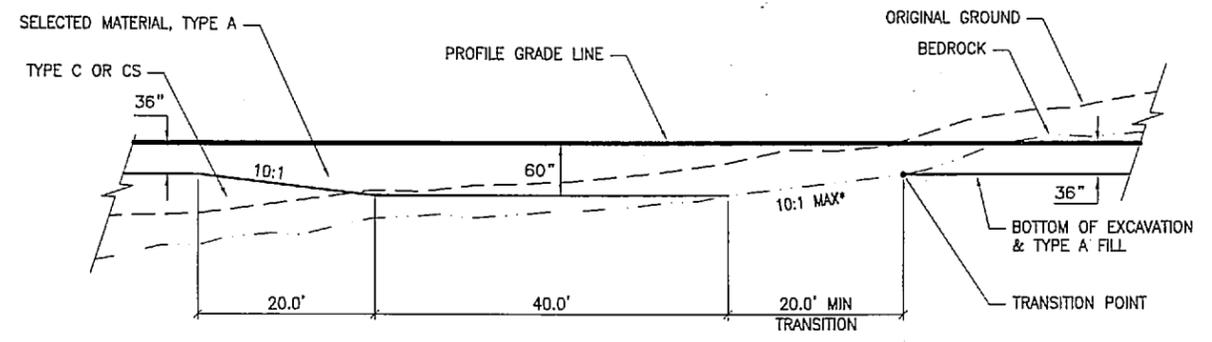


**CUT-FILL LONGITUDINAL TRANSITION DETAIL - CASE 1**

TO BE USED WHERE DIFFERENCE BETWEEN BEDROCK SLOPE AND PROPOSED GRADE IS LESS THAN 10%

\* FOLLOW NATURAL BEDROCK SLOPE


PND ENGINEERS, INC.  
1506 W. 36th Ave. Anchorage, AK 99503  
907-561-1011 engineering@pndengineers.com

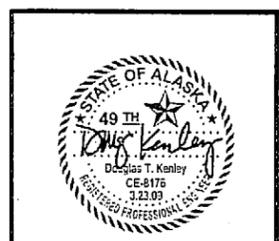



STATE OF ALASKA  
DEPARTMENT OF TRANSPORTATION  
AND  
PUBLIC FACILITIES  
  
GRAVINA ISLAND HIGHWAY  
GRADING, DRAINAGE, AND BRIDGES

DETAILS

REVISIONS			STATE	PROJECT DESIGNATION	YEAR	SHEET NO.	TOTAL SHEETS
No.	DATE	DESCRIPTION	ALASKA	ACH PRL-0003(123)/67818	2007	E5	E11

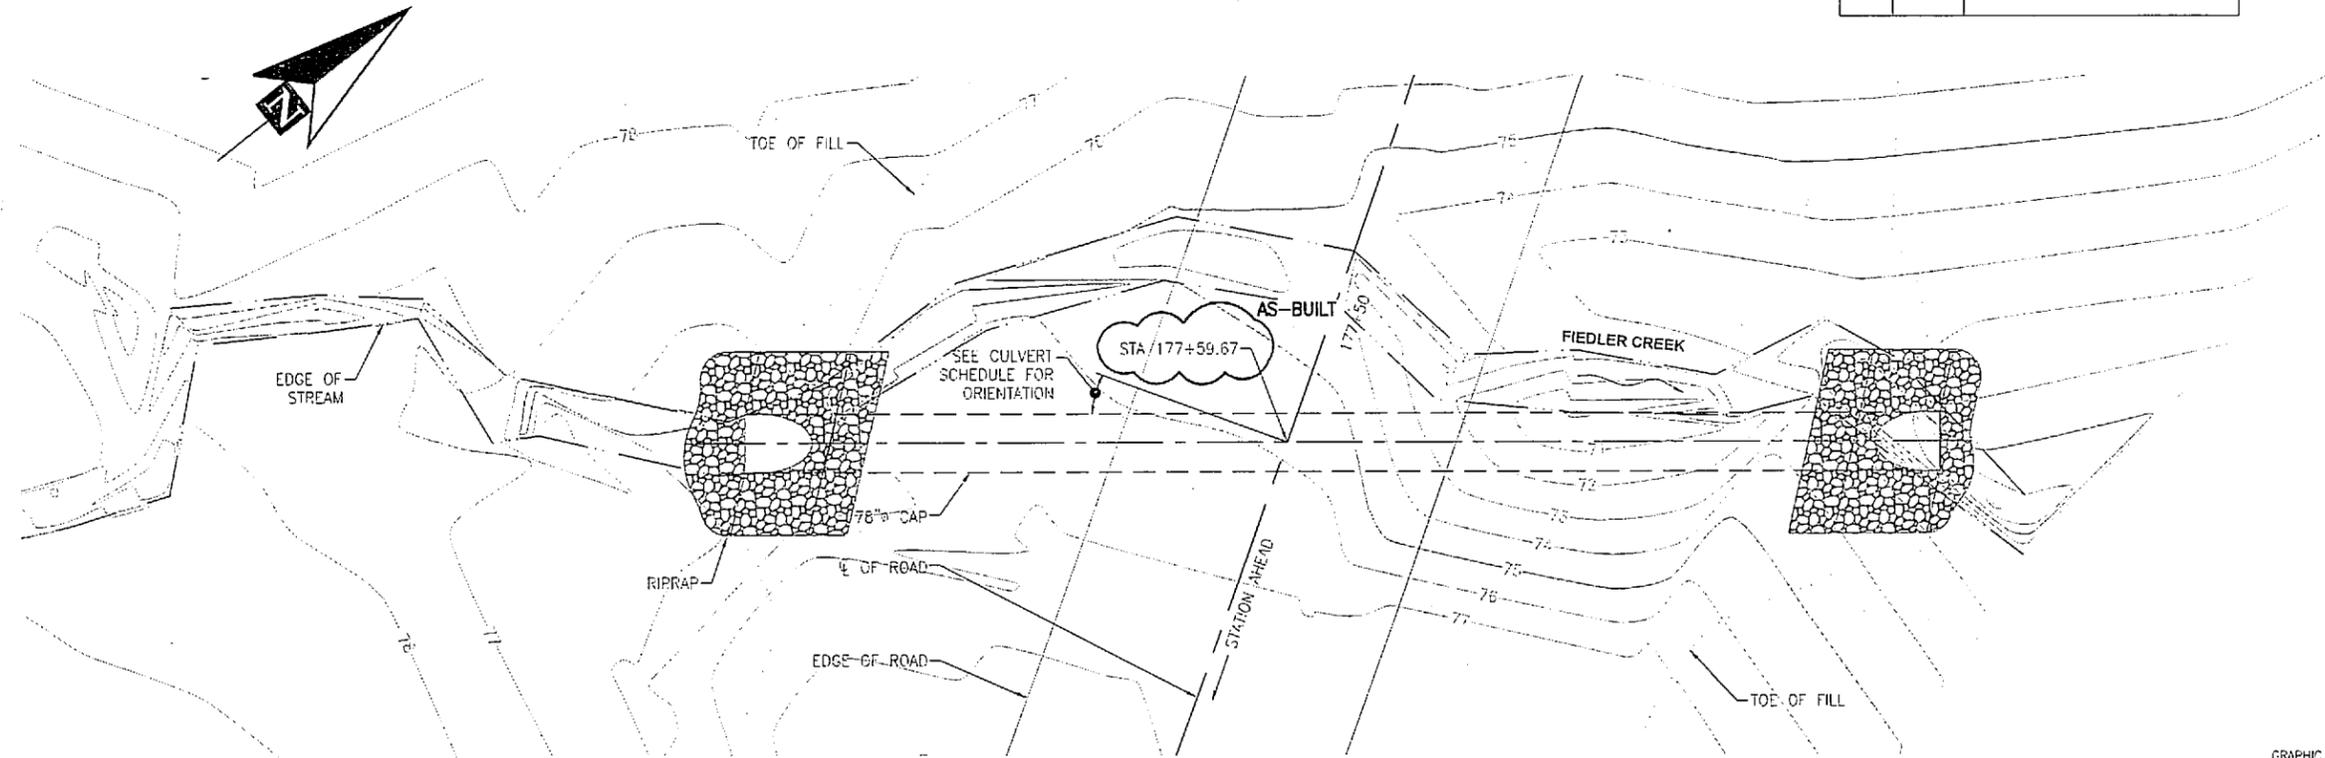

PLAN (SEE C7 ON CULVERT SCHEDULE)

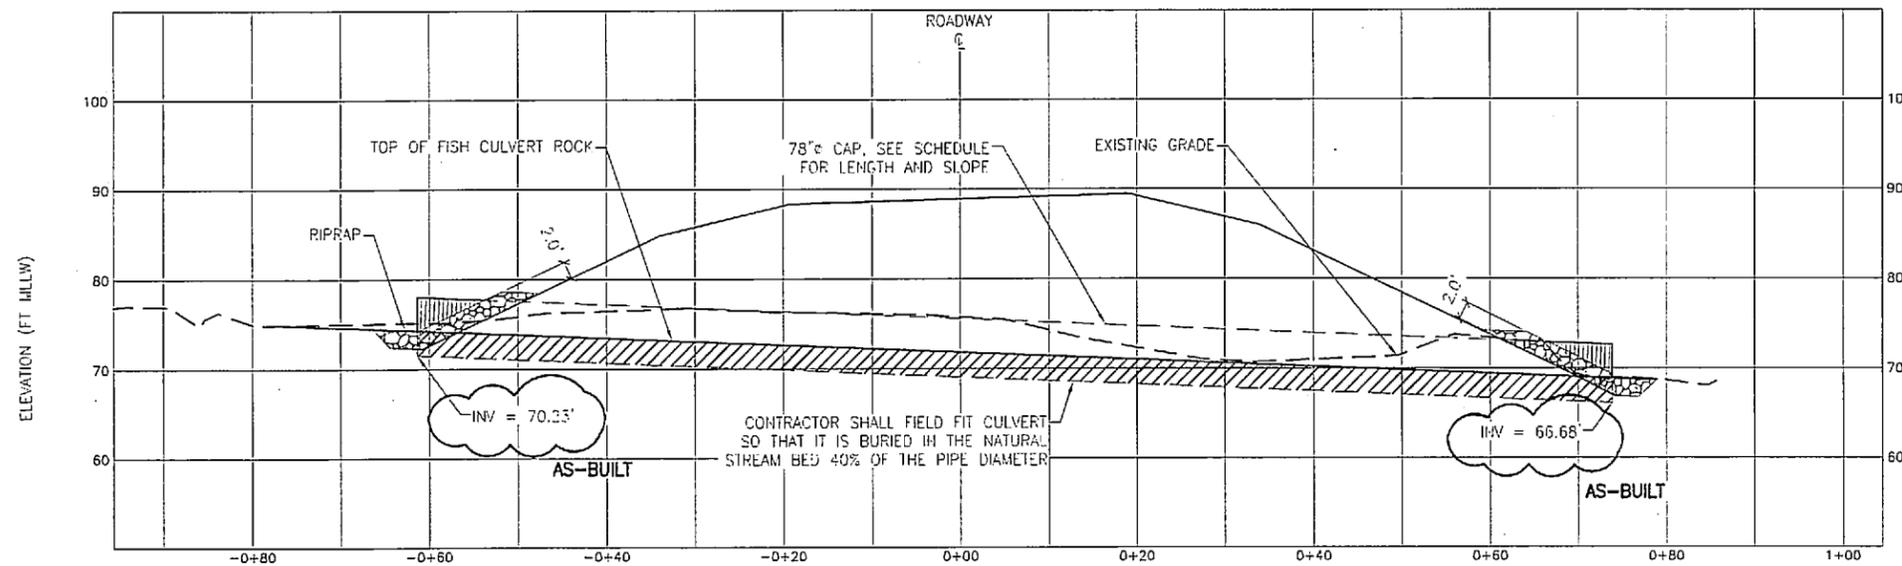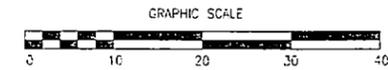

FIEDLER CREEK CROSS SECTION  
AT  $\phi$  OF INSTALLATION

**NOTES:**

1. SENSITIVE FISH STREAM !!! DO NOT BEGIN CONSTRUCTION UNTIL TITLE 41 PERMIT IS RECEIVED. THE CULVERT IS CURRENTLY DESIGNED TO TIER 1 REQUIREMENTS FOR FISH PASSAGE. ANY ADDITIONAL REQUIREMENTS IN THE TITLE 41 PERMIT SHALL BE MET AND DOCUMENTED IN THE PROJECT AS-BUILTS.

2. FIELD VERIFY INLET ELEVATIONS, OUTLET ELEVATIONS, AND SLOPE.

DRAINAGE AREA	= 0.116 SQ. MI	Q50 FLOOD ELEVATION	= 77.58 FT MLLW
DESIGN EXCEEDANCE	= 2 %	Q50 TAILWATER ELEVATION	= 70.85 FT MLLW
C2	= 47 CFS	OVERTOPPING FLOOD	= >0500 (126 CFS)
Q50	= 96 CFS	OVERTOPPING PROBABILITY	= <0.2%
C <sub>FISH</sub>	= 19 CFS	OVERTOPPING ELEVATION	= 84.5 FT

PND ENGINEERS, INC.  
1506 W. 36th Ave. Anchorage, AK 99503  
907-561-1011 engineering@pndengineers.com




STATE OF ALASKA  
DEPARTMENT OF TRANSPORTATION  
AND  
PUBLIC FACILITIES


GRAVINA ISLAND HIGHWAY  
GRADING, DRAINAGE, AND BRIDGES

FIEDLER CREEK  
CULVERT PLAN & PROFILES

REVISIONS			STATE	PROJECT DESIGNATION	YEAR	SHEET NO.	TOTAL SHEETS
No.	DATE	DESCRIPTION	ALASKA	ACH PRL-0003(123)/67818	2007	E6	E11

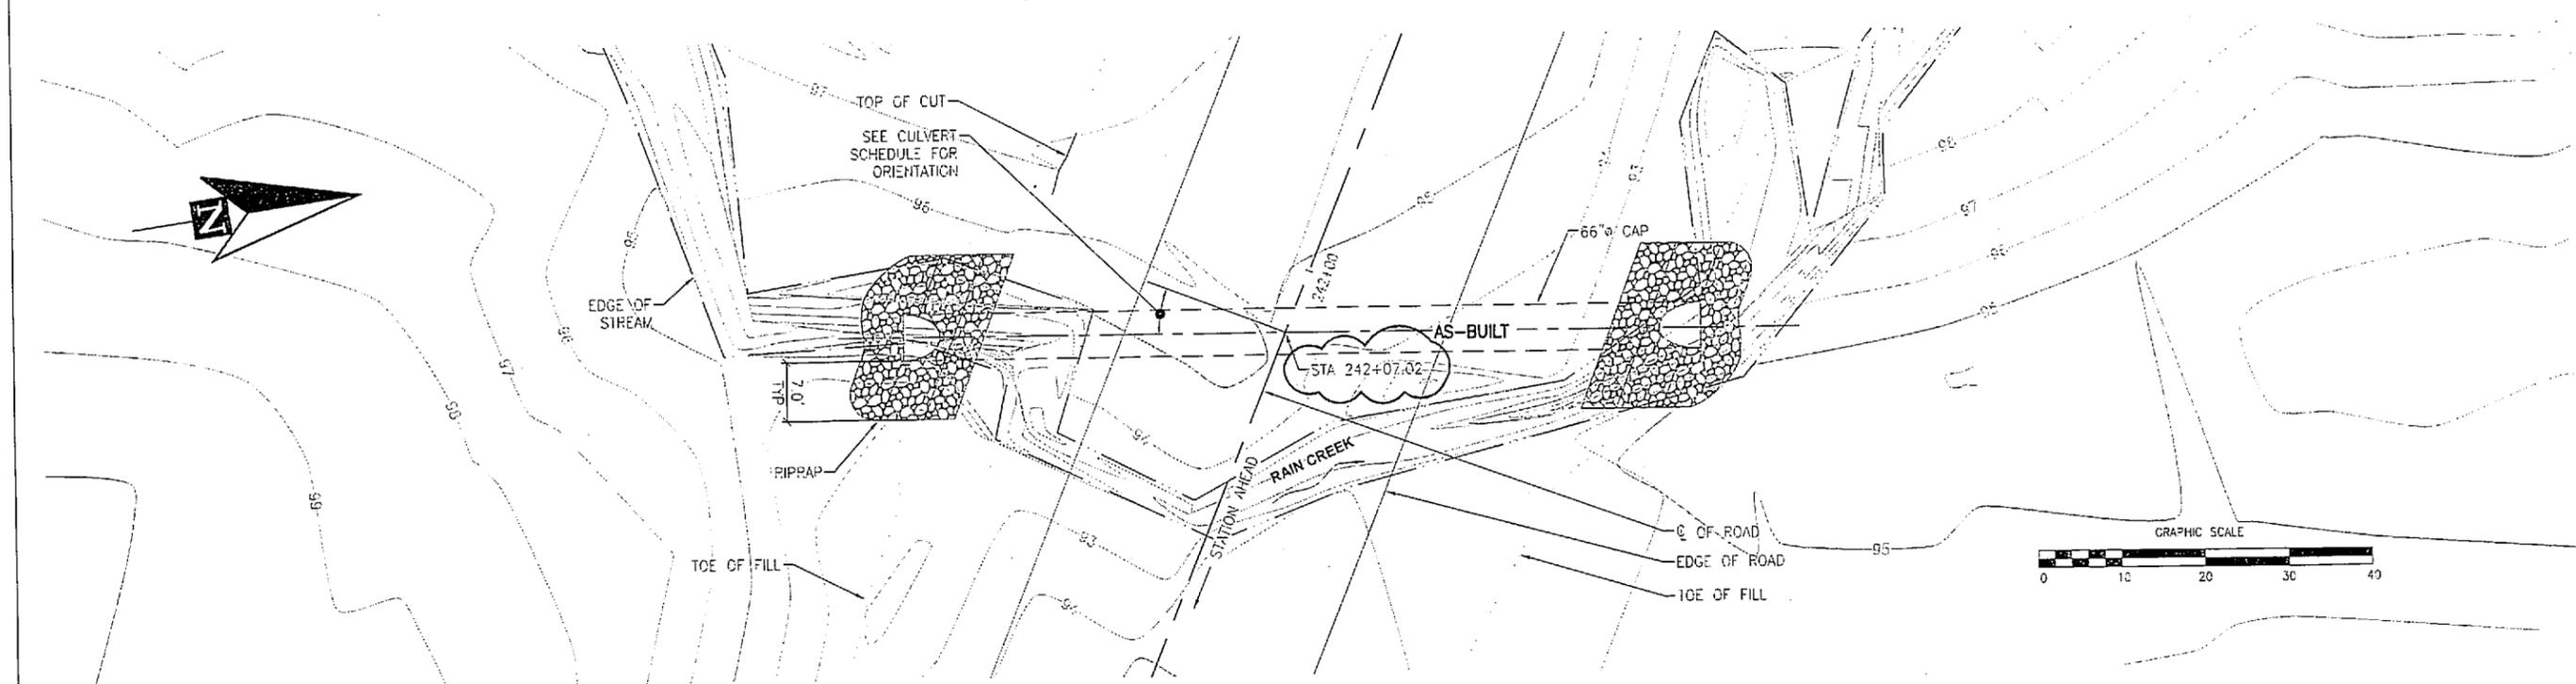

PLAN (SEE C12 ON CULVERT SCHEDULE)

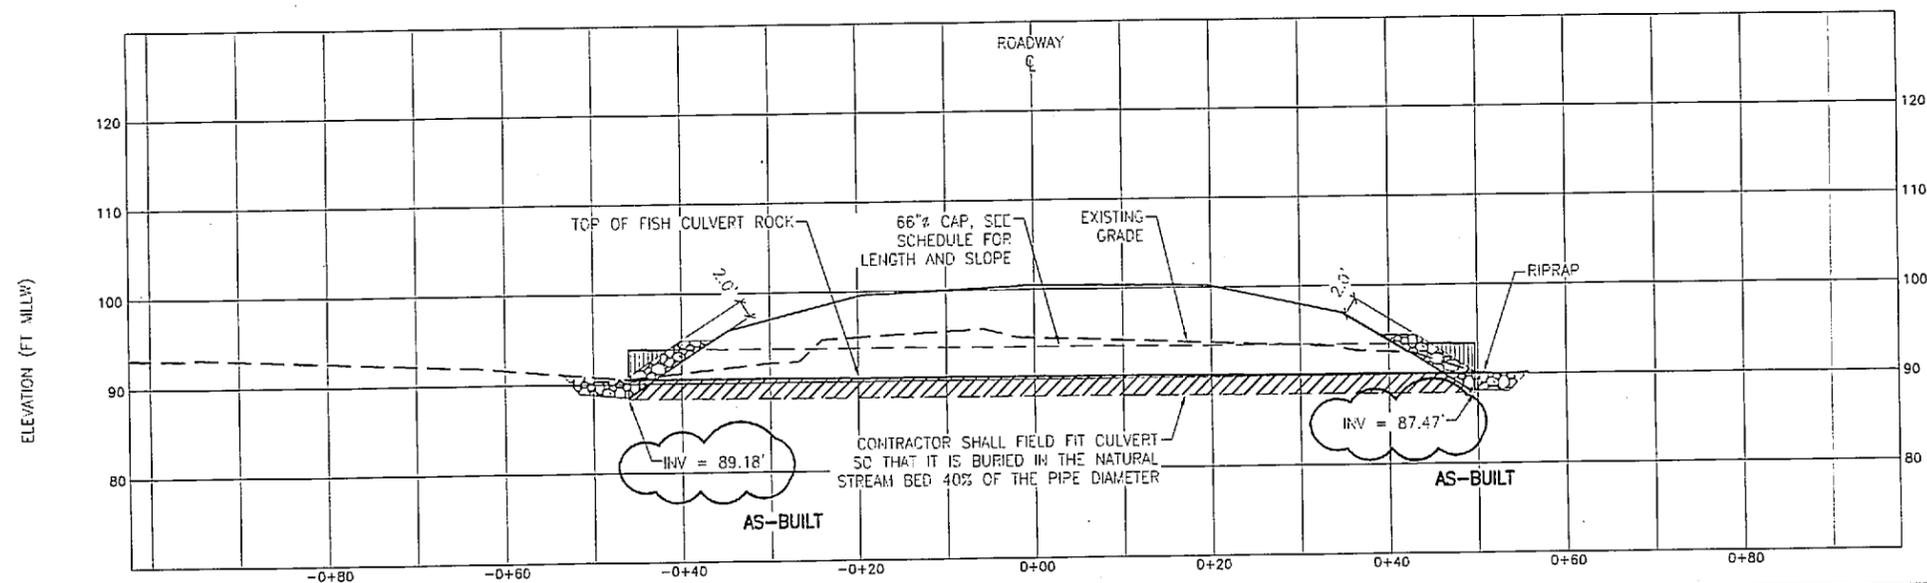

RAIN CREEK CROSS SECTION  
AT CENTERLINE OF INSTALLATION

NOTES:

- SENSITIVE FISH STREAM !!! DO NOT BEGIN CONSTRUCTION UNTIL TITLE 41 PERMIT IS RECEIVED. THE CULVERT IS CURRENTLY DESIGNED TO TIER 1 REQUIREMENTS FOR FISH PASSAGE. ANY ADDITIONAL REQUIREMENTS IN THE TITLE 41 PERMIT SHALL BE MET AND DOCUMENTED IN THE PROJECT AS-BUILTS.
- FIELD VERIFY INLET ELEVATIONS, OUTLET ELEVATIONS, AND SLOPE.

DRAINAGE AREA	= 0.181 SQ. MI	Q50 FLOOD ELEVATION	= 93.96 FT MLLW
DESIGN EXCEEDANCE	= 2 %	Q50 TAILWATER ELEVATION	= 92.22 FT MLLW
C2	= 32 CFS	OVERTOPPING FLOOD	= >Q500 (85 CFS)
C50	= 64 CFS	OVERTOPPING PROBABILITY	= <0.2%
C FISH	= 13 CFS	OVERTOPPING ELEVATION	= 100.5 FT

PND ENGINEERS, INC.  
1506 W. 36th Ave. Anchorage, AK 99503  
907-561-1011 engineering@pndengineers.com




STATE OF ALASKA  
DEPARTMENT OF TRANSPORTATION  
AND  
PUBLIC FACILITIES


GRAVINA ISLAND HIGHWAY  
GRADING, DRAINAGE, AND BRIDGES

RAIN CREEK  
CULVERT PLAN & PROFILES

REVISIONS			STATE	PROJECT DESIGNATION	YEAR	SHEET NO.	TOTAL SHEETS
No.	DATE	DESCRIPTION	ALASKA	ACH PRL-0003(123)/67818	2007	E7	E11

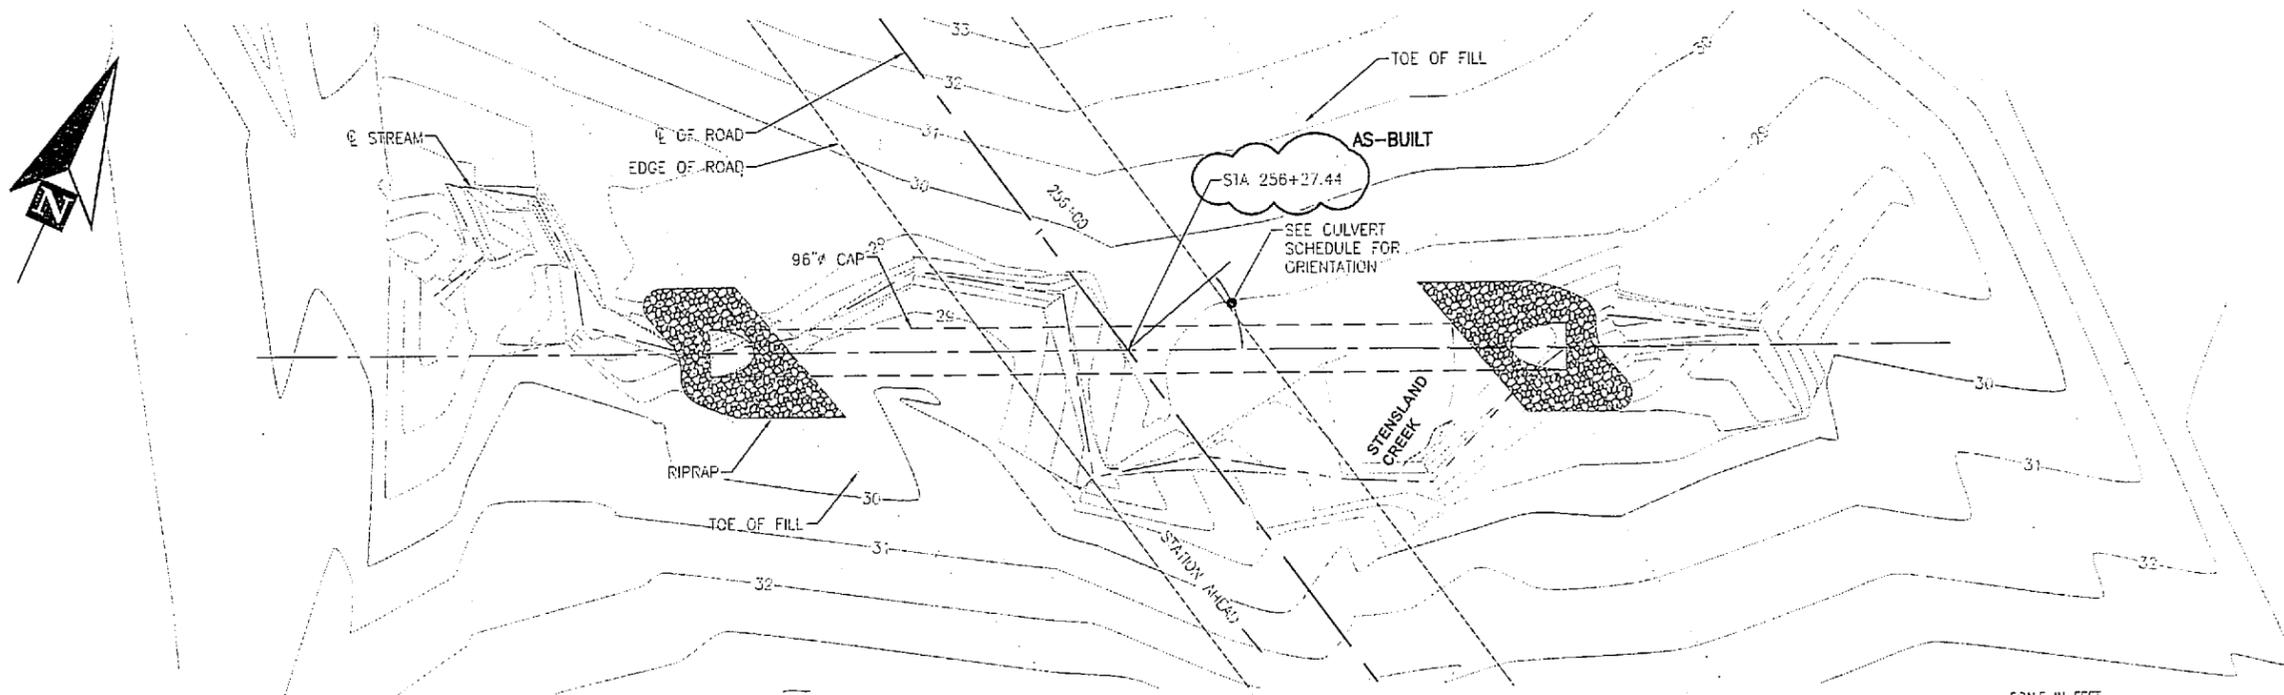

PLAN (SEE C14 ON CULVERT SCHEDULE)

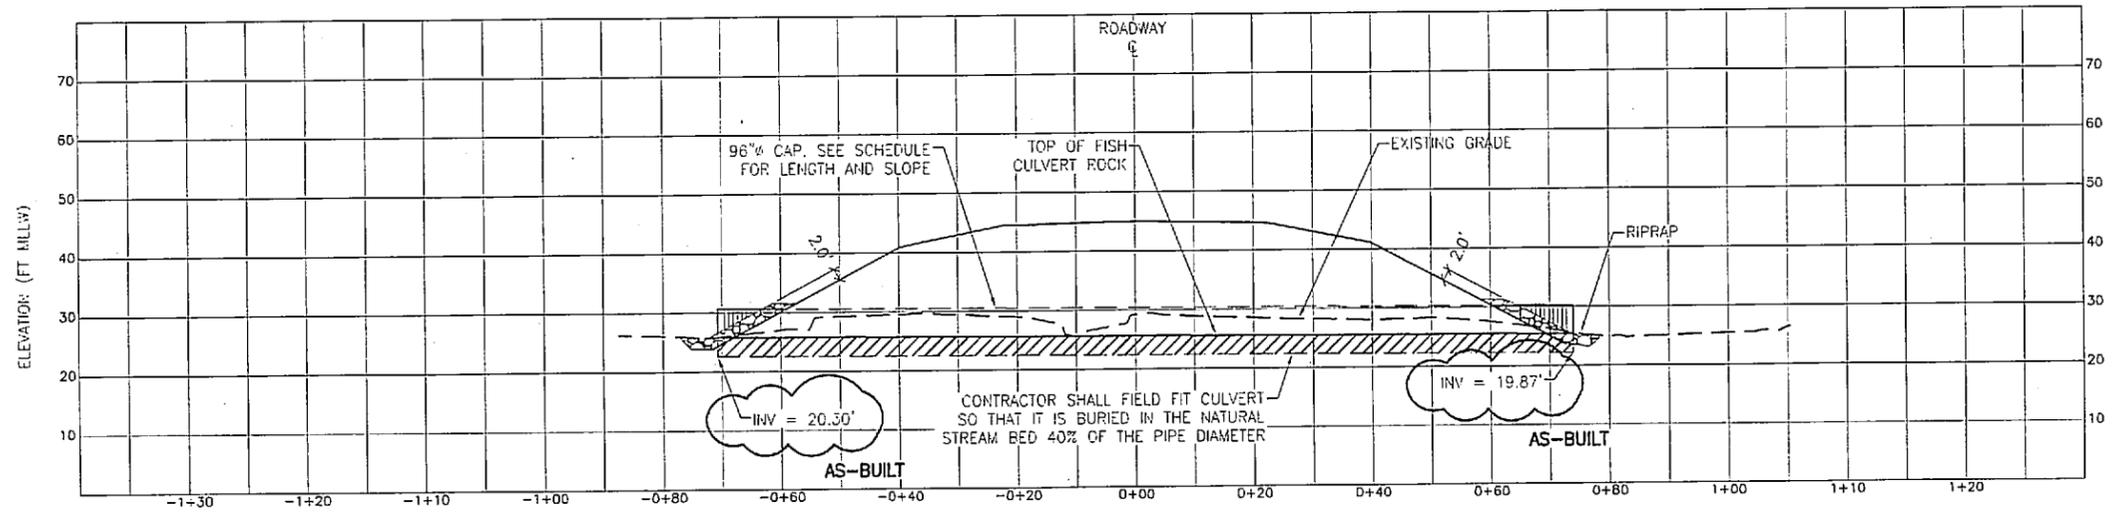

STENSLAND CREEK CROSS SECTION AT CL OF INSTALLATION

PND ENGINEERS, INC.  
1506 W. 36th Ave. Anchorage, AK 99503  
907-561-1011 engineering@pndengineers.com

NOTES:

1. SENSITIVE FISH STREAM !!! DO NOT BEGIN CONSTRUCTION UNTIL TITLE 41 PERMIT IS RECEIVED. THE CULVERT IS CURRENTLY DESIGNED TO TIER 1 REQUIREMENTS FOR FISH PASSAGE. ANY ADDITIONAL REQUIREMENTS IN THE TITLE 41 PERMIT SHALL BE MET AND DOCUMENTED IN THE PROJECT ASBUILTS.

2. FIELD VERIFY INLET ELEVATIONS, OUTLET ELEVATIONS, AND SLOPE.

DRAINAGE AREA	= 0.206 SQ. MI	Q50 FLOOD ELEVATION	= 31.17 FT MLLW
DESIGN EXCEEDANCE	= 2 %	Q50 TAILWATER ELEVATION	= 28.92 FT MLLW
C2	= 87 CFS	OVERTOPPING FLOOD	= >Q500 (232 CFS)
Q50	= 178 CFS	OVERTOPPING PROBABILITY	= <0.2%
Q <sub>FISH</sub>	= 35 CFS	OVERTOPPING ELEVATION	= 45.0 FT




STATE OF ALASKA  
DEPARTMENT OF TRANSPORTATION  
AND  
PUBLIC FACILITIES


GRAVINA ISLAND HIGHWAY  
GRADING, DRAINAGE, AND BRIDGES

STENSLAND CREEK  
CULVERT PLAN & PROFILES

REVISIONS			STATE	PROJECT DESIGNATION	YEAR	SHEET NO.	TOTAL SHEETS
No.	DATE	DESCRIPTION	ALASKA	ACH PRL-0003(123)/67818	2007	E8	E11

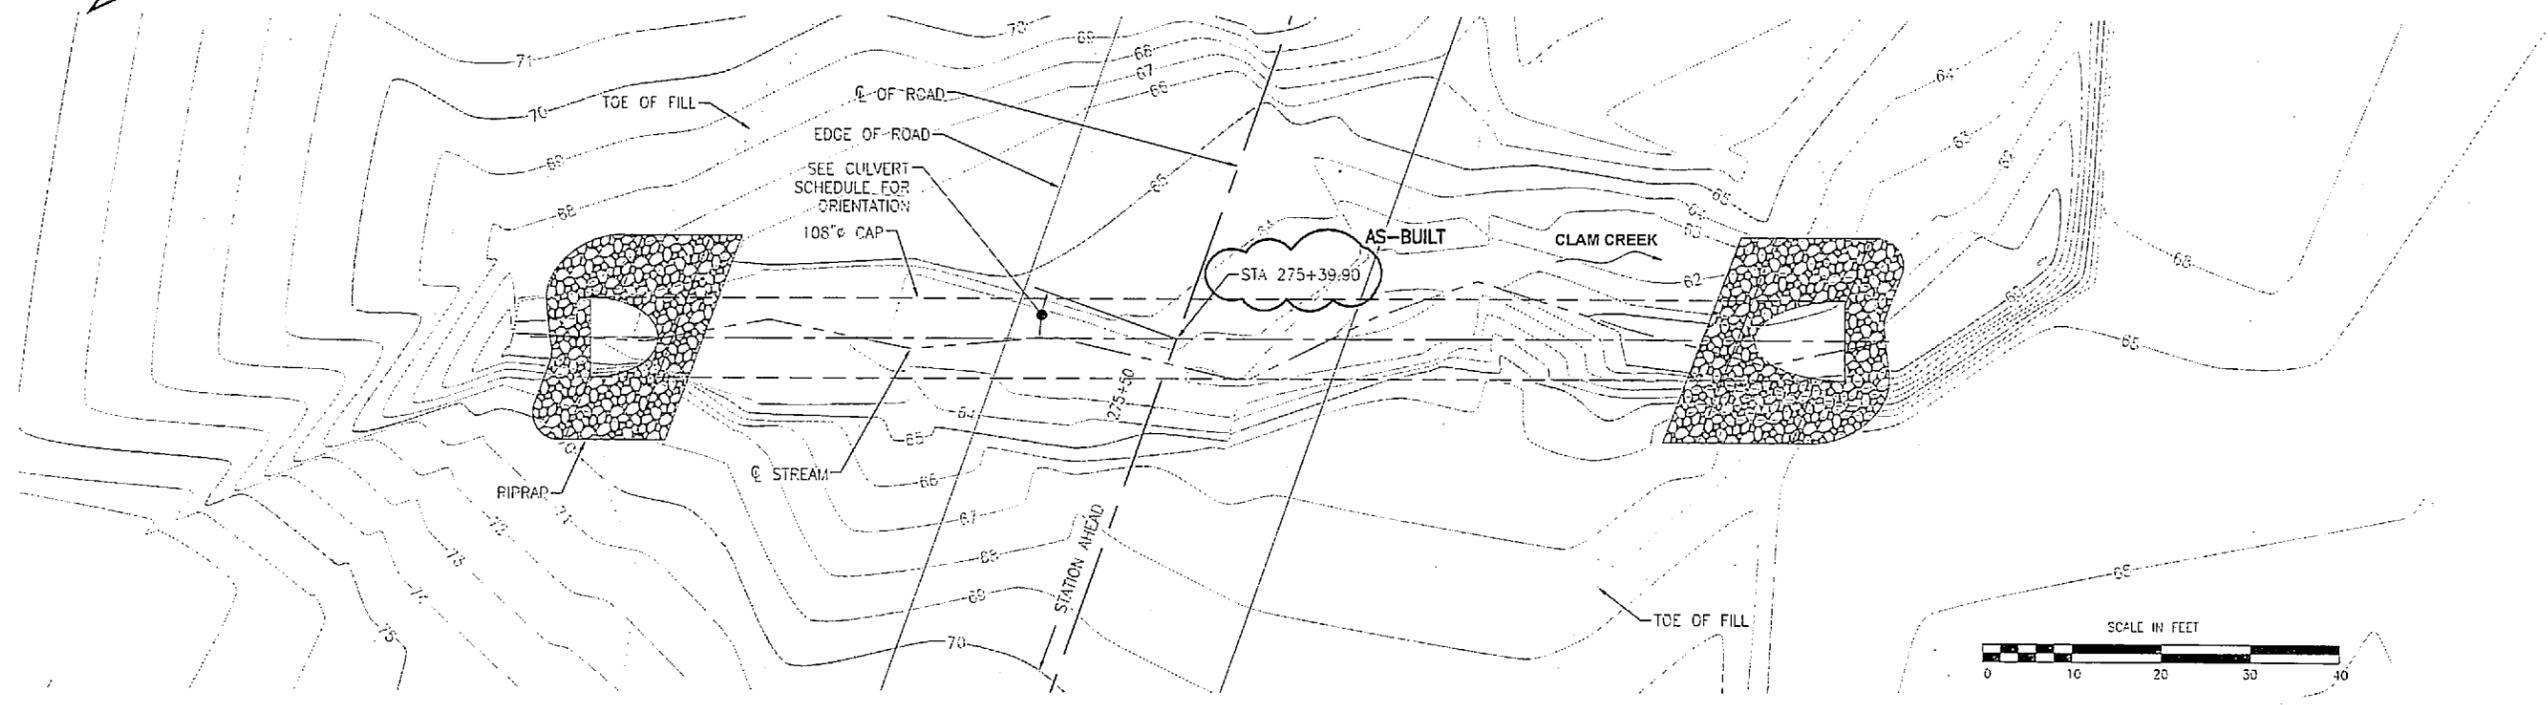

PLAN (SEE C17 ON CULVERT SCHEDULE)

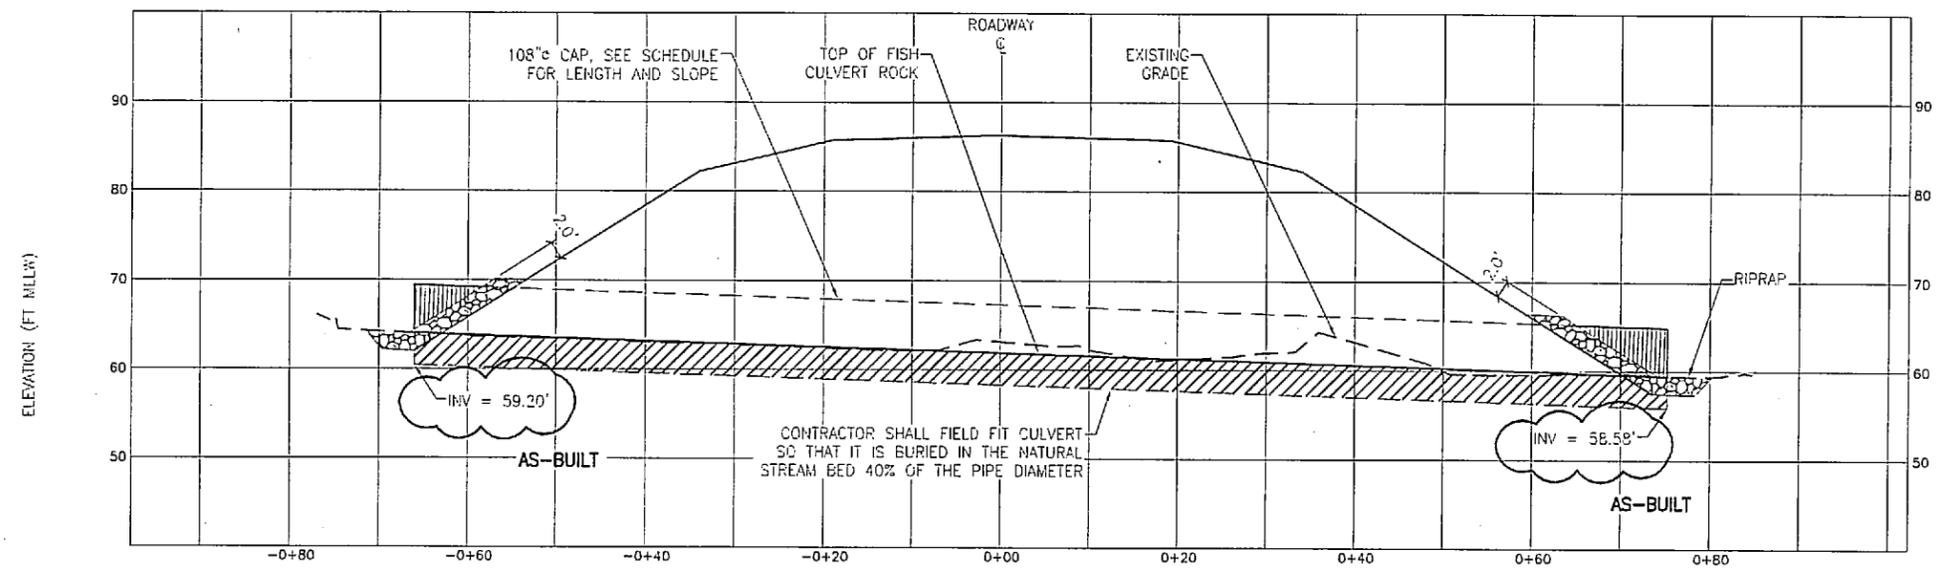

CLAM CREEK CROSS SECTION  
AT  $\phi$  OF INSTALLATION

NOTES:

1. SENSITIVE FISH STREAM !!! DO NOT BEGIN CONSTRUCTION UNTIL TITLE 41 PERMIT IS RECEIVED. THE CULVERT IS CURRENTLY DESIGNED TO TIER 1 REQUIREMENTS FOR FISH PASSAGE. ANY ADDITIONAL REQUIREMENTS IN THE TITLE 41 PERMIT SHALL BE MET AND DOCUMENTED IN THE PROJECT ASBUILTS.

2. FIELD VERIFY INLET ELEVATIONS, OUTLET ELEVATIONS, AND SLOPE.

DRAINAGE AREA	= 0.386 SQ. MI	Q50 FLOOD ELEVATION	= 68.82 FT MLLW
DESIGN EXCEEDANCE	= 2 %	Q50 TAILWATER ELEVATION	= 61.78 FT MLLW
Q2	= 98 CFS	OVERTOPPING FLOOD	= >Q500 (258 CFS)
Q50	= 197 CFS	OVERTOPPING PROBABILITY	= <0.2%
Q <sub>FISH</sub>	= 39 CFS	OVERTOPPING ELEVATION	= 88.3 FT

PND ENGINEERS, INC.  
1508 W. 35th Ave., Anchorage, AK 99503  
907-561-1011 [engineering@pndengineers.com](mailto:engineering@pndengineers.com)





STATE OF ALASKA  
DEPARTMENT OF TRANSPORTATION  
AND  
PUBLIC FACILITIES


GRAVINA ISLAND HIGHWAY  
GRADING, DRAINAGE, AND BRIDGES

CLAM CREEK  
CULVERT PLAN & PROFILES

REVISIONS		STATE	PROJECT DESIGNATION	YEAR	SHEET NO.	TOTAL SHEETS
No.	DATE	DESCRIPTION	ALASKA	ACH PRL-0003(123)/67818	E9	E11

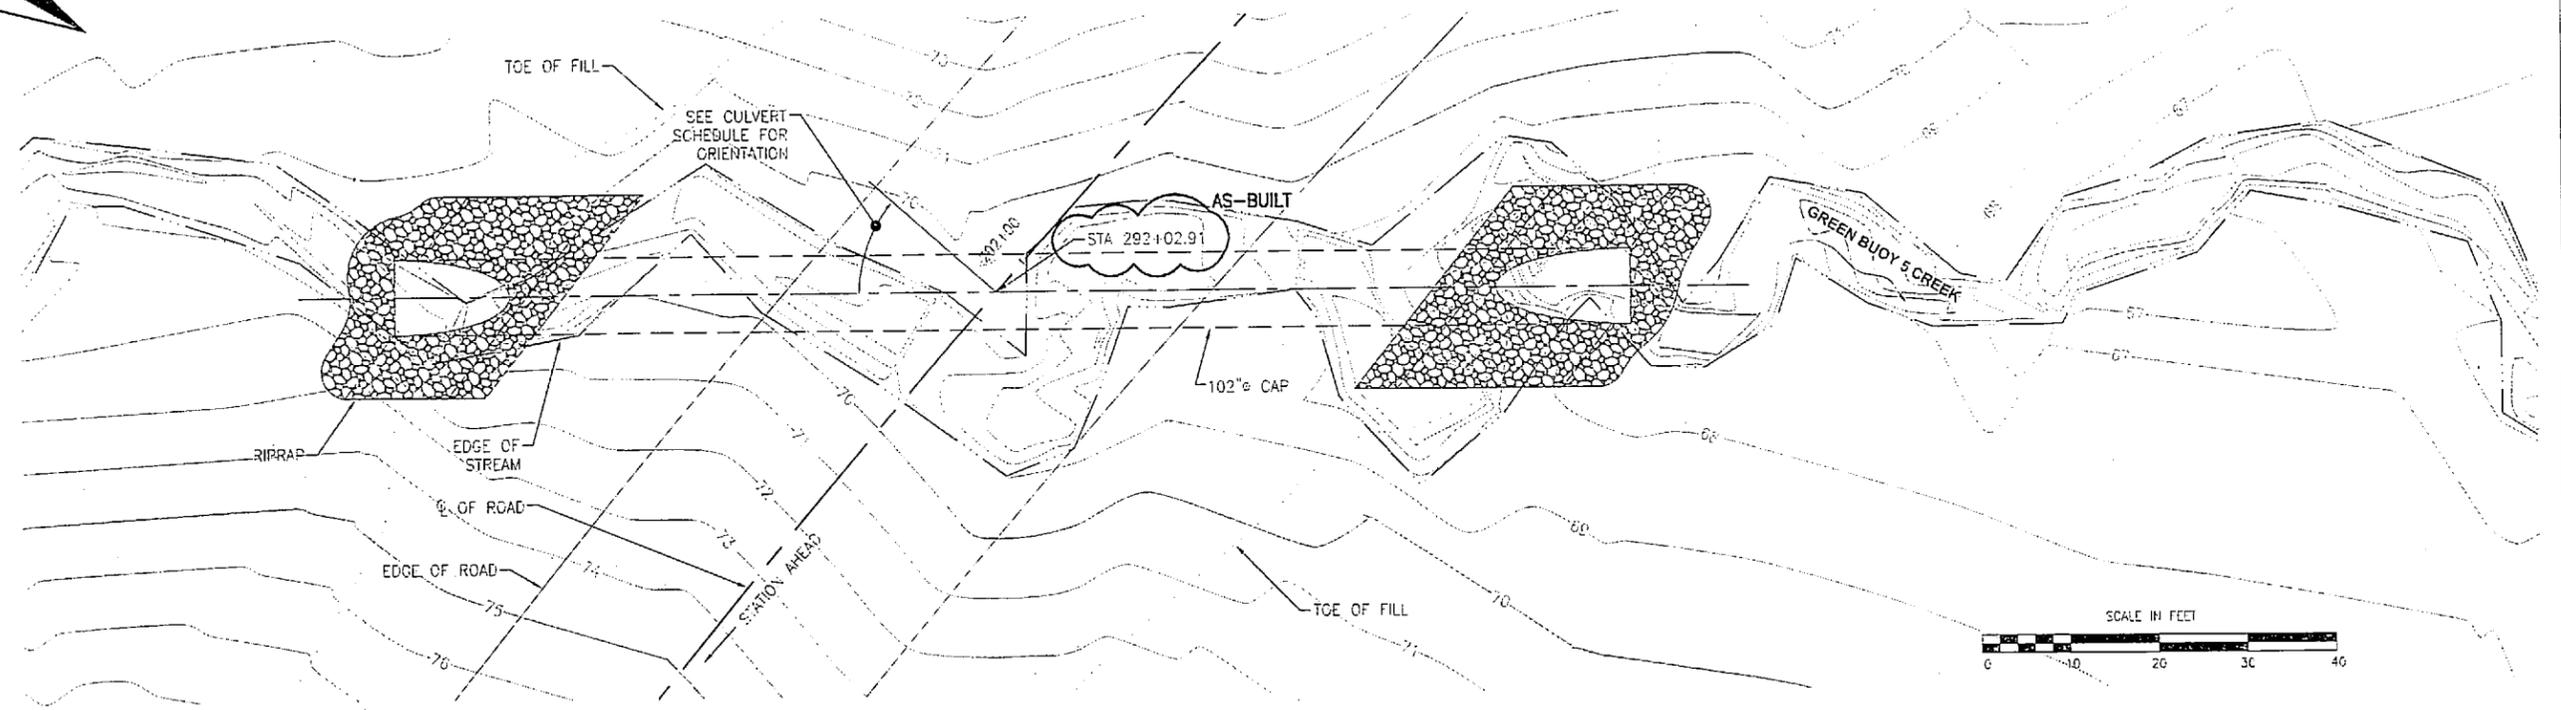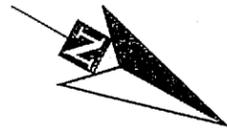

PLAN (SEE C19 ON CULVERT SCHEDULE)

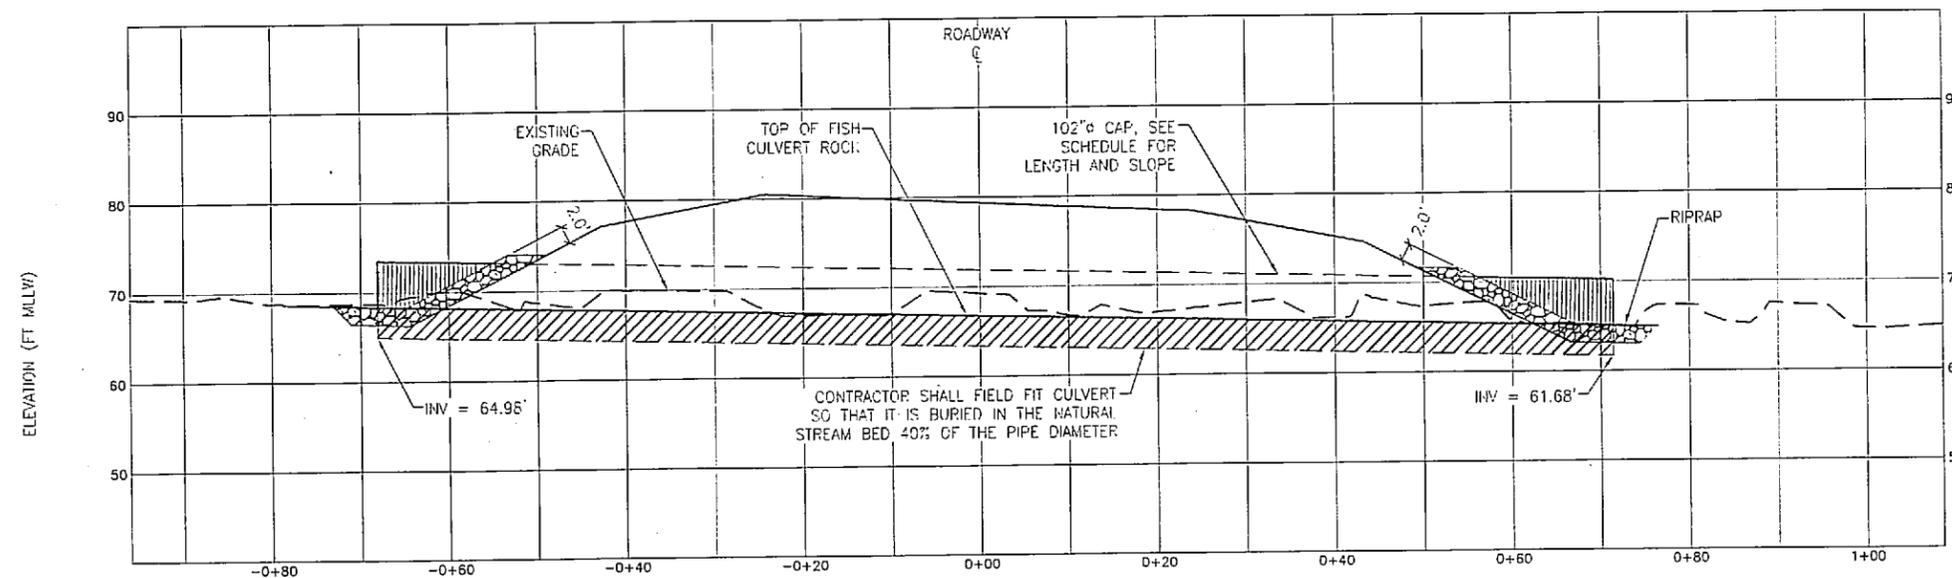

GREEN BUOY 5 CREEK CROSS SECTION  
AT  $\phi$  OF INSTALLATION

**NOTES:**

1. SENSITIVE FISH STREAM !!! DO NOT BEGIN CONSTRUCTION UNTIL TITLE 41 PERMIT IS RECEIVED. THE CULVERT IS CURRENTLY DESIGNED TO TIER 1 REQUIREMENTS FOR FISH PASSAGE. ANY ADDITIONAL REQUIREMENTS IN THE TITLE 41 PERMIT SHALL BE MET AND DOCUMENTED IN THE PROJECT ASBUILTS.

2. FIELD VERIFY INLET ELEVATIONS, OUTLET ELEVATIONS, AND SLOPE.

DRAINAGE AREA	= 0.253 SQ. MI	Q50 FLOOD ELEVATION	= 73.50 FT MLLW
DESIGN EXCEEDANCE	= 2 %	Q50 TAILWATER ELEVATION	= 68.07 FT MLLW
Q2	= 100 CFS	OVERTOPPING FLOOD	= >Q500 (267 CFS)
Q50	= 205 CFS	OVERTOPPING PROBABILITY	= <0.2%
Q <sub>FISH</sub>	= 40 CFS	OVERTOPPING ELEVATION	= 89.5 FT

PND ENGINEERS, INC.  
1506 W. 36th Ave. Anchorage, AK 99503  
907-561-1011 [engineering@pndengineers.com](mailto:engineering@pndengineers.com)




STATE OF ALASKA  
DEPARTMENT OF TRANSPORTATION  
AND  
PUBLIC FACILITIES

GRAVINA ISLAND HIGHWAY  
GRADING, DRAINAGE, AND BRIDGES

GREEN BUOY 5 CREEK  
CULVERT PLAN & PROFILES

REVISIONS			STATE	PROJECT DESIGNATION	YEAR	SHEET NO.	TOTAL SHEETS
No.	DATE	DESCRIPTION	ALASKA	ACH PRL-0003(123)/67818	2007	E10	E11

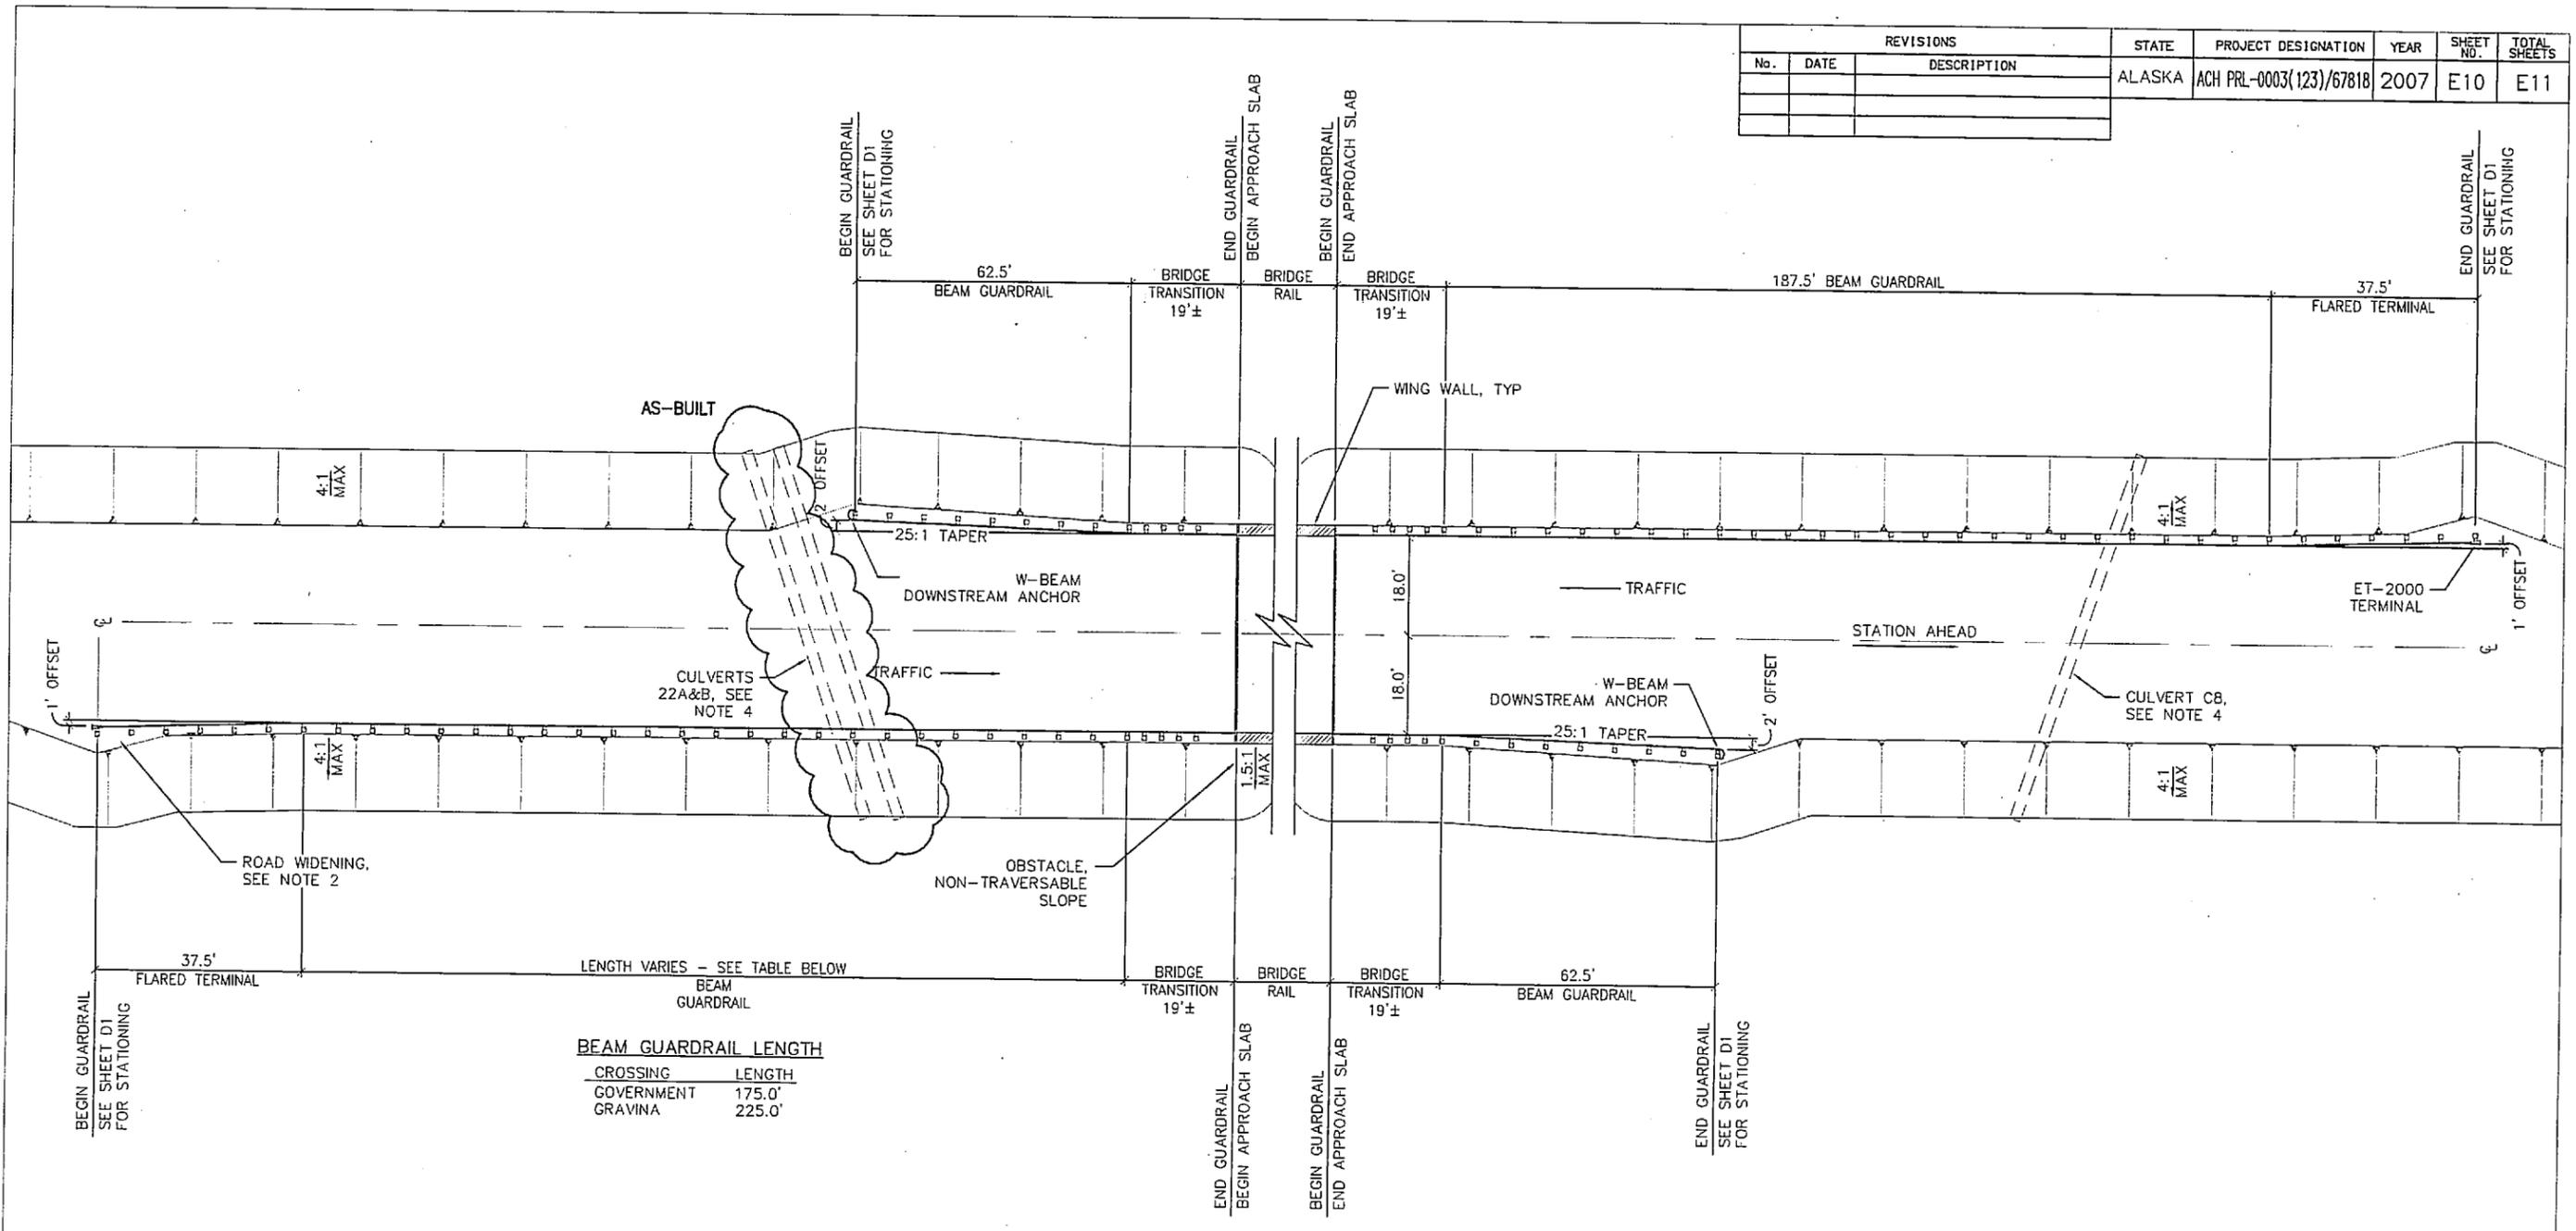

**GUARDRAIL LAYOUTS FOR GOVERNMENT CREEK AND GRAVINA CREEK**

- NOTES:
1. SEE STD DETAIL G31.00 FOR BRIDGE TRANSITION DETAIL
  2. SEE STD DETAIL G20.10 FOR GRADING REQUIREMENTS.
  3. SEE STD DETAIL G13.00 FOR W-BEAM DOWNSTREAM ANCHOR.
  4. AVOID CONFLICTS BETWEEN THE GUARDRAIL POST AND CULVERTS AT GOVERNMENT CREEK & GRAVINA CREEK. SEE STD DETAIL G28.00 IN CASE OF CONFLICT.

PND ENGINEERS, INC.  
 1506 W. 36th Ave. Anchorage, AK 99503  
 907-561-1011 engineering@pndengineers.com




STATE OF ALASKA  
 DEPARTMENT OF TRANSPORTATION  
 AND  
 PUBLIC FACILITIES

**GRAVINA ISLAND HIGHWAY  
 GRADING, DRAINAGE, AND BRIDGES**

GUARDRAIL LAYOUT

REVISIONS			STATE	PROJECT DESIGNATION	YEAR	SHEET NO.	TOTAL SHEETS
No.	DATE	DESCRIPTION	ALASKA	ACH PRL-0003(123)/67818	2007	E11	E11
Δ	5/30/08	RPLCD DSSPTR W/ CHNL					

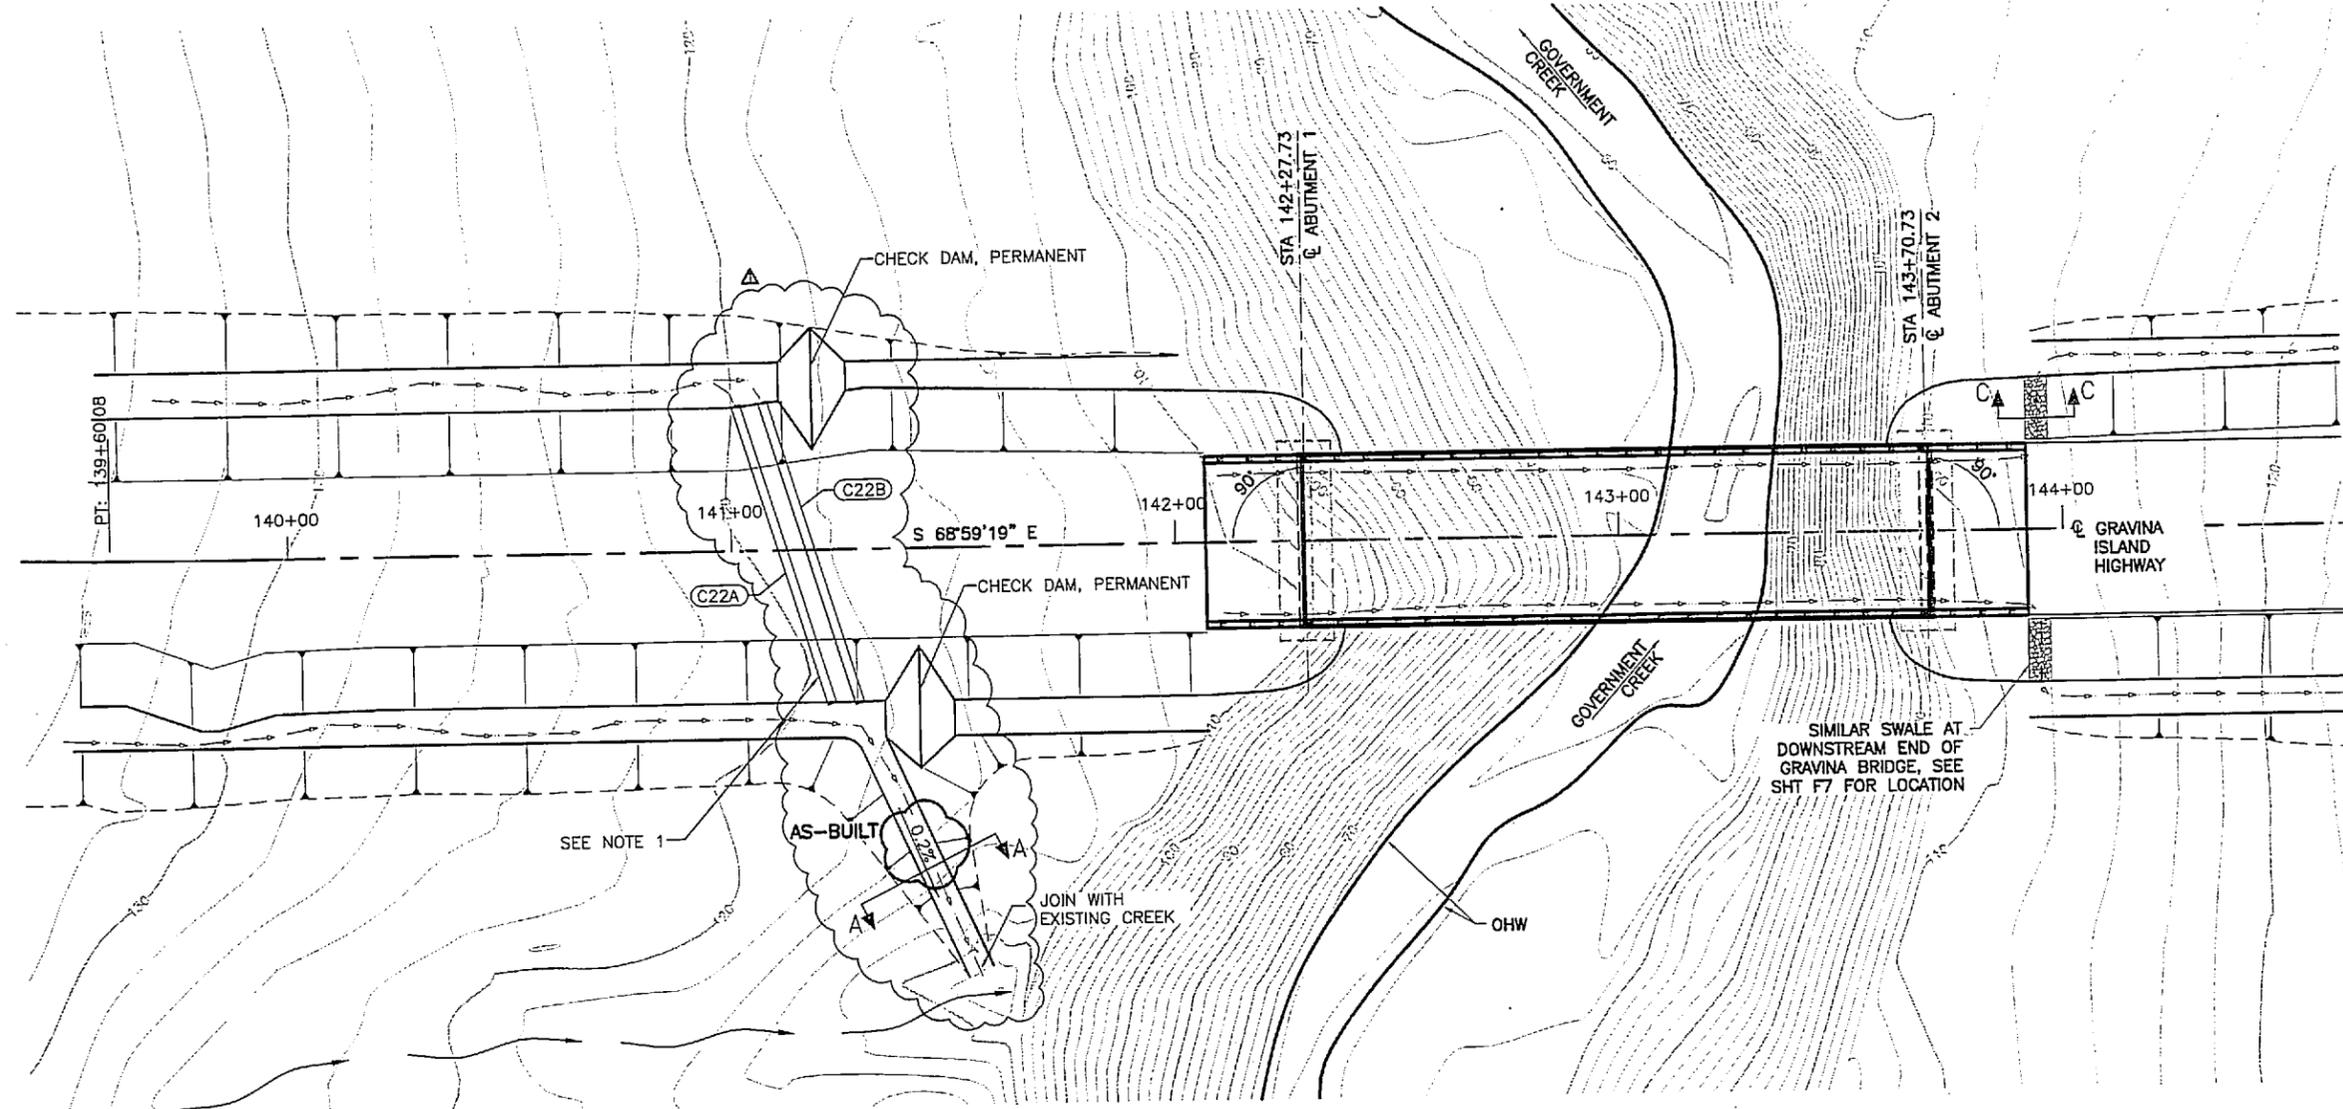


**ENLARGED DRAINAGE PLAN**




**NOTES:**

1. FIELD ADJUST CULVERT AS NECESSARY TO AVOID CONFLICT WITH GUARDRAIL POST.

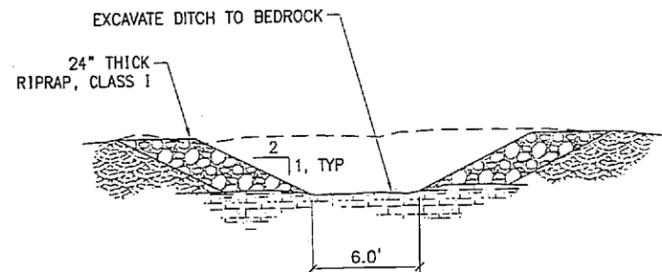

**DRAINAGE SWALE - SECTION A-A**

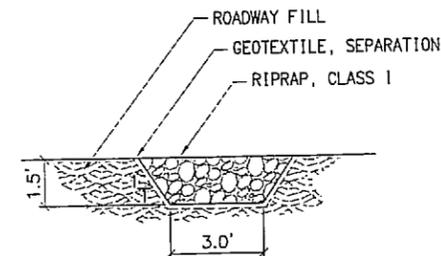

**DRAINAGE SWALE - SECTION C-C**

PND ENGINEERS, INC.  
1506 W. 36th Ave. Anchorage, AK 99503  
907-561-1011 engineering@pndengineers.com



STATE OF ALASKA  
DEPARTMENT OF TRANSPORTATION  
AND  
PUBLIC FACILITIES

GRAVINA ISLAND HIGHWAY  
GRADING, DRAINAGE, AND BRIDGES

ENLARGED DRAINAGE PLAN  
AND DETAIL


SHEET NO.	TOTAL SHEETS
F1	F16
STATE	YEAR
ALASKA	2007

PROJECT DESIGNATION  
**ACH PRL-0003(123)/67818**

ADDENDUM NO.  
 ATTACHMENT NO.


REVISIONS

NO.	DATE	DESCRIPTION

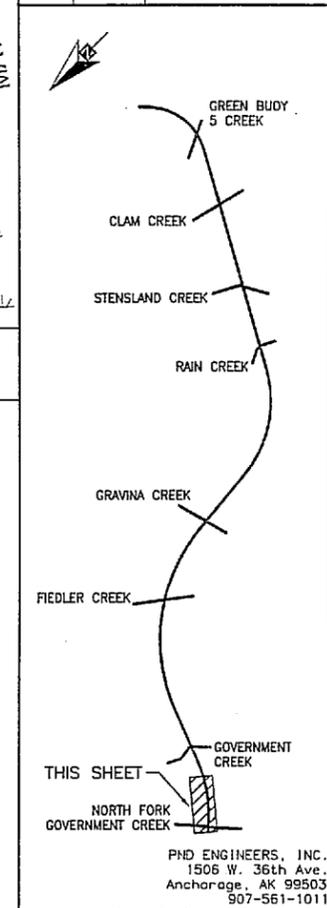


PHD ENGINEERS, INC.  
 1505 W. 36th Ave.  
 Anchorage, AK 99503  
 907-561-1011  
 engineer.ing@phdengineers.com

STATE OF ALASKA  
 DEPARTMENT OF TRANSPORTATION  
 AND PUBLIC FACILITIES  
**GRAVINA ISLAND HIGHWAY  
 GRADING, DRAINAGE AND  
 BRIDGES**  
**GRAVINA ISLAND  
 HIGHWAY  
 PLAN & PROFILE**

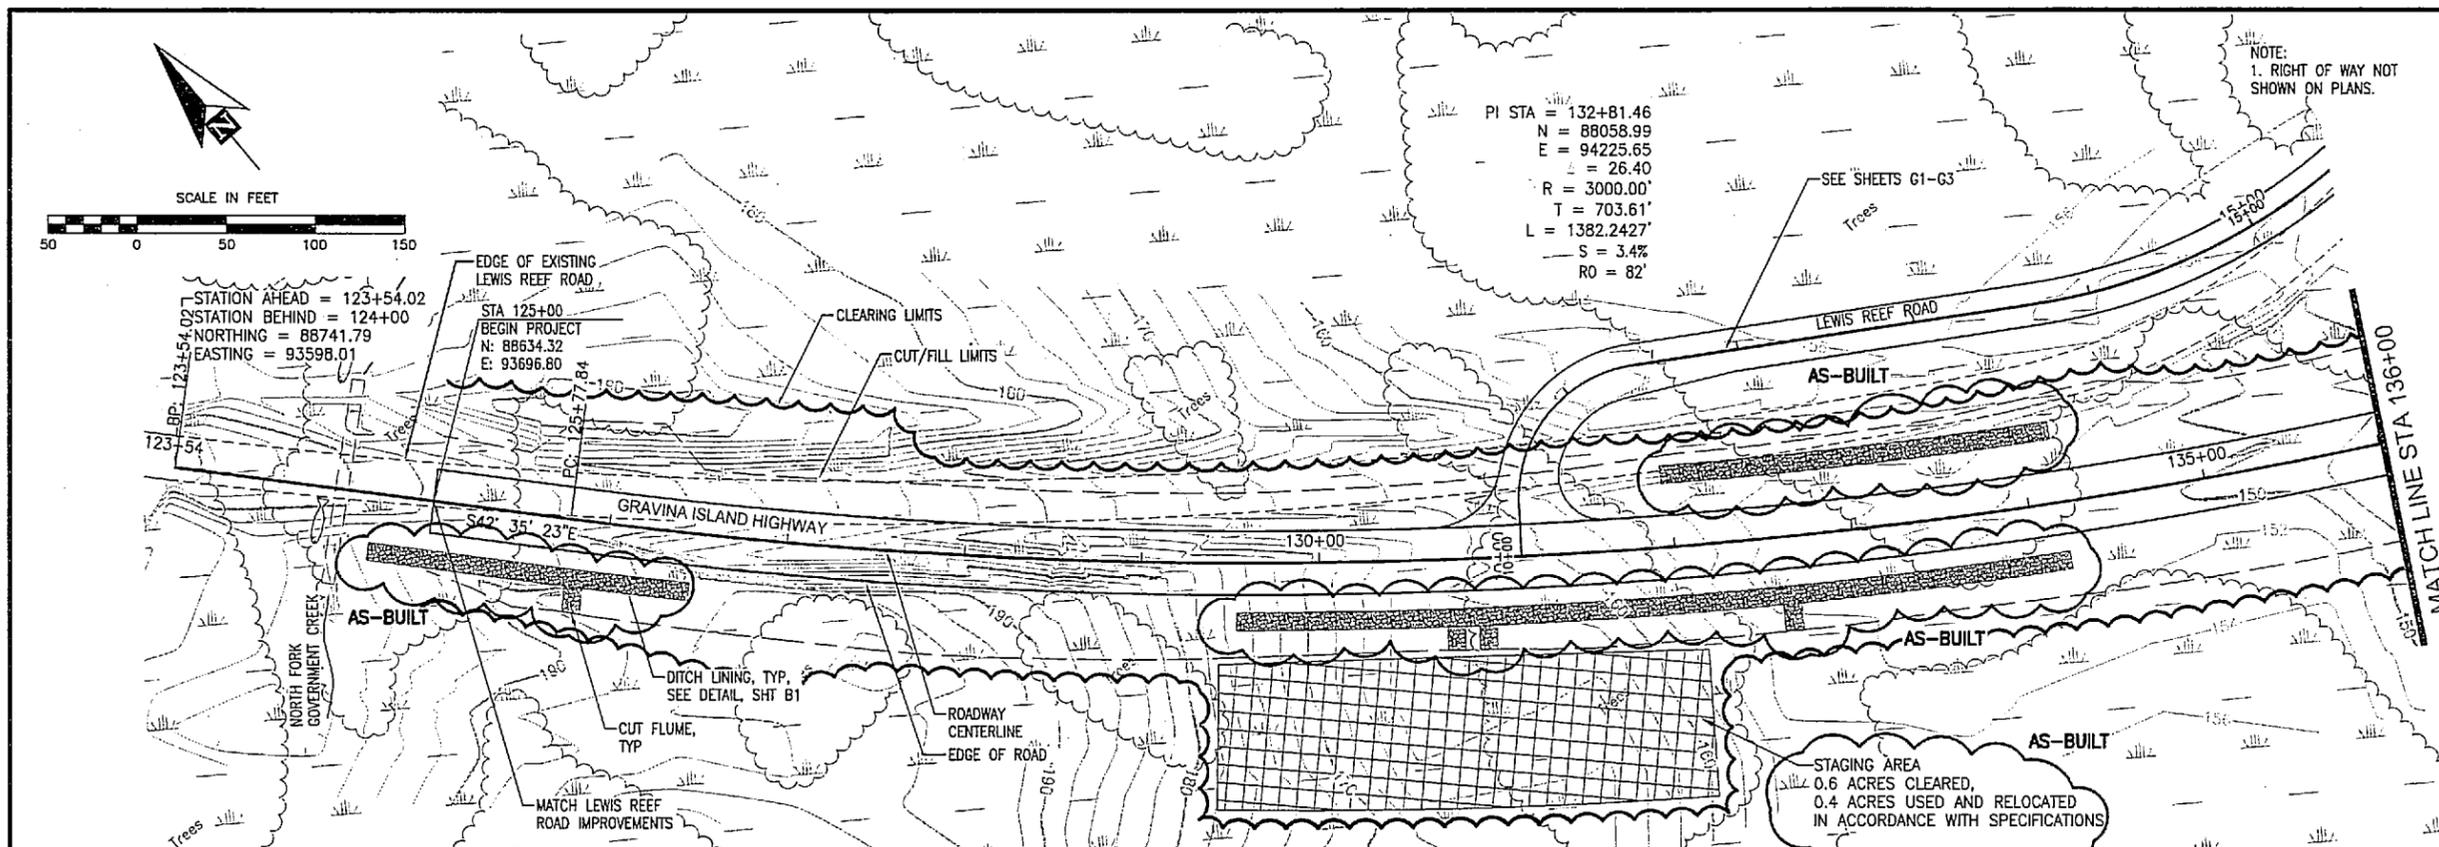

SECTION LEFT	CF (CUT/FILL)	CF	RC
SECTION RIGHT	RC (ROCK CUT)	RC	RC

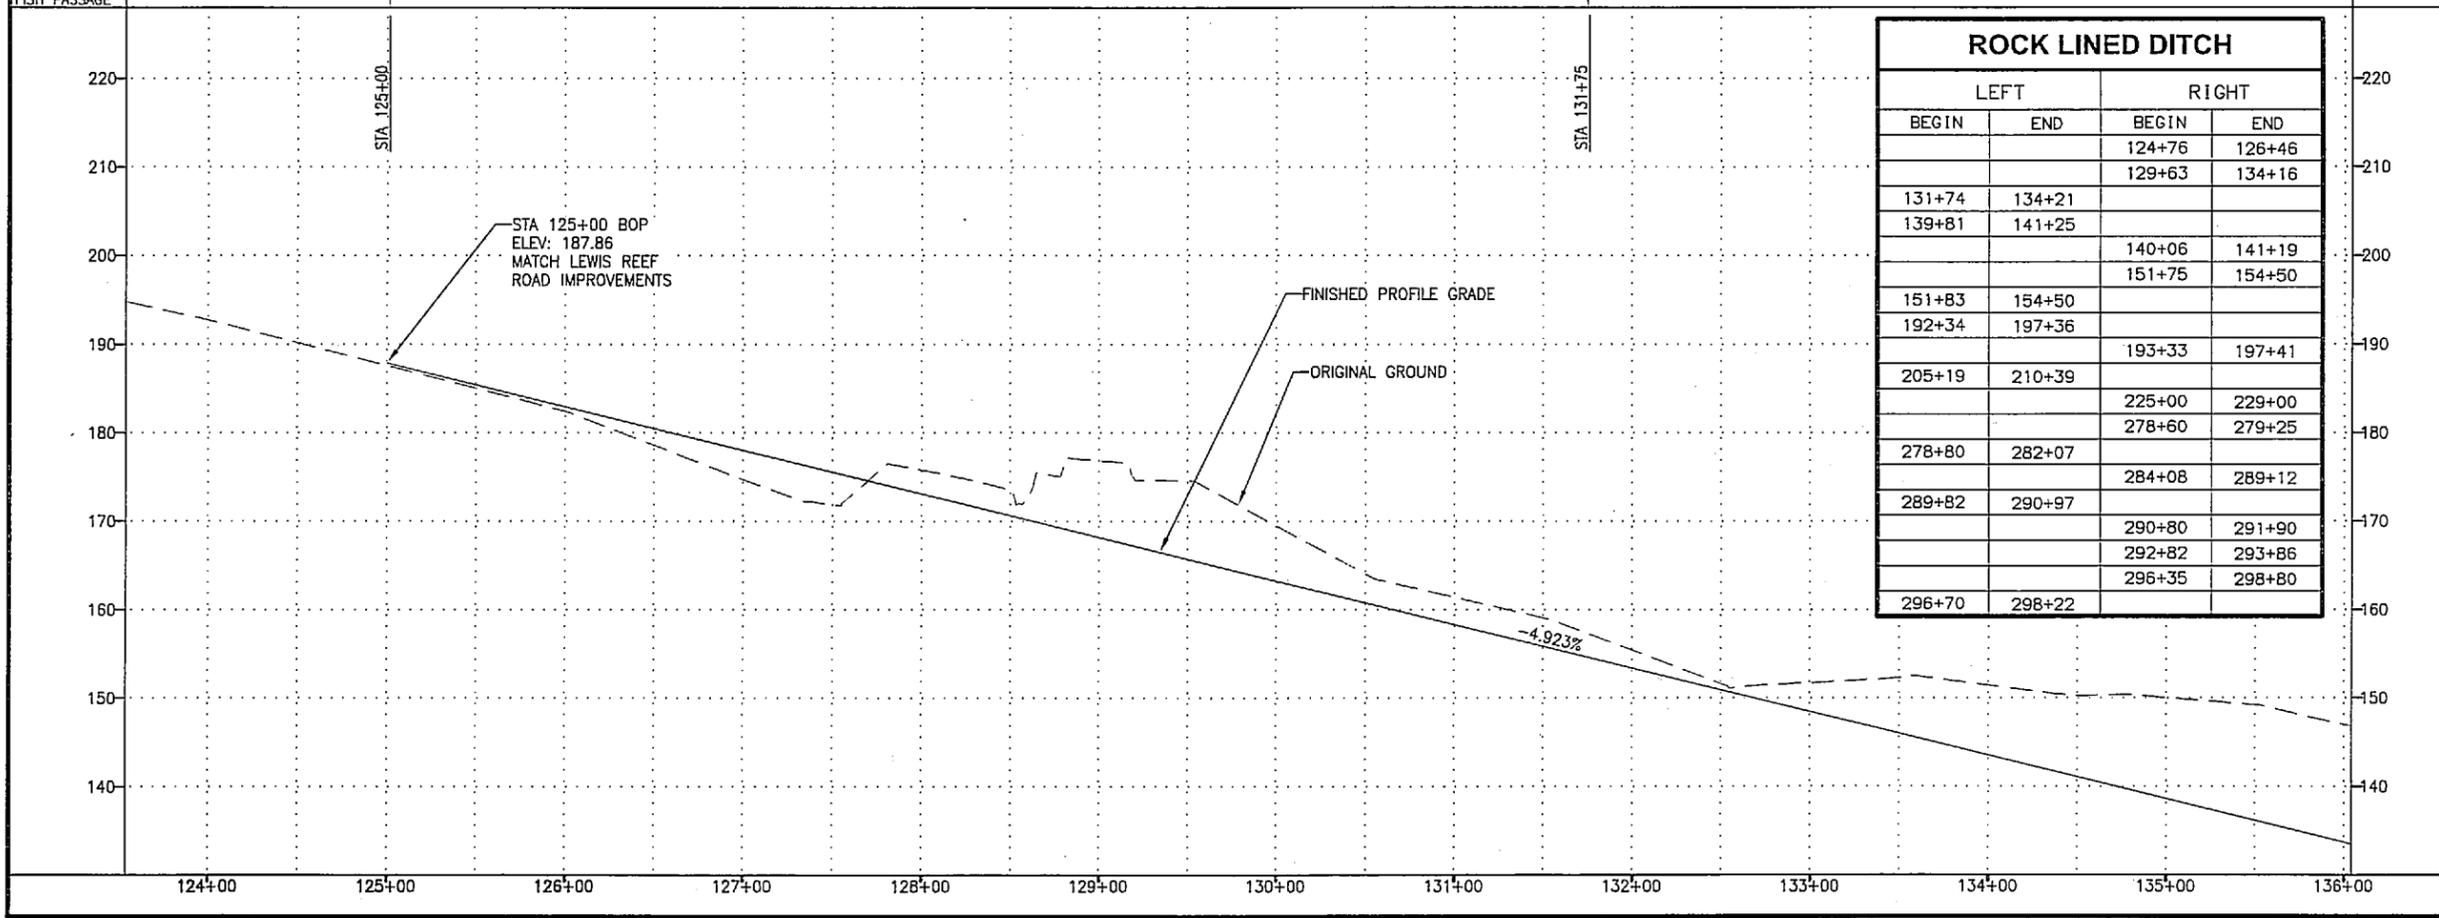


SHEET NO.	TOTAL SHEETS
F2	F16
STATE	YEAR
ALASKA	2007

PROJECT DESIGNATION  
ACH PRL-0003(123)/67818


ADDENDUM NO.

ATTACHMENT NO.


REVISIONS		
NO.	DATE	DESCRIPTION
1	5/30/08	RFLCD DSSPTR W/ CHNL

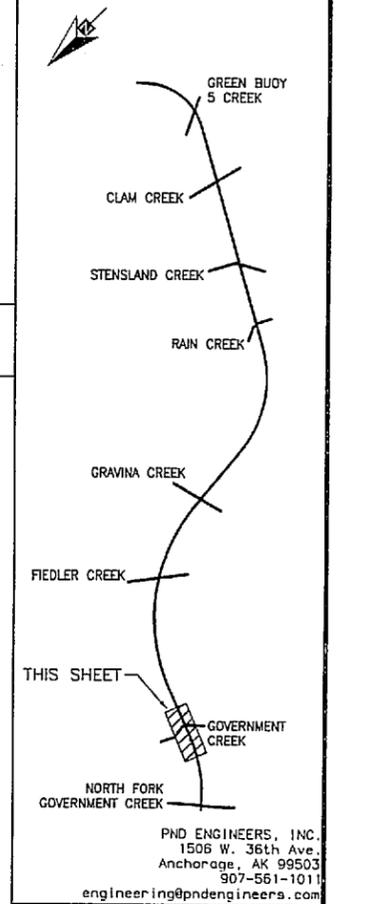


STATE OF ALASKA  
DEPARTMENT OF TRANSPORTATION  
AND PUBLIC FACILITIES  
GRAVINA ISLAND HIGHWAY  
GRADING, DRAINAGE AND  
BRIDGES  
GRAVINA ISLAND  
HIGHWAY  
PLAN & PROFILE

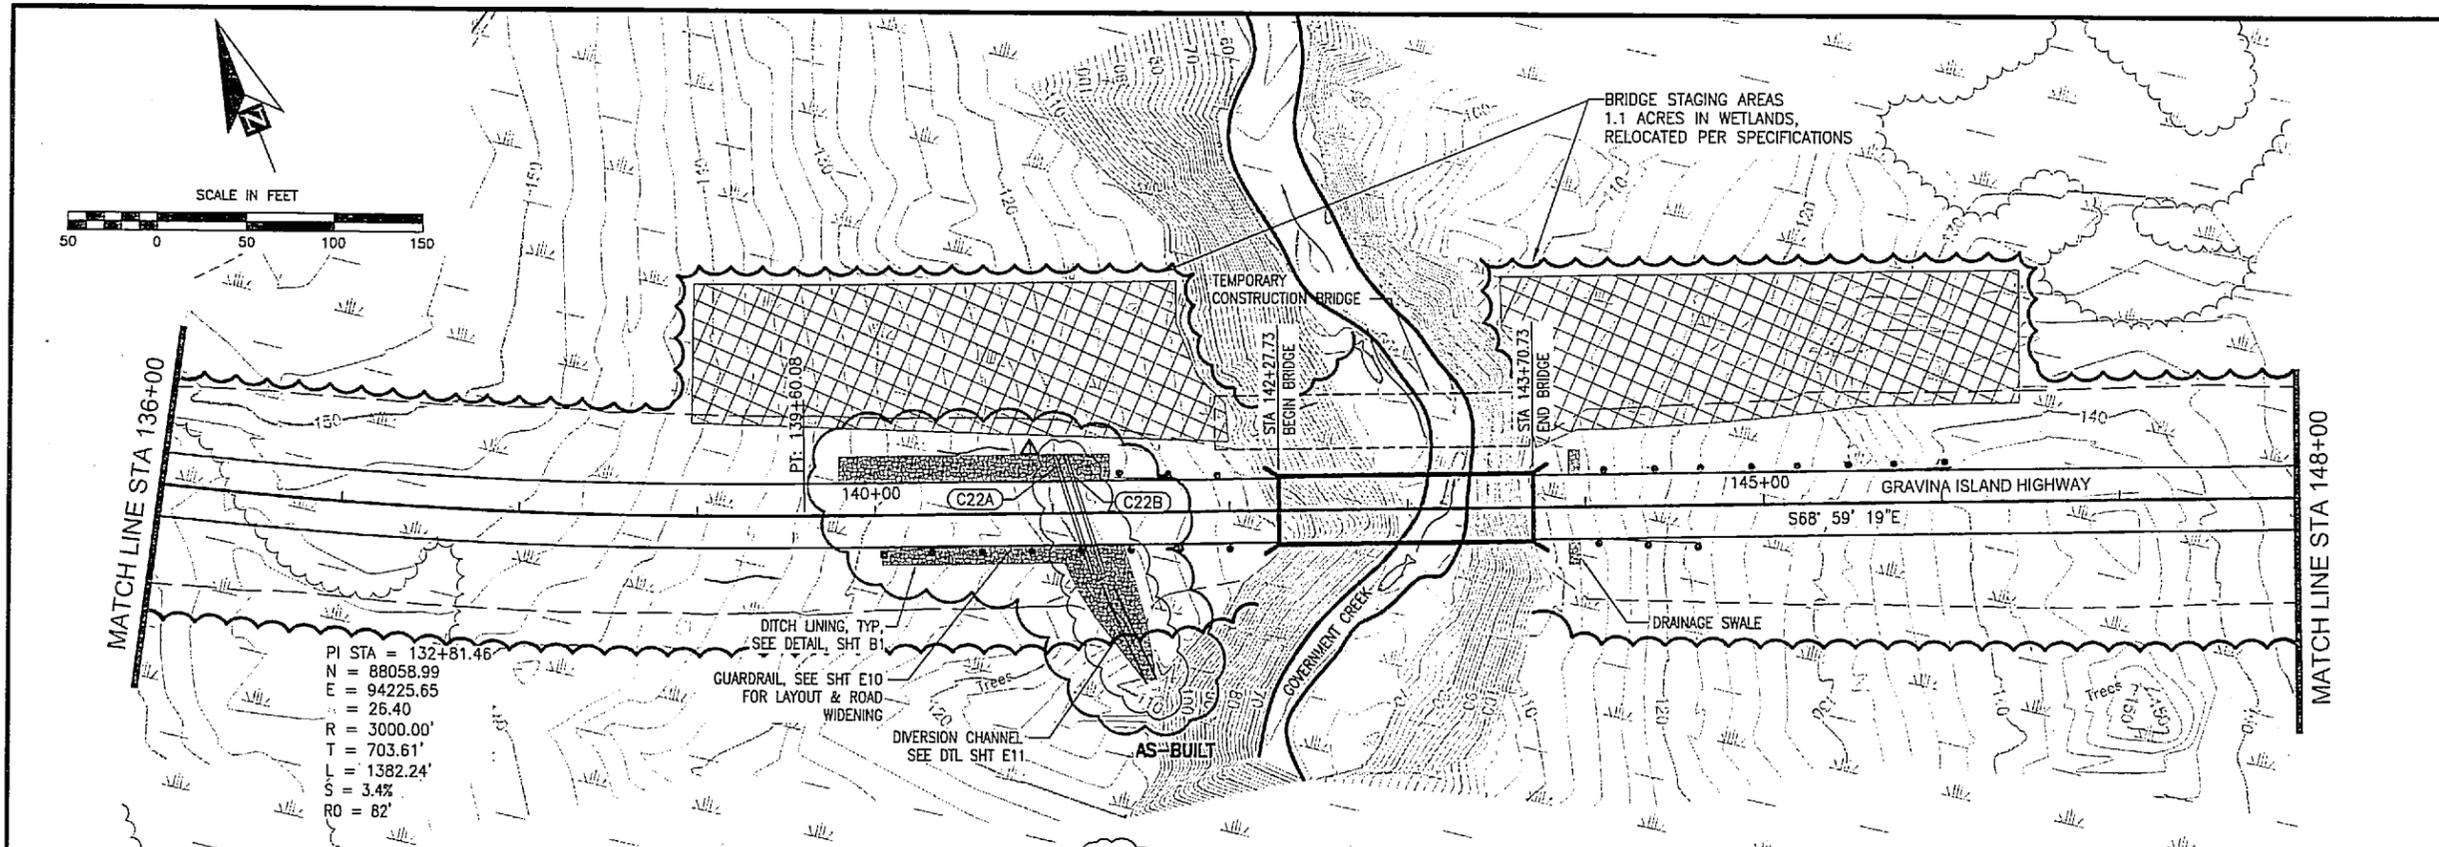


PI STA = 132+81.46  
N = 88058.99  
E = 94225.65  
S = 26.40  
R = 3000.00'  
T = 703.61'  
L = 1382.24'  
S = 3.4%  
RO = 82'

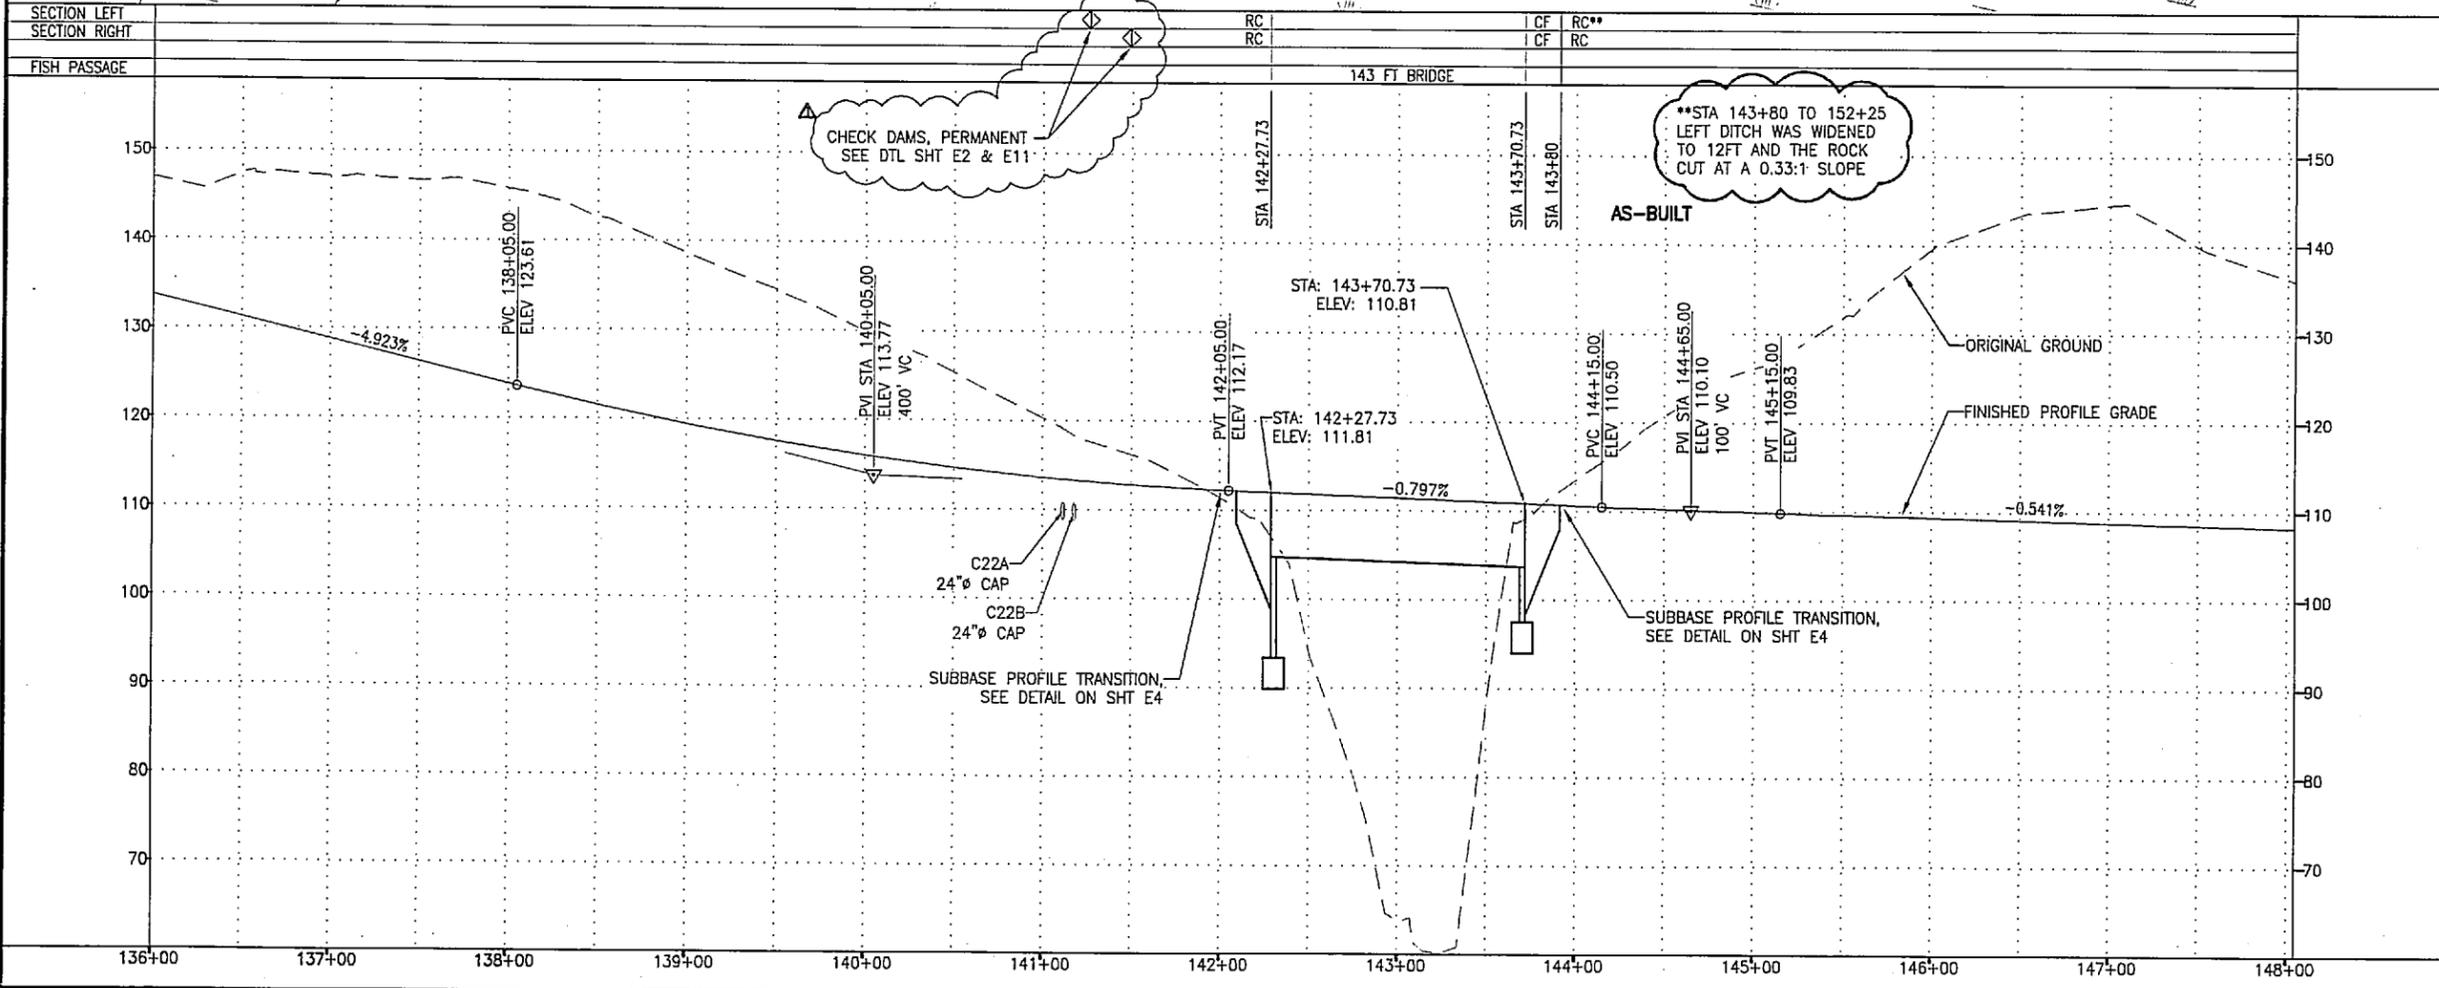


SECTION LEFT  
SECTION RIGHT  
FISH PASSAGE

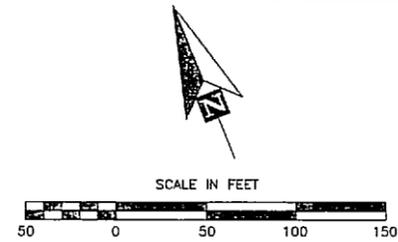

PI STA = 176+72.55  
 N = 86475.58  
 E = 98348.09  
 = 63.49  
 R = 3900.00'  
 T = 2412.75'  
 L = 4321.3811'  
 S = 3.0%  
 RO = 72'

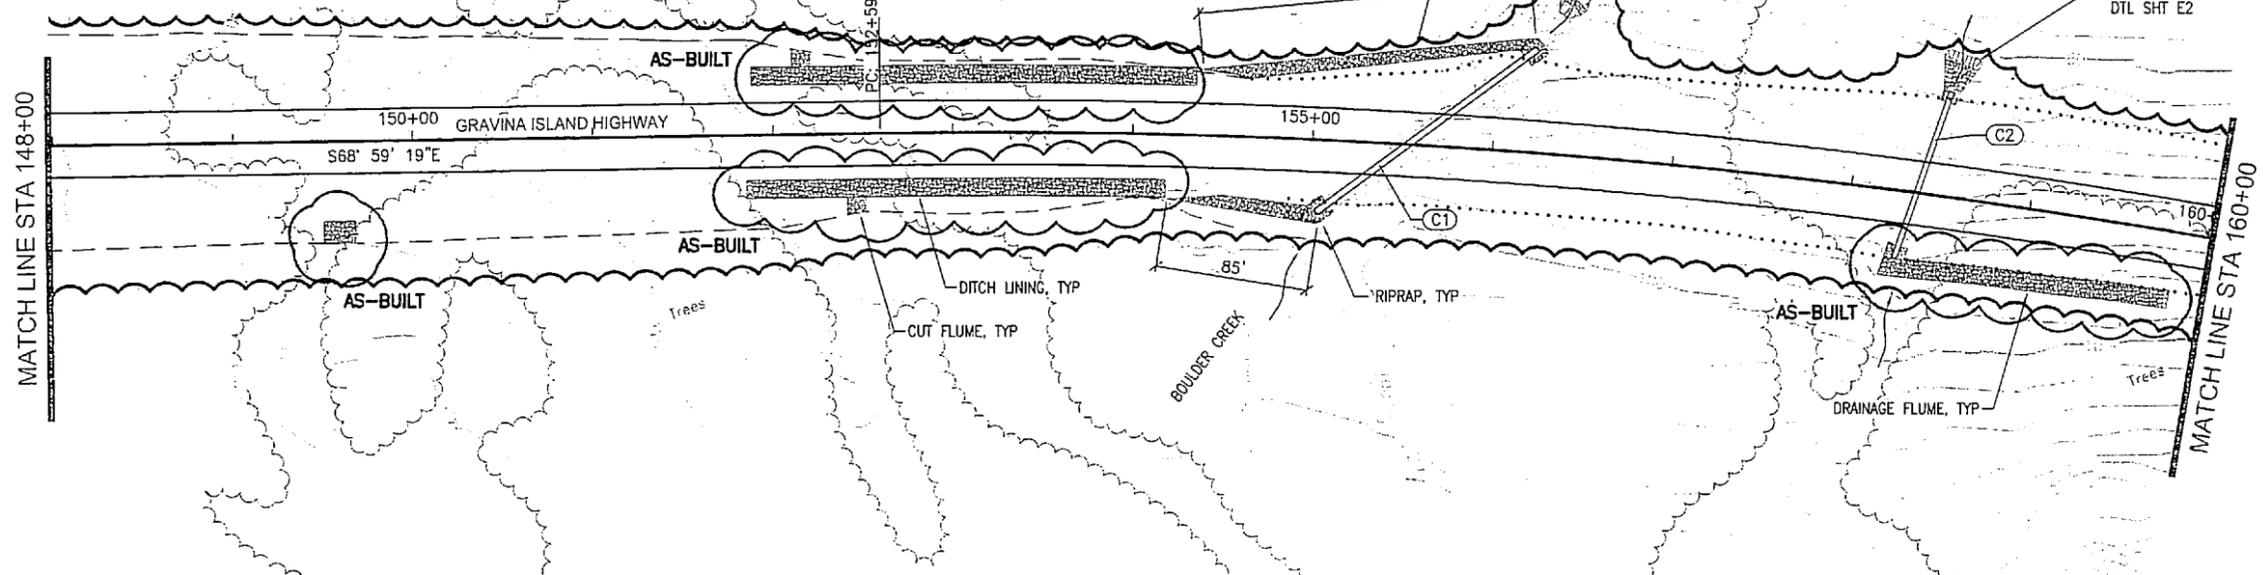


SECTION LEFT	RC   CF
SECTION RIGHT	**RC   CF
FISH PASSAGE	

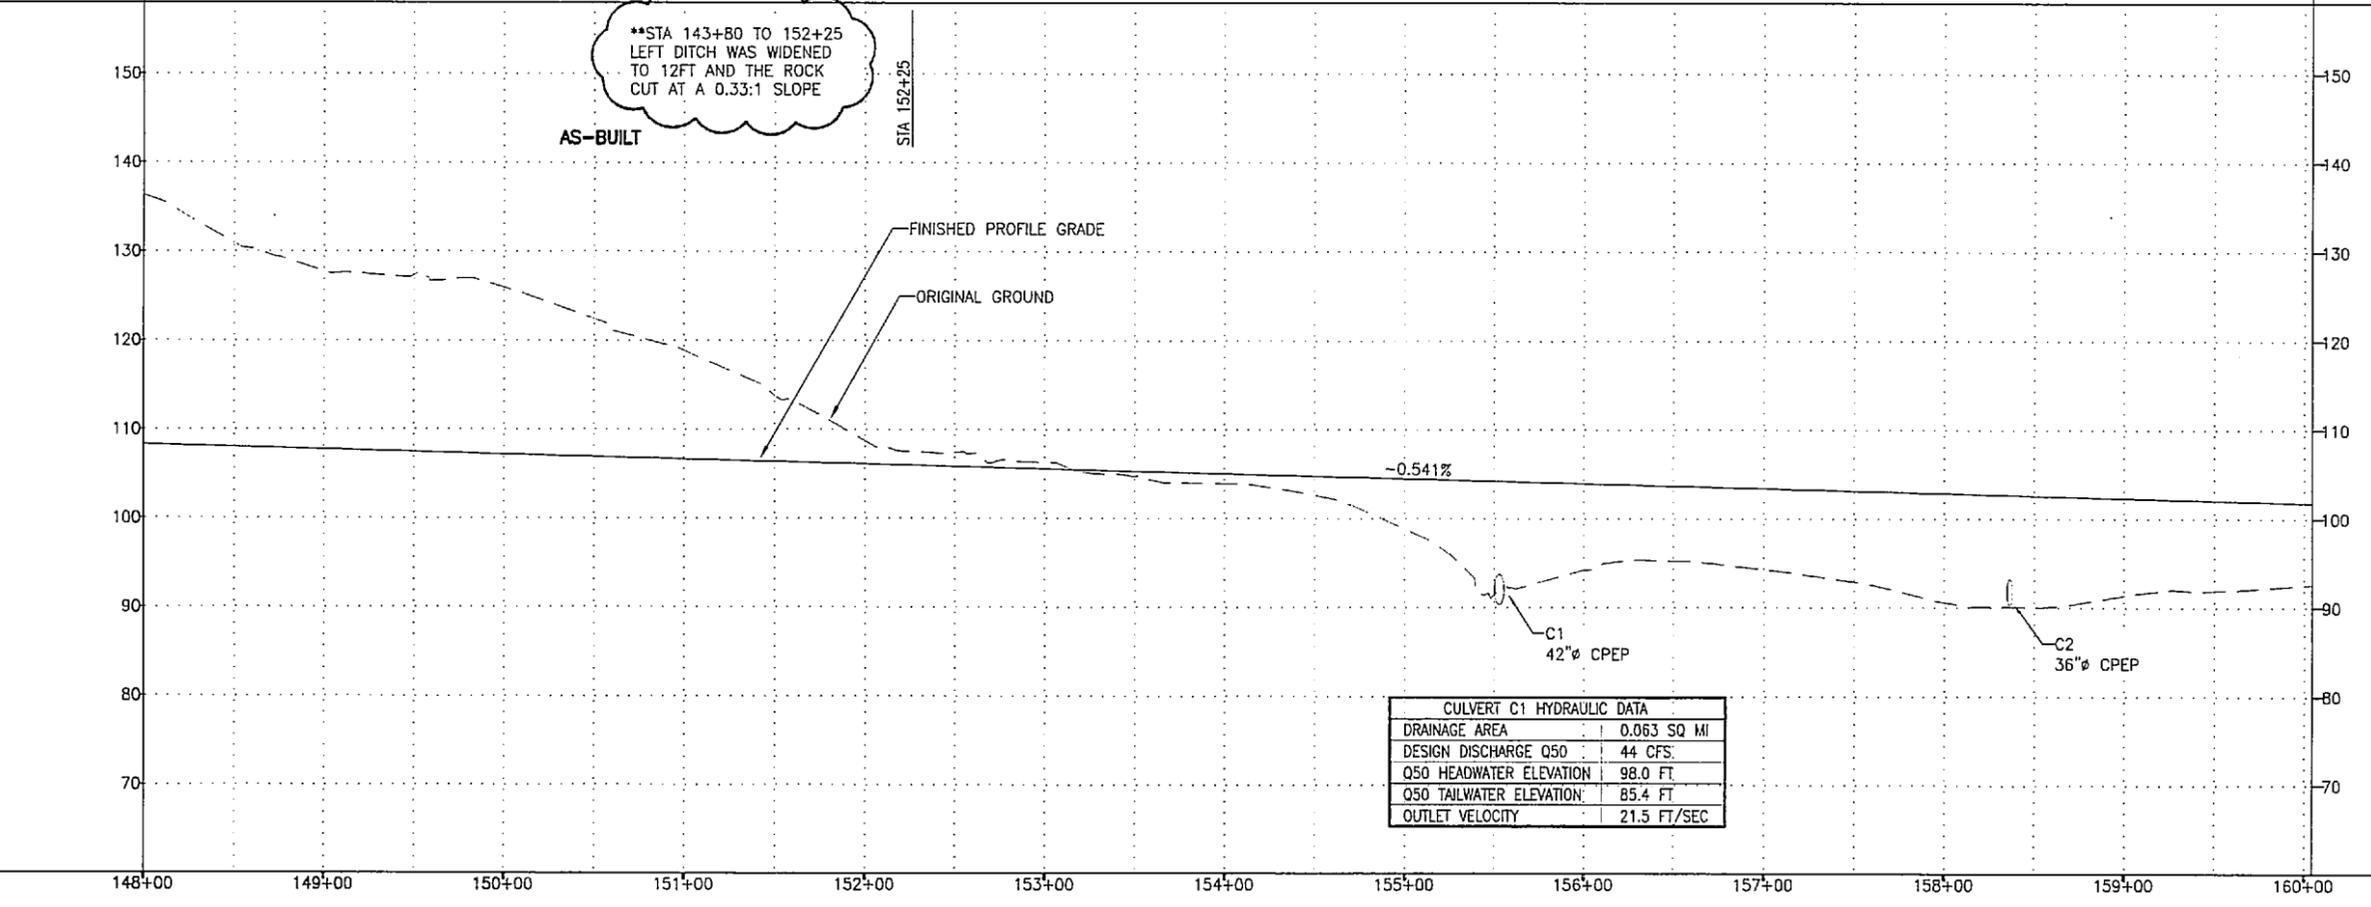

\*\*STA 143+80 TO 152+25  
 LEFT DITCH WAS WIDENED  
 TO 12FT AND THE ROCK  
 CUT AT A 0.33:1 SLOPE




CULVERT C1 HYDRAULIC DATA	
DRAINAGE AREA	0.063 SQ MI
DESIGN DISCHARGE Q50	44 CFS
Q50 HEADWATER ELEVATION	98.0 FT
Q50 TAILWATER ELEVATION	85.4 FT
OUTLET VELOCITY	21.5 FT/SEC

SHEET NO.	TOTAL SHEETS	
F3	F16	
STATE	YEAR	
ALASKA	2007	
PROJECT DESIGNATION		
ACH PRL-0003(123)/67818		
ADDENDUM NO.		
ATTACHMENT NO.		
REVISIONS		
NO.	DATE	DESCRIPTION

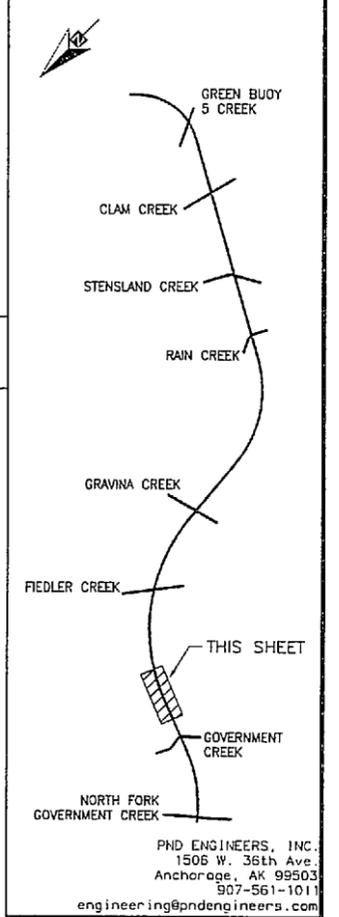

STATE OF ALASKA  
 DEPARTMENT OF TRANSPORTATION  
 AND PUBLIC FACILITIES  
**GRAVINA ISLAND HIGHWAY  
 GRADING, DRAINAGE AND  
 BRIDGES**  
**GRAVINA ISLAND  
 HIGHWAY  
 PLAN & PROFILE**

SHEET NO.	TOTAL SHEETS	
F4	F16	
STATE	YEAR	
ALASKA	2007	
PROJECT DESIGNATION		
ACH PRL-0003(123)/67818		
ADDENDUM NO.		
ATTACHMENT NO.		
REVISIONS		
NO.	DATE	DESCRIPTION

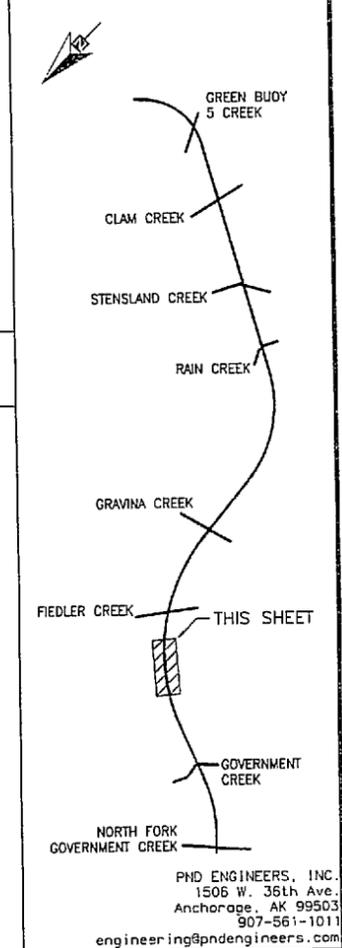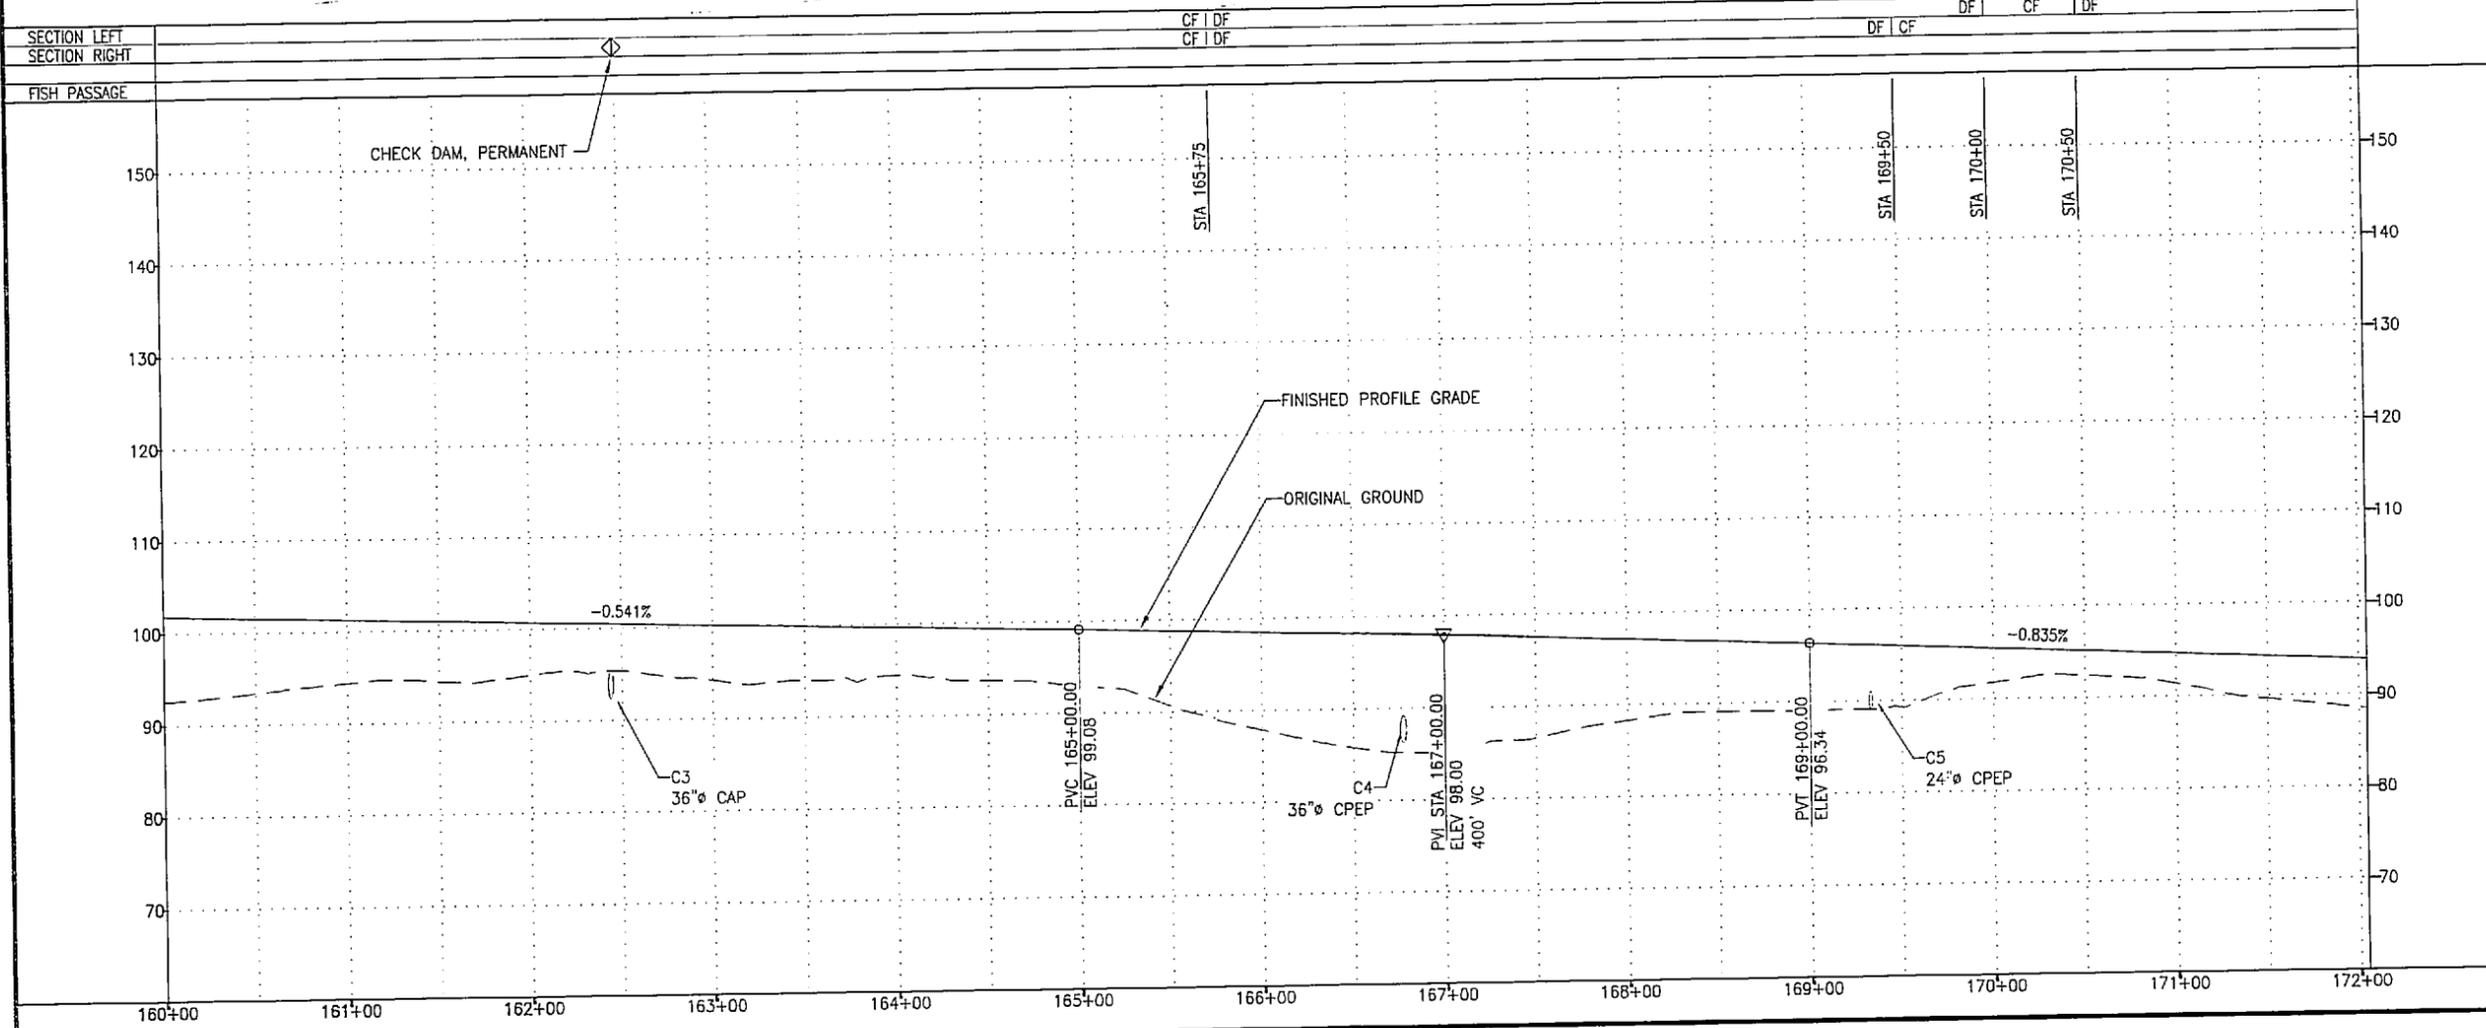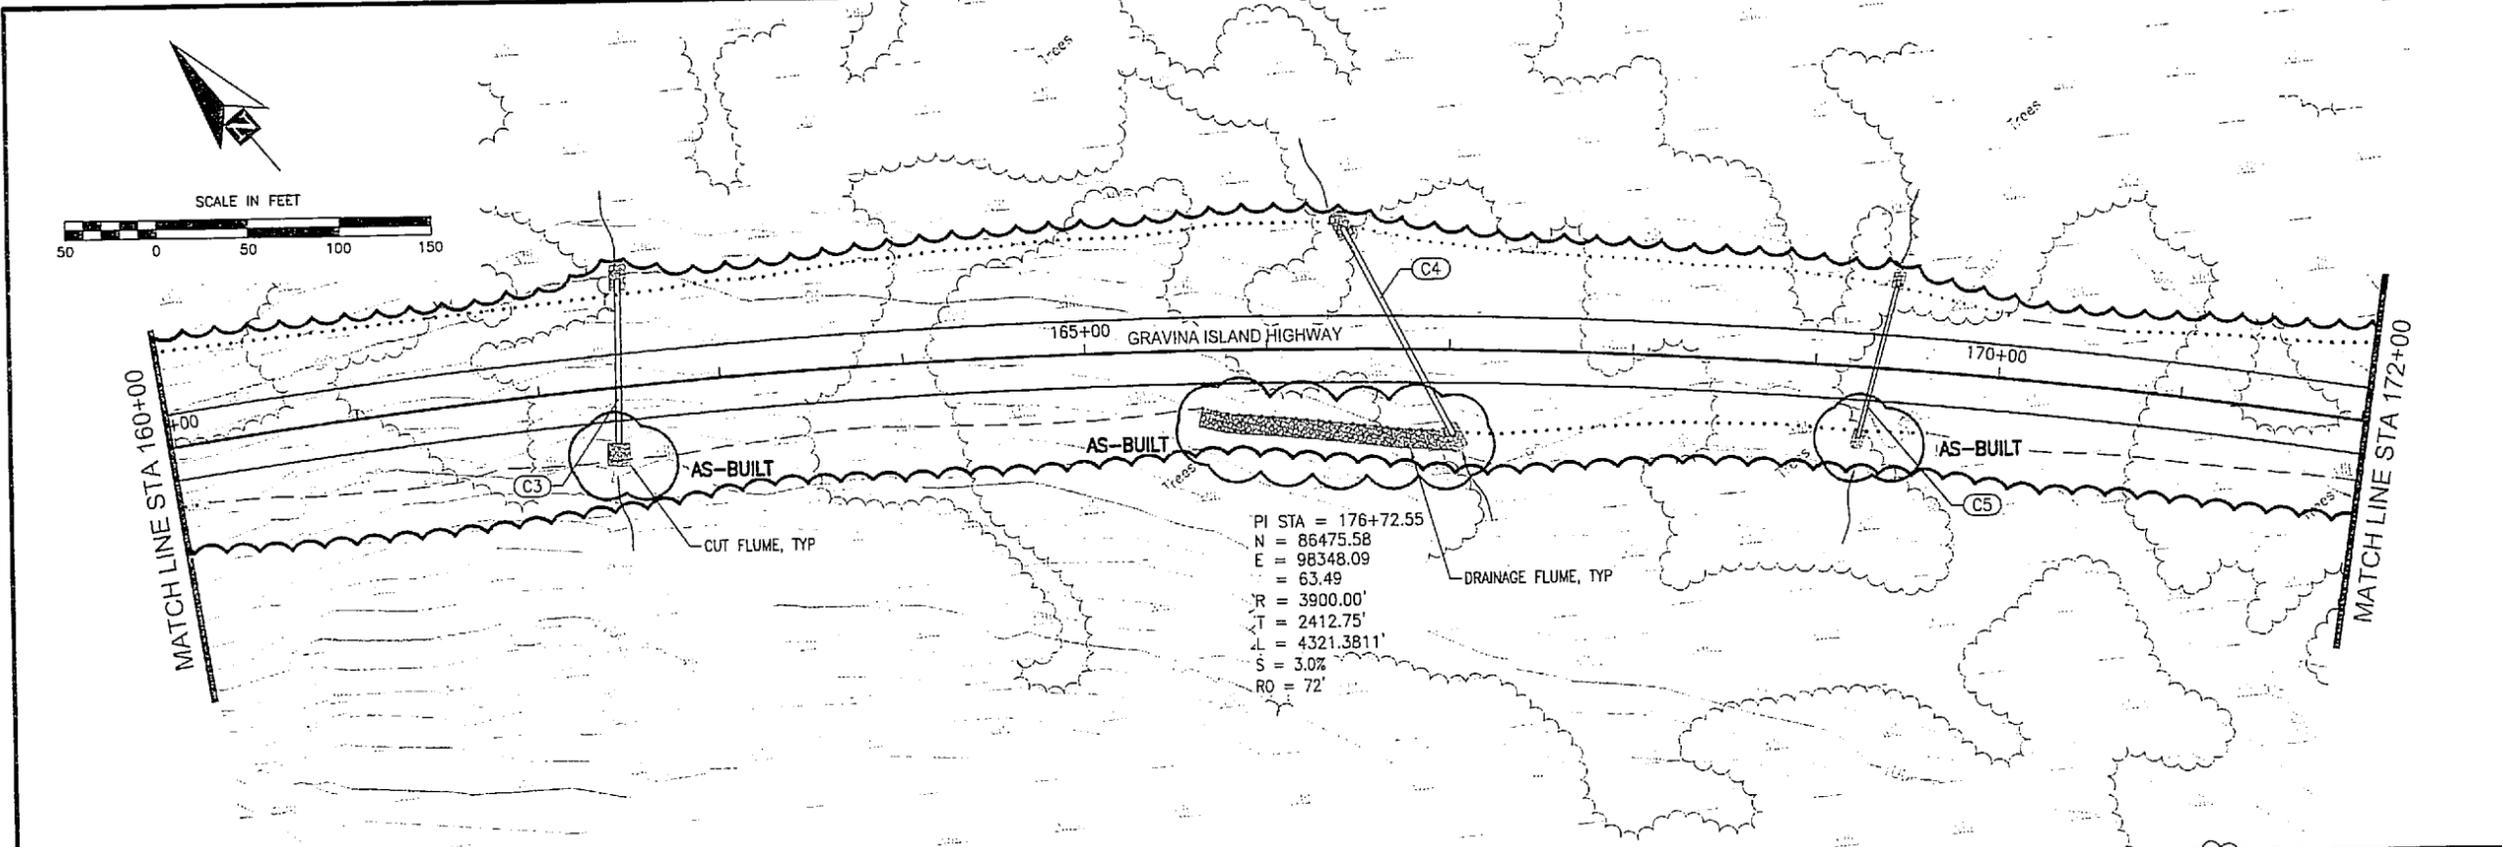


PHD ENGINEERS, INC.  
 1506 W. 36th Ave.  
 Anchorage, AK 99503  
 907-561-1011  
 engineering@phdengineers.com

STATE OF ALASKA  
 DEPARTMENT OF TRANSPORTATION  
 AND PUBLIC FACILITIES

GRAVINA ISLAND HIGHWAY  
 GRADING, DRAINAGE AND  
 BRIDGES

GRAVINA ISLAND  
 HIGHWAY  
 PLAN & PROFILE

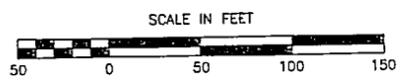


SHEET NO.	TOTAL SHEETS
F5	F16
STATE	YEAR
ALASKA	2007

PROJECT DESIGNATION  
ACH PRL-0003(123)/67818

ADDENDUM NO.

ATTACHMENT NO.


REVISIONS		
NO.	DATE	DESCRIPTION

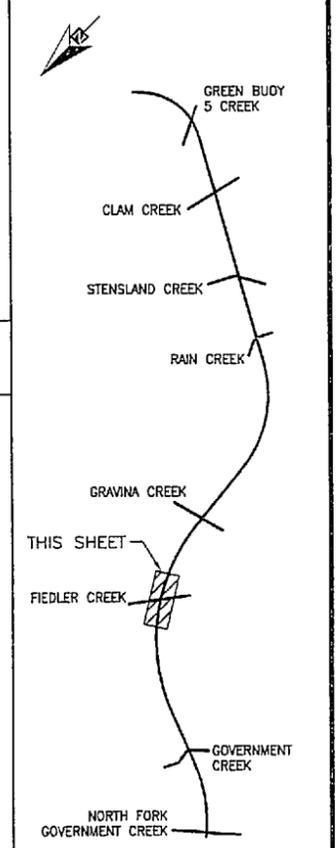


PND ENGINEERS, INC.  
1506 W. 36th Ave.  
Anchorage, AK 99503  
907-561-1011  
engineering@pndengineers.com



STATE OF ALASKA  
DEPARTMENT OF TRANSPORTATION  
AND PUBLIC FACILITIES  
GRAVINA ISLAND HIGHWAY  
GRADING, DRAINAGE AND  
BRIDGES  
GRAVINA ISLAND  
HIGHWAY  
PLAN & PROFILE

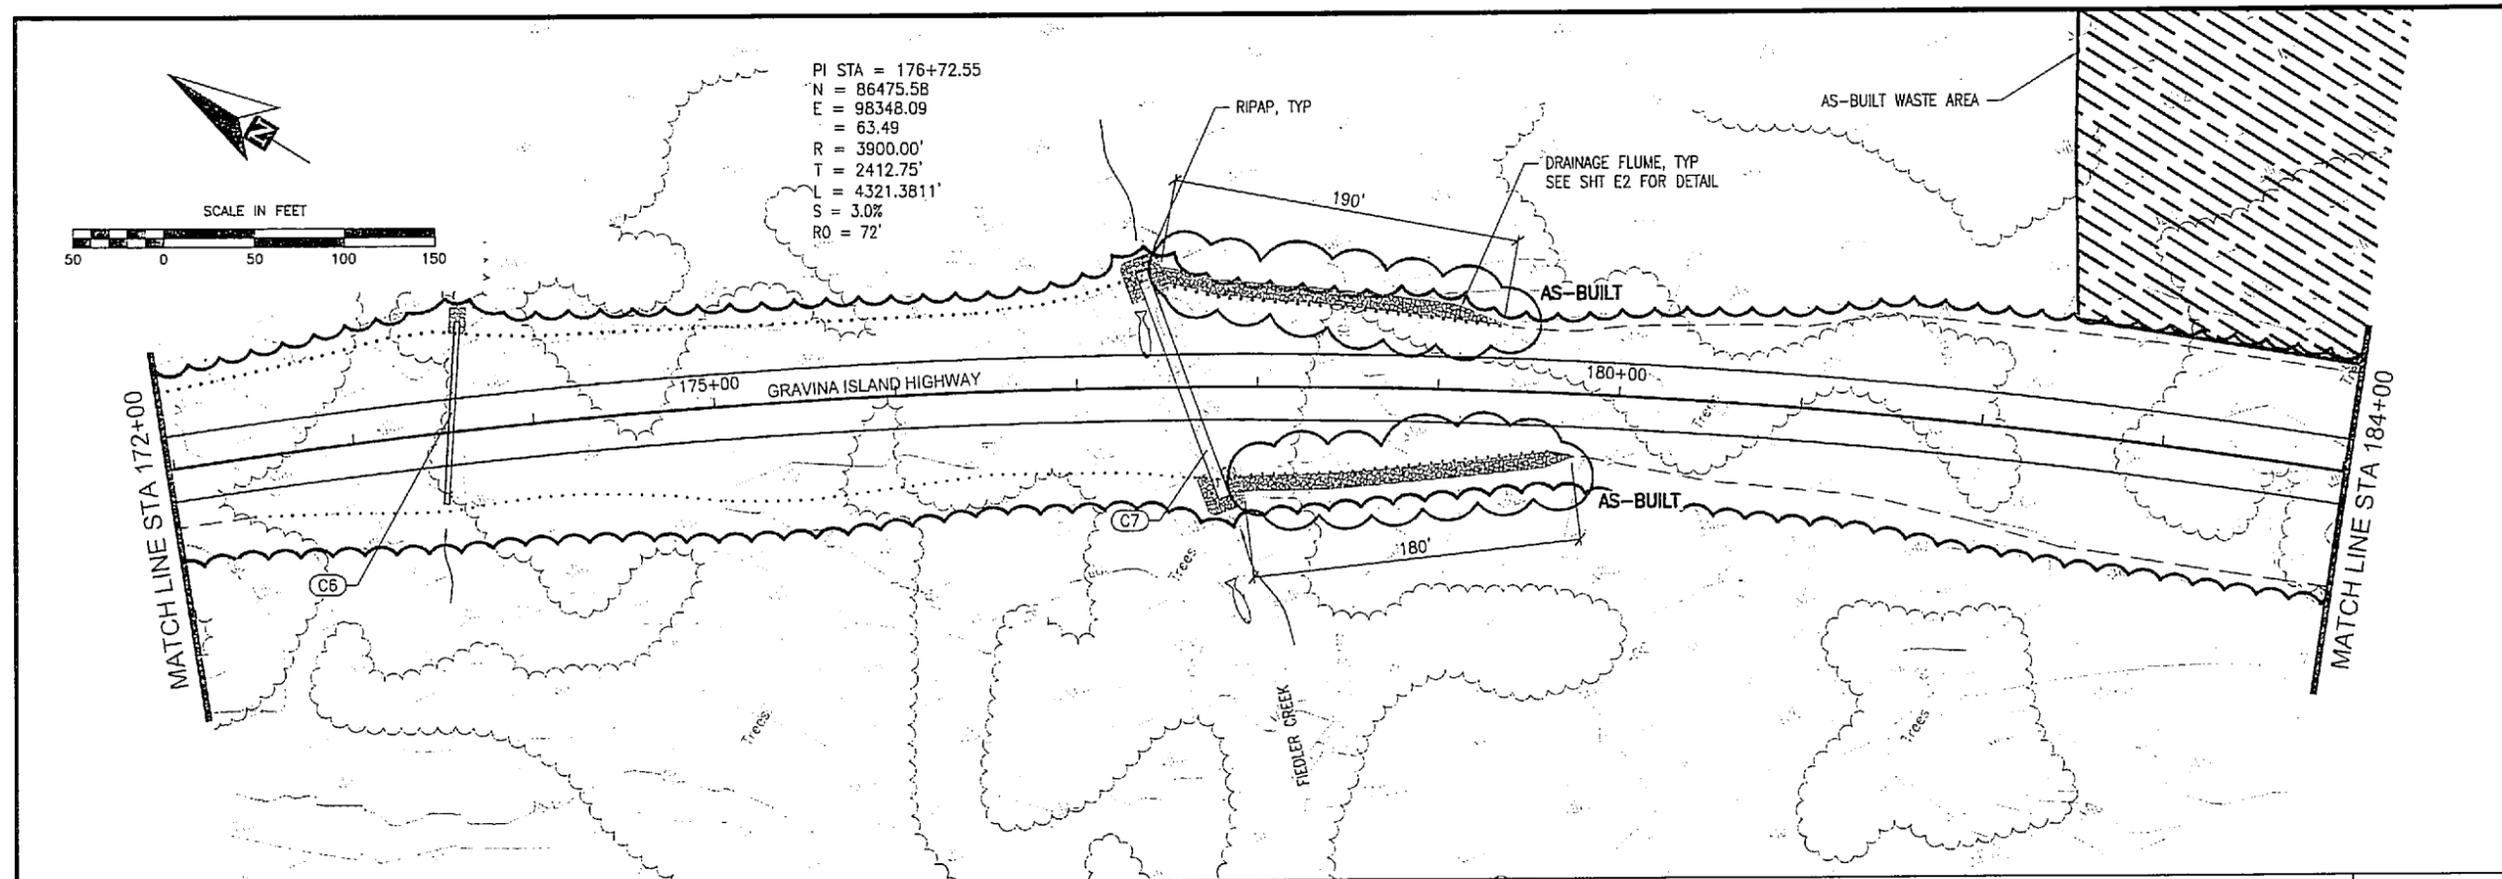

PI STA = 176+72.55  
N = 86475.58  
E = 98348.09  
= 63.49  
R = 3900.00'  
T = 2412.75'  
L = 4321.3811'  
S = 3.0%  
RO = 72'

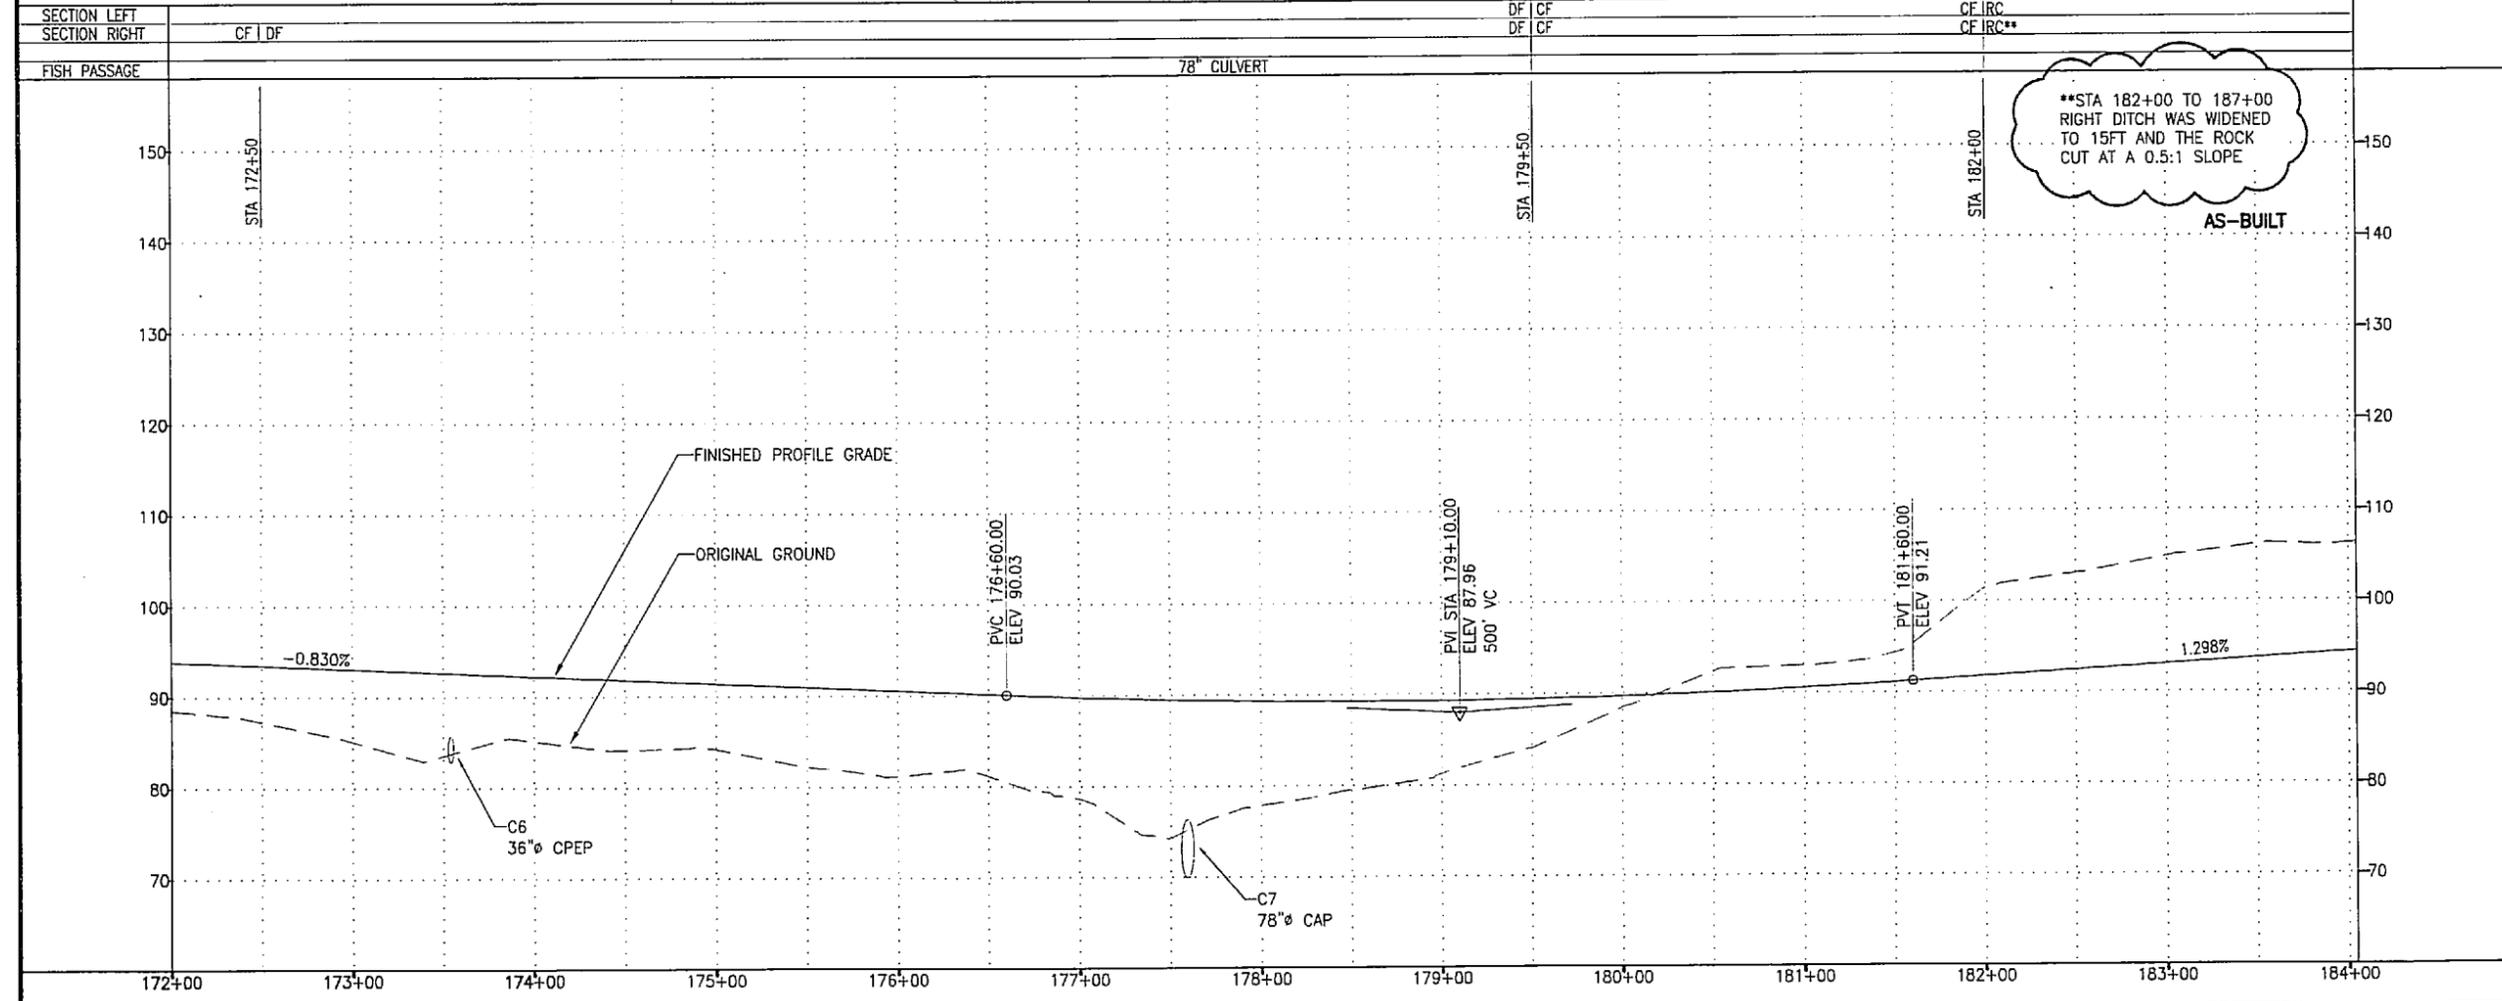

\*\*STA 182+00 TO 187+00  
RIGHT DITCH WAS WIDENED  
TO 15FT AND THE ROCK  
CUT AT A 0.5:1 SLOPE

SECTION LEFT	DF   CF	DF   CF	CF   RC
SECTION RIGHT	CF   DF	DF   CF	CF   RC**
FISH PASSAGE		78" CULVERT	

SHEET NO.	TOTAL SHEETS
F6	F16
STATE	YEAR
ALASKA	2007


PROJECT DESIGNATION  
ACH PRL-0003(123)/67818

ADDENDUM NO.


ATTACHMENT NO.

REVISIONS



NO.	DATE	DESCRIPTION

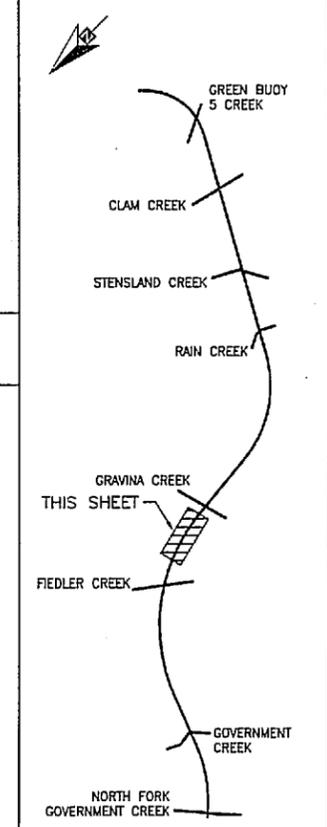

PHD ENGINEERS, INC.  
1506 W. 36th Ave.  
Anchorage, AK 99503  
907-561-1011  
engineering@phdengineers.com

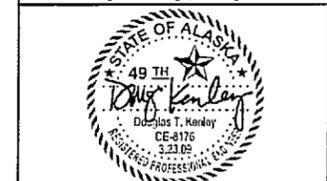

STATE OF ALASKA  
DEPARTMENT OF TRANSPORTATION  
AND PUBLIC FACILITIES  
GRAVINA ISLAND HIGHWAY  
GRADING, DRAINAGE AND  
BRIDGES  
GRAVINA ISLAND  
HIGHWAY  
PLAN & PROFILE

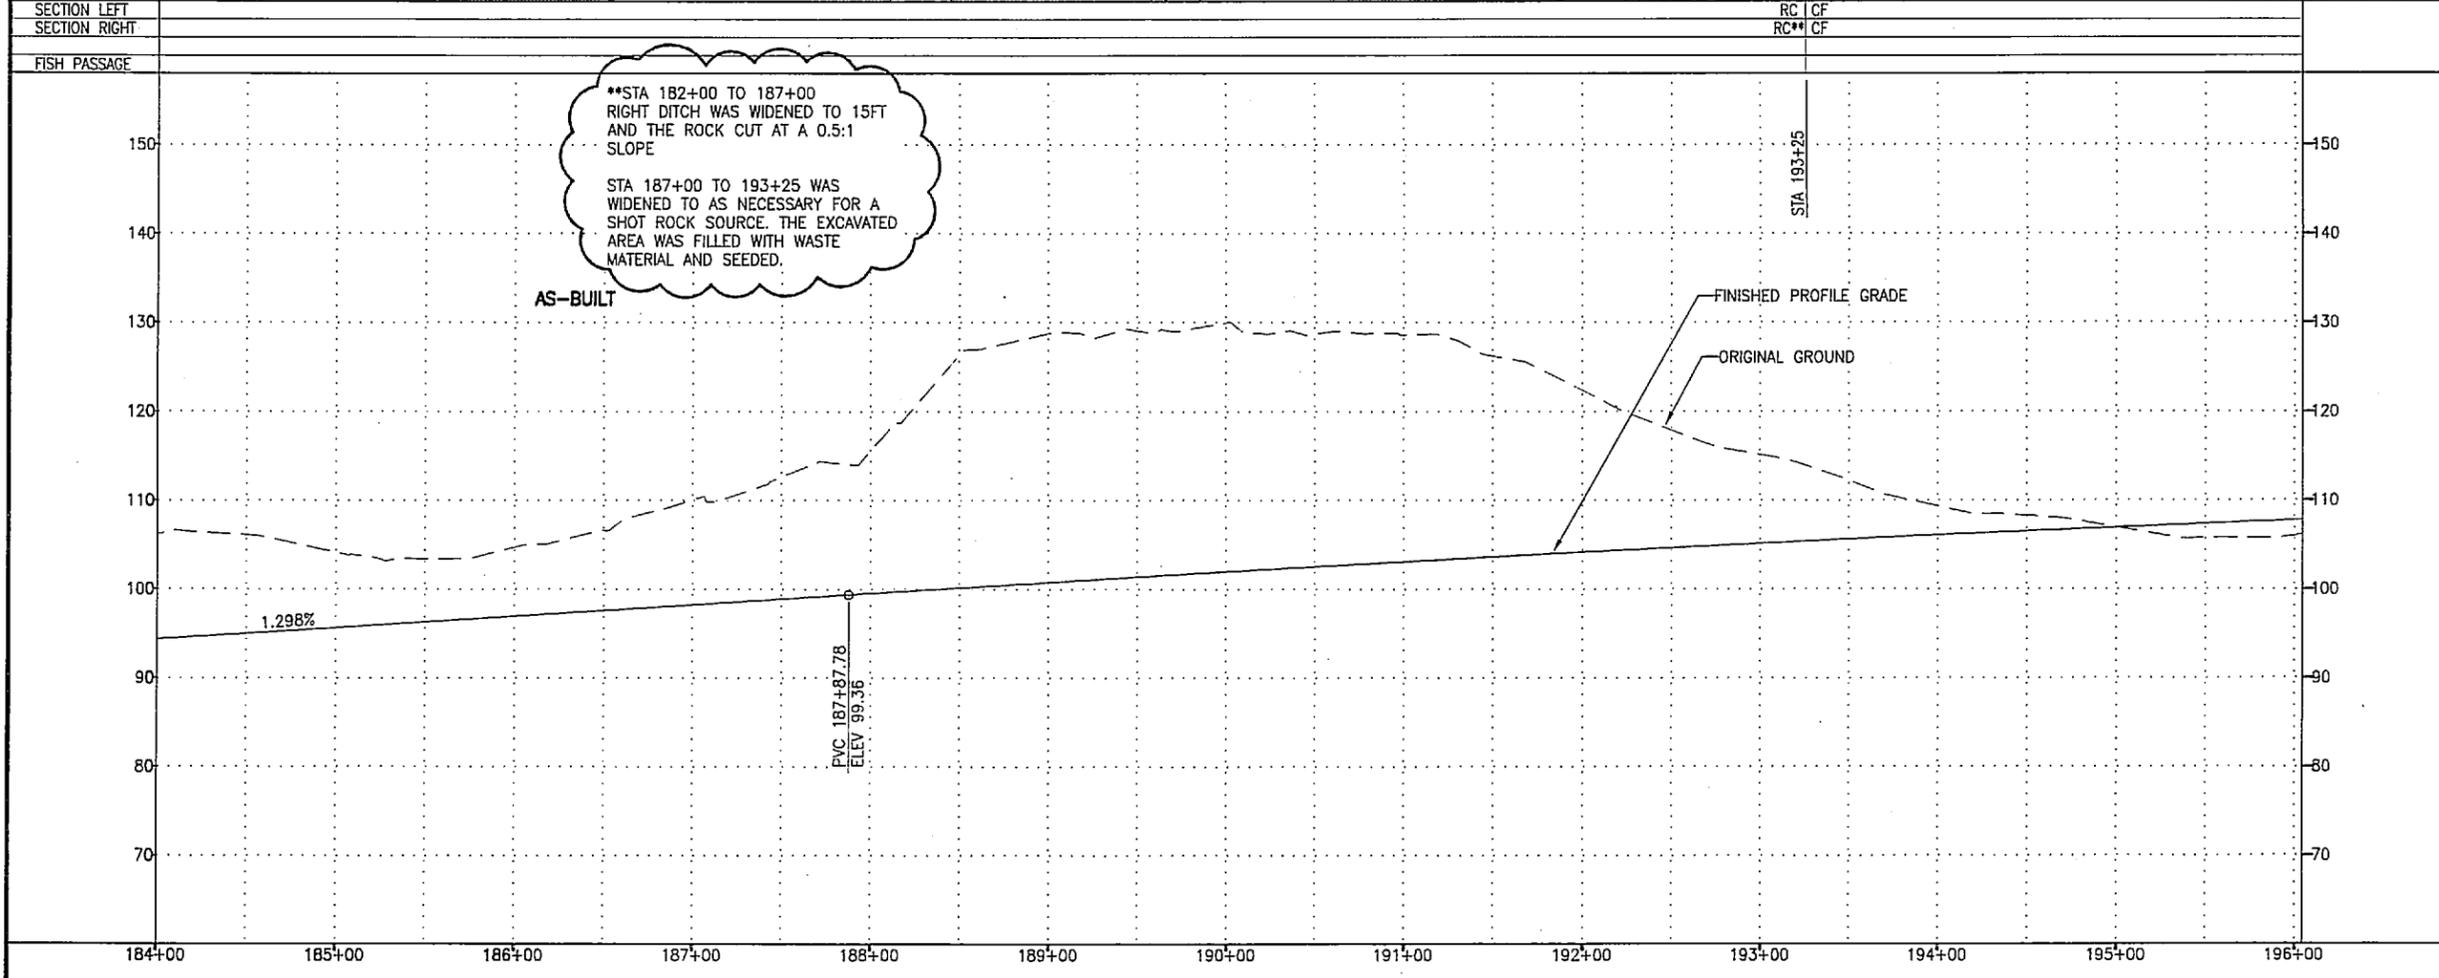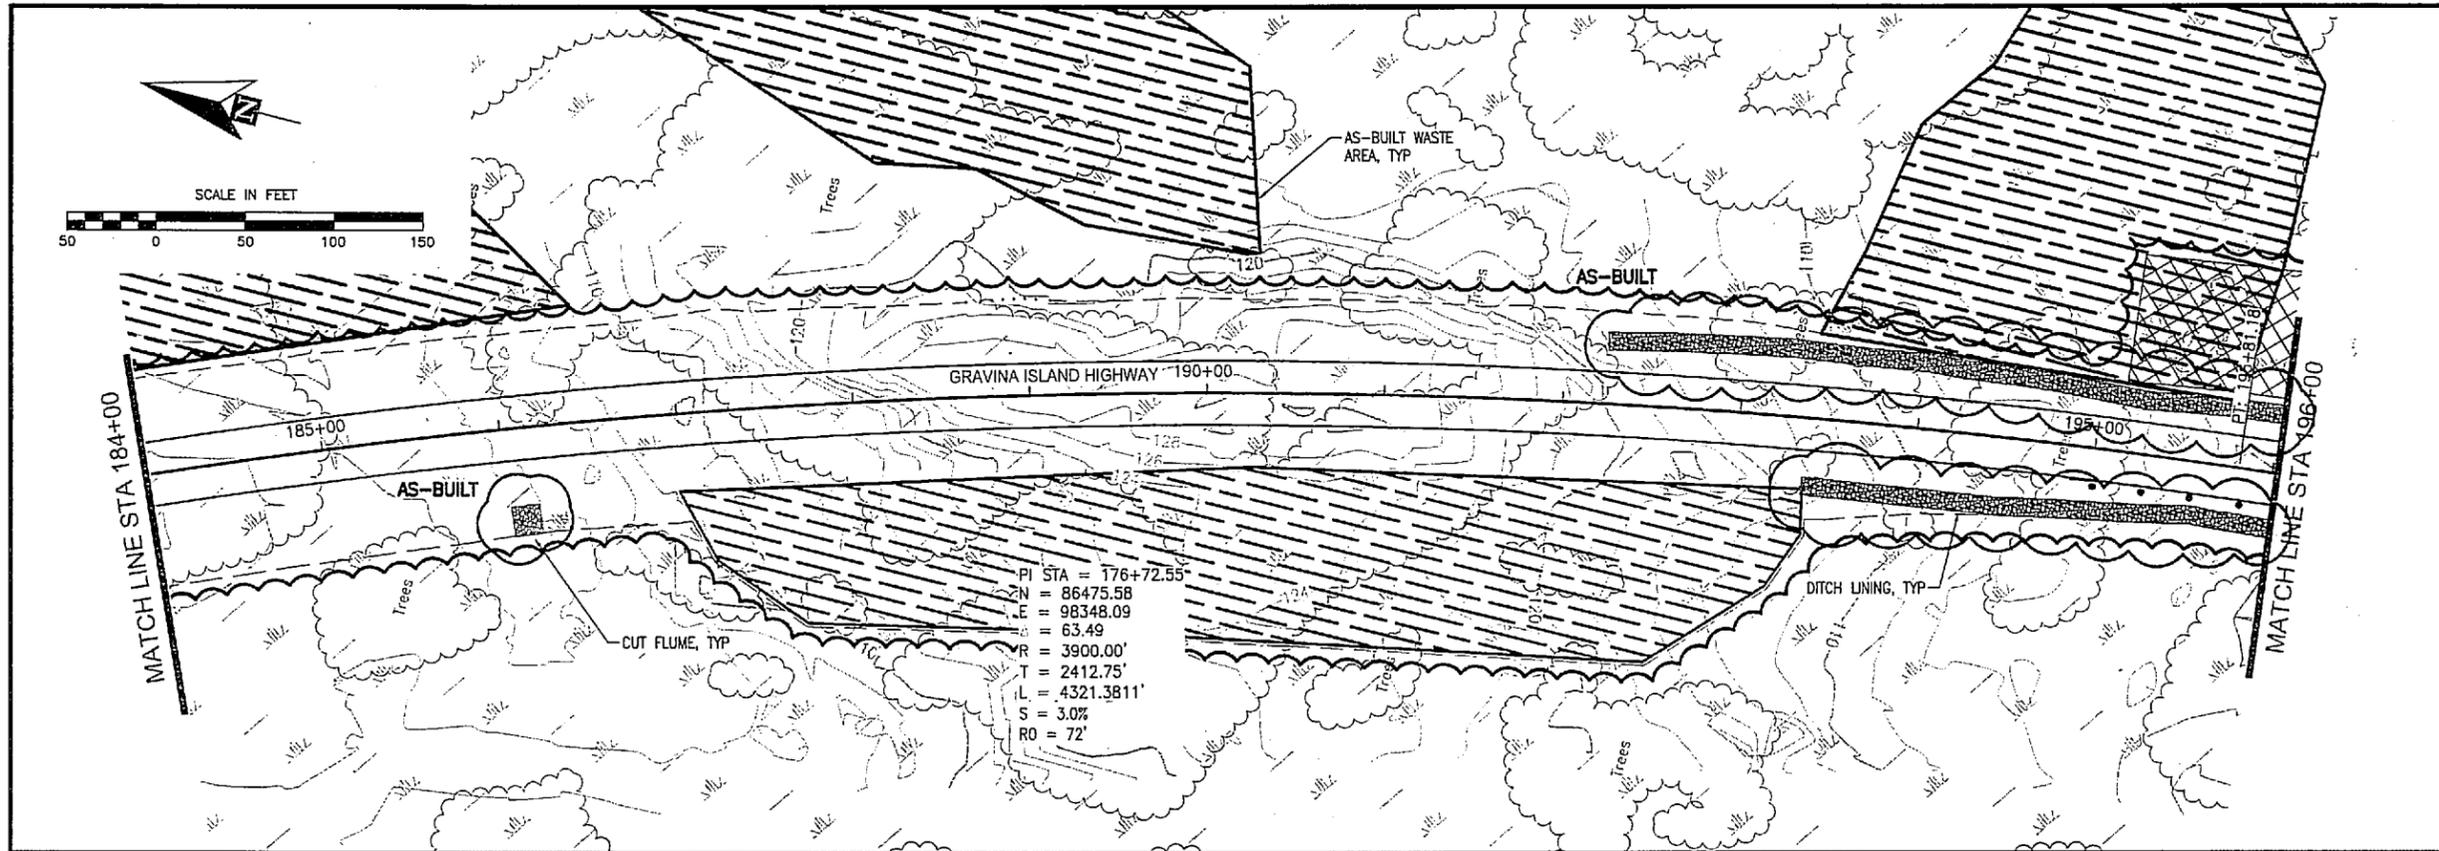

SHEET NO.	TOTAL SHEETS
F7	F16
STATE	YEAR
ALASKA	2007


PROJECT DESIGNATION  
ACH PRL-0003(123)/67818

ADDENDUM NO.


ATTACHMENT NO.

REVISIONS


NO.	DATE	DESCRIPTION

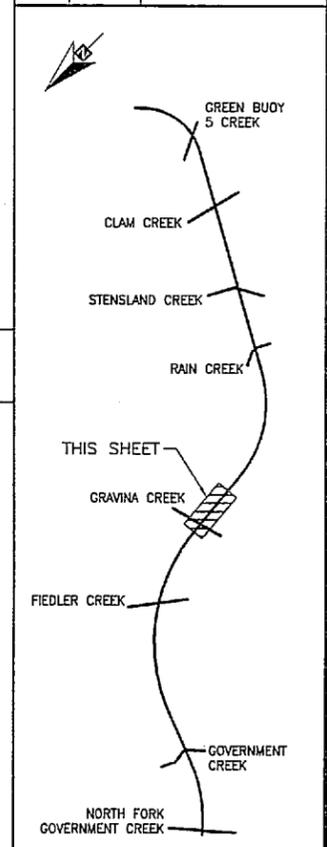


PND ENGINEERS, INC.  
1506 W. 36th Ave.  
Anchorage, AK 99503  
907-561-1011  
engineering@pndengineers.com

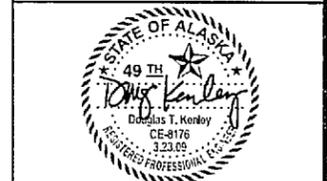

STATE OF ALASKA  
DEPARTMENT OF TRANSPORTATION  
AND PUBLIC FACILITIES  
GRAVINA ISLAND HIGHWAY  
GRADING, DRAINAGE AND  
BRIDGES  
GRAVINA ISLAND  
HIGHWAY  
PLAN & PROFILE

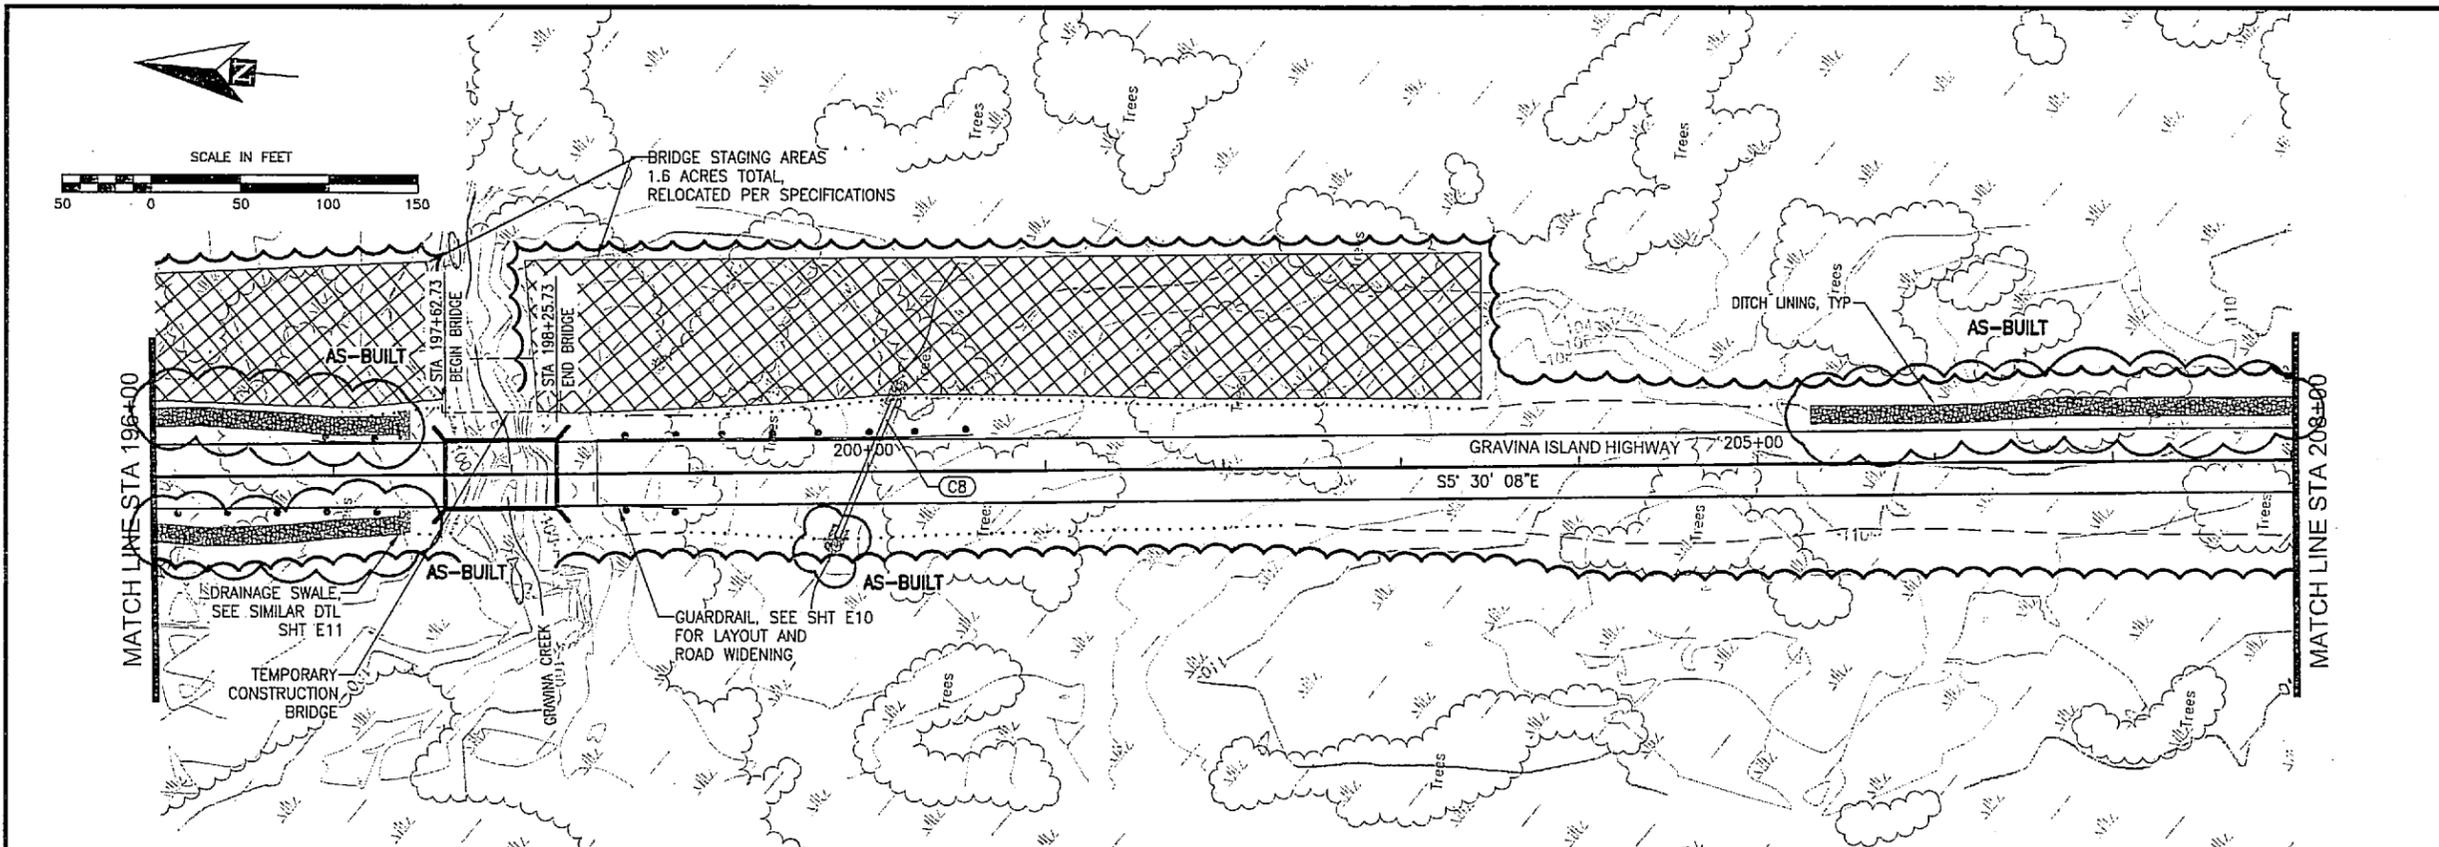

SECTION LEFT	CF	CF
SECTION RIGHT	CF	CF
FISH PASSAGE	63 FT BRIDGE	

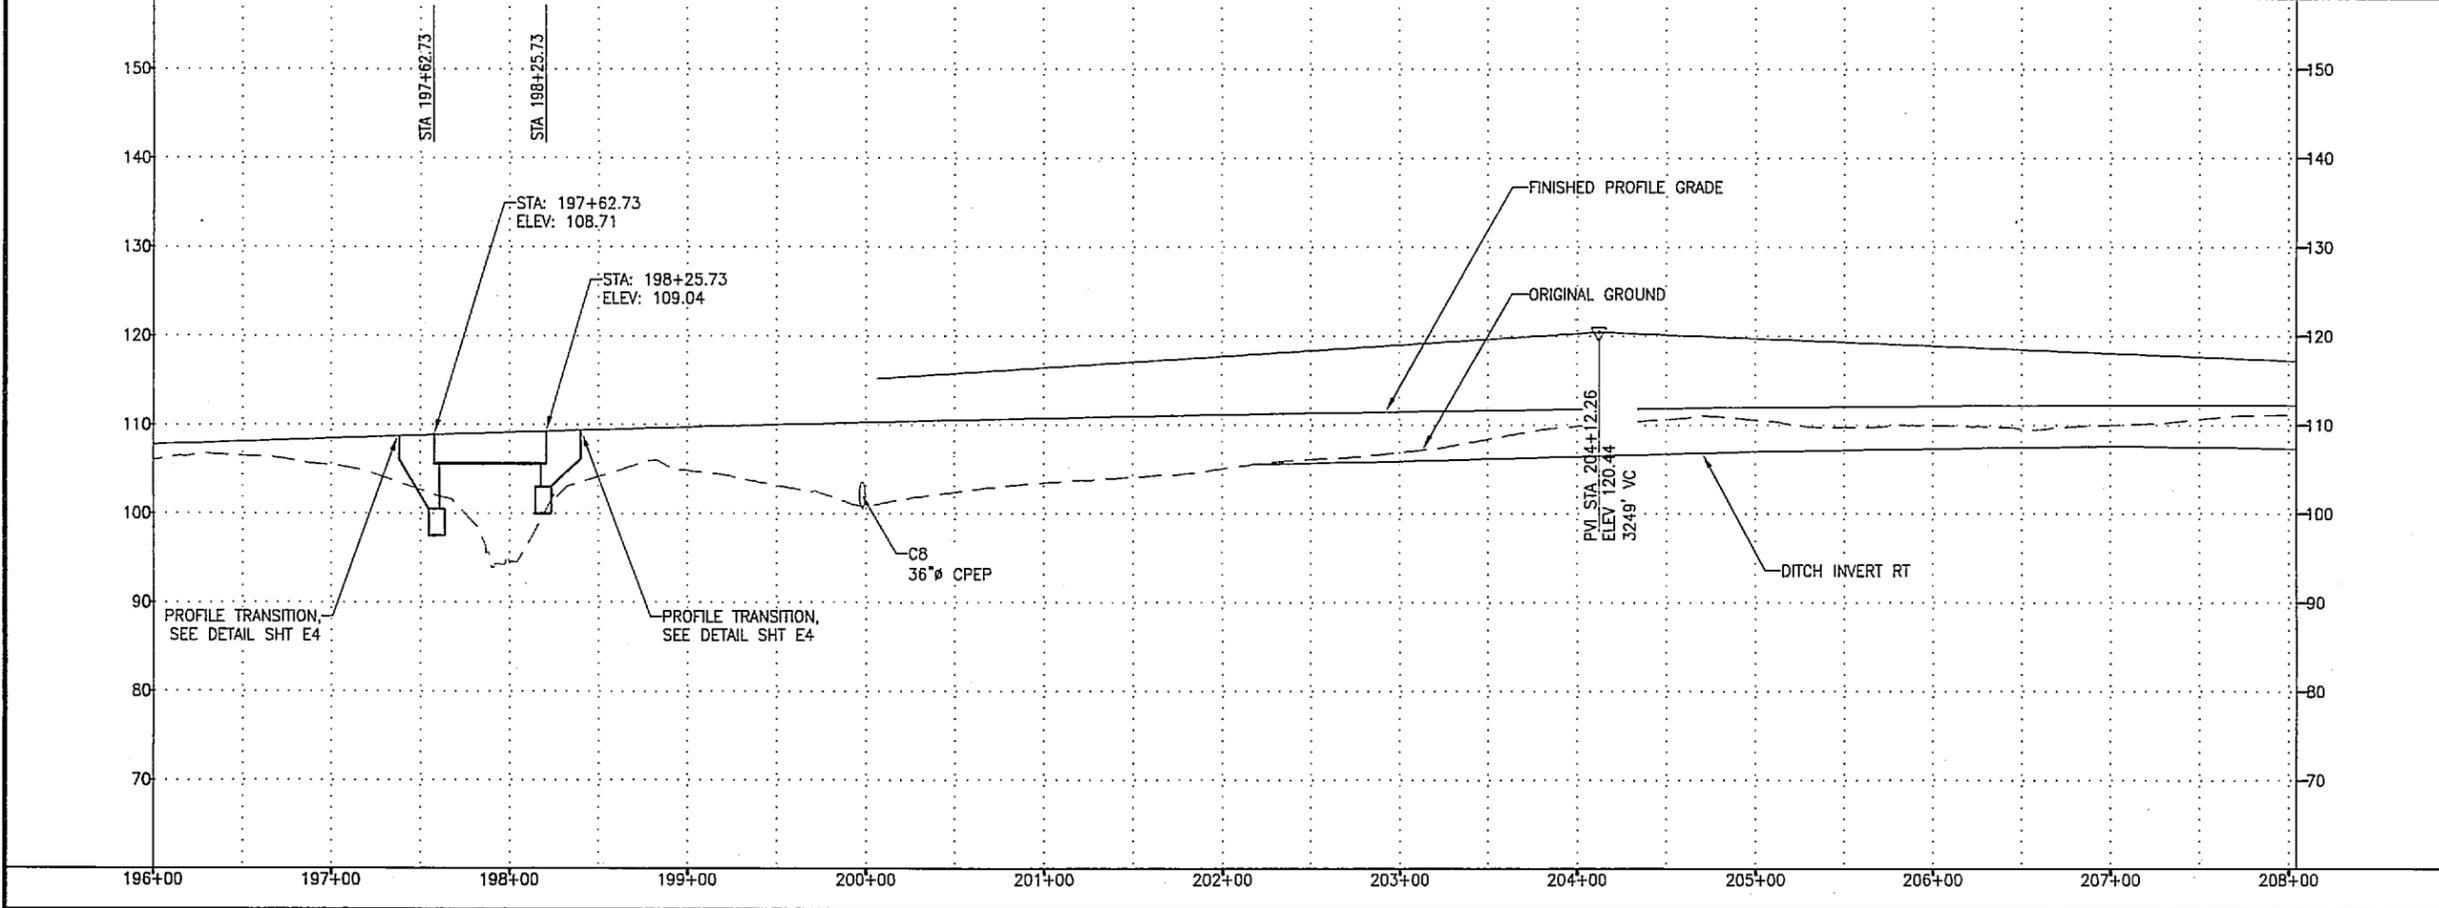


SHEET NO.	TOTAL SHEETS
F8	F16
STATE	YEAR
ALASKA	2007

PROJECT DESIGNATION  
ACH PRL-0003(123)/67818

ADDENDUM NO.

ATTACHMENT NO.




REVISIONS		
NO.	DATE	DESCRIPTION

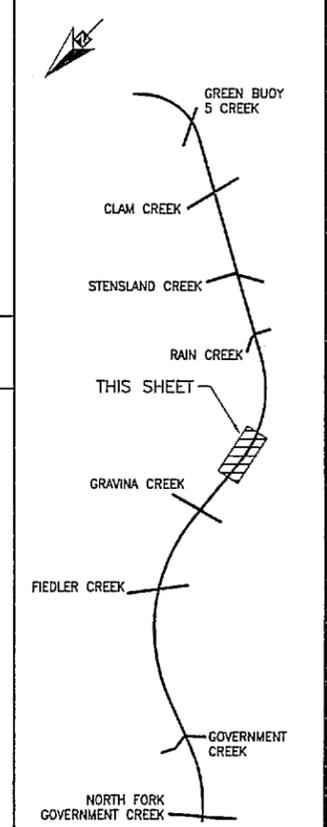

PND ENGINEERS, INC.  
1506 W. 36th Ave.  
Anchorage, AK 99503  
907-561-1011  
engineering@pndengineers.com



STATE OF ALASKA  
DEPARTMENT OF TRANSPORTATION  
AND PUBLIC FACILITIES  
GRAVINA ISLAND HIGHWAY  
GRADING, DRAINAGE AND  
BRIDGES  
GRAVINA ISLAND  
HIGHWAY  
PLAN & PROFILE

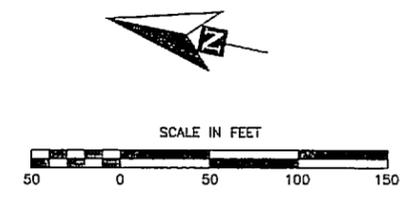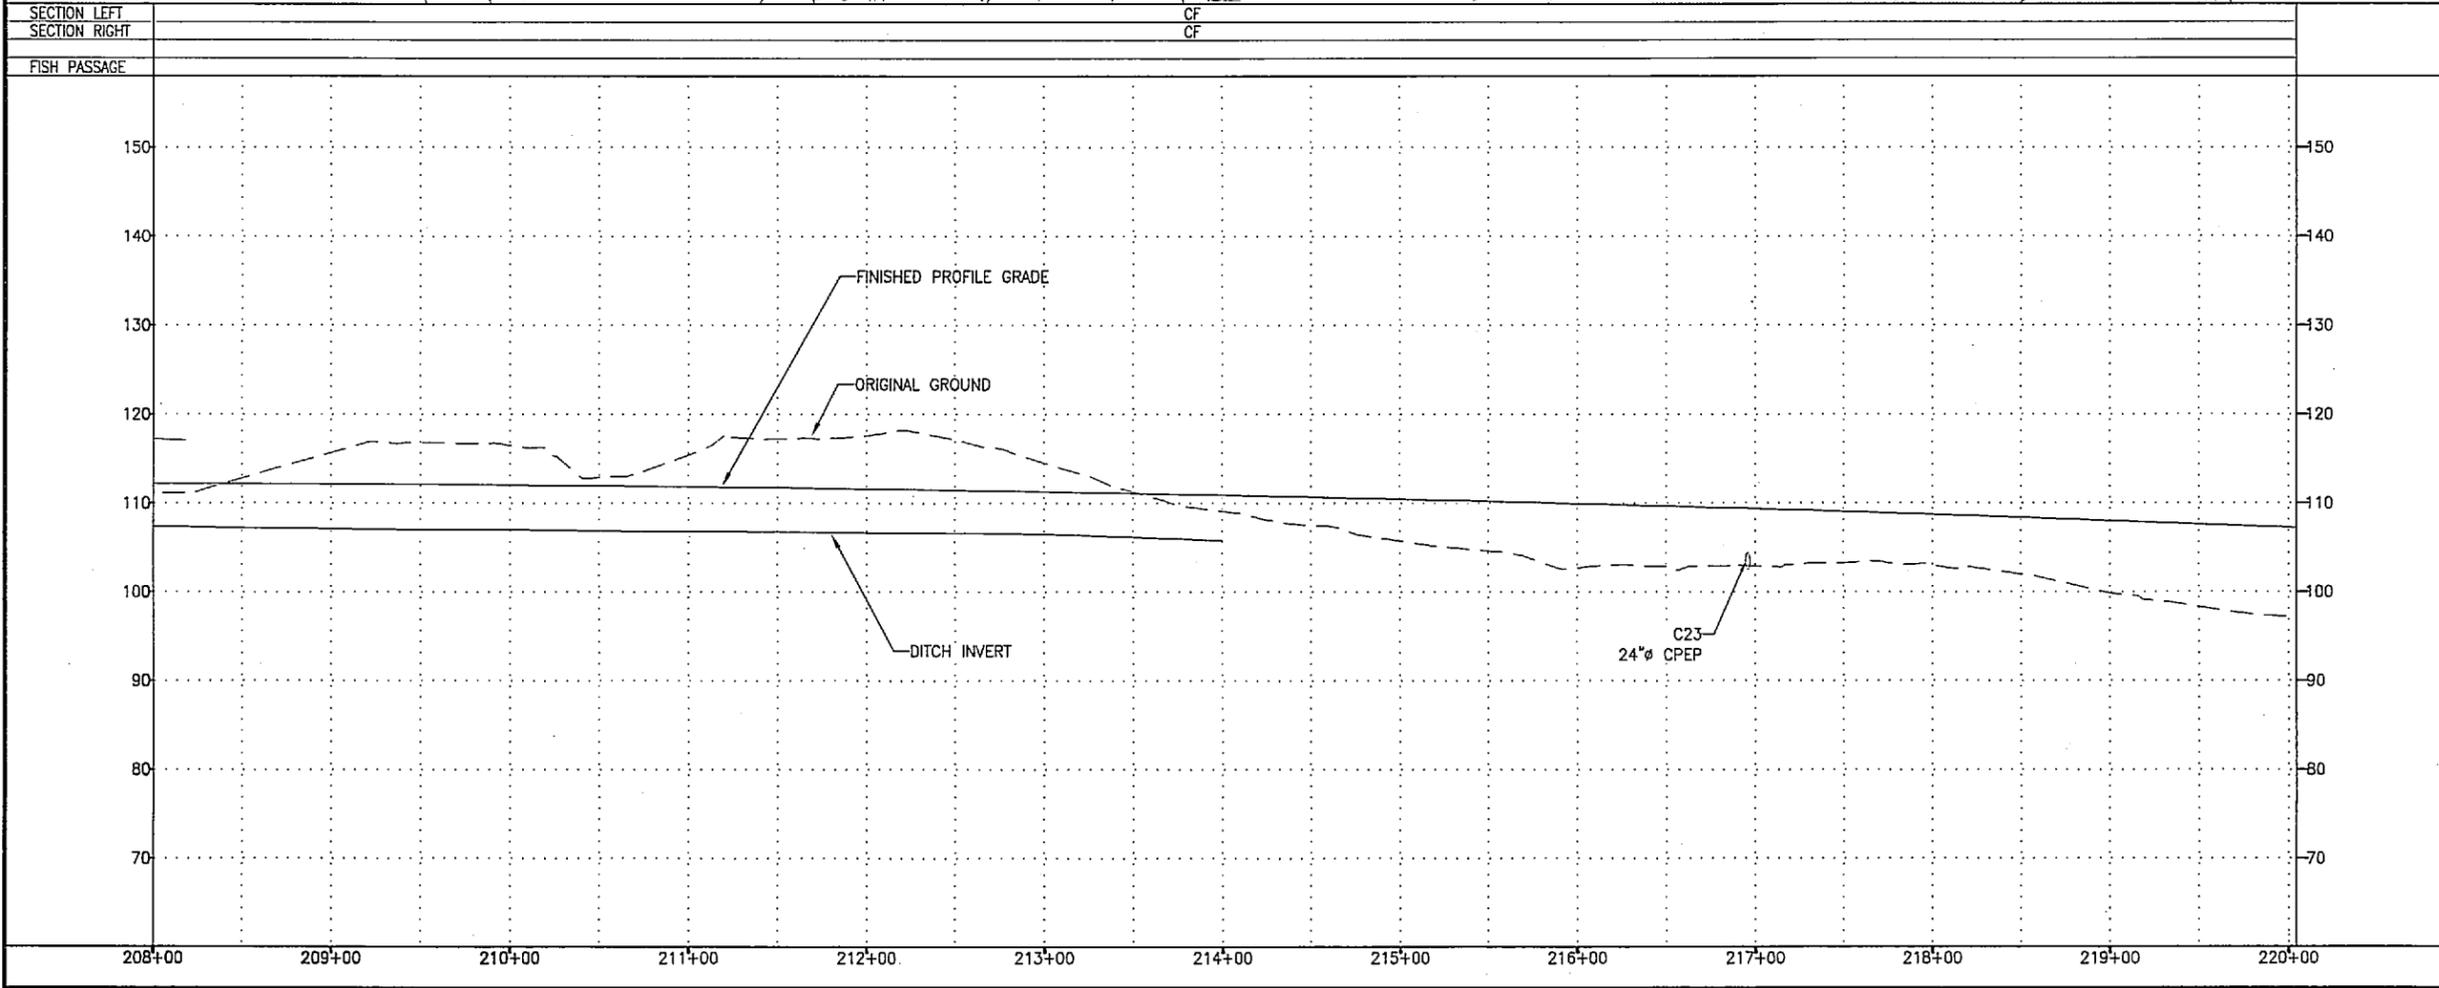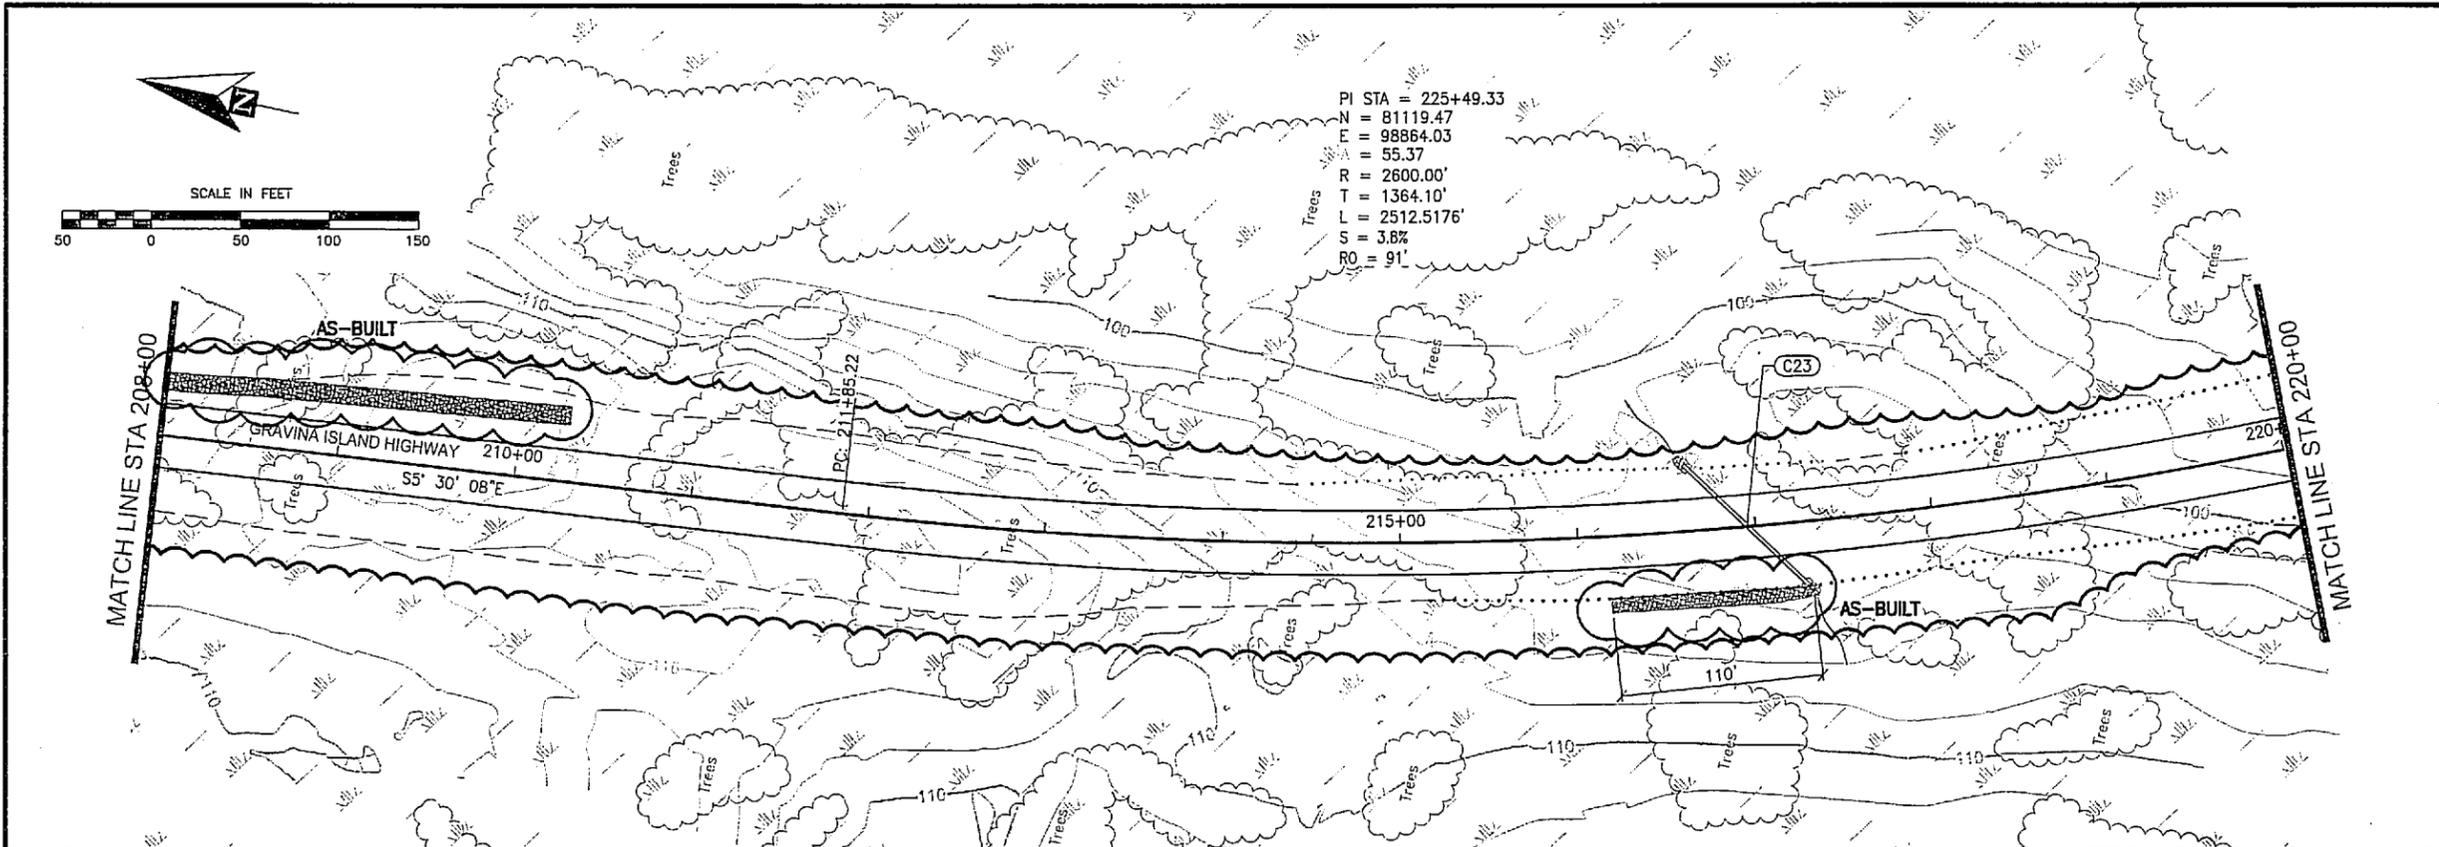

SECTION LEFT  
SECTION RIGHT  
FISH PASSAGE

CF  
CF

SHEET NO.	TOTAL SHEETS
F9	F16
STATE	YEAR
ALASKA	2007


PROJECT DESIGNATION  
ACH PRL-0003(123)/67818

ADDENDUM NO.


ATTACHMENT NO.

REVISIONS

NO.	DATE	DESCRIPTION



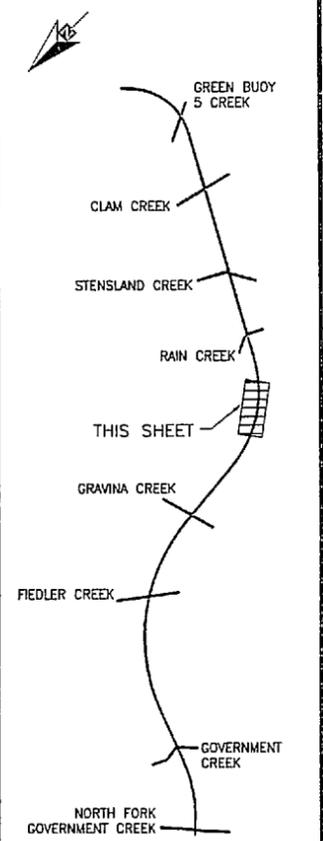


PND ENGINEERS, INC.  
1506 W. 36th Ave.  
Anchorage, AK 99503  
907-561-1011  
engineering@pndengineers.com

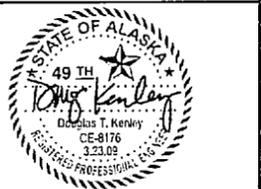

STATE OF ALASKA  
DEPARTMENT OF TRANSPORTATION  
AND PUBLIC FACILITIES  
GRAVINA ISLAND HIGHWAY  
GRADING, DRAINAGE AND  
BRIDGES  
GRAVINA ISLAND  
HIGHWAY  
PLAN & PROFILE

PI STA = 225+49.33  
N = 81119.47  
E = 98864.03  
L = 55.37  
R = 2600.00'  
T = 1364.10'  
L = 2512.5176'  
S = 3.8%  
RO = 91'

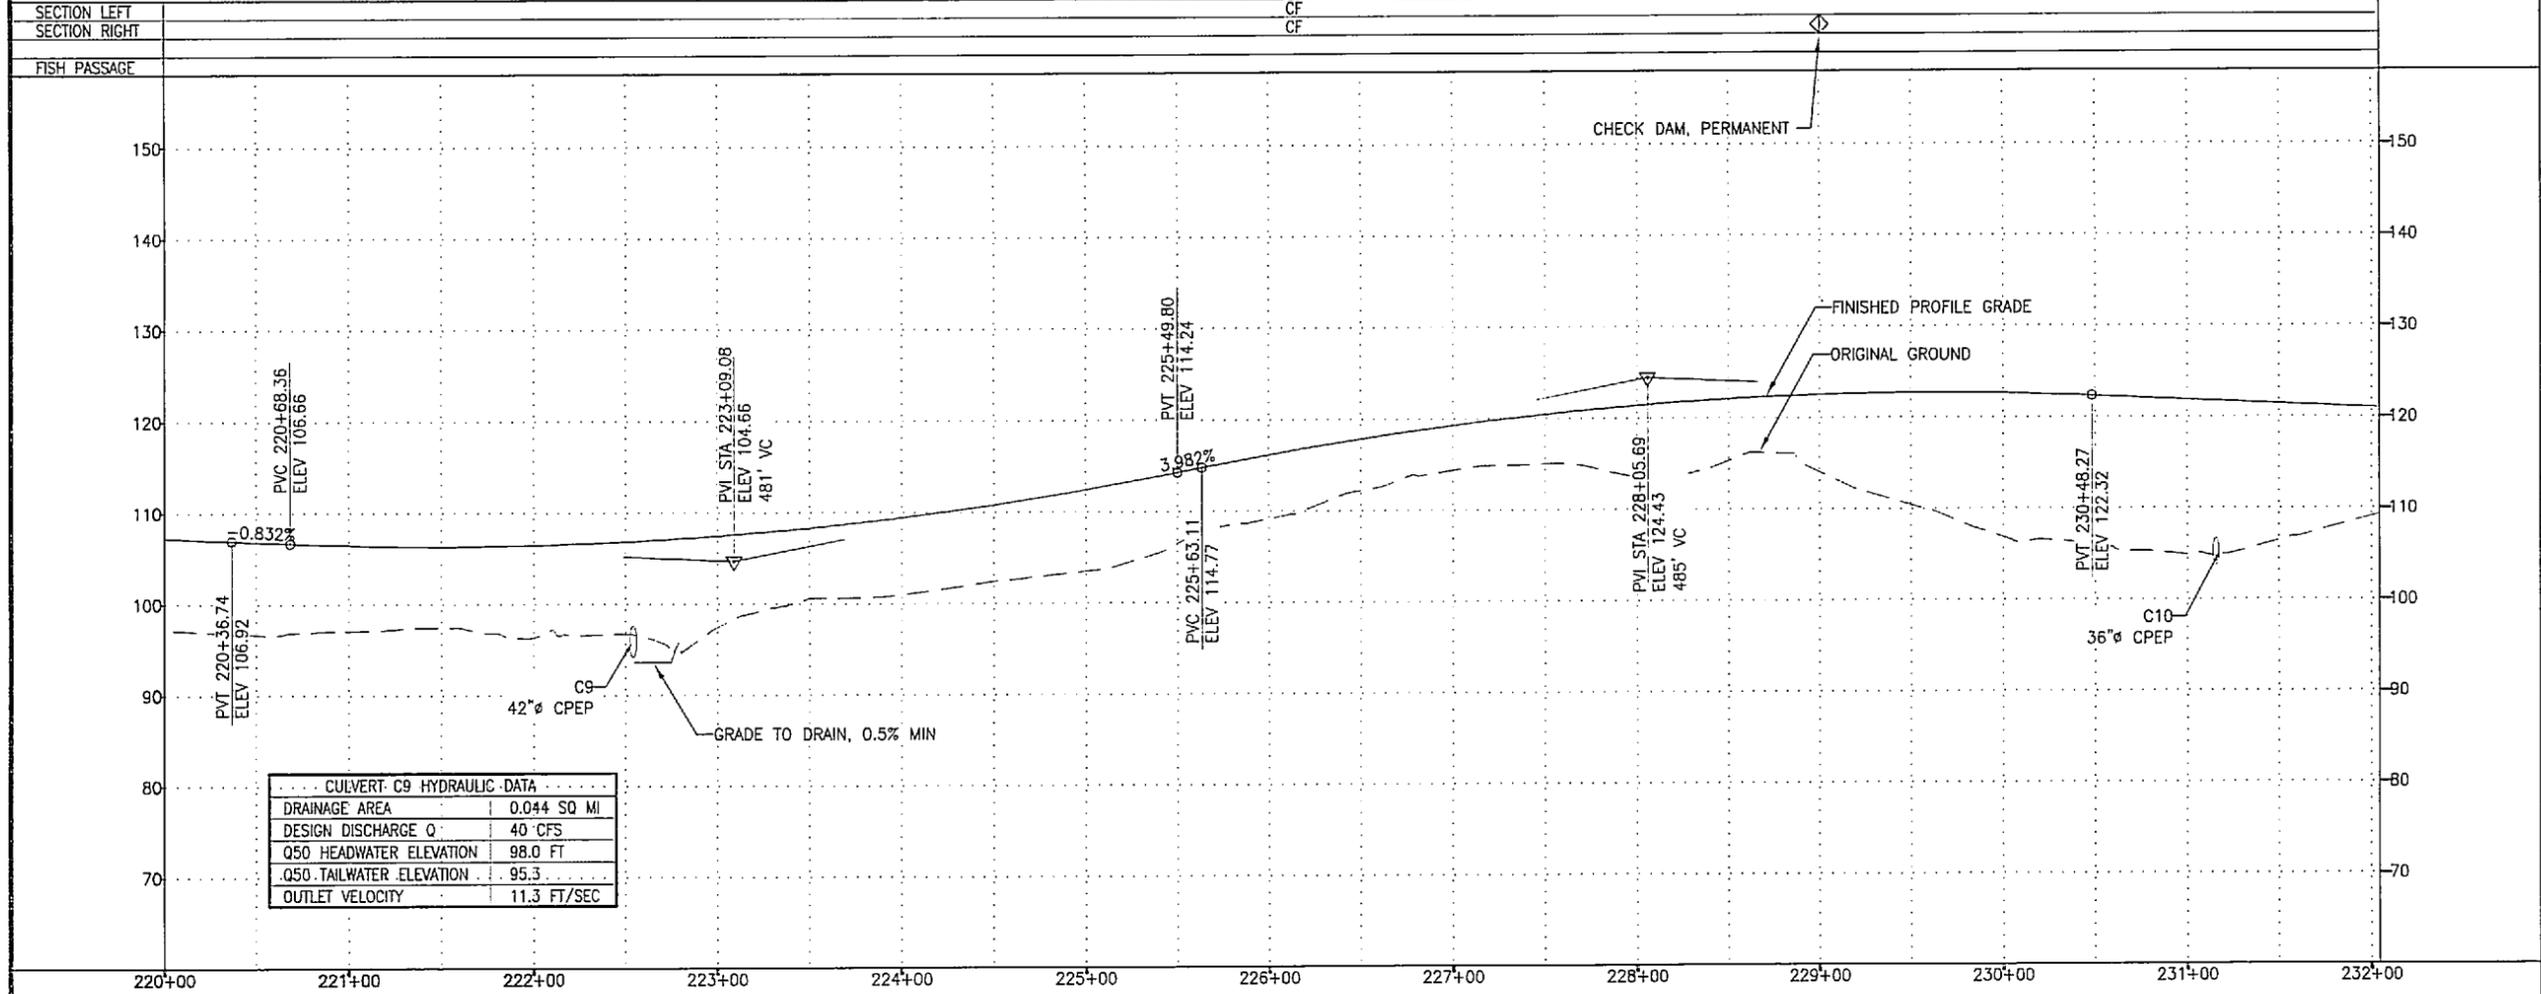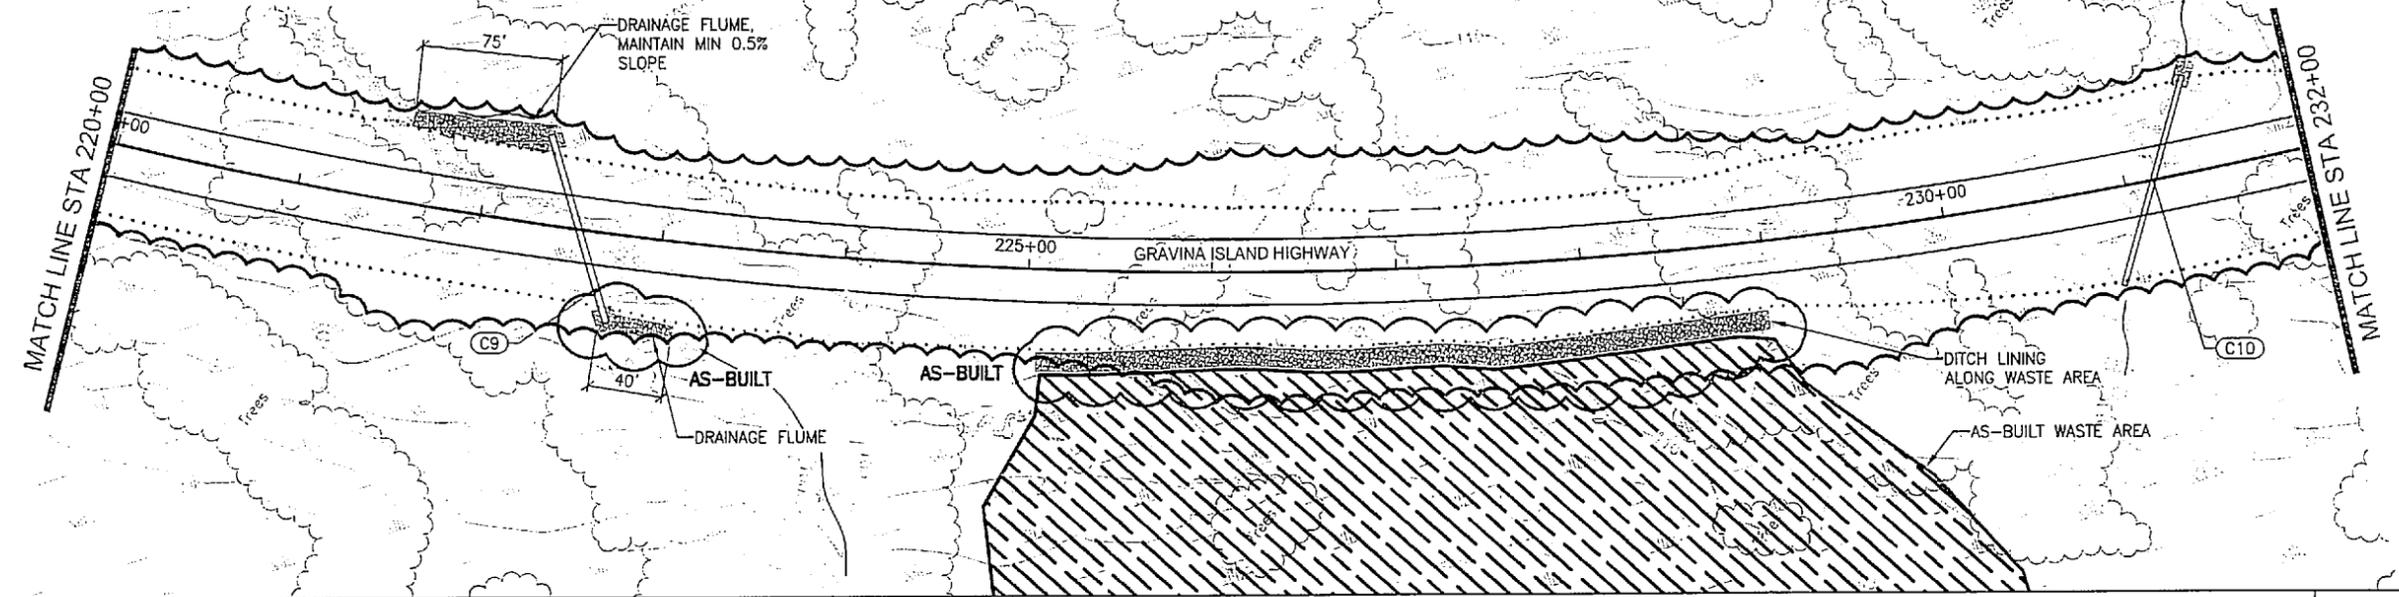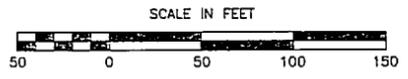

SHEET NO.	TOTAL SHEETS
F10	F16
STATE	YEAR
ALASKA	2007


PROJECT DESIGNATION  
ACH PRL-0003(123)/67818

ADDENDUM NO.

ATTACHMENT NO.

REVISIONS

NO.	DATE	DESCRIPTION



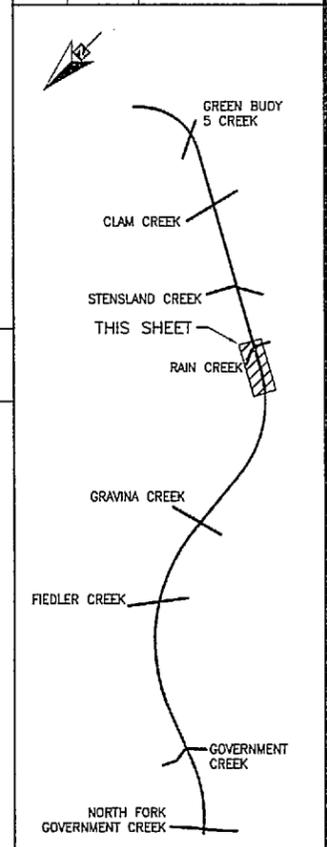


PND ENGINEERS, INC.  
1506 W. 36th Ave.  
Anchorage, AK 99503  
907-561-1011  
engineer ing@pndengineers.com



STATE OF ALASKA  
DEPARTMENT OF TRANSPORTATION  
AND PUBLIC FACILITIES  
GRAVINA ISLAND HIGHWAY  
GRADING, DRAINAGE AND  
BRIDGES  
GRAVINA ISLAND  
HIGHWAY  
PLAN & PROFILE

PI STA = 225+49.33  
N = 81119.47  
E = 98864.03  
L = 55.37  
R = 2600.00'  
T = 1364.10'  
L = 2512.5176'  
S = 3.8%  
RO = 91'

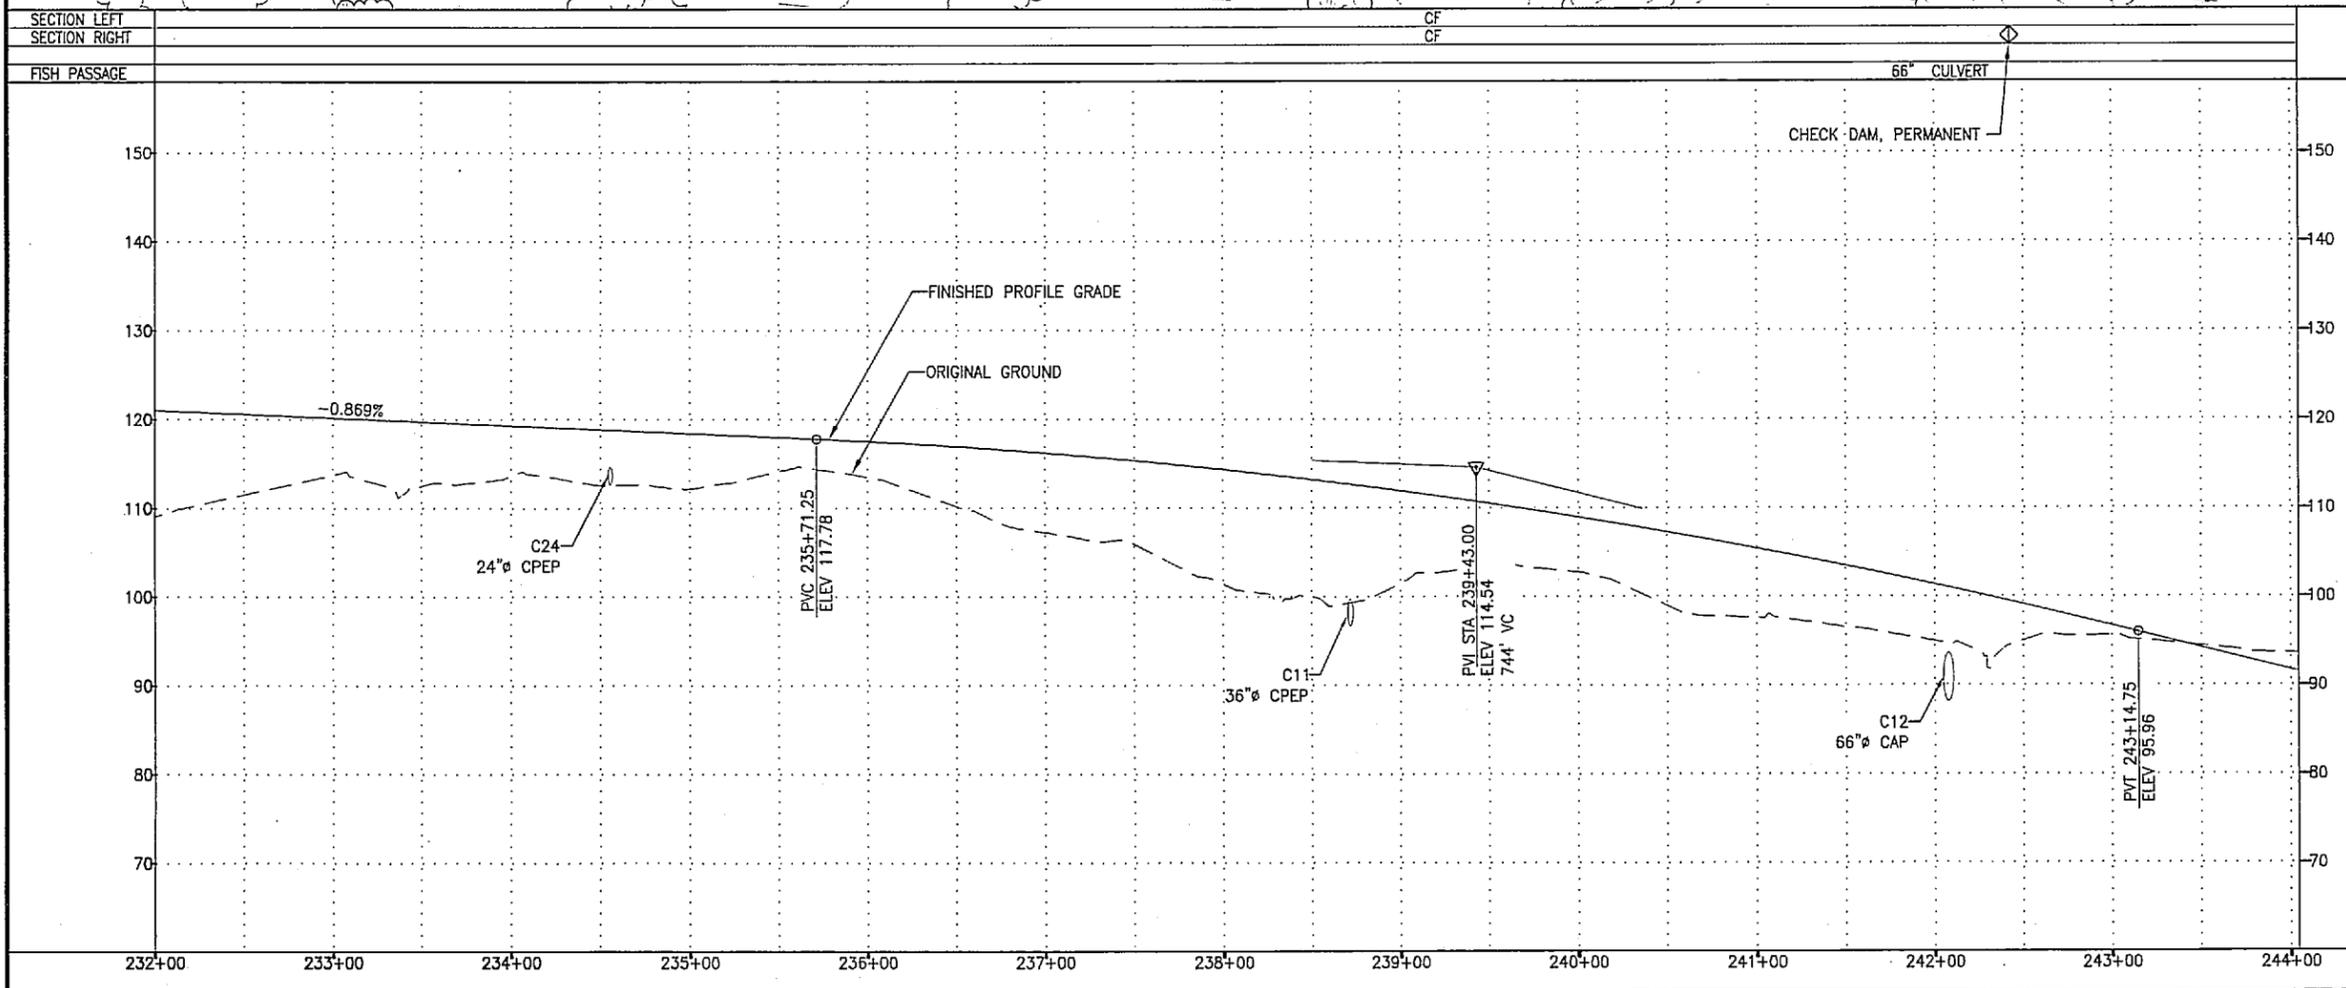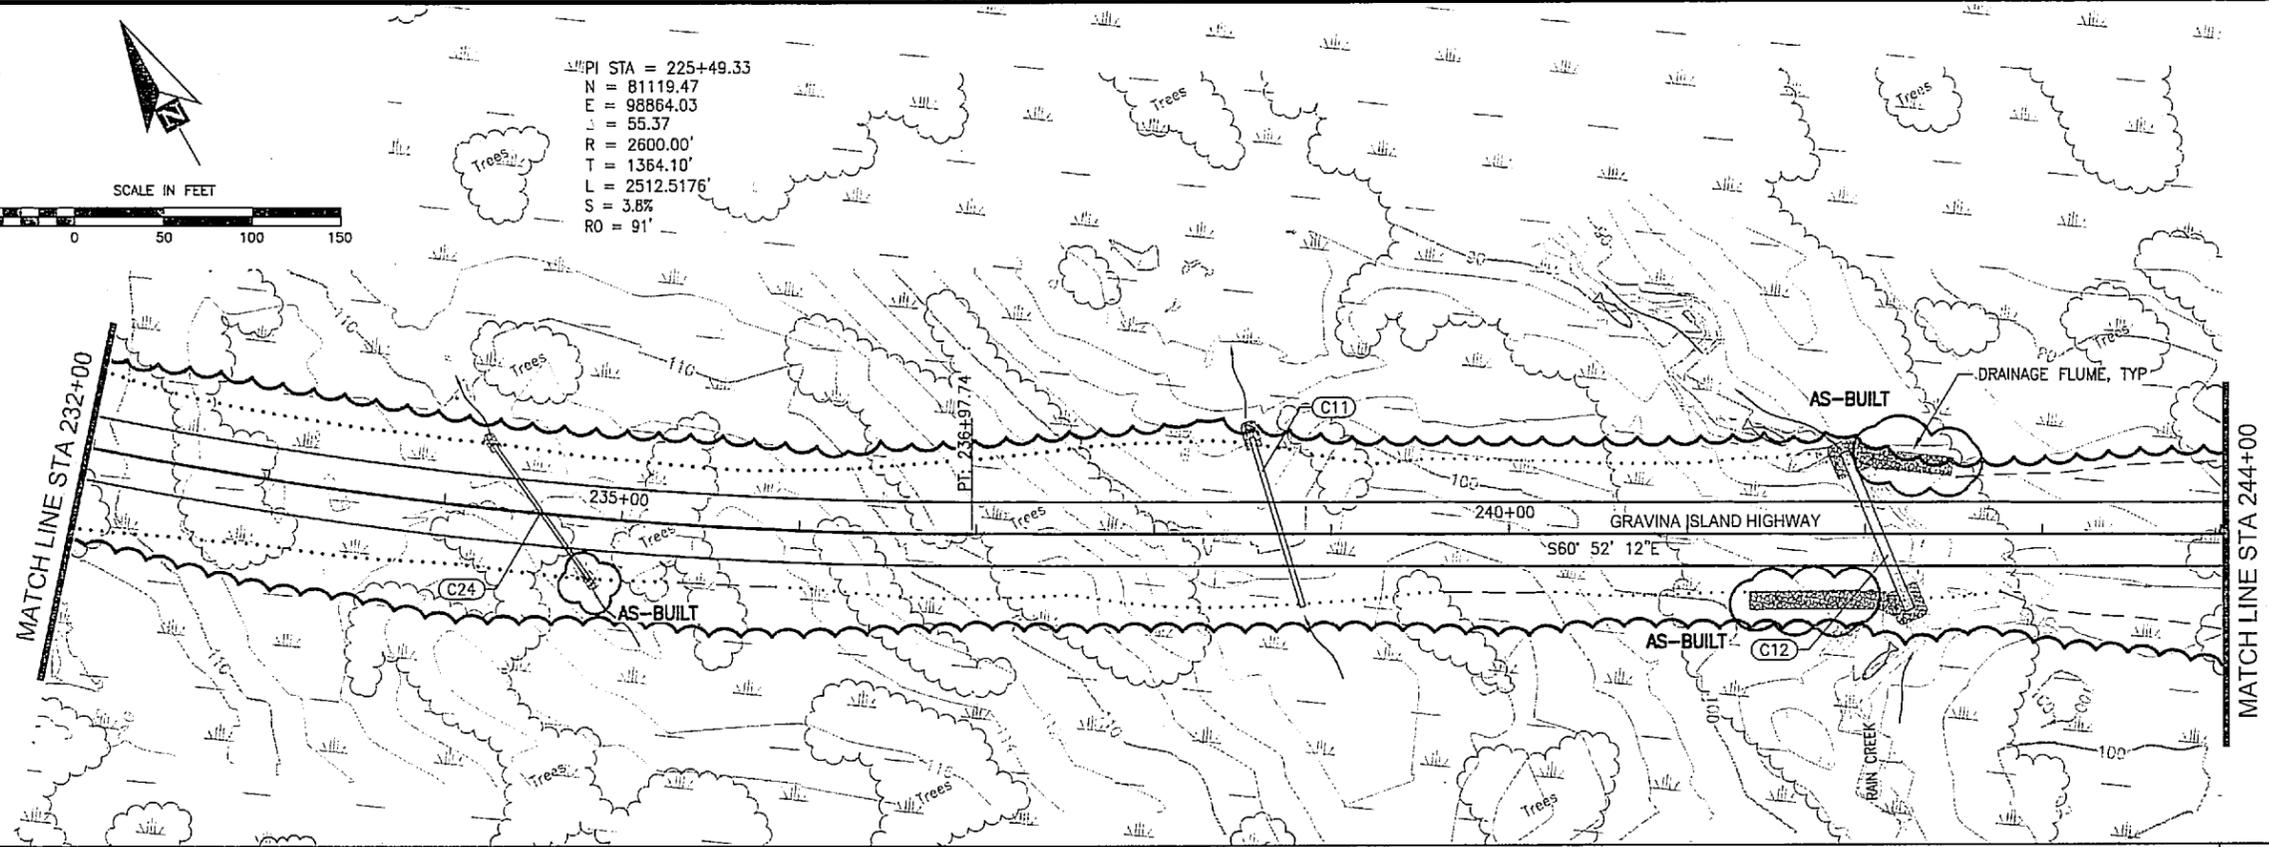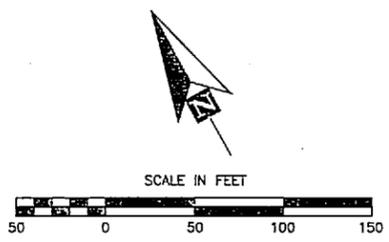



SHEET NO.	TOTAL SHEETS
F12	F16
STATE	YEAR
ALASKA	2007


PROJECT DESIGNATION  
ACH PRL-0003(123)/67818

ADDENDUM NO.



ATTACHMENT NO.

REVISIONS

NO.	DATE	DESCRIPTION

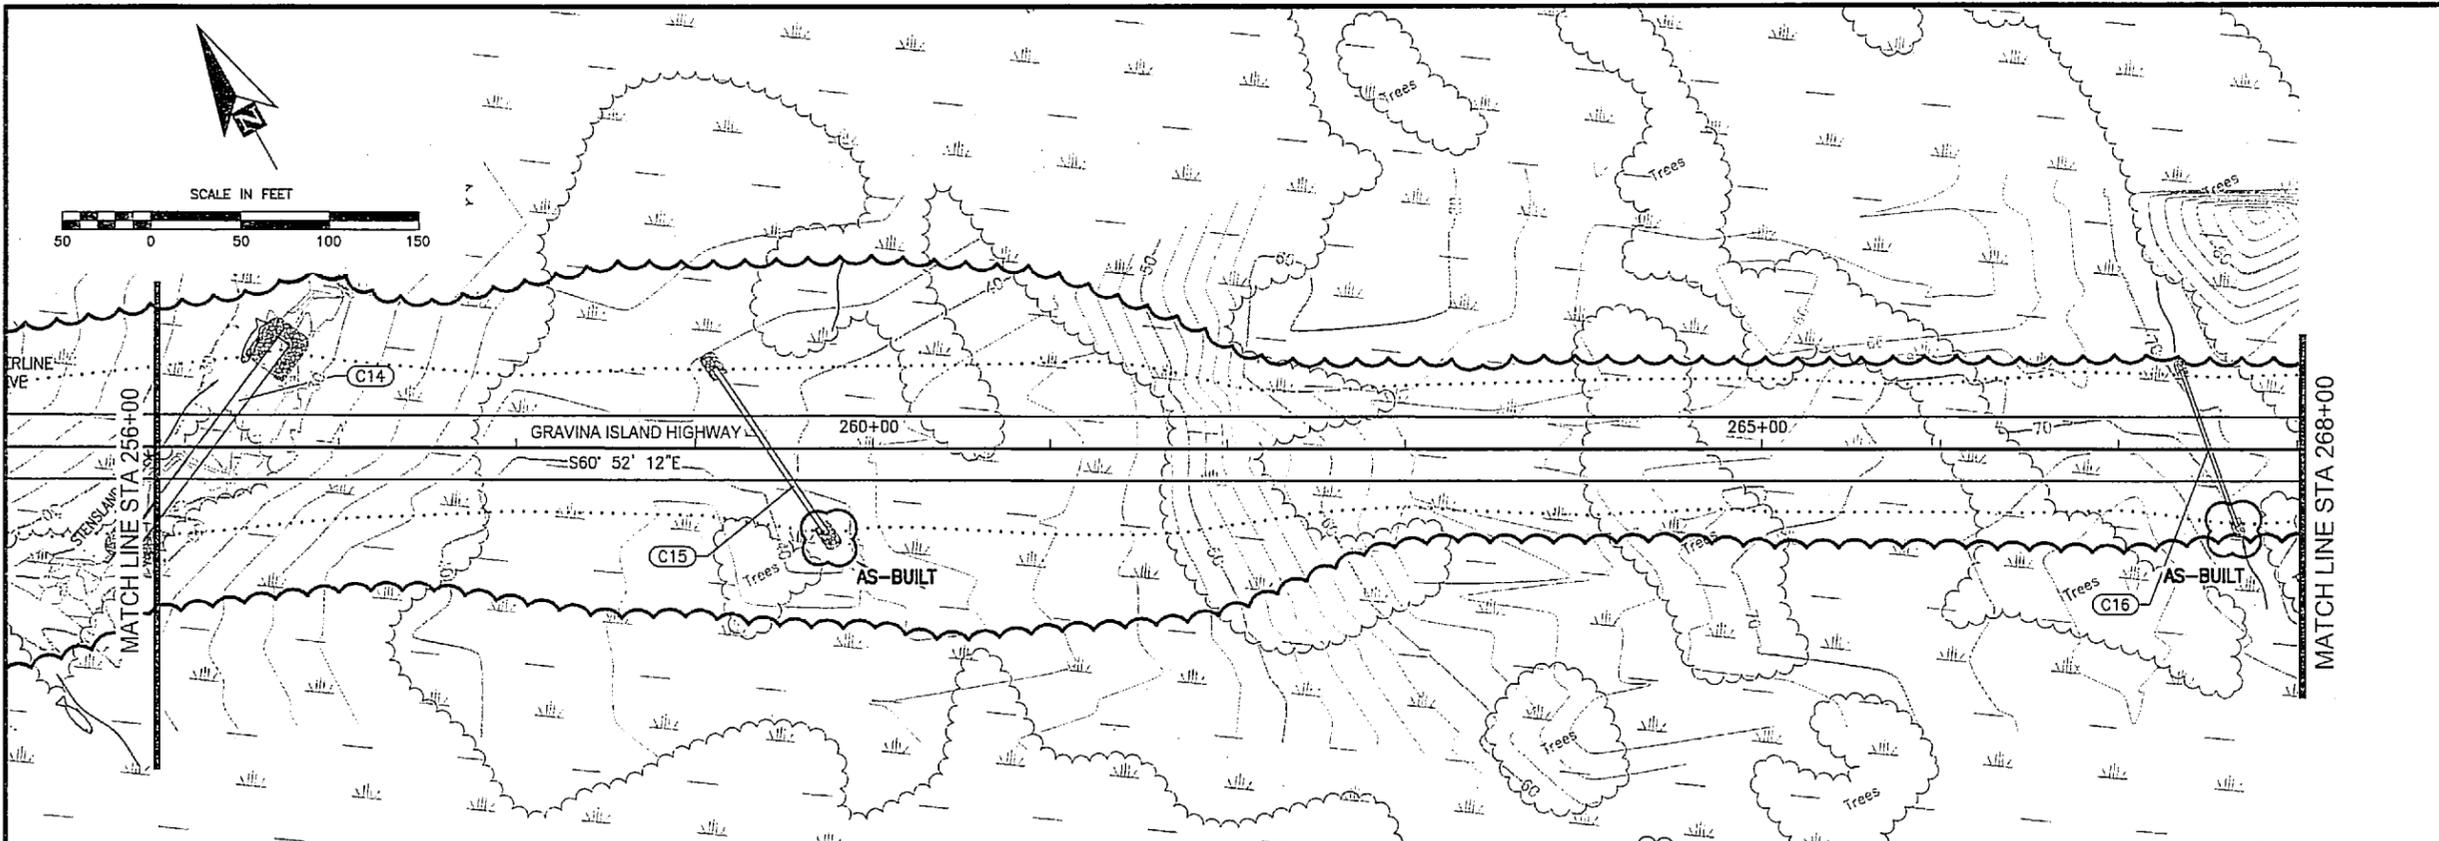

SECTION LEFT	DFICF
SECTION RIGHT	DFICF
FISH PASSAGE	96" CULVERT

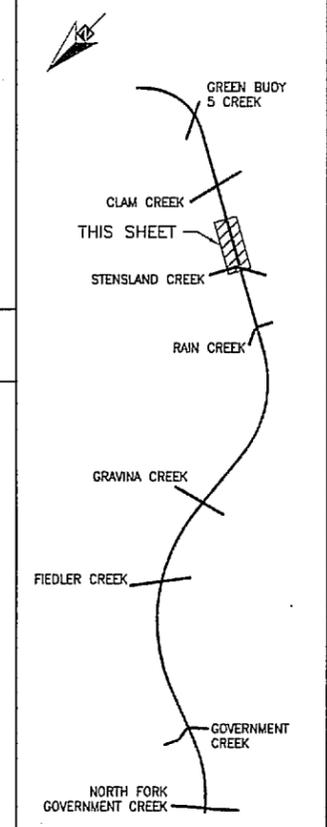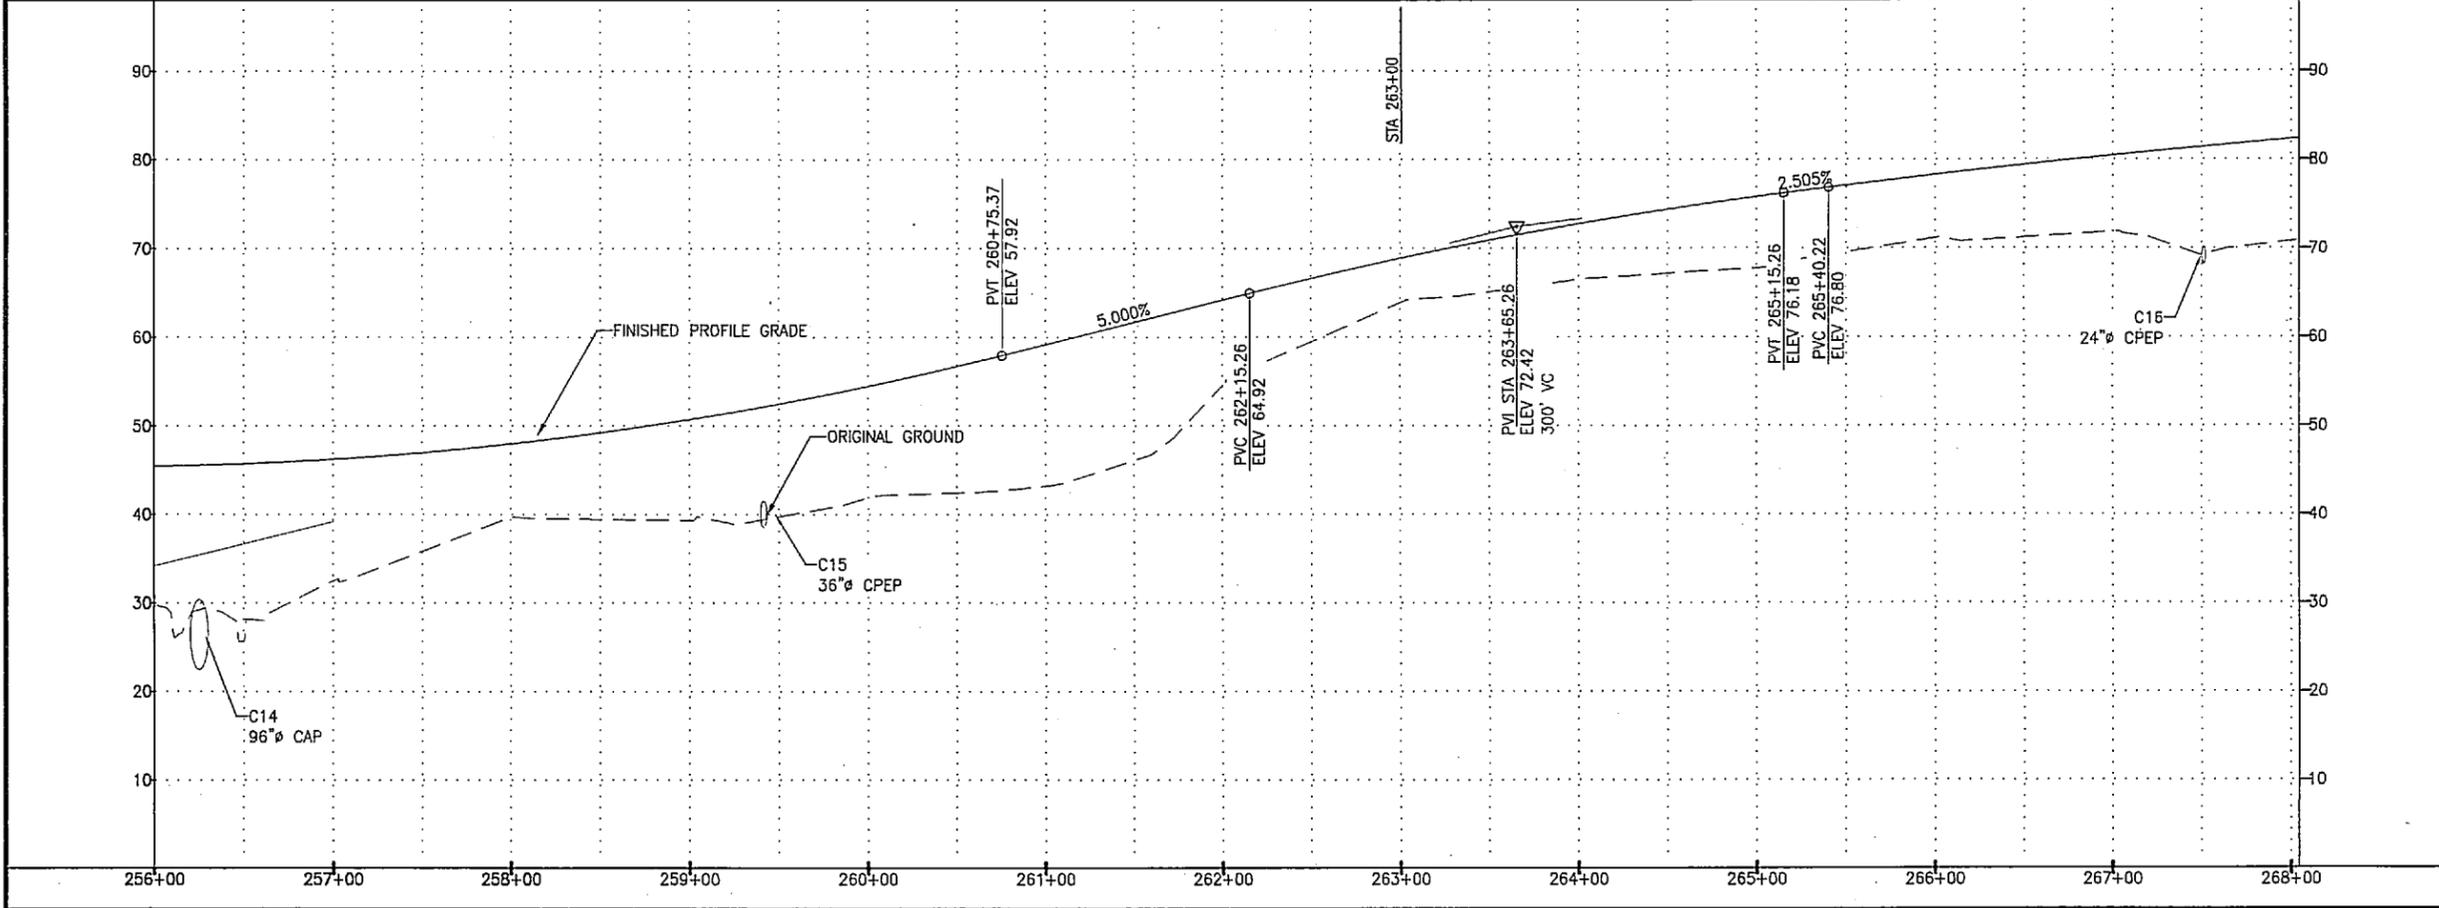

PND ENGINEERS, INC.  
1506 W. 36th Ave.  
Anchorage, AK 99503  
907-561-1011  
engineer ing@pndengineers.com



STATE OF ALASKA  
DEPARTMENT OF TRANSPORTATION  
AND PUBLIC FACILITIES  
GRAVINA ISLAND HIGHWAY  
GRADING, DRAINAGE AND  
BRIDGES  
GRAVINA ISLAND  
HIGHWAY  
PLAN & PROFILE


SHEET NO.	TOTAL SHEETS
F13	F16
STATE	YEAR
ALASKA	2007

PROJECT DESIGNATION  
ACH PRL-0003(123)/67818

ADDENDUM NO.



ATTACHMENT NO.

REVISIONS		
NO.	DATE	DESCRIPTION

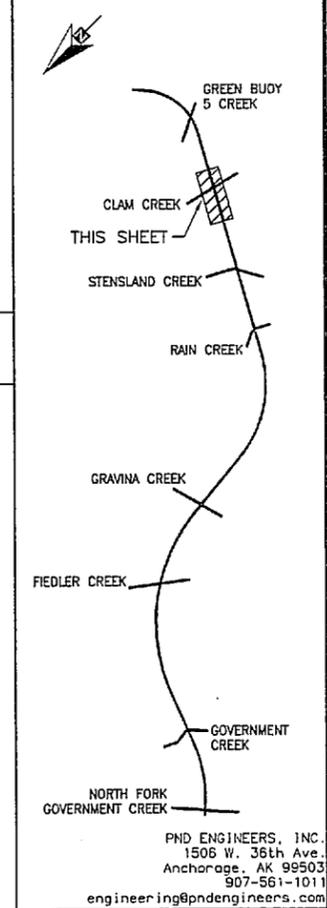

PND ENGINEERS, INC.  
1506 W. 36th Ave.  
Anchorage, AK 99503  
907-561-1011  
engineer.ing@pndengineers.com


STATE OF ALASKA  
DEPARTMENT OF TRANSPORTATION  
AND PUBLIC FACILITIES  
GRAVINA ISLAND HIGHWAY  
GRADING, DRAINAGE AND  
BRIDGES  
GRAVINA ISLAND  
HIGHWAY  
PLAN & PROFILE

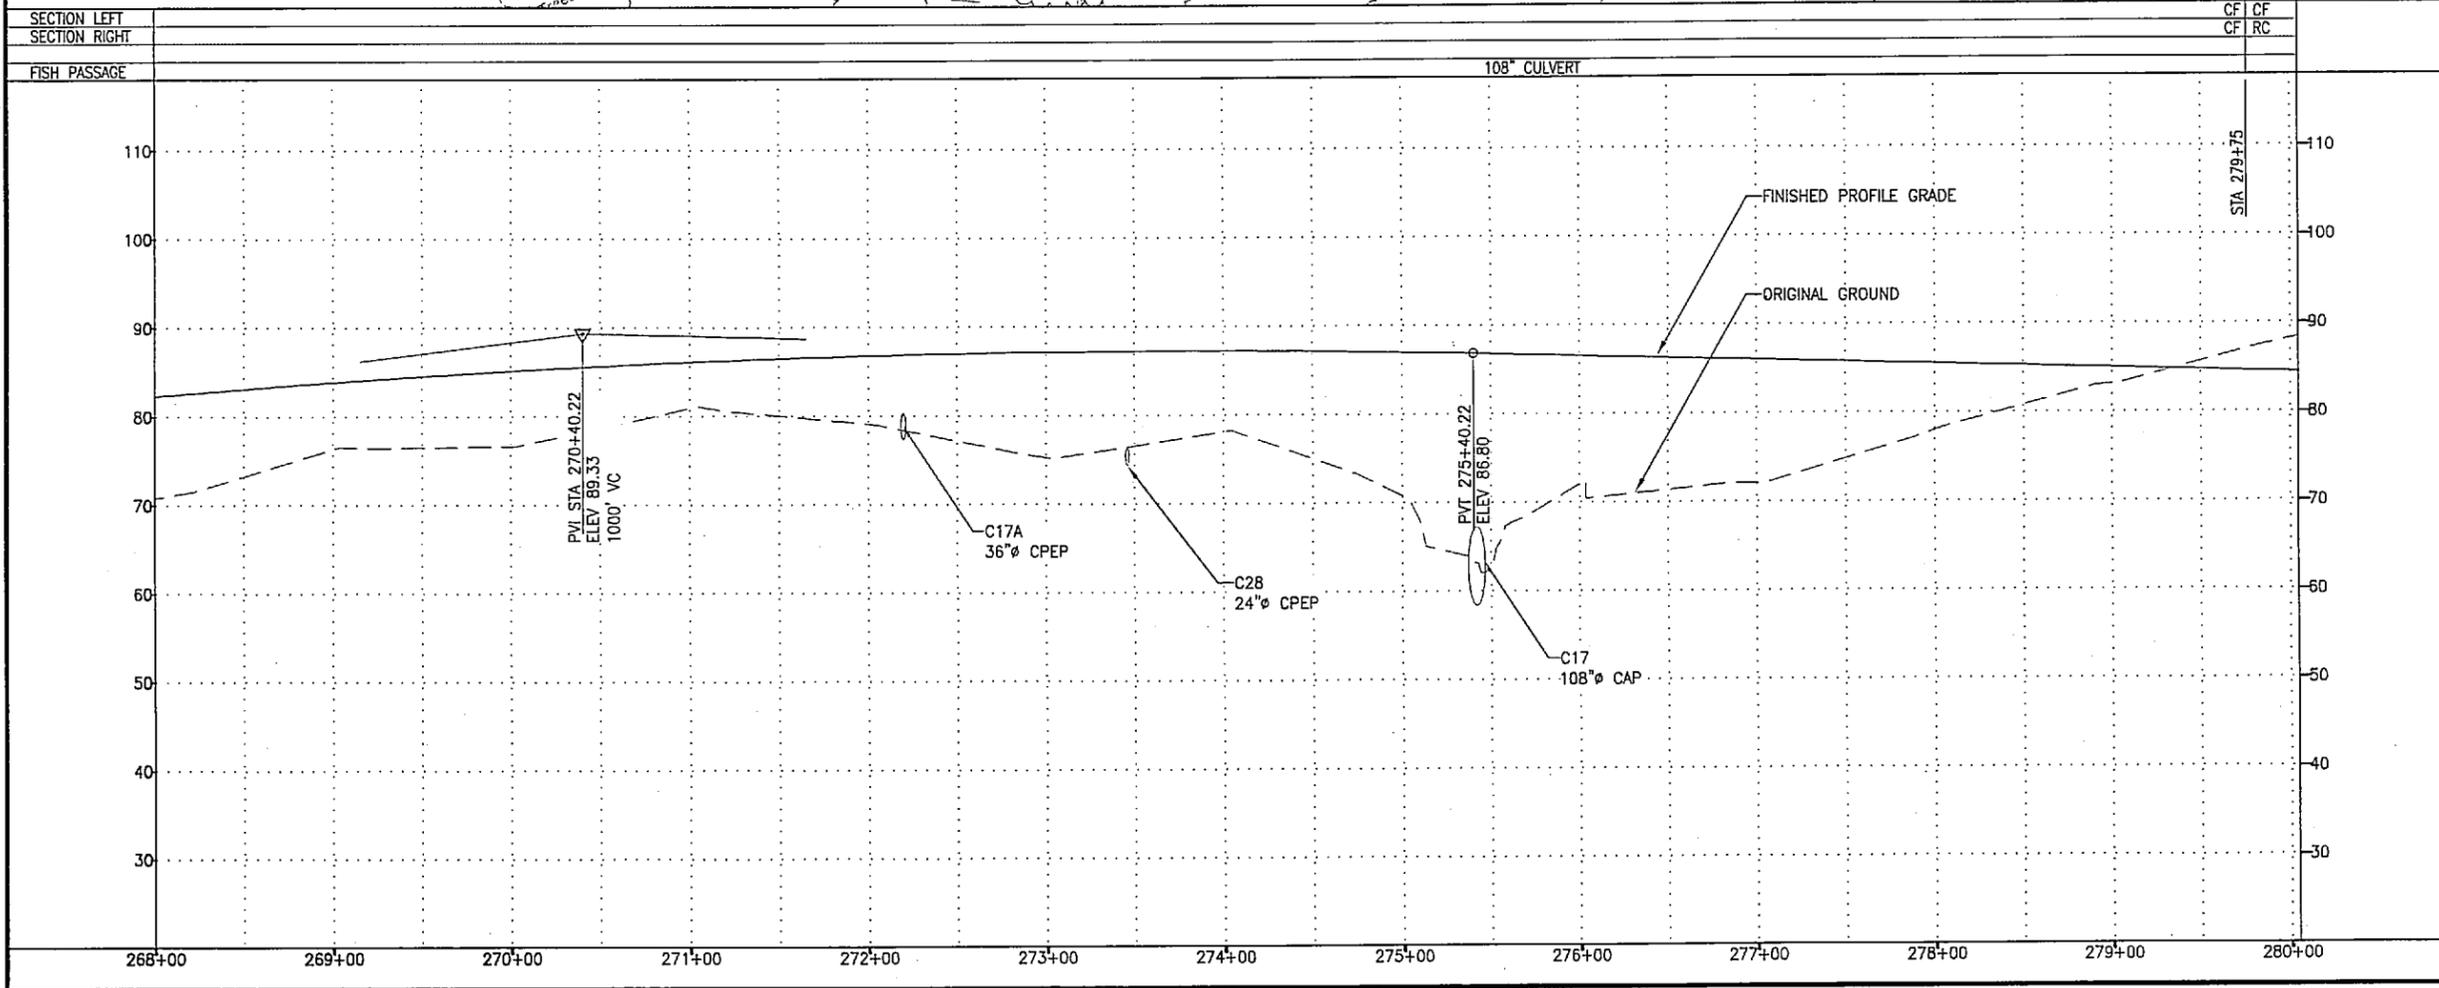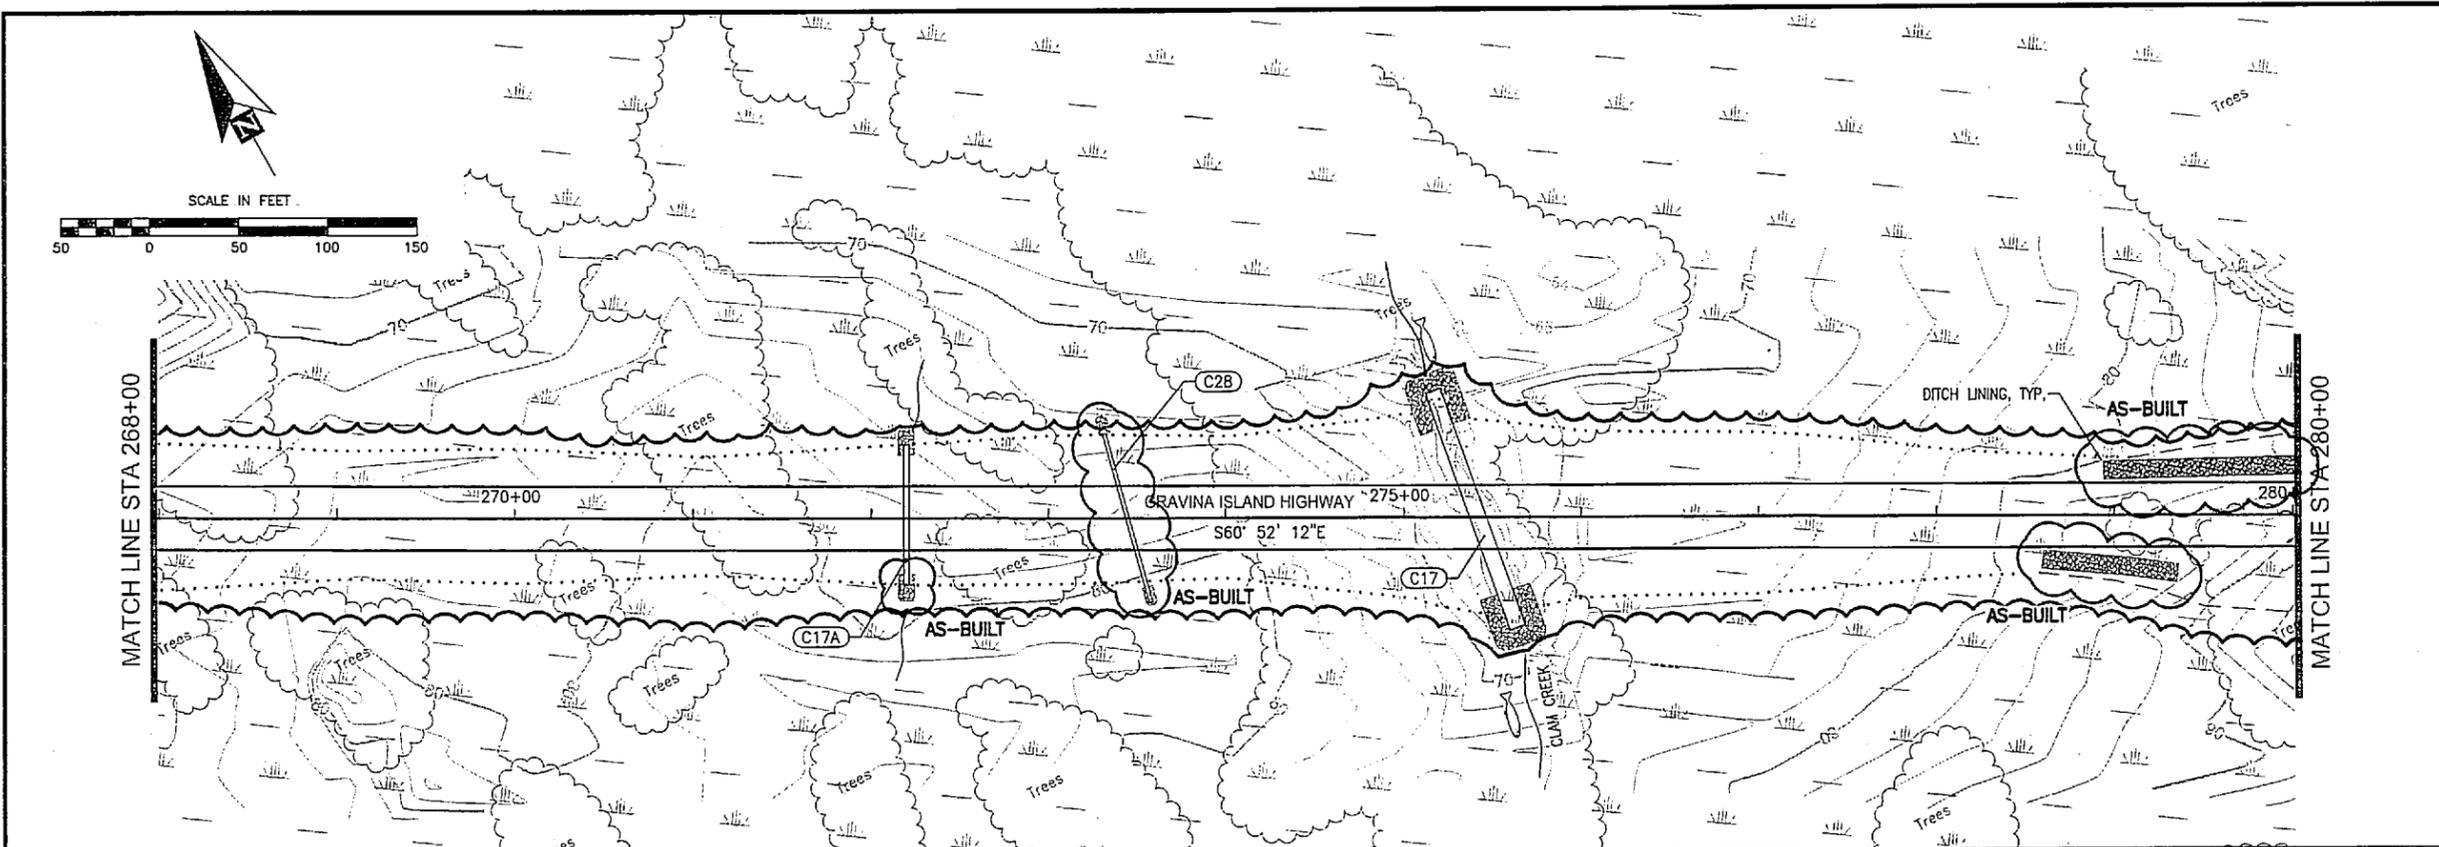

SECTION LEFT  
SECTION RIGHT

FISH PASSAGE


268+00 269+00 270+00 271+00 272+00 273+00 274+00 275+00 276+00 277+00 278+00 279+00 280+00

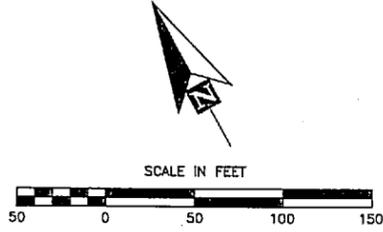


PI STA = 298+14.80  
 N = 77477.70  
 E = 105398.96  
 $\Delta = 73.47$   
 R = 1325.00'  
 T = 988.93'  
 L = 1699.0915'  
 S = 5.6%  
 RO = 134'

MATCH LINE STA-280+00


MATCH LINE STA-292+00

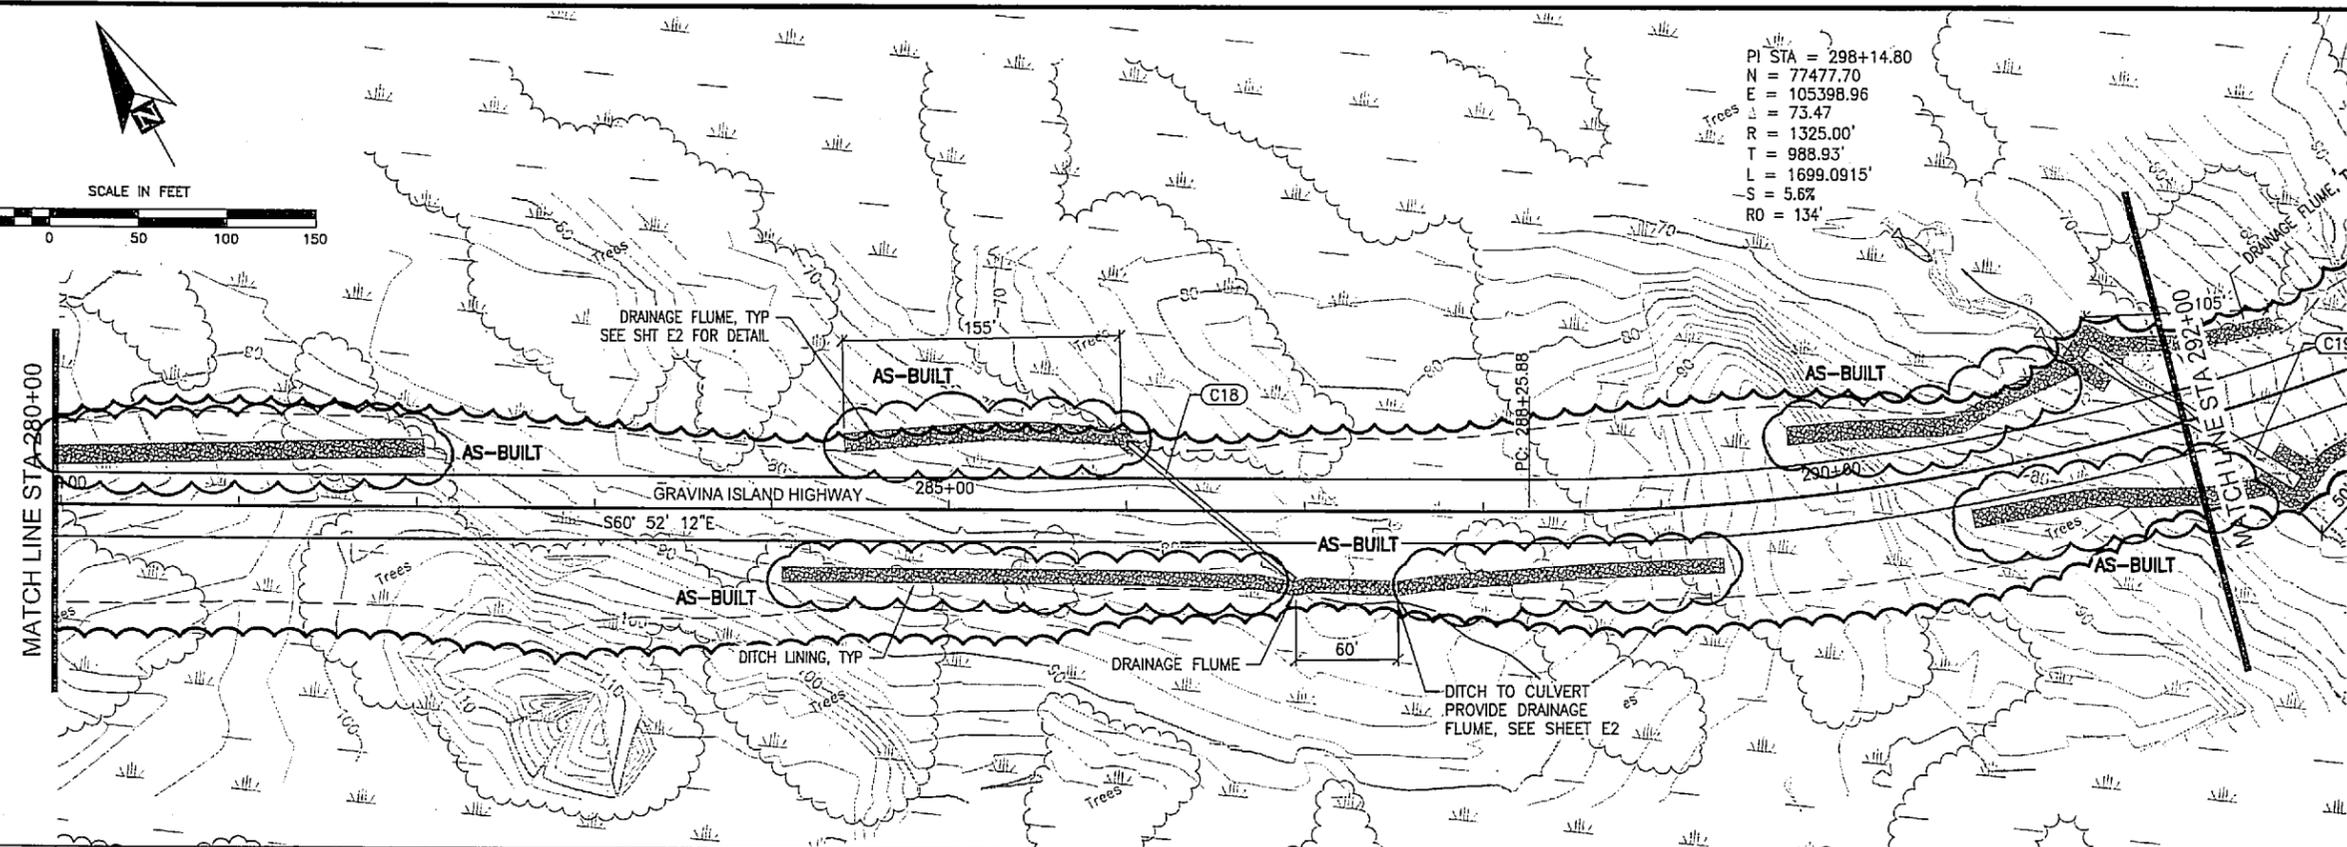

SECTION LEFT	CF   RC	RC   CF	CF   CF	CF   RC	RC   CF	CF   CF
SECTION RIGHT	RC   RC	RC   RC	RC   CF	CF   RC	RC   RC	RC   CF

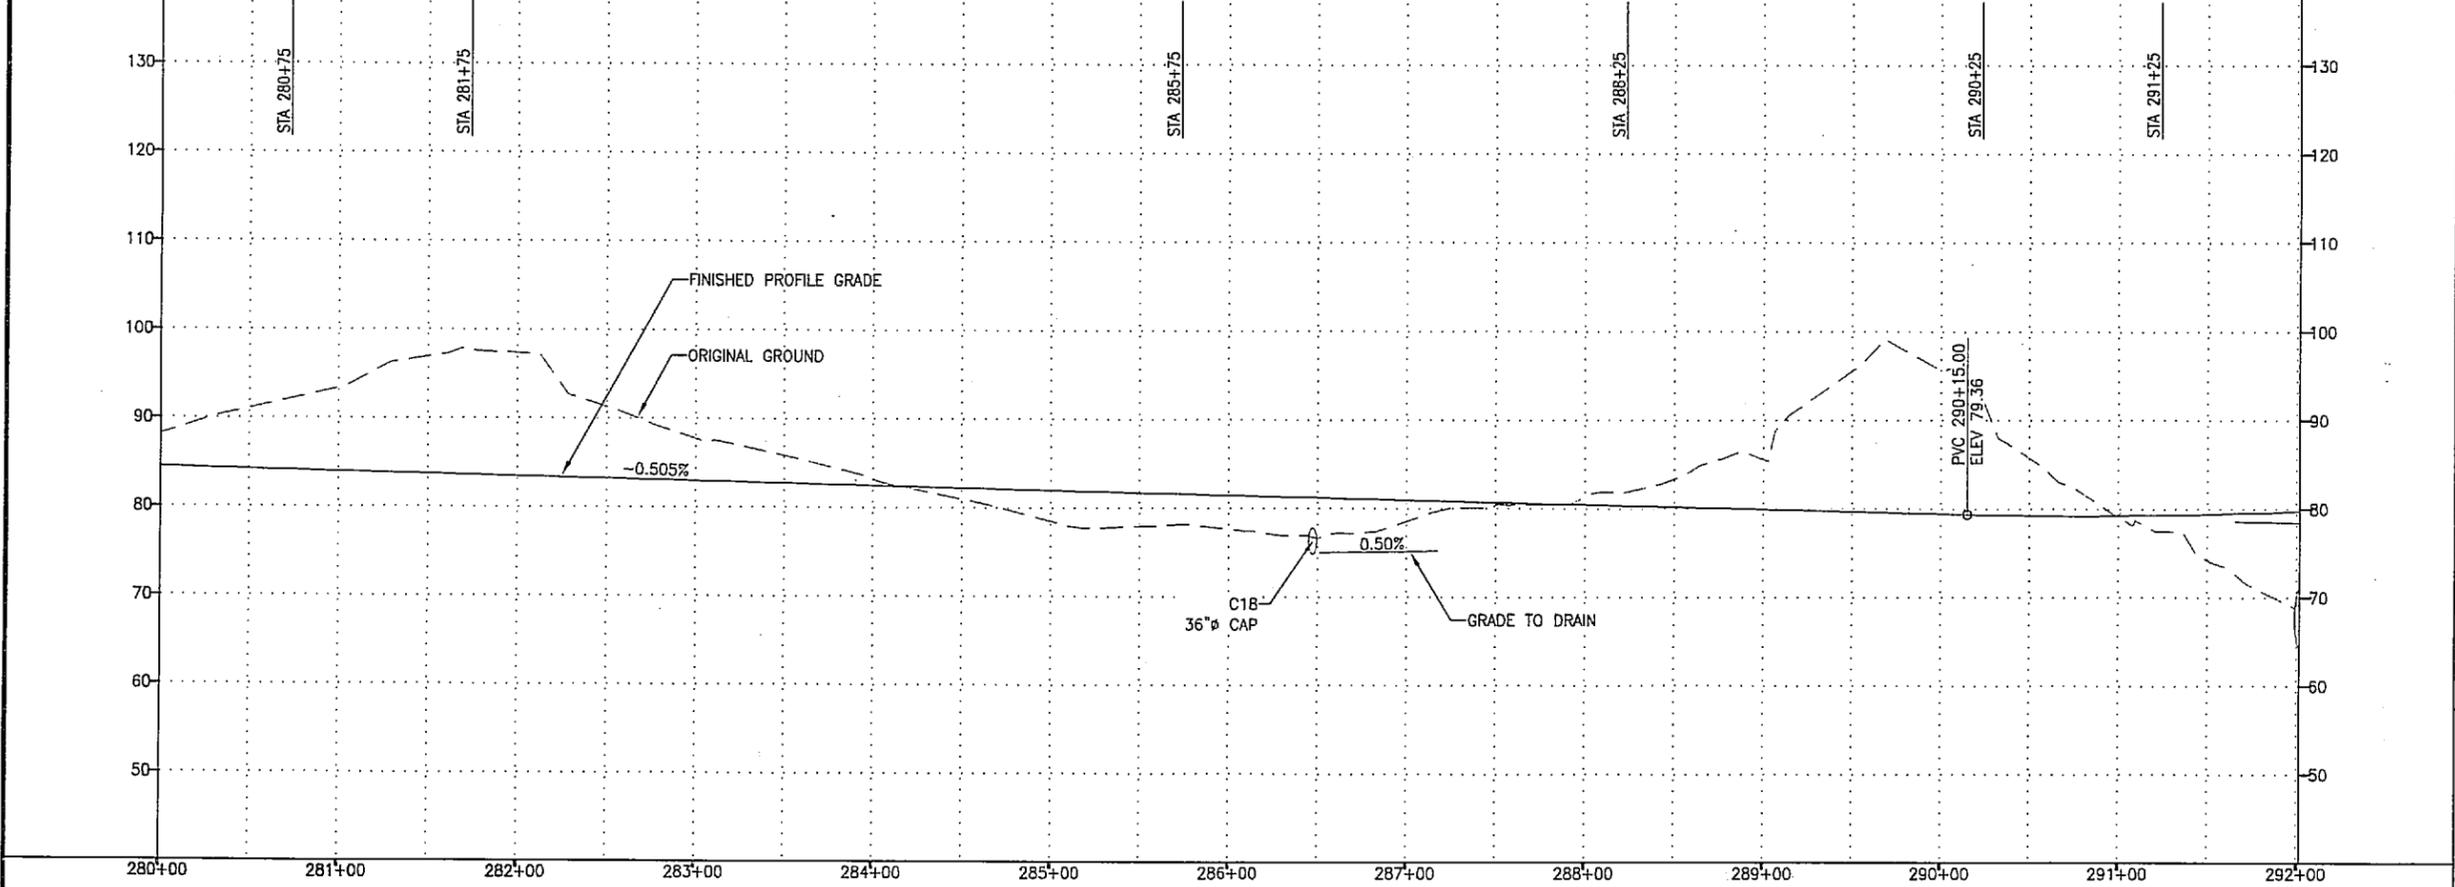

SHEET NO.	TOTAL SHEETS	
F14	F16	
STATE	YEAR	
ALASKA	2007	
PROJECT DESIGNATION		
ACH PRL-0003(123)/67818		
ADDENDUM NO.		
ATTACHMENT NO.		
REVISIONS		
NO.	DATE	DESCRIPTION

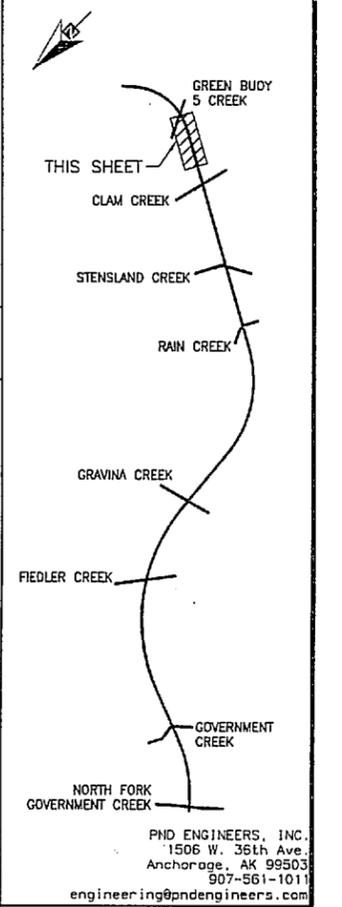

PND ENGINEERS, INC.  
 1506 W. 36th Ave.  
 Anchorage, AK 99503  
 907-561-1011  
 engineering@pndengineers.com

STATE OF ALASKA  
 DEPARTMENT OF TRANSPORTATION  
 AND PUBLIC FACILITIES  
 GRAVINA ISLAND HIGHWAY  
 GRADING, DRAINAGE AND  
 BRIDGES  
 GRAVINA ISLAND  
 HIGHWAY  
 PLAN & PROFILE

SHEET NO.	TOTAL SHEETS
F15	F16
STATE	YEAR
ALASKA	2007


PROJECT DESIGNATION  
**ACH PRL-0003(123)/67818**

ADDENDUM NO.

ATTACHMENT NO.

REVISIONS


NO.	DATE	DESCRIPTION

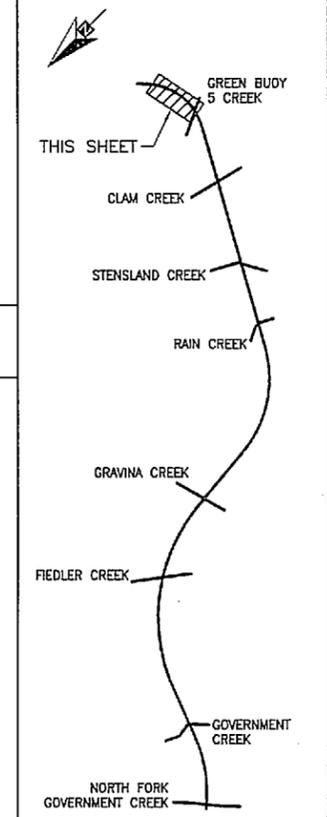


PND ENGINEERS, INC.  
 1506 W. 36th Ave.  
 Anchorage, AK 99503  
 907-561-1011  
 engineer.ing@pndengineers.com



STATE OF ALASKA  
 DEPARTMENT OF TRANSPORTATION  
 AND PUBLIC FACILITIES  
**GRAVINA ISLAND HIGHWAY  
 GRADING, DRAINAGE AND  
 BRIDGES**  
**GRAVINA ISLAND  
 HIGHWAY  
 PLAN & PROFILE**

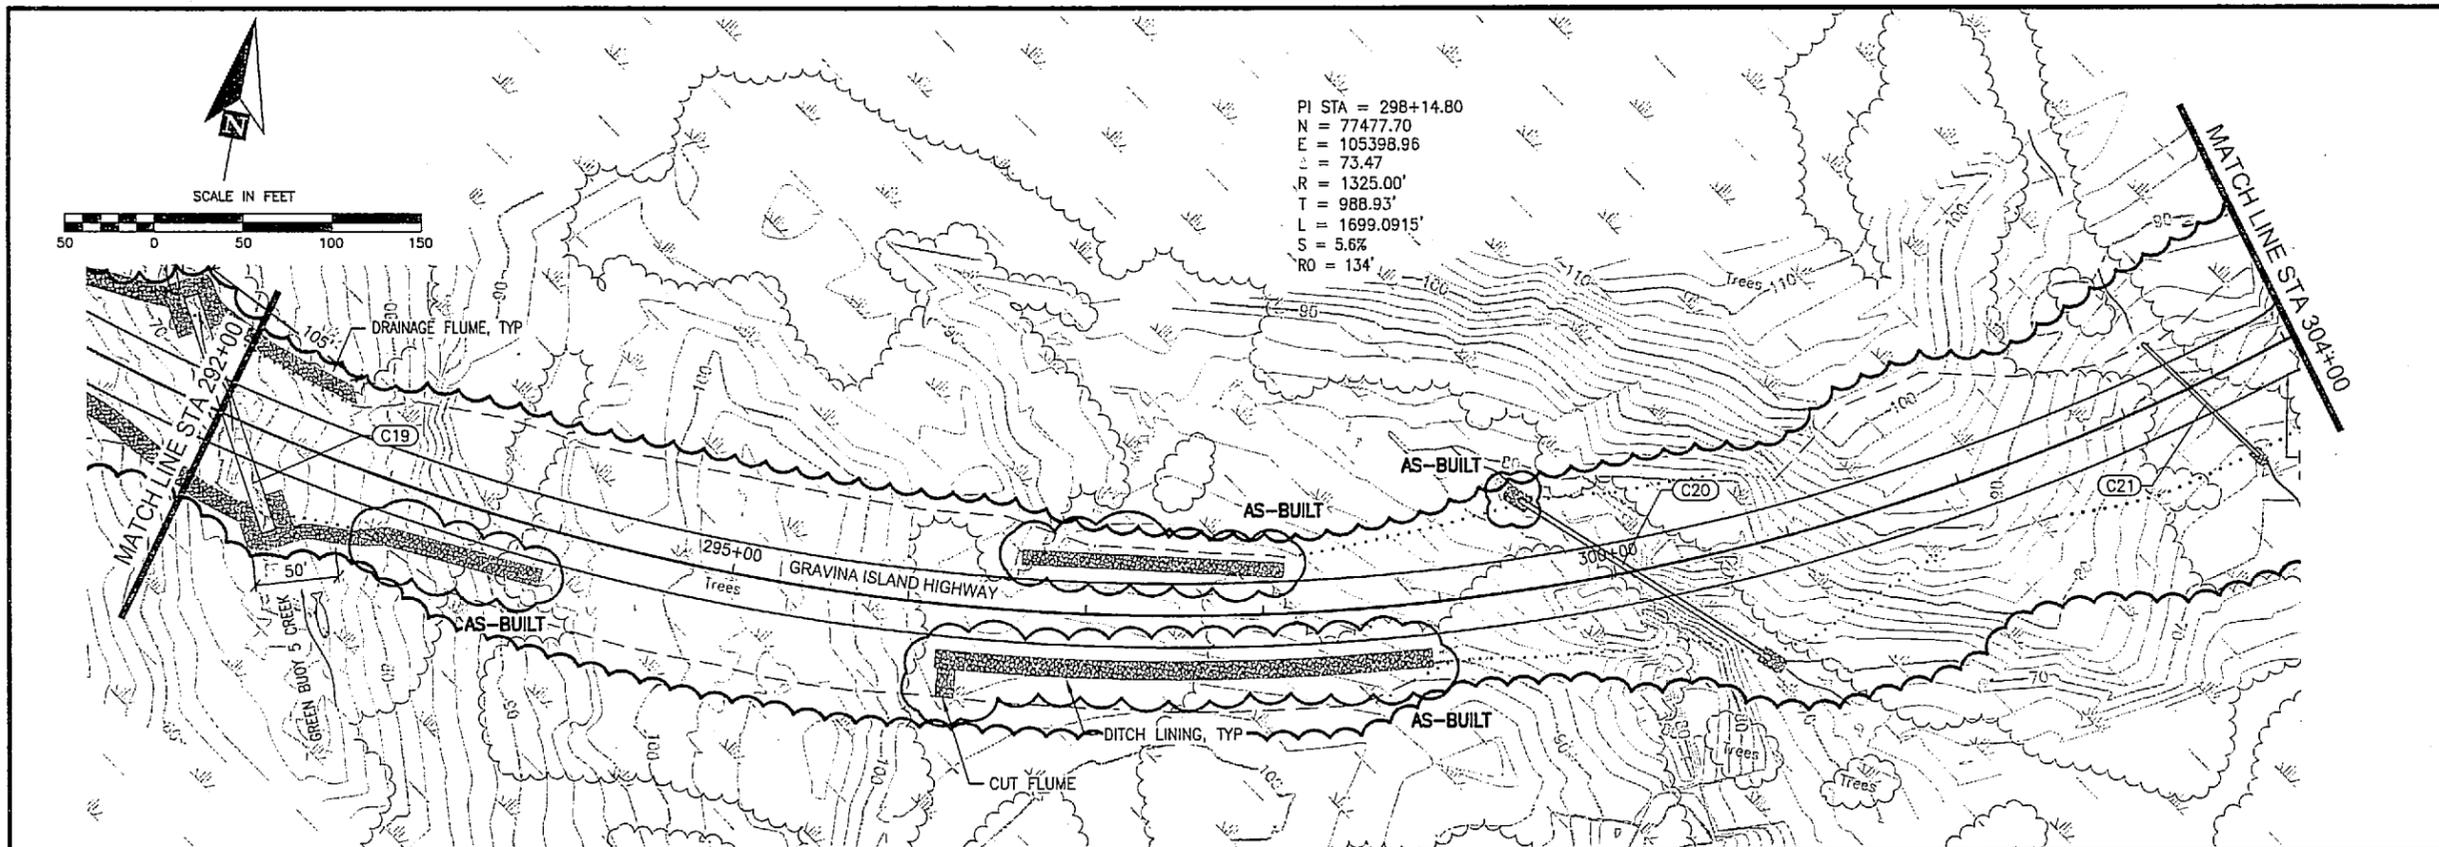


PI STA = 298+14.80  
 N = 77477.70  
 E = 105398.96  
 L = 73.47  
 R = 1325.00'  
 T = 988.93'  
 L = 1699.0915'  
 S = 5.6%  
 RO = 134'

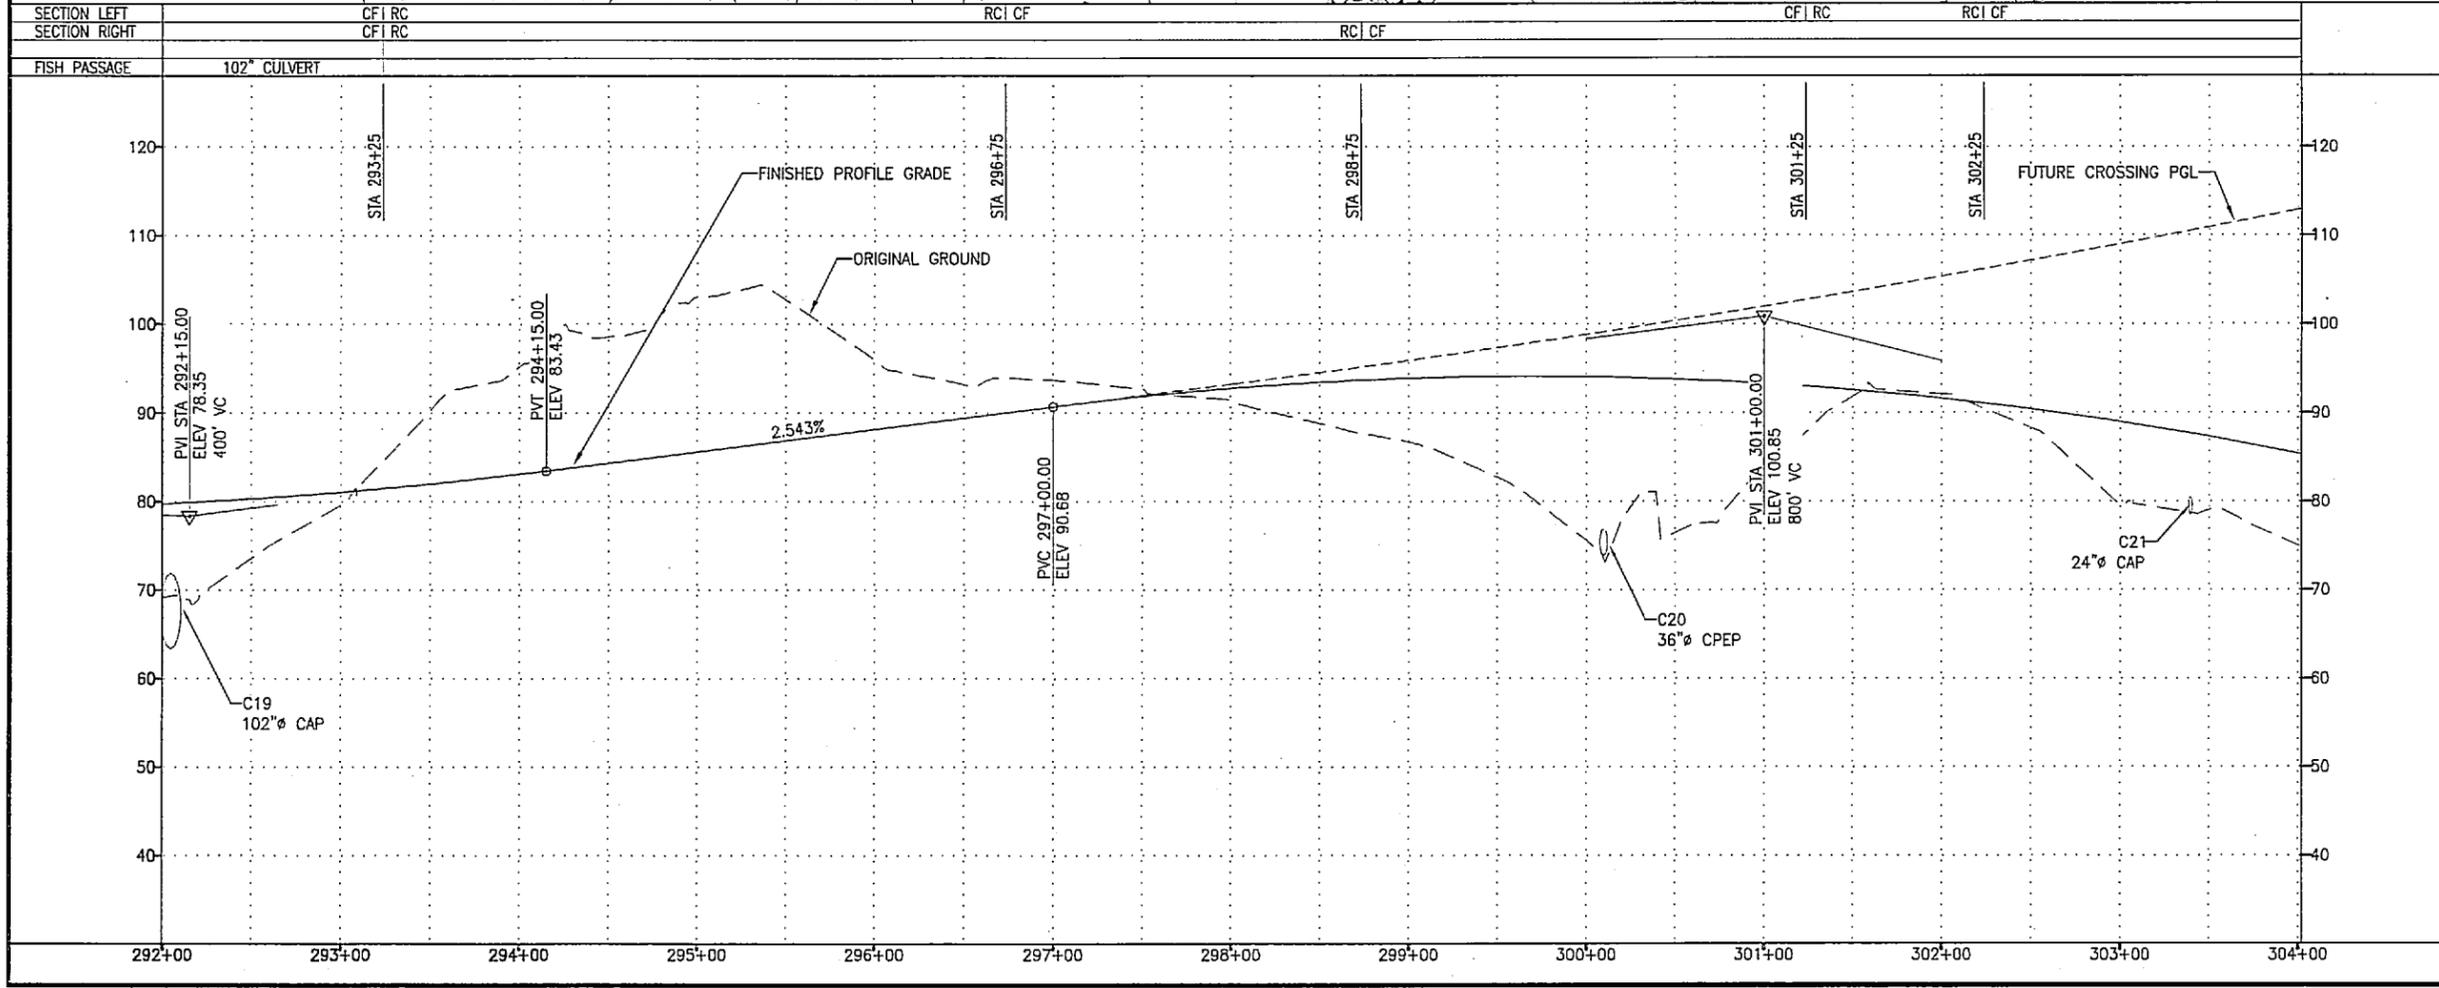


SECTION LEFT	CF   RC	RC   CF	CF   RC	RC   CF
SECTION RIGHT	CF   RC	RC   CF	RC   CF	CF   RC

FISH PASSAGE 102" CULVERT


SHEET NO.	TOTAL SHEETS	
F16	F16	
STATE	YEAR	
ALASKA	2007	
PROJECT DESIGNATION		
ACH PRL-0003(123)/67818		
ADDENDUM NO.		
ATTACHMENT NO.		
REVISIONS		
NO.	DATE	DESCRIPTION

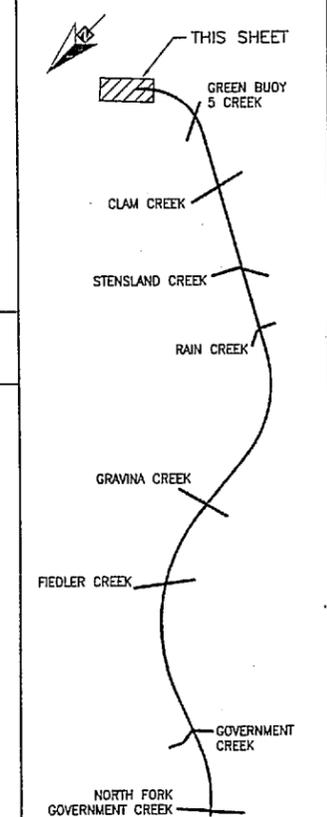


PND ENGINEERS, INC.  
 1506 W. 36th Ave.  
 Anchorage, AK 99503  
 907-561-1011  
 engineering@pndengineers.com

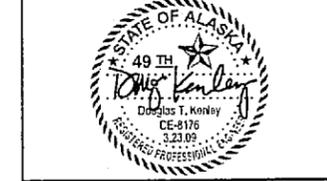

STATE OF ALASKA  
 DEPARTMENT OF TRANSPORTATION  
 AND PUBLIC FACILITIES  
 GRAVINA ISLAND HIGHWAY  
 GRADING, DRAINAGE AND  
 BRIDGES  
 GRAVINA ISLAND  
 HIGHWAY  
 PLAN & PROFILE

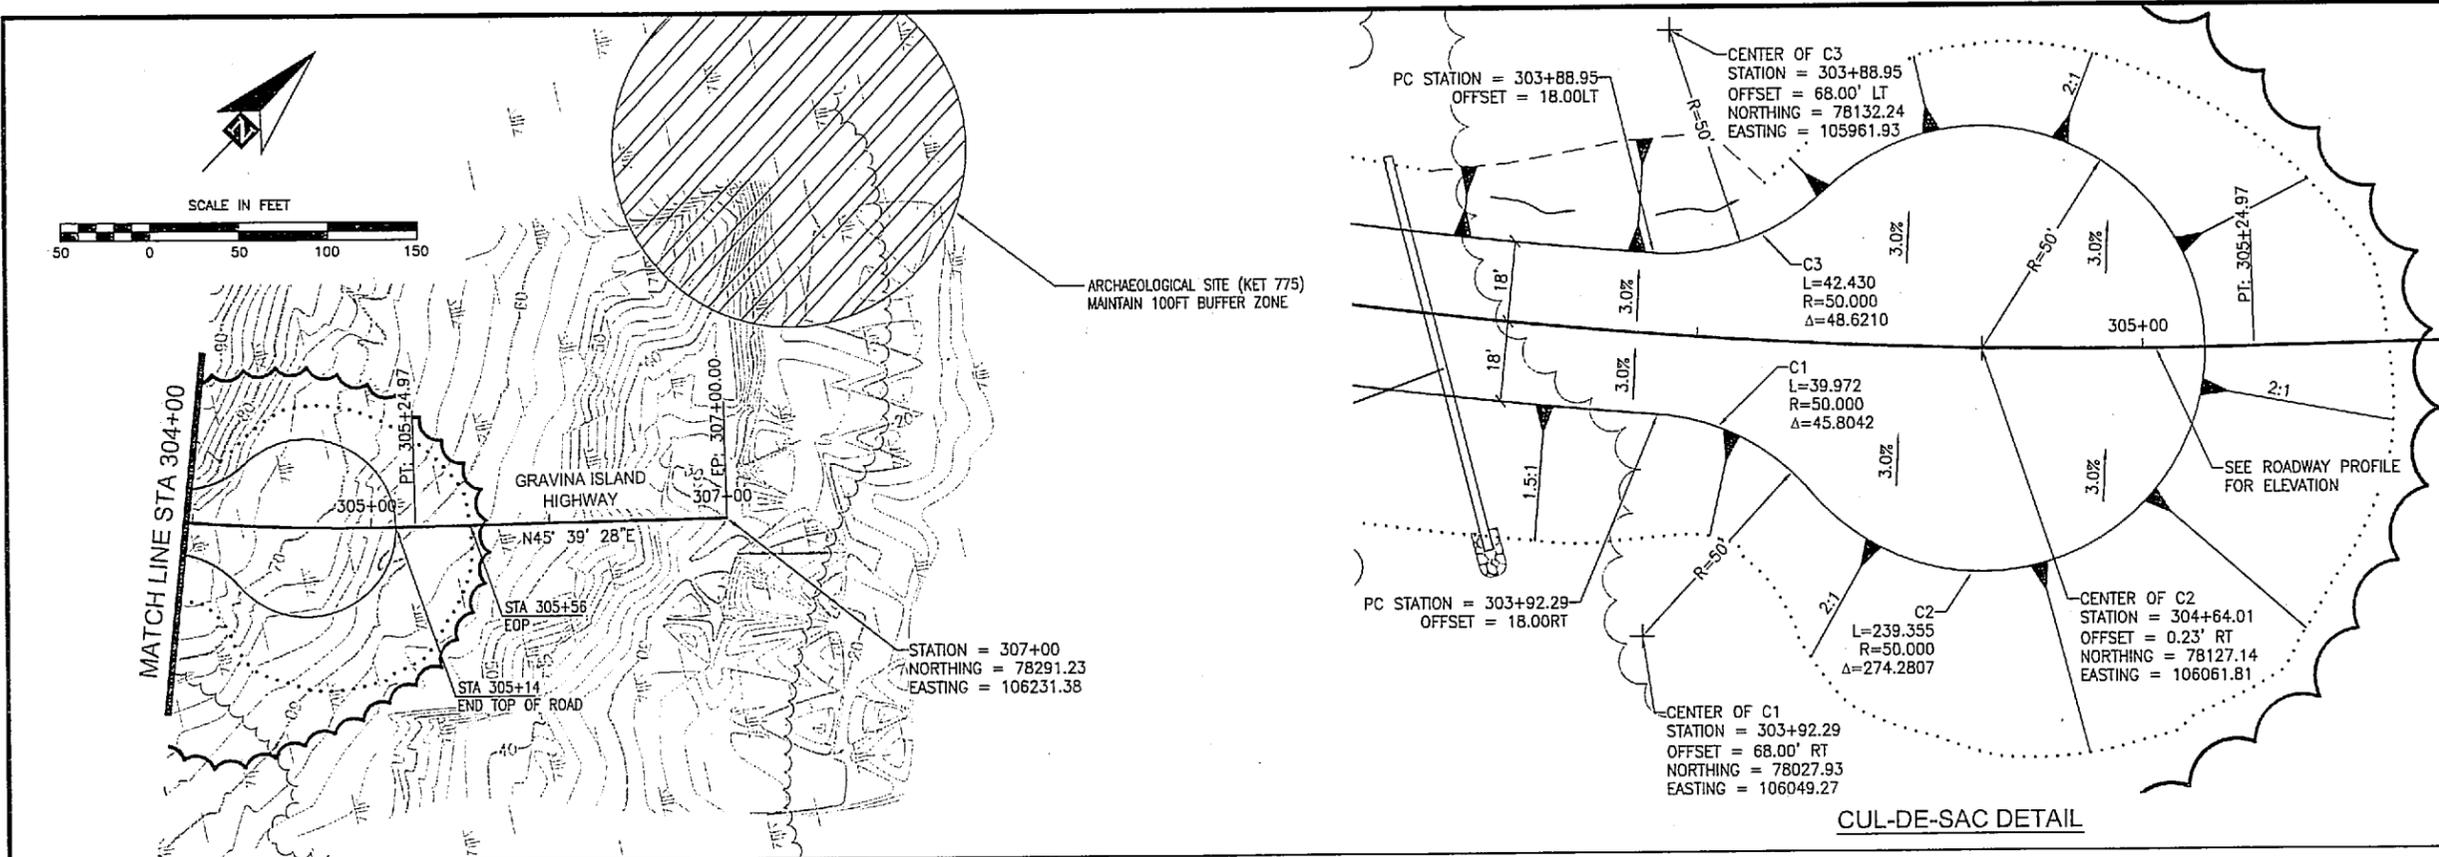


SECTION LEFT	CF
SECTION RIGHT	CF
FISH PASSAGE	

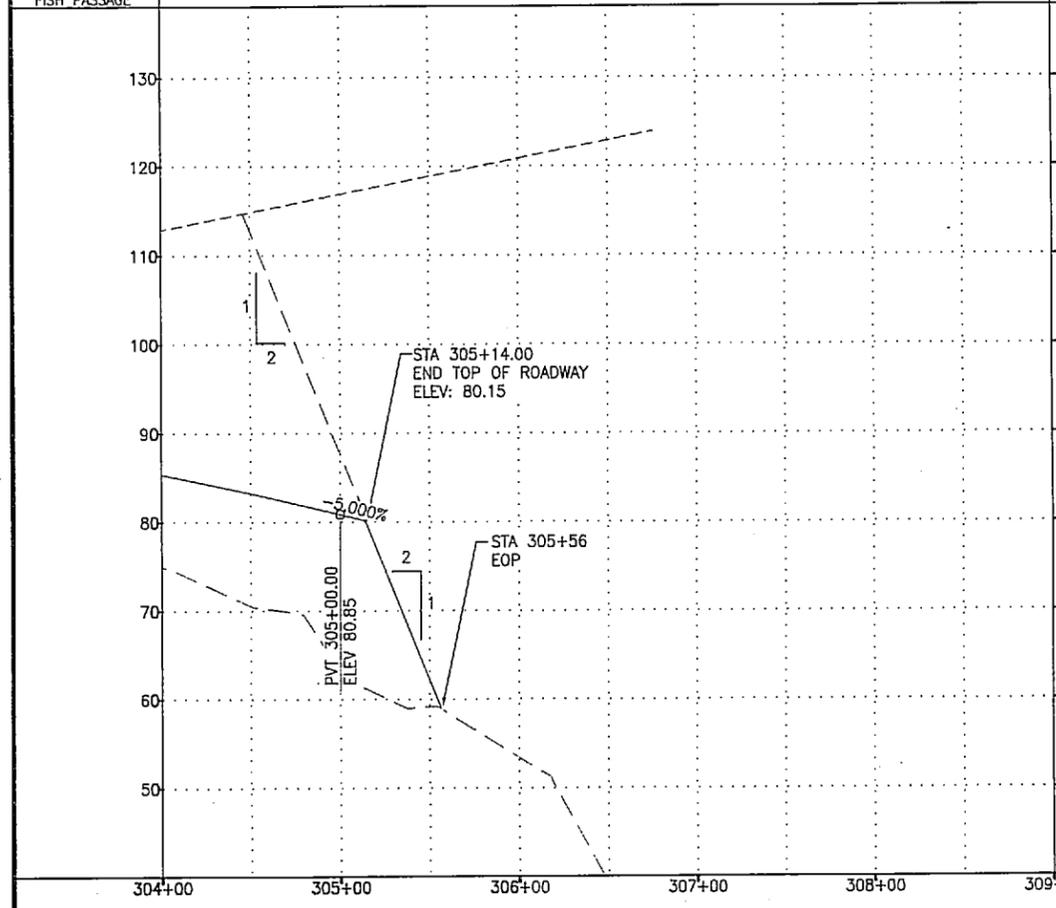

REVISIONS			STATE	PROJECT DESIGNATION	YEAR	SHEET NO.	TOTAL SHEETS
No.	DATE	DESCRIPTION	ALASKA	ACH PRL-0003(123)/67818	2007	G1	G3

PIPE NAME	SIZE	MATERIAL	START STATION	START OFFSET	END STATION	END OFFSET	START INVERT	END INVERT	RIPRAP OUTLET	REMARKS
C26	36"	CPEP	GIH 130+73.62	37.97' L	GIH 131+64.13	36.8' L	152.46'	148.36'	YES	SEE NOTE 5
C27	24"	CPEP	LRR 11+14.69	18.97' L	LRR 11+23.27	21.3' R	153.11'	152.49'		FIELD LOCATE INVERTS

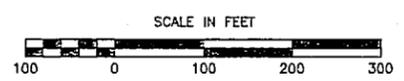


GIH STA 131+13.72 =  
LRR STA 10+00.00  
NORTHING = 88216.88  
EASTING = 94145.35

PI STA = 10+97.43  
N = 88294.51  
E = 94204.22  
Δ = 84.18  
R = 75.00'  
T = 67.75'  
L = 110.19'


PI STA = 17+55.82  
N = 87938.74  
E = 94788.05  
Δ = 98.26  
R = 335.00'  
T = 387.17'  
L = 574.55'

POINT	NORTHING	EASTING	REMARKS
P1	88261.39	94117.13	PC
P2	88262.10	94167.41	PT/PC
P3	88269.51	94268.31	PT
P4	88218.84	94305.33	BEGIN TAPER
P5	88247.62	94247.24	END TAPER/PC
P6	88242.27	94194.32	PT/PC
P7	88202.38	94194.90	PT

- NOTES:
- 1) REUSE GRAVEL FROM THE EXISTING LEWIS REEF ROAD TO CONSTRUCT ROADBED FOR TEMPORARY RELOCATION.
  - 2) WARP INTERSECTION GRADES TO MATCH THE EDGE OF THE GRAVINA ISLAND HIGHWAY.
  - 3) INLET INVERT AT CULVERT AT C26 TO BE DPRESSED AS NECESSARY TO MAINTAIN REQUIRED COVER. MATCH OUTLET INVERT WITH DITCH INVERT.
  - 4) PERMANENTLY STABILIZE ALL DISTURBED AREAS.

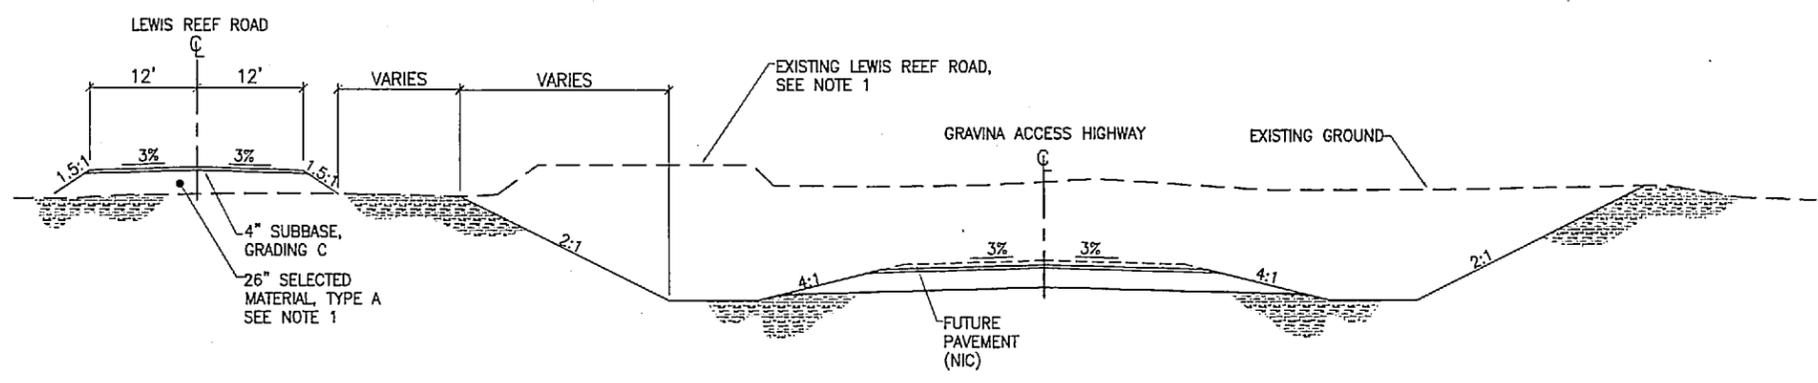

**TEMPORARY ROADWAY SECTION**  
TEMP LRR STA. 11+97.84 TO 15+00  
STA 15+00 TO 20+00 SIMILAR  
STA 10+00 TO 11+97.84 SEE PLAN VIEW FOR LAYOUT

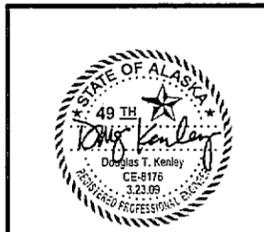


STATE OF ALASKA  
DEPARTMENT OF TRANSPORTATION  
AND  
PUBLIC FACILITIES

**GRAVINA ISLAND HIGHWAY  
GRADING, DRAINAGE, AND BRIDGES**

**LEWIS REEF ROAD  
REALIGNMENT & TEMPORARY  
INTERSECTION PLAN**

PND ENGINEERS, INC.  
1506 W. 36th Ave. Anchorage, AK 99503  
907-561-1011 engineering@pndengineers.com

REVISIONS			STATE	PROJECT DESIGNATION	YEAR	SHEET NO.	TOTAL SHEETS
No.	DATE	DESCRIPTION	ALASKA	ACH PRL-0003(123)/67818	2007	G2	G3

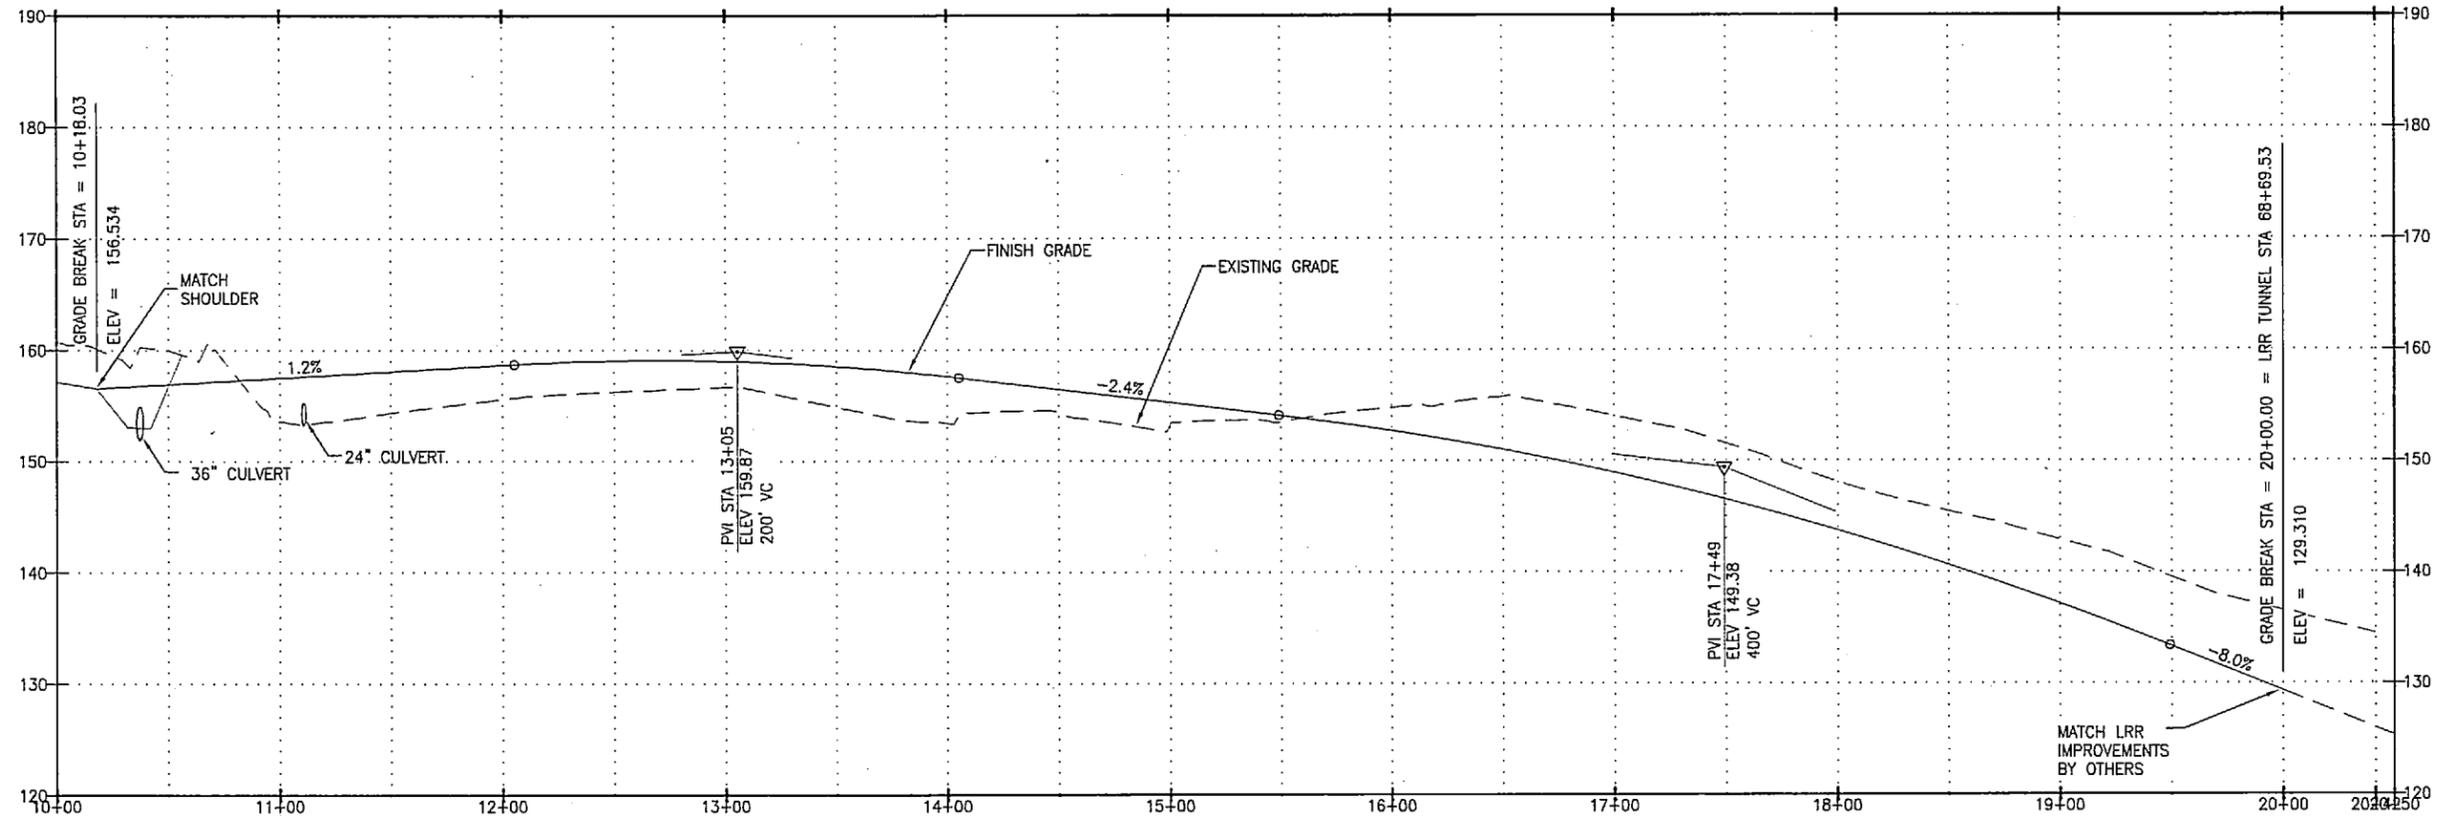

LEWIS REEF ROAD PROFILE

PND ENGINEERS, INC.  
 1506 W. 36th Ave. Anchorage, AK 99503  
 907-561-1011 engineering@pndengineers.com





STATE OF ALASKA  
 DEPARTMENT OF TRANSPORTATION  
 AND  
 PUBLIC FACILITIES

GRAVINA ISLAND HIGHWAY  
 GRADING, DRAINAGE, AND BRIDGES

LEWIS REEF ROAD  
 REALIGNMENT & TEMPORARY  
 INTERSECTION - PROFILE

REVISIONS			STATE	PROJECT DESIGNATION	YEAR	SHEET NO.	TOTAL SHEETS
No.	DATE	DESCRIPTION	ALASKA	ACH PRL-0003(123)/67818	2007	G3	G3

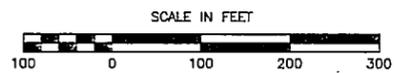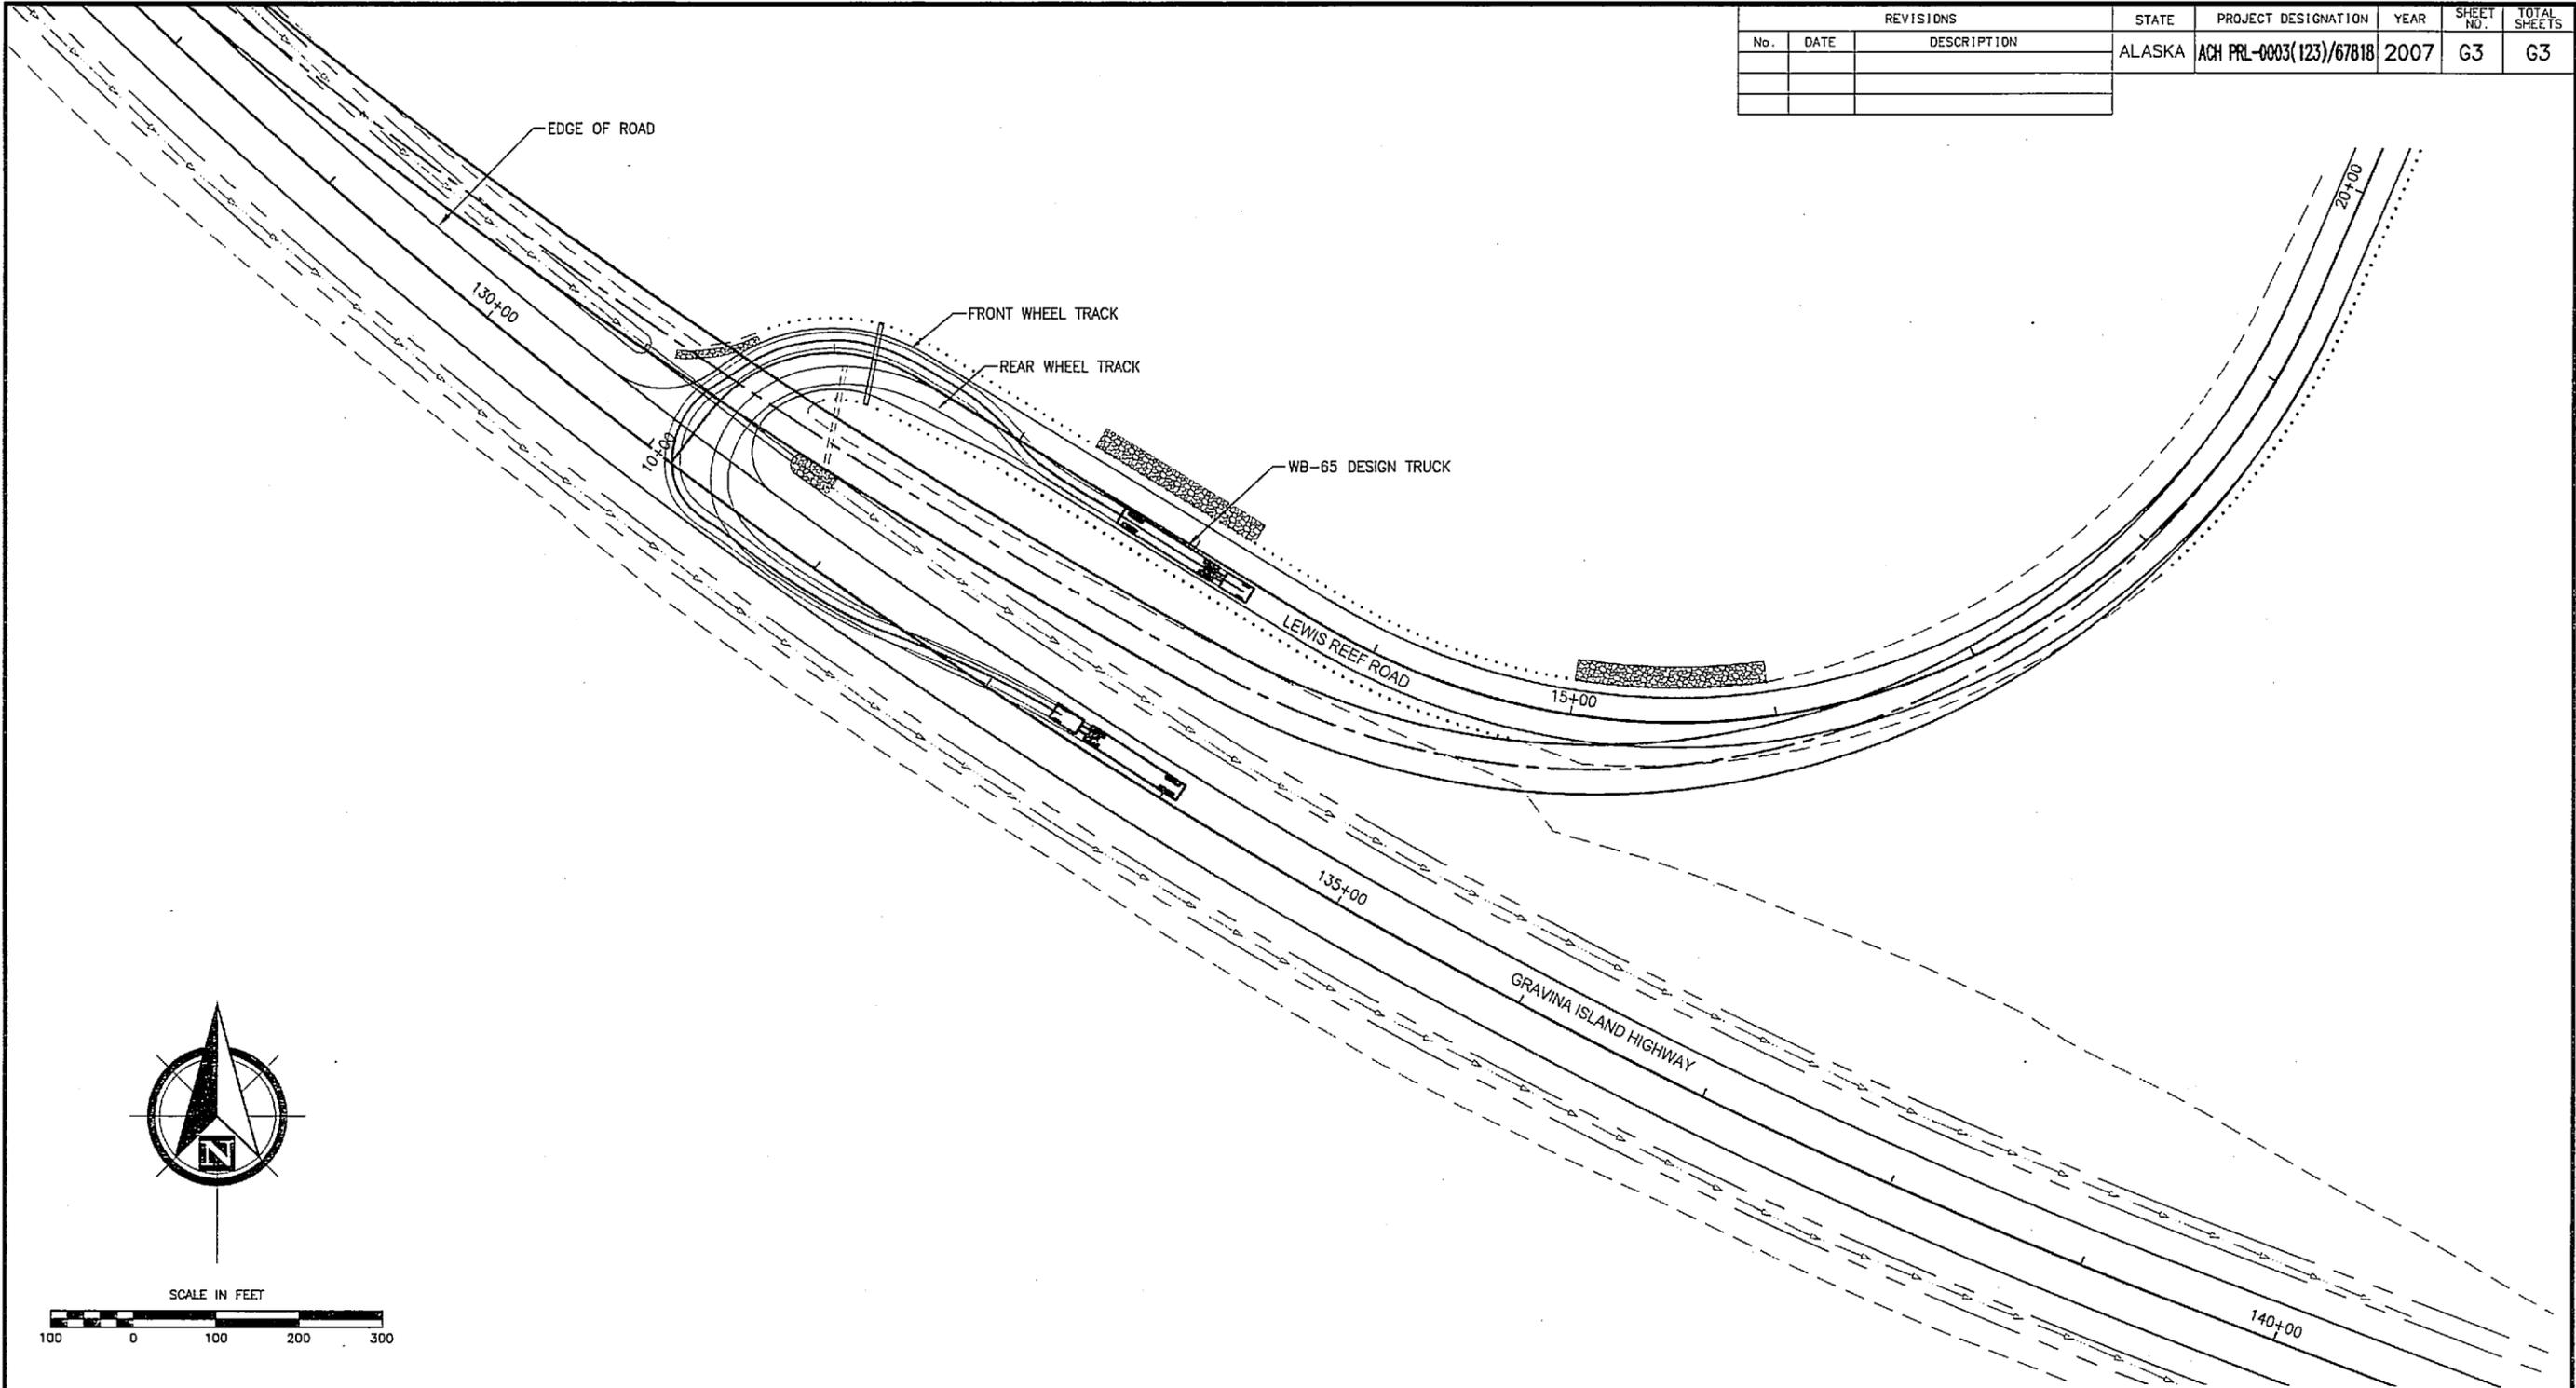


PND ENGINEERS, INC.  
 1506 W. 36th Ave. Anchorage, AK 99503  
 907-561-1011 engineering@pndengineers.com




STATE OF ALASKA  
 DEPARTMENT OF TRANSPORTATION  
 AND  
 PUBLIC FACILITIES

**GRAVINA ISLAND HIGHWAY  
 GRADING, DRAINAGE, AND BRIDGES  
 LEWIS REEF ROAD  
 REALIGNMENT & TEMPORARY  
 INTERSECTION - TURNING  
 ANALYSIS**

REVISIONS			STATE	PROJECT DESIGNATION	YEAR	SHEET NO.	TOTAL SHEETS
No.	DATE	DESCRIPTION	ALASKA	ACH PRL-0003(123)/67818	2007	H1	H3

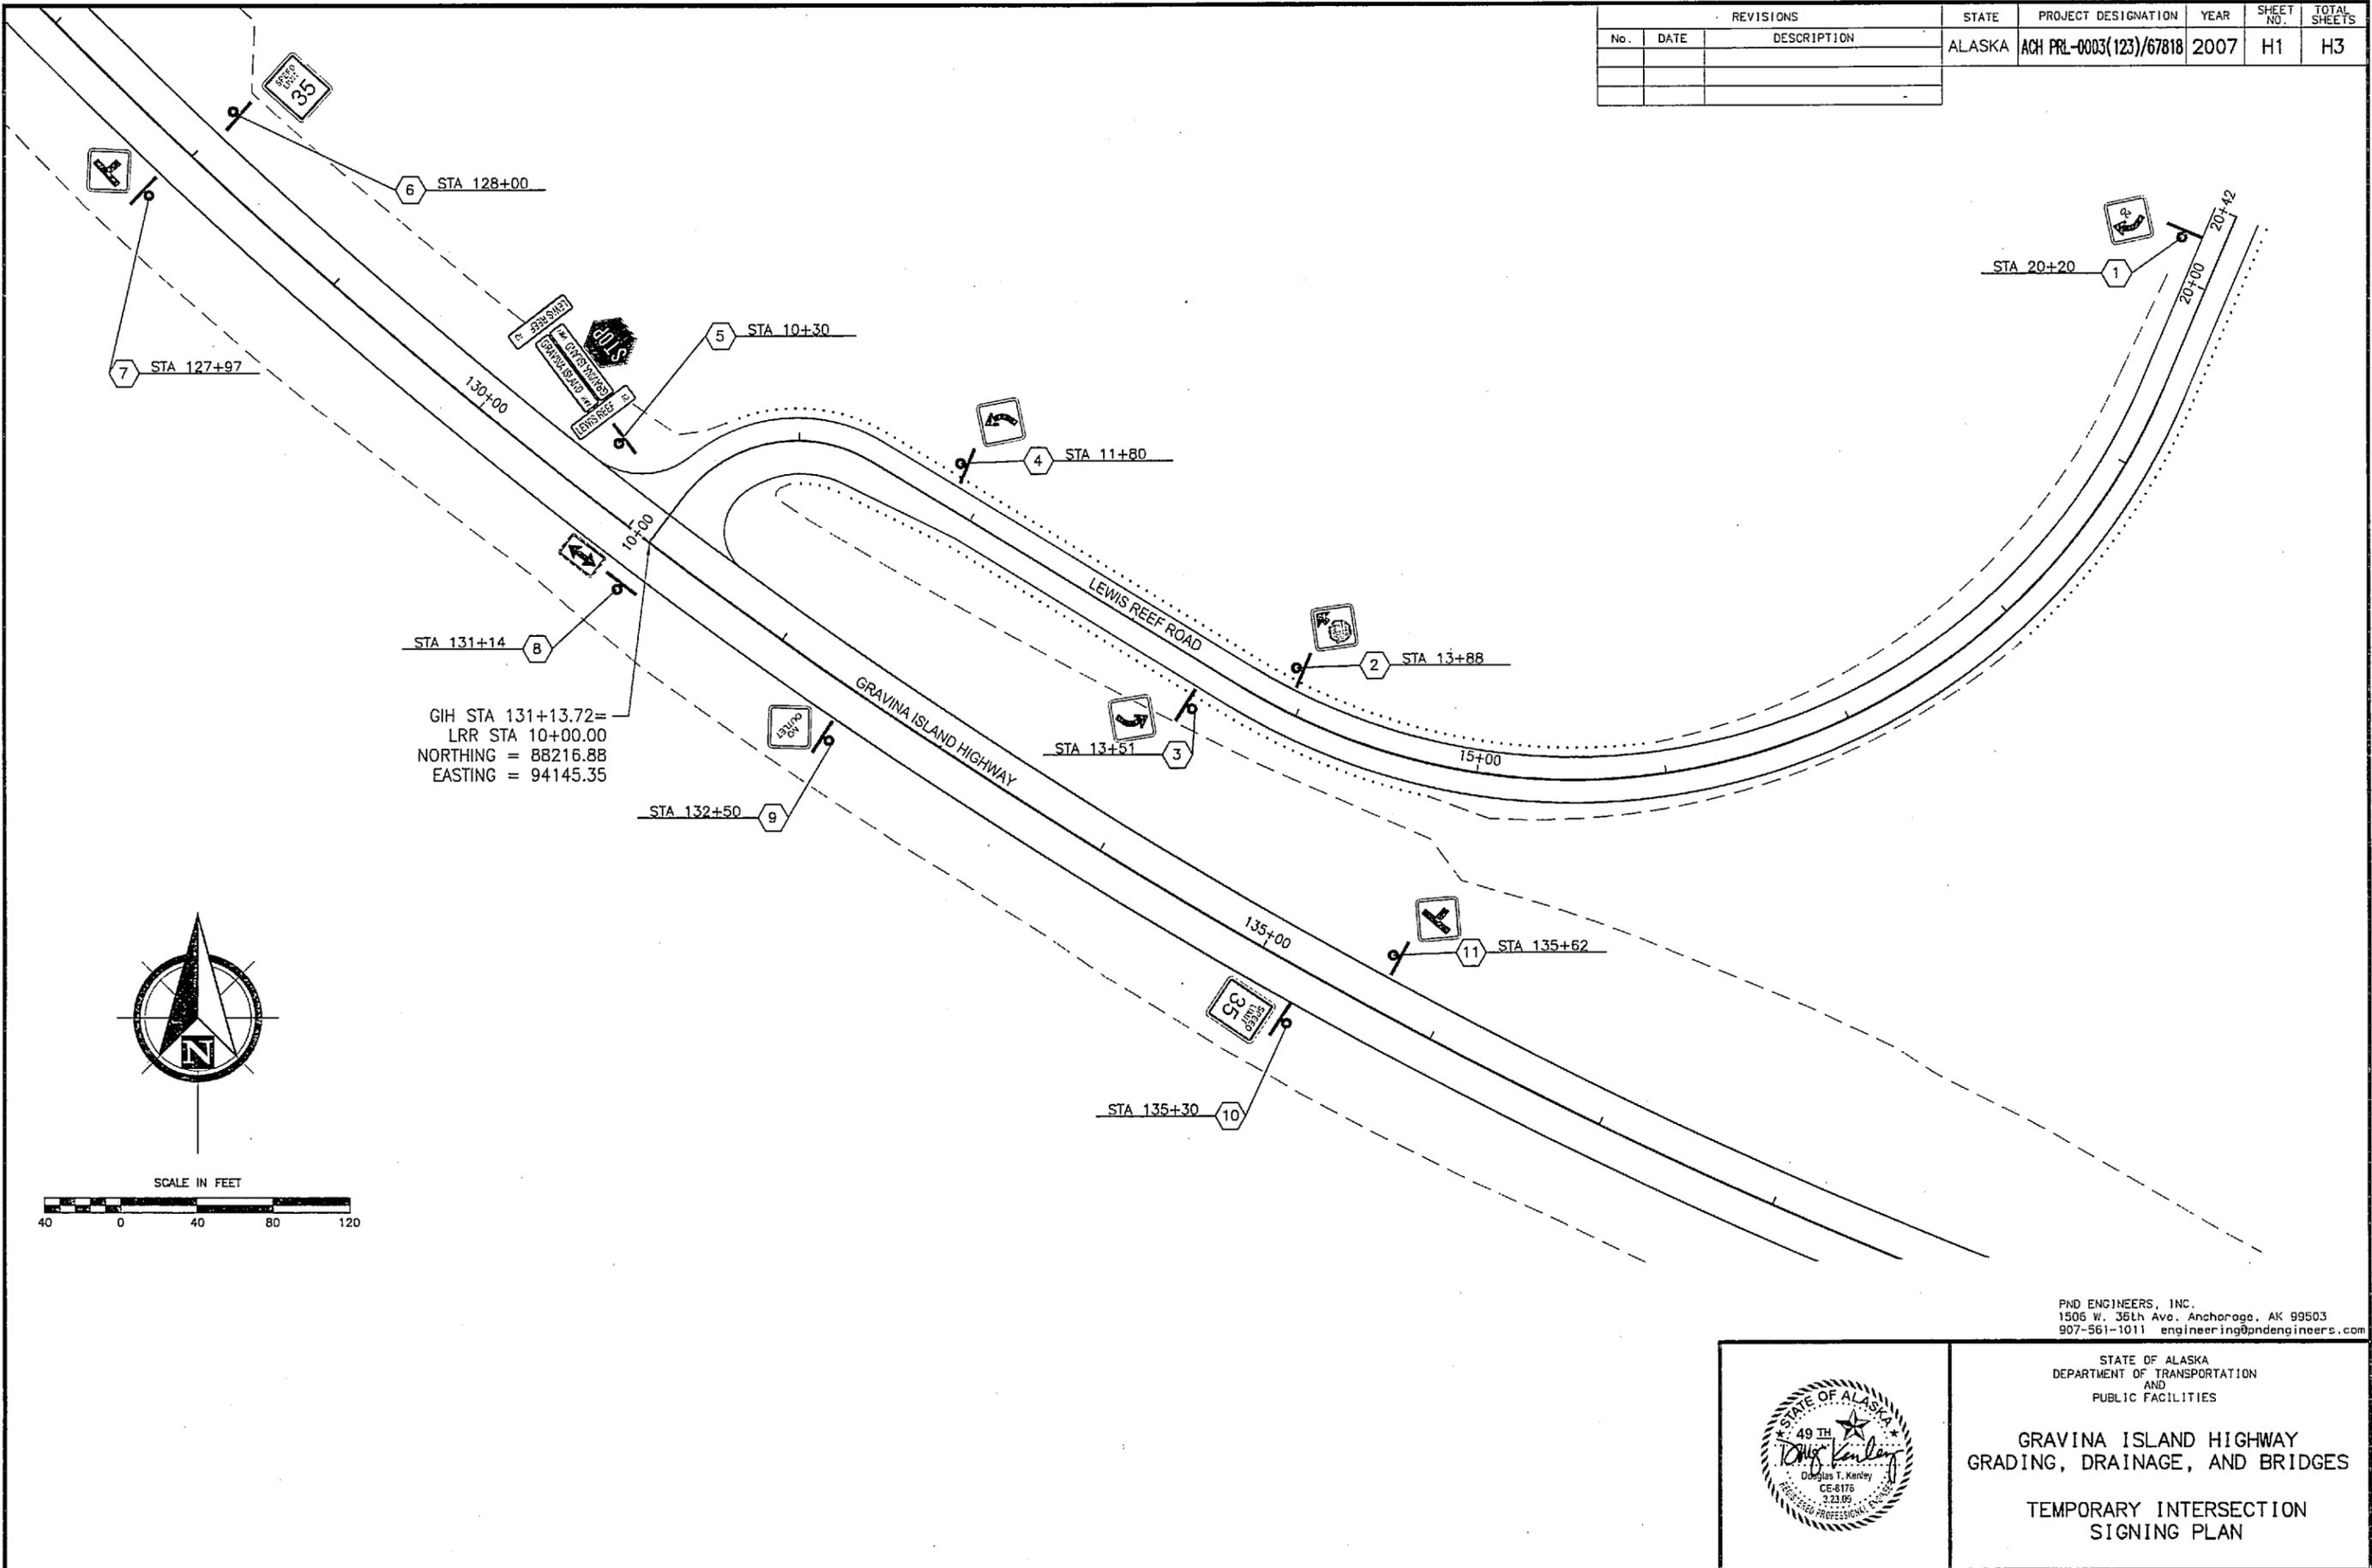





PND ENGINEERS, INC.  
 1506 W. 36th Ave. Anchorage, AK 99503  
 907-561-1011 engineering@pndengineers.com

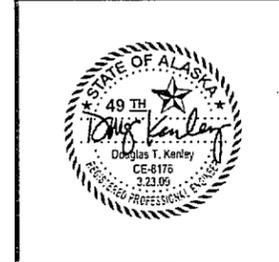

STATE OF ALASKA  
 DEPARTMENT OF TRANSPORTATION  
 AND  
 PUBLIC FACILITIES

**GRAVINA ISLAND HIGHWAY  
 GRADING, DRAINAGE, AND BRIDGES**

**TEMPORARY INTERSECTION  
 SIGNING PLAN**

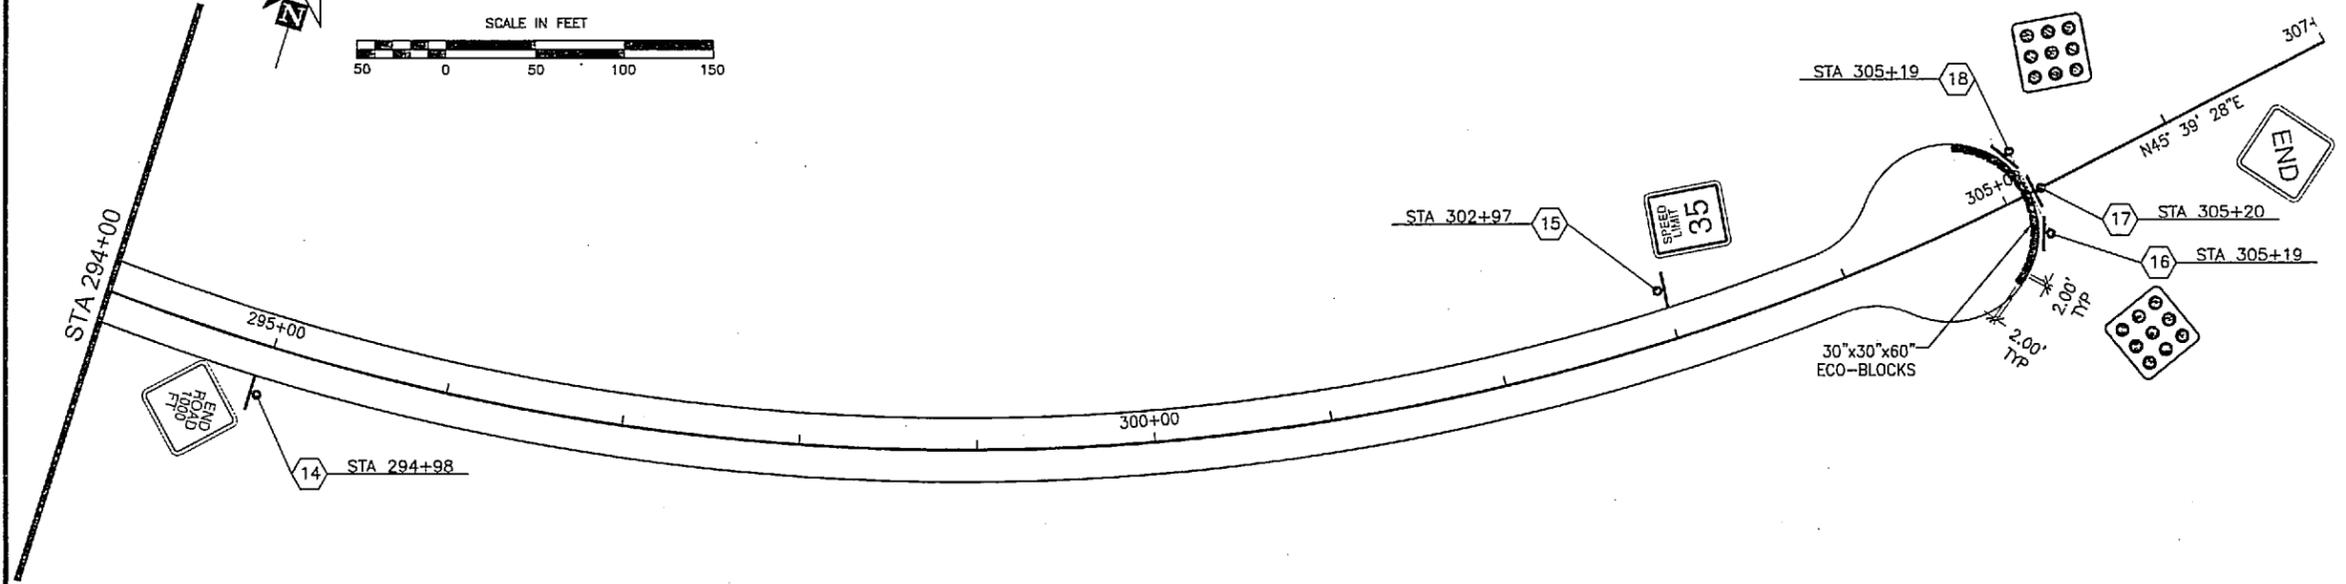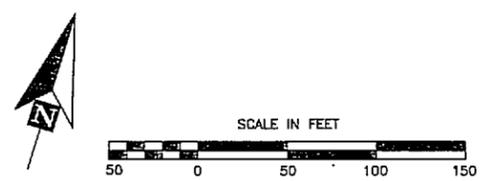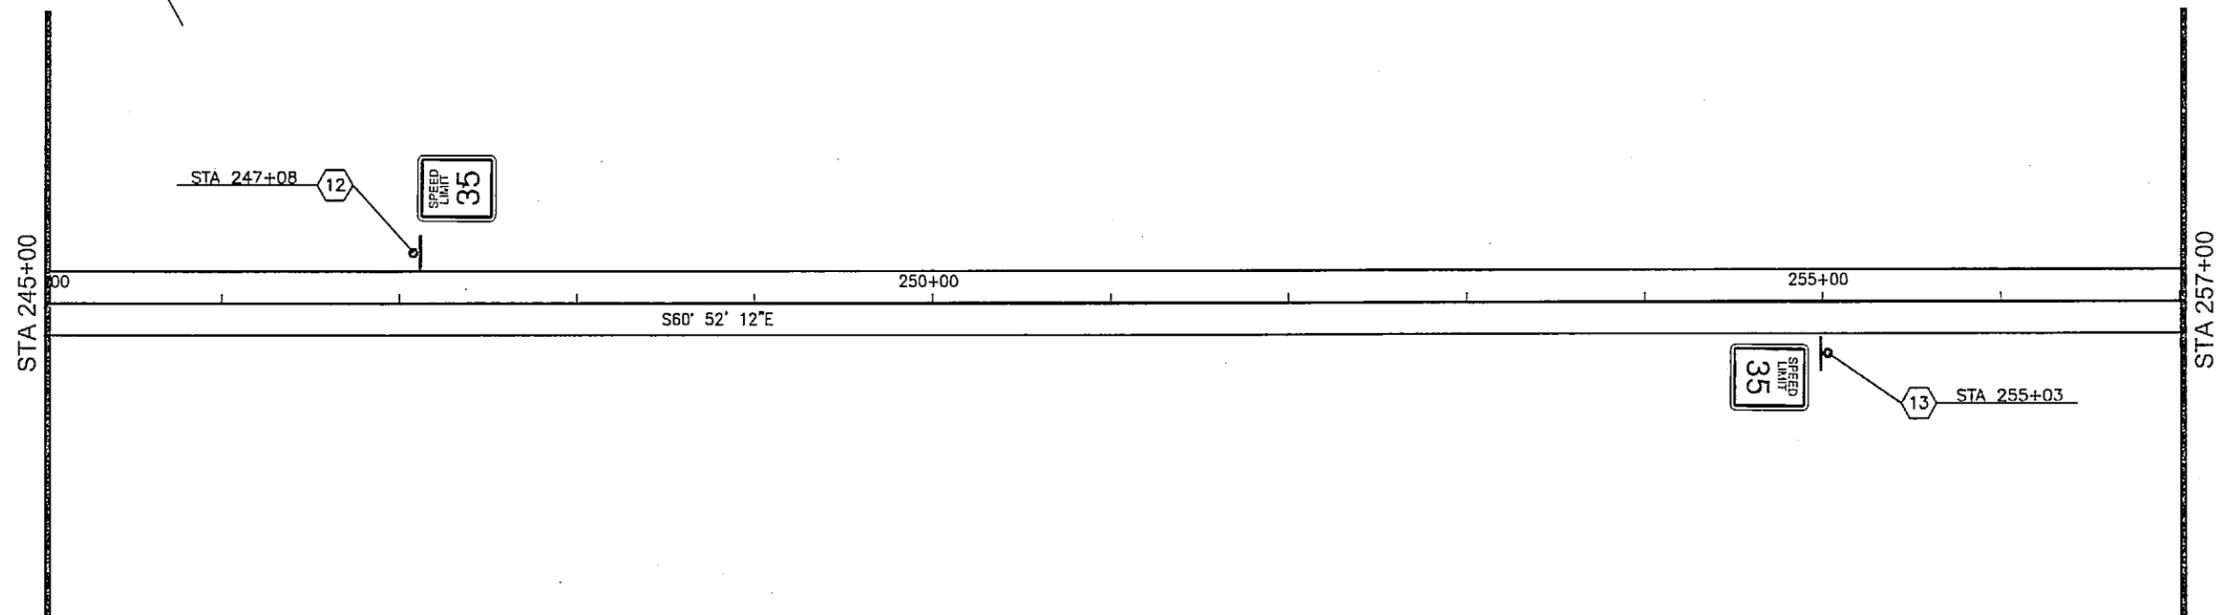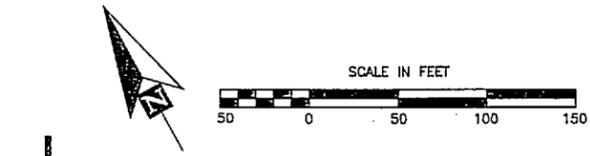

SHEET NO.	TOTAL SHEETS
H2	H3
STATE	YEAR
ALASKA	2007


PROJECT DESIGNATION  
ACH PRL-0003(123)/67818

ADDENDUM NO.

ATTACHMENT NO.

REVISIONS

NO.	DATE	DESCRIPTION

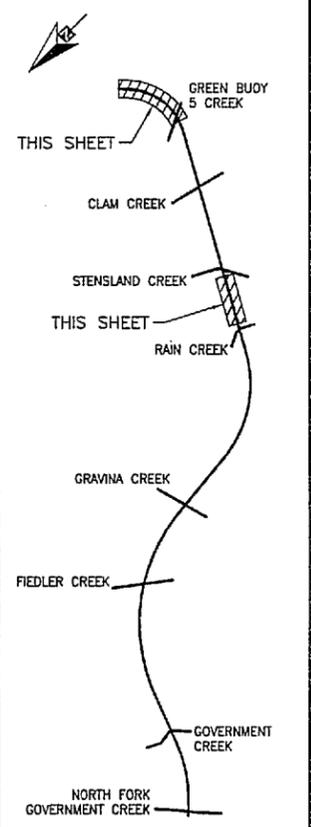

PND ENGINEERS, INC.  
1506 W. 36th Ave.  
Anchorage, AK 99503  
907-561-1011  
engineer ing@pndengineers.com



STATE OF ALASKA  
DEPARTMENT OF TRANSPORTATION  
AND PUBLIC FACILITIES  
GRAVINA ISLAND HIGHWAY  
GRADING, DRAINAGE AND  
BRIDGES

SIGNING PLAN

**STANDARD SIGN SUMMARY**

SHEET	POST NO.	STATION	OFFSET		TYPE	LEGEND	SIZE (in)		AREA SQ. FT.	POST		SIGN FACES	TOTAL QUANTITY	REMARKS
			LT	RT			W	H		SIZE	TYPE			
H1	1	* 20+20	25.5'		W1-2AR		30	30	6.25	1-2.5"	PST-S	N	1	SEE NOTE 1
H1	2	* 13+88	25.0'		W3-1A		36	36	9	1-2.5"	PST-S	E	1	SEE NOTE 1
H1	3	* 13+51		25.5'	W1-2L		30	30	6.25	1-2.5"	PST-S	W	1	SEE NOTE 1
H1	4	* 11+80	23.5'		W1-2L		30	30	6.25	1-2.5"	PST-S	E	1	SEE NOTE 1
H1	5	* 10+30	31.0'		R1-1 D3-1 D3-1	GRAVINA ISLAND HWY LEWIS REEF RD 	30 VAR. VAR.	30 12 12	5.25 VARIES VARIES	1-2.5"	PST-S	NE NE/SW NW/SE	1 2 2	SEE NOTE 1 SIGN FOR GH SIGN FOR LRR
H1	6	128+00	31.5'		R2-1		30	36	7.5	1-2.5"	PST-S	E	1	SEE NOTE 1
H1	7	127+97	31.5'		W2-2L		36	36	9	1-2.5"	PST-S	W	1	SEE NOTE 1
H1	8	131+14	31.5'		W1-7		48	24	8	1-2.5"	PST-S	W	1	SEE NOTE 1
H1	9	132+50	31.5'		W14-2		36	36	9	1-2.5"	PST-S	W	1	SEE NOTE 1
H1	10	135+30	31.5'		R2-1		30	36	7.5	1-2.5"	PST-S	W	1	SEE NOTE 1

\* - INDICATES STATIONING ON LEWIS REEF ROAD

REVISIONS			STATE	PROJECT DESIGNATION	YEAR	SHEET NO.	TOTAL SHEETS
No.	DATE	DESCRIPTION	ALASKA	ACH PRL-0003(123)/67818	2007	H3	H3

**STANDARD SIGN SUMMARY**

SHEET	POST NO.	STATION	OFFSET		TYPE	LEGEND	SIZE (in)		AREA SQ. FT.	POST		SIGN FACES	TOTAL QUANTITY	REMARKS
			LT	RT			W	H		SIZE	TYPE			
H1	11	135+62	31.5'		W2-2R		36	36	9	1-2.5"	PST-S	E	1	SEE NOTE 1
H2	12	247+08	31.5'		R2-1		30	36	7.5	1-2.5"	PST-S	E	1	SEE NOTE 1
H2	13	255+03	31.5'		R2-1		30	36	7.5	1-2.5"	PST-S	W	1	SEE NOTE 1
H2	14	294+98	31.5'		W14-2		36	36	9	1-2.5"	PST-S	W	1	SEE NOTE 1
H2	15	302+98	31.5'		R2-1		30	36	7.5	1-2.5"	PST-S	E	1	SEE NOTE 1
H2	16	305+19		8'	OM4-1		18	18	2.25	1-2.5"	PST-S	W	1	SEE NOTE 1 RED BACKGROUND RED BORDER RED REFLECTORS
H2	17	305+20		0'	W14-100		30	30	6.25	1-2.5"	PST-S	W	1	SEE NOTE 1
H2	18	305+19		8'	OM4-1		18	18	2.25	1-2.5"	PST-S	W	1	SEE NOTE 1 RED BACKGROUND RED BORDER RED REFLECTORS

**NOTES**

- ALL SIGN MOUNTINGS, BRACING AND POST EMBEDMENT ARE SUBJECT TO AKDOT&PF STANDARD DETAILS AND SPECIFICATIONS. CONTRACTOR MAY USE EITHER POST EMBEDMENT METHOD SHOWN IN STANDARD DETAILS S-30.03 AS PRACTICABLE.
- THE POST TYPES INDICATED IN THIS SUMMARY ARE ABBREVIATED.  
PST-S = PERFORATED SQUARE STEEL TUBE
- OFFSET IS TO APPROXIMATE CENTER OF SIGN POST, INSTALL SIGN WITH CLEARANCES AS SHOWN IN STANDARD DETAIL S-05.01.

PND ENGINEERS, INC.  
1506 W. 36th Ave. Anchorage, AK 99503  
907-561-1011 engineering@pndengineers.com






STATE OF ALASKA  
DEPARTMENT OF TRANSPORTATION  
AND  
PUBLIC FACILITIES

GRAVINA ISLAND HIGHWAY  
GRADING, DRAINAGE, AND BRIDGES

SIGN SUMMARY


STATE	PROJECT DESIGNATION	YEAR	SHEET NO.	TOTAL SHEETS
ALASKA	ACH PRL-0003(123)/67818	2007	N1	N26

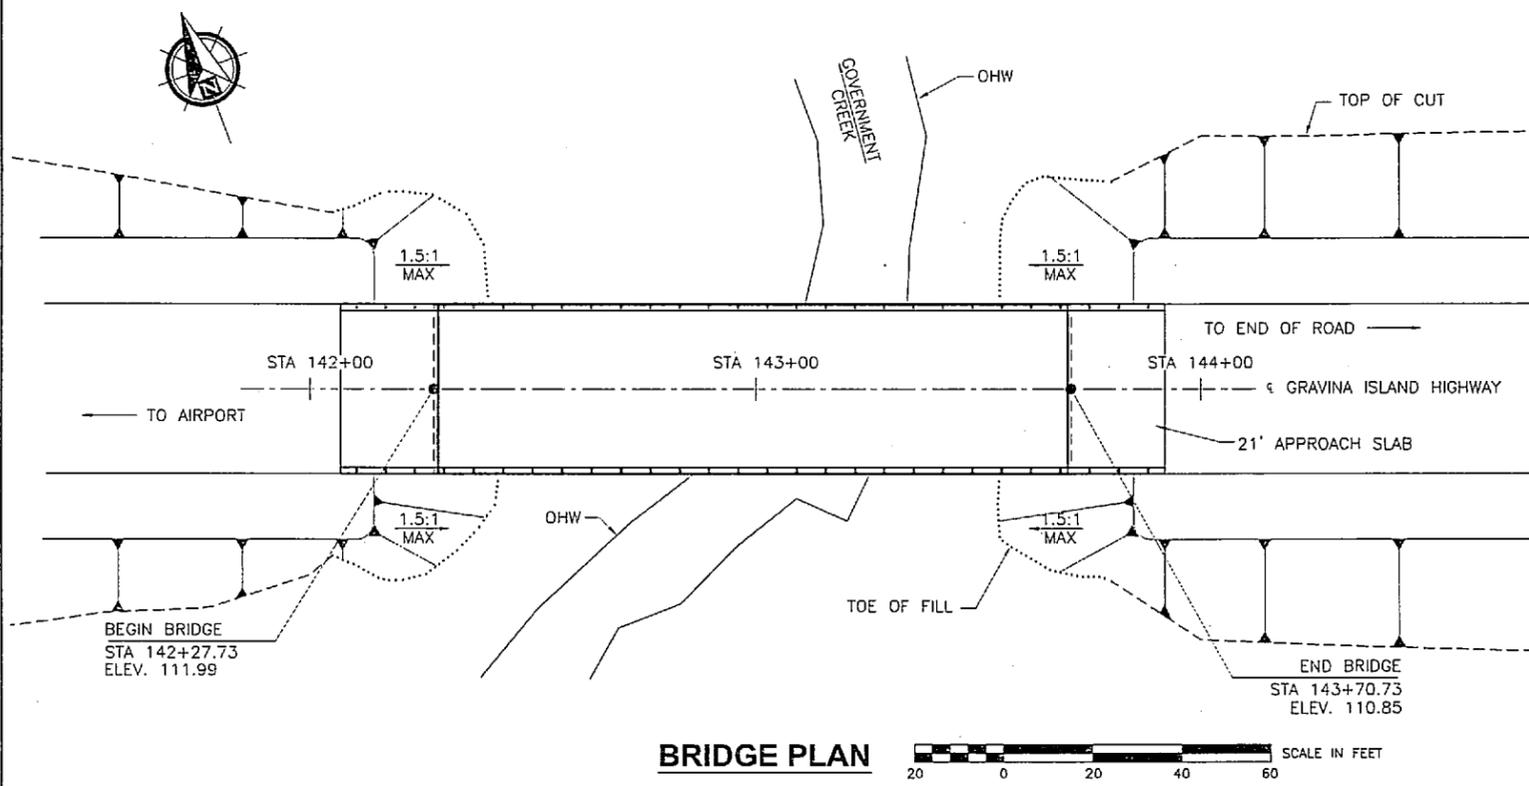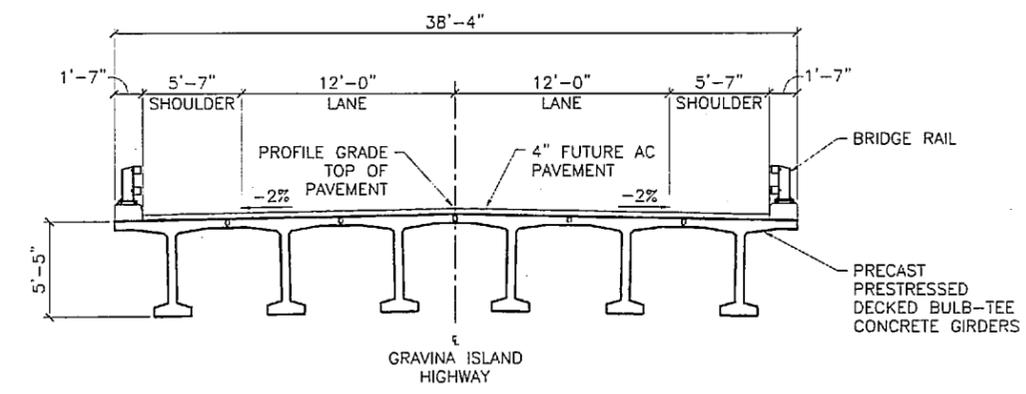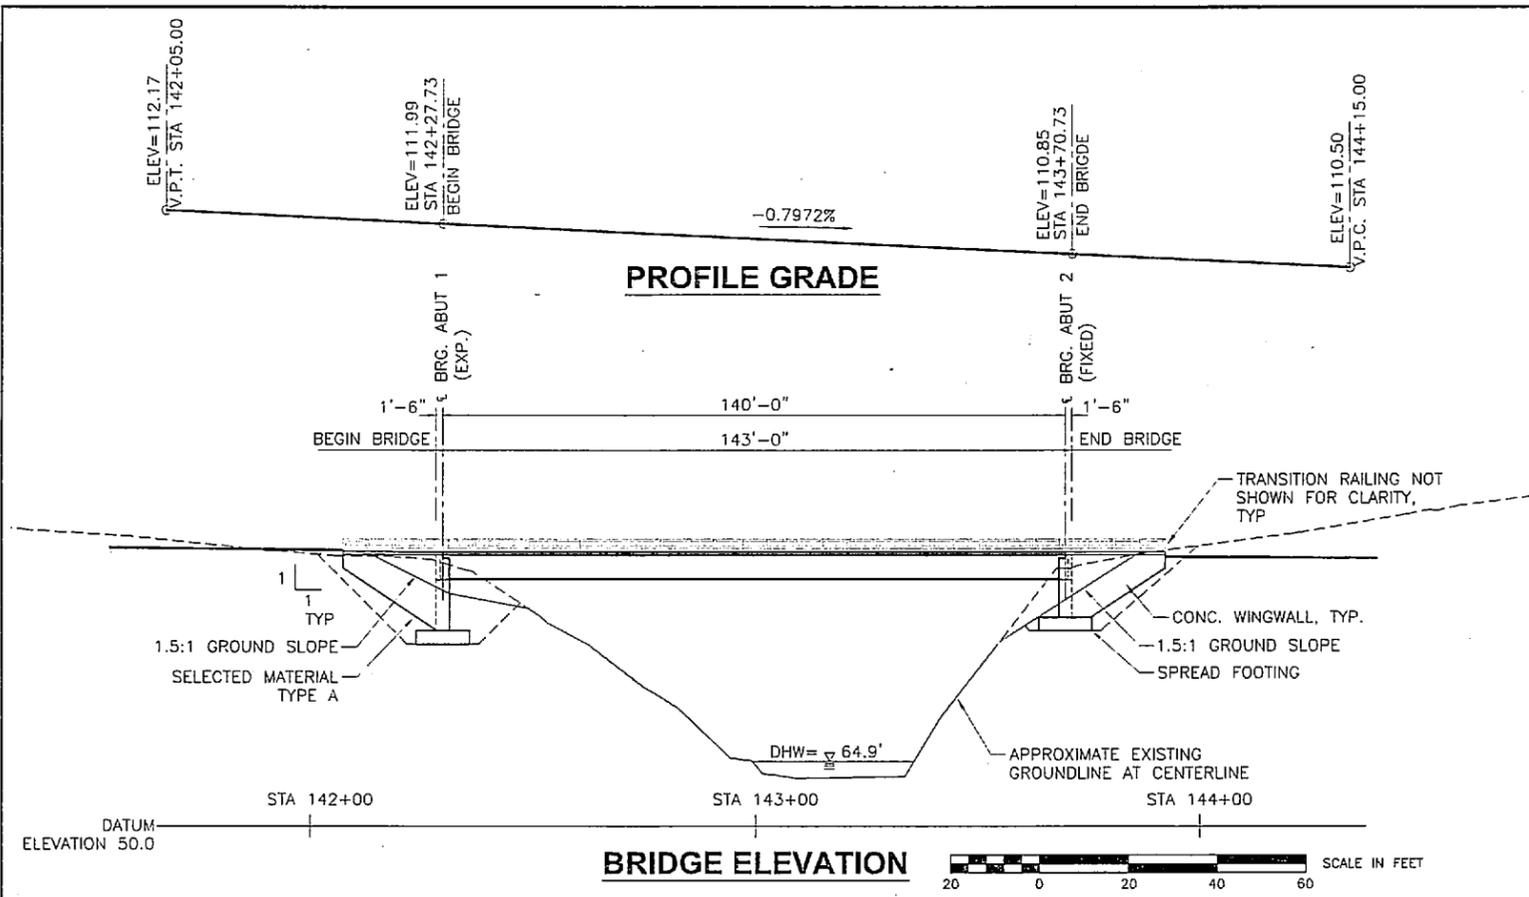

BRIDGE DRAWING INDEX	
TITLE	DWG. NO
GENERAL LAYOUT	1
SITE PLAN	2
ABUTMENT #2 ROCK BOLTING	3
ABUTMENT 1	4
ABUTMENT 2	5
ABUTMENT DETAILS	6
WINGWALL AT ABUTMENT 1	7
WINGWALL AT ABUTMENT 2	8
TYPICAL SECTION	9
GIRDERS	10
GIRDER DETAILS	11
APPROACH SLAB	12
BRIDGE RAILING	13

DESIGNED BY: C. KENLEY	CHECKED: J. GOBELI	LAYOUT BY: P. KENDALL	CHECKED BY: D. KENLEY
DRAWN BY: J. HELTON	CHECKED: J. GOBELI	SPECIFICATIONS BY: C. KENLEY	P. S. & E. COMPARED:
QUANTITIES BY: D. BENTTI	CHECKED: J. GOBELI	APPROVAL RECOMMENDED BY:	

STATE OF ALASKA  
DEPARTMENT OF TRANSPORTATION  
AND PUBLIC FACILITIES  
BRIDGE SECTION

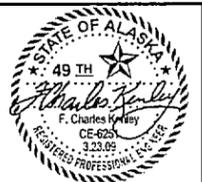

GOVERNMENT CREEK BRIDGE  
GRAVINA ISLAND HIGHWAY  
GENERAL LAYOUT


BRIDGE NO. 2159  
DWG. NO. 1

STATE	PROJECT DESIGNATION	YEAR	SHEET NO.	TOTAL SHEETS
ALASKA	ACH PRL-0003(123)/67818	2007	N2	N26

**GENERAL NOTES**

- DESIGN: AASHTO LRFD BRIDGE DESIGN SPECIFICATION, THIRD EDITION, WITH 2006 INTERIM SPECIFICATIONS.
- LIVE LOAD: HL-93
- SEISMIC PARAMETERS: ACCELERATION COEFFICIENT,  $a = 0.10g$   
SITE COEFFICIENT,  $S = 1.2$   
IMPORTANCE CLASSIFICATION OTHER  
LIQUEFACTION POTENTIAL = LOW  
AASHTO 90% PROBABILITY OF NOT BEING EXCEEDED IN 50 YEARS.
- DEAD LOAD: INCLUDES 50 PSF FOR ALL WEARING SURFACING, 500 PLF FOR UTILITIES
- PRECAST CONCRETE: SEE "GIRDERS" DWG.
- CONCRETE: USE CLASS A CONCRETE FOR ALL CONCRETE UNLESS OTHERWISE NOTED.  $f'_c = 4000$  PSI  
USE CLASS A-A CONCRETE FOR APPROACH SLABS.  $f'_c = 5000$  PSI
- REINFORCING STEEL: USE ASTM A706 REINFORCING STEEL.  $F_y = 60,000$  PSI  
SPACE BARS EVENLY UNLESS OTHERWISE NOTED.
- STRUCTURAL STEEL: USE ASTM A709, GRADE 36,  $F_y = 36,000$  PSI GALVANIZE ALL STRUCTURAL STEEL UNLESS OTHERWISE NOTED.

FOOTING INFORMATION				
LOCATION	CONTROLLING LIMIT STATE	RES. FACTOR	FACTORED BEARING RESISTANCE	DESIGN BEARING PRESSURE
ABUTMENT 1	SERVICE LIMIT STATE 1 GLOBAL STABILITY	0.65	7,500 PSF	7,300 PSF
ABUTMENT 2	SERVICE LIMIT STATE 1 GLOBAL STABILITY	0.65	6,000 PSF	5,900 PSF

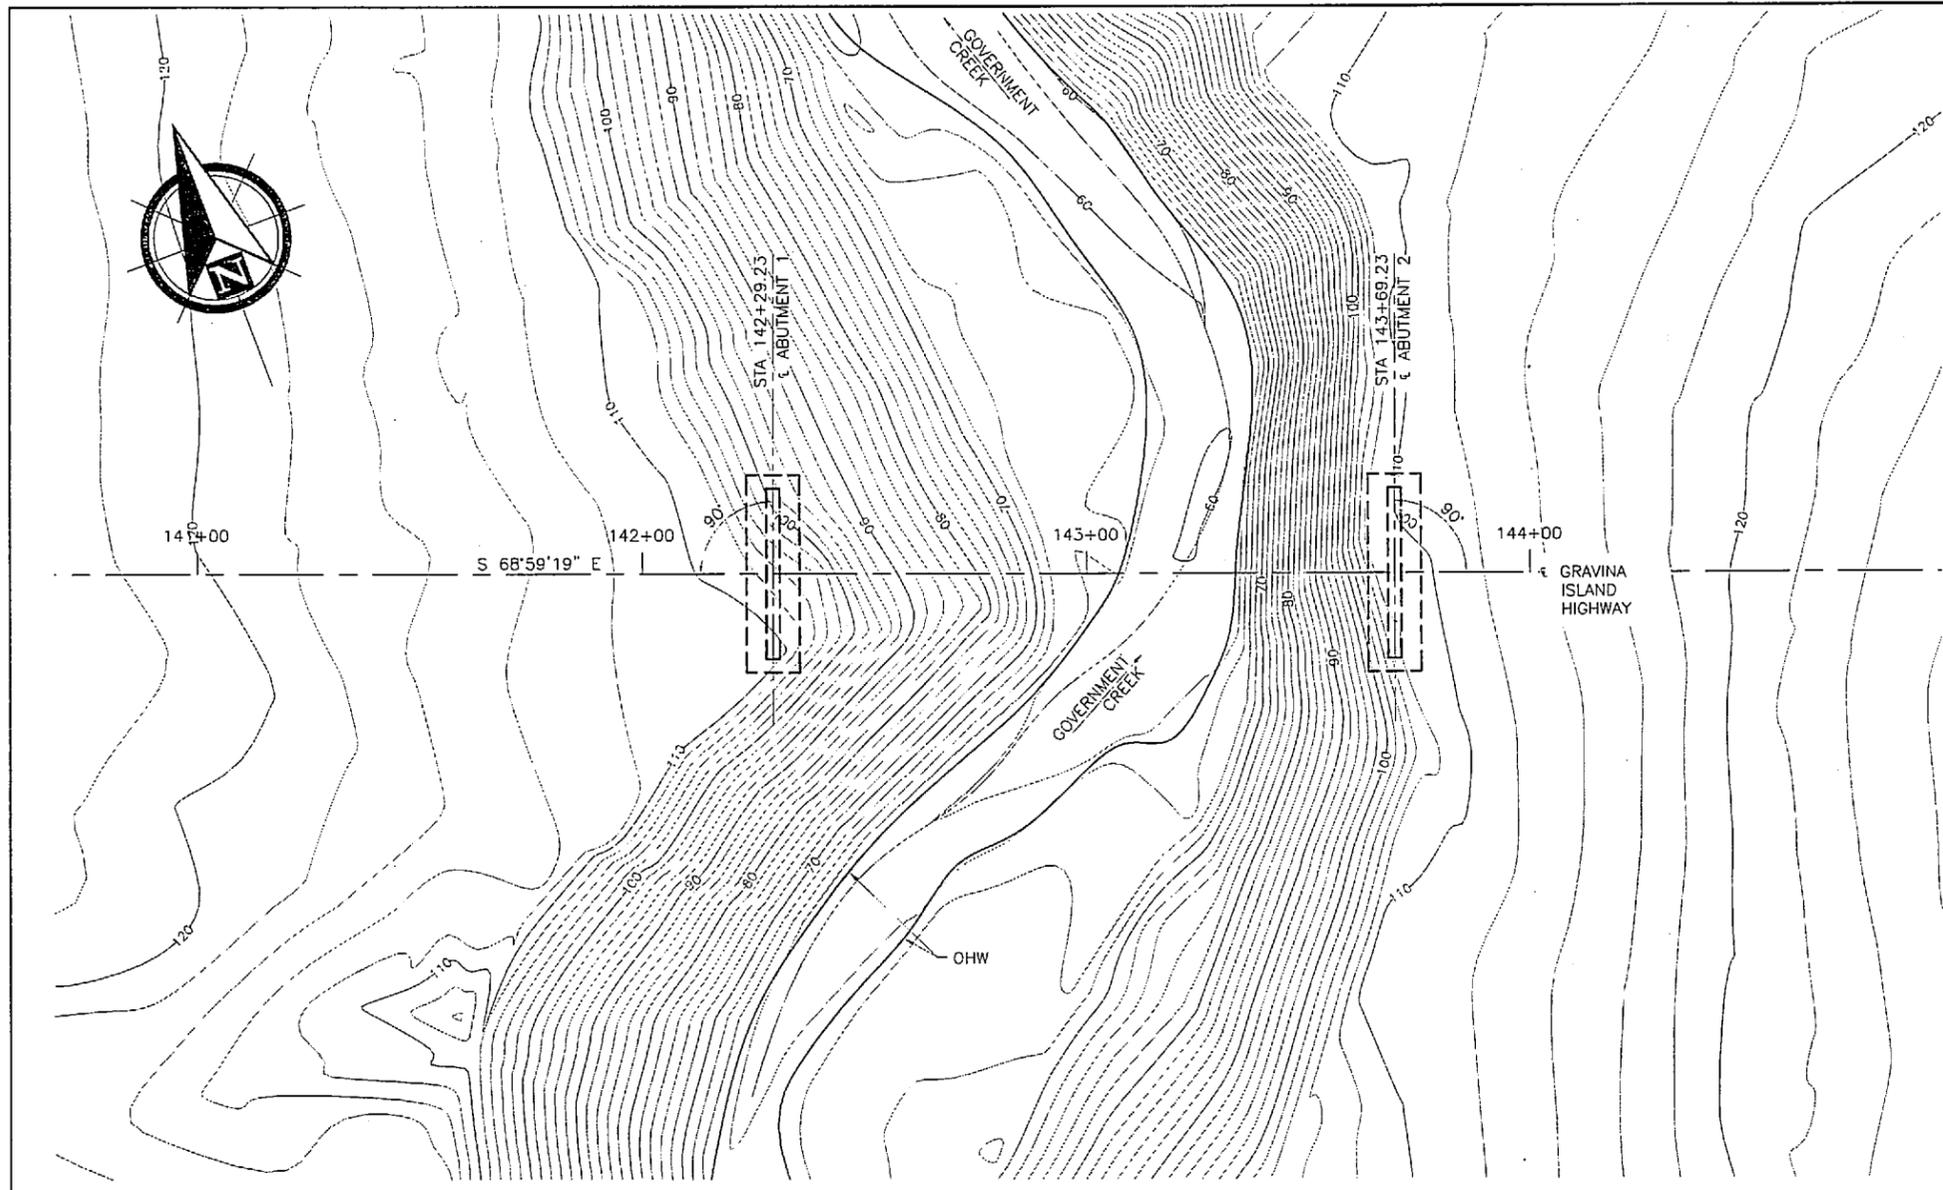

**SITE PLAN**



HYDRAULIC AND HYDROLOGIC SUMMARY			
FLOOD FREQUENCY (Yr.)	50 YR.	100 YR.	500 YR.
EXCEEDANCE PROBABILITY (%)	2	1	0.2
DESIGN DISCHARGE (FT <sup>3</sup> /SEC)	1000	1090	1304
WATER ELEV.	64.8	64.9	65.3
ANTICIPATED ADD'L BACKWATER	0	0	0
CONTRACTION SCOUR (FT.)	0	0	0
ABUTMENT SCOUR (FT.)	0	0	0

DRAINAGE AREA FOR THIS CROSSING: 1.95 SQUARE MILES


HYDRAULIC CAPACITY >>1304 CFS AT LOW SUPERSTRUCTURE ELEVATION OF 105.0 FEET WHICH HAS AN EXCEEDANCE PROBABILITY OF 0.2 PERCENT (Q500)

TOTAL SCOUR EQUALS CONTRACTION SCOUR + LOCAL SCOUR

DESIGN HIGH WATER (DHW) = 64.9 FT AT BRIDGE  
ORDINARY HIGH WATER (OHW) = 63.4 FT AT BRIDGE

DESIGNED BY: C KENLEY	CHECKED: J GOBELI	HYDRAULICS BY: J CAMPBELL	CHECKED BY: B ADAMS
DRAWN BY: J HELTON	CHECKED: J GOBELI	FOUNDATIONS REVIEWED BY:	C WRIGHT
QUANTITIES BY: D BENNETT	CHECKED: J GOBELI		

STATE OF ALASKA  
DEPARTMENT OF TRANSPORTATION  
AND PUBLIC FACILITIES  
BRIDGE SECTION

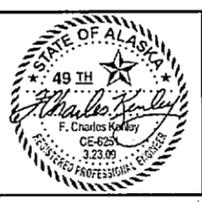

**GOVERNMENT CREEK BRIDGE**  
GRAVINA ISLAND HIGHWAY  
**SITE PLAN**

BRIDGE NO. 2159  
DWG. NO. 2

### ANCHORS

**MATERIALS**  
 ANCHOR ROD SHALL BE 1-1/4" DIAMETER A722 GRADE 150 KSI THREADBAR OR APPROVED EQUAL. ANCHOR SHALL BE GALVANIZED AND MEET THE REQUIREMENTS FOR CLASS 1 CORROSION PROTECTION AS RECOMMEND BY THE POST TENSIONING INSTITUTE.

ALL COUPLERS (STOP-TYPE) AND CONNECTORS SHALL BE CAPABLE OF DEVELOPING 100% OF THE ULTIMATE BAR STRENGTH. PROVIDE PVC CENTRALIZERS AT 8 FEET ON CENTER.

PROVIDE NEAT CEMENT GROUT USING EXPANSIVE HYDRAULIC CEMENT CONFORMING TO ASTM C845, WILLIAMS SS2 OR APPROVED EQUAL, WITH A WATER/CEMENT RATIO OF 0.40, PROVIDING 7 DAY CURE STRENGTH OF 4000 PSI. PROVIDE ADMIXTURES AS REQUIRED TO MINIMIZE BLEED WATER.

**CONSTRUCTION**  
 SUBMIT INFORMATION ON EQUIPMENT, INSTALLATION PROCEDURES, WELDING PROCEDURES, CONCRETE & GROUT MIXES WITH MANUFACTURERS INFORMATION TO THE ENGINEER FOR REVIEW.

THE CONTRACTOR SHALL PROVIDE A QUALIFIED INSPECTOR TO PERIODICALLY MONITOR ANCHOR INSTALLATION, MONITOR SOIL CLASSIFICATION, AND WITNESS ALL TESTS.

**ANCHORS**  
 EXCAVATE THROUGH OVERBURDEN AND WEATHERED ROCK INTO COMPETENT ROCK TO PROVIDE A BASE FOR BEARING PLATE.

ANCHORS SHALL BE PRESSURE GROUTED WITH PUMPING AIDS/FLUIDIZERS AS REQUIRED FROM THE BOTTOM OF HOLE UP WITH A MINIMUM PRESSURE OF 30 PSI.

TEST ANCHORS AS NOTED. SUBSEQUENT TO TESTING AND CAP PLACEMENT, TENSION ANCHORS AND LOCK OFF TO P=46 KIPS, GROUT HOLE UP TO CAP BEARING PLATE AFTER LOCK-OFF.

**ANCHOR TESTS**  
 PERFORMANCE TEST FIRST. PROOF TEST ALL OTHER ANCHORS UNLESS DIRECTED OTHERWISE.

THE PERFORMANCE TEST SHALL BE PERFORMED IN INCREMENTAL LOADING AND UNLOADING. THE MOVEMENT OF THE TENDON SHALL BE RECORDED TO THE NEAREST 0.001 INCHES WITH RESPECT TO AN INDEPENDENT FIXED REFERENCE POINT. JACK AND GAUGE SHALL BE CALIBRATED PRIOR TO USE.

LOADING SEQUENCE P= LOCK OFF LOAD = 46 KPS

ALIGNMENT LOAD 0.10\*P


- 0
- 0.25\*P
- 0.50\*P
- 0.75\*P
- 1.00\*P
- 1.25\*P MONITOR AT 1 MINUTE AND 10 MINUTES\*
- 1.00\*P
- 0.75\*P
- 0.50\*P
- 0.25\*P
- 0

\* IF THE TOTAL CREEP MOVEMENT BETWEEN 1 MINUTE AND 10 MINUTES EXCEED 0.04 INCHES THE TEST SHALL BE HELD FOR AN ADDITIONAL 50 MINUTES, MONITORING EVERY 10 MINUTE INTERVALS.

**PROOF TEST** ALL ANCHORS TO 1.25\*P. VARIATIONS BETWEEN PROOF TEST AND PERFORMANCE TEST RESULTS WARRANTS MAKING A PERFORMANCE TEST ON NEXT ANCHOR.

ANCHOR SHALL BE ACCEPTABLE IF:

1. TENDON ELONGATION > 0.35" (80% ELASTIC ELONGATION FOR THE FREE STRESSING LENGTH) AND < 1.25" (ELASTIC ELONGATION FOR (FREE STRESSING LENGTH AND 50% OF BONDED LENGTH)
2. CREEP MOVEMENT DOES NOT EXCEED 0.080 INCHES.

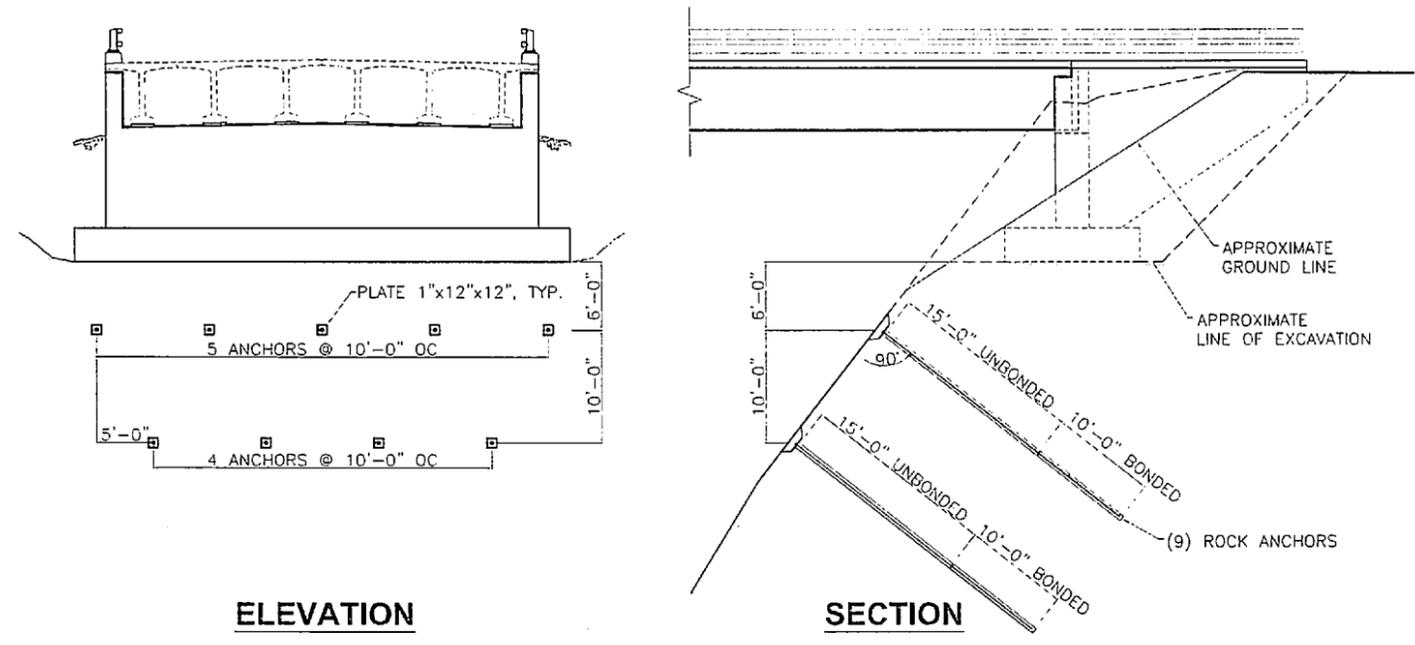


**ELEVATION**

**SECTION**

### ABUTMENT #2 ROCK ANCHORS

NTS

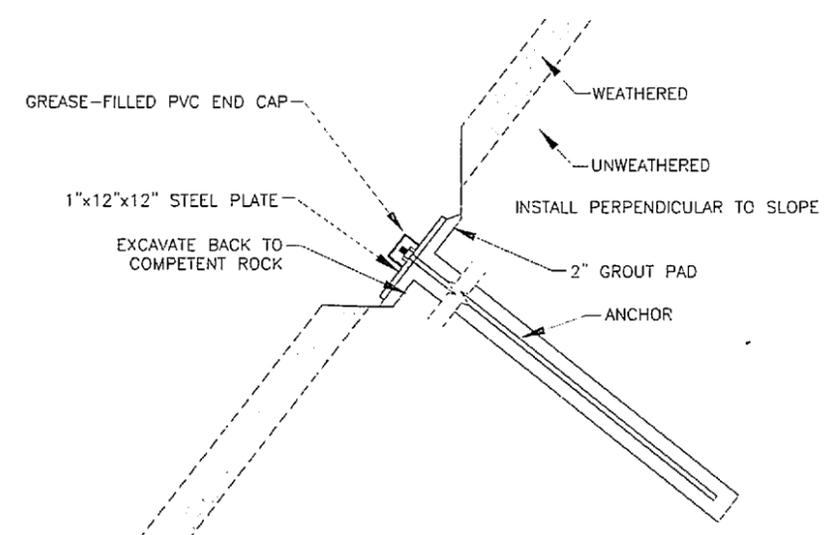


**ANCHOR HEAD DETAIL**

NTS

DESIGNED BY: C KENLEY	CHECKED: J GOBELI
DRAWN BY: J HELTON	CHECKED: J GOBELI
QUANTITIES BY: D BENNETT	CHECKED: J GOBELI

STATE OF ALASKA  
 DEPARTMENT OF TRANSPORTATION  
 AND PUBLIC FACILITIES  
 BRIDGE SECTION

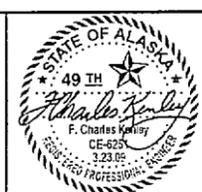

GOVERNMENT CREEK BRIDGE  
 GRAVINA ISLAND HIGHWAY  
 ABUTMENT #2 ROCK BOLTING




BRIDGE NO. 2159  
 DWG. NO. 3

STATE	PROJECT DESIGNATION	YEAR	SHEET NO.	TOTAL SHEETS
ALASKA	ACH PRL-0003(123)/67818	2007	N4	N26

### REINFORCING STEEL ONE ABUTMENT

MARK	SIZE	No.	LENGTH	TYPE	NOTES
A401	4	58	3'-5"	BENT	
A402	4	58	3'-5"	BENT	
A404	4	30	3'-8"	BENT	
A405	4	4	12'-2"	BENT	
A601	6	5	41'-6"	BENT	b
A602	6	28	38'-0"	-	b
A603	6	56	VARIES	-	
A801	8	56	VARIES	BENT	
B401	4	21	14'-0"	BENT	a
B402	4	28	12'-2"	BENT	a
B403	4	49	5'-4"	BENT	a
B501	5	5	34'-10"	-	a
B502	5	2	38'-0"	-	a,b
B503	5	3	4'-0"	-	a
B601	6	4	34'-10"	-	a,b
B701	7	24	VARIES	BENT	a
F601	6	67	11'-6"	-	
F602	6	89	16'-6"	BENT	
F603	6	36	46'-4"	BENT	b



#### BENDING DIAGRAMS

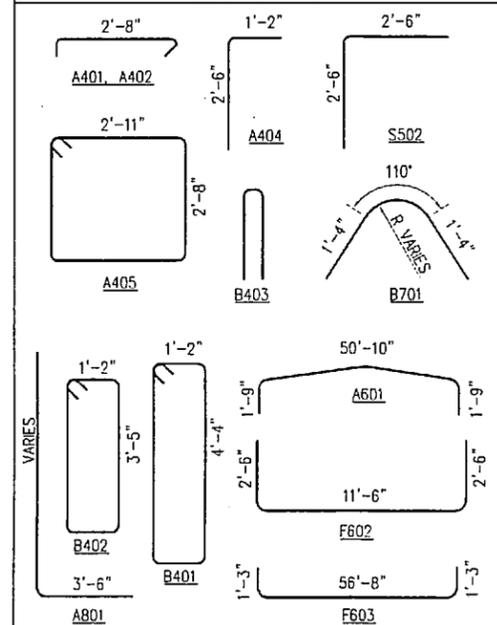

- a - EPOXY COATED REINFORCING STEEL
- b - LENGTH DOES NOT INCLUDE SPLICES
- c - FIELD BEND BARS TO MATCH CROWN.

#### TOP OF ABUTMENT WALL ELEVATIONS

POINT	ABUTMENT 1
A	+105.64 105.55
B	+105.99 105.82
C	+105.64 105.49
D	+105.62 105.53
E	+105.97 105.60
F	+105.62 105.47

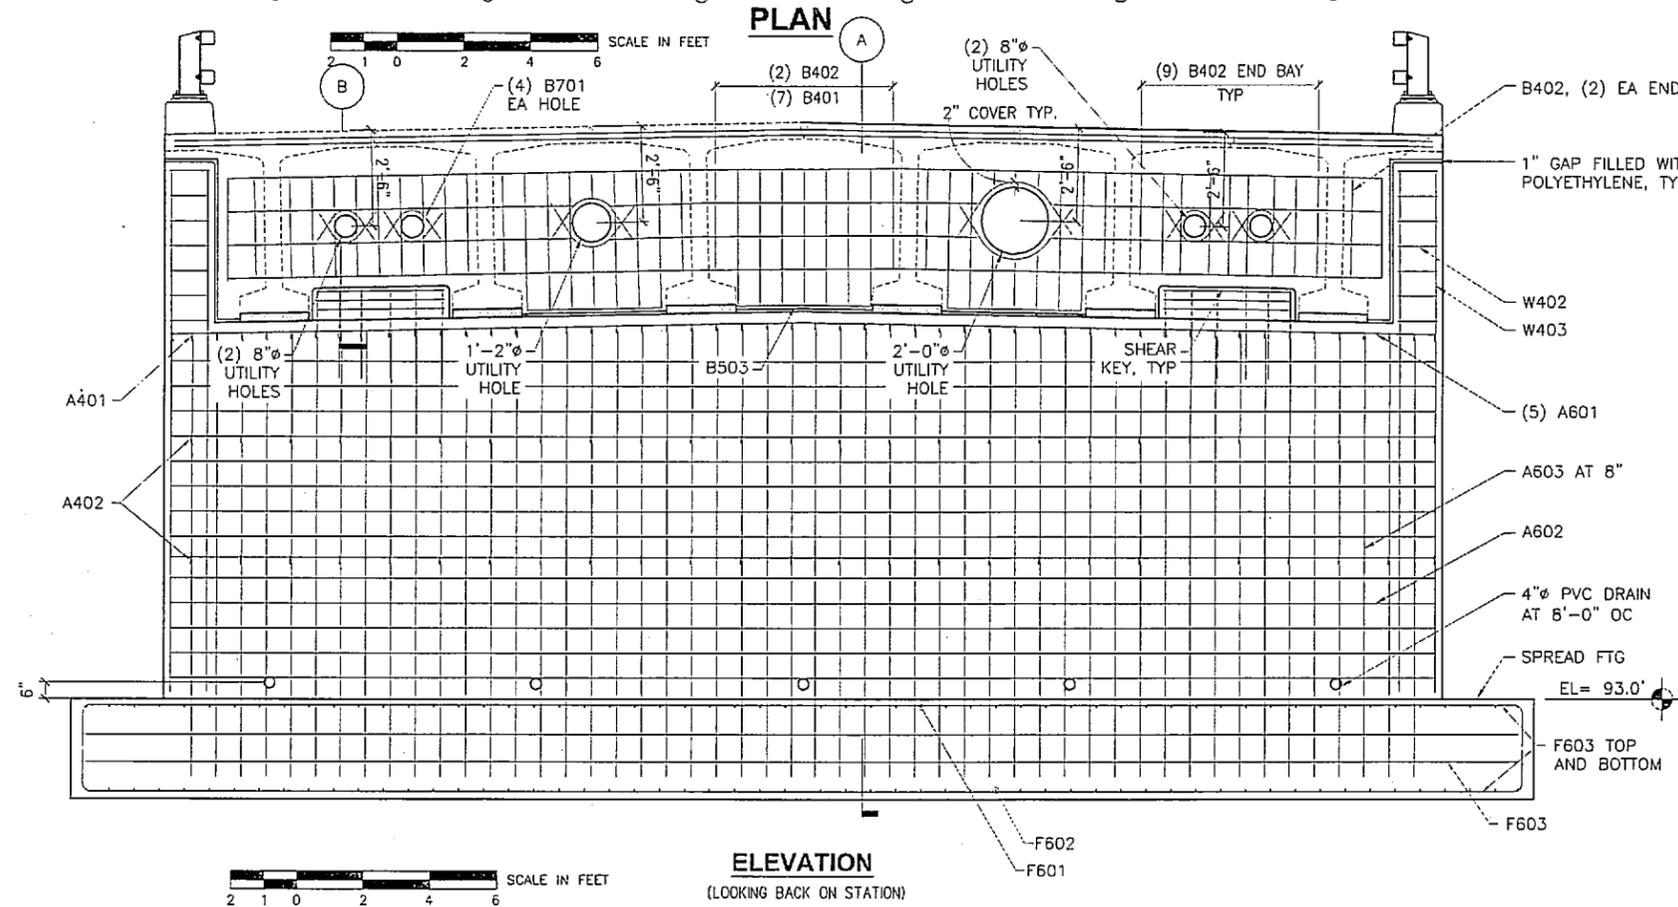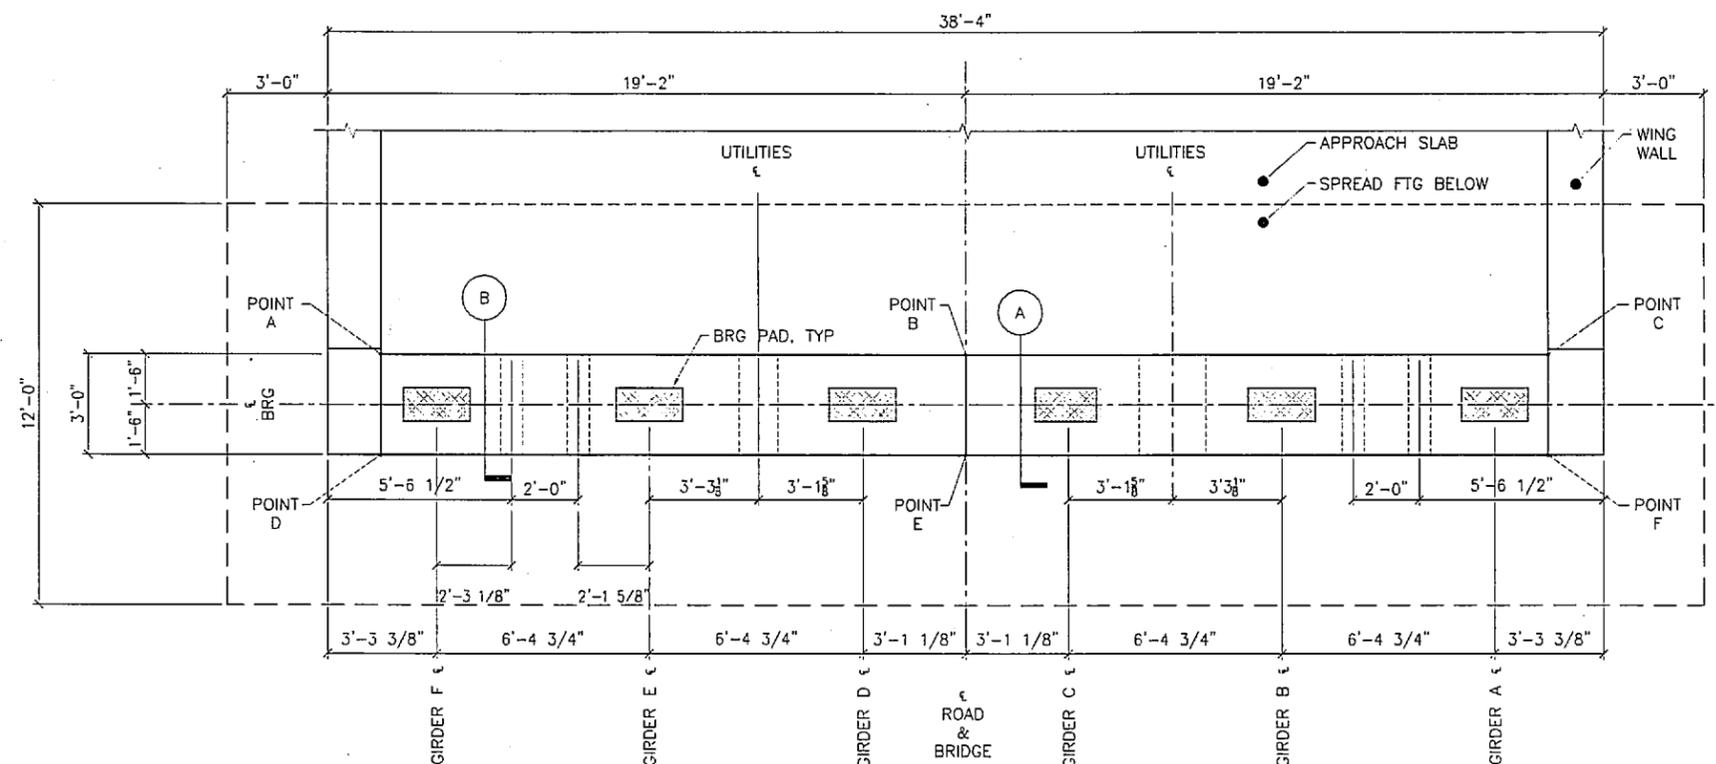

**ELEVATION**  
(LOOKING BACK ON STATION)

DESIGNED BY:	C KENLEY	CHECKED:	J GOBELI
DRAWN BY:	J HELTON	CHECKED:	J GOBELI
QUANTITIES BY:	D BENTTI	CHECKED:	J GOBELI

STATE OF ALASKA  
DEPARTMENT OF TRANSPORTATION  
AND PUBLIC FACILITIES  
BRIDGE SECTION



GOVERNMENT CREEK BRIDGE  
GRAVINA ISLAND HIGHWAY  
ABUTMENT 1


BRIDGE NO. 2159  
DWG. NO. 4

STATE	PROJECT DESIGNATION	YEAR	SHEET NO.	TOTAL SHEETS
ALASKA	ACH PRL-0003(123)/6781B	2007	N5	N26


### REINFORCING STEEL ONE ABUTMENT

MARK	SIZE	No.	LENGTH	TYPE	NOTES
A401	4	58	3'-5"	BENT	
A402	4	29	3'-5"	BENT	
A501	5	29	5'-0"	-	
A601	5	5	41'-6"	BENT	b
A602	6	28	38'-0"	-	b
A603	6	56	VARIES	-	
AB01	6	56	VARIES	BENT	
B401	4	35	14'-0"	BENT	a
B402	4	14	12'-2"	BENT	a
B501	5	5	34'-10"	-	a
B502	5	2	38'-0"	-	a,b
B503	5	5	4'-0"	-	a
B601	6	4	34'-10"	-	a
B701	7	24	VARIES	BENT	a
F601	6	67	11'-6"	-	
F602	6	89	16'-6"	BENT	
F603	6	36	46'-4"	BENT	b


#### BENDING DIAGRAMS

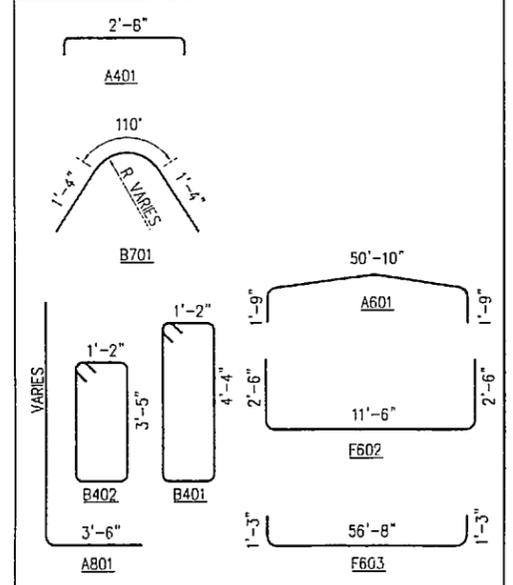

- a - EPOXY COATED REINFORCING STEEL
- b - LENGTH DOES NOT INCLUDE SPLICES
- c - FIELD BEND BARS TO MATCH CROWN.

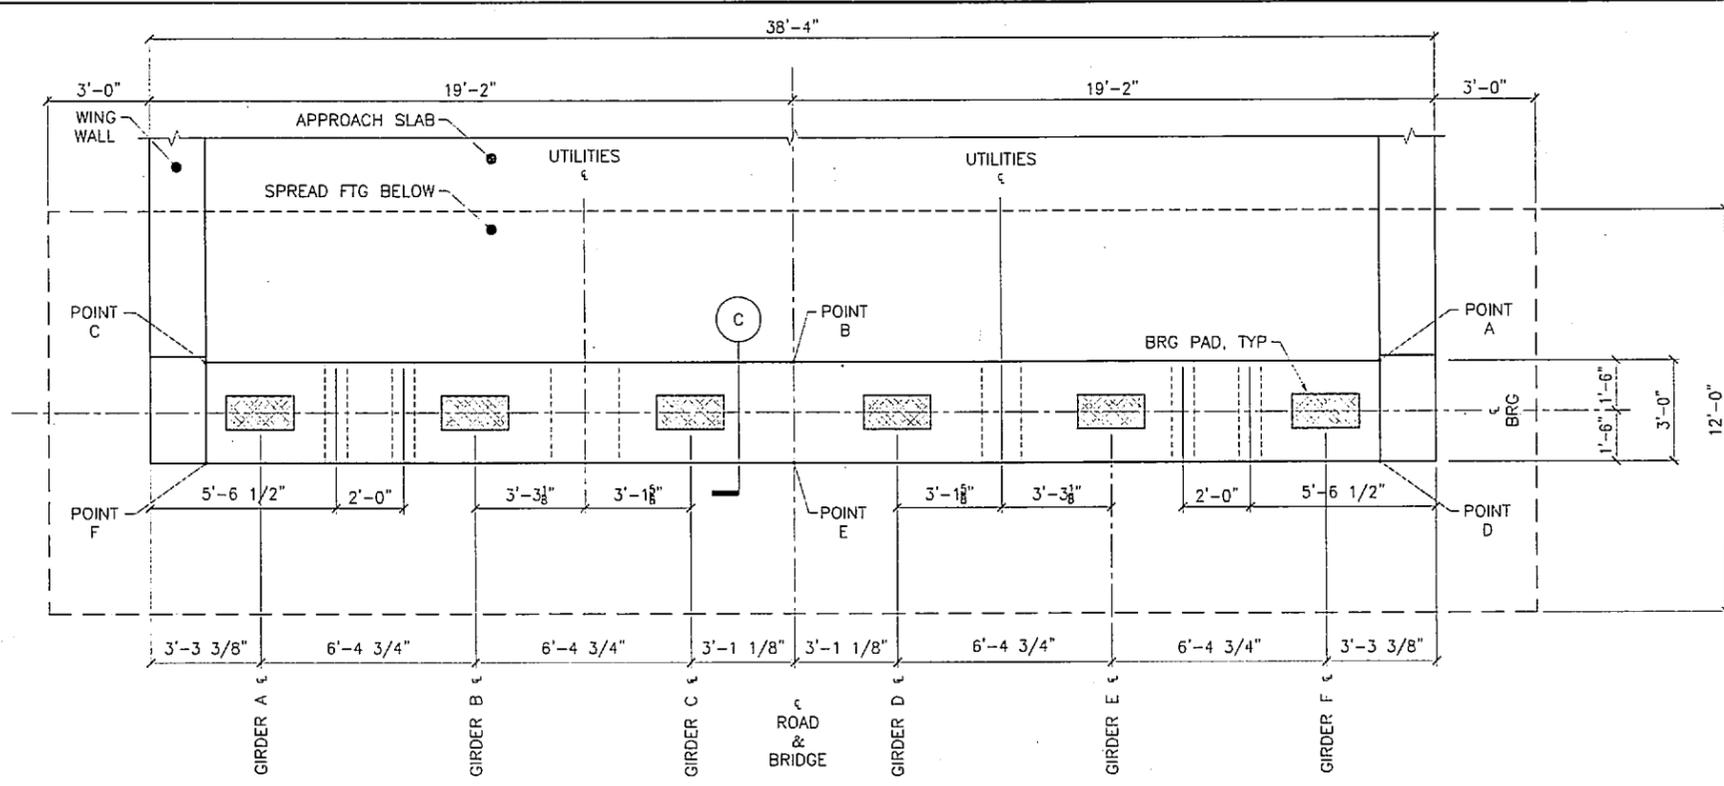

**PLAN** SCALE IN FEET

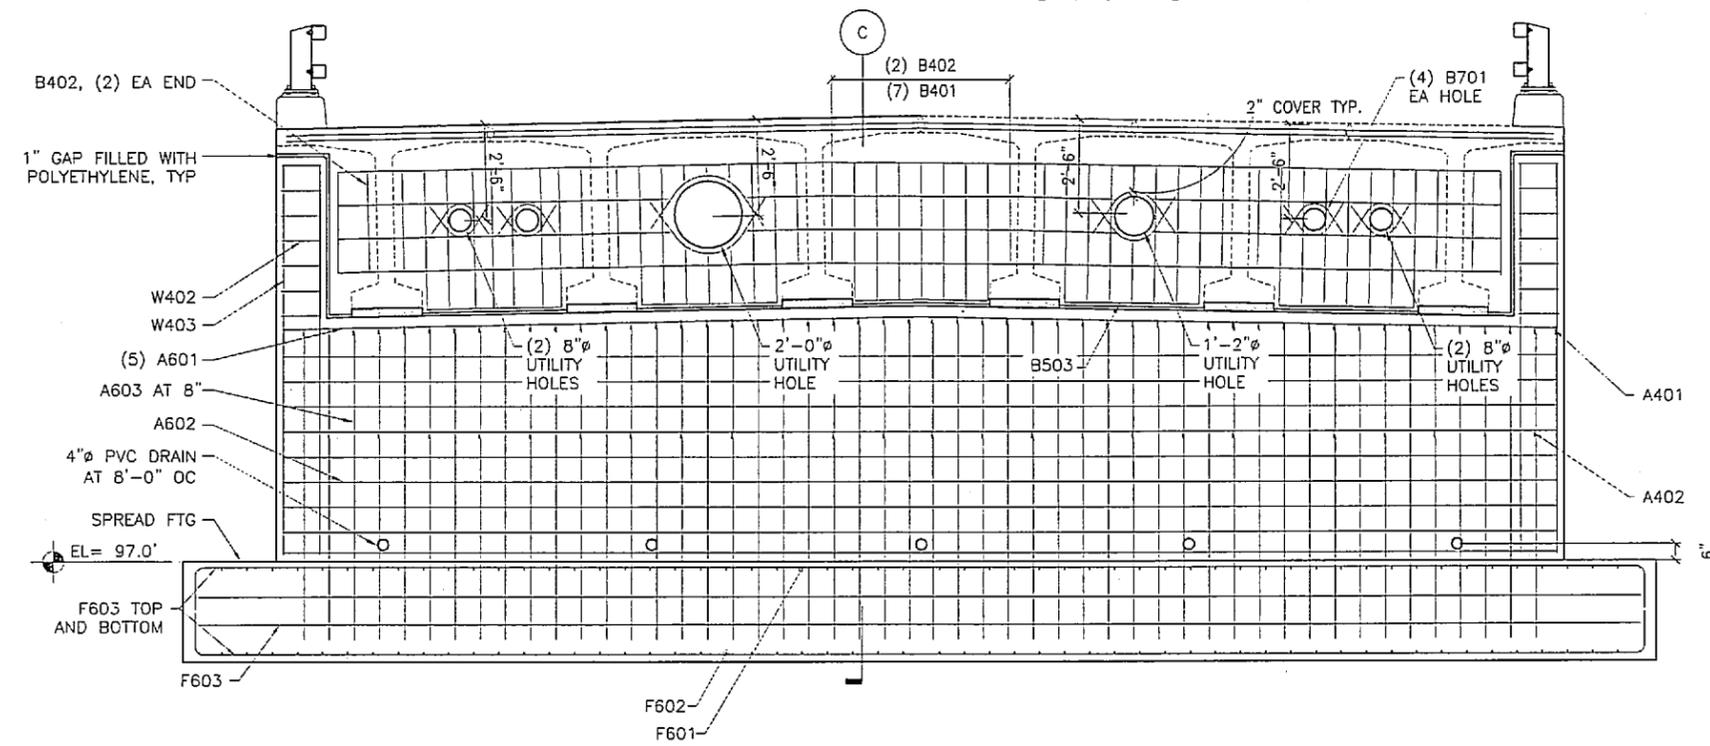

**ELEVATION** SCALE IN FEET

#### TOP OF ABUTMENT WALL ELEVATIONS

POINT	AS-BUILT	ABUTMENT 2
A	104.50	104.43
B	104.85	104.79
C	104.50	
D	104.52	104.45
E	104.87	104.81
F	104.52	

DESIGNED BY:	C. KENLEY	CHECKED:	J. GOBELT
DRAWN BY:	J. HELTON	CHECKED:	J. GOBELT
QUANTITIES BY:	D. BENTZ	CHECKED:	J. GOBELT


STATE OF ALASKA  
DEPARTMENT OF TRANSPORTATION  
AND PUBLIC FACILITIES  
BRIDGE SECTION




GOVERNMENT CREEK BRIDGE  
GRAVINA ISLAND HIGHWAY  
ABUTMENT 2



BRIDGE NO. 2159  
DWG. NO. 5

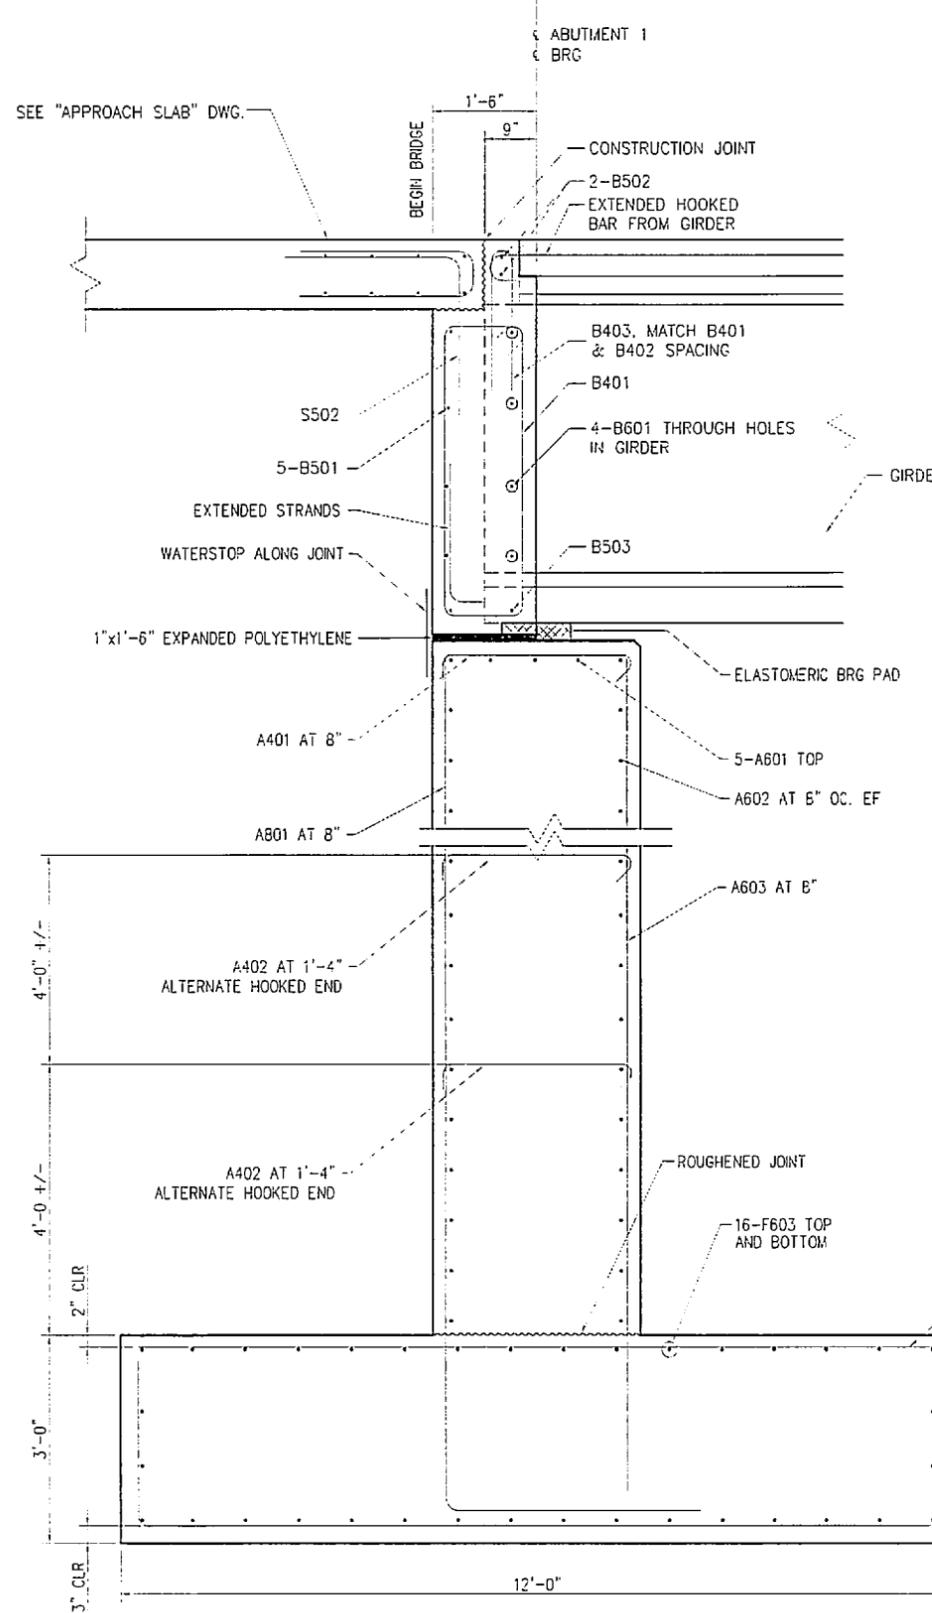


**SECTION A** SCALE IN FEET

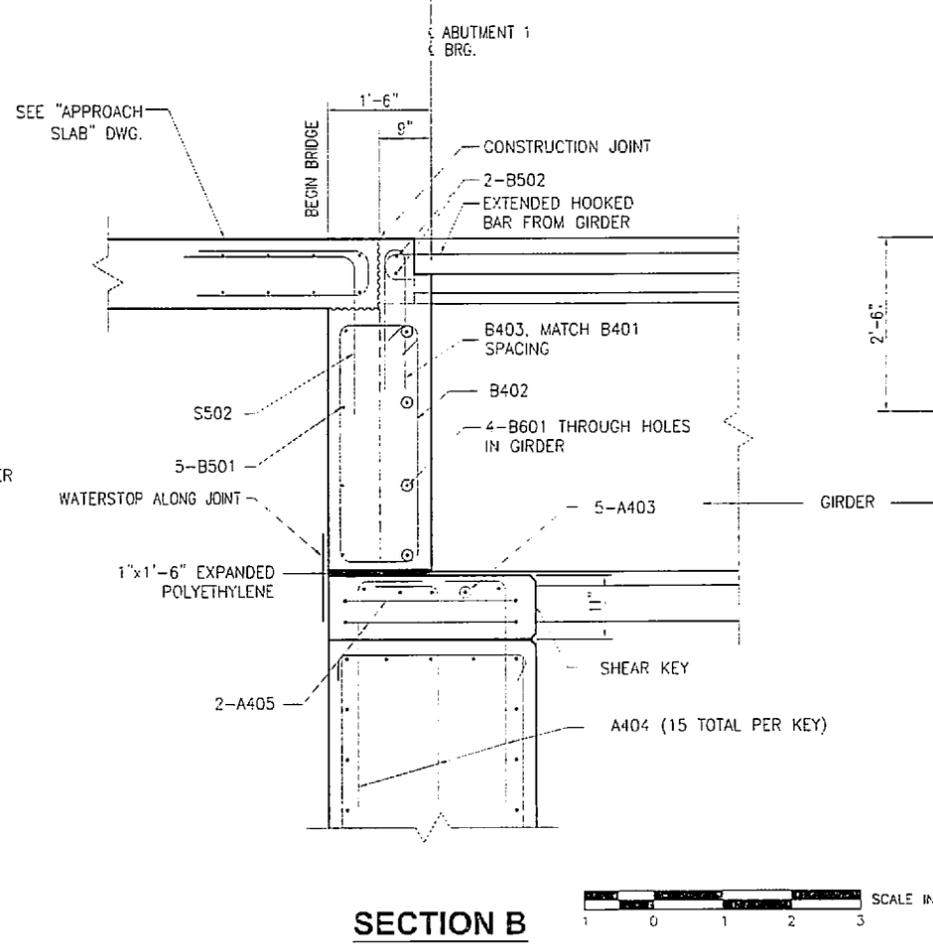


**SECTION B** SCALE IN FEET

**BEARING PAD REACTIONS**

LOCATION	D.L. PER BRG.	L.L. PER BRG.
ABUTMENTS	112.6 kips	77.4 kips

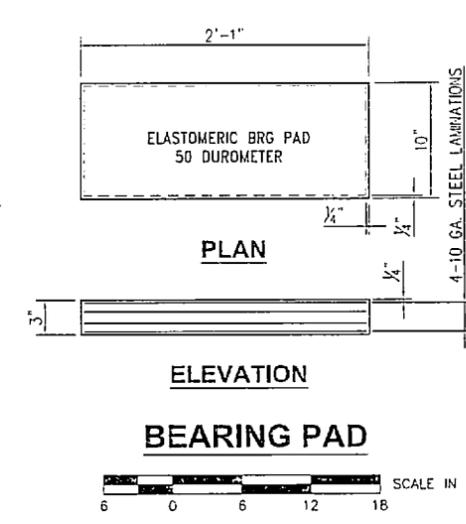

**BEARING PAD** SCALE IN INCHES

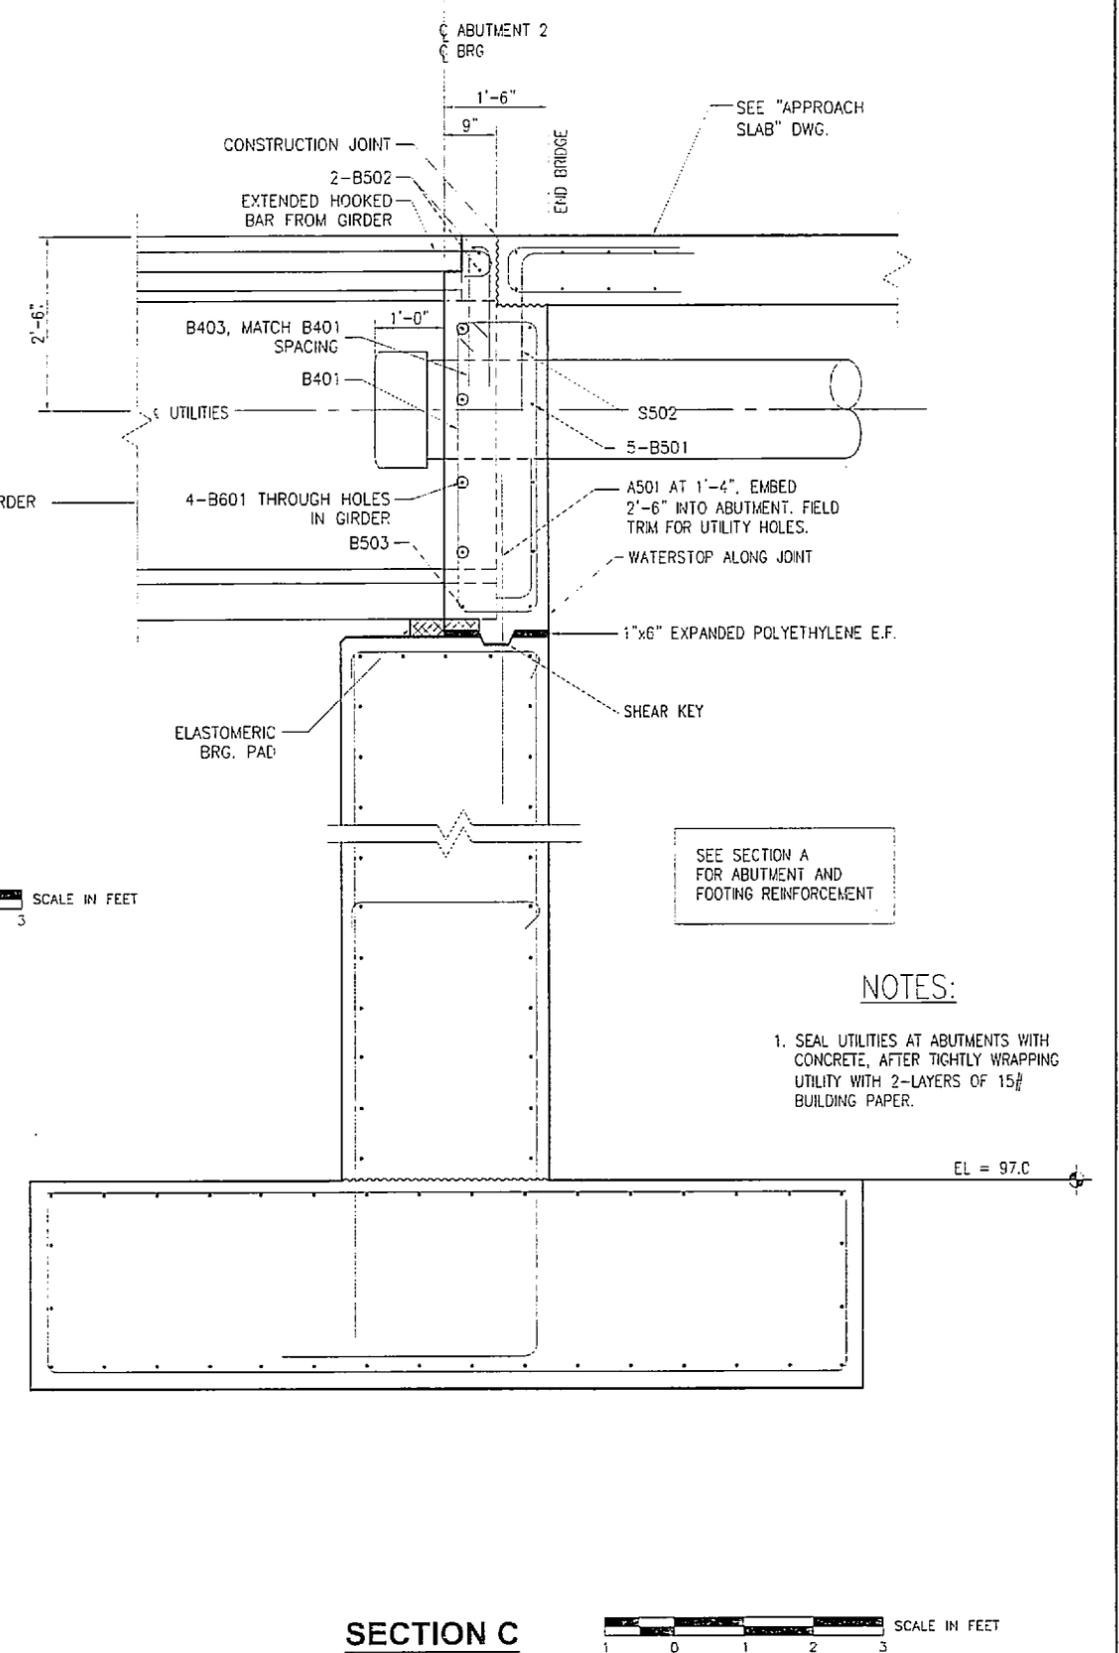

**SECTION C** SCALE IN FEET


SEE SECTION A FOR ABUTMENT AND FOOTING REINFORCEMENT

- NOTES:**
- SEAL UTILITIES AT ABUTMENTS WITH CONCRETE, AFTER TIGHTLY WRAPPING UTILITY WITH 2-LAYERS OF 15# BUILDING PAPER.

EL = 97.0

DESIGNED BY:	C. KENLEY	CHECKED:	J. GOBELT
DRAWN BY:	J. HELTON	CHECKED:	J. GOBELT
QUANTITIES BY:	D. BENNETT	CHECKED:	J. GOBELT

STATE OF ALASKA  
DEPARTMENT OF TRANSPORTATION  
AND PUBLIC FACILITIES  
BRIDGE SECTION

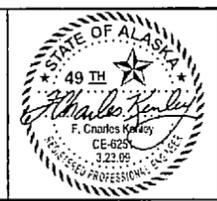

GOVERNMENT CREEK BRIDGE  
GRAVINA ISLAND HIGHWAY  
ABUTMENT DETAILS




BRIDGE NO. 2159  
DWG. NO. 6

### REINFORCING STEEL ONE ABUTMENT

MARK	SIZE	No.	LENGTH	TYPE	NOTES
W401	4	84	VARIES	-	
W402	4	20	9'-0"	BENT	
W403	4	16	18'-7"	-	
W501	5	40	VARIES	-	
W502	5	60	VARIES	-	
W901	9	60	VARIES	-	
W902	9	4	21'-2"	BENT	
W903	9	4	23'-6"	BENT	
C403	4	30	7'-8"	BENT	o
C502	5	4	19'-8"	-	o


#### BENDING DIAGRAMS

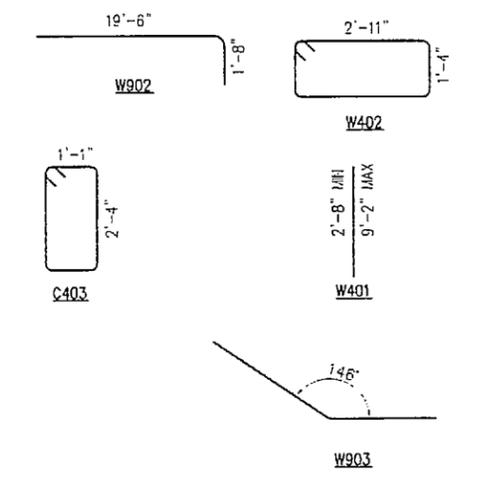

o - EPOXY COATED REINFORCING STEEL


#### TOP OF WALL ELEVATIONS

LOCATION	TOP OF WALL	
	A	B
TOP OF CURB	112.28	112.10
TOP OF WALL	111.44	111.27

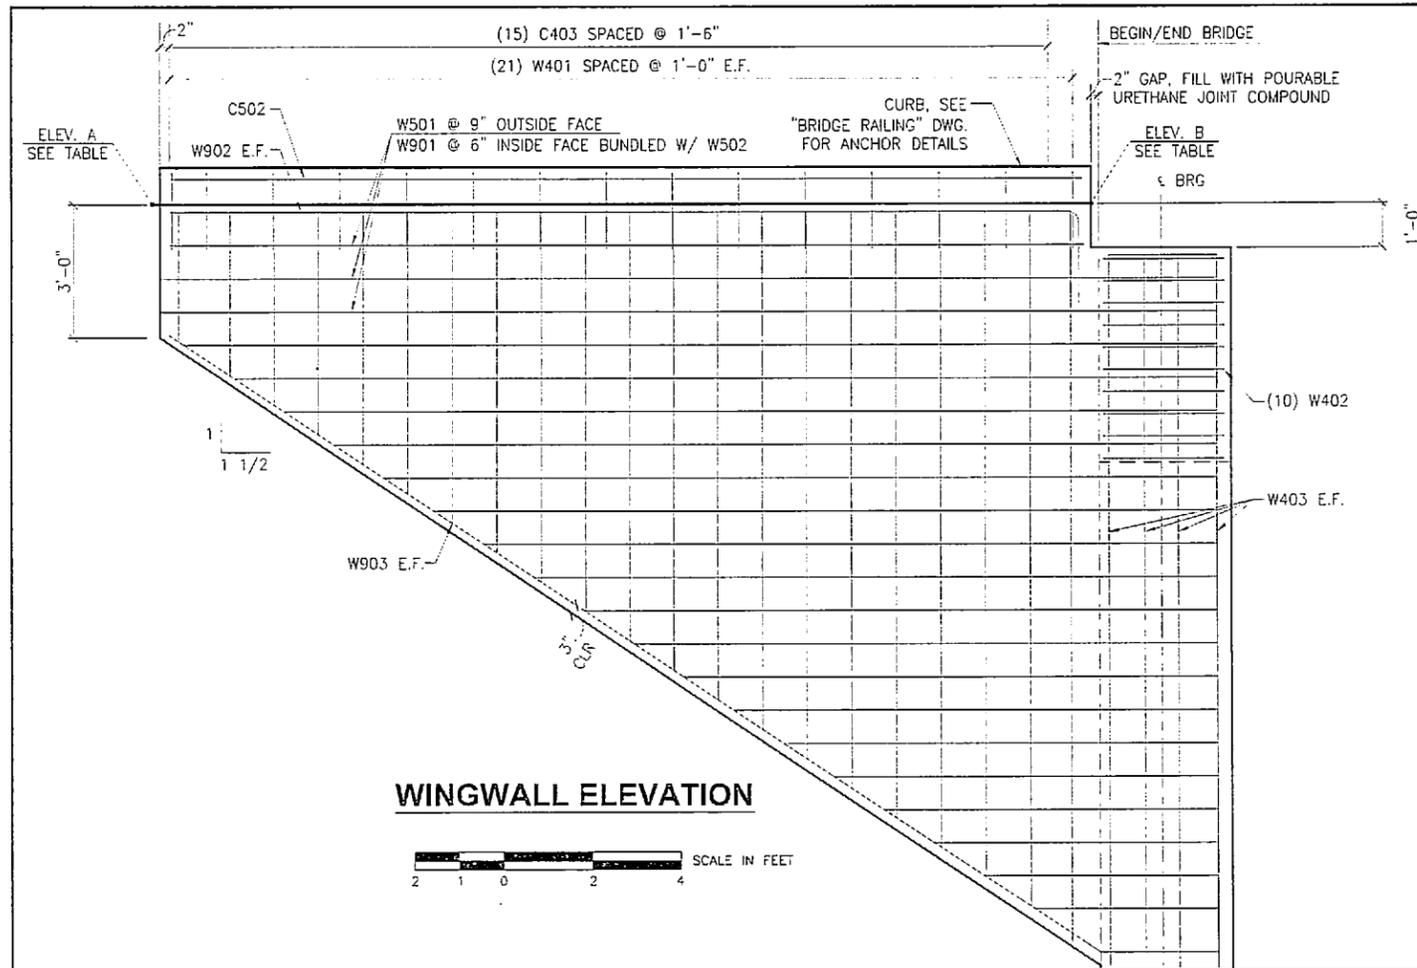


**WINGWALL ELEVATION**

SCALE IN FEET

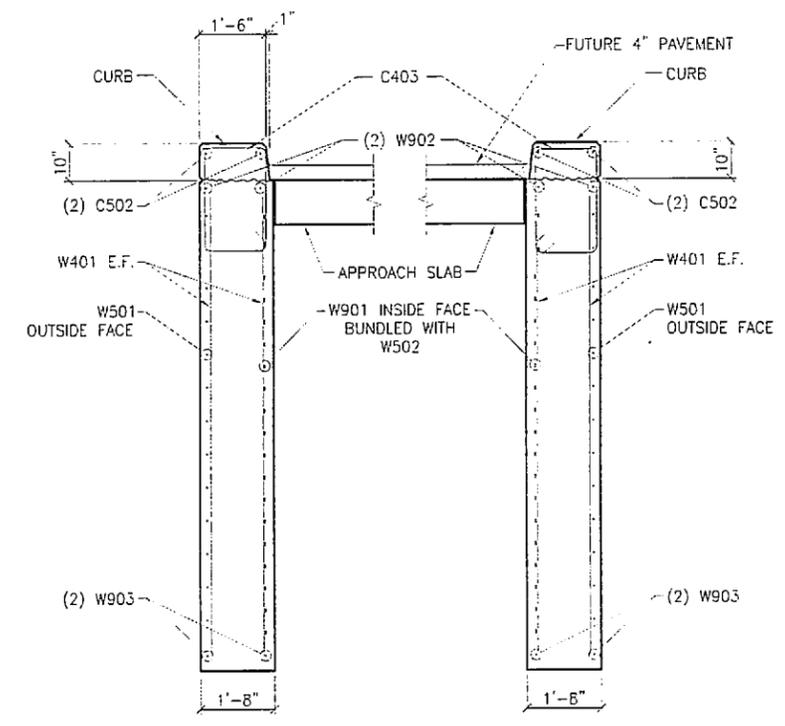


**WINGWALL SECTION**

SCALE IN FEET

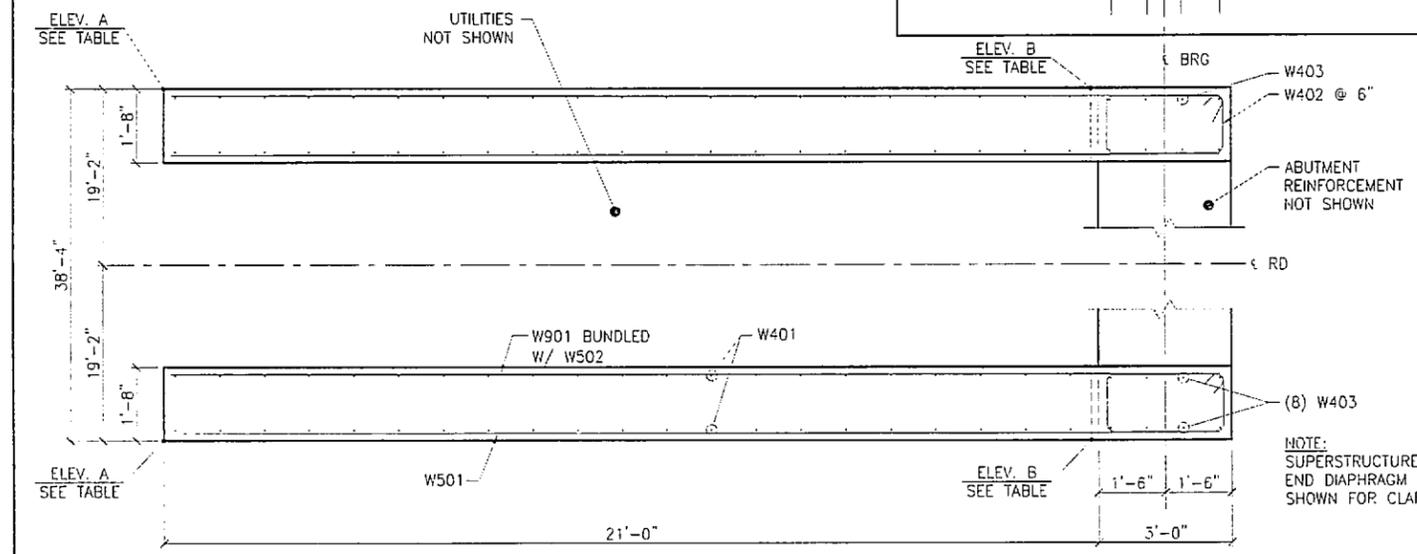

**WINGWALL PLAN**

SCALE IN FEET

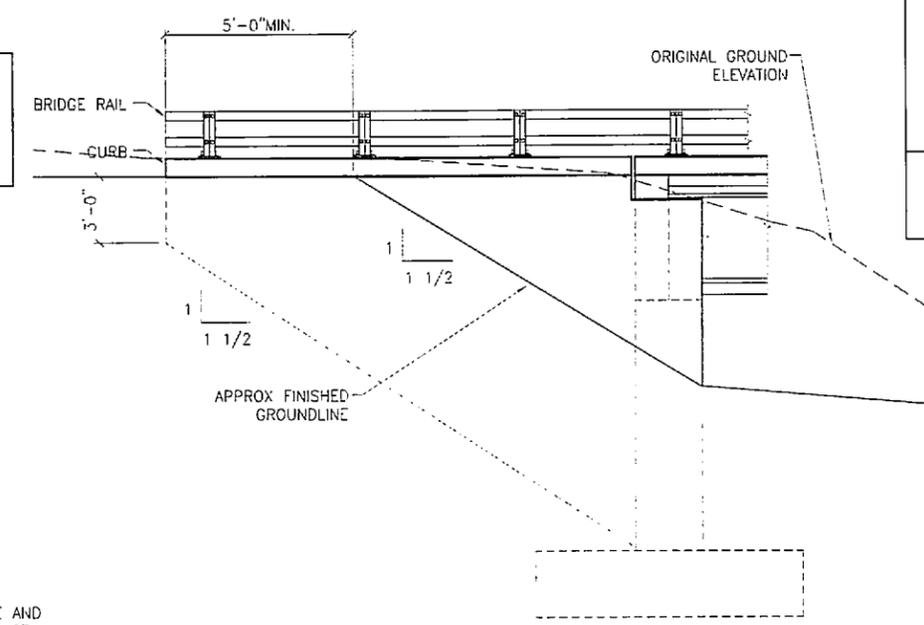


**FINISHED ELEVATION**

SCALE IN FEET

DESIGNED BY:	C KENLEY	CHECKED:	J GOBELT
DRAWN BY:	J HELTON	CHECKED:	J GOBELT
QUANTITIES BY:	D BEHTT	CHECKED:	J GOBELT

STATE OF ALASKA  
DEPARTMENT OF TRANSPORTATION  
AND PUBLIC FACILITIES  
BRIDGE SECTION

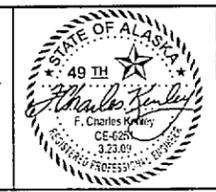

GOVERNMENT CREEK BRIDGE  
GRAVINA ISLAND HIGHWAY  
WINGWALL AT ABUTMENT 1




BRIDGE NO. 2159  
DWG. NO. 7

STATE	PROJECT DESIGNATION	YEAR	SHEET NO.	TOTAL SHEETS
ALASKA	ACH PRL-0003(123)/67818	2007	N8	N26

### REINFORCING STEEL ONE ABUTMENT

MARK	SIZE	No.	LENGTH	TYPE	NOTES
W401	4	84	VARIABLES	-	
W402	4	20	9'-0"	BENT	
W403	4	16	15'-6"	-	
W501	5	36	VARIABLES	-	
W502	5	54	VARIABLES	-	
W901	9	54	VARIABLES	-	
W902	9	4	21'-2"	BENT	
W903	9	4	23'-8"	BENT	
C403	4	30	7'-8"	BENT	o
C502	5	4	19'-8"	-	o


#### BENDING DIAGRAMS

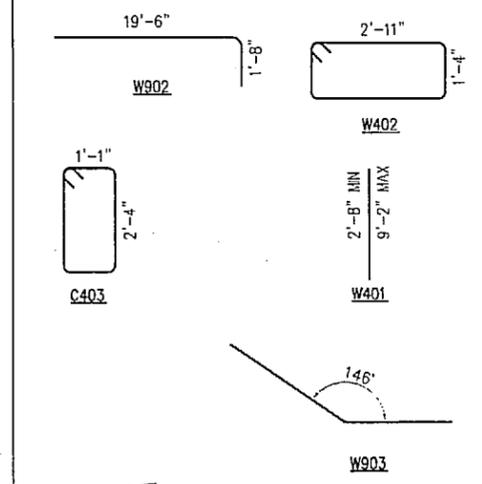


o - EPOXY COATED REINFORCING STEEL

#### TOP OF WALL ELEVATIONS



LOCATION	A	B
TOP OF CURB	110.60	110.79
TOP OF WALL	109.96	110.13

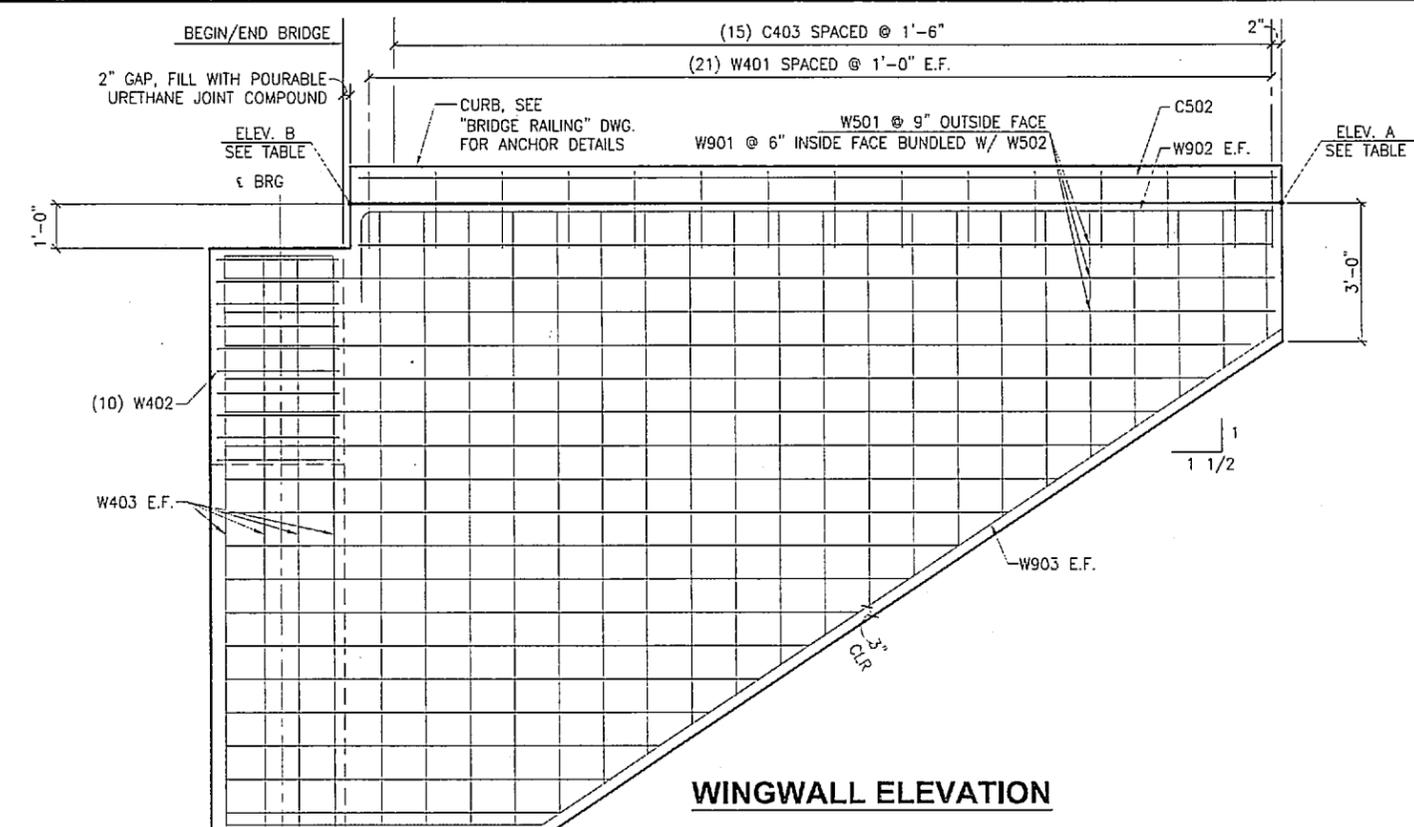


**WINGWALL ELEVATION**

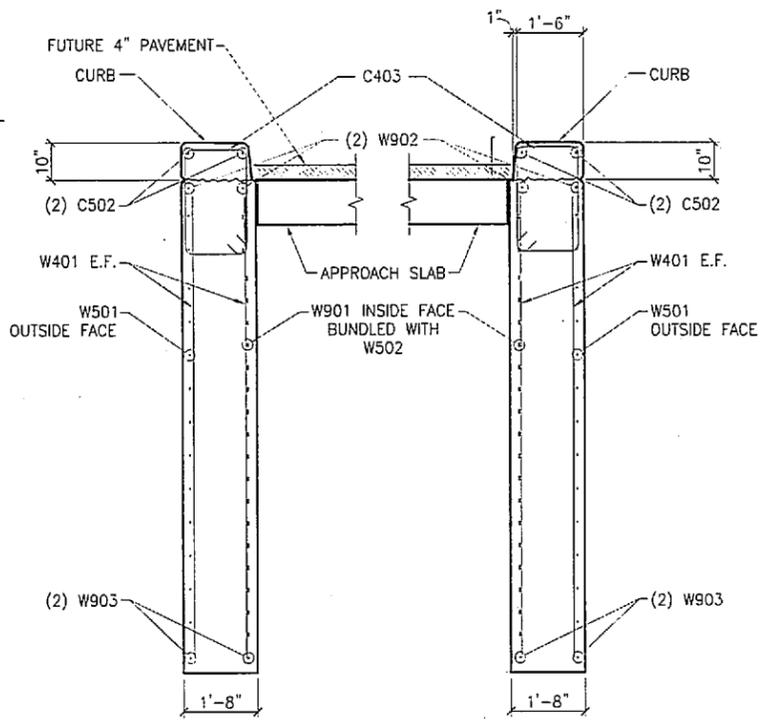

**WINGWALL SECTION**

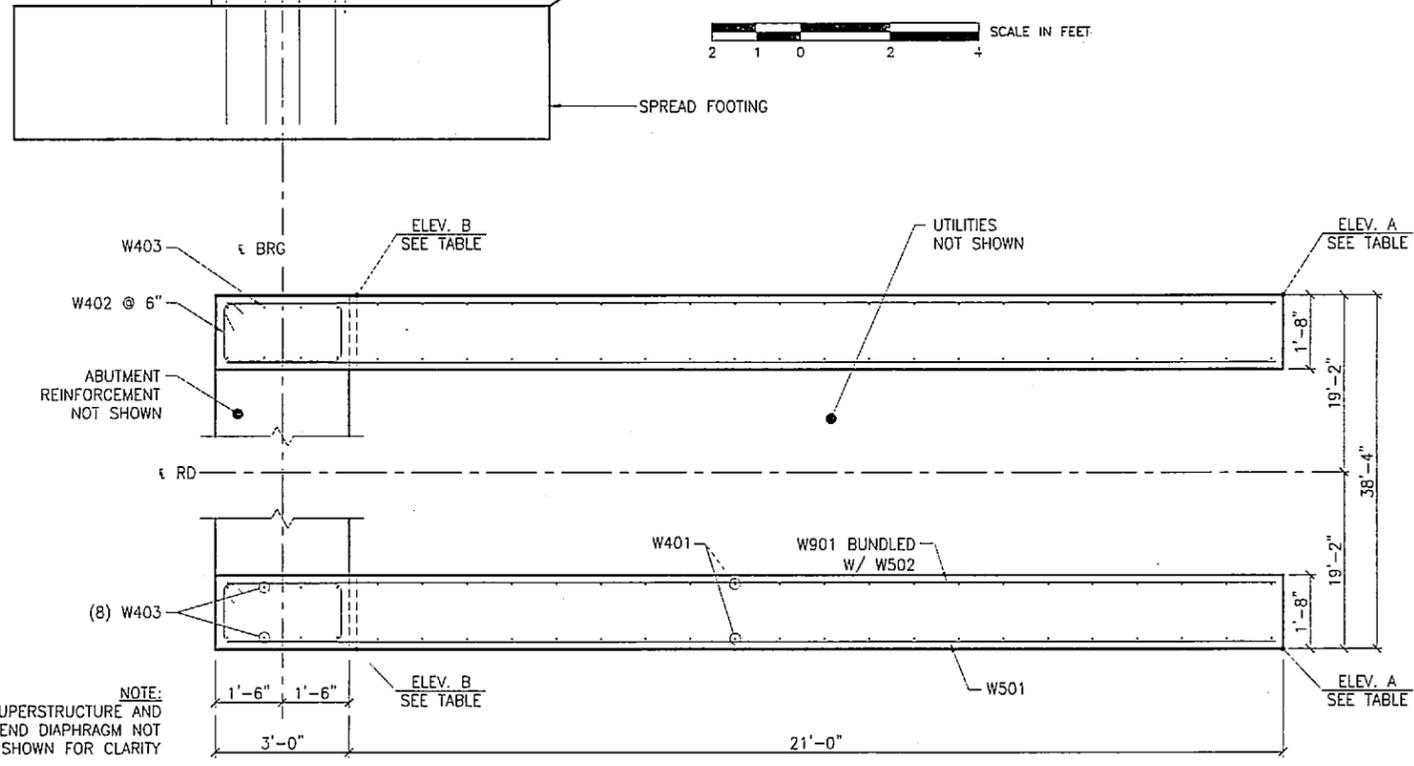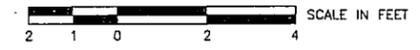

**WINGWALL PLAN**

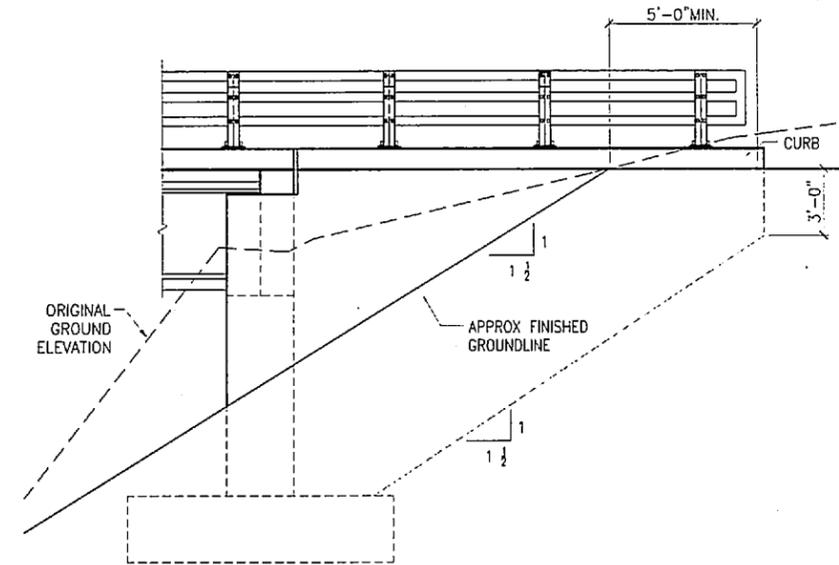


**FINISHED ELEVATION**



DESIGNED BY:	C. KENLEY	CHECKED:	J. GOBELT
DRAWN BY:	J. HELTOY	CHECKED:	J. GOBELT
QUANTITIES BY:	D. BENTTI	CHECKED:	J. GOBELT

STATE OF ALASKA  
DEPARTMENT OF TRANSPORTATION  
AND PUBLIC FACILITIES  
BRIDGE SECTION

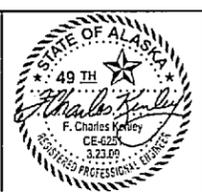

GOVERNMENT CREEK BRIDGE  
GRAVINA ISLAND HIGHWAY  
WINGWALL AT ABUTMENT 2



  
BRIDGE NO. 2159  
DWG. NO. 8

STATE	PROJECT DESIGNATION	YEAR	SHEET NO.	TOTAL SHEETS
ALASKA	ACH PRL-0003(123)/67818	2007	N9	N26


### REINFORCING STEEL ONE DIAPHRAGM

MARK	SIZE	No.	LENGTH	TYPE	NOTES
D401	4	59	8'-6"	BENT	a
D402	4	8	2'-2"	BENT	a
D403	4	28	5'-7"	-	a
D501	5	4	43'-10"	BENT	a,b
D701	7	4	4'-5"	BENT	c
D702	7	4	6'-3"	BENT	c



BENDING DIAGRAMS

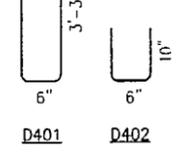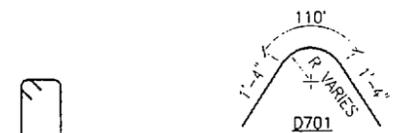


a - EPOXY COATED REINFORCING STEEL  
b - LENGTH DOES NOT INCLUDE SPLICES

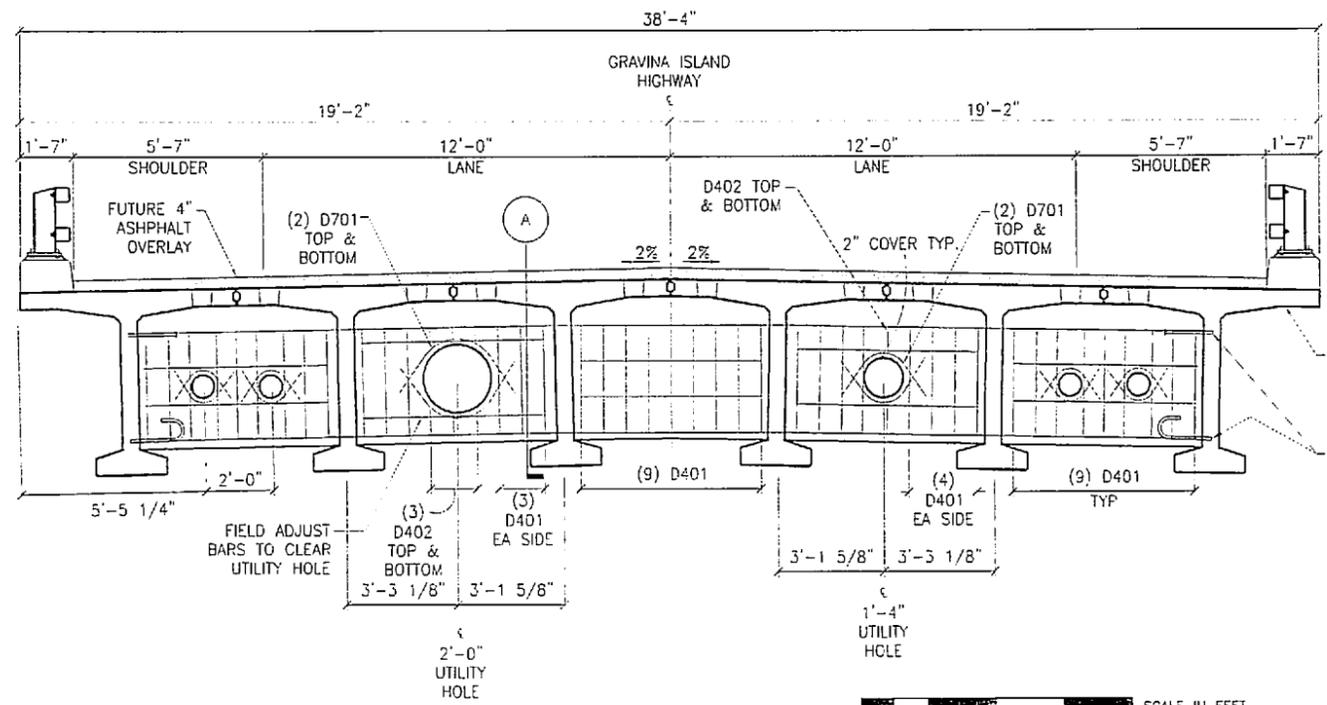

SECTION NEAR MIDSPAN SCALE IN FEET

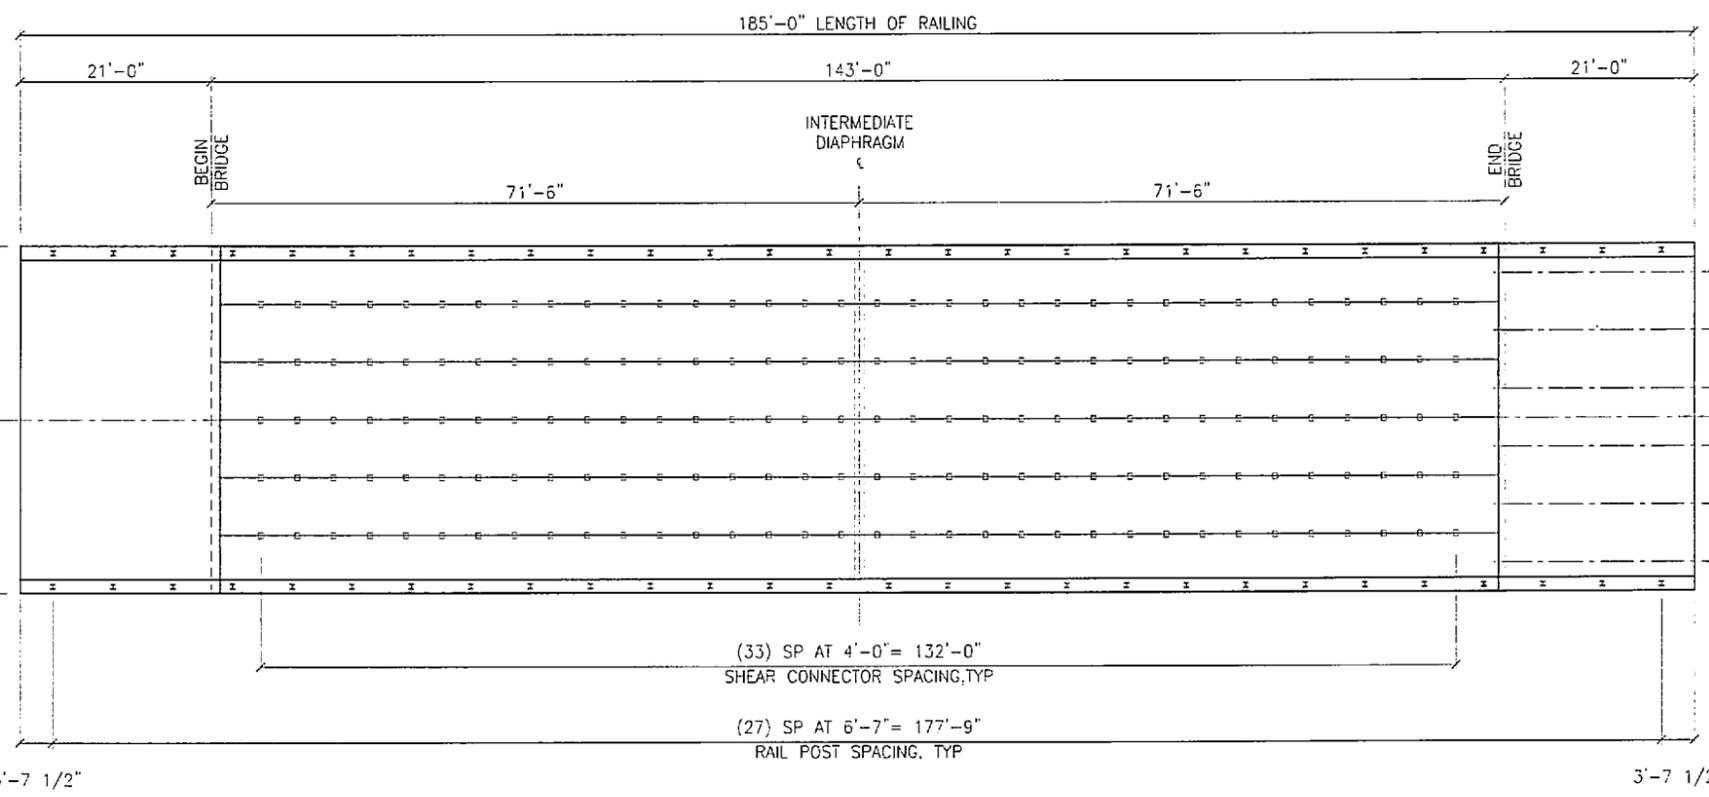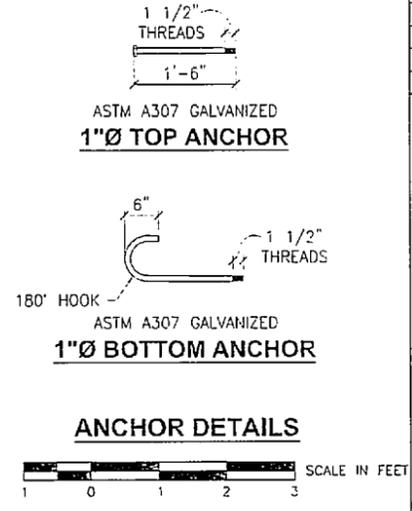


FRAMING PLAN SCALE IN FEET

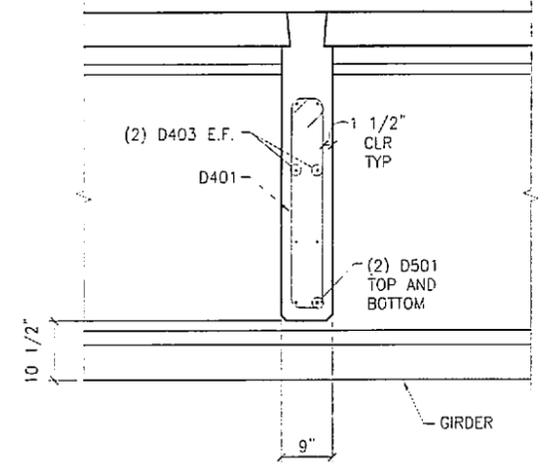

DIAPHRAGM SECTION A SCALE IN FEET

DESIGNED BY:	C KENLEY	CHECKED:	J GOBELI
DRAWN BY:	J HELTON	CHECKED:	J GOBELI
QUANTITIES BY:	D BENTTI	CHECKED:	J GOBELI

STATE OF ALASKA  
DEPARTMENT OF TRANSPORTATION  
AND PUBLIC FACILITIES  
BRIDGE SECTION

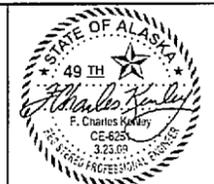

GOVERNMENT CREEK BRIDGE  
GRAVINA ISLAND HIGHWAY  
TYPICAL SECTION



BRIDGE NO. 2159  
DWG. NO. 9

141'-6" GIRDER LENGTH (ADJUST CASTING LENGTH FOR ELASTIC SHORTENING AND SHRINKAGE)

281 - G401 & G501 AT 6" OC INTERIOR GIRDERS  
281 - G401E & G501E AT 6" OC EXTERIOR GIRDERS

SYMM. ABOUT  $\epsilon$  SPAN VOID IN DECK

1'-0" 1'-0" COIL INSERT

70'-9" PLAN - TOP FLANGE

SYMM. ABOUT  $\epsilon$  SPAN


12 - G402 & G502

STATE	PROJECT DESIGNATION	YEAR	SHEET NO.	TOTAL SHEETS
ALASKA	ACH PRL-0003(123)/67818	2007	N10	N26

### REINFORCING STEEL ONE GIRDER

MARK	SIZE	No.	LENGTH	TYPE	NOTES
G401	4	281	6'-1"	BENT	a
G401E	4	281	6'-1"	BENT	a,d
G402	4	12	140'-2"	-	a
G403	4	464	6'-11"	BENT	a
G404	4	76	3'-3"	BENT	a
G405	4	95	2'-4"	BENT	a,q
G501	5	281	6'-1"	-	a
G501E	5	281	6'-8"	BENT	a,d
G502	5	12	143'-2"	BENT	a,b
C401E	4	95	4'-10"	BENT	a,c,e
C402E	4	95	4'-6"	BENT	a,c,f
C501E	5	2	142'-8"	-	a,b,d

BENDING DIAGRAMS

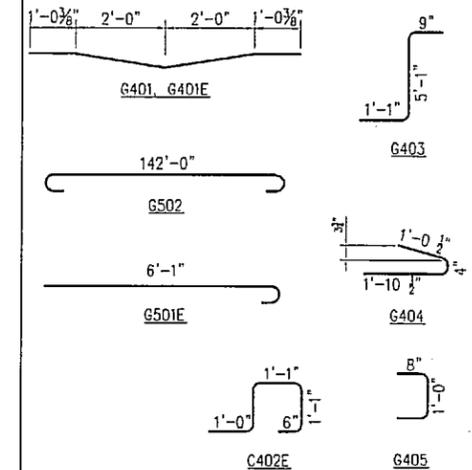

- a - EPOXY COATED REINFORCING STEEL
- b - LENGTH DOES NOT INCLUDE SPLICES
- c - SHIP FOUR LOOSE
- d - GIRDERS A, H ONLY
- e - GIRDER A ONLY
- f - GIRDER H ONLY
- g - GIRDER B ONLY

NOTES:  
USE NORMAL WEIGHT CONCRETE WITH THE FOLLOWING STRENGTHS:  
AT STRESS TRANSFER  $f'_{ci}$  = 6750 PSI  
AT 28 DAYS  $f'_{c}$  = 8000 PSI  
USE  $\frac{1}{2}$ " $\phi$  LOW-RELAXATION PRESTRESSING STRANDS WITH AN ULTIMATE STRENGTH OF 270 KSI AND A CROSS SECTION AREA OF 0.153 IN<sup>2</sup>.

DESIGN IS BASED ON THE FOLLOWING STEEL STRESSES:  
PRETENSIONING - JACKING STRESS 189 KSI  
AFTER ALL LOSSES 162 KSI


ONE INCH CLEAR ON ALL REINFORCING EXCEPT AS NOTED.

DEFLECT FORMS TO COMPENSATE FOR CAMBER AND ROADWAY GRADE.

PROVIDE BROOM FINISH ON THE ROADWAY SURFACE OF THE PRECAST MEMBER. ROUGHEN THE SURFACE UNDER THE RAILING CURBS.


OMIT SHEAR KEY AND SHEAR KEY CONNECTORS OUTSIDE THE EXTERIOR GIRDERS.

CAST GIRDER ENDS PLUMB WITH RESPECT TO ROADWAY GRADE.

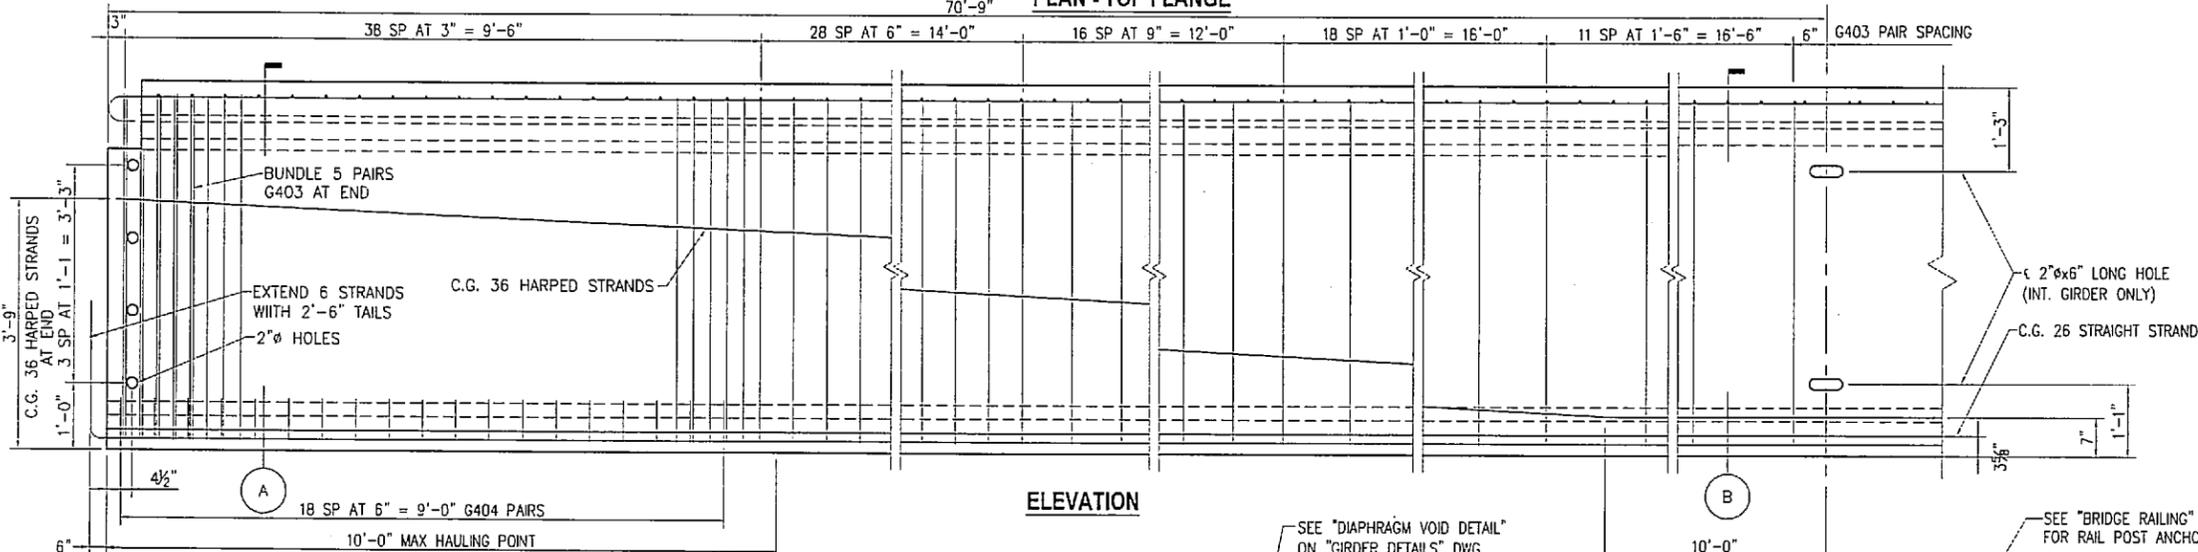


ELEVATION

EXTERIOR GIRDER NEAR MIDSPAN

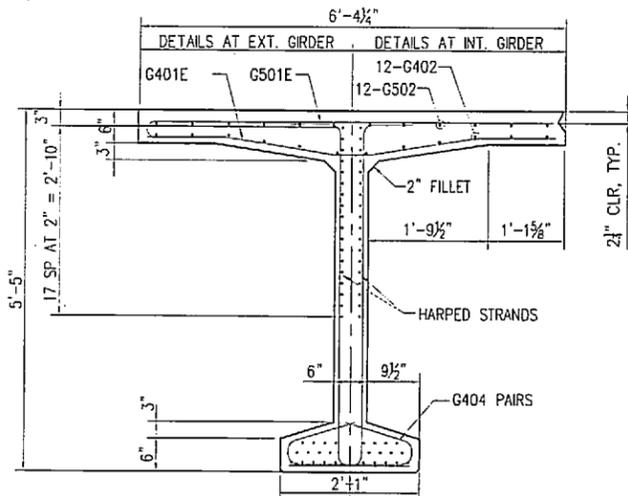

SECTION A

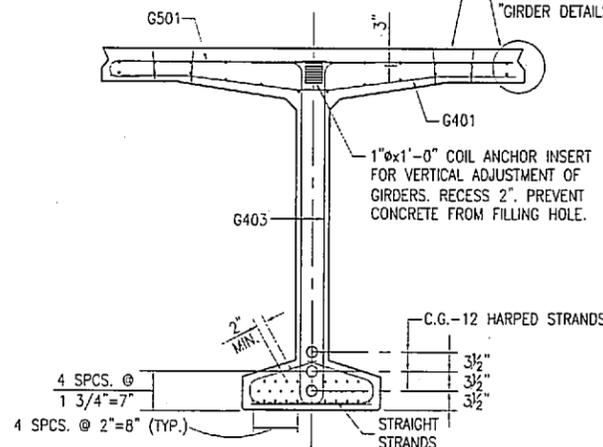

SECTION B

DESIGNED BY:	C KENLEY	CHECKED:	J GOBELT
DRAWN BY:	J HELTON	CHECKED:	J GOBELT
QUANTITIES BY:	D BENTTI	CHECKED:	J GOBELT

STATE OF ALASKA  
DEPARTMENT OF TRANSPORTATION  
AND PUBLIC FACILITIES  
BRIDGE SECTION



GOVERNMENT CREEK BRIDGE  
GRAVINA ISLAND HIGHWAY  
GIRDERS



BRIDGE NO. 2159  
DWG. NO. 10




STATE	PROJECT DESIGNATION	YEAR	SHEET NO.	TOTAL SHEETS
ALASKA	ACH PRL-0003(123)/67818	2007	N12	N26

### REINFORCING STEEL ONE SLAB


MARK	SIZE	No.	LENGTH	TYPE	NOTES
S401	4	60	34'-9"	-	a, b
S501	5	39	20'-5"	-	a
S502	5	39	5'-0"	BENT	a
S503	5	39	5'-7"	BENT	a
S801	8	77	20'-5"	-	a

#### BENDING DIAGRAMS


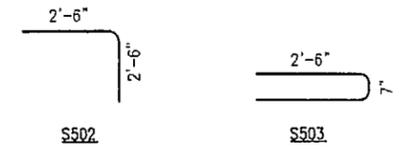


- a - EPOXY COATED REINFORCING STEEL
- b - LENGTH DOES NOT INCLUDE SPLICES



- NOTES:
- FIELD ADJUST S502 TO MSS UTILITIES.
  - CAP ALL UNUSED UTILITIES CONDUITS.

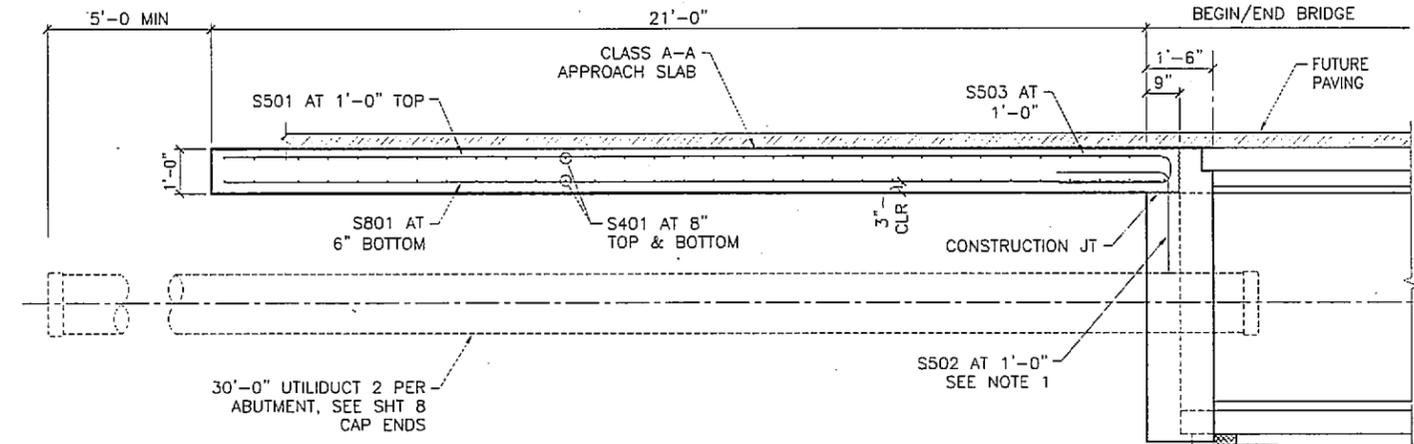

#### SECTION A

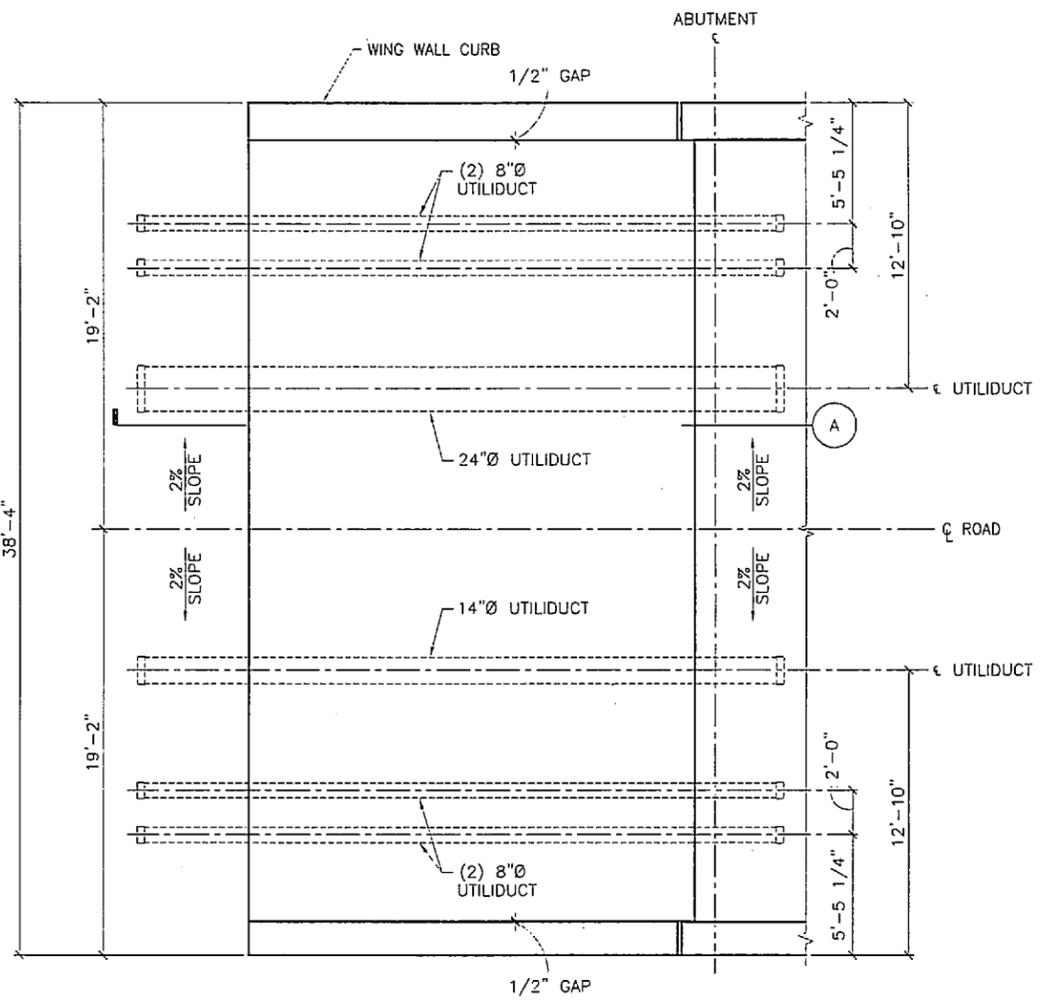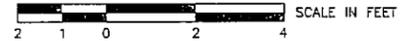

#### PLAN

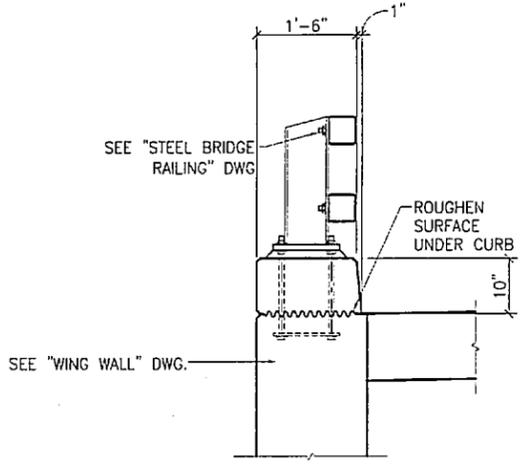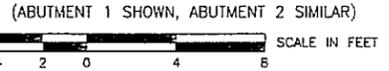

#### BRIDGE RAIL DETAIL



DESIGNED BY:	C. KENLEY	CHECKED:	J. GOBELT
DRAWN BY:	J. HELTON	CHECKED:	J. GOBELT
QUANTITIES BY:	D. BENTZ	CHECKED:	J. GOBELT

STATE OF ALASKA  
DEPARTMENT OF TRANSPORTATION  
AND PUBLIC FACILITIES  
BRIDGE SECTION




GOVERNMENT CREEK BRIDGE  
GRAVINA ISLAND HIGHWAY  
APPROACH SLAB





BRIDGE NO. 2159  
DWG. NO. 12



STATE	PROJECT DESIGNATION	YEAR	SHEET NO.	TOTAL SHEETS
ALASKA	ACH PRL-0003(123)/67818	2007	N13	N26

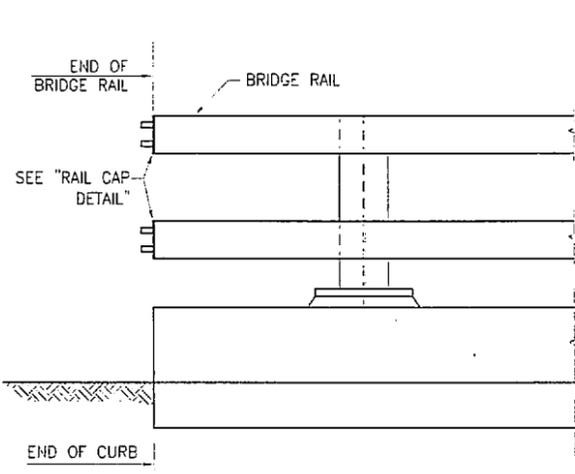



**ELEVATION**

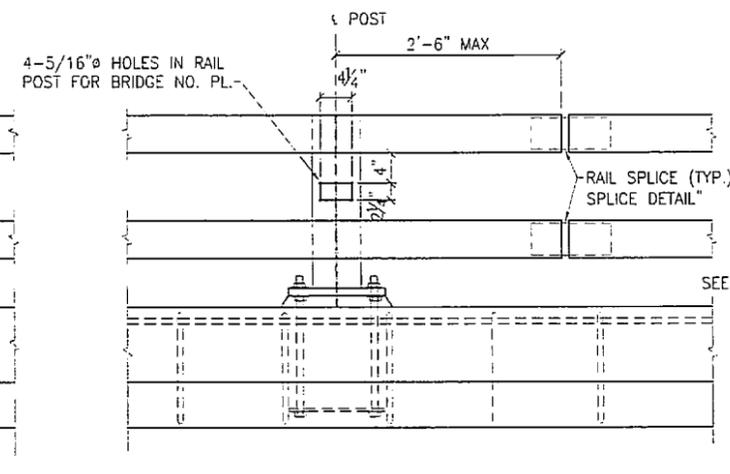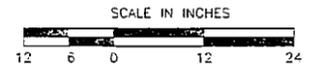



**EXPANSION JOINT**

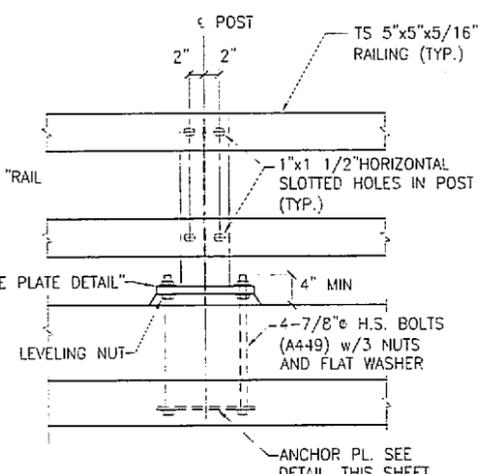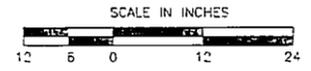



**TYPICAL POST ELEVATION**

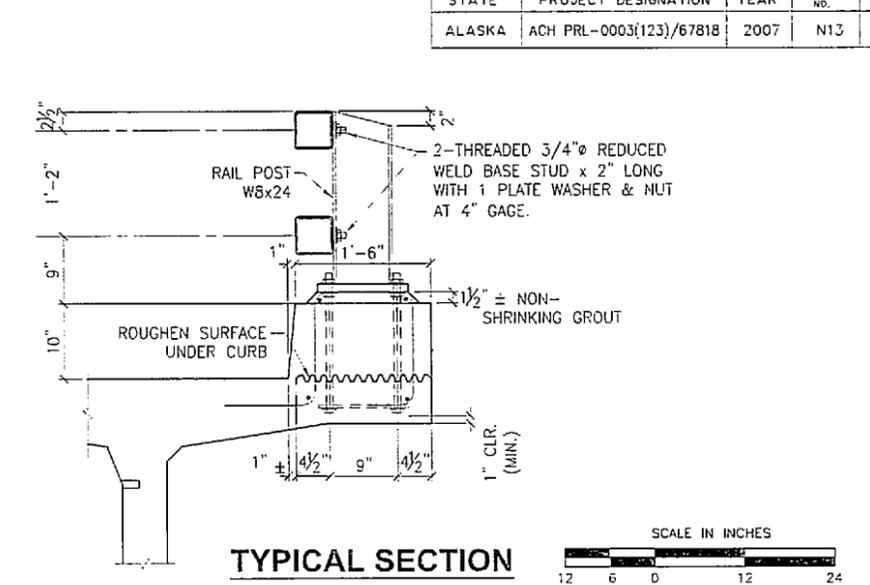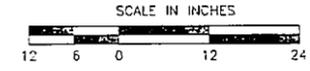


**TYPICAL SECTION**

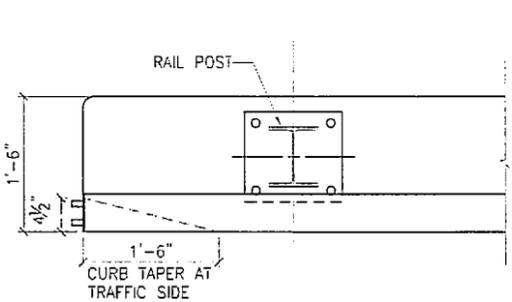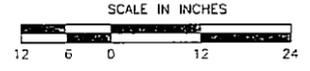



**PLAN  
END POST DETAIL**

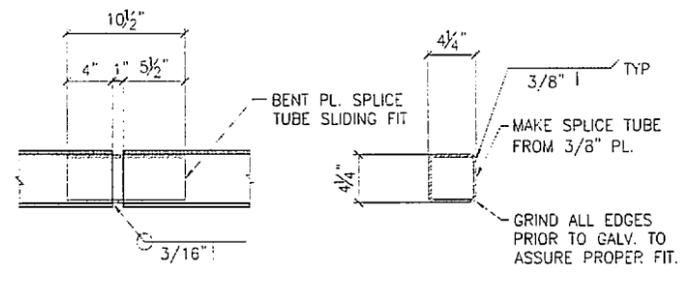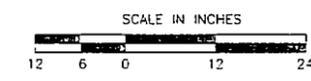



**RAIL SPLICE DETAIL**

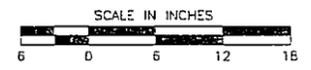



**SPLICE TUBE**

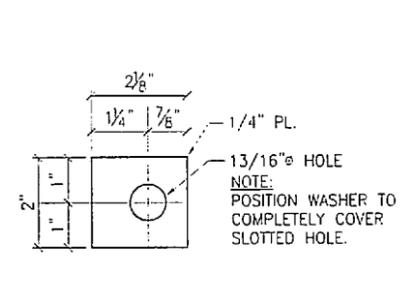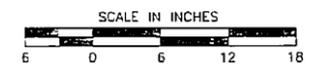



**PLATE WASHER**

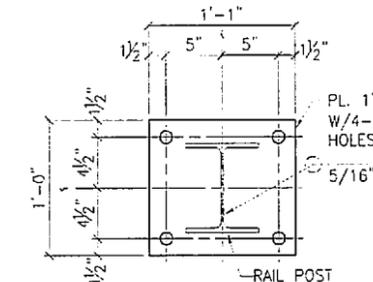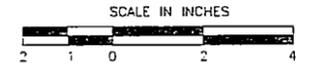



**BASE PLATE DETAIL**

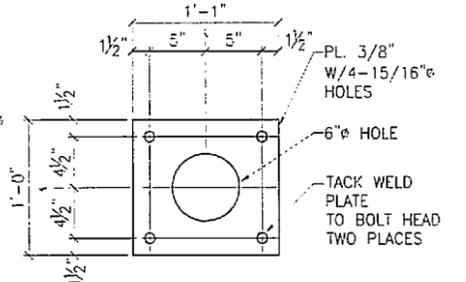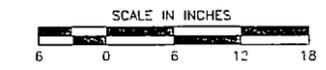


**ANCHOR PLATE DETAIL**

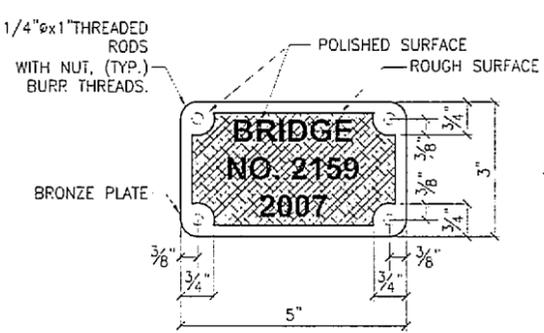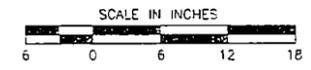


**BRONZE BRIDGE NO. PLATE**

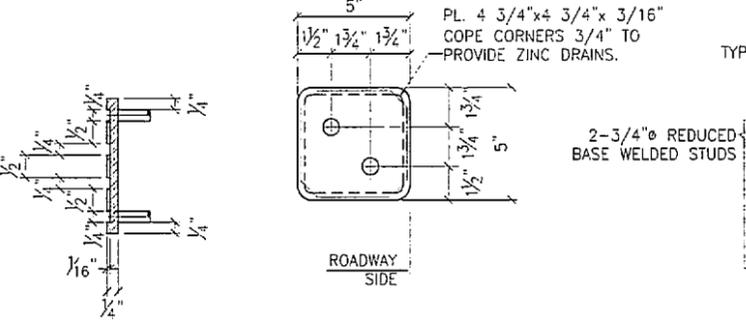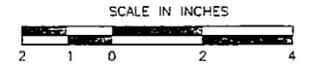

**RAIL CAP DETAIL**

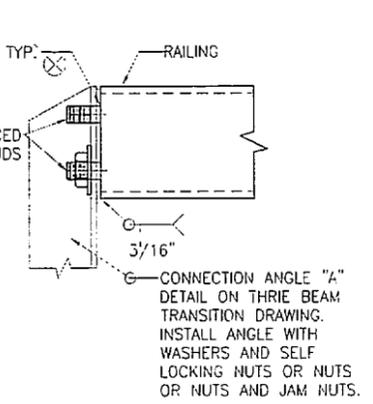


**RAILING STUD DETAIL**

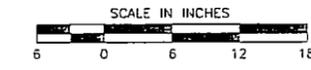

- NOTES**
- LOCATE BRIDGE NUMBER PLATES ON RIGHT HAND SIDE OF APPROACHING TRAFFIC NEAR EACH END AS SHOWN (1 TOTAL).
  - FURNISH BRIDGE NUMBER PLATES. USE BRONZE THAT CONFORMS TO A.S.T.M. B98-90, ALLOY "A" OR "B". USE "CENTURY" TYPE STYLE LETTERING. USE STUDS AND NUTS THAT CONFORMS TO UNS C65100 OR C65500. BRAZE 1/4" THREADED ROD TO BACK OF PLATE WITH NUT-4 REQUIRED. USE LOCKING NUTS OR LOCK WASHERS ON ALL MACHINE BOLTS.
  - PROVIDE RAILING EXPANSION JOINTS AT 50'-0" MAXIMUM INTERVALS. RAILING SHALL BE CONTINUOUS OVER 4 POSTS MAXIMUM.
  - USE GROUT WITH A MINIMUM 24 HOUR F' C OF 3000 PSI.
  - SEE "TYPICAL SECTION" DWG. FOR RAIL POST SPACING.
  - BRIDGE RAIL AND THRIE BEAM TRANSITION MEET THE REQUIREMENTS FOR TL-4 CRASH RATING.
  - INSTALL RAIL POSTS PLUME.
  - SEE STD. DWG G31.00 FOR THRIE BEAM TRANSITION.

DESIGNED BY:	C. KENLEY	CHECKED:	J. GOBELI
DRAWN BY:	J. HELTON	CHECKED:	J. GOBELI
QUANTITIES BY:	D. BENITI	CHECKED:	J. GOBELI

STATE OF ALASKA  
DEPARTMENT OF TRANSPORTATION  
AND PUBLIC FACILITIES  
BRIDGE SECTION

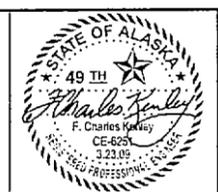


GOVERNMENT CREEK BRIDGE  
GRAVINA ISLAND HIGHWAY  
BRIDGE RAILING



BRIDGE NO. 2159  
DWG. NO. 13


STATE	PROJECT DESIGNATION	YEAR	SHEET NO.	TOTAL SHEETS
ALASKA	ACH PRL-0003(123)/67818	2007	N14	N26

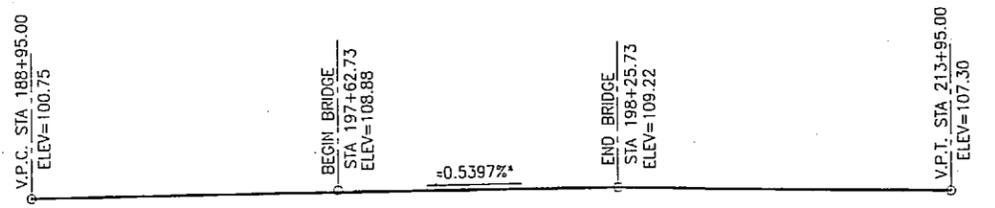

**PROFILE GRADE**


NO SCALE

\* BRIDGE IS ON A VERTICAL CURVE, SEE F SHEETS FOR CURVE DETAILS.


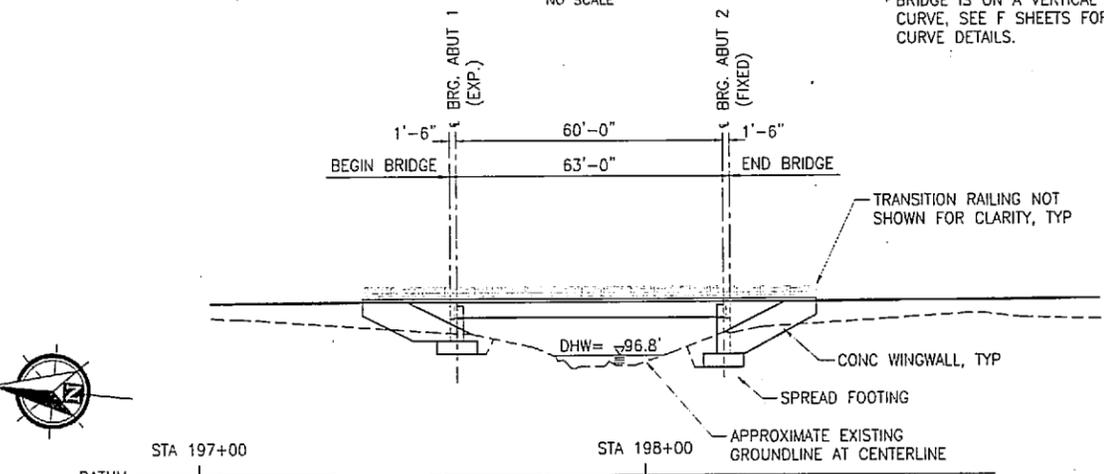


**BRIDGE ELEVATION**

SCALE IN FEET

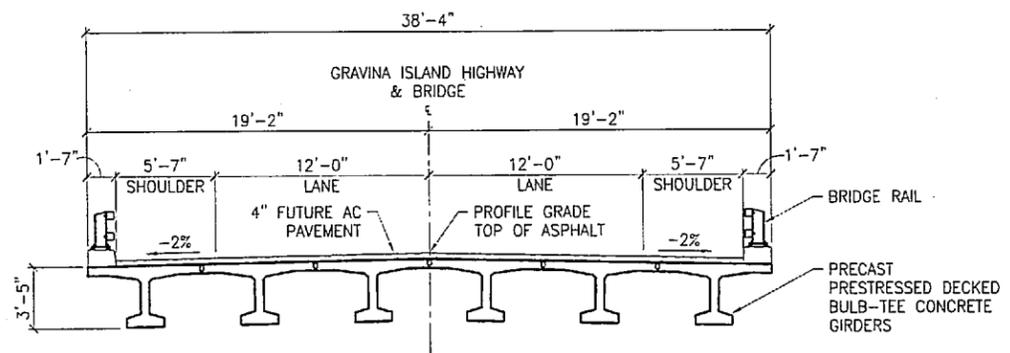

**TYPICAL BRIDGE SECTION**

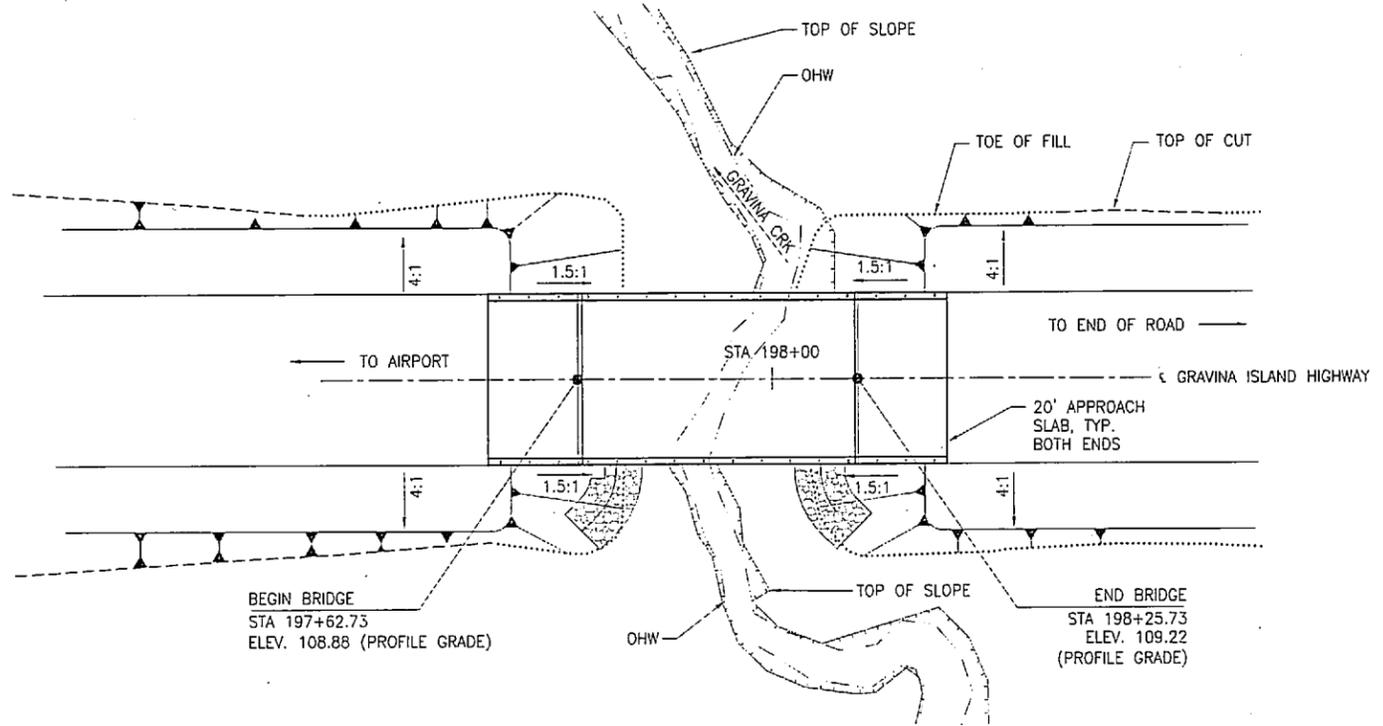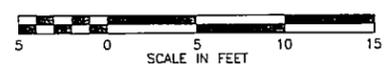


**BRIDGE PLAN**

SCALE IN FEET

BRIDGE DRAWING INDEX	
TITLE	DWG. NO
GENERAL LAYOUT	1
SITE PLAN	2
RIPRAP LAYOUT	3
ABUTMENT 1	4
ABUTMENT 2	5
ABUTMENT DETAILS	6
WINGWALL AT ABUTMENT 1	7
WINGWALL AT ABUTMENT 2	8
TYPICAL SECTION	9
GIRDERS	10
GIRDER DETAILS	11
APPROACH SLAB	12
BRIDGE RAILING	13

DESIGNED BY: C. KENLEY	CHECKED: J. GOBELT	LAYOUT BY: P. KENDALL	CHECKED BY: D. KENLEY
DRAWN BY: S. ABBETT	CHECKED: J. GOBELT	SPECIFICATIONS BY: C. KENLEY	P S & E COMPARED:
QUANTITIES BY: D. BENTTI	CHECKED: J. GOBELT	APPROVAL RECOMMENDED BY:	

STATE OF ALASKA  
DEPARTMENT OF TRANSPORTATION  
AND PUBLIC FACILITIES  
BRIDGE SECTION

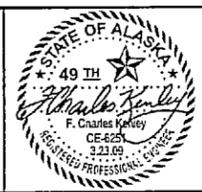

GRAVINA CREEK BRIDGE  
GRAVINA ISLAND HIGHWAY  
GENERAL LAYOUT



BRIDGE NO. 2222  
DWG. NO. 1

STATE	PROJECT DESIGNATION	YEAR	SHEET NO.	TOTAL SHEETS
ALASKA	ACH PRL-0003(123)/67818	2007	N15	N26

**GENERAL NOTES**

DESIGN: AASHTO LRFD BRIDGE DESIGN SPECIFICATION, THIRD EDITION, WITH 2006 INTERIM SPECIFICATIONS.

LIVE LOAD: HL-93

SEISMIC PARAMETERS: ACCELERATION COEFFICIENT,  $a = 0.10g$   
SITE COEFFICIENT,  $S = 1.2$   
IMPORTANCE CLASSIFICATION OTHER  
LIQUEFACTION POTENTIAL = LOW  
AASHTO 90% PROBABILITY OF NOT BEING EXCEEDED IN 50 YEARS.

DEAD LOAD: INCLUDES 50 PSF FOR ALL WEARING SURFACING, 500 PLF FOR UTILITIES



PRECAST CONCRETE: SEE "GIRDERS" DWG.

CONCRETE: USE CLASS A CONCRETE FOR ALL CONCRETE UNLESS OTHERWISE NOTED.  $f'c = 4000$  PSI  
USE CLASS A-A CONCRETE FOR APPROACH SLABS.  $f'c = 5000$  PSI

REINFORCING STEEL: USE ASTM A706 REINFORCING STEEL.  $F_y = 60,000$  PSI  
SPACE BARS EVENLY UNLESS OTHERWISE NOTED.

STRUCTURAL STEEL: USE ASTM A709, GRADE 36,  $F_y = 36,000$  PSI GALVANIZE ALL STRUCTURAL STEEL UNLESS OTHERWISE NOTED.

LOCATION	LIMIT STATE	RES. FACTOR	FACTORED BEARING RESISTANCE	FACTORED BEARING PRESSURE
ABUTMENT 1&2	STRENGTH EXTREME 1	0.45	64,800 PSF	8,300 PSF

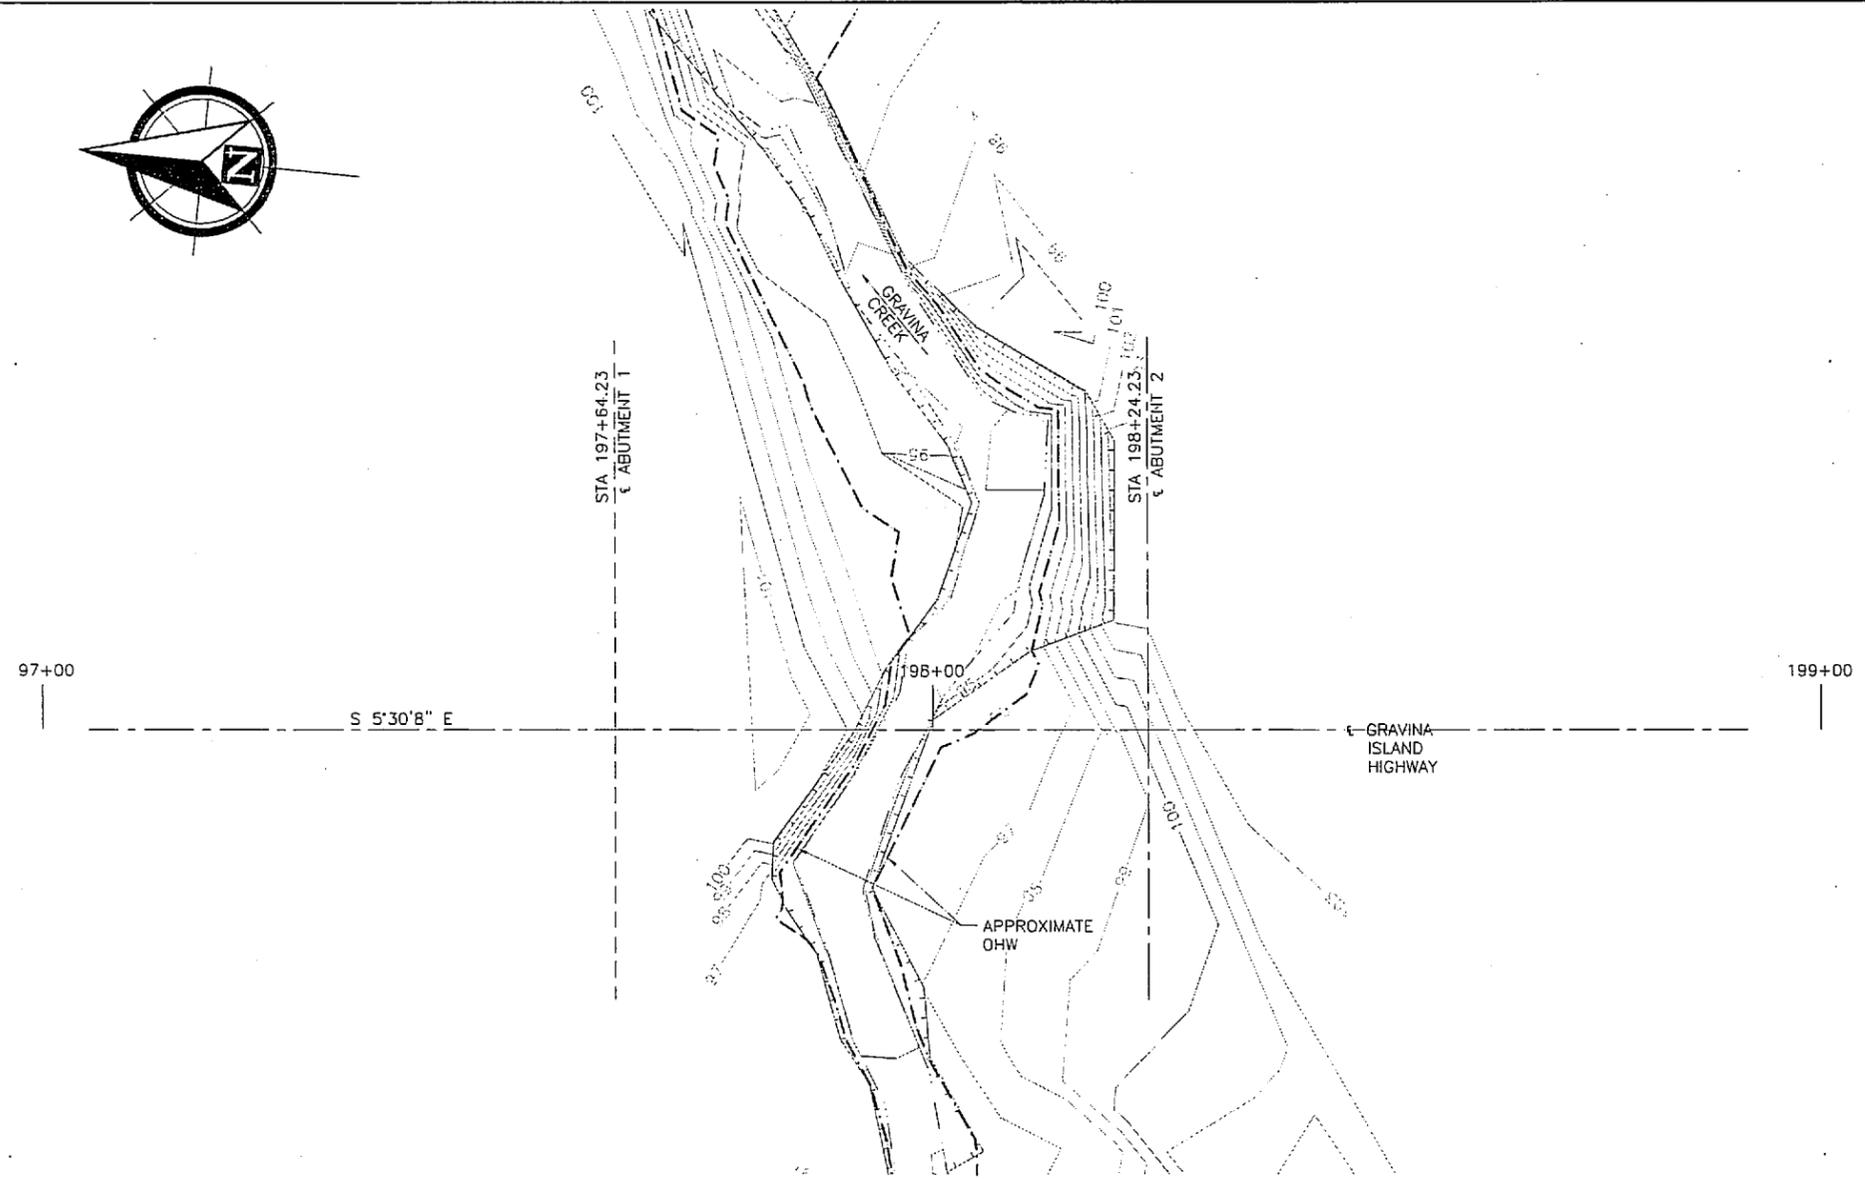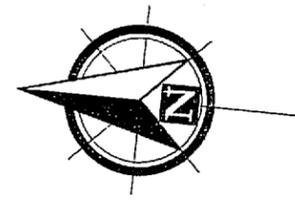

**SITE PLAN**



FLOOD FREQUENCY (Yr.)	50 YR.	100 YR.	500 YR.
EXCEEDANCE PROBABILITY (%)	2	1	0.2
DESIGN DISCHARGE (FT <sup>3</sup> /SEC)	119	130	157
WATER ELEV.	96.7	96.8	97.0
ANTICIPATED ADD'L BACKWATER	0	0	0
CONTRACTION SCOUR (FT.)	0	0	0
ABUTMENT SCOUR (FT.)	0	0	0

DRAINAGE AREA FOR THIS CROSSING: 0.375 SQUARE MILES

HYDRAULIC CAPACITY >>157 CFS AT LOW SUPERSTRUCTURE ELEVATION OF 105.0 FEET WHICH HAS AN EXCEEDANCE PROBABILITY OF 0.2 PERCENT

TOTAL SCOUR EQUALS CONTRACTION SCOUR + LOCAL SCOUR

DESIGN HIGH WATER (DHW) = 96.8 FT AT BRIDGE  
ORDINARY HIGH WATER (OHW) = 96.1 FT AT BRIDGE


DESIGNED BY: C. KENLEY	CHECKED: J. GOBELT	HYDRAULICS BY: J. CAMPBELL	CHECKED BY: B. ADAMS
DRAWN BY: S. ABBETT	CHECKED: J. GOBELT	FOUNDATIONS REVIEWED BY:	C. WRIGHT
QUANTITIES BY: D. BENTTI	CHECKED: J. GOBELT		

STATE OF ALASKA  
DEPARTMENT OF TRANSPORTATION  
AND PUBLIC FACILITIES  
BRIDGE SECTION

**GRAVINA CREEK BRIDGE**  
GRAVINA ISLAND HIGHWAY  
**SITE PLAN**

BRIDGE NO. 2222  
DWG. NO. 2

STATE	PROJECT DESIGNATION	YEAR	SHEET NO.	TOTAL SHEETS
ALASKA	ACH PRL-0003(123)/67818	2007	N16	N26

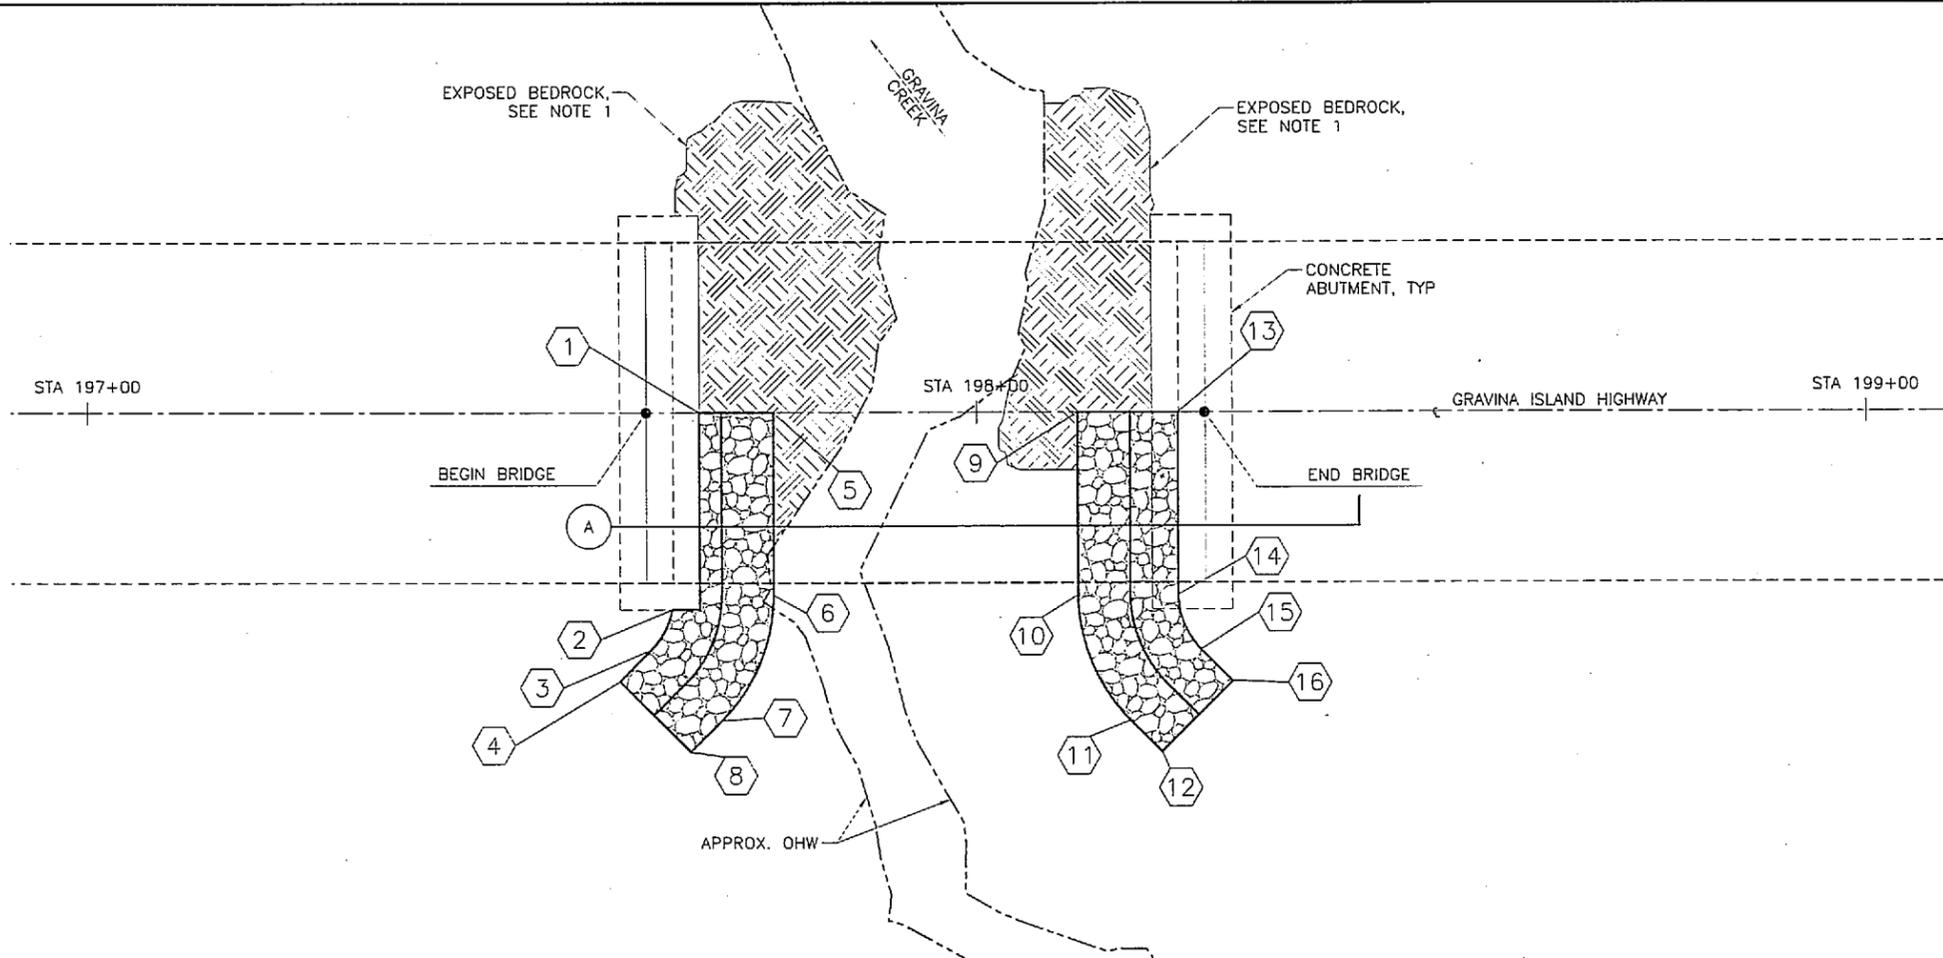

**RIPRAP LAYOUT**



NOTE:  
 1. CONTRACTOR SHALL FIELD FIT RIPRAP AGAINST EXISTING EXPOSED BEDROCK. RIP RAP IS NOT REQUIRED WHERE BEDROCK IS EXPOSED.

RIPRAP TABLE ABUTMENT 1			
POINT	STATION	OFFSET	ELEVATION
1	197+68.73	0.00	100
2	197+65.66	22.17 RT	100
3	197+63.25	26.73 RT	100
4	197+59.73	30.25 RT	100
5	197+77.07	0.00	96
6	197+77.07	20.55 RT	96
7	197+71.21	34.69 RT	96
8	197+67.69	38.21 RT	96




**SECTION A-A**



RIPRAP TABLE ABUTMENT 2			
POINT	STATION	OFFSET	ELEVATION
9	198+11.39	0.00	95
10	198+11.39	20.55 RT	95
11	198+17.25	34.69 RT	95
12	198+20.77	38.21 RT	95
13	198+22.65	0.00	100
14	198+22.65	20.55 RT	100
15	198+25.21	26.73 RT	100
16	198+28.73	30.25 RT	100

DESIGNED BY:	C. KEWLEY	CHECKED:	J. GOBELT
DRAWN BY:	S. ABBETT	CHECKED:	J. GOBELT
QUANTITIES BY:	D. BENTTI	CHECKED:	J. GOBELT

STATE OF ALASKA  
 DEPARTMENT OF TRANSPORTATION  
 AND PUBLIC FACILITIES  
 BRIDGE SECTION

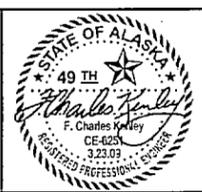


GRAVINA CREEK BRIDGE  
 GRAVINA ISLAND HIGHWAY  
 RIPRAP LAYOUT

  
 BRIDGE NO. 2222  
 DWG. NO. 3


STATE	PROJECT DESIGNATION	YEAR	SHEET NO.	TOTAL SHEETS
ALASKA	ACH PRL-0003(123)/67818	2007	N17	N26

### REINFORCING STEEL ONE ABUTMENT


MARK	SIZE	No.	LENGTH	TYPE	NOTES
A401	4	58	3'-5"	BENT	
A404	4	30	3'-8"	BENT	
A405	4	4	12'-2"	BENT	
A601	6	5	41'-6"	BENT	b
A602	6	10	38'-0"	-	b
A603	6	56	VARIES	-	
A801	8	56	VARIES	BENT	
B401	4	17	18'-0"	BENT	a
B402	4	28	8'-2"	BENT	a
B403	4	45	5'-4"	BENT	a
B501	5	3	34'-10"	-	a
B502	5	2	38'-0"	-	a,b
B503	5	3	4'-0"	-	a
B601	6	2	34'-10"	-	a,b
B701	7	24	VARIES	BENT	a
F601	6	67	8'-6"	-	
F602	6	89	12'-6"	BENT	
F603	6	28	46'-4"	BENT	b

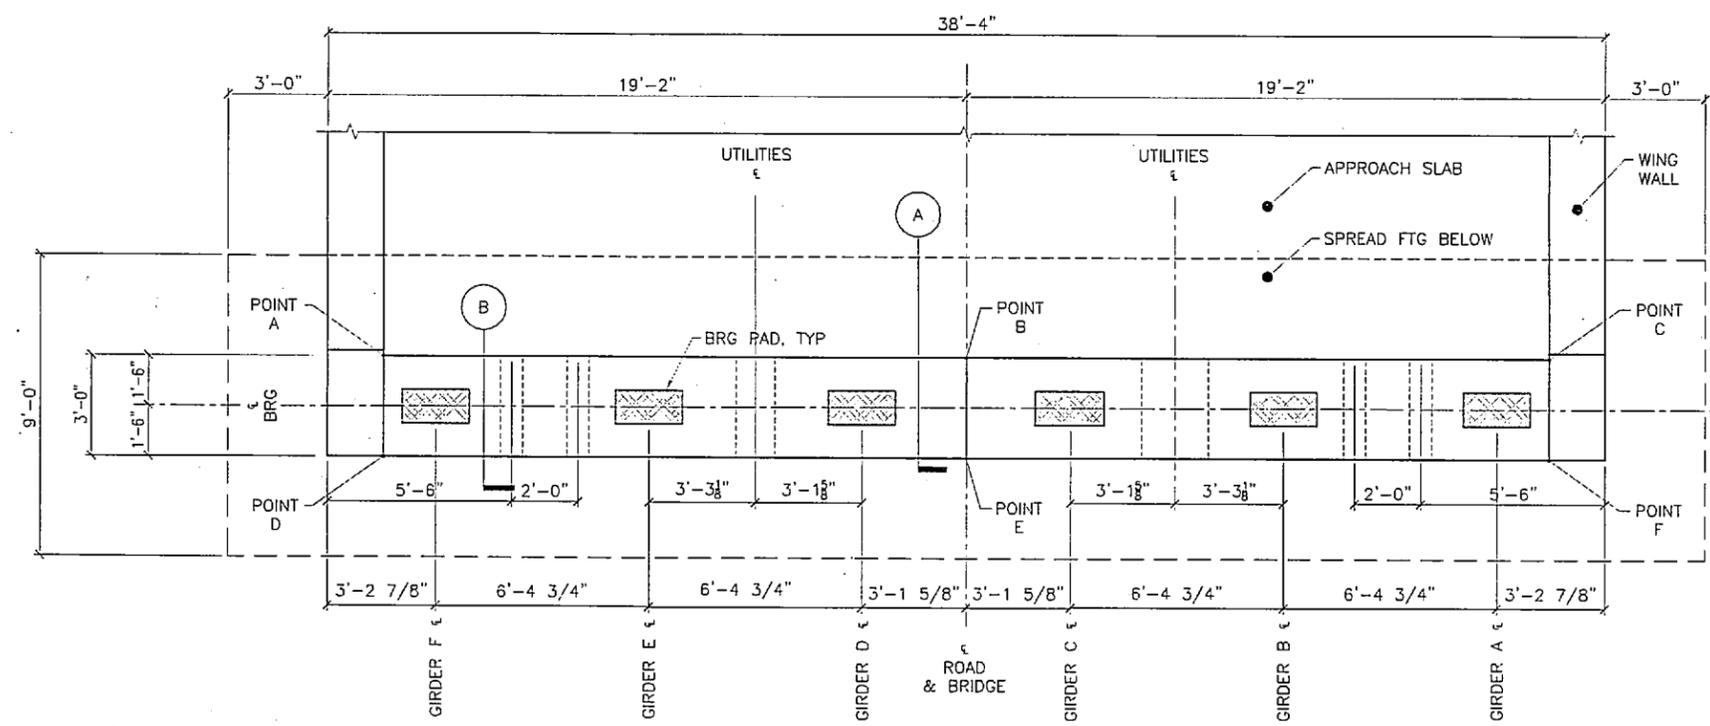

**PLAN** SCALE IN FEET

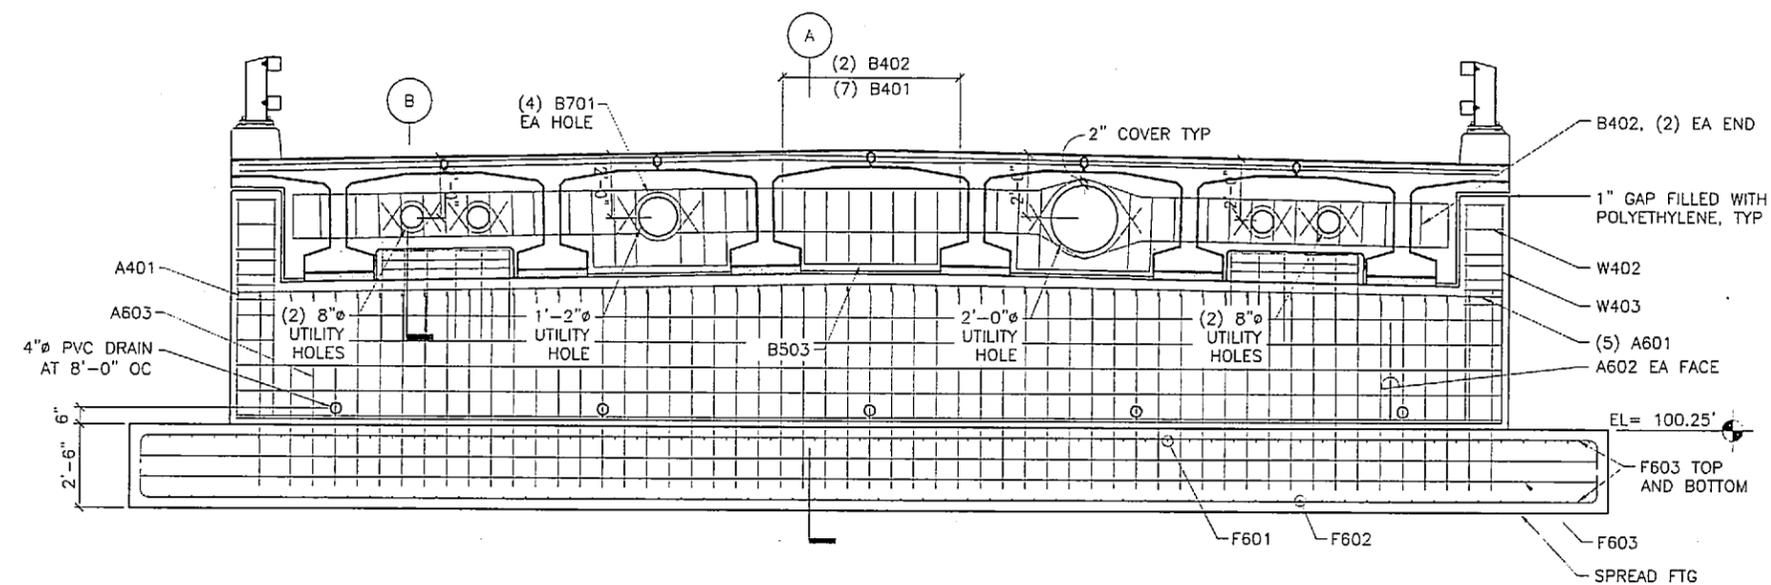

**ELEVATION** (LOOKING BACK ON STATION) SCALE IN FEET

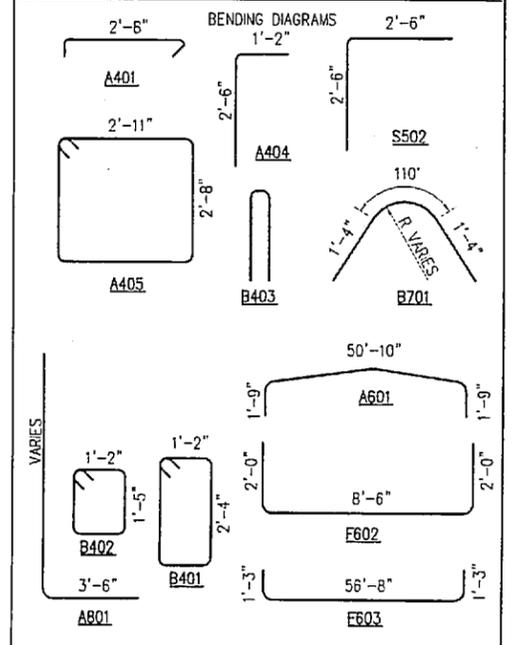

a - EPOXY COATED REINFORCING STEEL  
 b - LENGTH DOES NOT INCLUDE SPLICES  
 c - FIELD BEND BARS TO MATCH CROWN.

### TOP OF ABUTMENT WALL ELEVATIONS

POINT	AS-BUILT	ABUTMENT 1
A	-104.53	104.34
B	-104.88	104.70
C	-104.53	104.44
D	-104.55	104.36
E	-104.98	104.72
F	-104.55	104.46

DESIGNED BY: C KENLEY	CHECKED: J GOBELI
DRAWN BY: S ABBETT	CHECKED: J GOBELI
QUANTITIES BY: D BENTTI	CHECKED: J GOBELI

STATE OF ALASKA  
 DEPARTMENT OF TRANSPORTATION  
 AND PUBLIC FACILITIES  
 BRIDGE SECTION



GRAVINA CREEK BRIDGE  
 GRAVINA ISLAND HIGHWAY  
 ABUTMENT 1


BRIDGE NO. 2222  
 DWG. NO. 4

STATE	PROJECT DESIGNATION	YEAR	SHEET NO.	TOTAL SHEETS
ALASKA	ACH PRL-0003(123)/67818	2007	N18	N26


### REINFORCING STEEL ONE ABUTMENT

MARK	SIZE	No.	LENGTH	TYPE	NOTES
A401	4	58	3'-5"	BENT	
A402	4	29	3'-5"	BENT	
A501	5	29	5'-0"	-	
A601	5	5	41'-5"	BENT	b
A602	6	16	38'-0"	-	b
A603	6	56	VARIES	-	
A801	8	56	VARIES	BENT	
B401	4	31	10'-0"	BENT	a
B402	4	14	8'-2"	BENT	a
B403	4	45	5'-4"	BENT	a
B501	5	3	34'-10"	-	a
B502	5	2	38'-0"	-	a,b
B503	5	5	4'-0"	-	a
B601	6	2	34'-10"	-	a
B701	7	24	VARIES	BENT	a
F601	6	67	8'-6"	-	
F602	6	89	12'-6"	BENT	
F603	6	26	46'-4"	BENT	b


#### BENDING DIAGRAMS

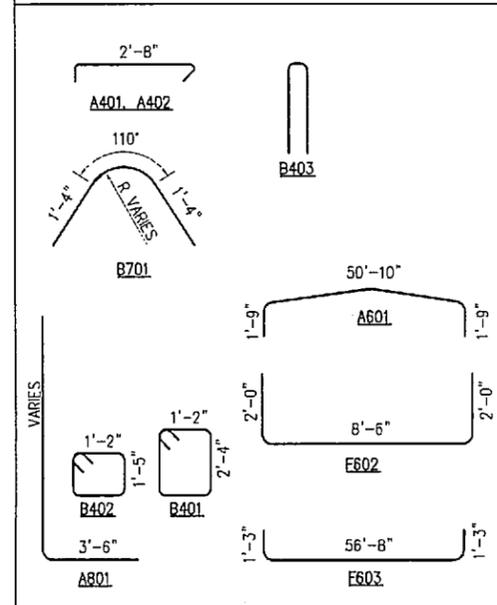

- a - EPOXY COATED REINFORCING STEEL
- b - LENGTH DOES NOT INCLUDE SPLICES
- c - FIELD BEND BARS TO MATCH CROWN.

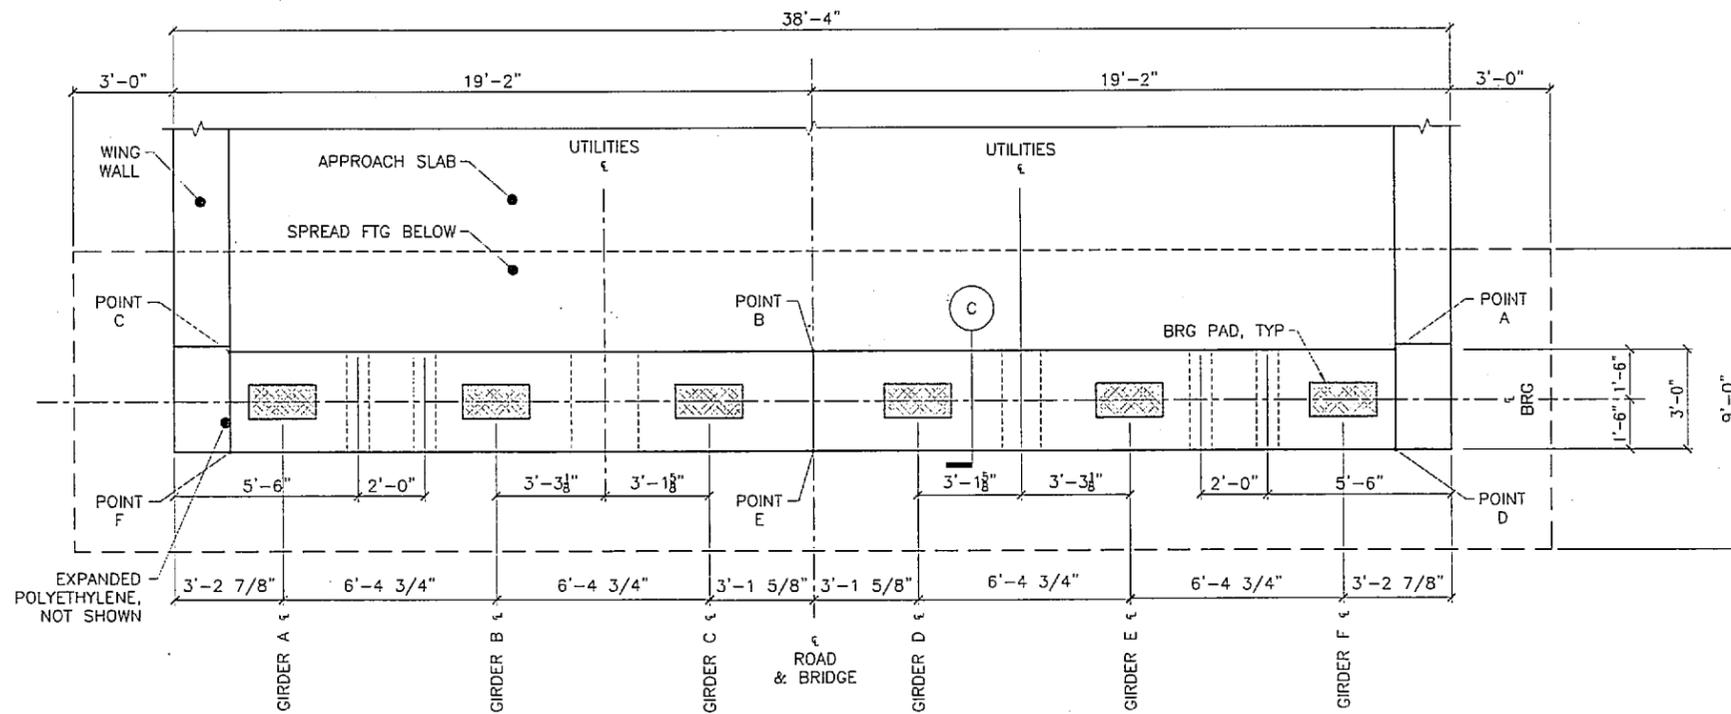

**PLAN** SCALE IN FEET

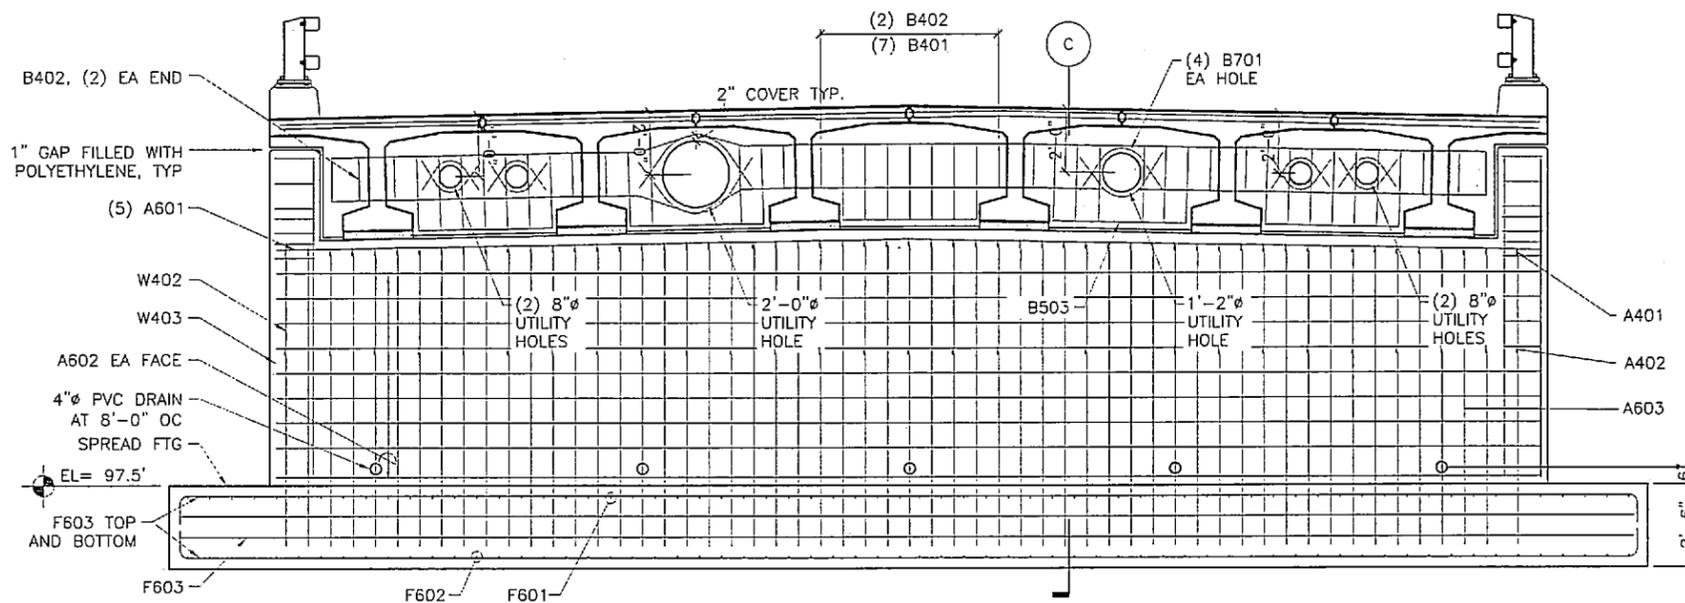


**ELEVATION** SCALE IN FEET

#### TOP OF ABUTMENT WALL ELEVATIONS

POINT	ABUTMENT 2
A	104.04 - 104.66
B	105.22 - 105.06
C	104.07 - 104.70
D	104.85 - 104.67
E	105.20 - 105.04
F	104.05 - 104.68


DESIGNED BY:	C. KENLEY	CHECKED:	J. GOBELT
DRAWN BY:	S. ABBETT	CHECKED:	J. GOBELT
QUANTITIES BY:	D. BENETTI	CHECKED:	J. GOBELT

STATE OF ALASKA  
DEPARTMENT OF TRANSPORTATION  
AND PUBLIC FACILITIES  
BRIDGE SECTION

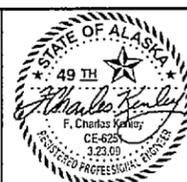


GRAVINA CREEK BRIDGE  
GRAVINA ISLAND HIGHWAY  
ABUTMENT 2


  
BRIDGE NO. 2222  
DWG. NO. 5

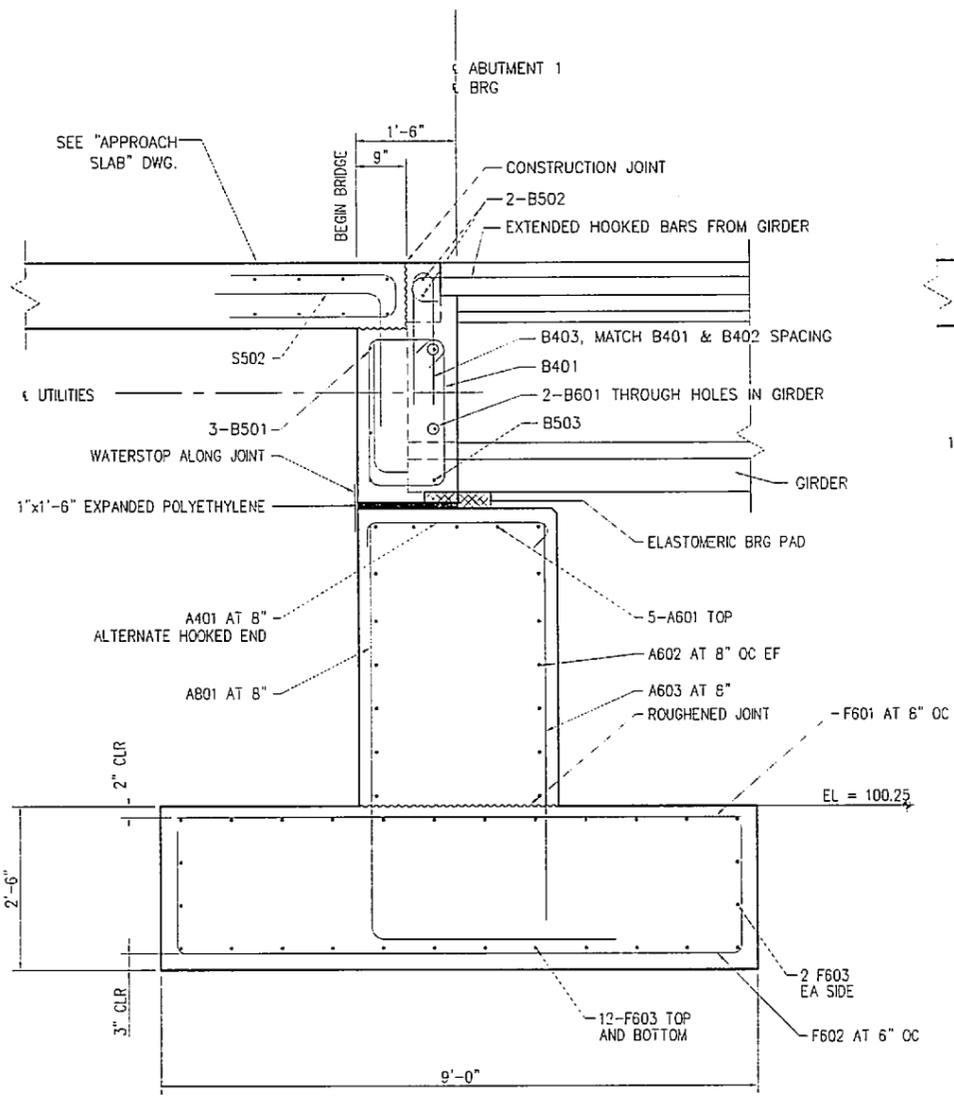


**SECTION A**  
SCALE IN FEET

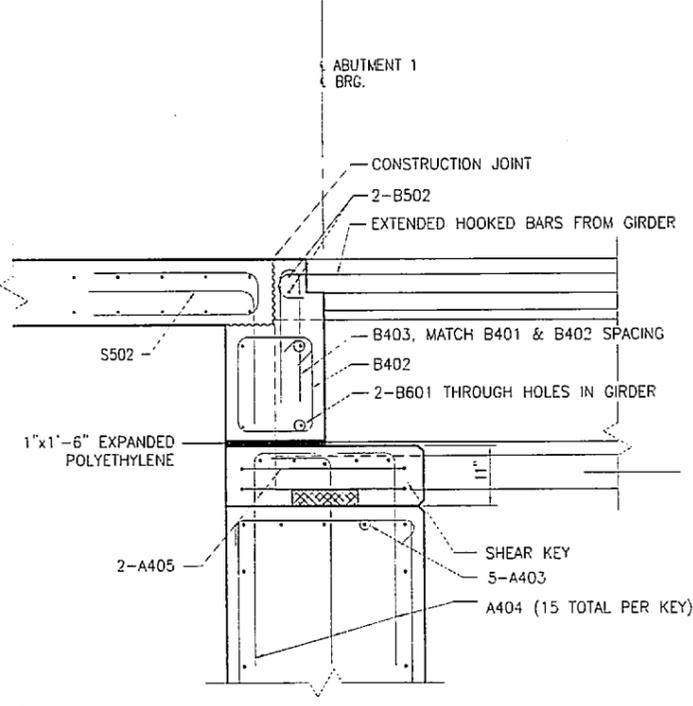

**SECTION B**  
SCALE IN FEET

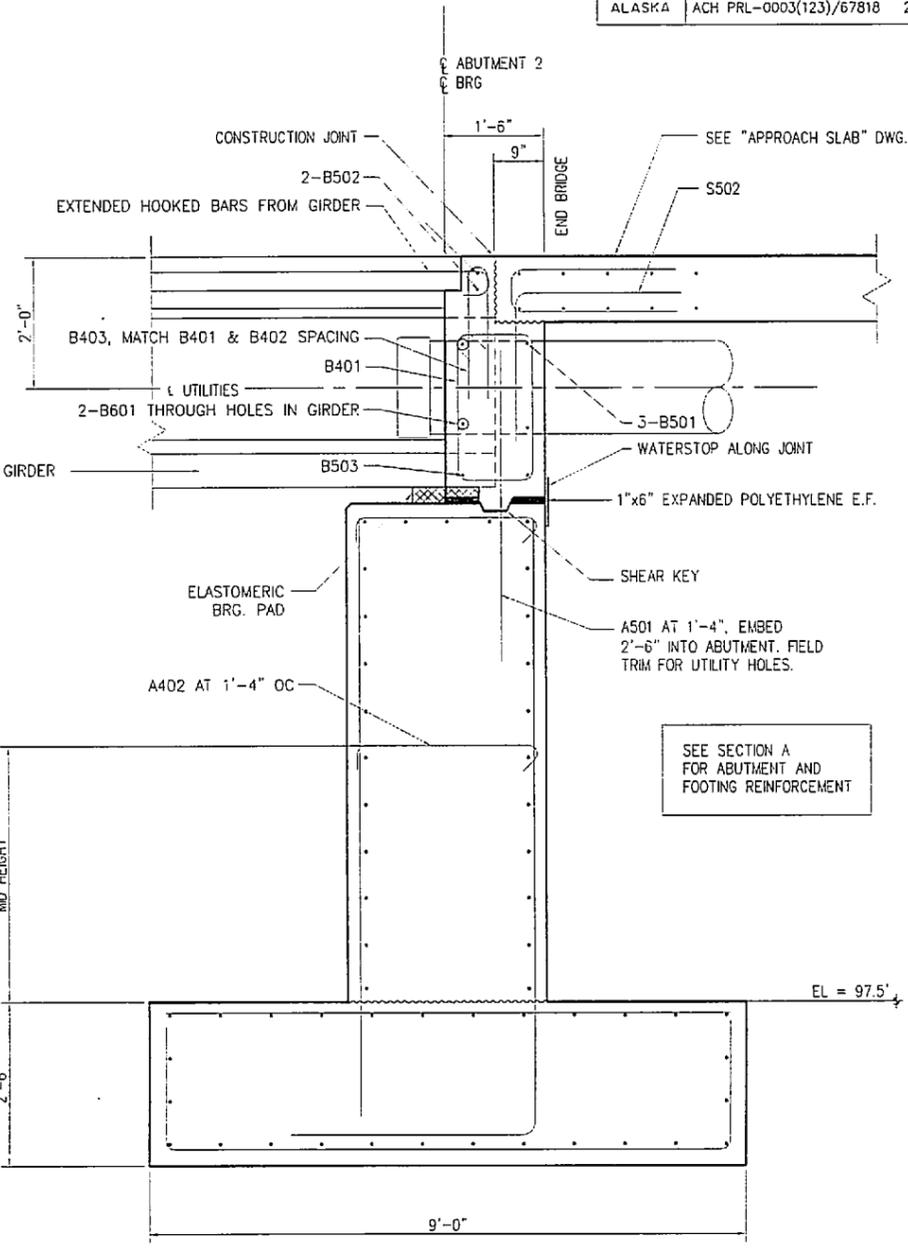

**SECTION C**  
SCALE IN FEET

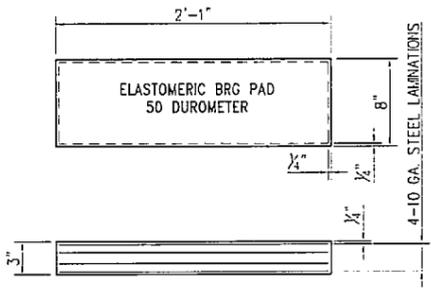

**BEARING PAD**  
SCALE IN INCHES

SEE SECTION A FOR ABUTMENT AND FOOTING REINFORCEMENT

**NOTES:**

1. SEAL UTILITIES AT ABUTMENTS WITH CONCRETE, AFTER TIGHTLY WRAPPING UTILITY WITH 2-LAYERS OF 15# BUILDING PAPER.

**BEARING PAD REACTIONS**

LOCATION	D.L. PER BRG.	L.L. PER BRG.
ABUTMENTS	48.7 kips	53.9 kips

DESIGNED BY:	C. KENLEY	CHECKED:	J. GOBELI
DRAWN BY:	S. ABBETT	CHECKED:	J. GOBELI
QUANTITIES BY:	D. BENTZ	CHECKED:	J. GOBELI

STATE OF ALASKA  
DEPARTMENT OF TRANSPORTATION  
AND PUBLIC FACILITIES  
BRIDGE SECTION



GRAVINA CREEK BRIDGE  
GRAVINA ISLAND HIGHWAY  
ABUTMENT DETAILS




BRIDGE NO. 2222  
DWG. NO. 6

STATE	PROJECT DESIGNATION	YEAR	SHEET NO.	TOTAL SHEETS
ALASKA	ACH PRL-0003(123)/67818	2007	N20	N26

### REINFORCING STEEL ONE ABUTMENT

MARK	SIZE	No.	LENGTH	TYPE	NOTES
W401	4	80	VARIES	-	
W402	4	20	9'-0"	BENT	
W403	4	16	8'-4"	-	
W501	5	18	VARIES	-	
W901	9	30	VARIES	-	
W902	9	4	21'-2"	BENT	
W903	9	4	23'-8"	BENT	
C403	4	26	7'-8"	BENT	a
C502	5	4	19'-8"	-	a


#### BENDING DIAGRAMS

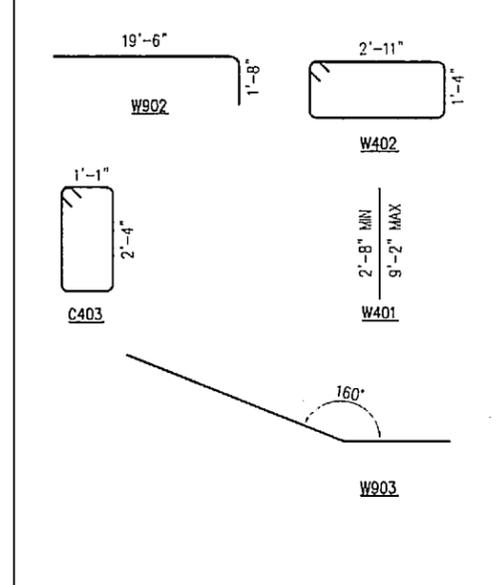


o - EPOXY COATED REINFORCING STEEL

#### TOP OF WALL ELEVATIONS


LOCATION	TOP OF WALL		TOP OF CURB	
	A	B	A	B
ABUTMENT 1	107.98	108.17	108.81	109.00
ABUTMENT 2	108.50	108.52	109.33	109.35

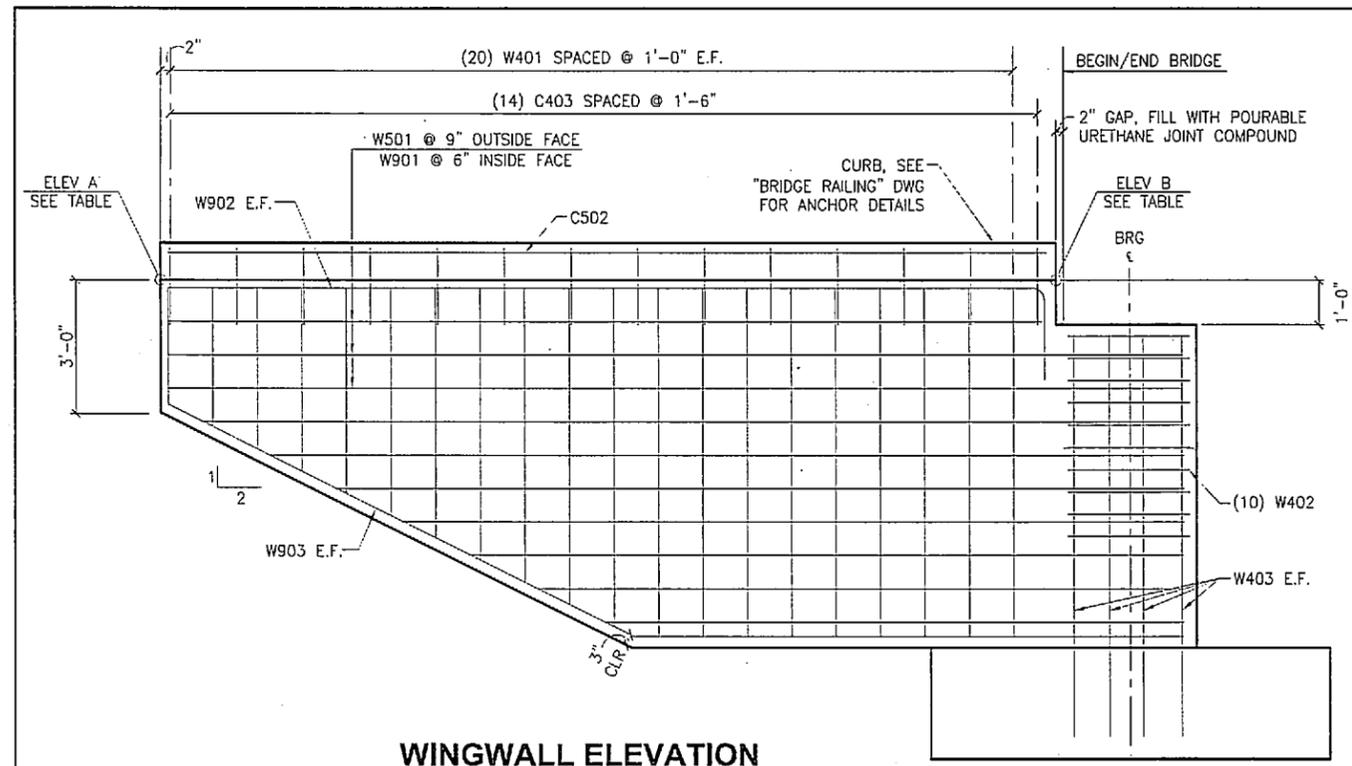


**WINGWALL ELEVATION**

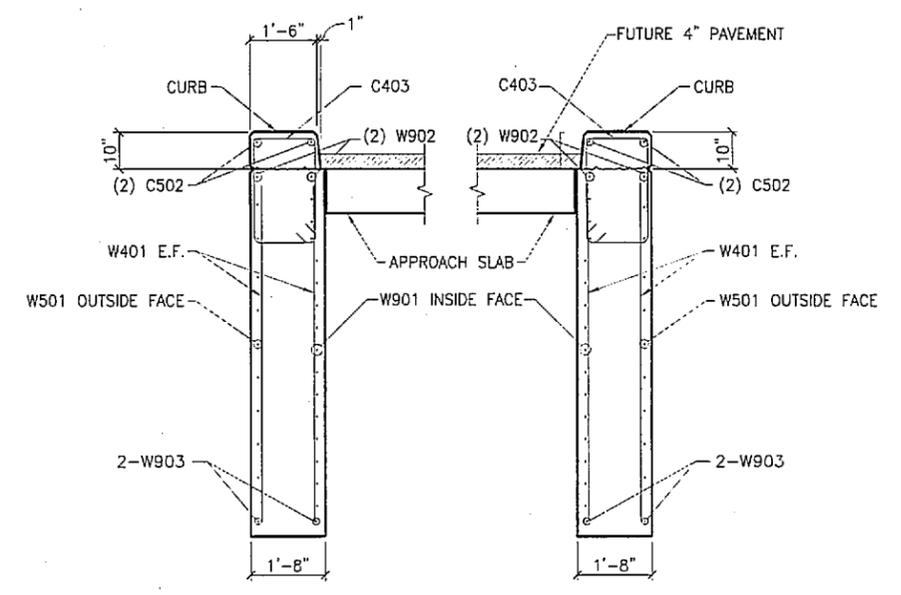


**WINGWALL SECTION**

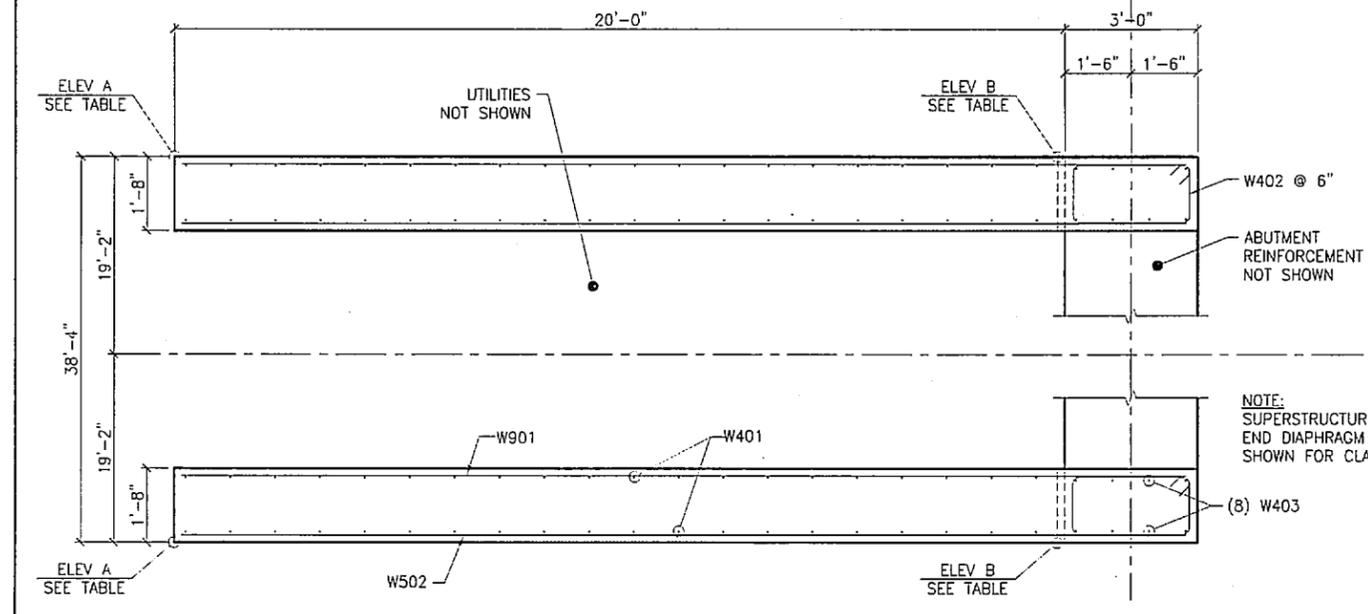

**WINGWALL PLAN**

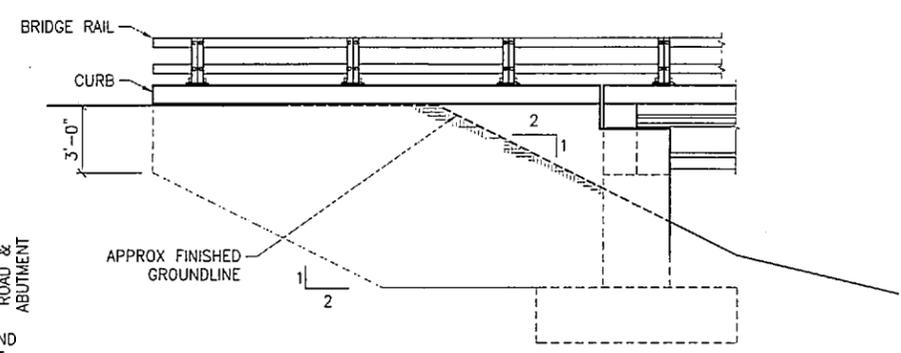

**FINISHED ELEVATION**

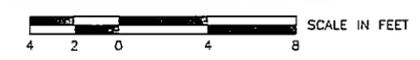

DESIGNED BY:	C KENLEY	CHECKED:	J GOBELI
DRAWN BY:	S ABBETT	CHECKED:	J GOBELI
QUANTITIES BY:	D BENTTI	CHECKED:	J GOBELI

STATE OF ALASKA  
DEPARTMENT OF TRANSPORTATION  
AND PUBLIC FACILITIES  
BRIDGE SECTION



GRAVINA CREEK BRIDGE  
GRAVINA ISLAND HIGHWAY  
WINGWALL AT ABUTMENT 1




BRIDGE NO. 2222  
DWG. NO. 7

STATE	PROJECT DESIGNATION	YEAR	SHEET NO.	TOTAL SHEETS
ALASKA	ACH PRL-0003(123)/67818	2007	N21	N26





### REINFORCING STEEL ONE ABUTMENT

MARK	SIZE	No.	LENGTH	TYPE	NOTES
W401	4	80	VARIABLES	-	
W402	4	20	9'-0"	BENT	
W403	4	16	8'-4"	-	
W501	5	28	VARIABLES	-	
W901	9	40	VARIABLES	-	
W902	9	4	21'-2"	BENT	
W903	9	4	23'-8"	BENT	
C403	4	28	7'-6"	BENT	o
C502	5	4	19'-8"	-	o

#### BENDING DIAGRAMS

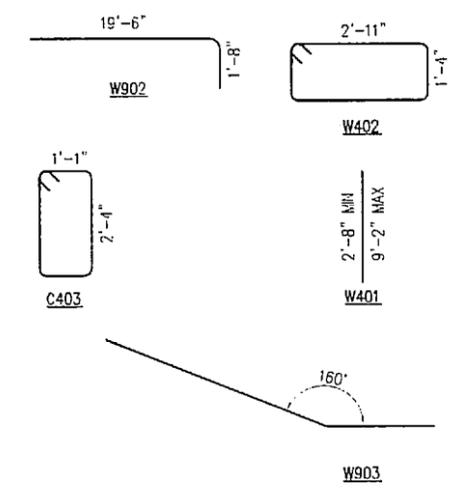

o - EPOXY COATED REINFORCING STEEL

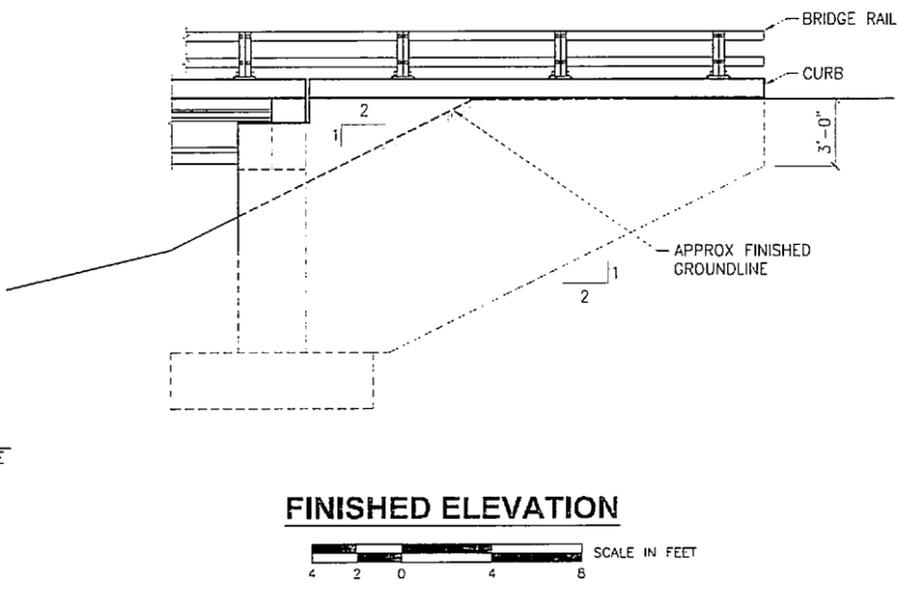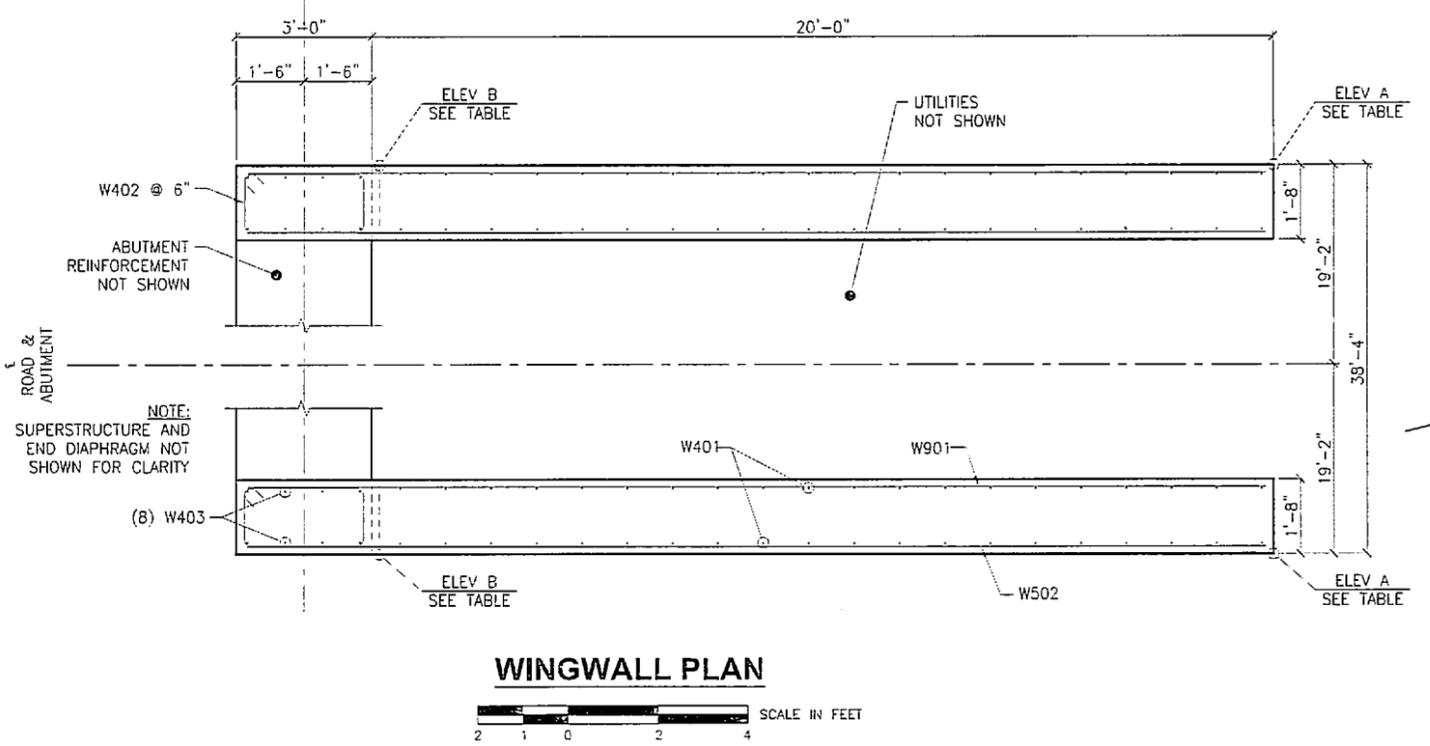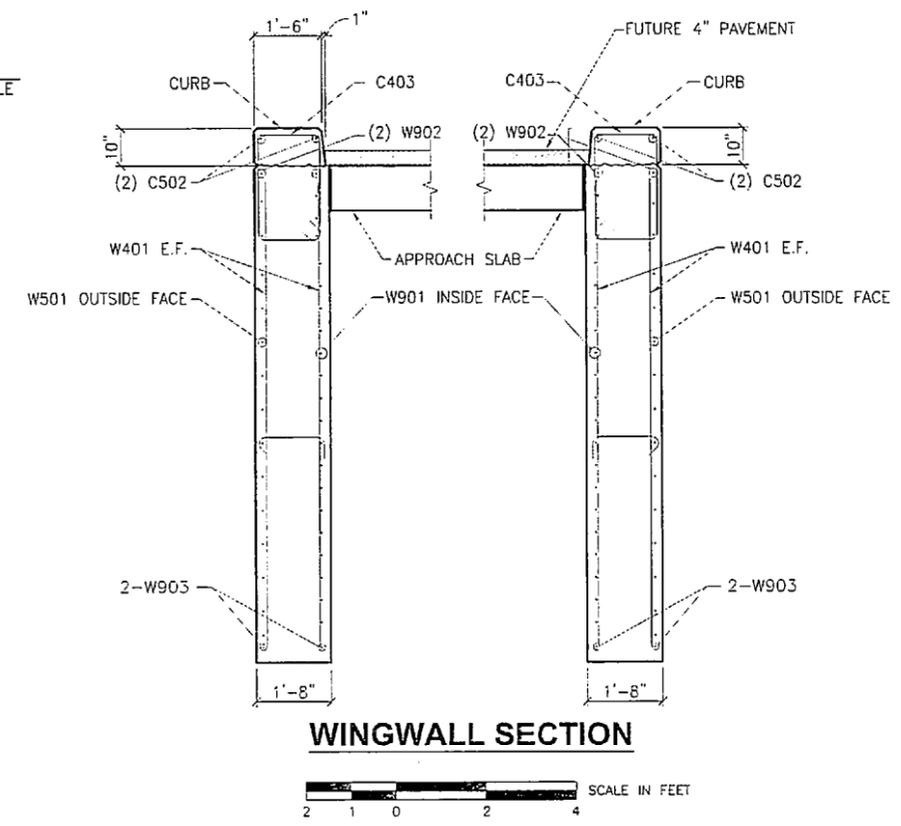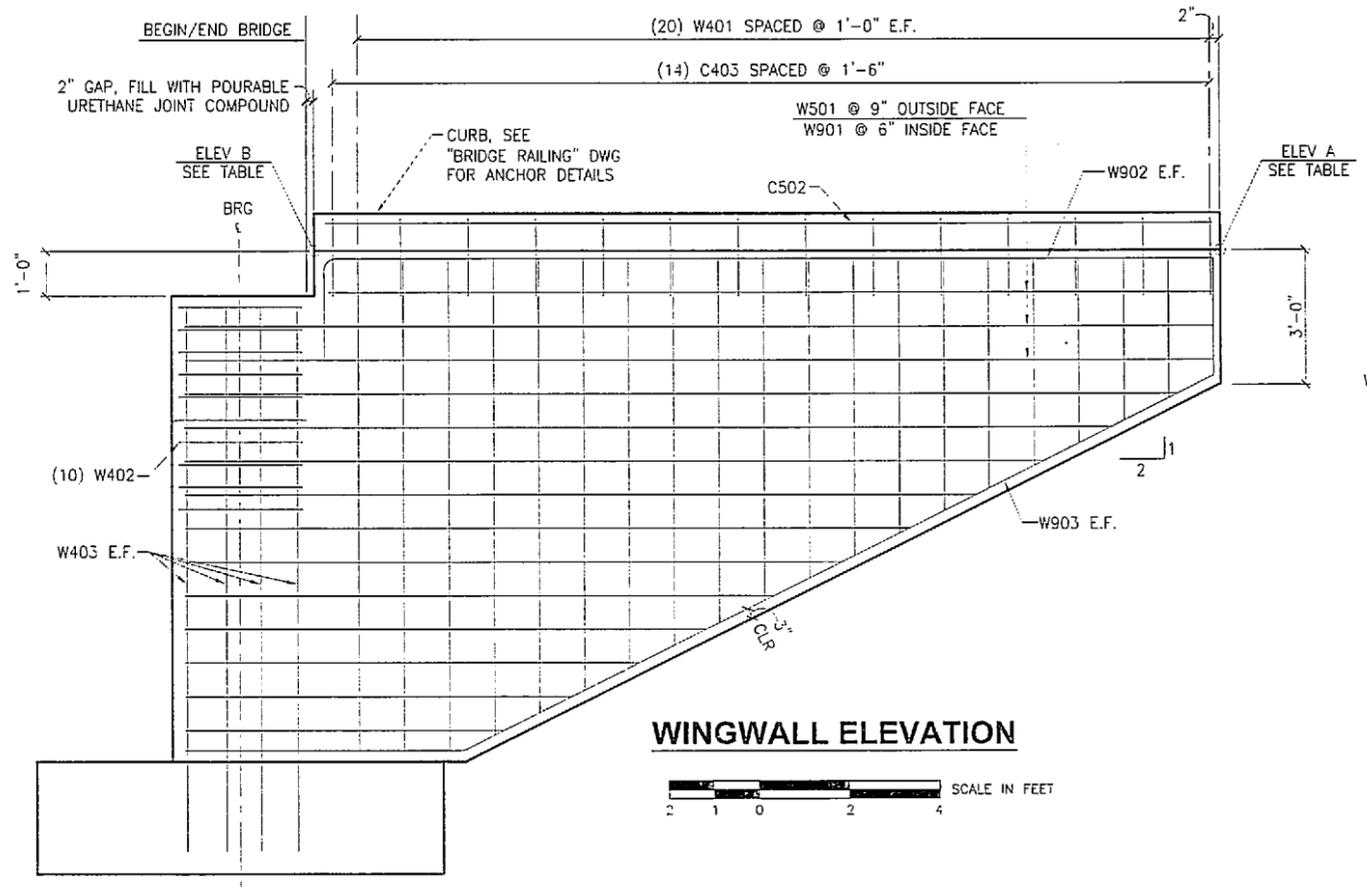


#### TOP OF WALL ELEVATIONS

LOCATION	TOP OF WALL		TOP OF CURB	
	A	B	A	B
ABUTMENT 1	107.96	108.17	108.81	109.00
ABUTMENT 2	109.50	108.52	109.33	109.35

DESIGNED BY:	C KENLEY	CHECKED:	J GOBELT
DRAWN BY:	S ABBETT	CHECKED:	J GOBELT
QUANTITIES BY:	D BENTTI	CHECKED:	J GOBELT

STATE OF ALASKA  
DEPARTMENT OF TRANSPORTATION  
AND PUBLIC FACILITIES  
BRIDGE SECTION

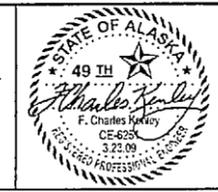

GRAVINA CREEK BRIDGE  
GRAVINA ISLAND HIGHWAY  
WINGWALL AT ABUTMENT 2




BRIDGE NO. 2222  
DWG. NO. 8

STATE	PROJECT DESIGNATION	YEAR	SHEET NO.	TOTAL SHEETS
ALASKA	ACH PRL-0003(123)/67818	2007	N22	N26


### REINFORCING STEEL ONE DIAPHRAGM

MARK	SIZE	No.	LENGTH	TYPE	NOTES
D401	4	55	4'-2"	BENT	a
D403	4	14	5'-7"	-	a
D501	5	4	43'-10"	BENT	a,b
D502	5	2	4'-0"	-	a
D503	5	4	5'-5"	-	a
D701	7	24	VARIES	BENT	a


#### BENDING DIAGRAMS

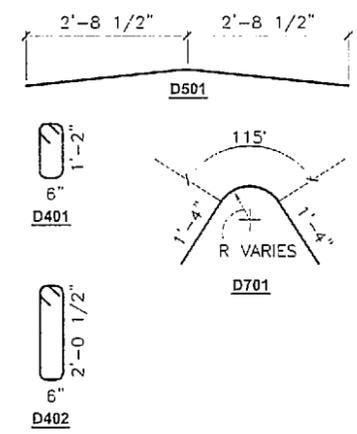


a - EPOXY COATED REINFORCING STEEL  
b - LENGTH DOES NOT INCLUDE SPLICES

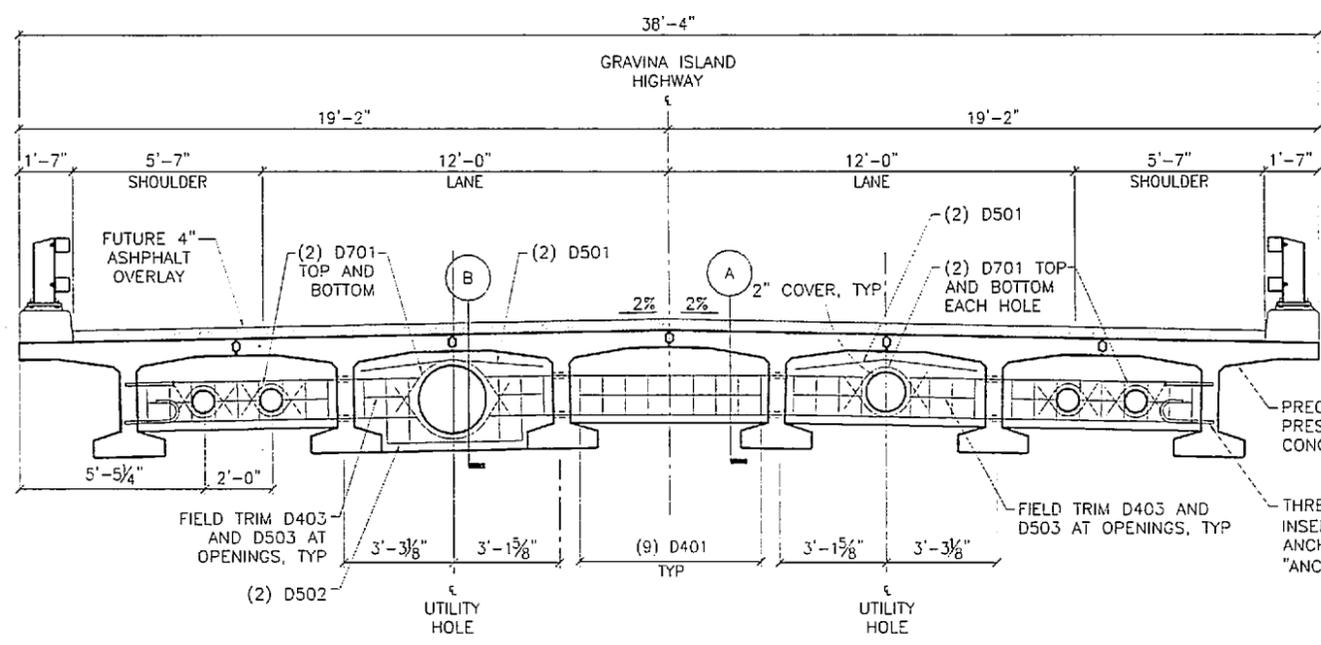


**SECTION NEAR MIDSPAN**

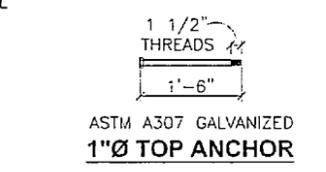


**ANCHOR DETAILS**  
SCALE IN FEET

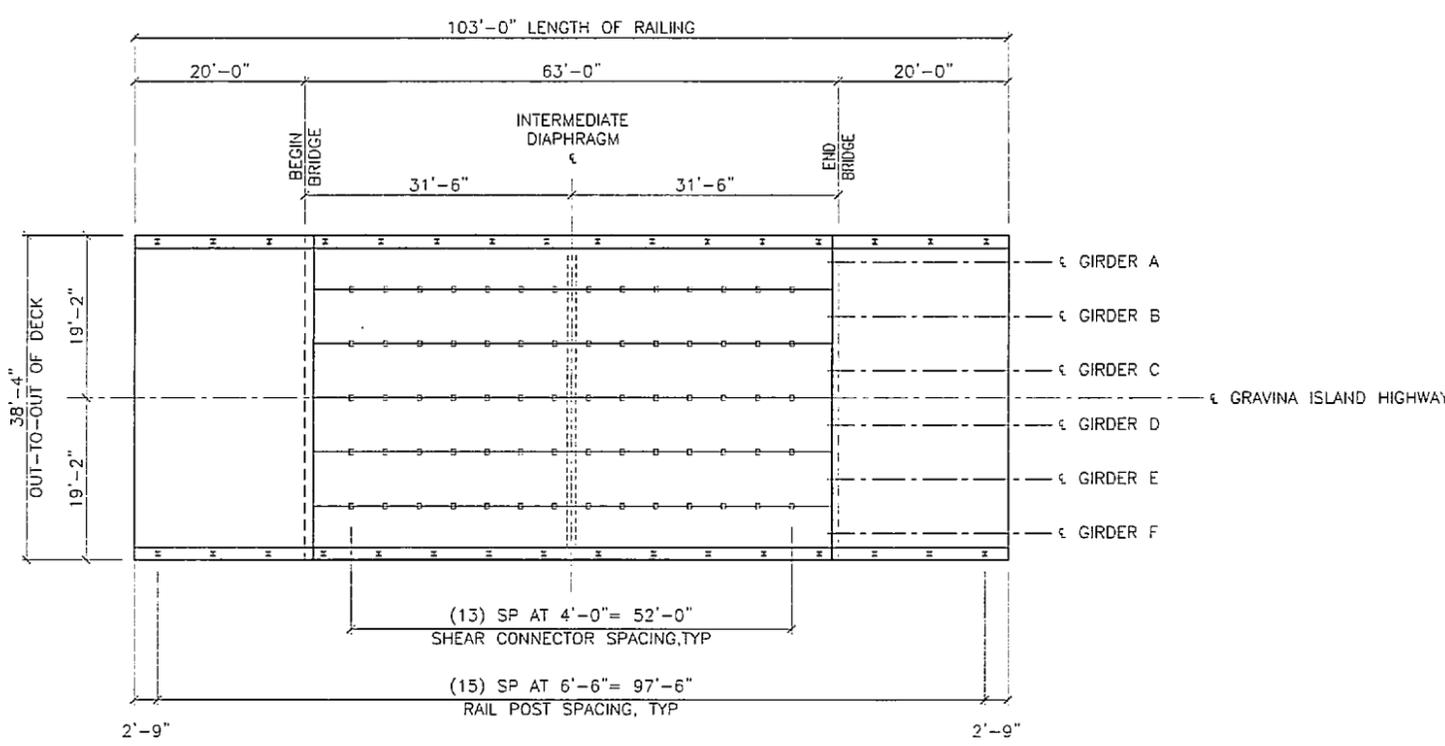

**FRAMING PLAN**

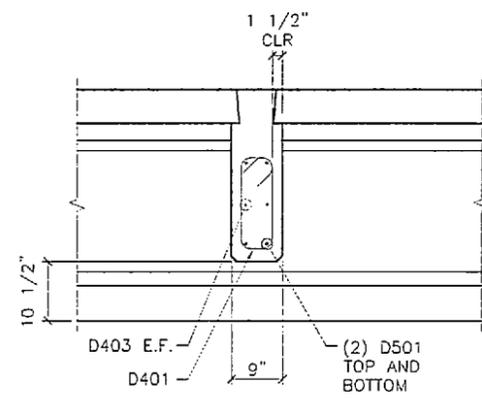

**DIAPHRAGM SECTION A**

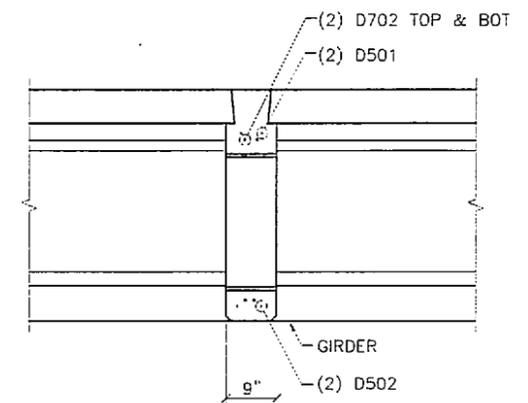


**DIAPHRAGM SECTION B**



DESIGNED BY:	C KENLEY	CHECKED:	J GOBELI
DRAWN BY:	S ABBETT	CHECKED:	J GOBELI
QUANTITIES BY:	D BENTTI	CHECKED:	J GOBELI

STATE OF ALASKA  
DEPARTMENT OF TRANSPORTATION  
AND PUBLIC FACILITIES  
BRIDGE SECTION

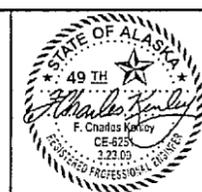

GRAVINA CREEK BRIDGE  
GRAVINA ISLAND HIGHWAY  
TYPICAL SECTION



BRIDGE NO. 2222  
DWG. NO. 9


61'-6" GIRDER LENGTH (ADJUST CASTING LENGTH FOR ELASTIC SHORTENING AND SHRINKAGE)

STATE	PROJECT DESIGNATION	YEAR	SHEET NO.	TOTAL SHEETS
ALASKA	ACH PRL-0003(123)/67818	2007	N23	N26

### REINFORCING STEEL ONE GIRDER

MARK	SIZE	No.	LENGTH	TYPE	NOTES
G401	4	122	6'-1"	BENT	a
G401E	4	122	6'-1"	BENT	a,d
G402	4	12	70'-2"	-	a
G404	4	120	4'-11"	BENT	a
G404	4	76	3'-3"	BENT	a
G405	4	41	2'-4"	BENT	a,q
C501	5	122	6'-1"	-	a
G501E	5	122	6'-8"	BENT	a,d
G502	5	12	73'-2"	BENT	a,b
C401E	4	41	4'-10"	BENT	a,c,e
C402E	4	41	4'-6"	BENT	a,c,i
C501E	5	2	72'-8"	-	a,b,d

#### BENDING DIAGRAMS

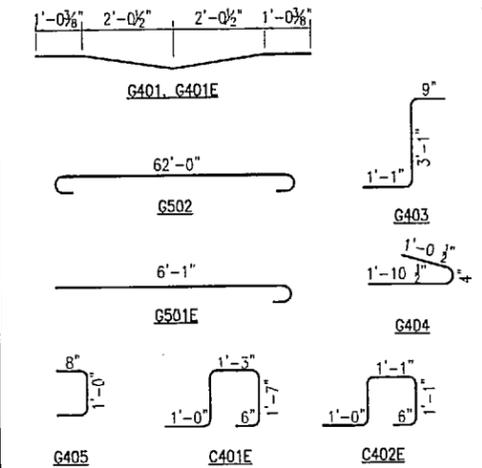

- a - EPOXY COATED REINFORCING STEEL
- b - LENGTH DOES NOT INCLUDE SPLICES
- c - SHIP FOUR LOOSE
- d - GIRDERS A, H ONLY
- e - GIRDER A ONLY
- f - GIRDER H ONLY
- g - GIRDER B ONLY

#### NOTES:

USE NORMAL WEIGHT CONCRETE WITH THE FOLLOWING STRENGTHS:  
 AT STRESS TRANSFER  $f'_{ci} = 6750$  PSI  
 AT 28 DAYS  $f'_{c} = 8000$  PSI

USE  $\frac{1}{2}$ " LOW-RELAXATION PRESTRESSING STRANDS WITH AN ULTIMATE STRENGTH OF 270 KSI AND A CROSS SECTION AREA OF 0.153 IN<sup>2</sup>.

DESIGN IS BASED ON THE FOLLOWING STEEL STRESSES:  
 PRETENSIONING - JACKING STRESS 189 KSI  
 AFTER ALL LOSSES 166 KSI


ONE INCH CLEAR ON ALL REINFORCING EXCEPT AS NOTED.

DEFLECT FORMS TO COMPENSTATE FOR CAMBER AND ROADWAY GRADE.


PROVIDE BROOM FINISH ON THE ROADWAY SURFACE OF THE PRECAST MEMBER. ROUGHEN THE SURFACE UNDER THE RAILING CURBS.

OMIT SHEAR KEY AND SHEAR KEY CONNECTORS OUTSIDE THE EXTERIOR GIRDERS.


CAST GIRDER AND ENDS PLUMB WITH RESPECT TO ROADWAY GRADE.

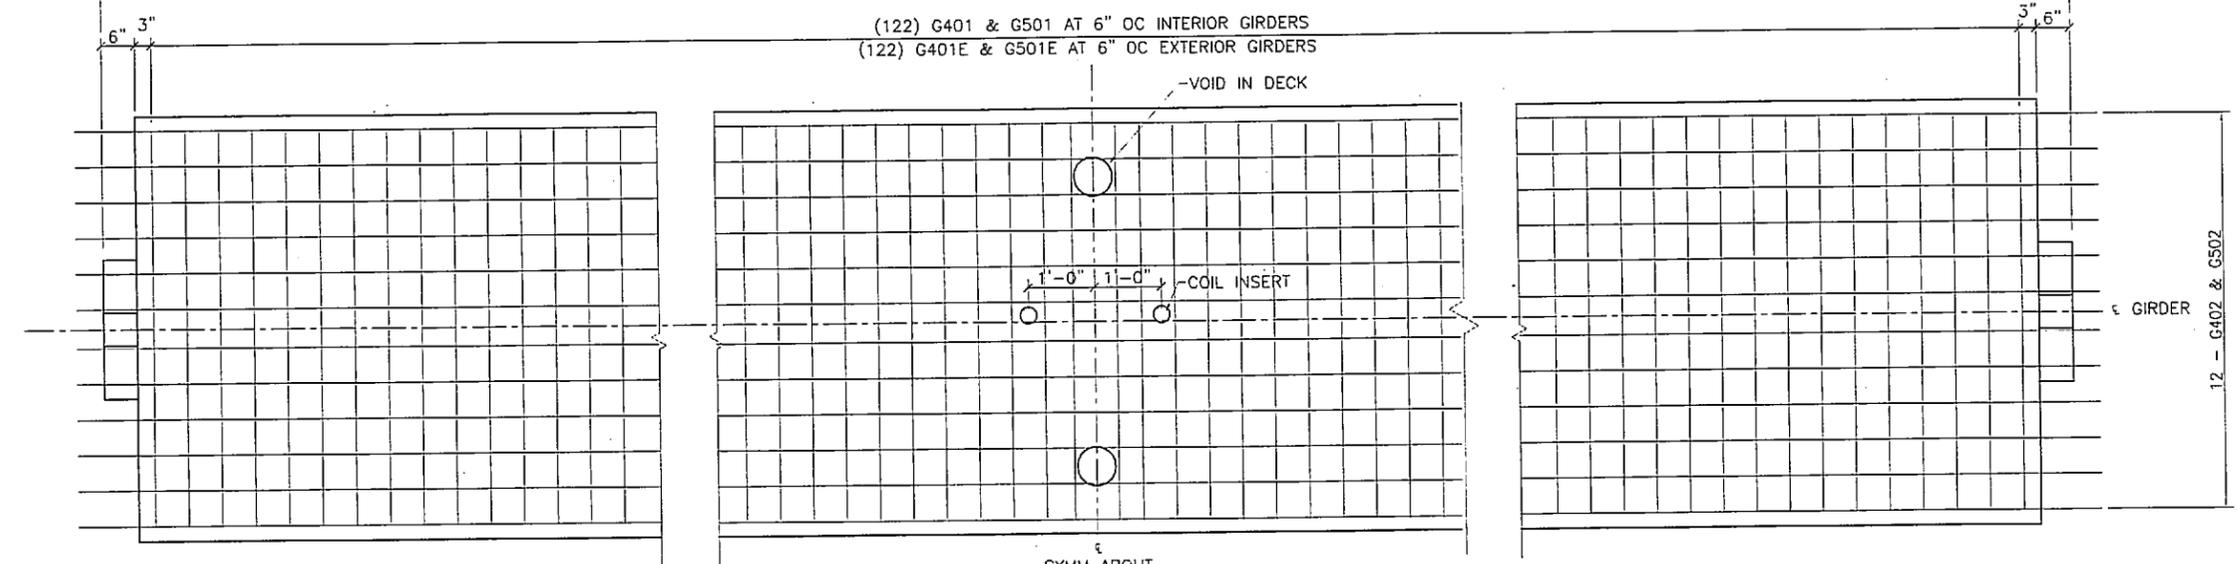


SYMM ABOUT  
**PLAN - TOP FLANGE**

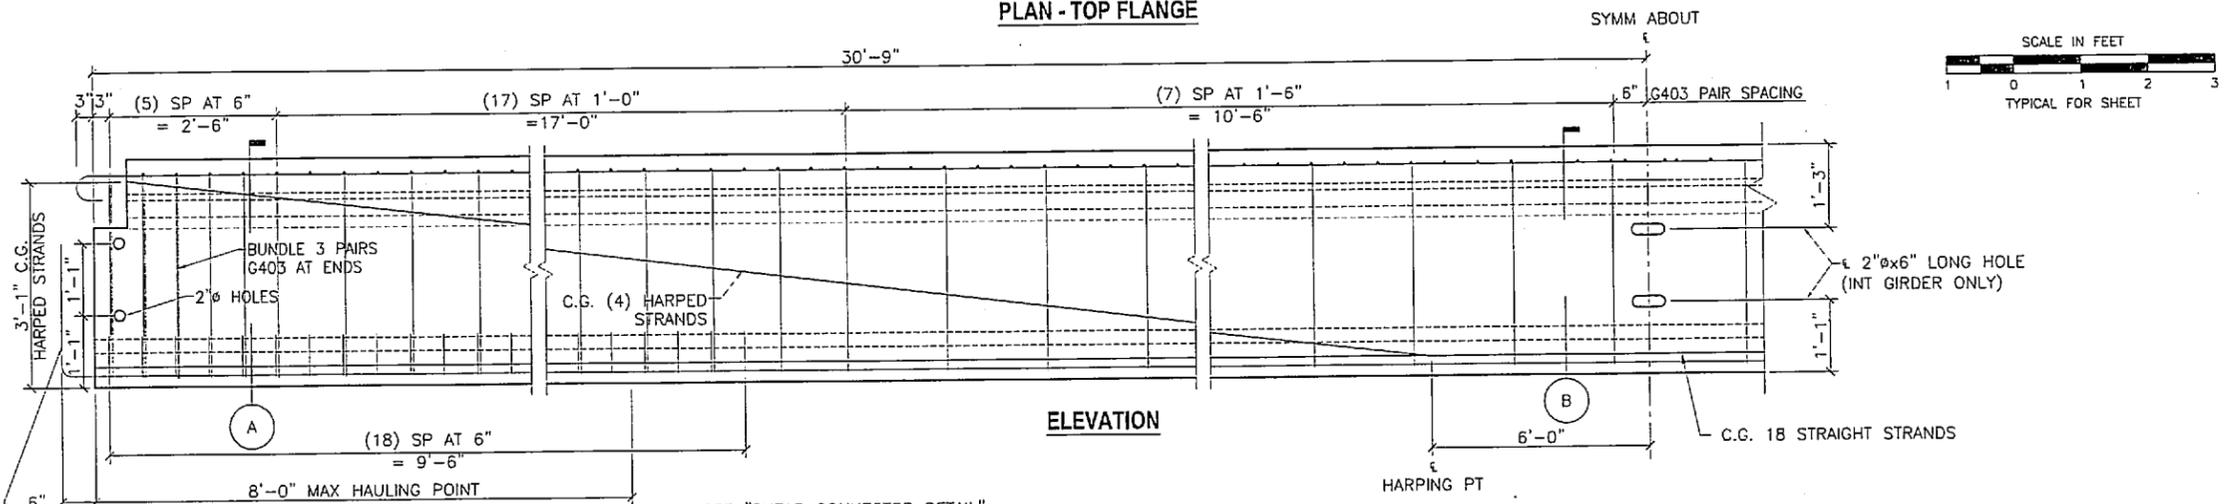


**ELEVATION**

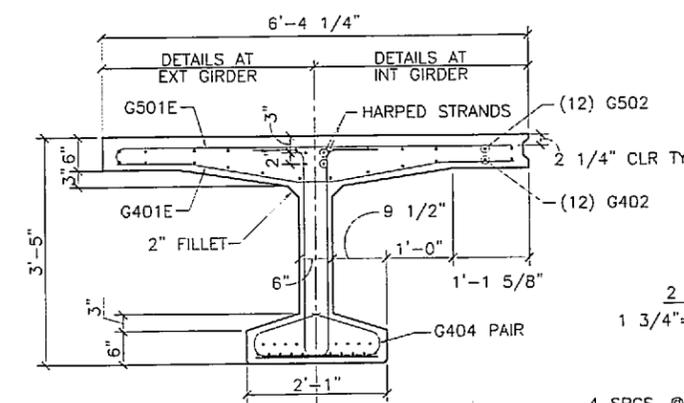

**SECTION A**

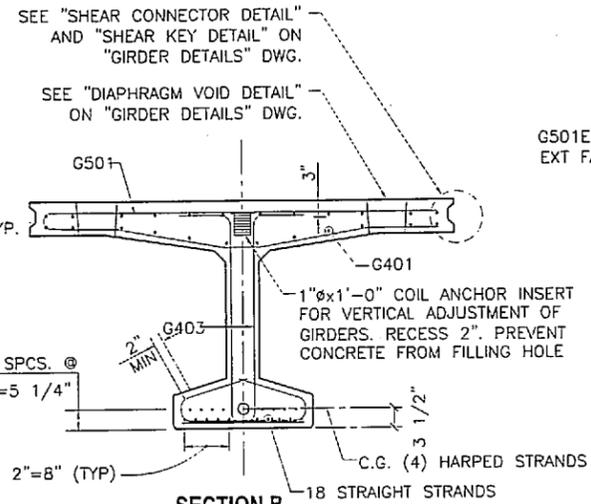


**SECTION B**

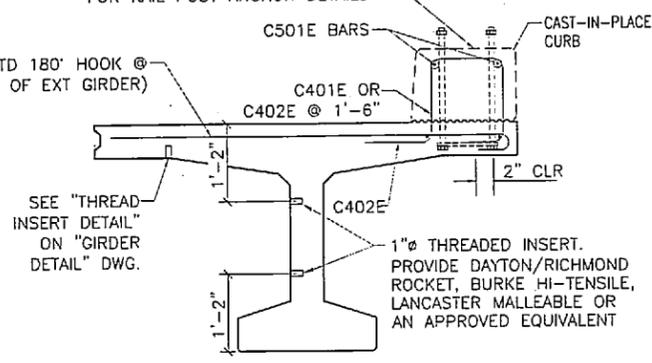

**EXTERIOR GIRDER NEAR MIDSPAN**

DESIGNED BY:	C KENLEY	CHECKED:	J GOBELT
DRAWN BY:	S ABBETT	CHECKED:	J GOBELT
QUANTITIES BY:	D BENTTI	CHECKED:	J GOBELT

STATE OF ALASKA  
 DEPARTMENT OF TRANSPORTATION  
 AND PUBLIC FACILITIES  
 BRIDGE SECTION

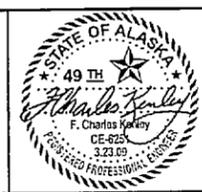

GRAVINA CREEK BRIDGE  
 GRAVINA ISLAND HIGHWAY  
 GIRDERS

  
 BRIDGE NO. 2222  
 DWG. NO. 10




STATE	PROJECT DESIGNATION	YEAR	SHEET NO.	TOTAL SHEETS
ALASKA	ACH PRL-0003(123)/67818	2007	N25	N26


### REINFORCING STEEL ONE SLAB

MARK	SIZE	No.	LENGTH	TYPE	NOTES
S401	4	60	34'-9"	-	a,b
S501	5	39	20'-5"	-	a
S502	5	39	5'-0"	BENT	a
S503	5	39	5'-7"	BENT	a
S801	8	77	20'-5"	-	a


#### BENDING DIAGRAMS

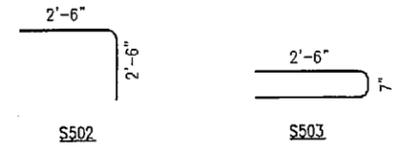


- a - EPOXY COATED REINFORCING STEEL
- b - LENGTH DOES NOT INCLUDE SPLICES

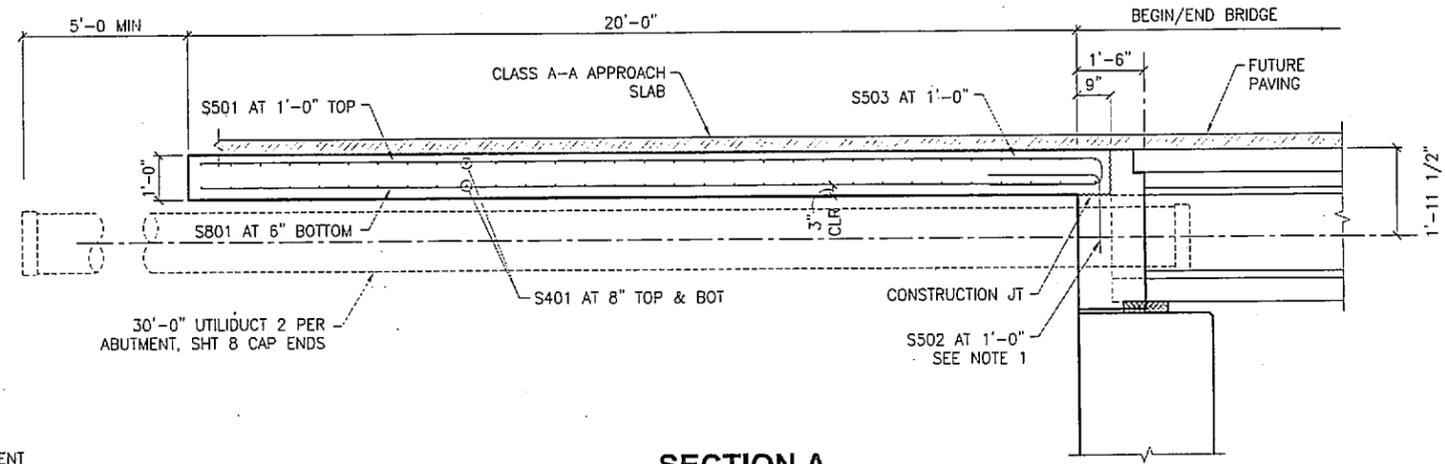

**SECTION A**  
SCALE IN FEET

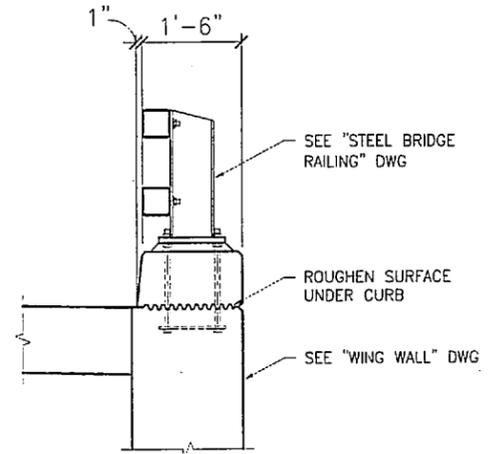

**BRIDGE RAIL**  
SCALE IN FEET

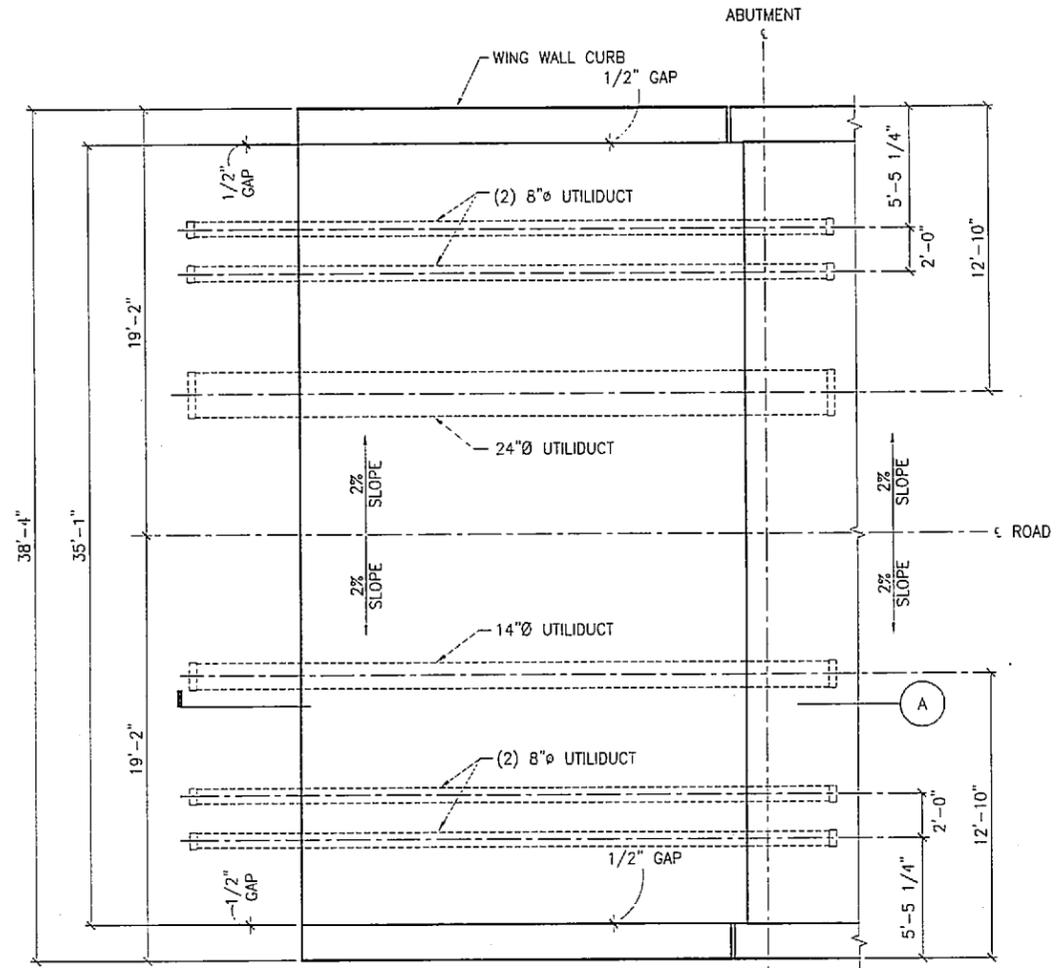

**PLAN**  
(ABUTMENT 1 SHOWN, ABUTMENT 2 SIMILAR)  
SCALE IN FEET

- NOTES:
- FIELD ADJUST S502 TO MSS UTILITIES.
  - CAP ALL UNUSED UTILITIES CONDUITS.

DESIGNED BY:	C. KENLEY	CHECKED:	J. GOBELT
DRAWN BY:	S. ABBETT	CHECKED:	J. GOBELT
QUANTITIES BY:	D. BENTTI	CHECKED:	J. GOBELT


STATE OF ALASKA  
DEPARTMENT OF TRANSPORTATION  
AND PUBLIC FACILITIES  
BRIDGE SECTION





GRAVINA CREEK BRIDGE  
GRAVINA ISLAND HIGHWAY  
APPROACH SLAB

BRIDGE NO. 2222  
DWG. NO. 12



STATE	PROJECT DESIGNATION	YEAR	SHEET NO.	TOTAL SHEETS
ALASKA	ACH PRL-0003(123)/67818	2007	N26	N26

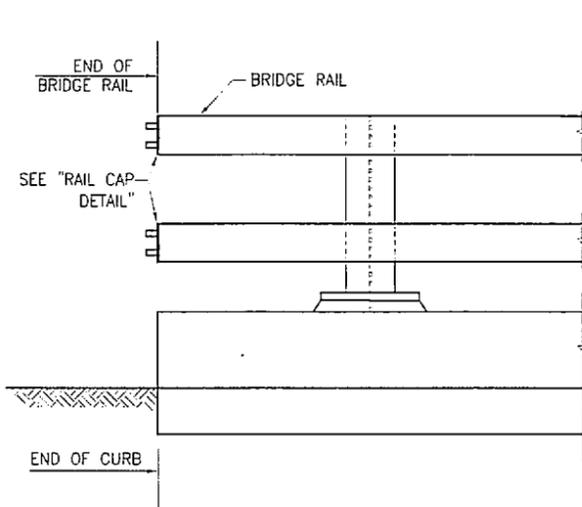



**ELEVATION**

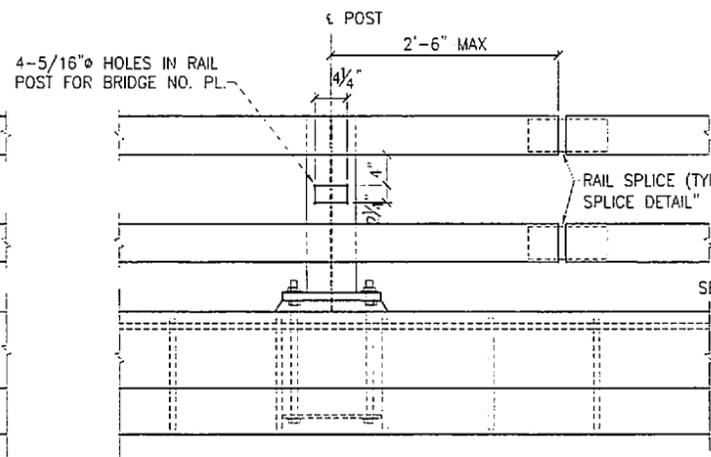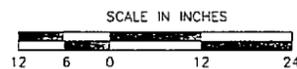



**EXPANSION JOINT**

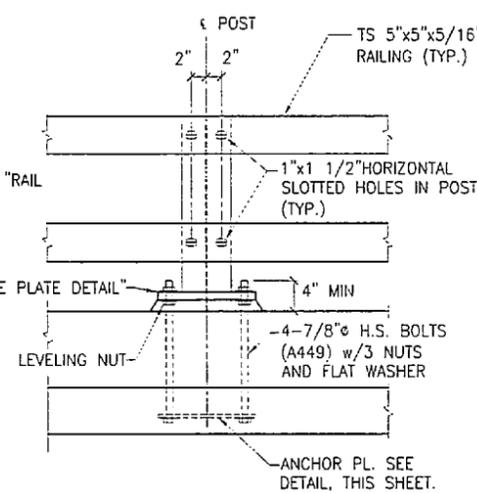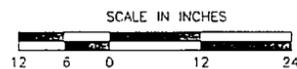


**TYPICAL POST ELEVATION**

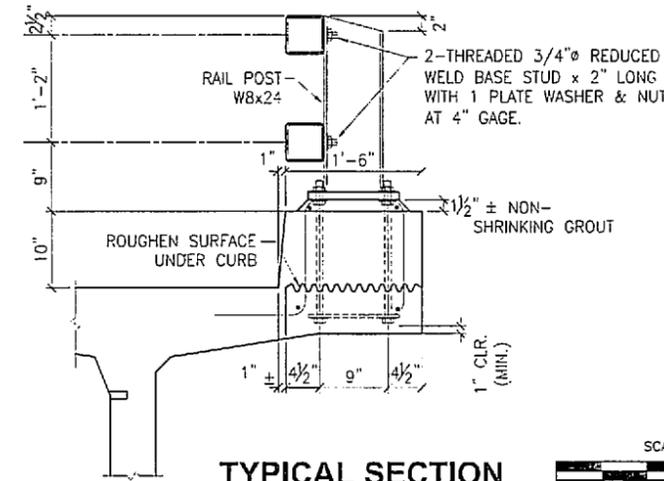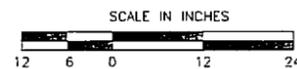


**TYPICAL SECTION**

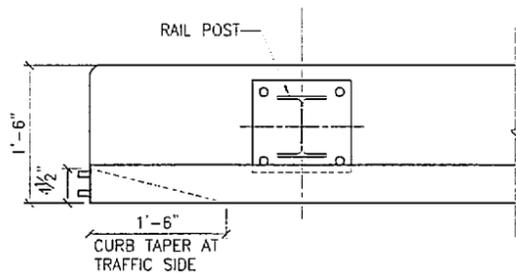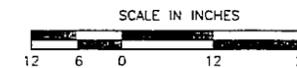



**PLAN  
END POST DETAIL**

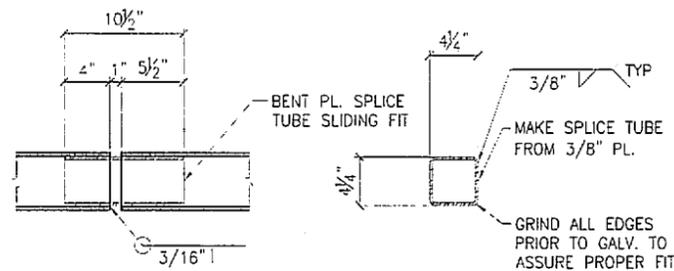



**RAIL SPLICE DETAIL**

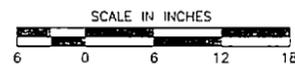



**SPLICE TUBE**

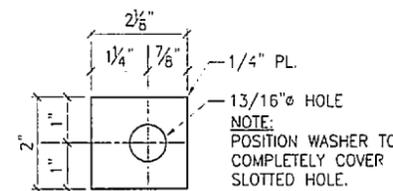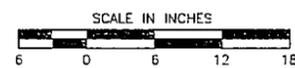



**PLATE WASHER**

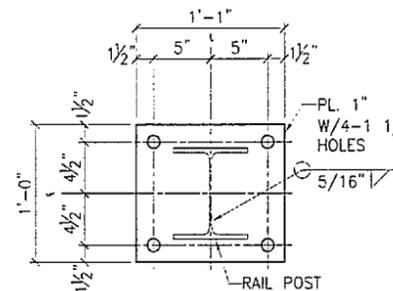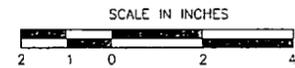



**BASE PLATE DETAIL**

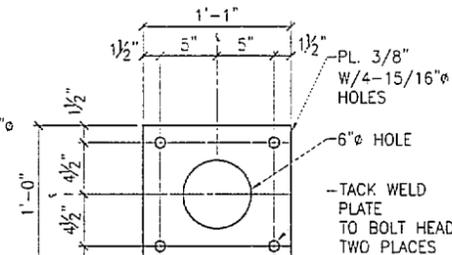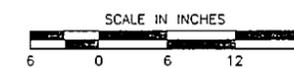



**ANCHOR PLATE DETAIL**

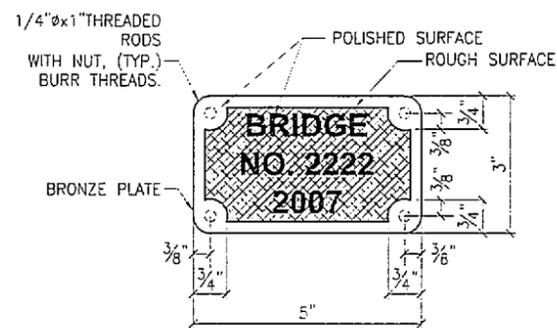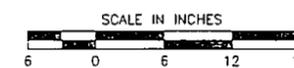


**BRONZE BRIDGE NO. PLATE**

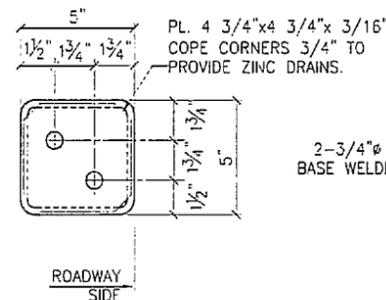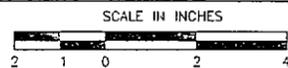

**RAIL CAP DETAIL**

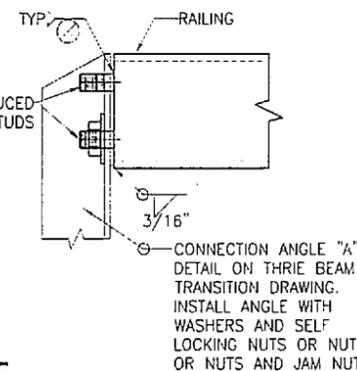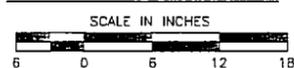

**RAILING STUD DETAIL**

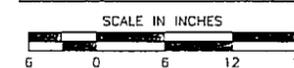

**NOTES**

- LOCATE BRIDGE NUMBER PLATES ON RIGHT HAND SIDE OF APPROACHING TRAFFIC NEAR EACH END AS SHOWN (1 TOTAL).
- FURNISH BRIDGE NUMBER PLATES. USE BRONZE THAT CONFORMS TO A.S.T.M. B98-90, ALLOY "A" OR "B". USE "CENTURY" TYPE STYLE LETTERING. USE STUDS AND NUTS THAT CONFORMS TO UNS C65100 OR C65500. BRAZE 1/4" Ø THREADED ROD TO BACK OF PLATE WITH NUT-4 REQUIRED. USE LOCKING NUTS OR LOCK WASHERS ON ALL MACHINE BOLTS.
- PROVIDE RAILING EXPANSION JOINTS AT 50'-0" MAXIMUM INTERVALS. RAILING SHALL BE CONTINUOUS OVER 4 POSTS MAXIMUM.
- USE GROUT WITH A MINIMUM 24 HOUR F'C OF 3000 PSI.
- SEE "TYPICAL SECTION" DWG. FOR RAIL POST SPACING.
- BRIDGE RAIL AND THRIE BEAM TRANSITION ARE TL-4 CRASH TEST RATED.
- INSTALL RAIL POSTS PLUMB.
- SEE STD. DWG. G31.00 FOR THRIE BEAM TRANSITION.

DESIGNED BY:	C. KENLEY	CHECKED:	J. GOBELT
DRAWN BY:	S. ABBETT	CHECKED:	J. GOBELT
QUANTITIES BY:	D. BENTTI	CHECKED:	J. GOBELT

STATE OF ALASKA  
DEPARTMENT OF TRANSPORTATION  
AND PUBLIC FACILITIES  
BRIDGE SECTION



GRAVINA CREEK BRIDGE  
GRAVINA ISLAND HIGHWAY  
BRIDGE RAILING





BRIDGE NO. 2222  
DWG. NO. 13

PROJECT DESIGNATION	SHEET NO	TOTAL SHEETS
HP-NCPD-0922(5)	1	7

# STATE OF ALASKA DEPARTMENT OF TRANSPORTATION & PUBLIC FACILITIES

## RIGHT-OF-WAY MAP ALASKA PROJECT

### KETCHIKAN GRAVINA ISLAND ACCESS HP-NCPD-0922(5) / 67698

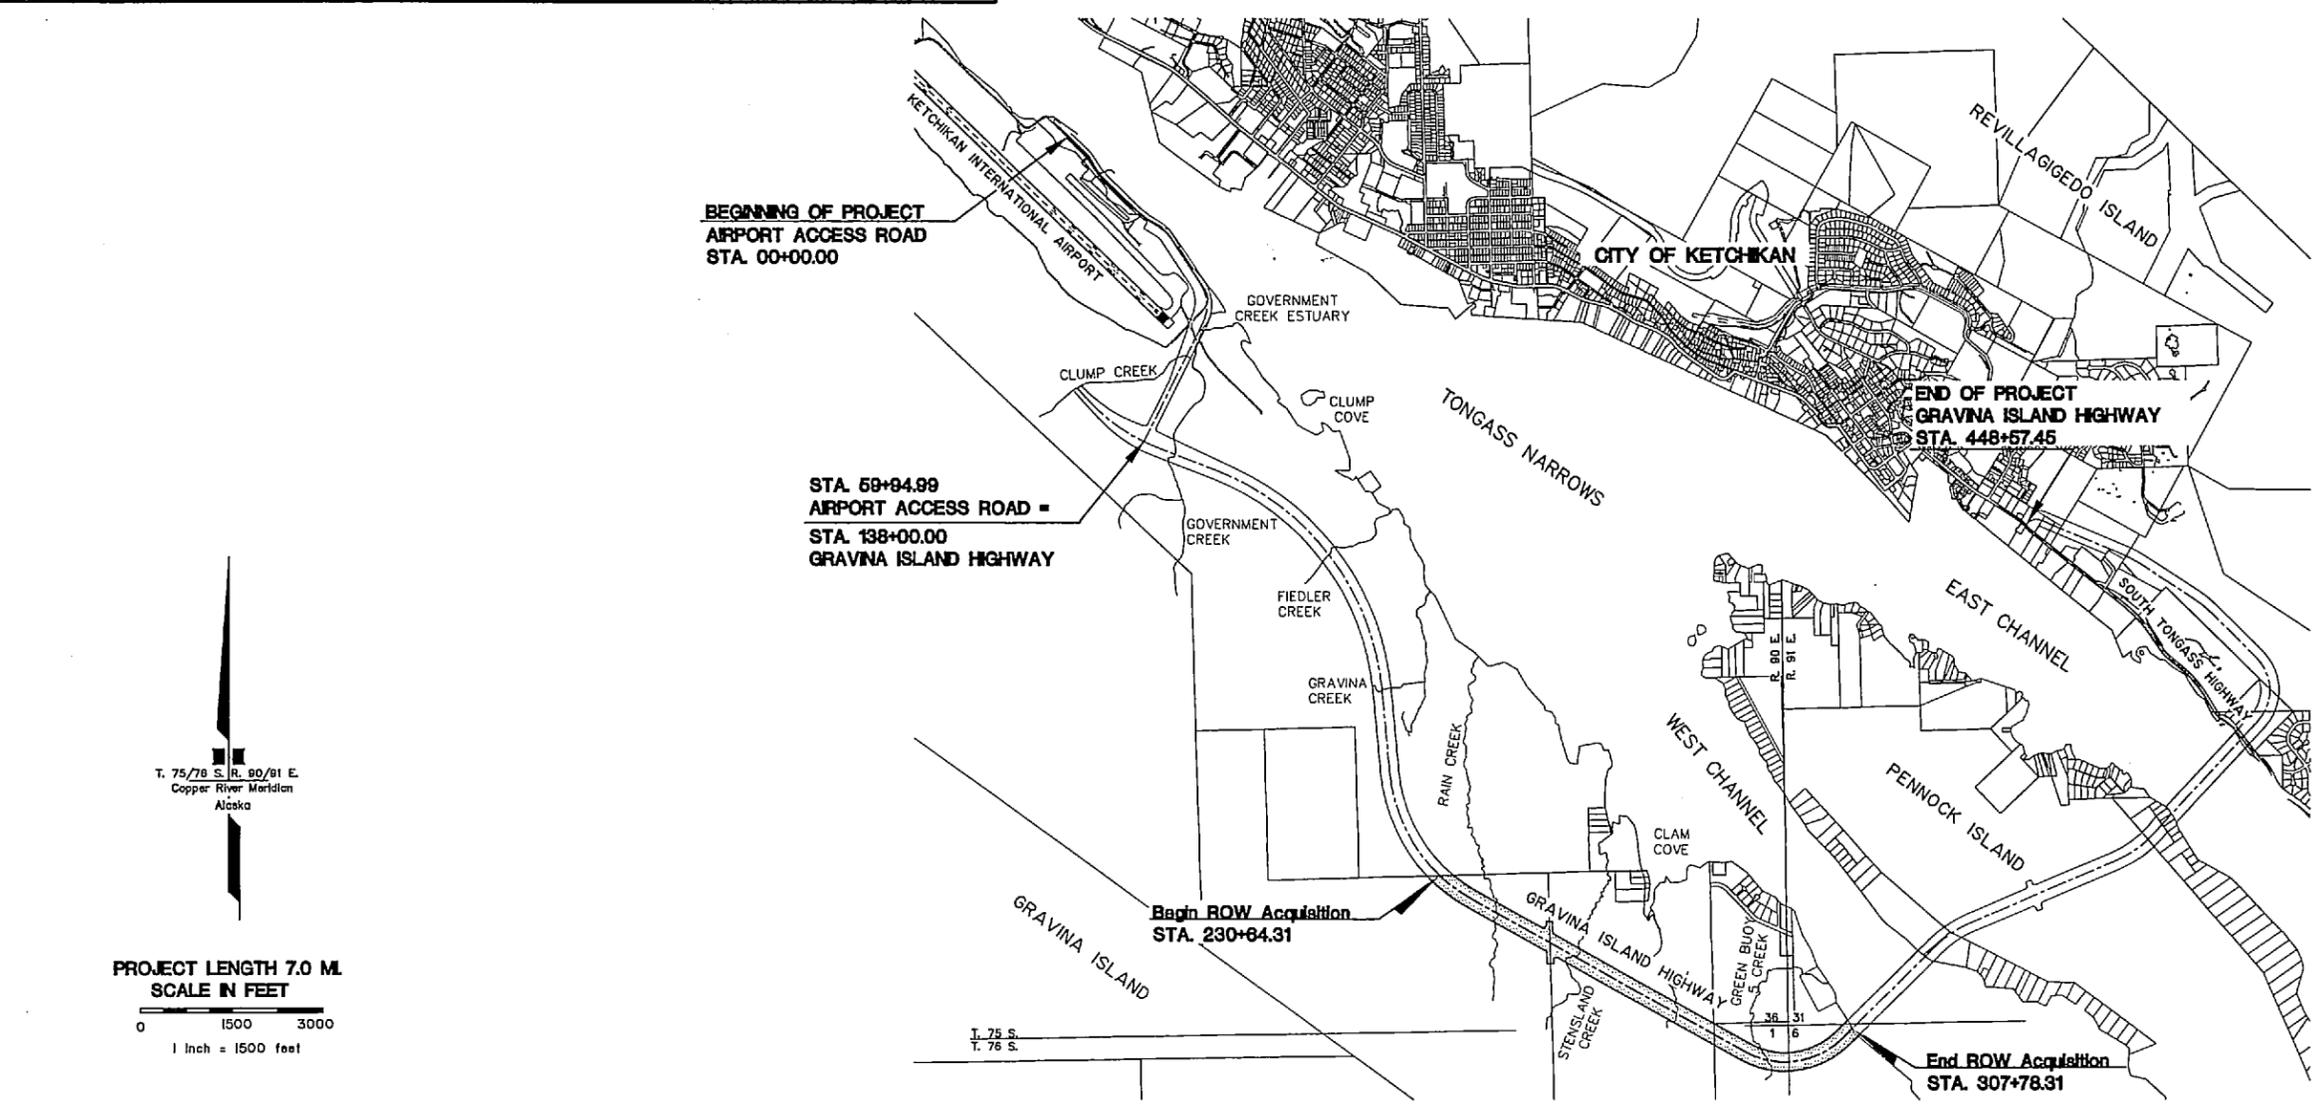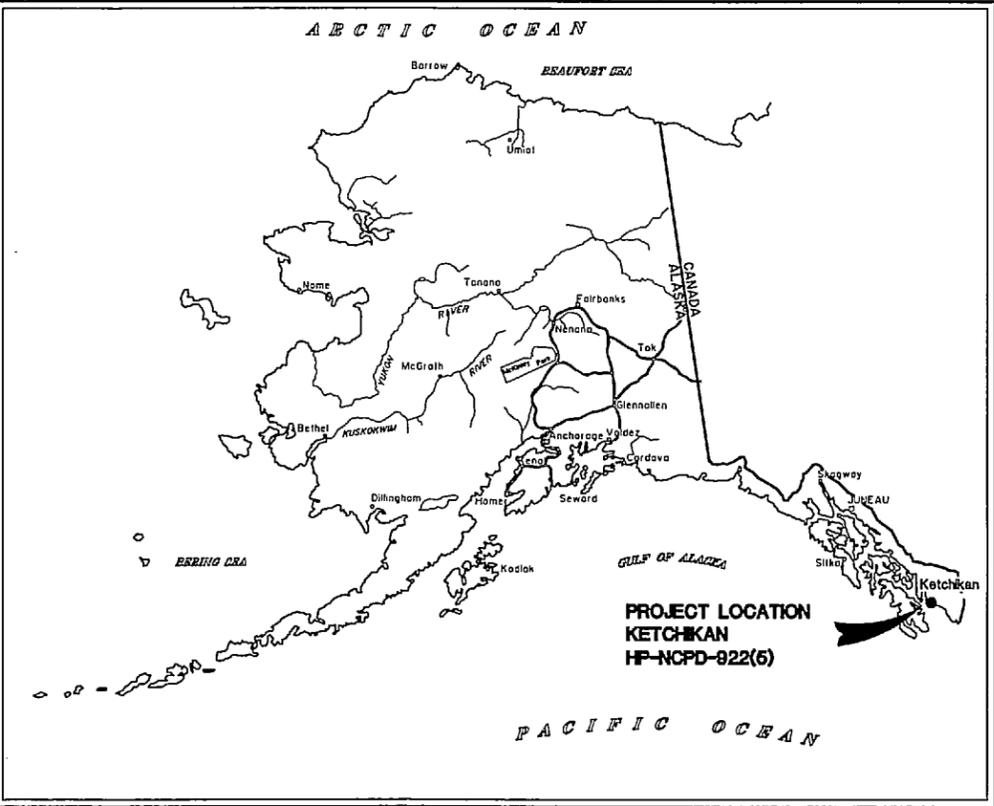

ALASKA DEPARTMENT OF  
TRANSPORTATION & PUBLIC FACILITIES

APPROVAL DATE: \_\_\_\_\_, 20\_\_

REGIONAL CHIEF R/W AGENT \_\_\_\_\_

Department Locations Surveyor's Certificate

I hereby certify that I am a Professional Land Surveyor registered in the State of Alaska and that all Right-of-Way centerline monument locations have been established as indicated on the Right-of-Way Plans, all existing found subdivision monuments, property corners and section line monumentation as indicated on the Right-of-Way plans have been referenced to project survey control by me or under my supervision.

Date: \_\_\_\_\_ Registration No. \_\_\_\_\_

Name of Surveyor \_\_\_\_\_

Surveyor's Certificate

I hereby certify that I am properly Registered and Licensed to practice Land Surveying in the State of Alaska, and that this drawing represents a survey made by me or under my direct supervision, and that the monuments shown hereon actually exist as described, and that all dimensions and other details are correct to the extent shown hereon.

Kenneth W. Ayers, PLS-8535 Date: \_\_\_\_\_

KETCHIKAN RECORDING DISTRICT  
STATE BUSINESS - NO FEE

PREPARED BY:  
LOUNSBURY & ASSOCIATES, INC.

PROJECT LENGTH 7.0 MI.  
SCALE IN FEET

0 1500 3000


1 Inch = 1500 feet

T. 75/78 S. R. 90/91 E.  
Copper River Meridian  
Alaska

T. 75 S.  
T. 76 S.

	RECOVERED	TO BE SET THIS PROJECT
FED. GOV'T SECTION CORNER		
FED. GOV'T 1/4 SECTION CORNER		
FED. GOV'T 1/16 SECTION CORNER		
FED. GOV'T SURVEY MONUMENT		
FED. GOV'T SURVEY CORNER		
GOV'T CONTROL STA.		
PRIMARY MONUMENT [BRASS/AL CAP]		
MISC. SECONDARY CORNER		
PRIMARY CENTERLINE MONUMENT		
PRIMARY RIGHT-OF-WAY MONUMENT		
CONTROL POINT		
INTERNATIONAL BOUNDARY LINE		
TOWNSHIP & RANGE LINE		
RECORD DATA		
RECORD ROTATED DATA		
SECTION LINE		
1/4 SECTION LINE		
1/16 SECTION LINE		
CORPORATE or CITY LIMITS		

SECTION LINE EASEMENT AND SECTION LINE-CENTERLINE INTERSECTION

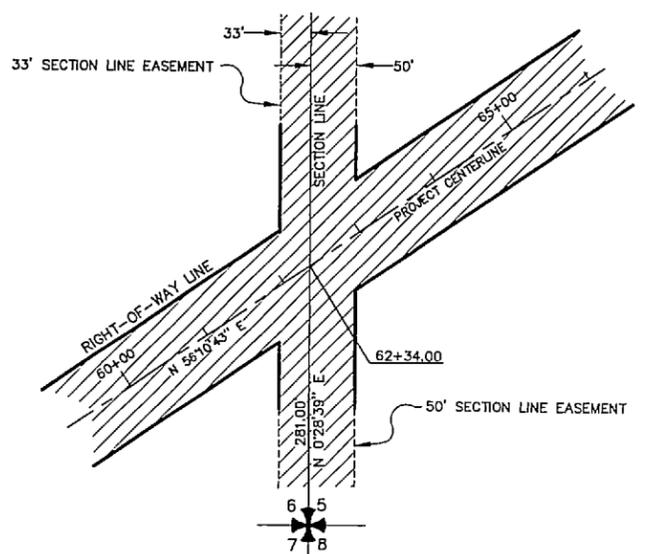

HIGHWAY MILEPOST	
RAILROAD MILEPOST	
PARCEL NUMBER TAG	
EDGE OF WATER	
EXISTING RIGHT-OF-WAY	
RIGHT-OF-WAY REQUIRED AREA REMAINING	
STATION EQUATION	
PROJECT CENTERLINE	
EXISTING CENTERLINE	
RAILROAD CENTERLINE	
PROJECT RIGHT-OF-WAY LINE	
EXISTING RECORD PROPERTY LINE	
RETRACED PROPERTY LINE	
PERMIT LINE	
EXISTING EASEMENT LINE	
LIMIT OF CUT SLOPE	
LIMIT OF FILL SLOPE	
PROPOSED ROADWAY	
EXISTING ROADWAY	
NOISE BARRIER	
FENCE	
STONE FENCE	
HEAD & WING WALL	
GUARD RAIL	
RETAINING WALL	
TUNNEL	
INTERMITTENT DRAINAGE	
INTERCEPTOR DITCH	
MARSHLAND	
CREEK	
RIVER	
LAKE	
RESERVOIR	
CHANNEL CHANGE	

	EXISTING	PROPOSED
PIPELINES:		
SANITARY SEWER		
OIL		
GAS		
WATER		
STORM DRAIN		
SIDEWALK		
CONCRETE CURB		
CONCRETE CURB & GUTTER		
DRIVEWAY, APPROACH, & SIDE DRAIN		
BRIDGE		
RIPRAP		
U.G. TELEPHONE (DIRECT BURY)		
U.G. ELECTRIC (DIRECT BURY)		
U.G. DUCT		
TELEPHONE MANHOLE		
ELECTRIC MANHOLE		
FOUNDATION		
BUILDING		
MANHOLE		
FIRE HYDRANT		
ELECTRIC METER		
PIPE CULVERT		
UTILITY POLE		
ELECTROLIER		
UTILITY POLE WITH LUMINAIRE		
POLE ANCHOR		
TRANSMISSION TOWER [WOOD]		
TRANSMISSION TOWER [STEEL]		
ELECTRICAL PEDESTAL		
TELEPHONE PEDESTAL		
CABLE T.V. PEDESTAL		


	EXISTING
PLANTER	
VENT	
TANK VENT	
WELL	
SEPTIC	
TANKS	
Above Ground	
Below Ground	
SATELLITE DISH	
ELECTRICAL OUTLET	
PRIVATE SIGN	
GAS PUMP	
POST	
BOULDER OR BOULDERS	
LANDSCAPE LIGHT	
DECIDUOUS TREE	
CONIFEROUS TREE	
SHRUB OR SHRUBS	

KETCHIKAN RECORDING DISTRICT  
STATE OF ALASKA  
DEPARTMENT OF TRANSPORTATION  
PUBLIC FACILITIES  
RIGHT-OF-WAY MAP LEGEND SHEET  
ALASKA PROJECT  
**KETCHIKAN**  
**GRAVINA ISLAND ACCESS**  
HP-NCPD-0922(5)  
67698



CURVE TABLE						
CURVE	DELTA	RADIUS	ARC LENGTH	TANGENT	CHORD	CHORD BEARING
C1	9° 48' 24"	2450.00'	419.34'	210.18'	418.83'	N 55° 58' 00" W
C2	13° 25' 11"	2600.00'	608.97'	305.88'	607.58'	S 54° 09' 37" E
C3	16° 27' 23"	2750.00'	789.86'	397.67'	787.14'	S 52° 38' 30" E
C4	120° 51' 41"	50.00'	105.47'	88.13'	86.98'	S 58° 41' 57" W
C5	59° 08' 19"	50.00'	51.61'	28.37'	49.35'	S 31° 18' 03" E

LINE TABLE		
LINE No.	BEARING	DISTANCE
L1	S 01° 43' 53" E	157.72'
L2	N 88° 16' 07" E	50.00'
L3	S 88° 16' 07" W	50.00'
L4	S 01° 43' 53" W	59.71'

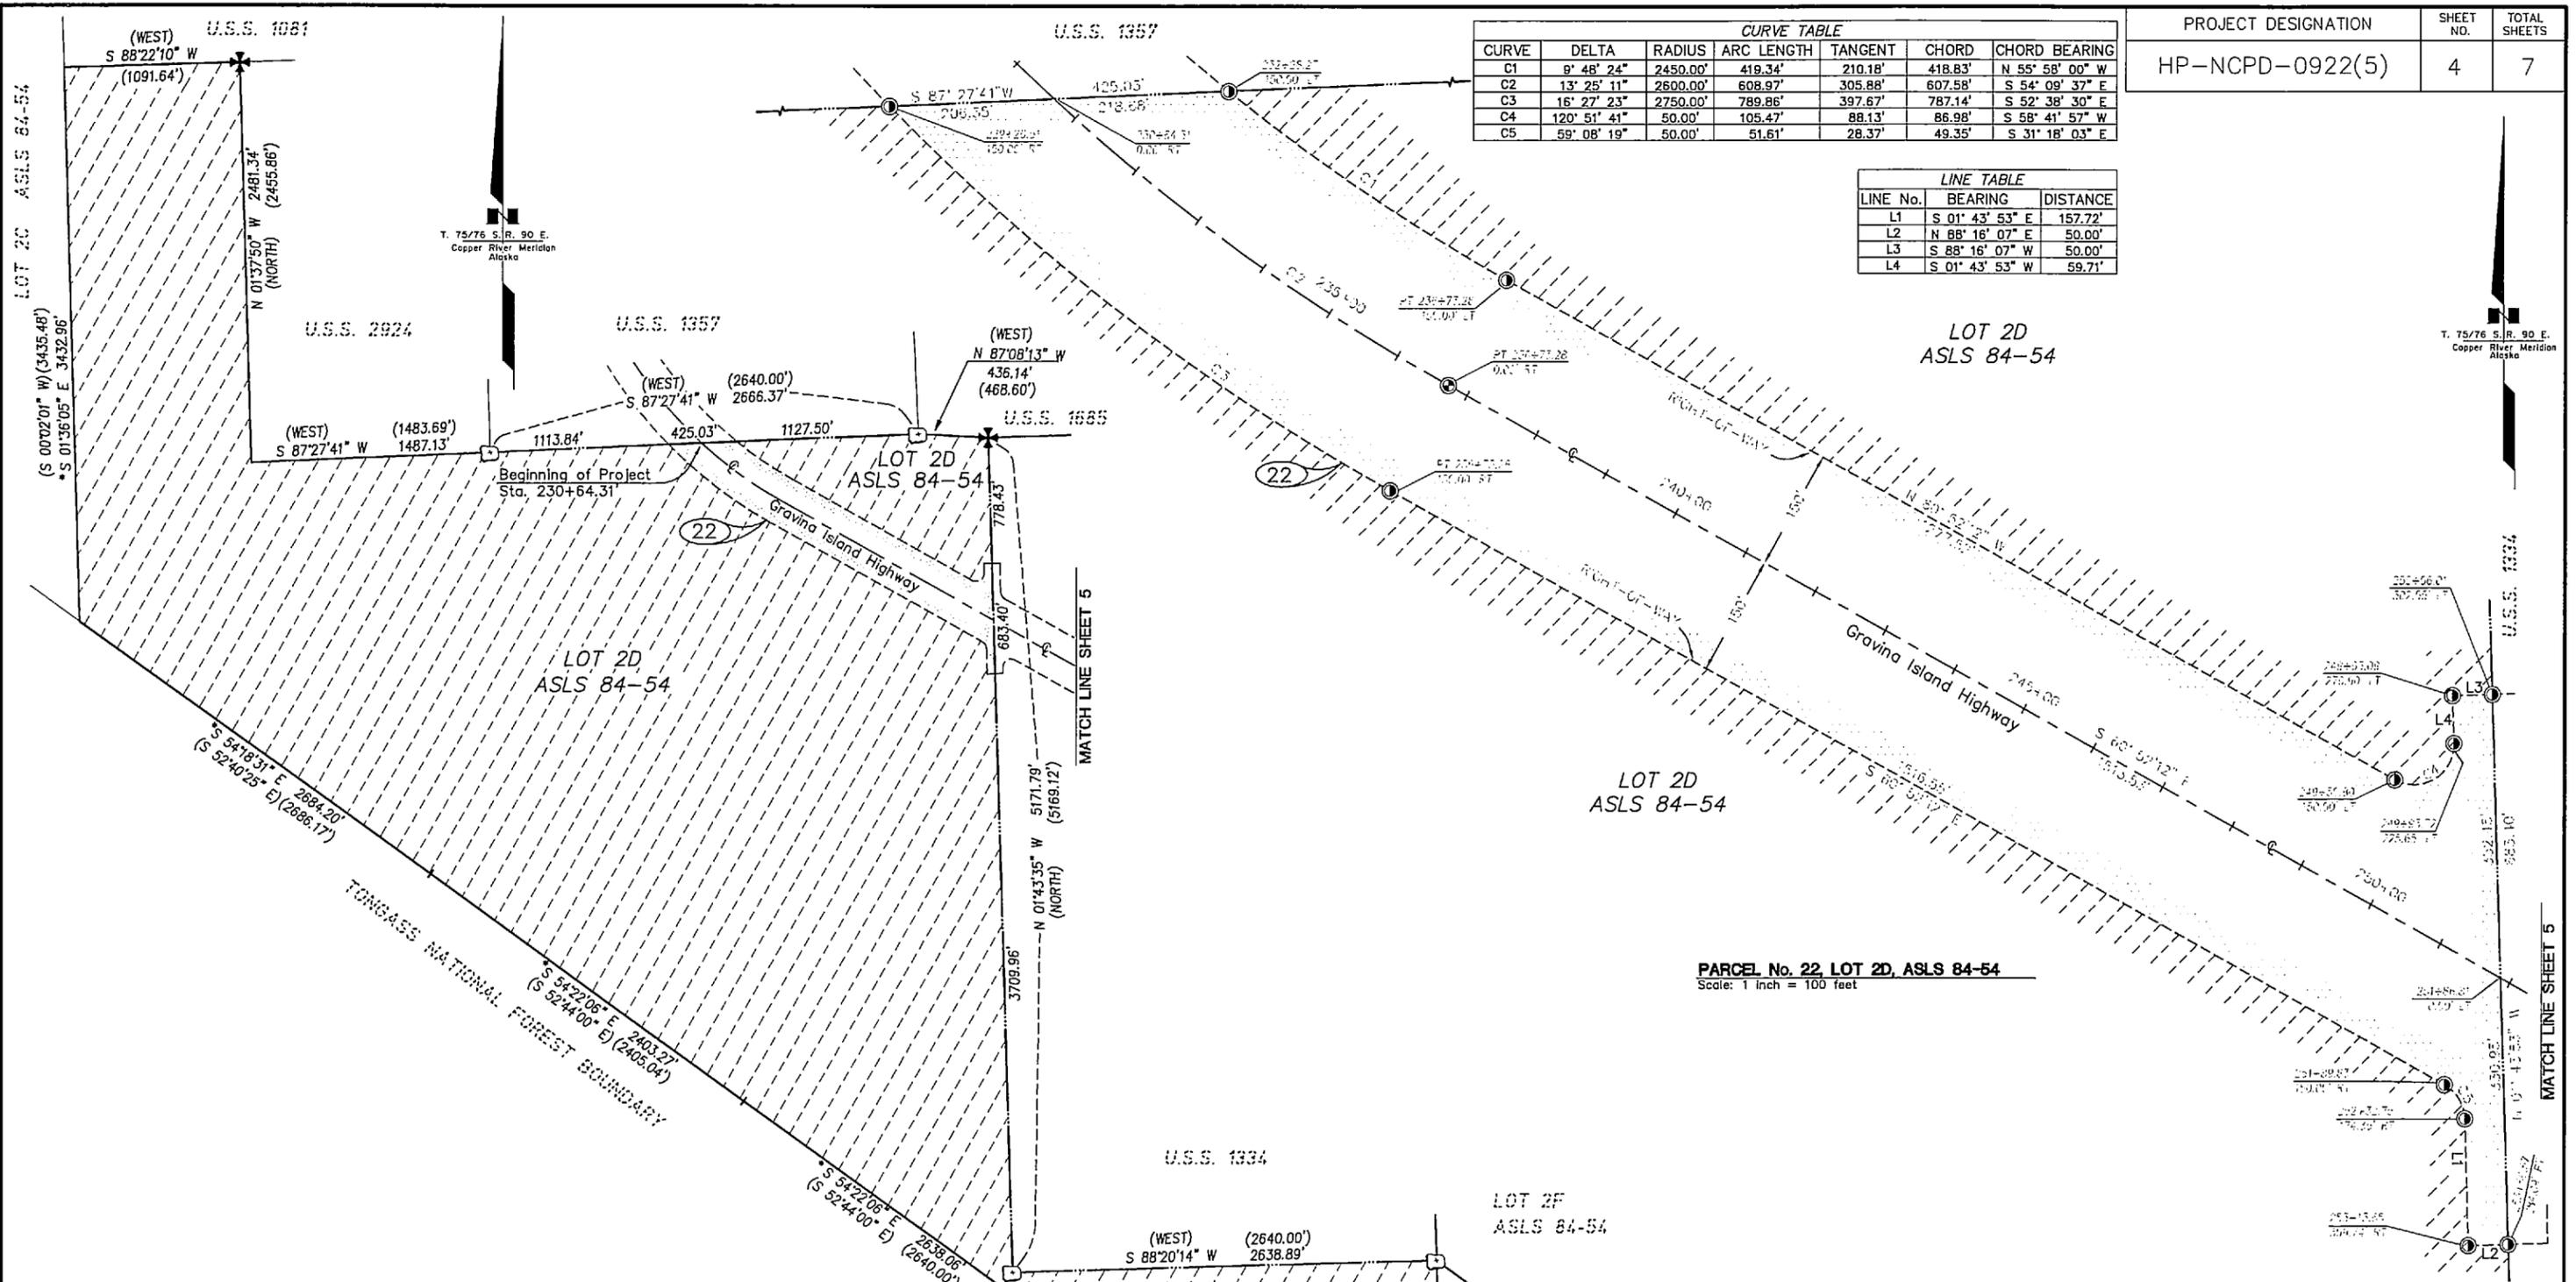


**LOT 2D RIGHT-OF-WAY ACQUISITION**  
Scale: 1 Inch = 500 feet

**PARCEL No. 22, LOT 2D, ASLS 84-54**  
Scale: 1 Inch = 100 feet

- NOTES:
1. Horizontal Control statement depicted on Sheet 7.
  2. \* - Denotes Grant Adjusted portion of boundary, Lot 2D, ASLS 84-54.

PARCEL NO.	FEE	OWNER	ORIGINAL PARCEL	NET TAKE	REMAINDER	RECORDED DOCUMENT NO.
22		KETCHIKAN GATEWAY BOROUGH	23,621,157 s.f.	654,909 s.f.	22,966,248 s.f.	

PARCEL INFORMATION

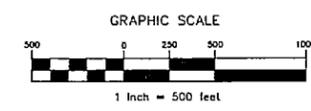

CONSULTANT LOCATIONS SURVEYOR'S CERTIFICATE  
CONSULTANT RIGHT-OF-WAY SURVEYOR'S CERTIFICATE

PREPARED BY:  
LOUNSBURY & ASSOCIATES, INC.


KETCHIKAN RECORDING DISTRICT

DATE	REVISIONS	BY

STATE OF ALASKA  
DEPARTMENT OF TRANSPORTATION  
&  
PUBLIC FACILITIES  
RIGHT-OF-WAY MAP  
ALASKA PROJECT  
**KETCHIKAN GRAVINA ISLAND ACCESS**  
HP-NCPD-0922(5)  
**67698**

DRAWN	PS	DATE	Feb. 1, 2007	SCALE	1"=500'
CHECKED	KWA	DATE	Feb. 1, 2007	SHEET	4 OF 7

U.S.S. 1685

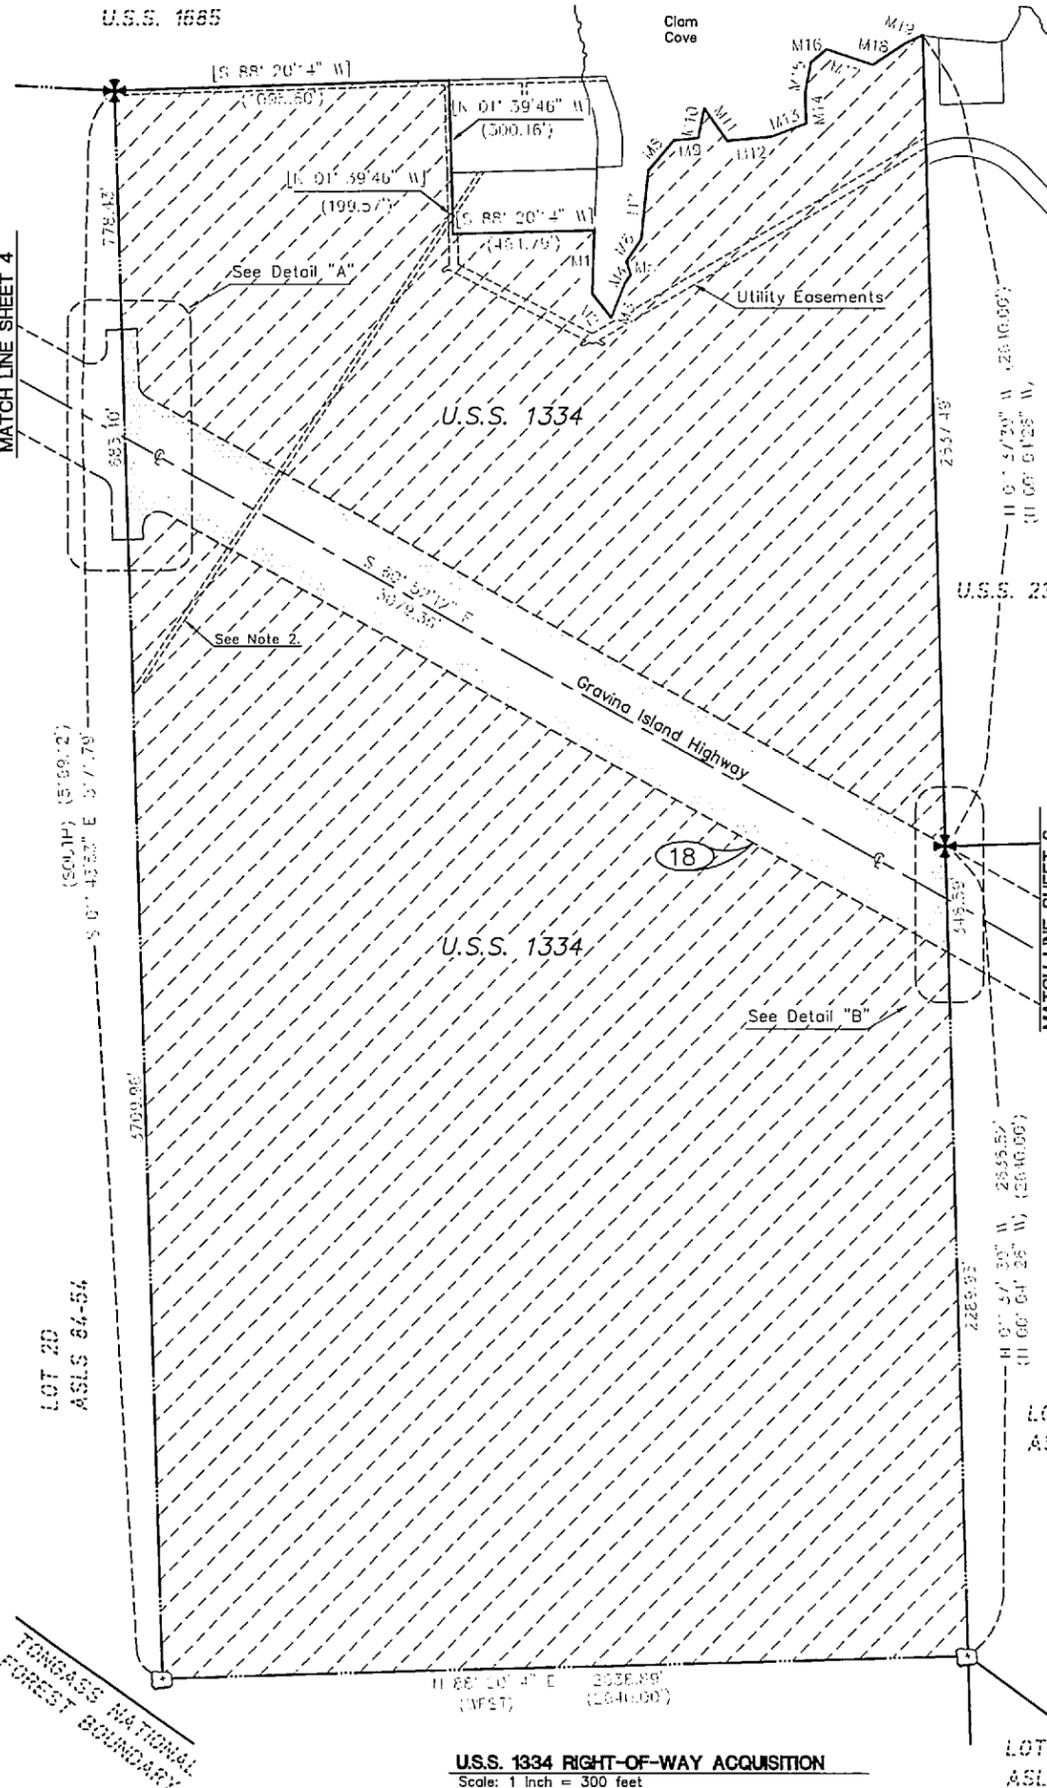



CURVE TABLE						
CURVE	DELTA	RADIUS	ARC LENGTH	TANGENT	CHORD	CHORD BEARING
C6	120° 51' 41"	50.00'	105.47'	88.13'	86.88'	N 58° 41' 57" E
C7	59° 08' 19"	50.00'	51.61'	28.37'	49.35'	N 31° 18' 03" W

PROJECT DESIGNATION	SHEET NO.	TOTAL SHEETS
HP-NCPD-0922(5)	5	7

LINE TABLE		
LINE No.	BEARING	DISTANCE
L5	S 88° 16' 07" W	50.00'
L6	N 01° 43' 53" W	179.22'
L7	N 88° 16' 07" E	50.00'
L8	N 01° 43' 53" W	38.20'
L9	N 01° 37' 39" W	2.51'
L10	N 88° 26' 47" E	4.23'


MEANDER LINES		
Meander	Bearing	Distance
M1	[N 02° 05' 14" E]	(208.60')
M2	[N 38° 24' 46" W]	(99.66')
M3	[N 21° 35' 14" E]	(121.44')
M4	[S 35° 20' 14" W]	(33.00')
M5	[S 17° 39' 46" E]	(46.20')
M6	[S 33° 35' 14" W]	(86.46')
M7	[S 05° 50' 14" W]	(225.06')
M8	[S 40° 05' 14" W]	(128.70')
M9	[S 84° 35' 14" W]	(79.20')
M10	[S 11° 50' 14" W]	(97.68')
M11	[N 35° 24' 46" W]	(128.70')
M12	[S 84° 20' 14" W]	(146.52')
M13	[S 69° 05' 14" W]	(120.78')
M14	[S 02° 09' 46" E]	(99.00')
M15	[S 11° 05' 14" W]	(100.98')
M16	[S 49° 35' 14" W]	(66.66')
M17	[N 71° 24' 46" W]	(159.06')
M18	[S 56° 35' 14" W]	(126.06')
*M19	[S 65° 26' 12" W]	63.44'

\*The meanders shown herein are record data from the official field notes for U.S. Survey 1334, as related to the basis of bearing for this survey. The sum of closure for the recorded data was placed Meander 19, to conform the highest degree of conformity to the record data.

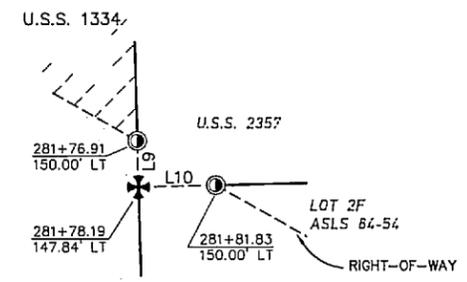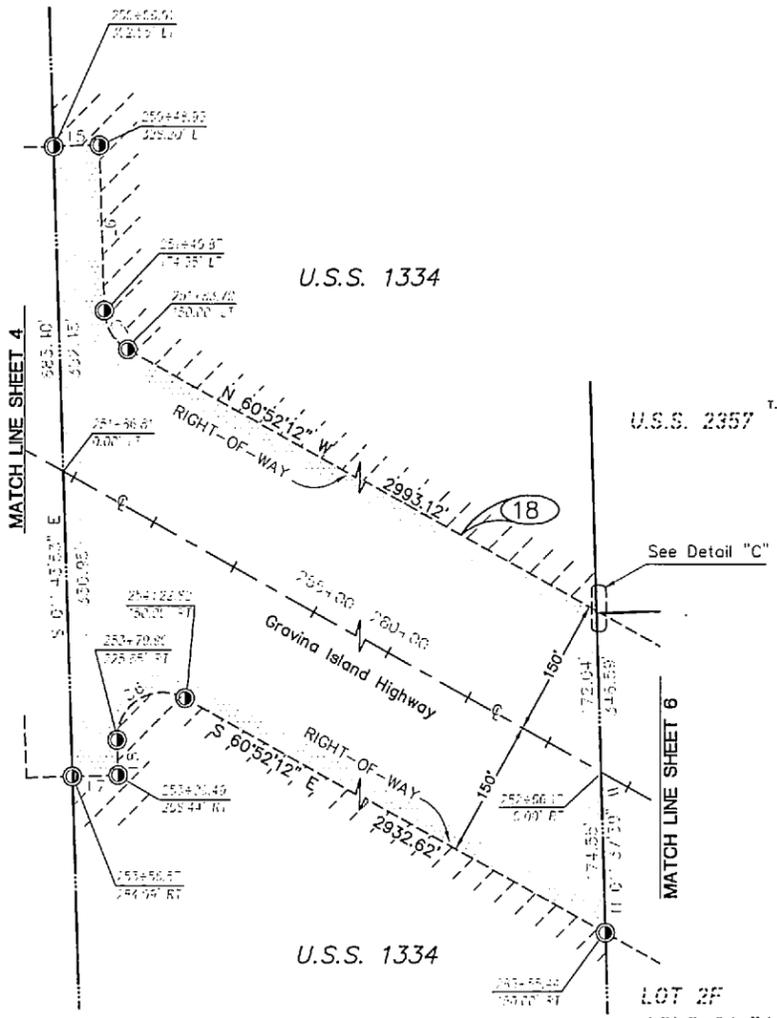

Detail "C"  
Scale: 1 inch = 5 feet

Detail "A"  
Detail "B"  
PARCEL 18, U.S.S. 1334  
Scale: 1 inch = 100 feet

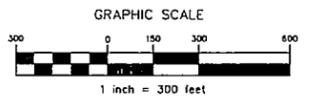

- NOTES:
- Horizontal Control statement depicted on Sheet 7.
  - Approximate location of 15ft. waterline right-of-way, see Ketchikan Recording District, Page 146, Volume "P" of Deeds, dated October 1, 1933.
  - Meanders subject to a 50ft. Public Access Easement measured upland from the line of mean or ordinary high water, pursuant to AS 38.05.127 and 11 AAC 53.330.
  - Only property lines where the alignment crosses said property line were surveyed and retraced in the field. The recovered monumentation was tied to local control. All other property lines use record calls (bearing and distance), that have been related to the Ketchikan Third Avenue Transformation coordinate system. These bearings are represented by [ ] brackets.



CONSULTANT LOCATIONS  
SURVEYOR'S CERTIFICATE  
CONSULTANT RIGHT-OF-WAY  
SURVEYOR'S CERTIFICATE  
PREPARED BY:  
LOUNSBURY & ASSOCIATES, INC.

KETCHIKAN RECORDING DISTRICT

DATE	REVISIONS	BY

STATE OF ALASKA  
DEPARTMENT OF TRANSPORTATION  
PUBLIC FACILITIES  
RIGHT-OF-WAY MAP  
ALASKA PROJECT  
KETCHIKAN  
GRAVINA ISLAND ACCESS  
HP-NCPD-0922(5)  
67698

DRAWN PS DATE Feb. 1, 2007 SCALE 1"=300'  
CHECKED KWA DATE Feb. 1, 2007 SHEET 5 OF 7

PARCEL NO.	FEE INTEREST TO BE ACQUIRED	OWNER	ORIGINAL PARCEL	NET TAKE	REMAINDER	RECORDED DOCUMENT NO.
18		George E. Stensland	13,233,355 s.f.	942,403 s.f.	12,290,952 s.f.	

PARCEL INFORMATION

TONGASS NATIONAL FOREST BOUNDARY

U.S.S. 1334 RIGHT-OF-WAY ACQUISITION  
Scale: 1 inch = 300 feet

**LINE TABLE**


LINE No.	BEARING	DISTANCE
L11	N 45° 39' 27" E	230.85'
L12	N 45° 39' 27" E	258.43'
L13	S 45° 39' 27" W	299.09'
L14	N 33° 23' 13" W	87.53'
L15	N 23° 47' 13" W	165.00'
L16	N 50° 24' 13" W	59.90'
L17	N 01° 37' 39" W	2.51'
L18	S 88° 26' 47" W	4.23'

**CURVE TABLE**


CURVE	DELTA	RADIUS	ARC LENGTH	TANGENT	CHORD	CHORD BEARING
C8	73° 28' 20"	1175.00'	1506.74'	876.97'	1405.61'	S 82° 23' 38" W
C9	73° 28' 20"	1325.00'	1699.09'	988.93'	1585.05'	N 82° 23' 38" E
C10	73° 28' 20"	1475.00'	1891.44'	1100.88'	1764.49'	N 82° 23' 38" E

**MEANDER LINES**

Meander	Bearing	Distance
M12	S 88° 26' 47" W	4.23'
M13	S 88° 26' 47" W	4.23'
M14	N 01° 37' 39" W	2.51'
M15	N 50° 24' 13" W	59.90'
M16	N 23° 47' 13" W	165.00'
M17	N 33° 23' 13" W	87.53'
M18	N 45° 39' 27" E	230.85'
M19	N 45° 39' 27" E	258.43'
M20	S 45° 39' 27" W	299.09'
M21	N 33° 23' 13" W	87.53'
M22	N 23° 47' 13" W	165.00'
M23	N 50° 24' 13" W	59.90'
M24	N 01° 37' 39" W	2.51'
M25	S 88° 26' 47" W	4.23'
M26	S 88° 26' 47" W	4.23'
M27	N 01° 37' 39" W	2.51'
M28	N 50° 24' 13" W	59.90'
M29	N 23° 47' 13" W	165.00'
M30	N 33° 23' 13" W	87.53'
M31	N 45° 39' 27" E	230.85'
M32	N 45° 39' 27" E	258.43'
M33	S 45° 39' 27" W	299.09'
M34	N 33° 23' 13" W	87.53'
M35	N 23° 47' 13" W	165.00'
M36	N 50° 24' 13" W	59.90'
M37	N 01° 37' 39" W	2.51'
M38	S 88° 26' 47" W	4.23'
M39	S 88° 26' 47" W	4.23'
M40	N 01° 37' 39" W	2.51'
M41	N 50° 24' 13" W	59.90'
M42	N 23° 47' 13" W	165.00'
M43	N 33° 23' 13" W	87.53'
M44	N 45° 39' 27" E	230.85'
M45	N 45° 39' 27" E	258.43'
M46	S 45° 39' 27" W	299.09'
M47	N 33° 23' 13" W	87.53'
M48	N 23° 47' 13" W	165.00'
M49	N 50° 24' 13" W	59.90'
M50	N 01° 37' 39" W	2.51'
M51	S 88° 26' 47" W	4.23'
M52	S 88° 26' 47" W	4.23'
M53	N 01° 37' 39" W	2.51'
M54	N 50° 24' 13" W	59.90'
M55	N 23° 47' 13" W	165.00'
M56	N 33° 23' 13" W	87.53'
M57	N 45° 39' 27" E	230.85'
M58	N 45° 39' 27" E	258.43'
M59	S 45° 39' 27" W	299.09'
M60	N 33° 23' 13" W	87.53'
M61	N 23° 47' 13" W	165.00'
M62	N 50° 24' 13" W	59.90'
M63	N 01° 37' 39" W	2.51'
M64	S 88° 26' 47" W	4.23'
M65	S 88° 26' 47" W	4.23'
M66	N 01° 37' 39" W	2.51'
M67	N 50° 24' 13" W	59.90'
M68	N 23° 47' 13" W	165.00'
M69	N 33° 23' 13" W	87.53'
M70	N 45° 39' 27" E	230.85'
M71	N 45° 39' 27" E	258.43'
M72	S 45° 39' 27" W	299.09'
M73	N 33° 23' 13" W	87.53'
M74	N 23° 47' 13" W	165.00'
M75	N 50° 24' 13" W	59.90'
M76	N 01° 37' 39" W	2.51'
M77	S 88° 26' 47" W	4.23'
M78	S 88° 26' 47" W	4.23'
M79	N 01° 37' 39" W	2.51'
M80	N 50° 24' 13" W	59.90'
M81	N 23° 47' 13" W	165.00'
M82	N 33° 23' 13" W	87.53'
M83	N 45° 39' 27" E	230.85'
M84	N 45° 39' 27" E	258.43'
M85	S 45° 39' 27" W	299.09'
M86	N 33° 23' 13" W	87.53'
M87	N 23° 47' 13" W	165.00'
M88	N 50° 24' 13" W	59.90'
M89	N 01° 37' 39" W	2.51'
M90	S 88° 26' 47" W	4.23'
M91	S 88° 26' 47" W	4.23'
M92	N 01° 37' 39" W	2.51'
M93	N 50° 24' 13" W	59.90'
M94	N 23° 47' 13" W	165.00'
M95	N 33° 23' 13" W	87.53'
M96	N 45° 39' 27" E	230.85'
M97	N 45° 39' 27" E	258.43'
M98	S 45° 39' 27" W	299.09'
M99	N 33° 23' 13" W	87.53'
M100	N 23° 47' 13" W	165.00'

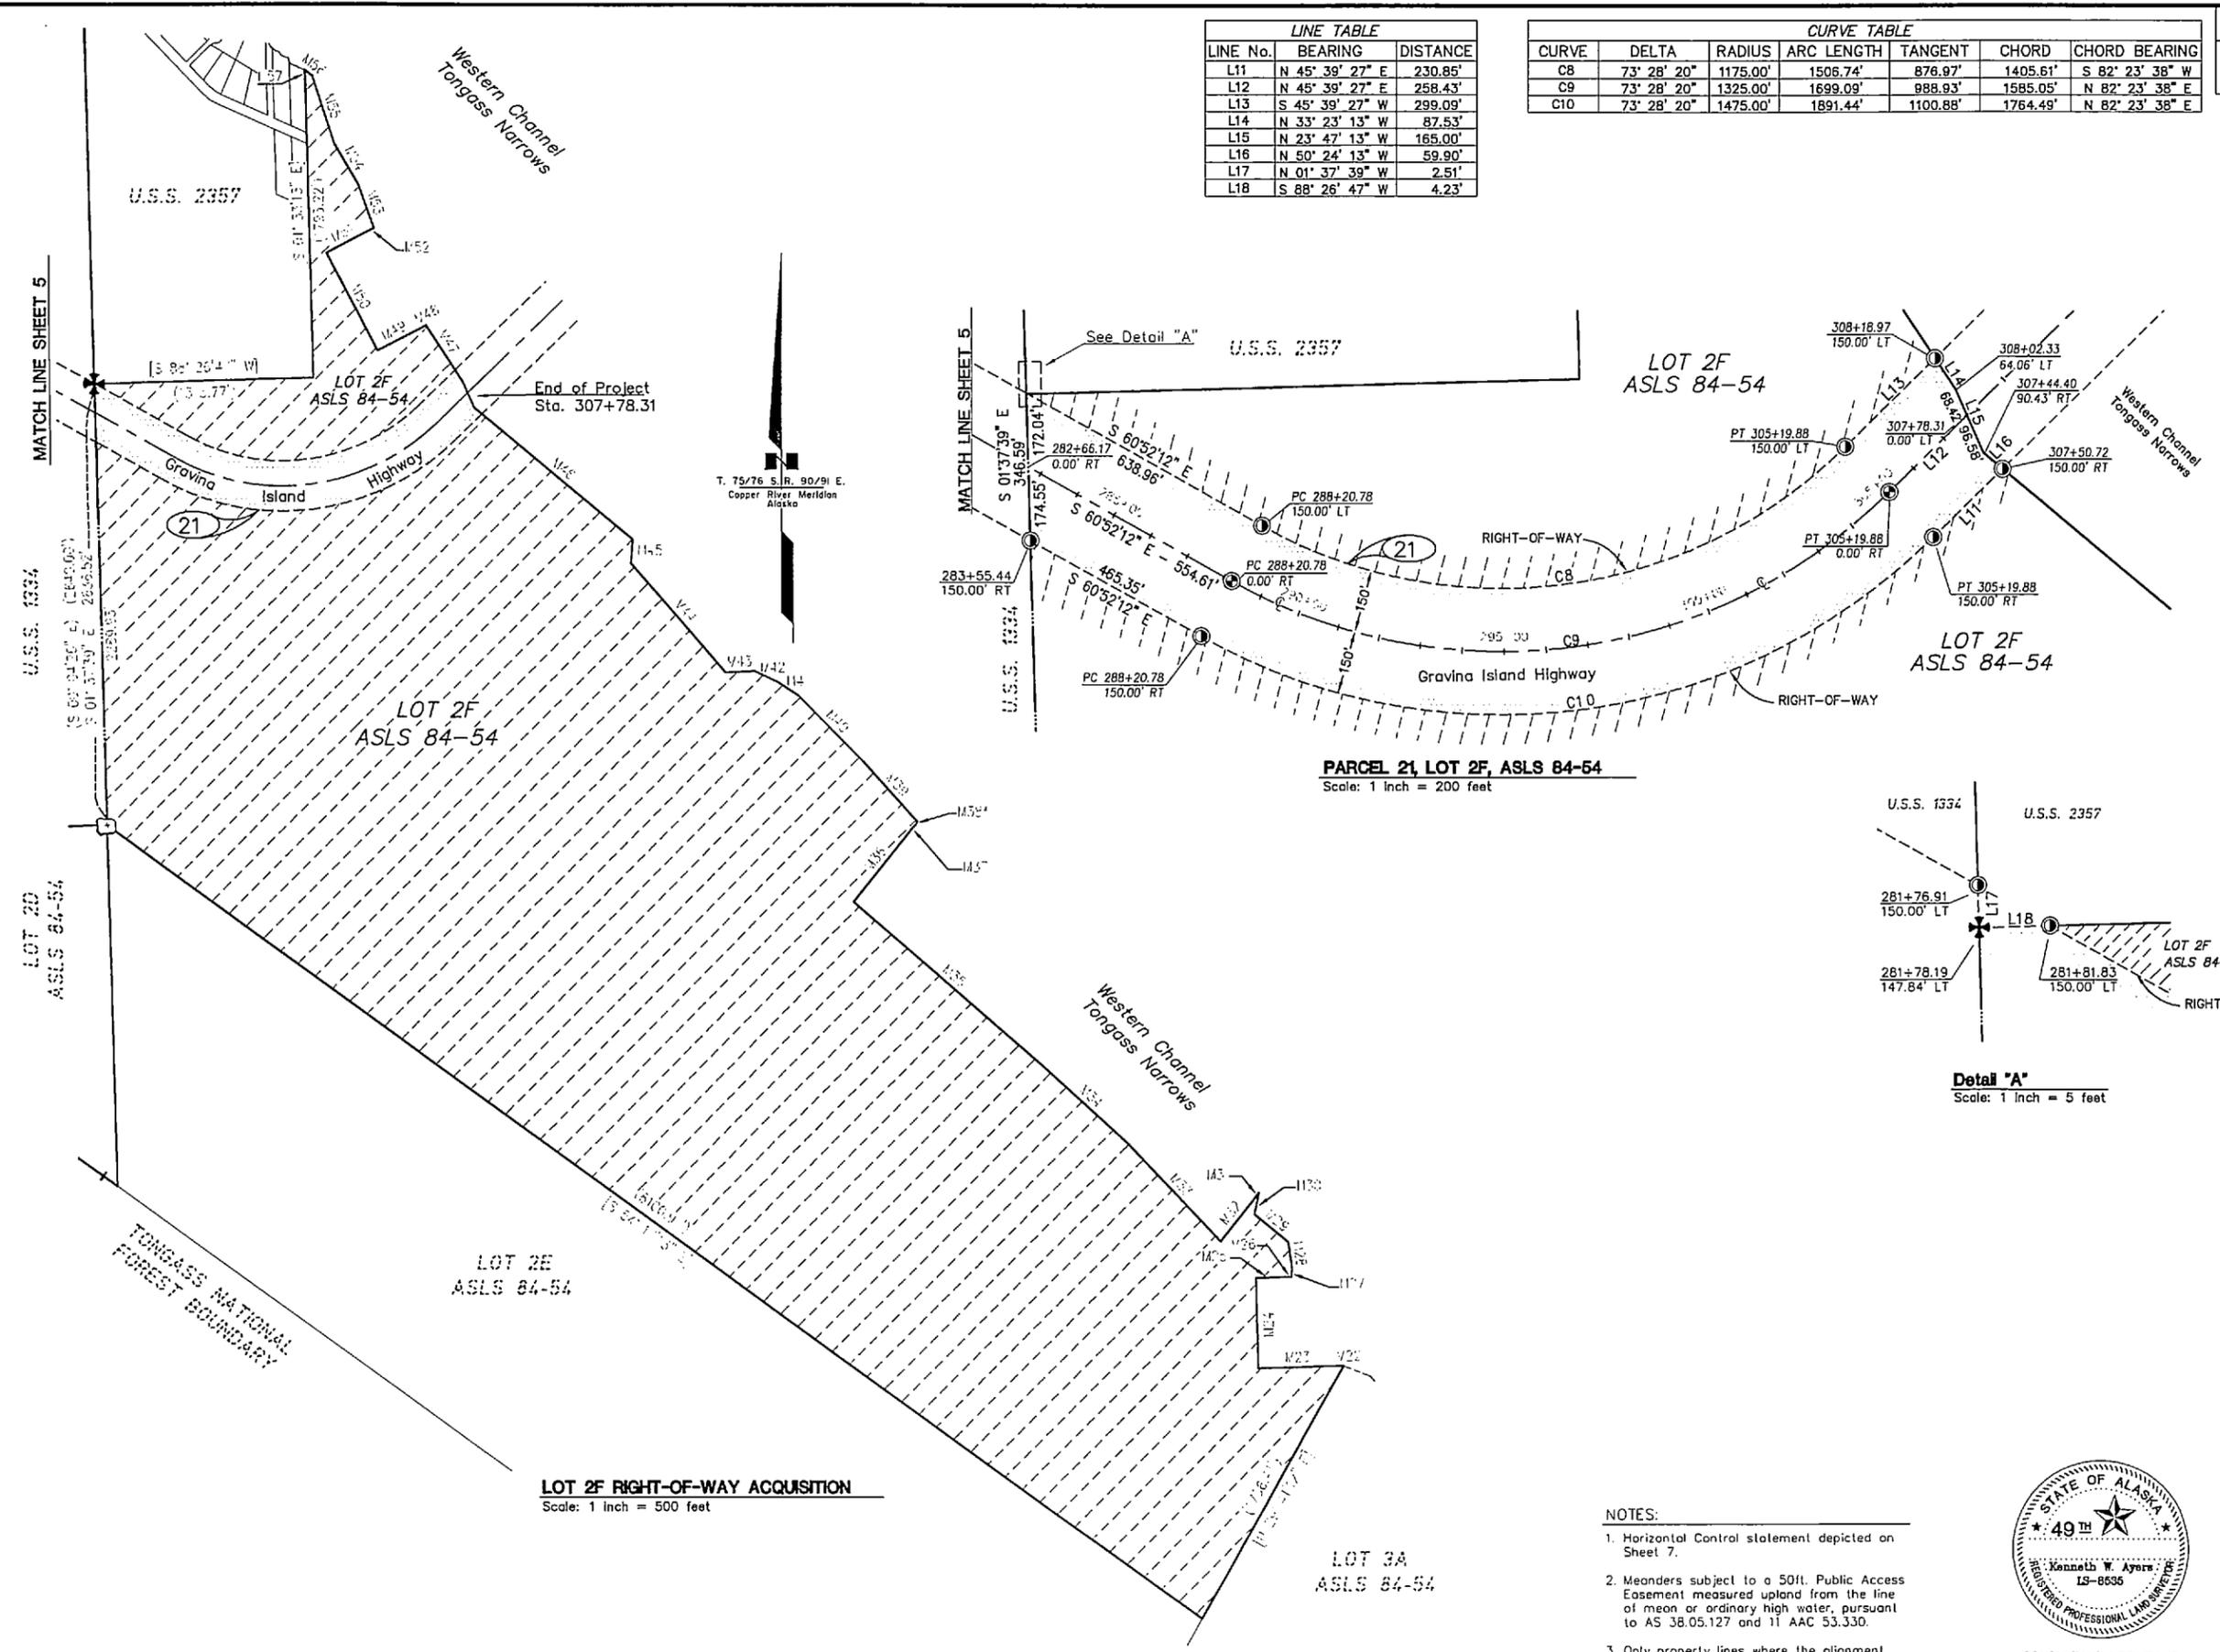


**PARCEL 21, LOT 2F, ASLS 84-54**  
 Scale: 1 inch = 200 feet

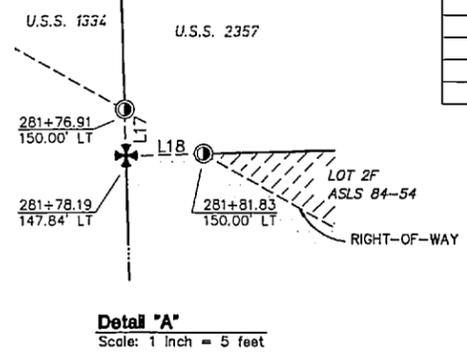

The meanders shown herein are record data from ASLS 84-54, Plat No. 93-28, Ketchikan Recording District, as related to the basis of bearing for this survey. The error of closure for the meander data was placed in Meander 55, the shortest meander, to maintain the highest degree of conformity to the record data.

**PARCEL INFORMATION**

PARCEL NO.	FEE INTEREST TO BE ACQUIRED	OWNER	ORIGINAL PARCEL	NET TAKE	REMAINDER	RECORDED DOCUMENT NO.
21		KETCHIKAN GATEWAY BOROUGH	23,647,590 s.f.	753,820 s.f.	22,893,770 s.f.	

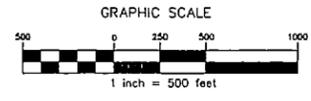

- NOTES:**
- Horizontal Control statement depicted on Sheet 7.
  - Meanders subject to a 50ft. Public Access Easement measured upland from the line of mean or ordinary high water, pursuant to AS 38.05.127 and 11 AAC 53.330.
  - Only property lines where the alignment crosses said property line were surveyed and retraced in the field. The recovered monumentation was tied to local control. All other property lines use record calls (bearing and distance), that have been related to the Ketchikan Third Avenue Transformation coordinate system. These bearings are represented by [ ] brackets.



CONSULTANT LOCATIONS SURVEYOR'S CERTIFICATE  
 CONSULTANT RIGHT-OF-WAY SURVEYOR'S CERTIFICATE

PREPARED BY:  
 LOUNSBURY & ASSOCIATES, INC.

KETCHIKAN RECORDING DISTRICT

DATE	REVISIONS	BY

STATE OF ALASKA  
 DEPARTMENT OF TRANSPORTATION  
 &  
 PUBLIC FACILITIES  
 RIGHT-OF-WAY MAP  
 ALASKA PROJECT  
**KETCHIKAN  
 GRAVINA ISLAND ACCESS**  
 HP-NCPD-0922(5)  
**67698**

DRAWN: PS DATE: Feb. 1, 2007 SCALE: 1"=500'  
 CHECKED: KWA DATE: Feb. 1, 2007 SHEET: 6 OF 7

**MONUMENT SUMMARY SHEET  
GRAVINA ISLAND ACCESS RIGHT-OF-WAY  
STATION 230+64.31 TO STATION 307+78.31**

SET and RECOVERED CORNERS - SHEETS 4 - 6						
LOCATION	DESCRIPTION	NORTHING	EASTING	STATION	OFFSET	WORK ITEM
CORNER 7, U.S.S. 2924	RECOVERED BRASS CAP	83172.9643	96667.2346	202+77.94	1969.78 RT	
CORNER 5, U.S.S. 2924	RECOVERED ROCK	80758.4964	98223.5078	223+94.01	1055.78 RT	
RIGHT-OF-WAY MONUMENT	SET ALUM. CAP	80807.8319	99336.2593	229+26.51	150.00 RT	
RIGHT-OF-WAY MONUMENT	SET ALUM. CAP	80826.6580	99760.8771	232+28.27	150.00 LT	
RIGHT-OF-WAY MONUMENT	SET ALUM. CAP	80330.1963	99961.9262	236+73.28	150.00 RT	
CENTERLINE MONUMENT	SET ALUM. MON	80461.2240	100034.9450	236+73.28	0.00 LT	
RIGHT-OF-WAY MONUMENT	SET ALUM. CAP	80592.2516	100107.9638	236+73.28	150.00 LT	
CORNER 7, U.S.S. 1357	RECOVERED ROCK	80876.5985	100887.2750	242+15.60	777.75 LT	
CORNER 4, U.S.S. 1334	Reestablished from BT's	80854.8145	101322.8726	246+06.71	970.76 LT	
RIGHT-OF-WAY MONUMENT	SET ALUM. CAP	79970.3641	101223.9020	249+50.80	150.00 LT	
RIGHT-OF-WAY MONUMENT	SET ALUM. CAP	80015.5507	101298.2188	249+93.72	225.65 LT	
RIGHT-OF-WAY MONUMENT	SET ALUM. CAP	80075.2297	101296.4148	249+63.09	276.90 LT	
RIGHT-OF-WAY MONUMENT	SET ALUM. CAP	80076.7404	101346.3920	250+06.01	302.55 LT	
RIGHT-OF-WAY MONUMENT	SET ALUM. CAP	79591.9515	101286.6602	251+89.83	150.00 RT	
RIGHT-OF-WAY MONUMENT	SET ALUM. CAP	79549.7863	101312.2978	252+32.75	174.35 RT	
RIGHT-OF-WAY MONUMENT	SET ALUM. CAP	79392.1399	101317.0631	253+13.65	309.74 RT	
RIGHT-OF-WAY MONUMENT	SET ALUM. CAP	79393.6506	101367.0403	253+56.57	284.09 RT	
RIGHT-OF-WAY MONUMENT	SET ALUM. CAP	80078.2511	101396.3692	250+48.94	328.20 LT	
RIGHT-OF-WAY MONUMENT	SET ALUM. CAP	79899.1123	101401.7841	251+40.87	174.35 LT	
RIGHT-OF-WAY MONUMENT	SET ALUM. CAP	79856.9471	101427.4217	251+83.79	150.00 LT	
RIGHT-OF-WAY MONUMENT	SET ALUM. CAP	79395.1613	101417.0174	253+99.49	258.44 RT	
RIGHT-OF-WAY MONUMENT	SET ALUM. CAP	79433.3479	101415.8632	253+79.90	225.65 RT	
RIGHT-OF-WAY MONUMENT	SET ALUM. CAP	79478.5345	101490.1799	254+22.82	150.00 RT	
CORNER 3, U.S.S. 1334	RECOVERED ROCK	75685.3857	101479.1328	272+59.64	3468.76 RT	
RIGHT-OF-WAY MONUMENT	SET ALUM. CAP	78399.9213	104041.9634	281+76.91	150.00 LT	
CORNER 2, U.S.S. 2357	RECOVERED BRASS CAP	78397.4118	104042.0347	281+78.19	147.84 LT	
RIGHT-OF-WAY MONUMENT	SET ALUM. CAP	78050.9573	104051.8778	283+55.44	150.00 RT	
RIGHT-OF-WAY MONUMENT	SET ALUM. CAP	78397.5264	104046.2608	281+81.83	150.00 LT	
RIGHT-OF-WAY MONUMENT	SET ALUM. CAP	77824.4310	104458.3652	288+20.78	150.00 RT	
CENTERLINE MONUMENT	SET ALUM. MON	77955.4586	104531.3840	288+20.78	0.00 LT	
RIGHT-OF-WAY MONUMENT	SET ALUM. CAP	78086.4863	104604.4028	288+20.78	150.00 LT	
CORNER 2, U.S.S. 1334	RECOVERED ROCK	75761.9531	104116.9107	290+88.68	2189.42 RT	
RIGHT-OF-WAY MONUMENT	SET ALUM. CAP	78057.9852	106207.3265	305+19.88	150.00 RT	
CENTERLINE MONUMENT	SET ALUM. MON	78165.2616	106102.4848	305+19.88	0.00 LT	
RIGHT-OF-WAY MONUMENT	SET ALUM. CAP	78272.5380	105997.6431	305+19.88	150.00 LT	
RIGHT-OF-WAY MONUMENT	SET ALUM. CAP	78219.3338	106372.4220	307+50.72	150.00 RT	
RIGHT-OF-WAY MONUMENT	SET ALUM. CAP	78481.5855	106211.5454	308+18.97	150.00 LT	

WORK ITEM	WORK REQUIRED	PAY ITEM NO.
1	Construction surveying	642111
2	Office engineering	642121
3	Three person survey party	642131
4	Set primary monument	642141
5	Set secondary monument	642151
6	Replace existing with primary monument	642161
7	Replace existing with secondary monument	642171
8	Adjust existing monument	642181
9	Reference existing monument	642191
10	Monument case	642110
11	Adjust existing monument case	642111
12	Final traverse	642112

**HORIZONTAL CONTROL STATEMENT:**

Gravina Island Access Right-of-Way Maps are based on the Ketchikan Third Avenue Transformation, a local Coordinate System. The Ketchikan Third Avenue Transformation was developed by the Alaska Department of Transportation and Public Facilities.

Location of recovered monumentation was obtained with GPS methodology and used Alaska State Plane Zone 1, a transverse mercator, NAD83(92) coordinates. Coordinates are in U.S. Survey feet, and are based on N.G.S. published values (as current in December, 2004) at BM 37, N.G.S. PID No. A14914 and KTN A, N.G.S. PID No. A11894.

To transform Alaska State Plane Zone 1 coordinates, U.S. Survey feet, to the Ketchikan Third Avenue Local coordinate system: scale all points at base point 1289213.0350 North, 3104427.6100 East by a factor of 0.9999007, then rotate all points at said base point +00° 00' 18", and finally move all points from said base point to new Ketchikan Third Avenue Transformation base point having a value of 89745.1675 North, 104488.6038 East.

**NOTES:**

- Whether listed or not, all monuments or property markers, corners or accessories which will be disturbed or buried shall be referenced and reestablished in their original position (A.S. 19.10.260) and recorded (A.S. 34.65.040).
- This set of Right-of-Way maps based on previous recorded surveys. They are: U.S.S. 1334, U.S.S. 2357, U.S.S. 2924 and ASLS 84-54.
- Field surveys performed in 2004 and 2005 to recover corners of Lots 2D & 2F, ASLS 84-54 and U.S.S. 1334. Tripod mounted Leica GPS receivers were used to obtain satellite data. Leica GeoOffice v2.1 software was used to reduce and calculate the horizontal positions of the recovered corners.
- Reference "Survey Control Plan" for ADOT&PF project "Ketchikan Airport Runway Safety Area", Project 68306, AIP No. 3-02-0144-1606, for additional information regarding the Ketchikan Third Avenue Transformation.



CONSULTANT LOCATIONS SURVEYOR'S CERTIFICATE

CONSULTANT RIGHT-OF-WAY SURVEYOR'S CERTIFICATE

PREPARED BY:  
LOUNSBURY & ASSOCIATES, INC.

KETCHIKAN RECORDING DISTRICT		
DATE	REVISIONS	BY
STATE OF ALASKA DEPARTMENT OF TRANSPORTATION & PUBLIC FACILITIES MONUMENT SUMMARY SHEET ALASKA PROJECT <b>KETCHIKAN GRAVINA ISLAND ACCESS</b> HP-NCPD-0922(5) 67698		
DRAWN	PS	DATE Feb. 1, 2007
CHECKED	KWA	DATE Feb. 1, 2007
		SCALE N/A
		SHEET 7 OF 7