


STATE OF ALASKA

DEPARTMENT OF TRANSPORTATION AND PUBLIC FACILITIES

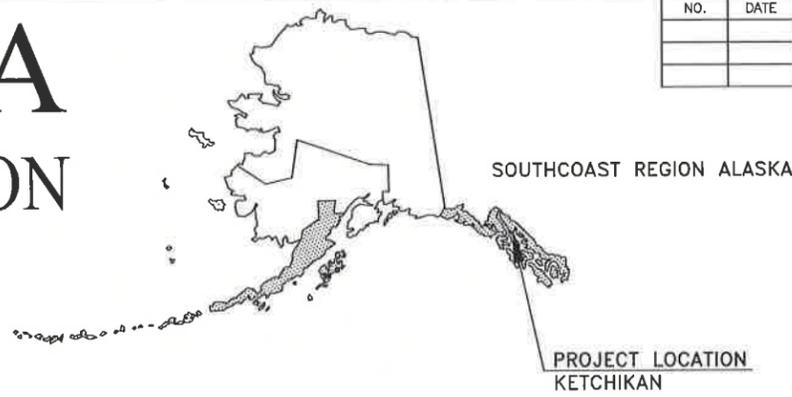

NO.	DATE	REVISIONS	STATE	PROJECT DESIGNATION	YEAR	SHEET NO.	TOTAL SHEETS
			ALASKA	PROJ. NO. Z682300000	2016	G-001	G-001
						PLAN SET TOTAL	57

SHEET	DESCRIPTION
G-001	TITLE SHEET
V-001	HAZMAT-NOTES AND LEGEND
V-101	HAZMAT-SOIL SAMPLE LOCATIONS & RESULTS
V-102	HAZMAT-ASBESTOS SAMPLE LOCATIONS & RESULTS 1ST FLR
V-103	HAZMAT-LEAD SAMPLE LOCATIONS & RESULTS 1ST FLR
V-104	HAZMAT-ASBESTOS SAMPLE LOCATIONS & RESULTS 2ND FLR
V-105	HAZMAT-LEAD SAMPLE LOCATIONS & RESULTS 2ND FLR
C-001	SITE PLAN
C-002	SITE SECTION & HOLDING TANK
C-003	CONSTRUCTION SAFETY AND PHASING PLAN
A-001	ARCH ABBREVIATIONS, SYMBOLS, LEGENDS & ASSEMBLIES
A-100	1ST FLOOR PLAN -- DEMOLITION
A-101	1ST FLOOR PLAN
A-201	REFLECTED CEILING PLAN
A-301	EXTERIOR ELEVATIONS
A-401	WALL SECTIONS
A-501	EXTERIOR DETAILS
A-502	EXTERIOR DETAILS
S-000	STRUCTURAL NOTES
S-001	SPECIAL INSPECTION TABLES & ABBREVIATIONS
S-002	PARTIAL DEMOLITION PLAN
S-003	FOUNDATION PLAN
S-004	STRUCTURAL FLOOR PLAN
S-005	2ND FLOOR FRAMING PLAN
S-006	ROOF FRAMING PLAN
S-007	FOUNDATION DETAILS
S-008	DETAILS
S-009	STRUCTURAL DETAILS
S-010	STEEL FRAMING DETAILS
S-011	BRACE DETAILS
S-012	OVERHEAD DOOR INFILL DET/MECH WALL PENETRATIONS
S-013	WALL PIER ELEVATIONS & SHORING DIAGRAM
M-001	SYMBOLS & SCHEDULES
M-002	SCHEDULES
M-101	FLOOR PLANS -- PIPING -- DEMOLITION
M-102	FLOOR PLANS -- HEATING & VENTILATION -- DEMOLITION
M-201	FLOOR PLANS -- PIPING
M-202	FLOOR PLANS -- HEATING
M-203	FLOOR PLANS -- VENTILATION
M-204	FLOOR PLANS -- SPRINKLER PIPING
M-301	ENLARGED PLANS
M-401	DETAILS & DIAGRAMS
M-402	DETAILS
M-501	CONTROLS
E-001	LEGEND
E-002	SITE PLAN
E-101	1ST FLOOR PLAN -- DEMOLITION
E-102	2ND FLOOR PLAN -- DEMOLITION
E-201	1ST FLOOR PLAN -- POWER
E-202	2ND FLOOR PLAN -- POWER
E-203	SCHEDULES AND SINGLE LINE DIAGRAM
E-204	SCHEDULES
E-301	1ST FLOOR PLAN -- LIGHTING
E-302	2ND FLOOR PLAN -- LIGHTING
E-303	LUMINAIRE SCHEDULE / DETAILS
E-401	1ST FLOOR PLAN -- LOW VOLTAGE
E-402	2ND FLOOR PLAN -- LOW VOLTAGE

PROPOSED PROJECT
KETCHIKAN AIRPORT ARFF BUILDING RENOVATION
PROJECT NO. Z682300000
A. I. P. NO. 3-02-0144-023-2016



May 31, 2016

AS-BUILTS

The undersigned hereby certifies that this duplicated document is an exact and true copy of the original.

Cody Butler

VICINITY MAP

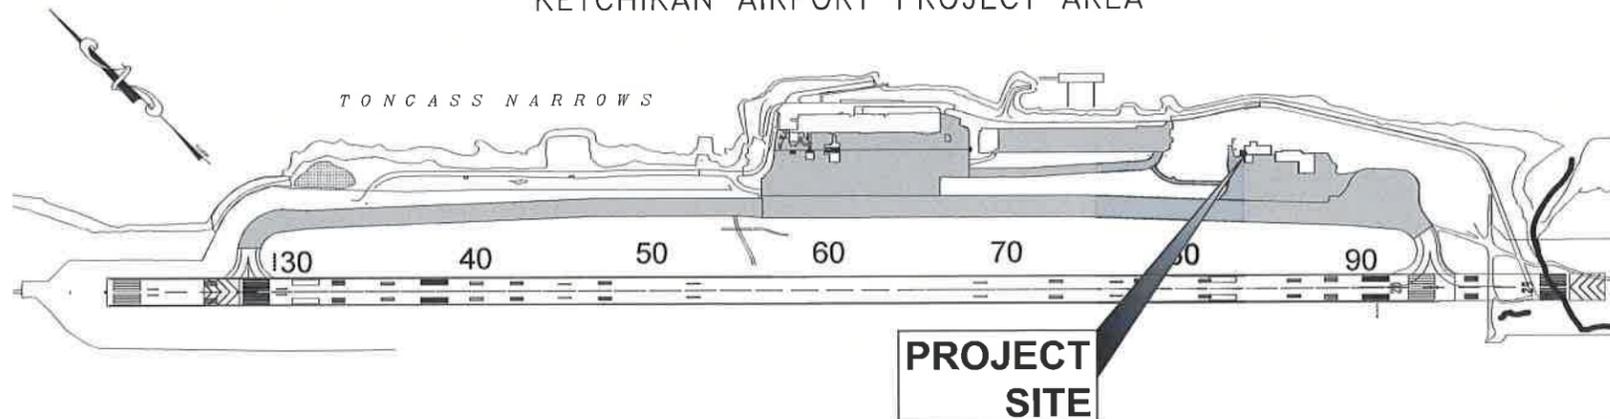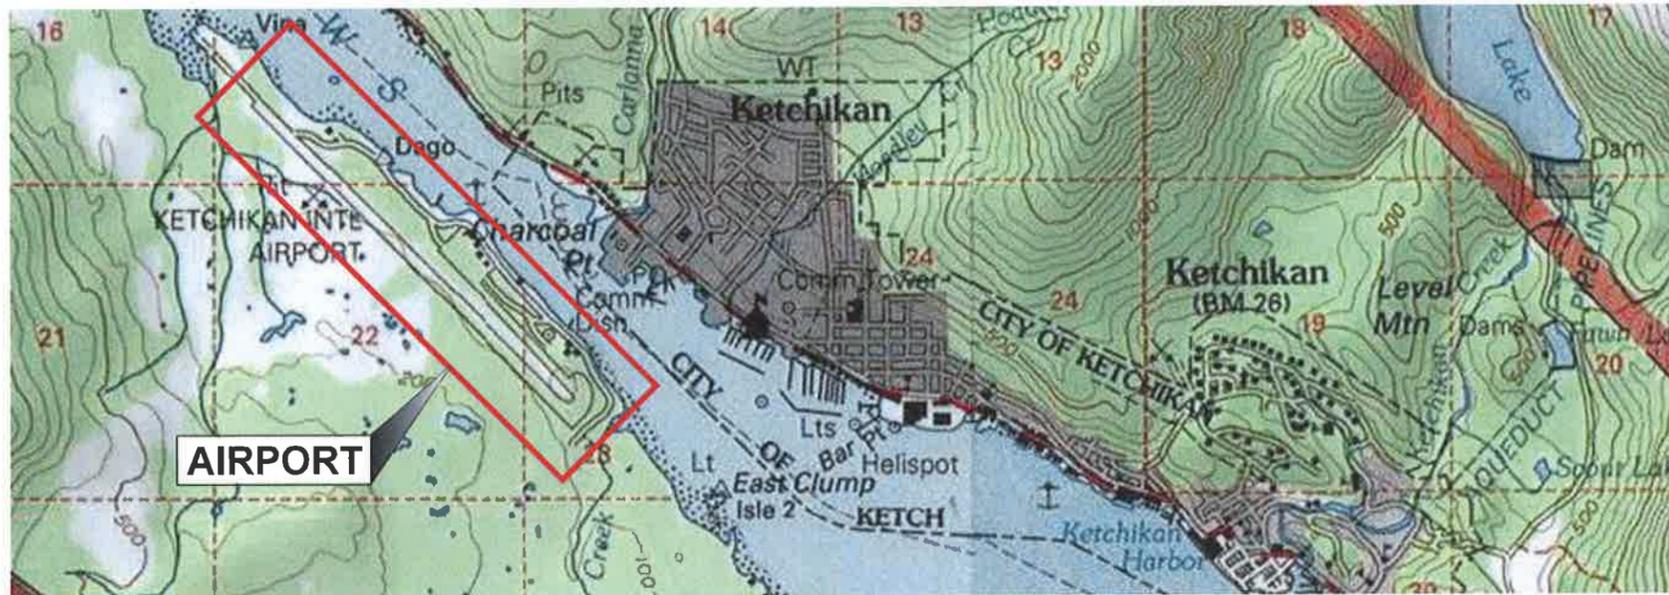

STATE OF ALASKA
 DEPARTMENT OF TRANSPORTATION & PUBLIC FACILITIES



APPROVED: *[Signature]* 3/9/16
 REGIONAL PRECONSTRUCTION ENGINEER
 L. PAT CARROLL, P.E. DATE

APPROVED: *[Signature]* 3/9/16
 DIRECTOR, SOUTHCOAST REGION
 MICHAEL J. COFFEY DATE

CERTIFIED TRUE & CORRECT AS-BUILT OF ACTUAL FIELD CONDITION:

CONSTRUCTION PROJECT MANAGER DATE

DESIGNED: [] CHECKED: [] DRAFTED: []
 XREFS: [] SCALE: [] LAYOUT: [] TITLE SHEET: []
 DATE: 3/9/2016 15:26
 DRAWING LOCATION: Z:\project\1825.06 DOT SE Term Ketchikan Airport ARFF Building Renovation\Civil\CAD\1825.06 - C1 - Title Sheet.dwg

NO.	DATE	REVISION	STATE	PROJECT DESIGNATION	YEAR	SHEET NO.	TOTAL SHEETS
			ALASKA	PROJ.NO. Z682300000	2016	V-001	V-105

DESIGNED: [] CHECKED: [] DRAFTED: []
 XREFS: [] SCALE: [] LAYOUT: V-001
 DATE: 2/9/2016 14:18
 TIME: []
 DRAWING LOCATION: C:\Users\veritche\SharePoint\15-2202 J - ADOT KTN ARFF Bid - Doc\Drawings\152202b.dwg

GENERAL NOTES

- THESE FIGURES ARE INTENDED TO BE USED WITH SECTION 02 26 00 IN COORDINATION WITH ALL OTHER CONTRACT DOCUMENTS.
- DRAWING LEGEND KEY AND GENERAL NOTES APPLY TO ALL HAZARDOUS MATERIALS (V) SHEETS.
- ABATEMENT OF HAZARDOUS MATERIALS IS NOT A SPECIFIC OBJECTIVE OF THESE CONTRACT DOCUMENTS. ABATEMENT AND/OR REMEDIATION OF HAZARDOUS MATERIALS IS ONLY NECESSARY TO THE EXTENT THE CONTRACTOR'S ACTIVITIES IMPACT THE HAZARDOUS MATERIALS PRESENT. THE CONTRACTOR MUST SUBMIT DETAILED PLANS INDICATING METHODS TO ASSESS, CONTAIN, ABATE, COLLECT, HANDLE AND DISPOSE OF ALL WASTE AND HAZARDOUS MATERIALS ASSOCIATED WITH COMPLETING THE PROJECT AS DESCRIBED IN THE CONTRACT DOCUMENTS.
- UNLESS A BALLAST IS CLEARLY LABELED AS "NON PCB CONTAINING," THE BALLAST SHALL BE CONSIDERED A PCB-CONTAINING BALLAST
- MERCURY CONTAINING THERMOSTATS AND SMOKE DETECTORS WITH RADIOLOGIC MATERIALS SHALL BE HANDLED AND DISPOSED OF IN ACCORDANCE WITH APPLICABLE REGULATIONS.
- LEAD IN PAINT CONCENTRATIONS FOR TESTED SURFACES INDICATE THAT DEMOLITION DEBRIS IS NON HAZARDOUS FOR LEAD WHEN THE PAINT AND SUBSTRATE ARE REMOVED AND DISPOSED OF TOGETHER (COMPONENT REMOVAL).
- ALL DEMOLITION, ABATEMENT, AND DISPOSAL OF ACM SHALL BE COMPLETED IN ACCORDANCE WITH APPLICABLE REGULATIONS AND THE CONTRACT DOCUMENTS.
- FRIABLE ACM AND NON-FRIABLE ACM THAT MAY BECOME FRIABLE DURING THE PROJECT, SHALL BE ABATED, OR REMOVED AND DISPOSED IN ACCORDANCE WITH THE APPLICABLE REGULATIONS AND SECTION 02 26 00.
- ACM FLOORING IS DEPICTED ON THE DRAWINGS AS ONE HATCH STYLE THIS MAY INCLUDE MORE THAN ONE COLOR OR TYPE OF ACM CONTAINING FLOORING INCLUDING: 12X12 TILES, 9X9 TILES, SHEET VINYL FLOORING AND/OR BLACK MASTIC.
- CONTRACTOR SHALL ASSUME THAT ACM TSI FITTINGS AND INSULATION MAY BE PRESENT IN THE HIDDEN CHASES THAT SERVE PLUMBING FIXTURES SUCH AS TOILETS, SINKS, ETC. AND IN HIDDEN SPACES ABOVE GYPSUM WALLBOARD CEILINGS. CONTRACTOR SHALL COMPLETE DESTRUCTIVE TESTING OF HIDDEN SPACES PRIOR TO WORK IN THESE PLACES AS NECESSARY TO COMPLETE PROJECT.
- CONTRACTOR SHOULD REFER TO THE CONTRACT DOCUMENTS FOR AVAILABLE INFORMATION ON BUILDING CONDITIONS.
- GENERAL BUILDING DESCRIPTION IS DESCRIBED IN SECTION 02 26 00.
- CONTRACTOR SHALL PROTECT MATERIALS NOT IMPACTED BY THE PROJECT. RESTORE TO ORIGINAL CONDITION ALL WORK DAMAGED OR OTHERWISE MADE DEFECTIVE IN APPEARANCE OR FUNCTION BY THE EXECUTION OF WORK REQUIRED BY THIS PROJECT.
- REMOVE AND PROPERLY DISPOSE OF ALL MATERIALS AND MISCELLANEOUS DEBRIS RESULTING FROM THE PROJECT. ALL REMOVED ITEMS AND MATERIALS SHALL BE MANIFESTED AND DISPOSED OF IN A LEGAL MANNER, COMPLYING WITH ALL LOCAL, STATE AND FEDERAL LAWS AND REGULATIONS.
- THE CONTRACTOR SHALL PROVIDE RECEIPTS TO THE OWNER/ENGINEER INDICATING THE FINAL DISPOSITION OF ALL MATERIALS. ALL MATERIALS REQUIRING A CHAIN OF CUSTODY WILL REMAIN IN THE CUSTODY OF THE CONTRACTOR UNTIL FINAL DISPOSITION. THE DEPARTMENT IS OWNER OF ONLY THOSE ITEMS DESIGNATED TO REMAIN AND WILL NOT BE SIGNATORY TO A MANIFEST, CERTIFICATE OF FINAL DISPOSITION OR TRANSFER, OR CHAIN OF CUSTODY FOR ITEMS SCHEDULED FOR DEMOLITION OR REMOVAL. RECEIPTS FOR ALL MATERIALS TRANSPORTED OFF SITE TO A PERMITTED FACILITY FOR DISPOSAL, REMEDIATION, OR TESTING WILL BE TRANSMITTED BY THE CONTRACTOR TO THE ENGINEER WITHIN 24 HOURS OF DELIVERY TO THE PERMITTED FACILITY.
- CONTAMINATED SOIL IS PRESENT NEAR THE EXISTING DISPENSER ISLANDS AND AT THE CONNEX STORAGE AREA. EXCAVATION IN THESE AREAS MUST BE COMPLETED UNDER A WORK PLAN APPROVED BY THE OWNER/ENGINEER.

ACRONYM KEY

- ACM-ASBESTOS CONTAINING MATERIAL
- VAT-VINYL ASBESTOS TILE
- LBP-LEAD BASED PAINT
- CAB-CEMENT ASBESTOS BOARD
- CMU-CEMENT MASONRY UNIT
- GWB-GYPSUM WALLBOARD
- TEM-TRANSMISSION ELECTRON MICROSCOPY
- PCB-POLYCHLORINATED BIPHENYLS
- TCLP-TOXICITY CHARACTERISTIC LEACHING PROCEDURE
- RACM-REGULATED ASBESTOS CONTAINING MATERIAL
- TSI-THERMAL SYSTEMS INSULATION
- RCRA-RESOURCE CONSERVATION AND RECOVERY ACT
- PC-POINT COUNT

LEGEND

- ASBESTOS SAMPLE LOCATIONS NEGATIVE (<1% ASBESTOS) } SEE ASBESTOS TABULATED RESULTS FOR ACM SAMPLE NUMBER
- ASBESTOS SAMPLE LOCATIONS POSITIVE (>= 1% ASBESTOS) }
- LEAD BASED PAINT SAMPLE (<1mg/cm²)(HUD) } SEE LEAD BASED PAINT TABULATION RESULTS FOR CONCENTRATION FOR LEAD SAMPLE NUMBER
- LEAD BASED PAINT SAMPLE (>mg/cm²)(HUD) }
- ACM FLOORING
- CEMENT ASBESTOS BOARD (CAB)
- BOLLARD



VICINITY MAP

List of Sheets	
V-001	Notes and Legend
V-101	Soil Sample Locations and Results
V-102	Asbestos Sample Locations and Results - First Floor
V-103	Lead Sample Locations and Results - First Floor
V-104	Asbestos Sample Locations and Results - Second Floor
V-105	Lead Sample Locations and Results - Second Floor

Hazardous Materials Quantities Table		
TSI Hard Fittings	300	Each
Flooring w/Mastic	5,000	Square Feet
Cement Asbestos Board of Exterior Wall	110	Square Feet
GWB System with 2% ACM Joint Compound	1	Throughout
Thermostats w/Mercury	6	Each
Fluorescent Lamps/Bulbs w/Mercury	325	Each
PCB containing Ballasts (Assumed)	75	Each


NOTES AND LEGEND




STATE OF ALASKA
 DEPARTMENT OF TRANSPORTATION
 AND PUBLIC FACILITIES
 KETCHIKAN AIRPORT ARFF
 BUILDING RENOVATION
 NOTES AND LEGEND

NO.	DATE	REVISION	STATE	PROJECT DESIGNATION	YEAR	SHEET NO.	TOTAL SHEETS
			ALASKA	PROJ.NO. Z682300000	2016	V-101	V-105

DESIGNED: XREFS
 CHECKED: SCALE
 DRAFTED: LAYOUT V-101
 DATE: TIME 2/9/2016 15:33
 DRAWING LOCATION: C:\Users\peter.NORTECHINC\SharePoint\15-2202 J - ADOT KTN ARFF Bid - Doc\Drawings\152202b.dwg

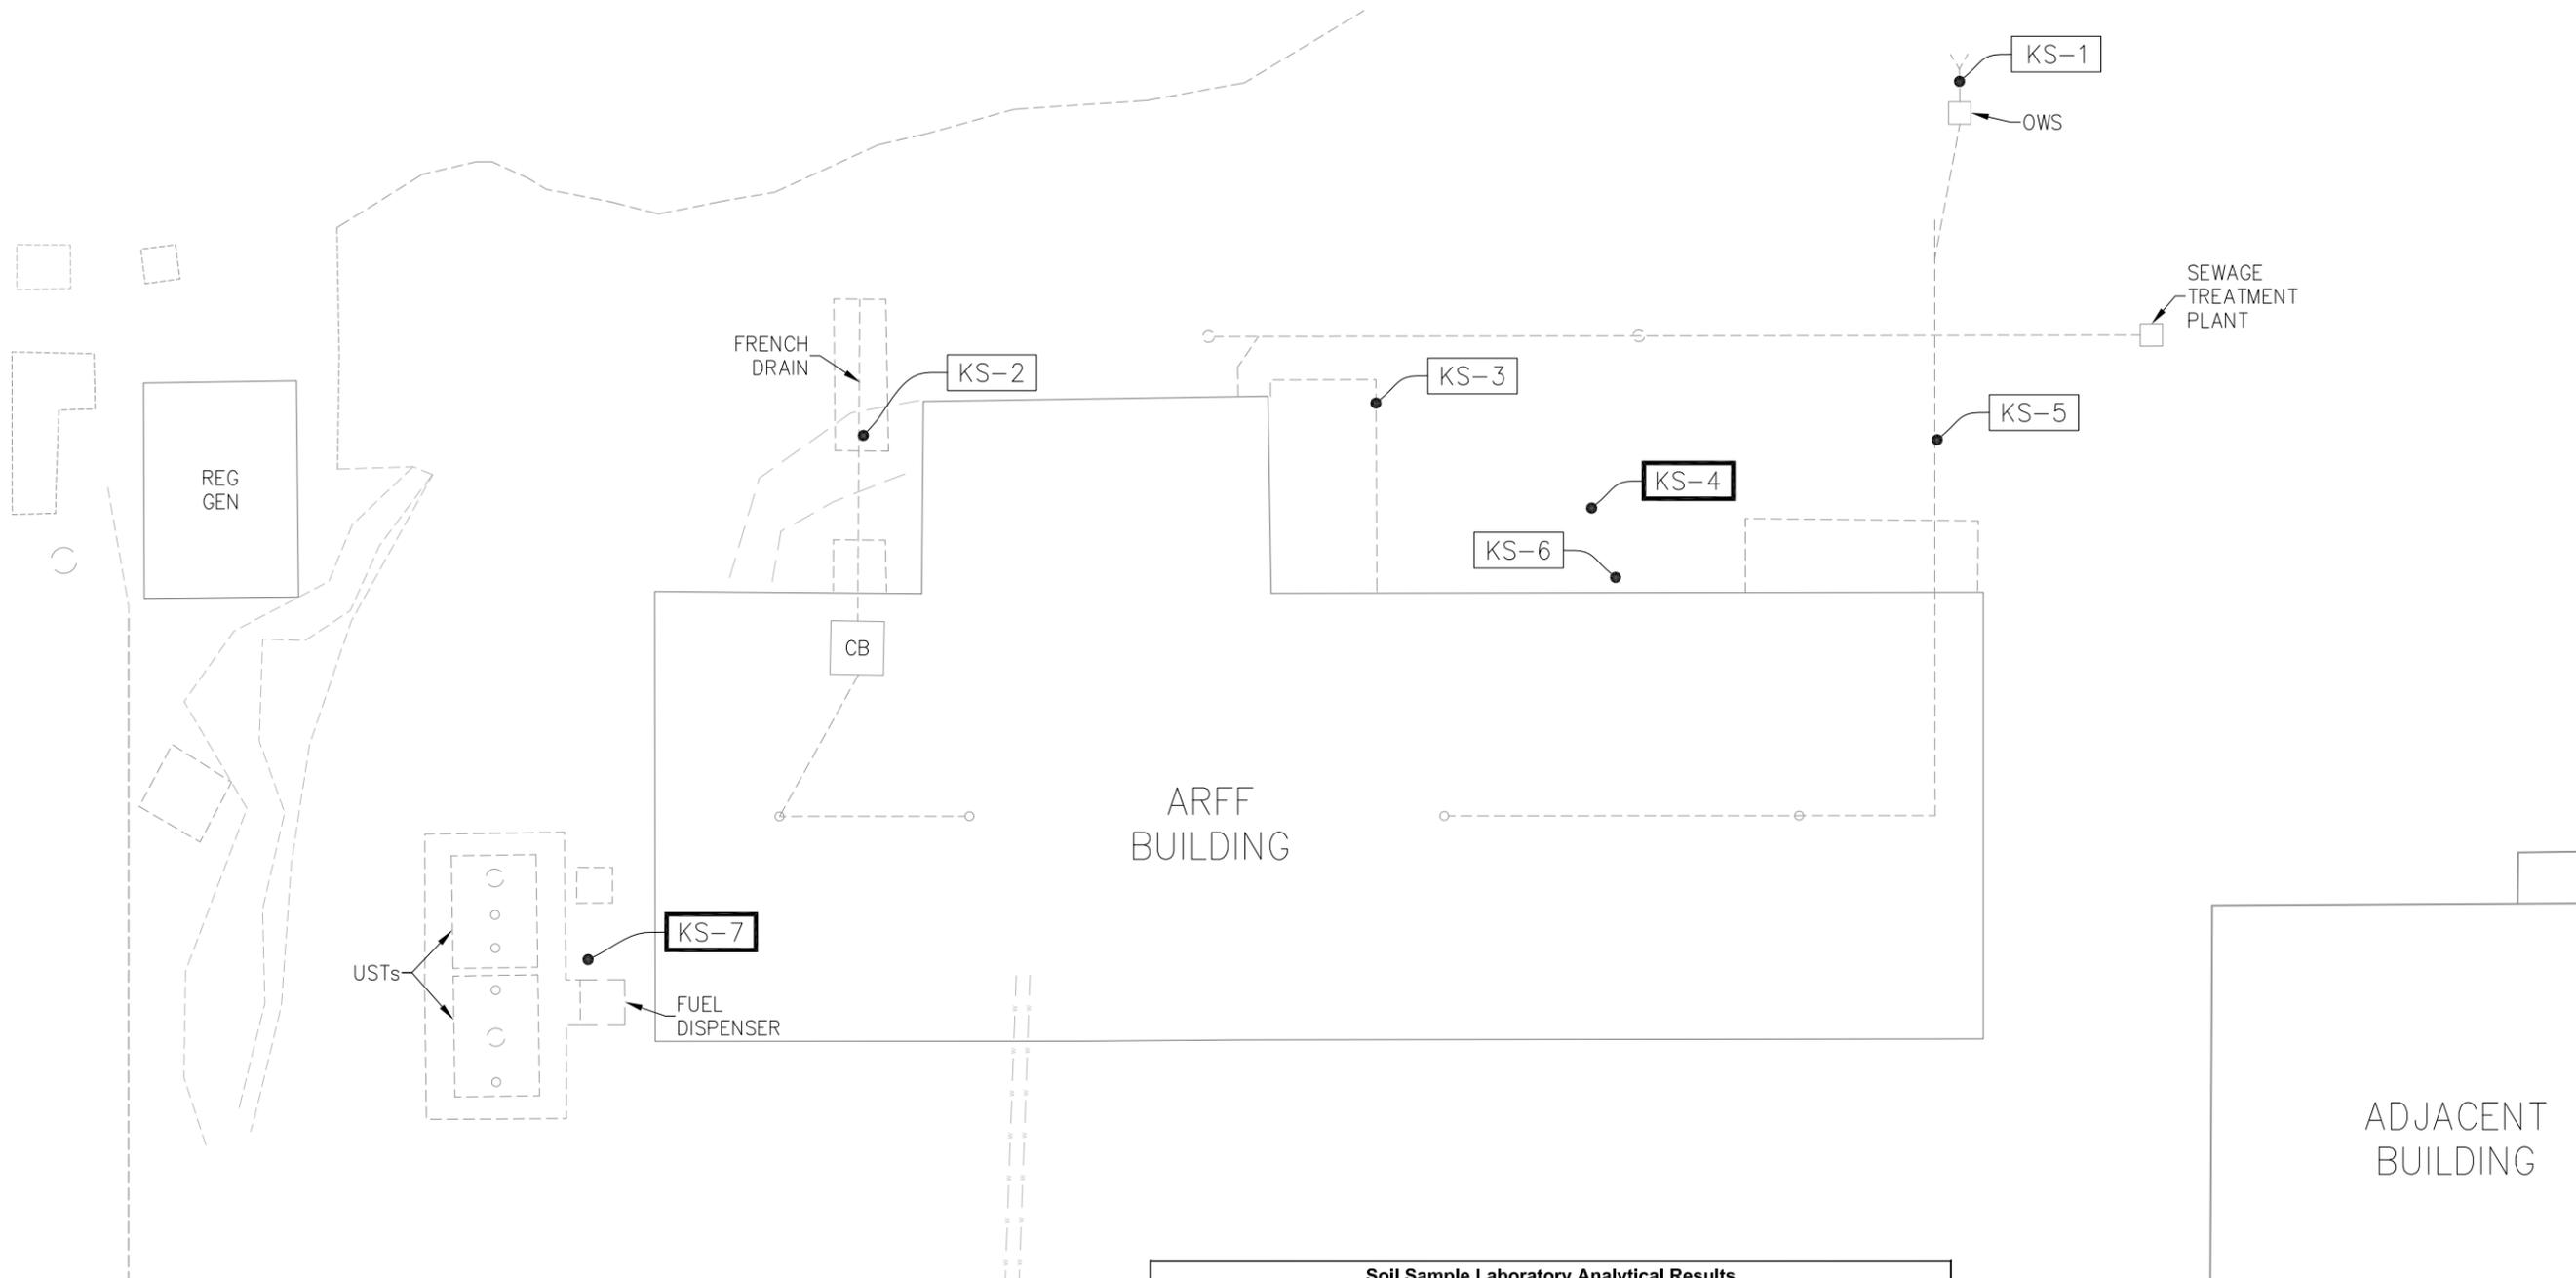

- LEGEND**
- 0123 HEADSPACE FIELD SCREENING LOCATION
BACKGROUND RESULT, NO LAB SAMPLE COLLECTED
 - 0123 LABORATORY SAMPLE LOCATION
RESULTS SHOWN IN TABLE

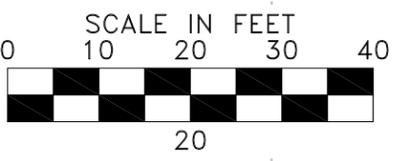

Soil Sample Laboratory Analytical Results			
Sample ID	ADEC	KS-4	KS-7
Sample Collection Date		7/16/15	7/16/15
Analyte	mg/kg	mg/kg	mg/kg
Petroleum Fractions			
DRO	230	609	4820
RRO	8300	5930	---
GRO	300	1.09J	14.9
BOLD	Analyte detected in concentration above the ADEC Cleanup level		
Shade	Analyte detected in concentration below the ADEC Cleanup level		
# U	Analyte not detected at the listed limit of quantitation (LOQ)		
J	Analyte estimated below LOQ		


SOIL SAMPLE LOCATIONS AND RESULTS

STATE OF ALASKA
DEPARTMENT OF TRANSPORTATION
AND PUBLIC FACILITIES

KETCHIKAN AIRPORT ARFF
BUILDING RENOVATION

SOIL SAMPLE LOCATIONS
AND RESULTS

NO.	DATE	REVISION	STATE	PROJECT DESIGNATION	YEAR	SHEET NO.	TOTAL SHEETS
			ALASKA	PROJ.NO. Z682300000	2016	V-102	V-105

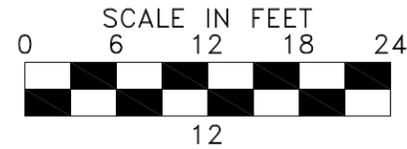

LEGEND

- ASBESTOS SAMPLE LOCATIONS NEGATIVE (<1% ASBESTOS)
- ASBESTOS SAMPLE LOCATIONS POSITIVE (>= 1% ASBESTOS) } SEE ASBESTOS TABULATED RESULTS FOR ACM SAMPLE NUMBER
- ACM CONTAINING VINYL FLOORING

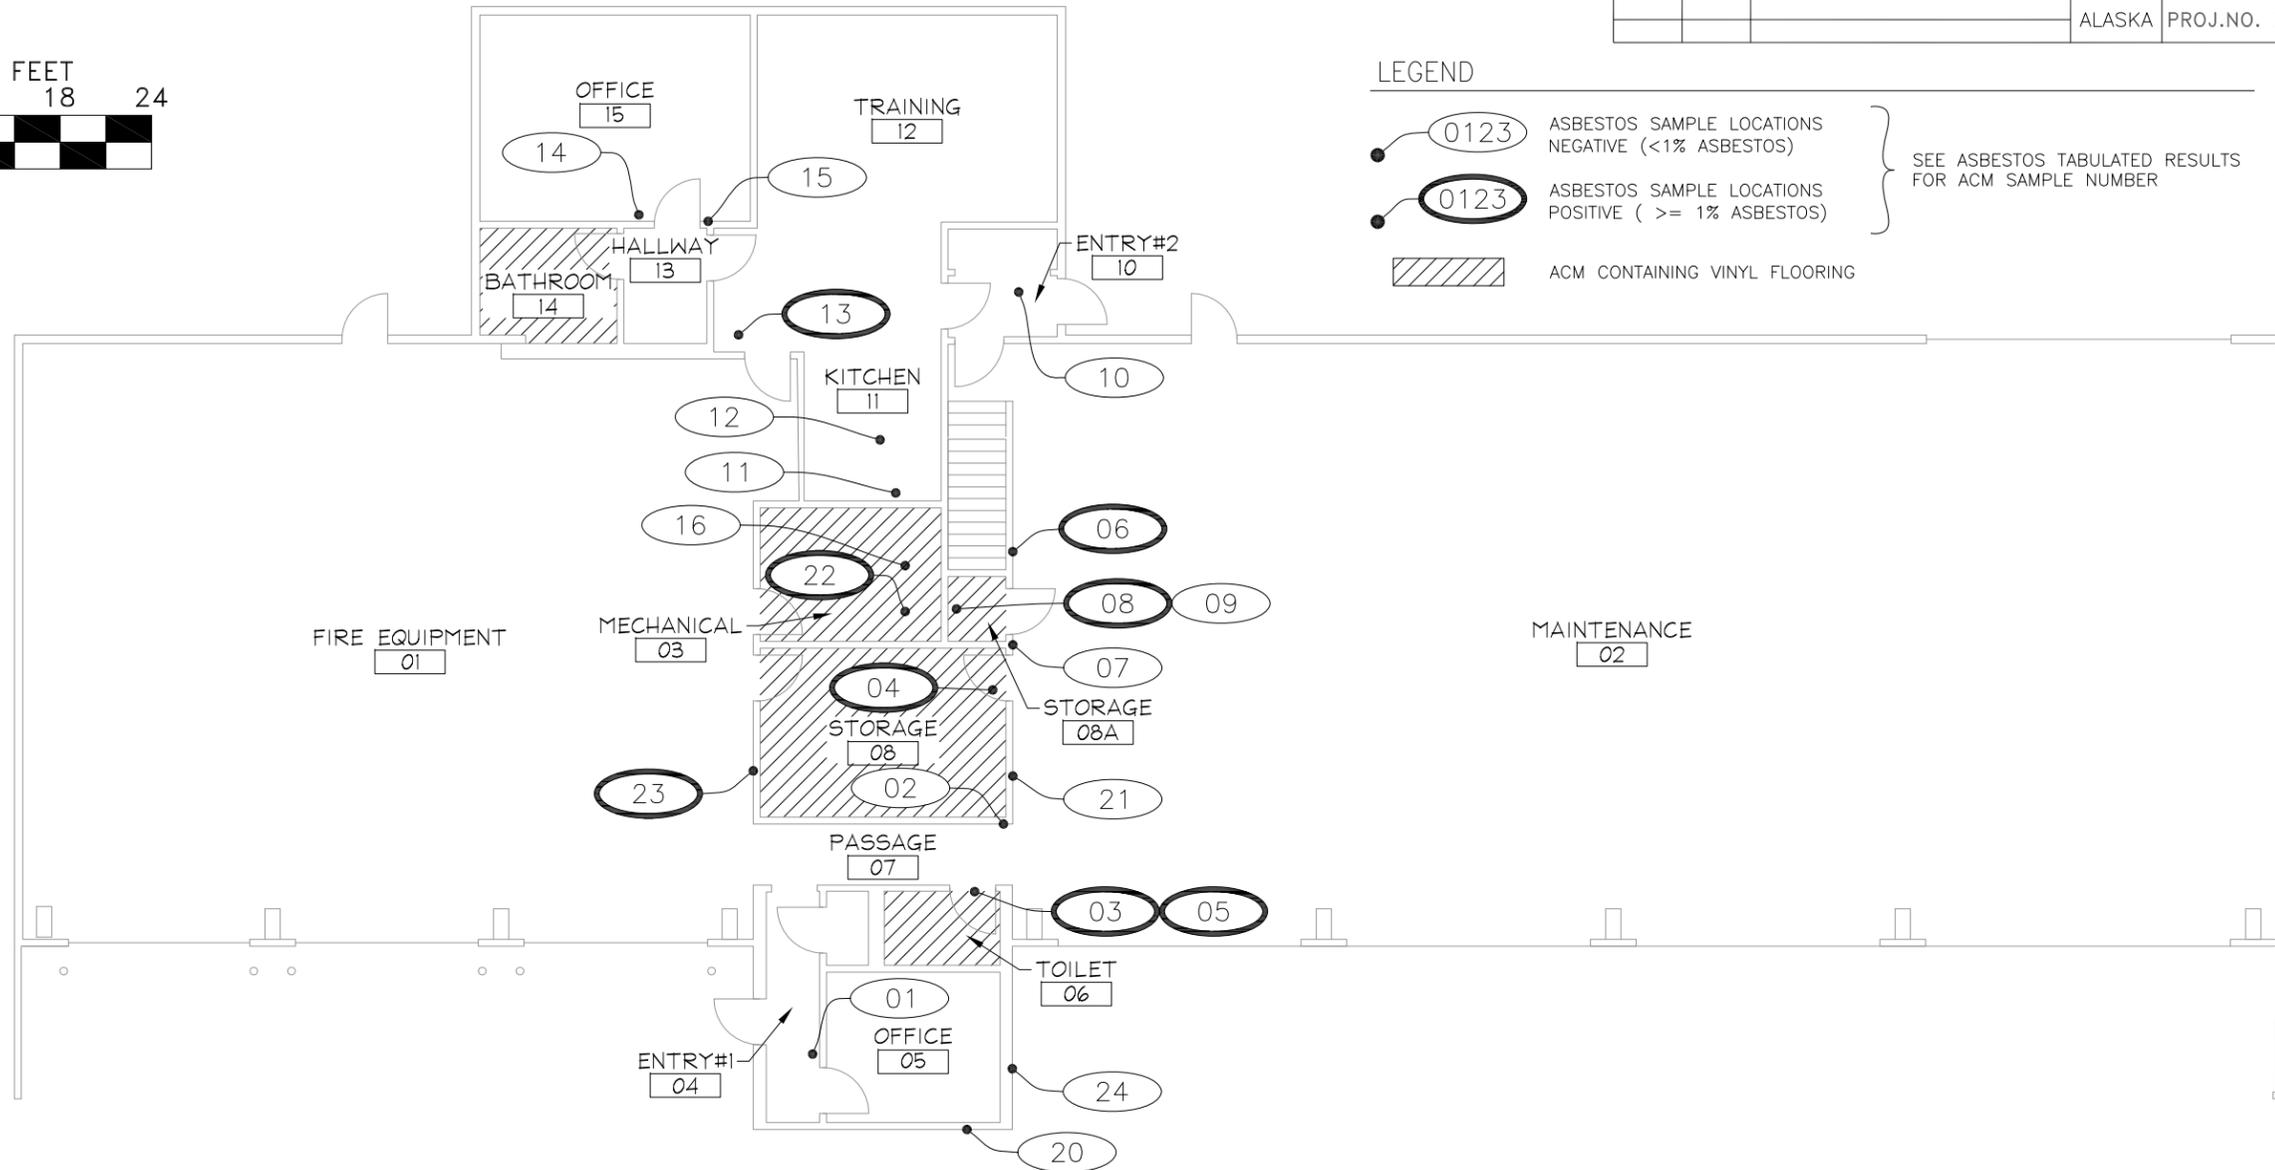


Table 1: Asbestos Sample Results - Ketchikan ARFF Hazmat Survey


Sample	DESCRIPTION	SAMPLE LOCATION	LAB RESULTS	COMMENTS
KDOT-1	Black Fibrous; Gray Foam	Carpet	Neg	75% Synthetic
KDOT-1	Yellow Adhesive	Mastic	Neg	2% Cellulose
KDOT-2	Black Vinyl	Cove Base	Neg	100% Non-Fibrous
KDOT-2	Brown Adhesive	Mastic	Neg	1% Cellulose
KDOT-3	Tan Vinyl; Tan Fibrous	Linoleum	20% Chrysotile	20% Cellulose
KDOT-3	Yellow Adhesive	Mastic	2% Chrysotile	3% Cellulose
KDOT-4	Tan Vinyl; Tan Fibrous		20%Chrysotile	20% Cellulose
KDOT-5	White Granular; Tan Fibrous; White Paint		Trace <1% Chrysotile	21% Cellulose
KDOT-6	Tan Granular; Tan Fibrous; White Paint		Trace <1% Chrysotile	20% Cellulose
KDOT-7	Brown Powder; Brown Fibrous; White Granular		Neg	20% Cellulose
KDOT-8	Gray Powder		Trace <1% Chrysotile 3% Amosite	1% Cellulose, 11% Fibrous Glass
KDOT-9	Yellow Fibrous		Neg	96% Fibrous Glass
KDOT-10	White Vinyl	Tile	Neg	100% Non-Fibrous
KDOT-10	Brown Adhesive	Mastic	Neg	8% Cellulose

Table 1 continued: Asbestos Sample Results - Ketchikan ARFF Hazmat Survey

Sample	DESCRIPTION	SAMPLE LOCATION	LAB RESULTS	COMMENTS
KDOT-11	White Adhesive		Neg	100% Non-Fibrous
KDOT-12	Yellow Brittle; Brown Fibrous	Formica	Neg	35% Cellulose
KDOT-12	Yellow Adhesive	Mastic	Neg	6% Cellulose
KDOT-13	White Powder; Brown Fibrous; White Granular		Trace <1% Chrysotile	20% Cellulose
KDOT-14	Brown Vinyl	Cove Base	Neg	100% Non-Fibrous
KDOT-14	Brown Adhesive	Mastic	Neg	2% Cellulose
KDOT-15	White/Blue Fibrous	Carpet	Neg	96% Synthetic
KDOT-15	Tan Adhesive	Mastic	Neg	7% Synthetic
KDOT-16	Gray Metallic; Tan Adhesive		Neg	2% Cellulose, 4% Synthetic
KDOT-20	Brown Adhesive		Neg	100% Non-Fibrous
KDOT-21	Gray Granular; White Paint		Neg	100% Non-Fibrous
KDOT-22	Gray Powder; Tan Fibrous		Trace <1% Chrysotile 3% Amosite	34% Cellulose, 6% Fibrous Glass
KDOT-23	Tan Granular		2% Chrysotile	98% Non-Fibrous
KDOT-24	Tan Rubbery		Neg	100% Non-Fibrous




ASBESTOS SAMPLE LOCATIONS AND RESULTS

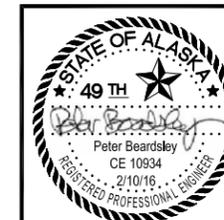

STATE OF ALASKA
DEPARTMENT OF TRANSPORTATION
AND PUBLIC FACILITIES
KETCHIKAN AIRPORT ARFF
BUILDING RENOVATION
ASBESTOS SAMPLE LOCATIONS
AND RESULTS – FIRST FLOOR

DESIGNED: XREFS
 CHECKED: SCALE
 DRAFTED: LAYOUT V-102
 DATE: 2/9/2016 14:18
 TIME: 2/9/2016 14:18
 DRAWING LOCATION: C:\Users\vertchie\SharePoint\15-2202 J - ADOT KTN ARFF Bid - Doc\Drawings\152202b.dwg

NO.	DATE	REVISION	STATE	PROJECT DESIGNATION	YEAR	SHEET NO.	TOTAL SHEETS
			ALASKA	PROJ.NO. Z682300000	2016	V-103	V-105

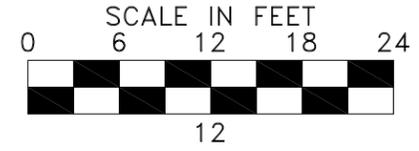

LEGEND

- LEAD BASED PAINT SAMPLE (<1mg/cm sq) (HUD)
 - LEAD BASED PAINT SAMPLE (>1mg/cm sq) (HUD)
- SEE LEAD BASED PAINT TABULATION RESULTS FOR CONCENTRATION FOR LEAD SAMPLE NUMBER

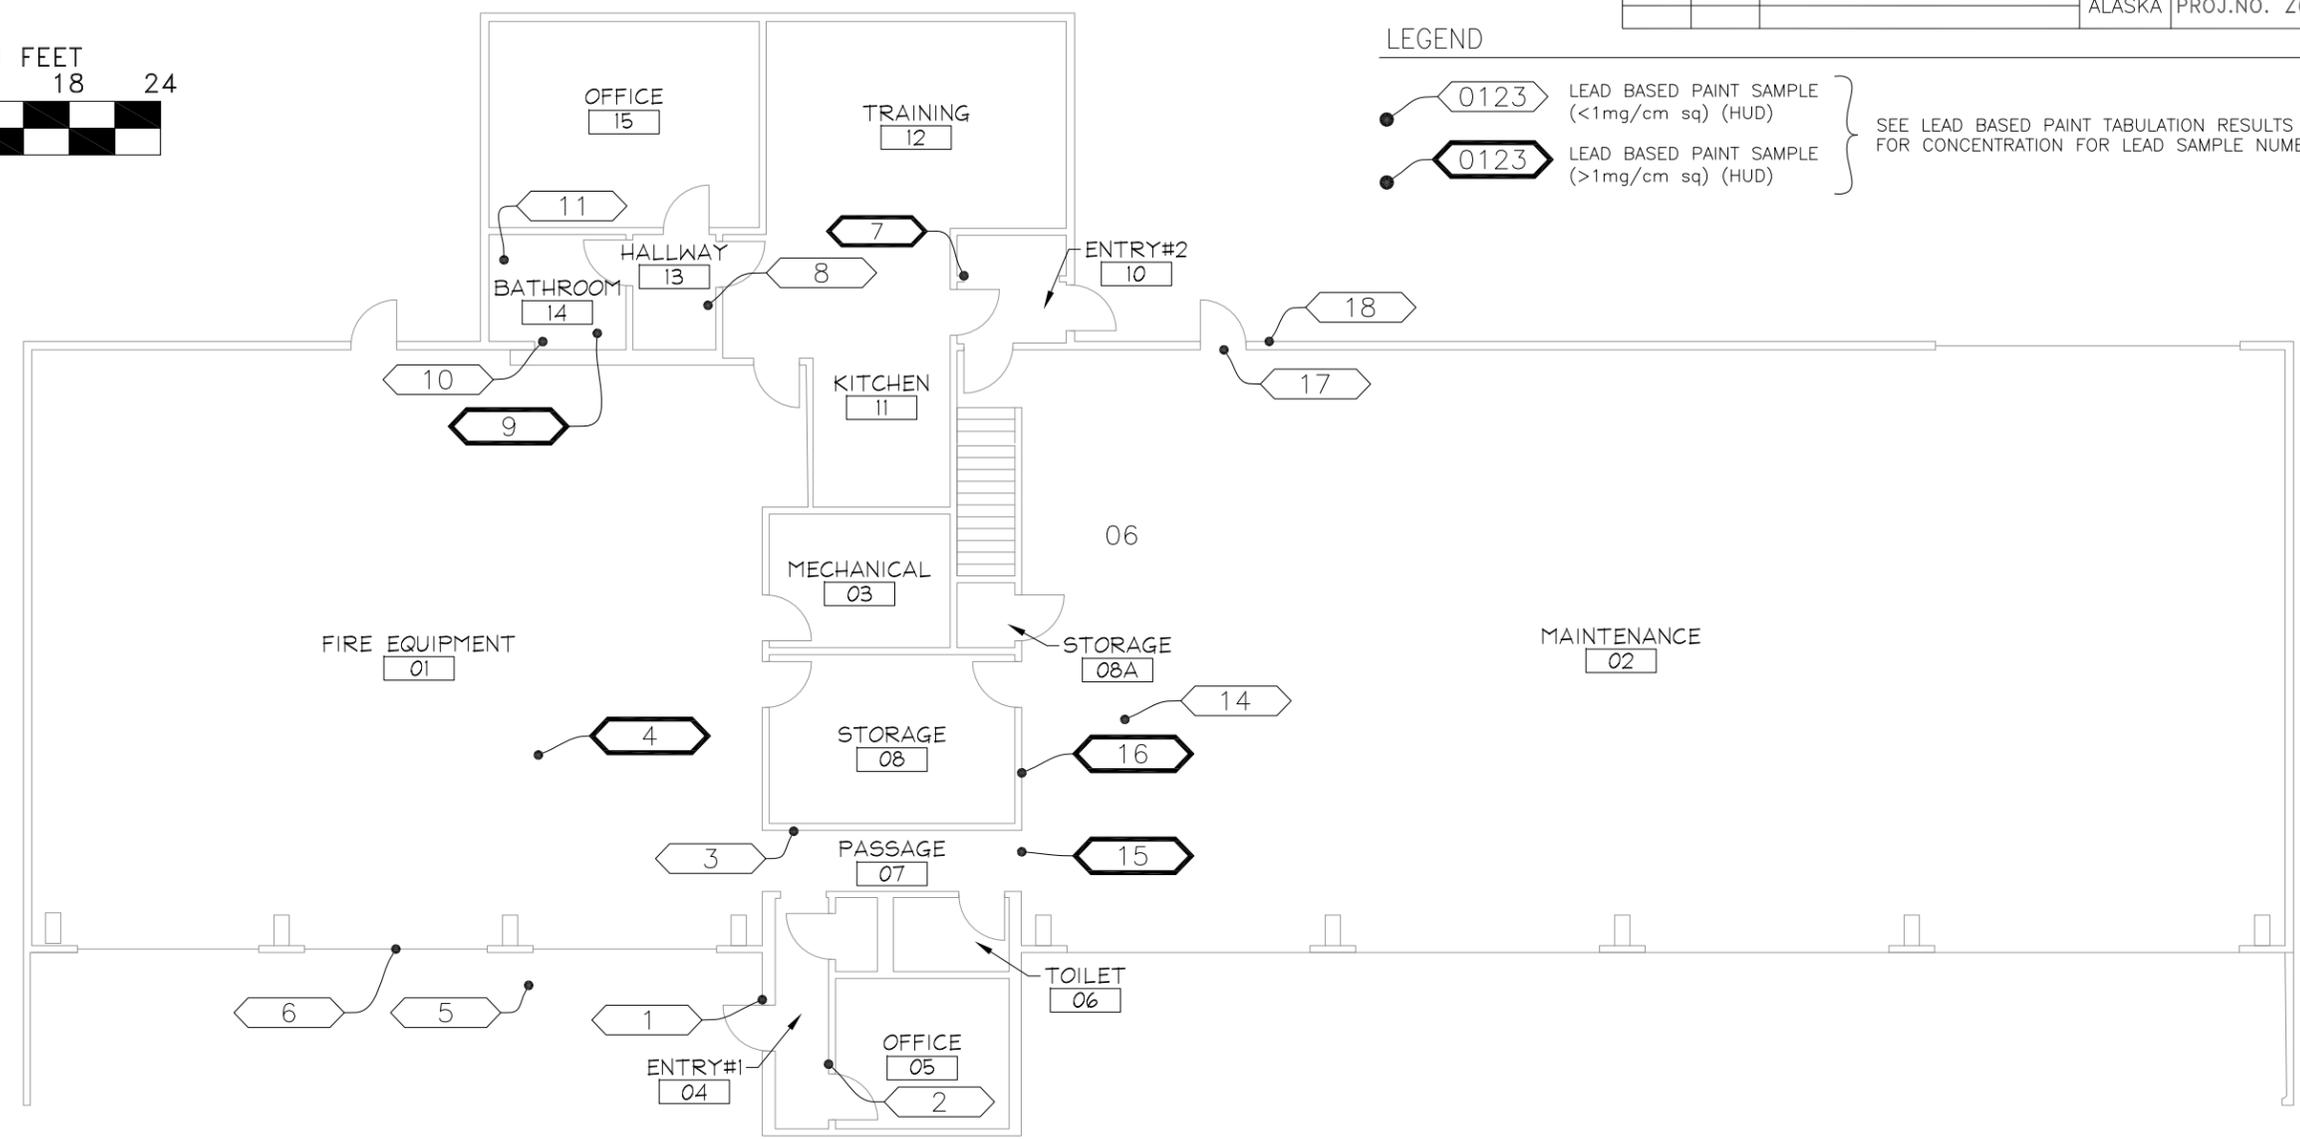


Table 2: Lead XRF Analysis Results - Ketchikan ARFF Hazmat Survey

Nlton #	Room #	Feature	Substrate	Color	Pos/Neg	Lead (mg/cm ²)
1	4	Paint	Entry #1 Door	Blue	Neg	0.7
2	5	Paint	Office 05	Gray	Neg	0.0
3	7	Paint	Passage 07	White	Neg	0.0
4	1	Paint	Fire Equipment Bay	Yellow	Pos	3.6
5	outside 1	Paint	bollards	Red	Neg	0.2
6	1	Paint	Fire Eq. Bay Door	Red	Neg	0.1
7	10	Paint	Entry #2 wall	White	Pos	1.0
8	13	Paint	Hallway 13	White	Neg	
9	14	Sink	Bath 14		Pos	34.0
10	14	Toilet	Bath 14		Neg	0.1

Table 2 continued: Lead XRF Analysis Results - Ketchikan ARFF Hazmat Survey


Nlton #	Room #	Feature	Substrate	Color	Pos/Neg	Lead (mg/cm ²)
11	14	Wall	Bath 14		Neg	0.0
13	6	Sink	Bath 06		Neg	0.0
14	4	Paint	Maintenance Area	Yellow	Neg	0.0
15	4	Paint	Maintenance Area	Yellow	Pos	4.4
16	4	Wash sink	Maintenance Area		Pos	7.7
17	4	Door	Exit Door in Maint. Area	Gray	Neg	0.0
18	4	Paint	Exit Door in Maint. Area	Brown	Neg	0.0

GENERAL NOTES

- RESULTS IN TABLE 2 ARE REPRESENTATIVE OF SIMILAR COLORS THROUGHOUT BUILDING, INCLUDING BOTH LEVELS
- MOST POSITIVE RESULTS ARE RELATED TO HIGH VISIBILITY YELLOW PAINT, WHICH MAY HAVE BEEN PAINTED OVER IN SOME LOCATIONS.
- POSITIVE WHITE PAINT RESULT IN SAMPLE #7 MAY BE RELATED TO PANELING SUBSTRATE THAT IS PRESENT IN ENTRY #2 (RM 10) AND ON WALL BETWEEN KITCHEN (RM 11) AND HALLWAY (RM 13). WHITE PAINT ON OTHER SUBSTRATES IS NEGATIVE FOR LEAD.



LEAD SAMPLE LOCATIONS AND RESULTS

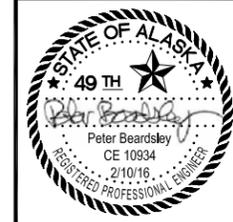


STATE OF ALASKA
DEPARTMENT OF TRANSPORTATION
AND PUBLIC FACILITIES

KETCHIKAN AIRPORT ARFF
BUILDING RENOVATION

LEAD SAMPLE LOCATIONS AND
RESULTS – FIRST FLOOR

DRAWING LOCATION: C:\Users\vertchie\SharePoint\15-2202 J - ADOT KTN ARFF Bid - Doc\Drawings\152202b.dwg
 DATE: 2/9/2016 14:18
 LAYOUT: V-103
 SCALE:
 XREFS:
 DESIGNED: [blank]
 CHECKED: [blank]
 DRAFTED: [blank]

NO.	DATE	REVISION	STATE	PROJECT DESIGNATION	YEAR	SHEET NO.	TOTAL SHEETS
			ALASKA	PROJ.NO. Z682300000	2016	V-104	V-105

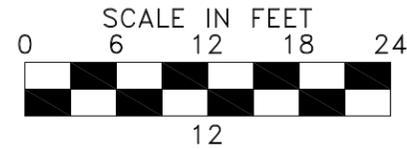

LEGEND

-  ASBESTOS SAMPLE LOCATIONS NEGATIVE (<1% ASBESTOS)
 -  ASBESTOS SAMPLE LOCATIONS POSITIVE (>= 1% ASBESTOS)
 -  ACM CONTAINING VINYL FLOORING
 -  CEMENT ASBESTOS BOARD (CAB)
- } SEE ASBESTOS TABULATED RESULTS FOR ACM SAMPLE NUMBER


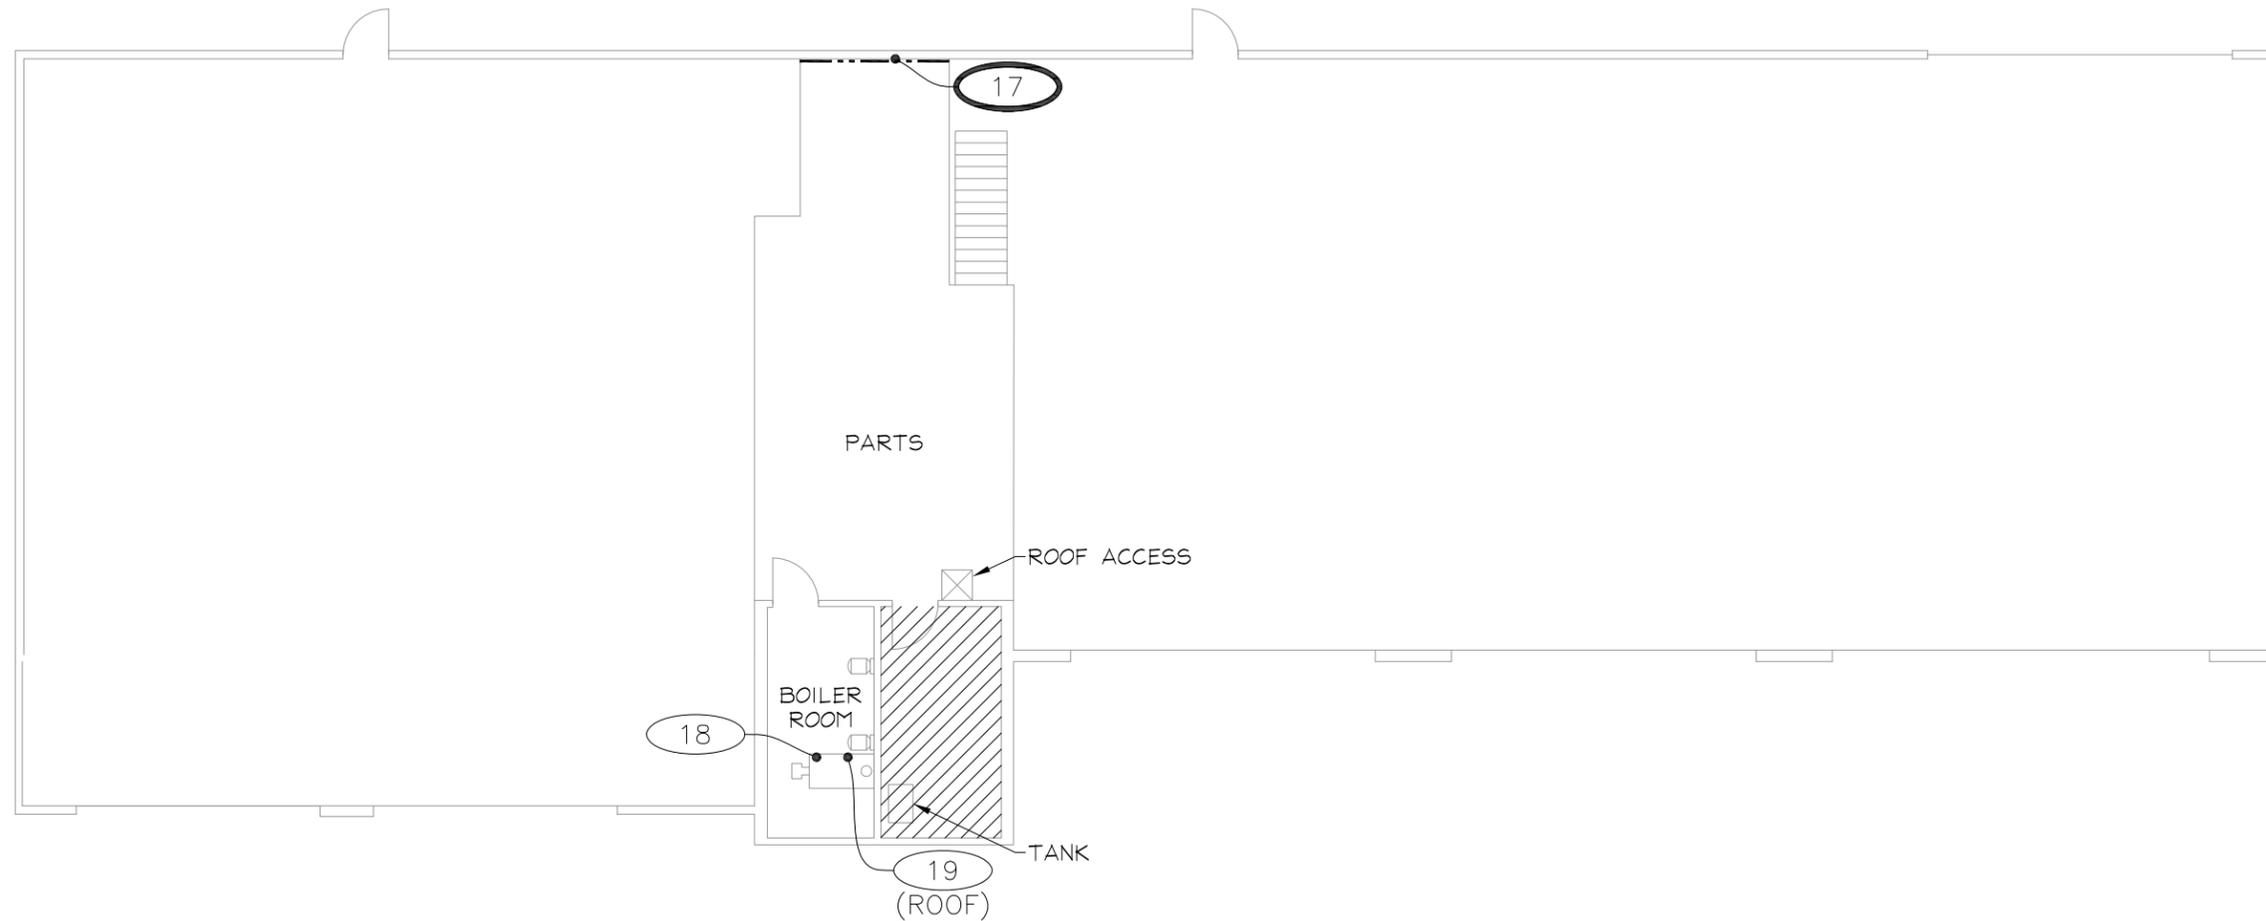


Table 1 continued: Asbestos Sample Results - Ketchikan ARFF Hazmat Survey

Sample	DESCRIPTION	SAMPLE LOCATION	LAB RESULTS	COMMENTS
KDOT-17	Gray Cementitious; Brown Powder		20% Chrysotile	80% Non-Fibrous
KDOT-18	White Fibrous; Brown Powder		Neg	98% Fibrous Glass
KDOT-19	Gray (boiler)	Roof	Neg	100% Non-Fibrous
KDOT-19	Yellow Adhesive (roof sealant)	Roof	Neg	2% Cellulose



ASBESTOS SAMPLE LOCATIONS AND RESULTS

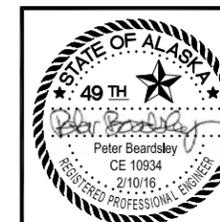

STATE OF ALASKA
DEPARTMENT OF TRANSPORTATION
AND PUBLIC FACILITIES

KETCHIKAN AIRPORT ARFF
BUILDING RENOVATION

ASBESTOS SAMPLE LOCATIONS
AND RESULTS – SECOND FLOOR

DESIGNED: XREFS
 CHECKED: SCALE
 DRAFTED: LAYOUT V-104
 DATE: TIME 2/9/2016 14:18
 DRAWING LOCATION: C:\Users\vertchie\SharePoint\15-2202 J - ADOT KTN ARFF Bid - Doc\Drawings\152202b.dwg

NO.	DATE	REVISION	STATE	PROJECT DESIGNATION	YEAR	SHEET NO.	TOTAL SHEETS
			ALASKA	PROJ.NO. Z682300000	2016	V-105	V-105

DESIGNED
CHECKED
DRAFTED

XREFS

SCALE

LAYOUT
V-105

DATE TIME
2/9/2016 14:18

DRAWING LOCATION
C:\Users\vertchie\SharePoint\15-2202 J - ADOT KTN ARFF Bid - Doc\Drawings\152202b.dwg

LEGEND

-  LEAD BASED PAINT SAMPLE (<1mg/cm sq) (HUD)
 -  LEAD BASED PAINT SAMPLE (>1mg/cm sq) (HUD)
- SEE LEAD BASED PAINT TABULATION RESULTS FOR CONCENTRATION FOR LEAD SAMPLE NUMBER

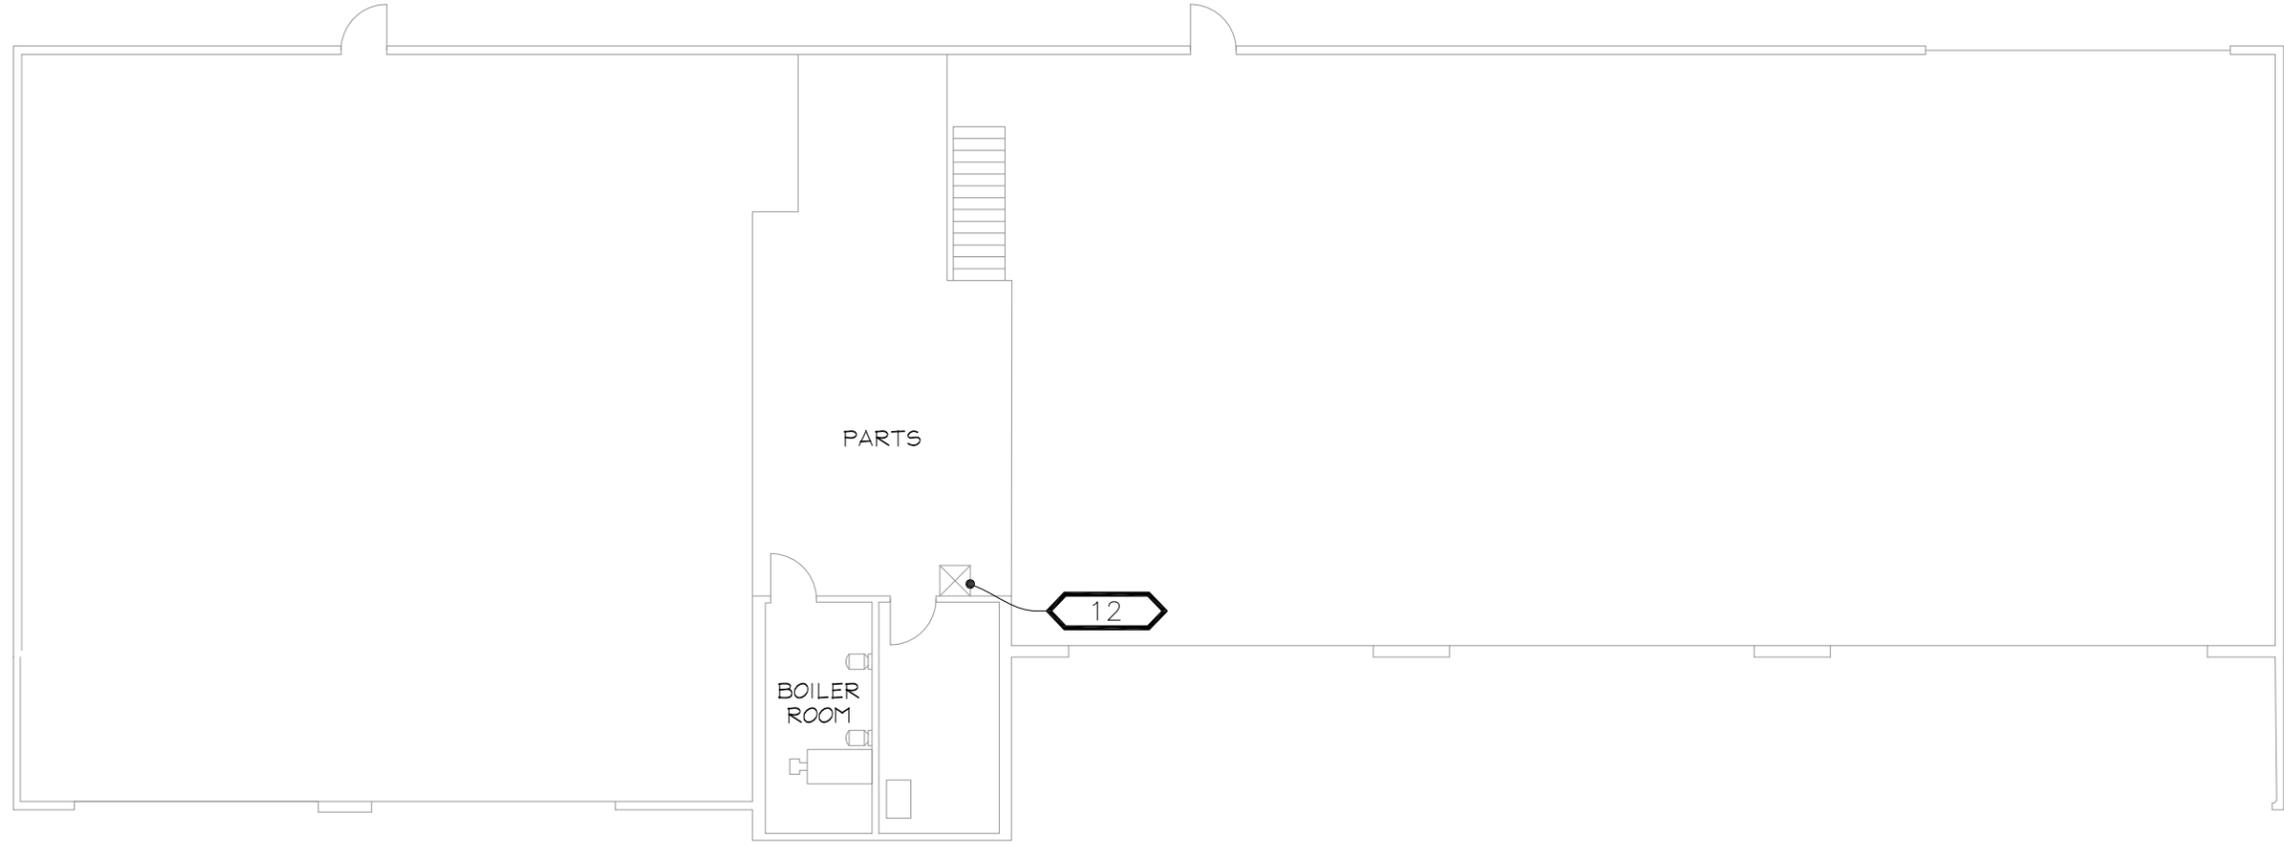


Table 2 continued: Lead XRF Analysis Results - Ketchikan ARFF Hazmat Survey

Niton #	Room #	Feature	Substrate	Color	Pos/Neg	Lead (mg/cm2)
12	Second Fl	Paint	Ladder to roof access	Yellow	Pos	2.0



LEAD SAMPLE LOCATIONS AND RESULTS




STATE OF ALASKA
DEPARTMENT OF TRANSPORTATION
AND PUBLIC FACILITIES

KETCHIKAN AIRPORT ARFF
BUILDING RENOVATION

LEAD SAMPLE LOCATIONS AND
RESULTS - SECOND FLOOR

NO.	DATE	REVISION	STATE	PROJECT DESIGNATION	YEAR	SHEET NO.	TOTAL SHEETS
			ALASKA	PROJ. NO. Z682300000	2016	C-001	C-003

DESIGNED: XREES
 CHECKED: XREES
 DRAFTED: XREES
 SCALE: C-001
 LAYOUT: C-001
 DATE: 2/9/2016 17:13
 TIME: 2/9/2016 17:13
 DRAWING LOCATION: Z:\project\1825.06 DOT_SE Term Ketchikan Airport ARFF Building Renovation\Civil\ACAD\1825.06 - C1 - Site Plan.dwg

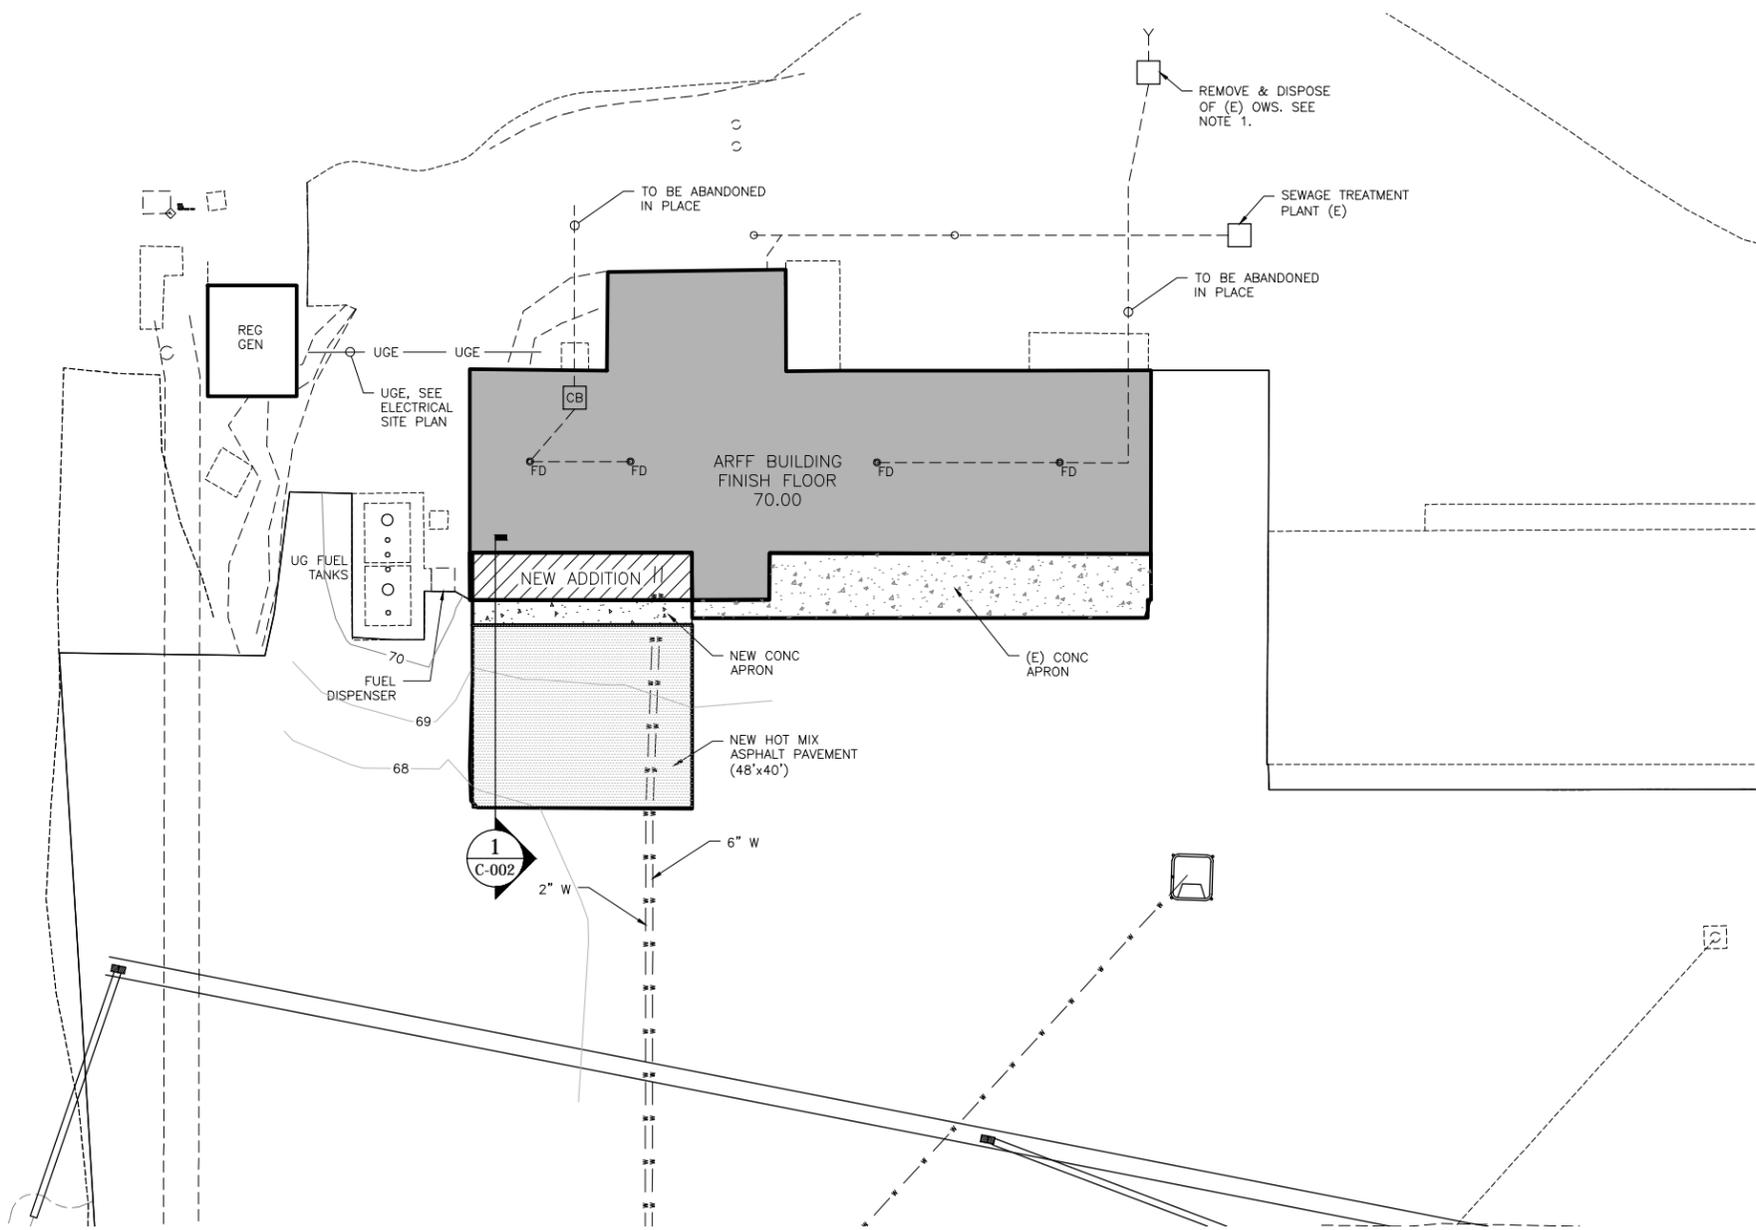

- CIVIL ABBREVIATIONS:**
- AC ASPHALT CONCRETE
 - ARFF AIRCRAFT RESCUE & FIRE FIGHTING
 - CB CIRCUIT BREAKER
 - CONC CONCRETE
 - (E) EXISTING
 - EX EXISTING
 - FD FLOOR DRAIN
 - FDN FOUNDATION
 - GEN GENERATOR
 - OWS OIL WATER SEPARATOR
 - REG REGULATOR
 - UG UNDERGROUND
 - UGE UNDERGROUND ELECTRIC
 - W WATER
- DRAWING NOTES:**
- CONTRACTOR SHALL RETAIN A QUALIFIED ENVIRONMENTAL RECYCLING AND WASTE MANAGEMENT FIRM TO VACUUM TANK CONTENTS FOR TREATMENT AND DISPOSAL AND CLEAN AND DISPOSE OF THE TANK PER LOCAL, STATE AND FEDERAL REGULATIONS. SUBMIT FIRM QUALIFICATIONS AND DISPOSAL PLAN FOR REVIEW PRIOR TO ACCOMPLISHING THE WORK.

SITE PLAN
 0 20' 40'
 SCALE IN FEET




ORIGINAL BORDER SCALES 32"x21"
 ADJUST SCALE ACCORDINGLY



STATE OF ALASKA
 DEPARTMENT OF TRANSPORTATION
 AND PUBLIC FACILITIES
**KETCHIKAN AIRPORT ARFF
 BUILDING RENOVATION**
 SITE PLAN

NO.	DATE	REVISION	STATE	PROJECT DESIGNATION	YEAR	SHEET NO.	TOTAL SHEETS
			ALASKA	PROJ. NO. Z682300000	2016	C-002	C-003

DRAWING LOCATION: Z:\project\1825.06 DOT_SE Term Ketchikan Airport ARFF Building Renovation\Civil\ACAD\1825.06 - C2 - Site Section.dwg
 DATE TIME: 2/10/2016 15:29
 LAYOUT: C-002
 SCALE:
 XREFS:
 DESIGNED:
 CHECKED:
 DRAFTED:

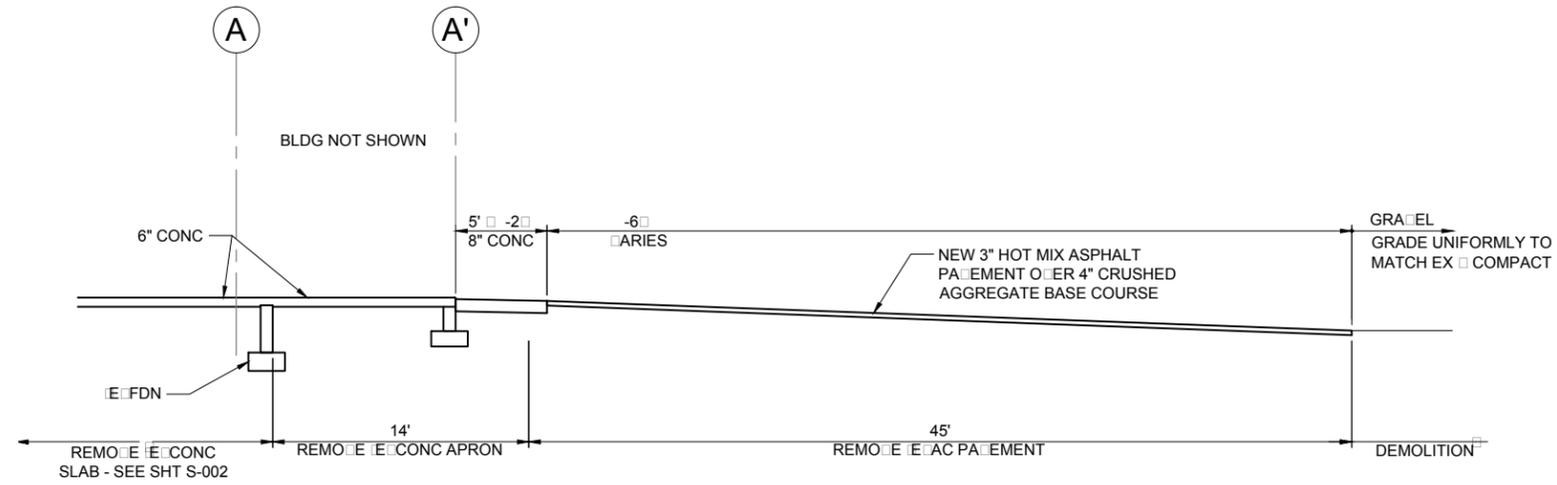

1 SITE SECTION
 SCALE: 1" = 5'



STATE OF ALASKA
 DEPARTMENT OF TRANSPORTATION
 AND PUBLIC FACILITIES
 KETCHIKAN AIRPORT ARFF
 BUILDING RENOVATION

SITE SECTION


DESIGNED: J. BOYER
 CHECKED: S. ROUNTREE
 DRAFTED: J. BOYER
 XREFS
 SCALE: As indicated
 LAYOUT: ARCHITECTURAL SYMBOLS, LEGENDS, ASSEMBLIES
 DATE & TIME: 2/9/2016 2:54:23 PM
 DRAWING LOCATION: C:\Users\jboyer\Documents\14-192_KTN ARFF-A.mxd | jboyer.rvt

SYMBOL LEGEND

BUILDING SECTION 

WALL SECTION 

EXTERIOR ELEVATION 

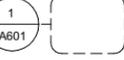PARTIAL/ENLARGED PLAN OR DETAIL 

INTERIOR ELEVATION 

DOOR NUMBER 

WINDOW NUMBER 

ROOM NAME 


ROOM NUMBER 

WALL TYPE 


GRID / COLUMN LINE DESIGNATOR 


SPOT ELEVATION 

MATERIAL LEGEND

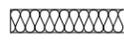BATT INSULATION 

BLOCKING 

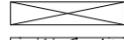
CONTINUOUS BLOCKING 

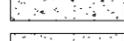CONCRETE 

GYPSUM BOARD 

PLYWOOD 

RIGID INSULATION 

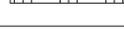SOIL 

CODE DATA

ALL WORK SHALL BE IN CONFORMANCE WITH APPLICABLE CODES AND REGULATIONS, AND THE 2012 INTERNATIONAL BUILDING CODE.

INTERNATIONAL EXISTING BUILDING CODE: SECTION 410: THIS PROJECT DOES NOT ALTER THE EXISTING PRIMARY FUNCTION OF THE BUILDING. SECTION 504: LEVEL 2 ALTERATION.


ARCHITECTURAL ABBREVIATIONS


ACT	ACOUSTICAL CEILING TILE	MFR	MANUFACTURER
AFF	ABOVE FINISHED FLOOR	MIN	MINIMUM OR MINUTE
ALUM	ALUMINUM	MIR	MIRROR
APPROX	APPROXIMATE	MISC	MISCELLANEOUS
BFF	BELOW FINISHED FLOOR	MRGYP	MOISTURE RESISTANT GYPSUM BOARD
BNAP	BETTISWORTH NORTH ARCHITECTS AND PLANNERS	NA	NOT APPLICABLE
CBU	CEMENTITIOUS BACKER UNIT	NIC	NOT IN CONTRACT
CG	CORNER GUARD	O.C.	ON CENTER
CJ	CONTROL JOINT	OFCL	OWNER FURNISHED/ CONTRACTOR INSTALLED
CL	CENTERLINE	OFD	OVERFLOW DRAIN
CLG	CEILING	OFOL	OWNER FURNISHED/ OWNER INSTALLED
CMU	CONCRETE MASONRY UNIT	OPP	OPPOSITE
COL	COLUMN	OTS	OPEN TO STRUCTURE
CONC	CONCRETE	PLAM	PLASTIC LAMINATE
CONT	CONTINUOUS	PTD	PAPER TOWEL DISPENSER
CPT	CARPET	PTDR	PAPER TOWEL DISPENSER/RECEPTACLE
CUH	CABINET UNIT HEATER	PVC	POLYVINYL CHLORIDE
DIA	DIAMETER	P-X	PAINT (X INDICATES PAINT NUMBER)
DN	DOWN	RAD	RADIUS
(E)	EXISTING	RB	RUBBER BASE
EA	EACH	RD	ROOF DRAIN
EF-X	EXTERIOR FINISH (X INDICATES FINISH NUMBER)	REF	REFRIGERATOR
ELEC	ELECTRICAL	REQ	REQUIRED
ELEV	ELEVATION	RF	RUBBER FLOORING
EM	ENTRY MAT	RFEC	RECESSED FIRE EXTINGUISHER CABINET
EMW	ELASTOMERIC MEMBRANE WATERPROOFING	RFT	RESILIENT FLOOR TILE
EPDM	ETHYLENE PROPYLENE DIENE MONOMER	RM	ROOM
EQ	EQUAL	RTU	ROOF TOP UNIT
EXT	EXTERIOR	SF	SQUARE FOOT/FEET
FCO	FLOOR CLEANOUT	SIM	SIMILAR
FD	FLOOR DRAIN	SLDS	SOLID SURFACE
FDC	FIRE DEPARTMENT CONNECTION	SND	SANITARY NAPKIN DISPENSER
FDN	FOUNDATION	SNR	SANITARY NAPKIN RECEPTACLE
FE	FIRE EXTINGUISHER	SPEC	SPECIFICATION(S)
FEC	FIRE EXTINGUISHER CABINET	SSTL	STAINLESS STEEL
FF	FACTORY FINISH	STL	STEEL
FRP	FIBERGLASS REINFORCED PANEL	STRUCT	STRUCTURAL
FRT	FIRE RETARDANT TREATED	SUSP	SUSPENDED
FTG	FOOTING	SV	SHEET VINYL
GA	GAUGE	SWI	SLOPE WITH INSULATION
GALV	GALVANIZED	SWS	SLOPE WITH STRUCTURE
GB-X	GRAB BAR (IF PROVIDED, X INDICATES LENGTH IN INCHES)	T&G	TONGUE AND GROOVE
GLB	GLULAM BEAM	TBD	TO BE DETERMINED
GYP	GYPSUM BOARD	TO CONC	TOP OF CONCRETE
HB	HOSE BIB	TO SLAB	TOP OF SLAB
HM	HOLLOW METAL	TO STEEL	TOP OF STEEL
HORIZ	HORIZONTAL	TSCD	TOILET SEAT COVER DISPENSER
HR	HOUR	TTD	TOILET TISSUE DISPENSER
HW-X	HARDWARE (IF PROVIDED, X INDICATES HW GROUP)	TYP	TYPICAL
ID	INSIDE DIAMETER	UNO	UNLESS NOTED OTHERWISE
IHM	INSULATED HOLLOW METAL	VCT	VINYL COMPOSITE TILE
INSUL	INSULATION	VIF	VERIFY IN FIELD
IRGYP	IMPACT-RESISTANT GYPSUM WALL BOARD	VR	VAPOR RETARDER
MAX	MAXIMUM	VTR	VENT THROUGH ROOF
MECH	MECHANICAL	WB	WEATHER BARRIER
		WD	WOOD
		WSCT	WAINSCOT

WALL TYPES

1 EXTERIOR WALL: INSULATED METAL PANELS


- 3" INSULATED METAL WALL PANEL
- 2" HAT CHANNELS PER STRUCTURAL
- (E) CONCRETE WALL

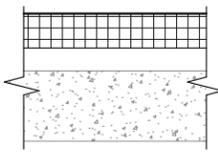
PLAN 

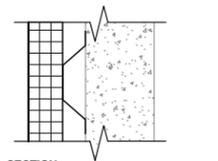SECTION 

2 EXTERIOR WALL: INSULATED METAL PANELS


- 3" INSULATED METAL WALL PANEL
- 2" HAT CHANNELS PER STRUCTURAL
- (E) CONCRETE WALL
- (E) WOOD STUDS WITH INSULATION
- (E) VAPOR BARRIER
- (E) GYPSUM WALL BOARD

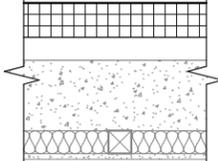
PLAN 

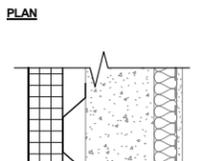SECTION 

3 EXTERIOR WALL: INSULATED METAL PANELS


- 3" INSULATED METAL WALL PANEL
- 8" Z-GIRTS
- 5/8" IMPACT RESISTANT GYPSUM WALL BOARD

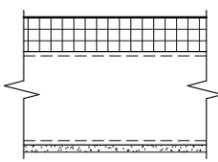
PLAN 

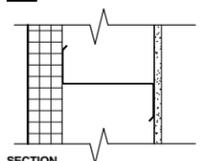SECTION 

4 EXTERIOR WALL: INSULATED METAL PANELS

- 3" INSULATED METAL WALL PANEL
- 2" HAT CHANNELS PER STRUCTURAL
- 5/8" PLYWOOD
- 6" METAL STUDS, 16" O.C.
- 15/32" PLYWOOD
- 5/8" IMPACT RESISTANT GYPSUM WALL BOARD

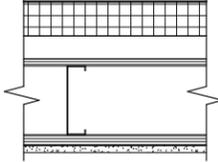PLAN 

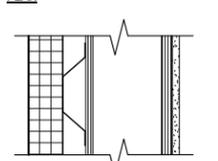SECTION 

STANDARD NOTES

1. **ELECTRONIC MEDIA:** THE CONSTRUCTION DOCUMENTS HAVE BEEN PREPARED UTILIZING ELECTRONIC DRAFTING FORMATS OF AUTOCAD (VERSION 2014) AND/OR REVIT (VERSION 2014). THE AVAILABILITY OF ELECTRONIC BASE FLOOR PLANS, AND/OR ANY OTHER RELATED DOCUMENT FOR USE BY THE GENERAL CONTRACTOR FOR THE USE ON THIS SPECIFIC PROJECT IS CONDITIONALLY GRANTED THROUGH PERMISSION OF THE A/E DESIGNER OF RECORD.

2. **REFERENCE CODES:** ALL WORK SHALL CONFORM TO ALL APPLICABLE BUILDING CODES, STANDARDS, REGULATIONS, AND OTHER SUPPLEMENTAL AMENDMENTS RELATED TO THE JURISDICTIONS OF THE PROJECT, IN THEIR LATEST AND MOST RECENT ADOPTED EDITIONS, AND EFFECTIVE DATES.

3. **VERIFY CONDITIONS:** THE CONTRACTOR SHALL VERIFY ALL PROJECT-RELATED NEW AND/OR EXISTING CONDITIONS, INCLUDING DIMENSIONS PRIOR TO THE COMMENCEMENT OF WORK. PROMPTLY NOTIFY THE ENGINEER OF RECORD, OWNER'S REPRESENTATIVE, AND/OR THE CONTRACTING OFFICER IN WRITING OF ALL DISCREPANCIES AND/OR UNKNOWN CONDITIONS OBSERVED.

4. **DRAWING FORMAT:** THESE CONSTRUCTION DOCUMENTS HAVE BEEN PRODUCED AT DRAWING SCALES THAT RELATE TO THEIR FULL-SIZE FORMAT 22x34 INCHES. ANY DEVIATIONS TO THIS FORMAT SIZE WILL PRODUCE DRAWINGS OUTSIDE OF THE SCALE LIMITS INDICATED. DRAWING REPRODUCTIONS IN ANY FORMAT SHOULD NOT BE SCALED FOR DIMENSIONAL ACCURACY. USE GRAPHIC SCALES ACCORDINGLY.

5. **HAZARDOUS MATERIALS:** THIS PROJECT CONTAINS AND REQUIRES THE REMEDIATION/ABATEMENT OF DESIGNATED HAZARDOUS MATERIALS CONSISTING OF ASBESTOS CONTAINING MATERIALS (ACM), LEADBASED PAINT (LBP), AND BALLAST CONTAINING PCBs, AS INDICATED IN PROJECT HAZARDOUS MATERIALS REPORT DATED AUGUST 2015. CONTRACTOR WILL BE RESPONSIBLE FOR THE REMOVAL, HANDLING AND DISPOSAL OF ALL MATERIALS, IN ACCORDANCE WITH ALL EPA, OSHA, GOJ, AND ANY OTHER RELATED REGULATIONS.

6. **SELECTIVE DEMOLITION:** THIS PROJECT INVOLVES THE SELECTIVE DEMOLITION OF EXISTING FACILITIES. CONTRACTOR IS RESPONSIBLE FOR THE REMOVAL AND DISPOSAL AS MANDATED IN THE DOCUMENTS. ALL DEMOLISHED MATERIALS WILL BECOME THE PROPERTY OF THE CONTRACTOR AND DISPOSITION OF ALL SUCH MATERIALS WILL BE DISPOSED OF OFF-SITE AT AN APPROVED DISPOSAL SITE. *NOTE: THE PRESENCE OF ANY HAZARDOUS MATERIALS MUST BE TAKEN INTO CONSIDERATION.*

7. **FIELD-VERIFICATION:** CONTRACTOR SHALL FIELD-VERIFY ALL DIMENSIONS PRIOR TO THE COMMENCEMENT OF WORK. PROMPTLY NOTIFY THE ENGINEER OF RECORD, OWNER'S REPRESENTATIVE, AND/OR THE CONTRACTING OFFICER IN WRITING OF ALL DISCREPANCIES OF NEW OR EXISTING CONDITIONS.

8. **DIMENSIONING GUIDE:** ALL DIMENSIONS ARE TAKEN TO/FROM GRID LINE, FACE OF CONCRETE AND MASONRY, AND FACE OF METAL/WOOD STUD PARTITION, UNLESS OTHERWISE NOTED. CLEAR DIMENSIONS BETWEEN SURFACES WILL BE NOTED WHERE APPLICABLE FROM MATERIAL FINISHES. ALL DIMENSIONS REFERENCED HEREIN ARE IMPERIAL STANDARDS, UNLESS OTHERWISE NOTED. FOR THE PURPOSE OF THIS PROJECT, ALL DIMENSIONS HEREIN SHALL BE TREATED EQUALLY, WITHOUT ANY HIERARCHY, AND/OR ORDER OF PRECEDENCE, UNLESS OTHERWISE NOTED.

NO.	DATE	REVISION	STATE	PROJECT DESIGNATION	YEAR	SHEET NO.	TOTAL SHEETS
			ALASKA	PROJ. NO. Z682300000	2015	A-001	A-8

FINISH SCHEDULE

RM #	ROOM NAME	FLOOR		WALL 1 - NORTH		WALL 2 - EAST		WALL 3 - SOUTH		WALL 4 - WEST		CEILING		REMARKS
		MAT.	FIN.	MAT.	FIN.	MAT.	FIN.	MAT.	FIN.	MAT.	FIN.	MAT.	FIN.	
01	FIRE EQUIPMENT	CONC	SEAL-1	RB-1										
02	MAINTENANCE			RB-1	IRGYP	P-1								
04	ENTRY #1													
05	OFFICE													
06	TLT													
07	PASSAGE													
08	STORAGE													
08A	STORAGE													
09	MECH.													
10	ENTRY #2													
11	KITCHEN													
12	TRAINING													
13	HALL													
14	BATH													
15	OFFICE													
101	STORAGE													
102	CLEAN RM													
103	BOILER													

FINISH LEGEND


SEAL-1 SEALED CONCRETE
 P-1 PAINT: PAINT ON GYPSUM WALL BOARD
 P-2* PAINT: ACRYLIC ON METAL
 P-3 PAINT: ACRYLIC ON GALVANIZED

* PAINT COLUMNS P-2
 RB-1 RUBBER BASE

NOTE: ALL BLANK FIELDS IN FINISH SCHEDULE INDICATE (E) FINISHES TO REMAIN

DOOR SCHEDULE - NEW DOORS

DOOR #	ROOM NAME	DOOR				FRAME		DETAILS			REMARKS			
		WIDTH	HGT	TYPE	MATL	FINISH	HDW	TYPE	MATL	FINISH		HEAD	JAMB	SILL
001	FIRE EQUIPMENT	16'-0"	15'-0"	B	STL	FF	2	-	STL	P-3	2 / A501	5 / A501	9 / A501	
002	FIRE EQUIPMENT	16'-0"	15'-0"	B	STL	FF	2	-	STL	P-3	2 / A501	5 / A501	9 / A501	
003	FIRE EQUIPMENT	3'-0"	7'-0"	A	IHM	P-2	1	1	IHM	P-2	1 / A501	4 / A501	8 / A501	
004	MAINTENANCE	20'-0"	15'-0"	B	STL	FF	2	-	STL	P-3	3 / A501	5 / A501	9 / A501	
005	MAINTENANCE	16'-0"	15'-0"	B	STL	FF	2	-	STL	P-3	3 / A501	5 / A501	9 / A501	
006	MAINTENANCE	27'-0"	15'-0"	B	STL	FF	2	-	STL	P-3	3 / A501	5 / A501	9 / A501	

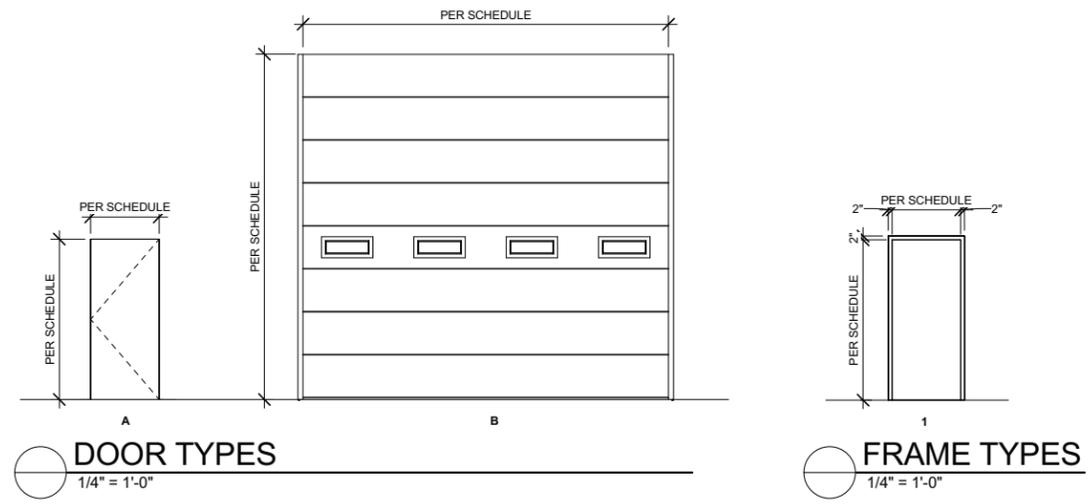


STATE OF ALASKA
 DEPARTMENT OF TRANSPORTATION
 AND PUBLIC FACILITIES

**KETCHIKAN AIRPORT ARFF
 BUILDING RENOVATION**


ARCHITECTURAL ABBREVIATIONS,
 SYMBOLS, LEGENDS, & ASSEMBLIES

NO.	DATE	REVISION	STATE	PROJECT DESIGNATION	YEAR	SHEET NO.	TOTAL SHEETS
			ALASKA	PROJ. NO. Z682300000	2015	A-100	A-8

- DEMOLITION PLAN NOTES:**
- 1 REMOVE (E) PLUMBING FIXTURE, SEE MECHANICAL
 - 2 REMOVE (E) FLOOR DRAIN, SEE MECHANICAL
 - 3 SAWCUT (E) SLAB, SEE MECHANICAL
 - 4 SAWCUT (E) SLAB, SEE MECHANICAL FOR EXTENTS
 - 5 REMOVE (E) COLUMN AND PILASTER, SEE STRUCTURAL
 - 6 REMOVE (E) GLAZING, OVERHEAD SECTIONAL DOORS, AND EXTERIOR WALL
 - 7 REMOVE (E) BOLLARDS, TYPICAL

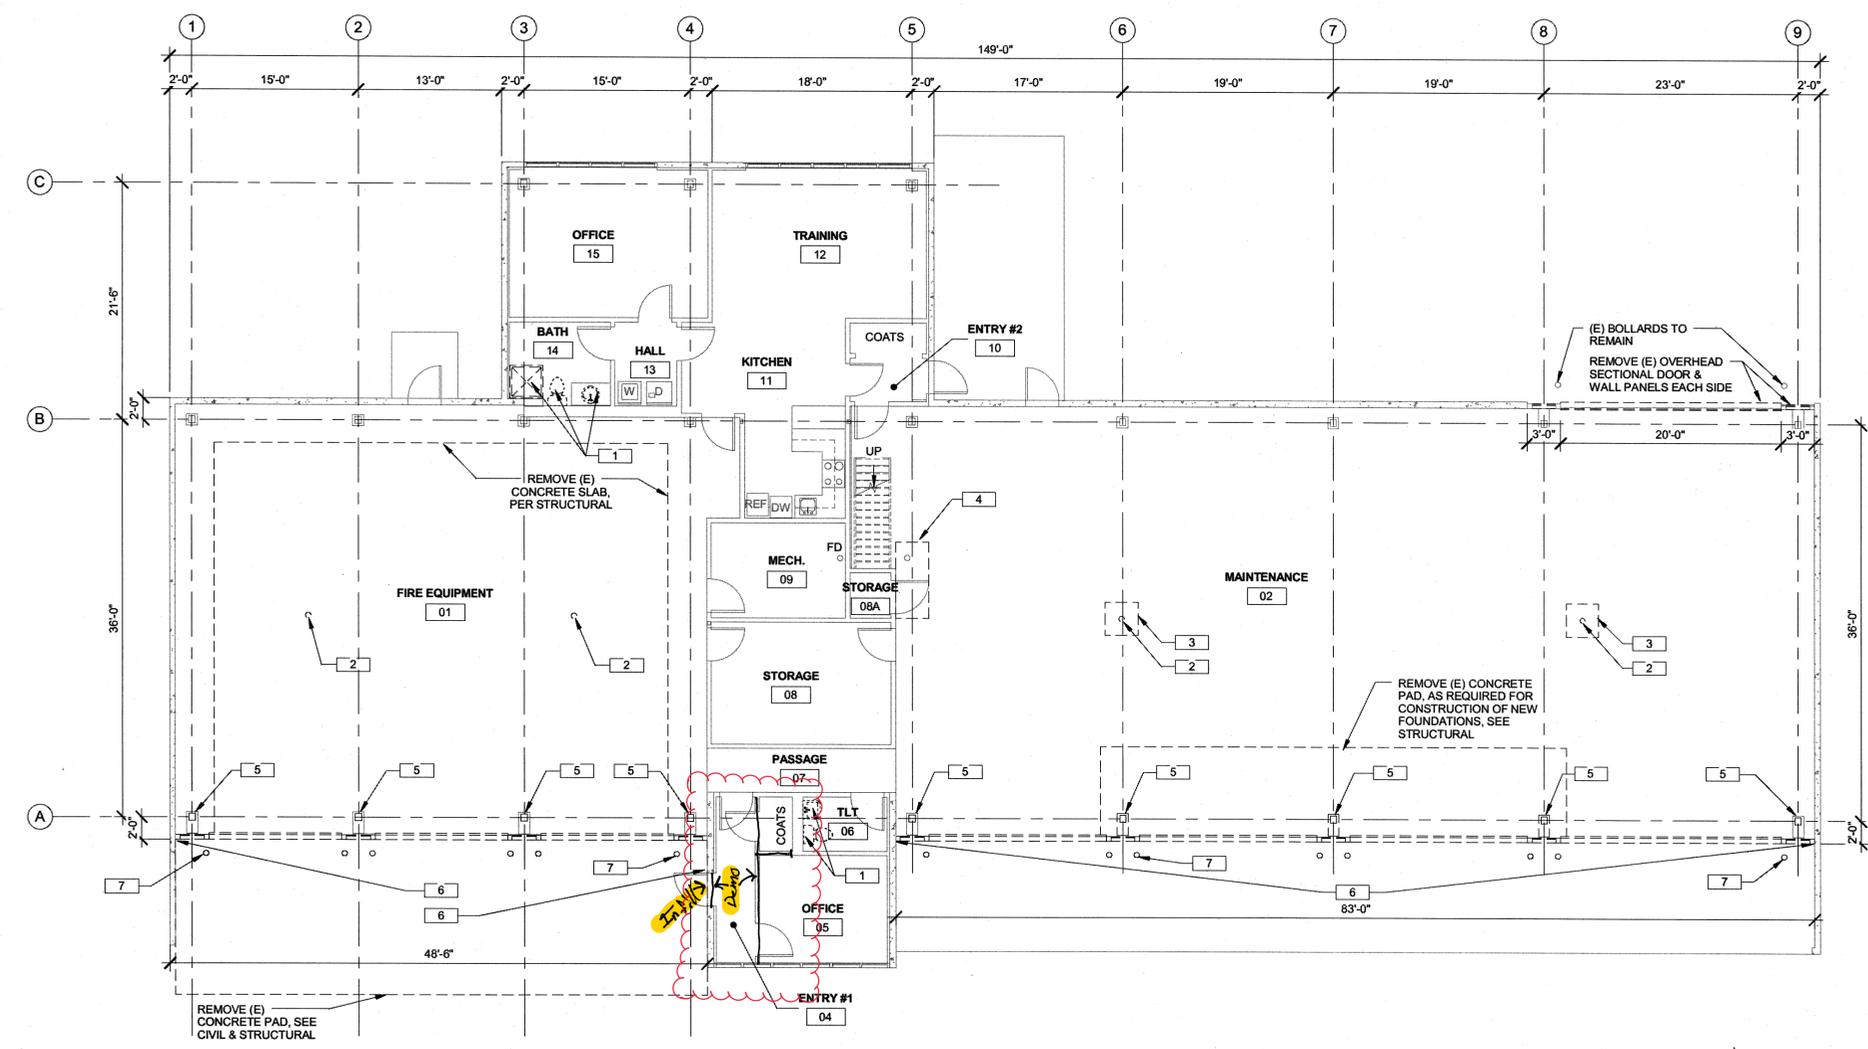

1 1ST FLOOR PLAN - DEMOLITION
A-100 1/8" = 1'-0"

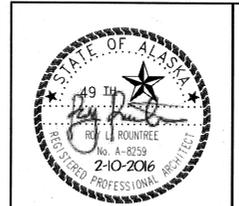

STATE OF ALASKA
DEPARTMENT OF TRANSPORTATION
AND PUBLIC FACILITIES

**KETCHIKAN AIRPORT ARFF
BUILDING RENOVATION**


1ST FLOOR PLAN - DEMOLITION

DRAWING LOCATION: C:\Users\jroberts\Documents\14-192_KTN_ARFF-A-model_jboyer.rvt
 DATE & TIME: 2/9/2016 2:54:24 PM
 LAYOUT: 1ST FLOOR PLAN - DEMOLITION
 SCALE: As indicated
 XREFS:
 DESIGNED: J. ROYER
 CHECKED: R. ROUNTREE
 DRAFTED: J. ROYER


NO.	DATE	REVISION	STATE	PROJECT DESIGNATION	YEAR	SHEET NO.	TOTAL SHEETS
			ALASKA	PROJ. NO. Z682300000	2015	A-101	A-8

- GENERAL FLOOR PLAN NOTES:**
- FIELD VERIFICATION:** CONTRACTOR SHALL FIELD-VERIFY ALL DIMENSIONS PRIOR TO THE COMMENCEMENT OF WORK. PROMPTLY NOTIFY THE ENGINEER OF RECORD, OWNER'S REPRESENTATIVE, AND/OR THE CONTRACTING OFFICER IN WRITING OF ALL DISCREPANCIES OF NEW OR EXISTING CONDITIONS.
 - DIMENSIONING GUIDE:** ALL DIMENSIONS ARE TAKEN TO/FROM GRID LINE, FACE OF CONCRETE AND MASONRY, AND FACE OF METAL WOOD STUD PARTITION, UNLESS OTHERWISE NOTED. CLEAR DIMENSIONS BETWEEN SURFACES WILL BE NOTED WHERE APPLICABLE FROM MATERIAL FINISHES. ALL DIMENSIONS REFERENCED HEREIN ARE IMPERIAL STANDARDS, UNLESS OTHERWISE NOTED. FOR THE PURPOSE OF THIS PROJECT, ALL DIMENSIONS HEREIN SHALL BE TREATED EQUALLY, WITHOUT ANY HIERARCHY, AND/OR ORDER OF PRECEDENCE, UNLESS OTHERWISE NOTED.
 - PARTITION/WALL TYPES:** SEE SHEET A001 FOR WALL ASSEMBLY TYPES.
 - DOOR OPENINGS:** ALL DOOR OPENINGS ARE DESIGNATED WITH REFERENCE NUMBERS CORRESPONDING TO A SEPARATE DOOR SCHEDULE. THIS MAY INCLUDE MISCELLANEOUS OPENINGS SUCH AS OVERHEAD SECTIONAL, COILING, OR SLIDING ASSEMBLIES. REFER TO SHEET A001 FOR THE DOOR OPENING SCHEDULE.
 - ROOM FINISHES:** ALL ROOMS ARE DESIGNATED WITH REFERENCE ROOM NAMES/NUMBERS CORRESPONDING TO A SEPARATE ROOM FINISH SCHEDULE. REFER TO SHEET SERIES A001 FOR THE ROOM FINISH SCHEDULE.
 - REFLECTED CEILING PLAN:** REFER TO SHEET A201 FOR THE CORRESPONDING RCP FOR THIS FLOOR PLAN AREA.

DRAWING LOCATION: C:\Users\jpr\OneDrive\Documents\14_02_KTN ARFF-A model\jpower.dwg
 DATE & TIME: 2/9/2016 2:54:26 PM
 LAYOUT: 1ST FLOOR PLAN
 SCALE: As indicated
 XREFS:
 DESIGNED BY: JBOYER
 CHECKED BY: JBOYER
 DRAFTED BY: JBOYER

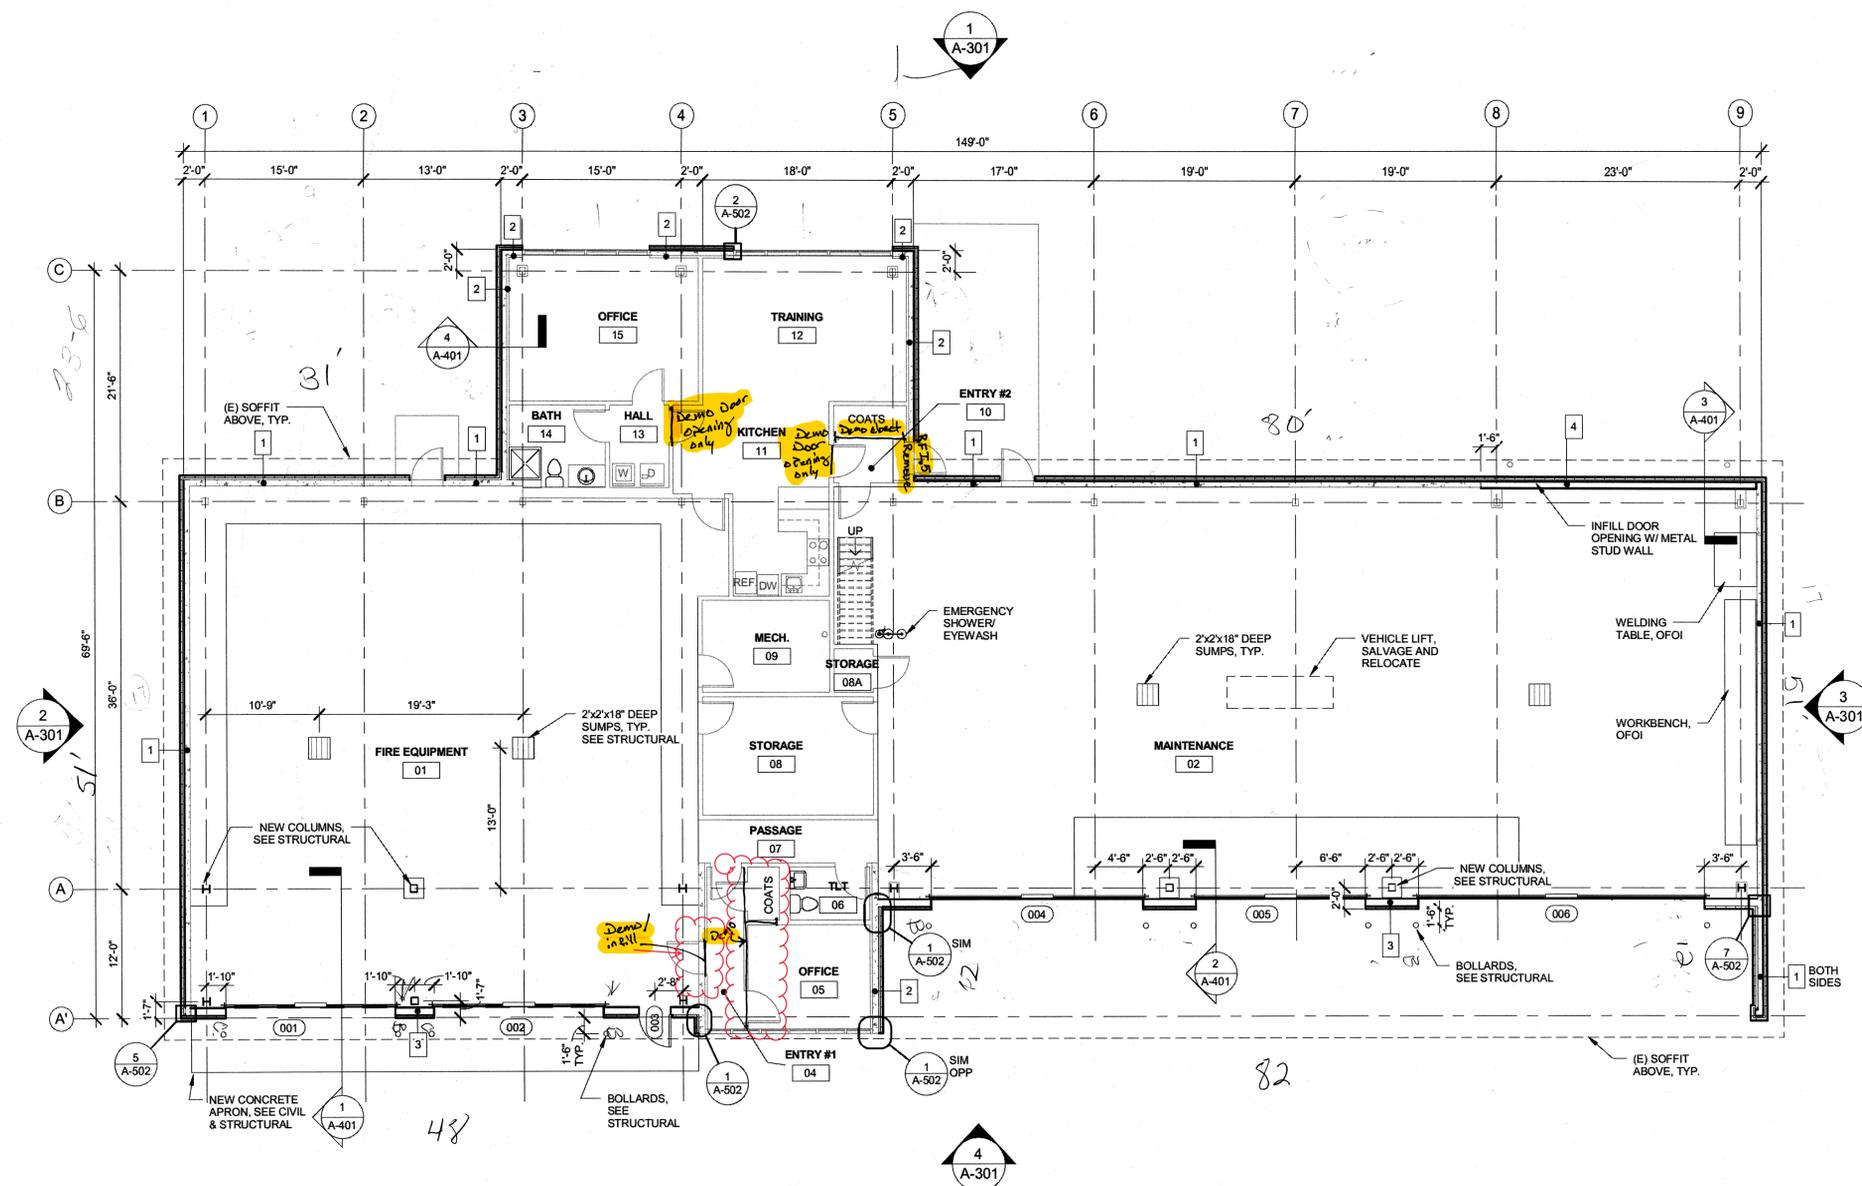


1 1ST FLOOR PLAN
A-101 1/8" = 1'-0"

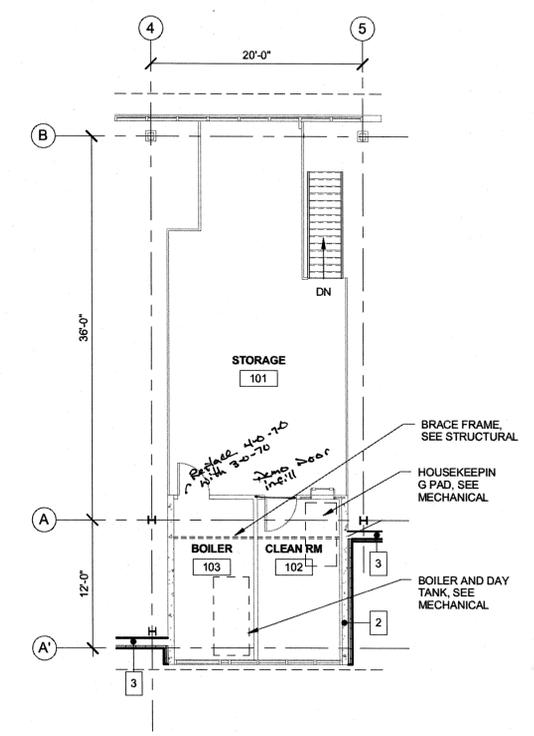

2 2ND FLOOR PLAN
A-101 1/8" = 1'-0"

27
16 2 sheets

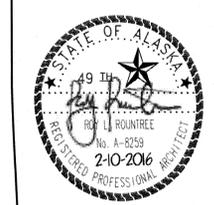

STATE OF ALASKA
DEPARTMENT OF TRANSPORTATION
AND PUBLIC FACILITIES
**KETCHIKAN AIRPORT ARFF
BUILDING RENOVATION**



1ST FLOOR PLAN

DRAWING LOCATION: C:\Users\jboyer\Documents\14-192_KTN ARFF-A\model_jboyer.rvt
 DATE & TIME: 2/9/2016 2:54:28 PM
 LAYOUT: REFLECTED CEILING PLANS
 SCALE: 1/8" = 1'-0"
 XREFS:
 DESIGNED: J. BOYER
 CHECKED: S. ROUNTREE
 DRAFTED: J. BOYER

NO.	DATE	REVISION	STATE	PROJECT DESIGNATION	YEAR	SHEET NO.	TOTAL SHEETS
			ALASKA	PROJ. NO. Z682300000	2015	A-201	A-8


- CEILING LEGEND**
- GYP OTS
- SEE MECHANICAL AND ELECTRICAL FOR FIXTURES:
- RECESSED DOWNLIGHT
 - LIGHT FIXTURE
 - LIGHT FIXTURE
 - EMERGENCY EXIT SIGN
 - SUPPLY DIFFUSERS
 - RETURN DIFFUSER

- GENERAL CEILING NOTES**
- FIELD VERIFICATION:** CONTRACTOR SHALL FIELD VERIFY ALL DIMENSIONS AND VERTICAL CONTROL PRIOR TO THE COMMENCEMENT OF WORK. PROMPTLY NOTIFY THE ENGINEER OF RECORD, OWNER'S REPRESENTATIVE OR CONTRACTING OFFICER IN WRITING OF ALL DISCREPANCIES IN NEW AND/OR EXISTING CONDITIONS. CONTRACTOR IS RESPONSIBLE FOR COORDINATION OF ALL ABOVE CEILING WORK TO ENSURE CLEARANCES FOR SCHEDULED CEILING HEIGHTS.
 - DIMENSION GUIDE:** ALL DIMENSIONS ARE TAKEN TO/FROM GRID LINE, FACE OF CONCRETE AND MASONRY, AND FACE OF METAL/WOOD STUD PARTITION, UNLESS OTHERWISE NOTED. CLEAR DIMENSIONS WILL BE NOTED WHERE APPLICABLE FROM MATERIAL FINISHES.
 - CEILING HEIGHTS:** ALL CEILINGS DESIGNATED ON THIS PLAN SHALL BE 8'-0" AFF, UNLESS OTHERWISE NOTED ON THE PLAN. ALL CEILING HEIGHTS CORRESPOND TO THE RESPECTIVE FINISH FLOOR ELEVATION/LEVEL.
 - CEILING FINISHES:** ALL ROOMS ARE DESIGNATED WITH REFERENCE NAMES/NUMBERS CORRESPONDING TO A SEPARATE ROOM FINISH SCHEDULE. REFER TO SHEETS A001 FOR SCHEDULED CEILING FINISHES.
 - CEILING DEVICES:** ALL CEILING LAYOUT PLANS SHOW MOST MAJOR MECHANICAL AND ELECTRICAL DEVICES. SEE MECHANICAL AND ELECTRICAL DOCUMENTS FOR ADDITIONAL M/E DEVICES INCLUDED IN THE CEILING CONFIGURATION. CONTRACTOR TO COORDINATE LAYOUT OF ALL DEVICES.
 - PARTITION TYPES:** PARTITION TYPES ARE REFERENCED ON THE CORRESPONDING FLOOR PLAN SHEETS A101 AND A111 FOR THIS AREA, AND SCHEDULED ON SHEET A001.

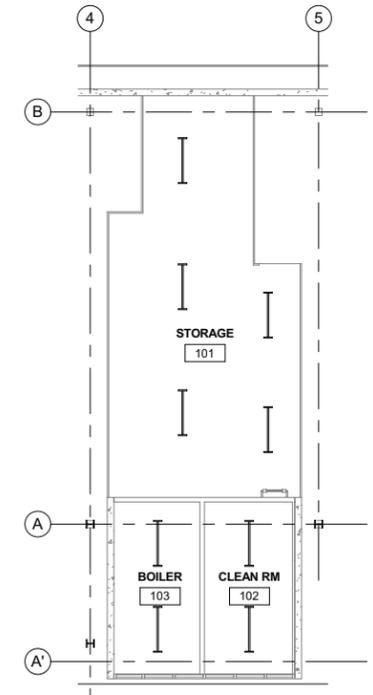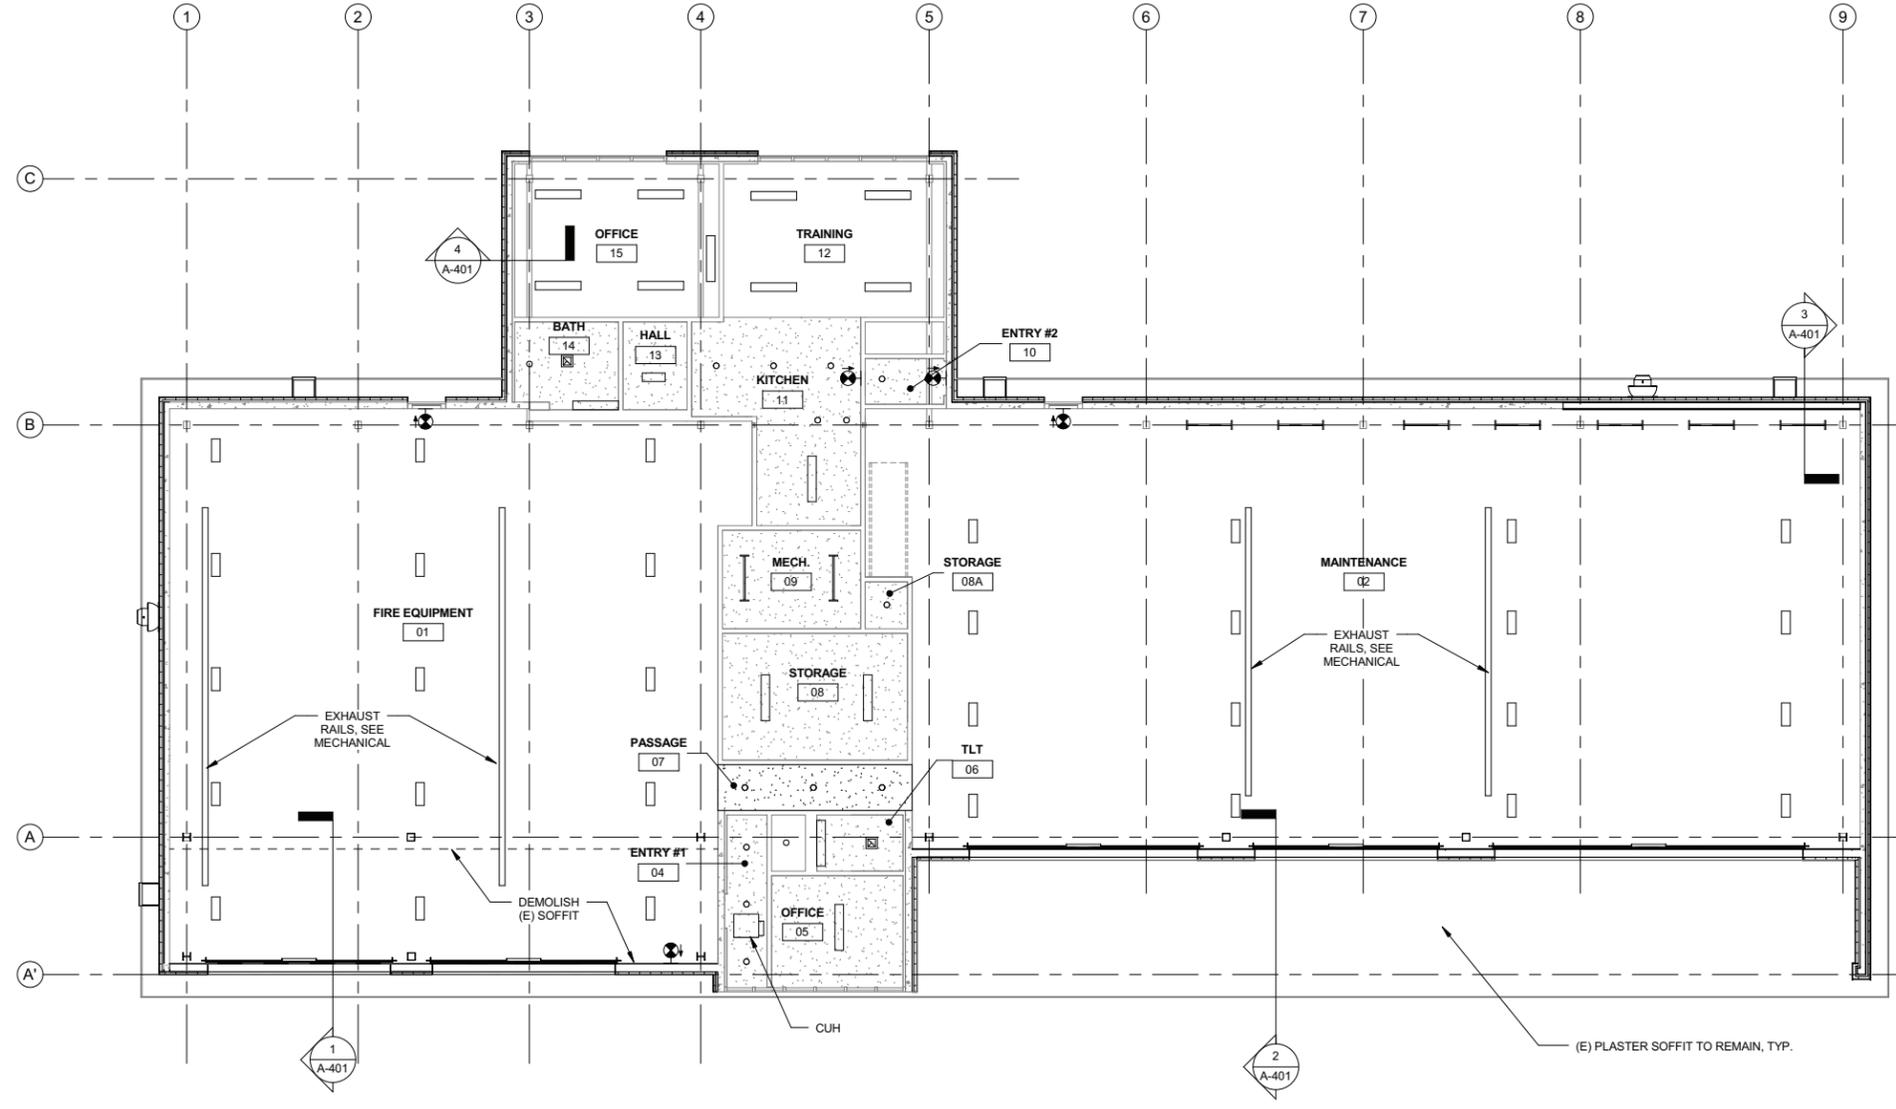

2 2ND FLOOR REFLECTED CEILING PLAN
1/8" = 1'-0"

1 1ST FLOOR REFLECTED CEILING PLAN
1/8" = 1'-0"

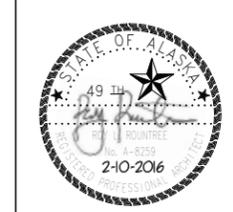


STATE OF ALASKA
 DEPARTMENT OF TRANSPORTATION
 AND PUBLIC FACILITIES

**KETCHIKAN AIRPORT ARFF
 BUILDING RENOVATION**


REFLECTED CEILING PLANS

NO.	DATE	REVISION	STATE	PROJECT DESIGNATION	YEAR	SHEET NO.	TOTAL SHEETS
			ALASKA	PROJ. NO. Z682300000	2015	A-301	A-8


DESIGNED BY: J. BOYER
 CHECKED BY: S. ROUNTREE
 DRAFTED BY: J. BOYER
 XREFS
 SCALE: 1/8" = 1'-0"
 LAYOUT: EXTERIOR ELEVATIONS
 DATE & TIME: 2/9/2016 2:54:30 PM
 DRAWING LOCATION: C:\Users\jboyer\Documents\14-192_KTN ARFF-A-model_jboyer.rvt

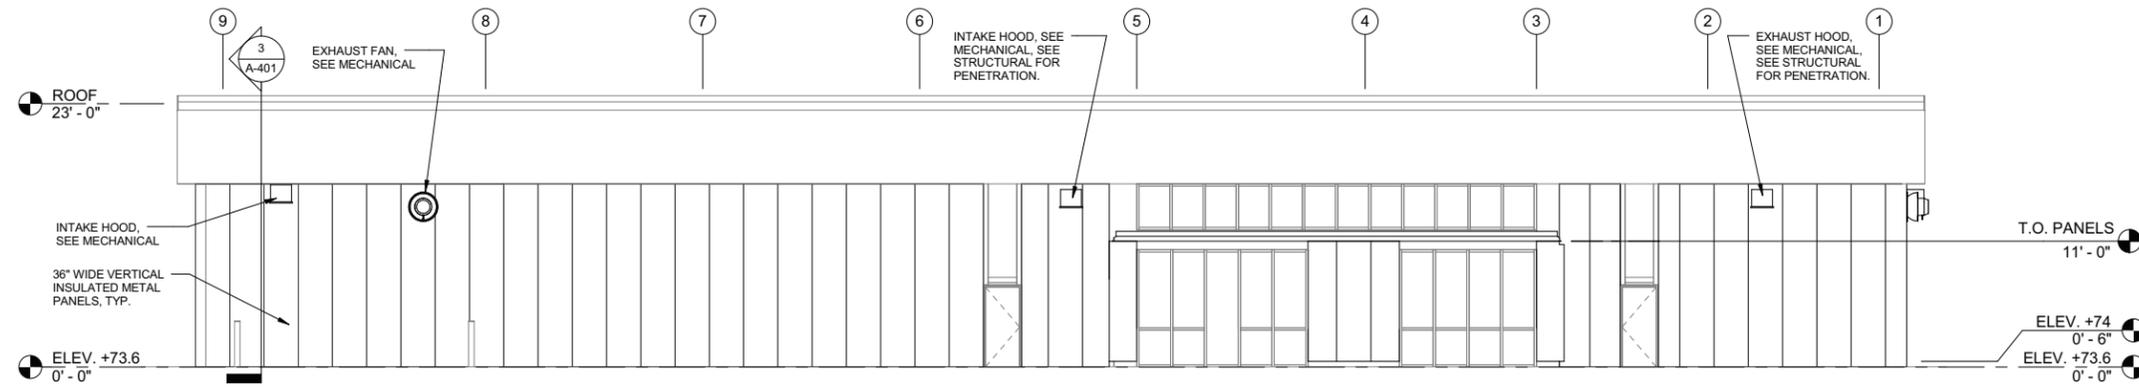


1 NORTH ELEVATION
A-301 1/8" = 1'-0"

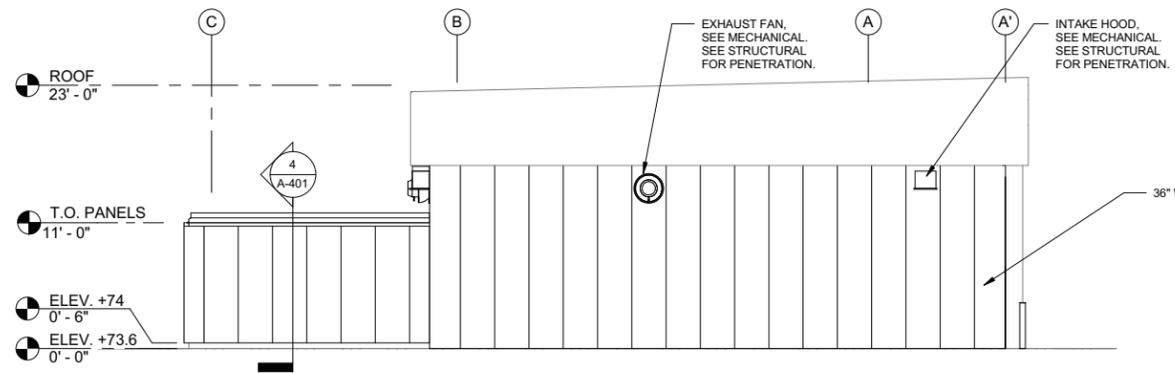

2 WEST ELEVATION
A-301 1/8" = 1'-0"

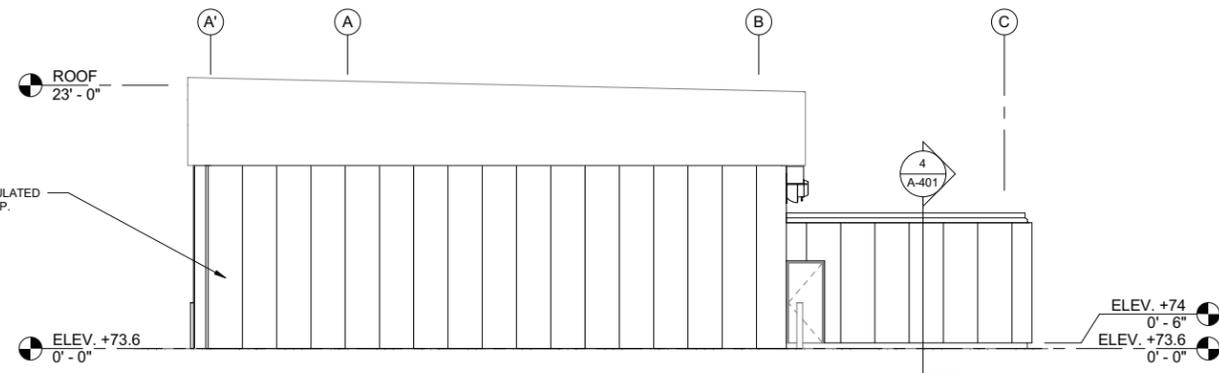

3 EAST ELEVATION
A-301 1/8" = 1'-0"

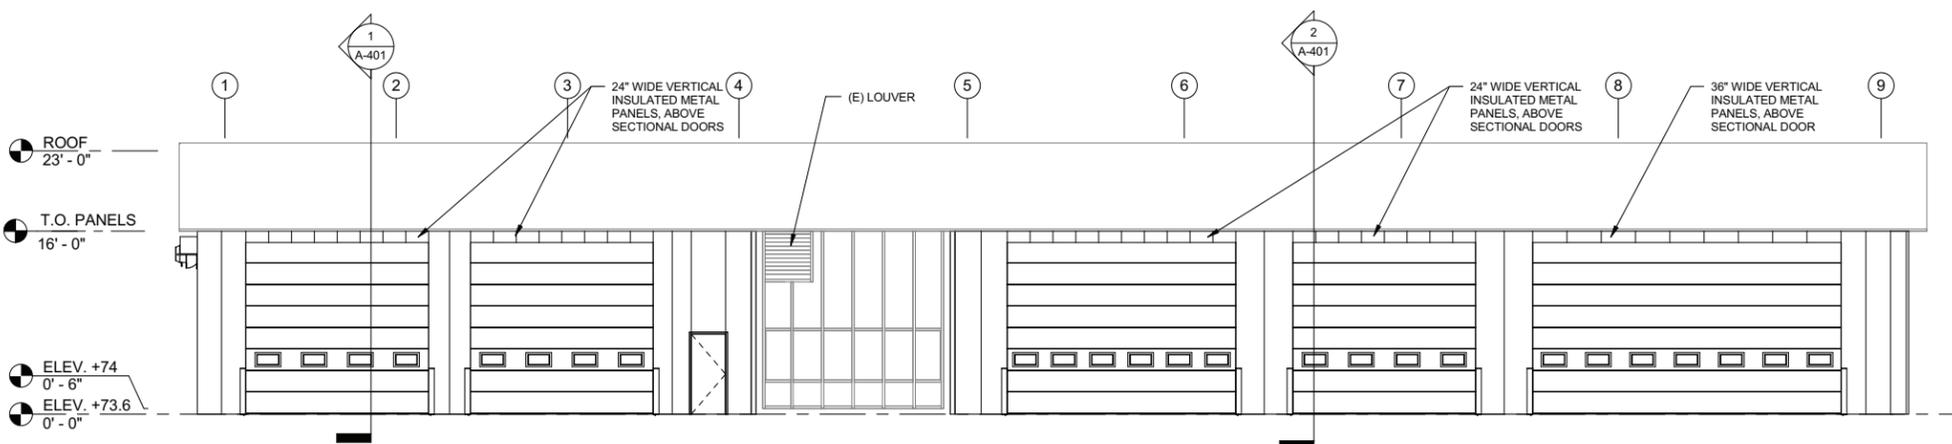


4 SOUTH ELEVATION
A-301 1/8" = 1'-0"




STATE OF ALASKA
 DEPARTMENT OF TRANSPORTATION
 AND PUBLIC FACILITIES
**KETCHIKAN AIRPORT ARFF
 BUILDING RENOVATION**
 EXTERIOR ELEVATIONS


NO.	DATE	REVISION	STATE	PROJECT DESIGNATION	YEAR	SHEET NO.	TOTAL SHEETS
			ALASKA	PROJ. NO. Z682300000	2015	A-401	A-8

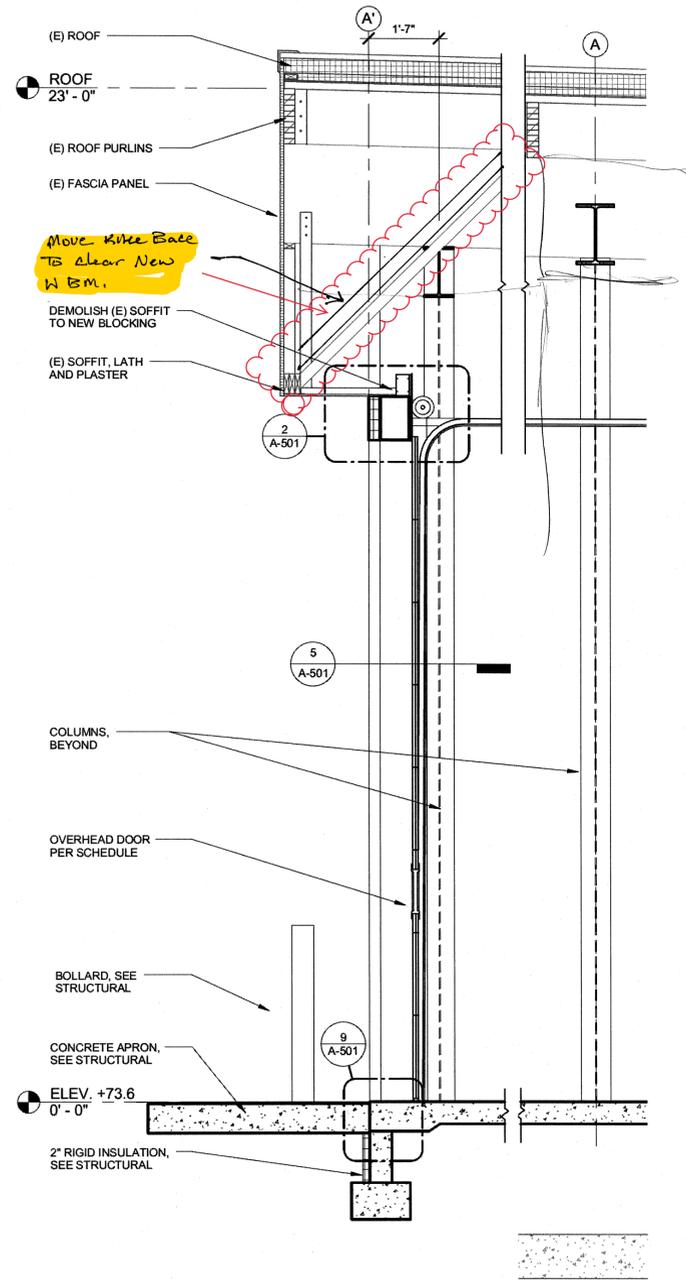


1 WALL SECTION
A-401 1/2" = 1'-0"

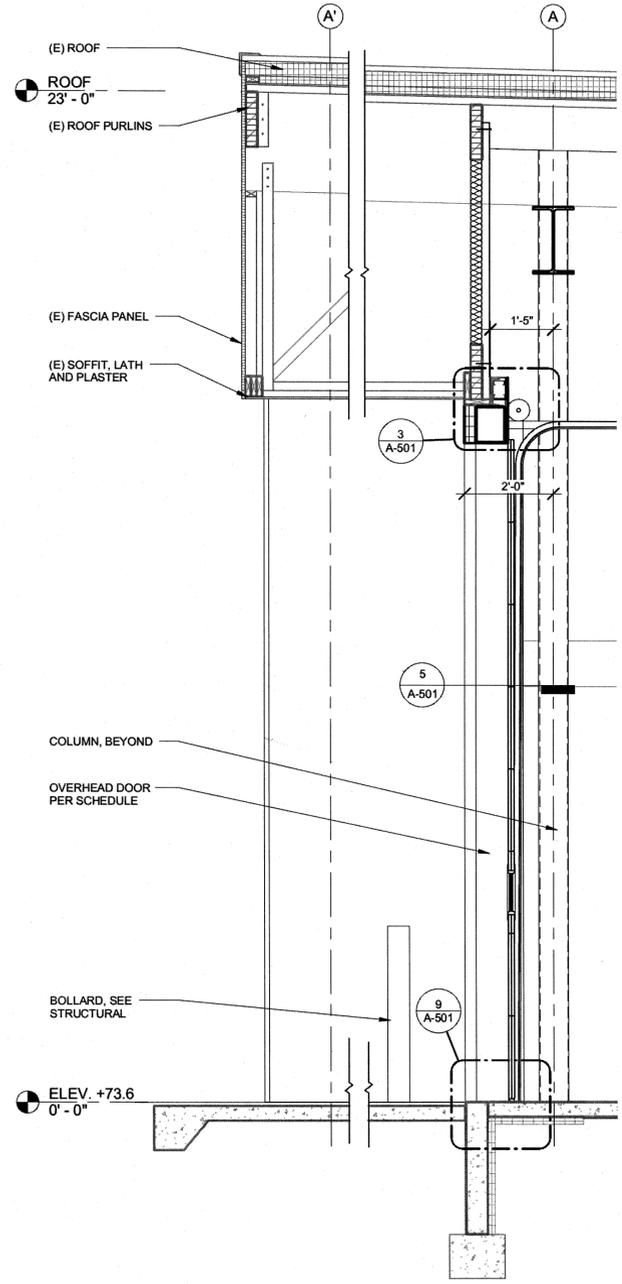

2 WALL SECTION
A-401 1/2" = 1'-0"

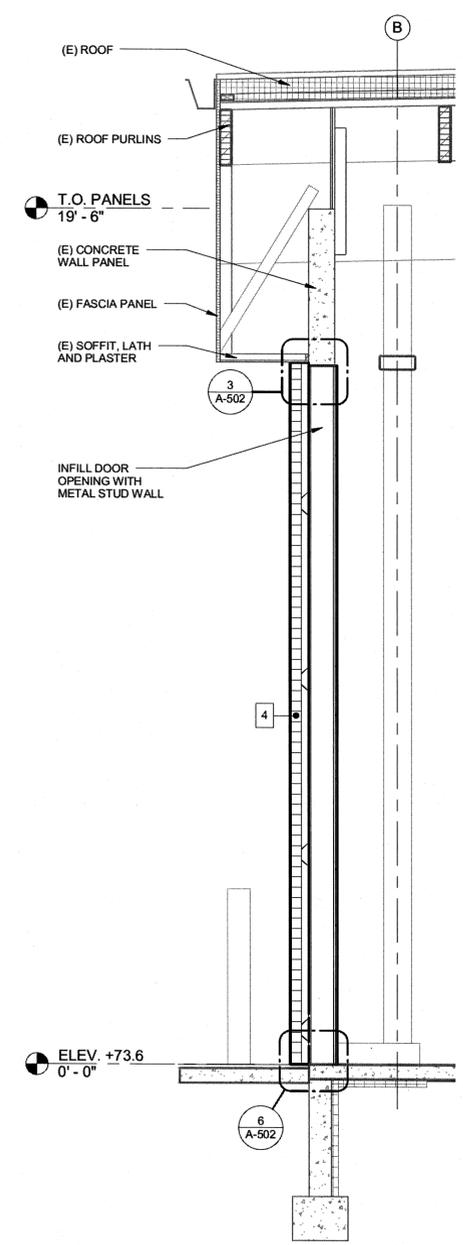

3 WALL SECTION
A-401 1/2" = 1'-0"

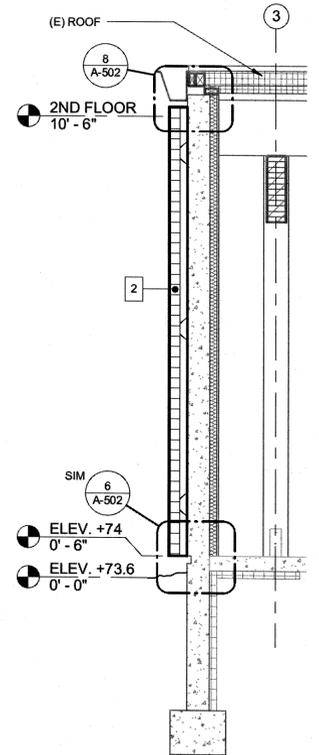

4 WALL SECTION
A-401 1/2" = 1'-0"


DESIGNED: JBOYER
 CHECKED: R.ROUNTREE
 DRAFTED: JBOYER
 XREFS
 SCALE: 1/2" = 1'-0"
 LAYOUT: WALL SECTIONS
 DATE & TIME: 2/8/2016 2:54:31 PM
 DRAWING LOCATION: C:\Users\jboyer\Documents\14-192_KTN ARFF-A.model\jboyer.rvt




STATE OF ALASKA
 DEPARTMENT OF TRANSPORTATION
 AND PUBLIC FACILITIES
**KETCHIKAN AIRPORT ARFF
 BUILDING RENOVATION**
 WALL SECTIONS

NO.	DATE	REVISION	STATE	PROJECT DESIGNATION	YEAR	SHEET NO.	TOTAL SHEETS
			ALASKA	PROJ. NO. Z682300000	2015	A-501	A-8


DRAWING LOCATION
 C:\Users\jrountree\Documents\14-192_KTM ARFF-A-model_jboyer.rvt
 DATE & TIME
 2/8/2016 2:54:33 PM
 LAYOUT
 EXTERIOR DETAILS
 SCALE
 3" = 1'-0"
 XREFS
 DESIGNED
 CHECKED
 DRAFTED
 JBOYER
 R.ROUNTREE
 JBOYER

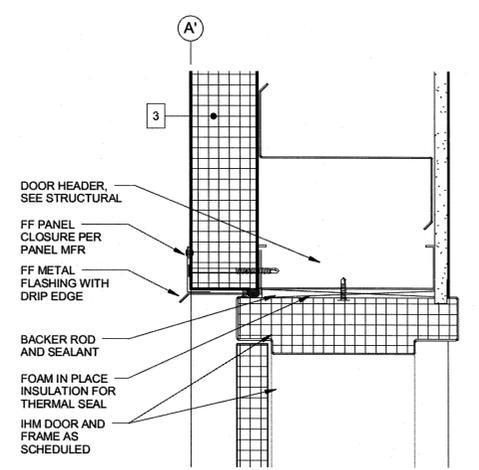


1 HEAD - DOOR 003
A-501 3" = 1'-0"

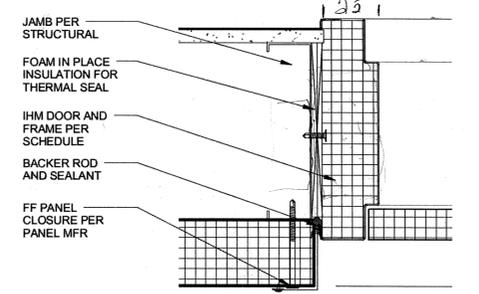


4 JAMB - DOOR 003
A-501 3" = 1'-0"

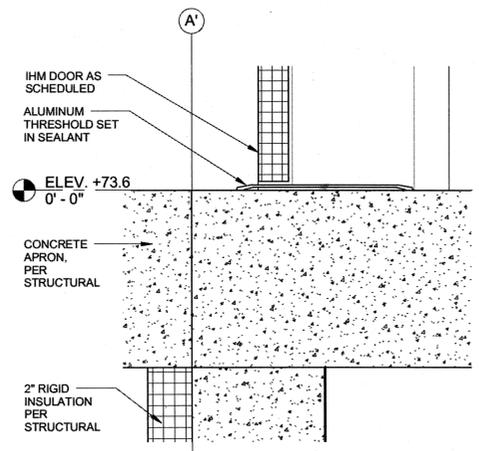


8 SILL - DOOR 003
A-501 3" = 1'-0"

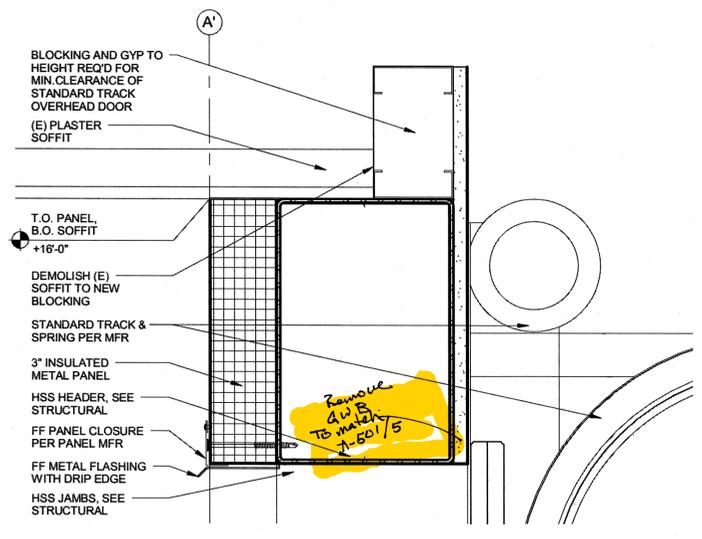


2 HEAD - OVERHEAD DOOR
A-501 3" = 1'-0"

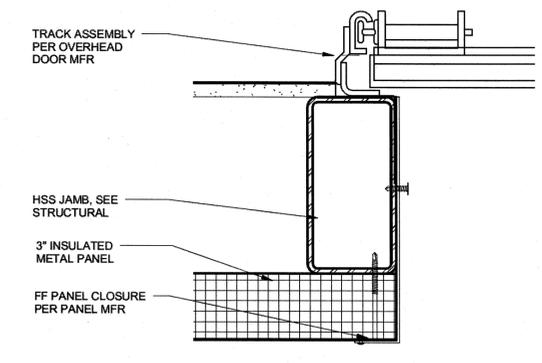


5 JAMB - OVERHEAD DOOR
A-501 3" = 1'-0"

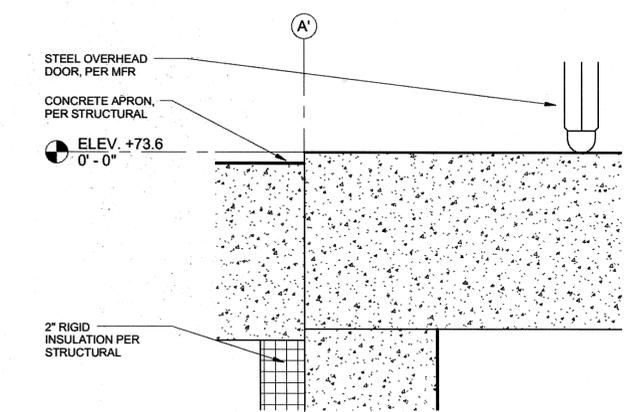


9 SILL - OVERHEAD DOOR
A-501 3" = 1'-0"

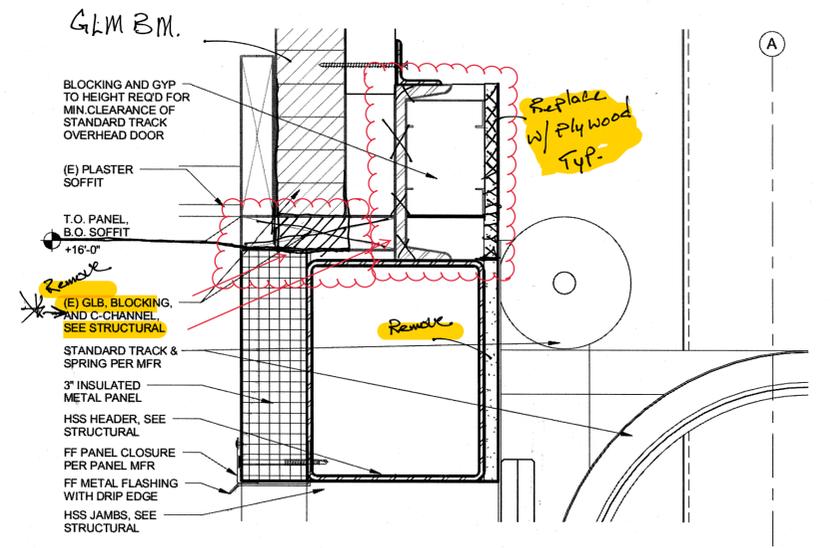


3 HEAD - OVERHEAD DOOR
A-501 3" = 1'-0"

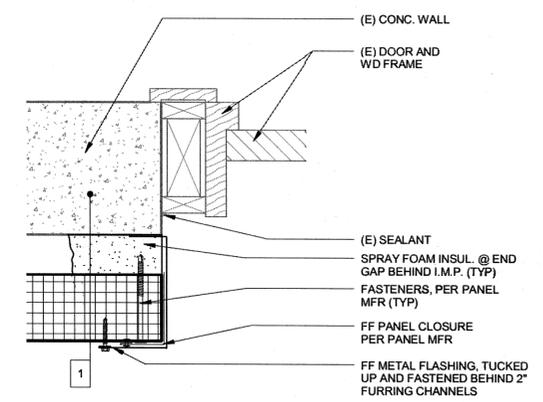

6 JAMB - EXIST. DOOR
A-501 3" = 1'-0"

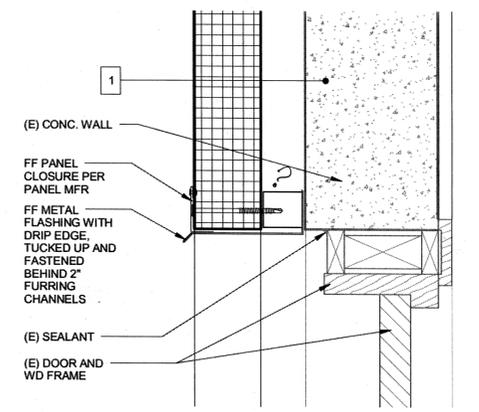

7 HEAD - EXIST. DOOR
A-501 3" = 1'-0"

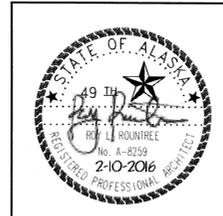


STATE OF ALASKA
 DEPARTMENT OF TRANSPORTATION
 AND PUBLIC FACILITIES
**KETCHIKAN AIRPORT ARFF
 BUILDING RENOVATION**


EXTERIOR DETAILS

DRAWING LOCATION: C:\Users\jboyer\Documents\14-192_KTN ARFF-A-model_jboyer.rvt
 DATE & TIME: 2/9/2016 2:54:34 PM
 LAYOUT: EXTERIOR DETAILS
 SCALE: 3" = 1'-0"
 XREFS:
 DESIGNED: J. BOYER
 CHECKED: S. ROUNTREE
 DRAFTED: J. BOYER


NO.	DATE	REVISION	STATE	PROJECT DESIGNATION	YEAR	SHEET NO.	TOTAL SHEETS
			ALASKA	PROJ. NO. Z682300000	2015	A-502	A-8

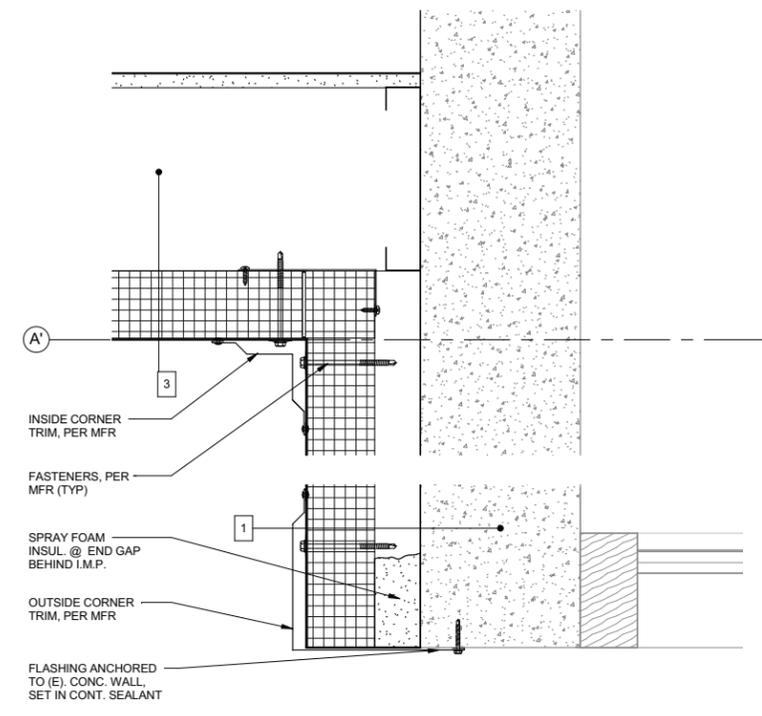


1 PLAN DETAIL - INSIDE CORNER, WALL END
A-502 3" = 1'-0"

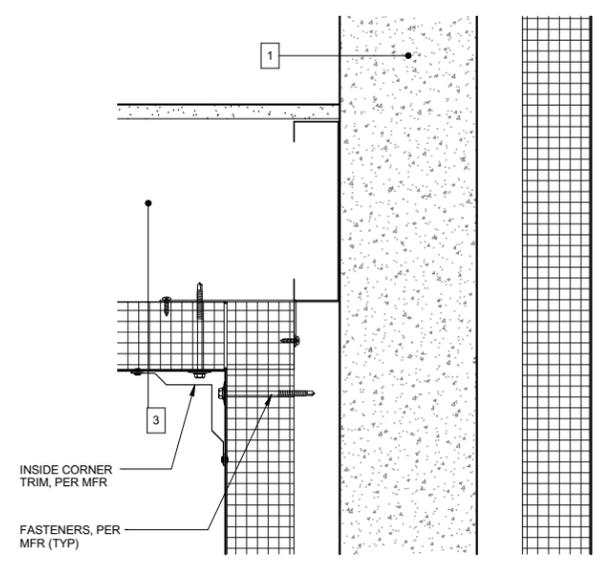


7 PLAN DETAIL - WALL INTERSECTION
A-502 3" = 1'-0"

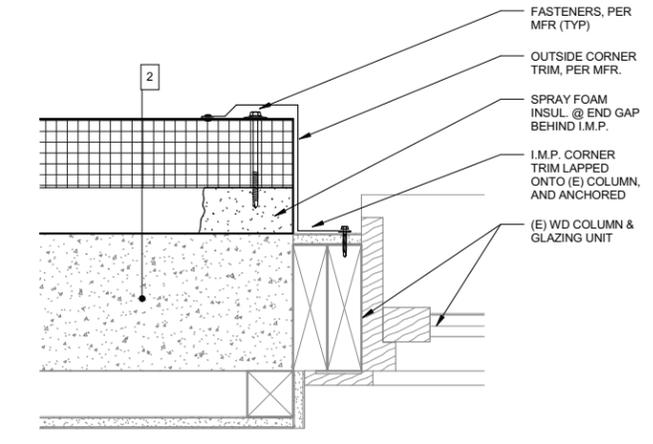


2 PLAN DETAIL - WALL TRANSITION
A-502 3" = 1'-0"

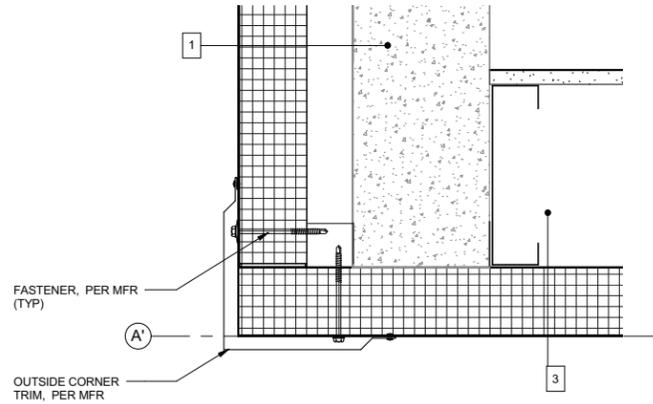


5 OUTSIDE CORNER
A-502 3" = 1'-0"

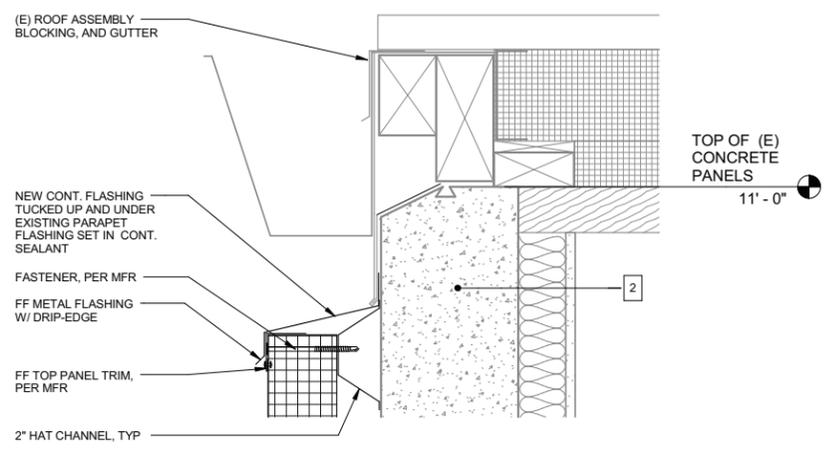

8 PARAPET DETAIL
A-502 3" = 1'-0"

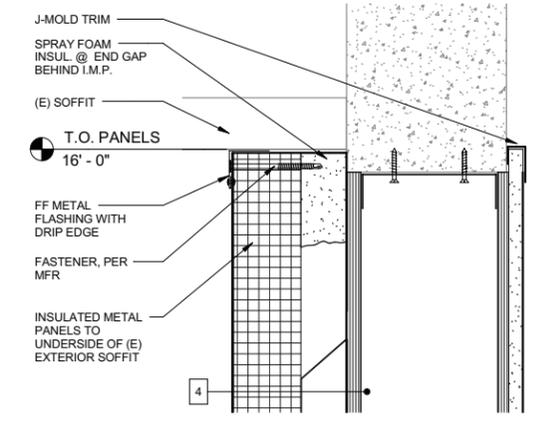

3 TOP OF WALL
A-502 3" = 1'-0"

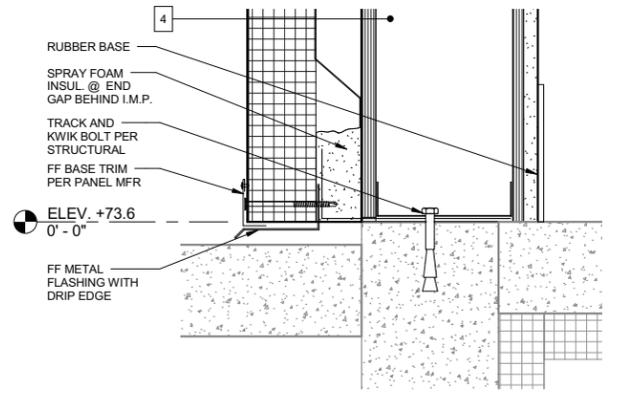

6 BASE DETAIL
A-502 3" = 1'-0"



STATE OF ALASKA
 DEPARTMENT OF TRANSPORTATION
 AND PUBLIC FACILITIES
**KETCHIKAN AIRPORT ARFF
 BUILDING RENOVATION**

EXTERIOR DETAILS

DRAWING LOCATION C:\Users\shewhit\Documents\Crash Maintenance Building_Central_phowitt.rvt
 DATE & TIME 2/10/2016 3:50:10 PM
 LAYOUT STRUCTURAL NOTES
 SCALE
 XREFS
 DESIGNED CHECKED DRAFTED
 Designer Checker Author

THE FOLLOWING NOTES APPLY UNLESS INDICATED OTHERWISE:

CODE: 2012 INTERNATIONAL BUILDING CODE (IBC)

DESIGN LOADS:

OCCUPANCY CATEGORY IV

DEAD LOAD	ROOF	15 PSF
LIVE LOAD	ROOF	40 PSF
SNOW LOAD	ROOF	40 PSF
WIND	WIND SPEED, V	140 MPH 3-SEC GUST
	ENCLOSURE CLASSIFICATION	ENCLOSED
	EXPOSURE CATEGORY	D
	IMPORTANCE FACTOR, Iw	1.15
	TOPOGRAPHIC FACTOR, Kzt	1.00
	DIRECTION FACTOR	0.85
	INTERNAL PRESSURE COEF, GCpi	+/- 0.18
SEISMIC	SS = 0.304g, S1 = 0.250g, SDS = 0.243g, SD1 = 0.258g	
	SEISMIC DESIGN CATEGORY	D
	SITE CLASS	C
	IMPORTANCE FACTOR, I	1.50
	SEISMIC RESPONSE COEF, Cs	0.07 (SD)
		0.10 (ASD)
	RESPONSE MOD FACTOR, R	3.25
	SYSTEM OVERSTRENGTH, Ω	2
	REDUNDANCY FACTOR, ρ	1.3

GENERAL:

GOVERNING CODE: THE DESIGN AND CONSTRUCTION OF THIS PROJECT IS GOVERNED BY THE INTERNATIONAL BUILDING CODE (IBC), 2012 EDITION, HEREAFTER REFERRED TO AS THE IBC, AS ADOPTED AND MODIFIED BY THE CITY OF KETCHIKAN, UNDERSTOOD TO BE THE AUTHORITY HAVING JURISDICTION (AHJ).

REFERENCE STANDARDS: REFER TO CHAPTER 35 OF THE IBC. WHERE OTHER STANDARDS ARE NOTED IN THE DRAWINGS, USE THE LATEST EDITION OF THE STANDARD UNLESS A SPECIFIC DATE IS INDICATED. REFERENCE TO A SPECIFIC SECTION IN A CODE DOES NOT RELIEVE THE CONTRACTOR FROM COMPLIANCE WITH THE ENTIRE STANDARD.

DEFINITIONS: THE FOLLOWING DEFINITIONS COVER THE MEANINGS OF CERTAIN TERMS USED IN THESE NOTES:

"ARCHITECT/ENGINEER" - THE ARCHITECT OF RECORD AND THE STRUCTURAL ENGINEER OF RECORD.

"STRUCTURAL ENGINEER OF RECORD" (SER) - THE STRUCTURAL ENGINEER WHO IS LICENSED TO STAMP & SIGN THE STRUCTURAL DOCUMENTS FOR THE PROJECT. THE SER IS RESPONSIBLE FOR THE DESIGN OF THE PRIMARY STRUCTURAL SYSTEM.

"SUBMIT FOR REVIEW" - SUBMIT TO THE ARCHITECT/ENGINEER FOR REVIEW PRIOR TO FABRICATION OR CONSTRUCTION.

"PER PLAN" - INDICATES REFERENCES TO THE STRUCTURAL PLANS, ELEVATIONS AND STRUCTURAL GENERAL NOTES.

CHANGES IN LOADING: THE CONTRACTOR HAS THE RESPONSIBILITY TO NOTIFY THE SER OF ANY ARCHITECTURAL, MECHANICAL, ELECTRICAL, OR PLUMBING LOAD IMPOSED ONTO THE STRUCTURE THAT DIFFERS FROM, OR THAT IS NOT DOCUMENTED ON THE ORIGINAL CONTRACT DOCUMENTS (ARCHITECTURAL/ STRUCTURAL/ MECHANICAL/ ELECTRICAL OR PLUMBING DRAWINGS). PROVIDE DOCUMENTATION OF LOCATION, LOAD, SIZE AND ANCHORAGE OF ALL UNDOCUMENTED LOADS IN EXCESS OF 400 POUNDS. PROVIDE MARKED-UP STRUCTURAL PLAN INDICATING LOCATIONS OF ANY NEW EQUIPMENT OR LOADS. SUBMIT PLANS TO THE ARCHITECT/ENGINEER FOR REVIEW PRIOR TO INSTALLATION.

NOTE PRIORITIES: PLAN AND DETAIL NOTES AND SPECIFIC LOADING DATA PROVIDED ON INDIVIDUAL PLANS AND DETAIL DRAWINGS SUPPLEMENTS INFORMATION IN THE STRUCTURAL GENERAL NOTES.

OTHER DRAWINGS: REFER TO THE ARCHITECTURAL, MECHANICAL, ELECTRICAL, CIVIL AND PLUMBING DRAWINGS FOR ADDITIONAL INFORMATION INCLUDING BUT NOT LIMITED TO: DIMENSIONS, ELEVATIONS, SLOPES, DOOR AND WINDOW OPENINGS, NON-BEARING WALLS, STAIRS, FINISHES, DRAINS, WATERPROOFING, RAILINGS, MECHANICAL UNIT LOCATIONS, AND OTHER NONSTRUCTURAL ITEMS.

STRUCTURAL DETAILS: THE STRUCTURAL DRAWINGS ARE INTENDED TO SHOW THE GENERAL CHARACTER AND EXTENT OF THE PROJECT AND ARE NOT INTENDED TO SHOW ALL DETAILS OF THE WORK. USE DETAILS MARKED "TYPICAL" WHEREVER THEY APPLY.

STRUCTURAL RESPONSIBILITIES: THE STRUCTURAL ENGINEER (SER) IS RESPONSIBLE FOR THE STRENGTH AND STABILITY OF THE PRIMARY STRUCTURE IN ITS COMPLETED FORM.

COORDINATION: THE CONTRACTOR IS RESPONSIBLE FOR COORDINATING DETAILS AND ACCURACY OF THE WORK; FOR CONFIRMING AND CORRELATING ALL QUANTITIES AND DIMENSIONS; FOR SELECTING FABRICATION PROCESSES; FOR TECHNIQUES OF ASSEMBLY; AND FOR PERFORMING WORK IN A SAFE AND SECURE MANNER.

MEANS, METHODS AND SAFETY REQUIREMENTS: THE CONTRACTOR IS RESPONSIBLE FOR THE MEANS METHODS OF CONSTRUCTION AND ALL JOB RELATED SAFETY STANDARDS SUCH AS OSHA AND DOSH (DEPARTMENT OF OCCUPATIONAL SAFETY AND HEALTH).

BRACING/SHORING DESIGN ENGINEER: THE CONTRACTOR SHALL AT HIS DISCRETION EMPLOY A REGISTERED PROFESSIONAL ENGINEER FOR THE DESIGN OF ANY TEMPORARY BRACING AND SHORING.

TEMPORARY SHORING, BRACING: THE CONTRACTOR IS RESPONSIBLE FOR THE STRENGTH AND STABILITY OF THE STRUCTURE DURING CONSTRUCTION AND SHALL PROVIDE TEMPORARY SHORING, BRACING AND OTHER ELEMENTS REQUIRED TO MAINTAIN STABILITY UNTIL THE STRUCTURE IS COMPLETE. IT IS THE CONTRACTOR'S RESPONSIBILITY TO BE FAMILIAR WITH THE WORK REQUIRED IN THE CONSTRUCTION DOCUMENTS AND THE REQUIREMENTS FOR EXECUTING IT PROPERLY.

CONSTRUCTION LOADS: LOADS ON THE STRUCTURE DURING CONSTRUCTION SHALL NOT EXCEED THE DESIGN LOADS AS NOTED IN "DESIGN LOADS" OR THE CAPACITY OF PARTIALLY COMPLETED CONSTRUCTION AS DETERMINED BY THE CONTRACTOR'S STRUCTURAL ENGINEER FOR BRACING/SHORING.

DISCREPANCIES: IN CASE OF DISCREPANCIES BETWEEN THE GENERAL NOTES, SPECIFICATIONS PLAN/DETAILS OR REFERENCE STANDARDS, THE ARCHITECT/ENGINEER SHALL DETERMINE WHICH SHALL GOVERN.

SITE VERIFICATION: THE CONTRACTOR SHALL VERIFY ALL DIMENSIONS AND CONDITIONS AT THE SITE. CONFLICTS BETWEEN THE DRAWINGS AND ACTUAL SITE CONDITIONS SHALL BE BROUGHT TO THE ATTENTION OF THE ARCHITECT/ENGINEER BEFORE PROCEEDING WITH THE WORK.

SOILS AND FOUNDATIONS:

REFERENCE STANDARDS: CONFORM TO IBC CHAPTER 18 "SOILS AND FOUNDATIONS."

GEOTECHNICAL SUBGRADE INSPECTION: THE GEOTECHNICAL ENGINEER OR RESIDENT ENGINEER SHALL INSPECT ALL SUB-GRADES AND PREPARED SOIL BEARING SURFACES, PRIOR TO PLACEMENT OF FOUNDATION REINFORCING STEEL AND CONCRETE TO CONFIRM THAT SOILS ARE ADEQUATE TO SUPPORT THE "ALLOWABLE SOIL BEARING PRESSURE(S)" SHOWN BELOW.

DESIGN SOIL VALUES: FOUNDATION DESIGN IS BASED ON AN ALLOWABLE SOIL BEARING PRESSURE OF 2500 PSF.

CAST -IN-PLACE CONCRETE:

REFERENCE STANDARDS: CONFORM TO:

1. ACI 301-10 "SPECIFICATIONS FOR STRUCTURAL CONCRETE",
2. IBC CHAPTER 19-CONCRETE,
3. ACI 318-11
4. ACI 117-10

FIELD REFERENCE: THE CONTRACTOR SHALL KEEP A COPY OF ACI FIELD REFERENCE MANUAL, SP-15, "STANDARD SPECIFICATIONS FOR STRUCTURAL CONCRETE (ACI 301) WITH SELECTED ACI AND ASTM REFERENCES."

MATERIALS: CONFORM TO ACI 301 SECTION 4.2.1 "MATERIALS" FOR REQUIREMENTS FOR CEMENTITIOUS MATERIALS, AGGREGATES, MIXING WATER AND ADMIXTURES.

EMBEDDED ITEMS: POSITION AND SECURE IN PLACE EXPANSION JOINT MATERIAL, ANCHORS AND OTHER STRUCTURAL AND NON-STRUCTURAL EMBEDDED ITEMS BEFORE PLACING CONCRETE. CONTRACTOR SHALL REFER TO MECHANICAL, ELECTRICAL, PLUMBING AND ARCHITECTURAL DRAWINGS AND COORDINATE OTHER EMBEDDED ITEMS.

CONCRETE REINFORCEMENT

REFERENCE STANDARDS: CONFORM TO:

1. ACI 301-10 "STANDARD SPECIFICATIONS FOR STRUCTURAL CONCRETE", SECTION 3 "REINFORCEMENT AND REINFORCEMENT SUPPORTS."
2. ACI SP-66-04 "ACI DETAILING MANUAL" INCLUDING ACI 315-99 "DETAILS AND DETAILING OF CONCRETE REINFORCEMENT."
3. CRSI MSP-09 28TH EDITION, "MANUAL OF STANDARD PRACTICE."
4. ANSI/AWS D1.4 "STRUCTURAL WELDING CODE- REINFORCING STEEL."
5. IBC CHAPTER 19-CONCRETE.
6. ACI 318-11.
7. ACI 117-10

MATERIALS:

REINFORCING BARS ASTM A615, GRADE 60, DEFORMED BARS.
 BAR SUPPORTS CRSI MSP-09 28TH EDITION, CHAPTER 3 "BAR SUPPORTS."
 TIE WIRE 16 GAGE OR HEAVIER, BLACK ANNEALED.
 ASTM A706, GRADE 60, REINFORCING STEEL SHALL BE USED FOR WELDED BARS.
 WELDED WIRE FABRIC PER ASTM A185.
 REINFORCING IN EXTERIOR CONCRETE SLABS & LANDINGS SHALL BE EPOXY-COATED.

CONCRETE COVER: CONFORM TO THE FOLLOWING COVER REQUIREMENTS UNLESS NOTED OTHERWISE IN THE DRAWINGS.

CONCRETE CAST AGAINST EARTH	3"
CONCRETE EXPOSED TO EARTH OR WEATHER	2"
CONCRETE NOT EXPOSED TO EARTH OR WEATHER	1.5

GROUT:

GROUT - 5000 PSI MINIMUM 7-DAY CUBE STRENGTH PER ASTM C109/ASTM C109.
 GROUT TO BE PREMIXED, NON-METALIC/NON-SHRINK. ICBO CERTIFICATION REQUIRED.
 USE SPECIFIC GROUT MIX RECOMMENDED BY MANUFACTURER FOR EACH GROUT APPLICATION AND FOLLOW MANUFACTURER'S INSTRUCTIONS.

ANCHOR BOLTS:

ANCHOR BOLTS, ASTM A307, OR F1554 GRADE 36, HOT DIP GALVANIZED. SPECIAL INSPECTION REQUIRED. SET ALL ANCHOR BOLTS FOR COLUMNS BY TEMPLATE.

POST-INSTALLED ANCHORS (INTO CONCRETE AND MASONRY):

DESIGN STANDARDS:

POST-INSTALLED ANCHORS INTO CONCRETE FOR THIS PROJECT ARE DESIGNED IN ACCORDANCE WITH AMERICAN CONCRETE INSTITUTE, ACI 318-11, APPENDIX D SPECIFICATIONS.

INSULATION:

FOUNDATION WALL INSULATION: EPS OR XPS RIGID BOARD INSULATION.

STRUCTURAL STEEL:

DESIGN STANDARDS: STRUCTURAL STEEL FOR THIS PROJECT IS DESIGNED IN ACCORDANCE WITH AMERICAN INSTITUTE OF STEEL CONSTRUCTION (AISC) SPECIFICATIONS AND AISC - MANUAL OF STEEL CONSTRUCTION, FOURTEENTH EDITION (2010).

REFERENCE STANDARDS:

1. IBC CHAPTER 22- STEEL.
2. ANSI/AISC 303-10 - CODE OF STANDARD PRACTICE FOR STEEL BUILDINGS & BRIDGES, HEREAFTER REFERENCED AS AISC 303.
3. ANSI/AISC 360-10- SPECIFICATION FOR STRUCTURAL STEEL BUILDINGS, HEREAFTER REFERENCED AS AISC 360.
4. AWS D1.1 -04 -STRUCTURAL WELDING CODE - STEEL, HEREAFTER REFERENCED AS AWS D1.1.

MATERIALS:

WIDE FLANGE (W), TEE (WT) SHAPES
 STRUCTURAL BARS & PLATES (PL)
 HOLLOW STRUCTURAL SECTION (HSS)
 STRUCTURAL PIPE, (PIPE)
 HIGH STRENGTH BOLTS
 BOLTS
 THREADED RODS (ANCHOR BOLTS)
 WELDING ELECTRODES

ASTM A992 Fy=50 KSI
 ASTM A36, Fy=36 KSI
 ASTM A500, Fy=46 KSI
 ASTM A53, GRADE B
 ASTM A325
 ASTM A325
 ASTM A307, OR F1554 GRADE 36
 E70XX, E71TXX UNO

WELDING:

WELDING SHALL CONFORM TO AWS D1.1 AND VISUALLY CONFORM TO AWS SECTION 6 AND TABLE 6.1. FABRICATION/ERECTION INSPECTIONS BY THE CONTRACTOR PER AWS D1.1 SECTION 6, SHALL BE BY ASSOCIATE/CERTIFIED INSPECTORS (AWI/CWI) PER AWS QC1 OR AWS B5.1. SPECIAL INSPECTIONS (VERIFICATION INSPECTIONS) SHALL BE BY A CERTIFIED WELDING INSPECTOR (WI) OR SENIOR WELDING INSPECTOR (SWI) PER AWS B5.1.

FABRICATION:

CONFORM TO AISC 303, SECTION 8 AND AISC 360 SECTION M2 AND M5.

ERECTION:

CONFORM TO AISC 303, SECTION 7 "ERECTION", SECTION 8 "QUALITY ASSURANCE." AND AISC 360, SECTION M4.

BRACING AND SAFETY PROTECTION: THE CONTRACTOR SHALL PROVIDE TEMPORARY BRACING AND SAFETY PROTECTION REQUIRED BY AISC 360 SECTION M4.2 AND AISC 303 SECTION 7.10 AND 7.11.

WOOD FRAMING:

REFERENCE STANDARDS:

1. IBC CHAPTER 23 - WOOD
2. 2005 NATIONAL DESIGN SPECIFICATION (NDS) FOR WOOD CONSTRUCTION
3. APA PLYWOOD DESIGN SPECIFICATION

GLUED-LAMINATED TIMBER:

GLUED-LAMINATED BEAMS SHALL BE DOUGLAS FIR LARCH WITH THE FOLLOWING MINIMUM PROPERTIES:

Fb = 2,400 PSI, Fv = 265 PSI, Fc (PERPENDICULAR) = 650 PSI, E = 1,800,000 PSI.

FABRICATED WITH WET-USE ADHESIVES. MEMBERS SHALL BE ARCHITECTURAL APPEARANCE GRADE, SEALED WITH A PENETRATING SEALER, AND INDIVIDUALLY WRAPPED AS STANDARD WITH THE MANUFACTURER AND APPROVED.

GLUED LAMINATED TIMBER CONNECTORS: SHALL BE "STRONG TIE" BY SIMPSON COMPANY OR APPROVED EQUAL. CONNECTORS SHALL BE INSTALLED PER THE MANUFACTURER'S INSTRUCTIONS.

COLD-FORMED METAL FRAMING:

ASTM A653, Fy=50 KSI, EXCEPT 18 GAUGE AND LIGHTER SHALL BE ASTM A570, Fy=33 KSI. GALVANIZED G60. REFER TO ARCHITECTURAL DRAWINGS FOR LOCATIONS OF METAL STUD WALLS.

SHOP DRAWINGS AND SUBMITTALS:

SHOP DRAWINGS SHALL BE SUBMITTED FOR ALL STRUCTURAL ITEMS IN ADDITION TO ITEMS REQUIRED BY ARCHITECTURAL SPECIFICATIONS. CONSTRUCTION DOCUMENTS SHALL NOT BE REPRODUCED FOR USE AS SHOP DRAWINGS.

THE CONTRACTOR SHALL REVIEW ALL SHOP DRAWINGS PRIOR TO SUBMITTAL. ITEMS NOT IN ACCORDANCE WITH CONTRACT DOCUMENTS SHALL BE FLAGGED UPON HIS REVIEW. VERIFY ALL DIMENSIONS WITH CONSTRUCTION DOCUMENTS.

ANY CHANGES, SUBSTITUTIONS, OR DEVIATIONS FROM CONTRACT DOCUMENTS SHALL BE CLOUDED BY MANUFACTURER OR FABRICATOR. ANY OF THE AFOREMENTIONED WHICH ARE NOT CLOUDED OR FLAGGED BY SUBMITTING PARTIES, SHALL NOT BE CONSIDERED ALLOWED AFTER ENGINEER'S REVIEW, UNLESS NOTED ACCORDINGLY BY THE ENGINEER OF RECORD.

ONCE THE CONTRACTOR HAS COMPLETED HIS REVIEW, THE SER WILL REVIEW THE SUBMITTAL FOR GENERAL CONFORMANCE WITH THE DESIGN CONCEPT AND THE CONTRACT DOCUMENTS OF THE BUILDING AND WILL STAMP THE SUBMITTAL ACCORDINGLY. MARKINGS OR COMMENTS SHALL NOT BE CONSTRUED AS RELIEVING THE CONTRACTOR FROM COMPLIANCE WITH THE PROJECT PLANS AND SPECIFICATIONS, NOR DEPARTURES THEREFROM.

NO.	DATE	REVISION	STATE	PROJECT DESIGNATION	YEAR	SHEET NO.	TOTAL SHEETS
			ALASKA	PROJ. NO. Z682300000	2016	S-000	S-013

SPECIAL INSPECTIONS:

SPECIAL INSPECTIONS SHALL BE PERFORMED BY QUALIFIED PERSONNEL EMPLOYED BY THE DEPARTMENT. SPECIAL INSPECTORS SHALL BE QUALIFIED PERSONS WHO DEMONSTRATE COMPETENCE TO THE SATISFACTION OF THE AUTHORITY HAVING JURISDICTION PER 1704.1.

SPECIAL INSPECTORS SHALL OBSERVE THE WORK ASSIGNED FOR CONFORMANCE WITH APPROVED DESIGN DRAWINGS AND SPECIFICATIONS. ALL DISCREPANCIES SHALL BE BROUGHT TO THE IMMEDIATE ATTENTION OF THE CONTRACTOR FOR CORRECTION, AND TO THE ATTENTION OF THE ENGINEER OF RECORD. SPECIAL INSPECTION REPORTS SHALL BE PROVIDED ON A WEEKLY BASIS. FINAL SPECIAL INSPECTION REPORTS WILL BE REQUIRED BY EACH SPECIAL INSPECTION FIRM PER IBC 1704.2.4. THE SPECIAL INSPECTORS FINAL SIGNED REPORT SHALL STATE WHETHER THE WORK REQUIRING SPECIAL INSPECTION WAS, TO THE BEST OF THE INSPECTOR'S KNOWLEDGE, IN CONFORMANCE WITH THE APPROVED PLANS AND SPECIFICATIONS AND THE APPLICABLE WORKMANSHIP PROVISION OF THE APPLICABLE CODES. SUBMIT COPIES OF ALL INSPECTION REPORTS TO THE ARCHITECT/ENGINEER AND THE AUTHORITY HAVING JURISDICTION FOR REVIEW.

CONTRACTOR RESPONSIBILITY: THE CONTRACTOR IS REQUIRED TO PROVIDE THE DEPARTMENT A SIGNED, WRITTEN ACKNOWLEDGEMENT OF THE CONTRACTOR'S RESPONSIBILITIES ASSOCIATED WITH THE ABOVE STATEMENT OF SPECIAL INSPECTIONS ADDRESSING THE REQUIREMENTS LISTED IN IBC SECTION 1714. CONTRACTOR IS REFERRED TO IBC CHAPTER 1705.11.5 AND 1705.11.6 FOR ARCHITECTURAL AND MEP BUILDING SYSTEMS THAT MAY BE SUBJECT TO ADDITIONAL INSPECTIONS (BASED ON THE BUILDING'S DESIGNATED SEISMIC DESIGN CATEGORY LISTED IN THE CRITERIA), INCLUDING ANCHORAGE OF HVAC DUCTWORK CONTAINING HAZARDOUS MATERIALS, PIPING SYSTEMS AND MECHANICAL UNITS CONTAINING FLAMMABLE, COMBUSTIBLE OR HIGHLY TOXIC MATERIALS, ELECTRICAL EQUIPMENT USED FOR EMERGENCY OR STANDBY POWER, EXTERIOR WALL PANELS AND SUSPENDED CEILING SYSTEMS.

STATEMENT OF SPECIAL INSPECTIONS PER 1704 AND 1705. SPECIAL INSPECTIONS AND TESTING ARE REQUIRED BY 1704, 1706, 1707 AND 1708 FOR THE FOLLOWING:

FABRICATORS PER IBC SECTION 1704.2. SPECIAL INSPECTIONS AS REQUIRED BY SECTION 1704.2 SHALL NOT BE REQUIRED WHERE THE WORK IS DONE ON THE PREMISES OF A FABRICATOR REGISTERED AND APPROVED TO PERFORM SUCH WORK WITHOUT SPECIAL INSPECTION.

STEEL CONSTRUCTION PER IBC SECTION 1705.2, THE ATTACHED TABLES AND THE FOLLOWING:

THE SPECIAL INSPECTOR NEED NOT BE CONTINUOUSLY PRESENT DURING WELDING OF THE FOLLOWING ITEMS, PROVIDED THE CONDITIONS OF SECTION 1705.2 EXCEPTIONS ARE MET:

SINGLE-PASS FILLET WELDS NOT EXCEEDING 5/16" IN SIZE
 FLOOR AND ROOF DECK WELDING
 WELDING OF STAIRS AND RAILING SYSTEMS

SOILS & FOUNDATION CONSTRUCTION PER IBC SECTION 1705.6 AND THE ATTACHED TABLES.

CONCRETE CONSTRUCTION PER IBC SECTION 1705.3 AND THE ATTACHED TABLES.


WIND REQUIREMENTS PER IBC SECTION 1711 AND THE ATTACHED TABLES.

SEISMIC REQUIREMENTS PER IBC SECTION 1712 AND THE ATTACHED TABLES.

STRUCTURAL TESTING FOR SEISMIC RESISTANCE PER IBC SECTION 1713 AND THE QUALITY ASSURANCE PLAN REQUIREMENTS OF AISC 341.

STRUCTURAL OBSERVATIONS
 STRUCTURAL OBSERVATIONS, AS DEFINED IN IBC SECTION 1702, SHALL BE PROVIDED FOR SEISMIC RESISTANCE PER IBC SECTION 1704.5.1 AND WIND REQUIREMENTS PER IBC SECTION 1704.5.2.

POST-INSTALLED ANCHORS TO CONCRETE AND MASONRY: SHALL COMPLY WITH IBC SECTION 1703. INSPECTIONS SHALL BE IN ACCORDANCE WITH THE REQUIREMENTS SET FORTH IN THE APPROVED ICC EVALUATION REPORT AND AS INDICATED BY THE DESIGN REQUIREMENTS SPECIFIED ON THE DRAWINGS. REFER TO THE POST INSTALLED ANCHORS SECTION OF THESE NOTES FOR ANCHORS THAT ARE THE BASIS OF THE DESIGN. SPECIAL INSPECTOR SHALL VERIFY ANCHORS ARE AS SPECIFIED IN THE POST INSTALLED ANCHORS SECTION OF THESE NOTES OR AS OTHERWISE SPECIFIED ON THE DRAWINGS. SUBSTITUTIONS REQUIRE APPROVAL BY THE SER AND REQUIRE SUBSTANTIATING CALCULATIONS AND CURRENT IBC RECOGNIZED ICC EVALUATION SERVICES (ES) REPORT. SPECIAL INSPECTOR SHALL DOCUMENT IN THEIR SPECIAL INSPECTION REPORT COMPLIANCE WITH EACH OF THE ELEMENTS REQUIRED WITHIN THE APPLICABLE ICC EVALUATION SERVICES (ES) REPORT.

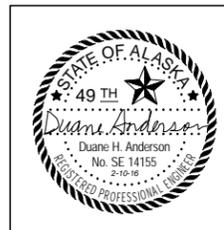

STATE OF ALASKA
 DEPARTMENT OF TRANSPORTATION
 AND PUBLIC FACILITIES

**KETCHIKAN AIRPORT ARFF
 BUILDING RENOVATION**

STRUCTURAL NOTES

DRAWING LOCATION C:\Users\shewit\Documents\Crash Maintenance Building_Central_pshewit.rvt
 DATE & TIME 2/10/2016 3:50:21 PM
 LAYOUT SPECIAL INSPECTION TABLES AND ABBREVIATIONS
 SCALE
 XREFS
 DESIGNED CHECKED DRAFTER
 Designer Checker Auditor

REQUIRED INSPECTION OF STEEL CONSTRUCTION		
VERIFICATION & INSPECTION	FREQUENCY OF INSPECTION	REFERENCE
MATERIAL VERIFICATION OF HIGH-STRENGTH BOLTS, NUTS AND WASHERS:		
A. IDENTIFICATION MARKINGS TO CONFORM TO ASTM STANDARDS SPECIFIED IN THE APPROVED CONSTRUCTION DOCUMENTS.	PERIODIC	AISC 360 SECTION A3.3 & APPLICABLE ASTM STANDARDS
B. MANUFACTURER'S CERTIFICATE COMPLIANCE REQUIRED.	PERIODIC	
INSPECTION OF HIGH-STRENGTH BOLTING:		
A. SNUG-TIGHT JOINTS.	PERIODIC	AISC 360, SECTION M2.5 IBC 1704.3.3
MATERIAL VERIFICATION OF STRUCTURAL STEEL AND COLD-FORMED STEEL DECK:		
A. FOR STRUCTURAL STEEL, IDENTIFICATION MARKINGS TO CONFORM TO AISI 360.	PERIODIC	AISC 360 SECTION M5.5
B. FOR OTHER STEEL, IDENTIFICATION MARKINGS TO CONFORM TO ASTM STANDARDS SPECIFIED IN THE APPROVED CONSTRUCTION DOCUMENTS.	PERIODIC	APPLICABLE ASTM STANDARDS
MANUFACTURER'S CERTIFIED TEST REPORTS.	PERIODIC	
MATERIAL VERIFICATION OF WELD FILLER MATERIALS:		
A. IDENTIFICATION MARKINGS TO CONFORM TO AWS SPECIFICATION IN THE APPROVED CONSTRUCTION DOCUMENTS.	PERIODIC	AISC 360 SECTION A3.5 & APPLICABLE AWS A5 DOCS
MANUFACTURER'S CERTIFICATE OF COMPLIANCE REQUIRED.	PERIODIC	
INSPECTION OF WELDING:		
A. STRUCTURAL STEEL AND COLD-FORMED STEEL		
1) COMPLETE & PARTIAL JOINT PENETRATION GROOVE WELDS. 2) MULTIPASS FILLET WELDS. 3) SINGLE-PASS FILLET WELDS > 5/16". 4) PLUG AND SLOT WELDS.	CONTINUOUS	AWS D1.1 IBC 1704.3.1
5) SINGLE-PASS FILLET WELDS <= 5/16"	PERIODIC	AWS D1.1 IBC 1704.3.1
B. REINFORCING STEEL:		
1) VERIFICATION OF WELDABILITY OF REINFORCING STEEL OTHER THAN ASTM A 706.	PERIODIC	AWS D1.4 ACI 318: SECTION 3.5.2
4) OTHER REINFORCING STEEL.	PERIODIC	
INSPECTION OF STEEL FRAME JOINT DETAILS FOR COMPLIANCE:		
A. MEMBER LOCATIONS.		IBC 1704.3.2
B. APPLICATION OF JOINT DETAILS AT EACH CONNECTION.		

REQUIRED INSPECTION OF CONCRETE CONSTRUCTION		
VERIFICATION & INSPECTION	FREQUENCY OF INSPECTION	REFERENCE
INSPECTION OF REINFORCING STEEL AND PLACEMENT.	PERIODIC	ACI 318: 3.5.7.1-7.7 IBC 1913.4
INSPECTION OF REINFORCING STEEL WELDING	SEE STEEL CONSTRUCTION INSPECTION TABLE	
INSPECTION OF BOLTS TO BE INSTALLED IN CONCRETE PRIOR TO & DURING PLACEMENT OF CONCRETE.	CONTINUOUS	ACI 318: 8.1.3,21.2.8 IBC 1911.5, 1912.1
INSPECTION OF ANCHORS INSTALLED INTO HARDENED CONCRETE.	PERIODIC	ACI 318: 3.8.6,8.1.3,21.2.8 IBC 1912.1
VERIFYING USE OF REQUIRED DESIGN MIX.	PERIODIC	
AT THE TIME FRESH CONCRETE IS SAMPLED TO FABRICATE SPECIMENS FOR STRENGTH TESTS, PERFORM SLUMP & AIR CONTENT TESTS, & DETERMINE THE TEMPERATURE OF THE CONCRETE.	CONTINUOUS	ASTMC 172 ASTM C 31 ACI 318: 5.6, 5.8 IBC 1913.10
INSPECTION OF CONCRETE & SHOTCRETE PLACEMENT FOR PROPER APPLICATION TECHNIQUES.	CONTINUOUS	ACI 318: 5.9,5.10 IBC 1913.6, 1913.7, 1913.8
INSPECTION FOR MAINTENANCE OF SPECIFIED CURING TEMPERATURE AND TECHNIQUES.	PERIODIC	ACI 318: 5.11-5.13 IBC 1913.9
INSPECT FORMWORK FOR SHAPE, LOCATION AND DIMENSIONS OF THE CONCRETE MEMBER BEING FORMED.	PERIODIC	ACI 318: 6.1.1

REQUIRED VERIFICATION & INSPECTION OF SOILS	
VERIFICATION & INSPECTION	FREQUENCY OF INSPECTION
VERIFY MATERIALS BELOW SHALLOW FOUNDATIONS ARE ADEQUATE TO ACHIEVE THE DESIGN BEARING CAPACITY.	PERIODIC
VERIFY EXCAVATIONS ARE EXTENDED TO PROPER DEPTH AND HAVE REACHED PROPER MATERIAL.	PERIODIC
PERFORM CLASSIFICATION AND TESTING OF COMPACTED FILL MATERIALS.	PERIODIC
VERIFY USE OF PROPER MATERIALS, DENSITIES AND LIFT THICKNESS DURING PLACEMENT AND COMPACTION OF COMPACTED FILL.	CONTINUOUS
PRIOR TO PLACEMENT OF COMPACTED FILL, OBSERVE SUBGRADE AND VERIFY THAT SITE HAS BEEN PREPARED PROPERLY.	PERIODIC

REQUIRED INSPECTION OF WIND RESISTING COMPONENTS	
VERIFICATION & INSPECTION	FREQUENCY OF INSPECTION
WALL CLADDING	PERIODIC

NO.	DATE	REVISION	STATE	PROJECT DESIGNATION	YEAR	SHEET NO.	TOTAL SHEETS
			ALASKA	PROJ. NO. Z682300000	2016	S-001	S-013

ABBREVIATIONS:

@	AT
ADH	ADHESIVE
ADJ	ADJACENT
AFF	ABOVE FINISHED FLOOR
BLDG	BUILDING
BLKG	BLOCKING
BM	BEAM
BOT	BOTTOM
B.O.F.	BOTTOM OF FOOTING
B.O. SOF	BOTTOM OF SOFFIT
BRG	BEARING
BTWN	BETWEEN
C/C	CENTER TO CENTER
CABC	CRUSHED AGGREGATE BASE COURSE
CL	CENTERLINE
CLR	CLEAR
COL	COLUMN
CONC	CONCRETE
CONN	CONNECTION
CONT	CONTINUOUS
DET	DETAIL
DIA	DIAMETER
DP	DEEP
DOT&PF	DEPT OF TRANSPORTATION & PUBLIC FACILITIES
E, EX, EXIST	EXISTING
EA	EACH
EMB	EMBED
EPS	EXPANDED POLYSTYRENE
EST	ESTIMATE
EW	EACH WAY
EXT	EXTERIOR
FB	FLAT BAR
FD	FLOOR DRAIN
FDN	FOUNDATION
FIN FLR	FINISHED FLOOR
FT	FOOT/FEET
FTG	FOOTING
GA	GAGE
GLB	GLUE LAMINATED BEAM
HDG	HOT DIP GALVANIZE
HORIZ	HORIZONTAL
HT	HEIGHT
ID	IDENTIFICATION
INSUL	INSULATION
INT	INTERIOR
JT	JOINT
LBS	POUNDS
MAX	MAXIMUM
MECH	MECHANICAL
MIN	MINIMUM
MTL	METAL
O/O	OUTSIDE TO OUTSIDE
O.C.	ON CENTER
OPNG	OPENING
OVHD	OVERHEAD DOOR
PL	PLATE
PLWD	PLYWOOD
QTY	QUANTITY
REINF	REINFORCING
REQD	REQUIRED
SER	STRUCTURAL ENGINEER OF RECORD
SIMP	SIMPSON
SPCG	SPACING
SS	STAINLESS STEEL
SSHC	STANDARD SPECIFICATION FOR HIGHWAY CONSTRUCTION
STL	STEEL
STR	STRONG
T&G	TUNG AND GROOVE
THRD	THREADED
T.O.B.	TOP OF BASE
TRANS	TRANSVERSE
TYP	TYPICAL
U.O.N.	UNLESS OTHERWISE NOTED
V, VERT	VERTICAL
w/	WITH
XPS	EXTRUDED POLYSTYRENE



STATE OF ALASKA
 DEPARTMENT OF TRANSPORTATION
 AND PUBLIC FACILITIES

**KETCHIKAN AIRPORT ARFF
 BUILDING RENOVATION**

**SPECIAL INSPECTION TABLES
 AND ABBREVIATIONS**

DESIGNED: D. ANDERSON
 CHECKED: D. ANDERSON
 DRAFTED: P. HEWLETT

XREFS:

SCALE: 1/8" = 1'-0"


LAYOUT: PARTIAL DEMOLITION PLAN

DATE & TIME: 2/10/2016 5:18:32 PM

DRAWING LOCATION: C:\Users\pshawlett\Documents\Crash Maintenance Building_Central_pshawlett.rvt

NO.	DATE	REVISION	STATE	PROJECT DESIGNATION	YEAR	SHEET NO.	TOTAL SHEETS
			ALASKA	PROJ. NO. Z682300000	2016	S-002	S-013

- DRAWING NOTES:**
- EXISTING WOOD COLUMN TO BE REMOVED, SEE SHORING DIAGRAM, SHEET S-012.
 - REMOVE EXISTING FLOOR DRAIN AND PLUG LINE WITH 12" MINIMUM CONCRETE OR CEMENT/SAND MORTAR.
 - DEMOLISH EXISTING COLUMN PLINTH TO 8" MINIMUM BELOW SLAB.
 - REMOVE EXISTING 8 BOLLARDS. CUT OFF 6" BELOW TOP OF CONC APRON. FILL CONC CUTOUT W/ CONC.
 - REMOVE EX 4" CONC SLAB & 6" BASE AS REQD FOR CONSTRUCTION OF NEW FOUNDATIONS. COMPACT BASE & CONSTRUCT 6" CONC SLAB OVER 4" CABG
 - SEE DRAWING NOTE 1 ON S-006.
 - REMOVE EX CONC SLAB. SEE SECTION 7/S-007

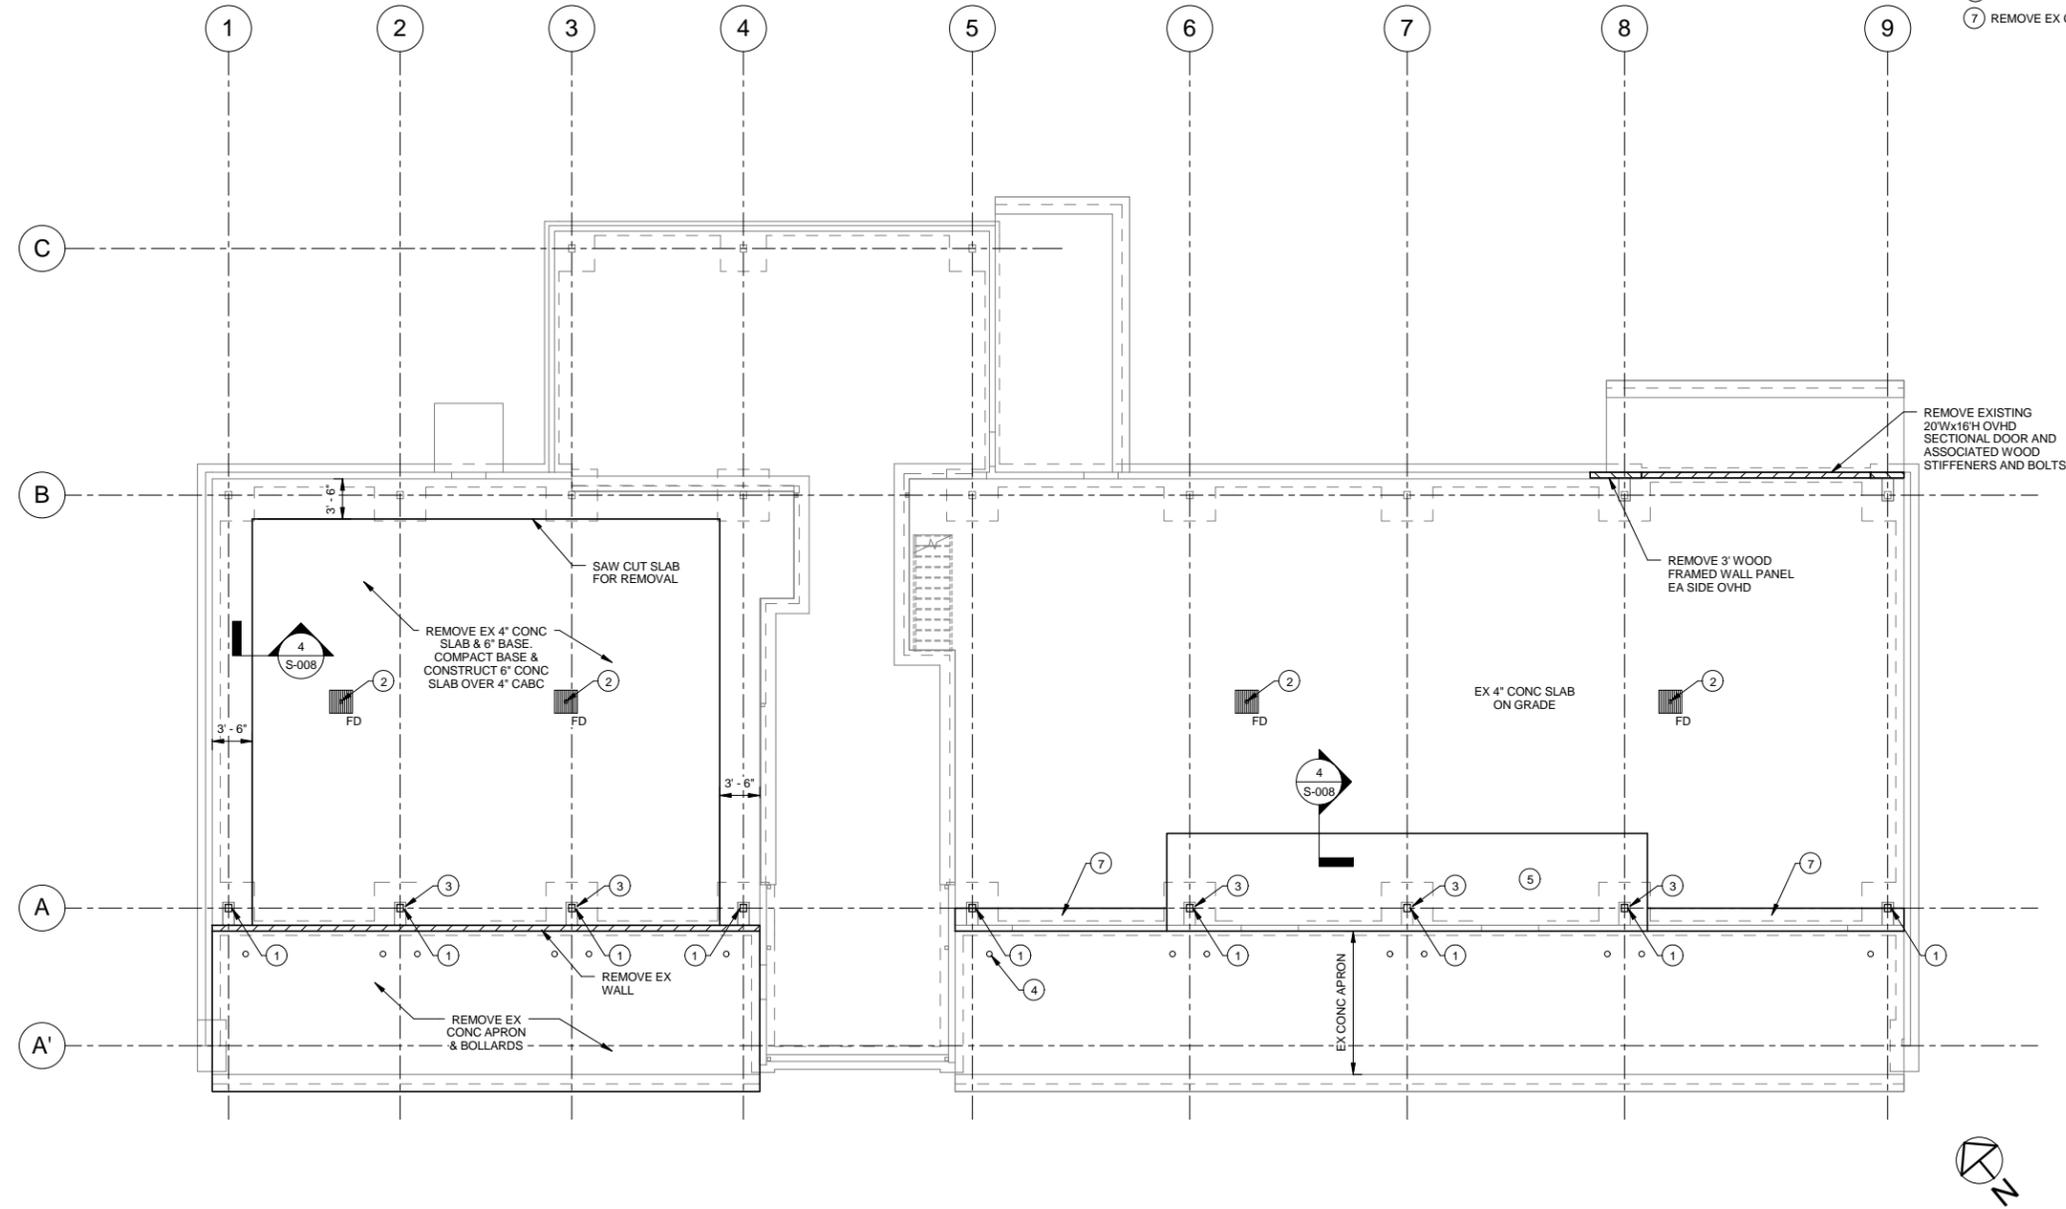

1 PARTIAL DEMOLITION PLAN
 1/8" = 1'-0"




STATE OF ALASKA
 DEPARTMENT OF TRANSPORTATION
 AND PUBLIC FACILITIES

**KETCHIKAN AIRPORT ARFF
 BUILDING RENOVATION**

PARTIAL DEMOLITION PLAN

NO.	DATE	REVISION	STATE	PROJECT DESIGNATION	YEAR	SHEET NO.	TOTAL SHEETS
			ALASKA	PROJ. NO. Z682300000	2016	S-003	S-013


DESIGNED: D. ANDERSON
 CHECKED: D. ANDERSON
 DRAFTED: P. HEWLETT
 XREFS:
 SCALE: 1/8" = 1'-0"
 LAYOUT: FOUNDATION PLAN
 DATE & TIME: 2/10/2016 5:18:33 PM
 DRAWING LOCATION: C:\Users\pshawlett\Documents\Crash Maintenance Building_Central_pshawlett.rvt

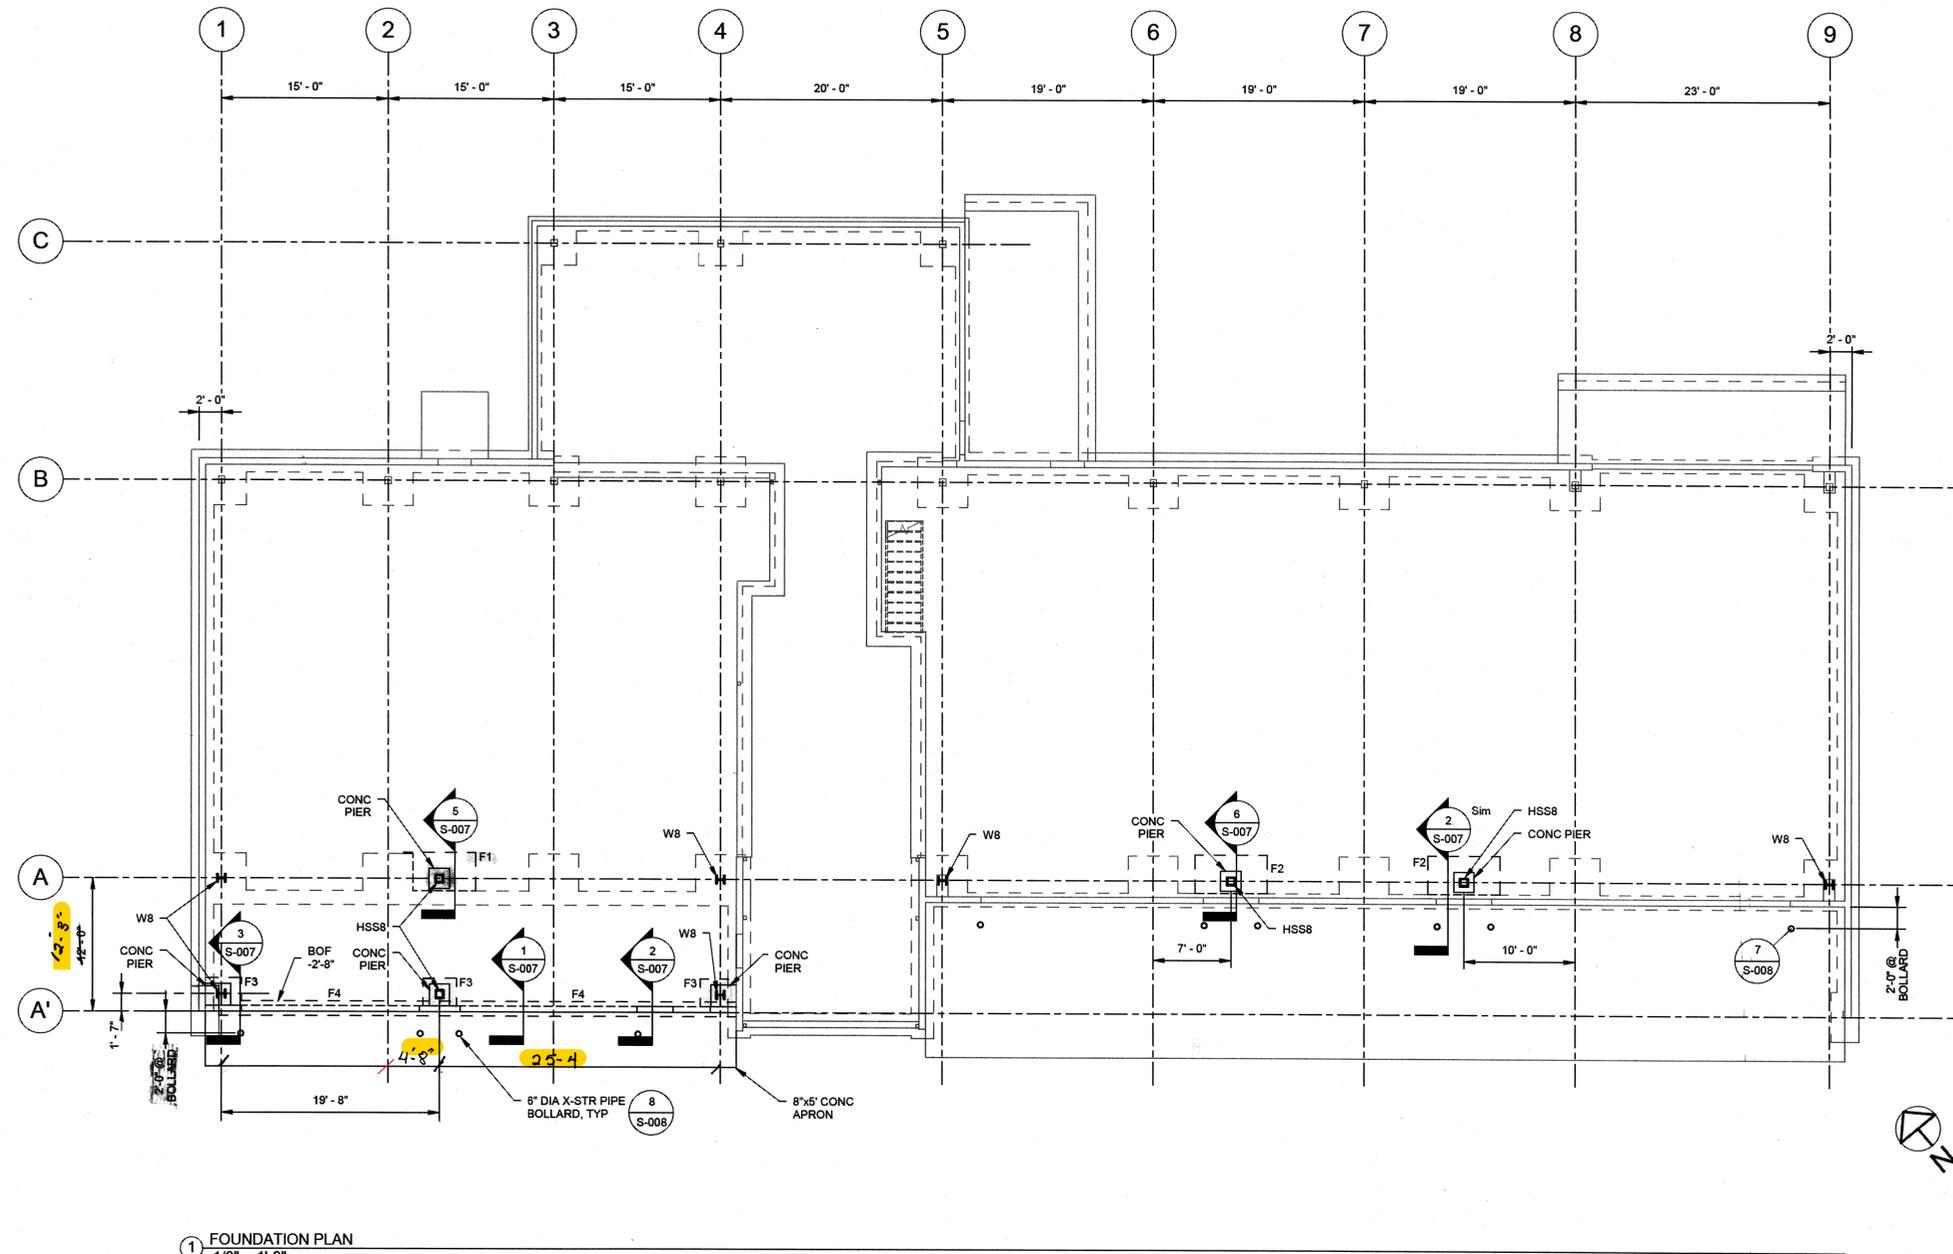

LEGEND:
 COLUMNS
 W8
 HSS8
 W8x40
 HSS8x8x1/4

FOOTING SCHEDULE			
ID	SIZE	THICK	REINF
F1	3'-6"x6'-0"	12"	(4) #6 LONG & (8) #4 TRANSV @ TOP & BOT
F2	3'-6"x6'-6"	12"	(4) #6 LONG & (8) #4 TRANSV @ TOP & BOT
F3	3'-0"x3'-6"	12"	(4) #5 EA WAY TOP & BOT
F4	1'-4" CONT	12"	(2) #5

1 FOUNDATION PLAN
 1/8" = 1'-0"

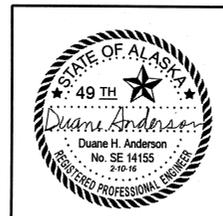

STATE OF ALASKA
 DEPARTMENT OF TRANSPORTATION
 AND PUBLIC FACILITIES
**KETCHIKAN AIRPORT ARFF
 BUILDING RENOVATION**
 FOUNDATION PLAN

S-013

DESIGNED: D. ANDERSON
 CHECKED: D. ANDERSON
 DRAFTED: P. HEWLETT

XREFS:


SCALE: 1/8" = 1'-0"

LAYOUT: 2ND FLOOR FRAMING PLAN

DATE & TIME: 2/10/2016 5:18:34 PM

DRAWING LOCATION: C:\Users\pshawlett\Documents\Crash Maintenance Building_Central_pshawlett.rvt

NO.	DATE	REVISION	STATE	PROJECT DESIGNATION	YEAR	SHEET NO.	TOTAL SHEETS
			ALASKA	PROJ. NO. Z682300000	2016	S-005	S-013

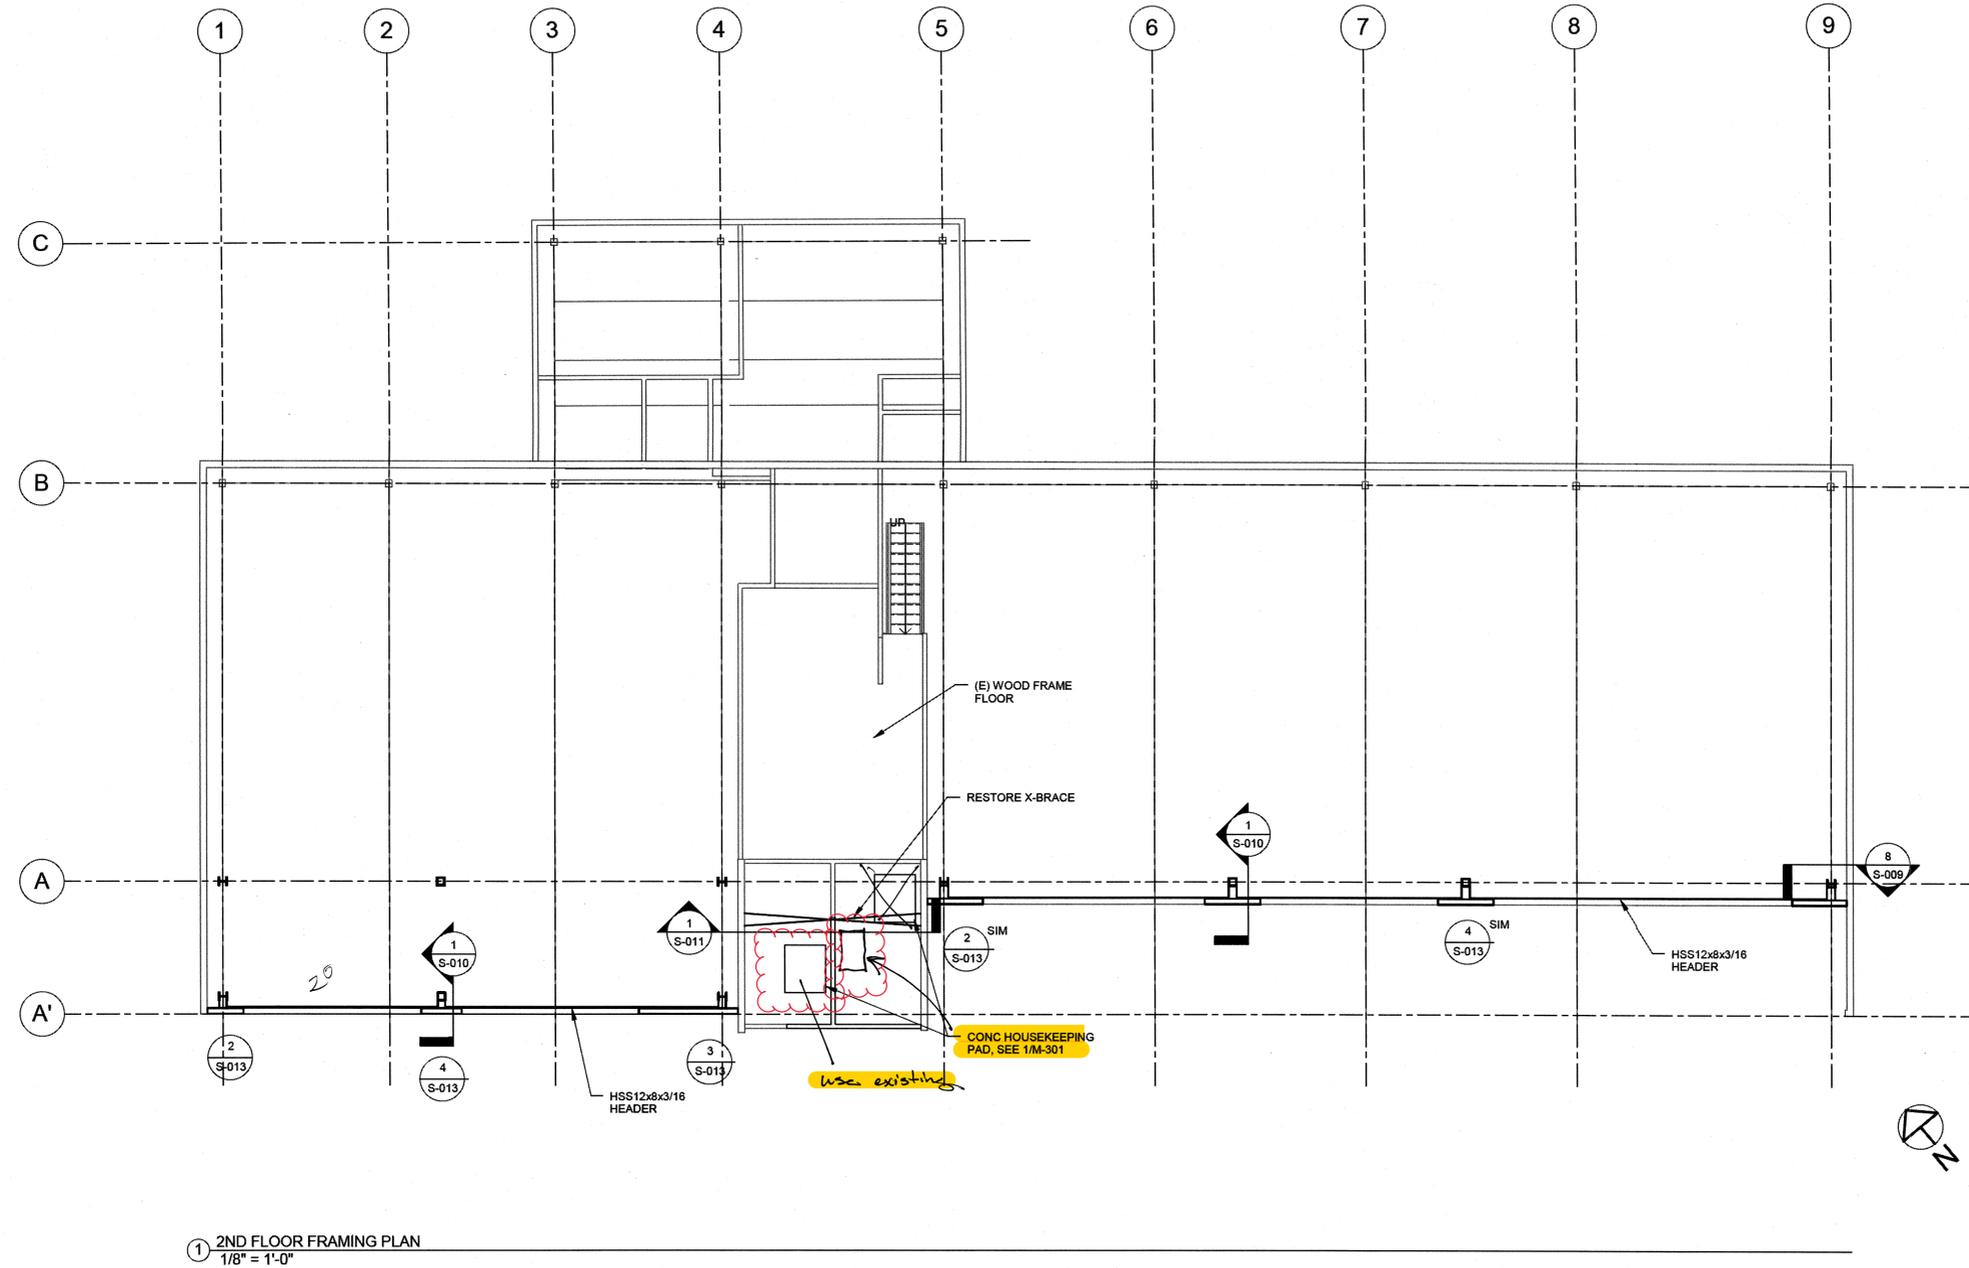

STATE OF ALASKA
 DEPARTMENT OF TRANSPORTATION
 AND PUBLIC FACILITIES

**KETCHIKAN AIRPORT ARFF
 BUILDING RENOVATION**

2ND FLOOR FRAMING PLAN

DESIGNED: D. ANDERSON
 CHECKED: D. ANDERSON
 DRAFTED: P. HEWLETT

XREFS:


SCALE: 1/8" = 1'-0"

LAYOUT: ROOF FRAMING PLAN

DATE & TIME: 2/10/2016 5:15:35 PM

DRAWING LOCATION: C:\Users\pshaw\Documents\Crash Maintenance Building_Central_pshaw\lrv

NO.	DATE	REVISION	STATE	PROJECT DESIGNATION	YEAR	SHEET NO.	TOTAL SHEETS
			ALASKA	PROJ. NO. Z682300000	2016	S-006	S-013

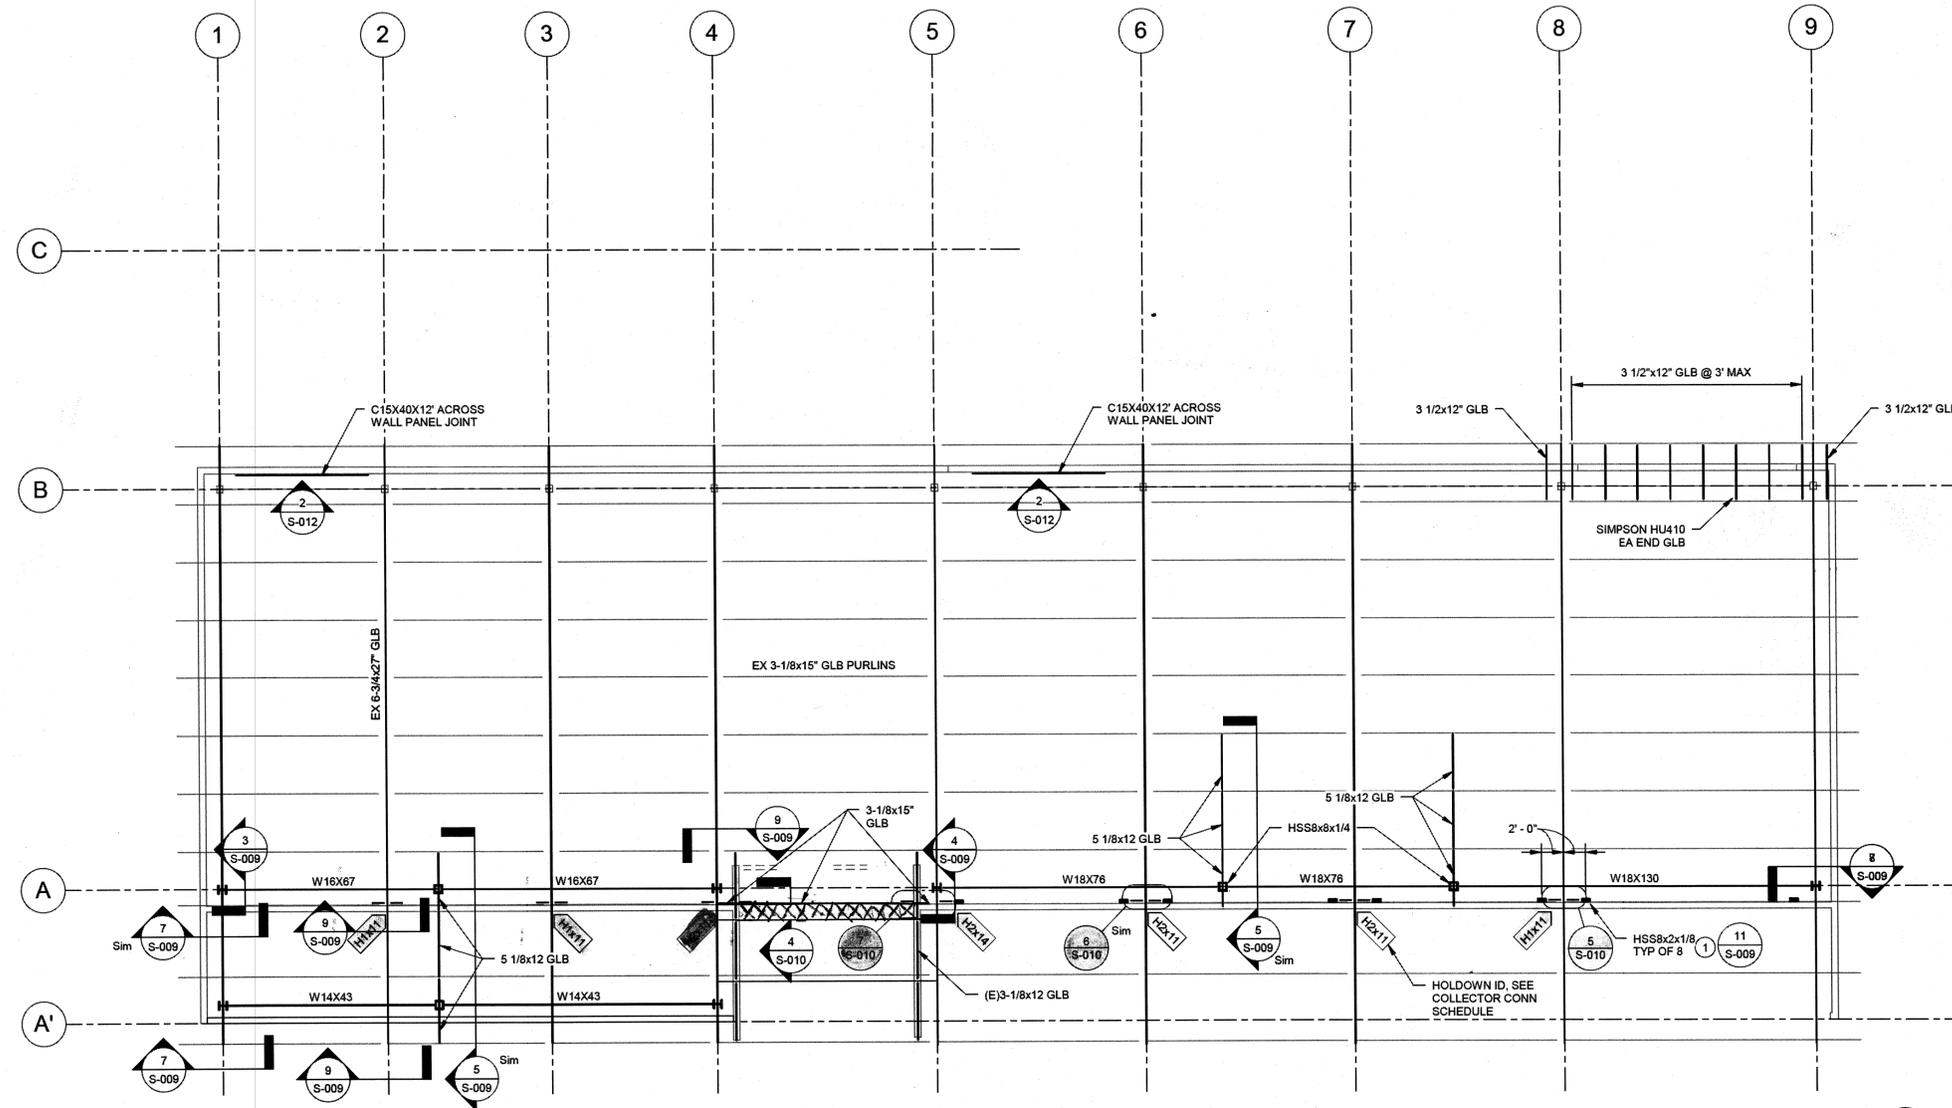

ID	HOLDOWNS	ANCHOR ROD	SDS	DET
H1x11	(1) HHDQ11	1" DIA	24	5/S-010
H2x11	(2) HHDQ11	1" DIA	24 EA	6/S-010
H2x14	(2) HHDQ14	1" DIA	30 EA	6/S-010

HOLDOWNS & SCREWS SPECIFIED AS SIMPSON OR EQUAL. HOLDOWN QTY SPECIFIED SHALL BE INSTALLED ON EACH SIDE OF 6-3/4" GLB. SEE DETAILS 5, 6 & 9 AT SHEET S-010.

DRAWING NOTES:
 1. INSTALL HSS8x2 HEADER HANGER MEMBERS BEFORE DEMOLITION OF WALL FRAMING.

1 ROOF FRAMING PLAN
 1/8" = 1'-0"




STATE OF ALASKA
 DEPARTMENT OF TRANSPORTATION
 AND PUBLIC FACILITIES


**KETCHIKAN AIRPORT ARFF
 BUILDING RENOVATION**

ROOF FRAMING PLAN


NO.	DATE	REVISION	STATE	PROJECT DESIGNATION	YEAR	SHEET NO.	TOTAL SHEETS
			ALASKA	PROJ. NO. Z682300000	2016	S-007	S-013

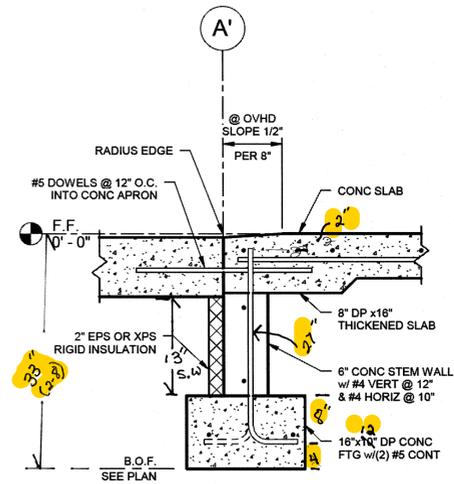


1 SECTION @ DOORS
1" = 1'-0"

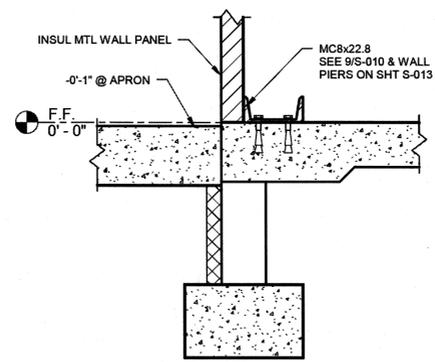


2 WALL PANEL CONN @ FDN
1" = 1'-0"

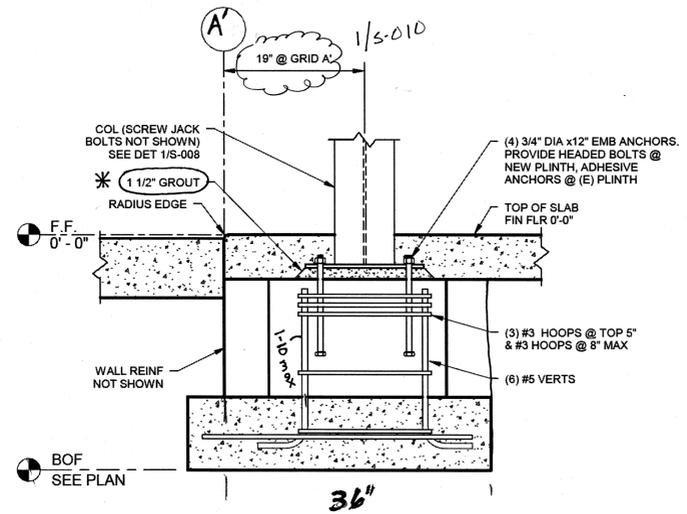


3 SECTION @ COL PLINTH
1" = 1'-0"

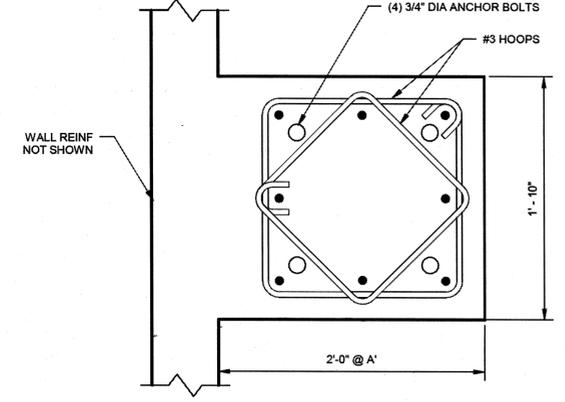


4 PLAN @ COL PLINTH
1 1/2" = 1'-0"

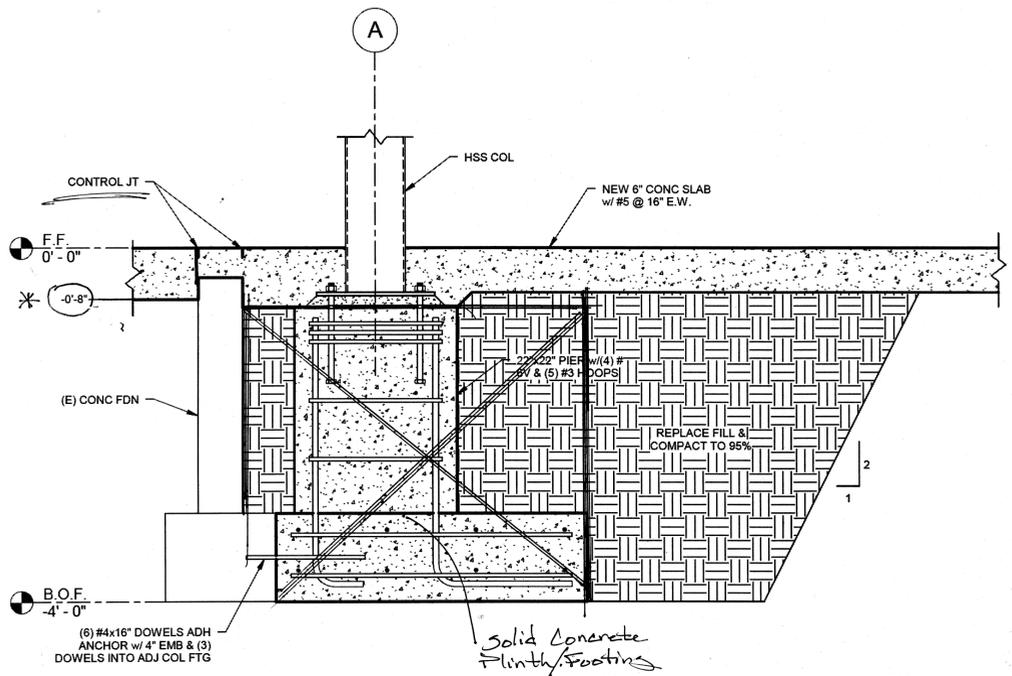

5 FOOTING @ GRID '2.3'
1" = 1'-0"

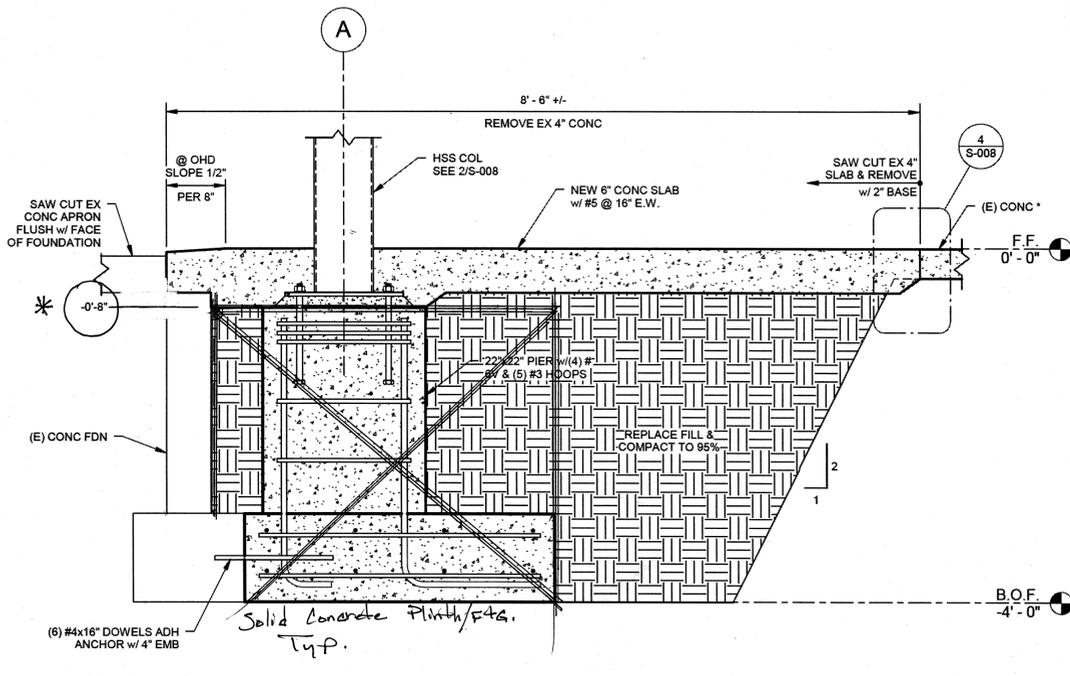

6 FOOTING @ GRIDS '6.3' & '7.7'
1" = 1'-0"

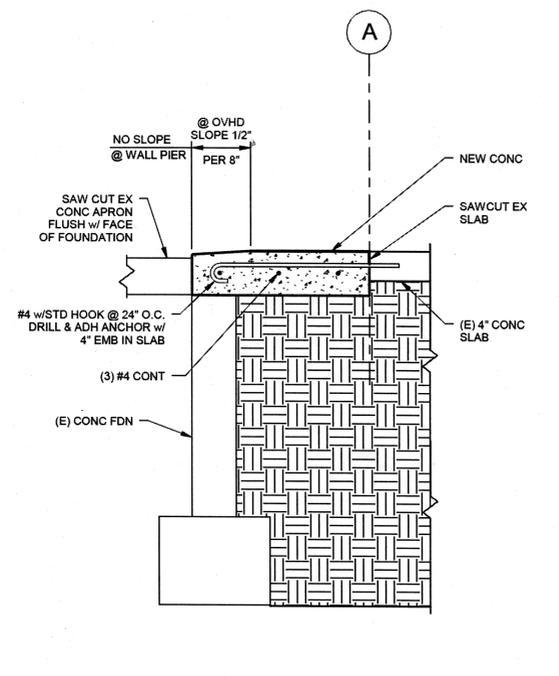

7 FOUNDATION SECTION
1" = 1'-0"

8-013

DESIGNED: D. ANDERSON
CHECKED: D. ANDERSON
DRAFTED: P. HEWLETT


XREFS

SCALE: As indicated

LAYOUT: FOUNDATION DETAILS

DATE & TIME: 2/10/2016 5:18:36 PM

DRAWING LOCATION: C:\Users\pshawlett\Documents\Crash Maintenance Building_Central_pshawlett.rvt

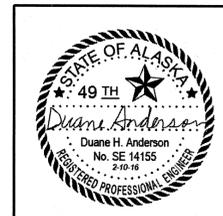


STATE OF ALASKA
DEPARTMENT OF TRANSPORTATION
AND PUBLIC FACILITIES

**KETCHIKAN AIRPORT ARFF
BUILDING RENOVATION**


FOUNDATION DETAILS

NO.	DATE	REVISION	STATE	PROJECT DESIGNATION	YEAR	SHEET NO.	TOTAL SHEETS
			ALASKA	PROJ. NO. Z682300000	2016	S-008	S-013


DRAWING LOCATION: C:\Users\shewhit\Documents\Crash Maintenance Building_Central_pshewhit.rvt
 DATE & TIME: 2/10/2016 5:18:37 PM
 LAYOUT: DETAILS
 SCALE: As indicated
 DESIGNED: XREES
 CHECKED: [blank]
 DRAFTED: [blank]

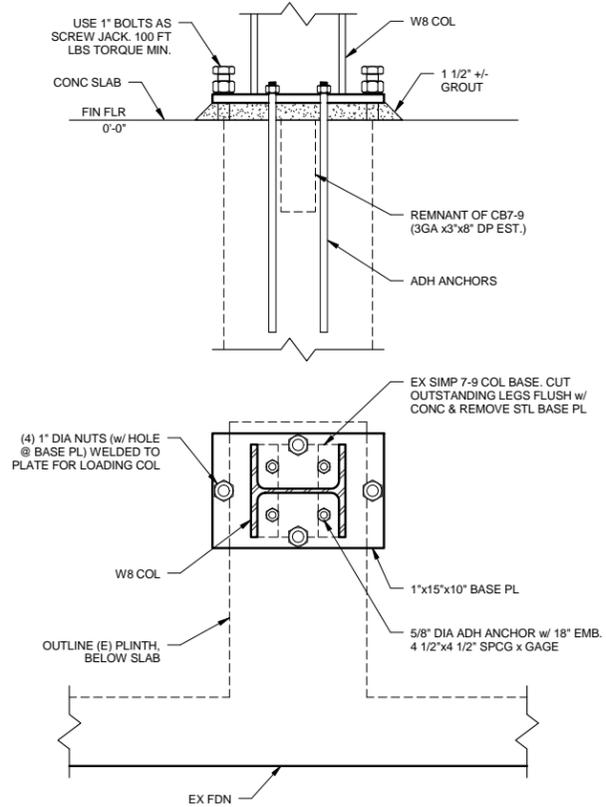


① NEW COL BRG DTL - GRID A @ 1, 4, 5 & 9
1 1/2" = 1'-0"

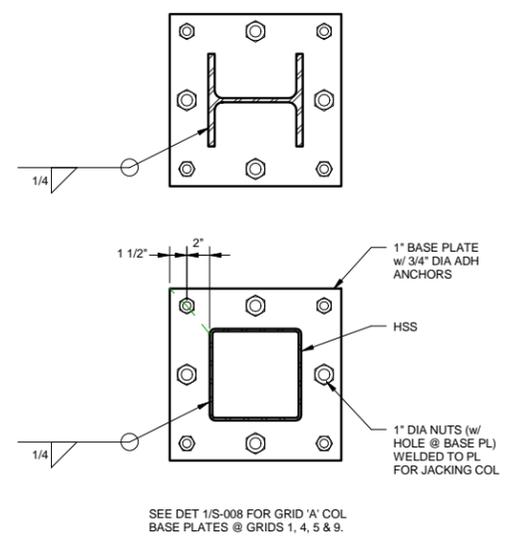


② COL HSS BASE PLATES
1 1/2" = 1'-0"

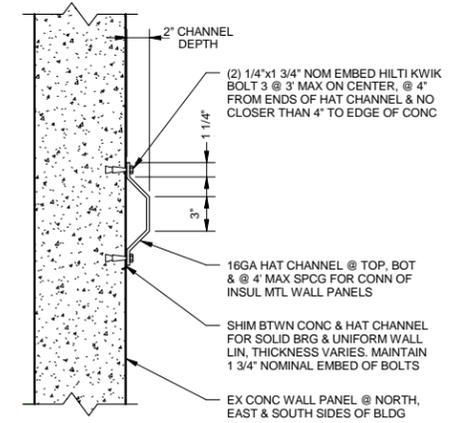


③ HAT CHANNEL CONN FOR INSUL WALL PANELS
1 1/2" = 1'-0"

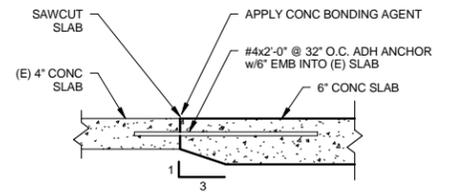


④ TRANSITION JOINT - 6" TO (E) 4" CONC SLAB
1" = 1'-0"

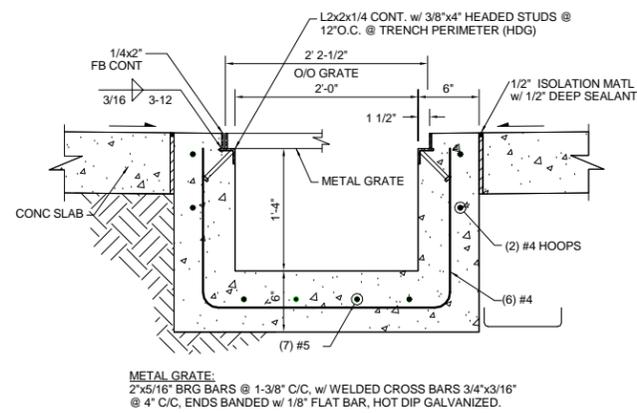


⑤ SUMP @ NEW SLAB
NTS

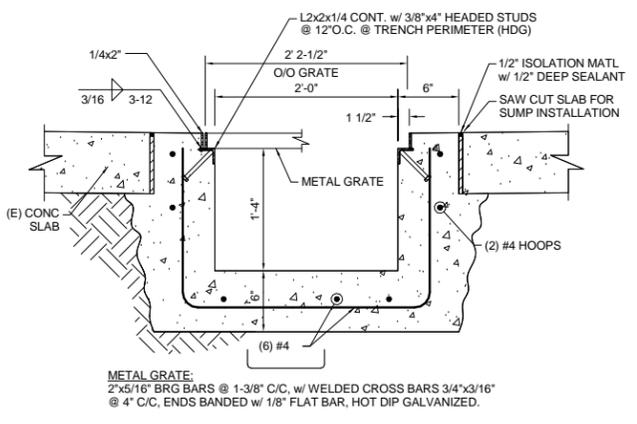


⑥ SUMP @ EX SLAB
NTS

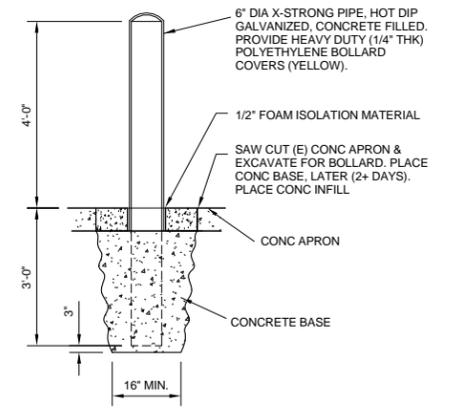

⑦ BOLLARD @ (E) CONC APRON
NTS

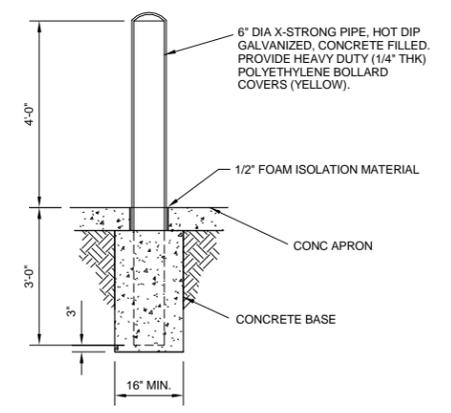

⑧ BOLLARD @ NEW APRON
NTS

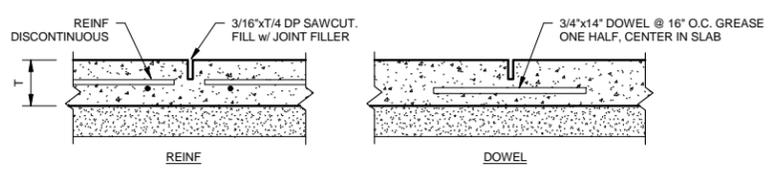


⑨ 6" SLAB CONTROL JOINT
1" = 1'-0"




STATE OF ALASKA
DEPARTMENT OF TRANSPORTATION
AND PUBLIC FACILITIES
**KETCHIKAN AIRPORT ARFF
BUILDING RENOVATION**

DETAILS


NO.	DATE	REVISION	STATE	PROJECT DESIGNATION	YEAR	SHEET NO.	TOTAL SHEETS
			ALASKA	PROJ. NO. Z682300000	2016	S-009	S-013

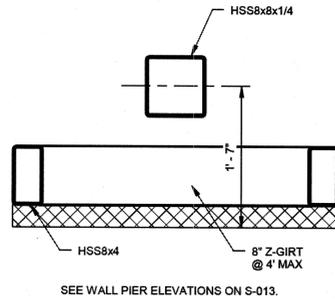


1 WALL PIER @ FIRE EQUIPMENT BAYS - GRID A
1" = 1'-0"

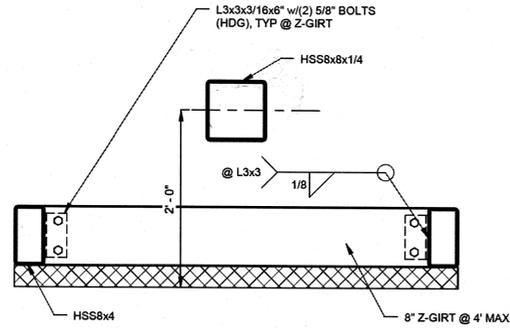


2 WALL PIER @ MAINT BAYS - GRID A
1" = 1'-0"

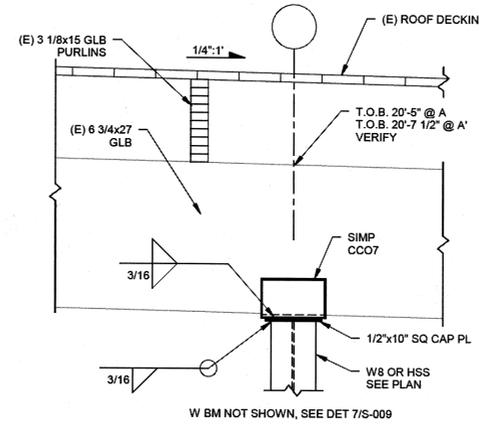


3 TOP OF COL CONN @ GRID 1 & 9
3/4" = 1'-0"

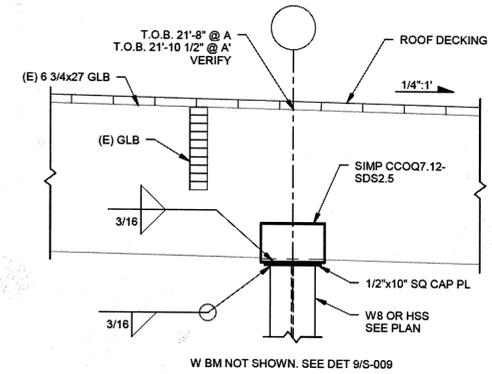


4 TOP OF COL CONN @ GRID 4 & 5
3/4" = 1'-0"

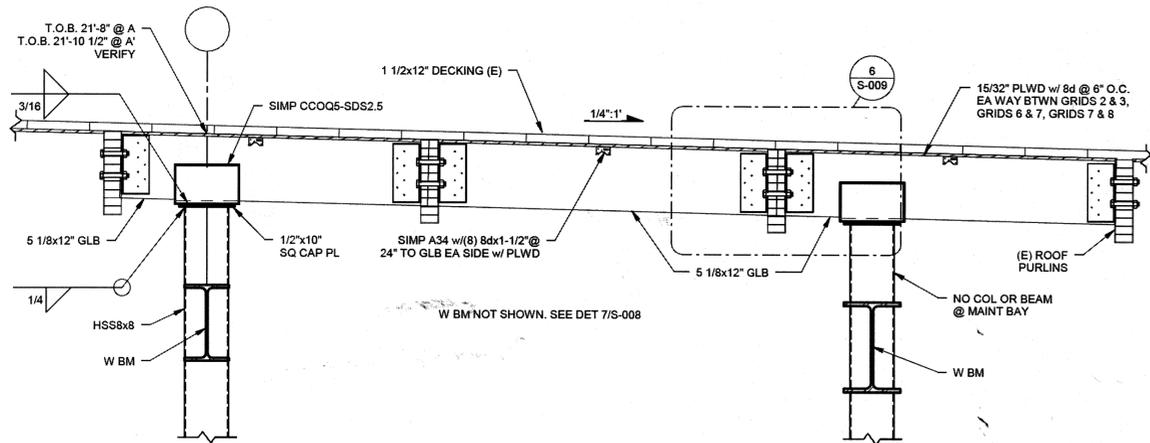


5 TOP OF COL CONN @ GRID A @ GRID 2.4, 6.4 & 7.7
TOP OF COL CONN @ GRID A' @ GRID 2.4
3/4" = 1'-0"

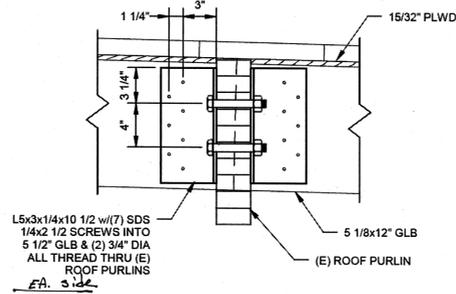


6 CONN OF 5 1/8" GLB TO (E) ROOF PURLINS
1 1/2" = 1'-0"

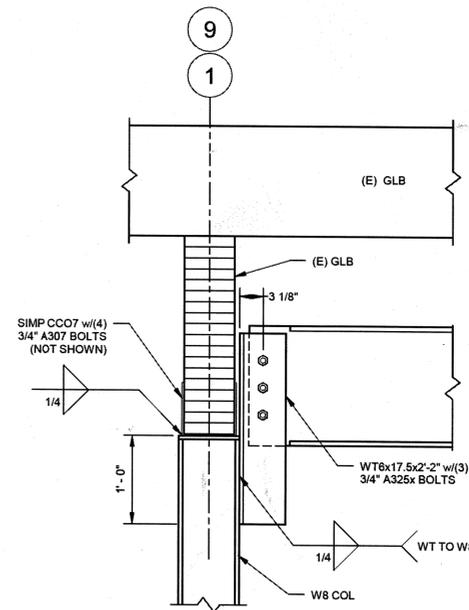


7 COL BM CONN @ GRID 1 & 9
1" = 1'-0"

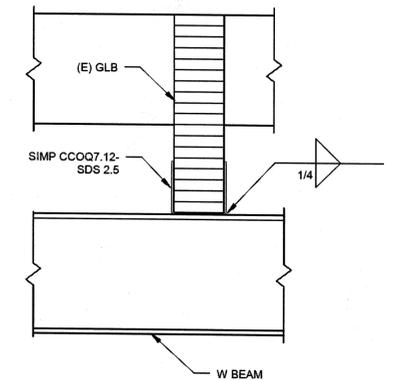


8 Copy of COL BM CONN @ GRID 1 & 9
1" = 1'-0"

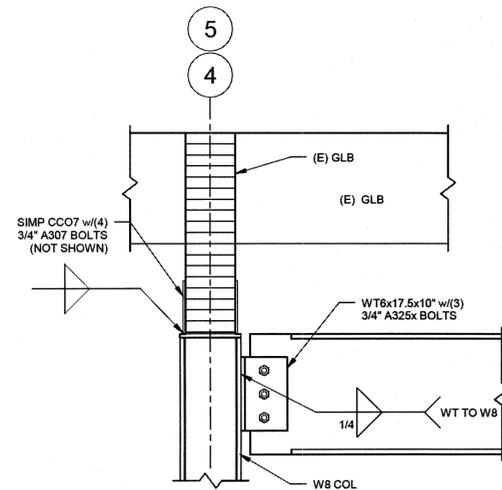

9 COL BM CONN @ GRID 4 & 5
1" = 1'-0"

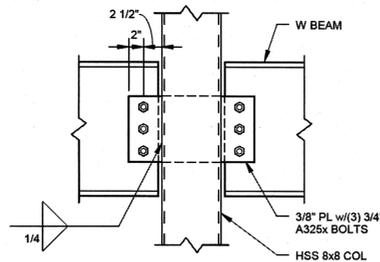


10 W BEAM CONN @ HSS COL
1" = 1'-0"

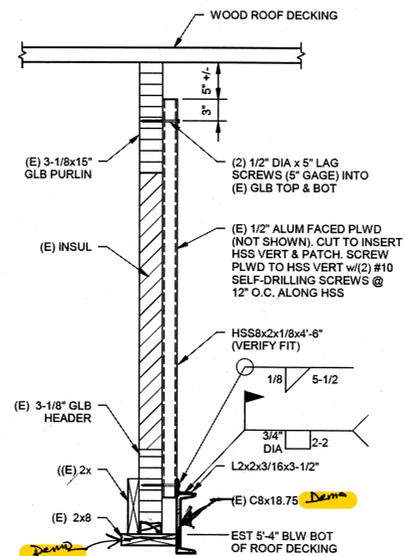

11 SUPPORT EX HEADER @ MAINTENANCE BAYS
1" = 1'-0"

DRAWING LOCATION: C:\Users\pshaw\Documents\Cash Maintenance Building_Central_pshaw.rvt
 DATE & TIME: 2/10/2016 5:18:38 PM
 LAYOUT: STRUCTURAL DETAILS
 SCALE: As indicated
 XREFS: D. ANDERSON (DESIGNED), D. ANDERSON (CHECKED), P. HEWLETT (DRAFTED)

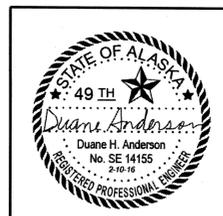


STATE OF ALASKA
DEPARTMENT OF TRANSPORTATION
AND PUBLIC FACILITIES

**KETCHIKAN AIRPORT ARFF
BUILDING RENOVATION**


STRUCTURAL DETAILS

NO.	DATE	REVISION	STATE	PROJECT DESIGNATION	YEAR	SHEET NO.	TOTAL SHEETS
			ALASKA	PROJ. NO. Z682300000	2016	S-010	S-013


DESIGNED: D. ANDERSON
 CHECKED: D. ANDERSON
 DRAFTED: P. HEWLETT
 XREFS:
 SCALE: As indicated
 LAYOUT: STEEL FRAMING DETAILS
 DATE & TIME: 2/10/2016 5:18:39 PM
 DRAWING LOCATION: C:\Users\pshaw\Documents\Crash Maintenance Building_Central_pshaw\1.rvt

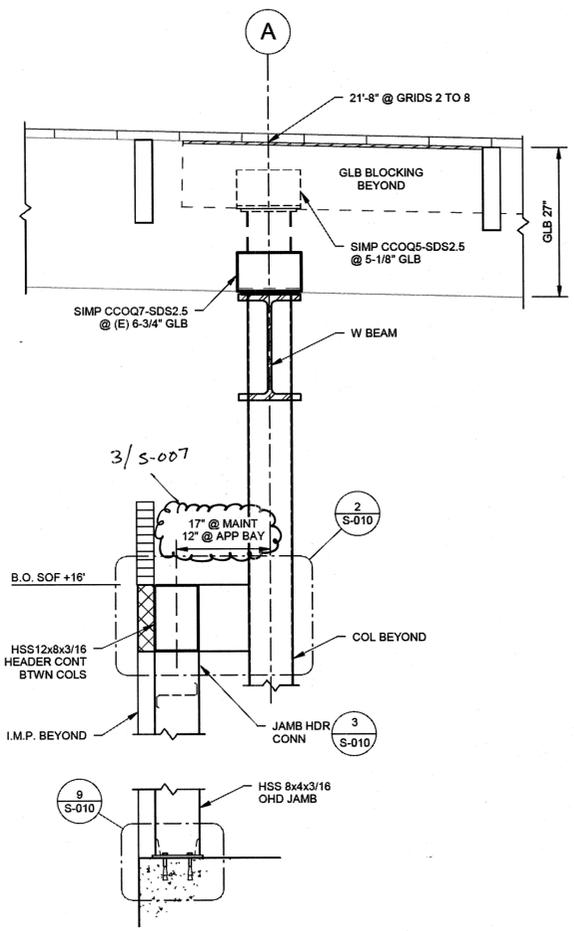


1 PARTIAL SECTION @ GRID A (MAINT BAY)
3/4" = 1'-0"

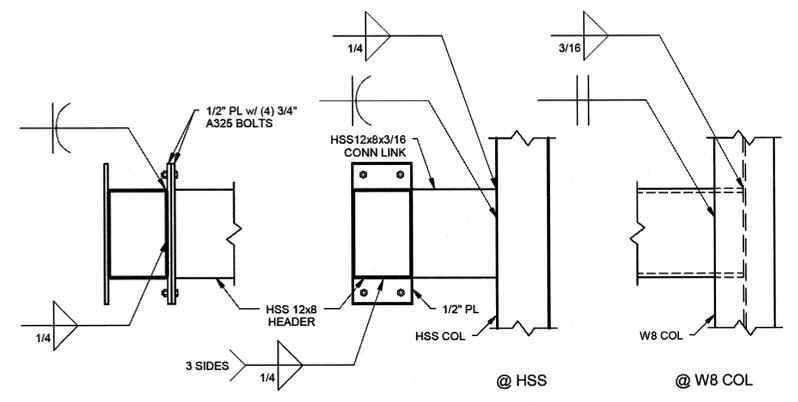


2 COLUMN HEADER CONNECTION
1" = 1'-0"

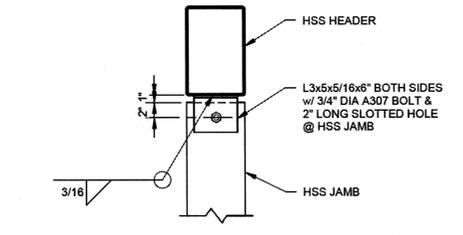


3 OHD JAMB CONN @ HDR
1" = 1'-0"

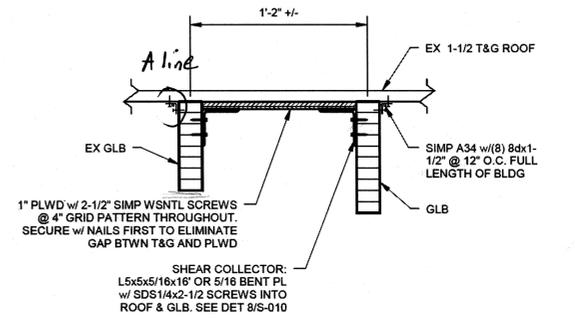


4 SECTION
1" = 1'-0"

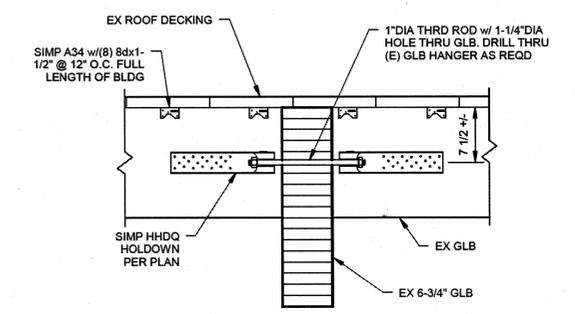


5 SECTION @ SINGLE COLLECTOR TIE *A' Line*
1" = 1'-0"

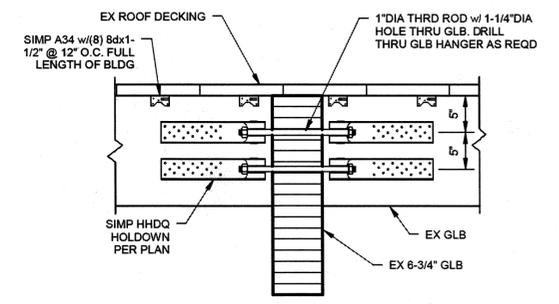


6 SECTION @ DBL COLLECTOR TIE *A' Line*
1" = 1'-0"

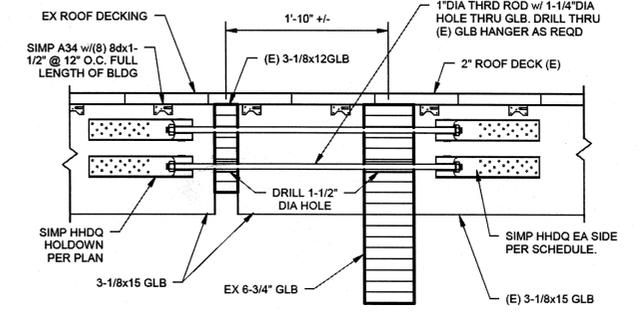


7 COLLECTOR CONNS @ GRIDS 4 & 5 *A' Line*
1" = 1'-0"

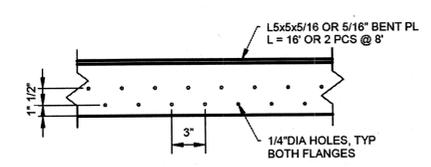

8 DET @ SHEAR COLLECTOR
1 1/2" = 1'-0"

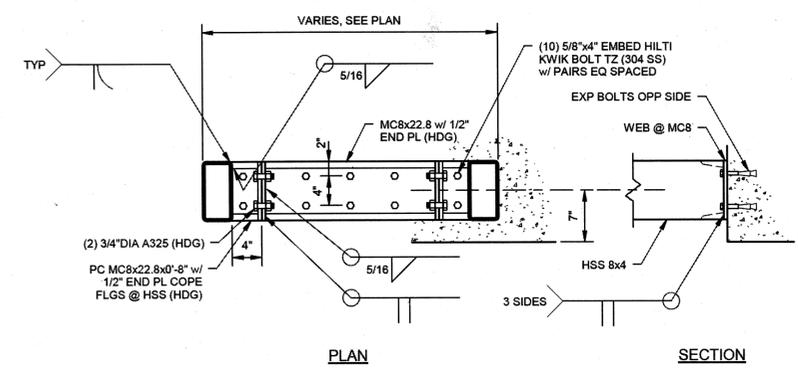

9 OVHD JAMB WALL PANEL CONN @ SLAB
1" = 1'-0"

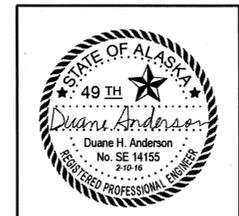

STATE OF ALASKA
 DEPARTMENT OF TRANSPORTATION
 AND PUBLIC FACILITIES
**KETCHIKAN AIRPORT ARFF
 BUILDING RENOVATION**
 STEEL FRAMING DETAILS

DESIGNED BY: D. ANDERSON
 CHECKED BY: D. ANDERSON
 DRAFTED BY: P. HEWLETT

XREFS:


SCALE: As indicated

LAYOUT: BRACE DETAILS


DATE & TIME: 2/10/2016 5:18:48 PM

DRAWING LOCATION: C:\Users\pshaw\Documents\Crash Maintenance Building_Central_pshaw\dwg.rvt

NO.	DATE	REVISION	STATE	PROJECT DESIGNATION	YEAR	SHEET NO.	TOTAL SHEETS
			ALASKA	PROJ. NO. Z682300000	2016	S-011	S-013

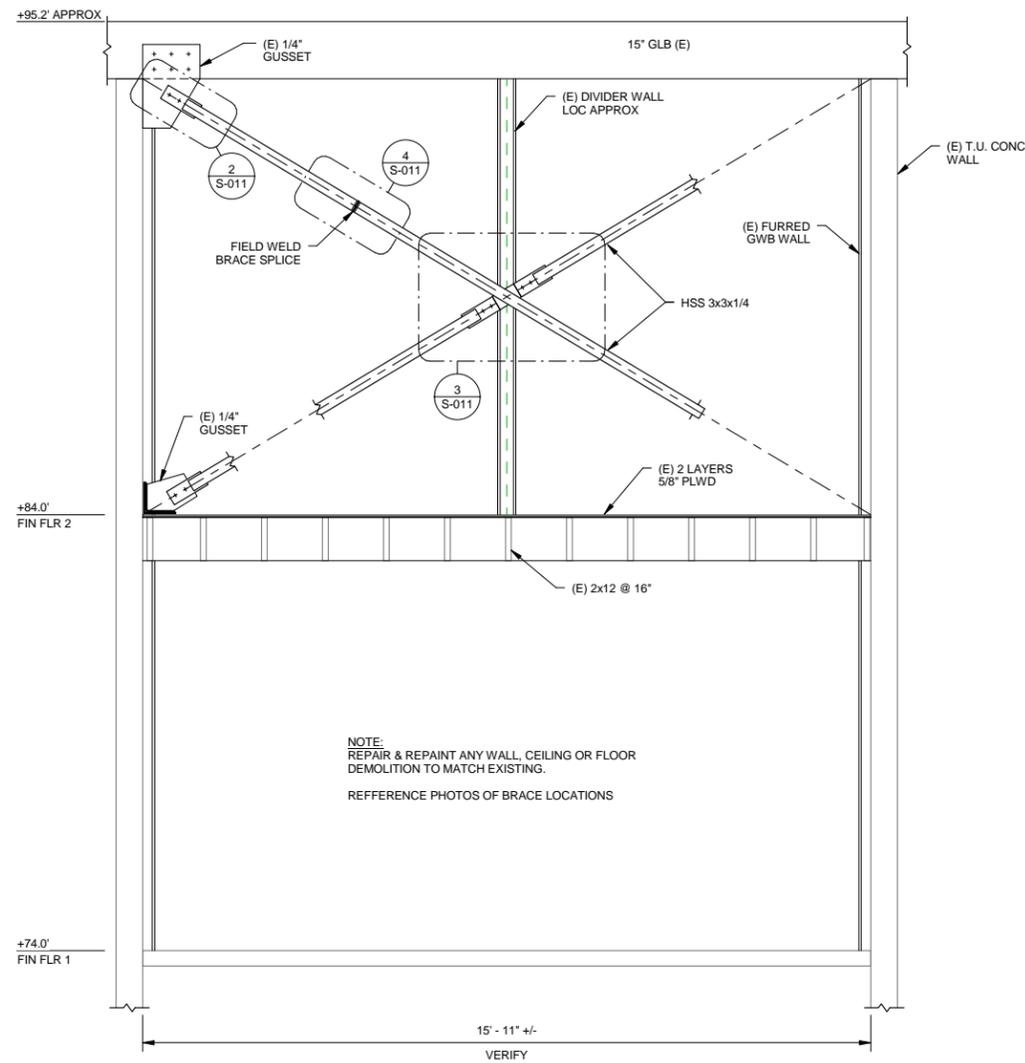


① ELEVATION @ BRACE REPLACEMENT
 1/2" = 1'-0"

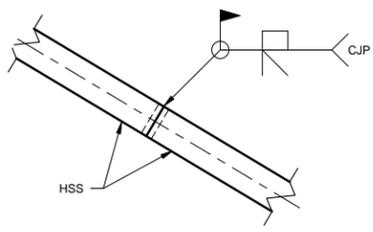


NOTE:
 MINIMUM 1 SPLICE REQUIRED TO GET BRACE IN PLACE.
 CONTRACTOR MAY ELECT TO USE ADDITIONAL SPLICE
 TO MINIMIZE WALL DEMO.


④ BRACE SPLICE
 1 1/2" = 1'-0"

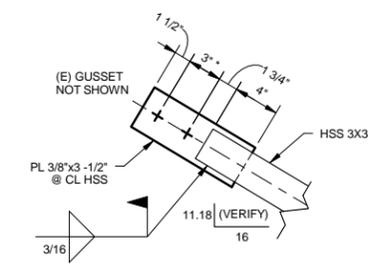

② BRACE CONN @ EX GUSSET
 1 1/2" = 1'-0"

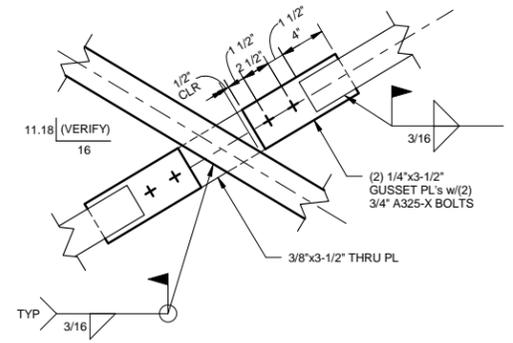

③ BRACE 'X' CONNECTION
 1 1/2" = 1'-0"

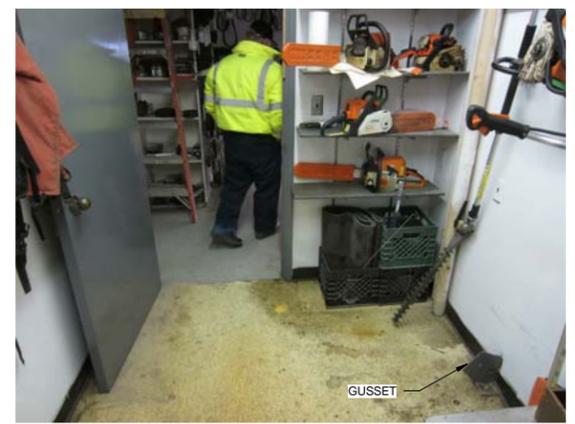

PHOTOS OF BRACE LOCATIONS & EXISTING GUSSETS




STATE OF ALASKA
 DEPARTMENT OF TRANSPORTATION
 AND PUBLIC FACILITIES

KETCHIKAN AIRPORT ARFF
 BUILDING RENOVATION


BRACE DETAILS

NO.	DATE	REVISION	STATE	PROJECT DESIGNATION	YEAR	SHEET NO.	TOTAL SHEETS
			ALASKA	PROJ. NO. Z682300000	2016	S-012	S-013


DRAWING LOCATION
 C:\Users\shewhit\Documents\Crash Maintenance Building_Central_pshewit.rvt
 DATE & TIME
 2/10/2016 5:18:49 PM
 LAYOUT OVERHEAD DOOR INFILL
 DETAILS MECHANICAL WALL PENETRATIONS
 SCALE As indicated
 XREFS
 DESIGNED
 CHECKED
 DRAFTED
 Designer
 Checker
 Author

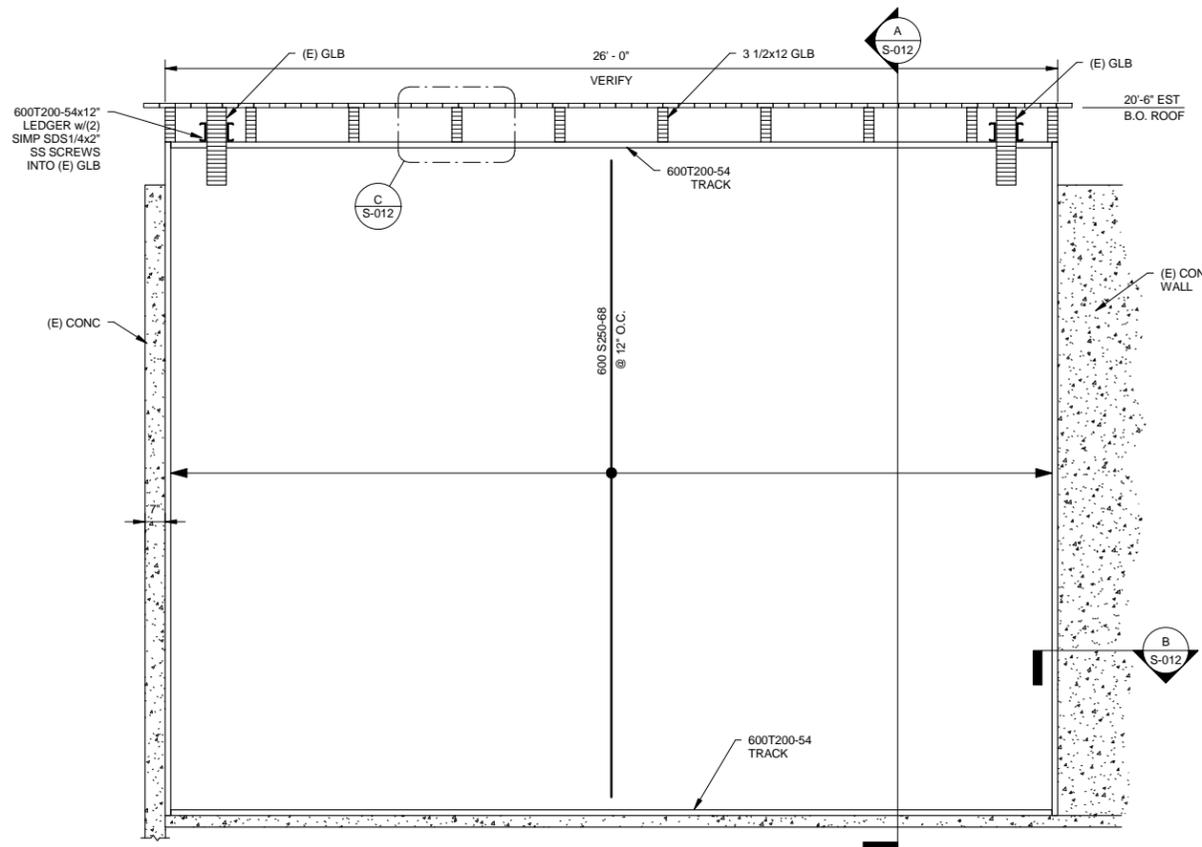


① ELEVATION @ OVHD INFILL
3/8" = 1'-0"

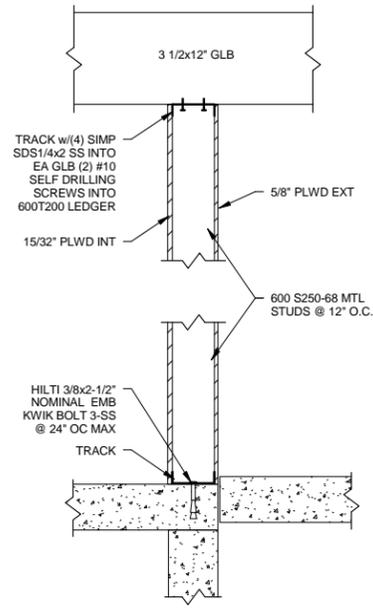

② VERT SECTION @ OVHD INFILL
1" = 1'-0"

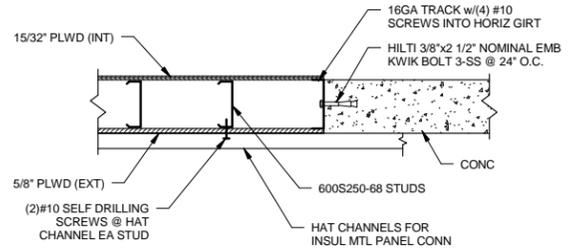


③ HORIZ SECTION @ JAMB
1" = 1'-0"

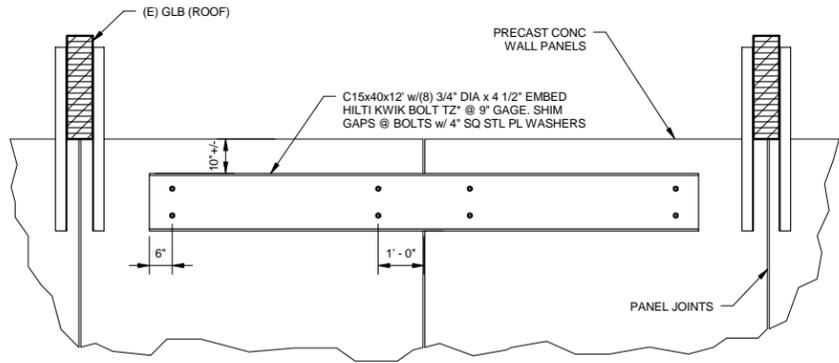


NOTE:
SET C15 AS HIGH ON WALL AS PRACTICAL AVOIDING PANEL TO PANEL CONNS. CENTER C15 ACROSS JOINT.
NTS

* ALTERNATIVELY DRILL THRU WALL PANEL & THRU BOLT w/ 3/8"x4" SQ PLATE WASHER ON EXTERIOR OF PANEL.

④ PANEL JOINT STIFFENER

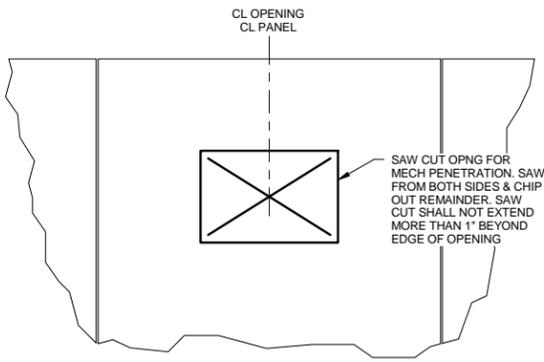

⑤ MECHANICAL WALL PENETRATION
1/2" = 1'-0"

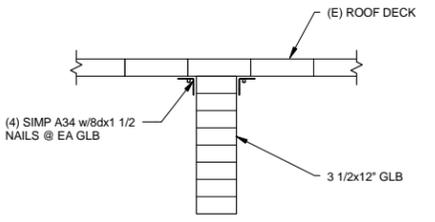

⑥ DETAIL
1 1/2" = 1'-0"




STATE OF ALASKA
 DEPARTMENT OF TRANSPORTATION
 AND PUBLIC FACILITIES

**KETCHIKAN AIRPORT ARFF
 BUILDING RENOVATION**


**OVERHEAD DOOR INFILL DETAILS
 MECHANICAL WALL PENETRATIONS**

NO.	DATE	REVISION	STATE	PROJECT DESIGNATION	YEAR	SHEET NO.	TOTAL SHEETS
			ALASKA	PROJ. NO. Z682300000	2016	S-013	S-013

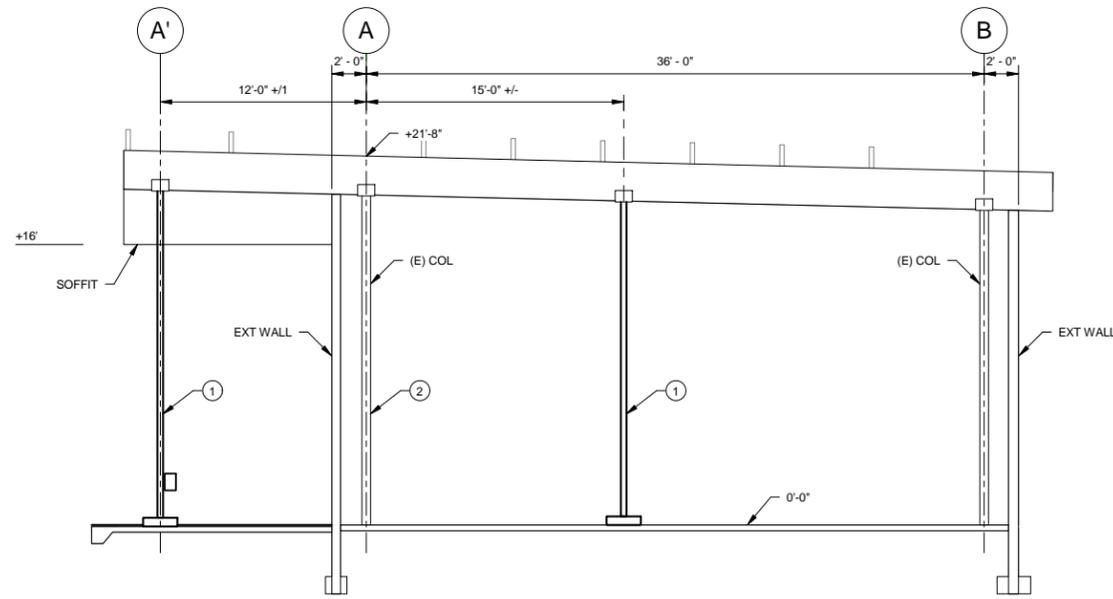


- NOTES:**
- TEMPORARY SHORES REQUIRED PRIOR TO COLUMN (2) REMOVAL & BEAM PLACEMENT.
 - COLUMNS TO BE REMOVED FOR PLACEMENT OF NEW SUPPORT BEAM.
- SHORING SEQUENCE:**
- PROVIDE SHORE COLUMNS IN POSITIONS 1 PRIOR TO REMOVAL OF COLUMNS 2 AT GRID A.
 - CONSTRUCT NEW FOUNDATIONS, COLUMNS AND SUPPORT BEAMS ALONG GRID A PRIOR TO ANY WORK AT GRID A'.
 - REMOVE SHORE COLUMNS TO PROCEED WITH CONSTRUCTION OF FOUNDATIONS, COLUMNS AND WALLS ALONG GRID A'.


1 Shoring Diagram
3/16" = 1'-0"

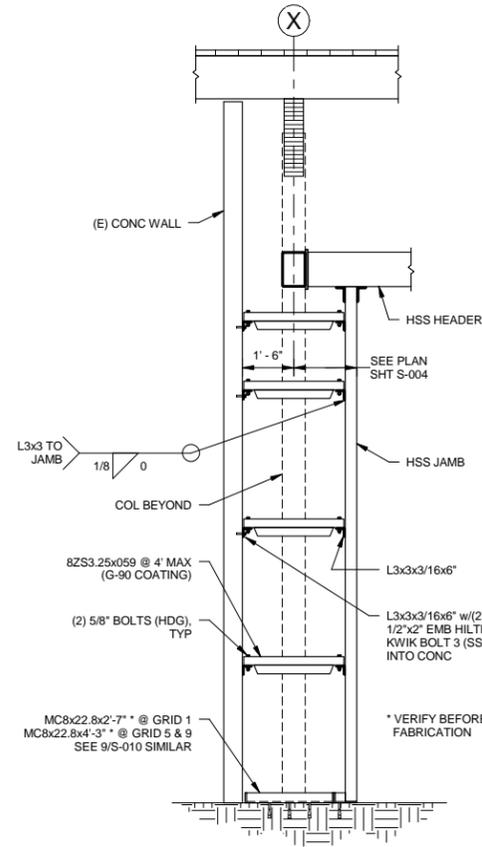

2 WALL PIER ELEVATION @ GRIDS 1, 5 & 9
3/8" = 1'-0"

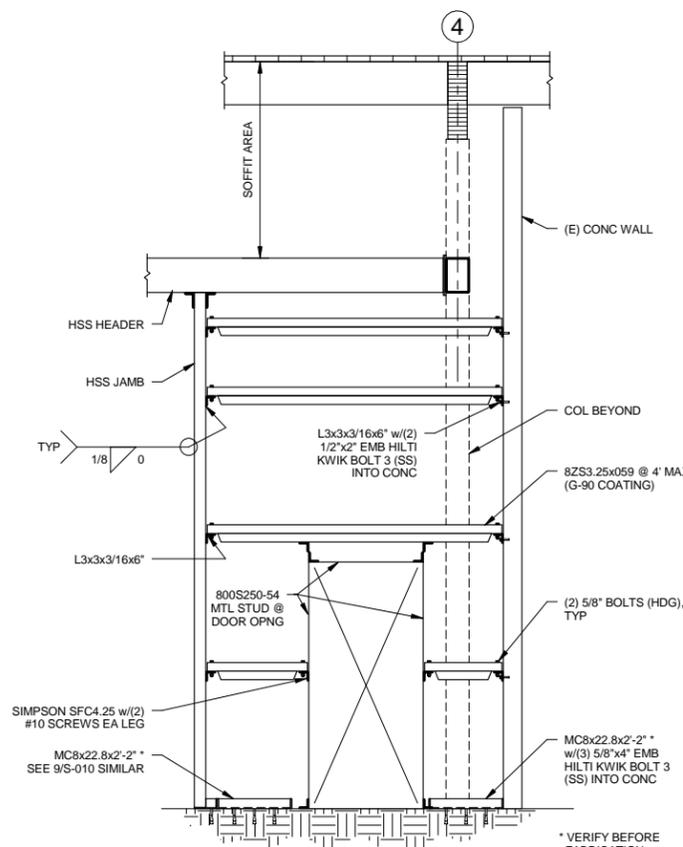

3 WALL PIER ELEVATION @ GRID 4
3/8" = 1'-0"

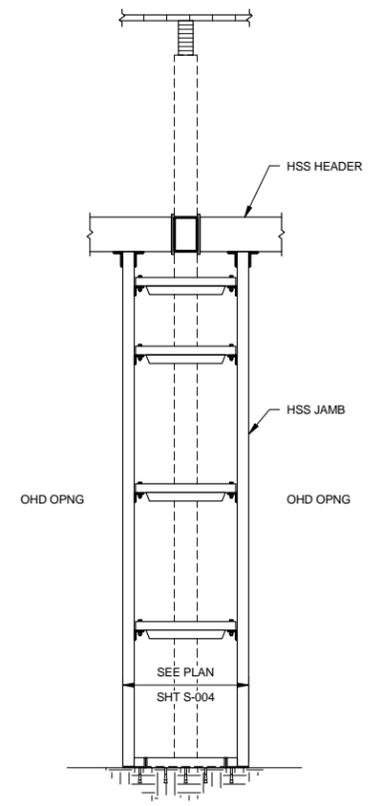

4 WALL PIER ELEVATION BTWN OHD
3/8" = 1'-0"



STATE OF ALASKA
DEPARTMENT OF TRANSPORTATION
AND PUBLIC FACILITIES

**KETCHIKAN AIRPORT ARFF
BUILDING RENOVATION**

**WALL PIER ELEVATIONS &
SHORING DIAGRAM**

DRAWING LOCATION: C:\Users\shewhit\Documents\Crash Maintenance Building_Central_pshewhit.rvt
 DATE & TIME: 2/10/2016 5:18:49 PM
 LAYOUT: WALL PIER ELEVATIONS & SHORING DIAGRAM
 SCALE: As indicated
 XREFS: