
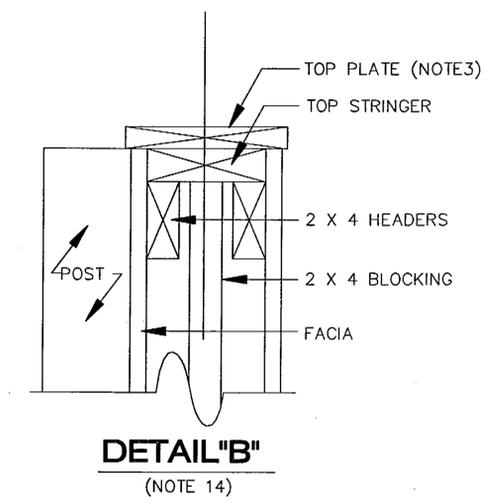
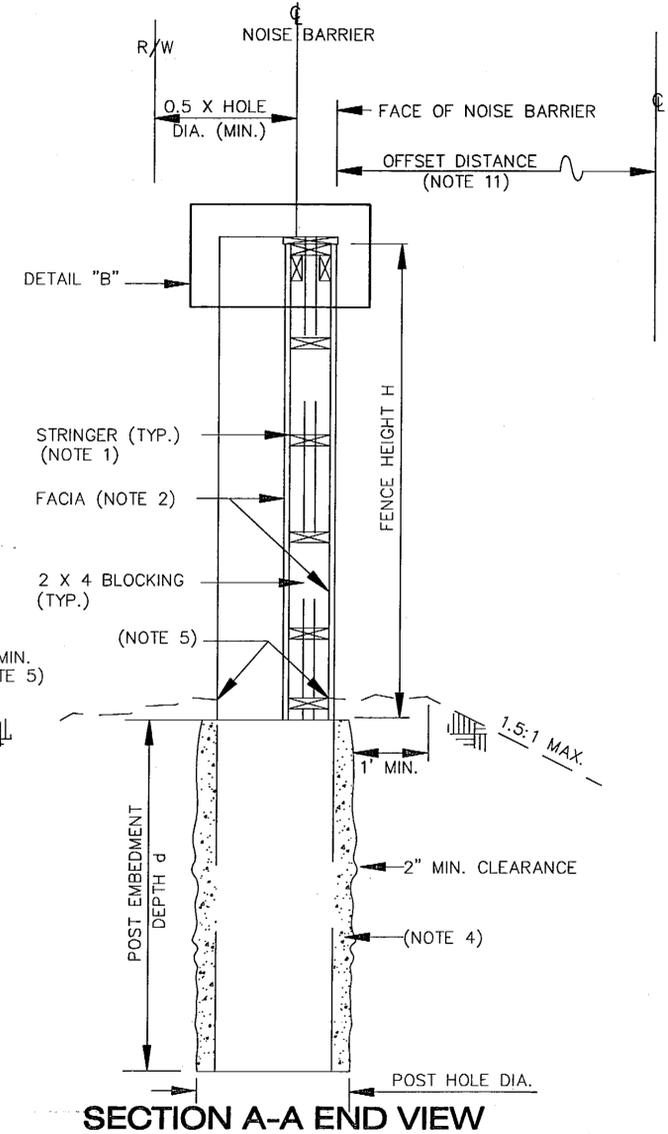
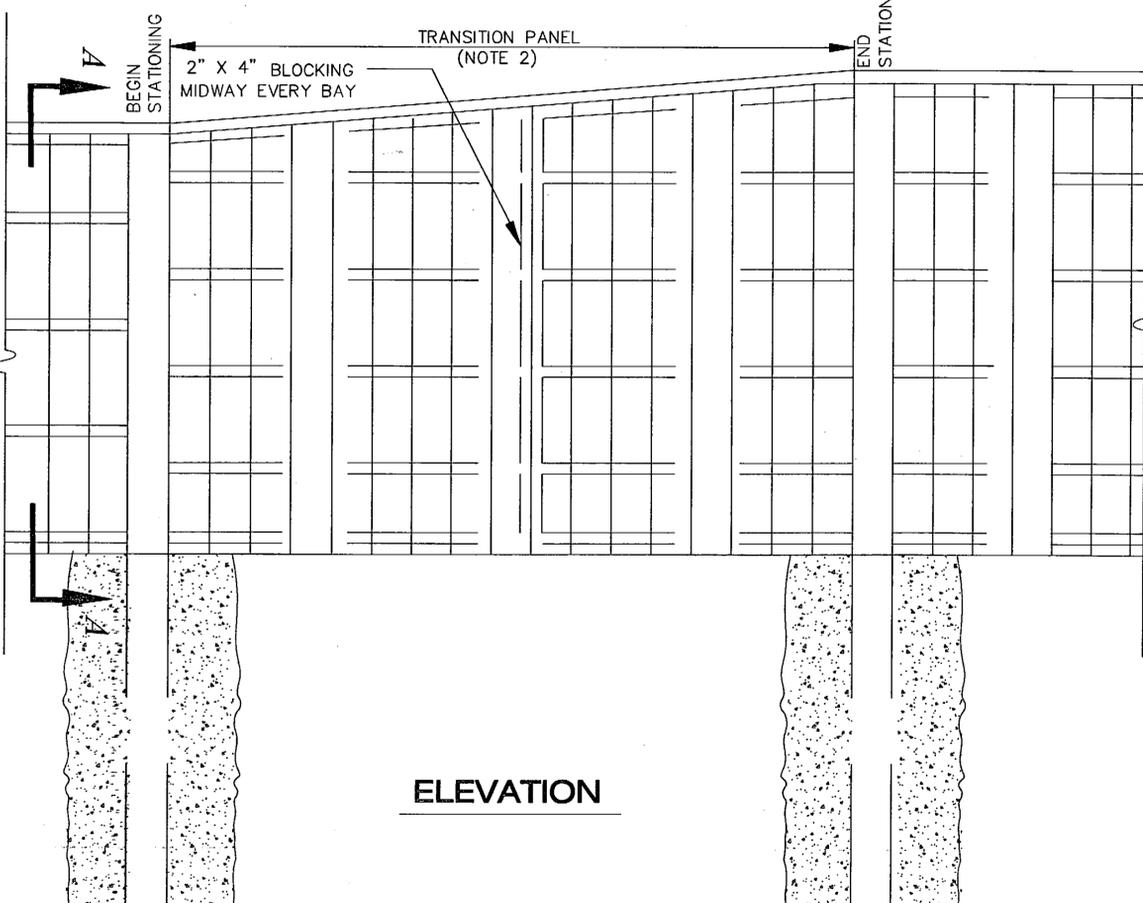


**NOISE BARRIER FENCE SCHEDULE
(B1 DESIGN LOADING NOTE 11)**

POST (NOTE 8)				STRINGER (NOTE 8)	
FENCE HEIGHT (FT)	SIZE (IN X IN)	SPACING (FT)	EMBEDMENT DEPTH <i>d</i> (FT)	HOLE DIAMETER (IN)	NO. REQ'D
6	4 X 6	8	8	14	4
8	4 X 8	8	8	14	4
10	4 X 12	12	8	24	5
12	4 X 14	12	10	20	6
14	6 X 14	12	10	22	7

**NOISE BARRIER FENCE SCHEDULE
(B2 DESIGN LOADING NOTE 11)**

POST (NOTE 8)				STRINGER (NOTE 8)	
FENCE HEIGHT (FT)	SIZE (IN X IN)	SPACING (FT)	EMBEDMENT DEPTH <i>d</i> (FT)	HOLE DIAMETER (IN)	NO. REQ'D
6	4 X 8	8	8	16	4
8	4 X 12	12	10	20	5
10	6 X 12	12	10	22	6
12	6 X 14	12	10	26	7
14	6 X 16	12	10	30	8

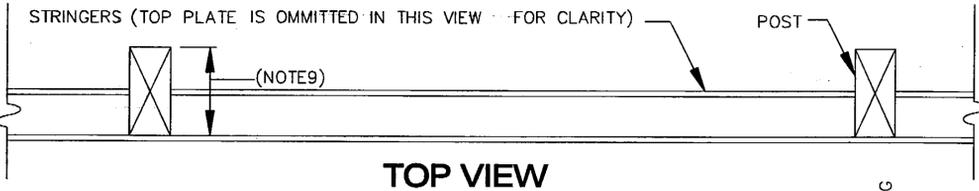

NOISE BARRIER FENCE NOTES

- ATTACH STRINGERS TO POST USING 18 GAGE FRAMING ANCHORS AT EACH END AND 10d NAILS. STRINGERS SHALL BE EVENLY SPACED AND CENTERED ON POST.
- VERTICAL FACIA BOARDS SHALL BE 1-INCH X 6-INCH (NOMINAL) CEDAR WITH SHIPLAPPED EDGES. FASTEN TO EACH STRINGER USING 2-10d NAILS.
- TOP PLATES SHALL BE 1-INCH (NOMINAL) CEDAR. WIDTH SHALL BE 2-INCHES GREATER THAN STRINGER. FASTEN USING 2-10d NAILS AT 24-INCH O.C.
- CLASS W CONCRETE USED FOR FILLING POST HOLES SHALL BE INCLUDED IN THE PRICE PAID FOR THE FENCE.
- GRADE THE GROUND AT THE BASE OF THE WALL PANELS SUCH THAT ALL FACIA BOARDS ARE BURIED A MINIMUM OF 1-INCH.
- LOCATE UTILITIES PRIOR TO POST EXCAVATION.
- STAKE RIGHT OF WAY AND FENCE LINES FOR INSPECTION BY THE ENGINEER PRIOR TO BEGINNING FENCE CONSTRUCTION.
- GRADING OF LUMBER AS STATED IN TIMBER CONSTRUCTION MANUAL, 2ND EDITION AMERICAN INSTITUTE OF TIMBER CONSTRUCTION FOR HEM FIR #1 OR BETTER. POSTS SHALL BE GRADED DENSE NO. 1. STRINGERS SHALL BE GRADED NO. 2.
- INSTALL POSTS WITH LARGE DIMENSION PERPENDICULAR TO FACE OF WALL.
- INSTALL POSTS AT ALL ANGLE POINTS.
- REFER TO NOISE BARRIER FENCE SUMMARY TABLE FOR STATION, OFFSET HEIGHT, AND APPLICABLE DESIGN LOADING (B1 OR B2) DATA.
- TRANSITION PANEL STRINGERS AND POST REQUIREMENTS SHALL BE THOSE OF THE HIGHER FENCE.
- ALL POSTS AND STRINGERS SHALL BE TREATED IN ACCORDANCE WITH SECTION 714, PRESERVATIVES AND PRESERVATIVE TREATMENT PROCESSES FOR WOOD MATERIALS.
- FOR 12-FOOT POST SPACING, INSTALL 2-INCH X 4-INCH HEADER BOARDS TO TOP AS SHOWN IN DETAIL "B". USE 16d 12-INCH O.C. CONNECT ENDS OF 2 X 4 HEADER BOARDS TO POST USING 18 GAGE FRAMING ANCHORS AND 10d NAILS.
- ALL NAILS AND ANCHOR PLATES SHALL BE GALVANIZED

PATH: Q:\Ktn\71811A\PlanSet\O_Noise.DWG
 Mon, 06/May/02 09:44AM Michael Limbaugh
 PSPACE 1=1(F) OR MSPACE 1=1(F)

ADDENDUM NUMBER		
ATTACHMENT NUMBER		
RECORD OF REVISIONS		
No.	DATE	DESCRIPTION

**KTN-THIRD AVENUE EXTENSION
 PROJECT NO. 68490**
Noise Barrier Details

DESIGNED BY: C. HOWARD


CHECKED BY: T. MOORE
 DRAWN BY: T.M./R.S.

STATE OF ALASKA
 DEPARTMENT OF TRANSPORTATION & PUBLIC FACILITIES
 STATEWIDE DESIGN & ENGINEERING SERVICES DIVISION
**THIRD AVENUE EXTENSION
 PROJECT NO. 68490**

Noise Barrier Details


PROJECT DESIGNATION NUMBER	
STP-MG-0904(2)	
STATE	YEAR
ALASKA	2002
SHEET NUMBER	TOTAL SHEETS
01	146

Project As Built Drawings have been reviewed by the Project Engineer. To the best of his/her knowledge, they represent the project as constructed.
 Proj. Eng. *[Signature]* Date 10/31/02

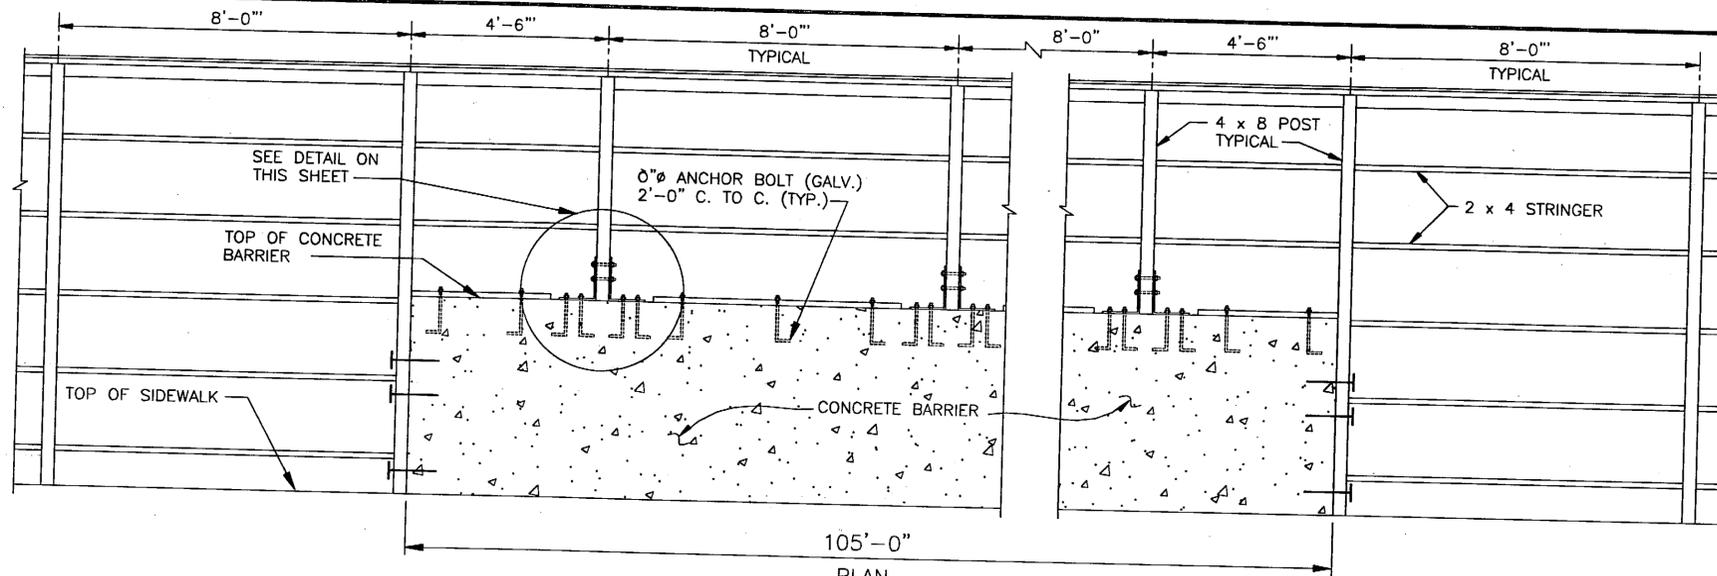

PLAN
POST LAYOUT


STA. "O" 24+70, RT., TO STA. "O" 25+75, RT.

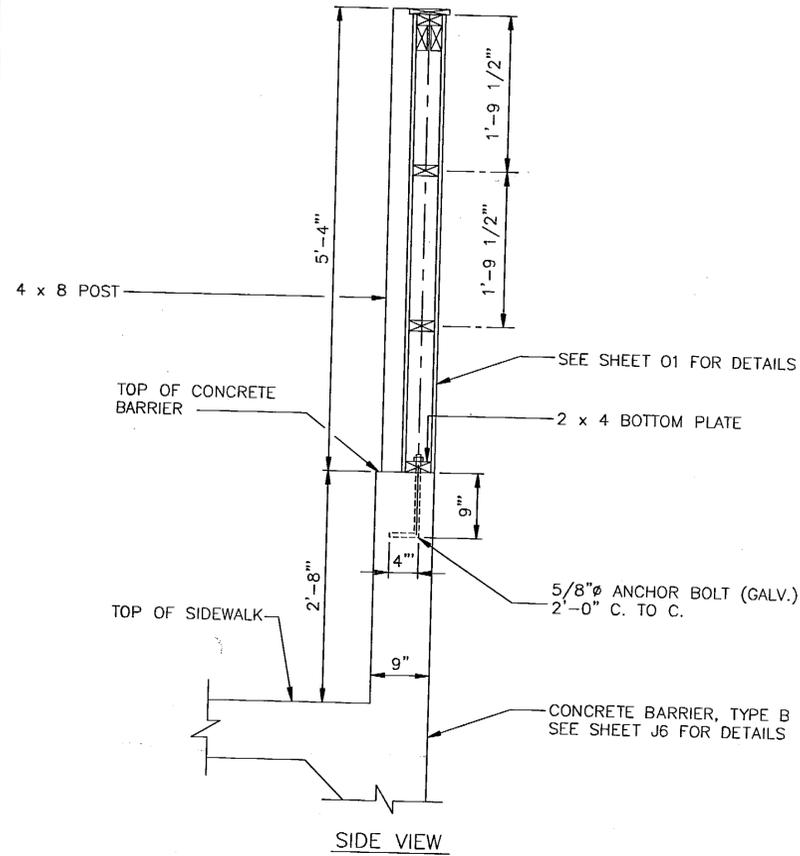

NOISE BARRIER


ABOVE CONCRETE BARRIER

STA. "O" 24+70, RT., TO STA. "O" 25+75, RT.

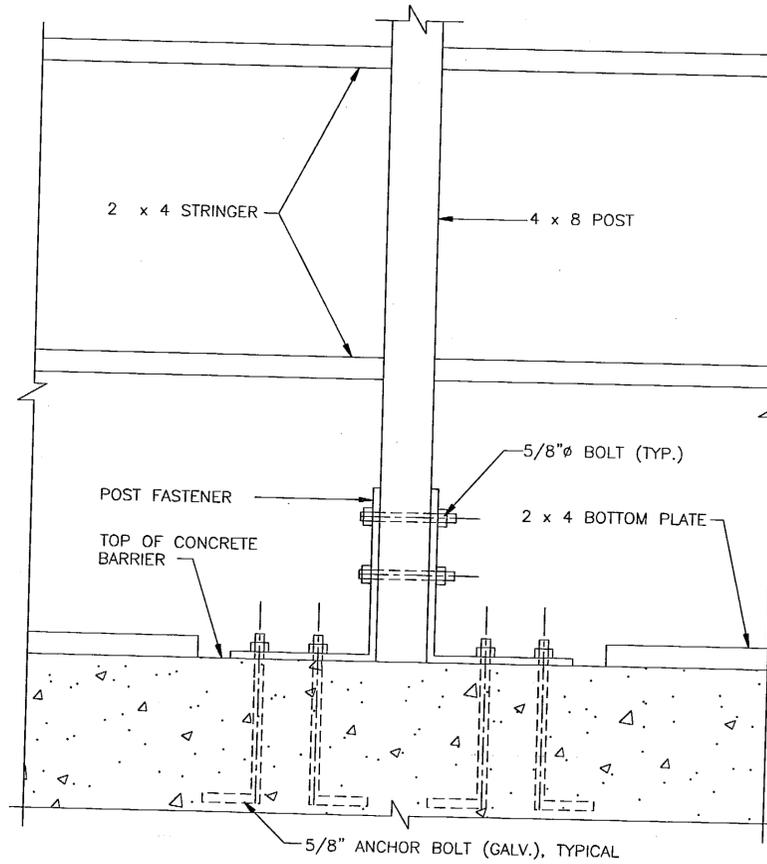


FRONT VIEW

POST CONNECTION

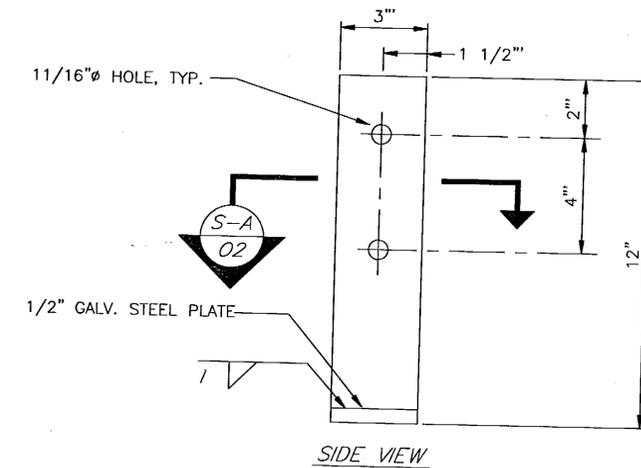

SIDE VIEW

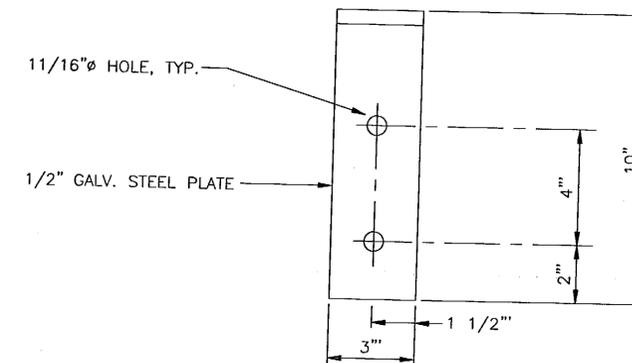

SECTION VIEW A

POST FASTENER

PATH: Q:\Ktn\71811A\PlanSet\O_Noise.DWG
Mon, 06/May/02 09:44AM Michael Limbaugh
PLOT: PSPACE 1=1(F) OR MSPACE 1=1(F)

ADDENDUM NUMBER		
ATTACHMENT NUMBER		
RECORD OF REVISIONS		
No.	DATE	DESCRIPTION

KTN-THIRD AVENUE EXTENSION
PROJECT NO. 68490

Noise Barrier Details

DESIGNED BY: C. HOWARD



CHECKED BY: T. MOORE
DRAWN BY: T.M./R.S.

STATE OF ALASKA
DEPARTMENT OF TRANSPORTATION
& PUBLIC FACILITIES
STATEWIDE DESIGN & ENGINEERING
SERVICES DIVISION
**THIRD AVENUE EXTENSION
PROJECT NO. 68490**

**Noise Barrier
Details**

PROJECT DESIGNATION NUMBER

STP-MG-0904(2)

STATE	YEAR
ALASKA	2002
SHEET NUMBER	TOTAL SHEETS
02	146


Project As Built Drawings have been reviewed by the Project Engineer. To the best of his/her knowledge, they represent the project as constructed.

Proj. Eng. *KS* Date 03-06

State of Alaska

Department of Transportation and Public Facilities

Statewide Design and Engineering Services Division

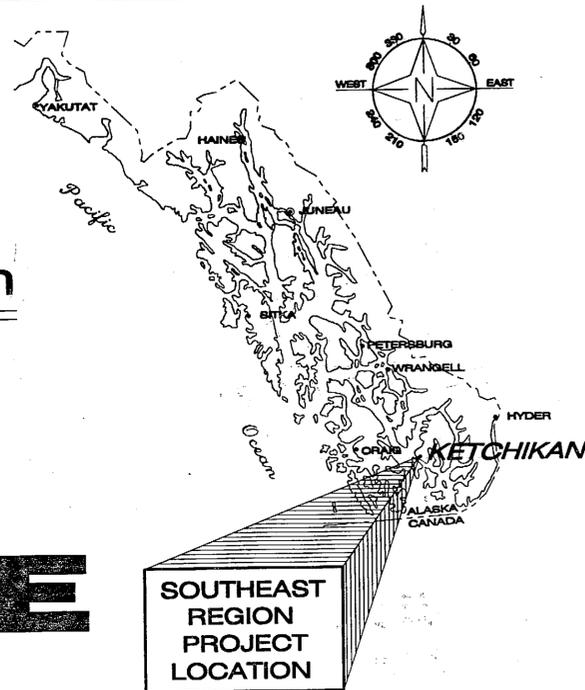

KETCHIKAN, ALASKA

KTN-THIRD AVENUE EXTENSION

STP-MG-0904(2)~68490

INDEX	
SHEET NO.	DESCRIPTION
A1	TITLE SHEET
A2	SURVEY CONTROL LAYOUT PLAN
A3	GENERAL LAYOUT PLAN
B1-B8	TYPICAL SECTIONS
C1-C2	ESTIMATE OF QUANTITIES
D1-D5	MISCELLANEOUS SUMMARIES
E1-E10	PLAN & PROFILE SHEETS
F1-F5	HAZARDOUS TREES & ROCKS
G1-G5	PARKING LOT AND DRIVEWAY DETAILS
H1-H5	CURB CUT, SIDEWALK & PEDESTRIAN RAIL DETAILS
J1-J6	RETAINING WALL DETAILS
K1-K4	RAINBIRD TRAIL LAYOUT PLAN & DETAILS
L1-L9	ROLLER COMPACTED CONCRETE WALL PLAN
M1-M8	EXCAVATION PLAN & DETAILS
N1-N8	DRAINAGE DETAILS
N9-N15	OFFSITE DRAINAGE IMPROVEMENTS
N16-N18	UNDERDRAIN DETAILS
N19-N26	EROSION & SEDIMENT CONTROL PLAN
O1-O2	NOISE BARRIER DETAILS
P1-P15	UTILITY PLANS AND DETAILS
R1-R5	RIGHT-OF-WAY PLANS
S1-S7	SLOPE STABILIZATION PLAN & DETAILS
T1-T2	TRAFFIC SUMMARIES
T3-T5	TRAFFIC CONTROL
T6-T13	ILLUMINATION, SIGNING & STRIPING
T14-T16	PTR DETAILS
W1-W3	CONCEPTUAL RCC WORK PLAN


AS BUILT PLAN

Contractor: SECON, INC.

Project Engineer: Allen Shepard

Start: JULY 15, 2002

End: JUNE 21, 2006

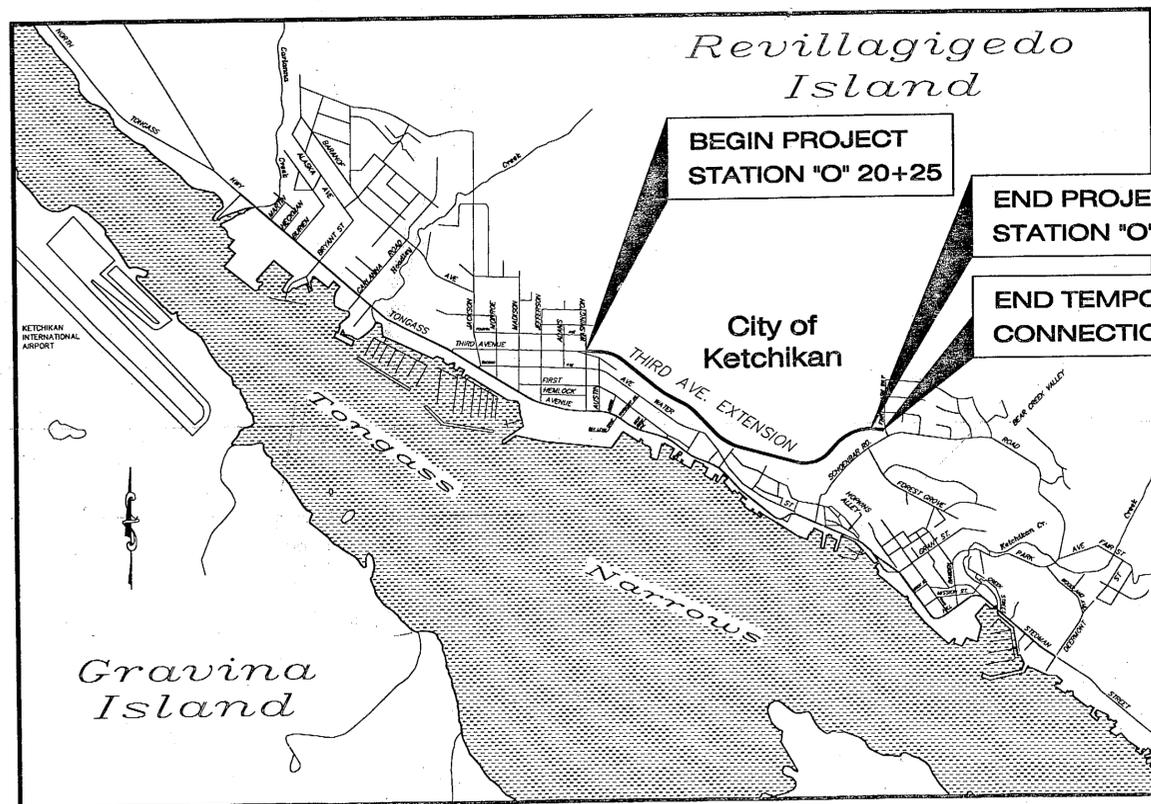

VICINITY MAP

DESIGN DESIGNATIONS

	2002	2023
A.D.T. (EST)	2300	4600
D.H.V. 10%	230	460
DESIGN SPEED	35 MPH	35 MPH
%T.	5	5
DESIGN EAL	<500K	<500K

PROJECT SUMMARY

CDS ROUTE NO.	NA
CDS MILEPOINT TO	NA
LENGTH OF PROJECT	5305 FT. (1.01 MI)
LENGTH OF GRADING	5305 FT. (1.01 MI)
LENGTH OF PAVING	5305 FT. (1.01 MI)
WIDTH OF PAVING	VARIES (31' TO 32.5')

THE FOLLOWING STANDARD DRAWINGS APPLY TO THIS PROJECT:

A-1	D-23.00	G-45.01	L-26.00	S-30.02
B-04.00	D-24.00	I-20.13	L-30.02	T-20.01
B-05.00	D-26.02	I-81.00	M-01.00	T-21.02
D-01.02	D-35.00	L-03.03	M-13.01	T-22.03
D-04.20	D-37.01	L-10.03	M-16.01	T-23.00
D-07.00	E-00.00	L-23.01	S-00.00	
D-20.03	E-13.00	L-24.00	S-05.01	
D-22.00	F-01.01	L-25.00	S-20.00	

PATH: Q:\Ktn\71811A\Planset\A_Tsht.dwg
Mon, 06/May/02 09:17AM Michael Limbaugh

PLOT: PSPACE OR MSPACE: 1000mm=1m(F)

TAB: TSHT

STATE OF ALASKA
DEPARTMENT OF TRANSPORTATION
& PUBLIC FACILITIES
STATEWIDE DESIGN & ENGINEERING SERVICES DIVISION



RECOMMENDED FOR APPROVAL:

for *Tracy Moore*
PATRICK J. KEMP, P.E.
REGIONAL PRECONSTRUCTION ENGINEER

5/3/02
DATE

[Signature]
ROBERT DOLL
DIRECTOR, S.E. REGION

5/3/02
DATE

CERTIFIED TRUE & CORRECT AS-BUILT OF ACTUAL FIELD CONDITION:

STATE	PROJECT DESIGNATION	YEAR	SHEET NO.	TOTAL SHEETS
ALASKA	STP-MG-0904(2)	2002	A1	146

ADDENDUM NUMBER

ATTACHMENT NUMBER

RECORD OF REVISIONS

No.	DATE	DESCRIPTION

KTN-THIRD AVENUE EXTENSION
 PROJECT NO. 68490

Survey Control Layout Plan

DESIGNED BY: C. HOWARD



CHECKED BY: T. MOORE

DRAWN BY: K.K.

STATE OF ALASKA
 DEPARTMENT OF TRANSPORTATION
 & PUBLIC FACILITIES
 STATEWIDE DESIGN & ENGINEERING
 SERVICES DIVISION

THIRD AVENUE EXTENSION
 PROJECT NO. 68490

Survey Control
 Layout Plan

PROJECT DESIGNATION NUMBER

STP-MG-0904(2)

STATE	YEAR
ALASKA	2002
SHEET NUMBER	TOTAL SHEETS
A2	146


ALIGNMENT "O"

BOP	20+25	91326.158	100873.497
PC	24+60.54	91337.562	101308.889
DELTA:	36-44-31	TYPE:	RIGHT
RADIUS:	575.000	DOC:	09-57-52
LENGTH:	368.728	TANGENT:	190.953
PT	28+29.27	91232.377	101655.733
LENGTH:	1839.301	COURSE:	S 54-45-31 E
PC	46+68.57	90171.056	103157.941
DELTA:	24-30-21	TYPE:	LEFT
RADIUS:	1500.000	DOC:	03-49-11
LENGTH:	641.559	TANGENT:	325.760
PT EQUATION STATION	53+10.13 BACK	89922.402	103744.057
	53+20.19 AHEAD		
LENGTH:	903.274	COURSE:	S 79-15-51 E
PC	62+23.46	89754.140	104631.521
DELTA:	57-37-29	TYPE:	LEFT
RADIUS:	500.000	DOC:	11-27-33
LENGTH:	502.872	TANGENT:	275.019
PT	67+26.34	89903.682	105089.677
LENGTH:	270.440	COURSE:	N 43-06-39 E
PC	69+96.78	90101.112	105274.499
DELTA:	50-40-00	TYPE:	RIGHT
RADIUS:	900.000	DOC:	06-21-58
LENGTH:	795.870	TANGENT:	426.069
PT	77+92.65	90384.085	105990.823
LENGTH:	227.357	COURSE:	S 86-13-21 E
END	80+20	90369.106	106217.686

BEGIN PROJECT
 STA."O" 20+25
 N= 91326.158
 E= 100873.497

END PROJECT
 STA."O" 73+30
 N= 90297.177
 E= 105541.583

END TEMPORARY
 CONNECTION

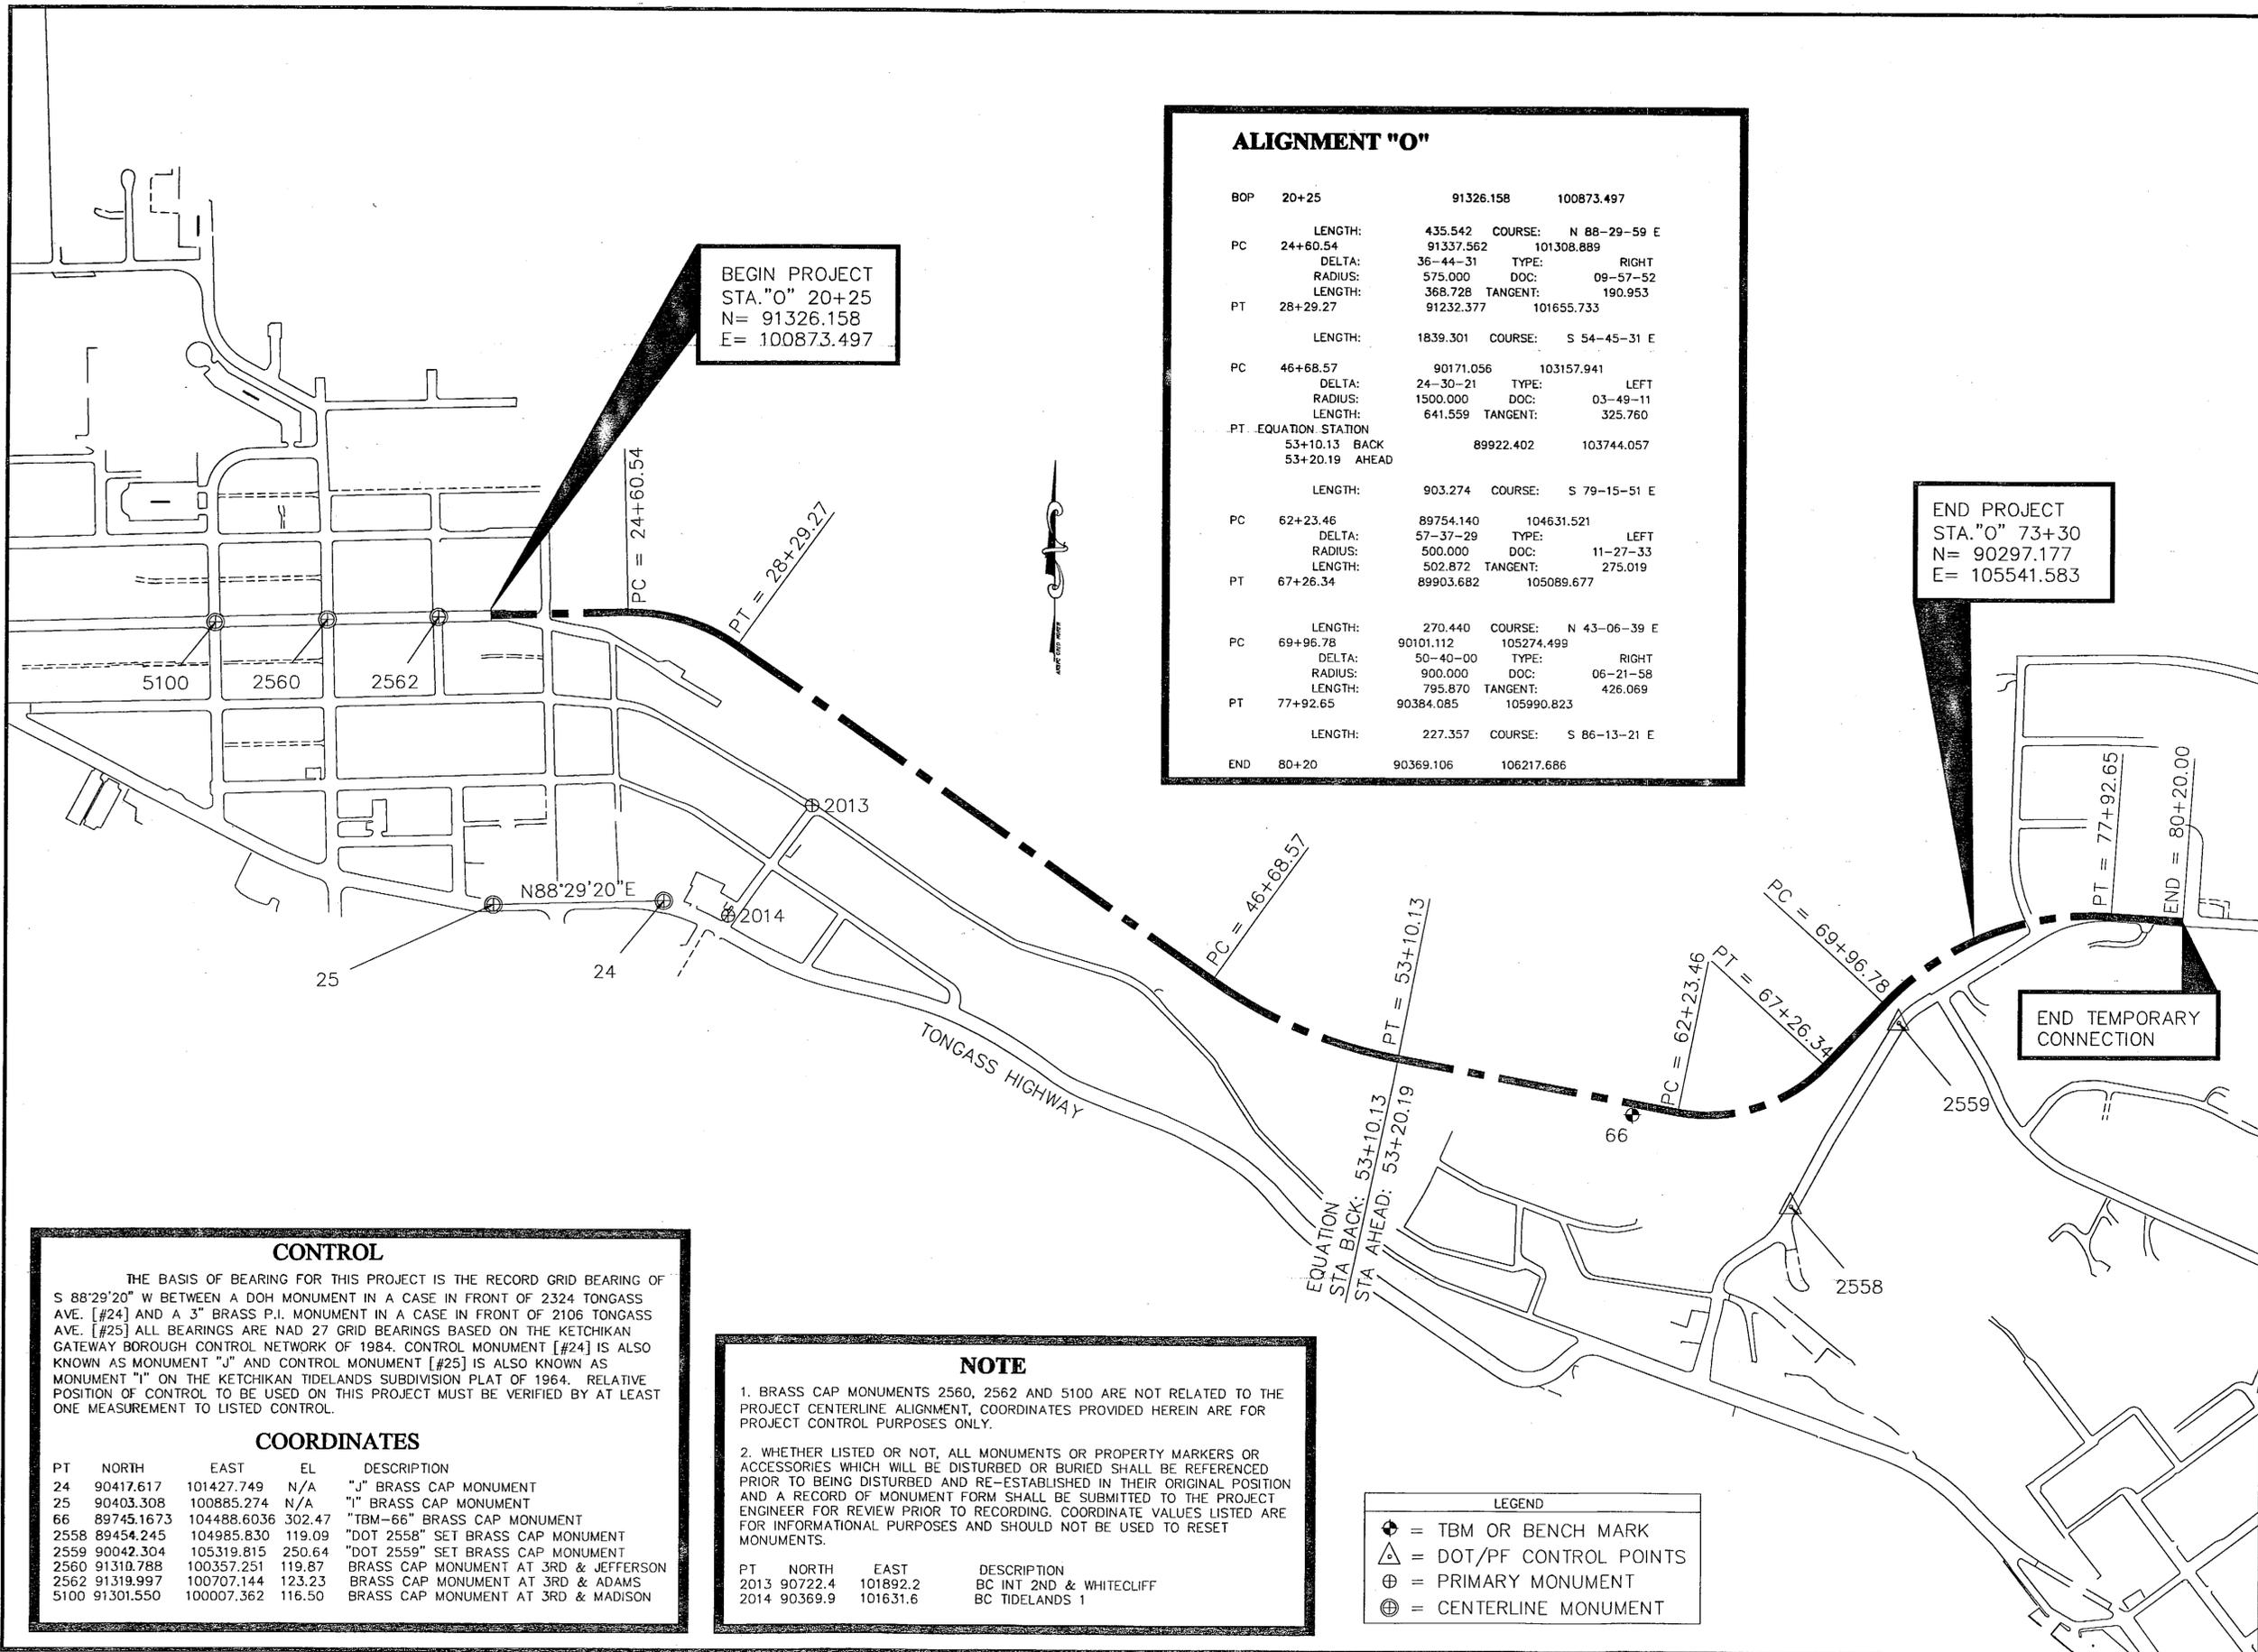

CONTROL

THE BASIS OF BEARING FOR THIS PROJECT IS THE RECORD GRID BEARING OF S 88°29'20" W BETWEEN A DOH MONUMENT IN A CASE IN FRONT OF 2324 TONGASS AVE. [#24] AND A 3" BRASS P.I. MONUMENT IN A CASE IN FRONT OF 2106 TONGASS AVE. [#25] ALL BEARINGS ARE NAD 27 GRID BEARINGS BASED ON THE KETCHIKAN GATEWAY BOROUGH CONTROL NETWORK OF 1984. CONTROL MONUMENT [#24] IS ALSO KNOWN AS MONUMENT "J" AND CONTROL MONUMENT [#25] IS ALSO KNOWN AS MONUMENT "I" ON THE KETCHIKAN TIDELANDS SUBDIVISION PLAT OF 1964. RELATIVE POSITION OF CONTROL TO BE USED ON THIS PROJECT MUST BE VERIFIED BY AT LEAST ONE MEASUREMENT TO LISTED CONTROL.

COORDINATES

PT	NORTH	EAST	EL	DESCRIPTION
24	90417.617	101427.749	N/A	"J" BRASS CAP MONUMENT
25	90403.308	100885.274	N/A	"I" BRASS CAP MONUMENT
66	89745.1673	104488.6036	302.47	"TBM-66" BRASS CAP MONUMENT
2558	89454.245	104985.830	119.09	"DOT 2558" SET BRASS CAP MONUMENT
2559	90042.304	105319.815	250.64	"DOT 2559" SET BRASS CAP MONUMENT
2560	91310.788	100357.251	119.87	BRASS CAP MONUMENT AT 3RD & JEFFERSON
2562	91319.997	100707.144	123.23	BRASS CAP MONUMENT AT 3RD & ADAMS
5100	91301.550	100007.362	116.50	BRASS CAP MONUMENT AT 3RD & MADISON

NOTE

1. BRASS CAP MONUMENTS 2560, 2562 AND 5100 ARE NOT RELATED TO THE PROJECT CENTERLINE ALIGNMENT, COORDINATES PROVIDED HEREIN ARE FOR PROJECT CONTROL PURPOSES ONLY.

2. WHETHER LISTED OR NOT, ALL MONUMENTS OR PROPERTY MARKERS OR ACCESSORIES WHICH WILL BE DISTURBED OR BURIED SHALL BE REFERENCED PRIOR TO BEING DISTURBED AND RE-ESTABLISHED IN THEIR ORIGINAL POSITION AND A RECORD OF MONUMENT FORM SHALL BE SUBMITTED TO THE PROJECT ENGINEER FOR REVIEW PRIOR TO RECORDING. COORDINATE VALUES LISTED ARE FOR INFORMATIONAL PURPOSES AND SHOULD NOT BE USED TO RESET MONUMENTS.

PT	NORTH	EAST	DESCRIPTION
2013	90722.4	101892.2	BC INT 2ND & WHITECLIFF
2014	90369.9	101631.6	BC TIDELANDS 1

LEGEND

- ⊕ = TBM OR BENCH MARK
- △ = DOT/PF CONTROL POINTS
- ⊙ = PRIMARY MONUMENT
- ⊕ = CENTERLINE MONUMENT

PATH:
 Q:\KIn\71811A\PlanSet\A3_General Layout.dwg
 Tue, 07/May/02 03:22PM Michael Limbaug
 PLOT:
 PSPACE 1=1(F) OR MSPACE 1=1(F)

ADDENDUM NUMBER		
ATTACHMENT NUMBER		
RECORD OF REVISIONS		
No.	DATE	DESCRIPTION

KTN-THIRD AVENUE EXTENSION
PROJECT NO. 68490
General Layout Plan

DESIGNED BY: C. HOWARD



CHECKED BY: T. MOORE
 DRAWN BY: K.K./R.S./M.L.

STATE OF ALASKA
 DEPARTMENT OF TRANSPORTATION
 & PUBLIC FACILITIES
 STATEWIDE DESIGN & ENGINEERING
 SERVICES DIVISION


THIRD AVENUE EXTENSION
PROJECT NO. 68490

General Layout Plan

PROJECT DESIGNATION NUMBER	
STP-MG-0904(2)	
STATE	YEAR
ALASKA	2002
SHEET NUMBER	TOTAL SHEETS
A3	146

Project As Built Drawings have been reviewed by the Project Engineer. To the best of his/her knowledge, they represent the project as constructed.


Proj. Eng. *[Signature]* Date *05/06*

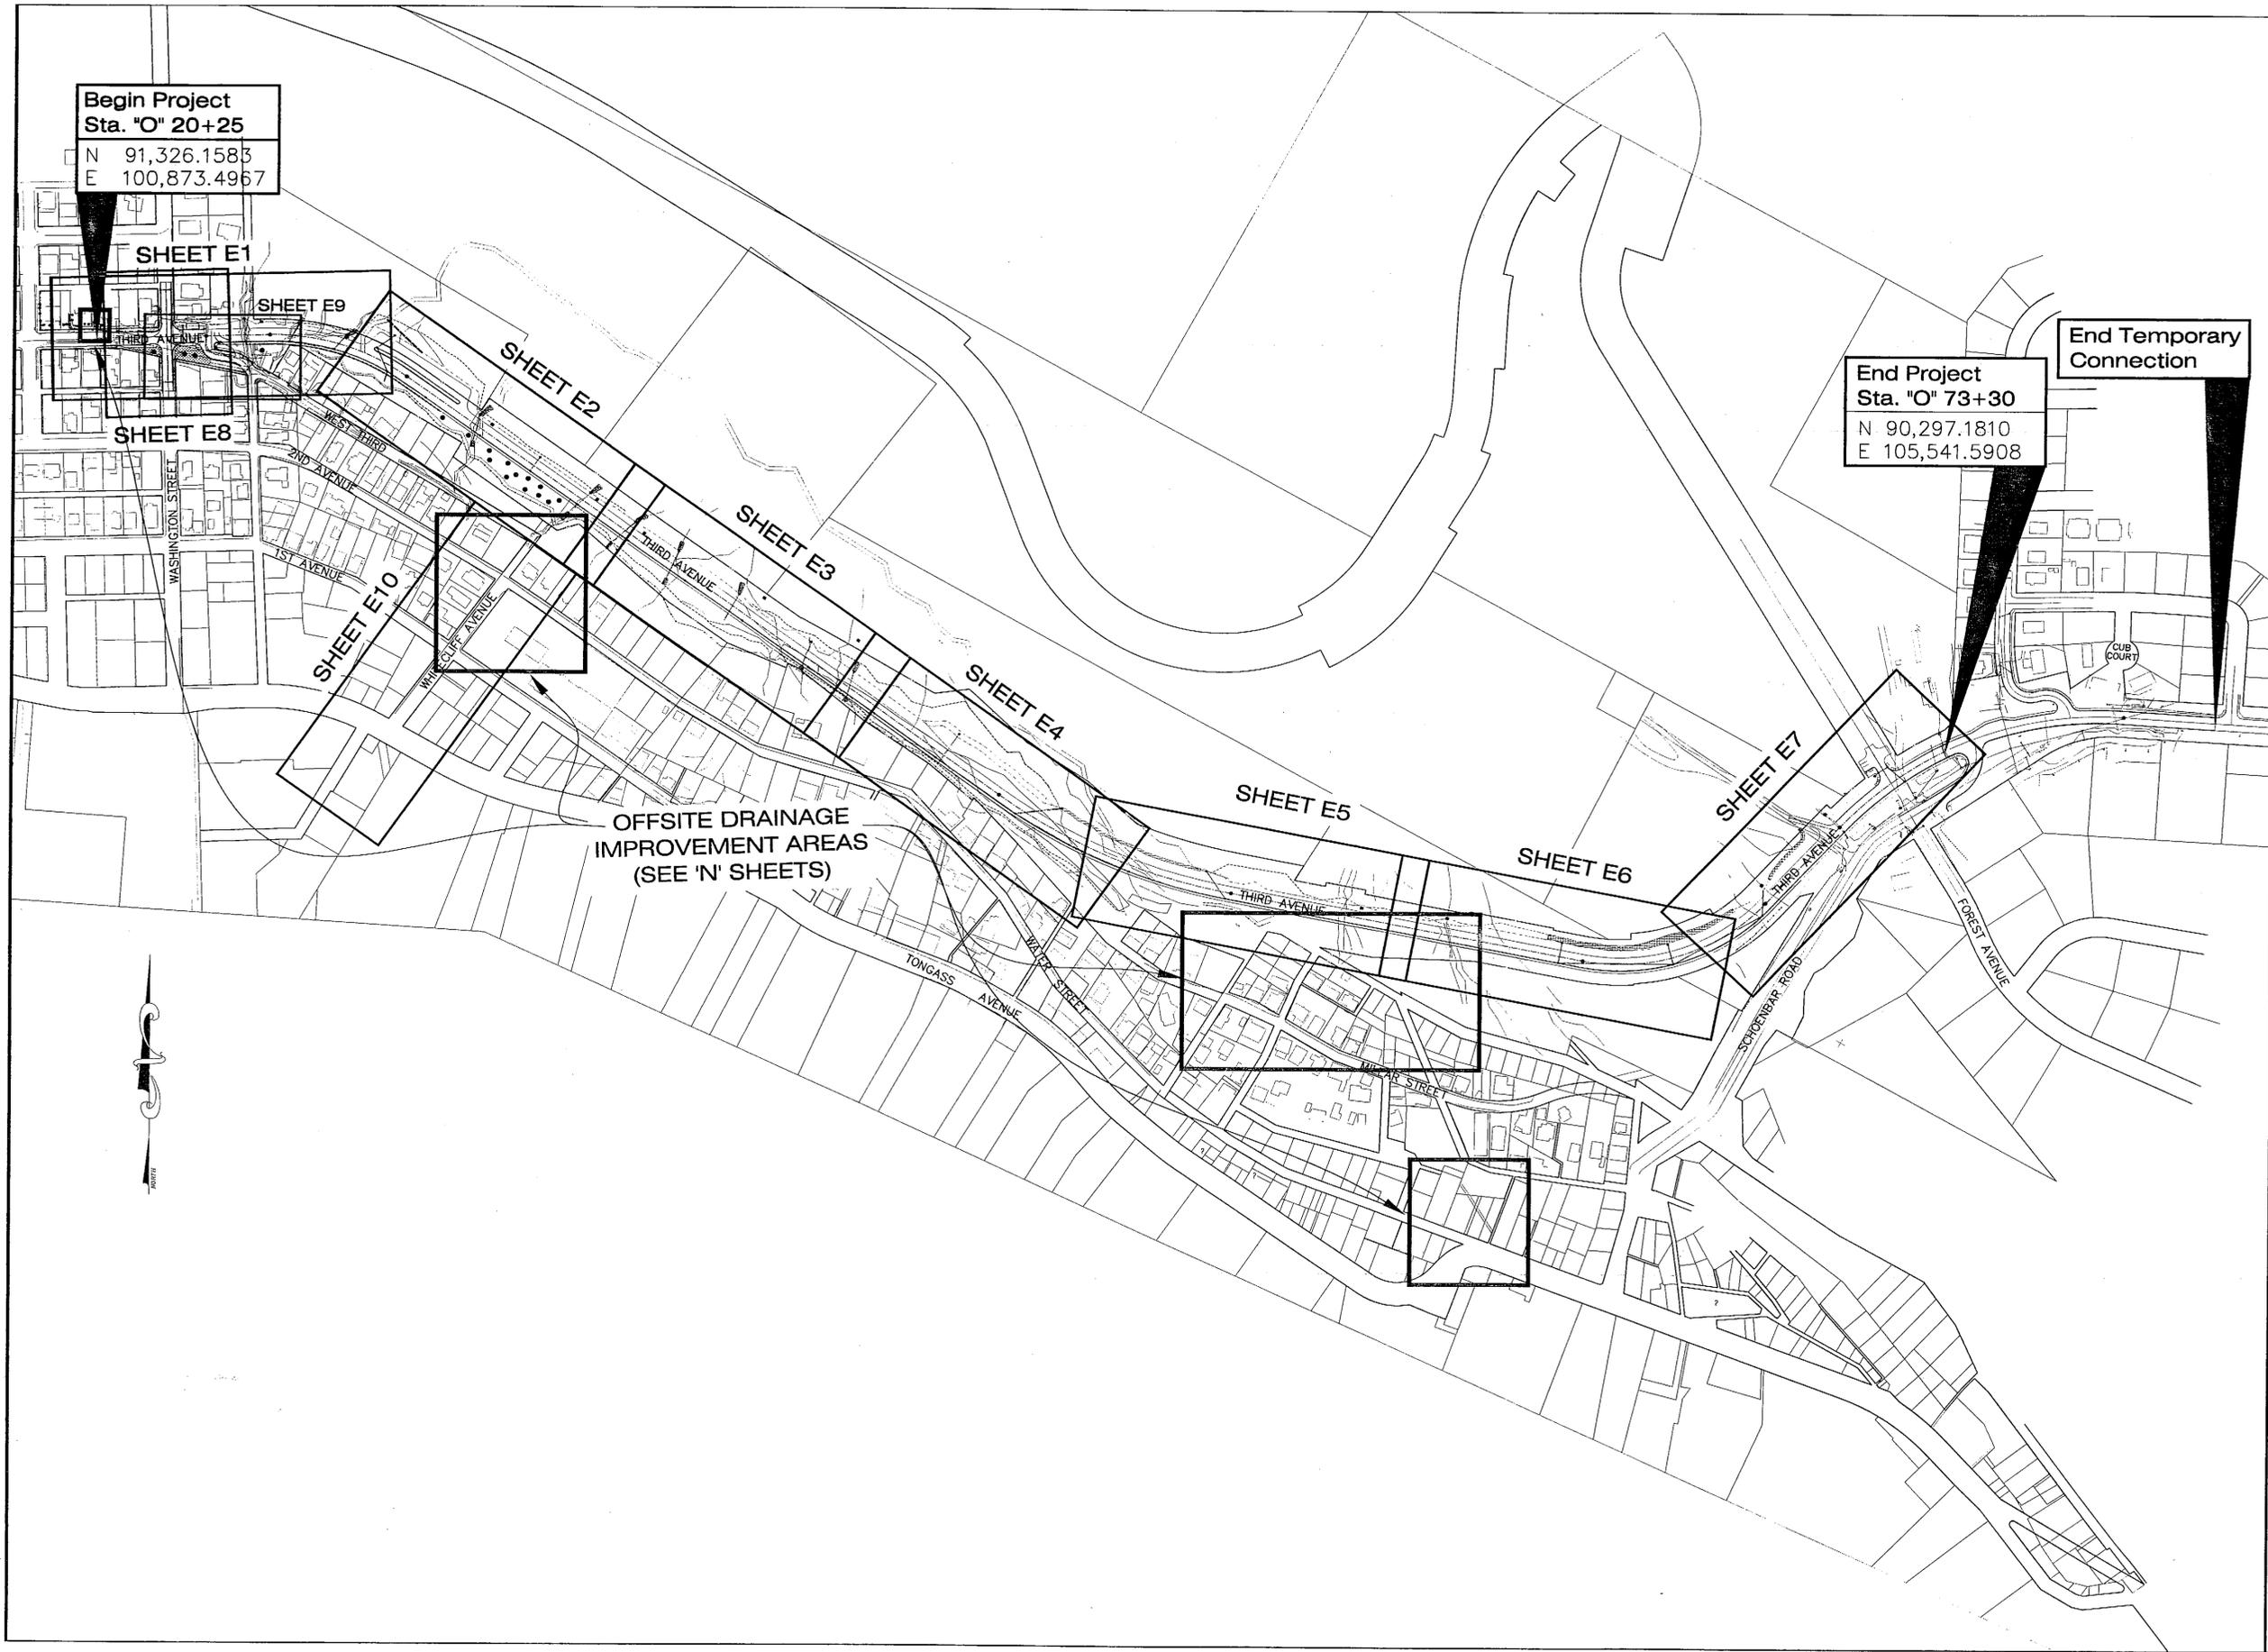

ADDENDUM NUMBER		
ATTACHMENT NUMBER		
RECORD OF REVISIONS		
No.	DATE	DESCRIPTION

KTN-THIRD AVENUE EXTENSION
PROJECT NO. 68490

Typical Sections

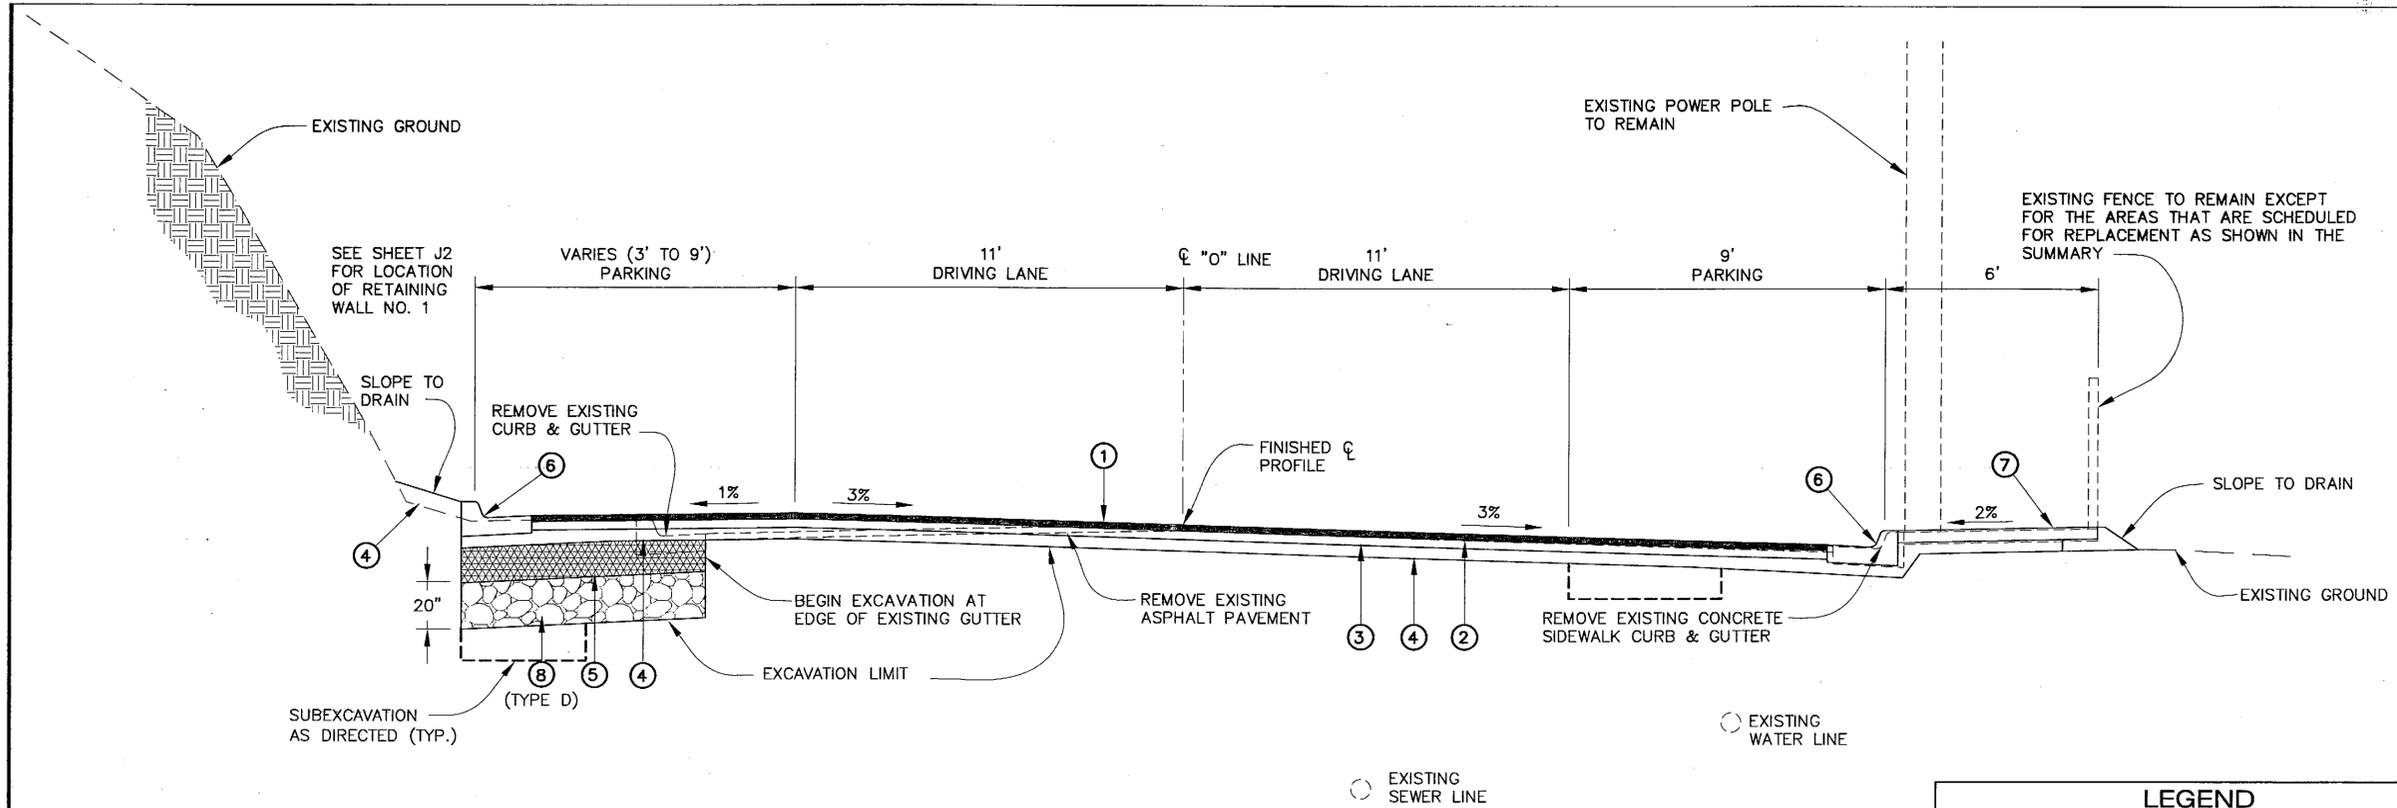


STA. "0" 20+25 (BOP) TO STA. "0" 22+00

SUPERELEVATION TABLE			
STATION	LT.	RT.	REMARKS
B.O.P	+3%	-3%	MATCH EXISTING
"0" 21+90.40	+9.74%	-9.74%	
"0" 22+14.40	+9.74%	-9.74%	
"0" 22+89.40	+2%	-2%	HOLD CONSTANT TO CURVE 1

LEGEND	
①	2" ASPHALT CONCRETE PAVEMENT, TYPE II, CLASS A
②	STE-1 ASPHALT FOR TACK COAT
③	3" ASPHALT TREATED BASE
④	4" CRUSHED AGGREGATE BASE COURSE
⑤	12" SUBBASE, GRADING "B"
⑥	CURB & GUTTER, TYPE 1
⑦	CONCRETE SIDEWALK, 4 INCHES THICK
⑧	EMBANKMENT (TYPE LISTED)*
⑨	28" FLUFF BLASTING
⑩	ROLLER COMPACTED CONCRETE EMBANKMENT
⑪	WASTE FILL
⑫	4" TOPSOIL
⑬	GEOTEXTILE, SEPARATION
⑭	UNCLASSIFIED EXCAVATION

* WHEN NO TYPE IS LISTED, TYPE A OR D MAY BE USED, CONTRACTORS OPTION.

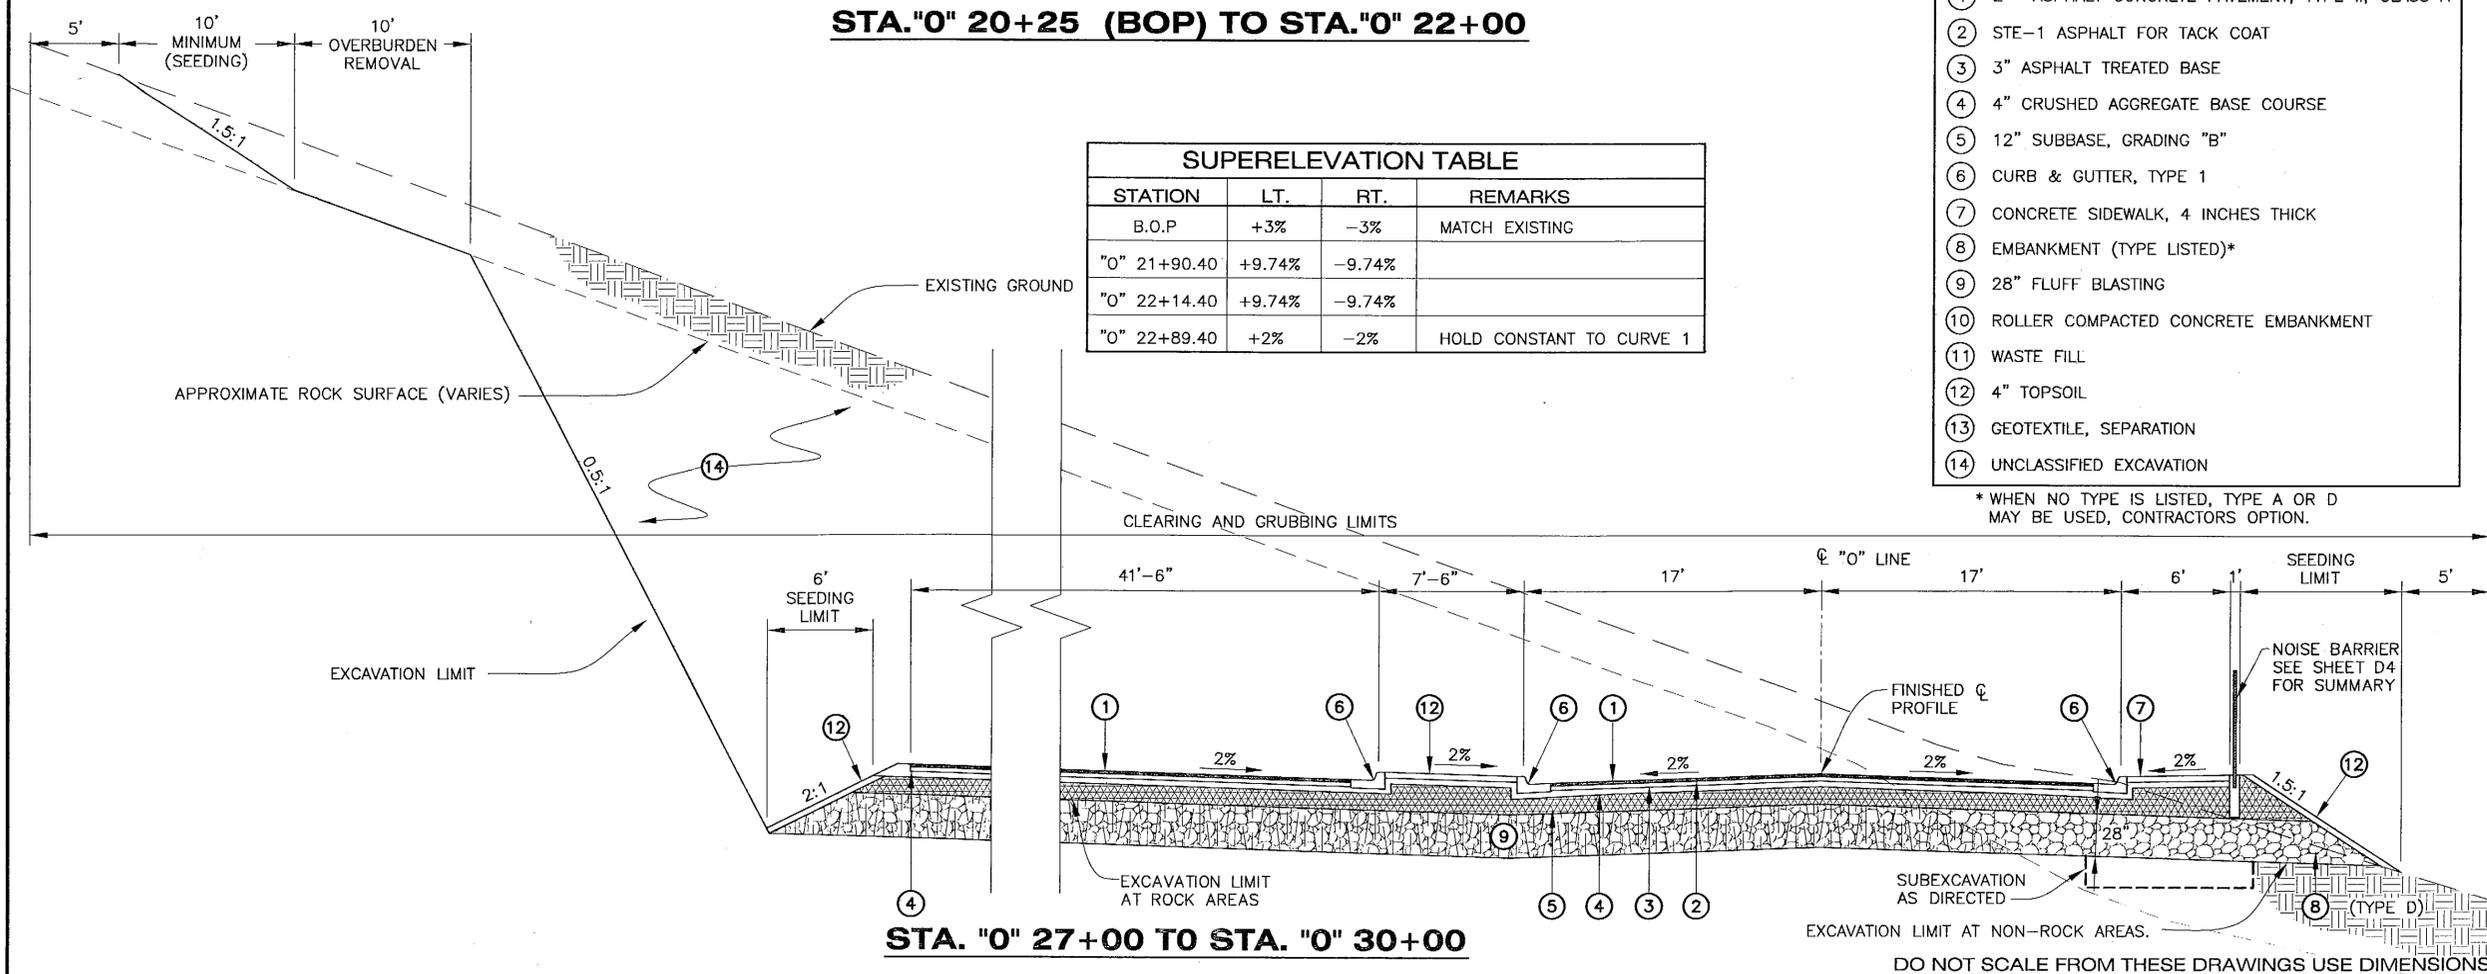

STA. "0" 27+00 TO STA. "0" 30+00

DO NOT SCALE FROM THESE DRAWINGS USE DIMENSIONS

DESIGNED BY: C. HOWARD




CHECKED BY: T. MOORE
DRAWN BY: M.L. / K.K.

STATE OF ALASKA
DEPARTMENT OF TRANSPORTATION
& PUBLIC FACILITIES
STATEWIDE DESIGN & ENGINEERING
SERVICES DIVISION
THIRD AVENUE EXTENSION
PROJECT NO. 68490

Typical Sections


PROJECT DESIGNATION NUMBER	
STP-MG-0904(2)	
STATE	YEAR
ALASKA	2002
SHEET NUMBER	TOTAL SHEETS
B1	146

Project As Built Drawings have been reviewed by the Project Engineer. To the best of his/her knowledge, they represent the project as constructed.
Proj. Eng. *[Signature]* Date 12/1/02

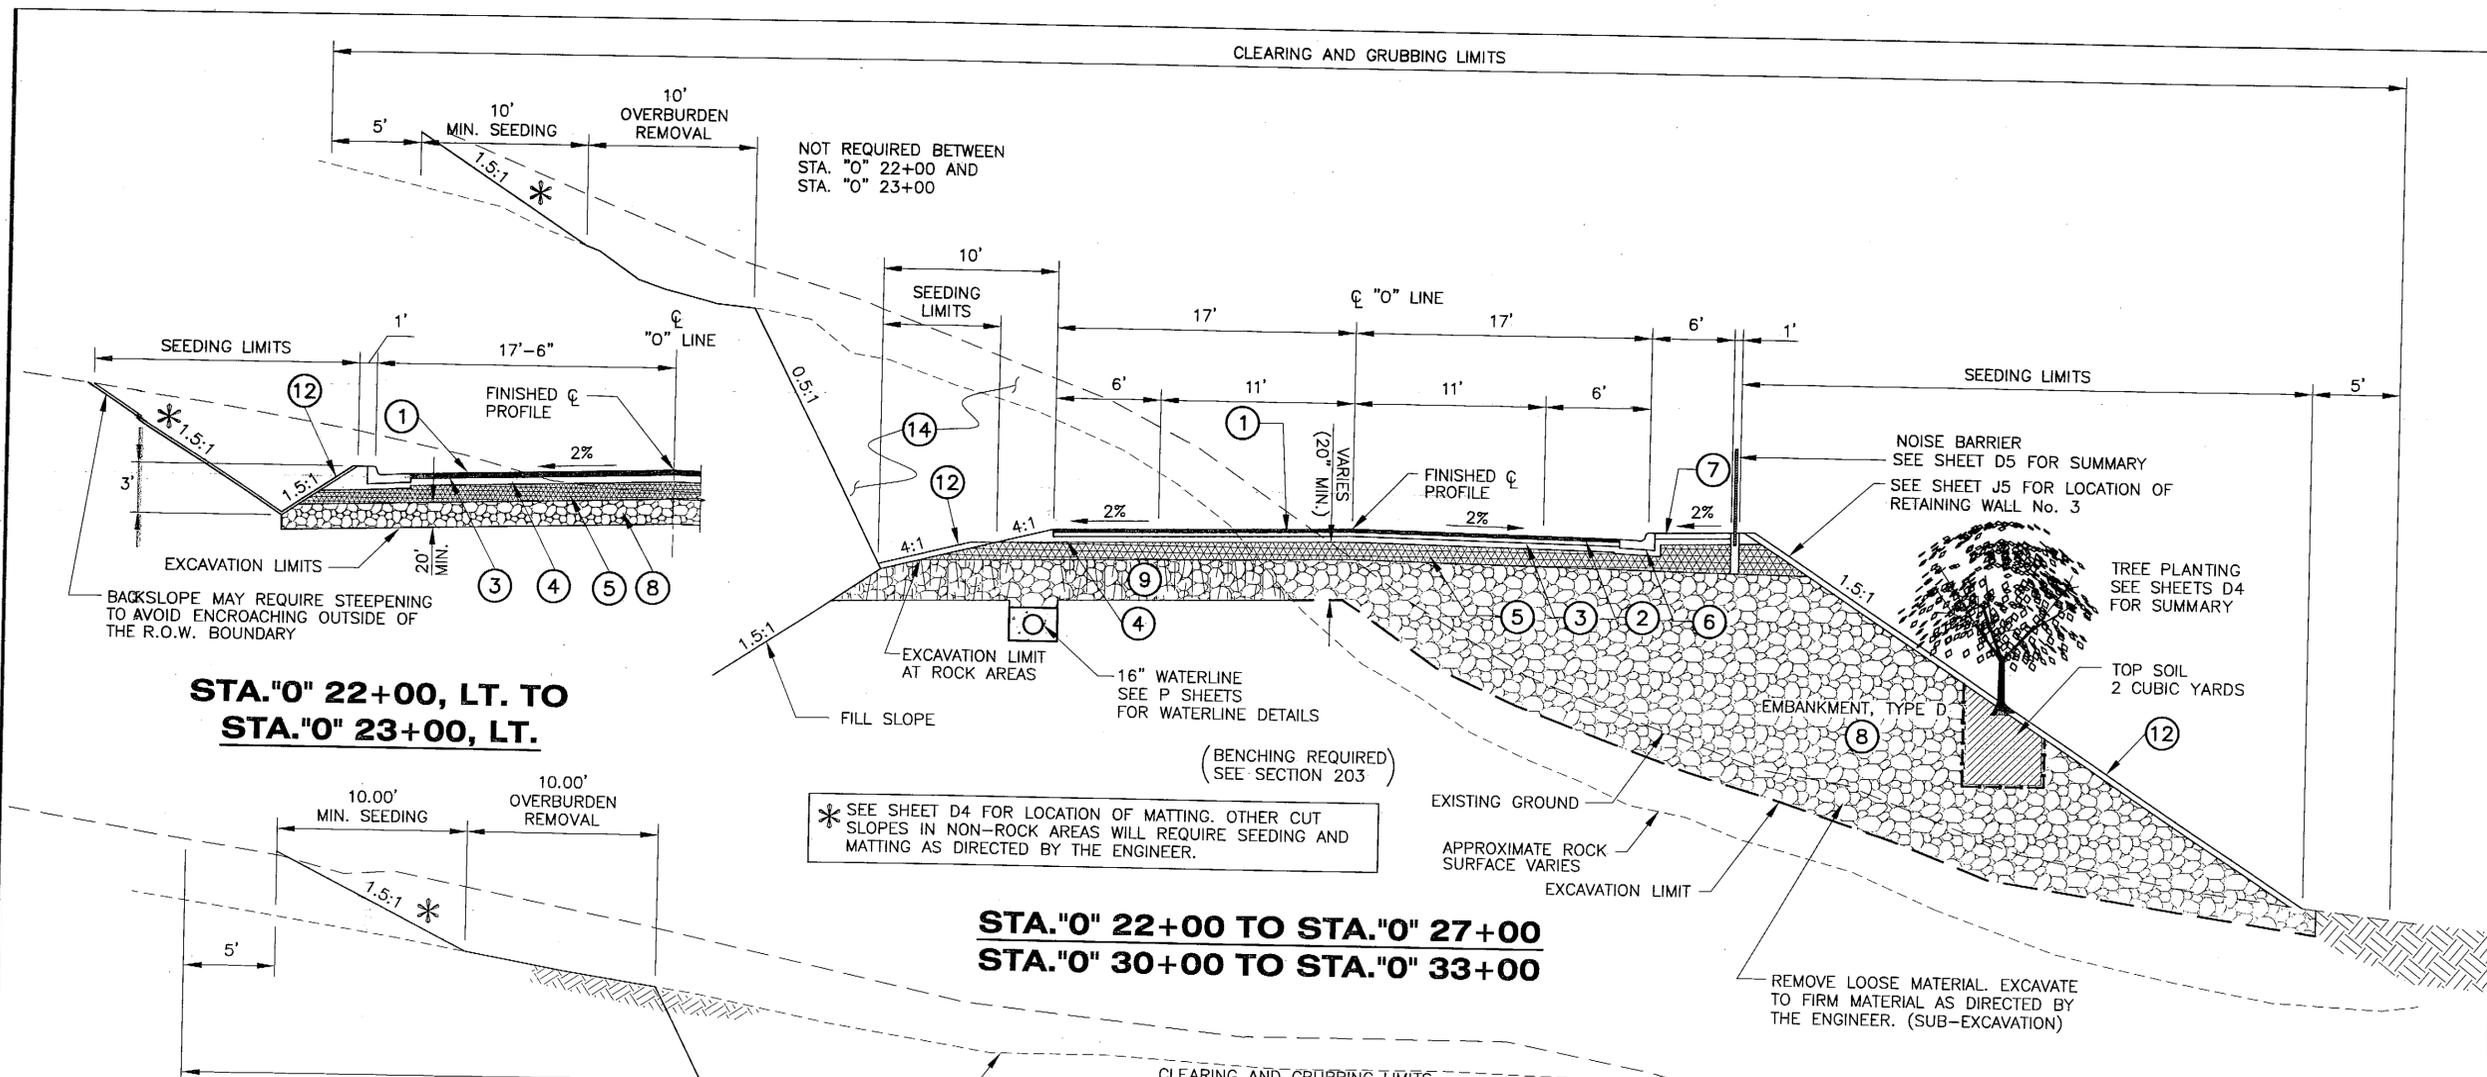

STA."0" 22+00, LT. TO STA."0" 23+00, LT.

**STA."0" 22+00 TO STA."0" 27+00
STA."0" 30+00 TO STA."0" 33+00**

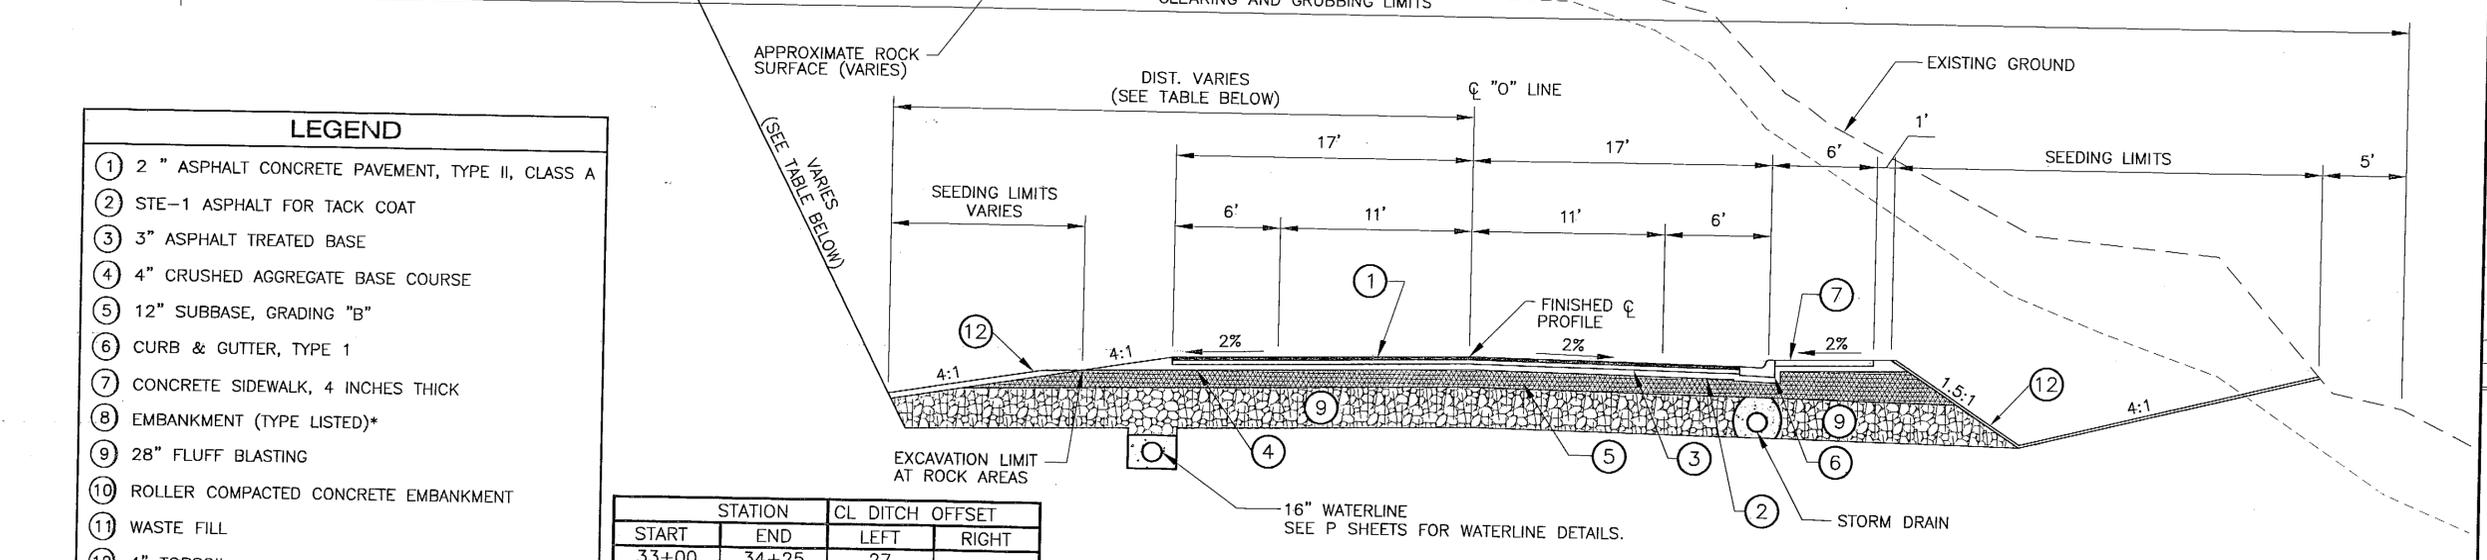

LEGEND

- ① 2" ASPHALT CONCRETE PAVEMENT, TYPE II, CLASS A
- ② STE-1 ASPHALT FOR TACK COAT
- ③ 3" ASPHALT TREATED BASE
- ④ 4" CRUSHED AGGREGATE BASE COURSE
- ⑤ 12" SUBBASE, GRADING "B"
- ⑥ CURB & GUTTER, TYPE 1
- ⑦ CONCRETE SIDEWALK, 4 INCHES THICK
- ⑧ EMBANKMENT (TYPE LISTED)*
- ⑨ 28" FLUFF BLASTING
- ⑩ ROLLER COMPACTED CONCRETE EMBANKMENT
- ⑪ WASTE FILL
- ⑫ 4" TOPSOIL
- ⑬ GEOTEXTILE, SEPARATION
- ⑭ UNCLASSIFIED EXCAVATION

* WHEN NO TYPE IS LISTED, TYPE A OR D MAY BE USED, CONTRACTORS OPTION.

STATION		CL DITCH OFFSET	
START	END	LEFT	RIGHT
33+00	34+25	27	
34+25	35+50	33	
35+50	38+25	36	
38+25	38+50	33	
38+50	40+00	27	

* SEE SHEET D4 FOR LOCATION OF MATTING. OTHER CUT SLOPES IN NON-ROCK AREAS WILL REQUIRE SEEDING AND MATTING AS DIRECTED BY THE ENGINEER.

ROCK CUT SLOPE

STATION	SLOPE
"0" 25+00 TO "0" 34+50	.5:1
"0" 34+50 TO "0" 40+00	.25:1

STA."0" 33+00 TO STA."0" 40+00

DO NOT SCALE FROM THESE DRAWINGS USE DIMENSIONS

PATH: O:\Ktn\71811A\Planset\B_Typs.dwg
Mon, 06/May/02 10:29AM Michael Limbough
PLOT: PSPACE 1=1(F) OR MSPACE 1=1(F)
TAB: B2

ADDENDUM NUMBER		
ATTACHMENT NUMBER		
RECORD OF REVISIONS		
No.	DATE	DESCRIPTION

KTN-THIRD AVENUE EXTENSION
PROJECT NO. 68490

Typical Sections

DESIGNED BY: C. HOWARD



CHECKED BY: T. MOORE
DRAWN BY: M.L. / K.K.

STATE OF ALASKA
DEPARTMENT OF TRANSPORTATION & PUBLIC FACILITIES
STATEWIDE DESIGN & ENGINEERING SERVICES DIVISION
THIRD AVENUE EXTENSION
PROJECT NO. 68490

Typical Sections

PROJECT DESIGNATION NUMBER


STP-MG-0904(2)

STATE	YEAR
ALASKA	2002
SHEET NUMBER	TOTAL SHEETS
B2	146

Project As Built Drawings have been reviewed by the Project Engineer. To the best of his/her knowledge, they represent the project as constructed.
Proj. Eng. [Signature] Date 05/02/06

ADDENDUM NUMBER		
ATTACHMENT NUMBER		
RECORD OF REVISIONS		
No.	DATE	DESCRIPTION

KTN-THIRD AVENUE EXTENSION
 PROJECT NO. 68490
 Typical Sections

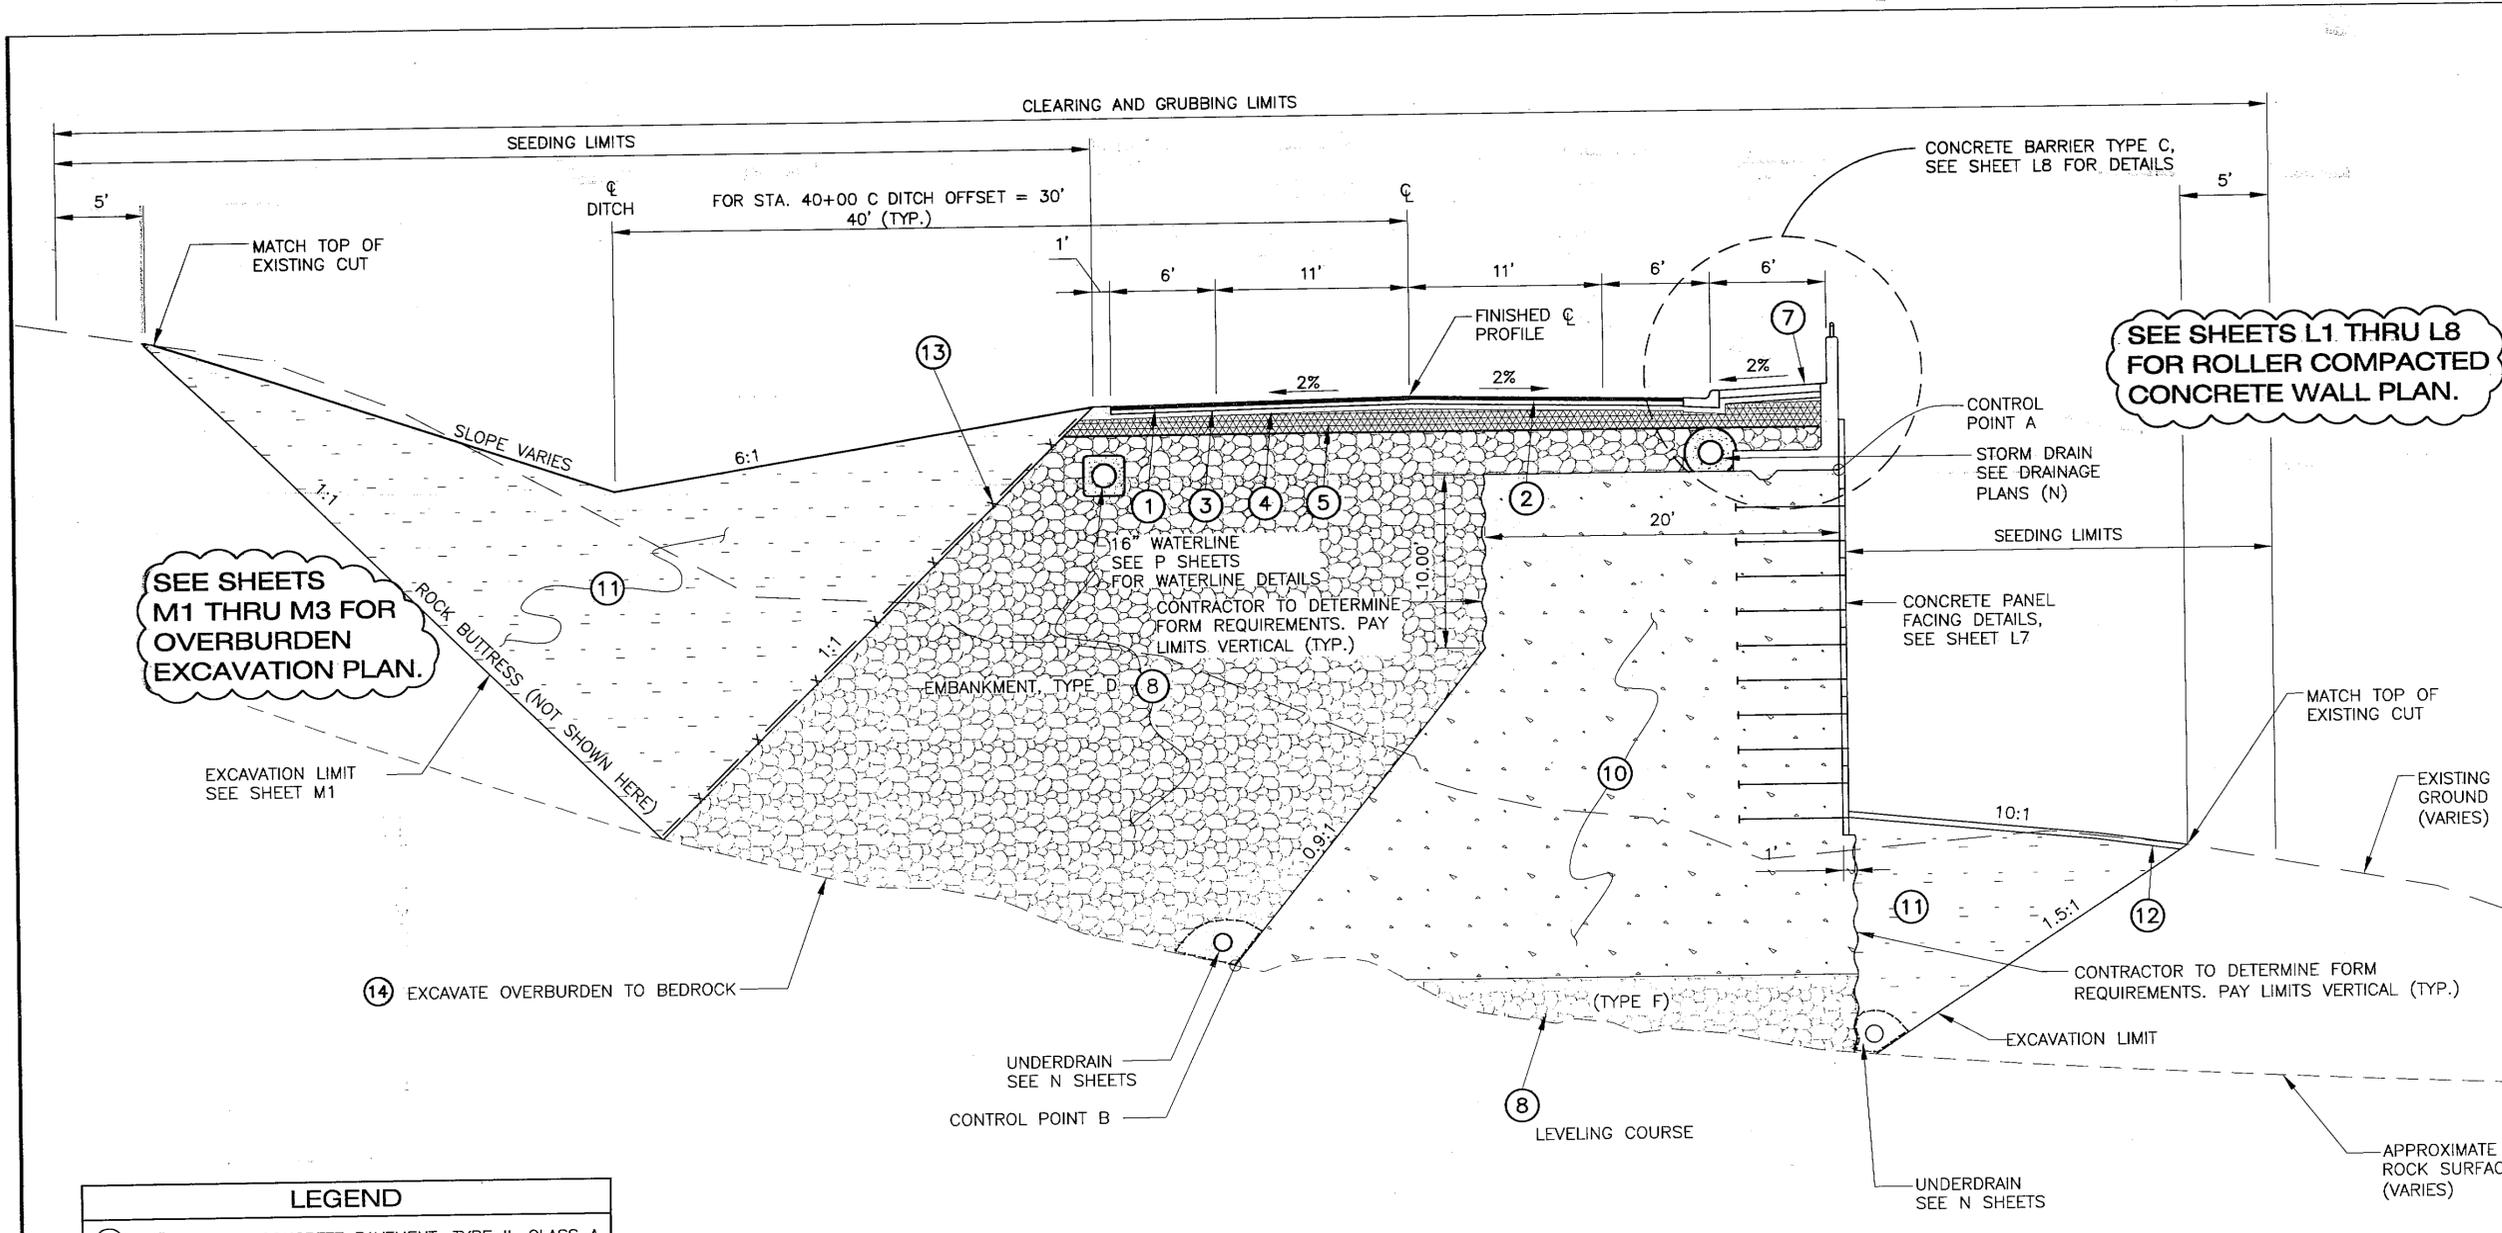

SEE SHEETS M1 THRU M3 FOR OVERBURDEN EXCAVATION PLAN.

SEE SHEETS L1 THRU L8 FOR ROLLER COMPACTED CONCRETE WALL PLAN.

EXCAVATION LIMIT SEE SHEET M1

EXCAVATE OVERBURDEN TO BEDROCK

STA."0" 40+00 TO STA."0" 44+00

LEGEND	
①	2" ASPHALT CONCRETE PAVEMENT, TYPE II, CLASS A
②	SIE-1 ASPHALT FOR TACK COAT
③	3" ASPHALT TREATED BASE
④	4" CRUSHED AGGREGATE BASE COURSE
⑤	12" SUBBASE, GRADING "B"
⑥	CURB & GUTTER, TYPE 1
⑦	CONCRETE SIDEWALK, 4 INCHES THICK
⑧	EMBANKMENT (TYPE LISTED)*
⑨	2 1/2" FLUFF BLASTING
⑩	ROLLER COMPACTED CONCRETE EMBANKMENT
⑪	WASTE FILL
⑫	4" TOPSOIL
⑬	GEOTEXTILE, SEPARATION
⑭	UNCLASSIFIED EXCAVATION

* WHEN NO TYPE IS LISTED, TYPE A OR D MAY BE USED, CONTRACTORS OPTION.

* TRANSITION BETWEEN 44+00 LT. AND 44+50 LT. TO BE DETERMINED IN FIELD BY THE ENGINEER.

NOTES:

- NO LEVELING COURSE ON BEDROCK SLOPES STEEPER THAN 15° PERPENDICULAR TO CENTERLINE. LEVELING COURSE MAY BE USED AT APPROXIMATE STATIONS 40+00 TO 42+75.
- 10.00' MINIMUM KEYWAY, SPECIAL CLEANING, BONDING, DENTAL CONCRETE, AND BEDDING MORTAR REQUIRED WHERE BEDROCK SLOPES EXCEED 4H:1V. THIS WORK REQUIRED AT APPROXIMATE STATIONS 42+75 TO 44+25. SEE SHEET B5 FOR DETAILS.

DO NOT SCALE FROM THESE DRAWINGS USE DIMENSIONS

DESIGNED BY: C. HOWARD



CHECKED BY: T. MOORE

DRAWN BY: M.L. / K.K.

STATE OF ALASKA
 DEPARTMENT OF TRANSPORTATION & PUBLIC FACILITIES
 STATEWIDE DESIGN & ENGINEERING SERVICES DIVISION

THIRD AVENUE EXTENSION
 PROJECT NO. 68490

Typical Sections

PROJECT DESIGNATION NUMBER

STP-MG-0904(2)

STATE	YEAR
ALASKA	2002

SHEET NUMBER	TOTAL SHEETS
B3	146

Project As Built Drawings have been reviewed by the Project Engineer. To the best of his/her knowledge, they represent the project as constructed.
 Proj. Eng. *[Signature]* Date 10/31/06

CLEARING AND GRUBBING LIMITS

PATH:
 C:\Ktn\71811A\Pionset\B_Typs.dwg
 Mon, 06/May/02 10:30AM Michael Limbaugh
 PLOT:
 PSPACE 1=1(F) OR MSPACE 1=1(F)
 TAB: B4

ADDENDUM NUMBER		
ATTACHMENT NUMBER		
RECORD OF REVISIONS		
No.	DATE	DESCRIPTION

KTN-THIRD AVENUE EXTENSION
 PROJECT NO. 68490

Typical Sections

DESIGNED BY: C. HOWARD




CHECKED BY: T. MOORE
 DRAWN BY: M.L. / K.K.

STATE OF ALASKA
 DEPARTMENT OF TRANSPORTATION
 & PUBLIC FACILITIES
 STATEWIDE DESIGN & ENGINEERING
 SERVICES DIVISION
 THIRD AVENUE EXTENSION
 PROJECT NO. 68490

Typical Sections

PROJECT DESIGNATION NUMBER	
STP-MG-0904(2)	
STATE	YEAR
ALASKA	2002
SHEET NUMBER	TOTAL SHEETS
B4	146

Project As Built Drawings have been reviewed by the Project Engineer. To the best of his/her knowledge, they represent the project as constructed.
 Proj. Eng. *[Signature]* Date: 5-1-06

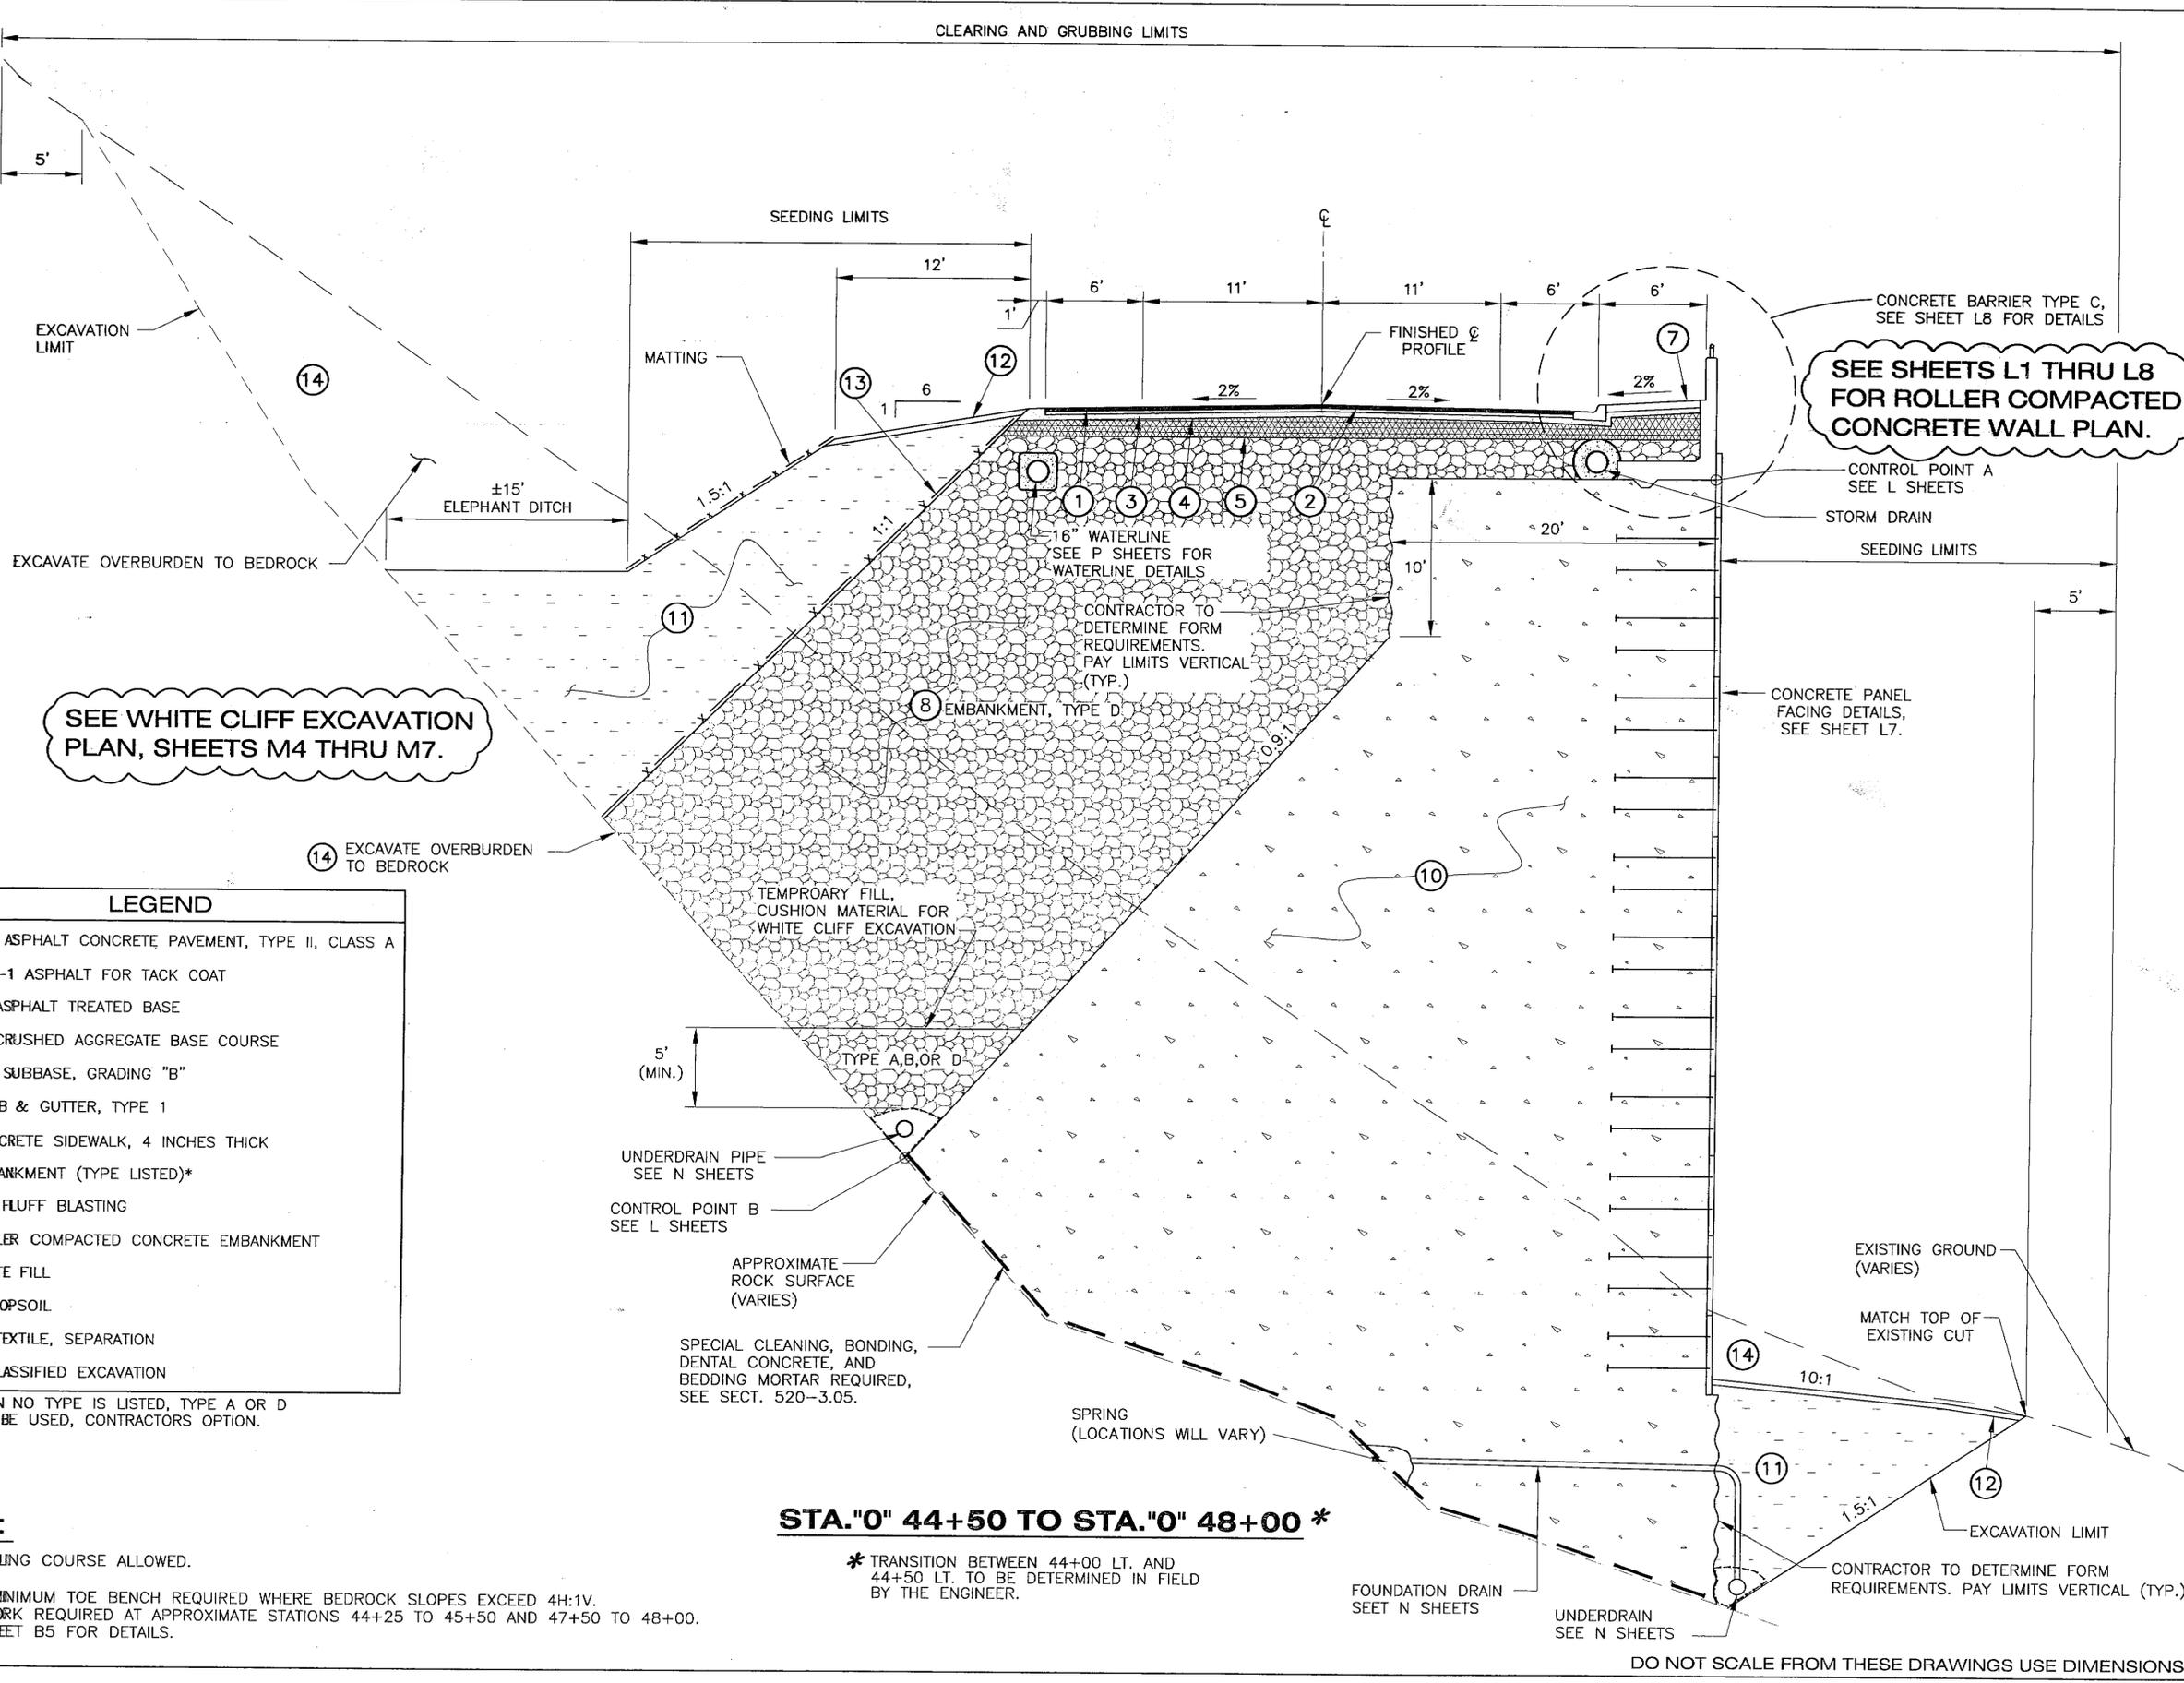

SEE WHITE CLIFF EXCAVATION PLAN, SHEETS M4 THRU M7.

SEE SHEETS L1 THRU L8 FOR ROLLER COMPACTED CONCRETE WALL PLAN.

LEGEND	
①	2" ASPHALT CONCRETE PAVEMENT, TYPE II, CLASS A
②	STE-1 ASPHALT FOR TACK COAT
③	3" ASPHALT TREATED BASE
④	4" CRUSHED AGGREGATE BASE COURSE
⑤	12" SUBBASE, GRADING "B"
⑥	CURB & GUTTER, TYPE 1
⑦	CONCRETE SIDEWALK, 4 INCHES THICK
⑧	EMBANKMENT (TYPE LISTED)*
⑨	28" FLUFF BLASTING
⑩	ROLLER COMPACTED CONCRETE EMBANKMENT
⑪	WASTE FILL
⑫	4" TOPSOIL
⑬	GEOTEXTILE, SEPARATION
⑭	UNCLASSIFIED EXCAVATION

* WHEN NO TYPE IS LISTED, TYPE A OR D MAY BE USED, CONTRACTORS OPTION.


- NOTE:**
- NO LEVELING COURSE ALLOWED.
 - 10.00' MINIMUM TOE BENCH REQUIRED WHERE BEDROCK SLOPES EXCEED 4H:1V. THIS WORK REQUIRED AT APPROXIMATE STATIONS 44+25 TO 45+50 AND 47+50 TO 48+00. SEE SHEET B5 FOR DETAILS.

STA."0" 44+50 TO STA."0" 48+00 *

* TRANSITION BETWEEN 44+00 LT. AND 44+50 LT. TO BE DETERMINED IN FIELD BY THE ENGINEER.

DO NOT SCALE FROM THESE DRAWINGS USE DIMENSIONS

CLEARING AND GRUBBING LIMITS

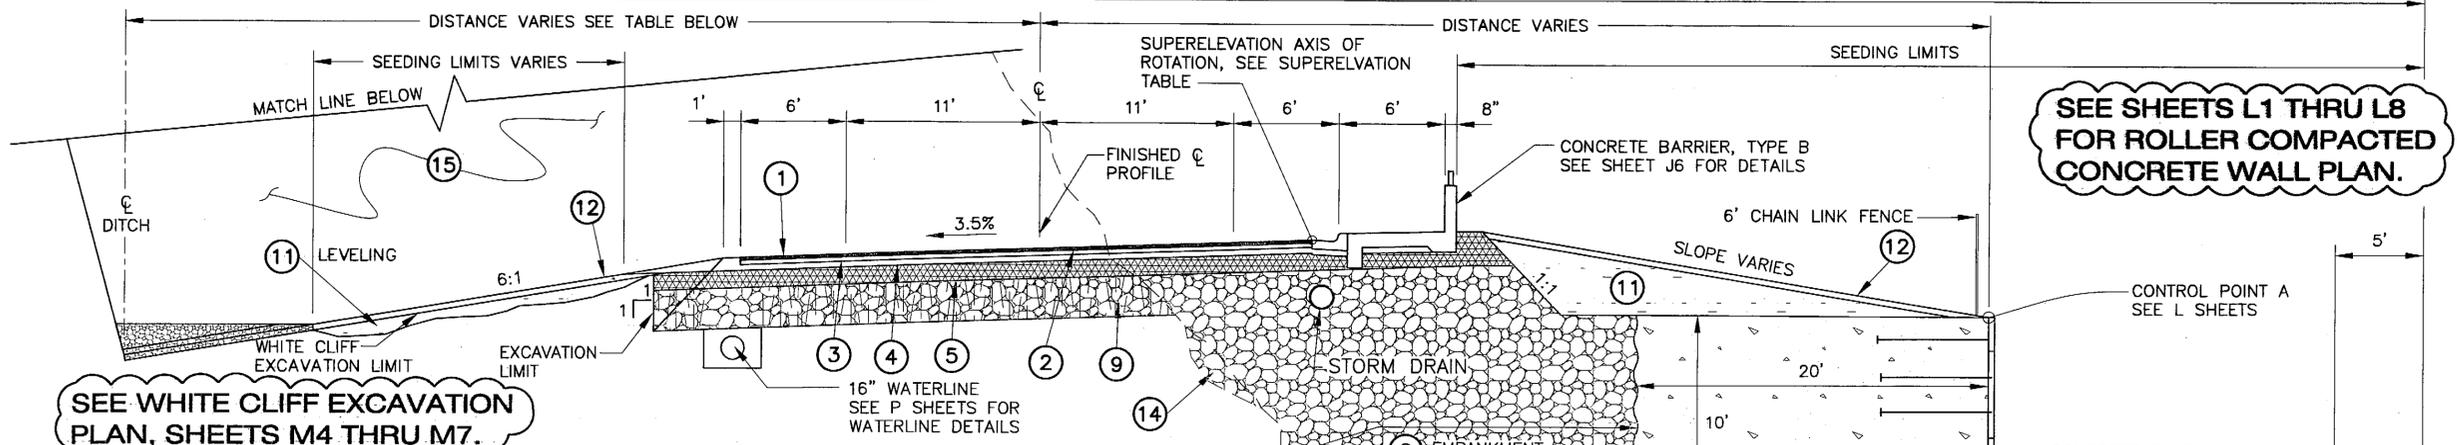



SEE SHEETS L1 THRU L8 FOR ROLLER COMPACTED CONCRETE WALL PLAN.

SEE WHITE CLIFF EXCAVATION PLAN, SHEETS M4 THRU M7.

STATION		ROCK CUT SLOPE	
START	END	LEFT	RIGHT
48+25	49+00	1/2 : 1	
49+25	50+50	1/4 : 1	

STATION		CL DITCH OFFSET	
START	END	LEFT	RIGHT
48+25	48+50	57	
48+75	49+25	52	
49+50	50+50	47	

CONTRACTOR TO DETERMINE FORM REQUIREMENTS. PAY LIMITS VERTICAL (TYP.)

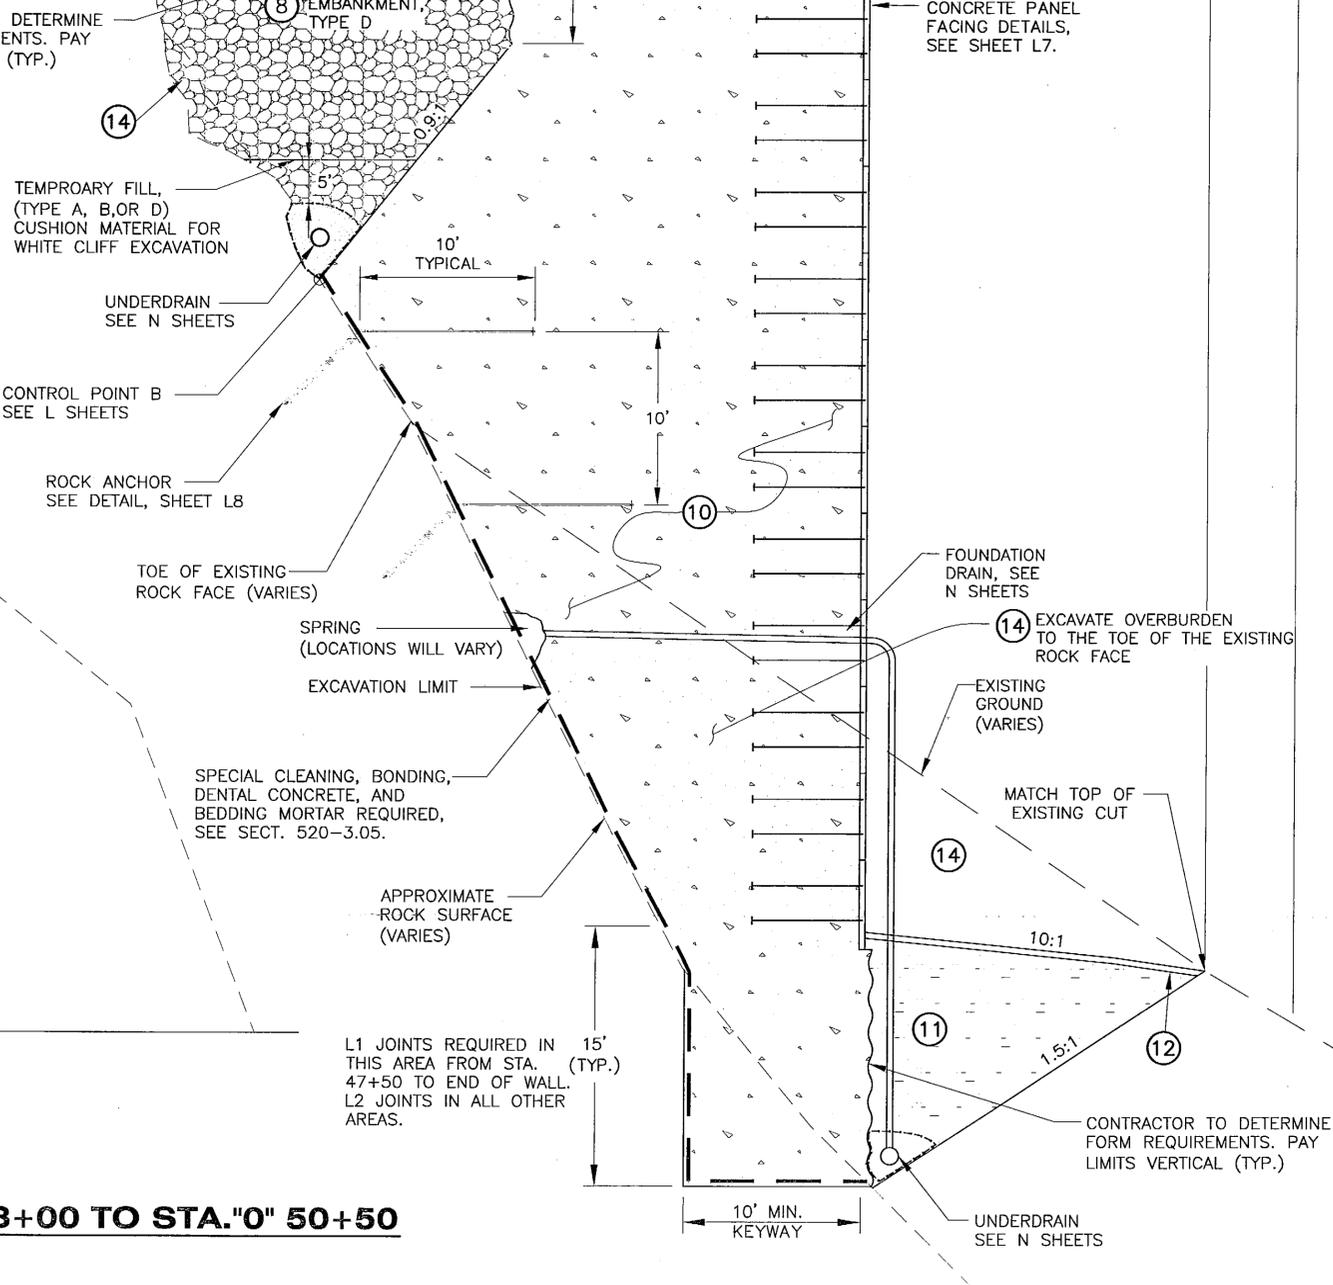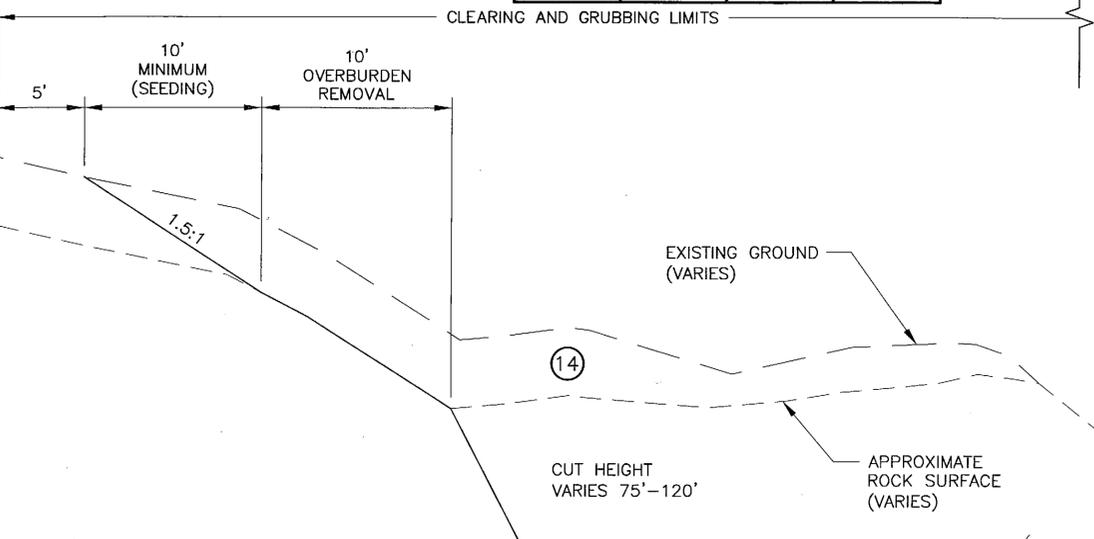

STA."0" 48+00 TO STA."0" 50+50

- LEGEND**
- ① 2" ASPHALT CONCRETE PAVEMENT, TYPE II, CLASS A
 - ② STE-1 ASPHALT FOR TACK COAT
 - ③ 3" ASPHALT TREATED BASE
 - ④ 4" CRUSHED AGGREGATE BASE COURSE
 - ⑤ 12" SUBBASE, GRADING "B"
 - ⑥ CURB & GUTTER, TYPE 1
 - ⑦ CONCRETE SIDEWALK, 4 INCHES THICK
 - ⑧ EMBANKMENT (TYPE LISTED)*
 - ⑨ 28" FLUFF BLASTING
 - ⑩ ROLLER COMPACTED CONCRETE EMBANKMENT
 - ⑪ WASTE FILL
 - ⑫ 4" TOPSOIL
 - ⑬ GEOTEXTILE, SEPARATION
 - ⑭ UNCLASSIFIED EXCAVATION
 - ⑮ WHITE CLIFF EXCAVATION

* WHEN NO TYPE IS LISTED, TYPE A OR D MAY BE USED, CONTRACTORS OPTION.

PATH: Q:\ktn\71811A\PlanSet\B_Typs.dwg
 Mon, 06/May/02 10:30AM Michael Limbaugh
 PLOT: PSPACE 1=1(F) OR MSPACE 1=1(F)
 TAB: B5

ADDENDUM NUMBER		
ATTACHMENT NUMBER		
RECORD OF REVISIONS		
No.	DATE	DESCRIPTION

KTN-THIRD AVENUE EXTENSION
 PROJECT NO. 68490

Typical Sections

DESIGNED BY: C. HOWARD



CHECKED BY: T. MOORE
 DRAWN BY: M.L. / K.K.

STATE OF ALASKA
 DEPARTMENT OF TRANSPORTATION & PUBLIC FACILITIES
 STATEWIDE DESIGN & ENGINEERING SERVICES DIVISION
 THIRD AVENUE EXTENSION
 PROJECT NO. 68490

Typical Sections

PROJECT DESIGNATION NUMBER	
STP-MG-0904(2)	
STATE	YEAR
ALASKA	2002
SHEET NUMBER	TOTAL SHEETS
B5	146

Project As Built Drawings have been reviewed by the Project Engineer. To the best of his/her knowledge, they represent the project as constructed.
 Proj. Eng. *[Signature]* Date: 03/06

ADDENDUM NUMBER		
ATTACHMENT NUMBER		
RECORD OF REVISIONS		
No.	DATE	DESCRIPTION

KTN-THIRD AVENUE EXTENSION
PROJECT NO. 68490


Typical Sections

CLEARING AND GRUBBING LIMITS

SEEDING LIMITS

SEE WHITE CLIFF EXCAVATION
PLAN, SHEETS M4 THRU M7.

SEE SHEETS L1 THRU L8
FOR ROLLER COMPACTED
CONCRETE WALL PLAN.

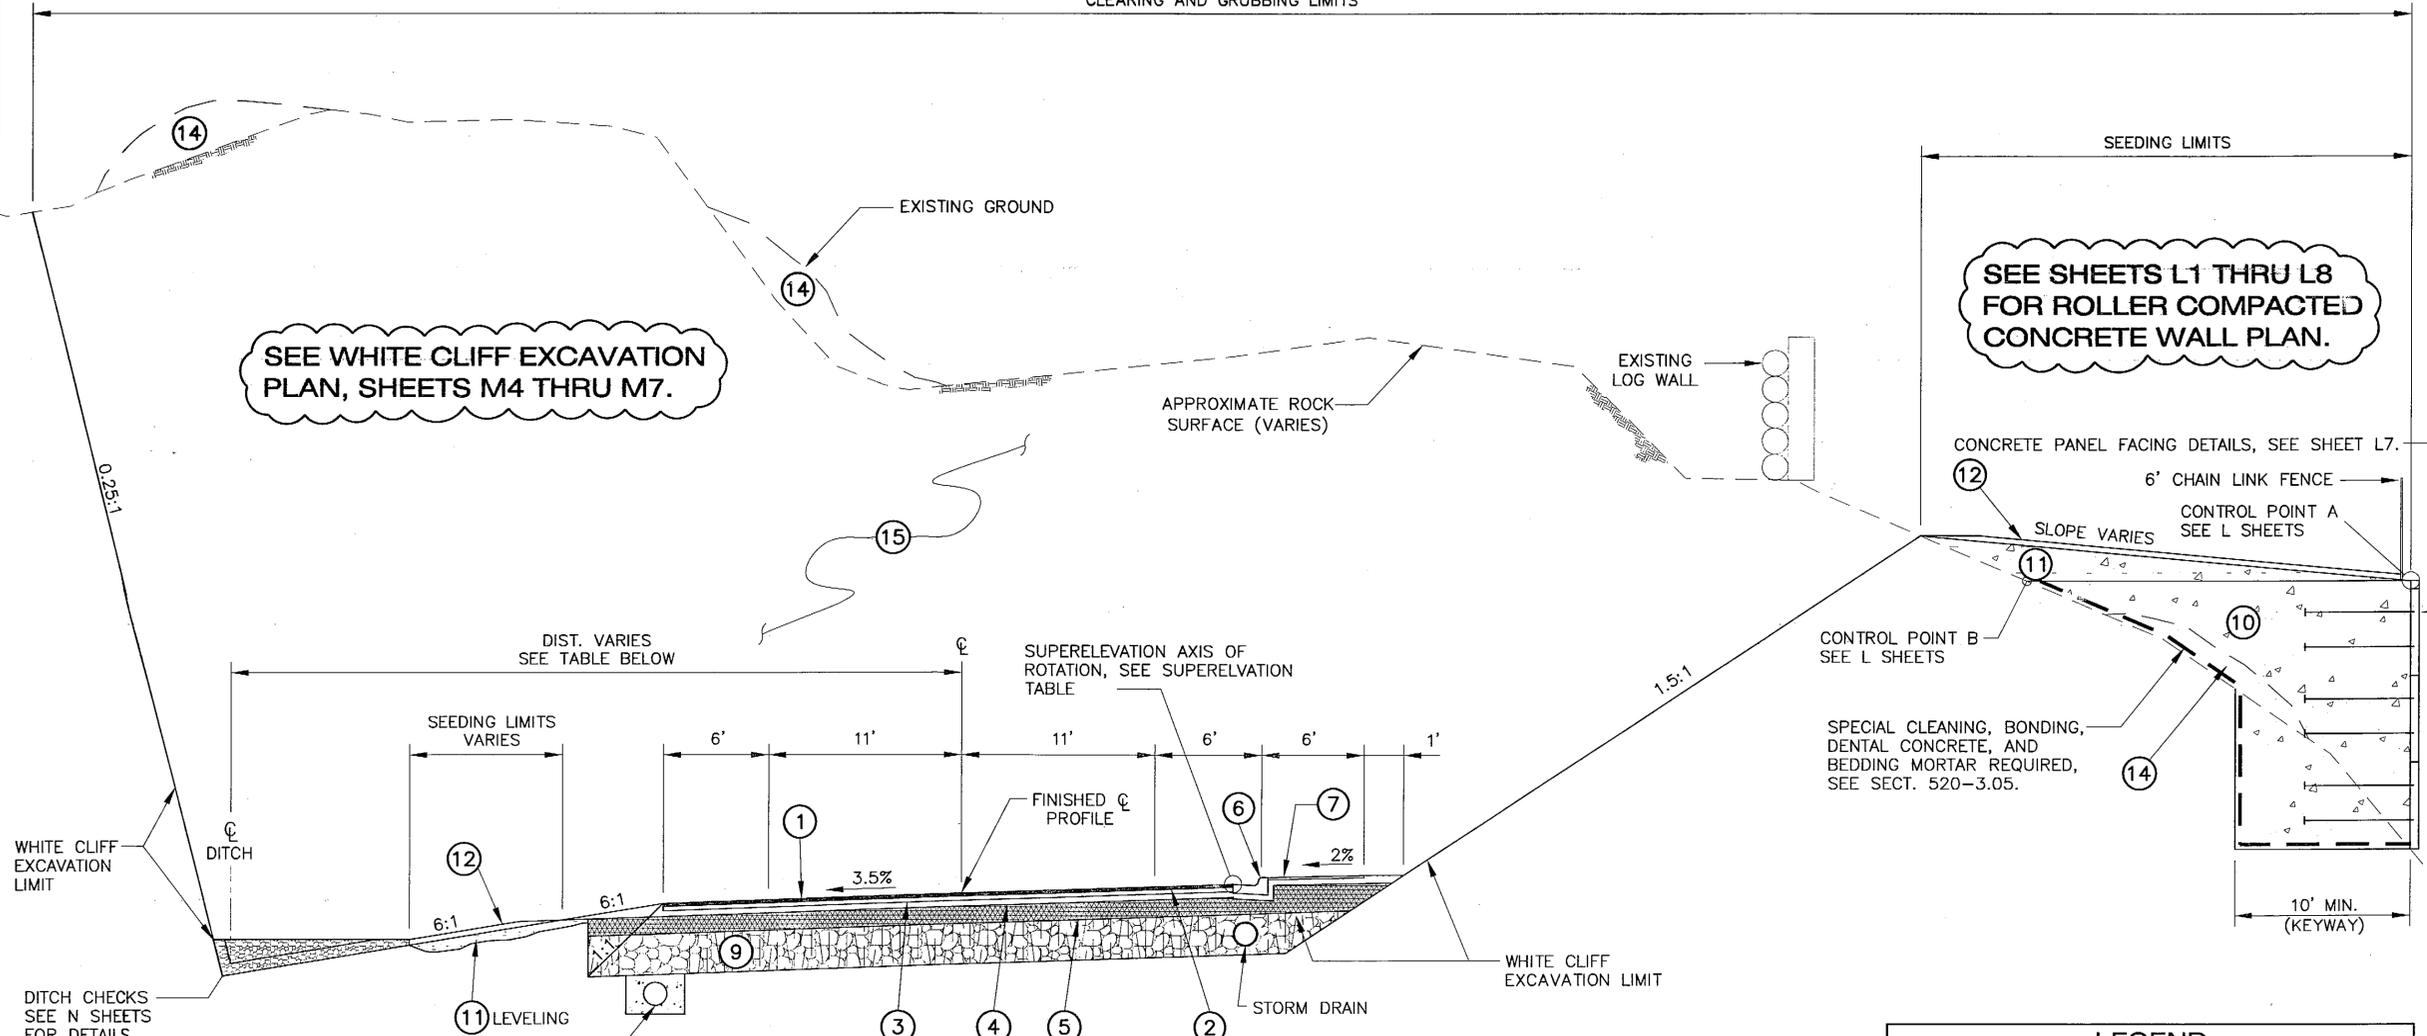

STA."0" 50+50 TO STA."0" 52+50

STATION		CL DITCH OFFSET	
START	END	LEFT	RIGHT
50+75	52+50	47	

LEGEND	
①	2" ASPHALT CONCRETE PAVEMENT, TYPE II, CLASS A
②	STE-1 ASPHALT FOR TACK COAT
③	3" ASPHALT TREATED BASE
④	4" CRUSHED AGGREGATE BASE COURSE
⑤	12" SUBBASE, GRADING "B"
⑥	CURB & GUTTER, TYPE 1
⑦	CONCRETE SIDEWALK, 4 INCHES THICK
⑧	EMBANKMENT (TYPE LISTED)*
⑨	28" FLUFF BLASTING
⑩	ROLLER COMPACTED CONCRETE EMBANKMENT
⑪	WASTE FILL
⑫	4" TOPSOIL
⑬	GEOTEXTILE, SEPARATION
⑭	UNCLASSIFIED EXCAVATION
⑮	WHITE CLIFF EXCAVATION

* WHEN NO TYPE IS LISTED, TYPE A OR D MAY BE USED, CONTRACTORS OPTION.

DO NOT SCALE FROM THESE DRAWINGS USE DIMENSIONS

DESIGNED BY: C. HOWARD

CHECKED BY: T. MOORE
DRAWN BY: M.L. / K.K.

STATE OF ALASKA
DEPARTMENT OF TRANSPORTATION
& PUBLIC FACILITIES
STATEWIDE DESIGN & ENGINEERING
SERVICES DIVISION
THIRD AVENUE EXTENSION
PROJECT NO. 68490

Typical Sections

PROJECT DESIGNATION NUMBER

STP-MG-0904(2)

STATE	YEAR
ALASKA	2002
SHEET NUMBER	TOTAL SHEETS
B6	146

ADDENDUM NUMBER		
ATTACHMENT NUMBER		
RECORD OF REVISIONS		
No.	DATE	DESCRIPTION

KTN-THIRD AVENUE EXTENSION
 PROJECT NO. 68490

Typical Sections

DESIGNED BY: C. HOWARD




CHECKED BY: T. MOORE
 DRAWN BY: M.L. / K.K.
 STATE OF ALASKA
 DEPARTMENT OF TRANSPORTATION
 & PUBLIC FACILITIES
 STATEWIDE DESIGN & ENGINEERING
 SERVICES DIVISION
 THIRD AVENUE EXTENSION
 PROJECT NO. 68490

Typical Sections

PROJECT DESIGNATION NUMBER	
STP-MG-0904(2)	
STATE	YEAR
ALASKA	2002
SHEET NUMBER	TOTAL SHEETS
B7	146

Project As Built Drawings have been reviewed by the Project Engineer. To the best of his/her knowledge, they represent the project as constructed.
 Proj. Eng. *KS* Date 10/2/06

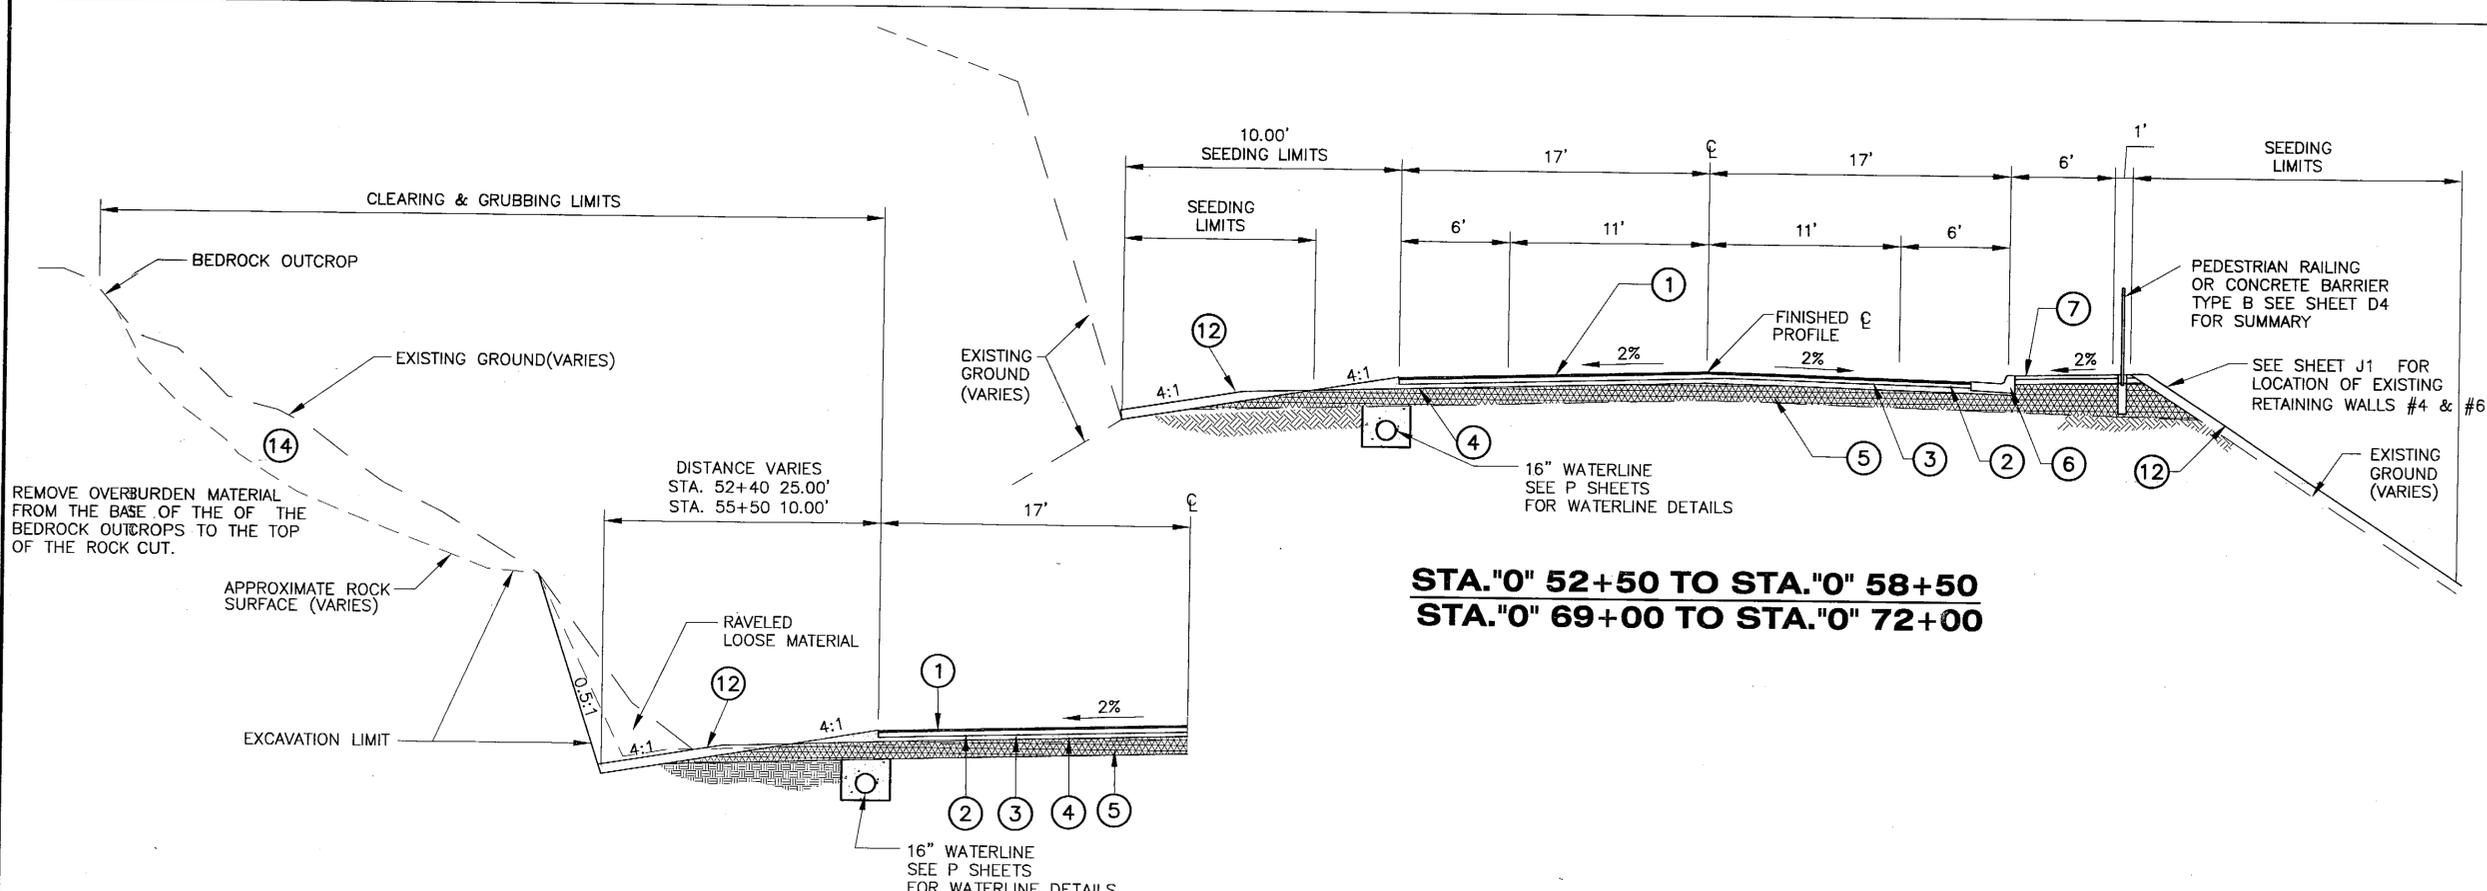


STA."0" 52+40 LT TO STA."0" 55+50 LT


LEGEND

①	2" ASPHALT CONCRETE PAVEMENT, TYPE II, CLASS A
②	STE-1 ASPHALT FOR TACK COAT
③	3" ASPHALT TREATED BASE
④	4" CRUSHED AGGREGATE BASE COURSE
⑤	12" SUBBASE, GRADING "B"
⑥	CURB & GUTTER, TYPE 1
⑦	CONCRETE SIDEWALK, 4 INCHES THICK
⑧	EMBANKMENT (TYPE LISTED)*
⑨	28" FLUFF BLASTING
⑩	ROLLER COMPACTED CONCRETE EMBANKMENT
⑪	WASTE FILL
⑫	4" TOPSOIL
⑬	GEOTEXTILE, SEPARATION
⑭	UNCLASSIFIED EXCAVATION

* WHEN NO TYPE IS LISTED, TYPE A OR D MAY BE USED, CONTRACTORS OPTION.

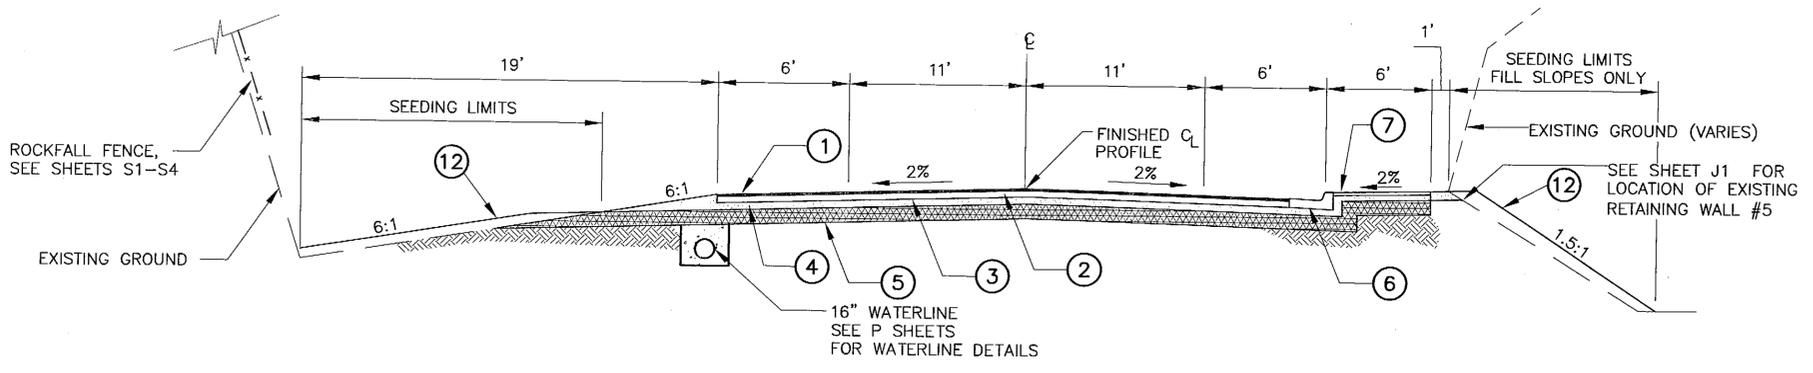


STA."0" 58+50 TO STA."0" 69+00

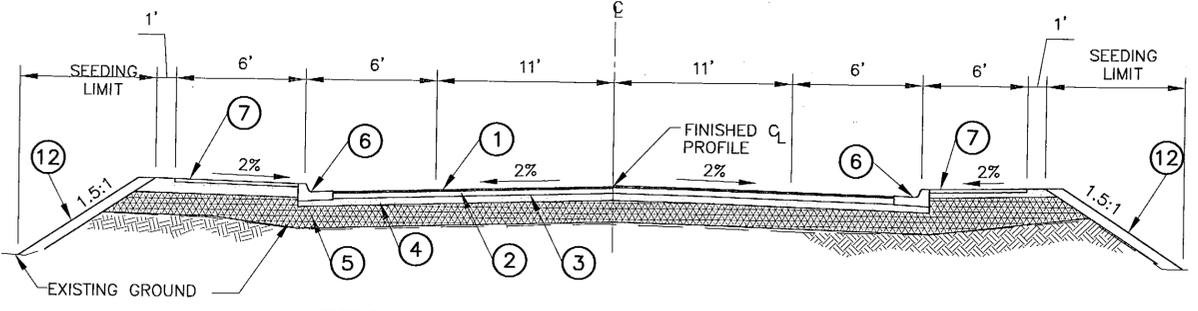


STA."0" 72+00 TO STA. "0" 73+30 (MATCH EXISTING)

DO NOT SCALE FROM THESE DRAWINGS USE DIMENSIONS

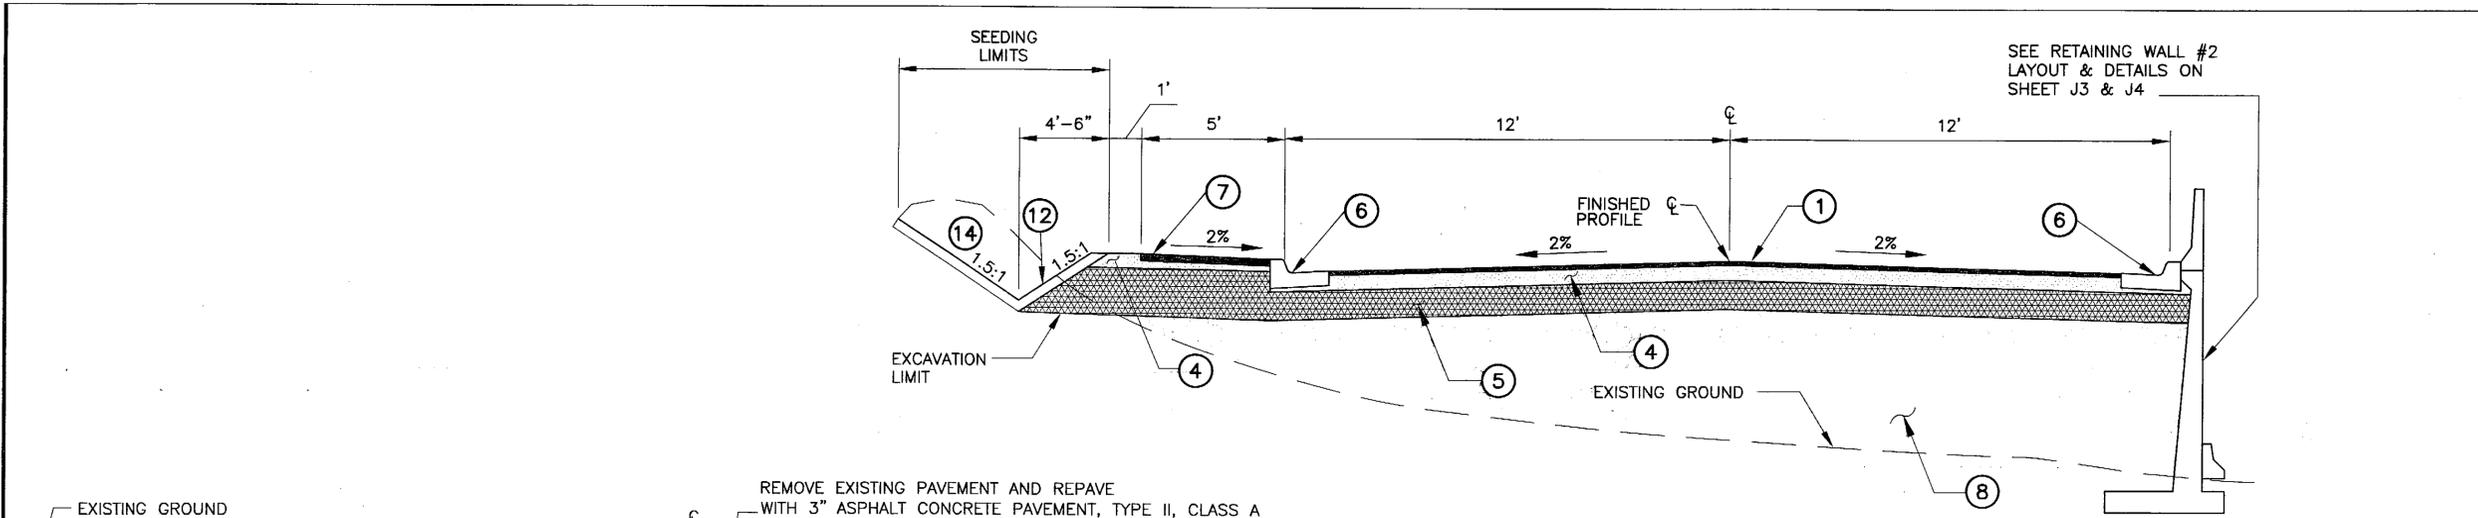


STA. "A" 10+23 TO STA. "A" 12+80

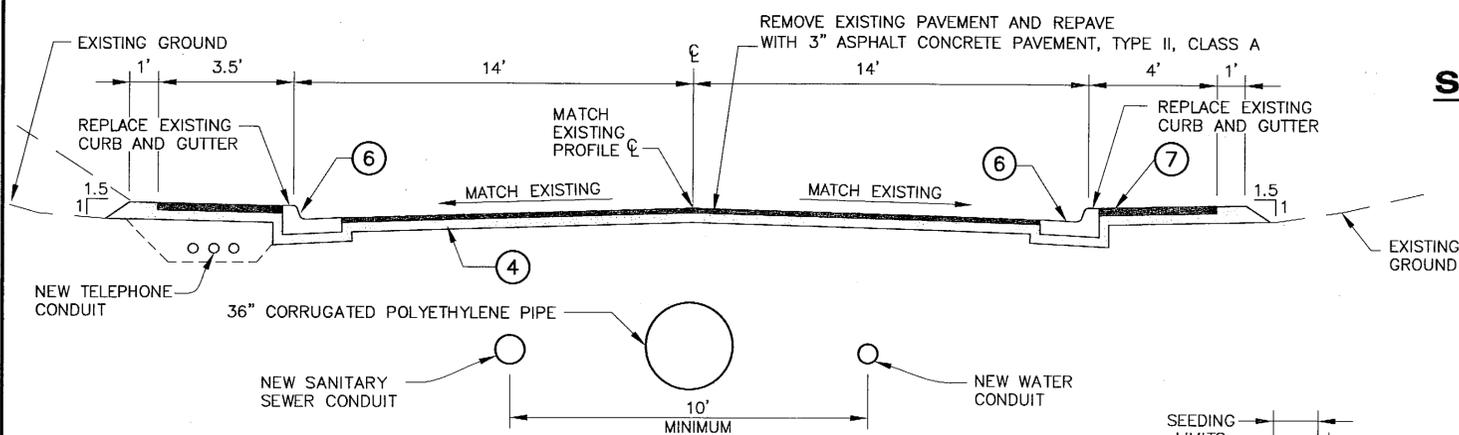


STA. "WC" 0+00 TO STA. "WC" 4+94.19

NOTE: SEE P SHEETS FOR WHITECLIFF DETAILS AND UTILITY PLANS

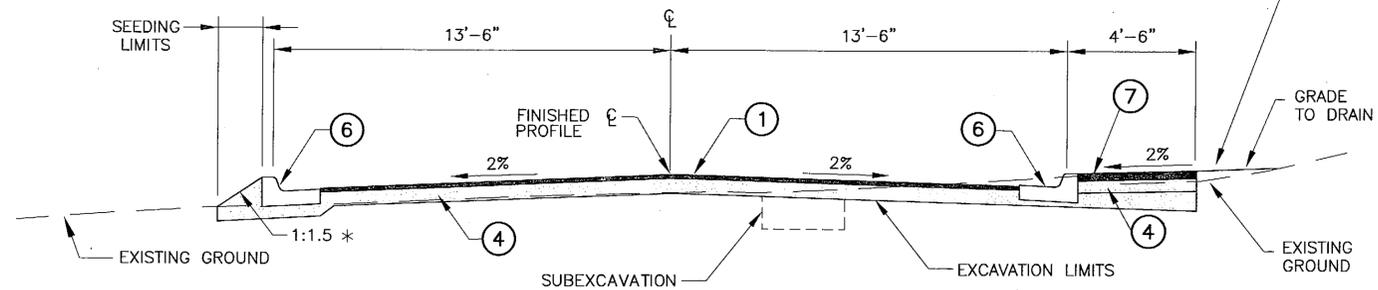

STA. "W" 11+50 TO STA. "W" 14+00

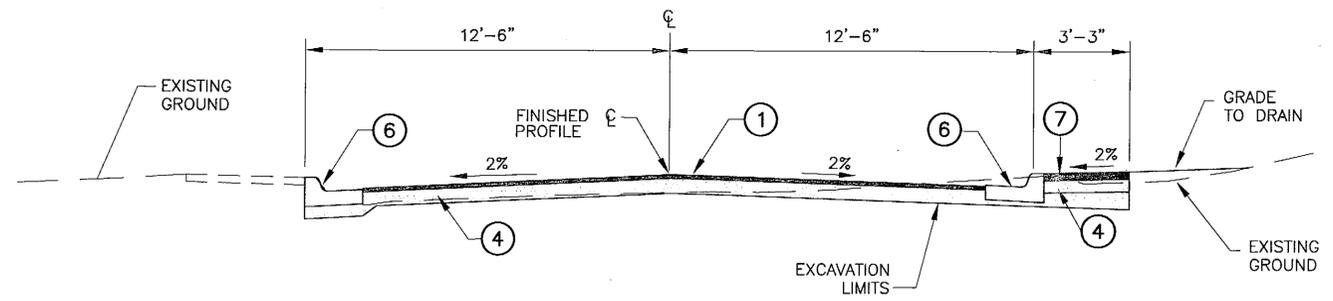

STA. "W2" 10+00 TO STA. "W2" 10+43.48

* STEEPENED SLOPE AS NECESSARY TO STAY WITHIN R.O.W. BOUNDARY

LEGEND	
①	2" ASPHALT CONCRETE PAVEMENT, TYPE II, CLASS A
④	4" CRUSHED AGGREGATE BASE COURSE
⑤	12" SUBBASE, GRADING "B"
⑥	CURB & GUTTER, TYPE 1
⑦	CONCRETE SIDEWALK, 4 INCHES THICK
⑧	EMBANKMENT (TYPE LISTED)*
⑫	4" TOPSOIL
⑭	UNCLASSIFIED EXCAVATION

*WHEN NO TYPE IS LISTED, TYPE A OR D MAY BE USED, CONTRACTORS OPTION.

DO NOT SCALE FROM THESE DRAWINGS USE DIMENSIONS

PATH: Q:\Ktn\71811A\Planset\B_Typs.dwg
 Mon, 06/May/02 10:30AM Michael Limbaugh
 PLOT: PSPACE 1=1(F) OR MSPACE 1=1(F)
 TAB: B8

RECORD OF REVISIONS		
No.	DATE	DESCRIPTION

ADDENDUM NUMBER
 ATTACHMENT NUMBER
 KTN-THIRD AVENUE EXTENSION
 PROJECT NO. 68490
 Typical Sections

DESIGNED BY: C. HOWARD


CHECKED BY: T. MOORE
 DRAWN BY: M.L. / K.K.
 STATE OF ALASKA
 DEPARTMENT OF TRANSPORTATION
 & PUBLIC FACILITIES
 STATEWIDE DESIGN & ENGINEERING
 SERVICES DIVISION
 THIRD AVENUE EXTENSION
 PROJECT NO. 68490

Typical Sections	
PROJECT DESIGNATION NUMBER	
STP-MG-0904(2)	
STATE	YEAR
ALASKA	2002
SHEET NUMBER	TOTAL SHEETS
B8	146

Project As Built Drawings have been reviewed by the Project Engineer. To the best of his/her knowledge, they represent the project as constructed.
 Proj. Eng.  Date 03/06

ESTIMATE OF QUANTITIES						
ITEM No.	ITEM	UNIT	PROJECT No. 68490	KPU (WATER)	CITY OF KETCH.	TOTAL
201 (3B)	Clearing and Grubbing	Lump Sum	All Required			All Required
202 (1)	Removal of Structures and Obstructions	Lump Sum	All Required			All Required
202 (2)	Removal of Pavement	Square Yard	3450 ^{2133.9}		750 ^{1197.6}	3900 ^{4331.5}
202 (3)	Removal of Sidewalk	Square Yard	185 ^{344.21}		400 ⁴⁵³	585 ^{797.21}
202 (4)	Removal of Culvert Pipe	Linear Foot	651 ^{678.6}			651 ^{678.6}
202 (9)	Removal of Curb and Gutter	Linear Foot	1150 ^{1226.3}	520	1103.3	2070 ^{2329.61}
202(13)	Removal/Securing of Rocks	Contingent Sum	All Required			All Required
203 (3)	Unclassified Excavation	Cubic Yard	1392 ¹³¹⁶		100.	2222 ¹³¹⁶
203 (5)	Embankment	Cubic Yard	6000 ³⁹		100'	6040 ^{7928.4}
203(10)	Controlled Blasting	Linear Foot	18100			18100 ^{25429.1}
203(11)	White Cliff Excavation	Lump Sum	All Required			All Required
203(12)abc	Rock Bolts + co#6, co#8, co#23	Each	50 ⁸⁸			50 ⁸⁸
203(13)	Rock Dowels	Each	50 ⁰			50 ⁰
203(14)	Drain Holes	Each	100 ¹⁷³			100 ¹⁷³
203(15)	Pre-Blast Survey	Each	50 ²⁹			50 ²⁹
203(16)	Contractor's Blasting Consultant	Lump Sum	All Required			All Required
203(17)	Occupant Relocation	Lump Sum	All Required			All Required
203(18)a	Dewatering Wells Trench Drain Buttress co#3	Linear Foot	10 ¹²⁰⁰			10 ¹²⁰⁰
203(19)	Blasting Price Adjustment	Contingent Sum	All Required			All Required
301 (1)	Aggregate Base Course	Ton	7070 ^{8416.2}		300 ^{622.79}	7370 ⁹⁰³³
304 (1)	Subbase, Grading B	Ton	20600 ^{18974.7}			20600 ^{18974.7}
306 (1)	Asphalt Treated Base	Ton	3600 ^{329.7}			3600 ^{329.7}
401 (1)	Asphalt Concrete Pavement, Type II, Class A	Ton	2700 ^{3137.2}		100 ¹⁴¹	2800 ^{3137.2}
401 (2)	PG 58-28 Asphalt Cement	Ton	306 ^{291.89}		6 ^{7.48}	312 ^{298.95}
401 (6)	Asphalt Price Adjustment	Contingent Sum	All Required			All Required
402 (1)	STE-1 Asphalt for Tack Coat	Ton	9 ^{5.23}			9 ^{5.23}
501 (4)	Concrete, Class A	Cubic Yard	38 ^{47.3}			38 ^{47.3}
501 (7)	Class A Concrete Retaining Wall	Square Foot	1100 ^{191.5}		90 ^{53.9}	1190 ^{191.5}
506 (1)a	Treated Timber co.#15	Lump Sum	All Required			All Required
507(6A)	Concrete Barrier-Type A	Linear Foot	90 ⁷⁵			90 ⁷⁵
507(6B)	Concrete Barrier-Type B Ref. co#5	Linear Foot	1140 ^{1027.5}			1140 ^{1027.5}
507 (6C)	Concrete Barrier-Type C Ref. co#5	Linear Foot	830 ^{820.8}			830 ^{820.8}
514 (1)	Temporary Rock Catchment Barrier	Linear Foot	350 ^{211.5}			350 ^{211.5}
514 (2)	Rockfall Fence	Square Foot	8400 ^{8506.9}			8400 ^{8506.9}
514 (3)	Draped Mesh	Square Foot	2712 ^{2712.5}			2712 ^{2712.5}
515 (1)	Interpretive Sign Support	Each	3			3
515 (2)	Interpretive Signs	Contingent Sum	All Required			All Required
516 (1)	Mechanically Stabilized Embankment Retaining Wall	Square Foot	1630 ^{1124.5}			1630 ^{1124.5}
516 (2)	Modification of existing MSE Wall	Lump Sum	All Required			All Required
520 (1)	Roller Compacted Concrete Embankment	Cubic Yard	6000 ^{5574.6}			6000 ^{5574.6}
520 (2)	Portland Cement	Ton	4500 ^{5279.6}			4500 ^{5279.6}
520 (3)	Fly Ash	Ton	3300 ^{3190.8}			3300 ^{3190.8}
520 (4)-a	Precast Panel System Ref. co #5	Lump Sum	All Required			All Required
603 (1-12)	12-Inch CSP	Linear Foot	110 ^{224.9}			110 ^{224.9}
603(21-12)	12-Inch Corrugated Polyethylene Pipe	Linear Foot	510 ³⁹¹			510 ³⁹¹
603(21-18)	18-Inch Corrugated Polyethylene Pipe	Linear Foot	2384 ^{189.4}			2384 ^{189.4}
603(21-24)	24-Inch Corrugated Polyethylene Pipe	Linear Foot	1768 ^{1624.5}			1768 ^{1624.5}
603(21-36)	36-Inch Corrugated Polyethylene Pipe	Linear Foot	640 ^{736.8}			640 ^{736.8}
604 (1A)	Storm Sewer Manhole, Type 1	Each	10 ¹⁷			10 ¹⁷
604 (1B)	Storm Sewer Manhole, Type 2	Each	3 ⁴			3 ⁴
604 (2)	Sanitary Sewer Manhole co#1 added item to 68490	Each	2	6 ⁵		6 ⁷
604 (3)	Reconstruct Existing Manhole	Each	1 ⁰			1 ⁰
604 (4)	Adjust Existing Manhole	Each	4 ²	6 ³		10 ⁵
604 (5)	Inlet, Type "A"	Each	33 ³²			33 ³²
605 (8)	12 Inch HDPE Underdrain	Linear Foot	2500 ^{222.5}			2500 ^{222.5}
605 (9)	Foundation Drain	Each	50 ²⁸			50 ²⁸
607 (3)	Chain-Link Fence	Linear Foot	900			900
607 (7)	Noise Barrier	Square Foot	3720 ^{3626.2}			3720 ^{3626.2}

UPDATED 03/05/2002 15:52

BASIS OF ESTIMATE		
ITEM No.	ITEM	ESTIMATING FACTOR
301 (1)	CRUSHED AGGREGATE BASE COURSE	1.96 TONS/CY
401 (1)	ASPHALT CONCRETE PAVEMENT	116 lbs/SY/INCH DEPTH OF ASPHALT CONCRETE
401 (2)	PG 58-28 ASPHALT CEMENT	6% OF 401 (1) & 4% OF 306 (1)
402 (2)	STE-1 ASPHALT FOR TACK COAT	0.10 GAL/SY. 233 GAL/TON
520 (2)	CEMENT	150 LBS/CY
520 (3)	FLY ASH	110 LBS/CY

GENERAL NOTES:

1. ALL NON-ROCK EXCAVATION IS CONSIDERED WASTE.
2. TRANSITIONS BETWEEN ROCK CUT SLOPES SHALL BE SMOOTH.
3. ALL SOIL SLOPES SHALL BE SEEDED UNLESS SHOWN OTHERWISE.

ESTIMATE OF QUANTITIES						
ITEM NO.	ITEM	UNIT	PROJECT No. 68490	KPU (WATER)	CITY OF KETCHIKAN	TOTAL
202(14)	Hazardous Tree Removal - co#28	Contingent Sum	All Required			All Required
203(4)	Utility Misc Adjustments - co#	Lump Sum	All Required			All Required
203(11b)	Vibration Monitoring: Seismic Surveying - co#4	Days	4			4
203(11c)	Vibration Monitoring: Prisms - co#4	Lump Sum	All Required			All Required
203(11d)	Vibration Monitoring: Prism Installation - co#4	Hours	17			17
203(11e)	Vibration Monitoring: Prism Surveying - co#4	Hours	502			502
203(11f)	Extra Prisms - co#14	Lump Sum	All Required			All Required
501(4a)	Stockpile Concrete Flumes - co#24	Lump Sum	All Required			All Required
501(4b)	Stockpile Concrete Special Inlet - co#24	Lump Sum	All Required			All Required
501(5)	Class AA Concrete - co#	Lump Sum	All Required			All Required
501(8)	Wall 1 Extra Work - co#25	Lump Sum	All Required			All Required
507(6b)	Barrier Handrail Extensions - co#19	Linear Foot	1526			1526
514(4)	10' Temporary Rock Catchment Barrier - co#5	Linear Foot	290.6			290.6
514(5)	12' Temporary Rock Catchment Barrier - co#5	Linear Foot	124.2			124.2
514(6)	18' Temporary Rock Catchment Barrier - co#5	Linear Foot	149.3			149.3
516(3)	MSE Wall Modifications - co#20	Lump Sum	All Required			All Required
520(5)	RCC Chamfer Strip - co#22	Lump Sum	All Required			All Required
603(22)	Sea Level Drive Drainage - co#2	Lump Sum	All Required			All Required
607(3)	White Cliff Chain Link Fence - co#17	Linear Foot	809.4			809.4
606(1)	Guardrail Installation - co#27	Lump Sum	All Required			All Required
606(13)	F-SHAPED BARRIER - co#30	Lump Sum	All Required			All Required
611(4)	TRAIL STABILIZATION - co#29	Lump Sum	All Required			All Required
606(4)	MISC. DRAINAGE ADJUSTMENTS - co#31	Lump Sum	All Required			All Required
604(2)	MISC. UTILITY ADJUSTMENTS - co#32	Lump Sum	All Required			All Required
203(20)	ROADSIDE STANDBY EQUIPMENT - co#33	Lump Sum	All Required			All Required

- continued on page C2

PATH: Q:\KTr\71811A\PlanSet\C_Est120701.dwg
 Mon, 06/May/02 09:25AM Michael Lumbaugh
 PSPACE 1=1(F) OR MSPACE 1=1(F)
 TAB: ESTIMATE

ADDENDUM NUMBER		
ATTACHMENT NUMBER		
RECORD OF REVISIONS		
No.	DATE	DESCRIPTION

KTN-THIRD AVENUE EXTENSION
 PROJECT NO. 68490

Estimate of Quantities

DESIGNED BY: C. HOWARD



CHECKED BY: T. MOORE

DRAWN BY: K.K.

STATE OF ALASKA
 DEPARTMENT OF TRANSPORTATION
 & PUBLIC FACILITIES
 STATEWIDE DESIGN & ENGINEERING
 SERVICES DIVISION

THIRD AVENUE EXTENSION
 PROJECT NO. 68490

Estimate of Quantities

PROJECT DESIGNATION NUMBER

STP-MG-0904(2)

STATE	YEAR
ALASKA	2002

SHEET NUMBER	TOTAL SHEETS
C1	146

Project As Built Drawings have been reviewed by the Project Engineer. To the best of his/her knowledge, they represent the project as constructed.

Proj. Eng. *[Signature]* Date 10/3/04

ESTIMATE OF QUANTITIES						
ITEM No.	ITEM	UNIT	PROJECT No. 68490	KPU (WATER)	CITY OF KETCH.	TOTAL
608 (1A)	Concrete Sidewalk, 4 inches thick	Square Yard	3100		400	3500
608 (1B)	Concrete Sidewalk, 6 inches thick	Square Yard	60		60	120
608 (3)	Asphalt Sidewalk	Square Yard	30		30	30
608 (6)	Curb Ramp	Each	17		17	17
609 (2)	Curb And Gutter, Type 1	Linear Foot	7300		920	8200
611 (3)	Slope Stabilization	Square Yard	2000			2000
615 (1)	Standard Signs	Square Foot	223			223
618 (1A)	Seeding CO #10	Acre	7.5			7.5
619 (2)	Matting	Square Yard	2500			2500
620 (1)	Top Soil	Square Yard	18500			18500
621 (1)	Tree	Each	120			120
625 (1)	Pedestrian Railing	Linear Foot	364			364
625 (2)	Bike Rack	Each	2			2
626 (1-4)	Sanitary Sewer Conduit, 4-Inch Del. by CO #1	Linear Foot			160	160
626 (1-6)	Sanitary Sewer Conduit, 6-Inch	Linear Foot			100	100
626 (1-8)	Sanitary Sewer Conduit, 8-Inch	Linear Foot			562	562
626 (1-12)	Sanitary Sewer Conduit, 12-Inch	Linear Foot			280	280
626 (2)	Sanitary Service Connection	Each			11	11
627 (1-8)	8-Inch Ductile Iron Water Conduit	Linear Foot		340		340
627 (1-16)	16-Inch Ductile Iron Water Conduit	Linear Foot		4900		4900
627 (3)	Install Valve Box	Each		14		14
627 (5)	Fire Hydrant Installation	Each		11		11
627 (9-6)	Install 6-Inch Gate/Butterfly Valve	Each		1		1
627 (9-8)	Install 8-Inch Gate/Butterfly Valve	Each		4		4
627 (9-16)	Install 16-Inch Gate/Butterfly Valve	Each		12		12
627(10)	Adjustment of Valve Box	Each		12		12
627(11)	Air Release Valve Assembly	Each		2		2
627(12)	Sewer Crossing Encasement	Each		12		12
630 (1)	Geotextile, Separation	Square Yard	4000			4000
635 (1)	Insulation Board	Square Foot		1650		1650
639 (1)	Residence Driveway	Each	7		9	16
640 (1)	Mobilization and Demobilization	Lump Sum	All Required	All Required	All Required	All Required
641 (1)	Erosion and Pollution Control Administration	Lump Sum	All Required	All Required	All Required	All Required
641 (2)	Erosion and Pollution Control	Contingent Sum	All Required	All Required	All Required	All Required
641 (3)	Ditch Block	Each		25		25
641 (4)	Straw Bale	Each		20		20
641 (5)	Sediment Mat	Square Yard		625		625
641 (6)	Temporary Seeding	Acre		30		30
641 (7)	Inlet Control Barrier	Each		57		57
641 (8)	Sediment Control Barrier	Linear Foot		5210		5210
641 (9)	Sediment Filter Bag	Each		6	0.072	6
641 (10)	Erosion and Pollution Control Price Adjustment	Contingent Sum	All Required			All Required
642 (1)	Construction Surveying	Lump Sum	All Required	All Required	All Required	All Required
642 (3)	Three Person Survey Party	Hour		30		30
642 (4)	Set Primary Monument	Each		8		8
642(10)	Monument Cases	Each		8		8
643 (2)	Traffic Maintenance	Lump Sum	All Required	All Required	All Required	All Required
643(25)	Public Informational Program	Lump Sum	All Required			All Required
644 (6)	Vehicles	Lump Sum	All Required			All Required
645 (1)	Training Program for 2 Trainee/Apprentice	Labor Hour		1000		1000
646 (1)	CPM Scheduling	Lump Sum	All Required			All Required
660 (3)	Highway Lighting System Complete	Lump Sum	All Required			All Required
660 (14)	Telephone Conduit Installation Del. by CO #1	Lump Sum	All Required	All Required		All Required
661 (1)	Load Center, Type 1	Each		2		2
669 (1)	Permanent Traffic Recorder System Complete	Lump Sum	All Required			All Required
670 (8)	Recessed Pavement Markers	Each		108		108
670(10)	Methyl Methacrylate Pavement Markings	Lump Sum	All Required			All Required

UPDATED 01/05/2002 11:26

ESTIMATE OF EXCAVATION QUANTITIES					
APPROXIMATE LOCATION	FROM STATION	TO STATION	ROCK (yd ^3)	NON-ROCK (yd ^3)	TOTAL (yd ^3)
BOP TO PARKING AREA	20+25	27+00	4,000	2,000	6,000
PARKING AREA	27+00	30+00	40,000	4,000	44,000
PARKING AREA TO LOWER RCC WALL	30+00	40+00	35,000	10,000	45,000
LOWER RCC WALL TO WHITECLIFF	40+00	48+00	500	59,500	60,000
WHITECLIFF (NON-ROCK)	48+00	53+00		2,000	2,000
OVERBURDEN REMOVAL	52+40	55+50		6,000	6,000
OVERBURDEN REMOVAL TO EOP	55+50	73+30		1,500	1,500
TOTALS			79,500	85,000	
TOTAL UNCLASSIFIED EXCAVATION = 164,500					

WHITECLIFF EXCAVATION				
WHITECLIFF EXCAVATION	FROM STATION	TO STATION	ROCK (yd ^3)	UNCLASSIFIED ABOVE
	48+50	53+00	60,000	
TOTAL WHITECLIFF EXCAVATION = 60,000				

ESTIMATE OF WASTE FILL QUANTITIES			
APPROXIMATE LOCATION	FROM STATION	TO STATION	TOTAL (yd ^3)
LOWER RCC WALL AREA	40+00	50+70	18,000

ESTIMATE OF QUANTITIES						
ITEM No.	ITEM	UNIT	PROJECT No. 68490	KPU (WATER)	CITY OF KETCHIKAN	TOTAL
608(1C)	Sidewalk Modification: Washington St - CO #21	Lump Sum	All Required			All Required
608(6A)	Detectable Warning Trips - CO #	Lump Sum	All Required			All Required
625(3)	Wooden Pedestrian Railing - CO #12	Lump Sum	All Required			All Required
627(1-6)	6 INCH DUCTILE IRON CONDUIT - CO #18	Lump Sum	All Required	All Required		All Required
641(11)	Miscellaneous Drainage Work - CO #26	Lump Sum	All Required			All Required
660(15)	Electrical Trench Widening - CO #7	Lump Sum	All Required	All Required		All Required

PATH: O:\Ktn\71811A\PlanSet\C_Est120701.dwg
 Mon, 06/May/02 09:25AM Michael Limbaugh
 PLOT: PSPACE 1=1(F) DR MSPACE 1=1(F)
 TAB: ESTIMATE

ADDENDUM NUMBER		
ATTACHMENT NUMBER		
RECORD OF REVISIONS		
No.	DATE	DESCRIPTION

KTN-THIRD AVENUE EXTENSION
 PROJECT NO. 68490

Estimate of Quantities

DESIGNED BY: C. HOWARD



CHECKED BY: T. MOORE

DRAWN BY: K.K.

STATE OF ALASKA
 DEPARTMENT OF TRANSPORTATION
 & PUBLIC FACILITIES
 STATEWIDE DESIGN & ENGINEERING
 SERVICES DIVISION
 THIRD AVENUE EXTENSION
 PROJECT NO. 68490

Estimate of Quantities

PROJECT DESIGNATION NUMBER

STP-MG-0904(2)

STATE	YEAR
ALASKA	2002

SHEET NUMBER	TOTAL SHEETS
C2	146


Project As Built Drawings have been reviewed by the Project Engineer. To the best of his/her knowledge, they represent the project as constructed.

Proj. Eng. *[Signature]* Date 10/31/06


DRAINAGE STRUCTURE SUMMARY					
STRUCTURE NUMBER	NORTHING	EASTING	FG ELEVATION	18" SUMP	DESCRIPTION
S-1	90346.2092	101631.1909	21.04	YES	72" MANHOLE WITH BOLTED LID, BITUMINOUS COATED INSIDE & OUTSIDE TO ELEV. 19.0'
S-2	90212.9001	1015799.9201	20.65	YES	72" MANHOLE WITH BOLTED LID, BITUMINOUS COATED INSIDE & OUTSIDE TO ELEV. 19.0'
OUTFALL	FIELD DETERMINE		N/A		

PIPE SUMMARY								
PIPE NUMBER	TYPE	DIAMETER	LENGTH	FROM	INVERT	TO	INVERT	REMARKS
P-1	CORRUGATED POLYETHYLENE	42"	137'	S-1	12.0' *	S-2	9.26' *	
P-2	CORRUGATED POLYETHYLENE	42"	147'	S-2	9.0' *	OUTFALL	6.0' *	MIN. PIPE SLOPE 2%

*NOTE: FIELD DETERMINE INVERTS, INSTALLING P-1 WITH AN INVERT OF 12.0' WOULD PUT THE TOP OF P-1 12" BELOW THE BOTTOM OF 16" S.S. FORCE MAIN. IT IS DESIRABLE TO HAVE THE INVERTS AS HIGH AS POSSIBLE TO MINIMIZE TIDAL INFLUENCE.

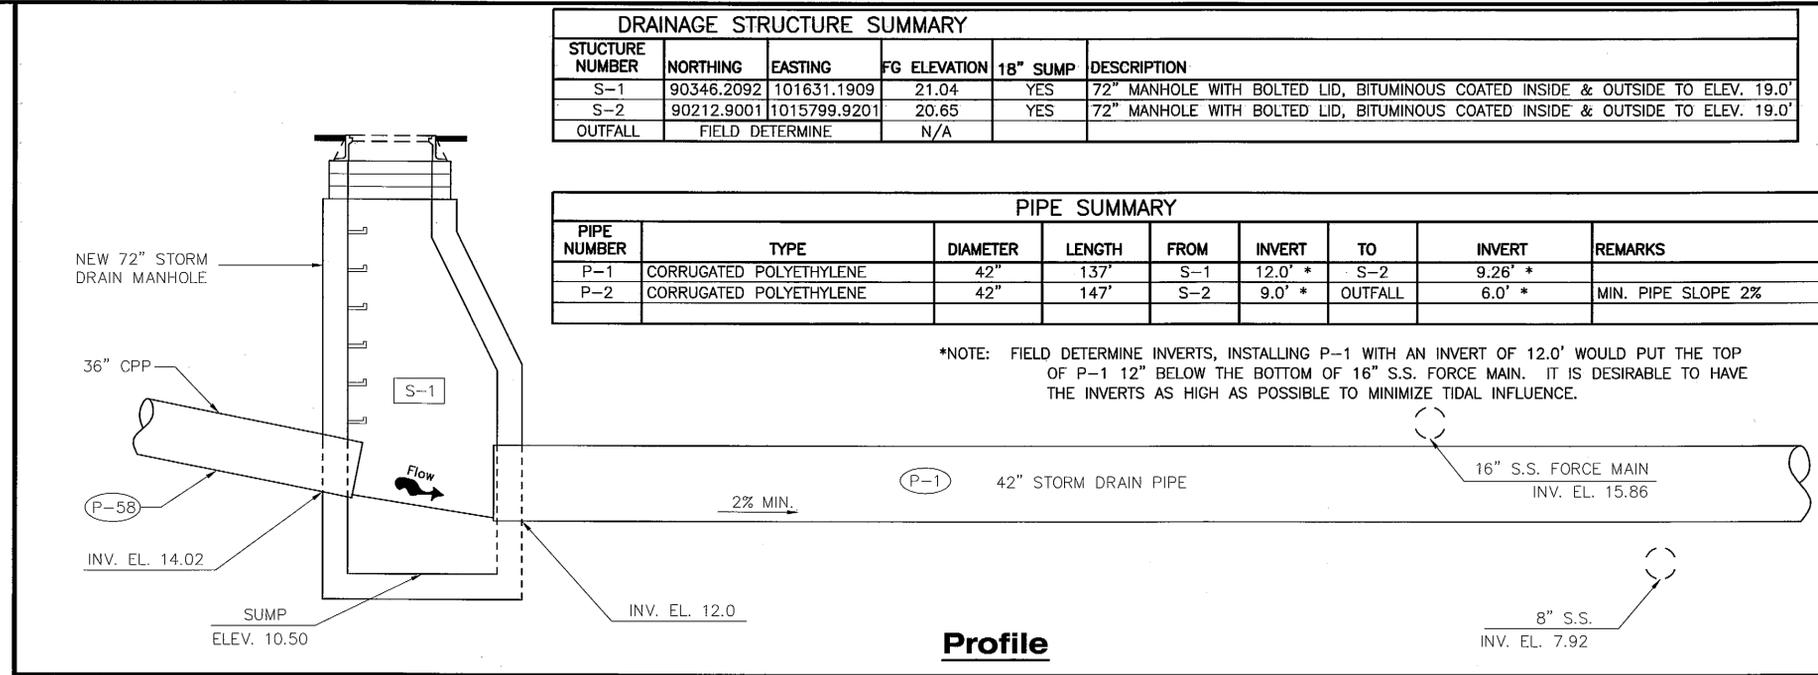

Profile

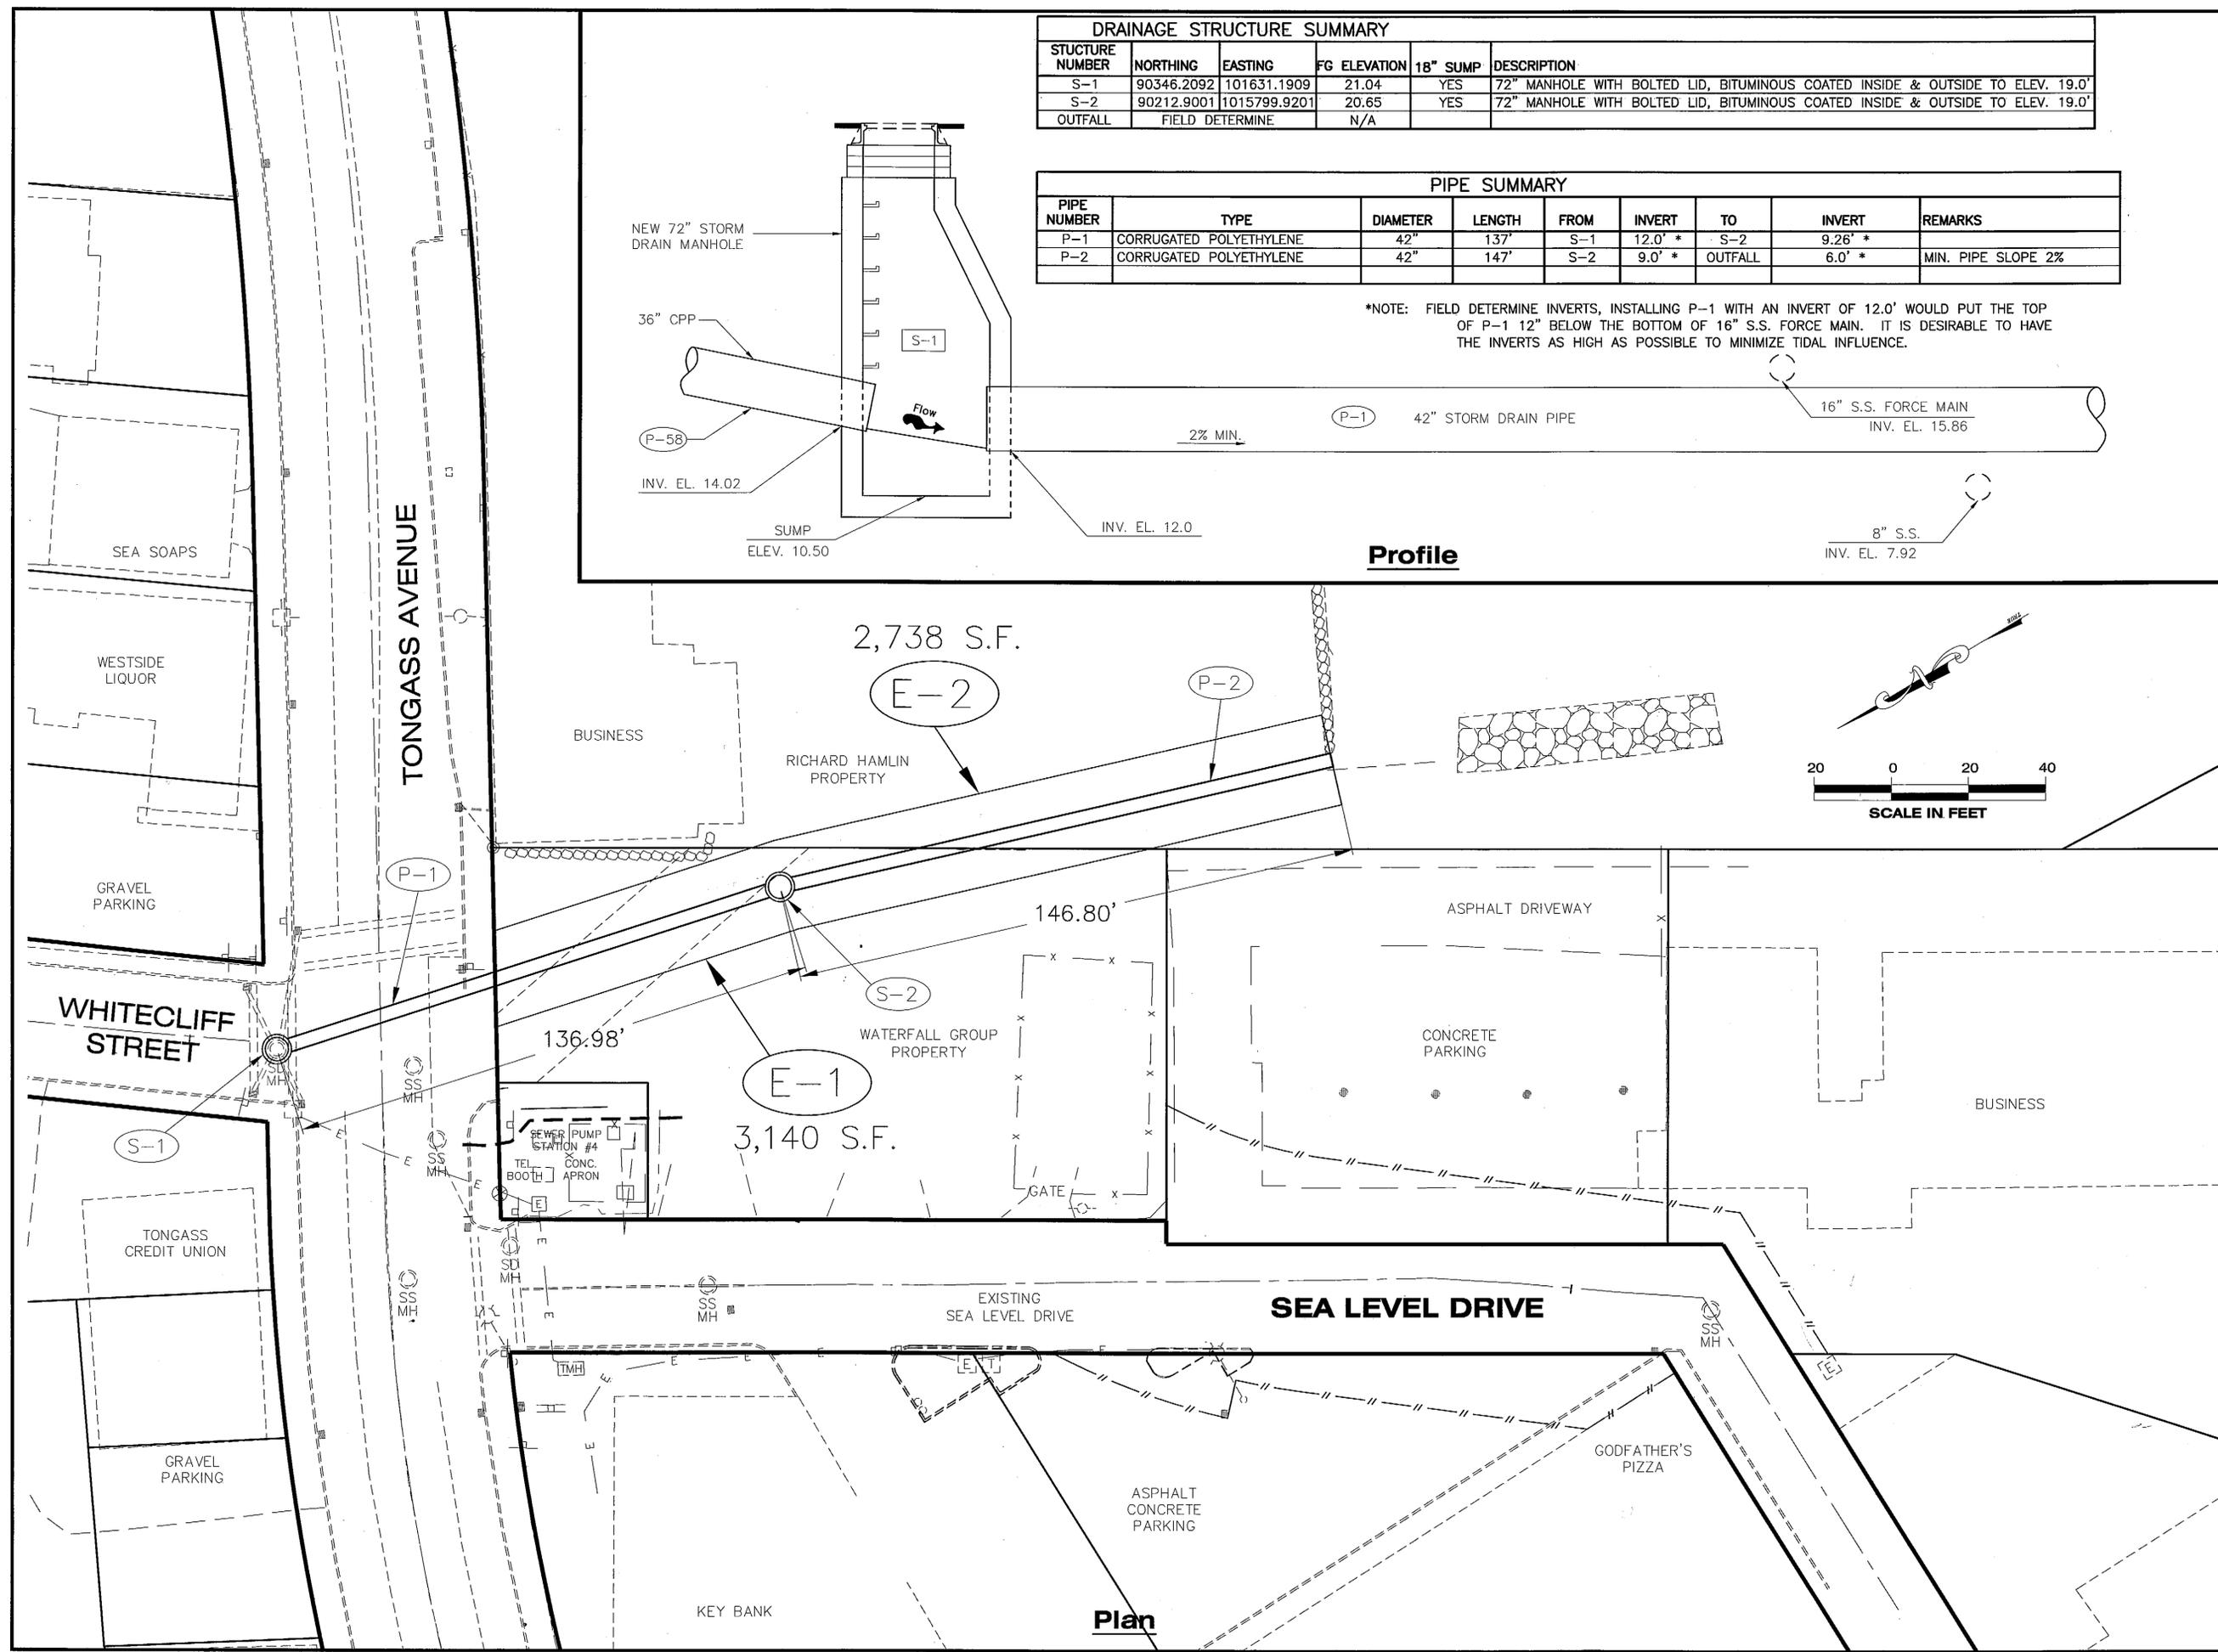

Plan

PATH:
Q:\Ktn\71811A\Dr\SEALEVEL_Revision.dwg
Wed, 10/Aug/05 10:12AM rksnyder
TAB: PLAN-PRO
ADDENDUM NUMBER
ATTACHMENT NUMBER
RECORD OF REVISIONS
No. DATE DESCRIPTION

Work completed under
C.O. #2

KTN-THIRD AVENUE EXTENSION
PROJECT NO. 68490

Plan & Profile

Project As Built Drawings have been reviewed by the Project Engineer. To the best of his/her knowledge, they represent the project as constructed.
Proj. Eng. [Signature] Date 10/21/06

DESIGNED BY: C. HOWARD



CHECKED BY: T. MOORE

DRAWN BY: R.S. / M.L.L.

STATE OF ALASKA
DEPARTMENT OF TRANSPORTATION & PUBLIC FACILITIES
STATEWIDE DESIGN & ENGINEERING SERVICES DIVISION
THIRD AVENUE EXTENSION
PROJECT NO. 68490

Plan & Profile
PROJECT DESIGNATION NUMBER
STP-MG-0904(2)

STATE	YEAR
ALASKA	2002

SHEET NUMBER	TOTAL SHEETS
C# 2	146

DRAINAGE STRUCTURE SUMMARY					
STRUCTURE NUMBER	STATION	OFFSET	ELEVATION	SUMP	REMARKS
S-1	"W" 14+00.0	LT 14.0	173.50'	YES	Inlet, Type A
S-2	"W" 14+00.0	RT 14.0	173.50'	YES	Inlet, Type A
S-3	"W" 13+16.6	RT 14.5	156.21'	YES	Inlet, Type A
S-4	"W" 13+16.3	LT 14.0	156.15'	YES	Inlet, Type A
S-5	"O" 22+13.0	RT 16.6	148.55'	YES	Storm Sewer Manhole, Type 1
S-6	"W" 11+63.5	RT 14.0	131.08'	YES	Inlet, Type A
S-7	"W" 11+63.5	LT 14.0	131.08'	YES	Inlet, Type A
S-8	"O" 22+42.6	RT 17.5	150.74'	YES	Inlet, Type A
S-9	"O" 22+42.3	LT 27.4	148.34'	YES	Inlet, Type A w/ Beehive Grate
S-10	"A" 10+61.4	LT 14.0	150.39'	YES	Storm Sewer Manhole, Type 1
S-11	"A" 11+30.7	RT 14.0	141.29'	YES	Storm Sewer Manhole, Type 1
S-12	"A" 11+60.1	RT 13.1	140.41'	YES	Storm Sewer Manhole, Type 1
S-13	"A" 11+51.3	LT 1.8	139.64'	YES	Storm Sewer Manhole, Type 2
S-14	"A" 11+49.6	LT 14.0	139.90'	YES	Inlet, Type A
S-15A	"O" 23+95.7	LT 42.2	155.34'	YES	Special Inlet, see sheet N14
S-15B	"O" 24+00.4	RT 17.5	161.66'	YES	Storm Sewer Manhole, Type 2
S-15C	"O" 23+35.6	RT 17.5	157.18'	YES	Inlet, Type A
S-17A	"O" 25+10.5	RT 17.5	169.75'	YES	Storm Sewer Manhole, Type 1
S-17B	"O" 25+31.1	LT 30.5	167.23'	YES	Inlet, Type A w/ Beehive Grate
S-17C	"O" 26+129.1	RT 17.5	176.95'	YES	Storm Sewer Manhole, Type 1
S-17D	"O" 26+48.5	LT 27.0	177.29'	YES	Inlet, Type A w/ Beehive Grate
S-20	"O" 27+29.4	LT 24.0	185.60'	YES	Storm Sewer Manhole, Type 1
S-21	"O" 27+79.7	RT 17.5	186.67'	YES	Storm Sewer Manhole, Type 1
S-22	"O" 27+52.5	LT 74.1	184.83'	YES	Inlet, Type A w/ Beehive Grate
S-23A	"O" 28+99.3	RT 17.5	191.82'	YES	Inlet, Type A
S-23B	"O" 30+35.9	LT 26.9	192.59'	YES	Storm Sewer M.H. Type 1 Inlet, Type A w/ Beehive Grate
S-24	"O" 30+66.1	RT 17.5	196.03'	YES	Inlet, Type A
S-25A	"O" 32+21.5	RT 17.5	199.97'	YES	Inlet, Type A
S-25B	"O" 32+21.5	LT 27.0	197.40'	YES	Inlet, Type A
S-26A	"O" 33+68.5	RT 17.5	203.79'	YES	Storm Sewer Manhole, Type 2
S-26B	"O" 33+78.3	LT 27.0	200.86'	YES	Inlet, Type A w/ Beehive Grate
S-27A	"O" 35+15.1	LT 33.2	202.75'	YES	Inlet, Type A w/ Beehive Grate
S-27B	"O" 35+27.4	RT 17.5	207.71'	YES	Inlet, Type A
S-28A	"O" 36+47.1	LT 36.0	205.68'	YES	Inlet, Type A w/ Beehive Grate
S-28B	"O" 37+03.0	RT 17.5	211.58'	YES	Inlet, Type A
S-29A	"O" 38+33.6	LT 34.5	208.36'	YES	Inlet, Type A w/ Beehive Grate
S-29B	"O" 38+79.6	RT 17.5	213.98'	YES	Inlet, Type A
S-30A	"O" 40+53.7	LT 40.0	211.84'	YES	Storm Sewer M.H. Type 1 Inlet, Type A w/ Beehive Grate
S-30B	"O" 40+84.3	RT 17.5	216.15'	NO	RCC Inlet Type 1
S-31A	"O" 41+85.3	LT 40.0	213.27'	YES (4')	Storm Sewer M.H. Type 1 Inlet, Type A w/ Beehive Grate
S-31B	"O" 42+90.5	RT 17.5	218.46'	NO	RCC Inlet Type 1
S-32A	"O" 44+82.0	RT 17.5	224.37'	NO	RCC Inlet Type 1
S-32B	"O" 44+78.4	RT 17.5	209.06'	YES (NO)	Storm Sewer Manhole, Type 1 w/ Beehive Grate
S-32C	"O" 44+78.4	LT 66.6	203.06'	YES (4')	Storm Sewer Manhole, Type 1 w/ Beehive Grate
S-32D	"O" 44+72.9	LT 66.4	213.86'	YES (4')	Inlet, Type A w/ Beehive Grate
S-33A	"O" 47+29.3	RT 17.5	240.08'	NO	RCC Inlet Type 1
S-33B	"O" 48+25.0	LT 57.0	240.57'	YES (5')	Storm Sewer Manhole, Type 1 w/ Beehive Grate
S-34	"O" 48+86.5	RT 17.5	254.73'	YES	Storm Sewer Manhole, Type 1
S-35	"O" 50+50.2	RT 17.5	268.04'	YES	Storm Sewer Manhole, Type 1
S-36	"O" 52+36.0	LT 42.6	273.24'	YES	Inlet, Type A w/ Beehive Grate
S-37	"O" 52+99.1	RT 17.5	280.92'	YES	Storm Sewer Manhole, Type 1
S-38	"O" 54+64.7	RT 17.5	-	YES	Reducer and Grate Only
S-39	"O" 55+79.3	RT 17.5	-	YES	Reducer and Grate Only
S-40	"O" 57+76.7	RT 17.5	-	YES	Reducer and Grate Only
S-41	"O" 69+98.2	RT 17.5	-	YES	New installation Reducer and Grate Only
S-42	"F" 10+37.0	LT 26.1	254.97'	YES	Inlet, Type A w/ Beehive Grate
S-43	"F" 10+40.0	LT 14.5	257.53'	YES	Inlet, Type A
S-44	"F" 10+40.2	RT 14.8	257.53'	YES	Inlet, Type A
S-45	"O" 72+00.7	RT 17.5	254.74'	YES	Inlet, Type A
S-46	"O" 46+50.0	LT 29.7	165.98'	YES	Storm Sewer Manhole, Type 1 w/ Beehive Grate underdrain collector

- NOTE:
- STATION, OFFSETS, AND ELEVATIONS FOR CURB INLETS ARE MEASURED TO THE TOP BACK OF CURB (TBC). FIELD INLETS ARE MEASURED TO THE CENTER OF STRUCTURE.
 - ALL STRUCTURES SHALL HAVE STANDARD 18" SUMP, UNLESS OTHERWISE NOTED IN THE TABLE ABOVE. DEVIATIONS FROM THE STANDARD SUMP DEPTH ARE SHOWN IN PARENTHESES.
 - INLET INFORMATION AND SPECIAL DETAILS SHOWN ON SHEET N5.
 - BEEHIVE GRATES SHALL BE THE NEENAH TYPE R-2560-E10, OR APPROVED EQUAL.

UPDATED 03/05/2002 14:28

SLOPE PROTECTION AT PIPE END		
PIPE	SLOPE PROTECTION TYPE	REMARKS
P-17	III	
P-19	III	
P-22	II	
P-25	I & III	
P-29	III	
P-30	II	
P-32	I & III	
P-34	I & III	
P-36	I & III	
P-38	I	
P-40	II & III	
P-43a	II	

UPDATED 02/05/2002 10:15

DRAINAGE STRUCTURE SUMMARY - CONTINUED (ADDITIONAL STRUCTURES)	
APPROXIMATE LOCATION	REMARKS
≈ "WC" 4+85	TYPE II Storm Sewer Manhole
≈ "WC" 2+70 20' LT	INLET, TYPE A
≈ "WC" 4+75 35' RT	INLET, TYPE A
1900/1902 Second Ave	INLET, TYPE A on property Ref. CO #20
1900/1902 Second Ave	INLET, TYPE A in gutter - 2nd Ave Ref. CO #20
White Cliff St. + Tonagass Ave intersection 9034g.2002 101631.1909	TYPE II Storm Sewer Manhole Ref. CO #2
South + Tonagass Ave, East of Sea Level Dr. 90212.9001 101599.9201	TYPE II Storm Sewer Manhole Ref. CO #2

SLOPE STABILIZATION				
FROM		FROM		REMARKS
STATION	OFFSET	STATION	OFFSET	
"O" 30+75	LT	"O" 31+75	LT	INSTALL AT CUT BACKSLOPE

UPDATED 02/05/2002 10:17

- NOTES:
- STATION AND OFFSET ARE ONLY APPROXIMATE AND MAYBE ADJUSTED AS DIRECTED BY THE ENGINEER.
 - OTHER AREAS MAY REQUIRE SLOPE STABILIZATION AS DIRECTED BY THE ENGINEER.
 - SEE SHEET N8 FOR DETAILS.

VALVE BOX ADJUSTMENT SUMMARY			
STATION	OFFSET		REMARKS
	LEFT	RIGHT	
"W" 12+42.7	17.9'		
"W" 12+40.4	9.9'		
"W" 12+42.7	9.2'		
"W" 12+40.8	6.7'		
"W" 13+00	8.5'		
"W" 13+35.5	10.3'		
"A" 11+79.9	3.6'		
"A" 11+79.8	4.4'		
"A" 11+83.6	4.4'		
"A" 11+85.1	7.1'		
"A" 11+84.8	14.1'		
"A" 11+86.1	19.1'		

UPDATED 26/04/2002 9:19

PATH: G:\Ktn\71811A\Planset\0_Sums.dwg
 Mon, 06/May/02 09:28AM Michael Limbourg
 PLOT: PSPACE 1=1(F) OR MSPACE 1=1(F)
 TAB: SUM1

ADDENDUM NUMBER
 ATTACHMENT NUMBER
 RECORD OF REVISIONS
 No. DATE DESCRIPTION

KTN-THIRD AVENUE EXTENSION
 PROJECT NO. 68490

Miscellaneous Summaries

DESIGNED BY: C. HOWARD



CHECKED BY: T. MOORE

DRAWN BY: T.M./R.S.

STATE OF ALASKA
 DEPARTMENT OF TRANSPORTATION & PUBLIC FACILITIES
 STATEWIDE DESIGN & ENGINEERING SERVICES DIVISION
 THIRD AVENUE EXTENSION
 PROJECT NO. 68490

Miscellaneous Summaries

PROJECT DESIGNATION NUMBER

STP-MG-0904(2)

STATE YEAR

ALASKA 2002

SHEET NUMBER TOTAL SHEETS

D1 146

Project As Built Drawings have been reviewed by the Project Engineer. To the best of his/her knowledge, they represent the project as constructed.
 Proj. Eng. Date 03/06

PIPE SUMMARY										
PIPE NUMBER	TYPE	DIAMETER (in)	LENGTH (ft)	FROM STRUCTURE/STATION	INVERT	TO STRUCTURE/STATION	INVERT	SLOPE	REMARKS	
P-1a	CPP	12"	26	S-1	168.28	S-2	168.23	0.2%		
P-1b	CPP	12"	10.0	"W" 14+02.51, 13.0 RT	168.24	S-2	168.23	1.0%		
P-2	CPP	12"	84.85.0	S-2	168.15	S-3	152.88	18.2%		
P-3	CPP	12"	27.26.0	S-4	152.92	S-3	152.80	0.4%		
P-4	CPP	12"	53.5	S-3	152.71	S-5	142.51	19.2%		
P-5a	CPP	12"	100.101.5	S-5	142.43	S-6	124.00	18.5%		
P-5b	CPP	12"	11.0	S-6	123.92	"W" 11+60.03, 13.0 RT	123.91	1.0%		
P-6	CPP	12"	26	S-7	124.05	S-6	124.00	0.2%		
P-7	CPP	12"	30.29.5	S-8	142.65	S-5	142.51	0.5%		
P-8	CPP	12"	44.43.5	S-9	142.81	S-8	142.72	0.2%		
P-9	CPP	18"	69	S-10	146.74	S-11	137.64	13.1%		
P-10	CPP	18"	22.21	S-11	137.50	S-12	136.76	3.4%		
P-11	CPP	18"	16	S-12	136.70	S-13	135.99	4.5%		
P-12	CPP	18"	12.13.5	S-14	136.25	S-13	136.00	2.2%		
P-13a	CPP	36"	67.69.8	S-15b	142.16	S-13	131.40	16.2%		
P-13b	CPP	36"	24.31.4	S-13	131.30	"A" 11+75.5, 1.6 RT	130.75	2.3%		
P-14	CPP	36"	53.55.5	S-15a	153.24	S-15b	146.87	12.1%		
P-15	CPP	18"	65	S-16	153.00	S-15b	152.70	0.5%		
P-16	CPP	24"	109	S-17a	162.02	S-15b	157.01	4.6%	DELETED	
P-17b	CPP	24"	48.135	S-17b	162.19	S-17a-15b	162.10	0.2%		
P-18	CPP	24"	115	S-18	173.49	S-17a	165.10	7.3%	DELETED	
P-19b	CPP	24"	43.62	S-19	174.13	S-18-17b	173.57	1.3%		
P-20	CPP	18"	65.60.3	S-20	181.29	S-21	181.14	0.2%		
P-21	CPP	18"	93.55.4	S-22	181.48	S-20	181.37	0.1%		
P-22	CPP	24"	27.30	S-21	175.00	"O" 27+87.0, 43.0' RT	173.94	3.9%		
P-23	CPP	18"	118.117	S-23a	187.67	S-21	179.50	6.9%		
P-24	-	-	-	-	-	-	-	-	NOT USED	
P-25	CPP	24" 36"	65.68	S-23b	187.03	"O" 30+60.9, 38.8' RT	185.75	2.0%		
P-26	CPP	18"	155	S-24	192.38	S-25a	191.90	0.3%		
P-27	CPP	24" 18"	33.44	S-25b	191.56	S-25a	191.49	0.2%		
P-28	CPP	24"	147.14.6	S-25a	191.41	S-26a	190.35	0.7%		
P-29	CPP	24"	44.46	S-26b	195.56	S-26a	194.68	2.0%		
P-30	CPP	36"	27.30	S-26a	190.00	"O" 33+62.3, 45.4' RT	189.50	1.9%		
P-31	CPP	24"	159.158	S-27b	203.56	S-26a	190.40	8.3%		
P-32	CPP	24"	76.82	S-27a	199.02	"O" 34+94.7, 44.8' RT	197.50	2.0%		
P-33	CPP	24"	176.174	S-28b	207.43	S-27b	203.70	2.1%		
P-34	CPP	24"	73.12.6	S-28a	202.68	"O" 36+61.5, 38.5' RT	201.23	2.0%		
P-35	CPP	24"	177.17.6	S-29b	210.24	S-28b	207.50	1.6%		
P-36	CPP	24"	76	S-29a	205.36	"O" 38+40.9, 41.0' RT	203.90	1.9%		
P-37	CPP	18"	205	S-30b	212.75	S-29b	210.33	1.2%		
P-38	CPP	24"	66.67	S-30a	207.84	"O" 40+71.3, 24.7' RT	207.84	0.0%		
P-39	CPP	18"	206.281.5	S-31b	215.23	S-30b	212.83	1.2%		
P-40	CPP	24"	69.65	S-31a	209.27	"O" 42+09.0, 26.2' RT	209.27	0.0%		
P-41	-	-	-	-	-	-	-	-	NOT USED	
P-42	CPP	18"	192.193.5	S-32a	221.14	S-31b	215.31	3.0%		
P-43a	CPP	24"	19.94	S-32c	200.06	S-32b	200.06	0.0%		
P-43b	CPP	24"	73	S-32b	173.80	"O" 44+96.1, 24.7' RT	173.80	0.0%	See Pipe 44b	
P-44a	CPP	18"	248	S-33a	236.02	S-32a	221.22	6.0%		
P-44b	CPP	24"	194.146.5	S-32+32	210.81	S-32c	199.66	5.8%		
P-45	-	-	-	-	-	-	-	-	NOT USED	
P-46	CPP	18"	95	S-34	251.29	S-33b	238.07	13.9%		
P-47	CPP	18"	120.121.5	S-33b	237.99	S-33a	236.10	1.6%		
P-48	CPP	18"	165	S-35	265.17	S-34	251.23	8.4%		
P-49	CPP	18"	194	S-36	269.74	S-35	265.25	2.3%		
P-50	CPP	18"	75.72	S-37	276.25	"O" 53+84, 16.5' RT	275.50	1.0%	CONNECT TO EX. PIPE STUB	
P-51	CPP	18"	43.43	S-42	250.50	S-43-S-44	250.37	1.0%		
P-52	CPP	18"	27	S-43	230.29	S-44	249.67	2.3%		
P-53	CPP	18"	58.46	S-44	249.59	S-45	248.38	2.1%		
P-54	CPP	18"	171.5	S-46	160.40	"O" 44+76.80	157.80	1.5%	Not on plans	
P-55	CMP	12"	60	"O" 33+84.4, 27.0' LT	200.86	"O" 33+68.7, 231.3' RT	199.25	2.7%	UTILITY PIPE	
P-56	CMP	12"	59.60	"O" 38+36.2, 34.4' LT	208.36	"O" 38+43.8, 37.8' RT	203.80	7.7%	UTILITY PIPE	
P-57	CPP	36"	234.233	"WC" 14+95.30, 3.4' LT	81.30	"WC" 12+64.12, 1.3' LT	44.58	15.7%		
P-58	CPP	36"	239.237	"WC" 12+64.12, 1.3' LT	43.78	"WC" 10+27.15, 1.3' LT	14.02	12.5%		
P-59	CPP	24"	22	"O" 42+95, 12.5' RT	246.73	"O" 42+94.92, 3.0' RT	246.35	0.2%	UPDATED	5/2/2002 10:32
P-59a	CPP	24"	45	"O" 42+95	246.73	"O" 42+95	246.35	0.2%		

CPP = CORRUGATED POLYETHYLENE PIPE

DITCH CHECKS			
STATION	OFFSET		REMARKS
	LEFT	RIGHT	
48+25 To 52+20		VARIES	SEE N SHEETS FOR SPECIAL DITCHING
62+60		35'	
64+15		35'	
65+70		35'	

UPDATED 02/05/2002 11:00

CENTERLINE MONUMENTS & CASES	
STATION	REMARKS
"O" 23+00.00	P.O.T.
"O" 24+60.54	P.C.
"O" 28+29.27	P.T.
"O" 46+68.57	P.C.
"O" 53+10.13 BK.	P.T. EQ.
"O" 62+23.46	P.C.
"O" 67+26.34	P.T.
"O" 69+96.78	P.C.

UPDATED 26/04/2002 9:23

TEMPORARY DITCH BLOCKING SUMMARY (SEE SHEET N6 FOR DETAILS)			
STATION	OFFSET		REMARKS
	LEFT	RIGHT	
"O" 24+30		X	
"O" 26+45		X	
"O" 30+70		X	
"O" 34+00		X	
"O" 35+50		X	
"O" 38+90		X	
"O" 41+55		X	
"O" 56+50		X	
"O" 59+00		X	
"O" 67+50		X	
"O" 70+00		X	

UPDATED 26/04/2002 9:22

INSULATION BOARD SUMMARY	
LOCATION	REMARKS
STORM PIPE CROSSING OVER OR UNDER WATER & SEWER LINE	
P-1	
P-3	
P-4	
P-6	
P-8	WATER OVER S.D.
P-14	WATER OVER S.D.
P-17	WATER OVER S.D.
P-19	WATER OVER S.D.
P-20	WATER UNDER S.D.
P-25	WATER OVER S.D.
P-27	WATER OVER S.D.
P-29	WATER OVER S.D.
P-32	WATER OVER S.D.
P-34	WATER OVER S.D.
P-36	WATER OVER S.D.
P-47	WATER UNDER S.D.
P-49	WATER UNDER S.D.

UPDATED 26/04/2002 9:17

PATH: G:\Ktr\71811A\Planset\D_Sums.dwg
 Mon, 06/May/02 09:28AM
 PLOT: Michael Limbaugh
 PSPACE 1=1(F) OR MSPACE 1=1(F)
 TAB: SUM2

ADDENDUM NUMBER		
ATTACHMENT NUMBER		
RECORD OF REVISIONS		
No.	DATE	DESCRIPTION

KTN-THIRD AVENUE EXTENSION
 PROJECT NO. 68490
 Miscellaneous Summaries

DESIGNED BY: C. HOWARD



CHECKED BY: T. MOORE
 DRAWN BY: T.M./R.S.

STATE OF ALASKA
 DEPARTMENT OF TRANSPORTATION & PUBLIC FACILITIES
 STATEWIDE DESIGN & ENGINEERING SERVICES DIVISION
 THIRD AVENUE EXTENSION
 PROJECT NO. 68490

Miscellaneous Summaries

PROJECT DESIGNATION NUMBER
 STP-MG-0904(2)

STATE	YEAR
ALASKA	2002
SHEET NUMBER	TOTAL SHEETS
D2	146

Project As Built Drawings have been reviewed by the Project Engineer. To the best of his/her knowledge, they represent the project as constructed.
 Proj. Eng. KS Date 10/22/02

UNDERDRAIN SUMMARY													
PIPE NO.	TYPE	PERFORATED	DIAMETER (in)	LENGTH (ft)	STATION	FROM OFFSET	INVERT	STATION	TO OFFSET	INVERT	CLEANOUT	*LOCATION	REMARKS
U-1	HDPE	YES	12	300.0	40+00	0.0	201.4	43+00	15.5 LT	188.5	YES	A	
U-2	HDPE	YES	12	206.5	40+00	25.0 RT	200.0	42+04	28.7 RT	189.1	YES	C	
U-3	HDPE	YES	12	81.0	42+20	25.0 RT	182.5	42+99	29.4 RT	177.1	YES	C	
U-4	HDPE	NO	12	44.5	43+00	15.5 LT	188.5	43+00	30.0 RT	187.8	YES	B	SLOPE PROTECTION, TYPE II
U-5	HDPE	YES	12	176.3	44+75	20.0 LT	188.7	43+00	15.5 LT	188.5	YES	A	
U-6	HDPE	YES	12	166.7	43+07	26.0 RT	174.3	44+73	26.0 RT	163.4	YES	C	
U-7	HDPE	NO	12	45.5	44+75	20.0 LT	175.0	44+75	26.0 RT	174.2	YES	B	SLOPE PROTECTION, TYPE II
U-8	HDPE	YES	12	178.0	44+75	20.0 LT	188.7	46+50	50.0 LT	201.9	NO	A	HIGH POINT IN CENTER
U-9	HDPE	YES	12	171.5	46+48	27.5 RT	160.3	44+80	27.5 RT	157.8	YES	C	
U-10	HDPE	NO	12	77.2	46+50	50.0 LT	162.0	S-46		160.9	YES	B	
U-11	HDPE	NO	12	77.2	46+50	50.0 LT	165.5	S-46		163.3	NO	B	RELIEF PIPE
U-12	HDPE	YES	12	20.0	46+40	50.0 LT	165.5	46+60	50.0 LT	165.5	NO	A	RELIEF PIPE
U-13	HDPE	YES	12	149.5	48+00	24.5 LT	201.9	46+50	50.0 LT	162.0	NO	A	
U-14	HDPE	NO	12	55.5	48+00	24.5 LT	201.9	48+00	31.0 RT	200.0	YES	B	VERTICAL OUTFALL PIPE
U-15	HDPE	YES	12	77.5	48+10	33.0 RT	171.8	S-46		160.9	YES	C	
U-16	HDPE	YES	12	267.5	50+43	112.0 RT	202.6	48+10	33.0 RT	171.8	YES	C	
U-17	HDPE	YES	12	291.5	50+65	85.6 RT	251.4	48+00	24.5 LT	201.9	YES	A	

HDPE = HIGH DENSITY POLYETHYLENE

UPDATED 01/05/2002 11:30

NOTES:

- ADJUST UNDERDRAIN PIPE LOCATIONS AND INVERTS TO FIT FIELD CONDITIONS.
- PLACE UNDERDRAIN PIPE WITH A MINIMUM 1% SLOPE.
- INSTALL CLEANOUTS AT ALL UNDERDRAIN PIPE ENDS AND AT ALL UNDERDRAIN PIPE ENDS PASSING THROUGH RCC.
- FOR S-46 AND P-54, SEE DRAINAGE STRUCTURE SUMMARY AND PIPE SUMMARY.
- SEE L-SHEET FOR UNDERDRAIN LOCATIONS AND N-UNDERDRAIN SHEETS FOR DETAILS.

* LOCATION DESCRIPTION:

- A = UPHILL FROM RCC WALL
- B = EMBEDDED, THROUGH RCC WALL
- C = DOWNHILL FROM RCC

CURB CUT SUMMARY					
**STATION	**OFFSET		DETAIL	WIDTH	REMARKS
	LEFT	RIGHT			
"0" 20+42.27		20'	II	12.0'	DRIVEWAY
"0" 20+67.54	14'		III	14.5'	DRIVEWAY
"0" 21+82.08		21.84'	V	8.0'	WHEELCHAIR
"0" 22+21.55	25.99'		IV	5.0'	WHEELCHAIR
"0" 22+23.23		24.47'	IV	5.0'	WHEELCHAIR
"0" 22+79.10		20.97'	V	8.0'	WHEELCHAIR
"0" 23+21.76		19.65'	IV	5.0'	WHEELCHAIR
"0" 71+48.33	22.01'		IV	5.0'	WHEELCHAIR
"0" 71+94.07	22.01'		IV	5.0'	WHEELCHAIR
"A" 11+62.79		10.62'	V	8.0'	WHEELCHAIR
"A" 11+59.95	17.55'		IV	5.0'	WHEELCHAIR
"A" 11+83.20	14.27'		IV	5.0'	WHEELCHAIR
"F" 10+58.50	26.50'		VI	5.0'	WHEELCHAIR
"W" 11+72.97	13.50'		III	8.0'	DRIVEWAY
"W" 13+33.46	13.50'		III	18.0'	DRIVEWAY
"W" 13+49.3		13.50'	III	18.0'	DRIVEWAY
OFFSITE DRAINAGE IMPROVEMENT AREA 2			II	20.0'	DRIVEWAY

UPDATED 26/04/2002 9:25

** STATION AND OFFSET ARE MEASURED TO FACE OF CURB

PEDESTRIAN RAILING INSTALLATION SUMMARY							
FROM				TO			
OFFSET				OFFSET			
STATION	LEFT	RIGHT	STATION	LEFT	RIGHT	LENGTH	REMARKS
"0" 50+60		23.50'	"0" 53+73		23.50'	313	
"A" 10+39	16.22'		"A" 10+60	13.50'		11	
OFFSITE DRAINAGE IMPROVEMENT AREA 2						40	
TOTAL						364.00	

UPDATED 26/04/2002 9:26

CHAIN-LINK FENCE (SEE STD. DWG. F-01.01)						
FROM		TO		LENGTH	HEIGHT	REMARKS
STATION	OFFSET	STATION	OFFSET			
47+29.55	24.3' RT	50+81.50	95.4' RT	400' 33.5'	6'	INSTALL ALONG FRONT EDGE OF LOWER RCC WALL
48+49+35.50	23.5' RT	48+53+73.52	33.523.9' RT	500' 11.1'	6'	INSTALL ALONG FRONT EDGE OF UPPER RCC WALL
48+00	LT	52+25	LT	444'	6'	vinyl coated - between Rainbird Trail & White Cliff cut - Ref. CO# 17
26+50	LT	30+00	TOTAL = LT	900' 34.5'	6'	vinyl coated - Top of Parking Area cut - Ref. CO# 17

UPDATED 26/04/2002 9:27

NOTE:

- INSTALL CHAIN-LINK FENCE AFTER WHITECLIFF EXCAVATION. PLACE CHAIN-LINK FENCE FROM BACK OF SIDEWALK, THEN ALONG THE FRONT TOP EDGE OF RCC WALLS, AND FINALLY TYING INTO FINAL CUT SLOPE OR BACK OF SIDEWALK AS REQUIRED BY THE ENGINEER.

RESIDENCE DRIVEWAYS				
STATION	OFFSET		LENGTH	REMARKS
	LEFT	RIGHT		
"0" 20+42.27		X		DRIVEWAY
"0" 20+67.54	X			DRIVEWAY
"0" 28+31.00	X			LANDING AT STAIRWAY
"0" 52+58.50	X			PAD FOR TRAILHEAD
"W" 11+72.97	X			DRIVEWAY
"W" 13+33.46	X			DRIVEWAY
"W" 13+49.30		X		DRIVEWAY


UPDATED 26/04/2002 9:28

PATH: Q:\Ktn\71811A\PlanSet\D_Sums.dwg
 Mon, 06/May/02 09:28AM Michael Limbough
 PLOT: PSPACE 1=1(F) OR MSPAGE 1=1(F)
 TAB: SUM3

ADDENDUM NUMBER		
ATTACHMENT NUMBER		
RECORD OF REVISIONS		
No.	DATE	DESCRIPTION

KTN-THIRD AVENUE EXTENSION
 PROJECT NO. 68490
 Miscellaneous Summaries

DESIGNED BY: C. HOWARD

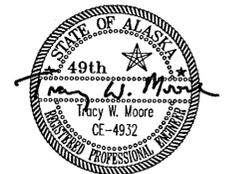

CHECKED BY: T. MOORE

DRAWN BY: T.M./R.S.

STATE OF ALASKA
 DEPARTMENT OF TRANSPORTATION & PUBLIC FACILITIES
 STATEWIDE DESIGN & ENGINEERING SERVICES DIVISION

THIRD AVENUE EXTENSION
 PROJECT NO. 68490

Miscellaneous Summaries

PROJECT DESIGNATION NUMBER

STP-MG-0904(2)

STATE	YEAR
ALASKA	2002
SHEET NUMBER	TOTAL SHEETS
D3	146

Project As Built Drawings have been reviewed by the Project Engineer. To the best of his/her knowledge, they represent the project as constructed.

Proj. Eng. Date 10/31/06

TEMPORARY ROCK CATCHMENT BARRIER							
FROM		TO		LENGTH	HEIGHT	DESIGN LOAD	REMARKS
STATION	OFFSET	STATION	OFFSET				
"O" 49+62.20	96.4 RT	"O" 50+75.00	138.0 RT	128.0'	6'	30 FT-TONS	
"O" 50+75.00	138.0 RT	"O" 52+68.50	173.7 RT	218.5'	6'	74 FT-TONS	

UPDATED 26/04/2002 9:31

NOTE:
STATION AND OFFSET ARE ONLY APPROXIMATE AND MAY BE ADJUSTED AT THE ENGINEERS APPROVAL.
TEMPORARY ROCK CATCHMENT BARRIER SHALL BE INSTALLED WITHIN THE TEMPORARY CONSTRUCTION PERMIT.

MATTING				
FROM		TO		REMARKS
STATION	OFFSET	STATION	OFFSET	
O 21+75	LT.	O 23+00	LT.	INSTALL AT CUT BACKSLOPE
O 31+75	LT.	O 32+75	LT.	INSTALL AT CUT BACKSLOPE

UPDATED 26/04/2002 9:32

NOTE:
OTHER AREAS MAY REQUIRE MATTING AS REQUIRED BY THE ENGINEER. STATIONING IS ONLY APPROXIMATE AND MAY REQUIRE ADJUSTMENT AS NEEDED TO BETTER FIT FIELD CONDITIONS.

TREE PLANTING			
STATION	OFFSET RIGHT	TYPE	REMARKS
"O" 21+70	38.0'	RED MAPLE	DELETED PER Proj. Eng.
"O" 22+46	45.5'	GREEN MAPLE	DELETED PER Proj. Eng.
"O" 22+72	50.0'	RED MAPLE	DELETED PER Proj. Eng.
"O" 24+40	39.5'	GREEN MAPLE	DELETED PER Proj. Eng.
"O" 29+64	33.5'	RED MAPLE	
"O" 30+43	32.5'	GREEN MAPLE	
"O" 31+08	33.5'	RED MAPLE	
"O" 31+23	53.0'	GREEN MAPLE	
"O" 31+65	32.5'	RED MAPLE	
"O" 31+83	63.5'	GREEN MAPLE	
"O" 31+99	45.0'	RED MAPLE	
"O" 32+29	35.0'	GREEN MAPLE	
"O" 32+39	62.0'	RED MAPLE	
"O" 32+67	34.0'	GREEN MAPLE	
"O" 32+76	54.5'	RED MAPLE	
"O" 33+05	53.5'	GREEN MAPLE	
"O" 33+25	35.5'	RED MAPLE	

UPDATED 26/04/2002 9:33

ROCK BOLT SUMMARY (SEE SHEET M8 FOR 22 ADDITIONAL ROCK BOLTS)				
QUANTITY	LENGTH	LOCATION	DESIGN LOAD	REMARKS
1	20'	"O" 57+25	69 KIPS	INSTALL ROCK BOLTS AS DIRECTED
2	20'	"O" 60+50	69 KIPS	INSTALL ROCK BOLTS AS DIRECTED
2	20'	"O" 64+50	69 KIPS	INSTALL ROCK BOLTS IN OVERHANGING BLOCK.
3	20'	"O" 68+50	69 KIPS	INSTALL ROCK BOLTS AS DIRECTED
10	20'	VARIES	69 KIPS	ON-SITE TO BE USED AS NEEDED
10	30'	VARIES	69 KIPS	ON-SITE TO BE USED AS NEEDED
22	VARIES	"O" 48+50	69 KIPS	SEE SHEET M7

TOTAL = 50

NOTES:
1. LOCATION OF ROCK BOLTS ARE APPROXIMATE AND WILL BE DIRECTED BY THE ENGINEER.

BOLT PROPERTIES
MECHANICAL ANCHOR, PRE-STRESSABLE, & GROUTABLE
1 3/8" DIA., 91 KSI YIELD, 124 KSI ULTIMATE

26/04/2002 9:34

NOISE BARRIER						
FROM		TO		LENGTH	HEIGHT	DESIGN LOADING
STATION	OFFSET	STATION	OFFSET			
"O" 24+00	RT.	"O" 24+70	RT.	70'	8'	B1
"O" 24+70	RT.	"O" 25+75	RT.	105'	5'-4"	B1
"O" 25+75	RT.	"O" 29+00	RT.	325'	8'	B1

UPDATED 26/04/2002 9:34

NOTE:
FACE OF NOISE BARRIER SHALL BE LOCATED SO THAT IT MATCHES THE BACK OF SIDEWALK

CONCRETE BARRIER						
FROM		TO		LENGTH	TYPE	REMARKS
STATION	OFFSET	STATION	OFFSET			
"A" 10+37	RT.	"A" 11+27	RT.	90'	A	FOR RETAINING WALL #2
"O" 24+75	RT.	"O" 25+75	RT.	100'	B	FOR RETAINING WALL #3
"O" 39+73	RT.	"O" 40+00	RT.	27'	B	FOR LOWER RCC WALL
"O" 40+00	RT.	"O" 48+30	RT.	830'	C	FOR LOWER RCC WALL
"O" 48+30	RT.	"O" 50+60	RT.	230'	B	FOR LOWER RCC WALL
"O" 53+73	RT.	"O" 56+98	RT.	325'	B	FOR EXISTING WALL #4
"O" 58+13	RT.	"O" 60+87	RT.	274'	B	FOR EXISTING WALL #5
"O" 66+49	RT.	"O" 68+32	RT.	183'	B	FOR EXISTING WALL #6


UPDATED 26/04/2002 9:35

NOTE:
FOR DETAILS:
TYPE A, SEE SHEET J4.
TYPE B, SEE SHEET J6.
TYPE C, SEE SHEET L8.

ADDENDUM NUMBER		
ATTACHMENT NUMBER		
RECORD OF REVISIONS		
No.	DATE	DESCRIPTION

KTN-THIRD AVENUE EXTENSION
 PROJECT NO. 68490
 Miscellaneous Summaries

DESIGNED BY: C. HOWARD

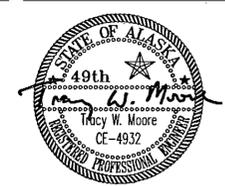

CHECKED BY: T. MOORE
DRAWN BY: T.M./R.S.

STATE OF ALASKA
DEPARTMENT OF TRANSPORTATION
& PUBLIC FACILITIES
STATEWIDE DESIGN & ENGINEERING
SERVICES DIVISION
THIRD AVENUE EXTENSION
PROJECT NO. 68490

Miscellaneous Summaries

PROJECT DESIGNATION NUMBER

STP-MG-0904(2)

STATE	YEAR
ALASKA	2002
SHEET NUMBER	TOTAL SHEETS
D4	146

Project As Built Drawings have been reviewed by the Project Engineer. To the best of his/her knowledge, they represent the project as constructed.

Proj. Eng. *KS* Date: 3/3/06

REMOVAL OF STRUCTURES AND CONSTRUCTIONS

FROM		TO		REMARKS
STATION	OFFSET	STATION	OFFSET	
"O" 21+40.4	10.3' LT.			APPROX. 20'x9' CONCRETE RETAINING WALL
"O" 21+50.7	7.4' LT.			POST
"O" 21+51.7	10.4' LT.			UTILITY BOX
"O" 21+90.0	33.3' LT.			CURB INLET GRATE & MANHOLE
"W" 12+90.5	15.1' LT.	"W" 13+10.2	15.0' RT.	APPROX. 20' OF ROCKERY WALL, APPROX. 6'-6.5' HIGH.
"W" 13+10.2	15.0' LT.	"W" 13+38.2	19.2' RT.	APPROX. 28' OF CONCRETE RETAINING WALL, APPROX. 2.5' HIGH
"O" 22+12.1	7.8' RT.			CURB INLET GRATE & MANHOLE
"O" 22+15.8	7.6' RT.			CURB INLET GRATE & MANHOLE
"O" 22+17	10.9' LT.	"O" 22+46.9	24.7' RT.	APPROX. 59' OF CONCRETE RETAINING WALL, APPROX. 2' TO 4.5' HIGH
"O" 22+67	23' LT.	2222	3RD AVE.	PORTION OF A CONCRETE FOUNDATION AND 5' DIAMETER STEEL BOILER
"O" 22+75.0	29.0' RT.			CURB INLET GRATE & MANHOLE
"A" 10+36.0	9.8' LT.	"A" 11+04.4	14.1' LT.	APPROX. 69' OF CONCRETE RETAINING WALL, APPROX. 6'-6.5' HIGH
"A" 11+23.9	5.5' LT.			CURB INLET GRATE & MANHOLE
"A" 11+27.9	6.40' LT.	"A" 11+47.5	20.2' LT.	APPROX. 28' OF GUARDRAIL
"A" 11+55.7	13.2' RT.			CURB INLET GRATE & MANHOLE
"O" 37+24	64.0' RT.	"O" 39+45	29.0' RT.	APPROX. 231' OF EXISTING LOGWALL, LEAVE IN PLACE UNTIL ROADWAY EMBANKMENT IS CONSTRUCTED
"O" 39+45	29.0' RT.	"O" 46+64	46.0' RT.	APPROX. 757' OF EXISTING LOGWALL, REMOVE AS CONFLICTS OCCUR WITH EMBANKMENT CONSTRUCTION
"O" 46+64	46.0' RT.	"O" 49+62	98.0' RT.	APPROX. 346' OF EXISTING LOGWALL, LEAVE IN PLACE UNTIL WHITECLIFF EXCAVATION IS COMPLETE
"O" 50+86	41.0' RT.	"O" 52+42	49.0' RT.	APPROX. 162' OF EXISTING LOGWALL, REMOVE AS CONFLICTS OCCUR WITH EMBANKMENT CONSTRUCTION
LOCATION VARIES THROUGHOUT PROJECT				CHAIN-LINK FENCE
OFFSITE DRAINAGE IMPROVEMENT AREA 1				APPROX. 42 CUBIC FEET OF CONCRETE HEADWALL (21'L x 4'H x 6"W)
OFFSITE DRAINAGE IMPROVEMENT AREA 2				APPROX. 103 CUBIC FEET OF CONCRETE HEADWALL (27.5'L x 5'H x 8"W)
OFFSITE DRAINAGE IMPROVEMENT AREA 2				4' x 8' CONCRETE VAULT
OFFSITE DRAINAGE IMPROVEMENT AREA 2				APPROX. 80 CUBIC FEET OF CONCRETE SIDEWALK AND 20 CUBIC FEET OF PONY WALL
OFFSITE DRAINAGE IMPROVEMENT AREA 3				APPROX. 11.5 CUBIC FEET OF CONCRETE HEADWALL (15.4'L x 2.3'H x 4"W)
OFFSITE DRAINAGE IMPROVEMENT AREA 4				CURB INLET GRATE & MANHOLE

UPDATED

01/05/2002 10:55

CULVERT REMOVAL SUMMARY

FROM		TO		TYPE	SIZE	LENGTH	REMARKS
STATION	OFFSET	STATION	OFFSET				
"W" 13+13.0	12.6' LT.	"W" 13+02.1	10.4' RT.	CMP	18"	26'	
"W" 13+22.6	11.0' RT.	"W" 12+72.0	13.4' RT.	CMP	24"	61'	
"WC" XX+XX.X	XX.X' XX	"WC" XX+XX.X	XX.X' XX	CMP	22" x 36"	465'	
"O" 24+02.9	62.1' RT.	"W" 24+07.8	84.2' RT.	CMP	36"	21'	
OFFSITE DRAINAGE IMPROVEMENT AREA 2				CMP	36"	48'	
OFFSITE DRAINAGE IMPROVEMENT AREA 2				CMP	26"x42"	30'	
				TOTAL =		573'	

UPDATED

26/04/2002 9:36

*** REMOVAL / SECURING OF HAZARDOUS ROCKS**

'O' STATION	ROCK NO.	OFFSET		'O' STATION	ROCK NO.	OFFSET	
		LEFT	RIGHT			LEFT	RIGHT
24+00	R-048	150'		44+93	R-020		85'
25+50	R-047	175'		45+05	R-061	191'	
27+10	R-046	150'		45+73	R-060	175'	
28+10	R-045	200'		45+73	*R-023	105'	
29+05	R-044	165'		45+57	R-063	269'	
29+45	R-043	150'		45+79	R-062	210'	
30+10	R-042	250'		46+77	R-064	281'	
30+65	R-041	260'		46+80	R-034		83'
31+15	R-040	240'		47+49	R-059	175'	
32+50	R-039	200'		47+69	R-033		93'
30+60	R-052		125'	47+22	R-065	285'	
33+60	R-038	201'		48+06	R-058	175'	
36+20	R-014		97'	48+70	R-066	242'	
35+10	R-037	214'		48+49	R-057	183'	
35+99	R-012	123'		49+23	R-056	176'	
35+93	R-036	252'		48+92	*R-029		33'
32+00	R-053		130'	49+42	*R-054	147'	
36+64	R-015		114'	49+75	R-067	253'	
36+63	R-011	192'		49+46	R-030		78'
37+55	R-010	234'		50+47	*R-031		104'
39+13	R-016		128'	50+35	R-068	226'	
40+02	R-017		67'	50+13	R-055	169'	
38+84	R-009	270'		50+80	R-069	230'	
40+82	R-008	226'		51+47	R-032		144'
41+22	R-007	260'		51+62	R-071	176'	
41+73	R-006	303'		52+84	R-072	88'	
42+29	R-018		33'	53+56	R-073	76'	
42+83	R-003	279'		53+91	R-088		172'
42+80	R-002	194'		55+81	R-077	278'	
42+66	R-005	319'		56+11	R-079	74'	
43+04	R-004	319'					

NOTE:

** HAZARDOUS ROCKS LOCATED OUTSIDE OF THE RIGHT OF WAY SHALL NOT BE REMOVED OR SECURED UNTIL THE PROJECT ENGINEER OBTAINED THE TEMPORARY CONSTRUCTION PERMIT FROM THE PROPERTY OWNER. SEE VOLUME III OF THE PHASE II GEOTECHNICAL INVESTIGATION FOR DETAILED DESCRIPTION OF HAZARDOUS ROCKS.

RECONSTRUCT EXISTING MANHOLE SUMMARY

**STATION	OFFSET		REMARKS
	LEFT	RIGHT	
"W" 12+51.61	7.5'		WATER MH DELETED

UPDATED

26/04/2002 9:58

** STATION AND OFFSET ARE MEASURED TO CENTER OF STRUCTURE

ADJUST EXISTING MANHOLE SUMMARY

**STATION	OFFSET		REMARKS
	LEFT	RIGHT	
"O" 21+22.22	11.0'		WATER MH DELETED
"O" 21+55.77		6.6'	WATER MH DELETED
"A" 11+81.46		0.8'	STORMDRAIN MH
"W2" 10+28.08	4.9'		SEWER MH
UPDATED 26/04/2002 9:59			
"W" 14+12		≈ 2.0'	Sanitary Sewer MH
"WC" 4+85		≈ 130.0'	Sanitary Sewer MH
"F" 11+20		X	Sanitary Sewer MH

PATH: Q:\Ktn\71811A\PlanSet\0_Sums.dwg
 Mon, 06/May/02 09:28AM Michael Limbaugh
 PLOT: PSPACE 1=1(F) OR MSPACE 1=1(F)
 TAB: SUM5

ADDENDUM NUMBER

ATTACHMENT NUMBER

RECORD OF REVISIONS

No.	DATE	DESCRIPTION

KTN-THIRD AVENUE EXTENSION
PROJECT NO. 68490

Miscellaneous Summaries

DESIGNED BY: C. HOWARD



CHECKED BY: T. MOORE

DRAWN BY: K.K.

STATE OF ALASKA
DEPARTMENT OF TRANSPORTATION & PUBLIC FACILITIES
STATEWIDE DESIGN & ENGINEERING SERVICES DIVISION

**THIRD AVENUE EXTENSION
PROJECT NO. 68490**

Miscellaneous Summaries



PROJECT DESIGNATION NUMBER

STP-MG-0904(2)

STATE	YEAR
ALASKA	2002
SHEET NUMBER	TOTAL SHEETS
D5	146


Project As Built Drawings have been reviewed by the Project Engineer. To the best of his/her knowledge, they represent the project as constructed.

Proj. Eng. *[Signature]* Date 10/26/02

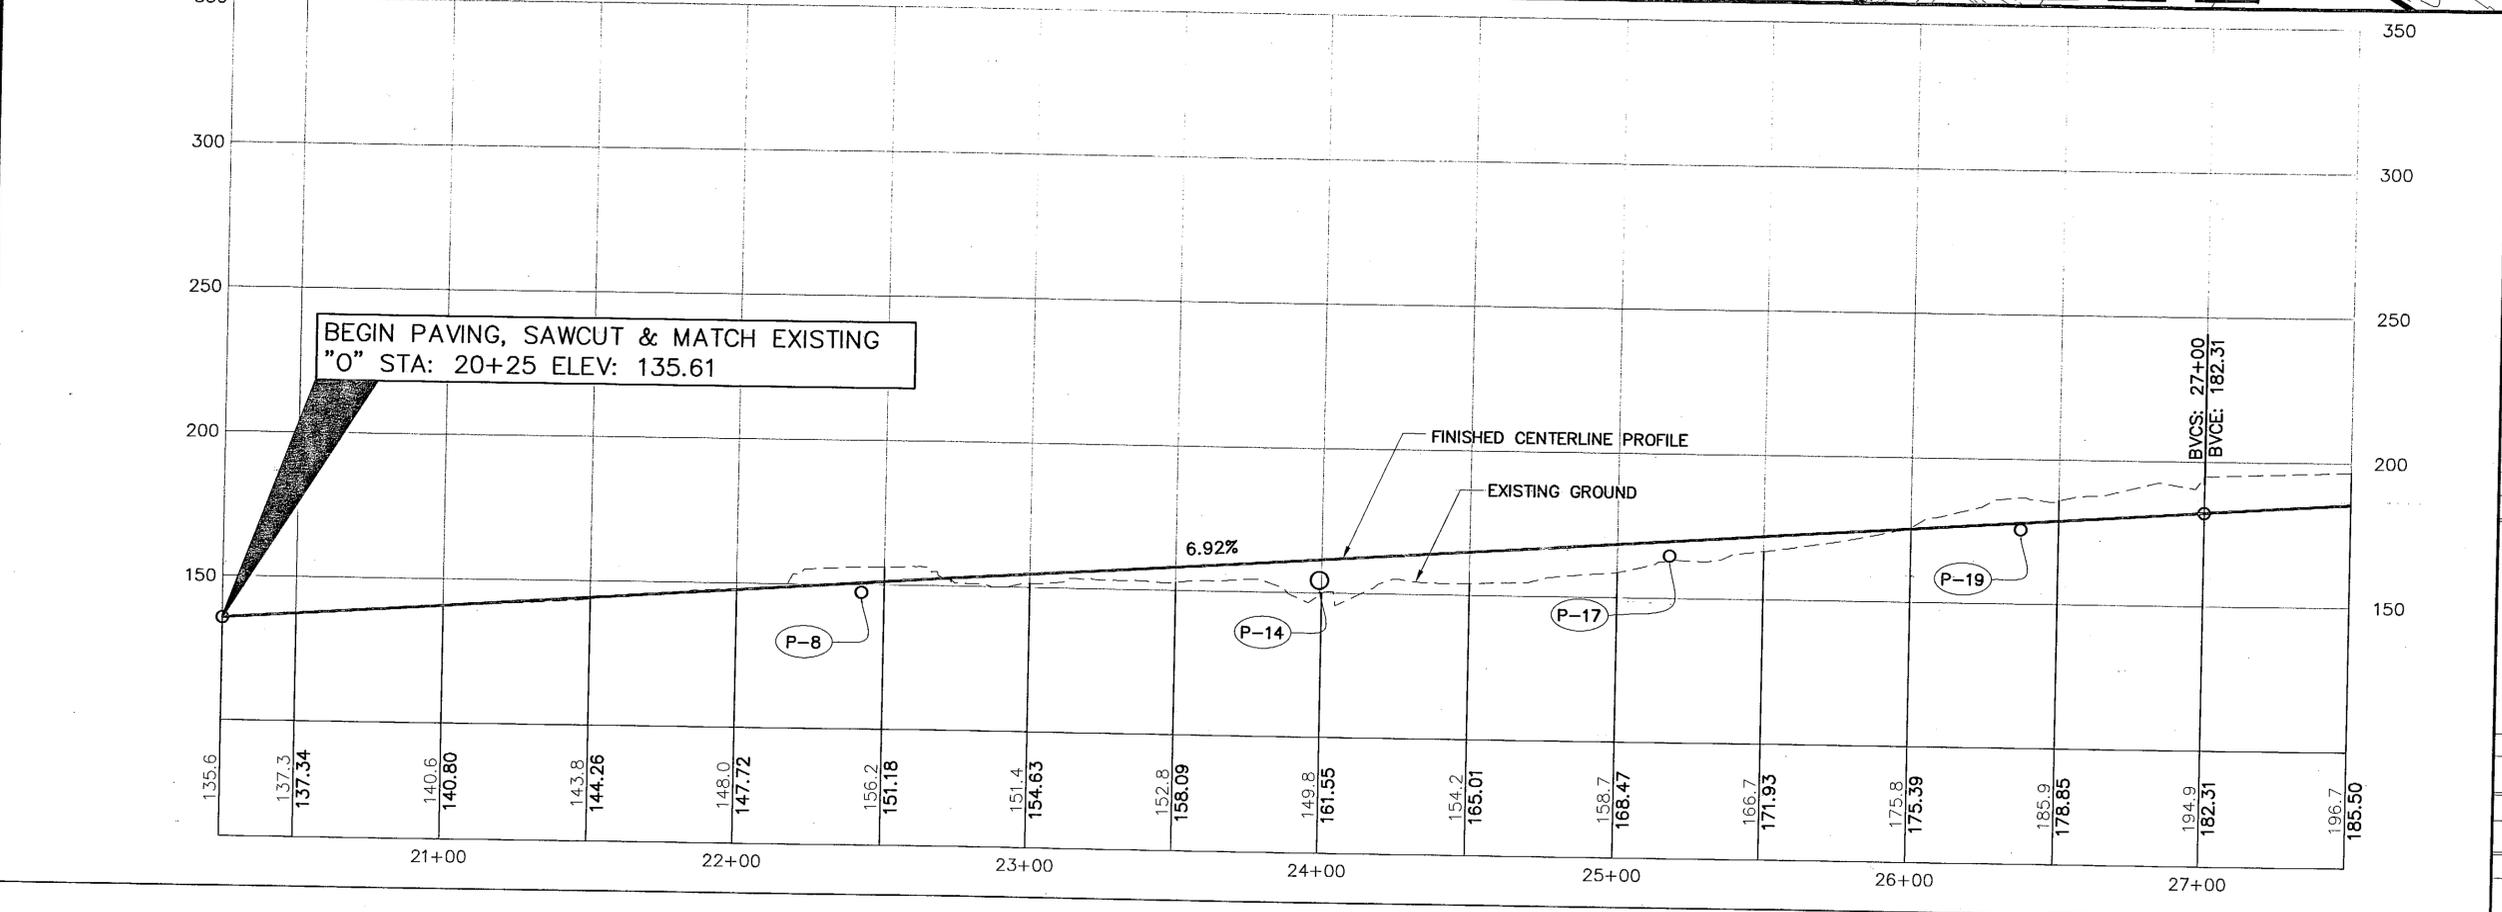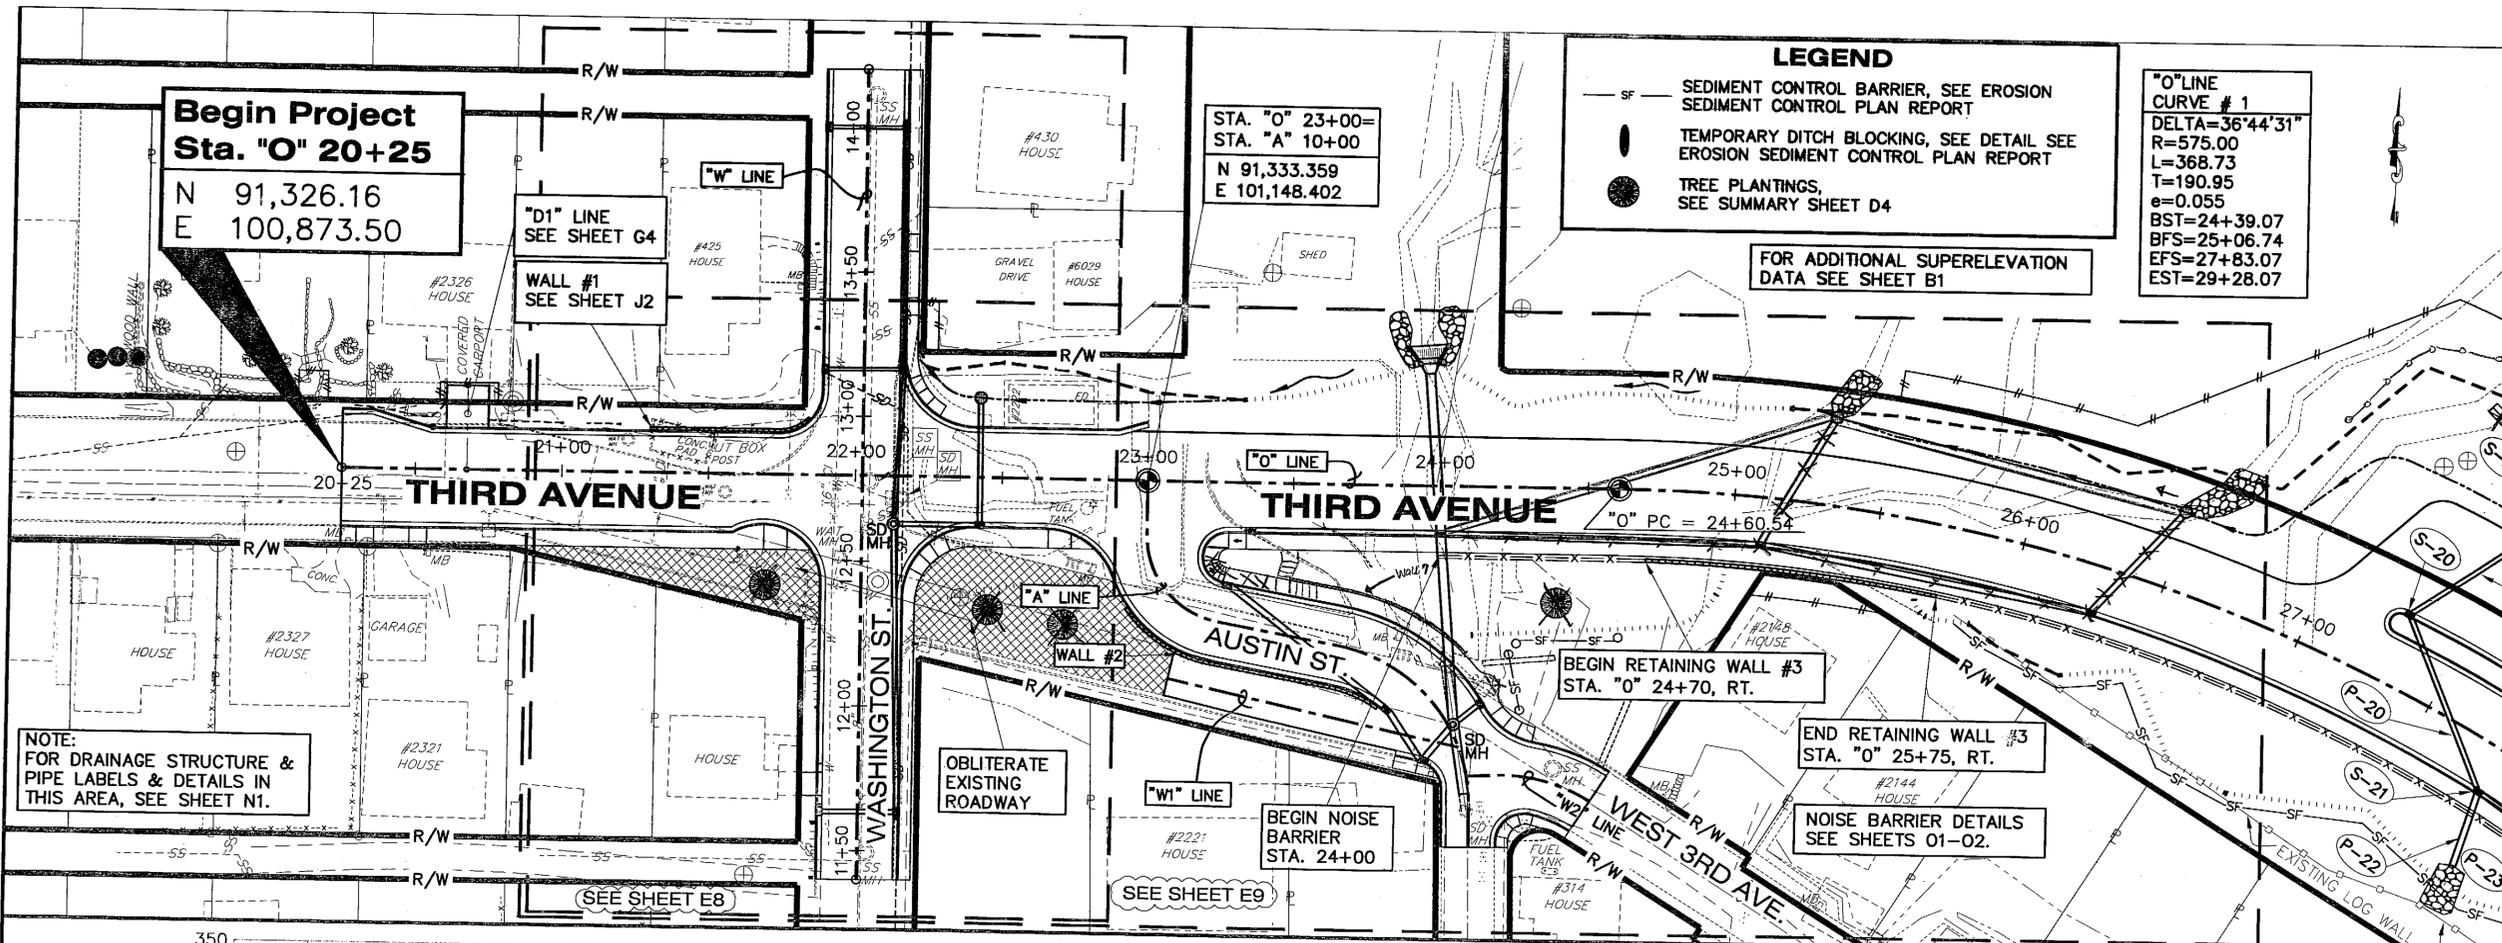


PATH:
 O:\ktn\71811A\Planset\E1_Plan.dwg
 Mon, 06/May/02 10:28AM Michael Limbough
 PLOT:
 PSPACE 1=1(F) OR MSPAGE 1=1(F)

ADDENDUM NUMBER		
ATTACHMENT NUMBER		
RECORD OF REVISIONS		
No.	DATE	DESCRIPTION

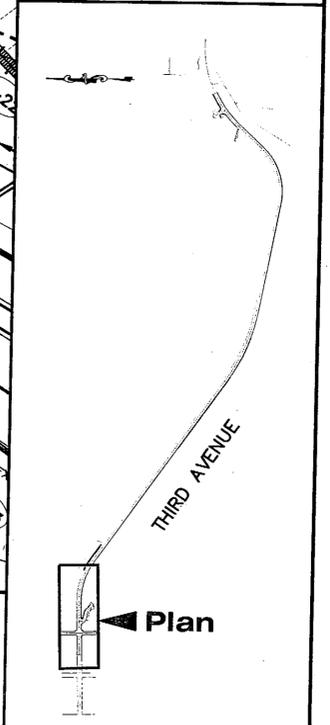

Layout Plan Key Map

DESIGNED BY: C. HOWARD

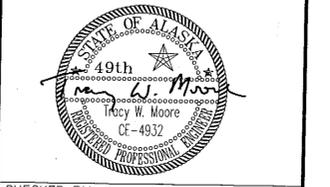

CHECKED BY: T. MOORE

DRAWN BY: K.K./R.S./M.L.

STATE OF ALASKA
 DEPARTMENT OF TRANSPORTATION & PUBLIC FACILITIES
 STATEWIDE DESIGN & ENGINEERING SERVICES DIVISION

THIRD AVENUE EXTENSION
 PROJECT NO. 68490

**Plan and Profile
 Sta "O" 20+25 to
 Sta. "O" 27+00**


PROJECT DESIGNATION NUMBER

STP-MG-0904(2)

STATE	YEAR
ALASKA	2002

SHEET NUMBER	TOTAL SHEETS
E1	146

Project As Built Drawings have been reviewed by the Project Engineer. To the best of his/her knowledge, they represent the project as constructed.

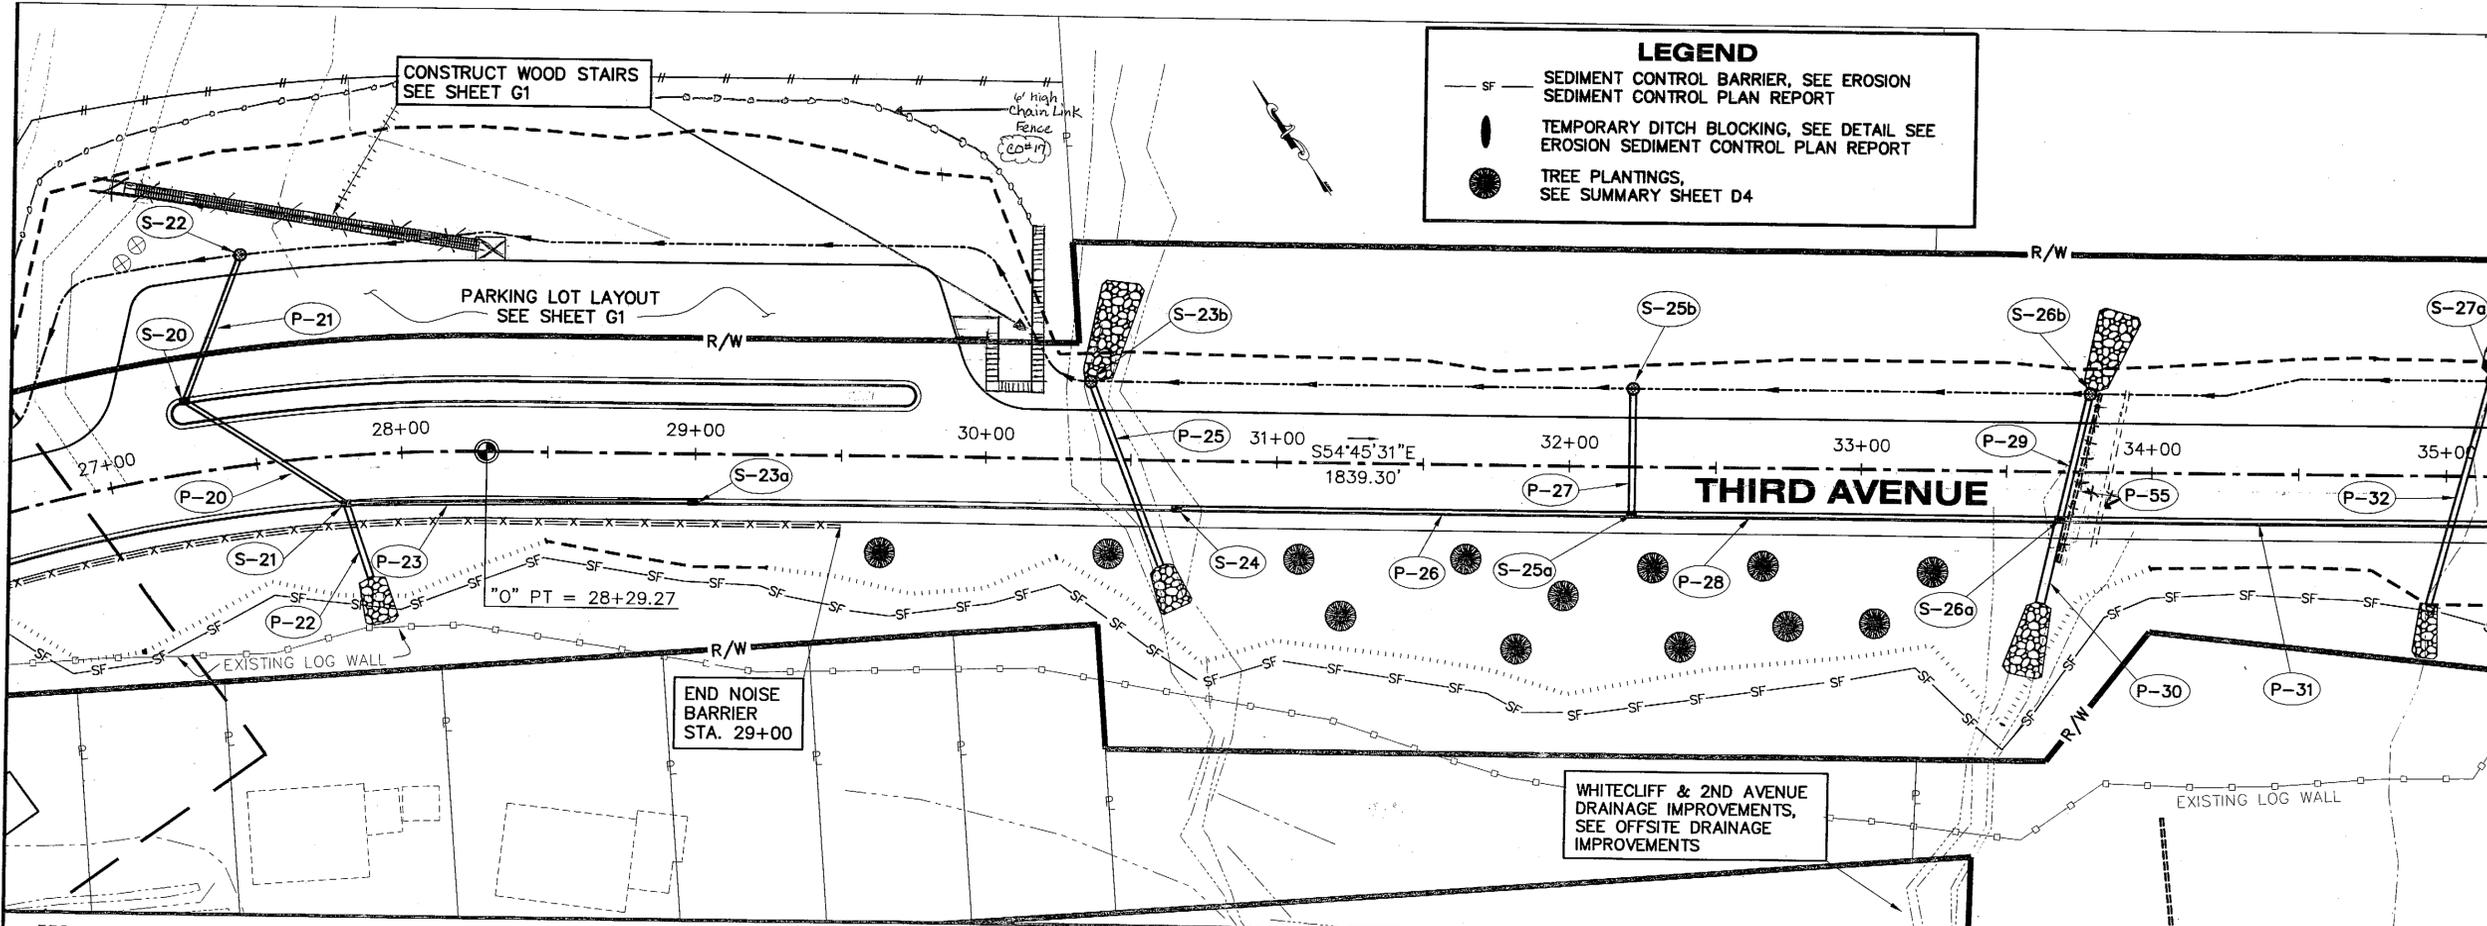


LEGEND

- SF — SEDIMENT CONTROL BARRIER, SEE EROSION SEDIMENT CONTROL PLAN REPORT
- P — TEMPORARY DITCH BLOCKING, SEE DETAIL SEE EROSION SEDIMENT CONTROL PLAN REPORT
- TREE PLANTINGS, SEE SUMMARY SHEET D4

PATH: Q:\ktn\71811A\Planset\E1_Plan.dwg
 Mon, 06/May/02 10:28AM Michael Limbaugh
 PLOT: PSPACE 1=1(F) OR MSPACE 1=1(F)
 TAB: ESTIMATE

ADDENDUM NUMBER		
ATTACHMENT NUMBER		
RECORD OF REVISIONS		
No.	DATE	DESCRIPTION

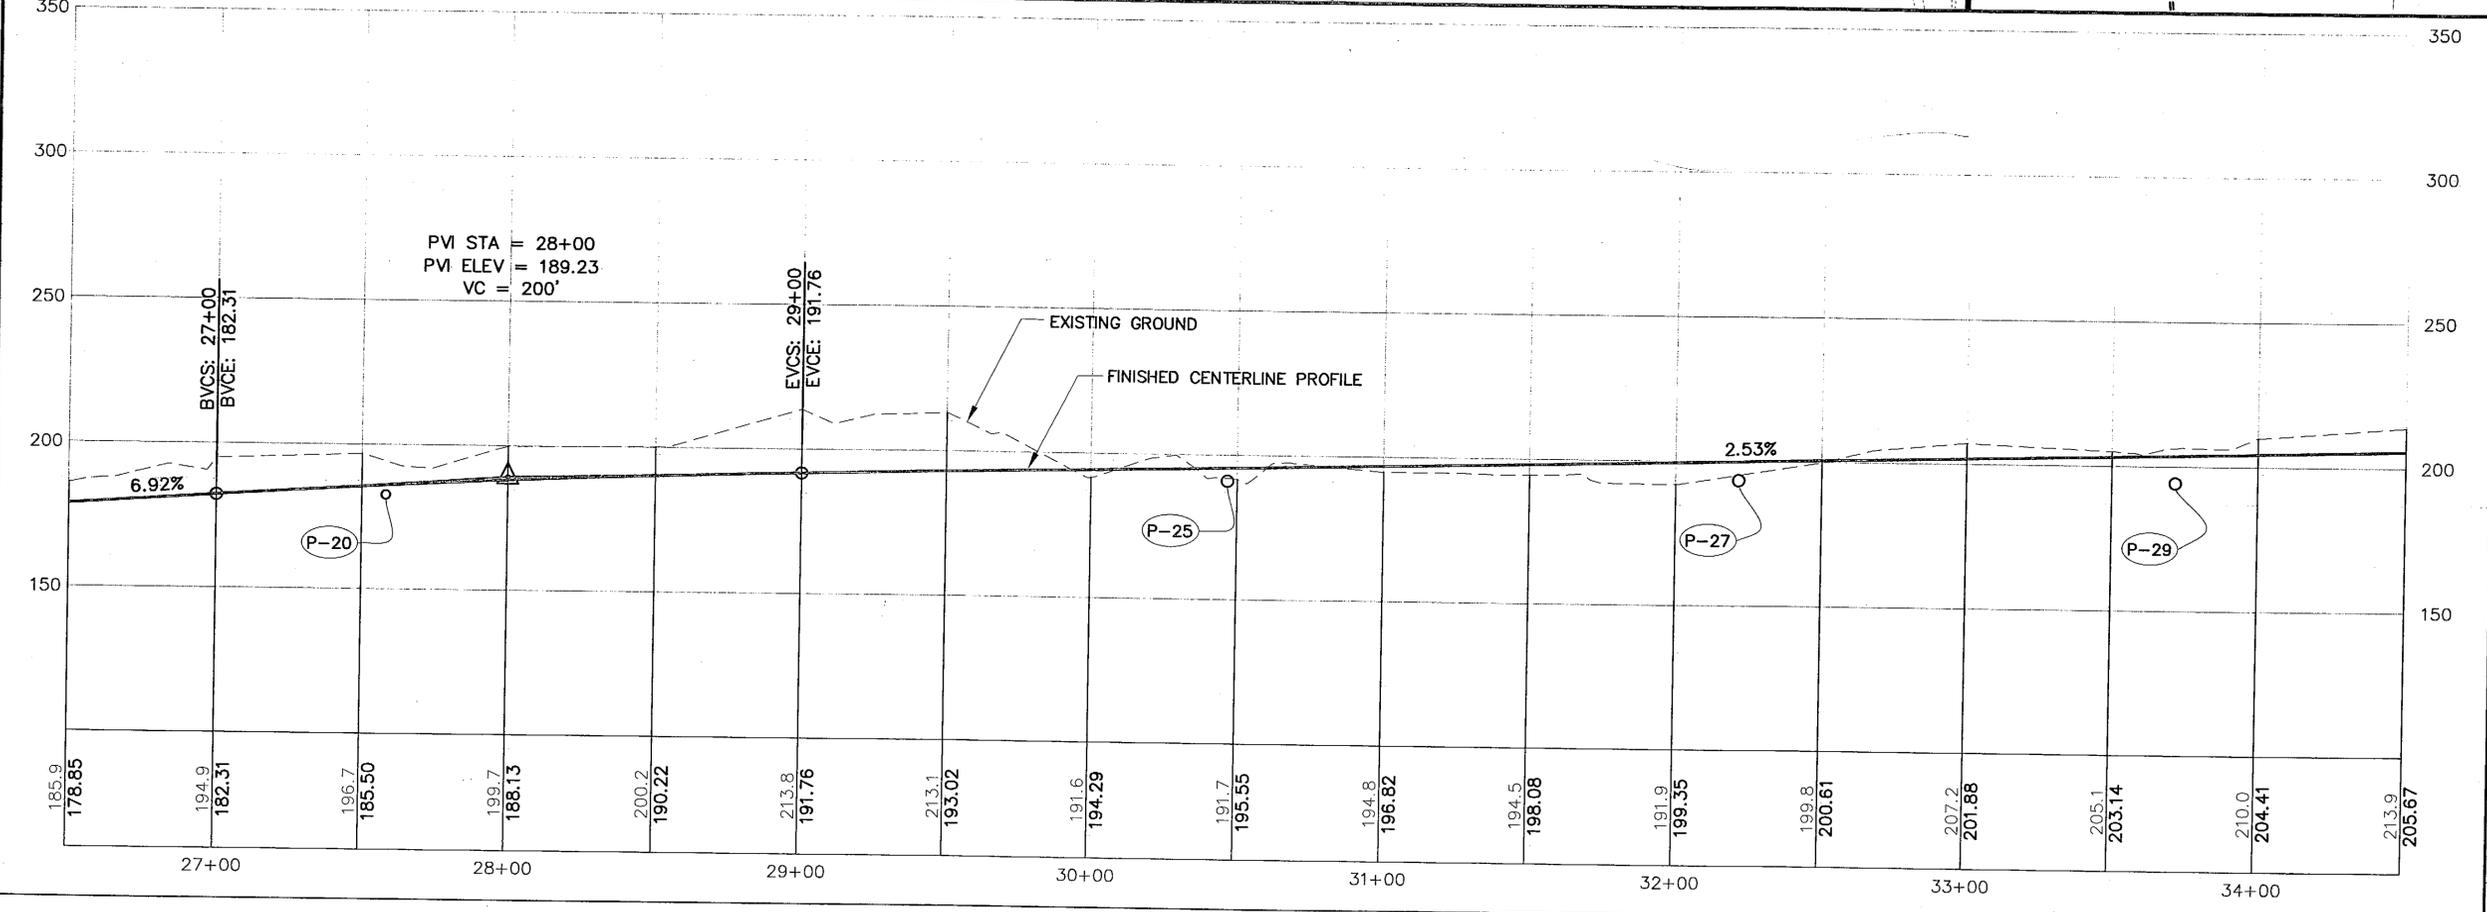

Layout Plan Key Map

DESIGNED BY:

CHECKED BY:

DRAWN BY:

STATE OF ALASKA
 DEPARTMENT OF TRANSPORTATION & PUBLIC FACILITIES
 STATEWIDE DESIGN & ENGINEERING SERVICES DIVISION

THIRD AVENUE EXTENSION
 PROJECT NO. 68490

Plan and Profile
 Sta. "0" 27+00 to Sta. "0" 35+00

PROJECT DESIGNATION NUMBER
STP-MG-0904(2)

STATE	YEAR
ALASKA	2002
SHEET NUMBER	TOTAL SHEETS
E2	146

Project As Built Drawings have been reviewed by the Project Engineer. To the best of his/her knowledge, they represent the project as constructed.



Proj. Eng. Date 10.21.02

LEGEND

- SF — SEDIMENT CONTROL BARRIER, SEE EROSION SEDIMENT CONTROL PLAN REPORT
- TEMPORARY DITCH BLOCKING, SEE DETAIL SEE EROSION SEDIMENT CONTROL PLAN REPORT
- * DITCH TO DRAIN


CONSTRUCTION ACTIVITIES WITHIN THE 330' RADIUS AROUND THE EAGLES'S NEST SHALL CONFORM TO THE REQUIREMENTS OF SECTION 107-1.01. SEE SHEET K1 FOR OVERALL VIEW.

OVERBURDEN/TALUS SLOPE EXCAVATION PLAN AND DETAILS, SEE SHEETS M1 THRU M3.

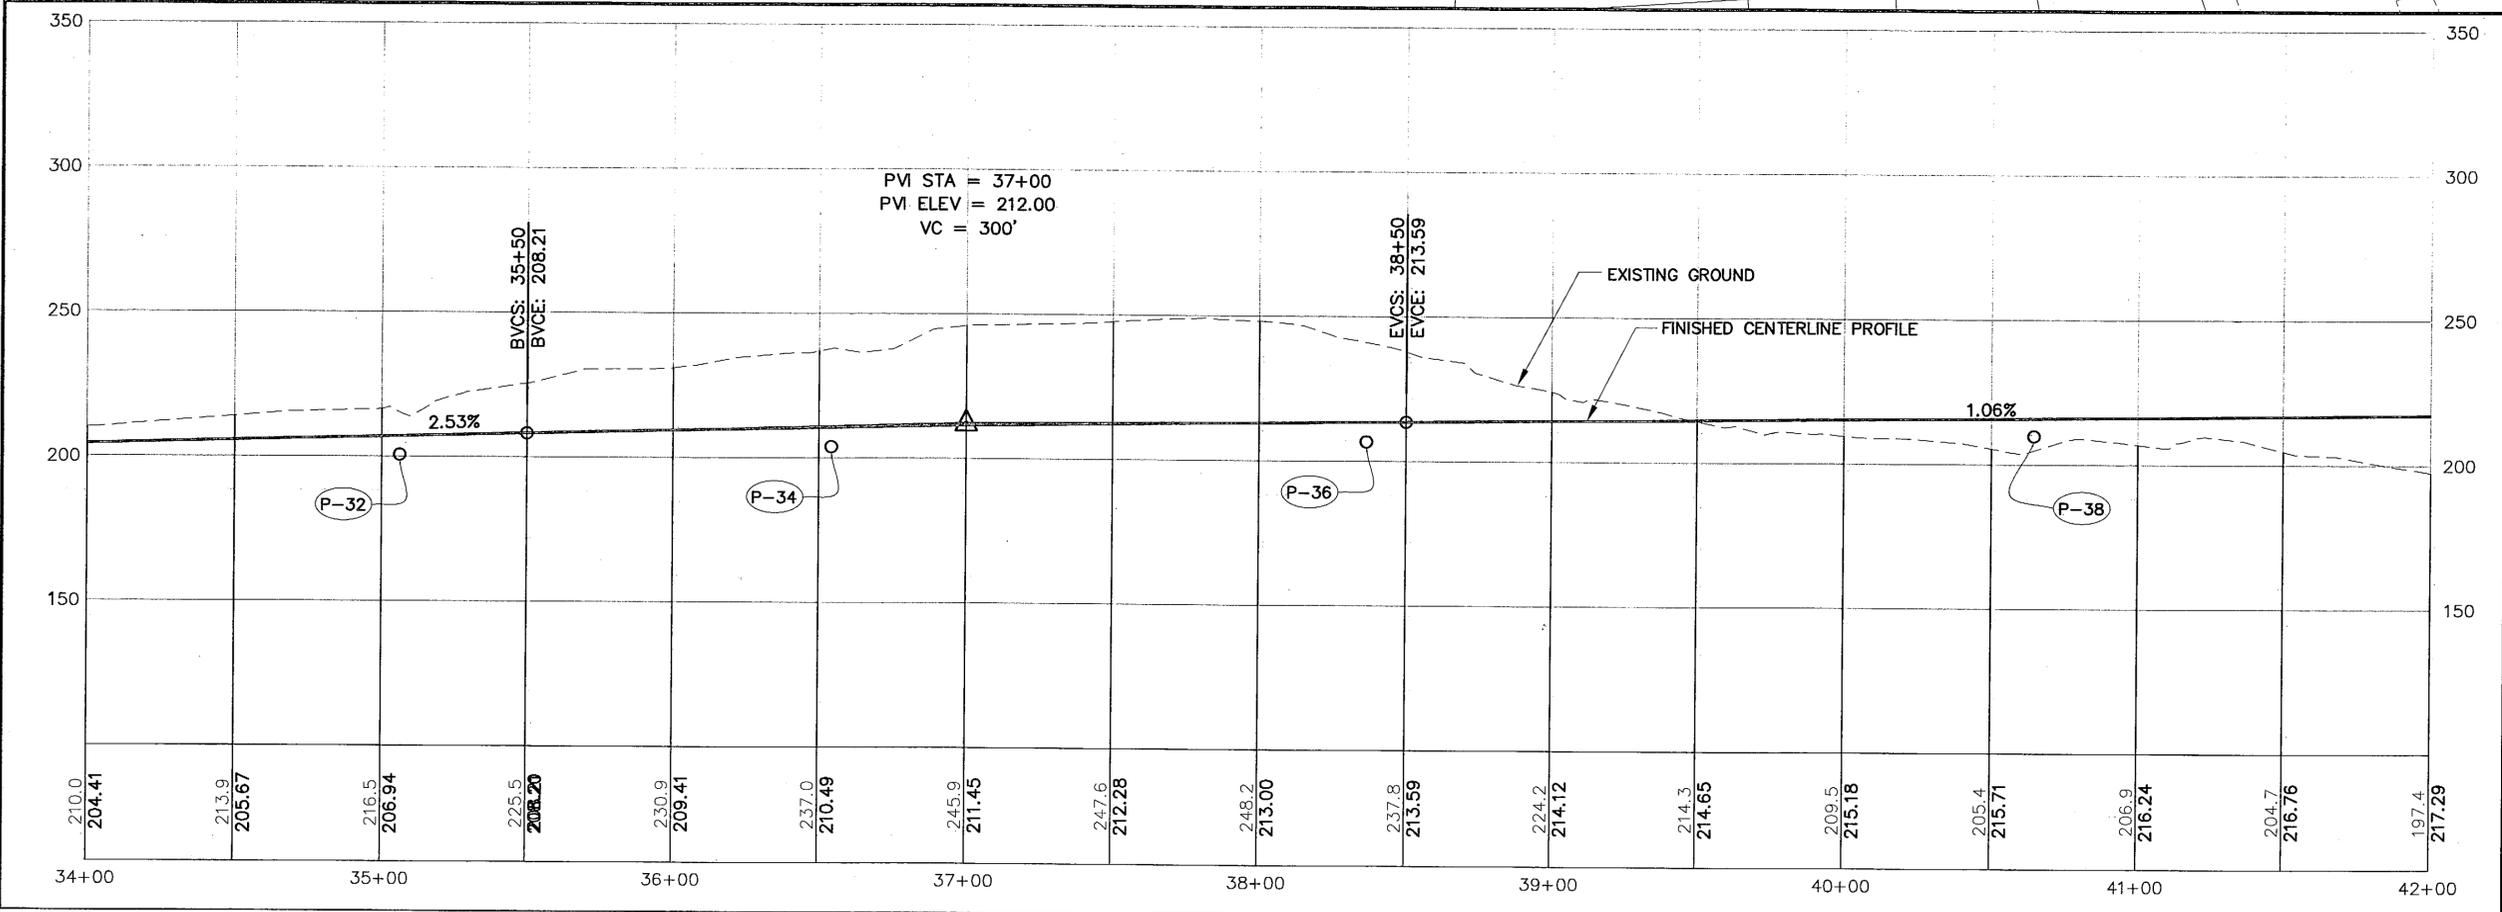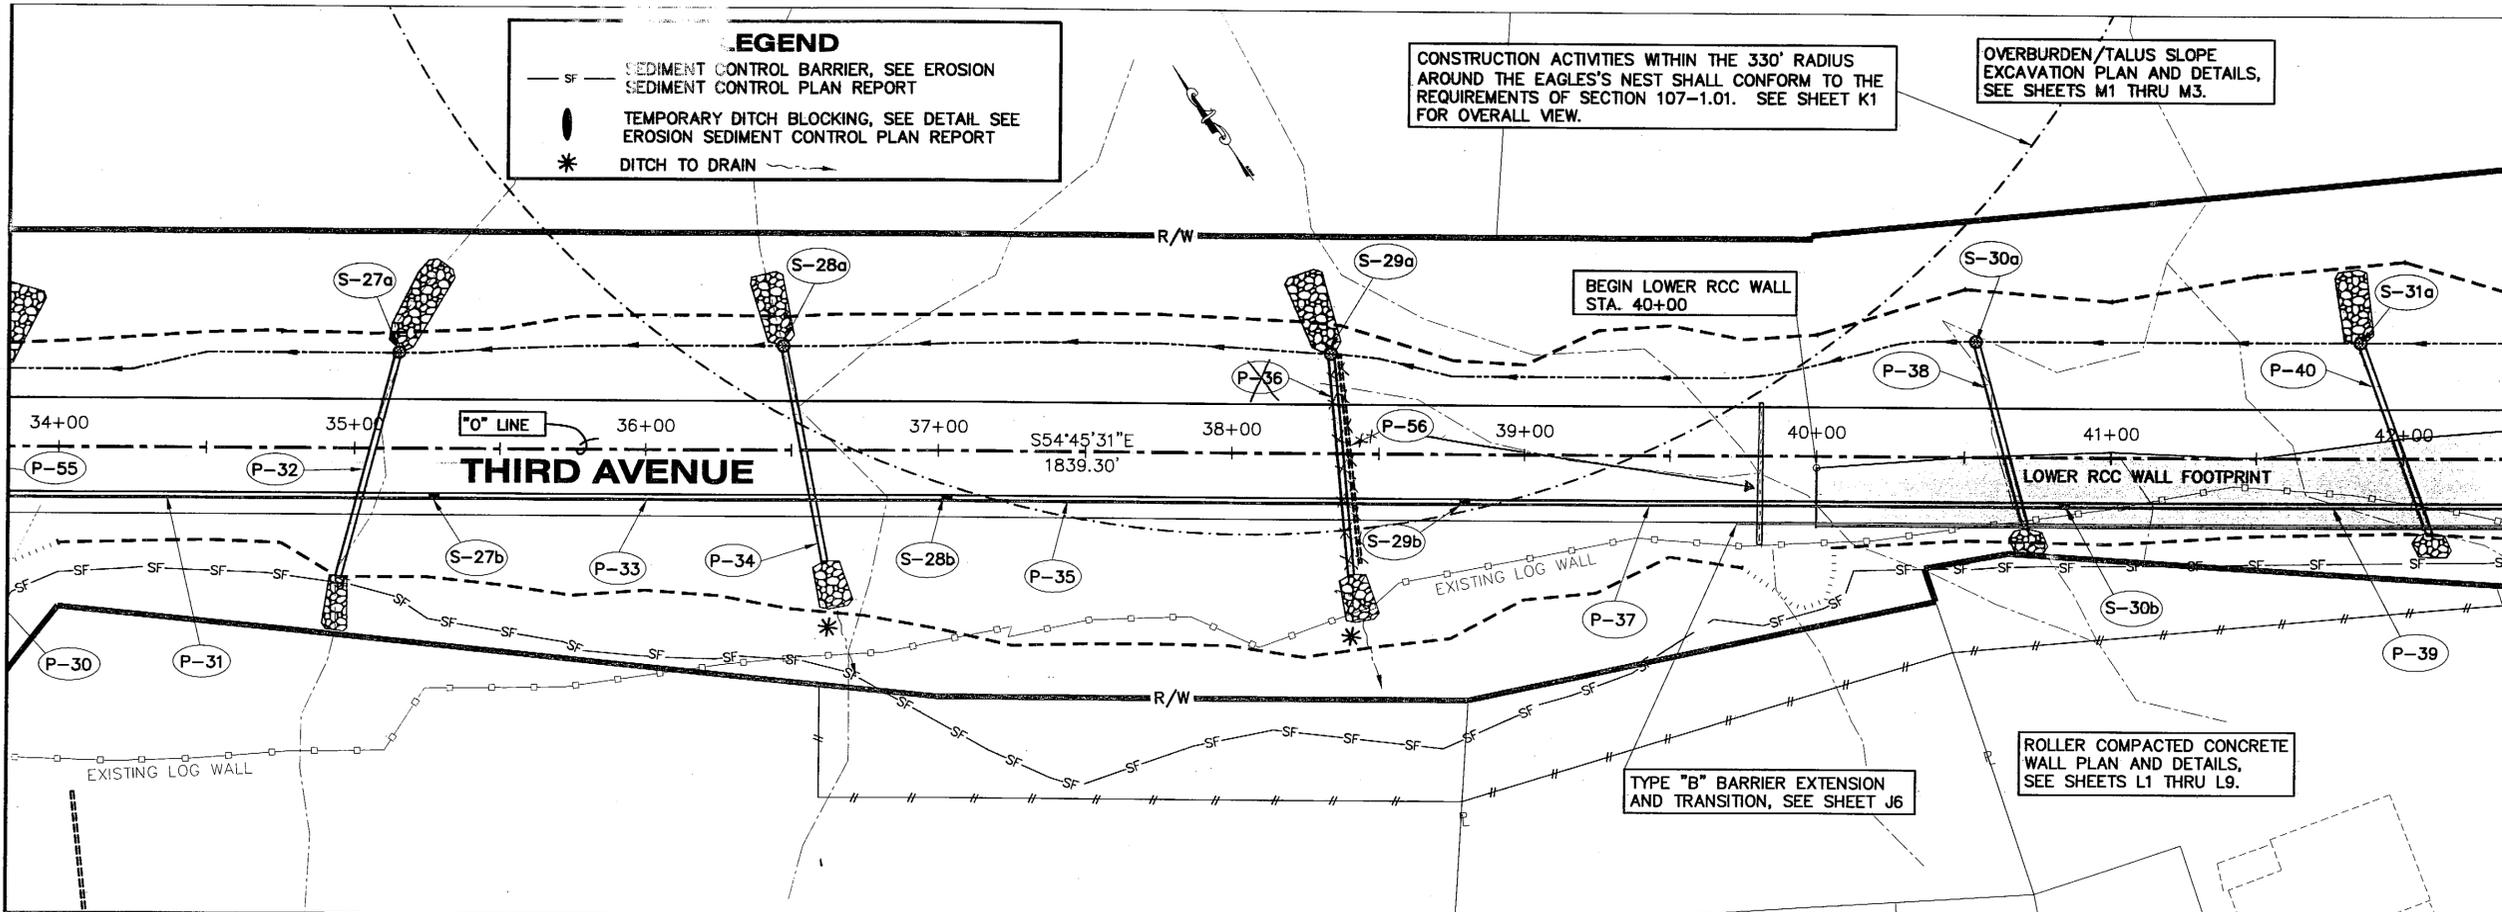

PATH: O:\Ktn\71811A\Planset\E1_Plan.dwg
 Mon, 06/May/02 10:28AM Michael Limbough
 PLOT: PSPACE 1=1(F) OR MSPACE 1=1(F)
 TAB: ESTIMATE

ADDENDUM NUMBER		
ATTACHMENT NUMBER		
RECORD OF REVISIONS		
No.	DATE	DESCRIPTION

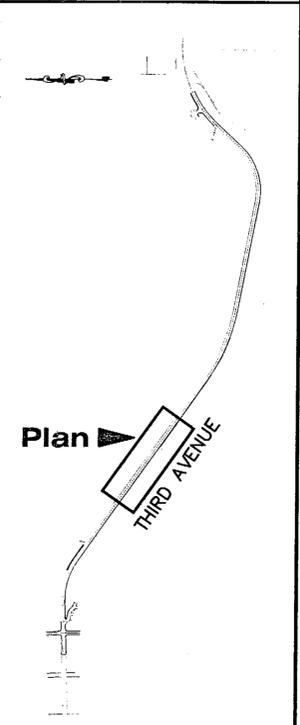

Layout Plan Key Map

DESIGNED BY: C. HOWARD



CHECKED BY: T. MOORE
 DRAWN BY: K.K./R.S./M.L.

STATE OF ALASKA
 DEPARTMENT OF TRANSPORTATION & PUBLIC FACILITIES
 STATEWIDE DESIGN & ENGINEERING SERVICES DIVISION
THIRD AVENUE EXTENSION
PROJECT NO. 68490
Plan and Profile
Sta. "0" 35+00 To
Sta. "0" 43+00

PROJECT DESIGNATION NUMBER

STP-MG-0904(2)

STATE	YEAR
ALASKA	2002

SHEET NUMBER	TOTAL SHEETS
E3	146

Project As Built Drawings have been reviewed by the Project Engineer. To the best of his/her knowledge, they represent the project as constructed.


Proj. Eng. *[Signature]* Date 12/31/06

OVERBURDEN/TALUS SLOPE
EXCAVATION PLAN AND DETAILS,
SEE SHEETS M1 THRU M3.

ROLLER COMPACTED CONCRETE
WALL PLAN AND DETAILS,
SEE SHEETS L1 THRU L9.

WHITE CLIFF EXCAVATION
PLAN AND DETAILS,
SEE SHEETS M4 THRU M8.

STAGE II
(WHITECLIFF EXCAVATION)

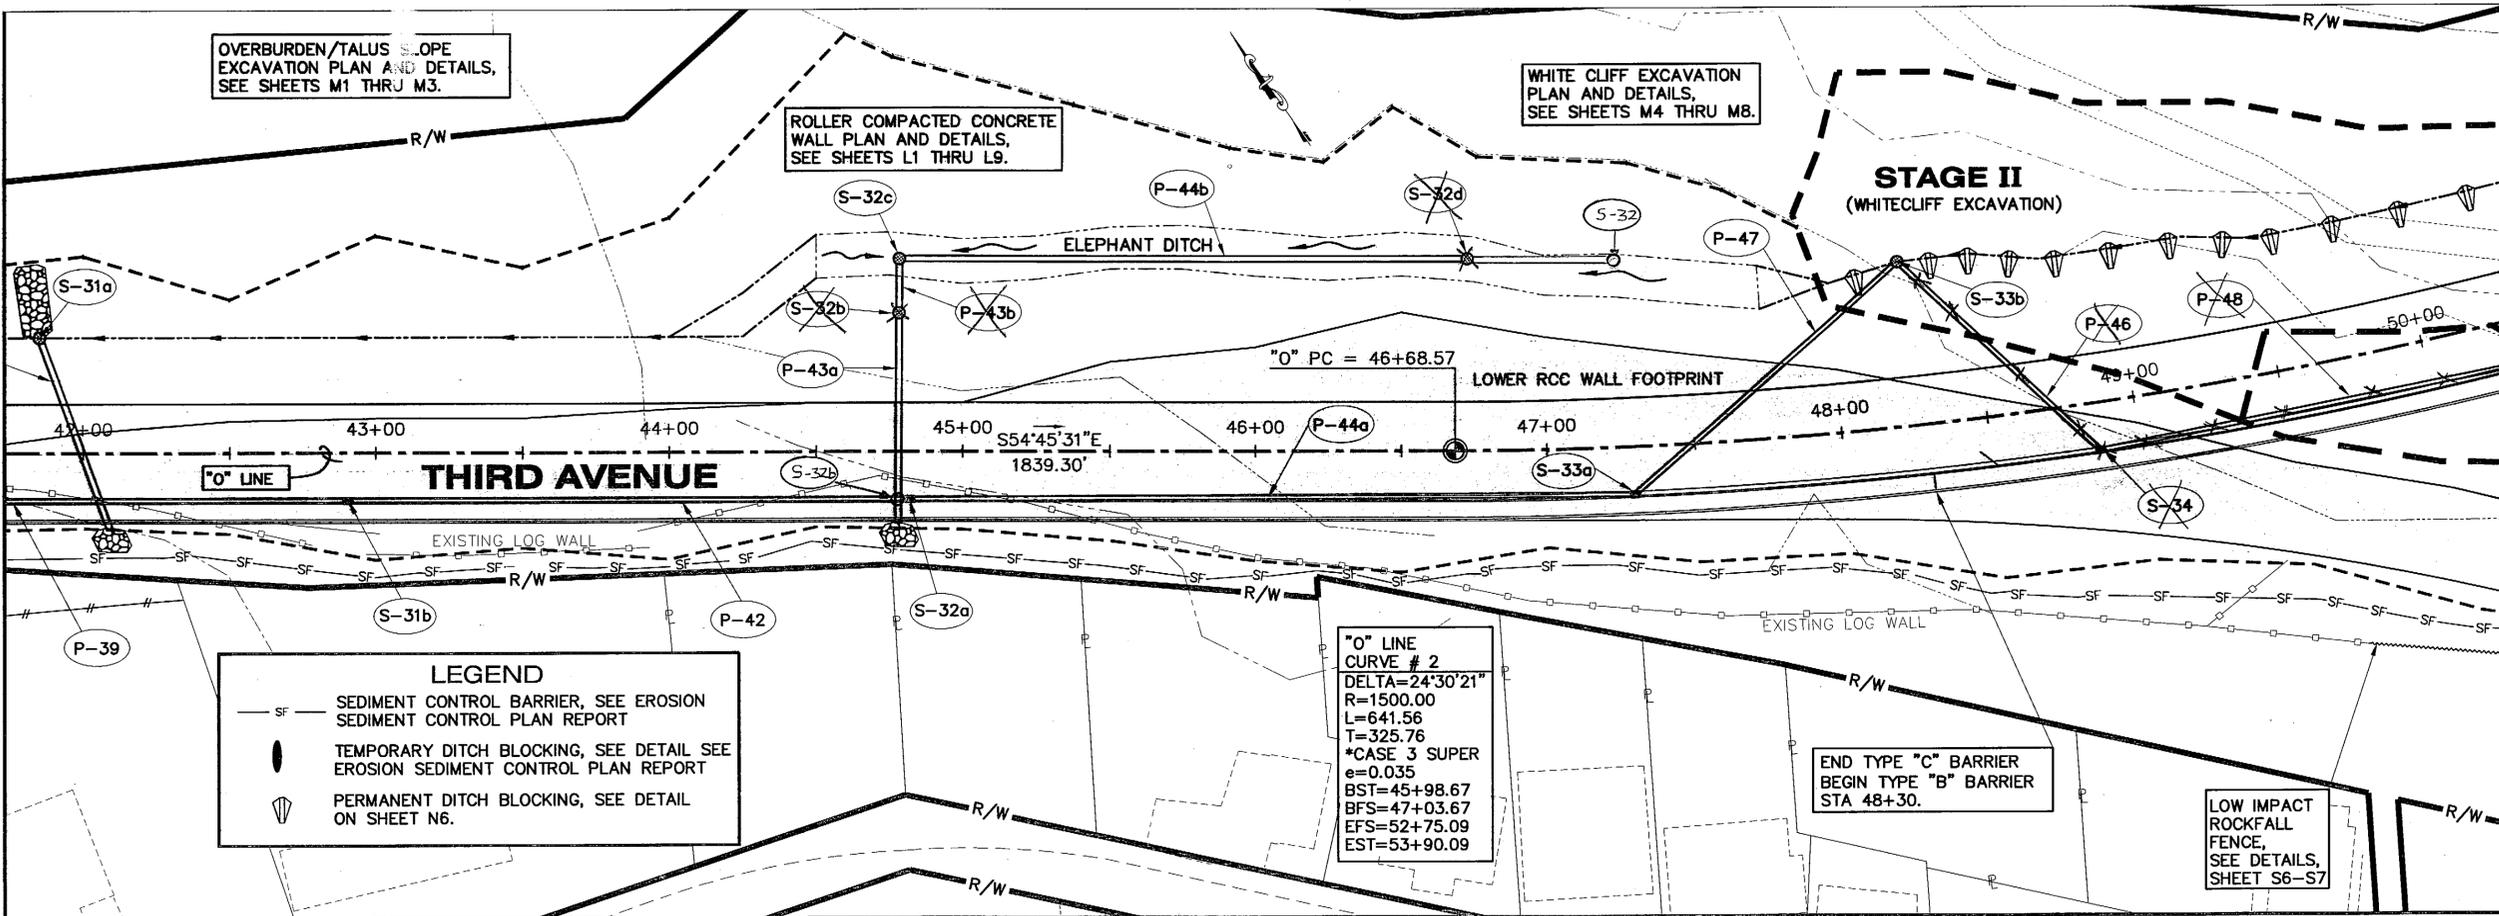

LEGEND

- SF — SEDIMENT CONTROL BARRIER, SEE EROSION SEDIMENT CONTROL PLAN REPORT
- — TEMPORARY DITCH BLOCKING, SEE DETAIL SEE EROSION SEDIMENT CONTROL PLAN REPORT
- ▽ — PERMANENT DITCH BLOCKING, SEE DETAIL ON SHEET N6.


"O" LINE
CURVE # 2
DELTA=24°30'21"
R=1500.00
L=641.56
T=325.76
e=0.035
BST=45+98.67
BFS=47+03.67
EFS=52+75.09
EST=53+90.09

END TYPE "C" BARRIER
BEGIN TYPE "B" BARRIER
STA 48+30.


LOW IMPACT
ROCKFALL
FENCE,
SEE DETAILS,
SHEET S6-S7

PATH: Q:\ktr\71811A\Planset\E1_Plan.dwg
Mon, 06/May/02 10:28AM Michael Limbaugh
PLOT: PSPACE 1=1(F) OR MSPACE 1=1(F)
TAB: ESTIMATE

ADDENDUM NUMBER		
ATTACHMENT NUMBER		
RECORD OF REVISIONS		
No.	DATE	DESCRIPTION

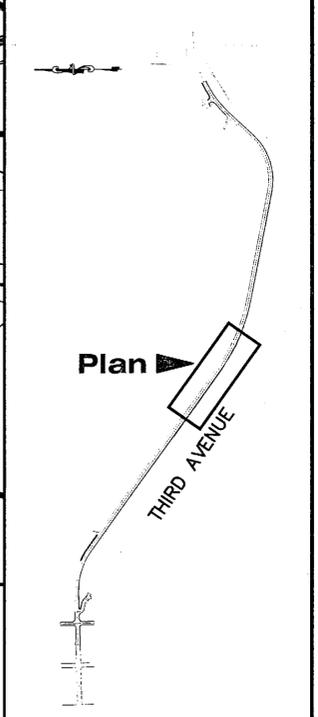

Layout Plan Key Map

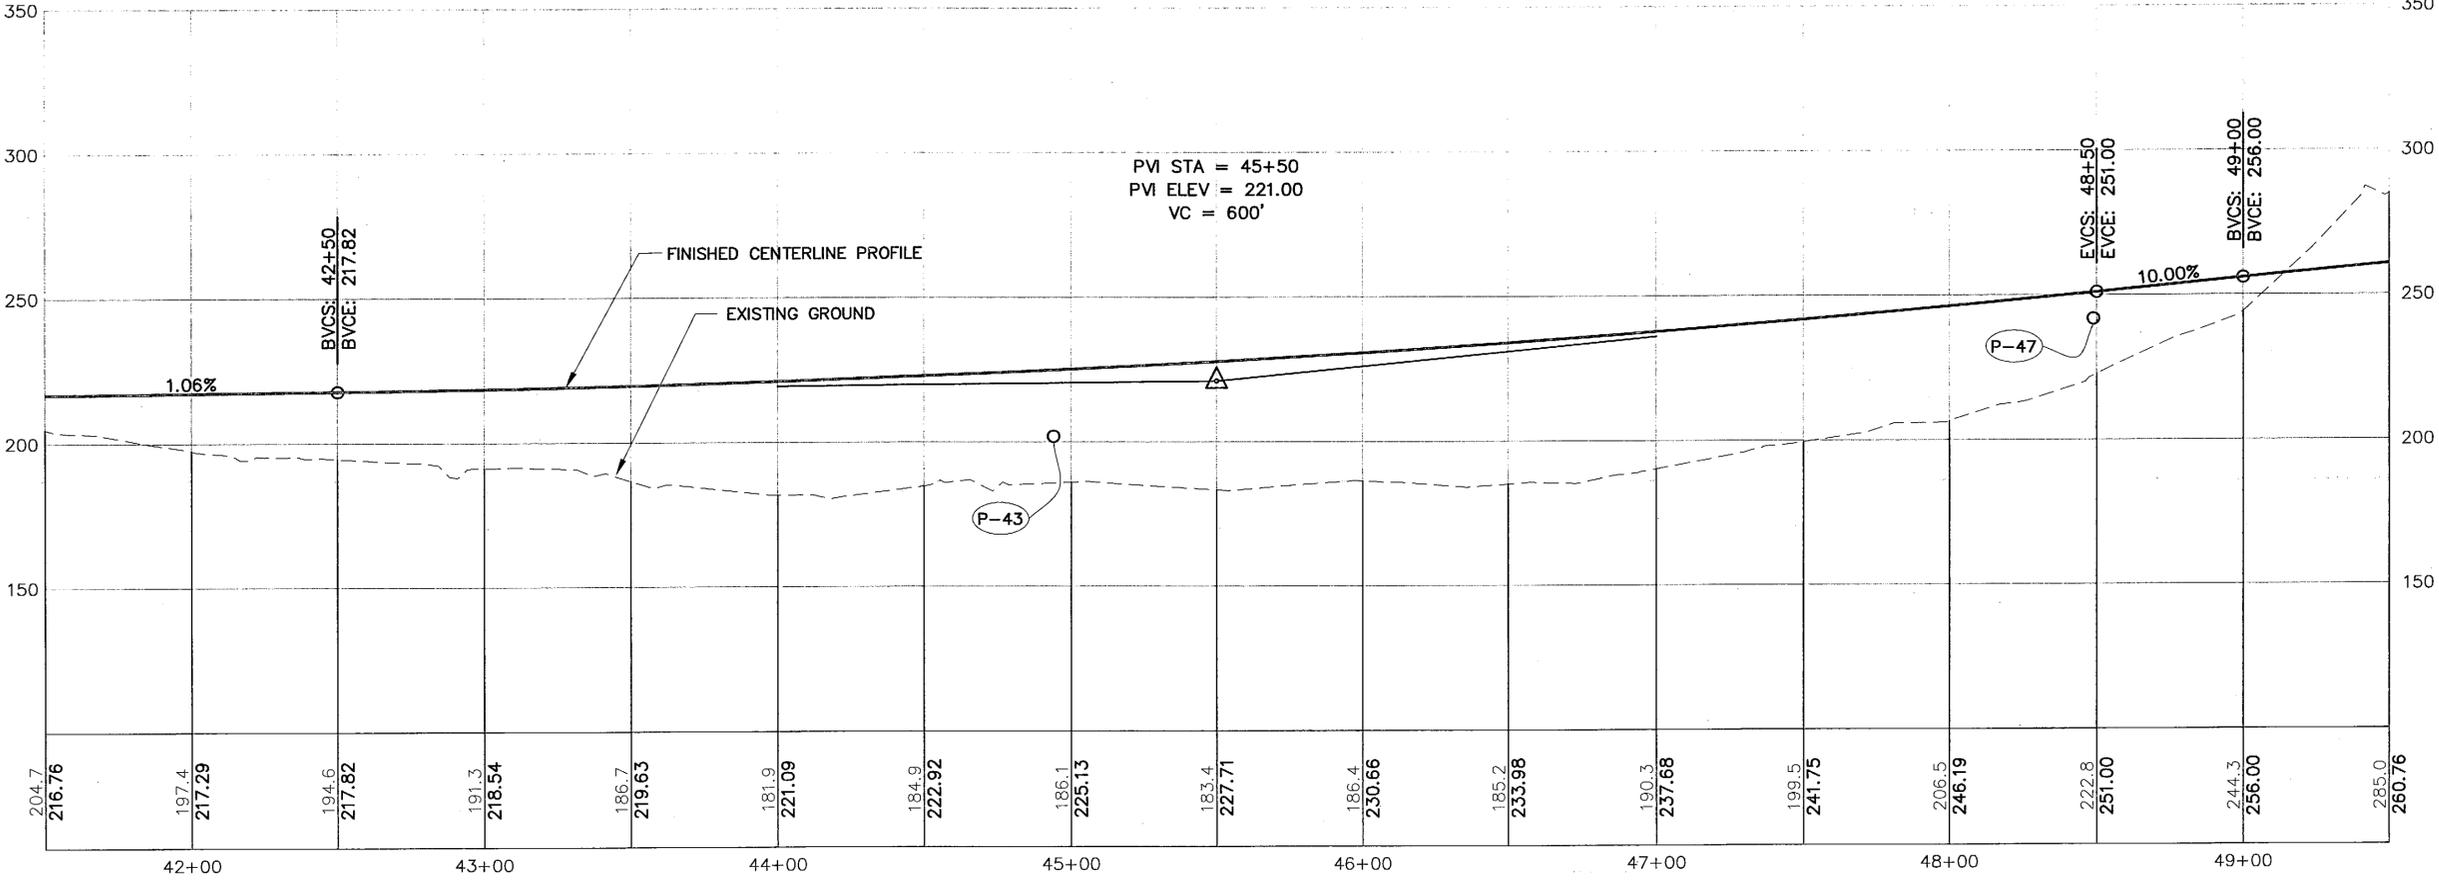

DESIGNED BY: C. HOWARD



CHECKED BY: T. MOORE

DRAWN BY: K.K./R.S./M.L.

STATE OF ALASKA
DEPARTMENT OF TRANSPORTATION
& PUBLIC FACILITIES
STATEWIDE DESIGN & ENGINEERING
SERVICES DIVISION

THIRD AVENUE EXTENSION
PROJECT NO. 68490

Plan and Profile
Sta. "O" 43+00 To
Sta. "O" 51+00


PROJECT DESIGNATION NUMBER

STP-MG-0904(2)

STATE	YEAR
ALASKA	2002
SHEET NUMBER	TOTAL SHEETS
E4	146

Project As Built Drawings have been reviewed by the Project Engineer. To the best of his/her knowledge, they represent the project as constructed.

Proj. Eng. *KS* Date 10-31-02

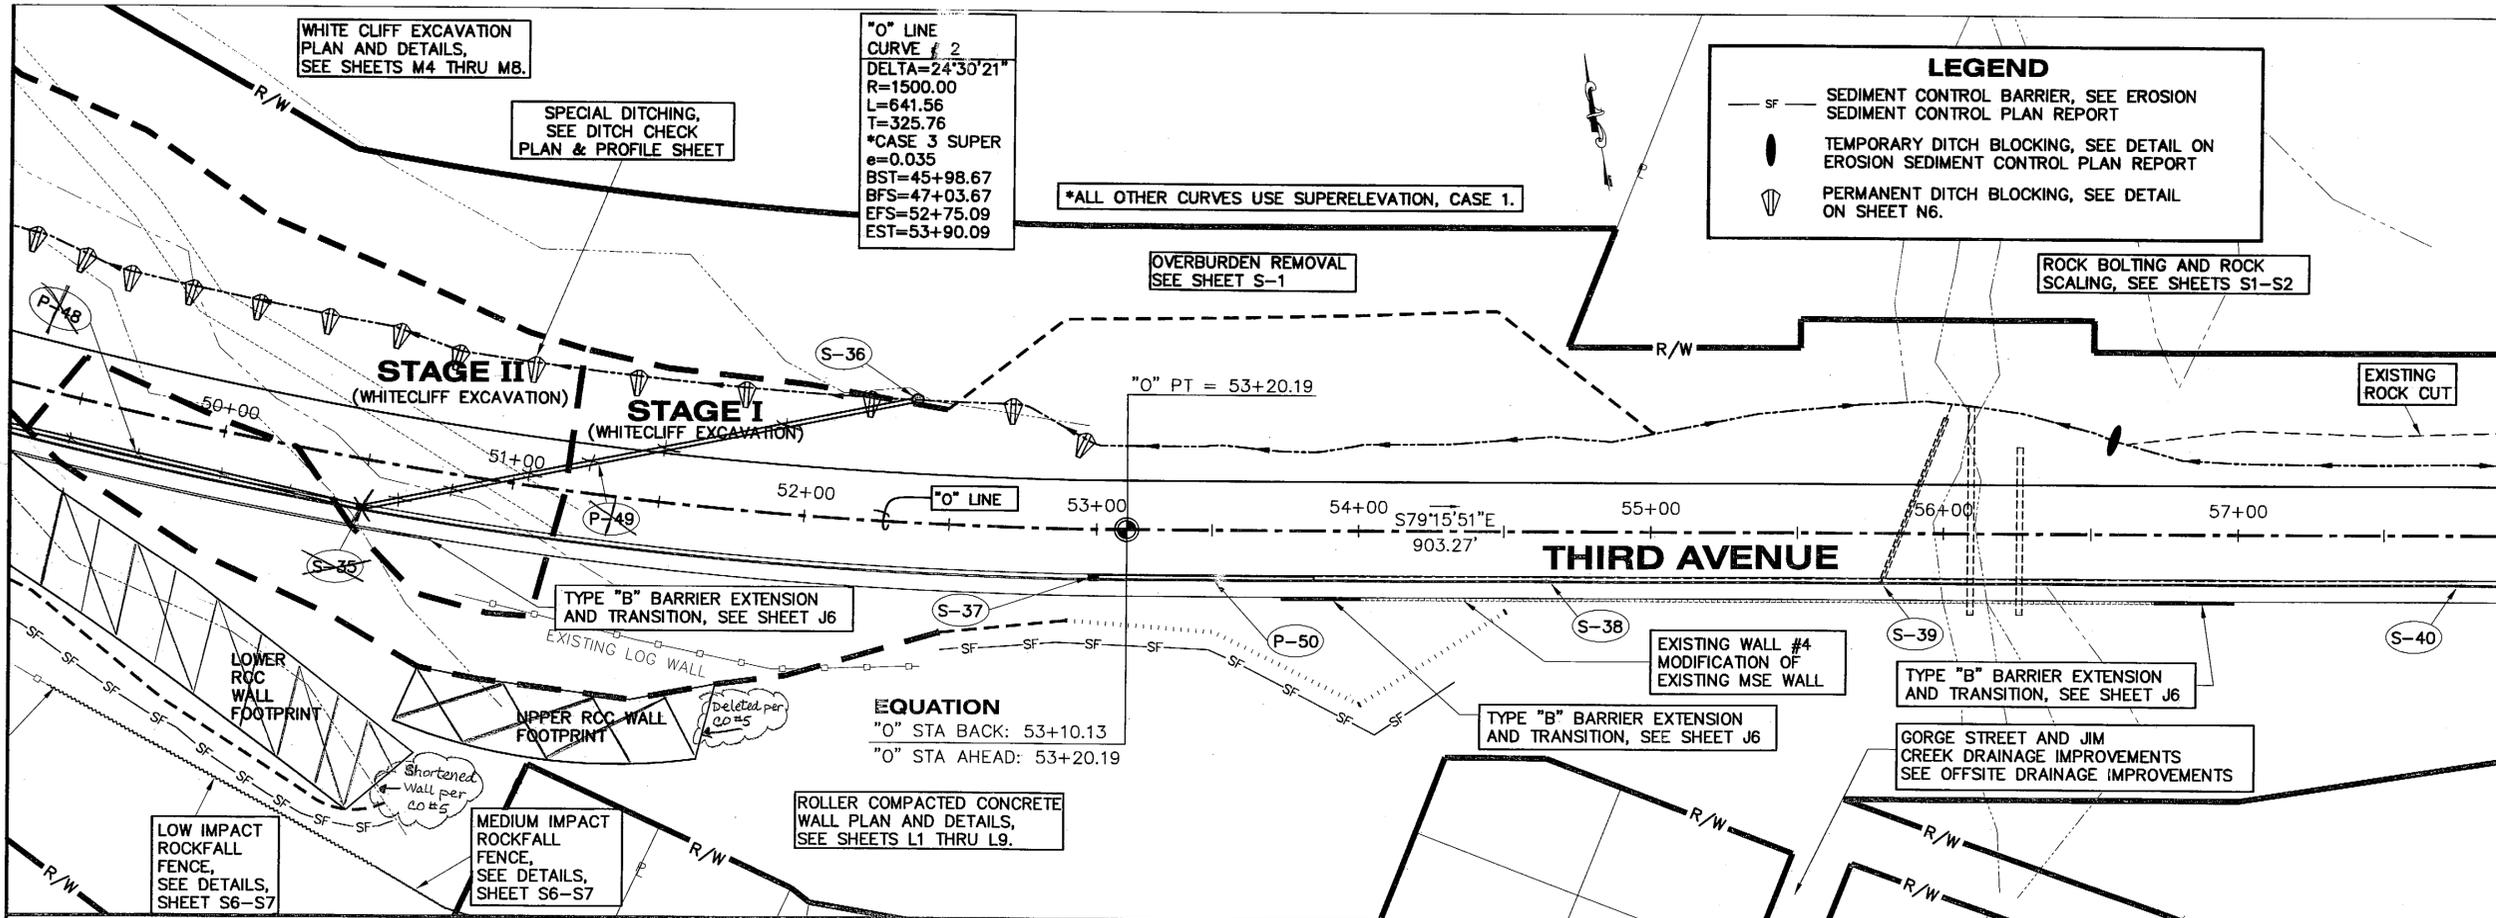


LEGEND

- SF SEDIMENT CONTROL BARRIER, SEE EROSION SEDIMENT CONTROL PLAN REPORT
- TEMPORARY DITCH BLOCKING, SEE DETAIL ON EROSION SEDIMENT CONTROL PLAN REPORT
- PERMANENT DITCH BLOCKING, SEE DETAIL ON SHEET N6.

PATH: Q:\Ktr\71811A\Planset\E1_Plan.dwg
 Mon, 06/May/02 10:28AM Michael Limbaugh
 PLOT: PSPACE 1=1(F) OR MSPACE 1=1(F)
 TAB: ESTIMATE

ADDENDUM NUMBER		
ATTACHMENT NUMBER		
RECORD OF REVISIONS		
No.	DATE	DESCRIPTION

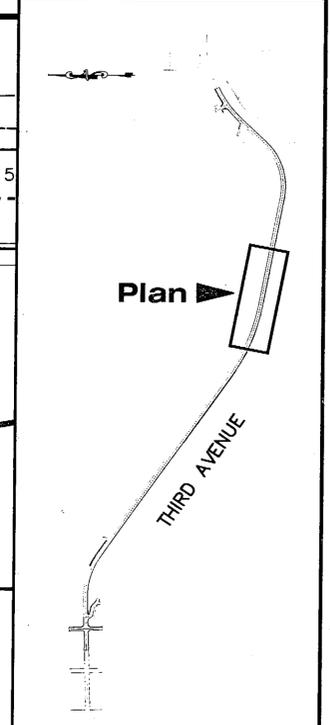

Layout Plan Key Map

DESIGNED BY: C. HOWARD




CHECKED BY: T. MOORE
 DRAWN BY: K.K./R.S./M.L.


STATE OF ALASKA
 DEPARTMENT OF TRANSPORTATION & PUBLIC FACILITIES
 STATEWIDE DESIGN & ENGINEERING SERVICES DIVISION

THIRD AVENUE EXTENSION PROJECT NO. 68490
Plan and Profile
Sta. "0" 51+00 To Sta. "0" 59+00

PROJECT DESIGNATION NUMBER	
STP-MG-0904(2)	
STATE	YEAR
ALASKA	2002
SHEET NUMBER	TOTAL SHEETS
E5	146

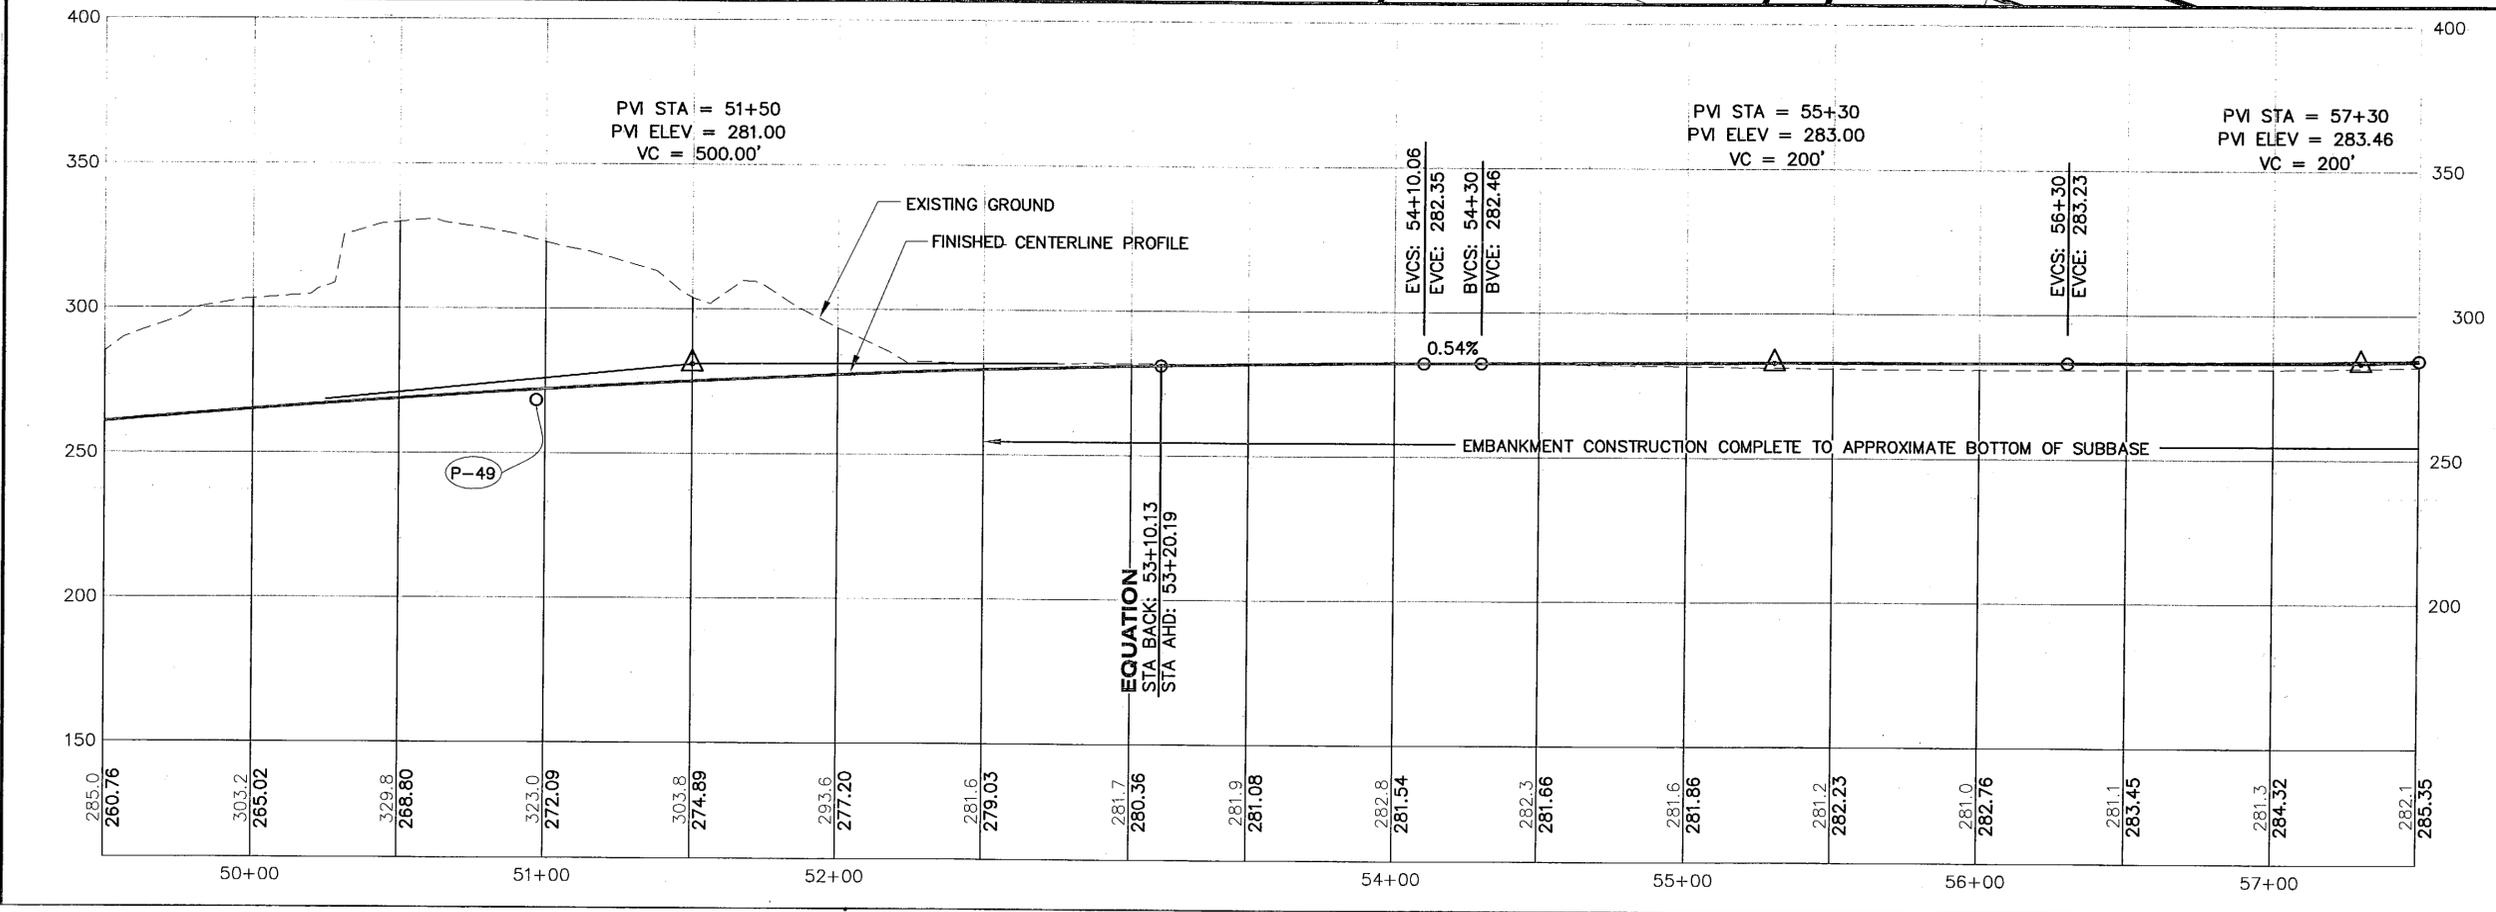


Project As Built Drawings have been reviewed by the Project Engineer. To the best of his/her knowledge, they represent the project as constructed.
 Proj. Eng. *[Signature]* Date 10/2/06

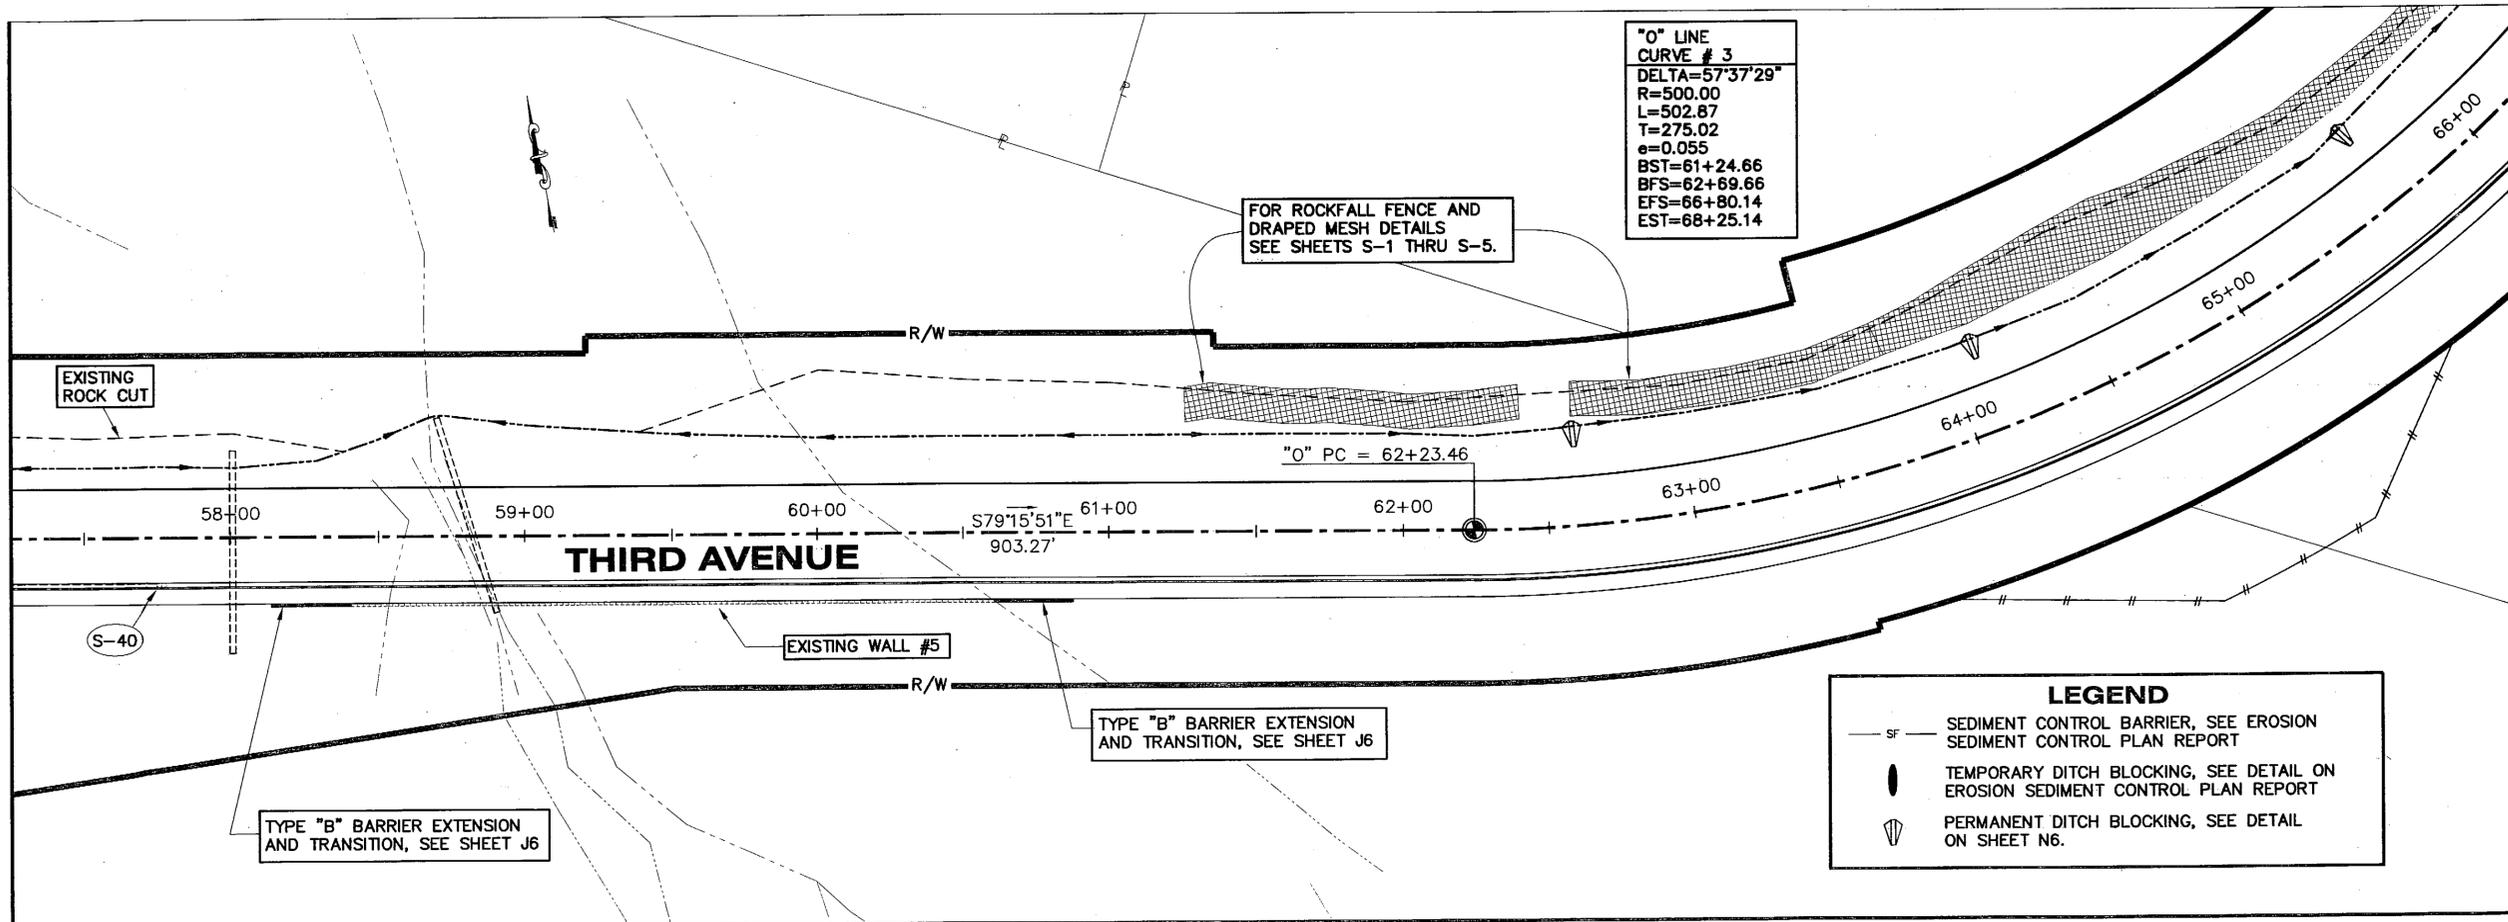


PATH: Q:\Ktn\71811A\PlanSet\E1_Plan.dwg
 Mon, 06/May/02 10:29AM Michael Limbaugh
 PLOT: PSPACE 1=1(F) OR MSPACE 1=1(F)
 TAB: ESTIMATE

ADDENDUM NUMBER		
ATTACHMENT NUMBER		
RECORD OF REVISIONS		
No.	DATE	DESCRIPTION

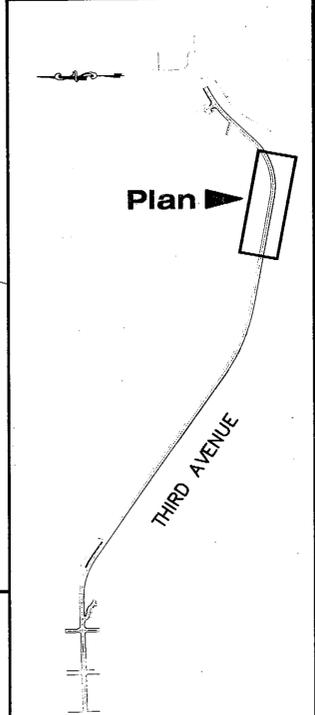

LEGEND

— SF —	SEDIMENT CONTROL BARRIER, SEE EROSION SEDIMENT CONTROL PLAN REPORT
●	TEMPORARY DITCH BLOCKING, SEE DETAIL ON EROSION SEDIMENT CONTROL PLAN REPORT
▽	PERMANENT DITCH BLOCKING, SEE DETAIL ON SHEET N6.

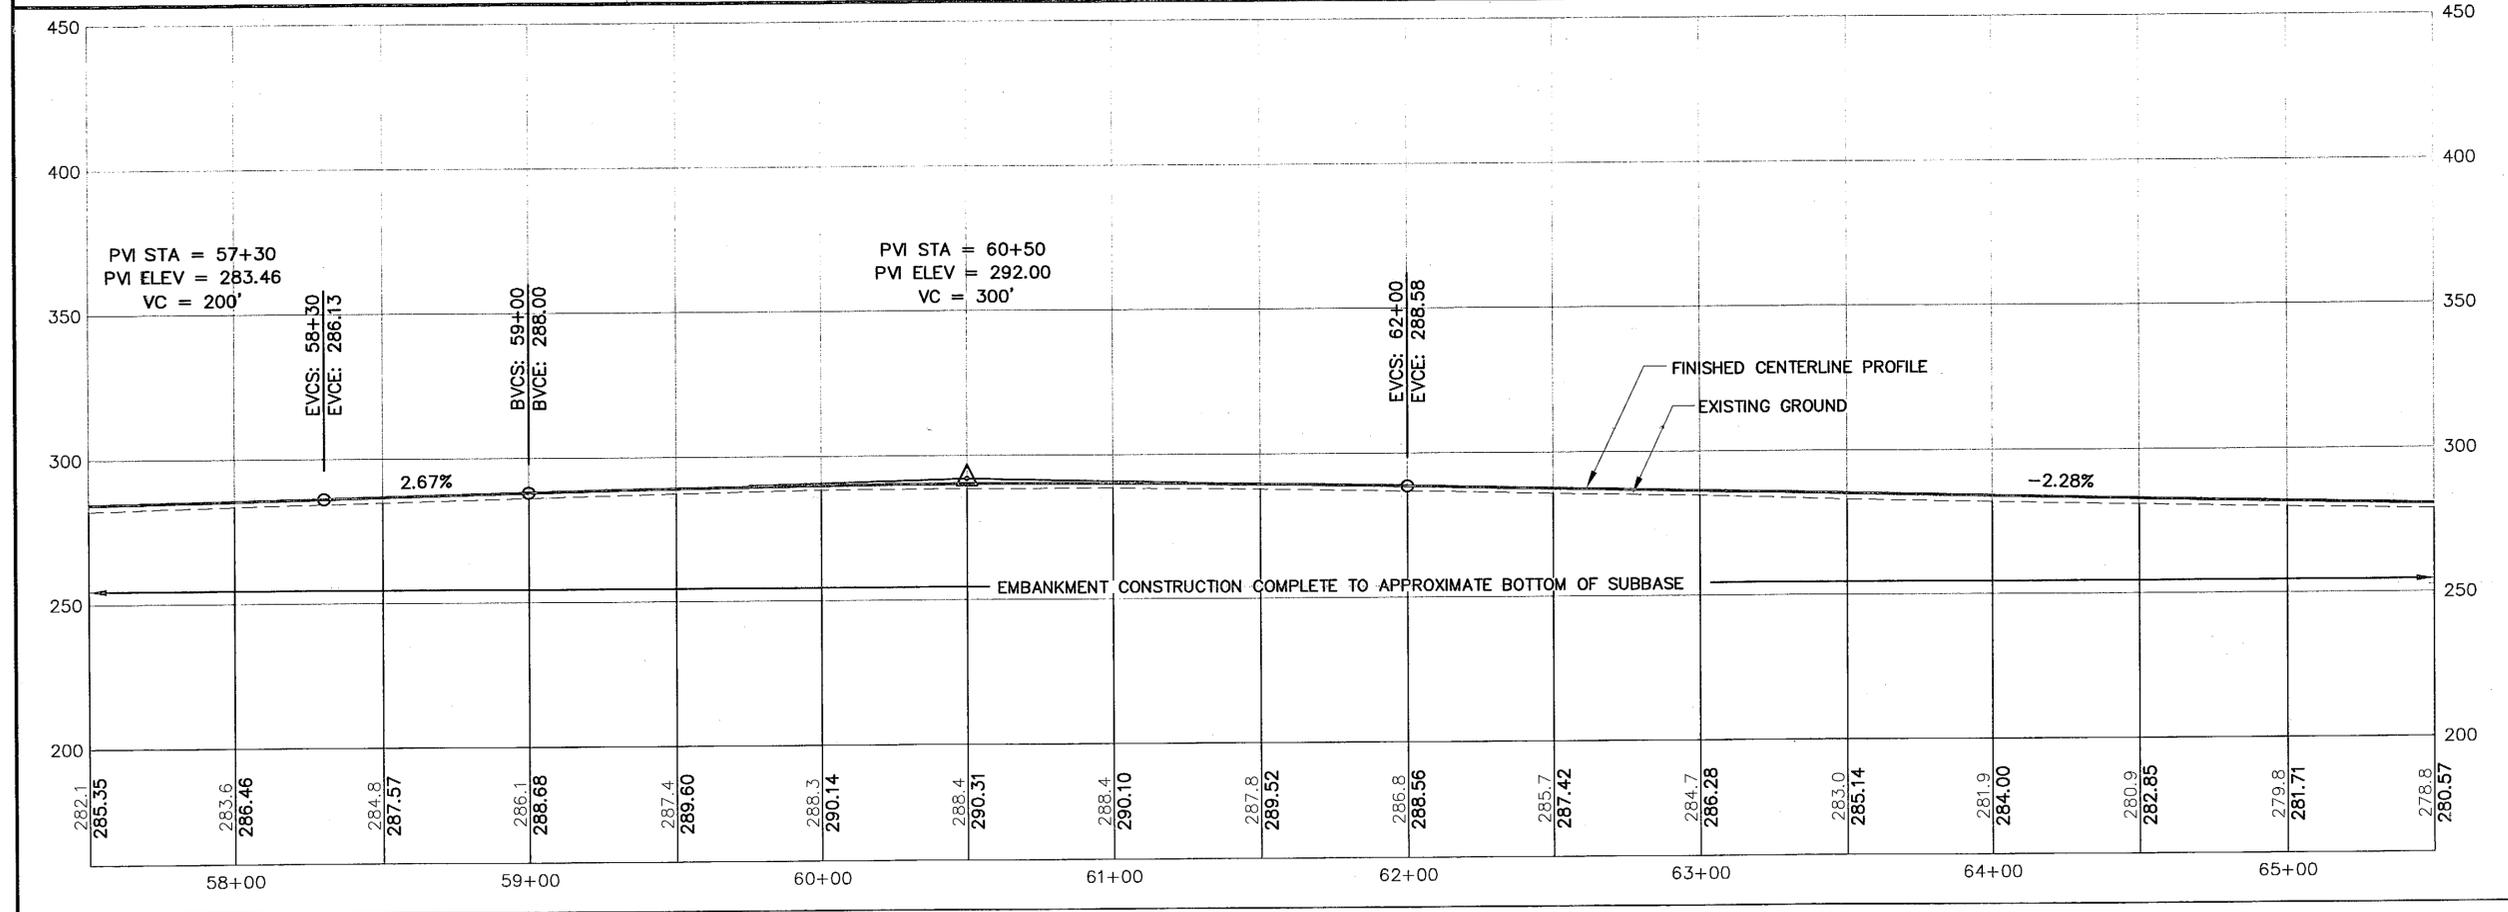

Layout Plan Key Map

DESIGNED BY: C. HOWARD

CHECKED BY: T. MOORE
 DRAWN BY: K.K./R.S./M.L.

STATE OF ALASKA
 DEPARTMENT OF TRANSPORTATION & PUBLIC FACILITIES
 STATEWIDE DESIGN & ENGINEERING SERVICES DIVISION

THIRD AVENUE EXTENSION
 PROJECT NO. 68490

Plan and Profile
 Sta. "0" 59+00 To
 Sta. "0" 67+00

PROJECT DESIGNATION NUMBER
STP-MG-0904(2)

STATE	YEAR
ALASKA	2002
SHEET NUMBER	TOTAL SHEETS
E6	146

Project As Built Drawings have been reviewed by the Project Engineer. To the best of his/her knowledge, they represent the project as constructed.

Proj. Eng. Date 10-31-06

LEGEND
 — SF — SEDIMENT CONTROL BARRIER, SEE EROSION SEDIMENT CONTROL PLAN REPORT
 ○ TEMPORARY DITCH BLOCKING, SEE DETAIL SEE EROSION SEDIMENT CONTROL PLAN REPORT

FOR ROCKFALL FENCE AND DRAPED MESH DETAILS SEE SHEETS S-1 THRU S-5.




ROCK BOLTING AND SCALING SEE SHEETS S1-S2

"O" LINE CURVE # 4
 DELTA=50°40'00"
 R= 900.00
 L= 795.87
 T= 426.07
 e=0.045
 BST=69+12.41
 BFS=70+39.41
 EFS=77+50.02
 EST=78+77.02

SEE SHEET G4 FOR PARKING LAYOUT
 See Sheet G4-Revised

End Project
Sta. "O" 73+30
 N 90,297.1810
 E 105,541.5908

ADDENDUM NUMBER		
ATTACHMENT NUMBER		
RECORD OF REVISIONS		
No.	DATE	DESCRIPTION

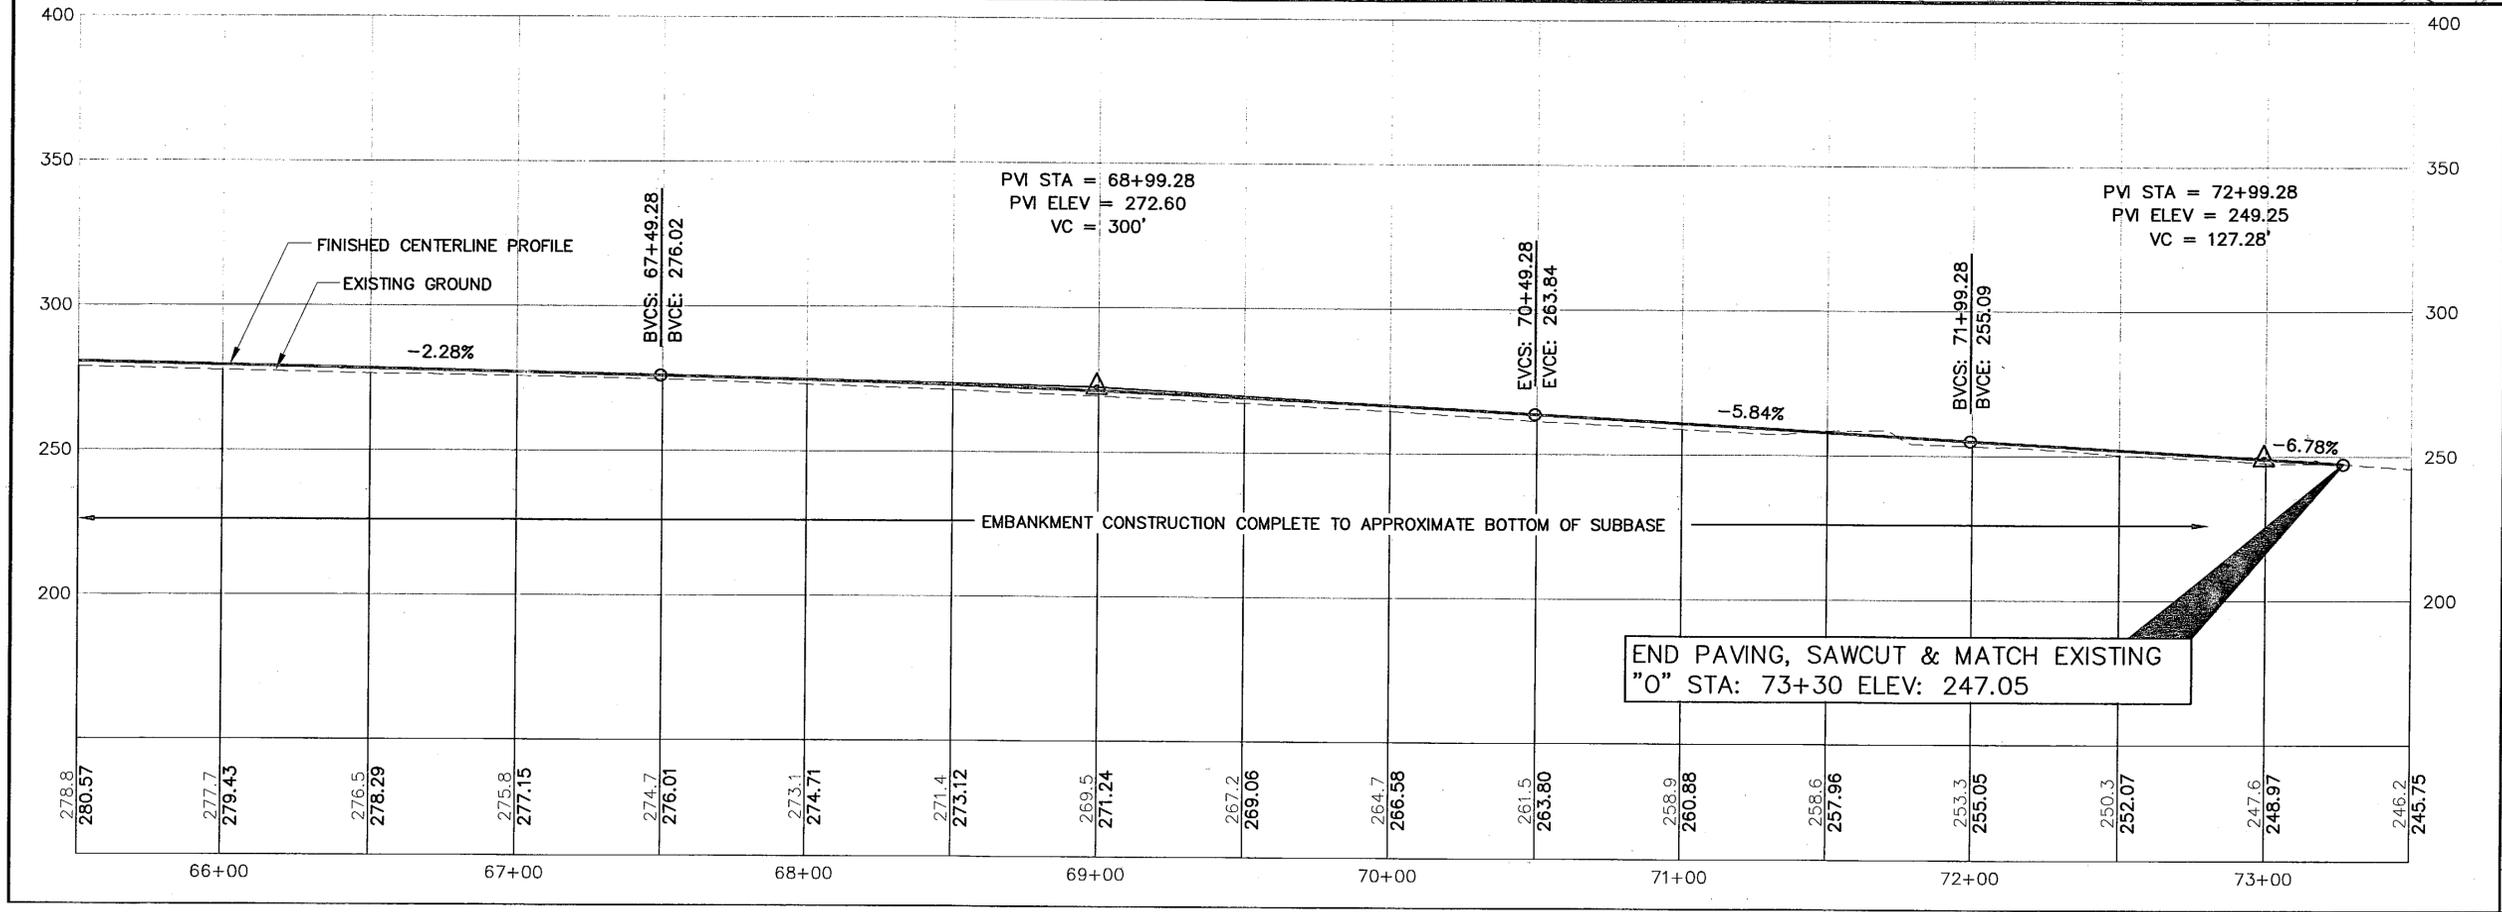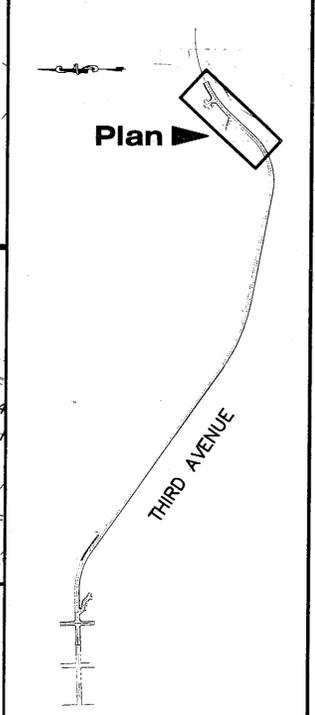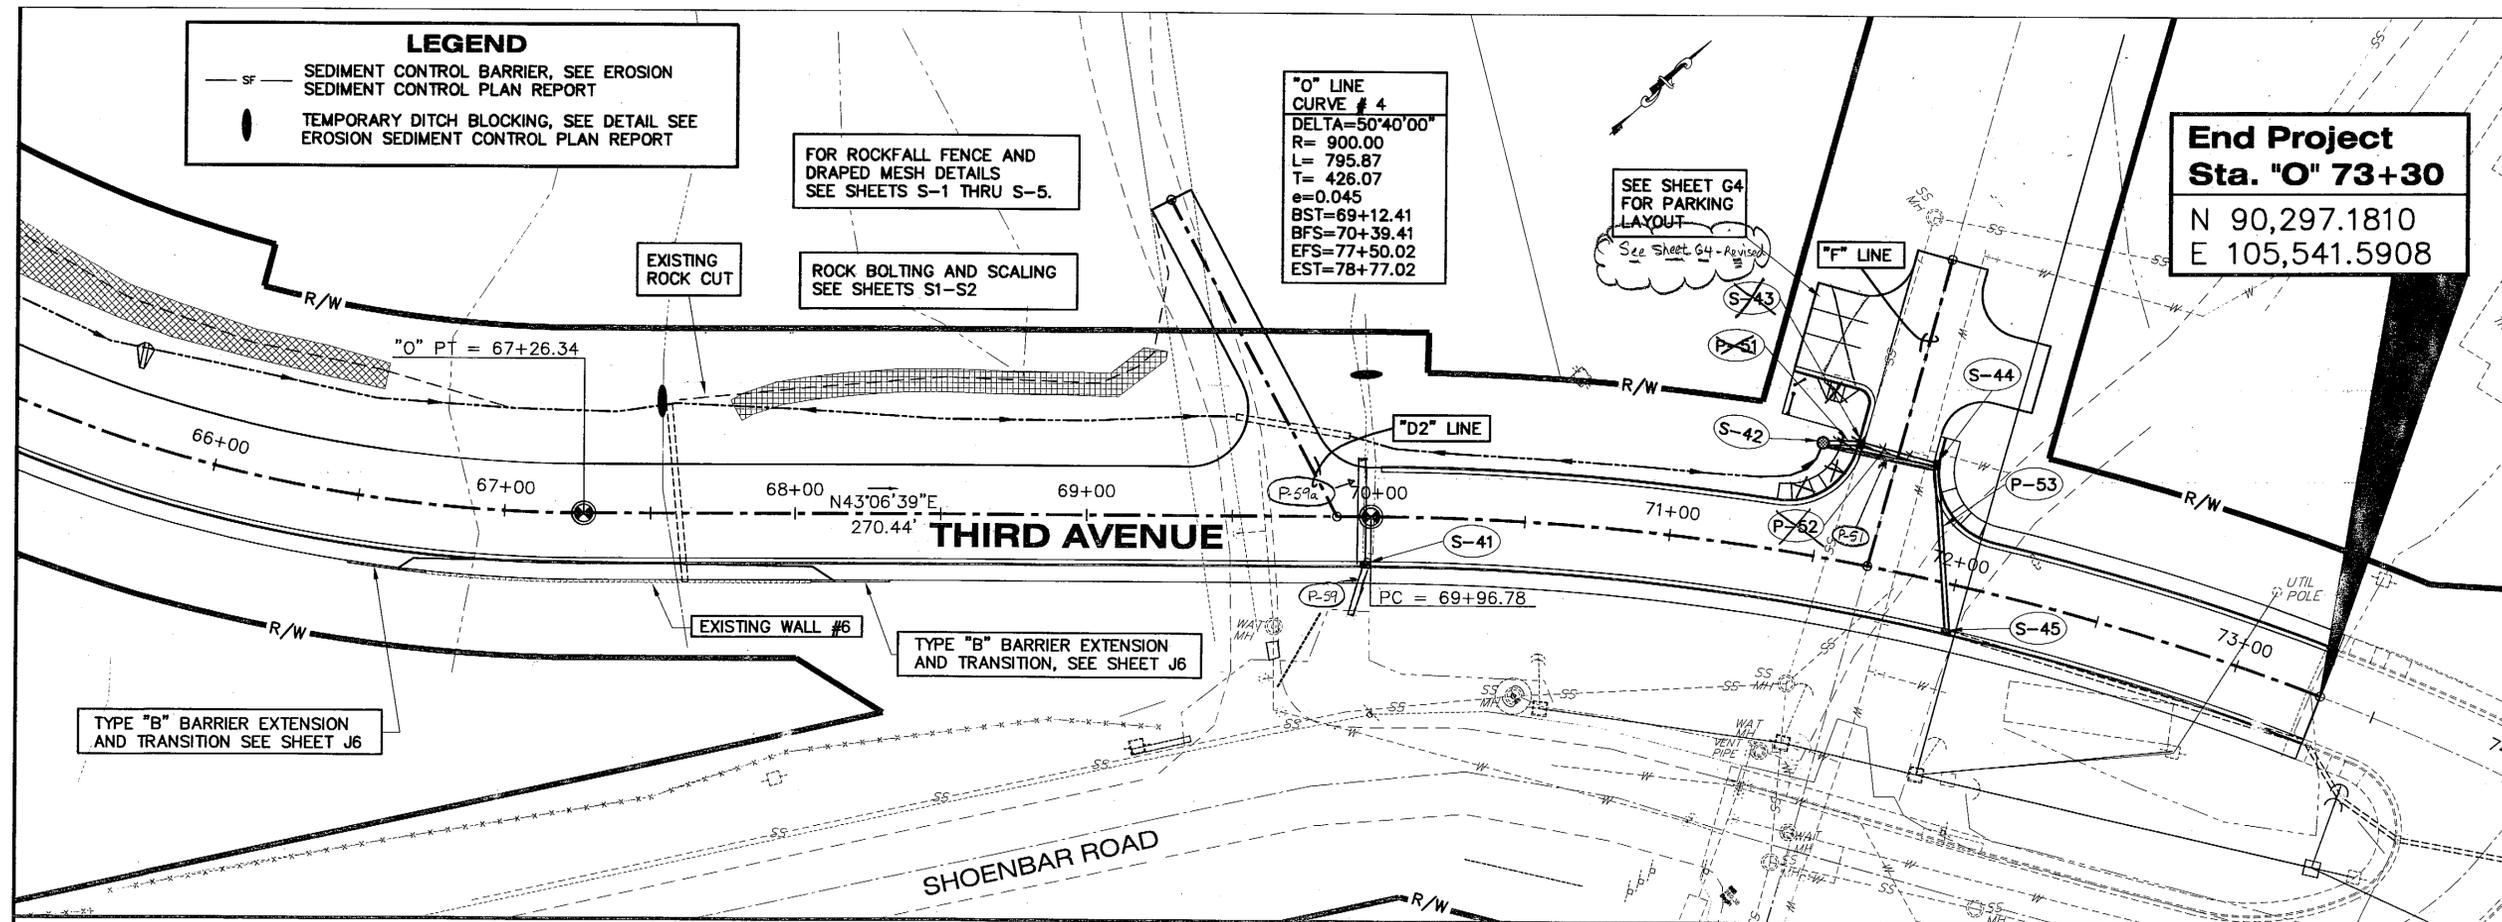

Layout Plan Key Map

DESIGNED BY:


CHECKED BY:
 DRAWN BY:


STATE OF ALASKA
 DEPARTMENT OF TRANSPORTATION & PUBLIC FACILITIES
 STATEWIDE DESIGN & ENGINEERING SERVICES DIVISION
 THIRD AVENUE EXTENSION PROJECT NO. 68490
Plan and Profile
Sta. "O" 67+00 To Sta. "O" 73+30

PROJECT DESIGNATION NUMBER	
STP-MG-0904(2)	
STATE	YEAR
ALASKA	2002
SHEET NUMBER	TOTAL SHEETS
E7	146


ADDENDUM NUMBER		
ATTACHMENT NUMBER		
RECORD OF REVISIONS		
No.	DATE	DESCRIPTION

KTN-THIRD AVENUE EXTENSION
PROJECT NO. 68490

Washington Street Plan & Profile

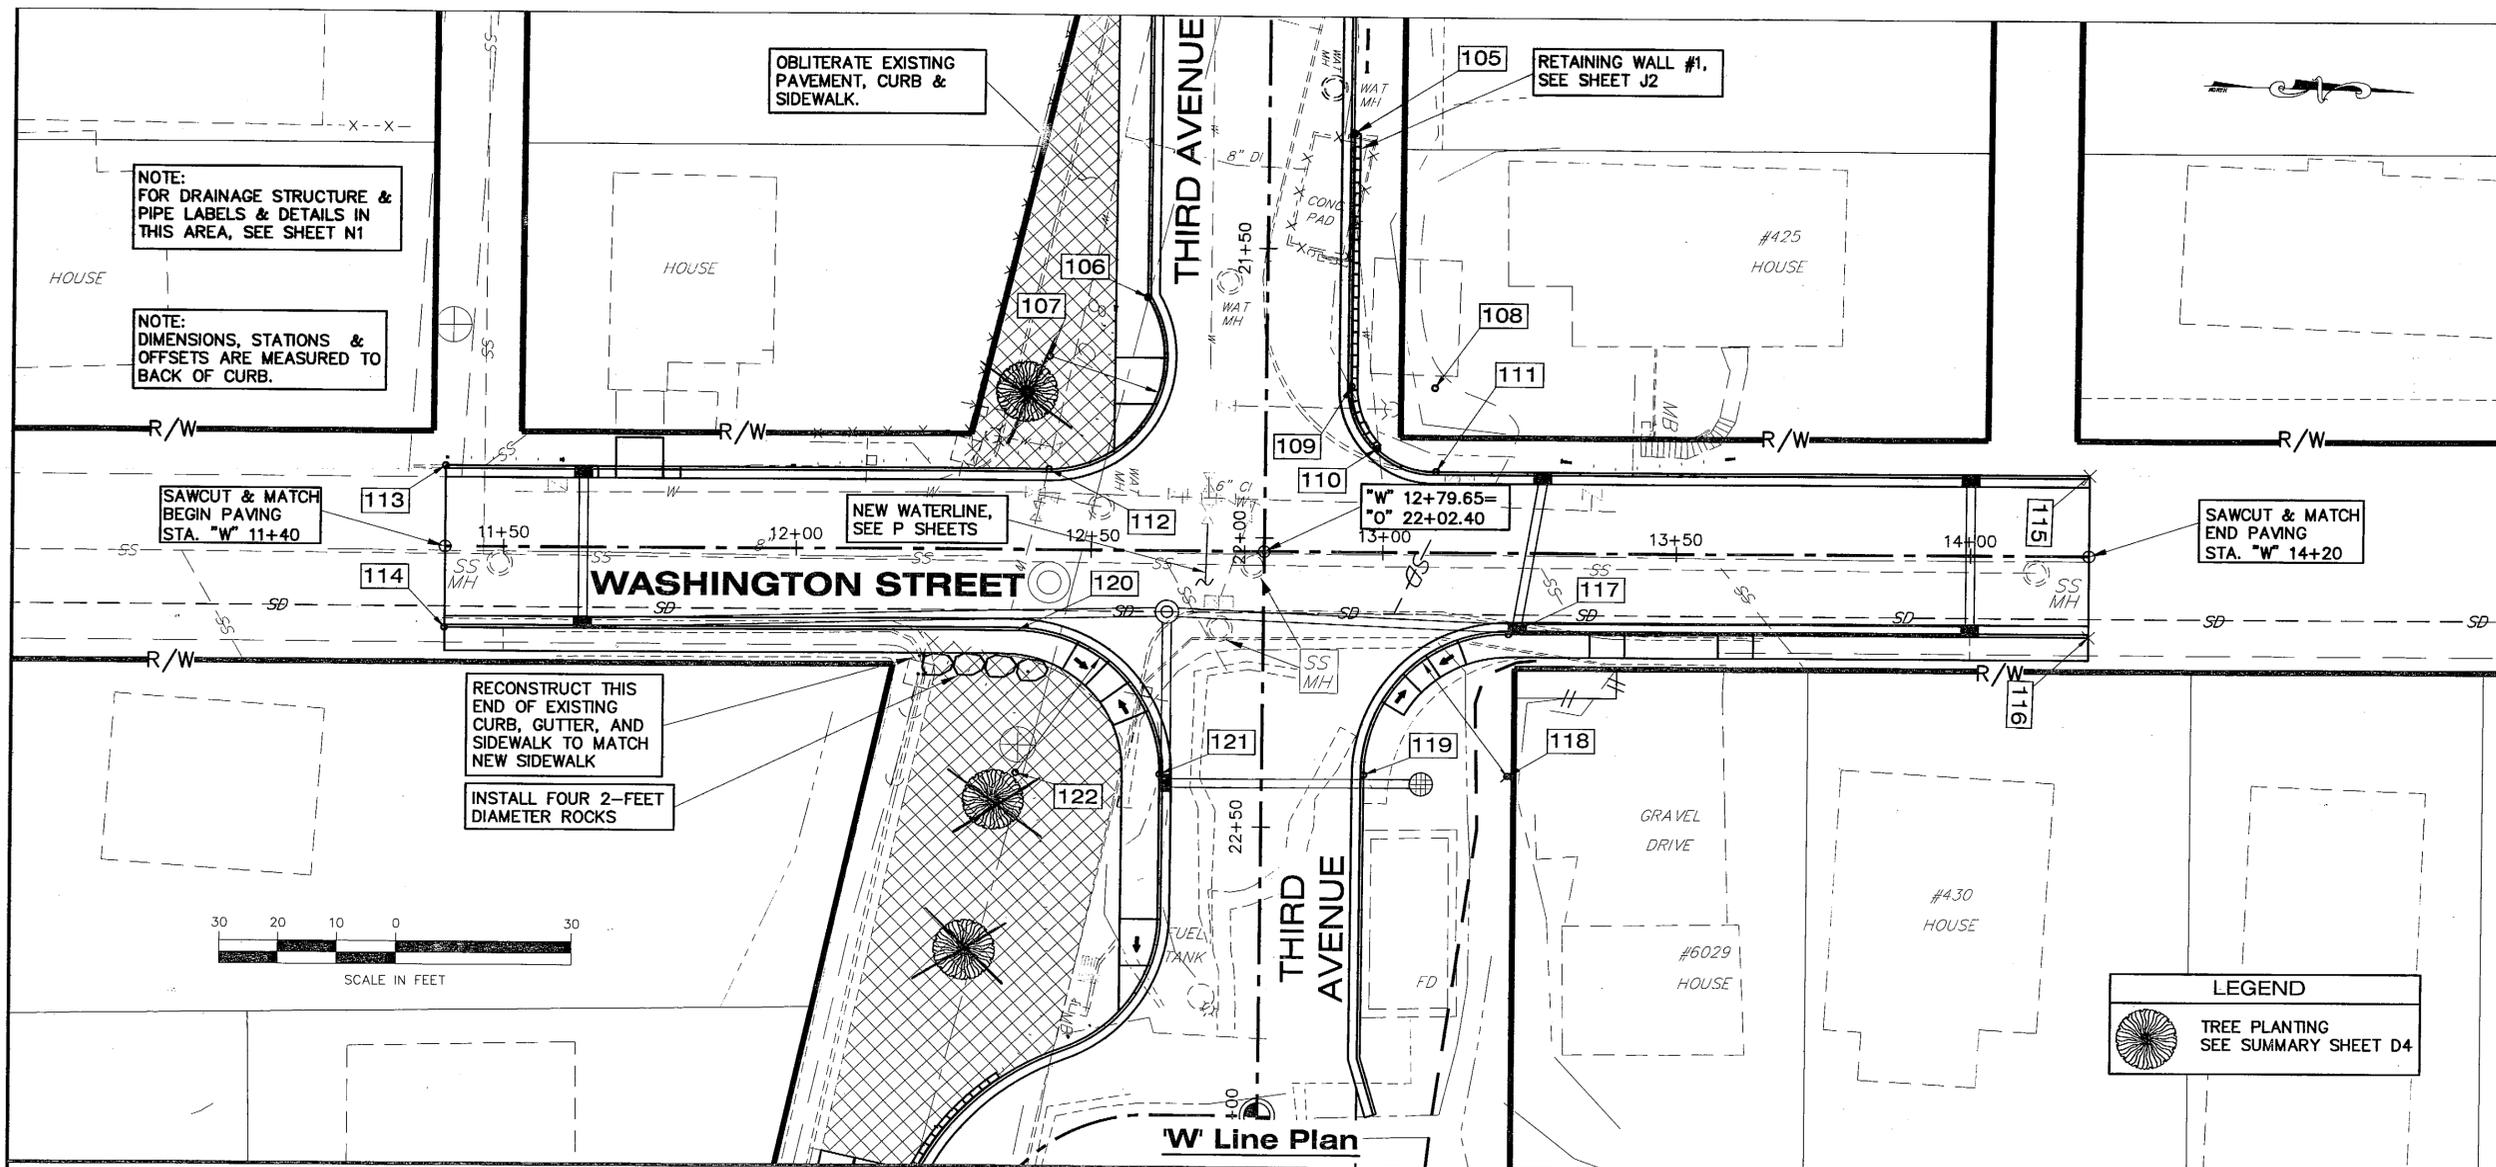

Point	Station	Offset	Elevation	Description
101	"O" 20+25.00	RT 20.50	-	MATCH
102	"O" 20+25.00	LT 20.50	-	MATCH
103	"O" 20+35.79	LT 20.50	137.29	POT
104	"O" 20+55.79	LT 14.50	138.10	POT
105	"O" 21+29.94	LT 14.62	-	BEGIN WALL 1
106	"O" 21+58.64	RT 20.50	144.68	PC
107	"O" 21+69.13	RT 37.00	-	RP
108	"W" 13+08.76	LT 28.50	-	RP
109	"O" 21+73.79	LT 14.50	146.66	PC
110	"W" 12+98.90	LT 17.96	-	END WALL 1
111	"W" 13+08.76	LT 14.00	154.50	PT
112	"W" 12+42.77	LT 14.00	145.35	PT
113	"W" 11+40.00	LT 14.00	-	MATCH
114	"W" 11+40.00	RT 14.00	-	MATCH
115	"W" 14+20.00	LT 14.00	-	MATCH
116	"W" 14+20.00	RT 14.00	-	MATCH
117	"W" 13+21.51	RT 14.00	157.29	PC
118	"W" 13+21.51	RT 38.50	-	RP
119	"O" 22+40.75	LT 17.50	151.24	PT
120	"W" 12+37.51	RT 14.00	144.40	PC
121	"O" 22+41.05	RT 17.50	150.64	PT

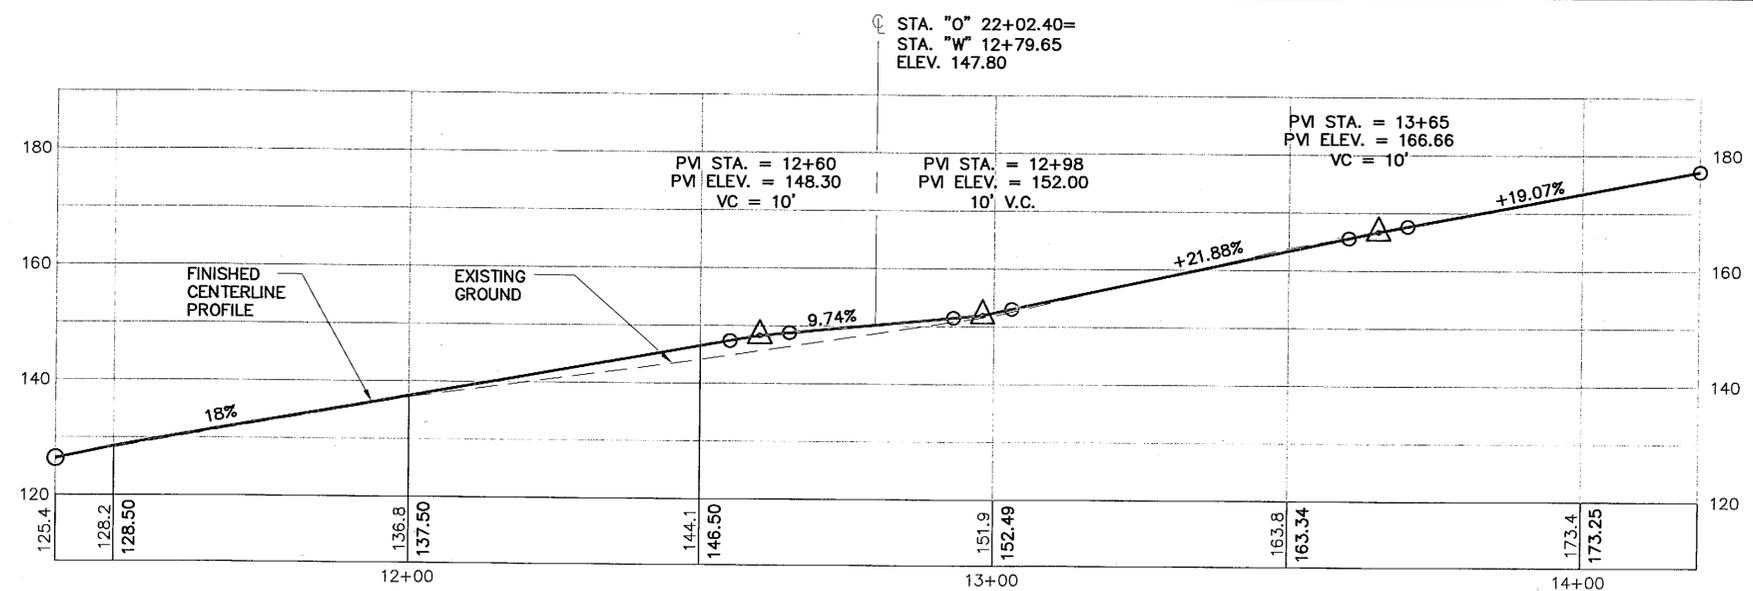

* NOTE: ALL POINTS ARE REFERENCED TO TOP BACK OF CURB (TBC).

'W' Line Profile


DESIGNED BY: C. HOWARD, J. OSBURN



CHECKED BY: T. MOORE
DRAWN BY: R.S.

STATE OF ALASKA
DEPARTMENT OF TRANSPORTATION & PUBLIC FACILITIES
STATEWIDE DESIGN & ENGINEERING SERVICES DIVISION
THIRD AVENUE EXTENSION
PROJECT NO. 68490
**Washington Street
Plan & Profile**

PROJECT DESIGNATION NUMBER	
STP-MG-0904(2)	
STATE	YEAR
ALASKA	2002
SHEET NUMBER	TOTAL SHEETS
E8	146

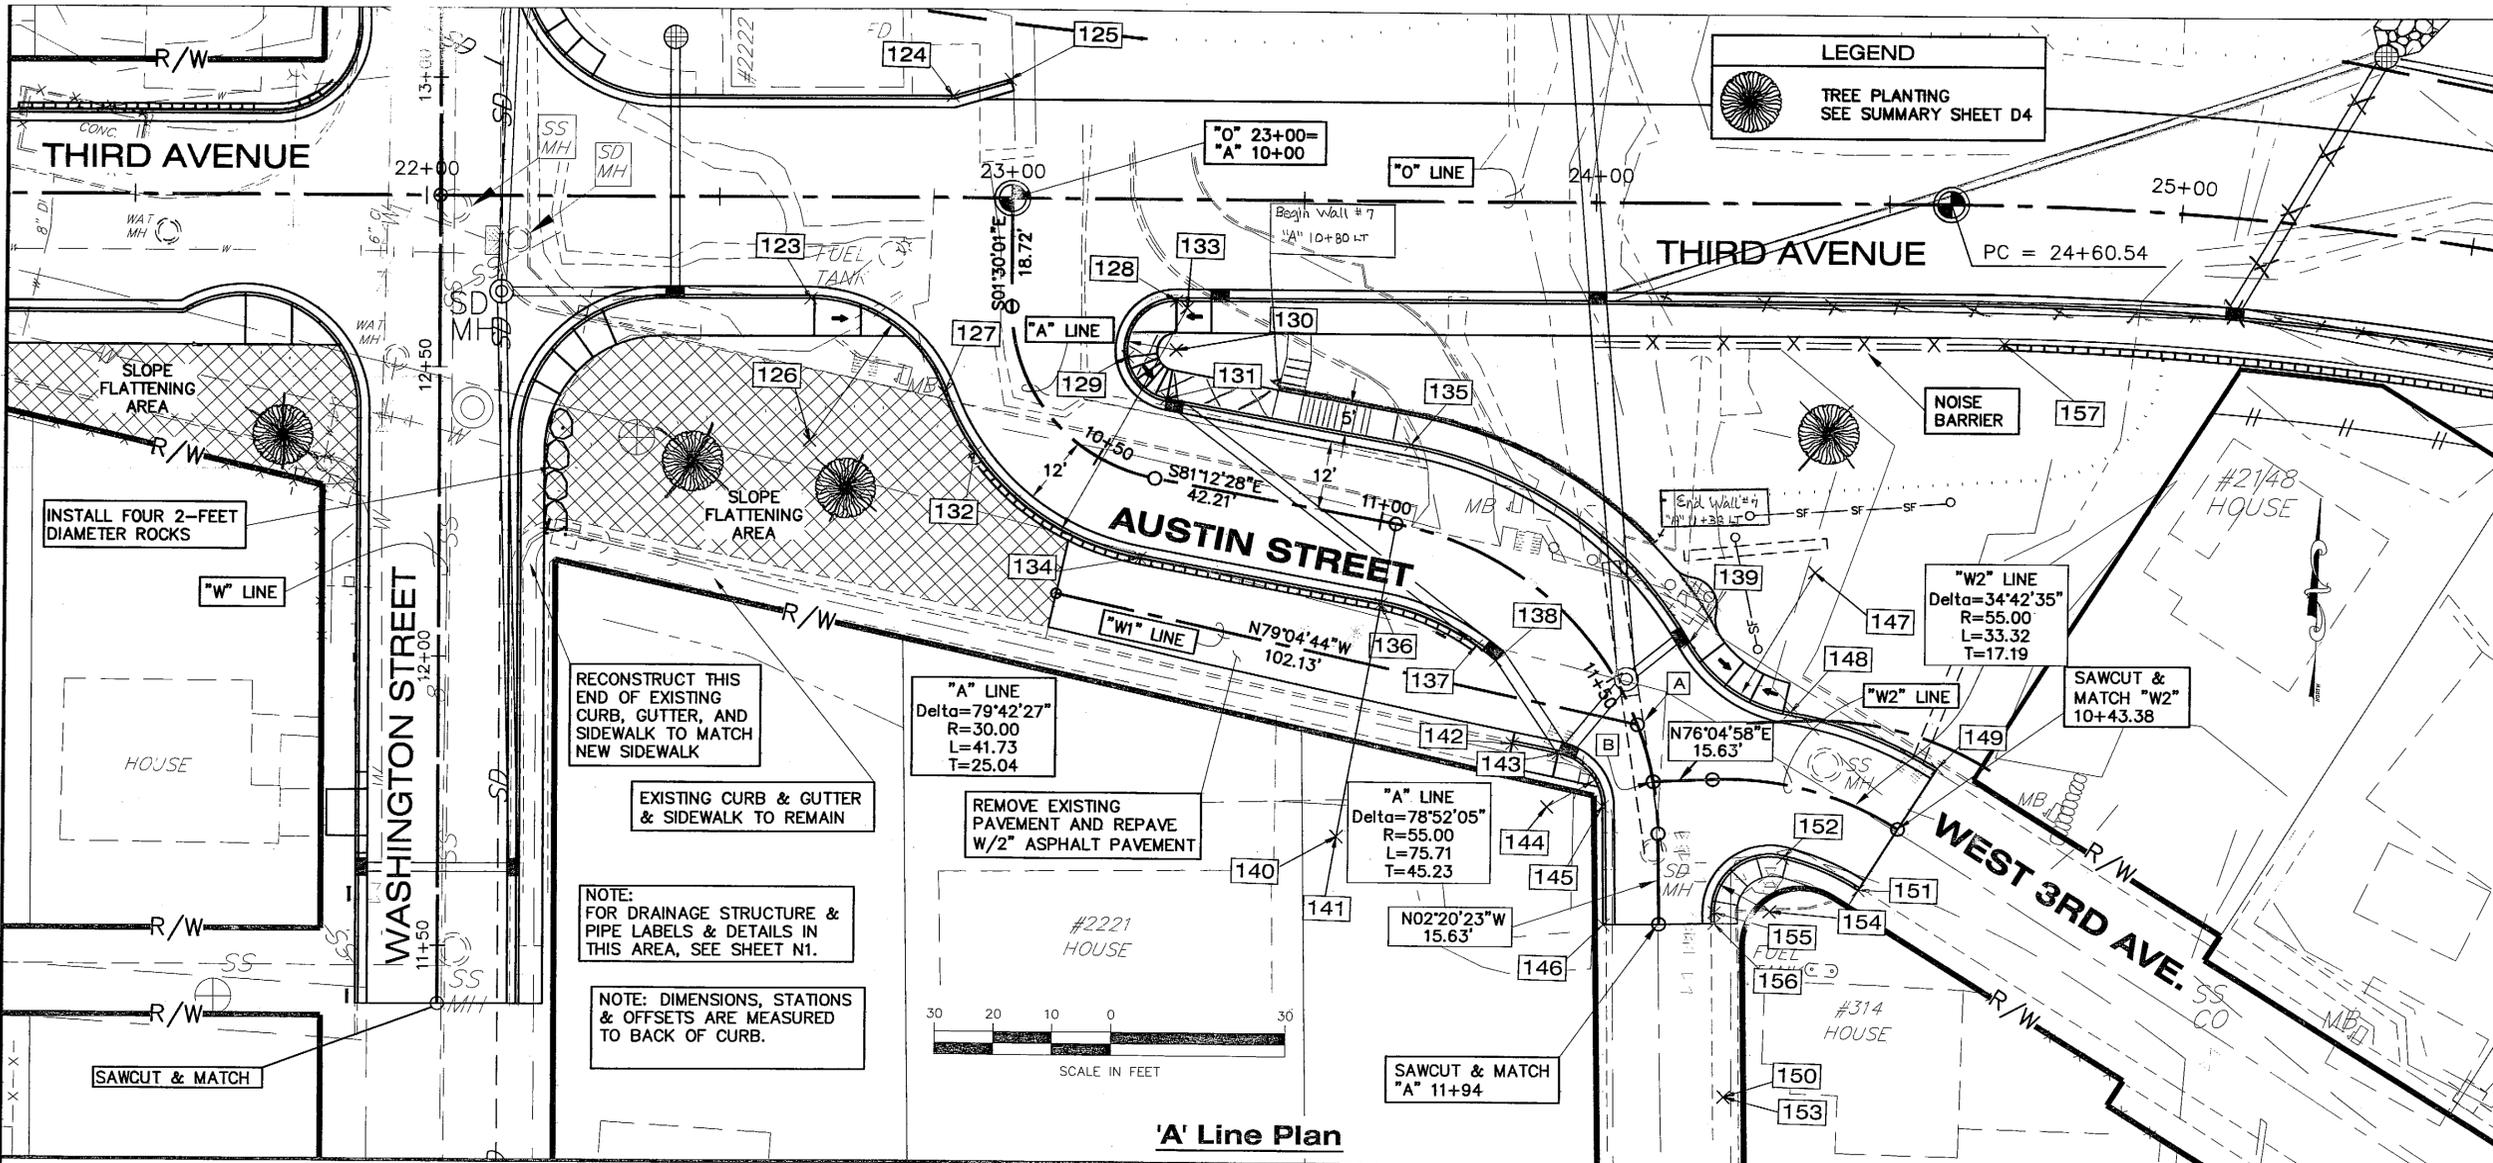

LEGEND

TREE PLANTING
SEE SUMMARY SHEET D4


PATH:
Q:\Ktn\71811A\PlanSet\E9_A-W1-W2Lines.dwg
Mon, 06/May/02 10:33AM Michael Limbough
PLOT:
PSPACE 1=1(F) OR MSPACE 1=15(F)

ADDENDUM NUMBER		
ATTACHMENT NUMBER		
RECORD OF REVISIONS		
No.	DATE	DESCRIPTION

KTN-THIRD AVENUE EXTENSION
PROJECT NO. 68490

**Austin Street & West 3rd Avenue
Plan & Profile**

Point	Station	Offset	Elevation	Description
123	"O" 22+65.58	RT 17.50	152.43	PC
124	"O" 22+89.71	LT 17.50	154.62	ANGLE PT.
125	"O" 22+99.43	LT 20.41	155.36	POT
126	"A" 10+29.12	RT 38.50	-	RP
127	"A" 10+29.12	RT 14.00	154.57	PRC
128	"O" 23+28.13	RT 17.50	156.66	PC
129	"A" 10+39.43	LT 16.66	154.49	BEGIN STAIRS
130	"A" 10+58.32	LT 22.48	-	RP
131	"A" 10+59.45	LT 13.99	150.65	PT
132	"A" 10+37.01	RT 14.10	-	BEGIN WALL 2
133	"A" 10+18.72	LT 30.00	-	RP
134	"A" 10+60.45	RT 14.00	150.52	PT
135	"A" 11+02.66	LT 14.00	144.93	PC
136	"A" 11+02.66	RT 14.00	144.93	PC
137	"A" 11+27.01	RT 14.10	-	END WALL 2
138	"A" 11+32.67	RT 14.00	141.08	PT
139	"A" 11+50.83	LT 14.00	139.84	PRC
140	"A" 11+02.66	RT 55.00	-	RP

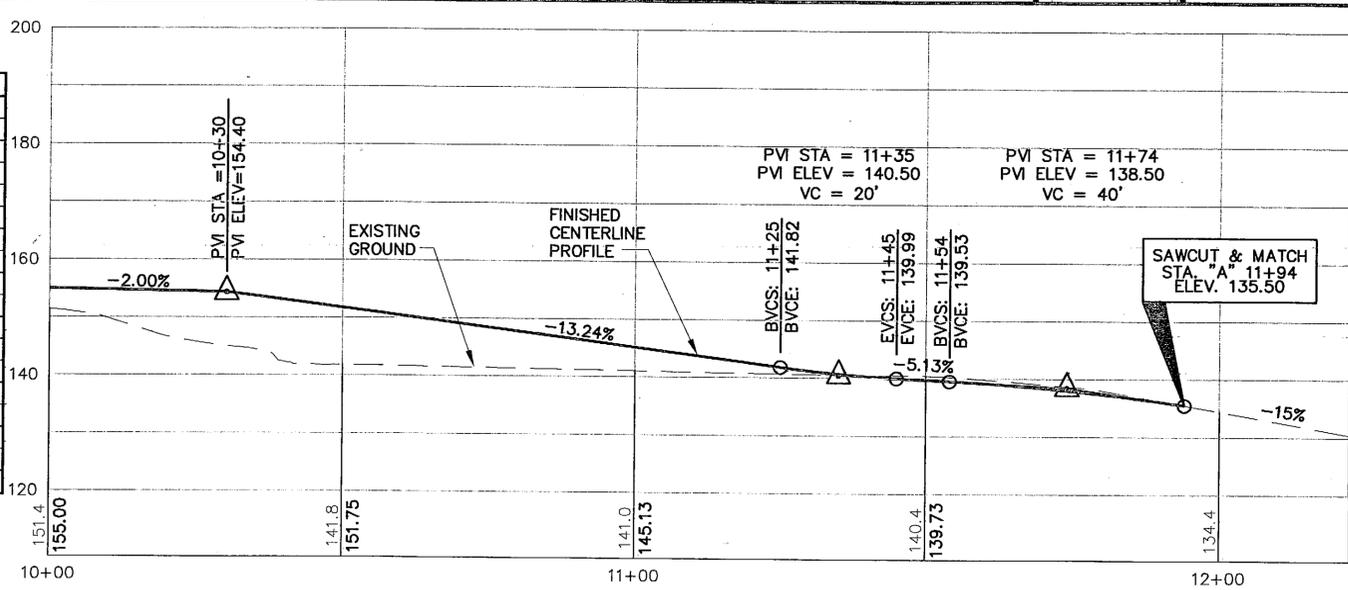

Point	Station	Offset	Elevation	Description
141	"A" 11+02.66	RT 55.00	-	RP
142	"W1" 10+20.01	RT 7.88	-	MATCH
143	"W1" 10+12.01	RT 7.88	139.69	PC
144	"A" 11+71.06	RT 18.60	-	RP
145	"A" 11+72.57	RT 9.17	138.39	PT
146	"A" 11+94.00	RT 9.42	-	MATCH
147	"A" 11+50.83	LT 38.50	-	RP
148	"W2" 10+21.31	LT 12.50	139.62	PRC
149	"A" 11+72.58	LT 48.29	-	MATCH
150	"A" 12+24.05	LT 10.82	-	RP
151	"A" 11+88.46	LT 34.05	-	MATCH
152	"W2" 10+25.21	RT 12.50	139.78	PCC
153	"A" 12+24.05	LT 10.82	-	RP
154	"A" 11+92.06	LT 18.92	-	RP
155	"A" 11+92.06	LT 9.42	136.02	PC
156	"A" 11+94.00	LT 9.42	-	MATCH
157	"O" 24+70.28	RT 24.00	-	BEGIN WALL 3
158	"O" 25+74.87	RT 24.00	-	END WALL 3

[A] "W1" 10+00 = "A" 11+59.05
[B] "W2" 10+00 = "A" 11+69.30

* NOTE: ALL POINTS ARE REFERENCED TO TOP BACK OF CURB (TBC).

'A' Line Profile

DESIGNED BY: C. HOWARD, J. OSBURN




CHECKED BY: T. MOORE
DRAWN BY: R.S.

STATE OF ALASKA
DEPARTMENT OF TRANSPORTATION
& PUBLIC FACILITIES
STATEWIDE DESIGN & ENGINEERING
SERVICES DIVISION
THIRD AVENUE EXTENSION
PROJECT NO. 68490
**Austin Street &
West 3rd Avenue
Plan & Profile**

PROJECT DESIGNATION NUMBER	
STP-MG-0904(2)	
STATE	YEAR
ALASKA	2002
SHEET NUMBER	TOTAL SHEETS
E9	146

Project As Built Drawings have been reviewed by the Project Engineer. To the best of his/her knowledge, they represent the project as constructed.
Proj. Eng. *[Signature]* Date 10/10/06

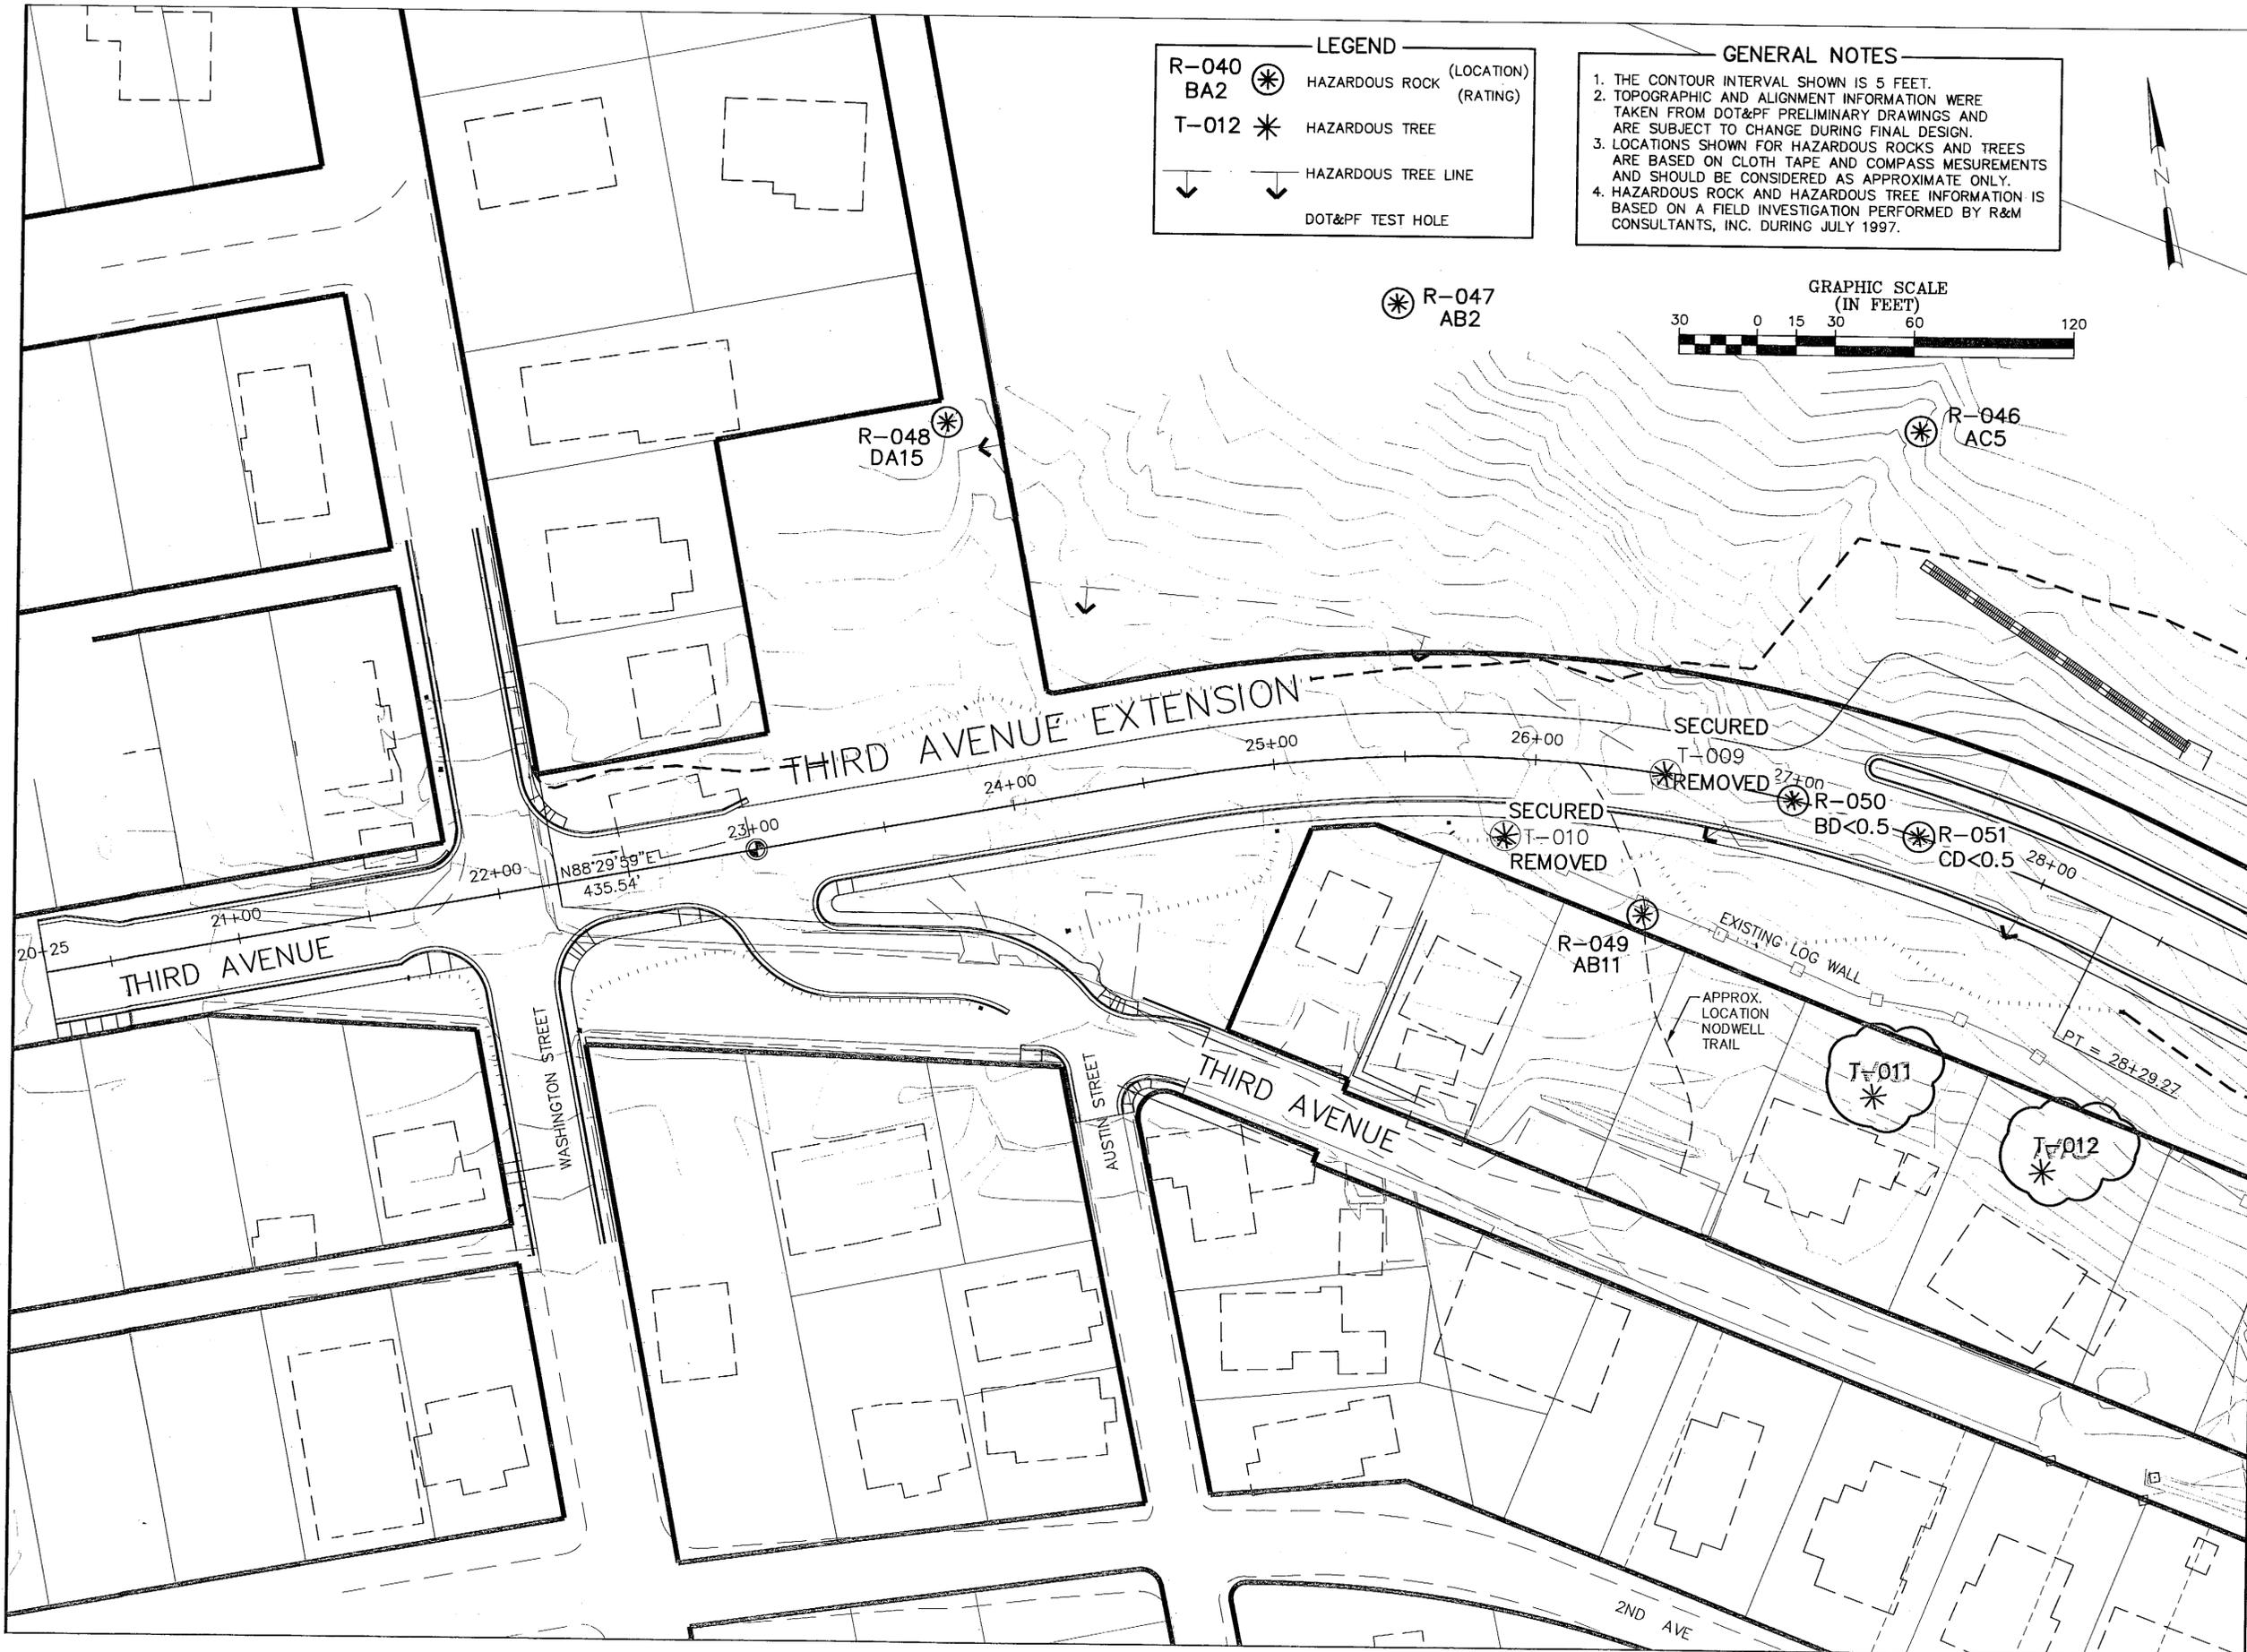

LEGEND

R-040 BA2	⊗	HAZARDOUS ROCK (LOCATION) (RATING)
T-012	⊗	HAZARDOUS TREE
↓	↓	HAZARDOUS TREE LINE
⊙		DOT&PF TEST HOLE

GENERAL NOTES

1. THE CONTOUR INTERVAL SHOWN IS 5 FEET.
2. TOPOGRAPHIC AND ALIGNMENT INFORMATION WERE TAKEN FROM DOT&PF PRELIMINARY DRAWINGS AND ARE SUBJECT TO CHANGE DURING FINAL DESIGN.
3. LOCATIONS SHOWN FOR HAZARDOUS ROCKS AND TREES ARE BASED ON CLOTH TAPE AND COMPASS MEASUREMENTS AND SHOULD BE CONSIDERED AS APPROXIMATE ONLY.
4. HAZARDOUS ROCK AND HAZARDOUS TREE INFORMATION IS BASED ON A FIELD INVESTIGATION PERFORMED BY R&M CONSULTANTS, INC. DURING JULY 1997.

PATH: Q:\Ktn\71811A\Planset\F_Hazards.dwg
 Mon, 06/May/02 10:35AM Michael Limbaugh
 PLOT: PSPACE 1=1(F) OR MSPAGE 1=1(F)
 TAB: PLAN1

ADDENDUM NUMBER		
ATTACHMENT NUMBER		
RECORD OF REVISIONS		
No.	DATE	DESCRIPTION

KTN-THIRD AVENUE EXTENSION
 PROJECT NO. 68490
Hazardous Trees & Rocks

DESIGNED BY: C. HOWARD

CHECKED BY: T. MOORE
 DRAWN BY: T.M. / R.S.

STATE OF ALASKA
 DEPARTMENT OF TRANSPORTATION & PUBLIC FACILITIES
 STATEWIDE DESIGN & ENGINEERING SERVICES DIVISION
 THIRD AVENUE EXTENSION
 PROJECT NO. 68490

Hazardous Trees & Rocks

PROJECT DESIGNATION NUMBER
STP-MG-0904(2)

STATE	YEAR
ALASKA	2002
SHEET NUMBER	TOTAL SHEETS
F1	146

Project As Built Drawings have been reviewed by the Project Engineer. To the best of his/her knowledge, they represent the project as constructed.

Proj. Eng. *KS* Date: 5/1/02

GENERAL NOTES

1. THE CONTOUR INTERVAL SHOWN IS 5 FEET.
2. TOPOGRAPHIC AND ALIGNMENT INFORMATION WERE TAKEN FROM DOT&PF PRELIMINARY DRAWINGS AND ARE SUBJECT TO CHANGE DURING FINAL DESIGN.
3. LOCATIONS SHOWN FOR HAZARDOUS ROCKS AND TREES ARE BASED ON CLOTH TAPE AND COMPASS MEASUREMENTS AND SHOULD BE CONSIDERED AS APPROXIMATE ONLY.
4. HAZARDOUS ROCK AND HAZARDOUS TREE INFORMATION IS BASED ON A FIELD INVESTIGATION PERFORMED BY R&M CONSULTANTS, INC. DURING JULY 1997.



LEGEND

R-040 BA2 * HAZARDOUS ROCK (LOCATION) (RATING)

T-012 * HAZARDOUS TREE

↓ HAZARDOUS TREE LINE

↓ DOT&PF TEST HOLE

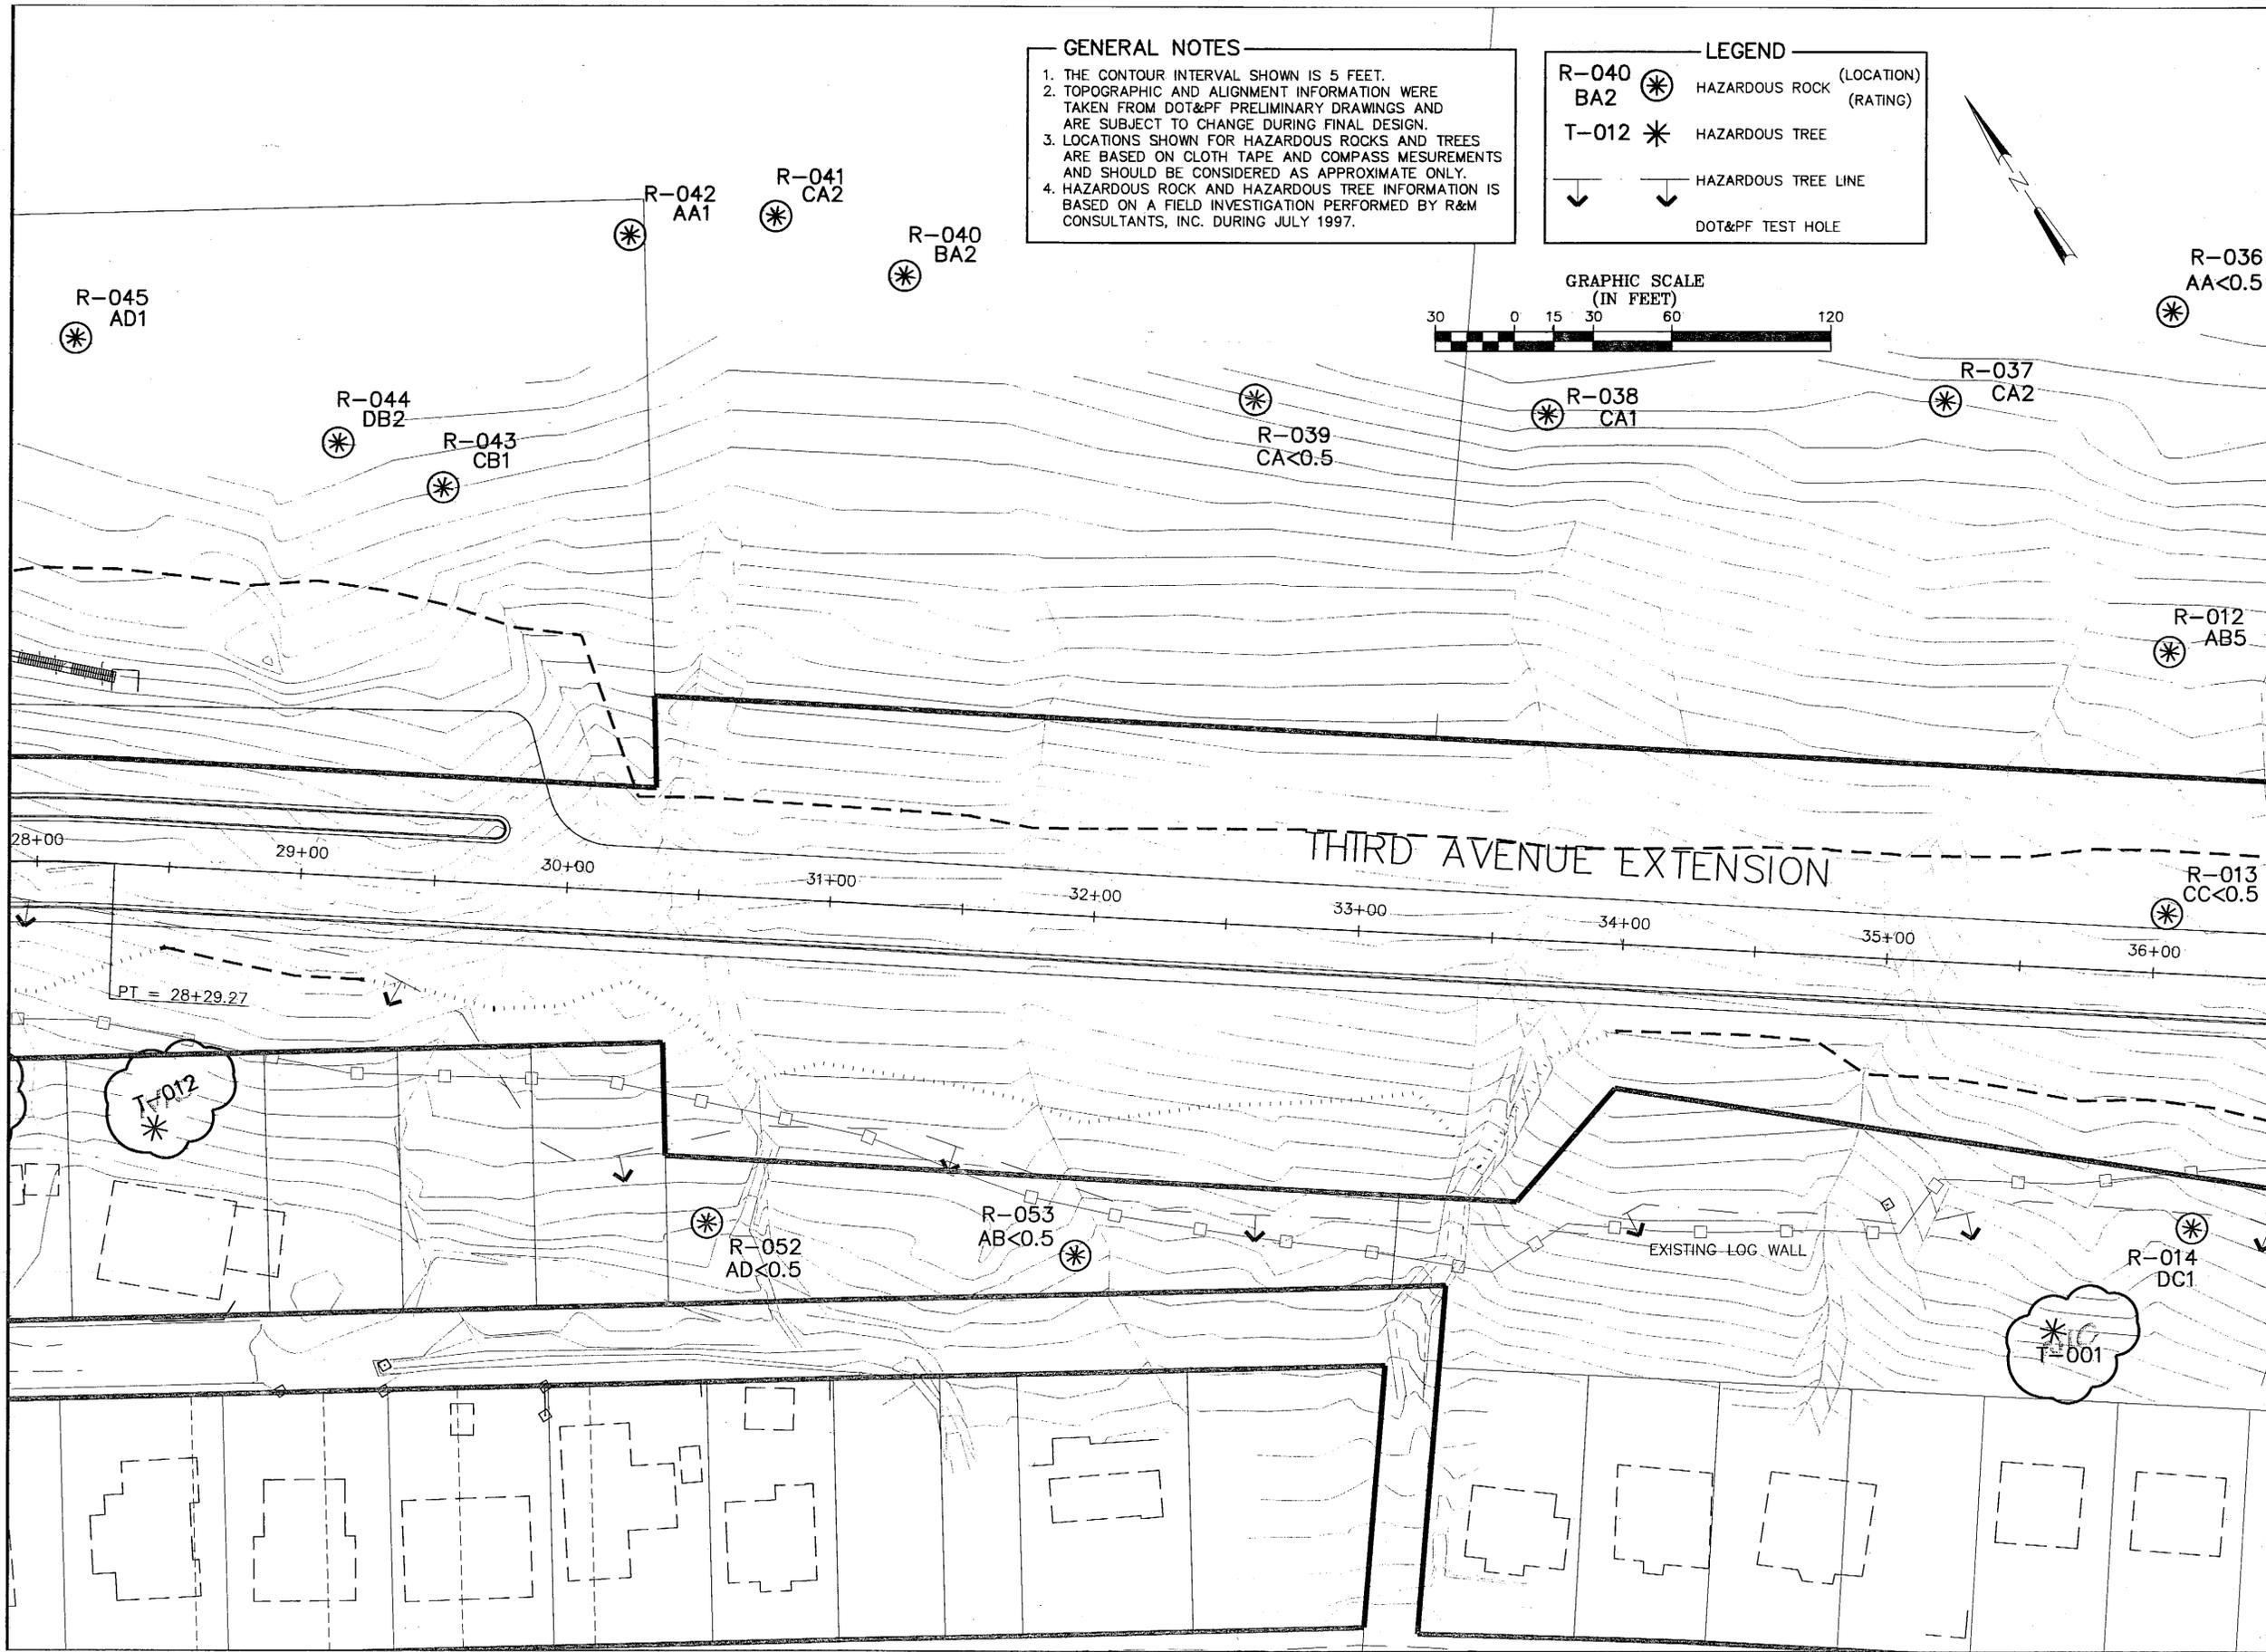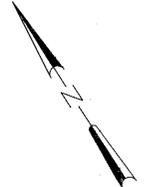

PATH:
Q:\Ktn\71811A\Planset\F_Hazards.dwg
Mon, 06/May/02 10:35AM Michael Limbaugh
PLOT:
PSPACE 1=1(F) OR MSPACE 1=1(F)
TAB: PLAN2

ADDENDUM NUMBER		
ATTACHMENT NUMBER		
RECORD OF REVISIONS		
No.	DATE	DESCRIPTION

KTN-THIRD AVENUE EXTENSION
PROJECT NO. 68490

Hazardous Trees & Rocks

DESIGNED BY: C. HOWARD



CHECKED BY: T. MOORE
DRAWN BY: T.M. / R.S.

STATE OF ALASKA
DEPARTMENT OF TRANSPORTATION
& PUBLIC FACILITIES
STATEWIDE DESIGN & ENGINEERING
SERVICES DIVISION
THIRD AVENUE EXTENSION
PROJECT NO. 68490

Hazardous Trees & Rocks	
PROJECT DESIGNATION NUMBER	
STP-MG-0904(2)	
STATE	YEAR
ALASKA	2002
SHEET NUMBER	TOTAL SHEETS
F2	146

Project As Built Drawings have been reviewed by the Project Engineer. To the best of his/her knowledge, they represent the project as constructed.
Proj. Eng. *[Signature]* Date 10/31/06


R-040 BA2	HAZARDOUS ROCK	(LOCATION) (RATING)
T-012	HAZARDOUS TREE	
↓	HAZARDOUS TREE LINE	
↓	DOT&PF TEST HOLE	

GENERAL NOTES

1. THE CONTOUR INTERVAL SHOWN IS 5 FEET.
2. TOPOGRAPHIC AND ALIGNMENT INFORMATION WERE TAKEN FROM DOT&PF PRELIMINARY DRAWINGS AND ARE SUBJECT TO CHANGE DURING FINAL DESIGN.
3. LOCATIONS SHOWN FOR HAZARDOUS ROCKS AND TREES ARE BASED ON CLOTH TAPE AND COMPASS MEASUREMENTS AND SHOULD BE CONSIDERED AS APPROXIMATE ONLY.
4. HAZARDOUS ROCK AND HAZARDOUS TREE INFORMATION IS BASED ON A FIELD INVESTIGATION PERFORMED BY R&M CONSULTANTS, INC. DURING JULY 1997.

PATH:
Q:\Ktn\71811A\Planset\F_Hazards.dwg
Mon, 06/May/02 10:35AM Michael Limbaugh
PLOT:
PSPACE 1=1(F) OR MSPACE 1=1(F)
TAB: PLAN3


ADDENDUM NUMBER		
ATTACHMENT NUMBER		
RECORD OF REVISIONS		
No.	DATE	DESCRIPTION

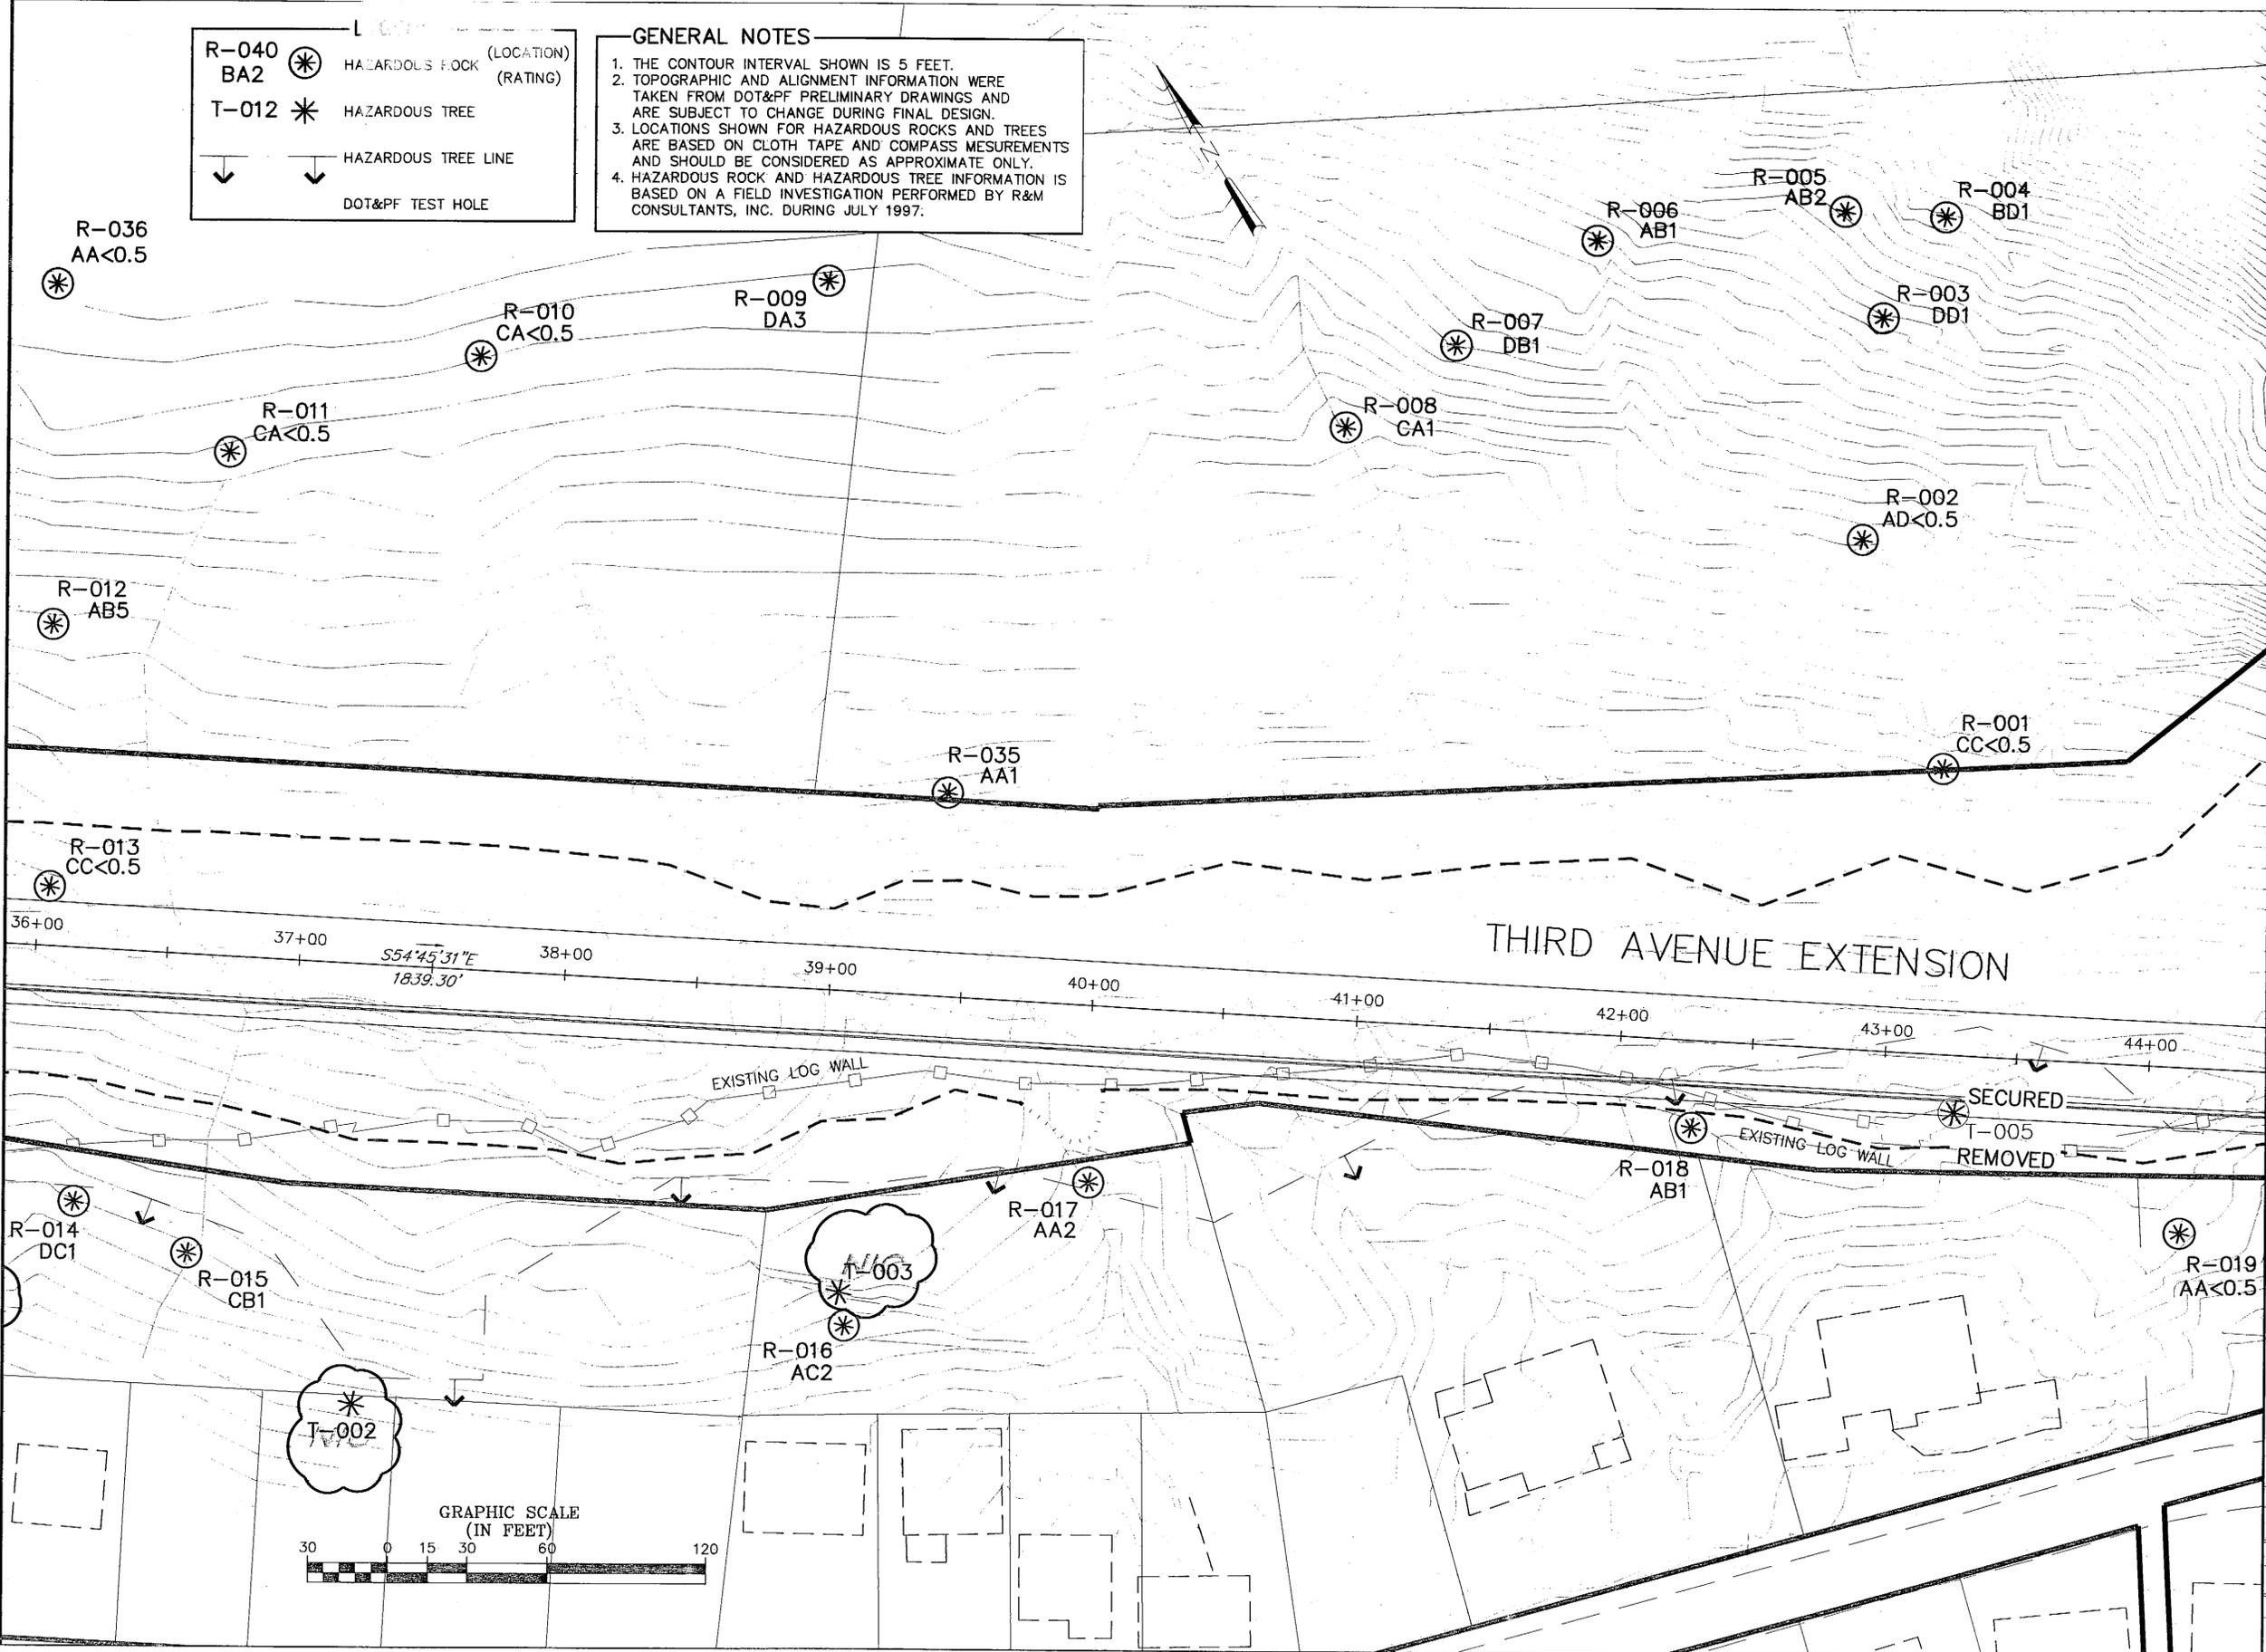

KTN-THIRD AVENUE EXTENSION
PROJECT NO. 68490

Hazardous Trees & Rocks

DESIGNED BY: C. HOWARD

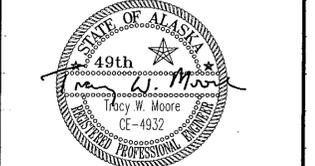

CHECKED BY: T. MOORE
DRAWN BY: T.M. / R.S.

STATE OF ALASKA
DEPARTMENT OF TRANSPORTATION
& PUBLIC FACILITIES
STATEWIDE DESIGN & ENGINEERING
SERVICES DIVISION
THIRD AVENUE EXTENSION
PROJECT NO. 68490

Hazardous Trees & Rocks	
PROJECT DESIGNATION NUMBER	
STP-MG-0904(2)	
STATE	YEAR
ALASKA	2002
SHEET NUMBER	TOTAL SHEETS
F3	146

Project As Built Drawings have been reviewed by the Project Engineer. To the best of his/her knowledge, they represent the project as constructed.
Proj. Eng. [Signature] Date: 6/3/06

GENERAL NOTES

1. THE CONTOUR INTERVAL SHOWN IS 5 FEET.
2. TOPOGRAPHIC AND ALIGNMENT INFORMATION WERE TAKEN FROM DOT&PF PRELIMINARY DRAWINGS AND ARE SUBJECT TO CHANGE DURING FINAL DESIGN.
3. LOCATIONS SHOWN FOR HAZARDOUS ROCKS AND TREES ARE BASED ON CLOTH TAPE AND COMPASS MEASUREMENTS AND SHOULD BE CONSIDERED AS APPROXIMATE ONLY.
4. HAZARDOUS ROCK AND HAZARDOUS TREE INFORMATION IS BASED ON A FIELD INVESTIGATION PERFORMED BY R&M CONSULTANTS, INC. DURING JULY 1997.



LEGEND

R-040 BA2 * HAZARDOUS ROCK (LOCATION) (RATING)

T-012 * HAZARDOUS TREE

↓ HAZARDOUS TREE LINE

↓ DOT&PF TEST HOLE

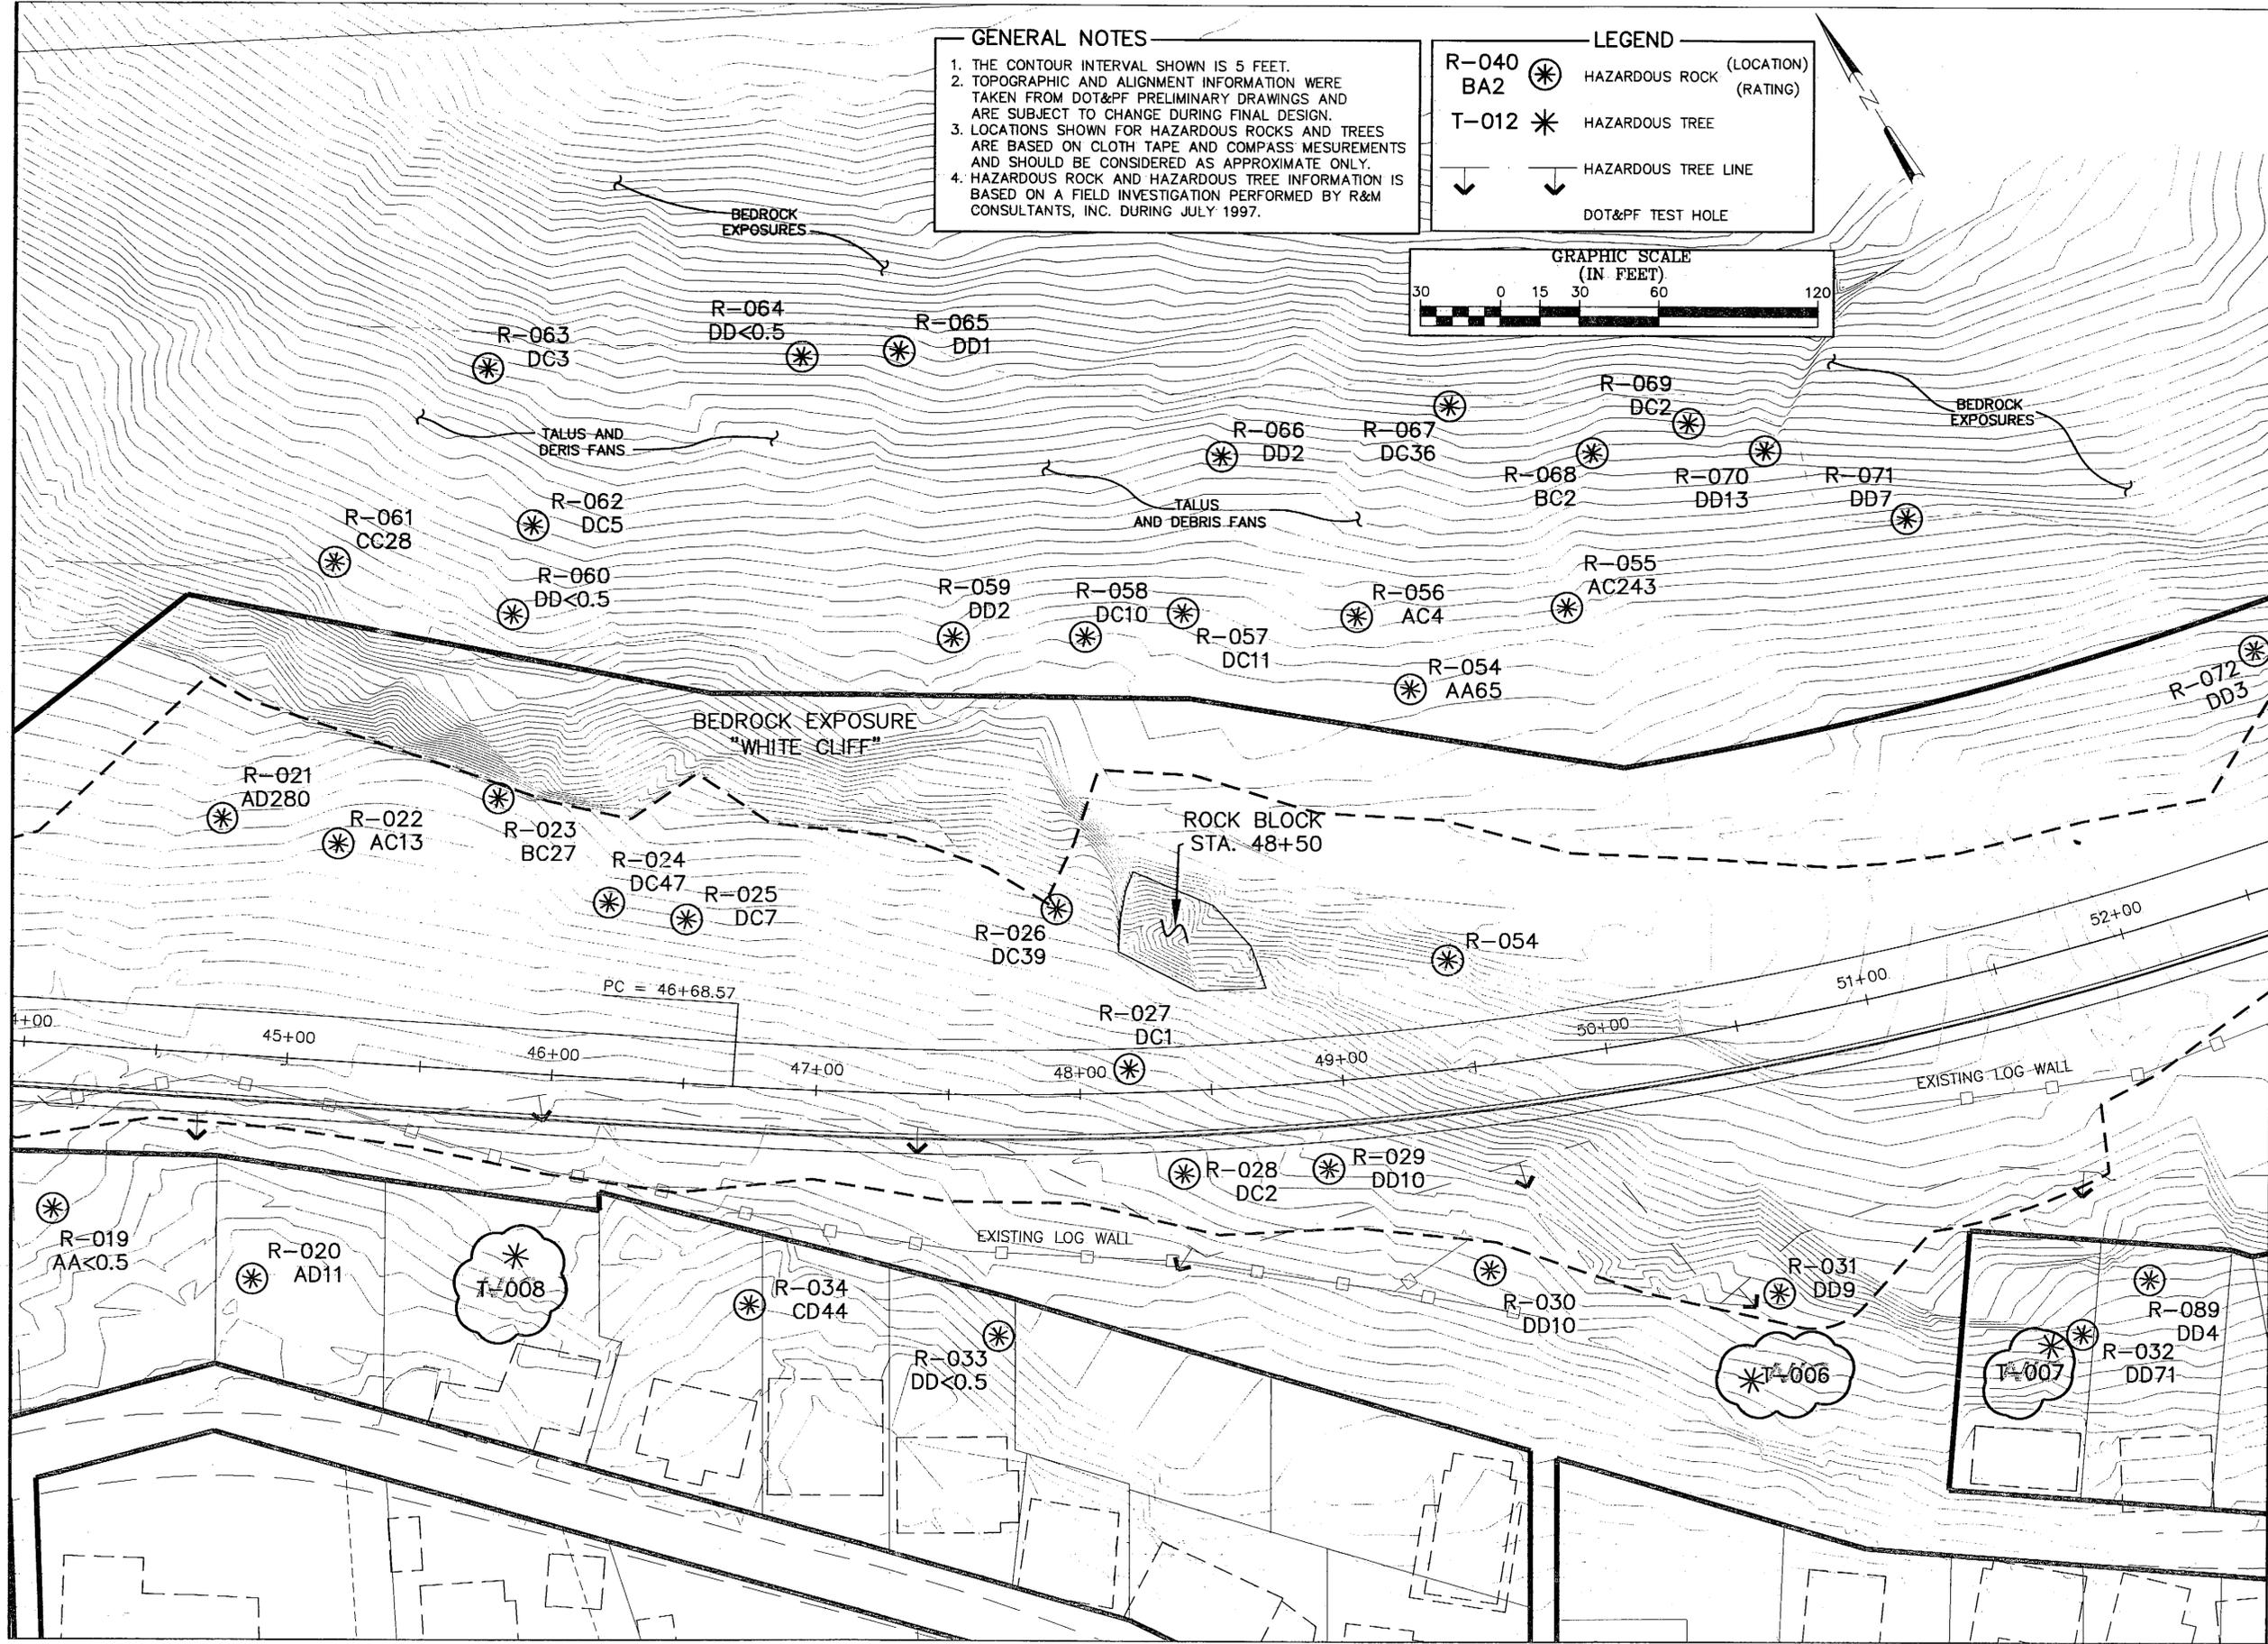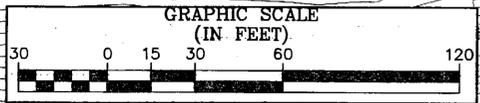

PATH:
Q:\Ktn\71811A\Planset\F_Hazards.dwg
Mon, 06/May/02 10:35AM Michael Limbaugh
PLOT:
PSPACE 1=1(F) OR MSPACE 1=1(F)
TAB: PLAN4

ADDENDUM NUMBER		
ATTACHMENT NUMBER		
RECORD OF REVISIONS		
No.	DATE	DESCRIPTION

KTN-THIRD AVENUE EXTENSION
PROJECT NO. 68490

Hazardous Trees & Rocks

DESIGNED BY: C. HOWARD




CHECKED BY: T. MOORE
DRAWN BY: T.M. / R.S.

STATE OF ALASKA
DEPARTMENT OF TRANSPORTATION & PUBLIC FACILITIES
STATEWIDE DESIGN & ENGINEERING SERVICES DIVISION
THIRD AVENUE EXTENSION
PROJECT NO. 68490

Hazardous Trees & Rocks
PROJECT DESIGNATION NUMBER

STP-MG-0904(2)	
STATE	YEAR
ALASKA	2002
SHEET NUMBER	TOTAL SHEETS
F4	146

Project As Built Drawings have been reviewed by the Project Engineer. To the best of his/her knowledge, they represent the project as constructed.
Proj. Eng. *[Signature]* Date: 5/14/02

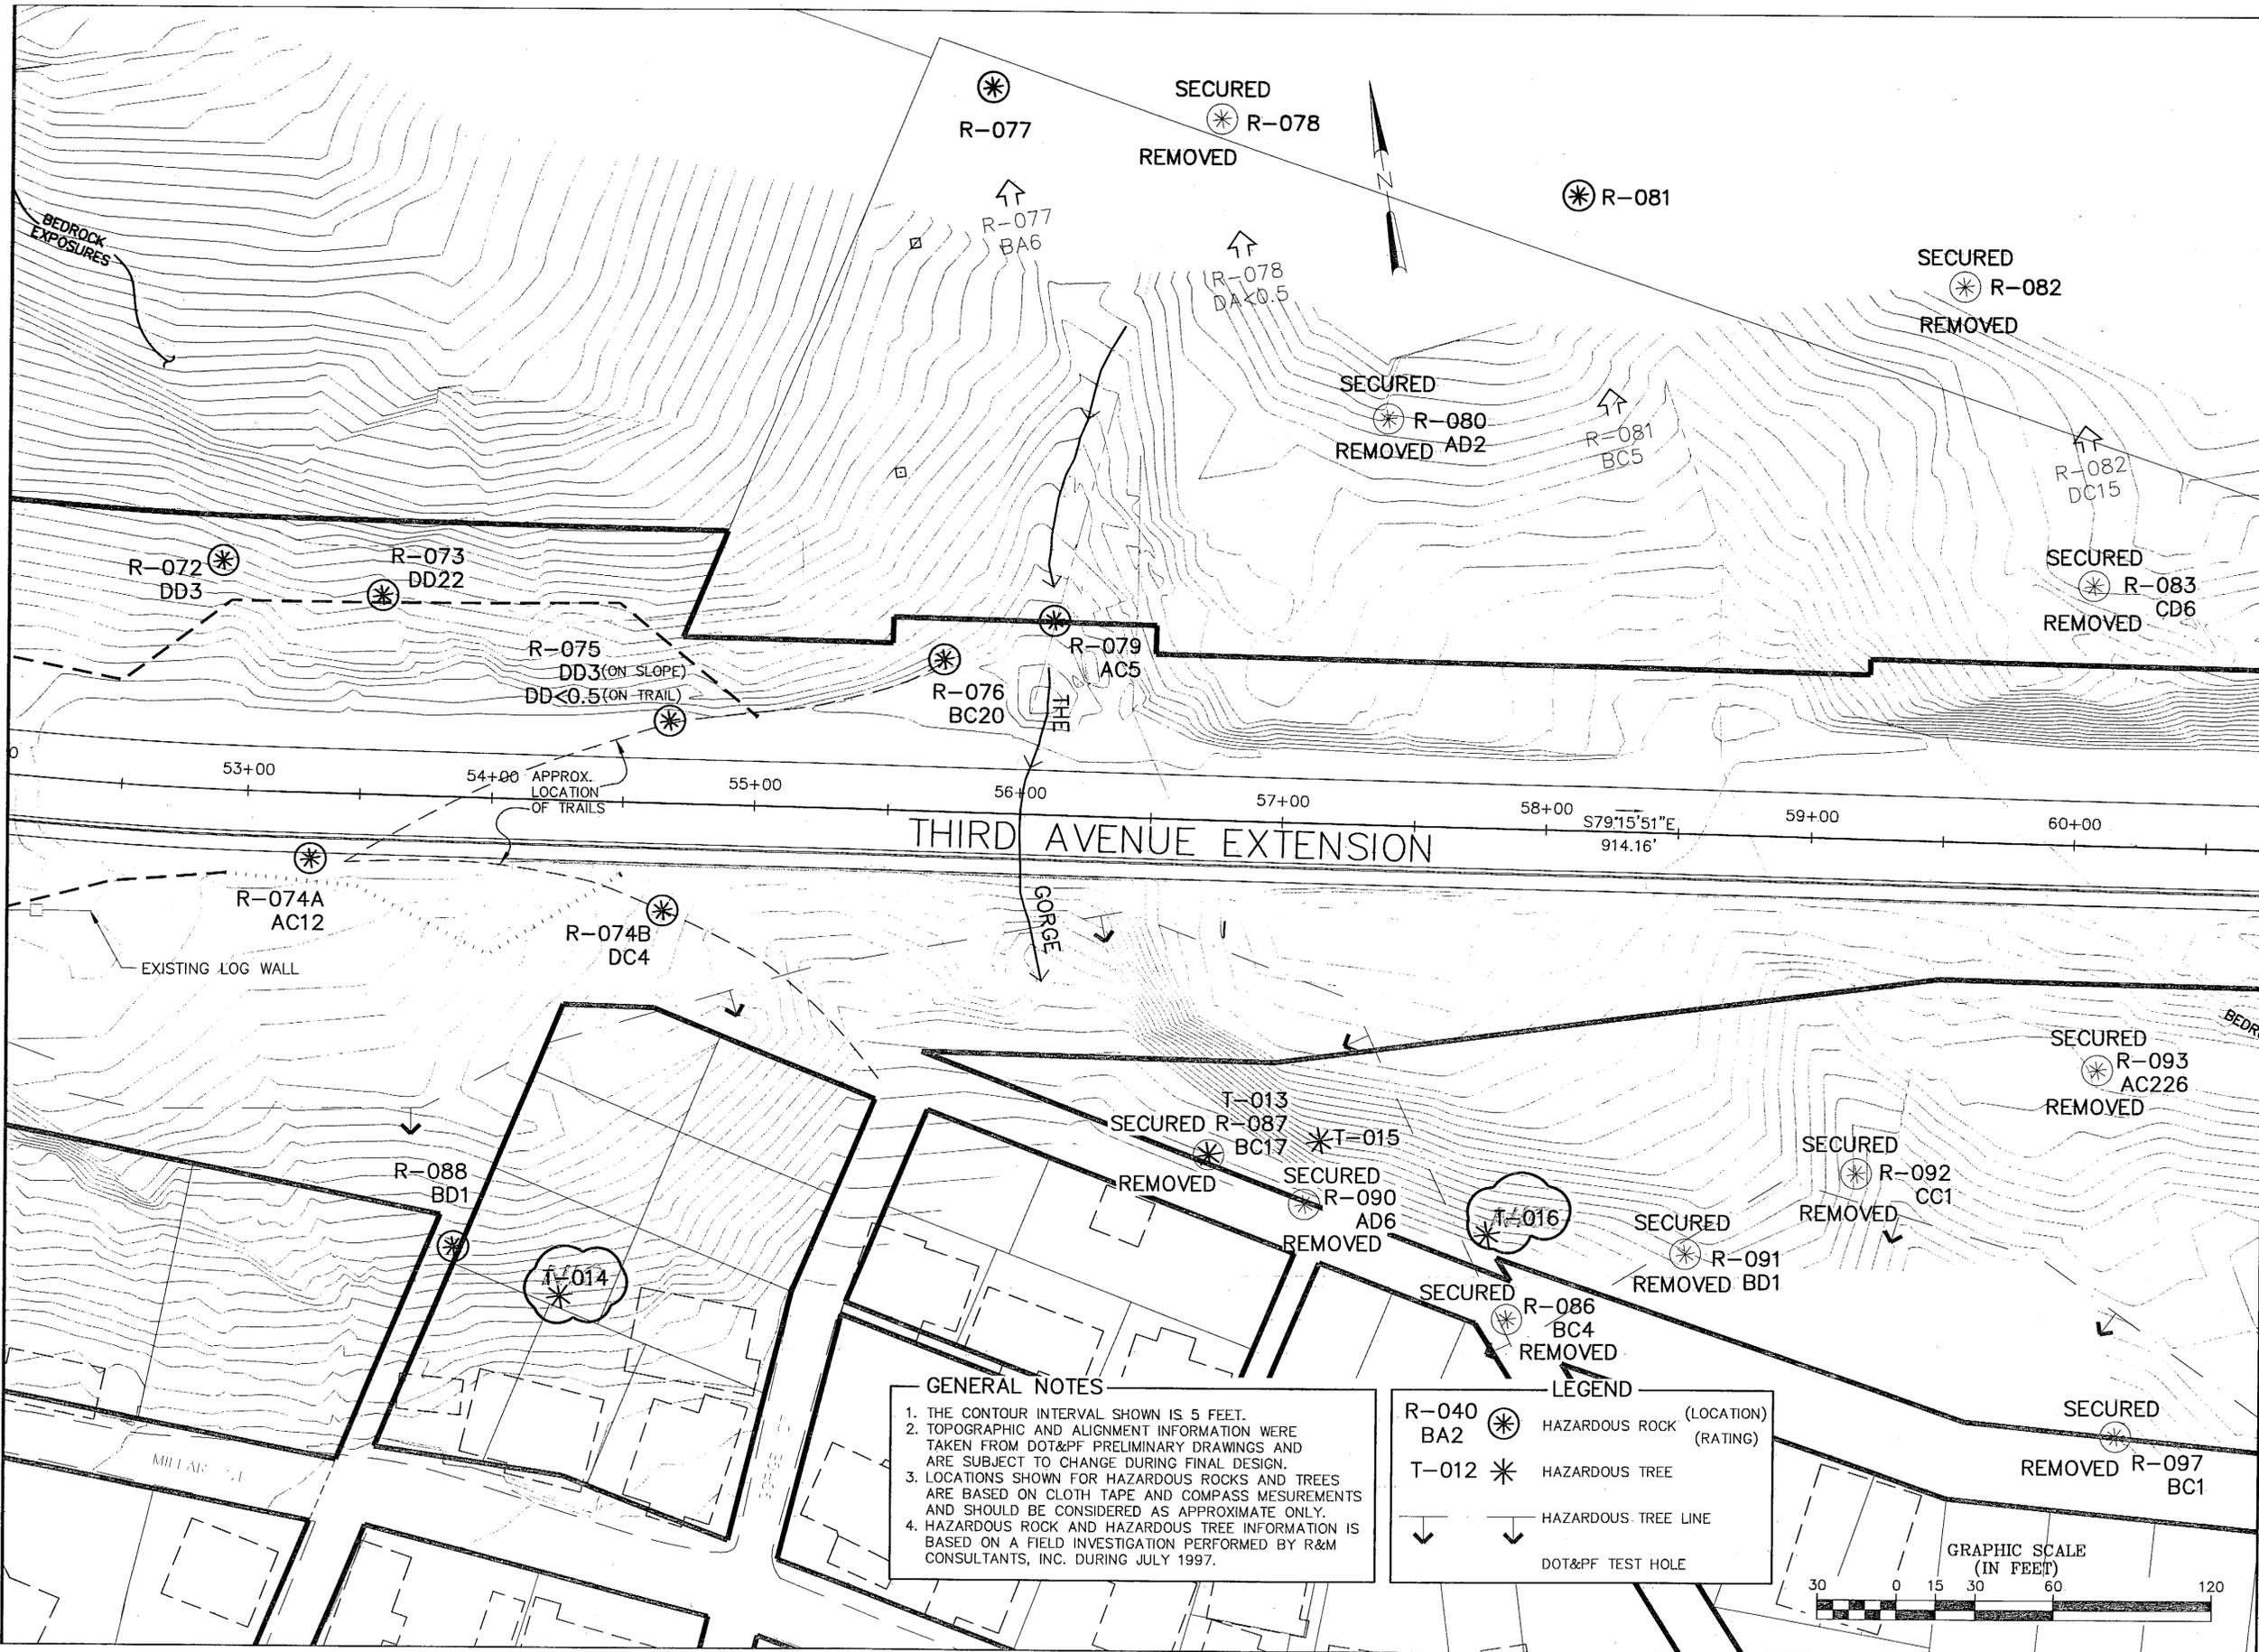

PATH:
 O:\ktn\71811A\Planset\F_Hazards.dwg
 Mon, 06/May/02 10:35AM Michael Limbaugh
 PLOT:
 PSPACE 1=1(F) OR MSPACE 1=1(F)
 TAB: PLANS

ADDENDUM NUMBER		
ATTACHMENT NUMBER		
RECORD OF REVISIONS		
No.	DATE	DESCRIPTION

KTN-THIRD AVENUE EXTENSION
 PROJECT NO. 68490
Hazardous Trees & Rocks

DESIGNED BY: C. HOWARD



CHECKED BY: T. MOORE
 DRAWN BY: T.M. / R.S.

STATE OF ALASKA
 DEPARTMENT OF TRANSPORTATION
 & PUBLIC FACILITIES
 STATEWIDE DESIGN & ENGINEERING
 SERVICES DIVISION
 THIRD AVENUE EXTENSION
 PROJECT NO. 68490

**Hazardous
 Trees & Rocks**

PROJECT DESIGNATION NUMBER

STP-MG-0904(2)

STATE	YEAR
ALASKA	2002

SHEET NUMBER	TOTAL SHEETS
F5	146

Project As Built Drawings have been reviewed by the Project Engineer. To the best of his/her knowledge, they represent the project as constructed.
 Prof. Eng. *[Signature]* Date: 6/3/02

PATH:
Q:\Ktn\71811A\PlanSet\C_ParkingLot.dwg
Mon, 06/May/02 09:32AM Michael Limbaug
PLOT:
PSPACE 1=1(F) OR MSPACE 1=1(F)
TAB: R-LINE-WLK+STAIRS

ADDENDUM NUMBER

ATTACHMENT NUMBER

RECORD OF REVISIONS		
No.	DATE	DESCRIPTION

**KTN-THIRD AVENUE EXTENSION
PROJECT NO. 68490**

**"R" Line Walkway &
Stairway Details**

DESIGNED BY: C. HOWARD



CHECKED BY: T. MOORE

DRAWN BY: T.M./R.S.

STATE OF ALASKA
DEPARTMENT OF TRANSPORTATION
& PUBLIC FACILITIES
STATEWIDE DESIGN & ENGINEERING
SERVICES DIVISION
**THIRD AVENUE EXTENSION
PROJECT NO. 68490**

**"R" Line Walkway
& Stairway Details**


PROJECT DESIGNATION NUMBER

STP-MG-0904(2)

STATE	YEAR
ALASKA	2002


SHEET NUMBER	TOTAL SHEETS
G2	146

Project As Built Drawings have been reviewed by the Project Engineer. To the best of his/her knowledge, they represent the project as constructed.
Proj. Eng. *[Signature]* Date 10-31-06

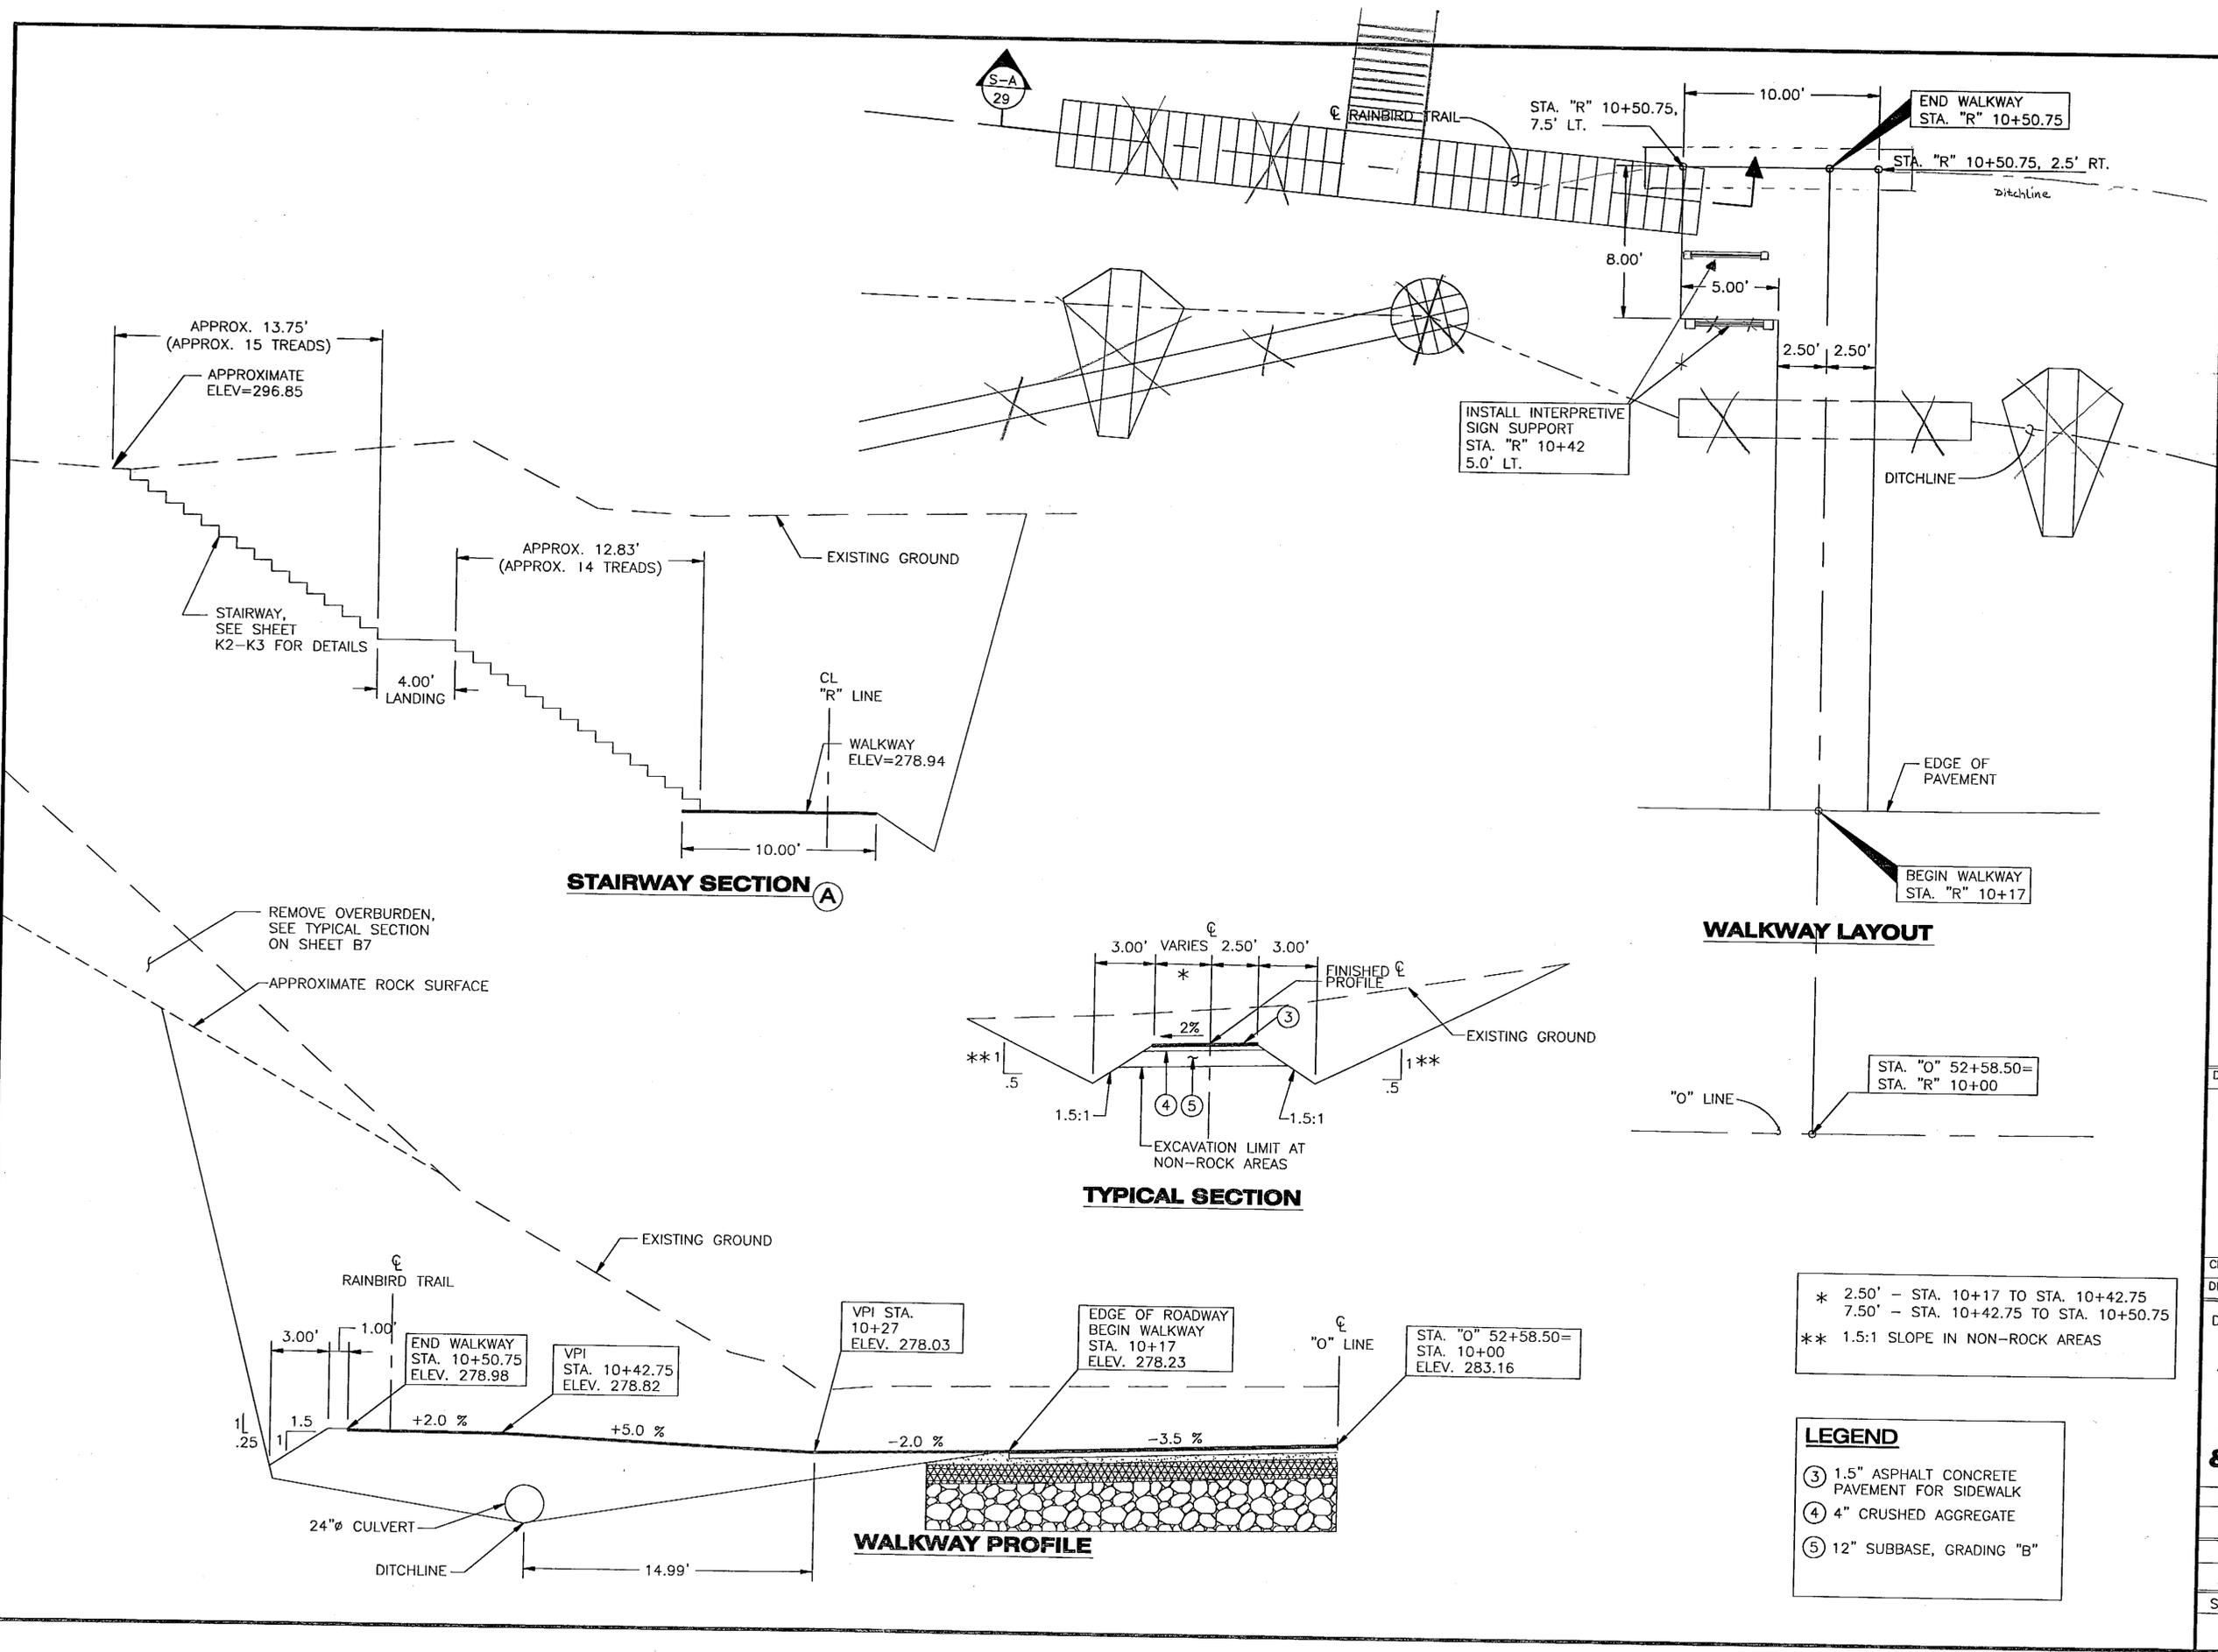


- * 2.50' - STA. 10+17 TO STA. 10+42.75
- 7.50' - STA. 10+42.75 TO STA. 10+50.75
- ** 1.5:1 SLOPE IN NON-ROCK AREAS

- LEGEND**
- ③ 1.5" ASPHALT CONCRETE PAVEMENT FOR SIDEWALK
 - ④ 4" CRUSHED AGGREGATE
 - ⑤ 12" SUBBASE, GRADING "B"

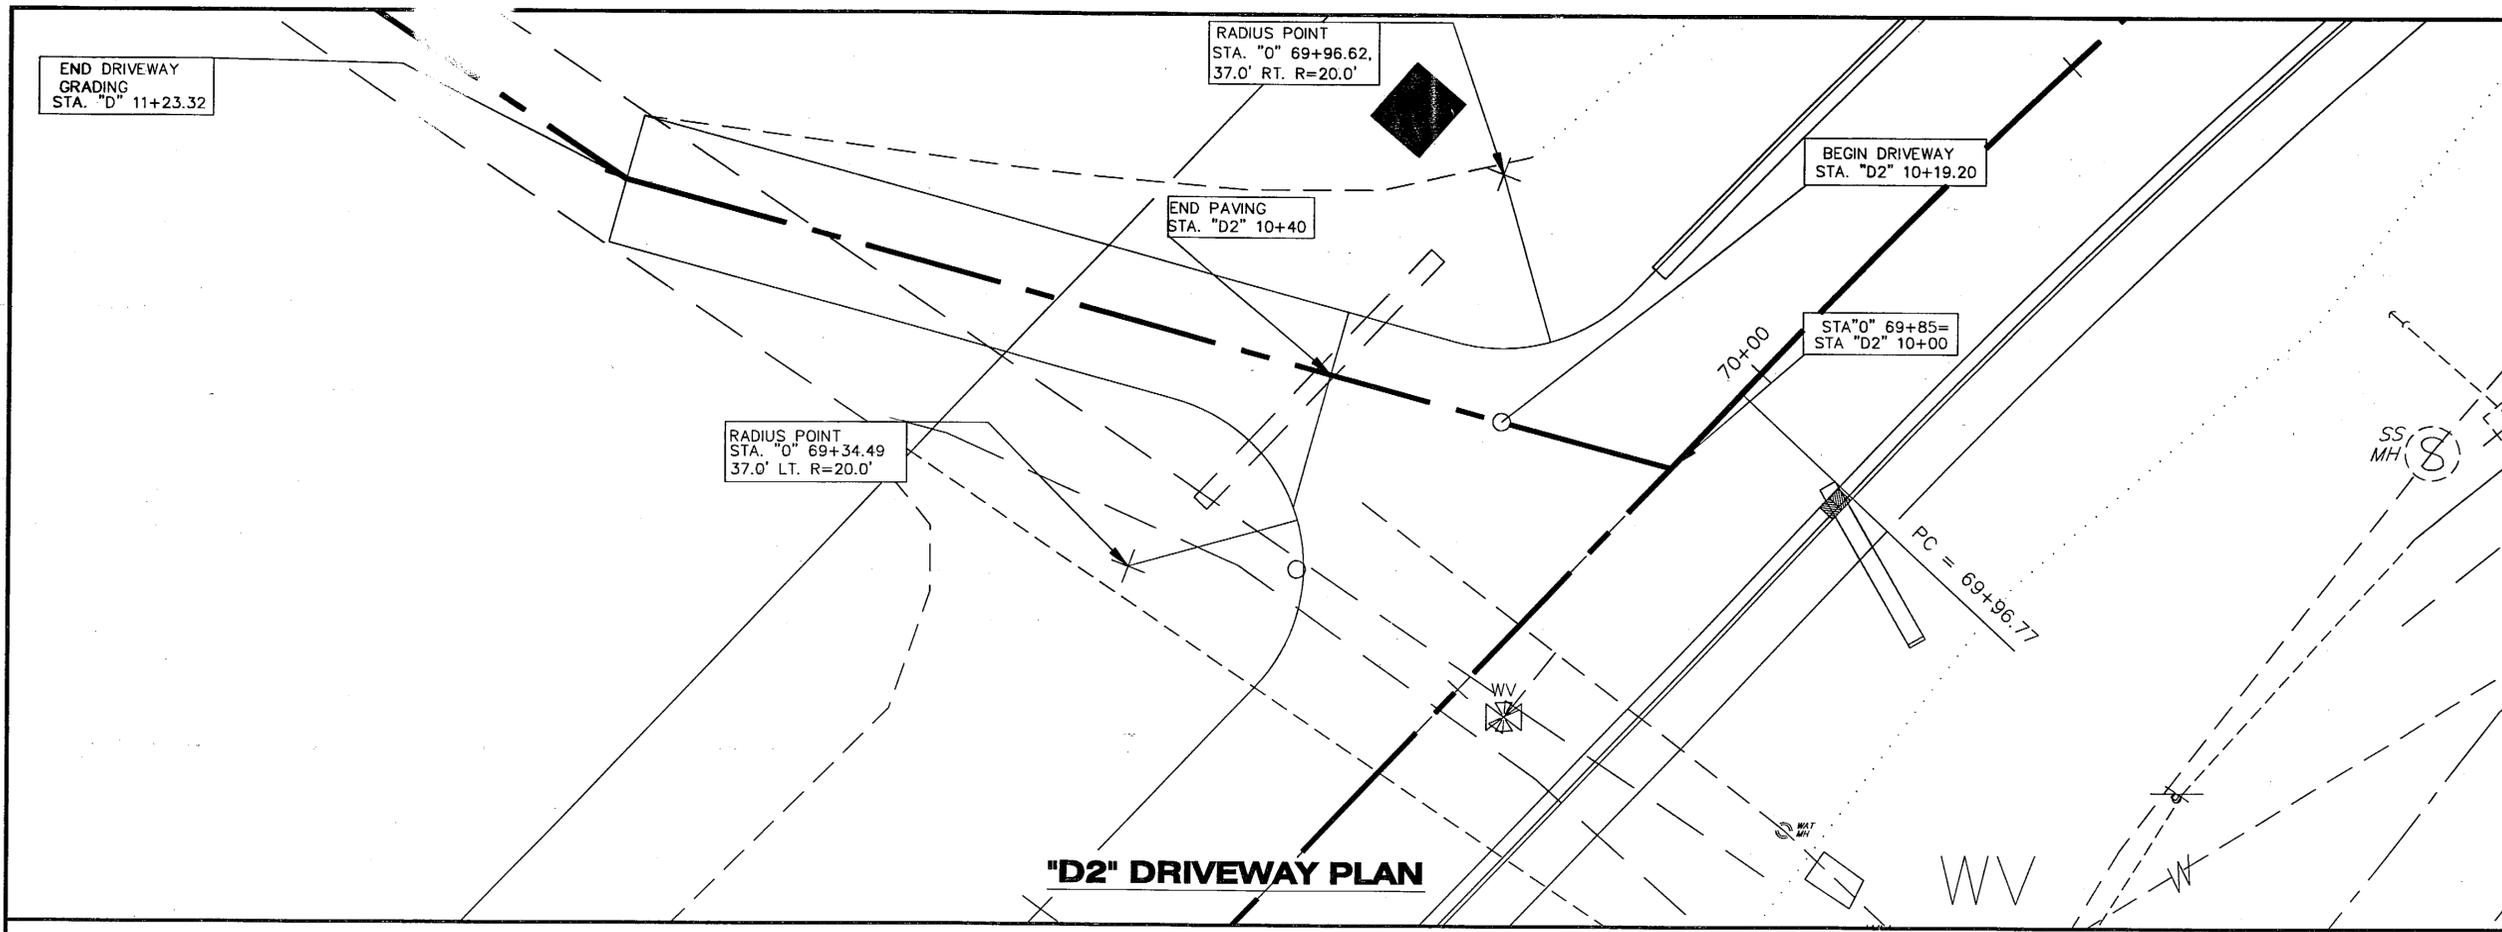

"D2" DRIVEWAY PLAN

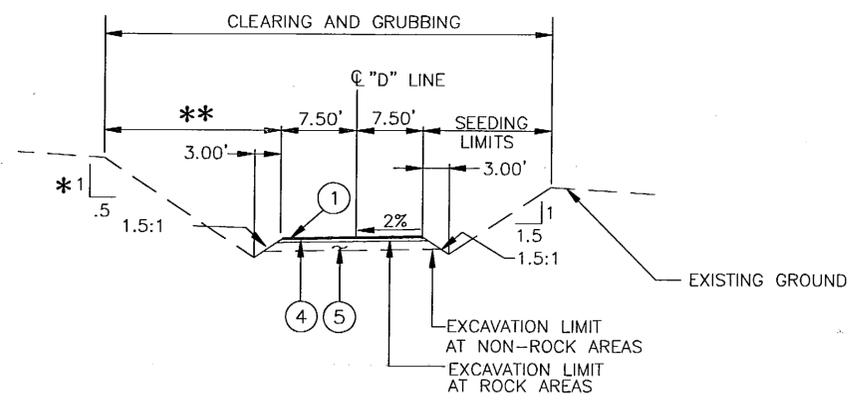


TYPICAL SECTION

*BACKSLOPE SHALL BE 1.5:1 IF NON-ROCK
 ** SEEDING REQUIRED IF CUT SURFACE CONSISTS OF NON-ROCK

LEDGEND	
①	2" ASPHALT CONCRETE PAVEMENT
④	4" CRUSHED AGGREGATE BASE COURSE
⑤	8" SUBBASE, GRADING "B"

"D2" DRIVEWAY DETAILS

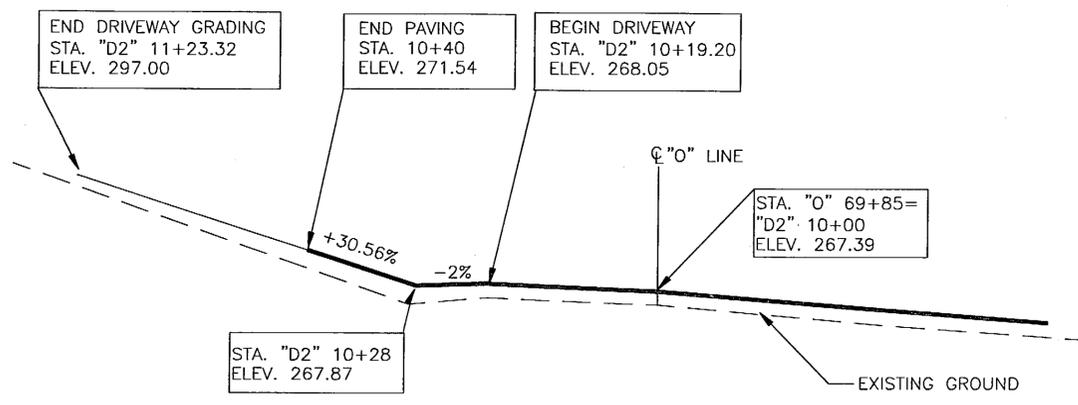

PROFILE

PATH: Q:\Ktn\71811A\PlanSet\G_ParkingLot.dwg
 Mon, 06/May/02 09:32AM Michael Limbaugh
 PLOT: PSPACE 1=1(F) OR MSPACE 1=1(F)
 TAB: D-LINE DRIVE

ADDENDUM NUMBER		
ATTACHMENT NUMBER		
RECORD OF REVISIONS		
No.	DATE	DESCRIPTION

KTN-THIRD AVENUE EXTENSION
PROJECT NO. 68490
"D2" Line Driveway
Plan & Details

DESIGNED BY: C. HOWARD



CHECKED BY: T. MOORE

DRAWN BY: T.M./R.S.

STATE OF ALASKA
 DEPARTMENT OF TRANSPORTATION
 & PUBLIC FACILITIES
 STATEWIDE DESIGN & ENGINEERING
 SERVICES DIVISION

THIRD AVENUE EXTENSION
PROJECT NO. 68490

"D2" Line Driveway
Plan & Details

PROJECT DESIGNATION NUMBER





STP-MG-0904(2)

STATE	YEAR
ALASKA	2002

SHEET NUMBER	TOTAL SHEETS
G3	146

Project As Built Drawings have been reviewed by the Project Engineer. To the best of his/her knowledge, they represent the project as constructed.

Proj. Eng. Date 10.31.06

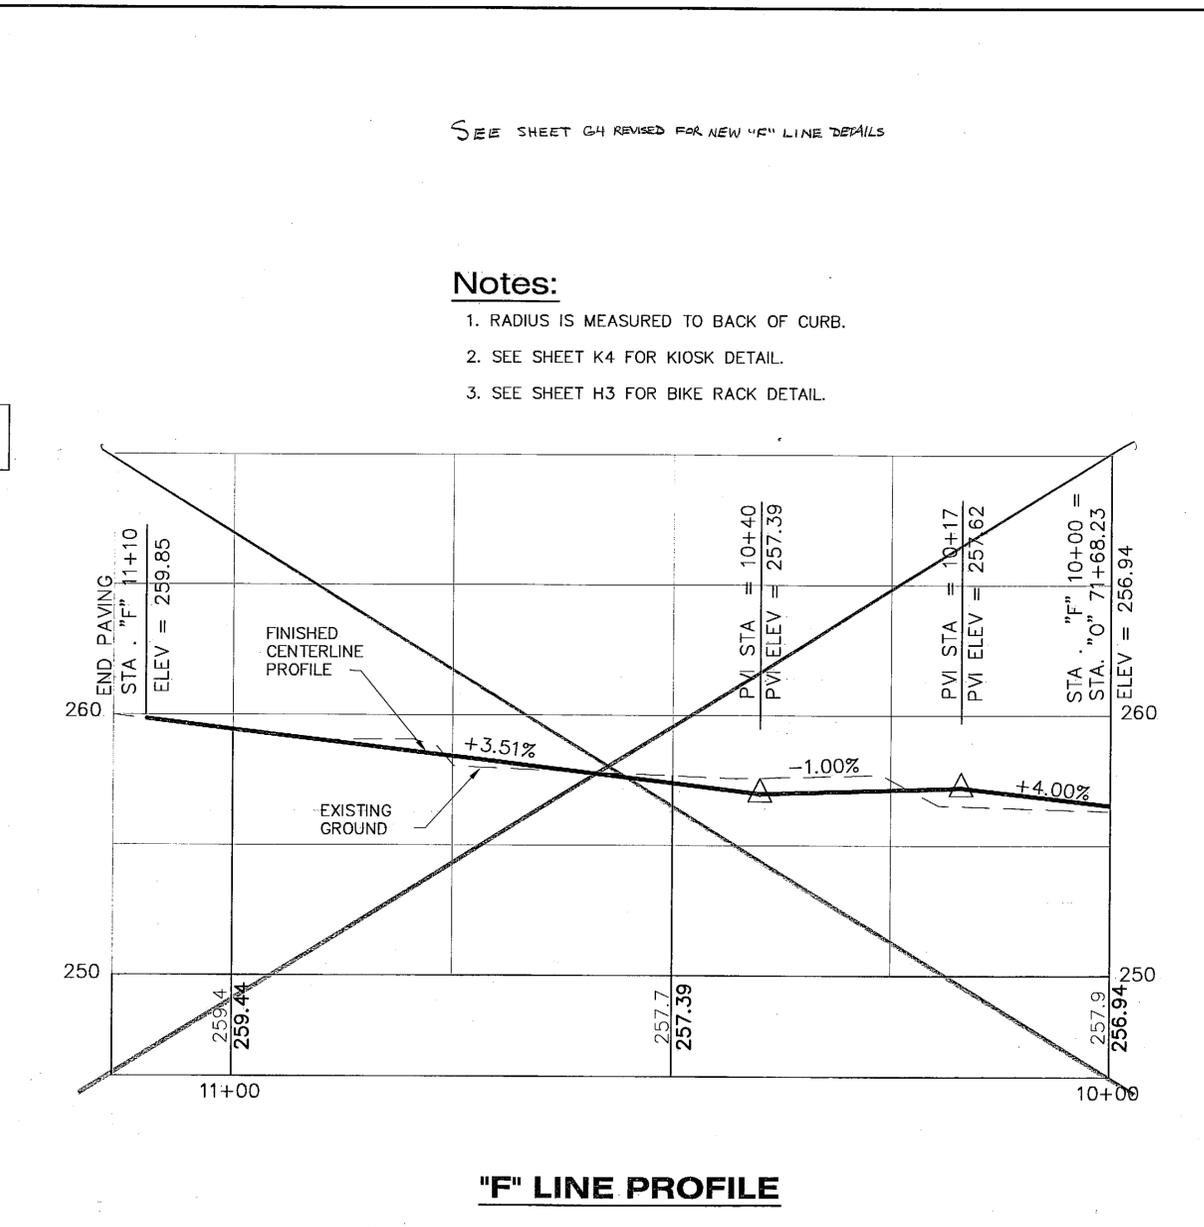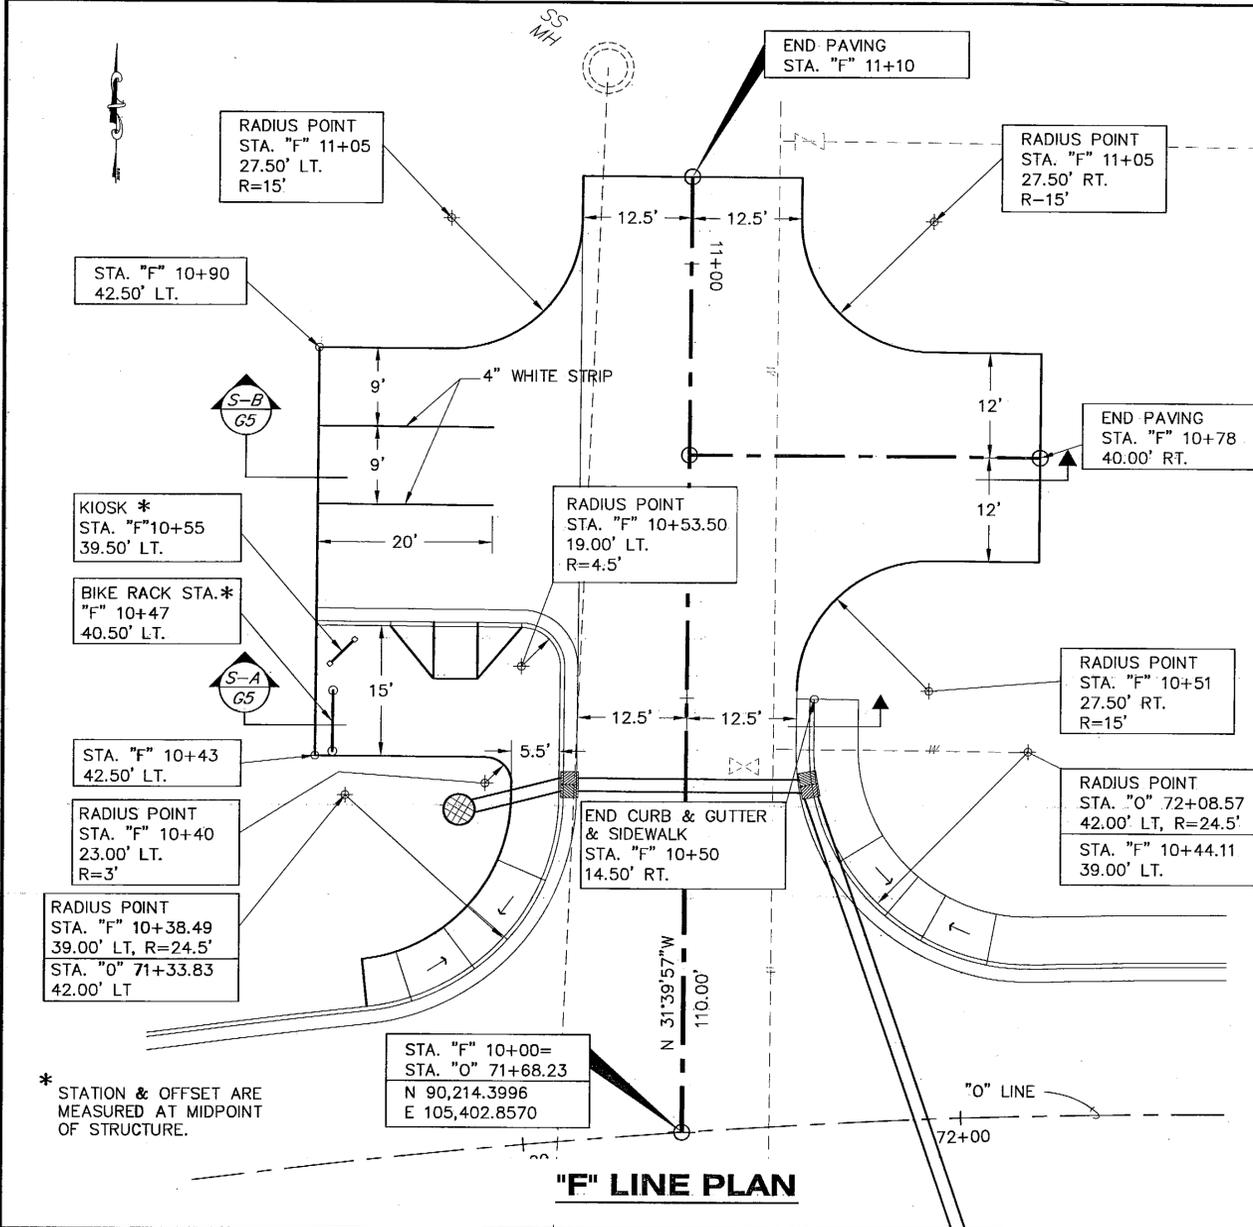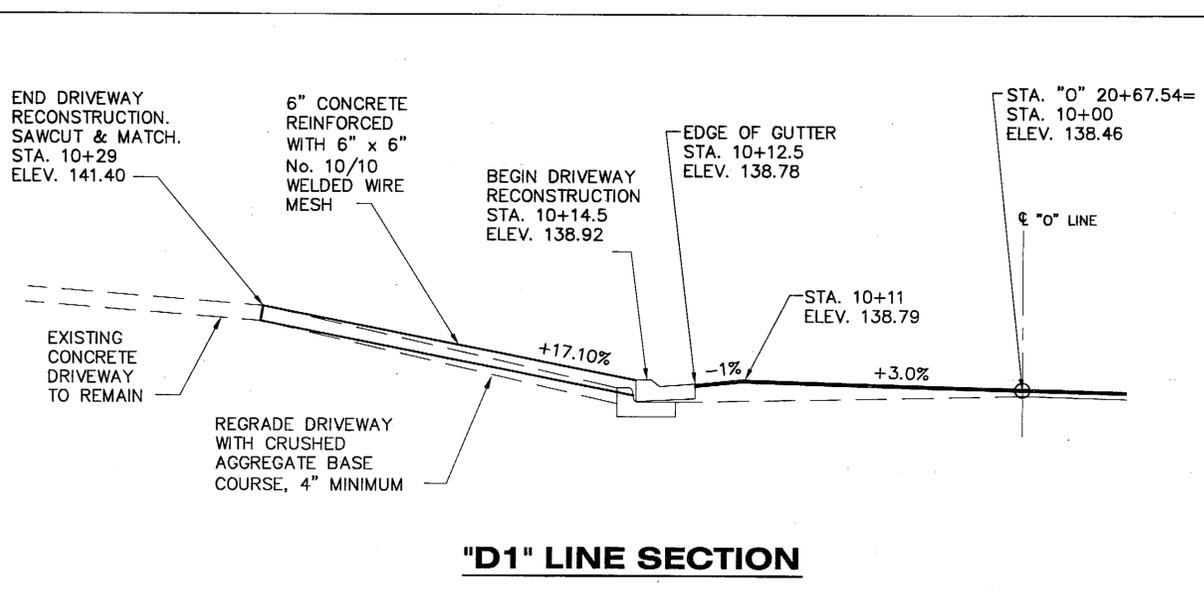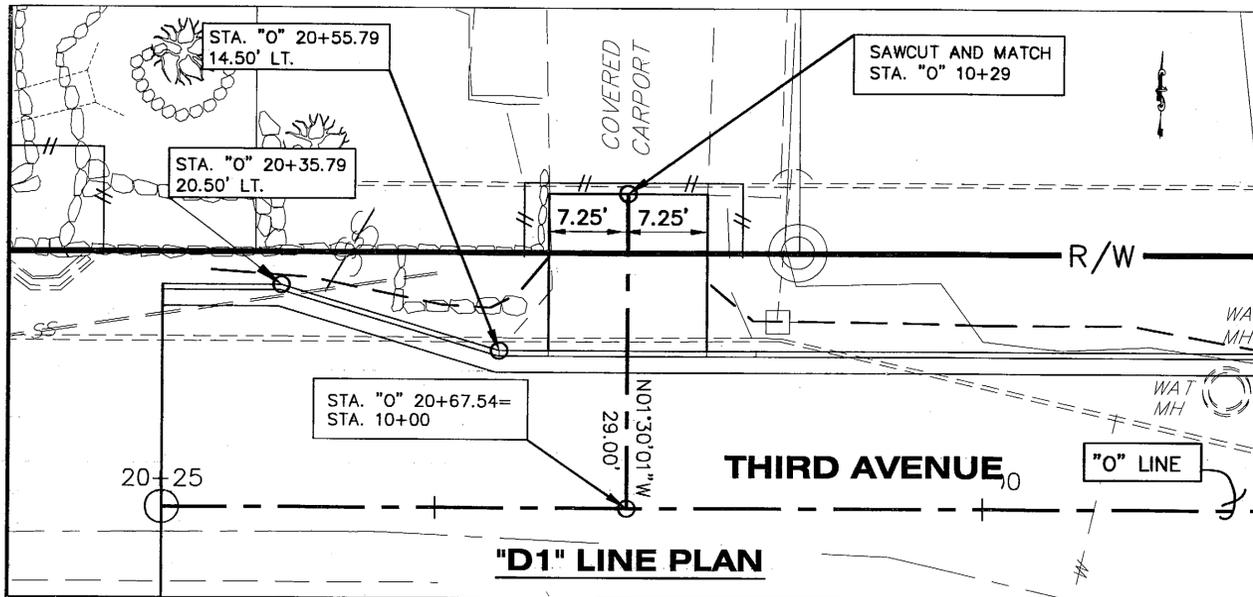

SEE SHEET G4 REVISED FOR NEW "F" LINE DETAILS

- Notes:**
1. RADIUS IS MEASURED TO BACK OF CURB.
 2. SEE SHEET K4 FOR KIOSK DETAIL.
 3. SEE SHEET H3 FOR BIKE RACK DETAIL.

PATH: Q:\Ktn\71811A\Planset\G_ParkingLot.dwg
 Mon, 06/May/02 10:37AM
 PLOT: Michael Limbaugh
 PSPACE 1=1(F) OR MSPACE 1=VARIES(F)
 TAB: D1-LN AND F-LN

ADDENDUM NUMBER		
ATTACHMENT NUMBER		
RECORD OF REVISIONS		
No.	DATE	DESCRIPTION

KTN-THIRD AVENUE EXTENSION
 PROJECT NO. 68490
Driveway Details
"D1" & "F" Lines

DESIGNED BY: C. HOWARD

CHECKED BY: T. MOORE
 DRAWN BY: T.M./R.S.

STATE OF ALASKA
 DEPARTMENT OF TRANSPORTATION & PUBLIC FACILITIES
 STATEWIDE DESIGN & ENGINEERING SERVICES DIVISION
 THIRD AVENUE EXTENSION
 PROJECT NO. 68490

Driveway Details
"D1" & "F" Lines

PROJECT DESIGNATION NUMBER	
STP-MG-0904(2)	
STATE	YEAR
ALASKA	2002
SHEET NUMBER	TOTAL SHEETS
G4	146

Project As Built Drawings have been reviewed by the Project Engineer. To the best of his/her knowledge, they represent the project as constructed.

Proj. Eng. *[Signature]* Date 10/31/02

ADDENDUM NUMBER
ATTACHMENT NUMBER

RECORD OF REVISIONS		
No.	DATE	DESCRIPTION

KTN-THIRD AVENUE EXTENSION
 PROJECT NO. 68490

Driveway Details "D1" & "F" Lines

DESIGNED BY: C. HOWARD



CHECKED BY: T. MOORE

DRAWN BY: T.M./R.S.

STATE OF ALASKA
 DEPARTMENT OF TRANSPORTATION
 & PUBLIC FACILITIES
 STATEWIDE DESIGN & ENGINEERING
 SERVICES DIVISION
**THIRD AVENUE EXTENSION
 PROJECT NO. 68490**

Driveway Details "D1" & "F" Lines

PROJECT DESIGNATION NUMBER

STP-MG-0904(2)


STATE	YEAR
ALASKA	2002

SHEET NUMBER	TOTAL SHEETS
G4	146


Project As Built Drawings have been reviewed by the Project Engineer. To the best of his/her knowledge, they represent the project as constructed.
 Prof. Enz Date: 6/3/06

Notes:

1. RADIUS IS MEASURED TO BACK OF CURB.
2. SEE SHEET K4 FOR KIOSK DETAIL.
3. SEE SHEET H3 FOR BIKE RACK DETAIL.

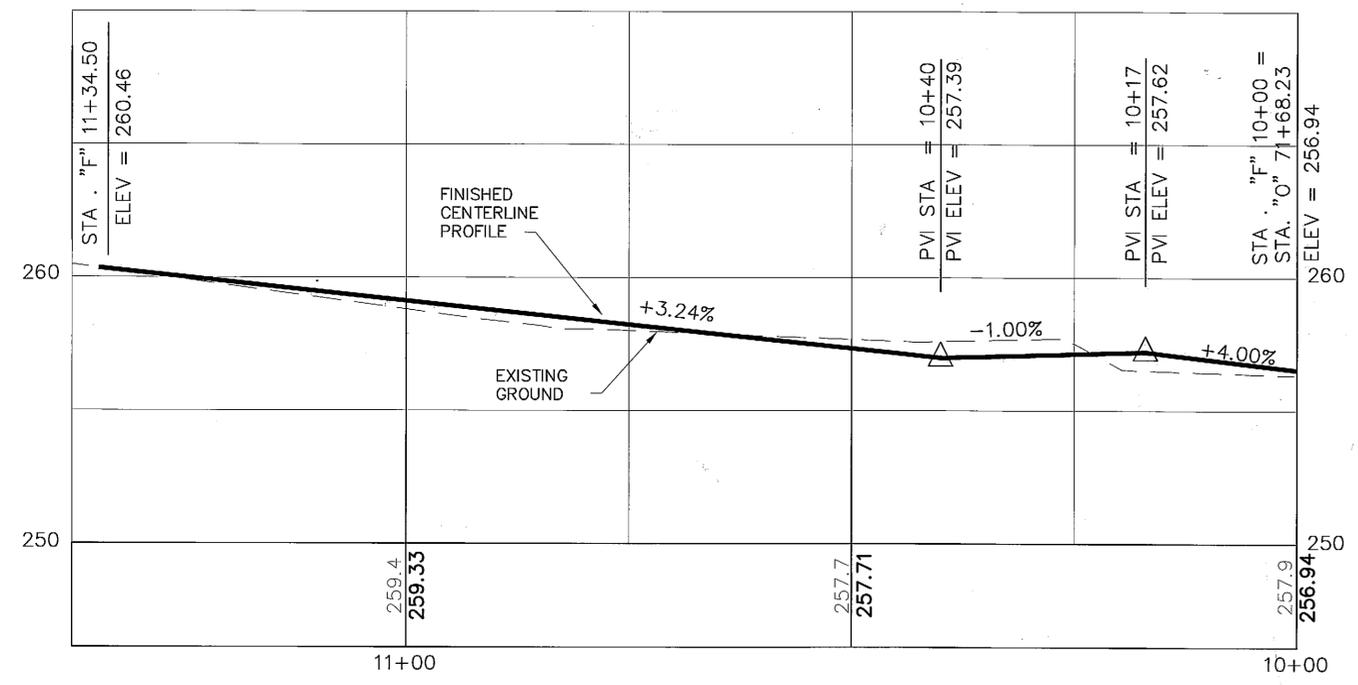

"F" LINE PLAN

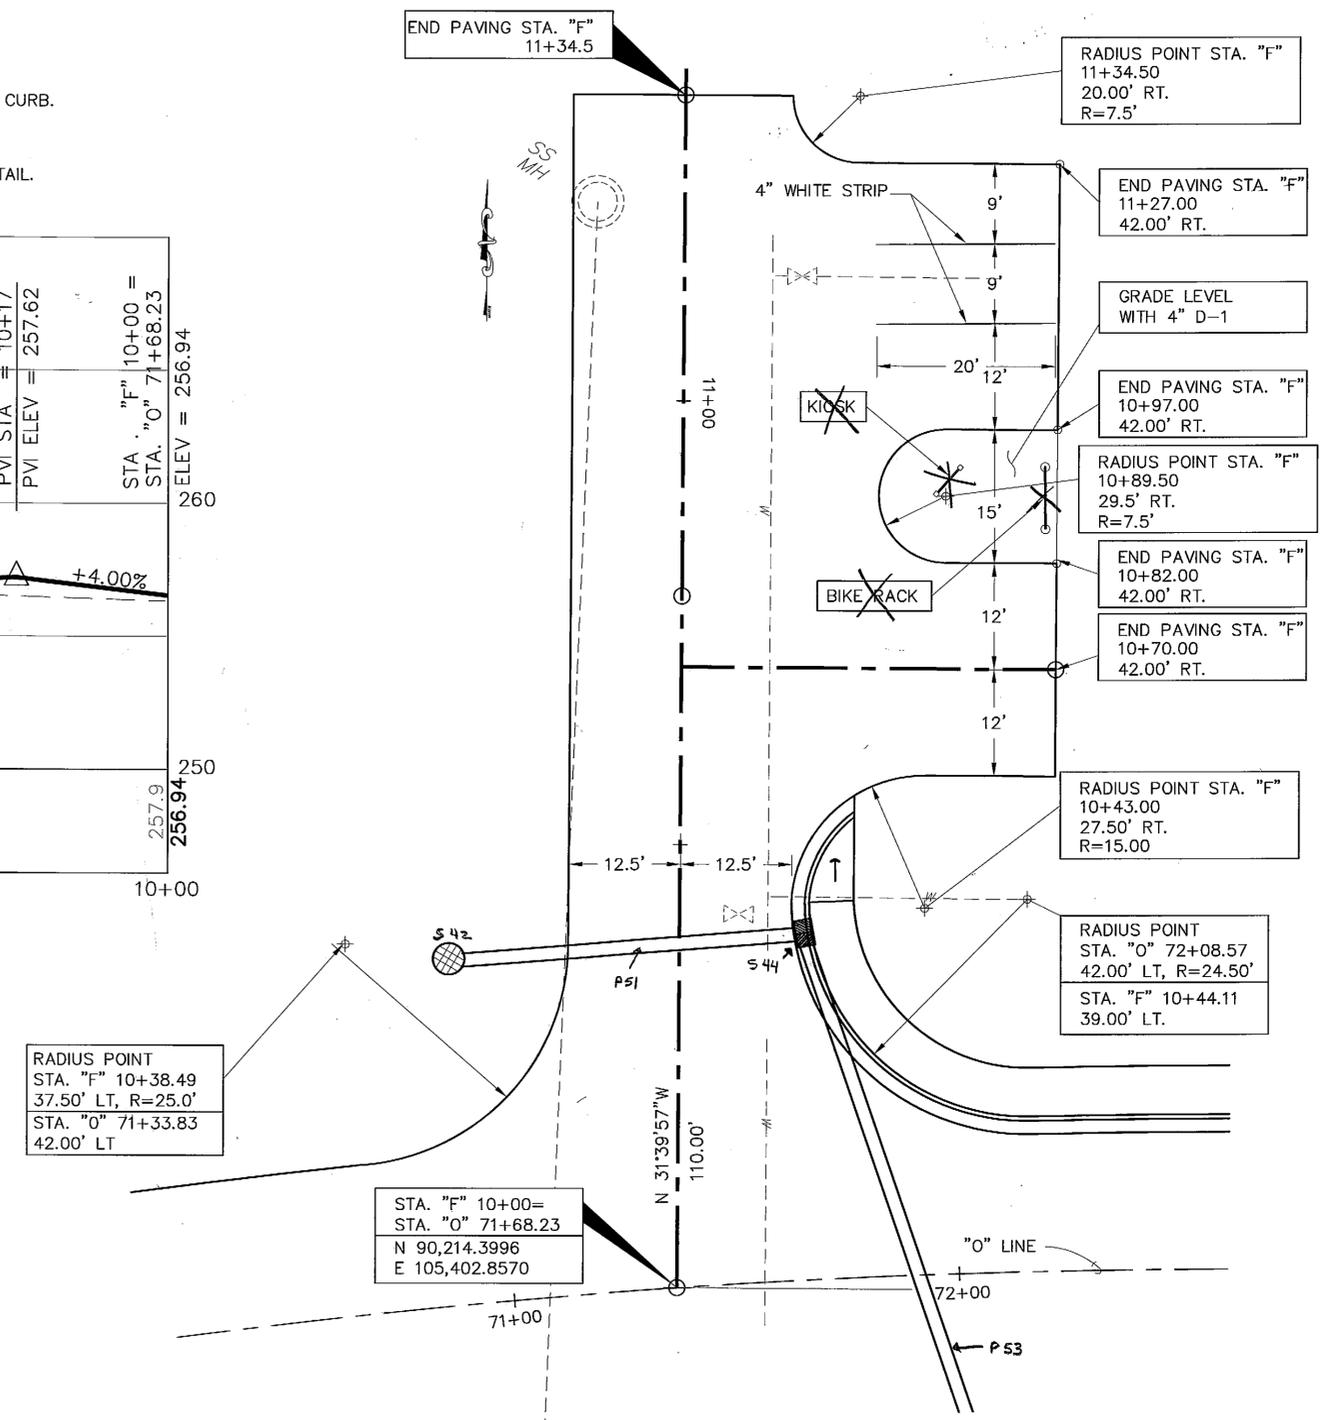

"F" LINE PROFILE - REVISED

RADIUS POINT
 STA. "F" 10+38.49
 37.50' LT, R=25.0'
 STA. "O" 71+33.83
 42.00' LT

STA. "F" 10+00=
 STA. "O" 71+68.23
 N 90,214.3996
 E 105,402.8570


PATH: Q:\Ktr\71811A\PlanSet\G_ParkingLot.dwg
 Mon, 06/May/02 09:32AM Michael Limbaugh
 PLOT: PSPACE 1=1(F) OR MSPACE 1=1(F)
 TAB: F-LINE-DRWY-SECTIONS

ADDENDUM NUMBER


ATTACHMENT NUMBER

RECORD OF REVISIONS

No.	DATE	DESCRIPTION

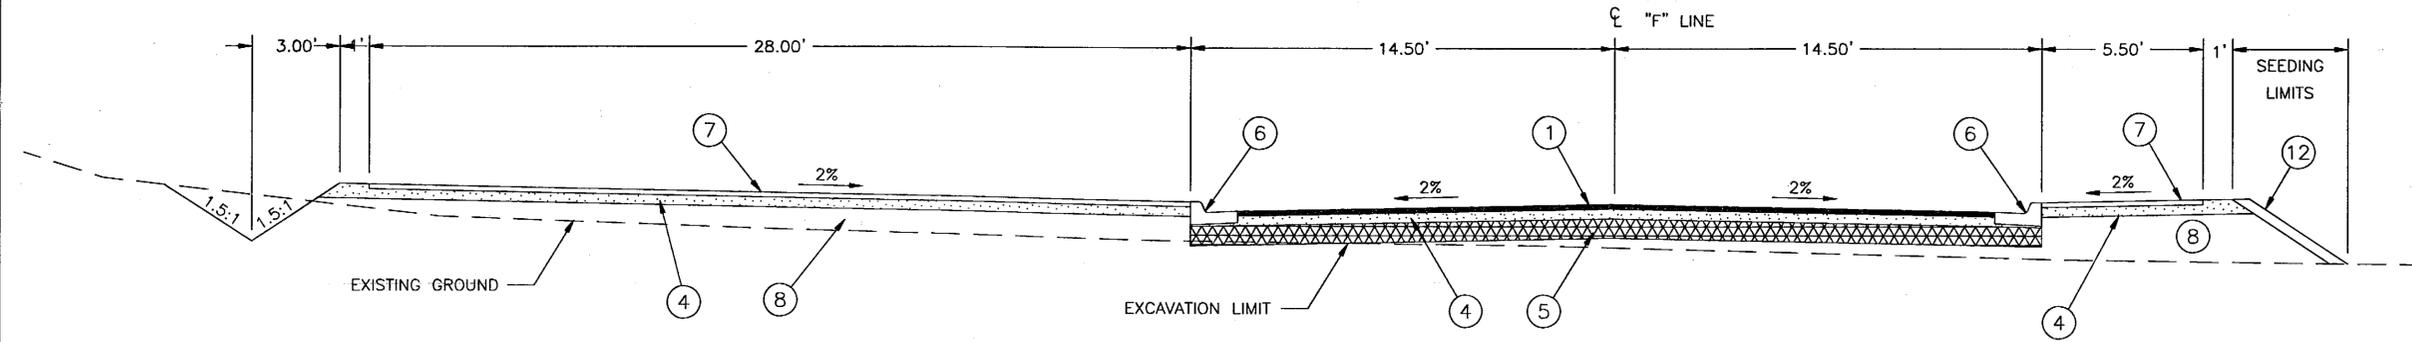

PARKING SECTION A

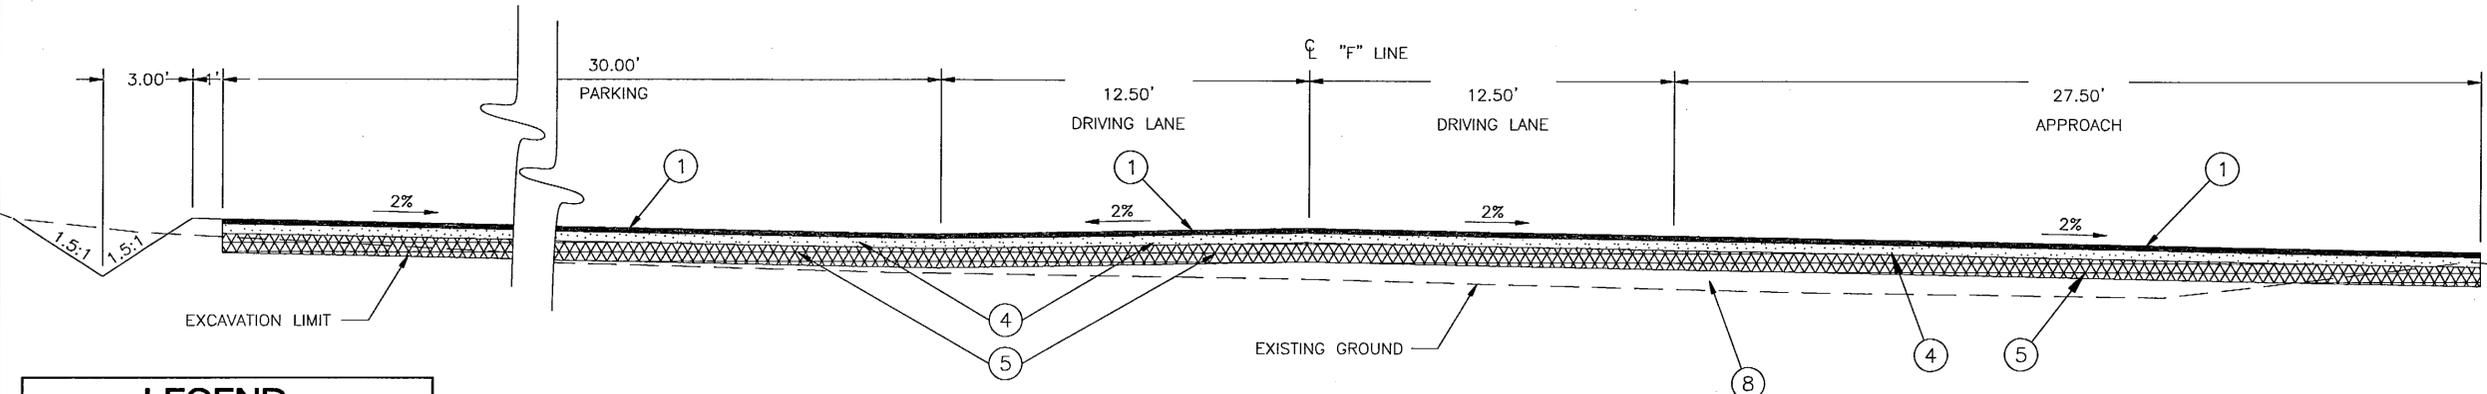

PARKING SECTION B

LEGEND

①	2" ASPHALT CONCRETE PAVEMENT TYPE II, CLASS A
④	4" CRUSHED AGGREGATE BASE COURSE
⑤	8" SUBBASE, GRADING "B"
⑥	CURB & GUTTER, TYPE 1
⑦	CONCRETE SIDEWALK, 4 INCHES THICK
⑧	EMBANKMENT (TYPE LISTED)*
⑫	4" TOPSOIL

* WHEN NO TYPE IS USED, TYP A OR D
MAY BE USED, CONTRACTORS OPTION.

DESIGNED BY: C. HOWARD



CHECKED BY: T. MOORE

DRAWN BY: T.M./R.S.

STATE OF ALASKA
 DEPARTMENT OF TRANSPORTATION
 & PUBLIC FACILITIES
 STATEWIDE DESIGN & ENGINEERING
 SERVICES DIVISION
**THIRD AVENUE EXTENSION
 PROJECT NO. 68490**

"F" Line Driveway Sections

PROJECT DESIGNATION NUMBER

STP-MG-0904(2)


STATE YEAR

ALASKA 2002

SHEET NUMBER TOTAL SHEETS

G5 146

Project As Built Drawings have been reviewed by the Project Engineer. To the best of his/her knowledge, they represent the project as constructed.
 Proj. Enr. *[Signature]* Date 10.31.06

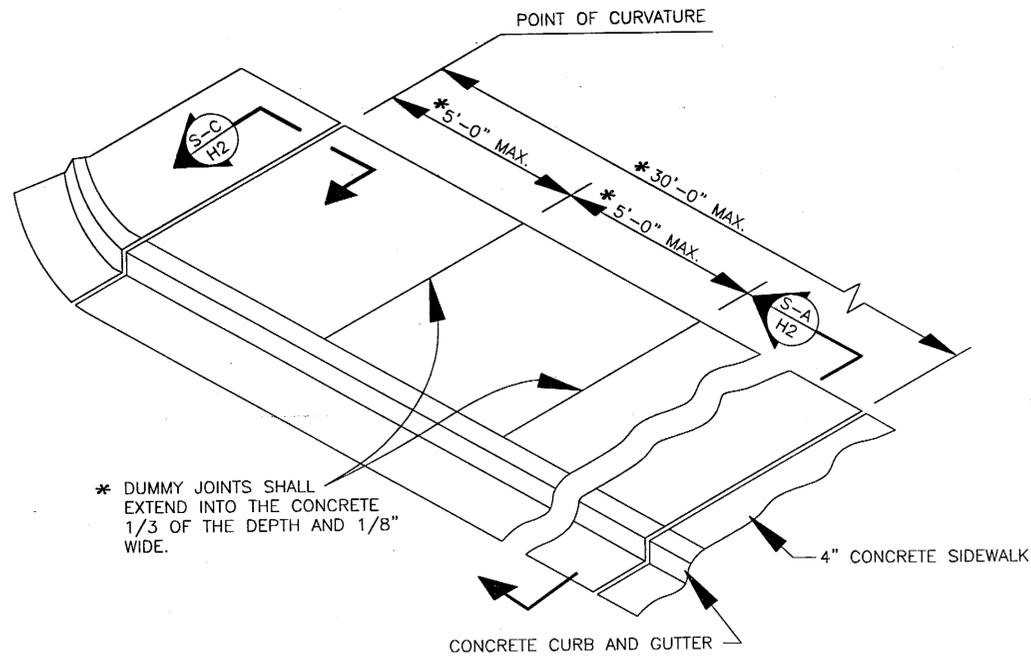


* DUMMY JOINTS SHALL EXTEND INTO THE CONCRETE 1/3 OF THE DEPTH AND 1/8\"/>


**DETAIL I
TYPICAL SIDEWALK, CURB & GUTTER**

SIDEWALK, CURB AND GUTTER NOTES


1. CURB AND GUTTER EXPANSION JOINTS SHALL BE AT EACH END OF THE CURB RETURNS AND IMMEDIATELY PRECEDING AND FOLLOWING ALL CURB CUTS. THEREAFTER, THEY SHALL BE PLACED AT 30'-0\"/>
- 2. ALL CURB AND GUTTERS SHALL BE CLASS "A" CONCRETE WITH A MINIMUM 28-DAY COMPRESSIVE STRENGTH OF $f_c = 3000$ psi.
- 3. CURB CUT FOR RESIDENTIAL DRIVEWAYS AND CURB RETURNS SHALL NOT EXCEED THE MAXIMUM ALLOWABLE SLOPE OF 12:1.
- 4. SEE WORK SUMMARY ON SHEET FOR DRIVEWAY WIDTHS. NEW CURB CUTS SHALL BE LOCATED TO MATCH EXISTING.
- 5. IF EXISTING JOINT IS WITHIN 2' OF RECONSTRUCTION AREAS, REMOVE AT JOINT INSTEAD OF SAWCUTTING. THIS DOES NOT APPLY TO NEW CONSTRUCTION.
- 6. CONCRETE SIDEWALK, DRIVEWAYS AND WALKWAYS SHALL BE REINFORCED WITH 6"x6"-No. 10/10 WIRE MESH REINFORCEMENT.
- 7. CONCRETE CURB SHALL BE REINFORCED WITH THREE #4 CONTINUOUS REBAR.

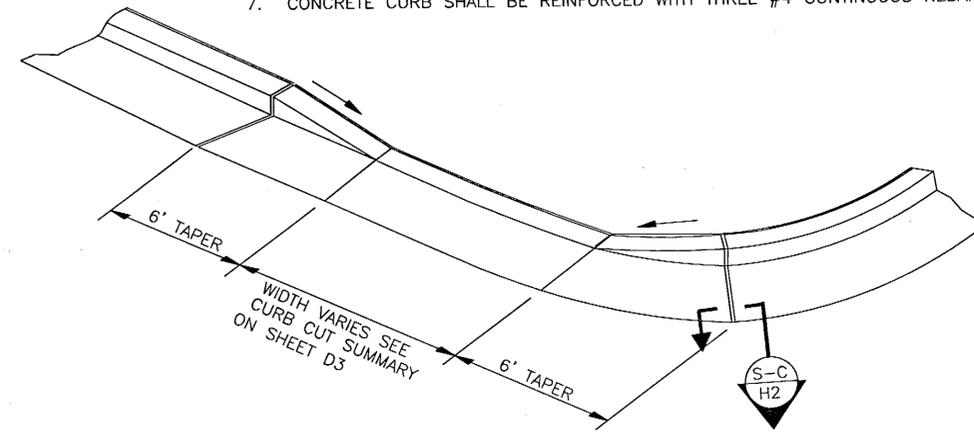

DRIVEWAY RAMP - DETAIL III

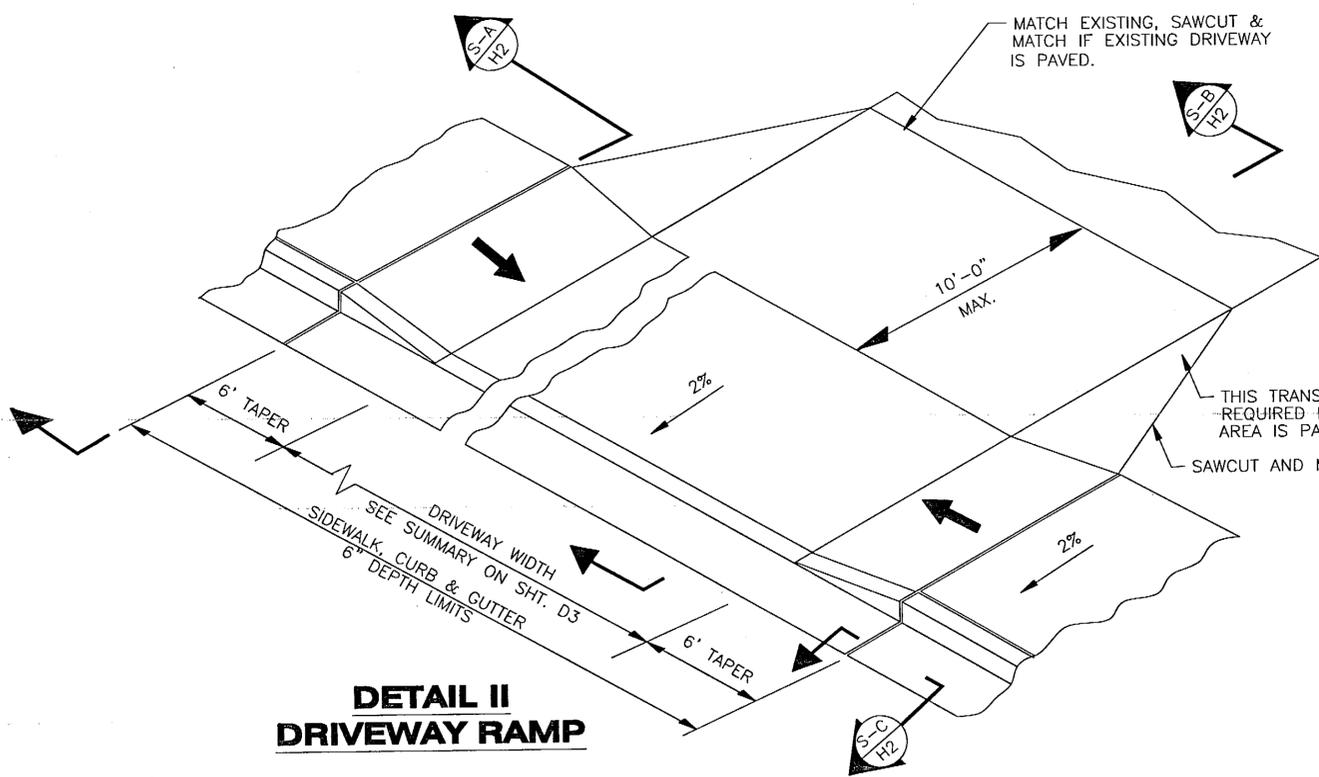

**DETAIL II
DRIVEWAY RAMP**

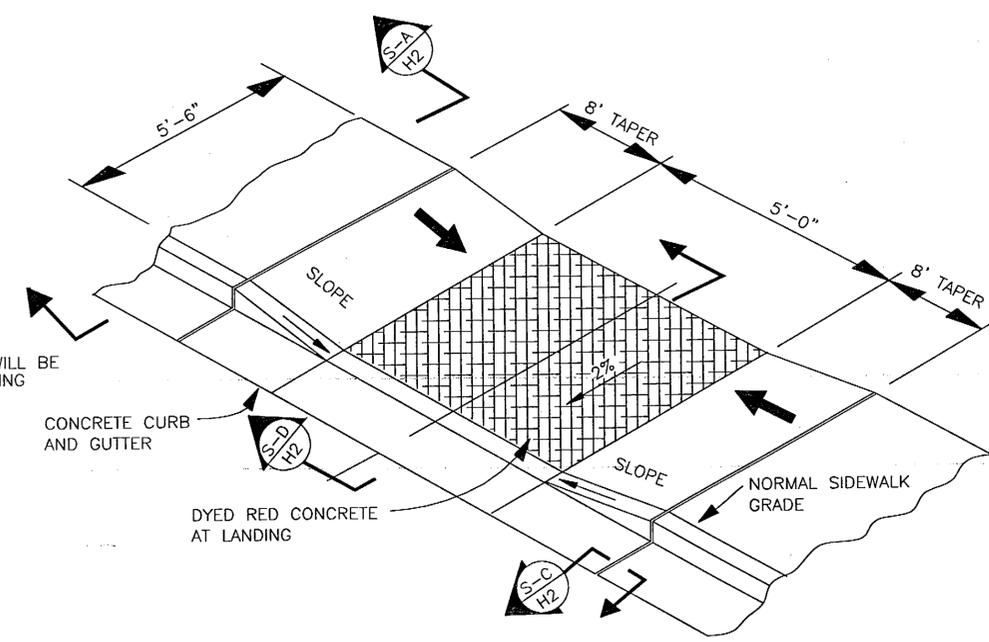

WHEELCHAIR - DETAIL IV

PATH: Q:\Ktn\71811A\Planset\H_SidewalkDets.dwg
 Mon, 06/May/02 09:34AM Michael Limbaugh
 PLOT: PSPACE 1=1(F) OR MSPACE 1=1(F)
 TAB: SDWK-DETI

ADDENDUM NUMBER		
ATTACHMENT NUMBER		
RECORD OF REVISIONS		
No.	DATE	DESCRIPTION

KTN-THIRD AVENUE EXTENSION
 PROJECT NO. 68490

Sidewalk & Curb Cut Details

DESIGNED BY: C. HOWARD



CHECKED BY: T. MOORE

DRAWN BY: T.M./R.S.

STATE OF ALASKA
 DEPARTMENT OF TRANSPORTATION
 & PUBLIC FACILITIES
 STATEWIDE DESIGN & ENGINEERING
 SERVICES DIVISION
**THIRD AVENUE EXTENSION
 PROJECT NO. 68490**

**Sidewalk & Curb
 Cut Details**

PROJECT DESIGNATION NUMBER

STP-MG-0904(2)

STATE	YEAR
ALASKA	2002
SHEET NUMBER	TOTAL SHEETS
H1	146

Project As Built Drawings have been reviewed by the Project Engineer. To the best of his/her knowledge, they represent the project as constructed.
 Proi. Eng. *[Signature]* Date 10-4-02

PATH:
 Q:\Ktn\71811A\PlanSet\H_SidewalkDets.dwg
 Mon, 06/May/02 09:34AM Michael Limbaugh
 PLOT:
 PSPACE 1=1(F) OR MSPACE 1=1(F)
 TAB: SDWK-DET2

ADDENDUM NUMBER


ATTACHMENT NUMBER

RECORD OF REVISIONS


No.	DATE	DESCRIPTION

KTN-THIRD AVENUE EXTENSION
 PROJECT NO. 68490


Sidewalk & Curb Cut Details

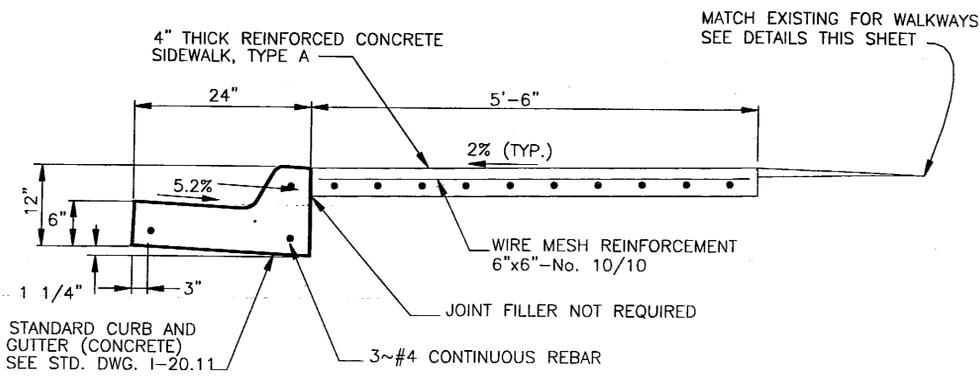


TYPICAL SECTION A

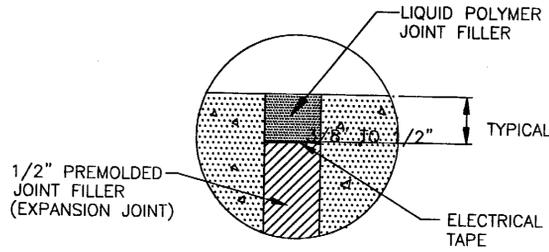

SECTION C

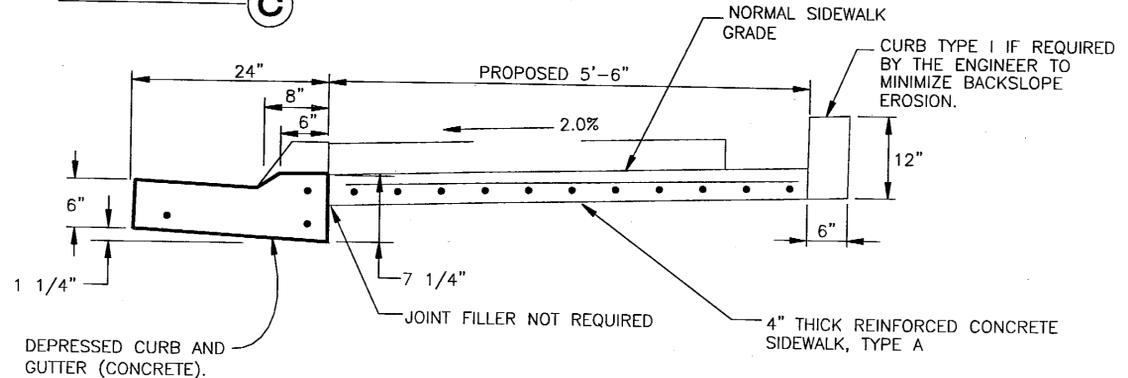


SECTION D
DEPRESSED CURB & RAMP

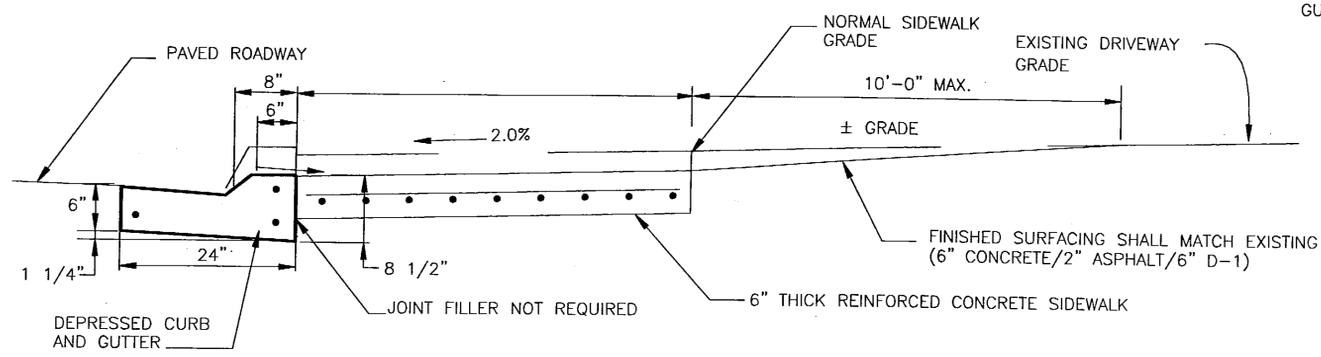


SECTION B

DEPRESSED CURB & DRIVEWAY

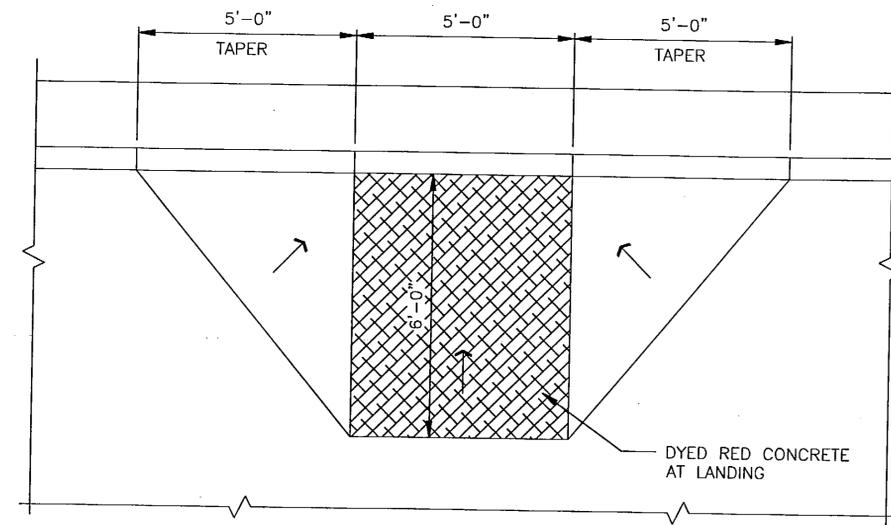

WHEELCHAIR RAMP DETAIL - VI

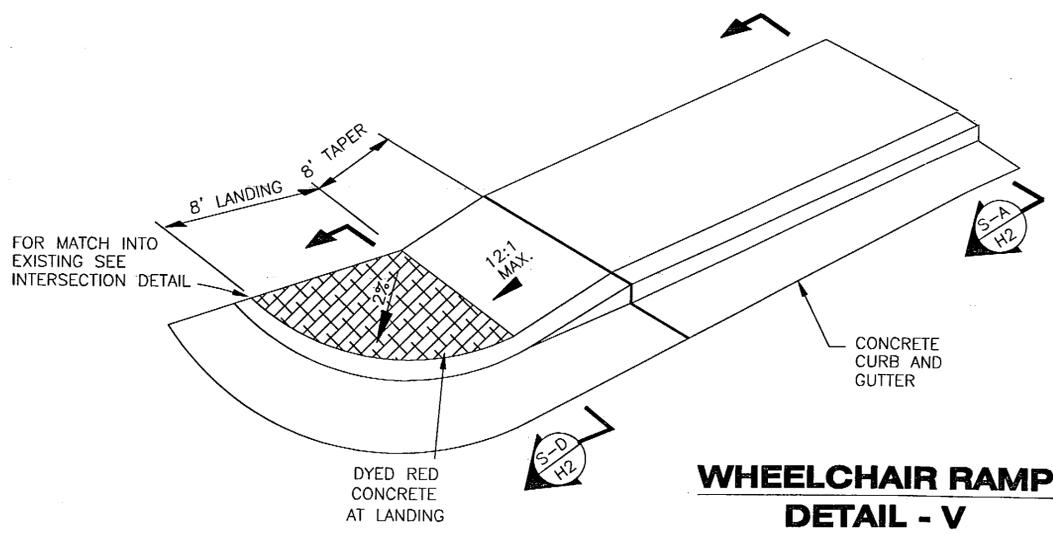

WHEELCHAIR RAMP DETAIL - V

DESIGNED BY: C. HOWARD



CHECKED BY: T. MOORE

DRAWN BY: T.M./R.S.

STATE OF ALASKA
 DEPARTMENT OF TRANSPORTATION
 & PUBLIC FACILITIES
 STATEWIDE DESIGN & ENGINEERING
 SERVICES DIVISION

THIRD AVENUE EXTENSION
PROJECT NO. 68490
Sidewalk & Curb
Cut Details

PROJECT DESIGNATION NUMBER

STP-MG-0904(2)

STATE	YEAR
ALASKA	2002

SHEET NUMBER	TOTAL SHEETS
H2	146

Project As Built Drawings have been reviewed by the Project Engineer. To the best of his/her knowledge, they represent the project as constructed.
 Proj. Eng. Date 10-3-06


PATH:
 O:\KIn\71811A\PlanSet\H_SidewalkDets.dwg
 Mon, 06/May/02 09:34AM Michael Limbaugh
 PLOT:
 PSPACE 1=1(F) OR MSPACE 1=1(F)
 TAB: SDWK-DETS

ADDENDUM NUMBER

ATTACHMENT NUMBER

RECORD OF REVISIONS

No.	DATE	DESCRIPTION

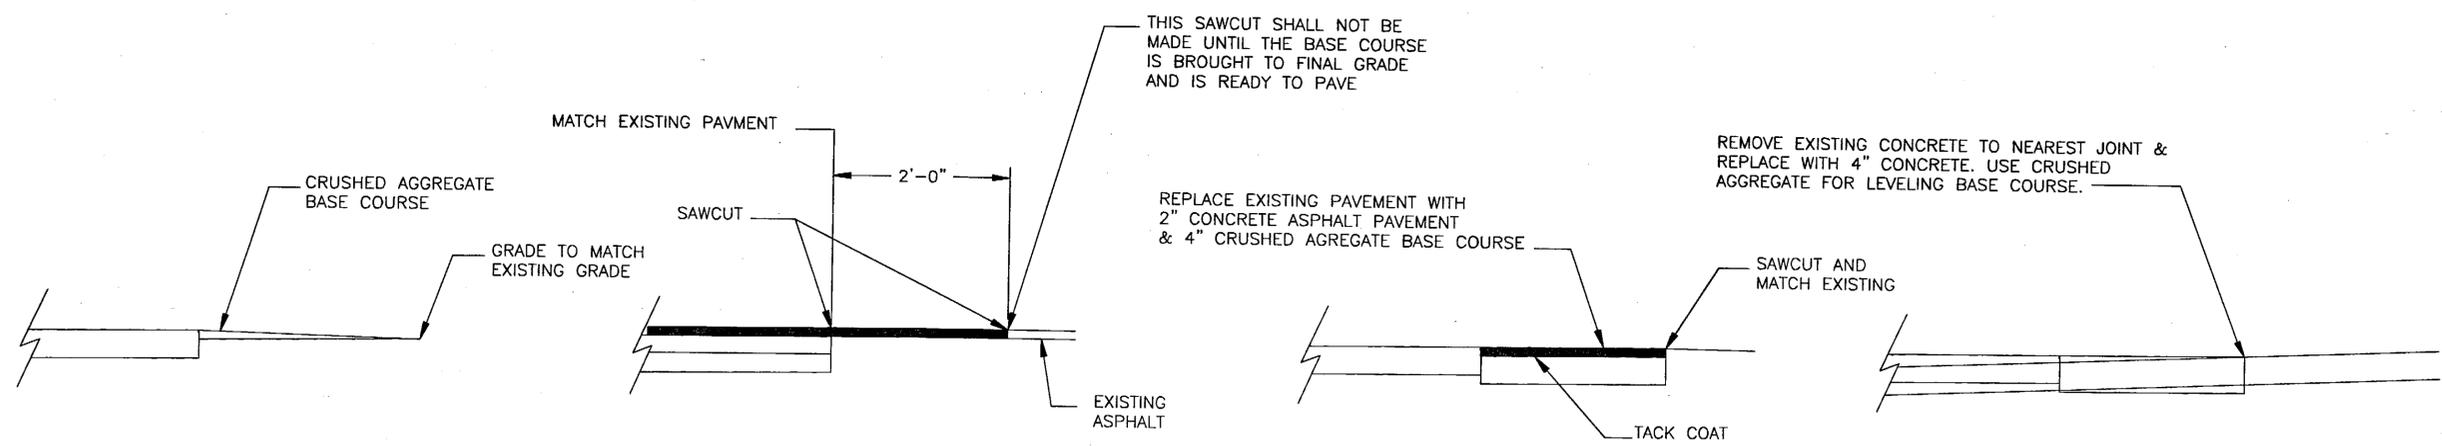


GRAVEL WALKWAY


PAVEMENT JOINT DETAIL

ASPHALT WALKWAY


CONCRETE WALKWAY

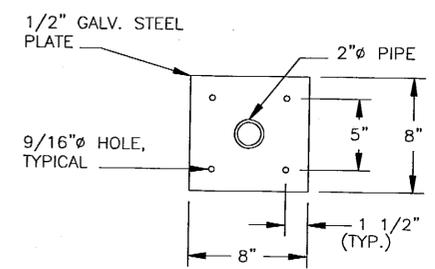

PLATE

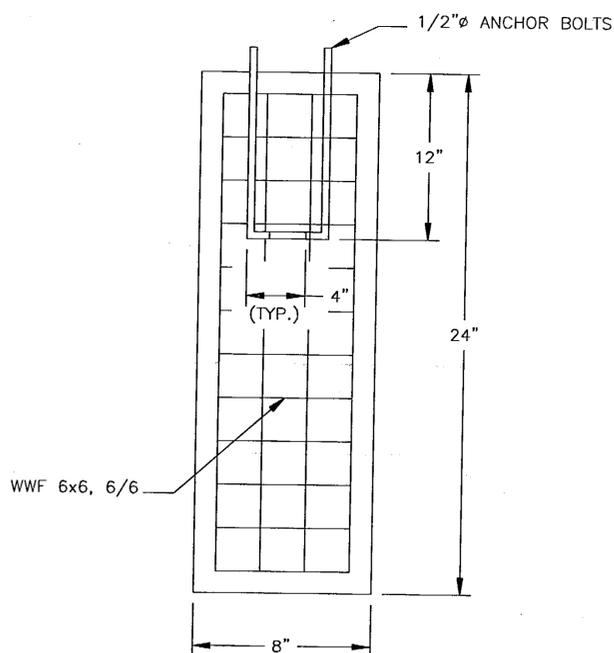

FOUNDATION

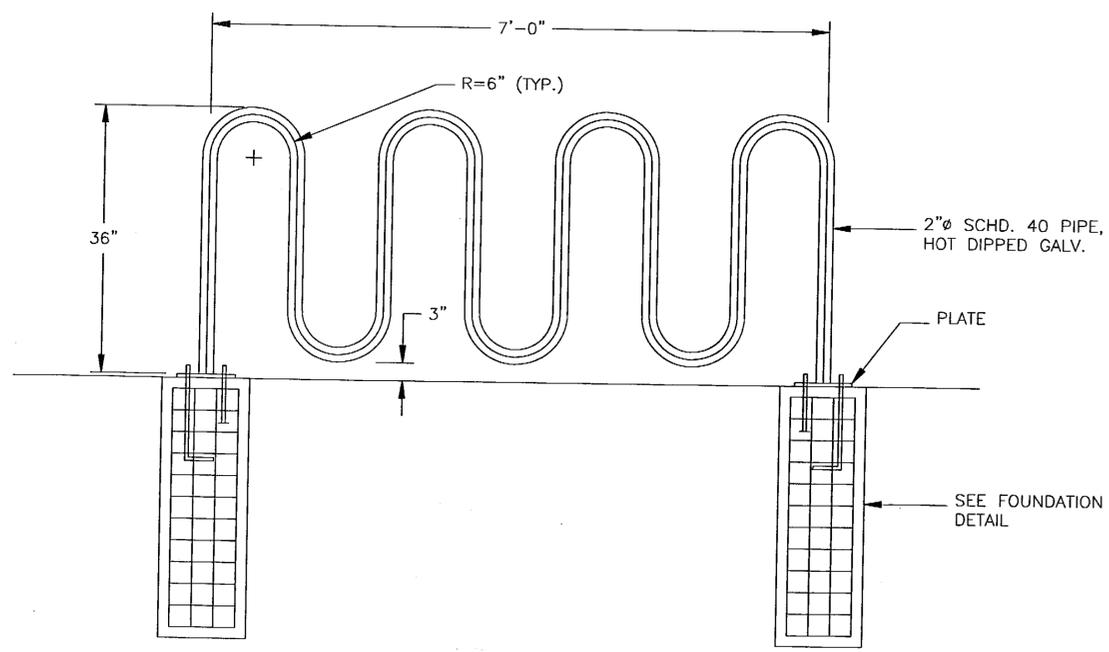

BIKE RACK DETAIL

KTN-THIRD AVENUE EXTENSION
 PROJECT NO. 68490

Sidewalk Details

DESIGNED BY: C. HOWARD



CHECKED BY: T. MOORE
 DRAWN BY: T.M./R.S.

STATE OF ALASKA
 DEPARTMENT OF TRANSPORTATION
 & PUBLIC FACILITIES
 STATEWIDE DESIGN & ENGINEERING
 SERVICES DIVISION
**THIRD AVENUE EXTENSION
 PROJECT NO. 68490**

Sidewalk Details

PROJECT DESIGNATION NUMBER



STP-MG-0904(2)

STATE	YEAR
ALASKA	2002
SHEET NUMBER	TOTAL SHEETS
H3	146




Project As Built Drawings have been reviewed by the Project Engineer. To the best of his/her knowledge, they represent the project as constructed.
 Proj. Eng. *KS* Date: 02.06

ADDENDUM NUMBER		
ATTACHMENT NUMBER		
RECORD OF REVISIONS		
No.	DATE	DESCRIPTION


KTN-THIRD AVENUE EXTENSION
PROJECT NO. 68490
Pedestrian Rail Details

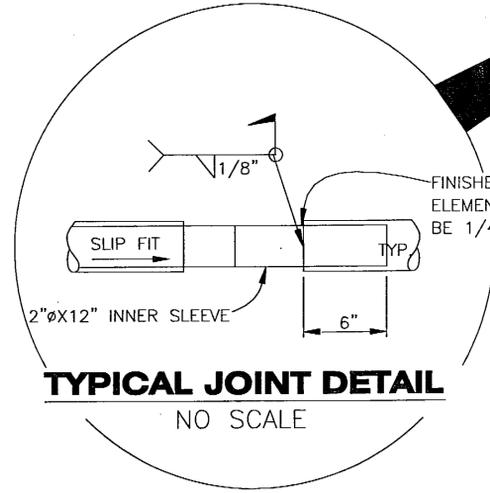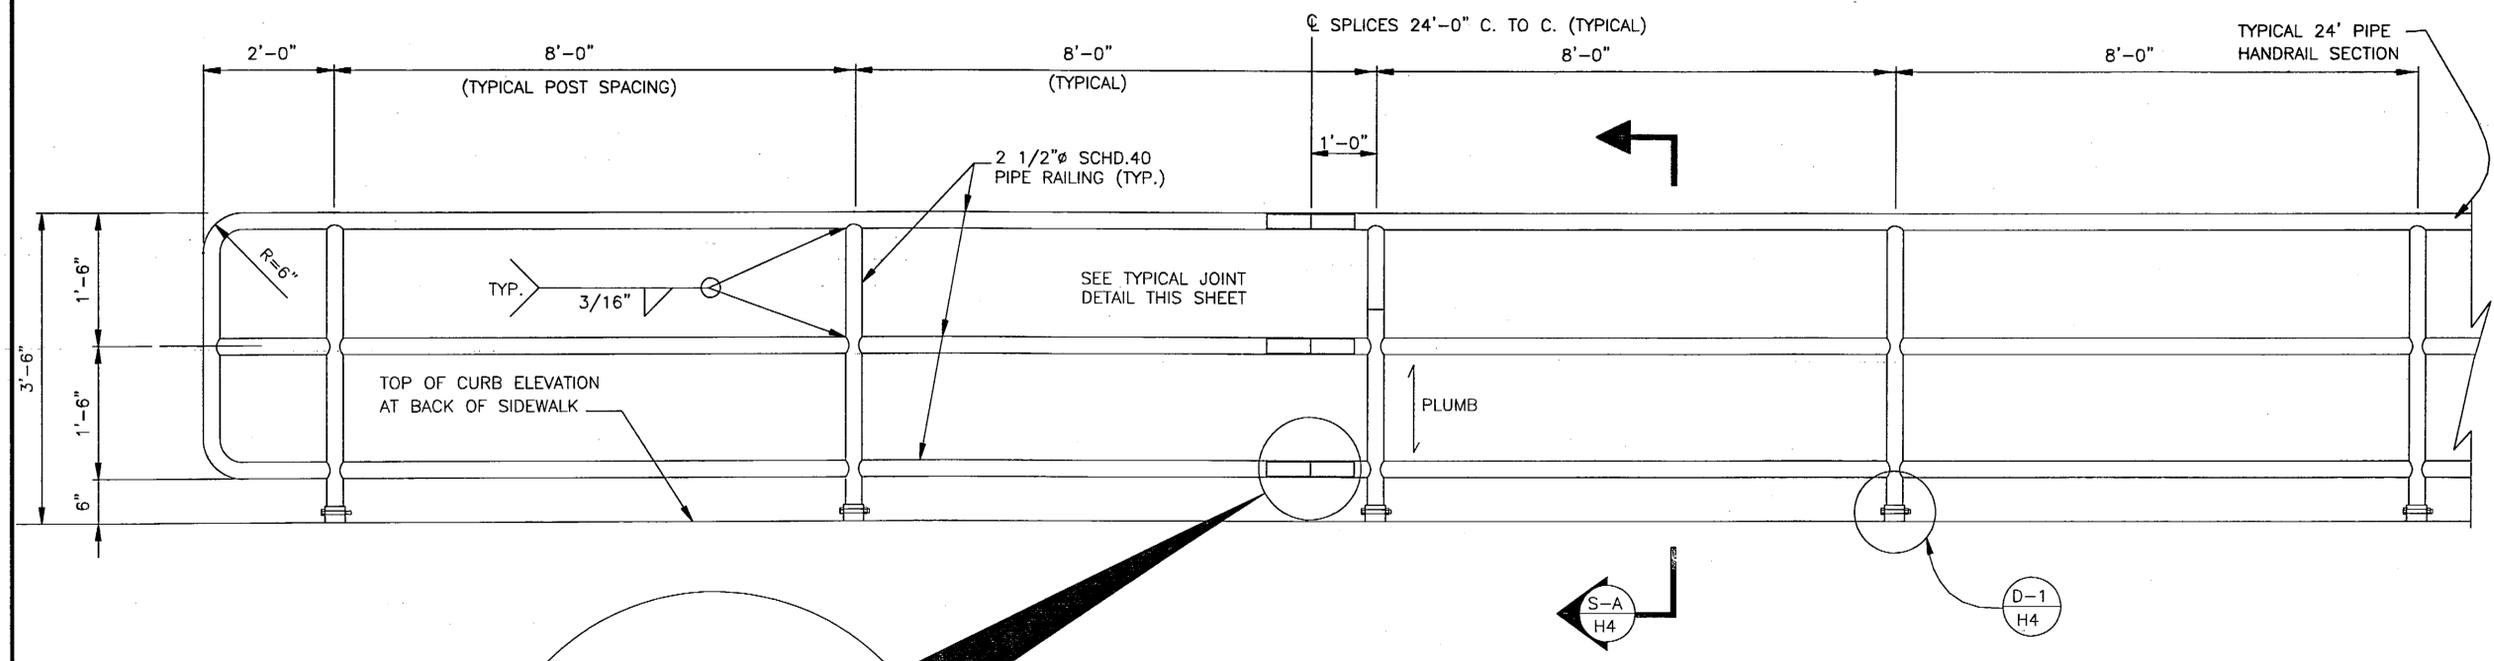

PEDESTRIAN RAILING DETAILS
NO SCALE

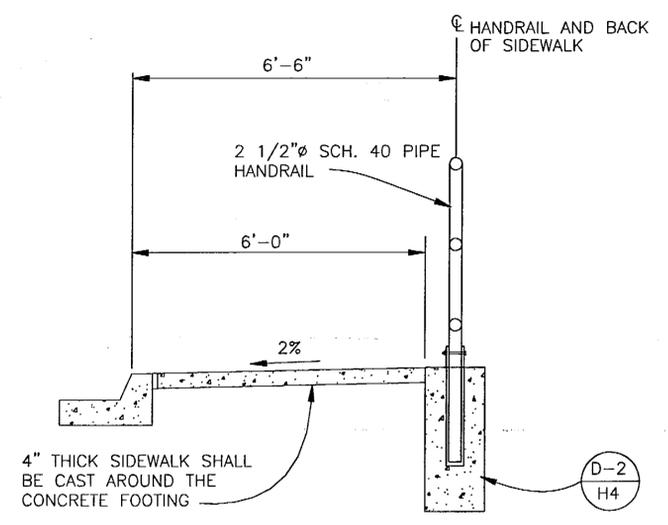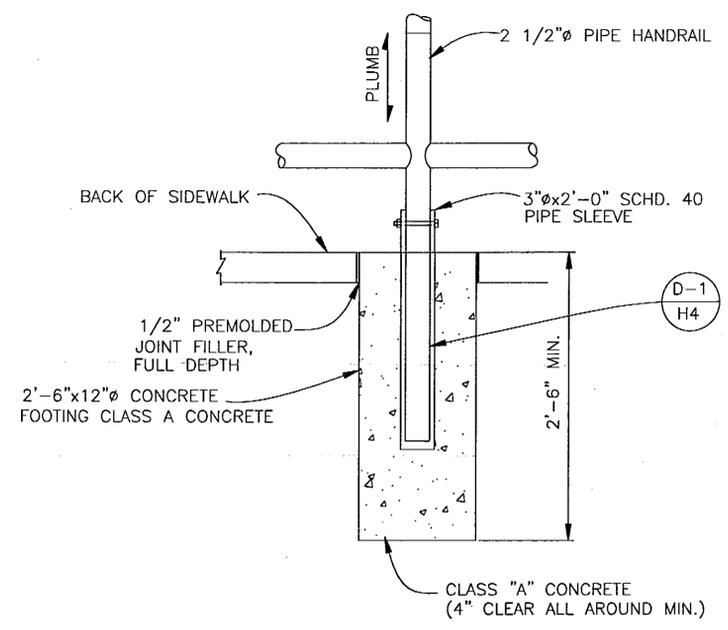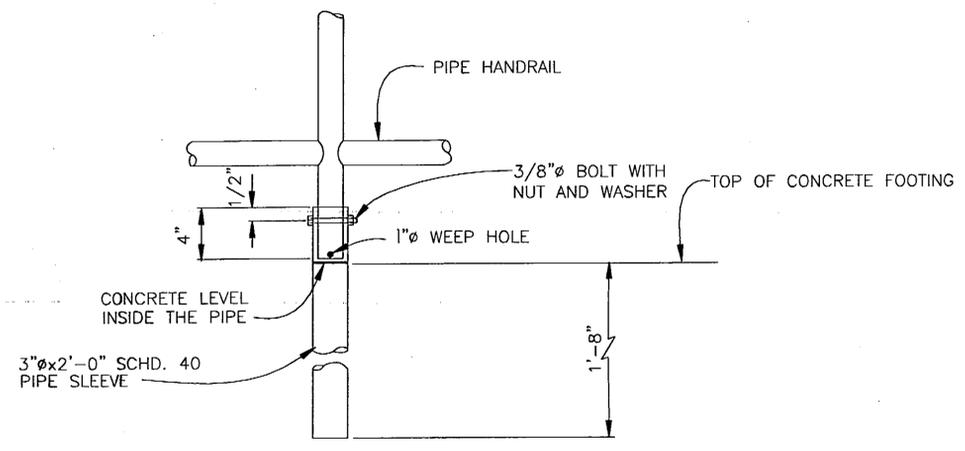

DESIGNED BY: C. HOWARD

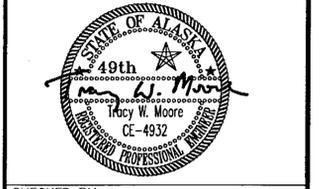

CHECKED BY: T. MOORE

DRAWN BY: T.M./R.S.

STATE OF ALASKA
 DEPARTMENT OF TRANSPORTATION
 & PUBLIC FACILITIES
 STATEWIDE DESIGN & ENGINEERING
 SERVICES DIVISION
THIRD AVENUE EXTENSION
PROJECT NO. 68490

Pedestrian Rail Details

PROJECT DESIGNATION NUMBER

STP-MG-0904(2)


STATE	YEAR
ALASKA	2002

SHEET NUMBER	TOTAL SHEETS
H4	146

PATH:
 Q:\ktn\71811A\Planset\H_SidewalkDets.dwg
 Mon, 06/May/02 09:34AM Michael Limbough
 PLOT:
 PSPACE 1=1(F) OR MSPACE 1=1(F)
 TAB: sdwk_rail-DET4


ADDENDUM NUMBER		
ATTACHMENT NUMBER		
RECORD OF REVISIONS		
No.	DATE	DESCRIPTION

KTN-THIRD AVENUE EXTENSION
 PROJECT NO. 68490
**Austin Street
 Pedestrian Rail Details**

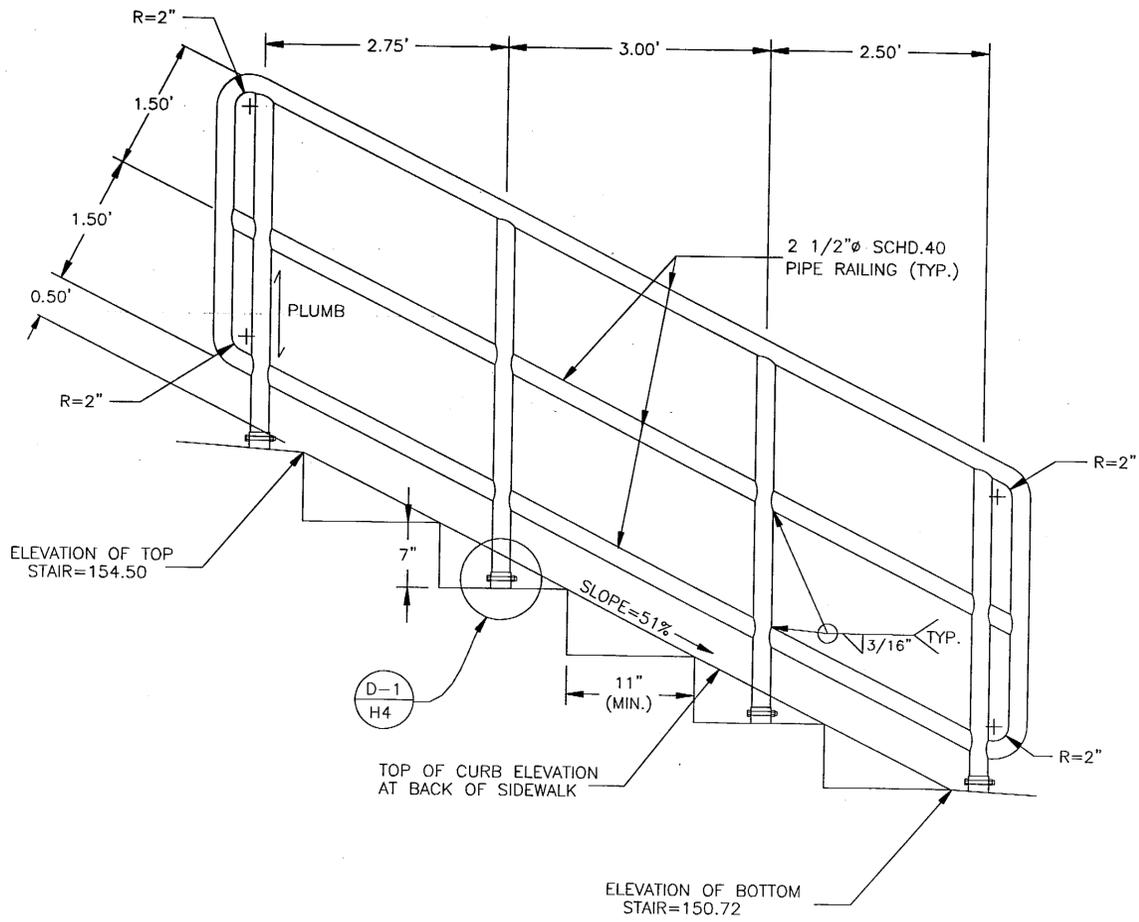

- NOTE:
1. ADJUST STAIRWAY PROFILE & RAILING TO FIT ACTUAL FIELD CONDITIONS.
 2. SEE STANDARD DRAWING M-01.00 FOR DETAILS.

STAIRWAY PROFILE
 NO SCALE

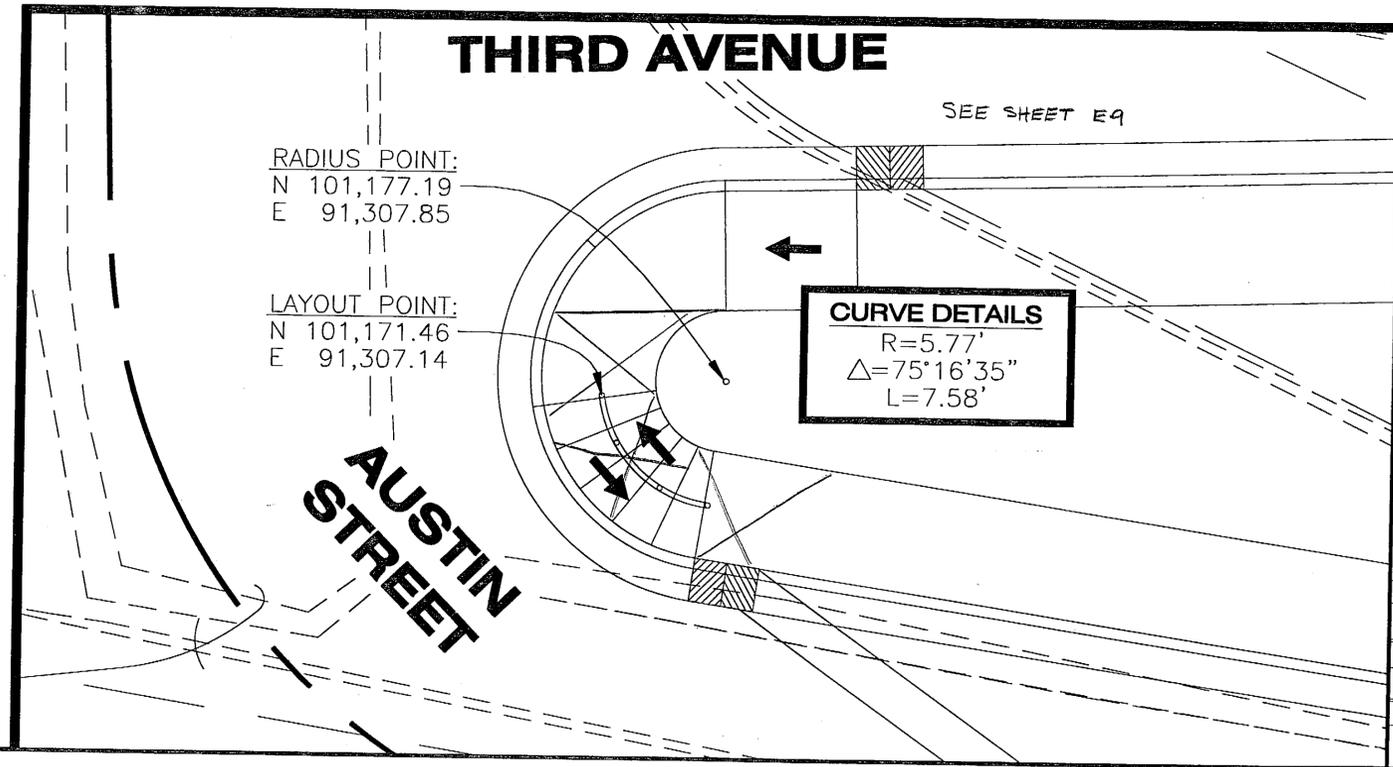

DESIGNED BY: J. OSBURN



CHECKED BY: T. MOORE
 DRAWN BY: T.M./R.S.

STATE OF ALASKA
 DEPARTMENT OF TRANSPORTATION
 & PUBLIC FACILITIES
 STATEWIDE DESIGN & ENGINEERING
 SERVICES DIVISION
**THIRD AVENUE EXTENSION
 PROJECT NO. 68490
 Austin Street
 Pedestrian Rail
 Details**

PROJECT DESIGNATION NUMBER	
STP-MG-0904(2)	
STATE	YEAR
ALASKA	2002
SHEET NUMBER	TOTAL SHEETS
H5	146

Project As Built Drawings have been reviewed by the Project Engineer. To the best of his/her knowledge, they represent the project as constructed.
 Proj. Eng. *KS* Date 06/04/06

PATH: Q:\Ktn\718114\Planset\J_RetainWalls.dwg
 Mon, 06/May/02 09:36AM Michael Limbaugh
 PLOT: PSPACE 1=1(F) OR MSPACE 1=1(F)

ADDENDUM NUMBER		
ATTACHMENT NUMBER		
RECORD OF REVISIONS		
No.	DATE	DESCRIPTION

KTN-THIRD AVENUE EXTENSION
PROJECT NO. 68490

Retaining Wall Locations Plan

DESIGNED BY: C. HOWARD



CHECKED BY: T. MOORE
 DRAWN BY: R.S./T.M.

STATE OF ALASKA
 DEPARTMENT OF TRANSPORTATION
 & PUBLIC FACILITIES
 STATEWIDE DESIGN & ENGINEERING
 SERVICES DIVISION
**THIRD AVENUE EXTENSION
 PROJECT NO. 68490**

**Retaining Wall
 Locations Plan**

PROJECT DESIGNATION NUMBER	
STP-MG-0904(2)	
STATE	YEAR
ALASKA	2002
SHEET NUMBER	TOTAL SHEETS
J1	146

Project As Built Drawings have been reviewed by the Project Engineer. To the best of his/her knowledge, they represent the project as constructed.
 Proj. Eng. *KS* Date 6.9.06

GENERAL NOTES:

1. Water may be encountered during the excavation phase for the MSE Walls. The Contractor shall submit a drainage plan to the Engineer for approval, prior to commencing excavation for each Retaining Wall Site. Drainage Plans Will Be an Amendment To The Projects SWPPP.
2. Adjustments may be necessary to some MSE Retaining Wall Sites line and grade. Prior to construction, the Contractor shall verify each Retaining Wall Sites line and grade with the Engineer.
3. Bottom of retaining walls may vary from the drawings. Bottom of retaining walls will be determined, based on the amount of excavation to firm ground or bedrock as required by the Engineer.

MSE WALL:

MATERIALS:


DESIGN DATA			
MSE BACKFILL	∅	130	40'
RANDOM BACKFILL	∅	125	35'
FOUNDATION SOIL	∅	130	40'
FOUNDATION BEDROCK			

FOUNDATION FOR WALLS WILL BE ON SOUND BEDROCK.

FACTORS OF SAFETY FOR STEEPEND SLOPES:
 INTERNAL F.S. = 1.3
 SLIDING F.S. = 1.5
 PULLOUT F.S. = 1.5

SURCHARGE: 350#/ft.² ,OVER 35' ROADWAY.

Design peak horizontal seismic acceleration (90% probability not to be exceeded in 50 years) on rock = 0.02g.

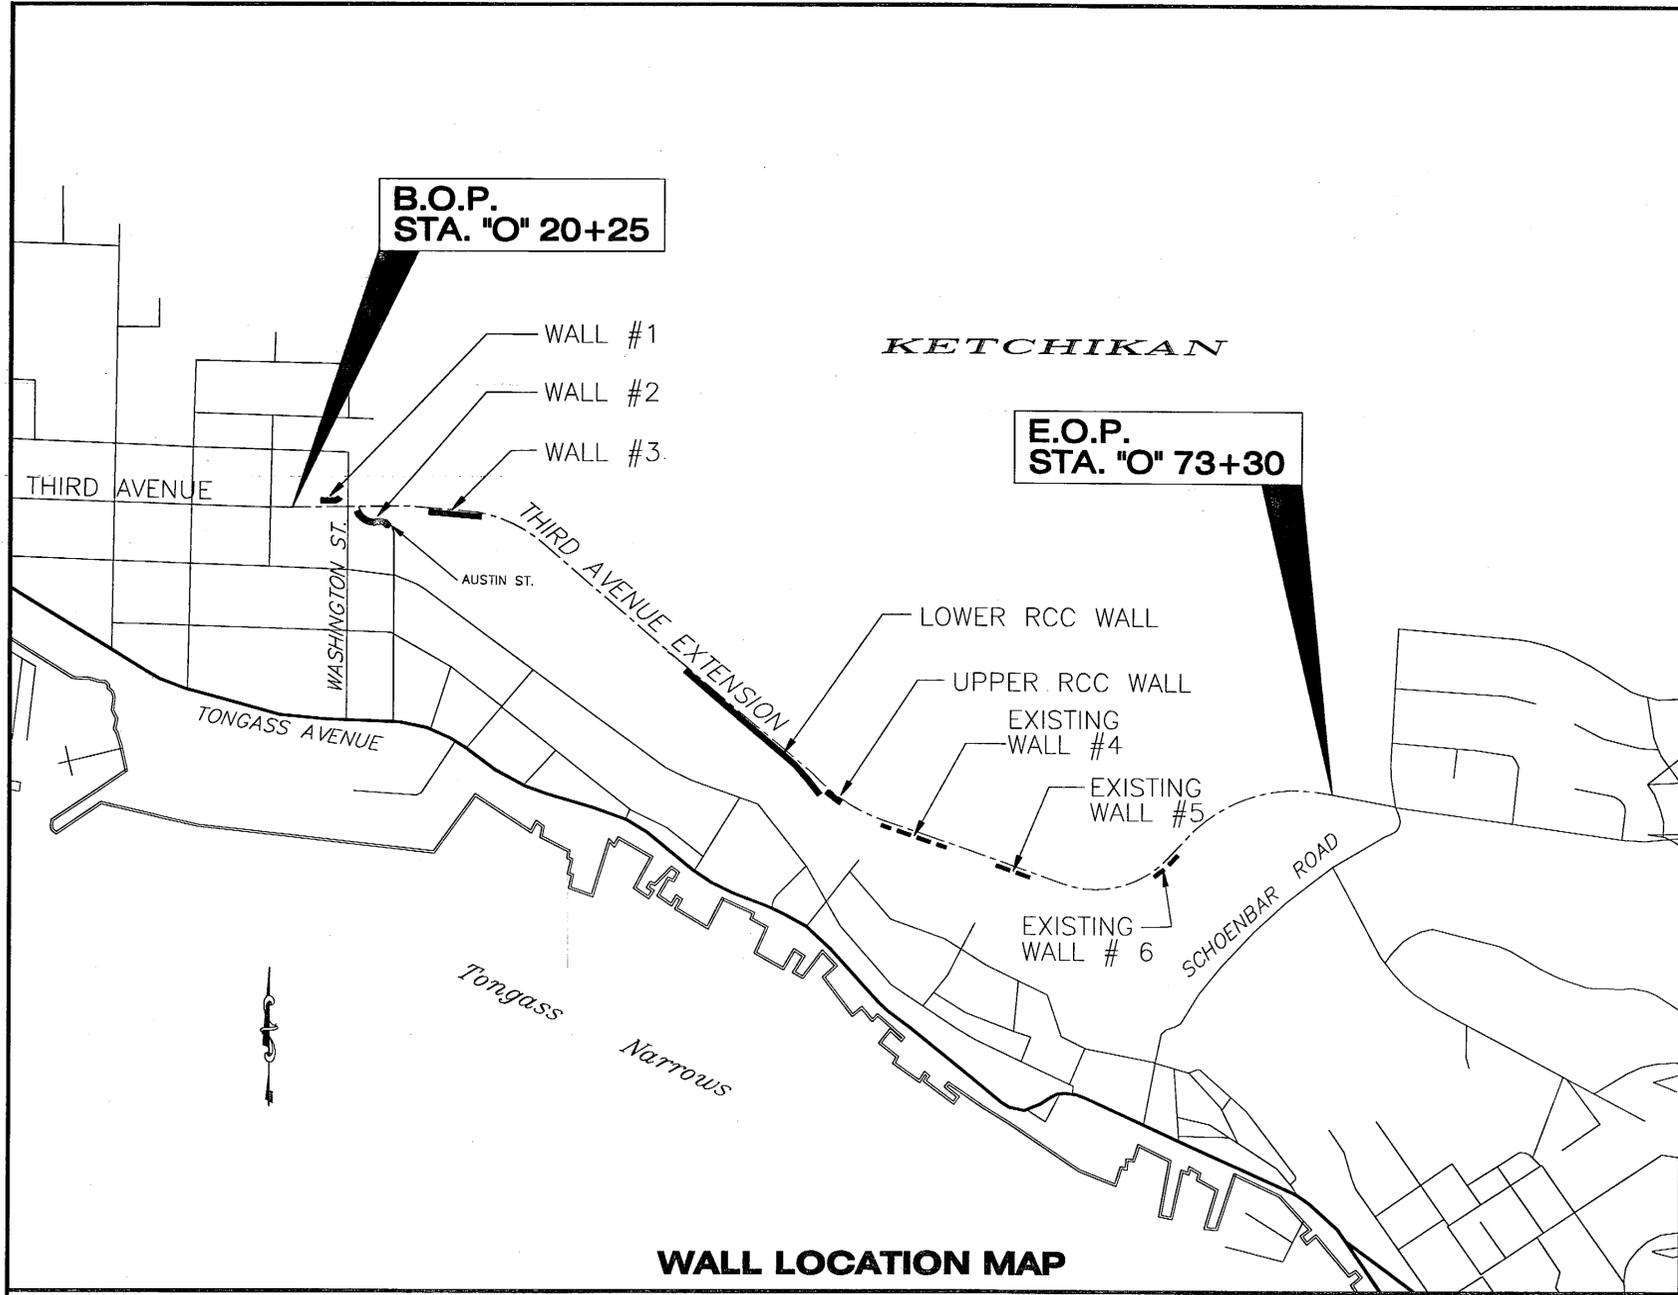

WALL LOCATION MAP

RCC = ROLLER COMPACTED CONCRETE
 MSE = MECHANICALLY STABILIZED EMBANKMENT

SPECIFICATIONS:

AASHTO Standard Specifications for Highway Bridges, 1996 Edition with the latest amendments.
 Design Loading = HS25, Design Life = 75 Years

CONSTRUCTION:

State of Alaska Standard Specifications for Highway Construction, 1988 Edition and the Special Provisions.



NOTE:

SEE SHEETS L1-L8 FOR ROLLER COMPACTED CONCRETE WALL PLAN AND DETAILS.

WALL	LOCATION	TYPE
WALL # 1	STA. "O" 21+30, LT. TO "O" 21+84, LT.	REINFORCED CONCRETE
WALL # 2	STA. "A" 10+25, RT. TO "A" 12+50, RT.	REINFORCED CONCRETE
WALL # 3	STA. "O" 24+50, RT. TO "O" 25+75, RT.	MSE
LOWER RCC WALL	STA. "O" 40+00, RT. TO "O" 50+64, RT.	ROLLER COMPACTED CONCRETE
UPPER RCC WALL	STA. "O" 50+72, RT. TO "O" 51+71, RT.	ROLLER COMPACTED CONCRETE
WALL # 4	STA. "O" 54+00, RT. TO "O" 56+71, RT.	EXISTING MSE
WALL # 5	STA. "O" 58+40, RT. TO "O" 60+60, RT.	EXISTING MSE
WALL # 6	STA. "O" 66+75, RT. TO "O" 68+05, RT.	EXISTING MSE

PATH: Q:\Ktn\71811A\PlanSet\J_RetainWalls.dwg
 Tue, 07/May/02 02:37PM Michael Limbaugh
 PLOT: PSPACE 1=1(F) OR MSPAGE 1=1(F)

ADDENDUM NUMBER		
ATTACHMENT NUMBER		
RECORD OF REVISIONS		
No.	DATE	DESCRIPTION

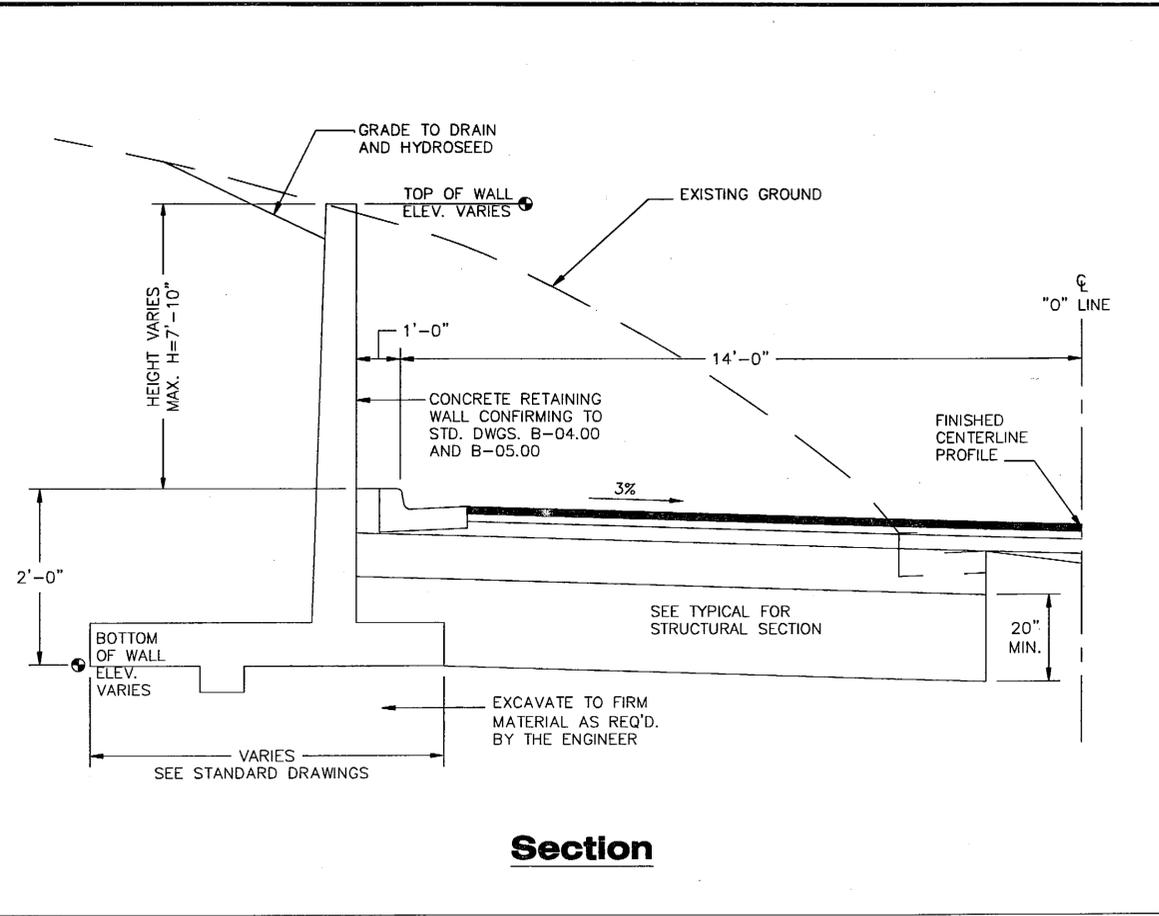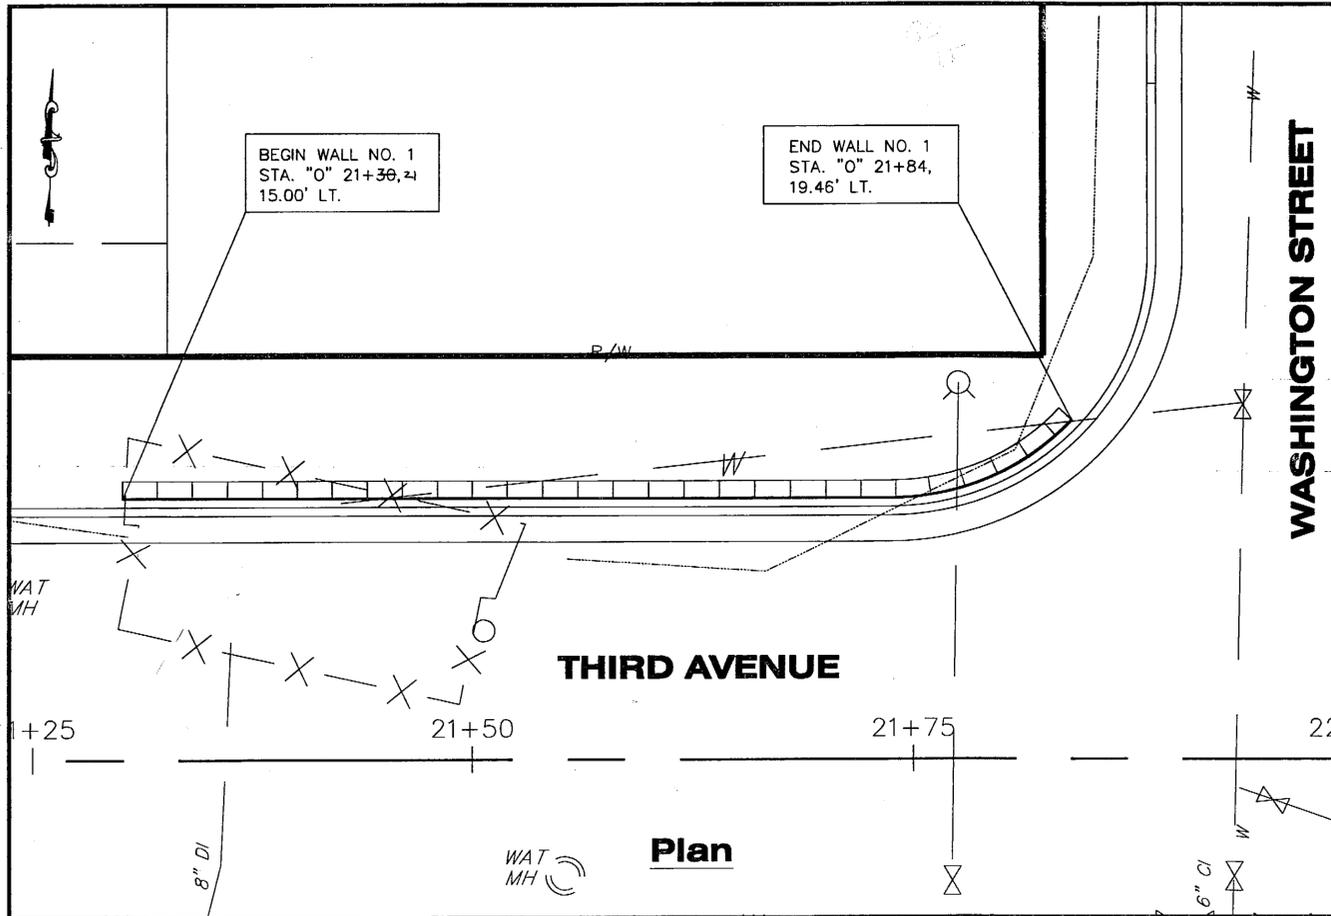


Plan

Section

**KTN-THIRD AVENUE EXTENSION
 PROJECT NO. 68490**

Retaining Wall No. 1

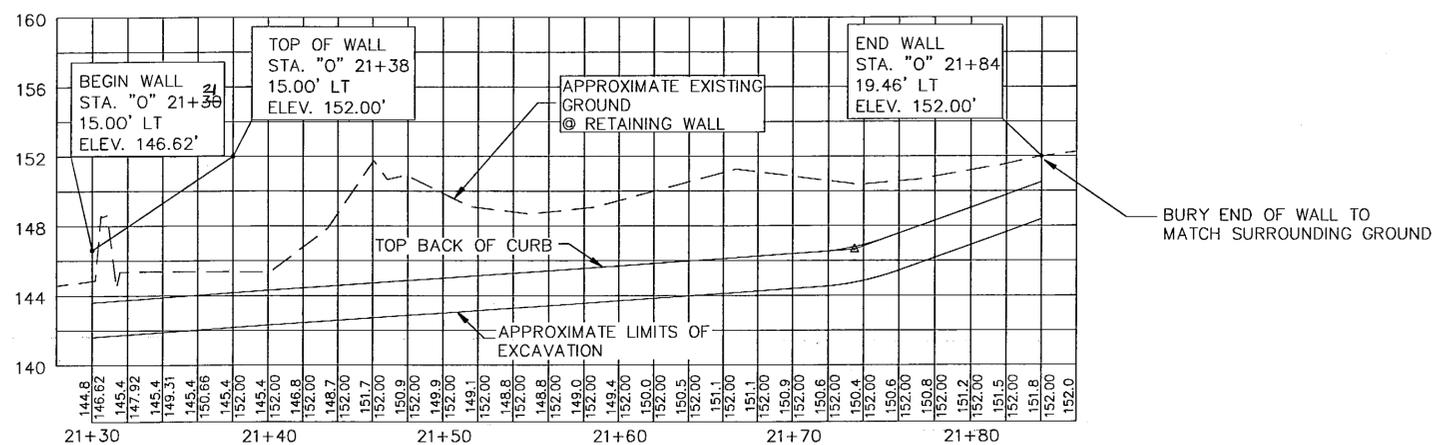

Profile

RETAINING WALL NO. 1
STA. "O" 21+30 TO "O" 21+84

DESIGNED BY: C. HOWARD

49th
 Tracy W. Moore
 CE-4932
 PROFESSIONAL ENGINEER

CHECKED BY: T. MOORE
 DRAWN BY: T.M./R.S.

STATE OF ALASKA
 DEPARTMENT OF TRANSPORTATION & PUBLIC FACILITIES
 STATEWIDE DESIGN & ENGINEERING SERVICES DIVISION

**THIRD AVENUE EXTENSION
 PROJECT NO. 68490**

**Retaining Wall
 No. 1**

PROJECT DESIGNATION NUMBER	
STP-MG-0904(2)	
STATE	YEAR
ALASKA	2002
SHEET NUMBER	TOTAL SHEETS
J2	146

Project As Built Drawings have been reviewed by the Project Engineer. To the best of his/her knowledge, they represent the project as constructed.
 Proj. Eng. *[Signature]* Date: 5/1/06


PATH:
 Q:\Ktn\71811A\PlanSet\J_RetainWalls.dwg
 Mon, 06/May/02 09:36AM Michael Limbaugh
 PLOT:
 PSPACE 1=1(F) OR MSPACE 1=1(F)

ADDENDUM NUMBER		
ATTACHMENT NUMBER		
RECORD OF REVISIONS		
No.	DATE	DESCRIPTION

**KTN-THIRD AVENUE EXTENSION
 PROJECT NO. 68490**

Retaining Wall No. 2

DESIGNED BY: C. HOWARD

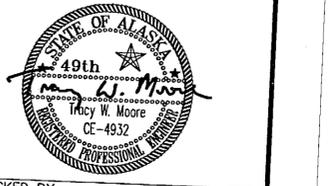




CHECKED BY: T. MOORE
 DRAWN BY: T.M./R.S

STATE OF ALASKA
 DEPARTMENT OF TRANSPORTATION
 & PUBLIC FACILITIES
 STATEWIDE DESIGN & ENGINEERING
 SERVICES DIVISION
**THIRD AVENUE EXTENSION
 PROJECT NO. 68490**


**Retaining Wall
 No. 2**

PROJECT DESIGNATION NUMBER	
STP-MG-0904(2)	
STATE	YEAR
ALASKA	2002
SHEET NUMBER	TOTAL SHEETS
J3	146


Project As Built Drawings have been reviewed by the Project Engineer. To the best of his/her knowledge, they represent the project as constructed.
 Proj. Eng. *[Signature]* Date 10/23/02

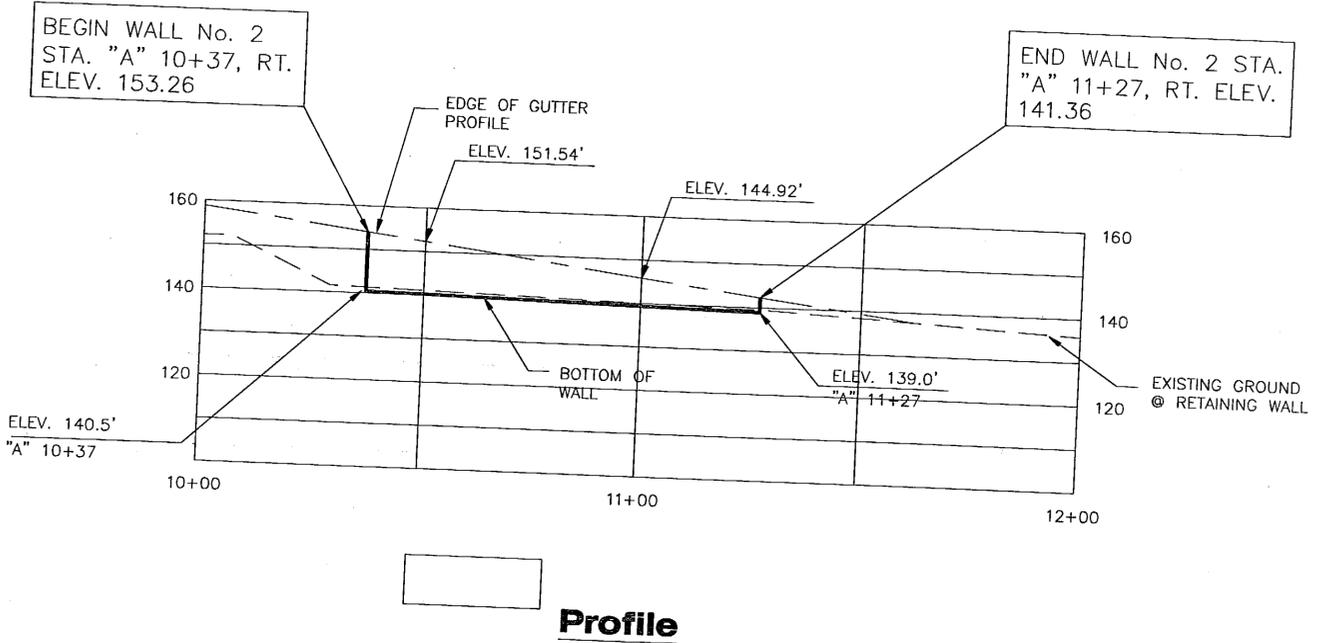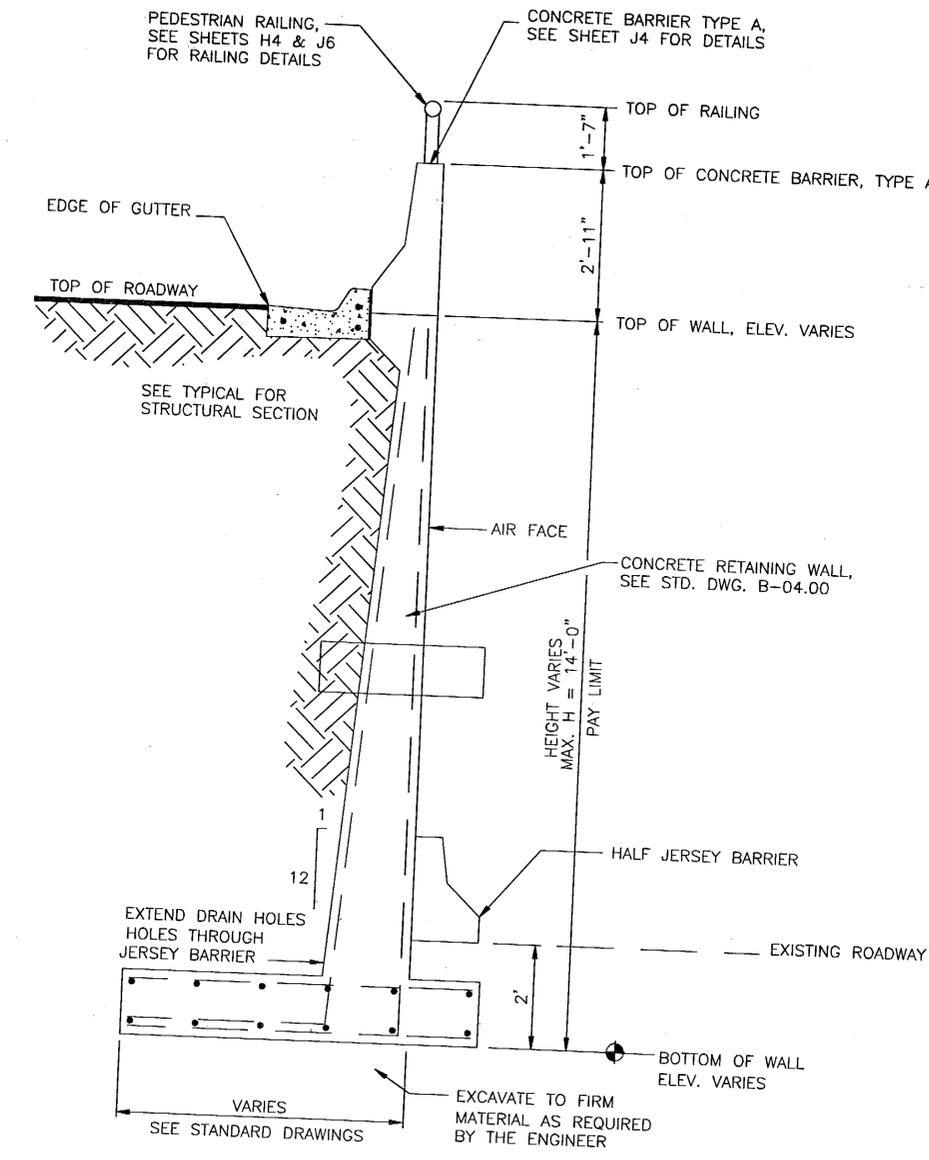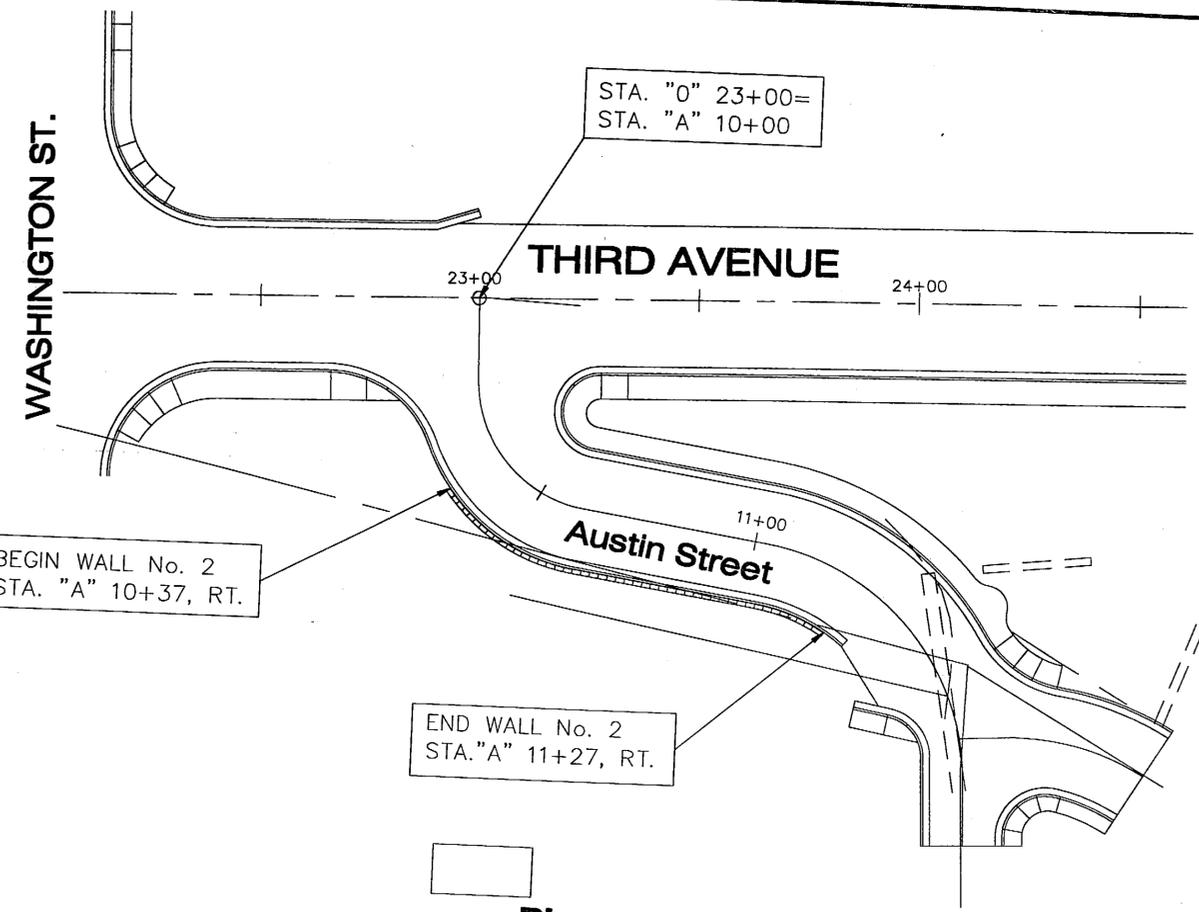


**RETAINING WALL NO. 2
 STA. "A" 10+25 TO "A" 12+50**

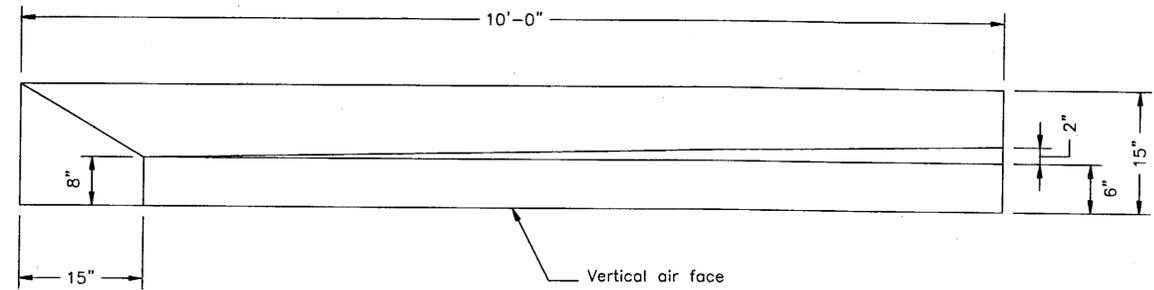


Transition Plan

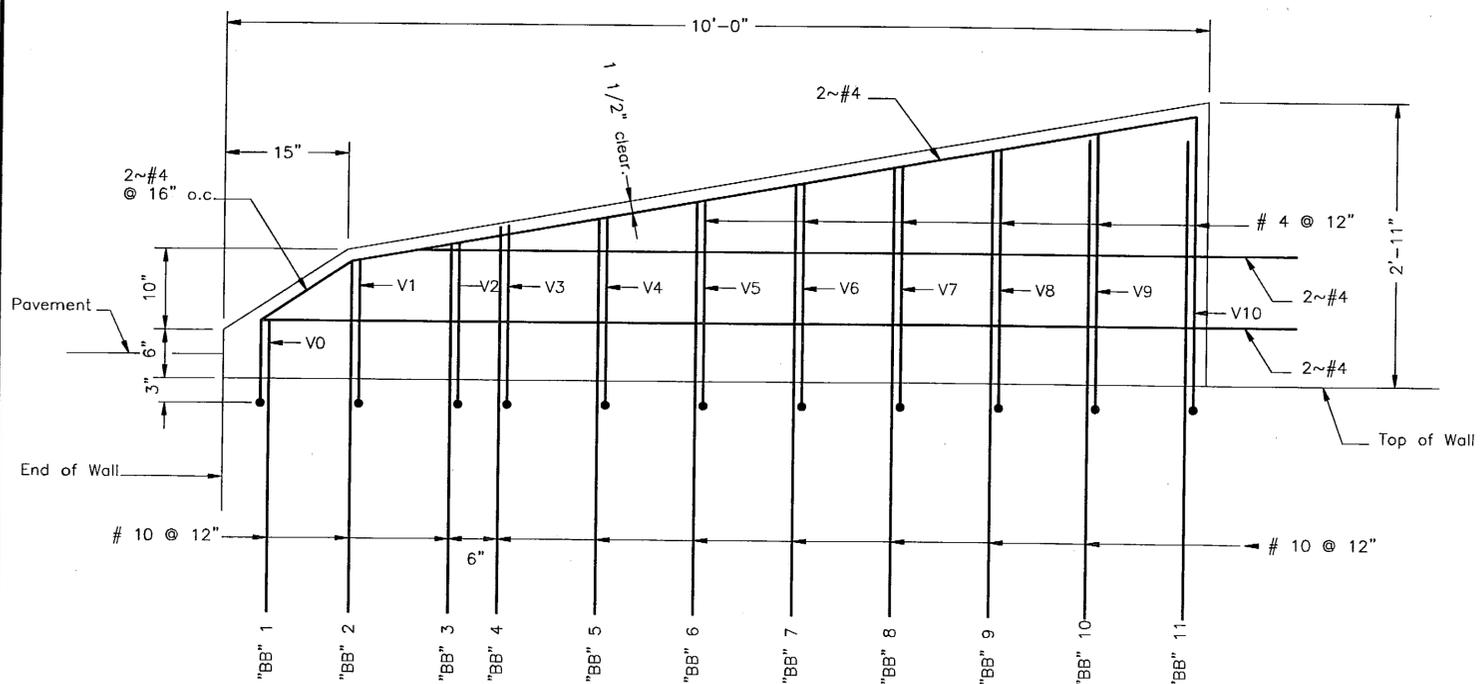


Transition Elevation

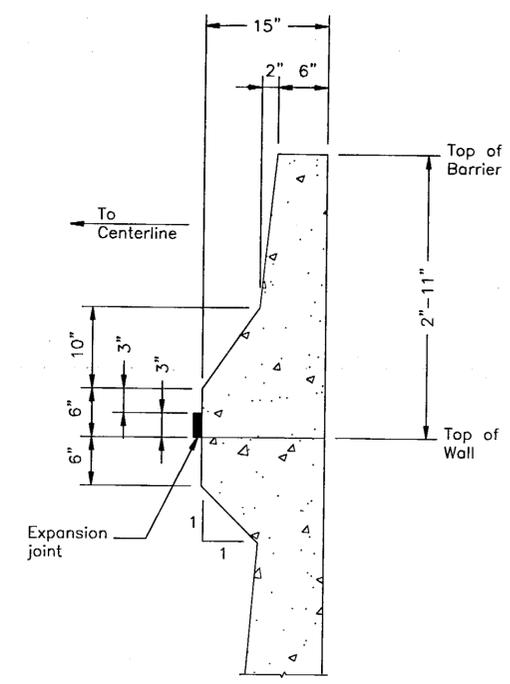

Concrete Barrier Type A

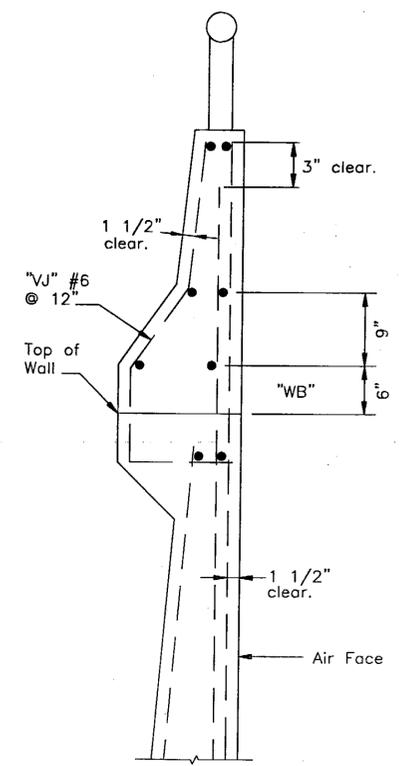

Rebar Detail

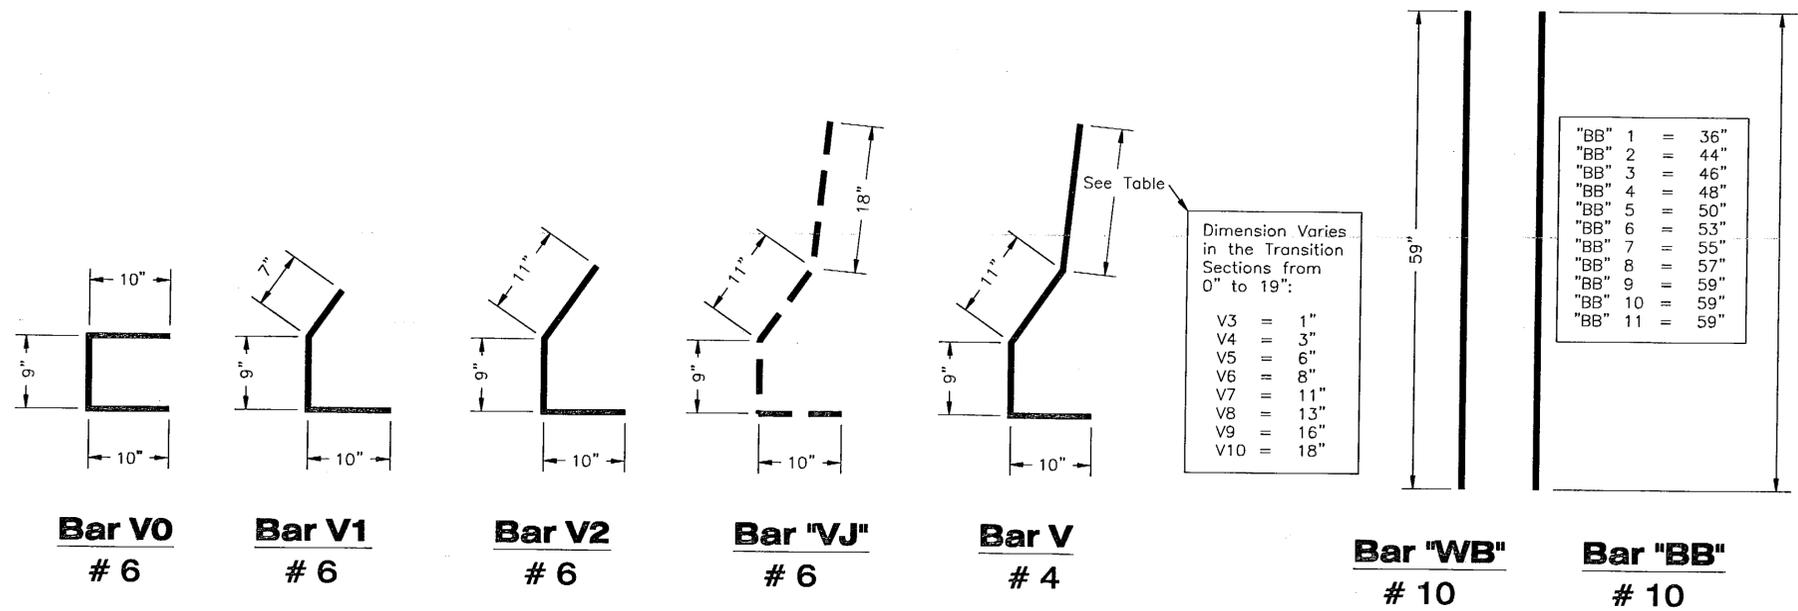

Notes:

- Concrete shall be Class A, $f'_c = 4,000$ psi @ 28 Days
- Concrete clear cover for reinforcing bars shall be minimum of 1 1/2".
- Reinforcing steel bars shall conform to A.S.T.M. A-615 Grade 60.
- Expansion joints shall be installed at the beginning and ending of the transition.
- Expansion joints shall be installed at 10 foot intervals for length of half concrete barrier.
- Connector hooks and pins (per Standard Drawing G-45.00 or approved equivalent) shall be used to fasten the concrete barrier end section to the half concrete barrier unless the contractor chooses to cast-in-place the concrete barrier end section, in which the hooks and pins shall be eliminated.
- Modify Standard Drawing G-45.00 as follows:
 A. Eliminate the two 2"x6" keys in base (as shown in the G-45.00 Transition Elevation View) and increase base depth to 6 inches.

KTN-THIRD AVENUE EXTENSION
 PROJECT NO. 68490

Retaining Wall No. 2 Details

DESIGNED BY: C. HOWARD



CHECKED BY: T. MOORE

DRAWN BY: T.M./R.S.

STATE OF ALASKA
 DEPARTMENT OF TRANSPORTATION
 & PUBLIC FACILITIES
 STATEWIDE DESIGN & ENGINEERING
 SERVICES DIVISION
**THIRD AVENUE EXTENSION
 PROJECT NO. 68490**

Retaining Wall Details


PROJECT DESIGNATION NUMBER

STP-MG-0904(2)

STATE	YEAR
ALASKA	2002
SHEET NUMBER	TOTAL SHEETS
J4	146


PATH: G:\Ktr\71811A\PlanSet\J_RetainWalls.dwg
 Mon, 06/May/02 09:36AM Michael Limbaugh
 PLOT: PSPACE 1=1(F) OR MSPACE 1=1(F)

ADDENDUM NUMBER		
ATTACHMENT NUMBER		
RECORD OF REVISIONS		
No.	DATE	DESCRIPTION

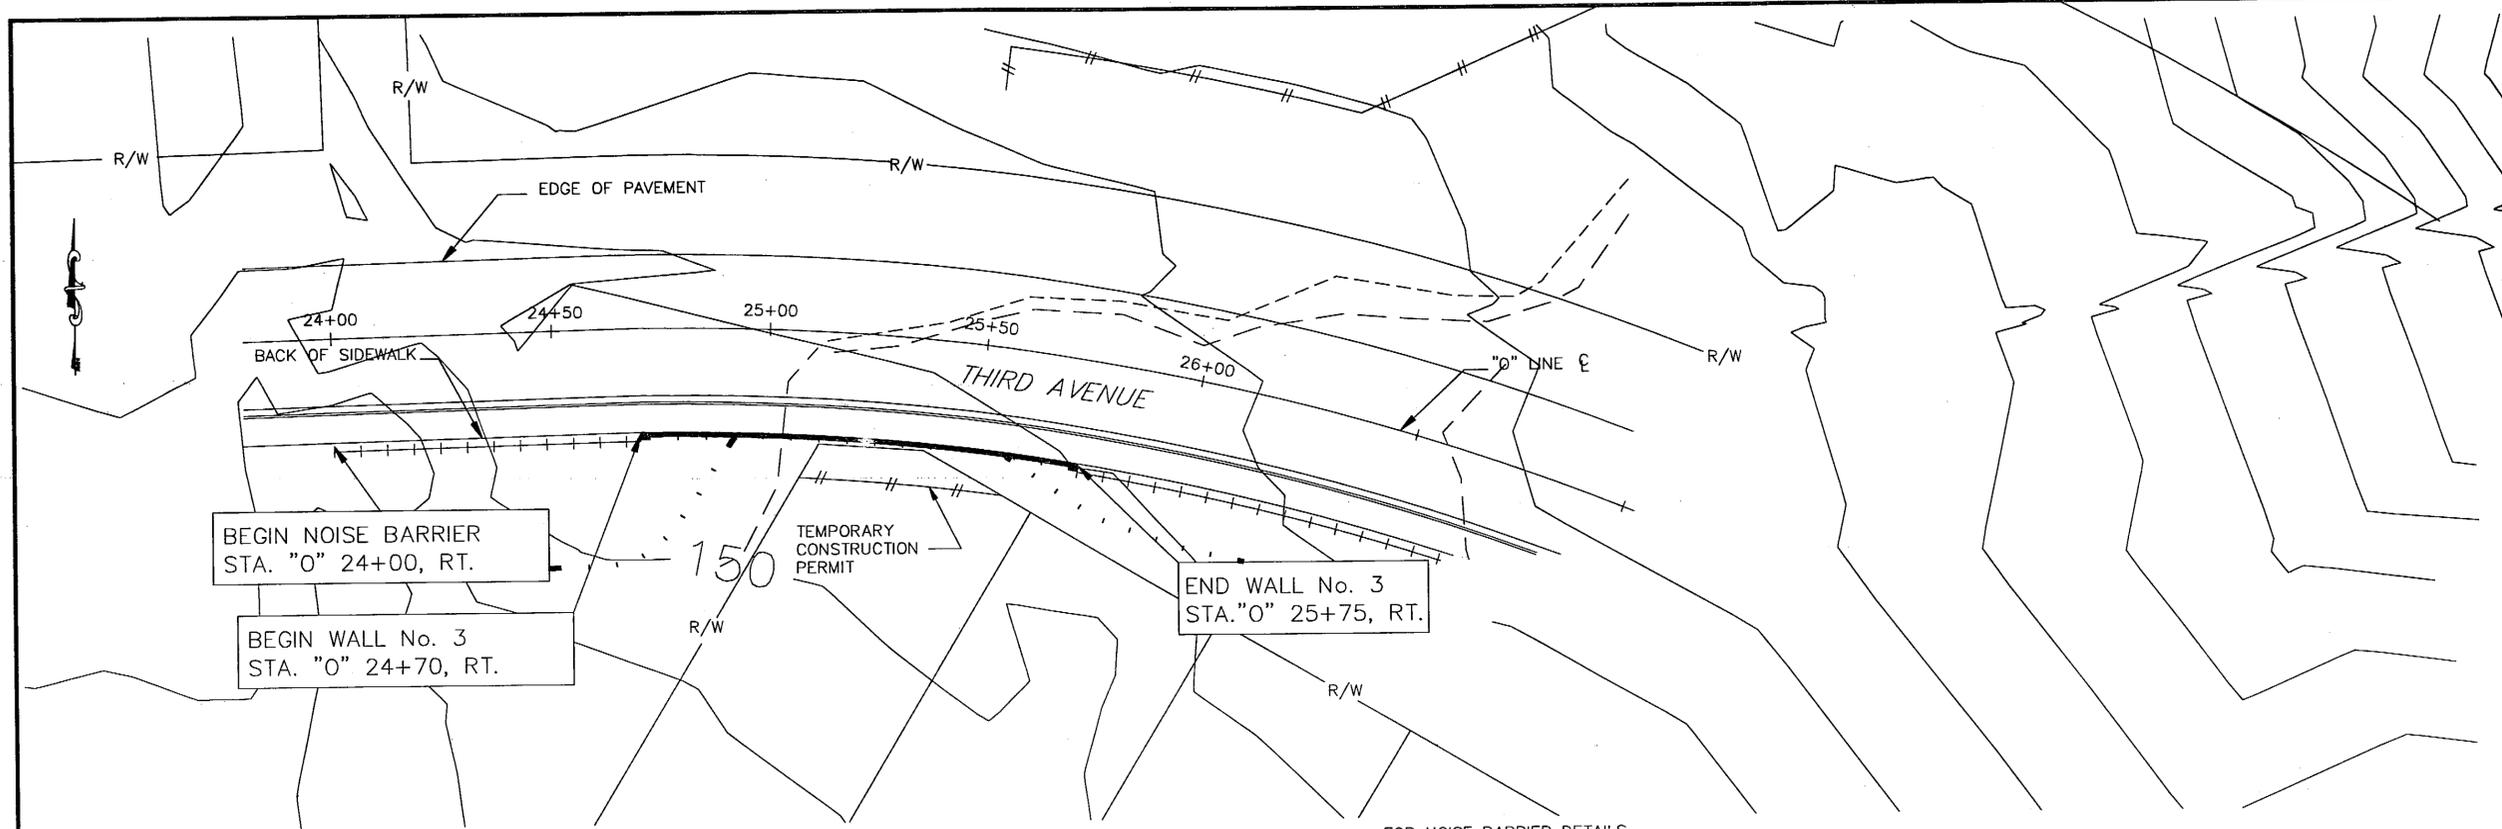


Plan

FOR NOISE BARRIER DETAILS
SEE SHEETS 01 THRU 02

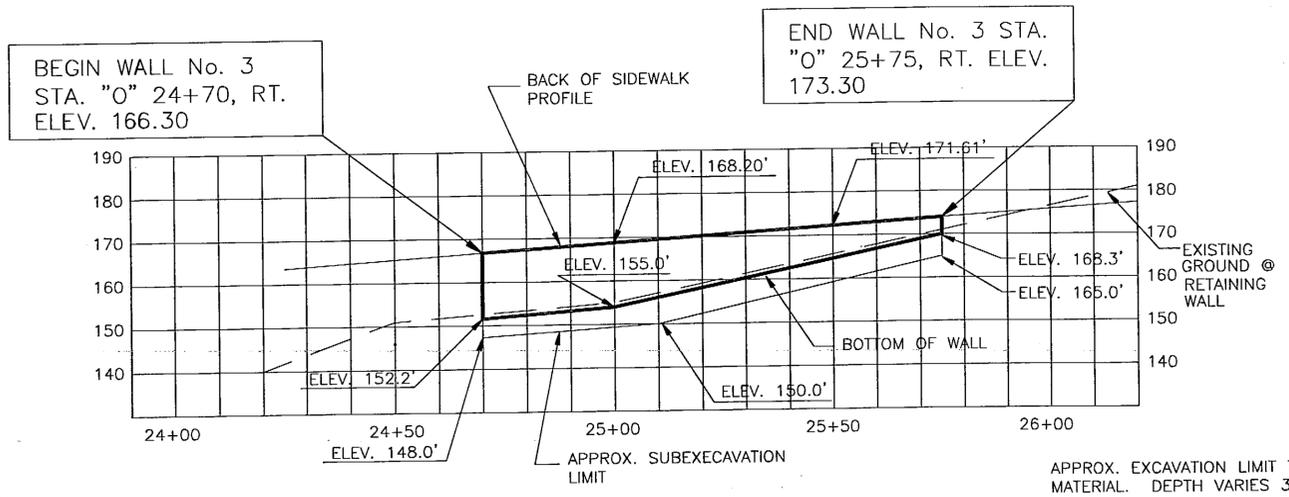

Profile

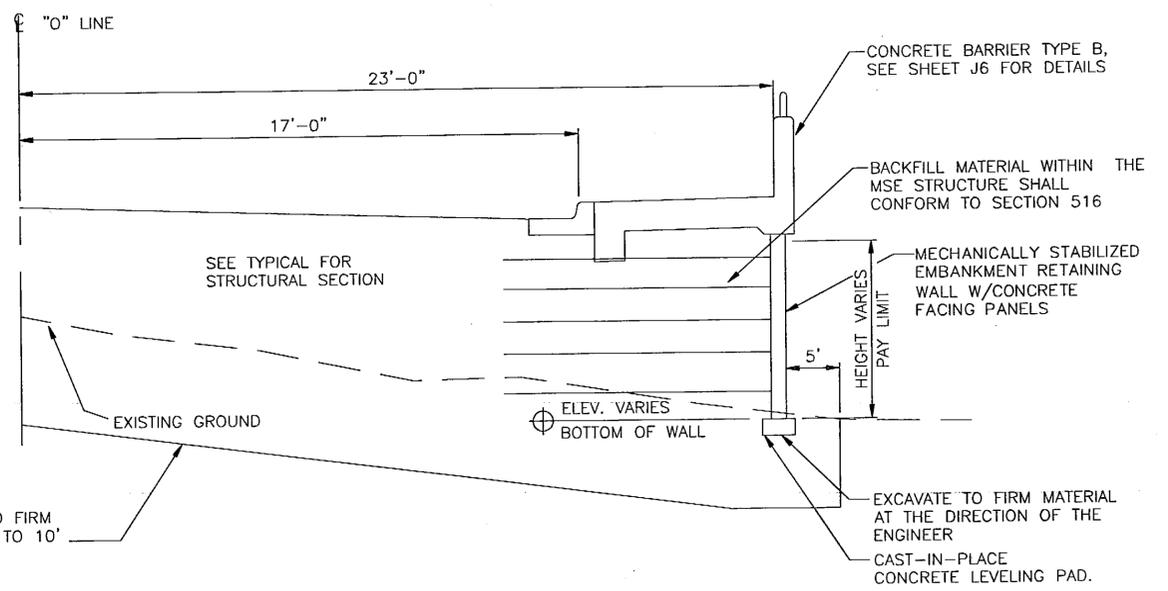

Section

RETAINING WALL NO. 3
STA. "O" 24+50 TO "O" 25+75

KTN-THIRD AVENUE EXTENSION
PROJECT NO. 68490

Retaining Wall No. 3

DESIGNED BY: C. HOWARD



CHECKED BY: T. MOORE

DRAWN BY: T.M./R.S.

STATE OF ALASKA
DEPARTMENT OF TRANSPORTATION
& PUBLIC FACILITIES
STATEWIDE DESIGN & ENGINEERING
SERVICES DIVISION

THIRD AVENUE EXTENSION
PROJECT NO. 68490





Retaining Wall
No. 3

PROJECT DESIGNATION NUMBER

STP-MG-0904(2)

STATE	YEAR
ALASKA	2002
SHEET NUMBER	TOTAL SHEETS
J5	146

Project As Built Drawings have been reviewed by the Project Engineer. To the best of his/her knowledge, they represent the project as constructed.
 Proj. Eng. *TL* Date 10/31/06

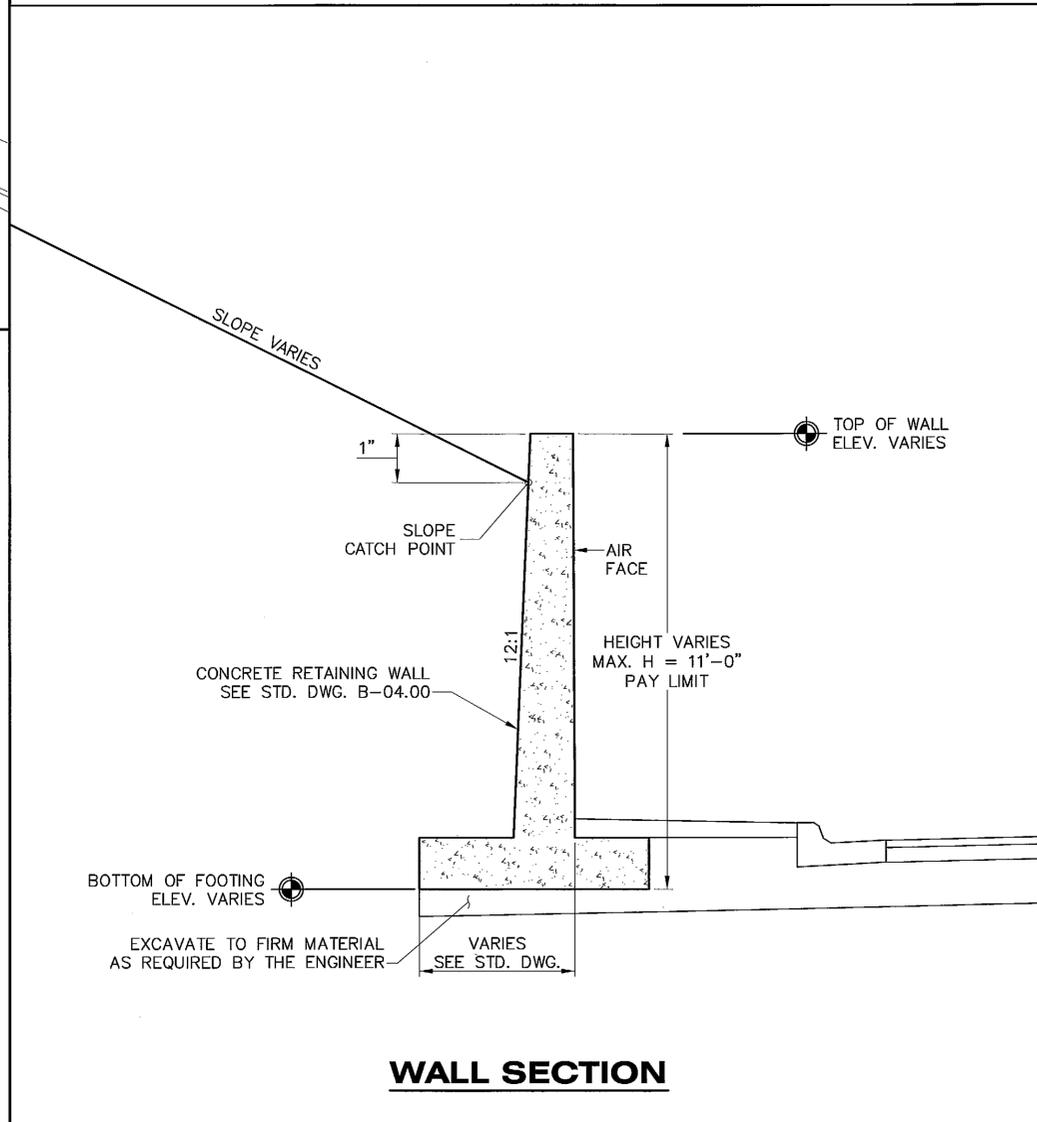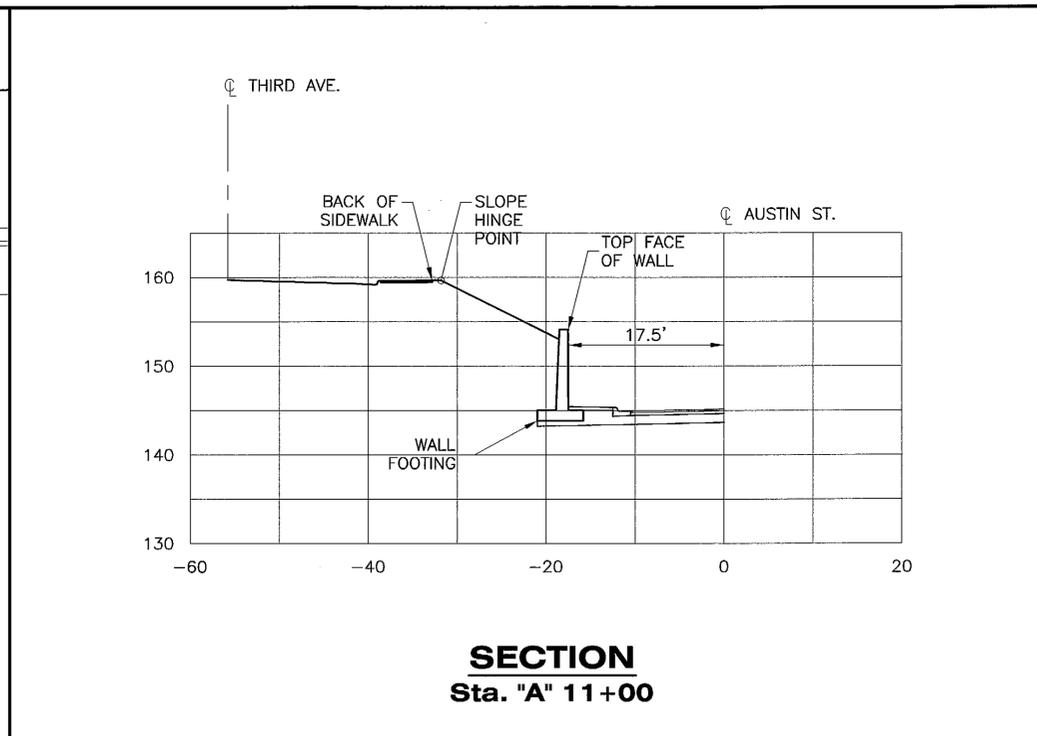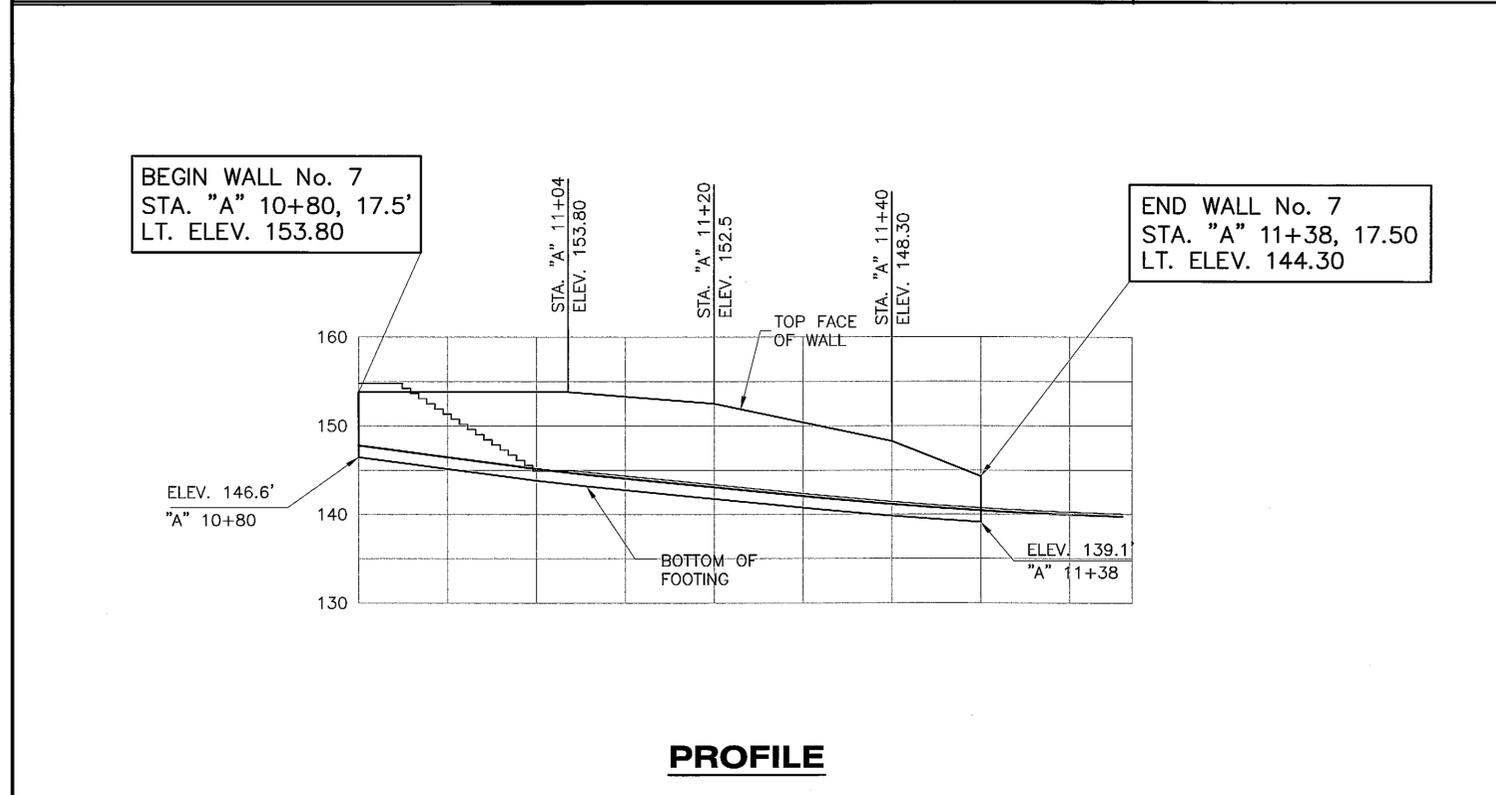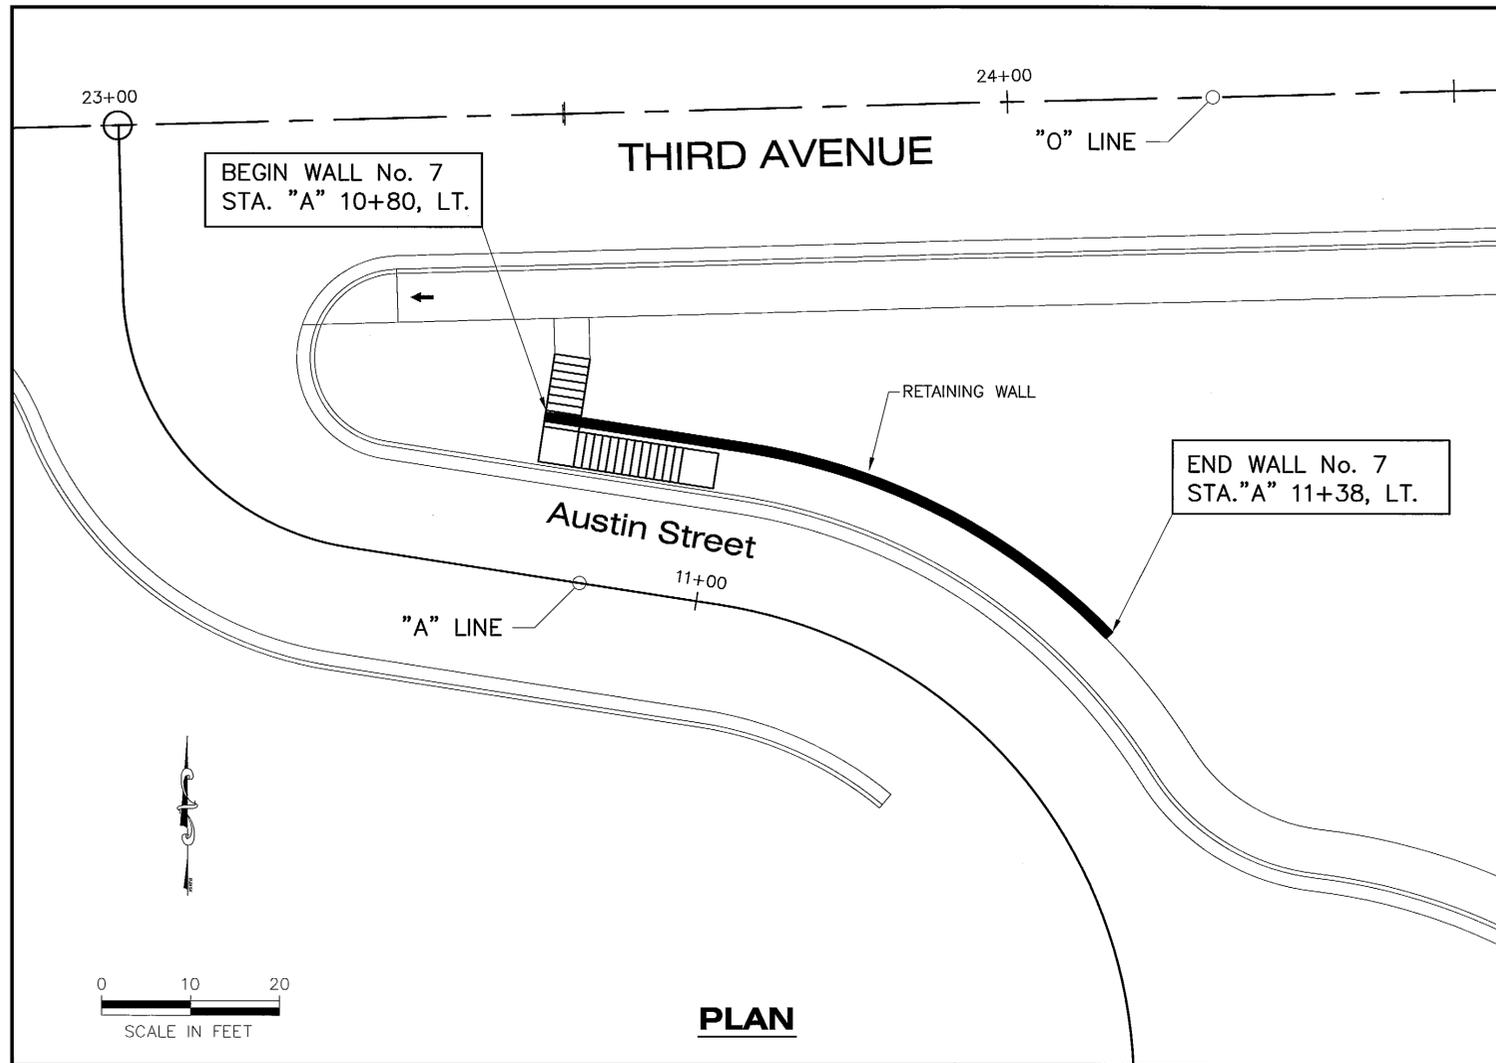

PATH: Q:\Ktn\71811A\En\p\3rdst\REVISION\FINAL DRAF
Tue, 28/Jun/05 10:39AM rksnyder
PLOT: PSPACE 1=1(F) OR MSPACE 1=1(F)
TAB: PLAN


ADDENDUM NUMBER		
ATTACHMENT NUMBER		
RECORD OF REVISIONS		
No.	DATE	DESCRIPTION

KTN-THIRD AVENUE EXTENSION
PROJECT NO. 68490

**Austin Street
Retaining Wall Details**

Project As Built Drawings have been reviewed by the Project Engineer. To the best of his/her knowledge, they represent the project as constructed.
Proj. Eng. *[Signature]* Date 10/2/06

DESIGNED BY: C. HOWARD

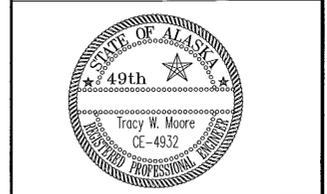

CHECKED BY: T. MOORE

DRAWN BY: C.H./R.S.

STATE OF ALASKA
DEPARTMENT OF TRANSPORTATION & PUBLIC FACILITIES
STATEWIDE DESIGN & ENGINEERING SERVICES DIVISION

THIRD AVENUE EXTENSION
PROJECT NO. 68490

**Austin Street
Retaining Wall
Details**

PROJECT DESIGNATION NUMBER

STP-MG-0904(2)

STATE	YEAR
ALASKA	2004
SHEET NUMBER	TOTAL SHEETS
J7	146

PATH:
 Q:\K1n\71811A\En\p\3rdst\REVISION\RAIL_MOD_...
 Thu, 06/Apr/06 10:58AM rksnyder
 PLOT:
 PSPACE 1=1(F) OR MSPACE 1=1(F)

ADDENDUM NUMBER		
ATTACHMENT NUMBER		
RECORD OF REVISIONS		
No.	DATE	DESCRIPTION

Notes:

- 1 1/2"Ø GALV. STEEL PIPE, SCH. 40 TO BE FIELD WELDED TO 2 1/2"Ø GALV. STEEL PIPE, SCH. 40 AFTER INSTALLATION AS SHOWN IN PROJECT PLANS.
2. PROPOSED RAILING SPLICES TO MATCH PROJECT PLAN RAILING SPLICE LOCATIONS.
3. REPAIRING GALVANIZED COATING AFTER WELDING.
 REPAIR STICKS USED TO REPAIR GALVANIZING SHALL BE ZINC-CADMIUM ALLOYS (MELTING POINT 518-527 °F), SUCH AS "REV-GALV" OR ZINC-TIN-LEAD ALLOYS (MELTING POINT 446-500 °F), SUCH AS "GALV-WELD, "ZILT" AND "GALVOVER". THE ZINC-TIN-LEAD ALLOYS SHALL COMPLY WITH U.S. FEDERAL SPECIFICATION O-G-93, NOVEMBER, 1949, AND CONTAIN FLUXING INGREDIENTS.
 THE PROCEDURE FOR USING REPAIR STICKS IS AS FOLLOWS:
 A. REMOVE WELDING SLAG BY CHIPPING HAMMER AND CLEAN WELD OR DAMAGED AREA BY VIGOROUS WIRE BRUSHING.
 B. PREHEAT THE REGION TO BE REPAIRED BY MEANS OF AN OXYACETYLENE TORCH OR OTHER CONVENIENT METHOD TO 600 °F. THE ALLOYS DO NOT SPREAD WELL AT LOWER TEMPERATURES.
 C. WIRE BRUSH SURFACE AGAIN.
 D. APPLY COATING BY RUBBING BAR OF THE ALLOY OVER THE HEATED SURFACE WHILE IT IS HOT ENOUGH TO MELT THE ALLOY.
 E. SPREAD THE MOLTEN ALLOY BY BRISKLY WIRE BRUSHING OR RUBBING WITH A FLAT EDGED STRIP OF STEEL OR PALETTE KNIFE.
 F. REMOVE FLUX RESIDUES BY WIPING WITH A DAMP CLOTH OR RINSING WITH WATER.
 G. BRUSH APPLY TWO COATS ZINC RICH PAINT (COLD GALVANIZE REPAIR).
 IT IS POSSIBLE TO UTILIZE THE RESIDUAL HEAT IN THE WELD TO MELT THE REPAIR STICK, AND THE PROCEDURE FOR WELDS THAT ARE STILL HOT (600 °F OR OVER) IS:
 A. REMOVE SLAG AND WIRE BRUSH VIGOROUSLY.
 B. APPLY COATING OF ALLOY AS ABOVE AND PAINT AS PER G ABOVE AFTER COOLING.
 IN ALL CASES, THE REPAIR STICK SHOULD NOT BE APPLIED TO A SURFACE MUCH ABOVE 600 °F, BECAUSE TOO MUCH DROSS WILL BE FORMED. SOME OF THESE REPAIR COMPONENTS ARE ALSO AVAILABLE IN POWDER FORM WHICH IS APPLIED IN A SIMILAR MANNER TO THE STICKS.
 CONTRACTOR MAY OPTIONALLY ELECT TO UTILIZE METALLIZING TECHNIQUES TO SPRAY APPLY A ZINC PROTECTIVE COATING AS A SUBSTITUTE FOR ZINC STICK REPAIR TECHNIQUE. IF METALLIZING TECHNIQUE IS EMPLOYED, SURFACE PREPARATION AND APPLICATION OF ZINC COATING SHALL BE PER CURRENT AWS SPECIFICATION C2.2. ONLY "ARC-SPRAY" METALLIZING METHODS WILL BE APPROVED FOR USE ON THIS PROJECT.

KTN-THIRD AVENUE EXTENSION
 PROJECT NO. 68490
**Barrier Railing Modification
 Detail**

Project As Built Drawings have been reviewed by the Project Engineer. To the best of his/her knowledge, they represent the project as constructed.
 Proj. Eng. *[Signature]* Date 10/3/06

DESIGNED BY: C. HOWARD




CHECKED BY: T. MOORE
 DRAWN BY: T.M./R.S

STATE OF ALASKA
 DEPARTMENT OF TRANSPORTATION & PUBLIC FACILITIES
 STATEWIDE DESIGN & ENGINEERING SERVICES DIVISION
 THIRD AVENUE EXTENSION
 PROJECT NO. 68490

**Retaining Wall
 Details**

PROJECT DESIGNATION NUMBER	
STP-MG-0904(2)	
STATE	YEAR
ALASKA	2002
SHEET NUMBER	TOTAL SHEETS
J8	146

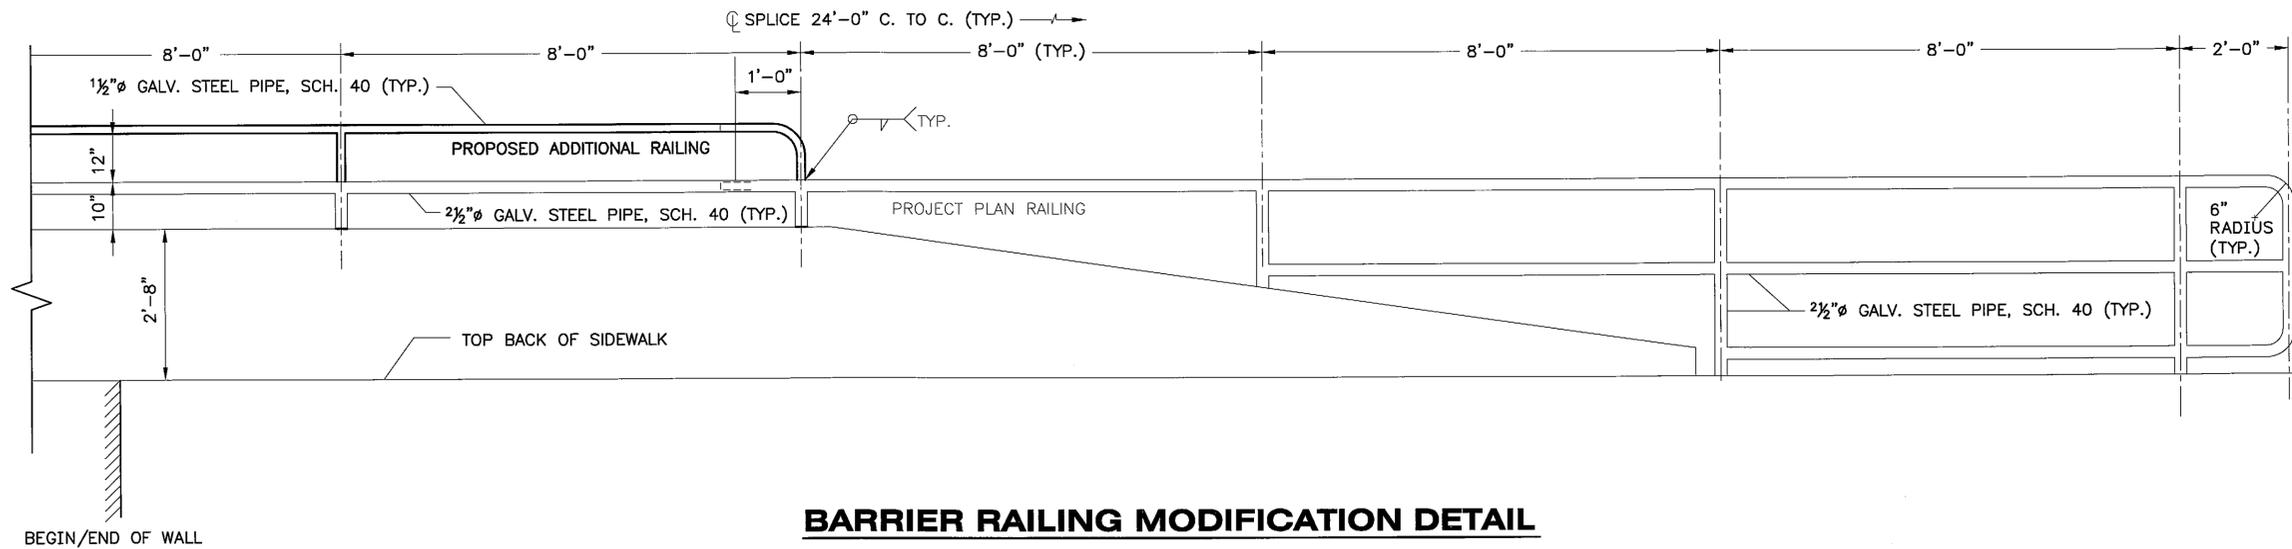

BARRIER RAILING MODIFICATION DETAIL

GENERAL NOTES:


1. Construct stairways and interpretive signs (kiosks) as shown on the plans.
2. Ketchikan Gateway Borough—Parks and Recreation Department, and the Ketchikan Trails Coalition will follow up with trail improvements connecting to the stairways.
3. Panel Legend for interpretive signs will be supplied by the engineer

Construction activities within the 330' and 1/2-mile radii around the eagle's nest shall conform to the requirements of section 107-1.01 of the specifications.

Approximate location of Rainbird Trail

See Sheet G2 for Concrete Pad Layout & Details

See Sheet E2 for Stairway Layout & Details

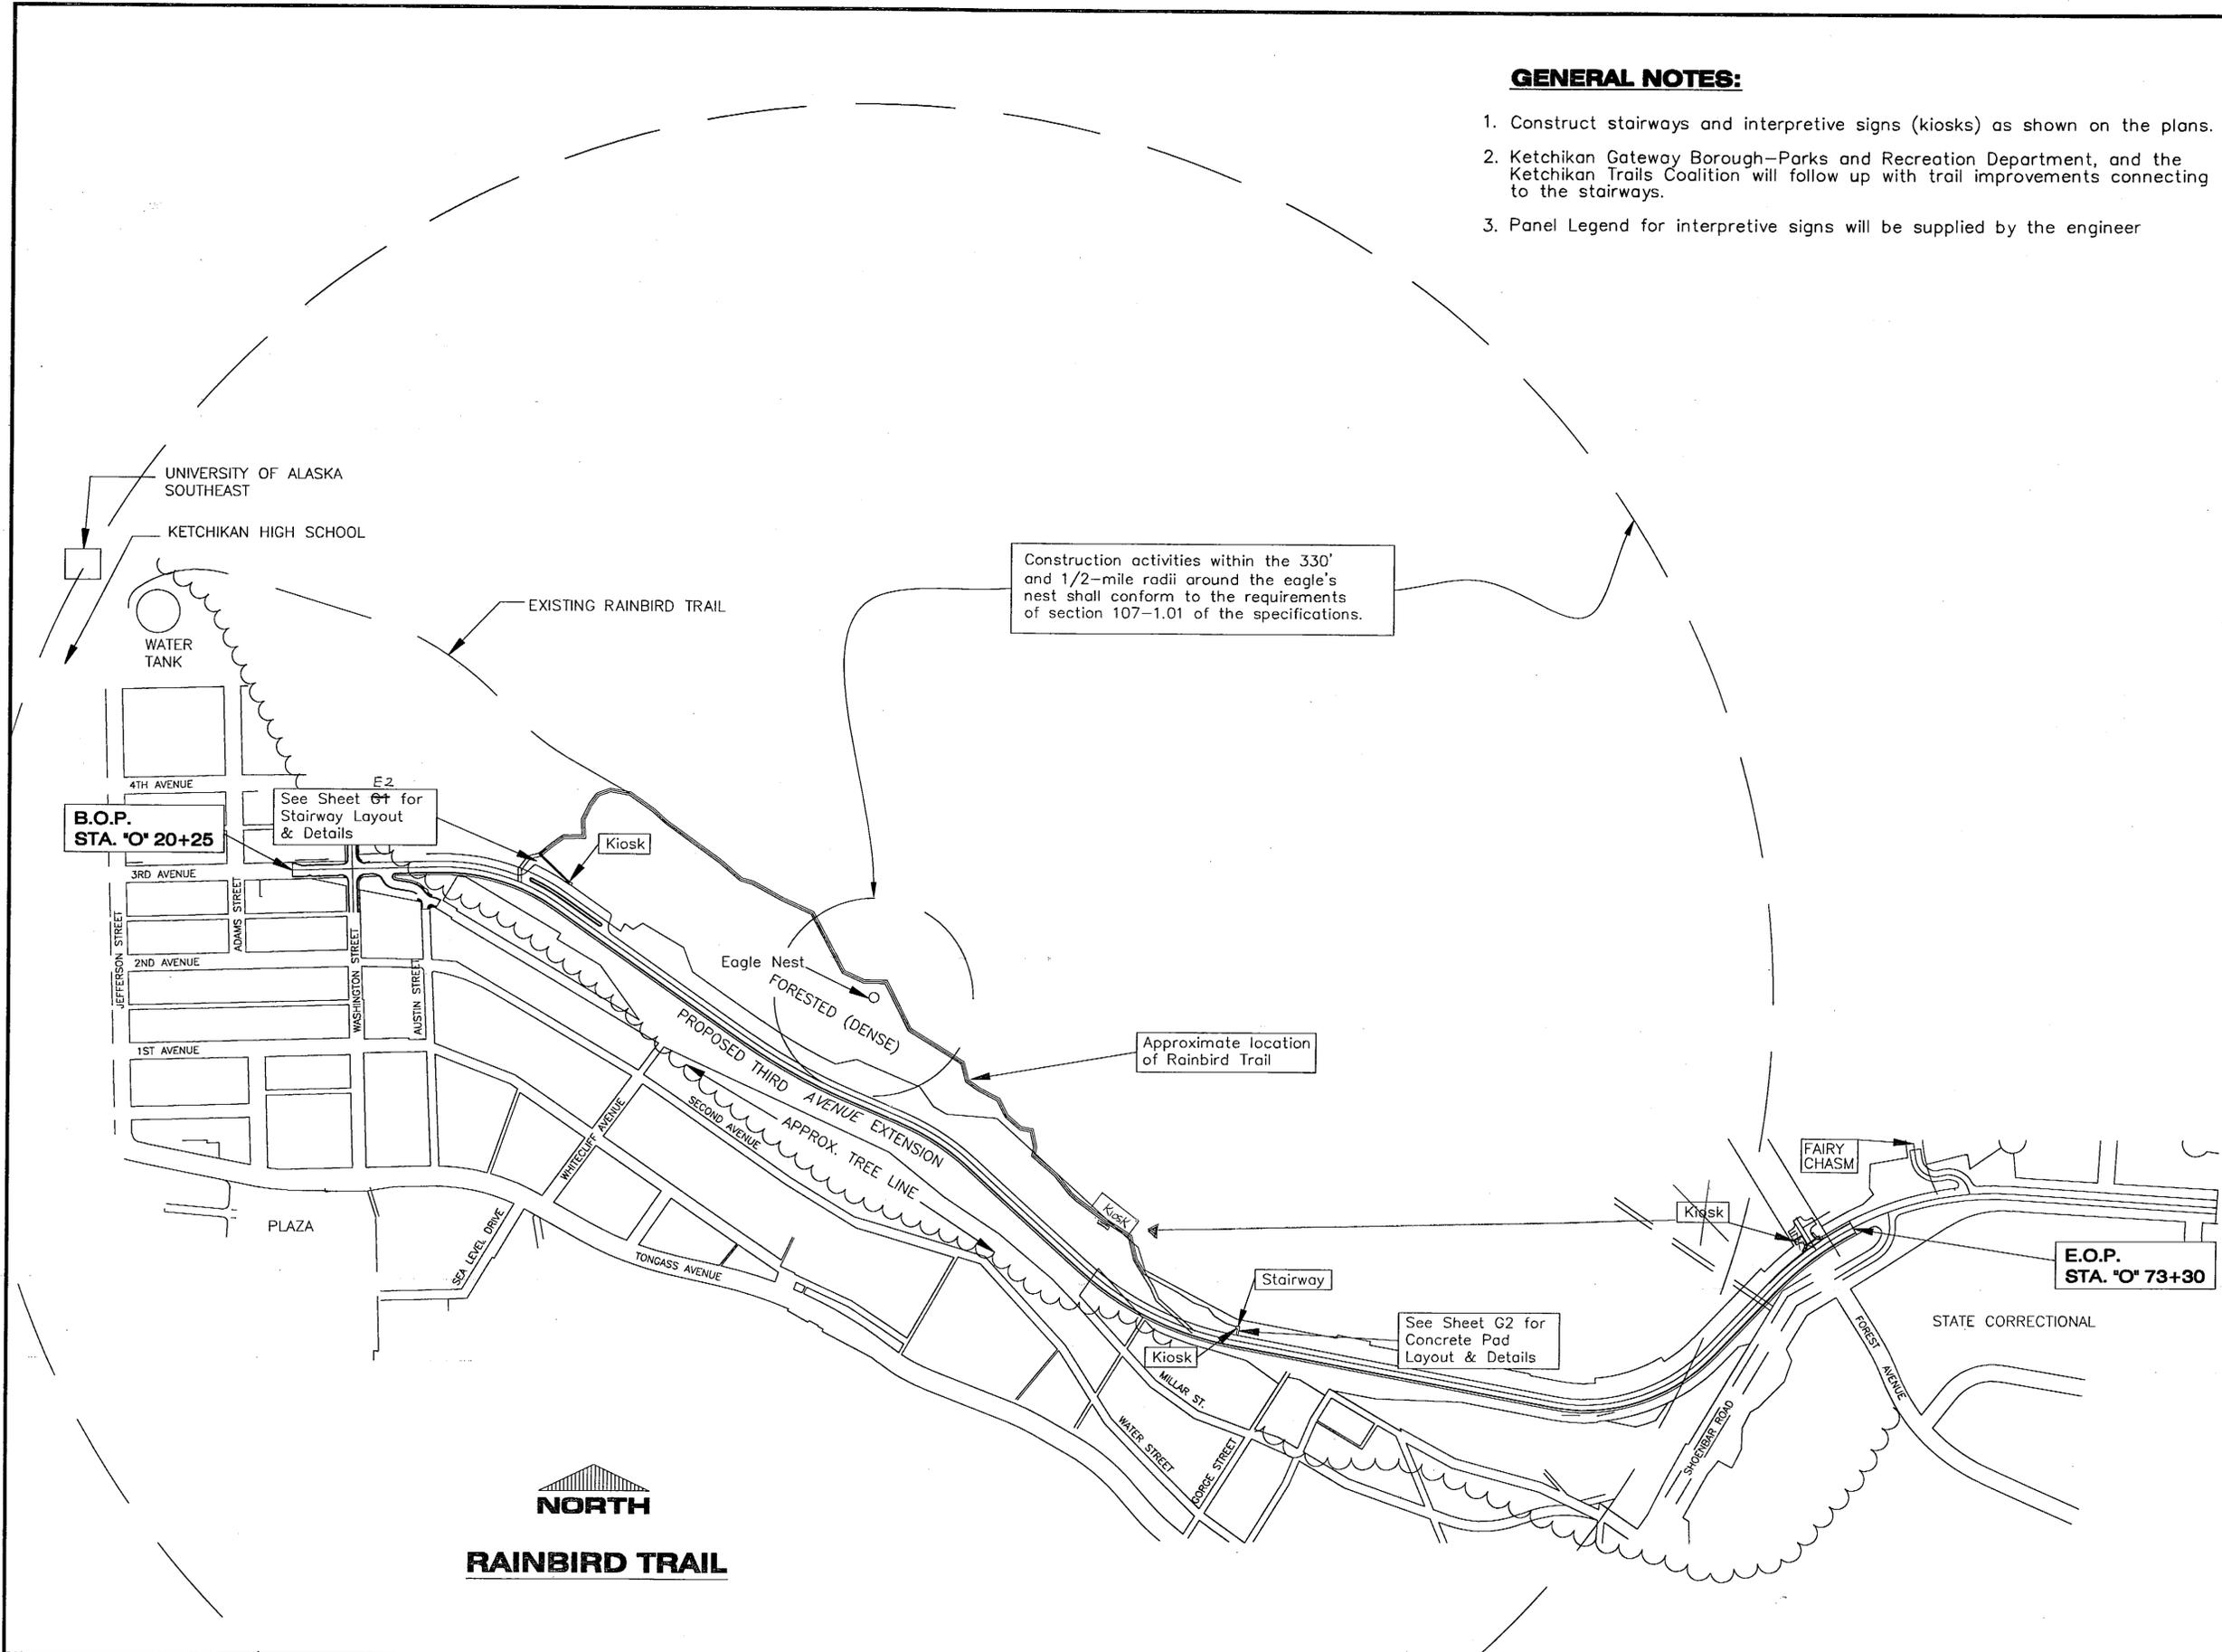

PATH: O:\Ktr\71811A\Planset\K_RainbirdTrail.dwg
 Mon. 06/May/02 09:38AM Michael Limbaugh
 PLOT: PSPACE 1=1(F) OR MSPACE 1=1(F)
 TAB: ESTIMATE

ADDENDUM NUMBER		
ATTACHMENT NUMBER		
RECORD OF REVISIONS		
No.	DATE	DESCRIPTION

KTN-THIRD AVENUE EXTENSION
PROJECT NO. 68490
Rainbird Trail Layout Plan

DESIGNED BY: C. HOWARD



CHECKED BY: T. MOORE
 DRAWN BY: T.M./R.S.

STATE OF ALASKA
 DEPARTMENT OF TRANSPORTATION & PUBLIC FACILITIES
 STATEWIDE DESIGN & ENGINEERING SERVICES DIVISION
THIRD AVENUE EXTENSION
PROJECT NO. 68490

Rainbird Trail
Layout Plan

PROJECT DESIGNATION NUMBER	
STP-MG-0904(2)	
STATE	YEAR
ALASKA	2002
SHEET NUMBER	TOTAL SHEETS
K1	146

Project As Built Drawings have been reviewed by the Project Engineer. To the best of his/her knowledge, they represent the project as constructed.
 Proj. Eng. *[Signature]* Date 05/06

PATH: Q:\Ktn\71811A\PlanSet\K_RainbirdTrail.dwg
 TUE, 07/May/02 01:18PM Michael Limbaugh
 PLOT: PSPACE 1=1(F) OR MSPACE 1=1(F)
 TAB: ESTIMATE


ADDENDUM NUMBER		
ATTACHMENT NUMBER		
RECORD OF REVISIONS		
No.	DATE	DESCRIPTION

KTN-THIRD AVENUE EXTENSION
PROJECT NO. 68490


Stairway Details

NOTES:


1. STAIRWAY AND LANDING TREAD SHALL BE STEEL GRATING 1" X 3/16" BEARING BARS AND 1/4" CROSS BARS, RYERSON 19W4, OR EQUAL.
2. POST BASES SHALL BE GALVANIZED, SIMPSON EPB 44A OR EQUAL
3. DIAGONAL BRACING TO INTERIOR SUPPORT 1/2" X 6" LAG SCREWS (2) EACH TREADS TO STRINGERS 3/8" X 3" LAG SCREWS (2) EACH SIDE
 4 X 6 POST TO STRINGER 1/2" X 8" BOLTS (2) EACH
 4 X 6 TO POST BASE Simpson Strong Tie, Co. EPB44A
 ALL OTHER CONNECTIONS SHALL BE MADE WITH GALVANIZED FASTENINGS IN ACCORDANCE WITH THE UNIFORM BUILDING CODE. WASHERS SHALL BE USED ON ALL BOLTS NOT BEARING ON METAL.
4. ALL HARDWARE SHALL BE GALVANIZED IN ACCORDANCE WITH ASTM-A-153.
5. ALL WOOD SHALL BE PRESSURE TREATED CONFORMING TO SECTION 506.
6. FOOTINGS SHALL BE ON UNDISTURBED EARTH AND A MINIMUM OF 32" BELOW THE SURFACE, EXCEPT BEDROCK FOOTINGS.
7. STEEL TUBE RAILING SHALL BE HOT-DIP GALVANIZED AND CONFORM TO ASTM-A-53-GRADE B. ALL JOINTS SHALL BE MADE WITH CONCEALED BUTT JOINT CONNECTORS, OR WELDED AND REGALVANIZED IN CONFORMANCE WITH AASHTO M 36.
8. DIAGONAL CROSS BRACING NOT REQUIRED IF POST HEIGHTS IS LESS THAN 4- FEET. DIAGONAL CROSS BRACING IS REQUIRED IF POST HEIGHT IS BETWEEN 4 AND 8 FEET. TWO DIAGONAL CROSS BRACING REQUIRED IF POST HEIGHT IS OVER 8- FEET.

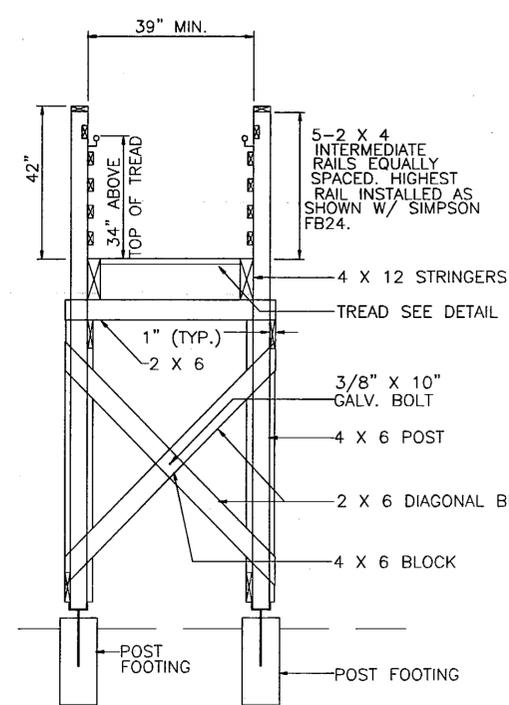


LANDING SECTION

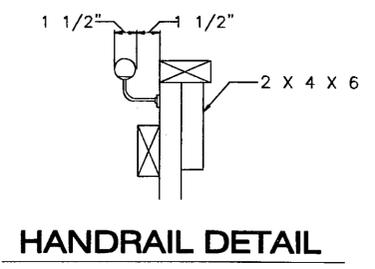


HANDRAIL DETAIL

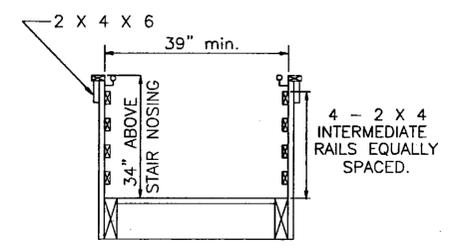


STAIRWAY SECTION

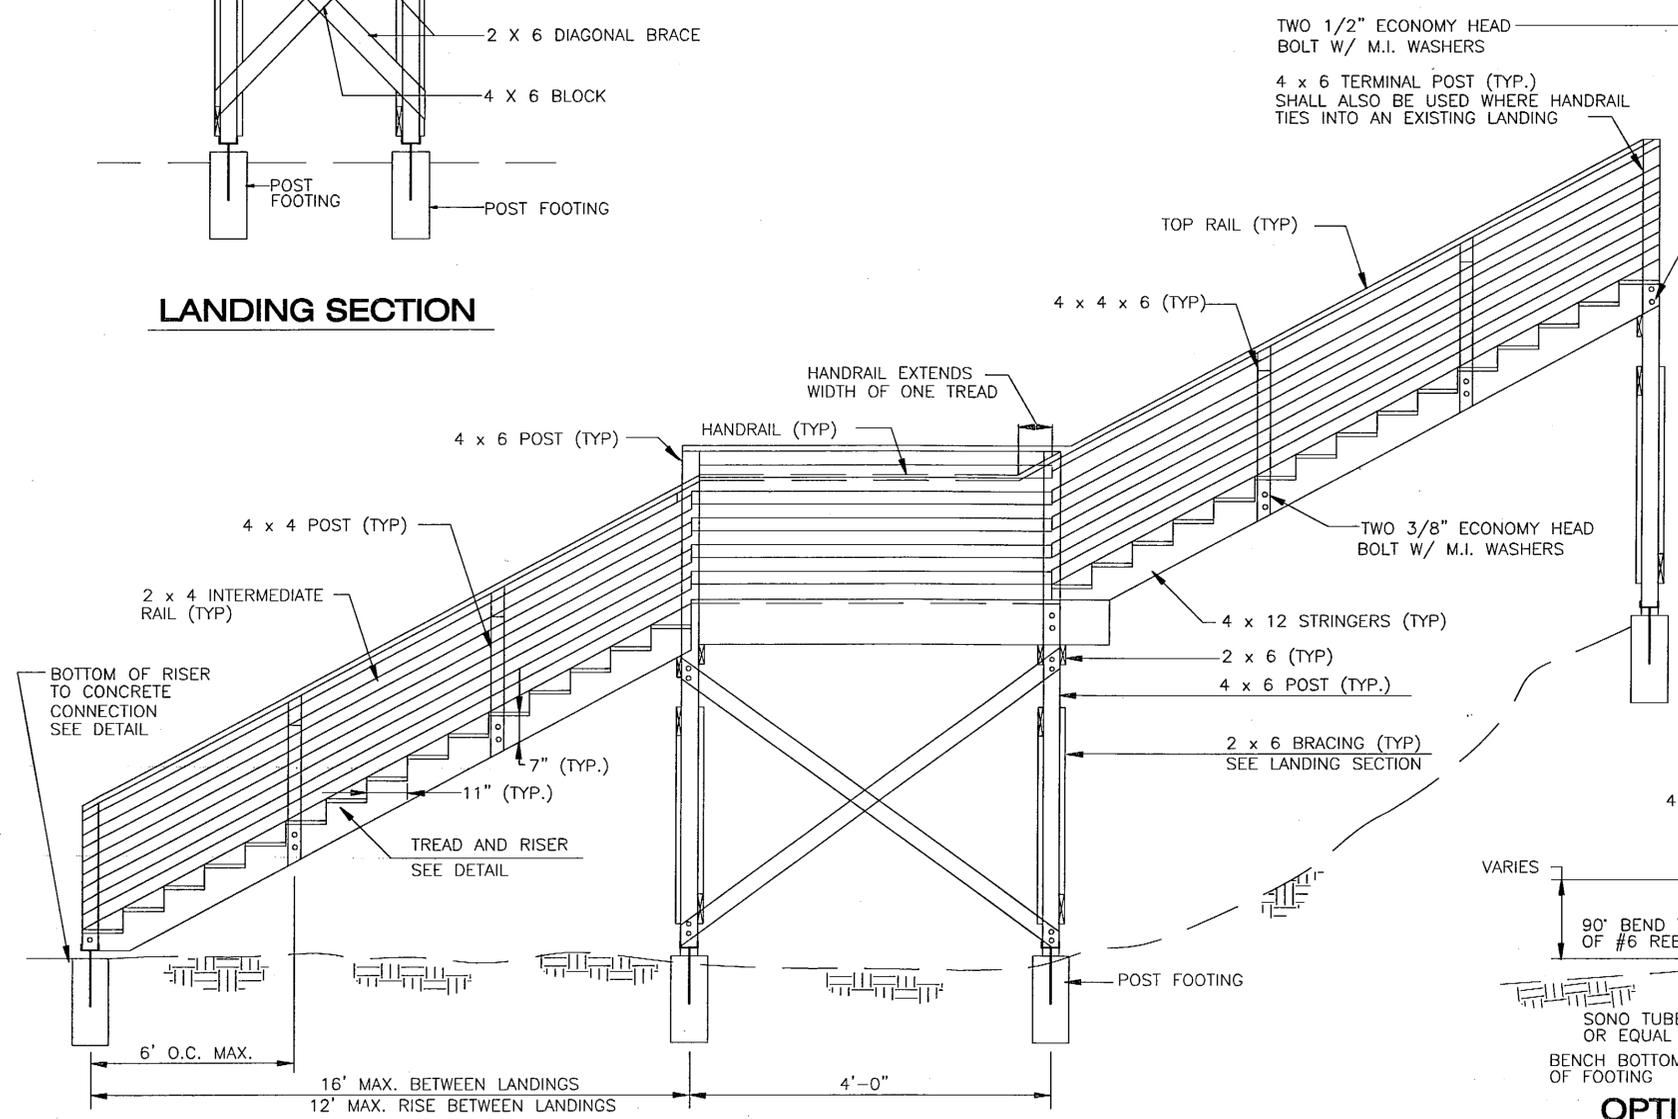

TYPICAL STAIRWAY PROFILE

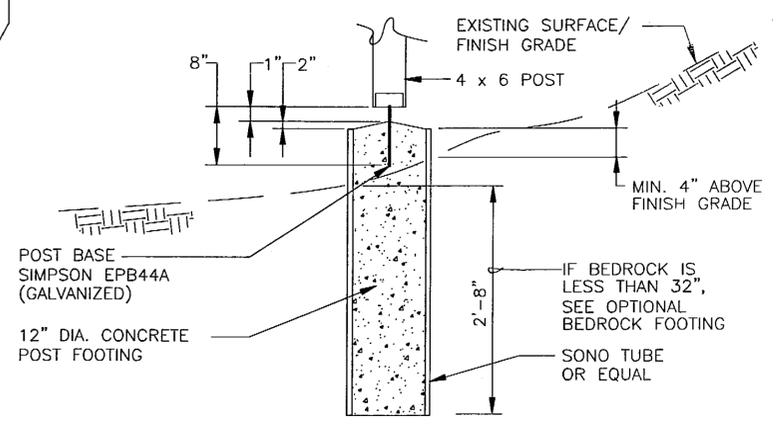

STAIRWAY POST FOOTING

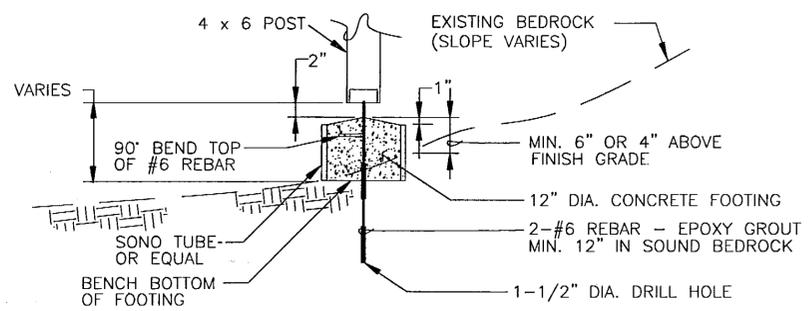

OPTIONAL BEDROCK FOOTING

DESIGNED BY: C. HOWARD



CHECKED BY: T. MOORE
 DRAWN BY: T.M./R.S.

STATE OF ALASKA
 DEPARTMENT OF TRANSPORTATION
 & PUBLIC FACILITIES
 STATEWIDE DESIGN & ENGINEERING
 SERVICES DIVISION
**THIRD AVENUE EXTENSION
 PROJECT NO. 68490**

Stairway Details

PROJECT DESIGNATION NUMBER	
STP-MG-0904(2)	
STATE	YEAR
ALASKA	2002
SHEET NUMBER	TOTAL SHEETS
K2	146


Project As Built Drawings have been reviewed by the Project Engineer. To the best of his/her knowledge, they represent the project as constructed.
 Proj. Eng. *[Signature]* Date 02/06

PATH: Q:\ktn\71811A\PlanSet\K_RainbirdTrail.dwg
 Tue, 07/May/02 02:33PM Michael Limbough
 PLOT: PSPACE 1=1(F) OR MSPACE 1=1(F)
 TAB: ESTIMATE


ADDENDUM NUMBER		
ATTACHMENT NUMBER		
RECORD OF REVISIONS		
No.	DATE	DESCRIPTION

KTN-THIRD AVENUE EXTENSION
 PROJECT NO. 68490

Stairway Details

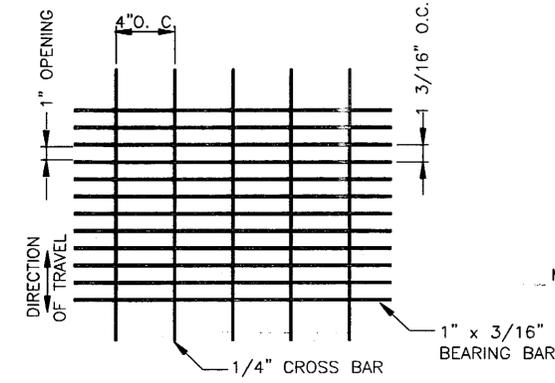


STAIR TREAD

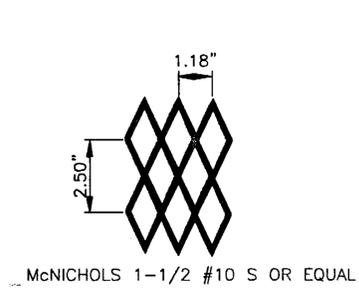


EXPANDED METAL RISER


McNICHOLS 1-1/2 #10 S OR EQUAL

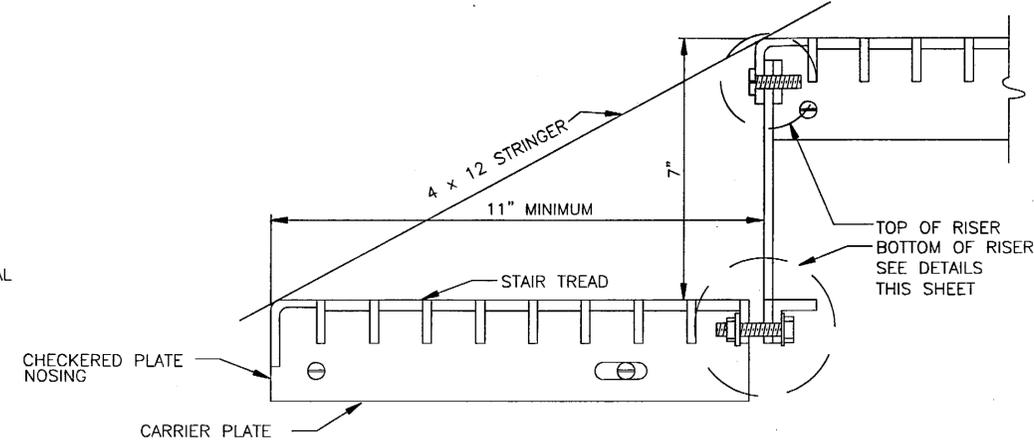


TREAD AND RISER PROFILE

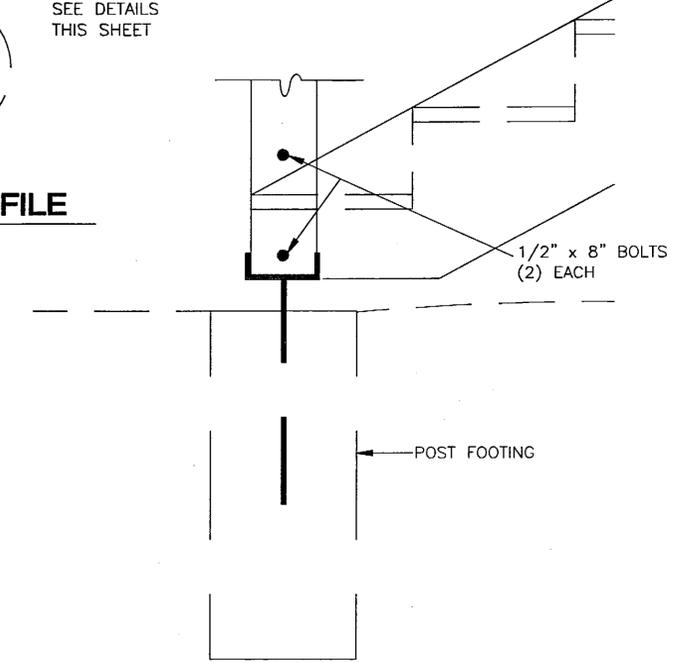


BOTTOM OF STAIRWAY PROFILE

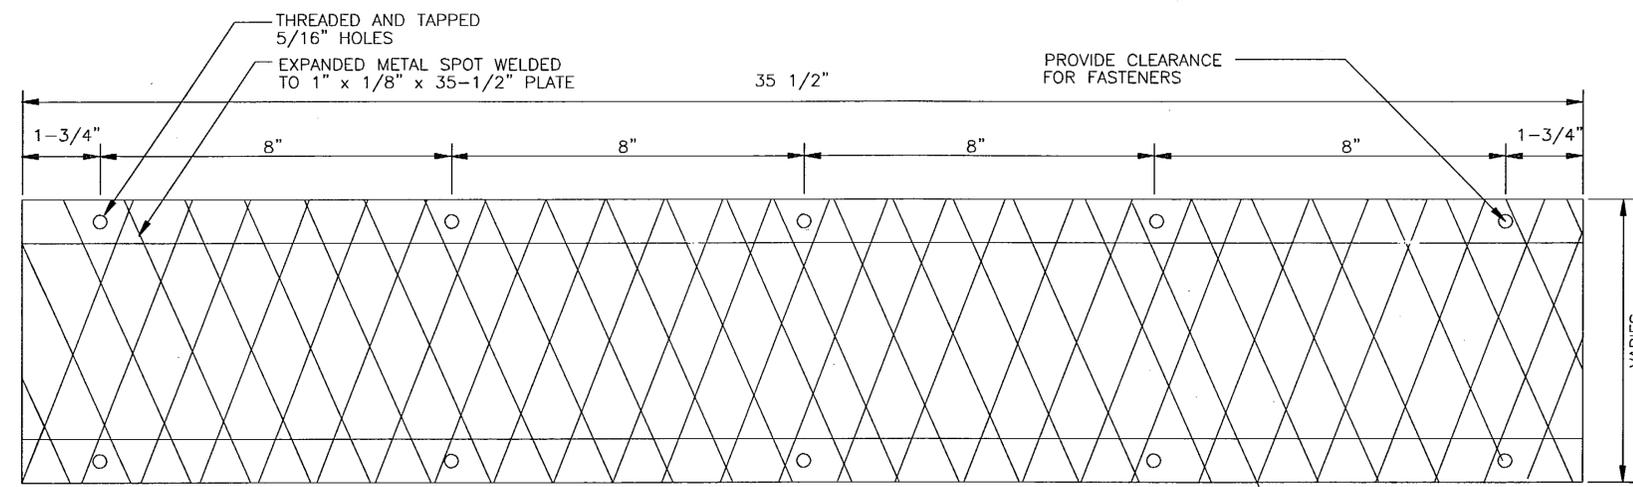


ADJUSTABLE HEIGHT RISER

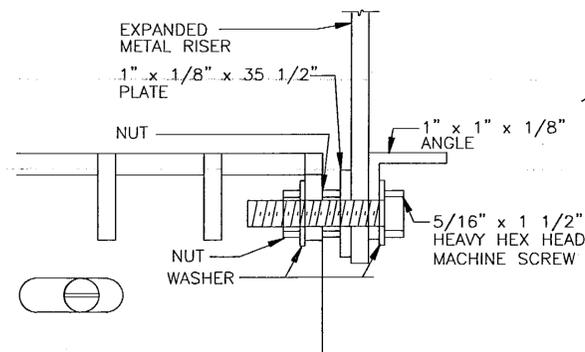


TYPICAL BOTTOM OF RISER

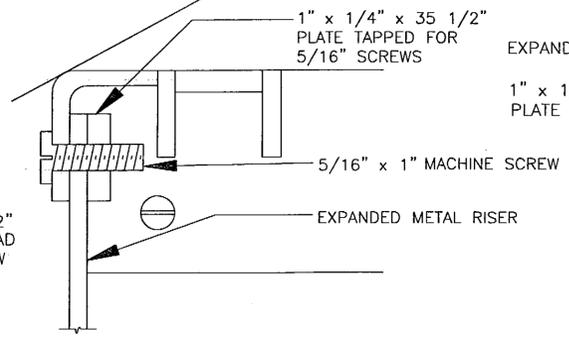

TYPICAL TOP OF RISER

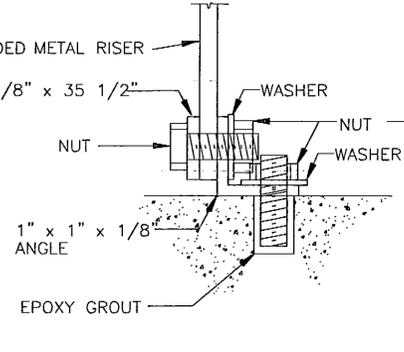

BOTTOM RISER TO CONCRETE CONNECTION

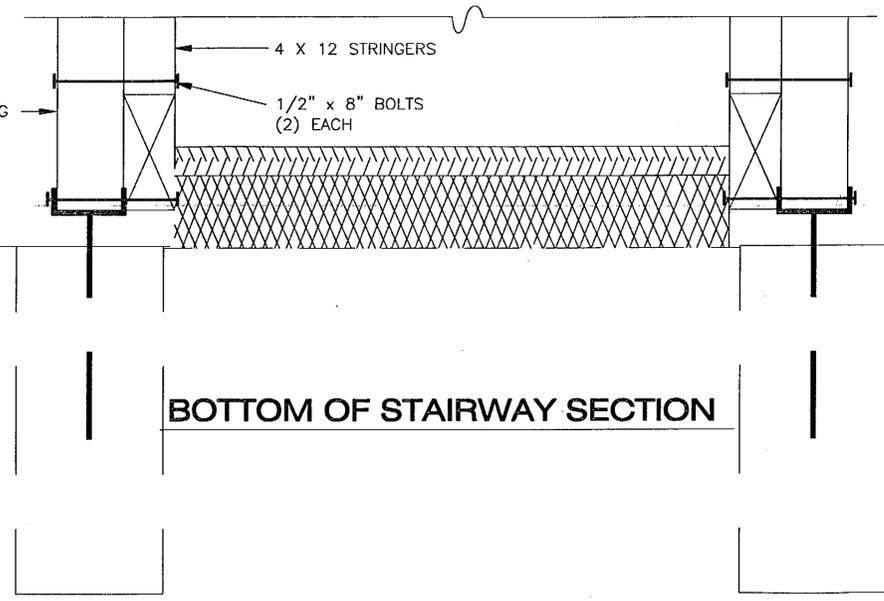

BOTTOM OF STAIRWAY SECTION

DESIGNED BY: C. HOWARD



CHECKED BY: T. MOORE
DRAWN BY: T.M./R.S.

STATE OF ALASKA
 DEPARTMENT OF TRANSPORTATION
 & PUBLIC FACILITIES
 STATEWIDE DESIGN & ENGINEERING
 SERVICES DIVISION
**THIRD AVENUE EXTENSION
 PROJECT NO. 68490**

Stairway Details

PROJECT DESIGNATION NUMBER	
STP-MG-0904(2)	
STATE	YEAR
ALASKA	2002
SHEET NUMBER	TOTAL SHEETS
K3	146

Project As Built Drawings have been reviewed by the Project Engineer. To the best of his/her knowledge, they represent the project as constructed.
 Proj. Eng. *[Signature]* Date: 3-06

ADDENDUM NUMBER		
ATTACHMENT NUMBER		
RECORD OF REVISIONS		
No.	DATE	DESCRIPTION

KTN-THIRD AVENUE EXTENSION
 PROJECT NO. 68490

Kiosk Detail

DESIGNED BY: C. HOWARD






CHECKED BY: T. MOORE
 DRAWN BY: K.K.

STATE OF ALASKA
 DEPARTMENT OF TRANSPORTATION
 & PUBLIC FACILITIES
 STATEWIDE DESIGN & ENGINEERING
 SERVICES DIVISION
 THIRD AVENUE EXTENSION
 PROJECT NO. 68490

Kiosk Detail


PROJECT DESIGNATION NUMBER	
STP-MG-0904(2)	
STATE	YEAR
ALASKA	2002
SHEET NUMBER	TOTAL SHEETS
K4	146

Project As Built Drawings have been reviewed by the Project Engineer. To the best of his/her knowledge, they represent the project as constructed.
 Proj. Eng. *KS* Date: 3/06

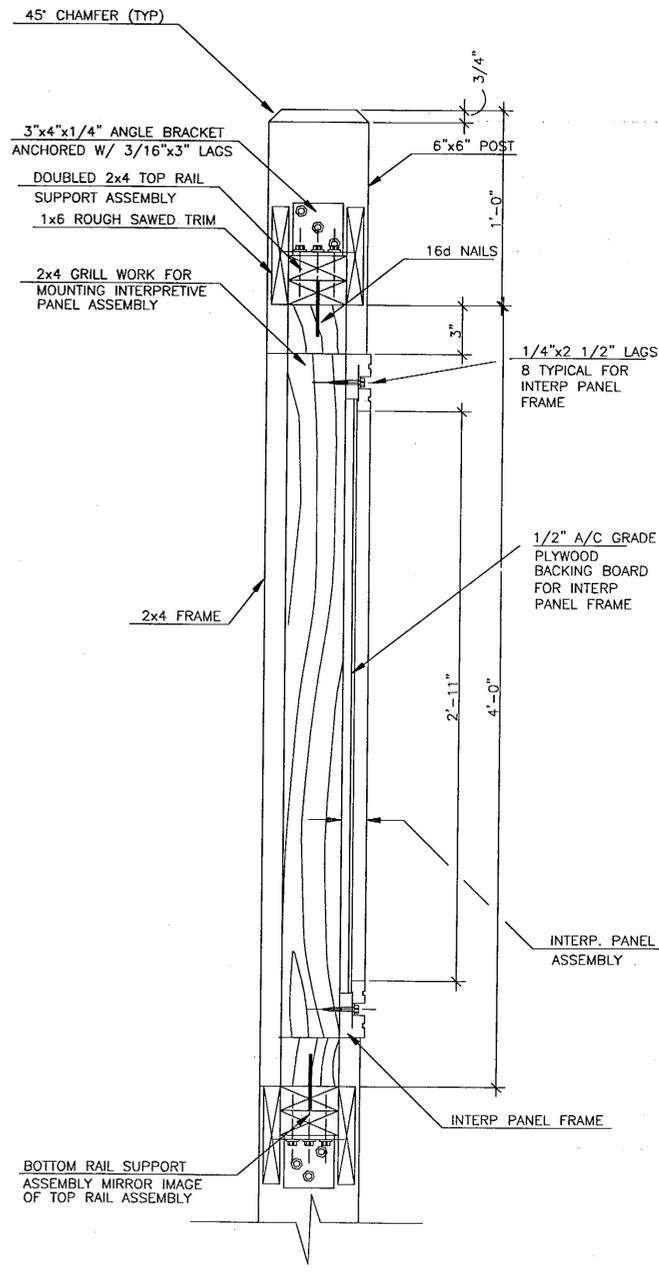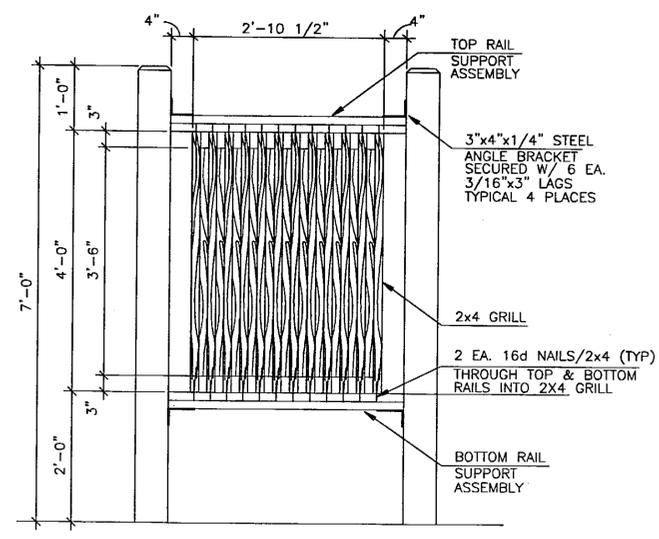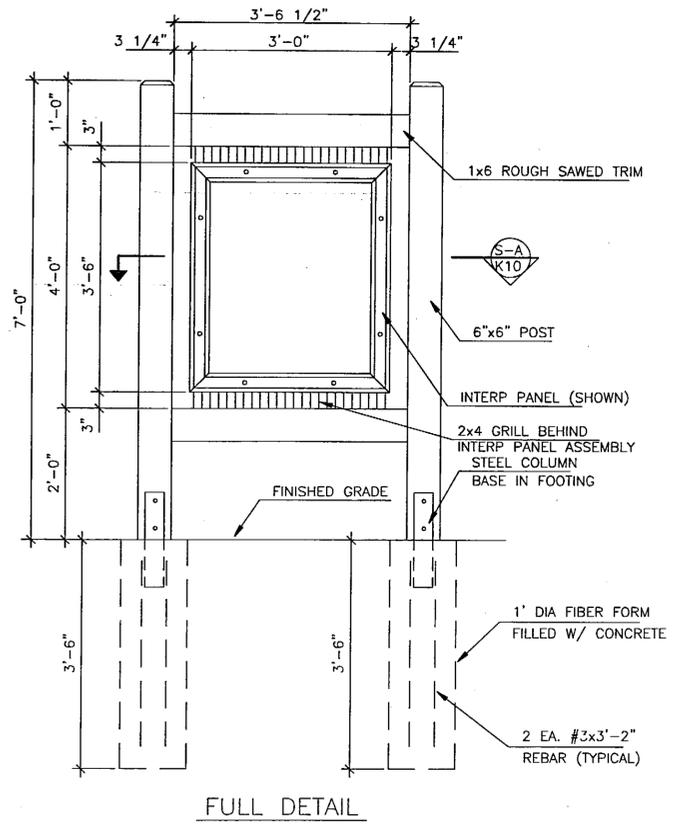


SIGN SUPPORT AND FOUNDATION
 DETAIL (3 REQUIRED)

1

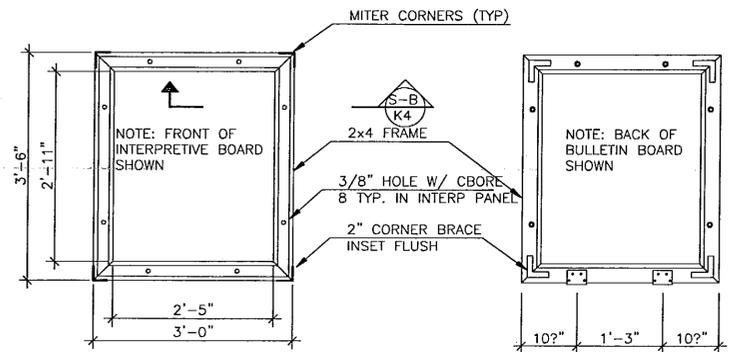

INTERPRETIVE PANEL FRAME
 DETAIL

A

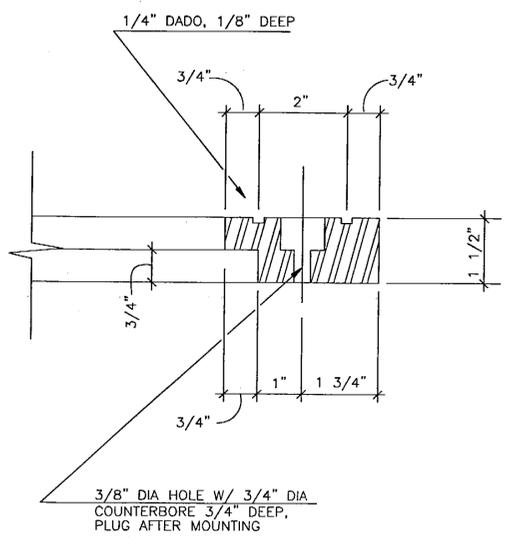

SECTION B

B


SECTION A

A

CONTROL POINT A - SHOWN ON TYPICAL SECTIONS IS DEFINED IN THE PLAN VIEW BY ALIGNMENT "R1" FOR THE LOWER RCC WALL, AND IS DEFINED IN THE PROFILE VIEW AS TOP OF ROLLER COMPACTED CONCRETE.

CONTROL POINT B - SHOWN ON THE TYPICAL SECTIONS IS THE APPROXIMATE INTERSECTING POINT BETWEEN THE ROLLER COMPACTED CONCRETE AND THE ROCK SURFACE.


PLAN VIEW

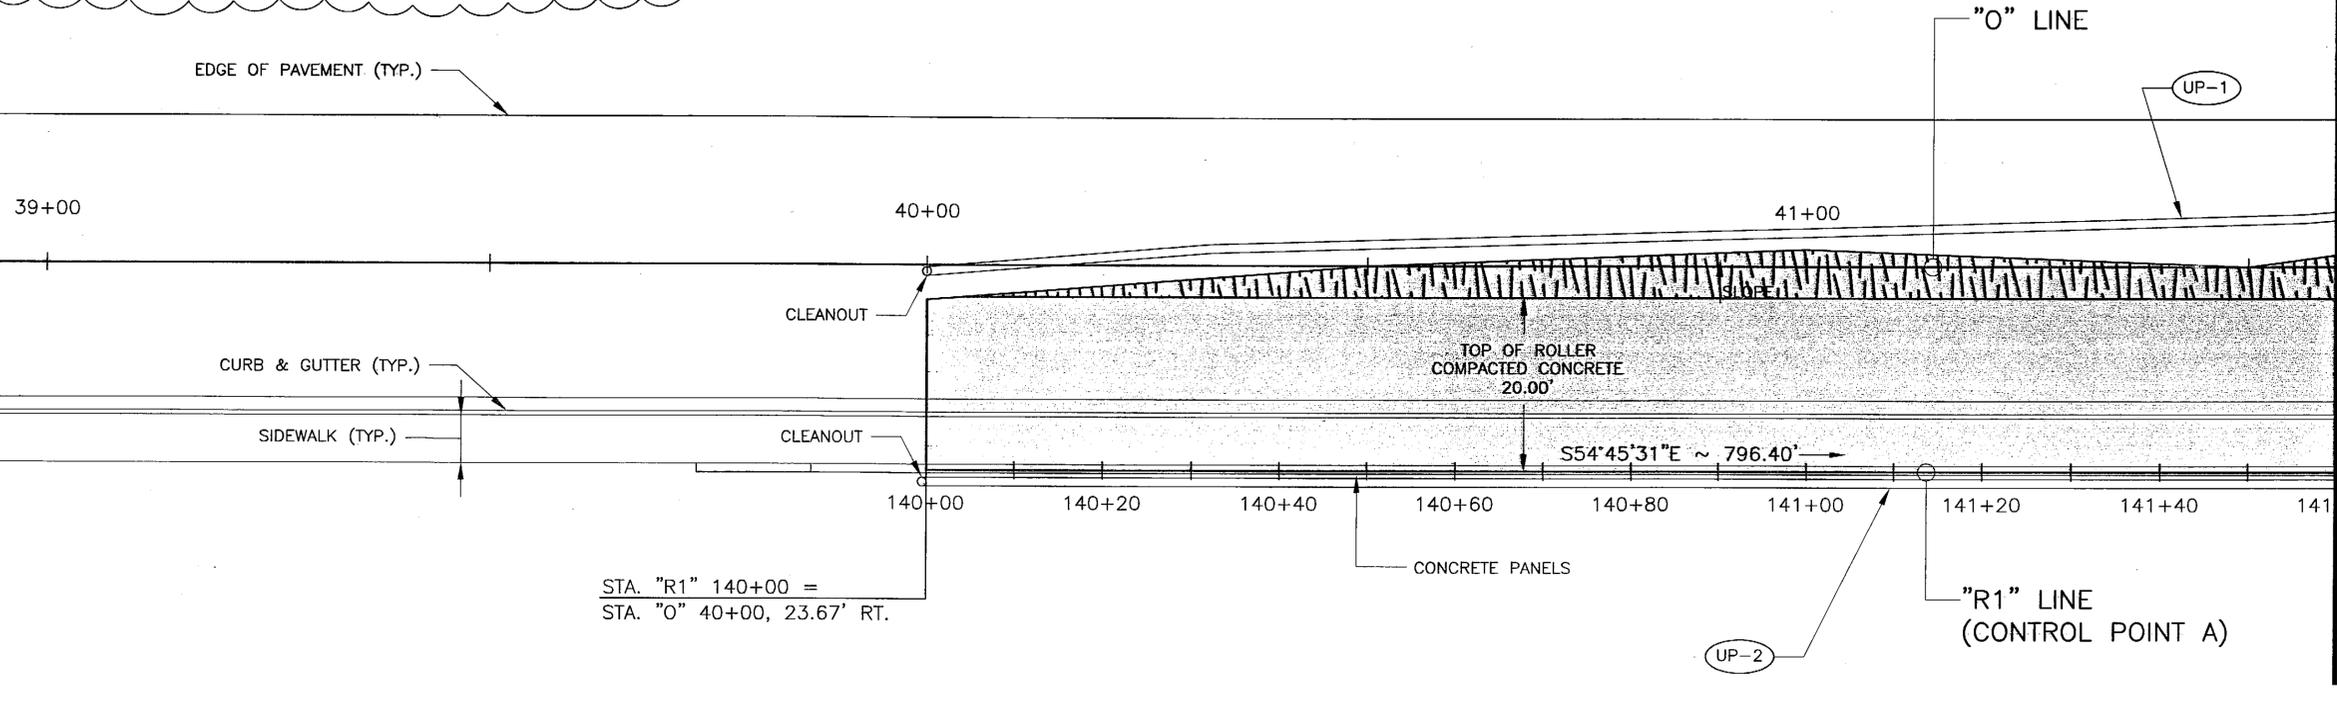

STA. "R1" 140+00 =
STA. "O" 40+00, 23.67' RT.

MATCH LINE STA. 141+60

PROFILE VIEW

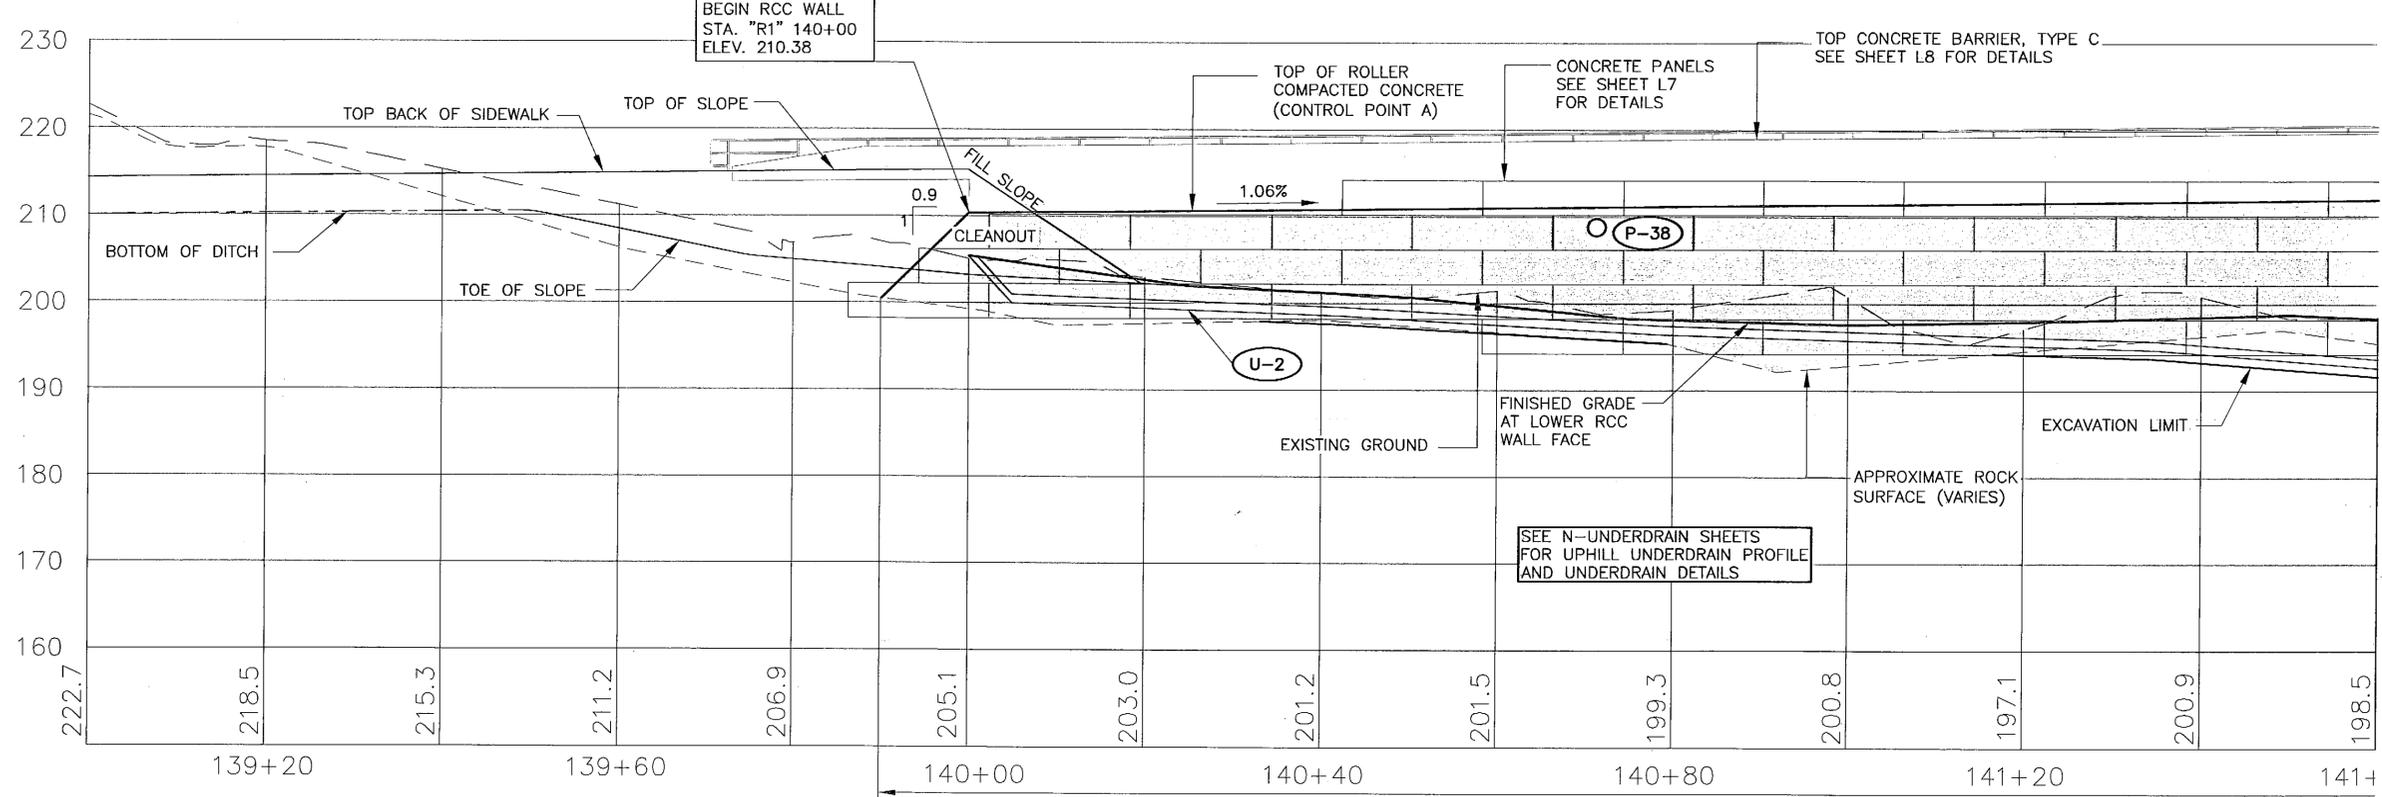

EMBANKMENT, TYPE F - LEVELING COURSE

PATH: Q:\ktn\71811A\Planset\L1-9_Roller.dwg
Mon, 06/May/02 10:42AM Michael Limbaugh
PLOT: PSPACE 1=1(F) OR MSPACE 1=1(F)
TAB: ESTIMATE

ADDENDUM NUMBER		
ATTACHMENT NUMBER		
RECORD OF REVISIONS		
No.	DATE	DESCRIPTION

KTN-THIRD AVENUE EXTENSION
PROJECT NO. 68490

**Roller Compacted
Concrete Wall Plan**

DESIGNED BY: C. HOWARD



CHECKED BY: T. MOORE
DRAWN BY: K.K. / M.L.L.

STATE OF ALASKA
DEPARTMENT OF TRANSPORTATION
& PUBLIC FACILITIES
STATEWIDE DESIGN & ENGINEERING
SERVICES DIVISION
THIRD AVENUE EXTENSION
PROJECT NO. 68490

Roller Compacted Concrete Wall Plan

PROJECT DESIGNATION NUMBER	
STP-MG-0904(2)	
STATE	YEAR
ALASKA	2002
SHEET NUMBER	TOTAL SHEETS
L1	146


Project As Built Drawings have been reviewed by the Project Engineer. To the best of his/her knowledge, they represent the project as constructed.
Proj. Eng. *[Signature]* Date: 5-2-06

CONTROL POINT A - SHOWN ON TYPICAL SECTIONS IS DEFINED IN THE PLAN VIEW BY ALIGNMENT "R1" FOR THE LOWER RCC WALL, AND IS DEFINED IN THE PROFILE VIEW AS TOP OF ROLLER COMPACTED CONCRETE.


CONTROL POINT B - SHOWN ON THE TYPICAL SECTIONS IS THE APPROXIMATE INTERSECTING POINT BETWEEN THE ROLLER COMPACTED CONCRETE AND THE ROCK SURFACE.

PLAN VIEW

UNDERDRAIN DETAILS
SEE SHEET N?-N?

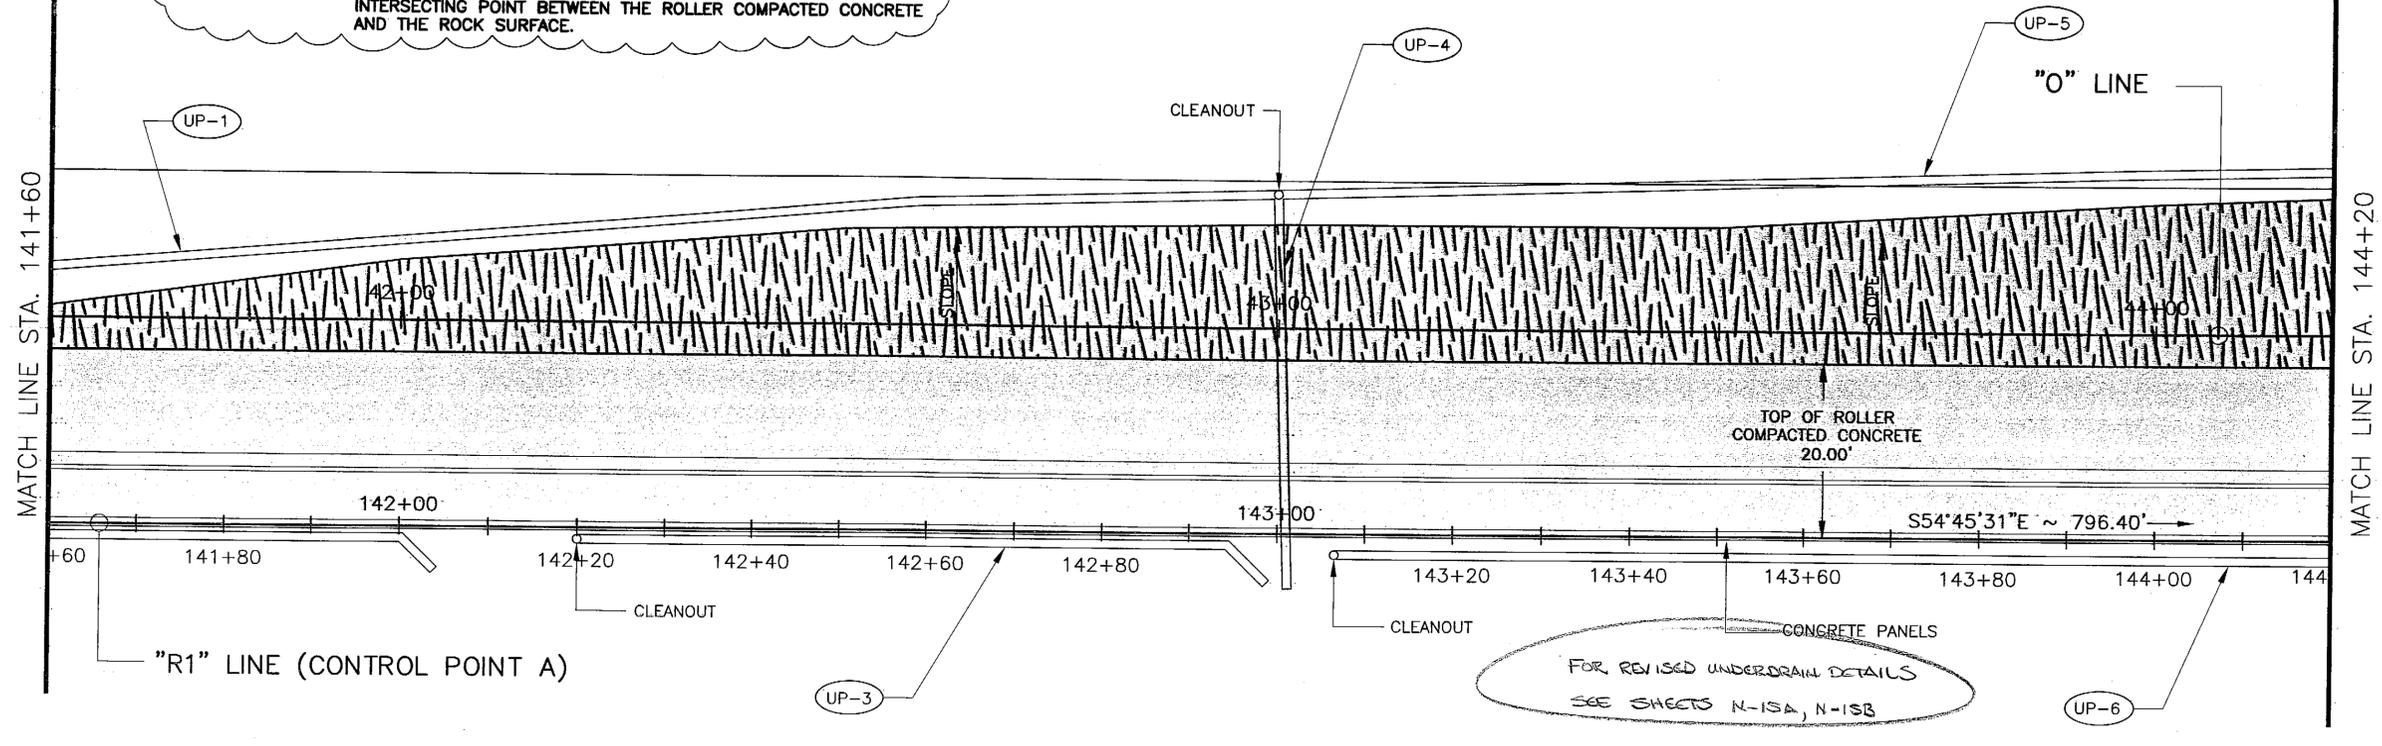

PROFILE VIEW

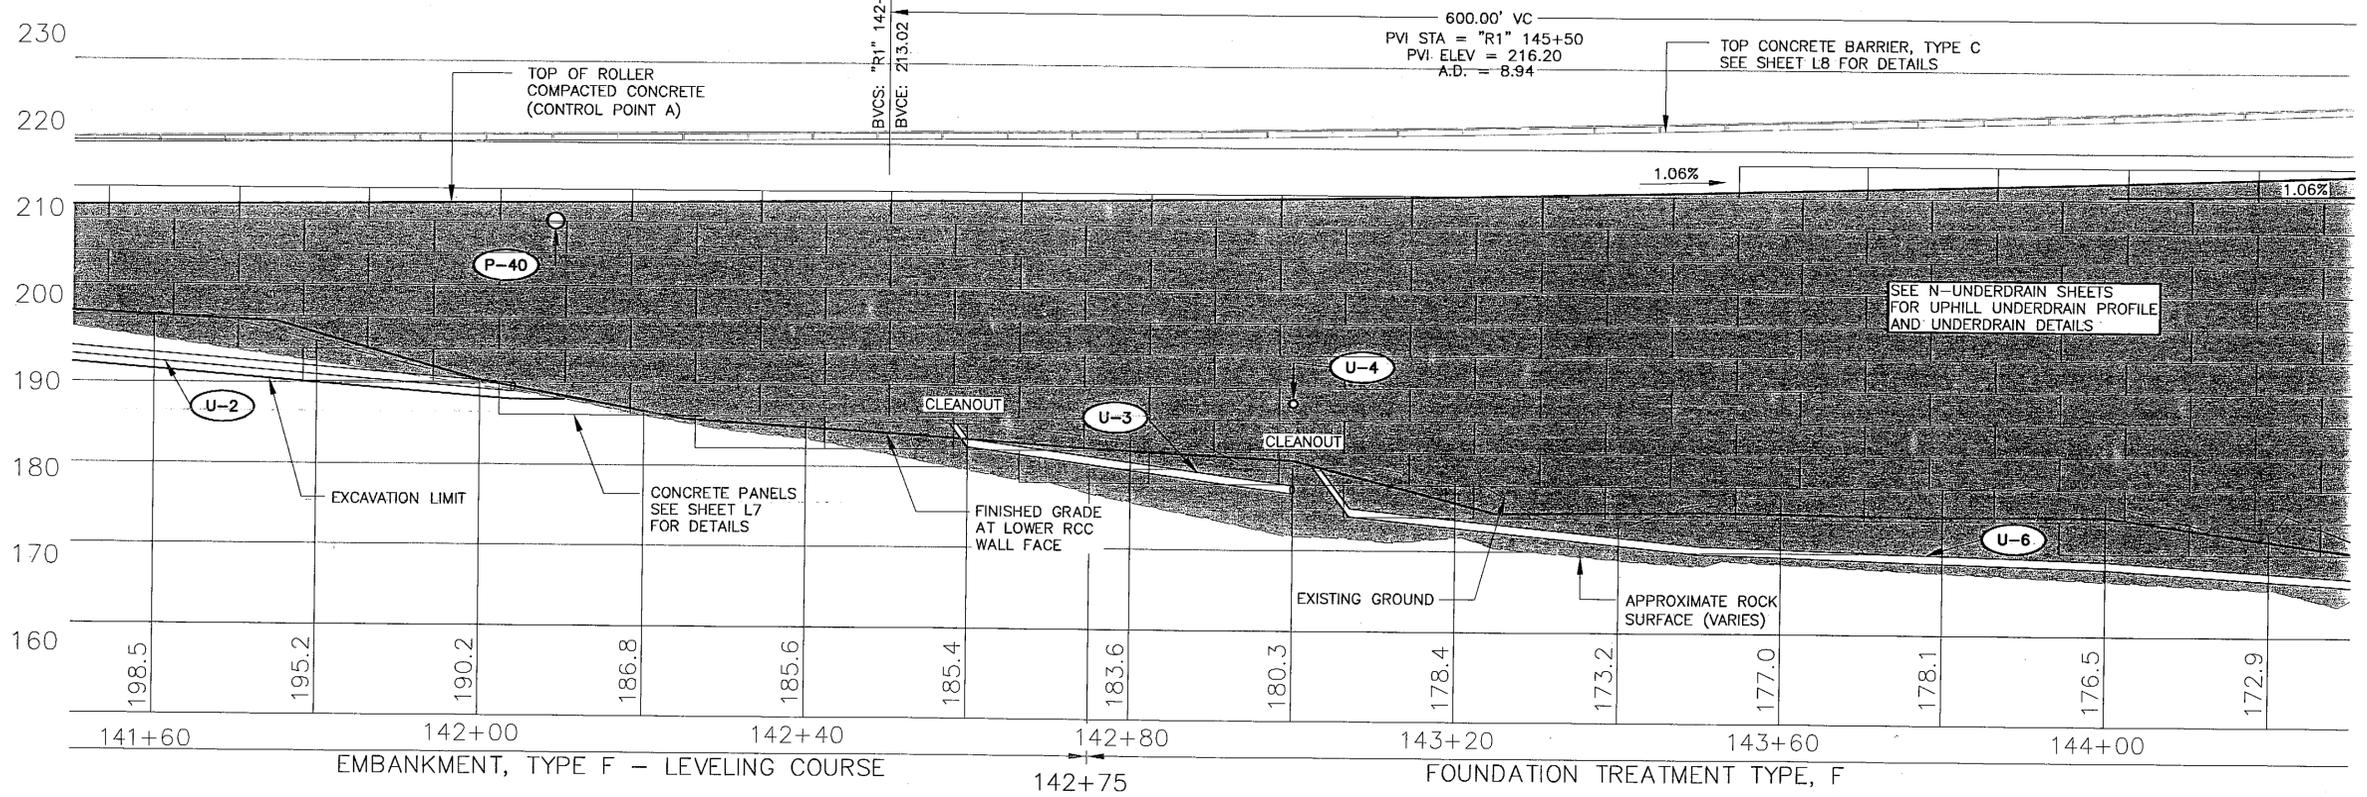

PATH: Q:\Ktn\71811A\Planset\L1-9_Roller.dwg
 Mon, 06/May/02 10:42AM Michael Limbaugh
 PLOT: PSPACE 1=1(F) OR MSPACE 1=1(F)
 TAB: ESTIMATE

ADDENDUM NUMBER		
ATTACHMENT NUMBER		
RECORD OF REVISIONS		
No.	DATE	DESCRIPTION

KTN-THIRD AVENUE EXTENSION
 PROJECT NO. 68490
**Roller Compacted
 Concrete Wall Plan**

DESIGNED BY: C. HOWARD

CHECKED BY: T. MOORE
 DRAWN BY: K.K. / M.L.L.

STATE OF ALASKA
 DEPARTMENT OF TRANSPORTATION
 & PUBLIC FACILITIES
 STATEWIDE DESIGN & ENGINEERING
 SERVICES DIVISION
 THIRD AVENUE EXTENSION
 PROJECT NO. 68490

Roller Compacted Concrete Wall Plan

PROJECT DESIGNATION NUMBER	
STP-MG-0904(2)	
STATE	YEAR
ALASKA	2002
SHEET NUMBER	TOTAL SHEETS
L2	146

Project As Built Drawings have been reviewed by the Project Engineer. To the best of his/her knowledge, they represent the project as constructed.

Proj. Eng. Date 5/3/02

PATH: O:\Ktn\71811A\Planset\L1-9_Roller.dwg
 Mon, 06/May/02 10:42AM Michael Limbaugh
 PLOT: PSPACE 1=1(F) OR MSPACE 1=1(F)
 TAB: ESTIMATE

ADDENDUM NUMBER		
ATTACHMENT NUMBER		
RECORD OF REVISIONS		
No.	DATE	DESCRIPTION

KTN-THIRD AVENUE EXTENSION
 PROJECT NO. 68490
**Roller Compacted
 Concrete Wall Plan**

DESIGNED BY: C. HOWARD





CHECKED BY: T. MOORE
 DRAWN BY: K.K. / M.L.L.

STATE OF ALASKA
 DEPARTMENT OF TRANSPORTATION
 & PUBLIC FACILITIES
 STATEWIDE DESIGN & ENGINEERING
 SERVICES DIVISION
 THIRD AVENUE EXTENSION
 PROJECT NO. 68490


**Roller Compacted
 Concrete Wall Plan**

PROJECT DESIGNATION NUMBER	
STP-MG-0904(2)	
STATE	YEAR
ALASKA	2002
SHEET NUMBER	TOTAL SHEETS
L3	146

Project As Built Drawings have been reviewed by the Project Engineer. To the best of his/her knowledge, they represent the project as constructed.
 Proj. Eng. Date 10/24/02

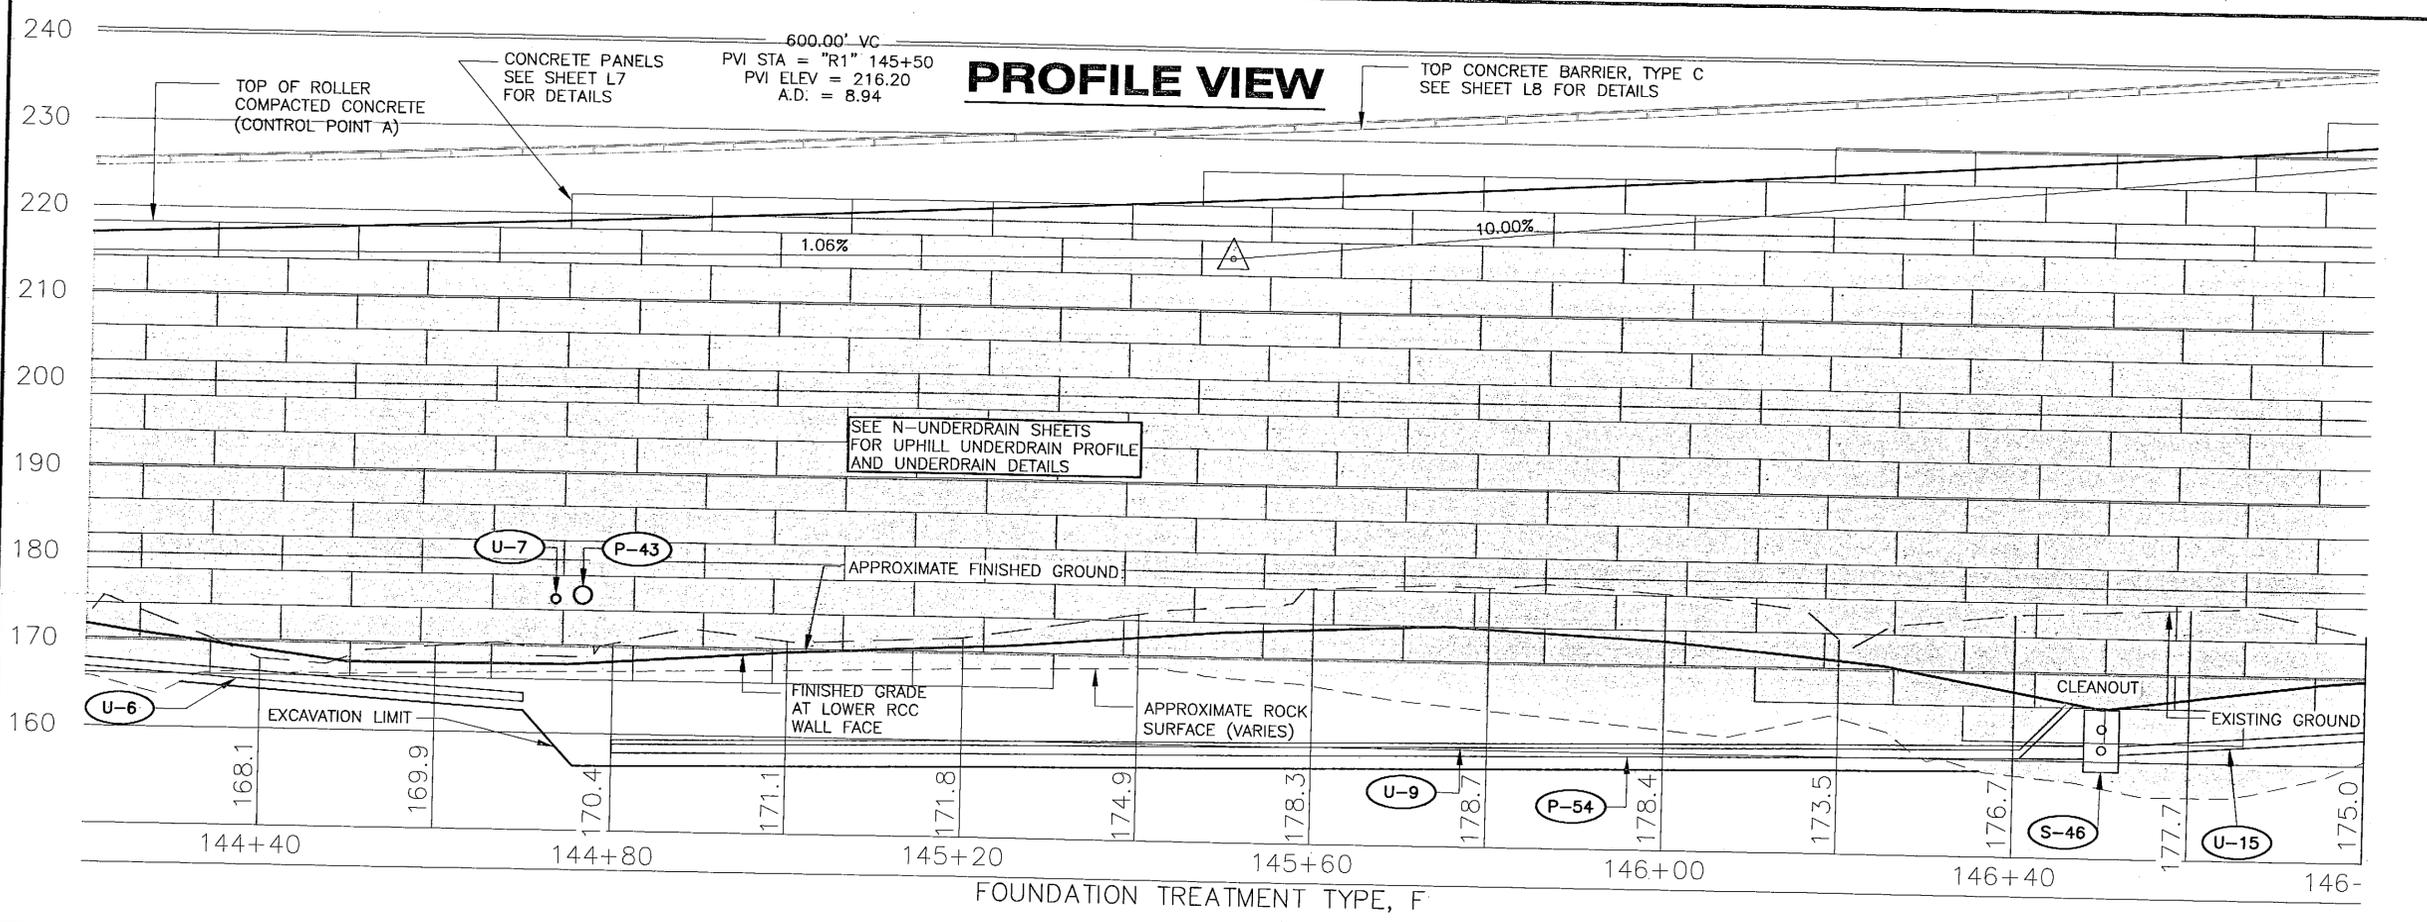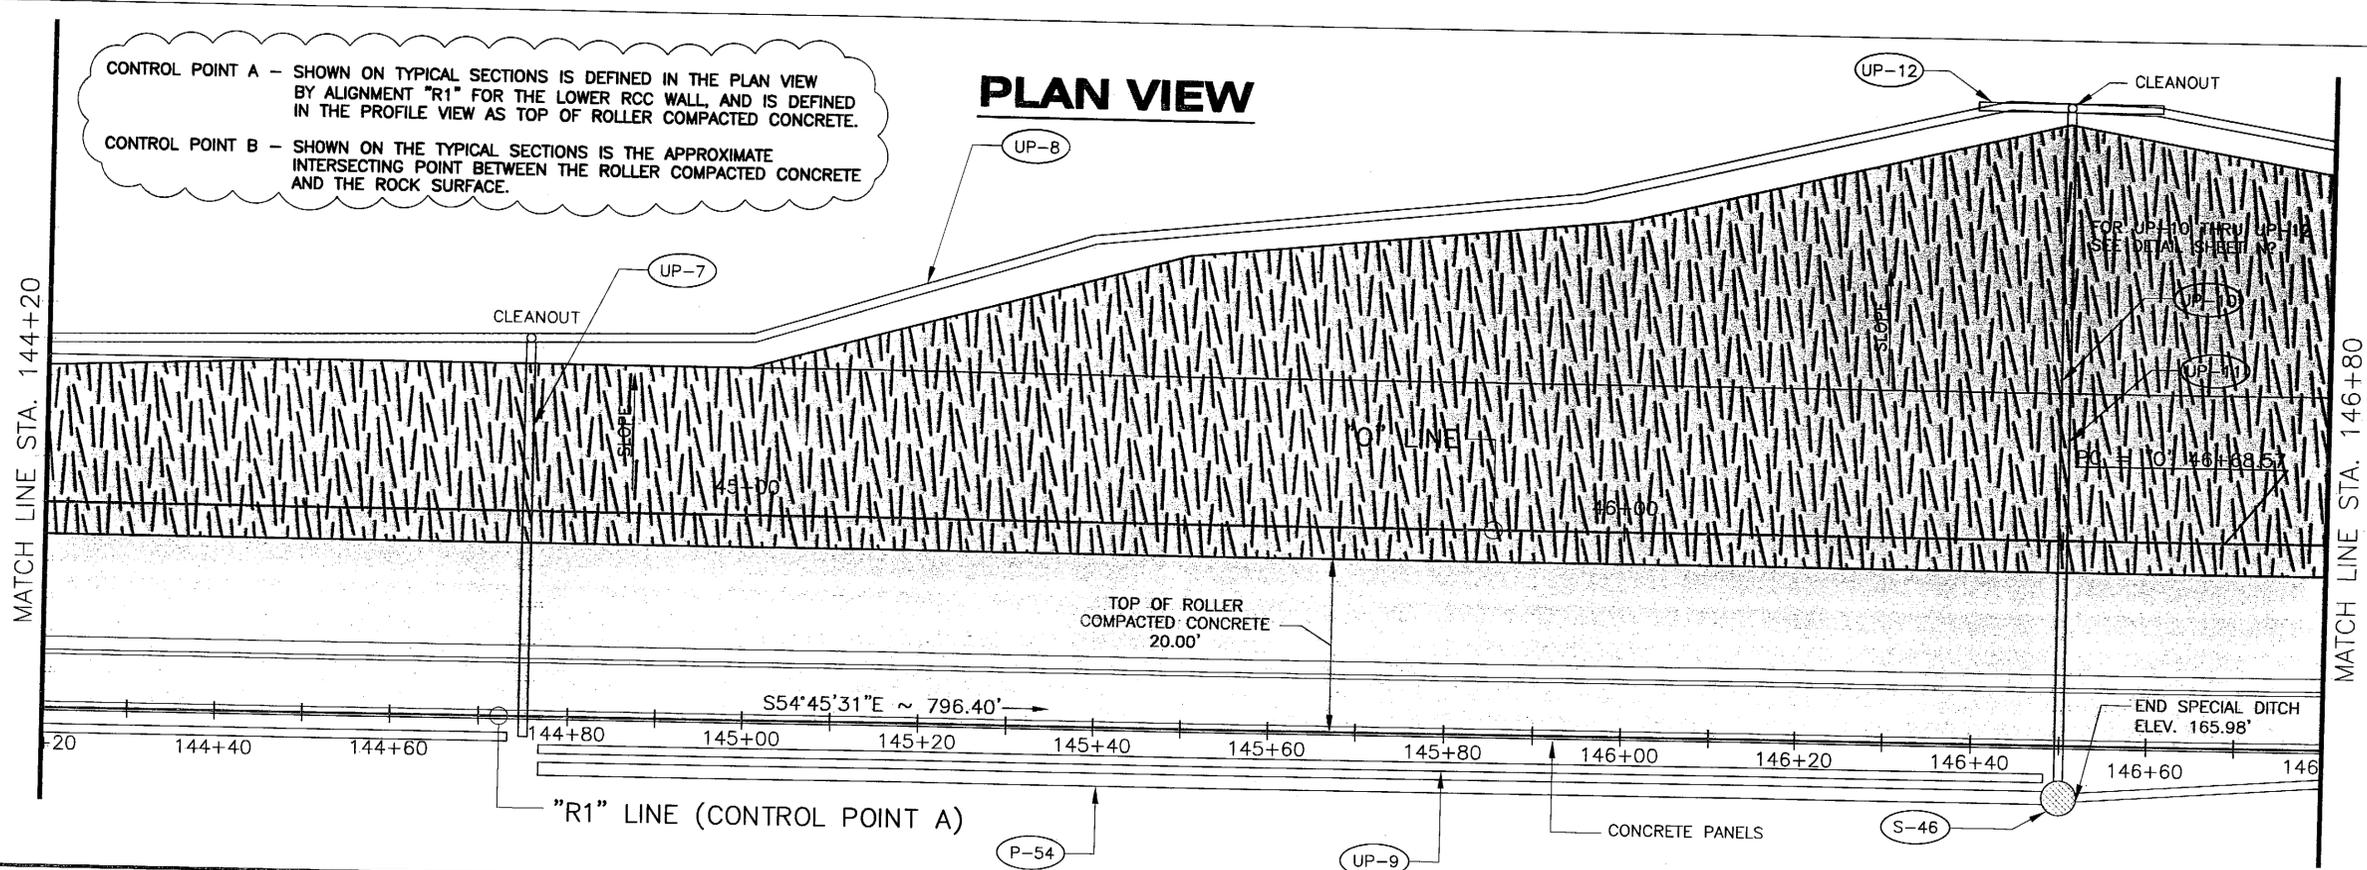


FOUNDATION TREATMENT TYPE, F

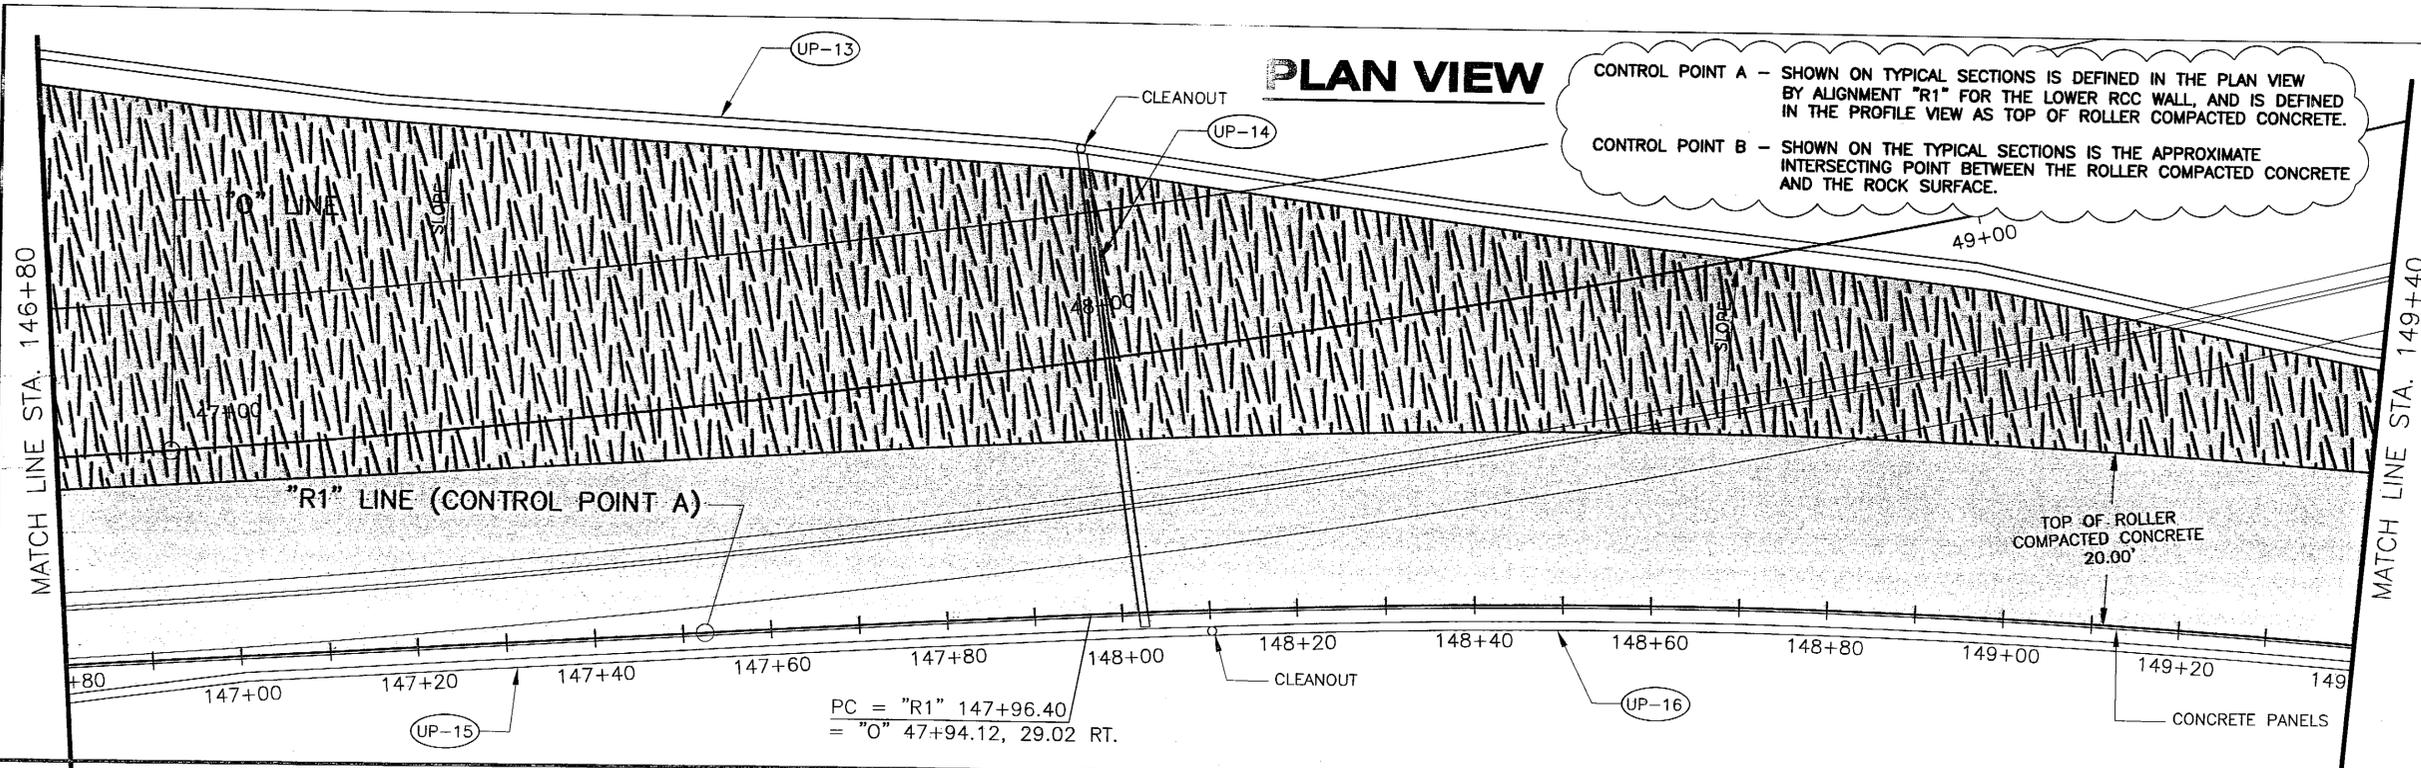

CONTROL POINT A - SHOWN ON TYPICAL SECTIONS IS DEFINED IN THE PLAN VIEW BY ALIGNMENT "R1" FOR THE LOWER RCC WALL, AND IS DEFINED IN THE PROFILE VIEW AS TOP OF ROLLER COMPACTED CONCRETE.

CONTROL POINT B - SHOWN ON THE TYPICAL SECTIONS IS THE APPROXIMATE INTERSECTING POINT BETWEEN THE ROLLER COMPACTED CONCRETE AND THE ROCK SURFACE.

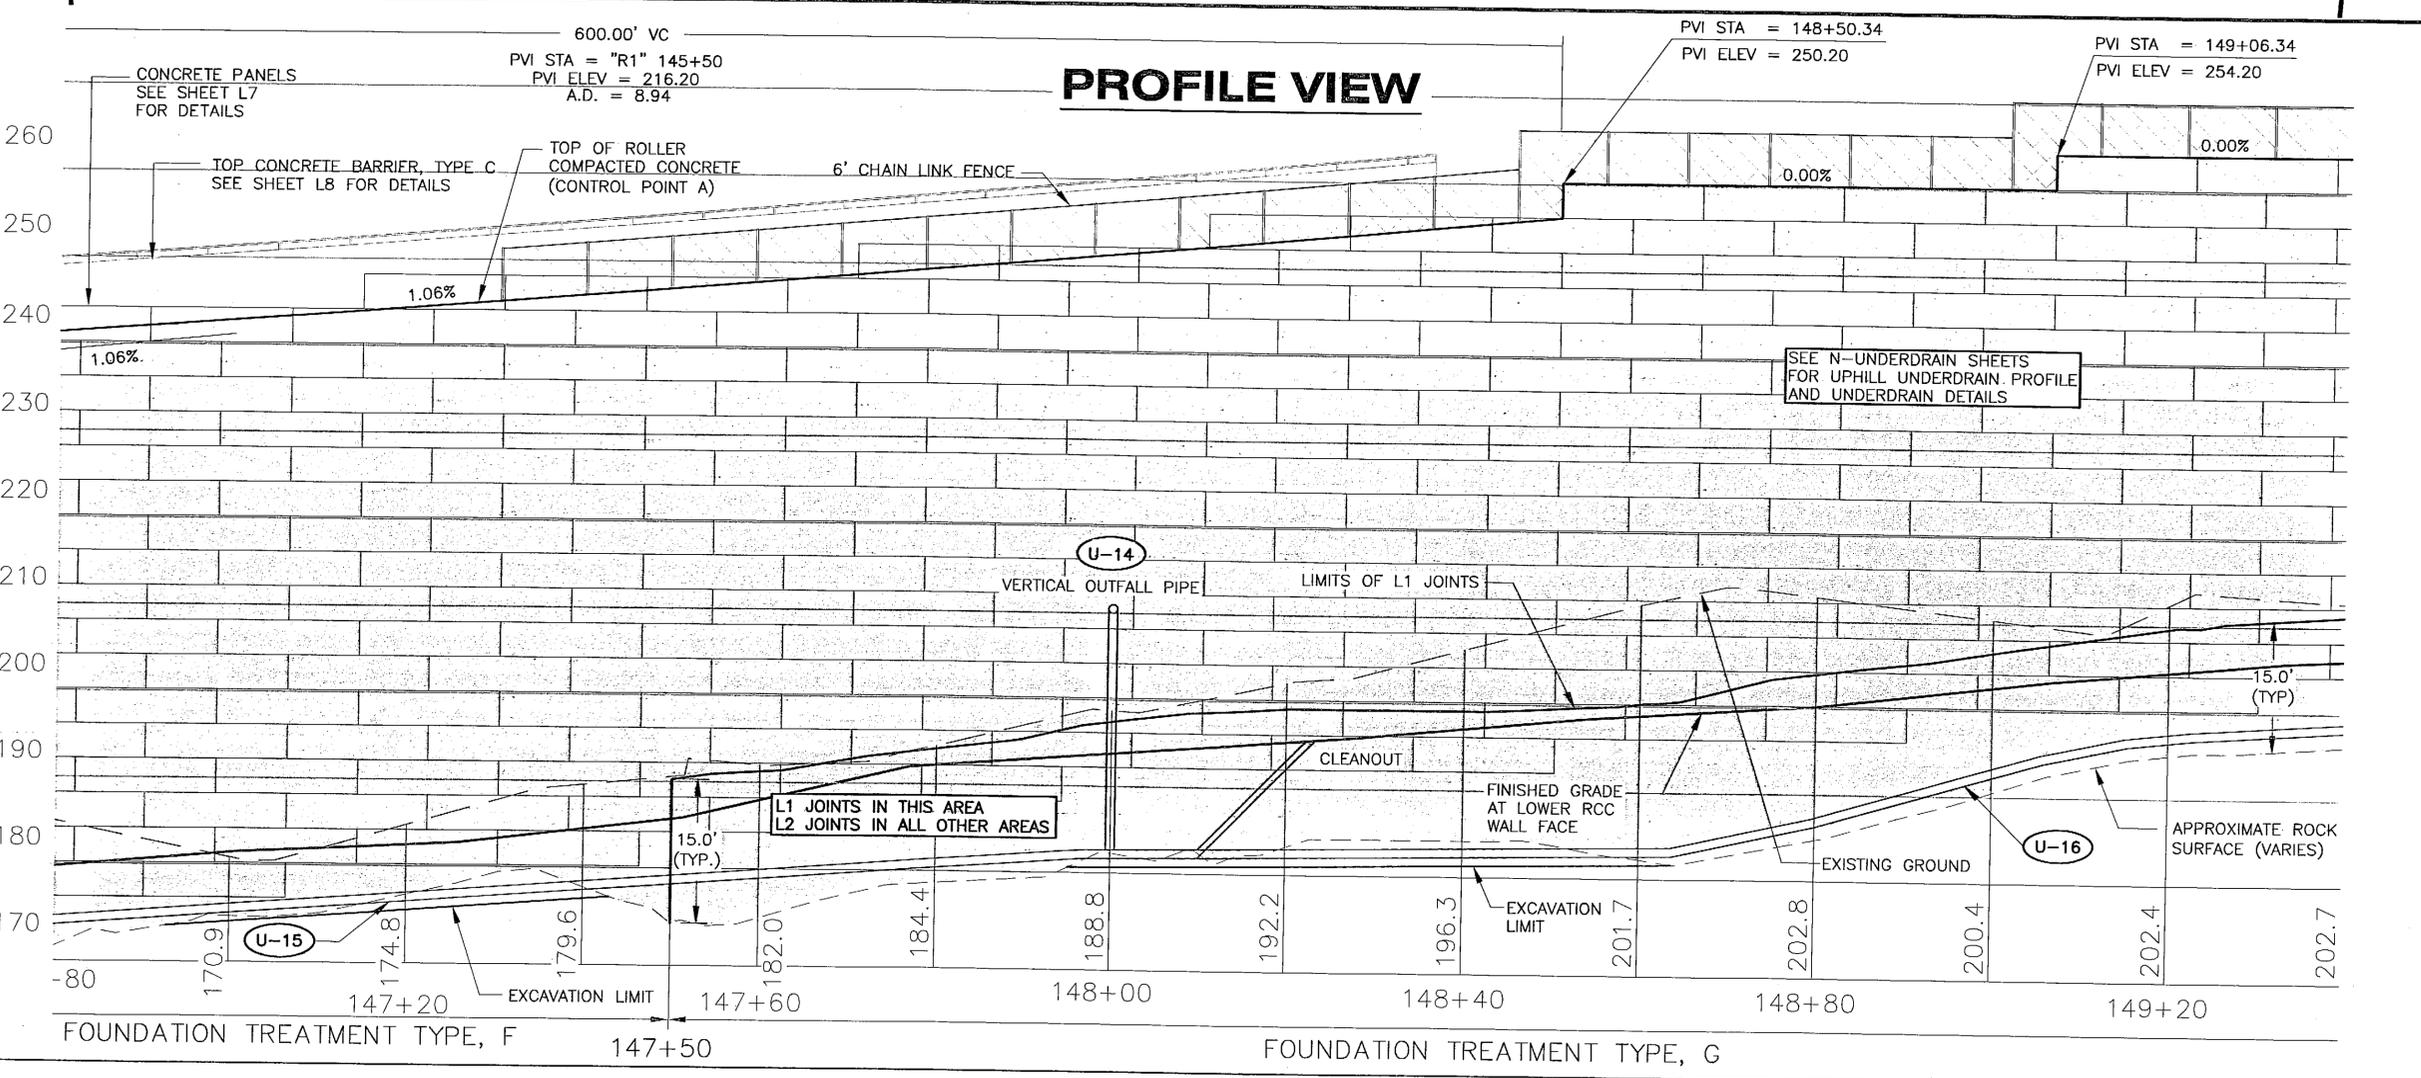

PATH: Q:\Ktn\71811A\PlanSet\L1-9_Roller.dwg
 Mon, 06/May/02 10:42AM Michael Limbaugh
 PLOT: PSPACE 1=1(F) OR MSPACE 1=1(F)
 TAB: ESTIMATE

ADDENDUM NUMBER		
ATTACHMENT NUMBER		
RECORD OF REVISIONS		
No.	DATE	DESCRIPTION

KTN-THIRD AVENUE EXTENSION
 PROJECT NO. 68490
**Roller Compacted
 Concrete Wall Plan**

DESIGNED BY: C. HOWARD






CHECKED BY: T. MOORE
 DRAWN BY: K.K. / M.L.L.
 STATE OF ALASKA
 DEPARTMENT OF TRANSPORTATION
 & PUBLIC FACILITIES
 STATEWIDE DESIGN & ENGINEERING
 SERVICES DIVISION
 THIRD AVENUE EXTENSION
 PROJECT NO. 68490

**Roller Compacted
 Concrete Wall Plan**

PROJECT DESIGNATION NUMBER	
STP-MG-0904(2)	
STATE	YEAR
ALASKA	2002
SHEET NUMBER	TOTAL SHEETS
L4	146

Project As Built Drawings have been reviewed by the Project Engineer. To the best of his/her knowledge, they represent the project as constructed.
 Proj. Eng. Date: 5/1/02

ADDENDUM NUMBER		
ATTACHMENT NUMBER		
RECORD OF REVISIONS		
No.	DATE	DESCRIPTION

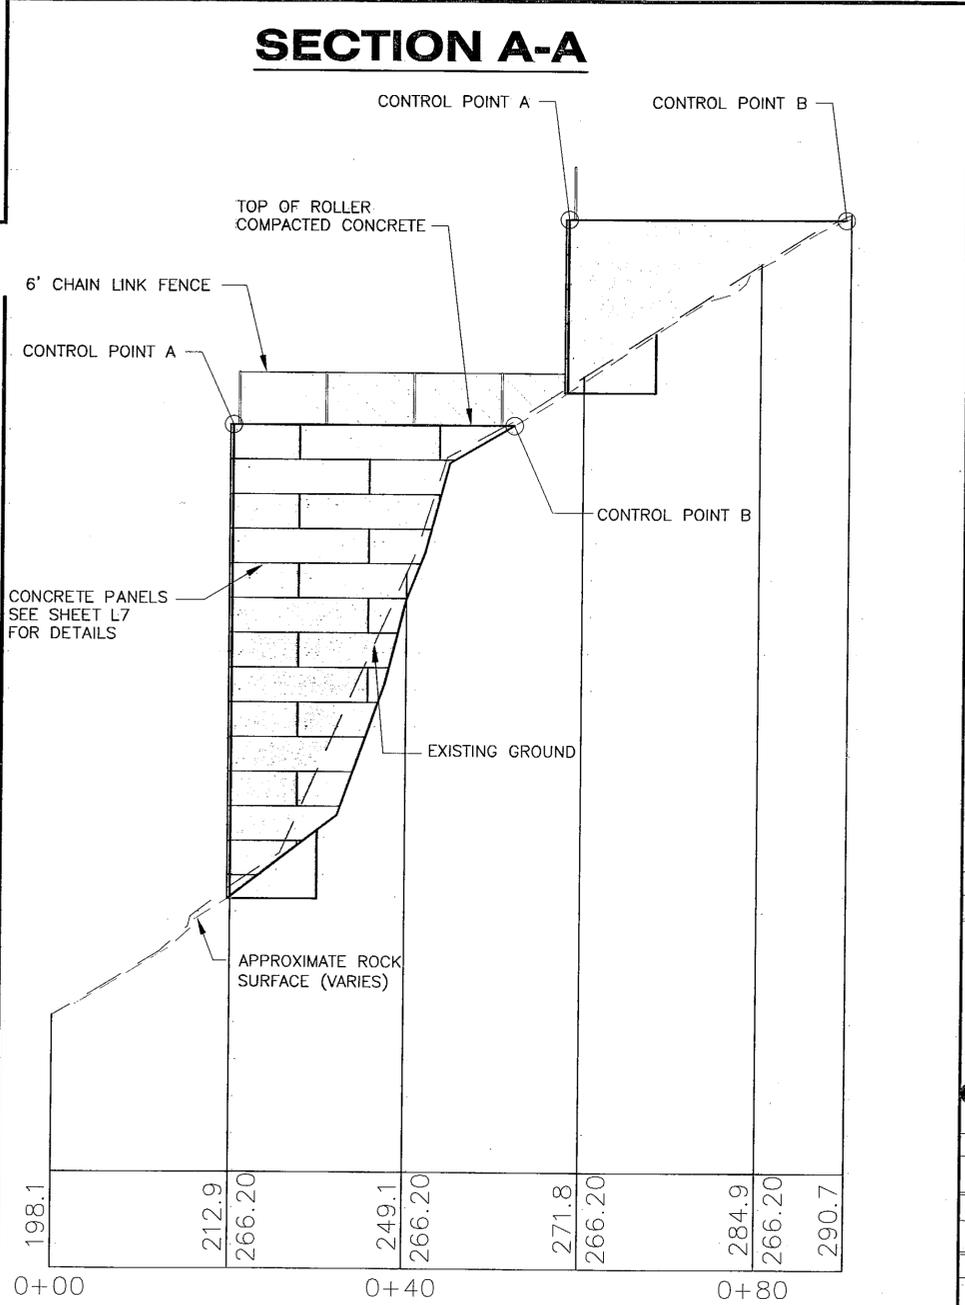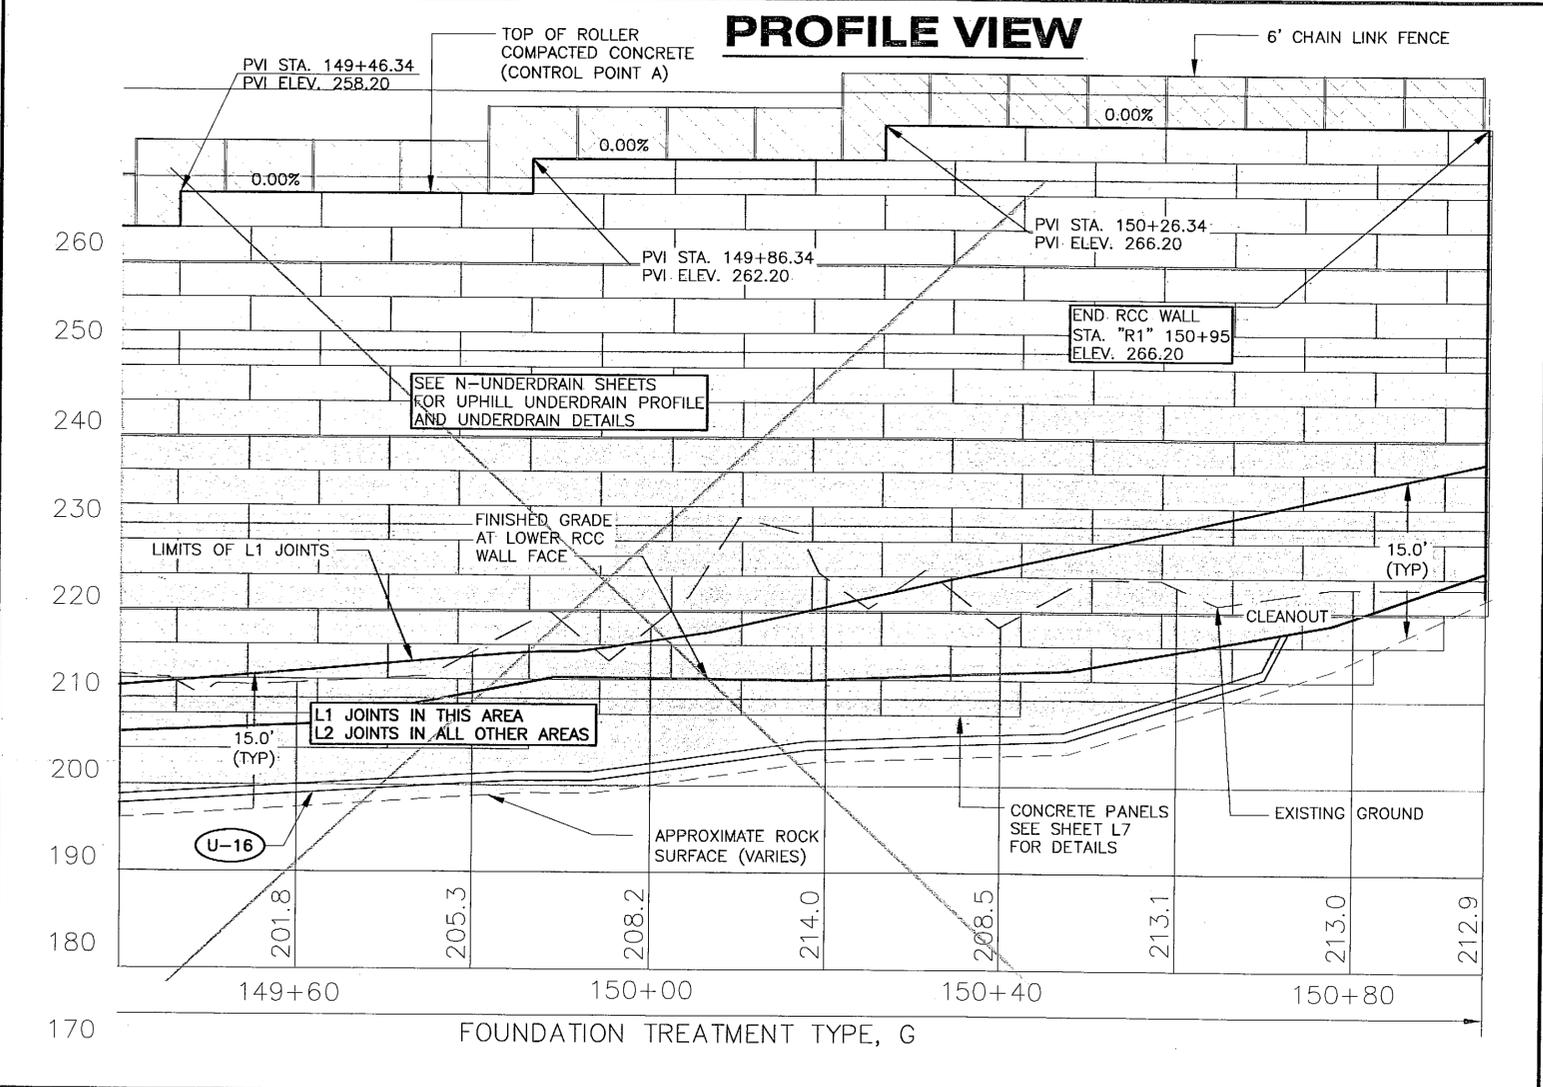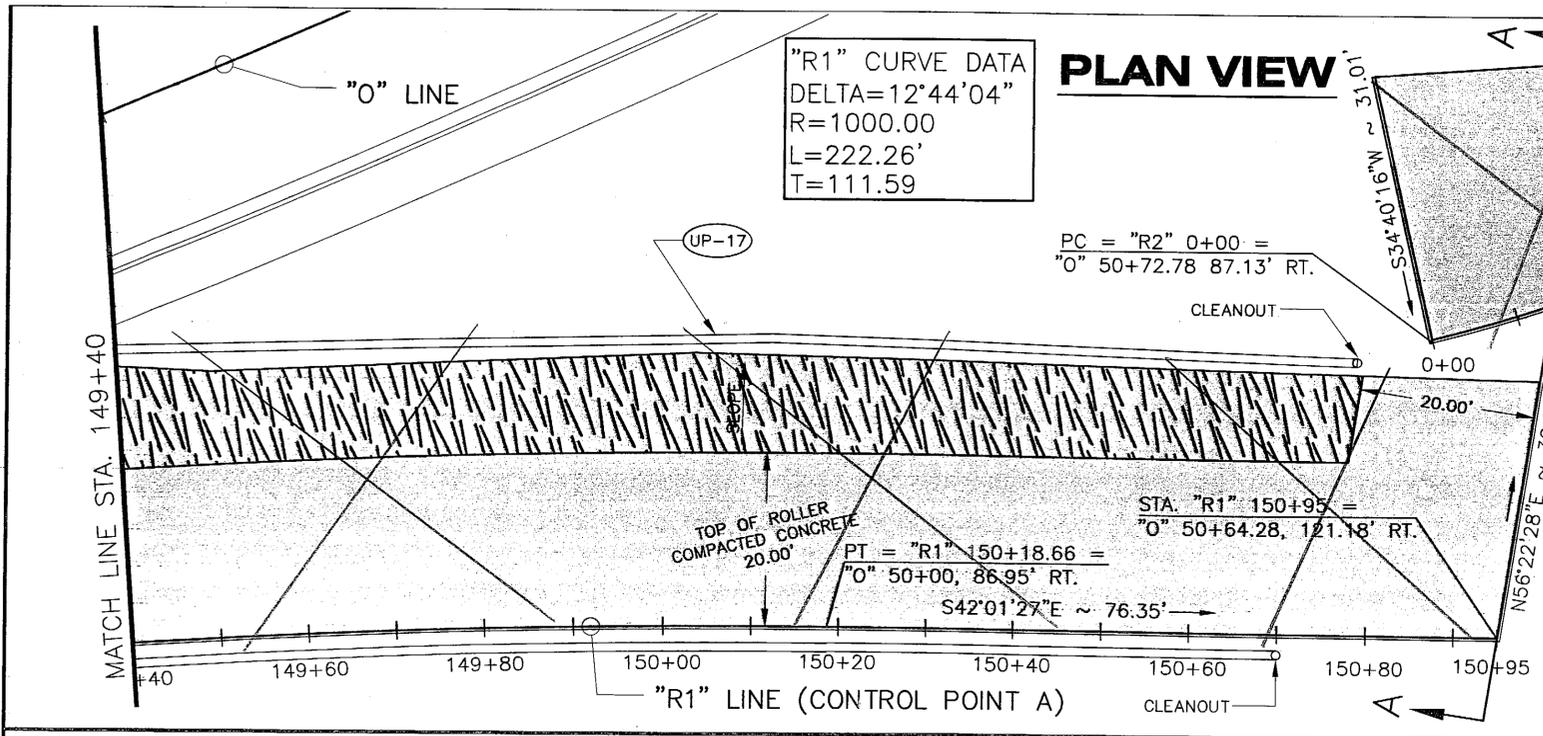

KTN-THIRD AVENUE EXTENSION
 PROJECT NO. 68490

**Roller Compacted
 Concrete Wall Plan**

DESIGNED BY: C. HOWARD

CHECKED BY: T. MOORE

DRAWN BY: K.K. / M.L.L.

STATE OF ALASKA
 DEPARTMENT OF TRANSPORTATION & PUBLIC FACILITIES
 STATEWIDE DESIGN & ENGINEERING SERVICES DIVISION
 THIRD AVENUE EXTENSION
 PROJECT NO. 68490

**Roller Compacted
 Concrete Wall Plan**





PROJECT DESIGNATION NUMBER
STP-MG-0904(2)

STATE	YEAR
ALASKA	2002

SHEET NUMBER	TOTAL SHEETS
L5	146

CONTROL POINT A - SHOWN ON TYPICAL SECTIONS IS DEFINED IN THE PLAN VIEW BY ALIGNMENT "R2" FOR THE UPPER RCC WALL, AND IS DEFINED IN THE PROFILE VIEW AS TOP OF ROLLER COMPACTED CONCRETE.

CONTROL POINT B - SHOWN ON THE TYPICAL SECTIONS IS THE APPROXIMATE INTERSECTING POINT BETWEEN THE ROLLER COMPACTED CONCRETE AND THE ROCK SURFACE.

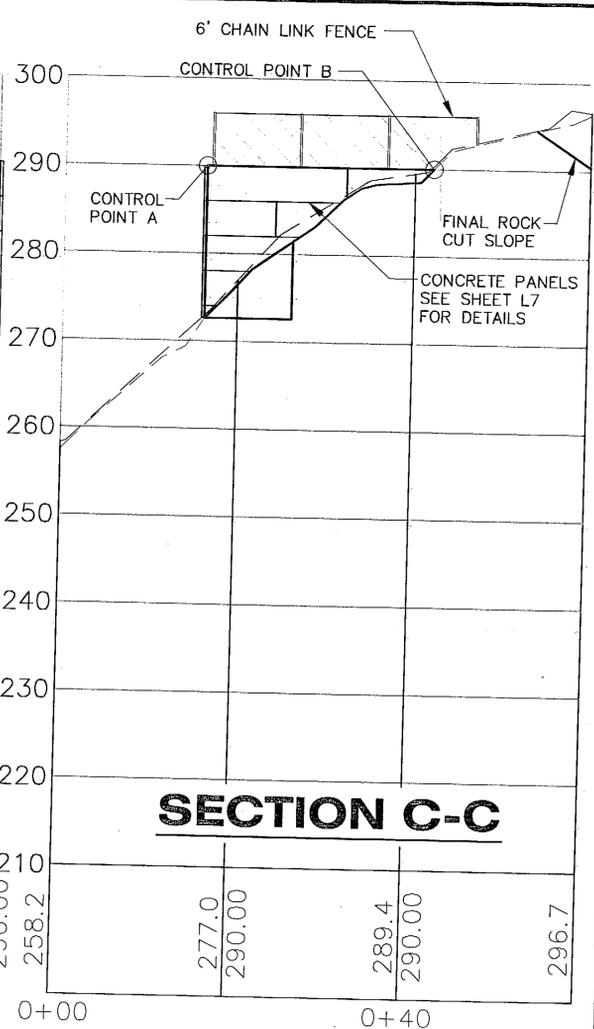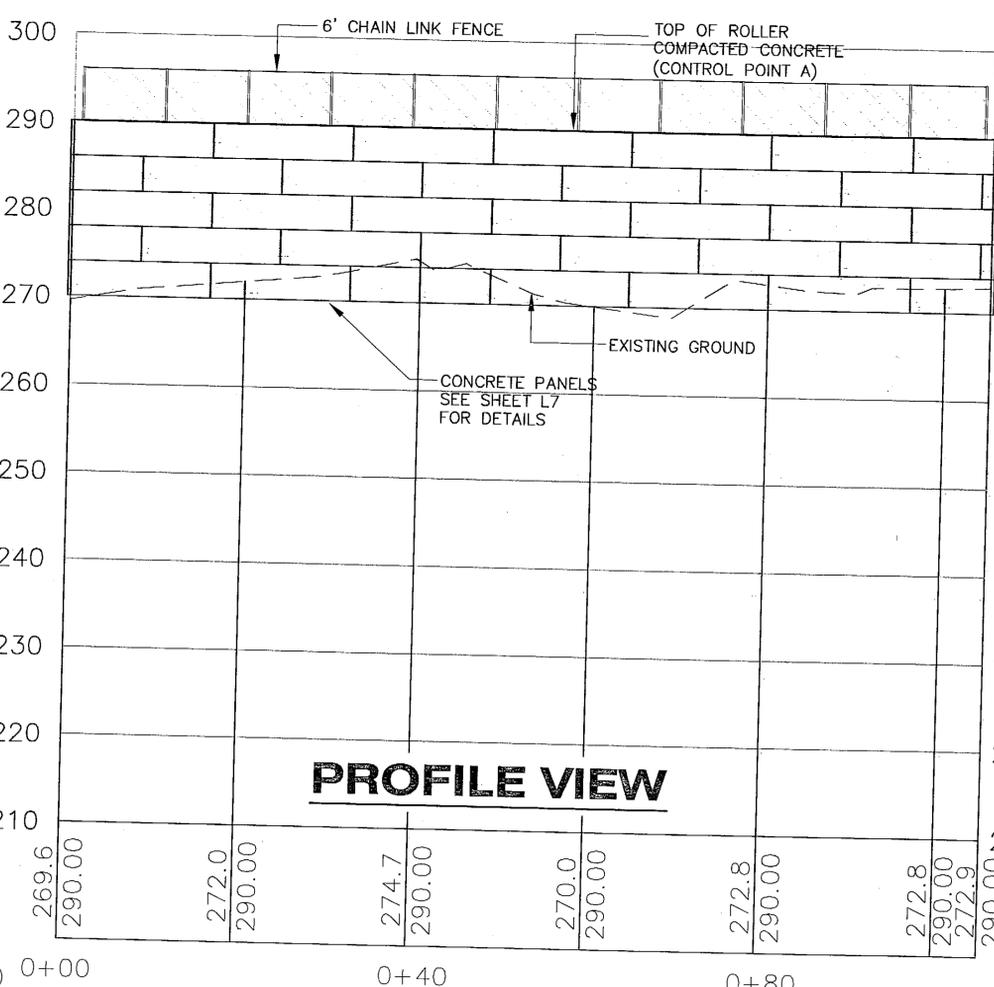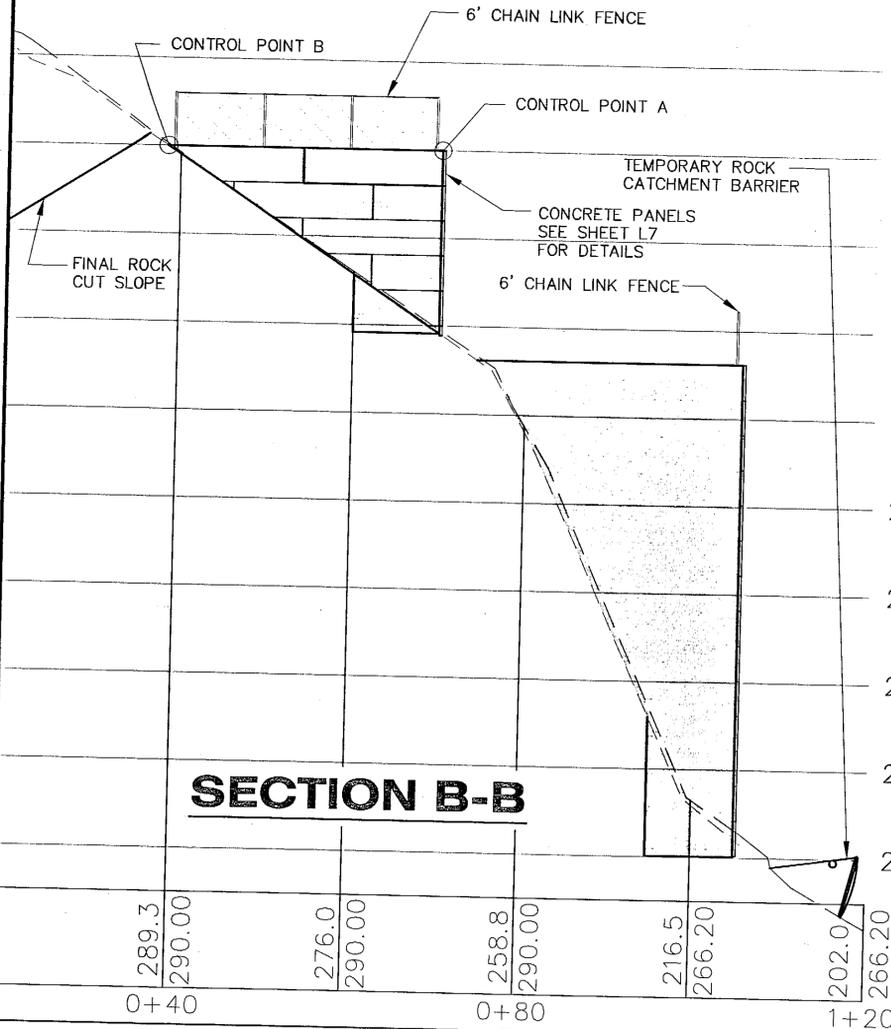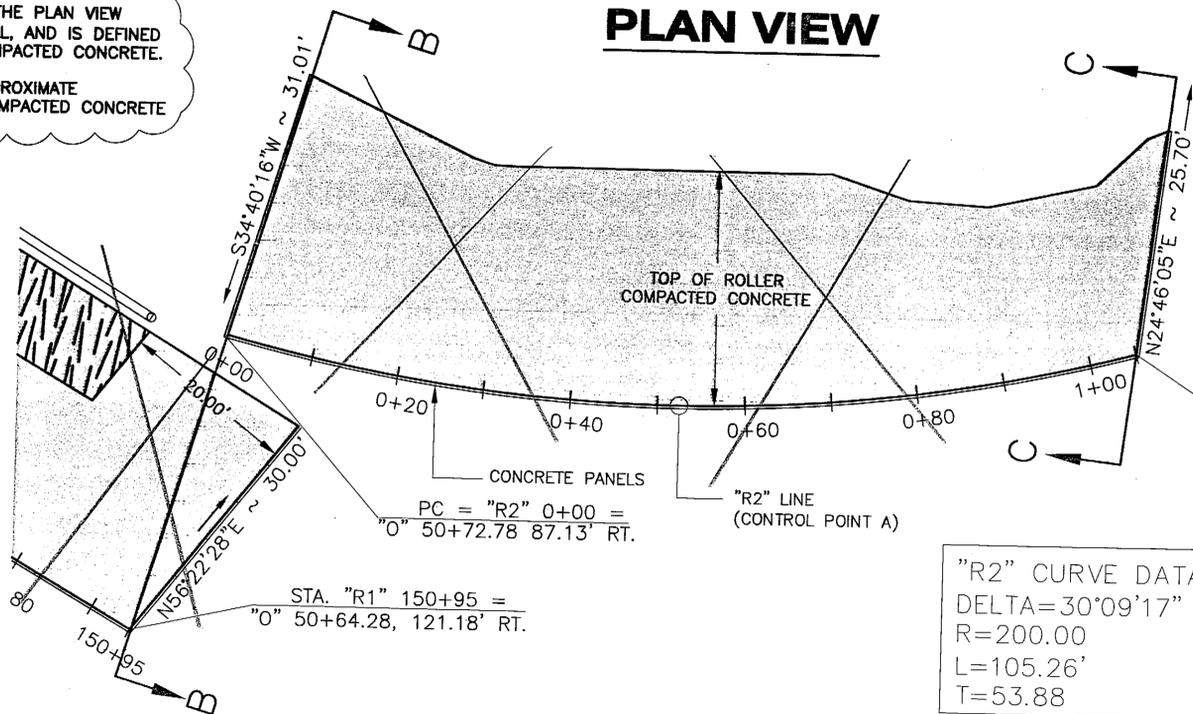

PATH: Q:\Ktn\71811A\Planset\L1-9_Roller.dwg
 Mon, 06/May/02 10:42AM Michael Limbaugh
 PLOT: PSPACE 1=1(F) OR MSPACE 1=1(F)
 TAB: ESTIMATE

ADDENDUM NUMBER		
ATTACHMENT NUMBER		
RECORD OF REVISIONS		
No.	DATE	DESCRIPTION

KTN-THIRD AVENUE EXTENSION
PROJECT NO. 68490
Roller Compacted Concrete Wall Plan

DESIGNED BY: C. HOWARD




CHECKED BY: T. MOORE
 DRAWN BY: K.K. / M.L.L.

STATE OF ALASKA
 DEPARTMENT OF TRANSPORTATION & PUBLIC FACILITIES
 STATEWIDE DESIGN & ENGINEERING SERVICES DIVISION

THIRD AVENUE EXTENSION
PROJECT NO. 68490
Roller Compacted Concrete Wall Plan

PROJECT DESIGNATION NUMBER	
STP-MG-0904(2)	
STATE	YEAR
ALASKA	2002
SHEET NUMBER	TOTAL SHEETS
L6	146



Project As Built Drawings have been reviewed by the Project Engineer. To the best of his/her knowledge, they represent the project as constructed.
 Proj. Eng. *[Signature]* Date 05/06

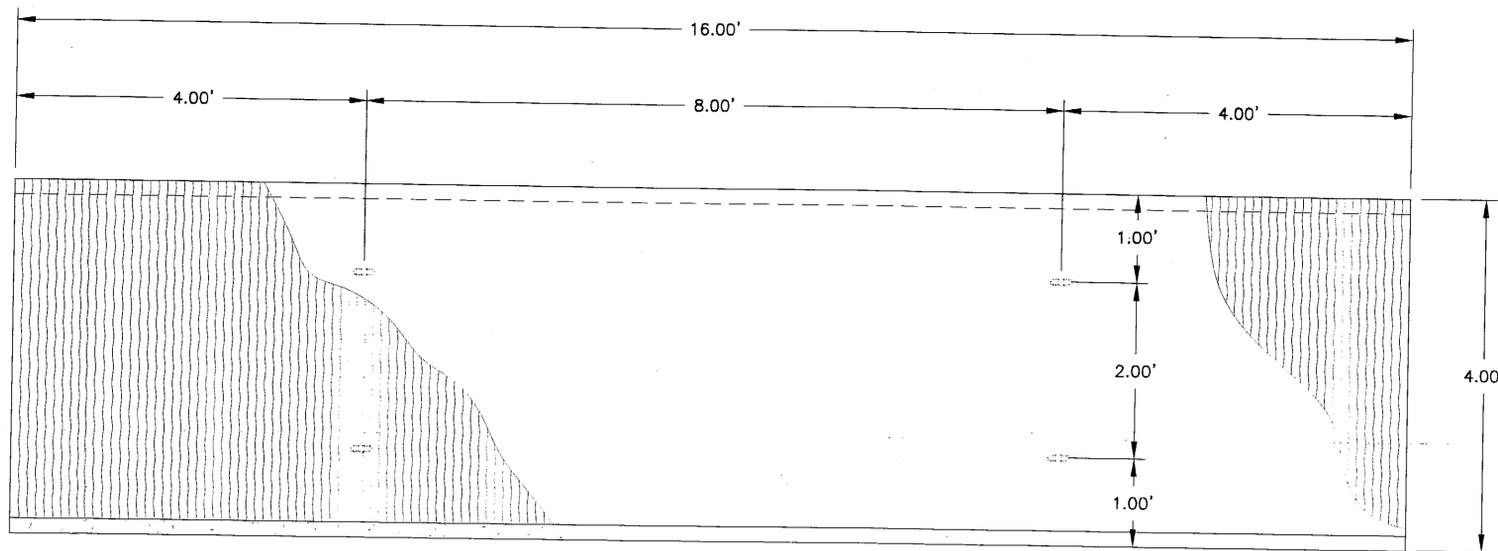


Front View

Notes:

1. CONTRACTOR SHALL BE RESPONSIBLE FOR THE PANEL DESIGN.
2. ANCHOR ROD CONNECTOR TO BE APPROVED BY THE ENGINEER.
3. CONSTRUCT BLOCKOUT FOR DRAINAGE PIPES IN THE CENTER OF A PANEL, PIPE INVERTS MAY NEED ADJUSTMENT.
4. ANCHORS FOR TEMPORARY BRACING ON PANEL FACE SHALL BE DETERMINED BY THE CONTRACTOR.

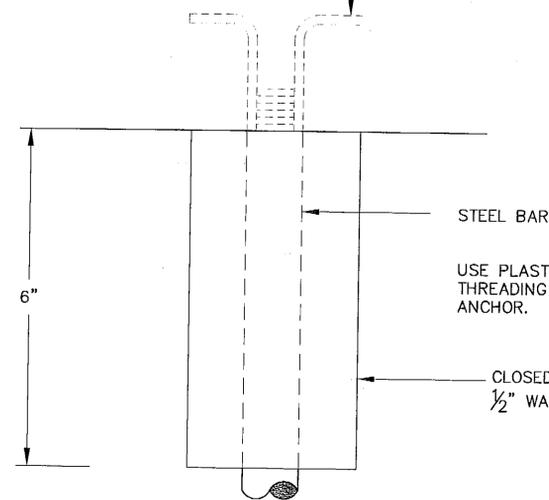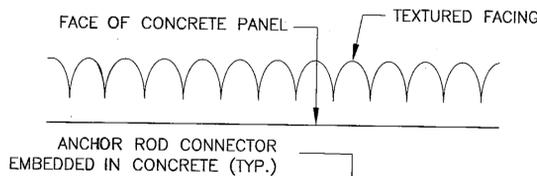


Rod Connector Detail

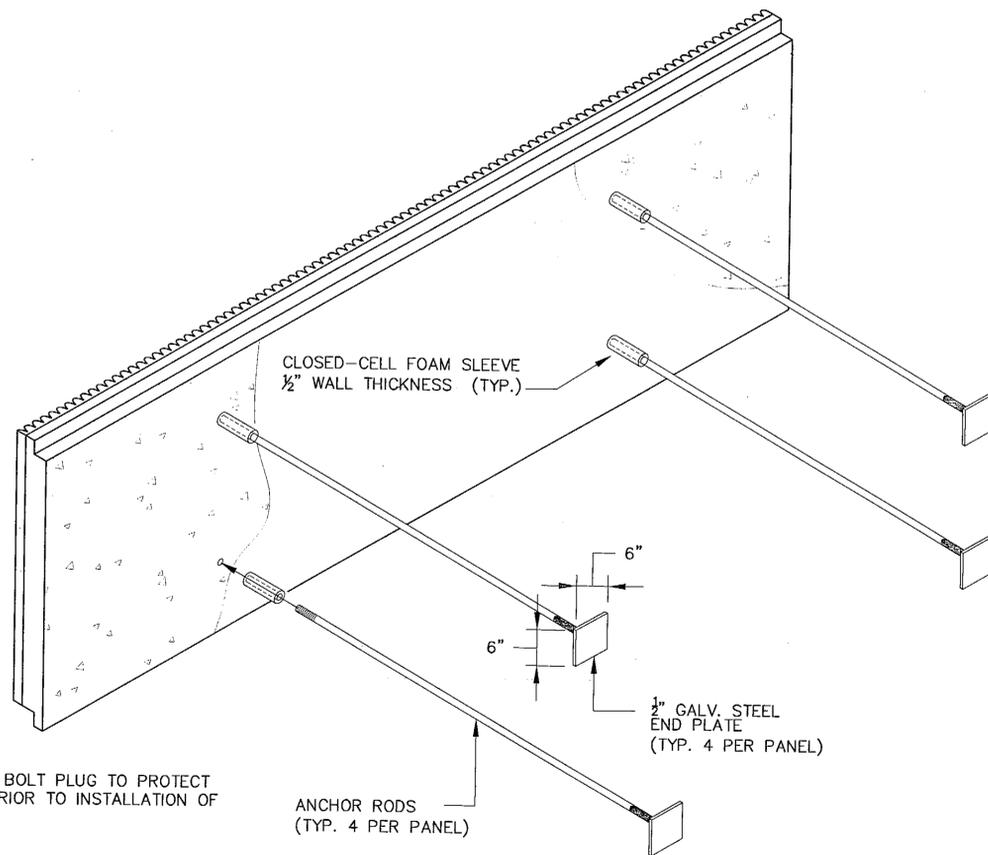


Isometric View

NOTE: DO NOT SCALE FROM DRAWING. USE DIMENSIONS.

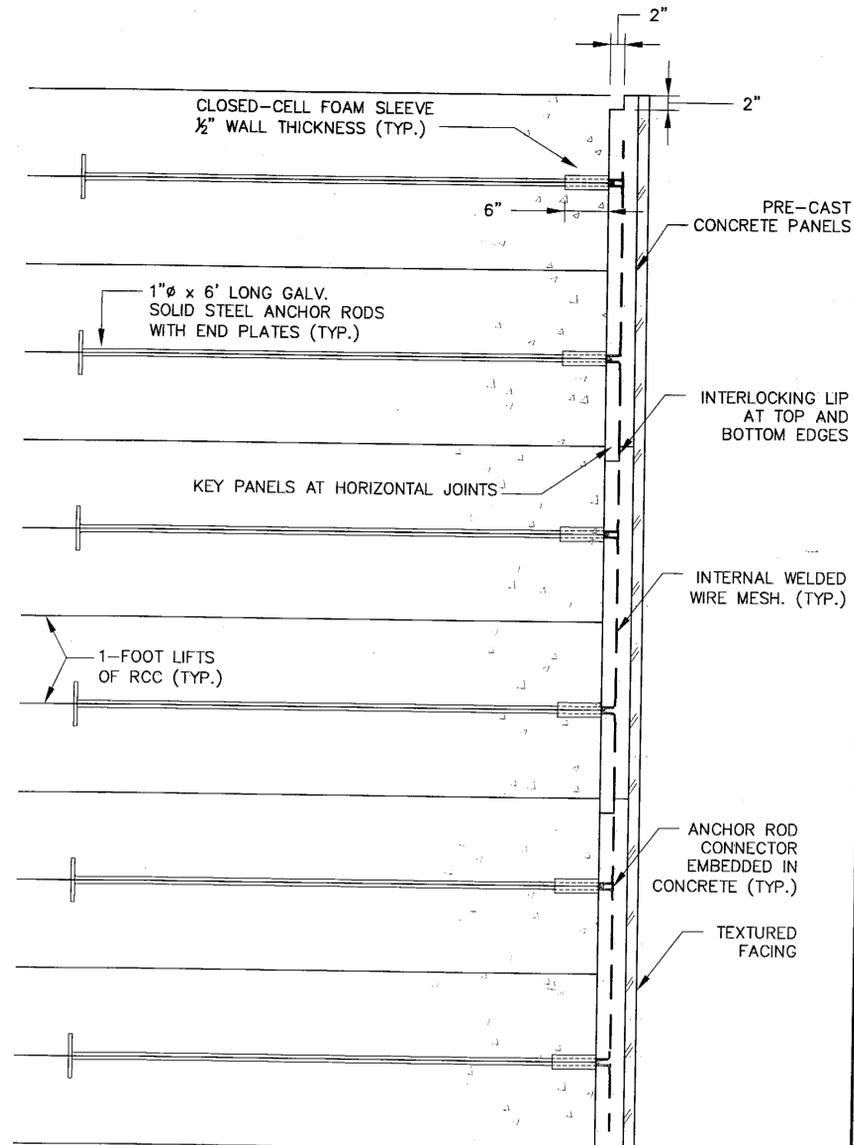

Side View

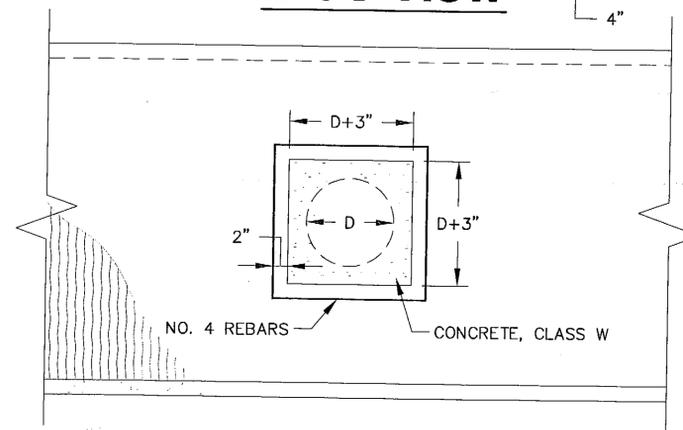

Blockout For Drainage Pipe

PATH: G:\Ktr\71811A\Planset\L1-9_Roller.dwg
 Mon, 06/May/02 10:42AM Michael Limbaugh
 PLOT: PSPACE 1=1(F) OR MSPACE 1=1(F)
 TAB: ESTIMATE

ADDENDUM NUMBER		
ATTACHMENT NUMBER		
RECORD OF REVISIONS		
No.	DATE	DESCRIPTION

KTN-THIRD AVENUE EXTENSION
 PROJECT NO. 68490

Precast Concrete Panel Details

DESIGNED BY: C. HOWARD



CHECKED BY: T. MOORE
 DRAWN BY: M. LIMBAUGH


STATE OF ALASKA
 DEPARTMENT OF TRANSPORTATION & PUBLIC FACILITIES
 STATEWIDE DESIGN & ENGINEERING SERVICES DIVISION
 THIRD AVENUE EXTENSION
 PROJECT NO. 68490

Precast Concrete Panel Details


PROJECT DESIGNATION NUMBER	
STP-MG-0904(2)	
STATE	YEAR
ALASKA	2002
SHEET NUMBER	TOTAL SHEETS
L7	146

Project As Built Drawings have been reviewed by the Project Engineer. To the best of his/her knowledge, they represent the project as constructed.

Proj. Eng. *KS* Date 12/3/06

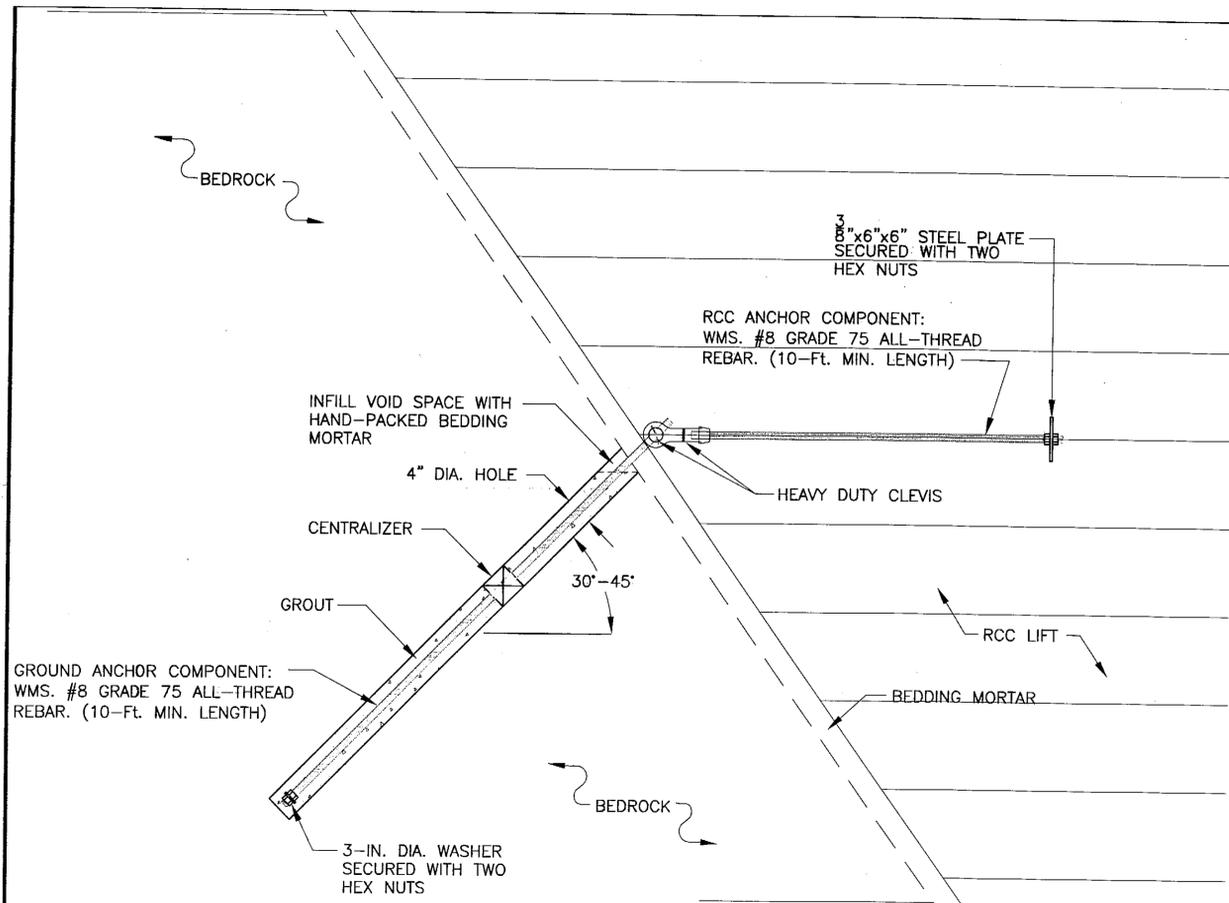

ROCK ANCHOR DETAIL
STA. 49+00 To 50+75

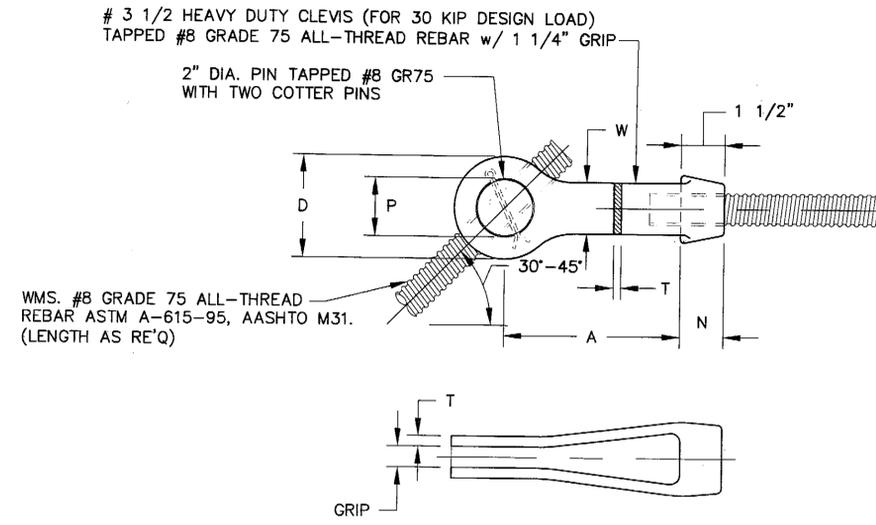


CLEVIS NO.	D	N	U MAX.	W	TOLERANCE	A	P MAX.	MAX. WORKING LOAD Kips.	Wgt. Each Lbs.
3 1/2	3 1/2	1 1/2	1 1/2	1 3/4	1/2 + 1/16 - 1/16	6	2	18	6

STANDARD CLEVIS DETAIL

Notes:

1. INSTALL TWO ROWS AT 10ft SPACING AND AS HIGH AS POSSIBLE ON THE ROCK SLOPE WITHIN THE RCC WALL TO MAXIMIZE THE ADDED RESISTANCE TO TOPPLING.

CONTROL POINT B					
STATION	OFFSET		STATION	OFFSET	
	RIGHT	LEFT		RIGHT	LEFT
40+00	3.26		45+50		31.57
40+25	1.43		45+75		34.03
40+50		0.46	46+00		36.40
40+75		2.17	46+25		42.09
41+00		1.89	46+50		48.30
41+25		1.70	46+75		44.97
41+50		1.00	47+00		38.93
41+75		3.86	47+25		33.33
42+00		7.30	47+50		29.46
42+25		10.93	47+75		23.64
42+50		11.27	48+00		18.59
42+75		12.14	48+25		12.92
43+00		11.64	48+50		6.07
43+25		10.06	48+75	1.57	
43+50		11.98	49+00	11.01	
43+75		12.90	49+25	24.48	
44+00		14.54	49+50	34.22	
44+25		17.23	49+75	42.64	
44+50		17.01	50+00	55.36	
44+75		16.09	50+25	68.10	
45+00		17.05	50+50	82.78	
45+25		18.34			

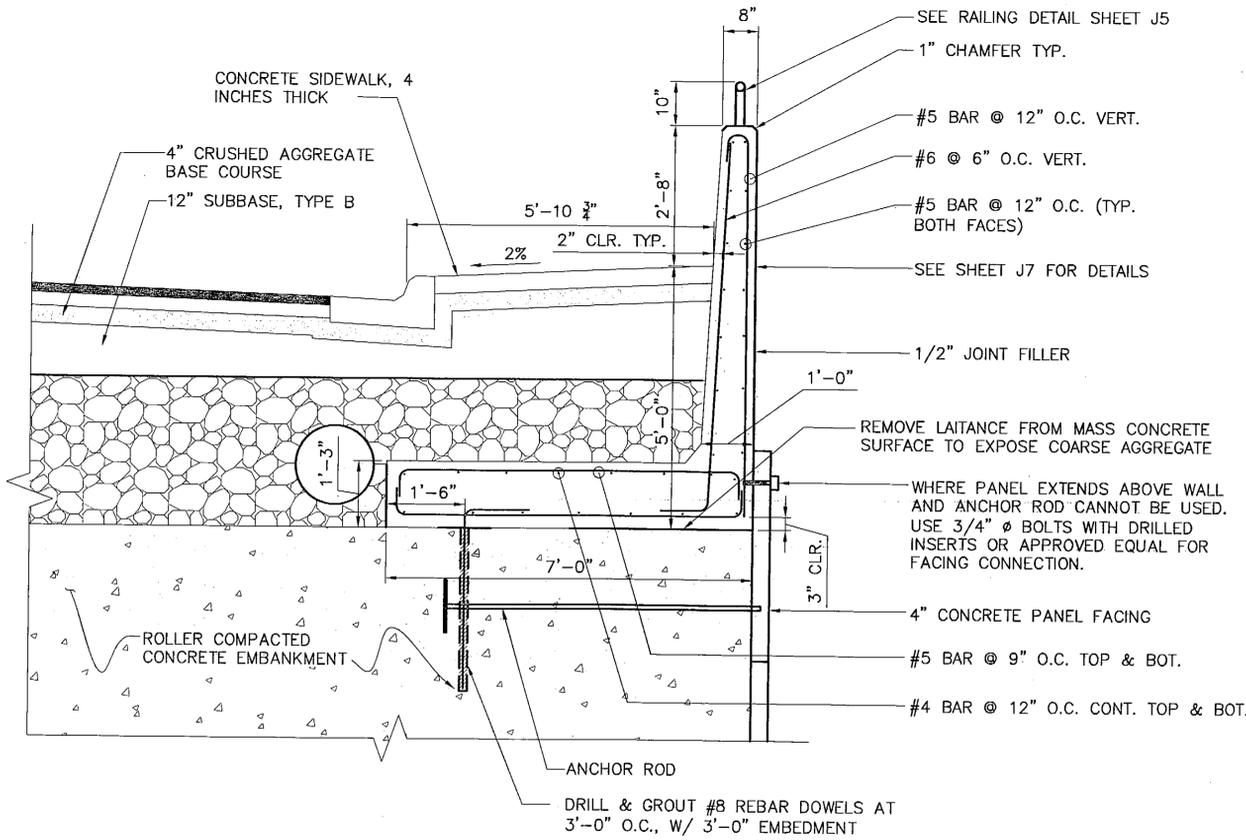

CONCRETE BARRIER TYPE C

PATH: O:\Ktn\71811A\Planset\L1-9_Roller.dwg
Mon, 06/May/02 10:42AM Michael Limbaugh
PLOT: PSPACE 1=1(F) OR MSPACE 1=1(F)
TAB: ESTIMATE

ADDENDUM NUMBER		
ATTACHMENT NUMBER		
RECORD OF REVISIONS		
No.	DATE	DESCRIPTION

KTN-THIRD AVENUE EXTENSION
PROJECT NO. 68490

Roller Compacted Concrete Wall Details

DESIGNED BY: C. HOWARD



CHECKED BY: T. MOORE
DRAWN BY: M. LIMBAUGH



STATE OF ALASKA
DEPARTMENT OF TRANSPORTATION & PUBLIC FACILITIES
STATEWIDE DESIGN & ENGINEERING SERVICES DIVISION
THIRD AVENUE EXTENSION
PROJECT NO. 68490
Roller Compacted Concrete Wall Details

PROJECT DESIGNATION NUMBER	
STP-MG-0904(2)	
STATE	YEAR
ALASKA	2002
SHEET NUMBER	TOTAL SHEETS
L8	146


Project As Built Drawings have been reviewed by the Project Engineer. To the best of his/her knowledge, they represent the project as constructed.
Proj. Eng. *KS* Date *12/26*

FOUNDATION TREATMENT PROCEDURES ON ROCK SURFACES


1. SLOPING BEDROCK SURFACES SHALL BE PREPARED BY A COMBINATION OF ROCK EXCAVATION AND DENTAL CONCRETE TO ACHIEVE A SMOOTHNESS AND UNIFORMITY GENERALLY SUITABLE FOR PLACEMENT OF ROLLER COMPACTED CONCRETE.
2. DENTAL CONCRETE SHALL BE PLACED ON THE FOUNDATION AT LOCATIONS DETERMINED BY THE ENGINEER.
3. ALL TREATMENT DIMENSIONS ARE GIVEN AS GUIDELINES AND ARE SUBJECT TO CHANGE AS REQUIRED BY THE ENGINEER.

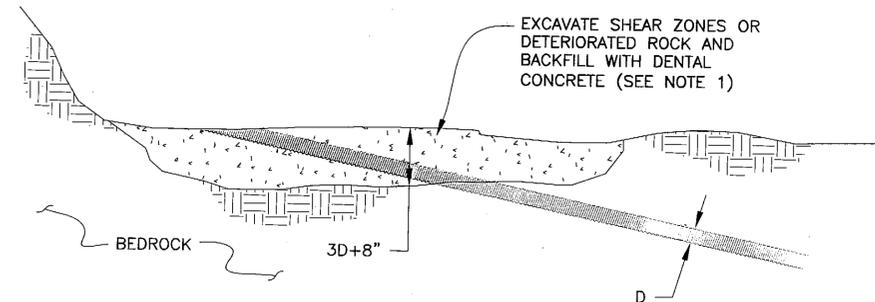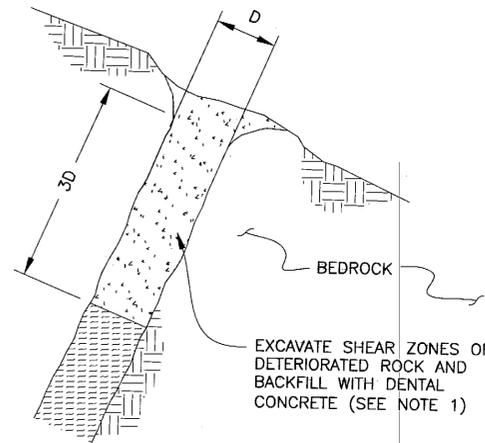


TREATMENT OF SHEAR OR DETERIORATED ROCK ZONES

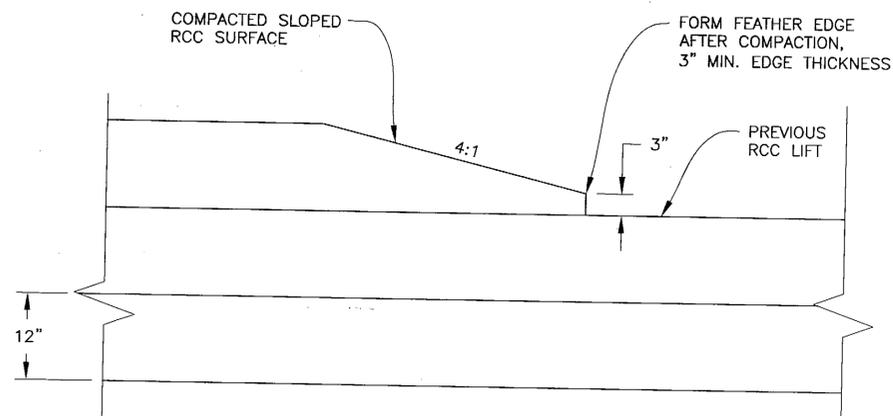

TYPICAL EDGE JOINT TREATMENT

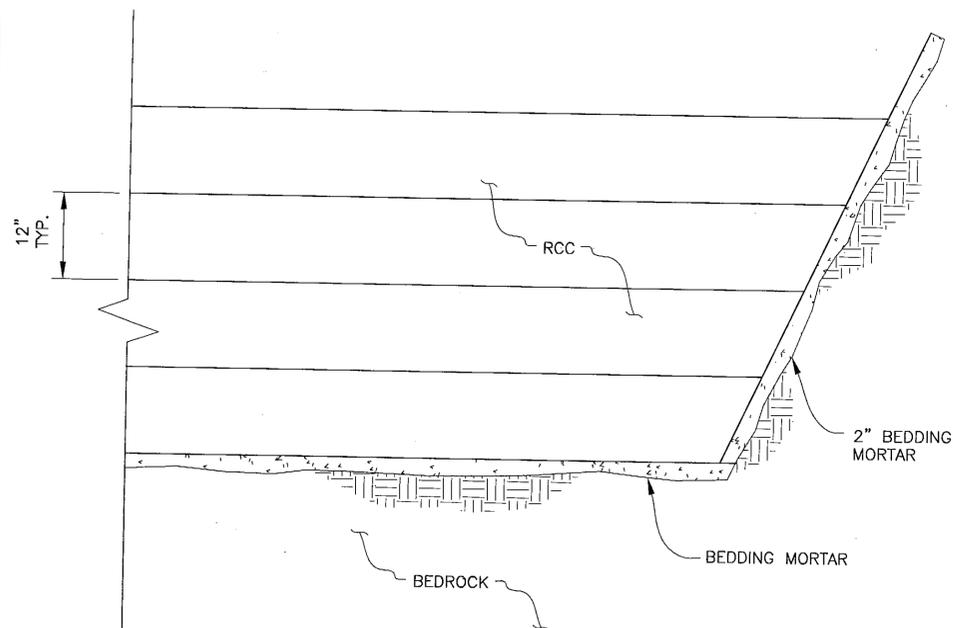

BEDDING MORTAR - ABUTMENTS AND SLOPES

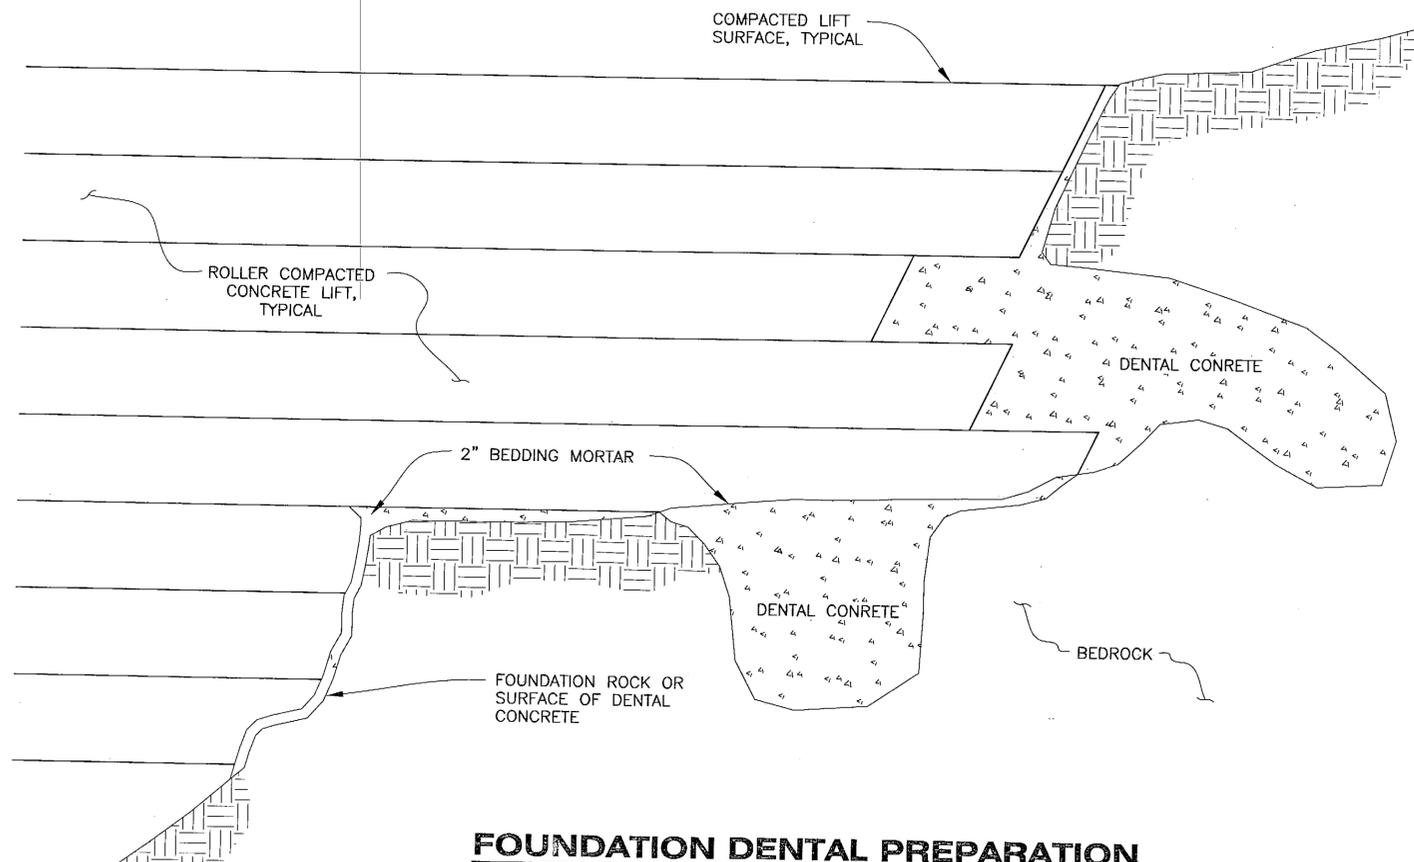

FOUNDATION DENTAL PREPARATION

PATH: O:\Ktn\71811A\PlanSet\L1-9_Roller.dwg
 Mon, 06/May/02 10:43AM Michael Limbaugh
 PLOT: PSPACE 1=1(F) OR MSPACE 1=1(F)
 TAB: ESTIMATE

ADDENDUM NUMBER		
ATTACHMENT NUMBER		
RECORD OF REVISIONS		
No.	DATE	DESCRIPTION

KTN-THIRD AVENUE EXTENSION
 PROJECT NO. 68490

Foundation Treatment Details

DESIGNED BY: C. HOWARD



CHECKED BY: T. MOORE

DRAWN BY: M. LIMBAUGH

STATE OF ALASKA
 DEPARTMENT OF TRANSPORTATION
 & PUBLIC FACILITIES
 STATEWIDE DESIGN & ENGINEERING
 SERVICES DIVISION
 THIRD AVENUE EXTENSION
 PROJECT NO. 68490

Foundation Treatment Details

PROJECT DESIGNATION NUMBER

STP-MG-0904(2)

STATE	YEAR
ALASKA	2002

SHEET NUMBER	TOTAL SHEETS
L9	146


Project As Built Drawings have been reviewed by the Project Engineer. To the best of his/her knowledge, they represent the project as constructed.

Proj. Eng. *LS* Date: 05/06


PATH:
 Q:\Ktn\71811A\Planset\M1-3_XPLAN.dwg
 Mon, 06/May/02 10:45AM Michael Limbaugh
 PLOT:
 PSPACE 1=1(F) DR MSPACE 1=1(F)
 TAB: ESTIMATE

ADDENDUM NUMBER		
ATTACHMENT NUMBER		
RECORD OF REVISIONS		
No.	DATE	DESCRIPTION

KTN-THIRD AVENUE EXTENSION
 PROJECT NO. 68490
**OVERBURDEN/TALUS
 SLOPE EXCAVATION PLAN**

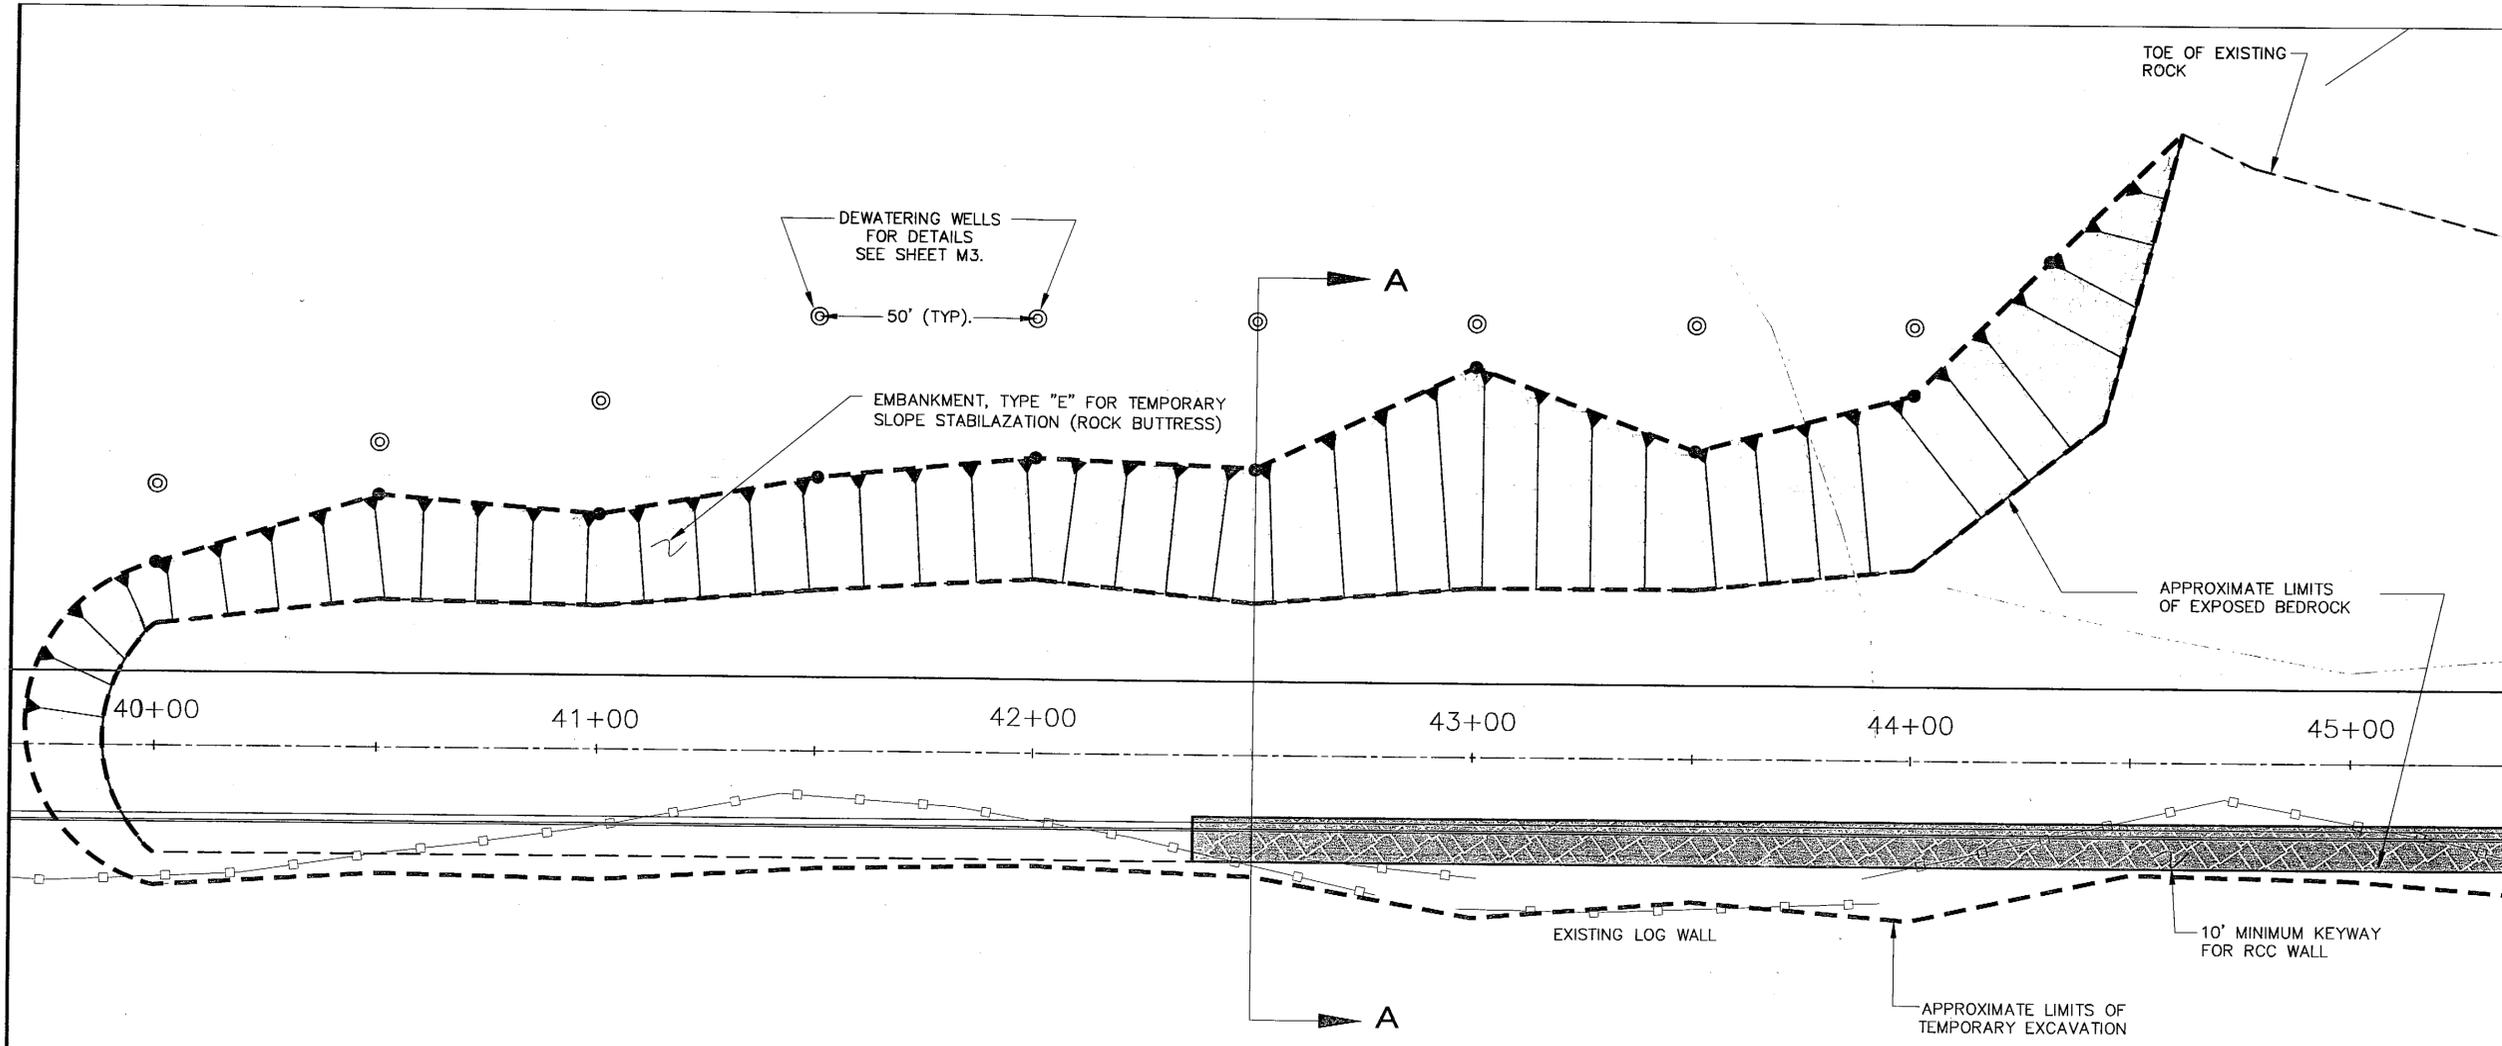

ROCK BUTTRESS	
STATION	OFFSET
40+00	-43.3
40+50	-59.0
41+00	-55.3
41+50	-63.5
42+00	-68.0
42+50	-66.2
43+00	-90.0
43+50	-71.0
44+00	-84.3

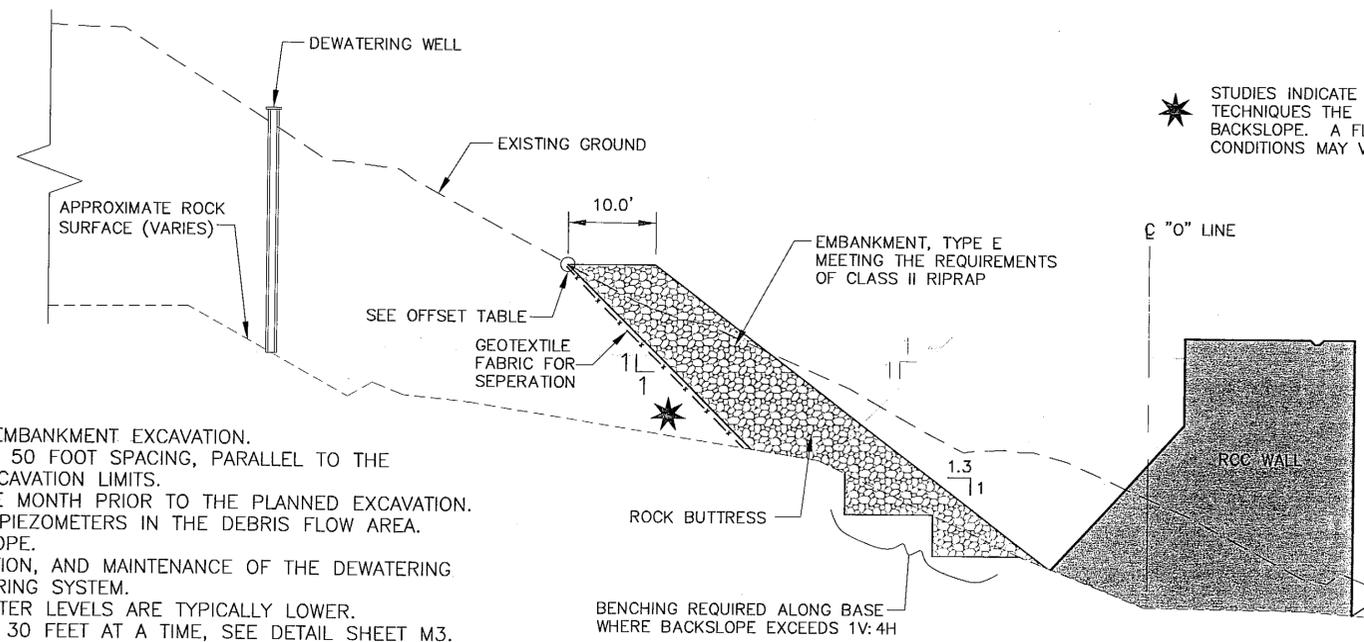

★ STUDIES INDICATE WITH PROPER DEWATERING AND EXCAVATION TECHNIQUES THE DEBRIS FLOW AREA WILL BE STABLE AT THIS BACKSLOPE. A FLATTER SLOPE MAY BE REQUIRED AS ACTUAL CONDITIONS MAY VARY.

- NOTES:
1. DEWATERING OF SLOPE REQUIRED PRIOR TO PERFORMING THE EMBANKMENT EXCAVATION.
 2. INSTALL A ROW OF 8 INCH DIAMETER DEWATERING WELLS ON A 50 FOOT SPACING, PARALLEL TO THE CENTERLINE ALIGNMENT, IMMEDIATELY UPSLOPE FROM THE EXCAVATION LIMITS.
 3. PUMPING FROM DEWATERING WELLS SHALL START AT LEAST ONE MONTH PRIOR TO THE PLANNED EXCAVATION.
 4. GROUNDWATER LEVELS CAN BE MONITORED WITH THE EXISTING PIEZOMETERS IN THE DEBRIS FLOW AREA.
 5. ADD DEWATERING WELLS AS NEEDED TO STABILIZE THE CUT SLOPE.
 6. CONTRACTOR SHALL BE RESPONSIBLE FOR THE DESIGN, OPERATION, AND MAINTENANCE OF THE DEWATERING SYSTEM, INCLUDING PROVISIONS FOR POWER OF THE DEWATERING SYSTEM.
 7. PERFORM EXCAVATION DURING DRIER MONTHS WHEN GROUNDWATER LEVELS ARE TYPICALLY LOWER.
 8. PERFORM EXCAVATION IN SHORT SEGMENTS OF NO MORE THAN 30 FEET AT A TIME, SEE DETAIL SHEET M3.
 9. USE EMBANKMENT, TYPE "E", MEETING THE REQUIREMENTS OF CLASS II RIPRAP, TO TEMPORARILY STABILIZE CUT SLOPE. ROCK BUTTRESS MUST BE PLACED PRIOR TO CONTINUING SEGMENTAL EXCAVATION, SEE S-A THIS SHEET.
 10. AFTER COMPLETION OF RCC WALL, ROCK BUTTRESS MAY BE REUSED IN THE ROCKFILL PRISM OF THE ROADWAY EMBANKMENT

SECTION A-A

NOTE: DO NOT SCALE FROM DRAWING. USE DIMENSIONS.

DESIGNED BY: C. HOWARD




CHECKED BY: T. MOORE
 DRAWN BY: K.K.

STATE OF ALASKA
 DEPARTMENT OF TRANSPORTATION
 & PUBLIC FACILITIES
 STATEWIDE DESIGN & ENGINEERING
 SERVICES DIVISION
 THIRD AVENUE EXTENSION
 PROJECT NO. 68490

**EXCAVATION
 PLAN**

PROJECT DESIGNATION NUMBER	
STP-MG-0904(2)	
STATE	YEAR
ALASKA	2002
SHEET NUMBER	TOTAL SHEETS
M1	146

Project As Built Drawings have been reviewed by the Project Engineer. To the best of his/her knowledge, they represent the project as constructed.
 Proj. Eng. *[Signature]* Date *[Date]*

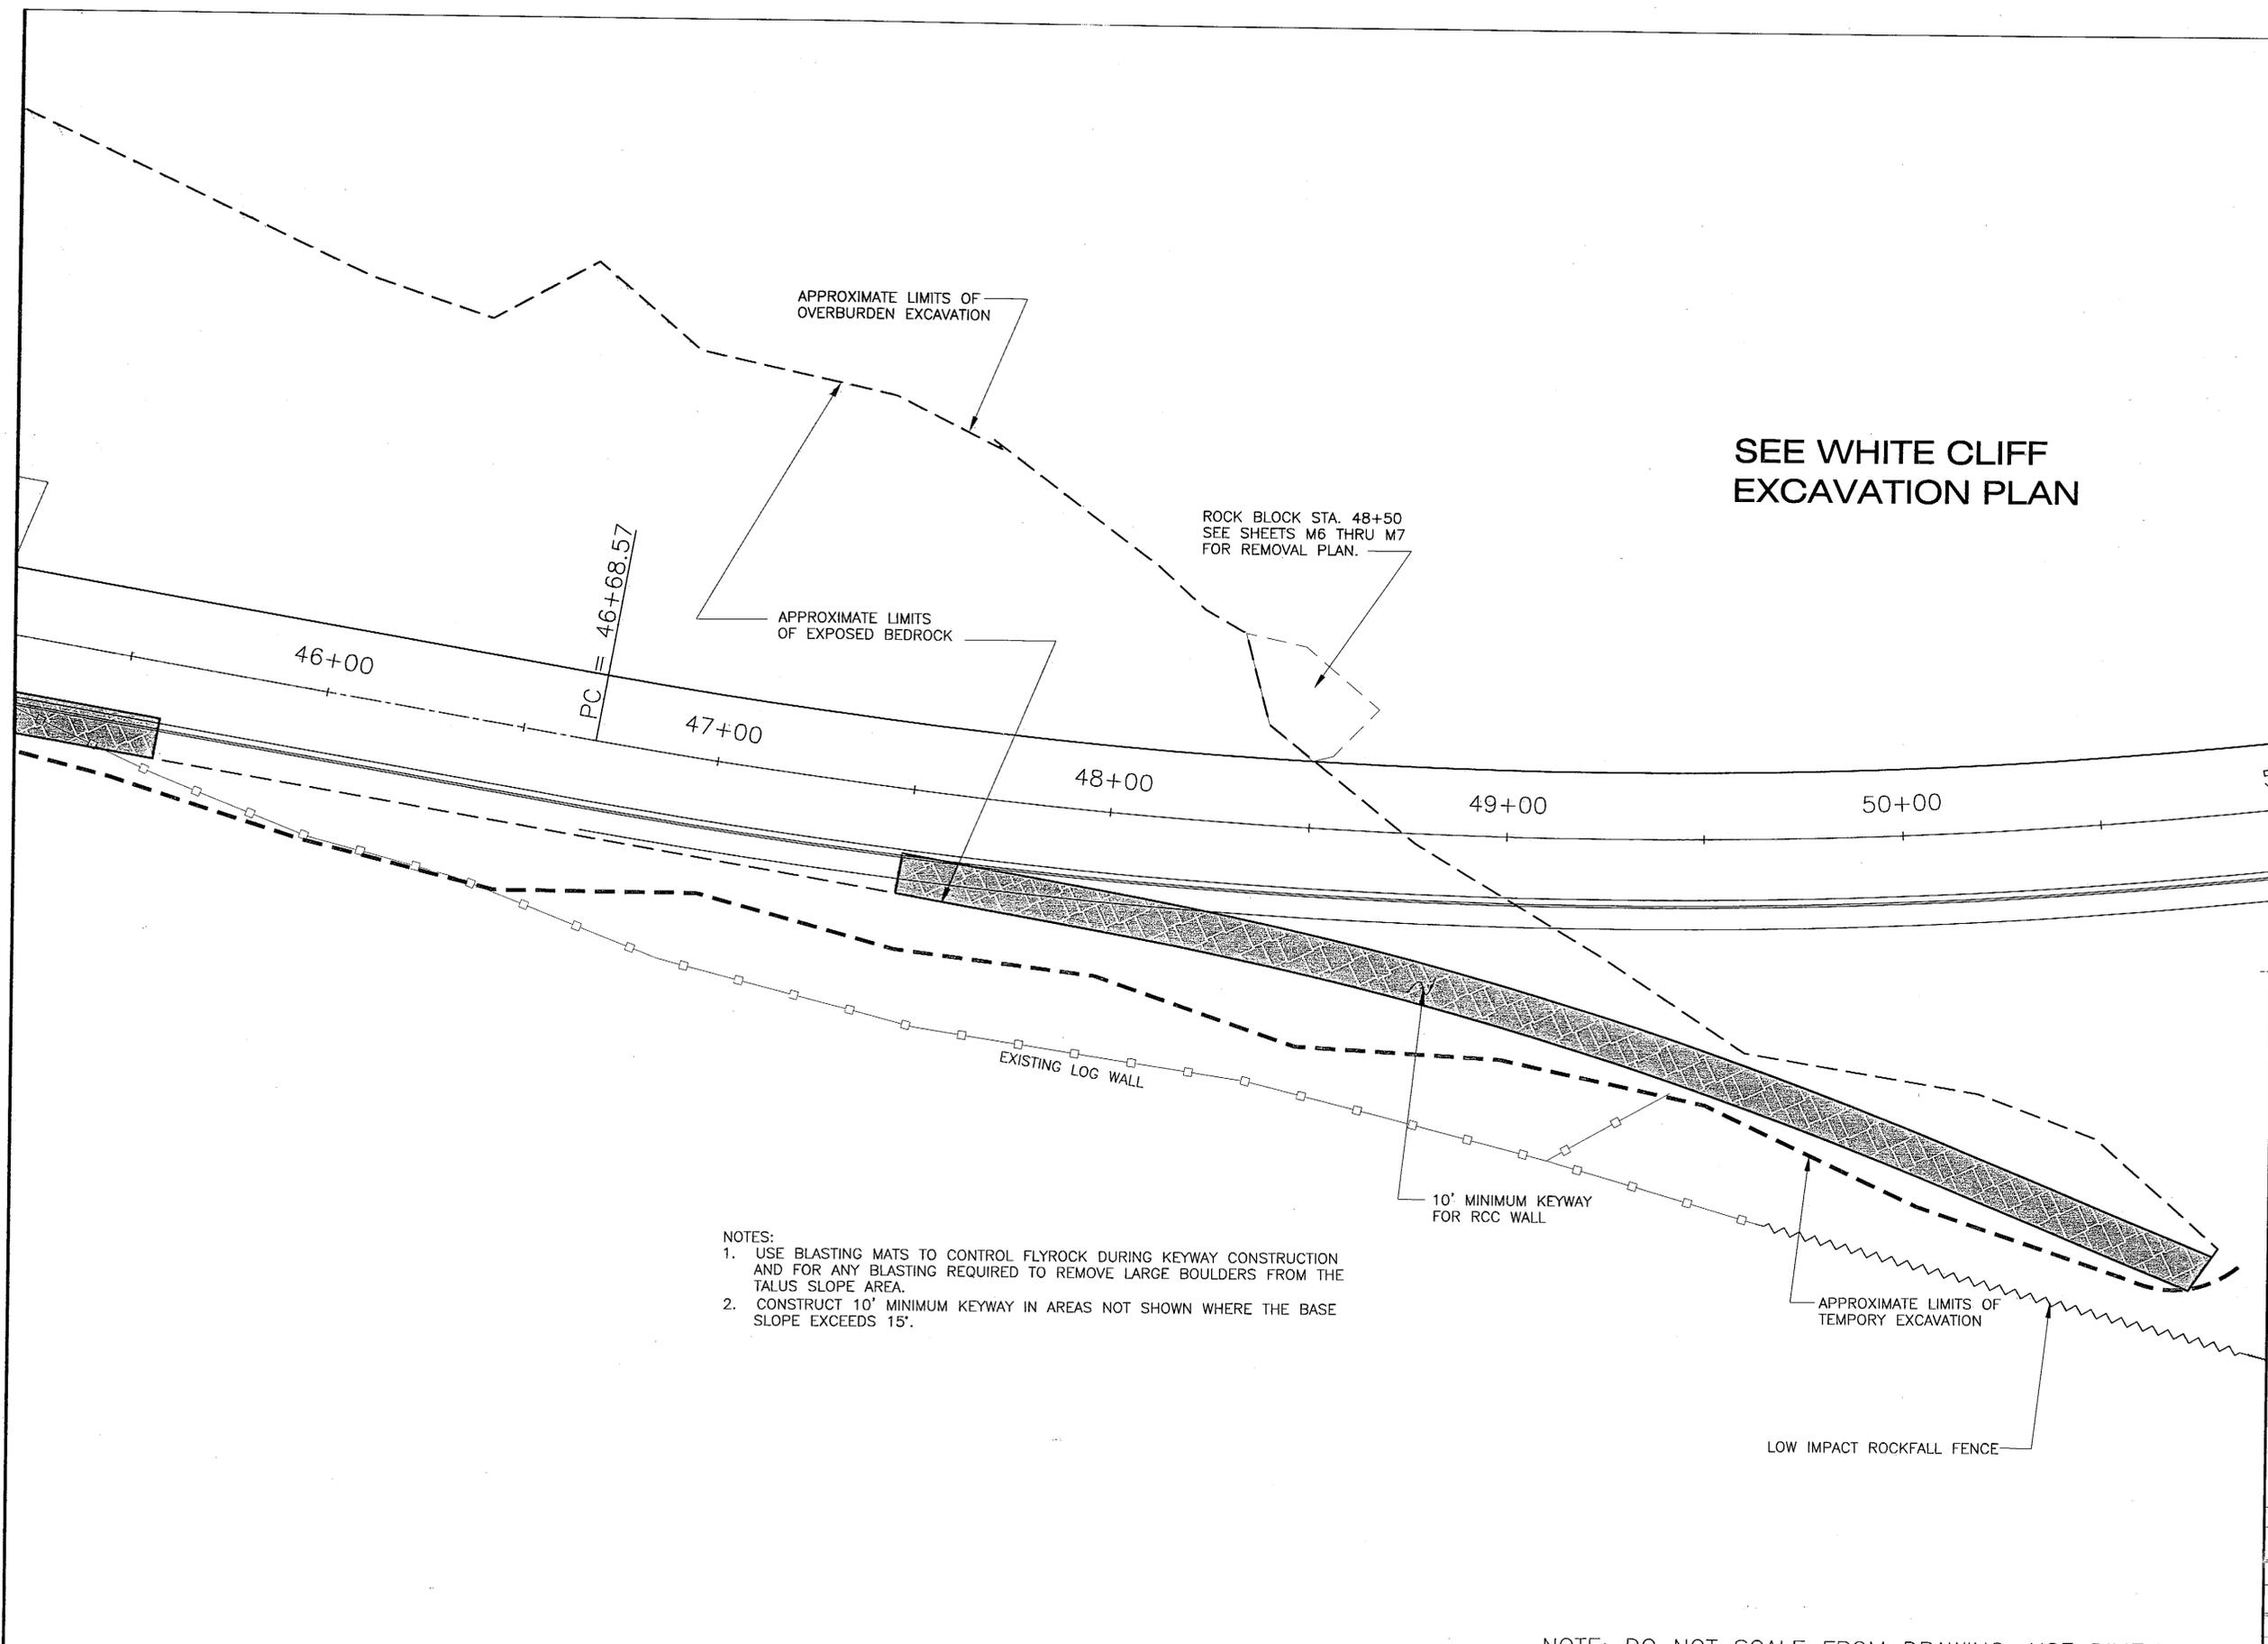

SEE WHITE CLIFF
EXCAVATION PLAN

- NOTES:
1. USE BLASTING MATS TO CONTROL FLYROCK DURING KEYWAY CONSTRUCTION AND FOR ANY BLASTING REQUIRED TO REMOVE LARGE BOULDERS FROM THE TALUS SLOPE AREA.
 2. CONSTRUCT 10' MINIMUM KEYWAY IN AREAS NOT SHOWN WHERE THE BASE SLOPE EXCEEDS 15'.

NOTE: DO NOT SCALE FROM DRAWING. USE DIMENSIONS.

PATH:
Q:\Ktn\71811A\Planset\M1-3_XPLAN.dwg
Mon, 06/May/02 10:45AM Michael Limbaugh
PLOT:
PSPACE 1=1(F) OR MSPACE 1=1(F)
TAB: ESTIMATE

ADDENDUM NUMBER		
ATTACHMENT NUMBER		
RECORD OF REVISIONS		
No.	DATE	DESCRIPTION

KTN-THIRD AVENUE EXTENSION
PROJECT NO. 68490

**OVERBURDEN/TALUS
SLOPE EXCAVATION PLAN**

DESIGNED BY: C. HOWARD

CHECKED BY: T. MOORE
DRAWN BY: K.K.


STATE OF ALASKA
DEPARTMENT OF TRANSPORTATION
& PUBLIC FACILITIES
STATEWIDE DESIGN & ENGINEERING
SERVICES DIVISION
THIRD AVENUE EXTENSION
PROJECT NO. 68490

**EXCAVATION
PLAN**

PROJECT DESIGNATION NUMBER	
STP-MG-0904(2)	
STATE	YEAR
ALASKA	2002
SHEET NUMBER	TOTAL SHEETS
M2	146

Project As Built Drawings have been reviewed by the Project Engineer. To the best of his/her knowledge, they represent the project as constructed.


Proj. Eng. *KS* Date 10-31-06

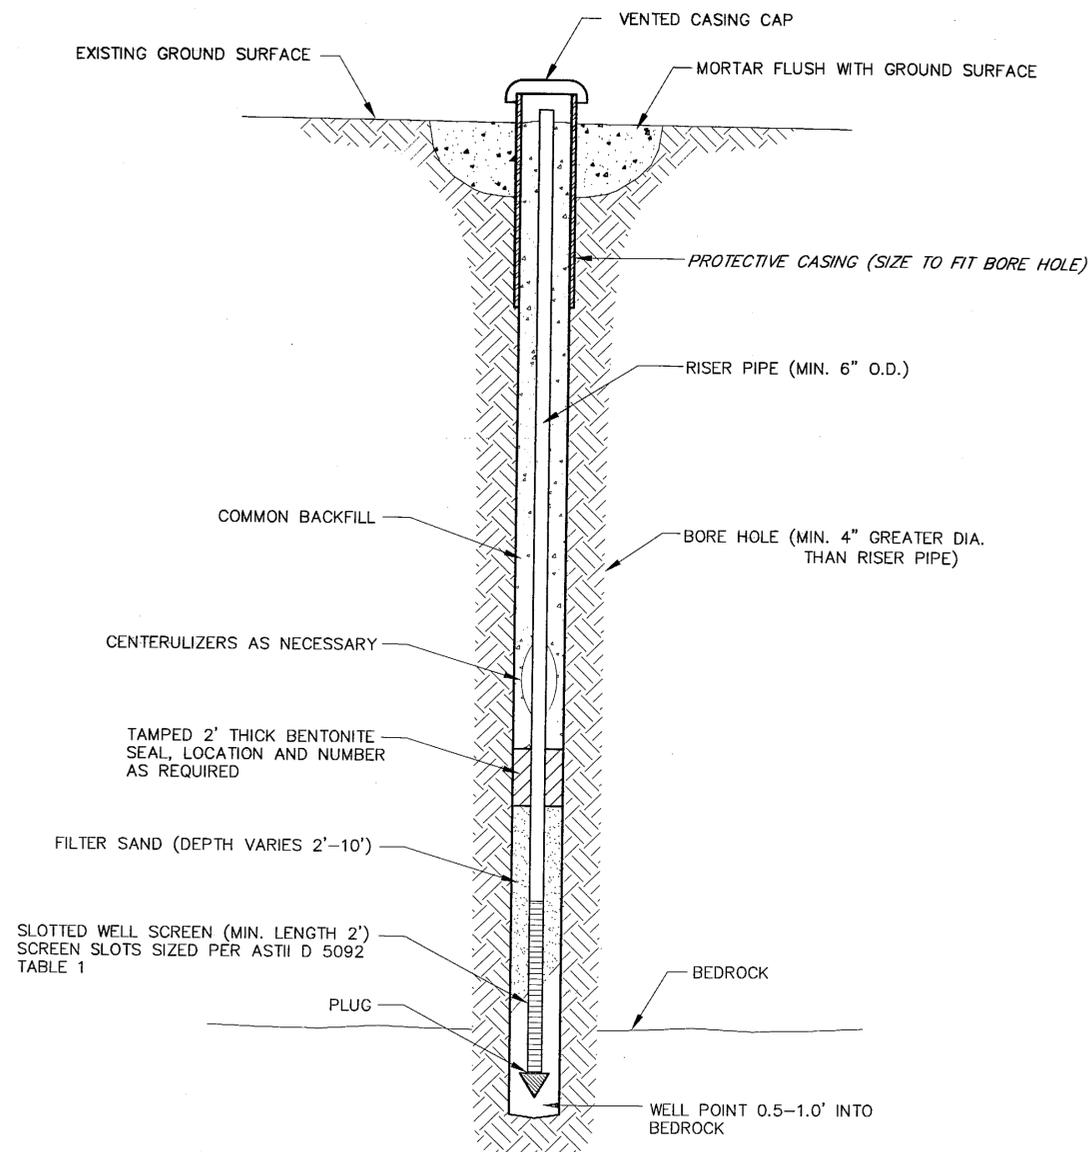

NOTES:

1. WELL MADE BY DRIVING OR DRILLING CASING TO REQUIRED DEPTH, CLEANING OUT AND INSERTING WELL POINT AND RISER PIPE, OTTAWA SAND, BENTONITE SEALS AND COMMON BACKFILL WHILE SIMULTANEOUSLY BUMPING BACK CASING UNTIL HOLE IS COMPLETELY BACKFILLED IN INCREMENTS AND CASING HAS BEEN REMOVED. MAY BE INSTALLED IN COMPLETED BOREHOLE IF BACKFILLED TO REQUIRED DEPTH.
2. FILTER SAND GRADATION TO COMFORM TO ASTM D 5092 (6.3.2 OR TABLE). PLACED TO COVER SLOTTED PORTION OF WELL SCREEN.
3. DEWATERING DISCHARGE IS TO BE COVERED BY SWPPP.
4. PUMP MUST BE ELECTRIC.

DEWATERING WELL

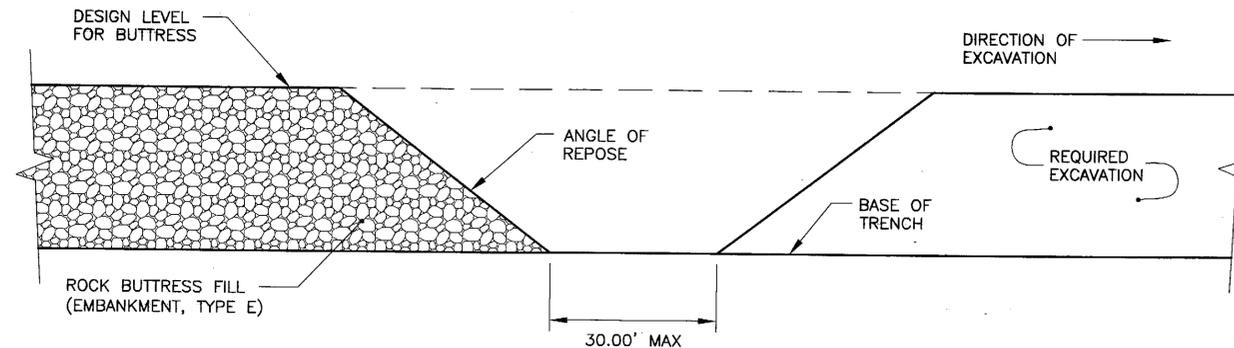

ROCK BUTTRESS BACKFILL DETAIL

NOTES:

- i) THE ROCK BUTTRESS SHALL BE CONSTRUCTED BY EXCAVATING AND BACKFILLING IN SHORT SEGMENTS. A MAXIMUM BASE LENGTH OF 30ft. (MEASURED PARALLEL TO THE ROADWAY CENTERLINE) WILL BE ALLOWED OPEN AT ANY TIME. ROCK MATERIALS SHALL BE PLACED UP TO THE DESIGN LEVEL IN THE OPEN SEGMENT PRIOR TO EXCAVATION OF THE NEXT SEGMENT. SEE ROCK BUTTRESS BACKFILL DETAIL, THIS SHEET.
- ii) ROCK BUTTRESS SHALL BE IN PLACE BEFORE CONSTRUCTION OF RCC WALL.


PATH: Q:\Ktn\71811A\Planset\M1-3_XPLAN.dwg
 Mon, 06/May/02 10:45AM Michael Limbaugh
 PLOT: PSPACE 1=1(F) OR MSPACE 1=1(F)
 TAB: ESTIMATE

ADDENDUM NUMBER		
ATTACHMENT NUMBER		
RECORD OF REVISIONS		
No.	DATE	DESCRIPTION

KTN-THIRD AVENUE EXTENSION
PROJECT NO. 68490

**Rock Buttress Backfill Detail
&
Dewatering Well Detail**

DESIGNED BY: C. HOWARD

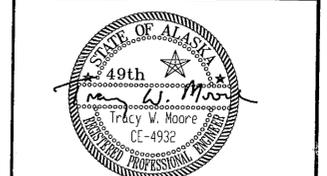

CHECKED BY: T. MOORE
 DRAWN BY: K.K.


STATE OF ALASKA
 DEPARTMENT OF TRANSPORTATION
 & PUBLIC FACILITIES
 STATEWIDE DESIGN & ENGINEERING
 SERVICES DIVISION
 THIRD AVENUE EXTENSION
 PROJECT NO. 68490
**Rock Buttress
 Backfill &
 Dewatering
 Well Detail**

PROJECT DESIGNATION NUMBER	
STP-MG-0904(2)	
STATE	YEAR
ALASKA	2002
SHEET NUMBER	TOTAL SHEETS
M3	146


Project As Built Drawings have been reviewed by the Project Engineer. To the best of his/her knowledge, they represent the project as constructed.
 Proj. Eng. *[Signature]* Date 10/21/06

ADDENDUM NUMBER		
ATTACHMENT NUMBER		
RECORD OF REVISIONS		
No.	DATE	DESCRIPTION

KTN-THIRD AVENUE EXTENSION
 PROJECT NO. 68490
White Cliff Excavation Plan

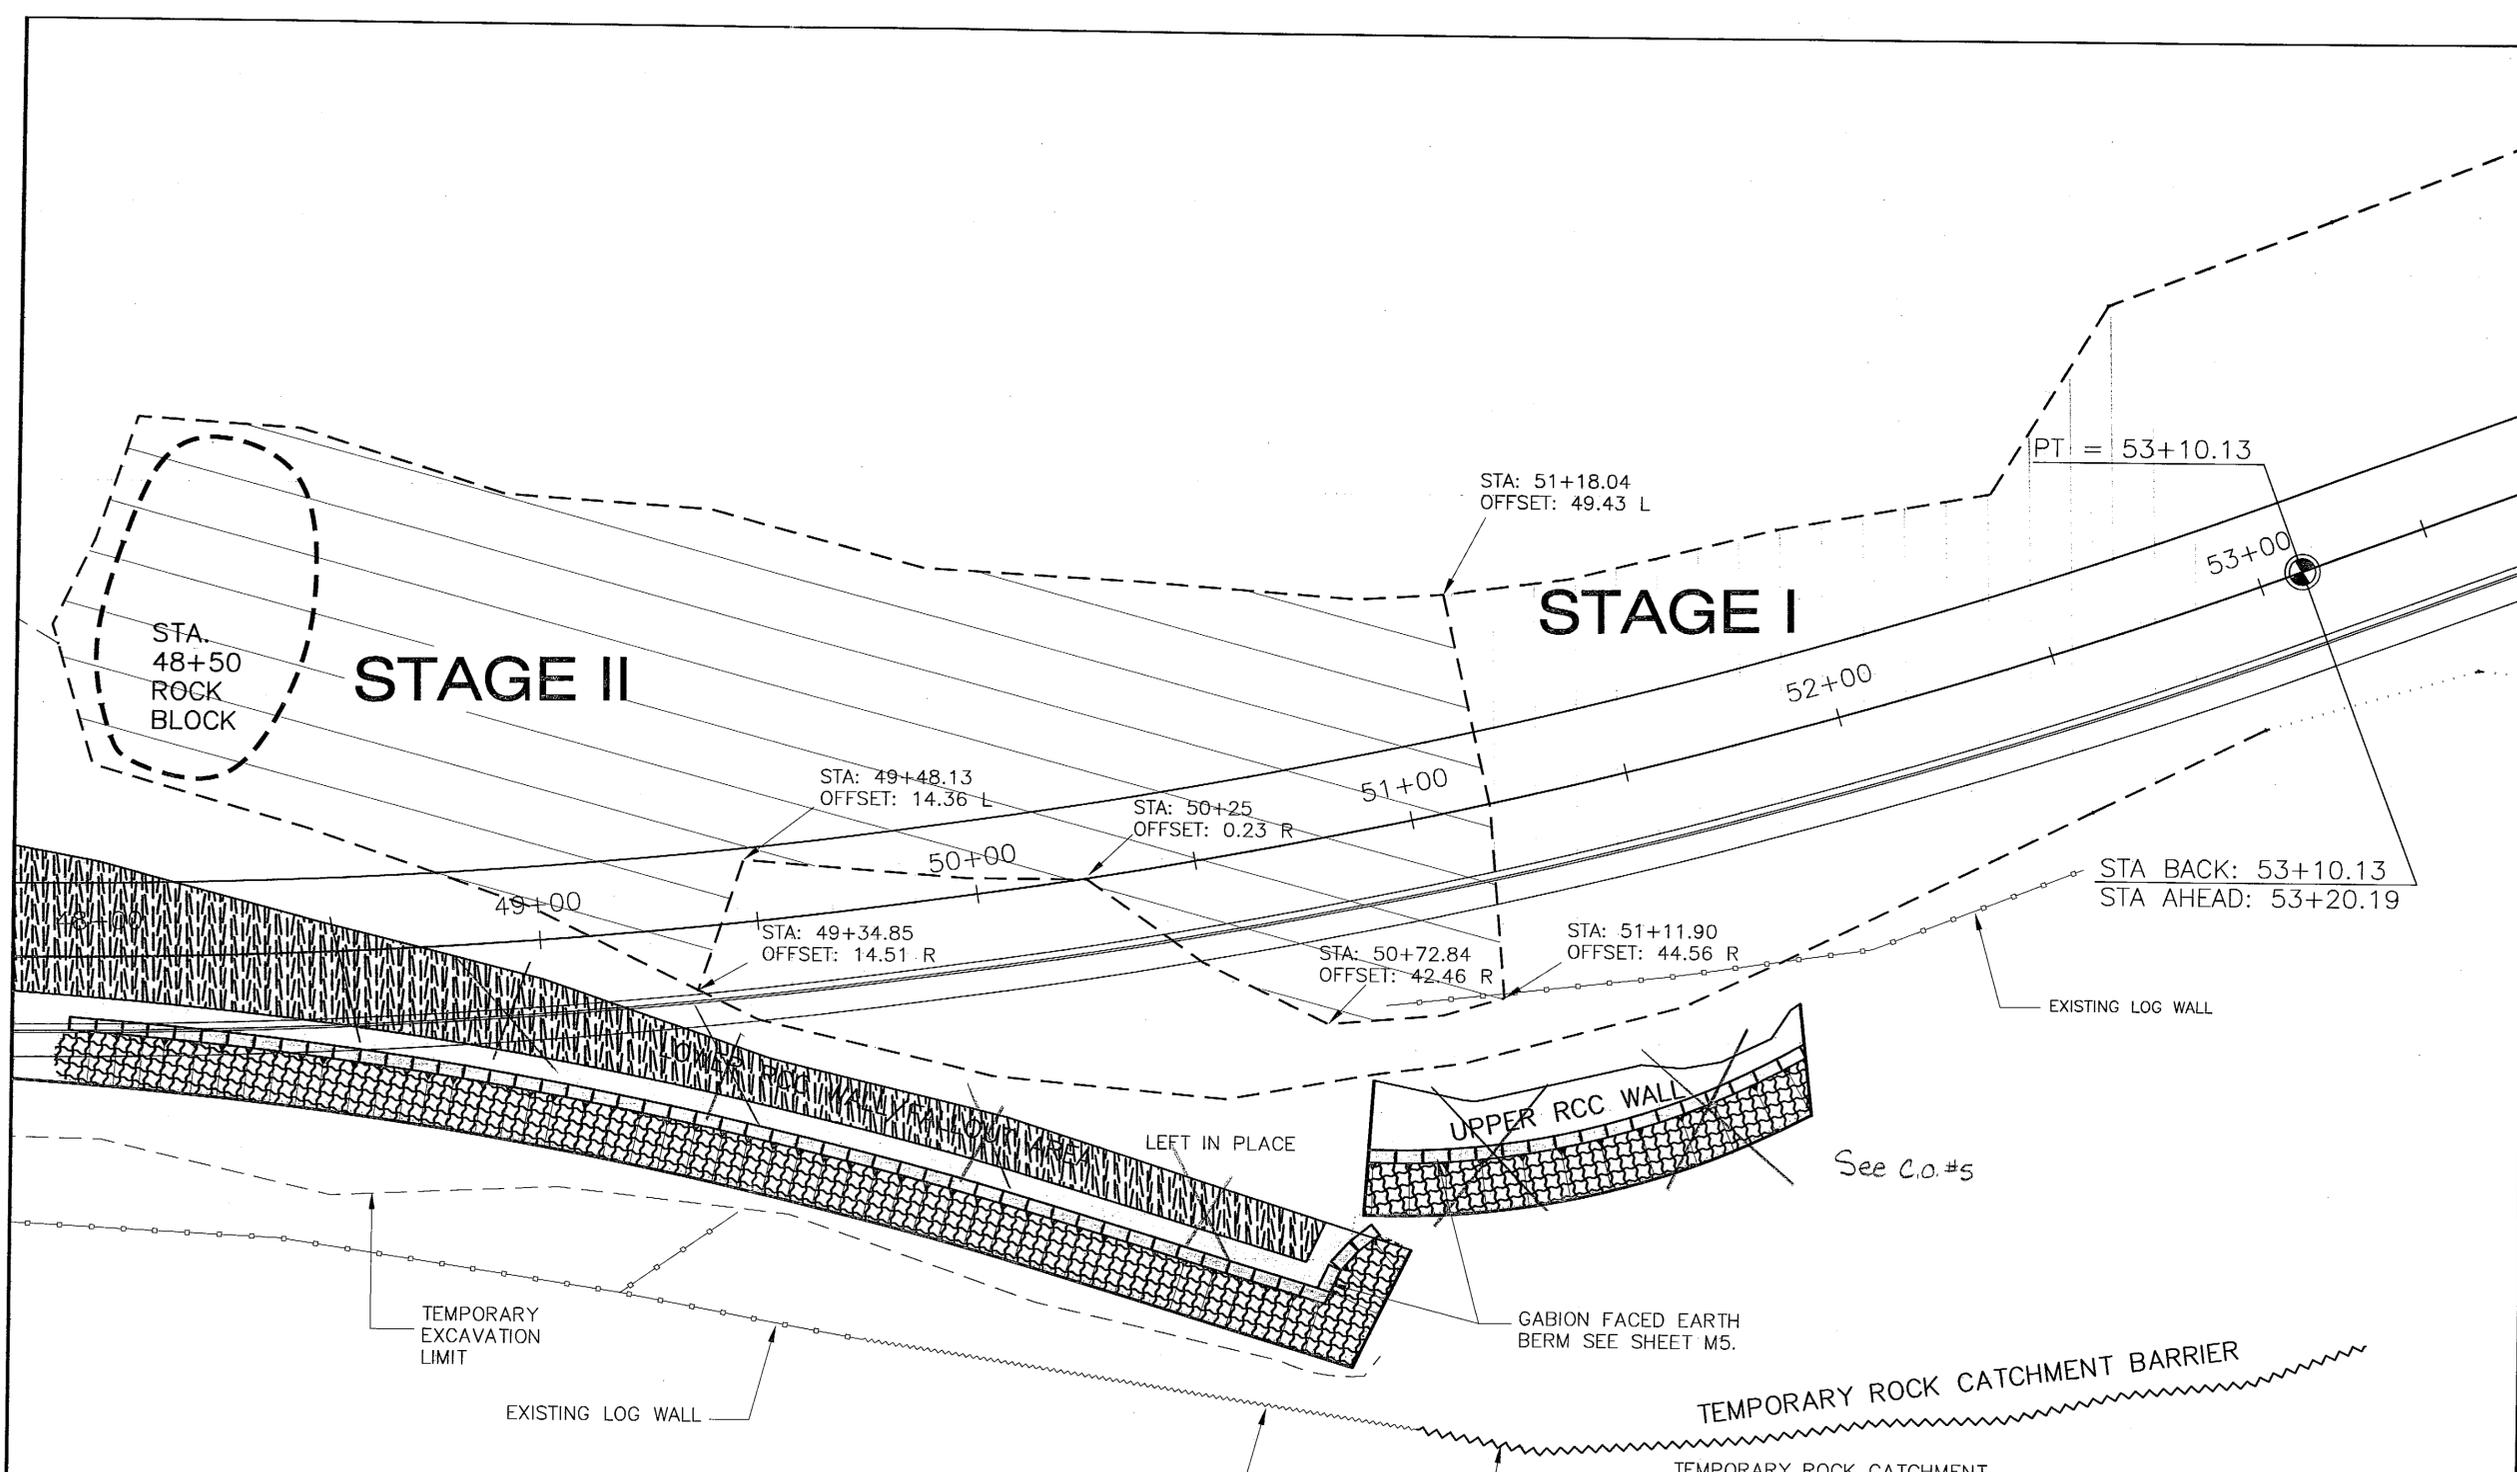

DESIGNED BY: C. HOWARD

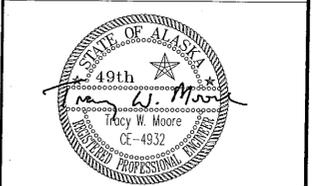

CHECKED BY: T. MOORE
 DRAWN BY: K.K.

STATE OF ALASKA
 DEPARTMENT OF TRANSPORTATION
 & PUBLIC FACILITIES
 STATEWIDE DESIGN & ENGINEERING
 SERVICES DIVISION
 THIRD AVENUE EXTENSION
 PROJECT NO. 68490

**White Cliff
 Excavation
 Plan**

PROJECT DESIGNATION NUMBER
 STP-MG-0904(2)

STATE	YEAR
ALASKA	2002
SHEET NUMBER	TOTAL SHEETS
M4	146

Project As Built Drawings have been reviewed by the Project Engineer. To the best of his/her knowledge, they represent the project as constructed.
 Proj. Eng. *KS* Date 5/10/02

- BEFORE COMMENCING WITH STAGE I OR STAGE II ROCK EXCAVATION THE FOLLOWING ROCKFALL MITIGATION MEASURES MUST BE IN PLACE:
1. ROLLER COMPACTED CONCRETE FALLOUT AREA MUST BE CONSTRUCTED.
 2. A GABION-FACED EARTH BERM MUST BE CONSTRUCTED BETWEEN STA. 48+00 AND STA. 51+40 TO INTERCEPT ROLLING AND BOUNCING ROCKS.
 3. THE ROCK CATCHMENT BARRIERS MUST BE INSTALLED.
 4. THE USE OF BLASTING MATS IS REQUIRED TO CONTROL FLYROCK.
 5. DURING ROCK EXCAVATION, THE FALLOUT AREA SHALL BE CLEANED AFTER EACH BLAST TO ENSURE ADEQUATE STORAGE FOR THE NEXT BLAST.

PATH:
 Q:\Ktn\71811A\PlanSet\M4-7_WhiteCliff.dwg
 Mon, 06/May/02 10:46AM Michael Limbaugh
 PLOT:
 PSPACE 1=1(F) OR MSPACE 1=1(F)
 TAB: M5

ADDENDUM NUMBER		
ATTACHMENT NUMBER		
RECORD OF REVISIONS		
No.	DATE	DESCRIPTION

KTN-THIRD AVENUE EXTENSION
 PROJECT NO. 68490

White Cliff Excavation Plan

DESIGNED BY: C. HOWARD





CHECKED BY: T. MOORE
 DRAWN BY: K.K.

STATE OF ALASKA
 DEPARTMENT OF TRANSPORTATION
 & PUBLIC FACILITIES
 STATEWIDE DESIGN & ENGINEERING
 SERVICES DIVISION
 THIRD AVENUE EXTENSION
 PROJECT NO. 68490


**White Cliff
Excavation
Plan**

PROJECT DESIGNATION NUMBER	
STP-MG-0904(2)	
STATE	YEAR
ALASKA	2002
SHEET NUMBER	TOTAL SHEETS
M5	146

Project As Built Drawings have been reviewed by the Project Engineer. To the best of his/her knowledge, they represent the project as constructed.
 Proj. Eng. *[Signature]* Date 10/21/06

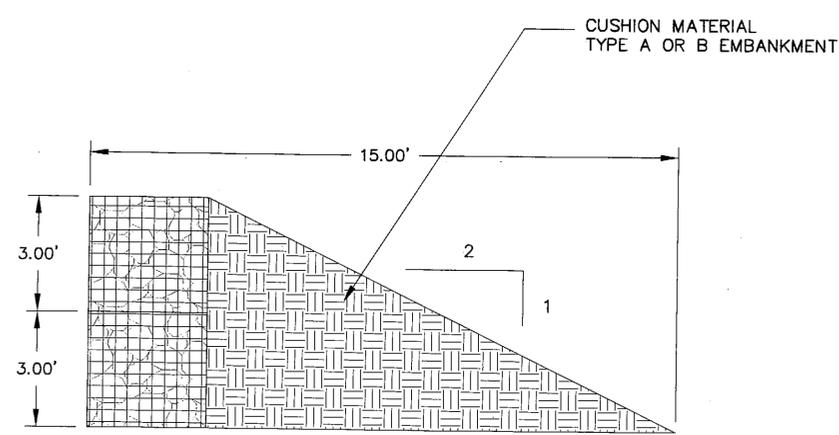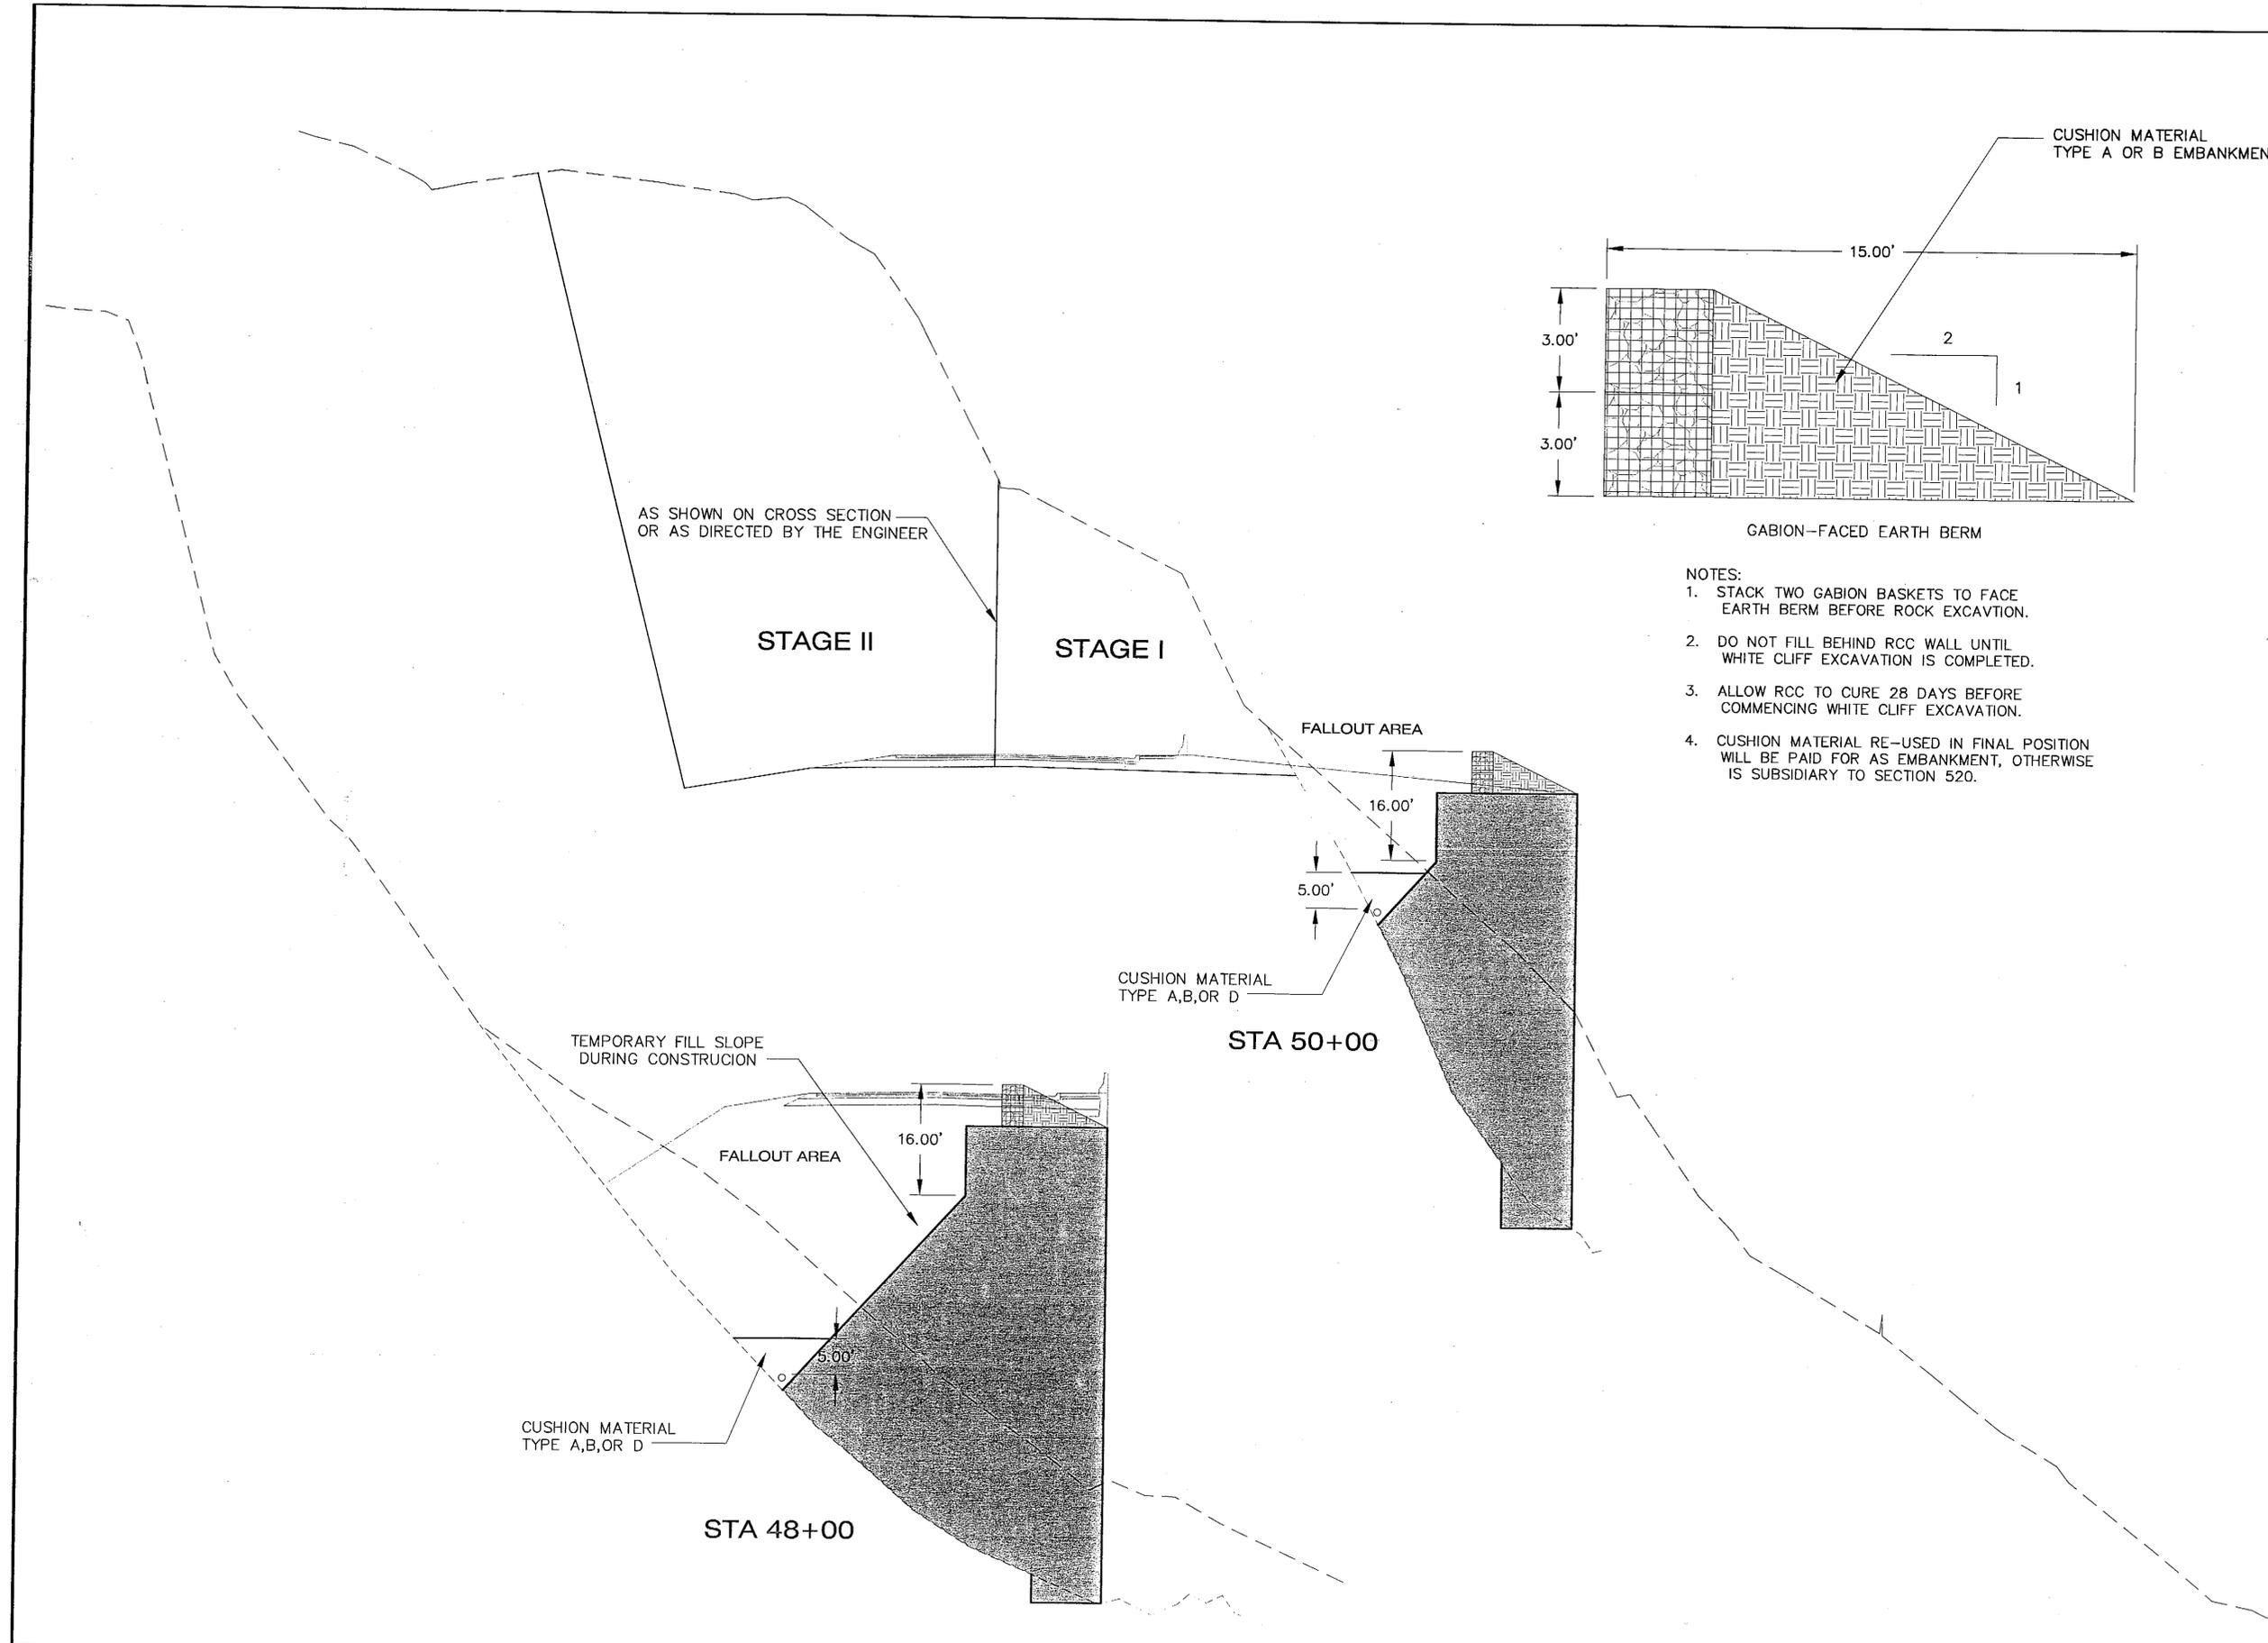

- NOTES:
1. STACK TWO GABION BASKETS TO FACE EARTH BERM BEFORE ROCK EXCAVATION.
 2. DO NOT FILL BEHIND RCC WALL UNTIL WHITE CLIFF EXCAVATION IS COMPLETED.
 3. ALLOW RCC TO CURE 28 DAYS BEFORE COMMENCING WHITE CLIFF EXCAVATION.
 4. CUSHION MATERIAL RE-USED IN FINAL POSITION WILL BE PAID FOR AS EMBANKMENT, OTHERWISE IS SUBSIDIARY TO SECTION 520.

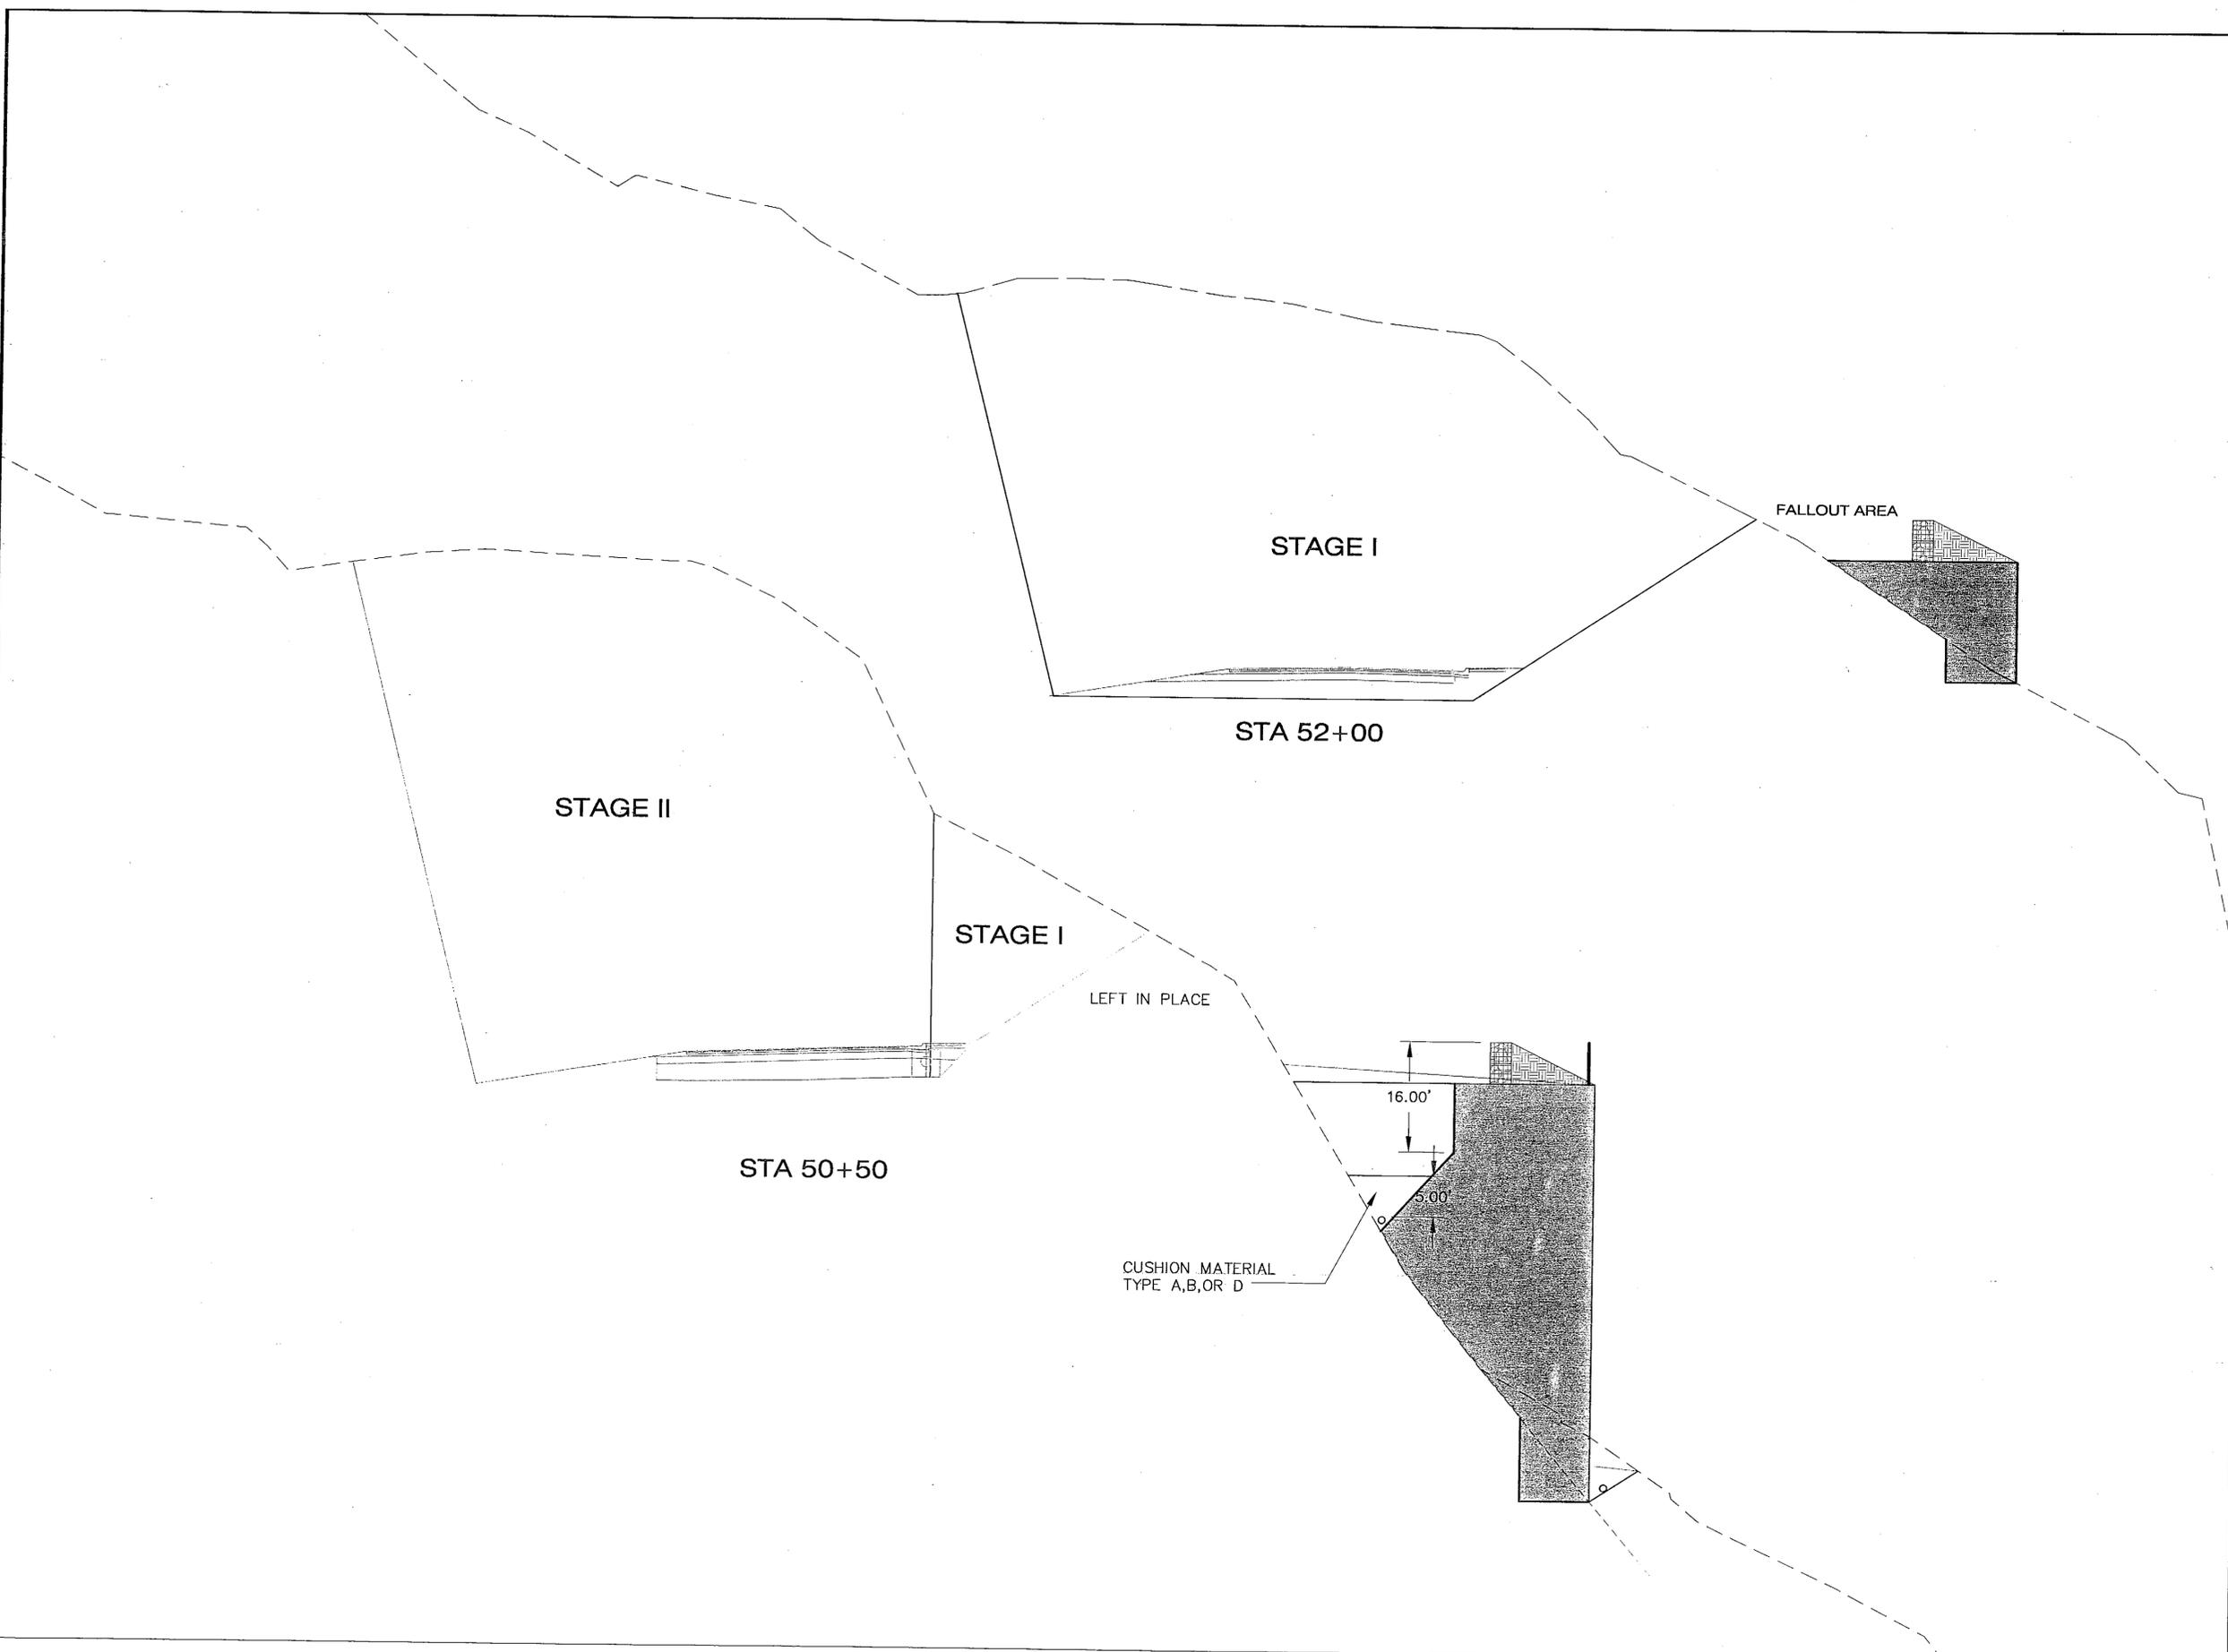

PATH: Q:\Ktn\71811A\Planset\M4-7_WhiteCliff.dwg
 Mon, 06/May/02 10:46AM Michael Limbaugh
 PLOT: PSPACE 1=1(F) OR MSPACE 1=1(F)
 TAB: M6

ADDENDUM NUMBER		
ATTACHMENT NUMBER		
RECORD OF REVISIONS		
No.	DATE	DESCRIPTION

White Cliff Excavation Plan

KTN-THIRD AVENUE EXTENSION
 PROJECT NO. 68490

DESIGNED BY: C. HOWARD



CHECKED BY: T. MOORE

DRAWN BY: K.K.

STATE OF ALASKA
 DEPARTMENT OF TRANSPORTATION
 & PUBLIC FACILITIES
 STATEWIDE DESIGN & ENGINEERING
 SERVICES DIVISION

THIRD AVENUE EXTENSION
 PROJECT NO. 68490


**White Cliff
 Excavation
 Plan**

PROJECT DESIGNATION NUMBER
STP-MG-0904(2)


STATE	YEAR
ALASKA	2002
SHEET NUMBER	TOTAL SHEETS
M6	146

Project As Built Drawings have been reviewed by the Project Engineer. To the best of his/her knowledge, they represent the project as constructed.

Proj. Eng. *[Signature]* Date 5-3-06

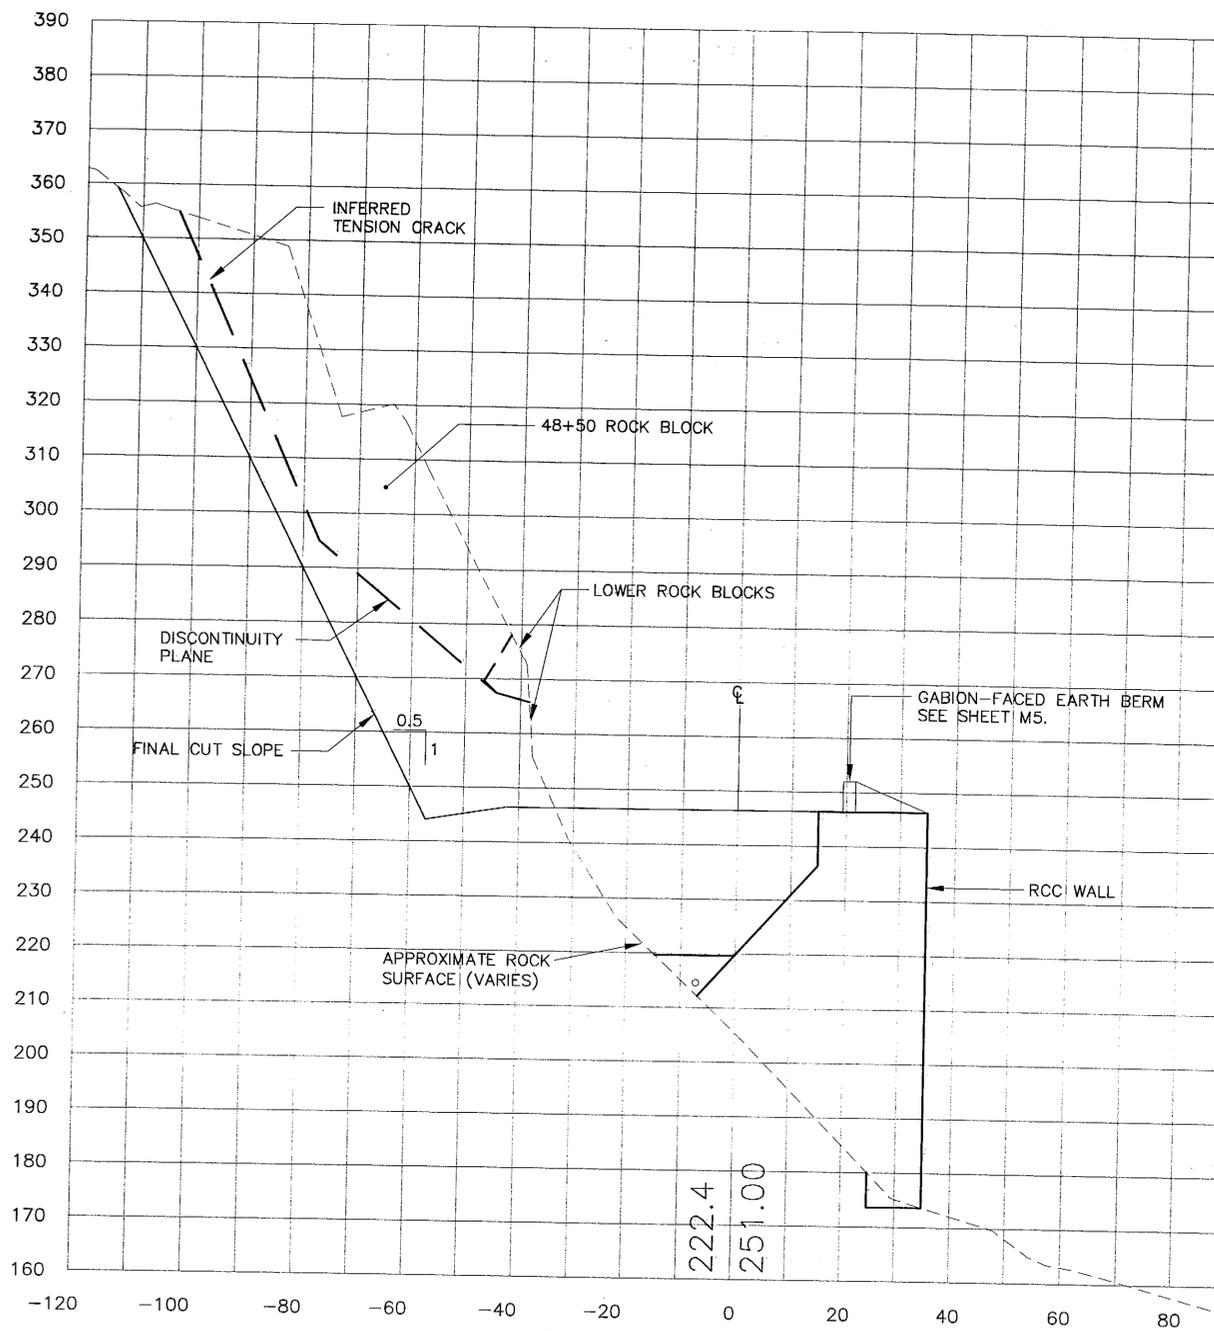

Cross Section Rock Block STA. 48+50

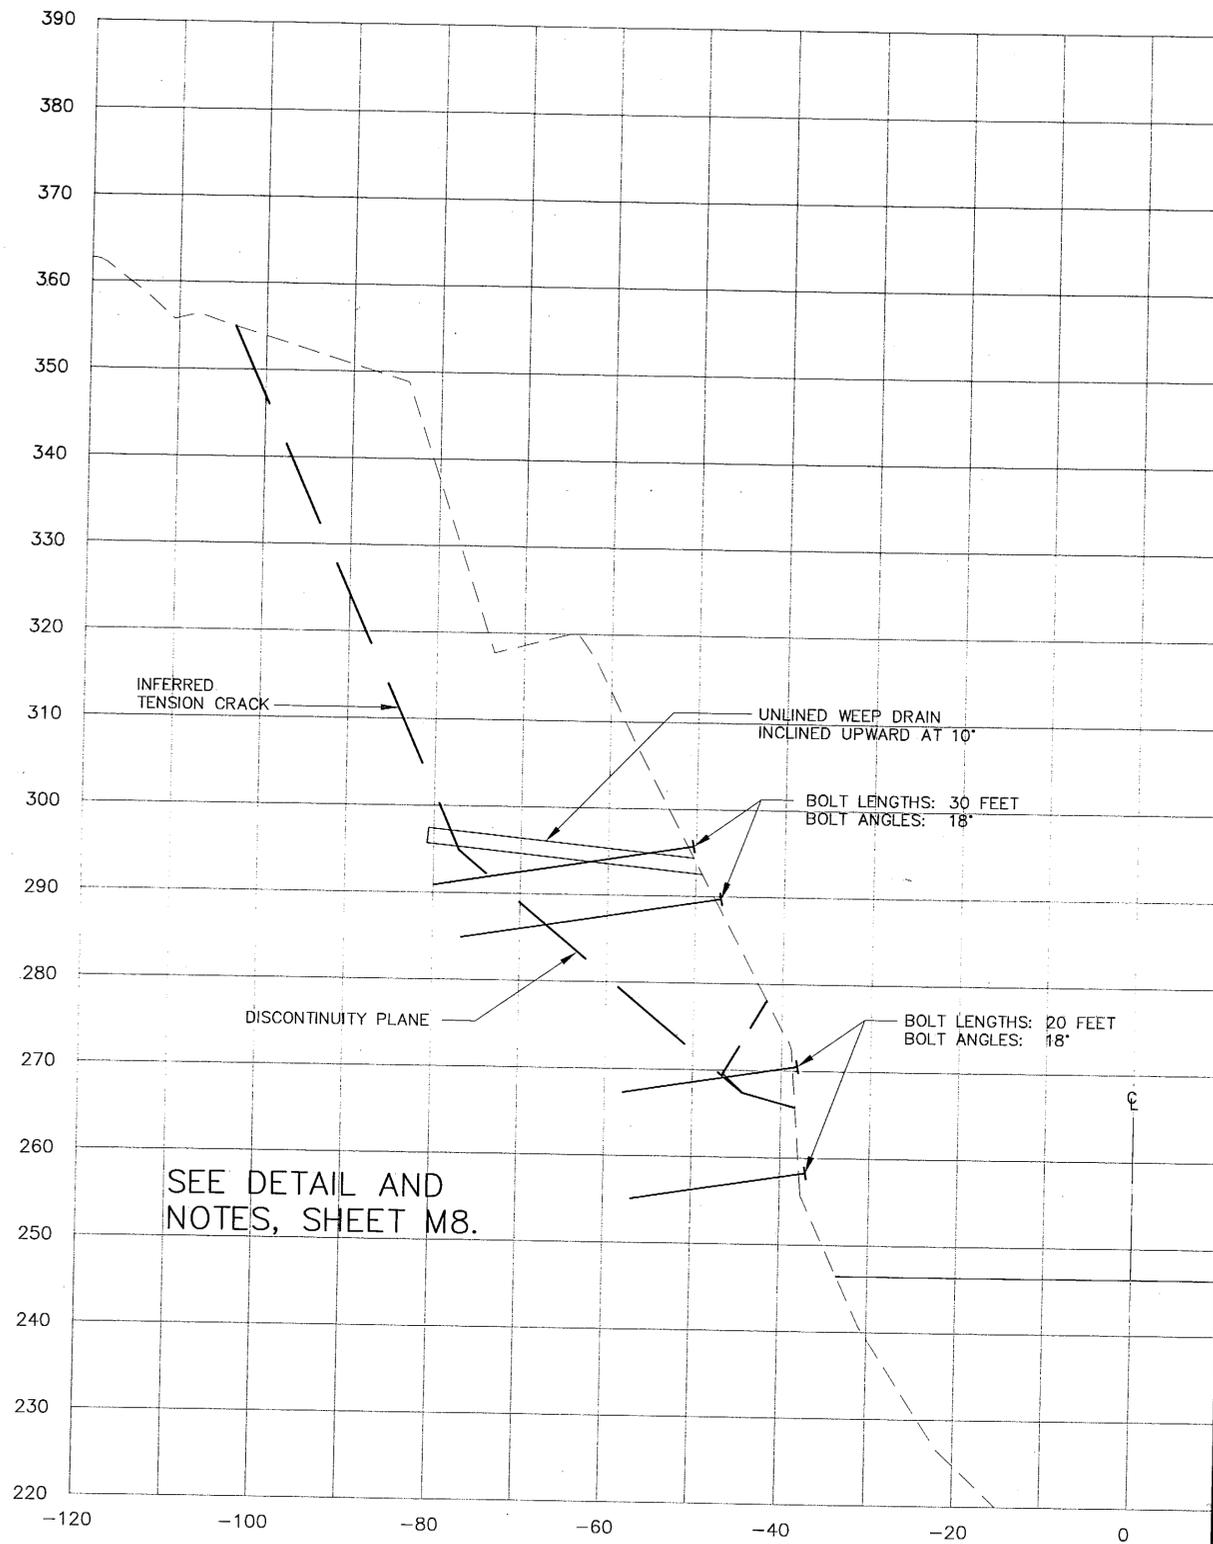

Rock Bolt Diagram Rock Block STA. 48+50

PATH: Q:\Ktn\71811A\Planet\M4-7_WhiteCliff.dwg
 Mon, 06/May/02 10:46AM Michael Limbaugh
 PLOT: PSPACE 1=1(F) OR MSPACE 1=1(F)
 TAB: M7

ADDENDUM NUMBER		
ATTACHMENT NUMBER		
RECORD OF REVISIONS		
No.	DATE	DESCRIPTION

KTN-THIRD AVENUE EXTENSION
 PROJECT NO. 68490
**Rock Block Sta. 48+50
 Removal Plan**

DESIGNED BY: C. HOWARD



CHECKED BY: T. MOORE
 DRAWN BY: M.L.L.
 STATE OF ALASKA
 DEPARTMENT OF TRANSPORTATION
 & PUBLIC FACILITIES
 STATEWIDE DESIGN & ENGINEERING
 SERVICES DIVISION
 THIRD AVENUE EXTENSION
 PROJECT NO. 68490


**Rock Block
 Sta. 48+50
 Removal Plan**

PROJECT DESIGNATION NUMBER	
STP-MG-0904(2)	
STATE	YEAR
ALASKA	2002
SHEET NUMBER	TOTAL SHEETS
M7	146


Project As Built Drawings have been reviewed by the Project Engineer. To the best of his/her knowledge, they represent the project as constructed.
 Proj. Eng. *KS* Date 10/31/06

NOTES:

1. THE ROCK BOLT REINFORCEMENT IS CONSIDERED TEMPORARY SINCE THE ROCKBLOCK IS SLATED FOR COMPLETE REMOVAL AS CONSTRUCTION PROCEEDS.
2. LOCATION OF ALL BOLTS TO BE DIRECTED IN THE FIELD BY THE ENGINEER.
3. THE BOTTOM FIVE, 20-FOOT LONG BOLTS AND WEEP DRAINS NEED TO BE INSTALLED BEFORE THE COLLUVIUM IS REMOVED IN ORDER TO SECURE THE LOWER KEY BLOCKS AND REPLACE THE SUPPORT PROVIDED BY THE COLLUVIUM.
4. STABILIZE THE STA. 48+50 ROCKBLOCK WITH A MECHANICALLY ANCHORED HOLLOW-CORE ROCK BOLT SYSTEM, SIMILAR TO THE WILLIAMS FORM ENGINEERING CORPORATION PROPRIETARY BOLT SYSTEM SHOWN ON THIS SHEET, OR AN APPROVED EQUAL.
5. ALL ROCK BOLTS WILL NEED TO BE INSTALLED BEFORE ANY PRODUCTION BLASTING FOR THE ROADWAY CUT SLOPES IS PERFORMED WITHIN 500 FEET OF STATION 48+50. ONCE ALL 22 BOLTS ARE INSTALLED, THE BLOCK CAN BE REMOVED IN 30-FOOT LIFTS.

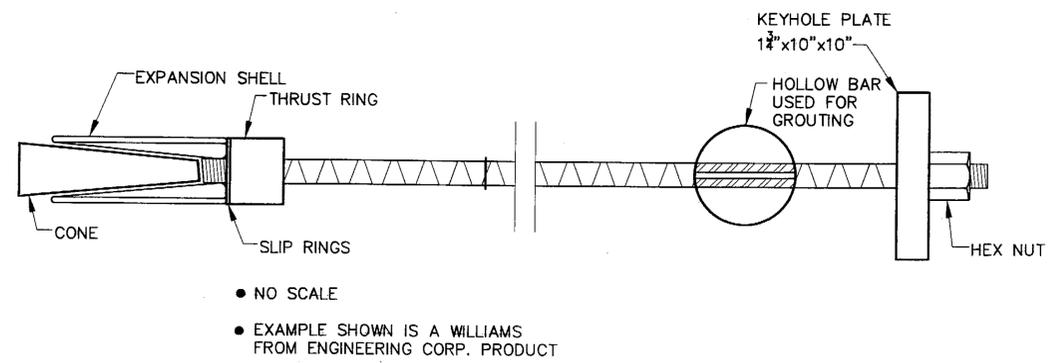

STA. 48+50 ROCK BLOCK-ROCK BOLT SUMMARY			
QUANTITY	LENGTH	DESIGN LOAD	REMARKS
9	20'	69 KIP	5 INSTALLED THRU LOWER BLOCKS, SEE NOTE 3 4 INSTALLED THRU ROCK BOLTS, SEE NOTE 5
13	30'	69 KIP	INSTALLED THRU ROCKBLOCK, SEE NOTES

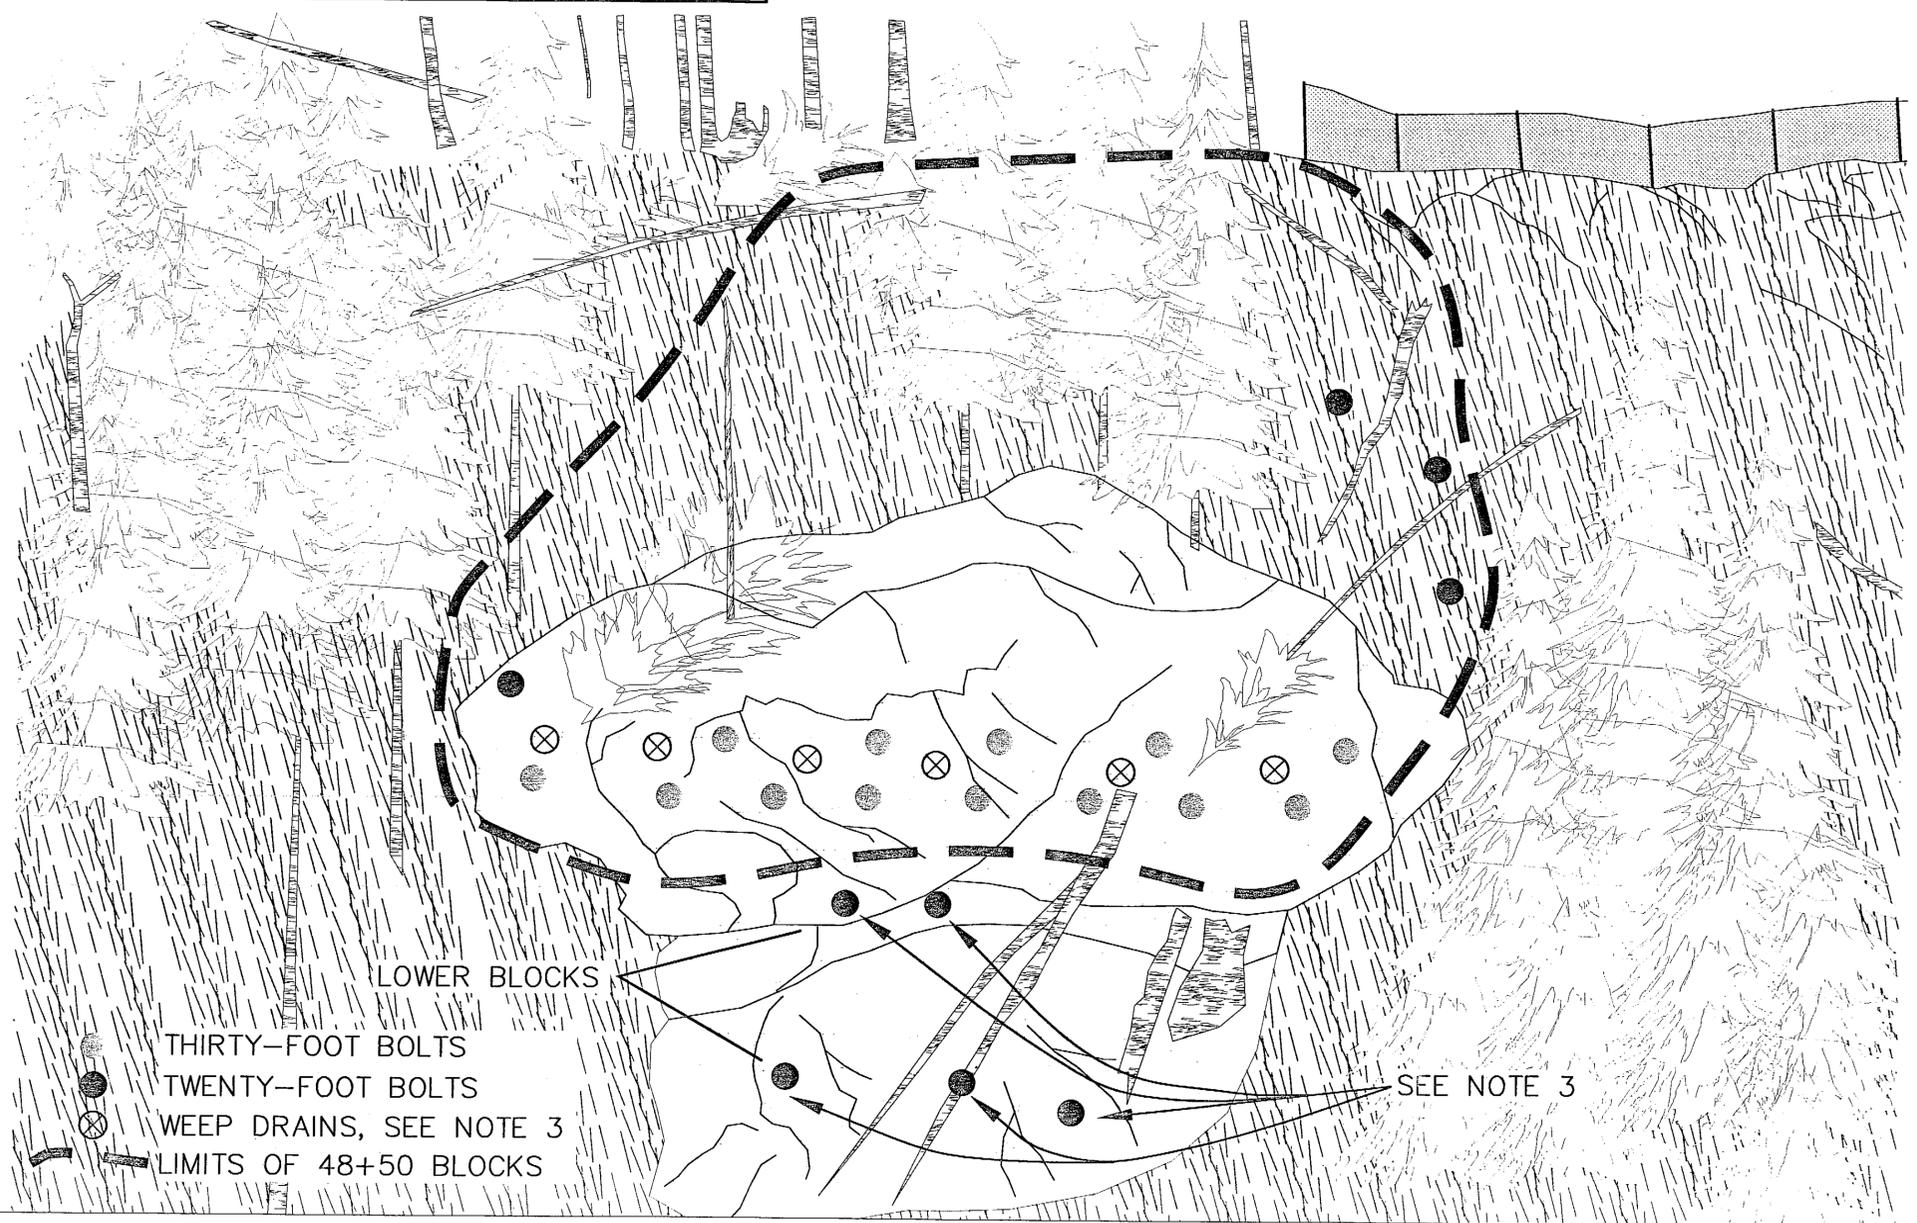

PATH:
 Q:\Ktn\71811A\Planset\M4-7_WhiteCliff.dwg
 Mon, 06/May/02 10:46AM Michael Limbaugh
 PLOT:
 PSPACE 1=1(F) OR MSPACE 1=1(F)
 TAB: M8

ADDENDUM NUMBER		
ATTACHMENT NUMBER		
RECORD OF REVISIONS		
No.	DATE	DESCRIPTION

KTN-THIRD AVENUE EXTENSION
 PROJECT NO. 68490
Sta. 48+50 Rock Block

DESIGNED BY: C. HOWARD




CHECKED BY: T. MOORE
 DRAWN BY: K.K.

STATE OF ALASKA
 DEPARTMENT OF TRANSPORTATION
 & PUBLIC FACILITIES
 STATEWIDE DESIGN & ENGINEERING
 SERVICES DIVISION
 THIRD AVENUE EXTENSION
 PROJECT NO. 68490

**Sta. 48+50
 Rock Block**

PROJECT DESIGNATION NUMBER	
STP-MG-0904(2)	
STATE	YEAR
ALASKA	2002
SHEET NUMBER	TOTAL SHEETS
M8	146

Project As Built Drawings have been reviewed by the Project Engineer. To the best of his/her knowledge, they represent the project as constructed.
 Proj. Eng. *KS* Date 10/2/06

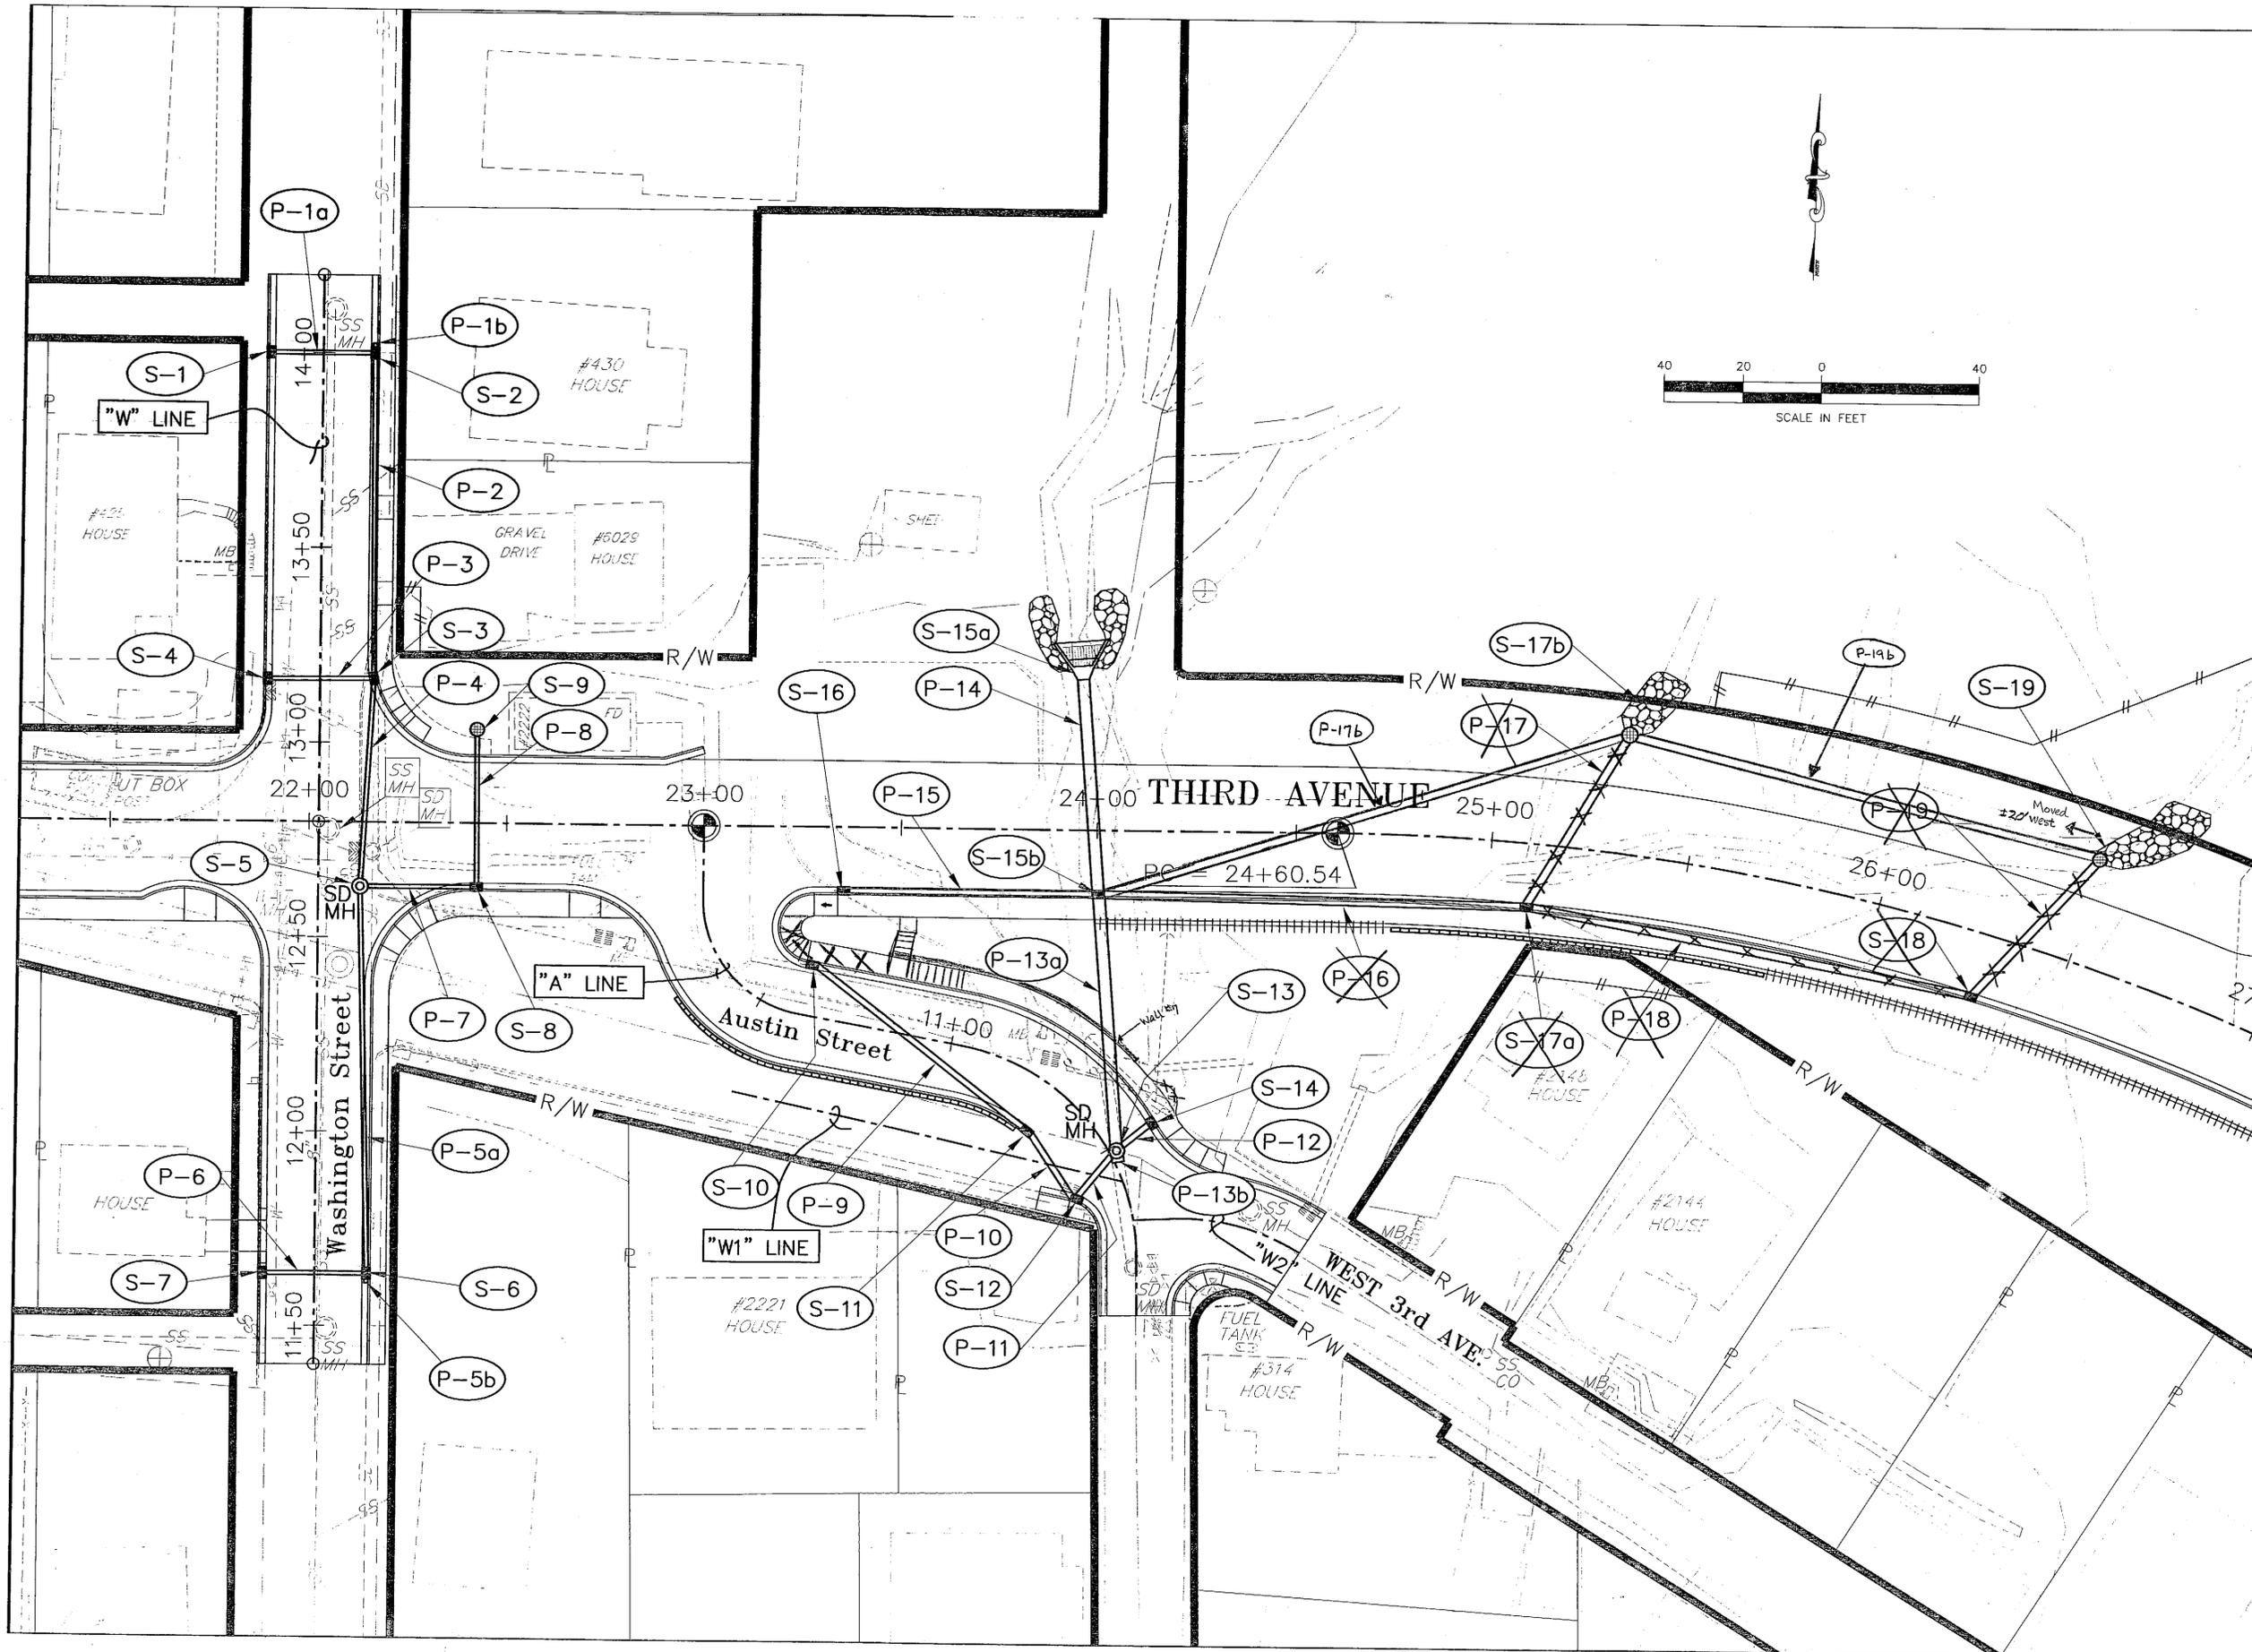


PATH: Q:\Ktn\71811A\Planset\N_DrainPlan.dwg
 Mon, 06/May/02 10:56AM Michael Limbaugh
 PLOT: PSPACE 1=1(F) OR MSPACE 1=1(F)
 TAB: PLAN

ADDENDUM NUMBER		
ATTACHMENT NUMBER		
RECORD OF REVISIONS		
No.	DATE	DESCRIPTION

KTN-THIRD AVENUE EXTENSION
 PROJECT NO. 68490
Drainage Plan

DESIGNED BY: C. HOWARD

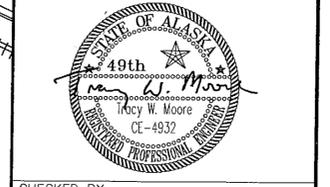


CHECKED BY: T. MOORE
DRAWN BY: K.K.

STATE OF ALASKA
 DEPARTMENT OF TRANSPORTATION
 & PUBLIC FACILITIES
 STATEWIDE DESIGN & ENGINEERING
 SERVICES DIVISION
THIRD AVENUE EXTENSION
PROJECT NO. 68490

Drainage Plan

PROJECT DESIGNATION NUMBER	
STP-MG-0904(2)	
STATE	YEAR
ALASKA	2002
SHEET NUMBER	TOTAL SHEETS
N1	146

Project As Built Drawings have been reviewed by the Project Engineer. To the best of his/her knowledge, they represent the project as constructed.
 Proj. Eng. *[Signature]* Date 12-31-06

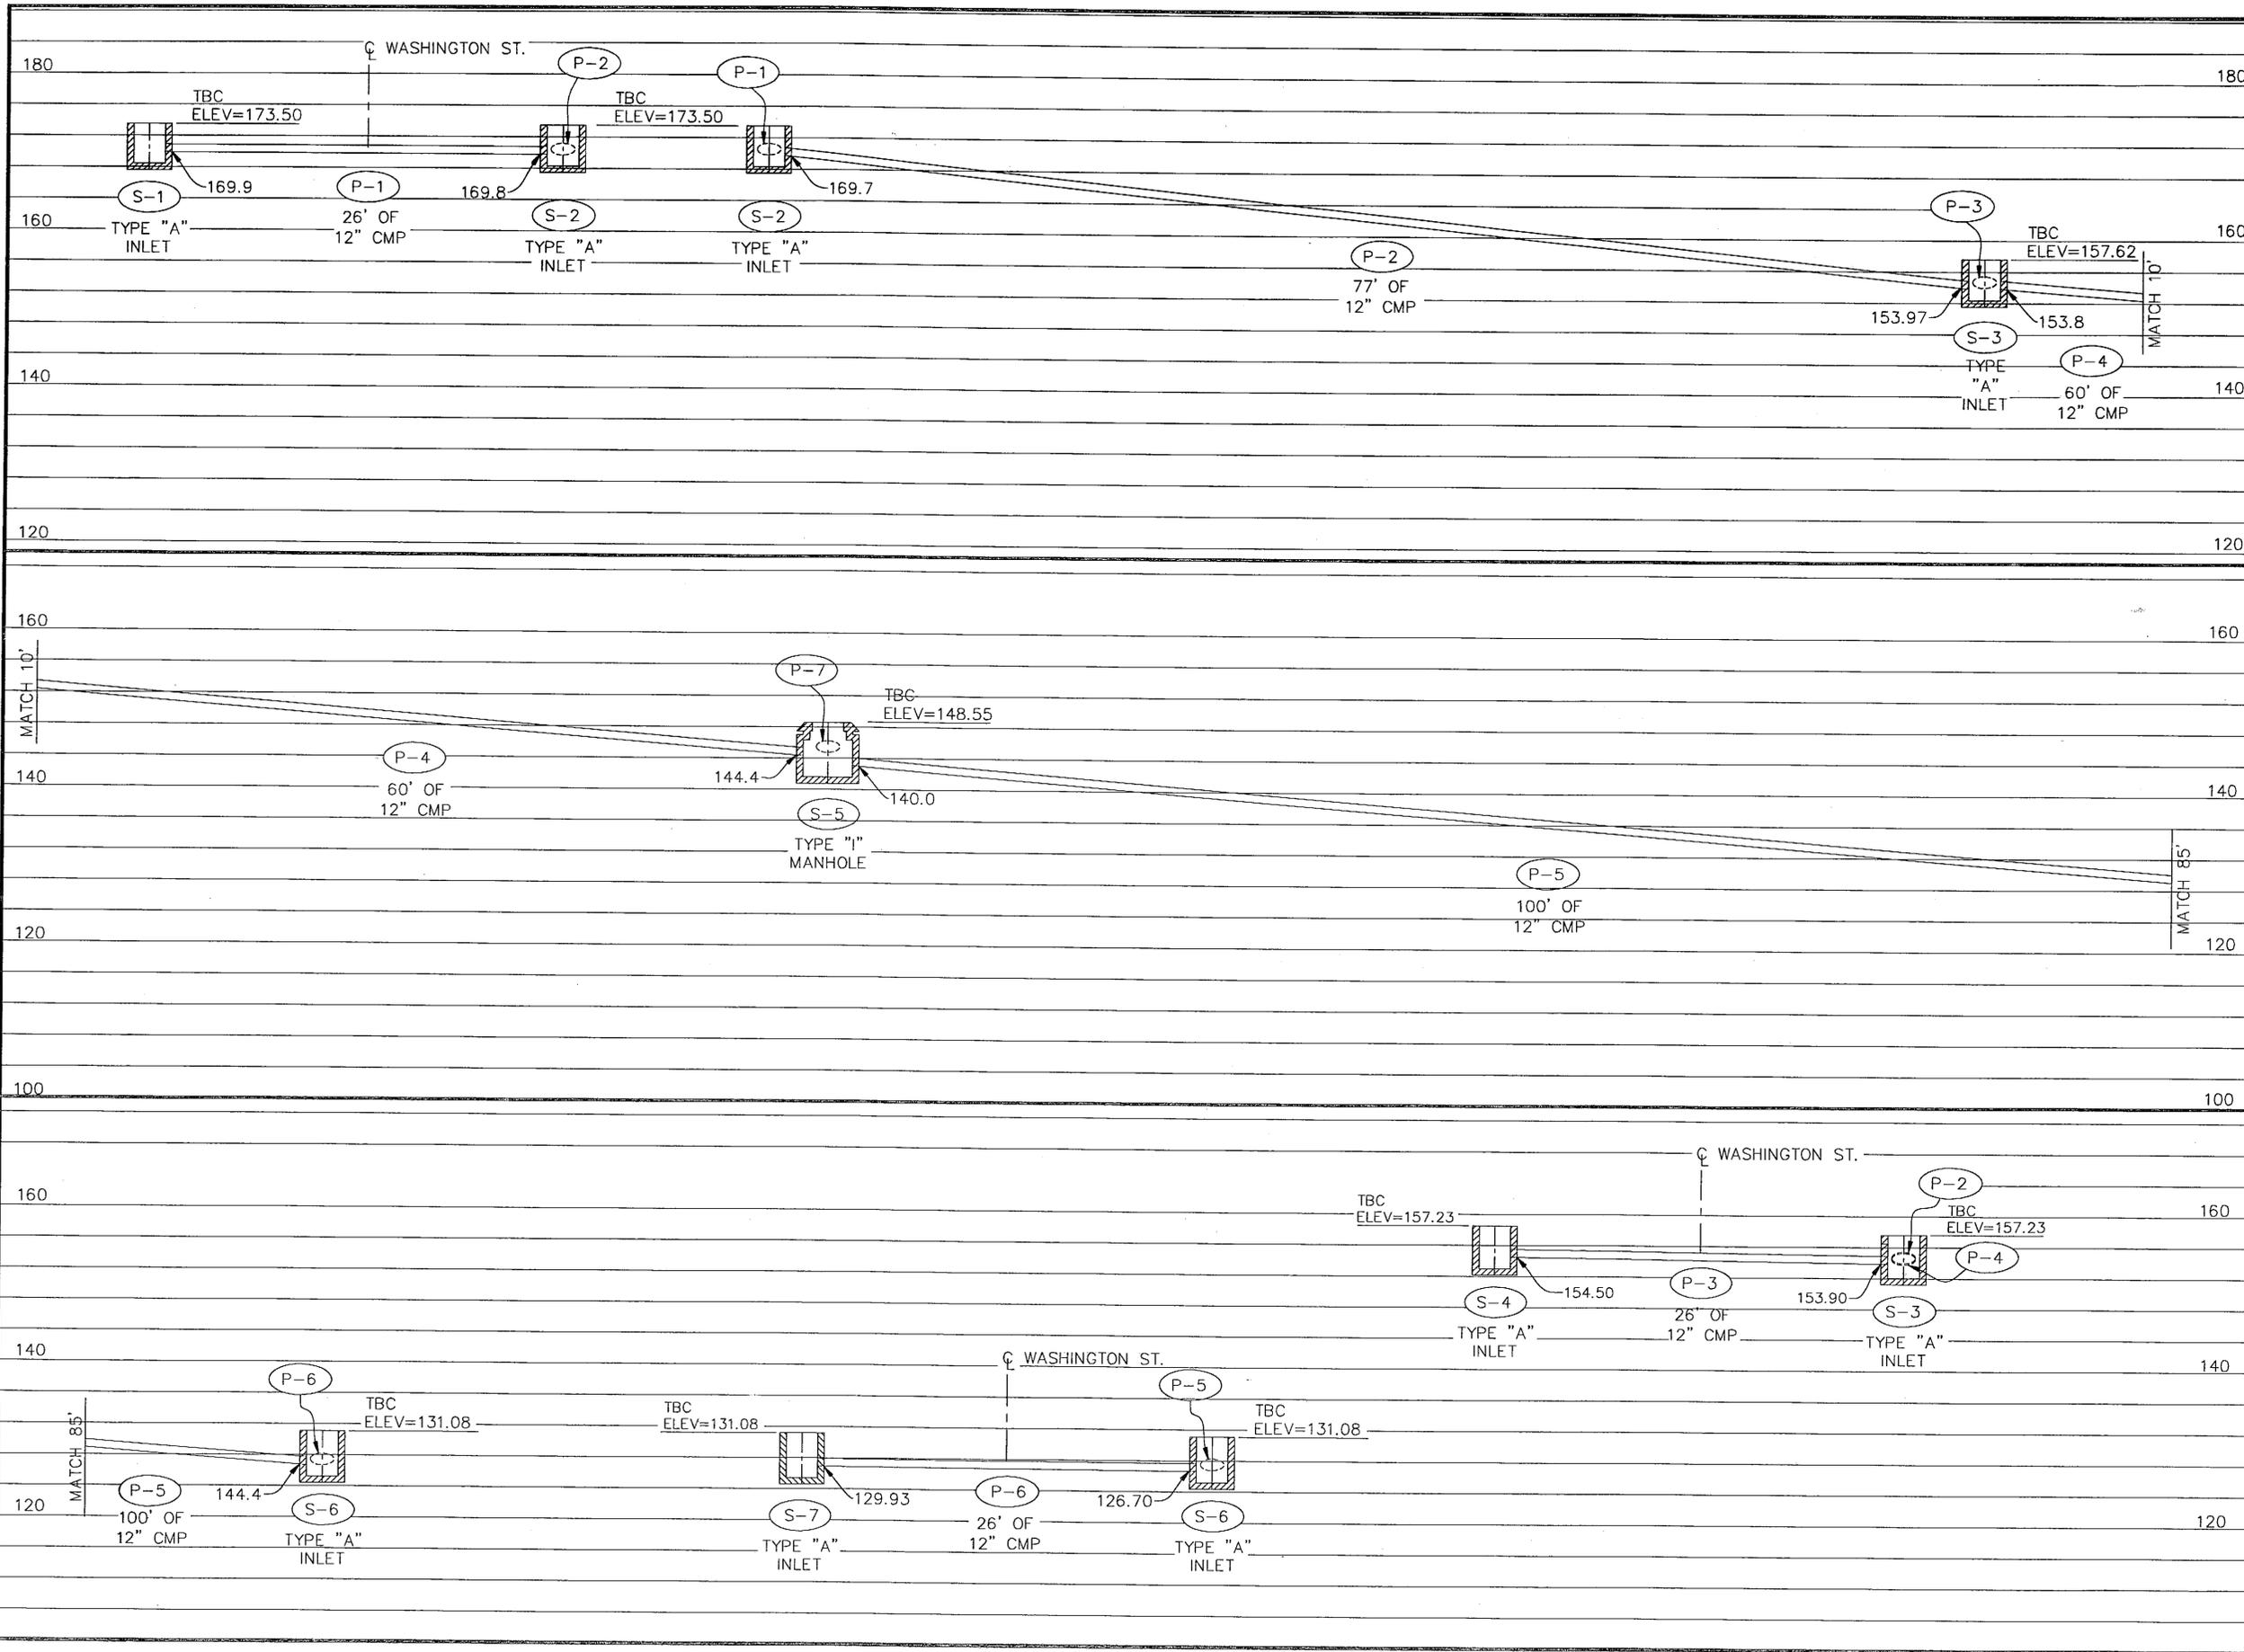

PATH: Q:\Ktn\71811A\PlanSet\N_Pipe-Profiles.dwg
 Mon, 06/May/02 11:53AM Michael Limbough
 PLOT: PSPACE 1=1(F) OR MSPACE 1=1(F)
 TAB: PR1

ADDENDUM NUMBER		
ATTACHMENT NUMBER		
RECORD OF REVISIONS		
No.	DATE	DESCRIPTION

KTN-THIRD AVENUE EXTENSION
 PROJECT NO. 68490

Storm Drain Pipe Profiles

DESIGNED BY: C. HOWARD



CHECKED BY: T. MOORE
 DRAWN BY: R.S.

STATE OF ALASKA
 DEPARTMENT OF TRANSPORTATION
 & PUBLIC FACILITIES
 STATEWIDE DESIGN & ENGINEERING
 SERVICES DIVISION
**THIRD AVENUE EXTENSION
 PROJECT NO. 68490**

Storm Drain
 Pipe Profiles

PROJECT DESIGNATION NUMBER
STP-MG-0904(2)

STATE	YEAR
ALASKA	2002
SHEET NUMBER	TOTAL SHEETS
N2	146

Project As Built Drawings have been reviewed by the Project Engineer. To the best of his/her knowledge, they represent the project as constructed.
 Proj. Eng. Date 12/31/02

PATH: Q:\Ktn\71811A\Planset\N_Pipe-Profiles.dwg
 Mon, 06/May/02 11:53AM Michael Limbaugh
 PLOT: PSPACE 1=1(F) OR MSPACE 1=1(F)
 TAB: PR2

ADDENDUM NUMBER		
ATTACHMENT NUMBER		
RECORD OF REVISIONS		
No.	DATE	DESCRIPTION

KTN-THIRD AVENUE EXTENSION
 PROJECT NO. 68490
 Storm Drain Pipe Profiles

DESIGNED BY: C. HOWARD



CHECKED BY: T. MOORE
 DRAWN BY: R.S.


STATE OF ALASKA
 DEPARTMENT OF TRANSPORTATION & PUBLIC FACILITIES
 STATEWIDE DESIGN & ENGINEERING SERVICES DIVISION
 THIRD AVENUE EXTENSION
 PROJECT NO. 68490

Storm Drain Pipe Profiles


PROJECT DESIGNATION NUMBER
STP-MG-0904(2)

STATE	YEAR
ALASKA	2002
SHEET NUMBER	TOTAL SHEETS
N3	146

Project As Built Drawings have been reviewed by the Project Engineer. To the best of his/her knowledge, they represent the project as constructed.
 Proj. Eng. Date 10-3-06

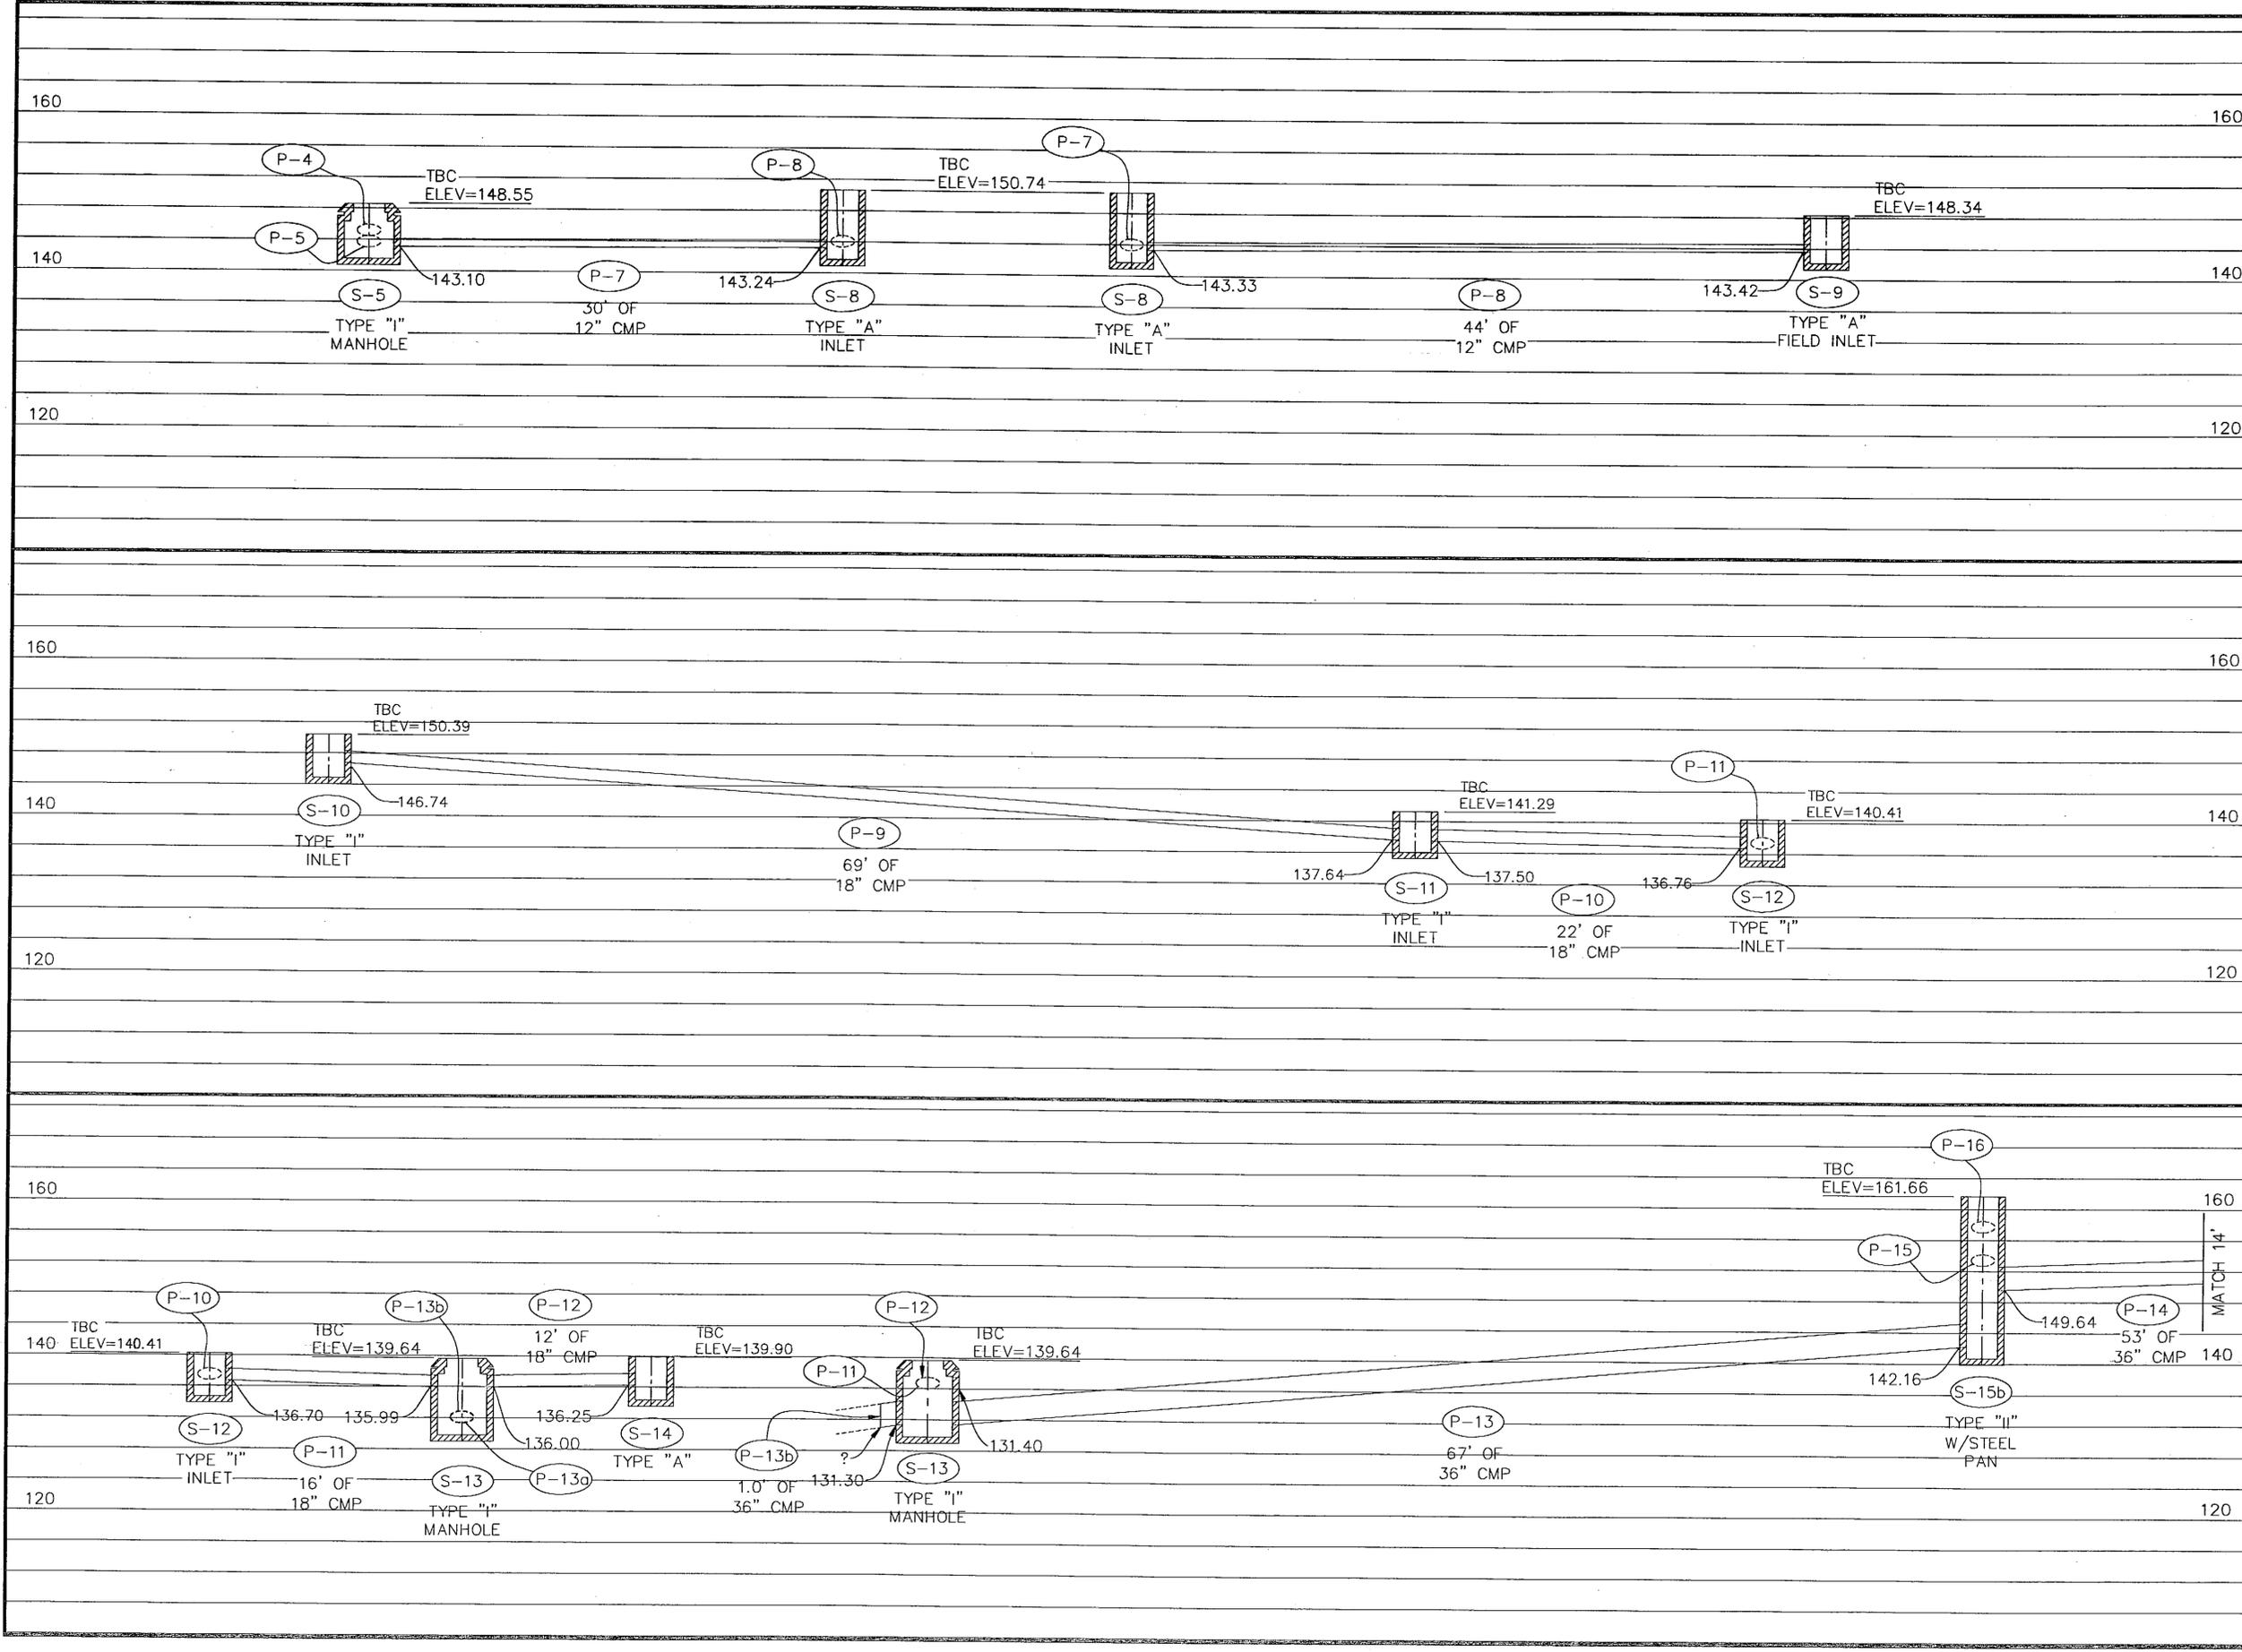

PATH:
 Q:\Ktn\71811A\PlanSet\N_Pipe-Profiles.dwg
 Mon, 06/May/02 11:53AM Michael Limbaugh
 PLOT:
 PSPACE 1=1(F) OR MSPACE 1=1(F)
 TAB: PR3

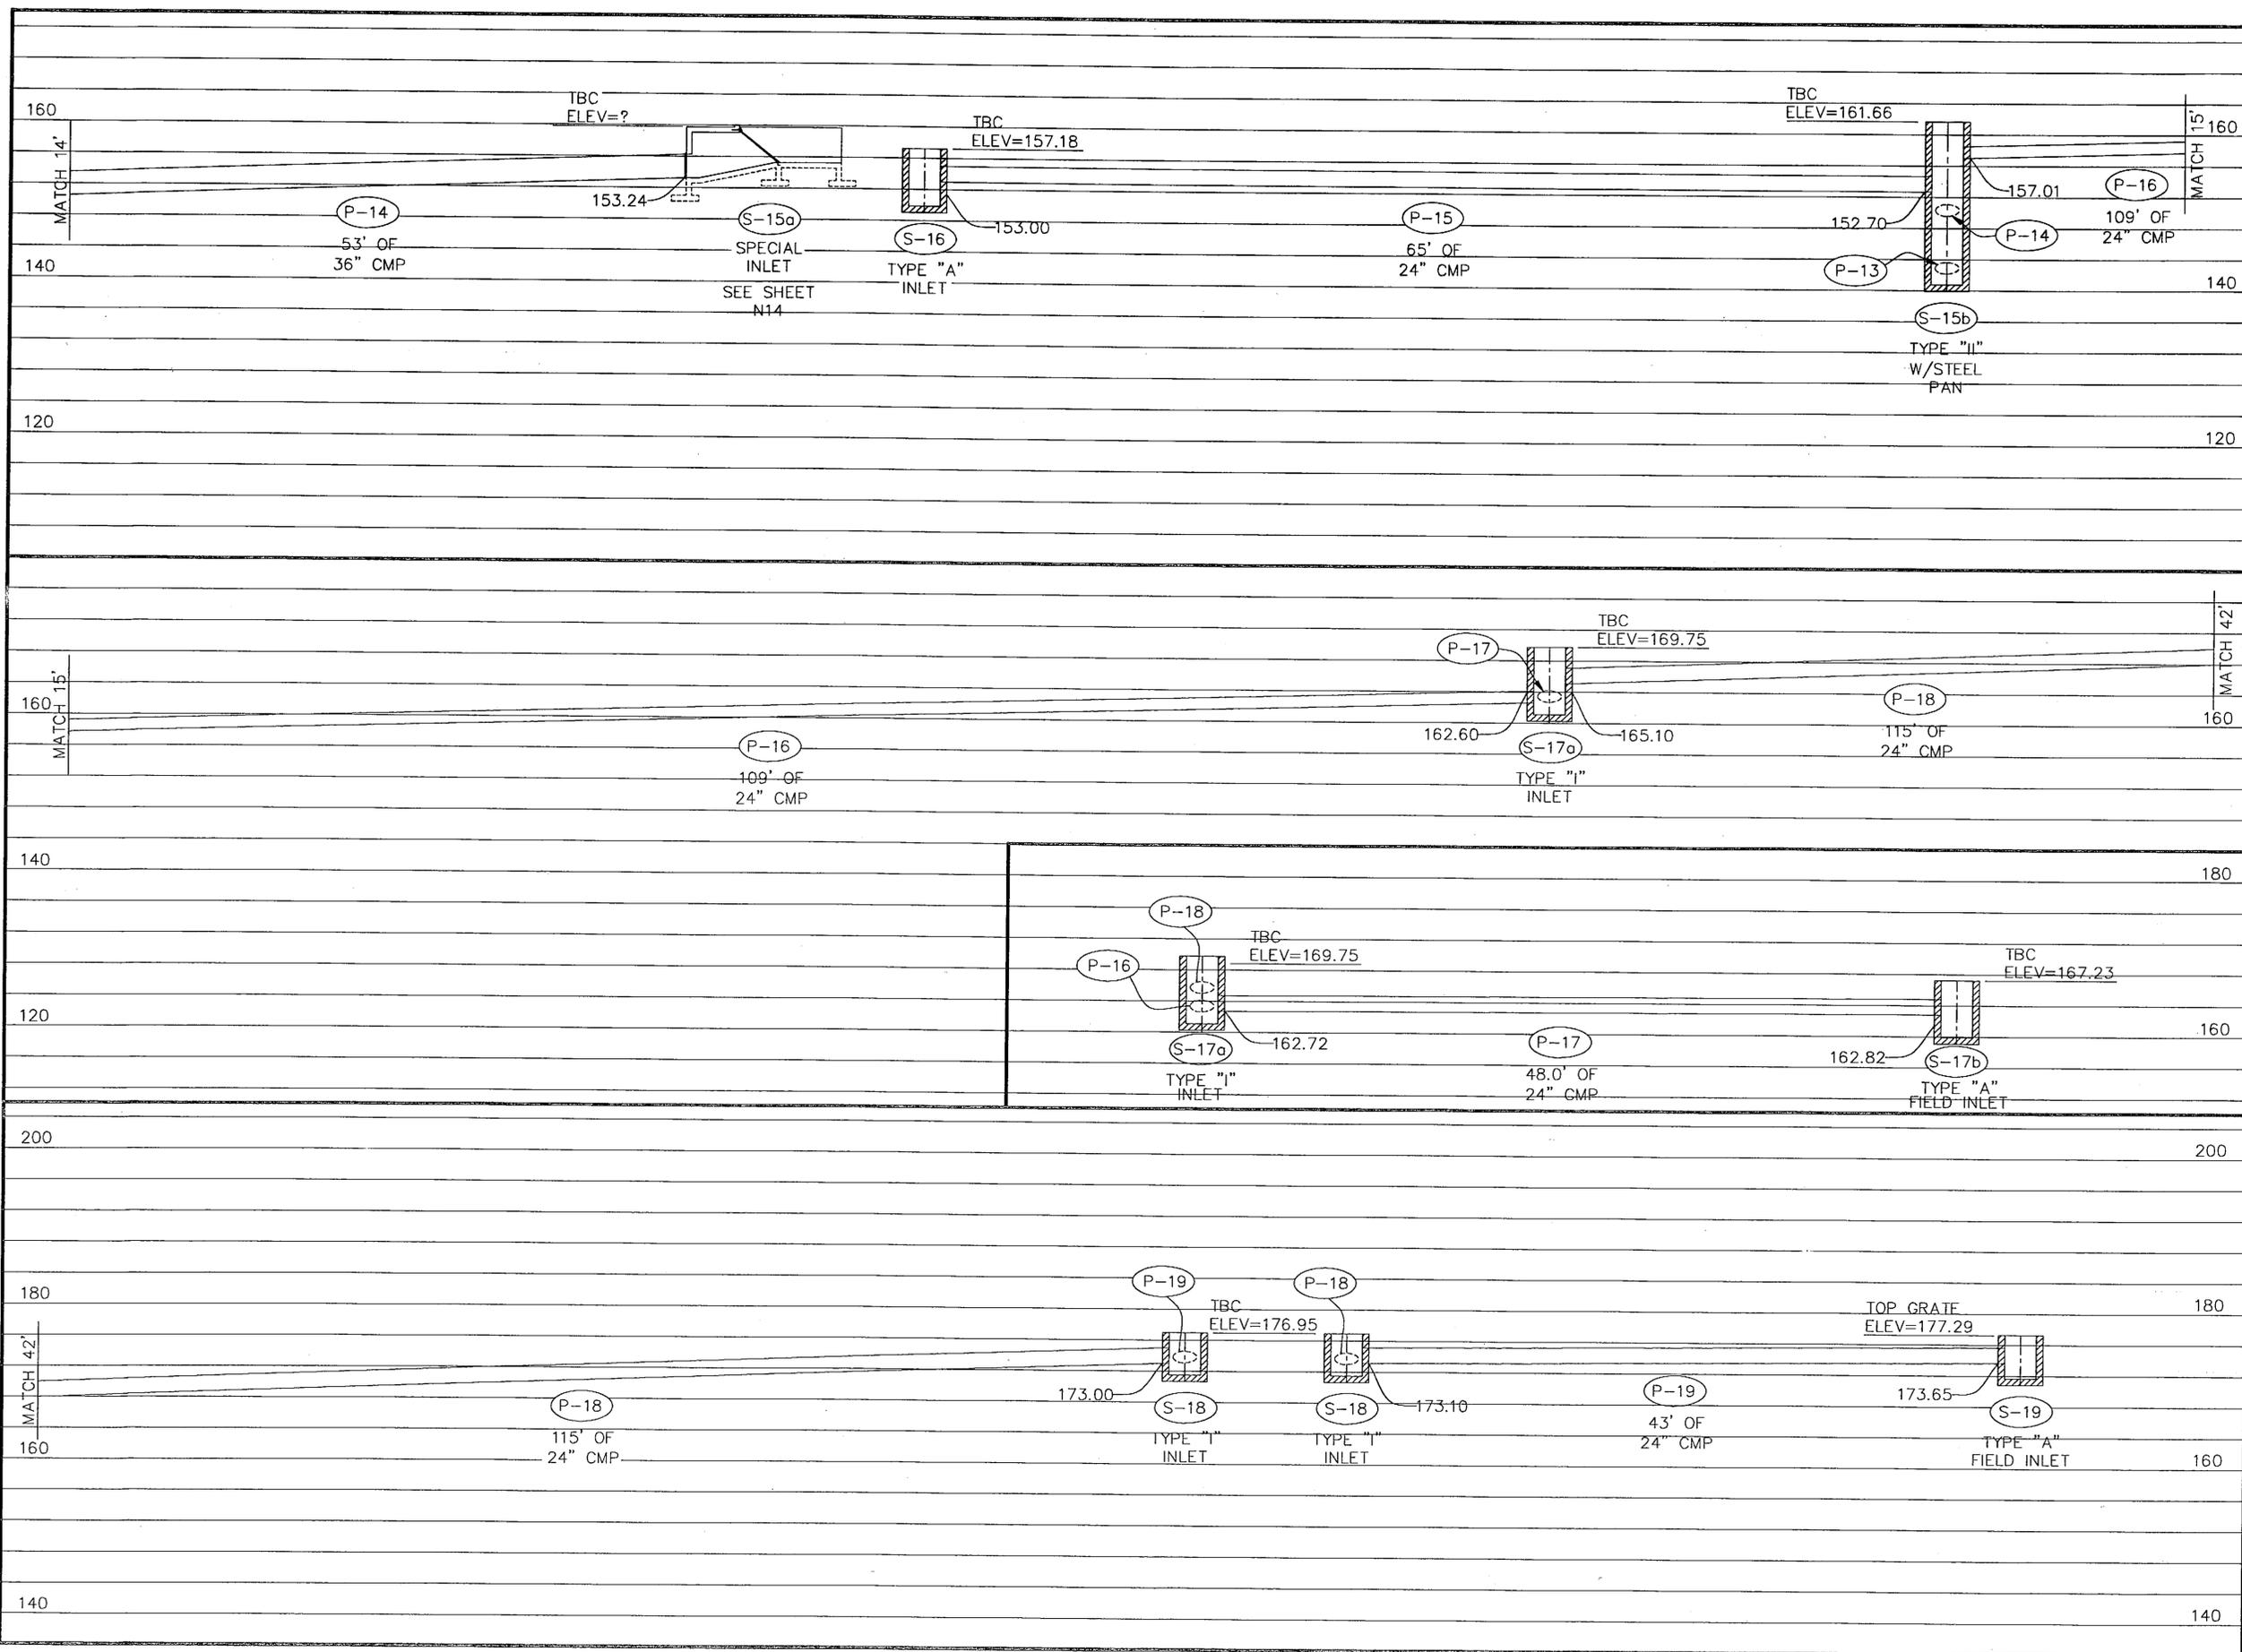


ADDENDUM NUMBER		
ATTACHMENT NUMBER		
RECORD OF REVISIONS		
No.	DATE	DESCRIPTION

**KTN-THIRD AVENUE EXTENSION
 PROJECT NO. 68490**

Storm Drain Pipe Profiles

DESIGNED BY: C. HOWARD

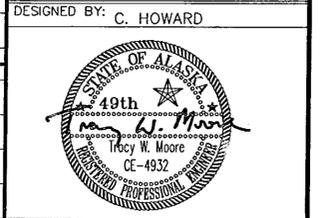

CHECKED BY: T. MOORE
 DRAWN BY: R.S.

STATE OF ALASKA
 DEPARTMENT OF TRANSPORTATION
 & PUBLIC FACILITIES
 STATEWIDE DESIGN & ENGINEERING
 SERVICES DIVISION

**THIRD AVENUE EXTENSION
 PROJECT NO. 68490**

**Storm Drain
 Pipe Profiles**

PROJECT DESIGNATION NUMBER	
STP-MG-0904(2)	
STATE	YEAR
ALASKA	2002
SHEET NUMBER	TOTAL SHEETS
N4	146


Project As Built Drawings have been reviewed by the Project Engineer. To the best of his/her knowledge, they represent the project as constructed.

Proj. Eng. Date 02.06

ADDENDUM NUMBER		
ATTACHMENT NUMBER		
RECORD OF REVISIONS		
No.	DATE	DESCRIPTION

KTN-THIRD AVENUE EXTENSION
PROJECT NO. 68490
Drainage Structure Details

DESIGNED BY: J. OSBURN

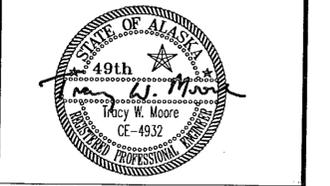


CHECKED BY: T. MOORE
 DRAWN BY: K.K.

STATE OF ALASKA
 DEPARTMENT OF TRANSPORTATION
 & PUBLIC FACILITIES
 STATEWIDE DESIGN & ENGINEERING
 SERVICES DIVISION
THIRD AVENUE EXTENSION
PROJECT NO. 68490


Drainage Structure Details

PROJECT DESIGNATION NUMBER	
STP-MG-0904(2)	
STATE	YEAR
ALASKA	2002
SHEET NUMBER	TOTAL SHEETS
N5	146


Project As Built Drawings have been reviewed by the Project Engineer. To the best of his/her knowledge, they represent the project as constructed.
 Proj. Eng. *KS* Date 10/21/06

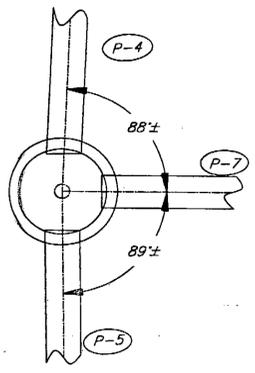


S-5
TYPE I

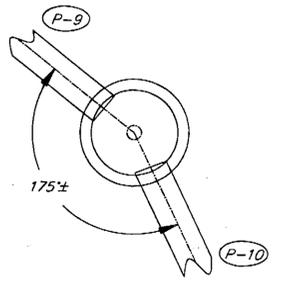


S-11
TYPE I

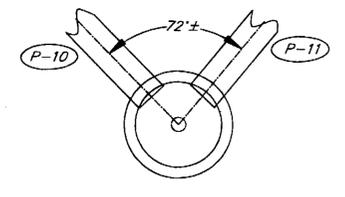


S-12
TYPE I

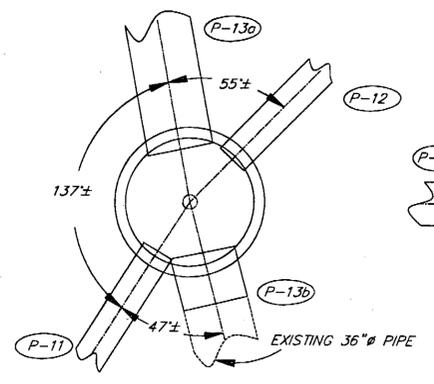


S-13
TYPE II

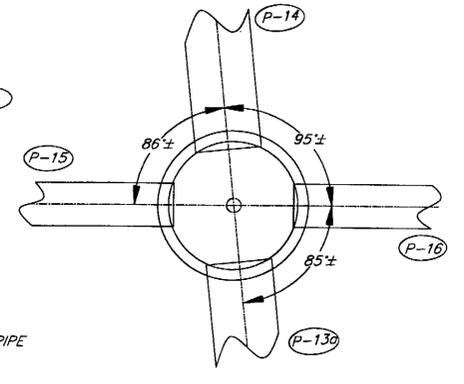


S-15b
TYPE II

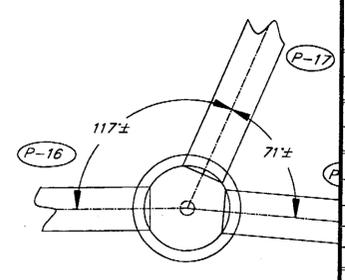


S-17a
TYPE I

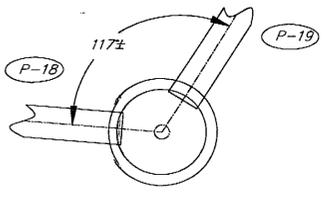


S-18
TYPE I

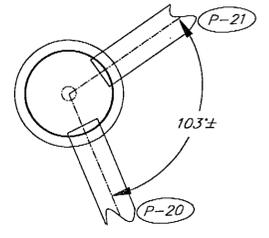


S-20
TYPE I

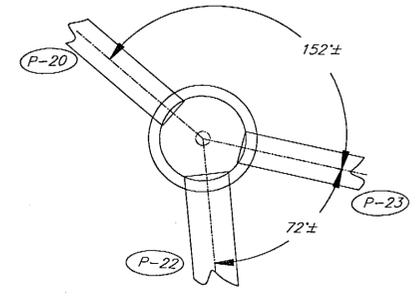


S-21
TYPE I

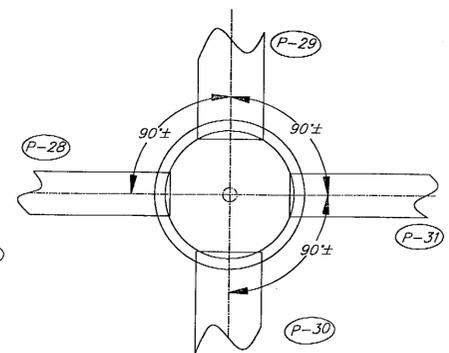


S-26a
TYPE II

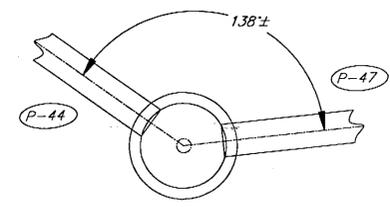


S-33a
TYPE I

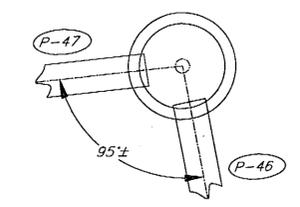

S-33b
TYPE I

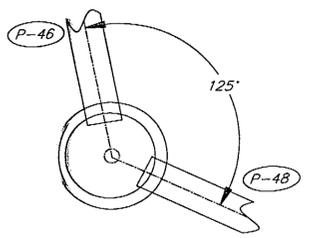


S-34
TYPE I

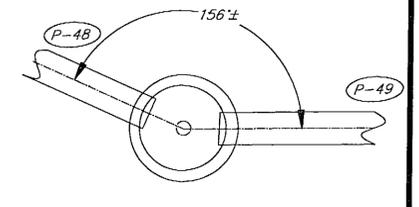


S-35
TYPE I

- NOTES:**
- STORM DRAIN MANHOLES SHALL CONFORM TO THE FOLLOWING STANDARD DRAWINGS:
 -INLET TYPE A, REFER TO SHEET D-26.02
 -INLET TYPE 1, REFER TO SHEET D-35.00
 -INLET TYPE 2, REFER TO SHEET D-37.01
 - CURB INLET FRAME & GRATE SHOULD CONFORM TO STD. DWG. D-23.00
 - FIELD INLETS SHOULD MEET TYPICAL DESIGN STANDARDS BASED ON EACH TYPE. CONTRACTOR MAY ADAPT DESIGN TO USE MATERIALS ON HAND, PER ENGINEER'S REVIEW.
 - FIELD INLET FRAME & GRATE SHALL CONFORM TO STD. DWG. D-22.00
 - REBAR DETAILS FOR RCC INLETS SHALL MEET DESIGN STANDARDS FOR THE TYPE I INLET.

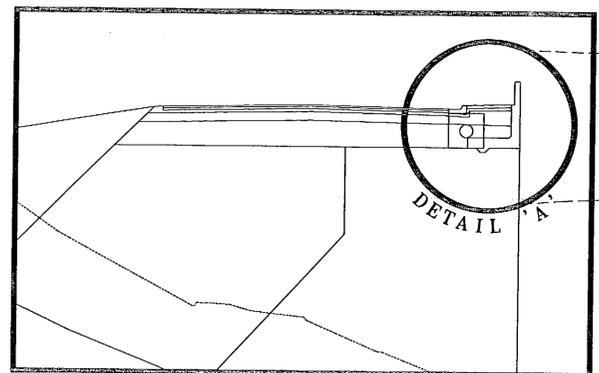

WALL VIEW




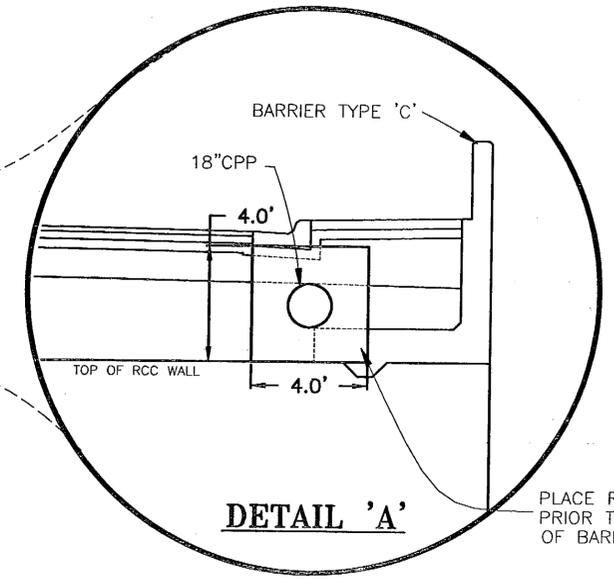


DETAIL 'A'

PLACE RCC INLETS PRIOR TO CONSTRUCTION OF BARRIER-TYPE 'C'

RCC INLET DETAIL

ADDENDUM NUMBER		
ATTACHMENT NUMBER		
RECORD OF REVISIONS		
No.	DATE	DESCRIPTION

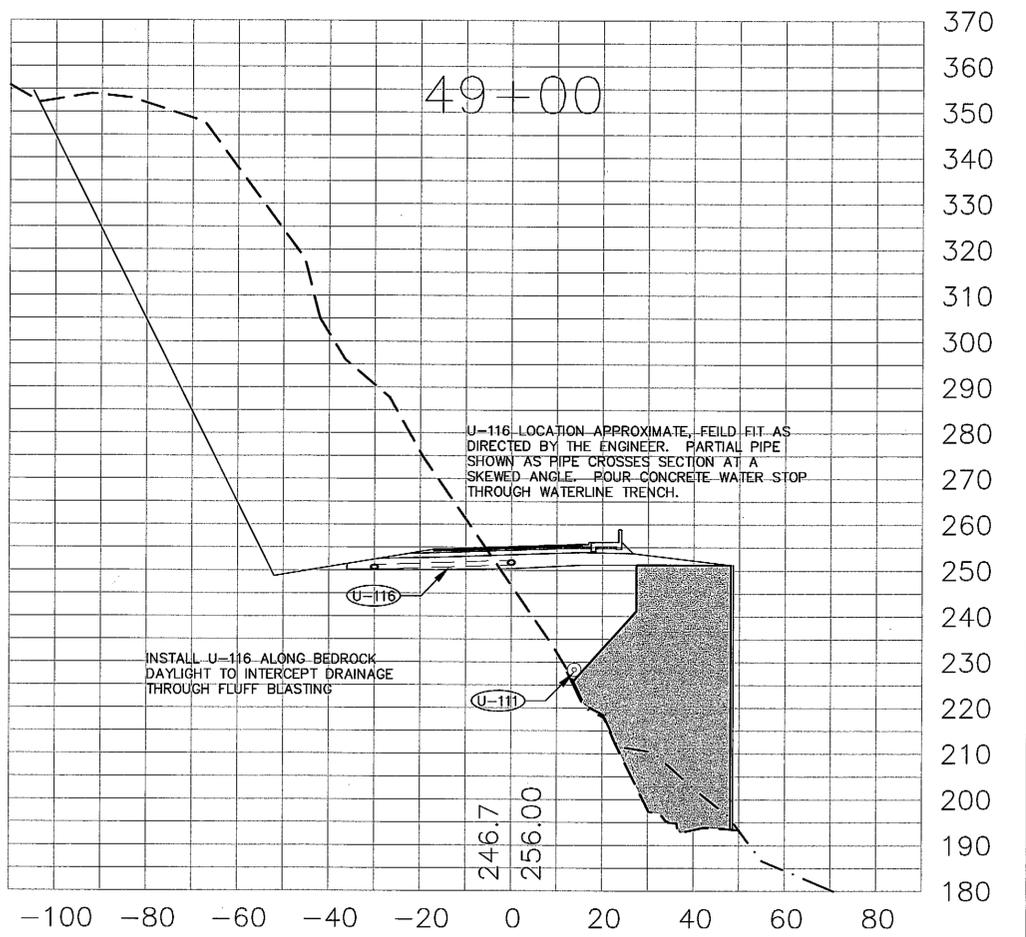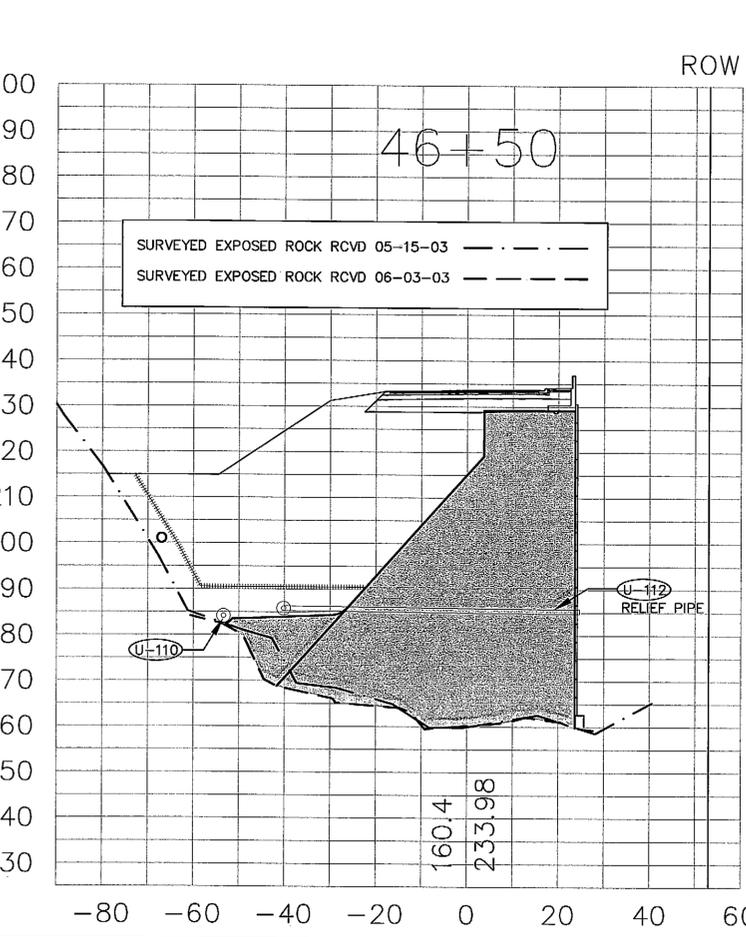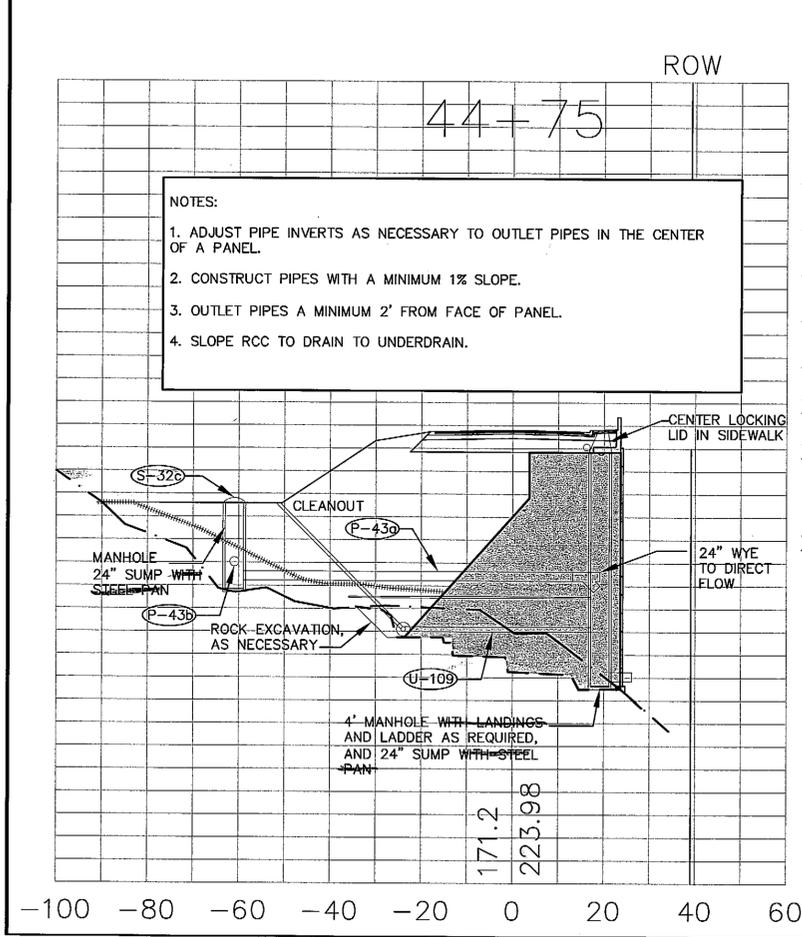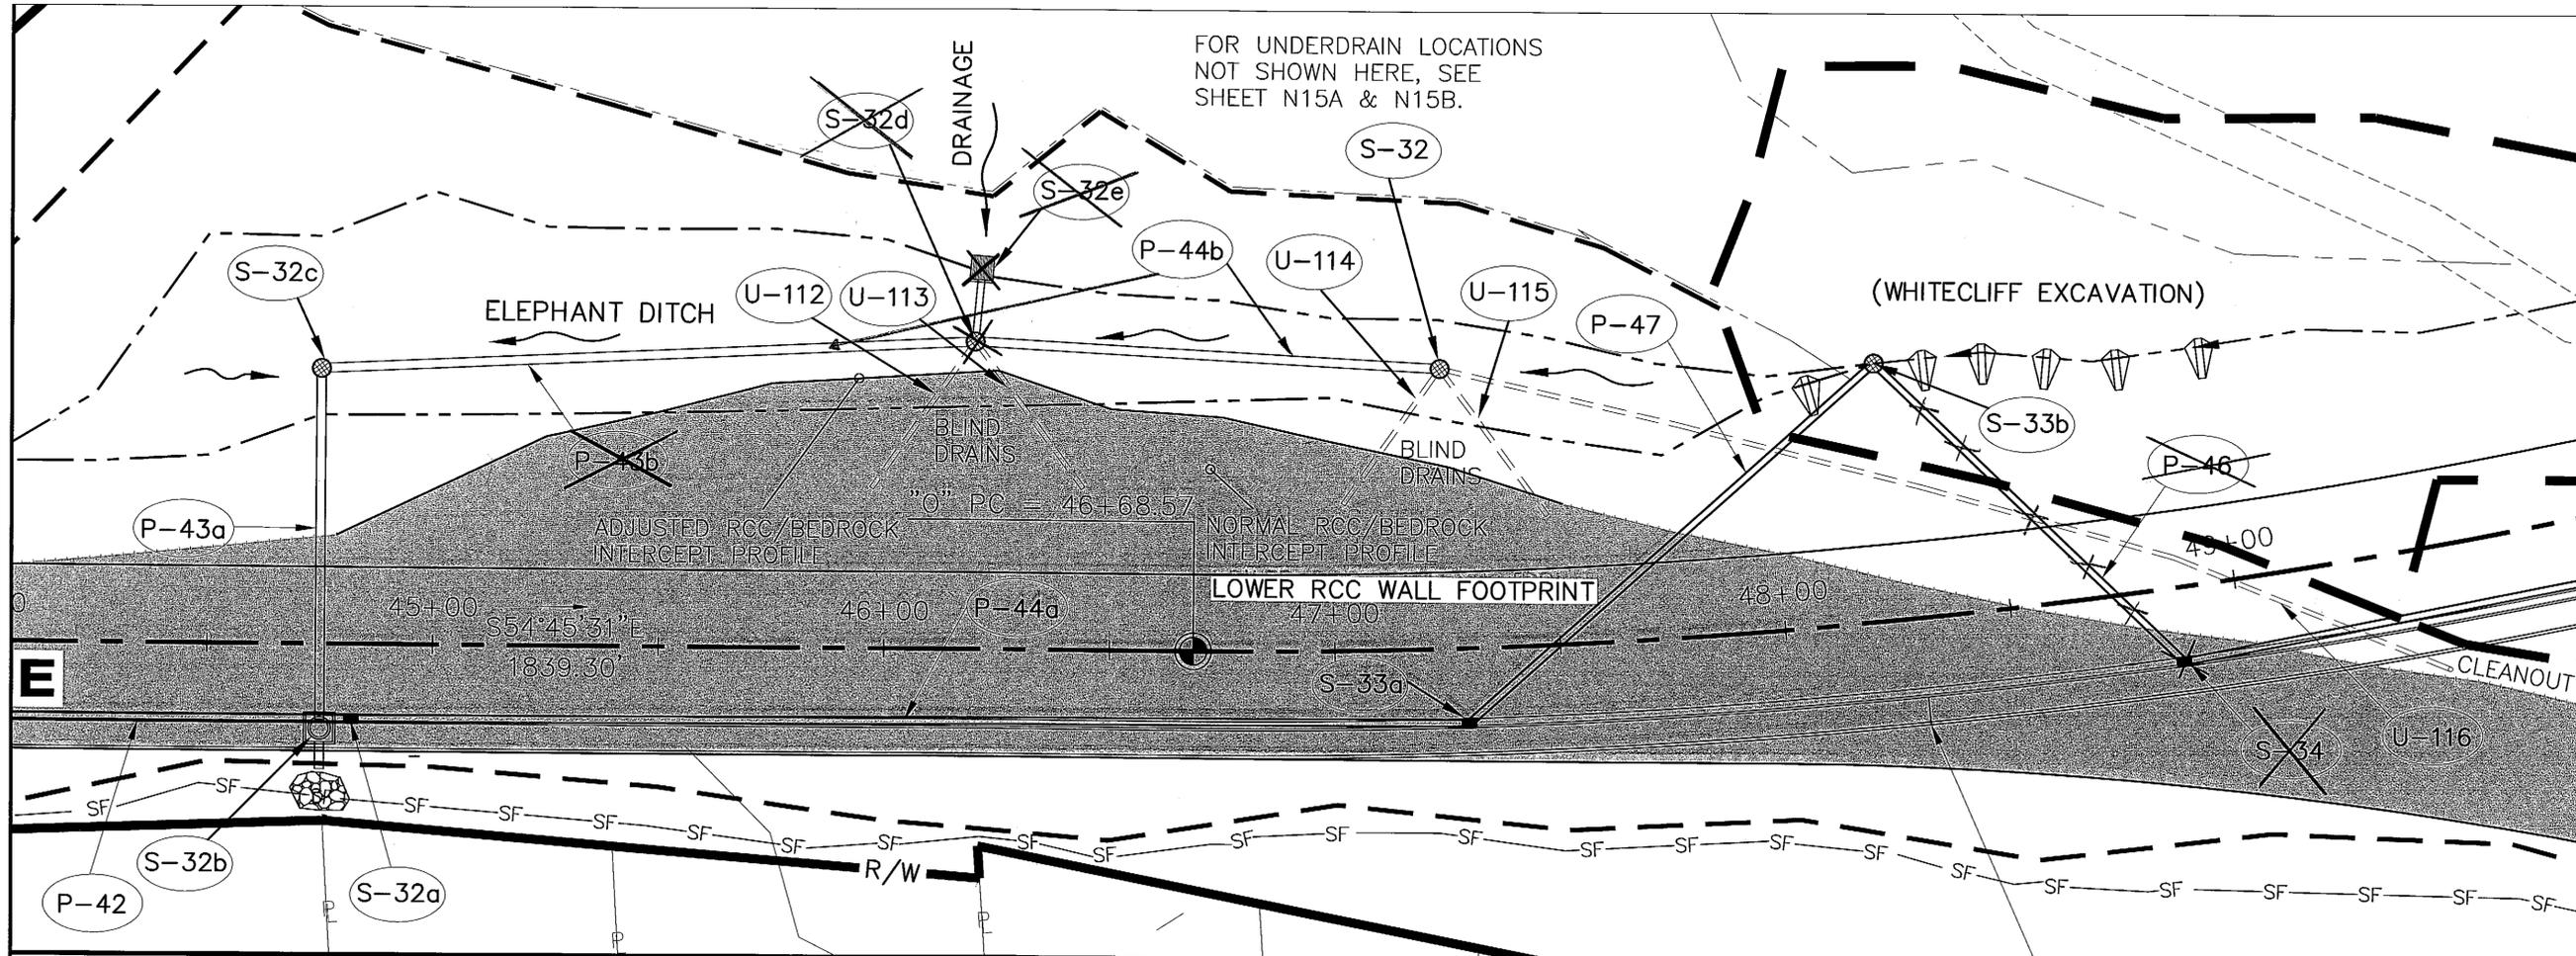

KTN-THIRD AVENUE EXTENSION
 PROJECT NO. 68490

REVISED
Elephant Ditch Drainage Pipe
Plan & Section Views

Project As Built Drawings have been reviewed by the Project Engineer. To the best of his/her knowledge, they represent the project as constructed.
 Proj. Eng. *KS* Date *10.31.06*

DESIGNED BY: J. OSBURN, C. HOWARD



CHECKED BY: T. MOORE




DRAWN BY: K.K./R.S./M.L.
 STATE OF ALASKA
 DEPARTMENT OF TRANSPORTATION & PUBLIC FACILITIES
 STATEWIDE DESIGN & ENGINEERING SERVICES DIVISION

THIRD AVENUE EXTENSION
PROJECT NO. 68490
Elephant Ditch
Drainage Pipe
Plan & Section Views

PROJECT DESIGNATION NUMBER	
STP-MG-0904(2)	
STATE	YEAR
ALASKA	2002
SHEET NUMBER	TOTAL SHEETS
N6	146

PATH: Q:\Ktn\71811A\Planset\N_Ditch Check P&P.dwg
 Mon, 06/May/02 10:47AM Michael Limbaugh
 PSPACE 1=1(F) OR MSPACE 1=1(F)
 TAB: DITCH CHECK DETAIL_N7

ADDENDUM NUMBER		
ATTACHMENT NUMBER		
RECORD OF REVISIONS		
No.	DATE	DESCRIPTION

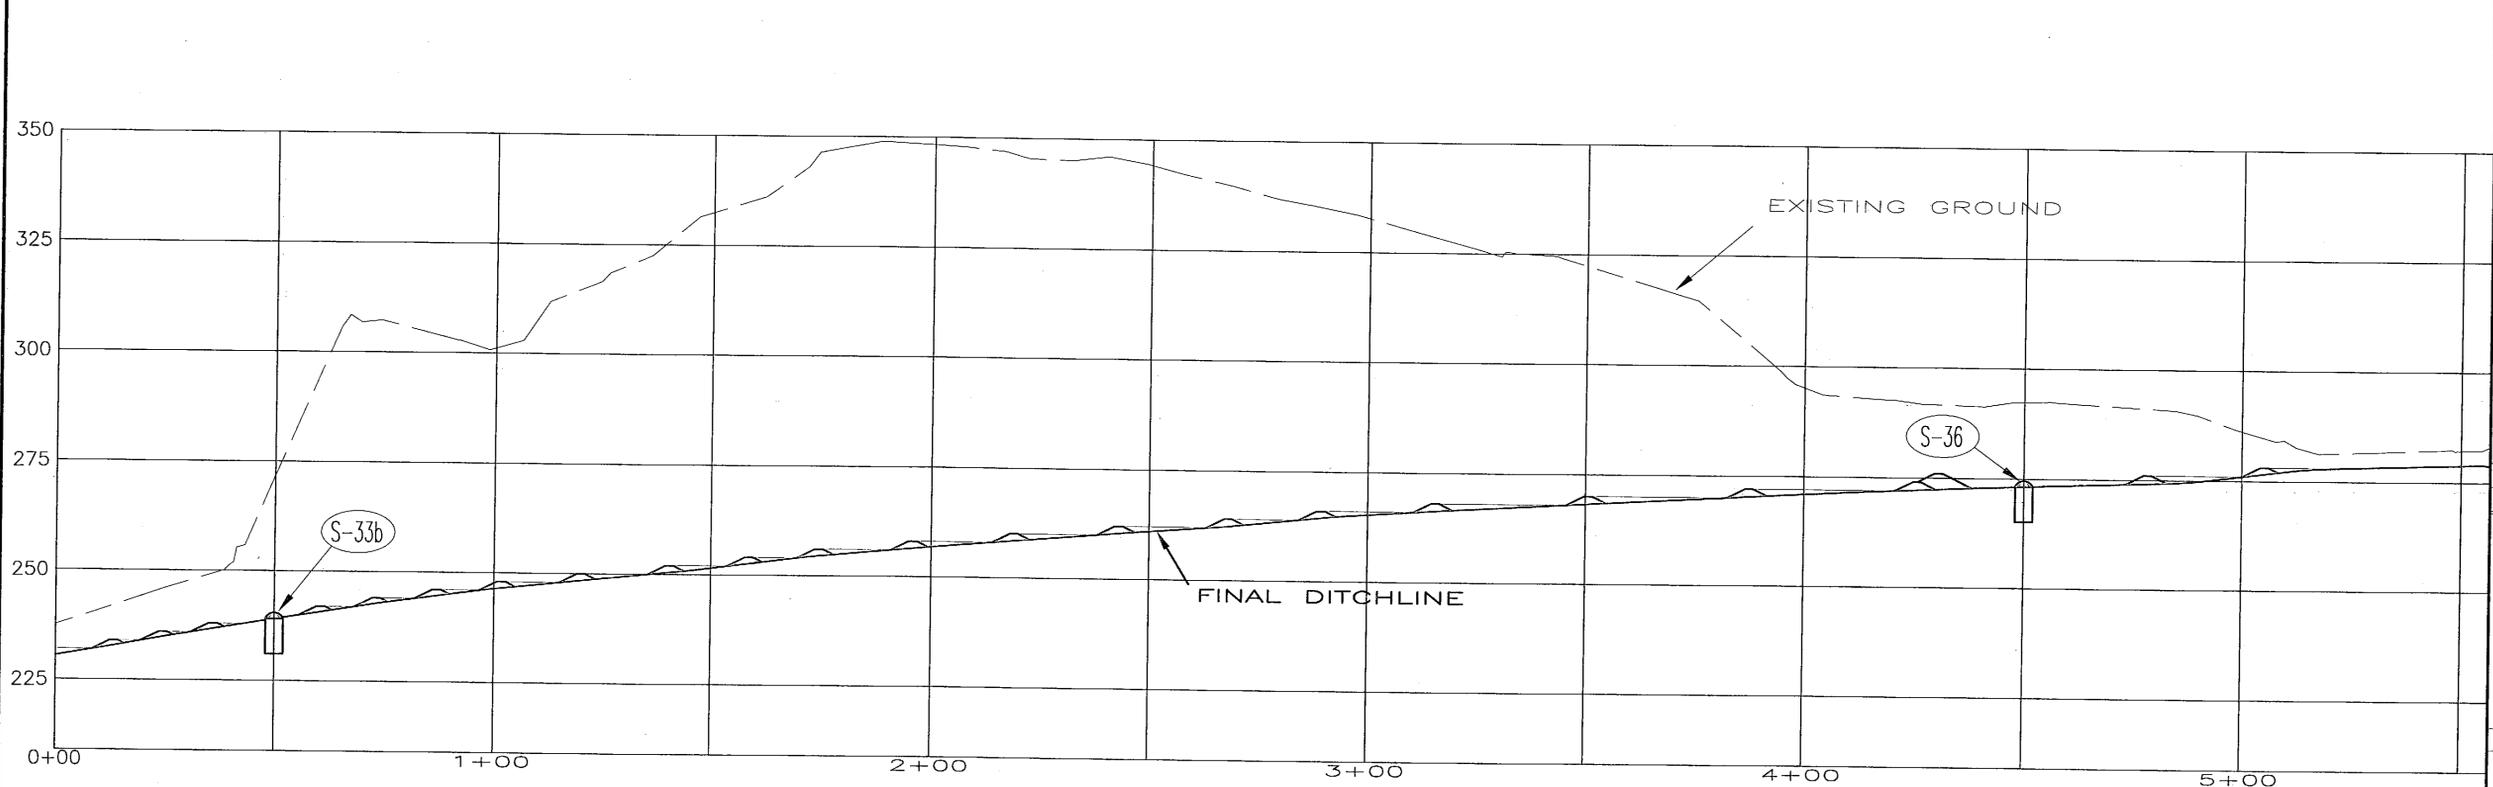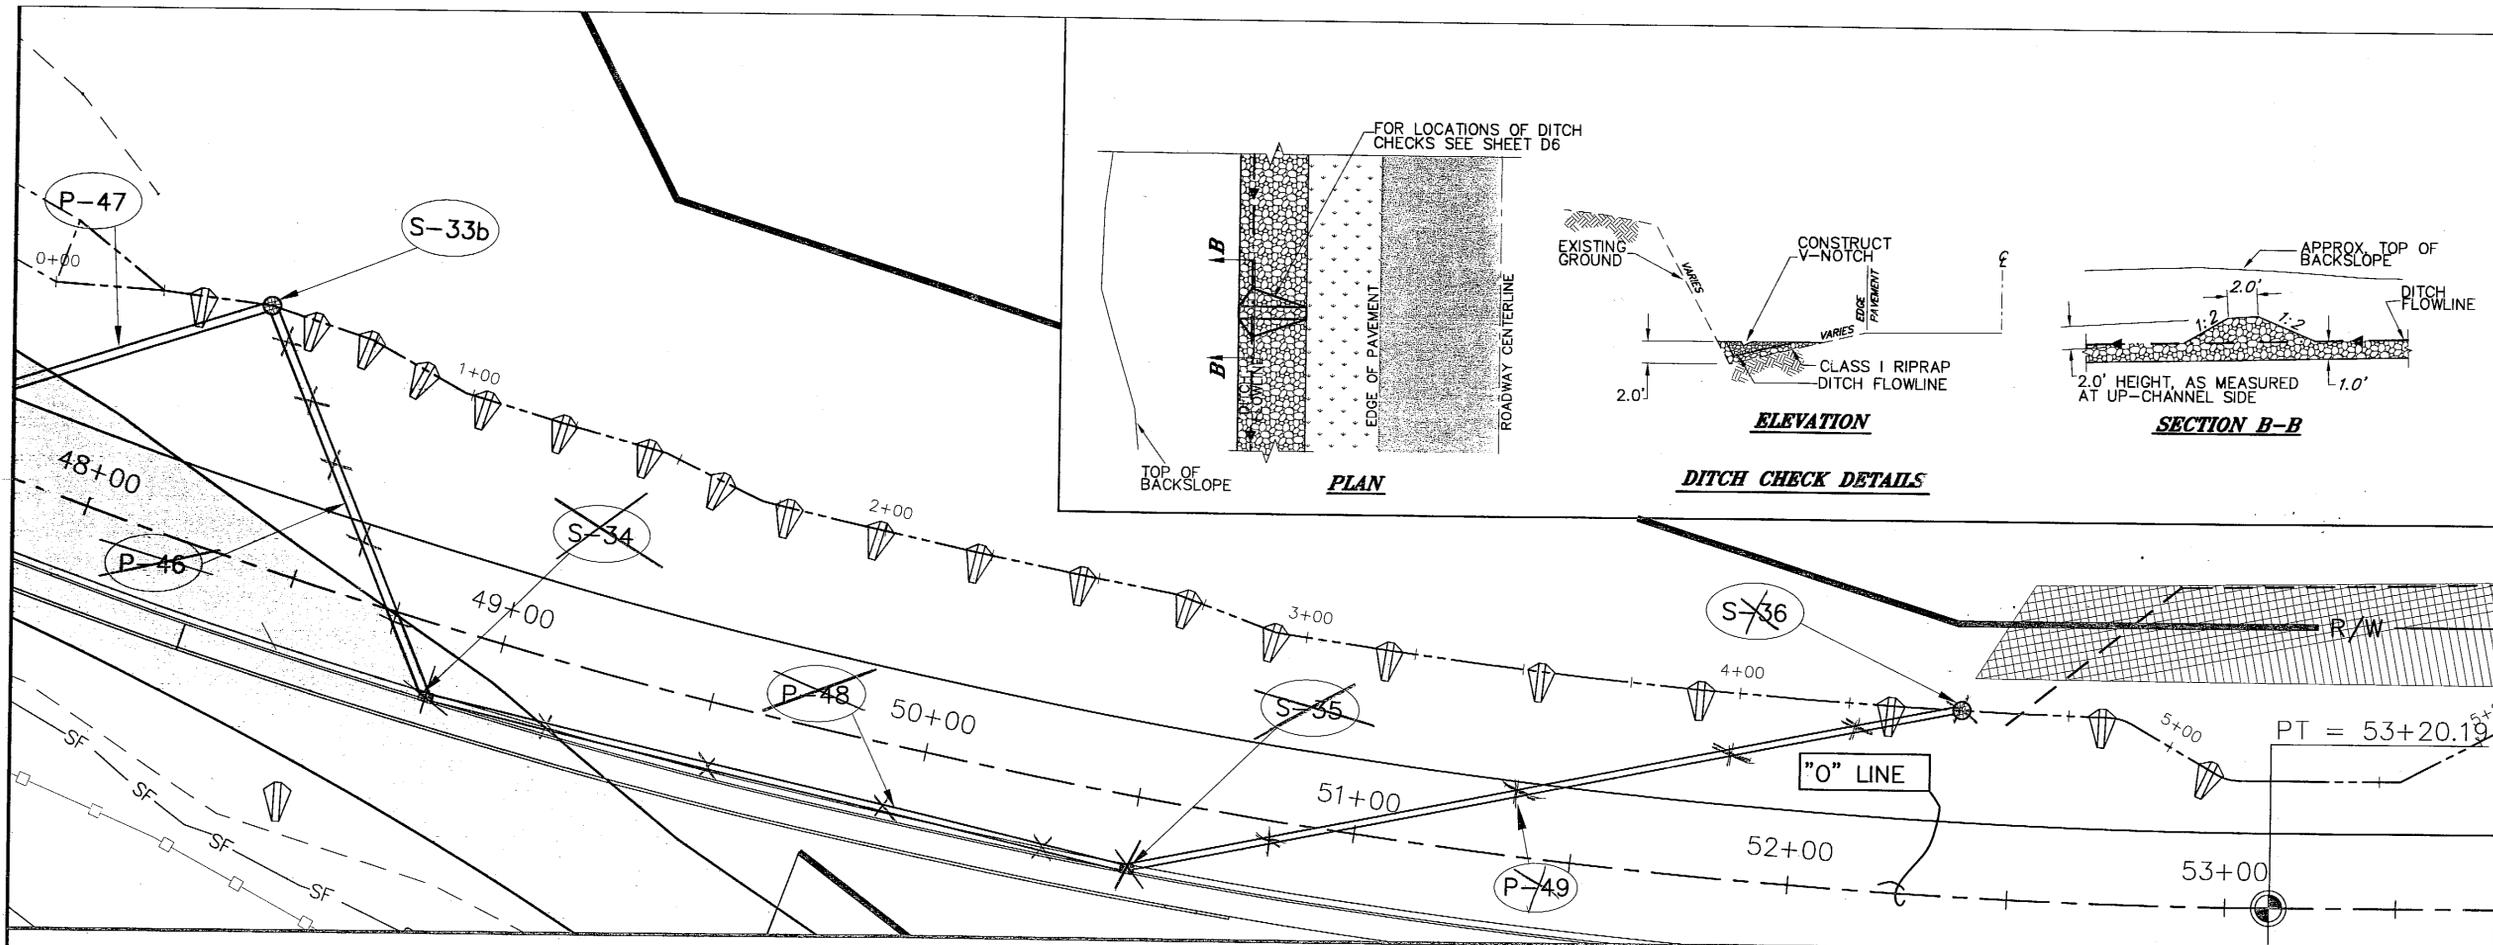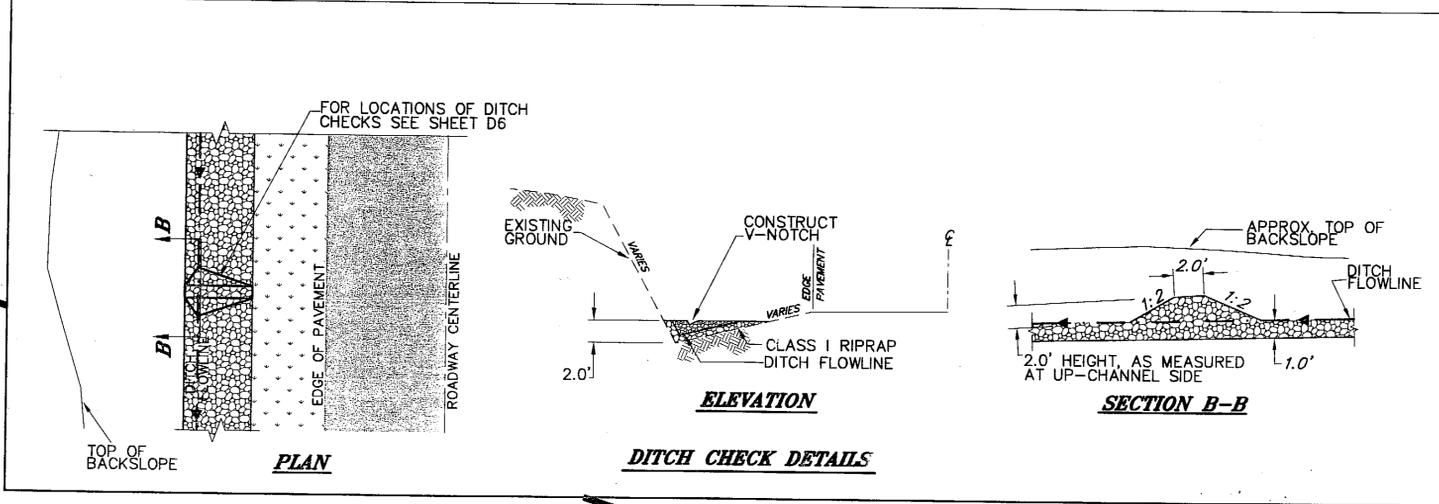

KTN-THIRD AVENUE EXTENSION
 PROJECT NO. 68490
**Ditch Check
 Plan and Profile**

DESIGNED BY: C. HOWARD



CHECKED BY: T. MOORE
 DRAWN BY: T.M./R.S.


STATE OF ALASKA
 DEPARTMENT OF TRANSPORTATION
 & PUBLIC FACILITIES
 STATEWIDE DESIGN & ENGINEERING
 SERVICES DIVISION
 THIRD AVENUE EXTENSION
 PROJECT NO. 68490

**Ditch Check
 Plan and Profile**

PROJECT DESIGNATION NUMBER
STP-MG-0904(2)

STATE	YEAR
ALASKA	2002
SHEET NUMBER	TOTAL SHEETS
N7	146

Project As Built Drawings have been reviewed by the Project Engineer. To the best of his/her knowledge, they represent the project as constructed.
 Proj. Eng. *[Signature]* Date 10/20/02

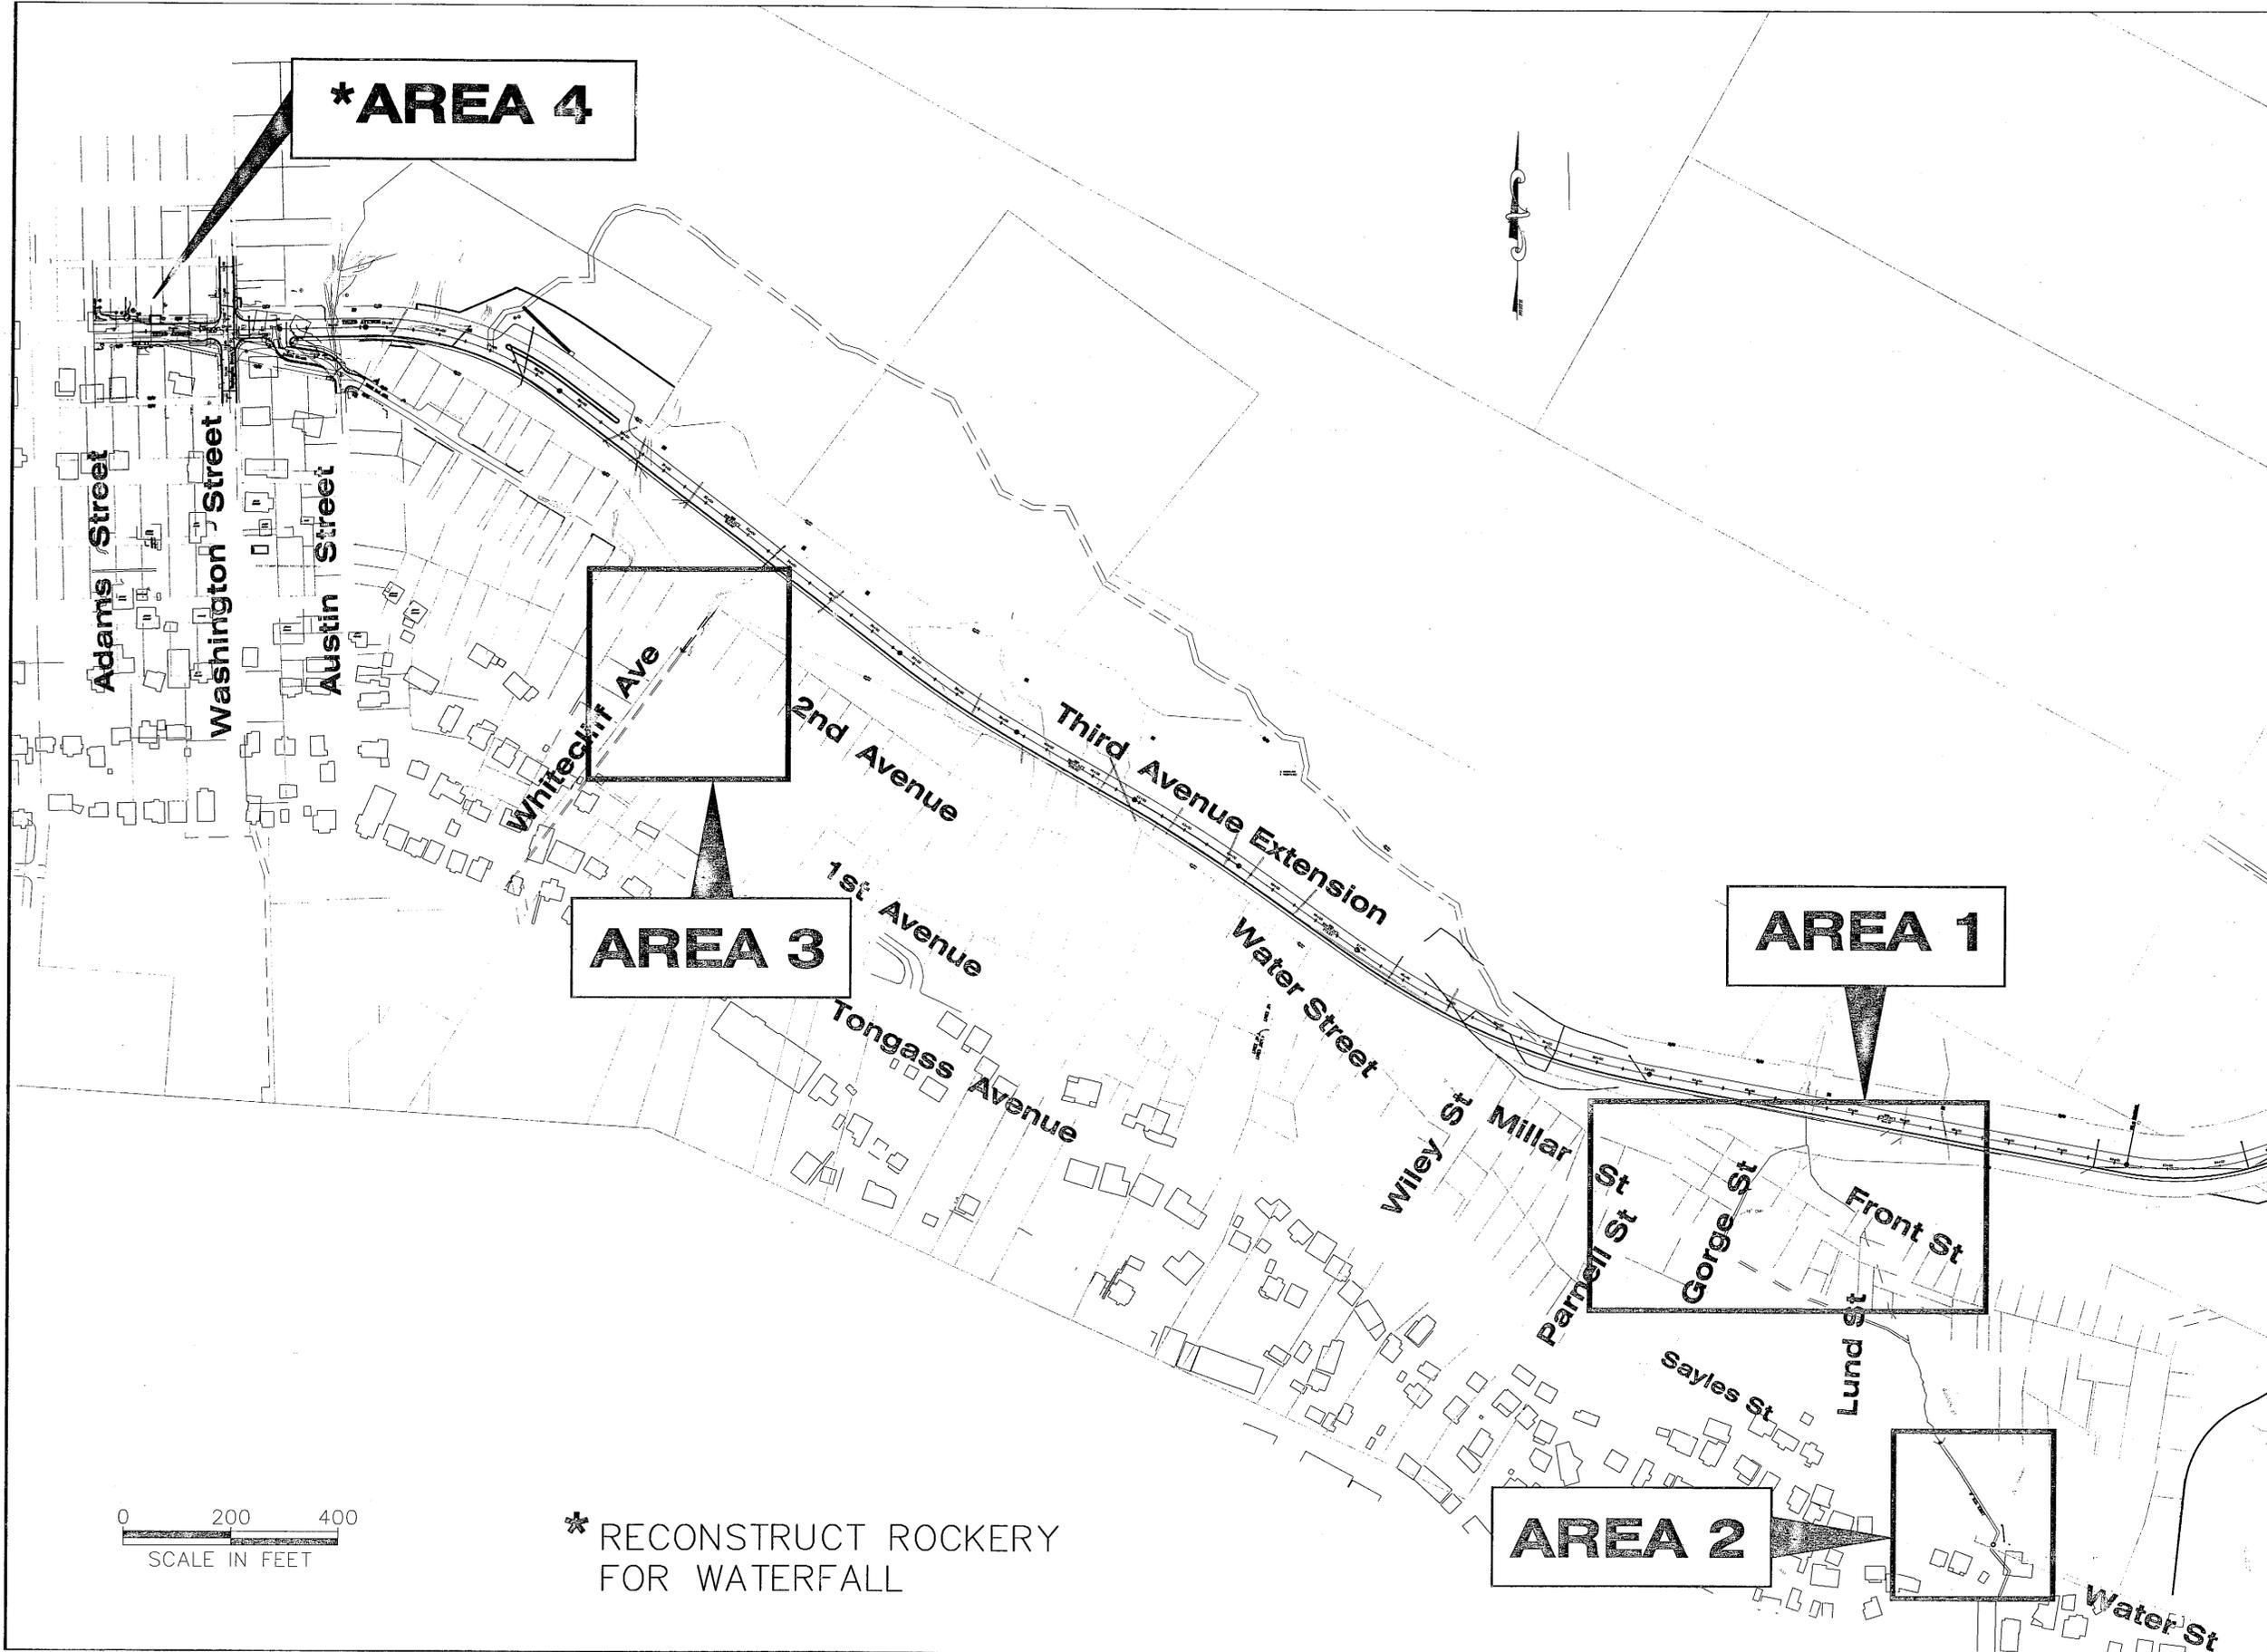

* RECONSTRUCT ROCKERY
FOR WATERFALL

PATH:
Q:\Ktn\71811A\PlanSet\N_DrainAreas.dwg
Mon, 06/May/02 10:53AM Michael Limbaugh
PLOT:
PSPACE: 1=1(F) OR MSPACE: 1=32(F)
TAB: LAYOUT-N1

ADDENDUM NUMBER		
ATTACHMENT NUMBER		
RECORD OF REVISIONS		
No.	DATE	DESCRIPTION

KTN-THIRD AVENUE EXTENSION
 PROJECT NO. 68490
**Offsite Drainage Improvements
 Layout Plan**

DESIGNED BY: J. OSBURN




CHECKED BY: T. MOORE
DRAWN BY: T.M./R.S

STATE OF ALASKA
DEPARTMENT OF TRANSPORTATION
& PUBLIC FACILITIES
STATEWIDE DESIGN & ENGINEERING
SERVICES DIVISION
THIRD AVENUE EXTENSION
PROJECT NO. 68490
**Offsite Drainage
Improvements
Layout Plan**

PROJECT DESIGNATION NUMBER	
STP-MG-0904(2)	
STATE	YEAR
ALASKA	2002
SHEET NUMBER	TOTAL SHEETS
N8	146

Project As Built Drawings have been reviewed by the Project Engineer. To the best of his/her knowledge, they represent the project as constructed.
Proj. Eng. Date 10/3/06

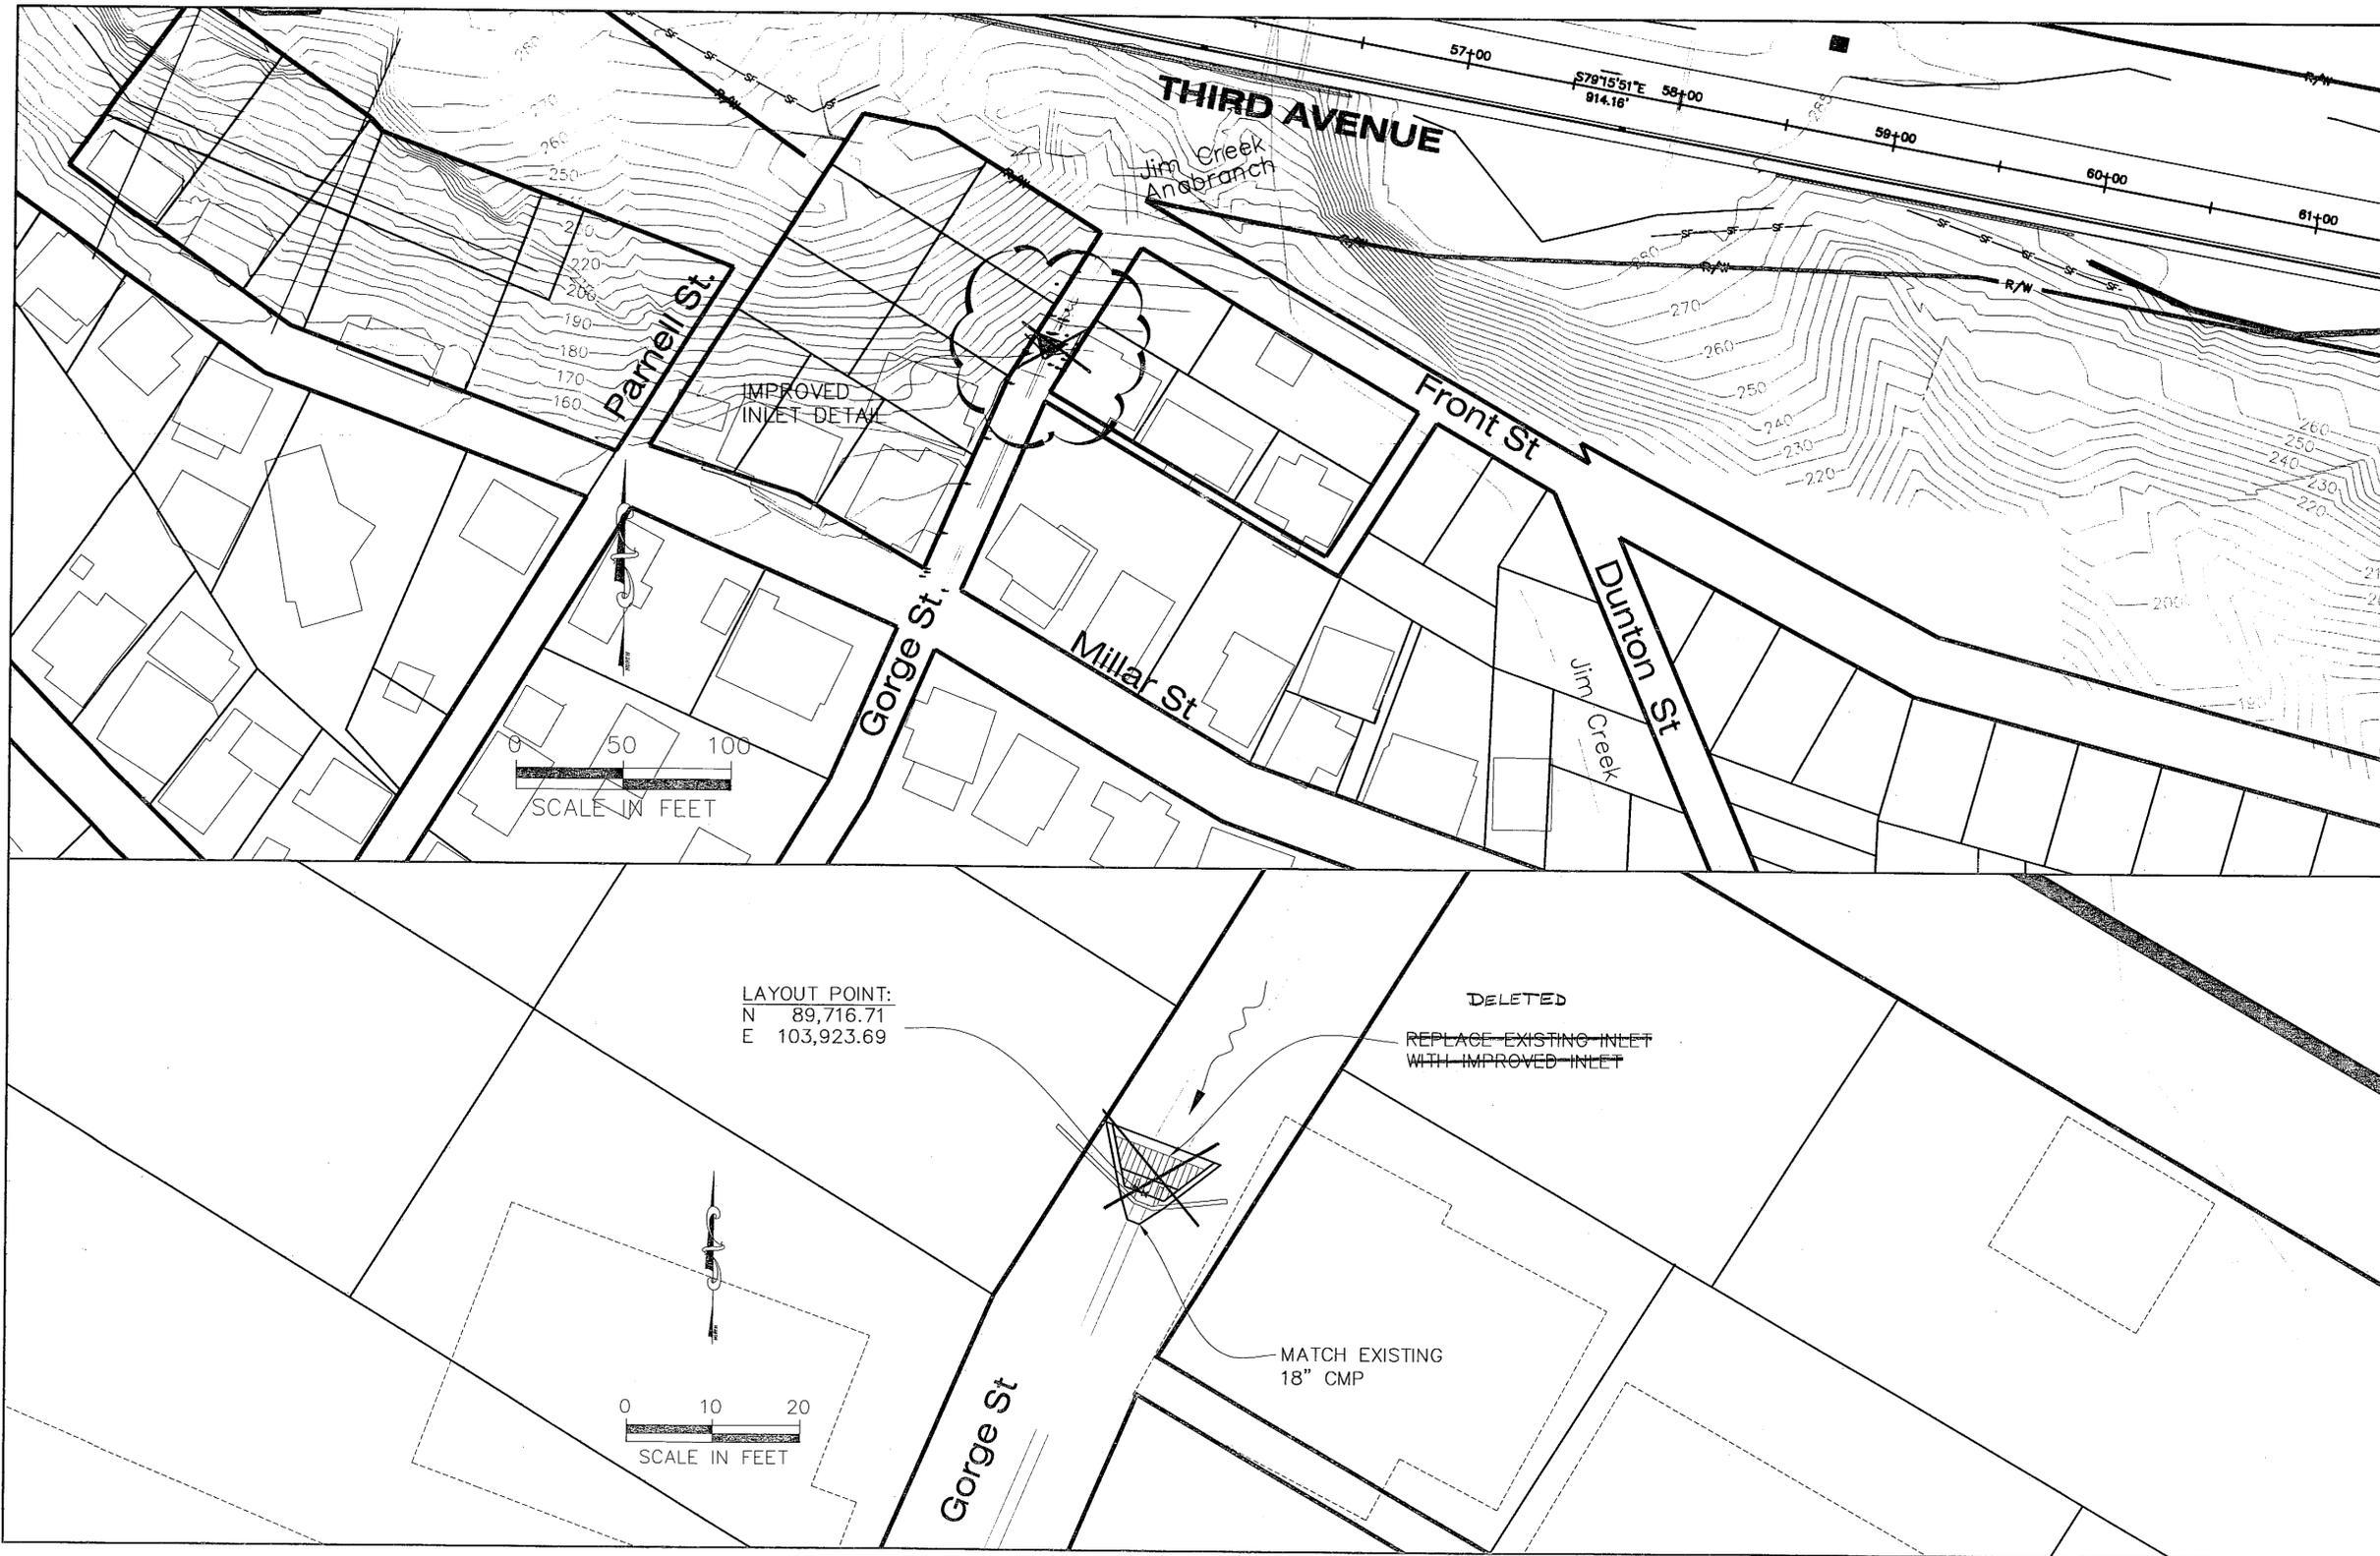

KTN-THIRD AVENUE EXTENSION
 PROJECT NO. 68490
DRAINAGE IMPROVEMENTS
AREA 1

PATH: Q:\ktn\71811A\Planset\N_DrainAreas.dwg
 Mon, 06/May/02 10:52AM Michael Limbough
 PLOT: PSPACE: 1=1(F) OR MSPACE: 1=32(F)
 TAB: AREA1-N

ADDENDUM NUMBER		
ATTACHMENT NUMBER		
RECORD OF REVISIONS		
No.	DATE	DESCRIPTION

KTN-THIRD AVENUE EXTENSION
 PROJECT NO. 68490

Offsite Drainage Improvements Area 1 Layout Plan

DESIGNED BY: J. OSBURN



CHECKED BY: T. MOORE
 DRAWN BY: T.M./R.S

STATE OF ALASKA
 DEPARTMENT OF TRANSPORTATION
 & PUBLIC FACILITIES
 STATEWIDE DESIGN & ENGINEERING
 SERVICES DIVISION



THIRD AVENUE EXTENSION
 PROJECT NO. 68490

Offsite Drainage Improvements Layout Plan


PROJECT DESIGNATION NUMBER	
STP-MG-0904(2)	
STATE	YEAR
ALASKA	2002
SHEET NUMBER	TOTAL SHEETS
N9	146

Project As Built Drawings have been reviewed by the Project Engineer. To the best of his/her knowledge, they represent the project as constructed.


Proj. Eng. Date: 5/1/02

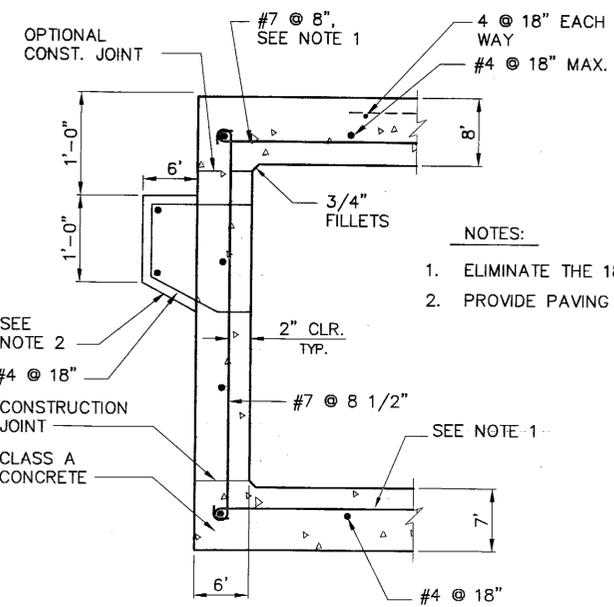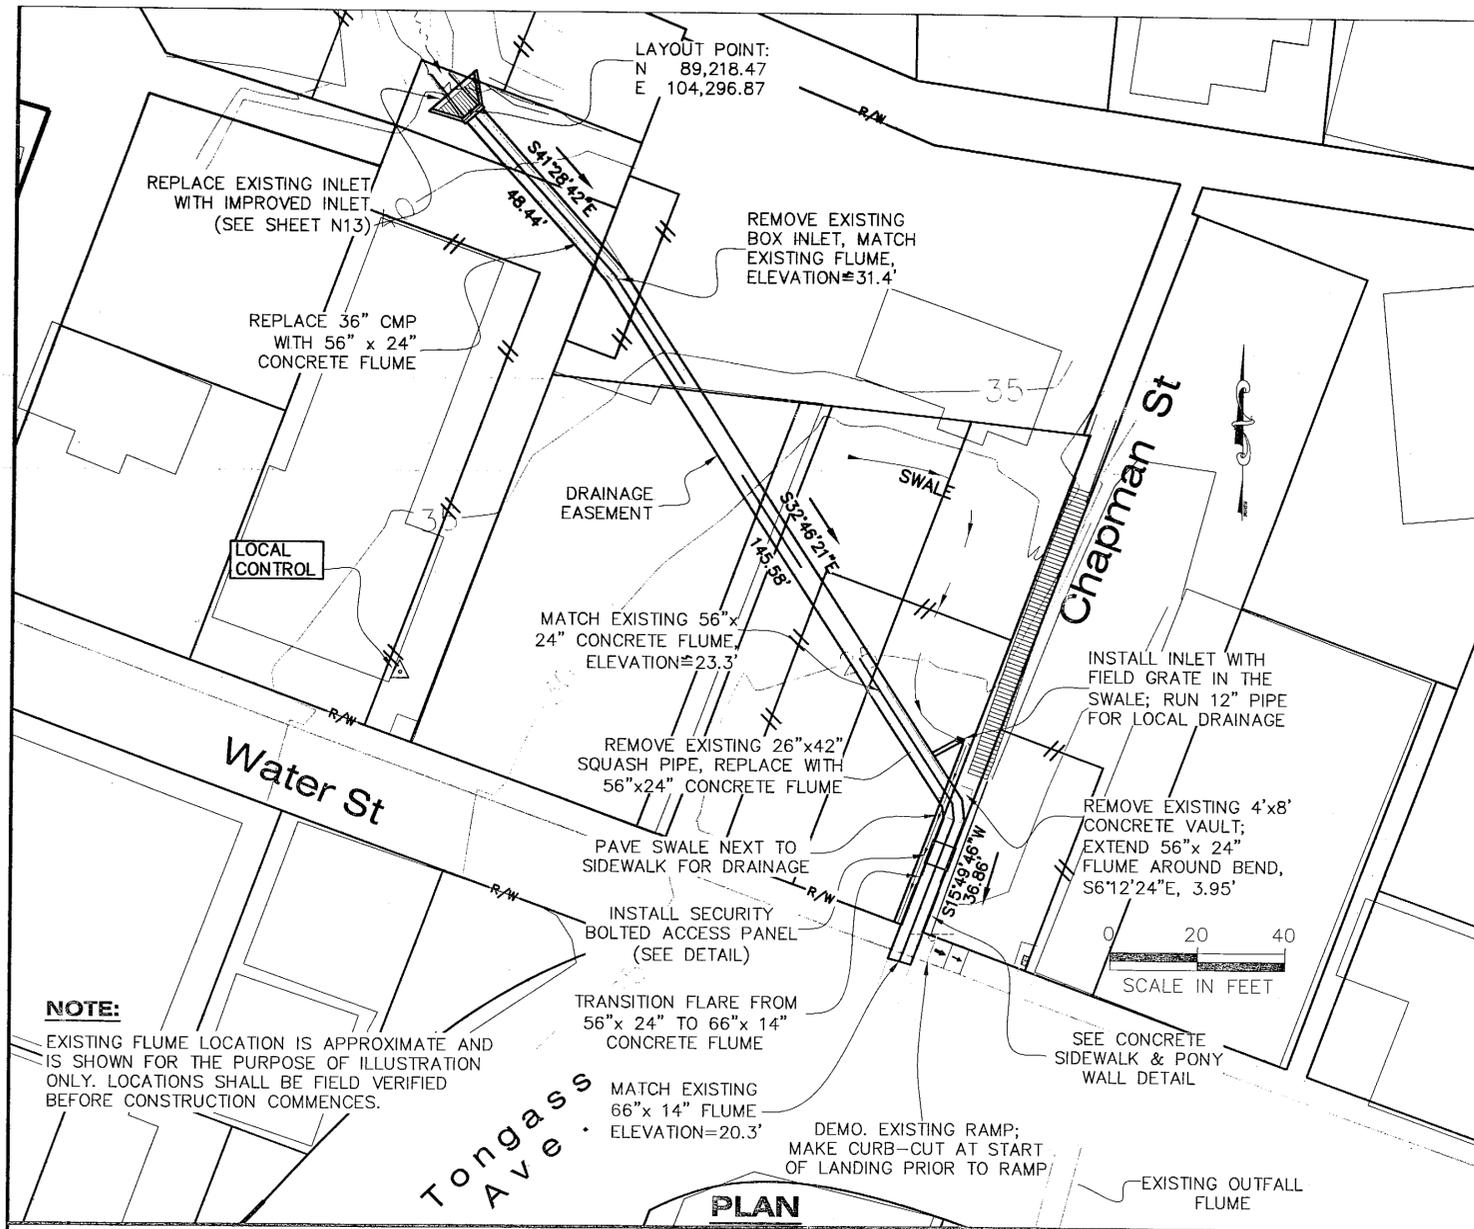


CONCRETE FLUME TYPICAL SECTION

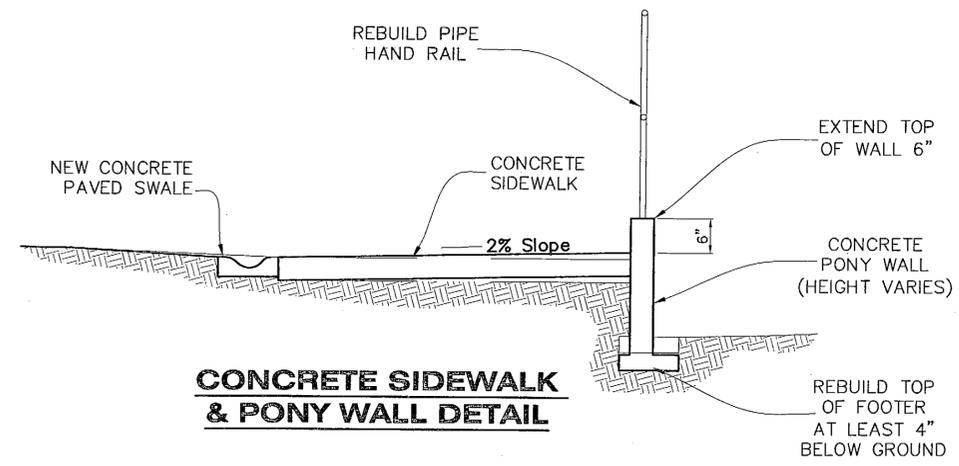

CONCRETE SIDEWALK & PONY WALL DETAIL

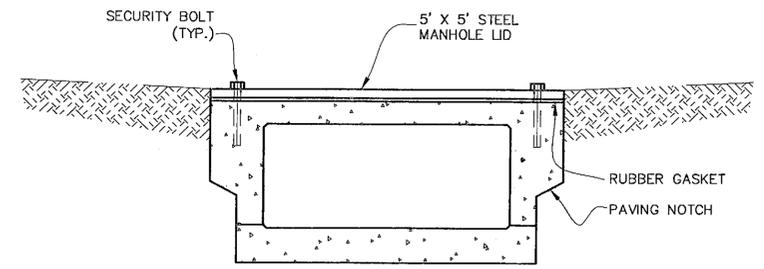

SECURITY BOLTED ACCESS PANEL DETAIL

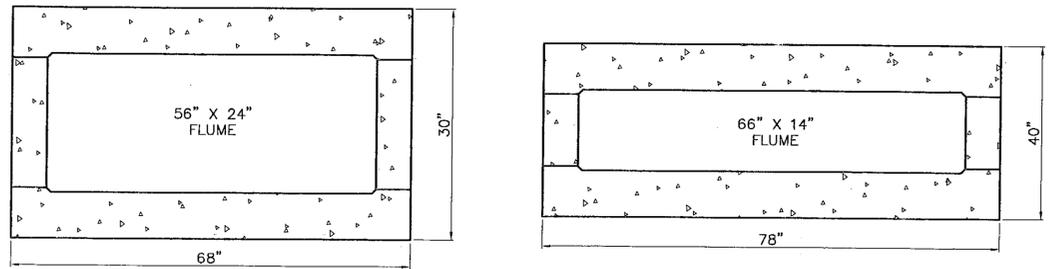

CONCRETE FLUME DETAIL


PATH: Q:\ktn\71811A\PlanSet\N_DrainAreas.dwg
Mon, 06/May/02 10:52AM Michael Limbaugh
PLOT: Michael Limbaugh
PSPACE: 1=1(F) OR MSPACE: 1=32(F)
TAB: AREA-N2

ADDENDUM NUMBER		
ATTACHMENT NUMBER		
RECORD OF REVISIONS		
No.	DATE	DESCRIPTION

KTN-THIRD AVENUE EXTENSION
PROJECT NO. 68490

Offsite Drainage Improvements Area 2 Layout Plan

DESIGNED BY: J. OSBURN

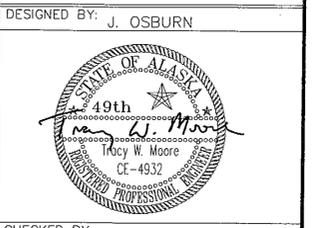

CHECKED BY: T. MOORE
DRAWN BY: T.M./R.S.

STATE OF ALASKA
DEPARTMENT OF TRANSPORTATION & PUBLIC FACILITIES
STATEWIDE DESIGN & ENGINEERING SERVICES DIVISION



THIRD AVENUE EXTENSION
PROJECT NO. 68490

Offsite Drainage Improvements Area 2 Layout Plan

PROJECT DESIGNATION NUMBER	
STP-MG-0904(2)	
STATE	YEAR
ALASKA	2002
SHEET NUMBER	TOTAL SHEETS
N10	146

Project As Built Drawings have been reviewed by the Project Engineer. To the best of his/her knowledge, they represent the project as constructed.

Proj. Eng. *KS* Date *02/06*

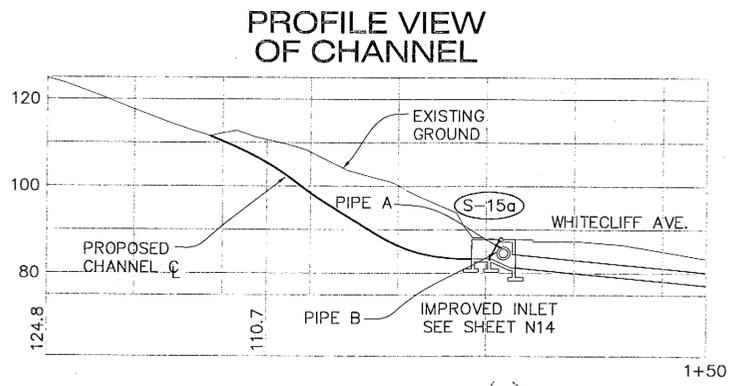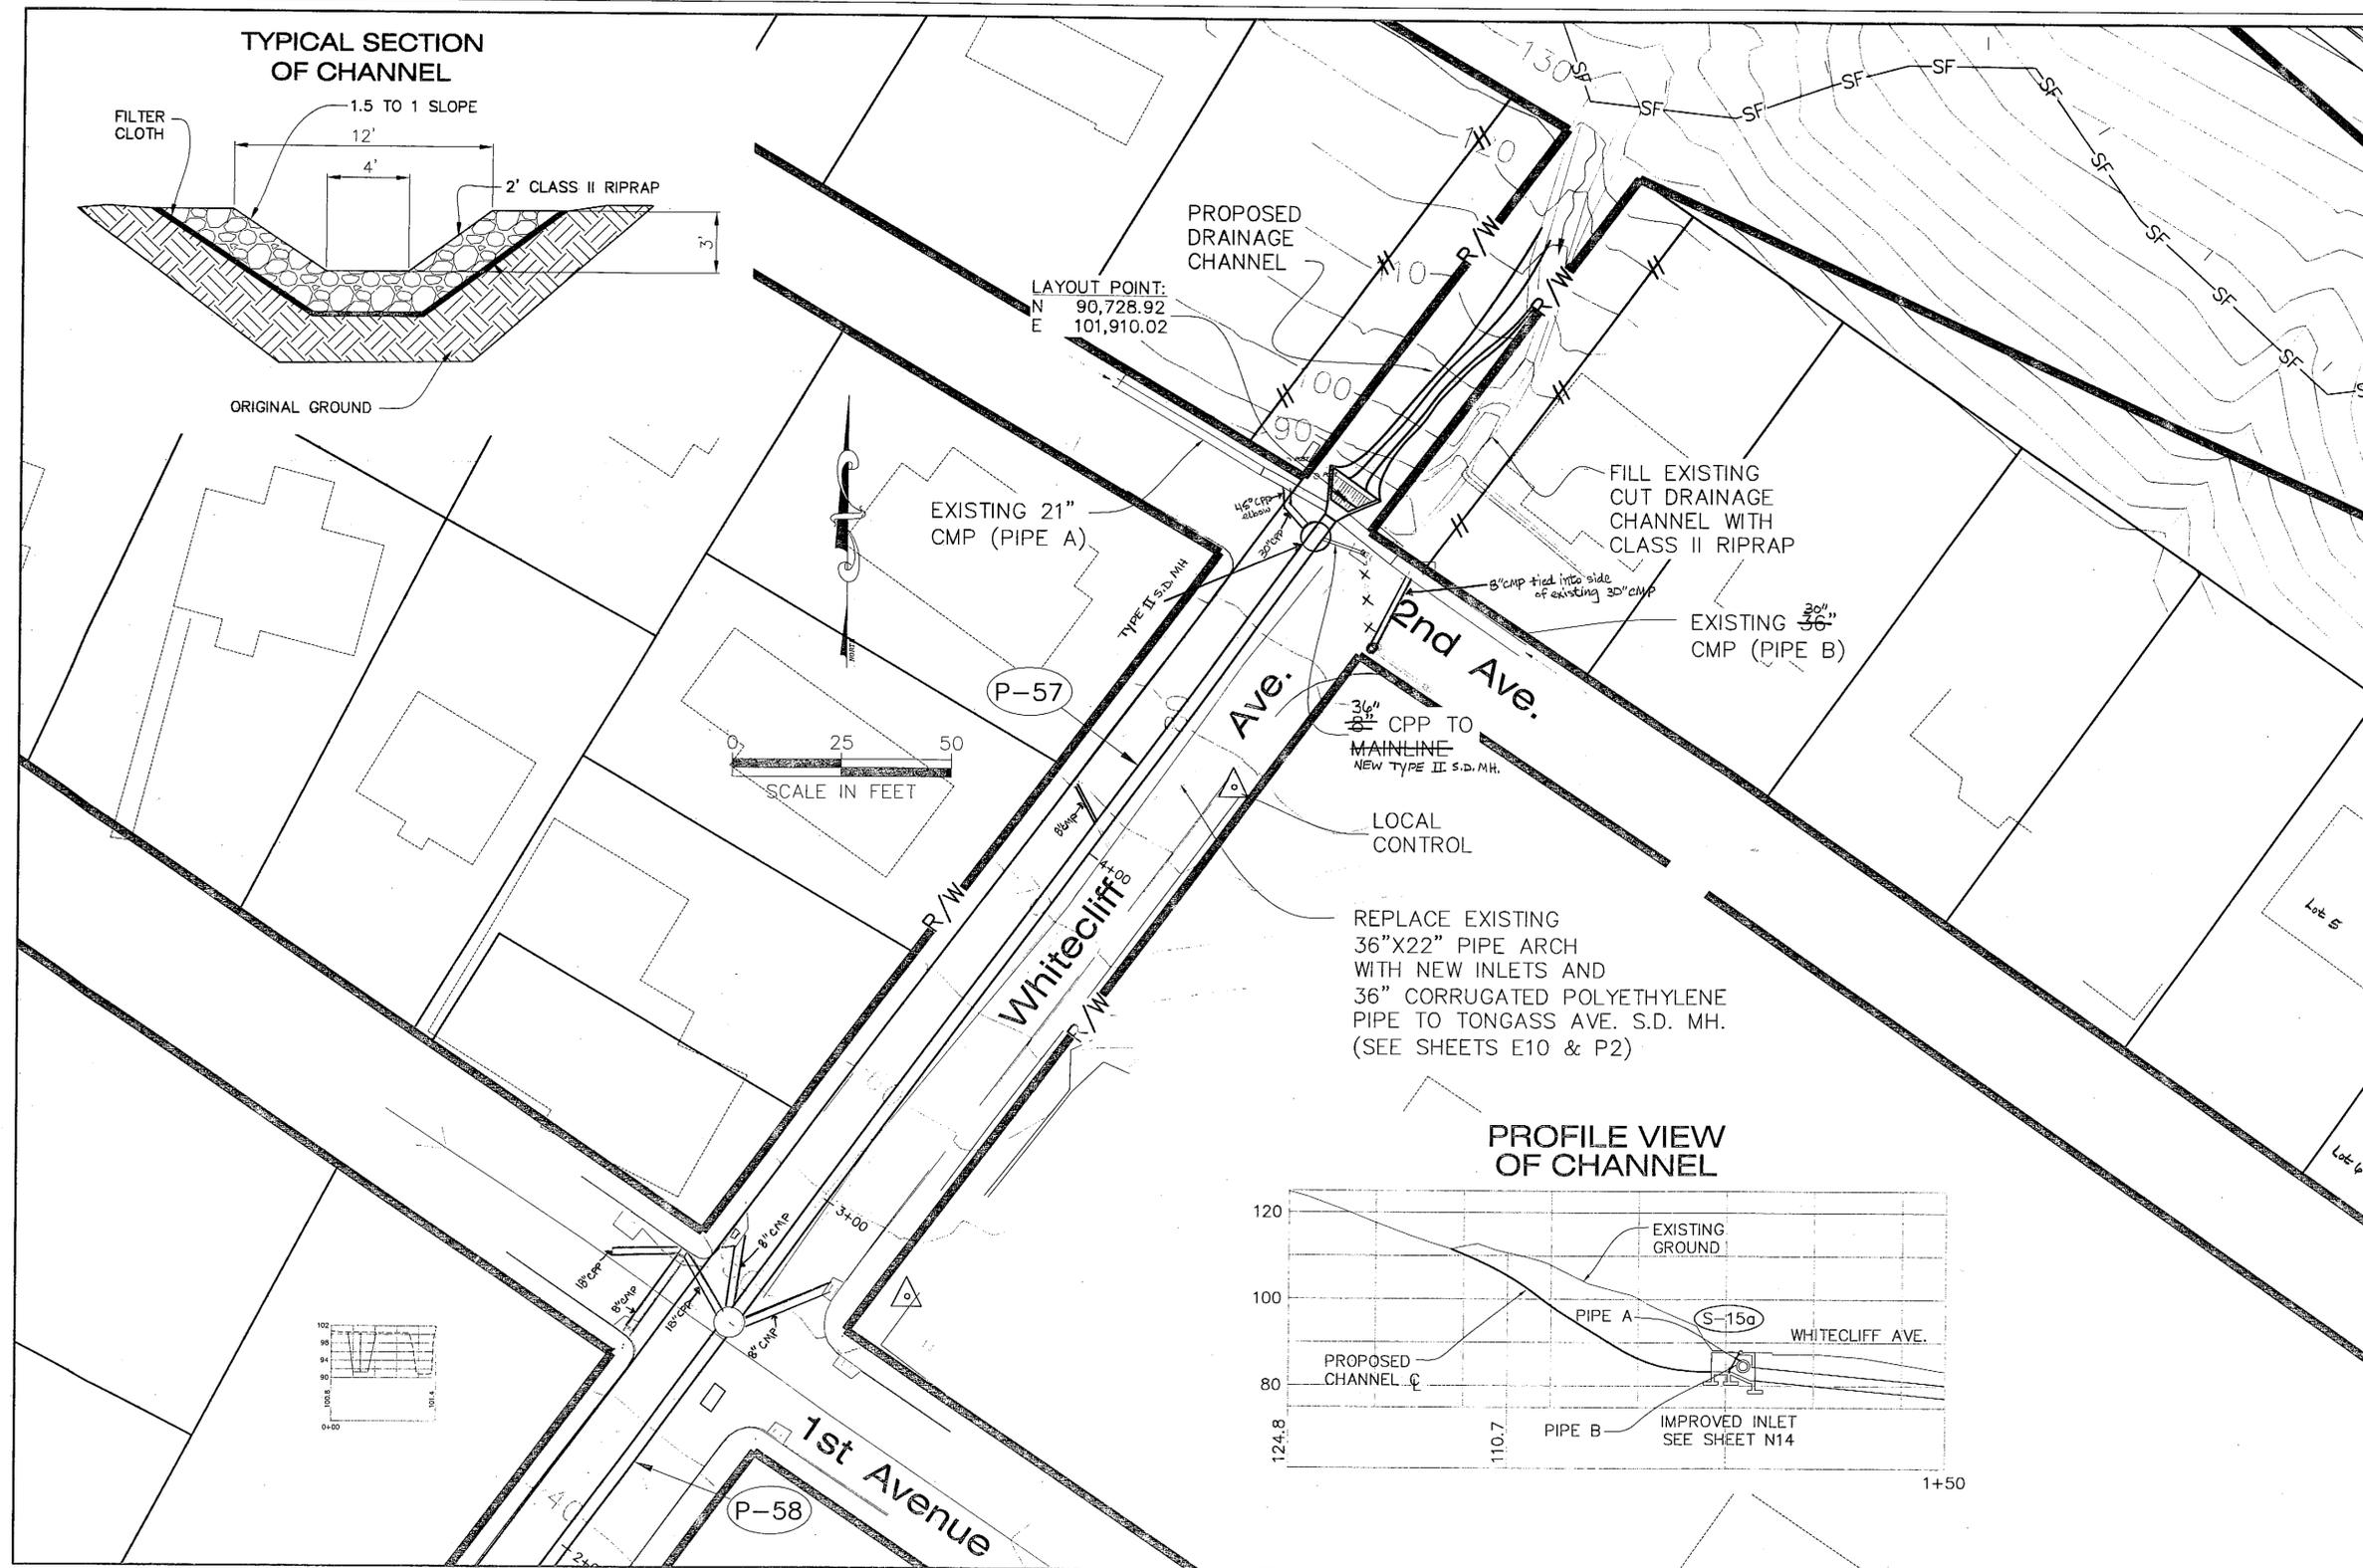

KTN-THIRD AVENUE EXTENSION
PROJECT NO. 68490
DRAINAGE IMPROVEMENTS
AREA 3

PATH: Q:\ktn\71811A\Plans\N_DrainAreas.dwg
Mon, 06/May/02 10:51AM
PLOT: Michael Limbaugh
PSPACE: 1=1(F) OR MSPACE: 1=32(F)
TAB: AREA-N2

ADDENDUM NUMBER		
ATTACHMENT NUMBER		
RECORD OF REVISIONS		
No.	DATE	DESCRIPTION

KTN-THIRD AVENUE EXTENSION
PROJECT NO. 68490

**Offsite Drainage Improvements
Area 3 Layout Plan**

DESIGNED BY: J. OSBURN



CHECKED BY: T. MOORE
DRAWN BY: T.M./R.S.

STATE OF ALASKA
DEPARTMENT OF TRANSPORTATION
& PUBLIC FACILITIES
STATEWIDE DESIGN & ENGINEERING
SERVICES DIVISION

THIRD AVENUE EXTENSION
PROJECT NO. 68490
**Offsite Drainage
Improvements
Layout Plan**

PROJECT DESIGNATION NUMBER	
STP-MG-0904(2)	
STATE	YEAR
ALASKA	2002
SHEET NUMBER	TOTAL SHEETS
N11	146

Project As Built Drawings have been reviewed by the Project Engineer. To the best of his/her knowledge, they represent the project as constructed.
Proj. Eng. Date 05/06

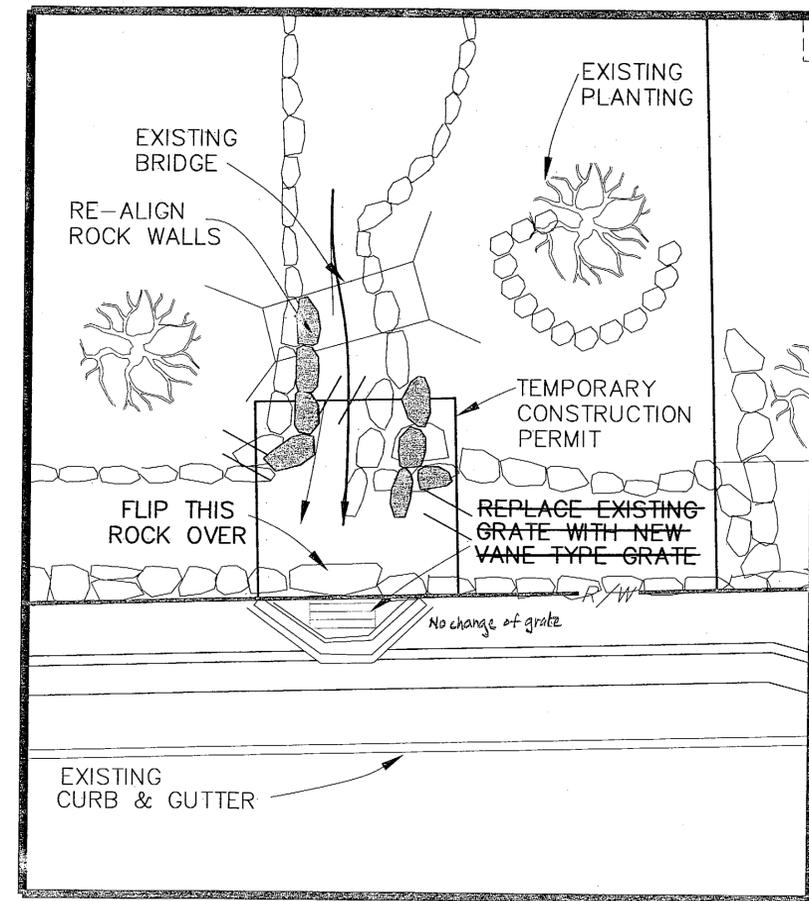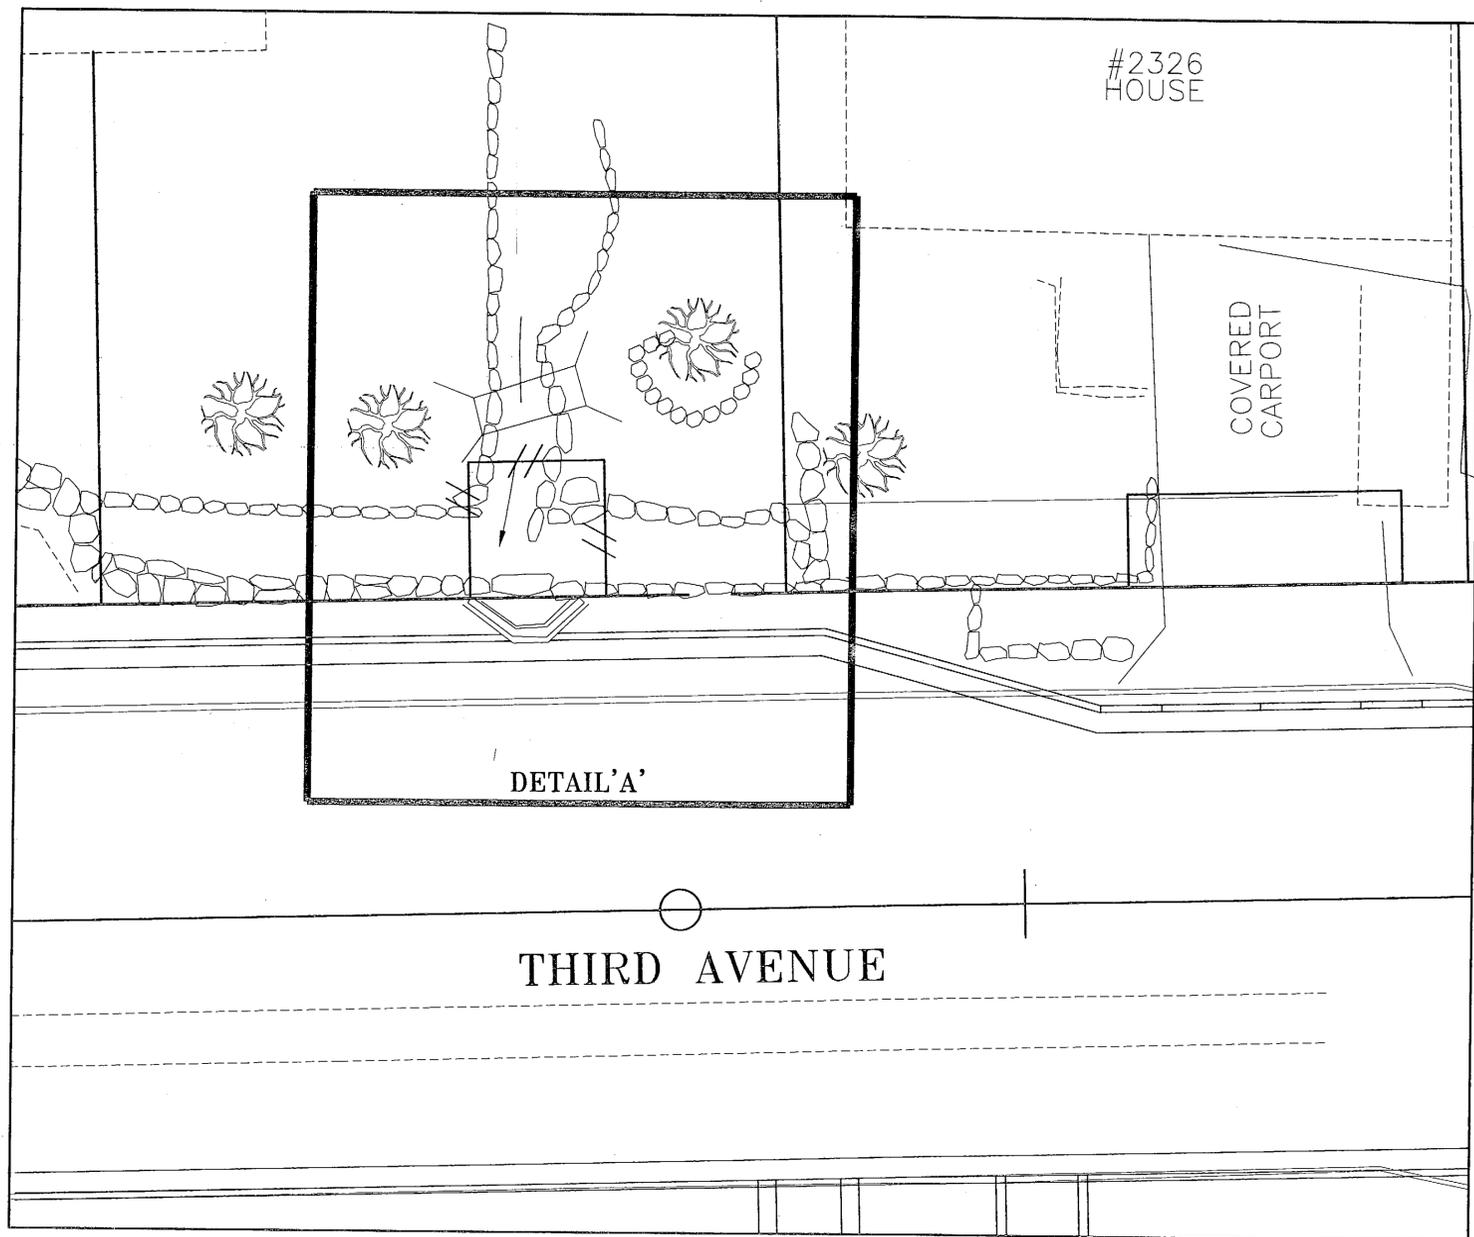

KTN-THIRD AVENUE EXTENSION
 PROJECT NO. 68490
DRAINAGE IMPROVEMENTS
AREA 4

PATH:
 Q:\Ktn\71811A\Planset\N_DrainAreas.dwg
 Mon, 06/May/02 10:51AM Michael Limbough
 PLOT:
 PSPACE: 1=1(F) OR MSPACE: 1=32(F)
 TAB: AREA-N2

ADDENDUM NUMBER		
ATTACHMENT NUMBER		
RECORD OF REVISIONS		
No.	DATE	DESCRIPTION

KTN-THIRD AVENUE EXTENSION
 PROJECT NO. 68490
Offsite Drainage Improvements
Area 4 Layout Plan

DESIGNED BY: J. OSBURN



CHECKED BY: T. MOORE
 DRAWN BY: T.M./R.S

STATE OF ALASKA
 DEPARTMENT OF TRANSPORTATION
 & PUBLIC FACILITIES
 STATEWIDE DESIGN & ENGINEERING
 SERVICES DIVISION
 THIRD AVENUE EXTENSION
 PROJECT NO. 68490
**Offsite Drainage
 Improvements
 Layout Plan**

PROJECT DESIGNATION NUMBER	
STP-MG-0904(2)	
STATE	YEAR
ALASKA	2002
SHEET NUMBER	TOTAL SHEETS
N12	146

Project As Built Drawings have been reviewed by the Project Engineer. To the best of his/her knowledge, they represent the project as constructed.
 Proj. Eng. Date 10/1/06

PATH: Q:\Ktr\71811A\PlanSet\N_DrainAreas.dwg
 Mon, 06/May/02 10:51AM Michael Limbaugh
 PLOT:
 PSPACE: 1=1(F) OR MSPACE: 1=32(F)
 TAB: AREA-N2

ADDENDUM NUMBER		
ATTACHMENT NUMBER		
RECORD OF REVISIONS		
No.	DATE	DESCRIPTION

KTN-THIRD AVENUE EXTENSION
 PROJECT NO. 68490

**Offsite Drainage Improvements
 Layout Plan**

DESIGNED BY: J. OSBURN




CHECKED BY: T. MOORE
 DRAWN BY: T.M./R.S.


STATE OF ALASKA
 DEPARTMENT OF TRANSPORTATION
 & PUBLIC FACILITIES
 STATEWIDE DESIGN & ENGINEERING
 SERVICES DIVISION
 THIRD AVENUE EXTENSION
 PROJECT NO. 68490
**Offsite Drainage
 Improvements
 Layout Plan**

PROJECT DESIGNATION NUMBER	
STP-MG-0904(2)	
STATE	YEAR
ALASKA	2002
SHEET NUMBER	TOTAL SHEETS
N13	146


Project As Built Drawings have been reviewed by the Project Engineer. To the best of his/her knowledge, they represent the project as constructed.
 Proj. Eng. *[Signature]* Date 10-31-06

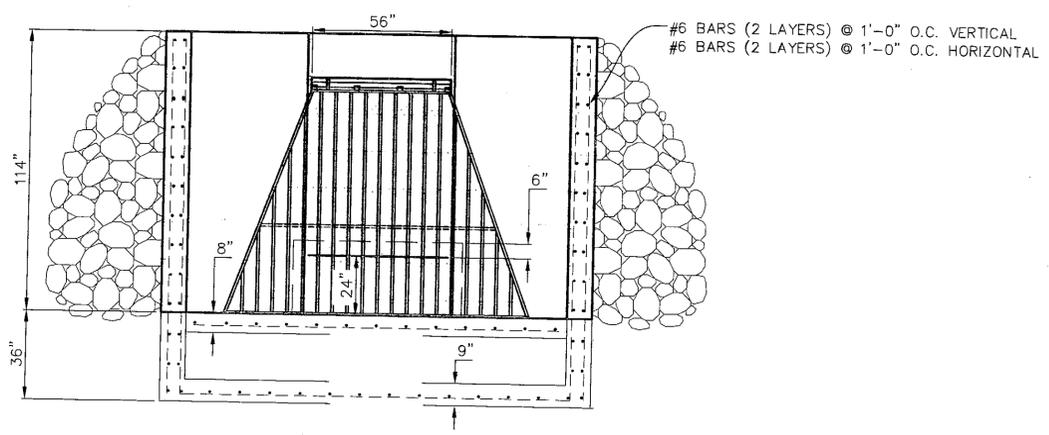


Front Profile View

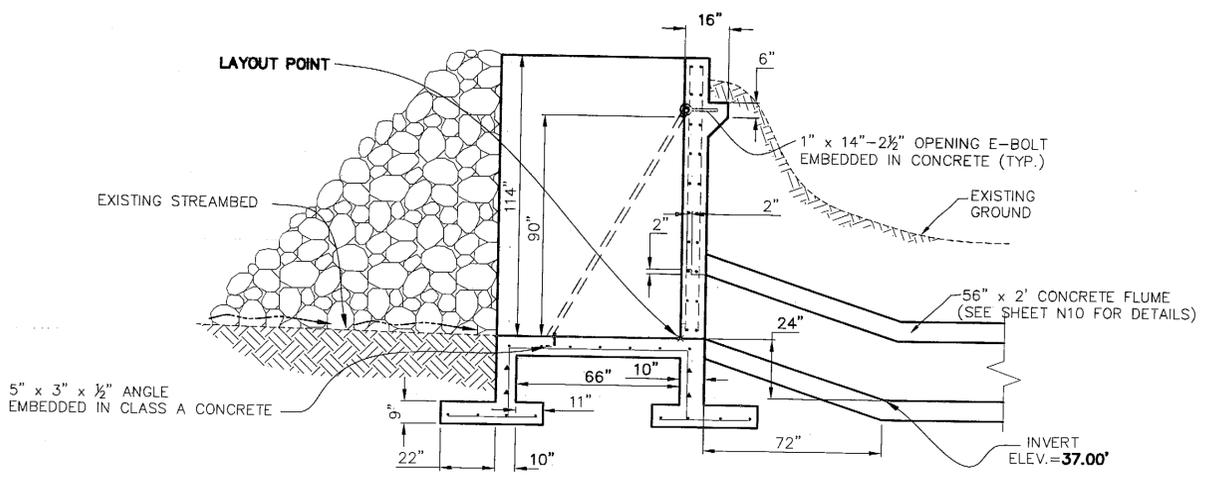

Side Profile View

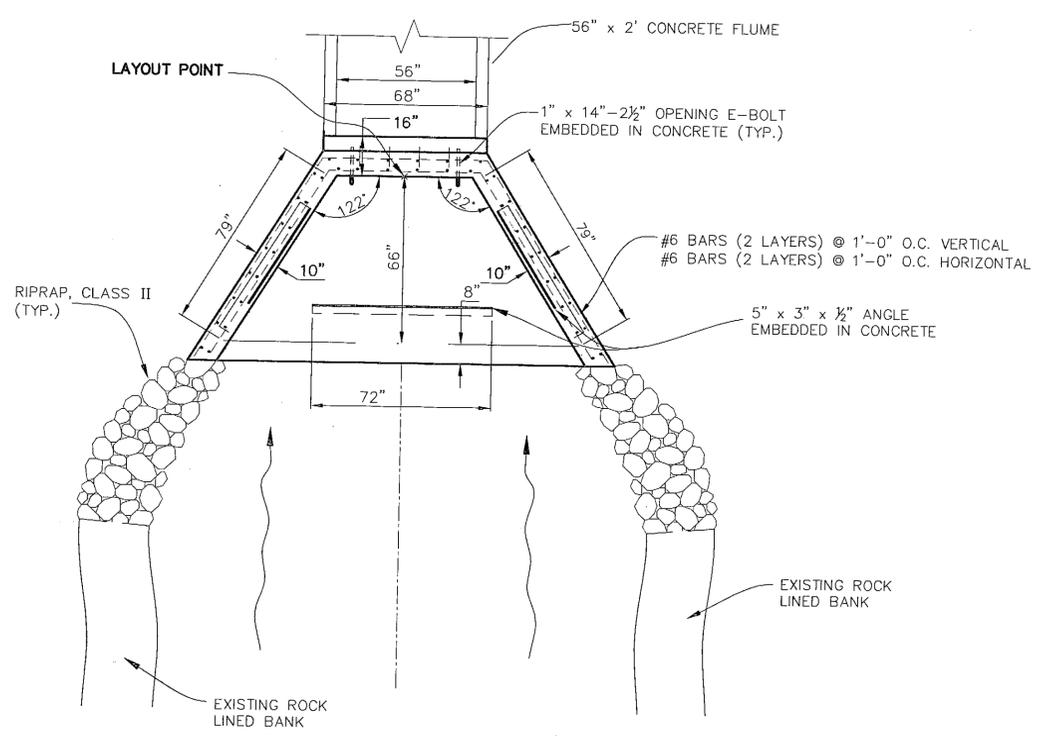

**Inlet
 Plan View**

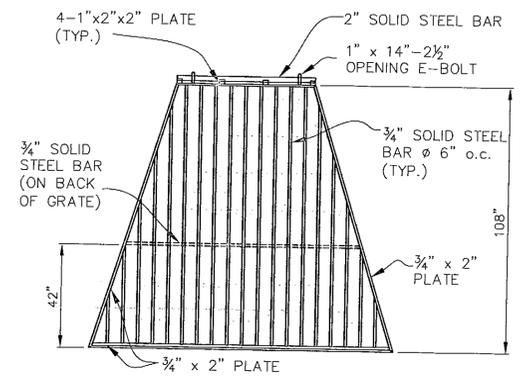

**Grate
 Plan View**


KTN-THIRD AVENUE EXTENSION
 PROJECT NO. 68490
**DRAINAGE IMPROVEMENTS
 AREA 2**

PATH:
 Q:\Ktr\71811A\PlanSet\N_DrainAreas.dwg
 Mon, 06/May/02 10:51AM Michael Limbaugh
 PLOT:
 PSPACE: 1=1(F) OR MSPACE: 1=32(F)
 TAB: AREA-N2

ADDENDUM NUMBER		
ATTACHMENT NUMBER		
RECORD OF REVISIONS		
No.	DATE	DESCRIPTION

KTN-THIRD AVENUE EXTENSION
 PROJECT NO. 68490
**Offsite Drainage Improvements
 Layout Plan**

DESIGNED BY: J.OSBURN

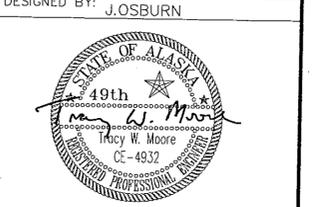


CHECKED BY: T. MOORE
 DRAWN BY: T.M./R.S.
 STATE OF ALASKA
 DEPARTMENT OF TRANSPORTATION
 & PUBLIC FACILITIES
 STATEWIDE DESIGN & ENGINEERING
 SERVICES DIVISION
 THIRD AVENUE EXTENSION
 PROJECT NO. 68490


**Offsite Drainage
 Improvements
 Layout Plan**

PROJECT DESIGNATION NUMBER	
STP-MG-0904(2)	
STATE	YEAR
ALASKA	2002
SHEET NUMBER	TOTAL SHEETS
N14	146


Project As Built Drawings have been reviewed by the Project Engineer. To the best of his/her knowledge, they represent the project as constructed.
 Proj. Eng. *[Signature]* Date 10/2/02

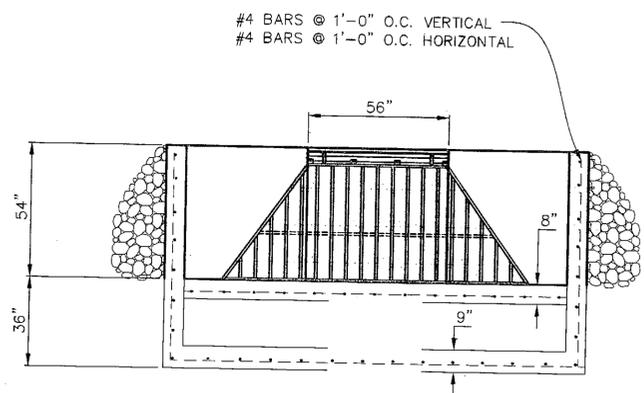


Front Profile View

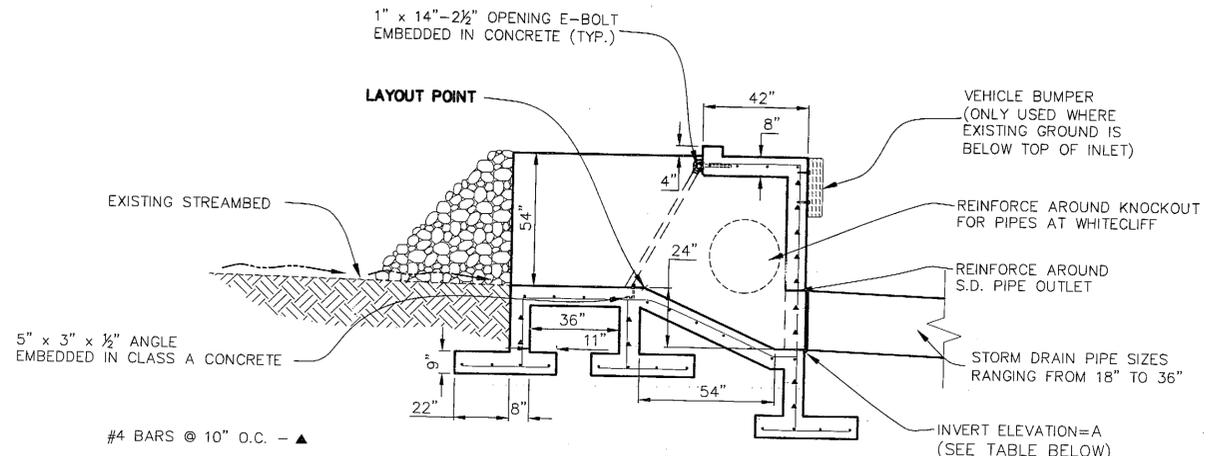

Side Profile View

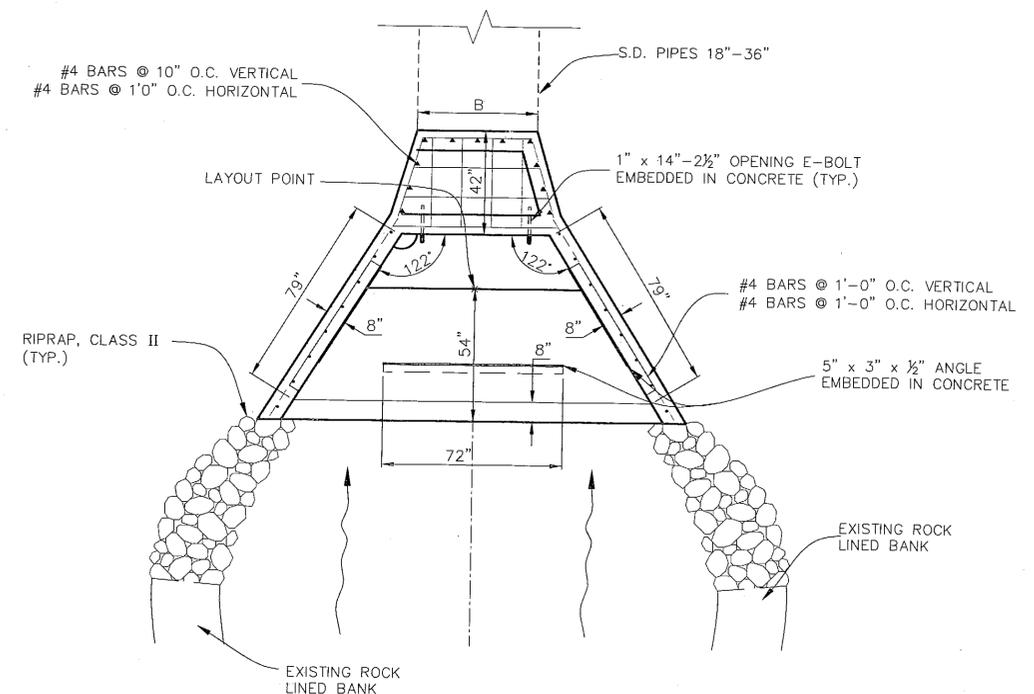

**Inlet
 Plan View**

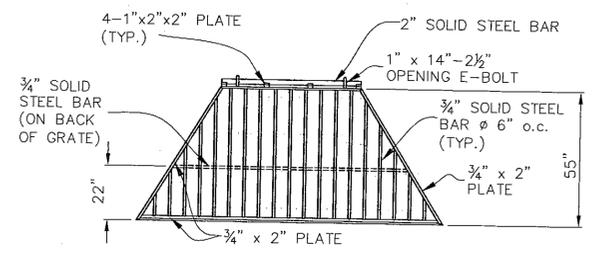


**Grate
 Plan View**


IMPROVED INLET VARIABLES		
INLET NAME	A	B
GORGE ST.	158.73'	18" CMP
WHITECLIFF AVE.	81.87'	36" CPP
S-15a	153.24'	36" CPP

KTN-THIRD AVENUE EXTENSION
 PROJECT NO. 68490
DRAINAGE IMPROVEMENTS

ADDENDUM NUMBER		
ATTACHMENT NUMBER		
RECORD OF REVISIONS		
No.	DATE	DESCRIPTION

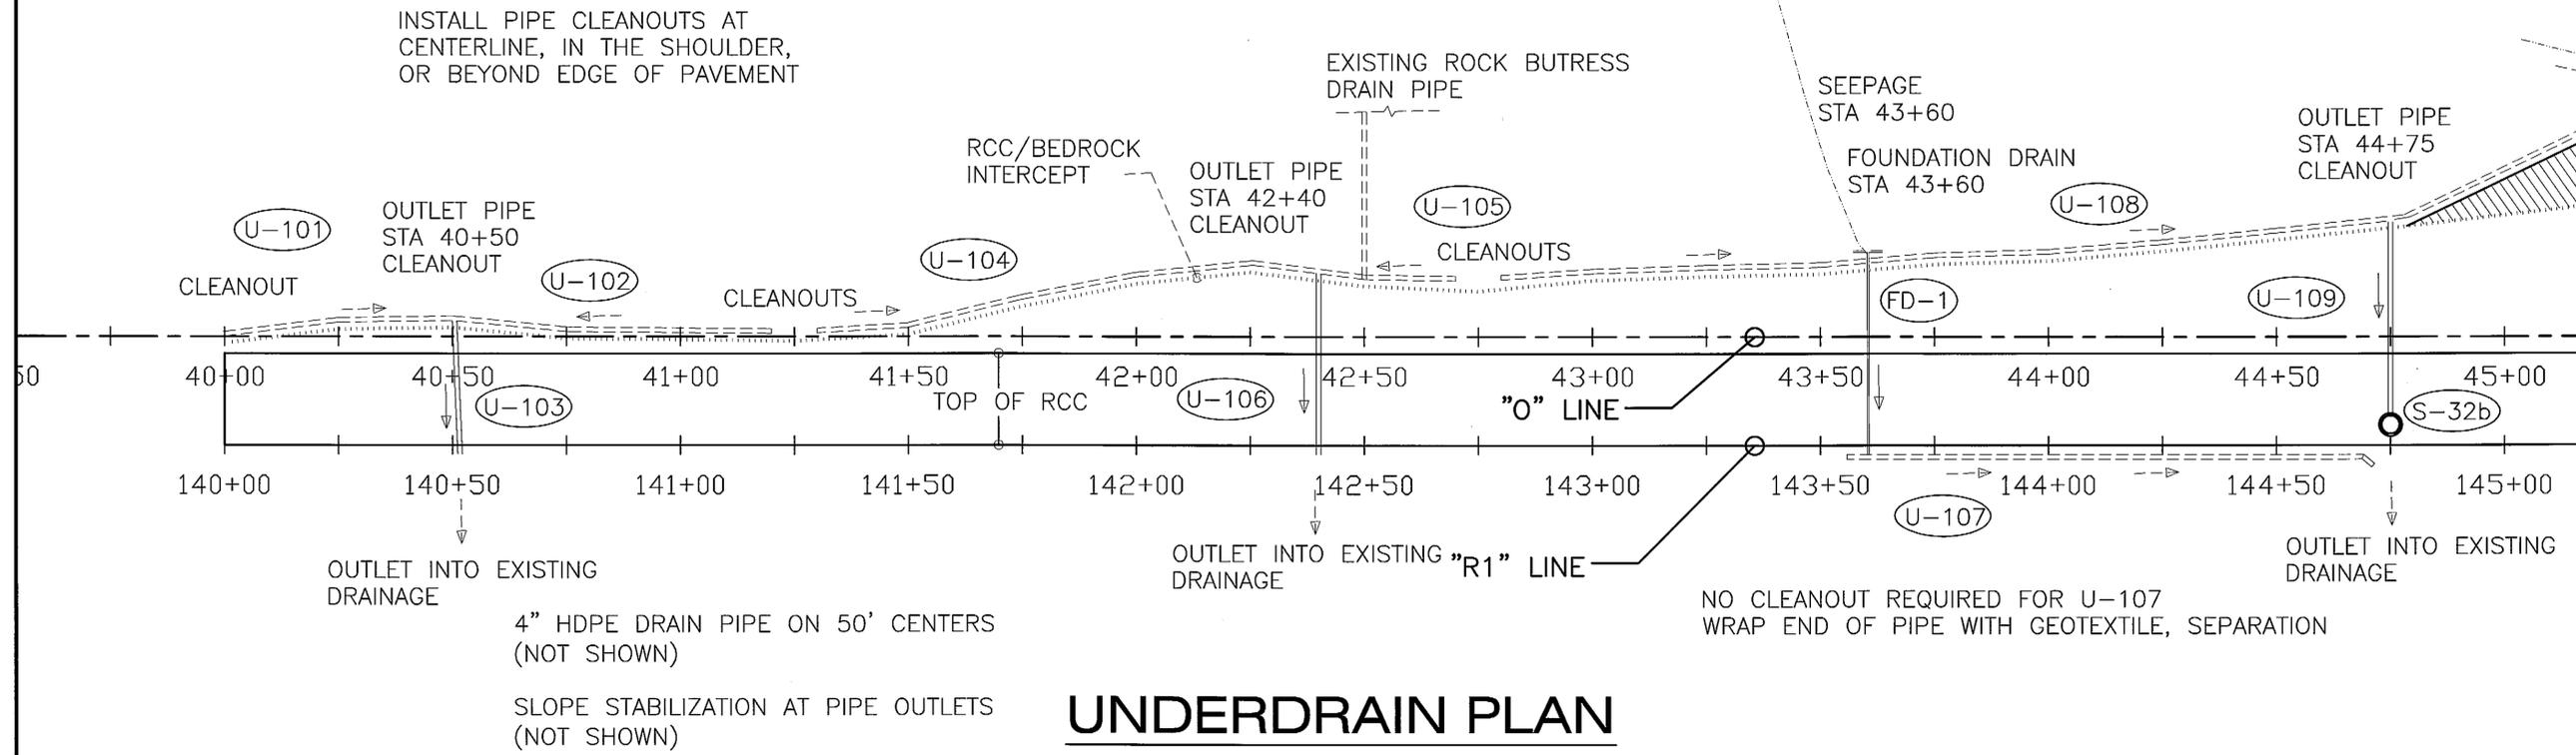

UNDERDRAIN PLAN

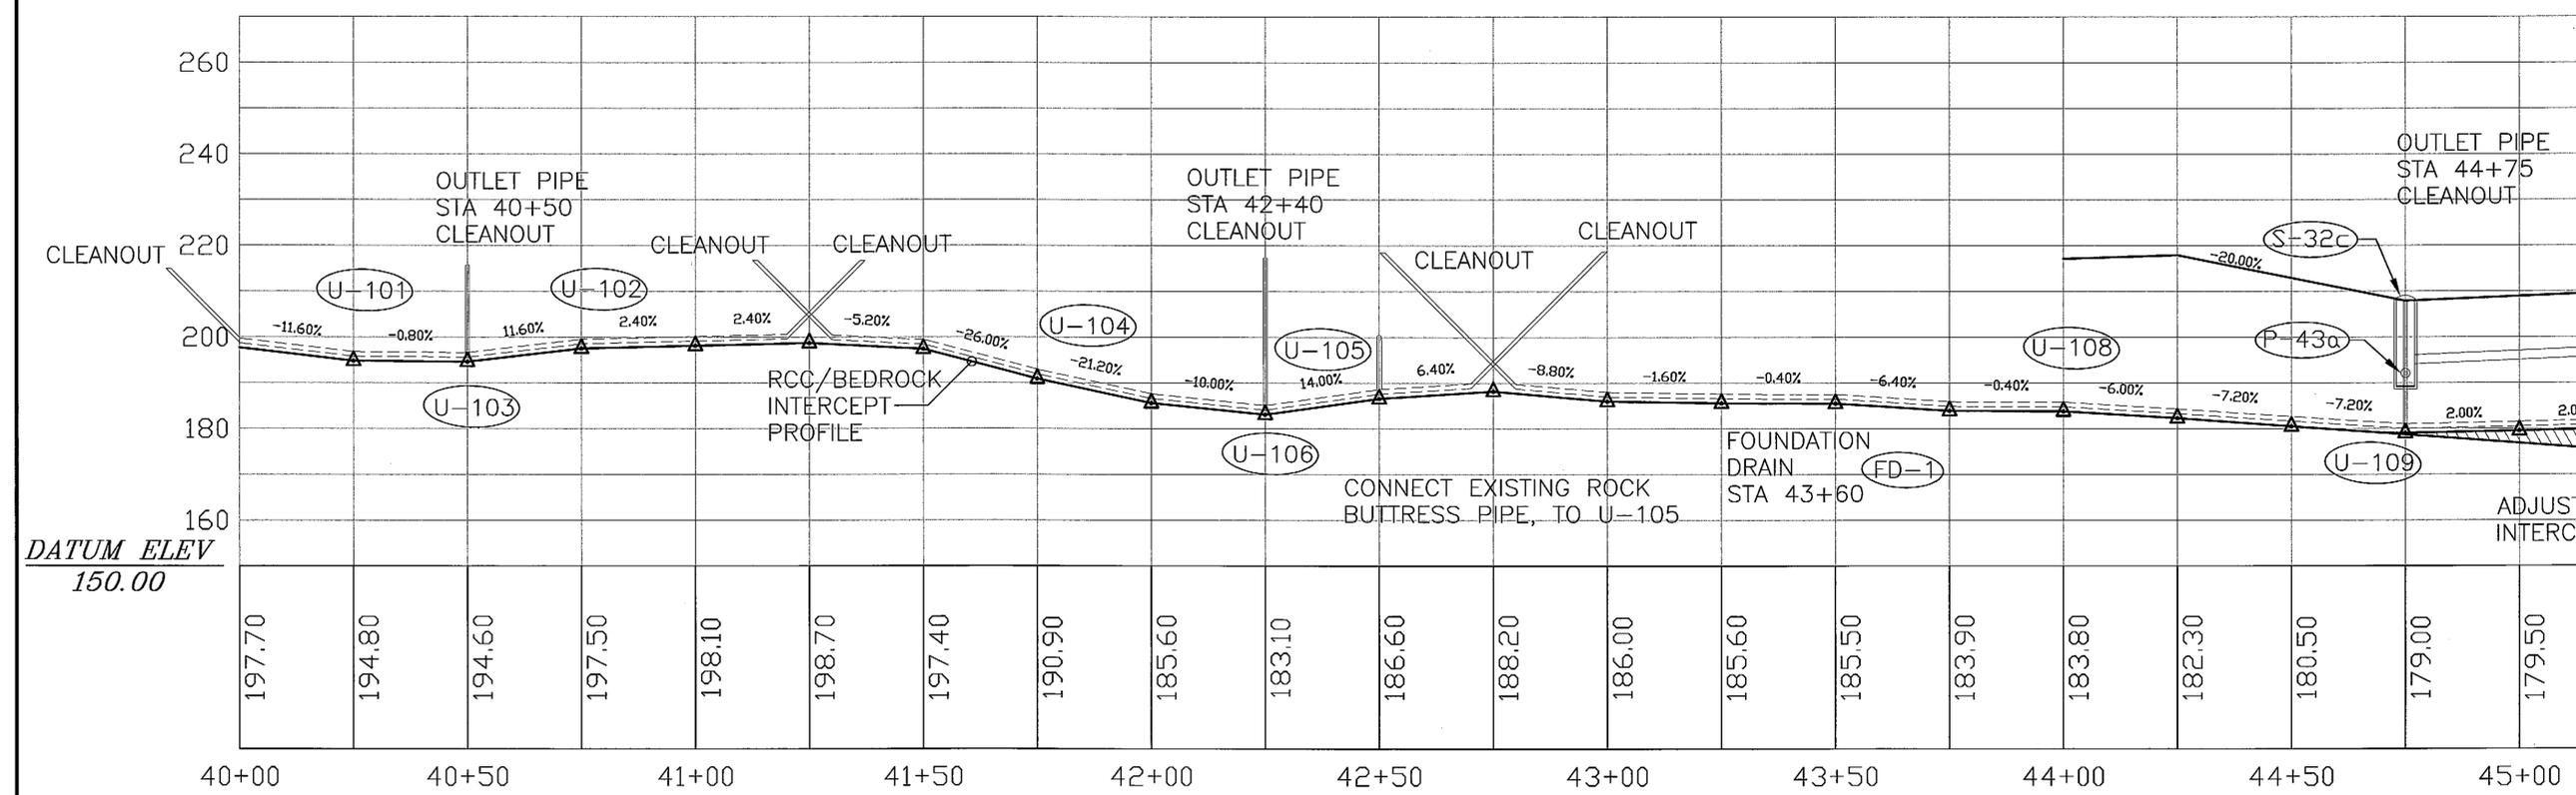

UNDERDRAIN PROFILE

PROFILE NOT SHOWN FOR U-107(FRONT OF WALL)
 SLOPE MINIMUM 1% OUTLET INTO EXISTING DRAINAGE

KTN-THIRD AVENUE EXTENSION
 PROJECT NO. 68490

REVISED
 Underdrain Profile

Project As Built Drawings have been reviewed by the Project Engineer. To the best of his/her knowledge, they represent the project as constructed.
 Proj. Eng. *[Signature]* Date 03/06


DESIGNED BY: C. HOWARD




CHECKED BY: T. MOORE
 DRAWN BY: M. LIMBAUGH

STATE OF ALASKA
 DEPARTMENT OF TRANSPORTATION & PUBLIC FACILITIES
 STATEWIDE DESIGN & ENGINEERING SERVICES DIVISION
 THIRD AVENUE EXTENSION
 PROJECT NO. 68490


Underdrain Profile	
PROJECT DESIGNATION NUMBER	
STP-MG-0904(2)	
STATE	YEAR
ALASKA	2002
SHEET NUMBER	TOTAL SHEETS
N15A	146

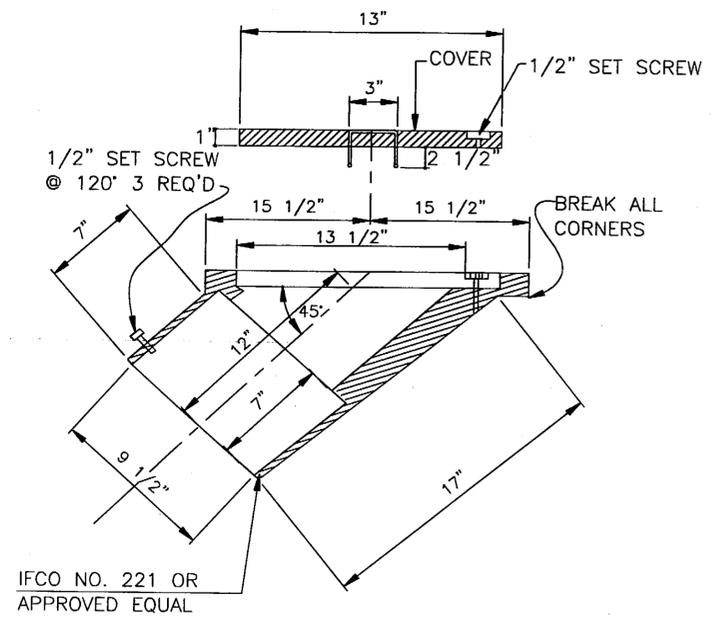


IFCO NO. 221 OR APPROVED EQUAL

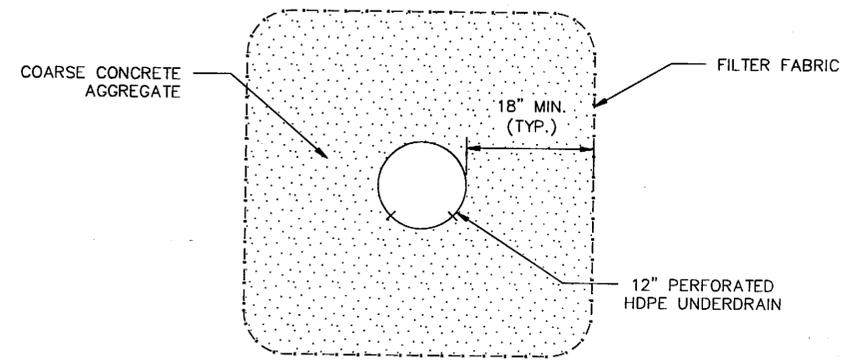


Typical Underdrain Detail

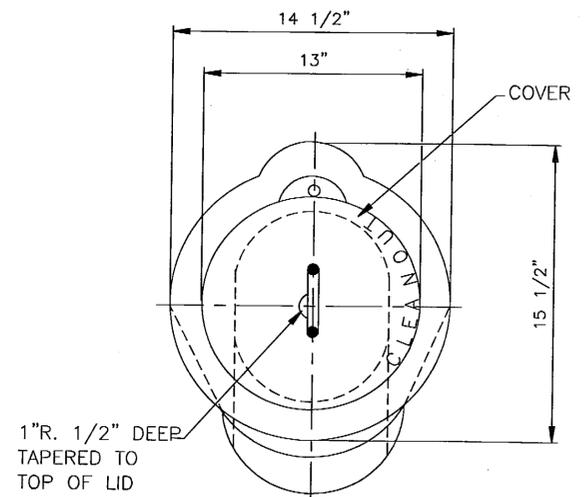


CLEANOUT FRAME & COVER

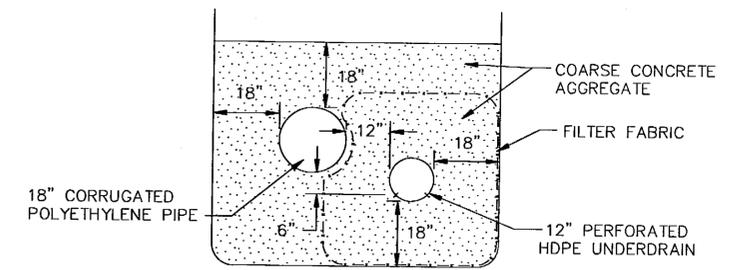

Dual Pipe Trench Detail

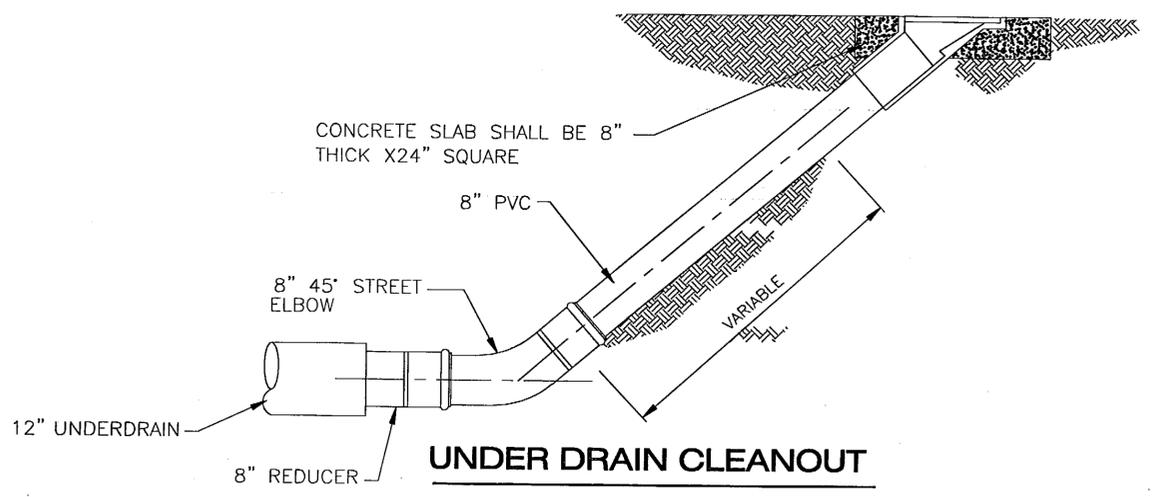

UNDER DRAIN CLEANOUT

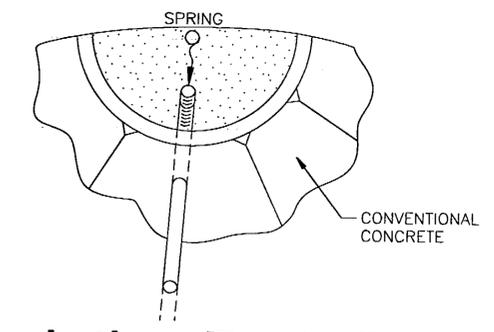

Foundation Drain Detail

PATH: Q:\Ktn\71811A\Planset\N_Underdrain Details.dwg
 Mon, 06/May/02 11:07AM Michael Limbaugh
 PLOT: PSPACE 1=1(F) DR MSPACE 1=1(F)
 TAB: N16

ADDENDUM NUMBER		
ATTACHMENT NUMBER		
RECORD OF REVISIONS		
No.	DATE	DESCRIPTION

KTN-THIRD AVENUE EXTENSION
 PROJECT NO. 68490

RCC Wall Underdrain Details

DESIGNED BY: C. HOWARD



CHECKED BY: T. MOORE
 DRAWN BY: M. LIMBAUGH

STATE OF ALASKA
 DEPARTMENT OF TRANSPORTATION
 & PUBLIC FACILITIES
 STATEWIDE DESIGN & ENGINEERING
 SERVICES DIVISION

THIRD AVENUE EXTENSION
 PROJECT NO. 68490


RCC Wall Underdrain Details

PROJECT DESIGNATION NUMBER

STP-MG-0904(2)


STATE	YEAR
ALASKA	2002
SHEET NUMBER	TOTAL SHEETS
N16	146

Project As Built Drawings have been reviewed by the Project Engineer. To the best of his/her knowledge, they represent the project as constructed.
 Proj. Eng. *KS* Date 10/21/06

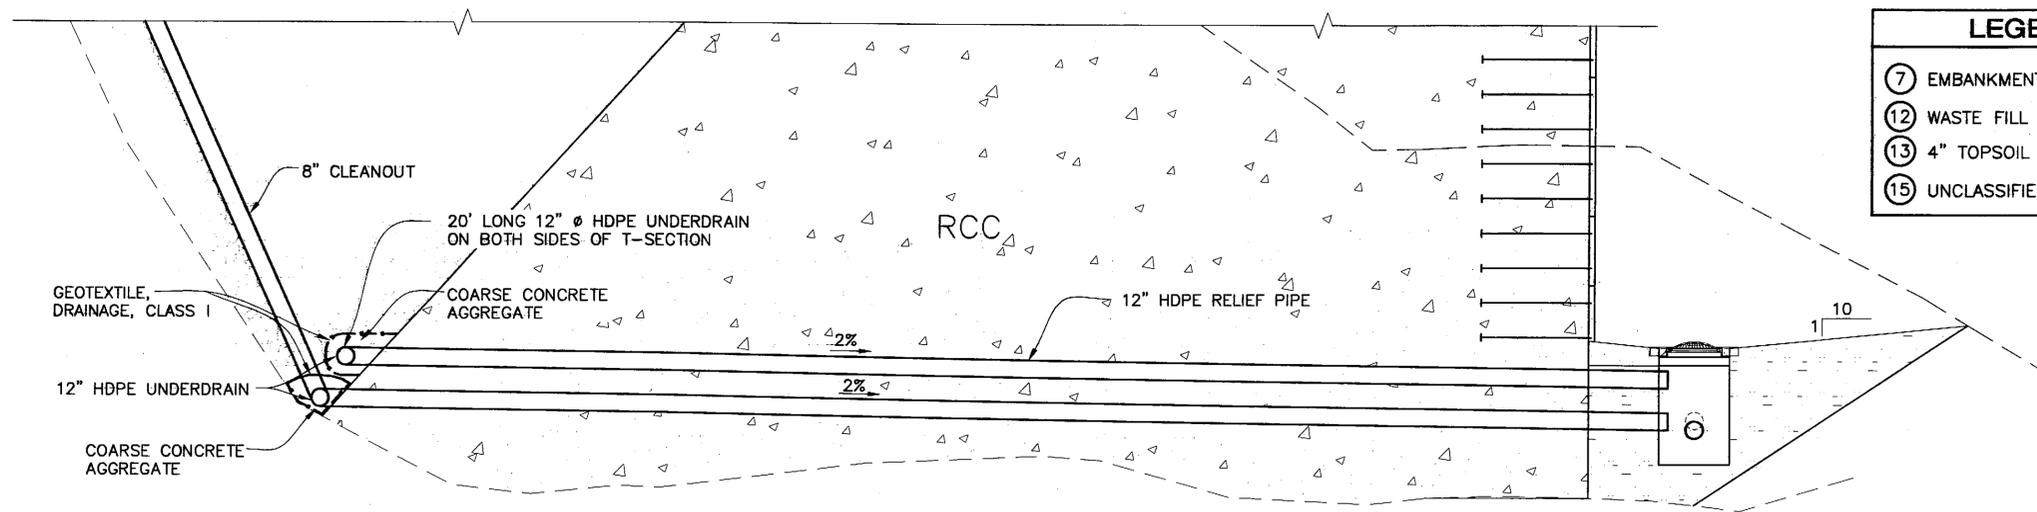

LEGEND	
⑦	EMBANKMENT
⑫	WASTE FILL
⑬	4" TOPSOIL
⑮	UNCLASSIFIED EXCAVATION

Sta. 46+50 Underdrain Detail

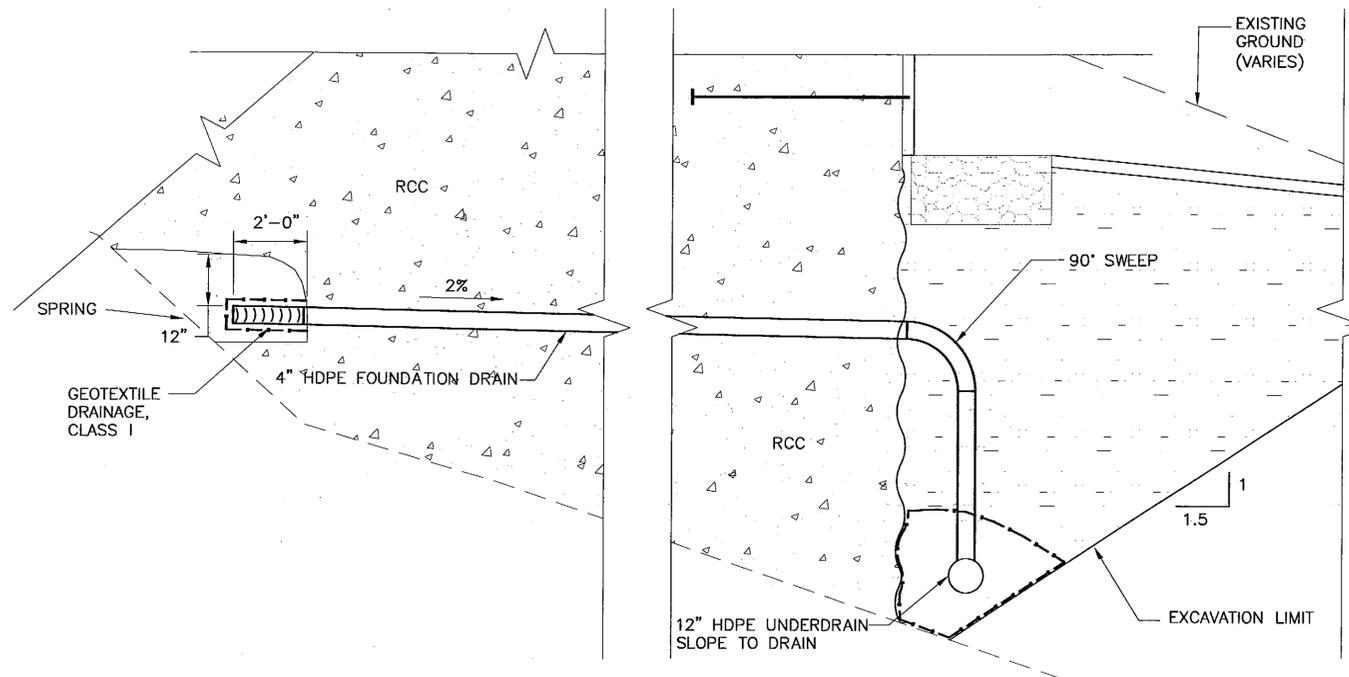

Foundation Drain Detail

NOTES:

1. CONSTRUCT UNDERDRAIN WITH A MINIMUM 1% SLOPE. PIPE PROFILE MAY REQUIRE ROCK EXCAVATION AND/OR BE BUILT UP WITH RCC TO BE BROUGHT TO GRADE.
2. FOR CLEANOUT DETAILS, SEE SHEET N16.

PATH:
Q:\Ktn\71811A\Planset\N_Underdrain Details.dwg
Tue, 07/May/02 09:15AM Michael Limbaugh
PLDT:
PSPACE 1=1(F) OR MSPACE 1=1(F)
TAB: N17

ADDENDUM NUMBER		
ATTACHMENT NUMBER		
RECORD OF REVISIONS		
No.	DATE	DESCRIPTION

KTN-THIRD AVENUE EXTENSION
 PROJECT NO. 68490
RCC Wall Underdrain Details

DESIGNED BY: C. HOWARD



CHECKED BY: T. MOORE

DRAWN BY: M. LIMBAUGH

STATE OF ALASKA
DEPARTMENT OF TRANSPORTATION
& PUBLIC FACILITIES
STATEWIDE DESIGN & ENGINEERING
SERVICES DIVISION

THIRD AVENUE EXTENSION
PROJECT NO. 68490

RCC Wall Underdrain Details


PROJECT DESIGNATION NUMBER

STP-MG-0904(2)


STATE	YEAR
ALASKA	2002

SHEET NUMBER	TOTAL SHEETS
N17	146

Project As Built Drawings have been reviewed by the Project Engineer. To the best of his/her knowledge, they represent the project as constructed.
Proj. Eng. *KS* Date 03/06

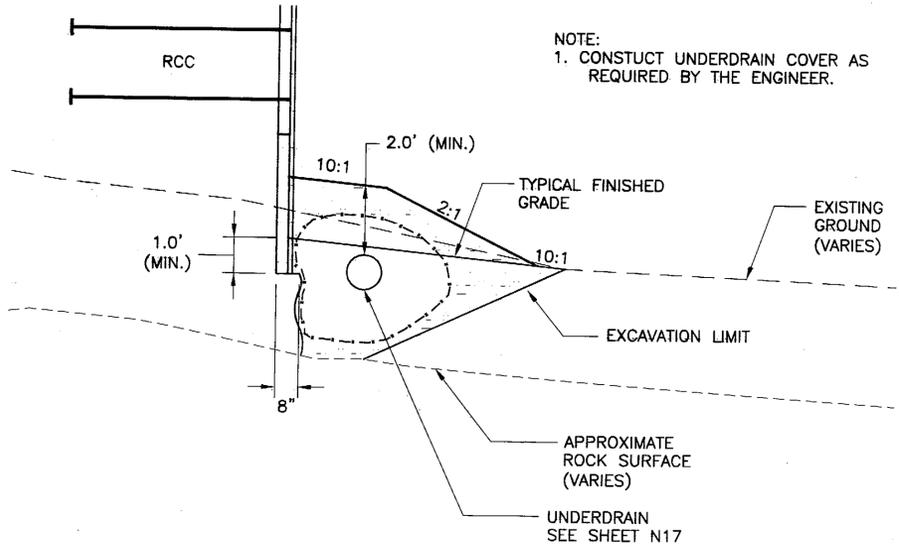

Underdrain Cover Detail

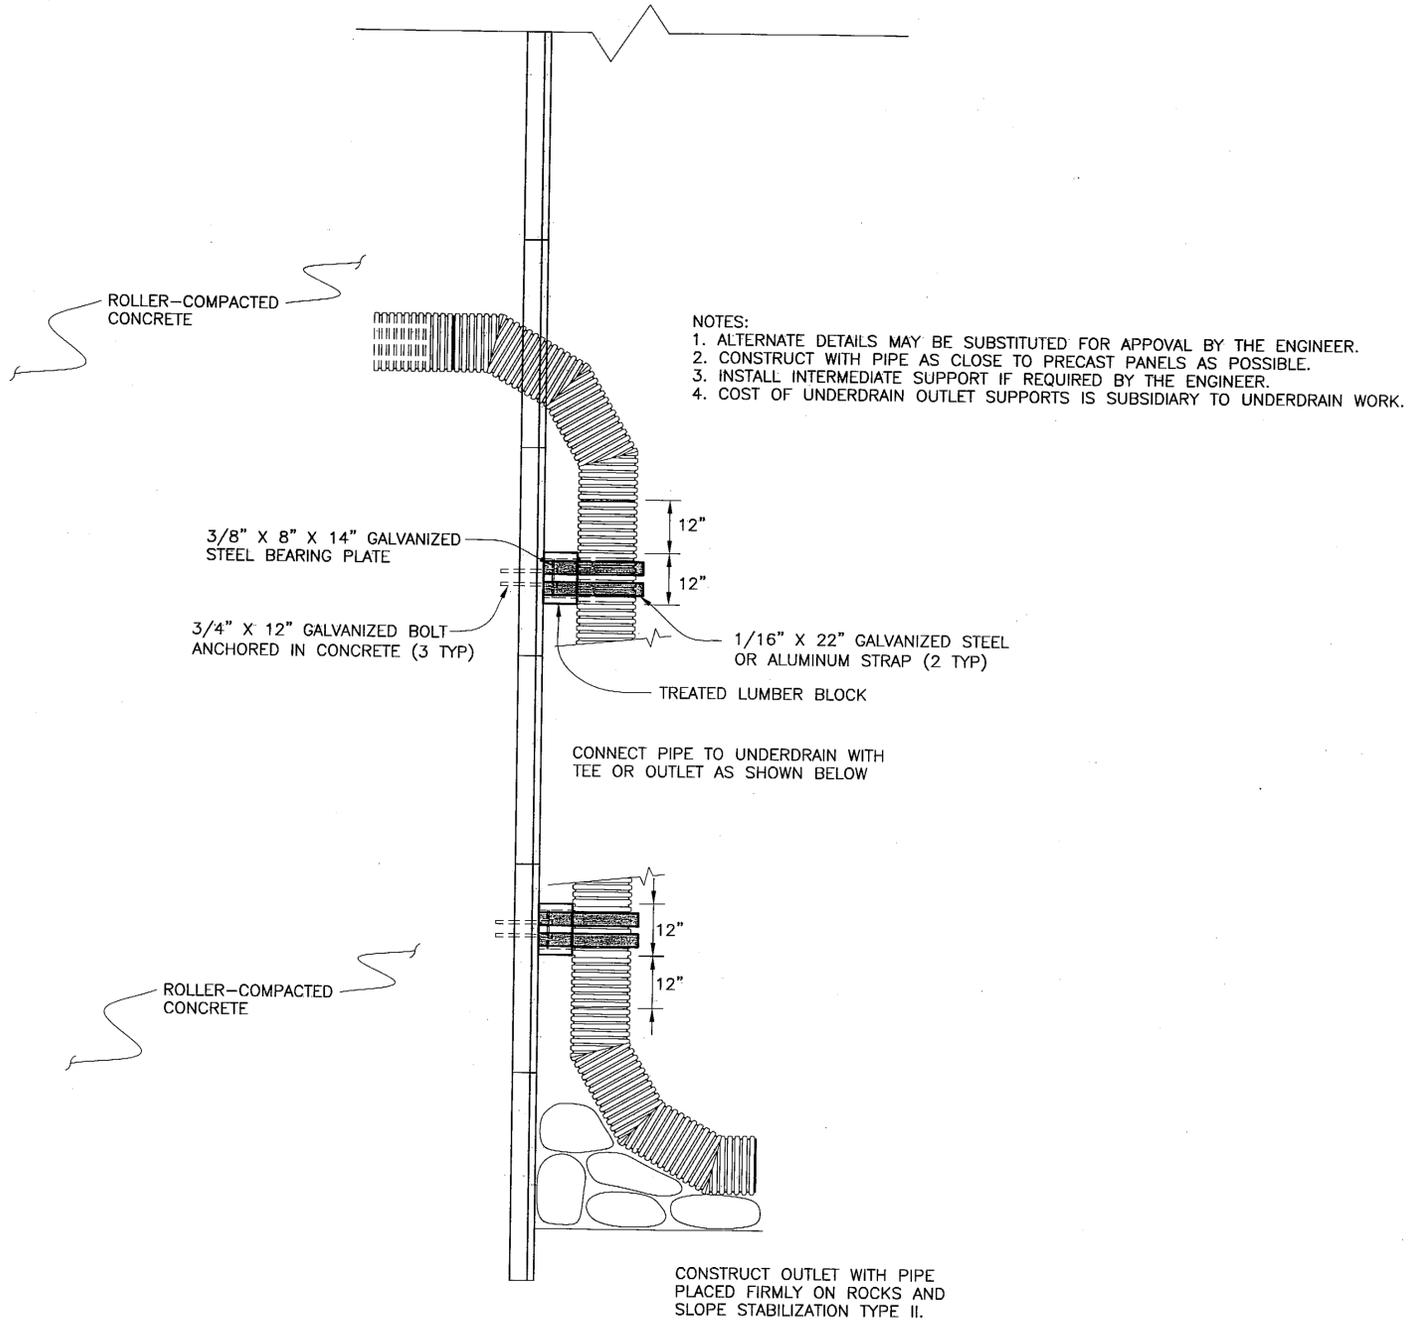

Underdrain Outlet Support Detail

PATH: Q:\Ktn\71811A\Planset\N_Underdrain_Details.dwg
 Tue, 07/May/02 09:15AM Michael Limbaugh
 PLOT: PSPACE 1=1(F) OR MSPACE 1=1(F)
 TAB: N18

ADDENDUM NUMBER		
ATTACHMENT NUMBER		
RECORD OF REVISIONS		
No.	DATE	DESCRIPTION

KTN-THIRD AVENUE EXTENSION
 PROJECT NO. 68490

Underdrain Details

DESIGNED BY: C. HOWARD




CHECKED BY: T. MOORE
 DRAWN BY: M. LIMBAUGH

STATE OF ALASKA
 DEPARTMENT OF TRANSPORTATION
 & PUBLIC FACILITIES
 STATEWIDE DESIGN & ENGINEERING
 SERVICES DIVISION
 THIRD AVENUE EXTENSION
 PROJECT NO. 68490

**Underdrain
 Details**

PROJECT DESIGNATION NUMBER	
STP-MG-0904(2)	
STATE	YEAR
ALASKA	2002
SHEET NUMBER	TOTAL SHEETS
N18	146


Project As Built Drawings have been reviewed by the Project Engineer. To the best of his/her knowledge, they represent the project as constructed.
 Proj. Eng. *[Signature]* Date 10/31/06

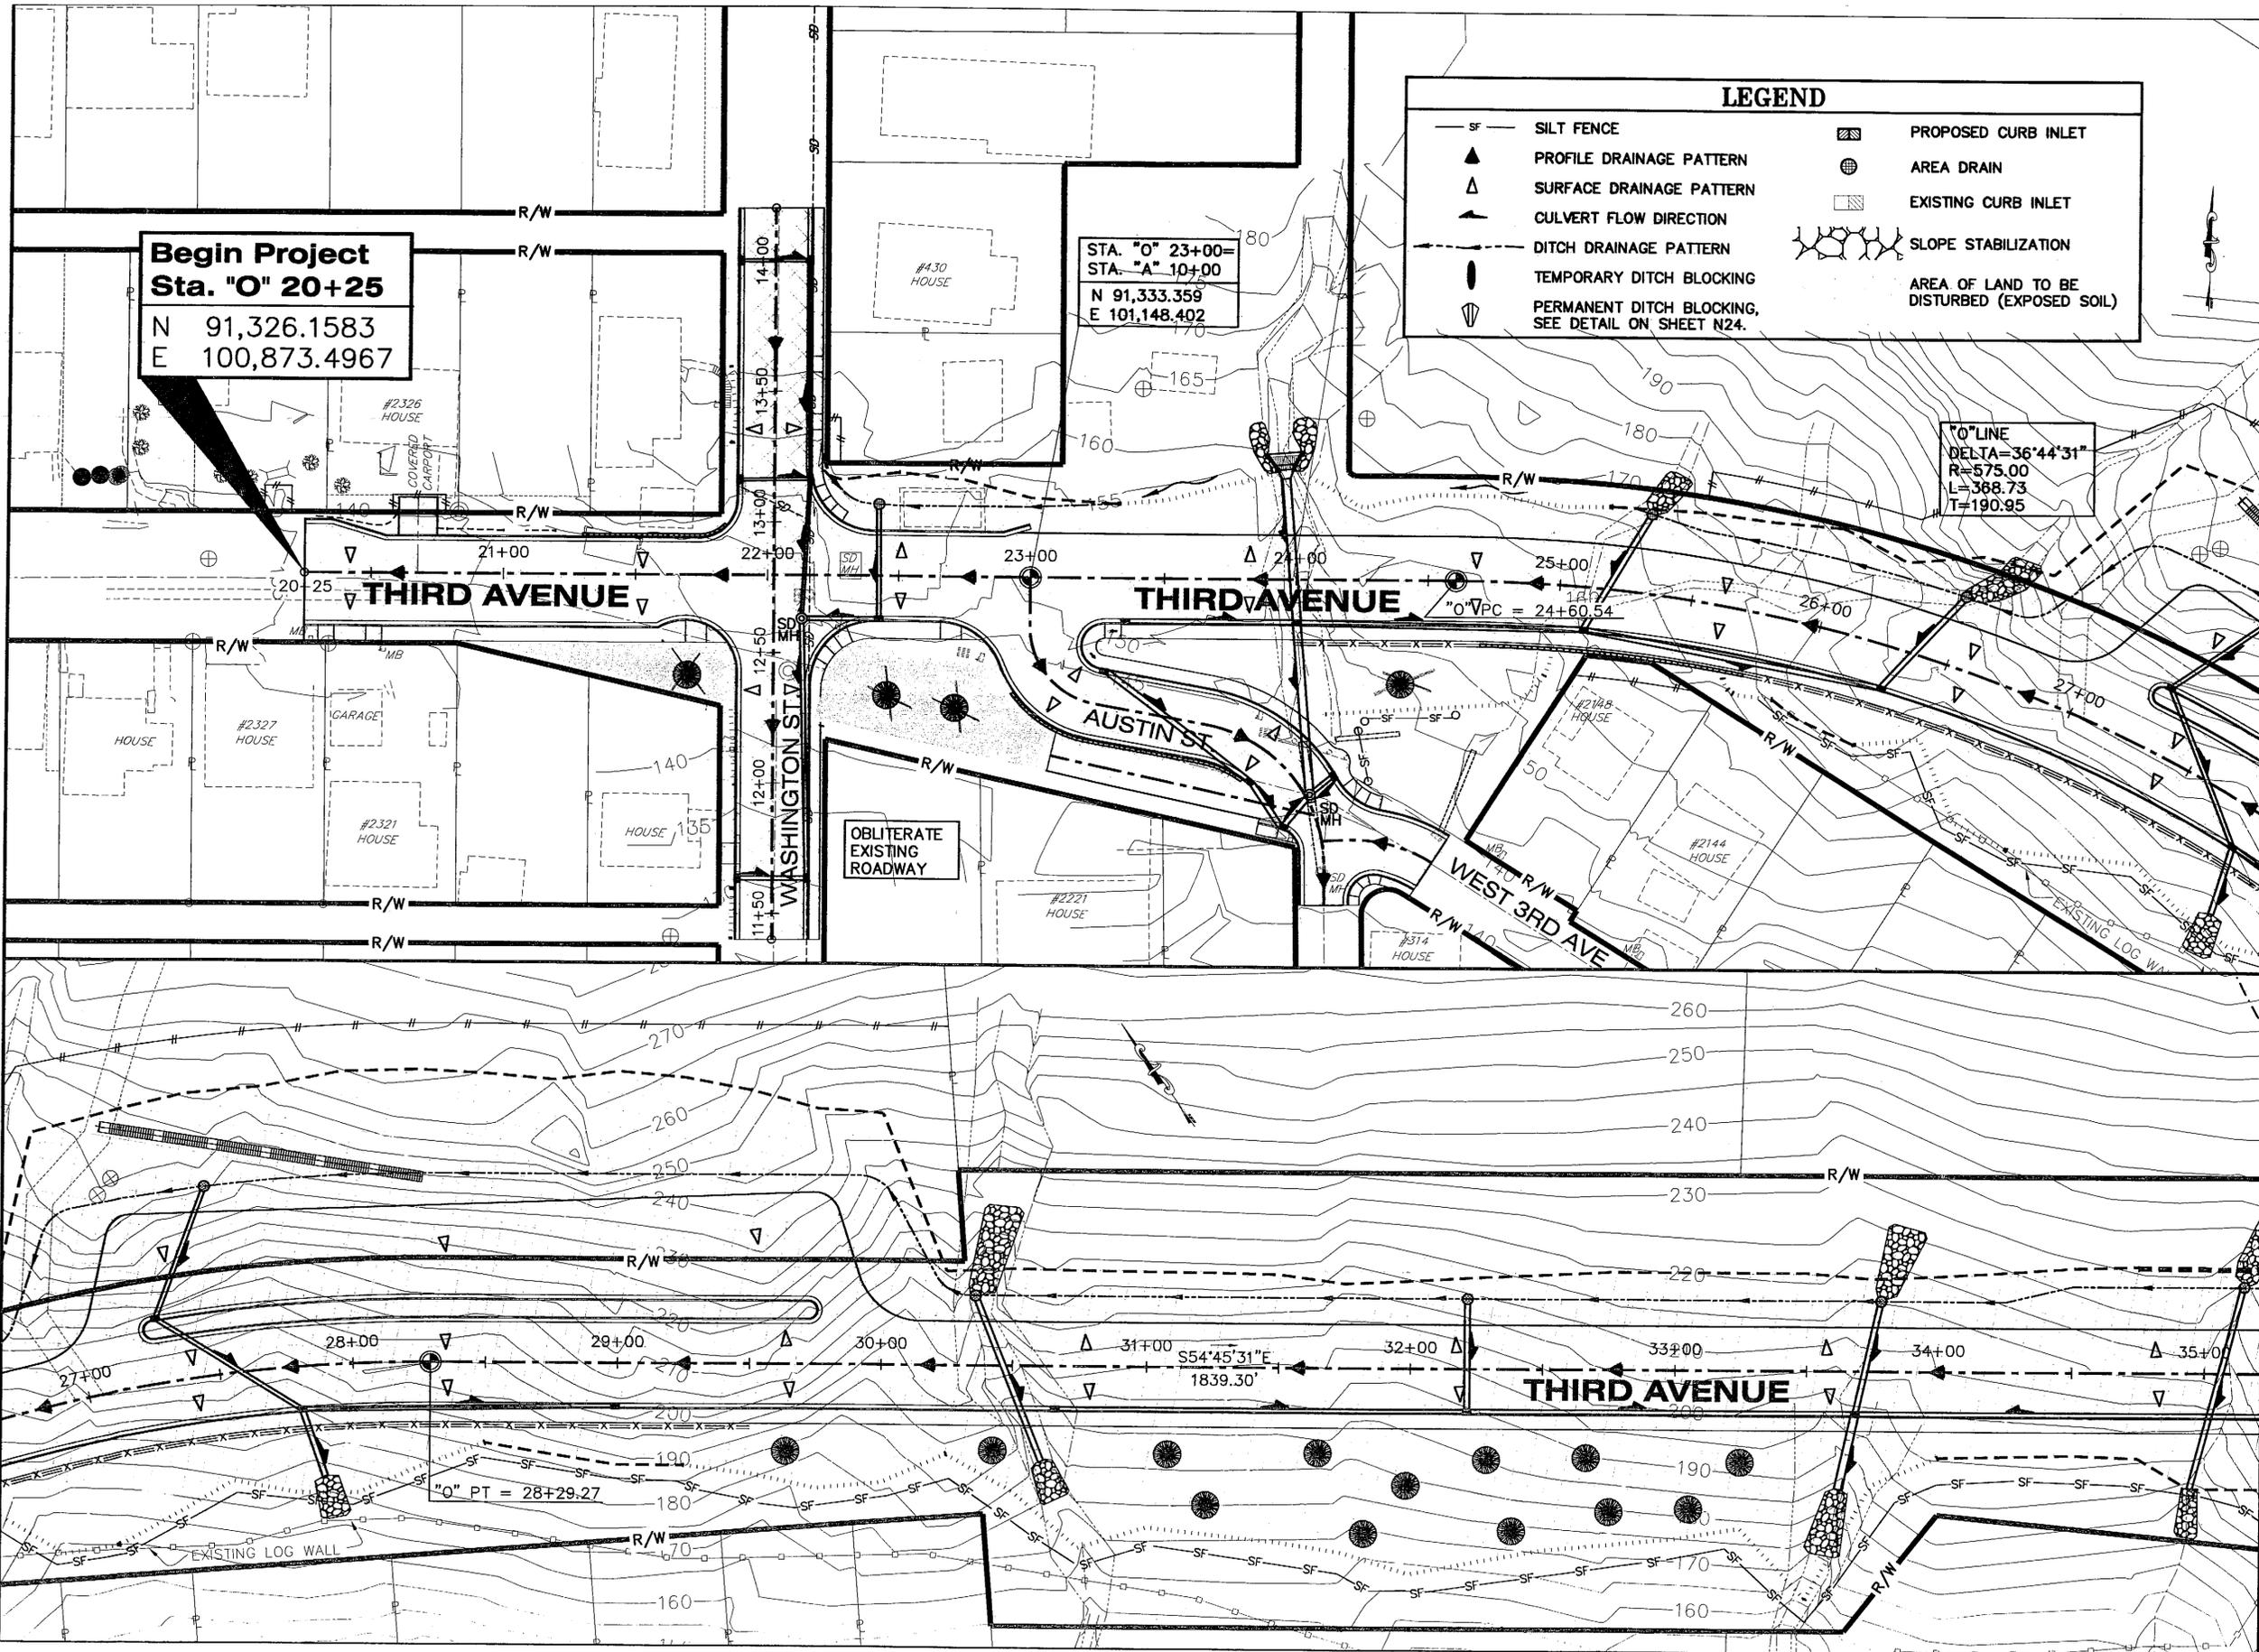

PATH: Q:\Ktn\71811A\Plan\N_ESCP.dwg
 Tue, 07/May/02 09:13AM Michael Limbaugh
 PLOT: PSPACE 1=1(F) OR MSPACE 1=1(F)
 TAB: N19

ADDENDUM NUMBER		
ATTACHMENT NUMBER		
RECORD OF REVISIONS		
No.	DATE	DESCRIPTION

KTN-THIRD AVENUE EXTENSION
PROJECT NO. 68490
Erosion & Sediment Control Plan

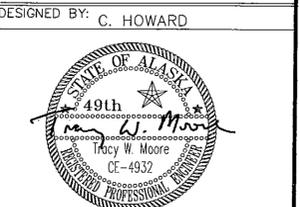


DESIGNED BY: C. HOWARD
 CHECKED BY: T. MOORE
 DRAWN BY: K.K.

STATE OF ALASKA
 DEPARTMENT OF TRANSPORTATION & PUBLIC FACILITIES
 STATEWIDE DESIGN & ENGINEERING SERVICES DIVISION
THIRD AVENUE EXTENSION
PROJECT NO. 68490

Erosion & Sediment Control Plan

PROJECT DESIGNATION NUMBER	
STP-MG-0904(2)	
STATE	YEAR
ALASKA	2002
SHEET NUMBER	TOTAL SHEETS
N19	146

Project As Built Drawings have been reviewed by the Project Engineer. To the best of his/her knowledge, they represent the project as constructed.
 Proj. Eng. *[Signature]* Date 10/31/06

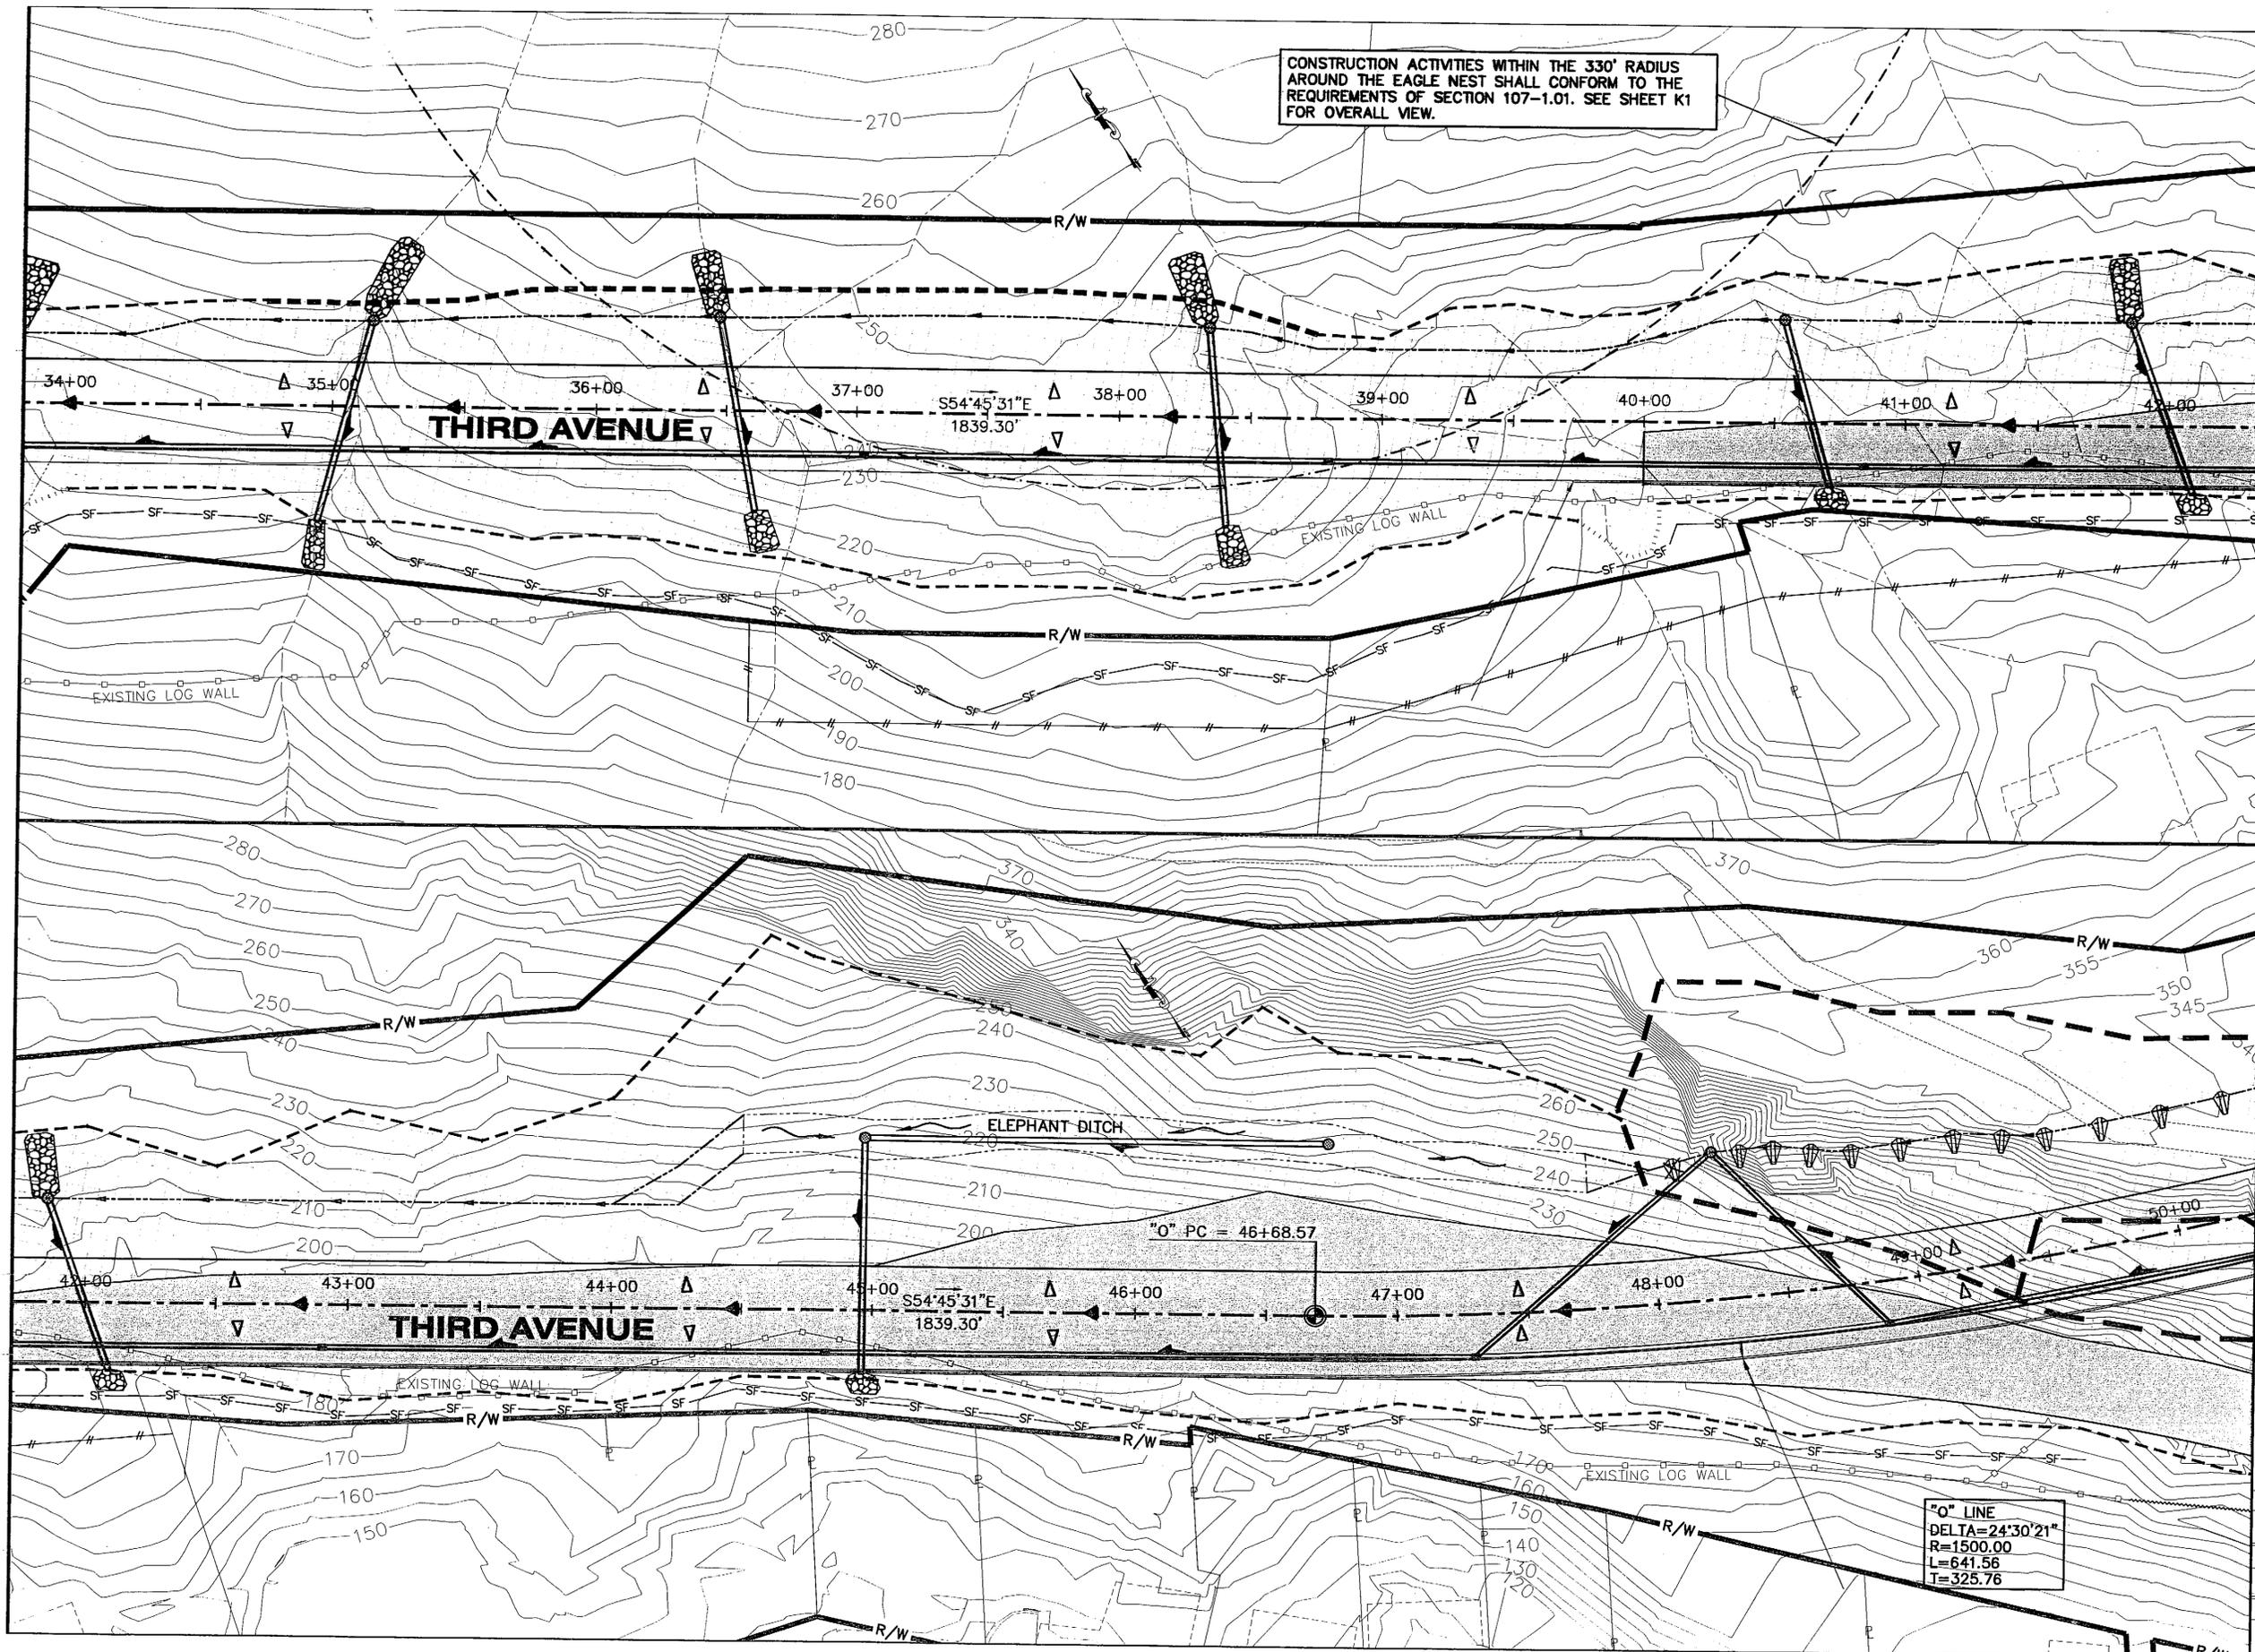

CONSTRUCTION ACTIVITIES WITHIN THE 330' RADIUS AROUND THE EAGLE NEST SHALL CONFORM TO THE REQUIREMENTS OF SECTION 107-1.01. SEE SHEET K1 FOR OVERALL VIEW.

PATH: C:\Ktr\71811A\PlanSet\N_ESCP.dwg
 Tue, 07/May/02 09:13AM Michael Limbaugh
 PLOT: PSPACE 1=1(F) OR MSPACE 1=1(F)
 TAB: N20

ADDENDUM NUMBER		
ATTACHMENT NUMBER		
RECORD OF REVISIONS		
No.	DATE	DESCRIPTION

KTN-THIRD AVENUE EXTENSION
 PROJECT NO. 68490
Erosion & Sediment Control Plan

DESIGNED BY: C. HOWARD




CHECKED BY: T. MOORE
 DRAWN BY: K.K.

STATE OF ALASKA
 DEPARTMENT OF TRANSPORTATION & PUBLIC FACILITIES
 STATEWIDE DESIGN & ENGINEERING SERVICES DIVISION
 THIRD AVENUE EXTENSION
 PROJECT NO. 68490

Erosion & Sediment Control Plan

PROJECT DESIGNATION NUMBER	
STP-MG-0904(2)	
STATE	YEAR
ALASKA	2002
SHEET NUMBER	TOTAL SHEETS
N20	146

Project As Built Drawings have been reviewed by the Project Engineer. To the best of his/her knowledge, they represent the project as constructed.
 Proj. Eng. [Signature] Date 10/1/06

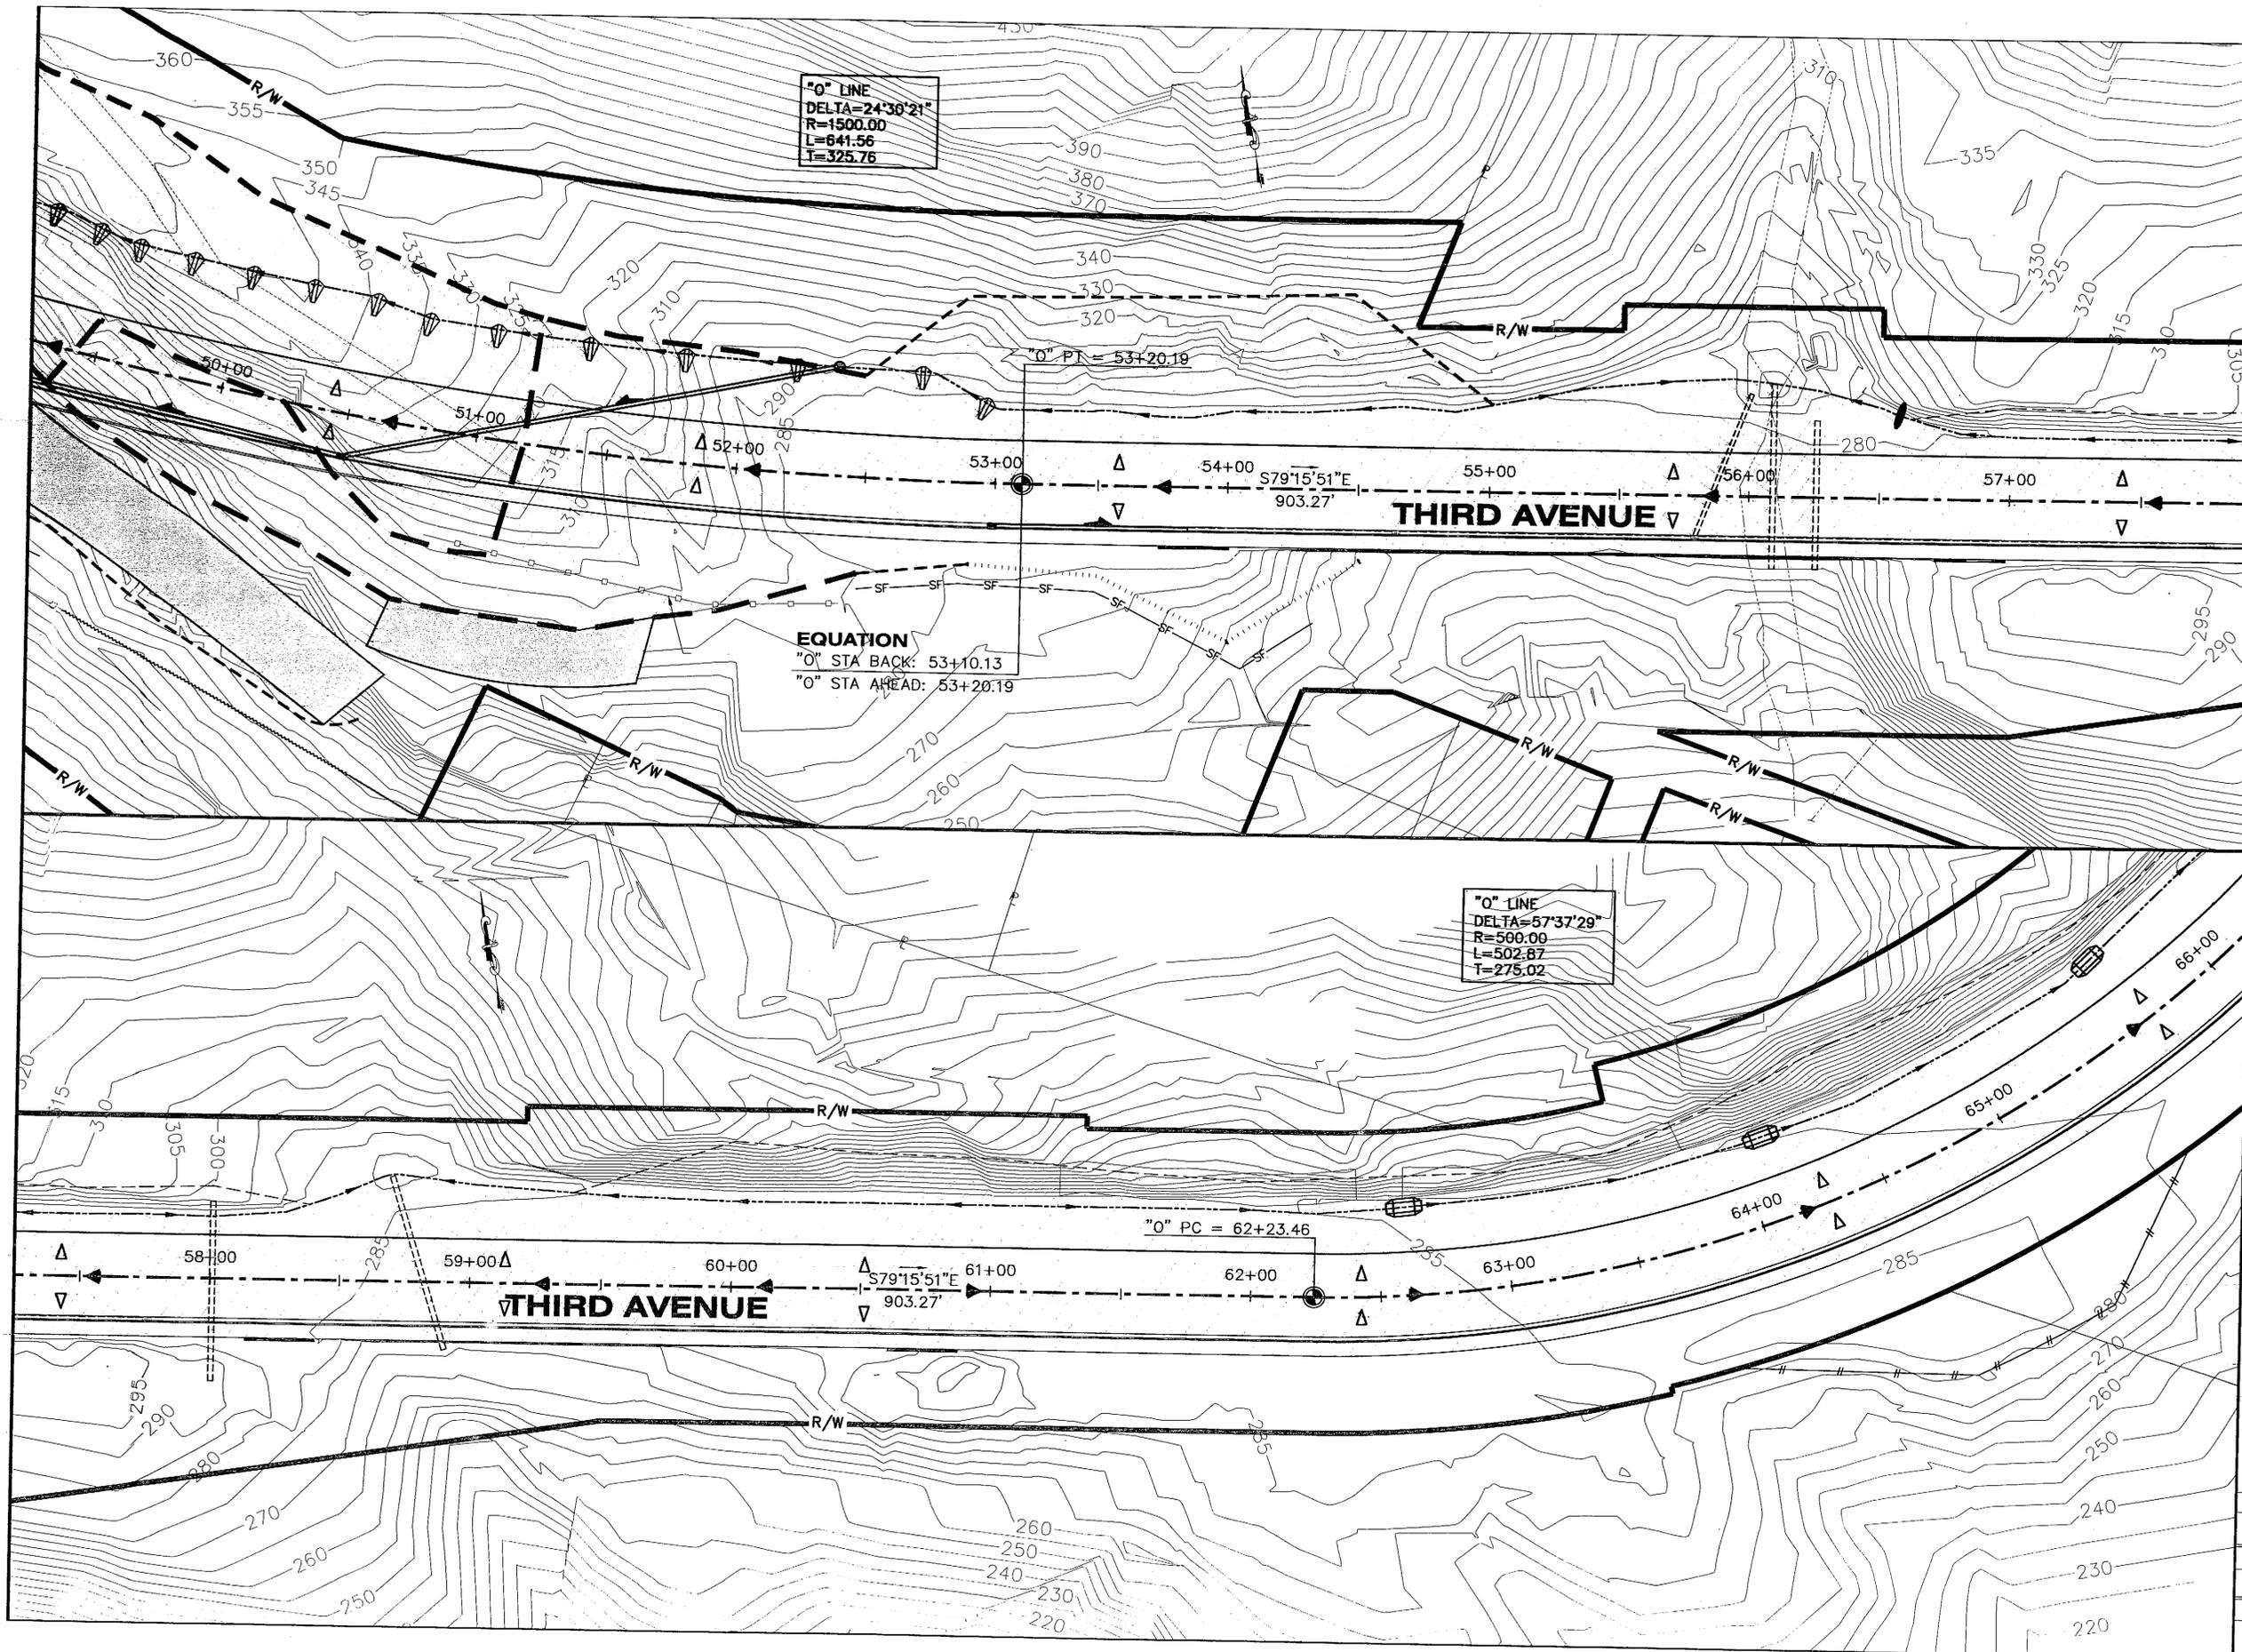

"O" LINE
 DELTA=24°30'21"
 R=1500.00
 L=641.56
 T=325.76

EQUATION
 "O" STA BACK: 53+10.13
 "O" STA AHEAD: 53+20.19

"O" LINE
 DELTA=57°37'29"
 R=500.00
 L=502.87
 T=275.02

PATH:
 Q:\Ktn\71811A\PlanSet\N_ESCP.dwg
 Tue, 07/May/02 09:13AM Michael Limbaugh
 PLOT:
 MSPACE 1=1(F) OR MSPACE 1=1(F)
 TAB: N21

ADDENDUM NUMBER		
ATTACHMENT NUMBER		
RECORD OF REVISIONS		
No.	DATE	DESCRIPTION

KTN-THIRD AVENUE EXTENSION
 PROJECT NO. 68490
**Erosion & Sediment
 Control Plan**

DESIGNED BY: C. HOWARD




CHECKED BY: T. MOORE
 DRAWN BY: K.K.

STATE OF ALASKA
 DEPARTMENT OF TRANSPORTATION
 & PUBLIC FACILITIES
 STATEWIDE DESIGN & ENGINEERING
 SERVICES DIVISION
 THIRD AVENUE EXTENSION
 PROJECT NO. 68490

**Erosion &
 Sediment Control
 Plan**

PROJECT DESIGNATION NUMBER	
STP-MG-0904(2)	
STATE	YEAR
ALASKA	2002
SHEET NUMBER	TOTAL SHEETS
N21	146

Project As Built Drawings have been reviewed by the Project Engineer. To the best of his/her knowledge, they represent the project as constructed.
 Proj. Eng. Date 10/31/06

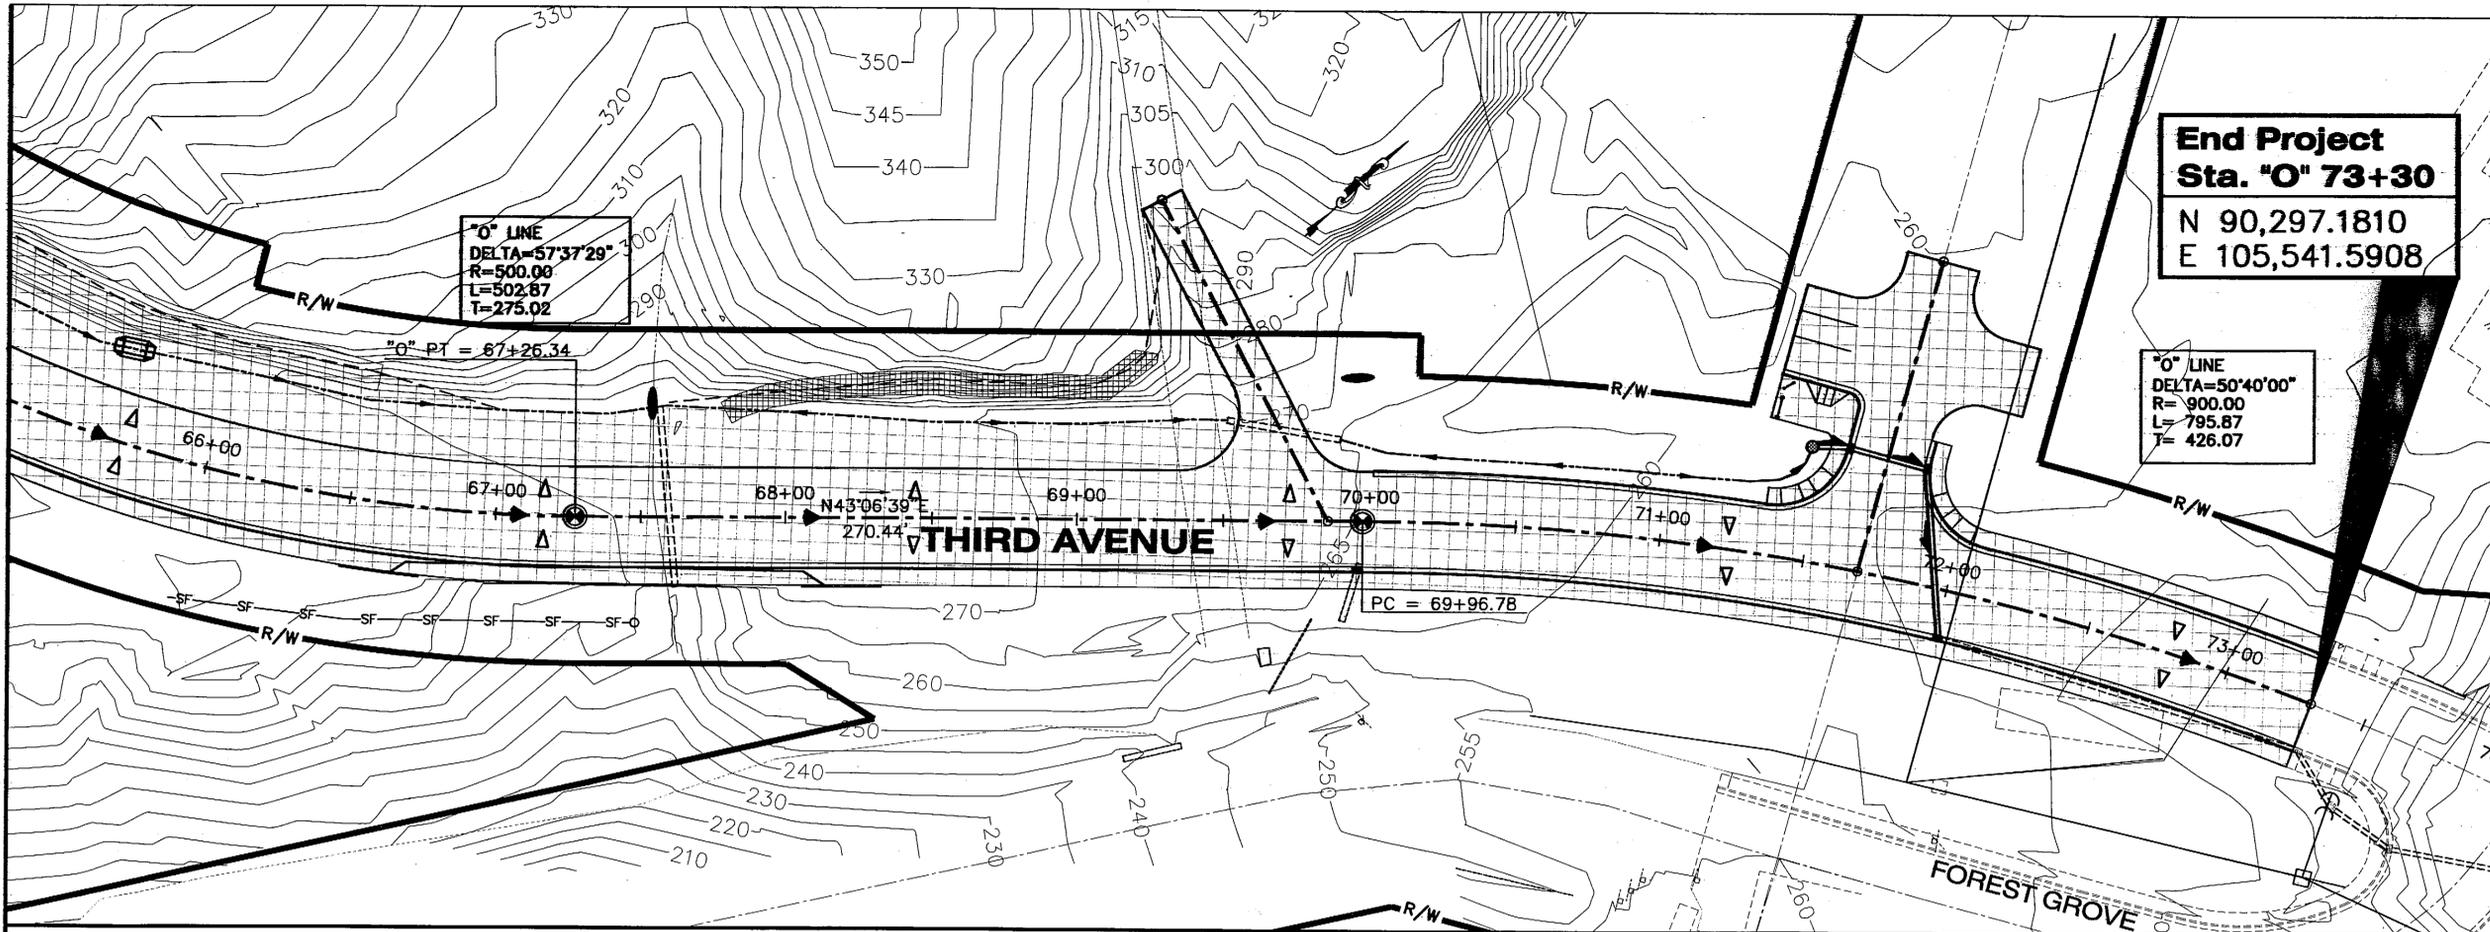

PATH:
 G:\Ktn\71811A\Planset\N_ESCP.dwg
 Tue, 07/May/02 09:14AM Michael Limbaugh
 PLOT:
 PSPACE 1=1(F) OR MSPACE 1=1(F)
 TAB: N22

ADDENDUM NUMBER		
ATTACHMENT NUMBER		
RECORD OF REVISIONS		
No.	DATE	DESCRIPTION

KTN-THIRD AVENUE EXTENSION
 PROJECT NO. 68490

**Erosion & Sediment
 Control Plan**

DESIGNED BY: C. HOWARD



CHECKED BY: T. MOORE

DRAWN BY: K.K.

STATE OF ALASKA
 DEPARTMENT OF TRANSPORTATION
 & PUBLIC FACILITIES
 STATEWIDE DESIGN & ENGINEERING
 SERVICES DIVISION

THIRD AVENUE EXTENSION
 PROJECT NO. 68490

**Erosion &
 Sediment Control
 Plan**

PROJECT DESIGNATION NUMBER


STP-MG-0904(2)

STATE	YEAR
ALASKA	2002

SHEET NUMBER	TOTAL SHEETS
N22	146


Project As Built Drawings have been reviewed by the Project Engineer. To the best of his/her knowledge, they represent the project as constructed.

Proj. Eng. *KS* Date 10/26/06

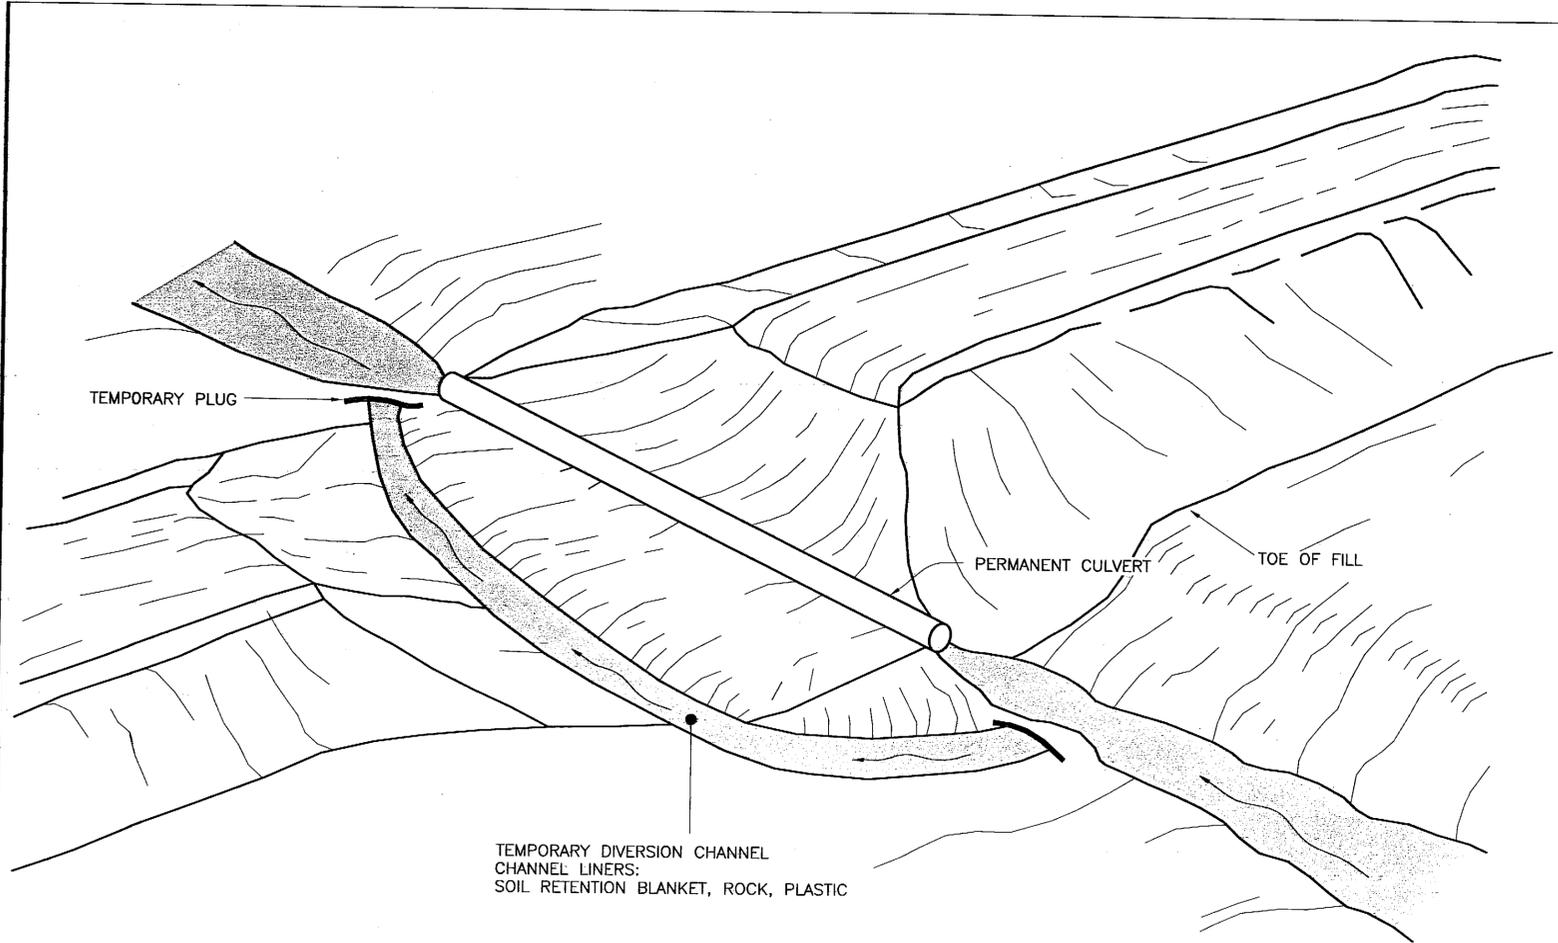


**TEMPORARY DIVERSION
ISOMETRIC VIEW**

LINING EDGES TO BE BURIED BY
EARTH MOUND OR TRENCHED-IN.

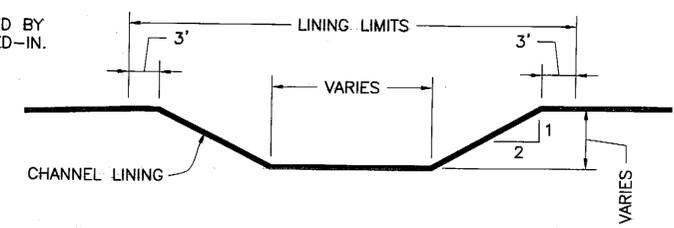

SECTION A-A

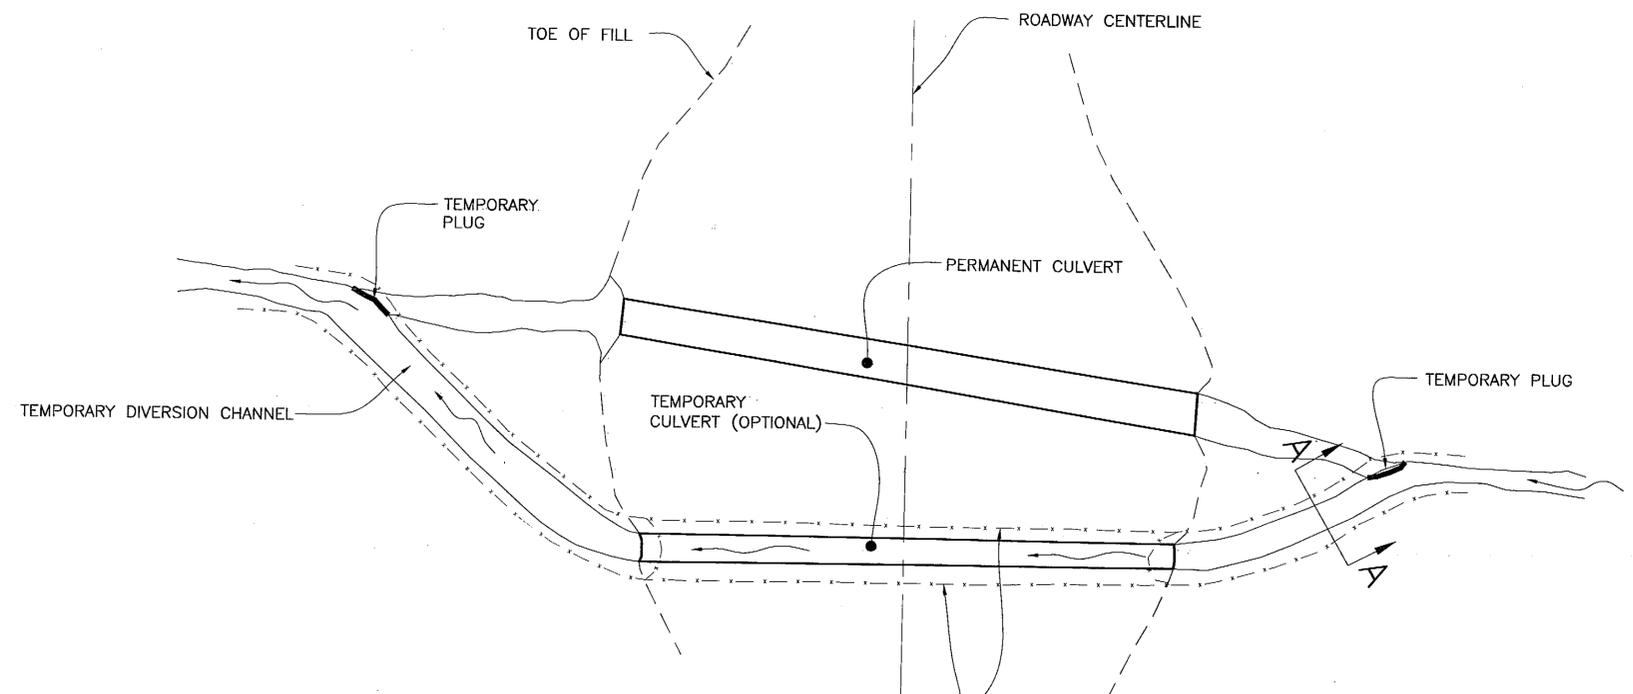

SILT FENCE REQUIRED
ALONG ENTIRE LENGTH OF
CHANNEL IF TEMPORARY
CULVERT IS NOT USED AND
AROUND INLET AND OUTLET
IF TEMPORARY CULVERT IS USED.

DIVERSION FOR CULVERT INSTALLATION


PATH:
Q:\Ktn\71611A\Planet\N_ESCP.dwg
Tue, 07/May/02 09:14AM Michael Limbaugh
PLOT:
PSPACE 1=1(F) OR MSPACE 1=1(F)
TAB: CULVERT DIVERSION_23

ADDENDUM NUMBER		
ATTACHMENT NUMBER		
RECORD OF REVISIONS		
No.	DATE	DESCRIPTION

**KTN-THIRD AVENUE EXTENSION
PROJECT NO. 68490**

**Culvert or Ditch Installation
By-Pass**

DESIGNED BY: C. HOWARD

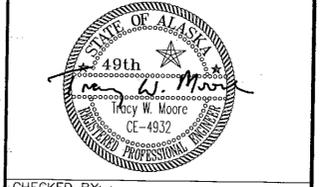

CHECKED BY: T. MOORE
DRAWN BY: K.K.

STATE OF ALASKA
DEPARTMENT OF TRANSPORTATION
& PUBLIC FACILITIES
STATEWIDE DESIGN & ENGINEERING
SERVICES DIVISION
**THIRD AVENUE EXTENSION
PROJECT NO. 68490**
**Culvert or Ditch
Installation
By-Pass**

PROJECT DESIGNATION NUMBER

STP-MG-0904(2)


STATE	YEAR
ALASKA	2002

SHEET NUMBER	TOTAL SHEETS
N23	146


Project As Built Drawings have been reviewed by the Project Engineer. To the best of his/her knowledge, they represent the project as constructed.

Proj. Eng. *KS* Date 10/31/06


DITCH BLOCK

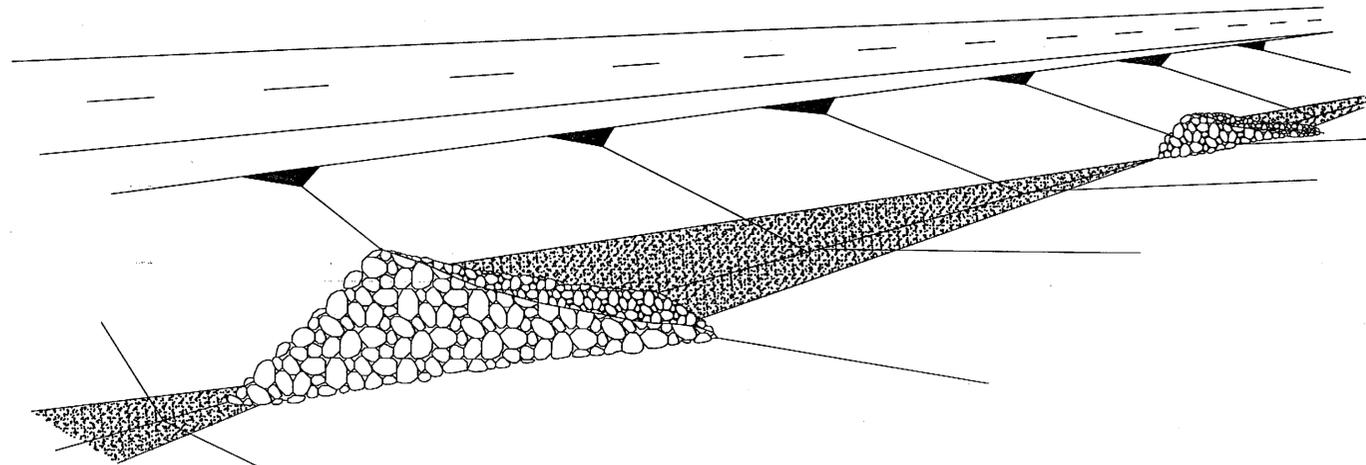

DEFINITION: A SMALL TEMPORARY DAM CONSTRUCTED IN A SWALE OR CHANNEL.

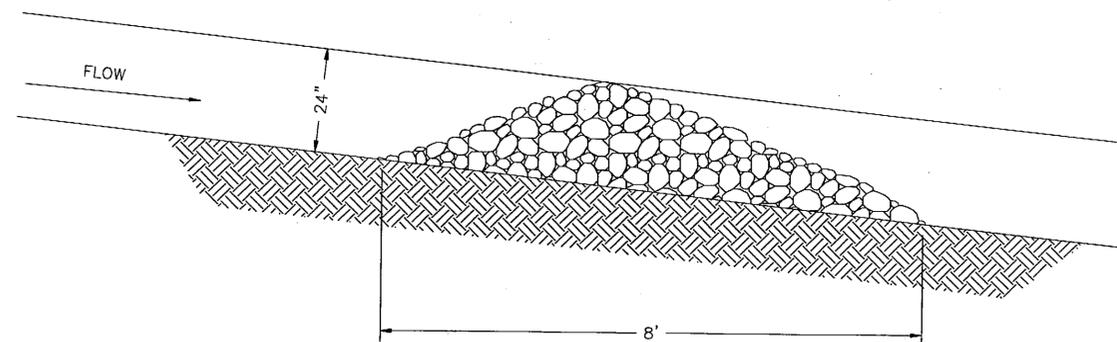


SECTION A-A

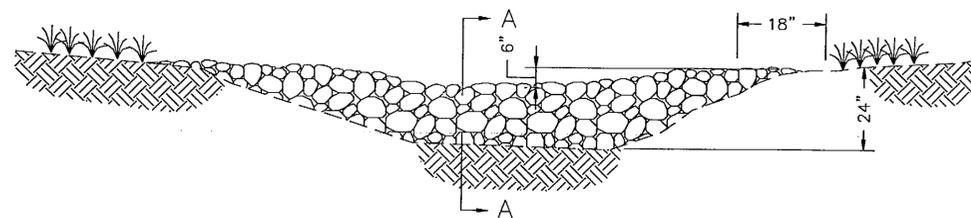

VIEW LOOKING UPSTREAM

NOTE:
KEY STONE INTO THE DITCH BANKS
AND EXTEND IT BEYOND THE ABUTMENTS
A MINIMUM OF 18" TO PREVENT OVER
FLOW AROUND DAM.

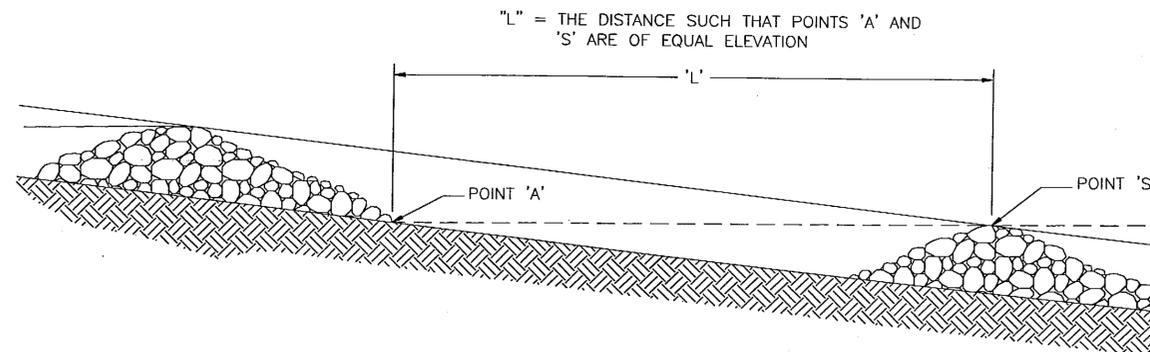

SPACING BETWEEN DITCH BLOCKING

PATH:
Q:\Ktn\71811A\Planset\N_ESCP.dwg
Mon, 06/May/02 11:03AM Michael Limbaugh
PLOT:
PSPACE 1=1(F) OR MSPACE 1=1(F)
TAB: DITCH CHECKS_24

ADDENDUM NUMBER		
ATTACHMENT NUMBER		
RECORD OF REVISIONS		
No.	DATE	DESCRIPTION

KTN-THIRD AVENUE EXTENSION
PROJECT NO. 68490
Ditch Block
Installation Details

DESIGNED BY: C. HOWARD



CHECKED BY: T. MOORE

DRAWN BY: K.K.

STATE OF ALASKA
DEPARTMENT OF TRANSPORTATION
& PUBLIC FACILITIES
STATEWIDE DESIGN & ENGINEERING
SERVICES DIVISION

THIRD AVENUE EXTENSION
PROJECT NO. 68490

Ditch Block
Installation Details

PROJECT DESIGNATION NUMBER


STP-MG-0904(2)

STATE	YEAR
ALASKA	2002

SHEET NUMBER	TOTAL SHEETS
N24	146

Project As Built Drawings have been reviewed by the Project Engineer. To the best of his/her knowledge, they represent the project as constructed.


Proj. Eng. *KS* Date 10-31-02

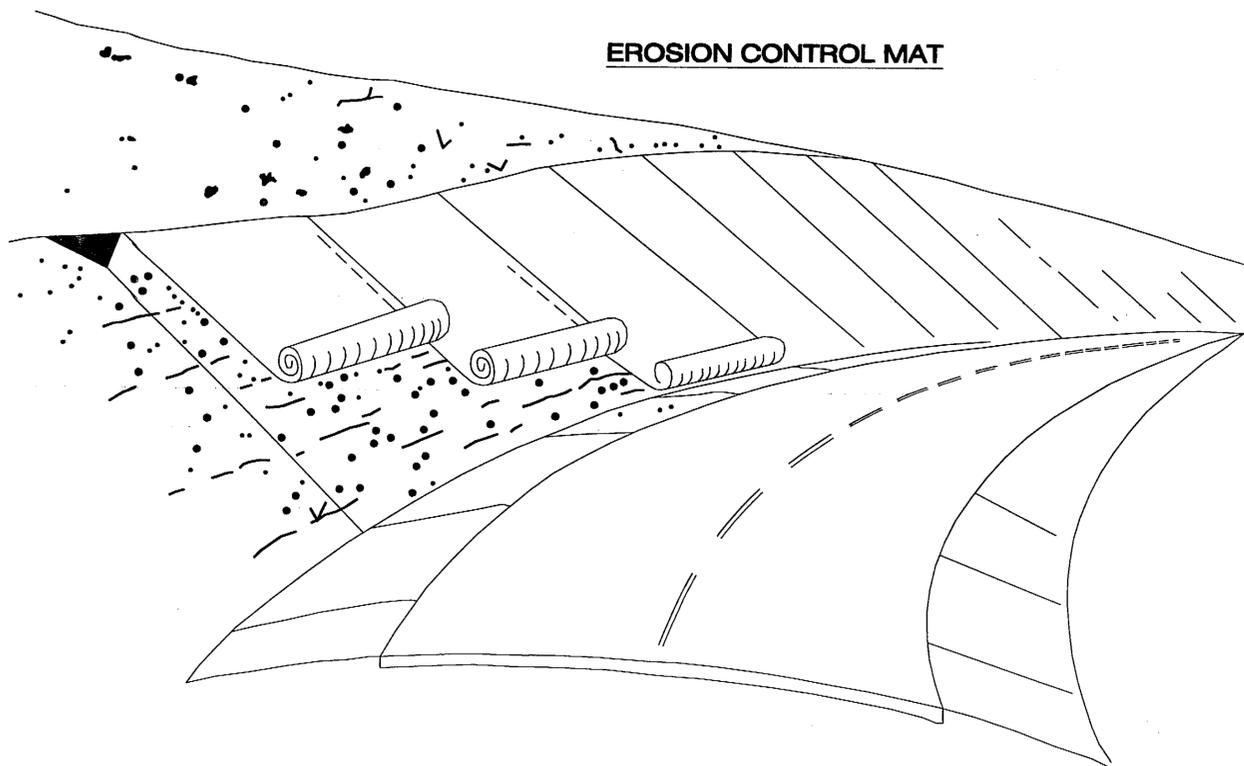


EROSION CONTROL MAT

DEFINITION


A NATURAL OR SYNTHETIC MAT INSTALLED ON STEEP SLOPES AND/OR PREPARED VEGETATIVE SEED BEDS TO REDUCE SOIL SURFACE EROSION

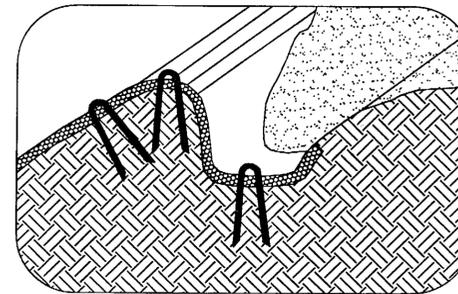


LONGITUDINAL ANCHOR TRENCH

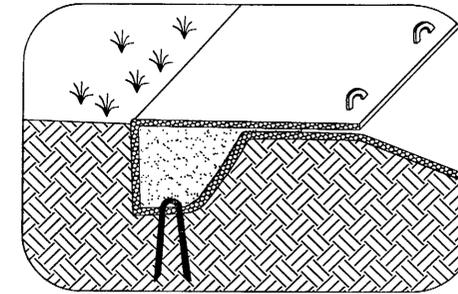

TERMINAL SLOPE AND CHANNEL ANCHOR TRENCH

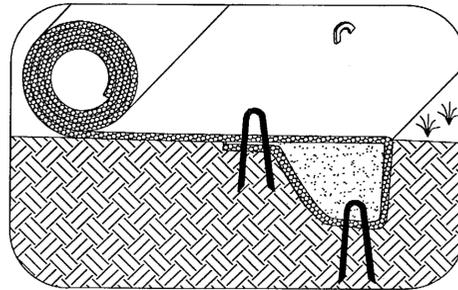

INITIAL CHANNEL ANCHOR TRENCH

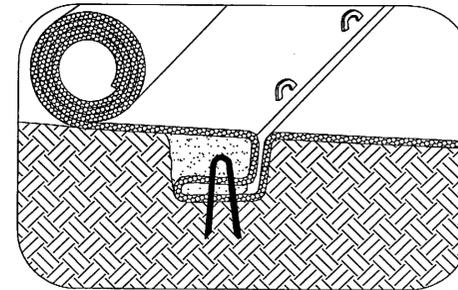


INTERMITTENT CHECK SLOT

NOTES:

1. CHECK SLOTS TO BE CONSTRUCTED PER MANUFACTURES SPECIFICATIONS.
2. STAKING OR STAPLING LAYOUT PER MANUFACTERES SPECIFICATIONS.

EROSION BLANKETS & TURF REINFORCEMENT MATS CHANNEL INSTALLATIONS

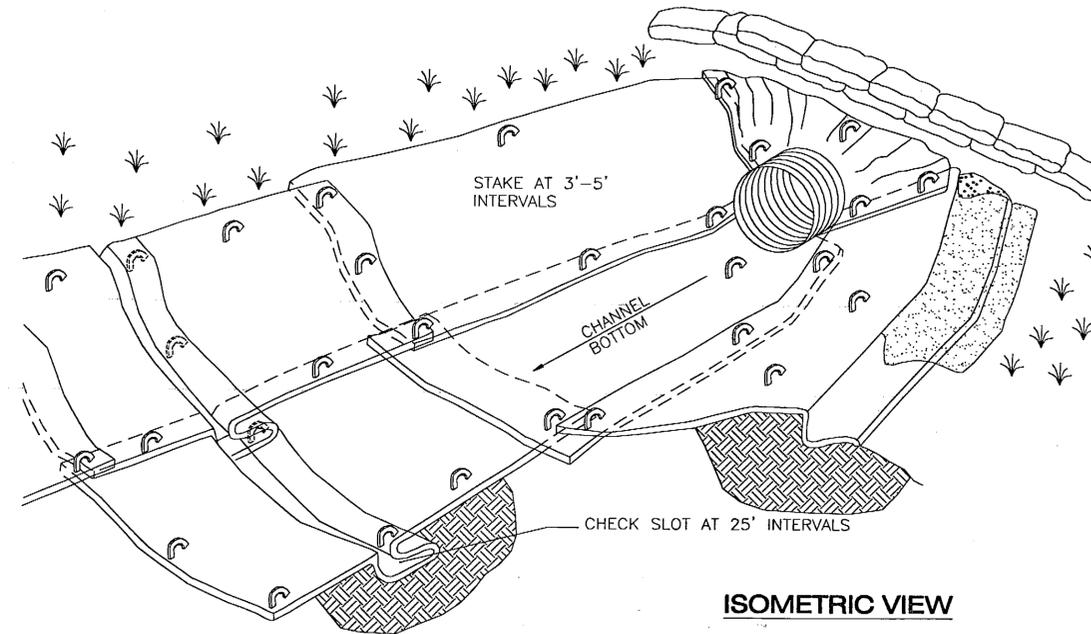

ISOMETRIC VIEW

PATH: Q:\Ktn\71811A\Planset\N_ESCP.dwg
 Mon, 06/May/02 11:04AM Michael Limbaugh
 PLOT: PSPACE 1=1(F) OR MSPACE 1=1(F)
 TAB: SEDIMENT MATS_25

ADDENDUM NUMBER		
ATTACHMENT NUMBER		
RECORD OF REVISIONS		
No.	DATE	DESCRIPTION

KTN-THIRD AVENUE EXTENSION
 PROJECT NO. 68490

**Sediment Mat
 Installation Details**

DESIGNED BY: C. HOWARD



CHECKED BY: T. MOORE

DRAWN BY: K.K.

STATE OF ALASKA
 DEPARTMENT OF TRANSPORTATION
 & PUBLIC FACILITIES
 STATEWIDE DESIGN & ENGINEERING
 SERVICES DIVISION
 THIRD AVENUE EXTENSION
 PROJECT NO. 68490

**Sediment Mat
 Installation Details**

PROJECT DESIGNATION NUMBER
STP-MG-0904(2)

STATE	YEAR
ALASKA	2002
SHEET NUMBER	TOTAL SHEETS
N25	146

Project As Built Drawings have been reviewed by the Project Engineer. To the best of his/her knowledge, they represent the project as constructed.
 Proj. Eng. *KS* Date 10-31-06

The Dewatering Bag is designed to control sediment discharge in dewatering applications where water is being pumped.


Installation

1. Lifting straps, not included, should be placed under the Dewatering Bag to facilitate removal after use.
2. Place the Dewatering Bag on a level stabilized area over dense vegetation/straw, or gravel (if increased drainage surface area is needed) or as detailed in plans.
3. Insert discharge hose from pump into the Dewatering Bag a minimum of six inches (6") and tightly secure with attached strap to prevent water from flowing out of the unit without being filtered.
4. Replace the unit when one half (1/2) full of sediment or when sediment has reduced the flow rate of the pump discharge to an impractical rate.

Maintenance

Remove and dispose of the sediment in a manner satisfactory to the engineer/inspector or in one of the following ways:

1. Remove the unit and sediment from environmentally sensitive area and waterways. At the approved disposal site open or slit the unit, remove sediment and grade smoothly into existing topography. Dispose of the Dewatering Bag, no longer in use, at an appropriate recycling or solid waste facility.
2. Bury unit on site; remove visible fabric and seed.

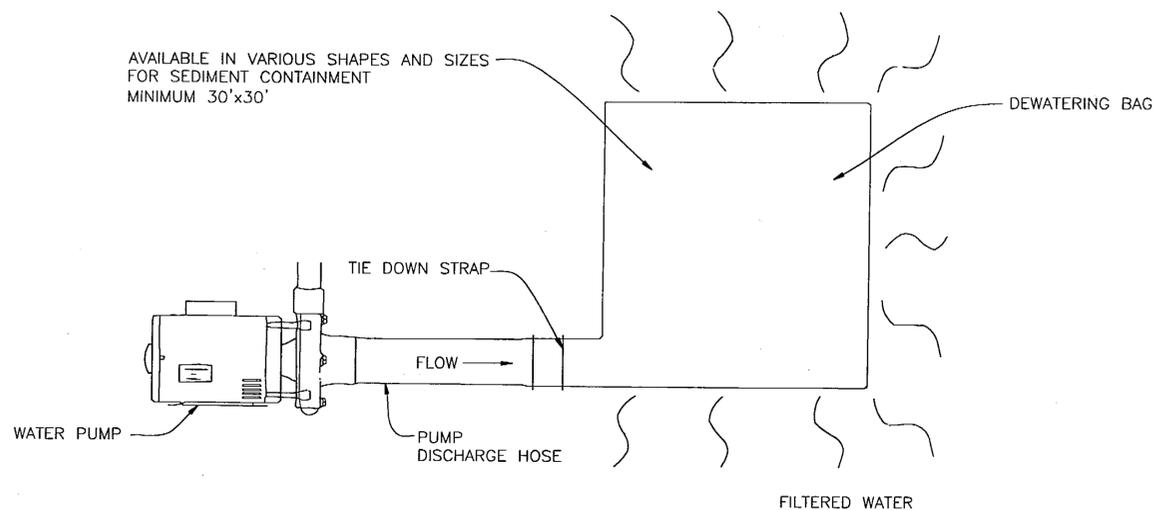

Sediment Filter (Dewatering) Bag Plan Insert

PATH: Q:\Ktn\71811A\Planset\N_ESCP.dwg
 Mon, 06/May/02 11:04AM Michael Limbaugh
 PLOT: PSPACE 1=1(F) OR MSPACE 1=1(F)
 TAB: DIRT BAGS_26

ADDENDUM NUMBER

ATTACHMENT NUMBER

RECORD OF REVISIONS

No.	DATE	DESCRIPTION

KTN-THIRD AVENUE EXTENSION
 PROJECT NO. 68490

Sediment Filter
 Bag Details

DESIGNED BY: C. HOWARD



CHECKED BY: T. MOORE

DRAWN BY: K.K.

STATE OF ALASKA
 DEPARTMENT OF TRANSPORTATION
 & PUBLIC FACILITIES
 STATEWIDE DESIGN & ENGINEERING
 SERVICES DIVISION

THIRD AVENUE EXTENSION
 PROJECT NO. 68490

Sediment Filter
 Bag Details

PROJECT DESIGNATION NUMBER

STP-MG-0904(2)


STATE	YEAR
ALASKA	2002

SHEET NUMBER	TOTAL SHEETS
N26	146

Project As Built Drawings have been reviewed by the Project Engineer. To the best of his/her knowledge, they represent the project as constructed.


Proj. Eng. *[Signature]* Date 5/9/02

ADDENDUM NUMBER		
ATTACHMENT NUMBER		
RECORD OF REVISIONS		
No.	DATE	DESCRIPTION

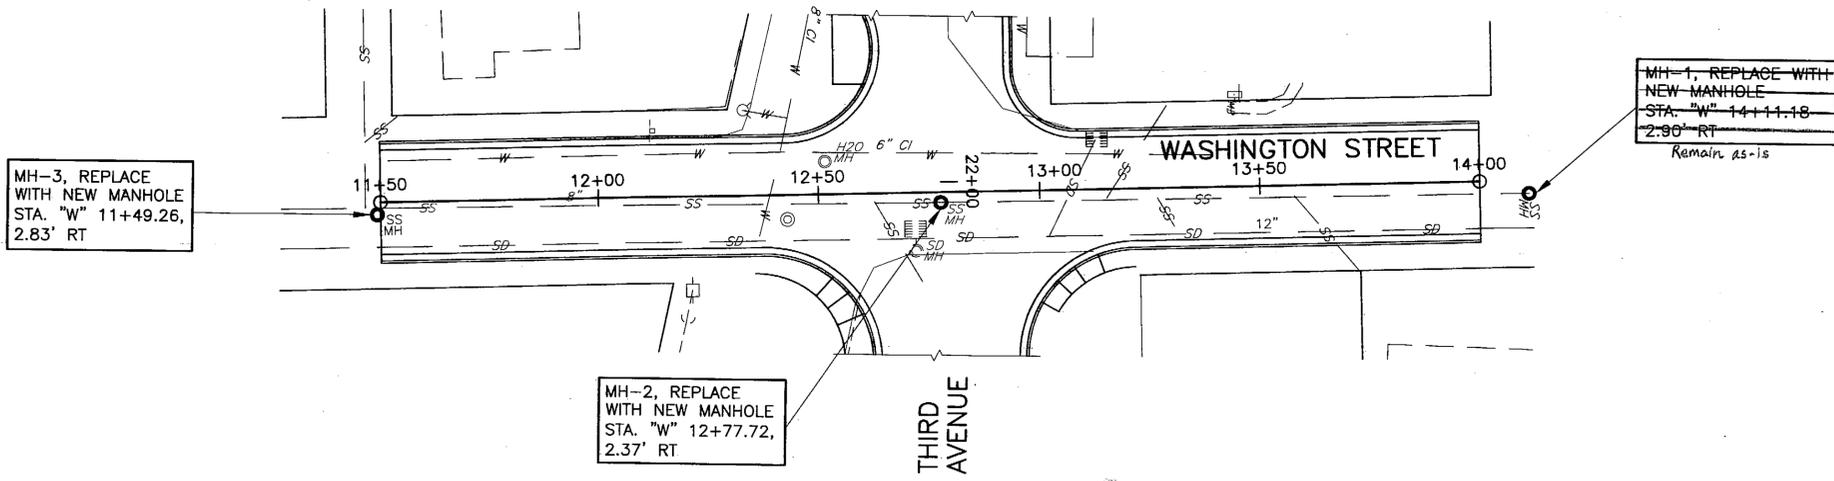

PLAN - SANITARY SEWER RECONSTRUCTION

Notes: CO #1 eliminated this work. Subsequent elevation conflicts with water and storm drain pipes required replacing MH-2 and MH-3, and installing new 8" C-400 PVC sanitary sewer pipe, at elevations that are different from those noted in the profile, below.

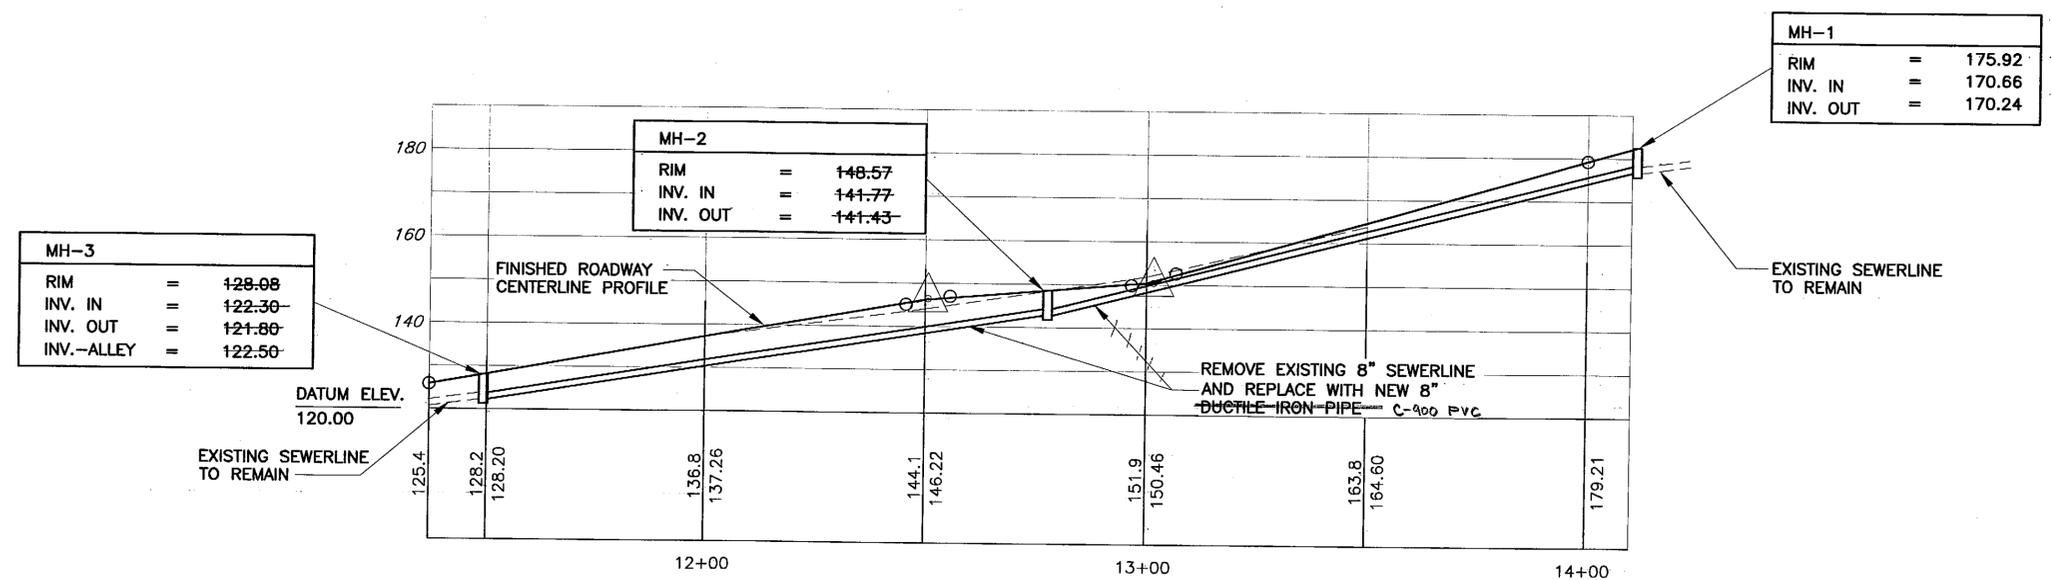

PROFILE - SANITARY SEWER RECONSTRUCTION

KTN-THIRD AVENUE EXTENSION
PROJECT NO. 68490
Sanitary Sewer Reconstruction

DESIGNED BY: C. HOWARD






CHECKED BY: T. MOORE
 DRAWN BY: T.M./R.S.

STATE OF ALASKA
 DEPARTMENT OF TRANSPORTATION
 & PUBLIC FACILITIES
 STATEWIDE DESIGN & ENGINEERING
 SERVICES DIVISION

Sanitary Sewer Reconstruction

PROJECT DESIGNATION NUMBER	
STP-MG-0904(2)	
STATE	YEAR
ALASKA	2002
SHEET NUMBER	TOTAL SHEETS
P1	146

ADDENDUM NO. 1 ATTACHMENT NO. 5

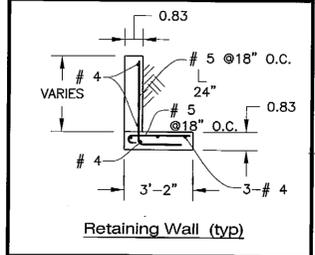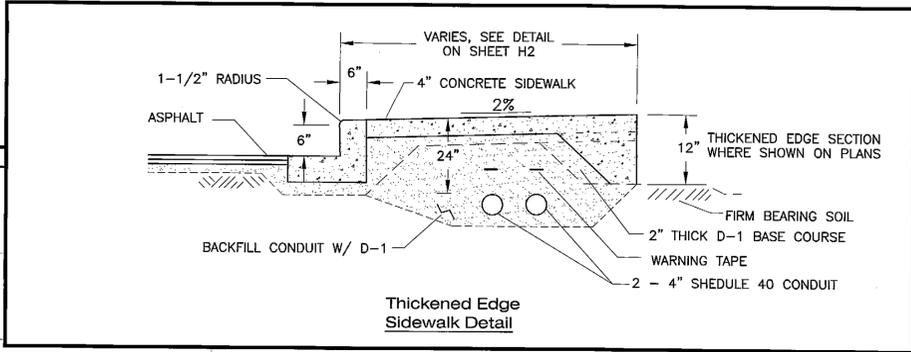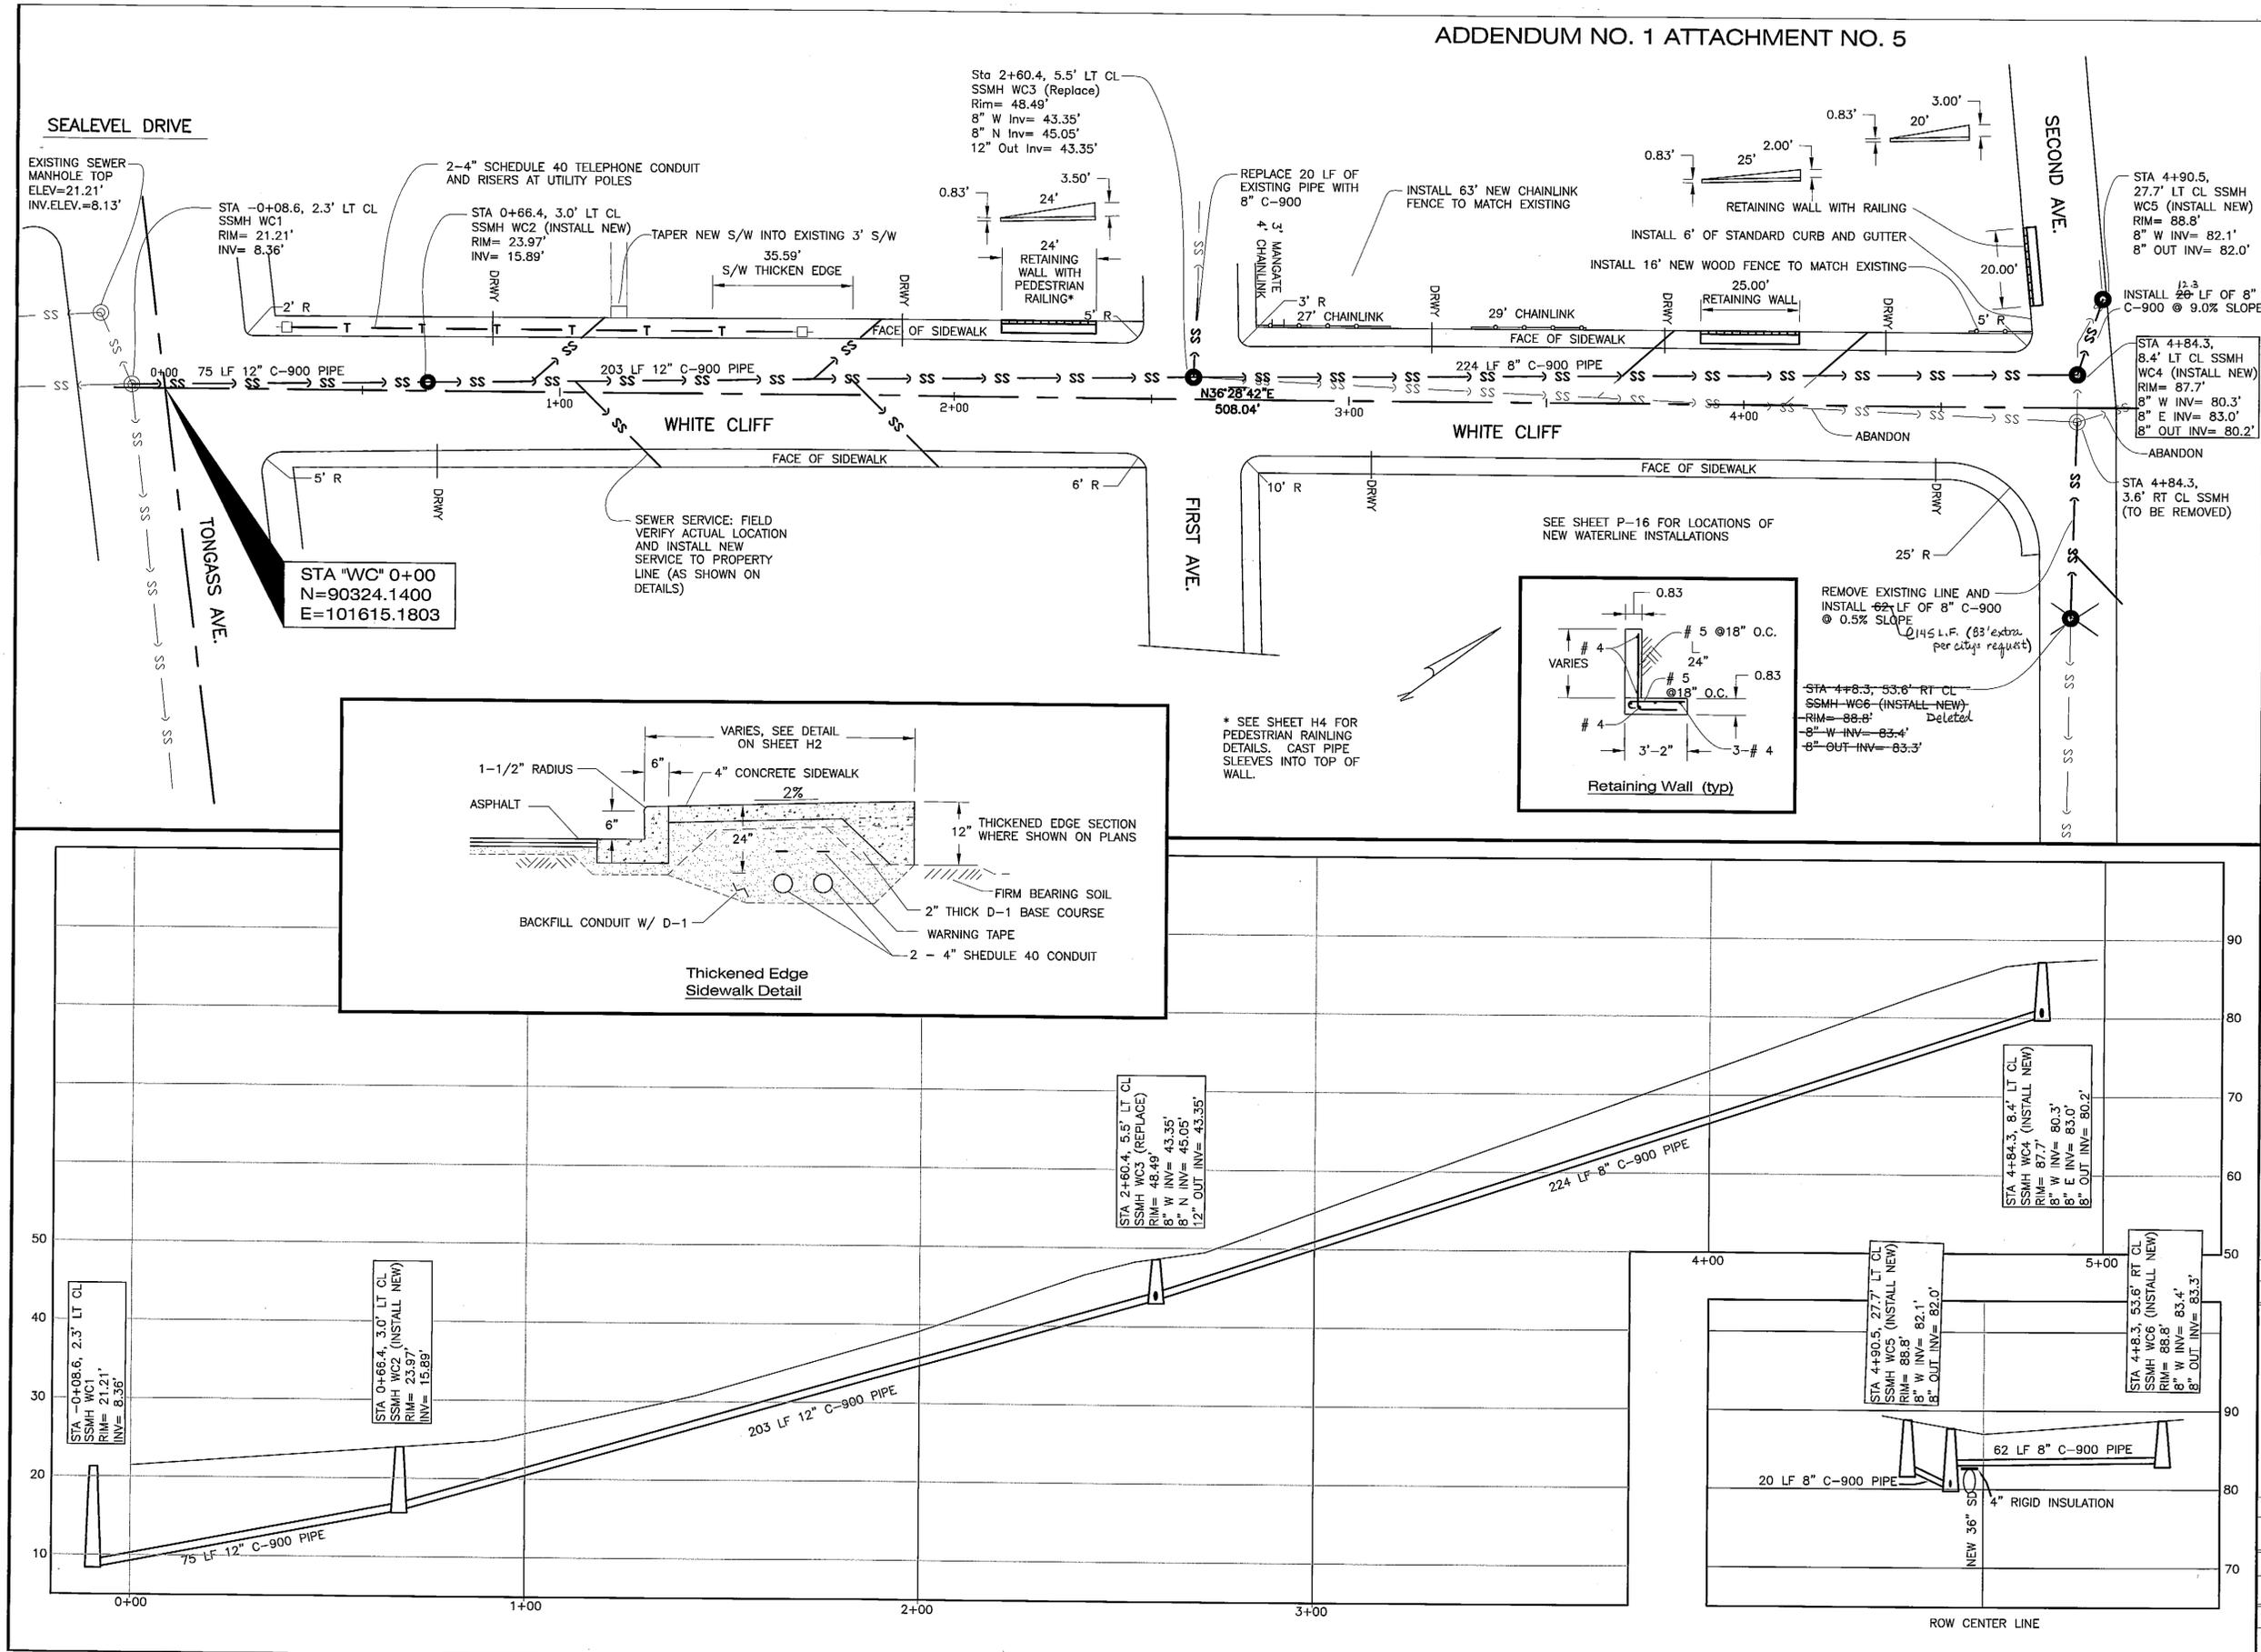

PATH: Q:\Ktn\71811A\PlanSet\P2_ADD-1_New_WhiteC Tue, 28/Jun/05 08:09AM rksnyder
 PLOT: PSPACE 1=1(F) DR MSPACE 1=1(F)

ADDENDUM NUMBER		
ATTACHMENT NUMBER		
RECORD OF REVISIONS		
No.	DATE	DESCRIPTION

KTN-THIRD AVENUE EXTENSION
 PROJECT NO. 68490

Sanitary Sewer Reconstruction

Project As Built Drawings have been reviewed by the Project Engineer. To the best of his/her knowledge, they represent the project as constructed.

Proj. Eng. *J. May* Date 10.31.06

DESIGNED BY: J. MAY

CHECKED BY: C. HOWARD
 DRAWN BY: JM/ML

STATE OF ALASKA
 DEPARTMENT OF TRANSPORTATION & PUBLIC FACILITIES
 STATEWIDE DESIGN & ENGINEERING SERVICES DIVISION


THIRD AVENUE EXTENSION
 PROJECT NO. 68490

Sanitary Sewer Reconstruction

PROJECT DESIGNATION NUMBER
STP-MG-0904(2)

STATE	YEAR
ALASKA	2002

SHEET NUMBER	TOTAL SHEETS
P2	146

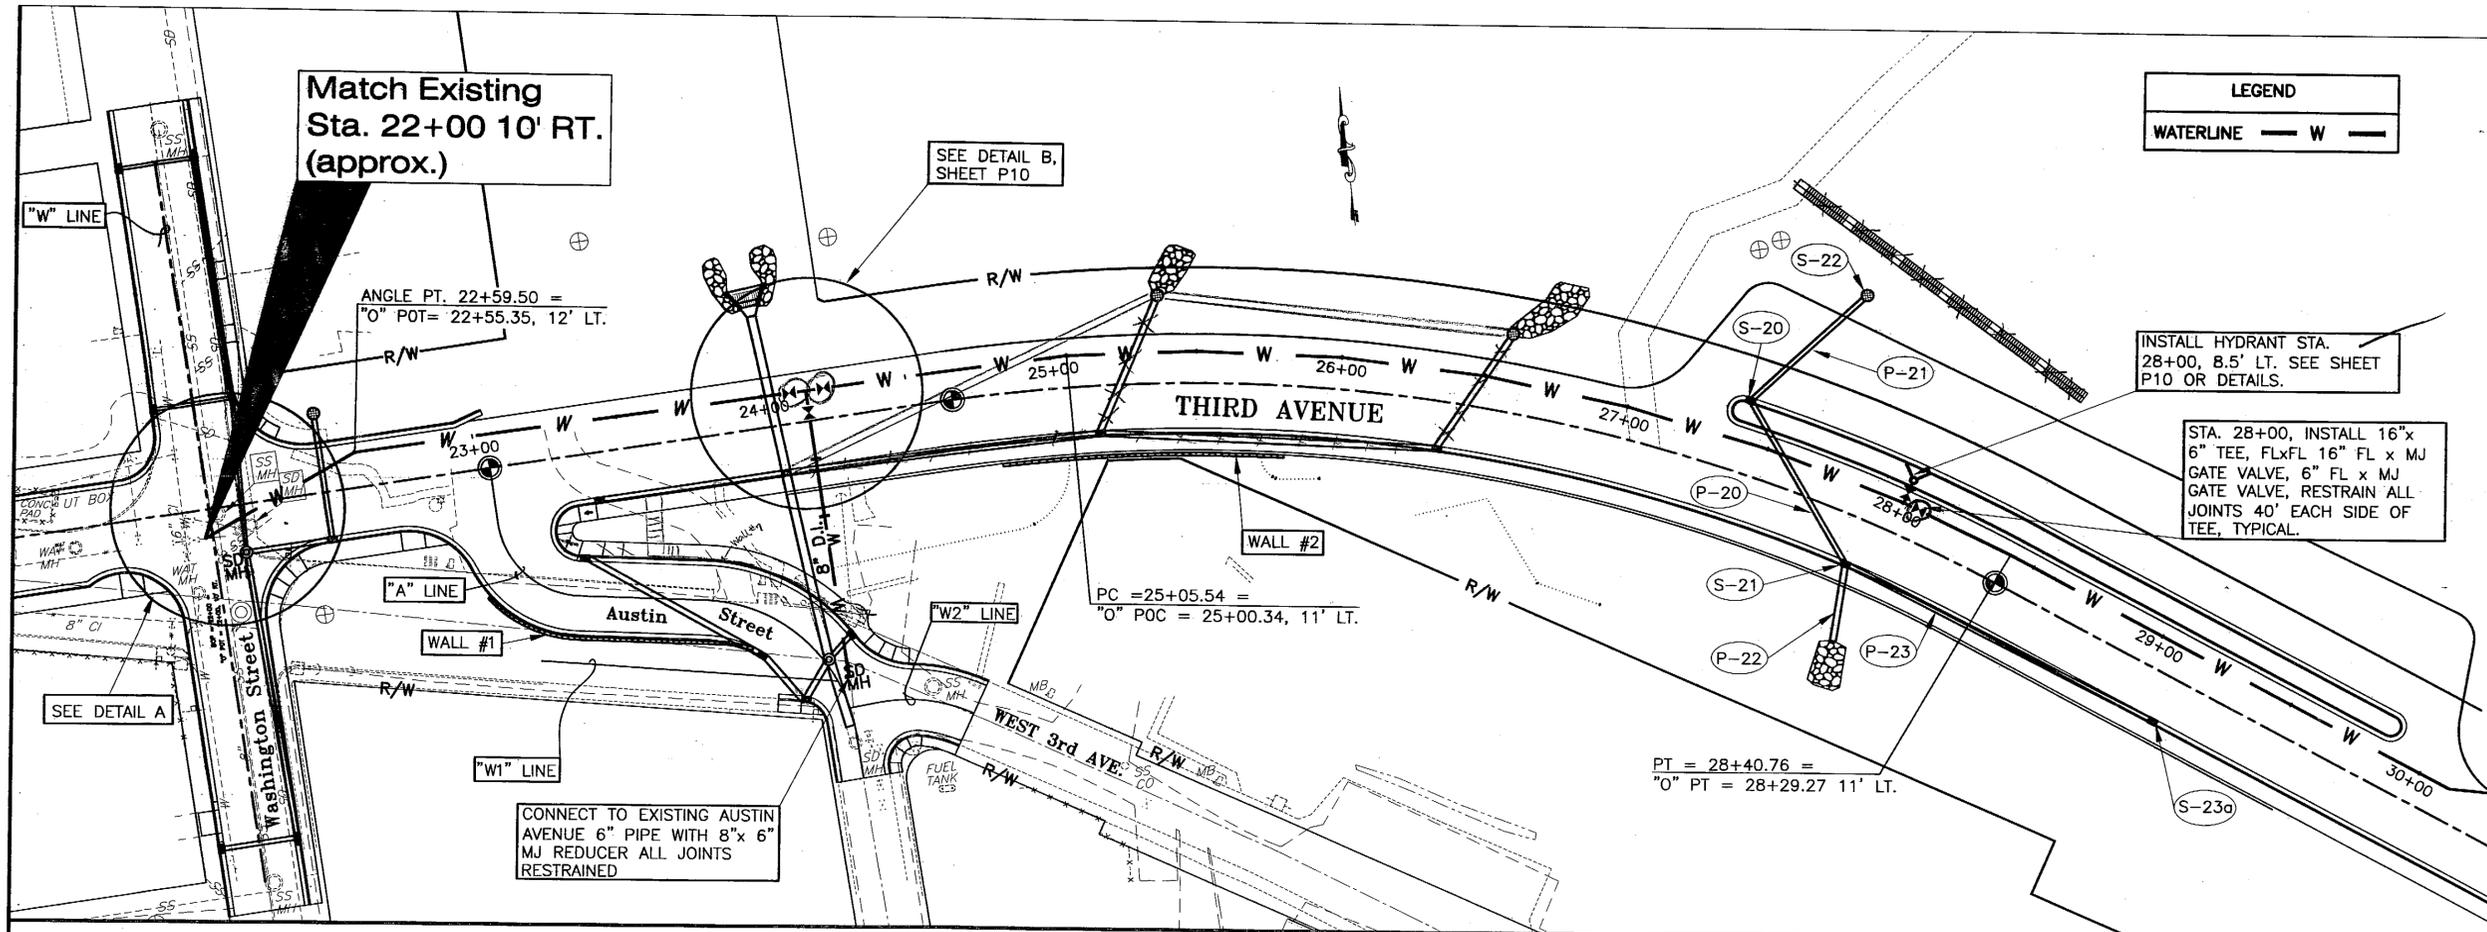

LEGEND


WATERLINE — W —

PATH: Q:\Ktn\71811A\Planset\P_Waterline.dwg
 Tue, 07/May/02 10:42AM Michael Limbaugh
 PLOT: PSPACE 1=1(F) OR MSPACE 1=1(F)


ADDENDUM NUMBER		
ATTACHMENT NUMBER		
RECORD OF REVISIONS		
No.	DATE	DESCRIPTION

KTN-THIRD AVENUE EXTENSION
 PROJECT NO. 68490

**B.O.P. STA. "O" 22+00
 TO STA. "O" 30+00**
 WATERLINE PLAN & PROFILE

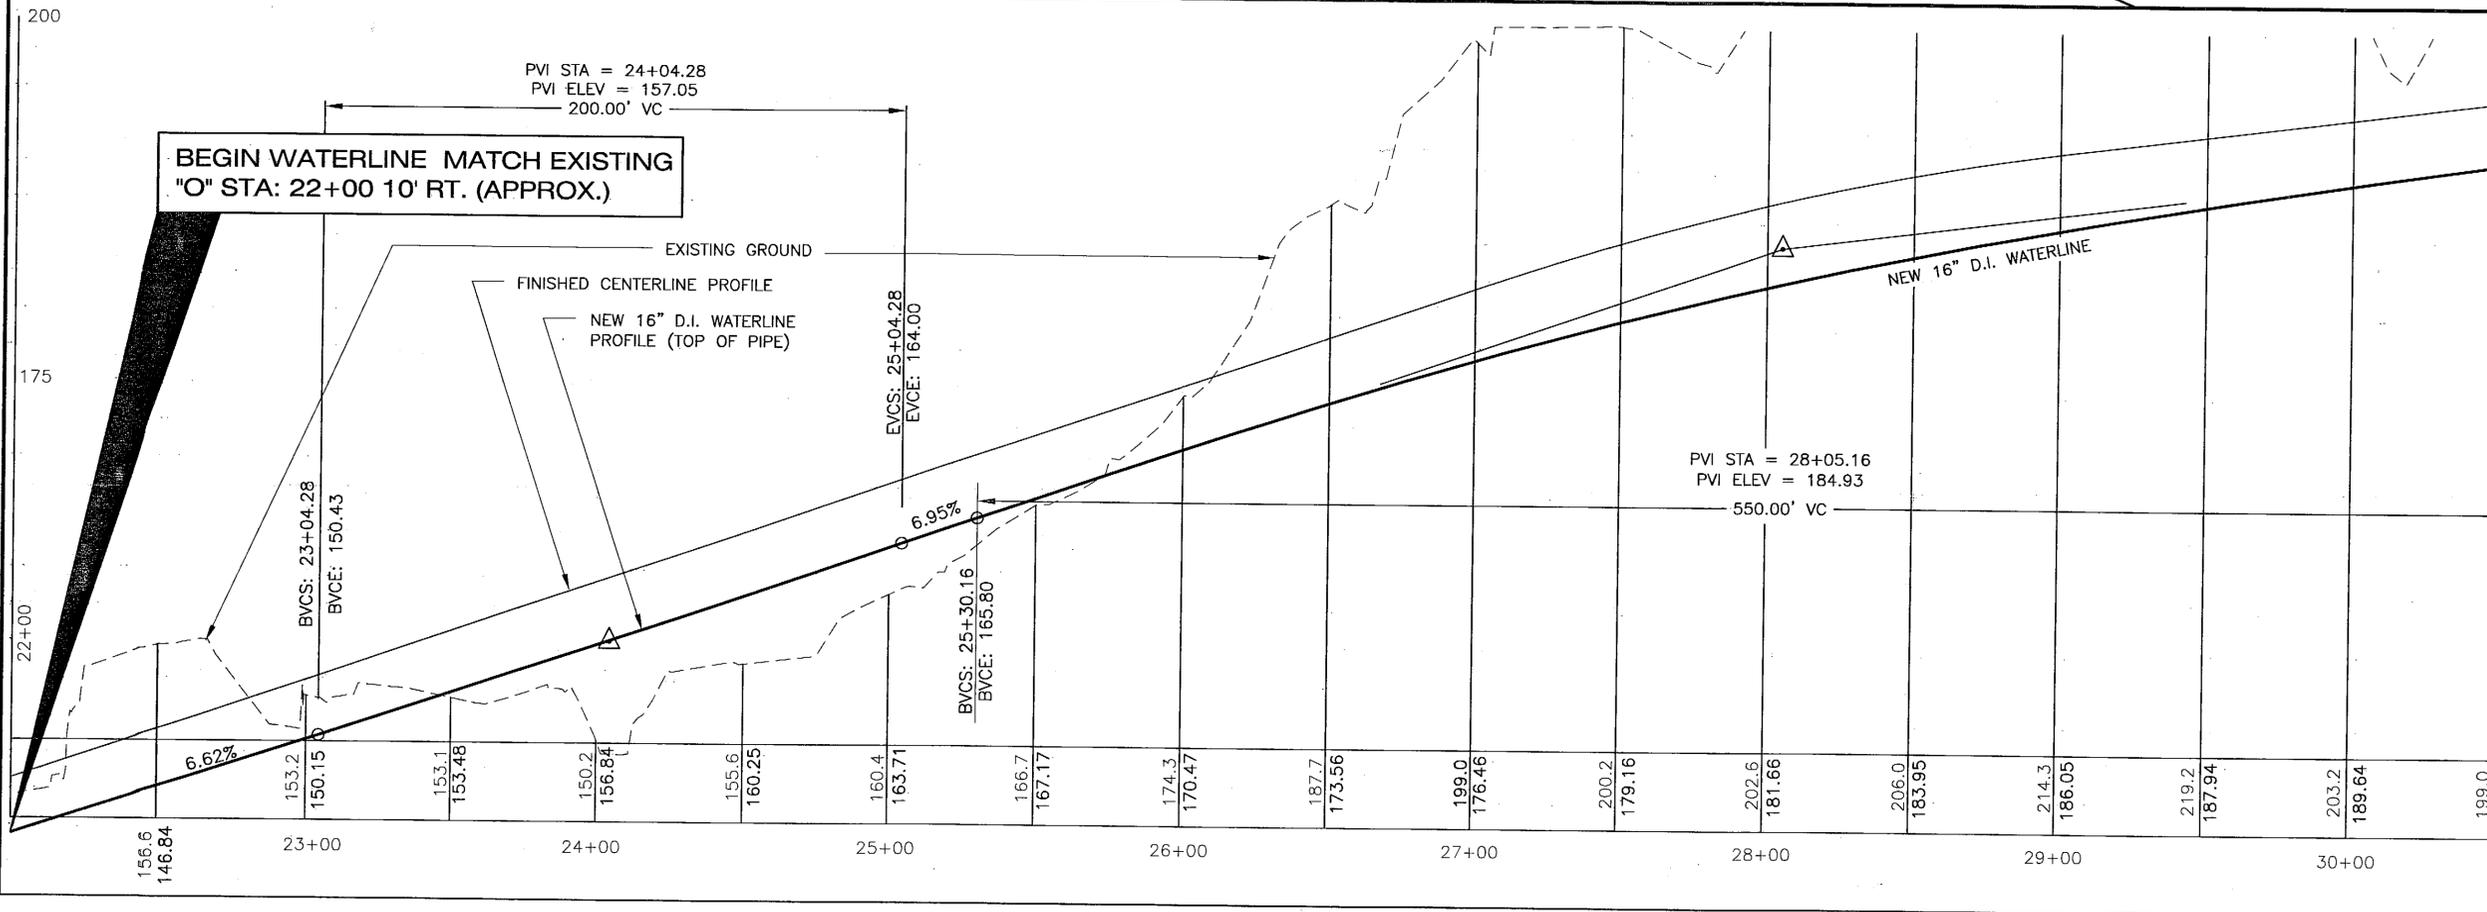

DESIGNED BY: C. HOWARD

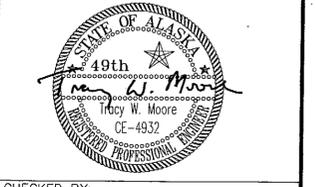

CHECKED BY: T. MOORE
 DRAWN BY: K. K.

STATE OF ALASKA
 DEPARTMENT OF TRANSPORTATION
 & PUBLIC FACILITIES
 STATEWIDE DESIGN & ENGINEERING
 SERVICES DIVISION

THIRD AVENUE EXTENSION
 PROJECT NO. 68490

**B.O.P. STA.
 "O" 22+00 TO
 STA. "O" 30+00**


PROJECT DESIGNATION NUMBER	
STP-MG-0904(2)	
STATE	YEAR
ALASKA	2002
SHEET NUMBER	TOTAL SHEETS
P3	146

Project As Built Drawings have been reviewed by the Project Engineer. To the best of his/her knowledge, they represent the project as constructed.


Proj. Eng. *KS* Date 10/31/06

LEGEND
 WATERLINE — W —


ADDENDUM NUMBER		
ATTACHMENT NUMBER		
RECORD OF REVISIONS		
No.	DATE	DESCRIPTION

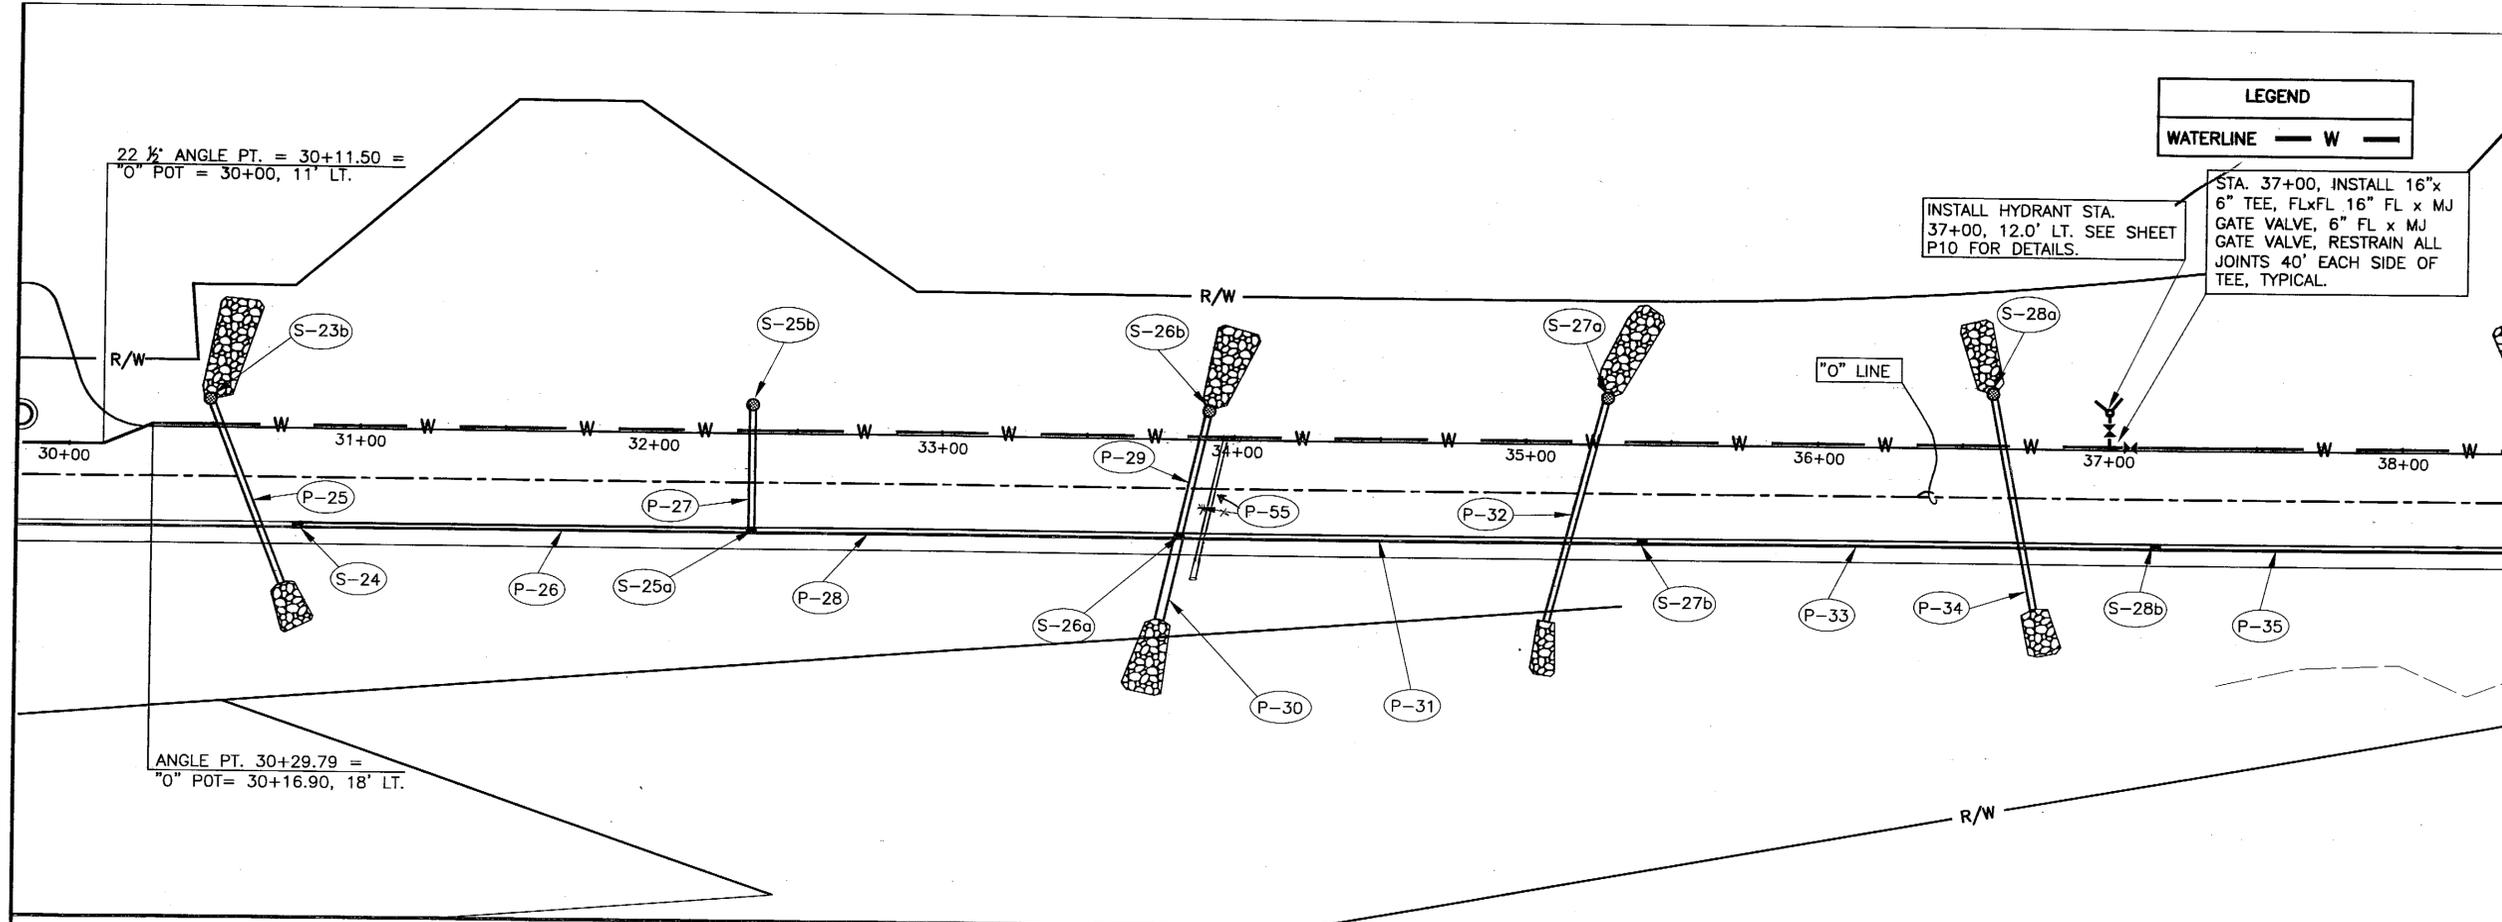

KTN-THIRD AVENUE EXTENSION
 PROJECT NO. 68490
**STA. "O" 30+50
 TO STA "O" 38+00**
 WATERLINE PLAN & PROFILE

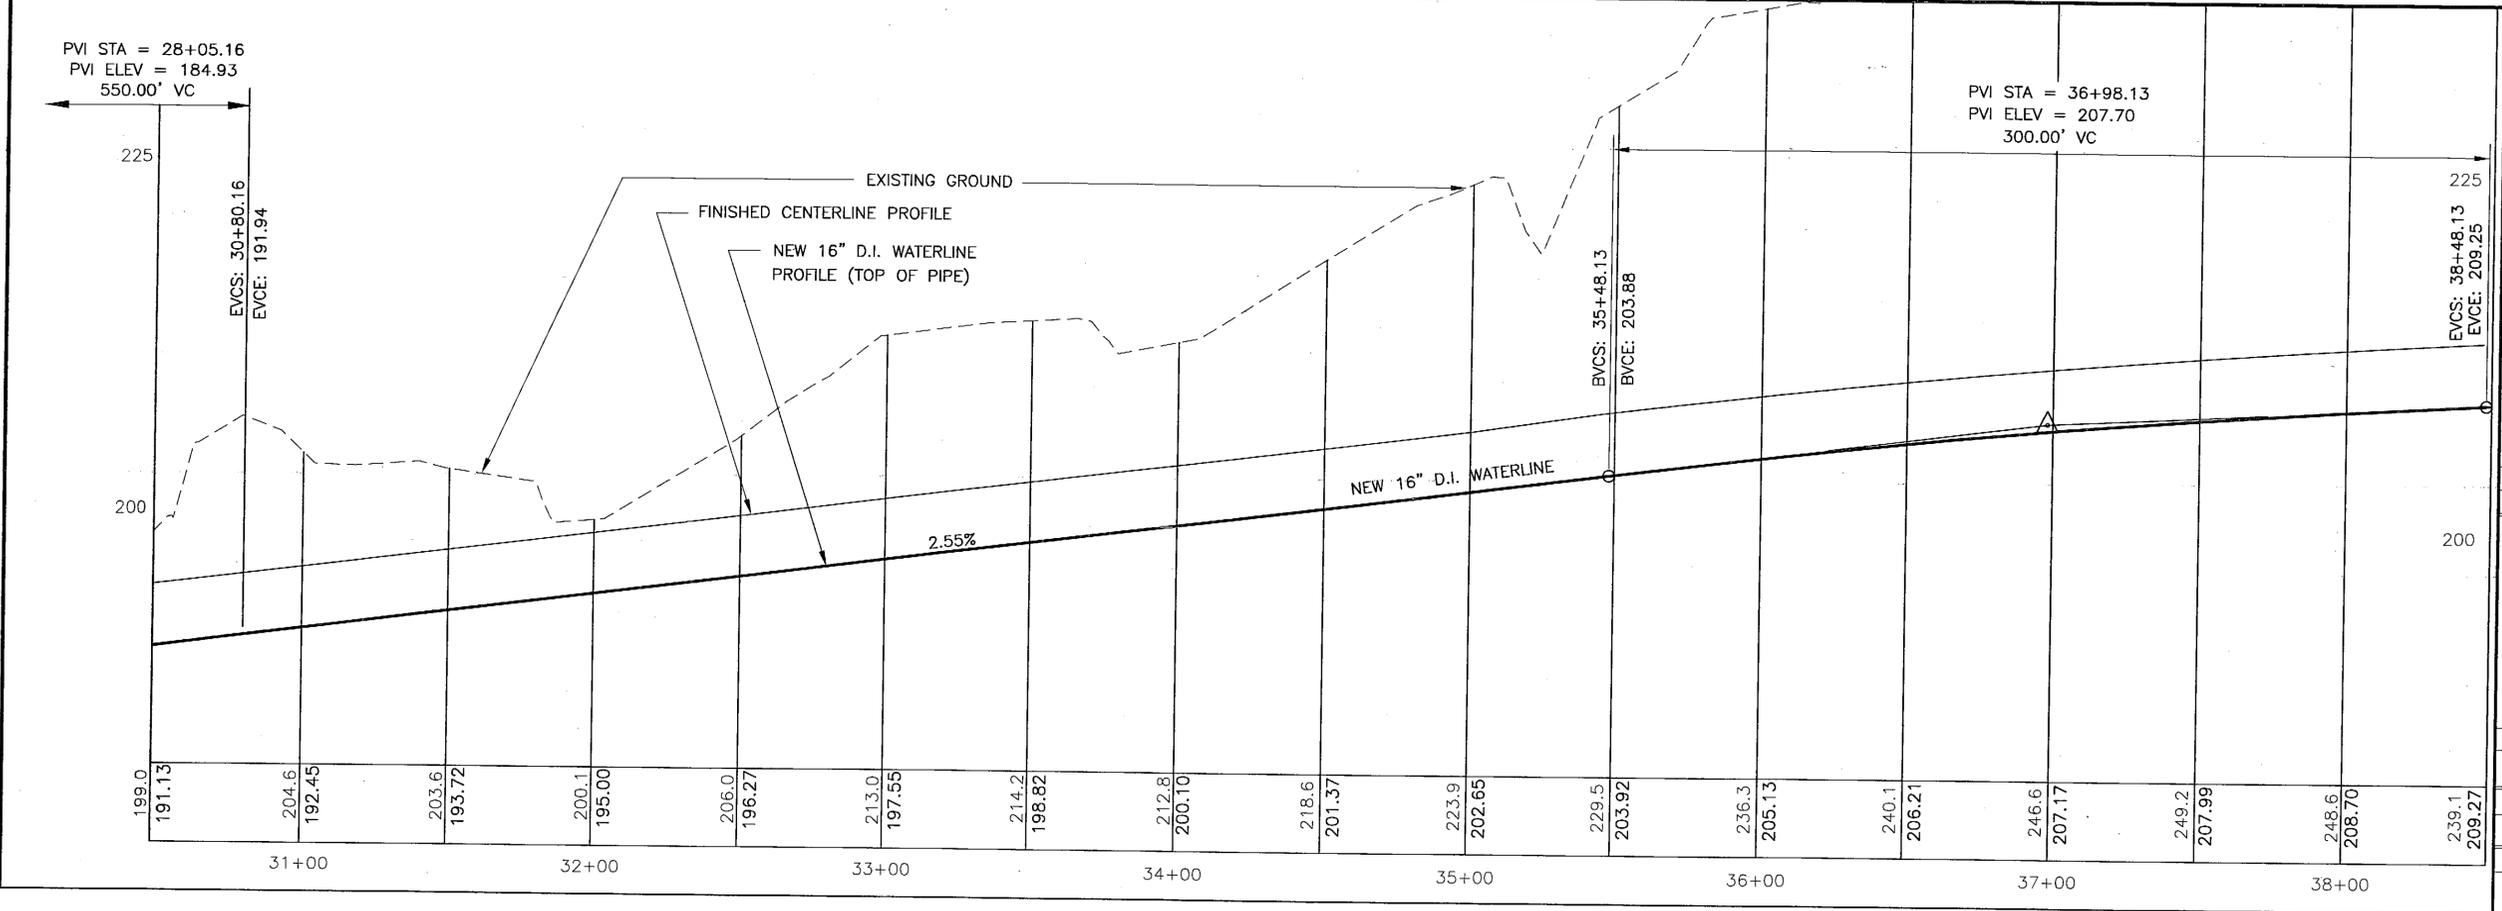

DESIGNED BY: C. HOWARD

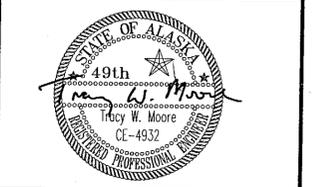

CHECKED BY: T. MOORE

DRAWN BY: K.K.

STATE OF ALASKA
 DEPARTMENT OF TRANSPORTATION
 & PUBLIC FACILITIES
 STATEWIDE DESIGN & ENGINEERING
 SERVICES DIVISION

THIRD AVENUE EXTENSION
 PROJECT NO. 68490


**STA. "O" 30+50
 TO STA. "O" 38+00**

PROJECT DESIGNATION NUMBER

STP-MG-0904(2)

STATE	YEAR
ALASKA	2002

SHEET NUMBER	TOTAL SHEETS
P4	146

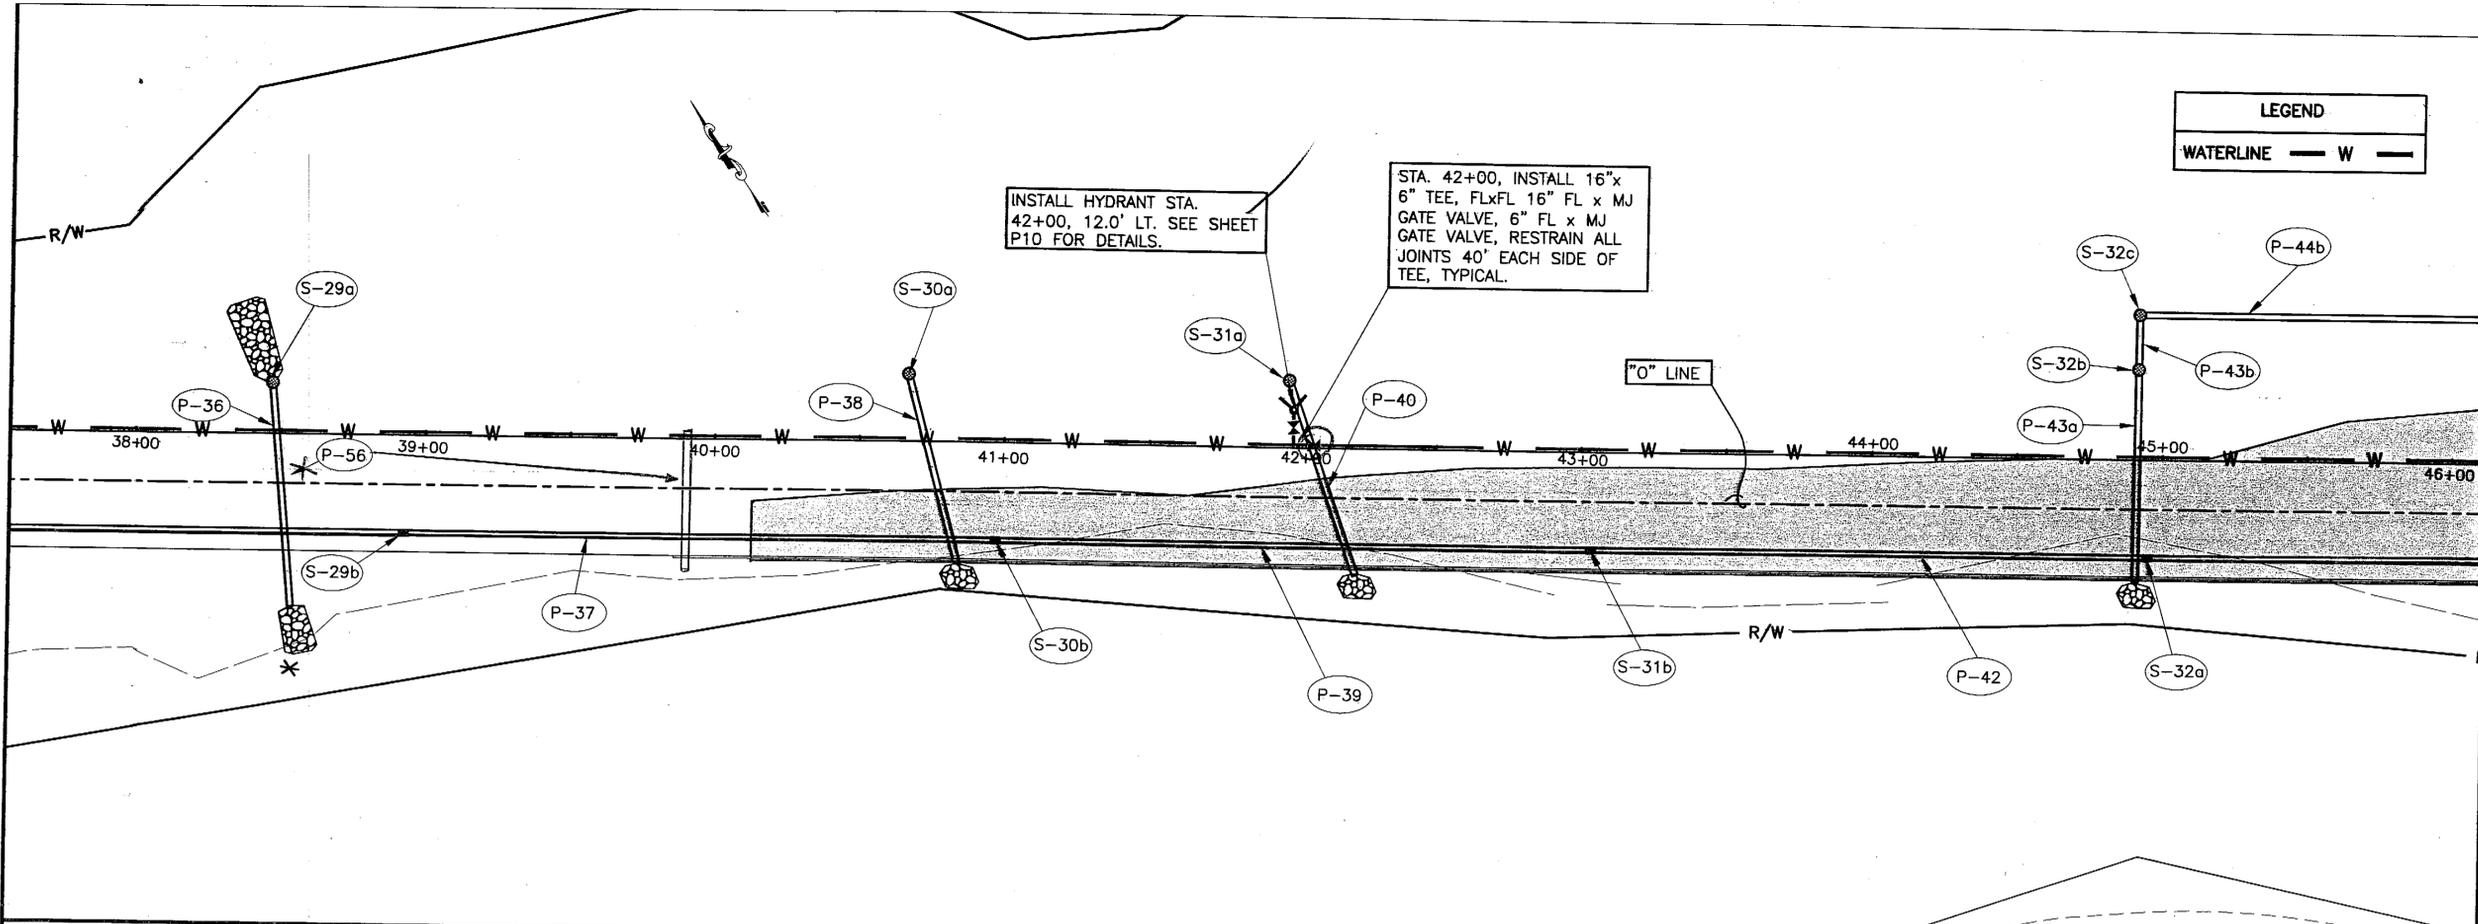

INSTALL HYDRANT STA. 42+00, 12.0' LT. SEE SHEET P10 FOR DETAILS.

STA. 42+00, INSTALL 16" x 6" TEE, FLxFL 16" FL x MJ GATE VALVE, 6" FL x MJ GATE VALVE, RESTRAIN ALL JOINTS 40' EACH SIDE OF TEE, TYPICAL.


LEGEND
WATERLINE — W —

PATH:
Q:\Ktn\71811A\Planset\P_Waterline.dwg
Tue, 07/May/02 09:16AM Michael Limbaugh
PLOT:
PSPACE 1=1(F) OR MSPACE 1=1(F)
TAB: ESTIMATE

ADDENDUM NUMBER		
ATTACHMENT NUMBER		
RECORD OF REVISIONS		
No.	DATE	DESCRIPTION

KTN-THIRD AVENUE EXTENSION
PROJECT NO. 68490

**STA. "O" 38+00
TO STA. "O" 45+50
WATERLINE PLAN & PROFILE**

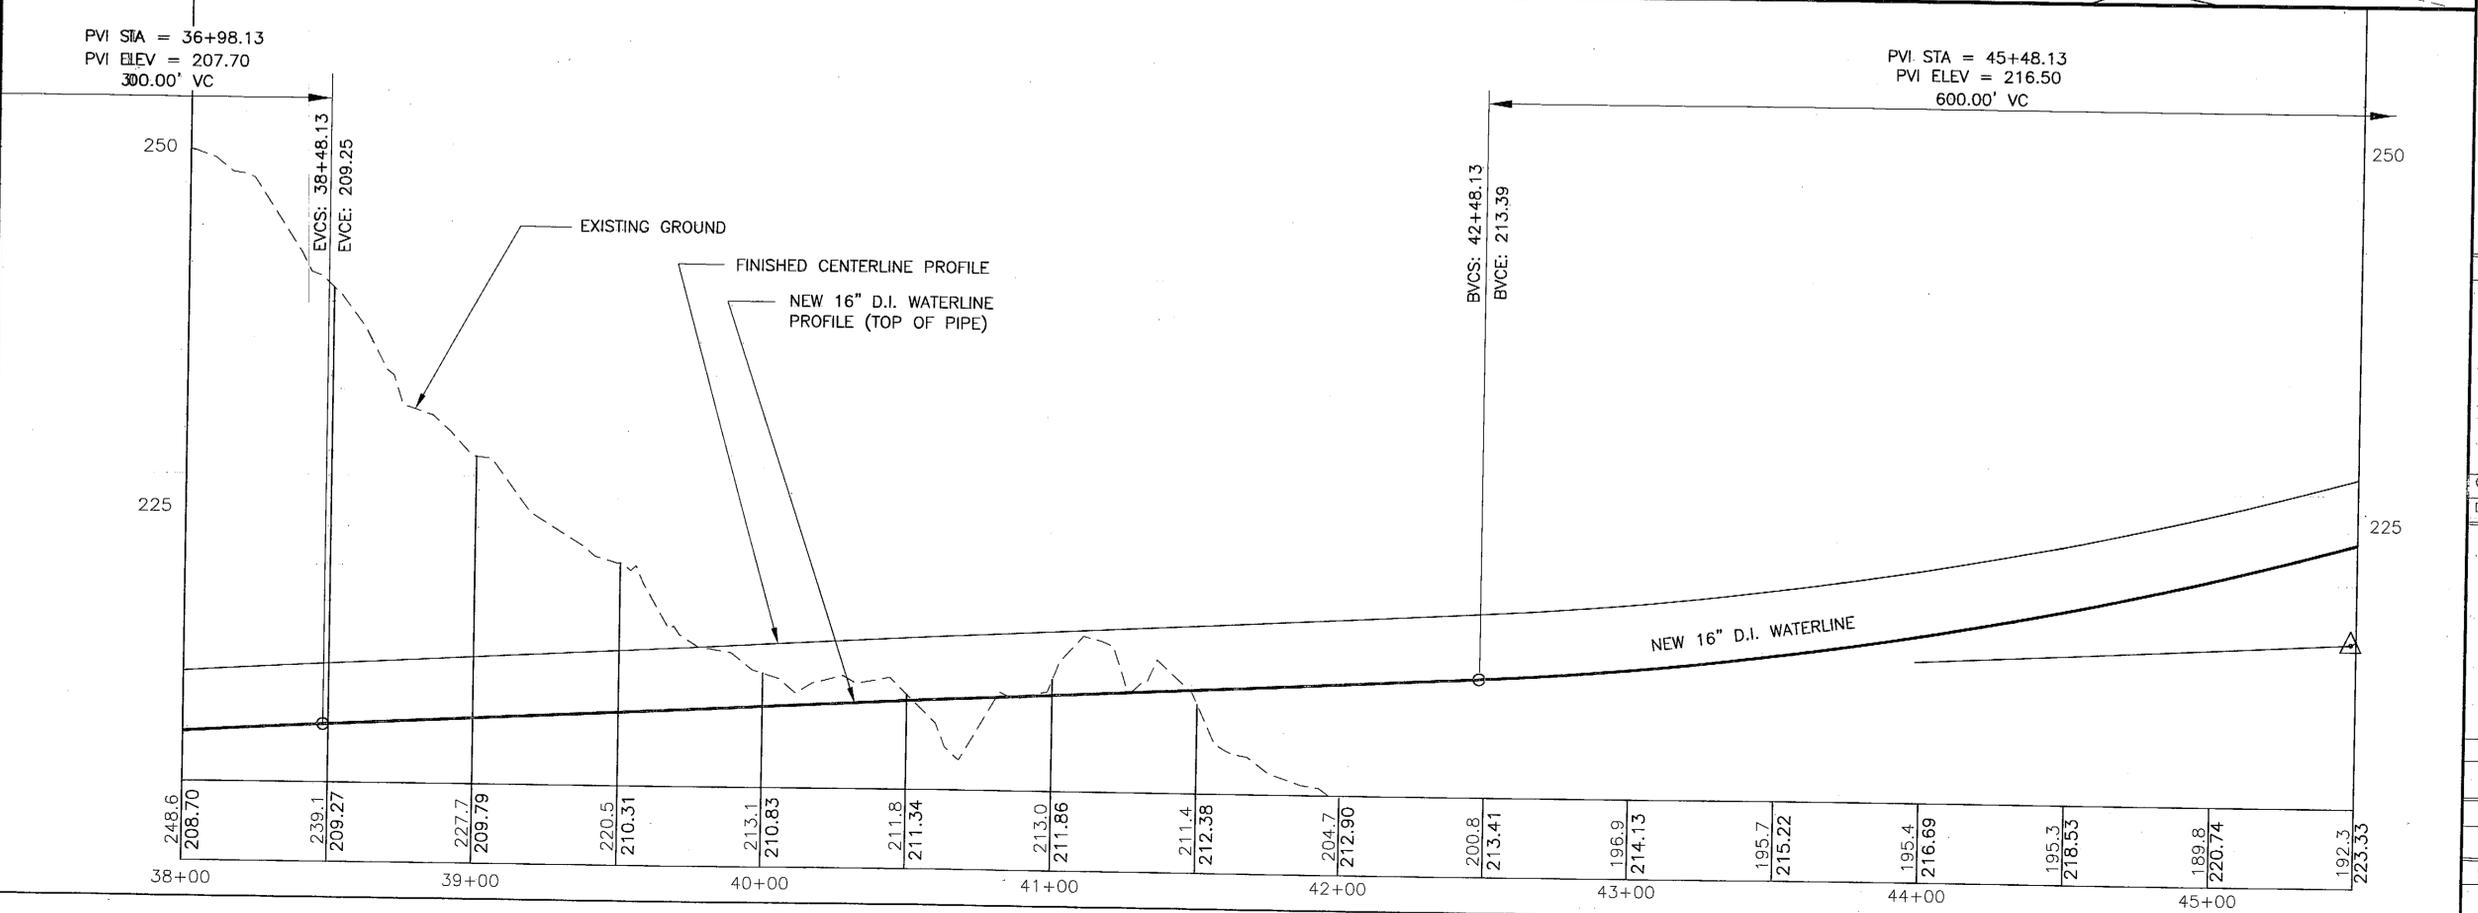

DESIGNED BY: C. HOWARD



CHECKED BY: T. MOORE
DRAWN BY: K.K.

STATE OF ALASKA
DEPARTMENT OF TRANSPORTATION
& PUBLIC FACILITIES
STATEWIDE DESIGN & ENGINEERING
SERVICES DIVISION

THIRD AVENUE EXTENSION
PROJECT NO. 68490

**STA. "O" 38+00
TO STA. "O" 45+50**

PROJECT DESIGNATION NUMBER
STP-MG-0904(2)

STATE	YEAR
ALASKA	2002
SHEET NUMBER	TOTAL SHEETS
P5	146



Project As Built Drawings have been reviewed by the Project Engineer. To the best of his/her knowledge, they represent the project as constructed.
Proj. Eng. *[Signature]* Date 10/2/06

PATH:
 Q:\Ktn\71811A\Planset\P_Waterline.dwg
 Tue, 07/May/02 03:01PM Michael Limbaugh
 PLOT:
 PSPACE 1=1(F) OR MSPACE 1=1(F)
 TAB: ESTIMATE

ADDENDUM NUMBER		
ATTACHMENT NUMBER		
RECORD OF REVISIONS		
No.	DATE	DESCRIPTION

KTN-THIRD AVENUE EXTENSION
 PROJECT NO. 68490

**STA. "0" 42+50
 TO STA "0" 50+50**
 WATERLINE PLAN & PROFILE

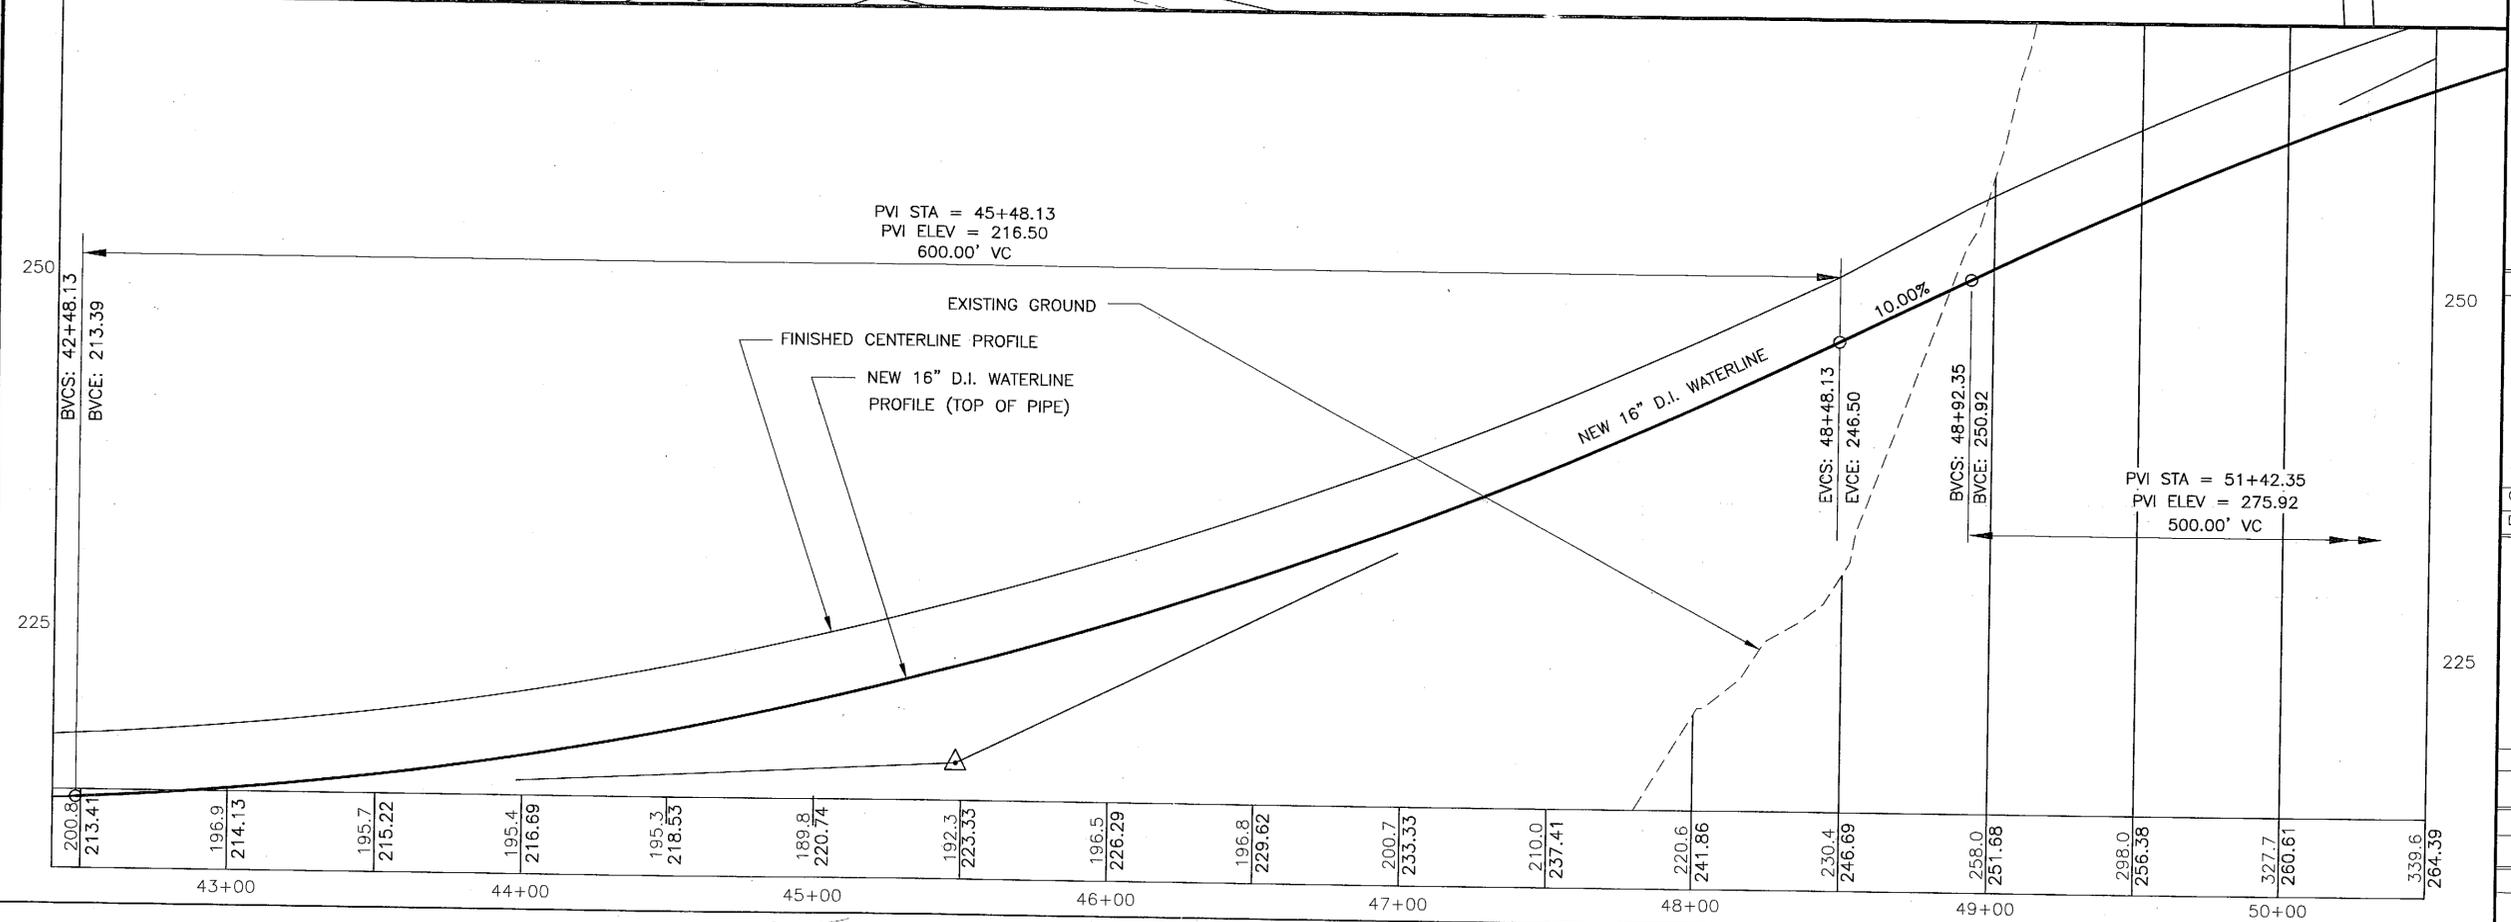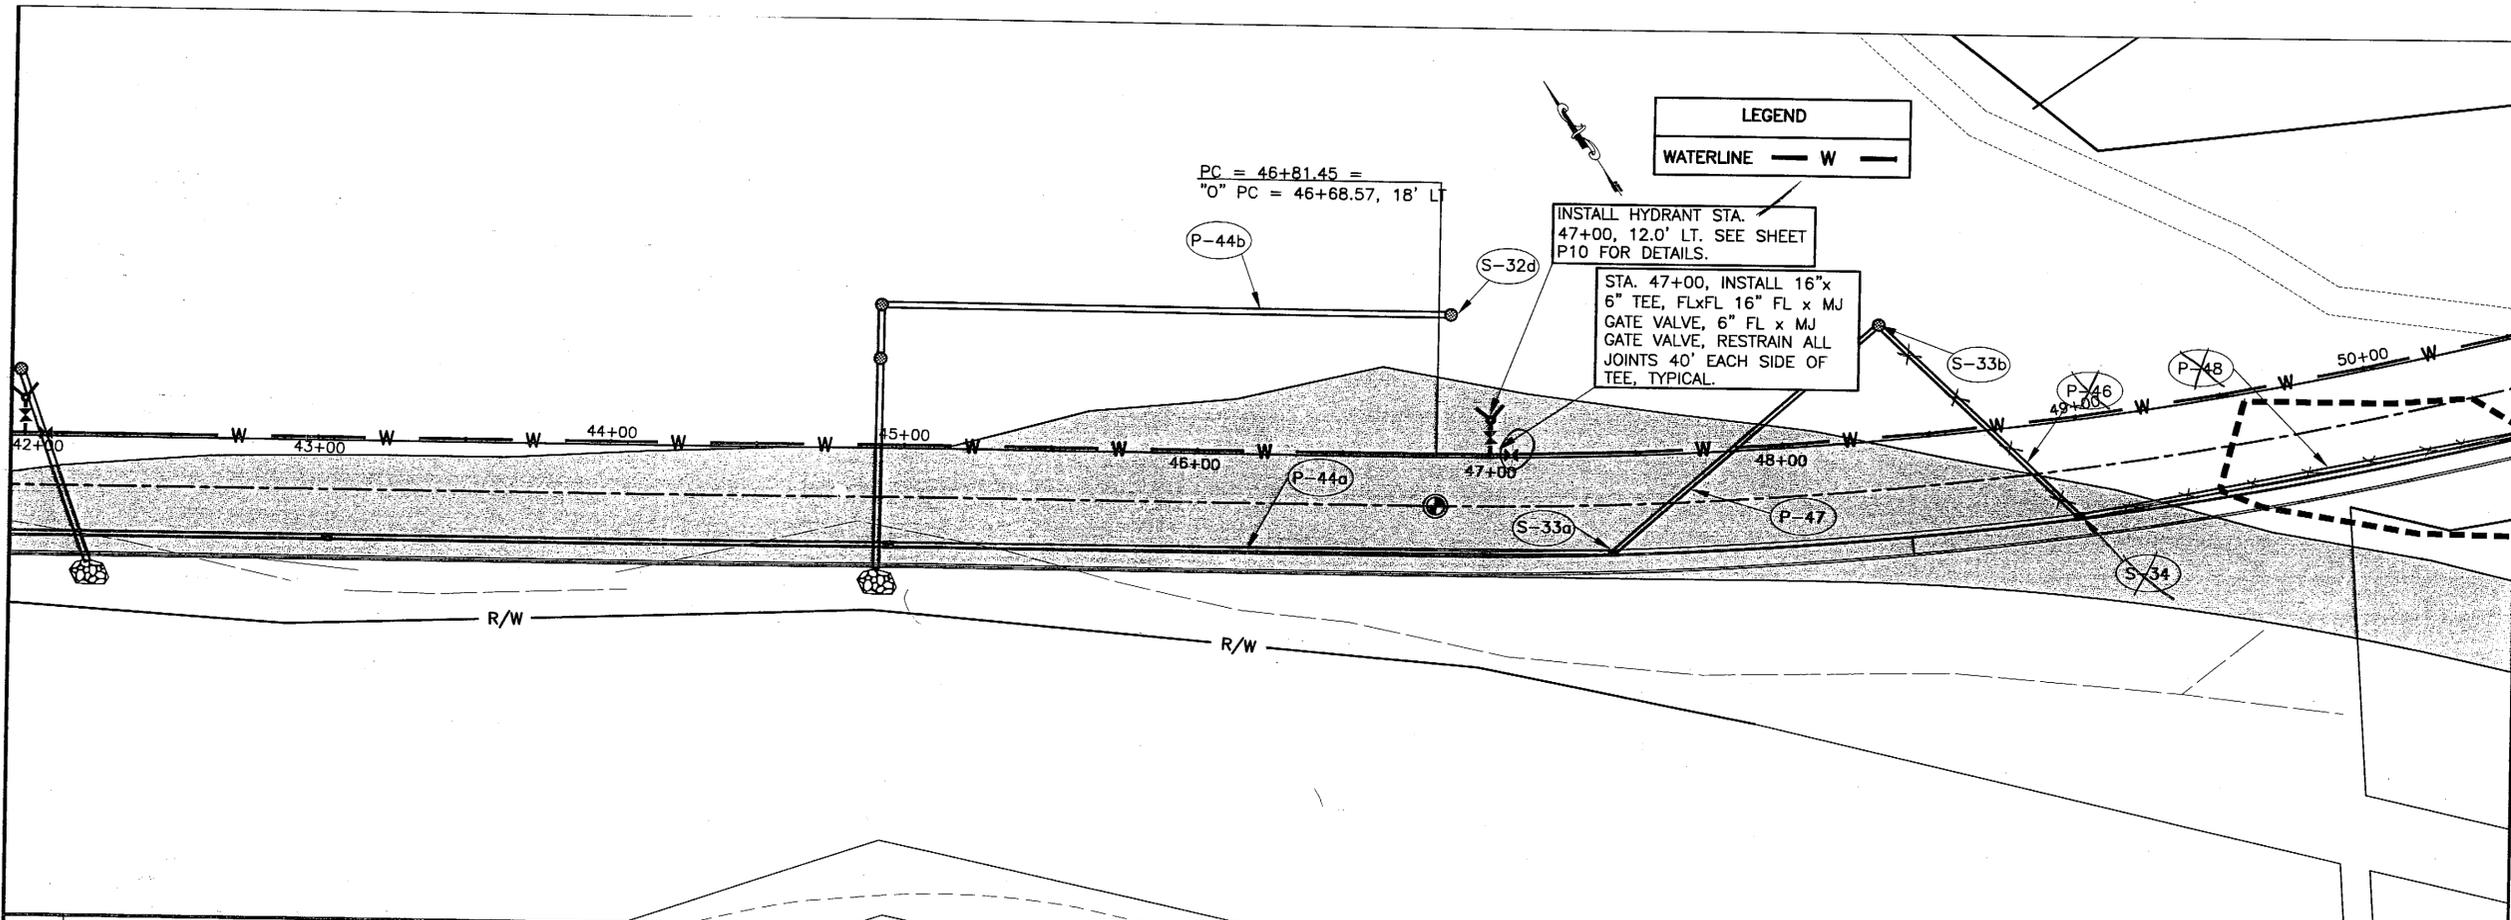

DESIGNED BY: C. HOWARD



CHECKED BY: T. MOORE

DRAWN BY: K.K.

STATE OF ALASKA
 DEPARTMENT OF TRANSPORTATION
 & PUBLIC FACILITIES
 STATEWIDE DESIGN & ENGINEERING
 SERVICES DIVISION
 THIRD AVENUE EXTENSION
 PROJECT NO. 68490

**STA."0" 42+50
 TO STA."0" 50+50**


PROJECT DESIGNATION NUMBER

STP-MG-0904(2)

STATE	YEAR
ALASKA	2002
SHEET NUMBER	TOTAL SHEETS
P6	146

Project As Built Drawings have been reviewed by the Project Engineer. To the best of his/her knowledge, they represent the project as constructed.

Proj. Eng. Date 10/31/06

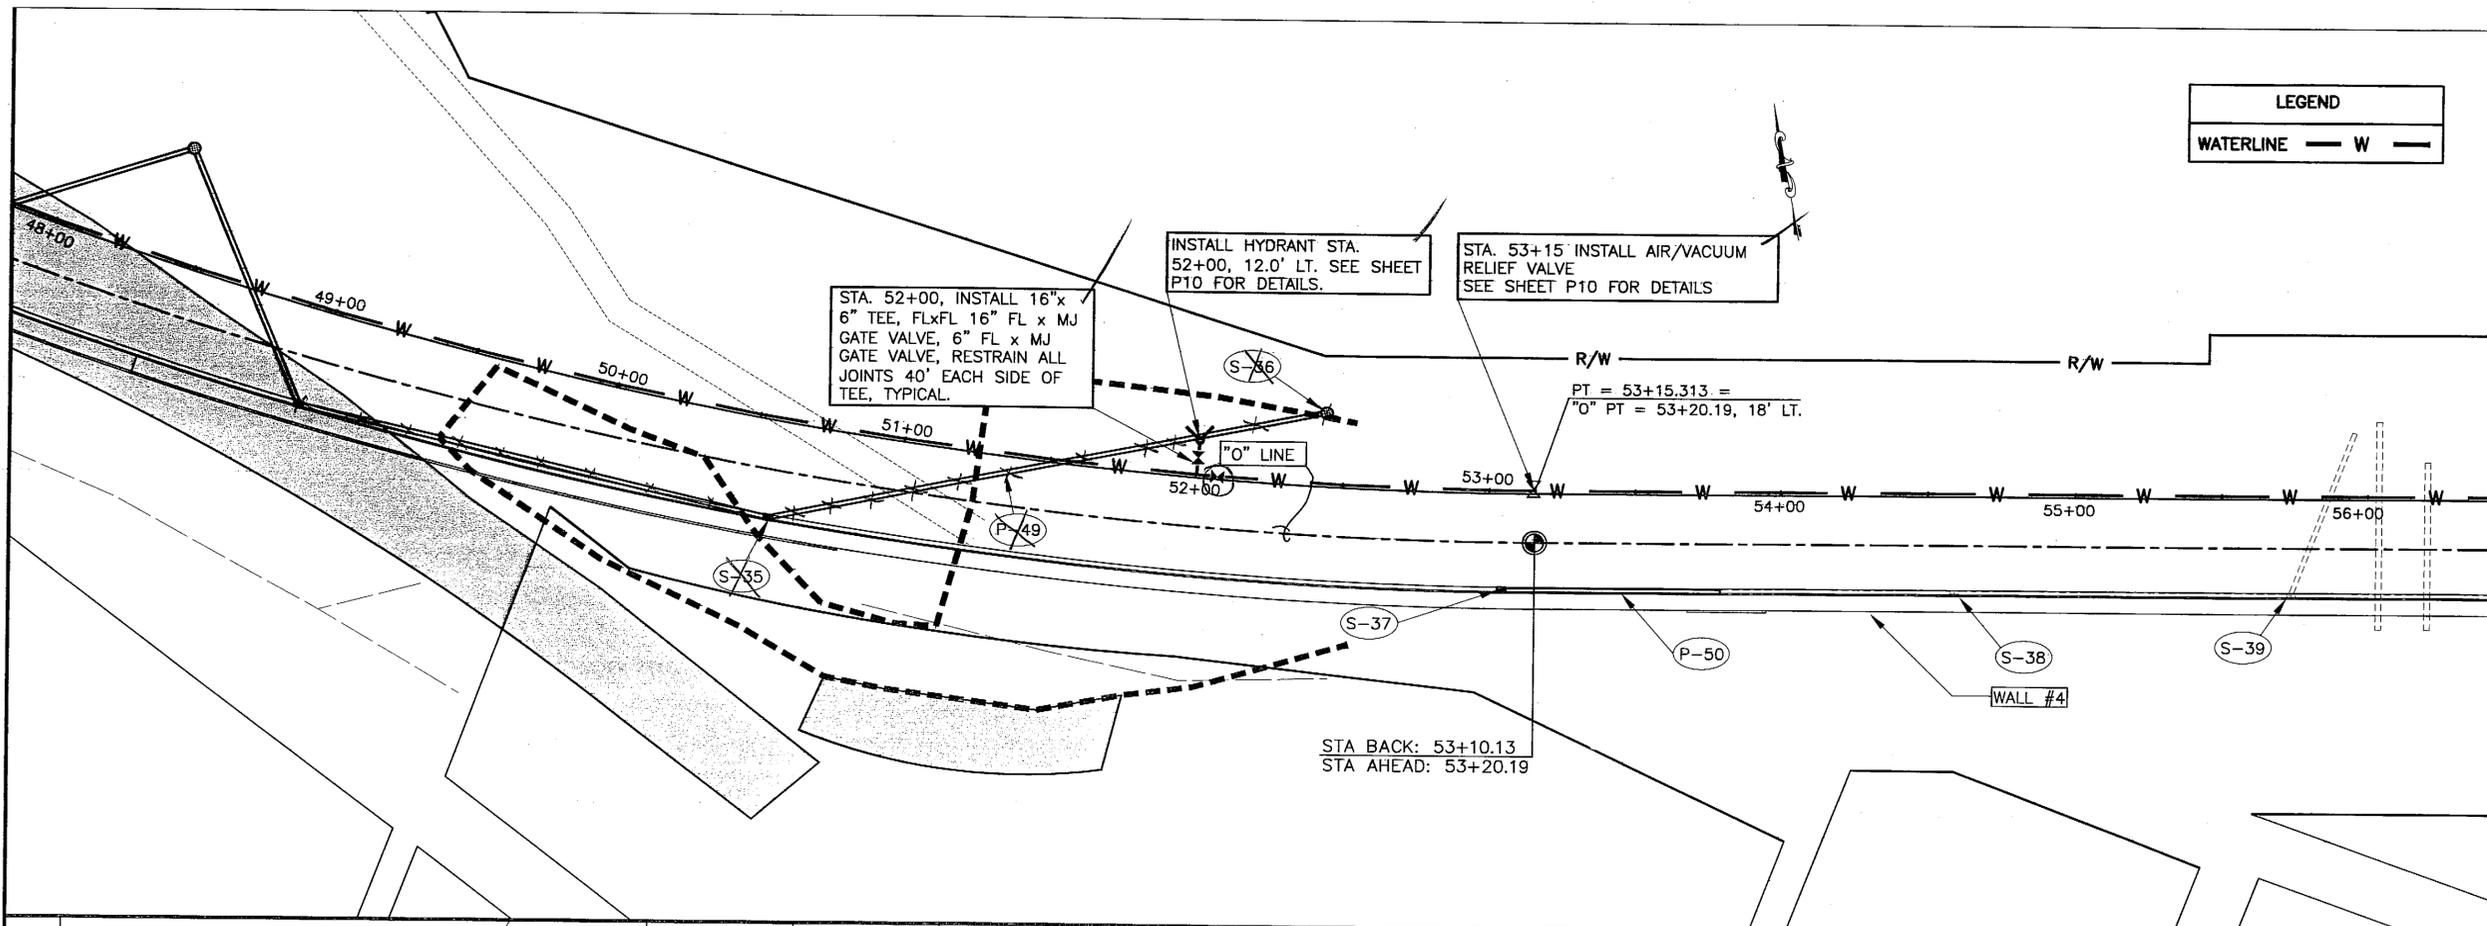


LEGEND	
WATERLINE	— W —


PATH: Q:\Ktn\71811A\Planset\P_Waterline.dwg
 Tue, 07/May/02 03:01PM Michael Limbaugh
 PLOT: PSPACE 1=1(F) OR MSPACE 1=1(F)
 TAB: ESTIMATE

ADDENDUM NUMBER		
ATTACHMENT NUMBER		
RECORD OF REVISIONS		
No.	DATE	DESCRIPTION

KTN-THIRD AVENUE EXTENSION
 PROJECT NO. 68490
**STA. "O" 48+00
 TO STA "O" 56+00**
 WATERLINE PLAN & PROFILE

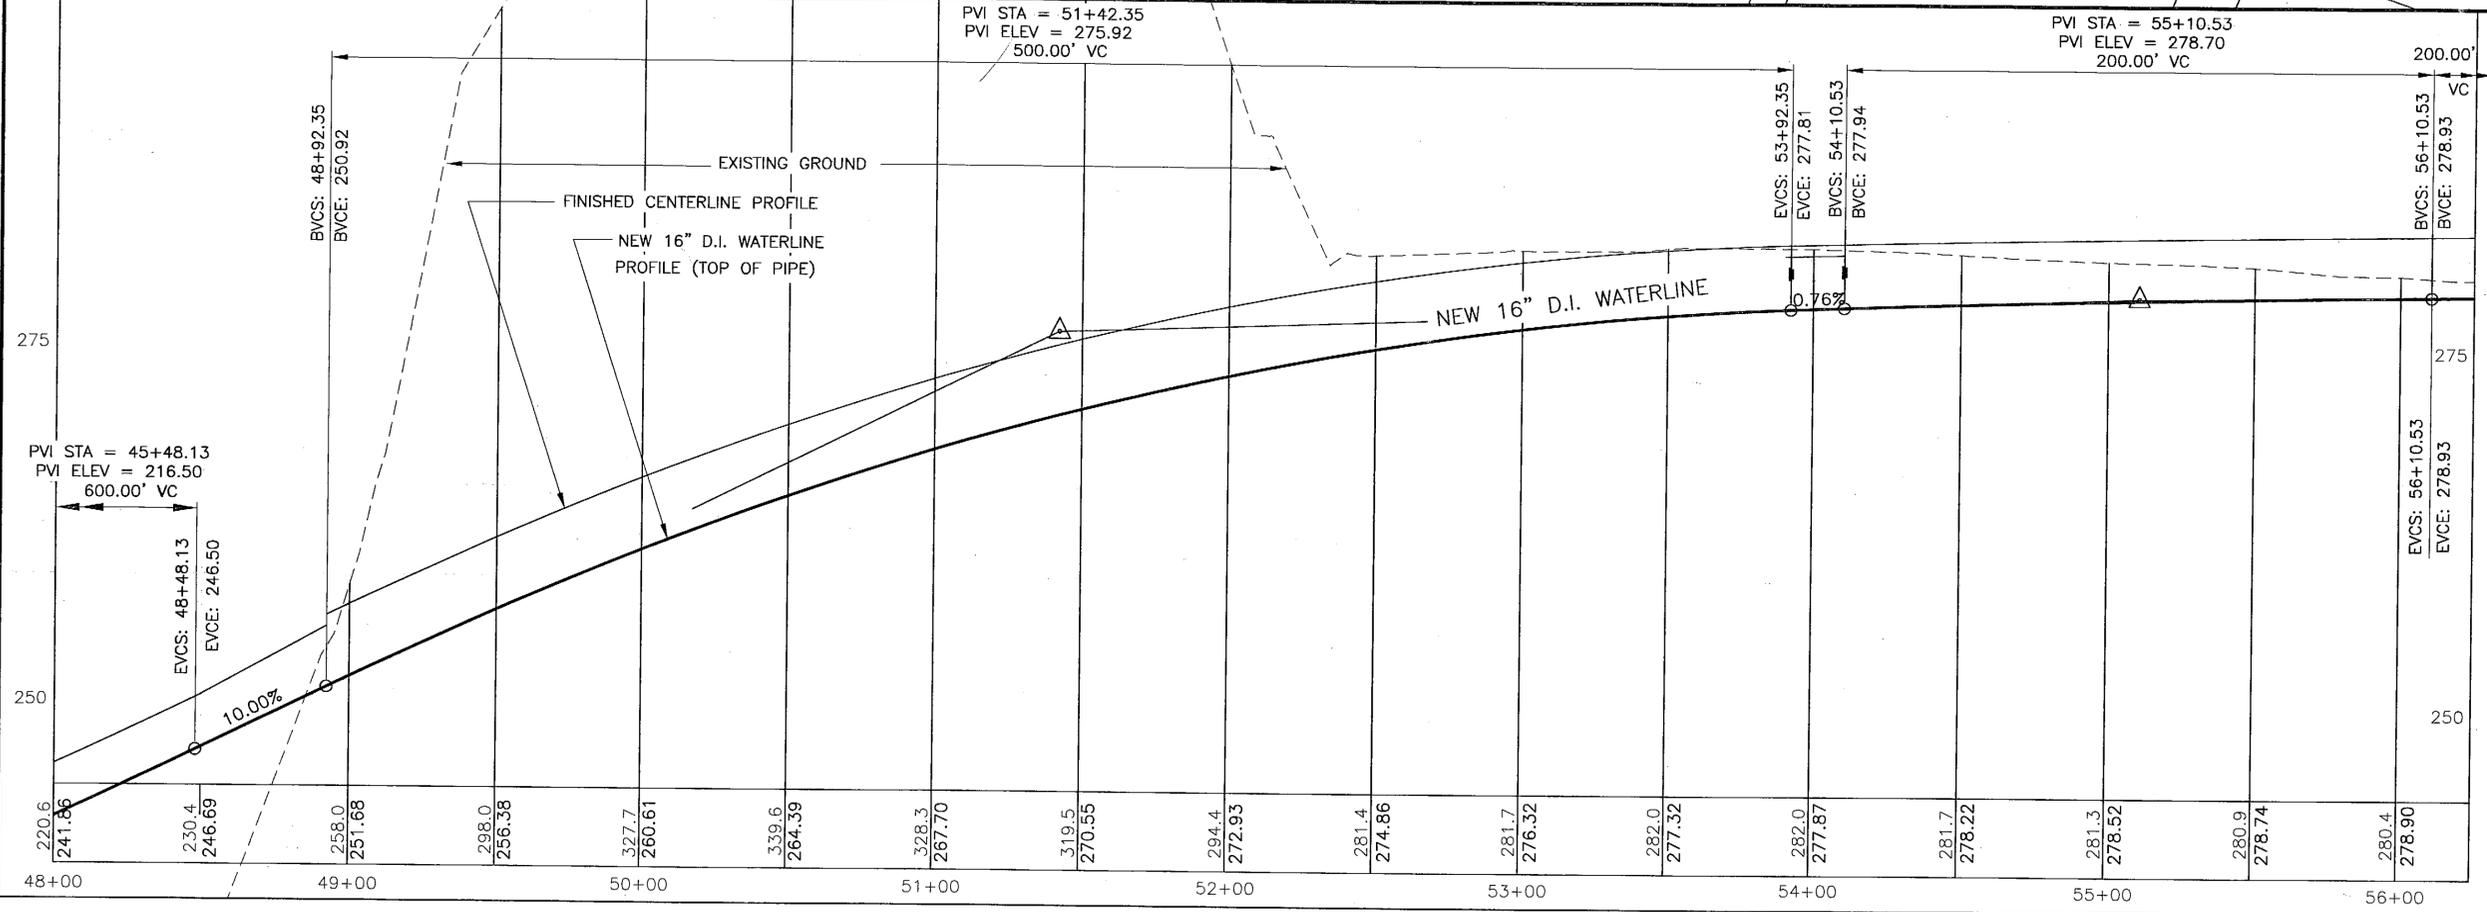

DESIGNED BY: C. HOWARD

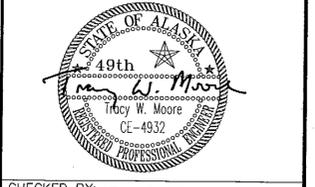

CHECKED BY: T. MOORE
 DRAWN BY: T.M./R.S.

STATE OF ALASKA
 DEPARTMENT OF TRANSPORTATION
 & PUBLIC FACILITIES
 STATEWIDE DESIGN & ENGINEERING
 SERVICES DIVISION
 THIRD AVENUE EXTENSION
 PROJECT NO. 68490


**STA. "O" 48+00
 TO STA. "O" 56+00**

PROJECT DESIGNATION NUMBER
STP-MG-0904(2)

STATE	YEAR
ALASKA	2002

SHEET NUMBER	TOTAL SHEETS
P7	146

Project As Built Drawings have been reviewed by the Project Engineer. To the best of his/her knowledge, they represent the project as constructed.
 Proj. Eng. *[Signature]* Date 10/21/02

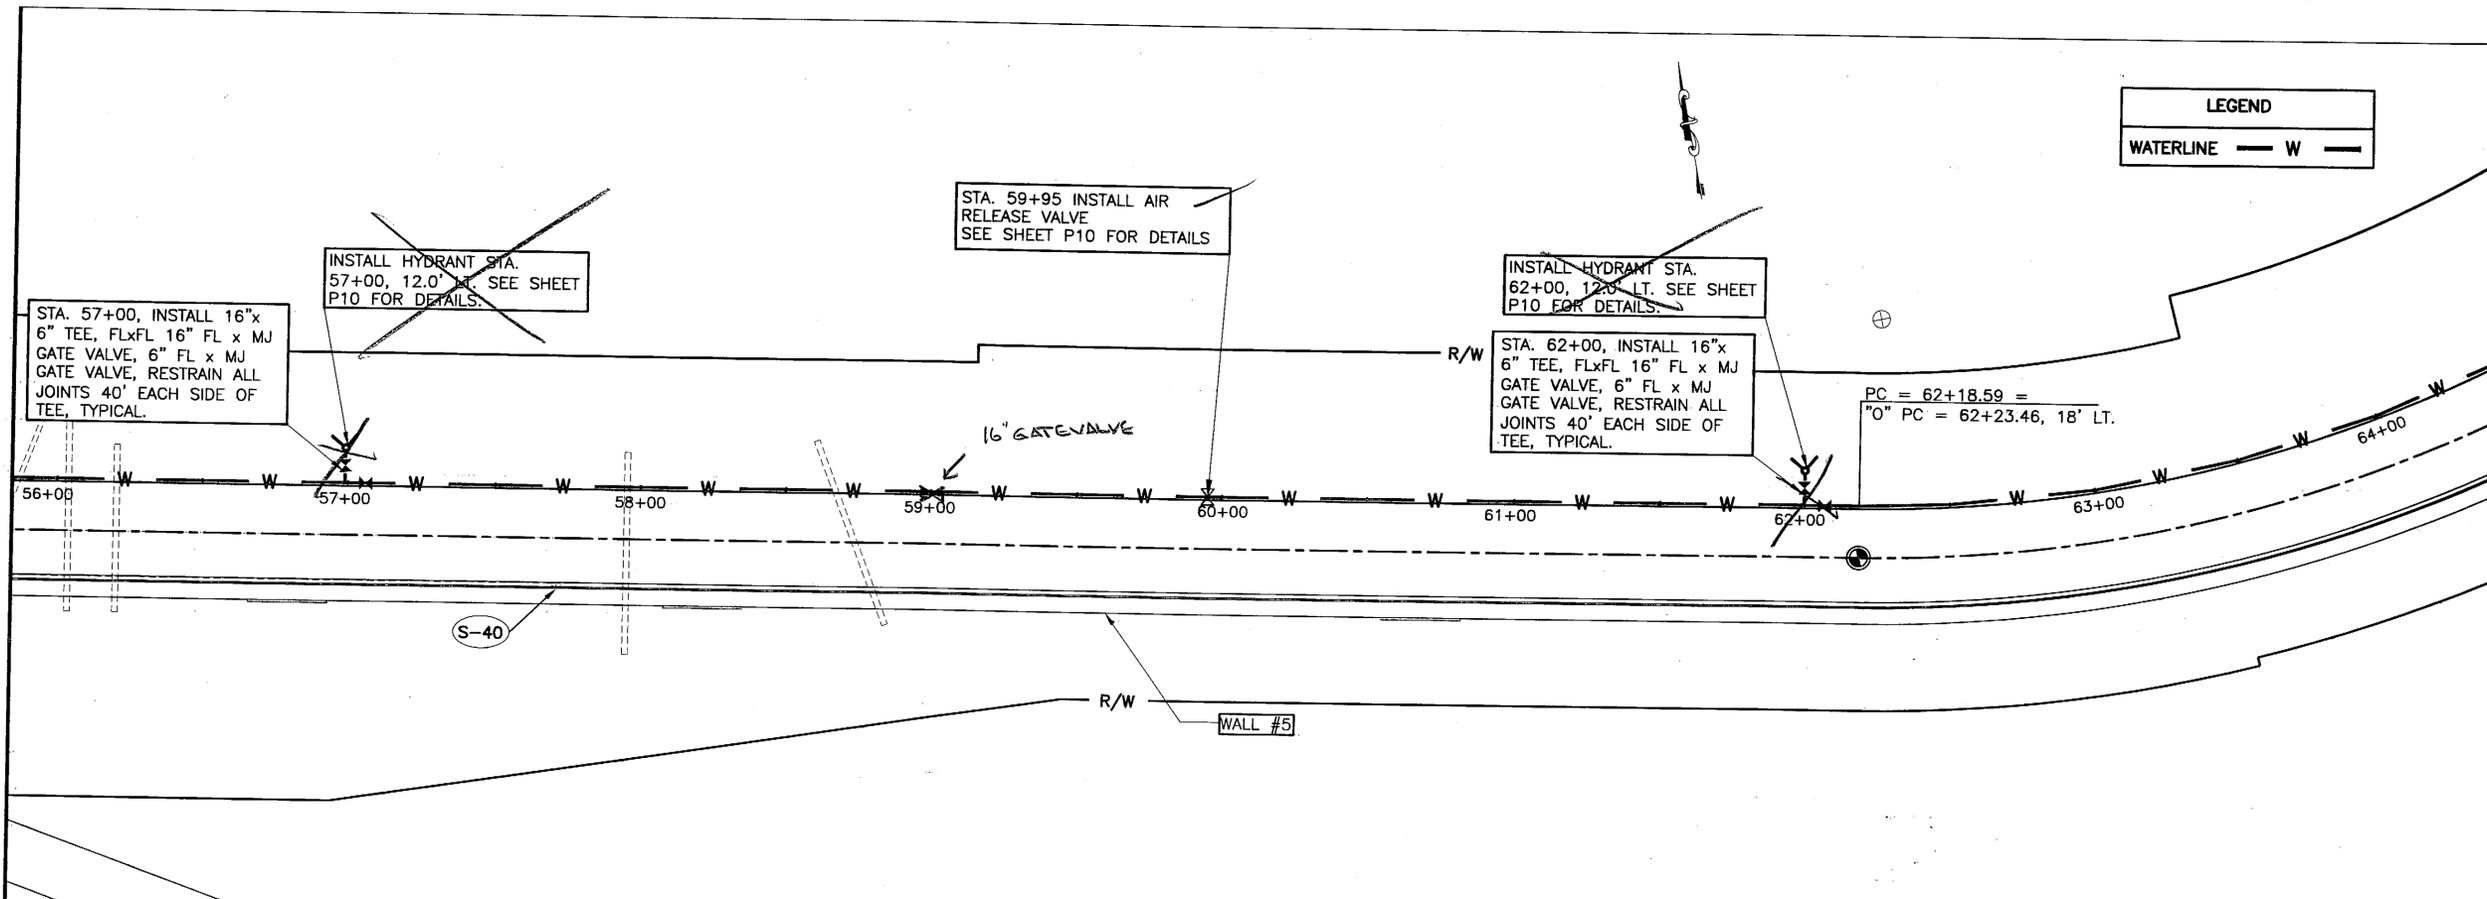


LEGEND	
WATERLINE	— W —

PATH:
 Q:\Ktn\71811A\Planset\Waterline.dwg
 Tue, 07/May/02 10:42AM Michael Limbaugh
 PLOT:
 PSPACE 1=1(F) OR MSPACE 1=1(F)
 TAB: ESTIMATE

ADDENDUM NUMBER		
ATTACHMENT NUMBER		
RECORD OF REVISIONS		
No.	DATE	DESCRIPTION

KTN-THIRD AVENUE EXTENSION
 PROJECT NO. 68490
**STA. "0" 56+00
 TO STA "0" 64+00**
 WATERLINE PLAN & PROFILE

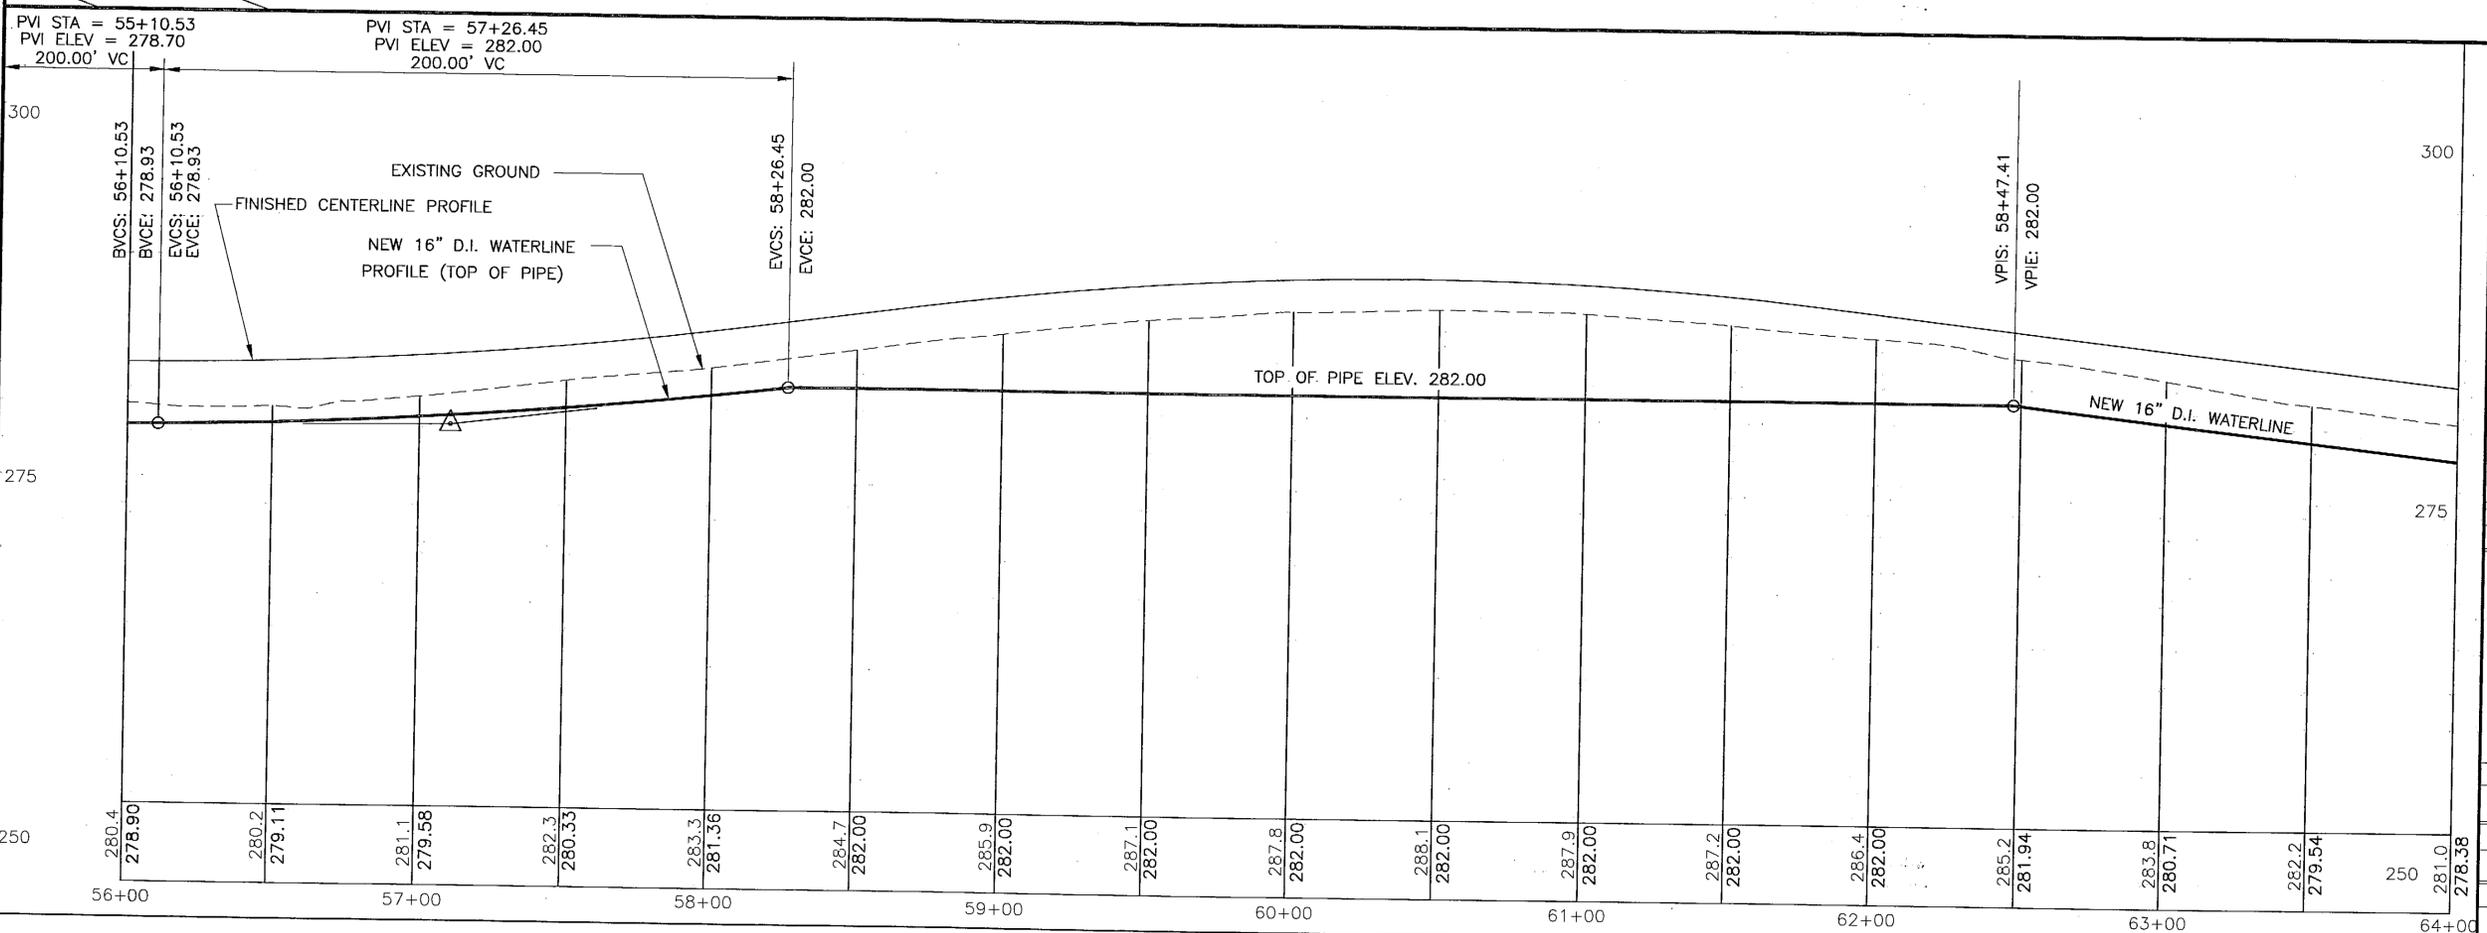

DESIGNED BY: C. HOWARD



CHECKED BY: T. MOORE
 DRAWN BY: T.M./R.S.

STATE OF ALASKA
 DEPARTMENT OF TRANSPORTATION
 & PUBLIC FACILITIES
 STATEWIDE DESIGN & ENGINEERING
 SERVICES DIVISION
 THIRD AVENUE EXTENSION
 PROJECT NO. 68490



**STA."0" 56+00
 TO STA."0" 64+00**

PROJECT DESIGNATION NUMBER
STP-MG-0904(2)

STATE	YEAR
ALASKA	2002

SHEET NUMBER	TOTAL SHEETS
P8	146

Project As Built Drawings have been reviewed by the Project Engineer. To the best of his/her knowledge, they represent the project as constructed.
 Proj. Eng. *[Signature]* Date: 05/06

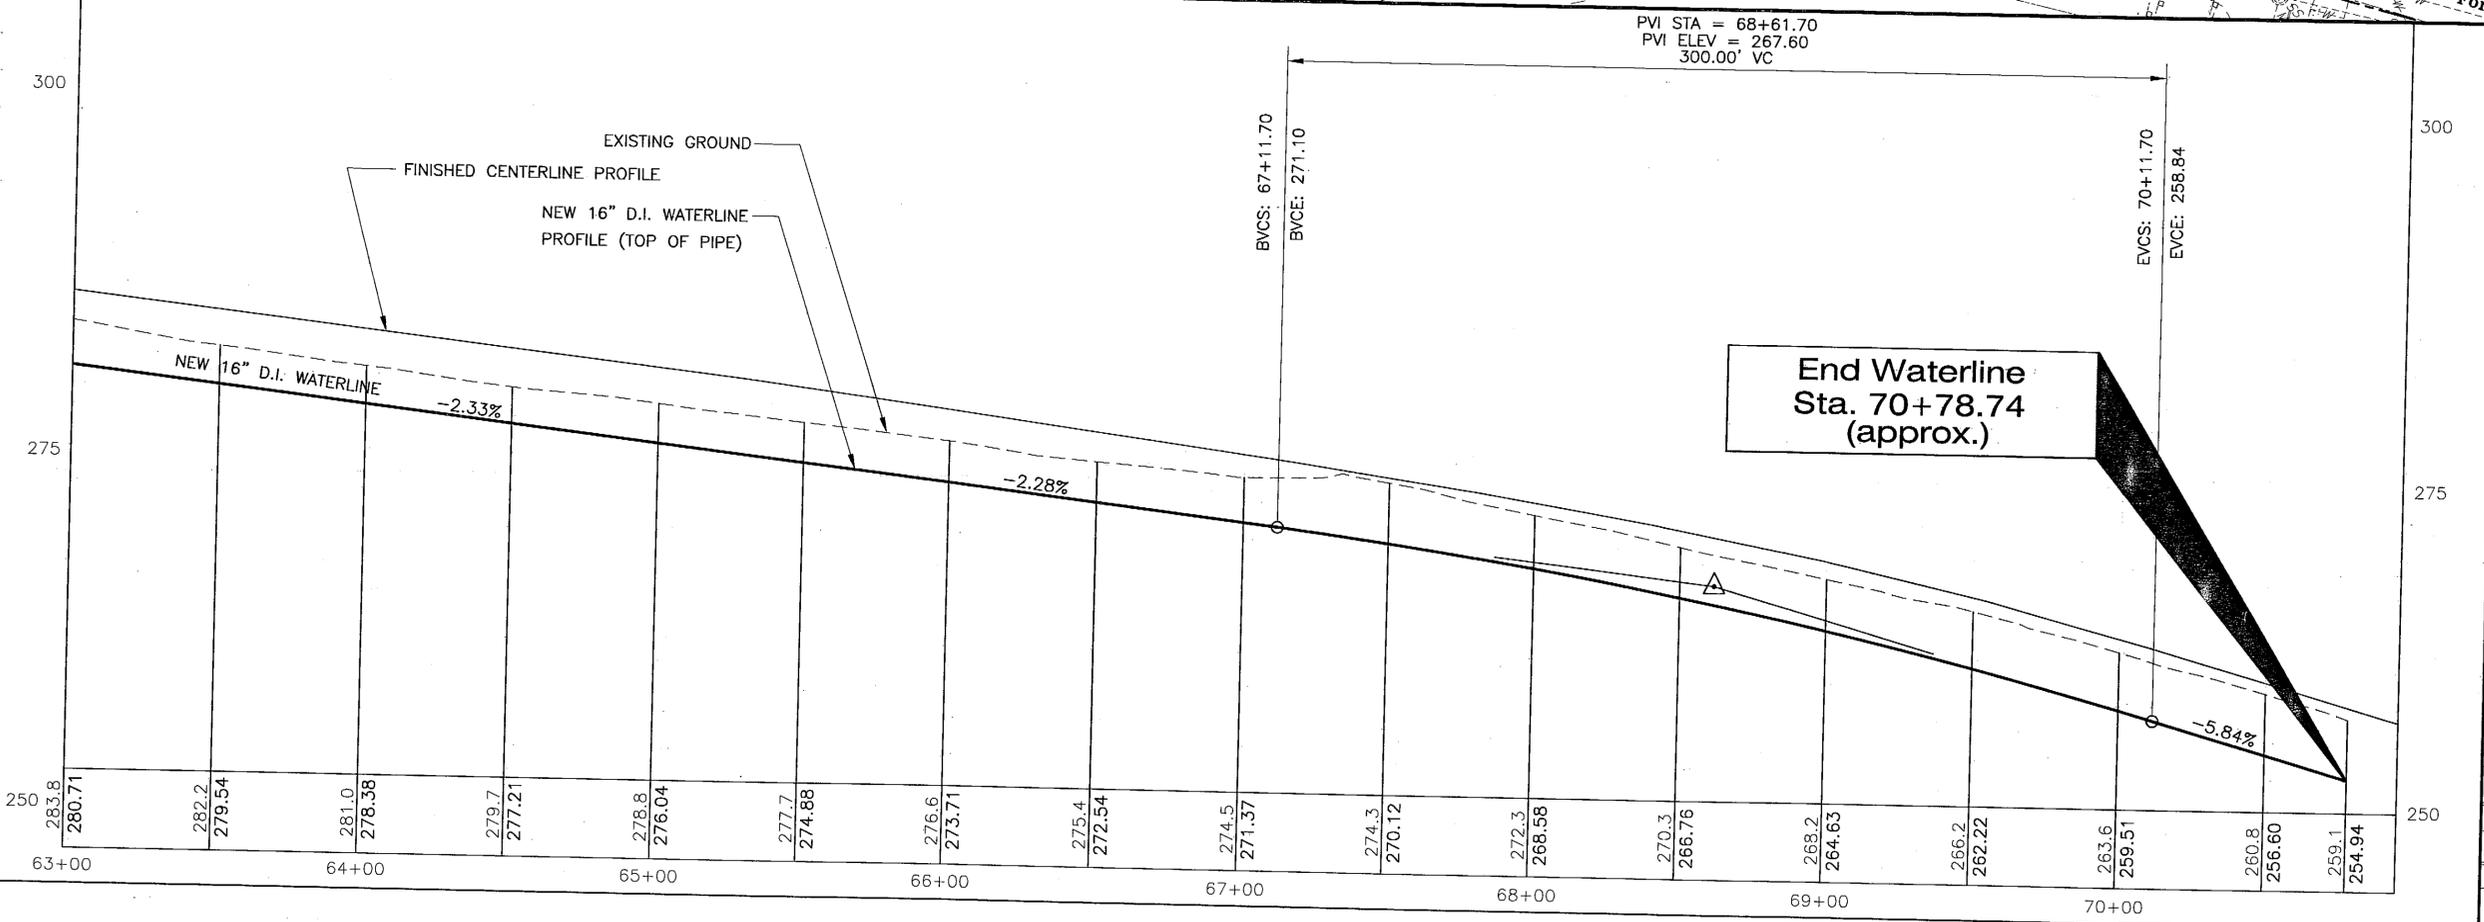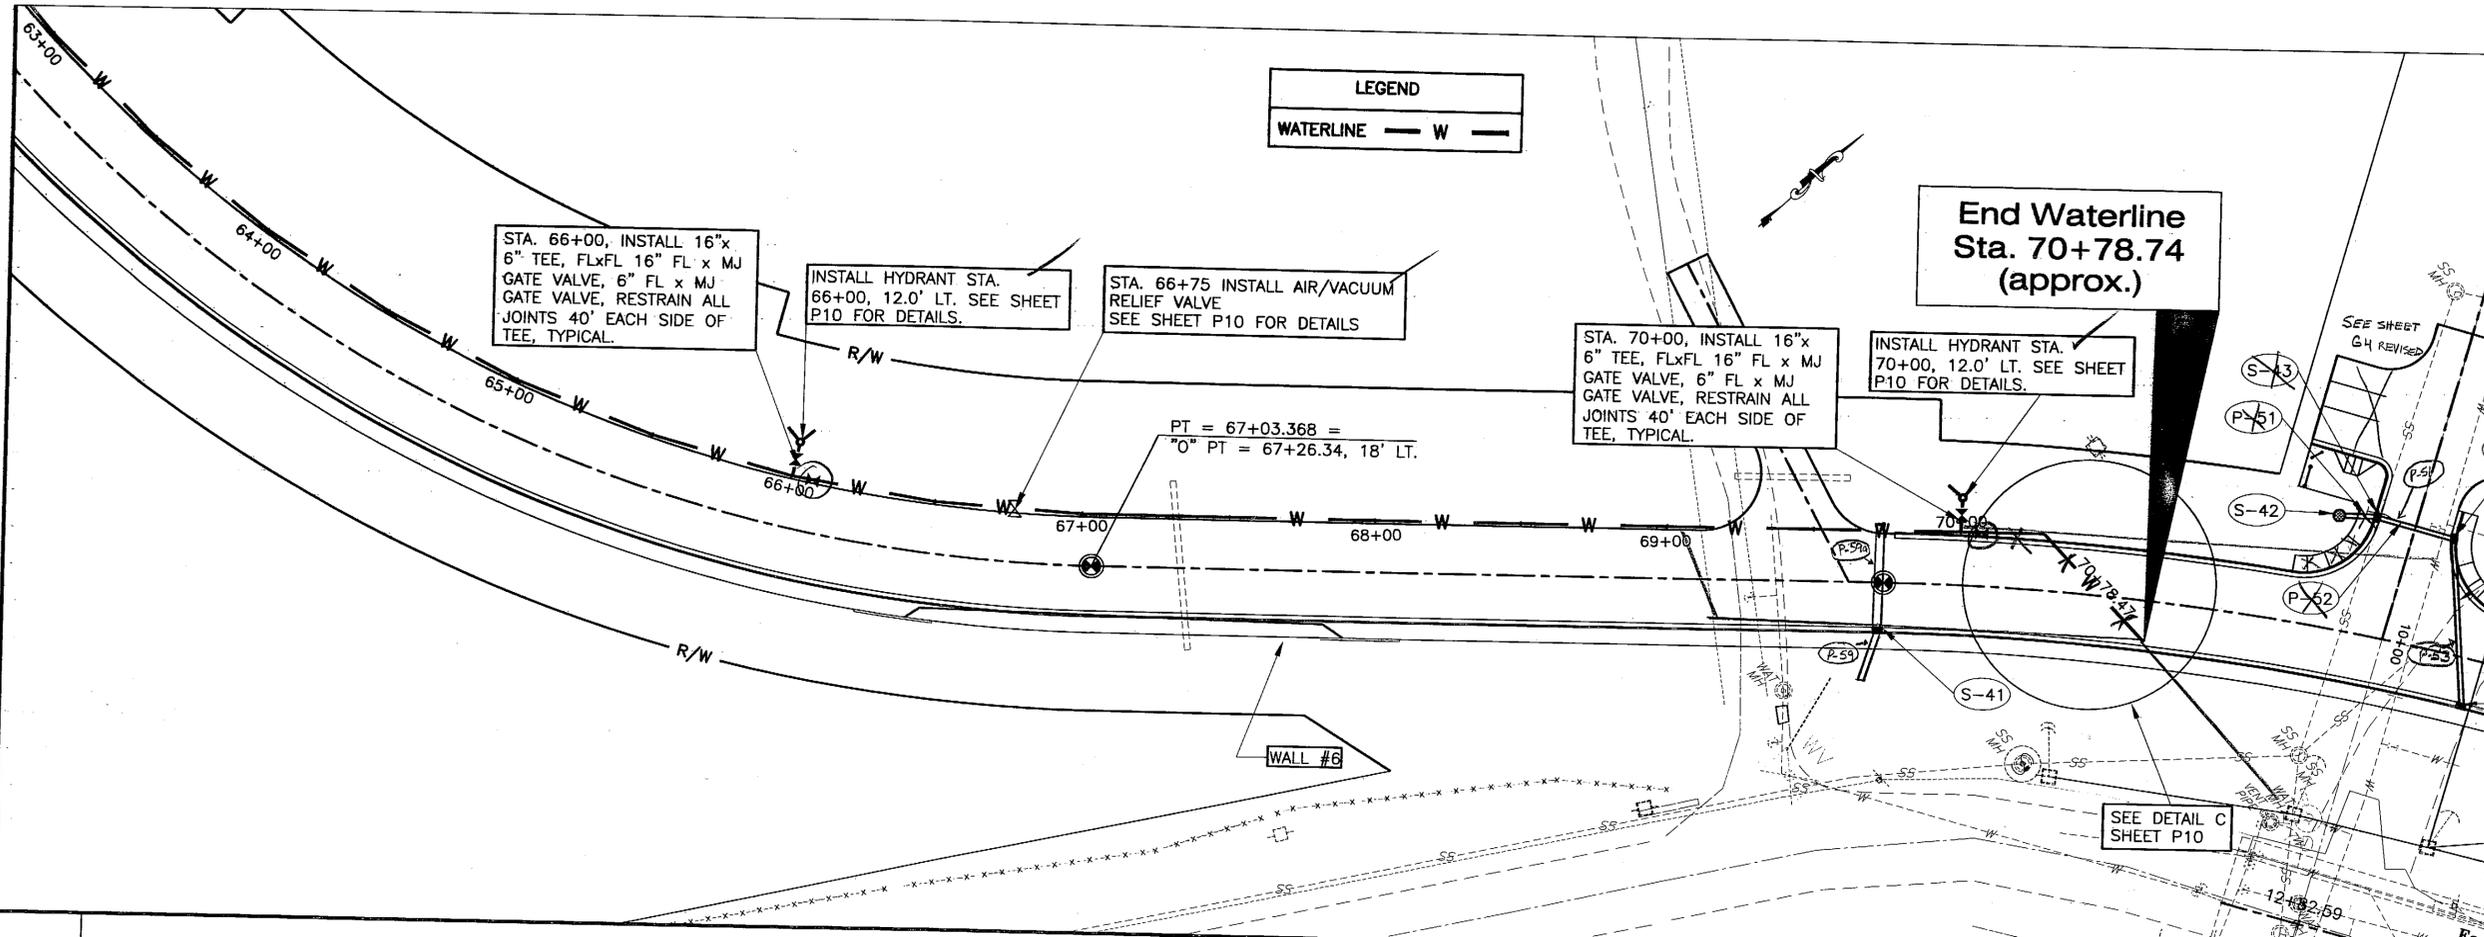

LEGEND
 WATERLINE — W —


PATH:
 G:\Ktr\71811A\Planset\P_Waterline.dwg
 Tue, 07/May/02 10:42AM Michael Limbaugh
 PLOT:
 PSPACE 1=1(F) OR MSPACE 1=1(F)
 TAB: ESTIMATE

ADDENDUM NUMBER		
ATTACHMENT NUMBER		
RECORD OF REVISIONS		
No.	DATE	DESCRIPTION

**STA. "0" 63+00
 TO STA "0" 70+00
 WATERLINE PLAN & PROFILE**

KTN-THIRD AVENUE EXTENSION
 PROJECT NO. 68490

DESIGNED BY: C. HOWARD

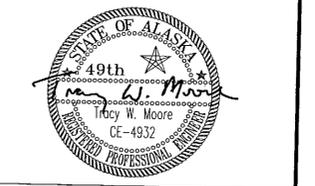


CHECKED BY: T. MOORE
 DRAWN BY: T.M./R.S.

STATE OF ALASKA
 DEPARTMENT OF TRANSPORTATION
 & PUBLIC FACILITIES
 STATEWIDE DESIGN & ENGINEERING
 SERVICES DIVISION
 THIRD AVENUE EXTENSION
 PROJECT NO. 68490


**STA."0" 63+00
 TO STA."0" 70+00**

PROJECT DESIGNATION NUMBER	
STP-MG-0904(2)	
STATE	YEAR
ALASKA	2002
SHEET NUMBER	TOTAL SHEETS
P9	146


Project As Built Drawings have been reviewed by the Project Engineer. To the best of his/her knowledge, they represent the project as constructed.
 Proj. Eng. _____ Date: 05-06

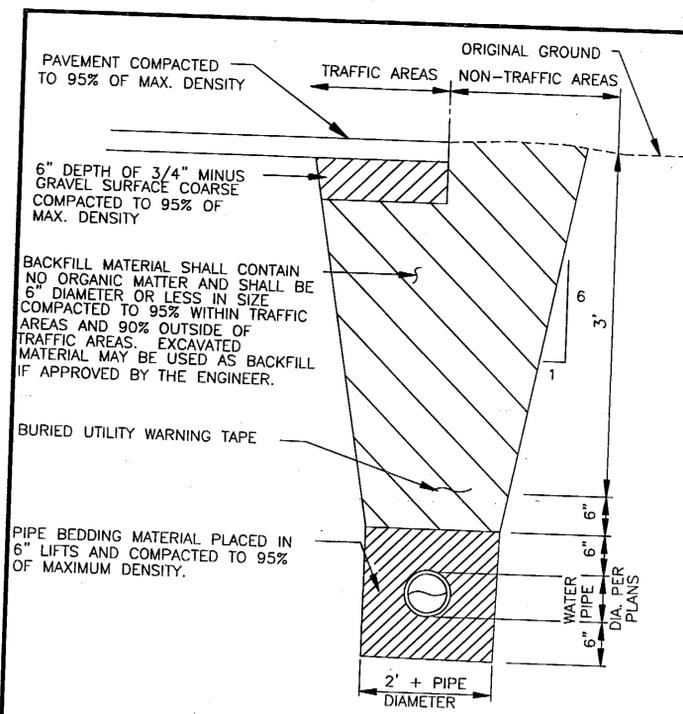

TYPICAL WATER TRENCH
NOT TO SCALE

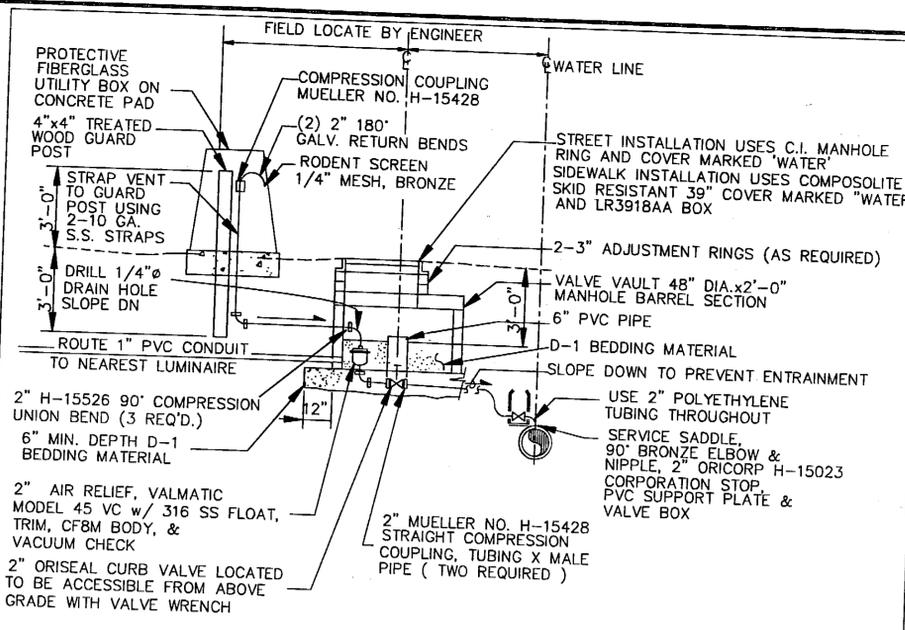


AIR RELIEF VALVE ASSEMBLY
STATION 59+95
NOT TO SCALE

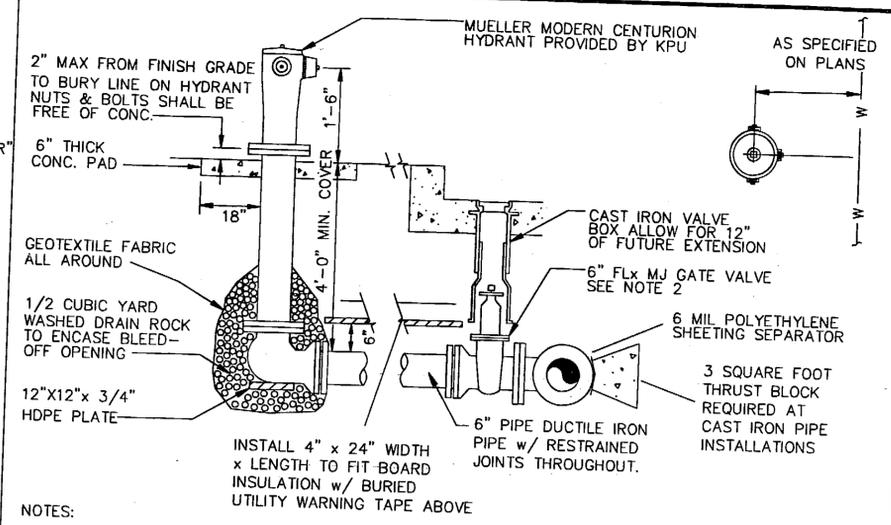


TYPICAL BURIED FIRE HYDRANT
NOT TO SCALE

NOTES:


1. ALL BOLT THREADS TO BE GREASED PRIOR TO INSTALLATION.
2. MECHANICAL RESTRAINED JOINTS TO BE USED THROUGHOUT.
3. HYDRANT PAINT SHALL BE SPECIFIED BY THE ENGINEER.
4. DOUBLE DIPPED GALVANIZED NUTS AND BOLTS SHALL BE FREE OF CONCRETE.
5. PLACE BURIED UTILITY WARNING TAPE ABOVE THE HYDRANT LEAD.

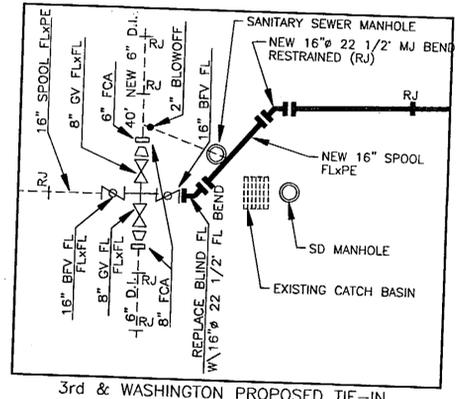


DETAIL A

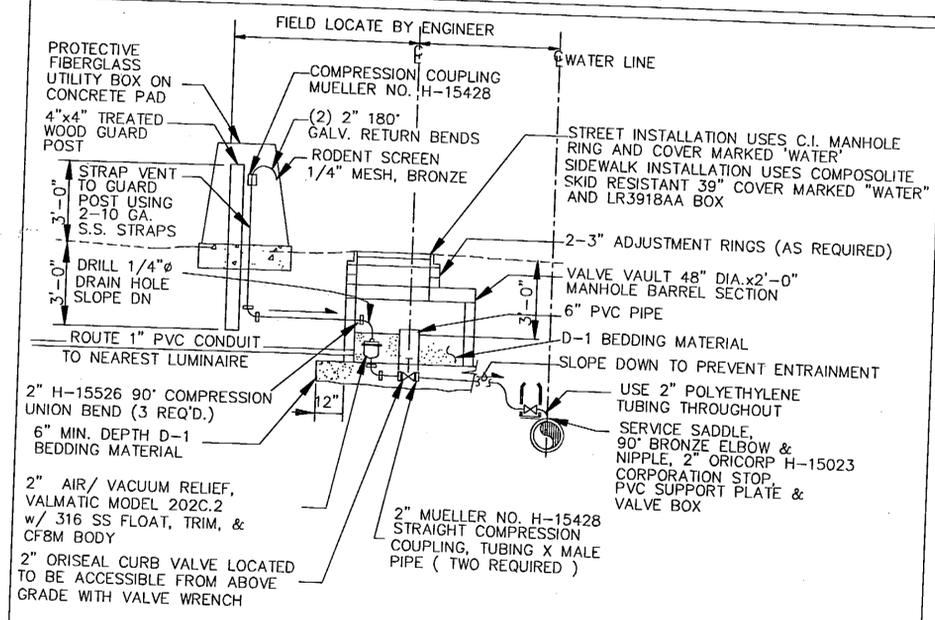


AIR/VACUUM RELIEF VALVE ASSEMBLY
STATIONS 53+15 & 66+75
NOT TO SCALE

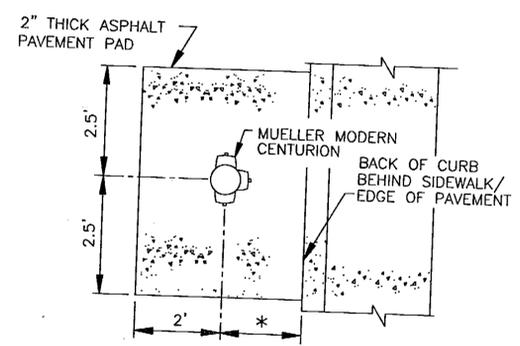

FIRE HYDRANT PAD
NOT TO SCALE
* VARIES, SEE PLAN FOR OFFSET DISTANCE

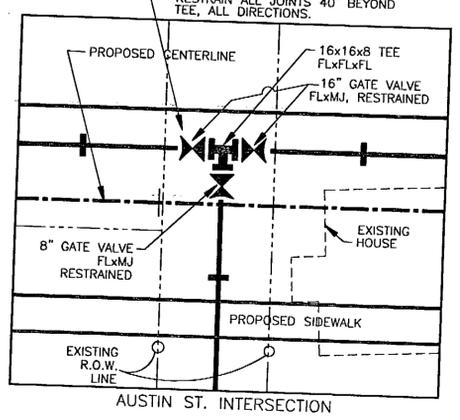


DETAIL B

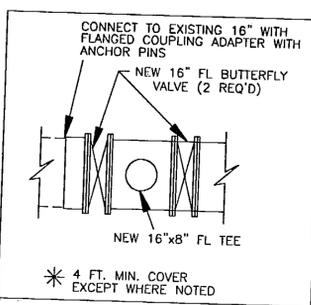

NOTES:

1. BACKFILL MATERIAL SHALL BE PLACED IN 12" MAXIMUM LIFTS.
2. TRENCH EXCAVATION AND SHORING SHALL COMPLY WITH LOCAL, STATE, AND OSHA REGULATIONS AND REQUIREMENTS. INDICATED SLOPE IS FOR PAY QUANTITY DETERMINATION ONLY FOR IMPORTED BACKFILL GRAVEL AND RESURFACING REQUIREMENTS.
3. ENGINEER MAY DIRECT THE CONTRACTOR TO OVER-EXCAVATE AND BACKFILL WITH SUITABLE MATERIAL, IF UNSUITABLE PIPE FOUNDATION MATERIAL IS ENCOUNTERED DURING EXCAVATION.
4. THE DITCH LINE, IF ONE EXISTS, SHALL BE RESHAPED IN SUCH A MANNER TO ALLOW POSITIVE DRAINAGE TO MATCH PRE-CONSTRUCTION CONDITIONS.

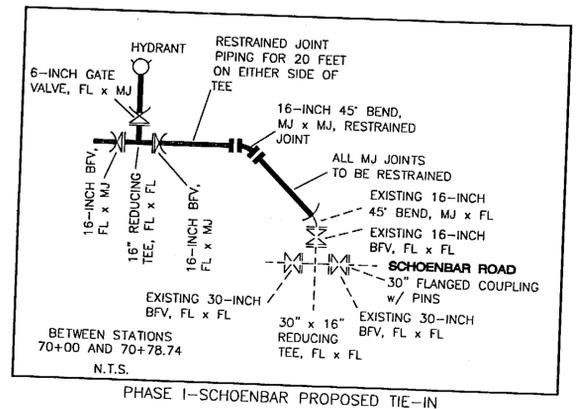

DETAIL C

PATH: Q:\ktr\71811A\PlanSet\P_Waterline.dwg
 Man: 06/May/02 11:12AM Michael Limbough
 PLOT: PSPACE 1=1(F) OR MSPACE 1=1(F)
 TAB: ESTIMATE

ADDENDUM NUMBER		
ATTACHMENT NUMBER		
RECORD OF REVISIONS		
No.	DATE	DESCRIPTION

KTN-THIRD AVENUE EXTENSION
PROJECT NO. 68490

Waterline Details

DESIGNED BY: C. HOWARD




CHECKED BY: T. MOORE
 DRAWN BY: T.M./R.S.


STATE OF ALASKA
 DEPARTMENT OF TRANSPORTATION & PUBLIC FACILITIES
 STATEWIDE DESIGN & ENGINEERING SERVICES DIVISION
THIRD AVENUE EXTENSION
PROJECT NO. 68490

Waterline Details


PROJECT DESIGNATION NUMBER	
STP-MG-0904(2)	
STATE	YEAR
ALASKA	2002
SHEET NUMBER	TOTAL SHEETS
P10	146

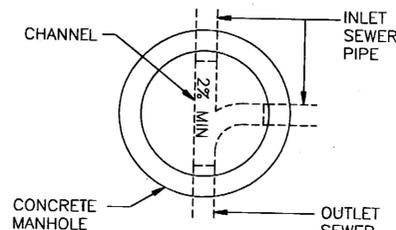


PLAN OF BASE AND FLOW CHANNELS

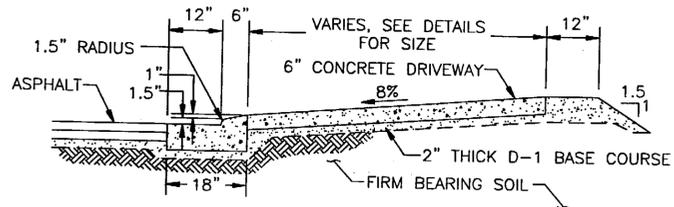

DRIVEWAY DETAIL

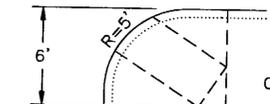


TYPICAL FOR 6' SIDEWALK

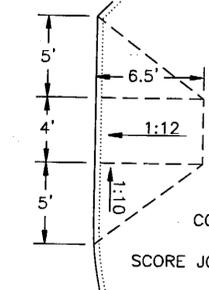


TYPICAL FOR WIDE SIDEWALK


HANDICAPPED RAMP

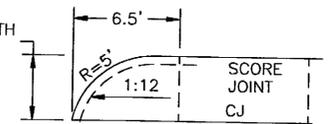

TYPICAL FOR SIDEWALK HANDICAPPED RAMP

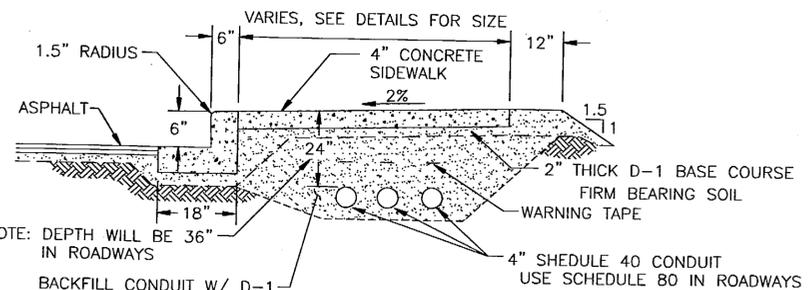


SIDEWALK DETAIL

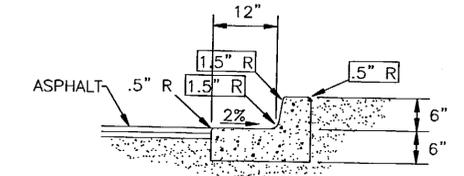


MIN 2" LAYER D-1 BASE COURSE INCLUDED IN UNIT PRICE OF C&G
D-1 SHOULDER INCLUDED IN UNIT PRICE OF C&G


CONCRETE CURB & GUTTER

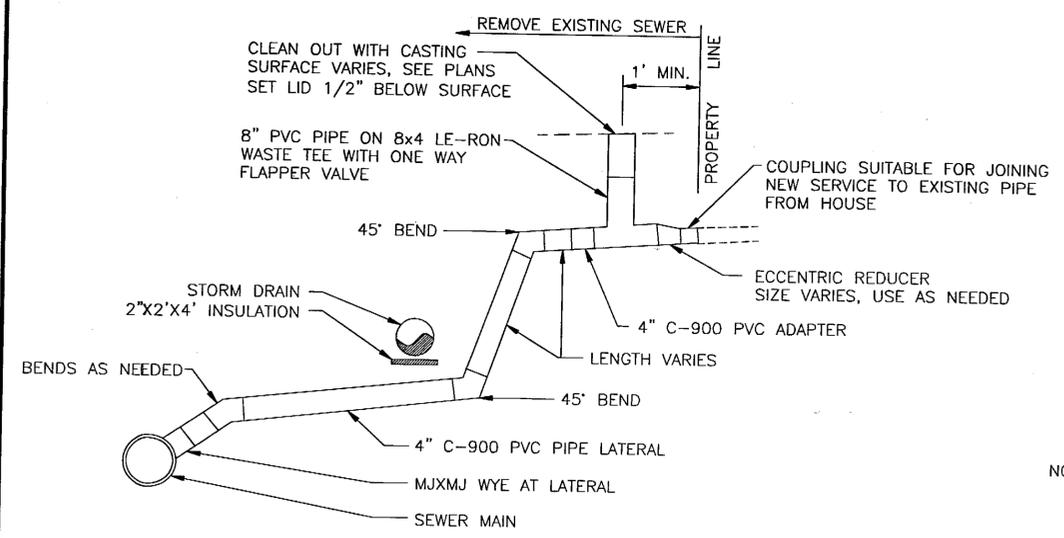


SEWER LATERAL PROFILE

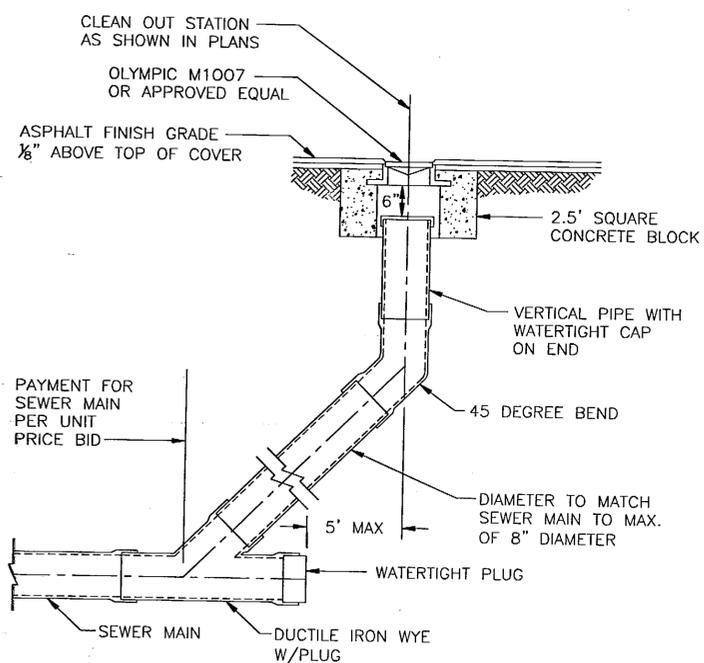

SEWER CLEAN OUT IN STREET

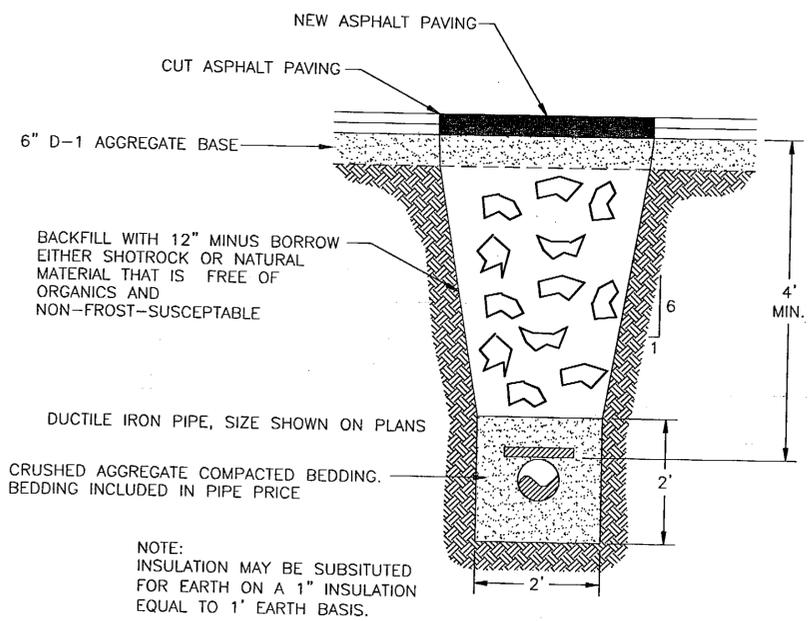

TYPICAL SEWER OR STORM DRAIN TRENCH

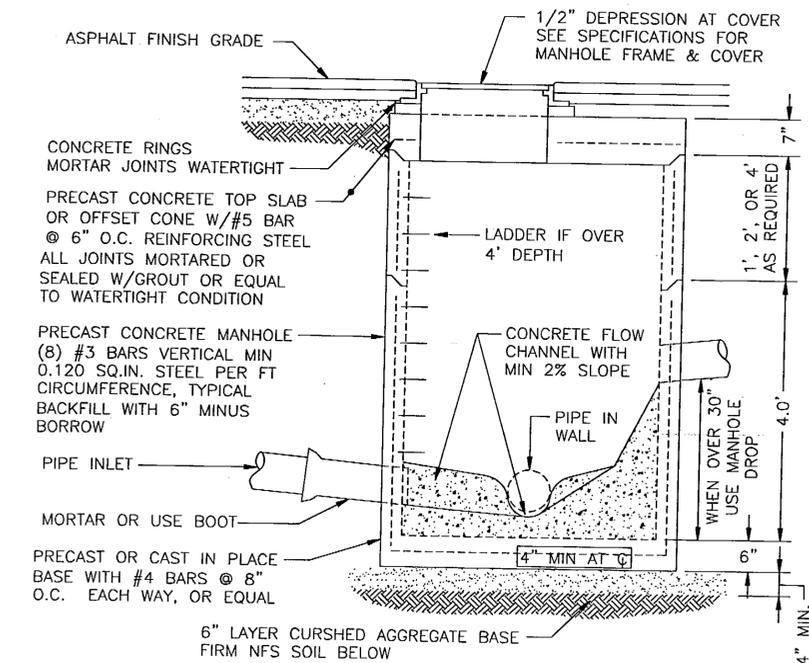

MANHOLE SECTION


PATH:
O:\ktn\71811A\PlanSet\P_Trench_Dets.dwg
Mon, 06/May/02 09:47AM
PLOT:
Michael Limbaugh
PSPACE: 1=1(F) OR MSPACE: NO SCALE
TAB: MANHO VAL AJ-N4

ADDENDUM NUMBER		
ATTACHMENT NUMBER		
RECORD OF REVISIONS		
No.	DATE	DESCRIPTION

KTN-THIRD AVENUE EXTENSION
PROJECT NO. 68490

**Whitecliff Avenue Details
And
Sanitary Sewer Manhole Details**

DESIGNED BY: C. HOWARD

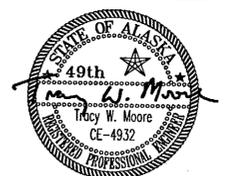

CHECKED BY: T. MOORE
DRAWN BY: T.M./R.S.

STATE OF ALASKA
DEPARTMENT OF TRANSPORTATION
& PUBLIC FACILITIES
STATEWIDE DESIGN & ENGINEERING
SERVICES DIVISION
**THIRD AVENUE EXTENSION
PROJECT NO. 68490**

**Sanitary Sewer
Manhole Details**

PROJECT DESIGNATION NUMBER

STP-MG-0904(2)

STATE YEAR

ALASKA 2002

SHEET NUMBER TOTAL SHEETS


P11 146

Project As Built Drawings have been reviewed by the Project Engineer. To the best of his/her knowledge, they represent the project as constructed.


Proj Eng *TS* Date 10/31/06

MANHOLE NOTES

- REFER TO A.S.T.M. DESIGNATION C-478 FOR DESIGN REQUIREMENTS.
- MINIMUM STEEL REQUIRED FOR BARREL AS PER A.S.T.M. C-478-69 SHALL BE EMBEDDED IN BASE SO THAT FIRST BARREL SECTION IS CONNECTED WITH BASE.
- RUNGS TO BE PLACED 12" O.C. ON UNOBSTRUCTED SIDE OF MANHOLE 18" MAXIMUM FROM BOTTOM OF MANHOLE AND 6" MAXIMUM FROM TOP OF CONE.
- ALL PIPES TO EXTEND 2" INTO MANHOLE.
- BLOCKOUTS TO BE FORMED.
- STORM SEWER MANHOLES SHALL BE 48" INSIDE DIAMETER FOR TYPE 1 AND 84" FOR TYPE 2.
- SPECIAL BEDDING RIPRAP, CLASS I (NO ROUND ROCK) REQUIRED FOR ALL MANHOLES, UNLESS OTHERWISE DIRECTED BY THE ENGINEER. IF SPECIAL BEDDING IS NOT REQUIRED, USE 24" MINIMUM DEPTH OF 1" MINUS WASHED ROCK. EXISTING SOILS OR OTHER GRANULAR MATERIALS MAY BE USED IF APPROVED BY THE ENGINEER AND COMPACTED TO 95% OF MAXIMUM DENSITY.

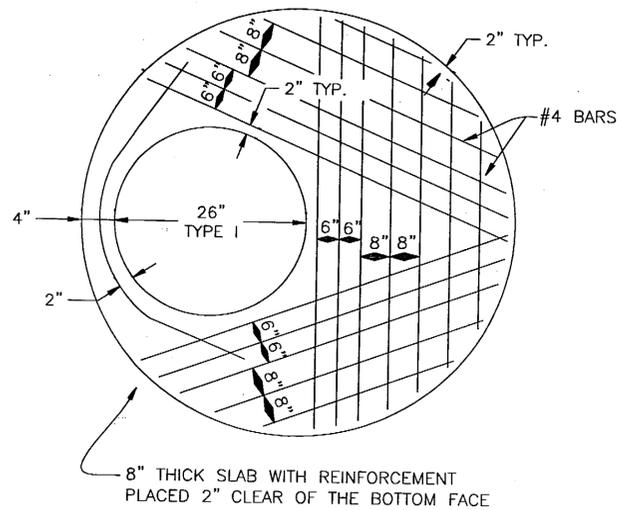

TYPE 1 MANHOLES

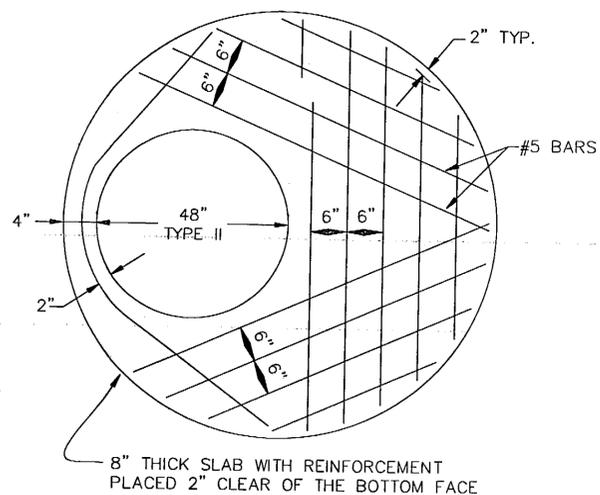


TYPE 2 MANHOLES

PRECAST CONCRETE REDUCING SLAB

N.T.S.


1

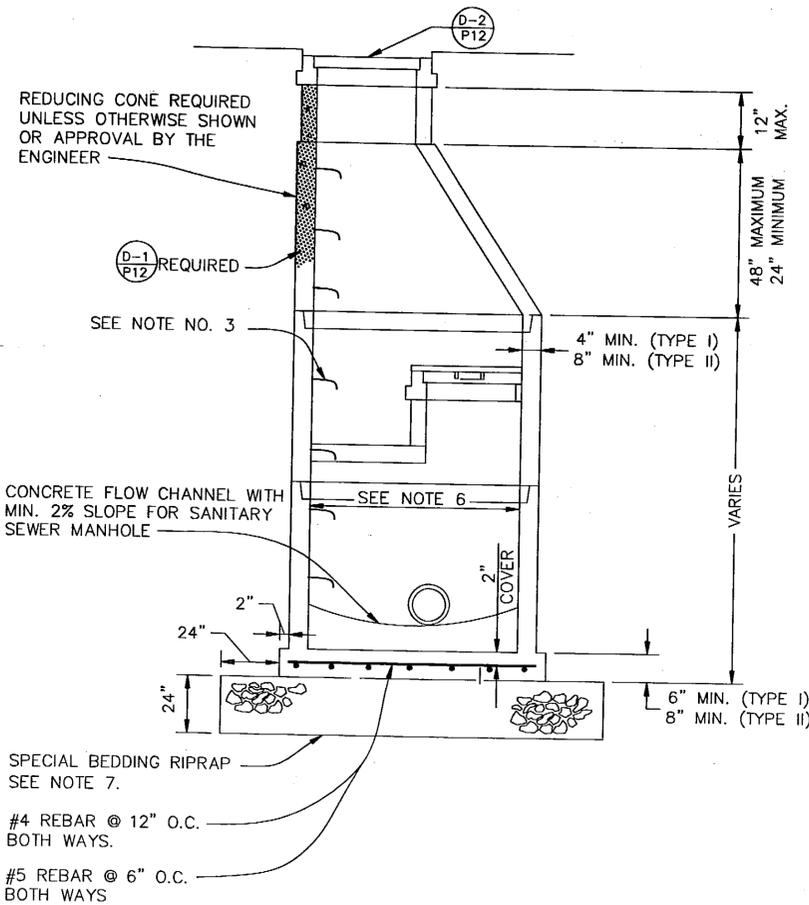


CONCRETE MANHOLE DETAIL

N.T.S.

4

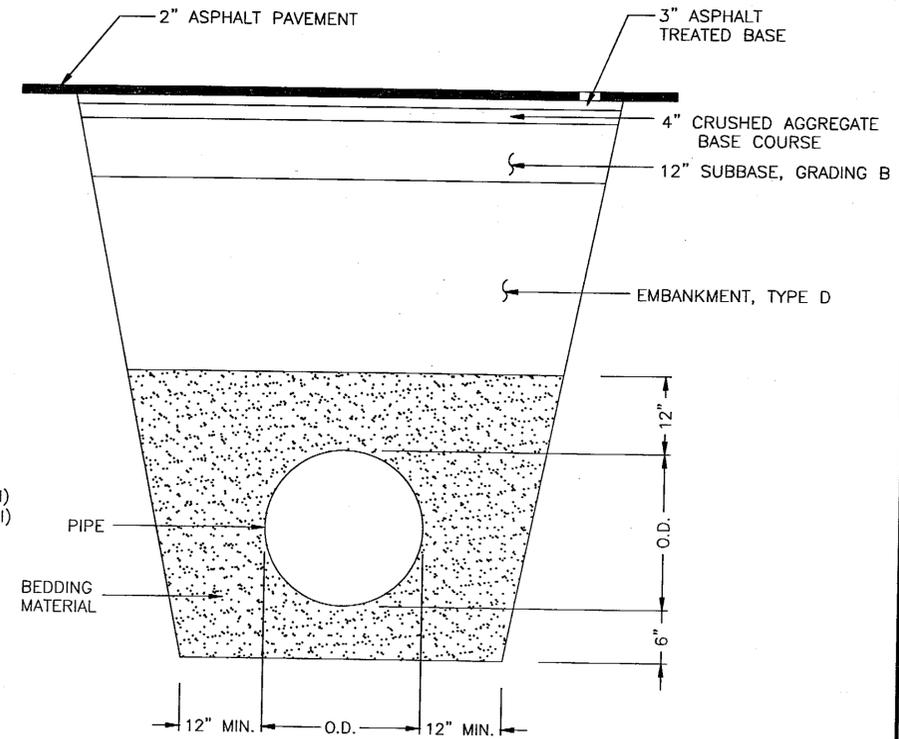

STORM DRAIN TRENCH DETAIL

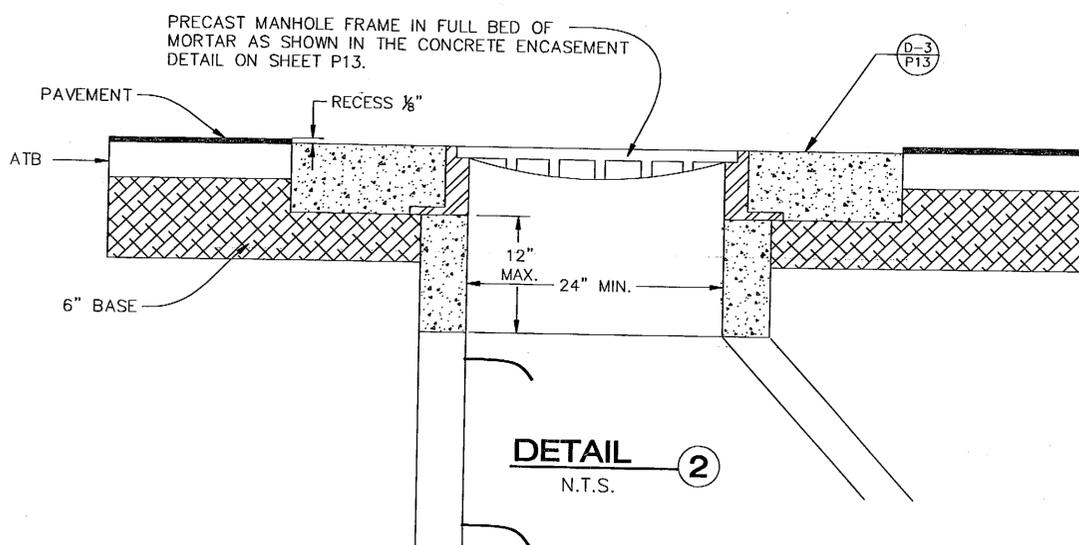

DETAIL

N.T.S.

2

PATH: Q:\Ktn\71811A\Planset\P_Trench_Dets.dwg
 Mon, 06/May/02 09:47AM Michael Limbaugh
 PLOT: PSPACE: 1=1(F) OR MSPACE: NO SCALE
 TAB: MANHO VAL AJ-N4

ADDENDUM NUMBER		
ATTACHMENT NUMBER		
RECORD OF REVISIONS		
No.	DATE	DESCRIPTION

KTN-THIRD AVENUE EXTENSION
PROJECT NO. 68490
Miscellaneous Utility Details

DESIGNED BY: C. HOWARD



CHECKED BY: T. MOORE
 DRAWN BY: T.M./R.S.


STATE OF ALASKA
 DEPARTMENT OF TRANSPORTATION
 & PUBLIC FACILITIES
 STATEWIDE DESIGN & ENGINEERING
 SERVICES DIVISION

THIRD AVENUE EXTENSION
PROJECT NO. 68490
Miscellaneous Utility Details

PROJECT DESIGNATION NUMBER
STP-MG-0904(2)

STATE	YEAR
ALASKA	2002
SHEET NUMBER	TOTAL SHEETS
P12	146


Project As Built Drawings have been reviewed by the Project Engineer. To the best of his/her knowledge, they represent the project as constructed.
 Proj. Eng. *[Signature]* Date 03/06

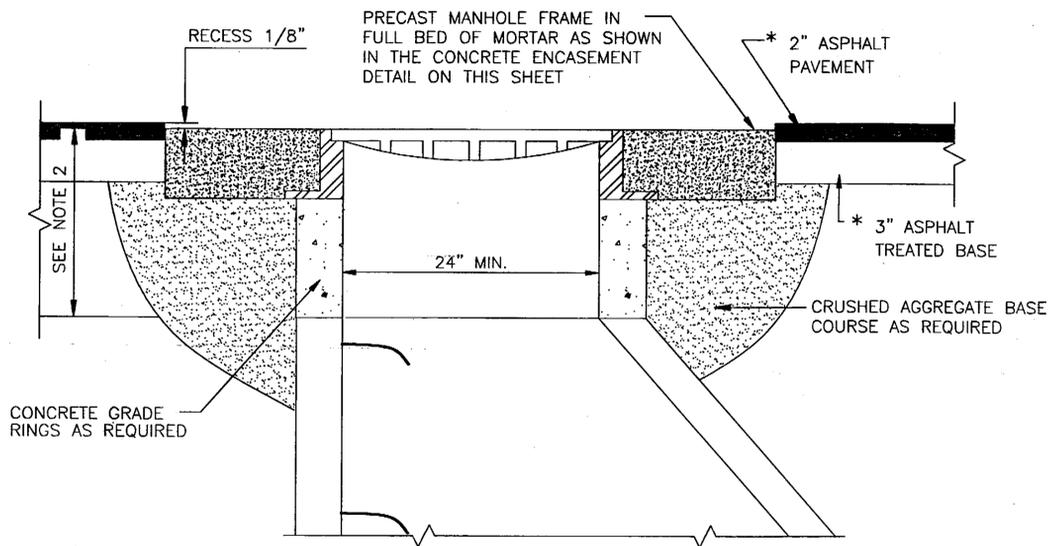

ADJUST STORM/SEWER MANHOLE

* MATCH TYPICAL SECTION

1

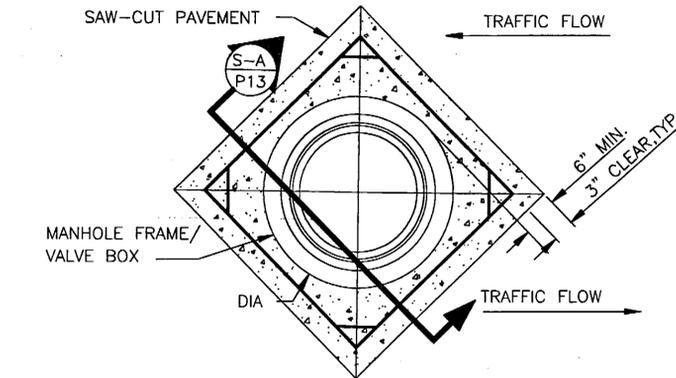


CONCRETE ENCASEMENT DETAIL

3

MANHOLE ADJUSTMENT NOTES:


1. MANHOLE ADJUSTMENT SHALL BE MADE WITH GRADE RINGS NOT EXCEEDING 12" TOTAL HEIGHT BETWEEN BOTTOM OF MANHOLE FRAME AND TOP OF MANHOLE CONE.
2. NEW STEP(S) AS DETAILED IN STD. DRAWINGS D-20.02 SHALL BE INSTALLED ON THE EXISTING MANHOLE IF THE FIRST STEP EXCEED 36" FROM THE TOP OF MANHOLE FRAME, FOR MANHOLE RECONSTRUCTION/ADJUSTMENT.
3. ANY RECONSTRUCTED OR ADJUSTED MANHOLES MUST CONFORM TO STANDARD DIMENSIONS.
4. CONCRETE ENCASEMENT IS NOT REQUIRED IF MANHOLE, INLETS OR VALVE BOX IS LOCATED IN THE SIDEWALK.

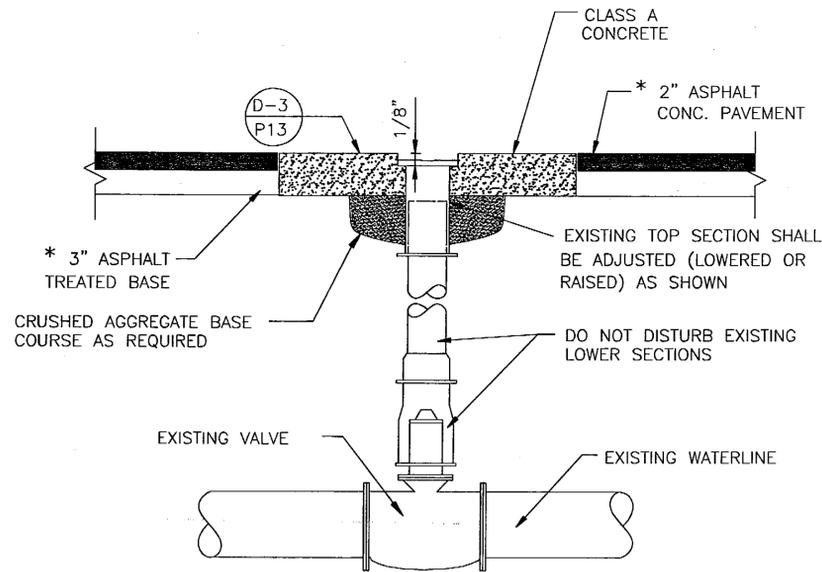

VALVE BOX ADJUSTMENT DETAIL

* MATCH TYPICAL SECTION

2

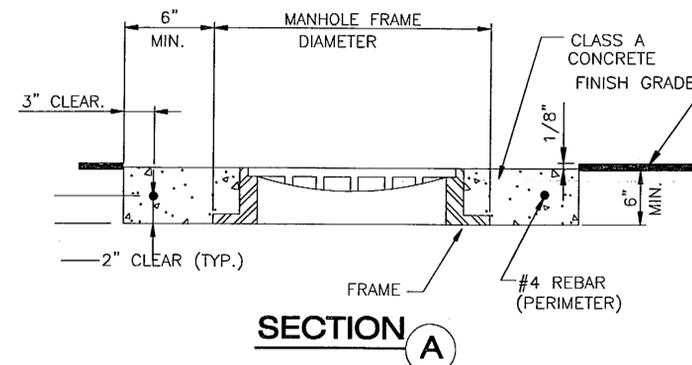

SECTION A

ADDENDUM NUMBER

ATTACHMENT NUMBER

RECORD OF REVISIONS

No.	DATE	DESCRIPTION

KTN-THIRD AVENUE EXTENSION
 PROJECT NO. 68490

Manhole & Valve Adjustment

DESIGNED BY: C. HOWARD



CHECKED BY: T. MOORE

DRAWN BY: T.M./R.S.

STATE OF ALASKA
 DEPARTMENT OF TRANSPORTATION
 & PUBLIC FACILITIES
 STATEWIDE DESIGN & ENGINEERING
 SERVICES DIVISION
**THIRD AVENUE EXTENSION
 PROJECT NO. 68490**

Manhole & Valve Adjustment

PROJECT DESIGNATION NUMBER

STP-MG-0904(2)

STATE YEAR

ALASKA 2002

SHEET NUMBER TOTAL SHEETS

P13 146

Project As Built Drawings have been reviewed by the Project Engineer. To the best of his/her knowledge, they represent the project as constructed.

Proj. Eng. *[Signature]* Date 10-21-06

ADDENDUM NUMBER		
ATTACHMENT NUMBER		
RECORD OF REVISIONS		
No.	DATE	DESCRIPTION

KTN-THIRD AVENUE EXTENSION
PROJECT NO. 68490

Waterline Details

DESIGNED BY: C. HOWARD



CHECKED BY: T. MOORE
 DRAWN BY: T.M./R.S.

STATE OF ALASKA
 DEPARTMENT OF TRANSPORTATION
 & PUBLIC FACILITIES
 STATEWIDE DESIGN & ENGINEERING
 SERVICES DIVISION
**THIRD AVENUE EXTENSION
 PROJECT NO. 68490**

**Waterline
Details**

PROJECT DESIGNATION NUMBER


STP-MG-0904(2)

STATE	YEAR
ALASKA	2002
SHEET NUMBER	TOTAL SHEETS

P14 146

Project As Built Drawings have been reviewed by the Project Engineer. To the best of his/her knowledge, they represent the project as constructed.

Proj. Eng. *[Signature]* Date: 07/06

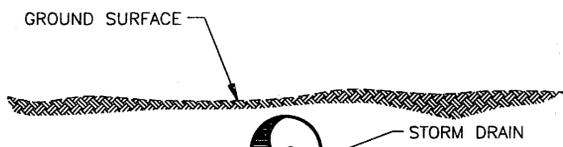


NOTE
 12-INCH MINIMUM CLEARANCE BETWEEN CULVERT INVERT AND TOP OF 16-INCH DUCTILE IRON PIPE


THREE LAYERS OF HI-60 INSULATION, 2 FOOT WIDTH X 8 FOOT LONG; AND THREE LAYERS OF HI-60 INSULATION, 2 FOOT WIDTH X 8 FOOT LONG. STAGGER EDGES SO THAT A THERMAL BREAK DOES NOT OCCUR.

**SECTION
N.T.S.**

16-INCH DUCTILE IRON WATER MAIN

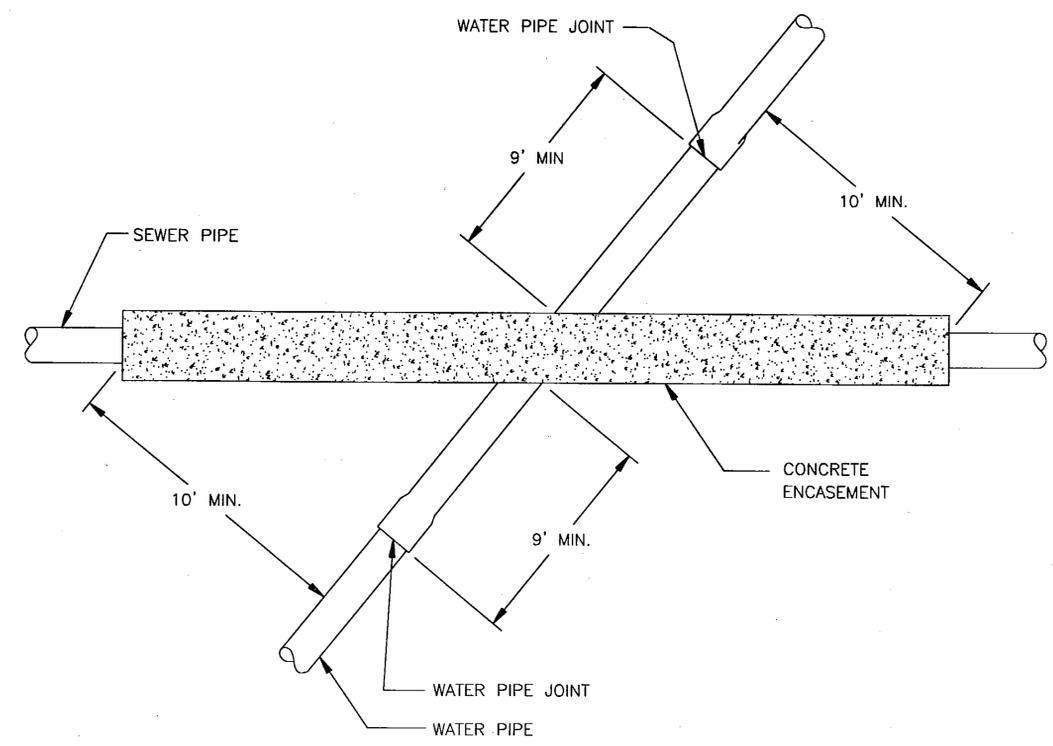


**PLAN VIEW
N.T.S.**

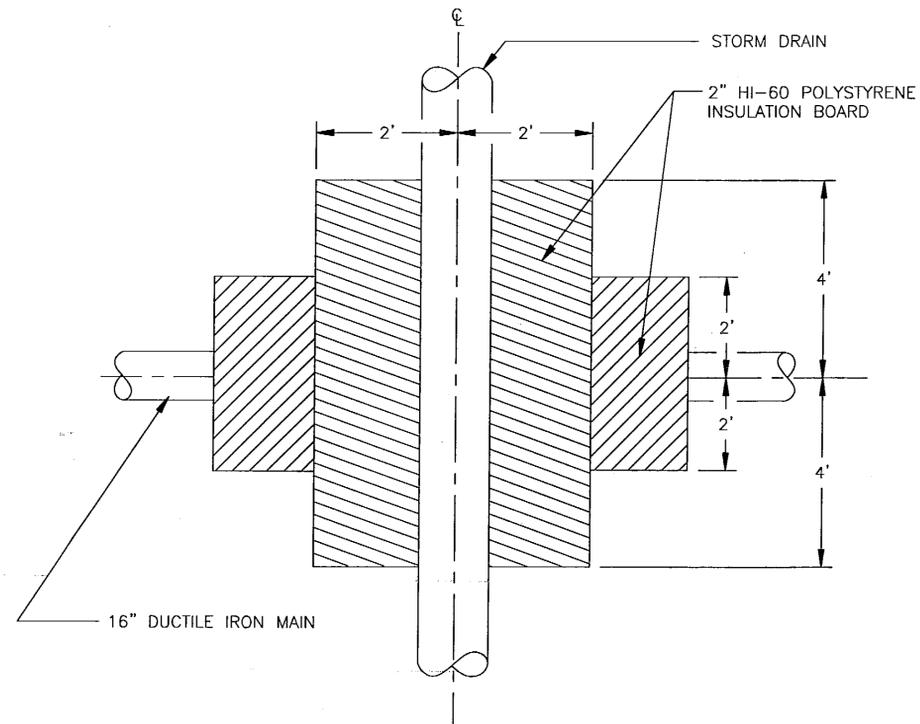


**PLAN
N.T.S.**

RIGID INSULATION

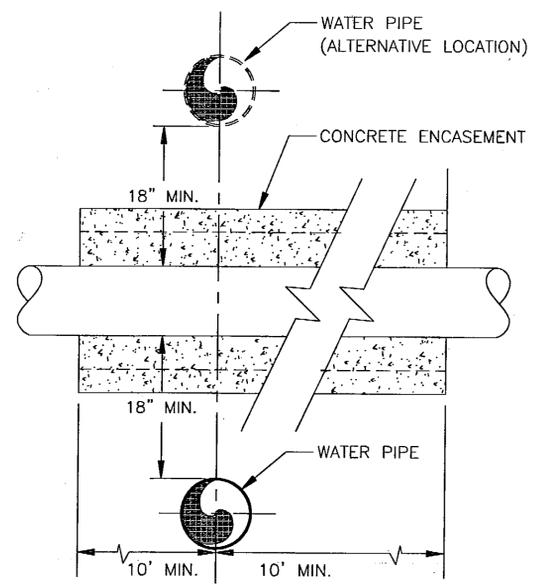

**ELEVATION VIEW
N.T.S.**

(SEE NOTE 2)

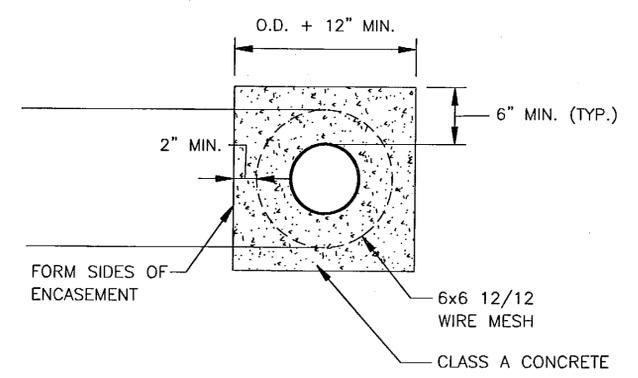

**SECTION VIEW
N.T.S.**

NOTES:


1. CONSTRUCT ENCASUREMENT WHERE WATERLINE IS WITHIN 10 FEET HORIZONTAL CLEARANCE AND IS BELOW OR LESS THAN 3 FEET ABOVE ANY EXISTING SANITARY SEWER LINES. THE SANITARY SEWER SHALL BE ENCASED WITH A JACKET OF CLASS A CONCRETE 6 INCHES THICK FOR A PERPENDICULAR DISTANCE OF 10 FEET ON EACH SIDE OF THE CROSSINGS.
2. A FULL LENGTH OF WATER PIPE SHALL BE CENTERED UNDER THE SANITARY SEWER CROSSING

SANITARY SEWER ENCASEMENT


ADDENDUM NUMBER		
ATTACHMENT NUMBER		
RECORD OF REVISIONS		
No.	DATE	DESCRIPTION

KTN-THIRD AVENUE EXTENSION
PROJECT NO. 68490


Hydrant Details

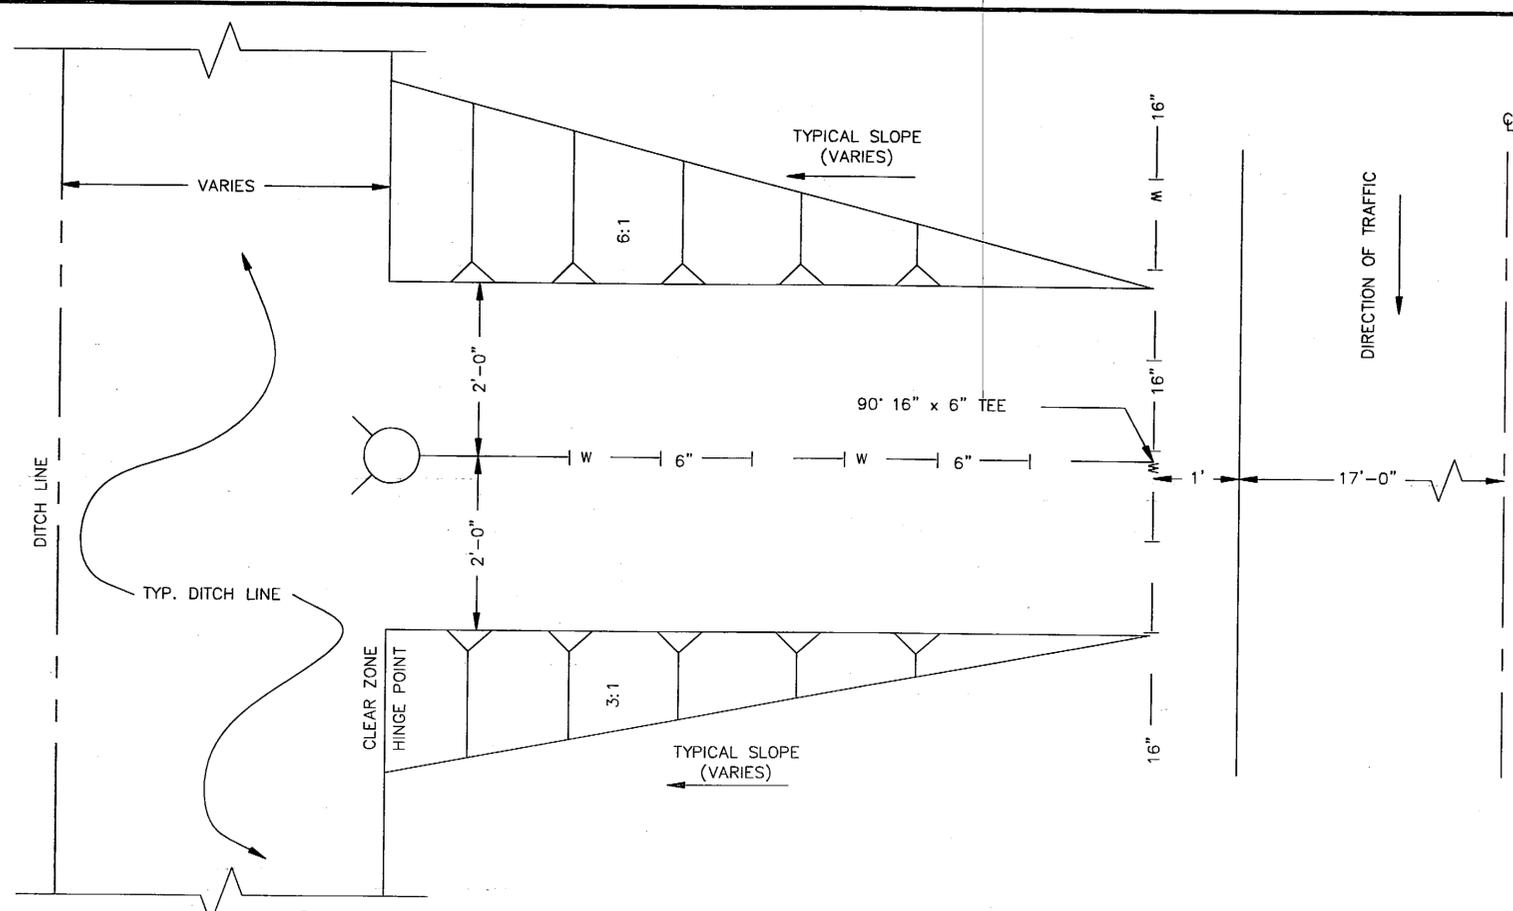

**STATION 32+00 TO STATION 62+00
PLAN VIEW**

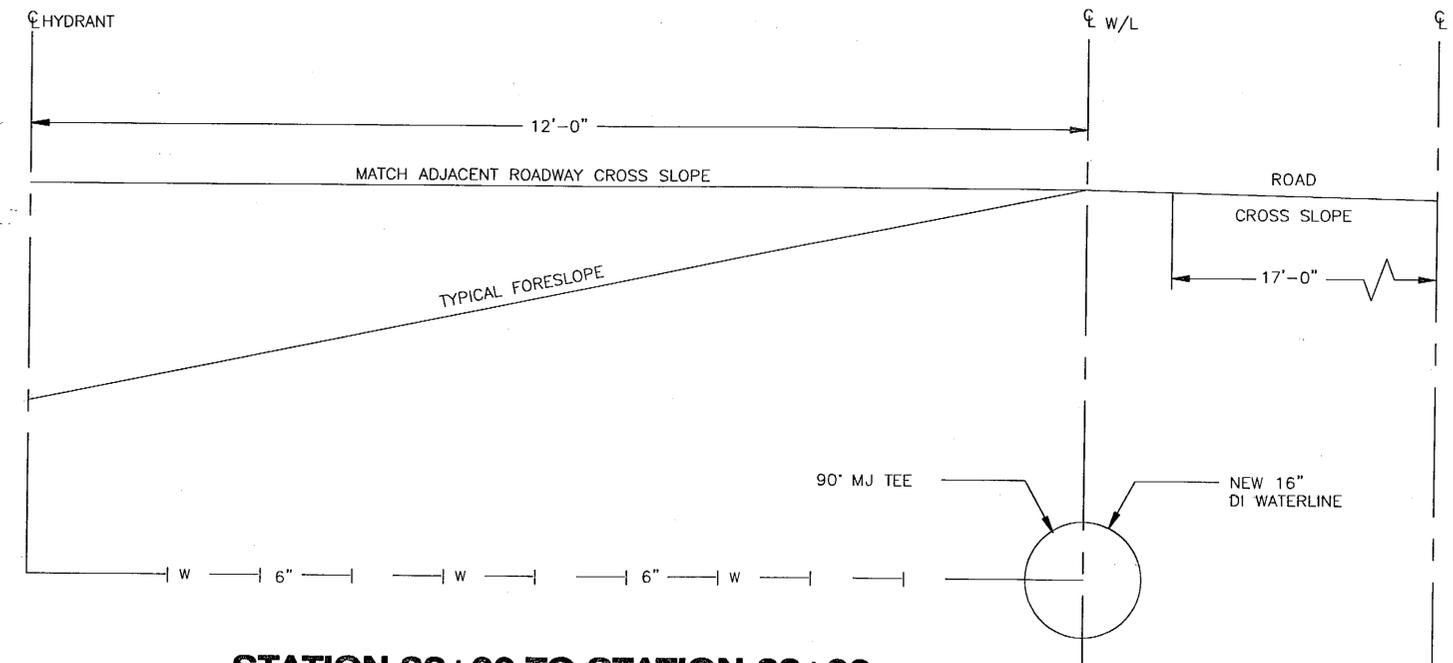

**STATION 32+00 TO STATION 62+00
SECTION VIEW**

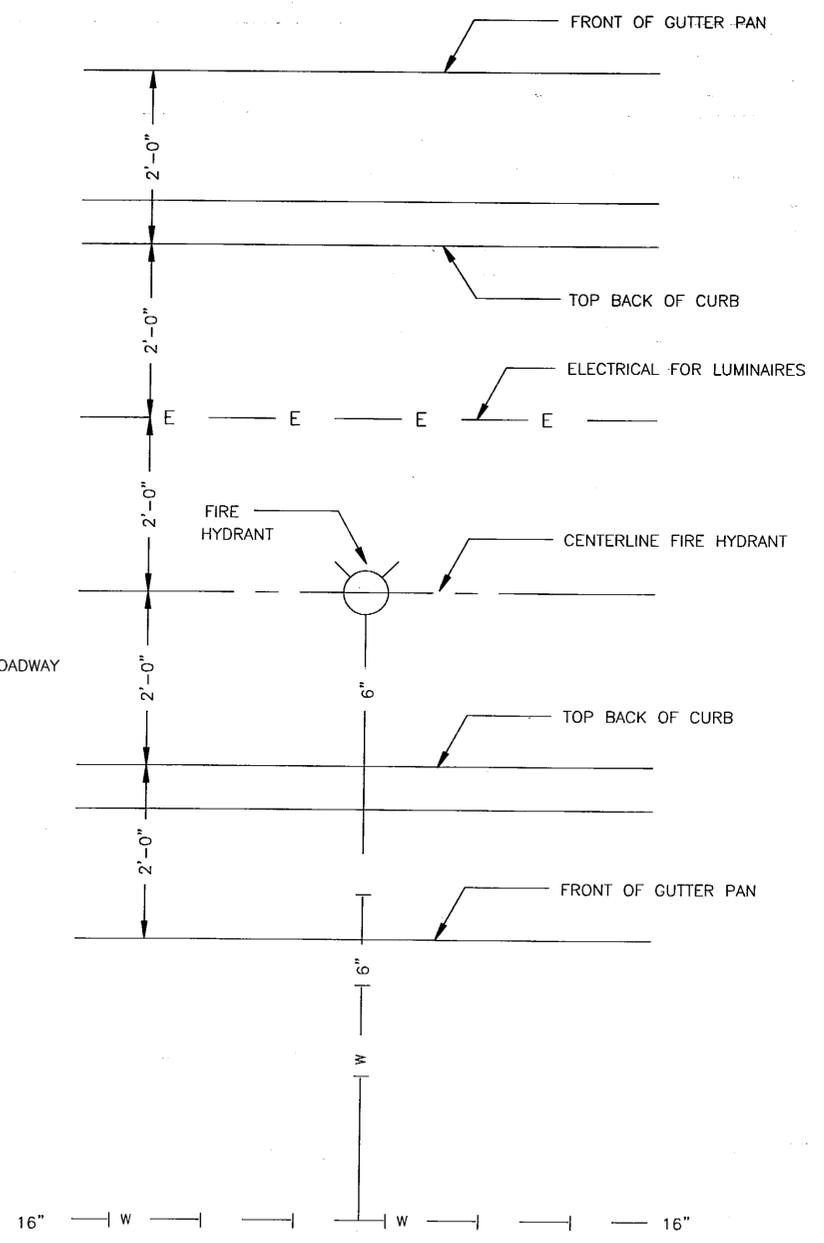

**STATION 28+00
PLAN VIEW**

DESIGNED BY: C. HOWARD



CHECKED BY: T. MOORE

DRAWN BY: K.K.

STATE OF ALASKA
DEPARTMENT OF TRANSPORTATION
& PUBLIC FACILITIES
STATEWIDE DESIGN & ENGINEERING
SERVICES DIVISION
**THIRD AVENUE EXTENSION
PROJECT NO. 68490**


Hydrant Details

PROJECT DESIGNATION NUMBER

STP-MG-0904(2)


STATE	YEAR
ALASKA	2002
SHEET NUMBER	TOTAL SHEETS
P15	146

PATH:
 C:\Ktn\71811A\PlanSet\P16_WHITECLIFF_WATER...
 Tue, 28/Jun/05 10:47AM rksnyder
 PLDT:
 PSPACE 1=1(F) OR MSPACE 1=1(F)
 TAB: layout1 (2)

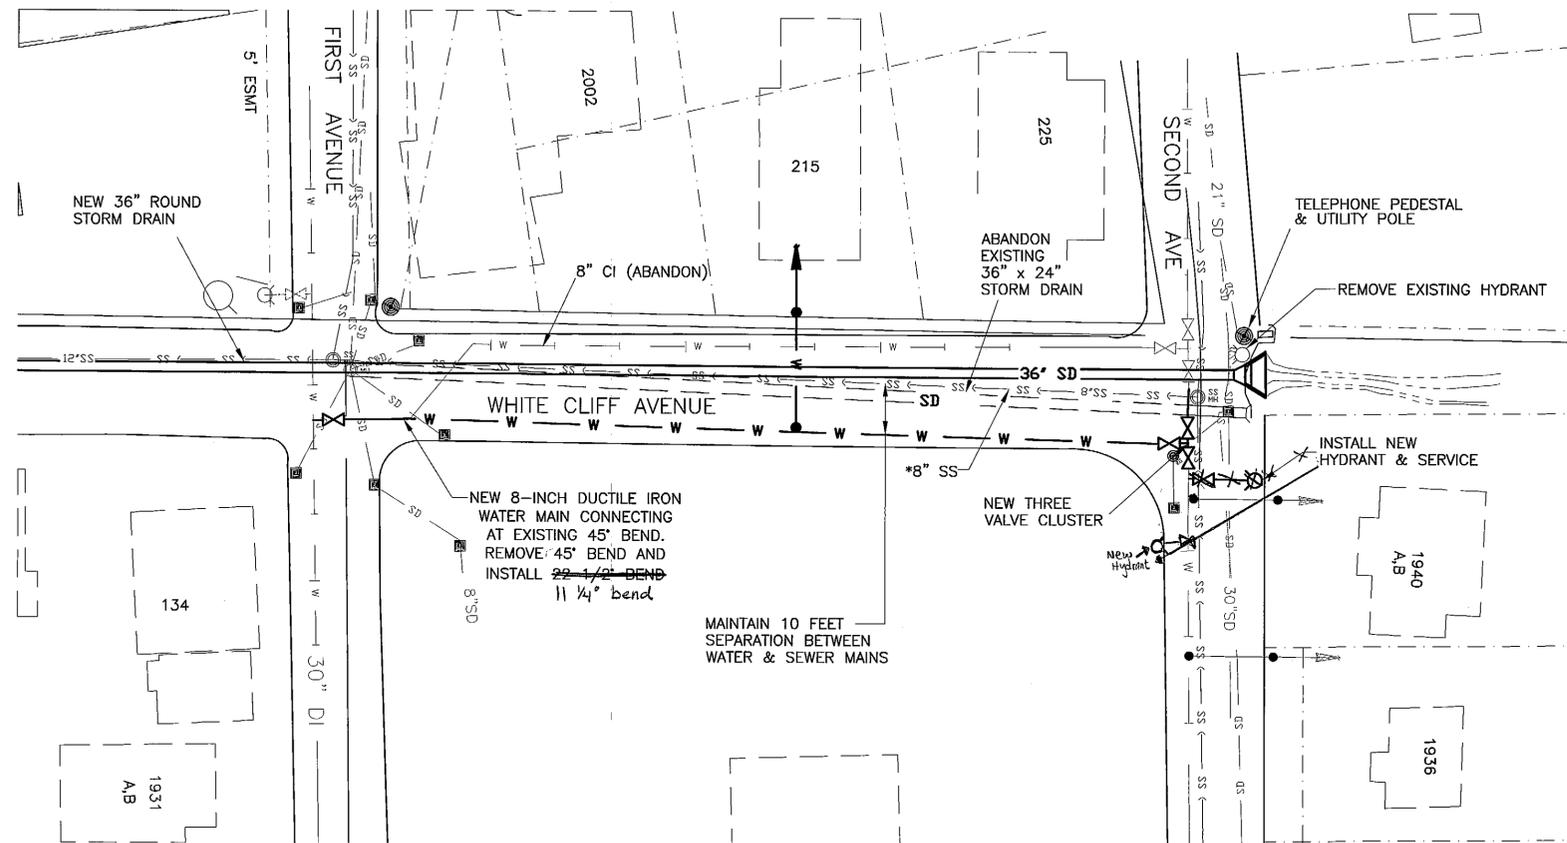

*NOTE: SEE SHEET P2 FOR LOCATION OF NEW SANITARY SEWER

WHITE CLIFF AVENUE - WATERMAIN PLAN VIEW

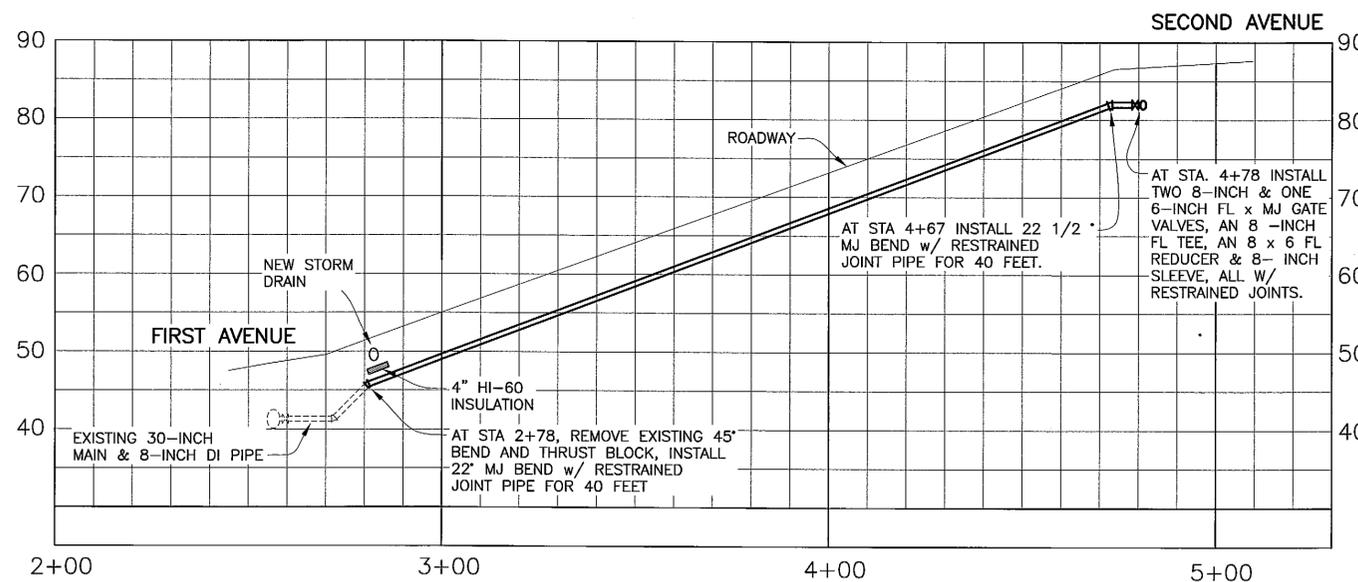

WHITE CLIFF AVENUE - WATERLINE PROFILE

ADDENDUM NUMBER

ATTACHMENT NUMBER

RECORD OF REVISIONS

No.	DATE	DESCRIPTION

KTN-THIRD AVENUE EXTENSION
 PROJECT NO. 68490

**White Cliff Avenue
 Water Main Replacement**

Project As Built Drawings have been reviewed by the Project Engineer. To the best of his/her knowledge, they represent the project as constructed.

Proj. Eng. *[Signature]* Date 6/2/06

DESIGNED BY: C. HOWARD



CHECKED BY: T. MOORE

DRAWN BY: K.K.

STATE OF ALASKA
 DEPARTMENT OF TRANSPORTATION
 & PUBLIC FACILITIES
 STATEWIDE DESIGN & ENGINEERING
 SERVICES DIVISION

THIRD AVENUE EXTENSION
 PROJECT NO. 68490

**White Cliff Avenue
 Water Main
 Replacement**

PROJECT DESIGNATION NUMBER


STP-MG-0904(2)

STATE	YEAR
ALASKA	2002


SHEET NUMBER	TOTAL SHEETS
P16	146

CONSTRUCTION NOTES:

1. POLYETHYLENE ENCASEMENT SHALL BE 8 MIL. POLYETHYLENE IN ACCORDANCE WITH AWWA C-105. ALL BURIED PIPE, FITTINGS, AND APPURTENANCES SHALL BE ENCASED IN POLYETHYLENE.
2. FOR PIPE JOINTS 4-INCH OR LARGER IN NOMINAL DIAMETER, CONTINUITY SHALL BE PROVIDED BY AN INSULATED, 4 AWG CABLE USING CadWeld CONNECTIONS ON EACH SIDE OF THE JOINT. AT VALVES ELECTRICAL CONTINUITY SHALL BE PROVIDED BY TWO EACH, INSULATED 4 AWG CABLES, WELDED AS ABOVE, BETWEEN PIPES ON EITHER SIDE OF THE VALVE.
3. CadWeld EXOTHERMIC CHARGES SHALL BE RATED FOR DUCTILE IRON PIPE APPLICATIONS.

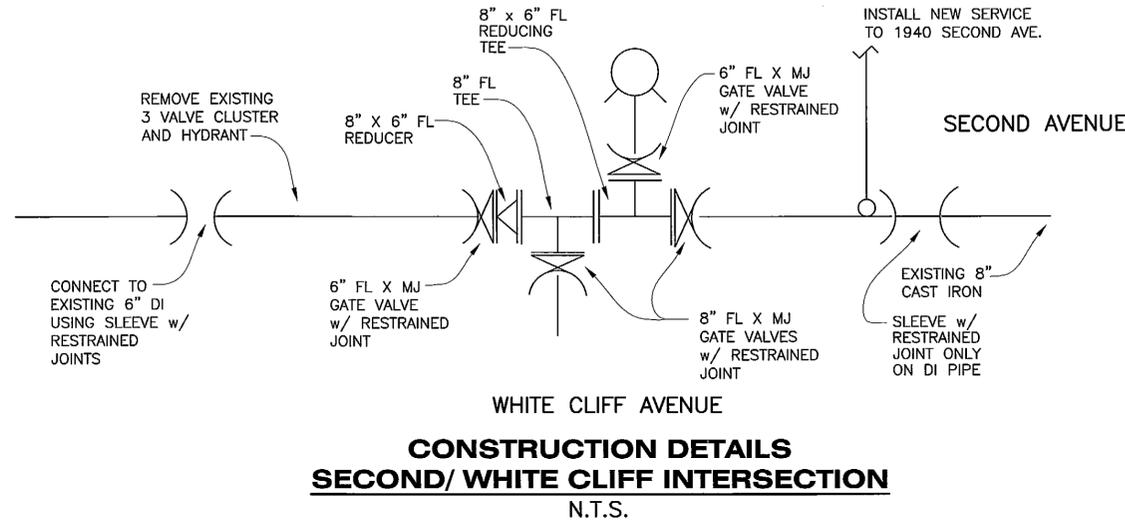


**CONSTRUCTION DETAILS
SECOND/ WHITE CLIFF INTERSECTION
N.T.S.**

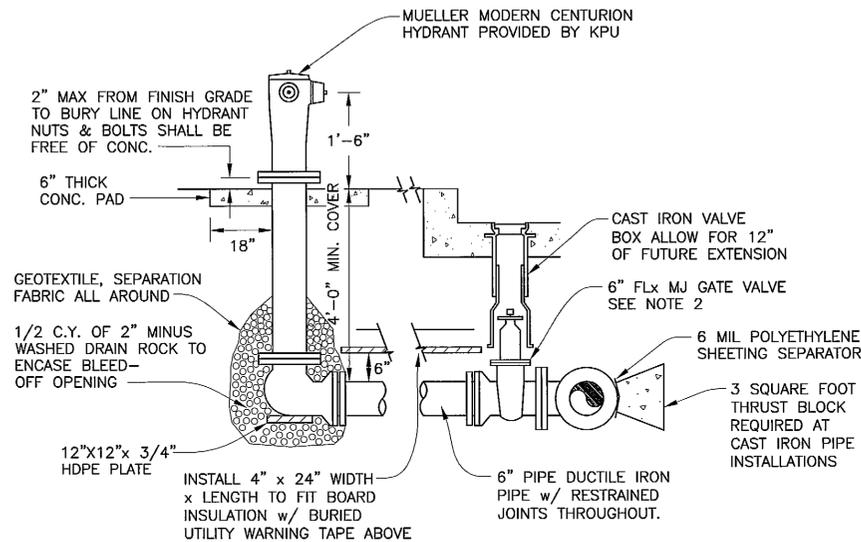


- NOTES:**
1. ALL BOLT THREADS TO BE GREASED PRIOR TO INSTALLATION.
 2. MECHANICAL RESTRAINED JOINTS TO BE USED THROUGHOUT.
 3. HYDRANT PAINT SHALL BE SPECIFIED BY THE ENGINEER.
 4. DOUBLE DIPPED GALVANIZED NUTS AND BOLTS SHALL BE FREE OF CONCRETE.
 5. PLACE BURIED UTILITY WARNING TAPE ABOVE THE HYDRANT LEAD.

**TYPICAL FIRE HYDRANT
N.T.S.**

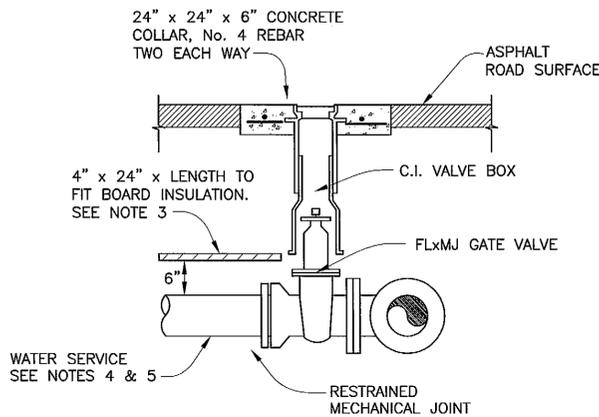

- NOTES:**
1. ALL BOLT THREADS TO BE GREASED PRIOR TO INSTALLATION.
 2. THRUST BLOCK MAY BE OMITTED IF PIPE BEYOND VALVE IS CONNECTED TOGETHER w/ RESTRAINED JOINTS 40 FEET EACH WAY.
 3. PLACE BOARD INSULATION w/ BURIED UTILITY WARNING TAPE ABOVE AS REQUIRED.
 4. SERVICES SMALLER THAN 4" SHALL BE COPPER PIPE. SERVICES 4" AND LARGER SHALL BE D.I.P. CLASS 250.
 5. WHERE WATER SERVICE IS ABOVE GROUND, PIPE SHALL HAVE MECHANICAL RESTRAINED JOINTS AND SHALL BE FACTORY INSULATED PIPE WITH 2" OF FOAM INSULATION AND INTEGRAL METAL JACKET.
 6. WHERE MULTIPLE CONNECTIONS ARE MADE TO END OF SERVICE LINE, INSTALL TEE FITTING WITH BLIND FLANGED ENDS. TAP CONNECTIONS INTO TEE FITTING.

**TYPICAL WATER SERVICE -
LARGER THAN 2"
N.T.S.**

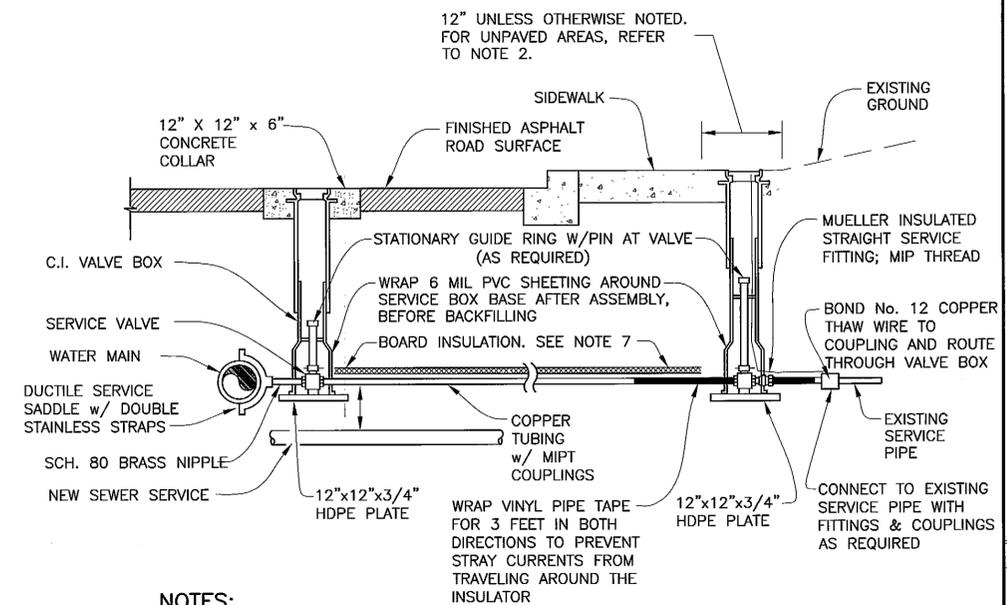

- NOTES:**
1. INSTALL TOP OF VALVE BOX IN SIDEWALK AS SHOWN, 1/4" BELOW TOP OF PAVED SURFACE.
 2. IN AREAS WITHOUT SIDEWALK, INSTALL VALVE BOX 6" BEHIND CURB, 1/4" BELOW PAVED SURFACE OR 3" BELOW UNPAVED SURFACES.
 3. ALLOW 12" FOR RAISING VALVE BOX. GREASE THE OVERLAPPING PORTION.
 4. ENLARGED BASE IS REQUIRED FOR 1" SERVICE VALVES AND LARGER.
 5. A SERVICE VALVE ROD EXTENSION IS REQUIRED ON ALL SERVICE VALVES 6' OR MORE BELOW FINISHED GRADE.
 6. EXTEND SERVICE PAST SERVICE VALVE TO EXISTING SERVICE PIPE AS REQUIRED TO ESTABLISH SERVICE OR AS INDICATED ON THE PLANS. WHERE SERVICE EXTENSION IS ABOVE GROUND, PIPE SHALL BE INSULATED WITH 2" OF FOAM INSULATION WITH PROTECTIVE COATING.
 7. PLACE BOARD INSULATION w/ BURIED UTILITY WARNING TAPE ABOVE AS REQUIRED.
 8. IN UNPAVED STREETS OR AREAS WITHOUT SIDEWALKS, EACH VALVE BOX TO BE SUPPORTED BY A 12"x 12"x 6" CONCRETE PAD POURED AROUND THE UPPER SERVICE BOX TOP.

**TYPICAL BURIED WATER SERVICE -
2" AND SMALLER
N.T.S.**

ADDENDUM NUMBER		
ATTACHMENT NUMBER		
RECORD OF REVISIONS		
No.	DATE	DESCRIPTION

KTN-THIRD AVENUE EXTENSION
PROJECT NO. 68490

Whitecliff Waterline Details

Project As Built Drawings have been reviewed by the Project Engineer. To the best of his/her knowledge, they represent the project as constructed.

Proj. Eng. *[Signature]* Date: *[Date]*

DESIGNED BY: C. HOWARD



CHECKED BY: T. MOORE
DRAWN BY: K.K.


STATE OF ALASKA
DEPARTMENT OF TRANSPORTATION
& PUBLIC FACILITIES
STATEWIDE DESIGN & ENGINEERING
SERVICES DIVISION
**THIRD AVENUE EXTENSION
PROJECT NO. 68490**

**Whitecliff
Waterline Details**

PROJECT DESIGNATION NUMBER	
STP-MG-0904(2)	
STATE	YEAR
ALASKA	2002
SHEET NUMBER	TOTAL SHEETS
P17	146


BEGIN PROJECT STA. "0"20+25

END PROJECT STA. "0"80+20

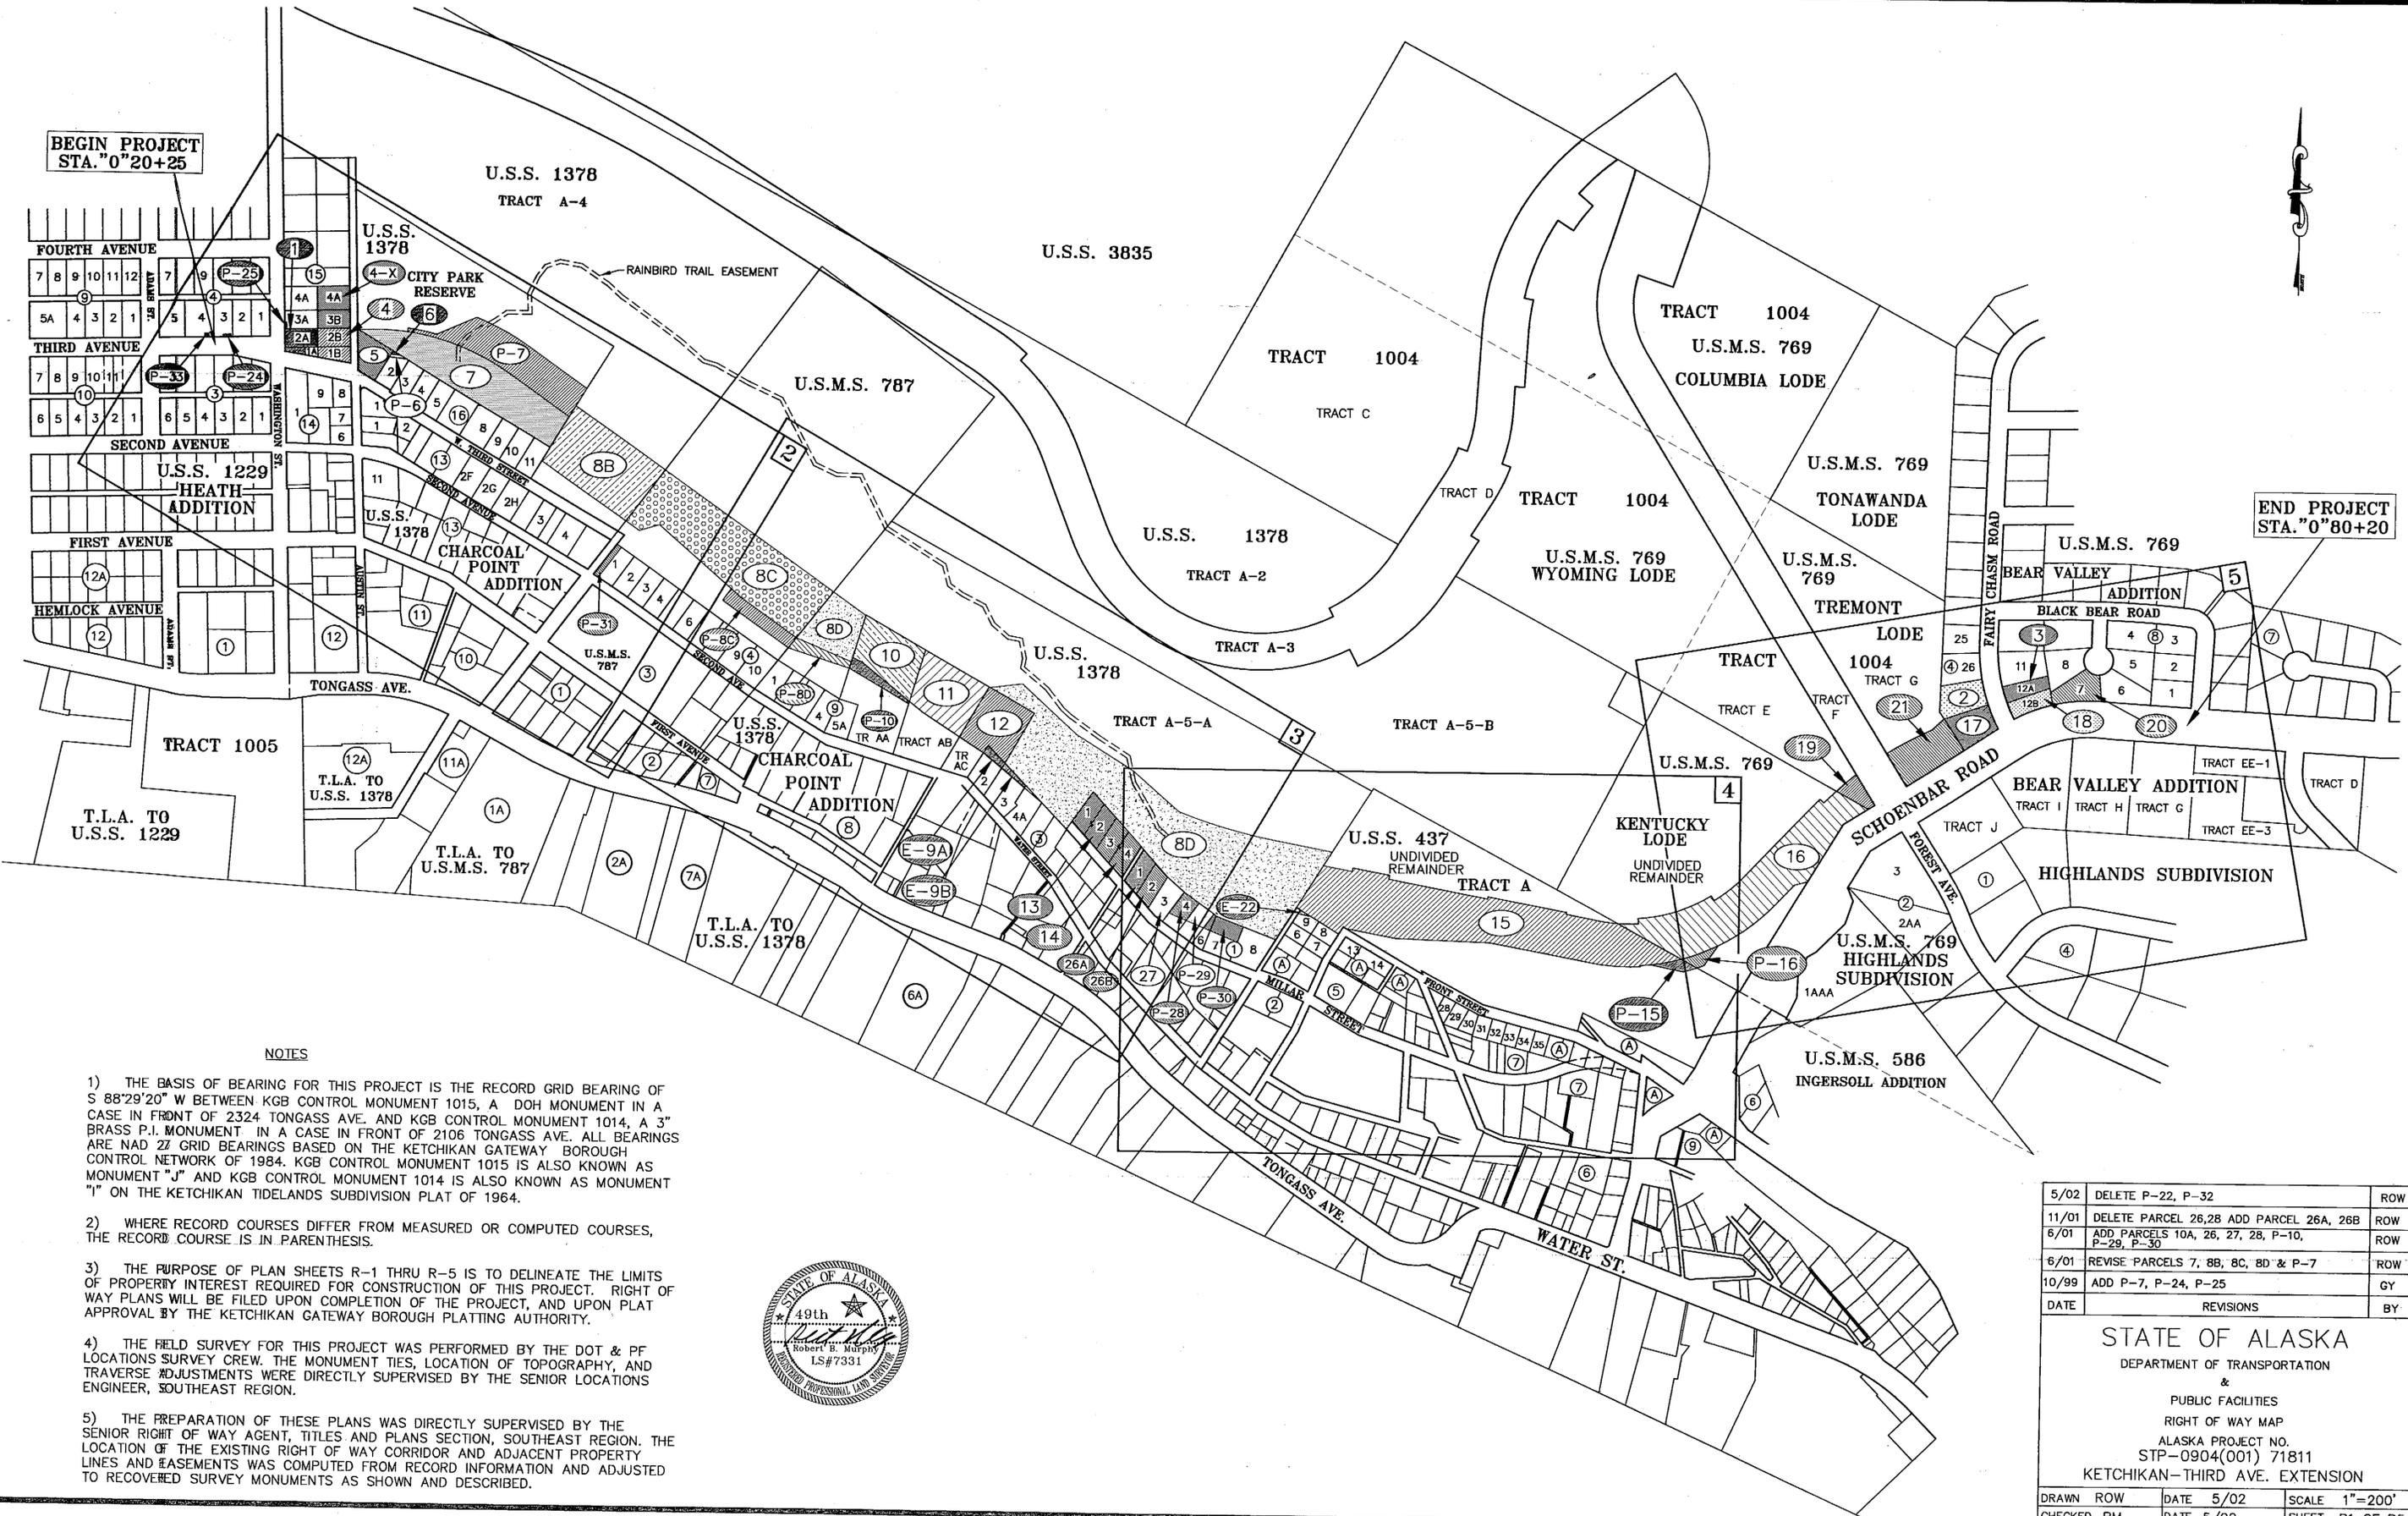

NOTES

- 1) THE BASIS OF BEARING FOR THIS PROJECT IS THE RECORD GRID BEARING OF S 88°29'20" W BETWEEN KGB CONTROL MONUMENT 1015, A DOH MONUMENT IN A CASE IN FRONT OF 2324 TONGASS AVE. AND KGB CONTROL MONUMENT 1014, A 3" BRASS P.I. MONUMENT IN A CASE IN FRONT OF 2106 TONGASS AVE. ALL BEARINGS ARE NAD 22 GRID BEARINGS BASED ON THE KETCHIKAN GATEWAY BOROUGH CONTROL NETWORK OF 1984. KGB CONTROL MONUMENT 1015 IS ALSO KNOWN AS MONUMENT "J" AND KGB CONTROL MONUMENT 1014 IS ALSO KNOWN AS MONUMENT "I" ON THE KETCHIKAN TIDELANDS SUBDIVISION PLAT OF 1964.
- 2) WHERE RECORD COURSES DIFFER FROM MEASURED OR COMPUTED COURSES, THE RECORD COURSE IS IN PARENTHESIS.
- 3) THE PURPOSE OF PLAN SHEETS R-1 THRU R-5 IS TO DELINEATE THE LIMITS OF PROPERTY INTEREST REQUIRED FOR CONSTRUCTION OF THIS PROJECT. RIGHT OF WAY PLANS WILL BE FILED UPON COMPLETION OF THE PROJECT, AND UPON PLAT APPROVAL BY THE KETCHIKAN GATEWAY BOROUGH PLATTING AUTHORITY.
- 4) THE FIELD SURVEY FOR THIS PROJECT WAS PERFORMED BY THE DOT & PF LOCATIONS SURVEY CREW. THE MONUMENT TIES, LOCATION OF TOPOGRAPHY, AND TRAVERSE ADJUSTMENTS WERE DIRECTLY SUPERVISED BY THE SENIOR LOCATIONS ENGINEER, SOUTHEAST REGION.
- 5) THE PREPARATION OF THESE PLANS WAS DIRECTLY SUPERVISED BY THE SENIOR RIGHT OF WAY AGENT, TITLES AND PLANS SECTION, SOUTHEAST REGION. THE LOCATION OF THE EXISTING RIGHT OF WAY CORRIDOR AND ADJACENT PROPERTY LINES AND EASEMENTS WAS COMPUTED FROM RECORD INFORMATION AND ADJUSTED TO RECOVERED SURVEY MONUMENTS AS SHOWN AND DESCRIBED.

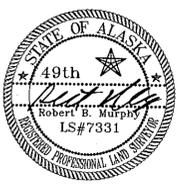


DATE	REVISIONS	BY
5/02	DELETE P-22, P-32	ROW
11/01	DELETE PARCEL 26,28 ADD PARCEL 26A, 26B	ROW
6/01	ADD PARCELS 10A, 26, 27, 28, P-10, P-29, P-30	ROW
6/01	REVISE PARCELS 7, 8B, 8C, 8D & P-7	ROW
10/99	ADD P-7, P-24, P-25	GY

STATE OF ALASKA DEPARTMENT OF TRANSPORTATION & PUBLIC FACILITIES RIGHT OF WAY MAP ALASKA PROJECT NO. STP-0904(001) 71811 KETCHIKAN-THIRD AVE. EXTENSION		
DRAWN ROW	DATE 5/02	SCALE 1"=200'
CHECKED RM	DATE 5/02	SHEET R1 OF R5

Project As Built Drawings have been reviewed by the Project Engineer. To the best of his/her knowledge, they represent the project as constructed.

Proj. Eng. Date 5/02

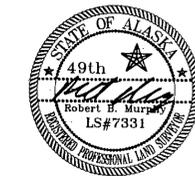


I HEREBY CERTIFY that I am properly registered and licensed to practice land surveying in the State of Alaska and that this plat was made by me or under my supervision. I declare that this plat was based upon the monuments recovered during State of Alaska Locations Survey 7/81 and that all dimensions and other details are accurate.

Robert B. Murphy LS-7331 Date 5-6-02

U.S.S. 1378
CHARCOAL POINT ADDITION
CITY PARK RESERVE
KETCHIKAN GATEWAY BOROUGH

U.S.S. 1378
TRACT A-4
CITY OF KETCHIKAN

U.S.M.S. 787
CITY OF KETCHIKAN

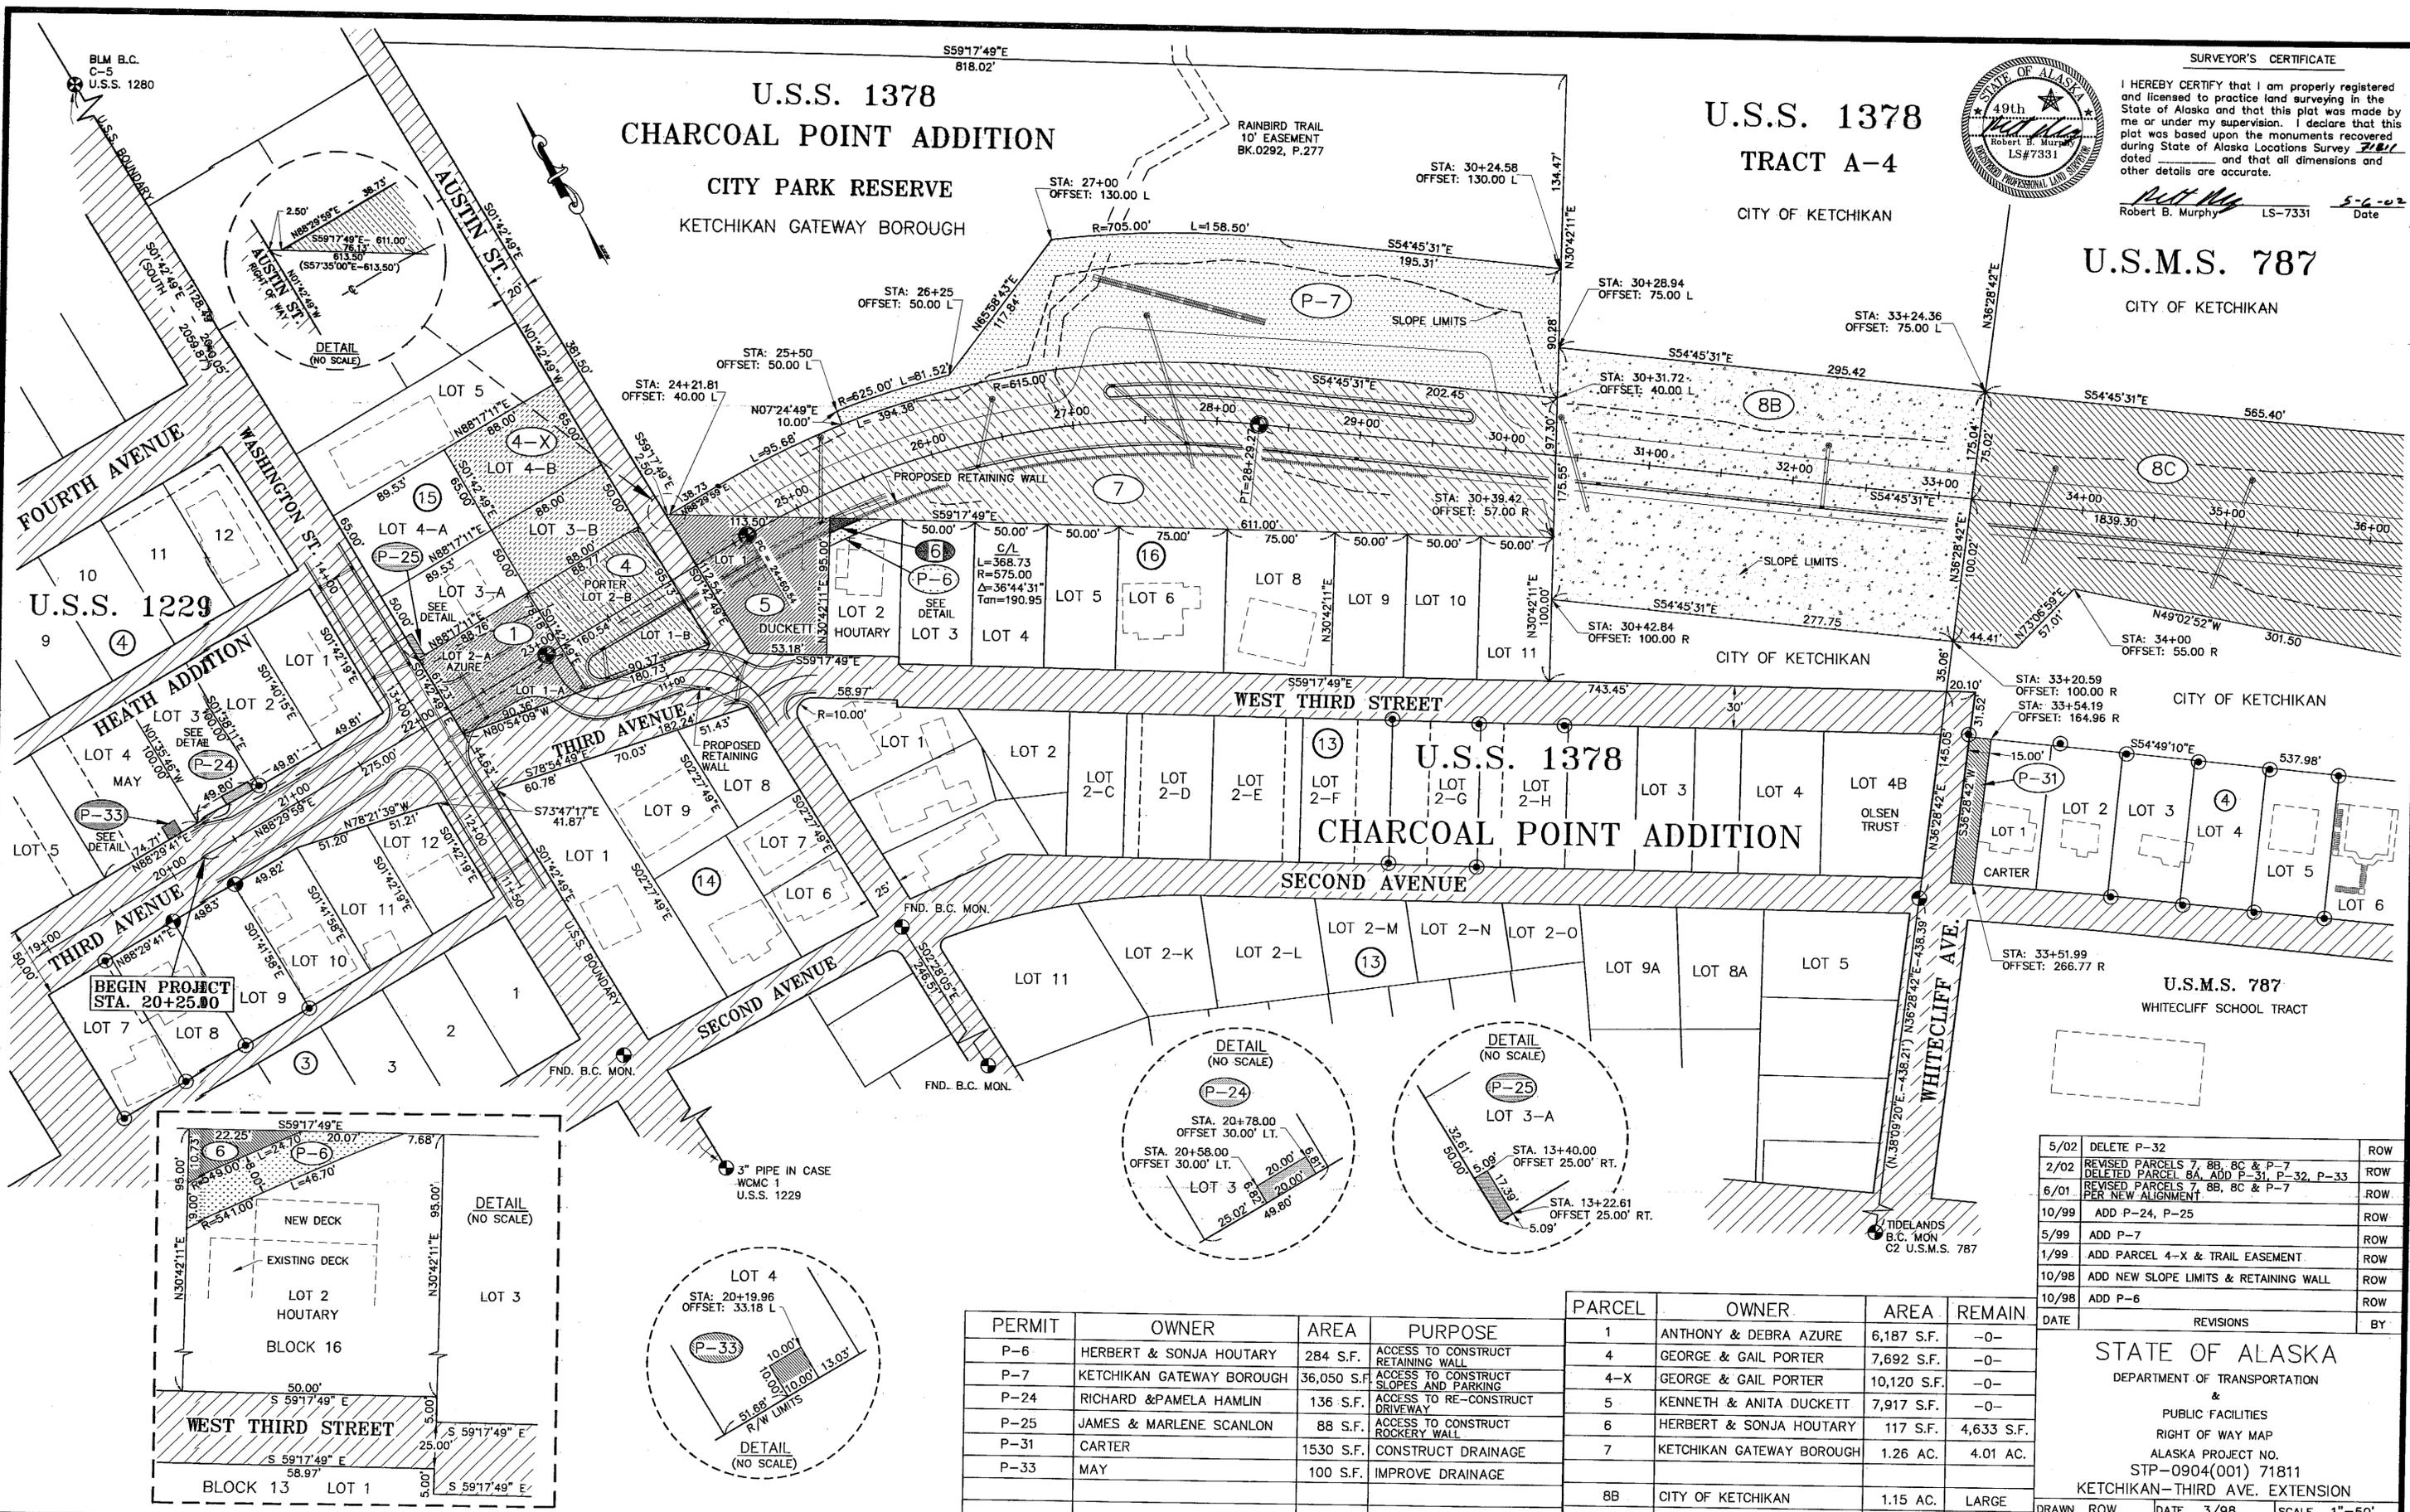

DATE	REVISIONS	BY
5/02	DELETE P-32	ROW
2/02	REVISED PARCELS 7, 8B, 8C & P-7	ROW
	DELETED PARCEL 8A, ADD P-31, P-32, P-33	ROW
6/01	REVISED PARCELS 7, 8B, 8C & P-7	ROW
	PER NEW ALIGNMENT	ROW
10/99	ADD P-24, P-25	ROW
5/99	ADD P-7	ROW
1/99	ADD PARCEL 4-X & TRAIL EASEMENT	ROW
10/98	ADD NEW SLOPE LIMITS & RETAINING WALL	ROW
10/98	ADD P-6	ROW

PERMIT	OWNER	AREA	PURPOSE
P-6	HERBERT & SONJA HOUTARY	284 S.F.	ACCESS TO CONSTRUCT RETAINING WALL
P-7	KETCHIKAN GATEWAY BOROUGH	36,050 S.F.	ACCESS TO CONSTRUCT SLOPES AND PARKING
P-24	RICHARD & PAMELA HAMLIN	136 S.F.	ACCESS TO RE-CONSTRUCT DRIVEWAY
P-25	JAMES & MARLENE SCANLON	88 S.F.	ACCESS TO CONSTRUCT ROCKERY WALL
P-31	CARTER	1530 S.F.	CONSTRUCT DRAINAGE
P-33	MAY	100 S.F.	IMPROVE DRAINAGE

PARCEL	OWNER	AREA	REMAIN
1	ANTHONY & DEBRA AZURE	6,187 S.F.	-0-
4	GEORGE & GAIL PORTER	7,692 S.F.	-0-
4-X	GEORGE & GAIL PORTER	10,120 S.F.	-0-
5	KENNETH & ANITA DUCKETT	7,917 S.F.	-0-
6	HERBERT & SONJA HOUTARY	117 S.F.	4,633 S.F.
7	KETCHIKAN GATEWAY BOROUGH	1.26 AC.	4.01 AC.
8B	CITY OF KETCHIKAN	1.15 AC.	LARGE
8C	CITY OF KETCHIKAN	1.97 AC.	LARGE

STATE OF ALASKA
DEPARTMENT OF TRANSPORTATION
&
PUBLIC FACILITIES
RIGHT OF WAY MAP
ALASKA PROJECT NO.
STP-0904(001) 71811
KETCHIKAN-THIRD AVE. EXTENSION

DRAWN ROW DATE 3/98 SCALE 1"=50'
CHECKED DATE SHEET R2 OF R5

Project As Built Drawings have been reviewed by the Project Engineer. To the best of his/her knowledge, they represent the project as constructed.
Proj. Eng. [Signature] Date 3-02

TRACT A-5-B

S61°23'20"E (S.59°38'00"E. 1493.49') 1493.64'


U.S.S. 1378

TRACT A-5-A

CITY OF KETCHIKAN

U.S.M.S. 787

CITY OF KETCHIKAN

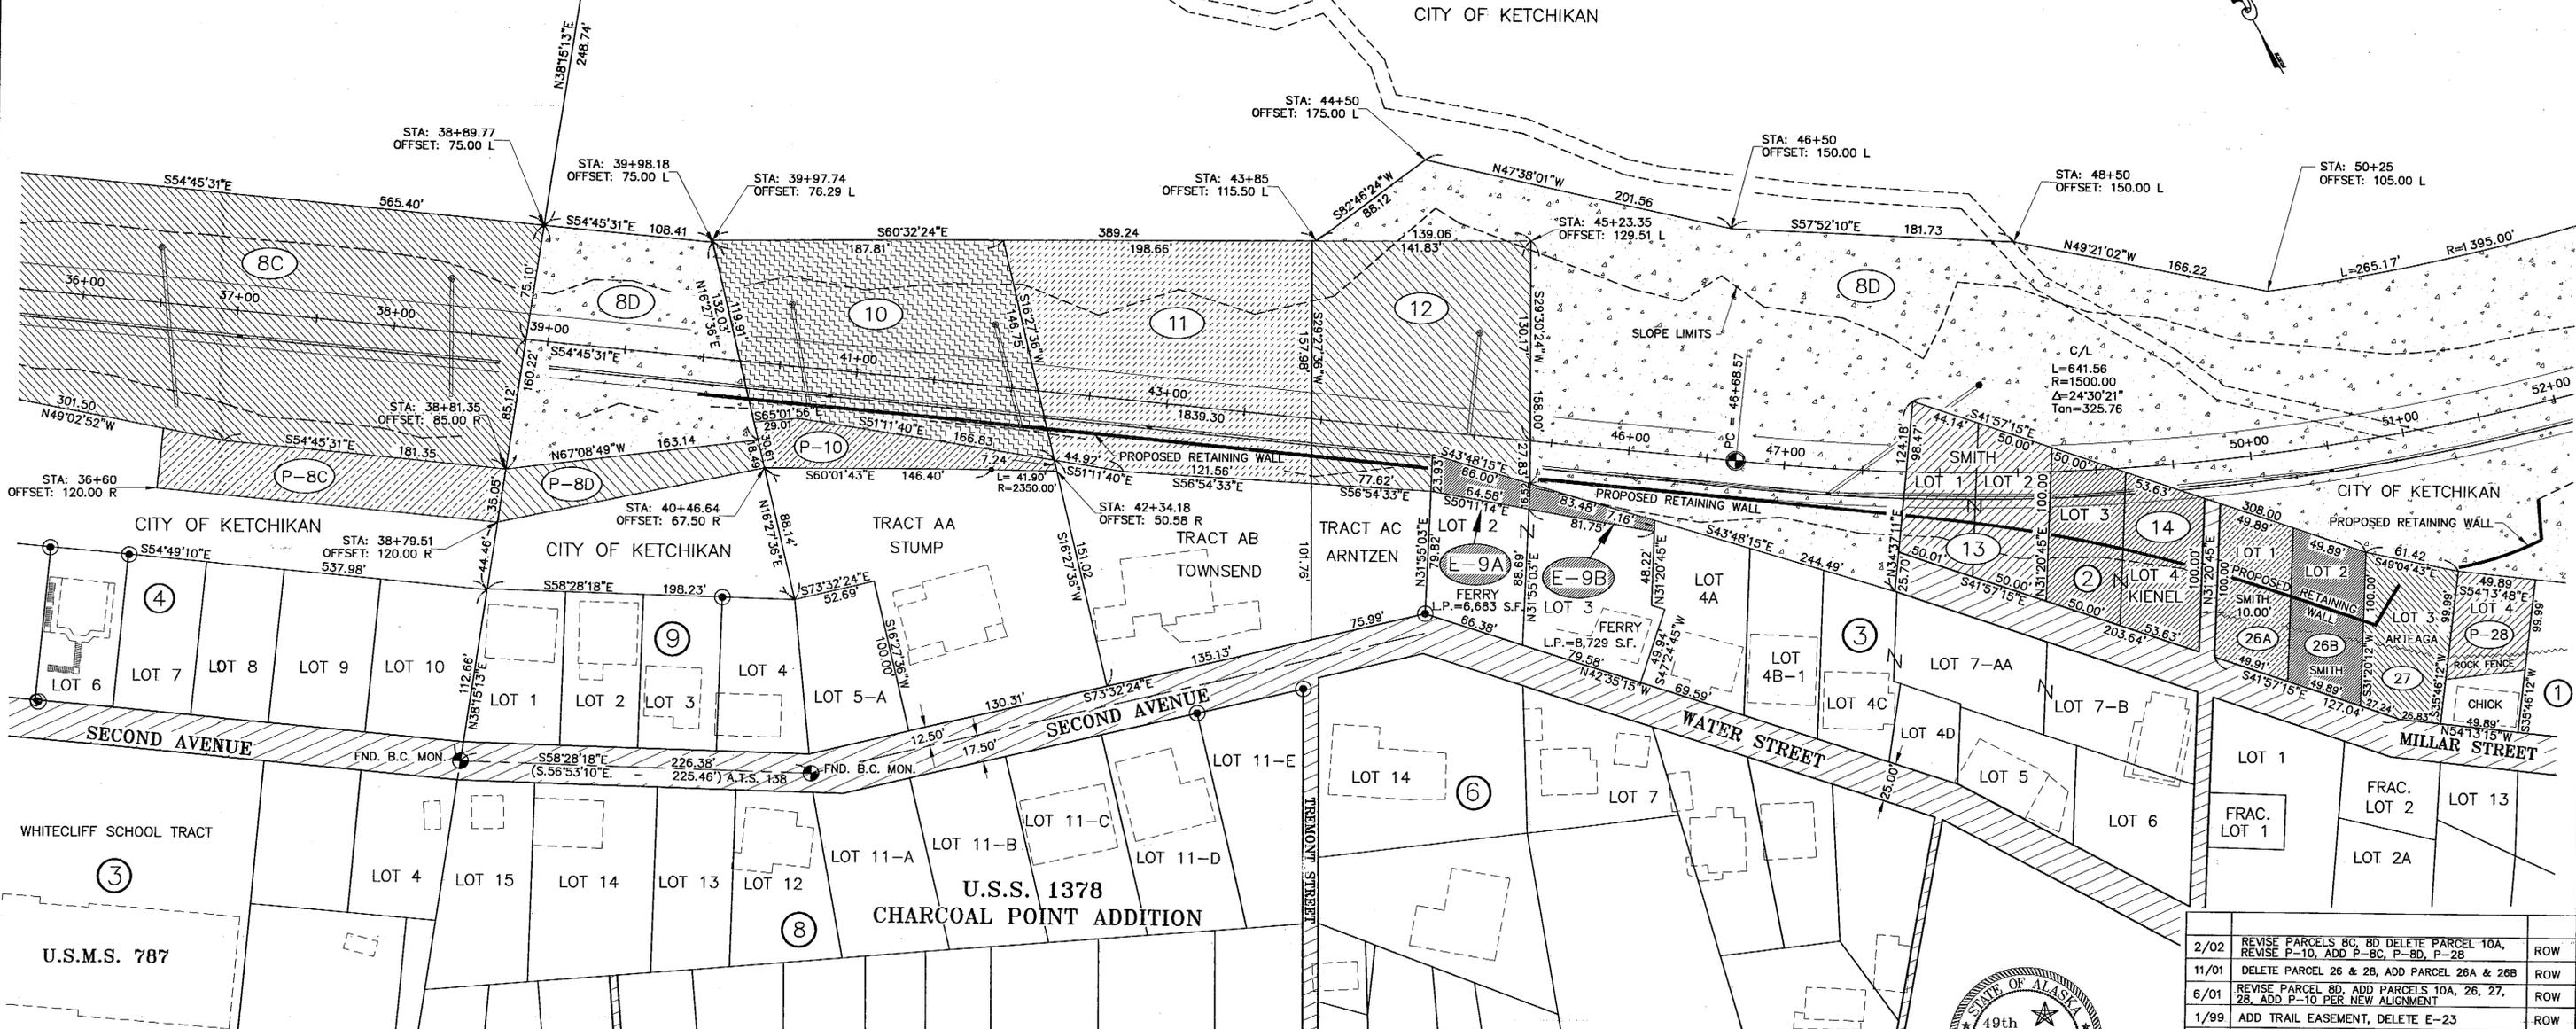

PERMIT	OWNER	AREA	PURPOSE
P-8C	CITY OF KETCHIKAN	7795 S.F.	CONSTRUCTION ACCESS
P-8D	CITY OF KETCHIKAN	4375 S.F.	CONSTRUCTION ACCESS
P-10	W. CLARK & DIANNE STUMP	1852 S.F.	CONSTRUCTION ACCESS
P-28	CHICK	3242 S.F.	CONSTRUCTION ACCESS
EASEMENT	OWNER	AREA	PURPOSE
E-9A	RAMONA L. FERRY	1294 S.F.	HIGHWAY CONSTRUCTION
E-9B	RAMONA L. FERRY	958 S.F.	HIGHWAY CONSTRUCTION

PARCEL	OWNER	AREA	REMAIN
8C	CITY OF KETCHIKAN	SEE SHT 3	
8D	CITY OF KETCHIKAN	4.54 AC.	LARGE
10	W. CLARK & DIANNE STUMP	23,946 S.F.	26,983 S.F.
11	HOWARD & KRISTINA TOWNSEND	27,559 S.F.	18,361 S.F.

PARCEL	OWNER	AREA	REMAIN
12	RONALD & KATHY ARNTZEN	21,980 S.F.	6,865 S.F.
13	HAROLD GILBERT SMITH	9,298 S.F.	-0-
14	SONJA M. KIENEL	9,926 S.F.	-0-
26A	HAROLD SMITH	4,780 S.F.	-0-
26B	HAROLD SMITH	4,799 S.F.	-0-
27	CHARLES & VEDA ARTEAGA	5,778 S.F.	-0-



SURVEYOR'S CERTIFICATE
 I HEREBY CERTIFY that I am properly registered and licensed to practice land surveying in the State of Alaska and that this plat was made by me or under my supervision. I declare that this plat was based upon the monuments recovered during State of Alaska Locations Survey 7/18/11 and that all dimensions and other details are accurate.
 Robert B. Murphy LS-7331 5-6-02 Date

DATE	REVISIONS	BY
2/02	REVISE PARCELS 8C, 8D DELETE PARCEL 10A, REVISE P-10, ADD P-8C, P-8D, P-28	ROW
11/01	DELETE PARCEL 26 & 28, ADD PARCEL 26A & 26B	ROW
6/01	REVISE PARCEL 8D, ADD PARCELS 10A, 26, 27, 28, ADD P-10 PER NEW ALIGNMENT	ROW
1/99	ADD TRAIL EASEMENT, DELETE E-23	ROW
10/98	ADD NEW SLOPES, REVISE RETAINING WALL	ROW
5/98	MODIFY C/L, SLOPES, PARCEL 8D	ROW

STATE OF ALASKA
 DEPARTMENT OF TRANSPORTATION
 &
 PUBLIC FACILITIES
 RIGHT OF WAY MAP
 ALASKA PROJECT NO.
 STP-0904(001) 71811
 KETCHIKAN-THIRD AVE. EXTENSION

DRAWN ROW DATE 3/98 SCALE 1"=50'
 CHECKED DATE SHEET R3 OF R5

Project As Built Drawings have been reviewed by the Project Engineer. To the best of his/her knowledge, they represent the project as constructed.
 Proj. Eng. [Signature] Date 10-3-06

U.S.S.

1378

TRACT A-5-A

CITY OF KETCHIKAN

U.S.S. 437

UNDIVIDED REMAINDER

TRACT A

CEDAR MOUNTAIN PROPERTIES

TRACT A-5-B




U.S.M.S. 769
KENTUCKY LODE

UNDIVIDED REMAINDER

EDWIN JOHNSON
&
SUSAN WANBERG

C/L

Δ = 57'37.29"
R = 500.00'
T = 275.02'
L = 502.87'

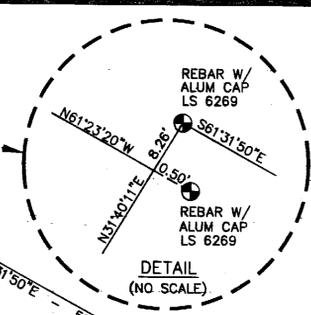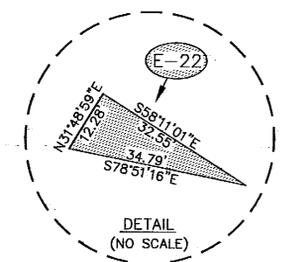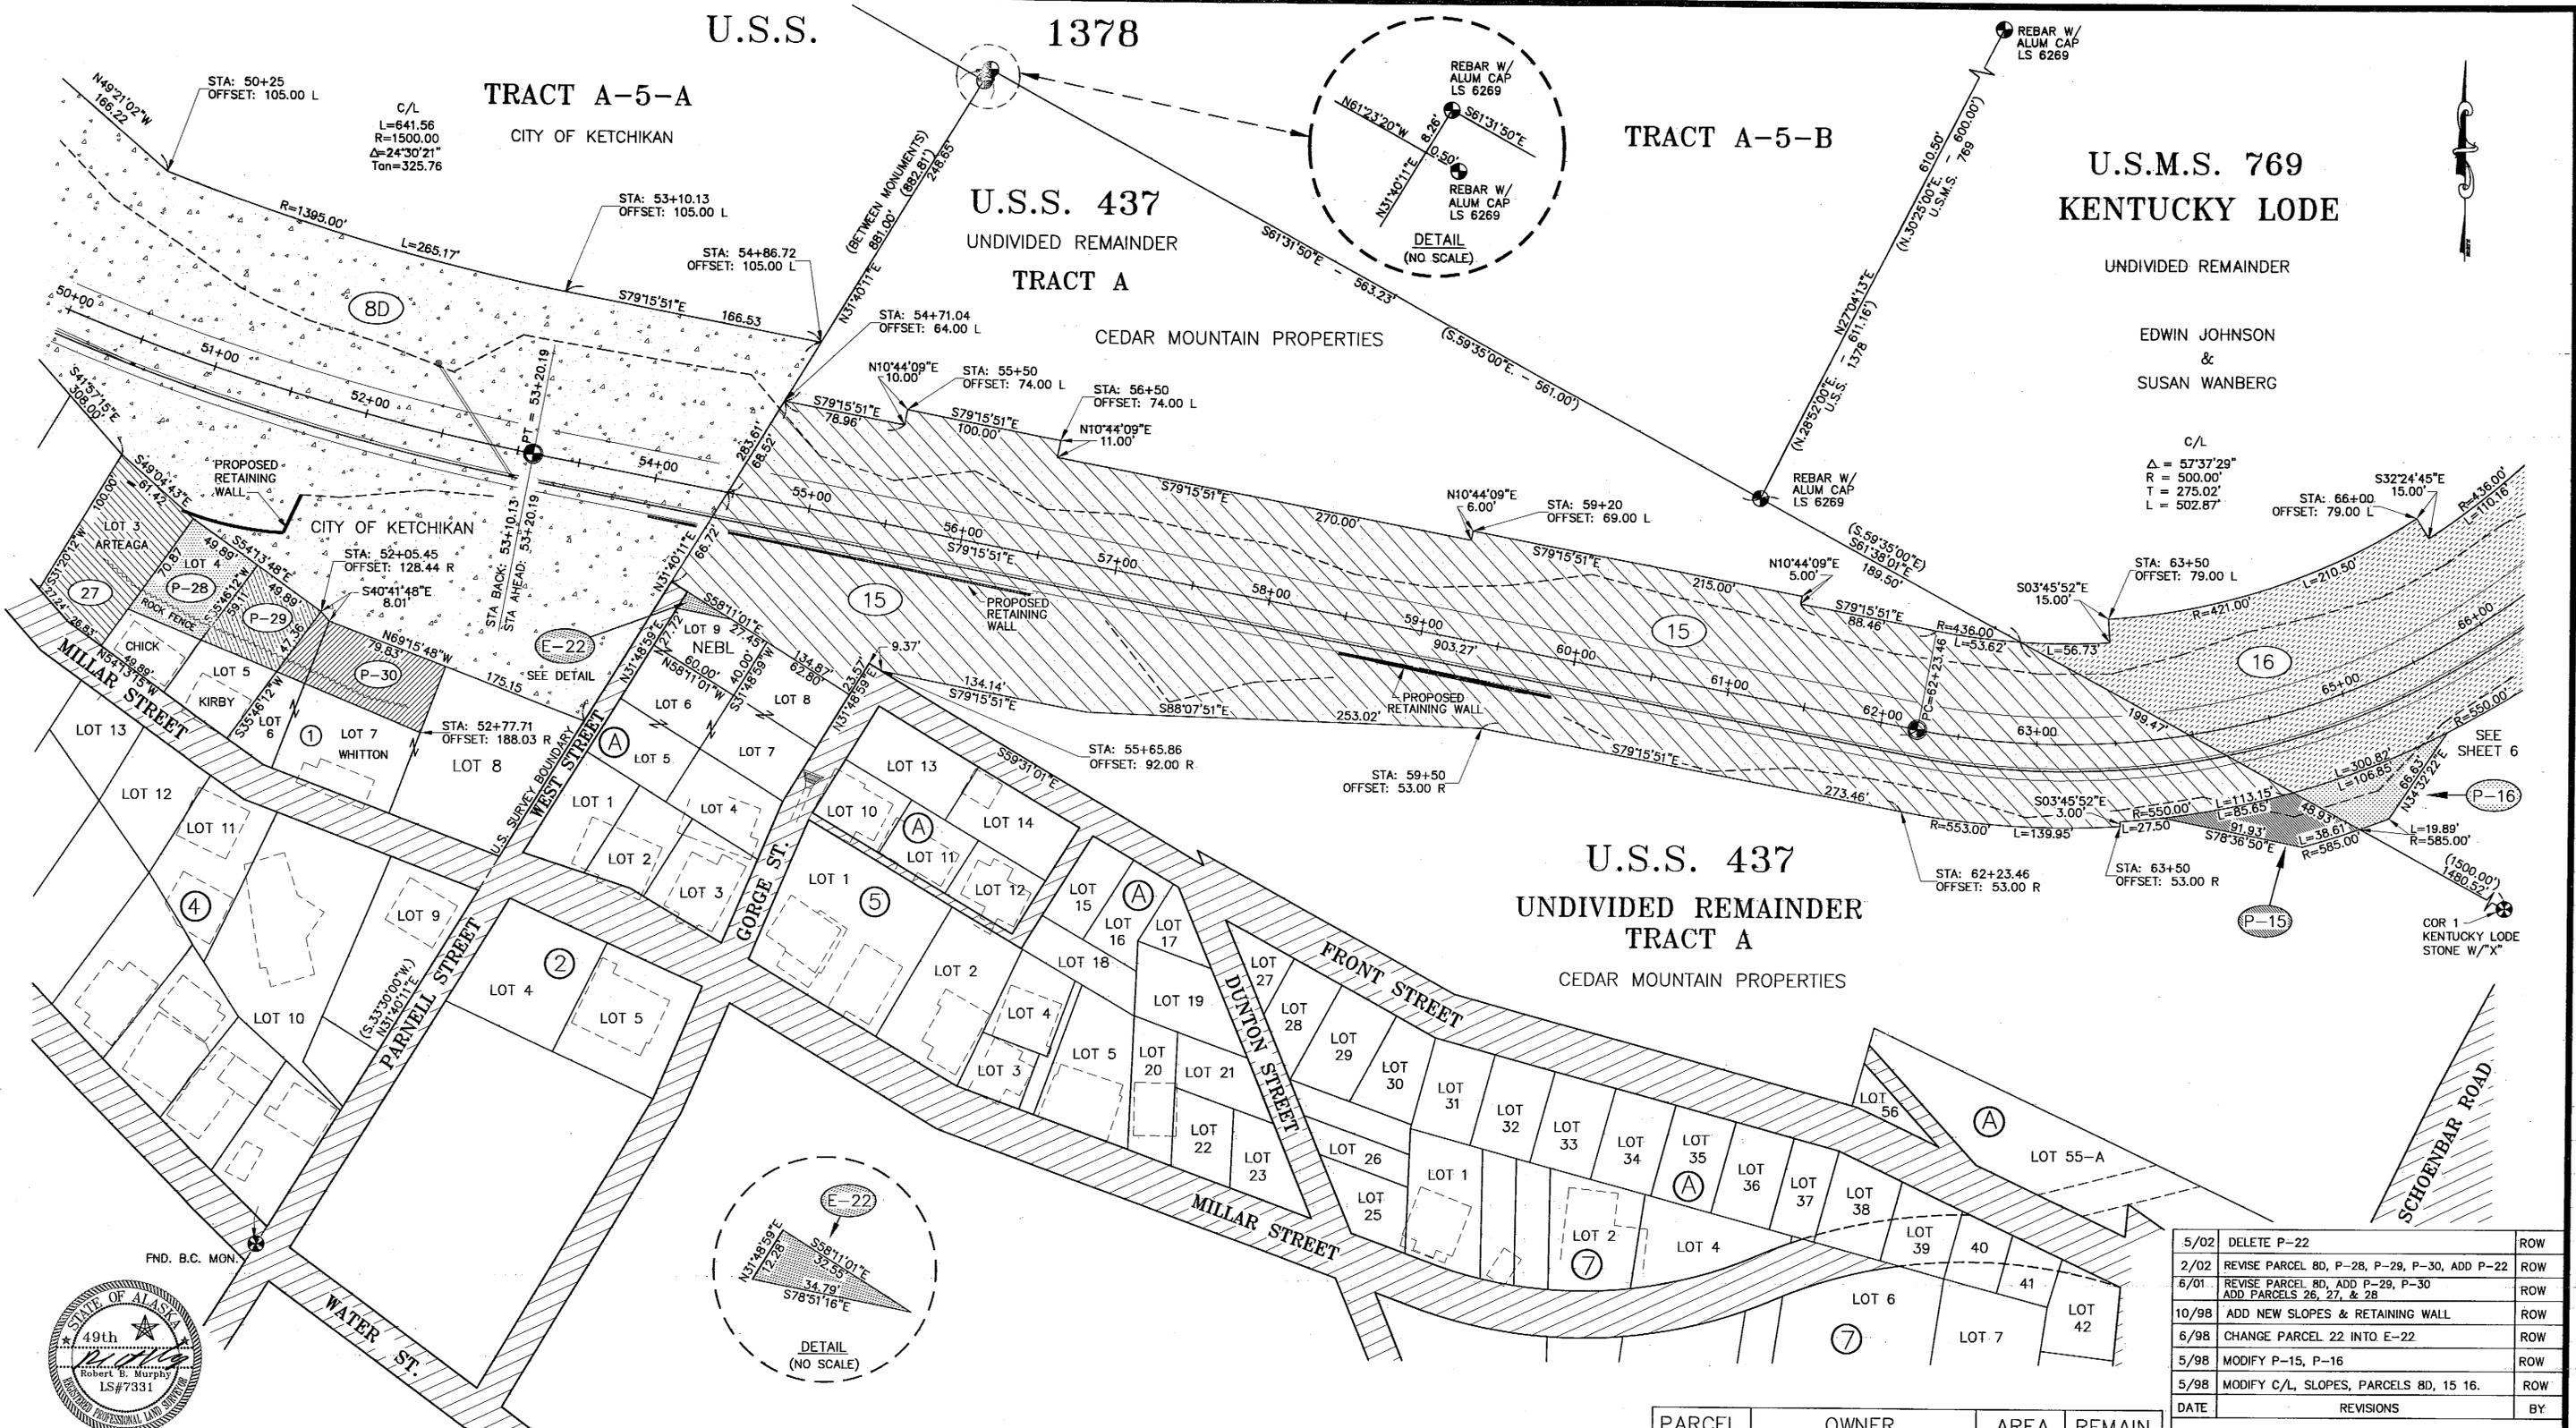

SURVEYOR'S CERTIFICATE

I HEREBY CERTIFY that I am properly registered and licensed to practice land surveying in the State of Alaska and that this plat was made by me or under my supervision. I declare that this plat was based upon the monuments recovered during State of Alaska Locations Survey 7-8-11 and that all dimensions and other details are accurate.

Robert B. Murphy LS-7331 Date 5-6-07

EASEMENT	OWNER	AREA	PURPOSE
E-22	NIKOLAUS & TOMMY LOU NEBL	200 S.F.	

PERMIT	OWNER	AREA	PURPOSE
P-15	CEDAR MOUNTAIN PROPERTIES	2090 S.F.	
P-16	JOHNSON / WANBERG	SEE SH 6	
P-28	CHICK	SEE SH 4	
P-29	KIRBY	2656 S.F.	CONSTRUCT ROCK CATCHMENT BARRIER
P-30	WHITTON	4088 S.F.	CONSTRUCT ROCK CATCHMENT BARRIER

PARCEL	OWNER	AREA	REMAIN
8D	CITY OF KETCHIKAN	SEE SH 4	
15	CEDAR MOUNTAIN PROPERTIES	2.90 AC.	5.75 AC.
16	JOHNSON / WANBERG	SEE SH 6	
27	CHARLES & VEDA ARTEAGA	SEE SH 4	

DATE	REVISIONS	BY
5/02	DELETE P-22	ROW
2/02	REVISE PARCEL 8D, P-28, P-29, P-30, ADD P-22	ROW
6/01	REVISE PARCEL 8D, ADD P-29, P-30	ROW
	ADD PARCELS 26, 27, & 28	
10/98	ADD NEW SLOPES & RETAINING WALL	ROW
6/98	CHANGE PARCEL 22 INTO E-22	ROW
5/98	MODIFY P-15, P-16	ROW
5/98	MODIFY C/L, SLOPES, PARCELS 8D, 15 16.	ROW

STATE OF ALASKA
DEPARTMENT OF TRANSPORTATION
&
PUBLIC FACILITIES
RIGHT OF WAY MAP
ALASKA PROJECT NO.
STP-0904(001) 71811
KETCHIKAN-THIRD AVE. EXTENSION

DRAWN ROW DATE 3/98 SCALE 1"=50'
CHECKED DATE SHEET R4 OF R5

Project As Built Drawings have been reviewed by the Project Engineer. To the best of his/her knowledge, they represent the project as constructed.
Proj. Eng. Date 5-11-06

U.S.M.S. 769
TREMONT LODE

U.S.M.S. 769

TRACT

(PLAT NO. 88-18, K.R.D.)
TRACT E

EDWIN JOHNSON
SUSAN WANBERG
DAVID & YVONNE
SEAFORD

1004

TRACT G
GEORGE LYBRAND

LOT 25
L=30.32'
R=486.06'

LOT 10
L=25.00'
R=436.06'

LOT 9

BLACK BEAR ROAD

BEAR VALLEY
ADDITION

CUB COURT

LOT 4

LOT 2

LOT 1

LOT 1

U.S.M.S. 769

KENTUCKY LODE
UNDIVIDED REMAINDER

EDWIN JOHNSON
&
SUSAN WANBERG

R=500.00'
L=502.87'
Tan=275.02'
Delta=57.37.29"

STA: 66+00
OFFSET: 79.00 L

R=964.00'
L=19.52'

STA: 70+57.89
OFFSET: 50.00 L

STA: 72+19.23
OFFSET: 50.00 L

STA: 75+17.50
OFFSET: 4.04 R

END PROJECT
STA. 80+20.00

SCHOENBAR ROAD

BEAR VALLEY ADDITION

HIGHLANDS SUBDIVISION

SCHOENBAR ROAD

FOREST AVE.

U.S.M.S. 769
HIGHLANDS SUBDIVISION

PARCEL	OWNER	AREA	REMAIN
2	STATE OF ALASKA	ACQUIRED UNDER STATE PROJECT NO. 71047	
3	CHARLES BREDEHOFT	4,969 S.F.	-0-
16	JOHNSON / WANBERG	1.82 AC.	6.42 AC.
17	CHARLES & NANCY RULE	10,016 S.F.	-0-
18	ROBERT BLOOM	5,153 S.F.	-0-
19	JOHNSON/WANBERG/SEAFORD	4,283 S.F.	13.96 AC.
20	MICHAEL & AURORA PECAROVICH	8,535 S.F.	-0-
21	GEORGE LYBRAND	18,382 S.F.	10.87 AC.

PERMIT	OWNER	AREA	PURPOSE
P-16	JOHNSON / WANBERG	2,185 S.F.	




SURVEYOR'S CERTIFICATE
I HEREBY CERTIFY that I am properly registered and licensed to practice land surveying in the State of Alaska and that this plot was made by me or under my supervision. I declare that this plot was based upon the monuments recovered during State of Alaska Locations Survey 71811 dated _____ and that all dimensions and other details are accurate.
Robert B. Murphy LS-7331 5-6-02 Date

DATE	REVISIONS	BY
1/99	MODIFY C/L, SLOPES & PARCELS 16,19,21	ROW
10/98	ADD NEW SLOPE LIMITS	ROW
5/98	MODIFY C/L, SLOPES, PARCEL 16, P-16.	ROW


STATE OF ALASKA
DEPARTMENT OF TRANSPORTATION
&
PUBLIC FACILITIES
RIGHT OF WAY MAP
ALASKA PROJECT NO.
STP-0904(001) 71811
KETCHIKAN-THIRD AVE. EXTENSION
DRAWN ROW DATE 3/98 SCALE 1"=50'
CHECKED DATE SHEET R5 OF R5

Project As Built Drawings have been reviewed by the Project Engineer. To the best of his/her knowledge, they represent the project as constructed.
Proj. Eng. _____ Date 10/21/06

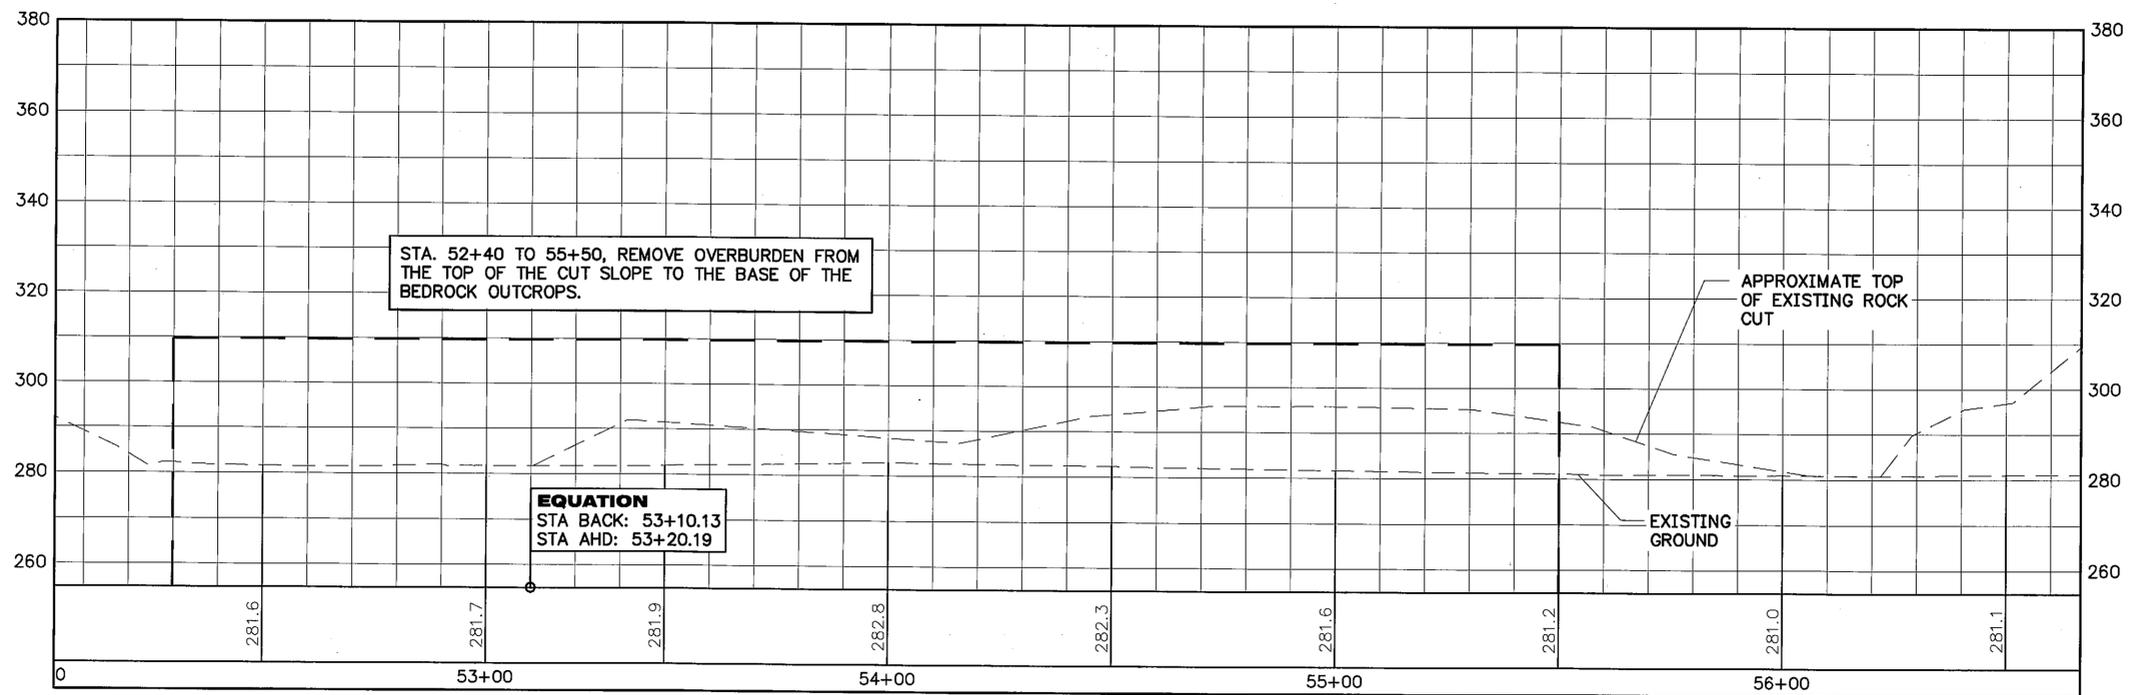

Notes:

1. LOCATIONS AND LENGTHS OF ROCK BOLTS ARE APPROXIMATE AND NEED TO BE FIELD VERIFIED BY THE ENGINEER.

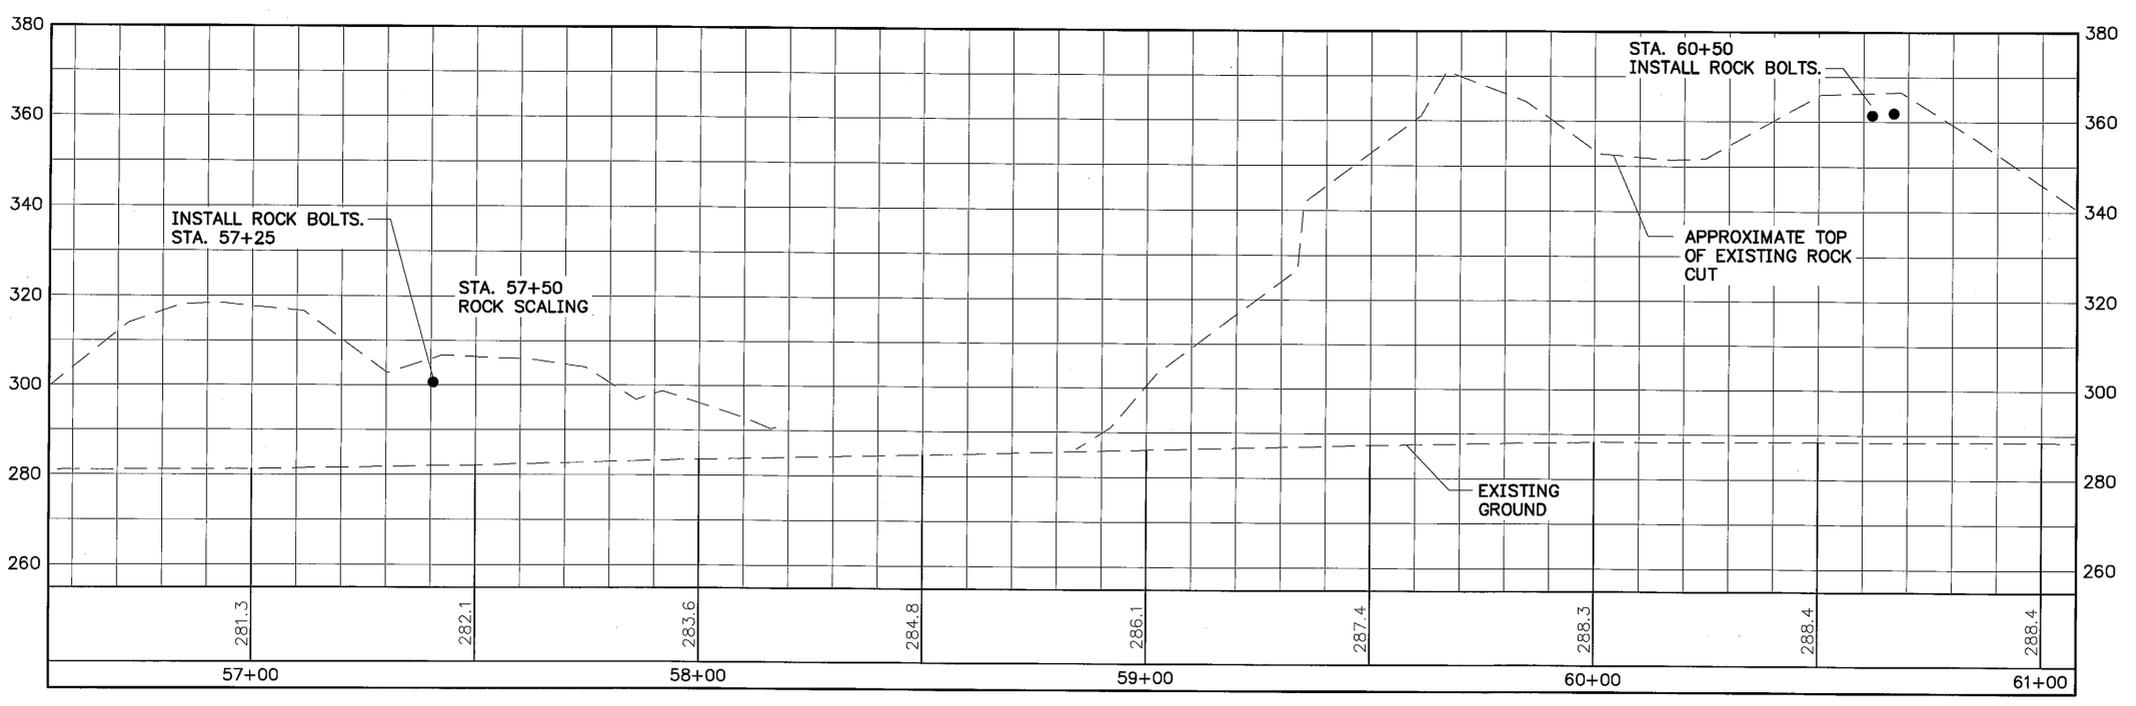

**Third Avenue
Slope Stabilization Plan**

ADDENDUM NUMBER		
ATTACHMENT NUMBER		
RECORD OF REVISIONS		
No.	DATE	DESCRIPTION

KTN-THIRD AVENUE EXTENSION
 PROJECT NO. 68490
Slope Stabilization Plan

DESIGNED BY: C. HOWARD




CHECKED BY: T. MOORE
 DRAWN BY: K.K.

STATE OF ALASKA
 DEPARTMENT OF TRANSPORTATION
 & PUBLIC FACILITIES
 STATEWIDE DESIGN & ENGINEERING
 SERVICES DIVISION
 THIRD AVENUE EXTENSION
 PROJECT NO. 68490


**Slope
Stabilization
Plan**

PROJECT DESIGNATION NUMBER	
STP-MG-0904(2)	
STATE	YEAR
ALASKA	2002
SHEET NUMBER	TOTAL SHEETS
S1	146

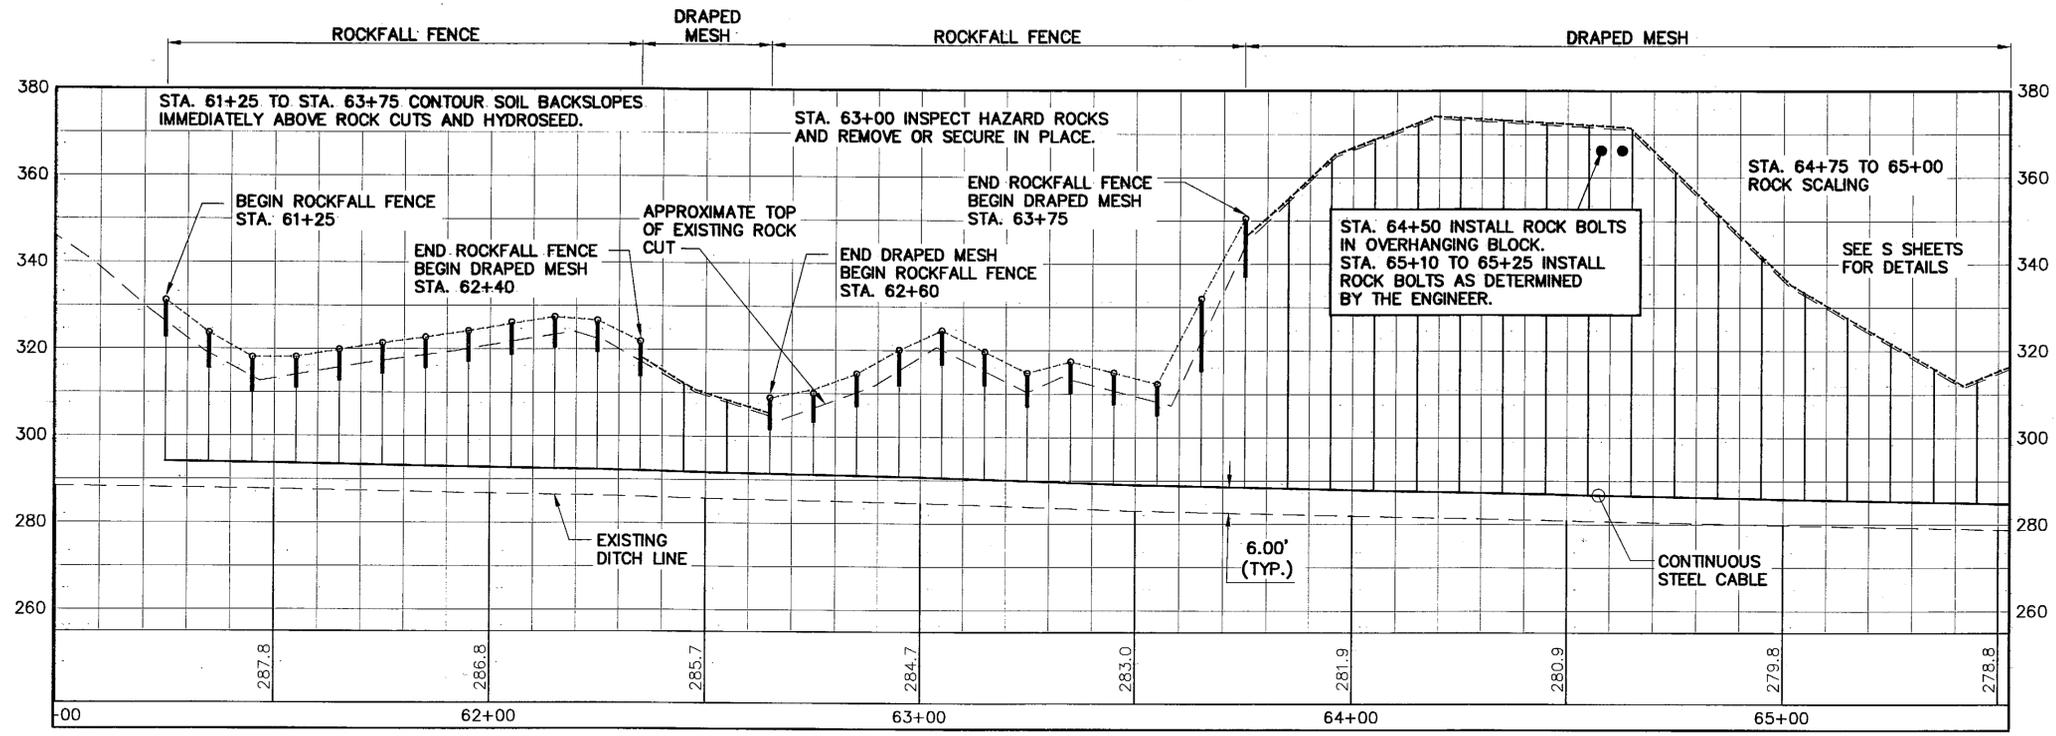

Notes:

- 1. LOCATIONS AND LENGTHS OF ROCK BOLTS ARE APPROXIMATE AND NEED TO BE FIELD VERIFIED BY THE ENGINEER.

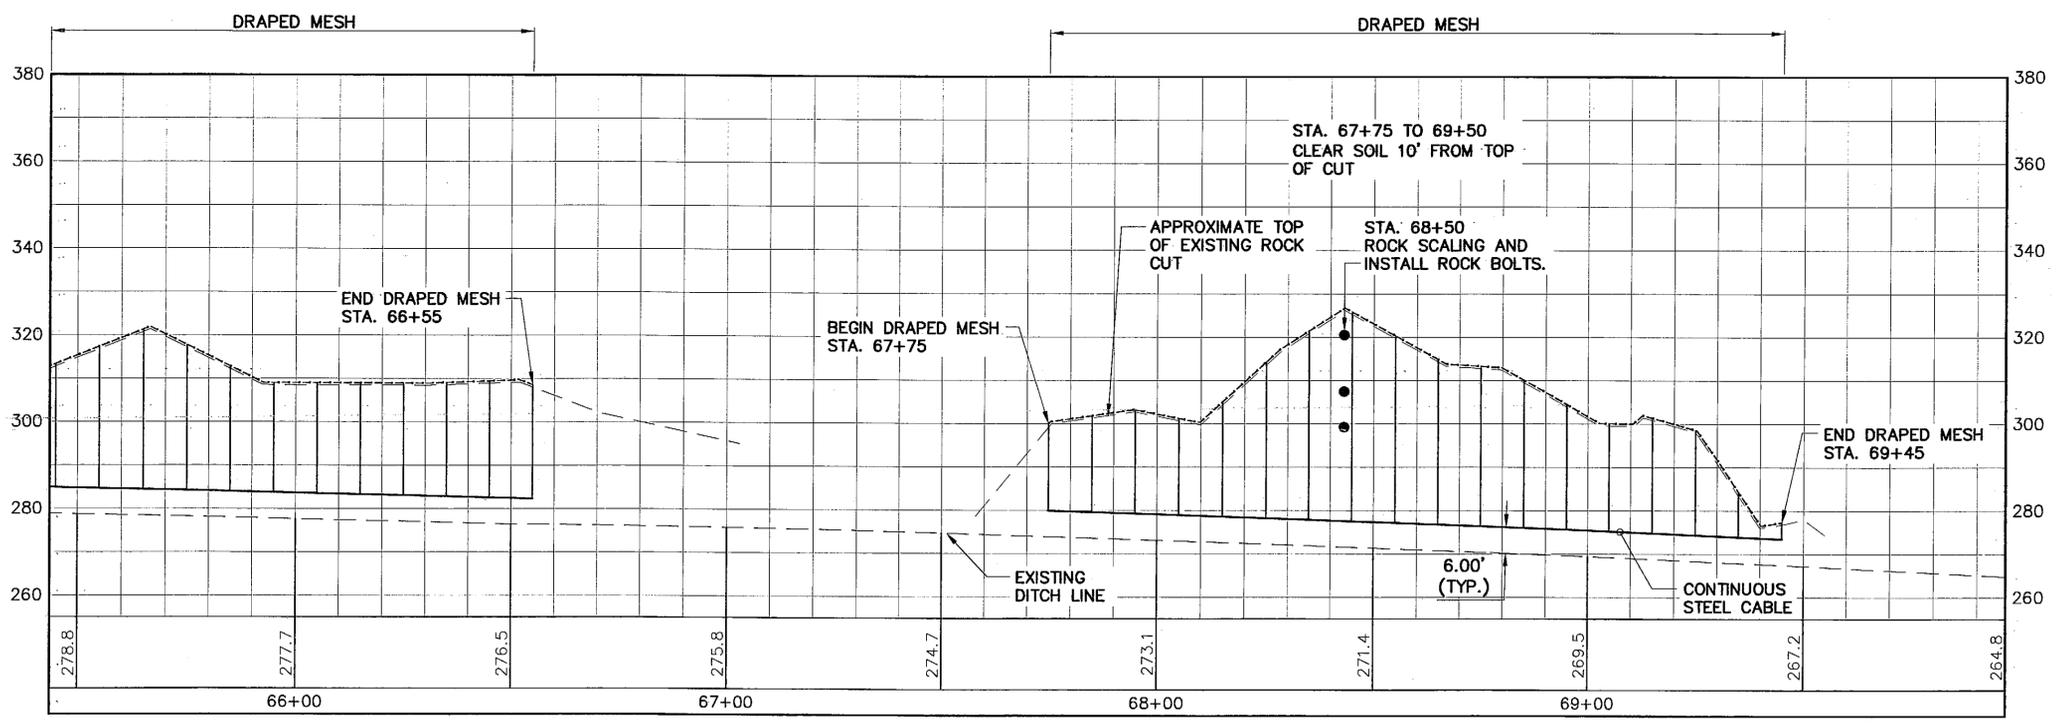

**Third Avenue
Slope Stabilization Plan**

PATH: Q:\Ktn\71811A\PlanSet\S_Slope Stabilization.dwg
Tue, 07/May/02 10:43AM Michael Limbough
PLOT: PSPACE 1=1(F) OR MSPACE 1=1(F)
TAB: ESTIMATE

ADDENDUM NUMBER		
ATTACHMENT NUMBER		
RECORD OF REVISIONS		
No.	DATE	DESCRIPTION

KTN-THIRD AVENUE EXTENSION
PROJECT NO. 68490

Slope Stabilization Plan

DESIGNED BY: C. HOWARD



CHECKED BY: T. MOORE
DRAWN BY: K.K.

STATE OF ALASKA
DEPARTMENT OF TRANSPORTATION
& PUBLIC FACILITIES
STATEWIDE DESIGN & ENGINEERING
SERVICES DIVISION
THIRD AVENUE EXTENSION
PROJECT NO. 68490


**Slope
Stabilization
Plan**

PROJECT DESIGNATION NUMBER
STP-MG-0904(2)


STATE	YEAR
ALASKA	2002
SHEET NUMBER	TOTAL SHEETS
S2	146

Project As Built Drawings have been reviewed by the Project Engineer. To the best of his/her knowledge, they represent the project as constructed.
Proj. Eng. *[Signature]* Date 10/31/06


ROCKFALL FENCE

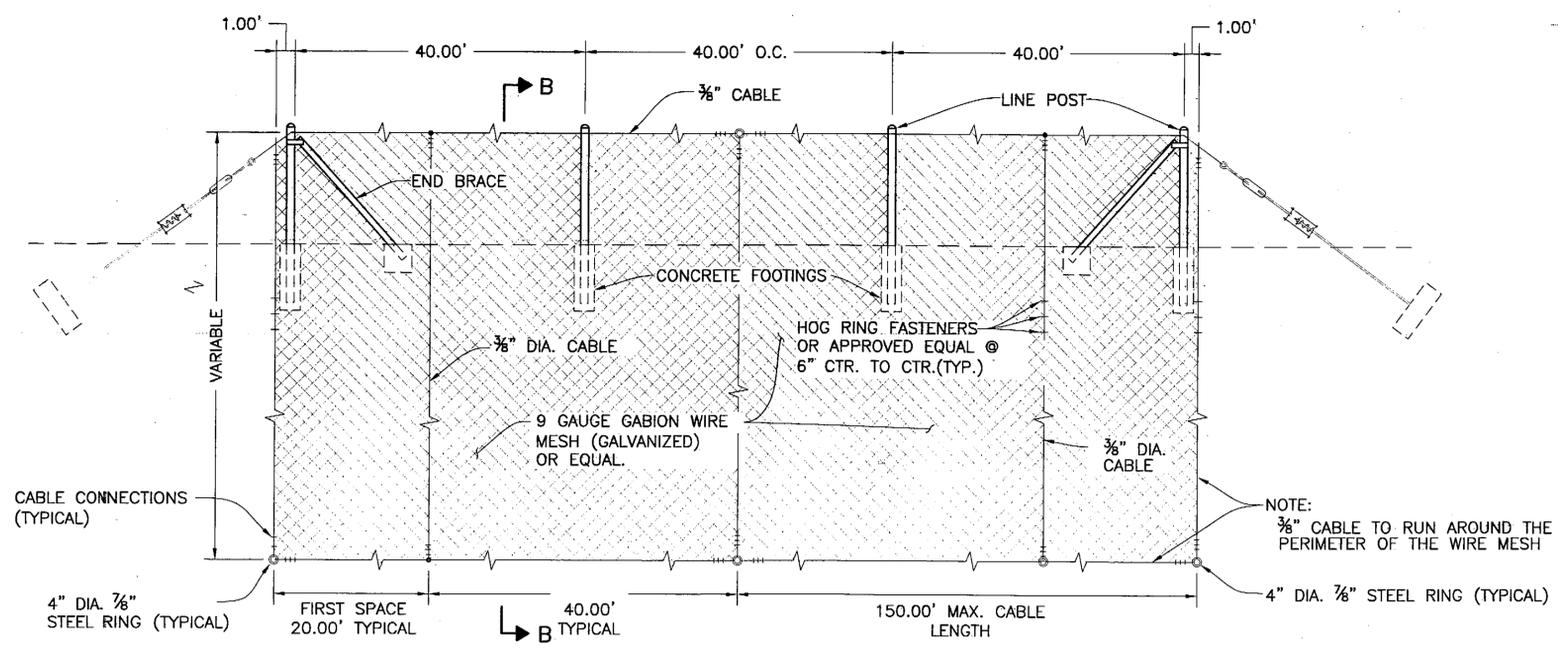


ROCKFALL FENCE

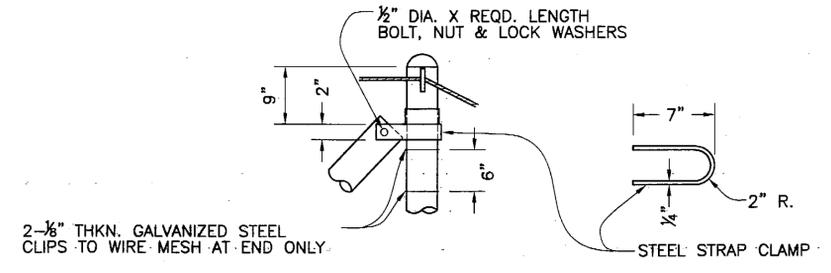


DETAIL "A"

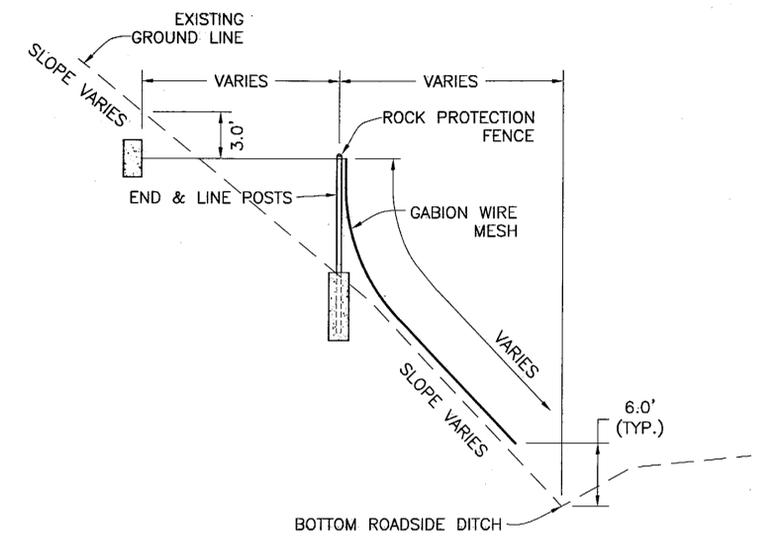


SECTION B-B

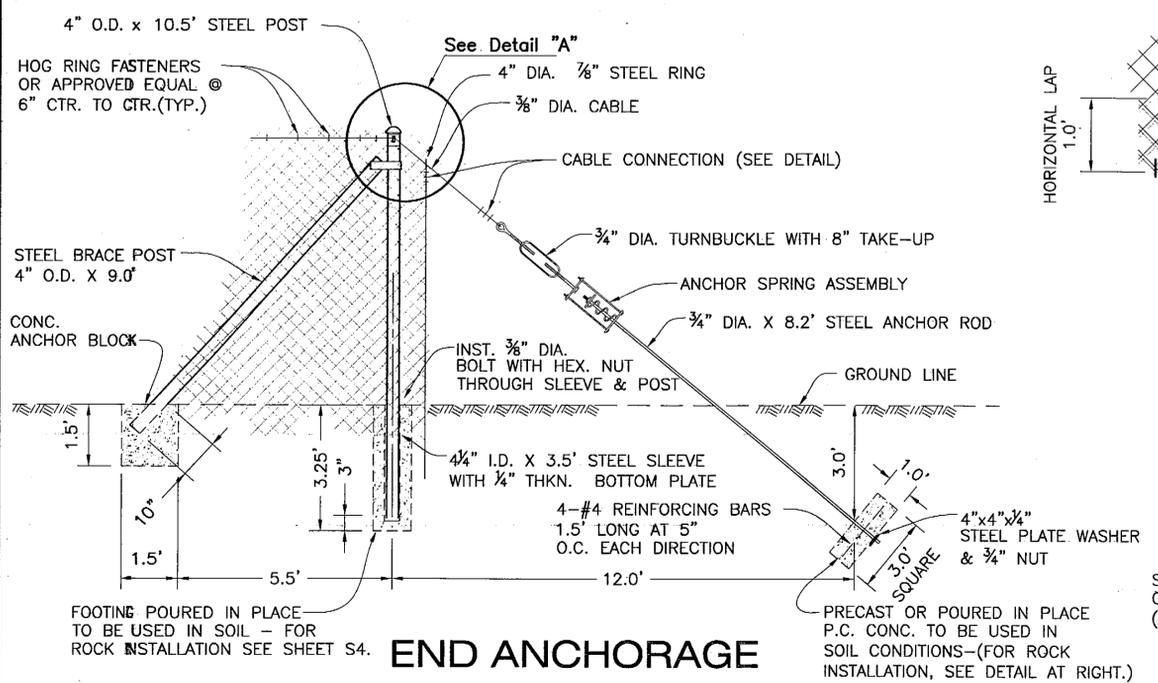


END ANCHORAGE

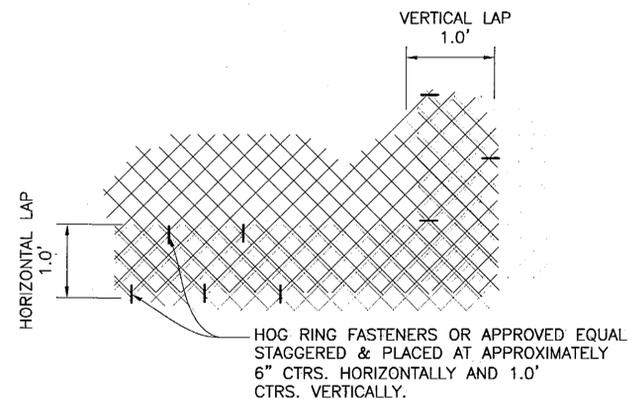

WIRE MESH LAP

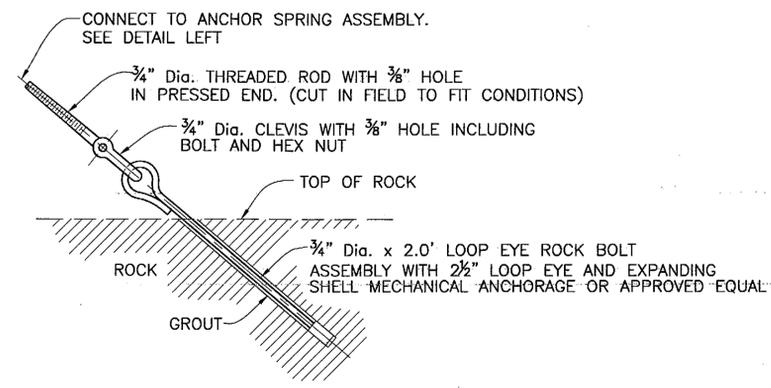

END ANCHOR (Installation in Rock)

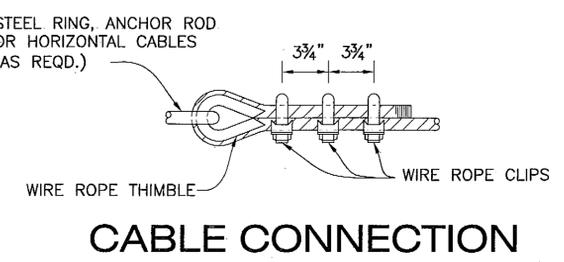

CABLE CONNECTION

PATH: Q:\Ktn\71811A\Planset\S3_ROCKFALLFENCE.dwg
 Tue, 07/May/02 10:50AM Michael Limbaugh
 PLDT:
 PSPACE 1=1(F) OR MSPACE 1=1(F)
 TAB: Layout1

ADDENDUM NUMBER		
ATTACHMENT NUMBER		
RECORD OF REVISIONS		
No.	DATE	DESCRIPTION

KTN-THIRD AVENUE EXTENSION
 PROJECT NO. 68490

Rockfall Fence

DESIGNED BY: C. HOWARD



CHECKED BY: T. MOORE

DRAWN BY: M. LIMBAUGH

STATE OF ALASKA
 DEPARTMENT OF TRANSPORTATION & PUBLIC FACILITIES
 STATEWIDE DESIGN & ENGINEERING SERVICES DIVISION

THIRD AVENUE EXTENSION
 PROJECT NO. 68490

Rockfall Fence

PROJECT DESIGNATION NUMBER

STP-MG-0904(2)

STATE	YEAR
ALASKA	2002
SHEET NUMBER	TOTAL SHEETS
S3	146

Project As Built Drawings have been reviewed by the Project Engineer. To the best of his/her knowledge, they represent the project as constructed.
 Proj. Eng. Date 10/31/06











ROCKFALL FENCE

PATH:
G:\Ktr\71811A\PlanSet\S4_ROCKFALLFENCE.dwg
Mon, 06/May/02 11:16AM Michael Limbaugh
PLDT:
PSPACE 1=1(F) DR MSPACE 1=1(F)
TAB: S4

ADDENDUM NUMBER		
ATTACHMENT NUMBER		
RECORD OF REVISIONS		
No.	DATE	DESCRIPTION

KTN-THIRD AVENUE EXTENSION
PROJECT NO. 68490

Rockfall Fence

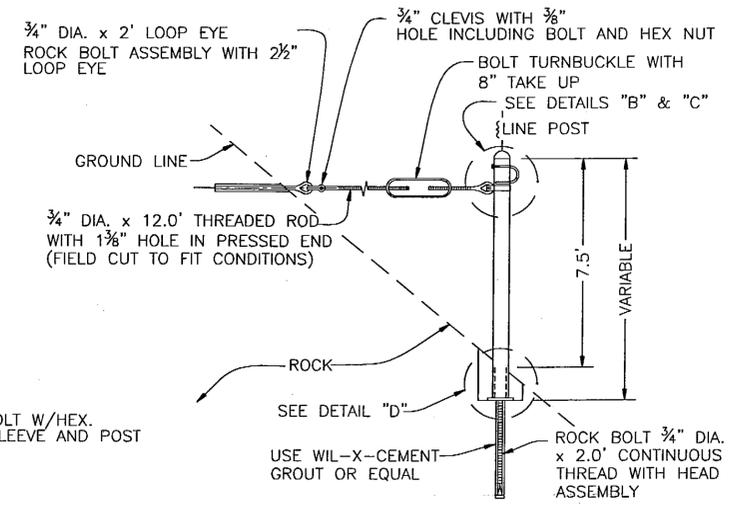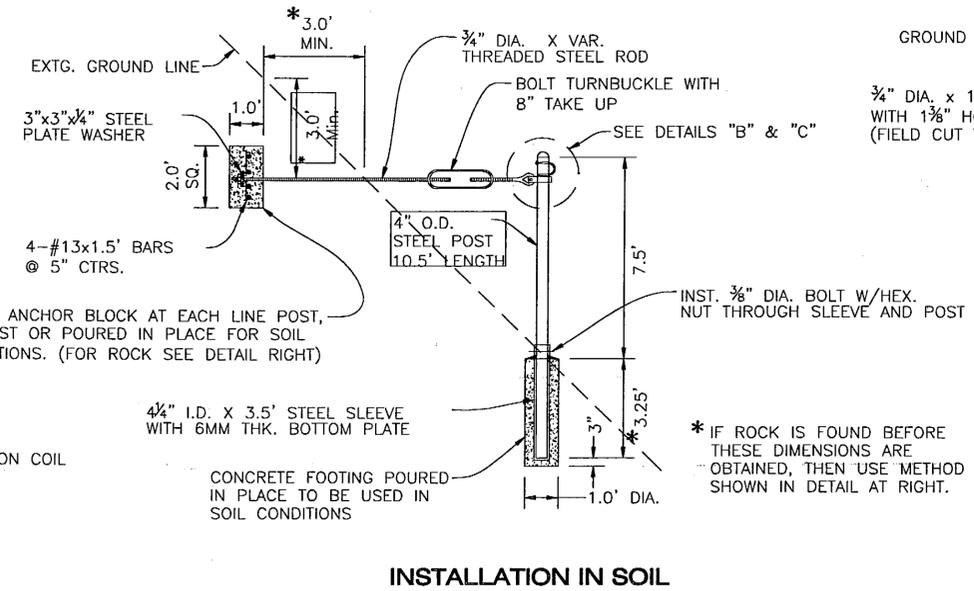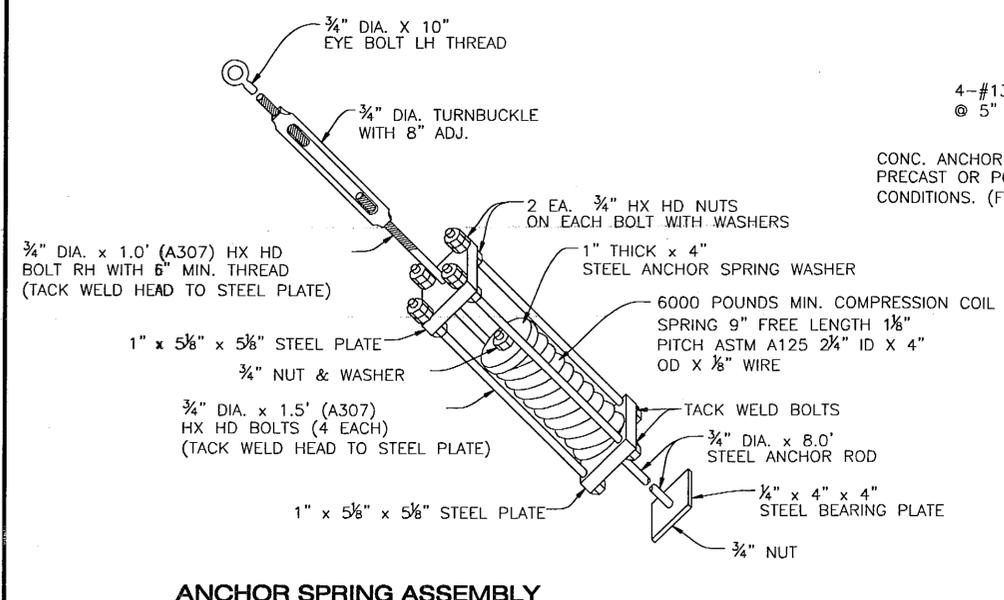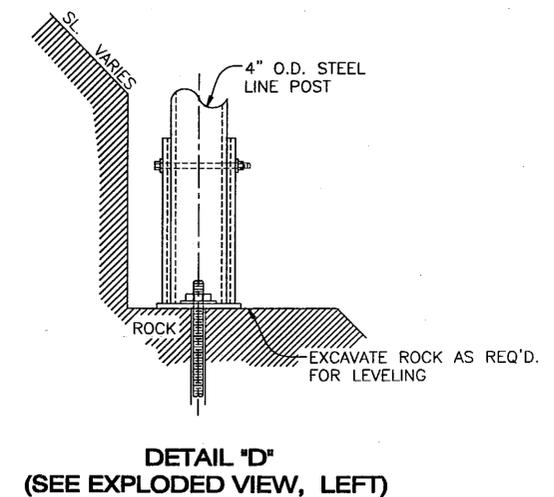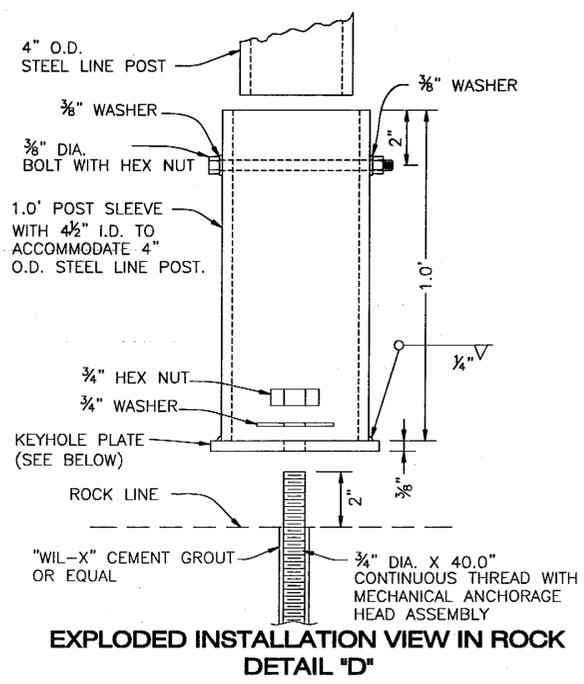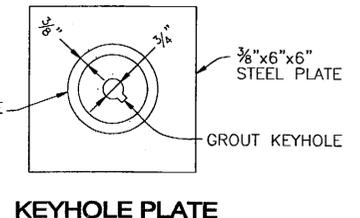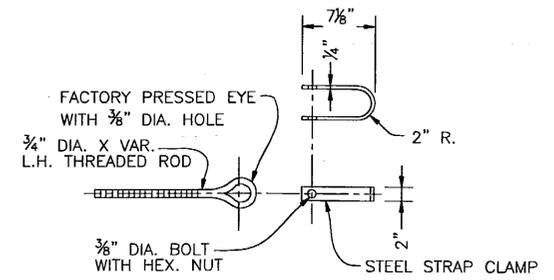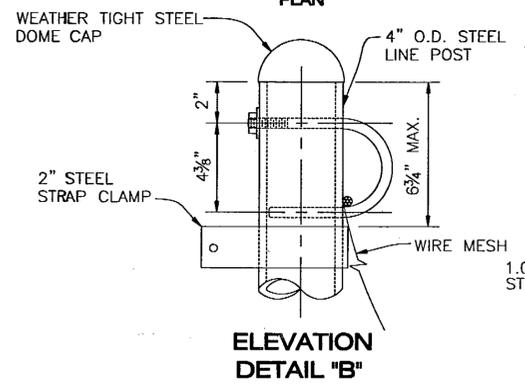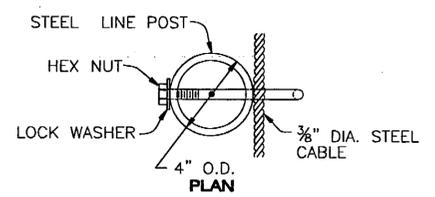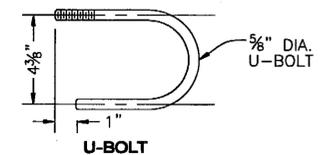

DESIGNED BY: C. HOWARD



CHECKED BY: T. MOORE

DRAWN BY: M. LIMBAUGH


STATE OF ALASKA
DEPARTMENT OF TRANSPORTATION & PUBLIC FACILITIES
STATEWIDE DESIGN & ENGINEERING SERVICES DIVISION
THIRD AVENUE EXTENSION PROJECT NO. 68490

Rockfall Fence


PROJECT DESIGNATION NUMBER	
STP-MG-0904(2)	
STATE	YEAR
ALASKA	2002
SHEET NUMBER	TOTAL SHEETS
S4	146

Project As Built Drawings have been reviewed by the Project Engineer. To the best of his/her knowledge, they represent the project as constructed.
Proj. Eng. *KS* Date 03/06


DRAPED MESH DETAILS

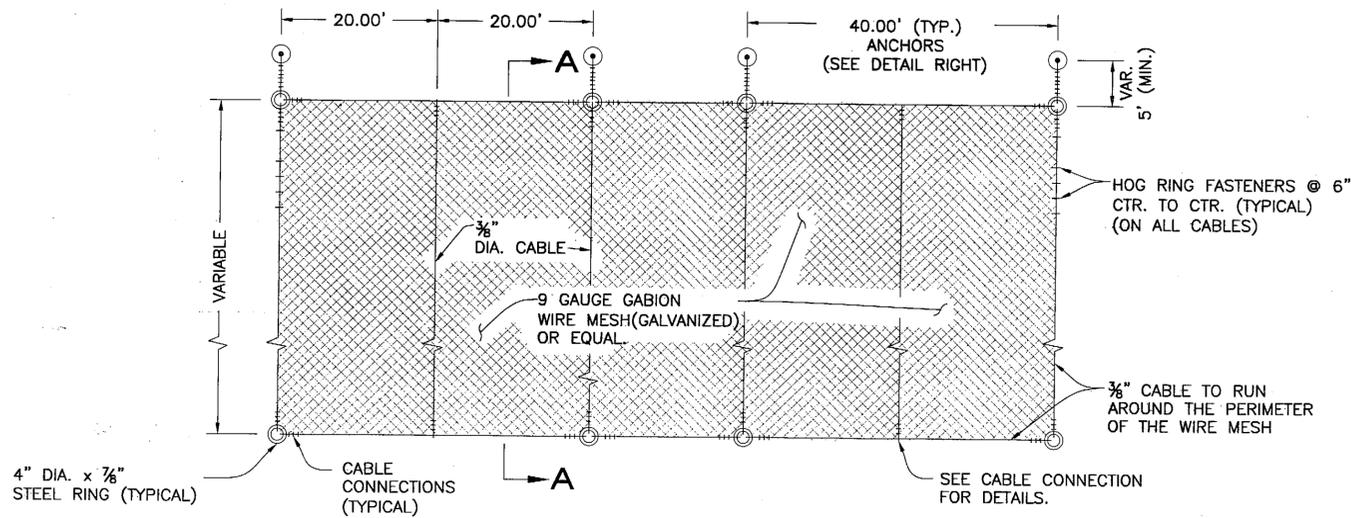


DRAPED MESH

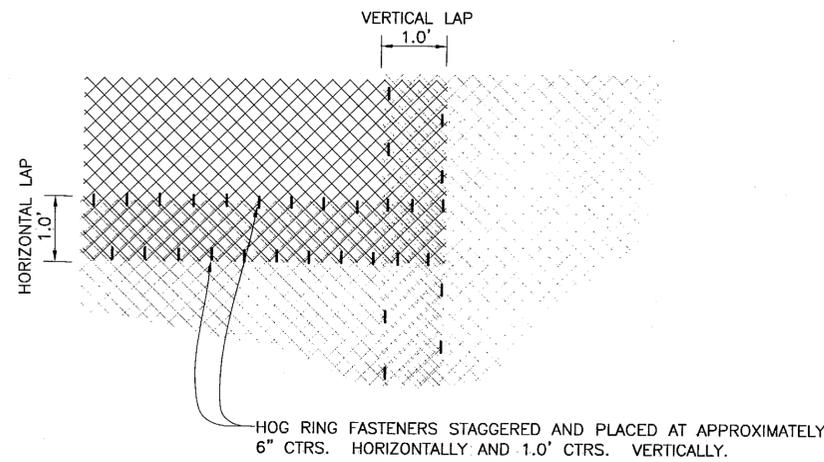


WIRE MESH LAP DETAIL

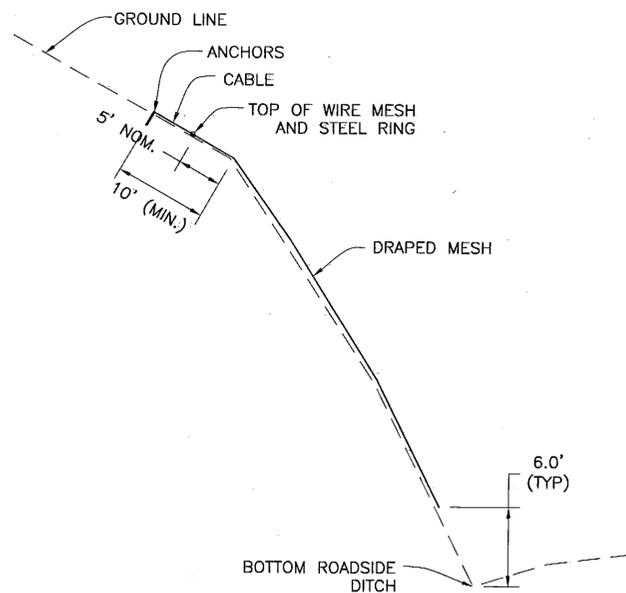


SECTION A-A

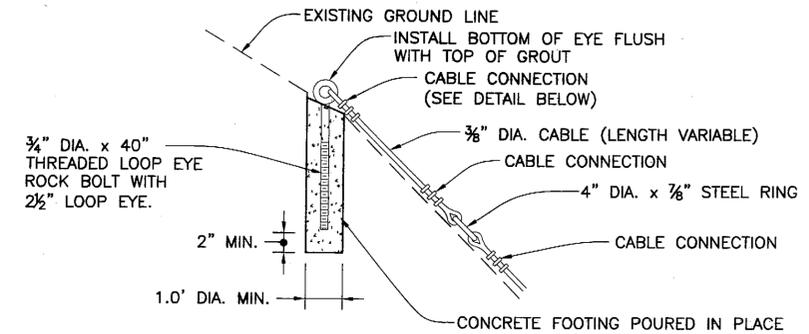

ANCHOR INSTALLATION IN SOIL

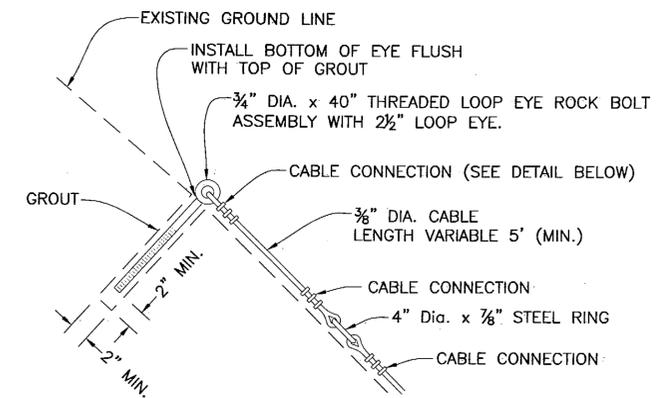

ANCHOR INSTALLATION IN ROCK

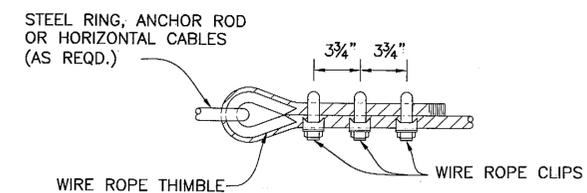

CABLE CONNECTION

PATH: Q:\Ktn\71811A\PlanSet\S5_DrapedMesh.dwg
 Tue, 07/May/02 10:50AM Michael Limbaugh
 PLDT:
 PSPACE 1=1(F) DR MSPACE 1=1(F)
 TAB: Layout1

ADDENDUM NUMBER		
ATTACHMENT NUMBER		
RECORD OF REVISIONS		
No.	DATE	DESCRIPTION

KTN-THIRD AVENUE EXTENSION
 PROJECT NO. 68490

Draped Mesh Details

DESIGNED BY: C. HOWARD



CHECKED BY: T. MOORE

DRAWN BY: M. LIMBAUGH


STATE OF ALASKA
 DEPARTMENT OF TRANSPORTATION & PUBLIC FACILITIES
 STATEWIDE DESIGN & ENGINEERING SERVICES DIVISION
 THIRD AVENUE EXTENSION
 PROJECT NO. 68490

Draped Mesh Details

PROJECT DESIGNATION NUMBER
 STP-MG-0904(2)


STATE	YEAR
ALASKA	2002
SHEET NUMBER	TOTAL SHEETS
S5	146

Project As Built Drawings have been reviewed by the Project Engineer. To the best of his/her knowledge, they represent the project as constructed.
 Proj. Eng. *[Signature]* Date 05/06

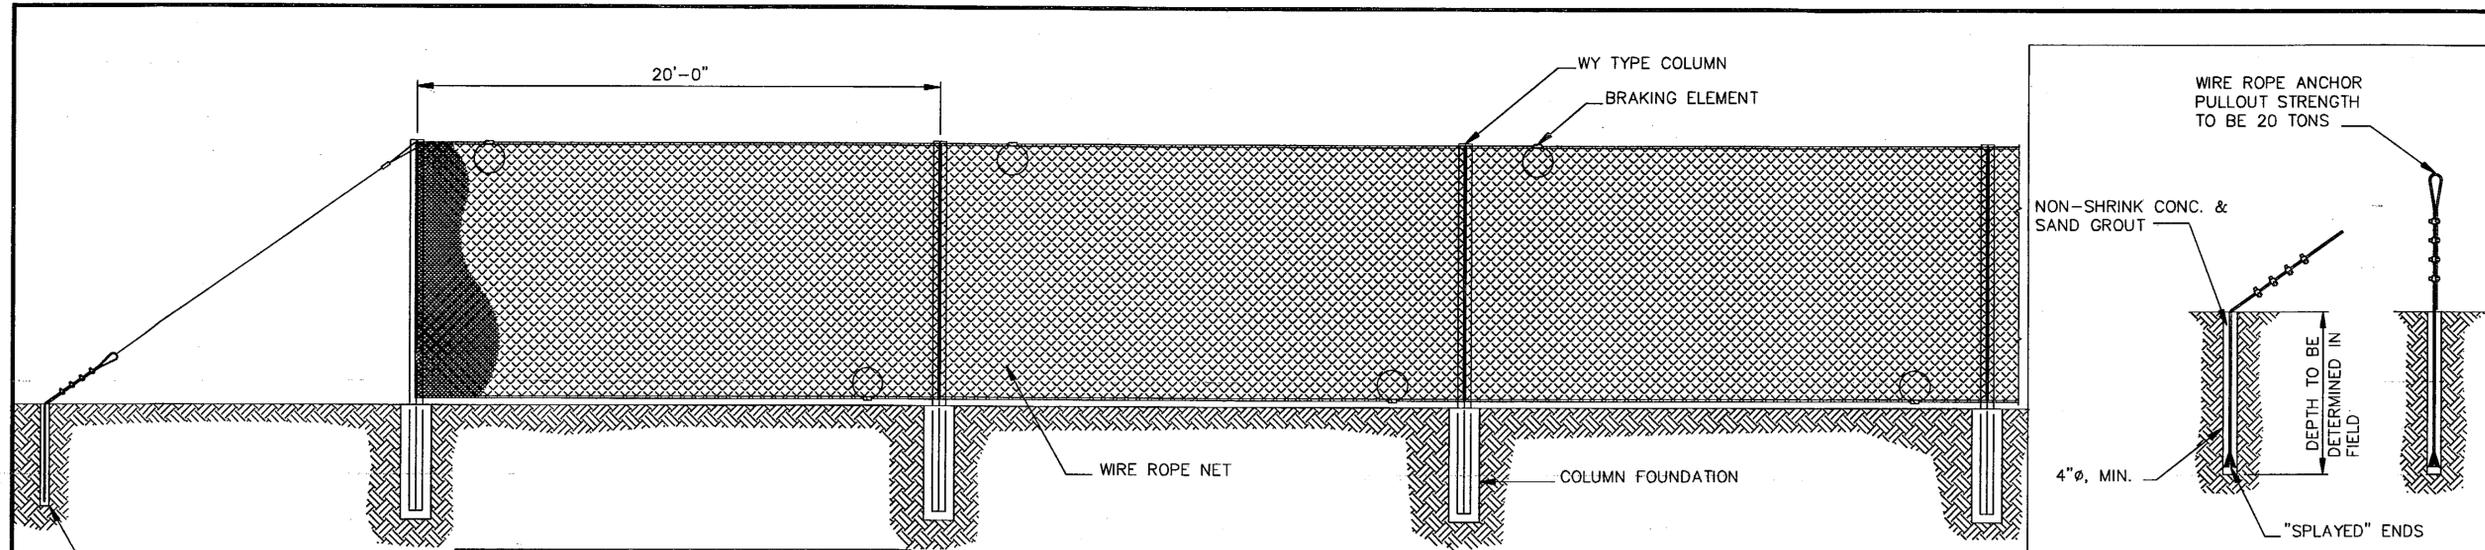


**FOR INFORMATION
USE ONLY**


TYPICAL LAYOUT

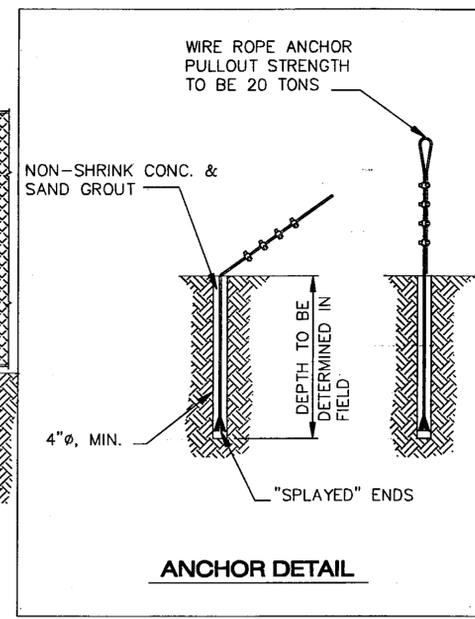

ANCHOR DETAIL

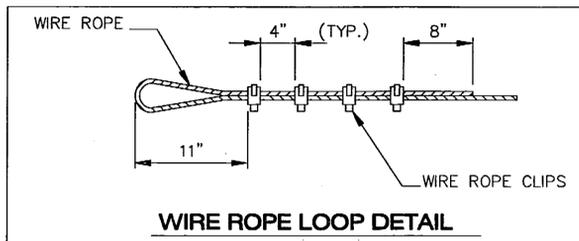


WIRE ROPE LOOP DETAIL

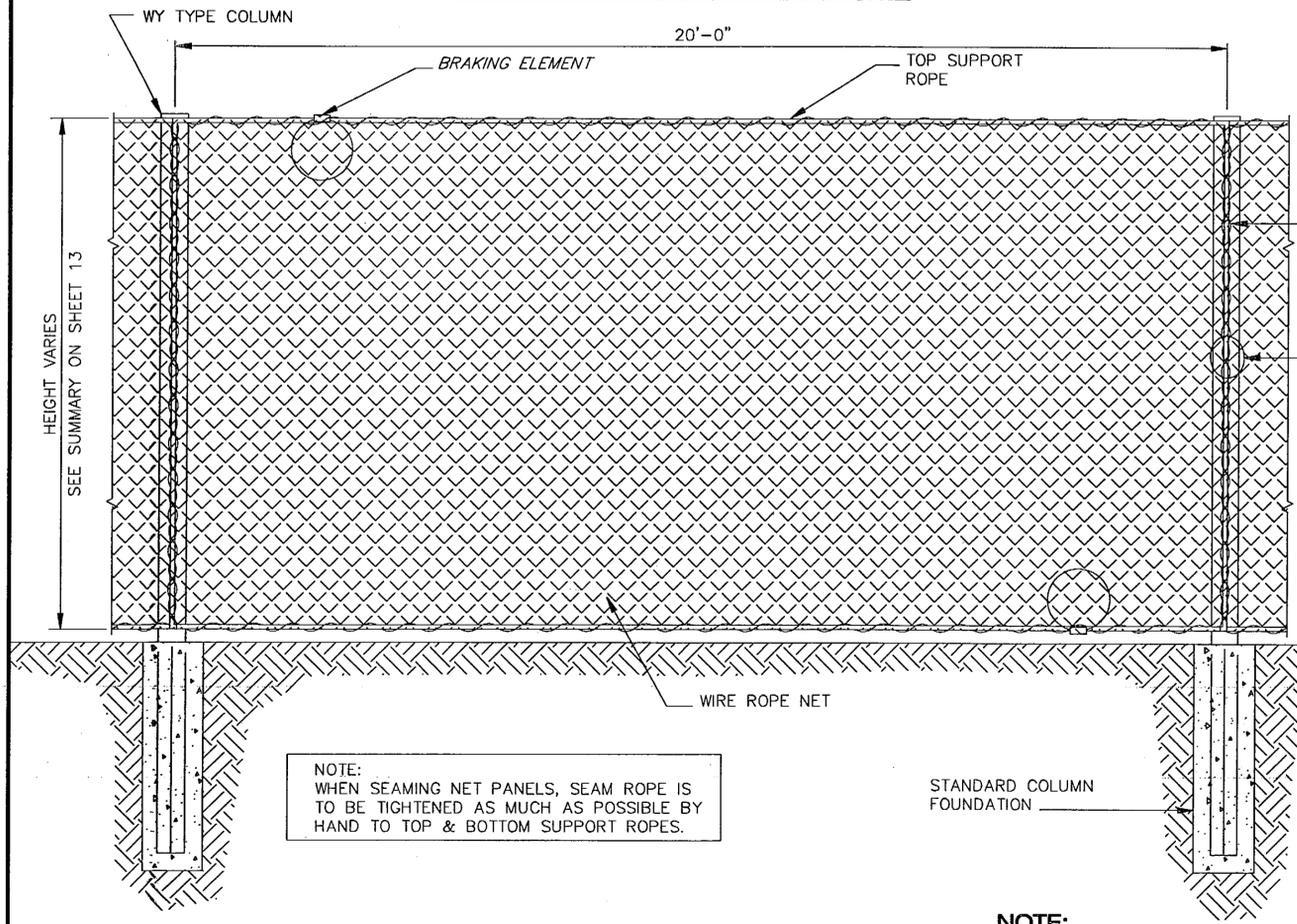

SEAMING DETAIL

NOTE:
DIFFERENT TYPE OF FOUNDATION,
OTHER THAN ROCK, MAY BE ENCOUNTERED.

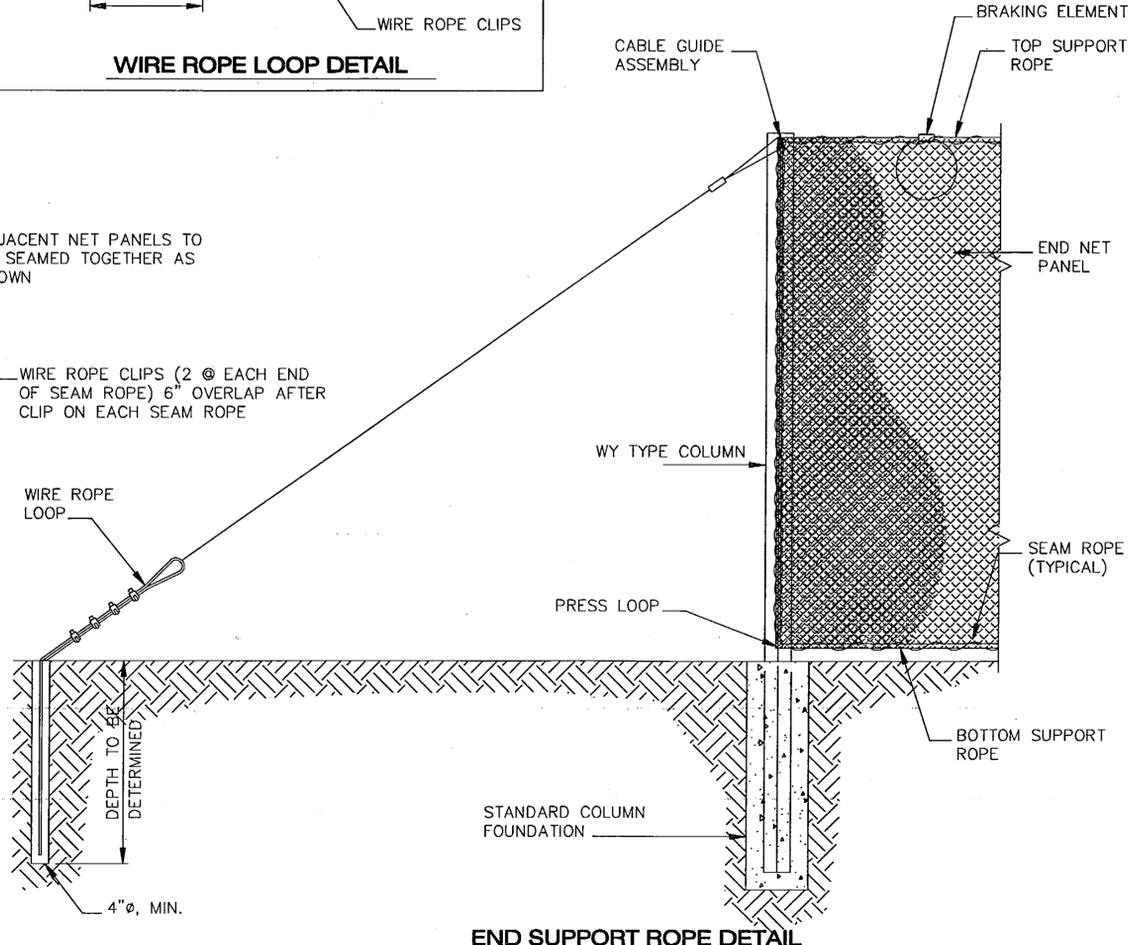

END SUPPORT ROPE DETAIL

PATH: Q:\Ktn\71811A\PlanSet\S6-7_RockFence.dwg
 Mon, 06/May/02 11:19AM Michael Limbaugh
 PLDT:
 PSPACE 1=1(F) OR MSPACE 1=1(F)
 TAB: S6

ADDENDUM NUMBER		
ATTACHMENT NUMBER		
RECORD OF REVISIONS		
No.	DATE	DESCRIPTION

**KTN-THIRD AVENUE EXTENSION
PROJECT NO. 68490**

**Temporary Rock
Catchment Barrier**

DESIGNED BY: C. HOWARD

CHECKED BY: T. MOORE
 DRAWN BY: K.K.
 STATE OF ALASKA
 DEPARTMENT OF TRANSPORTATION
 & PUBLIC FACILITIES
 STATEWIDE DESIGN & ENGINEERING
 SERVICES DIVISION
**THIRD AVENUE EXTENSION
PROJECT NO. 68490**

**Temporary Rock
Catchment Barrier**

PROJECT DESIGNATION NUMBER	
STP-MG-0904(2)	
STATE	YEAR
ALASKA	2002
SHEET NUMBER	TOTAL SHEETS
S6	146

Project As Built Drawings have been reviewed by the Project Engineer. To the best of his/her knowledge, they represent the project as constructed.
 Proj. Eng. *[Signature]* Date 10.2.06

PATH:
 Q:\Ktn\71811A\PlanSet\S6-7_RockFence.dwg
 Mon, 06/May/02 11:19AM Michael Limbaugh
 PLOT:
 PSPACE 1=1(F) DR MSPACE 1=1(F)
 TAB: S7

ADDENDUM NUMBER		
ATTACHMENT NUMBER		
RECORD OF REVISIONS		
No.	DATE	DESCRIPTION

KTN-THIRD AVENUE EXTENSION
PROJECT NO. 68490
Temporary Rock
Catchment Barrier

DESIGNED BY: C. HOWARD




CHECKED BY: T. MOORE
 DRAWN BY: K.K.

STATE OF ALASKA
 DEPARTMENT OF TRANSPORTATION
 & PUBLIC FACILITIES
 STATEWIDE DESIGN & ENGINEERING
 SERVICES DIVISION
THIRD AVENUE EXTENSION
PROJECT NO. 68490


Temporary Rock
Catchment Barrier
 PROJECT DESIGNATION NUMBER

STP-MG-0904(2)	
STATE	YEAR
ALASKA	2002
SHEET NUMBER	TOTAL SHEETS
S7	146


Project As Built Drawings have been reviewed by the Project Engineer. To the best of his/her knowledge, they represent the project as constructed.
 Proj. Eng. *KS* Date 10/31/06

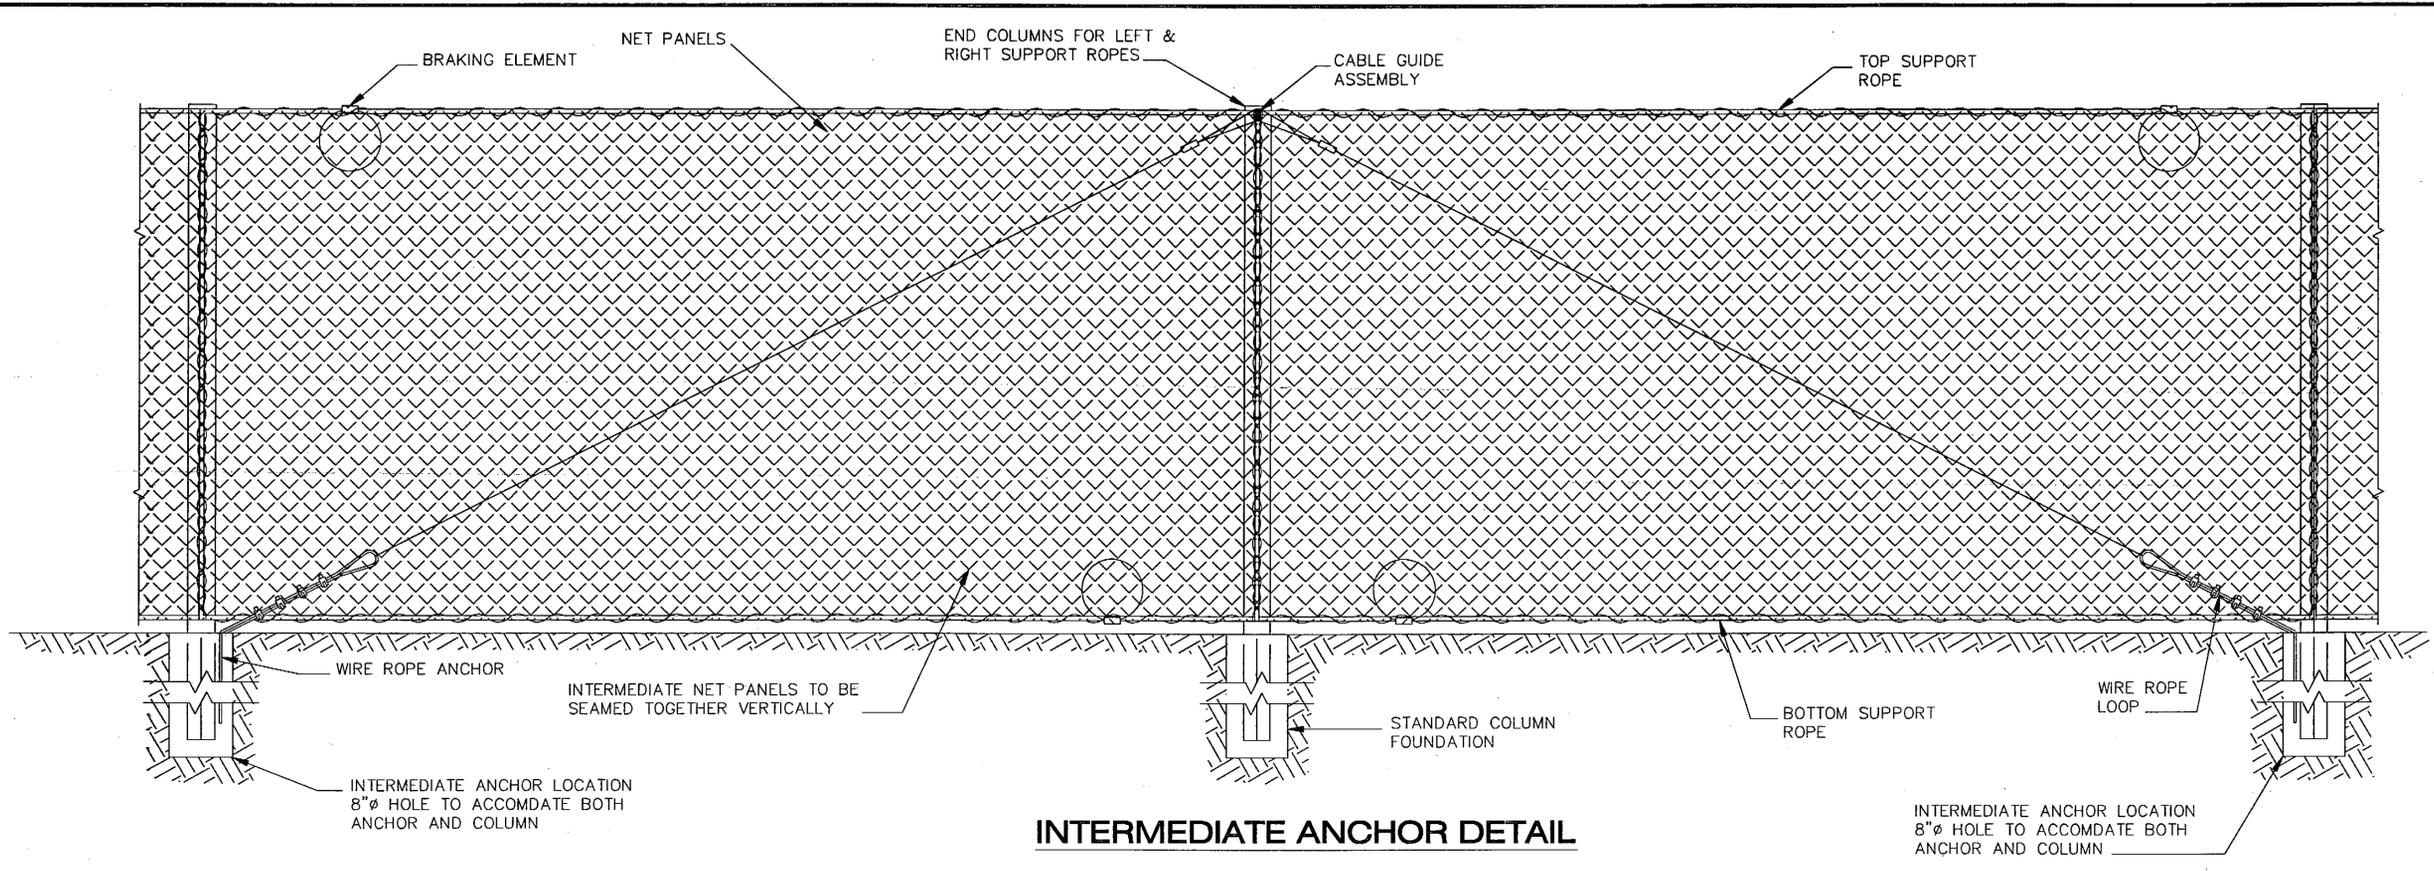


INTERMEDIATE ANCHOR DETAIL

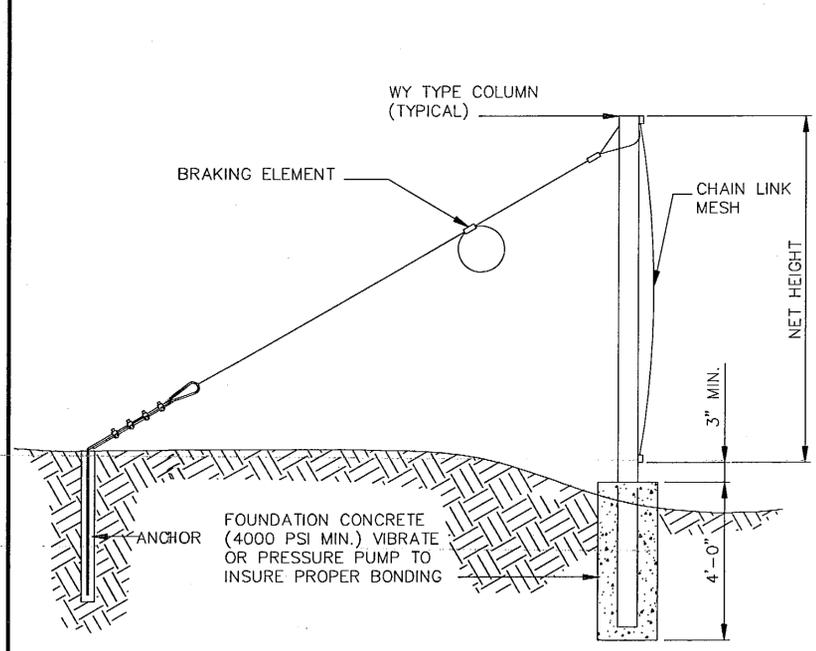

ALTERNATE FOUNDATION 1

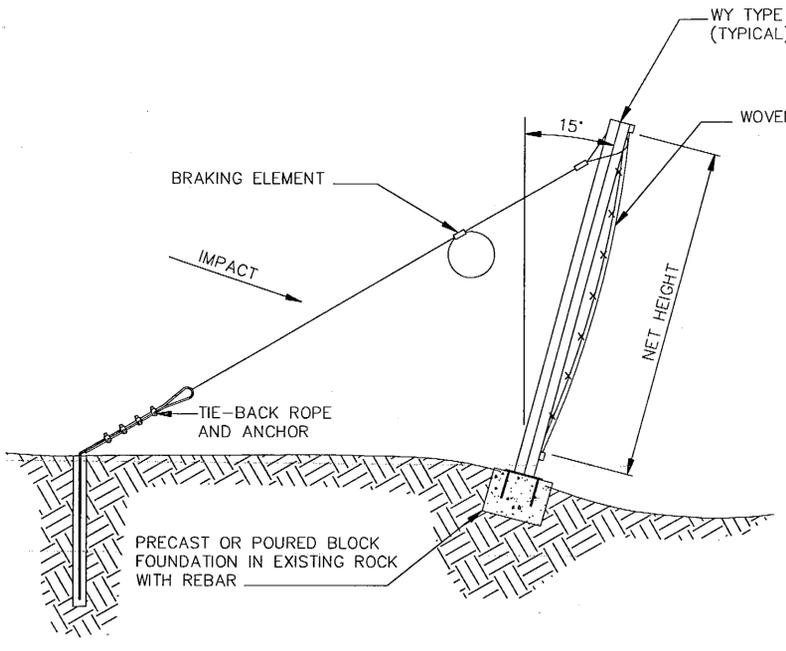

ALTERNATE FOUNDATION 2
 (ANGLED COLUMN W/BLOCK FOUNDATION)

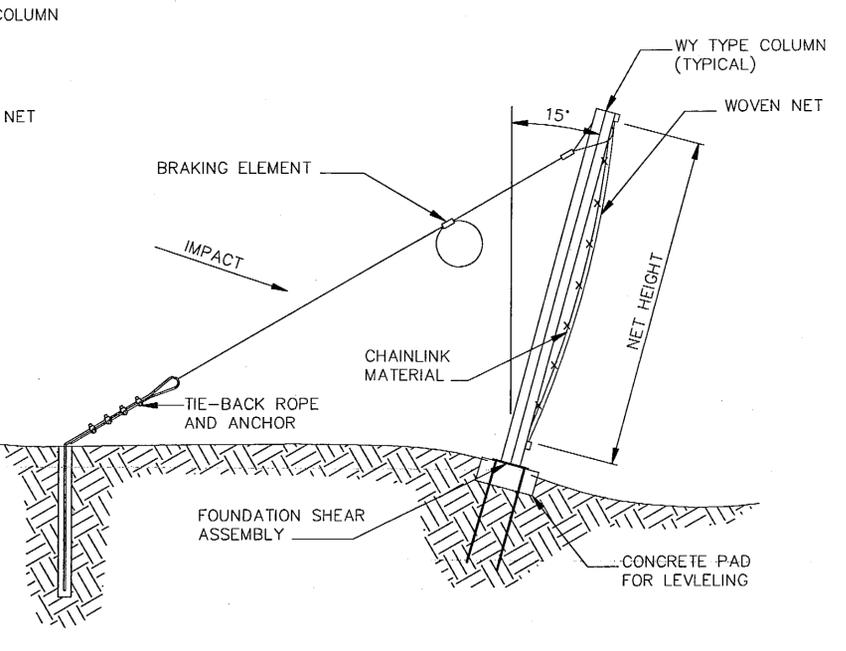

ALTERNATE FOUNDATION 3
 (ANGLED COLUMN W/ROCKBOLT FOUNDATION)

FOR INFORMATION
USE ONLY

STANDARD SIGNING SCHEDULE

SIGN No.	STATION	OFFSET LT. RT.	CODE No. (ASDS)	LEGEND	SIZE		AREA S.F.	POST SIZE	FACING TRAFFIC	REMARKS	
					H	W					
1	"0"21+82	30'	R1-1	STOP	30"	30"	6.25	2.5"	EB		
2	"0"21+82	30'	D3-1	3RD AVE	8"	24"	.67		NB/SB	MOUNT ABOVE STOP SIGN	
3	"0"21+82	30'	D3-1	WASHINGTON ST	8"	36"	1.00		WB/EB	MOUNT ABOVE STOP SIGN	
4	"0"22+30	30'	R1-1	STOP	30"	30"	6.25	2.5"	WB		
5	"0"22+30	30'	D3-1	3RD AVE	8"	24"	.67		NB/SB	MOUNT ABOVE STOP SIGN	
6	"0"22+30	30'	D3-1	WASHINGTON ST	8"	36"	1.00		WB/EB	MOUNT ABOVE STOP SIGN	
7	"0"23+25	27'	R1-1	STOP	30"	30"	6.25	2.5"	NB		
8	"A"11+70	17'	R1-1	STOP	30"	30"	6.25	2.5"	EB		
9	"A"11+55	27'	R1-1	STOP	30"	30"	6.25	2.5"	WB		
10	"0"24+12	25'	R2-1	SPEED LIMIT 35	36"	30"	7.50	2.5"	EB		
11	"0"25+80	25'	R8-1	NO PARKING ON PAVEMENT	30"	24"	5.00	2.5"	WB	MOUNT ON ELECTROLIER NO. 3	
12	"0"24+20	27'	R2-1	SPEED LIMIT 25	36"	30"	7.50		WB		
13	"0"23+60	25'	R8-1	NO PARKING ON PAVEMENT	30"	24"	5.00	2.5"	WB		
14	"0"23+75	25'	D11-1	BIKE ROUTE	18"	24"	3.00	2.5"	EB		
15	"0"26+95	25'	R1-1	STOP	30"	30"	6.25	2.5"	SB		
16	"0"26+95	25'	R6-1(R)	ONE WAY	12"	36"	3.00		EB	MOUNT ABOVE STOP SIGN	
17	"0"26+95	25'	R6-1(L)	ONE WAY	12"	36"	3.00		WB	MOUNT ABOVE STOP SIGN	
18	"0"27+00	25'	R3-2	NO LEFT TURN	24"	24"	7.00	2.5"	EB	(INCLUDES 18"x24" LEGEND PLAQUE)	
19	"0"27+00	25'	R3-2	NO RIGHT TURN	24"	24"	7.00	2.5"	WB	(INCLUDES 18"x24" LEGEND PLAQUE)	
20	"0"27+90	27'	R8-1	NO PARKING ON PAVEMENT	30"	24"	5.00	2.5"	WB	MOUNT ON ELECTROLIER No. 7	
21	"0"31+00	21'	R8-1	NO PARKING ON PAVEMENT	30"	24"	5.00	2.5"	WB		
22	"0"31+00	25'	R8-1	NO PARKING ON PAVEMENT	30"	24"	5.00	2.5"	EB		
23	"0"27+60	21'	R7-101	NO PARKING 10:00 PM TO 6:00 AM	18"	12"	1.50	2.5"	SB	MOUNT ON ELECTROLIER No. 5	
24	"0"28+62	21'	R7-101	NO PARKING 10:00 PM TO 6:00 AM	18"	12"	1.50	2.5"	SB		
25	"0"29+50	21'	R7-101	NO PARKING 10:00 PM TO 6:00 AM	18"	12"	1.50	2.5"	SB		
26	"0"29+73	21'	R6-1L	ONE WAY	12"	36"	3.00		EB		
27	"0"29+73	21'	R6-1R	ONE WAY	12"	36"	3.00		WB		
28	"0"38+00	25'	R8-1	NO PARKING ON PAVEMENT	30"	24"	5.00	2.5"	EB		
29	"0"37+80	21'	R8-1	NO PARKING ON PAVEMENT	30"	24"	5.00	2.5"	WB	MOUNT ON ELECTROLIER No. 11	
30	"0"48+05	25'	R8-1	NO PARKING ON PAVEMENT	30"	24"	5.00	2.5"	WB	MOUNT ON ELECTROLIER No. 17	
31	"0"48+00	21'	R8-1	NO PARKING ON PAVEMENT	30"	24"	5.00	2.5"	EB		
32	"0"61+70	25'	R8-1	NO PARKING ON PAVEMENT	30"	24"	5.00	2.5"	WB	MOUNT ON ELECTROLIER No. 25	
33	"0"61+60	21'	R8-1	NO PARKING ON PAVEMENT	30"	24"	5.00	2.5"	WB	MOUNT ON ELECTROLIER No. 29	
34	"0"68+40	25'	R8-1	NO PARKING ON PAVEMENT	30"	24"	5.00	2.5"	WB		
35	"0"70+50	25'	R2-1	SPEED LIMIT 35	36"	30"	7.50	2.5"	WB		
36	"0"70+10	25'	R8-1	NO PARKING ON PAVEMENT	30"	24"	5.00	2.5"	EB		
37	"0"71+75	25'	R2-1	SPEED LIMIT 25	36"	30"	7.50	2.5"	WB		
38	"0"71+45	30'	R1-1	STOP	30"	30"	6.25	2.5"	SB		
39	"0"72+20	25'	D11-1	BIKE ROUTE	18"	24"	3.00	2.5"	WB		
40	"0"74+25	30'	R1-1	STOP	30"	30"		2.5"	NB	EXISTING SIGNS INSTALL UNDER PREVIOUS PROJECT	
41	"0"74+25	30'	D3-1	3RD AVE	8"	24"			NB/SB	EXISTING SIGNS INSTALL UNDER PREVIOUS PROJECT	
42	"0"74+25	30'	D3-1	SCHOENBAR RD	8"	36"			EB/WB	EXISTING SIGNS INSTALL UNDER PREVIOUS PROJECT	
43	"S"11+50	25'	W7-1	TRUCK SYMBOL	36"	36"		2.5"	WB	EXISTING SIGNS INSTALL UNDER PREVIOUS PROJECT	
44	"S"11+50	25'	HILL	HILL	18"	24"			WB	EXISTING SIGNS INSTALL UNDER PREVIOUS PROJECT	
45	"0"76+50	25'	R8-1	NO PARKING ON PAVEMENT	30"	24"		2.5"	EB	EXISTING SIGNS INSTALL UNDER PREVIOUS PROJECT	
46	"0"77+50	25'	R2-1	SPEED LIMIT 25	36"	30"		2.5"	EB	EXISTING SIGNS INSTALL UNDER PREVIOUS PROJECT	
47	"0"76+25	X	R1-1	STOP	30"	30"		2.5"	SB	EXISTING SIGNS INSTALL UNDER PREVIOUS PROJECT	
48	"0"76+25	X	D3-1	3RD AVE	8"	24"			NB/SB	EXISTING SIGNS INSTALL UNDER PREVIOUS PROJECT	
49	"0"76+25	X	D3-1	W FAIRY CHASM	8"	36"			EB/WB	EXISTING SIGNS INSTALL UNDER PREVIOUS PROJECT	
50	*	25'	R8-1	NO PARKING ON PAVEMENT	30"	24"	5.00	2.5"	EB		
51	*	25'	R8-1	NO PARKING ON PAVEMENT	30"	24"	5.00	2.5"	WB		
52	*	25'	R8-1	NO PARKING ON PAVEMENT	30"	24"	5.00	2.5"	EB		
53	*	25'	R8-1	NO PARKING ON PAVEMENT	30"	24"	5.00	2.5"	WB		
54	*	25'	R8-1	NO PARKING ON PAVEMENT	30"	24"	5.00	2.5"	EB		
55	*	25'	R8-1	NO PARKING ON PAVEMENT	30"	24"	5.00	2.5"	WB		
56	*	25'	R8-1	NO PARKING ON PAVEMENT	30"	24"	5.00	2.5"	EB		
57	*	25'	R8-1	NO PARKING ON PAVEMENT	30"	24"	5.00	2.5"	WB		
					TOTAL =		223.59				

GENERAL SIGNING NOTES

- SIGN LOCATIONS ARE APPROXIMATE ONLY AND ARE SUBJECT TO MINOR REVISIONS.
- SEE STD. DWG. S-30.01 FOR POST SLEEVE TYPE SOIL EMBEDMENT.
- SALVAGED SIGNS AND REPLACED SIGN PANELS SHALL BE DELIVERED TO THE CITY OF KETCHIKAN AT 3915 TONGASS AVE.
- WHERE SIGNS ARE TO BE LOCATED ON THE DOWNHILL SIDE OF THE STREET, IN AREAS THAT HAVE RETAINING WALLS AT THE BACK OF SIDEWALKS, THE SIGNS SHALL BE MOUNTED TO THE SIDE OF THE RETAINING WALL.
- PT POST TYPE STANDS FOR PERFORATED STEEL TUBE WITH A POST SLEEVE FOR EMBEDMENT.
- ALL SIGN POSTS SHALL BE TELESCOPING PERFORATED GALVANIZED SQUARE STEEL POSTS OR 6"x6" TREATED WOOD POSTS.
- ALL NEW SIGNS SHALL BE UNFRAMED EXCEPT AS NOTED IN THE STANDARD SIGN SCHEDULE.
- ALL D3-1 STREET SIGNS HAVE THE LEGEND ON BOTH SIDES.
- SIGNS SHALL BE INSTALLED SO THAT THE BOTTOM OF THE SIGN PANEL IS 7 FEET ABOVE THE ROADWAY SURFACE.
- FOR SIGN LOCATION PURPOSES 3RD AVE. IS ASSUMED TO GO EB/WB.
- SIGNS 39-47 WERE INSTALLED UNDER THE PREVIOUS 3RD AVENUE PROJECT. THEY ARE INCLUDED FOR REFERENCE ONLY AND NO ADDITIONAL PAYMENT SHALL BE MADE.
- SIGNS (BUT NOT THE POSTS) #1-38 WERE PURCHASED BY THE STATE AND ARE AVAILABLE FOR INSTALLATION ON THIS PROJECT. NO CHARGE WILL BE MADE FOR THESE SIGNS.

* SIGNS SHALL BE SPACED EQUALLY AT LOCATIONS TO BE DETERMINED BY THE ENGINEER BETWEEN STATIONS "0" 80+50 AND STATIONS "0" 114+50.

PATH: Q:\Ktn\71811A\PlanSet\T1-5_Tcps.dwg
 Mon, 06/May/02 09:48AM Michael Limbough
 PLOT: PSPACE 1=1(F) OR MSPACE 1=1(F)
 TAB: SUM_T1

ADDENDUM NUMBER		
ATTACHMENT NUMBER		
RECORD OF REVISIONS		
No.	DATE	DESCRIPTION

KTN-THIRD AVENUE EXTENSION
PROJECT NO. 68490

Traffic Summaries

Project As Built Drawings have been reviewed by the Project Engineer. To the best of his/her knowledge, they represent the project as constructed.
 Proj. Eng.  Date 03/06

DESIGNED BY: R. PURVES



CHECKED BY: M. LUKSHIN

DRAWN BY: *J.M.R.S.*

STATE OF ALASKA
 DEPARTMENT OF TRANSPORTATION & PUBLIC FACILITIES
 STATEWIDE DESIGN & ENGINEERING SERVICES DIVISION
**THIRD AVENUE EXTENSION
 PROJECT NO. 68490**

Traffic Summaries

PROJECT DESIGNATION NUMBER	
STP-MG-0904(2)	
STATE	YEAR
ALASKA	2002
SHEET NUMBER	TOTAL SHEETS
T1	146

SUMMARY OF LOAD CENTER: A

Load Center Type 1

Location data:
"0" 22+24, 44' R
Power source:
POWER POLE NEAR "0" 22+30, 60' R
Photoelectric control:
INSTALL ON LOAD CENTER CABINET

Service voltage: 1 phase, 3 wire, 240/480 volts, 60 Hz.

Interrupting capacity of circuit breakers - series rated. 10,000 AIC
Provide meter socket? Yes Transformer? Yes Service Amps 125

Main Breaker A: 480 volt, 2 pole, 100 amperes

Contactors: 600 volt, 12 pole, 30 amperes

Load Panel A Summary

Circuit Number	Description	KVA Load	Breaker	
			Amps	Poles
AA1	Photo Electric Control	0.10	15A	1
AA2	Electroliers 1 - 2	0.7	15A	2
AA3	Electroliers 3 - 17	5.00	20A	2
AA4	PTR Cabinet	0.00	20A	1
AA5	Spare	0.00	20A	2
AA6	Space	-	-	-
Total Demand Load:		5.80		

SUMMARY OF LOAD CENTER: B

Load Center Type 1

Location data:
"0" 73+44, 26' R
Power source:
POWER POLE NEAR "0" 74+93, 51' R
Photoelectric control:
INSTALL ON LOAD CENTER CABINET

Service voltage: 1 phase, 3 wire, 240/480 volts, 60 Hz.
with grounded neutral

Interrupting capacity of circuit breakers - series rated. 10,000 AIC
Provide meter socket? Yes Transformer? Yes Service Amps 125

Main Breaker A: 480 volt, 2 pole, 100 amperes

Contactors: 600 volt, 12 pole, 30 amperes

Load Panel A Summary

Circuit Number	Description	KVA Load	Breaker	
			Amps	Poles
AA1	Photo Electric Control	0.10	15A	1
AA2	Electroliers 32 and 34	0.70	15A	2
AA3	Electroliers 18 - 31	5.40	20A	2
AA4	Spare	0.00	20A	2
AA5	Spare	0.00	20A	2
AA6	Space	-	-	-
Total Demand Load:		6.20		

LOAD CENTER NOTES

1. CONTRACTOR SHALL HAVE METERS INSTALLED, AND PAY ANY FEES REQUIRED BY THE LOCAL UTILITY. THE STATE WILL ACCEPT BILLING WHEN THE PROJECT IS ACCEPTED.
2. INSTALL STEP DOWN TRANSFORMER TO CONVERT 240/480V TO 120/240V IN BOTH LOAD CENTERS.

LOAD CENTER SUMMARY

NO.	STATION	OFFSET	TYPE	REMARKS
1	'0' 22+24	44' R	1	IN FRONT OF POWER POLE
2	'0' 73+44	26' R	1	IN FRONT OF POWER POLE

JUNCTION BOX SUMMARY

NO.	STATION	OFFSET	TYPE	REMARKS
JB#1	≈ '0' 29+055	21' L	II	FOR PTR STATION
1	'0' 21+75	17' L	1A	
2	'0' 22+50	21' R	1A	
3	'0' 24+20	21' L	1A	
4	'0' 25+90	21' L	1A	
5	'0' 27+60	21' L	1A	
6	'0' 29+30	21' L	1A	
7	'0' 31+00	21' L	1A	
8	'0' 32+70	21' L	1A	
9	'0' 34+40	21' L	1A	
10	'0' 36+10	21' L	1A	
11	'0' 37+80	21' L	1A	
12	'0' 39+50	21' L	1A	
13	'0' 41+20	21' L	1A	
14	'0' 42+90	21' L	1A	
15	'0' 44+60	21' L	1A	
16	'0' 46+30	21' L	1A	
17	'0' 48+00	21' L	1A	
18	'0' 49+70	21' L	1A	
19	'0' 51+40	21' L	1A	
20	'0' 53+10	21' L	1A	
21	'0' 54+80	21' L	1A	
22	'0' 56+50	21' L	1A	
23	'0' 58+20	21' L	1A	
24	'0' 59+90	21' L	1A	
25	'0' 61+60	21' L	1A	
26	'0' 63+30	21' L	1A	
27	'0' 65+00	21' L	1A	
28	'0' 66+70	21' L	1A	
29	'0' 68+40	21' L	1A	
30	'0' 70+10	20' R	1A	
31	'0' 71+80	20' R	1A	
32	'0' 73+50	21' R	1A	
40	'0' 22+41	20' L	1A	
41	'0' 70+10	21' R	1A	

POLE SUMMARY

POLE NO.	STATION	OFFSET	MAST ARM LENGTH	SPECIAL FEATURES
1	'0' 21+75	27' R	15'	250 WATT, MC TYPE II
2	'0' 22+50	27' R	15'	250 WATT, MC TYPE II
3	'0' 24+20	27' L	15'	250 WATT, MC TYPE II
4	'0' 25+90	27' L	15'	250 WATT, MC TYPE II
5	'0' 27+60	21' L	10'	250 WATT, MC TYPE II
6	'0' 29+30	21' L	10'	250 WATT, MC TYPE II
7	'0' 31+00	27' L	15'	250 WATT, MC TYPE II
8	'0' 32+70	27' L	15'	250 WATT, MC TYPE II
9	'0' 34+40	27' L	15'	250 WATT, MC TYPE II
10	'0' 36+10	27' L	15'	250 WATT, MC TYPE II
11	'0' 37+80	27' L	15'	250 WATT, MC TYPE II
12	'0' 39+50	27' L	15'	250 WATT, MC TYPE II
13	'0' 41+20	27' L	15'	250 WATT, MC TYPE II
14	'0' 42+90	27' L	15'	250 WATT, MC TYPE II
15	'0' 44+60	27' L	15'	250 WATT, MC TYPE II
16	'0' 46+30	27' L	15'	250 WATT, MC TYPE III
17	'S' 48+00	27' L	15'	250 WATT, MC TYPE III
18	'0' 49+70	27' L	15'	250 WATT, MC TYPE II
19	'0' 51+40	27' L	15'	250 WATT, MC TYPE II
20	'0' 53+10	27' L	15'	250 WATT, MC TYPE II
21	'0' 54+80	27' L	15'	250 WATT, MC TYPE II
22	'0' 56+50	27' L	15'	250 WATT, MC TYPE II
23	'0' 58+20	27' L	15'	250 WATT, MC TYPE II
24	'0' 59+90	27' L	15'	250 WATT, MC TYPE II
25	'0' 61+60	27' L	15'	250 WATT, MC TYPE II
26	'0' 63+30	27' L	15'	250 WATT, MC TYPE II
27	'0' 65+00	27' L	15'	250 WATT, MC TYPE II
28	'0' 66+70	27' L	15'	250 WATT, MC TYPE II
29	'0' 68+40	27' L	15'	250 WATT, MC TYPE II
30	'0' 70+10	27' R	15'	250 WATT, MC TYPE II
31	'0' 71+80	27' R	15'	250 WATT, MC TYPE II
32	'0' 73+20	27' L	15'	250 WATT, MC TYPE II

PATH:
Q:\Ktn\71811A\Planset\T1-5_Tops.dwg
Mon, 06/May/02 09:48AM Michael Limbaugh
PLOT:
PSPACE 1=1(F) OR MSPACE 1=1(F)
TAB: SUM_T2

ADDENDUM NUMBER

ATTACHMENT NUMBER

RECORD OF REVISIONS

No.	DATE	DESCRIPTION

KTN-THIRD AVENUE EXTENSION
PROJECT NO. 68490

Traffic Summaries

Project As Built Drawings have been reviewed by the Project Engineer. To the best of his/her knowledge, they represent the project as constructed.

Proj. Eng. *[Signature]* Date 10-31-06

DESIGNED BY: R. PURVES



CHECKED BY: M. LUKSHIN

DRAWN BY: T.M./R.S.

STATE OF ALASKA
DEPARTMENT OF TRANSPORTATION & PUBLIC FACILITIES
STATEWIDE DESIGN & ENGINEERING SERVICES DIVISION
THIRD AVENUE EXTENSION
PROJECT NO. 68490

Traffic Summaries


PROJECT DESIGNATION NUMBER

STP-MG-0904(2)

STATE	YEAR
ALASKA	2002
SHEET NUMBER	TOTAL SHEETS
T2	146

TRAFFIC CONTROL NOTES

1. IT IS THE INTENT OF THIS TRAFFIC CONTROL PLAN (TCP) TO ILLUSTRATE SOME BUT NOT ALL OF THE TRAFFIC CONTROL CONFIGURATIONS THAT WILL BE REQUIRED BY THIS PROJECT. TRAFFIC CONTROL PLANS FOR CONFIGURATIONS NOT COVERED BY THIS TCP SHALL BE DEVELOPED BY THE CONTRACTOR AND SUBMITTED TO THE ENGINEER FOR APPROVAL PRIOR TO USE.
2. TRAFFIC LANES SHALL BE A MINIMUM OF 10 FEET WIDE.
3. TEMPORARY PAVEMENT MARKINGS WILL BE REQUIRED AS DESCRIBED IN SECTION 643-3.04 OF THE SPECIFICATIONS.
4. THE CONTRACTOR SHALL RESTORE ACCESS TO BUSINESSES AND HOMES AT THE END OF EVERY WORK DAY. ACCESS TO BUSINESSES AND HOMES SHALL NOT BE SHUT OFF FOR MORE THAN A 24-HOUR PERIOD.
5. THE CONTRACTOR SHALL KEEP THE PUBLIC INFORMED OF HIS CONSTRUCTION ACTIVITIES THROUGH THE USE OF THE LOCAL NEWS MEDIA. NEWS RELEASES SHALL BE APPROVED BY THE PROJECT ENGINEER PRIOR TO THEIR RELEASE. NEWS RELEASES WILL BE REQUIRED BUT NOT LIMITED TO, THE ONSET OF WORK, GRINDING, PAVING, AND CHANGES IN THE LANE CONFIGURATIONS.
6. A SINGLE FLAGGER MAY BE APPROVED BY THE ENGINEER IF THE ENTIRE WORK AREA IS VISIBLE FROM THE FLAGGER STATION.
7. A FENCED PEDESTRIAN WALKWAY AND VIEWING AREA SHALL BE LOCATED FROM STA. "0" 45+00 TO "0" 53+00 FOR VISITORS TO VIEW THE SIGHT FROM ABOVE THE WORK AREA. THIS AREA WILL BE LIMITED TO ESCORTED TOURS BY CONTRACTOR OR STATE PERSONNEL.
8. THE CONTRACTOR SHALL MAINTAIN TWO-WAY TRAFFIC TO AUSTIN STREET AT ALL TIMES.
9. THE CONTRACTOR SHALL PROVIDE ALL REQUIRED ROAD CLOSURES ON SECOND AVENUE AND INFORM THE WHITECLIFF SCHOOL PRIOR TO ALL ROCK BLASTS.
10. ALL TRAFFIC DETOURS SHALL BE APPROVED BY THE ENGINEERS.

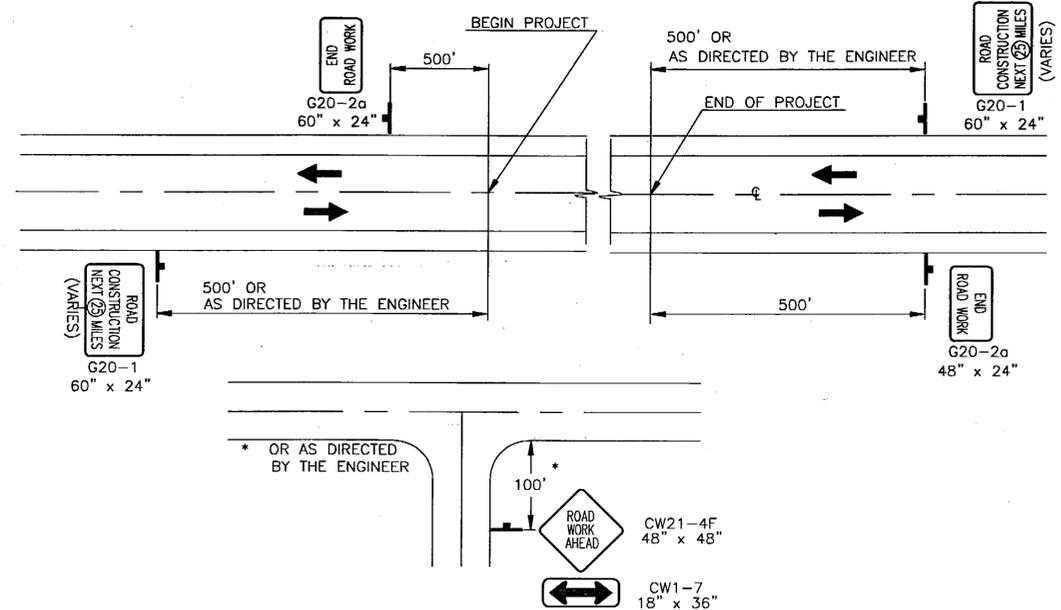

LEGEND

- SIGN
- CONE
- DRUM
- TYPE III BARRICADE
- FLAGGING STATION

* NO PARKING WITHIN 200' OF CONES


FORMULAS FOR L (TAPER LENGTH)

40 MPH OR LESS $L = \frac{W \times S^2}{60}$

45 MPH OR GREATER $L = W \times S$


WHERE W = WIDTH OF OFFSET
S = POSTED SPEED LIMIT OR ANTICIPATED OPERATING SPEED

TCP SETUP TABLE			
SPEED (MPH)	BUFFER LENGTH (FT)	CONE / DRUM SPACING (FT)	TAPER RATE (T)
20	35	20	4:1
25	55	25	6:1
30	85	30	8:1
35	120	35	12:1
40	170	40	17:1
45	220	45	22:1
50	280	50	28:1
55	335	55	34:1

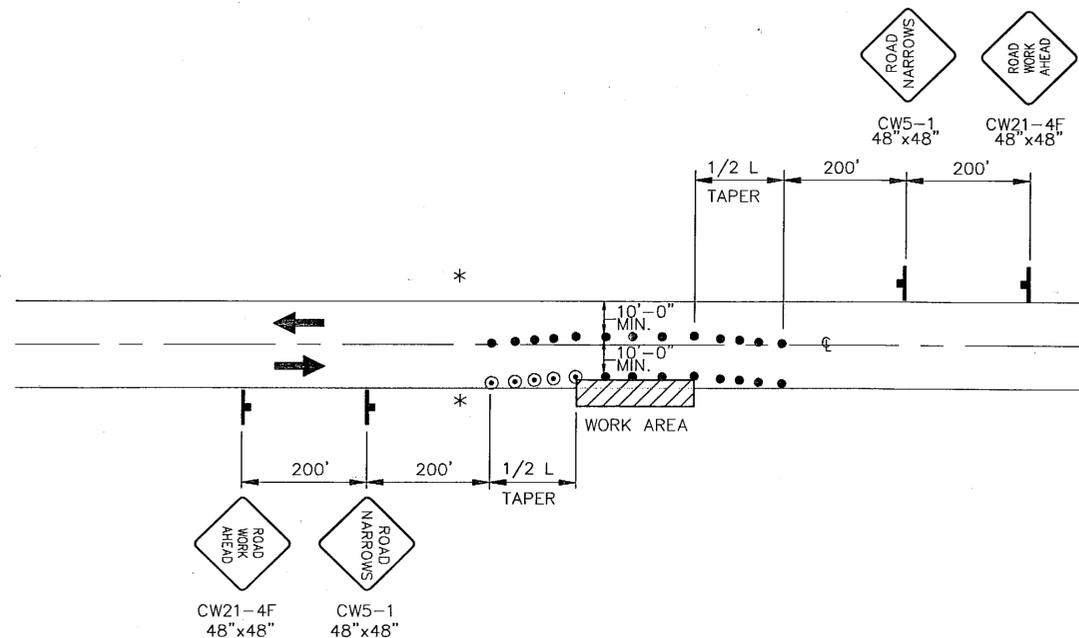

ROADWAY ENCROACHMENT

NOTE: IF ONLY ONE LANE IS AFFECTED BY ROAD WORK (THAT IS, THE CONES ALONG THE WORK AREA ARE NO CLOSER THAN 10' TO CENTERLINE) THE CENTERLINE CONES FOR THE OPPOSING LANE SHALL BE DELETED.

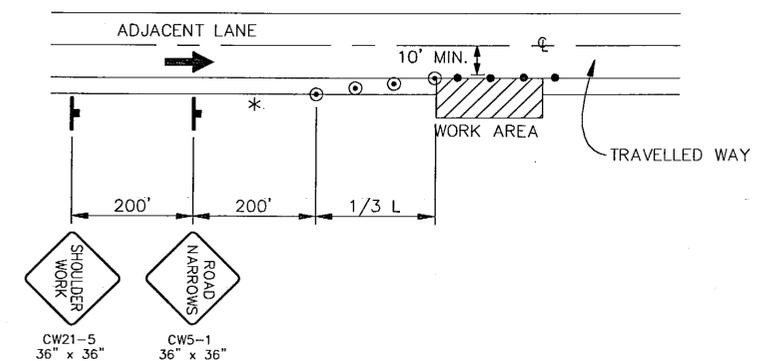

SHOULDER WORK

PATH: Q:\KIn\71811A\Planset\T1-5_Tcps.dwg
Mon, 06/May/02 09:48AM Michael Limbaugh
PLOT: PSPACE 1=1(F) OR MSPACE 1=1(F)
TAB: TCP1-T3

ADDENDUM NUMBER		
ATTACHMENT NUMBER		
RECORD OF REVISIONS		
No.	DATE	DESCRIPTION

KTN-THIRD AVENUE EXTENSION
PROJECT NO. 68490

Traffic Control Plan

DESIGNED BY: R. PURVES



CHECKED BY: M. LUKSHIN

DRAWN BY: T.M./R.S.
STATE OF ALASKA
DEPARTMENT OF TRANSPORTATION & PUBLIC FACILITIES
STATEWIDE DESIGN & ENGINEERING SERVICES DIVISION

**THIRD AVENUE EXTENSION
PROJECT NO. 68490**

Traffic Control Plan

PROJECT DESIGNATION NUMBER

STP-MG-0904(2)

STATE	YEAR
ALASKA	2002
SHEET NUMBER	TOTAL SHEETS
T3	146

Project As Built Drawings have been reviewed by the Project Engineer. To the best of his/her knowledge, they represent the project as constructed.
Proj. Eng. Date 05/06

PATH: Q:\ktn\71811A\PlanSet\T1-5_Tcps.dwg
 Mon, 06/May/02 09:48AM Michael Limbough
 PLOT: PSPACE 1=1(F) OR MSPACE 1=1(F)
 TAB: TCP2-T4

ADDENDUM NUMBER		
ATTACHMENT NUMBER		
RECORD OF REVISIONS		
No.	DATE	DESCRIPTION

KTN-THIRD AVENUE EXTENSION
 PROJECT NO. 68490
Traffic Control Plan

DESIGNED BY: M. LUKSHIN



CHECKED BY: K. MATTSO

DRAWN BY: T.M.R.S.

STATE OF ALASKA
 DEPARTMENT OF TRANSPORTATION
 & PUBLIC FACILITIES
 STATEWIDE DESIGN & ENGINEERING
 SERVICES DIVISION
**THIRD AVENUE EXTENSION
 PROJECT NO. 68490**

Traffic Control Plan


PROJECT DESIGNATION NUMBER

STP-MG-0904(2)


STATE	YEAR
ALASKA	2002

SHEET NUMBER	TOTAL SHEETS
T4	146

Project As Built Drawings have been reviewed by the Project Engineer. To the best of his/her knowledge, they represent the project as constructed.
 Proj. Eng. *[Signature]* Date 03/06

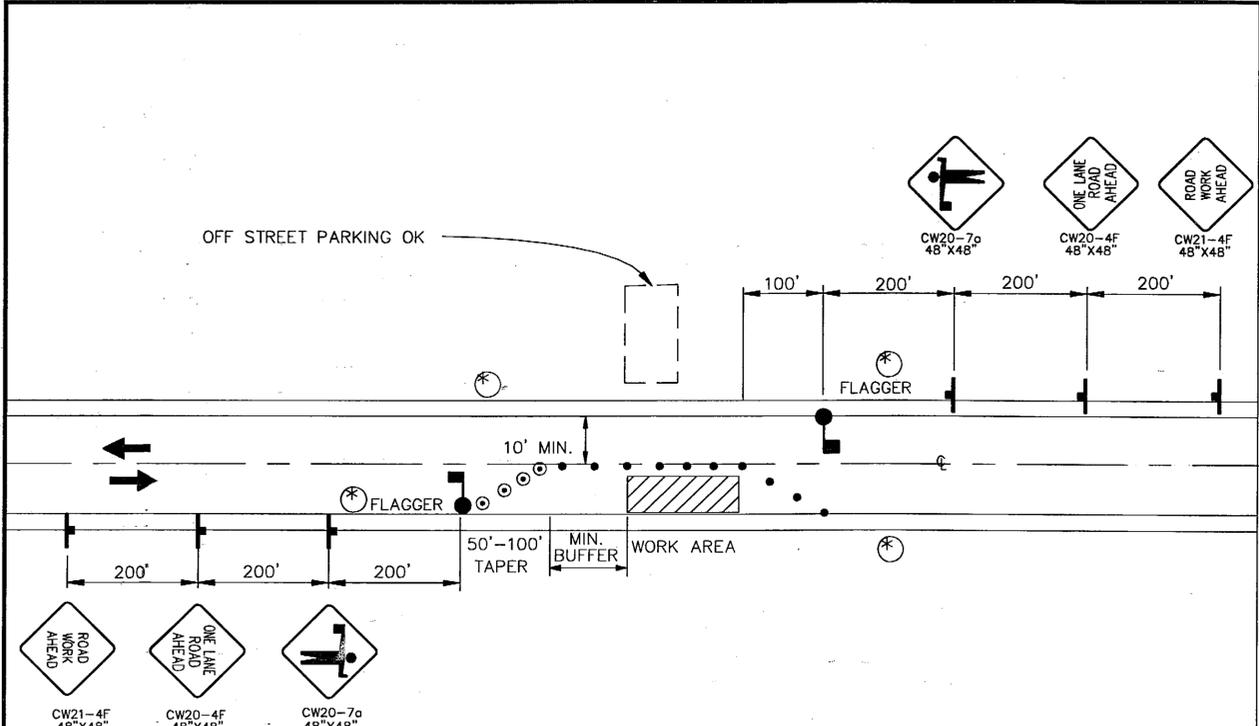

**SINGLE LANE CLOSURE
 TWO LANE ROAD**

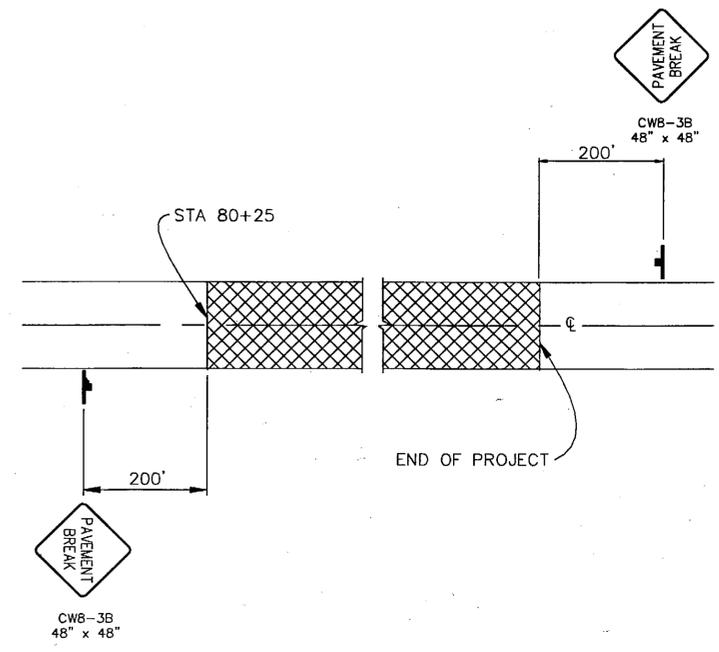

SIGNING FOR UNPAVED AREA

LEGEND

- SIGN
- CONE
- ⊙ DRUM
- III TYPE III BARRICADE
- ⌚ FLAGGING STATION
- ⊘ NO PARKING WITHIN 200' OF CONES

FORMULAS FOR L (TAPER LENGTH)

40 MPH OR LESS $L = \frac{W \times S^2}{60}$

45 MPH OR GREATER $L = W \times S$


WHERE W= WIDTH OF OFFSET
 S= POSTED SPEED LIMIT OR ANTICIPATED OPERATING SPEED

SPEED (MPH)	BUFFER LENGTH (FT)	CONE/DRUM SPACING (FT)	TAPER RATE (T)
20	35	20	4:1
25	55	25	6:1
30	85	30	8:1
35	120	35	12:1
40	170	40	17:1
45	220	45	22:1
50	280	50	28:1
55	335	55	34:1

ADDENDUM NUMBER		
ATTACHMENT NUMBER		
RECORD OF REVISIONS		
No.	DATE	DESCRIPTION

KTN-THIRD AVENUE EXTENSION
PROJECT NO. 68490


Traffic Control Plan

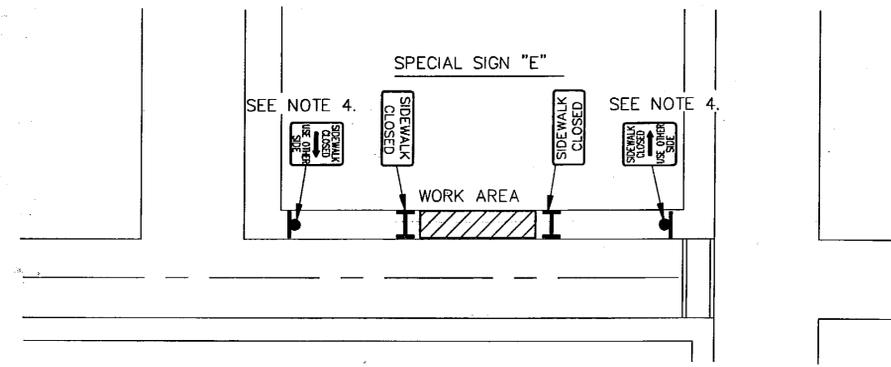


**EXISTING SIDEWALK
RECONSTRUCTION**

SIGN NOTES:

1. SIGNS SHALL HAVE WHITE BACKGROUND WITH BLACK LEGEND. LETTERING SHALL BE AS SHOWN ON THE PLAN.
2. SPECIAL SIGN "C" IS SHOWN. SPECIAL SIGN "D" SHALL HAVE THE ARROW POINTING IN THE OPPOSITE DIRECTION.
3. SIGNS SHALL CONFORM TO THE ALASKA SIGN DESIGN SPECIFICATIONS (ASDS). LETTERING SHALL BE 4 INCHES HIGH AND SERIES B.
4. WHERE IT IS IMPRACTICAL TO WALK AROUND THE CLOSED PORTION OF THE SIDEWALK, SPECIAL SIGNS "C" OR "D" SHALL BE SET UP AT THE NEAREST EXISTING CROSSWALK.

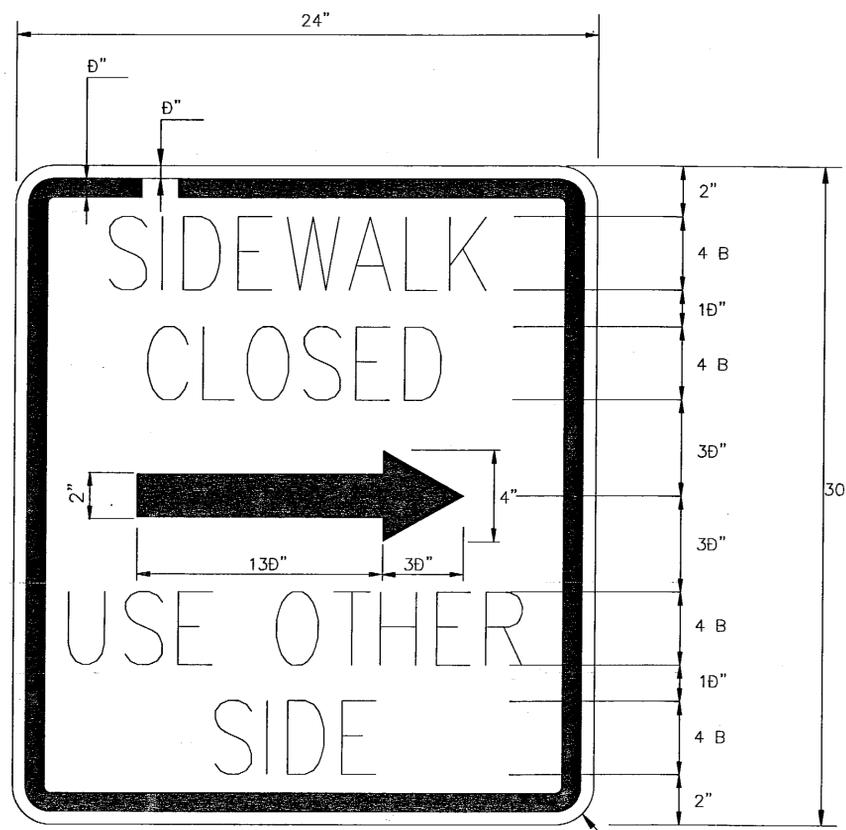

**SPECIAL SIGN "C" (RIGHT ARROW)
SPECIAL SIGN "D" (LEFT ARROW)**

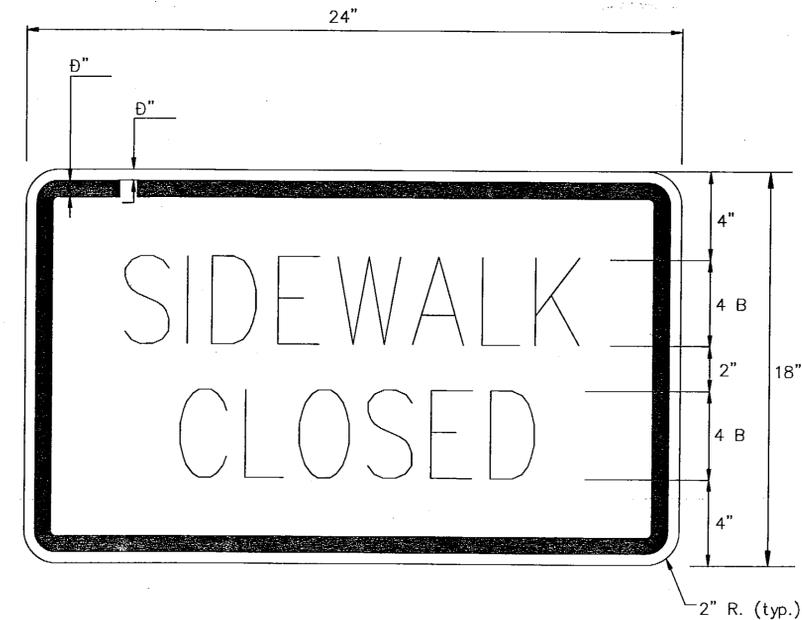

SPECIAL SIGN "E"

DESIGNED BY: R. PURVES



CHECKED BY: M. LUKSHIN

DRAWN BY: T.M.R.S.

STATE OF ALASKA
DEPARTMENT OF TRANSPORTATION
& PUBLIC FACILITIES
STATEWIDE DESIGN & ENGINEERING
SERVICES DIVISION


**THIRD AVENUE EXTENSION
PROJECT NO. 68490**

**Traffic Control
Plan**


PROJECT DESIGNATION NUMBER

STP-MG-0904(2)

STATE	YEAR
ALASKA	2002
SHEET NUMBER	TOTAL SHEETS
T5	146

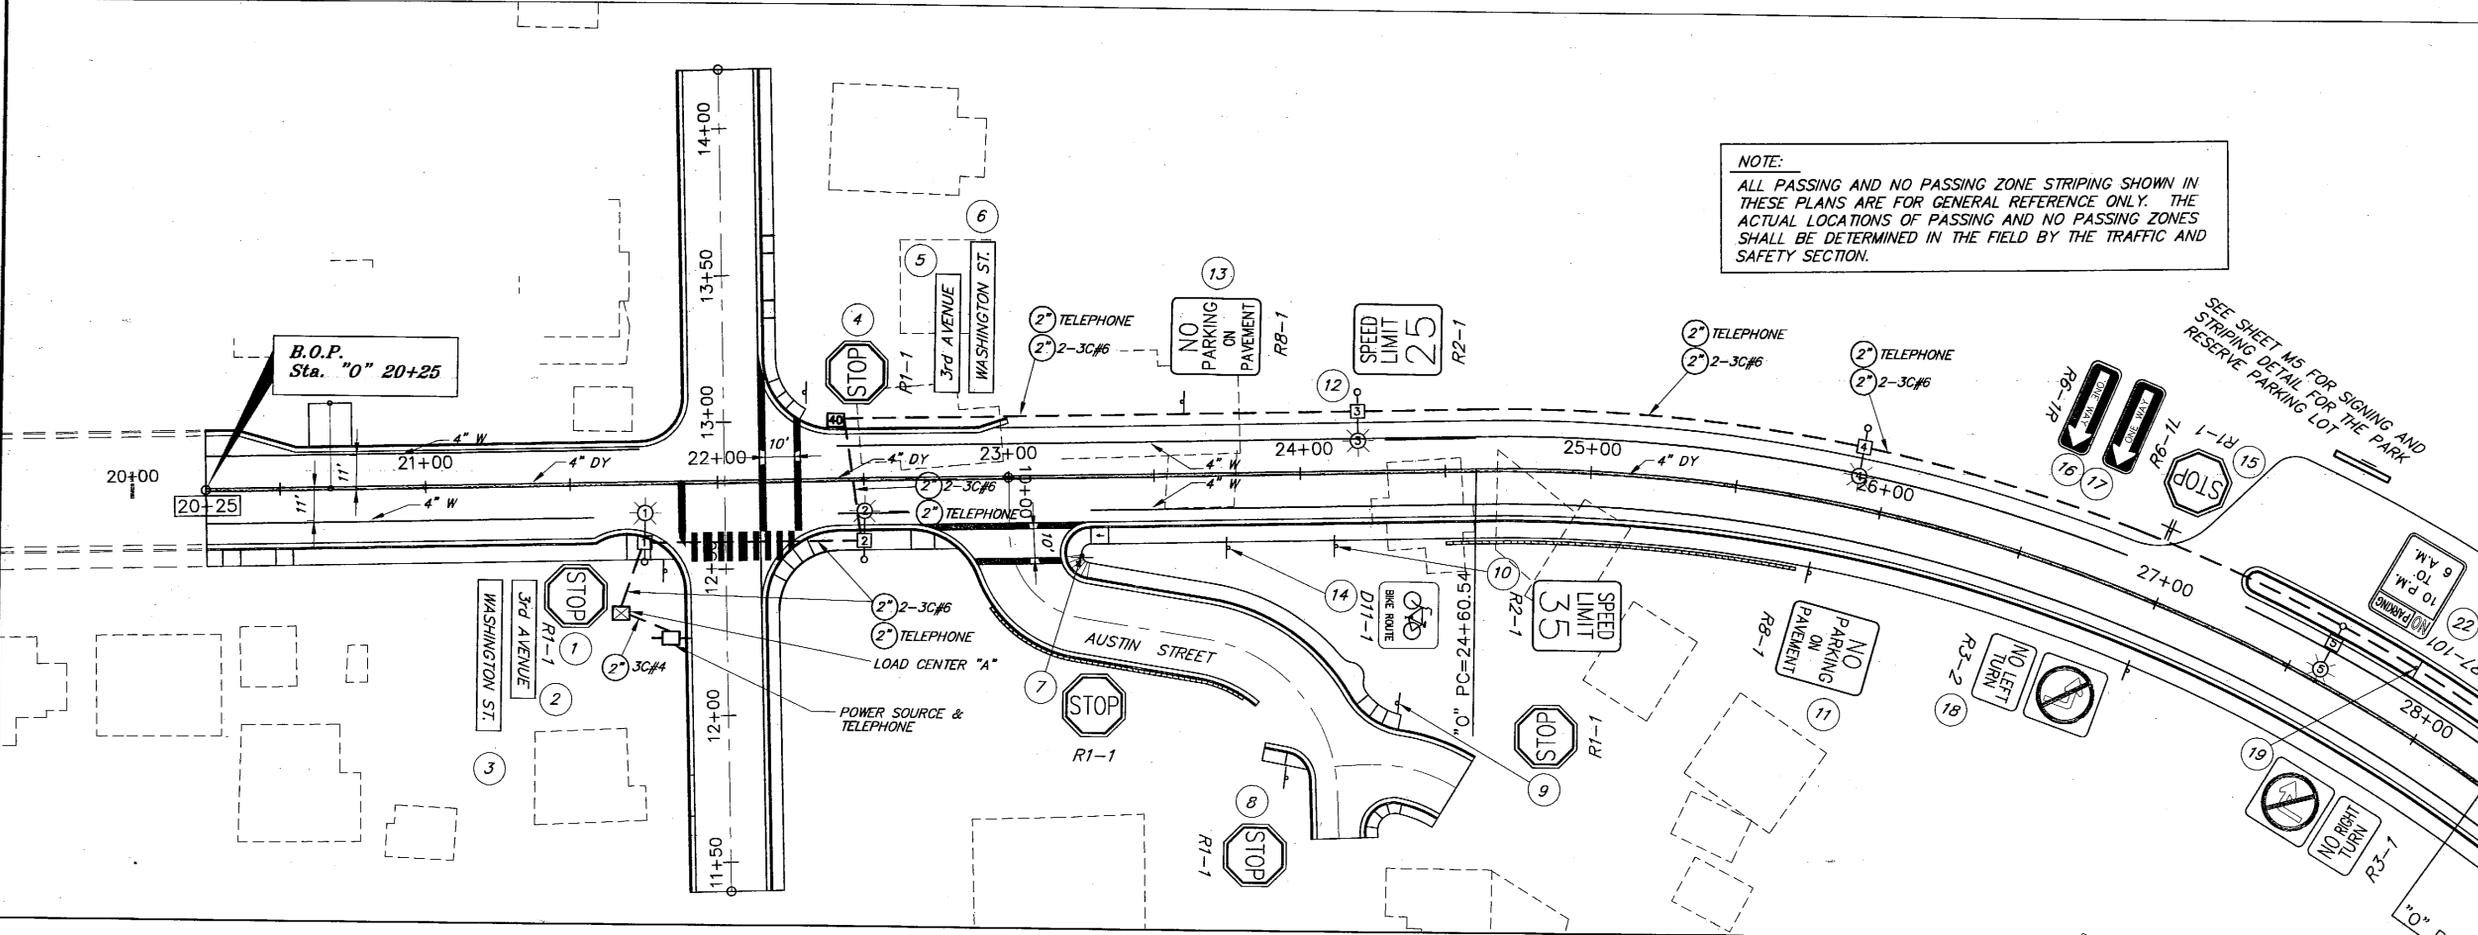

NOTE:
 ALL PASSING AND NO PASSING ZONE STRIPING SHOWN IN THESE PLANS ARE FOR GENERAL REFERENCE ONLY. THE ACTUAL LOCATIONS OF PASSING AND NO PASSING ZONES SHALL BE DETERMINED IN THE FIELD BY THE TRAFFIC AND SAFETY SECTION.

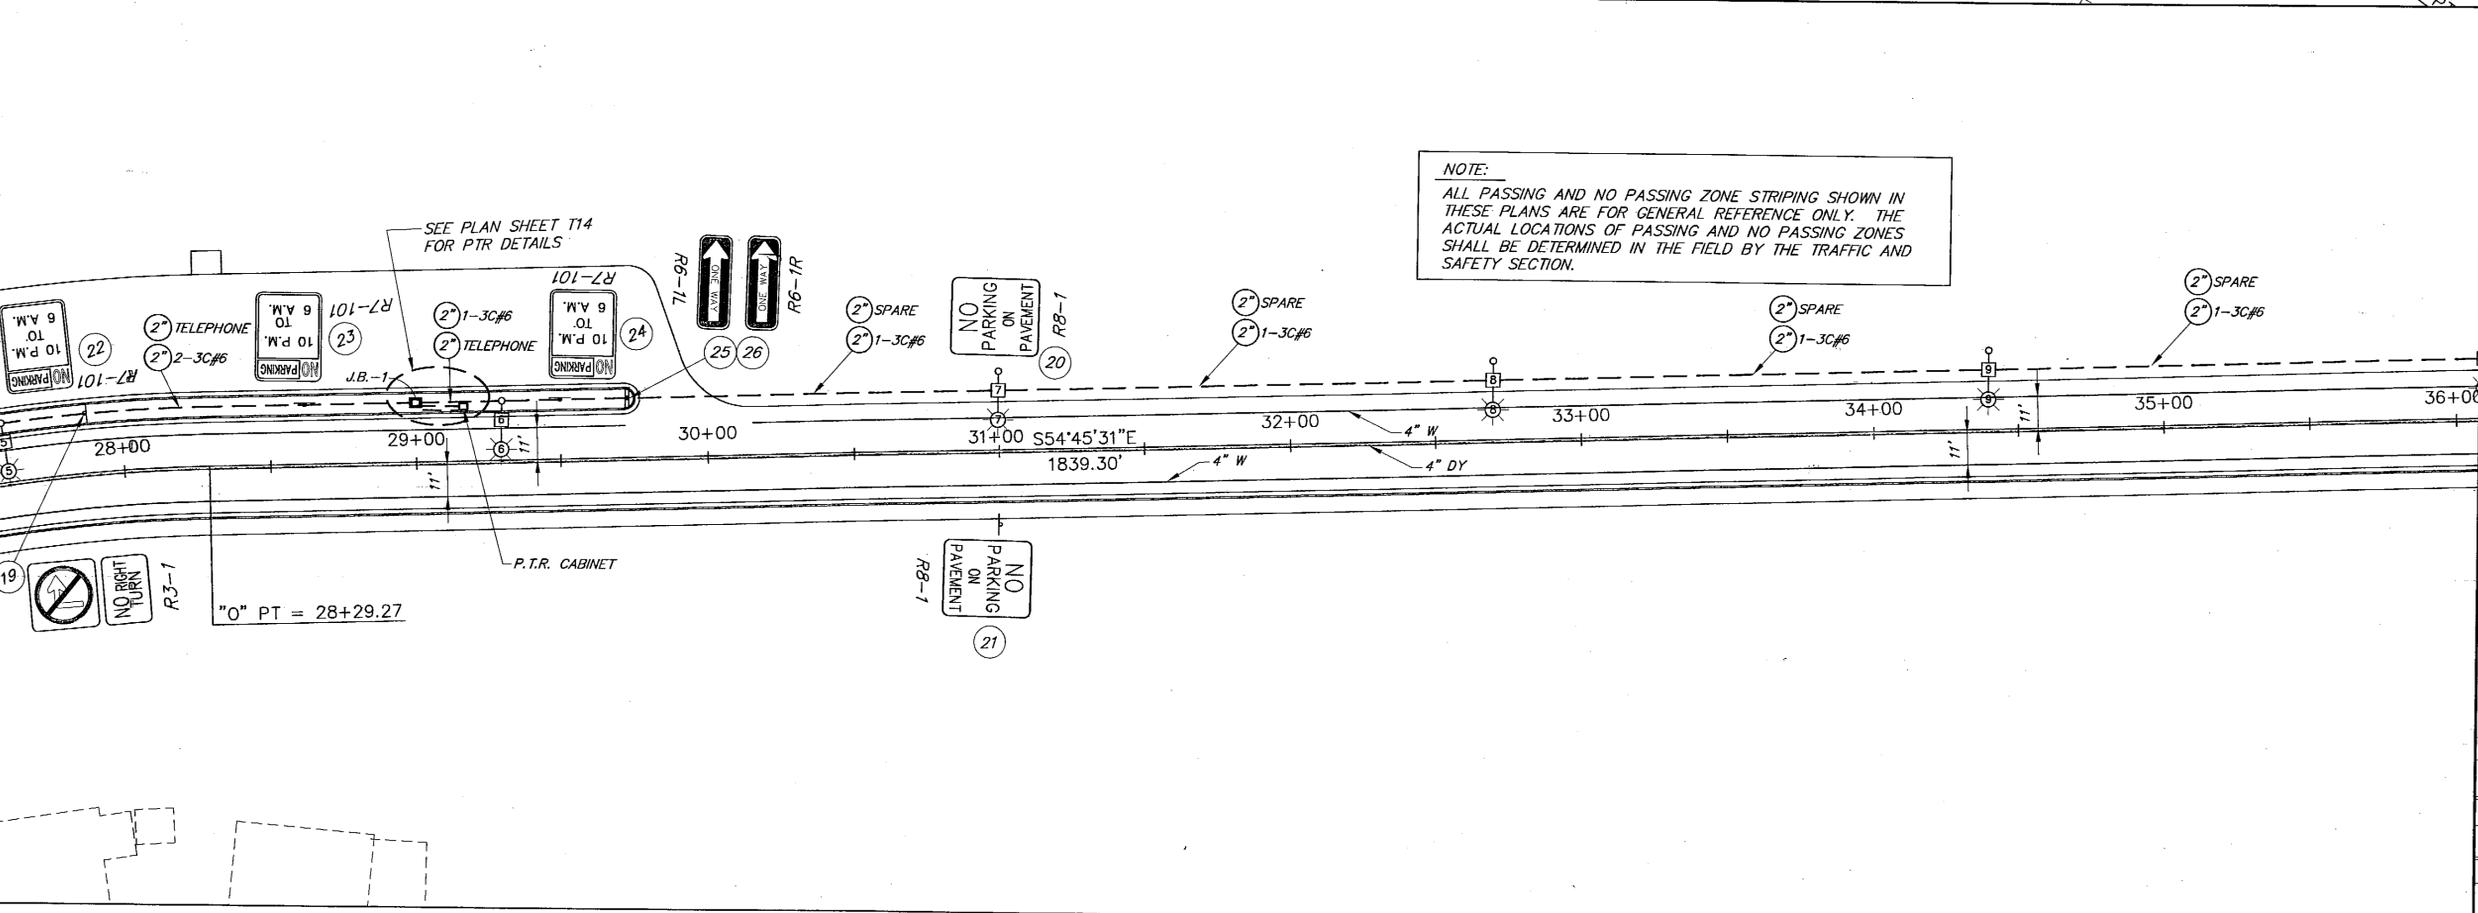

NOTE:
 ALL PASSING AND NO PASSING ZONE STRIPING SHOWN IN THESE PLANS ARE FOR GENERAL REFERENCE ONLY. THE ACTUAL LOCATIONS OF PASSING AND NO PASSING ZONES SHALL BE DETERMINED IN THE FIELD BY THE TRAFFIC AND SAFETY SECTION.

PATH:
 Q:\Ktn\71811A\PlanSet\T4-12_SignStriping.dwg
 Tue, 07/May/02 10:50AM Michael Limbough
 PLOT:
 PSPACE 1=1(F) OR MSPACE 1=1(F)
 TAB: ESTIMATE

ADDENDUM NUMBER		
ATTACHMENT NUMBER		
RECORD OF REVISIONS		
No.	DATE	DESCRIPTION

KTN-THIRD AVENUE EXTENSION
 PROJECT NO. 68490

Lighting, Signing and Striping

DESIGNED BY: R. PURVES



CHECKED BY: M. LUKSHIN
 DRAWN BY: T.M./R.S.

STATE OF ALASKA
 DEPARTMENT OF TRANSPORTATION & PUBLIC FACILITIES
 STATEWIDE DESIGN & ENGINEERING SERVICES DIVISION
 THIRD AVENUE EXTENSION
 PROJECT NO. 68490

Lighting, Signing and Striping

PROJECT DESIGNATION NUMBER	
STP-MG-0904(2)	
STATE	YEAR
ALASKA	2002
SHEET NUMBER	TOTAL SHEETS
T6	146

Project As Built Drawings have been reviewed by the Project Engineer. To the best of his/her knowledge, they represent the project as constructed.
 Proj. Eng. *[Signature]* Date 10-31-06

NOTE:
 ALL PASSING AND NO PASSING ZONE STRIPING SHOWN IN THESE PLANS ARE FOR GENERAL REFERENCE ONLY. THE ACTUAL LOCATIONS OF PASSING AND NO PASSING ZONES SHALL BE DETERMINED IN THE FIELD BY THE TRAFFIC AND SAFETY SECTION.

PATH:
 Q:\Ktn\71811A\PlanSet\T4-12_SignStriping.dwg
 Tue, 07/May/02 10:51AM Michael Limbough
 PLOT:
 PSPACE 1=1(F) OR MSPACE 1=1(F)
 TAB: ESTIMATE


ADDENDUM NUMBER

ATTACHMENT NUMBER

RECORD OF REVISIONS		
No.	DATE	DESCRIPTION

KTN-THIRD AVENUE EXTENSION
 PROJECT NO. 68490


Lighting, Signing and Striping

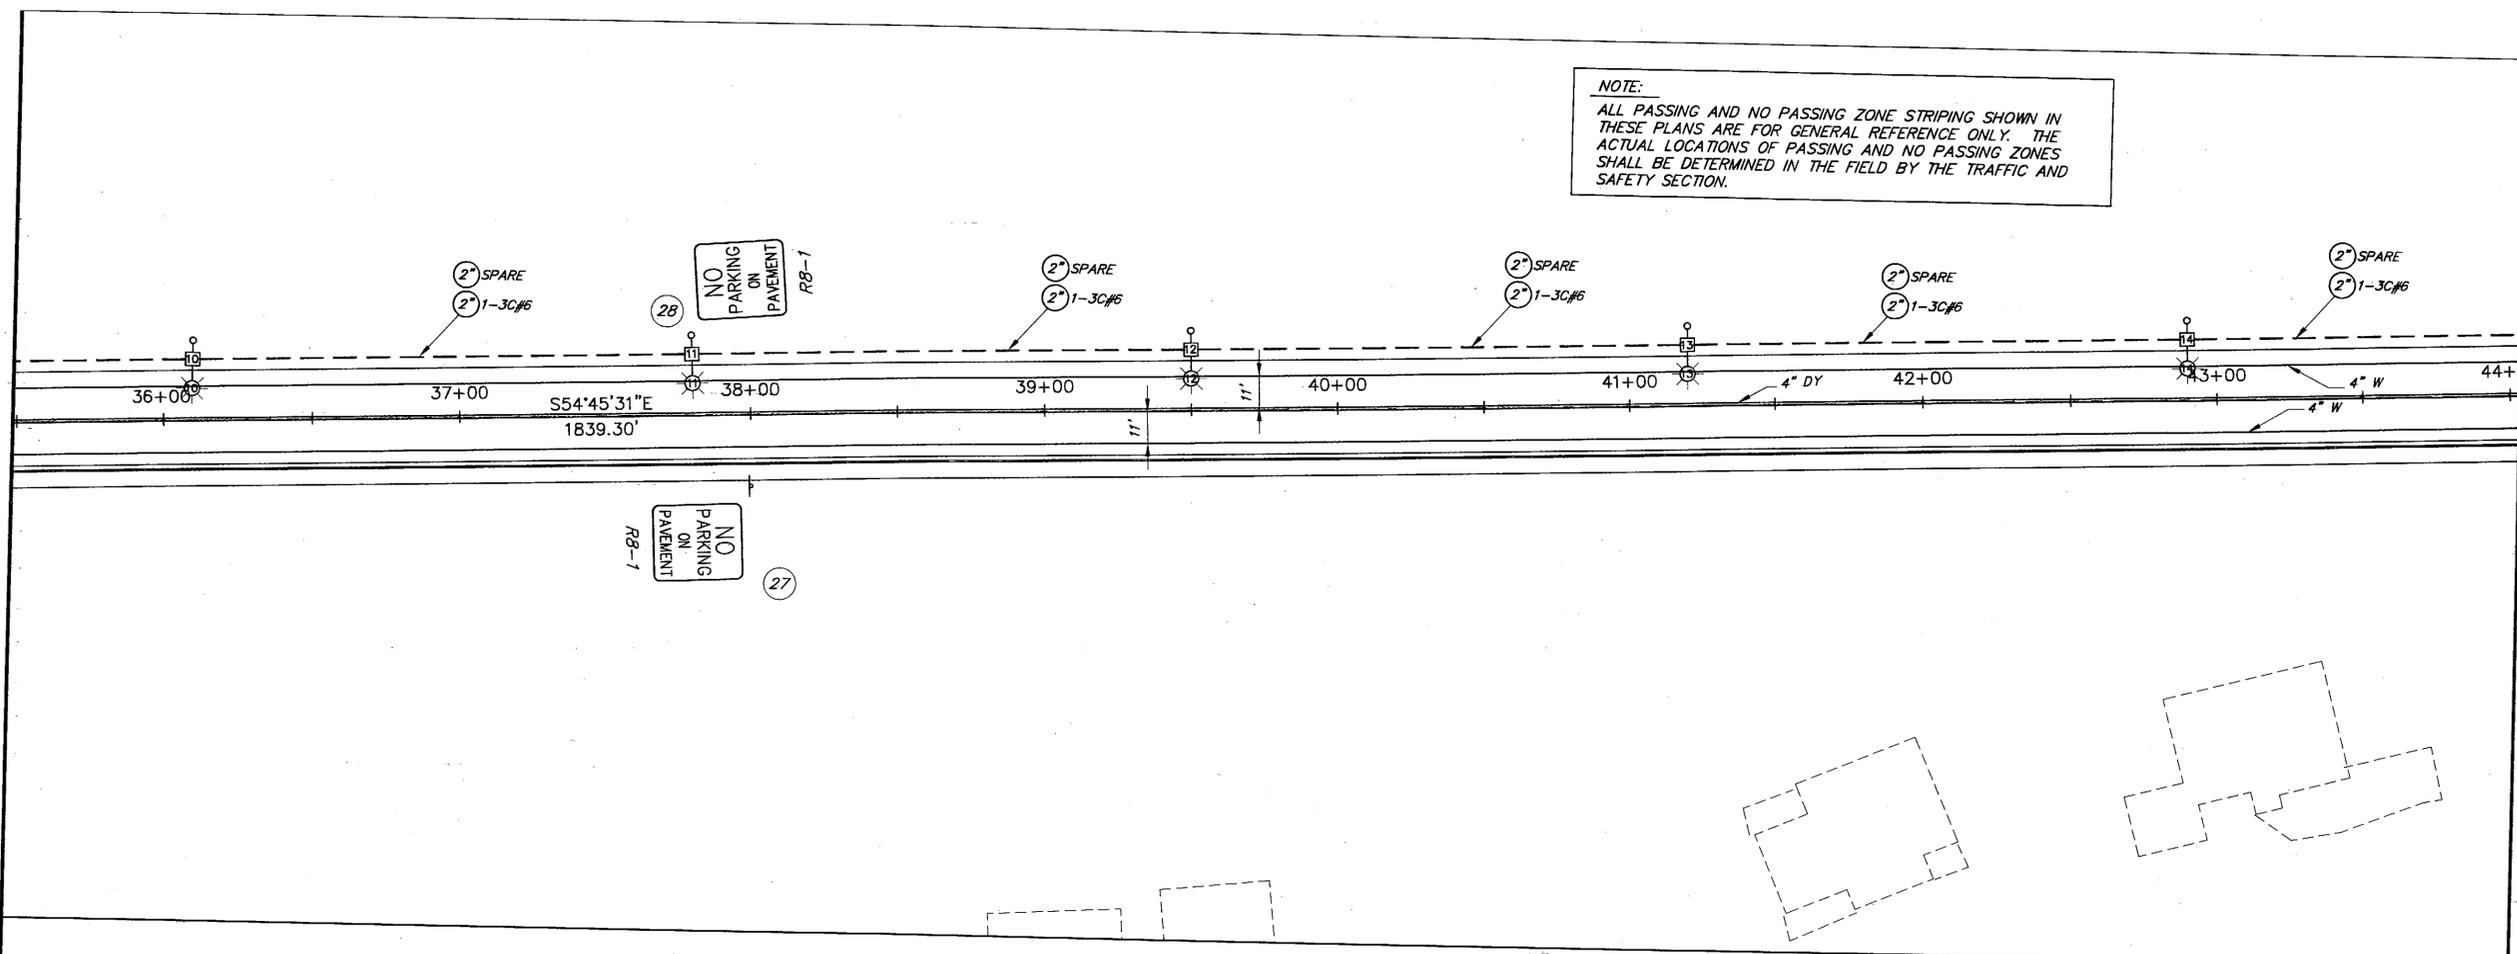

THE CONTRACTOR SHALL BUILD THE FENCED PEDESTRIAN VIEWING AREA AND WALKWAY PER THE ENGINEER. SEE SHEET T2 FOR FENCING DETAILS.

NOTE:
 ALL PASSING AND NO PASSING ZONE STRIPING SHOWN IN THESE PLANS ARE FOR GENERAL REFERENCE ONLY. THE ACTUAL LOCATIONS OF PASSING AND NO PASSING ZONES SHALL BE DETERMINED IN THE FIELD BY THE TRAFFIC AND SAFETY SECTION.

END OF FENCED PEDESTRIAN VIEWING AREA/WALKWAY

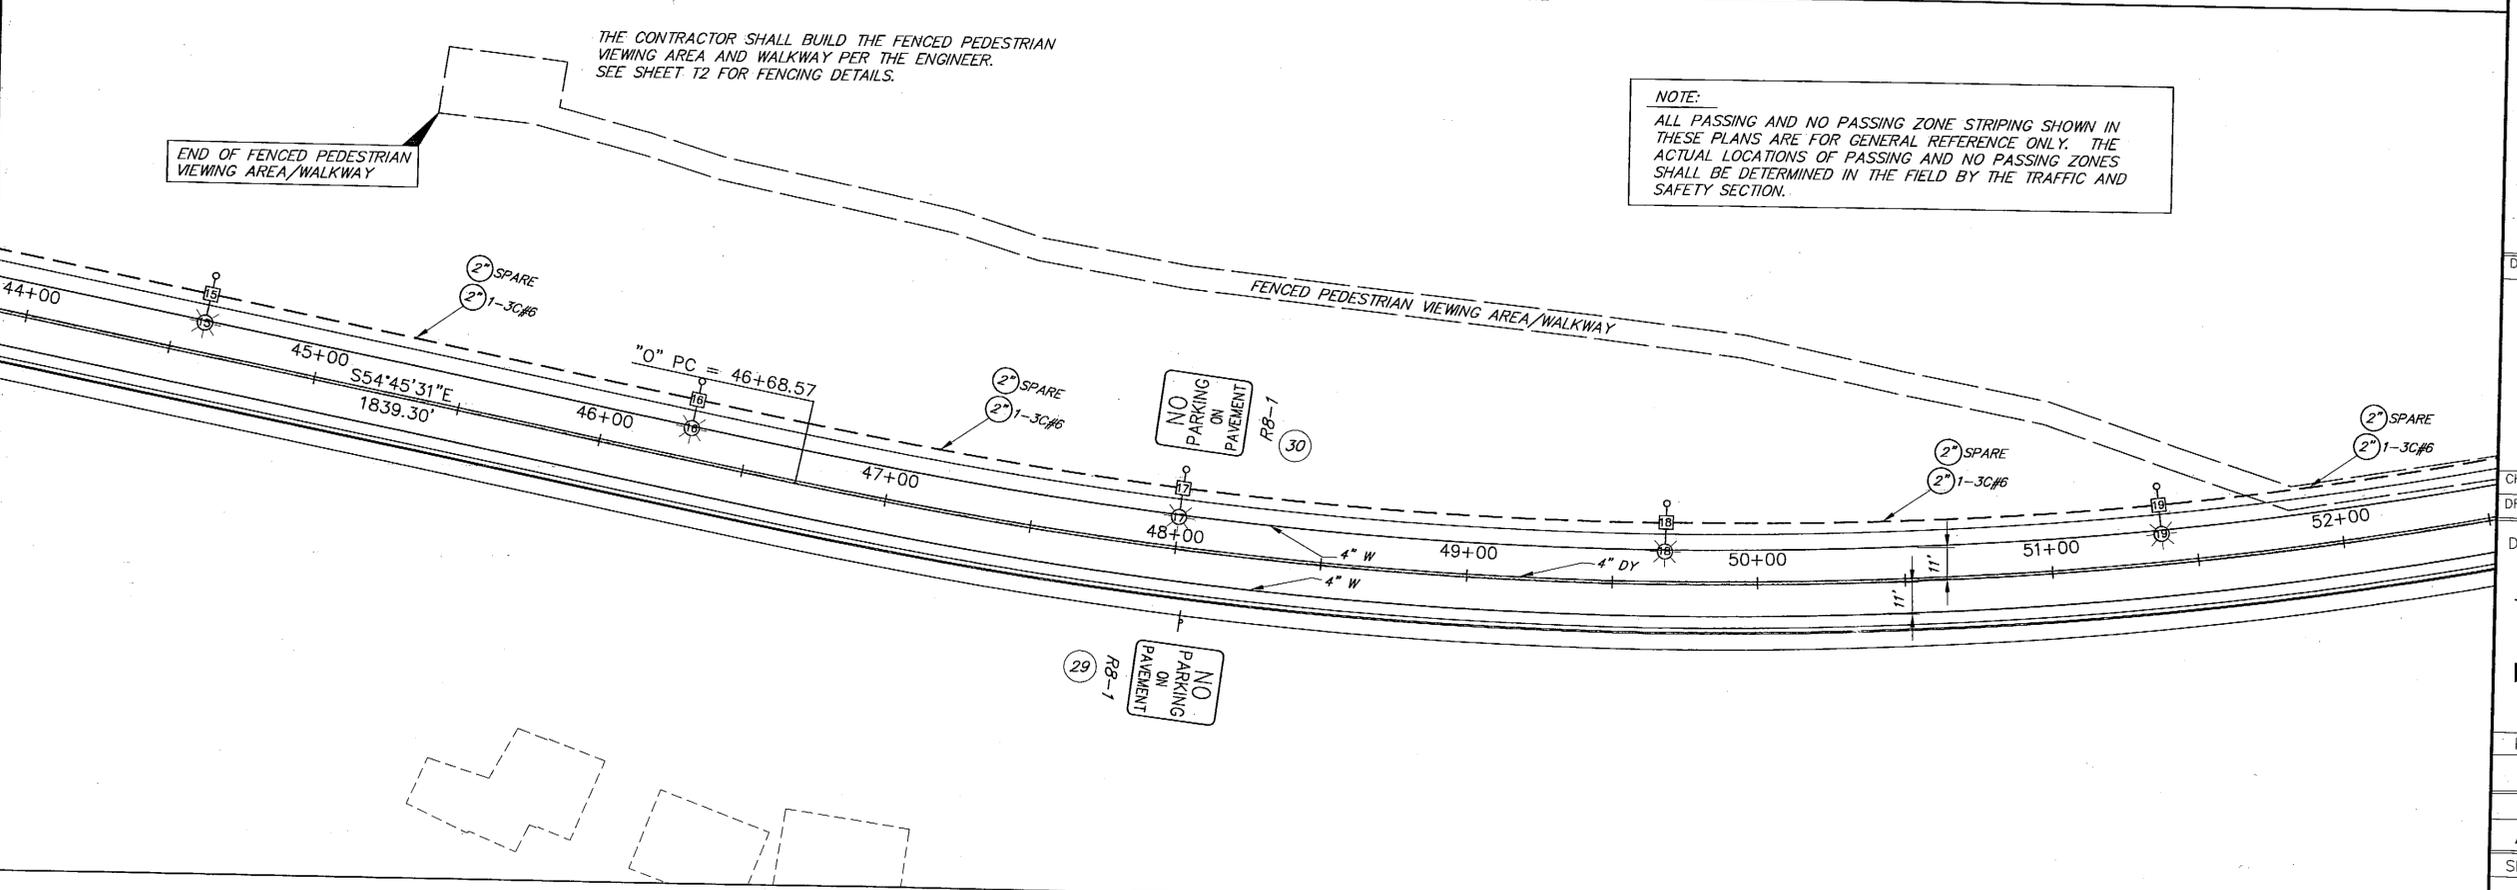

DESIGNED BY: R. PURVES



CHECKED BY: M. LUKSHIN

DRAWN BY: T.M./R.S.

STATE OF ALASKA
 DEPARTMENT OF TRANSPORTATION & PUBLIC FACILITIES
 STATEWIDE DESIGN & ENGINEERING SERVICES DIVISION
 THIRD AVENUE EXTENSION
 PROJECT NO. 68490

Lighting, Signing and Striping

PROJECT DESIGNATION NUMBER
 STP-MG-0904(2)

STATE	YEAR
ALASKA	2002


SHEET NUMBER	TOTAL SHEETS
T7	146

Project As Built Drawings have been reviewed by the Project Engineer. To the best of his/her knowledge, they represent the project as constructed.
 Proj. Eng. *KS* Date 10/31/06


PATH:
 Q:\Ktn\71811A\Planset\T4-12_SignStriping.dwg
 Tue, 07/May/02 10:51AM Michael Limbaugh
 PLOT:
 PSPACE 1=1(F) OR MSPACE 1=1(F)
 TAB: ESTIMATE

ADDENDUM NUMBER		
ATTACHMENT NUMBER		
RECORD OF REVISIONS		
No.	DATE	DESCRIPTION

NOTE:
 ALL PASSING AND NO PASSING ZONE STRIPING SHOWN IN THESE PLANS ARE FOR GENERAL REFERENCE ONLY. THE ACTUAL LOCATIONS OF PASSING AND NO PASSING ZONES SHALL BE DETERMINED IN THE FIELD BY THE TRAFFIC AND SAFETY SECTION.

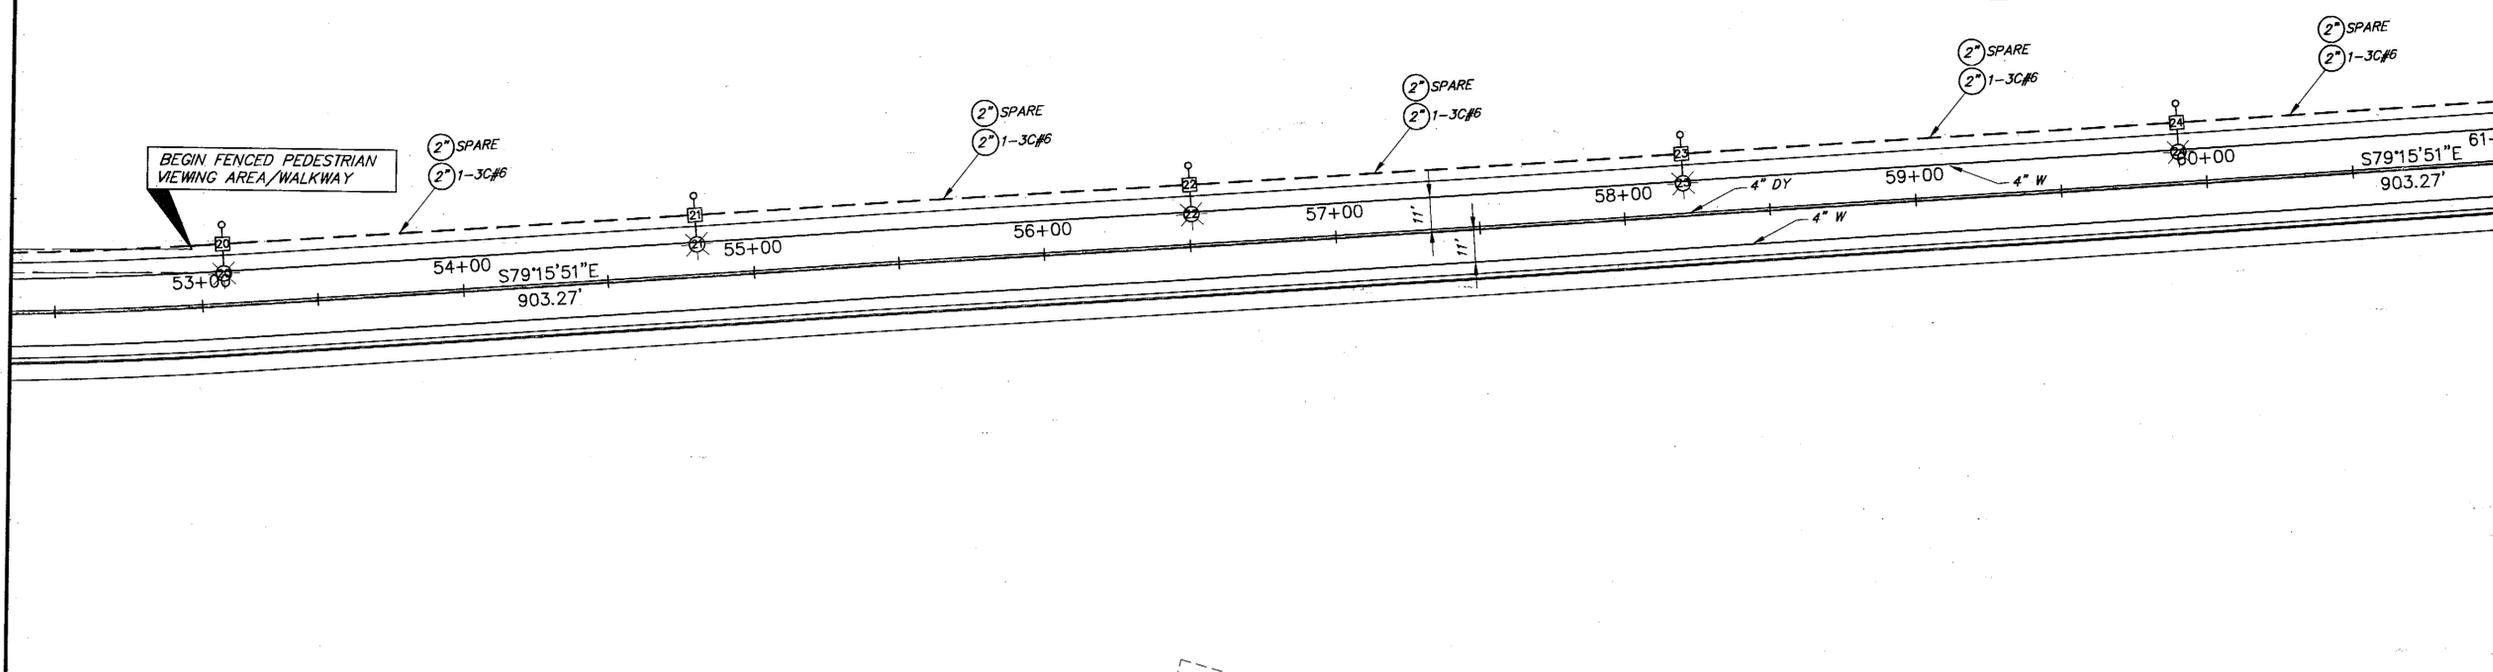

NOTE:
 ALL PASSING AND NO PASSING ZONE STRIPING SHOWN IN THESE PLANS ARE FOR GENERAL REFERENCE ONLY. THE ACTUAL LOCATIONS OF PASSING AND NO PASSING ZONES SHALL BE DETERMINED IN THE FIELD BY THE TRAFFIC AND SAFETY SECTION.

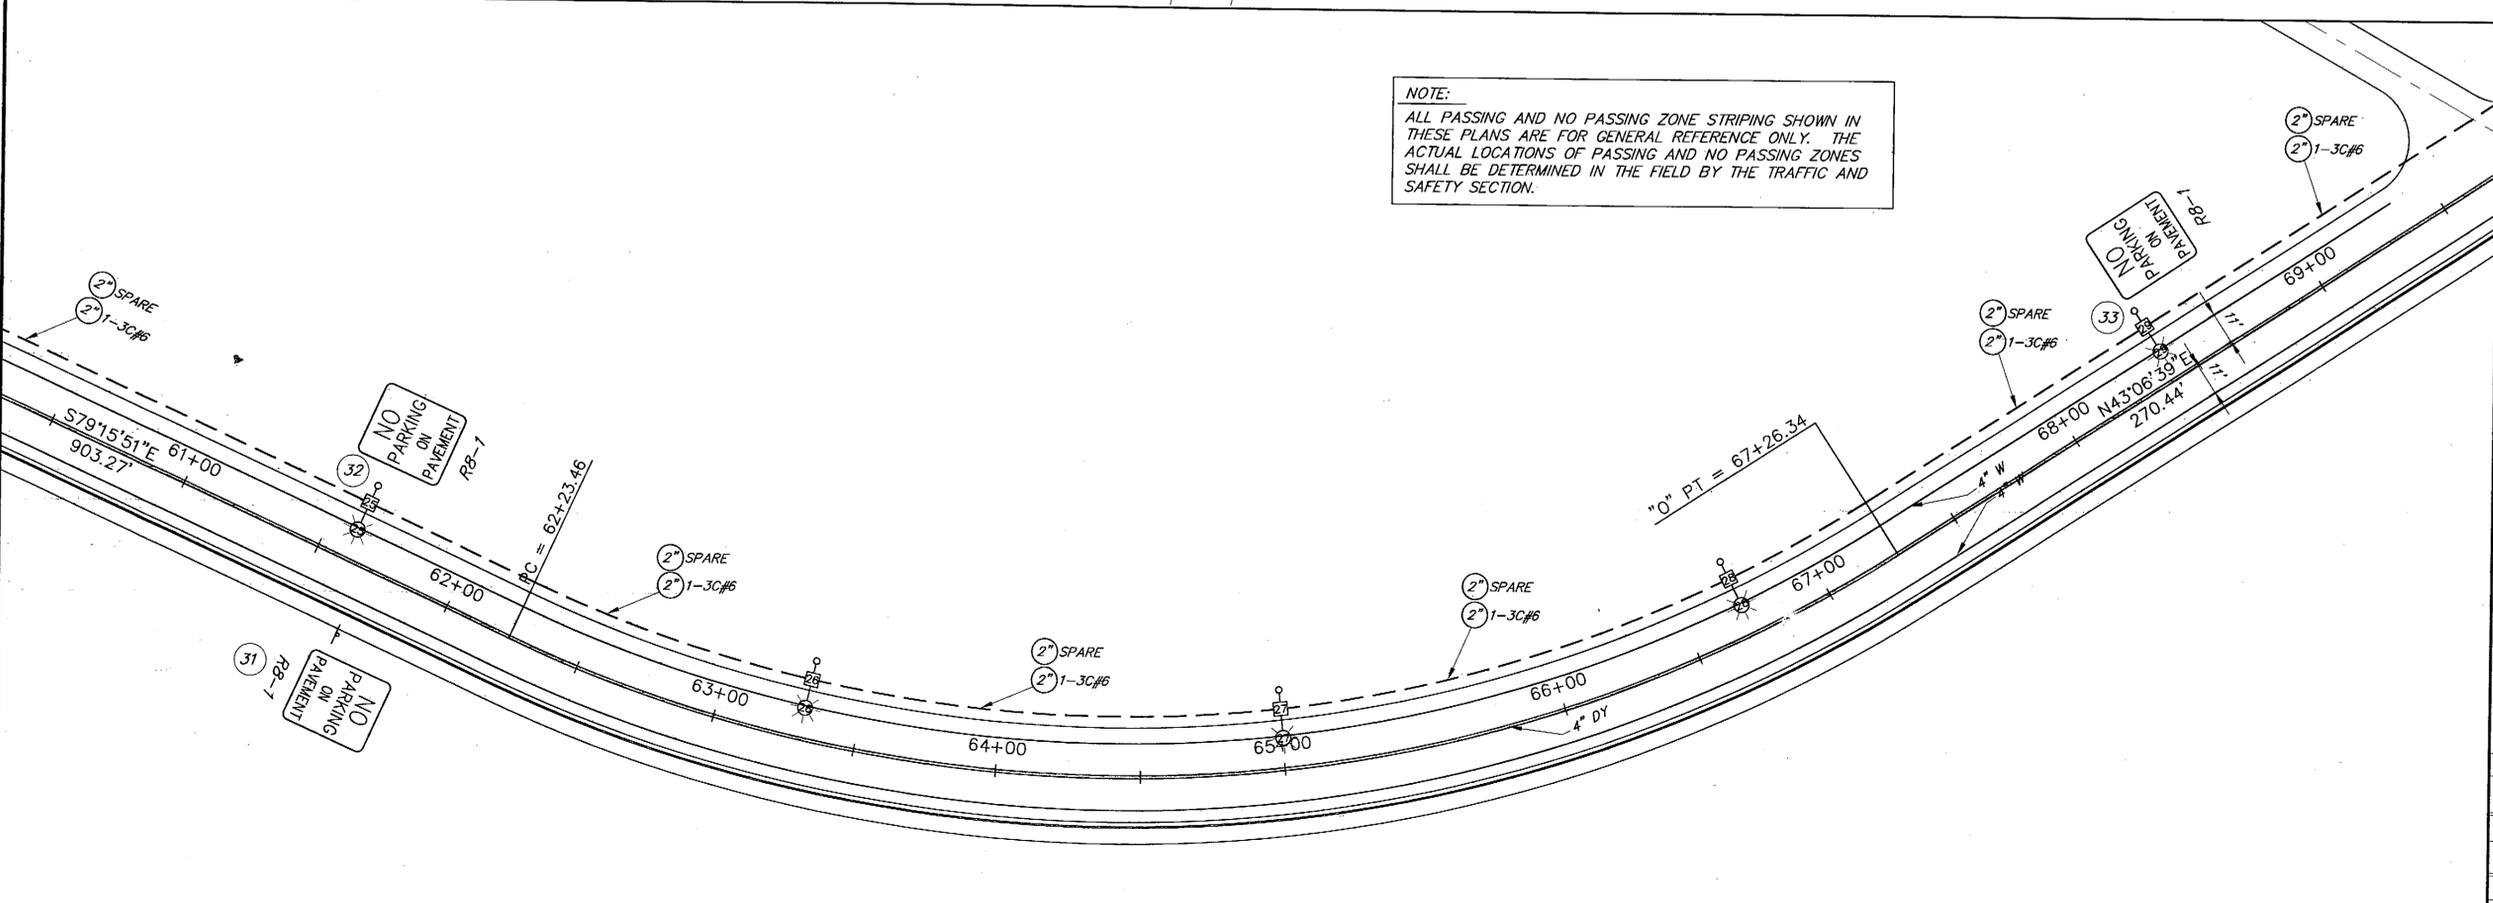

KTN-THIRD AVENUE EXTENSION
 PROJECT NO. 68490

Lighting, Signing and Striping

DESIGNED BY: R. PURVES



CHECKED BY: M. LUKSHIN

DRAWN BY: T.M./R.S.

STATE OF ALASKA
 DEPARTMENT OF TRANSPORTATION
 & PUBLIC FACILITIES
 STATEWIDE DESIGN & ENGINEERING
 SERVICES DIVISION

THIRD AVENUE EXTENSION
 PROJECT NO. 68490

Lighting, Signing and Striping

PROJECT DESIGNATION NUMBER

STP-MG-0904(2)


STATE	YEAR
ALASKA	2002
SHEET NUMBER	TOTAL SHEETS
T8	146

Project As Built Drawings have been reviewed by the Project Engineer. To the best of his/her knowledge, they represent the project as constructed.
 Proj. Eng. Date 6/31/06

NOTE:
 ALL PASSING AND NO PASSING ZONE STRIPING SHOWN IN THESE PLANS ARE FOR GENERAL REFERENCE ONLY. THE ACTUAL LOCATIONS OF PASSING AND NO PASSING ZONES SHALL BE DETERMINED IN THE FIELD BY THE TRAFFIC AND SAFETY SECTION.

E.O.P.
 Sta. "0" 73+30

NOTE: OVERHEAD ELECTRIC LINES.

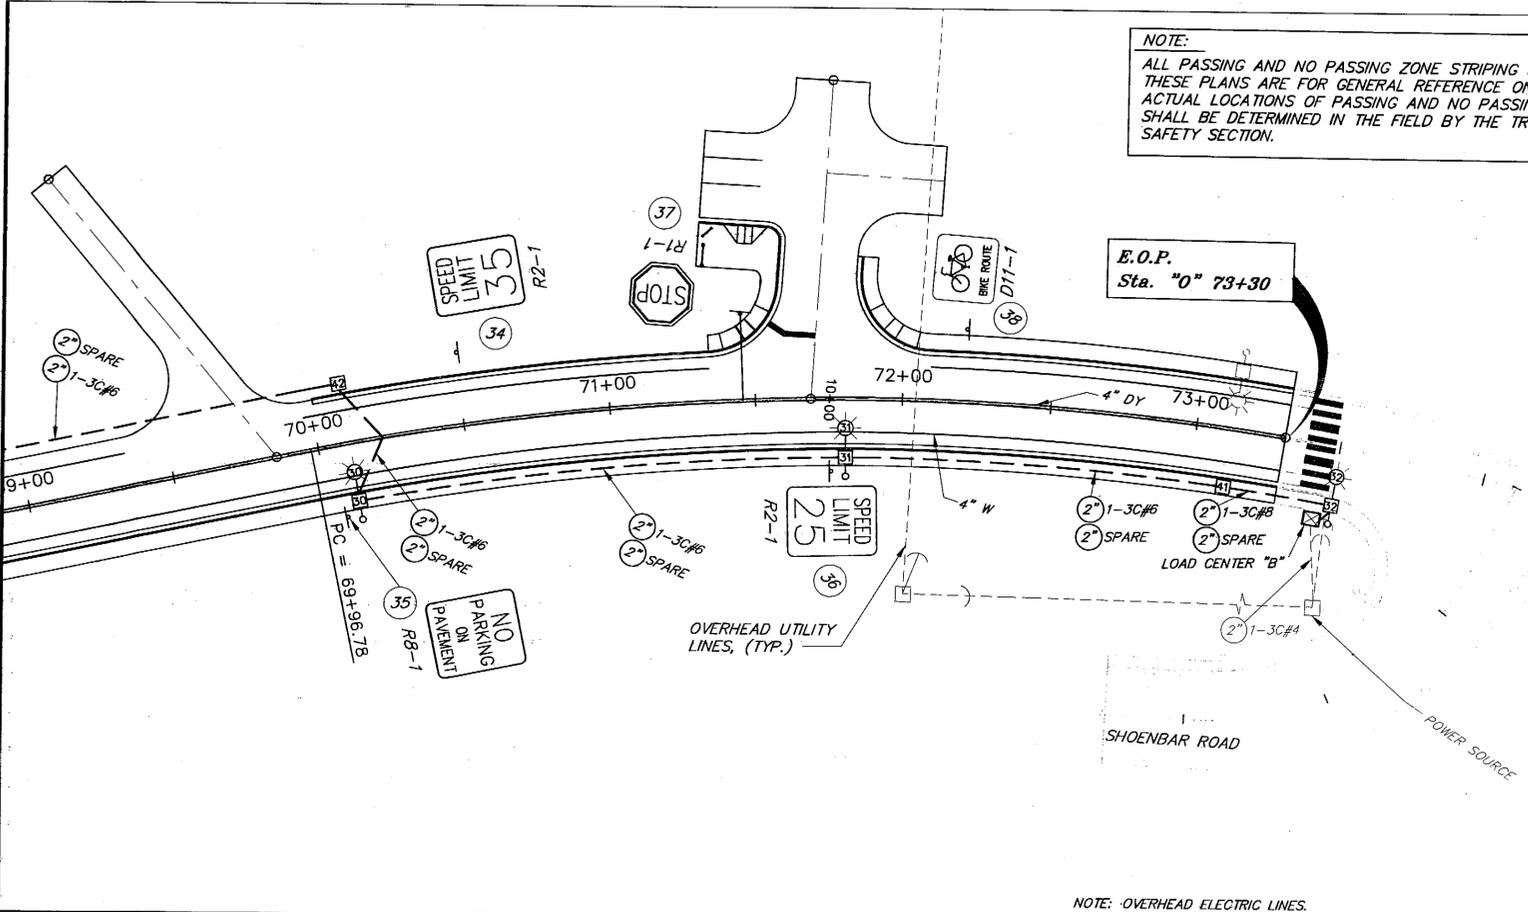

PATH:
 Q:\Ktn\71811A\PlanSet\T4-12_SignStriping.dwg
 Tue, 07/May/02 10:51AM Michael Limbaugh
 PLOT:
 PSPACE 1=1(F) OR MSPACE 1=1(F)
 TAB: ESTIMATE

ADDENDUM NUMBER		
ATTACHMENT NUMBER		
RECORD OF REVISIONS		
No.	DATE	DESCRIPTION

KTN-THIRD AVENUE EXTENSION
 PROJECT NO. 68490

Lighting, Signing and Striping

DESIGNED BY: R. PURVES



CHECKED BY: M. LUKSHIN
 DRAWN BY: T.M./R.S.

STATE OF ALASKA
 DEPARTMENT OF TRANSPORTATION
 & PUBLIC FACILITIES
 STATEWIDE DESIGN & ENGINEERING
 SERVICES DIVISION
 THIRD AVENUE EXTENSION
 PROJECT NO. 68490

Lighting, Signing and Striping

PROJECT DESIGNATION NUMBER	
STP-MG-0904(2)	
STATE	YEAR
ALASKA	2002
SHEET NUMBER	TOTAL SHEETS
T9	146

Project As Built Drawings have been reviewed by the Project Engineer. To the best of his/her knowledge, they represent the project as constructed.
 Proj. Eng. *KS* Date 10.31.02

PATH:
 Q:\Ktn\71811A\PlanSet\T4-12_SignStriping.dwg
 Mon, 06/May/02 09:52AM Michael Limbaugh
 PLOT:
 PSPACE 1=1(F) OR MSPACE 1=1(F)
 TAB: ESTIMATE

ADDENDUM NUMBER

ATTACHMENT NUMBER

RECORD OF REVISIONS

No.	DATE	DESCRIPTION

KTN-THIRD AVENUE EXTENSION
 PROJECT NO. 68490

**Signing & Striping
 City Park Reserve - Parking Lot**

DESIGNED BY: R. PURVES



CHECKED BY: M. LUKSHIN

DRAWN BY: T.M./R.S.

STATE OF ALASKA
 DEPARTMENT OF TRANSPORTATION
 & PUBLIC FACILITIES
 STATEWIDE DESIGN & ENGINEERING
 SERVICES DIVISION

THIRD AVENUE EXTENSION
 PROJECT NO. 68490

**Signing & Striping
 City Park Reserve -
 Parking Lot**

PROJECT DESIGNATION NUMBER

STP-MG-0904(2)


STATE	YEAR
ALASKA	2002

SHEET NUMBER	TOTAL SHEETS
T10	146


Project As Built Drawings have been reviewed by the Project Engineer. To the best of his/her knowledge, they represent the project as constructed.

Proj. Eng. *KS* Date 10.31.06

NOTE: STRIPPING FOR PARKING LOT SHALL BE PAINTED MARKINGS.

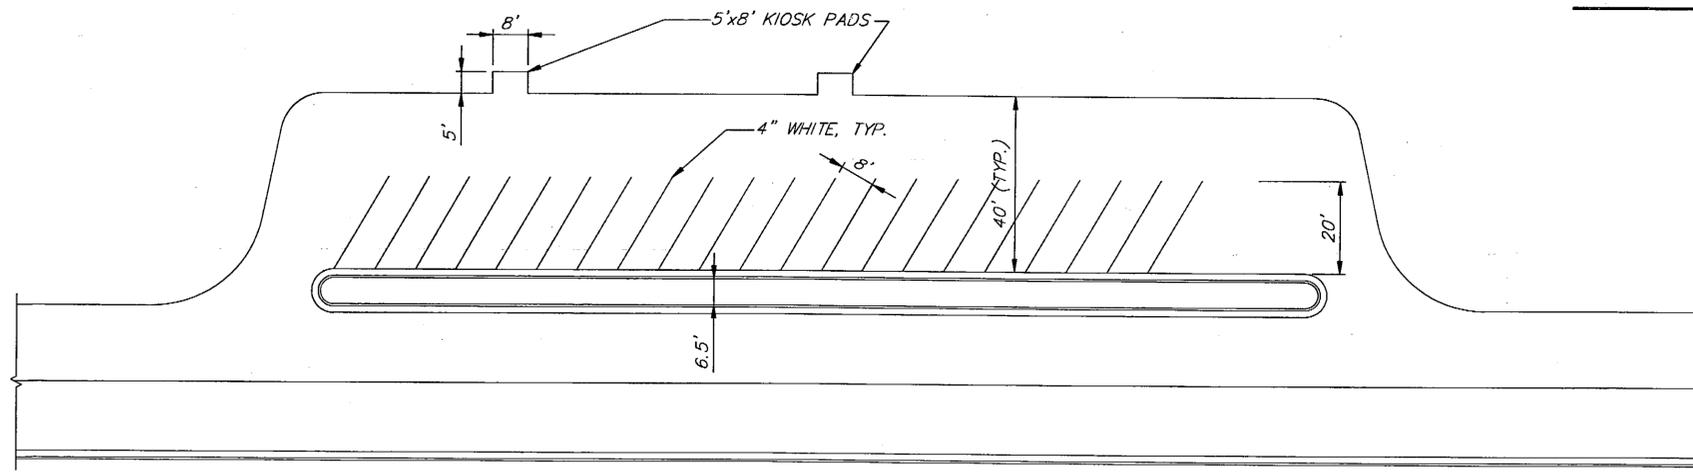

PLAN - PARKING LAYOUT

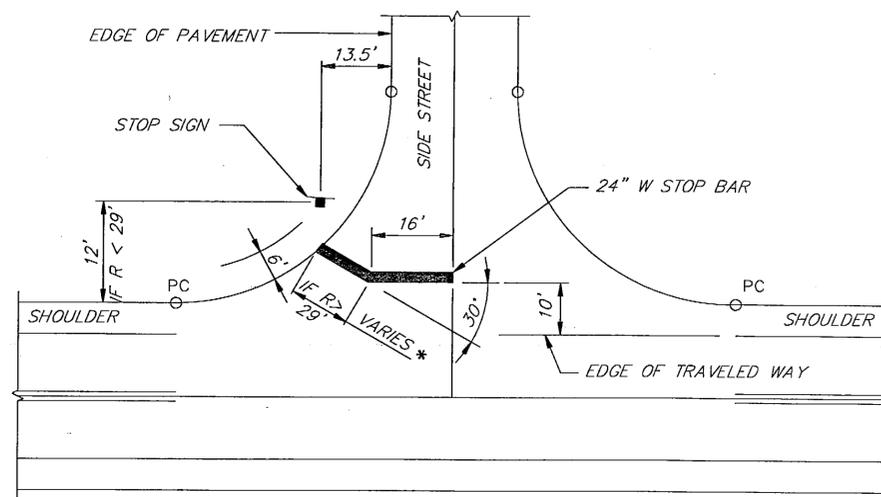

* OMIT ANGLE OF IS LESS THAN 8'



STOP BAR AND STOP SIGN
 INSTALLATION DETAIL

(WITHOUT PATHWAY)

PATH:
 Q:\Ktr\71811A\PlanSet\T4-12_SignStriping.dwg
 Mon, 06/May/02 09:52AM Michael Limbaugh
 PLOT:
 PSPACE 1=1(F) OR MSPACE 1=1(F)
 TAB: ESTIMATE



STRIPING AND RPM NOTES

1. STRIPED LANE WIDTHS SHALL BE 11'. WIDTH SHALL TAPER IN TO MATCH EXISTING AT B.O.P. AND E.O.P.
2. EXISTING NO-PASSING GROOVES AT ENDS OF NO-PASSING ZONES SHALL BE REFERENCED BEFORE CONSTRUCTION BEGINS BY THE CONTRACTOR FOR TEMPORARY AND PERMANENT MARKING PLACEMENT.
3. LATERAL PLACEMENT OF RECESSED PAVEMENT MARKERS SHALL BE BETWEEN DOUBLE YELLOW STRIPES ON CENTERLINE.
4. LOCATIONS OF MARKERS IN SITUATIONS WITH UNUSUAL GEOMETRICS WILL BE DETERMINED BY THE PROJECT ENGINEER.
5. RPM QUANTITIES ARE APPROXIMATE ONLY AND MAY VARY.
6. ALL RPM'S WILL BE TWOSIDED, YELLOW

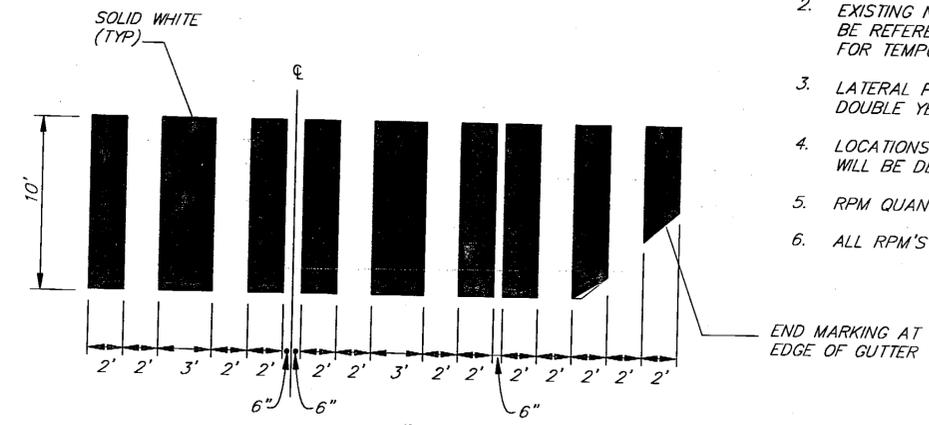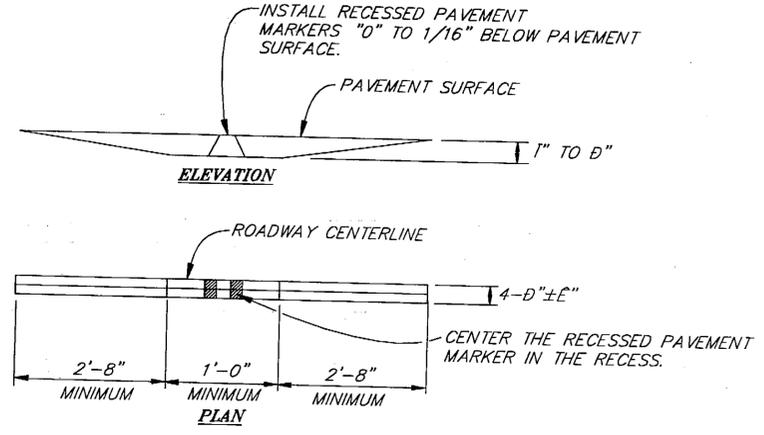


RECESSED PAVEMENT MARKER DETAIL

CROSSWALK MARKING SOUTH WASHINGTON STREET

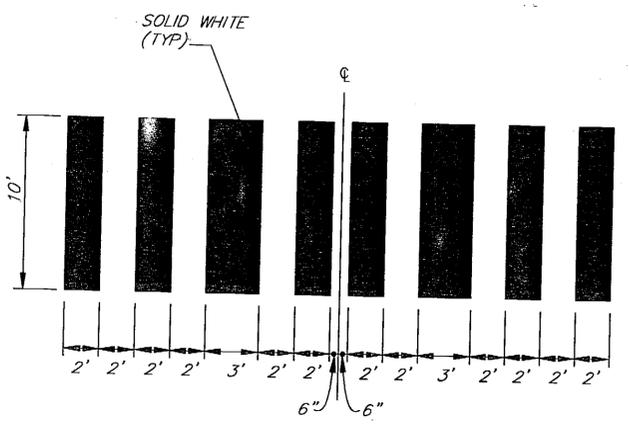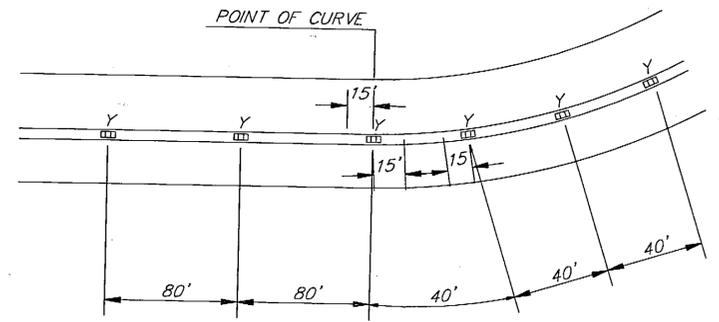

TWO LANE, TWO WAY DETAIL RECESSED PAVEMENT MARKER

CROSSWALK MARKING NEAR SHOENBAR ROAD

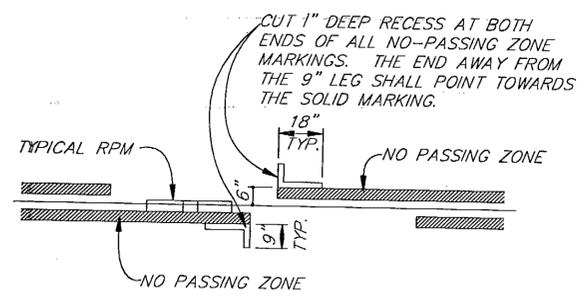

NO-PASSING GROOVES

STATION TO STATION		40' SEGMENTS	80' SEGMENTS
'0' 22+28	'0' 24+60.54 PC		4
'0' 24+60.54 PC	'0' 28+28.59 PT	9	
'0' 28+28.59 PT	'0' 35+29.37 PC		9
'0' 35+29.37 PC	'0' 38+75.52 PT	9	
'0' 38+75.52 PT	'0' 40+40.45 PC		2
'0' 40+40.45 PC	'0' 42+93.59 PT	6	
'0' 42+93.59 PT	'0' 47+52.33 PC		6
'0' 47+52.33 PC	'0' 52+48.49 PT	12	
'0' 52+48.49 PT	'0' 62+23.46 PC		12
'0' 62+23.46 PC	'0' 67+26.33 PT	13	
'0' 67+26.33 PT	'0' 69+96.77 PC		3
'0' 69+96.77 PC	'0' 77+92.64 PT	20	
'0' 77+92.67 PT	'0' 80+20 EOP	3	
TOTAL (EACH)			108

KTN-THIRD AVENUE EXTENSION
 PROJECT NO. 68490

Signing and Striping Details

DESIGNED BY: R. PURVES



CHECKED BY: M. LUKSHIN
 DRAWN BY: T.M./R.S.

STATE OF ALASKA
 DEPARTMENT OF TRANSPORTATION
 & PUBLIC FACILITIES
 STATEWIDE DESIGN & ENGINEERING
 SERVICES DIVISION
**THIRD AVENUE EXTENSION
 PROJECT NO. 68490**
**Signing and
 Striping
 Details**

PROJECT DESIGNATION NUMBER

STP-MG-0904(2)


STATE ALASKA
 YEAR 2002

SHEET NUMBER T11
 TOTAL SHEETS 146


Project As Built Drawings have been reviewed by the Project Engineer. To the best of his/her knowledge, they represent the project as constructed.
 Proj. Eng. Date 5/2/02

ILLUMINATION GENERAL NOTES


1. ALL WIRING SHALL BE ENCASED IN 2" DIA. RIGID METAL CONDUIT.
2. EACH ELECTROLIER SHALL HAVE A J-BOX INSTALLED ADJACENT TO THE FOUNDATION AS SHOWN IN THE POLE AND J-BOX WIRING DETAIL.
3. ALL JUNCTION BOXES SHALL BE TYPE IA, EXCEPT AT LOAD CENTERS, SEE STANDARD DRAWING L-23.01.
4. A BARE STRANDED GROUND CONDUCTOR SHALL BE INSTALLED THROUGH ALL CONDUITS. THE GROUND CONDUCTOR SHALL BE ATTACHED TO ALL CONDUIT END BUSHINGS AND POLES.
5. NEW ELECTROLIER FOUNDATIONS MAY BE PRE-CAST. PRE-CAST FOUNDATIONS SHALL BE TRANSPORTED USING A DEVICE THAT SPREADS THE LOAD EVENLY BETWEEN THE ANCHOR BOLTS.
6. INSTALL THE PHOTOELECTRIC CELL ON TOP OF THE NEAREST ELECTROLIER POLE.
7. ILLUMINATION CIRCUIT WIRES SHALL BE NO. 6 AWG. 3-CONDUCTOR CABLE AS SPECIFIED IN STANDARD SPECIFICATION 660-2.08.
8. LUMINAIRE'S SHALL BE 480 VOLT, 250 WATT, HIGH PRESSURE SODIUM, MEDIUM DISTRIBUTION, CUT-OFF, IES TYPE III AND SHALL HAVE MAGNETIC REGULATOR BALLASTS AND HPS LAMPS WITH A 24,000 HOUR RATED LIFE.
9. INSTALL ONE WHITE FLEXIBLE DELINEATOR POST AT EACH J-BOX TO MARK IT'S LOCATION. DELINEATOR POSTS SHALL BE OF 3.75" WIDE COMPOSITE MATERIAL (CARSONITE ROADMARKER OR APPROVED EQUAL) AND SHALL BE EMBEDDED TO STAND 48" ABOVE GROUND LEVEL.
10. INSTALL ONE SPARE TWO INCH RIGID METAL CONDUITS FROM THE LOAD CENTER TO THE FIRST JUNCTION BOX.
11. NON-BREAKAWAY PORTIONS OF FOUNDATIONS SHALL NOT PROTRUDE MORE THAN FOUR INCHES ABOVE ANY 60 INCH CHORD STARTING AND ENDING ON THE FINISHED GRADE OF THE ELECTROLIER PADS.
12. LUMINAIRE MASTARMS SHALL BE 15' LONG UNLESS NOTED ELSEWHERE.
13. THE CONTRACTOR SHOULD ANTICIPATE THAT MOST OF THE ELECTROLIER BASES WILL NEED TO BE INSTALLED IN ROCK OR LARGE SHOT ROCK FILL. BLASTING MAY BE REQUIRED. ALL DRILLING AND BLASTING COSTS SHALL BE INCIDENTAL TO THE HIGHWAY LIGHTING SYSTEM COMPLETE PAY ITEM.

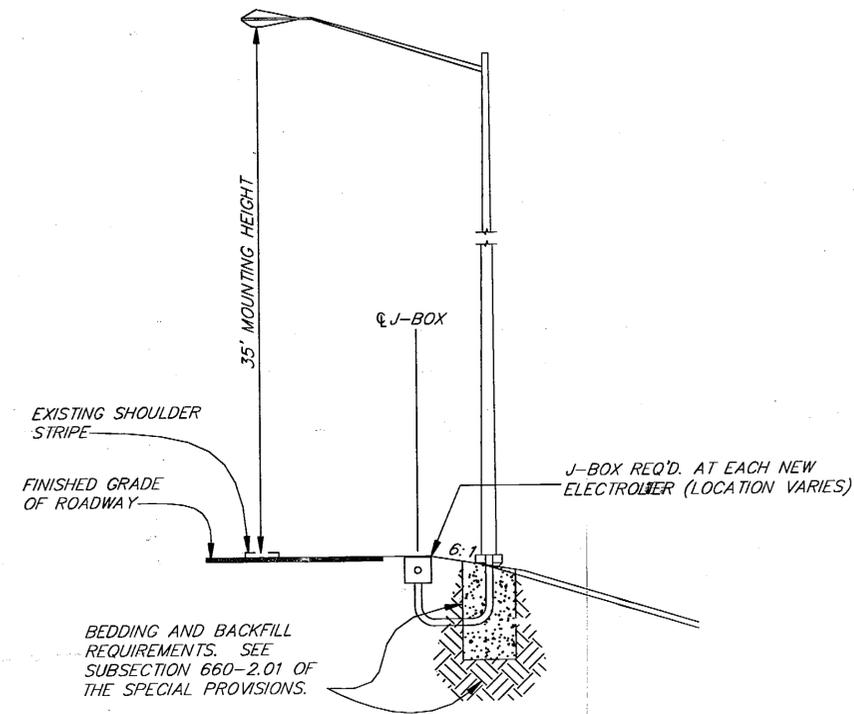


TYPICAL SECTION FOR ELECTROLIER

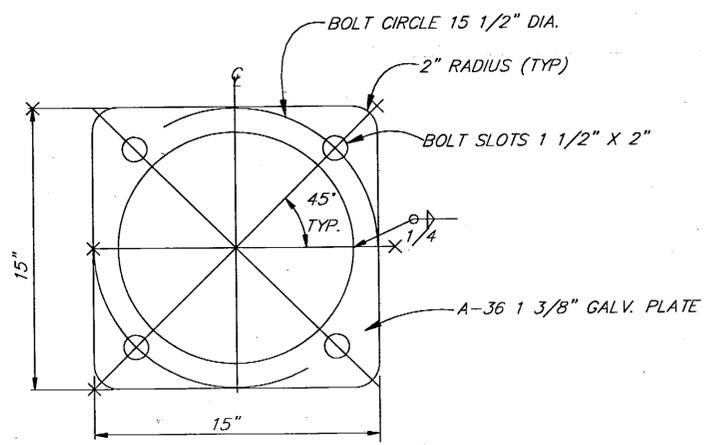

ANCHOR BASE DETAIL

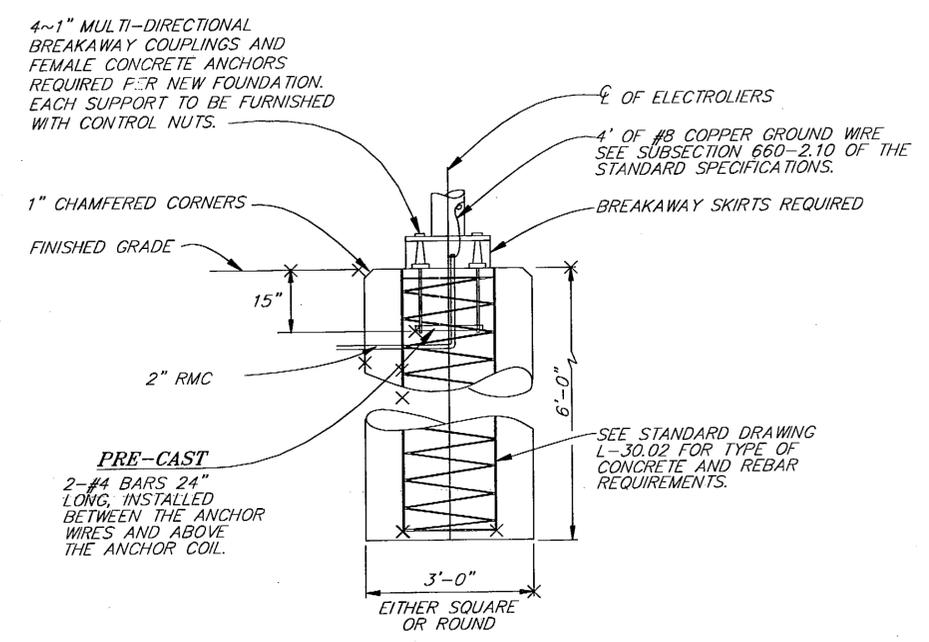

FOUNDATION WITH BREAKAWAY COUPLINGS

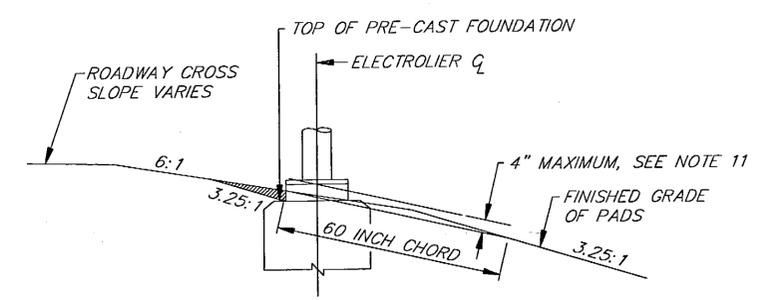

FOUNDATION INSTALLATION DETAIL

INDICATES EMBANKMENT MATERIAL TO BE REMOVED FROM AROUND BREAKAWAY SKIRTS

KTN-THIRD AVENUE EXTENSION
 PROJECT NO. 68490

ILLUMINATION DETAILS

DESIGNED BY: R. PURVES



CHECKED BY: M. LUKSHIN

DRAWN BY: T.M./R.S.

STATE OF ALASKA
 DEPARTMENT OF TRANSPORTATION & PUBLIC FACILITIES
 STATEWIDE DESIGN & ENGINEERING SERVICES DIVISION
THIRD AVENUE EXTENSION PROJECT NO. 68490

ILLUMINATION DETAILS

PROJECT DESIGNATION NUMBER

STP-MG-0904(2)

STATE	YEAR
ALASKA	2002
SHEET NUMBER	TOTAL SHEETS
T12	146

ADDENDUM NUMBER		
ATTACHMENT NUMBER		
RECORD OF REVISIONS		
No.	DATE	DESCRIPTION

KTN-THIRD AVENUE EXTENSION
 PROJECT NO. 68490
 Illumination Details

DESIGNED BY: R. PURVES



CHECKED BY: M. LUKSHIN
 DRAWN BY: T.M./R.S.


STATE OF ALASKA
 DEPARTMENT OF TRANSPORTATION
 & PUBLIC FACILITIES
 STATEWIDE DESIGN & ENGINEERING
 SERVICES DIVISION
**THIRD AVENUE EXTENSION
 PROJECT NO. 68490**

**Illumination
 Details**


PROJECT DESIGNATION NUMBER
STP-MG-0904(2)

STATE	YEAR
ALASKA	2002

SHEET NUMBER	TOTAL SHEETS
T13	146

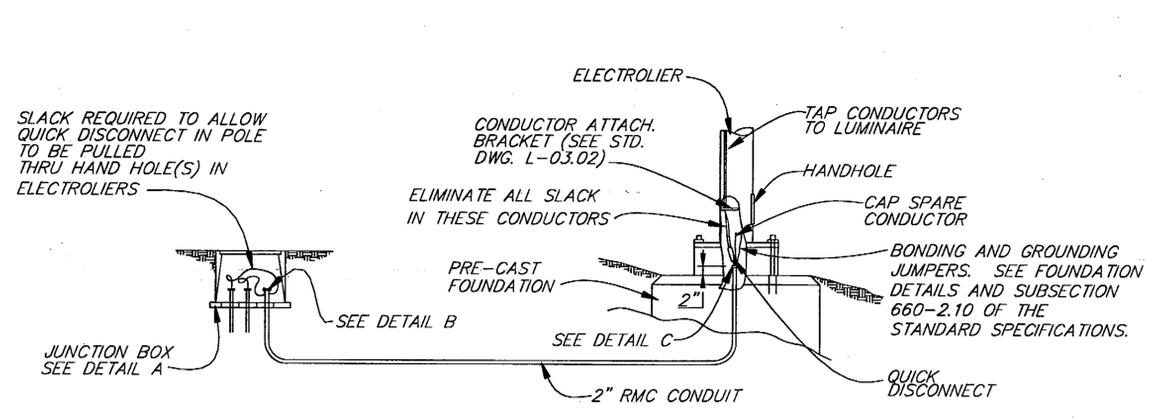


**LIGHTING SYSTEM POLE AND
 J-BOX WIRING DETAILS**
 (BREAKAWAY COUPLINGS)

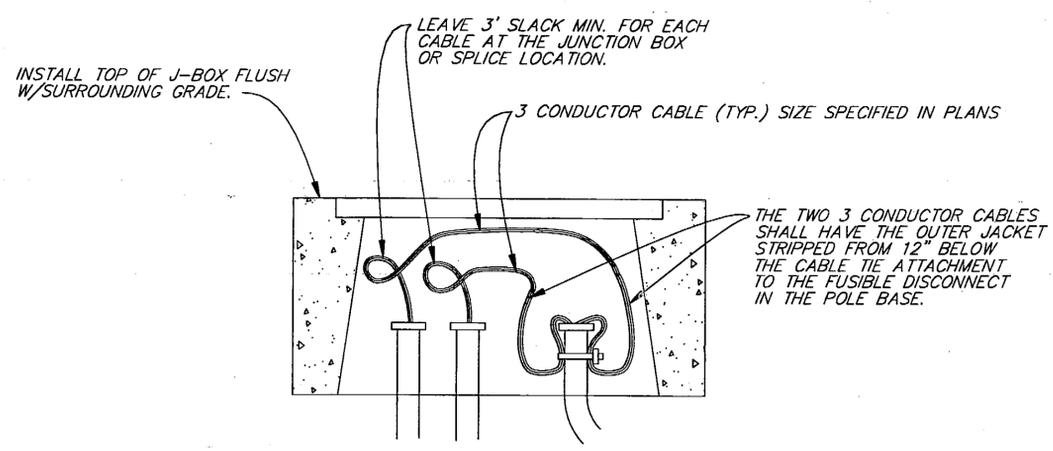


DETAIL A

NOTE:
 INSTALL A 3/4"x10' COPPER CLAD STEEL GROUND ROD IN EACH J-BOX AND CONNECT TO ALL GROUNDING CONDUCTORS. USE A SPLIT BOLT TO CLAMP ALL GROUNDING CONDUCTORS TOGETHER.

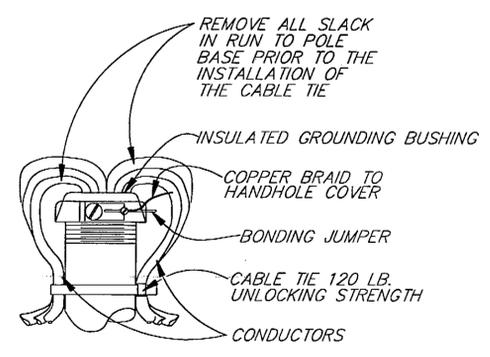


DETAIL B
 (IN J-BOX)

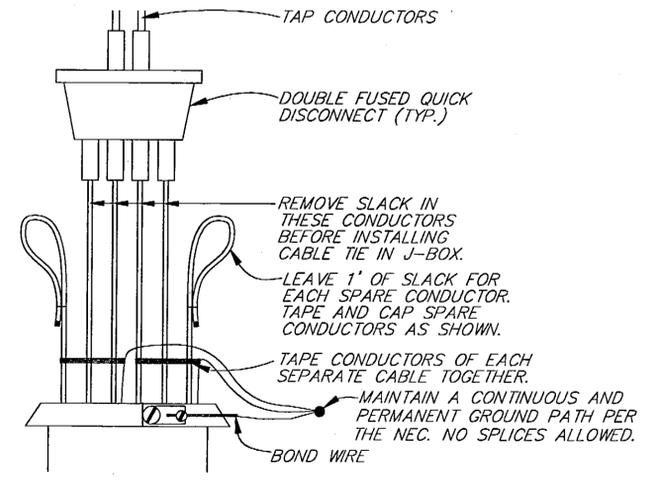

DETAIL C
 (IN POLE BASE)


PARKING LOT

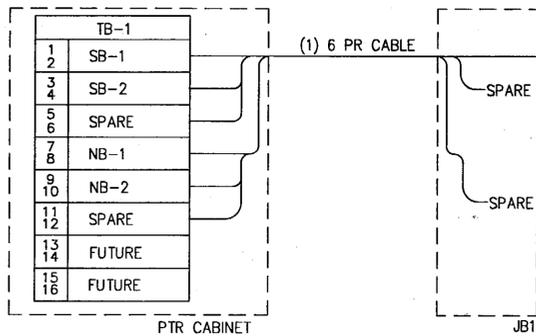

H1 WIRING SCHEMATIC

CONDUIT TYPE	SIZE	FROM	TO	QTY.	CABLE TYPE
RMC	2"	#6	JB1	1	1-3C #6
RMC	2"	PTR	JB1	1	(1) 6PR CABLE
PVC	1"	JB1	NB-1	1	1PR No.14
PVC	1"	JB1	NB-2	1	1PR No.14
PVC	1"	JB1	SB-1	1	1PR No.14
PVC	1"	JB1	SB-2	1	1PR No.14

H1 CONDUIT/CONDUCTOR SCHEDULE

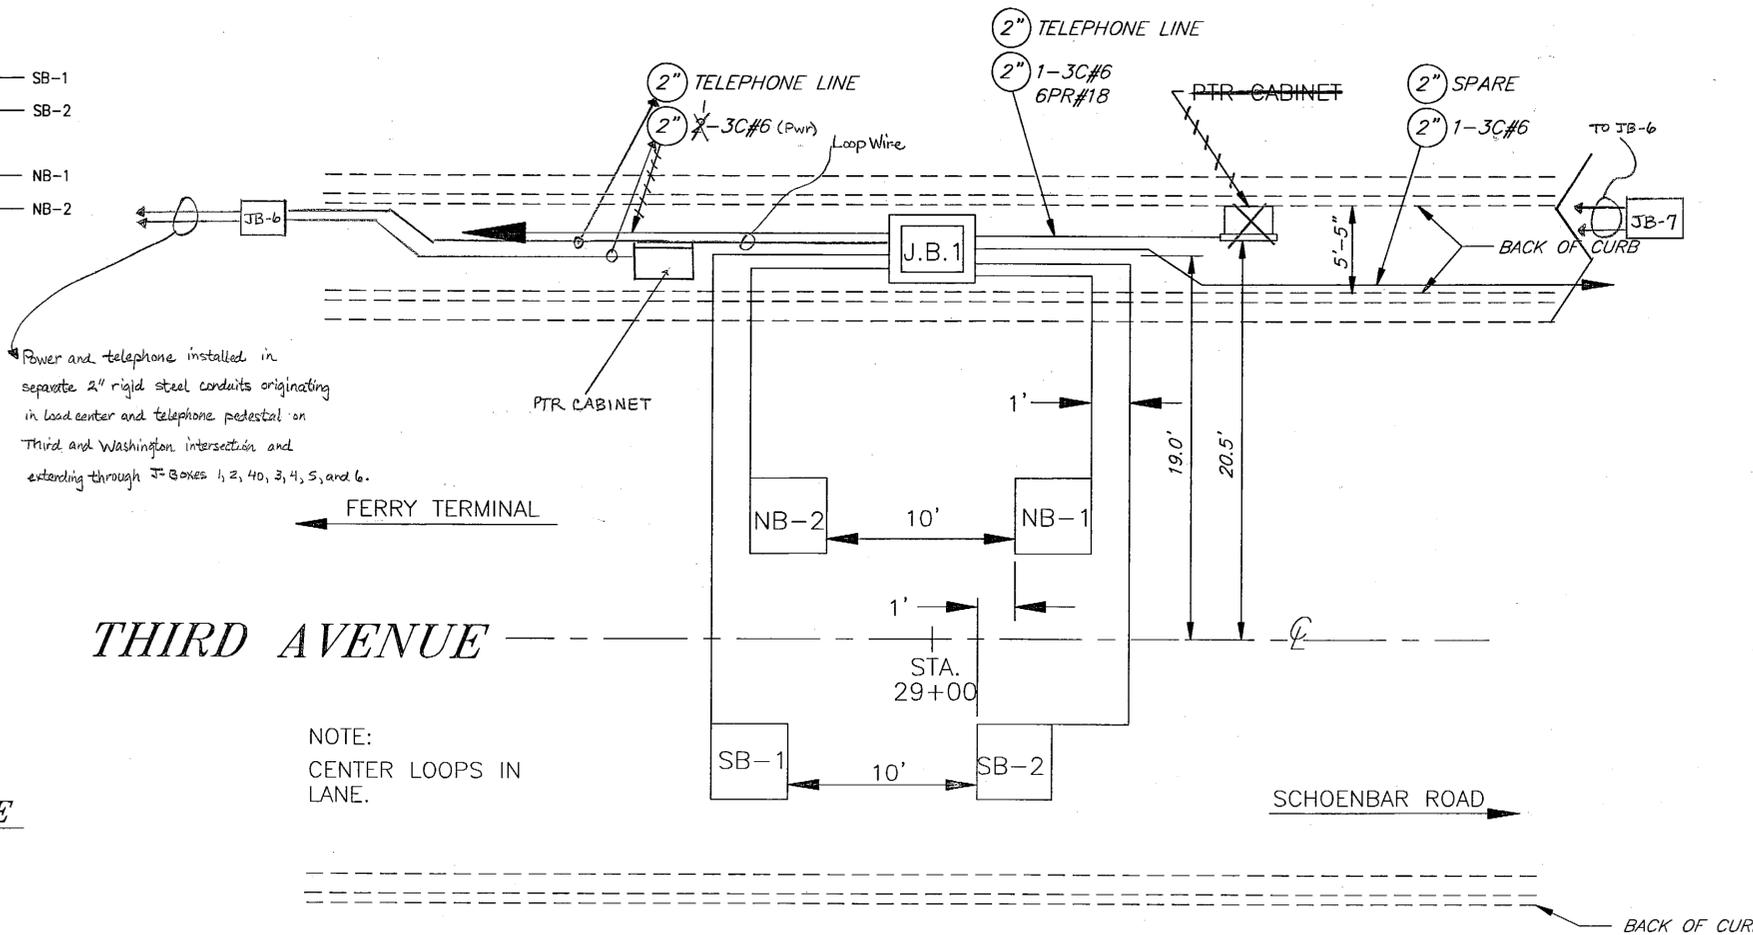

THIRD AVENUE


NOTE:
CENTER LOOPS IN LANE.

SHEET NOTES

- SEE TYPICAL SECTIONS FOR DIMENSIONS.
- INDUCTION LOOPS TO BE CENTERED IN TRAFFIC LANES.
- ALL JUNCTION BOXES SHALL BE TYPE II.
- THE CONTRACTOR SHALL INSTALL A TELEPHONE LINE INTO THE PTR CABINET AND PAY ALL FEES AND PERMITS FOR PROVIDING TELEPHONE SERVICE. THE STATE WILL ACCEPT BILLING FOR THE TELEPHONE AFTER PROJECT COMPLETION.
- INSTALL LOOPS PER PLAN SHEET T16.



- LEGEND
- 2" = 2" DIA. RMC
 - = TYPE II J-BOX

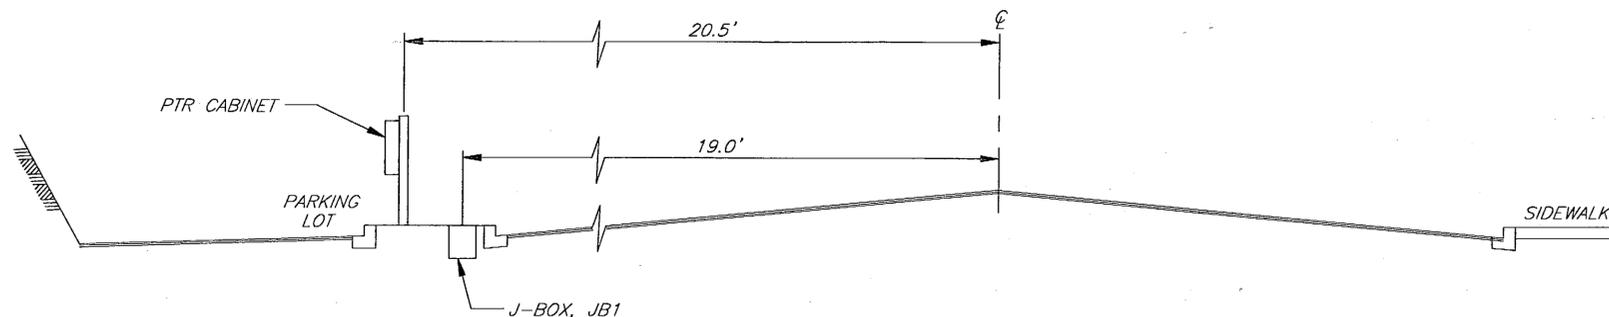

H1 ELEVATION VIEW
N.T.S.

PATH:
Q:\Kln\71811A\PlanSet\T4-12_SignStriping.dwg
Mon, 06/May/02 09:52AM Michael Limbaugh
PLOT:
PSPACE 1=1(F) OR MSPACE 1=1(F)
TAB: ESTIMATE

ADDENDUM NUMBER		
ATTACHMENT NUMBER		
RECORD OF REVISIONS		
No.	DATE	DESCRIPTION

KTN-THIRD AVENUE EXTENSION
PROJECT NO. 68490

PTR Details

DESIGNED BY: R. PURVES



CHECKED BY: M. LUKSHIN

DRAWN BY: T.M./R.S.

STATE OF ALASKA
DEPARTMENT OF TRANSPORTATION
& PUBLIC FACILITIES
STATEWIDE DESIGN & ENGINEERING
SERVICES DIVISION
**THIRD AVENUE EXTENSION
PROJECT NO. 68490**

PTR Details

PROJECT DESIGNATION NUMBER

STP-MG-0904(2)


STATE	YEAR
ALASKA	2002
SHEET NUMBER	TOTAL SHEETS
T14	146

Project As Built Drawings have been reviewed by the Project Engineer. To the best of his/her knowledge, they represent the project as constructed.

Proj. Eng. *KS* Date 10.31.06


PATH:
 Q:\Ktn\71811A\PlanSet\T4-12_SignStriping.dwg
 Mon, 05/May/02 09:52AM Michael Limbaugh
 PLOT:
 PSPACE 1=1(F) OR MSPACE 1=1(F)
 TAB: ESTIMATE

ADDENDUM NUMBER		
ATTACHMENT NUMBER		
RECORD OF REVISIONS		
No.	DATE	DESCRIPTION

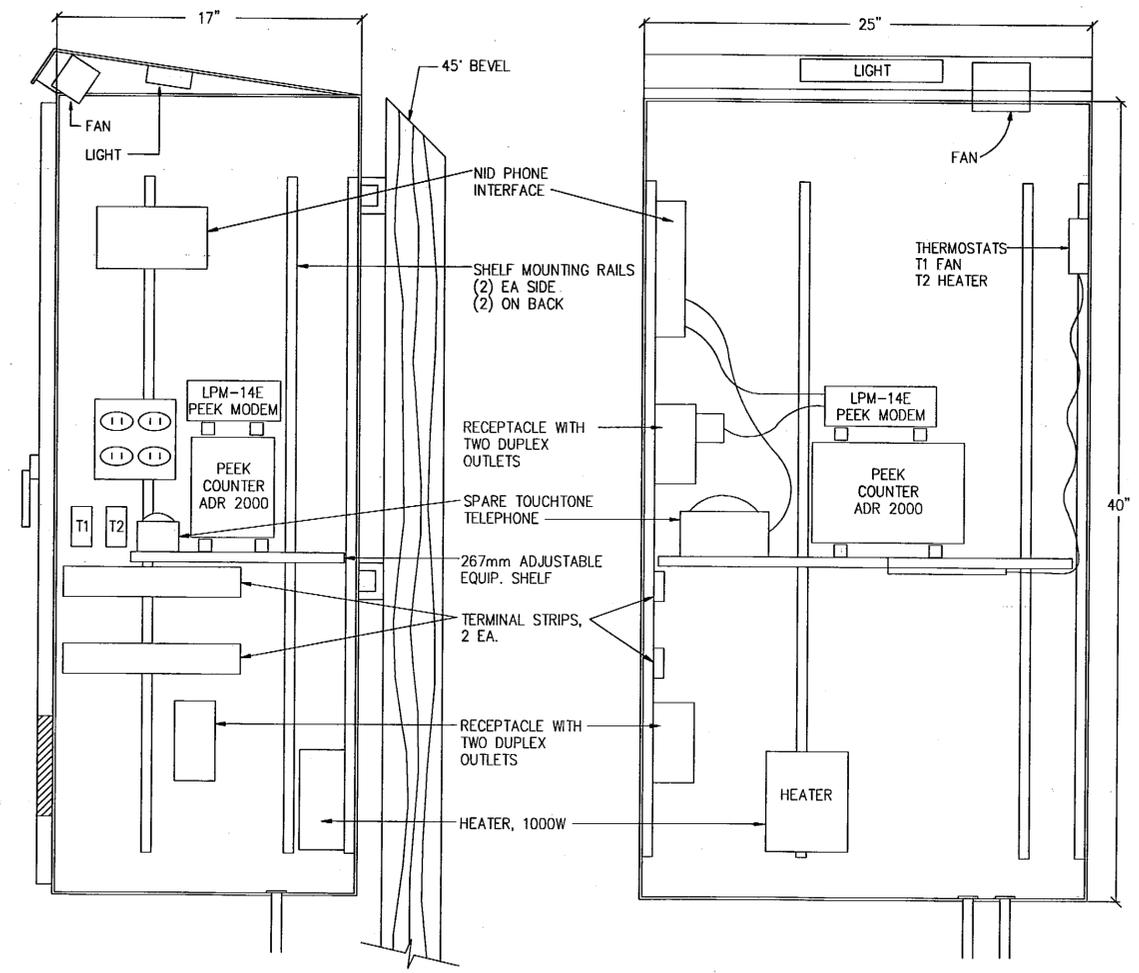

PTR CABINET DETAILS

- NOTES:
1. USE CONDUIT HUBS IN BOTTOM OF CABINET. USE TYPE CHT WITH NEOPRENE SEAL AND INSULATED THROAT FOR NON-POWER CONDUITS WITH DETECTOR LEAD-IN CABLES AND TELEPHONE SERVICE. USE TYPE CHN FOR SERVICE ENTRANCE CONDUIT AND CONNECT FLEXIBLE METAL CONDUIT TO CB PANEL INSIDE CABINET.
 2. SEE SPECIFICATIONS FOR ADDITIONAL CABINET REQUIREMENTS.
 3. CABINET DOOR SHALL FACE AWAY FROM ROADWAY.
 4. PROVIDE VOLTAGE SURGE PROTECTION IN CB PANEL.
 5. ALL 120V WIRING, INCLUDING THAT FOR PANELBOARD, LIGHT, FAN, AND THERMOSTATS TO BE IN FLEXIBLE METAL CONDUIT WITH EXCEPTION OF CORD CONNECTED ELECTRONIC EQUIPMENT.
 6. ALL EQUIPMENT INSIDE CABINET TO BE FASTENED TO RAILS WITH NO SCREW PENETRATIONS OF THE CABINET SURFACE.
 7. CABINET DIMENSIONS ARE NOMINAL AND WILL VARY BETWEEN MANUFACTURERS.
 8. THE CABINET LIGHT SHALL BE LOW PROFILE WITH CHROME WIRE GUARD.

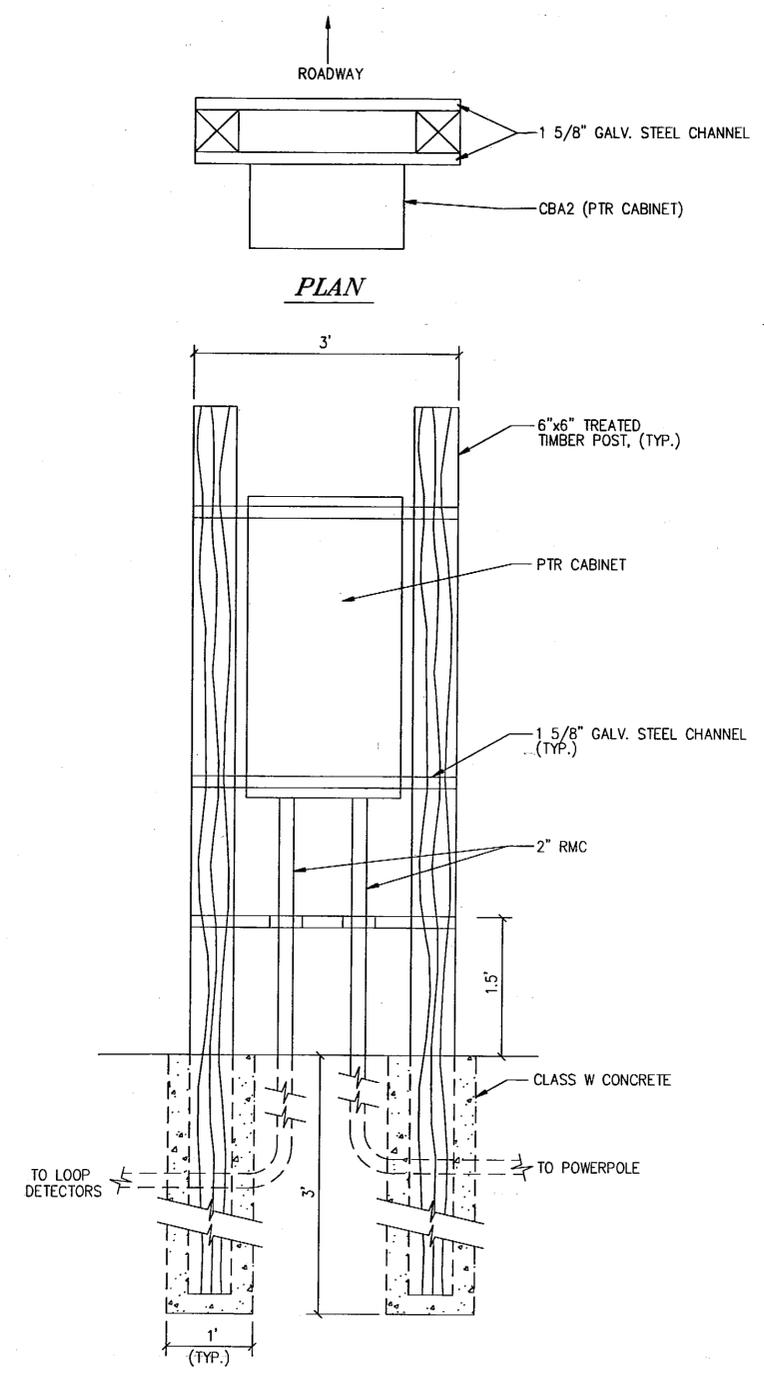

TYPICAL CABINET DETAIL

KTN-THIRD AVENUE EXTENSION
 PROJECT NO. 68490

Control Cabinet Details

DESIGNED BY: R. PURVES



CHECKED BY: M. LUKSHIN
 DRAWN BY: T.M./R.S.

STATE OF ALASKA
 DEPARTMENT OF TRANSPORTATION
 & PUBLIC FACILITIES
 STATEWIDE DESIGN & ENGINEERING
 SERVICES DIVISION
**THIRD AVENUE EXTENSION
 PROJECT NO. 68490**

**Control Cabinet
 Details**


PROJECT DESIGNATION NUMBER	
STP-MG-0904(2)	
STATE	YEAR
ALASKA	2002
SHEET NUMBER	TOTAL SHEETS
T15	146

Project As Built Drawings have been reviewed by the Project Engineer. To the best of his/her knowledge, they represent the project as constructed.
 Proj. Eng. *KS* Date 05-06


ADDENDUM NUMBER		
ATTACHMENT NUMBER		
RECORD OF REVISIONS		
No.	DATE	DESCRIPTION

GENERAL NOTES


- EACH LOOP DETECTOR SHALL CONSIST OF A SINGLE PIECE OF #14 AWG CONDUCTOR INSTALLED IN 1" SCHEDULE 80 PVC CONDUIT. FORM ALL LOOPS 6' SQUARE, SOLVENT WELD ALL PVC TO PVC JOINTS. USE TYPE X OUTLET BODIES THAT ARE MADE OF HOT DIP GALVANIZED STEEL TO JOIN THE LOOPS AND TAILS.
- INSTALL 4 TURNS OF CONDUCTOR IN ALL LOOPS AND PROVIDE TAILS THAT EXTEND TO THE JUNCTION BOX SPECIFIED ON THE PLANS. USE #14 AWG CONDUCTOR IN A POLYETHYLENE TUBE CONFORMING TO IMSA SPECIFICATION 51-5. WIND THE TAIL CONDUCTORS TOGETHER AT A RATE OF 4 TWISTS PER FOOT.
- INSTALL ALL LOOP DETECTORS PRIOR TO OVERLAYING EXISTING PAVEMENT OR PAVING A NEW ROADWAY.
- INSTALL ALL LOOP DETECTORS SLOPED TO DRAIN INTO THE JUNCTION BOX THE LOOP TAIL ENTERS.
- NO MINIMUM CLEARANCE IS REQUIRED BETWEEN A LOOP AND A TAIL OR BETWEEN TAILS. LOOP TAILS SHALL NOT CROSS LOOP CONDUITS.
- TEST ALL LOOP DETECTORS FOR CONTINUITY AND INSULATION INTEGRITY PRIOR TO SEALING THE LOOPS UNDER ASPHALT.
- WHEN INSTALLING LOOP DETECTORS IN EXISTING PAVEMENT, CUT THE ASPHALT WITH A SAW AND REMOVE ALL ASPHALT WITHIN THE SAW CUT. MATCH EXISTING PAVEMENT THICKNESS WHEN REPAIRING THE CUTOUT.
- WHERE EXISTING PAVEMENT WILL NOT BE OVERLAID, ENCLOSE ALL LOOPS THAT ENTER A COMMON JUNCTION BOX WITHIN A TRAPEZOIDAL SAW CUT. CUT TO WITHIN 12" OF THE LANE AND EDGE LINES, PRESERVING THESE PAVEMENT MARKINGS; REMOVE THE ASPHALT TO THE LIP OF THE GUTTER WHEN THERE ARE NO EDGE LINES. CUT ACROSS LANE LINES WHEN LOOPS IN ADJACENT LANES ARE SIDE BY SIDE. CUT TRENCHES A MINIMUM OF 1 METER WIDE WHEN INSTALLING LOOP TAILS ACROSS A LANE; TRENCHES CROSSING A SHOULDER ONLY MAY BE A MINIMUM 12" WIDE.
- HEAT AND TACK COAT THE EDGES OF EXISTING PAVEMENT PRIOR TO PAVING THE CUTOUTS. COMPACT THE ASPHALT MIXTURE WITH A SELF PROPELLED STEEL WHEELED ROLLER. THE ASPHALT MIX SHALL CONFORM TO SECTION 401 OF THE SPECIFICATIONS, AND APPROVED FOR USE BY THE ENGINEER.
- MAINTAIN THE REPLACEMENT ASPHALT MIX AT A TEMPERATURE OF 108° C UNTIL THE TIME OF APPLICATION; IF NECESSARY, STORE THE MIX IN AN INSULATED BOX TO MAINTAIN THE SPECIFIED TEMPERATURE.
- ALL WORK ASSOCIATED WITH INSTALLING LOOP DETECTORS IS CONSIDERED PART OF ITEM 669(1) AND WILL NOT BE MEASURED SEPARATELY OR PAID FOR DIRECTLY. THIS WORK INCLUDES BUT IS NOT LIMITED TO: LOOP MATERIALS; JUNCTION BOXES; CONDUIT; LOOP LEAD IN CABLE; TESTING; SPLICING; CONDUCTOR LABELING AND SAW CUTTING. ASPHALT REMOVAL AND INSTALLATION OF NEW ASPHALT SHALL BE PAID UNDER THEIR RESPECTIVE PAY ITEMS.
- DUCK SEAL ALL CONDUITS INSIDE THE JUNCTION BOXES.

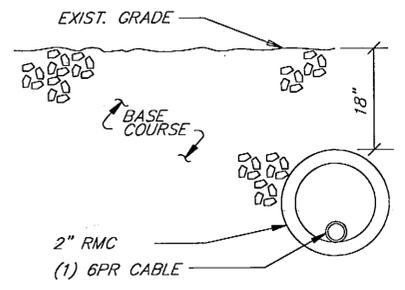

SECTION B-B

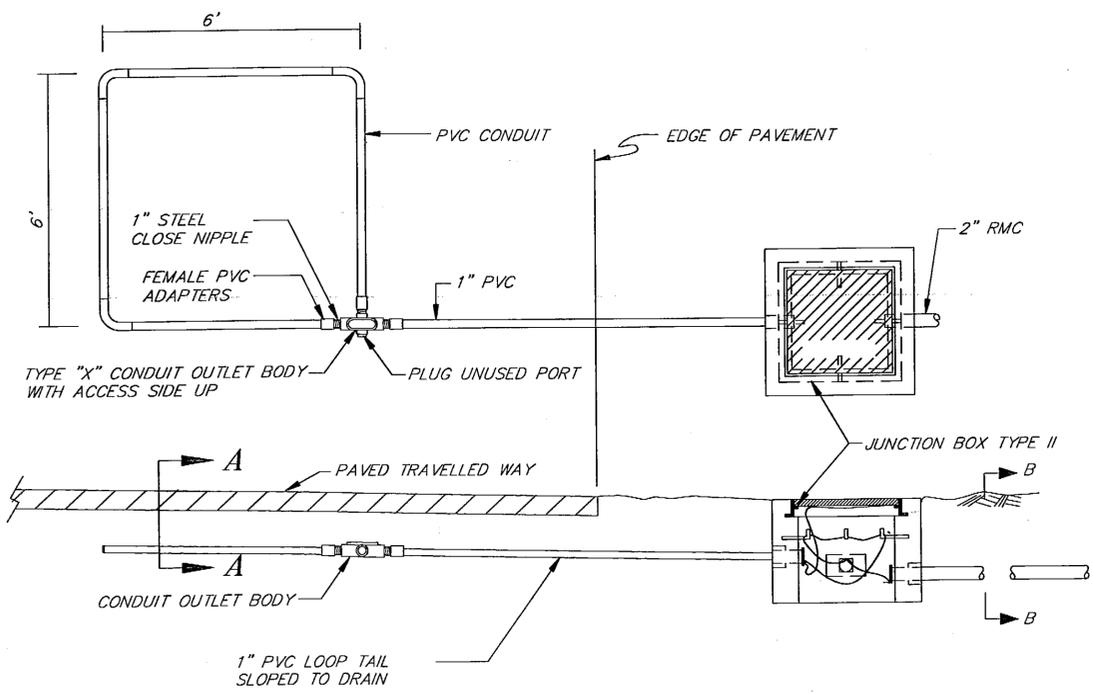

SHOULDER SECTION

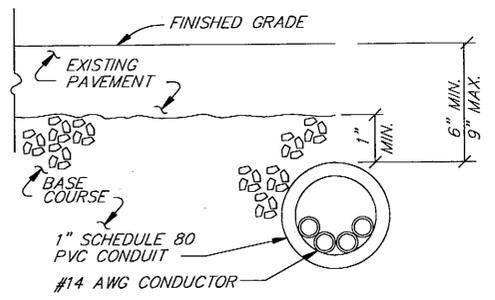


PVC CONDUIT DETAIL SECTION A-A

INDUCTIVE LOOPS

LEAD-IN WIRES FOR EACH LOOP SHALL BE IN SEPARATE CONDUITS TO THE FIRST JUNCTION BOX. THESE CONDUITS SHALL BE SEPARATED FROM OTHER LOOPS BY A MINIMUM OF 12".

INDUCTIVE LOOPS SHALL BE INSTALLED IMMEDIATELY PRIOR TO PAVING THIS SECTION OF ROADWAY. FINAL LIFT ASPHALT PAVEMENT SHALL BE SMOOTH OVER ALL INDUCTIVE-LOOPS AND WITHOUT TRANSVERSE SEAMS, JOINTS, OR ROUGHNESS WITHIN 50' OF THE LOOPS.

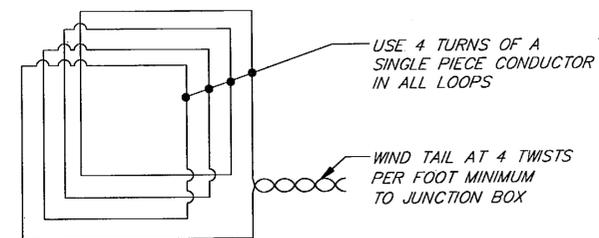

LOOP WIRING DETAIL

TYPICAL PVC CONDUIT ENCASED LOOP DETECTOR INSTALLATION

**KTN-THIRD AVENUE EXTENSION
 PROJECT NO. 68490**

Loop Detector Details

DESIGNED BY: R. PURVES



CHECKED BY: M. LUKSHIN

DRAWN BY: I.M./R.S.

STATE OF ALASKA
 DEPARTMENT OF TRANSPORTATION
 & PUBLIC FACILITIES
 STATEWIDE DESIGN & ENGINEERING
 SERVICES DIVISION
**THIRD AVENUE EXTENSION
 PROJECT NO. 68490**



Loop Detector Details

PROJECT DESIGNATION NUMBER	
STP-MG-0904(2)	
STATE	YEAR
ALASKA	2002
SHEET NUMBER	TOTAL SHEETS
T16	146

Project As Built Drawings have been reviewed by the Project Engineer. To the best of his/her knowledge, they represent the project as constructed.
 Proj. Eng. *[Signature]* Date 5/9/06

PATH:
 O:\Ktn\71811A\Planset\W1_Pioneer_Staging.dwg
 Tue, 07/May/02 10:51AM Michael Limbaugh
 PLOT:
 PSPACE 1=1(F) OR MSPACE 1=1(F)

ADDENDUM NUMBER		
ATTACHMENT NUMBER		
RECORD OF REVISIONS		
No.	DATE	DESCRIPTION

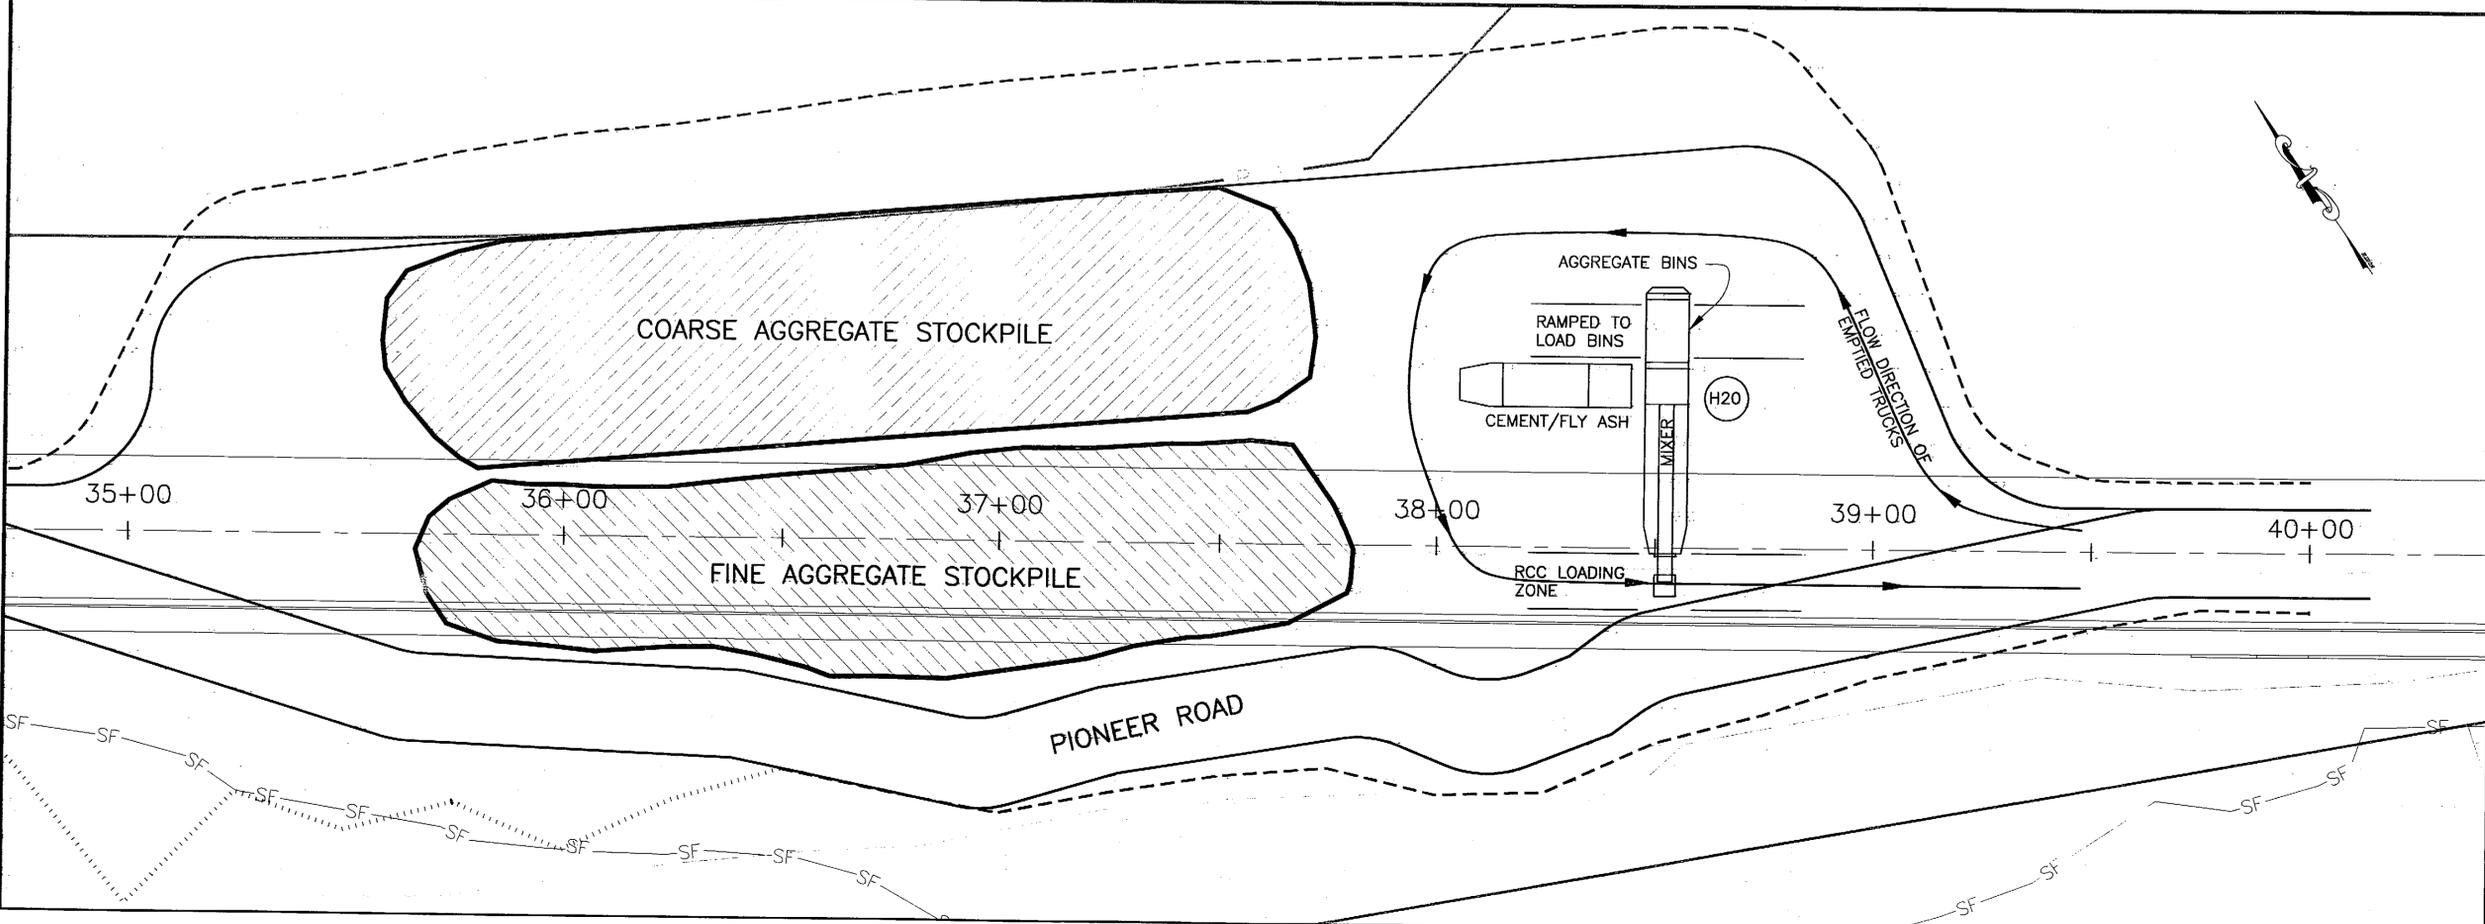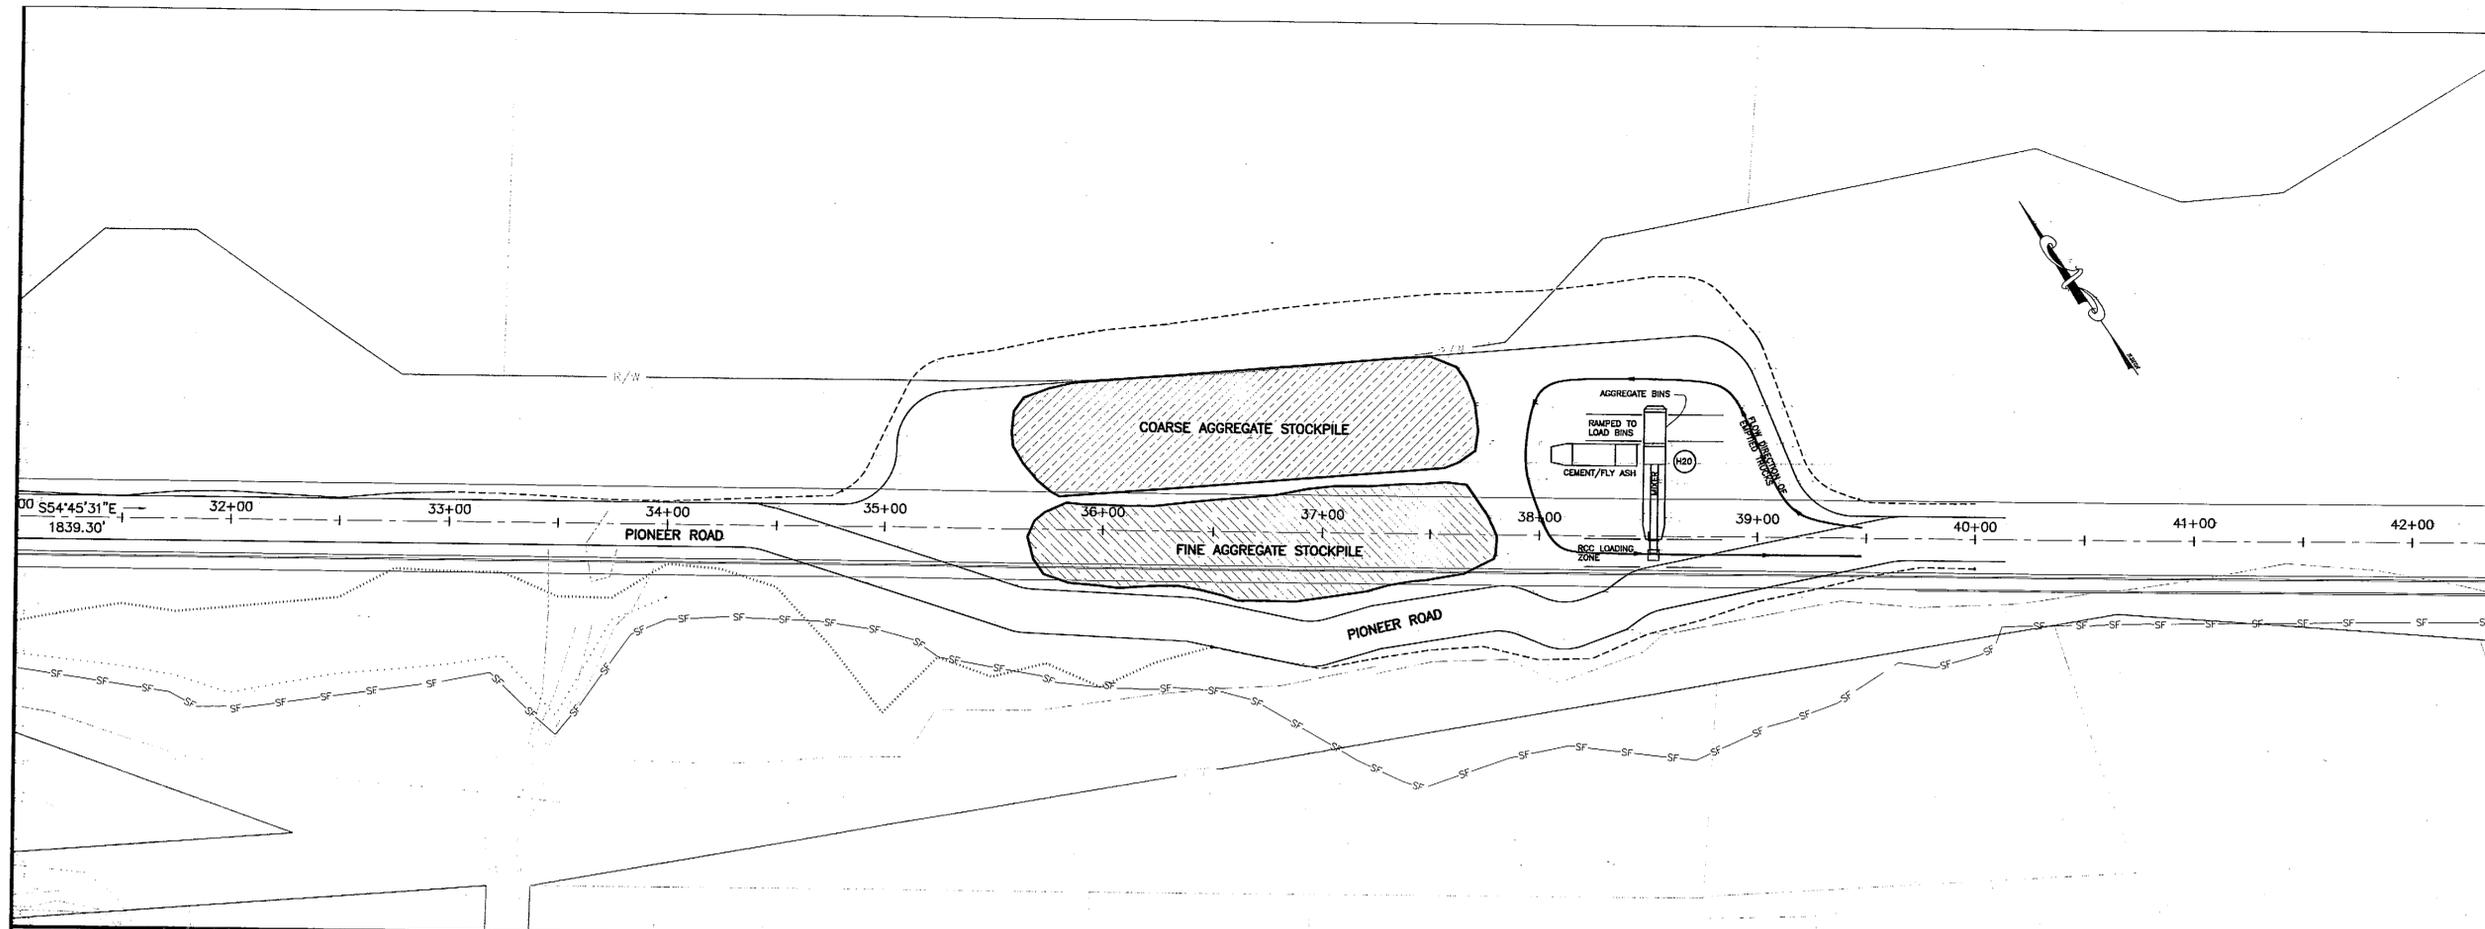

KTN-THIRD AVENUE EXTENSION
 PROJECT NO. 68490

**Conceptual Work Plan
 Staging Area**

DESIGNED BY: C. HOWARD



CHECKED BY: T. MOORE
 DRAWN BY: K.K.



STATE OF ALASKA
 DEPARTMENT OF TRANSPORTATION
 & PUBLIC FACILITIES
 STATEWIDE DESIGN & ENGINEERING
 SERVICES DIVISION
 THIRD AVENUE EXTENSION
 PROJECT NO. 68490
**Conceptual
 Work Plan
 Staging Area**

PROJECT DESIGNATION NUMBER	
STP-MG-0904(2)	
STATE	YEAR
ALASKA	2002
SHEET NUMBER	TOTAL SHEETS
W1	146


Project As Built Drawings have been reviewed by the Project Engineer. To the best of his/her knowledge, they represent the project as constructed.
 Proj. Eng. *KS* Date 10/30

PATH:
 Q:\ktn\71811A\Planset\W2_RCC-LIFTS.dwg
 Tue, 07/May/02 01:29PM Michael Limbough
 PLOT:
 PSPACE 1=1(F) OR MSPACE 1=1(F)
 TAB: ESTIMATE

ADDENDUM NUMBER		
ATTACHMENT NUMBER		
RECORD OF REVISIONS		
No.	DATE	DESCRIPTION

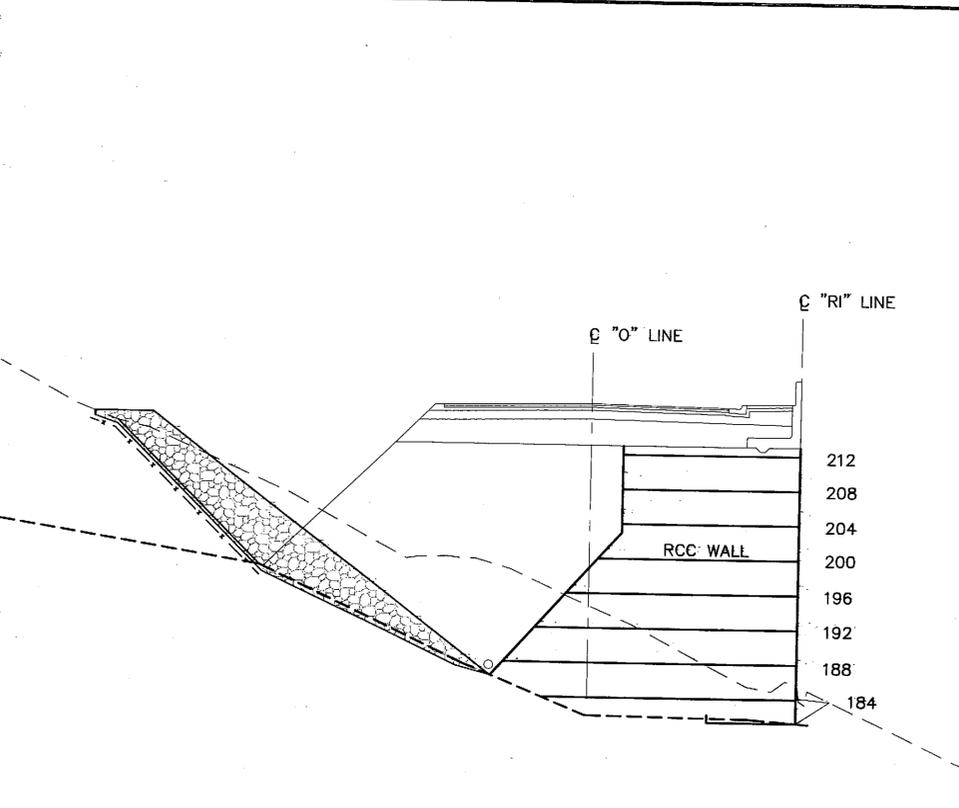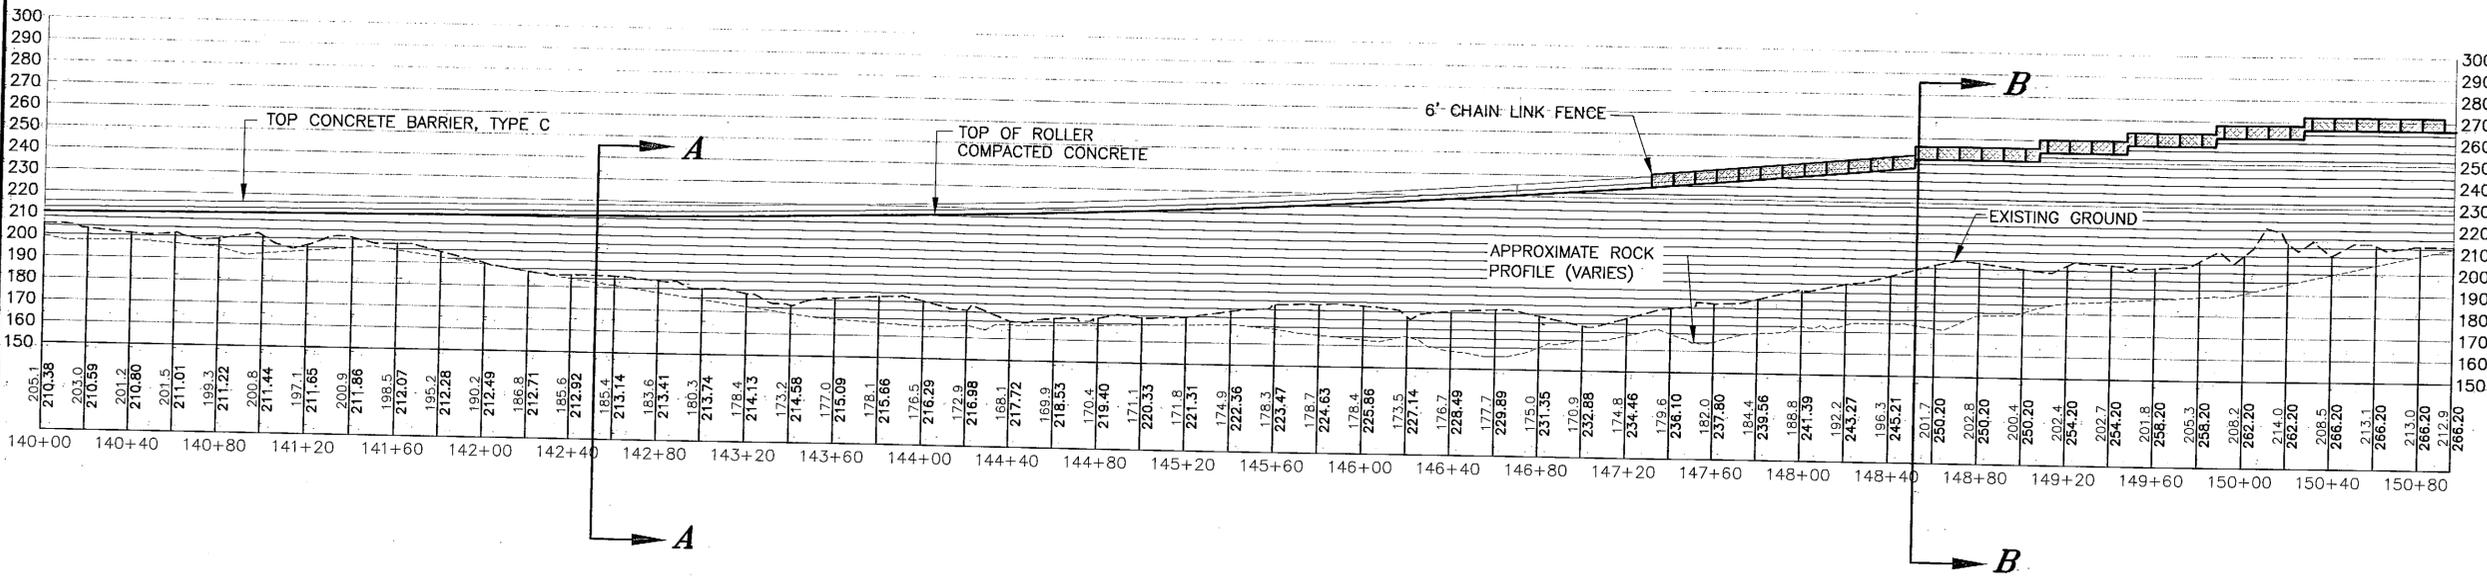

SECTION A-A

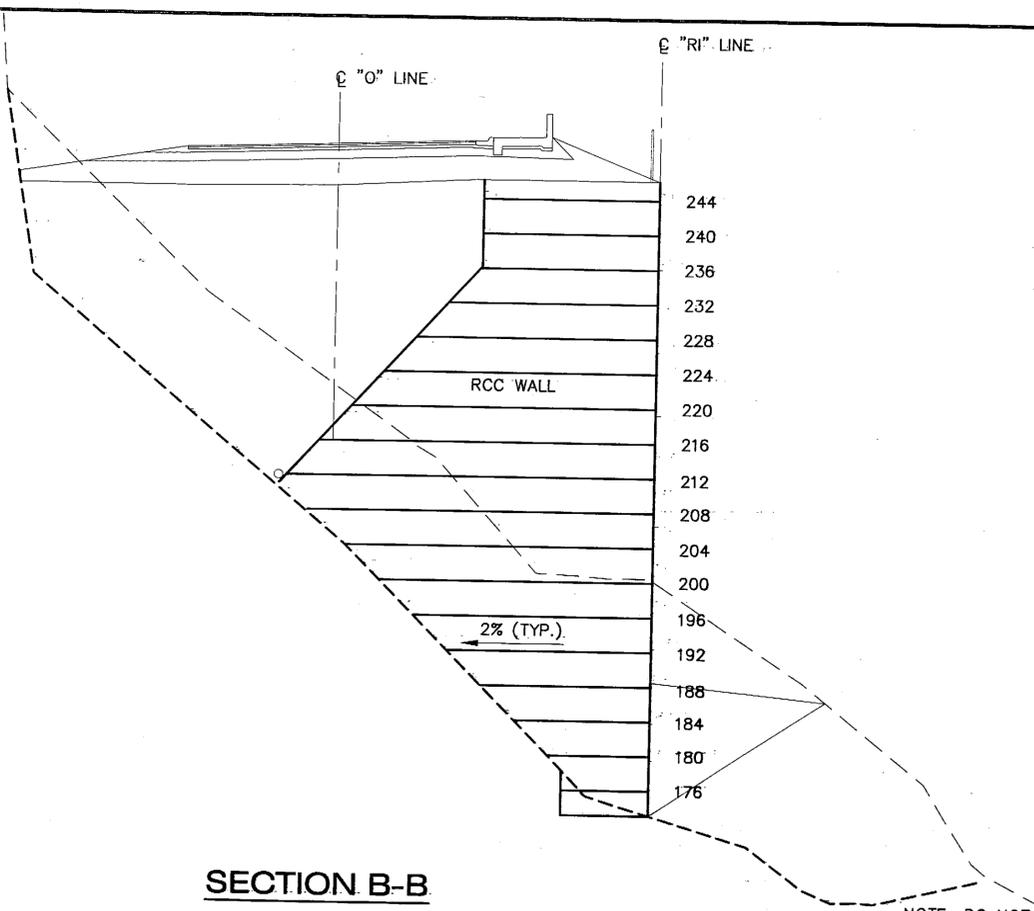

SECTION B-B

*LIFT ELEVATION	APPROXIMATE QUANTITY (cy.)
156	175
160	570
164	1075
168	1705
172	2315
176	2780
180	3200
184	3645
188	3860
192	3935
196	4030
200	3920
204	3740
208	3415
212	2780
216	2255
220	1990
224	1790
228	1615
232	1420
236	1220
240	1035
244	885
248	710
252	525
256	385
260	265
264	
TOTAL:	55,240

* LIFT ELEVATION SHOWN IS BOTTOM OF 4' LIFT

NOTE: DO NOT SCALE FROM DRAWING. USE DIMENSIONS.

KTN-THIRD AVENUE EXTENSION
 PROJECT NO. 68490

**Work Plan
 Roller Compacted
 Concrete Lifts**

DESIGNED BY: C. HOWARD



CHECKED BY: T. MOORE

DRAWN BY: K.K. / M.L.L.

STATE OF ALASKA
 DEPARTMENT OF TRANSPORTATION
 & PUBLIC FACILITIES
 STATEWIDE DESIGN & ENGINEERING
 SERVICES DIVISION

THIRD AVENUE EXTENSION
 PROJECT NO. 68490

**Work Plan
 Roller Compacted
 Concrete Lifts**

PROJECT DESIGNATION NUMBER

STP-MG-0904(2)

STATE	YEAR
ALASKA	2002
SHEET NUMBER	TOTAL SHEETS
W2	146

Project As Built Drawings have been reviewed by the Project Engineer. To the best of his/her knowledge, they represent the project as constructed.
 Proj. Eng. *KS* Date 03/06

ROLLER COMPACTED CONCRETE WALL CONCEPTUAL WORK PLAN

1. CONSTRUCT PIONEER ROAD FOR ACCESS TO FACE OF WHITE CLIFF AND GENERAL AREA OF RCC WALL.
2. PREPARE CONSTRUCTION PLAN FOR RCC WALL AND EROSION CONTROL PLAN.
3. DEVELOP STAGING AREA PLAN.
4. DEVELOP MATERIAL SUPPLY PLAN INCLUDING PANEL FACING SYSTEM AND IMPLEMENT IN SCHEDULE REQUIRED.
5. CONSTRUCT DEWATERING WELLS BETWEEN STATIONS 40+00 TO 44+00 AND PUMP 30 DAYS PRIOR TO OVERBURDEN EXCAVATION.
6. INSTALL TEMPORARY ROCK CATCHMENT BARRIER.
7. DEVELOP STA. 48+50 ROCK BLOCK PLAN AND INSTALL ROCK BOLTS AND WEEP DRAINS PRIOR TO BEGINNING OVERBURDEN REMOVAL.
8. PROVIDE TEMPORARY DRAINAGE SYSTEM AT LOW POINT OF OVERBURDEN REMOVAL FOR COLLECTION OF STORM WATER. TREATMENT SYSTEM AND DISPOSAL TO ACCOMPANY THIS PLAN.
9. BEGIN OVERBURDEN EXCAVATION IN ACCORDANCE WITH PLANS FROM THE FACE OF WHITE CLIFF BACK STATION. HAUL MATERIAL OFFSITE TO DISPOSAL AREA.
10. EVALUATE EAGLE NEST TREE REQUIREMENTS PRIOR TO OVERBURDEN REMOVAL FROM STA. 40+00 TO 44+00. THIS AREA CANNOT BE LEFT WITHOUT THE RCC WALL AND BACKFILL IN PLACE OVER A WINTER SEASON (NOV. TRHU MARCH).
11. EVALUATE DEBRIS FLOW OVERBURDEN REMOVAL AND COMPLETE REMOVAL AS PER PLAN OR DELAY FOR WINTER SEASON.
12. CLEAN AND PREPARE FOUNDATION FOR PLACEMENT OF RCC WALL ON PORTIONS AVAILABLE FOR PLACEMENT.
13. PLACE RCC TEST STRIP FOR EVALUATION.
14. PLACE RCC EMBANKMENT AFTER EVALUATIONS ARE COMPLETE AND APPROVED. INSTALL AND MAINTAIN DRAINAGE THROUGHOUT INSTALLATION.
15. BUILD RCC IN LIFTS UNTIL THE UNDERDRAIN CAN BE INSTALLED ON UPHILL SIDE AND CONSTRUCT UNDERDRAIN.
16. CONTINUE BRINGING RCC UP IN LAYERS UNTIL COMPLETE. INSTALL ROCK ANCHORS AND PIPES WHEN REQUIRED.

PATH:
G:\Ktn\71811A\Planset\W1_Pioneer_Staging.dwg
Mon, 06/May/02 11:22AM Michael Limbough
PLOT:
PSPACE 1=1(F) OR MSPACE 1=1(F)

ADDENDUM NUMBER

ATTACHMENT NUMBER

RECORD OF REVISIONS

No.	DATE	DESCRIPTION

KTN-THIRD AVENUE EXTENSION
PROJECT NO. 68490

**Conceptual Work Plan
Construction Sequence**

DESIGNED BY: C. HOWARD



CHECKED BY: T. MOORE

DRAWN BY: K.K.

STATE OF ALASKA
DEPARTMENT OF TRANSPORTATION
& PUBLIC FACILITIES
STATEWIDE DESIGN & ENGINEERING
SERVICES DIVISION

**THIRD AVENUE EXTENSION
PROJECT NO. 68490
Conceptual
Work Plan
Sequence**

PROJECT DESIGNATION NUMBER

STP-MG-0904(2)

STATE	YEAR
ALASKA	2002
SHEET NUMBER	TOTAL SHEETS
W3	146



Project As Built Drawings have been reviewed by the Project Engineer. To the best of his/her knowledge, they represent the project as constructed.

Proj. Eng. *KS* Date 12-3-06


NOTE: REFER STD. DWG B-04.00 & B-05.00 FOR DETAIL "B" AND DETAIL "E". SEE SHEET C3 FOR DETAIL "A".

RETAINING WALL No. 1 REBAR SCHEDULE

BAR LABEL	BAR SIZE	QTY	STRAIGHT	BEND		TOTAL LENGTH	SPACING	NOTES
				A	B			
C102	#5	55		2'-6"	4'	6'-6"	12" O.C.	
D101	#4	55	VARIABLE				18" O.C.	
D102	#5	55	VARIABLE				12" O.C.	3' MINIMUM LAP TO C100 BARS
A100	#4	14	CONT. HORIZ.			20'	18" O.C.	7 RUNS
B100	#4	55	4'-10"				12" O.C.	
B101	#4	15				20'		
A101	#4		CONT. HORIZ.				36" O.C.	
A102	#4		CONT. HORIZ.				12" O.C.	LAP 3', SPLICE 6' MIN TO END

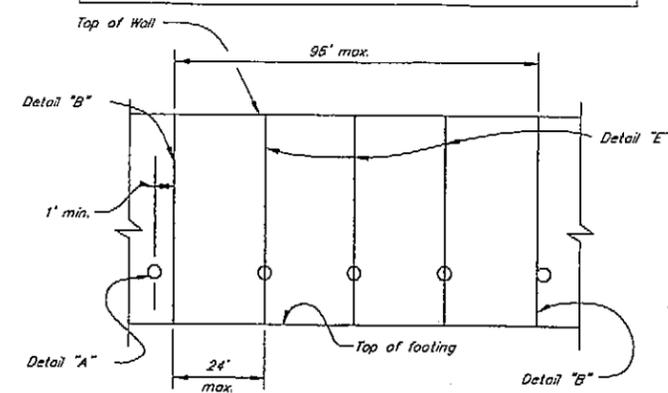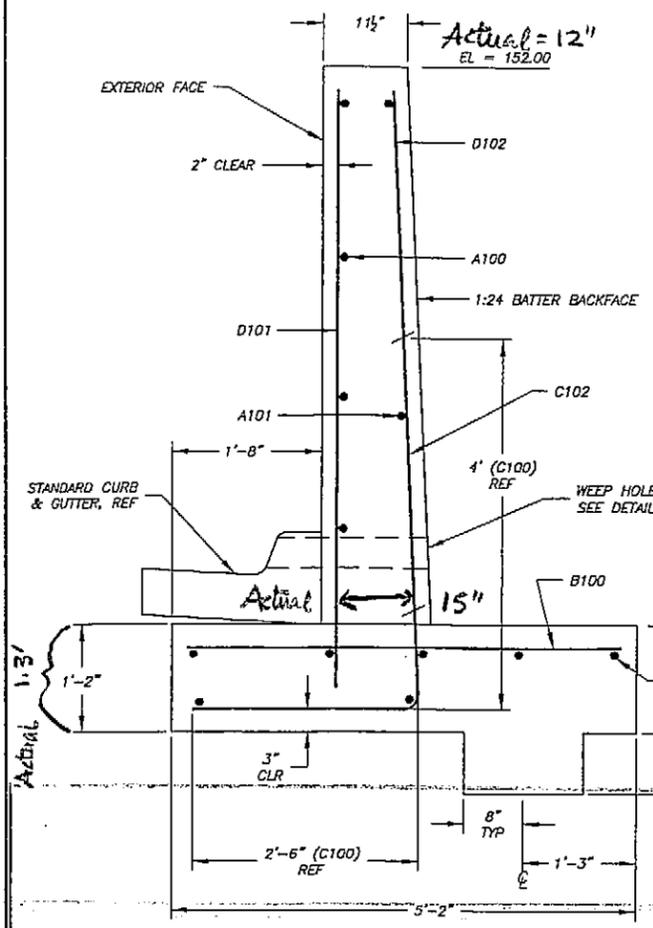

WALL EXPANSION JOINT AND WEAKENED PLANES
DETAIL "C"

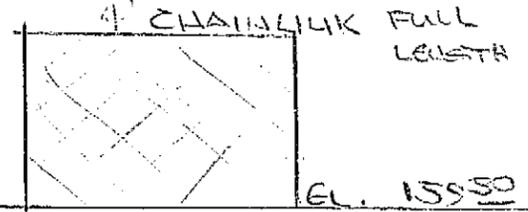


BEND SCHEDULE C BARS

MINIMUM BEND SIZES		
BAR	DIAMETER	RADIUS
#4	3"	1-1/2"
#5	3-3/4"	1-7/8"
#6	4-1/2"	2-1/4"

APPROVED FOR CONSTRUCTION AS NOTED

- NOTES:
- FOOTING WILL STAY 5'-2" ENTIRE LENGTH OF WALL.
 - HEIGHT VARIES SO VERTICAL REBAR WILL VARY. TOP OF WALL STAYS AT 152.00'.
 - 11'-1/2" WALL (TOP), 12:1/2 BATTER
 - NO EXPANSION JOINTS LESS THAN 96' MAX. WEAKENED PLANES TO BE PLACED AT 1/3 INTERVALS (18' APART)

WALL No. 1 TYPICAL SECTION NOT TO SCALE

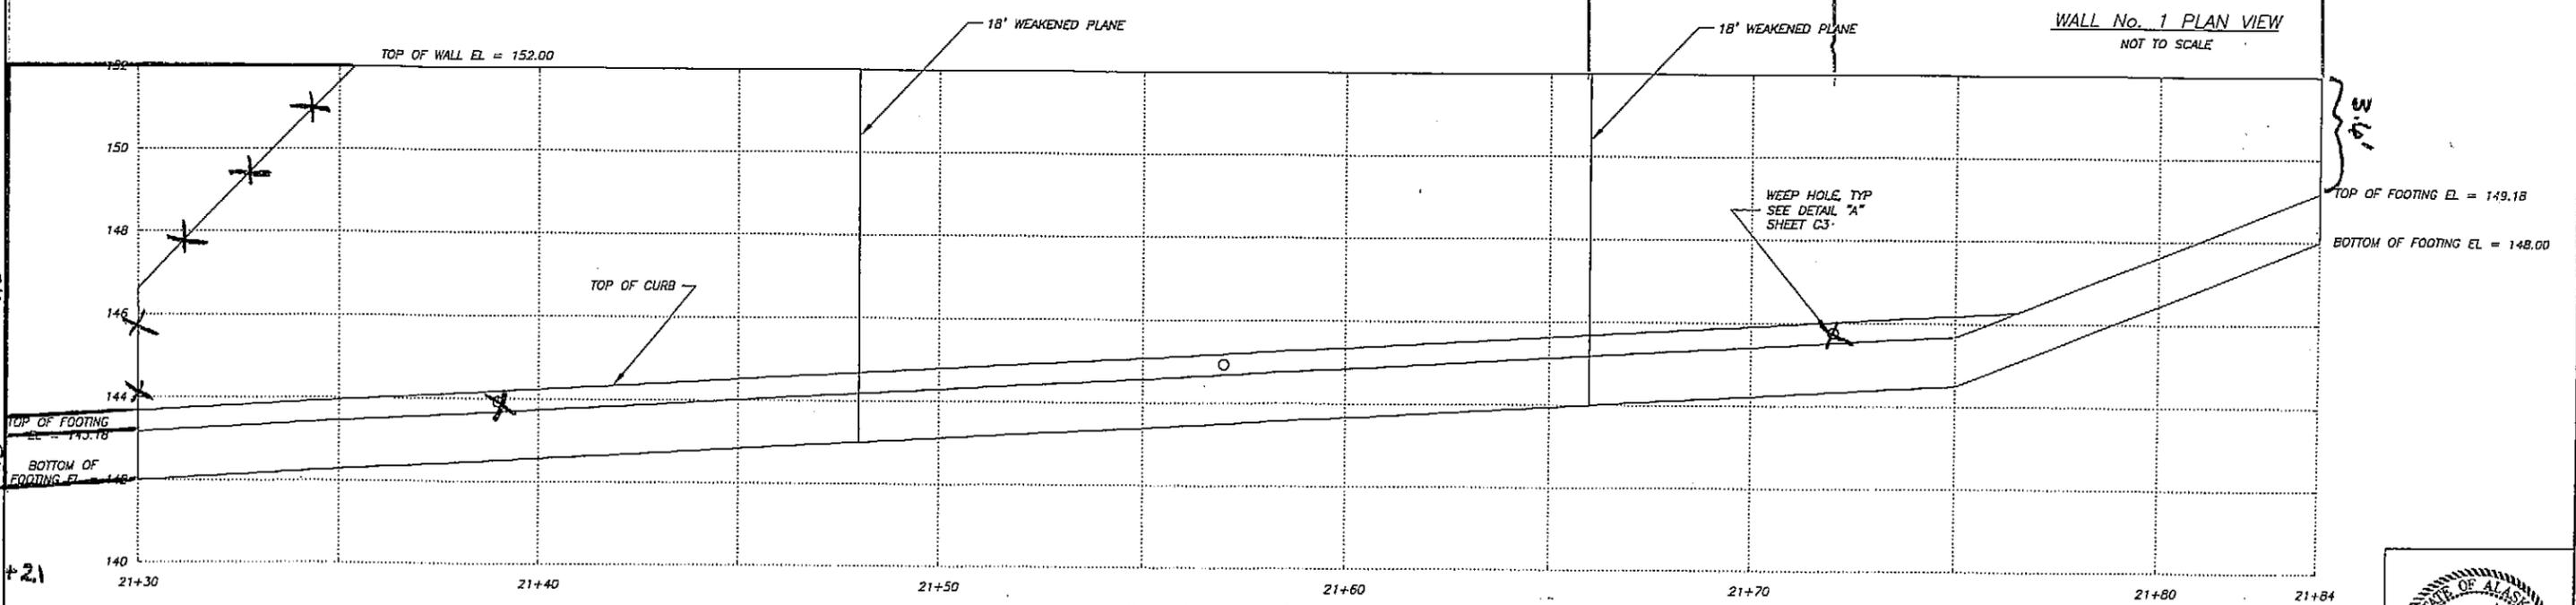

RETAINING WALL I PROFILE
HORIZ/VERT SCALE: 1"=2'

Date	No.	Description	By	Checked
12/11/03	3	REVISED PER ADOT	JMR	TSS
10/2/03	2	REVISED PER ADOT	JMR	TSS

Designed: JMR
Approved: TSS
Scale: AS NOTED
Drawn: JMR
Date: 8/18/03
Project: 032365
Checked: TSS
File:

R&M
R&M ENGINEERING-KETCHIKAN, INC.
355 CARLANNA LAKE ROAD
KETCHIKAN, ALASKA 99901








Client: ARROW CONSTRUCTION

Project: THIRD AVENUE EXTENSION PROJECT 68490

Sheet Description: PROPOSED WALL No. 1 REBAR SCHEDULE

Sheet No. C1



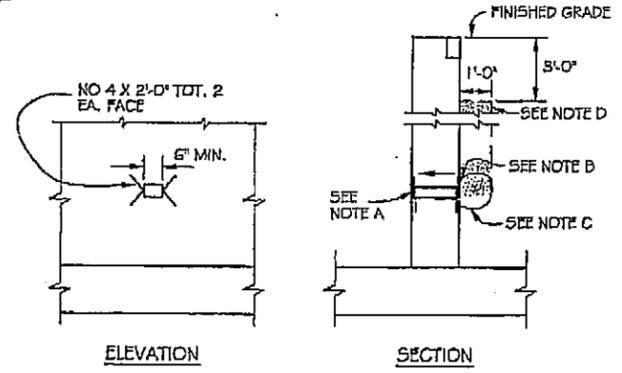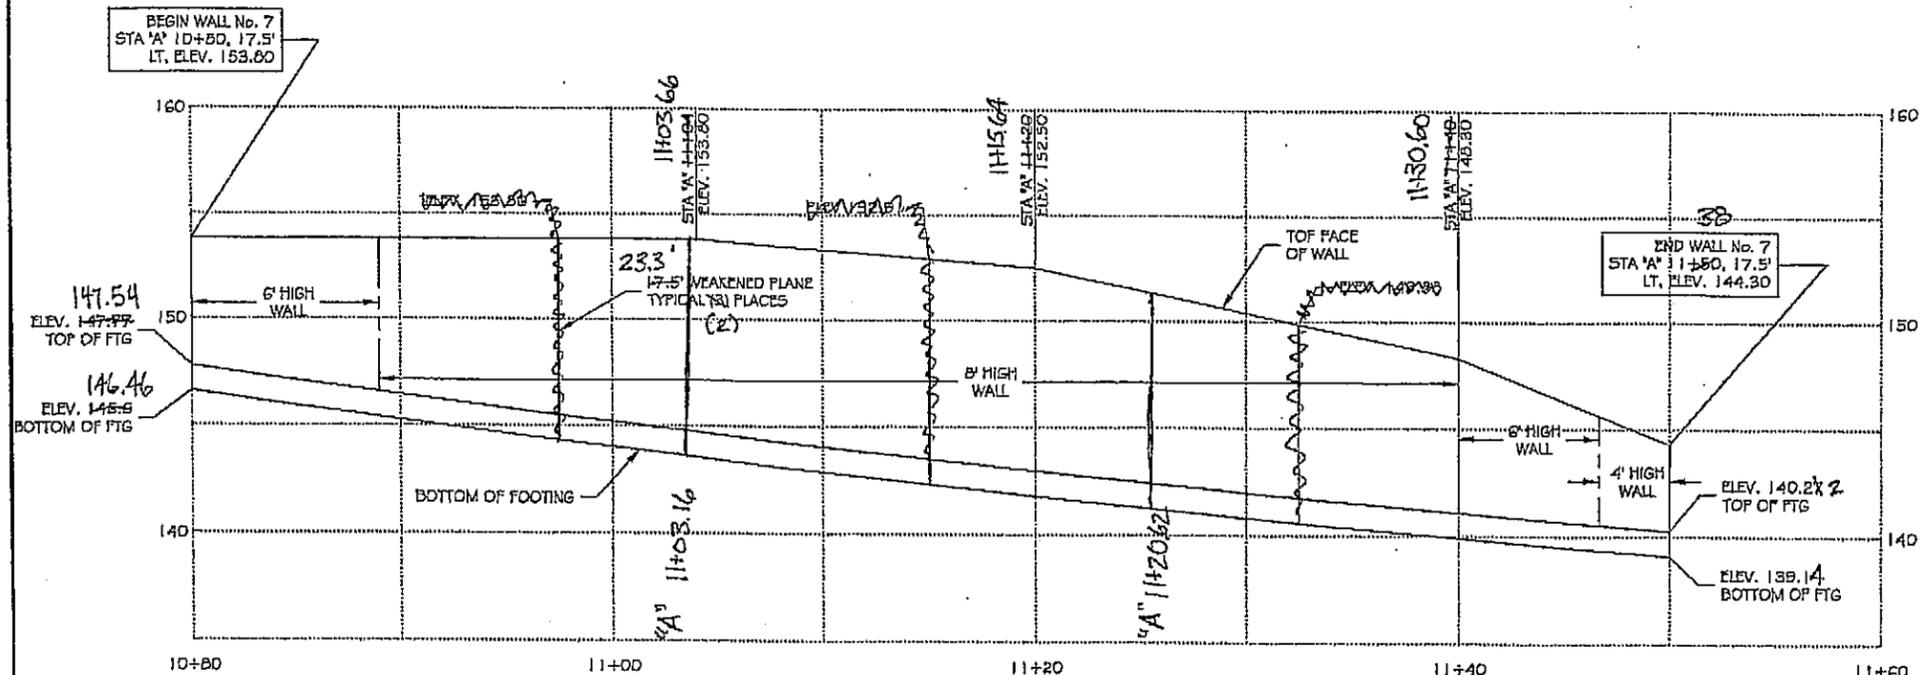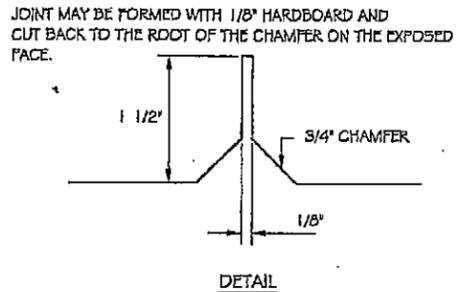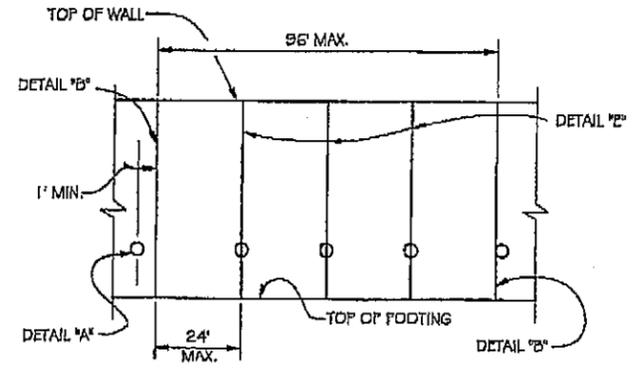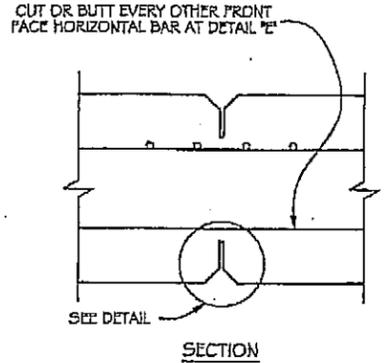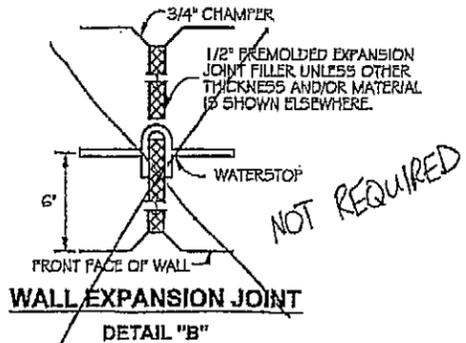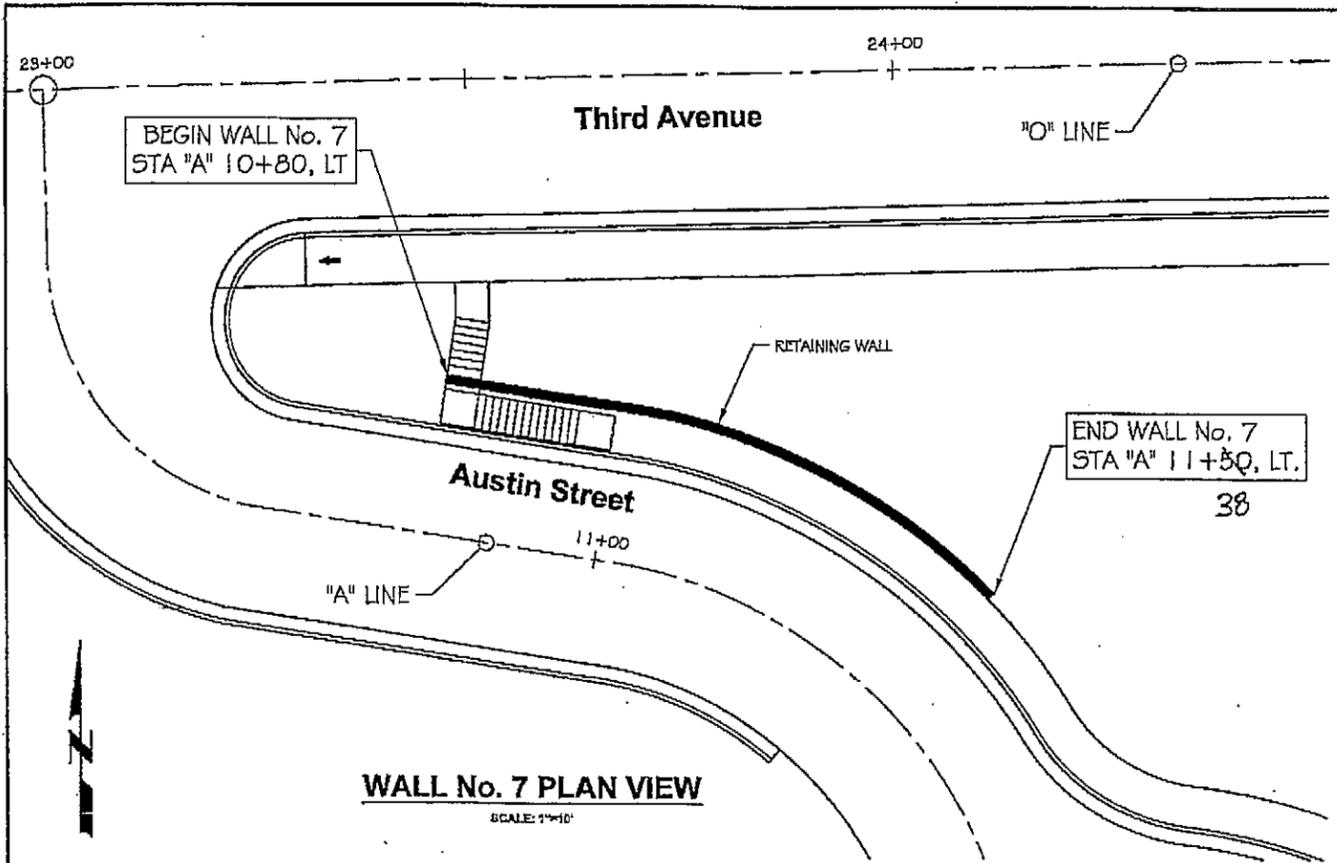

- NOTES: *SEE EMAIL*
- A. 4" DIA. DRAINS 25' MAX. CENTER TO CENTER. FOR WALLS ADJACENT TO SIDEWALKS OR CURBS, PROVIDE 4" CAST IRON PIPE UNDER THE SIDEWALK TO DISCHARGE THRU FACE CURB FACE. EXPOSED WALL DRAINS SHALL BE LOCATED 3" ABOVE FINISHED GRADE.
 - B. 6" SQUARE ALUMINUM OR GALVANIZED STEEL WIRE 4 MESH HARDWARE CLOTH (MIN WIRE DIAMETER 0.03") ANCHOR FIRMLY TO BACKFACE.
 - C. ONE CUBIC FOOT PERVIOUS BACKFILL MATERIAL IN A BURLAP SACK, SECURELY TIED.
 - D. PERVIOUS BACKFILL MATERIAL CONTINUOUS BEHIND RETAINING WALL OR ABUTMENT.

REVIEW COPY



Designed: TSS	Approved: TSS	Scale: AS NOTED	Client: COALASKA	Project: THIRD AVENUE EXTENSION PROJECT NO. 68490	Sheet Description: PROPOSED WALL No. 7 PLAN & PROFILE	Sheet No. C1
Drawn: JMR	Date: 5/13/00	Project: 002305.02	RAM ENGINEERING-KETCHIKAN, INC. 355 CARLIANNA LAKE ROAD KETCHIKAN, ALASKA 99901			
Date: _____	No. _____	Description: _____	By: _____	Checked: TSS	File: _____	

Additional sheet - attach to N11


CITY OF KETCHIKAN

WHITE CLIFF LODGE
TRACT C


N54°49'10"W
50.00'

U.S.M.S. 787

WHITECLIFF ADDITION
BLOCK 4

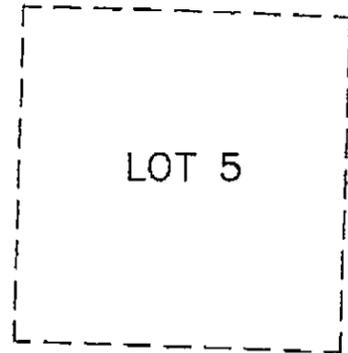

LOT 5

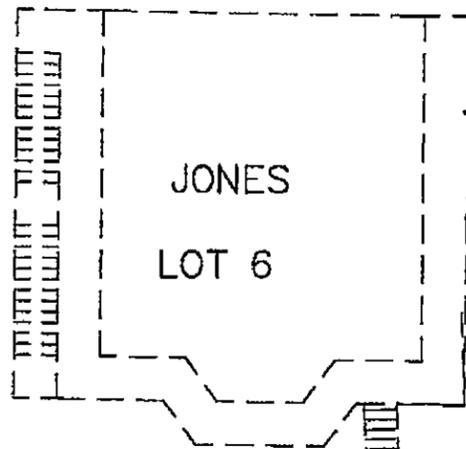

JONES
LOT 6

100.00'

LOT 7

CITY OF KETCHIKAN

100.00'

S35°13'46"W


S35°13'46"W



LINE TABLE		
LINE	BEARING	LENGTH
L1	N54°49'10"W	15.00'
L2	S54°46'14"E	8.50'
L3	S35°13'46"W	18.00'
L4	N54°49'10"W	8.50'

TCE-38

E-38

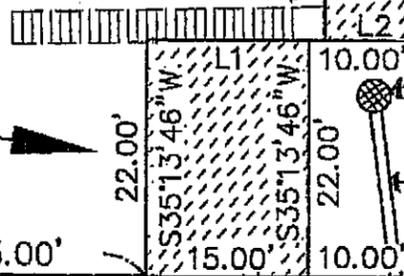


Type A Inlet

18" CPP

Type A Inlet

See C.O. #21p

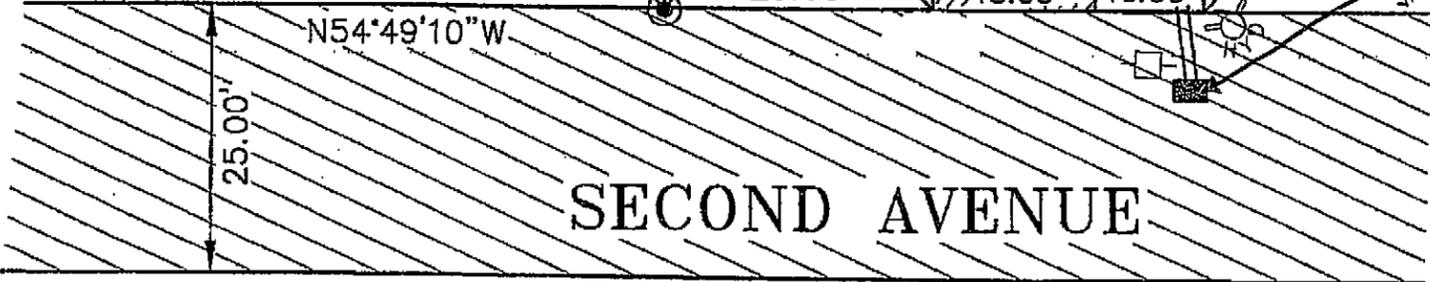

N54°49'10"W

25.00'

SECOND AVENUE

STATE OF ALASKA DEPARTMENT OF TRANSPORTATION AND PUBLIC FACILITIES	RIGHT OF WAY REQUIRED FOR:
	OWNER'S INITIAL _____ ATTACHED TO _____ PAGE _____ OF _____ DATE _____
PARCEL NO. TCE-38 DATE: 8/2004 AREA: 483 S.F. SCALE: 1"=20'	
DRAWN BY: ROW CHECKED BY: _____	