
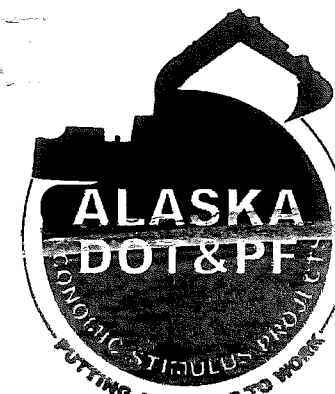
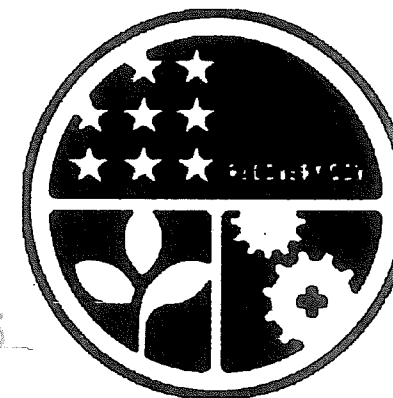



State of Alaska
Department of Transportation
and Public Facilities
Statewide Design and Engineering Services Division

**KETCHIKAN, ALASKA
VIADUCTS
REHABILITATION
STAGE II
NH-0902(34)/68571**

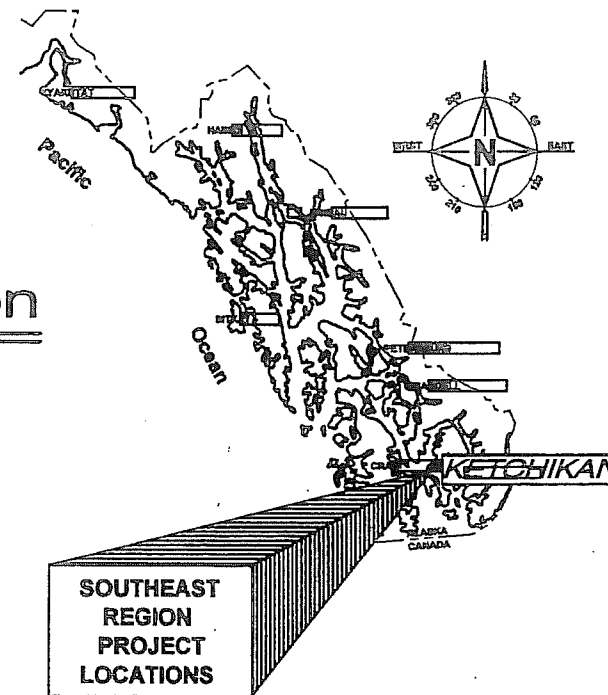

TIDAL DATA

ESTIMATED EXTREME HIGH WATER	=	20.8 FT.
MEAN HIGHER HIGH WATER	=	15.4 FT.
MEAN HIGH WATER	=	14.5 FT.
MEAN TIDE WATER	=	8.0 FT.
MEAN LOW WATER	=	4.5 FT.
MEAN LOWER LOW WATER	=	0.0 FT.
ESTIMATED EXTREME LOW WATER	=	5.0 FT.

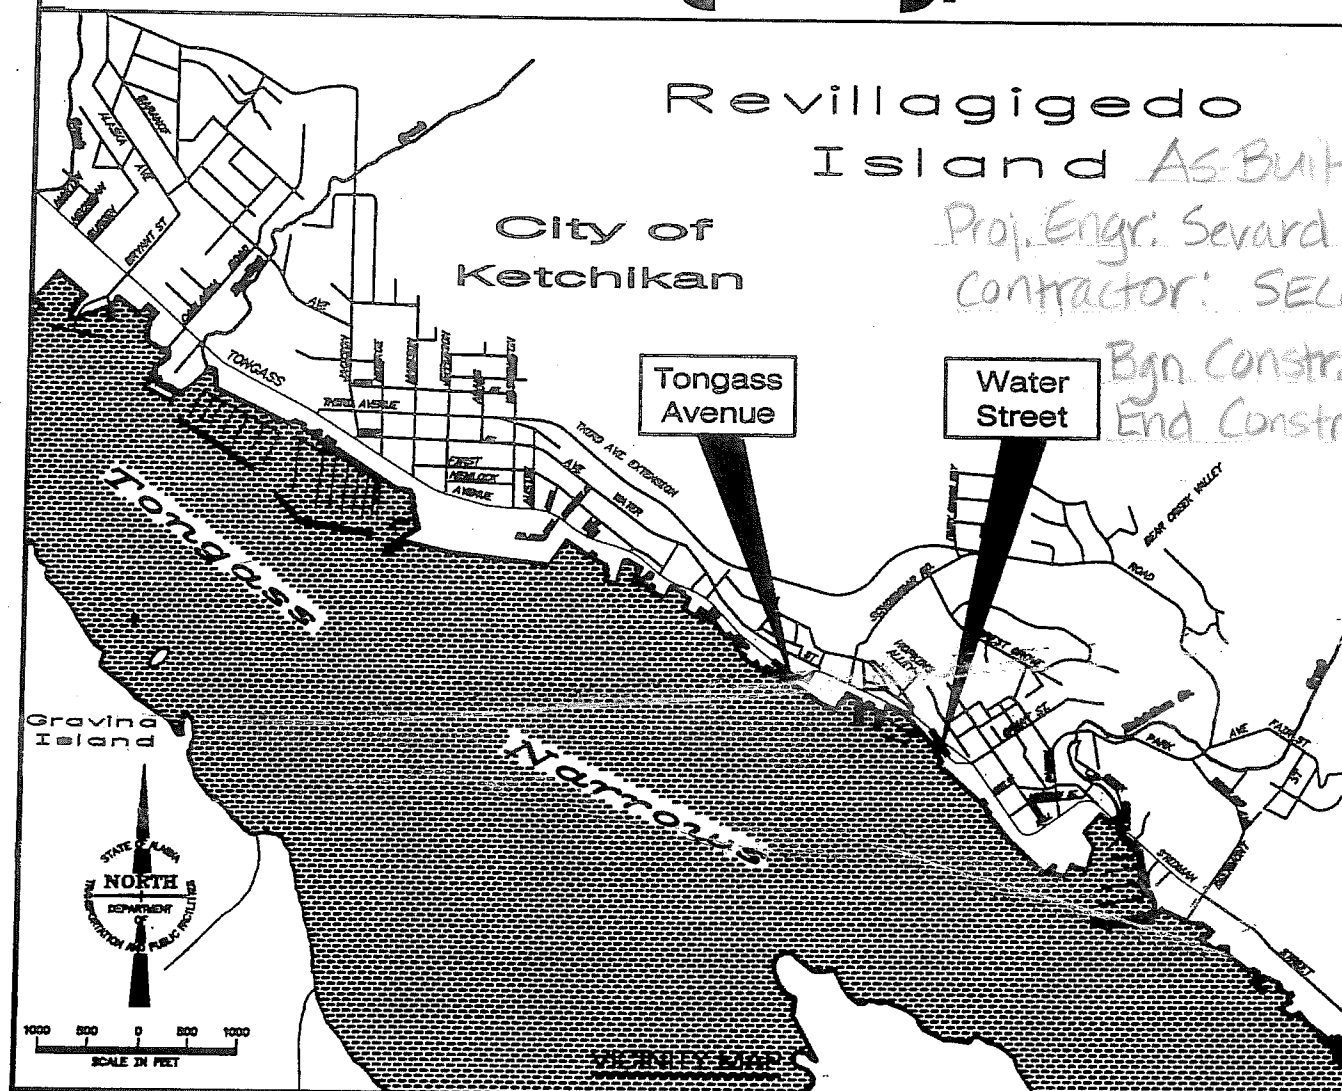

INDEX

SHEET NO.	DESCRIPTION
T 1.0	TITLE SHEET
T 1.1	GENERAL INFORMATION
T 1.2	ESTIMATE OF QUANTITIES
T.C. 2.0-2.1	TRAFFIC CONTROL
S-1.0	STRUCTURAL SCOPE OF WORK & GENERAL NOTES
S-2.0	TONGASS AVENUE STRUCTURAL REPAIR PLAN
S-2.1	WATER STREET STRUCTURAL REPAIR PLAN
S 3.0-3.3	TONGASS AVENUE REPAIR DETAILS
S 3.4-3.14	WATER STREET REPAIR DETAILS
S 4.0-4.2	TONGASS AVE. & WATER STREET MISC. REPAIRS
CP 1.0-1.1	TONGASS AVENUE CORROSION CONTROL
CP 1.2-1.3	WATER STREET CORROSION CONTROL
CP 2.0	TONGASS AVENUE LAYOUT PLAN
CP 2.1	WATER STREET LAYOUT PLAN
CP 3.0-3.9	TONGASS AVENUE BENTS
CP 3.10-3.15	WATER STREET BENTS
CP 4.0-4.4	PILE JACKET DETAILS
CP 4.5-4.6	GIRDER SECTION & MISCELLANEOUS DETAILS
CP 4.7-4.8	TRANSITION CAP DETAILS
CP 5.0-5.4	CONCRETE REPAIR
CP 5.5	RETAINING WALL DETAILS
CP 6.0-6.3	TONGASS AVENUE WIRING DIAGRAMS
CP 6.4-6.5	WATER STREET WIRING DIAGRAMS
Q 1	STAGING AREA SITE PLAN
CPT9A-T31 TONGASS AVENUE Electrical Asbuilts	
CPW24-W76 WATER STREET Electrical Asbuilts	

THE FOLLOWING STANDARD DRAWINGS APPLY TO THIS PROJECT:

A-1
C-04.11

PATH: r:\cad\ketchikanviaduct-2009

PLT: PSPACE OR MSPAGE 1=1(F)

STATE OF ALASKA
DEPARTMENT OF TRANSPORTATION
& PUBLIC FACILITIES
DESIGN & ENGINEERING SERVICES DIVISION-SOUTHEAST REGION



RECOMMENDED FOR APPROVAL:

Vicki Winters 8-24-09
DATE

Vicki Winters
SOUTHEAST REGION PRE-CONSTRUCTION ENGINEER

APPROVED: *Gary L. Gove* 8-24-09
DATE

Gary L. Gove
DIRECTOR, SOUTHEAST REGION

CERTIFIED TRUE & CORRECT AS-BUILT OF ACTUAL FIELD CONDITION:

CONSTRUCTION PROJECT MANAGER 10/29/13
DATE

T-1.0	PROJECT DESIGNATION	YEAR	SHEET NO.	TOTAL SHEETS
	NH-0902(34) / 68571	2009	1	70

ABBREVIATIONS

A.B.	= ANCHOR BOLT	LM	= LINEAL METERS
ABAN	= ABANDONED	LS	= LUMP SUM
ABV	= ABOVE	LT	= LEFT
ABUT	= ABUTMENT	M	= METER (DIST. MEAS.)
AC	= ASPHALT CONCRETE	MATL	= MATERIAL
ADDL	= ADDITIONAL	MAX	= MAXIMUM
ADJ	= ADJACENT	MEAS	= MEASURE(MENT)
ADOT&PF	= ALASKA DEPARTMENT OF TRANSPORTATION & PUBLIC FACILITIES	MECH	= MECHANICAL
AHD	= AHEAD	MISC	= MISCELLANEOUS
AK	= ALASKA	MFR	= MANUFACTURER
ALT	= ALTERNATE	mG	= MILLIGRAM
A	= AMP	MH	= MANHOLE
APPROX	= APPROXIMATE	MHHW	= MEAN HIGH HIGH WATER
ARCH	= ARCHITECTURAL	MHW	= MEAN HIGH WATER
AVE	= AVENUE	MIN	= MINIMUM
AVG	= AVERAGE	MLLW	= MEAN LOW LOW WATER
BB	= BEGINNING OF BRIDGE	MLW	= MEAN LOW WATER
BOT	= BOTTOM	mm	= MILLIMETER
BLDG	= BUILDING	MPa	= MEGA PASCAL
BLW	= BELOW	MSDS	= MFR SAFETY DATA SHEET
BR	= BRIDGE	MSE	= MECHANICALLY STABILIZED EARTH
BRG	= BEARING	MTL	= MATERIAL
CANT	= CANTILEVERED	N	= NEWTON
CP	= CAST-IN-PLACE	NO	= NUMBER
C-C	= CENTER TO CENTER	N.S.	= NEAR SIDE
CL	= CENTERLINE	N.T.S.	= NOT TO SCALE
CLR	= CLEAR	O.C.	= ON CENTER
cm	= CENTIMETER	O.D.	= OUTSIDE DIAMETER
COL	= COLUMN	O.F.	= OUTSIDE FACE
CONC	= CONCRETE	O.H.	= OVERHANG
CONN	= CONNECTION	OPNG	= OPENING
CS	= CONTINGENT SUM	OPP	= OPPOSITE
CONST	= CONSTRUCTION	ORNT	= ORIENTATE(ION)
CONT	= CONTINUOUS	PAR	= PARALLEL
CU	= COPPER	P/C	= PRE-CAST
CM	= CUBIC METER	PERP	= PERPENDICULAR
DBL	= DOUBLE	PG	= PROFILE GRADE
DIP	= DUCTILE IRON PIPE	PPM	= PARTS PER MILLION
DIA	= DIAMETER	PPT	= PARTS PER THOUSAND
DIAG	= DIAGONAL	P/S	= PRE-STRESSED
DIAPH	= DIAPHRAGM	PVC	= POLY VINYL CHLORIDE
DIM	= DIMENSION	PVMT	= PAVEMENT
DIST	= DISTANCE	QTY	= QUANTITY
DTR	= DETOUR	R	= RADIUS
DWG	= DRAWING	R/C	= REINFORCED CONCRETE
DWL	= DOWEL	RDWY	= ROADWAY
EA	= EACH	REBAR	= REINFORCED STEEL
EB	= END OF BRIDGE	REF	= REFERENCE
E.F.	= EACH FACE	REINF	= REINFORCED
EL. ELEV	= ELEVATION	REQD	= REQUIRED
EMBD	= EMBEDDED	ROW	= RIGHT-OF-WAY
ENG	= ENGINEER	RT	= RIGHT
EQ	= EQUAL	SCHD	= SCHEDULE
E.S.	= EACH SIDE	SHT	= SHEET
EXIST	= EXISTING	SIM	= SIMILAR
EXP	= EXPANSION	SM	= SQUARE METER
EXPD	= EXPANDED	SPC	= SPACE(ING)
EXT	= EXTERIOR	SPRT	= SUPPORT
FE	= FINISHED ELEVATION	SQ	= SQUARE
FAB	= FABRICATION	SS	= SANITARY SEWER
FND	= FOUNDATION	SSD	= SATURATED SURFACE DRY
FIN	= FINISH(ED)	STD	= STANDARD
FLEX	= FLEXIBLE	ST	= STREET
FLG	= FLANGE	STA	= STATION
FM	= FORCE MAIN	STR	= STIRRUP
FT	= FOOT	STL	= STEEL
FTG	= FOOTING	STRUC	= STRUCTURE(AL)
GALV	= GALVANIZED	SYM	= SYMMETRICAL
G	= GRAM	S/W	= SIDEWALK
GRD	= GRADE	TEMP	= TEMPERATURE
HORZ	= HORIZONTAL	TEMP	= TEMPORARY
HS	= HIGH STRENGTH	THRD	= THREADED
HWY	= HIGHWAY	THRU	= THROUGH
I.D.	= INSIDE DIAMETER	T.O.	= TOP OF
I.F.	= INSIDE FACE	TRANS	= TRANSVERSE
IN	= INCH	TEL	= TELEPHONE
INT	= INTERIOR	TYP	= TYPICAL
JNT	= JOINT	UBC	= UNIFORM BLDG CODE
KG	= KILOGRAM	VERT	= VERTICAL
KGCM	= KILOGRAMS PER CUBIC METER	V	= VOLT
KPU	= KETCHIKAN PUBLIC UTILITIES	VFY	= VERIFY
L	= LITER	W	= WATER
LONG	= LONGITUDINAL	W/	= WITH
		W/C	= WATER CEMENT RATIO
		W.P.	= WORK POINT
		WWF	= WELDED WIRE FABRIC


SYMBOLS USED AS ABBREVIATIONS

&	= AND
@	= AT
C	= CENTERLINE
Ø	= DIAMETER
'	= FOOT
"	= INCH
⌒	= PLATE
±	= PLUS OR MINUS
M2	= SQUARE METER
M3	= CUBIC METER

SHEET INDEX

T	TITLE & GENERAL INFORMATION	CP	CORROSION CONTROL CONT.
T-1.0	COVER		CATHODIC PROTECTION JACKET
T-1.1	PROJECT GENERAL INFORMATION	CP-4.0	PILE JACKET & SUBMERGED ANODE DETAILS
T-1.2	ESTIMATE OF QUANTITIES & GENERAL NOTES	CP-4.1	PILE JACKETS & SECTIONS
		CP-4.2	PILASTER JACKET & SECTION
		CP-4.3	CORNER PILASTER JACKET & SECTION
		CP-4.4	SQUARE PILE JACKET & SECTION
		CP-4.5	INTERMEDIATE GIRDER SECTION & MISC. DETAILS
		CP-4.6	INTERMEDIATE GIRDER SECTION & BEAM
		CP-4.7	TRANSITION CAP SECTION
		CP-4.8	TRANSITION CAP SECTION & BEAM
			CORROSION CONTROL DETAILS
		CP-5.0	HORIZONTAL CONCRETE REPAIR
		CP-5.1	THERMAL SPRAY ANODE CONNECTION
		CP-5.2	JUNCTION BOX OR TEST STATION DETAILS
		CP-5.3	REBAR BONDING DETAILS
		CP-5.4	PRESTRESSED WIRE
		CP-5.5	RETAINING WALL DETAILS
			VIADUCT WIRING FOR SPANS
		CP-6.0	TONGASS AVE. PRESTRESSED SPAN W/REFERENCE CELLS
		CP-6.1	TONGASS AVE. PRESTRESSED SPAN, NO REFERENCE CELLS
		CP-6.2	TONGASS AVE. FLAT SPAN W/REFERENCE CELLS
		CP-6.3	TONGASS AVE. FLAT SPAN, NO REFERENCE CELLS
		CP-6.4	WATER STREET WITH REFERENCE CELLS
		CP-6.5	WATER STREET, NO REFERENCE CELLS
			STAGING AREAS
		Q1	STAGING AREA SITE PLANS
TC	TRAFFIC CONTROL		
TC-2.0	TRAFFIC CONTROL PLAN DETAILS		
TC-2.1	TRAFFIC CONTROL DETAILS		
TC-2.2	TRAFFIC CONTROL DETAILS		
S	STRUCTURAL		
S-1.0	GENERAL NOTES & SCOPE OF WORK PLAN		
	PLANS		
S-2.0	TONGASS AVE. STRUCTURAL REPAIRS SCOPE PLAN		
S-2.1	WATER ST. STRUCTURAL REPAIRS SCOPE PLAN		
S-3.0	TONGASS AVE. BENT 6 REPAIR		
S-3.1	TONGASS AVE. BENT 5 REPAIR		
	PILASTER REPAIRS		
S-3.2	TONGASS AVE. EXISTING BENT 2A PILASTER REPAIR		
S-3.3	TONGASS AVE. EXISTING BENT 3A PILASTER REPAIR		
S-3.4	WATER ST. EXISTING BENT 65 PILASTER REPAIR		
S-3.5	WATER ST. EXISTING BENT 66 PILASTER REPAIR		
S-3.6	WATER ST. EXISTING BENT 67 PILASTER REPAIR		
S-3.7	WATER ST. EXISTING BENT 68 PILASTER REPAIR		
S-3.8	WATER ST. EXISTING BENT 69 PILASTER REPAIR		
S-3.9	WATER ST. EXISTING BENT 70 PILASTER REPAIR		
S-3.10	WATER ST. EXISTING BENT 71 PILASTER REPAIR		
S-3.11	WATER ST. EXISTING BENT 72 PILASTER REPAIR		
S-3.12	WATER ST. EXISTING BENT 73 PILASTER REPAIR		
S-3.13	WATER ST. EXISTING BENT 74 PILASTER REPAIR		
S-3.14	WATER ST. EXISTING BENT 75 PILASTER REPAIR		
	MISCELLANEOUS REPAIRS		
S-4.0	TONGASS AVE. MISC. CONCRETE REPAIRS		
S-4.1	TONGASS AVE. BEARING REPLACEMENT DETAILS		
S-4.2	WATER ST. MISC. CONCRETE REPAIR DETAILS		
CP	CORROSION CONTROL		
CP-1.0	TONGASS AVENUE WORK PLAN		
CP-1.1	TONGASS AVE. CORROSION CONTROL PLAN		
CP-1.2	WATER STREET WORK PLAN		
CP-1.3	WATER ST. CORROSION CONTROL PLAN		
	PLANS		
CP-2.0	TONGASS AVENUE LAYOUT PLAN		
CP-2.1	WATER STREET LAYOUT PLAN		
	ELEVATIONS		
	TONGASS AVENUE VIADUCT		
CP-3.0	ELEVATION VIEW - BENTS 10-9		
CP-3.1	ELEVATION VIEW - BENTS 8-7		
CP-3.2	ELEVATION VIEW - BENTS 6-5		
CP-3.3	ELEVATION VIEW - BENTS 4-3		
CP-3.4	ELEVATION VIEW - BENTS 2-1		
CP-3.5	ELEVATION VIEW - BENTS 1A-2A		
CP-3.6	ELEVATION VIEW - BENTS 3A-4A		
CP-3.7	ELEVATION VIEW - BENTS 5A-6A		
CP-3.8	ELEVATION VIEW - BENTS 7A-8A		
CP-3.9	ELEVATION VIEW - BENTS 9A		
	WATER STREET VIADUCT		
CP-3.10	ELEVATION VIEW - BENTS 65-66		
CP-3.11	ELEVATION VIEW - BENTS 67-68		
CP-3.12	ELEVATION VIEW - BENTS 69-70		
CP-3.13	ELEVATION VIEW - BENTS 71-72		
CP-3.14	ELEVATION VIEW - BENTS 73-74		
CP-3.15	ELEVATION VIEW - BENTS 75-76		

ELEVATIONS, BENCHMARKS AND DIMENSIONS ARE BASED ON "AS-BUILT" PLANS. VERIFY ALL CONTROLLING FIELD DIMENSIONS BEFORE ORDERING OR FABRICATING ANY MATERIAL.

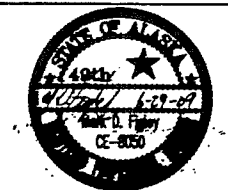DESIGNED BY: M. FIGLEY	STATE OF ALASKA DEPARTMENT OF TRANSPORTATION & PUBLIC FACILITIES STATEWIDE DESIGN & ENGINEERING SERVICES DIVISION				
	KTN-VIADUCTS REHABILITATION PROJECT NO. 68571				
	PROJECT GENERAL INFORMATION				
CHECKED BY: <i>[Signature]</i>					
DRAWN/REVISED BY: R. SNYDER					
PATH:					
PLOT: PSPACE: 1=1(F) OR MSPACE: 1=1(F)	T-1.1				
REVISIONS		PROJECT DESIGNATION	YEAR	SHEET NO.	TOTAL SHEETS
NO.	DATE	DESCRIPTION	NH-0902(34)	2009	2
					70

ESTIMATE OF QUANTITIES			
ITEM NO.	ITEM	PAY UNIT	ESTIMATED QUANTITIES
501 (8)	Core Holes	Each	70 91
501 (9)	Drill and Bond Dowels	Each	87 98
507 (6)	Replace Rail Bolts	Lump Sum	All Req'd
516 (1)	Replace Bearings	Each	3 11
520 (1)	Furnish Epoxy Injection Compounds	Gallon	32 18
520 (2)	Inject Cracks	Foot	220 953
640 (1)	Mobilization and Demobilization	Lump Sum	All Req'd
640 (4)	Worker's Meals and lodging or Per Diem	Lump Sum	All Req'd
640 (30)	Public Information Program	Lump Sum	All Req'd
641 (1)	Erosion And Pollution Control Administration	Lump Sum	All Req'd
641 (3)	Erosion And Pollution Control	Lump Sum	All Req'd
643 (2)	Traffic Maintenance	Lump Sum	All Req'd
643 (15)	Flagging	Hour	32
643 (25)	Traffic Control	Contingent Sum	All Req'd
644 (1)	Field Office	Lump Sum	All Req'd
644 (6)	Vehicles	Lump Sum	All Req'd
645 (1)	Training Program - Trainers/Apprentices	Labor Hr.	500
646 (2)	CPM Scheduling	Bi Monthly	25 25
681(1)	Provide Work Platform	Lump Sum	All Req'd
681(2)	Provide Enclosure	Lump Sum	All Req'd
681(3)	Enclosure Price Adjustment	Contingent Sum	All Req'd
682(1)	Training of Contractor Personnel	Lump Sum	All Req'd
683 (1)	Locate Near Surface Metal	Lump Sum	All Req'd
683 (2)	Remove Near Surface Metal<3/8" Avg. Dia.	Each	10,000 14,317
683 (3)	Remove Near Surface Metal>3/8" Avg. Dia.	Each	1,000 2,548
683 (4)	Replace Damaged Concrete	Square Foot	3,175 4663
684 (1)	Basic Continuity Check	Lump Sum	All Req'd
684 (2)	Girder End Continuity	Each	85 70
684 (3)	Establish Continuity	Each	400 1,672
684 (4)	Install Structure Negative Connections	Each	300 326
684 (5)	Reference Electrodes	Each	12 13
684 (6)	Main Junction Box	Each	109 101 - see electrical as-builts
684 (7)	Install Primary Anode Terminal Plates	Each	210 134
684 (8)	Rewire Tongass Ave. & Water Str. Bent Spars	Lump Sum	All Req'd
686 (1)	Prepare Metallized Anode Surfaces	Lump Sum	All Req'd
686 (2)	Install Spray Metallized Anodes	Lump Sum	All Req'd
686 (3)	Isolate Metallized Anodes, Existing W.S. Caps	Lump Sum	All Req'd
687 (1)	Install Pile Jackets	Lump Sum	All Req'd
687 (2)	Install Pile Cap Jackets	Lump Sum	All Req'd
687 (3)	Cut Wetting Holes in Existing Jackets	Lump Sum	All Req'd
688 (1)	Install Submerged Ingot Anodes	Lump Sum	All Req'd

GENERAL NOTES

The Water Street Viaduct was constructed in 1955, with construction of Tongass Avenue following in 1956. The roadways are approximately 60 feet wide, including sidewalks. The two viaducts carry essentially all north/south traffic through Ketchikan. Therefore, preservation of the traffic carrying capacity is essential for local transportation and a critical component of this construction work.

The Water Street Viaduct is constructed of steel H-piles encased in cast-in-place concrete. The piles caps are composed of one of two precast elements. The deck is composed of precast concrete beam and deck panels, with short sections of the deck slab-on-grade. The Tongass Avenue spans employ precast prestressed concrete piles and cast-in-place caps. The girder spans are carried by precast prestressed concrete beams.

Areas of the bottom of the deck, beams, bents, retaining wall surfaces, and piles have been damaged by corrosion of the embedded reinforcing steel. The corrosion of the reinforcing steel has resulted from exposure to salt water and deicing salts. The objective of this project is to repair spalled and delaminated concrete and to install corrosion protection in the form of cathodic protection systems. The various systems and installation requirements are described in the Standard Specifications and these Special Provisions. The locations and details for installation are shown in the Plans. The drawings do not show adjacent structures or buildings. The contractor shall confine his work operations to within the ROW, unless other access is shown on the plans, or is approved by the Engineer. The ROW lines are vertical lines on the left and right edges of the viaduct structure, unless otherwise shown on the plans. The contractor shall familiarize his/herself with project conditions and access.

OVERALL SCOPE

Loose and damaged concrete shall be removed and galvanic cathodic protection systems shall be installed to prevent future corrosion. When the systems are energized, an electric field will be established. Corrosion of the galvanic anode material will provide protective current to the embedded steel. This current flow will also move chloride ions away from the steel surface.

Marine Traffic:

The waterway adjacent to the project is a very high traffic volume marine area. Contractor's schedule shall consider marine activities such as arrival and departures, prop wash and other potential hazards from marine traffic.

Tides:

The tidal range in Ketchikan, Alaska can exceed 24 feet. High tides can reach to almost +20 feet. Storms can push the water level even higher. The successful Contractor should be prepared for potential flood levels at +22 feet. The average elevation of the bottom of a Water Street Viaduct pile cap is +18.2 feet. The average elevation of the bottom of a Tongass Avenue prestressed girder bearing cap is +16.8 feet. It is critical that the Contractor is aware of the construction access problems the Ketchikan tides will present. At times the tides will completely prevent construction access to the underside of the two viaducts. The Contractor must obtain accurate tide prediction data and carefully utilize that information in planning the construction schedule. Failure to adequately address local tide variations will severely impact the vast majority of the work. Work and materials required to allow productive construction work in the presence of the Ketchikan's large tidal range will be supplied by the Contractor at no additional cost to the Owner.


Rainfall:


The City of Ketchikan's average annual rainfall is about 162 inches. It is essential that the Contractor include handling or redirecting the flow of run-off rainwater from the roadway, sidewalks and surrounding buildings and wharves in accordance with Section 689. For the metallizing to properly adhere to concrete, the concrete must be dry. Scuppers, drains, joints and cracks may allow rain run-off water to wet previously prepared surfaces. The run-off water may also present problems with short-circuit detecting equipment used to control zinc metallizing power output. The Contractor must anticipate there will be construction problems related to Ketchikan's heavy rainfall and make allowances to control rainfall run-off water. Work and materials required to allow productive construction work in the presence of the heavy Ketchikan rainfall will be supplied by the Contractor at no additional cost to the Department.

Weather:

It is not unusual to have periods with overnight lows below 32° F. anytime between September through May.


ELEVATIONS, BENCHMARKS AND DIMENSIONS ARE BASED ON "AS-BUILT" PLANS. VERIFY ALL CONTROLLING FIELD DIMENSIONS BEFORE ORDERING OR FABRICATING ANY MATERIAL.

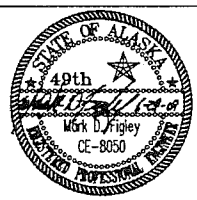DESIGNED BY: M. FIGLEY	STATE OF ALASKA DEPARTMENT OF TRANSPORTATION & PUBLIC FACILITIES STATEWIDE DESIGN & ENGINEERING SERVICES DIVISION			
	KTN-VIADUCTS REHABILITATION PROJECT NO. 68571			
	ESTIMATE OF QUANTITIES			
CHECKED BY: G. IMBSEN	DRAWN/REVISED BY: R.S., R.G.			
PATH: PLOT: PSPACE: 1=1(F) OR MSPACE: 1=1(F)		T-1.2		
REVISIONS		PROJECT DESIGNATION	YEAR	SHEET NO.
NO. DATE DESCRIPTION		NH-0902(34)	2009	3
				TOTAL SHEETS 70

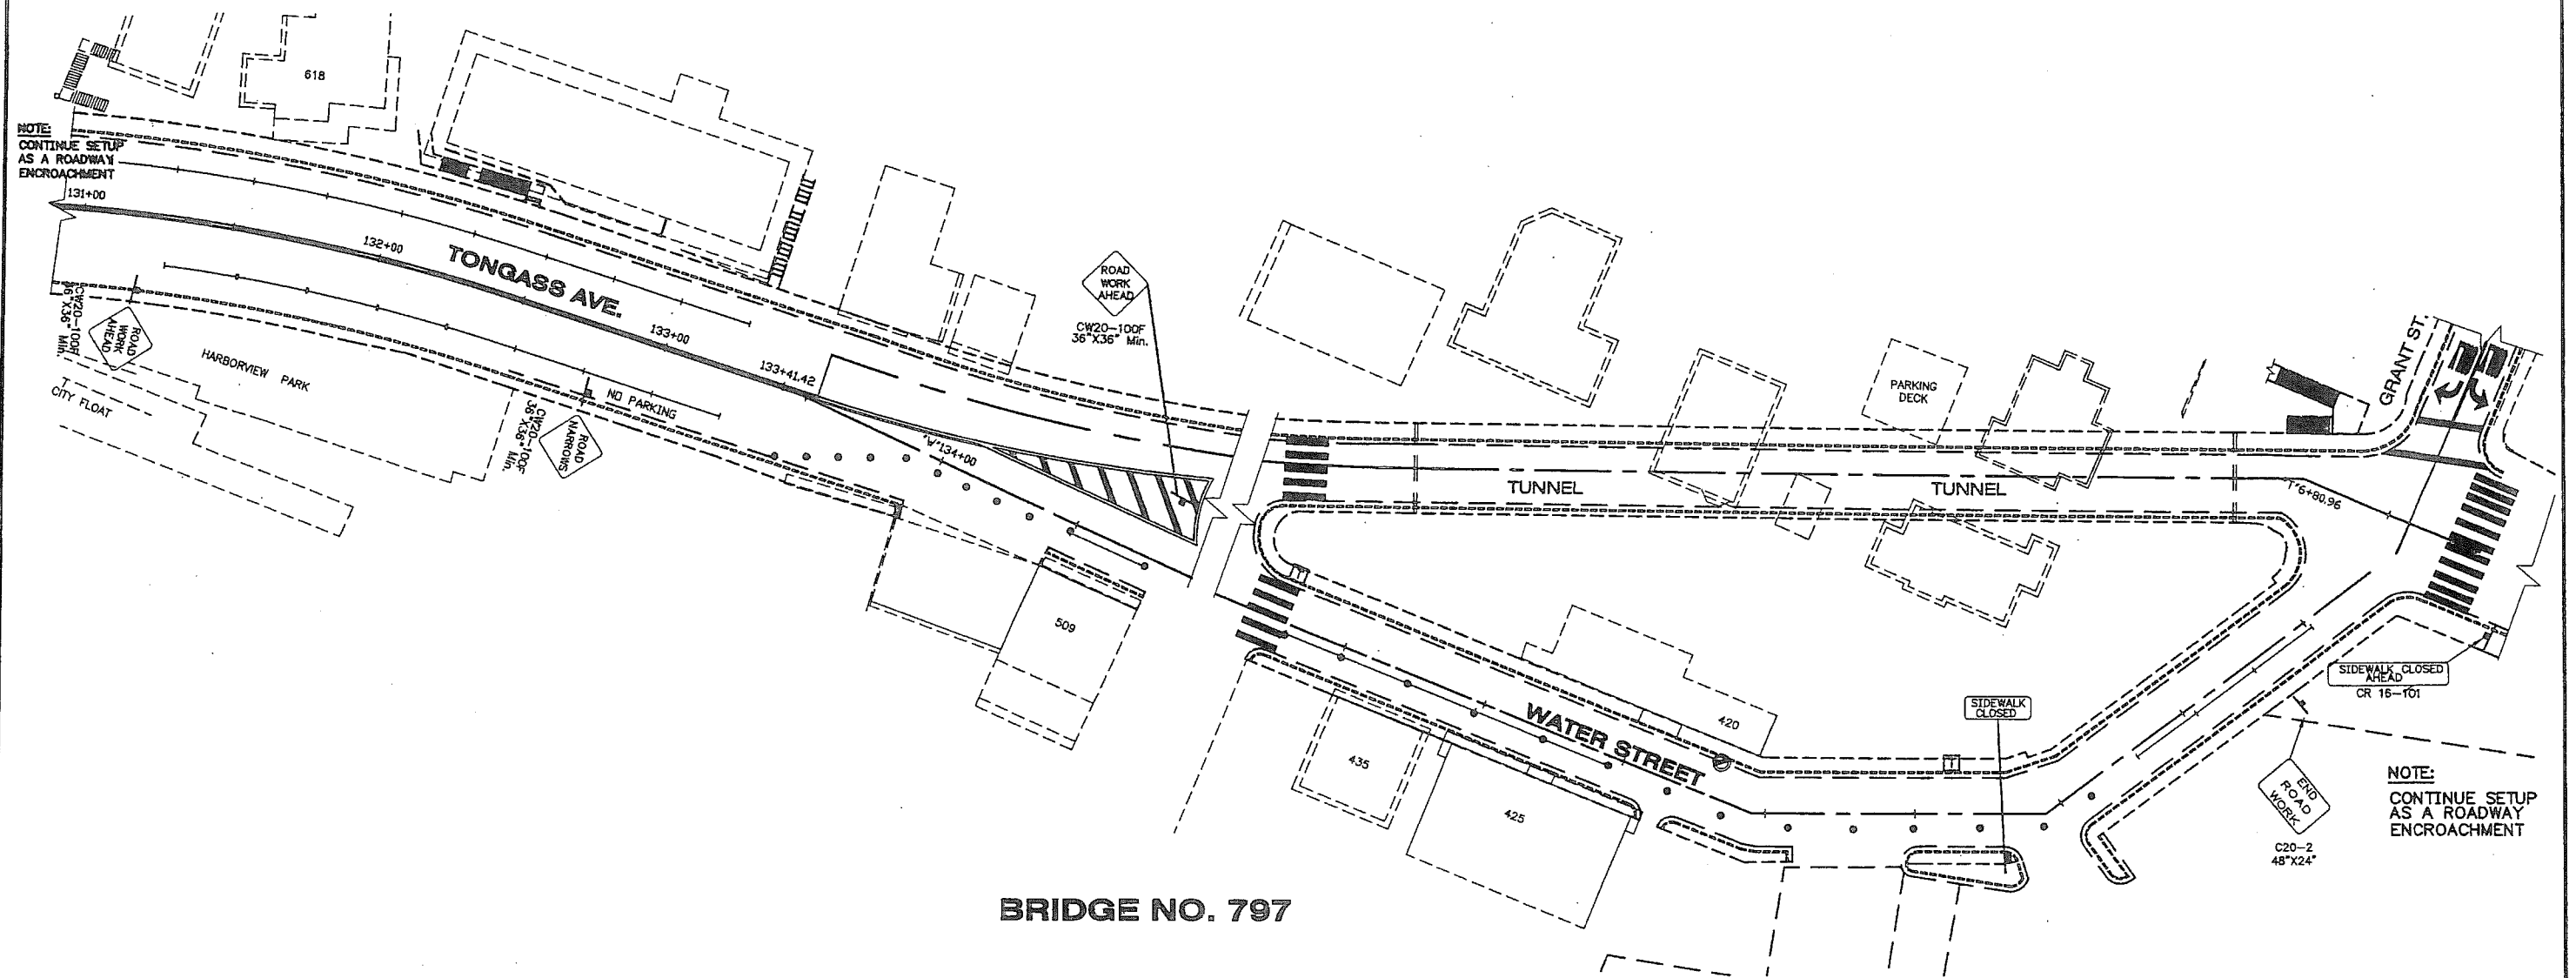

BRIDGE NO. 797


NOTE:
CONTINUE SETUP
AS A ROADWAY
ENCROACHMENT

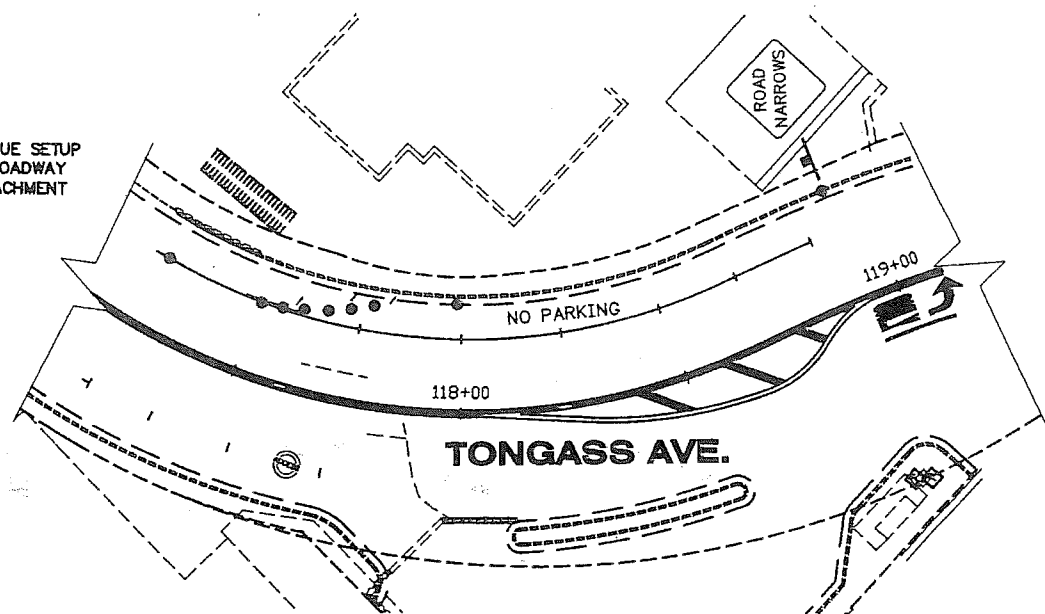

BRIDGE NO. 987

ELEVATIONS, BENCHMARKS AND DIMENSIONS ARE BASED ON "AS-BUILT" PLANS. VERIFY ALL CONTROLLING FIELD DIMENSIONS BEFORE ORDERING OR FABRICATING ANY MATERIAL.

DESIGNED BY: CAROLYN MOREHOUSE

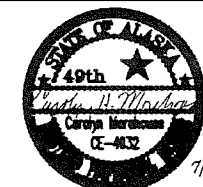


STATE OF ALASKA
DEPARTMENT OF TRANSPORTATION
& PUBLIC FACILITIES
STATEWIDE DESIGN & ENGINEERING SERVICES DIVISION
KTN-VIADUCTS
REHABILITATION
PROJECT NO. 68571
TRAFFIC CONTROL
PLAN DETAILS

CHECKED BY: C. Driscoll
DRAWN/REVISED BY: R.S., R.G.


PATH:
PLOT: PSPACE: 1=1(F) OR MSPACE: 1=1(F)

TC-2.0

REVISIONS			PROJECT DESIGNATION	YEAR	SHEET NO.	TOTAL SHEETS
NO.	DATE	DESCRIPTION				
			NH-0902(34)	2009	4	70

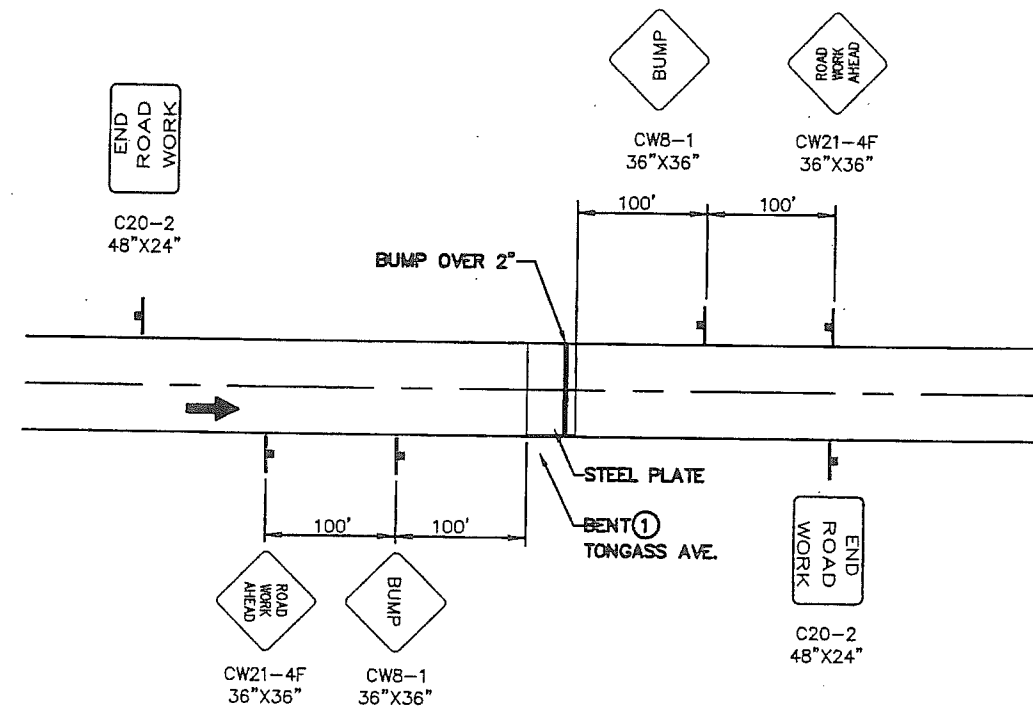

VIADUCT REPAIR

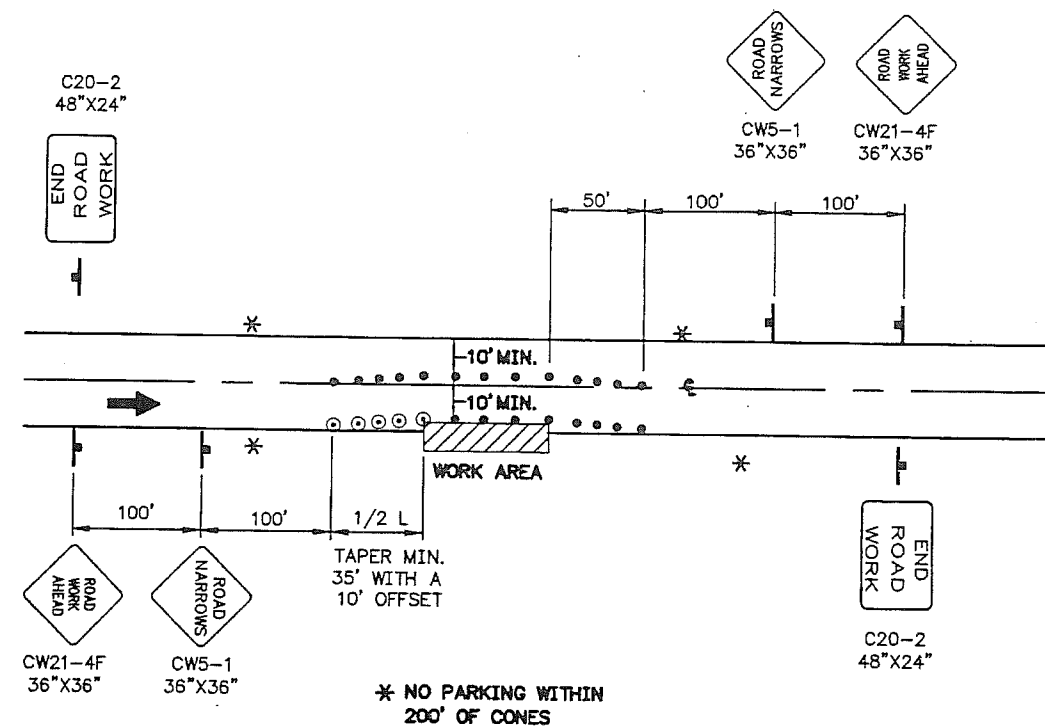

ROADWAY ENCROACHMENT

NOTE: IF ONLY ONE LANE IS EFFECTED BY ROAD WORK (THAT IS, THE CONES ALONG THE WORK AREA ARE NO CLOSER THAN 10' TO CENTERLINE) THE CENTERLINE CONES FOR THE OPPOSING LANE MAY BE DELETED.

TRAFFIC CONTROL NOTES

1. FLAGGER MAY BE NEEDED AT BRIDGE 997. SEE TYPICAL MUTCD (TA-10). DELAY MAY NOT EXCEED 3 MINUTES OR ENGINEER MAY REQUIRE NIGHT TIME OPERATIONS.
2. SPEED LIMIT IS 20 MPH WITH AVERAGE ANNUAL DAILY TRAFFIC AT 17,000 VEHICLES PER DAY.
3. PEDESTRIAN DETOURS MAY BE NECESSARY. SEE STANDARD DRAWING C-03.10 FOR DETAILS.
4. ALL SIGNS ARE DESIGNED PER ALASKA SIGN DESIGN SPECIFICATION FOR CONVENTIONAL ROADWAY.


$$\text{WHERE: } L = \frac{W \times S^2}{60}$$

L = LENGTH OF TAPER (FT.)
W = WIDTH OF OFFSET (FT.)
S = SPEED (MPH)

LEGEND

- SIGN
- ----- CONE
- ⊙ ----- DRUM
- III ----- TYPE III BARRICADE
- ----- FLAGGING STATION

ELEVATIONS, BENCHMARKS AND DIMENSIONS ARE BASED ON "AS-BUILT" PLANS. VERIFY ALL CONTROLLING FIELD DIMENSIONS BEFORE ORDERING OR FABRICATING ANY MATERIAL.

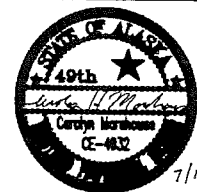DESIGNED BY: CAROLYN MOREHOUSE		STATE OF ALASKA DEPARTMENT OF TRANSPORTATION & PUBLIC FACILITIES STATEWIDE DESIGN & ENGINEERING SERVICES DIVISION KTN-VIADUCTS REHABILITATION PROJECT NO. 68571 TRAFFIC CONTROL PLAN				
		CHECKED BY: C. Drusman DRAWN/REVISED BY: R.S., R.G. PATH: R:\cad\KETCHIKANVIADUCT-2008\KETCH. VIADUCT 2008\T-1(2).dwg PLOT: PSPACE: 1=1(F) OR MSPACE: 1=1(F)				
TC-2.1						
NO.	DATE	REVISIONS	PROJECT DESIGNATION	YEAR	SHEET NO.	TOTAL SHEETS
			NH-0902(34)	2009	5	70

GENERAL NOTES

Design:.....AASHTO Standard Specifications for Highway Bridges, 17th Edition, 2002, with the latest Interim Specifications.

Live Load:HS20

Concrete:.....Use Class "A" Concrete unless otherwise noted. $f_c = 4000$ psi

Reinforcing Steel:.....Use ASTM A706, $F_y = 60,000$ psi
2" clear cover to all reinforcing steel unless otherwise shown.

Structural Steel:.....Use ASTM A709, Grade 50 unless otherwise noted. $F_y = 50,000$ psi. Galvanize all steel after fabrication except as noted.

'S' CURVE


Sta. 116+56.470 to
Sta. 117+94.469

LEGEND

-  = Earth
-  = Bent Number
-  = Completed Rehabilitation
-  = Rehabilitation this contract
-  = Fill (Future)
-  = Bearing Replacement

ELEVATIONS, BENCHMARKS AND DIMENSIONS ARE BASED ON "AS-BUILT" PLANS. VERIFY ALL CONTROLLING FIELD DIMENSIONS BEFORE ORDERING OR FABRICATING ANY MATERIAL.

DESIGNED BY: GEORGE IMBSEN

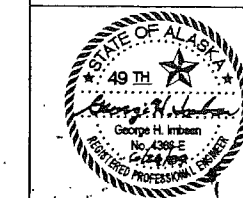

CHECKED BY: Mark Figley
DRAWN/REVISED BY: C.S.A.



STATE OF ALASKA
DEPARTMENT OF TRANSPORTATION
& PUBLIC FACILITIES
STATEWIDE DESIGN & ENGINEERING SERVICES DIVISION


**KTN-VIADUCTS
REHABILITATION
PROJECT NO. 68571**

**STRUCTURAL SCOPE OF WORK
AND GENERAL NOTES**

S-1.0

REVISIONS			PROJECT DESIGNATION	YEAR	SHEET NO.	TOTAL SHEETS
NO.	DATE	DESCRIPTION				
			NH-0902(34)	2009	6	70

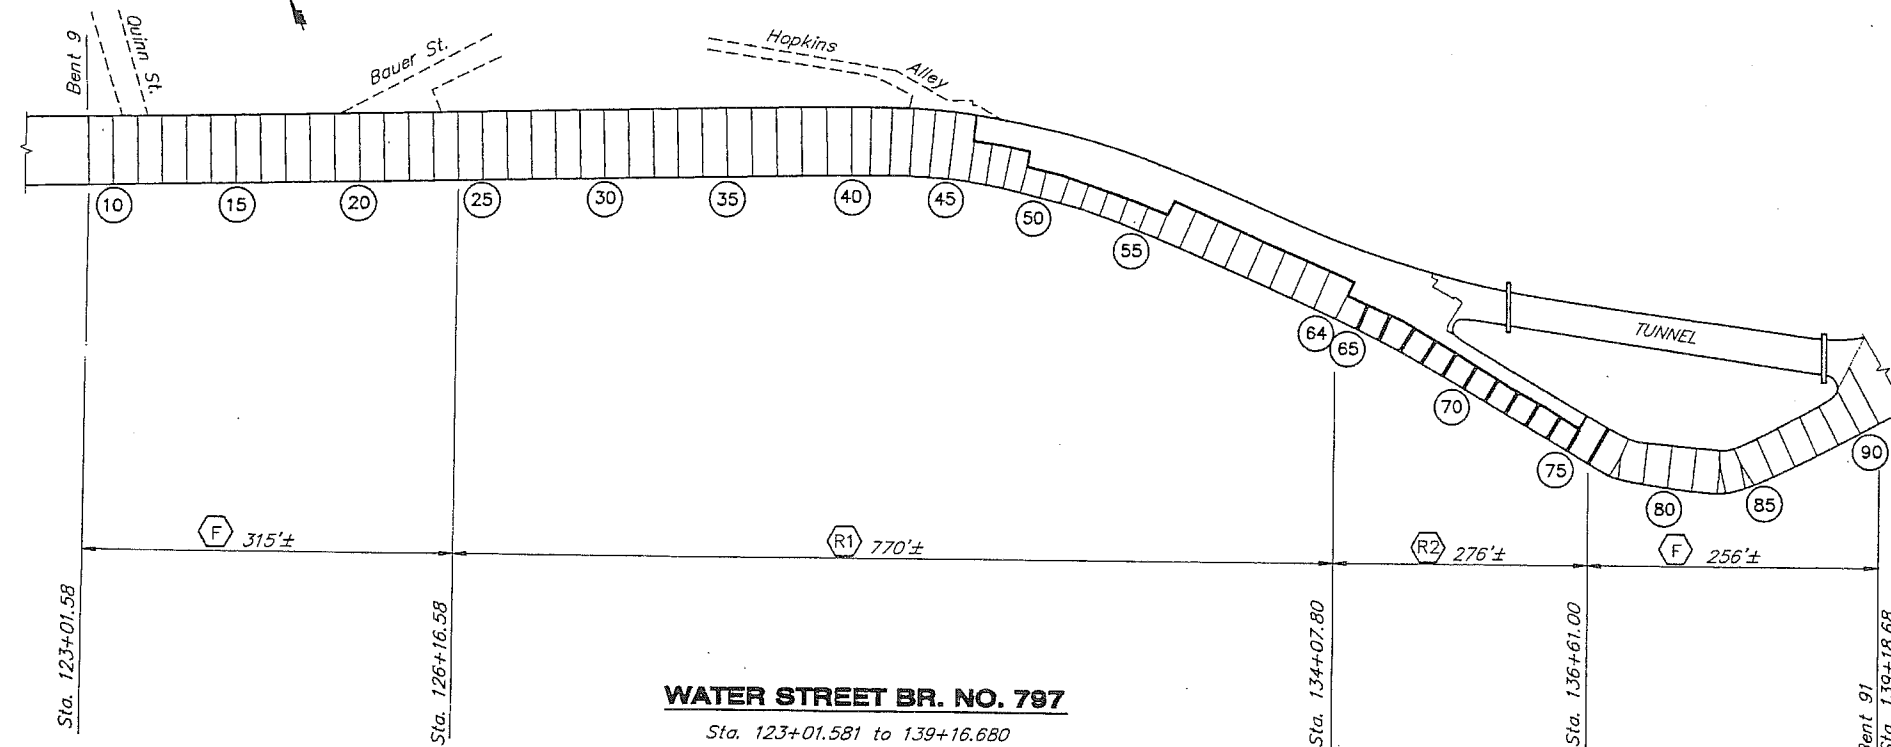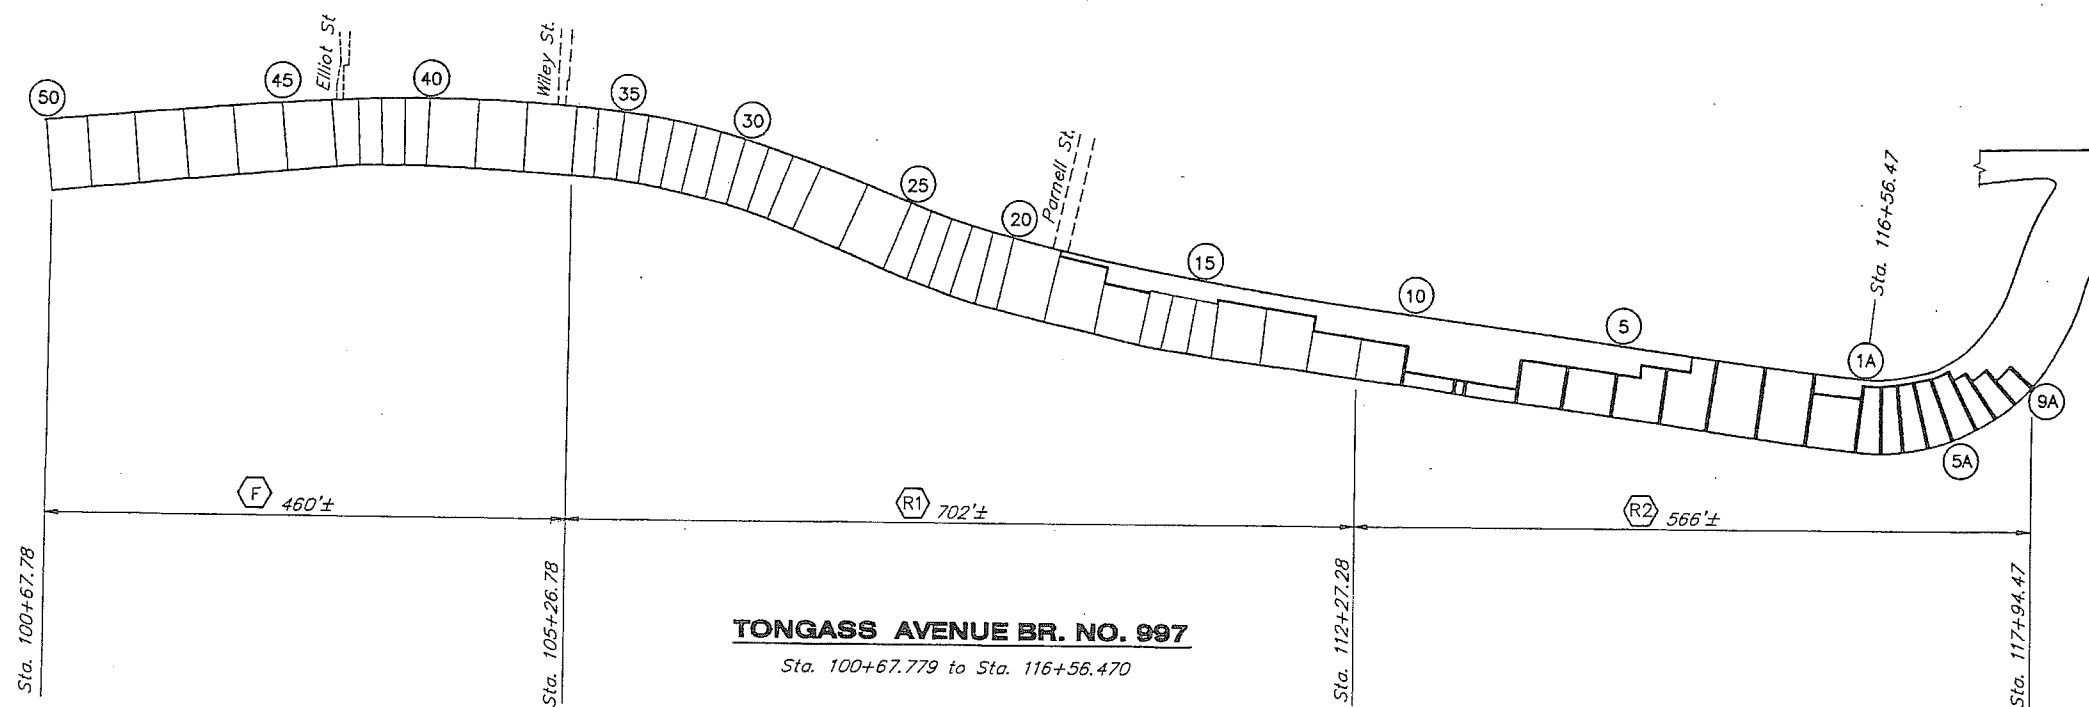


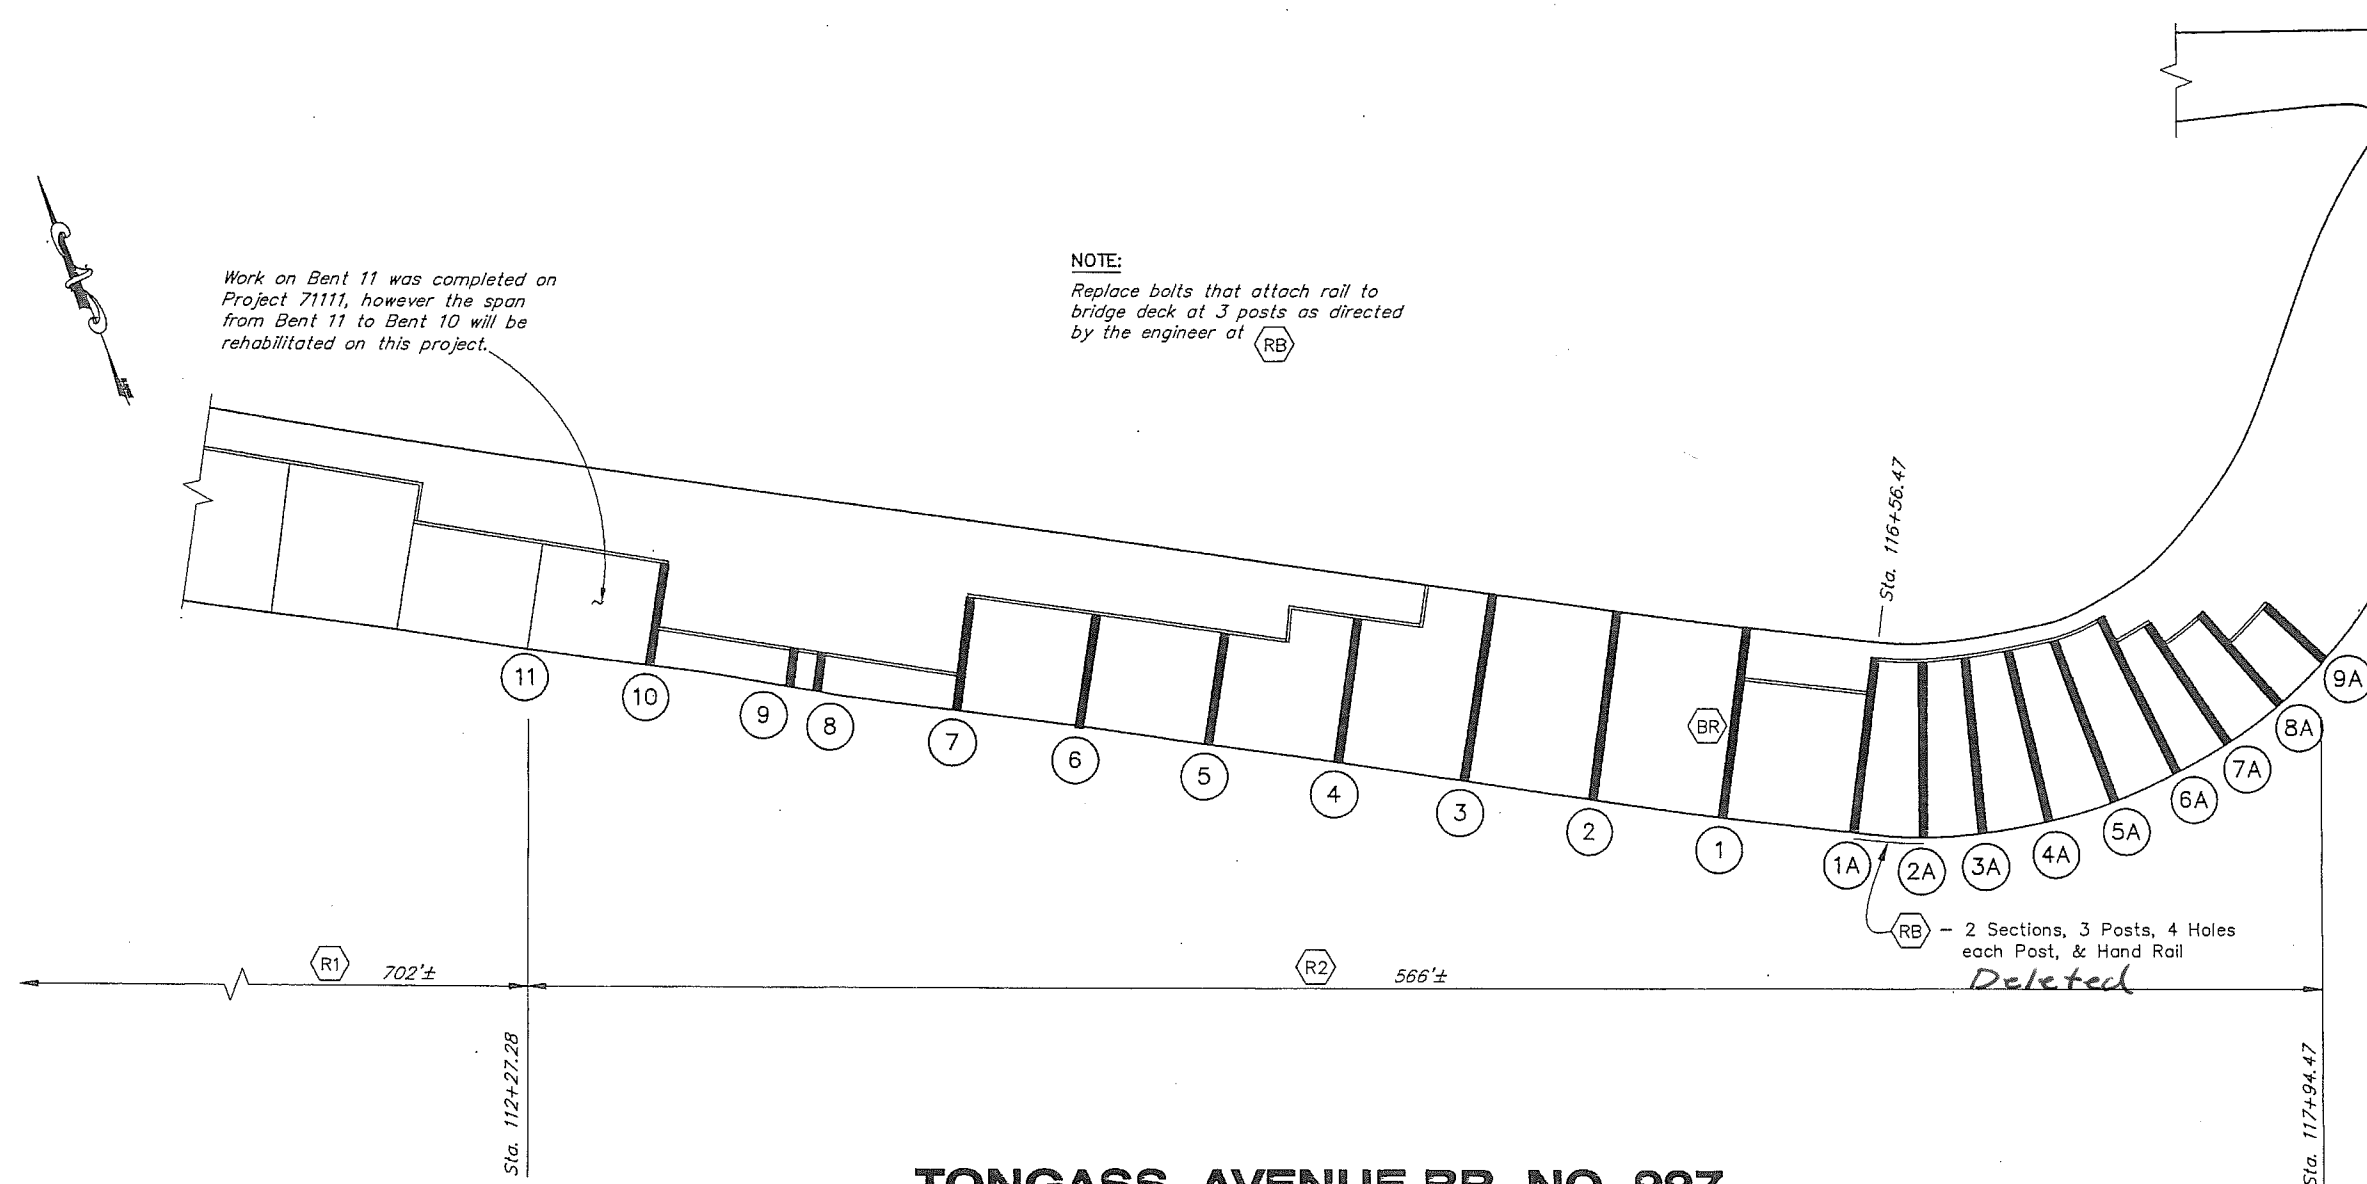

TONGASS AVENUE BR. NO. 997

ELEVATIONS, BENCHMARKS AND DIMENSIONS ARE BASED ON "AS-BUILT" PLANS. VERIFY ALL CONTROLLING FIELD DIMENSIONS BEFORE ORDERING OR FABRICATING ANY MATERIAL.


DESIGNED BY: GEORGE IMBSEN  CHECKED BY: Mark Figley DRAWN/REVISED BY: C.S.A.		STATE OF ALASKA DEPARTMENT OF TRANSPORTATION & PUBLIC FACILITIES STATEWIDE DESIGN & ENGINEERING SERVICES DIVISION KTN-VIADUCTS REHABILITATION PROJECT NO. 68571 TONGASS AVE. STRUCTURAL REPAIR PLAN				
PATH: PLOT:		PROJECT DESIGNATION NH-0902(34)		YEAR 2009	SHEET NO. 7	TOTAL SHEETS 70
NO. DATE REVISIONS DESCRIPTION		YEAR SHEET NO. TOTAL SHEETS		S-2.0		

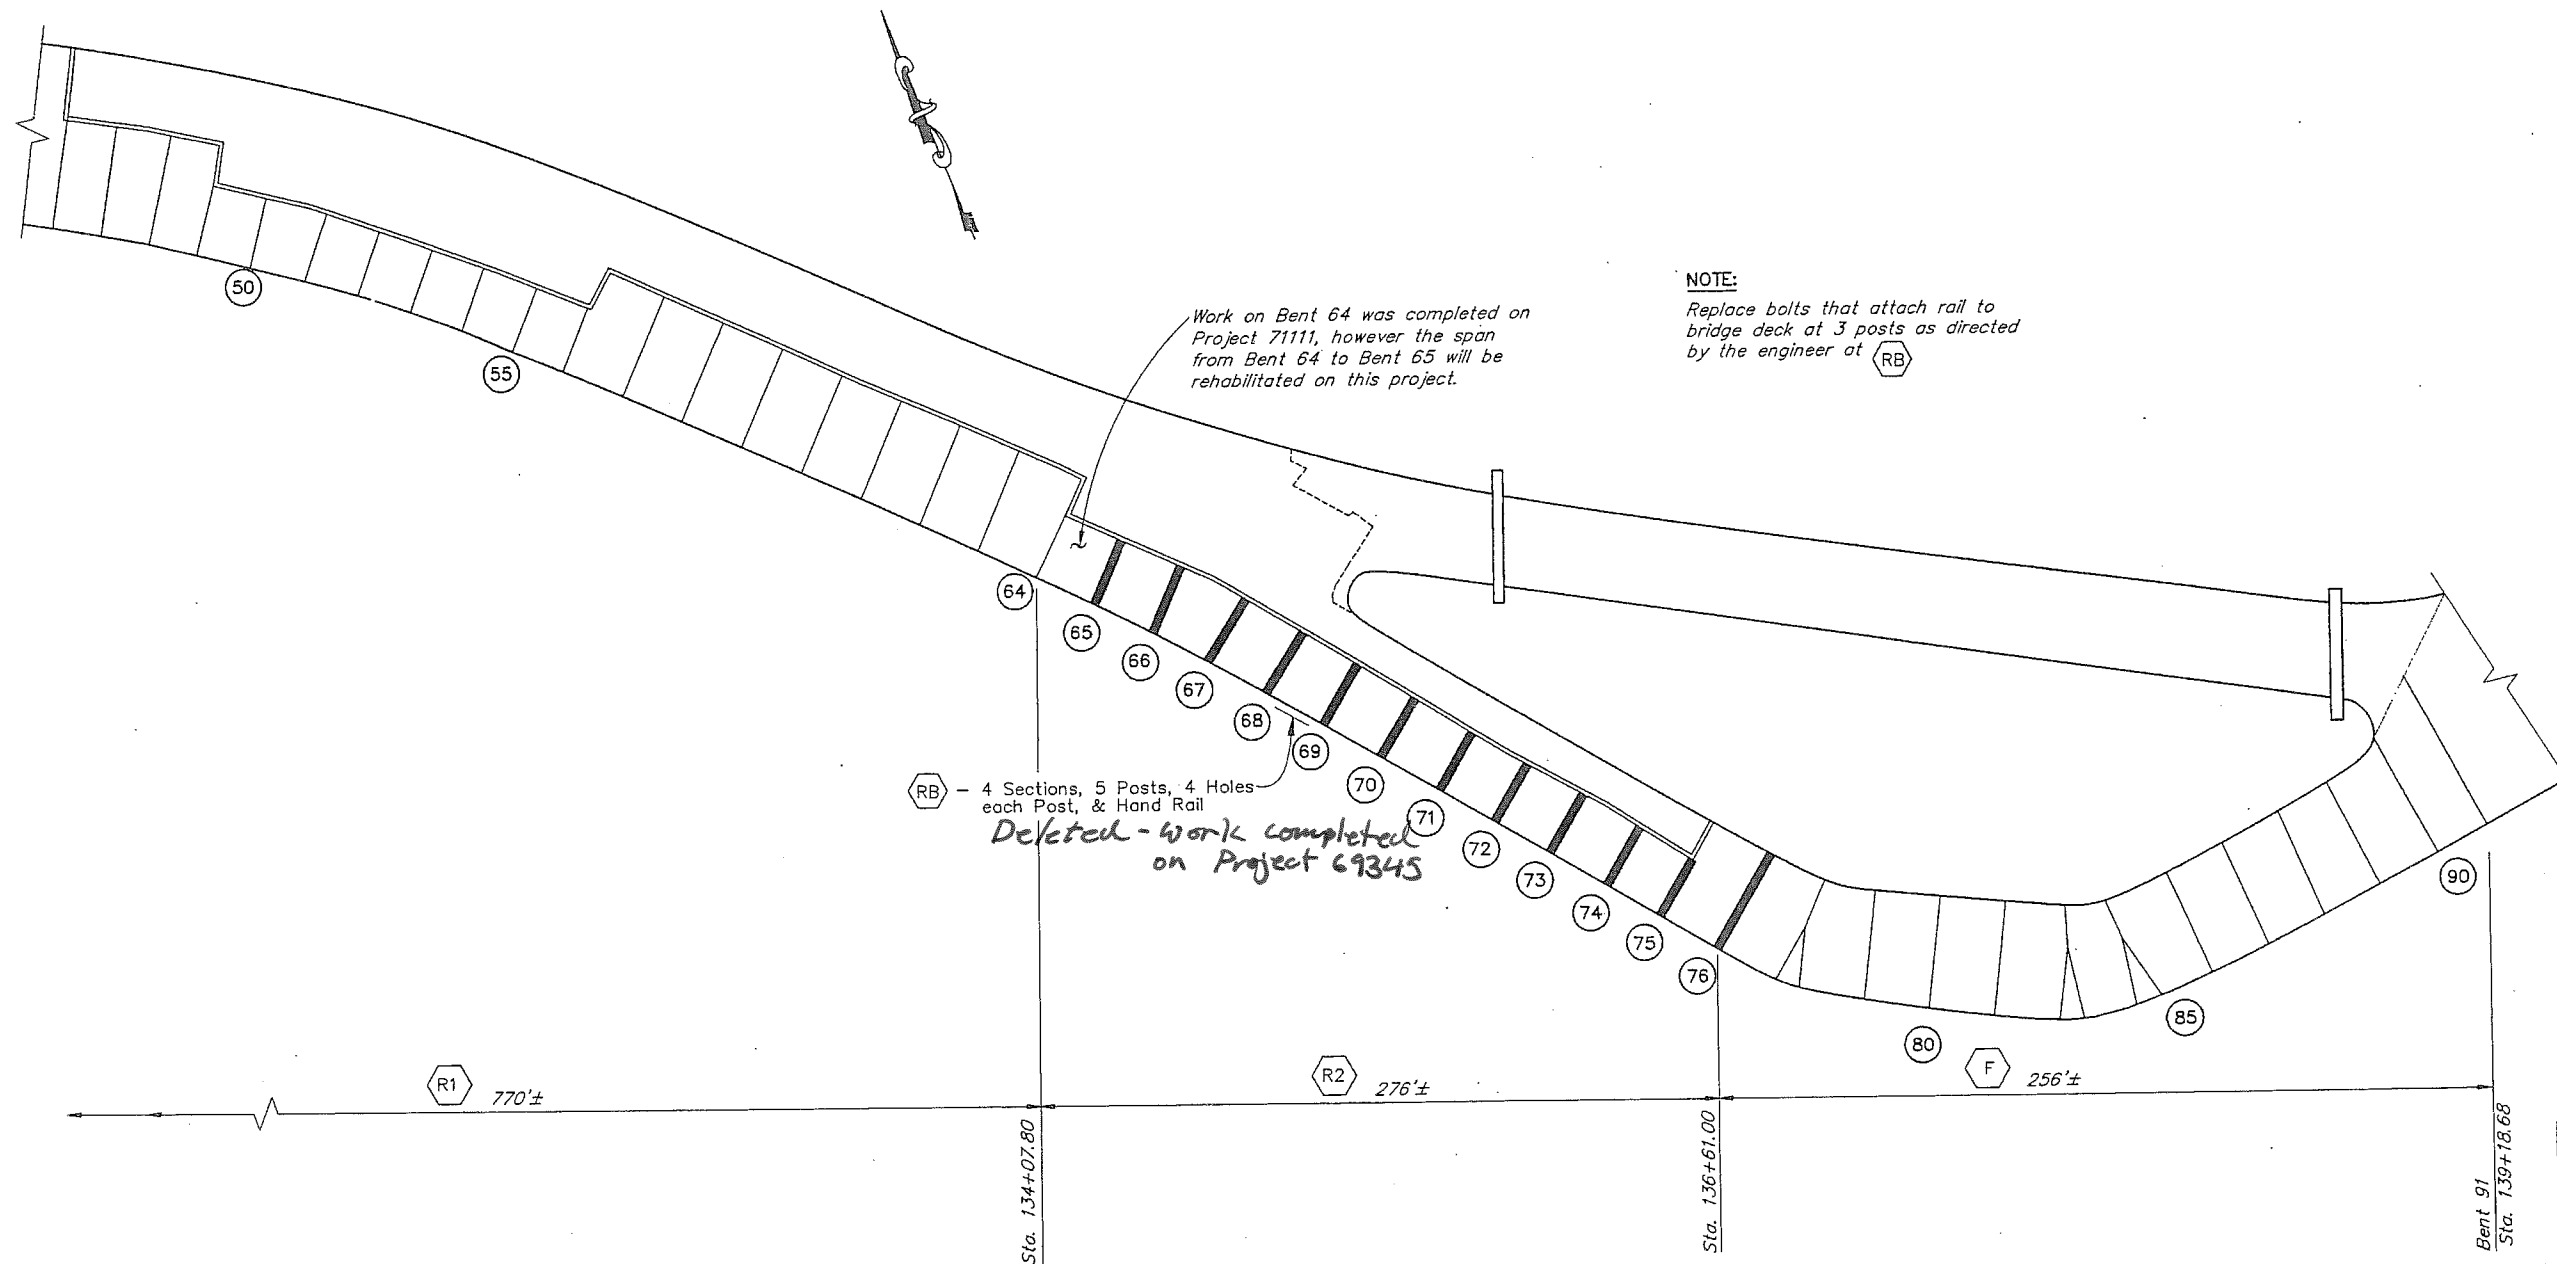


WATER STREET BRIDGE. NO. 797

ELEVATIONS, BENCHMARKS AND DIMENSIONS ARE BASED ON "AS-BUILT" PLANS. VERIFY ALL CONTROLLING FIELD DIMENSIONS BEFORE ORDERING OR FABRICATING ANY MATERIAL.

DESIGNED BY: George Imbsen		STATE OF ALASKA DEPARTMENT OF TRANSPORTATION & PUBLIC FACILITIES STATEWIDE DESIGN & ENGINEERING SERVICES DIVISION			
		KTN-VIADUCTS REHABILITATION PROJECT NO. 68571 WATER STREET STRUCTURAL REPAIR PLAN			
CHECKED BY: Mark Figley		S-2.1			
DRAWN/REVISED BY: R.S., R.G.					
PATH:		PROJECT DESIGNATION			
PLOT: PSPACE 1=1(F) OR MSPACE 1=1(F)		YEAR			
NO.		DATE		SHEET NO.	
DESCRIPTION		TOTAL SHEETS		8	
NH-0902(34)		2009		70	

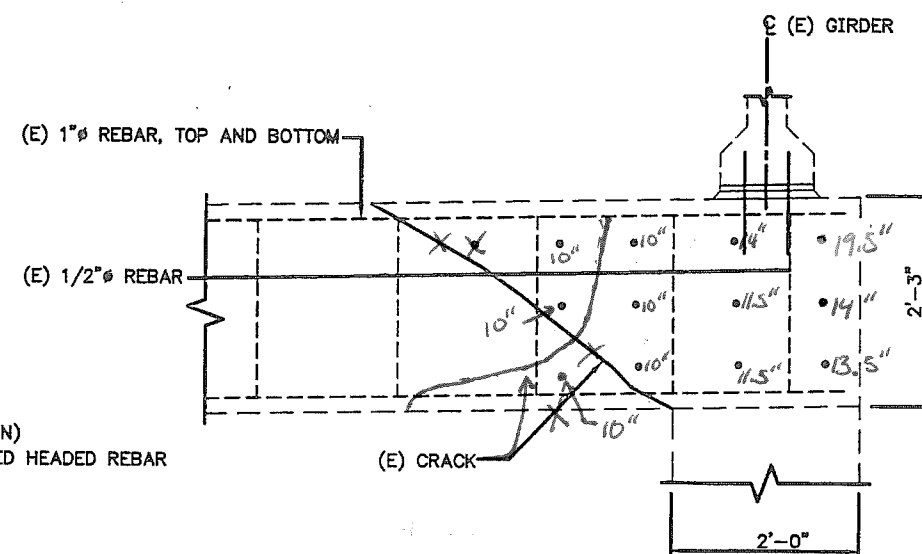

VIEW B-B

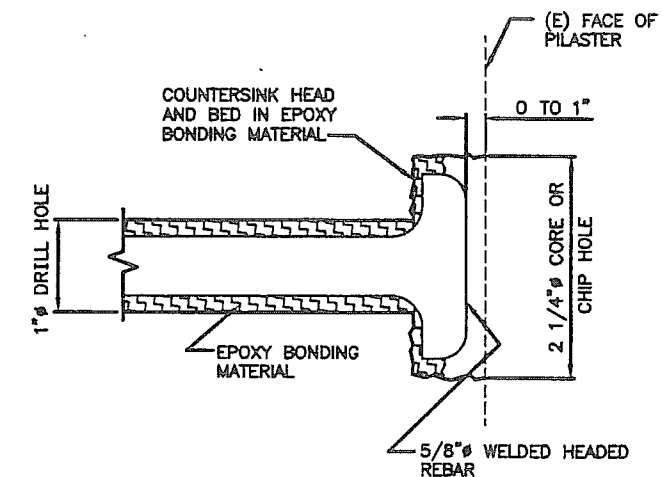

LEGEND


- | | |
|---|--------------------------|
|  | DENOTES EXISTING |
|  | DENOTES NEW CONSTRUCTION |
|  | DENOTES GROUNDLINE |
| (E) | EXISTING |
|  | SPALL |
|  | NEW CONCRETE |
|  | EPOXY BONDING MATERIAL |

NOTES


1. REPAIR ALL SPALLS AND DELAMINATIONS AS OUTLINED IN THE SPECIFICATIONS BEFORE JACKETING.
2. EXACT LOCATION OF DOWELS WILL BE DETERMINED IN ACCORDANCE WITH SECTION 5.01-3.08 OF THE SPECIFICATIONS.
3. COMPLETE INSTALLATION OF WELDED HEADED REINFORCEMENT BEFORE INJECTING CRACK WITH EPOXY.
4. TEMPORARY SHORING WILL BE REQUIRED.

ELEVATIONS, BENCHMARKS AND DIMENSIONS ARE BASED ON "AS-BUILT" PLANS. VERIFY ALL CONTROLLING FIELD DIMENSIONS BEFORE ORDERING OR FABRICATING ANY MATERIAL.


DESIGNED BY: G. IMBSEN 		STATE OF ALASKA DEPARTMENT OF TRANSPORTATION & PUBLIC FACILITIES STATEWIDE DESIGN & ENGINEERING SERVICES DIVISION KTN-VIADUCTS REHABILITATION PROJECT NO. 68571																										
CHECKED BY: M. FIGLEY DRAWN/REVISED BY: R.S., R.G. C.A.		TONGASS AVENUE BENT #6 REPAIR																										
PATH: PLOT: PSPACE 1=1(F) OR MSPACE 1=1(F)		S-3.0																										
<table border="1"> <thead> <tr> <th colspan="3">REVISIONS</th> </tr> <tr> <th>NO.</th> <th>DATE</th> <th>DESCRIPTION</th> </tr> </thead> <tbody> <tr><td> </td><td> </td><td> </td></tr> <tr><td> </td><td> </td><td> </td></tr> <tr><td> </td><td> </td><td> </td></tr> </tbody> </table>		REVISIONS			NO.	DATE	DESCRIPTION										<table border="1"> <tr> <td>PROJECT DESIGNATION</td> <td>YEAR</td> <td>SHEET NO.</td> <td>TOTAL SHEETS</td> </tr> <tr> <td>NH-0902(34)</td> <td>2009</td> <td>9</td> <td>70</td> </tr> </table>				PROJECT DESIGNATION	YEAR	SHEET NO.	TOTAL SHEETS	NH-0902(34)	2009	9	70
REVISIONS																												
NO.	DATE	DESCRIPTION																										
PROJECT DESIGNATION	YEAR	SHEET NO.	TOTAL SHEETS																									
NH-0902(34)	2009	9	70																									

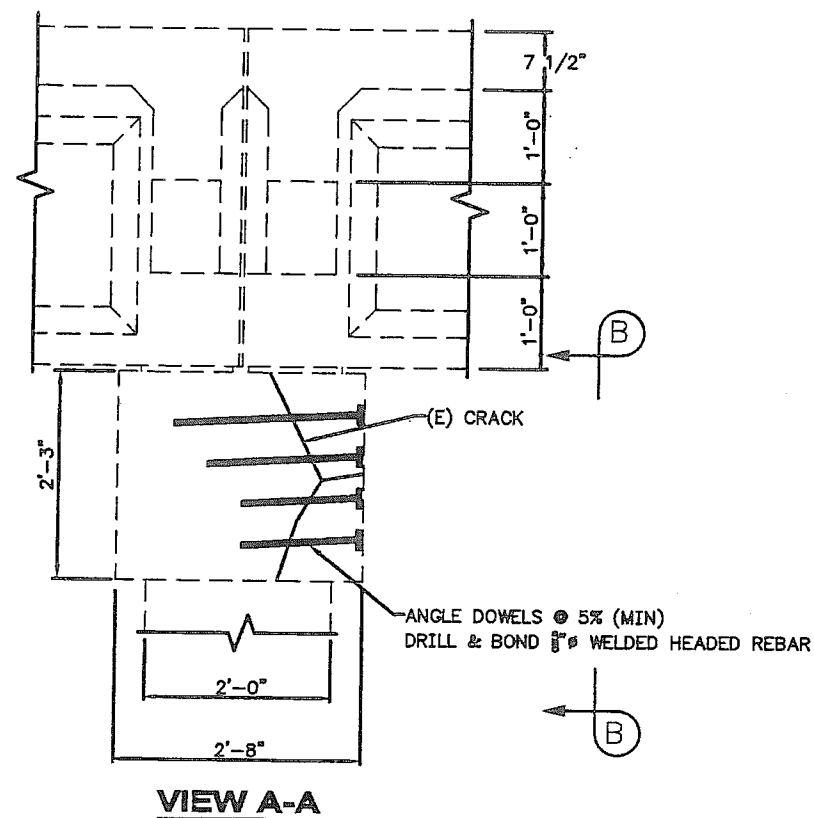

VIEW A-A

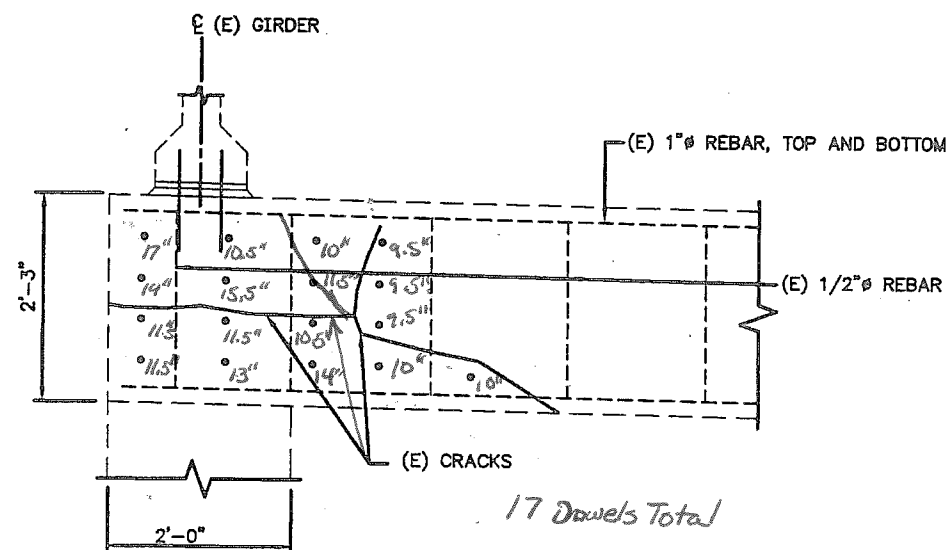

VIEW B-B

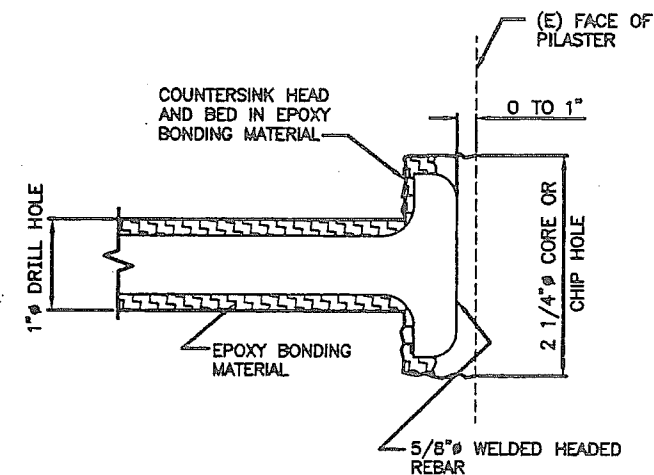

WELDED HEADED REBAR


LEGEND

- DENOTES EXISTING
- DENOTES NEW CONSTRUCTION
- /// DENOTES GROUNDLINE
- (E) EXISTING
- SPALL
- NEW CONCRETE
- EPOXY BONDING MATERIAL

NOTES


- REPAIR ALL SPALLS AND DELAMINATIONS AS OUTLINED IN THE SPECIFICATIONS BEFORE JACKETING.
- EXACT LOCATION OF DOWELS WILL BE DETERMINED IN ACCORDANCE WITH SECTION 5.01-3.08 OF THE SPECIFICATIONS.
- COMPLETE INSTALLATION OF WELDED HEADED REINFORCEMENT BEFORE INJECTING CRACK WITH EPOXY.
- TEMPORARY SHORING WILL BE REQUIRED.

ELEVATIONS, BENCHMARKS AND DIMENSIONS ARE BASED ON "AS-BUILT" PLANS. VERIFY ALL CONTROLLING FIELD DIMENSIONS BEFORE ORDERING OR FABRICATING ANY MATERIAL.

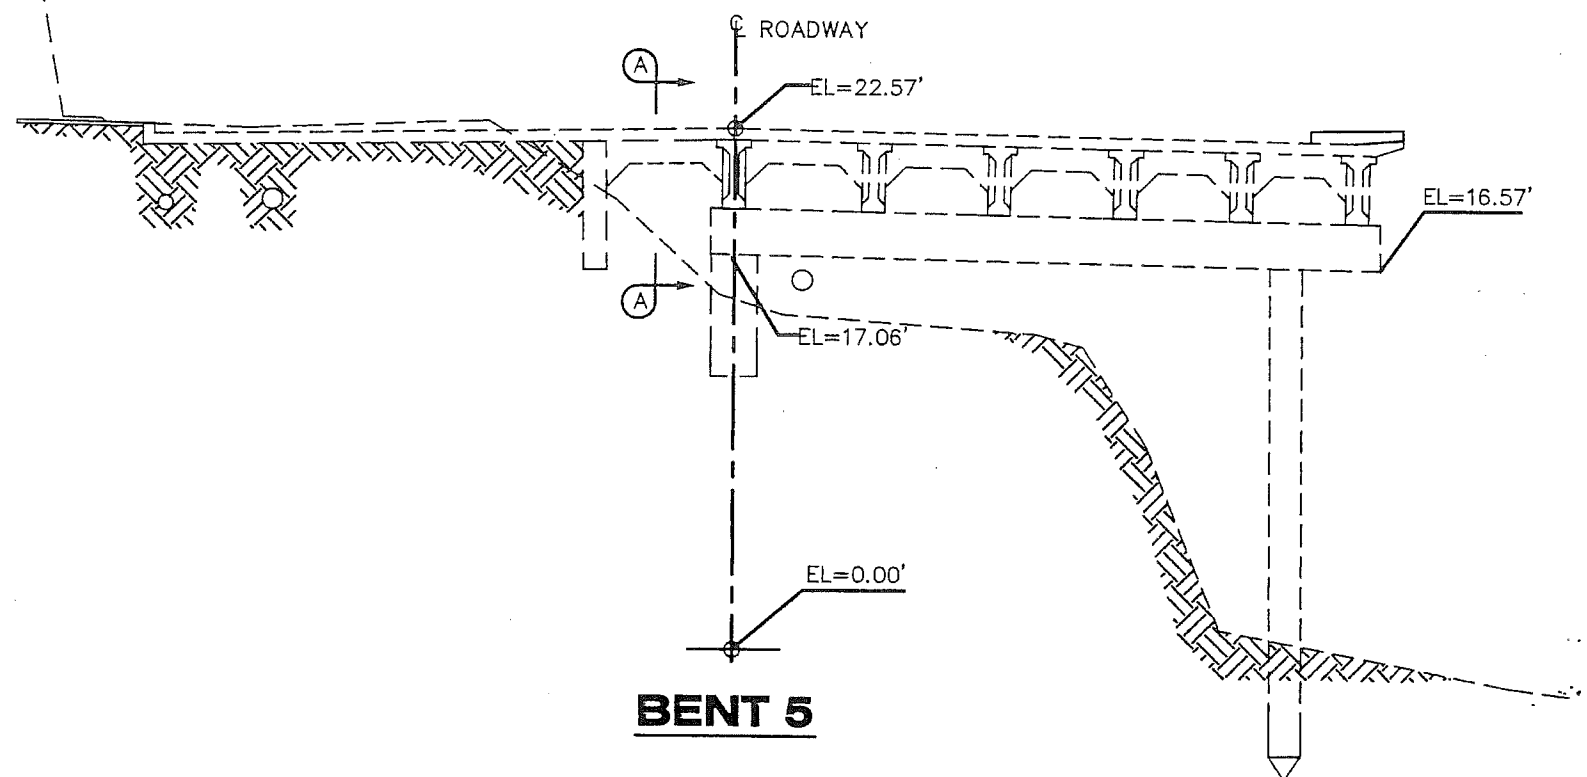


BENT 5


DESIGNED BY: G. IMSEN		STATE OF ALASKA DEPARTMENT OF TRANSPORTATION & PUBLIC FACILITIES STATEWIDE DESIGN & ENGINEERING SERVICES DIVISION			
		KTN-VIADUCTS REHABILITATION PROJECT NO. 68571			
		TONGASS AVENUE BENT #5 REPAIR			
CHECKED BY: M. FIGLEY DRAWN/REVISED BY: R.S., R.G./C.A.		S-3.1			
PATH: PLOT: PSPACE 1=1(F) OR MSPACE 1=1(F)					
REVISIONS		PROJECT DESIGNATION			
NO.	DATE	DESCRIPTION	YEAR	SHEET NO.	TOTAL SHEETS
NH-0902(34)			2009	10	70

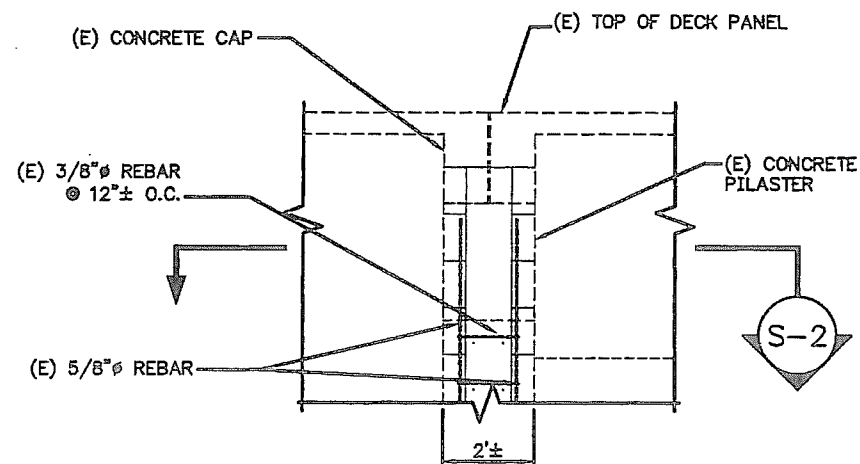

SECTION S-1

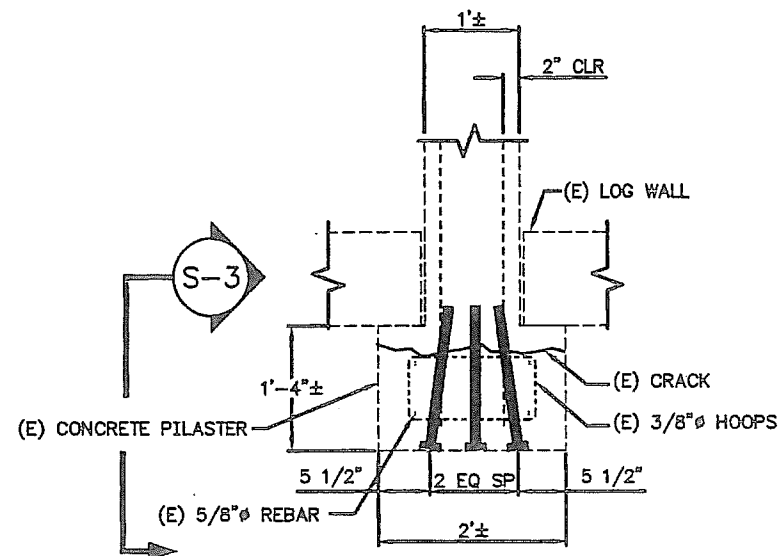

SECTION S-2
CRACK REPAIR

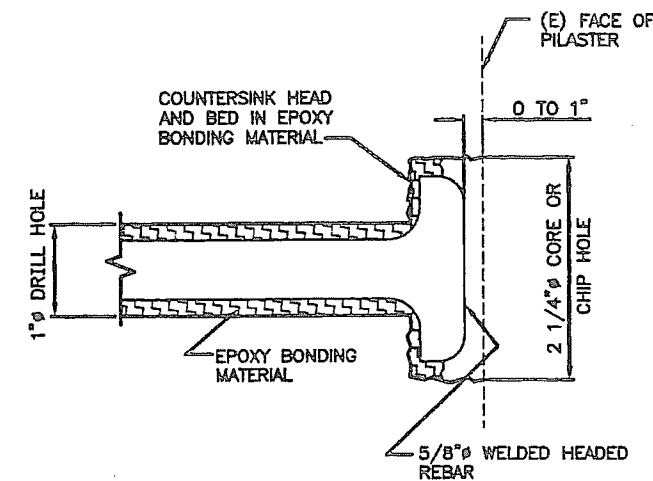

WELDED HEADED REBAR

LEGEND

- DENOTES EXISTING
- DENOTES NEW CONSTRUCTION
- ||||| DENOTES GROUNDLINE
- (E) EXISTING
- ||||| SPALL
- ||||| NEW CONCRETE
- ||||| EPOXY BONDING MATERIAL

NOTES


- REPAIR ALL SPALLS AND DELAMINATIONS AS OUTLINED IN THE SPECIFICATIONS BEFORE JACKETING.
- EXACT LOCATION OF DOWELS WILL BE DETERMINED IN ACCORDANCE WITH SECTION 5.01-3.08 OF THE SPECIFICATIONS.
- COMPLETE INSTALLATION OF WELDED HEADED REINFORCEMENT BEFORE INJECTING CRACK WITH EPOXY.

ELEVATIONS, BENCHMARKS AND DIMENSIONS ARE BASED ON "AS-BUILT" PLANS. VERIFY ALL CONTROLLING FIELD DIMENSIONS BEFORE ORDERING OR FABRICATING ANY MATERIAL.


DESIGNED BY: G. IMBSEN		STATE OF ALASKA DEPARTMENT OF TRANSPORTATION & PUBLIC FACILITIES STATEWIDE DESIGN & ENGINEERING SERVICES DIVISION			
		KTN-VIADUCTS REHABILITATION PROJECT NO. 68571 TONGASS AVENUE BENT #2A PILASTER REPAIR			
		S-3.2			
CHECKED BY: M. FIGLEY DRAWN/REVISED BY: R.S., R.G. C.A.		PATH: PLOT: PSPACE 1=1(F) OR MSPACE 1=1(F)		YEAR: 2009	
REVISIONS		PROJECT DESIGNATION		SHEET NO.	
NO. DATE DESCRIPTION		NH-0902(34)		11	
				TOTAL SHEETS: 70	

Welded Headed Reinforcement


Deleted

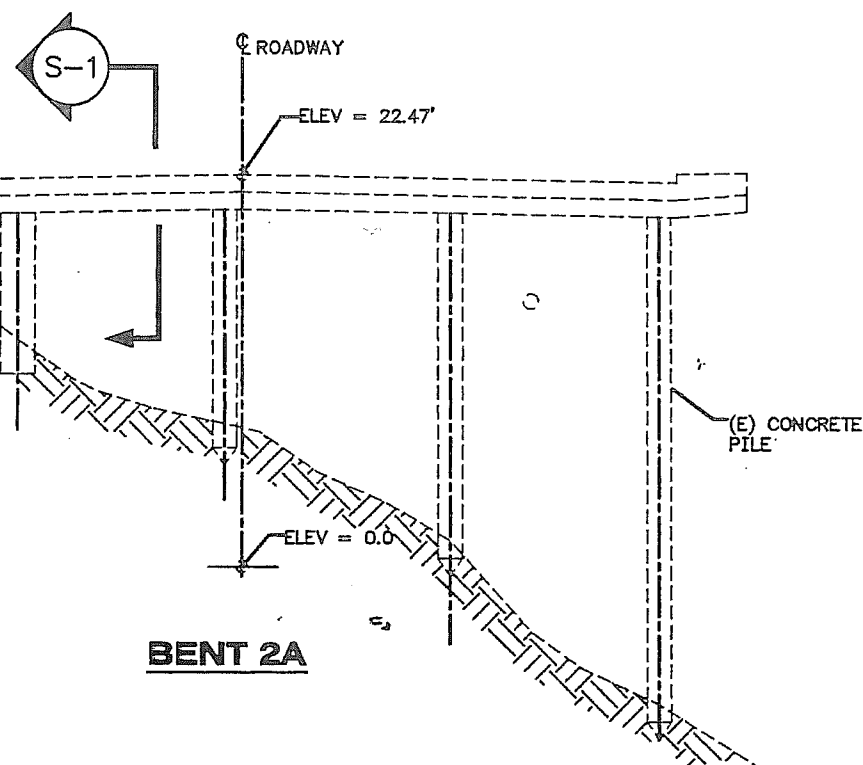


BENT 2A

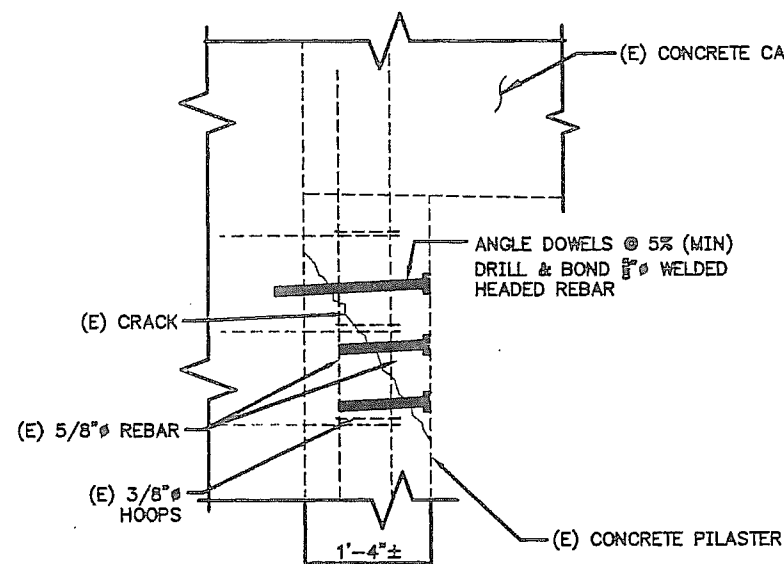


SECTION S-3
CRACK REPAIR

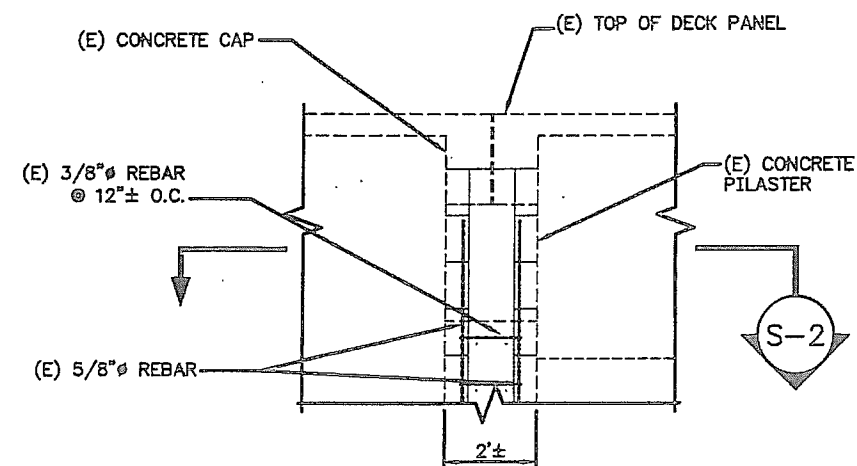

SECTION S-1

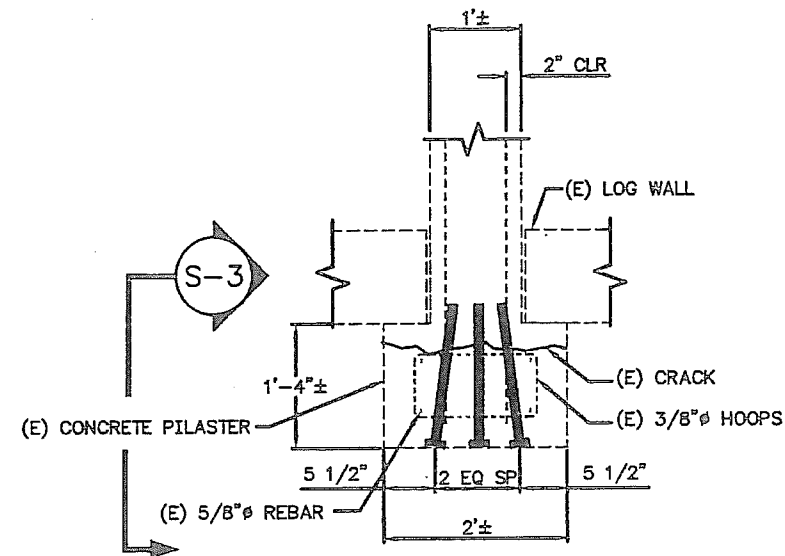

SECTION S-2
CRACK REPAIR
Welded Headed Reinforcement Deleted

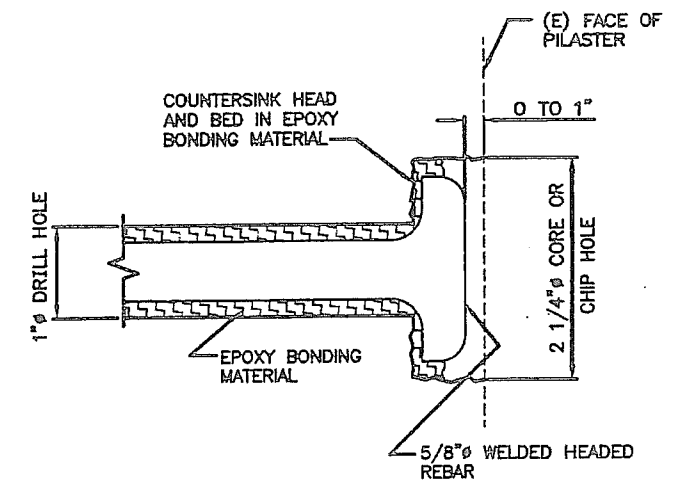

WELDED HEADED REBAR

LEGEND


- DENOTES EXISTING
- DENOTES NEW CONSTRUCTION
- /// DENOTES GROUNDLINE
- (E) EXISTING
- SPALL
- NEW CONCRETE
- EPOXY BONDING MATERIAL

NOTES


- REPAIR ALL SPALLS AND DELAMINATIONS AS OUTLINED IN THE SPECIFICATIONS BEFORE JACKETING.
- EXACT LOCATION OF DOWELS WILL BE DETERMINED IN ACCORDANCE WITH SECTION 5.01-3.08 OF THE SPECIFICATIONS.
- COMPLETE INSTALLATION OF WELDED HEADED REINFORCEMENT BEFORE INJECTING CRACK WITH EPOXY.

ELEVATIONS, BENCHMARKS AND DIMENSIONS ARE BASED ON "AS-BUILT" PLANS. VERIFY ALL CONTROLLING FIELD DIMENSIONS BEFORE ORDERING OR FABRICATING ANY MATERIAL.

DESIGNED BY: G. IMSEN		STATE OF ALASKA DEPARTMENT OF TRANSPORTATION & PUBLIC FACILITIES STATEWIDE DESIGN & ENGINEERING SERVICES DIVISION			
		KTN-VIADUCTS REHABILITATION PROJECT NO. 68571 TONGASS AVENUE BENT #3A PILASTER REPAIR			
		S-3.3			
CHECKED BY: M. FIGLEY DRAWN/REVISED BY: R.S., R.G., C.A.		PATH: PLOT: PSPACE 1=1(F) OR MSPACE 1=1(F)		YEAR 2009	
REVISIONS		PROJECT DESIGNATION NH-0902(34)		SHEET NO. 12	
NO. DATE DESCRIPTION				TOTAL SHEETS 70	

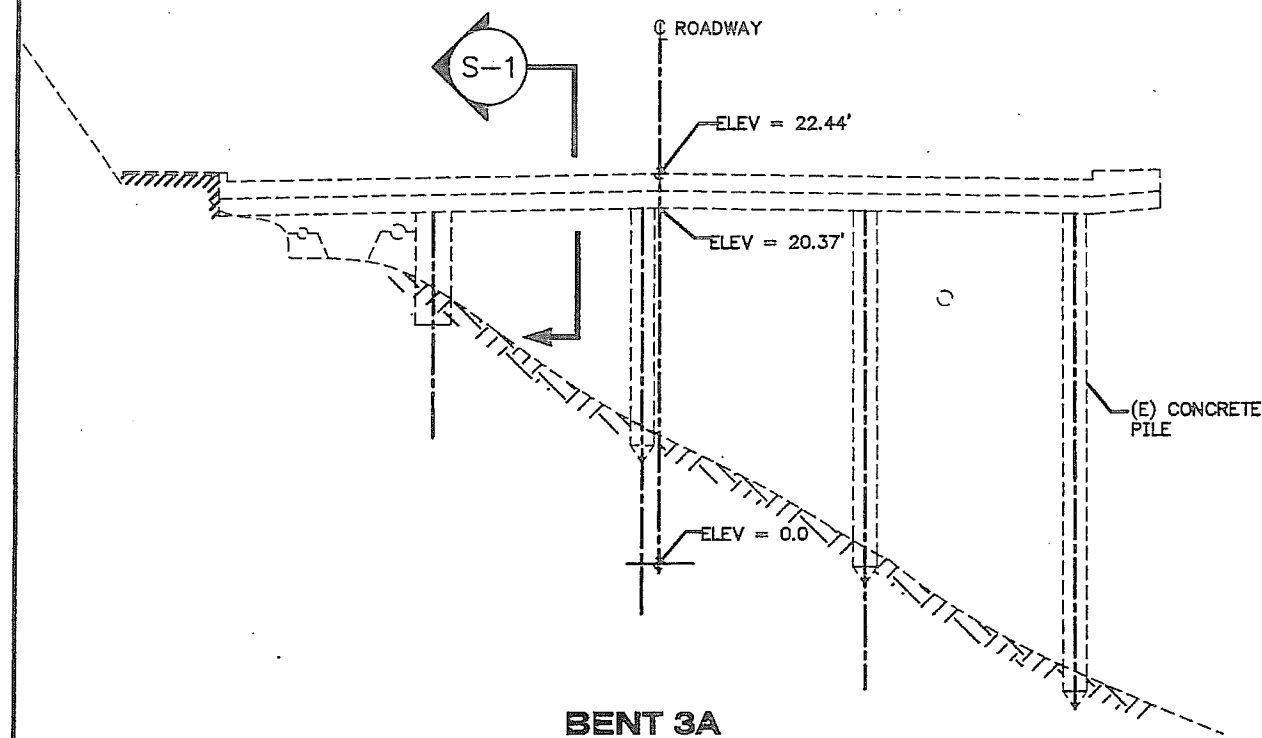

BENT 3A

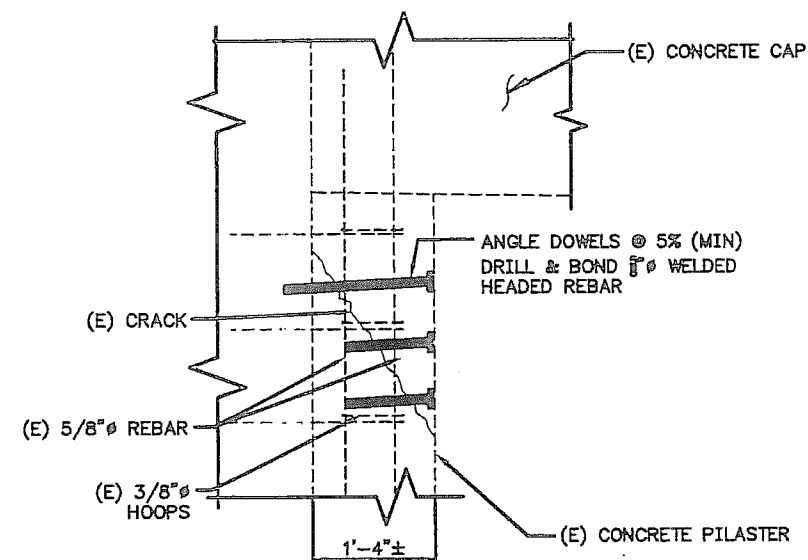

SECTION S-3
CRACK REPAIR




NOTES


1. REPAIR ALL SPALLS AND DELAMINATIONS AS OUTLINED IN THE SPECIFICATIONS BEFORE JACKETING.
2. EXACT LOCATION OF DOWELS WILL BE DETERMINED IN ACCORDANCE WITH SECTION 5.01-3.08 OF THE SPECIFICATIONS.
3. COMPLETE INSTALLATION OF WELDED HEADED REINFORCEMENT BEFORE INJECTING CRACK WITH EPOXY.

ELEVATIONS, BENCHMARKS AND DIMENSIONS ARE BASED ON "AS-BUILT"
PLANS. VERIFY ALL CONTROLLING FIELD DIMENSIONS BEFORE ORDERING
OR FABRICATING ANY MATERIAL.


DESIGNED BY: G. IMBSEN 	STATE OF ALASKA DEPARTMENT OF TRANSPORTATION & PUBLIC FACILITIES STATEWIDE DESIGN & ENGINEERING SERVICES DIVISION KTN-VIADUCTS REHABILITATION PROJECT NO. 168571 WATER STREET BENT #65 PILASTER REPAIR																							
CHECKED BY: M. FIGLEY DRAWN/REVISED BY: R.S., R.G., C.A.																								
PATH: _____ PLOT: PSPACE 1=1(F) OR NSPACE 1=1(F)																								
S-3.4																								
<table border="1" style="width: 100%; border-collapse: collapse;"> <thead> <tr> <th colspan="3" style="text-align: center;">REVISIONS</th> </tr> <tr> <th style="width: 10%;">NO.</th> <th style="width: 15%;">DATE</th> <th style="width: 85%;">DESCRIPTION</th> </tr> </thead> <tbody> <tr><td> </td><td> </td><td> </td></tr> <tr><td> </td><td> </td><td> </td></tr> <tr><td> </td><td> </td><td> </td></tr> </tbody> </table>	REVISIONS			NO.	DATE	DESCRIPTION										<table border="1" style="width: 100%; border-collapse: collapse;"> <thead> <tr> <th style="width: 35%;">PROJECT DESIGNATION</th> <th style="width: 15%;">YEAR</th> <th style="width: 15%;">SHEET NO.</th> <th style="width: 35%;">TOTAL SHEETS</th> </tr> </thead> <tbody> <tr> <td style="text-align: center;">NH-0902(34)</td> <td style="text-align: center;">2009</td> <td style="text-align: center;">13</td> <td style="text-align: center;">70</td> </tr> </tbody> </table>	PROJECT DESIGNATION	YEAR	SHEET NO.	TOTAL SHEETS	NH-0902(34)	2009	13	70
REVISIONS																								
NO.	DATE	DESCRIPTION																						
PROJECT DESIGNATION	YEAR	SHEET NO.	TOTAL SHEETS																					
NH-0902(34)	2009	13	70																					

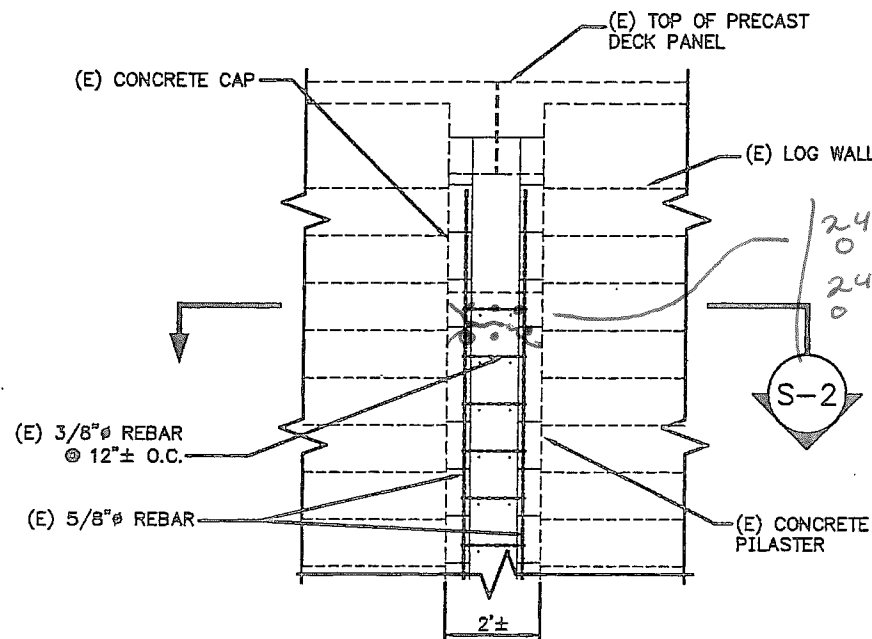


SECTION S-1

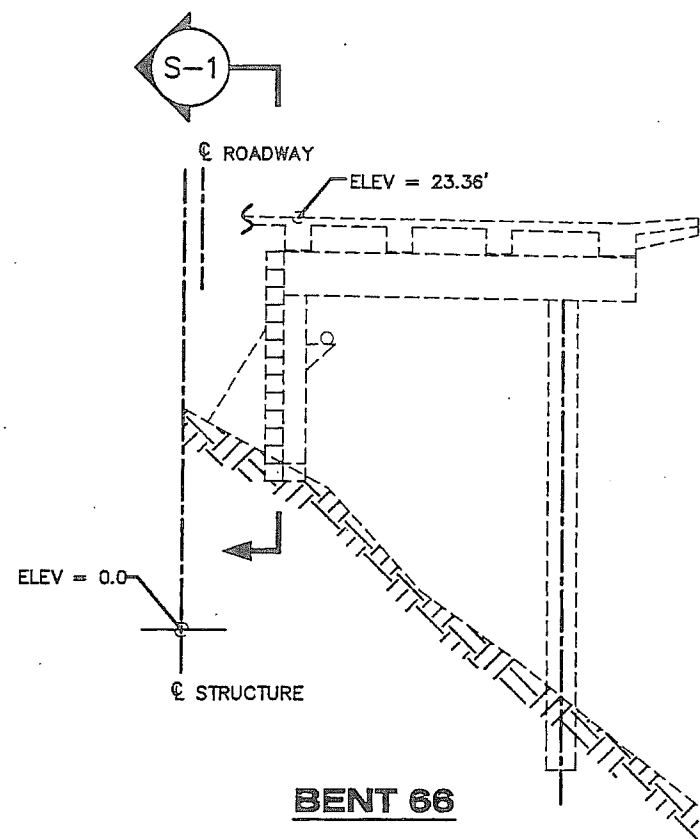


BENT 66

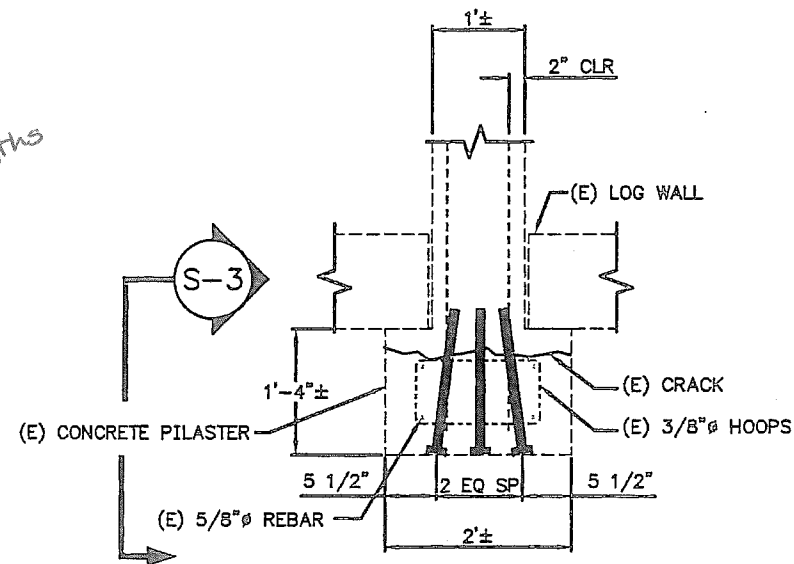

SECTION S-2
CRACK REPAIR

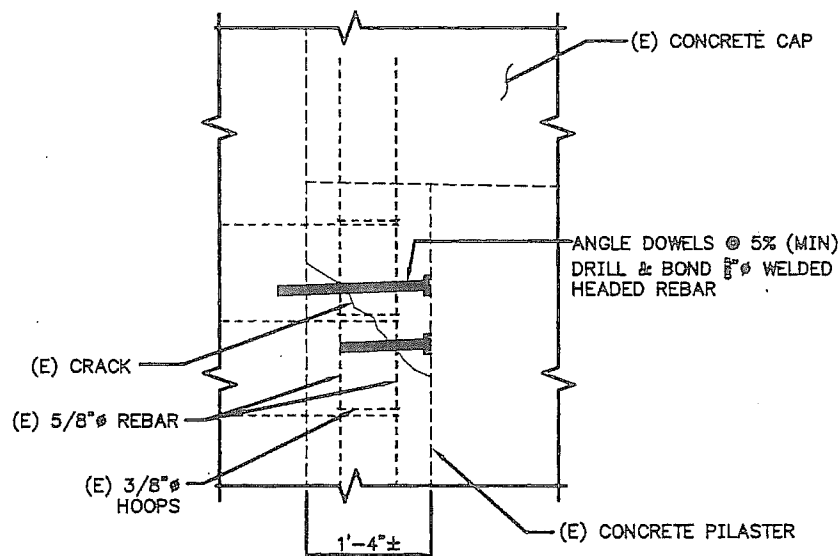

SECTION S-3
CRACK REPAIR

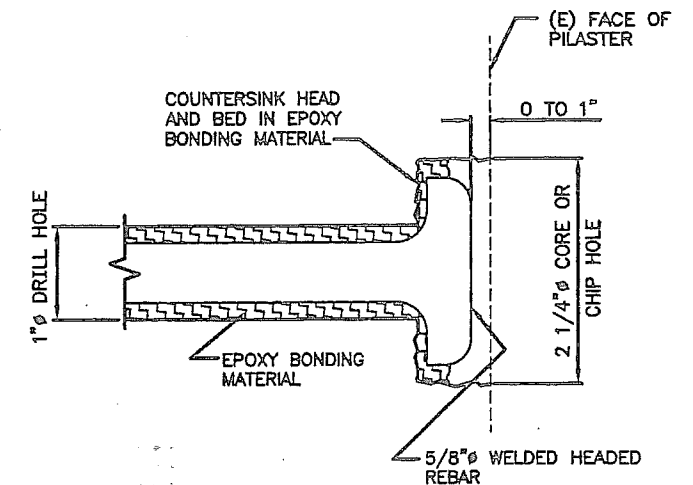

WELDED HEADED REBAR

LEGEND


- DENOTES EXISTING
- DENOTES NEW CONSTRUCTION
- DENOTES GROUNDLINE
- (E) EXISTING
- SPALL
- NEW CONCRETE
- EPOXY BONDING MATERIAL

NOTES


1. REPAIR ALL SPALLS AND DELAMINATIONS AS OUTLINED IN THE SPECIFICATIONS BEFORE JACKETING.
2. EXACT LOCATION OF DOWELS WILL BE DETERMINED IN ACCORDANCE WITH SECTION 5.01-3.08 OF THE SPECIFICATIONS.
3. COMPLETE INSTALLATION OF WELDED HEADED REINFORCEMENT BEFORE INJECTING CRACK WITH EPOXY.

ELEVATIONS, BENCHMARKS AND DIMENSIONS ARE BASED ON "AS-BUILT" PLANS. VERIFY ALL CONTROLLING FIELD DIMENSIONS BEFORE ORDERING OR FABRICATING ANY MATERIAL.

DESIGNED BY: G. IMBSEN		STATE OF ALASKA DEPARTMENT OF TRANSPORTATION & PUBLIC FACILITIES STATEWIDE DESIGN & ENGINEERING SERVICES DIVISION			
		KTN-VIADUCTS REHABILITATION PROJECT NO. 68571 WATER STREET BENT #66 PILASTER REPAIR			
		S-3.5			
CHECKED BY: M. FIGLEY DRAWN/REVISED BY: R.S.R.C., C.A.		PROJECT DESIGNATION			
PATH: PLOT: PSPACE 1=1(F) OR MSPACE 1=1(F)		YEAR			
NO.		DATE		TOTAL SHEETS	
DESCRIPTION		NO.		14	
NH-0902(34)		2009		70	

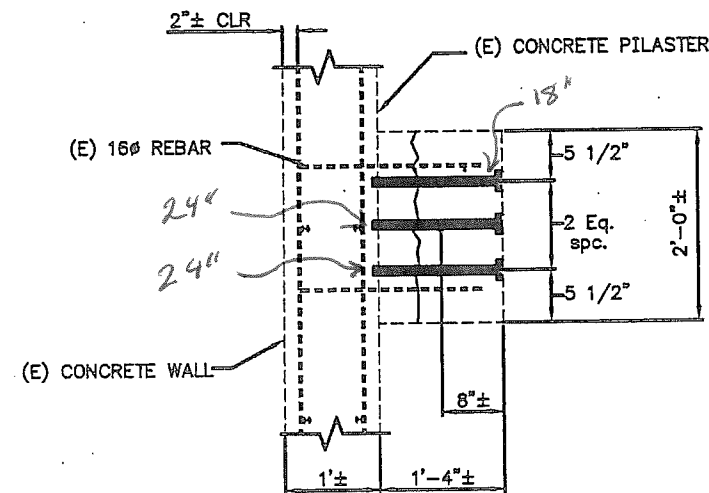

**SECTION
CRACK REPAIR** S-1

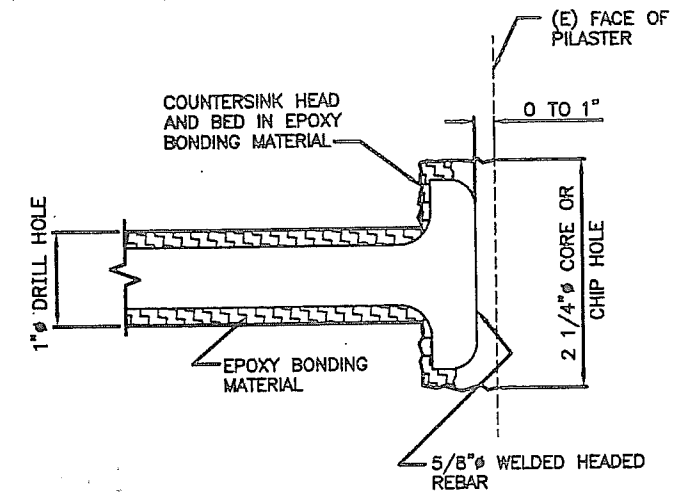

WELDED HEADED REBAR

LEGEND



- DENOTES EXISTING
- DENOTES NEW CONSTRUCTION
- ////// DENOTES GROUNDLINE
- (E) EXISTING
- XXXXXX SPALL
- NEW CONCRETE
- XXXXXX EPOXY BONDING MATERIAL

NOTES


1. REPAIR ALL SPALLS AND DELAMINATIONS AS OUTLINED IN THE SPECIFICATIONS BEFORE JACKETING.
2. EXACT LOCATION OF DOWELS WILL BE DETERMINED IN ACCORDANCE WITH SECTION 5.01-3.03 OF THE SPECIFICATIONS.
3. COMPLETE INSTALLATION OF WELDED HEADED REINFORCEMENT BEFORE INJECTING CRACK WITH EPOXY.

ELEVATIONS, BENCHMARKS AND DIMENSIONS ARE BASED ON "AS-BUILT" PLANS. VERIFY ALL CONTROLLING FIELD DIMENSIONS BEFORE ORDERING OR FABRICATING ANY MATERIAL.


DESIGNED BY: G. IMBSEN		STATE OF ALASKA DEPARTMENT OF TRANSPORTATION & PUBLIC FACILITIES STATEWIDE DESIGN & ENGINEERING SERVICES DIVISION			
		KTN-VIADUCTS REHABILITATION PROJECT NO. 68571 WATER STREET BENT #67 PILASTER REPAIR			
		S-3.6			
CHECKED BY: M. FIGLEY DRAWN/REVISED BY: R.S., R.G., C.A.		PATH: PLOT: PSPACE 1=1(F) OR MSPACE 1=1(F)			
REVISIONS		PROJECT DESIGNATION	YEAR	SHEET NO.	TOTAL SHEETS
NO. DATE DESCRIPTION		NH-0902(34)	2009	15	70

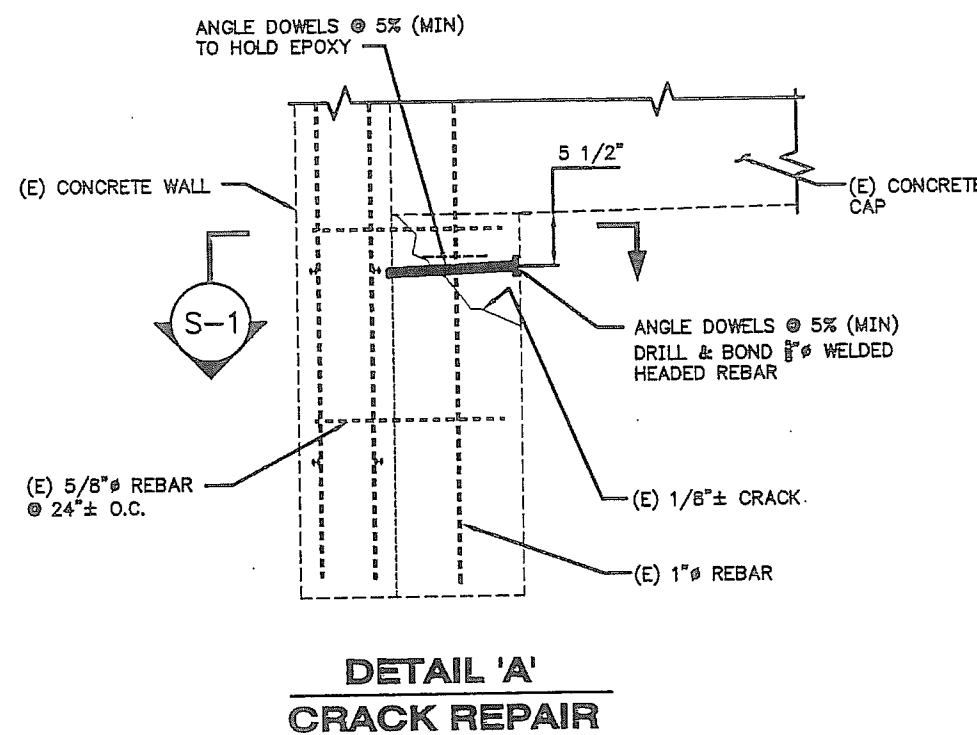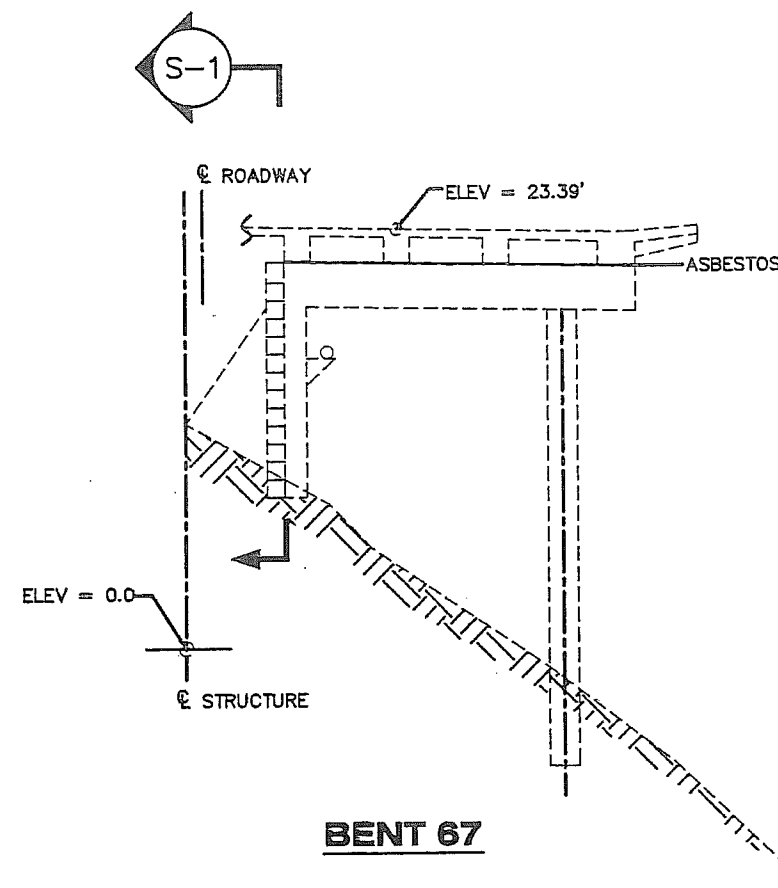


**DETAIL 'A'
CRACK REPAIR**

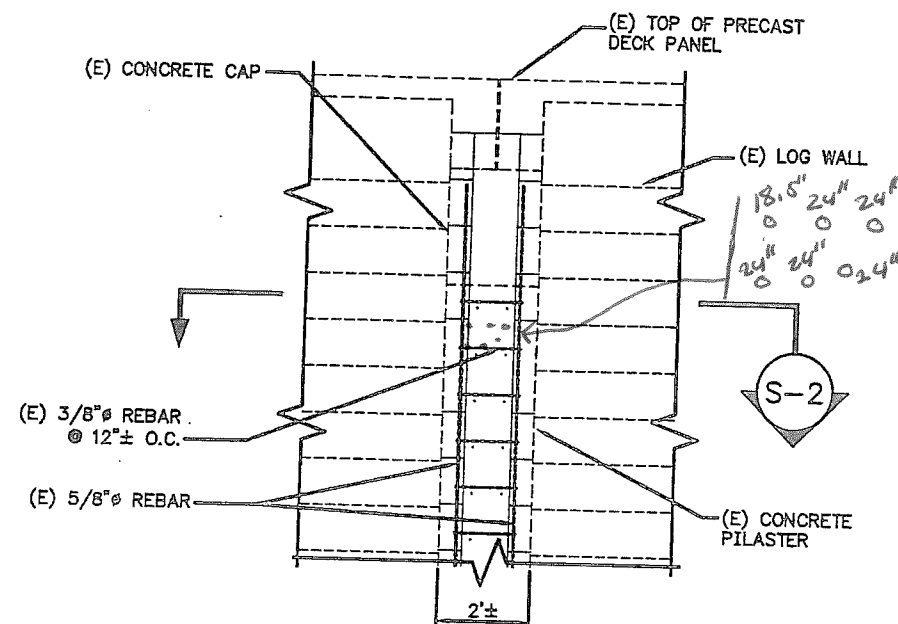


SECTION S-1

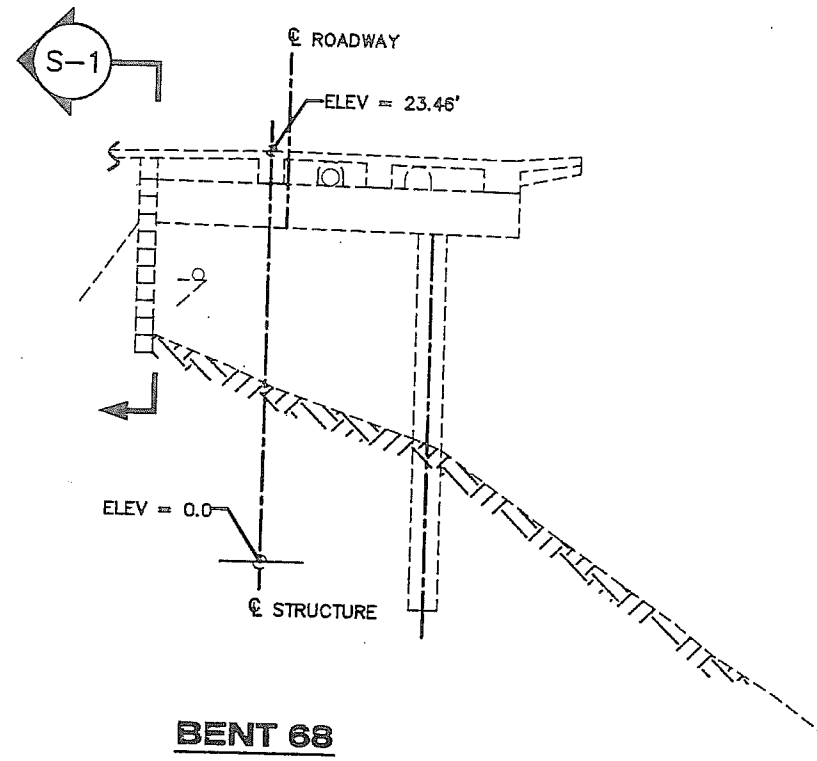


BENT 68

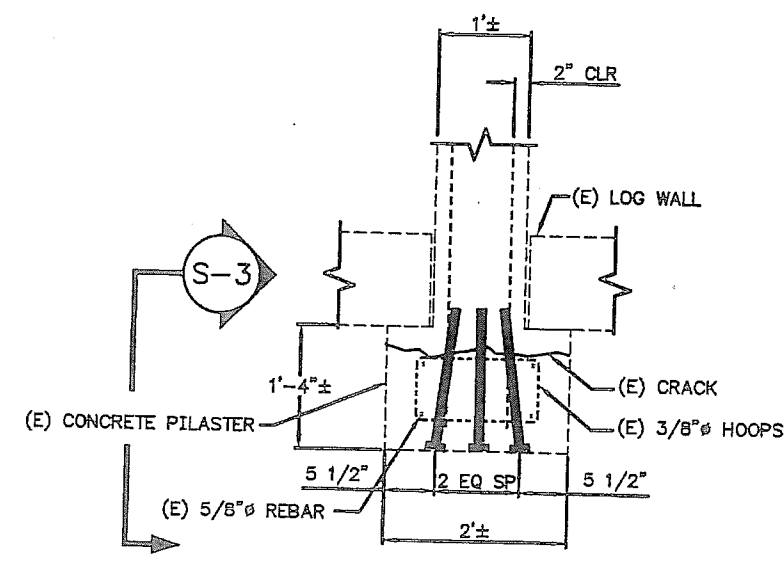

SECTION CRACK REPAIR S-2

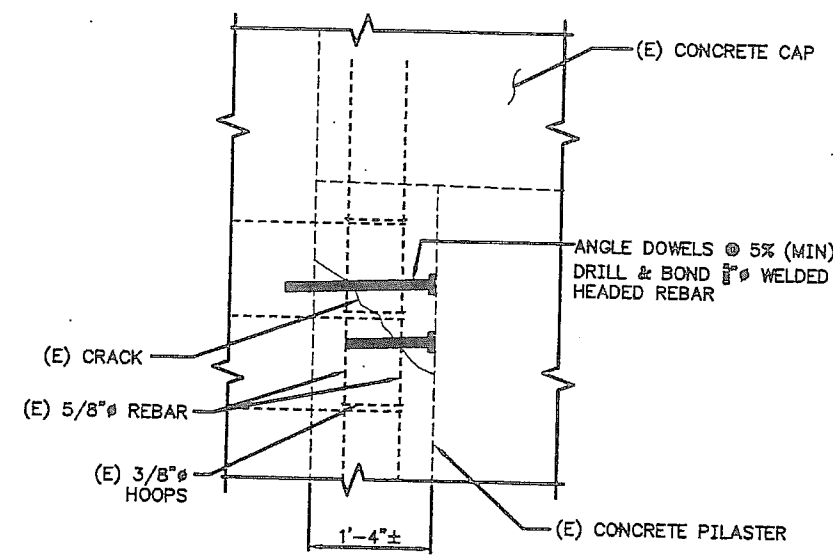

SECTION CRACK REPAIR S-3

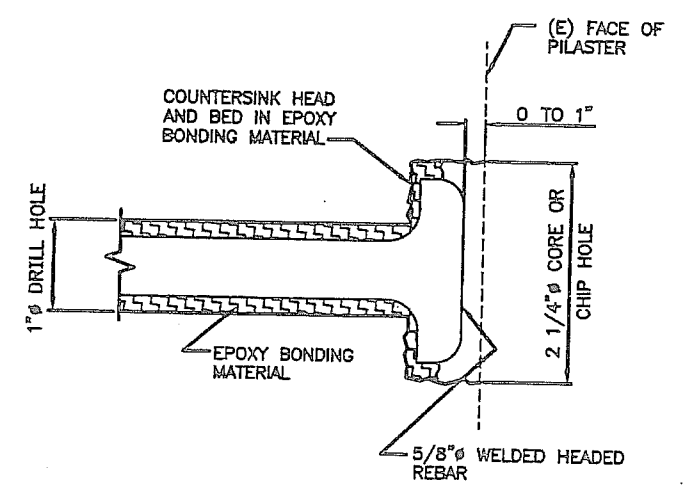

WELDED HEADED REBAR

LEGEND


- DENOTES EXISTING
- DENOTES NEW CONSTRUCTION
- ||||| DENOTES GROUNDLINE
- (E) EXISTING
- ||||| SPALL
- ||||| NEW CONCRETE
- ||||| EPOXY BONDING MATERIAL

NOTES


1. REPAIR ALL SPALLS AND DELAMINATIONS AS OUTLINED IN THE SPECIFICATIONS BEFORE JACKETING.
2. EXACT LOCATION OF DOWELS WILL BE DETERMINED IN ACCORDANCE WITH SECTION 5.01-3.08 OF THE SPECIFICATIONS.
3. COMPLETE INSTALLATION OF WELDED HEADED REINFORCEMENT BEFORE INJECTING CRACK WITH EPOXY.

ELEVATIONS, BENCHMARKS AND DIMENSIONS ARE BASED ON "AS-BUILT" PLANS. VERIFY ALL CONTROLLING FIELD DIMENSIONS BEFORE ORDERING OR FABRICATING ANY MATERIAL.


DESIGNED BY: G. IMBSEN		STATE OF ALASKA DEPARTMENT OF TRANSPORTATION & PUBLIC FACILITIES STATEWIDE DESIGN & ENGINEERING SERVICES DIVISION			
		KTN-VIADUCTS REHABILITATION PROJECT NO. 68571 WATER STREET BENT #68 PILASTER REPAIR			
		S-3.7			
CHECKED BY: M. FIDLEY DRAWN/REVISED BY: R.S., R.O./C.A.		PATH: PLOT: PSPACE 1=1(F) OR MSPACE 1=1(F)			
REVISIONS		PROJECT DESIGNATION		YEAR	SHEET NO.
NO.	DATE	DESCRIPTION			
			NH-0902(34)	2009	16
					TOTAL SHEETS 70

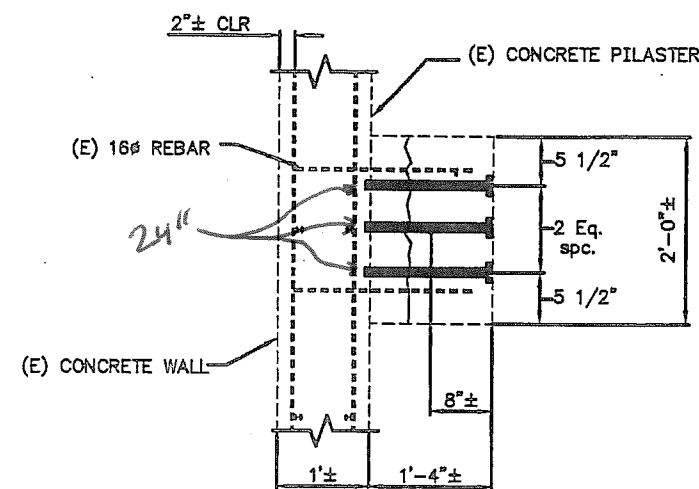


**SECTION
CRACK REPAIR** S-1

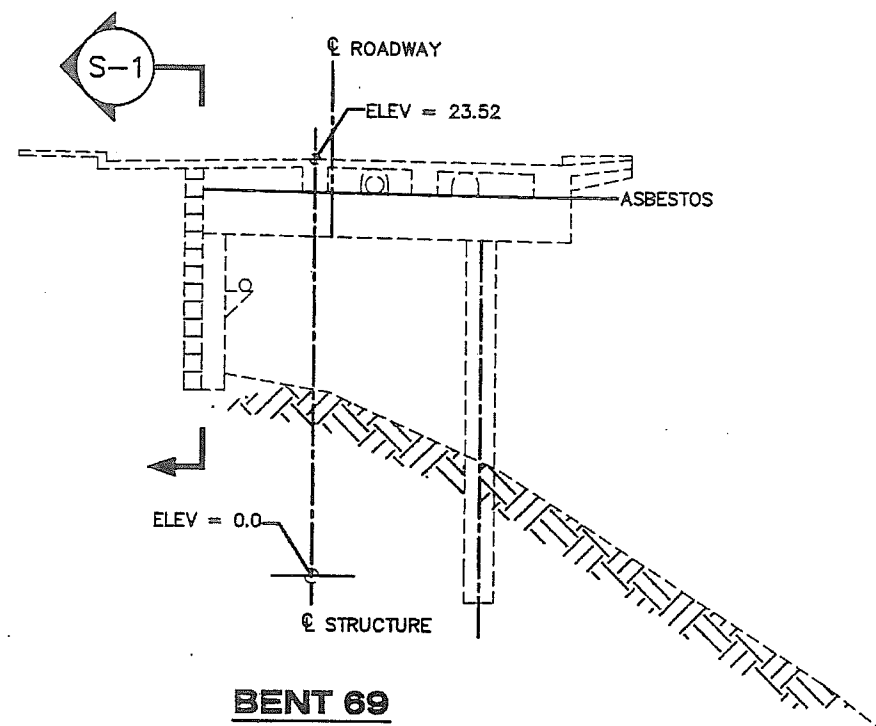

BENT 69

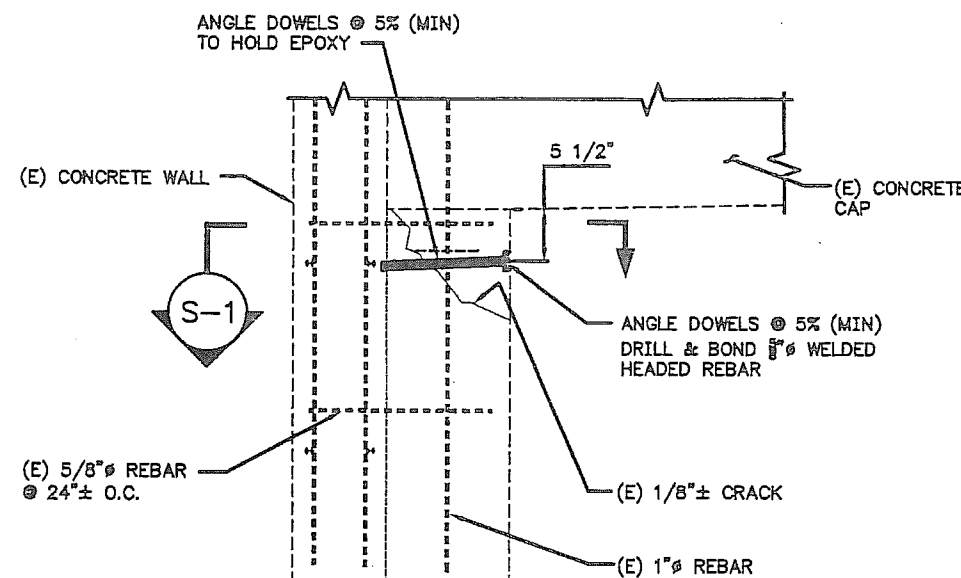

**DETAIL 'A'
CRACK REPAIR**

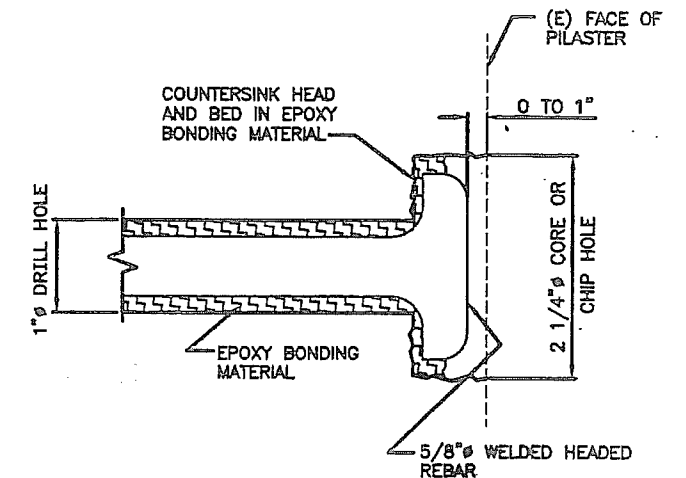

WELDED HEADED REBAR

LEGEND


- DENOTES EXISTING
- DENOTES NEW CONSTRUCTION
- ////// DENOTES GROUNDLINE
- (E) EXISTING
- XXXXXX SPALL
- NEW CONCRETE
- EPOXY BONDING MATERIAL

NOTES


1. REPAIR ALL SPALLS AND DELAMINATIONS AS OUTLINED IN THE SPECIFICATIONS BEFORE JACKETING.
2. EXACT LOCATION OF DOWELS WILL BE DETERMINED IN ACCORDANCE WITH SECTION 5.01-3.08 OF THE SPECIFICATIONS.
3. COMPLETE INSTALLATION OF WELDED HEADED REINFORCEMENT BEFORE INJECTING CRACK WITH EPOXY.

ELEVATIONS, BENCHMARKS AND DIMENSIONS ARE BASED ON "AS-BUILT" PLANS. VERIFY ALL CONTROLLING FIELD DIMENSIONS BEFORE ORDERING OR FABRICATING ANY MATERIAL.


DESIGNED BY: G. IMSEN		STATE OF ALASKA DEPARTMENT OF TRANSPORTATION & PUBLIC FACILITIES STATEWIDE DESIGN & ENGINEERING SERVICES DIVISION			
		KTN-VIADUCTS REHABILITATION PROJECT NO. 68571 WATER STREET BENT #69 PILASTER REPAIR			
		S-3.8			
CHECKED BY: M. FIGLEY		PROJECT DESIGNATION			
DRAWN/REVISED BY: R.S., R.G.C.A.		YEAR			
PATH:		SHEET NO.			
PLOT: PSPACE 1=1(F) OR MSPACE 1=1(F)		TOTAL SHEETS			
NO. DATE REVISIONS DESCRIPTION		NH-0902(34) 2009 17 70			

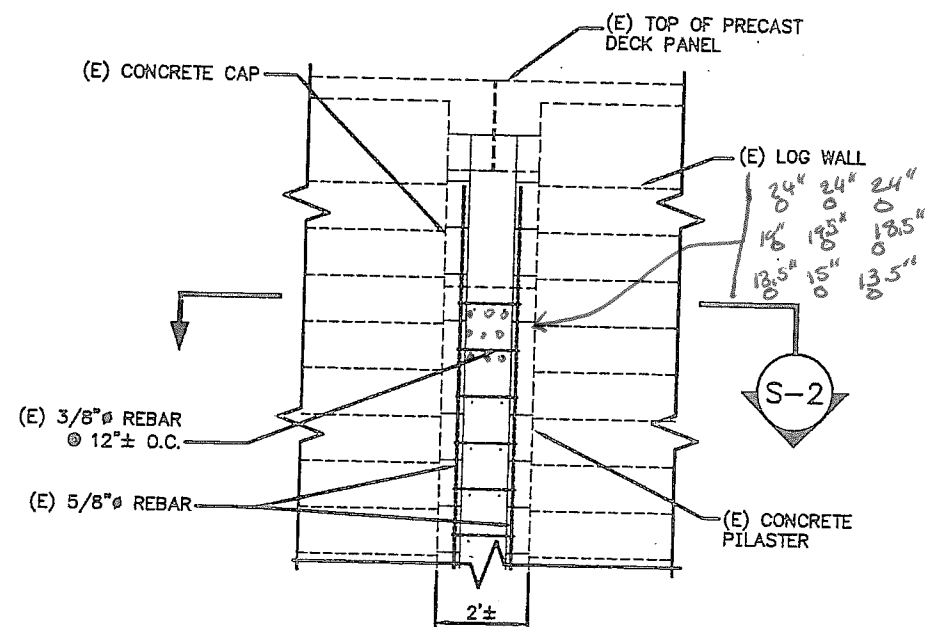

SECTION S-1

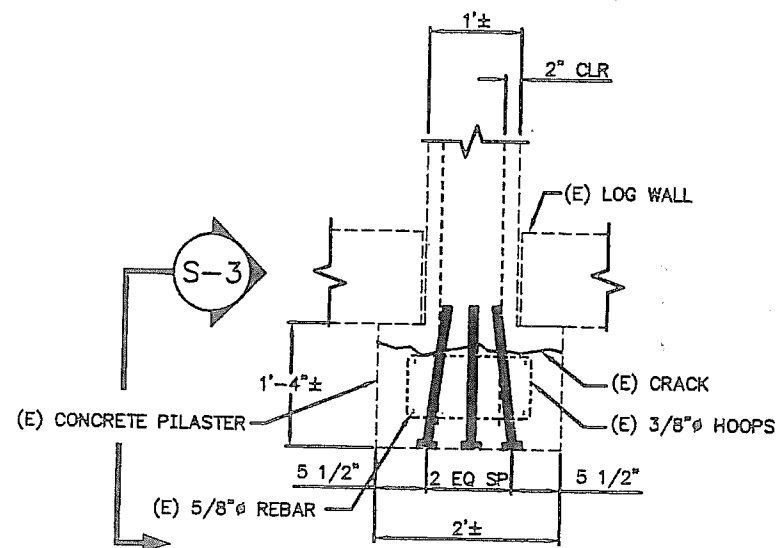

SECTION S-2
CRACK REPAIR

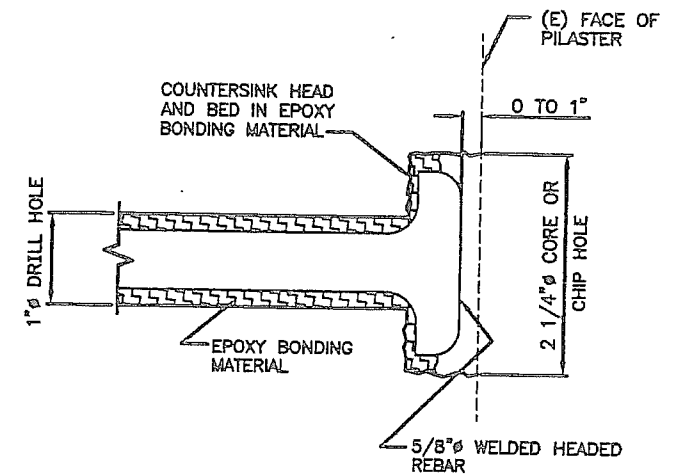

WELDED HEADED REBAR


LEGEND


- DENOTES EXISTING
- DENOTES NEW CONSTRUCTION
- /// DENOTES GROUNDLINE
- (E) EXISTING
- SPALL
- NEW CONCRETE
- EPOXY BONDING MATERIAL

NOTES


- REPAIR ALL SPALLS AND DELAMINATIONS AS OUTLINED IN THE SPECIFICATIONS BEFORE JACKETING.
- EXACT LOCATION OF DOWELS WILL BE DETERMINED IN ACCORDANCE WITH SECTION 5.01-3.08 OF THE SPECIFICATIONS.
- COMPLETE INSTALLATION OF WELDED HEADED REINFORCEMENT BEFORE INJECTING CRACK WITH EPOXY.

ELEVATIONS, BENCHMARKS AND DIMENSIONS ARE BASED ON "AS-BUILT" PLANS. VERIFY ALL CONTROLLING FIELD DIMENSIONS BEFORE ORDERING OR FABRICATING ANY MATERIAL.

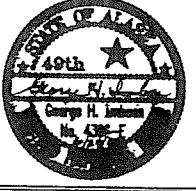DESIGNED BY: G. IMSEN		STATE OF ALASKA DEPARTMENT OF TRANSPORTATION & PUBLIC FACILITIES STATEWIDE DESIGN & ENGINEERING SERVICES DIVISION			
		KTN-VIADUCTS REHABILITATION PROJECT NO. 68571 WATER STREET BENT #70 PILASTER REPAIR			
		S-3.9			
CHECKED BY: M. FIGLEY DRAWN/REVISED BY: R.S., R.C., E.A.		PROJECT DESIGNATION			
PATH:		YEAR			
PLOT: PSPACE 1=1(F) OR WSPACE 1=1(F)		SHEET NO.			
NO.		DATE		TOTAL SHEETS	
DESCRIPTION		NH-0902(34)			
		2009 18 70			

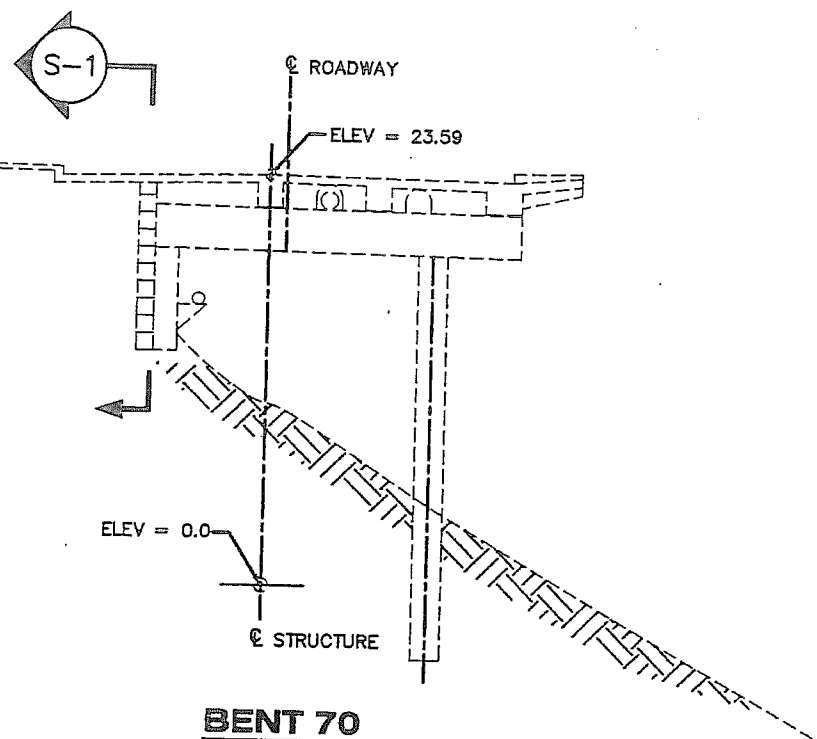

BENT 70

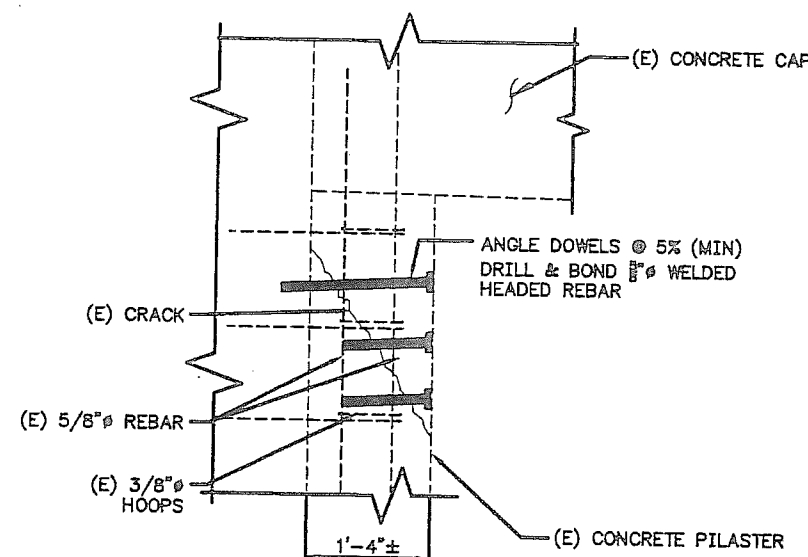


SECTION S-3
CRACK REPAIR




1. REPAIR ALL SPALLS AND DELAMINATIONS AS OUTLINED IN THE SPECIFICATIONS BEFORE JACKETING.
2. EXACT LOCATION OF DOWELS WILL BE DETERMINED IN ACCORDANCE WITH SECTION 5.01-3.08 OF THE SPECIFICATIONS.
3. COMPLETE INSTALLATION OF WELDED HEADED REINFORCEMENT BEFORE INJECTING CRACK WITH EPOXY.

ELEVATIONS, BENCHMARKS AND DIMENSIONS ARE BASED ON "AS-BUILT"
PLANS. VERIFY ALL CONTROLLING FIELD DIMENSIONS BEFORE ORDERING
OR FABRICATING ANY MATERIAL.


DESIGNED BY: G. IMBSEN		STATE OF ALASKA DEPARTMENT OF TRANSPORTATION & PUBLIC FACILITIES STATEWIDE DESIGN & ENGINEERING SERVICES DIVISION KTN-VIADUCTS REHABILITATION PROJECT NO. 68571 WATER STREET BENT #71 PILASTER REPAIR																		
		CHECKED BY: M. FIGLEY DRAWN/REVISED BY: R.S., R.G., C.A. PATH: PLOT: PSPACE 1=1(F) OR MSPACE 1=1(F)																		
<table border="1"> <thead> <tr> <th colspan="3">REVISIONS</th> </tr> <tr> <th>NO.</th> <th>DATE</th> <th>DESCRIPTION</th> </tr> </thead> <tbody> <tr><td> </td><td> </td><td> </td></tr> <tr><td> </td><td> </td><td> </td></tr> <tr><td> </td><td> </td><td> </td></tr> </tbody> </table>		REVISIONS			NO.	DATE	DESCRIPTION										PROJECT DESIGNATION	YEAR	SHEET NO.	TOTAL SHEETS
REVISIONS																				
NO.	DATE	DESCRIPTION																		
		NH-0902(34)	2009	19	70															

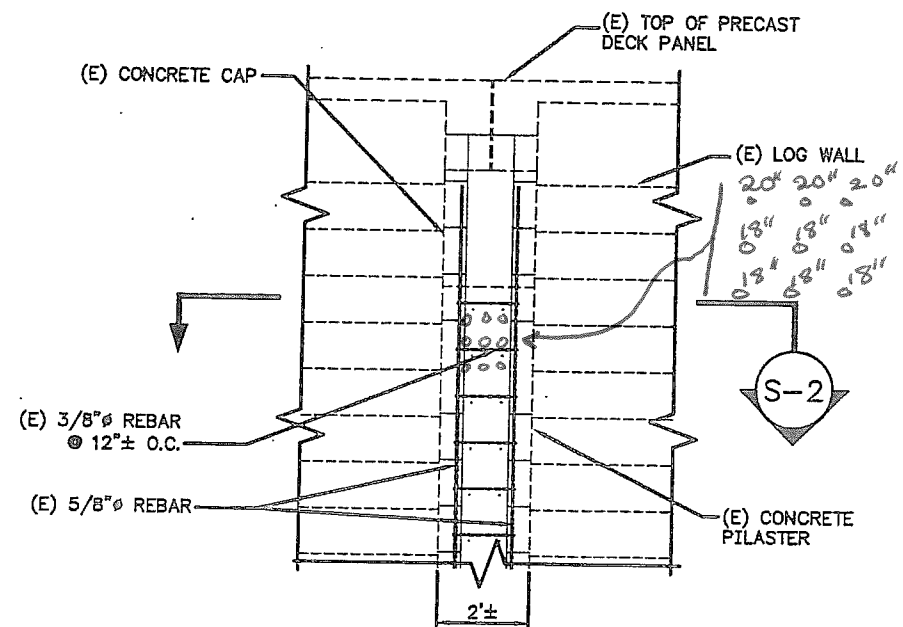

SECTION S-1

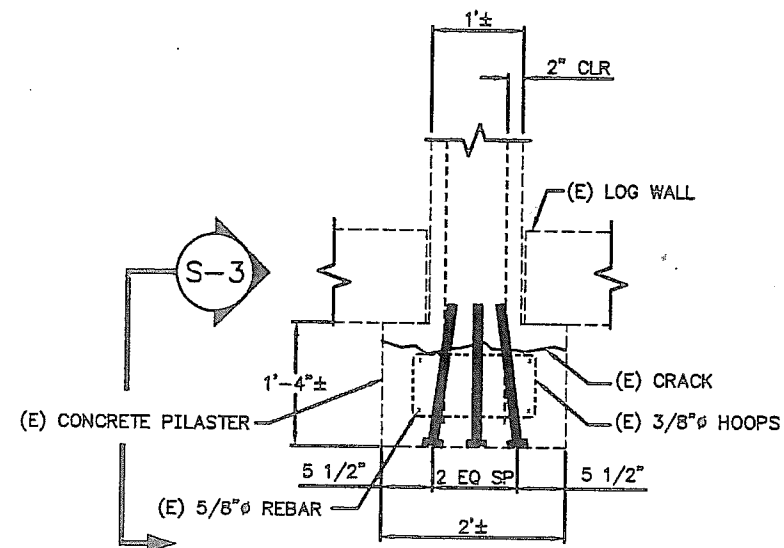

SECTION CRACK REPAIR S-2

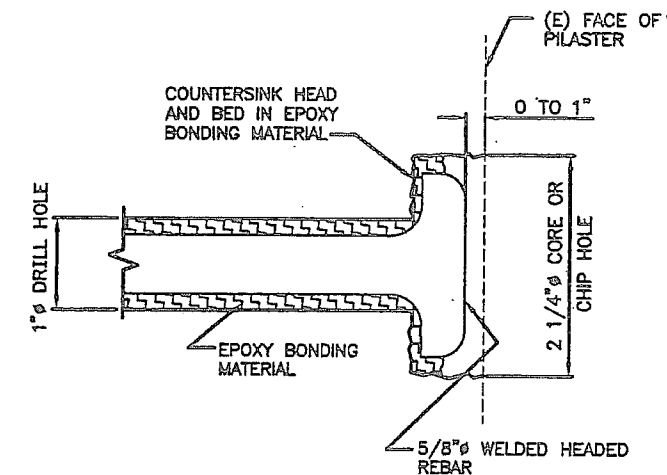

WELDED HEADED REBAR

LEGEND


- DENOTES EXISTING
- DENOTES NEW CONSTRUCTION
- /// DENOTES GROUNDLINE
- (E) EXISTING
- ▨ SPALL
- ▤ NEW CONCRETE
- ▦ EPOXY BONDING MATERIAL

NOTES

1. REPAIR ALL SPALLS AND DELAMINATIONS AS OUTLINED IN THE SPECIFICATIONS BEFORE JACKETING.
2. EXACT LOCATION OF DOWELS WILL BE DETERMINED IN ACCORDANCE WITH SECTION 5.01-3.08 OF THE SPECIFICATIONS.
3. COMPLETE INSTALLATION OF WELDED HEADED REINFORCEMENT BEFORE INJECTING CRACK WITH EPOXY.


ELEVATIONS, BENCHMARKS AND DIMENSIONS ARE BASED ON "AS-BUILT" PLANS. VERIFY ALL CONTROLLING FIELD DIMENSIONS BEFORE ORDERING OR FABRICATING ANY MATERIAL.

DESIGNED BY: G. IMSEN		STATE OF ALASKA DEPARTMENT OF TRANSPORTATION & PUBLIC FACILITIES STATEWIDE DESIGN & ENGINEERING SERVICES DIVISION				
		KTN-VIADUCTS REHABILITATION PROJECT NO. 68571 WATER STREET BENT #72 PILASTER REPAIR				
		S-3.11				
CHECKED BY: M. FIGLEY DRAWN/REVISED BY: R.S., R.G., C.A.		PATH: PSPACE 1=1(F) OR MSPACE 1=1(F)				
PLOT: PSPACE 1=1(F) OR MSPACE 1=1(F)		REVISIONS				
NO.	DATE	DESCRIPTION	PROJECT DESIGNATION	YEAR	SHEET NO.	TOTAL SHEETS
			NH-0902(34)	2009	20	70

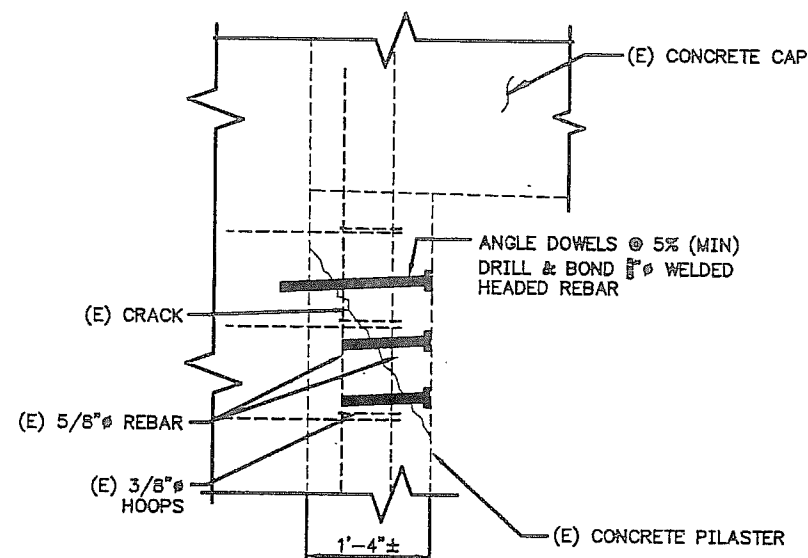


SECTION CRACK REPAIR S-3

BENT 72

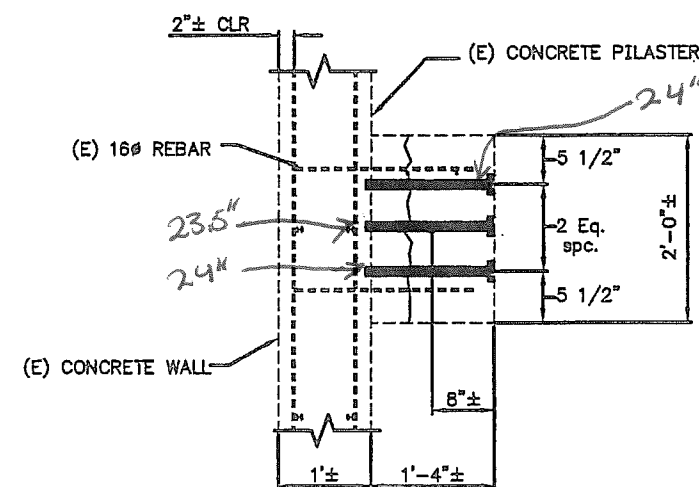

**SECTION
CRACK REPAIR** S-1

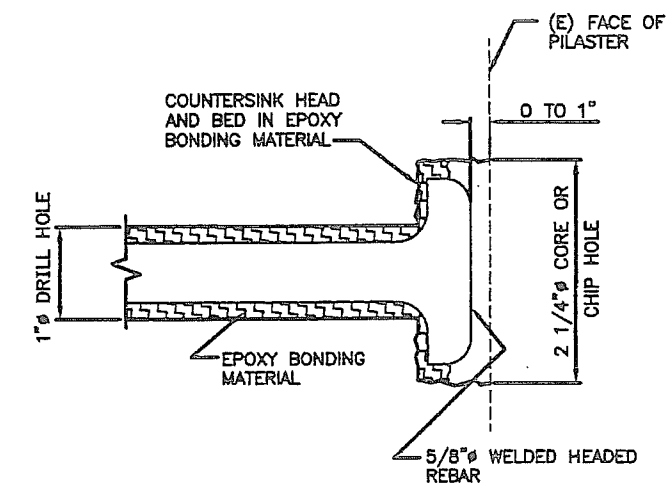

WELDED HEADED REBAR

LEGEND


- DENOTES EXISTING
- DENOTES NEW CONSTRUCTION
- /// DENOTES GROUNDLINE
- (E) EXISTING
- ▨ SPALL
- NEW CONCRETE
- ▤ EPOXY BONDING MATERIAL

NOTES


- REPAIR ALL SPALLS AND DELAMINATIONS AS OUTLINED IN THE SPECIFICATIONS BEFORE JACKETING.
- EXACT LOCATION OF DOWELS WILL BE DETERMINED IN ACCORDANCE WITH SECTION 5.01-3.08 OF THE SPECIFICATIONS.
- COMPLETE INSTALLATION OF WELDED HEADED REINFORCEMENT BEFORE INJECTING CRACK WITH EPOXY.

ELEVATIONS, BENCHMARKS AND DIMENSIONS ARE BASED ON "AS-BUILT" PLANS. VERIFY ALL CONTROLLING FIELD DIMENSIONS BEFORE ORDERING OR FABRICATING ANY MATERIAL.


DESIGNED BY: G. IMBSEN		STATE OF ALASKA DEPARTMENT OF TRANSPORTATION & PUBLIC FACILITIES STATEWIDE DESIGN & ENGINEERING SERVICES DIVISION			
		KTN-VIADUCTS REHABILITATION PROJECT NO. 68571 WATER STREET BENT #73 PILASTER REPAIR			
		S-3.12			
CHECKED BY: M. FIGLEY DRAWN/REVISED BY: R.S., R.G., C.A.		PROJECT DESIGNATION		YEAR	SHEET NO.
PATH: PLOT: PSPACE 1=1(F) OR MSPACE 1=1(F)		NH-0902(34)		2009	21
REVISIONS		TOTAL SHEETS			
NO.	DATE	DESCRIPTION			

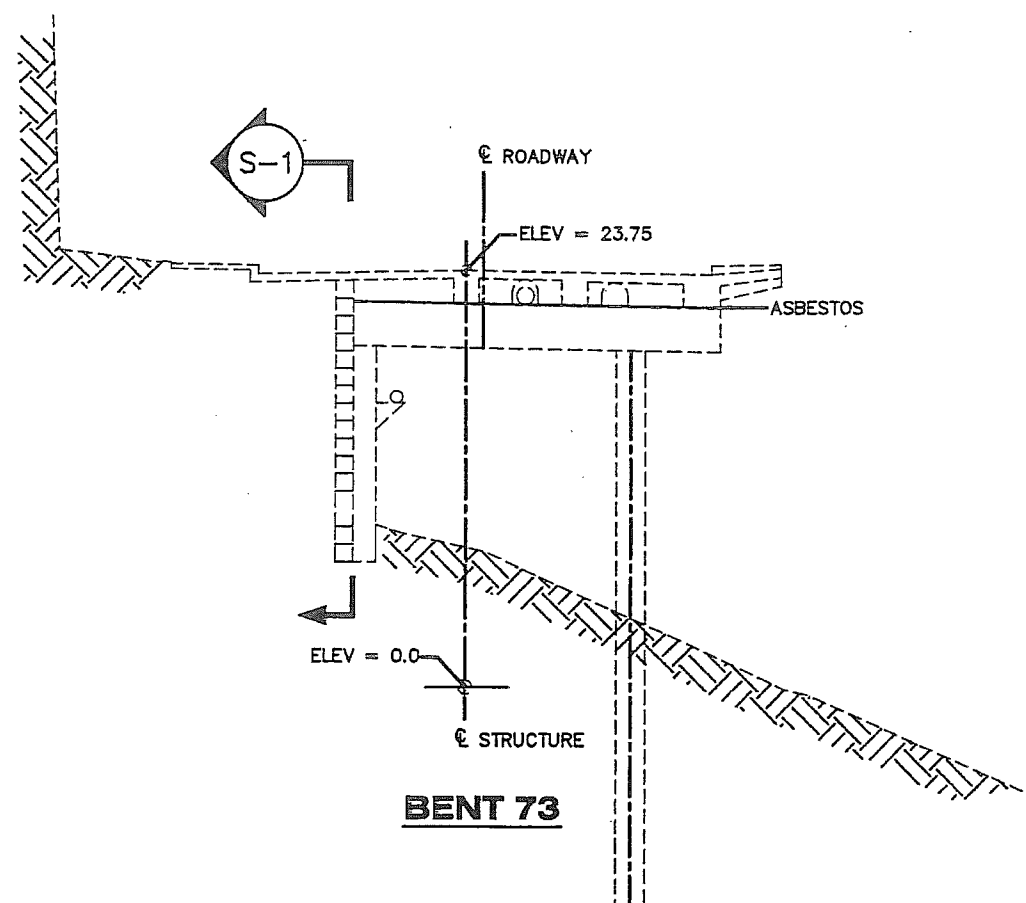



BENT 73

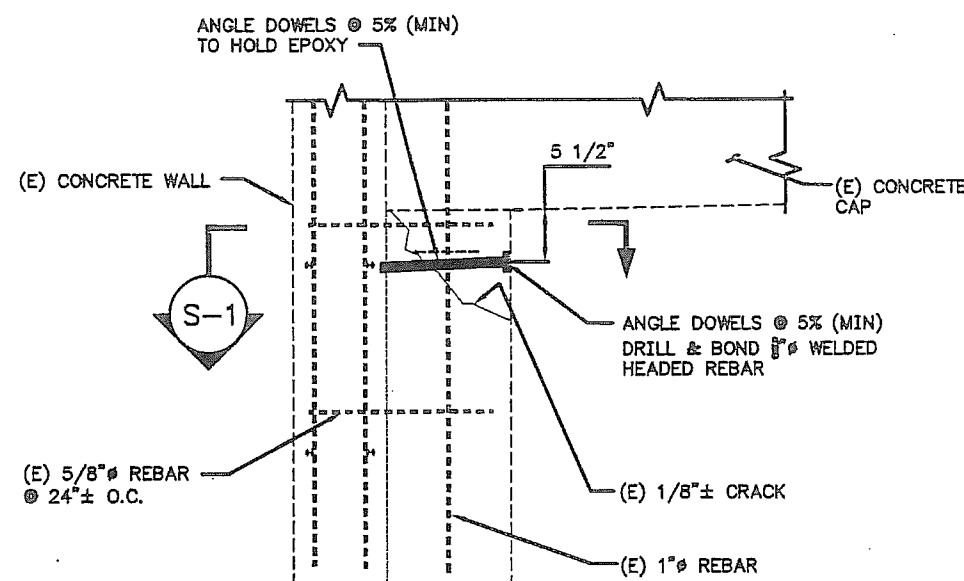


**DETAIL 'A'
CRACK REPAIR**

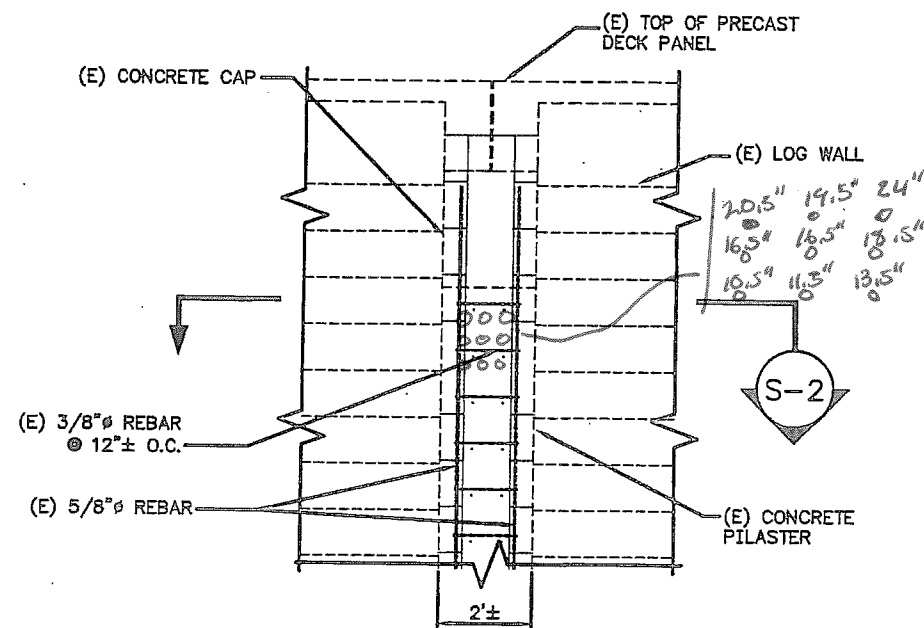


SECTION S-1

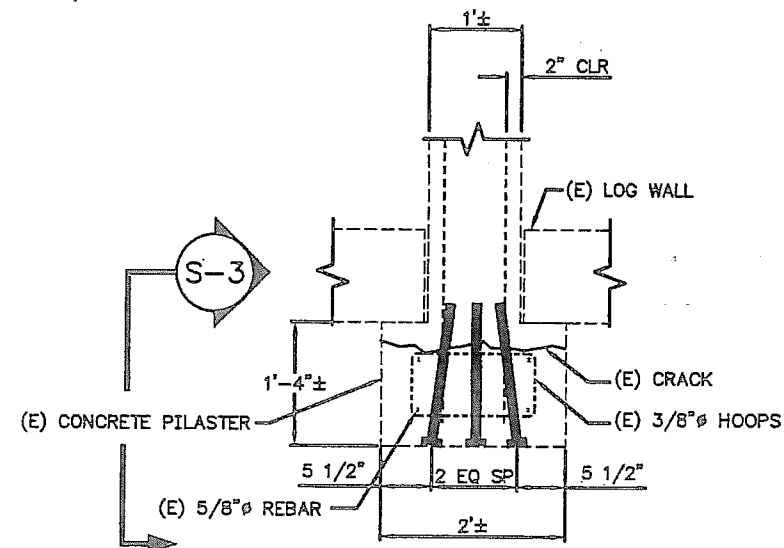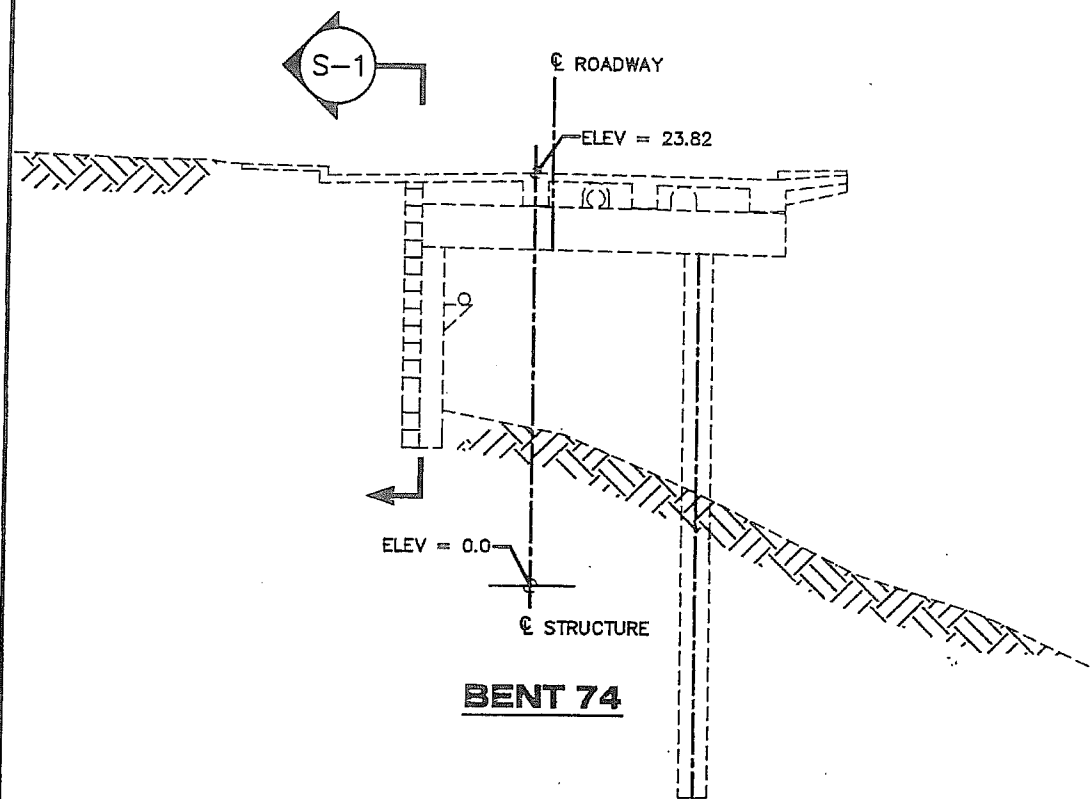

**SECTION S-2
CRACK REPAIR**

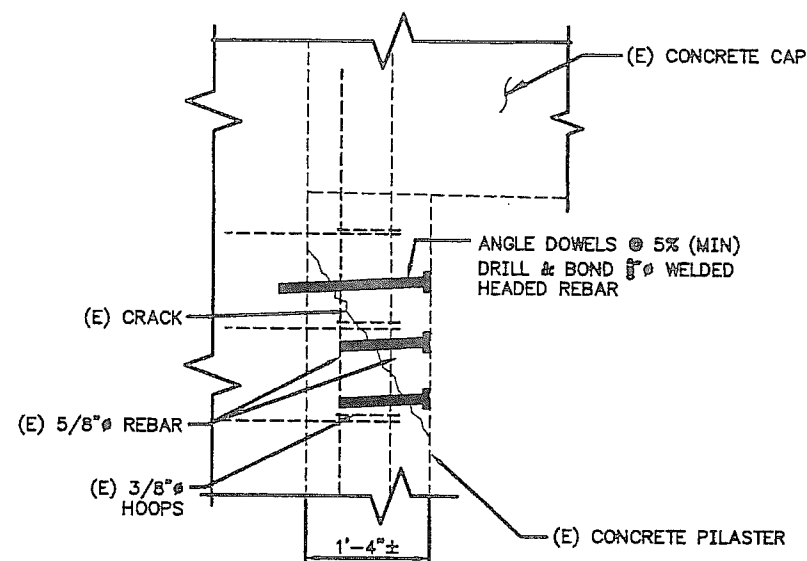

**SECTION S-3
CRACK REPAIR**

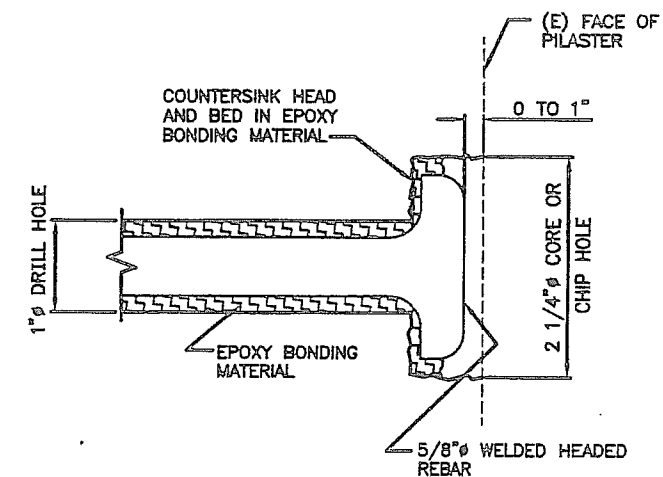

WELDED HEADED REBAR


LEGEND


- DENOTES EXISTING
- DENOTES NEW CONSTRUCTION
- /// DENOTES GROUNDLINE
- (E) EXISTING
- SPALL
- NEW CONCRETE
- EPOXY BONDING MATERIAL

NOTES


1. REPAIR ALL SPALLS AND DELAMINATIONS AS OUTLINED IN THE SPECIFICATIONS BEFORE JACKETING.
2. EXACT LOCATION OF DOWELS WILL BE DETERMINED IN ACCORDANCE WITH SECTION 5.01-3.08 OF THE SPECIFICATIONS.
3. COMPLETE INSTALLATION OF WELDED HEADED REINFORCEMENT BEFORE INJECTING CRACK WITH EPOXY.

ELEVATIONS, BENCHMARKS AND DIMENSIONS ARE BASED ON "AS-BUILT" PLANS. VERIFY ALL CONTROLLING FIELD DIMENSIONS BEFORE ORDERING OR FABRICATING ANY MATERIAL.

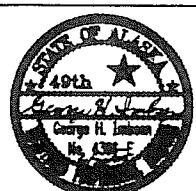
DESIGNED BY: G. IMSEN		STATE OF ALASKA DEPARTMENT OF TRANSPORTATION & PUBLIC FACILITIES STATEWIDE DESIGN & ENGINEERING SERVICES DIVISION			
		KTN-VIADUCTS REHABILITATION PROJECT NO. 68571 WATER STREET BENT #74 PILASTER REPAIR			
CHECKED BY: M. FIGLEY		S-3.13			
DRAWN/REVISED BY: R.S., R.G., C.A.					
PATH:					
PLOT: PSPACE 1=1(F) OR MSPACE 1=1(F)					
REVISIONS		PROJECT DESIGNATION	YEAR	SHEET NO.	TOTAL SHEETS
NO.	DATE	DESCRIPTION			
			NH-0902(34)	2009	22
					70

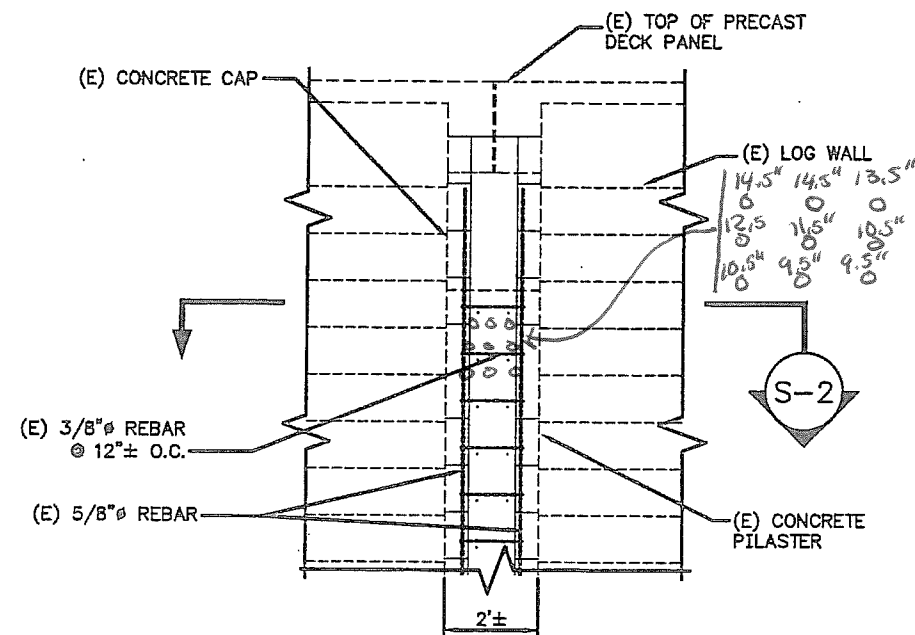

SECTION S-1

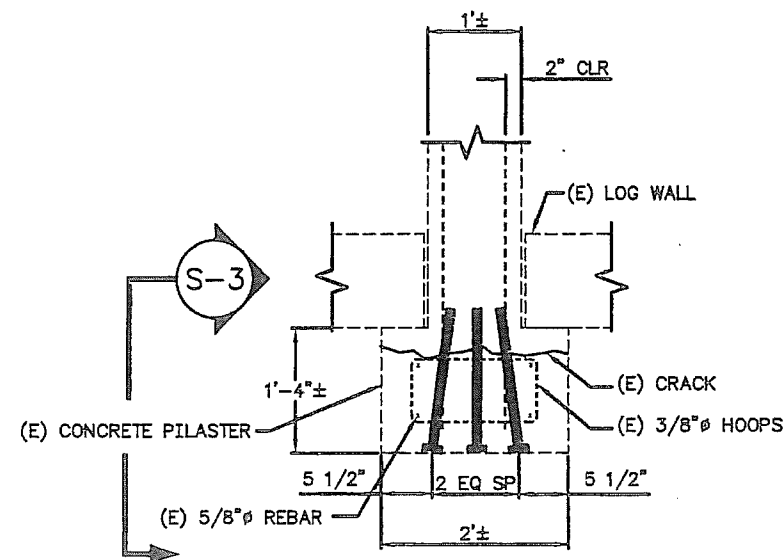

**SECTION S-2
CRACK REPAIR**

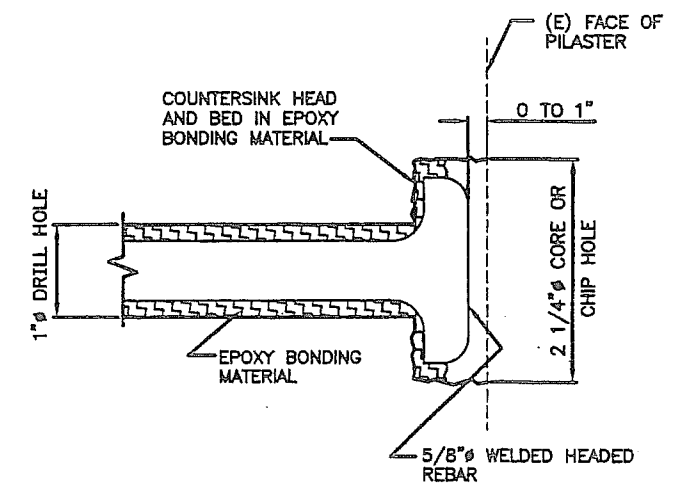

WELDED HEADED REBAR


LEGEND

- DENOTES EXISTING
- DENOTES NEW CONSTRUCTION
- ////// DENOTES GROUNDLINE
- (E) EXISTING
- XXXXXX SPALL
- NEW CONCRETE
- XXXXXX EPOXY BONDING MATERIAL


NOTES

1. REPAIR ALL SPALLS AND DELAMINATIONS AS OUTLINED IN THE SPECIFICATIONS BEFORE JACKETING.
2. EXACT LOCATION OF DOWELS WILL BE DETERMINED IN ACCORDANCE WITH SECTION 5.01-3.08 OF THE SPECIFICATIONS.
3. COMPLETE INSTALLATION OF WELDED HEADED REINFORCEMENT BEFORE INJECTING CRACK WITH EPOXY.

ELEVATIONS, BENCHMARKS AND DIMENSIONS ARE BASED ON "AS-BUILT" PLANS. VERIFY ALL CONTROLLING FIELD DIMENSIONS BEFORE ORDERING OR FABRICATING ANY MATERIAL.

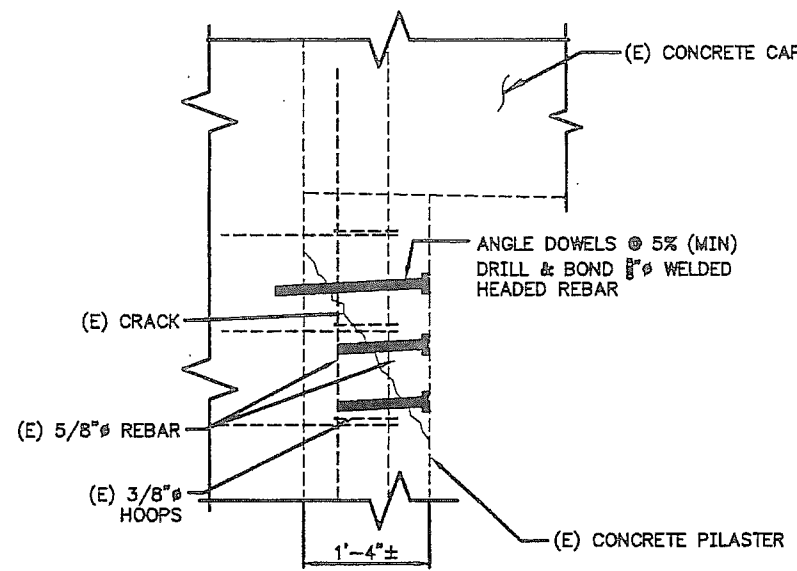

**SECTION S-3
CRACK REPAIR**

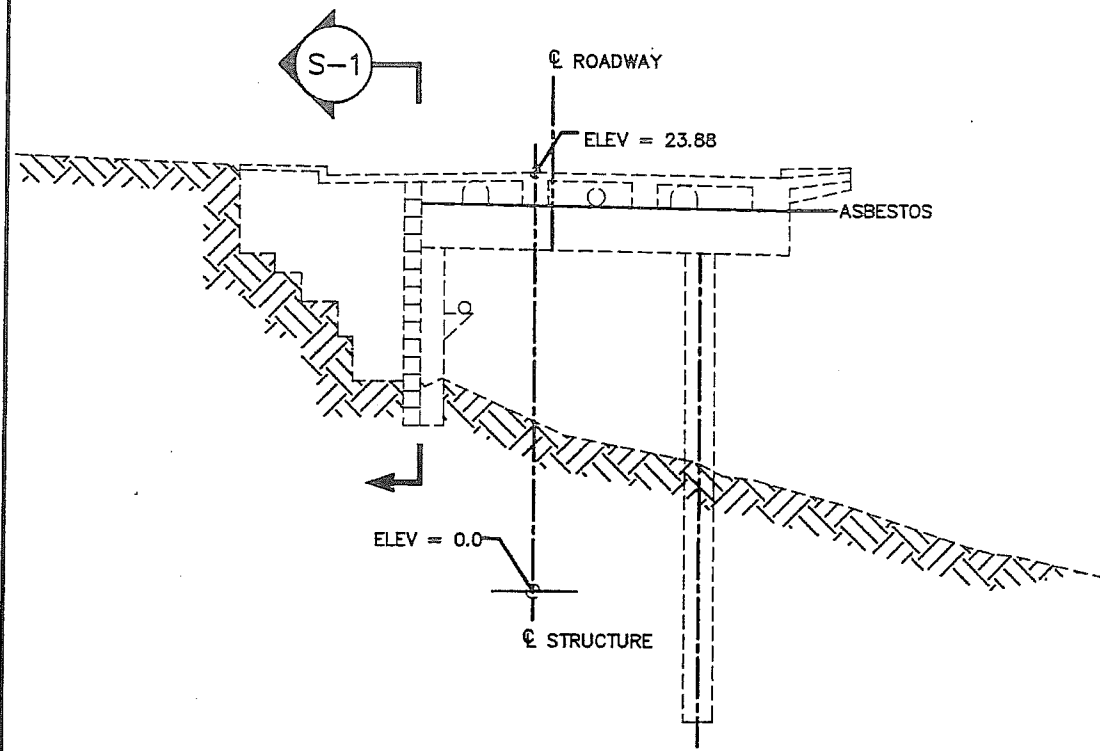


BENT 75

DESIGNED BY: G. IMSEN		STATE OF ALASKA DEPARTMENT OF TRANSPORTATION & PUBLIC FACILITIES STATEWIDE DESIGN & ENGINEERING SERVICES DIVISION			
		KTN-VIADUCTS REHABILITATION PROJECT NO. 68571			
		WATER STREET BENT #75 PILASTER REPAIR			
CHECKED BY: M. FIGLEY DRAWN/REVISED BY: R.S., R.G., C.A.		S-3.14			
PATH: PSPACE 1=1(F) OR WSPACE 1=1(F)					
REVISIONS		PROJECT DESIGNATION			
NO.	DATE	DESCRIPTION	YEAR		
			SHEET NO.		
			TOTAL SHEETS		
			NH-0902(34)		
			2009		
			23		
			70		

MISCELLANEOUS CONCRETE REPAIRS TO TONGASS AVENUE VIADUCT		
BENT/ SPAN**	CAP, PILES, DECK, GIRDER, DIAPHRAGMS	CAP, PILES, GIRDER, DIAPHRAGMS
	SPALL/DELAM (FT)	CRACKS (FT)
10	80	3
9	10	
8	20	
7	80	3
6	80	22
5	90	22
4	100	0
3	140	6
2	140	6
1	140	
1A	100	
2A	240	9
3A	275	4
4A	200	6
5A	200	
6A	150	6
7A	150	5
8A	150	6
9A	120	13
TOTAL *	2465	105

* These quantities are estimates based on visual inspection and quantities encountered in previous work. The actual quantities will be determined as part of the bid item work.

* **Span numbers between Bents 1 through 10 are numbered as the lower bent number supporting the span. Span numbers between Bents 1 through 9A are numbered with the higher "A" number, the span between Bents 1 & 1A being Span 1A.

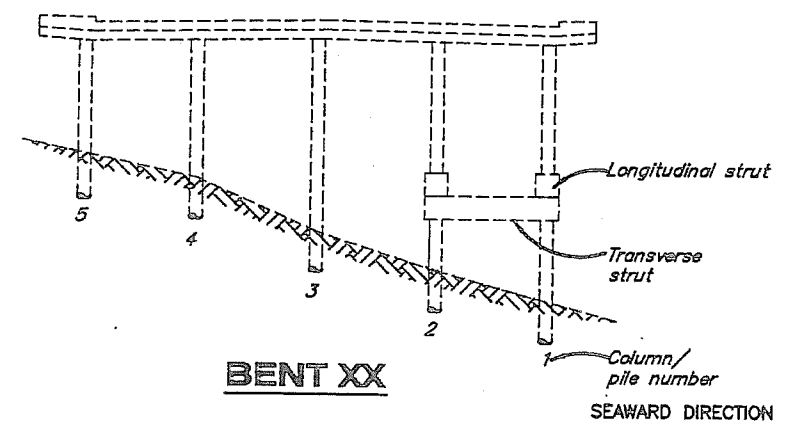

LEGEND


(E) = Existing
 ----- = Existing
 ————— = Proposed

NOTES:


1. Inject cracks identified in table as outlined in Alaska Specification Special Provisions.
2. Repair all spalls and delaminations identified in table as outlined in Alaska Specification Special Provisions before jacketing. Vertical surfaces that will be jacketed need not be hand patched.

ELEVATIONS, BENCHMARKS AND DIMENSIONS ARE BASED ON "AS-BUILT" PLANS. VERIFY ALL CONTROLLING FIELD DIMENSIONS BEFORE ORDERING OR FABRICATING ANY MATERIAL.

DESIGNED BY: George Imbeen		STATE OF ALASKA DEPARTMENT OF TRANSPORTATION & PUBLIC FACILITIES STATEWIDE DESIGN & ENGINEERING SERVICES DIVISION				
		KTN-VIADUCTS REHABILITATION PROJECT NO. 68571 TONGASS AVENUE MISCELLANEOUS CONCRETE REPAIRS				
CHECKED BY: Mark Figley						
DRAWN/REVISED BY: R.S., R.G.						
PATH:						
PLOT: PSPACE 1=1(F) OR MSPACE 1=1(F)		S-4.0				
REVISIONS		PROJECT DESIGNATION		YEAR	SHEET NO.	TOTAL SHEETS
NO.	DATE	DESCRIPTION				
				NH-0902(34)	2009	24
						70

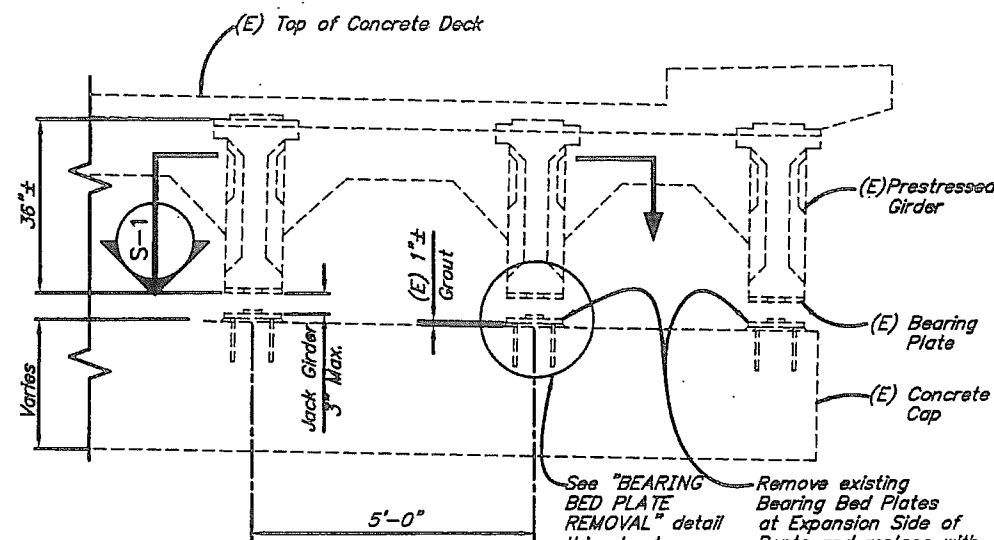


EXISTING TYPICAL SECTION

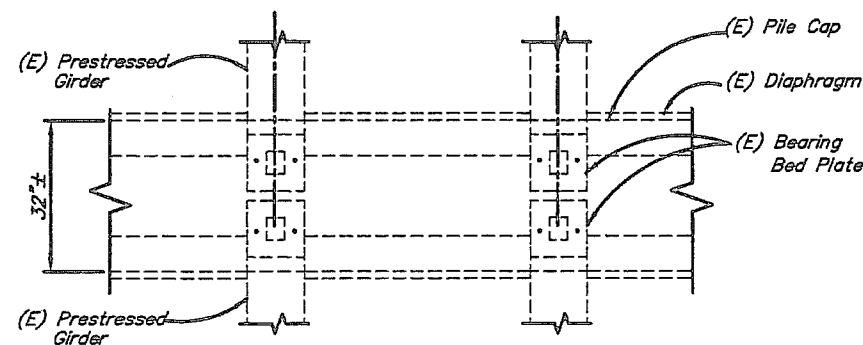


SECTION @ BENTS


S-1

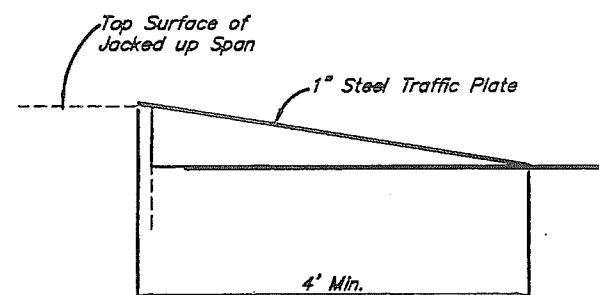


DECK STEP WEDGE

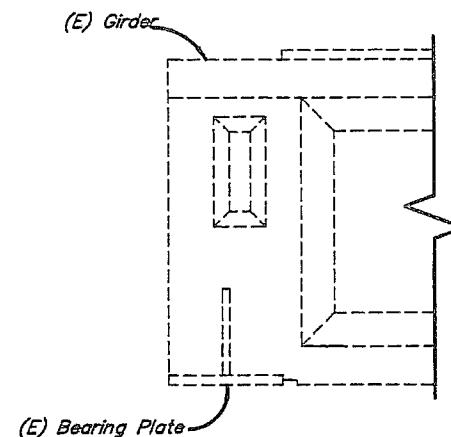


GIRDER END

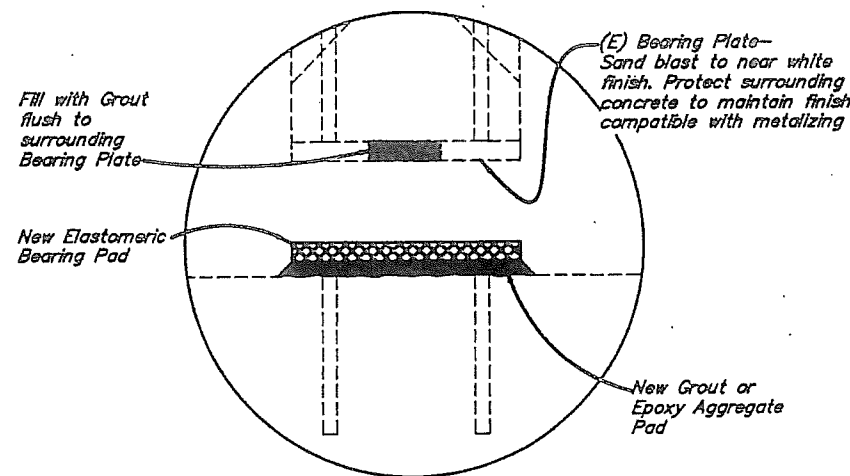


NEW BEARING PAD INSTALLATION

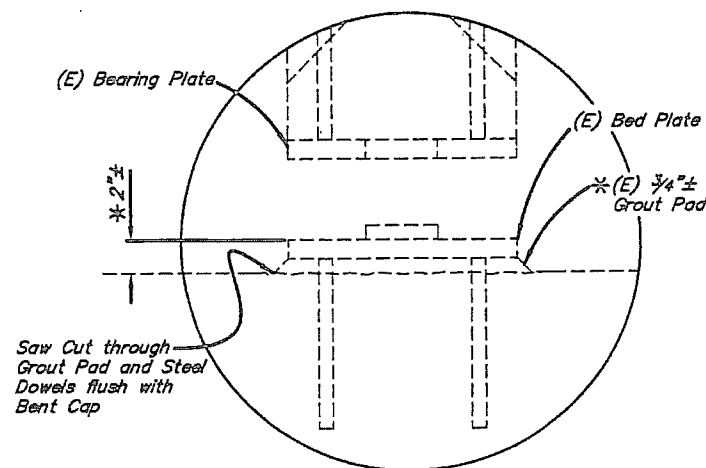


BEARING BED PLATE REMOVAL

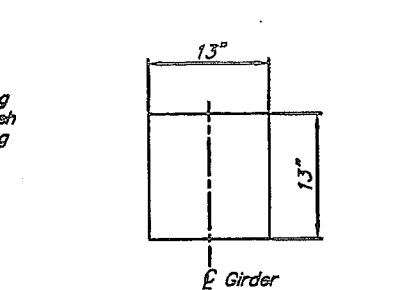


ELASTOMERIC PAD

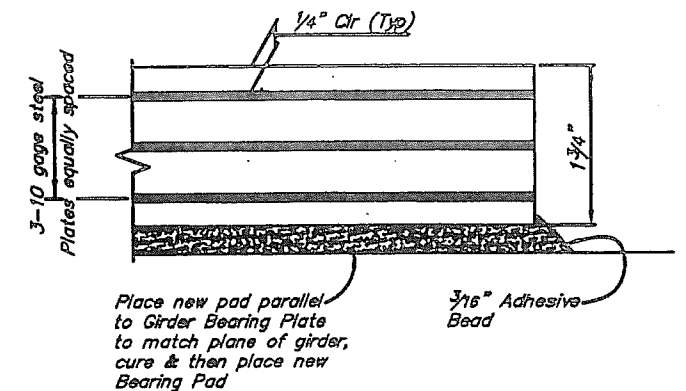



ELASTOMERIC PAD SECTION

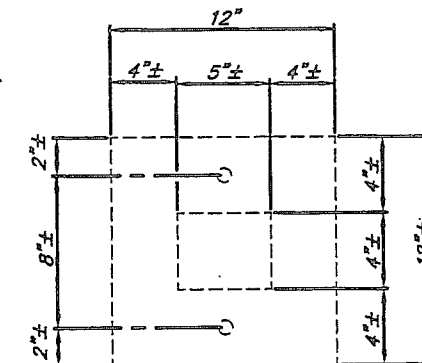

EXISTING BEARING PLATE

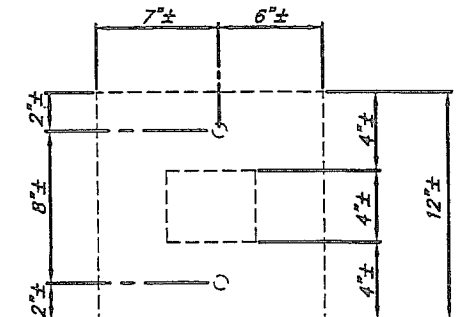

EXISTING BEARING BED PLATE

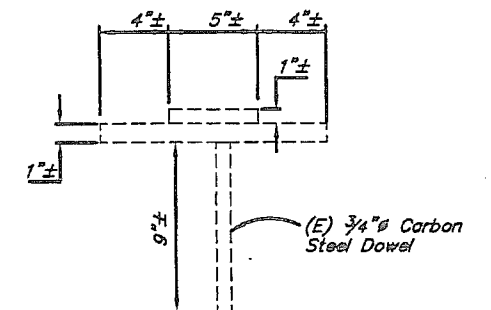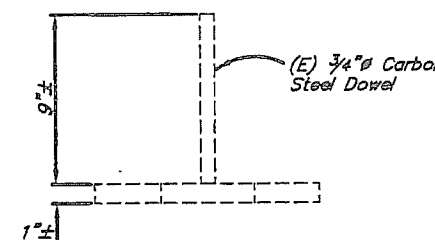

LEGEND

- (E) = Existing
- = Existing
- = Proposed

NOTES:

Elevations, Bearings and Dimensions are based on "AS-BUILT" plans. Verify all controlling field dimensions before ordering or fabricating any material.

Hot dip galvanize all shims after fabrication.

* Field verify dimensions for replacement with elastomeric pad thickness as shown.


ELEVATIONS, BENCHMARKS AND DIMENSIONS ARE BASED ON "AS-BUILT" PLANS. VERIFY ALL CONTROLLING FIELD DIMENSIONS BEFORE ORDERING OR FABRICATING ANY MATERIAL.

DESIGNED BY: George Imbean		STATE OF ALASKA DEPARTMENT OF TRANSPORTATION & PUBLIC FACILITIES STATEWIDE DESIGN & ENGINEERING SERVICES DIVISION KTN-VIADUCTS REHABILITATION PROJECT NO. 68571				
CHECKED BY: Mark Figley						
DRAWN/REVISED BY: R.S., R.G.						
PATH:		TONGASS AVE. BEARING REPLACEMENT S-4.1				
PLOT: PSPACE 1=1(F) OR MSPACE 1=1(F)						
REVISIONS		PROJECT DESIGNATION	YEAR	SHEET NO.	TOTAL SHEETS	
NO.	DATE	DESCRIPTION	NH-0902(34)	2009	25	70

MISCELLANEOUS CONCRETE REPAIRS TO WATER STREET VIADUCT		
BENT/SPAN **	BENT & SPAN	
	SPALL/DELAM (FT ²)	CRACKS (FT)
64	20	
65	65	14
66	45	8
67	55	7
68	65	12
69	65	15
70	65	15
71	65	7
72	55	7
73	55	7
74	45	7
75	45	7
76	150	9
TOTAL *	710	115

NOTE:

* These quantities are estimates based on visual inspection and quantities encountered in previous work. The actual quantities will be determined as part of the bid item work.

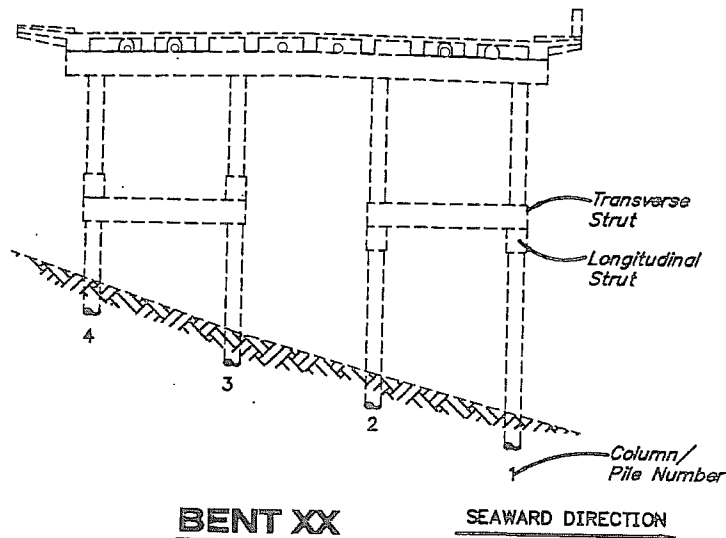

LEGEND

- (E) = Existing
- = Existing
- = Proposed

NOTES:

1. Inject cracks identified in table as outlined in Ak. Specification Special Provisions.
2. Repair all spalls and delaminations identified in table as outlined in Ak. Specification Special Provisions before jacking. Vertical surfaces that will be jacked need not be hand patched.


** Spans are numbered to the lower bent number supporting the span.

ELEVATIONS, BENCHMARKS AND DIMENSIONS ARE BASED ON "AS-BUILT" PLANS. VERIFY ALL CONTROLLING FIELD DIMENSIONS BEFORE ORDERING OR FABRICATING ANY MATERIAL.

DESIGNED BY: George Imbeon		STATE OF ALASKA DEPARTMENT OF TRANSPORTATION & PUBLIC FACILITIES STATEWIDE DESIGN & ENGINEERING SERVICES DIVISION				
		KTN-VIADUCTS REHABILITATION PROJECT NO. 68571 WATER STREET MISCELLANEOUS CONCRETE REPAIRS				
CHECKED BY: Mark Figley						
DRAWN/REVISED BY: R.S., R.G.						
PATH:						
PLOT: PSPACE 1=1(F) OR MSPACE 1=1(F)		S-4.2				
REVISIONS		PROJECT DESIGNATION		YEAR	SHEET NO.	TOTAL SHEETS
NO.	DATE	DESCRIPTION				
				NH-0902(34)	2009	26
						70

NOTES:

1. IN ACCORDANCE WITH SUB SECTION 108-1.05 OF THE SPECIFICATIONS, THE ENGINEER WILL ORDER THE CONTRACTOR TO REMOVE WORKERS WHO WILLINGLY OR NEGLIGENTLY CAUSE OR ALLOW DEBRIS FROM SPRAY METALLIZATION OR SAND BLASTING TO ENTER THE WETLANDS OF TONGASS NARROWS.
2. METALLIZE ALL DECK AND SIDEWALK SOFFIT, LONGITUDINAL BEAMS, GIRDERS, DIAPHRAGMS AND CROSS-BRACES IN THE AREAS SHOWN. PILE CAPS THAT DO NOT HAVE A JACKET WILL BE METALLIZED.
3. ALL METALLIZING SHALL BE IN ACCORDANCE WITH THE SPECIFICATIONS.
4. INSTALL PILE AND CAP JACKETS AT THE LOCATIONS INDICED ON THE PLANS AND IN ACCORDANCE WITH THE SPECIFICATIONS.
5. INSTALL REFERENCE CELLS ON TONGASS AVENUE IN ACCORDANCE WITH THE SPECIFICATIONS AT LOCATIONS SELECTED BASED ON THE REINFORCEMENT POTENTIAL SURVEY. SEE CP-5.1.
6. USE DUCT TAPE, OR SIMILAR PRODUCT, TO MASK EACH CATHODICALLY PROTECTED PILE CAP FROM THE ADJACENT SOFFIT AND GIRDER SYSTEMS. TO FACILITATE ESTABLISHING TEST AREAS, THE ENGINEER RESERVES THE RIGHT TO REQUIRE ADDITIONAL MASKING AT NO ADDITIONAL COST TO THE OWNER.
7. COMPLETE ALL BEARING PAD WORK PRIOR TO INSTALLING CATHODIC PROTECTION EQUIPMENT IN THOSE LOCATIONS.

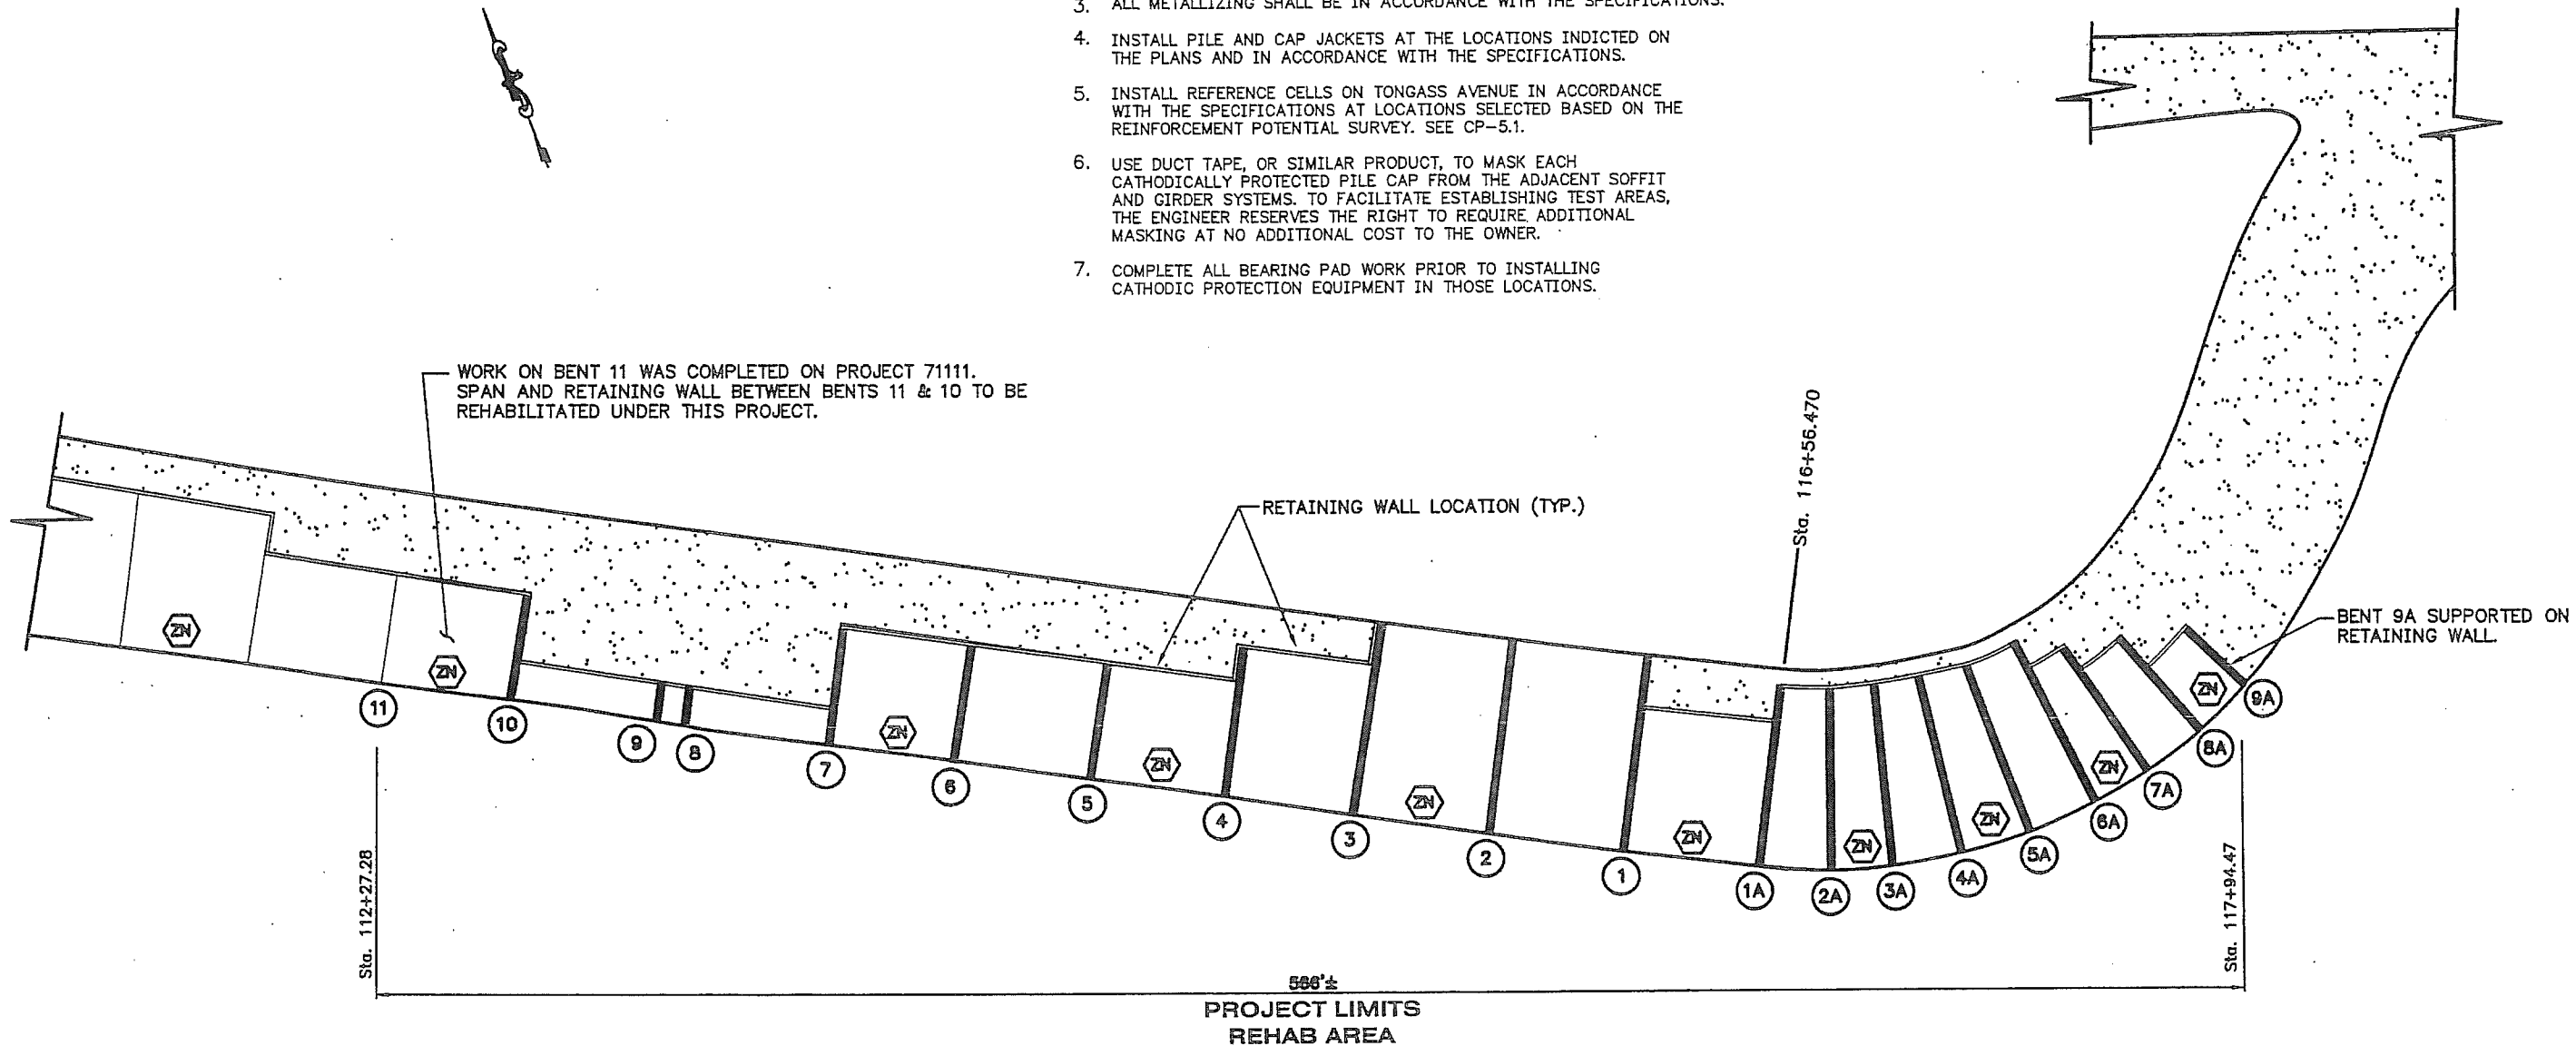


SEE S-1.0 FOR LOCATION OF CP PREVIOUS REWORK

TONGASS AVENUE BR. NO. 997

LEGEND

- EARTH
- XX BENT NUMBER
- PI PILASTER INJECTION
- PR PILASTER REPAIR
- ZN SOIL & SEDIMENT ZINC SAMPLING PER SPECIFICATIONS

ELEVATIONS, BENCHMARKS AND DIMENSIONS ARE BASED ON "AS-BUILT" PLANS. VERIFY ALL CONTROLLING FIELD DIMENSIONS BEFORE ORDERING OR FABRICATING ANY MATERIAL.

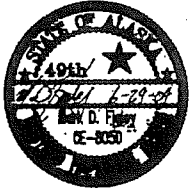
DESIGNED BY: M. FIGLEY	STATE OF ALASKA DEPARTMENT OF TRANSPORTATION & PUBLIC FACILITIES STATEWIDE DESIGN & ENGINEERING SERVICES DIVISION			
	KTN-VIADUCTS REHABILITATION PROJECT NO. 68571 TONGASS AVENUE CORROSION CONTROL WORK PLAN			
	CHECKED BY: G. IMBSEN	YEAR: 2009		
DRAWN/REVISED BY: R.S., R.G.	SHEET NO.: 27			
PATH: PLOT: PSPACE 1=1(F) OR MSPACE 1=1(F)		TOTAL SHEETS: 70		
REVISIONS		PROJECT DESIGNATION: NH-0902(34)		
NO.	DATE	DESCRIPTION		

CORROSION CONTROL ELEMENTS FOR TONGASS AVENUE VIADUCT									
BENT/SPAN	METALLIZE (FT ²)		CAP JACKET (JKT)	PILE JKT				PILASTER JKT 4 FT.	BULK ANODES 93 LBS.
	RETAINING WALL	CAP-DECK-S/W GIRDER-DIAPH		SQUARE		ROUND			
				4 FT.	6 FT.	4 FT.	6 FT.		
10	200	3,305	1	1		1			1
9	200	915	1 *						1 FOR BOTH BENTS
8	100	120	1 *						
7	80	915	1 *						
6	80	3,100	1	3					1
5	80	3,100	1	1		1			2
4	80	3,875	1	2		1		1	2
3	150	5,035	1	2		3			2
2	0	5,680	1	2		3			2
1	0	5,680	1			3			2
1A	120	4,300	1			3			2
2A	80	1,075					3	1	2
3A	80	1,075			1		3	1	2
4A	0	1,075			1		3		2
5A	0	1,075			1		3		2
6A	80	1,075			2		1	1	2
7A	80	900			2		1	1	2
8A	80	740					3		1
9A	80	630							1
TOTAL	1,530	43,670	11	11	6	15	19	5	32
TOTAL	45,200								

* = NON STANDARD CAP

NOTE:

1. NEAR SURFACE METAL WILL NOT BE REMOVED FROM RETAINING WALL.
2. PILE CAPS THAT DO NOT HAVE A JACKET WILL BE METALLIZED.
3. WITH THE ENGINEER'S APPROVAL, PILE/PILASTER/CORNER JACKETS MAY BE SHORTER THAN SHOWN TO AVOID CONFLICT WITH GROUND ELEVATIONS.
4. ALL JACKETS WILL HAVE WETTING HOLES CUT IN. SEE CP 4.1 & CP 4.5.

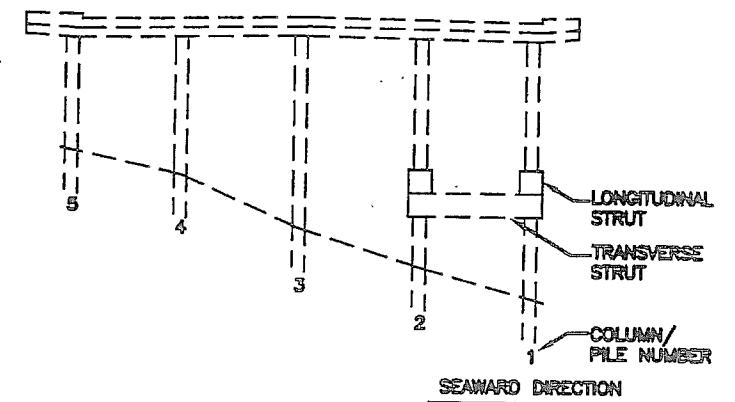

BENT XX

LEGEND

- DENOTES EXISTING
- DENOTES NEW CONSTRUCTION
- (E) EXISTING


NOTES

INSTALL CATHODIC PROTECTION EQUIPMENT IN ACCORDANCE WITH THE SPECIFICATIONS. COMPLETE CONCRETE REPAIRS, DISCUSSED ELSEWHERE, BEFORE INSTALLING JACKETS.

MODIFY THE JACKETS TO FIT AROUND EXISTING UTILITIES, HANGERS AND BRACKETS. SEE SPECIFICATIONS.

ELEVATIONS, BENCHMARKS AND DIMENSIONS ARE BASED ON "AS-BUILT" PLANS. VERIFY ALL CONTROLLING FIELD DIMENSIONS BEFORE ORDERING OR FABRICATING ANY MATERIAL.

DESIGNED BY: M. FIGLEY		STATE OF ALASKA DEPARTMENT OF TRANSPORTATION & PUBLIC FACILITIES STATEWIDE DESIGN & ENGINEERING SERVICES DIVISION				
		KTN-VIADUCTS REHABILITATION PROJECT NO. 68571 TONGASS AVENUE CORROSION CONTROL WORK PLAN				
		CP-1.1				
CHECKED BY: G. IMBSEN		PROJECT DESIGNATION		YEAR	SHEET NO.	TOTAL SHEETS
DRAWN/REVISED BY: R.S., R.G.		NH-0902(34)		2009	28	70
PATH:						
PLOT: PSPACE 1=1(F) OR MSPACE 1=1(F)						
REVISIONS						
NO.	DATE	DESCRIPTION				

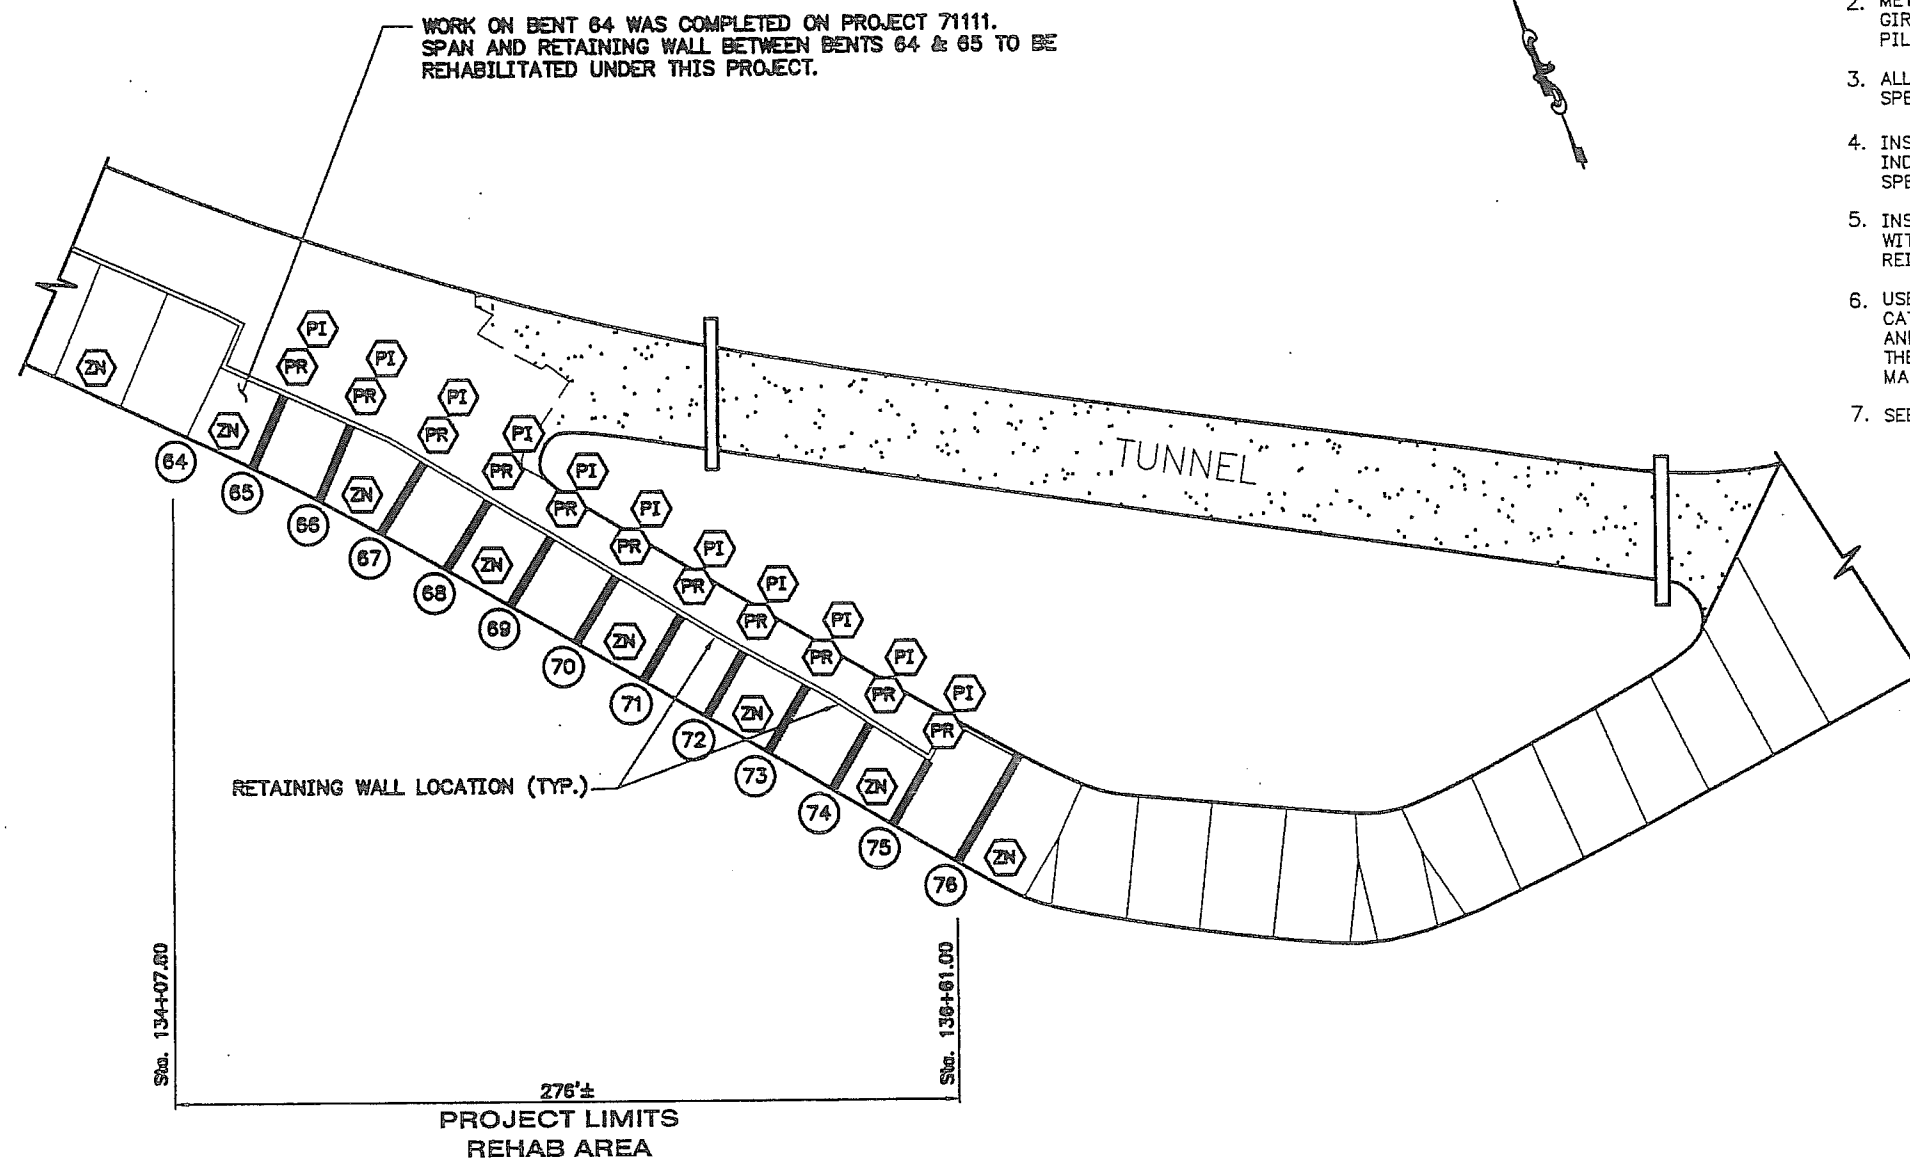

NOTES:

1. IN ACCORDANCE WITH SUB SECTION 108-1.05 OF THE SPECIFICATIONS, THE ENGINEER WILL ORDER THE CONTRACTOR TO REMOVE WORKERS WHO WILLINGLY OR NEGLEGENTLY CAUSE OR ALLOW DEBRIS FROM SPRAY METALLIZATION OR SAND BLASTING TO ENTER THE WETLANDS OF TONGASS NARROWS.
2. METALLIZE ALL DECK AND SIDEWALK SOFFIT, LONGITUDINAL BEAMS, GIRDERS, DIAPHRAGMS AND CROSS-BRACES IN THE AREAS SHOWN. PILE CAPS THAT DO NOT HAVE A JACKET WILL BE METALLIZED.
3. ALL METALLIZING SHALL BE ACCORDANCE WITH THE SPECIFICATIONS.
4. INSTALL PILE, PILASTER AND CORNER JACKETS AT THE LOCATIONS INDICED ON THE PLANS AND IN ACCORDANCE WITH THE SPECIFICATIONS.
5. INSTALL REFERENCE CELLS ON WATER STREET IN ACCORDANCE WITH THE SPECIFICATIONS AT LOCATIONS SELECTED BASED ON THE REINFORCEMENT POTENTIAL SURVEY. SEE CP-5.1.
6. USE DUCT TAPE, OR SIMILAR PRODUCT, TO MASK EACH CATHODICALLY PROTECTED PILE CAP FROM THE ADJACENT SOFFIT AND GIRDER SYSTEMS. TO FACILITATE ESTABLISHING TEST AREAS, THE ENGINEER RESERVES THE RIGHT TO REQUIRE ADDITIONAL MASKING AT NO ADDITIONAL COST TO THE DEPARTMENT.
7. SEE S-1.0 FOR LOCATION OF PREVIOUS PROJECT REWORK.

ELEVATIONS, BENCHMARKS AND DIMENSIONS ARE BASED ON "AS-BUILT" PLANS. VERIFY ALL CONTROLLING FIELD DIMENSIONS BEFORE ORDERING OR FABRICATING ANY MATERIAL.

DESIGNED BY: M. FIGLEY		STATE OF ALASKA DEPARTMENT OF TRANSPORTATION & PUBLIC FACILITIES STATEWIDE DESIGN & ENGINEERING SERVICES DIVISION			
		KTN-VIADUCTS REHABILITATION PROJECT NO. 68571 WATER STREET CORROSION CONTROL WORK PLAN			
		CP-1.2			
CHECKED BY: G. IMBSEN		PROJECT DESIGNATION			
DRAWN/REVISED BY: R.S., R.G.		YEAR			
PATH:		SHEET NO.			
PLOT: PSPACE 1=1(F) OR MSPACE 1=1(F)		TOTAL SHEETS			
NO.		DATE		DESCRIPTION	
				NH-0902(34)	
				2009	
				29	
				70	


LEGEND

-  EARTH
-  BENT NUMBER
-  PILASTER INJECTION
-  PILASTER REPAIR
-  SOIL & SEDIMENT
ZINC SAMPLING
PER SPECIFICATIONS

WATER STREET BR. NO. 797

CORROSION CONTROL ELEMENTS FOR WATER STREET VIADUCT								
BENT/SPAN	METALLIZE (FT ²)			PILE JKT. 6 FT.	SQUARE PILE JKT. 6 FT.	CORNER JKT. 6 FT.	PILASTER JKT. 6 FT.	BULK ANODES 93 LBS.
	RETAINING WALL	DECK-S/W	CAP					
64	126	636	-	1			1	2
65	126	636	131	1			1	2
66	126	636	131	1			1	2
67	126	636	131	1			1	2
68	126	636	131	1			1	2
69	126	636	131	1			1	2
70	126	636	131	1			1	2
71	126	636	131	1			1	2
72	126	636	131	1			1	2
73	126	636	131	1			1	2
74	126	636	131	1			1	2
75	126	880	131	1		1		2
76	126	-	166	1	1			2
TOTAL	1,512	7,876	1,629	13	1	1	11	26
TOTAL	11,017							

1. WITH THE ENGINEER'S APPROVAL; PILE/PILASTER/CORNER JACKETS MAY BE SHORTER THAN SHOWN TO AVOID CONFLICT WITH GROUND ELEVATION.
2. ALL JACKETS WILL HAVE WETTING HOLES CUT IN. SEE CP 4.1 & CP 4.5.

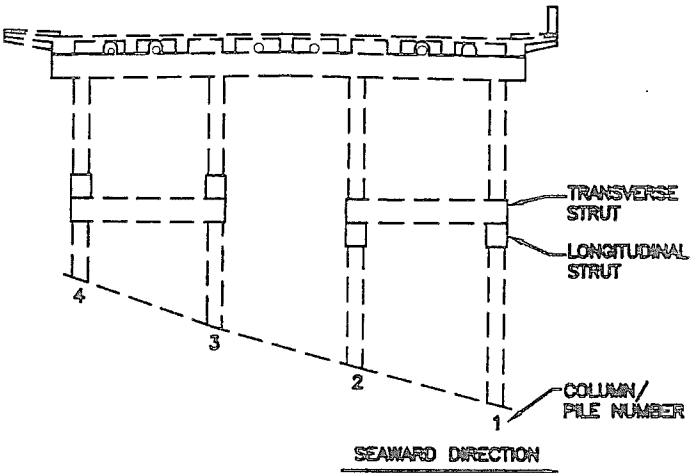

BENT XX

LEGEND

- DENOTES EXISTING
- DENOTES NEW CONSTRUCTION
- (E)

 EXISTING

NOTES

INSTALL CATHODIC PROTECTION EQUIPMENT IN ACCORDANCE WITH THE SPECIFICATIONS. COMPLETE CONCRETE REPAIRS, DISCUSSED ELSEWHERE, BEFORE INSTALLING JACKETS.


MODIFY THE JACKETS TO FIT AROUND EXISTING UTILITIES, HANGERS AND BRACKETS. SEE SPECIFICATIONS.

ELEVATIONS, BENCHMARKS AND DIMENSIONS ARE BASED ON "AS-BUILT" PLANS. VERIFY ALL CONTROLLING FIELD DIMENSIONS BEFORE ORDERING OR FABRICATING ANY MATERIAL.

DESIGNED BY: M. FIGLEY	STATE OF ALASKA DEPARTMENT OF TRANSPORTATION & PUBLIC FACILITIES STATEWIDE DESIGN & ENGINEERING SERVICES DIVISION KTN-VIADUCTS REHABILITATION PROJECT NO. 68571 WATER STREET CORROSION CONTROL WORK PLAN					
						
CHECKED BY: G. IMBESSEN DRAWN/REVISED BY: R.S., R.G.						
PATH: PLOT: PSPACE 1=1(F) OR MSPACE 1=1(F)			CP-1.3			
REVISIONS		PROJECT DESIGNATION	YEAR	SHEET NO.	TOTAL SHEETS	
NO.	DATE	DESCRIPTION	NH-0902(34)	2009	30	70

NOTES


1. BENT 11 HAS BEEN REHABILITATED AS PART OF PROJECT 71111 HOWEVER, THE SPAN BETWEEN BENTS 10 AND 11 WILL BE REHABILITATED UNDER THIS PROJECT.
2. ALL DRAINS HAVE AN OUTLET THAT WILL DRAIN THROUGH WORK AREA.
3. REMOVE WATER FROM DECK DRAINS FOR ENVIRONMENTAL REQUIREMENTS AND PRODUCT SPECIFICATION REQUIREMENTS.

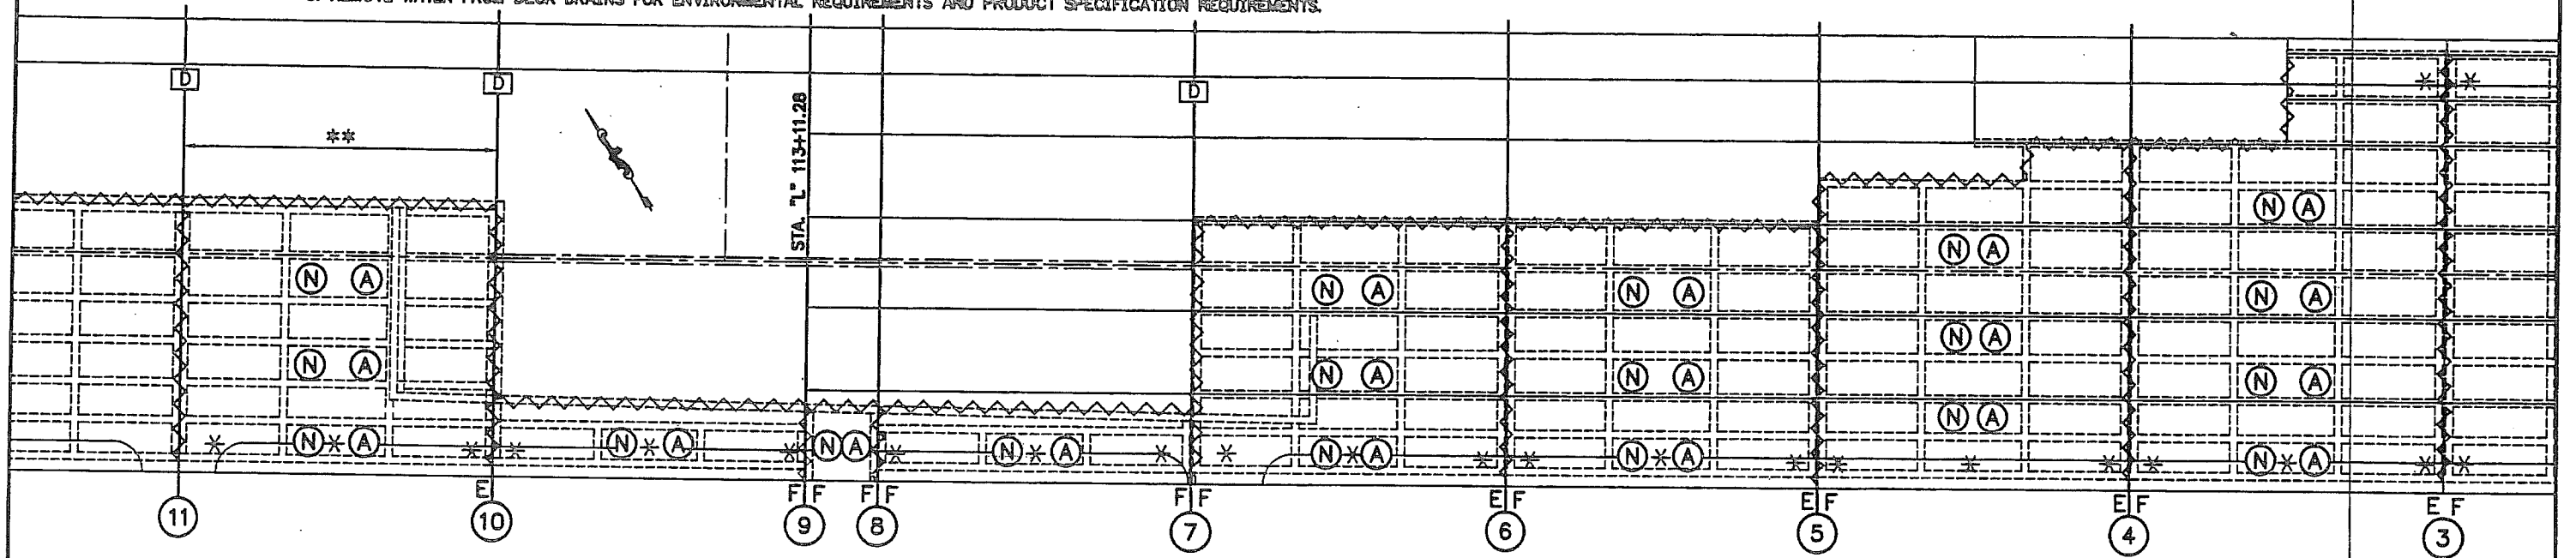

LEGEND:


- E = NEW EXPANSION BEARINGS THIS BENT
- F = FIXED
- (N) = SYSTEM NEGATIVE
- (A) = ANODE CONNECTION
- [D] = 1'x2' RECTANGULAR DECK DRAIN
- * = DECK DRAIN W/4" PIPE OUTLET
- ~~~~~ = JOINTS WHERE LEAKING MAY OCCUR

GENERAL NOTE:
JOINTS BETWEEN SPANS LEAK WATER.
SEAL JOINTS BEFORE ZINCING, NO SPAN WILL
BE ZINCED UNTIL THE JOINTS ARE SEALED.

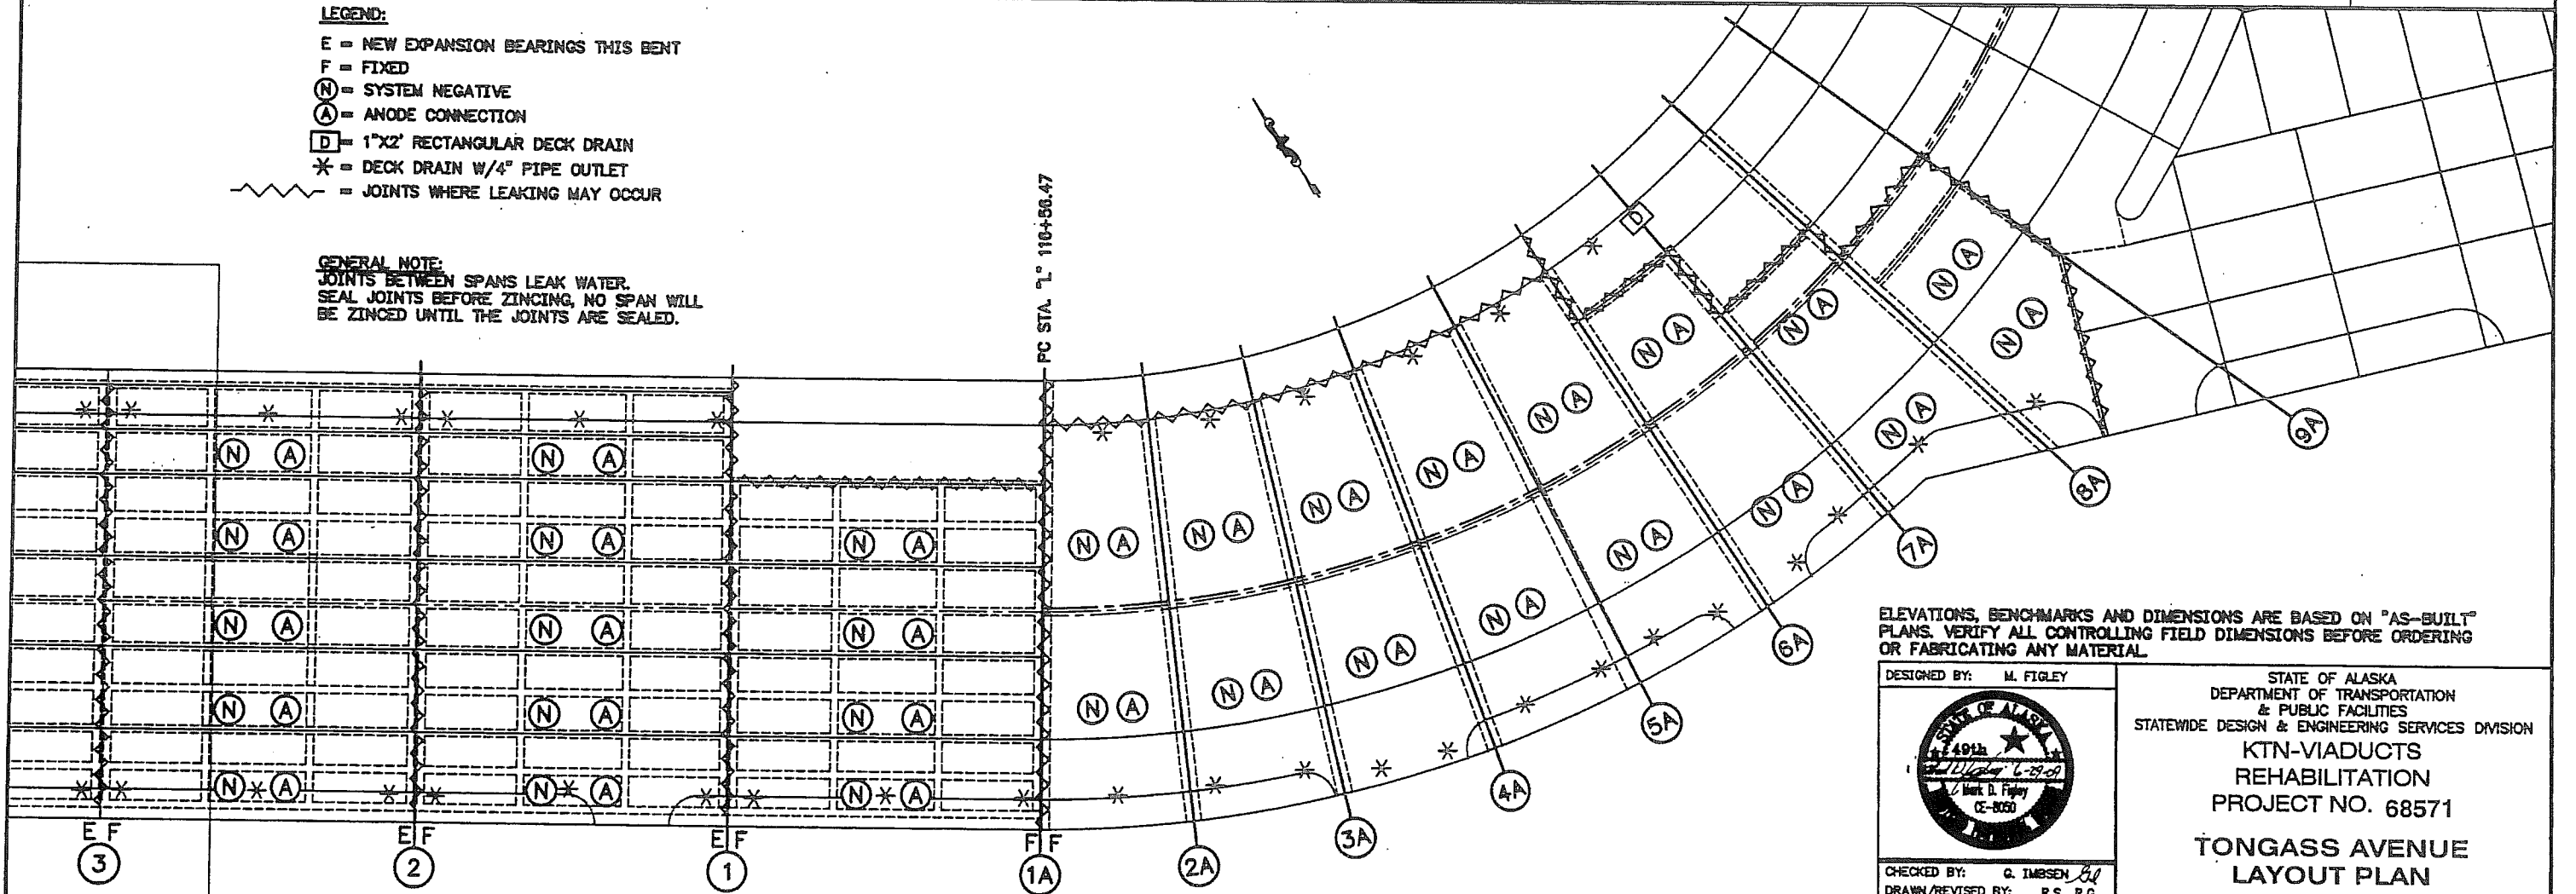

ELEVATIONS, BENCHMARKS AND DIMENSIONS ARE BASED ON "AS-BUILT" PLANS. VERIFY ALL CONTROLLING FIELD DIMENSIONS BEFORE ORDERING OR FABRICATING ANY MATERIAL.

DESIGNED BY: M. FIGLEY

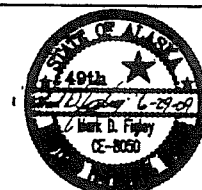

CHECKED BY: G. IMBSEN
DRAWN/REVISED BY: R.S., R.G.

PATH:
PLOT: PSPACE 1=1(F) OR MSPACE 1=1(F)


STATE OF ALASKA
DEPARTMENT OF TRANSPORTATION
& PUBLIC FACILITIES
STATEWIDE DESIGN & ENGINEERING SERVICES DIVISION

KTN-VIADUCTS
REHABILITATION
PROJECT NO. 68571

TONGASS AVENUE
LAYOUT PLAN

CP-2.0

REVISIONS			PROJECT DESIGNATION	YEAR	SHEET NO.	TOTAL SHEETS
NO.	DATE	DESCRIPTION				
			NH-0902(34)	2009	31	70

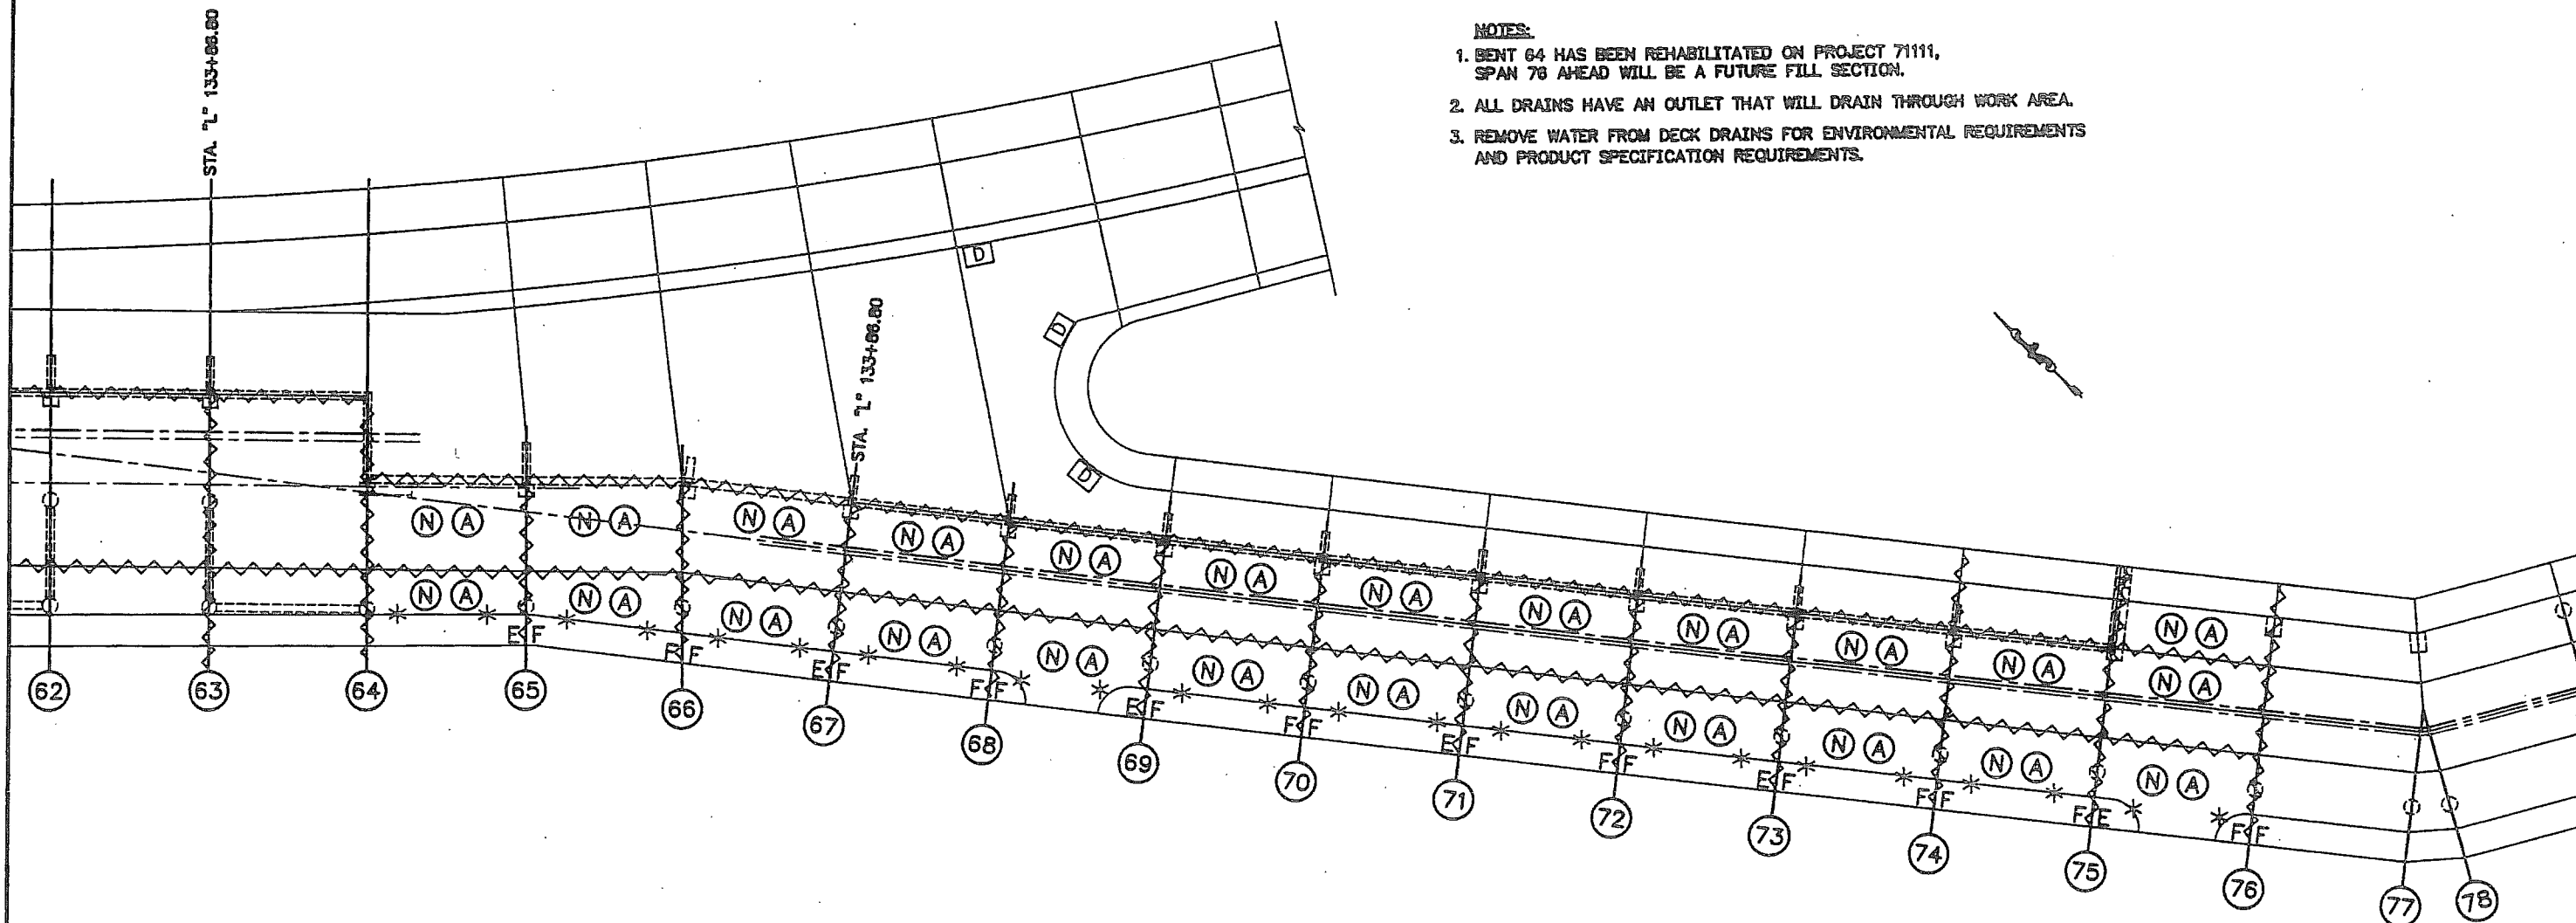

- NOTES:**
1. BENT 64 HAS BEEN REHABILITATED ON PROJECT 71111, SPAN 78 AHEAD WILL BE A FUTURE FILL SECTION.
 2. ALL DRAINS HAVE AN OUTLET THAT WILL DRAIN THROUGH WORK AREA.
 3. REMOVE WATER FROM DECK DRAINS FOR ENVIRONMENTAL REQUIREMENTS AND PRODUCT SPECIFICATION REQUIREMENTS.

- LEGEND:**
- E = NEW EXPANSION BEARINGS THIS BENT
 - F = FIXED
 - (N) = SYSTEM NEGATIVE
 - (A) = ANODE CONNECTION
 - [D] = 1'x2' RECTANGULAR DECK DRAIN
 - * = DECK DRAIN W/4" PIPE OUTLET
 - ~~~~~ = JOINTS WHERE LEAKING MAY OCCUR


- GENERAL NOTES:**
1. ASBESTOS IS PRESENT IN EXPANSION JOINT SIDE OF BENT. SEE SPECIFICATIONS.
 2. JOINTS BETWEEN SPANS LEAK WATER. SEAL JOINTS BEFORE ZINCING, NO SPAN WILL BE ZINCED UNTIL THE JOINTS ARE SEALED.

ELEVATIONS, BENCHMARKS AND DIMENSIONS ARE BASED ON "AS-BUILT" PLANS. VERIFY ALL CONTROLLING FIELD DIMENSIONS BEFORE ORDERING OR FABRICATING ANY MATERIAL.


DESIGNED BY: M. FIGLEY  CHECKED BY: G. IMBSEN DRAWN/REVISED BY: R.S., R.G.		STATE OF ALASKA DEPARTMENT OF TRANSPORTATION & PUBLIC FACILITIES STATEWIDE DESIGN & ENGINEERING SERVICES DIVISION KTN-VIADUCTS REHABILITATION PROJECT NO. 68571 WATER STREET LAYOUT PLAN																									
PATH: PLOT: PSPACE 1=1(F) OR MSPACE 1=1(F)		CP-2.1																									
<table border="1" style="width: 100%; border-collapse: collapse;"> <thead> <tr> <th colspan="3">REVISIONS</th> </tr> <tr> <th>NO.</th> <th>DATE</th> <th>DESCRIPTION</th> </tr> </thead> <tbody> <tr><td> </td><td> </td><td> </td></tr> <tr><td> </td><td> </td><td> </td></tr> <tr><td> </td><td> </td><td> </td></tr> </tbody> </table>		REVISIONS			NO.	DATE	DESCRIPTION										<table border="1" style="width: 100%; border-collapse: collapse;"> <tr> <td>PROJECT DESIGNATION</td> <td>YEAR</td> <td>SHEET NO.</td> <td>TOTAL SHEETS</td> </tr> <tr> <td>NH-0902(34)</td> <td>2009</td> <td>32</td> <td>70</td> </tr> </table>			PROJECT DESIGNATION	YEAR	SHEET NO.	TOTAL SHEETS	NH-0902(34)	2009	32	70
REVISIONS																											
NO.	DATE	DESCRIPTION																									
PROJECT DESIGNATION	YEAR	SHEET NO.	TOTAL SHEETS																								
NH-0902(34)	2009	32	70																								

BENT 10 NOTE:

BENT 11 WAS REHABILITATED ON PROJECT 71111, HOWEVER, THE SPAN FROM BENT 10 TO BENT 11 WILL BE SPRAY METALLIZED UNDER THIS PROJECT.

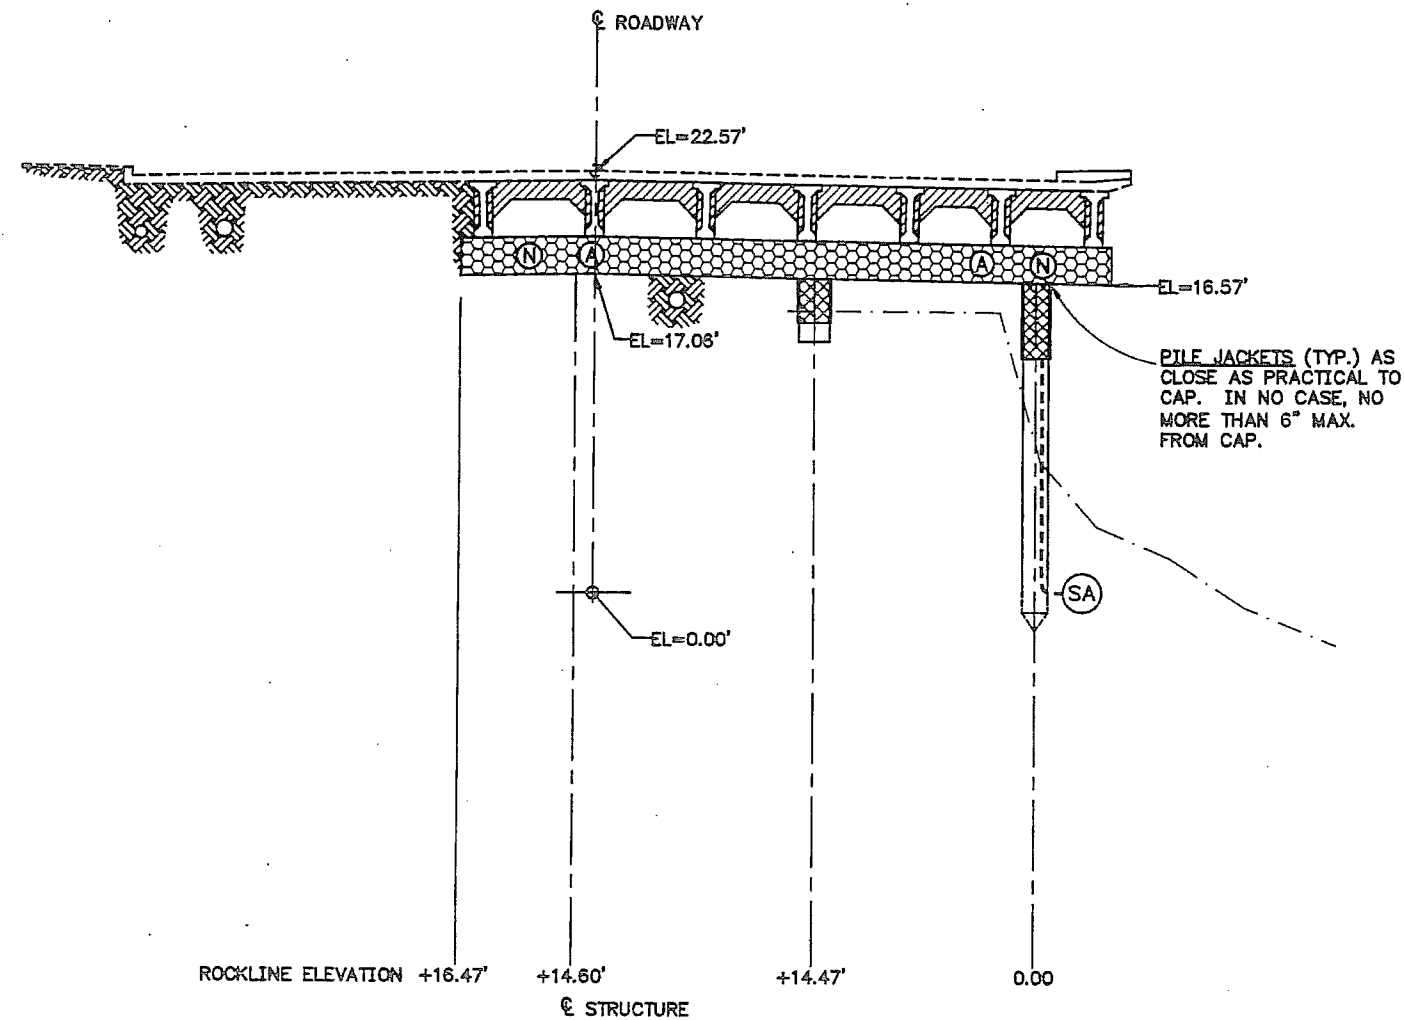

BENT 10

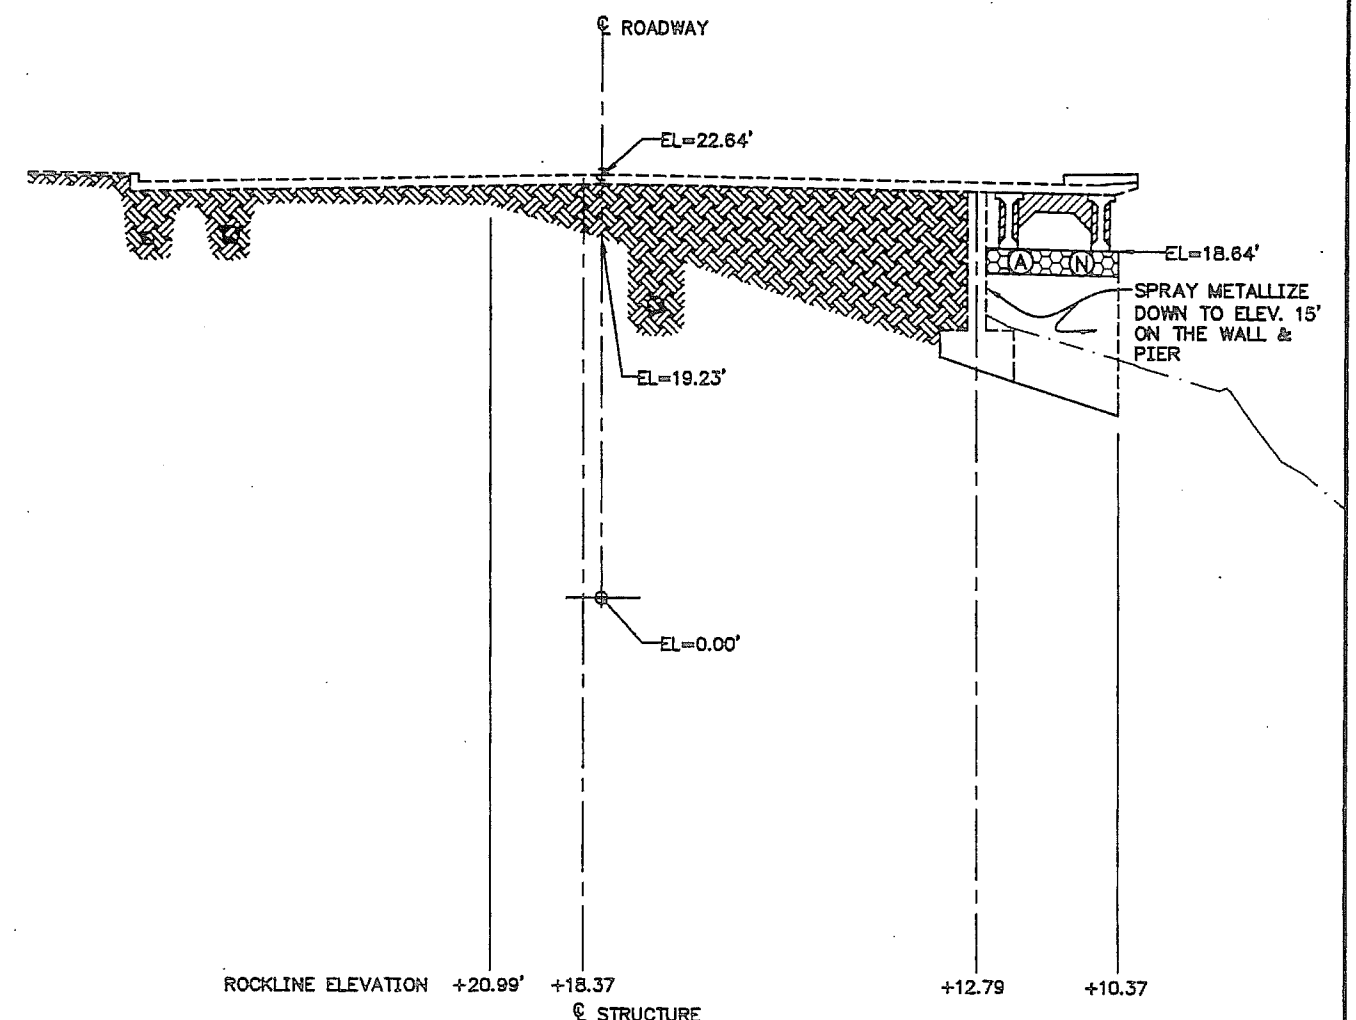

BENT 9


LEGEND

- SURVEY-MUDLINE
- 1999 MUDLINE
- 1955 ROCKLINE
- (N) SYSTEM NEGATIVE
- (A) ANODE TERMINAL PLATE
- (SA) SUBMERGED ANODE
- [Pattern] CAP JACKET
- [Pattern] PILE JACKET
- [Pattern] THERMAL SPRAY

NOTES:


1. MODIFY GENERAL JACKET CONFIGURATION TO FIT AROUND EXISTING UTILITIES.
2. IN SOME LOCATIONS EXISTING UTILITIES AND SERVICE LINES MAY BE CONGESTED. PROTECT EXISTING UTILITY PROPERTY WHILE COMPLETING THE REQUIRED OF THIS WORK.
3. REFER TO DETAILS FOR DIMENSIONS.
4. GIRDER END CONNECTION REQUIRED AT ONE END OF EACH PRESTRESSED GIRDER.
5. ONE SYSTEM NEGATIVE REQUIRED TOP OF EACH PILE OR PILASTER.

TONGASS AVENUE

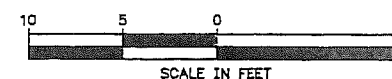


ELEVATIONS, BENCHMARKS AND DIMENSIONS ARE BASED ON "AS-BUILT" PLANS. VERIFY ALL CONTROLLING FIELD DIMENSIONS BEFORE ORDERING OR FABRICATING ANY MATERIAL.

DESIGNED BY: M. FIGLEY		STATE OF ALASKA DEPARTMENT OF TRANSPORTATION & PUBLIC FACILITIES STATEWIDE DESIGN & ENGINEERING SERVICES DIVISION				
		KTN-VIADUCTS REHABILITATION PROJECT NO. 68571				
		Tongass Avenue Bents 10 & 9				
CHECKED BY: G. IMBSEN DRAWN/REVISED BY: R.S., R.G.		CP-3.0				
PATH: PLOT: PSPACE 1=1(F) OR MSPACE 1=1(F)						
REVISIONS		PROJECT DESIGNATION		YEAR	SHEET NO.	TOTAL SHEETS
NO.	DATE	DESCRIPTION				
				NH-0902(34)	2009	33
						70

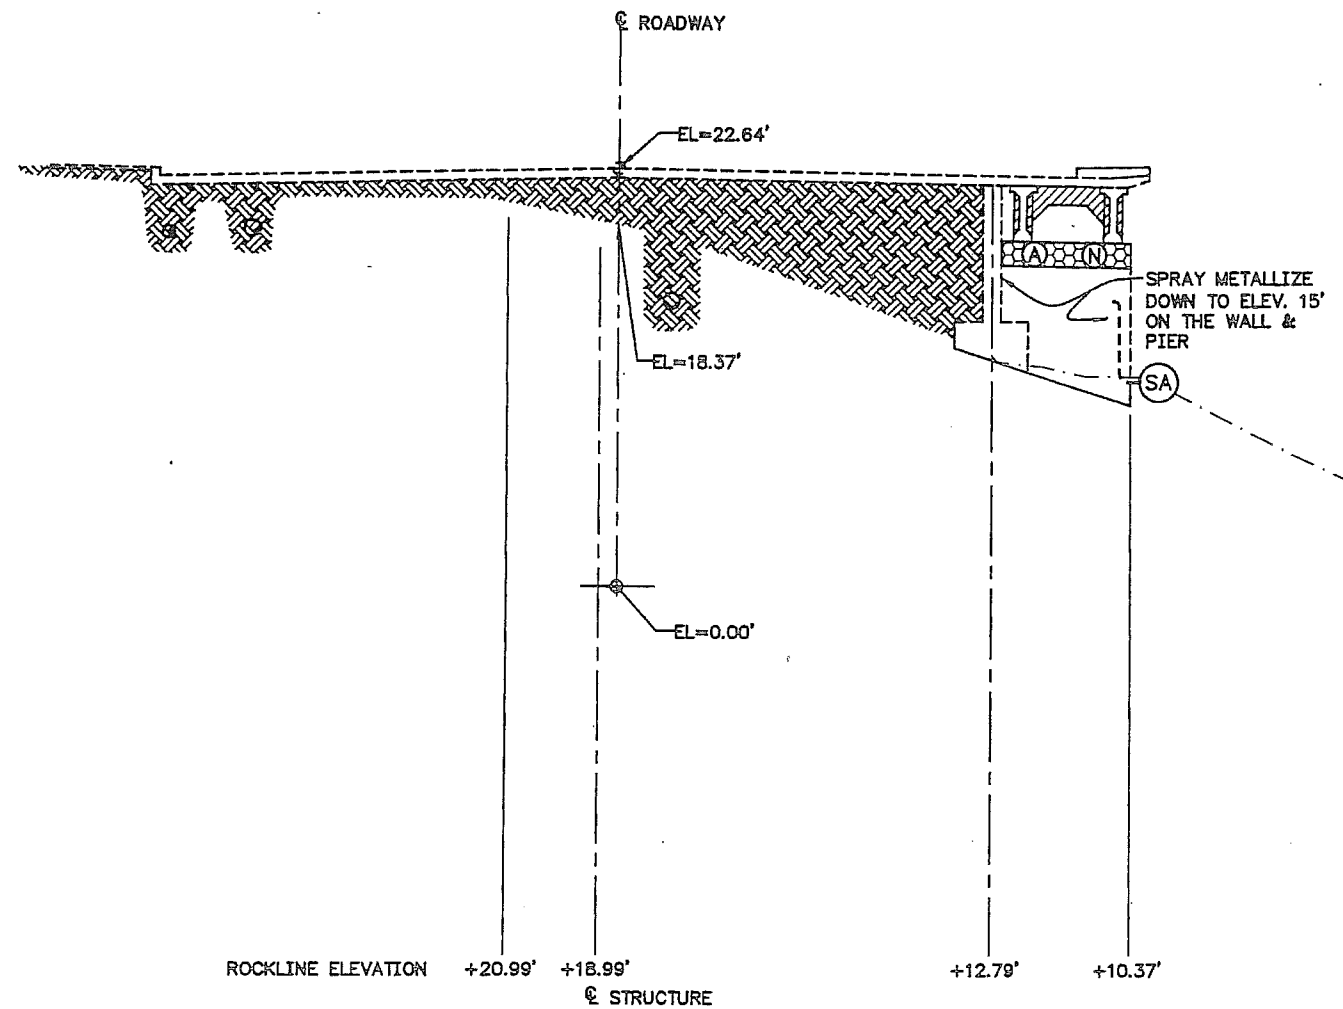


BENT 8

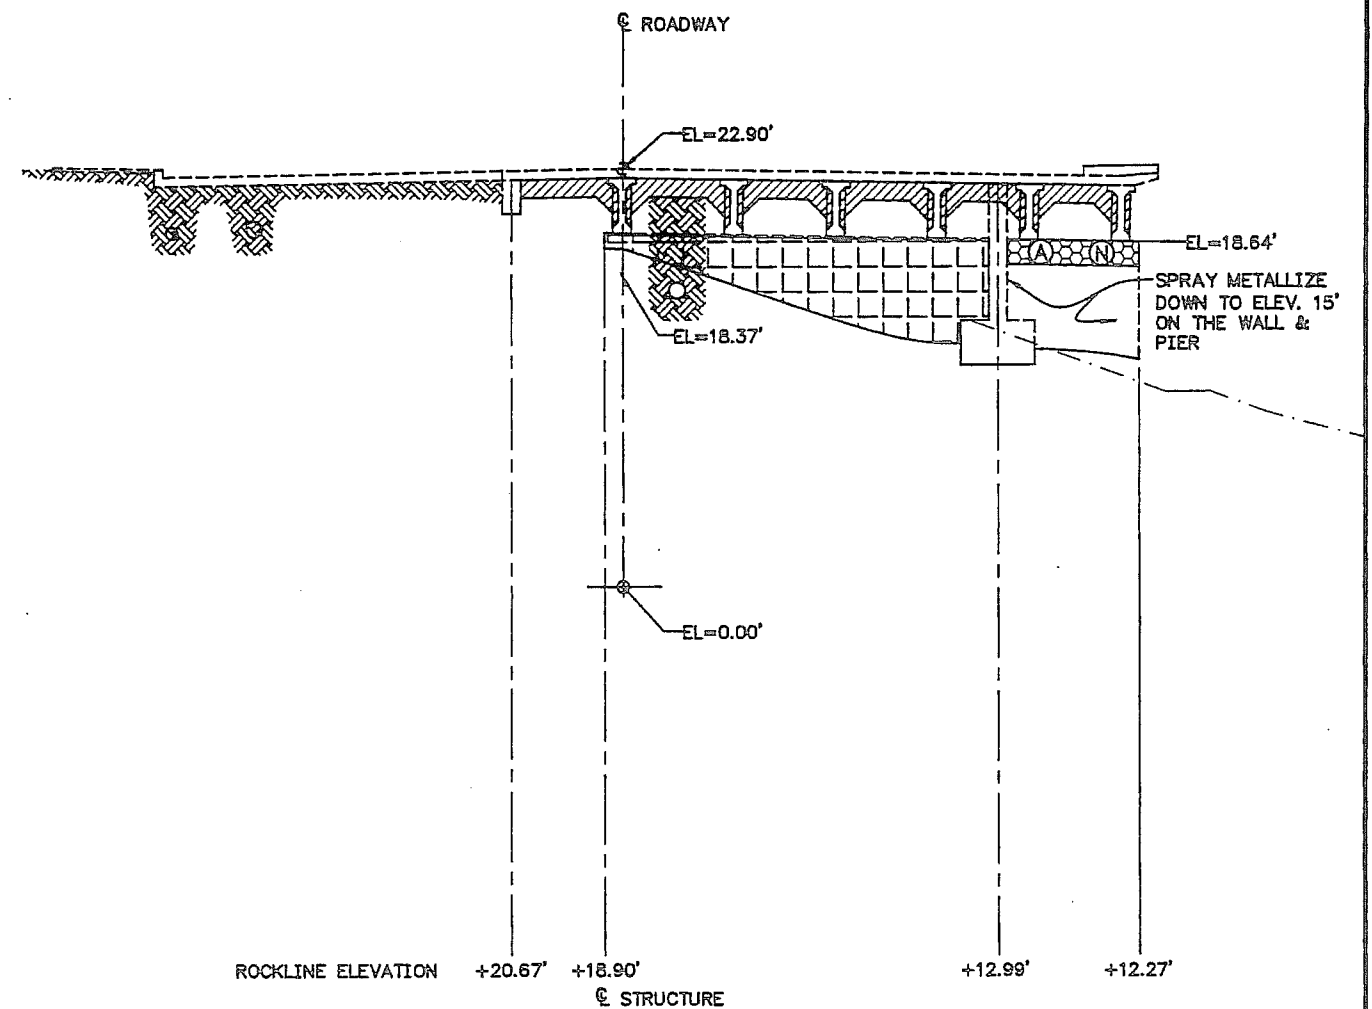

BENT 7

TONGASS AVENUE

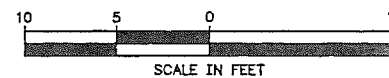

LEGEND


- SURVEY-MUDLINE
- 1999 MUDLINE
- 1955 ROCKLINE
- (N) SYSTEM NEGATIVE
- (A) ANODE TERMINAL PLATE
- (SA) SUBMERGED ANODE
- [Pattern] CAP JACKET
- [Pattern] PILE JACKET
- [Pattern] THERMAL SPRAY

NOTES:


1. MODIFY GENERAL JACKET CONFIGURATION TO FIT AROUND EXISTING UTILITIES.
2. IN SOME LOCATIONS EXISTING UTILITIES AND SERVICE LINES MAY BE CONGESTED. PROTECT EXISTING UTILITY PROPERTY WHILE COMPLETING THE REQUIRED OF THIS WORK.
3. REFER TO DETAILS FOR DIMENSIONS.
4. GIRDER END CONNECTION REQUIRED AT ONE END OF EACH PRESTRESSED GIRDER.
5. ONE SYSTEM NEGATIVE REQUIRED TOP OF EACH PILE OR PILASTER.

ELEVATIONS, BENCHMARKS AND DIMENSIONS ARE BASED ON "AS-BUILT" PLANS. VERIFY ALL CONTROLLING FIELD DIMENSIONS BEFORE ORDERING OR FABRICATING ANY MATERIAL.

DESIGNED BY: M. FIGLEY		STATE OF ALASKA DEPARTMENT OF TRANSPORTATION & PUBLIC FACILITIES STATEWIDE DESIGN & ENGINEERING SERVICES DIVISION			
 CHECKED BY: G. IMBSEN DRAWN/REVISED BY: R.S., R.G.		KTN-VIADUCTS REHABILITATION PROJECT NO. 68571			
		Tongass Avenue Bents 8 & 7			
PATH: PLOT: PSPACE 1=1(F) OR MSPACE 1=1(F)		CP-3.1			
REVISIONS		PROJECT DESIGNATION	YEAR	SHEET NO.	TOTAL SHEETS
NO.	DATE	DESCRIPTION	NH-0902(34)	2009	34
					70

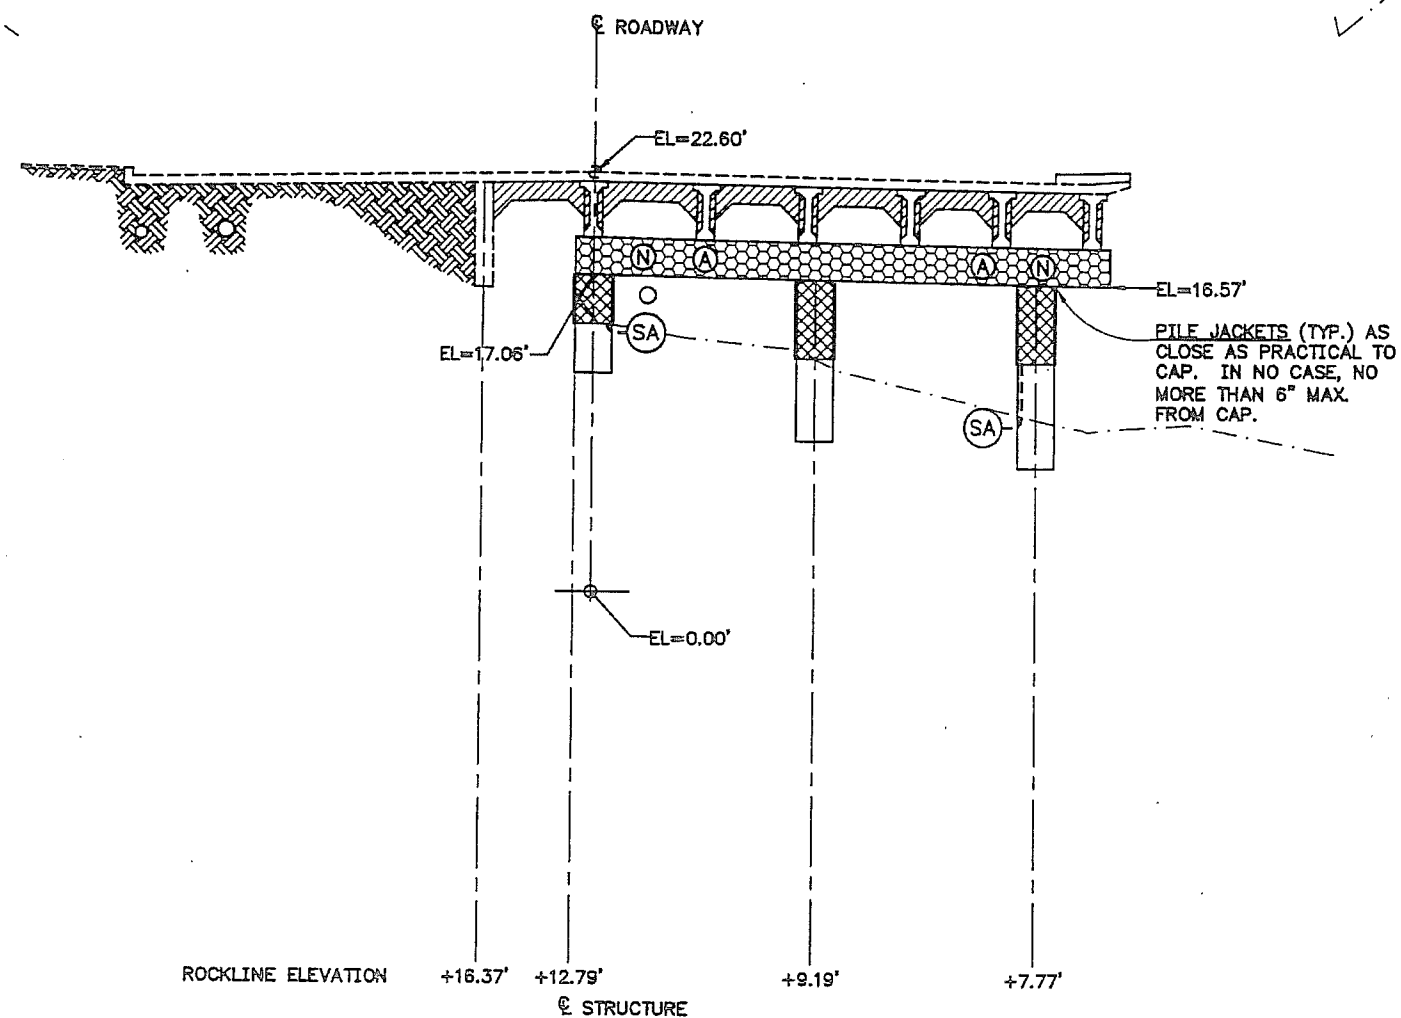

BENT 6

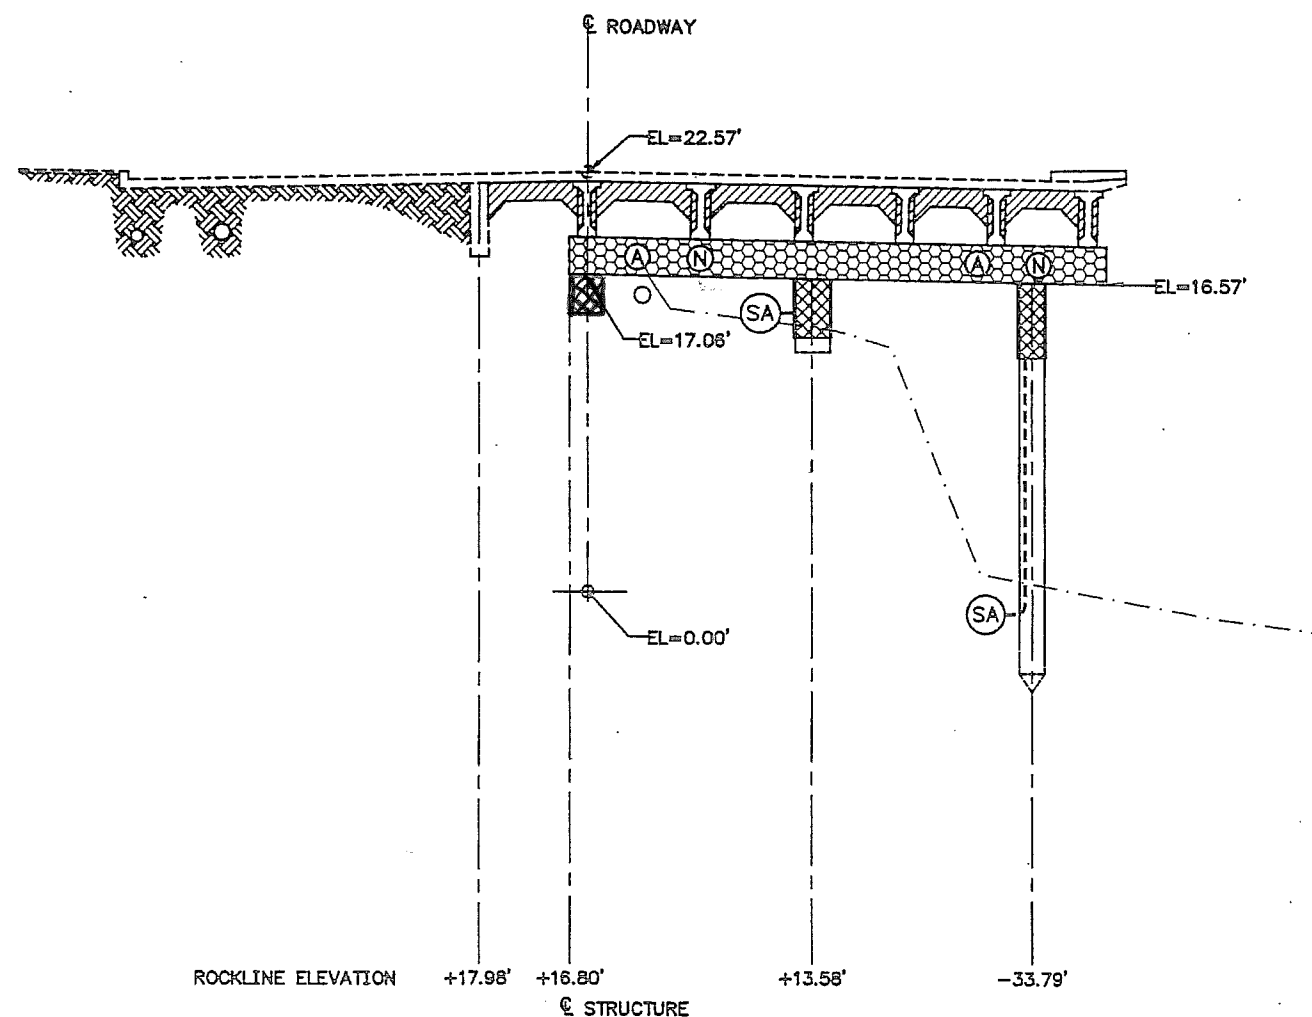

BENT 5


LEGEND

- SURVEY-MUDLINE
- 1999 MUDLINE
- 1855 ROCKLINE
- (N) SYSTEM NEGATIVE
- (A) ANODE TERMINAL PLATE
- (SA) SUBMERGED ANODE
- [Pattern] CAP JACKET
- [Pattern] PILE JACKET
- [Pattern] THERMAL SPRAY

NOTES:



1. MODIFY GENERAL JACKET CONFIGURATION TO FIT AROUND EXISTING UTILITIES.
2. IN SOME LOCATIONS EXISTING UTILITIES AND SERVICE LINES MAY BE CONGESTED. PROTECT EXISTING UTILITY PROPERTY WHILE COMPLETING THE REQUIRED OF THIS WORK.
3. REFER TO DETAILS FOR DIMENSIONS.
4. GIRDER END CONNECTION REQUIRED AT ONE END OF EACH PRESTRESSED GIRDER.
5. ONE SYSTEM NEGATIVE REQUIRED TOP OF EACH PILE OR PILASTER.

TONGASS AVENUE

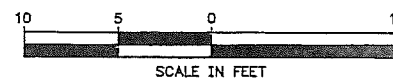

ELEVATIONS, BENCHMARKS AND DIMENSIONS ARE BASED ON "AS-BUILT" PLANS. VERIFY ALL CONTROLLING FIELD DIMENSIONS BEFORE ORDERING OR FABRICATING ANY MATERIAL.


DESIGNED BY: M. FIGLEY		STATE OF ALASKA DEPARTMENT OF TRANSPORTATION & PUBLIC FACILITIES STATEWIDE DESIGN & ENGINEERING SERVICES DIVISION			
		KTN-VIADUCTS REHABILITATION PROJECT NO. 68571			
		Tongass Avenue Bents 6 & 5			
CHECKED BY: G. IMBSEN		CP-3.2			
DRAWN/REVISED BY: R.S., R.G.		PROJECT DESIGNATION: NH-0902(34)			
PATH: PSPACE 1=1(F) OR MSPACE 1=1(F)		YEAR: 2009			
REVISIONS		SHEET NO. 35			
NO. DATE DESCRIPTION		TOTAL SHEETS 70			

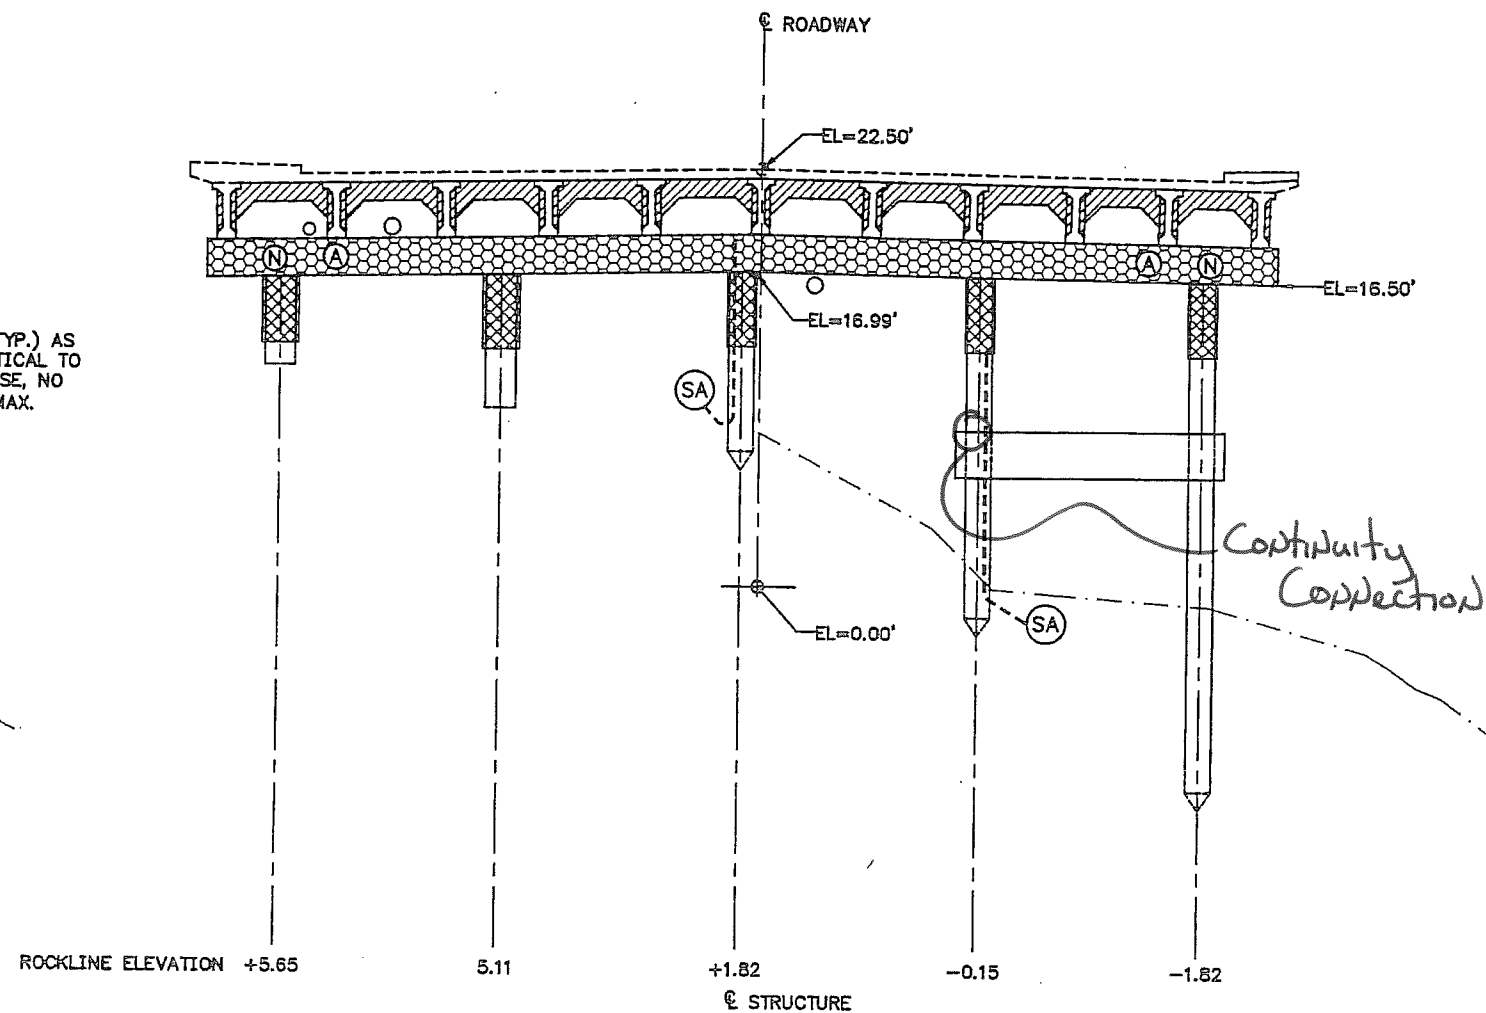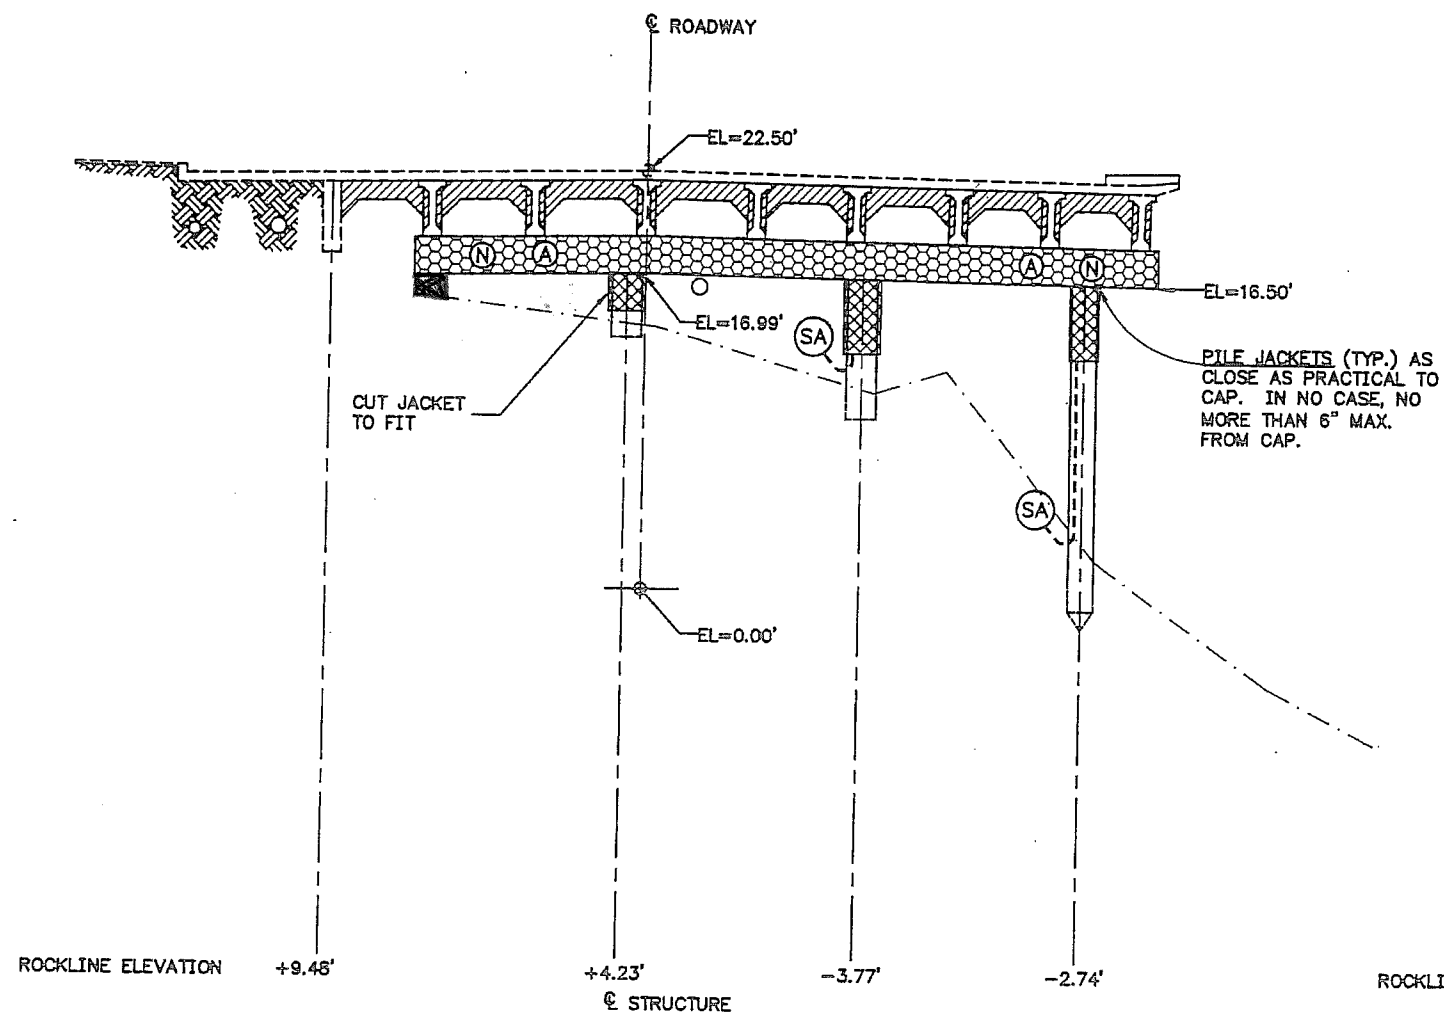

BENT 4

BENT 3

TONGASS AVENUE

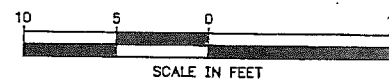

LEGEND


- SURVEY-MUDLINE
- 1999 MUDLINE
- 1955 ROCKLINE
- (N) SYSTEM NEGATIVE
- (A) ANODE TERMINAL PLATE
- (SA) SUBMERGED ANODE
- [Pattern] CAP JACKET
- [Pattern] PILE JACKET
- [Pattern] THERMAL SPRAY

NOTES:


1. MODIFY GENERAL JACKET CONFIGURATION TO FIT AROUND EXISTING UTILITIES.
2. IN SOME LOCATIONS EXISTING UTILITIES AND SERVICE LINES MAY BE CONGESTED. PROTECT EXISTING UTILITY PROPERTY WHILE COMPLETING THE REQUIRED OF THIS WORK.
3. REFER TO DETAILS FOR DIMENSIONS.
4. GIRDER END CONNECTION REQUIRED AT ONE END OF EACH PRESTRESSED GIRDER.
5. ONE SYSTEM NEGATIVE REQUIRED TOP OF EACH PILE OR PILASTER.

ELEVATIONS, BENCHMARKS AND DIMENSIONS ARE BASED ON "AS-BUILT" PLANS. VERIFY ALL CONTROLLING FIELD DIMENSIONS BEFORE ORDERING OR FABRICATING ANY MATERIAL.

DESIGNED BY: M. FOLEY		STATE OF ALASKA DEPARTMENT OF TRANSPORTATION & PUBLIC FACILITIES STATEWIDE DESIGN & ENGINEERING SERVICES DIVISION			
		KTN-VIADUCTS REHABILITATION PROJECT NO. 68571			
		Tongass Avenue Bents 4 & 3			
CHECKED BY: G. IMBSEN		CP-3.3			
DRAWN/REVISED BY: R.S., R.G.		PATH: PLOT: PSPACE 1=1(F) OR MSPACE 1=1(F)			
REVISIONS		PROJECT DESIGNATION		YEAR	SHEET NO.
NO.	DATE	DESCRIPTION			
				NH-0902(34)	2009
				36	70

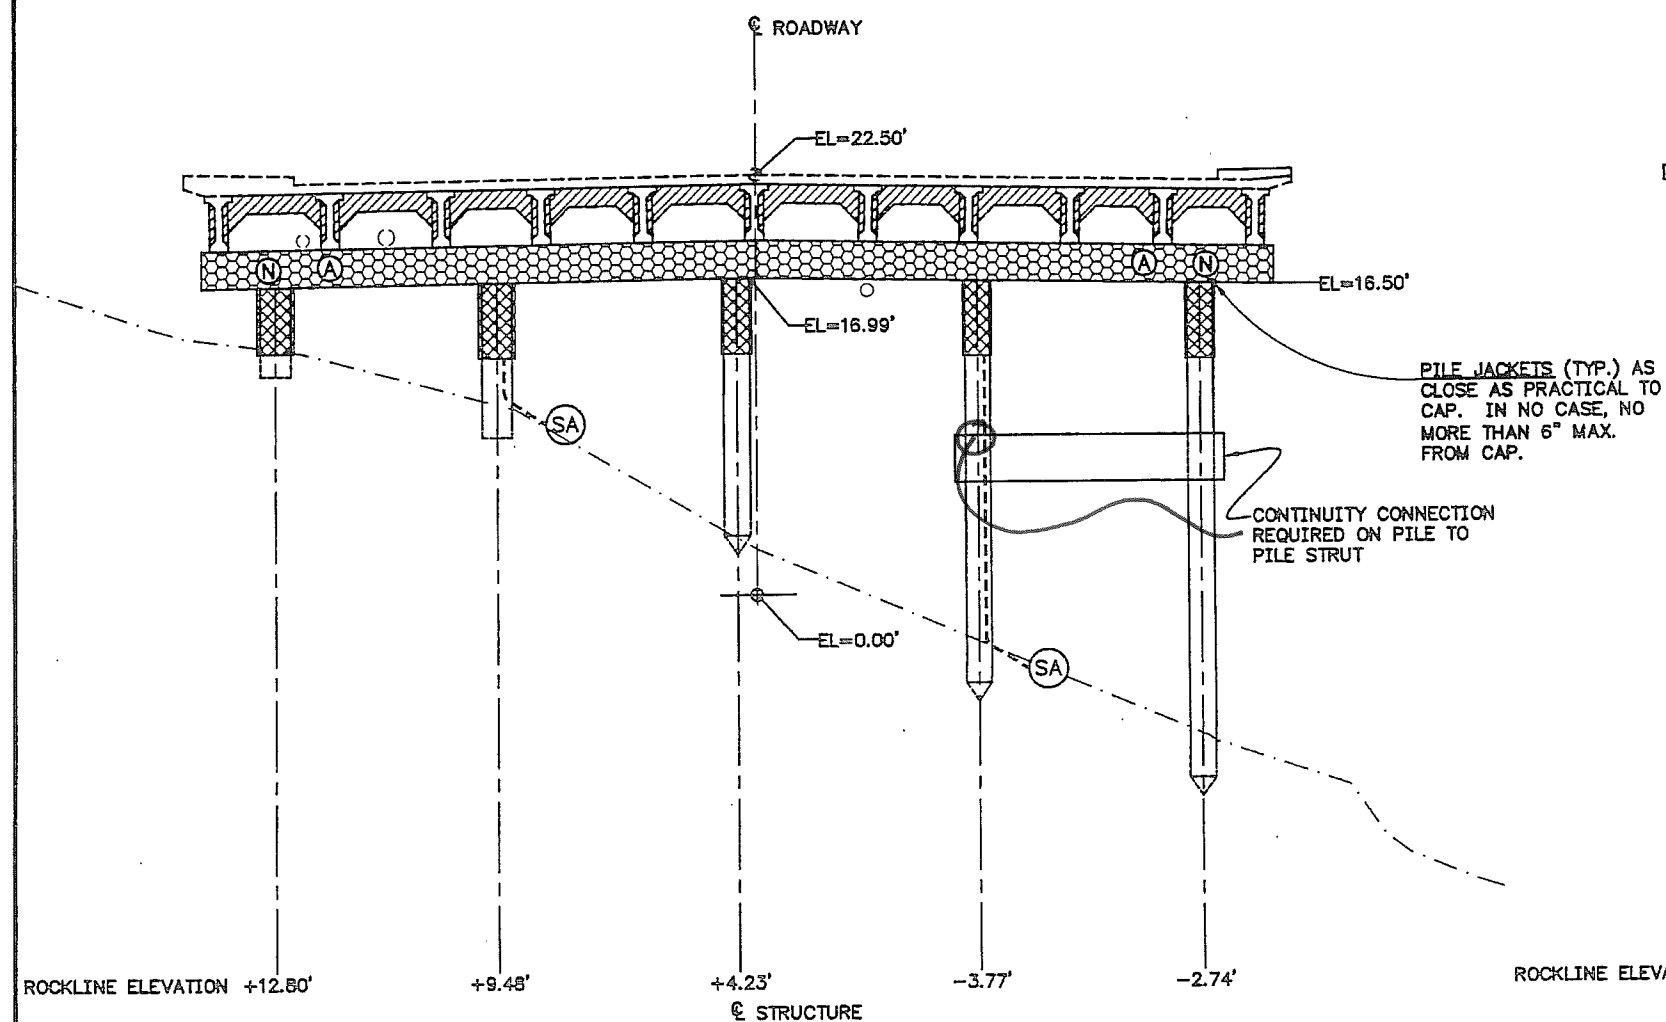

BENT 2

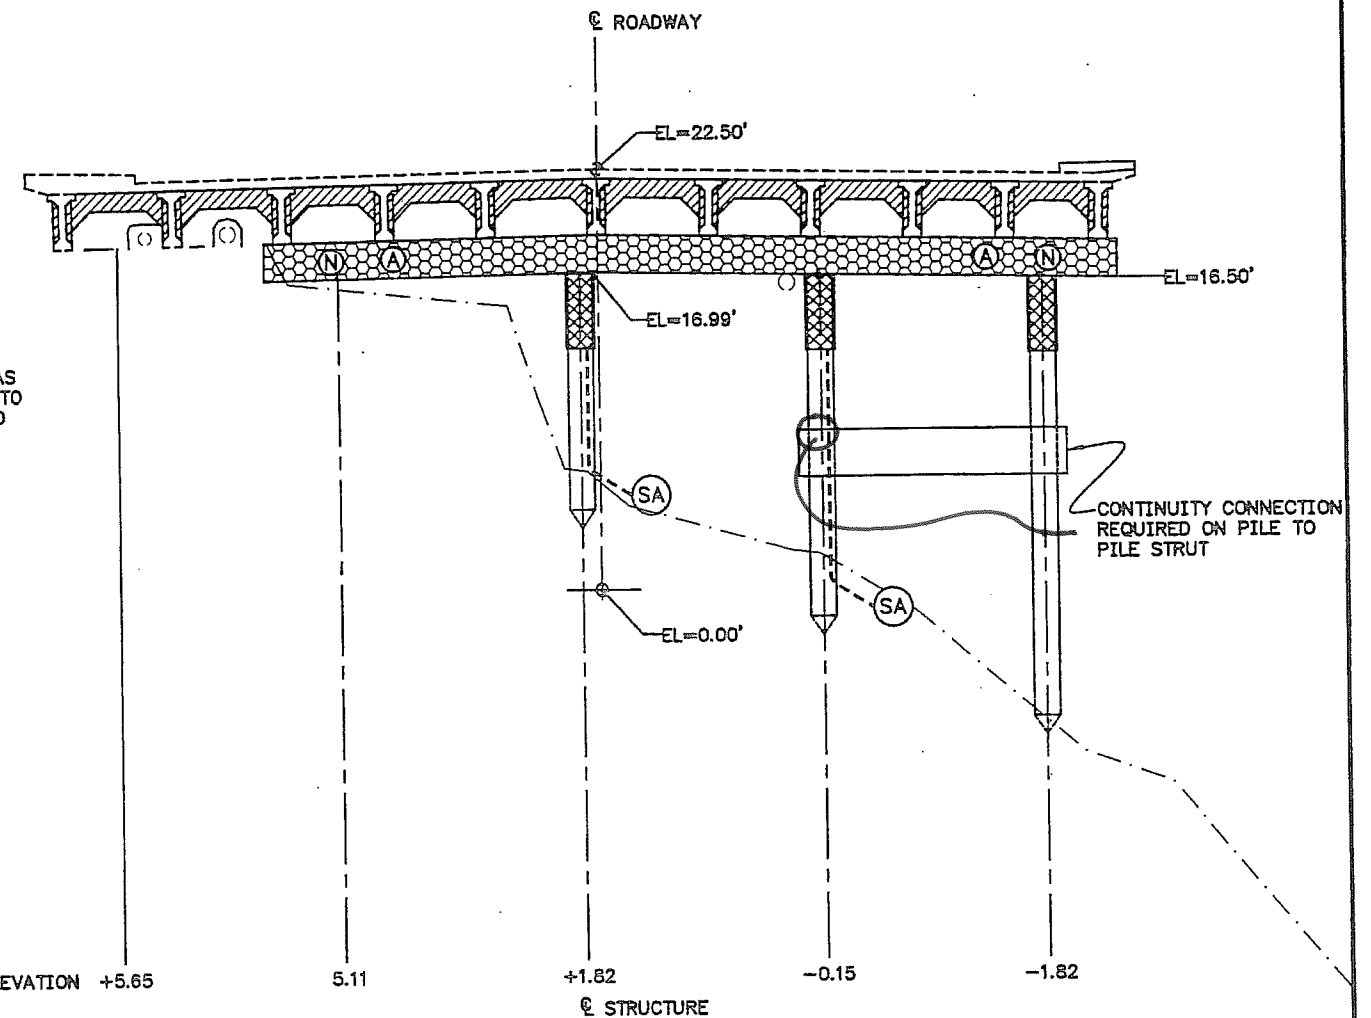

BENT 1


LEGEND

- SURVEY-MUDLINE
- 1999 MUDLINE
- 1955 ROCKLINE
- (N) SYSTEM NEGATIVE
- (A) ANODE TERMINAL PLATE
- (SA) SUBMERGED ANODE
- [Pattern] CAP JACKET
- [Pattern] PILE JACKET
- [Pattern] THERMAL SPRAY

NOTES:


1. MODIFY GENERAL JACKET CONFIGURATION TO FIT AROUND EXISTING UTILITIES.
2. IN SOME LOCATIONS EXISTING UTILITIES AND SERVICE LINES MAY BE CONGESTED. PROTECT EXISTING UTILITY PROPERTY WHILE COMPLETING THE REQUIRED OF THIS WORK.
3. REFER TO DETAILS FOR DIMENSIONS.
4. GIRDER END CONNECTION REQUIRED AT ONE END OF EACH PRESTRESSED GIRDER.
5. ONE SYSTEM NEGATIVE REQUIRED TOP OF EACH PILE OR PILASTER.

TONGASS AVENUE

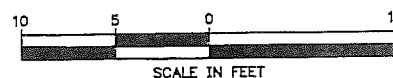

ELEVATIONS, BENCHMARKS AND DIMENSIONS ARE BASED ON "AS-BUILT" PLANS. VERIFY ALL CONTROLLING FIELD DIMENSIONS BEFORE ORDERING OR FABRICATING ANY MATERIAL.


DESIGNED BY: M. FIGLEY		STATE OF ALASKA DEPARTMENT OF TRANSPORTATION & PUBLIC FACILITIES STATEWIDE DESIGN & ENGINEERING SERVICES DIVISION	
		KTN-VIADUCTS REHABILITATION PROJECT NO. 68571	
		Tongass Avenue Bents 2 & 1	
CHECKED BY: G. IMSEN		YEAR: 2009	
DRAWN/REVISED BY: R.S., R.G.		SHEET NO. 37	
PATH: PLOT: PSPACE 1=1(F) OR MSPACE 1=1(F)		TOTAL SHEETS 70	
REVISONS		PROJECT DESIGNATION	
NO.	DATE	DESCRIPTION	
		NH-0902(34)	

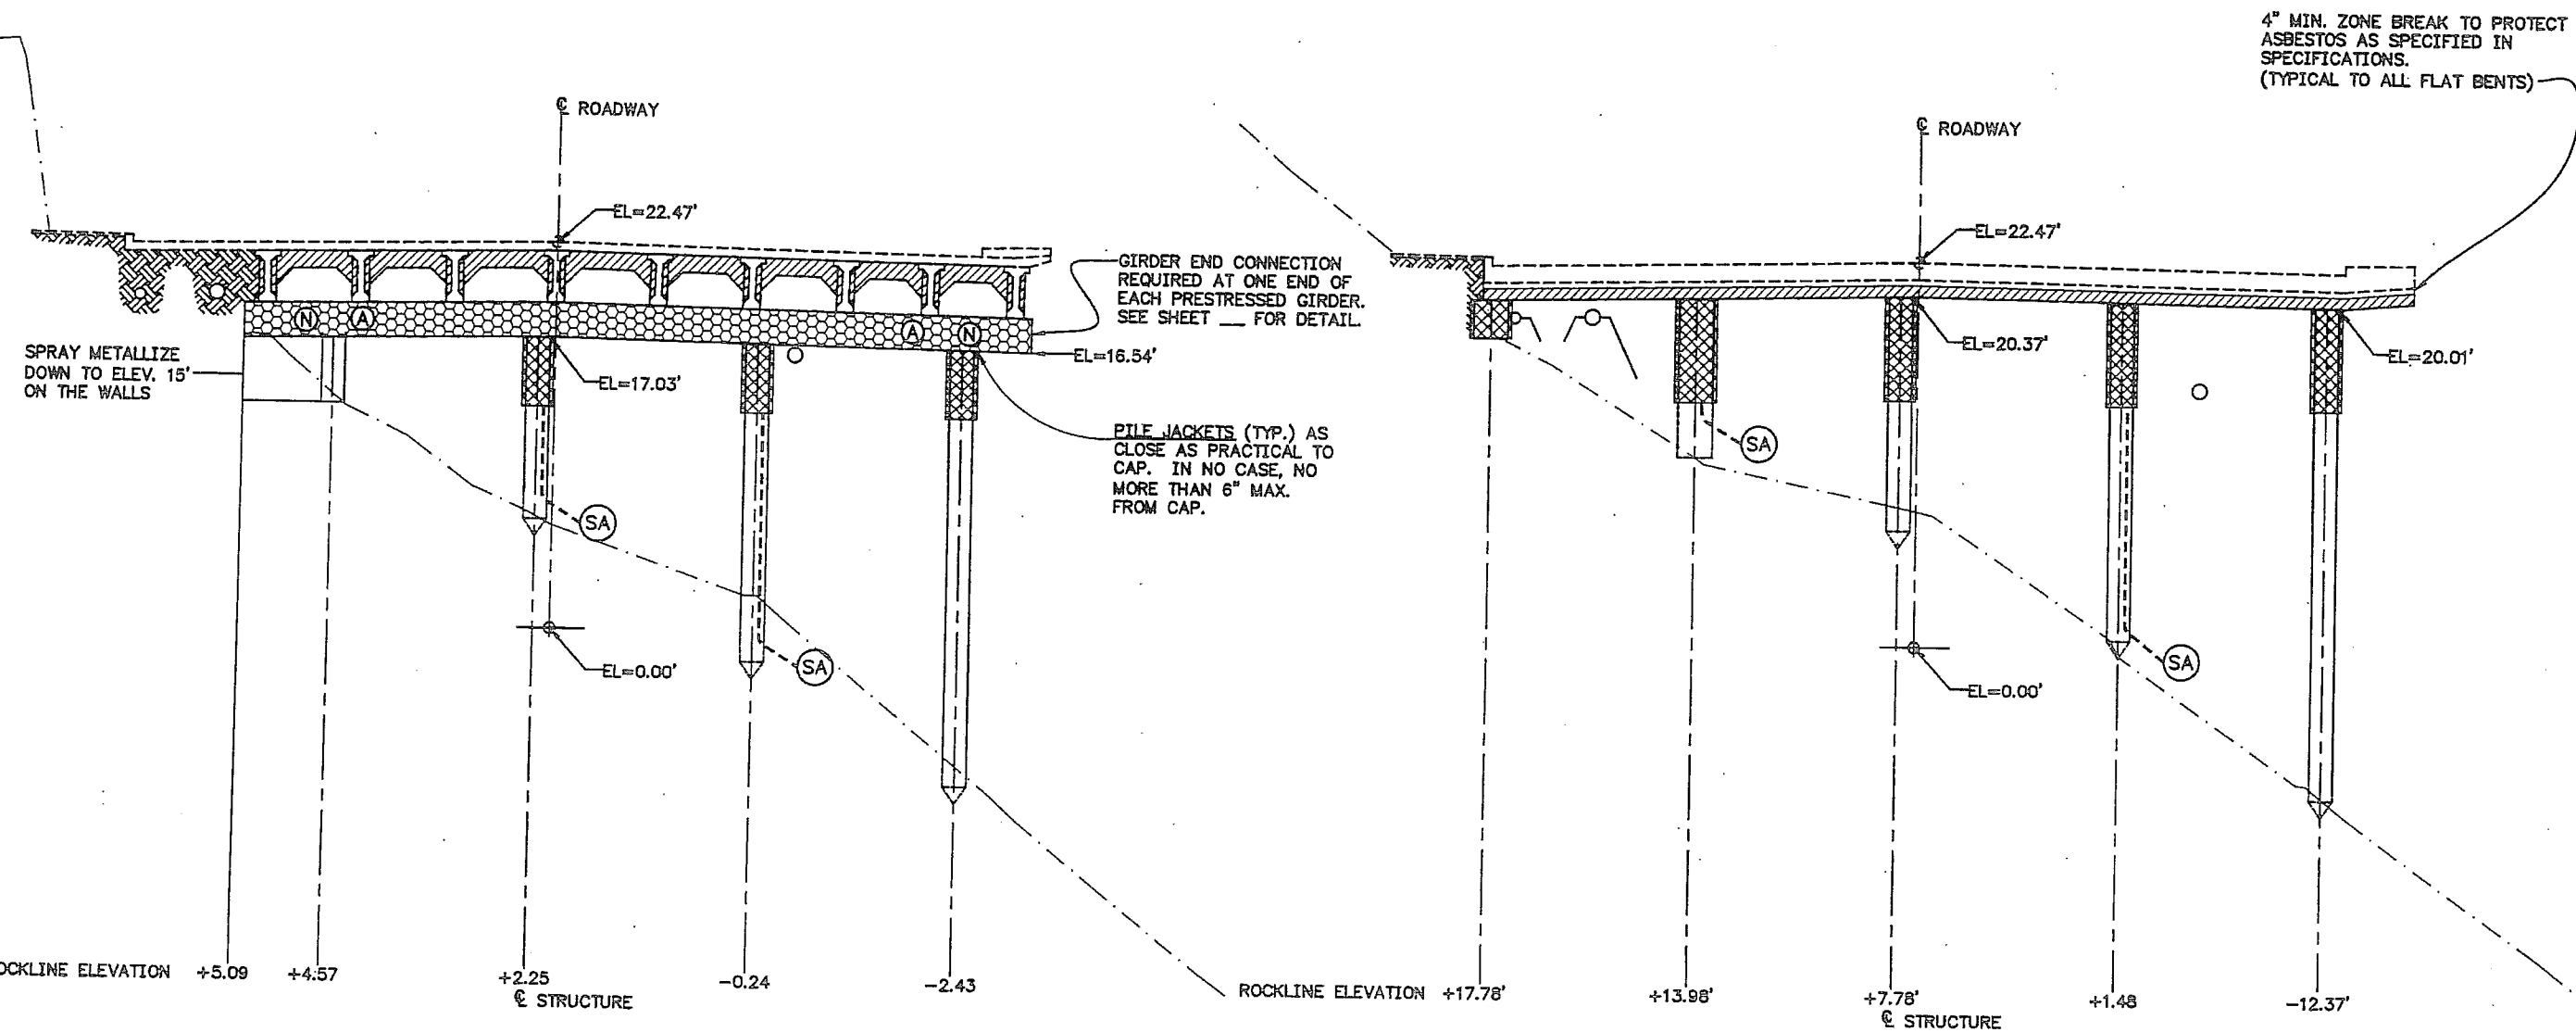

BENT 1A

BENT 2A

TONGASS AVENUE

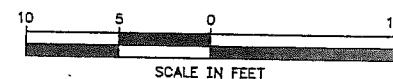

LEGEND


- SURVEY-MUDLINE
- 1999 MUDLINE
- 1955 ROCKLINE
- (N) SYSTEM NEGATIVE
- (A) ANODE TERMINAL PLATE
- (SA) SUBMERGED ANODE
- [Pattern] CAP JACKET
- [Pattern] PILE JACKET
- [Pattern] THERMAL SPRAY

NOTES:

- MODIFY GENERAL JACKET CONFIGURATION TO FIT AROUND EXISTING UTILITIES.
- IN SOME LOCATIONS EXISTING UTILITIES AND SERVICE LINES MAY BE CONGESTED. PROTECT EXISTING UTILITY PROPERTY WHILE COMPLETING THE REQUIRED OF THIS WORK.
- REFER TO DETAILS FOR DIMENSIONS.
- GIRDER END CONNECTION REQUIRED AT ONE END OF EACH PRESTRESSED GIRDER.
- ONE SYSTEM NEGATIVE REQUIRED TOP OF EACH PILE OR PILASTER.


ELEVATIONS, BENCHMARKS AND DIMENSIONS ARE BASED ON "AS-BUILT" PLANS. VERIFY ALL CONTROLLING FIELD DIMENSIONS BEFORE ORDERING OR FABRICATING ANY MATERIAL.

DESIGNED BY: M. FIGLEY		STATE OF ALASKA DEPARTMENT OF TRANSPORTATION & PUBLIC FACILITIES STATEWIDE DESIGN & ENGINEERING SERVICES DIVISION			
		KTN-VIADUCTS REHABILITATION PROJECT NO. 68571			
		Tongass Avenue Bents 1A & 2A			
CHECKED BY: G. IMBSEN		CP-3.5			
DRAWN/REVISED BY: R.S., R.G.		PATH: PSPACE 1=1(F) OR MSPACE 1=1(F)			
REVISIONS		PROJECT DESIGNATION	YEAR	SHEET NO.	TOTAL SHEETS
NO.	DATE	DESCRIPTION	NH-0902(34)	2009	38
					70

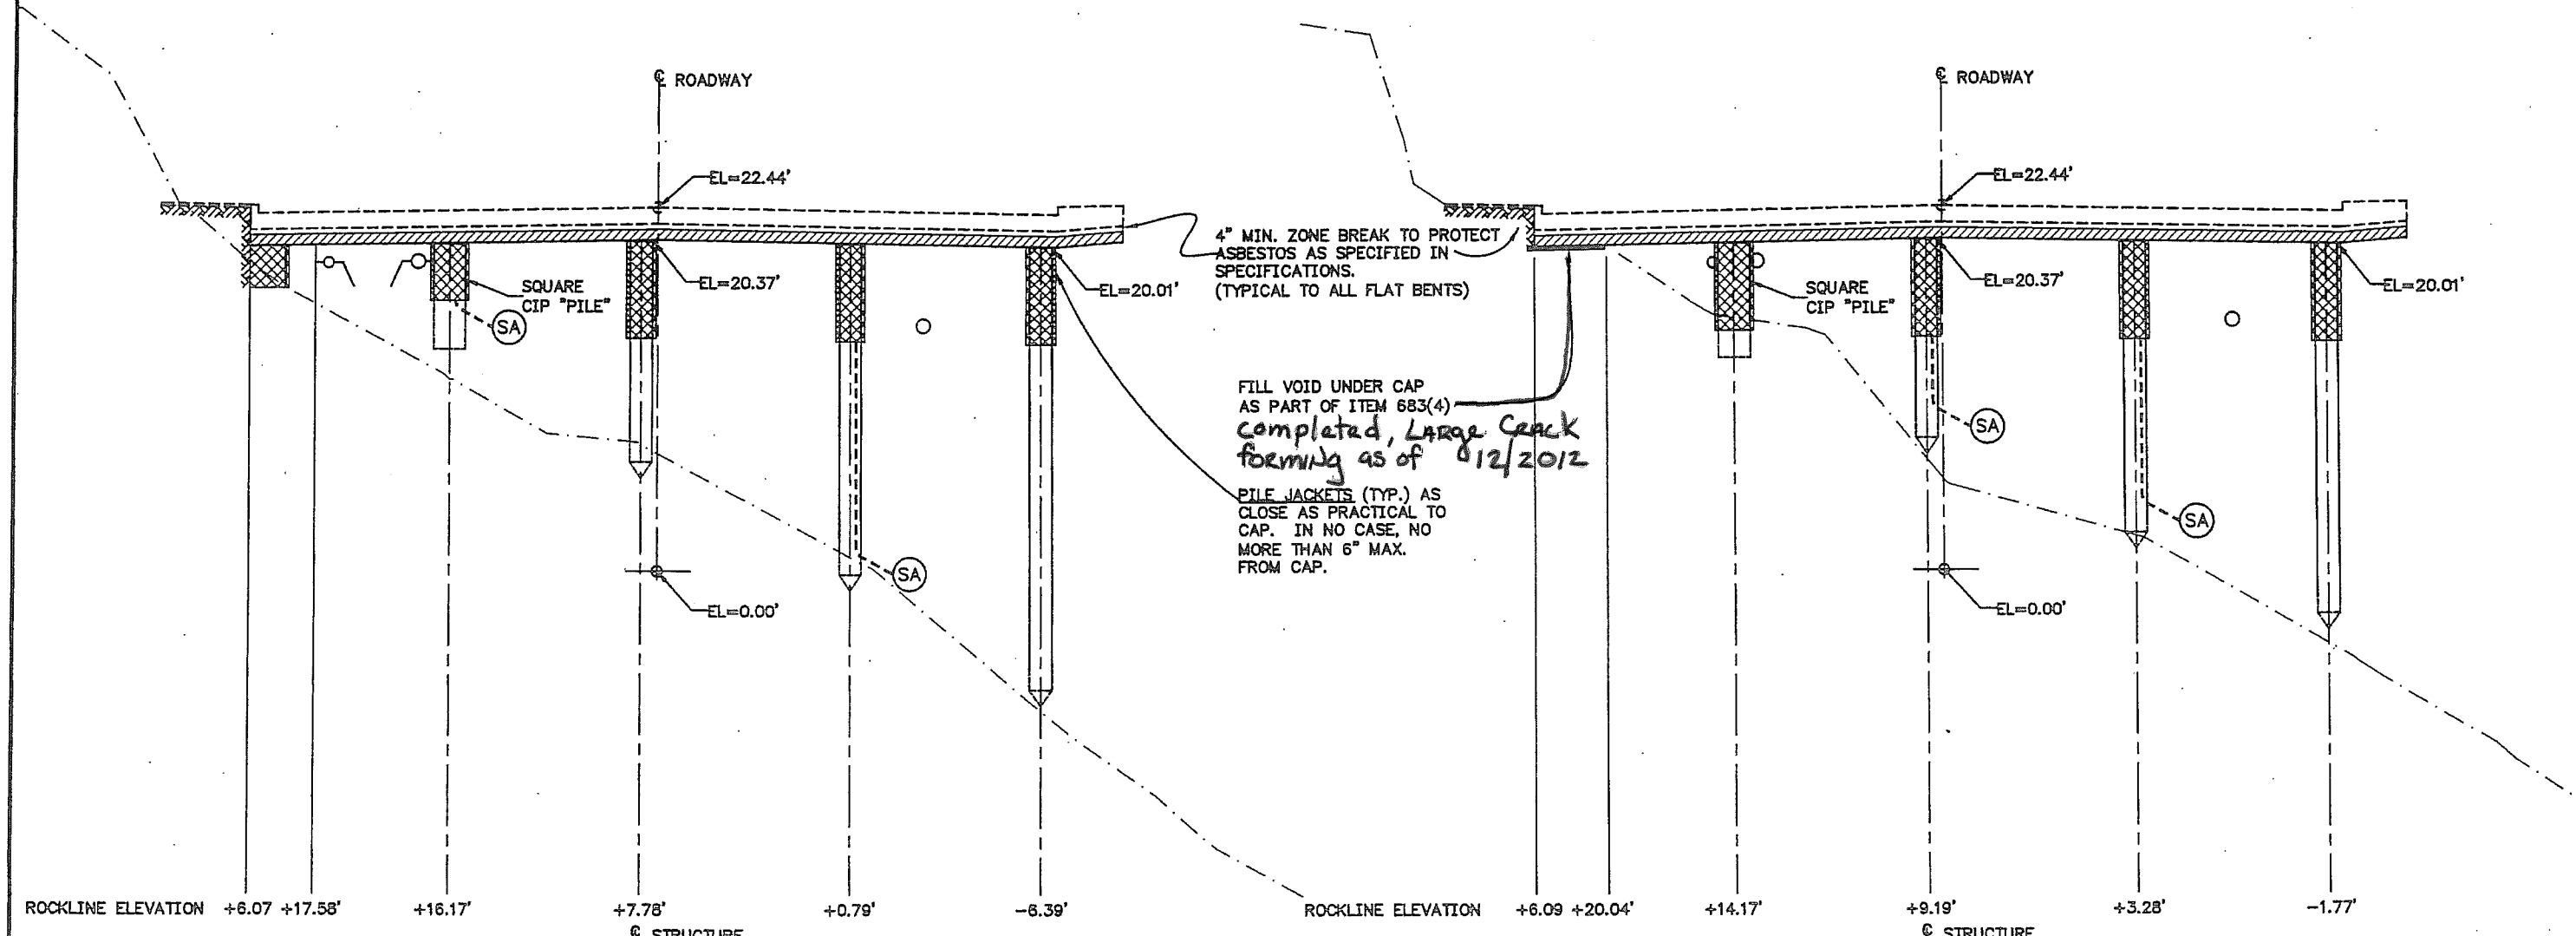

BENT 3A

BENT 4A

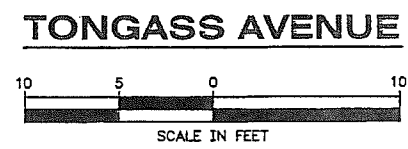

LEGEND


- SURVEY-MUDLINE
- 1999 MUDLINE
- 1955 ROCKLINE
- (N) SYSTEM NEGATIVE
- (A) ANODE TERMINAL PLATE
- (SA) SUBMERGED ANODE
- [Pattern] CAP JACKET
- [Pattern] PILE JACKET
- [Pattern] THERMAL SPRAY

NOTES:

1. MODIFY GENERAL JACKET CONFIGURATION TO FIT AROUND EXISTING UTILITIES.
2. IN SOME LOCATIONS EXISTING UTILITIES AND SERVICE LINES MAY BE CONGESTED. PROTECT EXISTING UTILITY PROPERTY WHILE COMPLETING THE REQUIRED OF THIS WORK.
3. REFER TO DETAILS FOR DIMENSIONS.
4. GIRDER END CONNECTION REQUIRED AT ONE END OF EACH PRESTRESSED GIRDER.
5. ONE SYSTEM NEGATIVE REQUIRED TOP OF EACH PILE OR PILASTER.

ELEVATIONS, BENCHMARKS AND DIMENSIONS ARE BASED ON "AS-BUILT" PLANS. VERIFY ALL CONTROLLING FIELD DIMENSIONS BEFORE ORDERING OR FABRICATING ANY MATERIAL.


DESIGNED BY: M. FIGLEY		STATE OF ALASKA DEPARTMENT OF TRANSPORTATION & PUBLIC FACILITIES STATEWIDE DESIGN & ENGINEERING SERVICES DIVISION			
		KTN-VIADUCTS REHABILITATION PROJECT NO. 68571			
		Tongass Avenue Bents 3A & 4A			
CHECKED BY: G. IMBSEN		CP-3.6			
DRAWN/REVISED BY: R.S., R.G.		PROJECT DESIGNATION			
PATH:		YEAR			
PLOT: PSPACE 1=1(F) OR MSPACE 1=1(F)		SHEET NO.			
NO.		TOTAL SHEETS			
DATE		NH-0902(34)			
REVISIONS		2009			
DESCRIPTION		39			
		70			

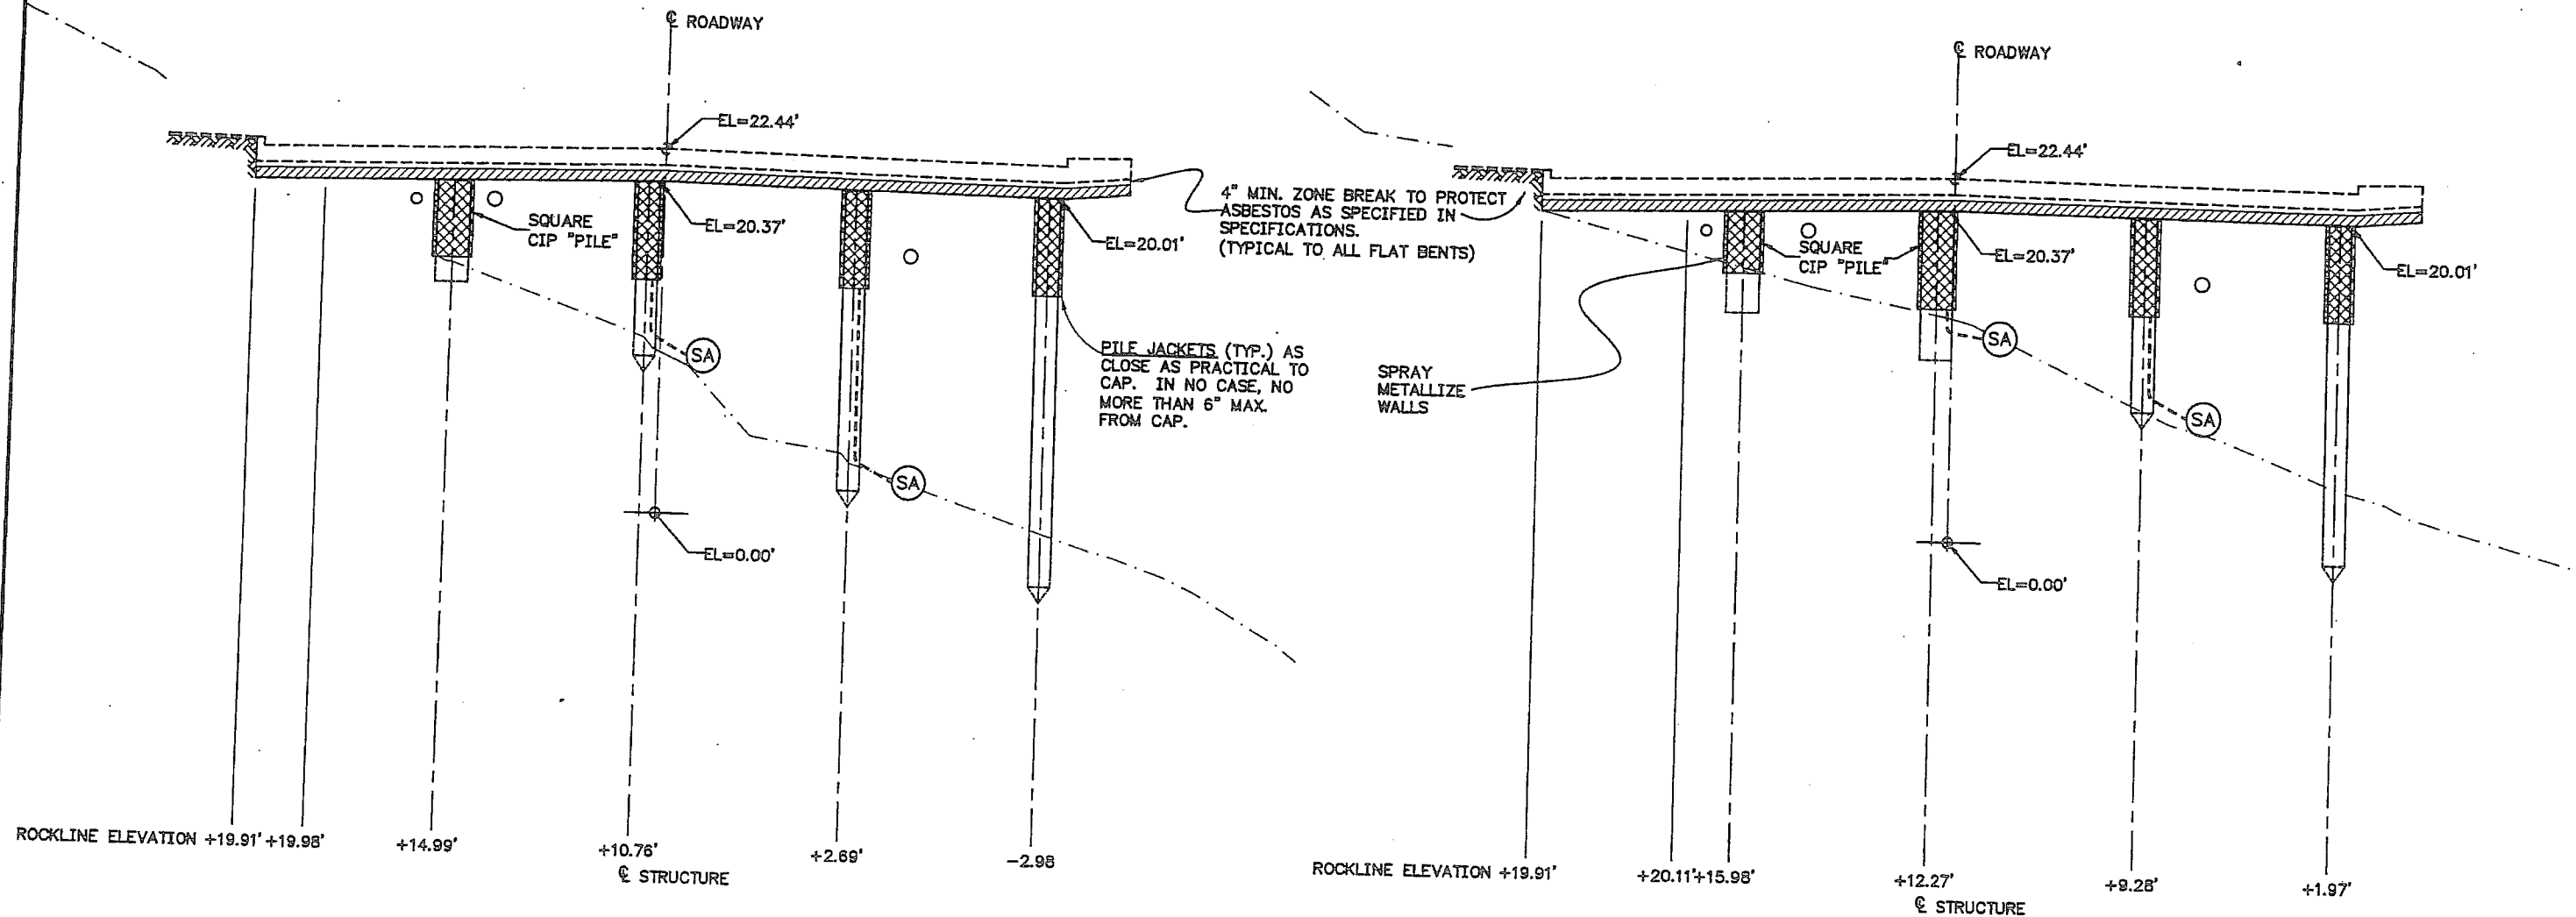

BENT 5A

BENT 6A

TONGASS AVENUE

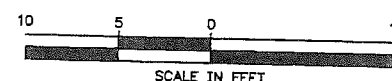

LEGEND


- SURVEY-MUDLINE
- 1999 MUDLINE
- 1955 ROCKLINE
- (N) SYSTEM NEGATIVE
- (A) ANODE TERMINAL PLATE
- (SA) SUBMERGED ANODE
- [Pattern] CAP JACKET
- [Pattern] PILE JACKET
- [Pattern] THERMAL SPRAY

NOTES:

1. MODIFY GENERAL JACKET CONFIGURATION TO FIT AROUND EXISTING UTILITIES.
2. IN SOME LOCATIONS EXISTING UTILITIES AND SERVICE LINES MAY BE CONGESTED. PROTECT EXISTING UTILITY PROPERTY WHILE COMPLETING THE REQUIRED OF THIS WORK.
3. REFER TO DETAILS FOR DIMENSIONS.
4. GIRDER END CONNECTION REQUIRED AT ONE END OF EACH PRESTRESSED GIRDER.
5. ONE SYSTEM NEGATIVE REQUIRED TOP OF EACH PILE OR PILASTER.

ELEVATIONS, BENCHMARKS AND DIMENSIONS ARE BASED ON "AS-BUILT" PLANS. VERIFY ALL CONTROLLING FIELD DIMENSIONS BEFORE ORDERING OR FABRICATING ANY MATERIAL.

DESIGNED BY: M. FIGLEY		STATE OF ALASKA DEPARTMENT OF TRANSPORTATION & PUBLIC FACILITIES STATEWIDE DESIGN & ENGINEERING SERVICES DIVISION	
		KTN-VIADUCTS REHABILITATION PROJECT NO. 68571	
		Tongass Avenue Bents 5A & 6A	
CHECKED BY: G. IMBSEN		CP-3.7	
DRAWN/REVISED BY: R.S., R.G.		NH-0902(34)	
PATH:		YEAR	SHEET NO.
PLOT: PSPACE 1=1(F) OR MSPACE 1=1(F)		2009	40
REVISIONS		TOTAL SHEETS	70
NO.	DATE	DESCRIPTION	

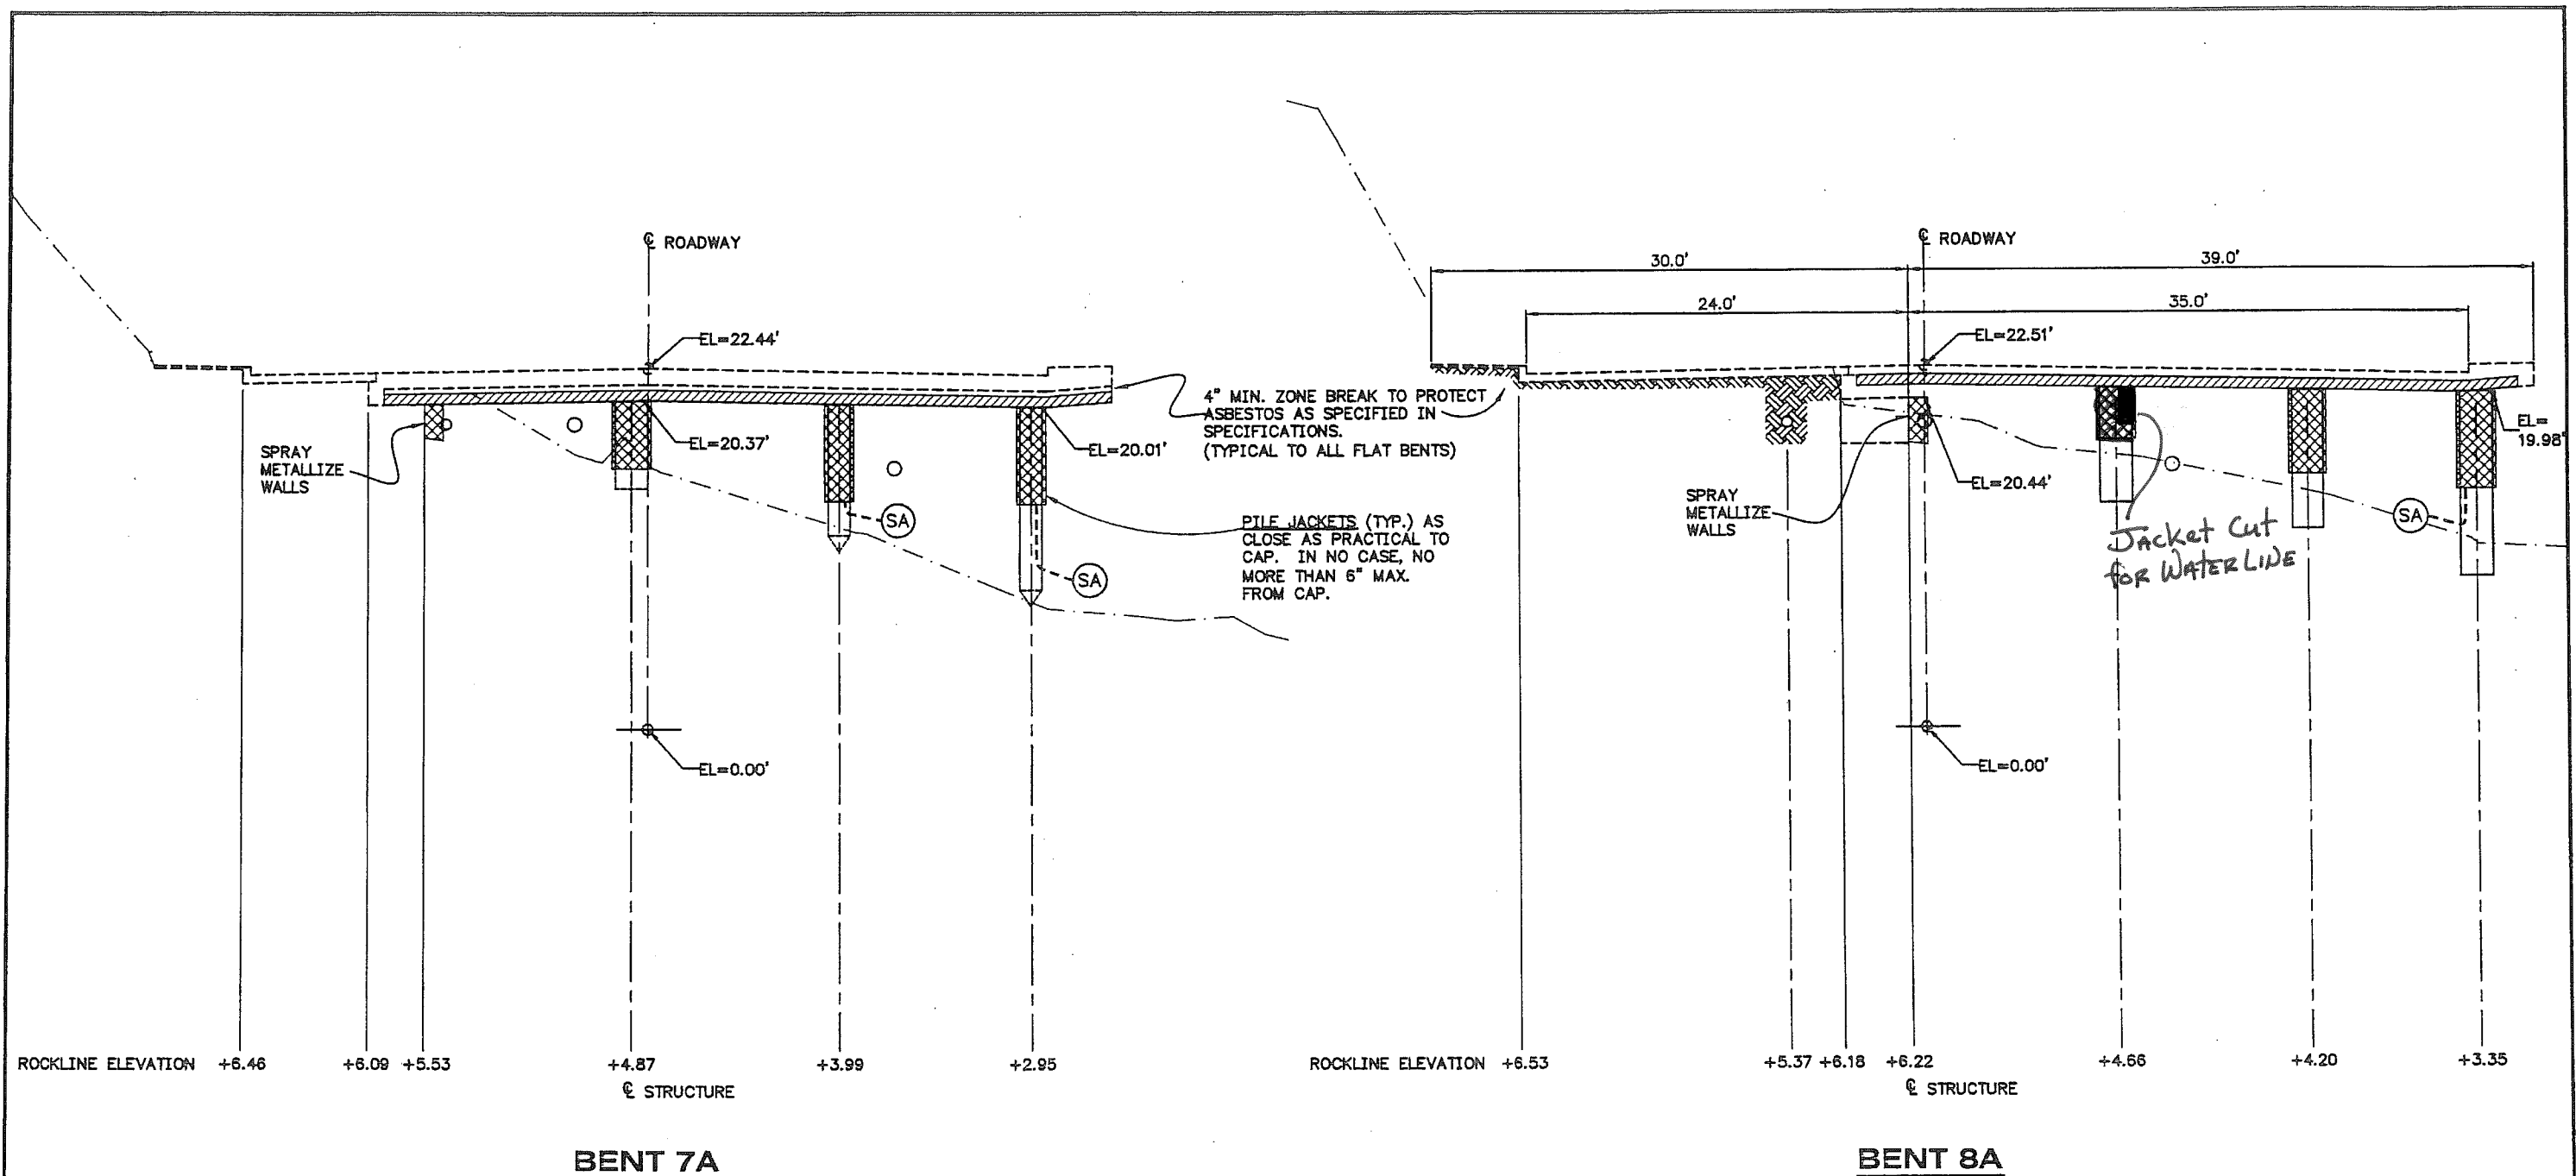


LEGEND

---	SURVEY-MUDLINE
---	1999 MUDLINE
---	1955 ROCKLINE
(N)	SYSTEM NEGATIVE
(A)	ANODE TERMINAL PLATE
(SA)	SUBMERGED ANODE
[Pattern]	CAP JACKET
[Pattern]	PILE JACKET
[Pattern]	THERMAL SPRAY

NOTES:


1. MODIFY GENERAL JACKET CONFIGURATION TO FIT AROUND EXISTING UTILITIES.
2. IN SOME LOCATIONS EXISTING UTILITIES AND SERVICE LINES MAY BE CONGESTED. PROTECT EXISTING UTILITY PROPERTY WHILE COMPLETING THE REQUIRED OF THIS WORK.
3. REFER TO DETAILS FOR DIMENSIONS.
4. GIRDER END CONNECTION REQUIRED AT ONE END OF EACH PRESTRESSED GIRDER.
5. ONE SYSTEM NEGATIVE REQUIRED TOP OF EACH PILE OR PILASTER.

TONGASS AVENUE

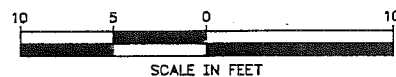


ELEVATIONS, BENCHMARKS AND DIMENSIONS ARE BASED ON "AS-BUILT" PLANS. VERIFY ALL CONTROLLING FIELD DIMENSIONS BEFORE ORDERING OR FABRICATING ANY MATERIAL.

DESIGNED BY: M. FIGLEY		STATE OF ALASKA DEPARTMENT OF TRANSPORTATION & PUBLIC FACILITIES STATEWIDE DESIGN & ENGINEERING SERVICES DIVISION			
		KTN-VIADUCTS REHABILITATION PROJECT NO. 68571			
		Tongass Avenue Bents 7A & 8A			
CHECKED BY: G. IMBSEN		CP-3.8			
DRAWN/REVISED BY: R.S., R.G.		PROJECT DESIGNATION			
PATH:		YEAR			
PLOT: PSPACE 1=1(F) OR MSPACE 1=1(F)		SHEET NO.			
NO.		TOTAL SHEETS			
DATE		NH-0902(34)			
DESCRIPTION		2009			
		41			
		70			

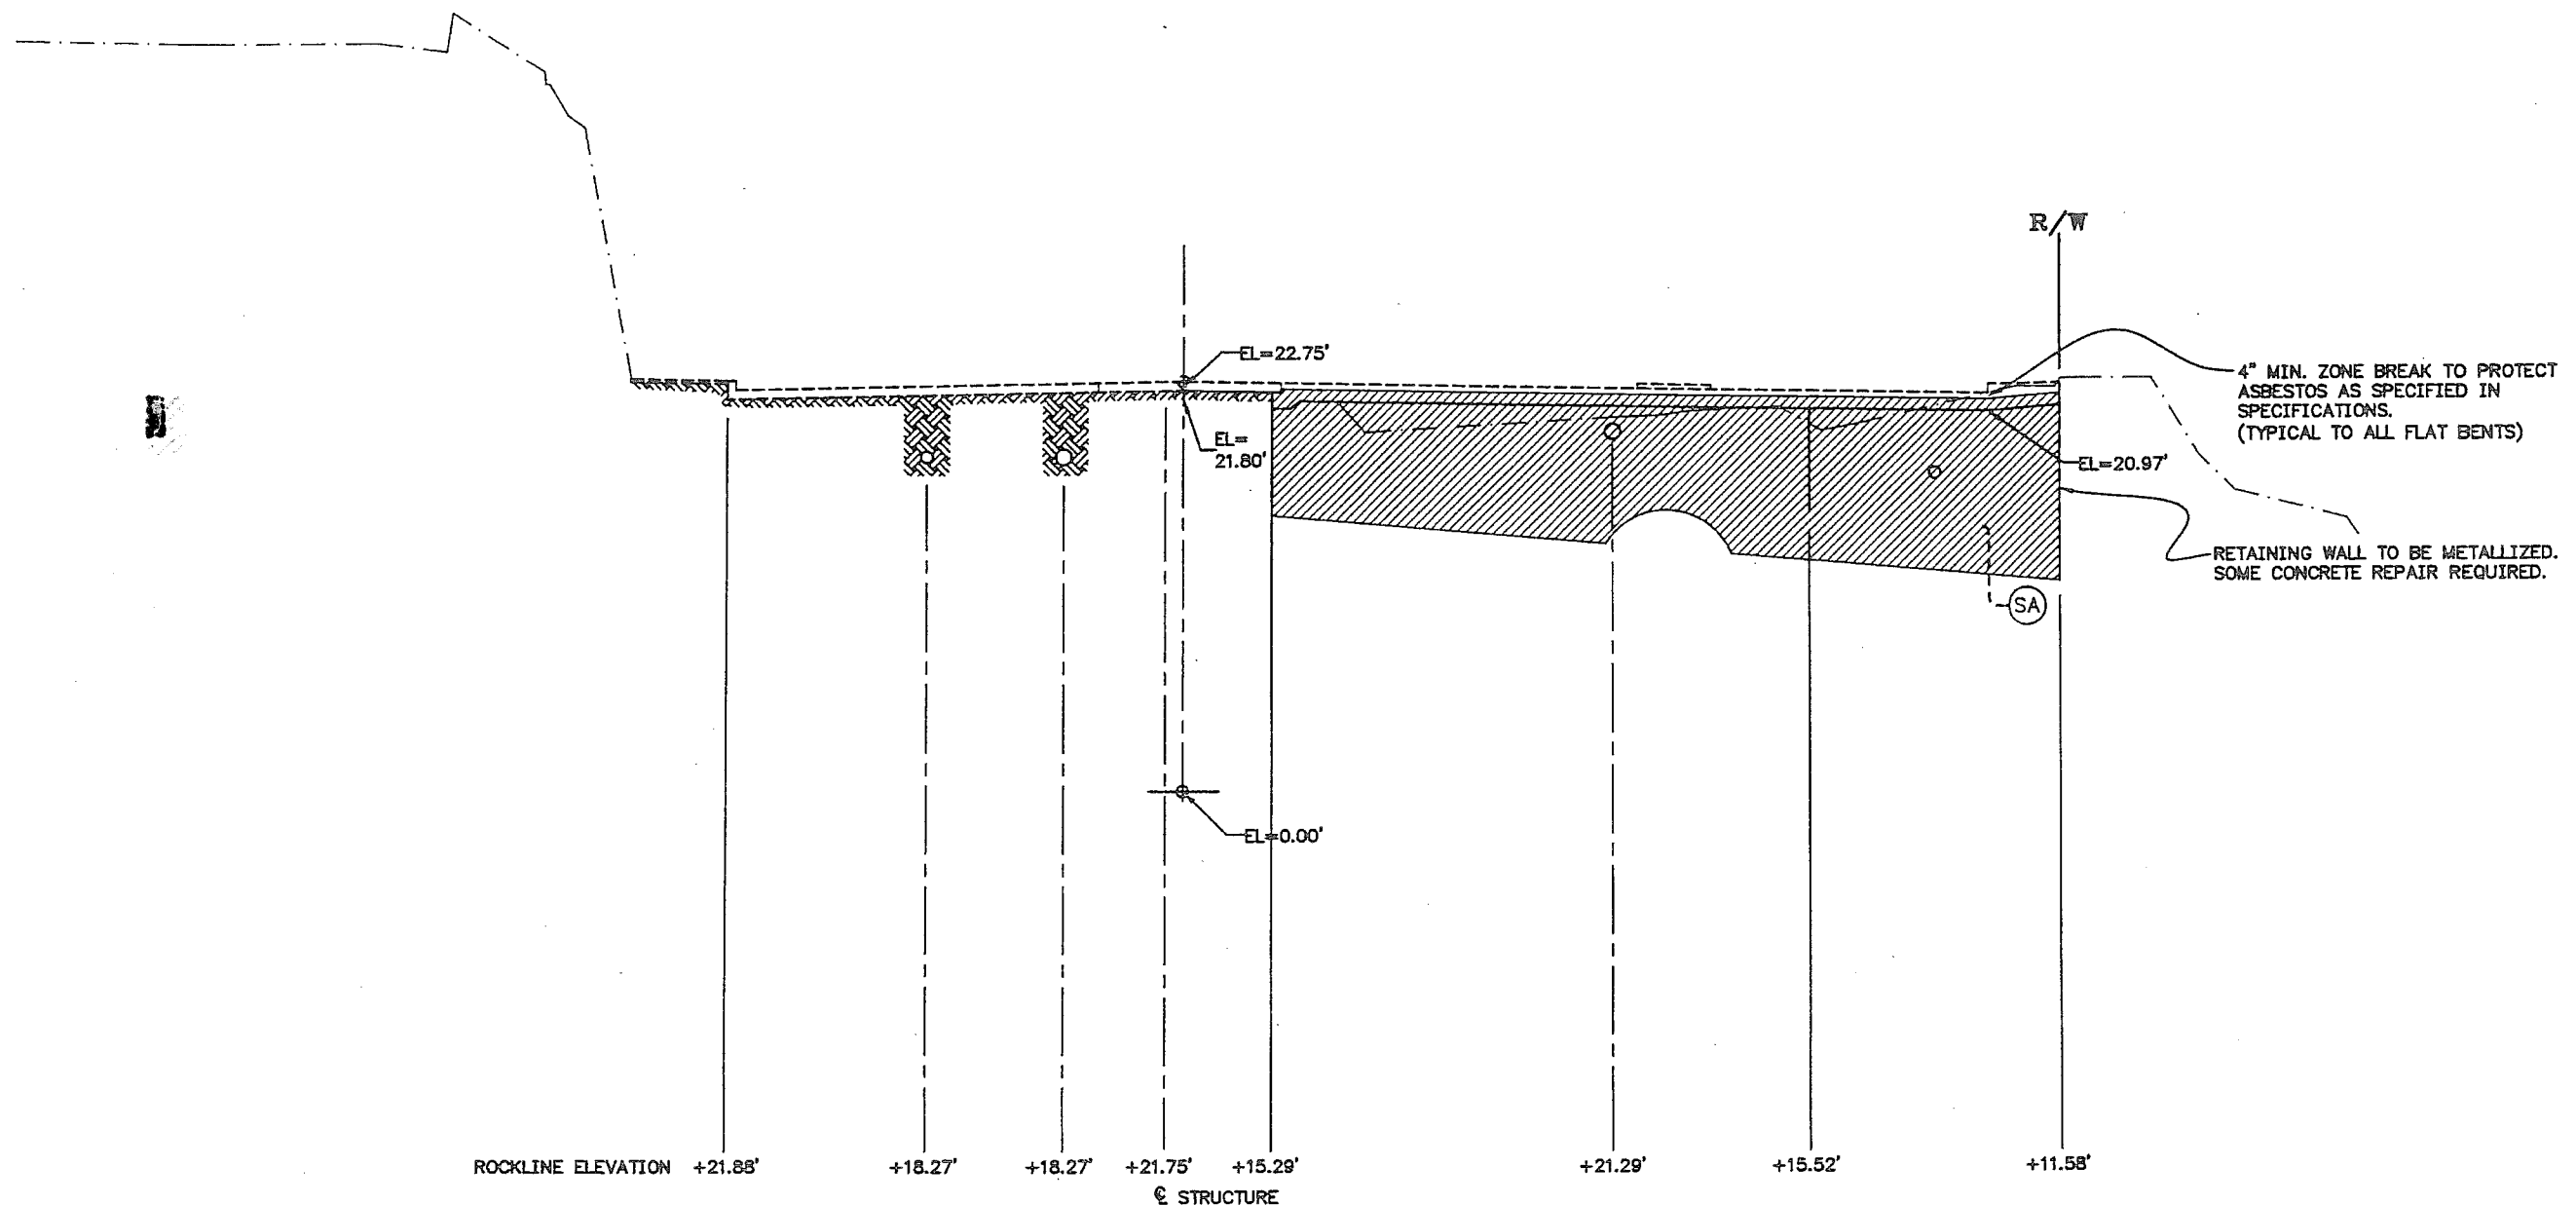

BENT 9A

TONGASS AVENUE

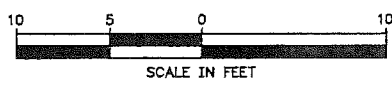

LEGEND

- SURVEY-MUDLINE
- 1999 MUDLINE
- 1955 ROCKLINE
- (N) SYSTEM NEGATIVE
- (A) ANODE TERMINAL PLATE
- (SA) SUBMERGED ANODE
- CAP JACKET
- PILE JACKET
- THERMAL SPRAY

NOTES:

1. MODIFY GENERAL JACKET CONFIGURATION TO FIT AROUND EXISTING UTILITIES.
2. IN SOME LOCATIONS EXISTING UTILITIES AND SERVICE LINES MAY BE CONGESTED. PROTECT EXISTING UTILITY PROPERTY WHILE COMPLETING THE REQUIRED OF THIS WORK.
3. REFER TO DETAILS FOR DIMENSIONS.
4. GIRDER END CONNECTION REQUIRED AT ONE END OF EACH PRESTRESSED GIRDER.
5. ONE SYSTEM NEGATIVE REQUIRED TOP OF EACH PILE OR PILASTER.

ELEVATIONS, BENCHMARKS AND DIMENSIONS ARE BASED ON "AS-BUILT" PLANS. VERIFY ALL CONTROLLING FIELD DIMENSIONS BEFORE ORDERING OR FABRICATING ANY MATERIAL.

DESIGNED BY: M. FIGLEY		STATE OF ALASKA DEPARTMENT OF TRANSPORTATION & PUBLIC FACILITIES STATEWIDE DESIGN & ENGINEERING SERVICES DIVISION			
		KTN-VIADUCTS REHABILITATION PROJECT NO. 68571			
		Tongass Avenue Bent 9A			
CHECKED BY: G. IMBSEN		CP-3.9			
DRAWN/REVISED BY: R.S., R.G.		PATH:			
PLOT: PSPACE 1=1(F) OR MSPACE 1=1(F)		PROJECT DESIGNATION			
		NH-0902(34)			
		YEAR			
		2009			
		SHEET NO.			
		42			
		TOTAL SHEETS			
		70			

BENT 65 NOTES:


1. BENT 64 WAS REHABILITATED ON PROJECT 71111, HOWEVER, THE SPAN FROM BENT 64 TO BENT 65 WILL BE SPRAY METALLIZED UNDER THIS PROJECT.
2. THERE IS A GRAVITY SEWER MANHOLE STRUCTURE BETWEEN BENTS 64 AND 65. WORK DECK MUST BE BUILT AROUND THIS STRUCTURE.
3. WORK AROUND SEAWARD BUILDING, TIE BACK CABLES.

NOTE:

AT THESE BENT/SPAN LOCATIONS, ALL WORK ON ITEMS 681(1), 681(2), 683(1), 683(2), 683(3), 683(4), 684(1), 684(2), 684(3), 684(4), 684(5), 684(7), 686(1), 686(2), AND 687(1) MUST BE COMPLETED BETWEEN OCTOBER 1ST. AND MAY 1ST.

BENT 66 NOTE:

WORK AROUND SEAWARD BUILDING, TIE BACK CABLES.

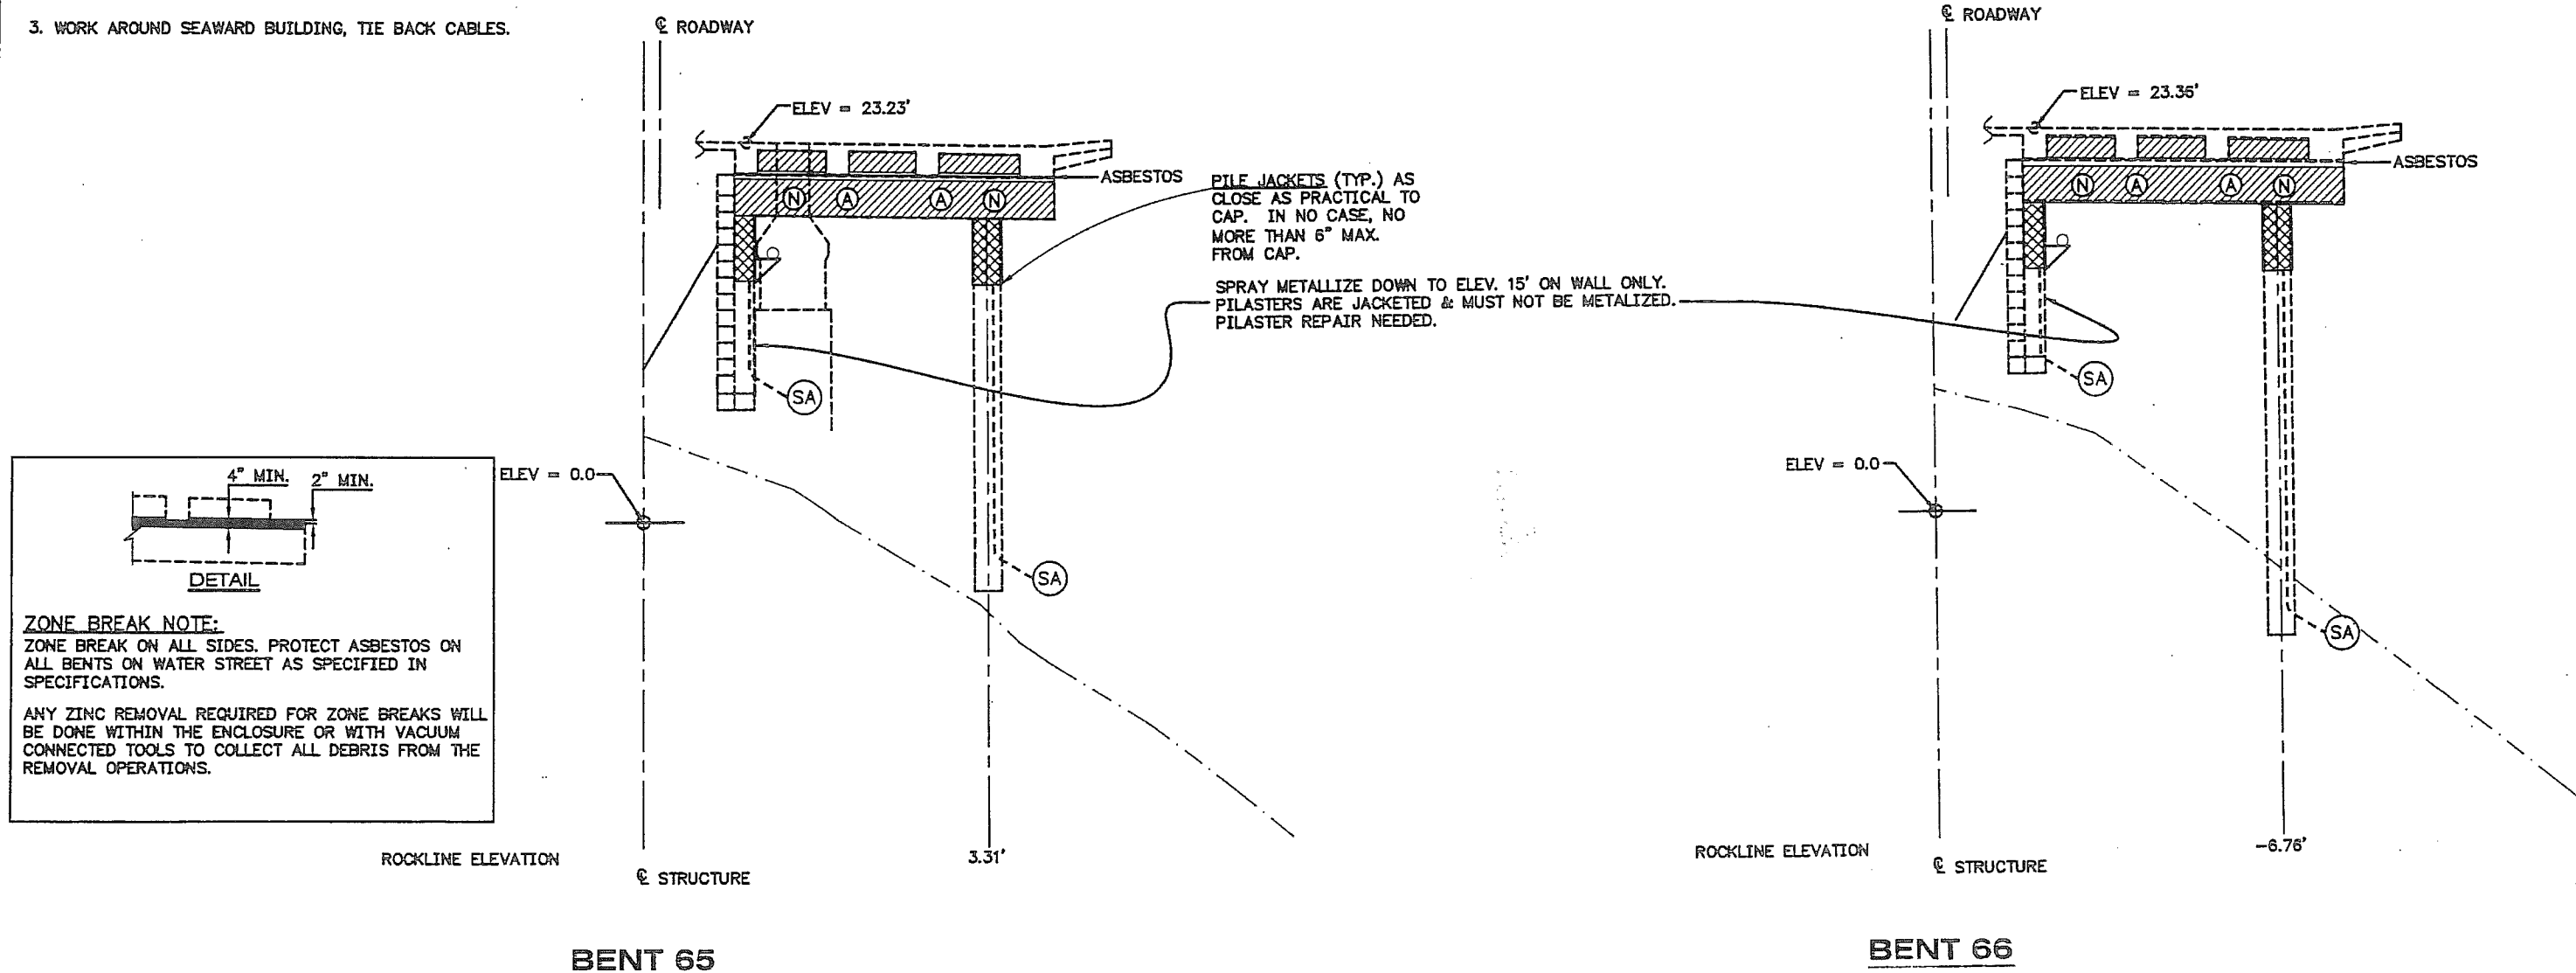

LEGEND

- SURVEY-MUDLINE
- 1999 MUDLINE
- 1955 ROCKLINE
- (N) SYSTEM NEGATIVE
- (A) ANODE TERMINAL PLATE
- (SA) SUBMERGED ANODE
- [Pattern] CAP JACKET
- [Pattern] PILE JACKET
- [Pattern] THERMAL SPRAY

NOTES:

1. ASBESTOS IS PRESENT IN EXPANSION SIDE OF JOINT. SPECIAL HANDLING IS REQUIRED. SEE SPECIFICATIONS.
2. MODIFY GENERAL JACKET CONFIGURATION TO FIT AROUND EXISTING UTILITIES.
3. IN SOME LOCATIONS EXISTING UTILITIES AND SERVICE LINES MAY BE CONGESTED. PROTECT EXISTING UTILITY PROPERTY WHILE COMPLETING THE REQUIRED WORK.
4. REFER TO DETAILS FOR DIMENSIONS.
5. ONE SYSTEM NEGATIVE REQUIRED TOP OF EACH PILE OR PILASTER.

ELEVATIONS, BENCHMARKS AND DIMENSIONS ARE BASED ON "AS-BUILT" PLANS. VERIFY ALL CONTROLLING FIELD DIMENSIONS BEFORE ORDERING OR FABRICATING ANY MATERIAL.




DESIGNED BY: M. FILEY		STATE OF ALASKA DEPARTMENT OF TRANSPORTATION & PUBLIC FACILITIES STATEWIDE DESIGN & ENGINEERING SERVICES DIVISION			
		KTN-VIADUCTS REHABILITATION PROJECT NO. 68571			
		Water Street Bents 65 & 66			
CHECKED BY: G. IMSEN		CP-3.10			
DRAWN/REVISED BY: R.S., R.G.		PROJECT DESIGNATION: NH-0902(34)			
PATH: PSPACE 1=1(F) OR MSPACE 1=1(F)		YEAR: 2009			
NO. DATE DESCRIPTION		SHEET NO. 43			
		TOTAL SHEETS 70			

NOTE:

WORK AROUND SEAWARD BUILDING, TIE BACK CABLES.

NOTE:

AT THESE BENT/SPAN LOCATIONS, ALL WORK ON ITEMS 681(1), 681(2), 683(1), 683(2), 683(3), 683(4), 684(1), 684(2), 684(3), 684(4), 684(5), 684(7), 686(1), 686(2), AND 687(1) MUST BE COMPLETED BETWEEN OCTOBER 1ST. AND MAY 1ST.

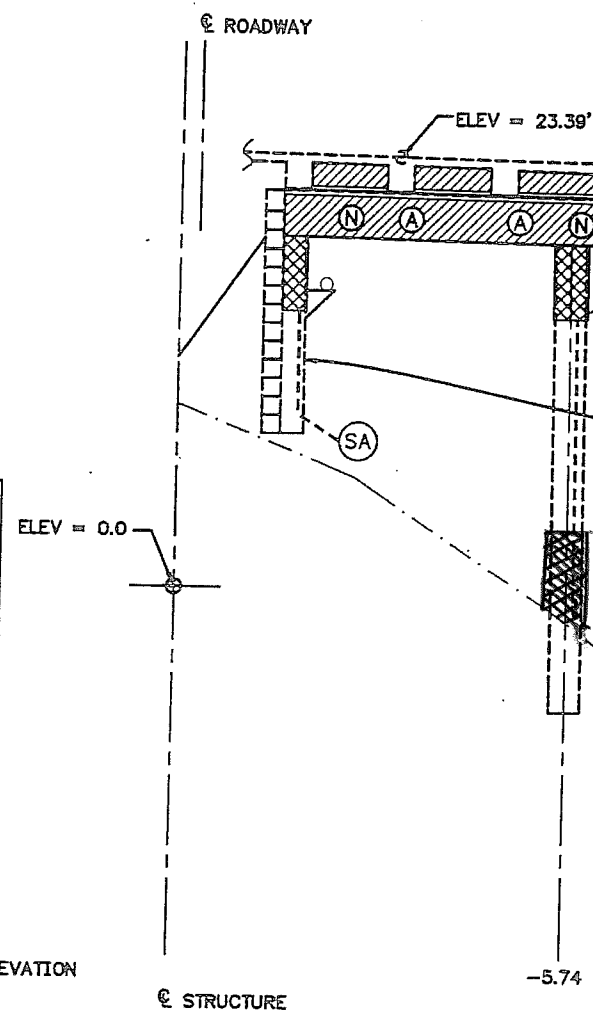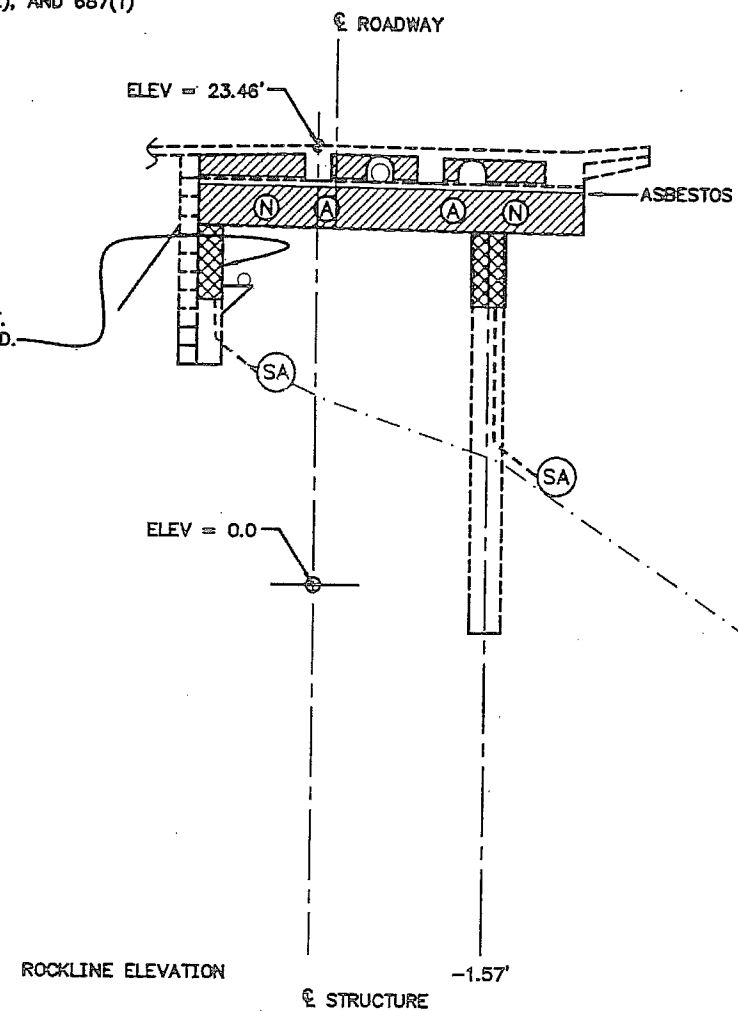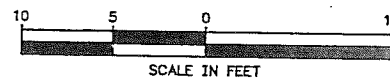**BENT 67****BENT 68****WATER STREET****LEGEND**


- SURVEY-MUDLINE
- 1999 MUDLINE
- 1955 ROCKLINE
- (N) SYSTEM NEGATIVE
- (A) ANODE TERMINAL PLATE
- (SA) SUBMERGED ANODE
- CAP JACKET
- PILE JACKET
- THERMAL SPRAY

NOTES:

- ASBESTOS IS PRESENT IN EXPANSION SIDE OF JOINT. SPECIAL HANDLING IS REQUIRED. SEE SPECIFICATIONS.
- MODIFY GENERAL JACKET CONFIGURATION TO FIT AROUND EXISTING UTILITIES.
- IN SOME LOCATIONS EXISTING UTILITIES AND SERVICE LINES MAY BE CONGESTED. PROTECT EXISTING UTILITY PROPERTY WHILE COMPLETING THE REQUIRED WORK.
- REFER TO DETAILS FOR DIMENSIONS.
- ONE SYSTEM NEGATIVE REQUIRED TOP OF EACH PILE OR PILASTER.

ELEVATIONS, BENCHMARKS AND DIMENSIONS ARE BASED ON "AS-BUILT" PLANS. VERIFY ALL CONTROLLING FIELD DIMENSIONS BEFORE ORDERING OR FABRICATING ANY MATERIAL.

DESIGNED BY: M. FIGLEY

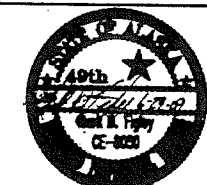

STATE OF ALASKA
DEPARTMENT OF TRANSPORTATION
& PUBLIC FACILITIES
STATEWIDE DESIGN & ENGINEERING SERVICES DIVISION
**KTN-VIADUCTS
REHABILITATION
PROJECT NO. 68571**

CHECKED BY: G. JENSEN
DRAWN/REVISED BY: R.S., R.G.

**Water Street
Bents 67 & 68**


PATH:
PLOT: PSPACE 1=1(F) OR LSPACE 1=1(F)

CP-3.11

NO.	DATE	REVISIONS DESCRIPTION	PROJECT DESIGNATION	YEAR	SHEET NO.	TOTAL SHEETS
			NH-0902(34)	2009	44	70

NOTE:

AT THESE BENT/SPAN LOCATIONS, ALL WORK ON ITEMS 681(1), 681(2), 683(1), 683(2), 683(3), 683(4), 684(1), 684(2), 684(3), 684(4), 684(5), 684(7), 686(1), 686(2), AND 687(1) MUST BE COMPLETED BETWEEN OCTOBER 1ST. AND MAY 1ST.

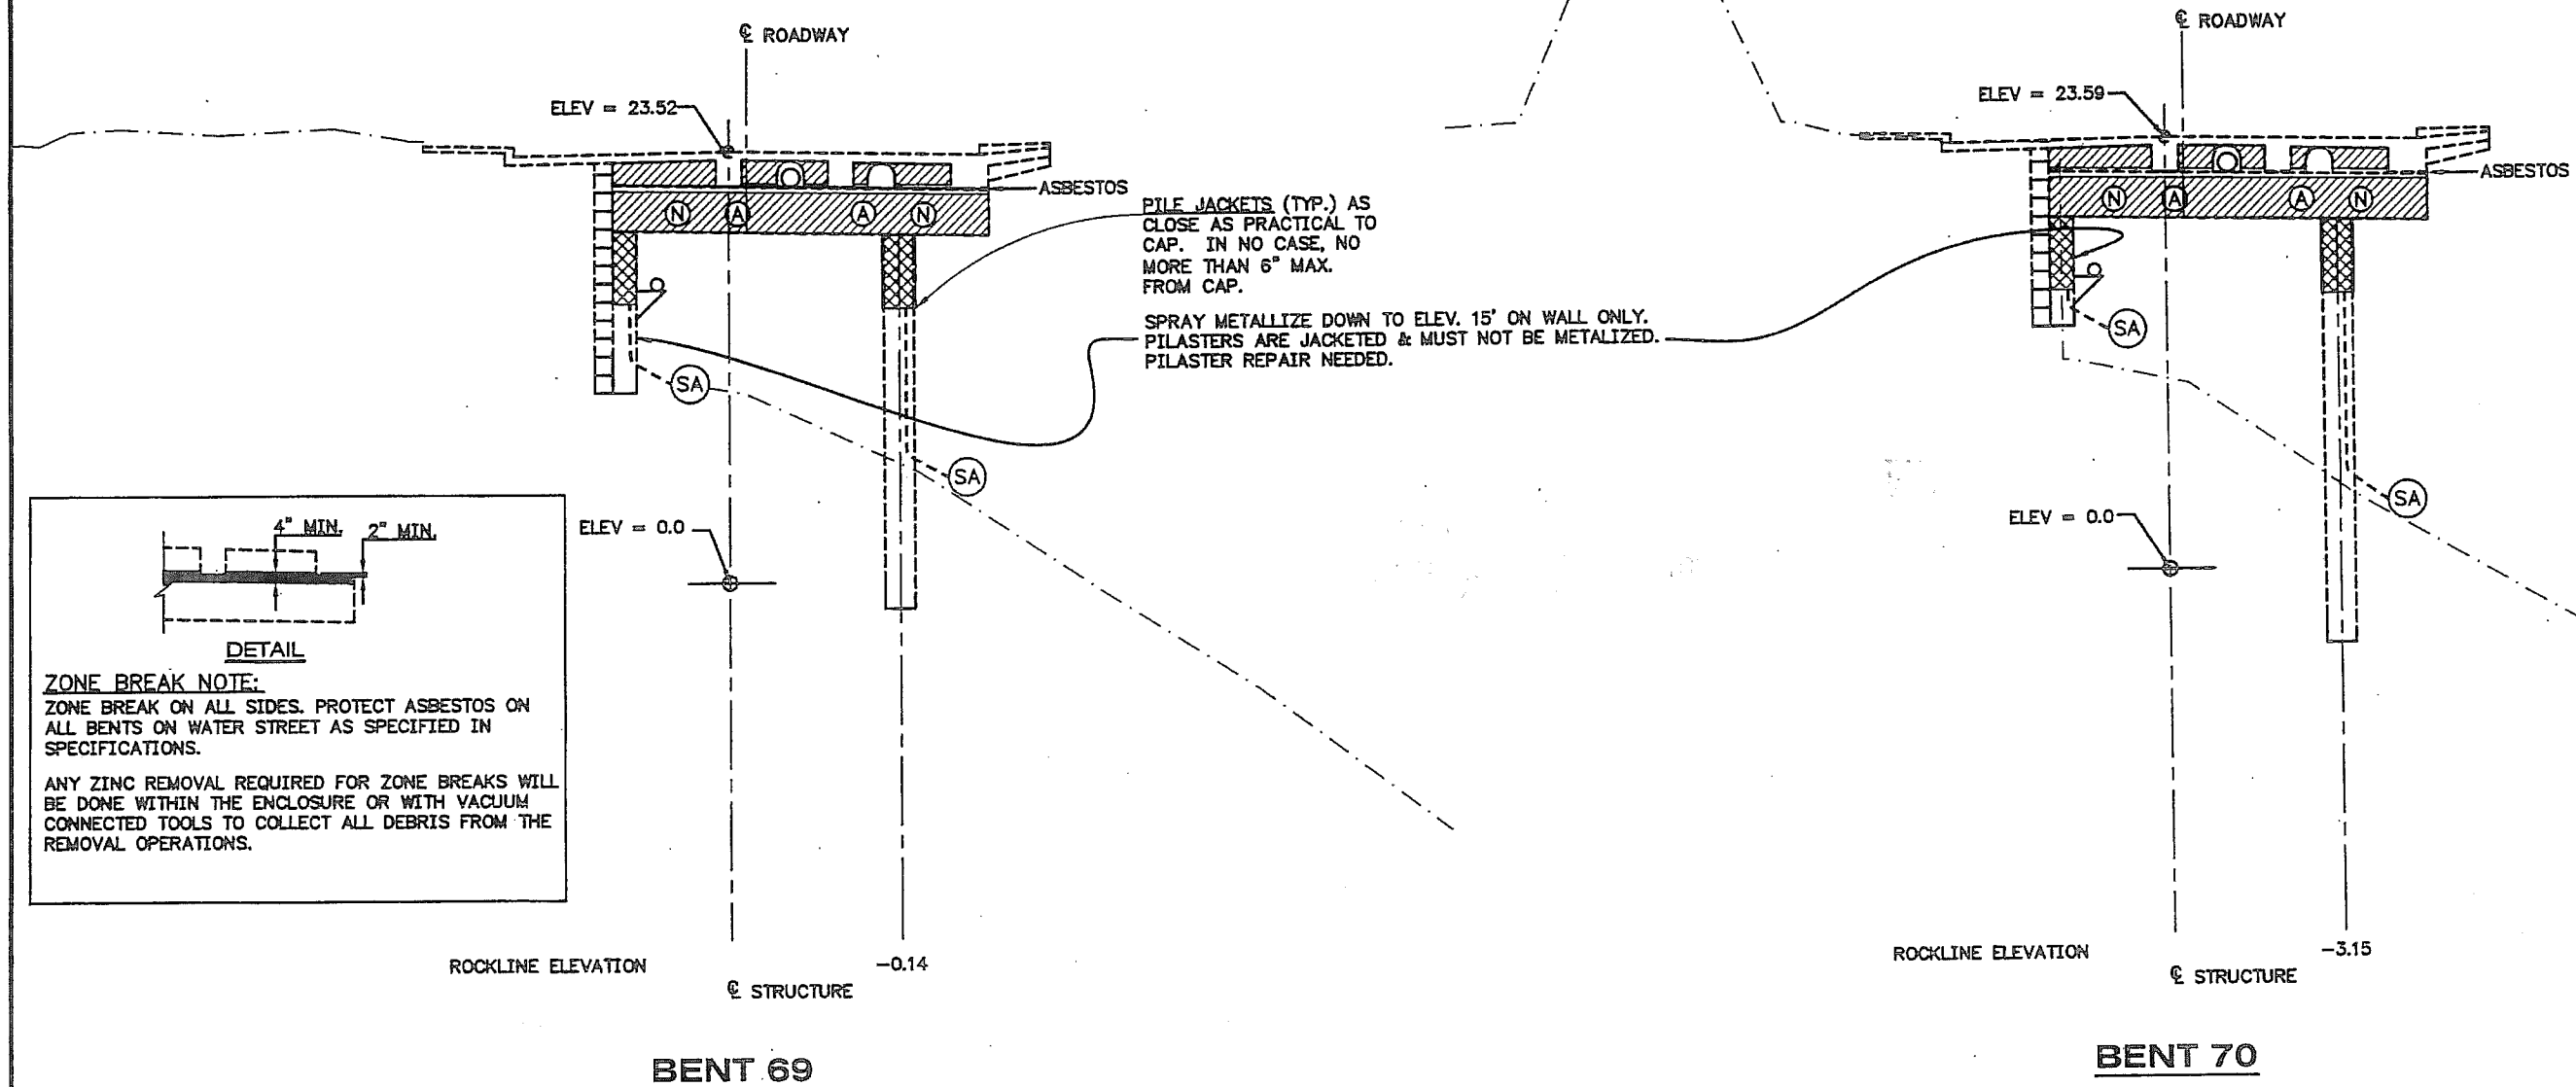

DETAIL

ZONE BREAK NOTE:
ZONE BREAK ON ALL SIDES. PROTECT ASBESTOS ON ALL BENTS ON WATER STREET AS SPECIFIED IN SPECIFICATIONS.
ANY ZINC REMOVAL REQUIRED FOR ZONE BREAKS WILL BE DONE WITHIN THE ENCLOSURE OR WITH VACUUM CONNECTED TOOLS TO COLLECT ALL DEBRIS FROM THE REMOVAL OPERATIONS.


LEGEND

- SURVEY-MUDLINE
- 1999 MUDLINE
- 1955 ROCKLINE
- (N) SYSTEM NEGATIVE
- (A) ANODE TERMINAL PLATE
- (SA) SUBMERGED ANODE
- [Pattern] CAP JACKET
- [Pattern] PILE JACKET
- [Pattern] THERMAL SPRAY

NOTES:

1. ASBESTOS IS PRESENT IN EXPANSION SIDE OF JOINT. SPECIAL HANDLING IS REQUIRED. SEE SPECIFICATIONS.
2. MODIFY GENERAL JACKET CONFIGURATION TO FIT AROUND EXISTING UTILITIES.
3. IN SOME LOCATIONS EXISTING UTILITIES AND SERVICE LINES MAY BE CONGESTED. PROTECT EXISTING UTILITY PROPERTY WHILE COMPLETING THE REQUIRED WORK.
4. REFER TO DETAILS FOR DIMENSIONS.
5. ONE SYSTEM NEGATIVE REQUIRED TOP OF EACH PILE OR PILASTER.

WATER STREET

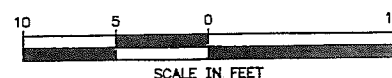

ELEVATIONS, BENCHMARKS AND DIMENSIONS ARE BASED ON "AS-BUILT" PLANS. VERIFY ALL CONTROLLING FIELD DIMENSIONS BEFORE ORDERING OR FABRICATING ANY MATERIAL.

DESIGNED BY: M. FIGLEY		STATE OF ALASKA DEPARTMENT OF TRANSPORTATION & PUBLIC FACILITIES STATEWIDE DESIGN & ENGINEERING SERVICES DIVISION			
		KTN-VIADUCTS REHABILITATION PROJECT NO. 68571			
		Water Street Bents 69 & 70			
CHECKED BY: G. IMSEN		CP-3.12			
DRAWN/REVISED BY: R.S., R.G.		PATH: PLOT: PSPACE 1=1(F) OR MSPACE 1=1(F)			
REVISIONS		PROJECT DESIGNATION	YEAR	SHEET NO.	TOTAL SHEETS
		NH-0902(34)	2009	45	70

NOTE:

AT THESE BENT/SPAN LOCATIONS, ALL WORK ON ITEMS 681(1), 681(2), 683(1), 683(2), 683(3), 683(4), 684(1), 684(2), 684(3), 684(4), 684(5), 684(7), 686(1), 686(2), AND 687(1) MUST BE COMPLETED BETWEEN OCTOBER 1ST. AND MAY 1ST.

⊕ ROADWAY
ELEV = 23.62

ELEV = 23.62

ASBESTOS

PILE JACKETS (TYP.) AS CLOSE AS PRACTICAL TO CAP. IN NO CASE, NO MORE THAN 6" MAX. FROM CAP.

SPRAY METALLIZE DOWN TO ELEV. 15' ON WALL ONLY. PILASTERS ARE JACKETED & MUST NOT BE METALIZED. PILASTER REPAIR NEEDED.

3' jacket installed used as form. Not tied into electrical CP system.

ELEV = 0.0

ROCKLINE ELEVATION

-11.09

⊕ STRUCTURE

BENT 71

35.0'
⊕ ROADWAY
5.0' 13.0' 13.0' 4.0'
ELEV = 23.69

ASBESTOS


ELEV = 0.0

ROCKLINE ELEVATION

-15.91

⊕ STRUCTURE

BENT 72

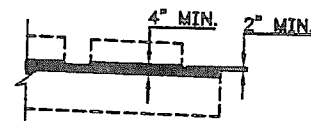

DETAIL

ZONE BREAK NOTE:

ZONE BREAK ON ALL SIDES. PROTECT ASBESTOS ON ALL BENTS ON WATER STREET AS SPECIFIED IN SPECIFICATIONS.

ANY ZINC REMOVAL REQUIRED FOR ZONE BREAKS WILL BE DONE WITHIN THE ENCLOSURE OR WITH VACUUM CONNECTED TOOLS TO COLLECT ALL DEBRIS FROM THE REMOVAL OPERATIONS.

LEGEND

--- SURVEY-MUDLINE

--- 1999 MUDLINE

--- 1955 ROCKLINE

(N) SYSTEM NEGATIVE

(A) ANODE TERMINAL PLATE

(SA) SUBMERGED ANODE

□ CAP JACKET


□ PILE JACKET

□ THERMAL SPRAY

NOTES:


1. ASBESTOS IS PRESENT IN EXPANSION SIDE OF JOINT. SPECIAL HANDLING IS REQUIRED. SEE SPECIFICATIONS.
2. MODIFY GENERAL JACKET CONFIGURATION TO FIT AROUND EXISTING UTILITIES.
3. IN SOME LOCATIONS EXISTING UTILITIES AND SERVICE LINES MAY BE CONGESTED. PROTECT EXISTING UTILITY PROPERTY WHILE COMPLETING THE REQUIRED WORK.
4. REFER TO DETAILS FOR DIMENSIONS.
5. ONE SYSTEM NEGATIVE REQUIRED TOP OF EACH PILE OR PILASTER.

WATER STREET

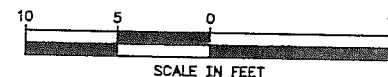

ELEVATIONS, BENCHMARKS AND DIMENSIONS ARE BASED ON "AS-BUILT" PLANS. VERIFY ALL CONTROLLING FIELD DIMENSIONS BEFORE ORDERING OR FABRICATING ANY MATERIAL.

DESIGNED BY: M. FIGLEY

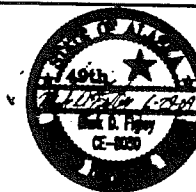

CHECKED BY: G. JENSEN

DRAWN/REVISED BY: R.S., R.G.

STATE OF ALASKA
DEPARTMENT OF TRANSPORTATION
& PUBLIC FACILITIES
STATEWIDE DESIGN & ENGINEERING SERVICES DIVISION
**KTN-VIADUCTS
REHABILITATION**
PROJECT NO. 68571

**Water Street
Bents 71 & 72**


PATH:
PLOT: PSPACE 1=1(F) OR MSPACE 1=1(F)

CP-3.13

NO.	DATE	REVISIONS DESCRIPTION	PROJECT DESIGNATION	YEAR	SHEET NO.	TOTAL SHEETS
			NH-0902(34)	2009	46	70


NOTE:

AT THESE BENT/SPAN LOCATIONS, ALL WORK ON ITEMS 681(1), 681(2), 683(1), 683(2), 683(3), 683(4), 684(1), 684(2), 684(3), 684(4), 684(5), 684(7), 686(1), 686(2), AND 687(1) MUST BE COMPLETED BETWEEN OCTOBER 1ST. AND MAY 1ST.

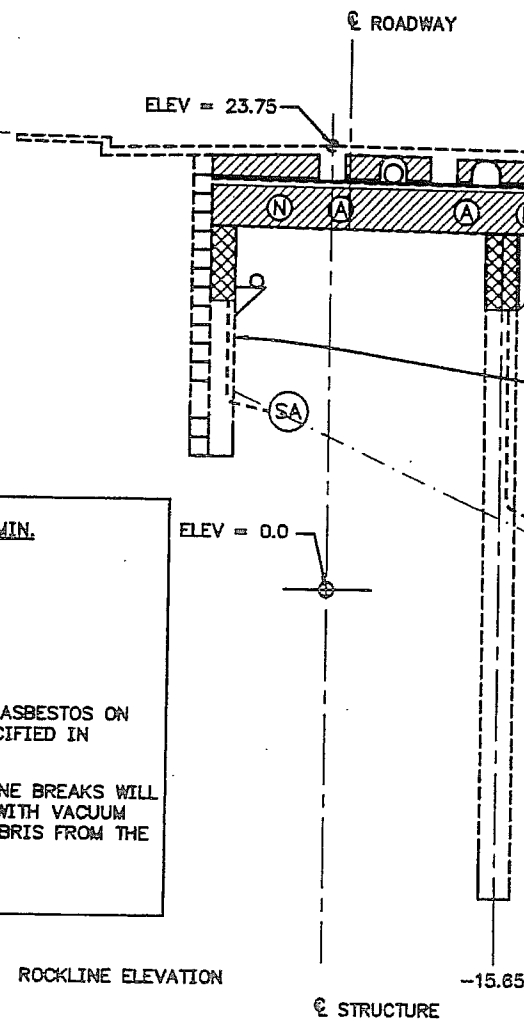

PILE JACKETS (TYP.) AS CLOSE AS PRACTICAL TO CAP. IN NO CASE, NO MORE THAN 6" MAX. FROM CAP.

SPRAY METALLIZE DOWN TO ELEV. 15' ON WALL ONLY. PILASTERS ARE JACKETED & MUST NOT BE METALIZED. PILASTER REPAIR NEEDED.

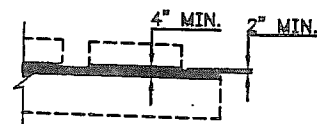

DETAIL

ZONE BREAK NOTE:


ZONE BREAK ON ALL SIDES. PROTECT ASBESTOS ON ALL BENTS ON WATER STREET AS SPECIFIED IN SPECIFICATIONS.

ANY ZINC REMOVAL REQUIRED FOR ZONE BREAKS WILL BE DONE WITHIN THE ENCLOSURE OR WITH VACUUM CONNECTED TOOLS TO COLLECT ALL DEBRIS FROM THE REMOVAL OPERATIONS.

ROCKLINE ELEVATION

STRUCTURE

BENT 73

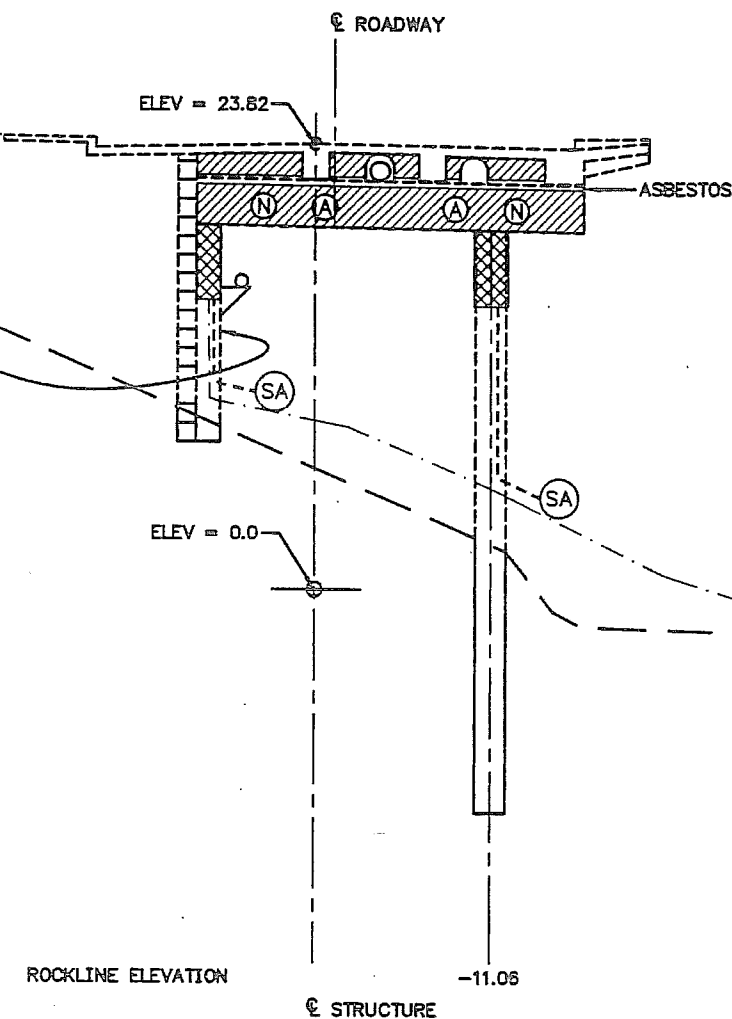


ROCKLINE ELEVATION

STRUCTURE

BENT 74

WATER STREET

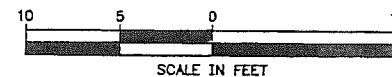

SCALE IN FEET

LEGEND

- SURVEY-MUDLINE
- 1999 MUDLINE
- 1955 ROCKLINE
- (N) SYSTEM NEGATIVE
- (A) ANODE TERMINAL PLATE
- (SA) SUBMERGED ANODE
- [Pattern] CAP JACKET
- [Pattern] PILE JACKET
- [Pattern] THERMAL SPRAY

NOTES:

- ASBESTOS IS PRESENT IN EXPANSION SIDE OF JOINT. SPECIAL HANDLING IS REQUIRED. SEE SPECIFICATIONS.
- MODIFY GENERAL JACKET CONFIGURATION TO FIT AROUND EXISTING UTILITIES.
- IN SOME LOCATIONS EXISTING UTILITIES AND SERVICE LINES MAY BE CONGESTED. PROTECT EXISTING UTILITY PROPERTY WHILE COMPLETING THE REQUIRED WORK.
- REFER TO DETAILS FOR DIMENSIONS.
- ONE SYSTEM NEGATIVE REQUIRED TOP OF EACH PILE OR PILASTER.

ELEVATIONS, BENCHMARKS AND DIMENSIONS ARE BASED ON "AS-BUILT" PLANS. VERIFY ALL CONTROLLING FIELD DIMENSIONS BEFORE ORDERING OR FABRICATING ANY MATERIAL.


DESIGNED BY: M. FOLEY		STATE OF ALASKA DEPARTMENT OF TRANSPORTATION & PUBLIC FACILITIES STATEWIDE DESIGN & ENGINEERING SERVICES DIVISION			
		KTN-VIADUCTS REHABILITATION PROJECT NO. 68571			
		Water Street Bents 73 & 74			
CHECKED BY: G. JENSEN, G.D.		CP-3.14			
DRAWN/REVISED BY: R.S. R.G.		PROJECT DESIGNATION			
PATH:		YEAR			
PLOT: PSPACE 1=1(F) OR MSPACE 1=1(F)		SHEET NO.			
NO.		TOTAL SHEETS			
DATE		NH-0902(34)			
DESCRIPTION		2009			
		47			
		70			

NOTE:


AT THESE BENT/SPAN LOCATIONS, ALL WORK ON ITEMS 681(1), 681(2), 683(1), 683(2), 683(3), 683(4), 684(1), 684(2), 684(3), 684(4), 684(5), 684(7), 686(1), 686(2), AND 687(1) MUST BE COMPLETED BETWEEN OCTOBER 1ST. AND MAY 1ST.

BENT 76 NOTE:


BENT 76 IS THE END OF REHABILITATION. SPAN 76 AHEAD WILL BE A FILL SECTION. FORM BOARDS IN SPAN NEED TO BE REMOVED.

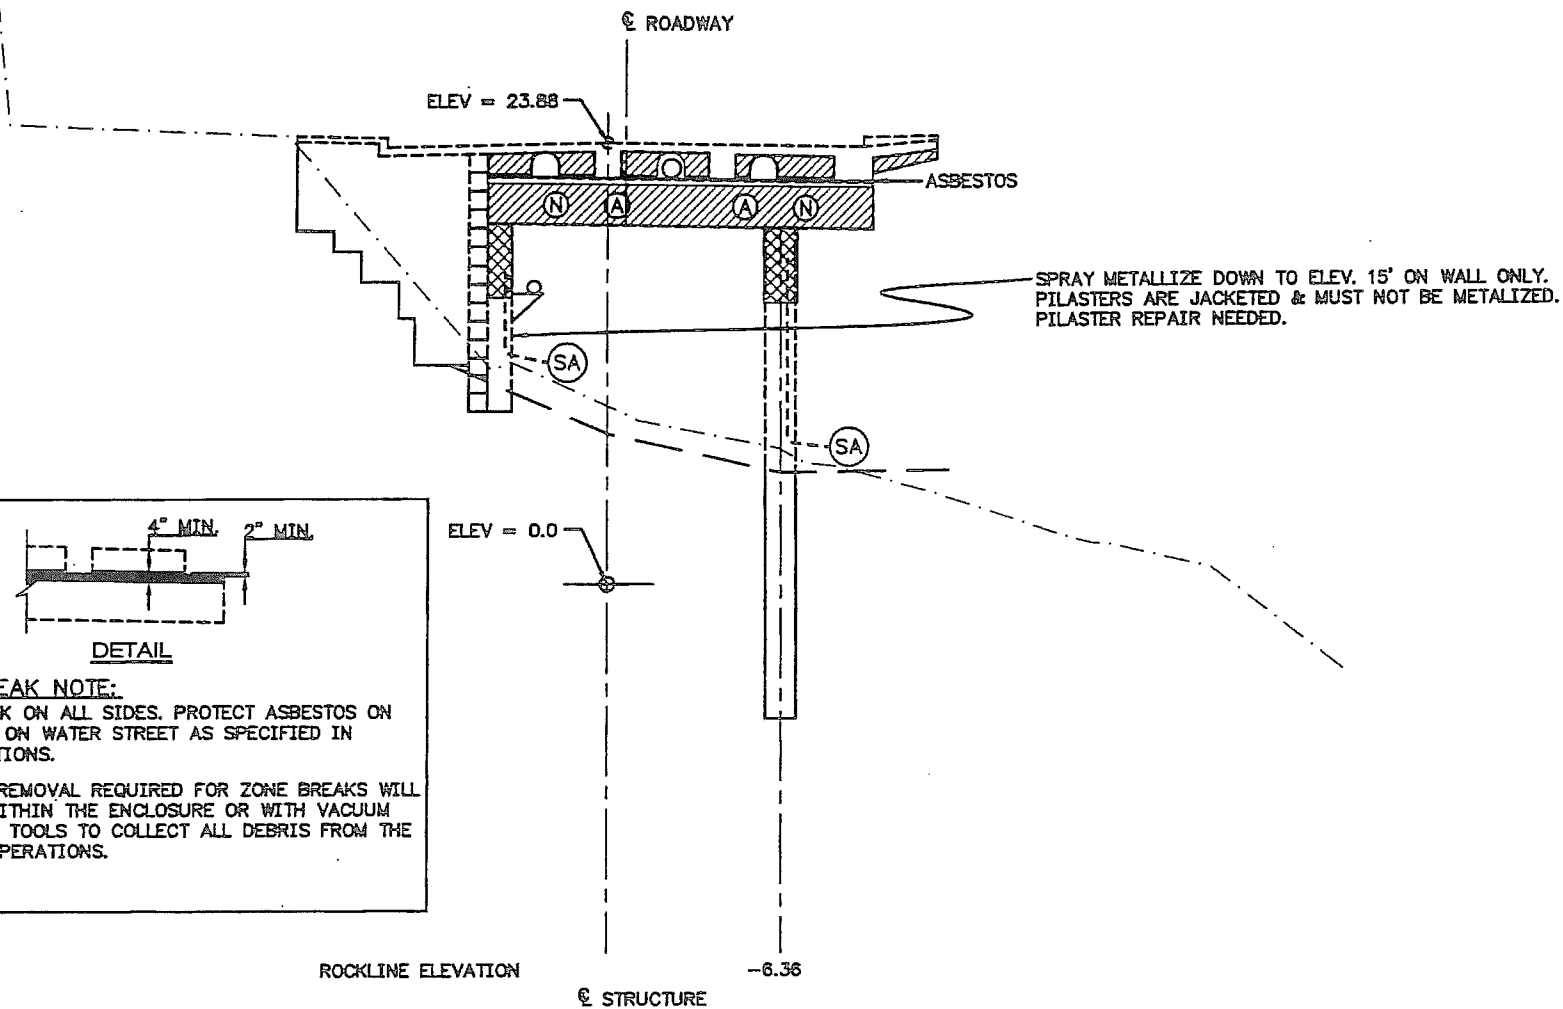

BENT 75

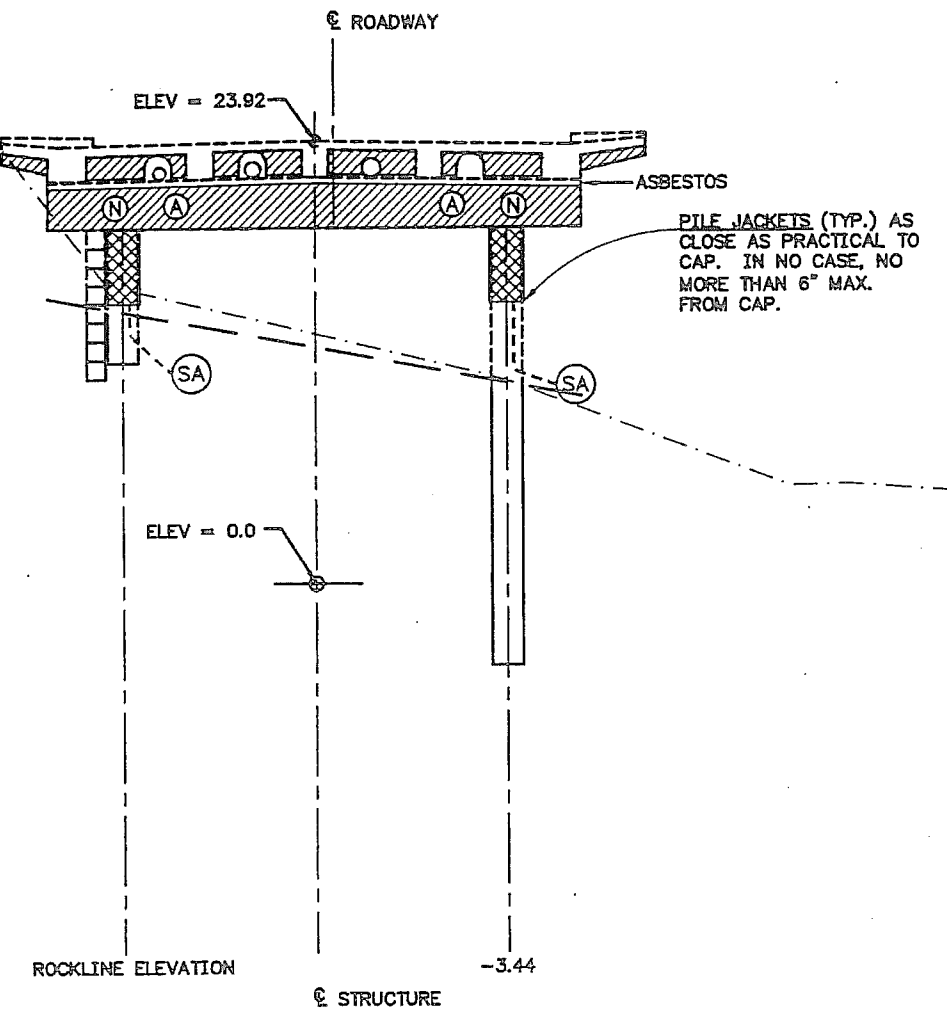

BENT 76

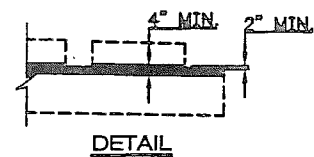

ZONE BREAK NOTE:

ZONE BREAK ON ALL SIDES. PROTECT ASBESTOS ON ALL BENTS ON WATER STREET AS SPECIFIED IN SPECIFICATIONS.

ANY ZINC REMOVAL REQUIRED FOR ZONE BREAKS WILL BE DONE WITHIN THE ENCLOSURE OR WITH VACUUM CONNECTED TOOLS TO COLLECT ALL DEBRIS FROM THE REMOVAL OPERATIONS.


LEGEND

- SURVEY-MUDLINE
- 1999 MUDLINE
- 1955 ROCKLINE
- (N) SYSTEM NEGATIVE
- (A) ANODE TERMINAL PLATE
- (SA) SUBMERGED ANODE
- [Pattern] CAP JACKET
- [Pattern] PILE JACKET
- [Pattern] THERMAL SPRAY

NOTES:

- ASBESTOS IS PRESENT IN EXPANSION SIDE OF JOINT. SPECIAL HANDLING IS REQUIRED. SEE SPECIFICATIONS.
- MODIFY GENERAL JACKET CONFIGURATION TO FIT AROUND EXISTING UTILITIES.
- IN SOME LOCATIONS EXISTING UTILITIES AND SERVICE LINES MAY BE CONGESTED. PROTECT EXISTING UTILITY PROPERTY WHILE COMPLETING THE REQUIRED WORK.
- REFER TO DETAILS FOR DIMENSIONS.
- ONE SYSTEM NEGATIVE REQUIRED TOP OF EACH PILE OR PILASTER.

WATER STREET




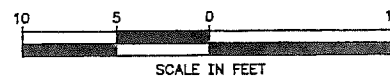


ELEVATIONS, BENCHMARKS AND DIMENSIONS ARE BASED ON "AS-BUILT" PLANS. VERIFY ALL CONTROLLING FIELD DIMENSIONS BEFORE ORDERING OR FABRICATING ANY MATERIAL.

DESIGNED BY: M. FIGLEY		STATE OF ALASKA DEPARTMENT OF TRANSPORTATION & PUBLIC FACILITIES STATEWIDE DESIGN & ENGINEERING SERVICES DIVISION			
		KTN-VIADUCTS REHABILITATION PROJECT NO. 68571			
		Water Street Bents 75 & 76			
CHECKED BY: G. DABSEN, P.E.		CP-3.15			
DRAWN/REVISED BY: R.S., R.G.		PATH: PLOT: PSPACE 1=1(F) OR MSPACE 1=1(F)			
REVISIONS		PROJECT DESIGNATION	YEAR	SHEET NO.	TOTAL SHEETS
NO.	DATE	DESCRIPTION	NH-0902(34)	2009	48
					70



NOTES:

1. SUBMIT MIX DESIGN AND PLACEMENT PLAN FOR APPROVAL AT LEAST 14 DAYS PRIOR TO CONCRETING.
2. THE JACKETS AS INSTALLED SHALL CONFORM TO THE PILE THEY SURROUND. USE STRONGBACKS AND WALES TO PREVENT THE FIBERGLASS JACKETS FROM BOWING OR DISTORTING DURING CONCRETING OPERATIONS. ANY JOINTS BETWEEN THE FIBERGLASS JACKET AND FORMWORK SHALL NOT LEAK OR BURST DURING CONCRETING OPERATIONS.
3. INSTALLING FORMWORK AT THE BOTTOM OF THE FIBERGLASS JACKET, MAY BE REQUIRED.
4. THE SEAMS OF THE FIBERGLASS JACKET SHALL NOT LEAK OR BURST DURING CONCRETING OPERATIONS.
5. IT IS CRITICAL THAT THE MORTAR BE FULLY CONSOLIDATED AND ENCASE THE EXPANDED ZINC MESH.
6. ALL VIBRATING MUST BE PERFORMED BY WORKERS EXPERIENCED IN THE PLACEMENT OF ARCHITECTURAL CONCRETE.
7. USE HAND TOOLS TO BEVEL TOP EDGE OF MORTAR. FORMWORK USED AT THE BOTTOM MAY PRODUCE EITHER A SQUARE OR 45° BEVEL EDGE THAT MIRRORS THE TOP EDGE. THE BOTTOM MORTAR EDGE SHALL BE SQUARE AND FREE FROM BUG HOLES, HONEYCOMBING OR OTHER PLACEMENT DEFECTS.
8. THE JACKET ANODE SHALL BE OF A TYPE WITH A MINIMUM OF 5-YEARS DOCUMENTED SUCCESSFUL PERFORMANCE, SUCH AS AN ALLTRISTA LIFEJACKET OR AN APPROVED EQUAL.
9. RUN THE BULK ANODE CABLE AND CONDUIT AS DIRECTED TO AVOID FUTURE DRAINAGE FROM THE DRIFT.
10. SECURE THE CONDUIT TO CIP PILES OR PILASTERS WITH PUC CLAMP. APPROVED 2-HOLE CONDUIT 18" O.C.
11. SECURE THE CONDUIT TO PRESTRESSED PILES WITH LOCKING NYLON TIES (3/4"). USE COLLARS OR HUBS GLUED TO CONDUIT TO SECURE TIES AGAINST VERTICAL SLIPPAGE. SET TIES 18" O.C.
12. ANY ANODES MOVED OR SUSPENDED BY THEIR LEAD WIRES WILL BE REJECTED ON THE SPOT AND WILL NOT BE INSTALLED AS PART OF THE WORK. THE MISHANDLED ANODES WILL BE REPLACED AT NO ADDITIONAL COST TO THE DEPARTMENT.
13. THE PREPACKAGED BULK ANODE SHALL BE INSTALLED, ALL REBAR CONNECTIONS, REFERENCE ELECTRODE (IF PRESENT), CABLES AND CONDUIT FOR EACH JACKET SHALL BE INSTALLED AND INSPECTED PRIOR TO FILLING THE ANNULUS BETWEEN THE JACKET AND THE PILE WITH CONCRETE.

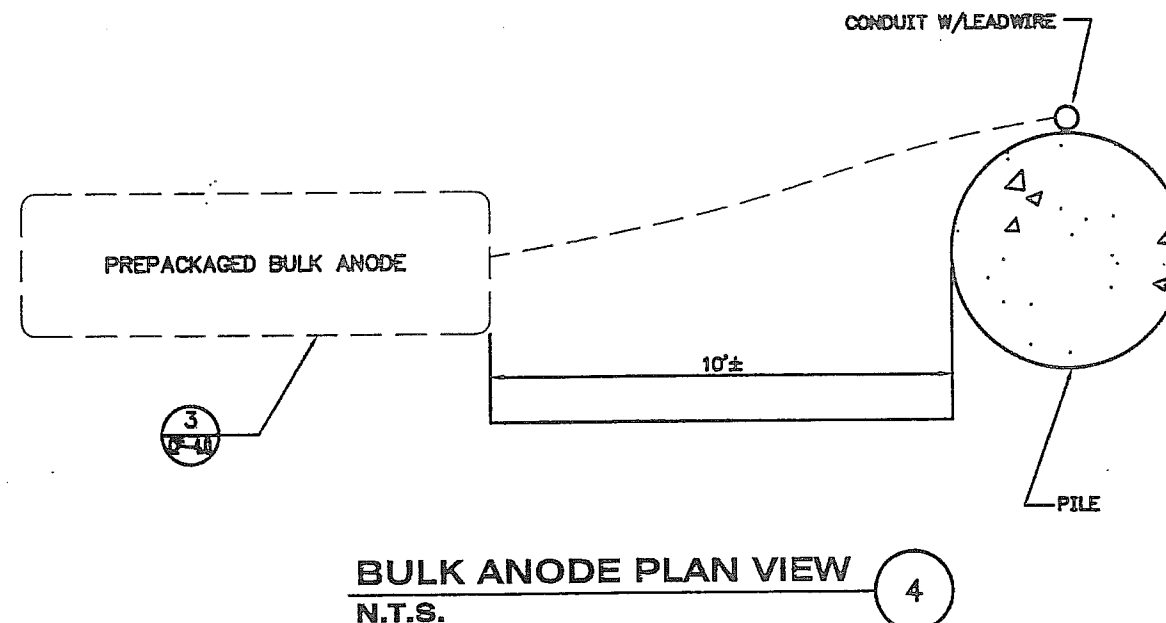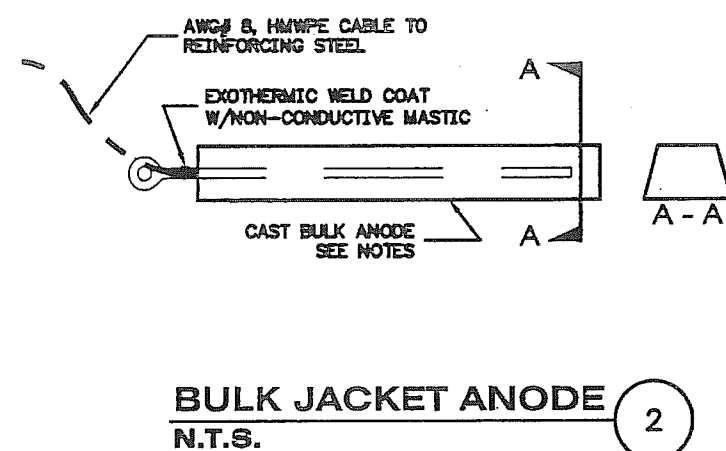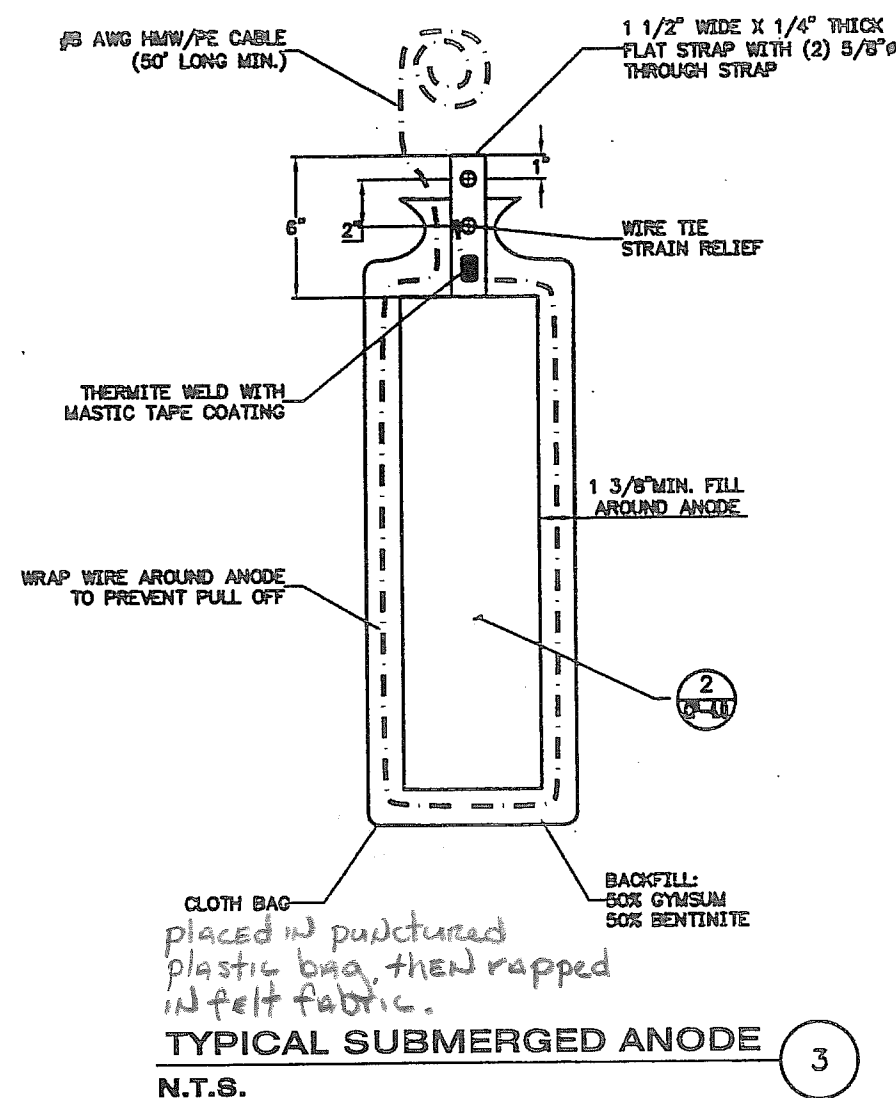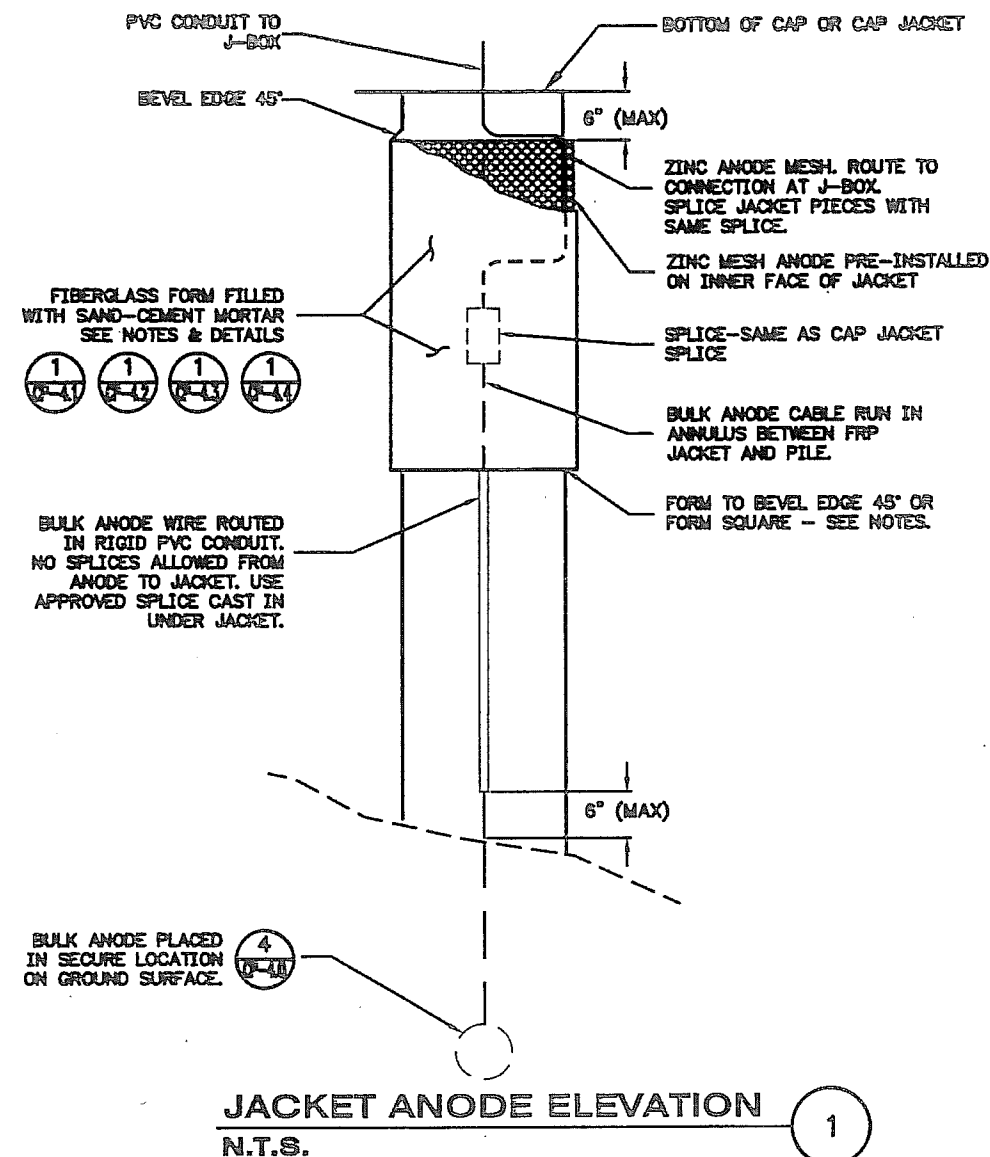

ELEVATIONS, BENCHMARKS AND DIMENSIONS ARE BASED ON "AS-BUILT" PLANS. VERIFY ALL CONTROLLING FIELD DIMENSIONS BEFORE ORDERING OR FABRICATING ANY MATERIAL.


DESIGNED BY: M. FIGLEY		STATE OF ALASKA DEPARTMENT OF TRANSPORTATION & PUBLIC FACILITIES STATEWIDE DESIGN & ENGINEERING SERVICES DIVISION			
		KTN-VIADUCTS REHABILITATION PROJECT NO. 68571 PILE JACKET & SUBMERGED ANODE DETAILS			
		CP-4.0			
CHECKED BY: G. IMBEN DRAWN/REVISED BY: R.S., R.G.		PROJECT DESIGNATION NH-0902(34)			
PATH: PLOT: PSPACE 1=1(F), OR WSPACE 1=1(F)		YEAR	SHEET NO.	TOTAL SHEETS	
		2009	49	70	

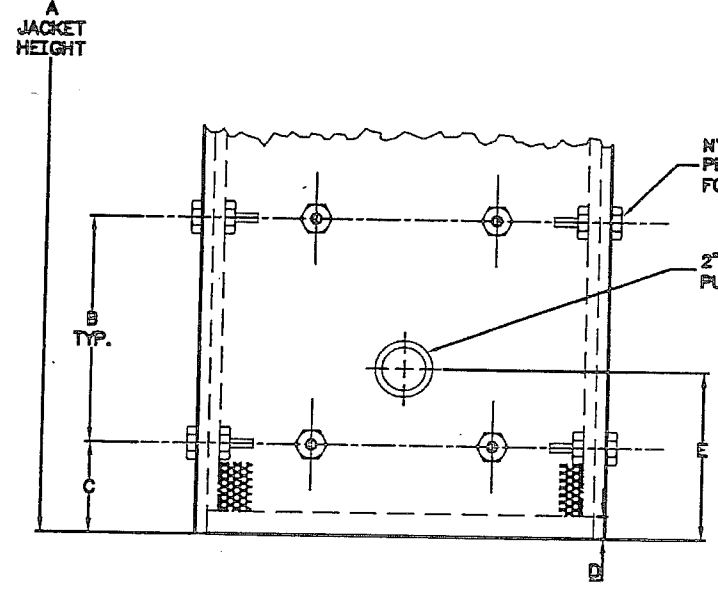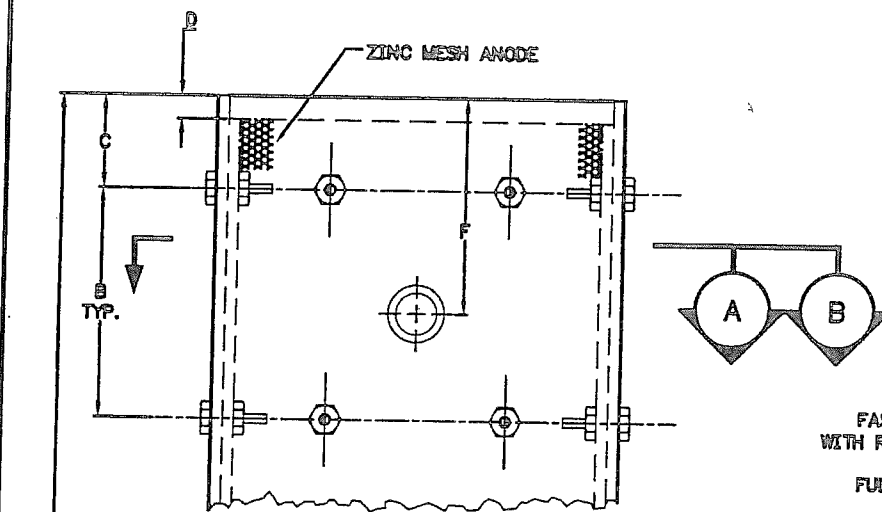


PILE JACKET ELEVATION
N.T.S. 1

* = SEE SHEETS CP 11 & CP 13

DIMENSIONS										BENT NO.	VIADUCT
A	B	C	D	E	F	G	H	I	J		
* 6'	16"	4"	2"	10"	6"	45°	3/16"	16 1/2"	2"	* ALL BENTS	WATER ST.
* 6'	16"	4"	2"	10"	6"	45°	3/16"	16 1/2"	2"	* ALL BENTS	TONGASS AVE.

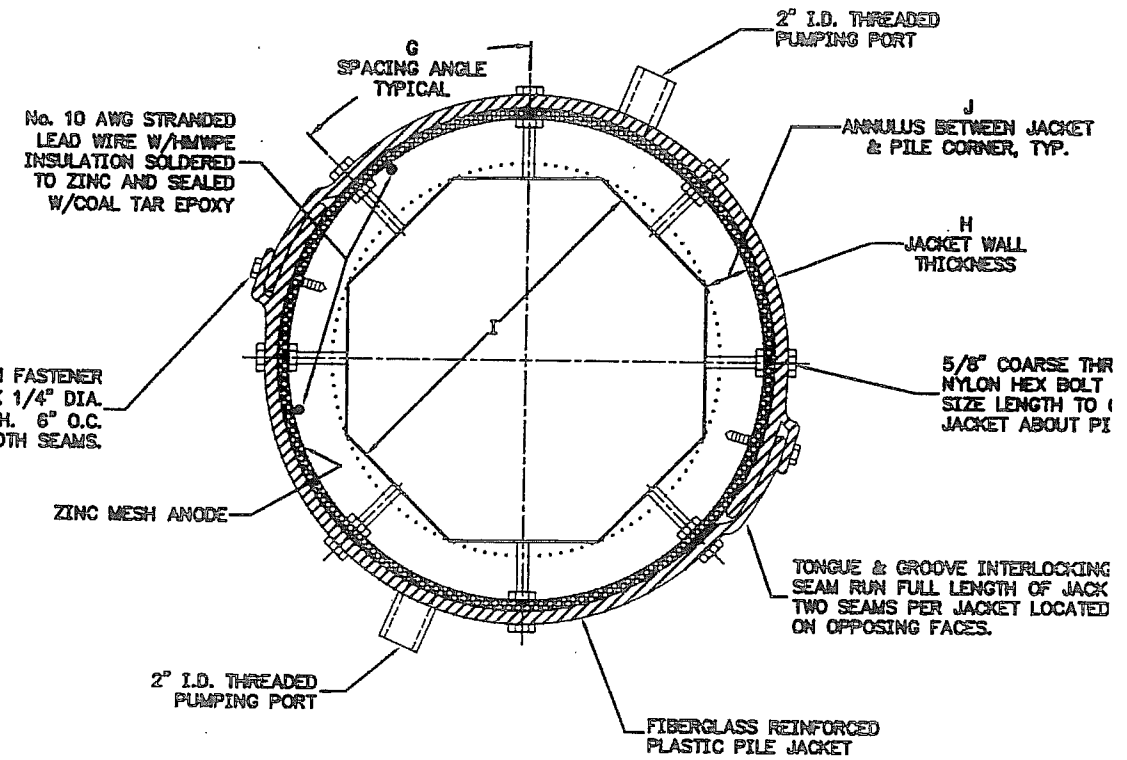


**TONGASS AVENUE VIADUCT
PILE JACKET**
N.T.S.
VIEW ROTATED CLOCKWISE 22.5 DEG.

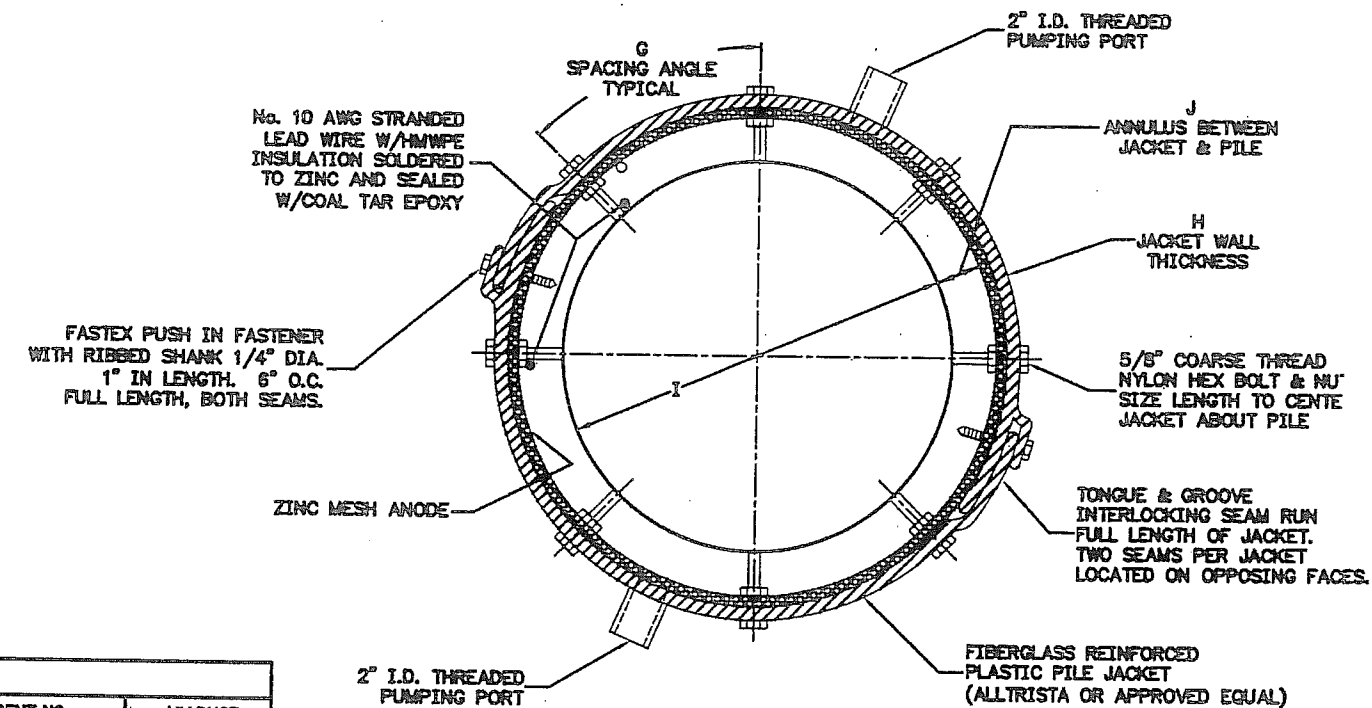

**WATER STREET VIADUCT
PILE JACKET**
N.T.S.
VIEW ROTATED CLOCKWISE 22.5 DEG.

NOTES:

- SEE SHEETS CP-1.1 & CP-1.3 FOR GENERAL LAYOUT.
- EACH PILE JACKET CONSISTS OF A RIGHT AND LEFT HALF.
- ASSEMBLE JACKETS SO THAT LEAD WIRES ARE ON THE SAME SIDE OF THE PILE.
- INSIDE JACKET SURFACE MUST BE ROUGHENED ACCORDING TO SPECIFICATION.
- IT IS COMMON THAT THE TOPS OF TONGASS AVENUE PILES HAVE CAST-IN-PLACE EXTENSIONS. THESE EXTENSIONS MAY REQUIRE MINOR ADJUSTMENTS IN JACKET CONFIGURATIONS. SEE SPECIFICATION.
- COMPLETELY FILL THE ENTIRE ANNULUS BETWEEN THE FIBERGLASS JACKET AND STRUCTURE WITH GROUT.
- THE PUMPING PORT LOCATIONS ARE OPTIONAL. ALTERNATE METHODS/PROCEDURE MAY BE SUBMITTED FOR APPROVAL, INCLUDING PORTS OR AIR VENTS LOCATIONS IF USED.
- WETTING HOLES ARE TO BE CUT IN JACKETS AFTER GROUT IS PUMPED AND SET AS FOLLOWS:
 - 2" diameter holes in fiberglass jacket equally spaced around circumference.
 - Three holes each row for round, pile, buttressed and corner plates.
 - Four holes each row for square jackets.
 - 4 foot jackets require 1 row of holes.
 - 6 foot jackets require 2 rows of holes.
 - 8 foot jackets require 3 rows of holes.

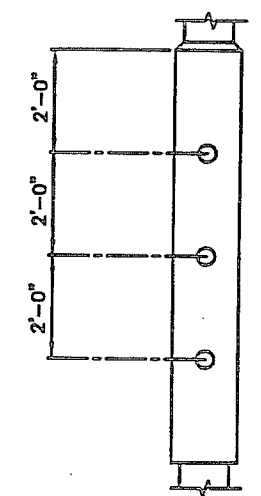

WETTING HOLES, TYP.
N.T.S.


ELEVATIONS, BENCHMARKS AND DIMENSIONS ARE BASED ON "AS-BUILT" PLANS. VERIFY ALL CONTROLLING FIELD DIMENSIONS BEFORE ORDERING OR FABRICATING ANY MATERIAL.

DESIGNED BY: M. FOLEY		STATE OF ALASKA DEPARTMENT OF TRANSPORTATION & PUBLIC FACILITIES STATEWIDE DESIGN & ENGINEERING SERVICES DIVISION KTN-VIADUCTS REHABILITATION PROJECT NO. 68571			
CHECKED BY: G. THOMSEN					
DRAWN/REVISED BY: R.S., R.G.					
PATH:		PROJECT DESIGNATION		YEAR	SHEET NO.
PLOT: PSPACE 1=1(F) OR MSPACE 1=1(F)		NH-0902(34)		2009	50
NO. DATE DESCRIPTION		TOTAL SHEETS			
		90		70	

DIMENSIONS																		BENT NO.	VIADUCT
A	B	C	D	E	F	G	H	I	J	K	L	M	N	O	P	Q	R	* 65-74	WATER STREET
* = SEE SHEETS CP 1.1 & CP 1.3.																		* 4, 2A, 3A, 6A, 7A	TONGASS AVE.

NOTES:

- SEE SHEET CP-1.3 FOR GENERAL LAYOUT.
- INSIDE JACKET SURFACE MUST BE ROUGHENED ACCORDING TO SPECIFICATIONS.
- THREADED ROD MUST BE INSTALLED AND EPOXY FULLY CURED BEFORE PLACING AND SECURING JACKET.
- FOLLOW SPECIFICATIONS THE EPOXY RESIN MANUFACTURER'S DIRECTIONS DURING SURFACE PREPARATION, STORAGE, SAFE AND PROPER USE, MIXING AND APPLICATION OF THE EPOXY RESIN. STRICTLY FOLLOW ANY TEMPERATURE OR MOISTURE RESTRICTIONS, REQUIREMENTS OR LIMITATIONS.
- DRILL HOLE FOR THREADED ROD ALONG HORIZONTAL CENTERLINE OF INTERSECTING CONCRETE LOGS.
- THREADED ROD MUST BE INSTALLED IN A CLEAN AND DRY HOLE.
- TO INSTALL THREADED ROD:
 - DRILL HOLE;
 - CLEAN HOLE W/NYLON BRUSH--DO NOT USE METAL BRUSH;
 - BLOWOUT HOLE WITH DRY COMPRESSED AIR;
 - STARTING AT THE DEEPEST END, FILL HOLE TO APPROXIMATELY 1/2 DEPTH W/EPOXY;
 - INSERT ROD TO DEPTH WITH TWISTING MOTION; CAREFULLY REMOVE EXCESS AND KEEP NON-EMBEDDED THREADS CLEAN.
- INSTALL THE THREADED ROD IMMEDIATELY AFTER HOLE SURFACE PREPARATION, OR THE HOLE MUST BE RE-CLEANED (DRIED IF NECESSARY).
- COMPLETELY FILL THE ENTIRE ANNULUS BETWEEN THE FIBERGLASS JACKET AND STRUCTURE WITH GROUT.
- THE PUMPING PORT LOCATIONS ARE OPTIONAL. ALTERNATE METHODS/PROCEDURE MAY BE SUBMITTED FOR APPROVAL, INCLUDING PORTS OR AIR VENTS LOCATIONS IF USED.
- WETTING HOLES REQUIRED. SEE NOTE 8 & DETAIL ON SHEET CP-4.1.

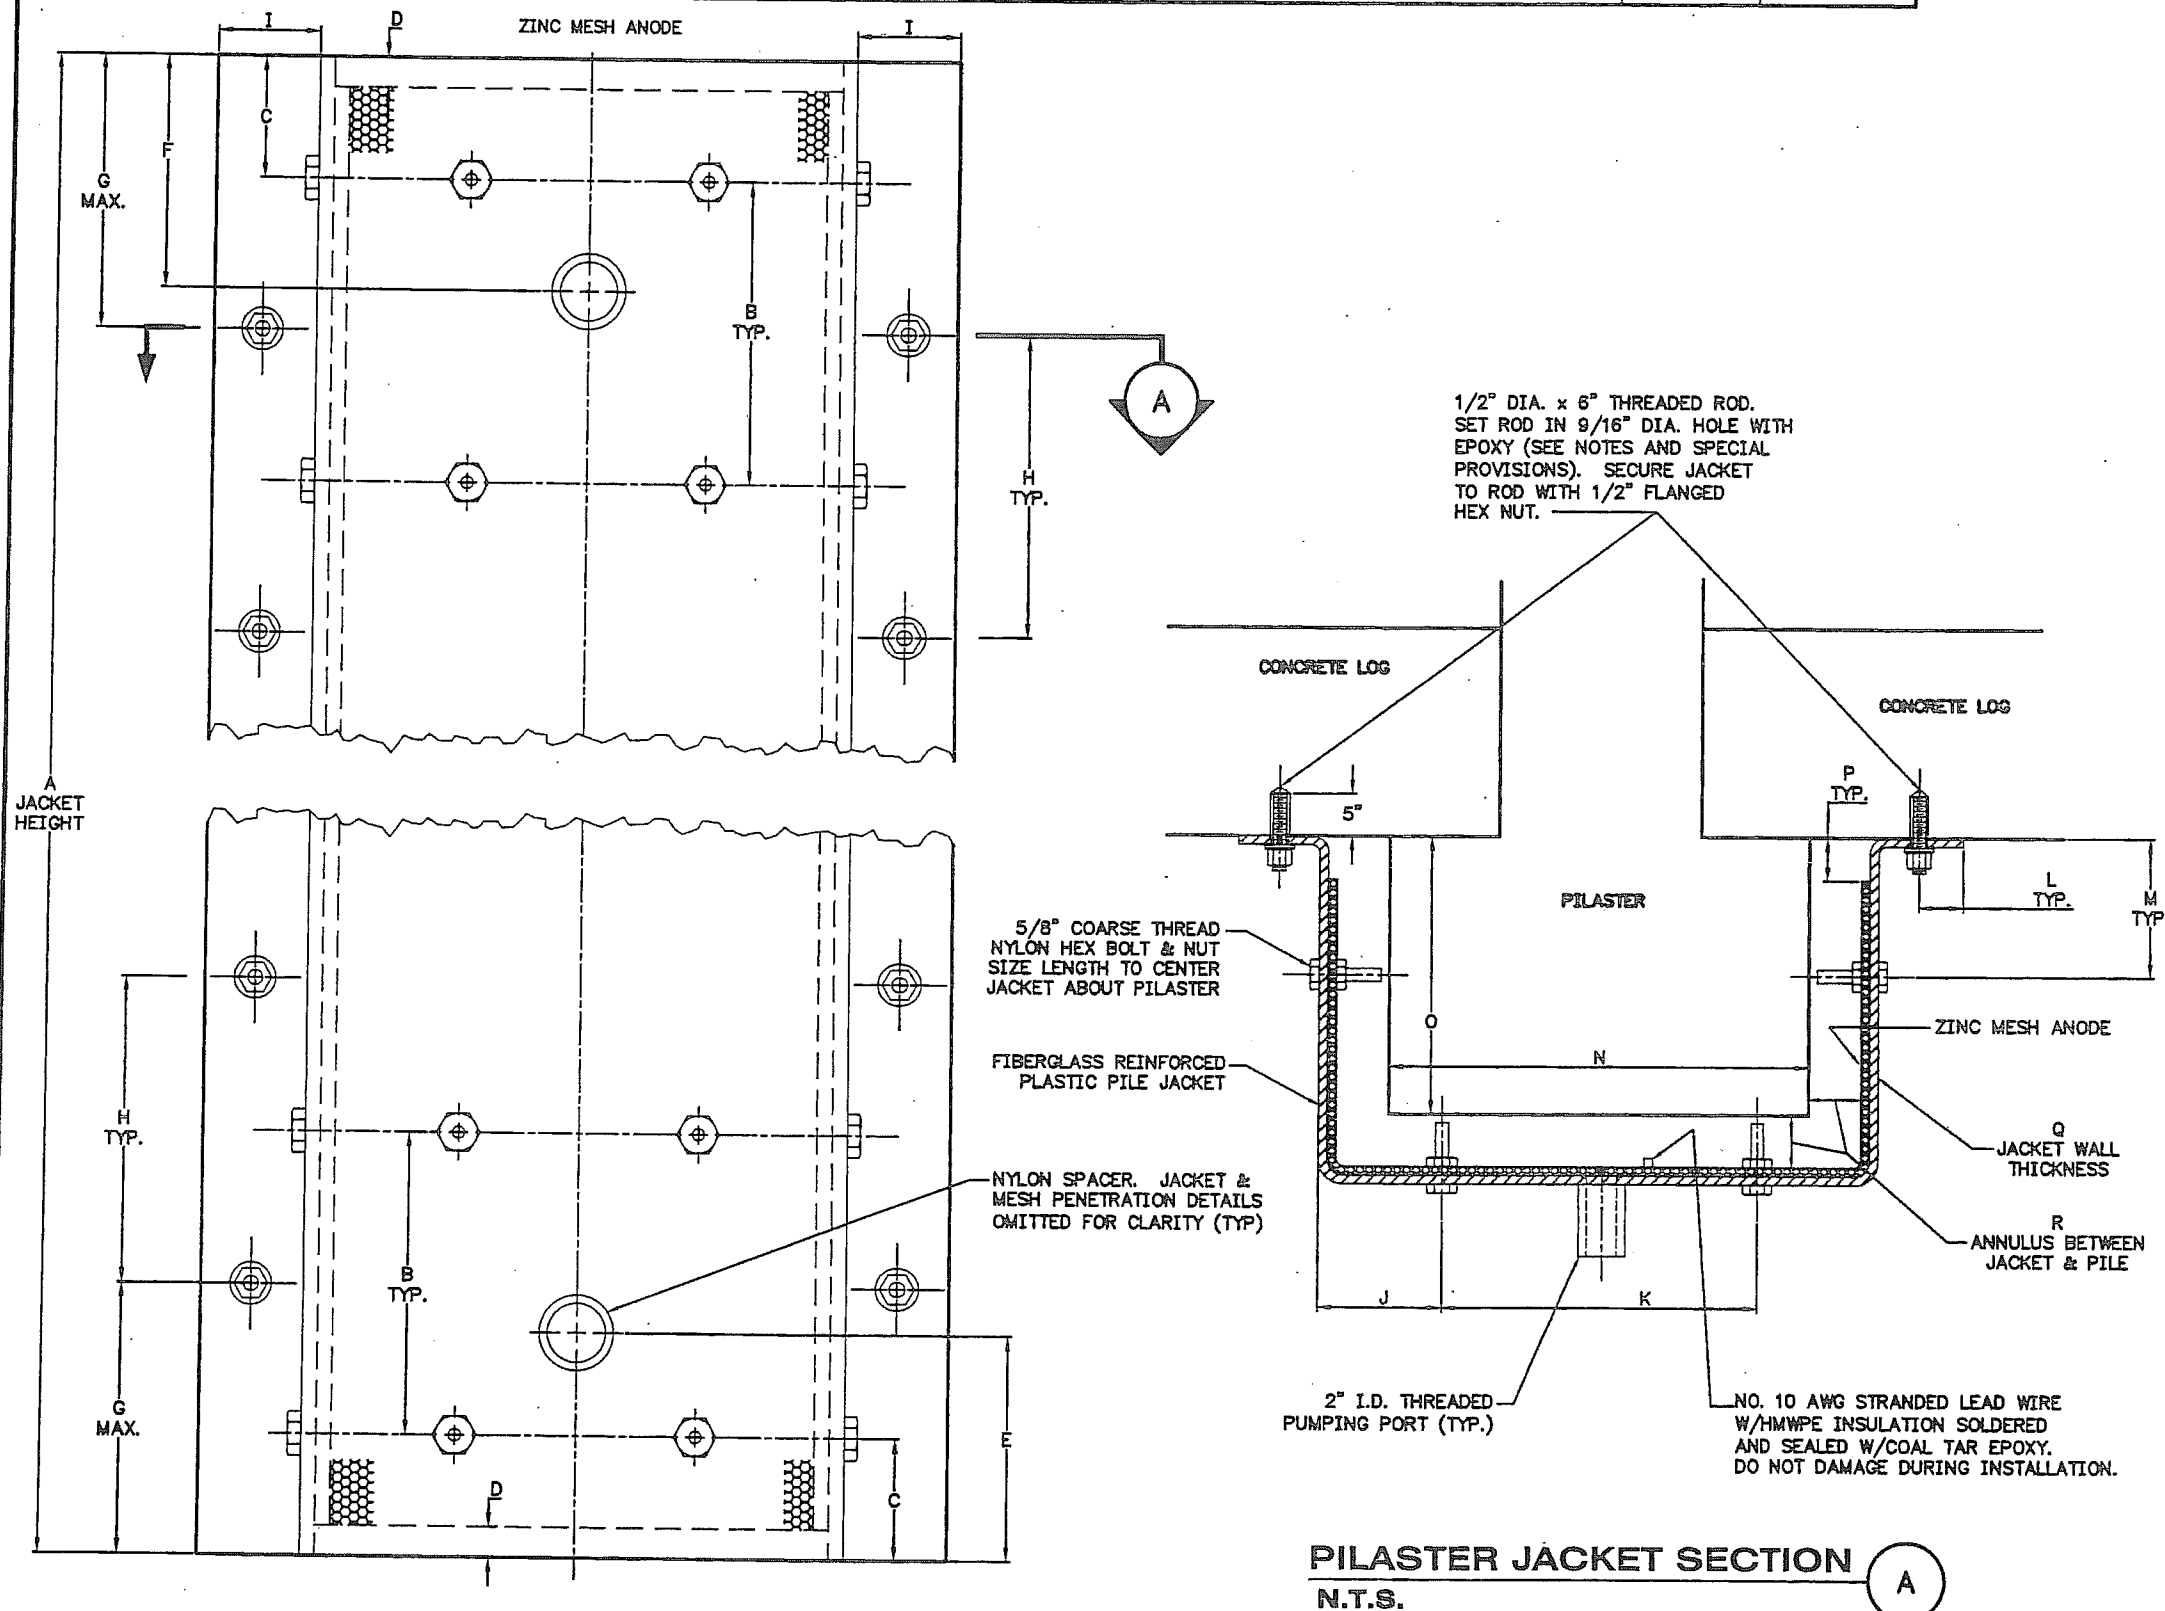


PILASTER JACKET ELEVATION
N.T.S. 1


PILASTER JACKET SECTION
N.T.S. A

ELEVATIONS, BENCHMARKS AND DIMENSIONS ARE BASED ON "AS-BUILT" PLANS. VERIFY ALL CONTROLLING FIELD DIMENSIONS BEFORE ORDERING OR FABRICATING ANY MATERIAL.

DESIGNED BY: M. FIGLEY		STATE OF ALASKA DEPARTMENT OF TRANSPORTATION & PUBLIC FACILITIES STATEWIDE DESIGN & ENGINEERING SERVICES DIVISION KTN-VIADUCTS REHABILITATION PROJECT NO. 68571			
		PILE JACKETS AND SECTION			
CHECKED BY: G. IMBSEN		CP-4.2			
DRAWN/REVISED BY: R.S., R.G.					
PATH:					
PLOT: PSPACE 1=1(F) OR WSPACE 1=1(F)					
REVISIONS		PROJECT DESIGNATION		YEAR	SHEET NO.
NO.	DATE	DESCRIPTION			TOTAL SHEETS
		NH-0902(34)		2009	51
					70

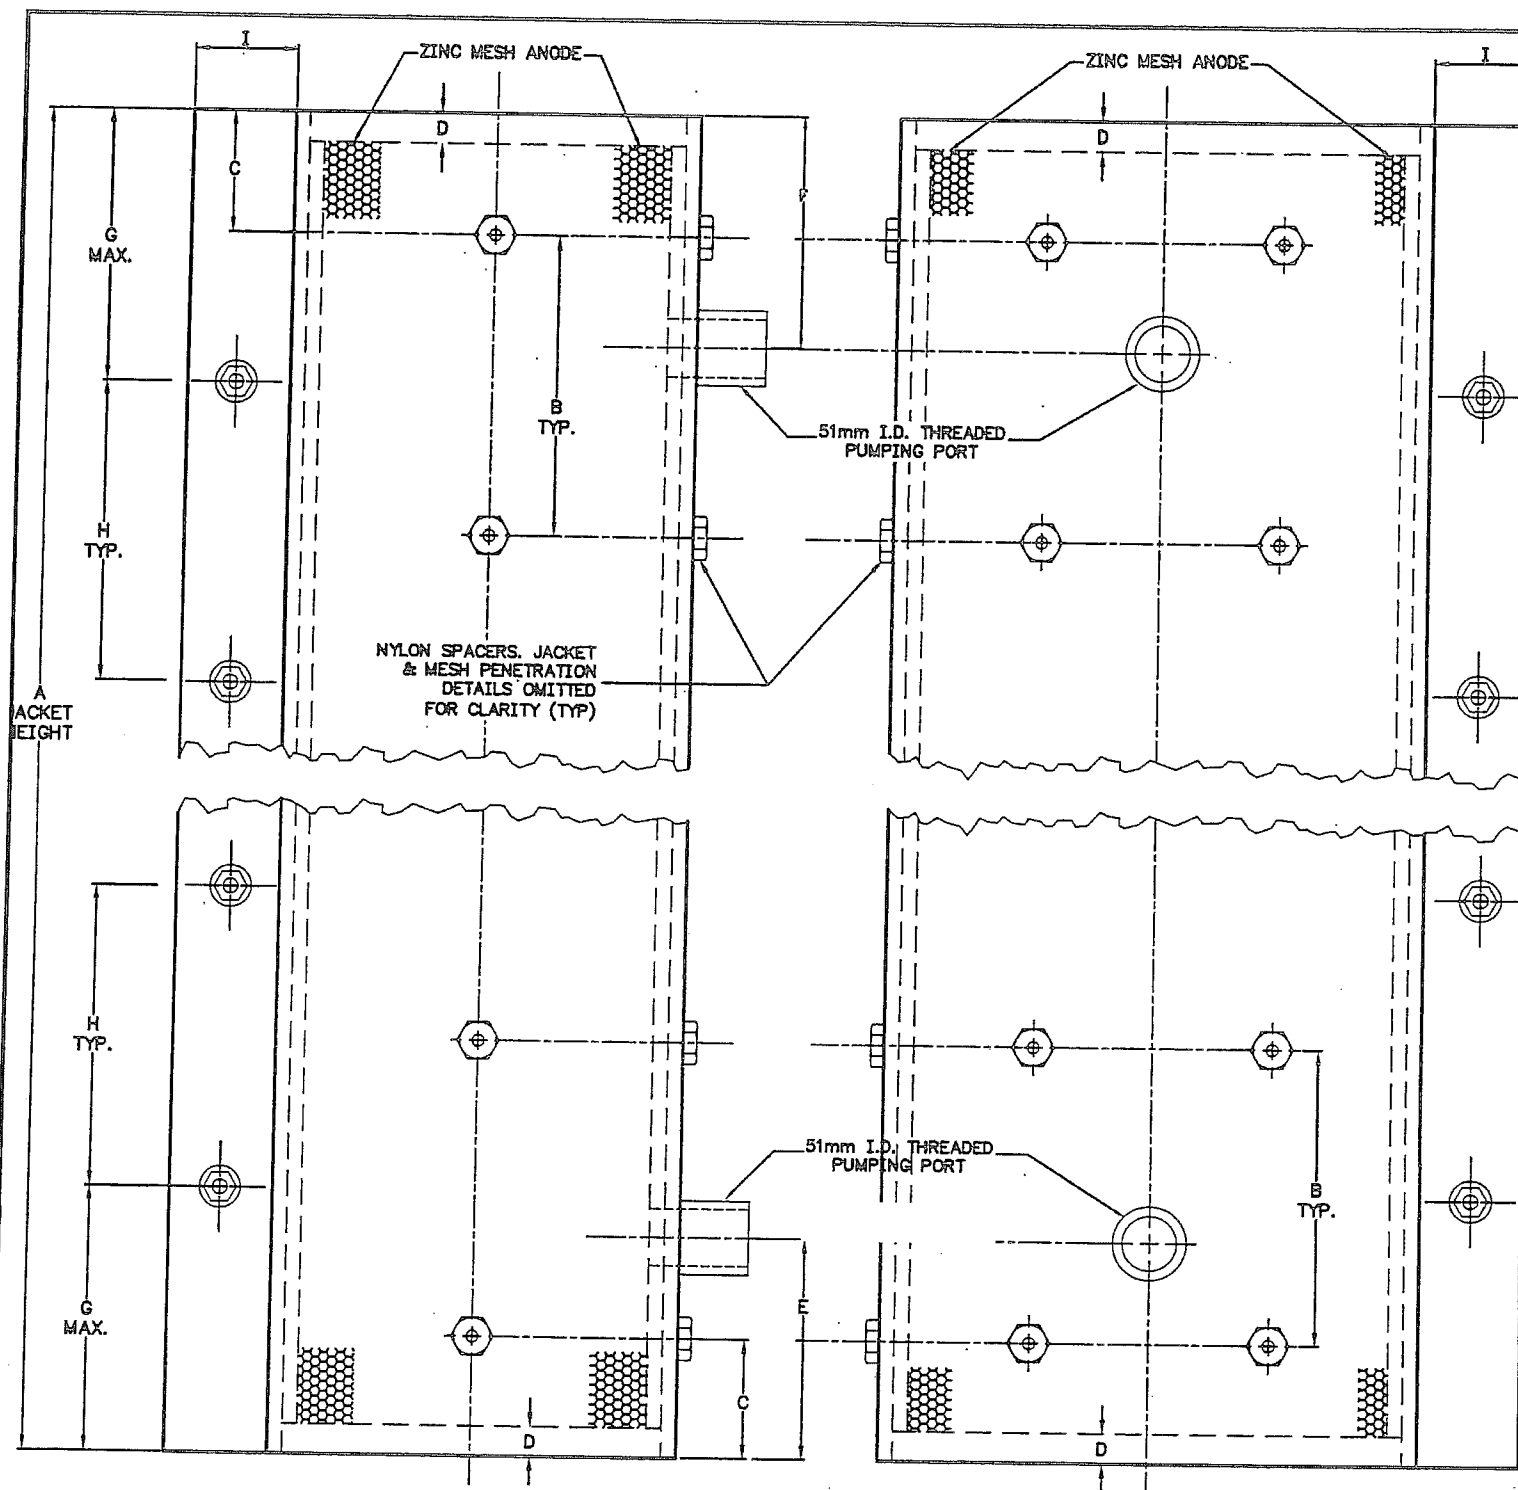

DIMENSIONS																			
A	B	C	D	E	F	G	H	I	J	K	L	M	N	O	P	Q	R	BENT NO.	VIADUCT
*	15"	4"	2"	6"	6"	6"	12"	4"	8"	12"	2"	10"	24"	16"	2"	1/4"	2"	*	WATER STREET
* = SEE SHEETS CP 1.1 & CP 1.3.																			TONGASS AVE.

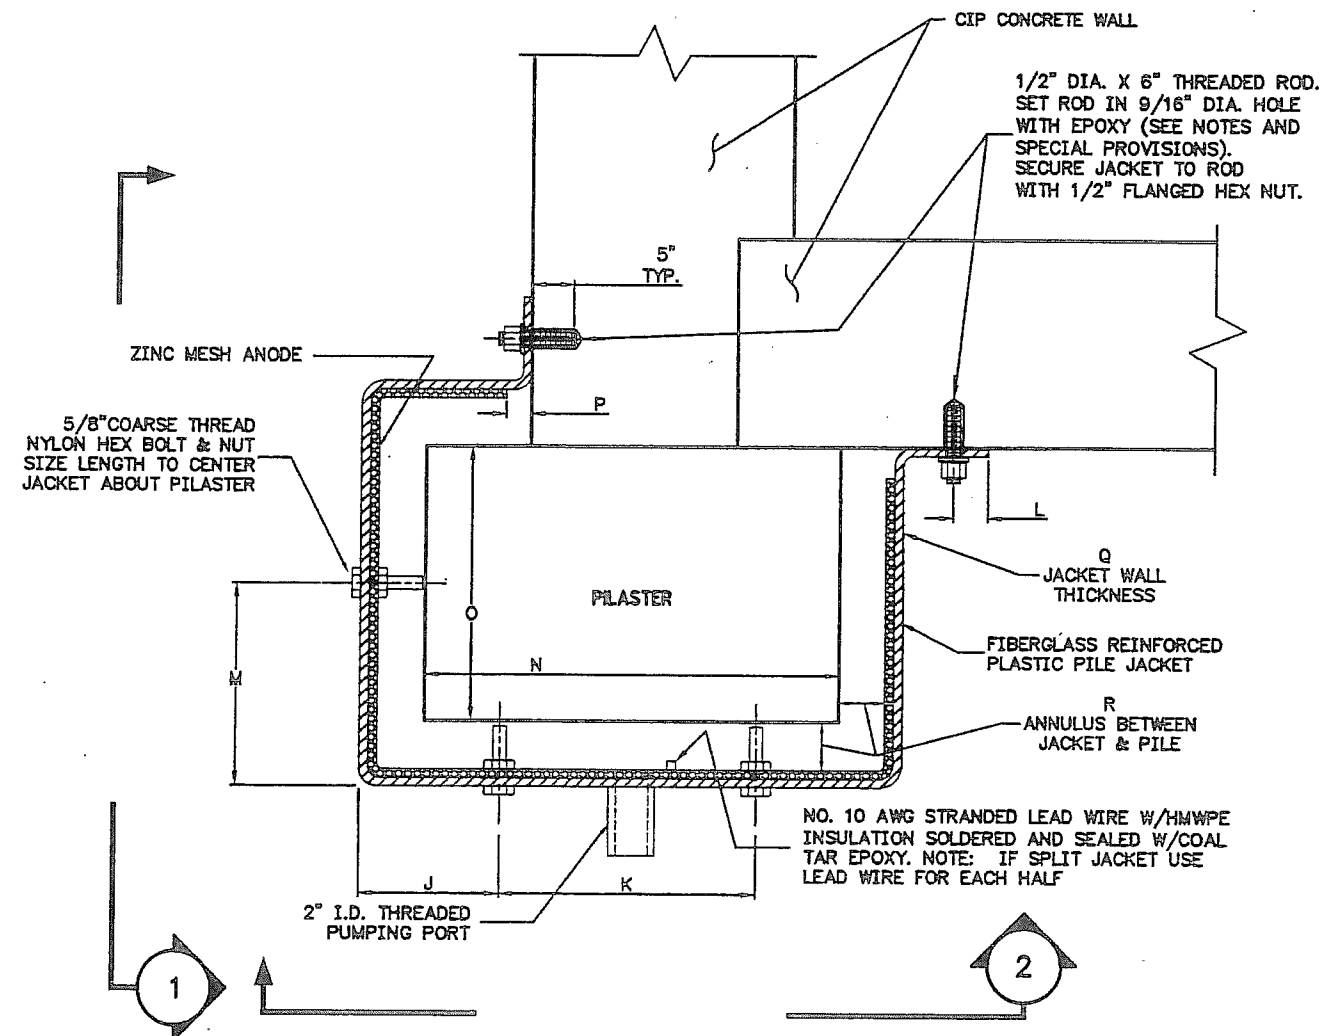


NOTES:

- SEE SHEET CP-1.3 FOR GENERAL LAYOUT.
- INSIDE JACKET SURFACE MUST BE ROUGHENED ACCORDING TO SPECIFICATIONS.
- THREADED ROD MUST BE INSTALLED AND EPOXY FULLY CURED BEFORE PLACING AND SECURING JACKET.
- FOLLOW SPECIFICATIONS THE EPOXY RESIN MANUFACTURER'S DIRECTIONS DURING SURFACE PREPARATION, STORAGE, SAFE AND PROPER USE, MIXING AND APPLICATION OF THE EPOXY RESIN. STRICTLY FOLLOW ANY TEMPERATURE OR MOISTURE RESTRICTIONS, REQUIREMENTS OR LIMITATIONS.
- DRILL HOLE FOR THREADED ROD ALONG HORIZONTAL CENTERLINE OF INTERSECTING CONCRETE LOGS.
- THREADED ROD MUST BE INSTALLED IN A CLEAN AND DRY HOLE.
- TO INSTALL THREADED ROD:
 - DRILL HOLE;
 - CLEAN HOLE W/NYLON BRUSH--DO NOT USE METAL BRUSH;
 - BLOWOUT HOLE WITH DRY COMPRESSED AIR;
 - STARTING AT THE DEEPEST END, FILL HOLE TO APPROXIMATELY 1/2 DEPTH W/EPOXY;
 - INSERT ROD TO DEPTH WITH TWISTING MOTION; CAREFULLY REMOVE EXCESS AND KEEP NON-EMBEDDED THREADS CLEAN.
- INSTALL THE THREADED ROD IMMEDIATELY AFTER HOLE SURFACE PREPARATION, OR THE HOLE MUST BE RE-CLEANED (DRIED IF NECESSARY).
- COMPLETELY FILL THE ENTIRE ANNULUS BETWEEN THE FIBERGLASS JACKET AND STRUCTURE WITH GROUT.
- THE PUMPING PORT LOCATIONS ARE OPTIONAL. ALTERNATE METHODS/PROCEDURE MAY BE SUBMITTED FOR APPROVAL, INCLUDING PORTS OR AIR VENTS LOCATIONS IF USED.
- WETTING HOLE REQ'D. SEE NOTE 8 & DETAIL ON SHEET CP-4.1.

ELEVATIONS, BENCHMARKS AND DIMENSIONS ARE BASED ON "AS-BUILT" PLANS. VERIFY ALL CONTROLLING FIELD DIMENSIONS BEFORE ORDERING OR FABRICATING ANY MATERIAL.

DESIGNED BY: M. FIGLEY

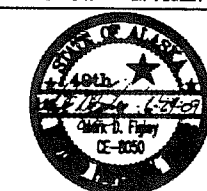

CHECKED BY: G. IMBESSEN
DRAWN/REVISED BY: R.S., R.G.

PATH:
PLOT: PSPACE 1-1(F) OR WSPACE 1-1(F)

REVISIONS		
NO.	DATE	DESCRIPTION


STATE OF ALASKA
DEPARTMENT OF TRANSPORTATION
& PUBLIC FACILITIES
STATEWIDE DESIGN & ENGINEERING SERVICES DIVISION

KTN-VIADUCTS
REHABILITATION
PROJECT NO. 68571
CORNER PILASTER
JACKET
AND SECTION


PROJECT DESIGNATION		YEAR	SHEET NO.	TOTAL SHEETS
NH-0902(34)		2009	52	70

CP-4.3

DIMENSIONS									
A	B	C	D	E	F	G	H	CAP	VIADUCT
32"	27"	2"	6"	28"	9"	18"	1/4"	INTERMEDIATE	TONGASS AVE.

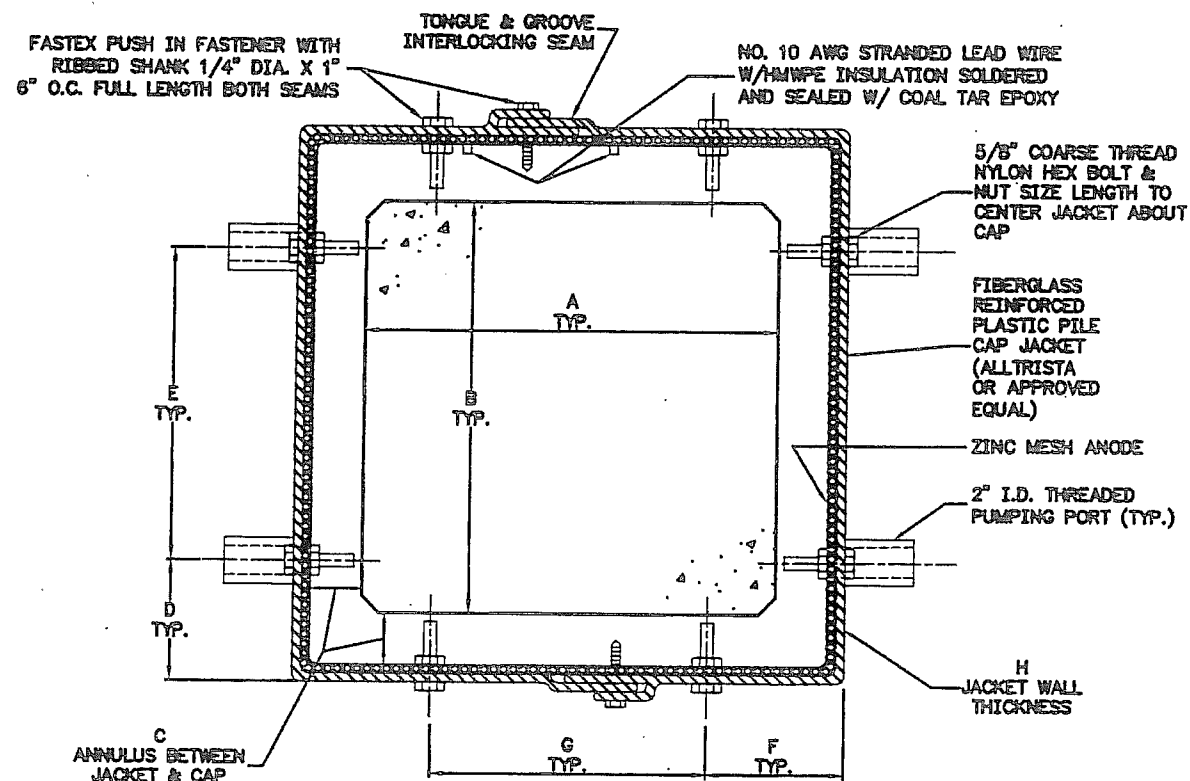

INTERMEDIATE GIRDER CAP
TYPICAL SECTION
N.T.S.

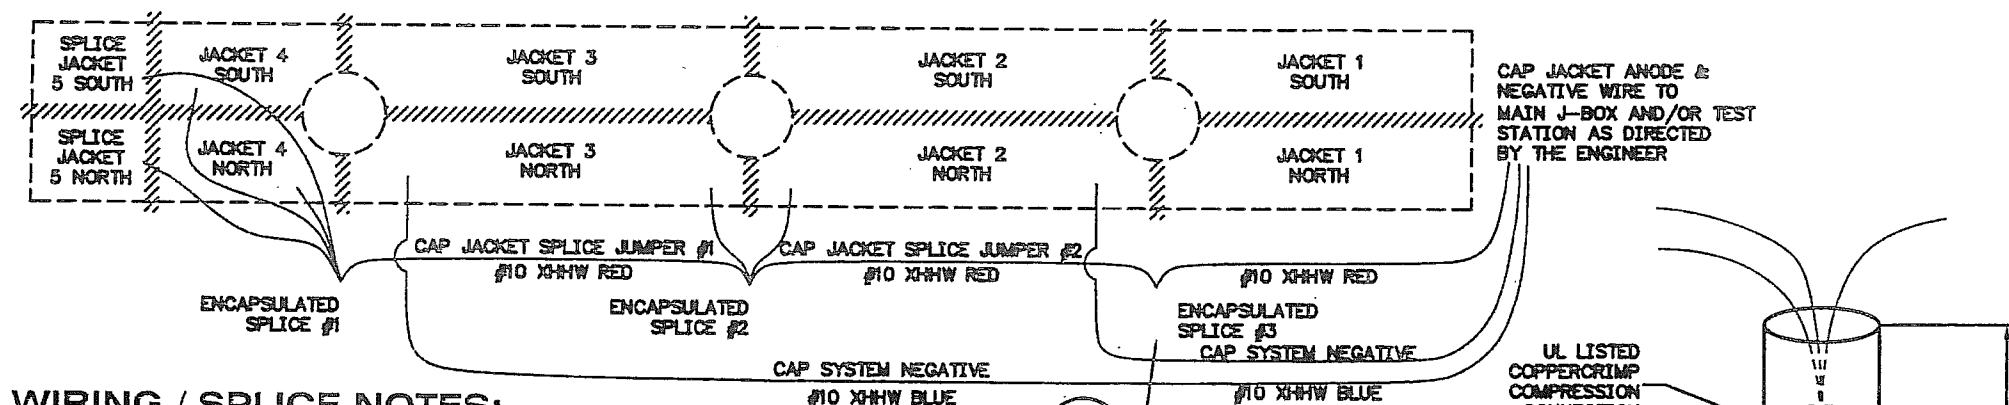

WIRING / SPLICE NOTES:


1. ALL ENCAPSULATED SPLICES FOR THE CAP JACKETS, PILE JACKETS, AND SUBMERGED ANODES SHALL BE CRIMPED WITH COPPER BUTT SPLICES OR C-TAP COMPONENTS, WRAPPED WITH A DOUBLE LAYER OF 600 VOLT ELECTRICAL TAPE AND FULLY ENCAPSULATED WITH SCOTCHCAST 2104 OR APPROVED EQUAL PER THE MANUFACTURER'S RECOMMENDATION.
2. THE PVC PIPE MOLD SIZE AND NUMBER OF WIRES IS CONTINGENT ON THE LOCATION.
3. ALL ENCAPSULATED SPLICES AND RELATED WIRE RUNS TO BE ENCASED IN EITHER THE CAP OR PILE JACKET CONCRETE.
4. CONTINUITY OF SPLICES MUST BE VERIFIED AND APPROVED PRIOR TO PUMPING CONCRETE INTO JACKETS.

CAP JACKET WIRING & SPLICE DETAIL
N.T.S.


TYPICAL
ENCAPSULATED
SPLICE
N.T.S.

JACKET / GROUT NOTES:

1. INSIDE JACKET SURFACE MUST BE ROUGHENED ACCORDING TO SPECIAL PROVISIONS.
2. COMPLETELY FILL THE ENTIRE ANNULUS BETWEEN THE FIBERGLASS JACKET AND STRUCTURE WITH GROUT.
3. THE PUMPING PORT LOCATIONS ARE OPTIONAL. ALTERNATE METHODS/PROCEDURE MAY BE SUBMITTED FOR APPROVAL, INCLUDING PORTS OR AIR VENTS LOCATIONS IF USED.

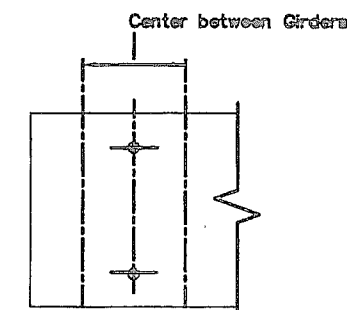

CAP TOP VIEW
n.t.s.

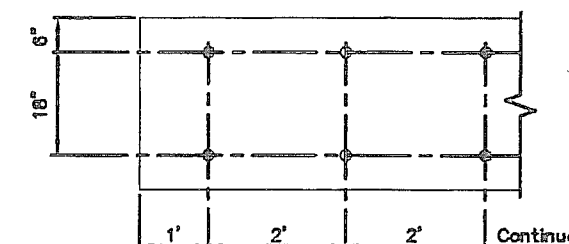


CAP SIDE VIEW
(Typ. both sides)

WETTING HOLES LAYOUT
n.t.s.

ELEVATIONS, BENCHMARKS AND DIMENSIONS ARE BASED ON "AS-BUILT" PLANS. VERIFY ALL CONTROLLING FIELD DIMENSIONS BEFORE ORDERING OR FABRICATING ANY MATERIAL.

DESIGNED BY: M. FIOLEY		STATE OF ALASKA DEPARTMENT OF TRANSPORTATION & PUBLIC FACILITIES STATEWIDE DESIGN & ENGINEERING SERVICES DIVISION KTN-VIADUCTS REHABILITATION PROJECT NO. 68571 INTERMEDIATE GIRDER SECTION DETAIL & MISCELLANEOUS DETAILS				
CHECKED BY: G. THOMSEN						
DRAWN/REVISED BY: R.S., R.G.						
PLOT: PSPACE 1=1(F) OR MSPACE 1=1(F)		CP-4.5				
NO.	DATE	REVISIONS DESCRIPTION	PROJECT DESIGNATION NH-0902(34)	YEAR 2009	SHEET NO. 54	TOTAL SHEETS 70


DIMENSIONS												CAP	VIADUCT
A	B	C	D	E	F	G	H	I	J			INTERMEDIATE	TONGASS AVE.
32"	27"	2"	6"	16"	9"	18"	1/4"	16"	2"				

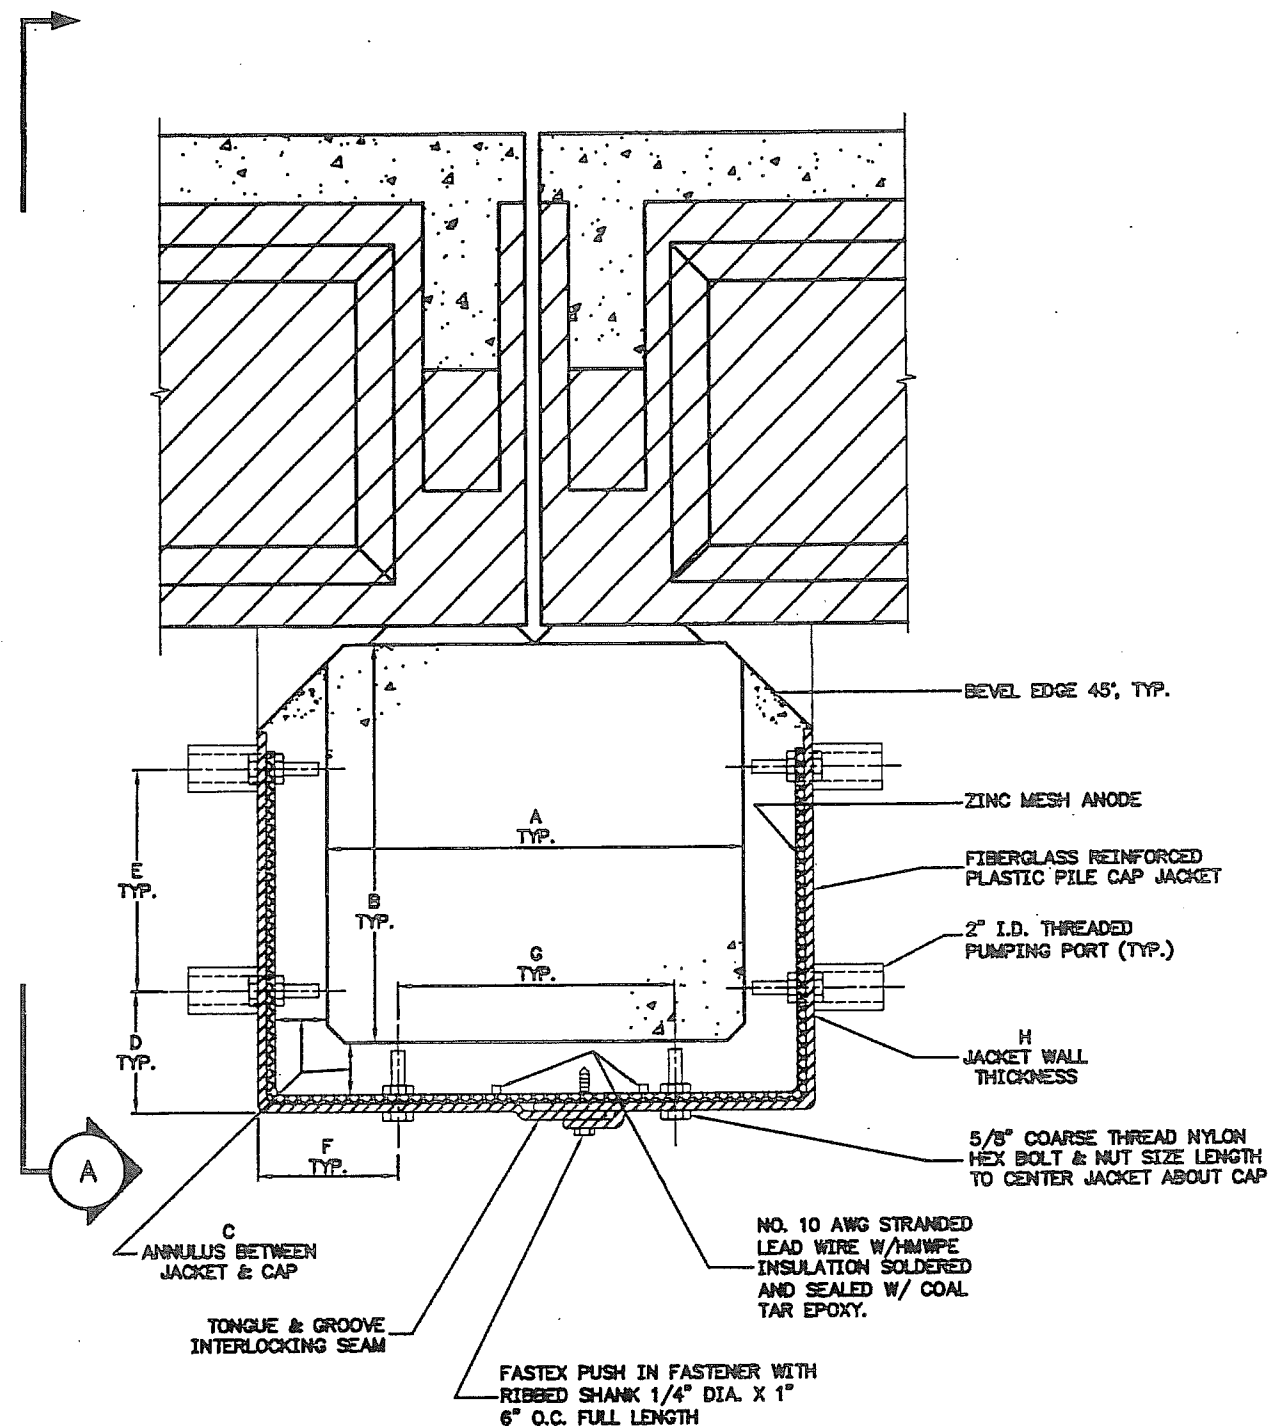

**CAP JACKET SECTION
@ GIRDER BEARING LOCATION**

N.T.S.

1

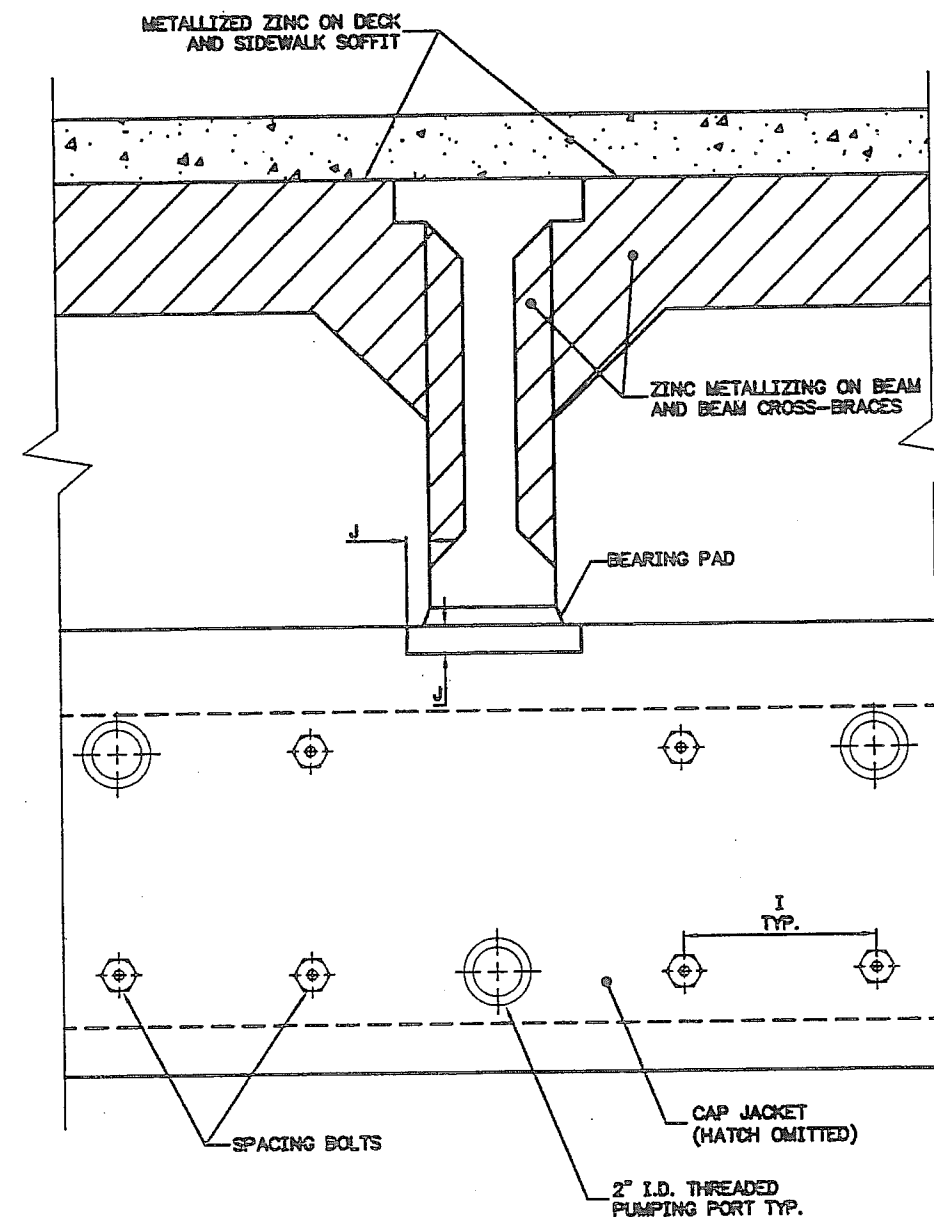

**INTERMEDIATE GIRDER CAP
ELEVATION DETAIL**

N.T.S.

A

NOTES:

1. INSIDE JACKET SURFACE MUST BE ROUGHENED ACCORDING TO SPECIAL PROVISIONS.
2. COMPLETELY FILL THE ENTIRE ANNULUS BETWEEN THE FIBERGLASS JACKET AND STRUCTURE WITH GROUT.
3. THE PUMPING PORT LOCATIONS ARE OPTIONAL. ALTERNATE METHODS/PROCEDURE MAY BE SUBMITTED FOR APPROVAL, INCLUDING PORTS OR AIR VENTS LOCATIONS IF USED.
4. WETTING HOLES REQ'D. SEE DETAIL ON CP-4.5.



ELEVATIONS, BENCHMARKS AND DIMENSIONS ARE BASED ON "AS-BUILT" PLANS. VERIFY ALL CONTROLLING FIELD DIMENSIONS BEFORE ORDERING OR FABRICATING ANY MATERIAL.

DESIGNED BY: M. FIGLEY		STATE OF ALASKA DEPARTMENT OF TRANSPORTATION & PUBLIC FACILITIES STATEWIDE DESIGN & ENGINEERING SERVICES DIVISION KTN-VIADUCTS REHABILITATION PROJECT NO. 68571			
CHECKED BY: G. JENSEN, R.L.		INTERMEDIATE GIRDER SECTION & BEAM CP-4.6			
DRAWN/REVISED BY: R.S., R.G.					
PATH: PLOT: PSPACE 1-1(F) OR MSPACE 1-1(F)		PROJECT DESIGNATION NH-0902(34)			
REVISIONS		YEAR	SHEET NO.	TOTAL SHEETS	
NO.	DATE	DESCRIPTION	2009	55	70

DIMENSIONS															CAP	VIADUCT
A	B	C	D	E	F	G	H	I	J	K	L	M	N	O	TRANSITION	TONGASS AVE.
26"	24"	12"	2"	2"	6"	16"	14"	6"	10"	2"	4"	1/4"	10"	12"		

NOTES:

- 1. INSIDE JACKET SURFACE MUST BE ROUGHENED ACCORDING TO SPECIFICATIONS.
- 2. COMPLETELY FILL THE ENTIRE ANNULUS BETWEEN THE FIBERGLASS JACKET AND STRUCTURE WITH GROUT.
- 3. THE PUMPING PORT LOCATIONS ARE OPTIONAL. ALTERNATE METHODS/PROCEDURE MAY BE SUBMITTED FOR APPROVAL, INCLUDING PORTS OR AIR VENTS LOCATIONS IF USED.
- 4. THREADED ROD MUST BE INSTALLED AND EPOXY FULLY CURED BEFORE PLACING AND SECURING JACKET.
- 5. FOLLOW SPECIFICATIONS THE EPOXY RESIN MANUFACTURER'S DIRECTIONS DURING SURFACE PREPARATION, STORAGE, SAFE AND PROPER USE, MIXING AND APPLICATION OF THE EPOXY RESIN. STRICTLY FOLLOW ANY TEMPERATURE OR MOISTURE RESTRICTIONS, REQUIREMENTS OR LIMITATIONS.
- 6. THREADED ROD MUST BE INSTALLED IN A CLEAN AND DRY HOLE.
- 7. TO INSTALL THREADED ROD:
 - a) DRILL HOLE;
 - b) CLEAN HOLE W/NYLON BRUSH--DO NOT USE METAL BRUSH;
 - c) BLOWOUT HOLE WITH DRY COMPRESSED AIR;
 - d) STARTING AT THE DEEPEST END, FILL HOLE TO APPROXIMATELY 1/2 DEPTH W/EPOXY;
 - e) INSERT ROD TO DEPTH WITH TWISTING MOTION; CAREFULLY REMOVE EXCESS AND KEEP NON-EMBEDDED THREADS CLEAN.
- 8. INSTALL THE THREADED ROD IMMEDIATELY AFTER HOLE SURFACE PREPARATION, OR THE HOLE MUST BE RE-CLEANED (DRIED IF NECESSARY).
- 9. WETTING HOLES REQ'D. SEE DETAIL ON CP-4.5.

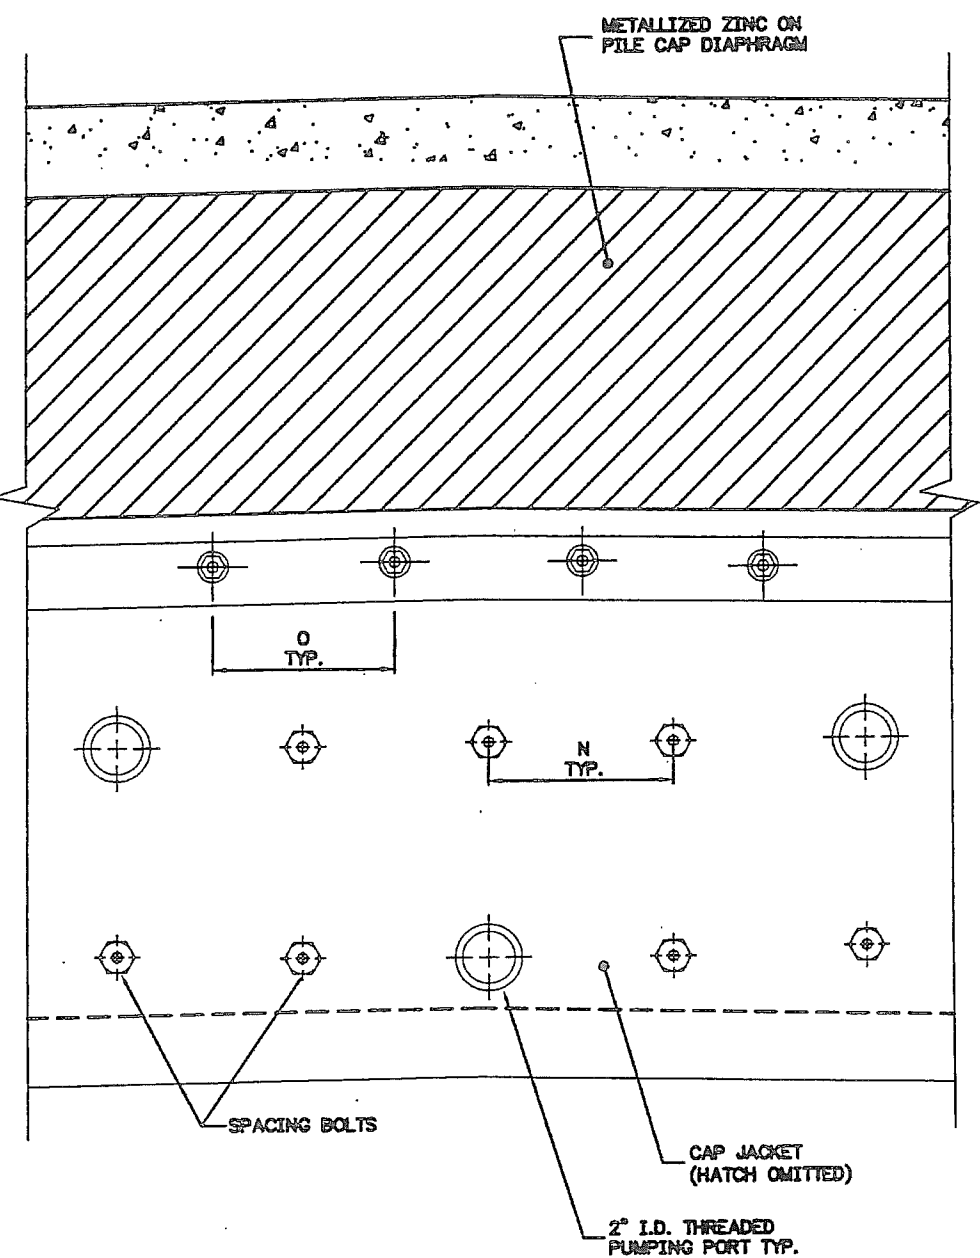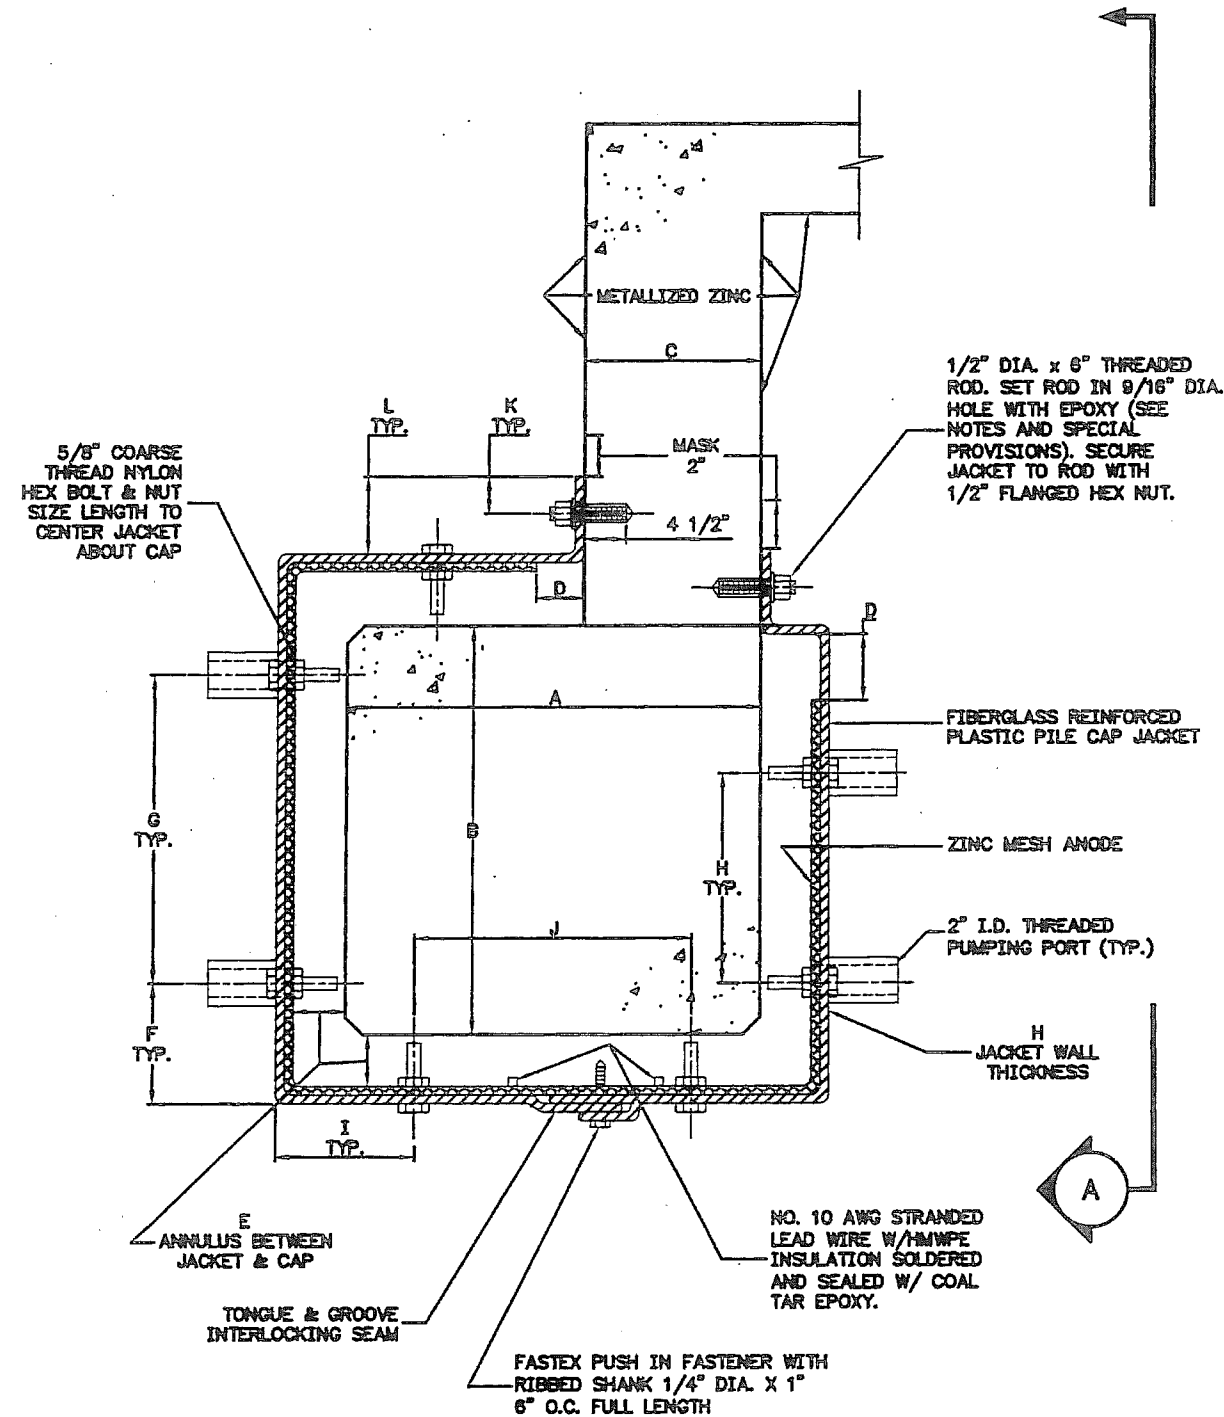

CAP JACKET SECTION
@ SOLID DIAPHRAGM BENTS
(Transition Bents)
N.T.S.

INTERMEDIATE GIRDER CAP
ELEVATION DETAIL
N.T.S.

ELEVATIONS, BENCHMARKS AND DIMENSIONS ARE BASED ON "AS-BUILT" PLANS. VERIFY ALL CONTROLLING FIELD DIMENSIONS BEFORE ORDERING OR FABRICATING ANY MATERIAL.

DESIGNED BY: M. FOLEY



CHECKED BY: G. JENSEN
DRAWN/REVISED BY: R.S., R.G.

STATE OF ALASKA
DEPARTMENT OF TRANSPORTATION
& PUBLIC FACILITIES
STATEWIDE DESIGN & ENGINEERING SERVICES DIVISION
KTN-VIADUCTS
REHABILITATION
PROJECT NO. 68571

TRANSITION CAP
SECTION


CP-4.7

REVISIONS		PROJECT DESIGNATION	YEAR	SHEET NO.	TOTAL SHEETS
NO.	DATE				
		NH-0902(34)	2009	56	70

DIMENSIONS															
A	B	C	D	E	F	G	H	I	J	K	L	M	N	O	
28"	24"	12"	2"	2"	7 3/16"	14 3/8"	12"	8 3/16"	16 5/16"	2"	3 13/16"	1/4"	16"	12"	


NOTES:

- INSIDE JACKET SURFACE MUST BE ROUGHENED ACCORDING TO SPECIAL PROVISIONS.
- COMPLETELY FILL THE ENTIRE ANNULUS BETWEEN THE FIBERGLASS JACKET AND STRUCTURE WITH GROUT.
- THE PUMPING PORT LOCATIONS ARE OPTIONAL. ALTERNATE METHODS/PROCEDURE MAY BE SUBMITTED FOR APPROVAL, INCLUDING PORTS OR AIR VENTS LOCATIONS IF USED.
- THREADED ROD MUST BE INSTALLED AND EPOXY FULLY CURED BEFORE PLACING AND SECURING JACKET.
- FOLLOW SPECIFICATIONS THE EPOXY RESIN MANUFACTURER'S DIRECTIONS DURING SURFACE PREPARATION, STORAGE, SAFE AND PROPER USE, MIXING AND APPLICATION OF THE EPOXY RESIN. STRICTLY FOLLOW ANY TEMPERATURE OR MOISTURE RESTRICTIONS, REQUIREMENTS OR LIMITATIONS.
- THREADED ROD MUST BE INSTALLED IN A CLEAN AND DRY HOLE.
- TO INSTALL THREADED ROD:
 - DRILL HOLE;
 - CLEAN HOLE W/NYLON BRUSH--DO NOT USE METAL BRUSH;
 - BLOWOUT HOLE WITH DRY COMPRESSED AIR;
 - STARTING AT THE DEEPEST END, FILL HOLE TO APPROXIMATELY 1/2 DEPTH W/EPOXY;
 - INSERT ROD TO DEPTH WITH TWISTING MOTION; CAREFULLY REMOVE EXCESS AND KEEP NON-EMBEDDED THREADS CLEAN.
- INSTALL THE THREADED ROD IMMEDIATELY AFTER HOLE SURFACE PREPARATION, OR THE HOLE MUST BE RE-CLEANED (DRIED IF NECESSARY).
- WETTING HOLES REQ'D. SEE DETAIL ON CP-4.5.

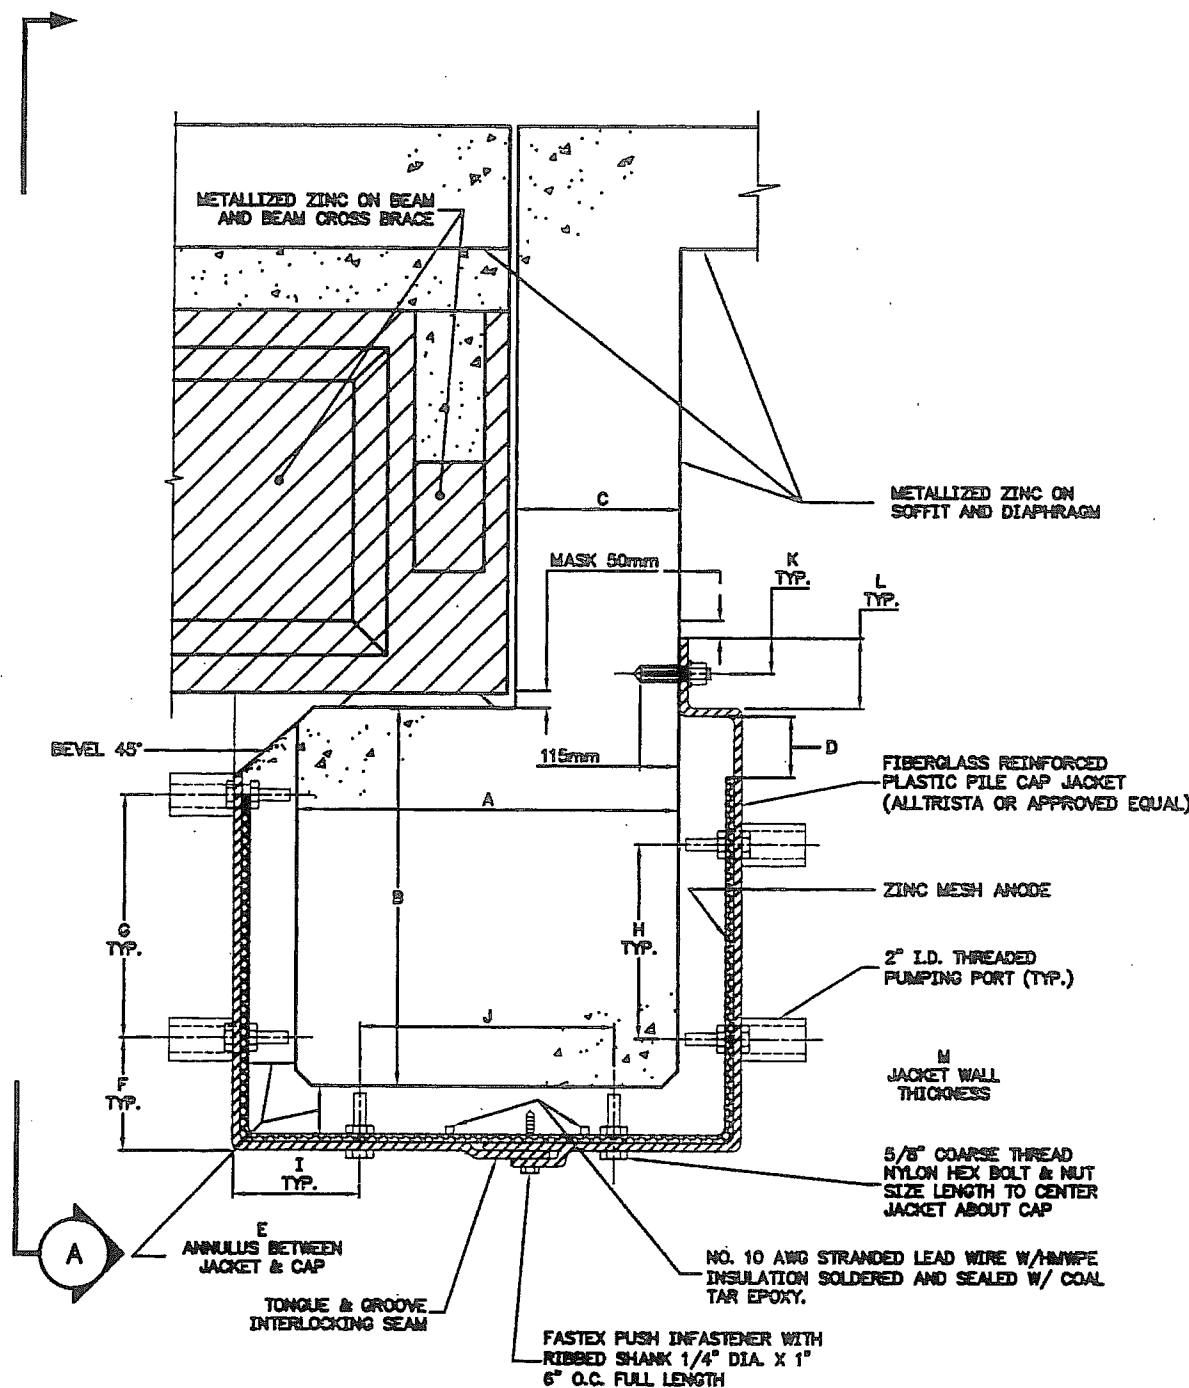

TRANSITION CAP JACKET SECTION
@ GIRDER BEARING LOCATION


N.T.S.

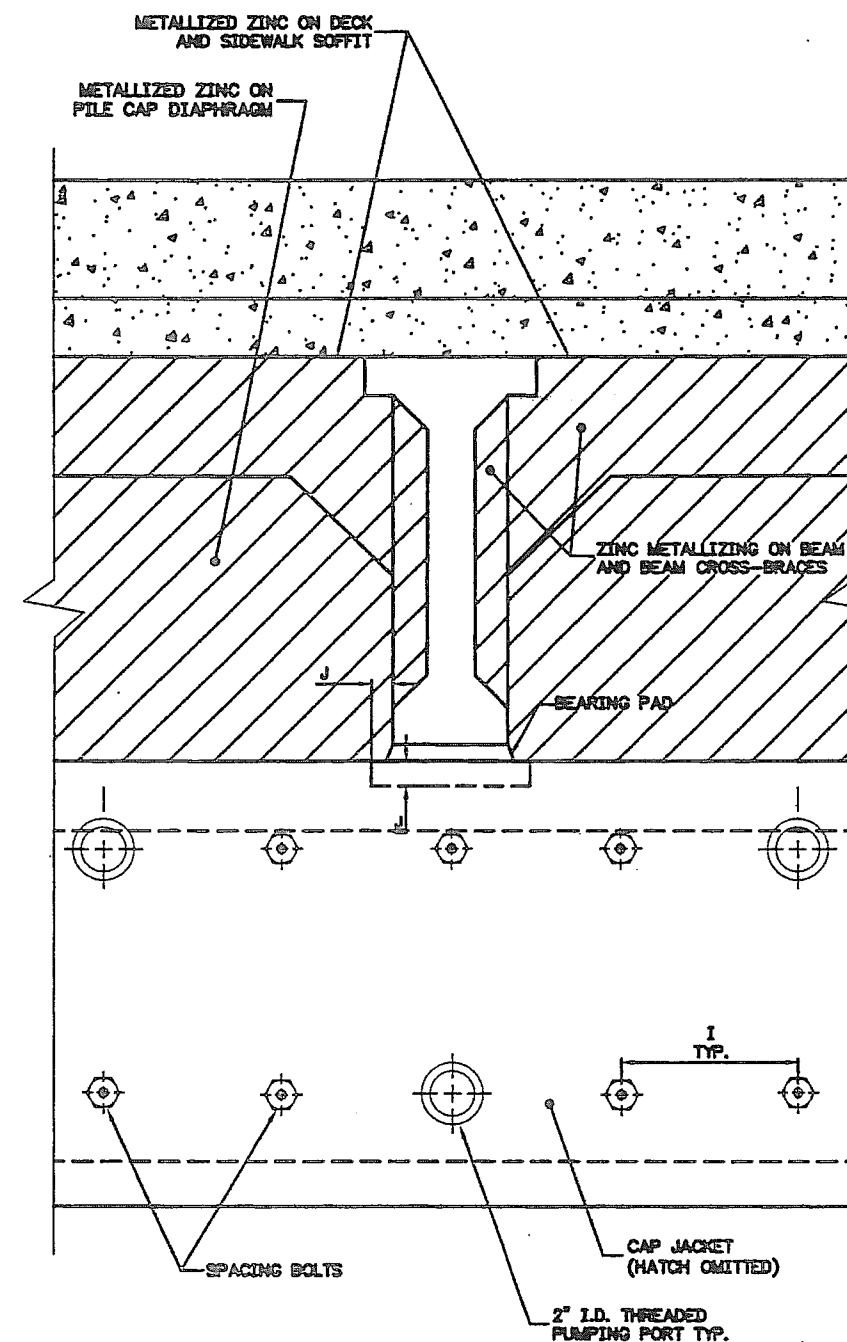

CAP JACKET ELEVATION DETAIL
N.T.S.

ELEVATIONS, BENCHMARKS AND DIMENSIONS ARE BASED ON "AS-BUILT" PLANS. VERIFY ALL CONTROLLING FIELD DIMENSIONS BEFORE ORDERING OR FABRICATING ANY MATERIAL.

DESIGNED BY: M. FOLEY

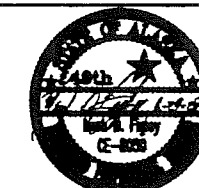

CHECKED BY: G. IMSEN
DRAWN/REVISED BY: R.S., R.G.


STATE OF ALASKA
DEPARTMENT OF TRANSPORTATION
& PUBLIC FACILITIES
STATEWIDE DESIGN & ENGINEERING SERVICES DIVISION
KTN-VIADUCTS
REHABILITATION
PROJECT NO. 68571

TRANSITION CAP
SECTION & BEAM


PATH:
PLOT: PSPACE 1=1(F) OR MSPACE 1=1(F)

CP-4.8

NO.	DATE	REVISIONS DESCRIPTION	PROJECT DESIGNATION	YEAR	SHEET NO.	TOTAL SHEETS
			NH-0902(34)	2009	57	70

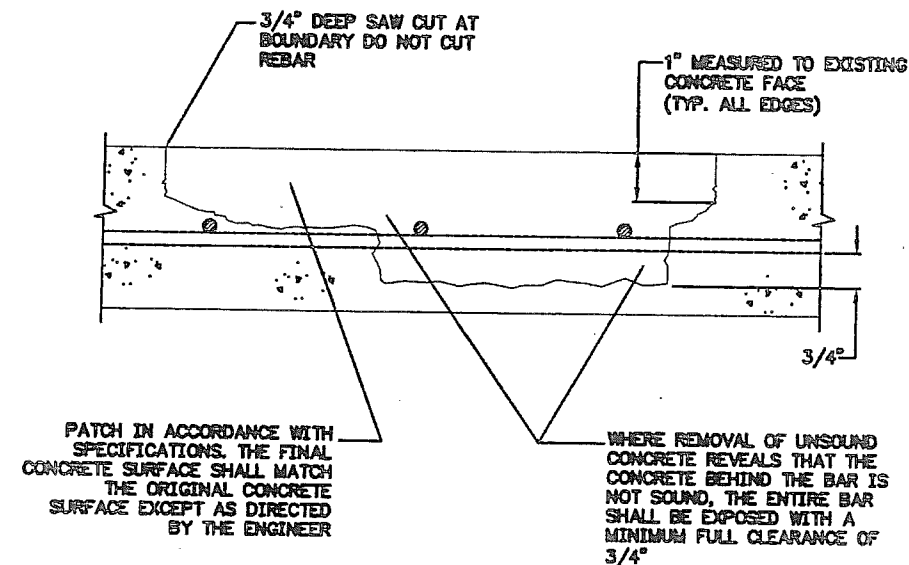


HORIZONTAL PATCH
N.T.S.

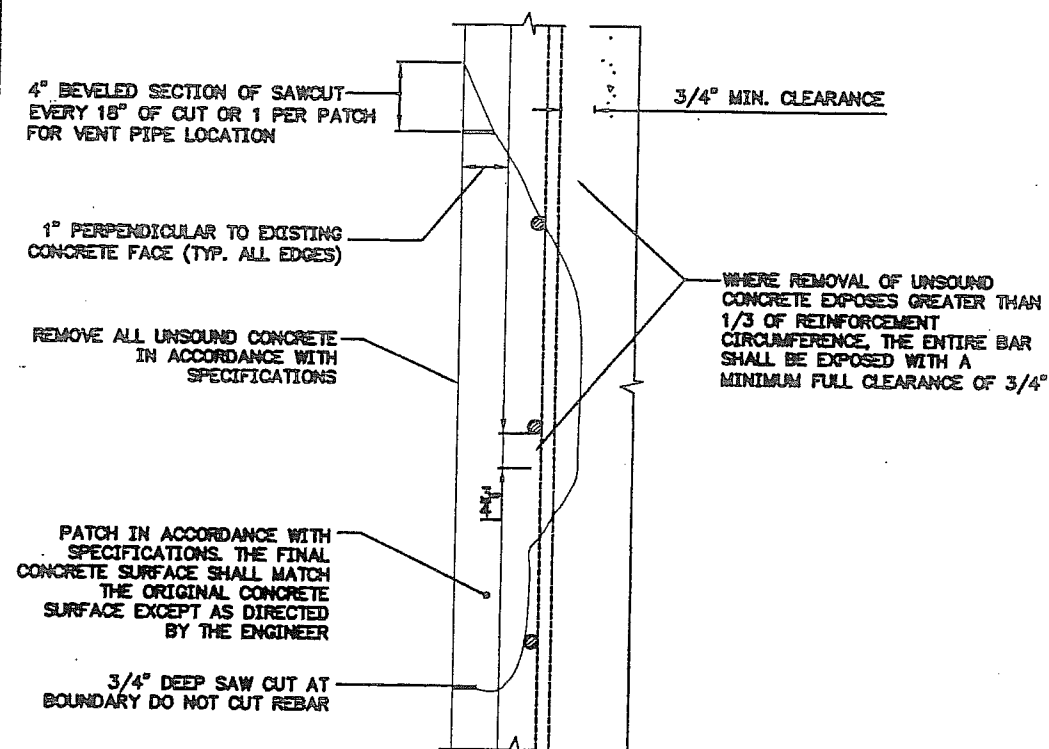


VERTICAL PATCH
N.T.S.

WHERE REMOVAL OF UNSOUND CONCRETE REVEALS THAT THE CONCRETE BEHIND THE BAR IS NOT SOUND, THE ENTIRE BAR SHALL BE EXPOSED WITH A MINIMUM FULL CLEARANCE OF 19mm. SEE DETAIL

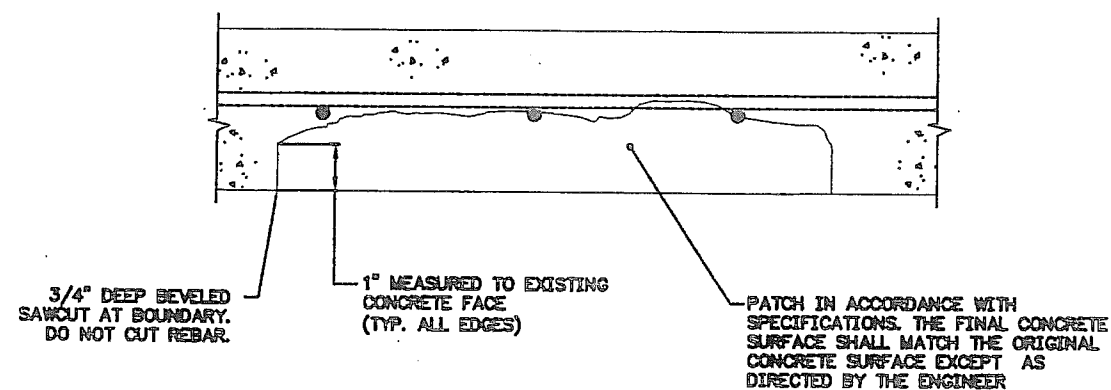

OVERHEAD PATCH
N.T.S.

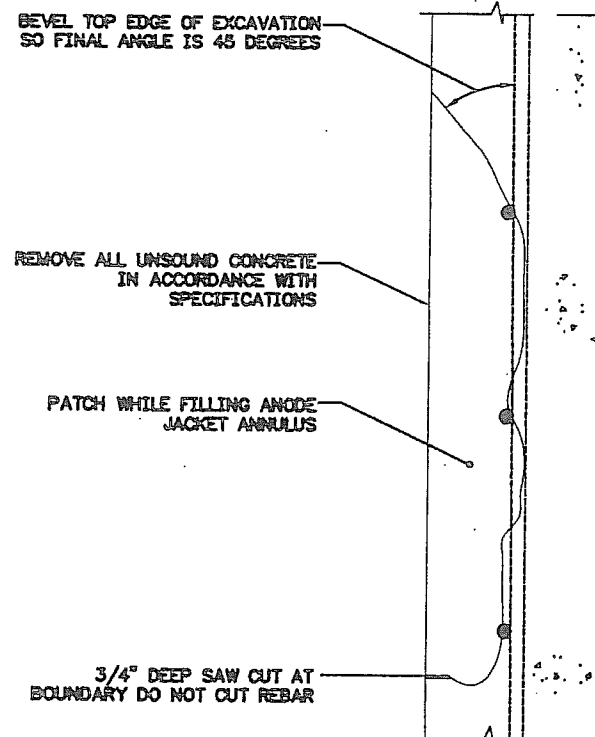


EXCAVATION WITHIN ANODE JACKET
N.T.S.

WHERE REMOVAL OF UNSOUND CONCRETE REVEALS THAT THE CONCRETE BEHIND THE BAR IS NOT SOUND, THEN THE ENTIRE BAR SHALL BE EXPOSED WITH A MINIMUM FULL CLEARANCE OF 3/4". SEE DETAIL

NOTES:


1. REMOVE ALL UNSOUND CONCRETE IN ACCORDANCE WITH THE SPECIFICATIONS.
2. PRIOR TO RESTORING CONCRETE COVER, CLEAN EXCAVATED CONCRETE SURFACE AND EXPOSED REINFORCEMENT IN ACCORDANCE WITH THE SPECIFICATIONS. IN ADDITION TO BEING CLEAN, ALL SURFACES IN CONTACT WITH THE PATCH MUST BE SSD PRIOR TO PLACING PATCH MATERIAL. THIS WILL REQUIRE PRE-WETTING THE CONCRETE FOR A MINIMUM OF 24-HOURS.
3. WHERE THE REBAR HAS SECTION LOSS FROM CORROSION, THE EXCAVATION SHALL BE ENLARGED AS DIRECTED TO PROVIDE ADEQUATE DEVELOPMENT LENGTH FOR A NEW SPICED REINFORCING BAR. THE BAR SHALL BE GRADE 40 AND WILL BE WIRED IN PLACE. THE ADDITIONAL EXCAVATION SHALL BE DONE ONLY AS DIRECTED. THE REBAR FOR THIS REPAIR IS CONSIDERED PART OF SUBSIDIARY TO OTHER ITEMS OF WORK.

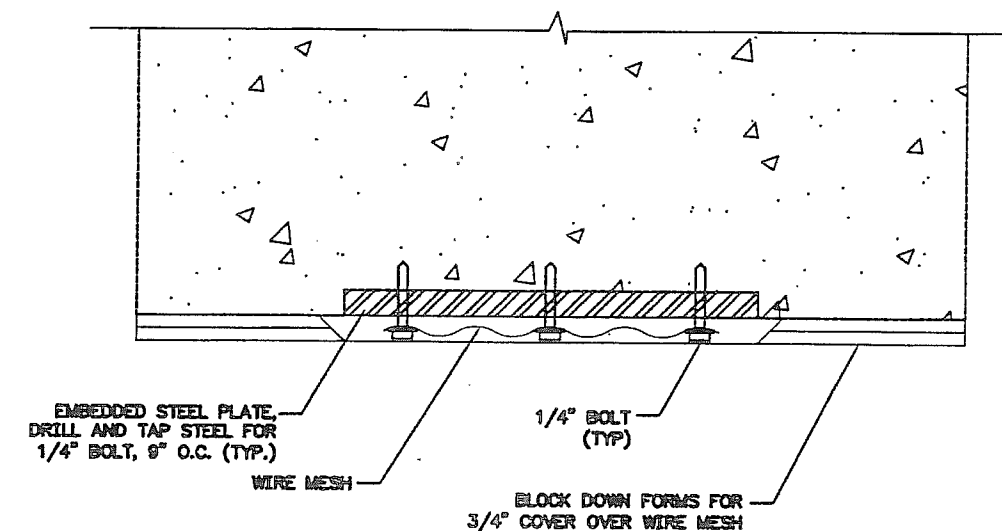


CONCRETE REPAIR AT EMBEDDED STEEL PLATE
N.T.S.

ELEVATIONS, BENCHMARKS AND DIMENSIONS ARE BASED ON "AS-BUILT" PLANS. VERIFY ALL CONTROLLING FIELD DIMENSIONS BEFORE ORDERING OR FABRICATING ANY MATERIAL.


DESIGNED BY: M. FOLEY		STATE OF ALASKA DEPARTMENT OF TRANSPORTATION & PUBLIC FACILITIES STATEWIDE DESIGN & ENGINEERING SERVICES DIVISION			
		KTN-VIADUCTS REHABILITATION PROJECT NO. 68571			
		HORIZONTAL & VERTICAL CONCRETE REPAIR			
CHECKED BY: G. IMBSEN DRAWN/REVISED BY: R.S., R.G.		CP-5.0			
PATH: PLOT: PSPACE 1=1(F) OR MSPACE 1=1(F)					
REVISIONS		PROJECT DESIGNATION			
NO.	DATE	DESCRIPTION	YEAR		
			SHEET NO.		
			TOTAL SHEETS		
NH-0902(34)			2009 58 70		

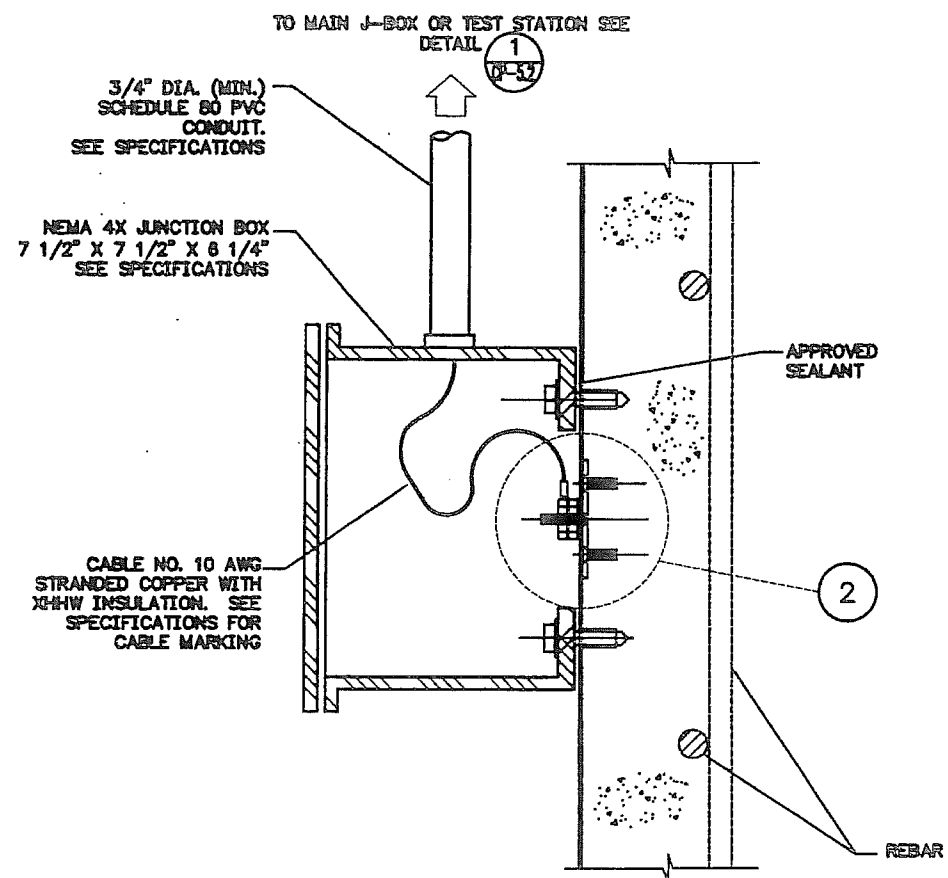

SPRAYED ZINC ANODE CONNECTION
N.T.S. 1

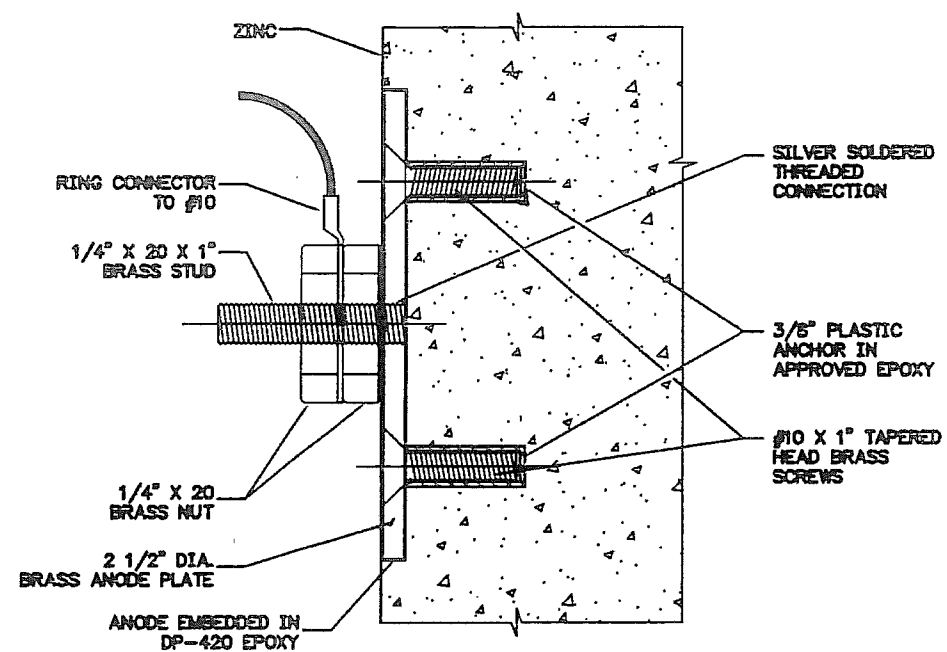

**PRIMARY ANODE
TERMINAL PLATE**
N.T.S. 2

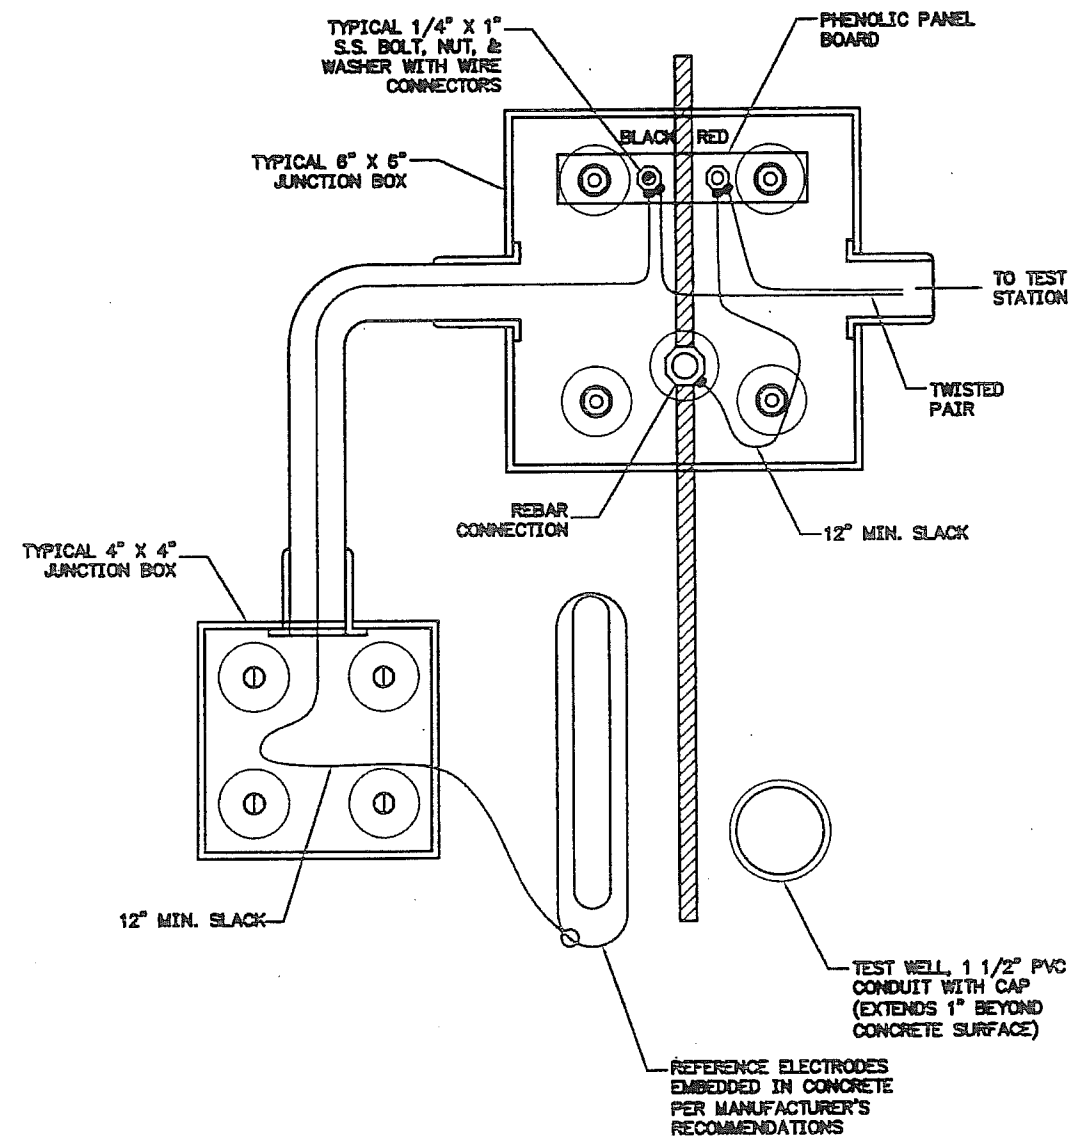

**EMBEDDED ELECTRODE
CONNECTION DETAIL**
N.T.S. 3


NOTES:

1. PROTECT EXISTING UTILITIES AND PROPERTY FROM ANY CONSTRUCTION RELATED DAMAGE.
2. SECURE PERMISSION OF UTILITY OWNER, OR OWNER OF OTHER PROPERTY, PRIOR TO MOVING OR TEMPORARILY RELOCATING ANY PROPERTY FOR THE CONVENIENCE OF CONSTRUCTION ACTIVITIES.
3. CONDUIT SHALL BE UL 651 SCHEDULE 80 RIGID PVC. SIZE AND SUPPORT CONDUIT PER NEC FOR NONMETALLIC CONDUIT. MINIMUM DIAMETER IS 3/4".
4. USE APPROVED NONMETALLIC CONDUIT CLAMPS AND/OR STRUTS. ATTACH WITH STAINLESS STEEL ANCHOR BOLT/NON-METALLIC ANCHOR SLEEVE FASTENERS.
5. SIZE JUNCTION BOXES AND ENCLOSURES BASED ON NUMBER AND SIZE OF CONDUCTORS AND CONDUIT.
6. CONDUIT RUNS SHALL BE INSTALLED NEAT, STRAIGHT AND LEVEL. USE 1/2" PVC CONDUIT STAND OFFS OR NONMETALLIC STRUTS AS REQUIRED TO MAINTAIN LEVEL RUNS.
7. ENCLOSURES AND JUNCTION BOXES SHALL BE NEMA 4X RATED PVC WITH FLAT TOPS SECURED BY STAINLESS STEEL SCREWS.
8. DO NOT MAKE ATTACHMENTS TO PRESTRESSED CONCRETE USING DRILLED ANCHORS WITHOUT PRIOR APPROVAL.
9. SEE SPECIFICATIONS FOR MARKING AND CABLE INSULATION COLORS.
10. LEAVE FREE CABLE IN ALL BOXES TO ALLOW FOR RECONNECTION, SEE SPECIFICATIONS.
11. WIRE CONNECTIONS TO PANEL BOARD & PRIMARY ANODE SHALL BE COATED WITH APPROVED ANTI-CORROSIVE COMPOUND, 1/4" THICK LAYER.

ELEVATIONS, BENCHMARKS AND DIMENSIONS ARE BASED ON "AS-BUILT" PLANS. VERIFY ALL CONTROLLING FIELD DIMENSIONS BEFORE ORDERING OR FABRICATING ANY MATERIAL.

DESIGNED BY: M. FIGLEY		STATE OF ALASKA DEPARTMENT OF TRANSPORTATION & PUBLIC FACILITIES STATEWIDE DESIGN & ENGINEERING SERVICES DIVISION KTN-VIADUCTS REHABILITATION PROJECT NO. 68571			
CHECKED BY: G. IMBSEN DRAWN/REVISED BY: R.S., R.G.		THERMAL SPRAY ANODE CONNECTION			
PATH: PLDT: PSPACE 1=1(F) OR MSPACE 1=1(F)					
NO. DATE REVISIONS DESCRIPTION		PROJECT DESIGNATION	YEAR	SHEET NO.	TOTAL SHEETS
		NH-0902(34)	2009	59	70

REVISIONS			PROJECT DESIGNATION	YEAR	SHEET NO.	TOTAL SHEETS
NO.	DATE	DESCRIPTION				
			NH-0902(34)	2009	60	70

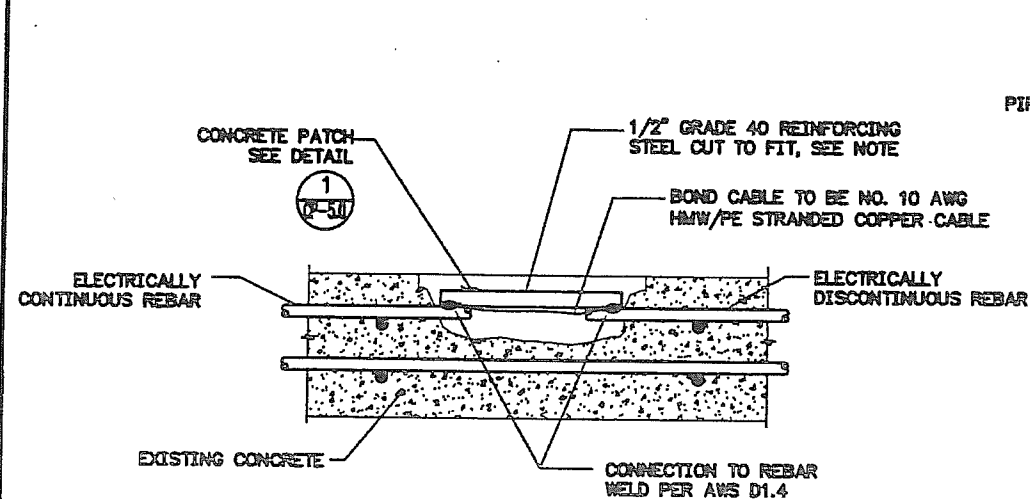


USE EITHER BOND CABLE OR 1/2" REINFORCING STEEL
CHECK WITH ENGINEER FOR STRUCTURAL REQUIREMENTS.

DISCONTINUOUS REBAR BOND

N.T.S.


1

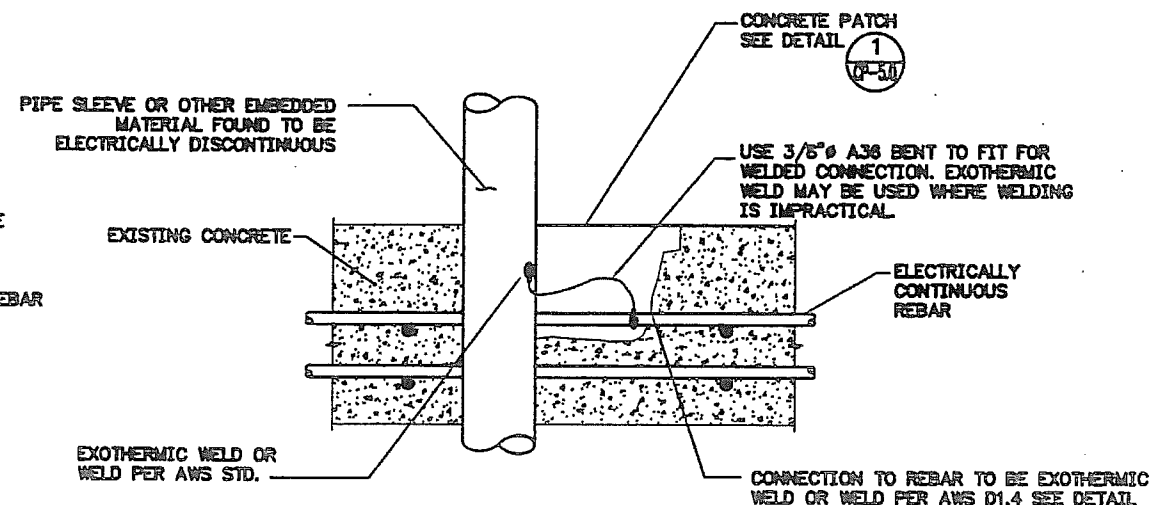

DISCONTINUOUS REBAR BOND

N.T.S.

2

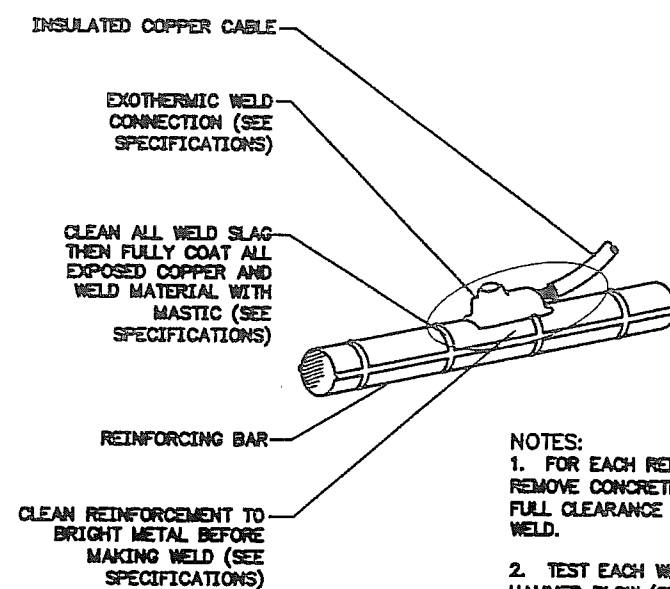


- NOTES:
1. FOR EACH REBAR TO BE BONDED, REMOVE CONCRETE TO PROVIDE 5/8" FULL CLEARANCE 3" EITHER SIDE OF WELD.
 2. TEST EACH WELD WITH OBLIQUE HAMMER BLOW (SEE SPECIFICATIONS).

DISCONTINUOUS REBAR BOND

N.T.S.

3

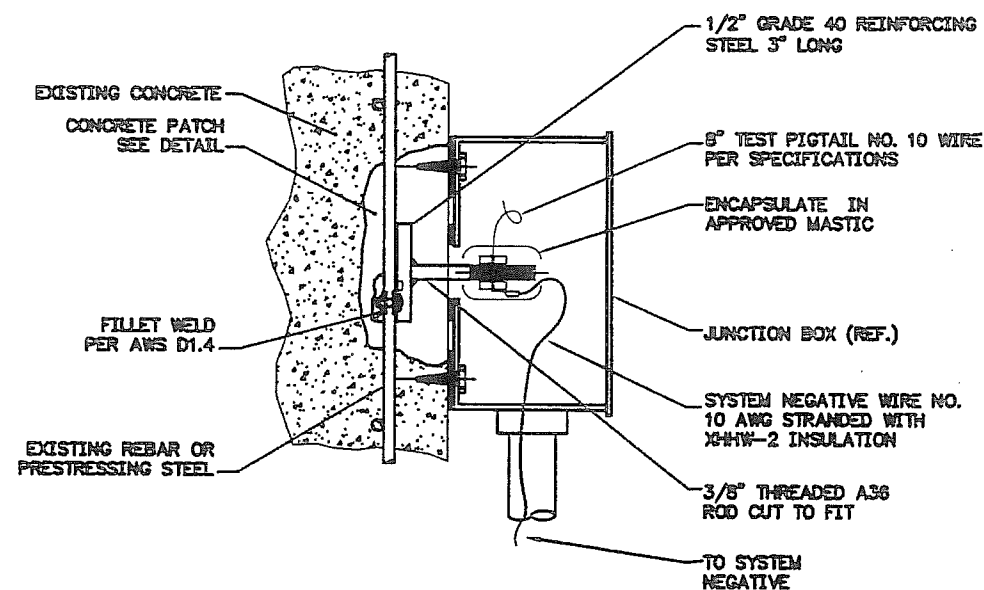

DISCONTINUOUS REBAR BOND


N.T.S.


4

NOTES:

1. BONDS TO PRESTRESSING STEEL MUST BE MECHANICAL. DO NOT USE WELDING OR EXOTHERMIC WELDING TO MAKE ELECTRICAL CONNECTIONS TO PRESTRESSING STEEL.
2. AFTER REVIEWING AS-BUILT RECORDS OF PRESTRESSED GIRDERS AND BEAMS PROVIDE SHOP DRAWINGS AND PROCEDURES THAT CLEARLY STATE HOW THE TENDONS WILL BE EXPOSED, ELECTRICAL CONNECTIONS MADE AND THE EXCAVATIONS PATCHED.
3. WHEN WELDING TO REINFORCEMENT, AWS D1.4 MUST BE FOLLOWED, SEE SPECIFICATIONS.


ELEVATIONS, BENCHMARKS AND DIMENSIONS ARE BASED ON "AS-BUILT" PLANS. VERIFY ALL CONTROLLING FIELD DIMENSIONS BEFORE ORDERING OR FABRICATING ANY MATERIAL.

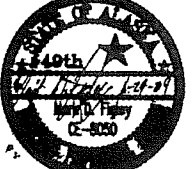DESIGNED BY: M. FIGLEY		STATE OF ALASKA DEPARTMENT OF TRANSPORTATION & PUBLIC FACILITIES STATEWIDE DESIGN & ENGINEERING SERVICES DIVISION			
		KTN-VIADUCTS REHABILITATION PROJECT NO. 68571			
		REBAR BONDING DETAILS			
CHECKED BY: G. IMBSEN DRAWN/REVISED BY: R.S., R.G.					
PATH:					
PLOT: PSPACE 1=1(F) OR MSPACE 1=1(F)		CP-5.3			
REVISIONS		PROJECT DESIGNATION		YEAR	SHEET NO.
NO.	DATE	DESCRIPTION			
		NH-0902(34)		2009	61
				TOTAL SHEETS	70

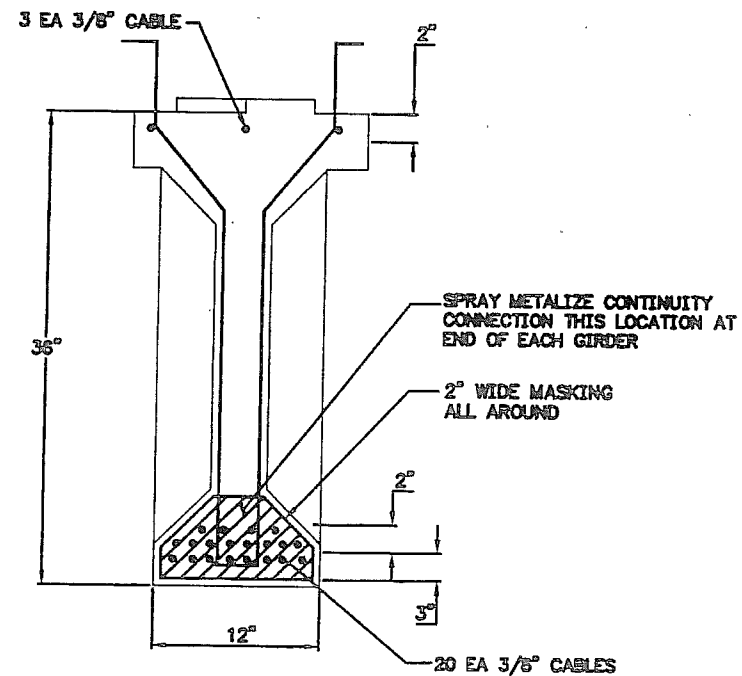


GIRDER PRESTRESS WIRE
N.T.S.

1

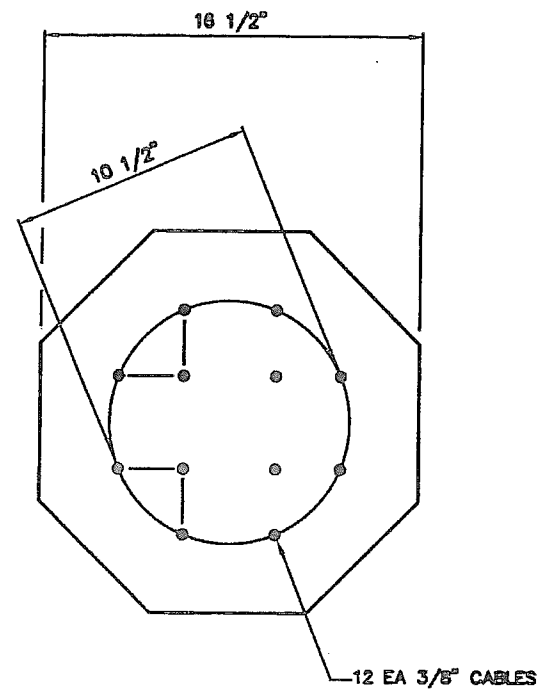

PILE PRESTRESS WIRE
N.T.S.

2

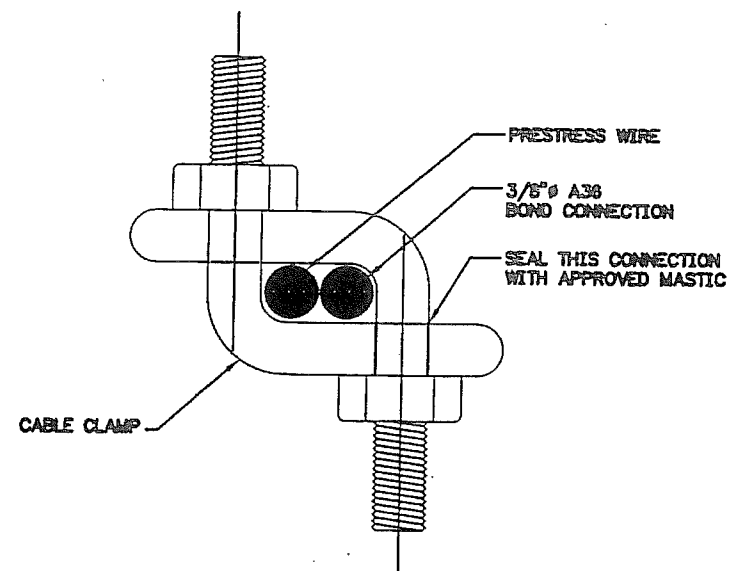

MECHANICAL CLAMP
N.T.S.


3

NOTES:

1. BONDS TO PRESTRESSING STEEL MUST BE MECHANICAL. DO NOT USE WELDING OR EXOTHERMIC WELDING TO MAKE ELECTRICAL CONNECTIONS TO PRESTRESSING STEEL.
2. THESE WIRE LAYOUTS ARE DEVELOPED FROM AS-BUILT DRAWINGS. CONFIRM LAYOUT IN THE FIELD BEFORE EXCAVATING AND MAKING ELECTRICAL CONNECTIONS.
3. NO DAMAGE TO THE PRESTRESS WIRES WILL BE TOLERATED.

ELEVATIONS, BENCHMARKS AND DIMENSIONS ARE BASED ON "AS-BUILT" PLANS. VERIFY ALL CONTROLLING FIELD DIMENSIONS BEFORE ORDERING OR FABRICATING ANY MATERIAL.

DESIGNED BY: M. FIGLEY

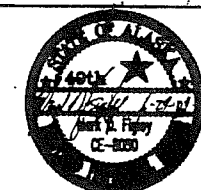

STATE OF ALASKA
DEPARTMENT OF TRANSPORTATION
& PUBLIC FACILITIES
STATEWIDE DESIGN & ENGINEERING SERVICES DIVISION
KTN-VIADUCTS
REHABILITATION
PROJECT NO. 68571


CHECKED BY: G. IMSEN
DRAWN/REVISED BY: R.S., R.G.

PRE-STRESSED WIRE

PATH:
PLOT: PSPACE 1=1(F) OR MSPACE 1=1(F)

CP-5.4

NO.	DATE	REVISIONS DESCRIPTION	PROJECT DESIGNATION	YEAR	SHEET NO.	TOTAL SHEETS
			NH-0902(34)	2009	62	70

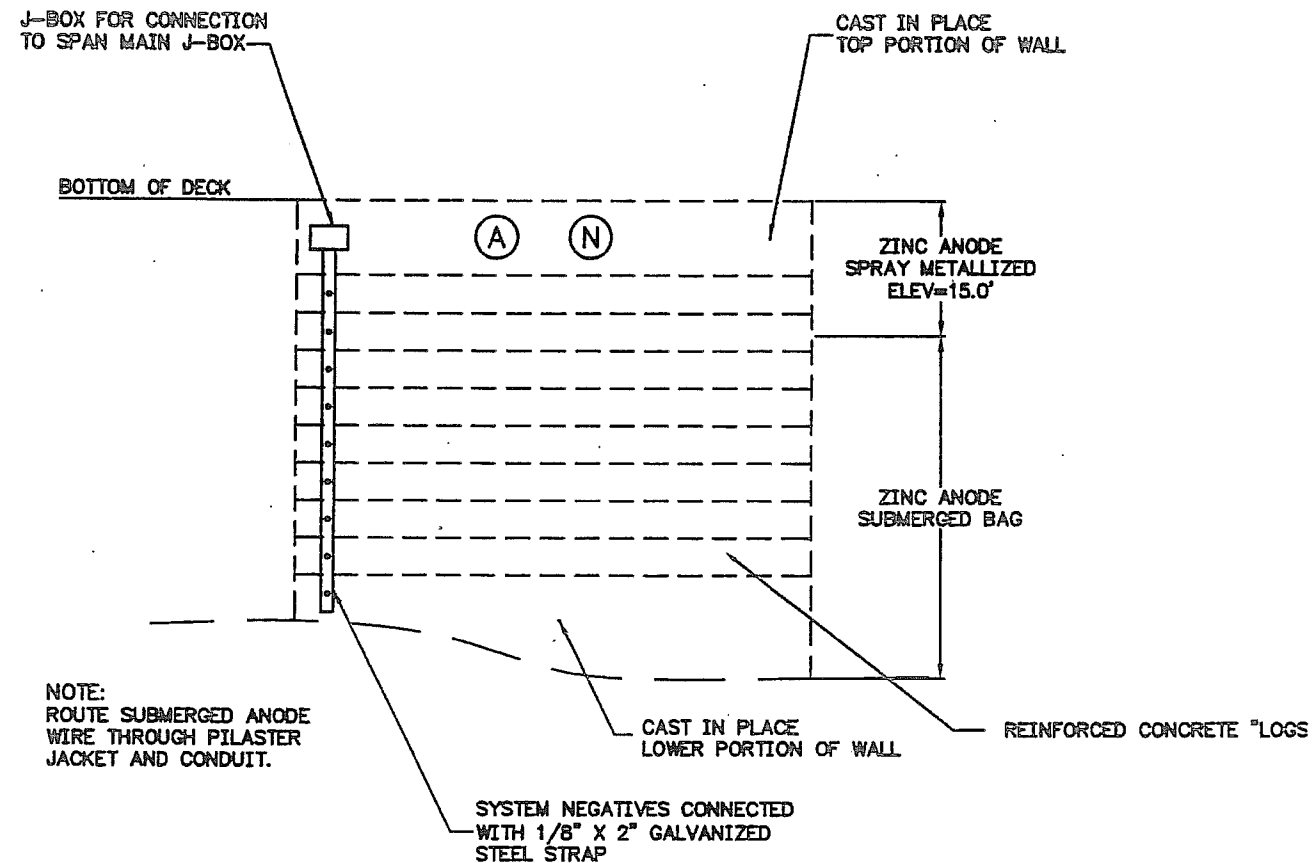


**RETAINING WALL PANEL
CATHODIC PROTECTION**
N.T.S.


2

NOTES

1. RETAINING WALL SHOWN INCLUDES REINFORCED CONCRETE "LOGS". NOT ALL RETAINING WALLS INCLUDE REINFORCED CONCRETE "LOGS".
2. RETAINING WALLS DO NOT REQUIRE REMOVAL OF NEAR SURFACE METAL.
3. WALLS WITHOUT REINFORCED CONCRETE "LOGS" WILL NOT REQUIRE 1/8"x2" GALVANIZED STEEL STRAP.
4. EACH REINFORCED CONCRETE "LOG" REQUIRES A SYSTEM NEGATIVE.
5. EACH SEPARATE PORTION OF CAST IN PLACE WALL REQUIRES A SYSTEM NEGATIVE AND PORTIONS WHICH ARE SPRAY METALLIZED REQUIRE ANODE CONNECTION.
6. SUBMERGED ANODES WILL BE CONNECTED THROUGH THE MAIN JUNCTION BOX.
7. ANODE AND SYSTEM NEGATIVE ON CAST IN PLACE PORTION ABOVE 15.0' ELEVATION WILL BE CONNECTED DIRECTLY TOGETHER; THEY WILL NOT BE CONNECTED THROUGH THE MAIN JUNCTION BOX.

ELEVATIONS, BENCHMARKS AND DIMENSIONS ARE BASED ON "AS-BUILT" PLANS. VERIFY ALL CONTROLLING FIELD DIMENSIONS BEFORE ORDERING OR FABRICATING ANY MATERIAL.

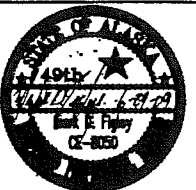DESIGNED BY: M. FIGLEY		STATE OF ALASKA DEPARTMENT OF TRANSPORTATION & PUBLIC FACILITIES STATEWIDE DESIGN & ENGINEERING SERVICES DIVISION KTN-VIADUCTS REHABILITATION PROJECT NO. 68571				
		RETAINING WALL DETAILS				
CHECKED BY: G. IMBSEN, G.D.						
DRAWN/REVISED BY: R.S., R.G.						
PATH:						
PLOT: PSPACE 1=1(F) OR WSPACE 1=1(F)		CP-5.5				
REVISIONS		PROJECT DESIGNATION		YEAR	SHEET NO.	TOTAL SHEETS
NO.	DATE	DESCRIPTION				
				NH-0902(34)	2009	63
						70

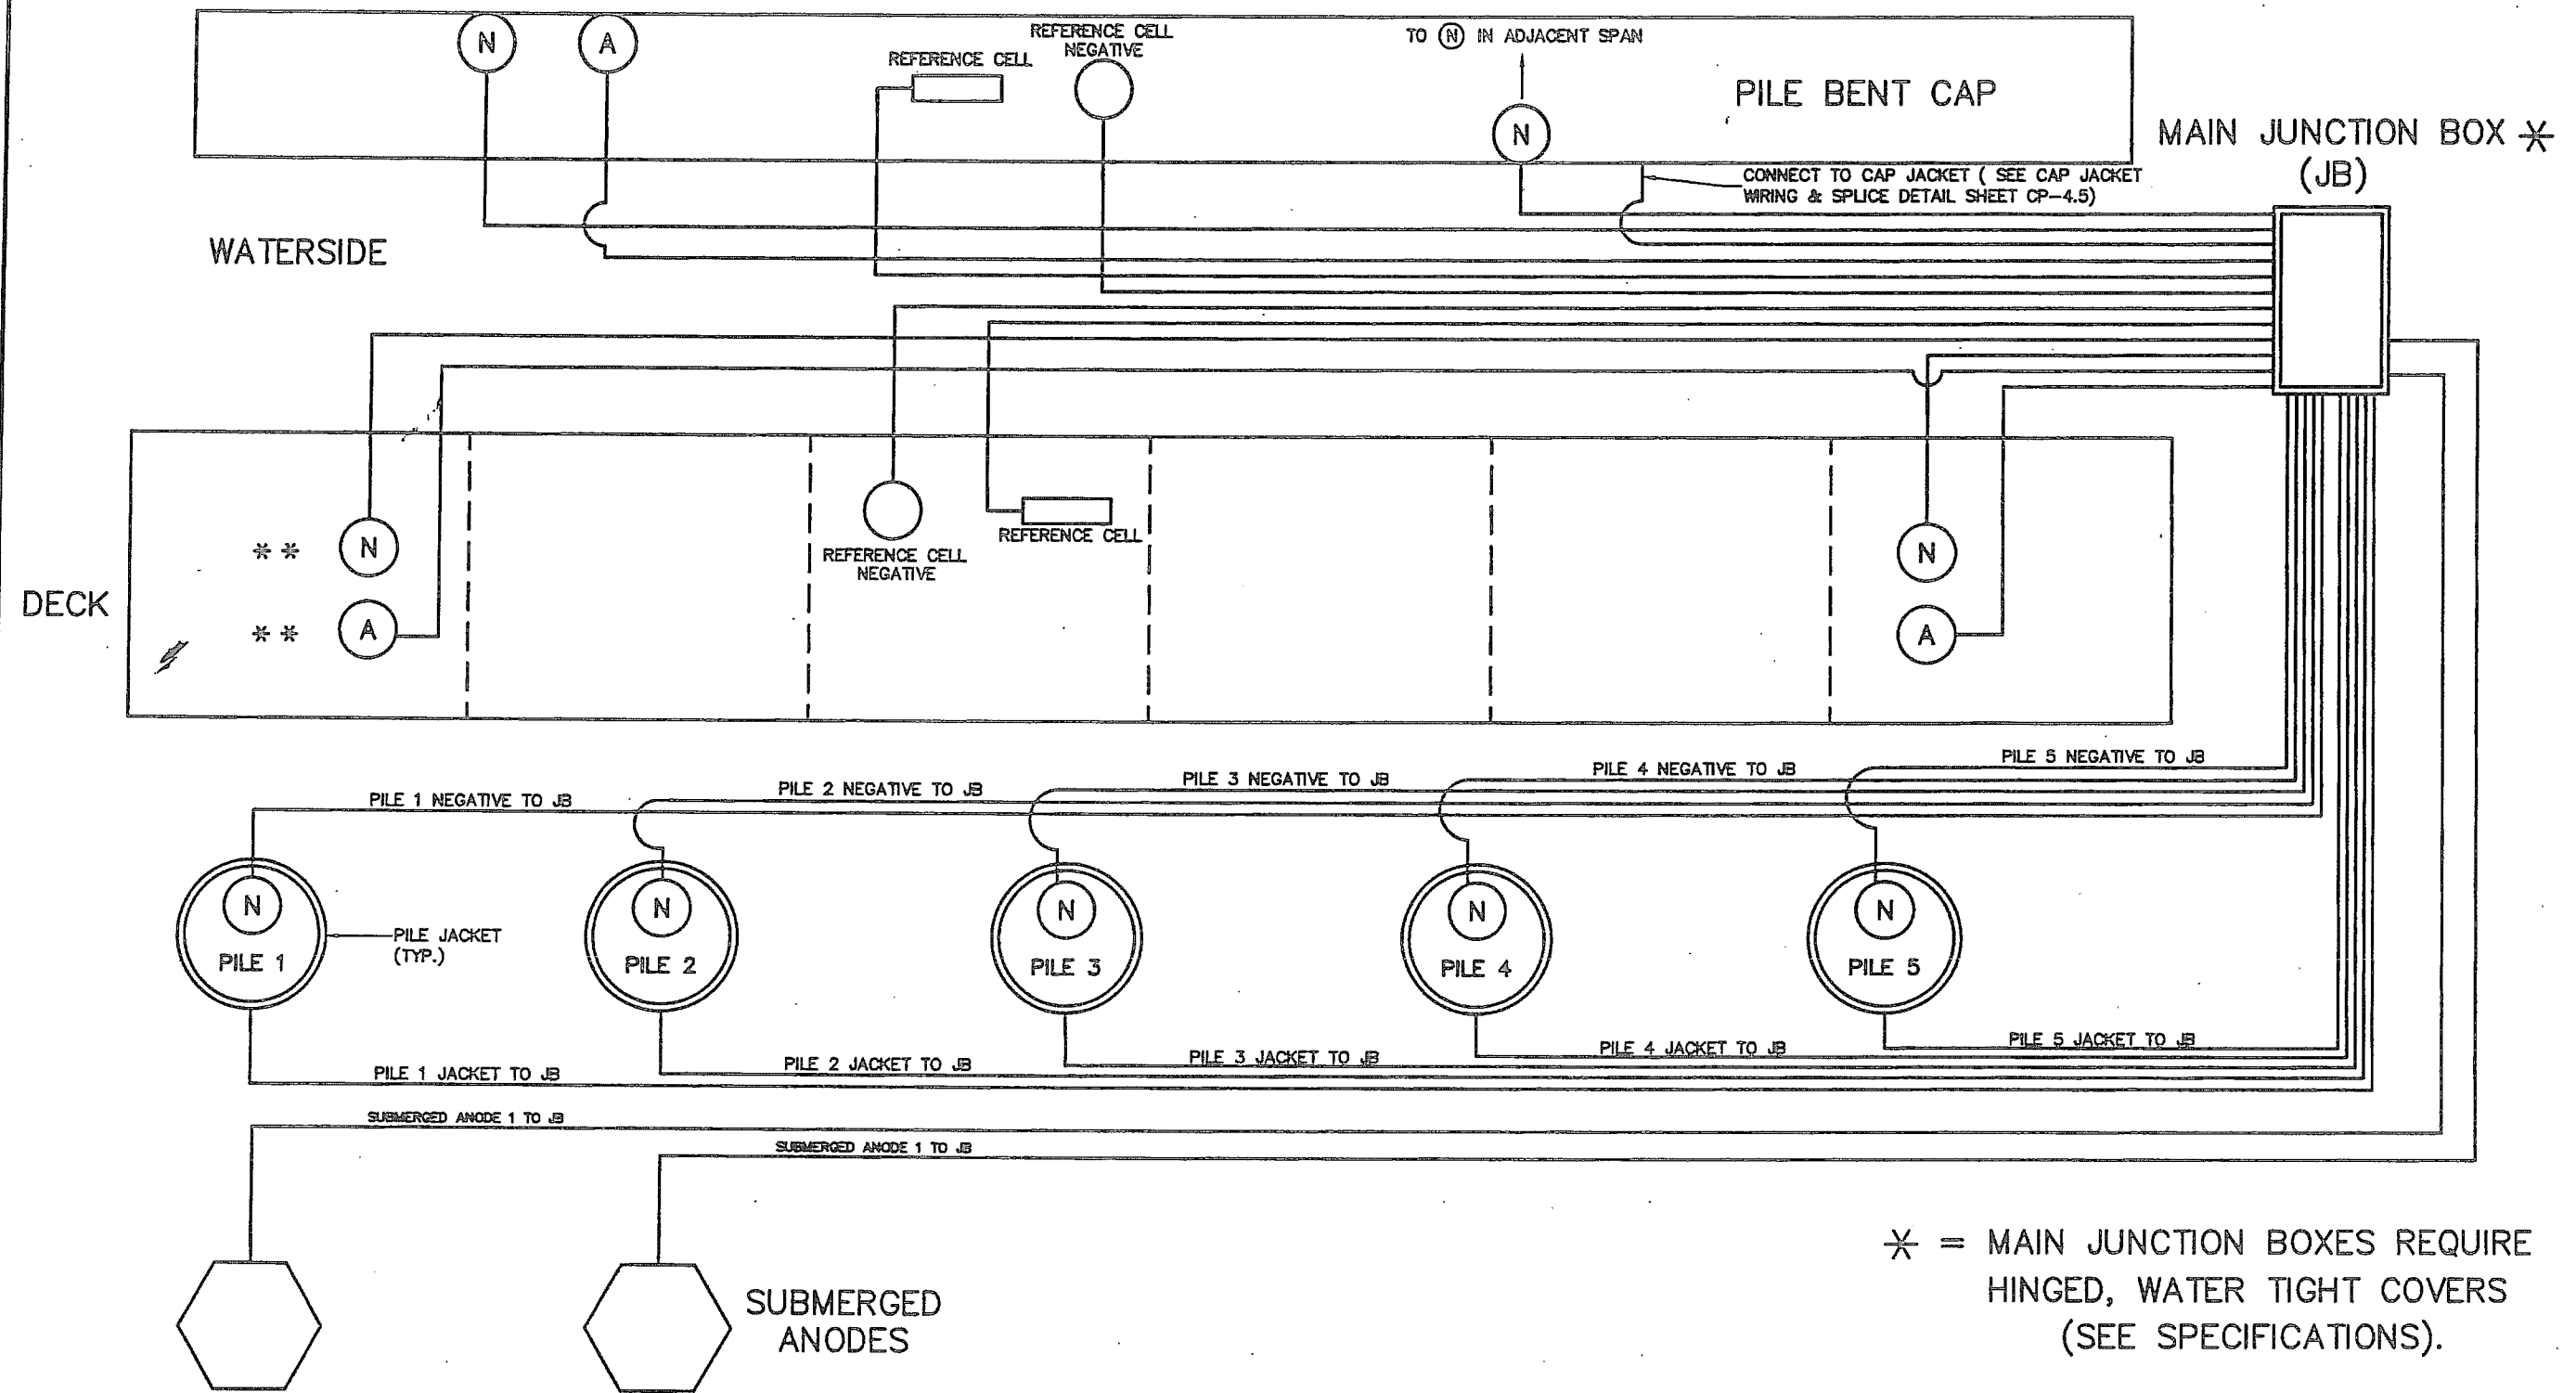

NOTE:


1. TONGASS AVENUE COULD HAVE BETWEEN 1 AND 5 PILES. THE WIRING IS SIMILAR WITH LESS ELEMENTS. SEE PLAN LAYOUT OF (N) & (A).
2. SOME SPANS WILL NOT HAVE REFERENCE CELLS.
3. JB LOCATION MUST BE APPROVED BY THE ENGINEER.

LEGEND

- (N) = SYSTEM NEGATIVE
- (A) = ANODE TERMINAL
- ** MAY BE UP TO 5 PER SPAN, OTHERS NOT SHOWN FOR CLARITY.

TONGASS AVENUE VIADUCT WIRING FOR PRESTRESSED GIRDER SPANS

DESIGNED BY: M. FIGLEY		STATE OF ALASKA DEPARTMENT OF TRANSPORTATION & PUBLIC FACILITIES STATEWIDE DESIGN & ENGINEERING SERVICES DIVISION KTN-VIADUCTS REHABILITATION PROJECT NO. 68571 Tongass Avenue Viaduct Wiring for Spans				
CHECKED BY: G. MISSEN						
DRAWN/REVISED BY: R.S., R.G.						
PATH:						
PLOT: PSPACE 1=1(F) OR MSPACE 1=1(F)		CP-6.0				
NO. DATE REVISIONS DESCRIPTION		PROJECT DESIGNATION		YEAR	SHEET NO.	TOTAL SHEETS
		NH-0902(34)		2009	64	70

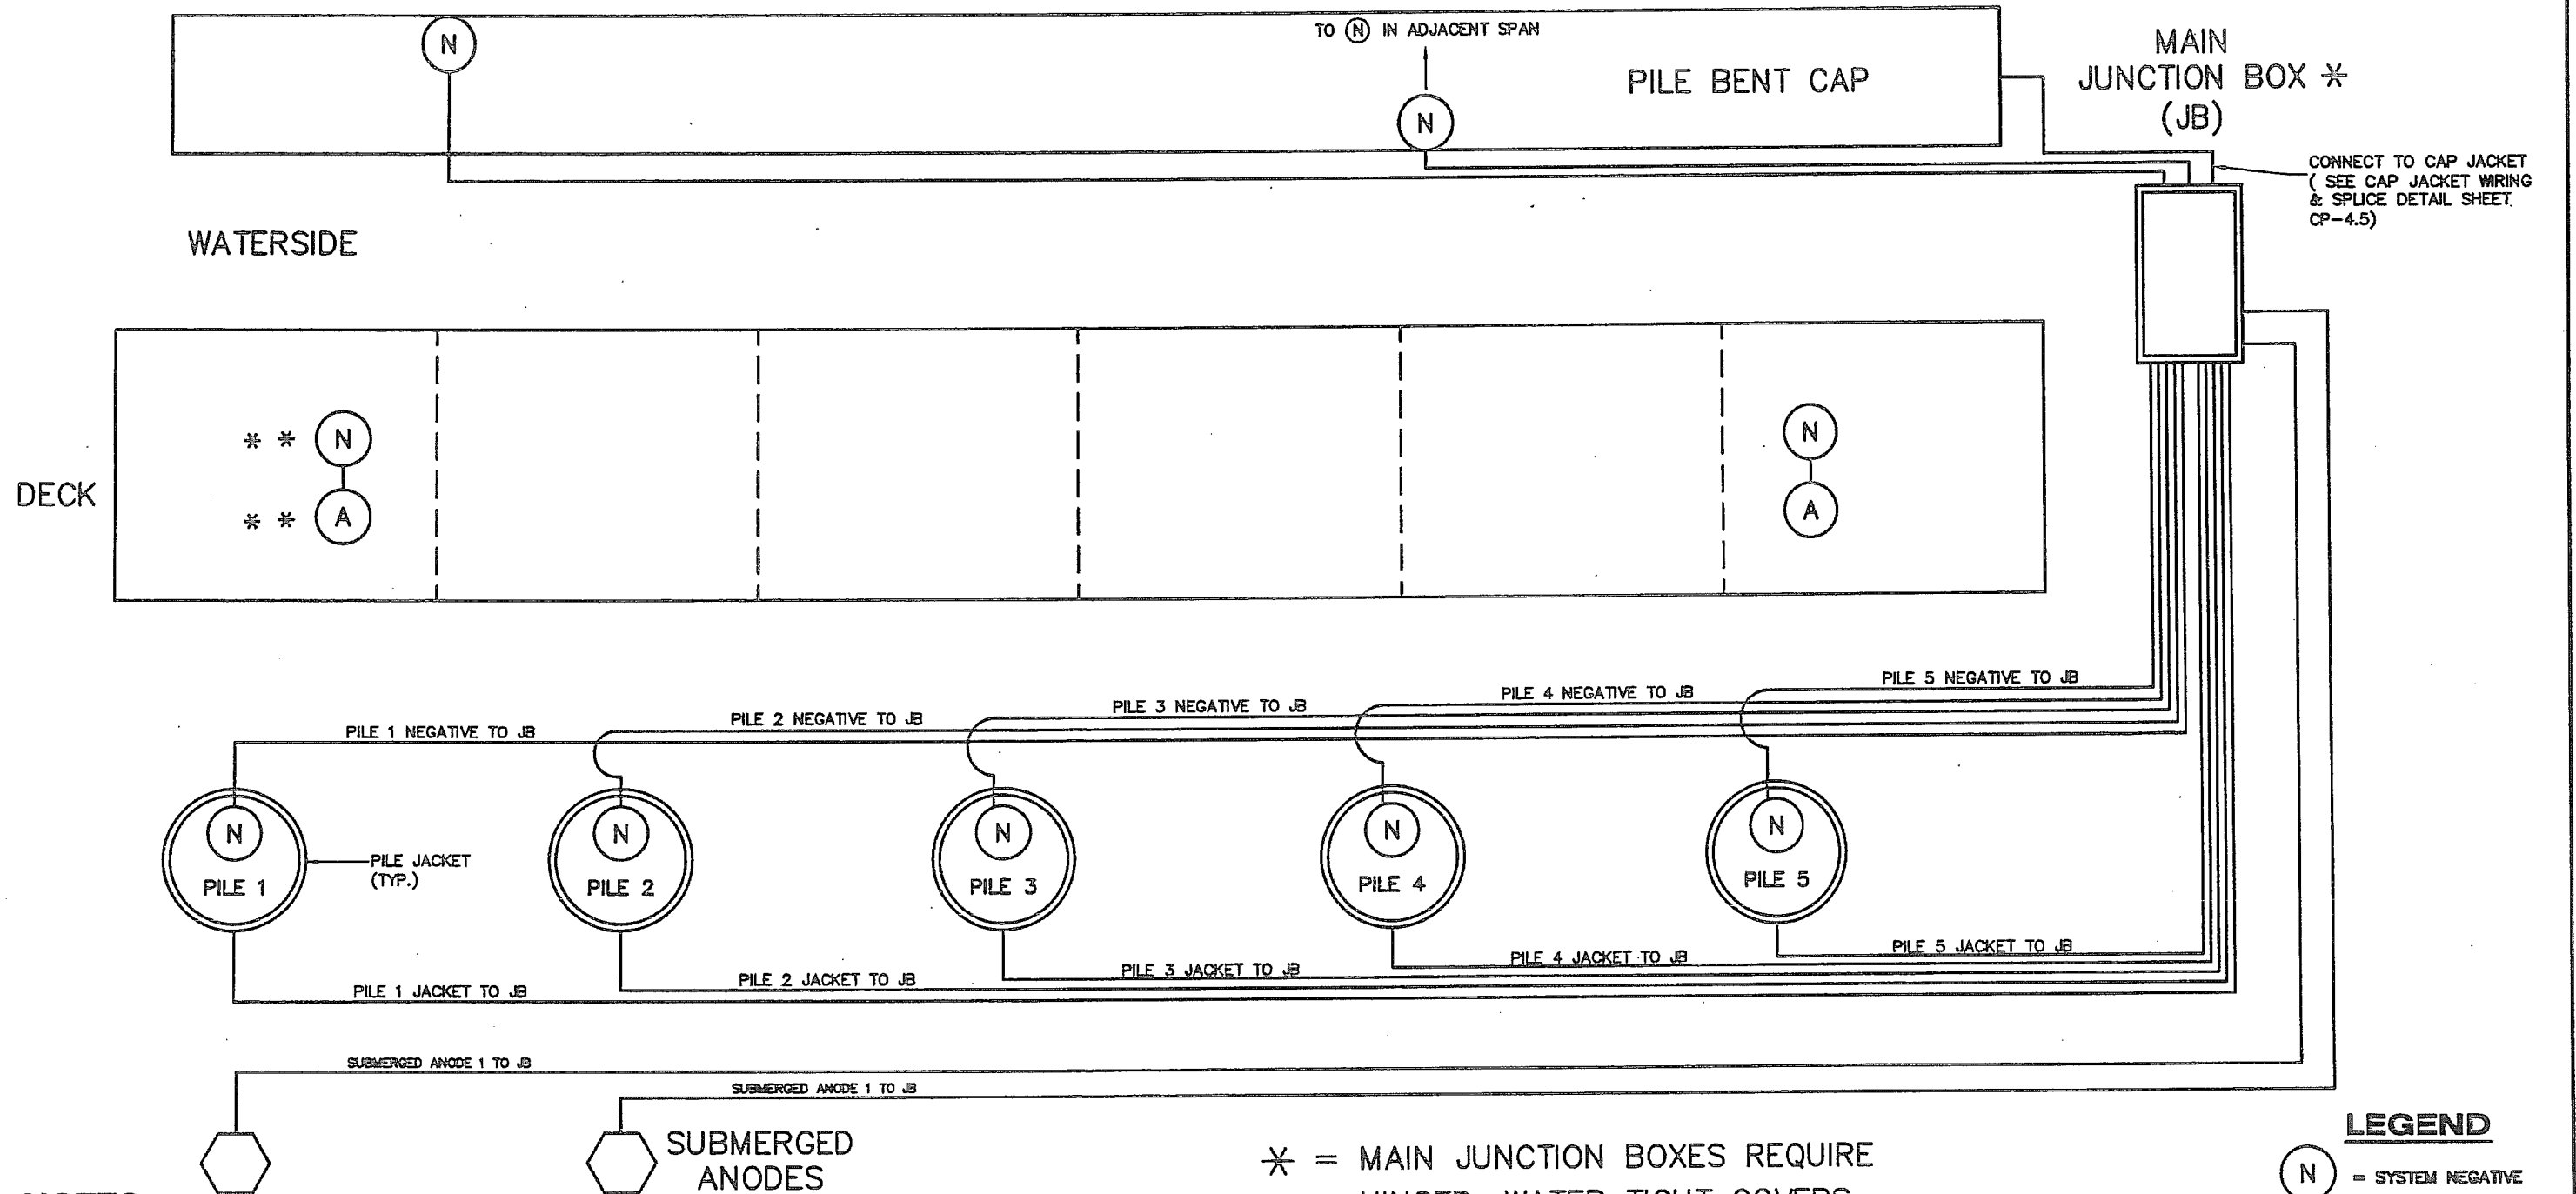


NOTES:

1. TONGASS AVENUE COULD HAVE BETWEEN 1 AND 5 PILES. THE WIRING IS SIMILAR WITH LESS ELEMENTS. SEE PLAN LAYOUT OF (N) & (A).
2. NEGATIVE ON NORTH SIDE OF CAP WILL BE BONDED TO NEAREST DECK NEGATIVE OF THE ADJACENT ZONE.
3. THIS SHEET DEPICTS THE EXISTING WIRING ON BENT/SPANS 18, 20 (BENT ONLY), 27 (BENT ONLY), AND 37 (BENT ONLY).
4. BENT/SPANS 18, 25, 28 ARE WIRED AS SHOWN ON SHEET CP 6.0.
5. PILE JACKETS AND SUBMERGED ANODES ARE NOT WIRED TO MAIN JUNCTION BOX ON BENT/SPANS 14,15 AND 16. THE ANODE/NEGATIVE CONNECTION IS MADE IN A JUNCTION BOX AT THE TOP OF EACH PILE. THESE CONNECTIONS WILL BE REWIRED TO A MAIN JUNCTION BOX AS SHOWN ON CP 6.2 UNDER ITEM 684(B) REWIRE EXISTING SPANS.
6. WIRING AND CONDUIT TO REFERENCE ELECTRODES WILL BE PRESERVED AND INCLUDED IN THE NEW JUNCTION BOXES INSTALLED IN CONJUNCTION WITH ITEM 684(B) REWIRE EXISTING SPANS.
7. SEE SHEET S-1 FOR BENT/SPAN LOCATIONS.

TONGASS AVENUE VIADUCT WIRING FOR PRESTRESSED EXISTING GIRDER SPANS WITHOUT REFERENCE CELLS

DESIGNED BY: M. FIGLEY		STATE OF ALASKA DEPARTMENT OF TRANSPORTATION & PUBLIC FACILITIES STATEWIDE DESIGN & ENGINEERING SERVICES DIVISION KTN-VIADUCTS REHABILITATION PROJECT NO. 68571			
 CHECKED BY: G. IMSEN DRAWN/REVISED BY: R.S., R.G.		Tongass Avenue Viaduct Wiring for Spans			
PATH: PLOT: PSPACE 1=1(F) OR MSPACE 1=1(F)		CP-6.1			
REVISIONS NO. DATE DESCRIPTION		PROJECT DESIGNATION	YEAR	SHEET NO.	TOTAL SHEETS
		NH-0902(34)	2009	65	70

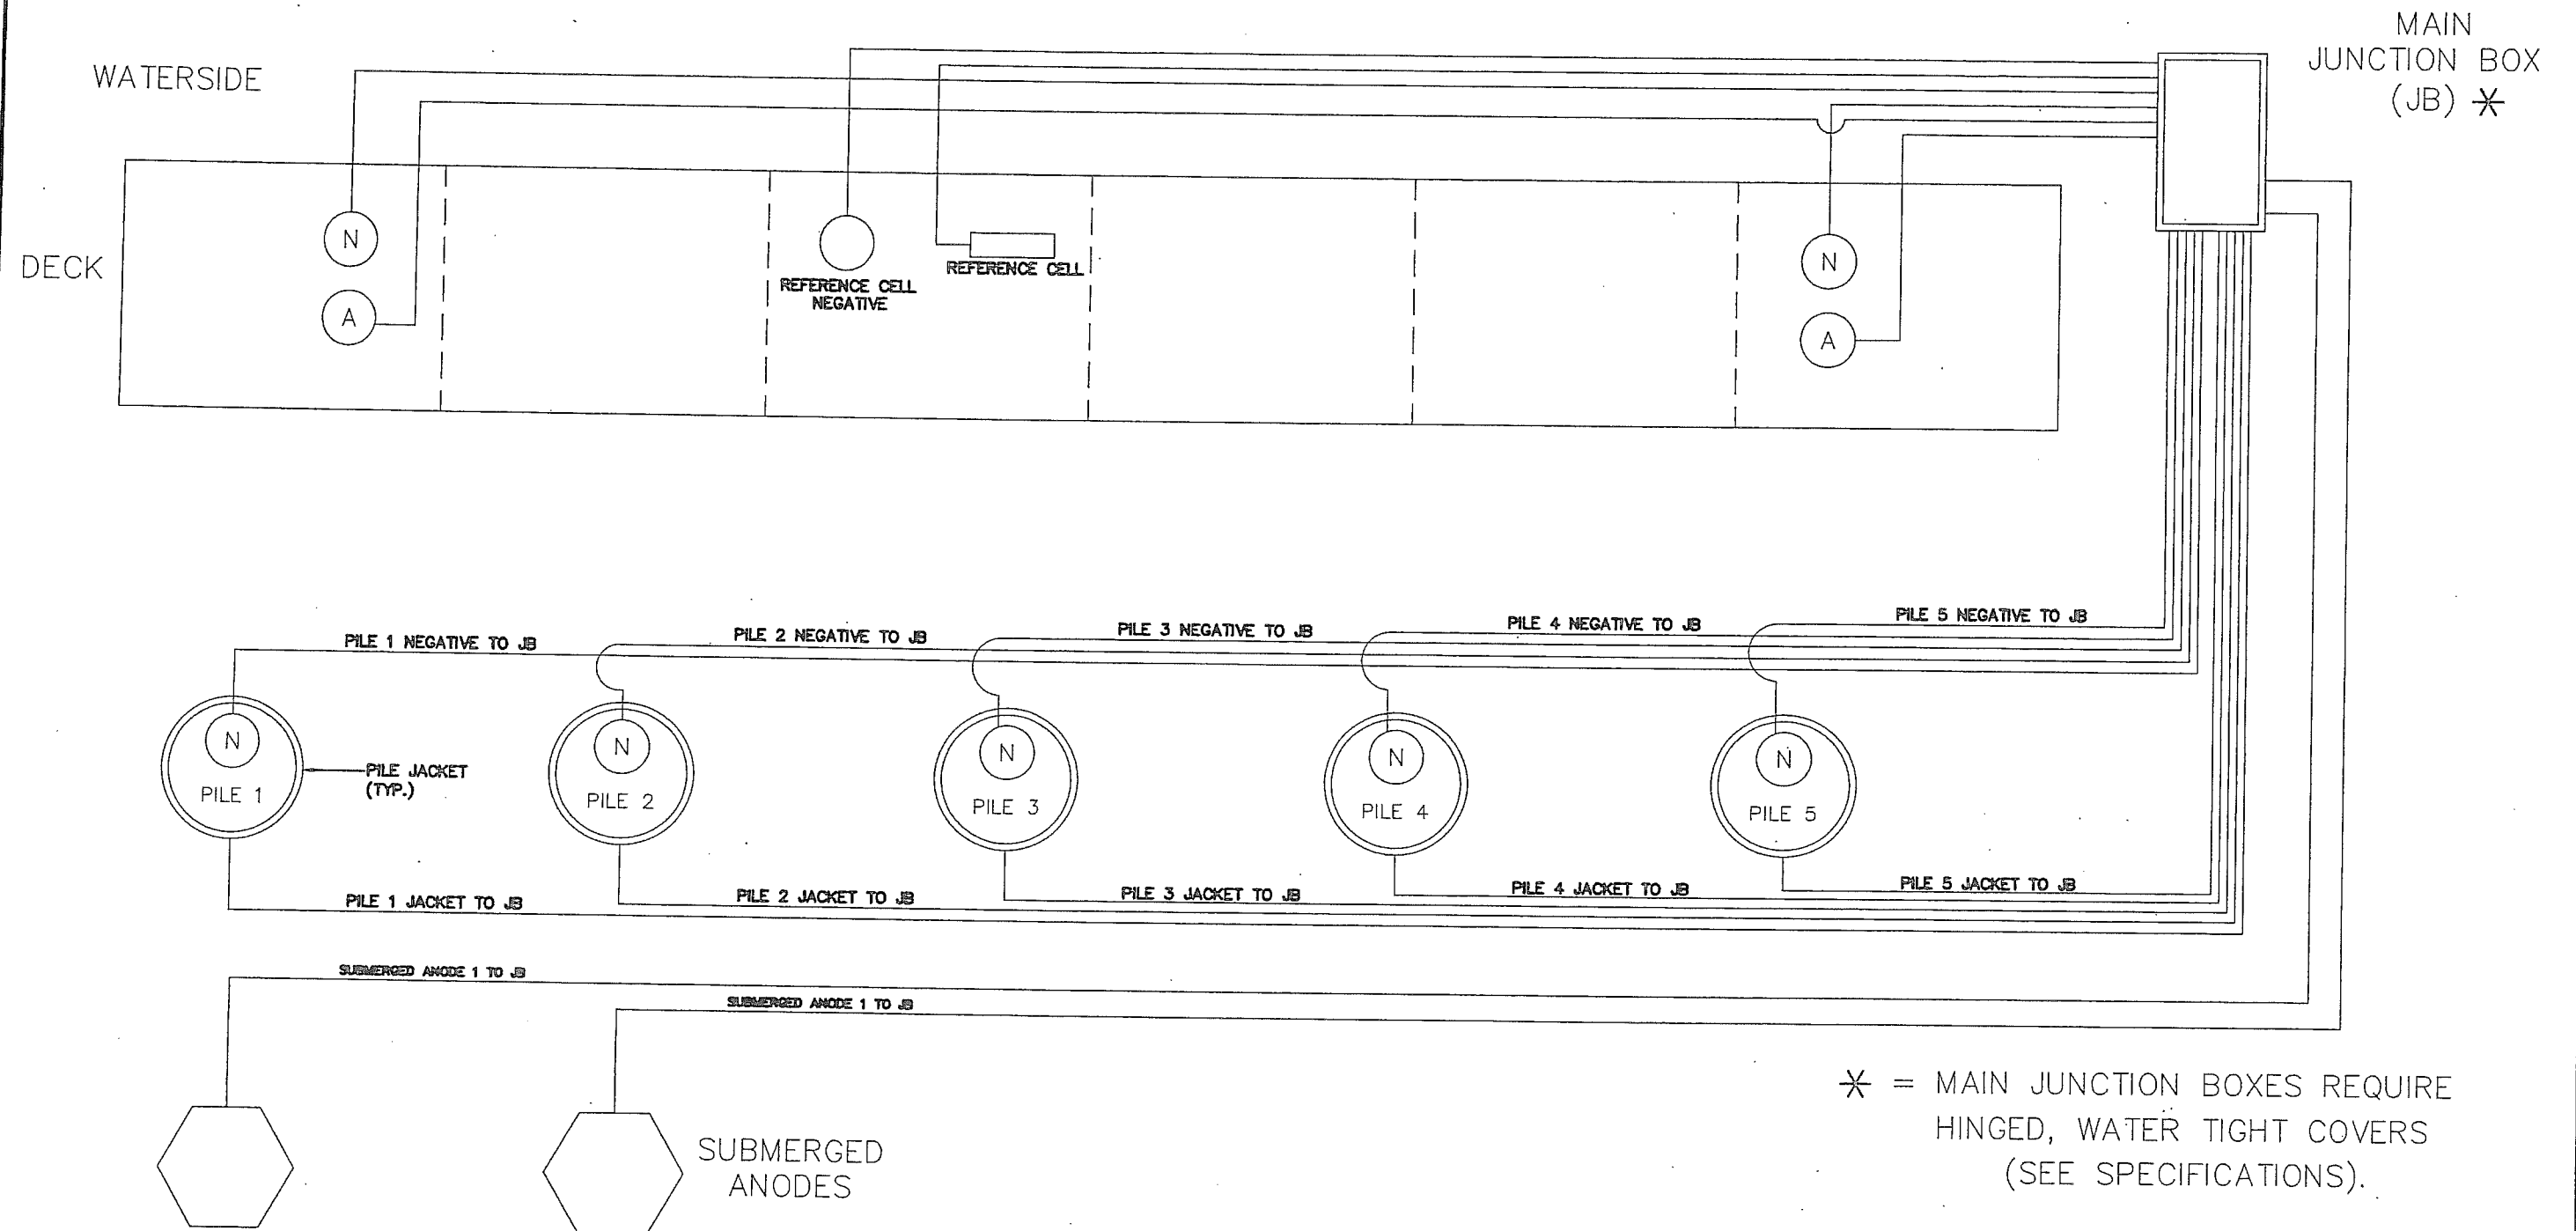

NOTE:


1. TONGASS AVENUE COULD HAVE BETWEEN 1 AND 5 PILES. THE WIRING IS SIMILAR WITH LESS ELEMENTS. SEE PLAN LAYOUT OF (N) & (A).
2. SOME SPANS WILL NOT HAVE REFERENCE CELLS.
3. JB LOCATION MUST BE APPROVED BY THE ENGINEER.

LEGEND

- (N) = SYSTEM NEGATIVE
- (A) = ANODE TERMINAL

TONGASS AVENUE VIADUCT WIRING FOR FLAT SPANS

DESIGNED BY: M. FIGLEY		STATE OF ALASKA DEPARTMENT OF TRANSPORTATION & PUBLIC FACILITIES STATEWIDE DESIGN & ENGINEERING SERVICES DIVISION KTN-VIADUCTS REHABILITATION PROJECT NO. 68571			
CHECKED BY: G. IMBSEN DRAWN/REVISED BY: R.S., R.G.		Tongass Avenue Viaduct Wiring for Spans			
PATH: PLOT: PSPACE 1=1(F) OR MSPACE 1=1(F)		CP-6.2			
REVISIONS		PROJECT DESIGNATION		YEAR	SHEET NO.
NO.	DATE	DESCRIPTION			
		NH-0902(34)		2009	66
				TOTAL SHEETS	70

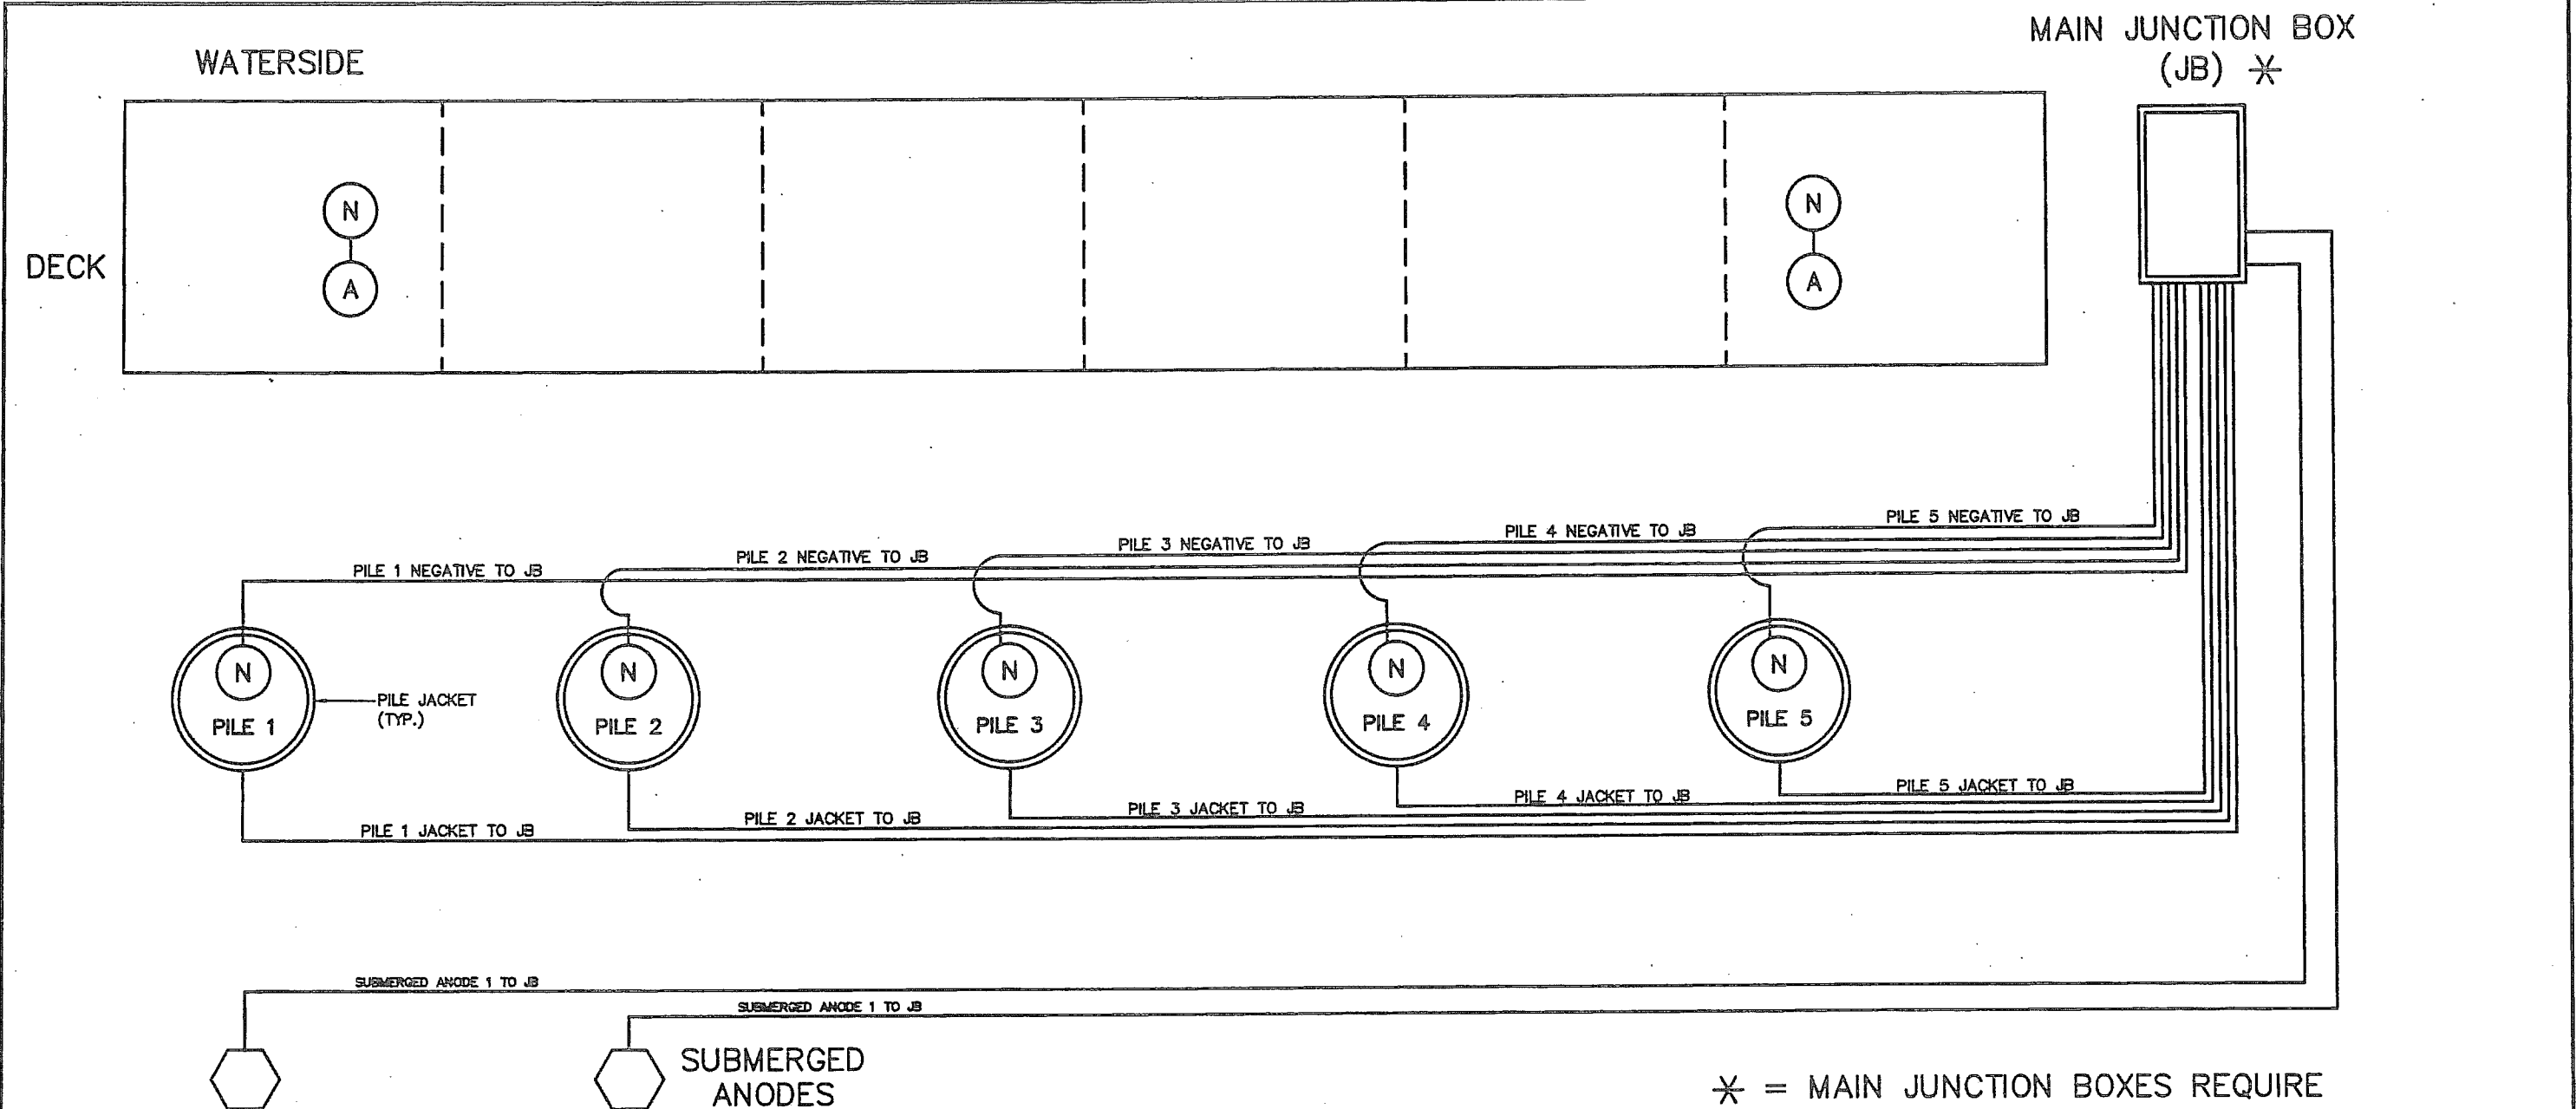

1. **NOTES:**

- TONGASS AVENUE COULD HAVE BETWEEN 1 AND 5 PILES. THE WIRING IS SIMILAR WITH LESS ELEMENTS. SEE PLAN LAYOUT OF (N) & (A).
- NEGATIVE ON NORTH SIDE OF CAP WILL BE BONDED TO NEAREST DECK NEGATIVE OF THE ADJACENT ZONE.
- THIS SHEET DEPICTS THE EXISTING WIRING ON BENT/SPANS 20, 21, 23, 24, 27, 28, 31, 32, 33, 34, 35, AND 36.
- BENT/SPANS 22, 29, 30 ARE WIRED AS SHOWN ON SHEET CP 6.2.
- PILE JACKETS AND SUBMERGED ANODES ARE NOT WIRED TO A MAIN JUNCTION BOX ON BENT/SPANS 14, 15 AND 16. THE ANODE/NEGATIVE CONNECTION IS MADE IN A JUNCTION BOX AT THE TOP OF EACH PILE. THESE CONNECTIONS WILL BE REWIRED TO A MAIN JUNCTION BOX AS SHOWN ON CP 6.2 UNDER ITEM 684(B) REWIRE EXISTING SPANS.
- WIRING AND CONDUIT TO REFERENCE ELECTRODES WILL BE PRESERVED AND INCLUDED IN THE NEW JUNCTION BOXES INSTALLED IN CONJUNCTION WITH ITEM 684(B) REWIRE EXISTING SPANS.
- SEE SHEET S-1.1 FOR BENT/SPAN LOCATIONS.

TONGASS AVE. EXISTING REFERENCE CELL LOCATIONS		
J-BOX LOCATION BENT	NUMBER OF ELECTRODES IN TEST STATION	REFERENCE ELECTRODES LOCATED
13	1	SPAN 12, DECK CELL 1B
15	1	SPAN 14, DECK
19	3	SPAN 19 DECK CELL 5B, GIRDER 5 EAST FACE, CAP 19 SOUTH FACE
22	1	SPAN 22, DECK WEST SIDE
28	2	SPAN 25, DECK CELL 1A, SPAN 28 DECK CELL 8C.
29	1	SPAN 29, DECK
30	2	CAP 30 NORTH FACE, CAP 31 SOUTH FACE.
34	1	SPAN 34, DECK


**TONGASS AVENUE
VIADUCT WIRING FOR FLAT EXISTING SPANS
WITHOUT REFERENCE CELLS**

* = MAIN JUNCTION BOXES REQUIRE HINGED, WATER TIGHT COVERS (SEE SPECIFICATIONS).

LEGEND

- (N) = SYSTEM NEGATIVE
(A) = ANODE TERMINAL

DESIGNED BY: M. FIGLEY	STATE OF ALASKA DEPARTMENT OF TRANSPORTATION & PUBLIC FACILITIES STATEWIDE DESIGN & ENGINEERING SERVICES DIVISION			
	KTN-VIADUCTS REHABILITATION PROJECT NO. 68571 Tongass Avenue Viaduct Existing Wiring for Spans			
	CHECKED BY: G. MENSEN DRAWN/REVISED BY: R.S., R.G.			
PATH: PLOT: PSPACE 1=1(F) OR MSPACE 1=5(F)		CP-6.3		
NO. DATE REVISIONS DESCRIPTION		PROJECT DESIGNATION	YEAR	SHEET NO.
		NH-0902(34)	2009	67
				TOTAL SHEETS 70

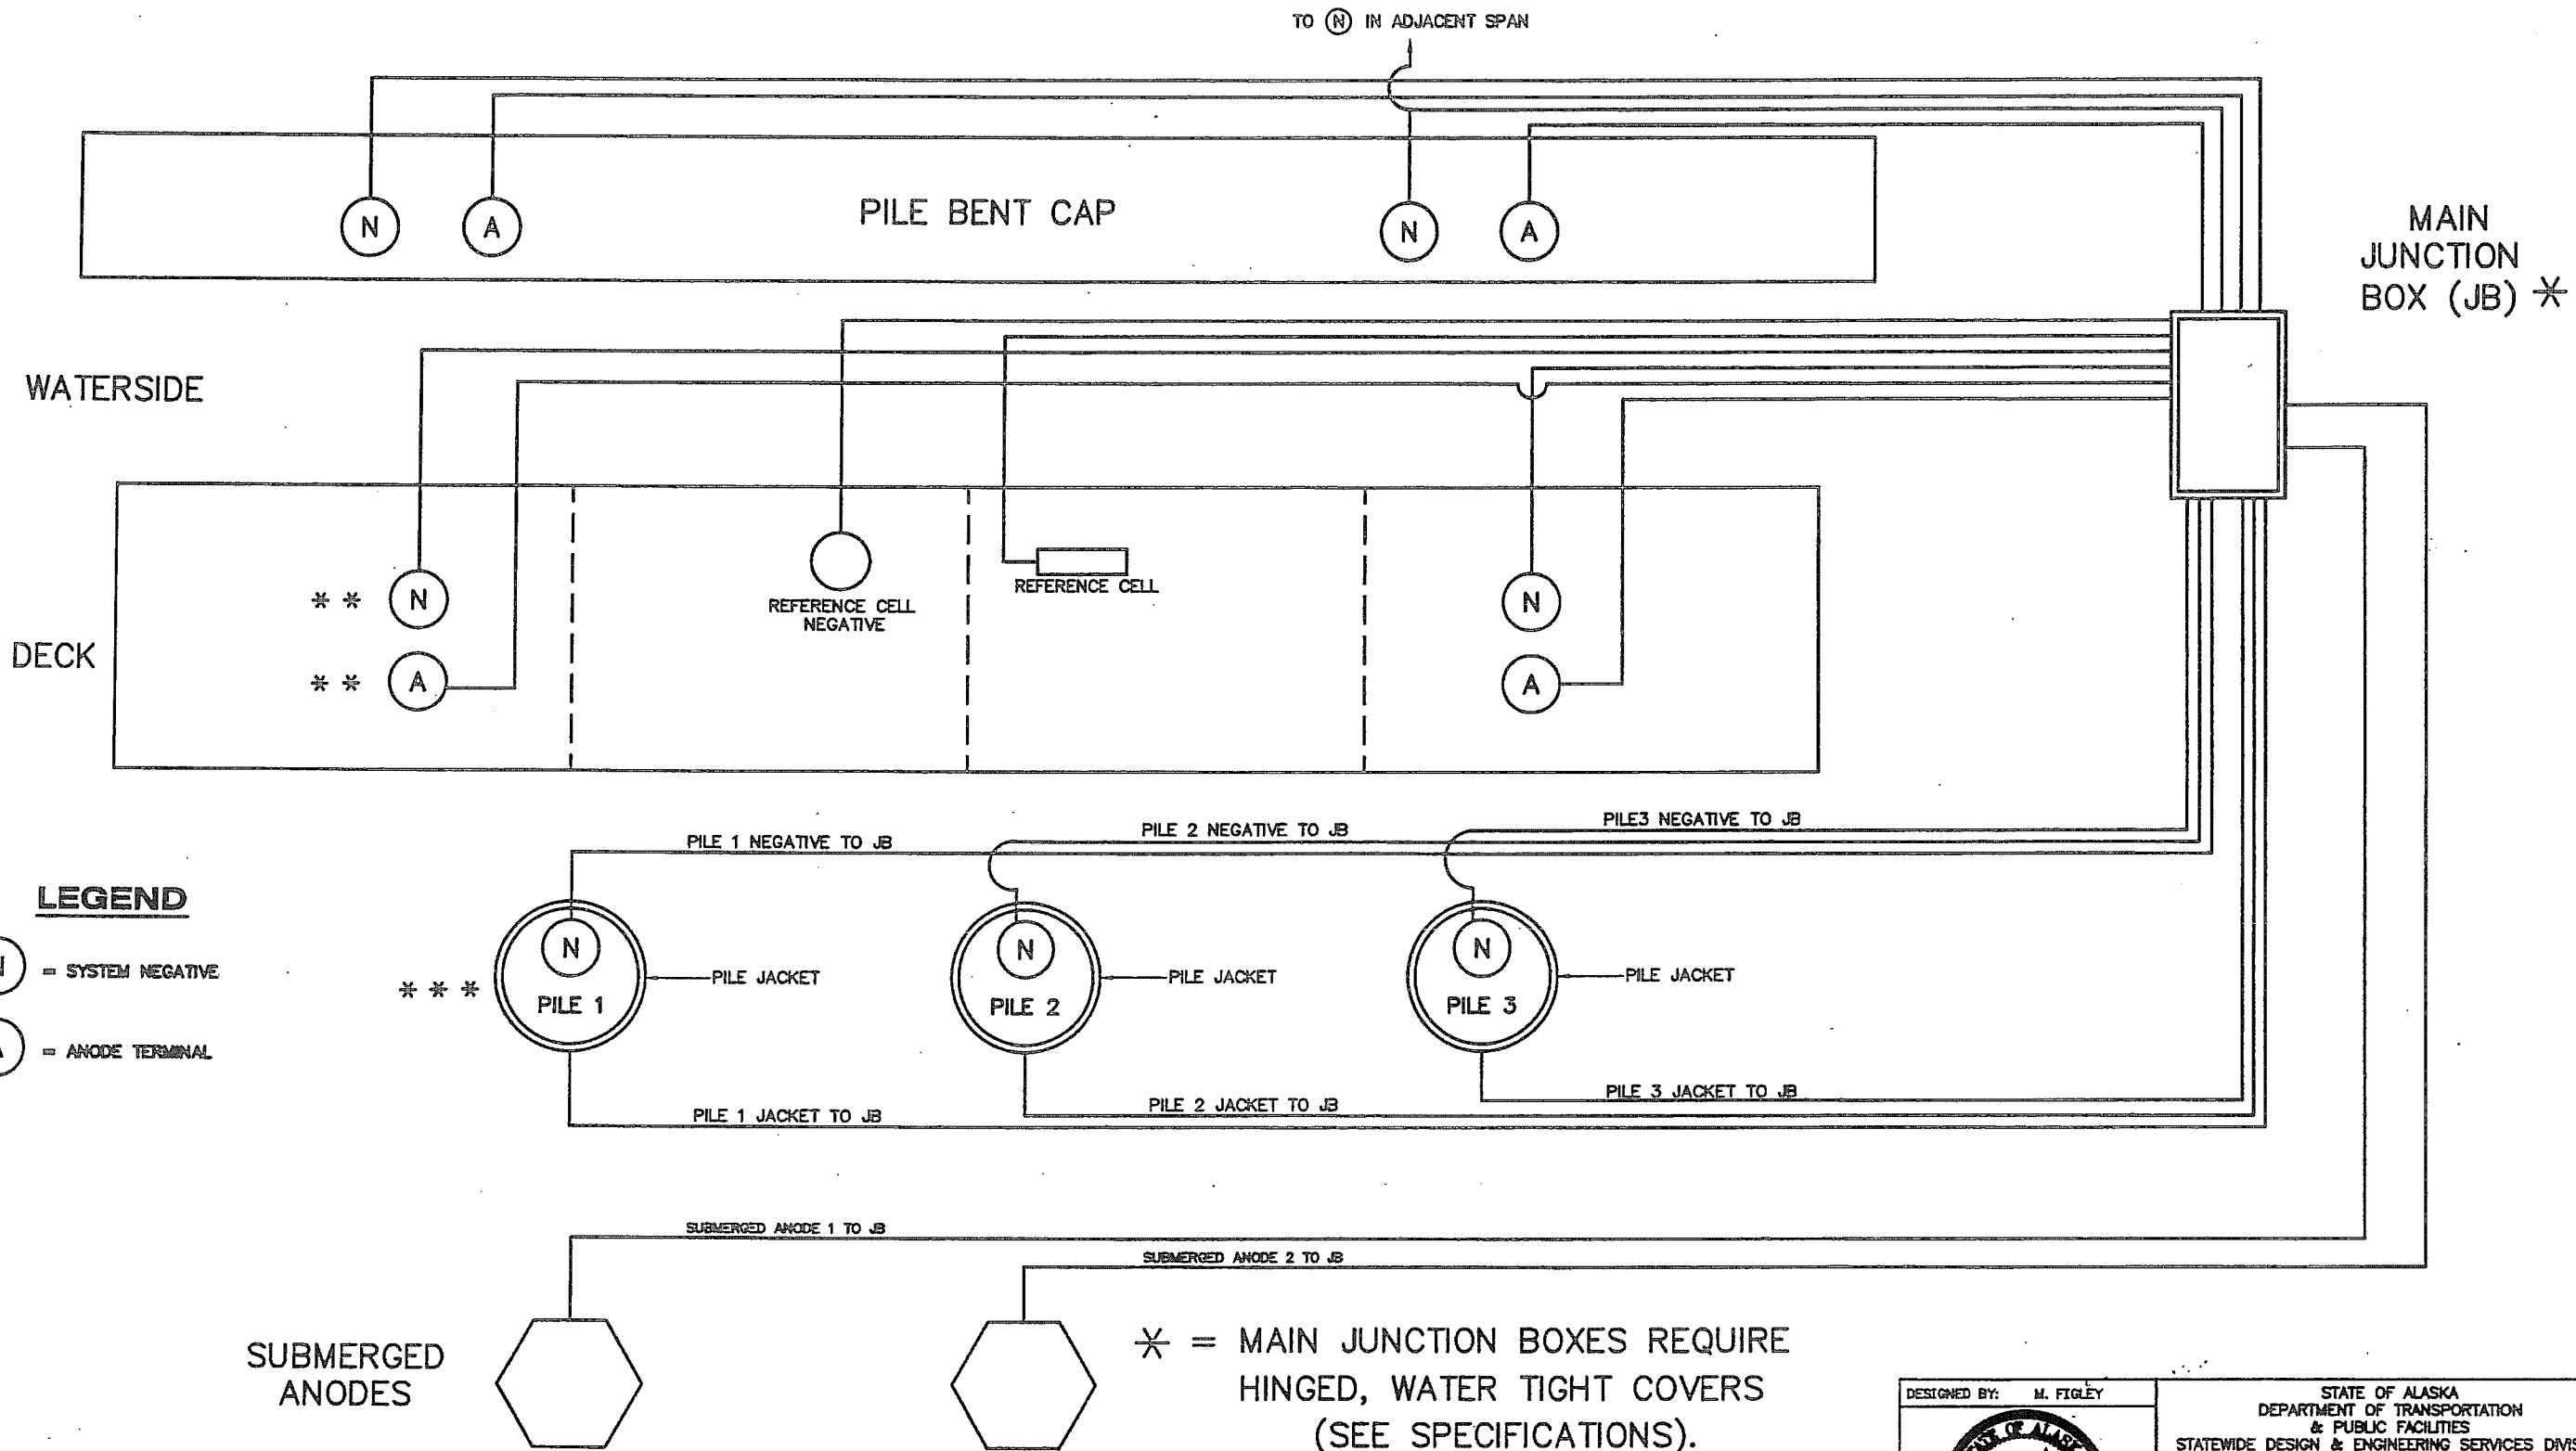

LEGEND

- (N) = SYSTEM NEGATIVE
(A) = ANODE TERMINAL

NOTES:

1. WIRING IS THE SAME ON NARROWER SPANS. THERE IS JUST ONE LESS PILE AND ONE LESS SET OF (N) & (A) IN THE SPAN. SEE PLAN LAYOUT OF (N) & (A).
2. REFERENCE CELL MAY BE LOCATED IN PILES OR CAPS. WIRING WILL BE SIMILAR.
3. SOME SPANS WILL NOT HAVE CORNER CELLS.
4. JB LOCATION MUST BE APPROVED BY THE ENGINEER.

- ** MAY BE UP TO 4 PER SPAN, OTHERS NOT SHOWN FOR CLARITY.
*** MAY BE UP TO 5 PER SPAN, OTHERS NOT SHOWN FOR CLARITY.


**WATER STREET
VIADUCT WIRING FOR SPANS**

DESIGNED BY: M. FIGLEY		STATE OF ALASKA DEPARTMENT OF TRANSPORTATION & PUBLIC FACILITIES STATEWIDE DESIGN & ENGINEERING SERVICES DIVISION KTN-VIADUCTS REHABILITATION PROJECT NO. 68571			
CHECKED BY: G. MBSSEN		Water Street Viaduct Wiring for Spans			
DRAWN/REVISED BY: R.S., R.G.		CP-6.4			
PATH: PLOT: PSPACE 1=1(F) OR MSPACE 1=1(F)		PROJECT DESIGNATION NH-0902(34)		YEAR 2009	TOTAL SHEETS 70
NO.	DATE	REVISIONS DESCRIPTION			

WATERSIDE

DECK

MAIN JUNCTION BOX
(JB) ✕

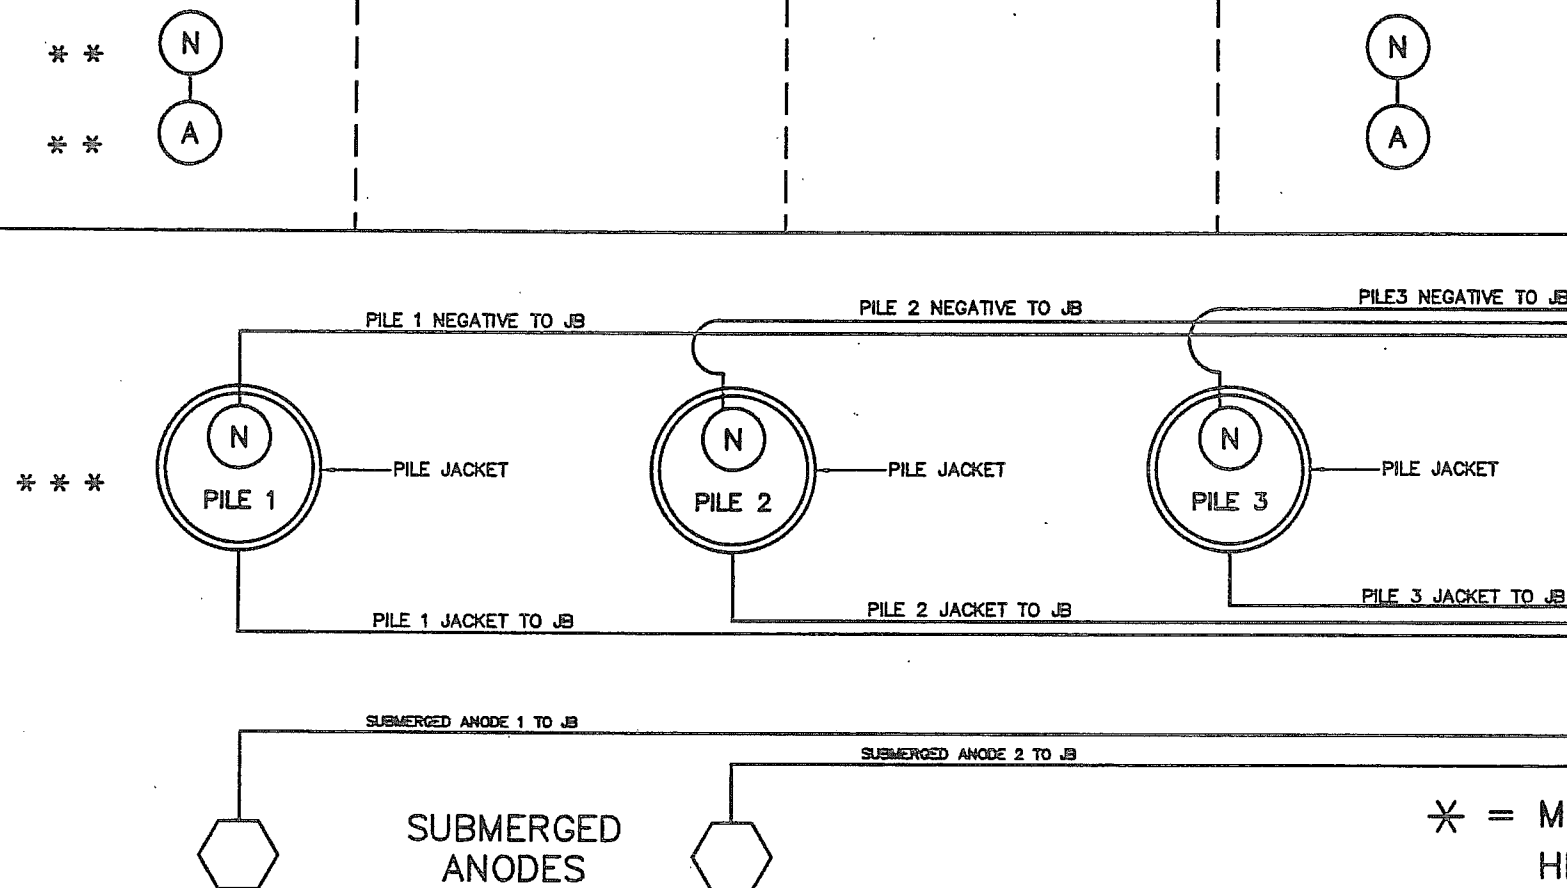

✕ = MAIN JUNCTION BOXES REQUIRE
HINGED, WATER TIGHT COVERS
(SEE SPECIFICATIONS).

LEGEND

(N) = SYSTEM NEGATIVE
(A) = ANODE TERMINAL

NOTES:


1. WIRING IS THE SAME ON NARROWER SPANS, THERE IS JUST ONE LESS PILE AND ONE LESS SET OF (N) & (A) IN THE SPAN. SEE PLAN LAYOUT OF (N) & (A).
2. EXISTING WIRING ON WATER STREET WITH REFERENCE CELLS ARE WIRED AS SHOWN ON SHEET CP 6.4
3. THIS SHEET DEPICTS THE EXISTING WIRING ON BENT/SPANS 24-27, 30, 31, 32, 34, 35, 37-41, 43-53, 55-60, 62, 64 (BENT ONLY).
4. THE WIRING ON BENT/SPANS 28, 32, 36, 42, 54 AND 61 IS AS SHOWN ON SHEET CP 6.4.
5. PILE JACKETS AND SUBMERGED ANODES ARE NOT WIRED TO A MAIN JUNCTION BOX ON BENT/SPANS 14, 15 AND 16. THE ANODE/NEGATIVE CONNECTION IS MADE IN A JUNCTION BOX AT THE TOP OF EACH PILE. THESE CONNECTIONS WILL BE REWIRED TO A MAIN JUNCTION BOX AS SHOWN ON CP 6.2 UNDER ITEM 684(8) REWIRE EXISTING SPANS.
6. WIRING AND CONDUIT TO REFERENCE ELECTRODES WILL BE PRESERVED AND INCLUDED IN THE NEW JUNCTION BOXES INSTALLED UNDER ITEM 684(8) REWIRE EXISTING SPANS.
7. SEE SHEET S-1.1 FOR BENT/SPAN LOCATIONS.




**WATER STREET VIADUCT EXISTING
REFERENCE CELL LOCATIONS**

J-BOX LOCATION BENT	NUMBER OF ELECTRODES IN TEST STATION	REFERENCE ELECTRODES LOCATED
27	2	BENT 27, PILE NO. 1 AND PILE STRUT
29	2	SPAN 28, DECK, CAP 29 WEST
33	2	SPAN 32, BEAM 3 EAST FACE, SPAN 32 EAST SIDEWALK
36	1	SPAN 36, DECK BAY 6
42	1	SPAN 42, BEAM 3 EAST FACE
54	1	SPAN 54, BEAM 3 EAST FACE
61	2	SPAN 61, DECK AND WALL ADJACENT TO SPAN 61

**WATER STREET
VIADUCT WIRING ON EXISTING SPANS
WITHOUT REFERENCE CELLS**


DESIGNED BY: M. FIOLEY	STATE OF ALASKA DEPARTMENT OF TRANSPORTATION & PUBLIC FACILITIES STATEWIDE DESIGN & ENGINEERING SERVICES DIVISION KTN-VIADUCTS REHABILITATION PROJECT NO. 68571
	Water Street Existing Wiring for Spans
CHECKED BY: G. IMBSEN DRAWN/REVISED BY: R.S., R.G.	CP-6.5
PATH: PLOT: PSPACE 1=1(F) OR WSPACE 1=1(F)	PROJECT DESIGNATION NH-0902(34)
NO. DATE REVISIONS DESCRIPTION	YEAR SHEET TOTAL 2009 69 70

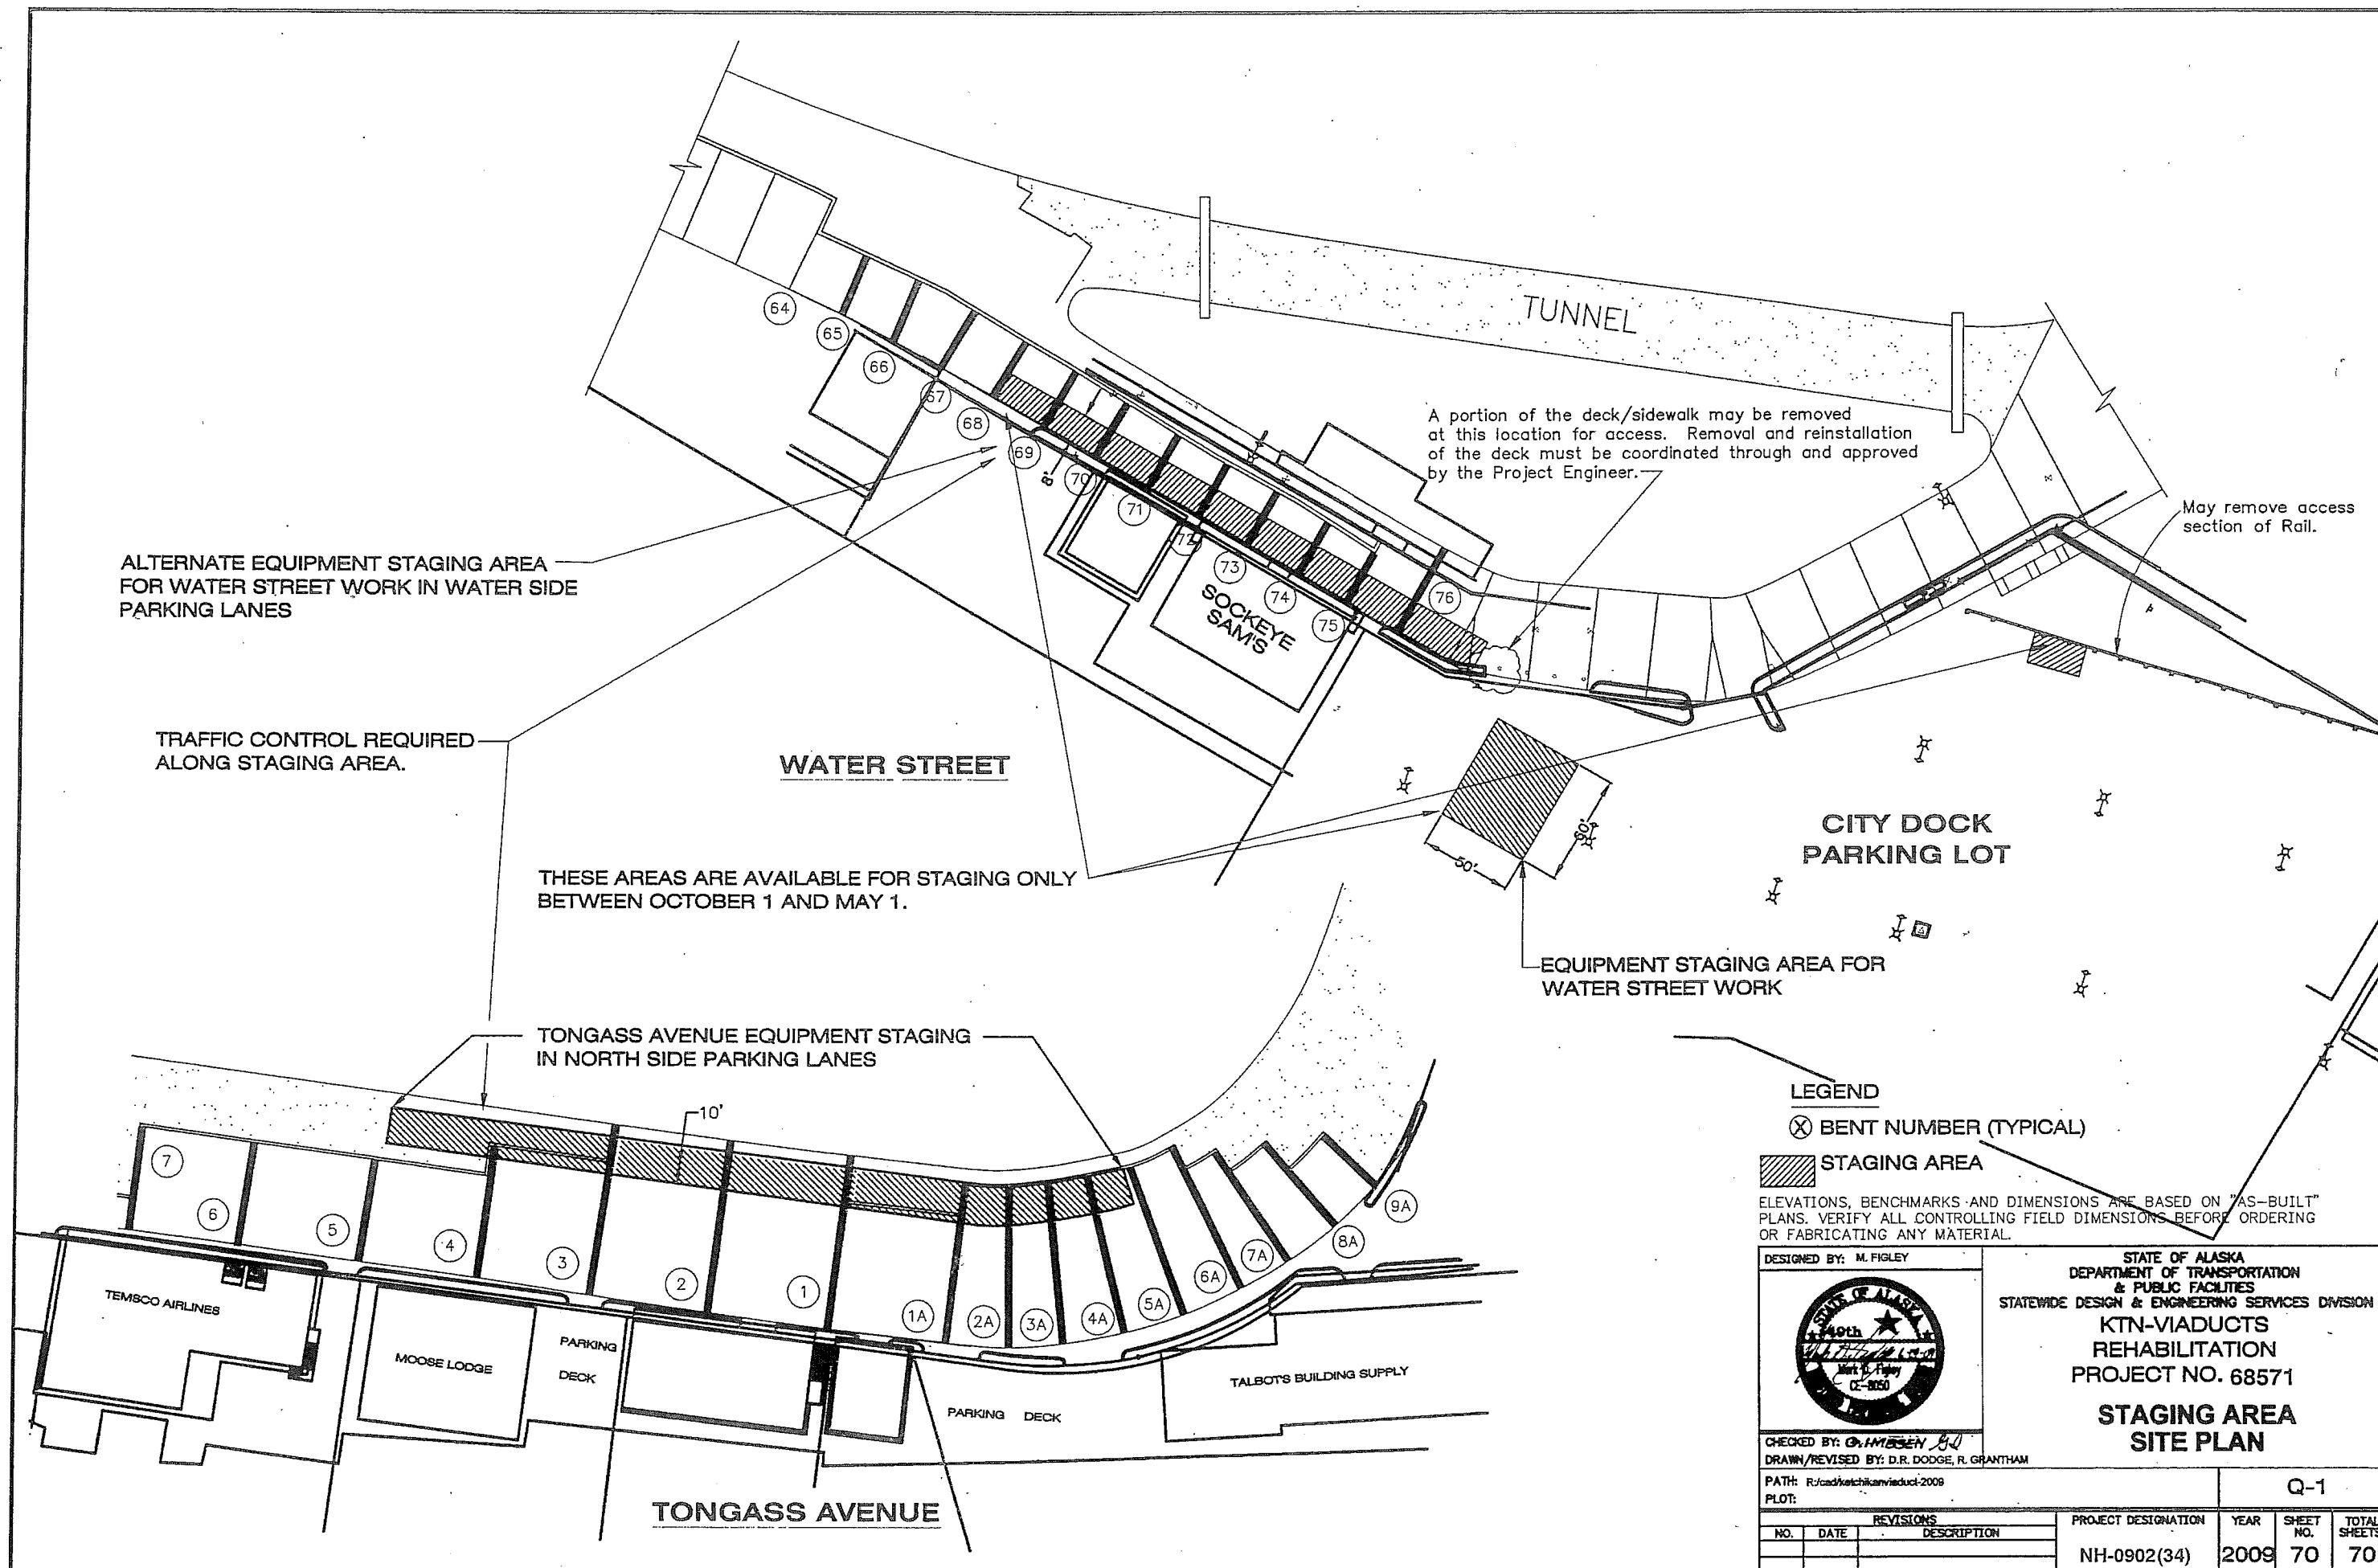

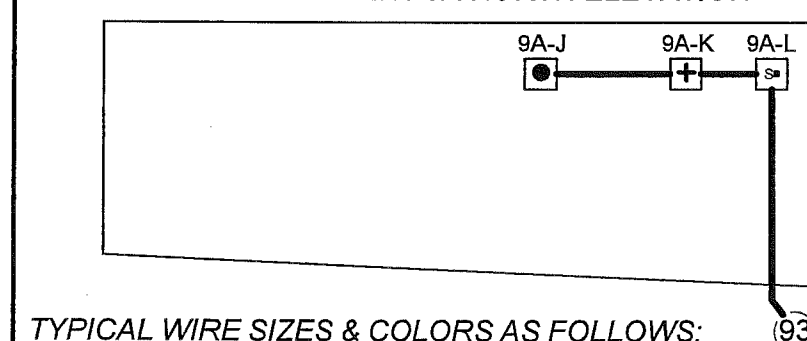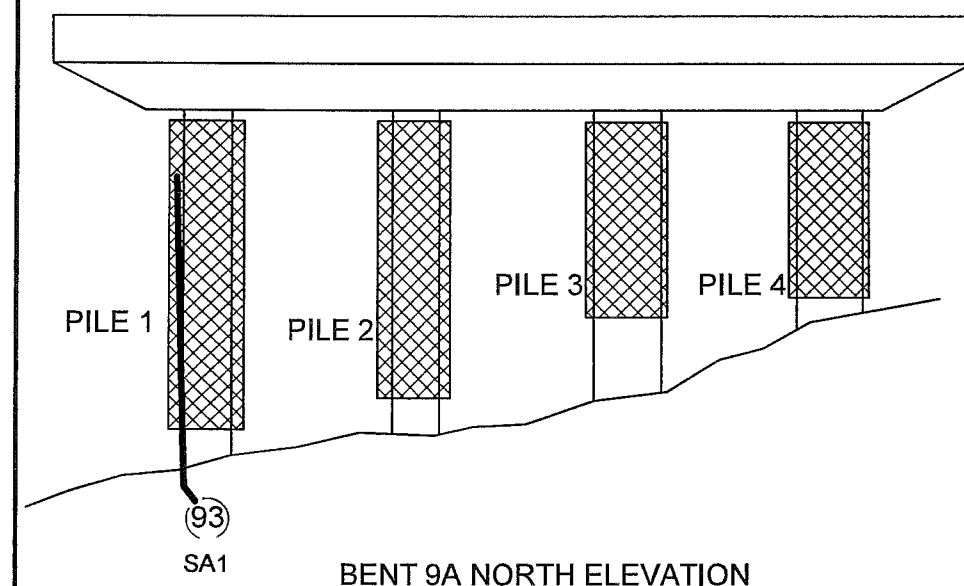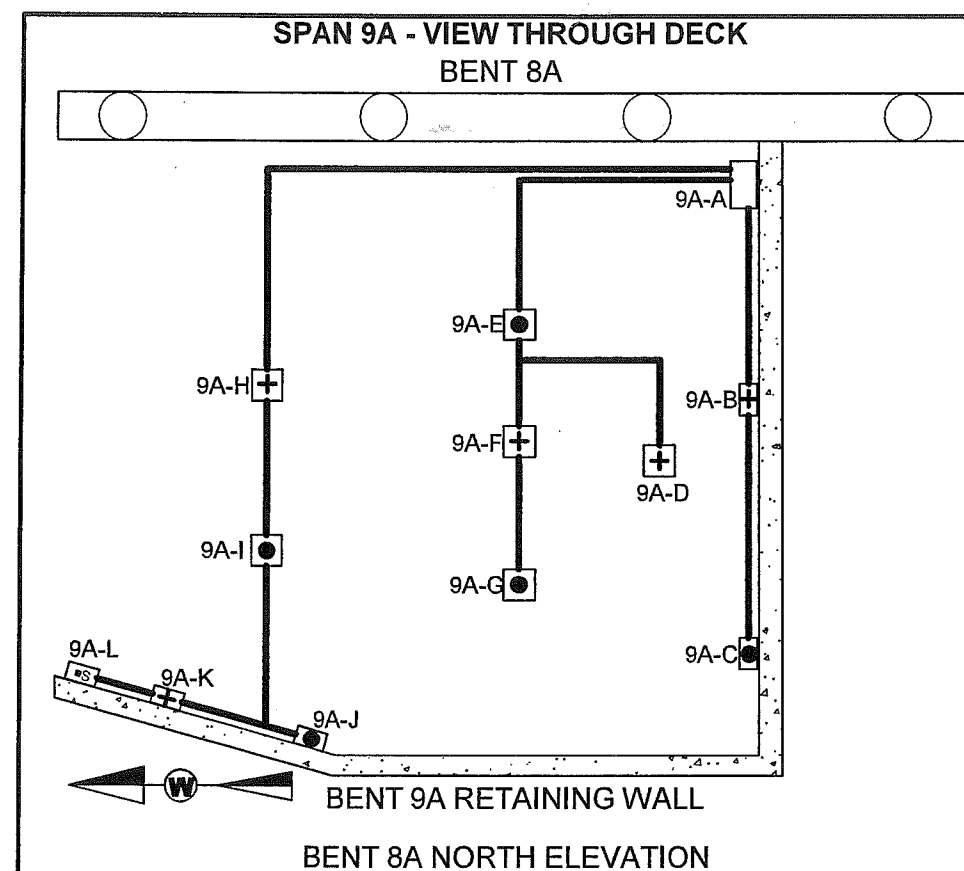

TYPICAL WIRE SIZES & COLORS AS FOLLOWS:
MZA & PJA = #10 Red
MZN; PJN = #10 Blue
SA = #8 Black
RE/REN: #16 Twisted Pair Red/Black

ABBREVIATIONS:
MZN = Metallized Zinc Negative
PJN = Pile Jacket Negative
CJN = Cap Jacket Negative
SAN = Submerged Anode Negative
MZA = Metallized Zinc Anode
PJA = Pile Jacket Anode
CJA = Cap Jacket Anode
SA = Submerged Anode
RE = Reference Electrode
REN = Reference Electrode Negative

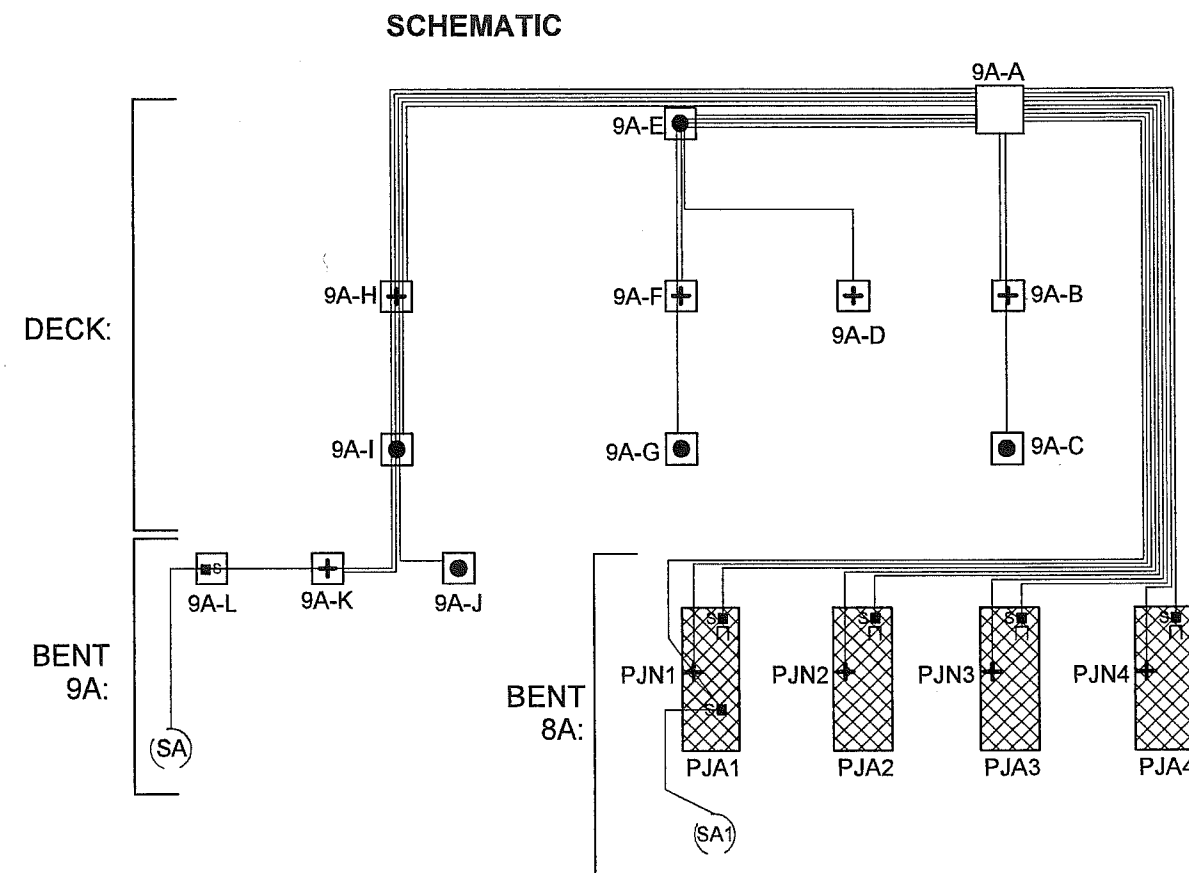

J-BOX DETAILS:

	J-Box Size	Wires or Structure
9A-A	14" x 12" x 8"	MAIN J-BOX: (5) MZA; (5) MZN; (4) PJA; (4) PJN; (2) SA; SAN jumpered from PJN
9A-B	4" x 4" x 2"	Structure Negative (MZN); (1) MZA
9A-C	4" x 4" x 2"	Primary Anode Terminal Plate (MZA)
9A-D	4" x 4" x 2"	Structure Negative (MZN)
9A-E	4" x 4" x 2"	Primary Anode Terminal Plate (MZA); (2) MZN; (1) MZA
9A-F	4" x 4" x 2"	Structure Negative (MZN); (1) MZA
9A-G	4" x 4" x 2"	Primary Anode Terminal Plate (MZA)
9A-H	4" x 4" x 2"	Structure Negative (MZN); (2) MZA; (1) MZN; (1) SA
9A-I	4" x 4" x 2"	Primary Anode Terminal Plate (MZA); (1) MZA; (1) MZN; (1) SA
9A-J	4" x 4" x 2"	Primary Anode Terminal Plate (MZA)
9A-K	4" x 4" x 2"	Structure Negative (MZN)
9A-L	6" x 6" x 4"	Submerged Anode Encapsulated Splice (SA)

LEGEND

- (x) Submerged Anode
x = Weight in LBS
- ⊗ Pile Jacket
- ⊠ Cap Jacket
- Primary Anode Terminal
- + Negative Connection
- Encapsulated Splice


Tongass Span 9A

SCALE: NONE	Field Sketch	DRAWN BY KRH
DATE: 10-19-10	Electrical As-Built	REVISED 09-08-11


GREAT WESTERN CORPORATION

Ketchikan Viaduct II Repair & C.P.	DRAWING NUMBER T9A
---------------------------------------	------------------------------

SPAN 8A - VIEW THROUGH DECK

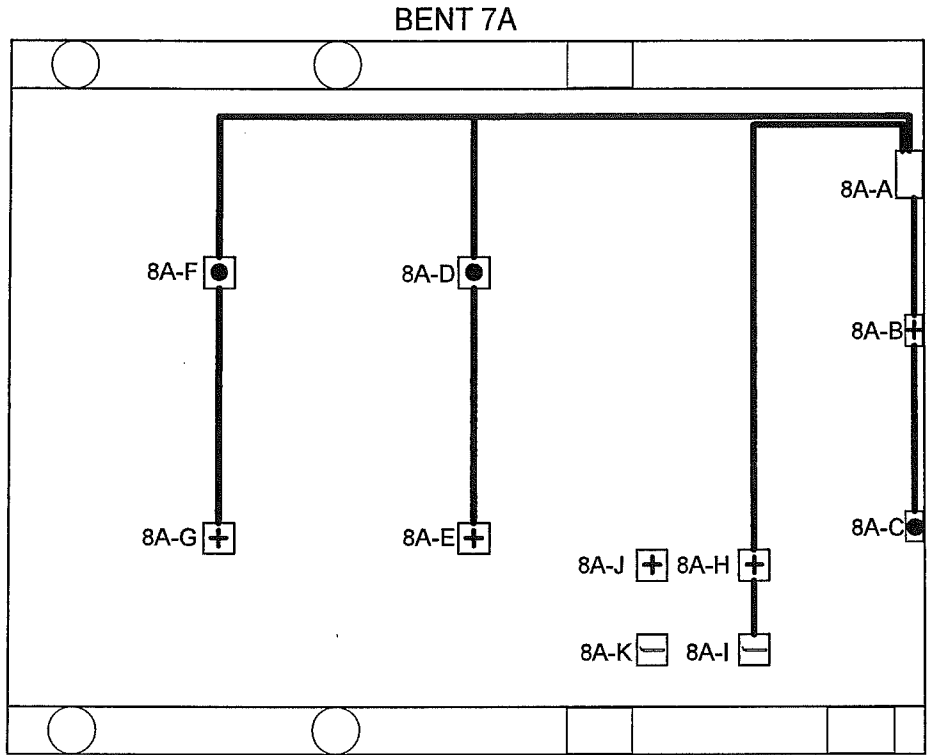


BENT 7A SOUTH ELEVATION

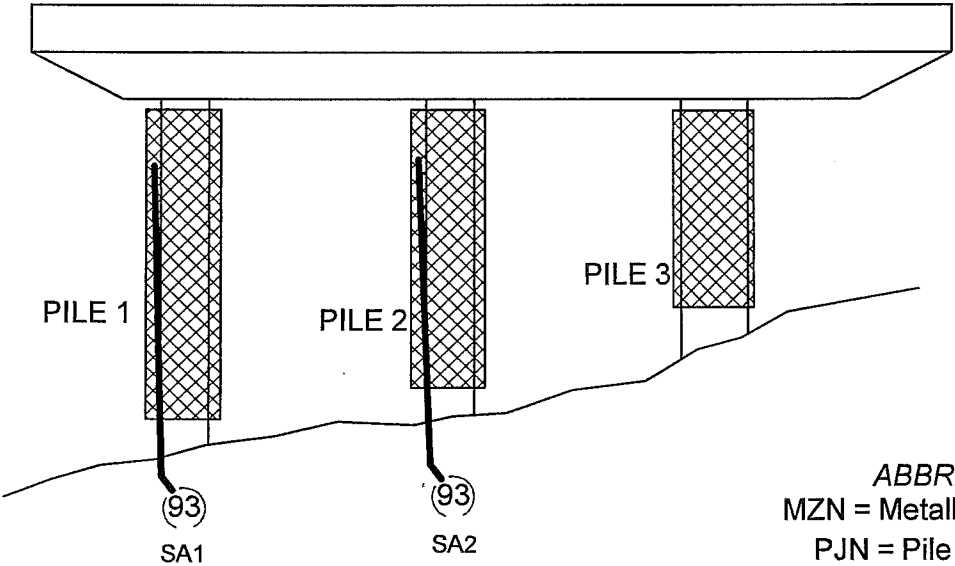

TYPICAL WIRE SIZES & COLORS AS FOLLOWS:
MZA & PJA = #10 Red
MZN; PJN = #10 Blue
SA = #8 Black
RE/REN: #16 Twisted Pair Red/Black

ABBREVIATIONS:
MZN = Metallized Zinc Negative
PJN = Pile Jacket Negative
CJN = Cap Jacket Negative
SAN = Submerged Anode Negative
MZA = Metallized Zinc Anode
PJA = Pile Jacket Anode
CJA = Cap Jacket Anode
SA = Submerged Anode
RE = Reference Electrode
REN = Reference Electrode Negative

SCHEMATIC

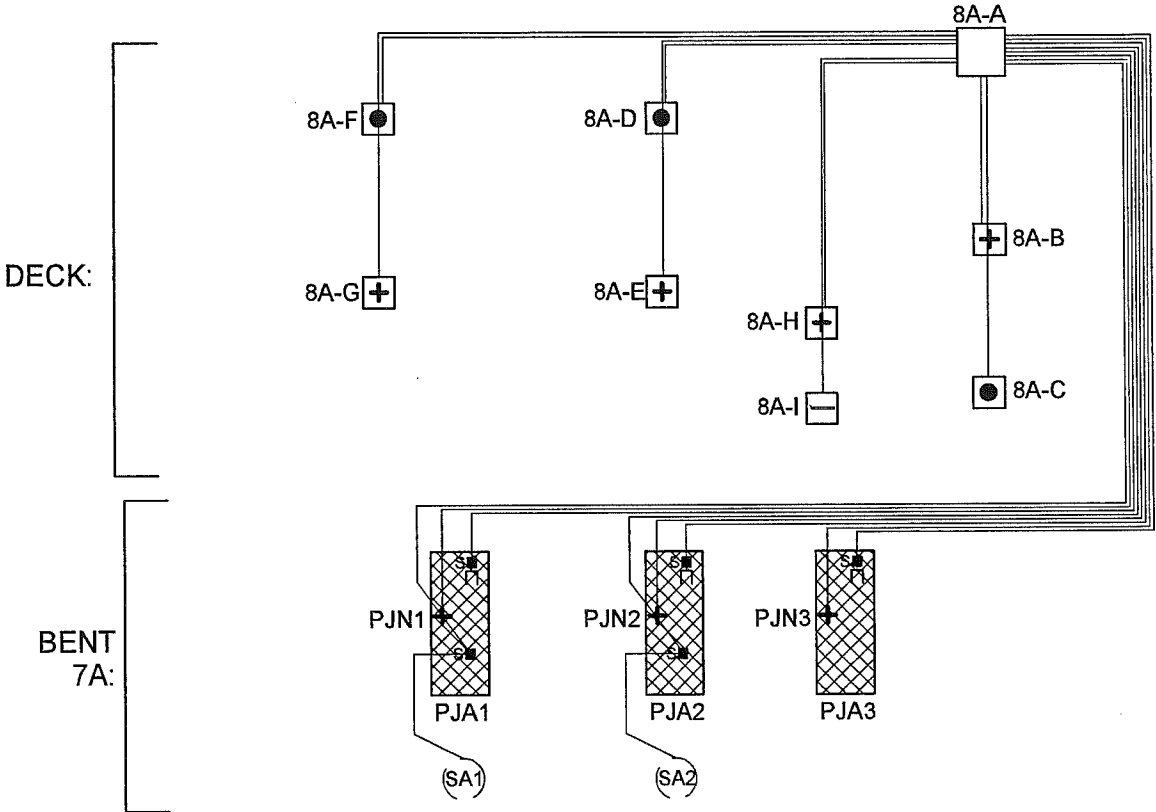

J-BOX DETAILS:

	J-Box Size	Wires or Structure
8AA	14" x 12" x 8"	MAIN J-BOX: (3) MZA; (3) MZN; (3) PJA; (3) PJN; (2) SA; SAN jumpered from PJN; (1) RE; (1) REN
8AB	4" x 4" x 2"	Structure Negative (MZN); (1) MZA
8AC	4" x 4" x 2"	Primary Anode Terminal Plate (MZA)
8AD	4" x 4" x 2"	Primary Anode Terminal Plate (MZA); Structure Negative (MZN)
8AE	4" x 4" x 2"	Structure Negative (MZN)
8AF	4" x 4" x 2"	Primary Anode Terminal Plate (MZA); Structure Negative (MZN)
8AG	4" x 4" x 2"	Structure Negative (MZN)
8AH	4" x 4" x 2"	Reference Electrode Negative (REN); (1) RE
8AI	4" x 4" x 2"	Reference Electrode (RE) SN410205
8AJ	4" x 4" x 2"	REN - Abandoned Location
8AK	4" x 4" x 2"	RE - Abandoned Location

LEGEND

- (x) Submerged Anode
x = Weight in LBS
- ▨ Pile Jacket
- ▩ Cap Jacket
- Primary Anode Terminal
- + Negative Connection
- s Encapsulated Splice
- Reference Electrode


Tongass Span 8A

SCALE: NONE	Field Sketch	DRAWN BY KRH
DATE: 10-21-10	Electrical As-Built	REVISED 09-08-11


GREAT WESTERN CORPORATION

Ketchikan Viaduct II Repair & C.P.	DRAWING NUMBER T8A
---------------------------------------	-----------------------

SPAN 7A - VIEW THROUGH DECK

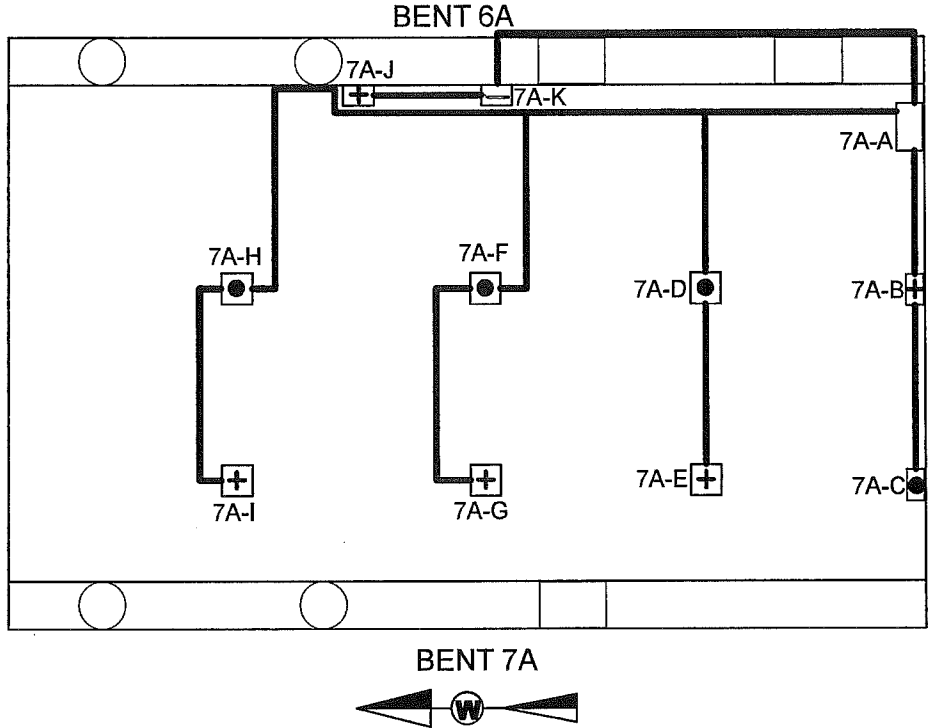


SCHEMATIC

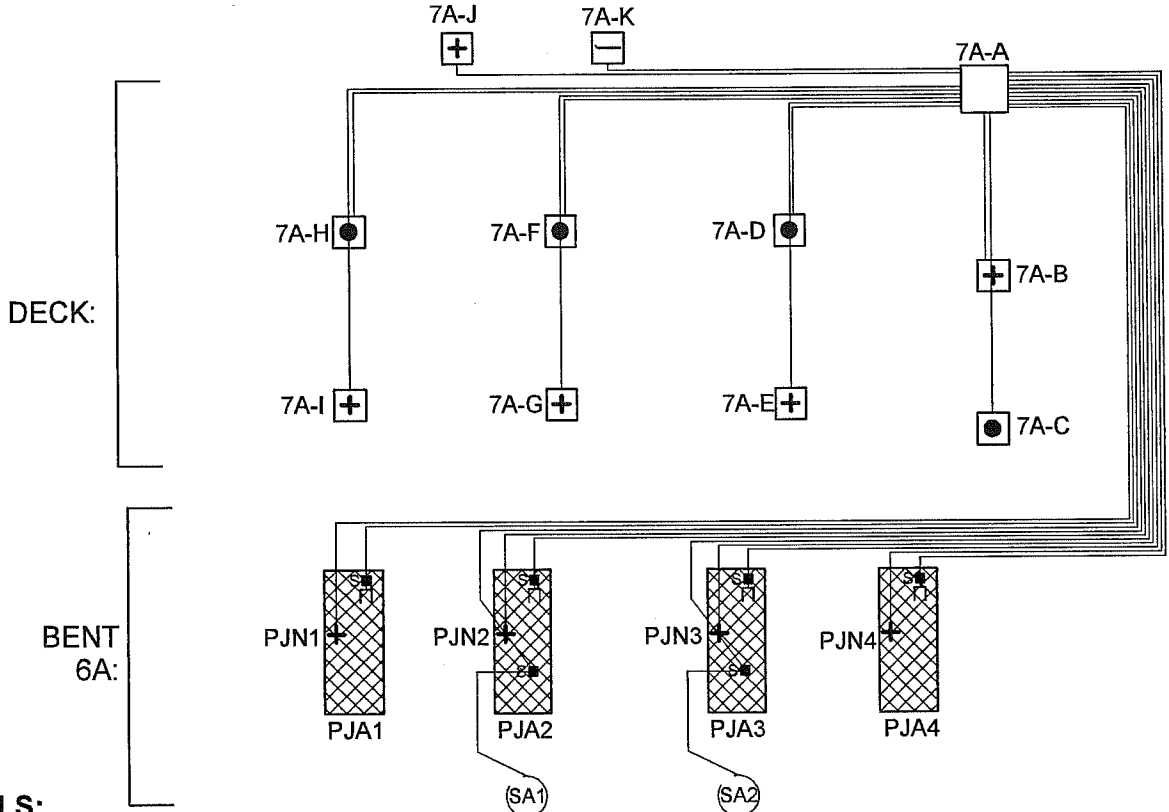

J-BOX DETAILS:

	J-Box Size	Wires or Structure
7A-A	14" x 12" x 8"	MAIN J-BOX: (4) MZA; (4) MZN; (4) PJA; (4) PJN; (2) SA; SAN jumpered from PJN; (1) RE; (1) REN
7A-B	4" x 4" x 2"	Structure Negative (MZN); (1) MZA
7A-C	4" x 4" x 2"	Primary Anode Terminal Plate (MZA)
7A-D	4" x 4" x 2"	Primary Anode Terminal Plate (MZA); Structure Negative (MZN)
7A-E	4" x 4" x 2"	Structure Negative (MZN)
7A-F	4" x 4" x 2"	Primary Anode Terminal Plate (MZA); Structure Negative (MZN)
7A-G	4" x 4" x 2"	Structure Negative (MZN)
7A-H	4" x 4" x 2"	Primary Anode Terminal Plate (MZA); Structure Negative (MZN)
7A-I	4" x 4" x 2"	Structure Negative (MZN)
7A-J	4" x 4" x 2"	Reference Electrode (RE) S/N 410209; (1) REN
7A-K	4" x 4" x 2"	Reference Electrode NEGATIVE (REN)

BENT 6A SOUTH ELEVATION

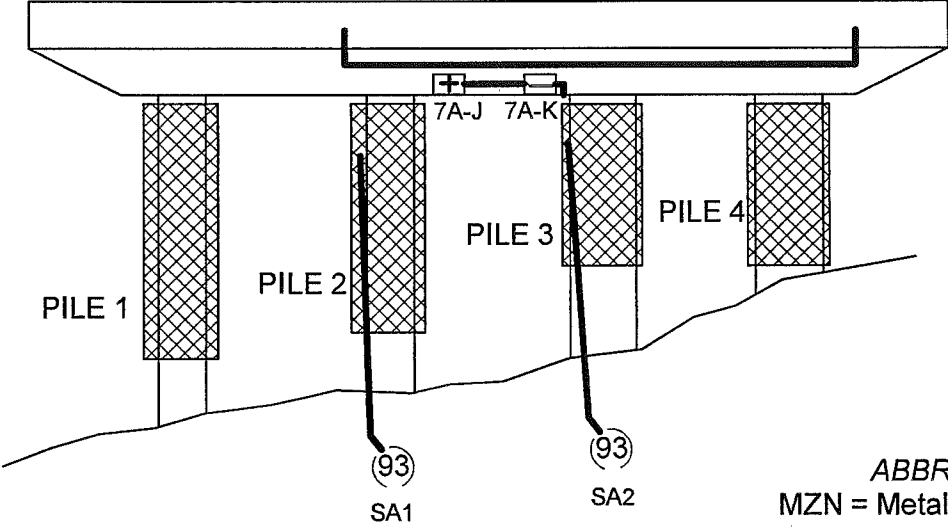

ABBREVIATIONS:

MZN = Metallized Zinc Negative
PJN = Pile Jacket Negative
CJN = Cap Jacket Negative
SAN = Submerged Anode Negative
MZA = Metallized Zinc Anode
PJA = Pile Jacket Anode
CJA = Cap Jacket Anode
SA = Submerged Anode
RE = Reference Electrode
REN = Reference Electrode Negative


LEGEND

- (x) Submerged Anode
x = Weight in LBS
- ▣ Pile Jacket
- ▢ Cap Jacket
- Primary Anode Terminal
- + Negative Connection
- Encapsulated Splice
- Reference Electrode

TYPICAL WIRE SIZES & COLORS AS FOLLOWS:
MZA & PJA = #10 Red
MZN; PJN = #10 Blue
SA = #8 Black
RE/REN: #16 Twisted Pair Red/Black

Tongass Span 7A


SCALE: NONE	Field Sketch	DRAWN BY KRH
DATE: 10-21-10	Electrical As-Built	REVISED 09-08-11
GREAT WESTERN CORPORATION		
Ketchikan Viaduct II Repair & C.P.		DRAWING NUMBER T7A

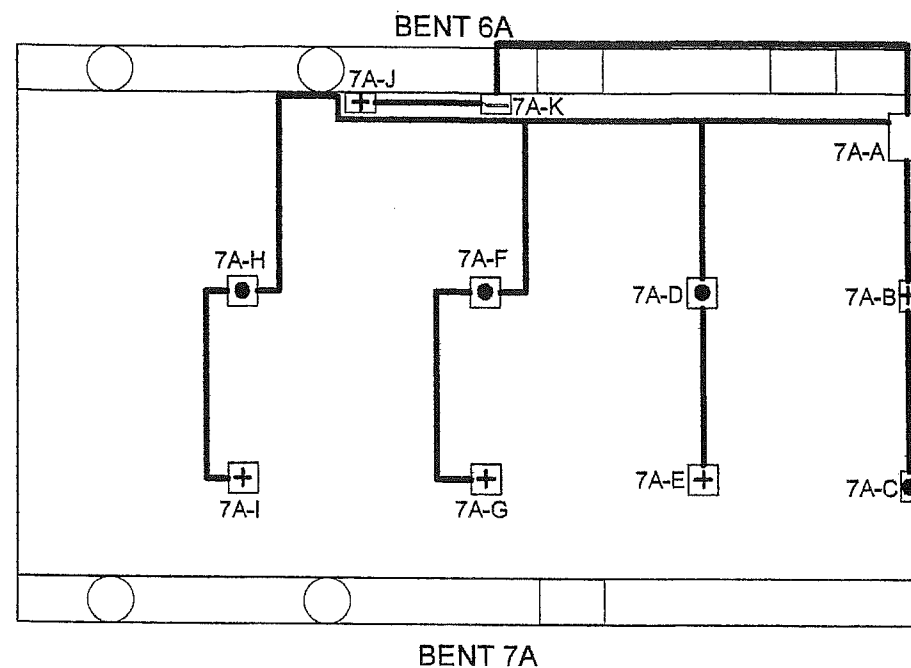

DECK:

BENT 6A:


SCHEMATIC

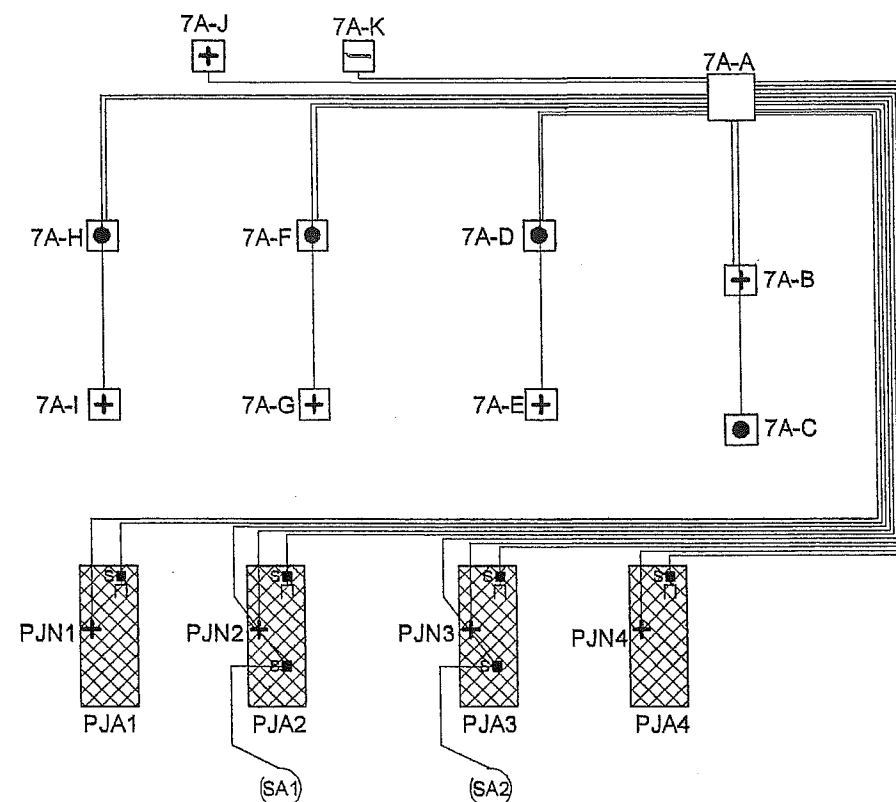

J-BOX DETAILS:

	J-Box Size	Wires or Structure
7A-A	14" x 12" x 8"	MAIN J-BOX: (4) MZA; (4) MZN; (4) PJA; (4) PJN; (2) SA; SAN jumpered from PJN; (1) RE; (1) REN
7A-B	4" x 4" x 2"	Structure Negative (MZN); (1) MZA
7A-C	4" x 4" x 2"	Primary Anode Terminal Plate (MZA)
7A-D	4" x 4" x 2"	Primary Anode Terminal Plate (MZA); Structure Negative (MZN)
7A-E	4" x 4" x 2"	Structure Negative (MZN)
7A-F	4" x 4" x 2"	Primary Anode Terminal Plate (MZA); Structure Negative (MZN)
7A-G	4" x 4" x 2"	Structure Negative (MZN)
7A-H	4" x 4" x 2"	Primary Anode Terminal Plate (MZA); Structure Negative (MZN)
7A-I	4" x 4" x 2"	Structure Negative (MZN)
7A-J	4" x 4" x 2"	Reference Electrode (RE) S/N 410209; (1) REN
7A-K	4" x 4" x 2"	Reference Electrode NEGATIVE (REN)

BENT 6A NORTH ELEVATION

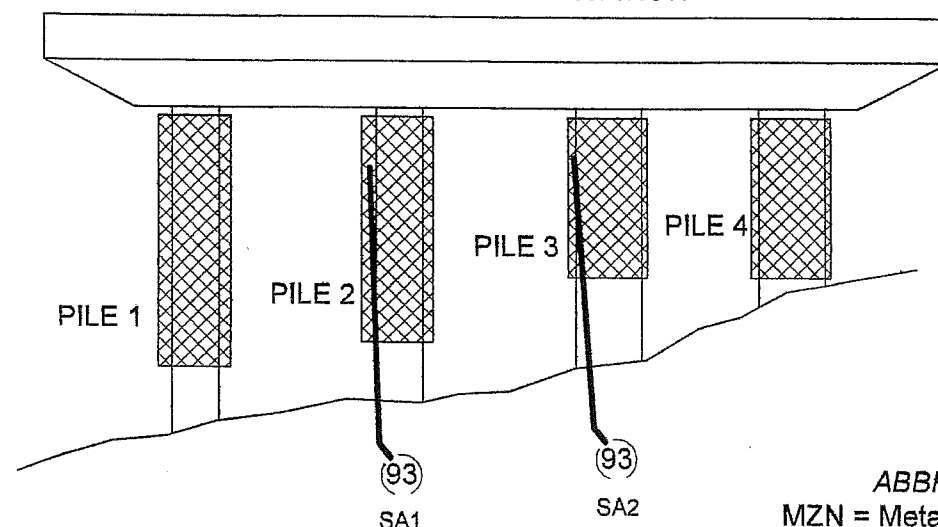

ABBREVIATIONS:

MZN = Metallized Zinc Negative
 PJN = Pile Jacket Negative
 CJN = Cap Jacket Negative
 SAN = Submerged Anode Negative
 MZA = Metallized Zinc Anode
 PJA = Pile Jacket Anode
 CJA = Cap Jacket Anode
 SA = Submerged Anode
 RE = Reference Electrode
 REN = Reference Electrode Negative

LEGEND

- (x) Submerged Anode
- x = Weight in LBS
- ▨ Pile Jacket
- ▩ Cap Jacket
- Primary Anode Terminal
- + Negative Connection
- Encapsulated Splice
- Reference Electrode

TYPICAL WIRE SIZES & COLORS AS FOLLOWS:
 MZA & PJA = #10 Red
 MZN; PJN = #10 Blue
 SA = #8 Black
 RE/REN: #16 Twisted Pair Red/Black

Tongass Span 7A


SCALE: NONE	Field Sketch	DRAWN BY KRH
DATE: 10-21-10	Electrical As-Built	REVISED 10-27-10

GREAT WESTERN CORPORATION


Ketchikan Viaduct II
Repair & C.P.

DRAWING NUMBER
T7A


SPAN 6A - VIEW THROUGH DECK

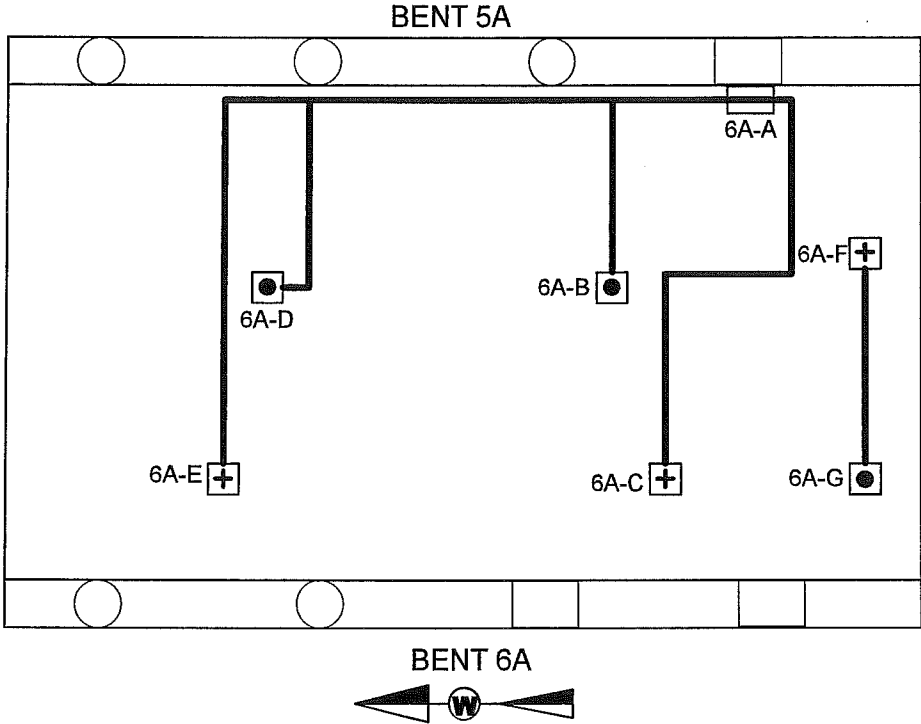

SCHEMATIC

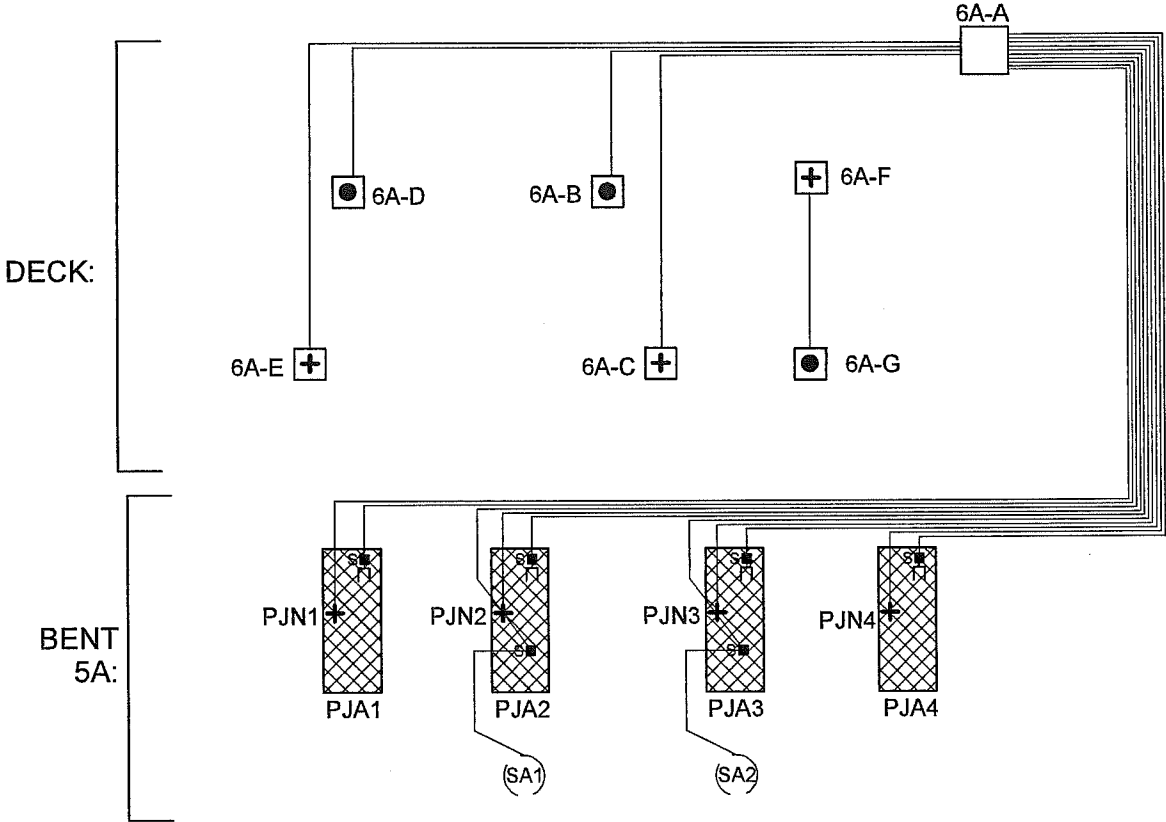

BENT 5A SOUTH ELEVATION

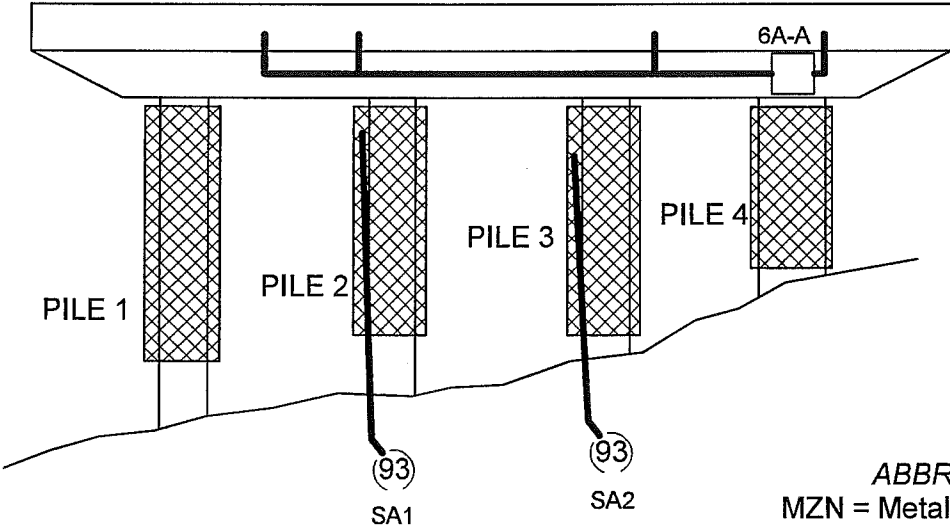

J-BOX DETAILS:

	J-Box Size	Wires or Structure
6A-A	14" x 12" x 8"	MAIN J-BOX: (2) MZA; (2) MZN; (4) PJA; (4) PJN; (2) SA; SAN jumpered from PJN
6A-B	4" x 4" x 2"	Primary Anode Terminal Plate (MZA)
6A-C	4" x 4" x 2"	Structure Negative (MZN)
6A-D	4" x 4" x 2"	Primary Anode Terminal Plate (MZA)
6A-E	4" x 4" x 2"	Structure Negative (MZN)
6A-F	4" x 4" x 2"	Structure Negative (MZN)
6A-G	4" x 4" x 2"	Primary Anode Terminal Plate (MZA)

ABBREVIATIONS:

MZN = Metallized Zinc Negative
PJN = Pile Jacket Negative
CJN = Cap Jacket Negative
SAN = Submerged Anode Negative
MZA = Metallized Zinc Anode
PJA = Pile Jacket Anode
CJA = Cap Jacket Anode
SA = Submerged Anode
RE = Reference Electrode
REN = Reference Electrode Negative

LEGEND


- (x) Submerged Anode
x = Weight in LBS
- ▨ Pile Jacket
- ▩ Cap Jacket
- Primary Anode Terminal
- + Negative Connection
- ⊞ Encapsulated Splice
- Reference Electrode

TYPICAL WIRE SIZES & COLORS AS FOLLOWS:
MZA & PJA = #10 Red
MZN; PJN = #10 Blue
SA = #8 Black
RE/REN: #16 Twisted Pair Red/Black


Tongass Span 6A

SCALE: NONE	Field Sketch	DRAWN BY KRH
DATE: 10-21-10	Electrical As-Built	REVISED 09-08-11
GREAT WESTERN CORPORATION		
Ketchikan Viaduct II Repair & C.P.		DRAWING NUMBER T6A


SPAN 5A - VIEW THROUGH DECK

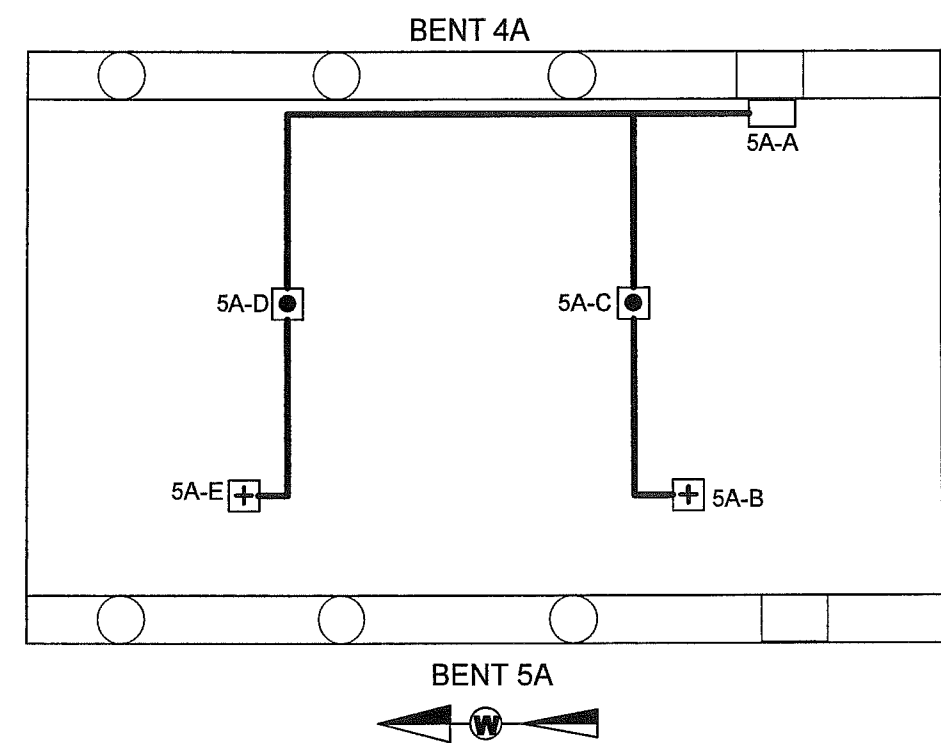

SCHEMATIC

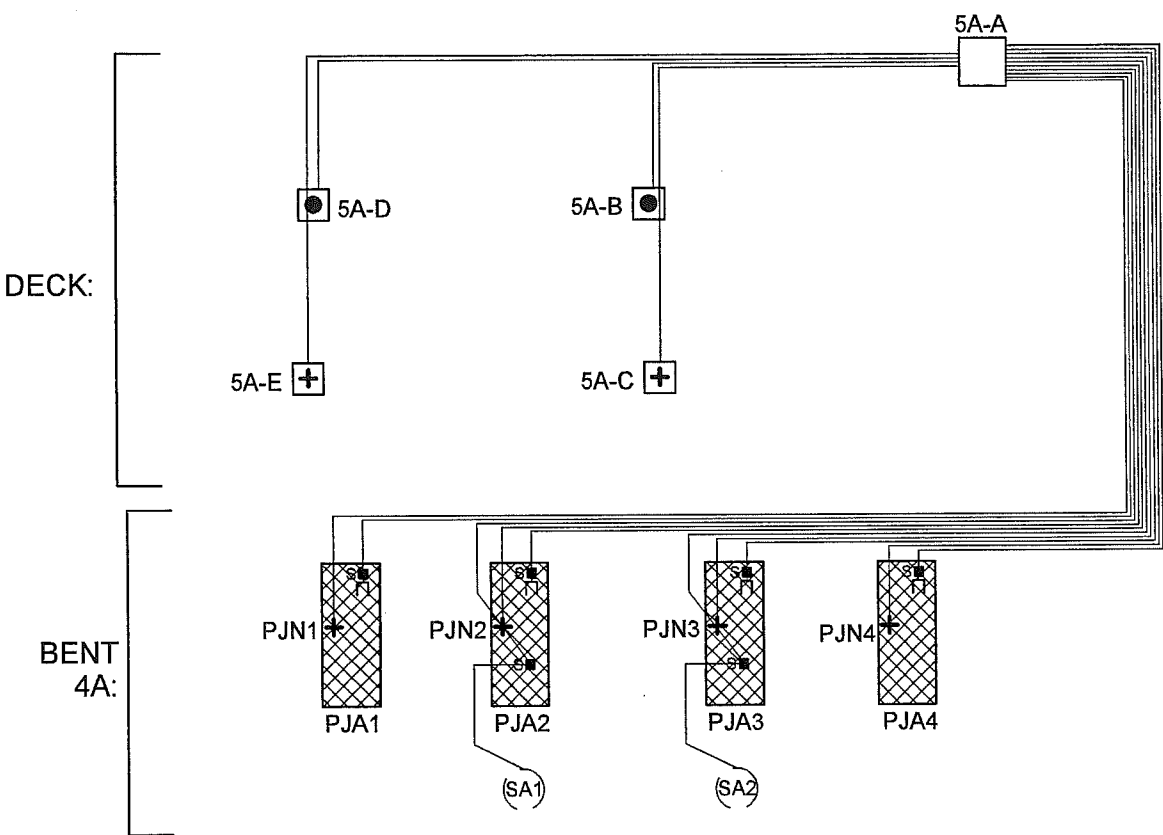

BENT 4A SOUTH ELEVATION

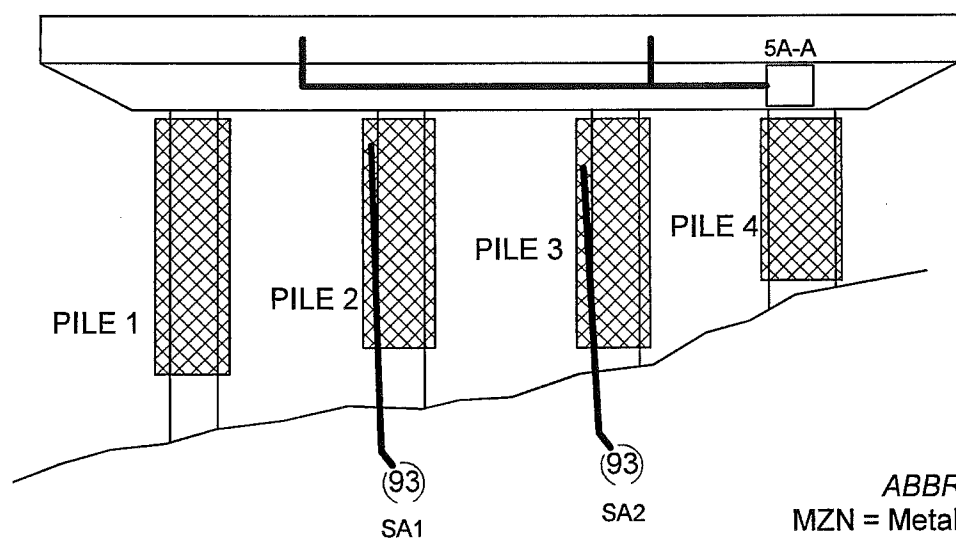

J-BOX DETAILS:

	J-Box Size	Wires or Structure
5A-A	14" x 12" x 8"	MAIN J-BOX: (2) MZA; (2) MZN; (4) PJA; (4) PJN; (2) SA; SAN jumpered from PJN
5A-B	4" x 4" x 2"	Structure Negative (MZN)
5A-C	4" x 4" x 2"	Primary Anode Terminal Plate (MZA); (1) (MZN)
5A-D	4" x 4" x 2"	Structure Negative (MZN)
5A-E	4" x 4" x 2"	Primary Anode Terminal Plate (MZA); (1) (MZN)

ABBREVIATIONS:

MZN = Metallized Zinc Negative
PJN = Pile Jacket Negative
CJN = Cap Jacket Negative
SAN = Submerged Anode Negative
MZA = Metallized Zinc Anode
PJA = Pile Jacket Anode
CJA = Cap Jacket Anode
SA = Submerged Anode
RE = Reference Electrode
REN = Reference Electrode Negative

LEGEND

- (x) Submerged Anode
x = Weight in LBS
- ⊠ Pile Jacket
- ⊞ Cap Jacket
- Primary Anode Terminal
- + Negative Connection
- Encapsulated Splice
- Reference Electrode

TYPICAL WIRE SIZES & COLORS AS FOLLOWS:
MZA & PJA = #10 Red
MZN; PJN = #10 Blue
SA = #8 Black
RE/REN: #16 Twisted Pair Red/Black

Tongass Span 5A


SCALE: NONE	Field Sketch	DRAWN BY KRH
DATE: 04-27-11	Electrical As-Built	REVISED 09-08-11

GREAT WESTERN CORPORATION


Ketchikan Viaduct II
Repair & C.P.

DRAWING NUMBER
T5A


SPAN 4A - VIEW THROUGH DECK

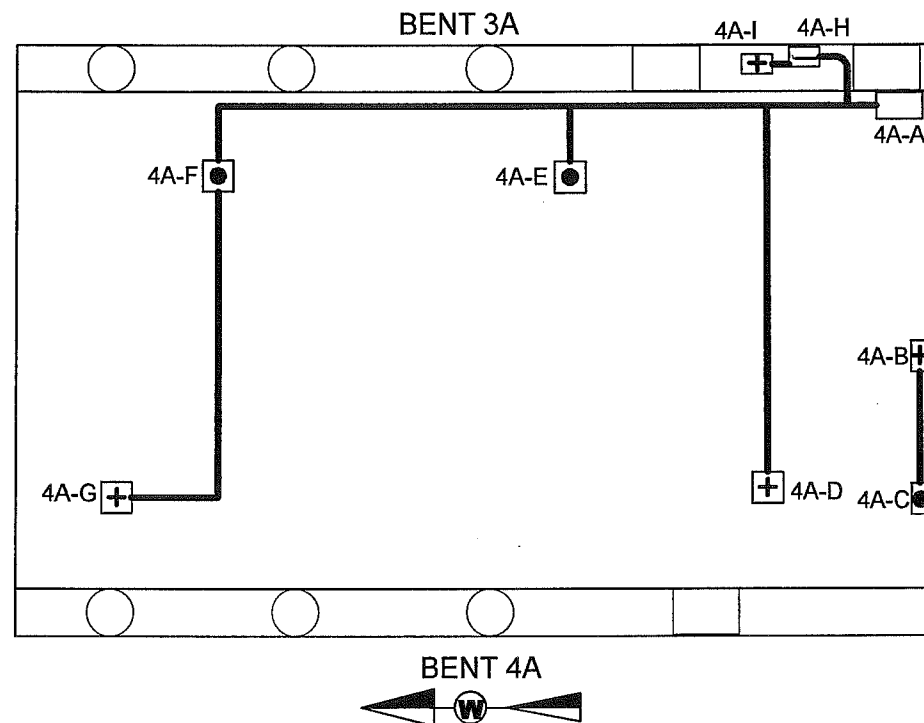

SCHEMATIC

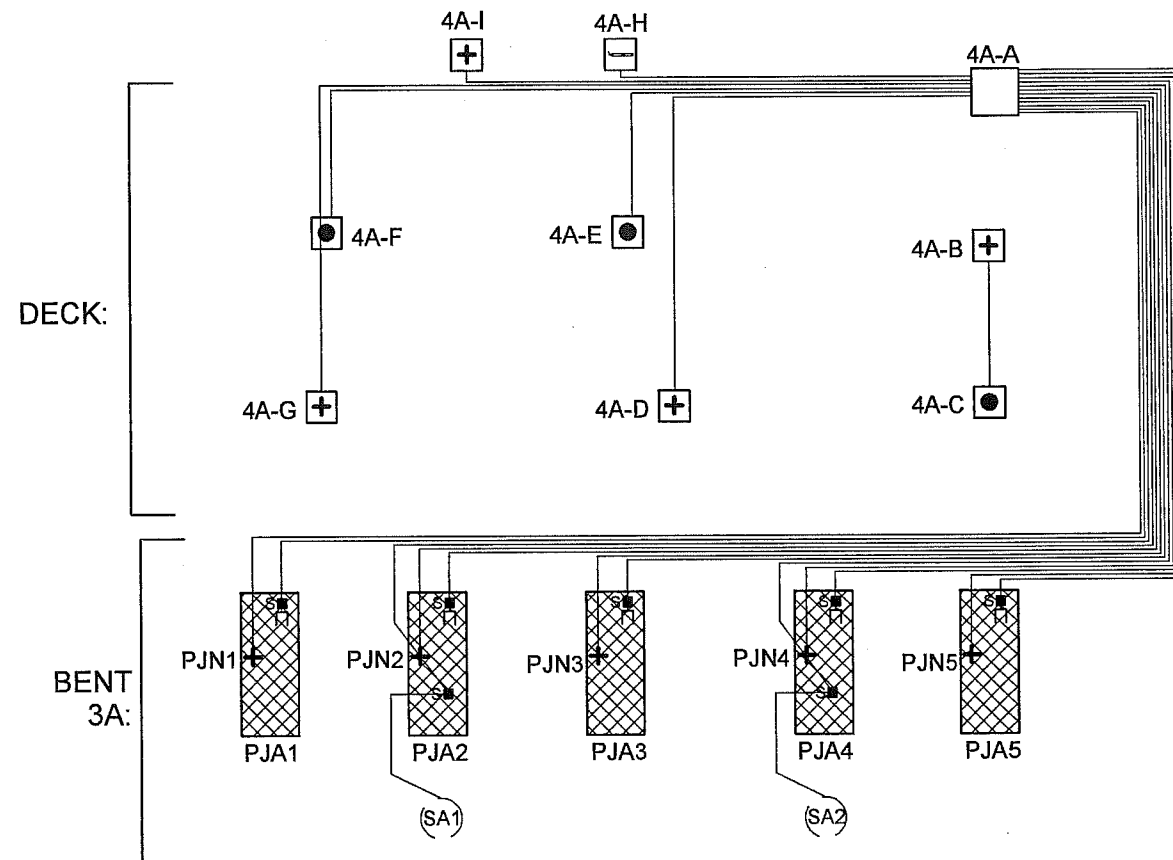

BENT 3A SOUTH ELEVATION

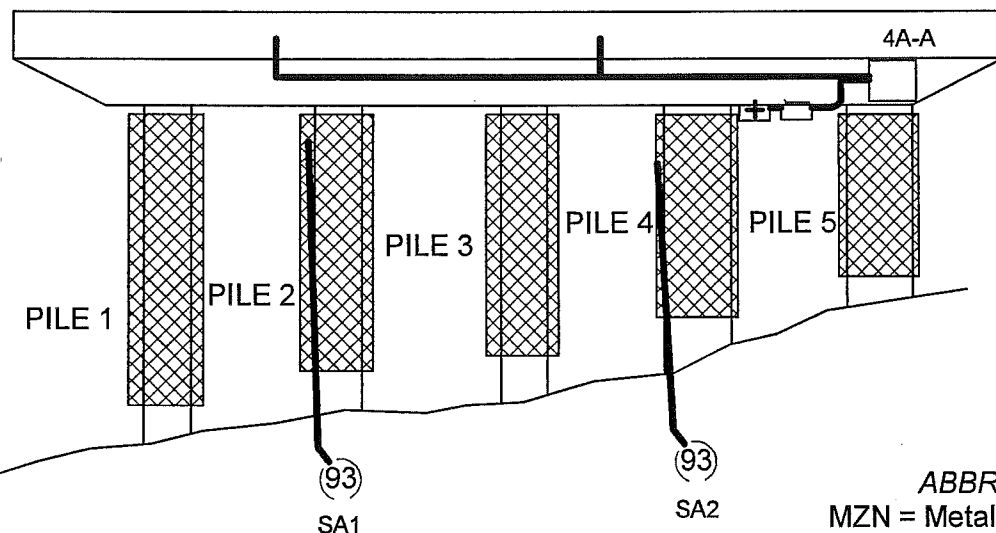

J-BOX DETAILS:

	J-Box Size	Wires or Structure
4A-A	14" x 12" x 8"	MAIN J-BOX: (2) MZA; (2) MZN; (5) PJA; (5) PJN; (2) SA; SAN jumpered from PJN; (1) RE; (1) REN
4A-B	4" x 4" x 2"	Structure Negative (MZN)
4A-C	4" x 4" x 2"	Primary Anode Terminal Plate (MZA)
4A-D	4" x 4" x 2"	Structure Negative (MZN)
4A-E	4" x 4" x 2"	Primary Anode Terminal Plate (MZA)
4A-F	4" x 4" x 2"	Primary Anode Terminal Plate (MZA); (1) MZN
4A-G	4" x 4" x 2"	Structure Negative (MZN)
4A-H	4" x 4" x 2"	Reference Electrode (RE) S/N 410197; (1) REN
4A-I	4" x 4" x 2"	Reference Electrode NEGATIVE (REN)

ABBREVIATIONS:

MZN = Metallized Zinc Negative
 PJN = Pile Jacket Negative
 CJN = Cap Jacket Negative
 SAN = Submerged Anode Negative
 MZA = Metallized Zinc Anode
 PJA = Pile Jacket Anode
 CJA = Cap Jacket Anode
 SA = Submerged Anode
 RE = Reference Electrode
 REN = Reference Electrode Negative

LEGEND


(x) Submerged Anode
 x = Weight in LBS
 [X] Pile Jacket
 [O] Cap Jacket
 ● Primary Anode Terminal
 + Negative Connection
 ■ Encapsulated Splice
 — Reference Electrode

TYPICAL WIRE SIZES & COLORS AS FOLLOWS:
 MZA & PJA = #10 Red
 MZN; PJN = #10 Blue
 SA = #8 Black
 RE/REN: #16 Twisted Pair Red/Black


Tongass Span 4A

SCALE: NONE	Field Sketch	DRAWN BY KRH
DATE: 5-9-11	Electrical As-Built	REVISED 09-08-11
GREAT WESTERN CORPORATION		
Ketchikan Viaduct II Repair & C.P.		DRAWING NUMBER T4A


SPAN 3A - VIEW THROUGH DECK

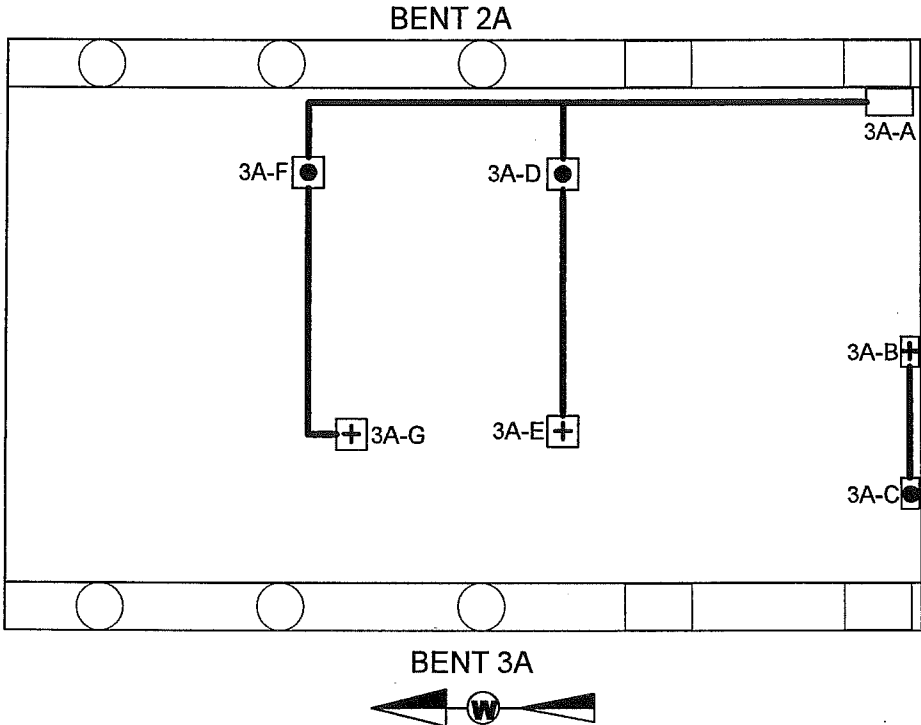

SCHEMATIC

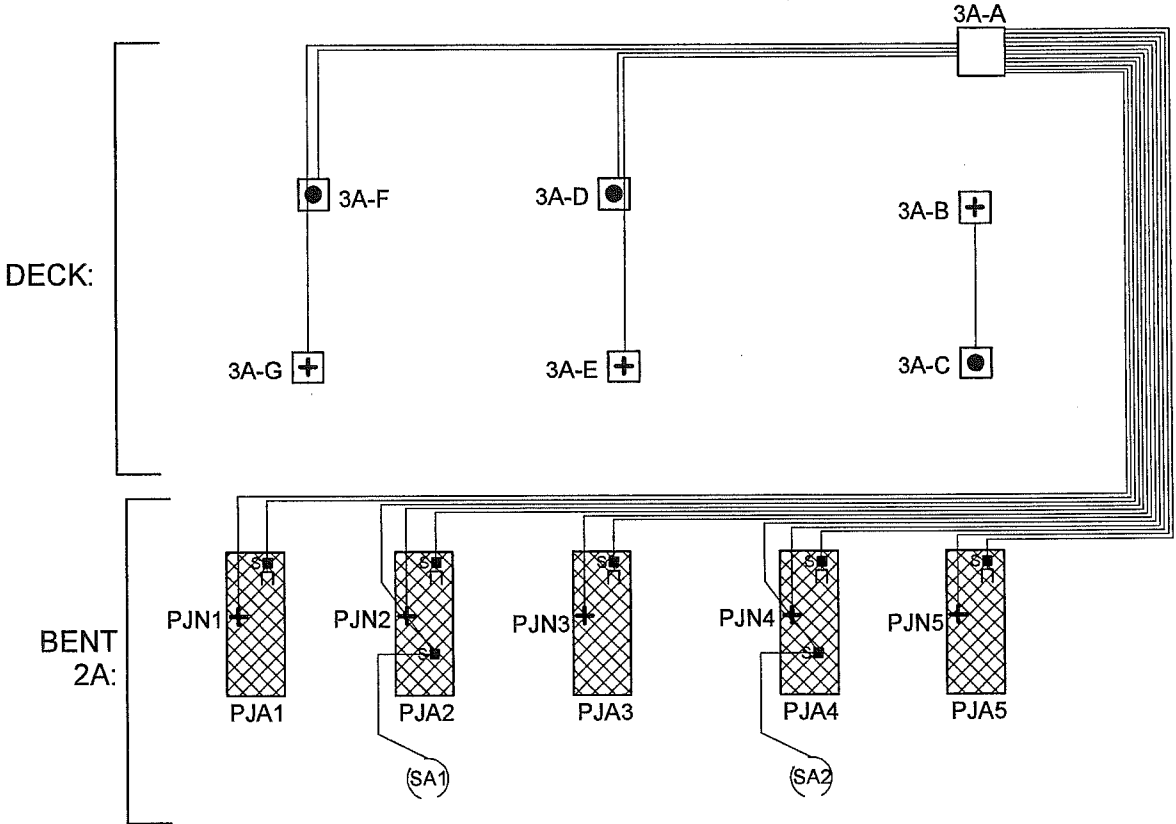

BENT 2A SOUTH ELEVATION

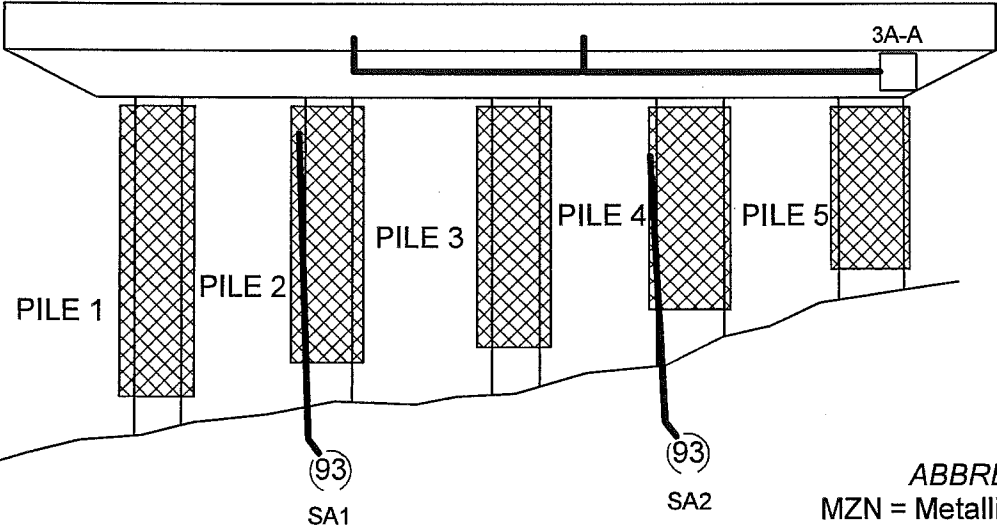

J-BOX DETAILS:

	J-Box Size	Wires or Structure
3A-A	14" x 12" x 8"	MAIN J-BOX: (2) MZA; (2) MZN; (5) PJA; (5) PJN; (2) SA; SAN jumpered from PJN
3A-B	4" x 4" x 2"	Structure Negative (MZN)
3A-C	4" x 4" x 2"	Primary Anode Terminal Plate (MZA)
3A-D	4" x 4" x 2"	Primary Anode Terminal Plate (MZA); (1) MZN
3A-E	4" x 4" x 2"	Structure Negative (MZN)
3A-F	4" x 4" x 2"	Primary Anode Terminal Plate (MZA); (1) MZN
3A-G	4" x 4" x 2"	Structure Negative (MZN)

ABBREVIATIONS:

MZN = Metallized Zinc Negative
PJN = Pile Jacket Negative
CJN = Cap Jacket Negative
SAN = Submerged Anode Negative
MZA = Metallized Zinc Anode
PJA = Pile Jacket Anode
CJA = Cap Jacket Anode
SA = Submerged Anode
RE = Reference Electrode
REN = Reference Electrode Negative

LEGEND

- (x) Submerged Anode
x = Weight in LBS
- ⊗ Pile Jacket
- ⊠ Cap Jacket
- Primary Anode Terminal
- + Negative Connection
- Encapsulated Splice
- Reference Electrode

TYPICAL WIRE SIZES & COLORS AS FOLLOWS:
MZA & PJA = #10 Red
MZN; PJN = #10 Blue
SA = #8 Black
RE/REN: #16 Twisted Pair Red/Black

Tongass Span 3A


SCALE: NONE	Field Sketch	DRAWN BY KRH
DATE: 5-9-11	Electrical As-Built	REVISED 9-8-11

GREAT WESTERN CORPORATION


Ketchikan Viaduct II
Repair & C.P.

DRAWING NUMBER
T3A


SPAN 2A - VIEW THROUGH DECK

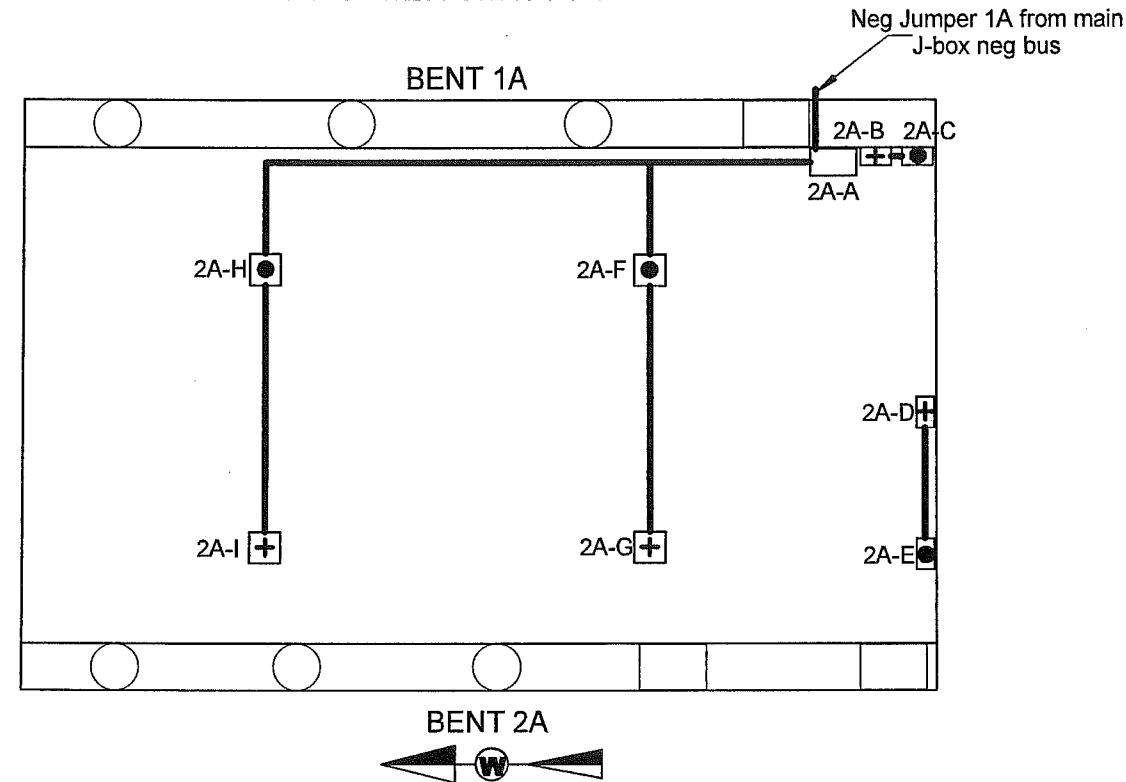

SCHEMATIC

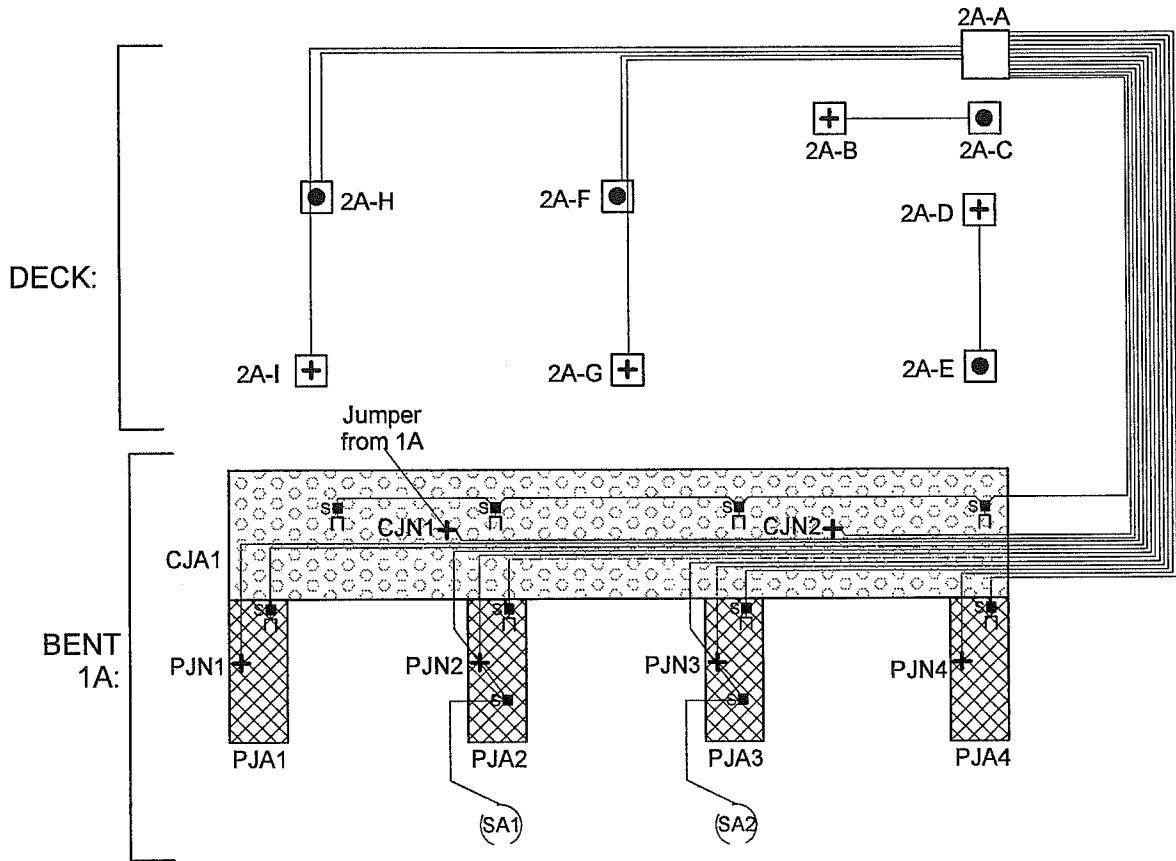

BENT 1A SOUTH ELEVATION

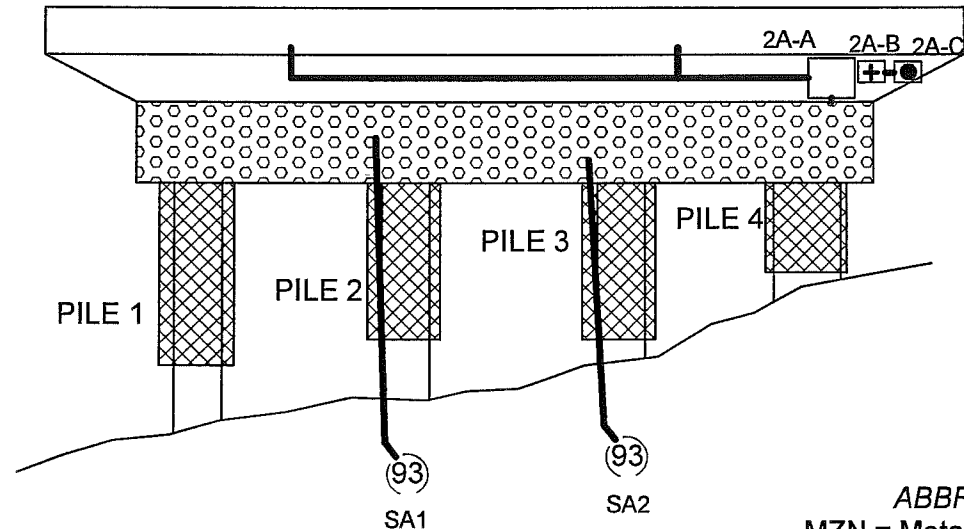

J-BOX DETAILS:

	J-Box Size	Wires or Structure
2A-A	14" x 12" x 8"	MAIN J-BOX: (2) MZA; (2) MZN; (4) PJA; (4) PJN; (1) CJA; (2) CJN; (2) SA; SAN jumpered from PJN; CJN1 jumpered from Span 1A
2A-B	4" x 4" x 2"	Structure Negative (MZN)
2A-C	4" x 4" x 2"	Primary Anode Terminal Plate (MZA)
2A-D	4" x 4" x 2"	Structure Negative (MZN)
2A-E	4" x 4" x 2"	Primary Anode Terminal Plate (MZA)
2A-F	4" x 4" x 2"	Primary Anode Terminal Plate (MZA); (1) MZN
2A-G	4" x 4" x 2"	Structure Negative (MZN)
2A-H	4" x 4" x 2"	Primary Anode Terminal Plate (MZA); (1) MZN
2A-I	4" x 4" x 2"	Structure Negative (MZN)

ABBREVIATIONS:

MZN = Metallized Zinc Negative
PJN = Pile Jacket Negative
CJN = Cap Jacket Negative
SAN = Submerged Anode Negative
MZA = Metallized Zinc Anode
PJA = Pile Jacket Anode
CJA = Cap Jacket Anode
SA = Submerged Anode
RE = Reference Electrode
REN = Reference Electrode Negative



LEGEND

- (x) Submerged Anode
x = Weight in LBS
- ⊗ Pile Jacket
- ⊙ Cap Jacket
- Primary Anode Terminal
- + Negative Connection
- Encapsulated Splice
- Reference Electrode

TYPICAL WIRE SIZES & COLORS AS FOLLOWS:
MZA & PJA = #10 Red
MZN; PJN = #10 Blue
SA = #8 Black
RE/REN: #16 Twisted Pair Red/Black

Tongass Span 2A

SCALE: NONE	Field Sketch	DRAWN BY KRH
DATE: 5-9-11	Electrical As-Built	REVISED 09-08-11
GREAT WESTERN CORPORATION		
Ketchikan Viaduct II Repair & C.P.		DRAWING NUMBER T2A

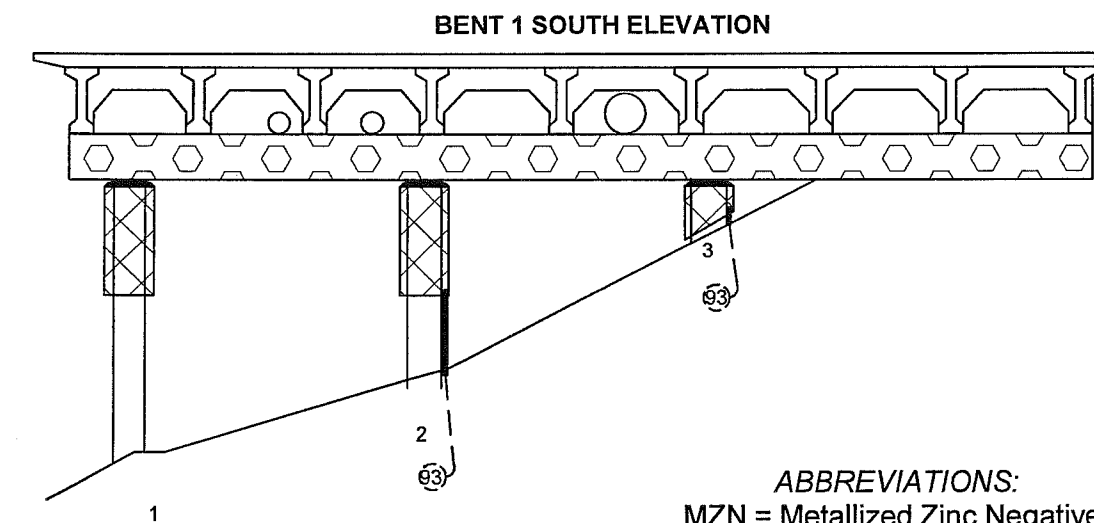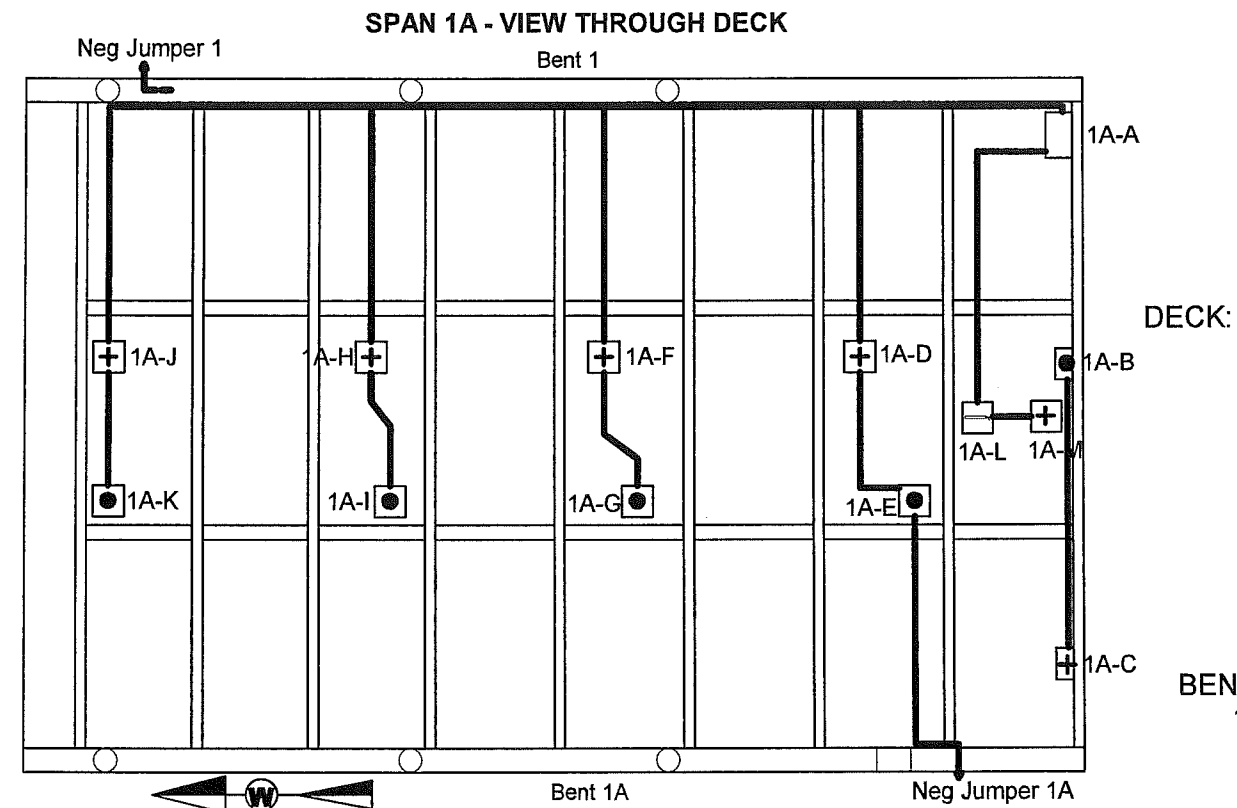

ABBREVIATIONS:

MZN = Metallized Zinc Negative

PJN = Pile Jacket Negative

CJN = Cap Jacket Negative

SAN = Submerged Anode Negative

MZA = Metallized Zinc Anode

PJA = Pile Jacket Anode

CJA = Cap Jacket Anode

SA = Submerged Anode

RE = Reference Electrode

REN = Reference Electrode Negative


TYPICAL WIRE SIZES & COLORS AS FOLLOWS:

MZA & PJA = #10 Red

MZN; PJN = #10 Blue

SA = #8 Black

RE/REN: #16 Twisted Pair Red/Black

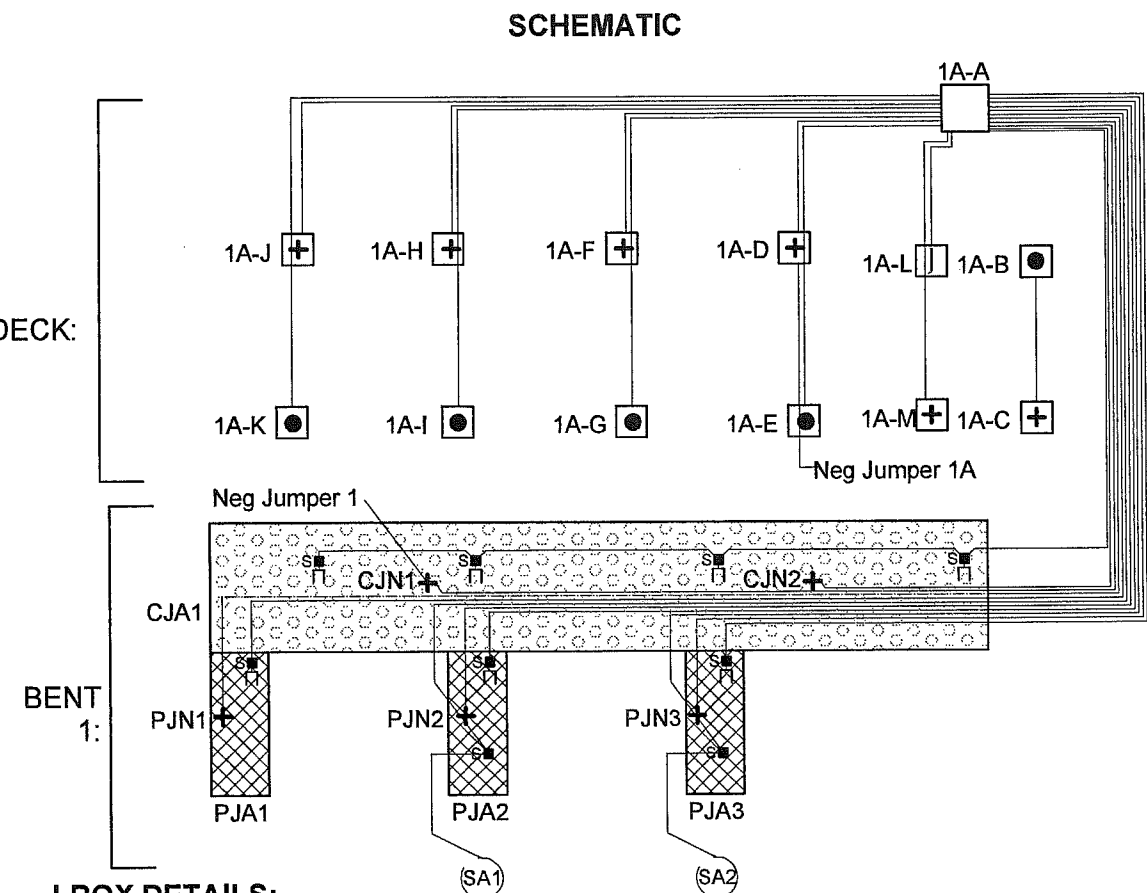




J-BOX DETAILS:

	J-Box Size	Wires or Structure
1A-A	14" x 12" x 8"	MAIN J-BOX: (4) MZA; (4) MZN; (3) PJA; (3) PJN; (1) CJA; (2) CJN; (2) SA; SAN jumpered from PJN; CJN1 jumpered from Span 1
1A-B	4" x 4" x 2"	Primary Anode Terminal Plate (MZA)
1A-C	4" x 4" x 2"	Structure Negative (MZN)
1A-D	4" x 4" x 2"	Structure Negative (MZN); (1) MZA
1A-E	4" x 4" x 2"	Primary Anode Terminal Plate (MZA); (1) MZN JUMPER TO SPAN 2A
1A-F	4" x 4" x 2"	Structure Negative (MZN); (1) MZA
1A-G	4" x 4" x 2"	Primary Anode Terminal Plate (MZA)
1A-H	4" x 4" x 2"	Structure Negative (MZN); (1) MZA
1A-I	4" x 4" x 2"	Primary Anode Terminal Plate (MZA)
1A-J	4" x 4" x 2"	Structure Negative (MZN); (1) MZA
1A-K	4" x 4" x 2"	Primary Anode Terminal Plate (MZA)
1A-L	4" x 4" x 2"	Reference Electrode (RE) S/N 410197; (1) REN
1A-M	4" x 4" x 2"	Reference Electrode Negative (REN)

LEGEND

- (x) Submerged Anode
- x = Weight in LBS
- ⊠ Pile Jacket
- ⊠ Cap Jacket
- Primary Anode Terminal
- + Negative Connection
- Encapsulated Splice
- Reference Electrode

Tongass Span 1A		
SCALE: NONE	Field Sketch	DRAWN BY KRH
DATE: 9-8-11	Electrical As-Built	REVISED 9-12-11
GREAT WESTERN CORPORATION		
Ketchikan Viaduct II Repair & C.P.		DRAWING NUMBER T1A

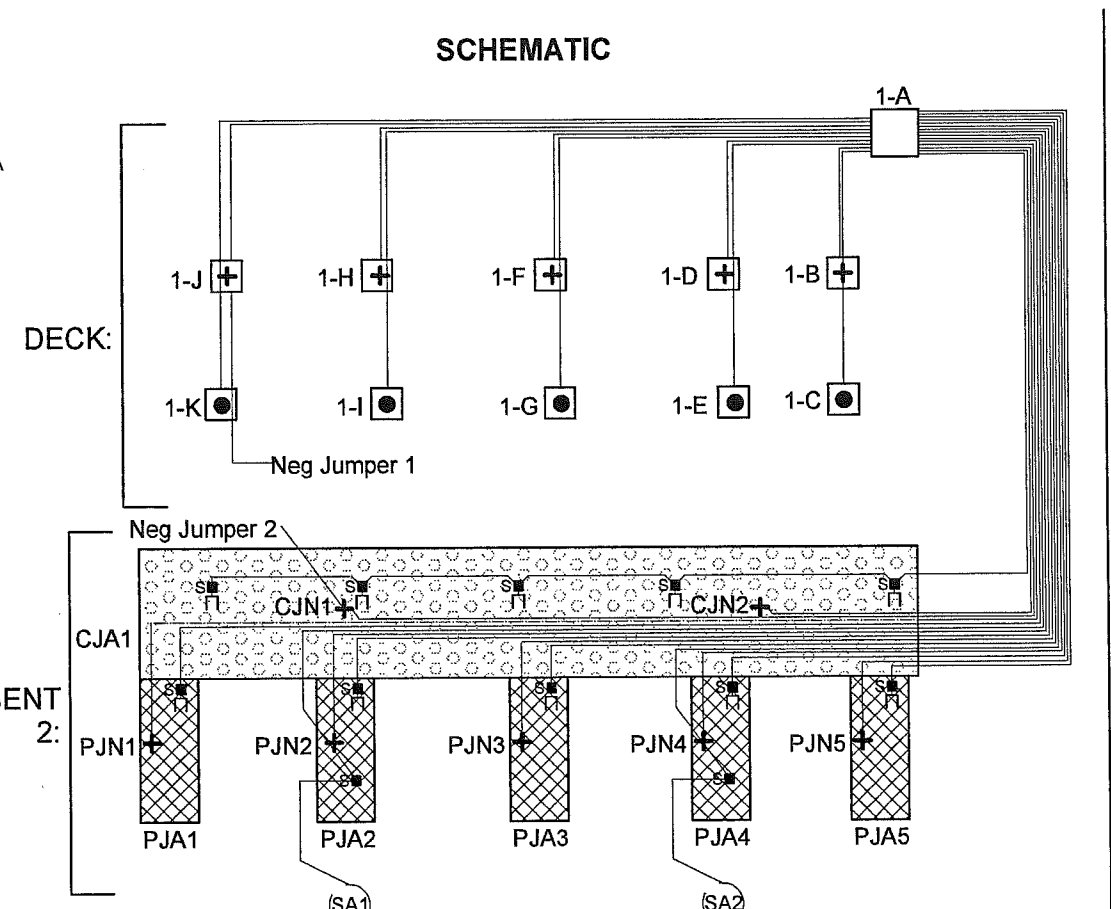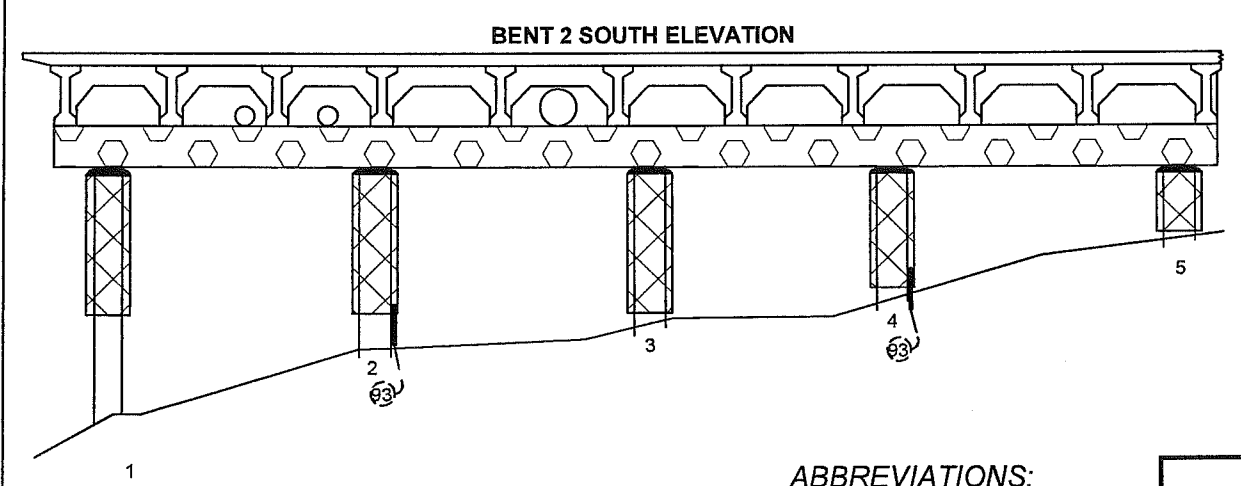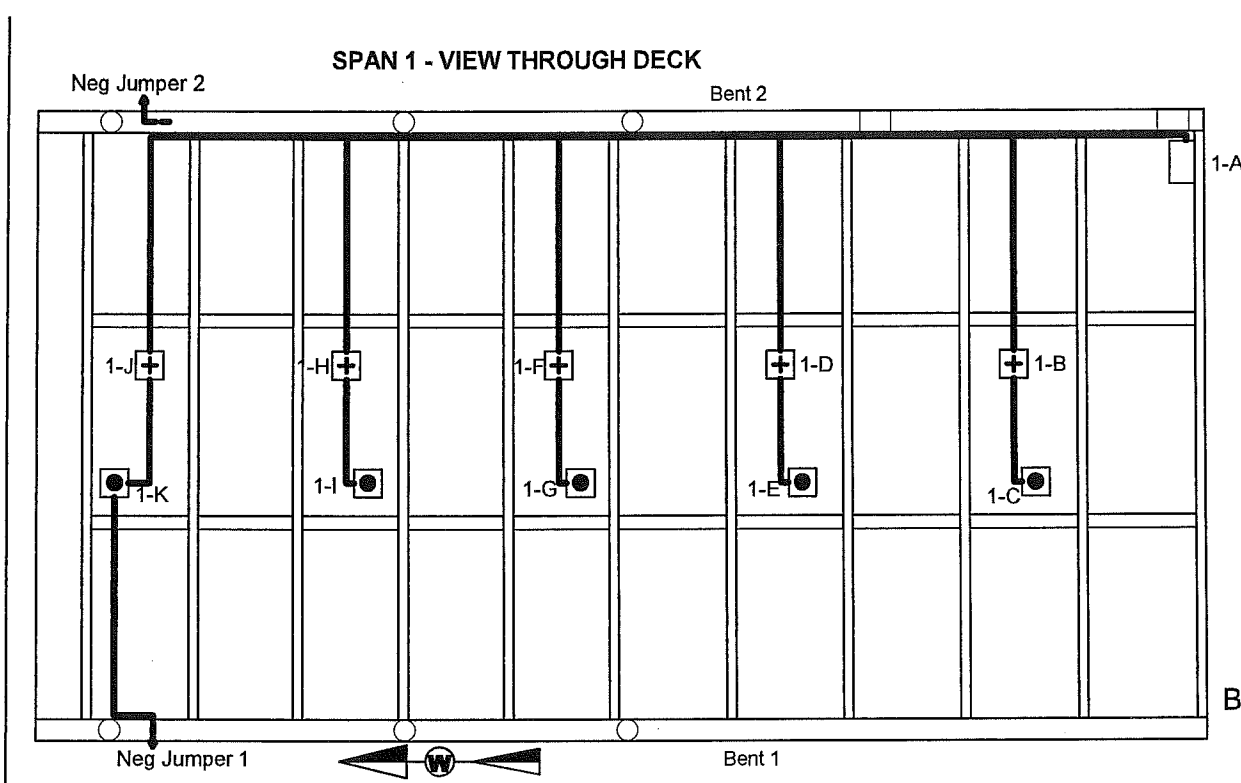

J-BOX DETAILS:

	J-Box Size	Wires or Structure
1-A	14" x 12" x 8"	MAIN J-BOX: (5) MZA; (5) MZN; (5) PJA; (5) PJN; (1) CJA; (2) CJN; (2) SA; SAN jumpered from PJN
1-B	4" x 4" x 2"	Structure Negative (MZN); (1) MZA
1-C	4" x 4" x 2"	Primary Anode Terminal Plate (MZA)
1-D	4" x 4" x 2"	Structure Negative (MZN); (1) MZA
1-E	4" x 4" x 2"	Primary Anode Terminal Plate (MZA)
1-F	4" x 4" x 2"	Structure Negative (MZN); (1) MZA
1-G	4" x 4" x 2"	Primary Anode Terminal Plate (MZA)
1-H	4" x 4" x 2"	Structure Negative (MZN); (1) MZA
1-I	4" x 4" x 2"	Primary Anode Terminal Plate (MZA)
1-J	4" x 4" x 2"	Structure Negative (MZN); (1) MZA
1-K	4" x 4" x 2"	Primary Anode Terminal Plate (MZA); (1) MZN JUMPER 1




ABBREVIATIONS:
 MZN = Metallized Zinc Negative
 PJN = Pile Jacket Negative
 CJN = Cap Jacket Negative
 SAN = Submerged Anode Negative
 MZA = Metallized Zinc Anode
 PJA = Pile Jacket Anode
 CJA = Cap Jacket Anode
 SA = Submerged Anode
 RE = Reference Electrode
 REN = Reference Electrode Negative

TYPICAL WIRE SIZES & COLORS AS FOLLOWS:
 MZA & PJA = #10 Red
 MZN; PJN = #10 Blue
 SA = #8 Black
 RE/REN: #16 Twisted Pair Red/Black

LEGEND

- (x) Submerged Anode
- x = Weight in LBS
- ⊠ Pile Jacket
- ⊞ Cap Jacket
- Primary Anode Terminal
- ⊕ Negative Connection
- Encapsulated Splice
- Reference Electrode

Tongass Span 1		
SCALE: NONE	Field Sketch	DRAWN BY KRH
DATE: 9-12-11	Electrical As-Built	REVISED
GREAT WESTERN CORPORATION		
Ketchikan Viaduct II Repair & C.P.		DRAWING NUMBER T1

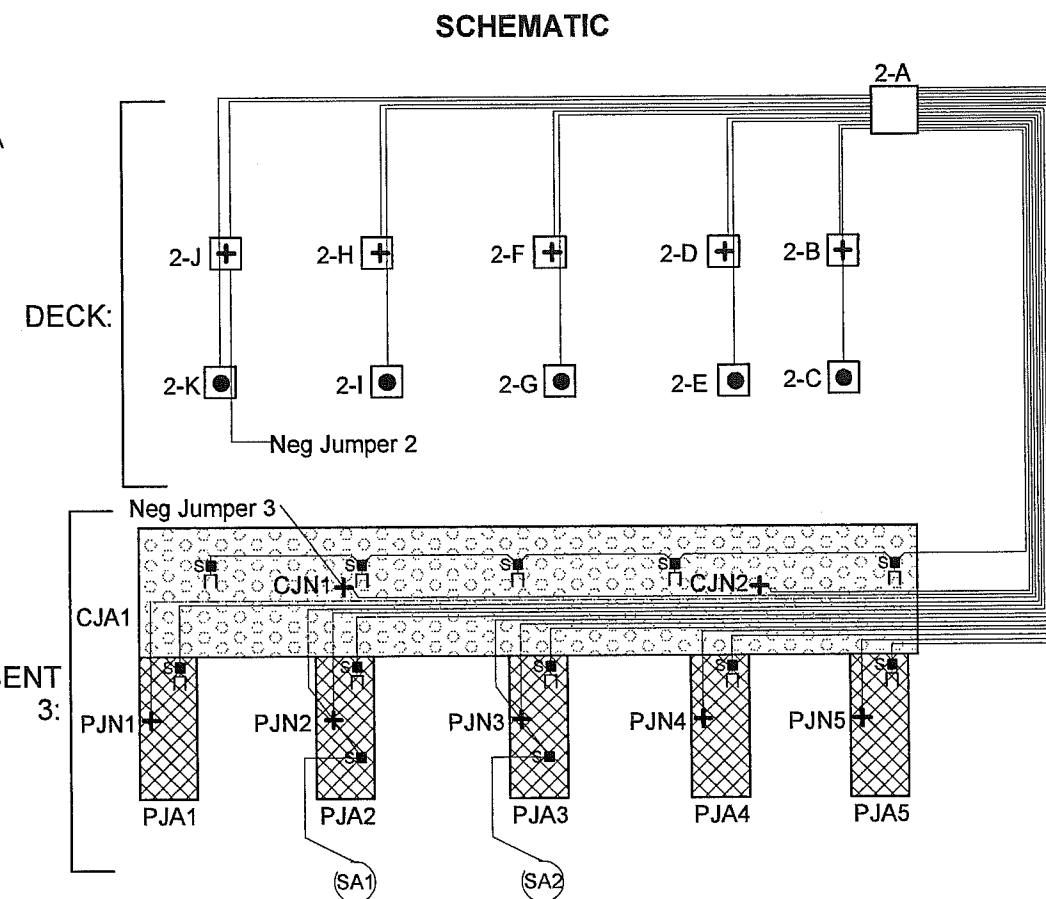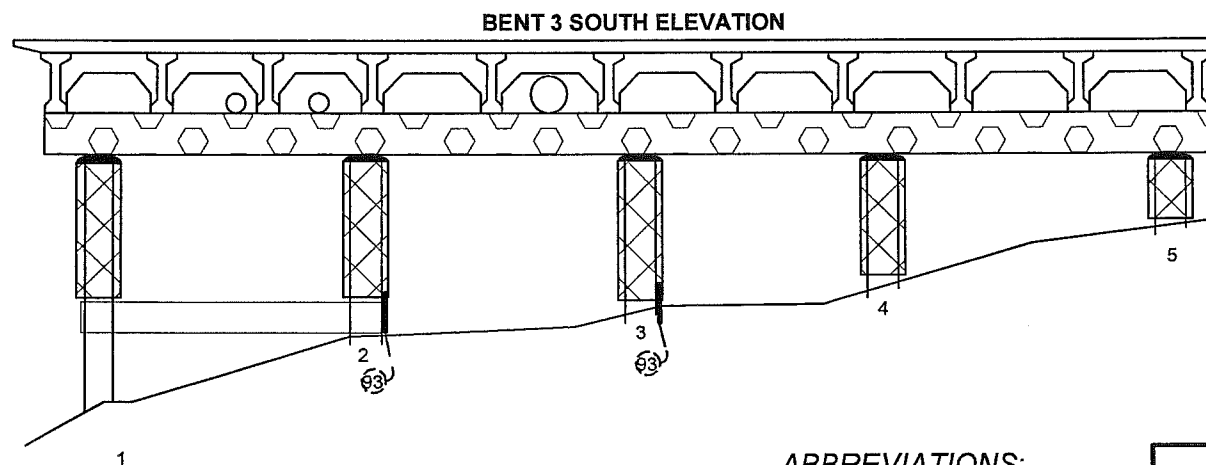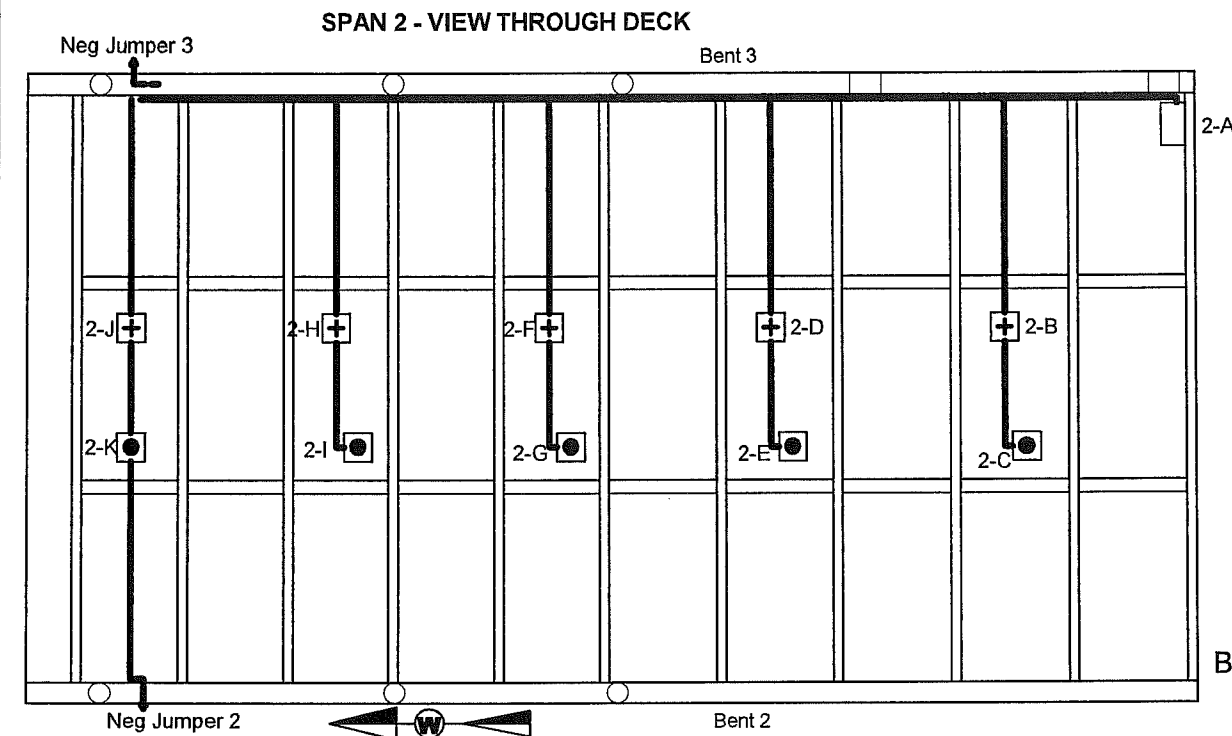

J-BOX DETAILS:

J-Box Size	Wires or Structure
2-A	14" x 12" x 8" MAIN J-BOX: (5) MZA; (5) MZN; (5) PJA; (5) PJN; (1) CJA; (2) CJN; (2) SA; SAN jumpered from PJN
2-B	4" x 4" x 2" Structure Negative (MZN); (1) MZA
2-C	4" x 4" x 2" Primary Anode Terminal Plate (MZA)
2-D	4" x 4" x 2" Structure Negative (MZN); (1) MZA
2-E	4" x 4" x 2" Primary Anode Terminal Plate (MZA)
2-F	4" x 4" x 2" Structure Negative (MZN); (1) MZA
2-G	4" x 4" x 2" Primary Anode Terminal Plate (MZA)
2-H	4" x 4" x 2" Structure Negative (MZN); (1) MZA
2-I	4" x 4" x 2" Primary Anode Terminal Plate (MZA)
2-J	4" x 4" x 2" Structure Negative (MZN); (1) MZA
2-K	4" x 4" x 2" Primary Anode Terminal Plate (MZA); (1) MZN JUMPER 1

ABBREVIATIONS:



MZN = Metallized Zinc Negative
 PJN = Pile Jacket Negative
 CJN = Cap Jacket Negative
 SAN = Submerged Anode Negative
 MZA = Metallized Zinc Anode
 PJA = Pile Jacket Anode
 CJA = Cap Jacket Anode
 SA = Submerged Anode
 RE = Reference Electrode
 REN = Reference Electrode Negative

LEGEND

- (x) Submerged Anode
- x = Weight in LBS
- ⊠ Pile Jacket
- ⊡ Cap Jacket
- Primary Anode Terminal
- + Negative Connection
- Encapsulated Splice
- Reference Electrode


TYPICAL WIRE SIZES & COLORS AS FOLLOWS:
 MZA & PJA = #10 Red
 MZN; PJN = #10 Blue
 SA = #8 Black
 RE/REN: #16 Twisted Pair Red/Black

Tongass Span 2		
SCALE: NONE	Field Sketch	DRAWN BY KRH
DATE: 9-12-11	Electrical As-Built	REVISED
GREAT WESTERN CORPORATION		
Ketchikan Viaduct II Repair & C.P.		DRAWING NUMBER T2

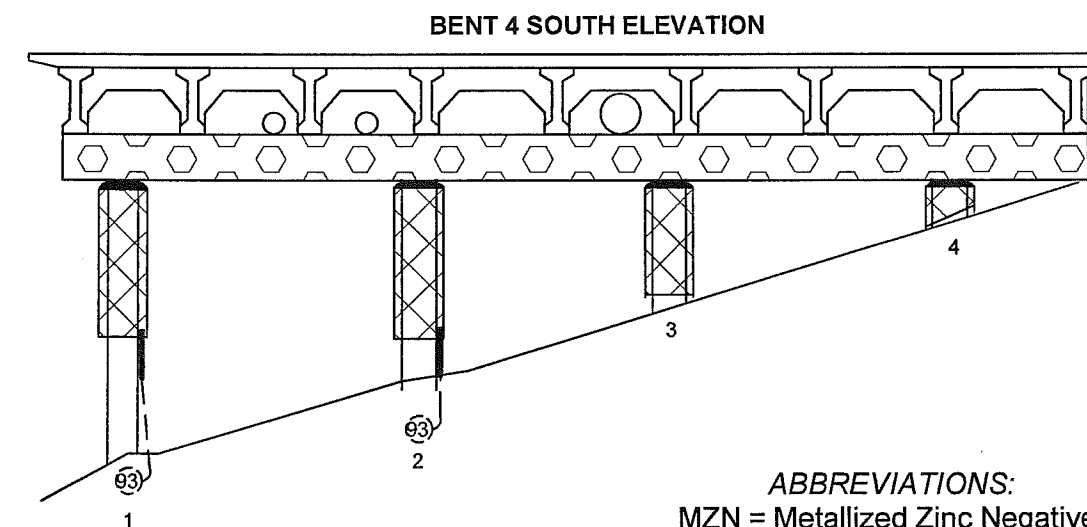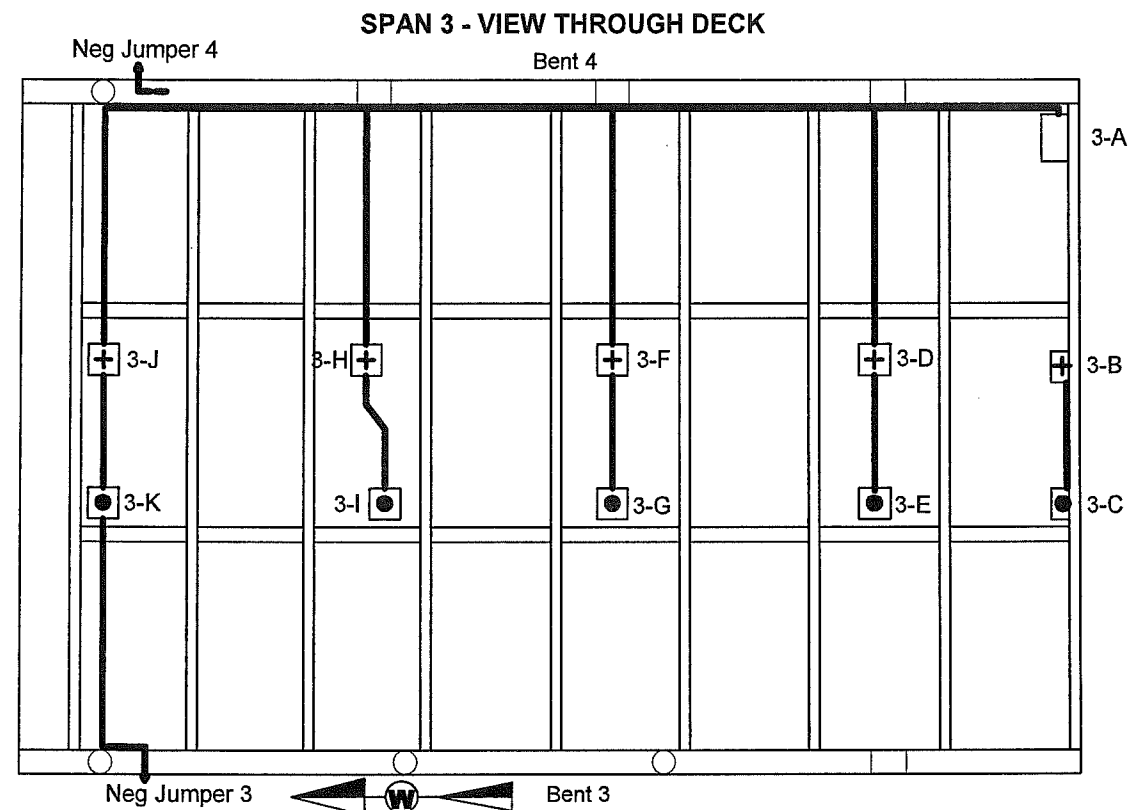

ABBREVIATIONS:
 MZN = Metallized Zinc Negative
 PJN = Pile Jacket Negative
 CJN = Cap Jacket Negative
 SAN = Submerged Anode Negative
 MZA = Metallized Zinc Anode
 PJA = Pile Jacket Anode
 CJA = Cap Jacket Anode
 SA = Submerged Anode
 RE = Reference Electrode
 REN = Reference Electrode Negative

TYPICAL WIRE SIZES & COLORS AS FOLLOWS:
 MZA & PJA = #10 Red
 MZN; PJN = #10 Blue
 SA = #8 Black
 RE/REN: #16 Twisted Pair Red/Black

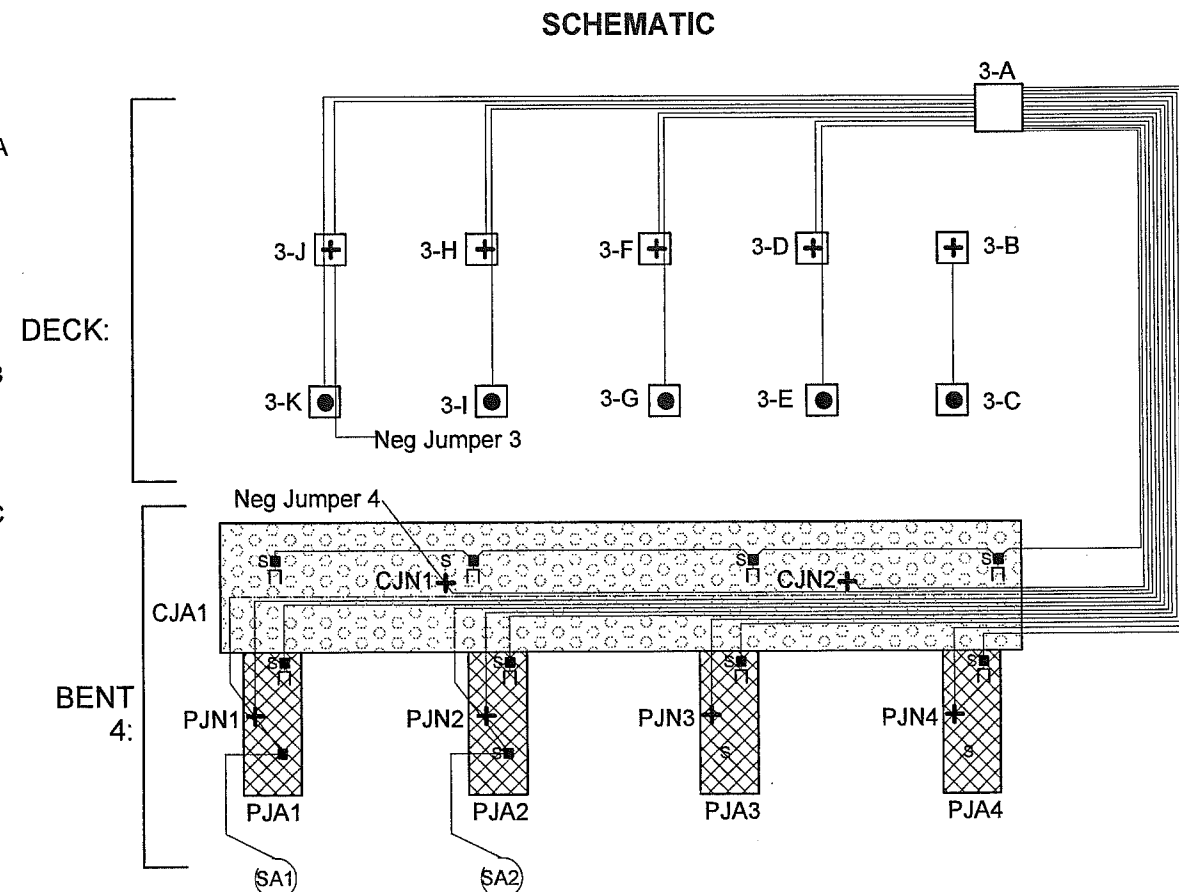



J-BOX DETAILS:

	J-Box Size	Wires or Structure
3-A	14" x 12" x 8"	MAIN J-BOX: (4) MZA; (4) MZN; (3) PJA; (3) PJN; (1) CJA; (2) CJN; (2) SA; SAN jumpered from PJN
3-B	4" x 4" x 2"	Structure Negative (MZN)
3-C	4" x 4" x 2"	Primary Anode Terminal Plate (MZA)
3-D	4" x 4" x 2"	Structure Negative (MZN); (1) MZA
3-E	4" x 4" x 2"	Primary Anode Terminal Plate (MZA)
3-F	4" x 4" x 2"	Structure Negative (MZN); (1) MZA
3-G	4" x 4" x 2"	Primary Anode Terminal Plate (MZA)
3-H	4" x 4" x 2"	Structure Negative (MZN); (1) MZA
3-I	4" x 4" x 2"	Primary Anode Terminal Plate (MZA)
3-J	4" x 4" x 2"	Structure Negative (MZN); (1) MZA
3-K	4" x 4" x 2"	Primary Anode Terminal Plate (MZA); (1) MZN JUMPER 3

LEGEND


- (x) Submerged Anode
x = Weight in LBS
- ⊠ Pile Jacket
- ⊡ Cap Jacket
- Primary Anode Terminal
- + Negative Connection
- Encapsulated Splice
- Reference Electrode

Tongass Span 3		
SCALE: NONE	Field Sketch	DRAWN BY KRH
DATE: 9-12-11	Electrical As-Built	REVISED
GREAT WESTERN CORPORATION		
Ketchikan Viaduct II Repair & C.P.		DRAWING NUMBER T3

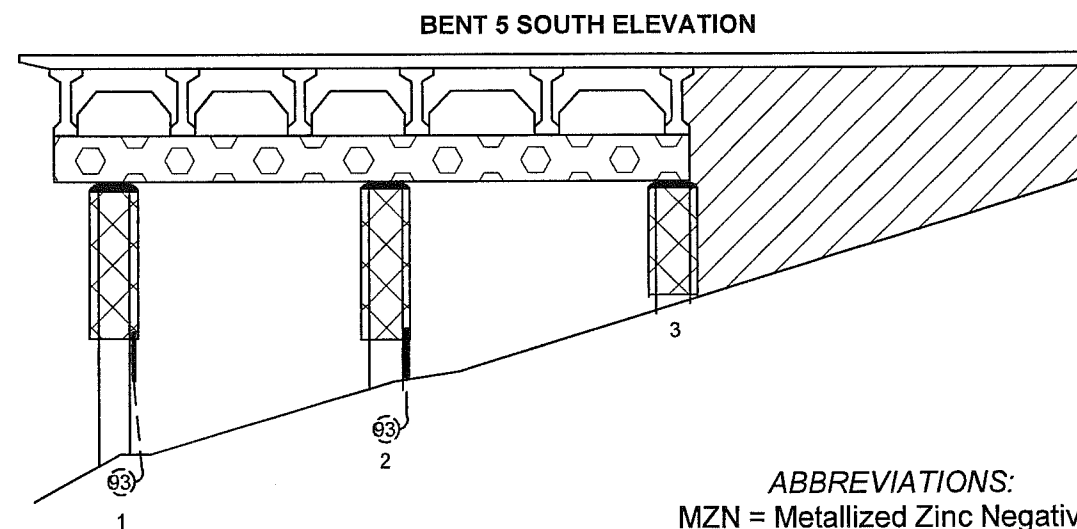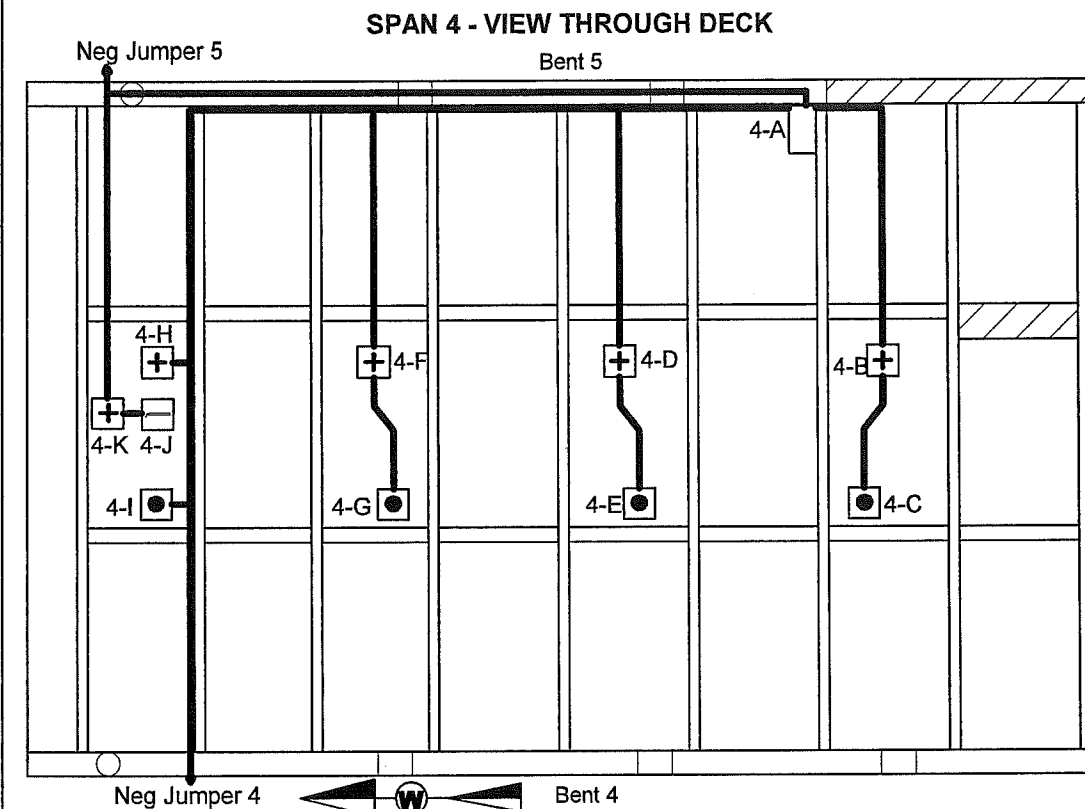

TYPICAL WIRE SIZES & COLORS AS FOLLOWS:
 MZA & PJA = #10 Red
 MZN; PJN = #10 Blue
 SA = #8 Black
 RE/REN: #16 Twisted Pair Red/Black

ABBREVIATIONS:
 MZN = Metallized Zinc Negative
 PJN = Pile Jacket Negative
 CJN = Cap Jacket Negative
 SAN = Submerged Anode Negative
 MZA = Metallized Zinc Anode
 PJA = Pile Jacket Anode
 CJA = Cap Jacket Anode
 SA = Submerged Anode
 RE = Reference Electrode
 REN = Reference Electrode Negative


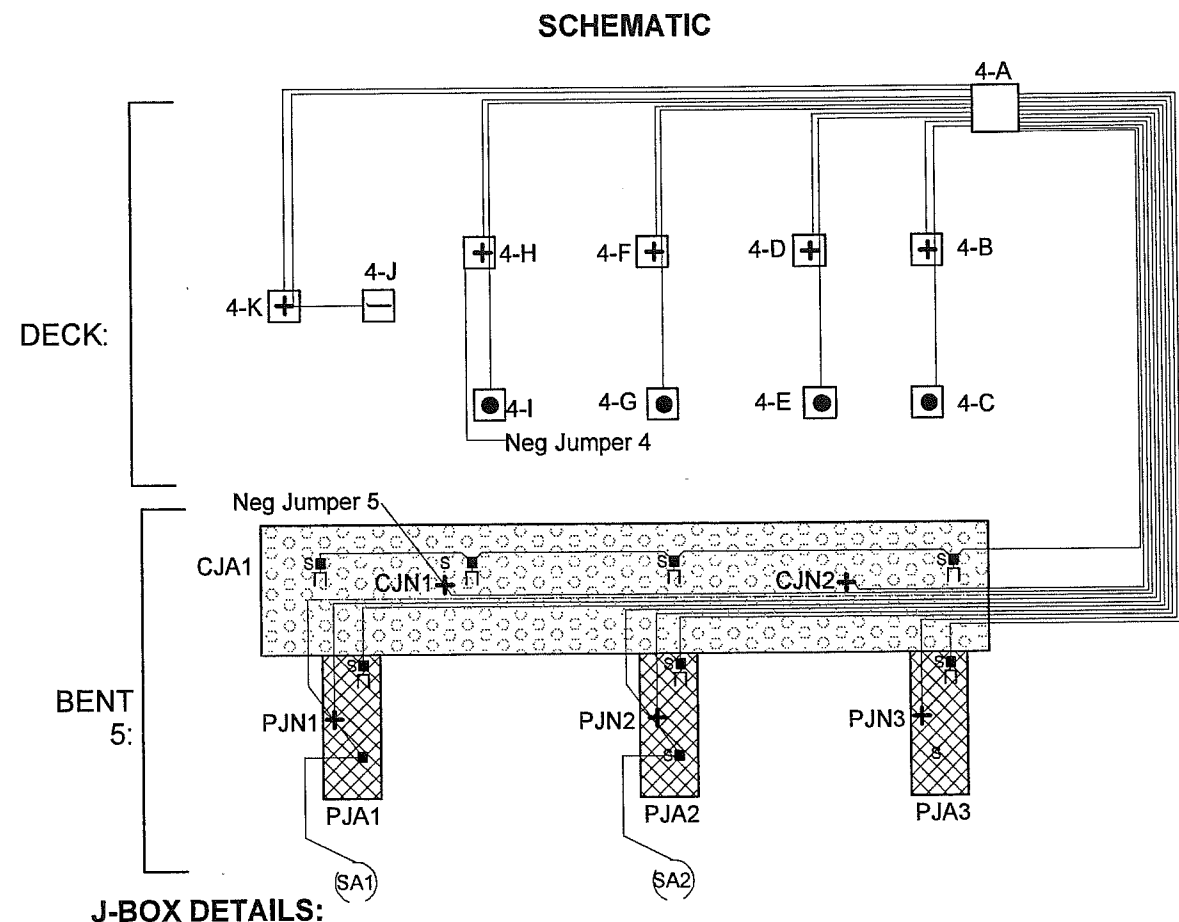


	J-Box Size	Wires or Structure
4-A	15" x 12" x 8"	MAIN J-BOX: (4) MZA; (4) MZN; (3) PJA; (3) PJN; (1) CJA; (2) CJN; (2) SA; SAN jumpered from PJN
4-B	5" x 5" x 2"	Structure Negative (MZN); (1) MZA
4-C	5" x 5" x 2"	Primary Anode Terminal Plate (MZA)
4-D	5" x 5" x 2"	Structure Negative (MZN); (1) MZA
4-E	5" x 5" x 2"	Primary Anode Terminal Plate (MZA)
4-F	5" x 5" x 2"	Structure Negative (MZN); (1) MZA
4-G	5" x 5" x 2"	Primary Anode Terminal Plate (MZA)
4-H	5" x 5" x 2"	Structure Negative (MZN)
4-I	5" x 5" x 2"	Primary Anode Terminal Plate (MZA)
4-J	5" x 5" x 2"	Reference Electrode (RE) S/N 410203
4-K	5" x 5" x 2"	Reference Electrode Negative (REN); (1) RE

LEGEND


(x)	Submerged Anode
x	Weight in LBS
⊗	Pile Jacket
⊠	Cap Jacket
●	Primary Anode Terminal
+	Negative Connection
■	Encapsulated Splice
—	Reference Electrode

Tongass Span 4		
SCALE: NONE	Field Sketch	DRAWN BY KRH
DATE: 9-12-11	Electrical As-Built	REVISED
GREAT WESTERN CORPORATION		
Ketchikan Viaduct II Repair & C.P.		DRAWING NUMBER T4

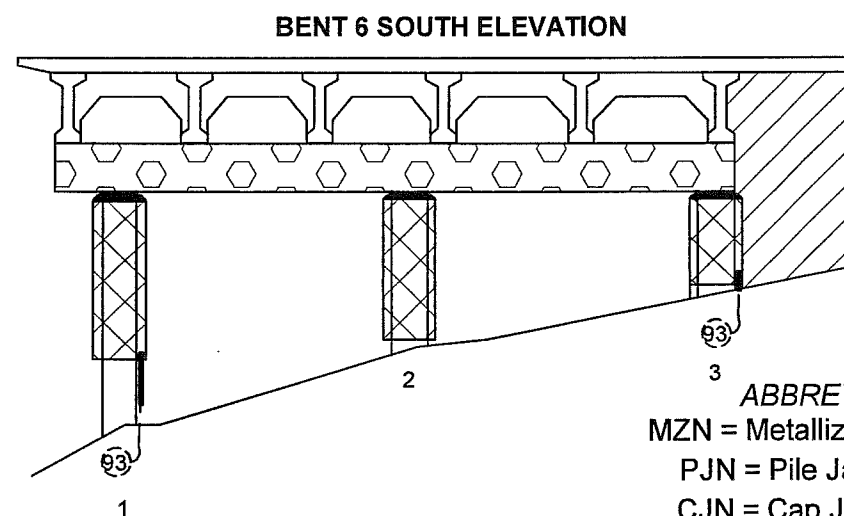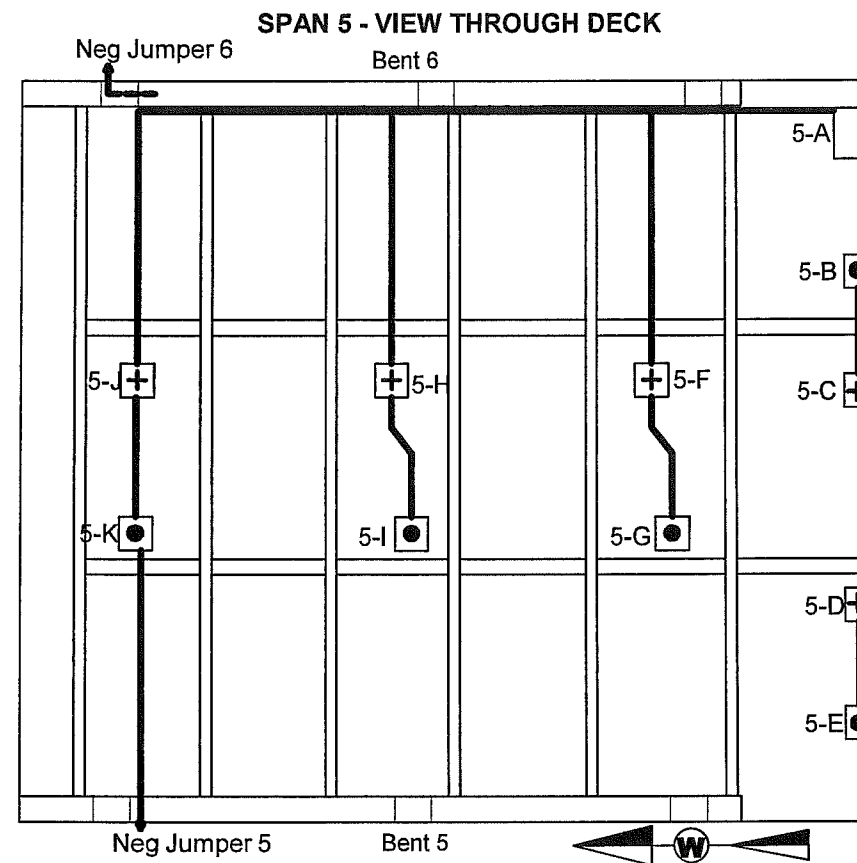

TYPICAL WIRE SIZES & COLORS AS FOLLOWS:
 MZA & PJA = #10 Red
 MZN; PJN = #10 Blue
 SA = #8 Black
 RE/REN: #16 Twisted Pair Red/Black

ABBREVIATIONS:
 MZN = Metallized Zinc Negative
 PJN = Pile Jacket Negative
 CJN = Cap Jacket Negative
 SAN = Submerged Anode Negative
 MZA = Metallized Zinc Anode
 PJA = Pile Jacket Anode
 CJA = Cap Jacket Anode
 SA = Submerged Anode
 RE = Reference Electrode
 REN = Reference Electrode Negative

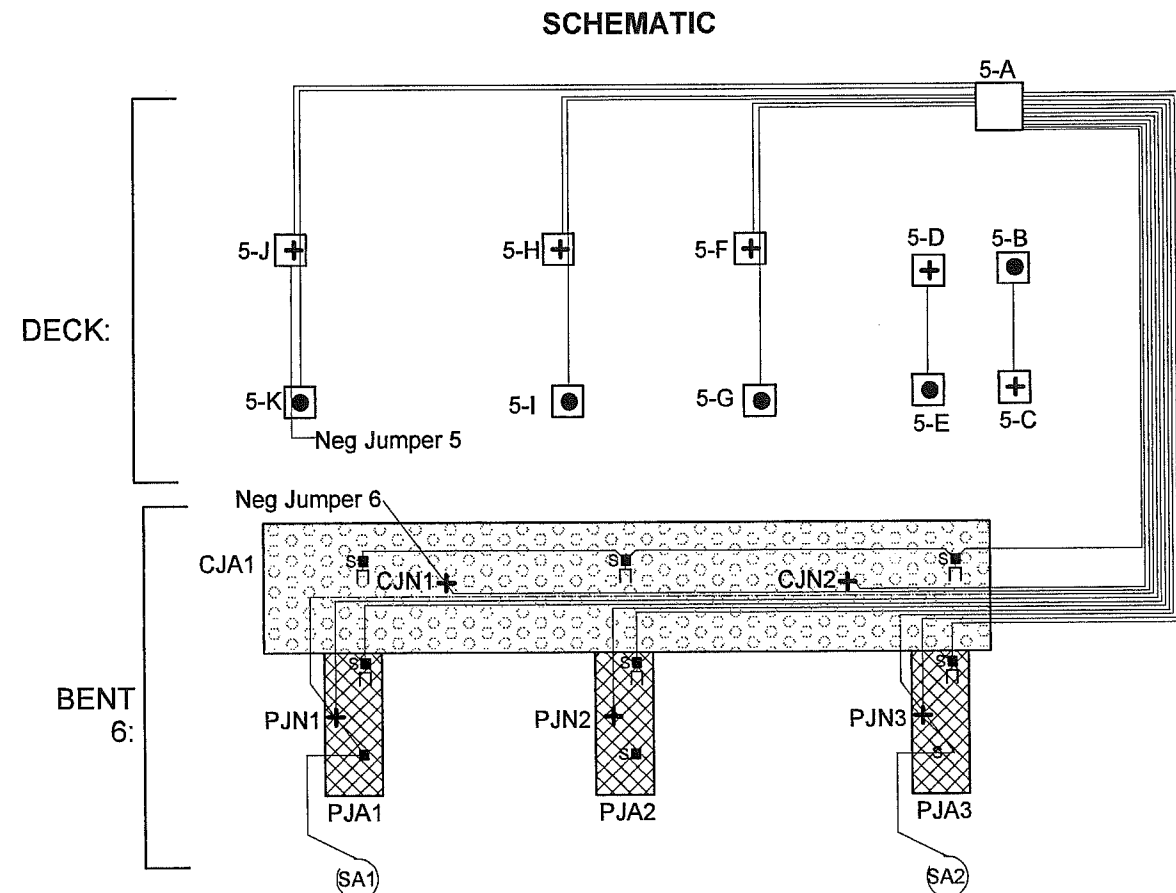




J-BOX DETAILS:

	J-Box Size	Wires or Structure
5-A	14" x 12" x 8"	MAIN J-BOX: (3) MZA; (3) MZN; (3) PJA; (3) PJN; (1) CJA; (2) CJN; (2) SA; SAN jumpered from PJN
5-B	5" x 5" x 2"	Primary Anode Terminal Plate (MZA)
5-C	5" x 5" x 2"	Structure Negative (MZN)
5-D	5" x 5" x 2"	Structure Negative (MZN)
5-E	5" x 5" x 2"	Primary Anode Terminal Plate (MZA)
5-F	5" x 5" x 2"	Structure Negative (MZN); (1) MZA
5-G	5" x 5" x 2"	Primary Anode Terminal Plate (MZA)
5-H	5" x 5" x 2"	Structure Negative (MZN); (1) MZA
5-I	5" x 5" x 2"	Primary Anode Terminal Plate (MZA)
5-J	5" x 5" x 2"	Structure Negative (MZN); (1) MZA
5-K	5" x 5" x 2"	Primary Anode Terminal Plate (MZA); (1) MZN JUMPER 5

LEGEND

- (x) Submerged Anode
- x = Weight in LBS
- ⊠ Pile Jacket
- ⊡ Cap Jacket
- Primary Anode Terminal
- + Negative Connection
- Encapsulated Splice
- Reference Electrode

Tongass Span 5		
SCALE: NONE	Field Sketch	DRAWN BY KRH
DATE: 9-12-11	Electrical As-Built	REVISED
GREAT WESTERN CORPORATION		
Ketchikan Viaduct II Repair & C.P.		DRAWING NUMBER T5

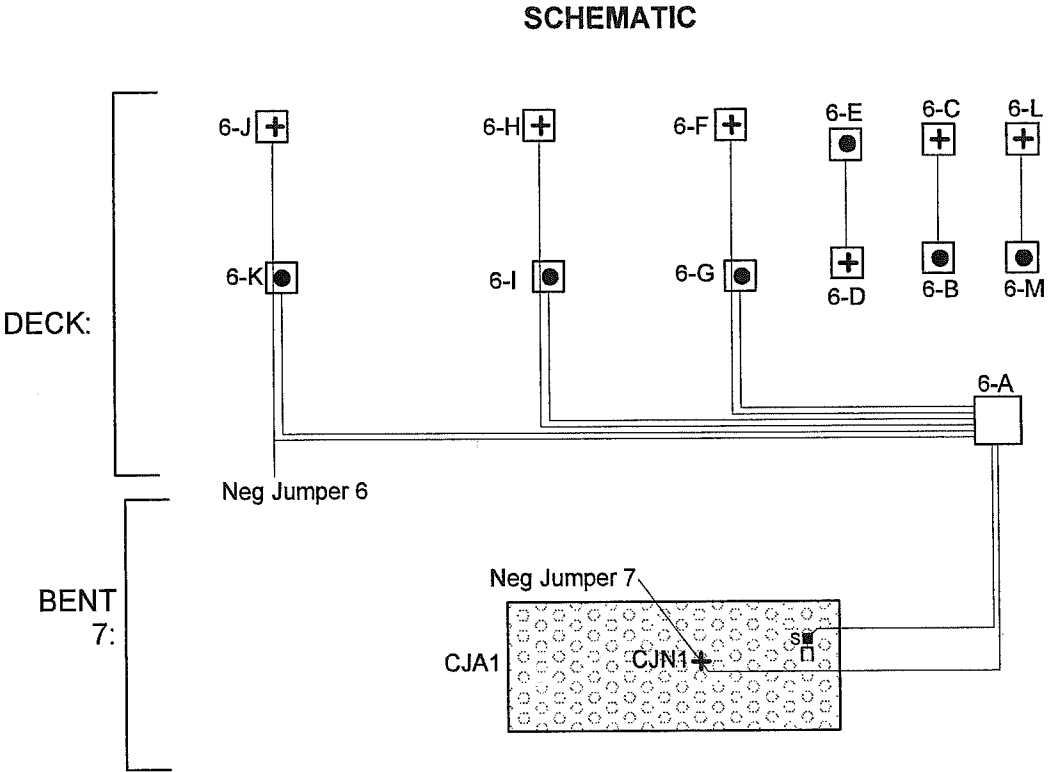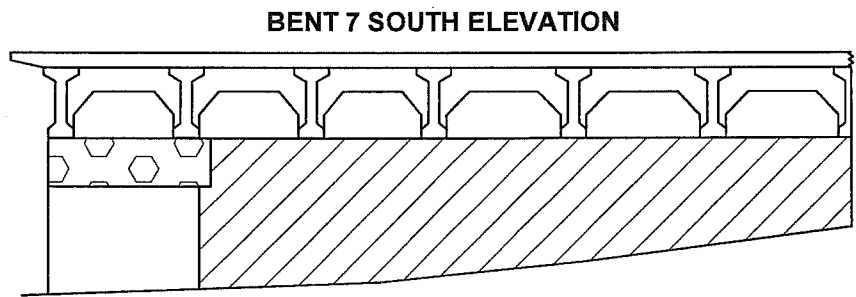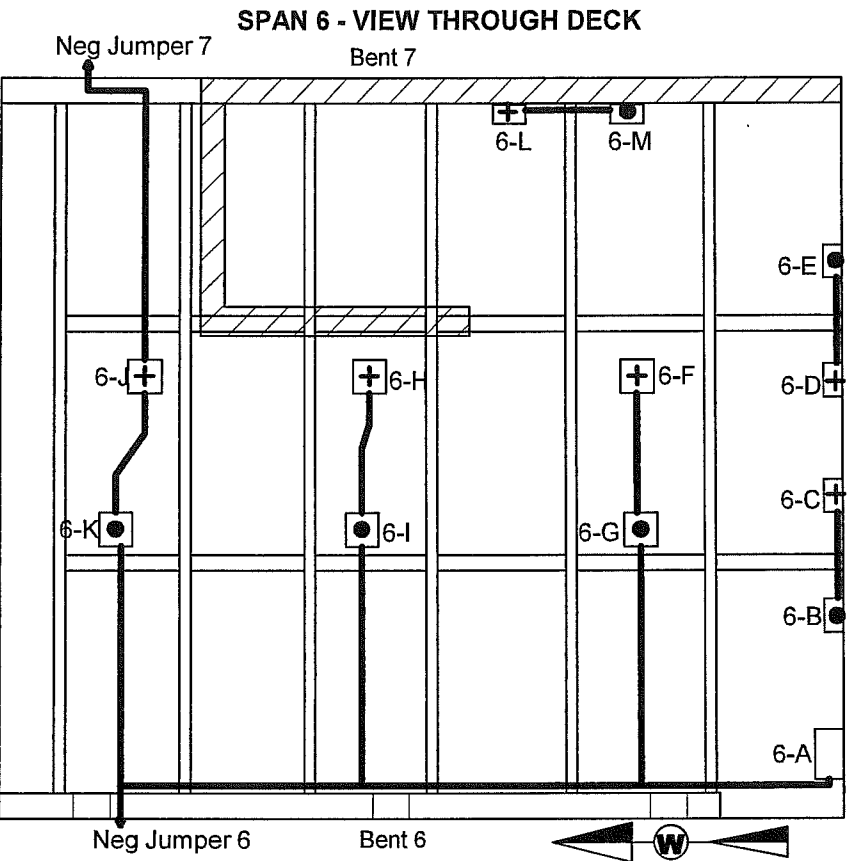

J-BOX DETAILS:

	J-Box Size	Wires or Structure
6-A	14" x 12" x 8"	MAIN J-BOX: (3) MZA; (3) MZN; (1) CJA; (1) CJN
6-B	5" x 5" x 2"	Primary Anode Terminal Plate (MZA)
6-C	5" x 5" x 2"	Structure Negative (MZN)
6-D	5" x 5" x 2"	Structure Negative (MZN)
6-E	5" x 5" x 2"	Primary Anode Terminal Plate (MZA)
6-F	5" x 5" x 2"	Structure Negative (MZN)
6-G	5" x 5" x 2"	Primary Anode Terminal Plate (MZA); (1) MZN
6-H	5" x 5" x 2"	Structure Negative (MZN)
6-I	5" x 5" x 2"	Primary Anode Terminal Plate (MZA); (1) MZN
6-J	5" x 5" x 2"	Structure Negative (MZN) - NEG JUMPER 6
6-K	5" x 5" x 2"	Primary Anode Terminal Plate (MZA); (1) MZN
6-L	5" x 5" x 2"	Structure Negative (MZN)
6-M	5" x 5" x 2"	Primary Anode Terminal Plate (MZA)


ABBREVIATIONS:
 MZN = Metallized Zinc Negative
 PJN = Pile Jacket Negative
 CJN = Cap Jacket Negative
 SAN = Submerged Anode Negative
 MZA = Metallized Zinc Anode
 PJA = Pile Jacket Anode
 CJA = Cap Jacket Anode
 SA = Submerged Anode
 RE = Reference Electrode
 REN = Reference Electrode Negative

TYPICAL WIRE SIZES & COLORS AS FOLLOWS:
 MZA & PJA = #10 Red
 MZN; PJN = #10 Blue
 SA = #8 Black
 RE/REN: #16 Twisted Pair Red/Black


LEGEND	
(x)	Submerged Anode x = Weight in LBS
▨	Pile Jacket
▩	Cap Jacket
●	Primary Anode Terminal
+	Negative Connection
■	Encapsulated Splice
—	Reference Electrode

Tongass Span 6		
SCALE: NONE	Field Sketch	DRAWN BY KRH
DATE: 9-12-11	Electrical As-Built	REVISED
GREAT WESTERN CORPORATION		
Ketchikan Viaduct II Repair & C.P.		DRAWING NUMBER T6


SPAN 7 - VIEW THROUGH DECK

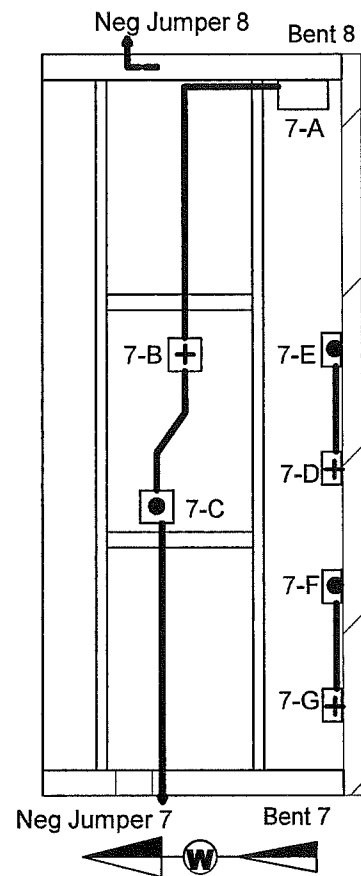

BENT 8 SOUTH ELEVATION

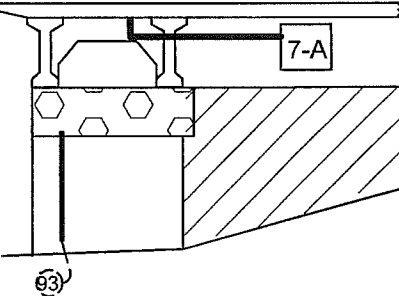

SCHEMATIC

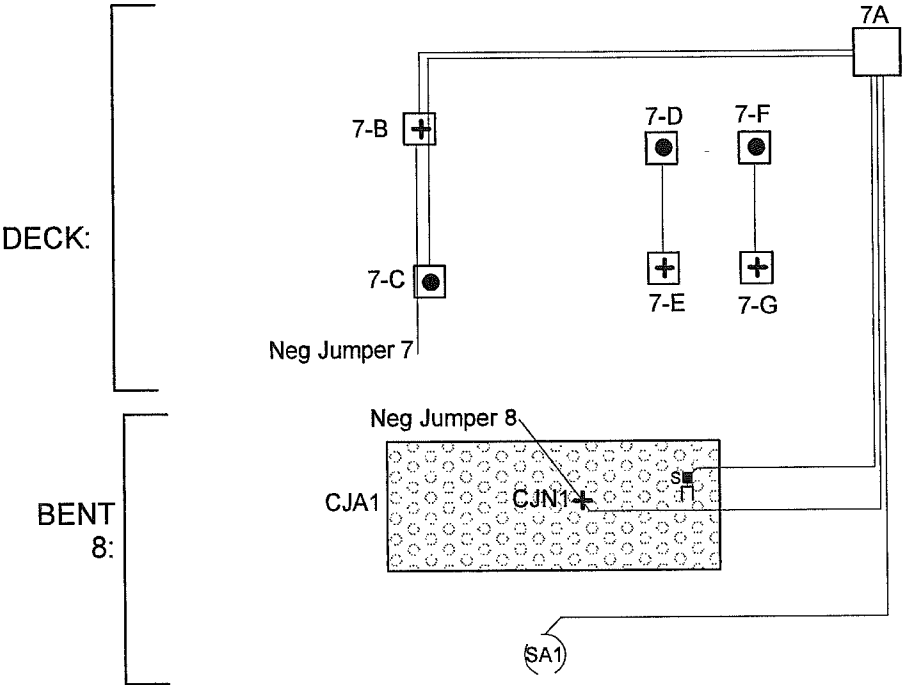

J-BOX DETAILS:

	J-Box Size	Wires or Structure
7-A	14" x 12" x 8"	MAIN J-BOX: (1) MZA; (1) MZN; (1) CJA; (1) CJN; (1) SA
7-B	5" x 5" x 2"	Structure Negative (MZN) - NEG JUMPER 7; (1) MZA
7-C	5" x 5" x 2"	Primary Anode Terminal Plate (MZA); (1) NEG JMPR 7
7-D	5" x 5" x 2"	Primary Anode Terminal Plate (MZA)
7-E	5" x 5" x 2"	Structure Negative (MZN)
7-F	5" x 5" x 2"	Primary Anode Terminal Plate (MZA)
7-G	5" x 5" x 2"	Structure Negative (MZN)

ABBREVIATIONS:

MZN = Metallized Zinc Negative
PJN = Pile Jacket Negative
CJN = Cap Jacket Negative
SAN = Submerged Anode Negative
MZA = Metallized Zinc Anode
PJA = Pile Jacket Anode
CJA = Cap Jacket Anode
SA = Submerged Anode
RE = Reference Electrode
REN = Reference Electrode Negative


LEGEND

- (x) Submerged Anode
x = Weight in LBS
- ▨ Pile Jacket
- ▩ Cap Jacket
- Primary Anode Terminal
- + Negative Connection
- Encapsulated Splice
- Reference Electrode


TYPICAL WIRE SIZES & COLORS AS FOLLOWS:
MZA & PJA = #10 Red
MZN; PJN = #10 Blue
SA = #8 Black
RE/REN: #16 Twisted Pair Red/Black

Tongass Span 7		
SCALE: NONE	Field Sketch	DRAWN BY KRH
DATE: 9-12-11	Electrical As-Built	REVISED
GREAT WESTERN CORPORATION		
Ketchikan Viaduct II Repair & C.P.		DRAWING NUMBER T7


SPAN 8 - VIEW THROUGH DECK

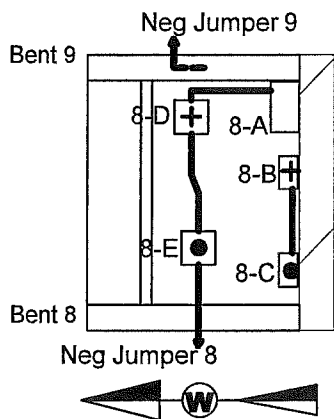

SCHEMATIC

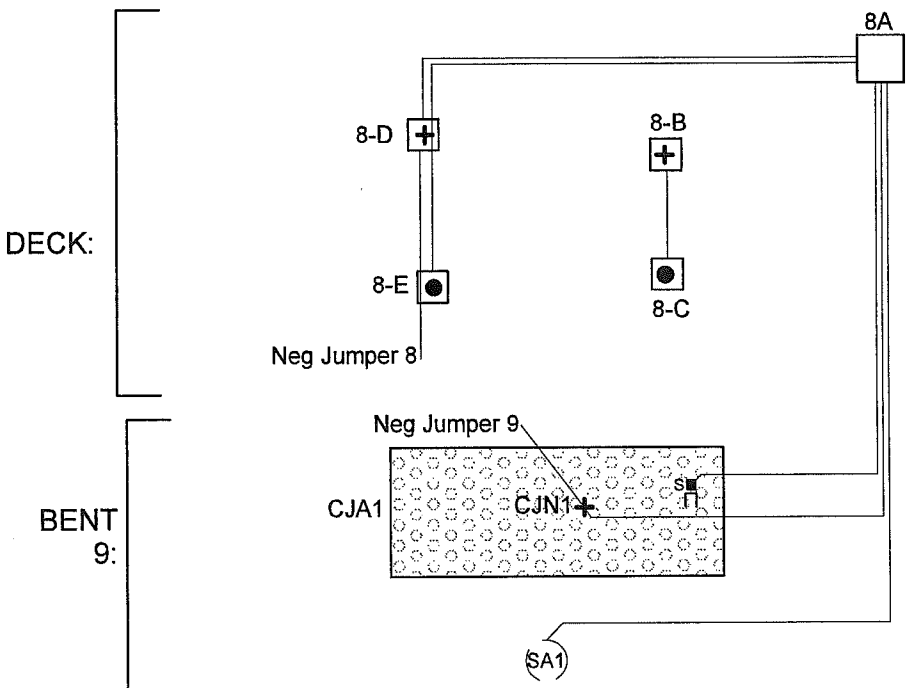

BENT 9 SOUTH ELEVATION

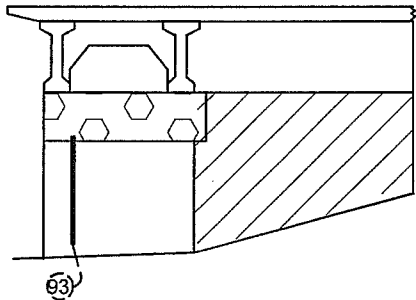

J-BOX DETAILS:

	J-Box Size	Wires or Structure
8-A	14" x 12" x 8"	MAIN J-BOX: (1) MZA; (1) MZN; (1) CJA; (1) CJN; (1) SA
8-B	5" x 5" x 2"	Structure Negative (MZN)
8-C	5" x 5" x 2"	Primary Anode Terminal Plate (MZA)
8-D	5" x 5" x 2"	Structure Negative (MZN) - NEG JUMPER 8; (1) MZA
8-E	5" x 5" x 2"	Primary Anode Terminal Plate (MZA); (1) NEG JMPR 8

ABBREVIATIONS:

MZN = Metallized Zinc Negative
PJN = Pile Jacket Negative
CJN = Cap Jacket Negative
SAN = Submerged Anode Negative
MZA = Metallized Zinc Anode
PJA = Pile Jacket Anode
CJA = Cap Jacket Anode
SA = Submerged Anode
RE = Reference Electrode
REN = Reference Electrode Negative


LEGEND

- (x) Submerged Anode
x = Weight in LBS
- ⊗ Pile Jacket
- ⊠ Cap Jacket
- Primary Anode Terminal
- + Negative Connection
- Encapsulated Splice
- Reference Electrode


TYPICAL WIRE SIZES & COLORS AS FOLLOWS:
MZA & PJA = #10 Red
MZN; PJN = #10 Blue
SA = #8 Black
RE/REN: #16 Twisted Pair Red/Black

Tongass Span 8		
SCALE: NONE	Field Sketch	DRAWN BY KRH
DATE: 9-12-11	Electrical As-Built	REVISED
GREAT WESTERN CORPORATION		
Ketchikan Viaduct II Repair & C.P.		DRAWING NUMBER T8

SPAN 9 - VIEW THROUGH DECK

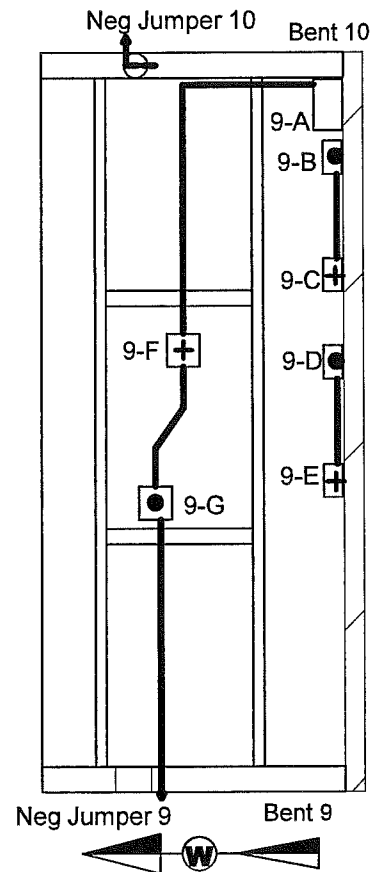


BENT 10 SOUTH ELEVATION

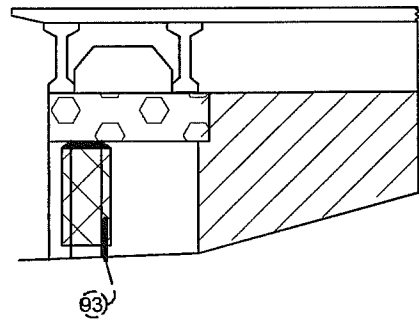

TYPICAL WIRE SIZES & COLORS AS FOLLOWS:
MZA & PJA = #10 Red
MZN; PJN = #10 Blue
SA = #8 Black
RE/REN: #16 Twisted Pair Red/Black

ABBREVIATIONS:
MZN = Metallized Zinc Negative
PJN = Pile Jacket Negative
CJN = Cap Jacket Negative
SAN = Submerged Anode Negative
MZA = Metallized Zinc Anode
PJA = Pile Jacket Anode
CJA = Cap Jacket Anode
SA = Submerged Anode
RE = Reference Electrode
REN = Reference Electrode Negative

SCHEMATIC

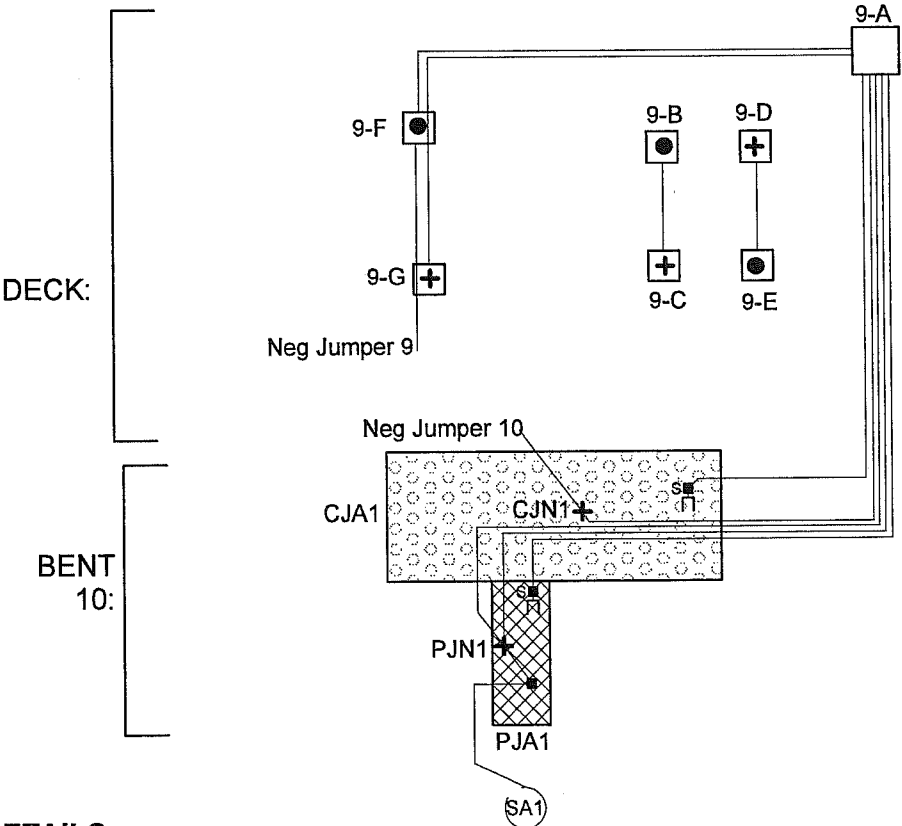

J-BOX DETAILS:

	J-Box Size	Wires or Structure
9-A	14" x 12" x 8"	MAIN J-BOX: (1) MZA; (1) MZN; (1) CJA; (1) CJN; (1) PJA; (1) PJN; (1) SA; SAN jumpered from PJN
9-B	5" x 5" x 2"	Primary Anode Terminal Plate (MZA)
9-C	5" x 5" x 2"	Structure Negative (MZN)
9-D	5" x 5" x 2"	Structure Negative (MZN)
9-E	5" x 5" x 2"	Primary Anode Terminal Plate (MZA)
9-F	5" x 5" x 2"	Primary Anode Terminal Plate (MZA); (1) MZN
9-G	5" x 5" x 2"	Structure Negative (MZN) - NEG JUMPER 9

LEGEND

- (x) Submerged Anode
x = Weight in LBS
- ▨ Pile Jacket
- ▩ Cap Jacket
- Primary Anode Terminal
- + Negative Connection
- Encapsulated Splice
- Reference Electrode

Tongass Span 9

SCALE: NONE

Field Sketch

DRAWN BY KRH

DATE: 9-12-11



Electrical As-Built

REVISED

GREAT WESTERN CORPORATION


Ketchikan Viaduct II
Repair & C.P.

DRAWING NUMBER
T9

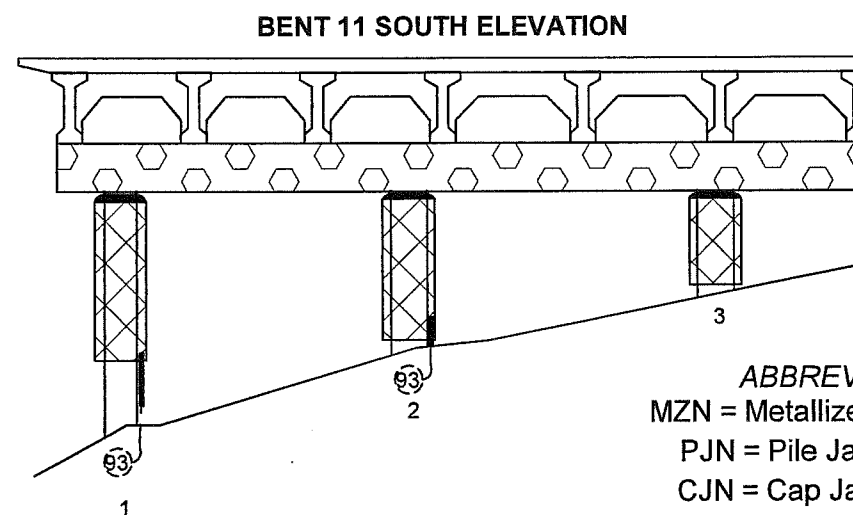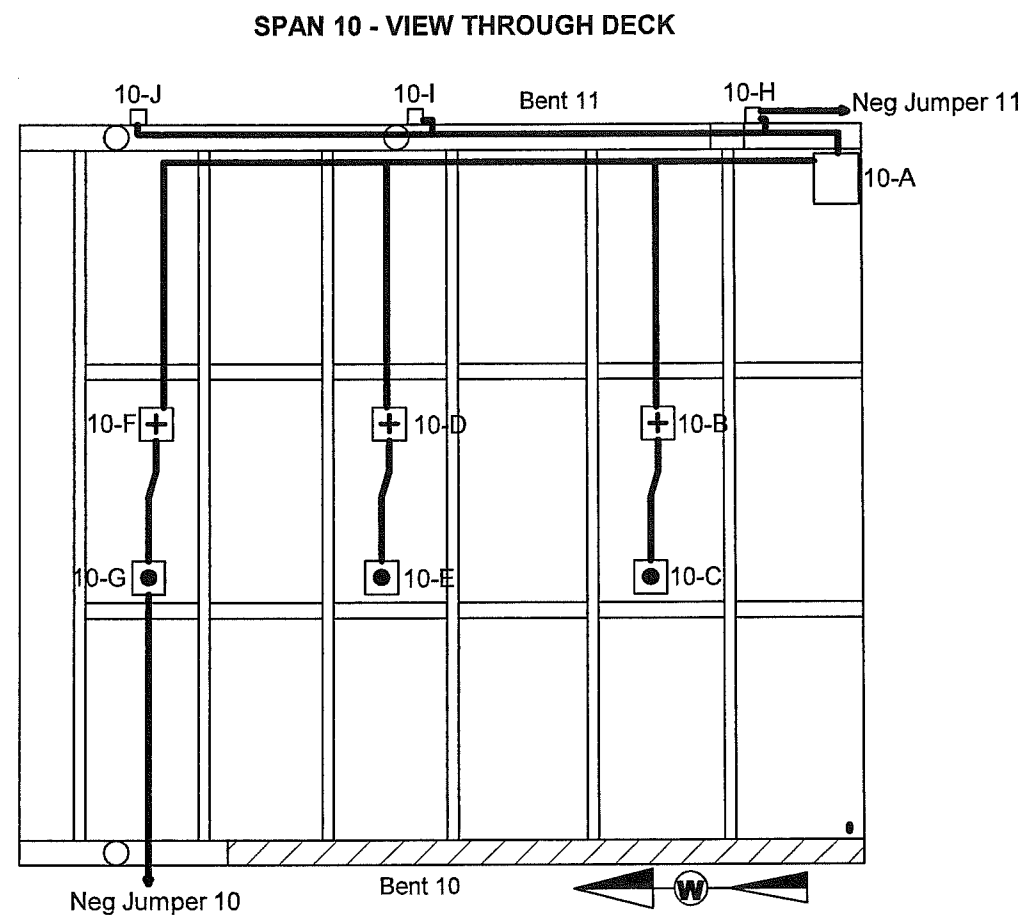

TYPICAL WIRE SIZES & COLORS AS FOLLOWS:
 MZA & PJA = #10 Red
 MZN; PJN = #10 Blue
 SA = #8 Black
 RE/REN: #16 Twisted Pair Red/Black

ABBREVIATIONS:
 MZN = Metallized Zinc Negative
 PJN = Pile Jacket Negative
 CJN = Cap Jacket Negative
 SAN = Submerged Anode Negative
 MZA = Metallized Zinc Anode
 PJA = Pile Jacket Anode
 CJA = Cap Jacket Anode
 SA = Submerged Anode
 RE = Reference Electrode
 REN = Reference Electrode Negative

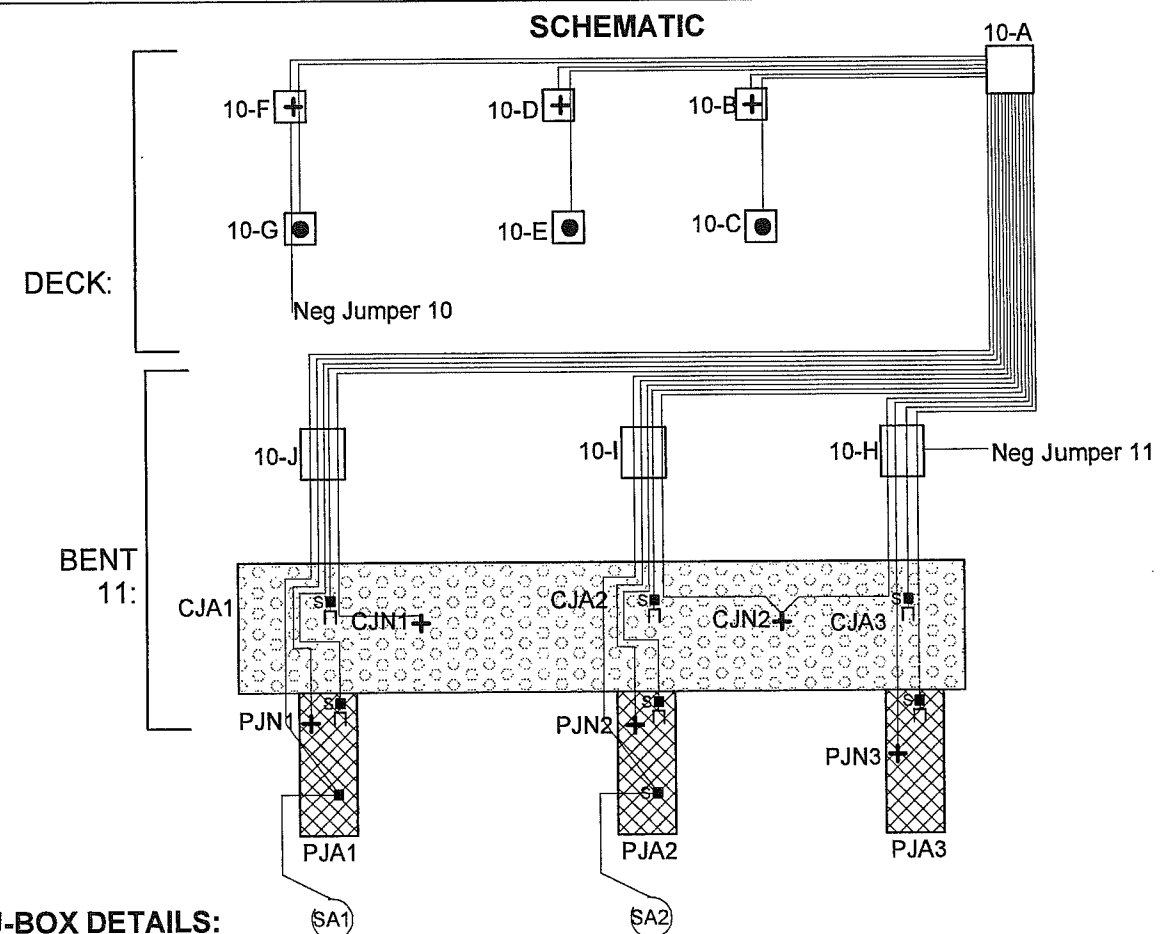

J-BOX DETAILS:

	J-Box Size	Wires or Structure
10-A	14" x 12" x 8"	MAIN J-BOX: (1) MZA; (1) MZN; (1) CJA; (1) CJN; (1) PJA; (1) PJN; (1) SA; SAN jumped from PJN
10-B	5" x 5" x 2"	Structure Negative (MZN); (1) MZA
10-C	5" x 5" x 2"	Primary Anode Terminal Plate (MZA)
10-D	5" x 5" x 2"	Structure Negative (MZN); (1) MZA
10-E	5" x 5" x 2"	Primary Anode Terminal Plate (MZA)
10-F	5" x 5" x 2"	Structure Negative (MZN) - NEG JUMPER 10; (1) MZA
10-G	5" x 5" x 2"	Primary Anode Terminal Plate (MZA); (1) NEG JMPR 10
10-H	8" x 8" x 4"	CJA3; CJN3; PJA3; PJN3; NEG JMPR 11
10-I	8" x 8" x 4"	CJA2; CJN2; PJA2; PJN2; SA2
10-J	8" x 8" x 4"	CJA1; CJN1; PJA1; PJN1; SA1

LEGEND

- (x) Submerged Anode
- x = Weight in LBS
- ⊠ Pile Jacket
- ⊡ Cap Jacket
- Primary Anode Terminal
- + Negative Connection
- Encapsulated Splice
- Reference Electrode



Tongass Span 10

SCALE: NONE Field Sketch DRAWN BY KRH
 DATE: 9-12-11 Electrical As-Built REVISED 9-13-11

GREAT WESTERN CORPORATION


Ketchikan Viaduct II
 Repair & C.P.

DRAWING NUMBER
 T10

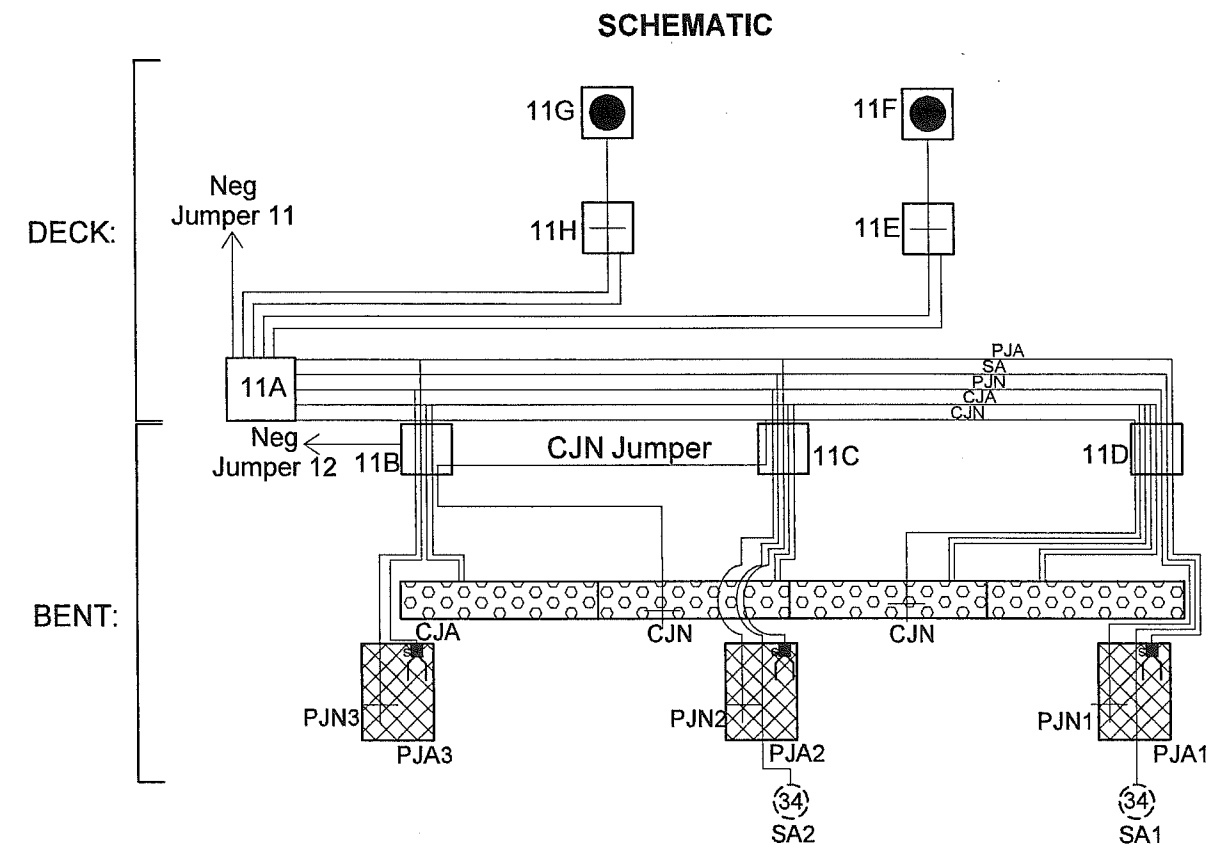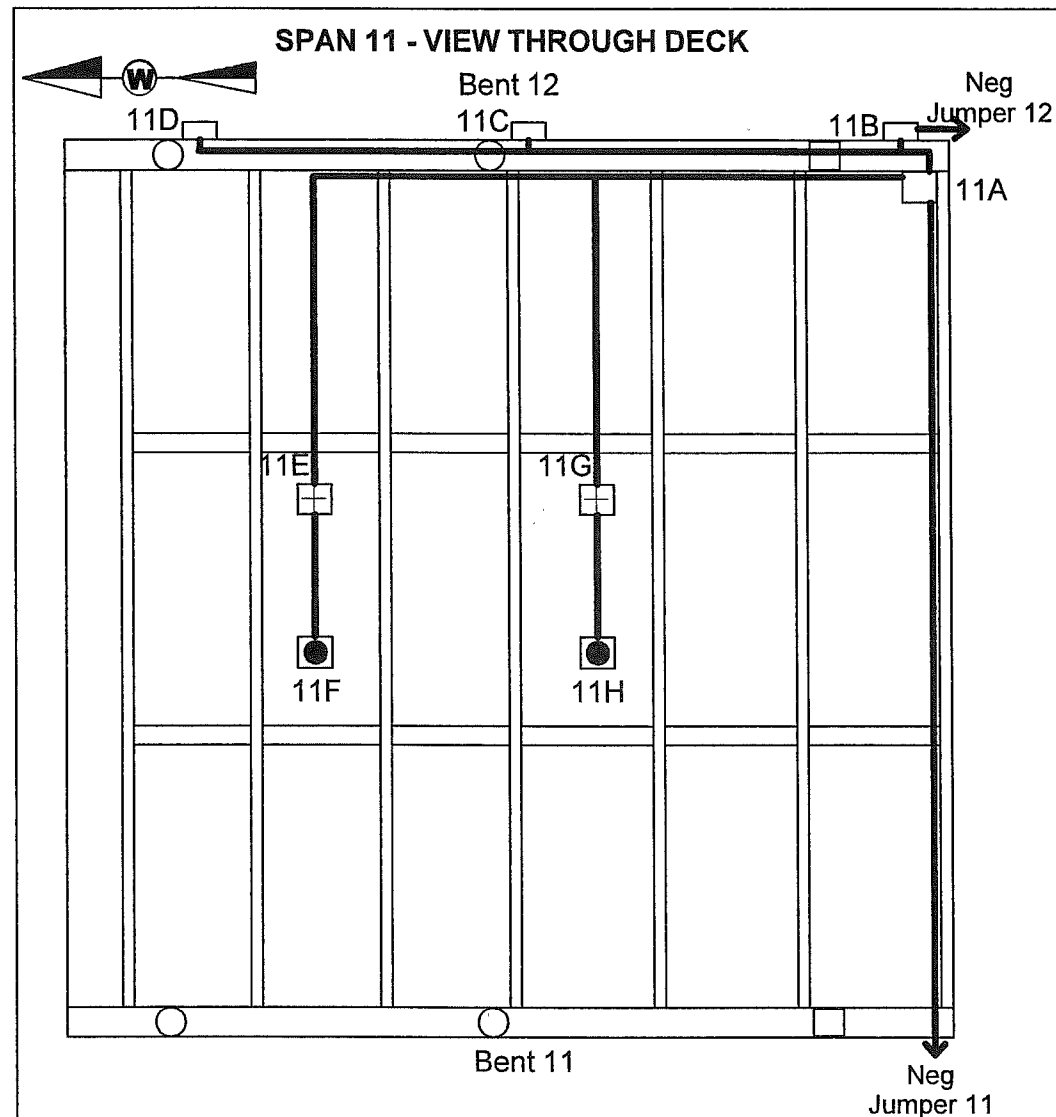

J-BOX DETAILS:

	J-Box Size	Wires or Structure
11-A	14" x 12" x 8"	MAIN J-BOX: (2) MZA; (2) MZN; (1) PJA; (1) PJN; (1) SA; SAN jumpered from PJN; NEG. JUMPER 11
11-B	8" x 8" x 4"	PJA3; PJN3; CJA3; CJN3; NEG JUMPER 12
11-C	8" x 8" x 4"	PJA2; PJN2; CJA2; CJN2; SA2
11-D	8" x 8" x 4"	PJA1; PJN1; CJA1; CJN1; SA1
11-E	5" x 5" x 2"	Structure Negative (MZN); (1) MZA
11-F	5" x 5" x 2"	Primary Anode Terminal Plate (MZA)
11-G	5" x 5" x 2"	Structure Negative (MZN); (1) MZA
11-H	5" x 5" x 2"	Primary Anode Terminal Plate (MZA)

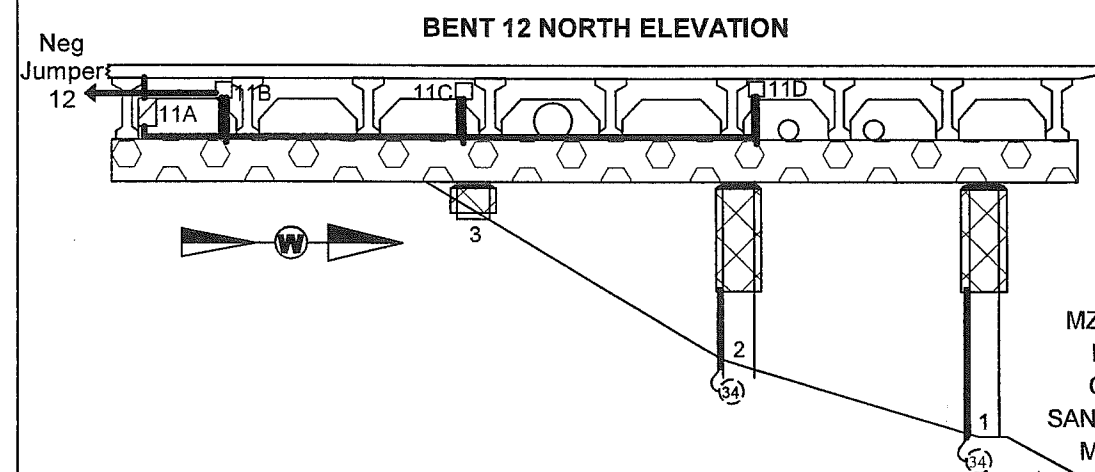


TYPICAL WIRE SIZES & COLORS AS FOLLOWS:
MZA & PJA = #10 Red
MZN; PJN = #10 Blue
SA = #8 Black
RE/REN: #16 Twisted Pair Red/Black

ABBREVIATIONS:
MZN = Metallized Zinc Negative
PJN = Pile Jacket Negative
CJN = Cap Jacket Negative
SAN = Submerged Anode Negative
MZA = Metallized Zinc Anode
PJA = Pile Jacket Anode
CJA = Cap Jacket Anode
SA = Submerged Anode
RE = Reference Electrode
REN = Reference Electrode Negative


LEGEND
(x) Submerged Anode
x = Weight in LBS
[] Pile Jacket
[] Cap Jacket
● Primary Anode Terminal
+ Negative Connection
[] Encapsulated Splice
— Reference Electrode

Tongass Ave Bent 12 North Elevation & Span 11			
SCALE: NONE	Field Sketch	DRAWN BY: KRH	
DATE: 10-26-11	As-Built	REVISED 10-27-11	
GREAT WESTERN CORPORATION			
Ketchikan Viaduct II Repair & C.P.		DRAWING NUMBER T-11	


SPAN 14 - VIEW THROUGH DECK

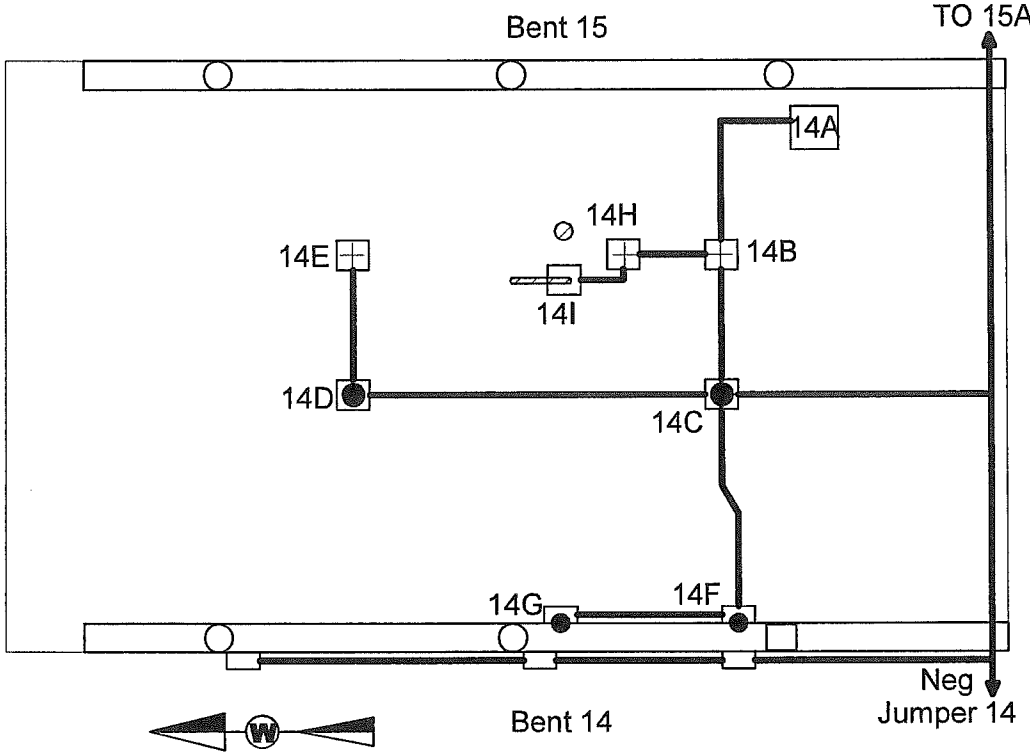

SCHEMATIC

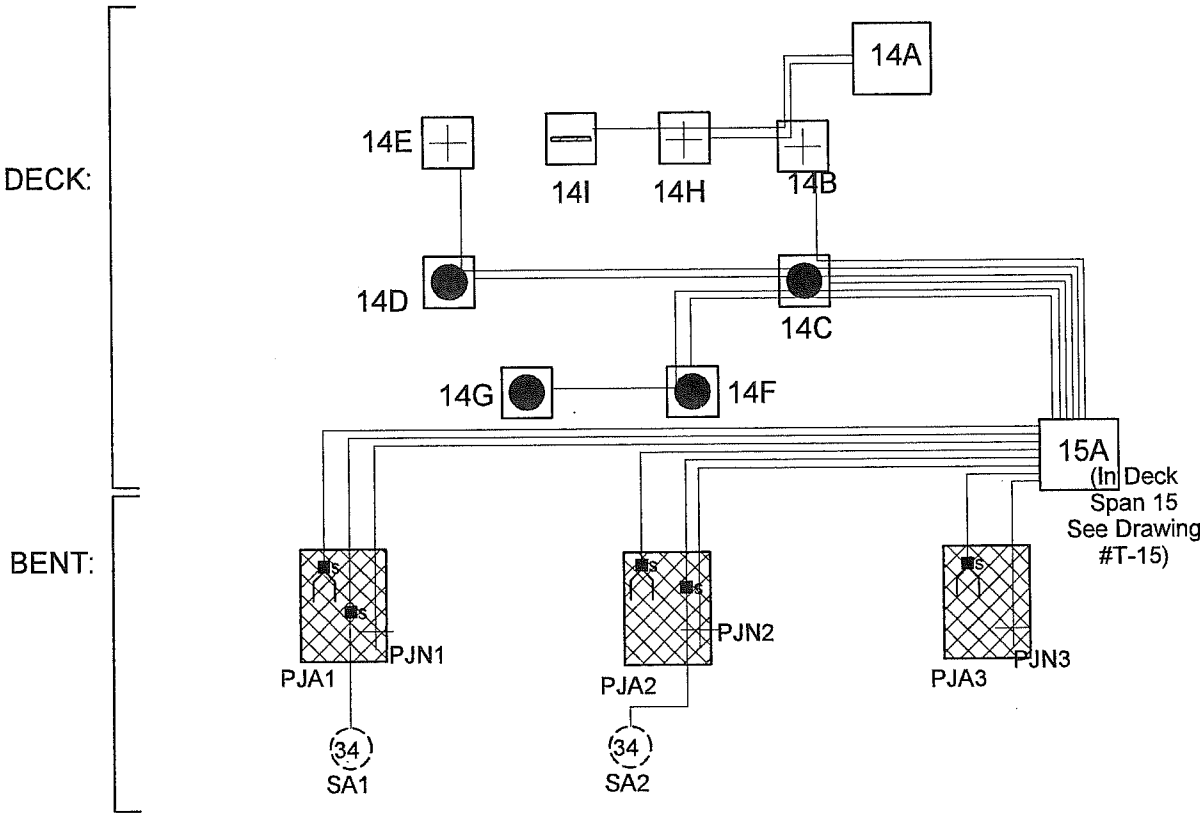

BENT 15 SOUTH ELEVATION

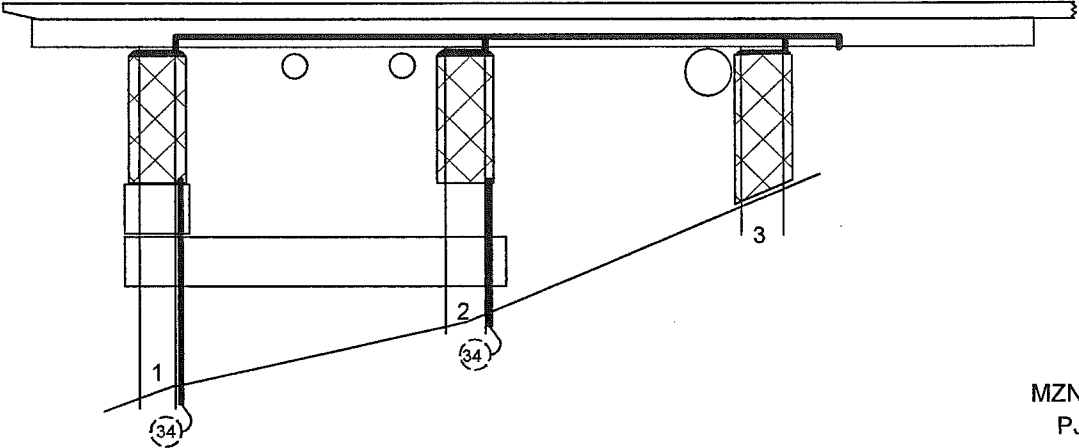

J-BOX DETAILS:



	J-Box Size	Wires or Structure	
14-A	14" x 12" x 8"	MAIN J-BOX: (1) RE; (1) REN	
14-B	5" x 5" x 2"	Structure Negative (MZN) - TO 15A; (1) RE; (1) REN	Run to Span 15 Main J-Box (15A)
14-C	5" x 5" x 2"	Primary Anode Terminal Plate (MZA); (2) MZN; (3) MZA	
14-D	5" x 5" x 2"	Primary Anode Terminal Plate (MZA); (1) MZN	
14-E	5" x 5" x 2"	Structure Negative (MZN)	
14-F	5" x 5" x 2"	Primary Anode Terminal Plate (MZA); (1) MZA	
14-G	5" x 5" x 2"	Primary Anode Terminal Plate (MZA)	
14-H	5" x 5" x 2"	Reference Electrode Negative (REN)	
14-I	5" x 5" x 2"	Reference Electrode (RE)	

TYPICAL WIRE SIZES & COLORS AS FOLLOWS:
MZA & PJA = #10 Red
MZN; PJN = #10 Blue
SA = #8 Black
RE/REN: #16 Twisted Pair Red/Black

ABBREVIATIONS:
MZN = Metallized Zinc Negative
PJN = Pile Jacket Negative
CJN = Cap Jacket Negative
SAN = Submerged Anode Negative
MZA = Metallized Zinc Anode
PJA = Pile Jacket Anode
CJA = Cap Jacket Anode
SA = Submerged Anode
RE = Reference Electrode
REN = Reference Electrode Negative


LEGEND
⊗ Submerged Anode
x = Weight in LBS
⊠ Pile Jacket
⊡ Cap Jacket
● Primary Anode Terminal
+ Negative Connection
⊞ Encapsulated Splice
— Reference Electrode

Tongass Ave Bent 15 South Elevation & Span 14			
SCALE:	NONE	Field Sketch	DRAWN BY KRH
DATE:	10-27-11	As-Built	REVISED
GREAT WESTERN CORPORATION			
Ketchikan Viaduct II Repair & C.P.			DRAWING NUMBER T-14

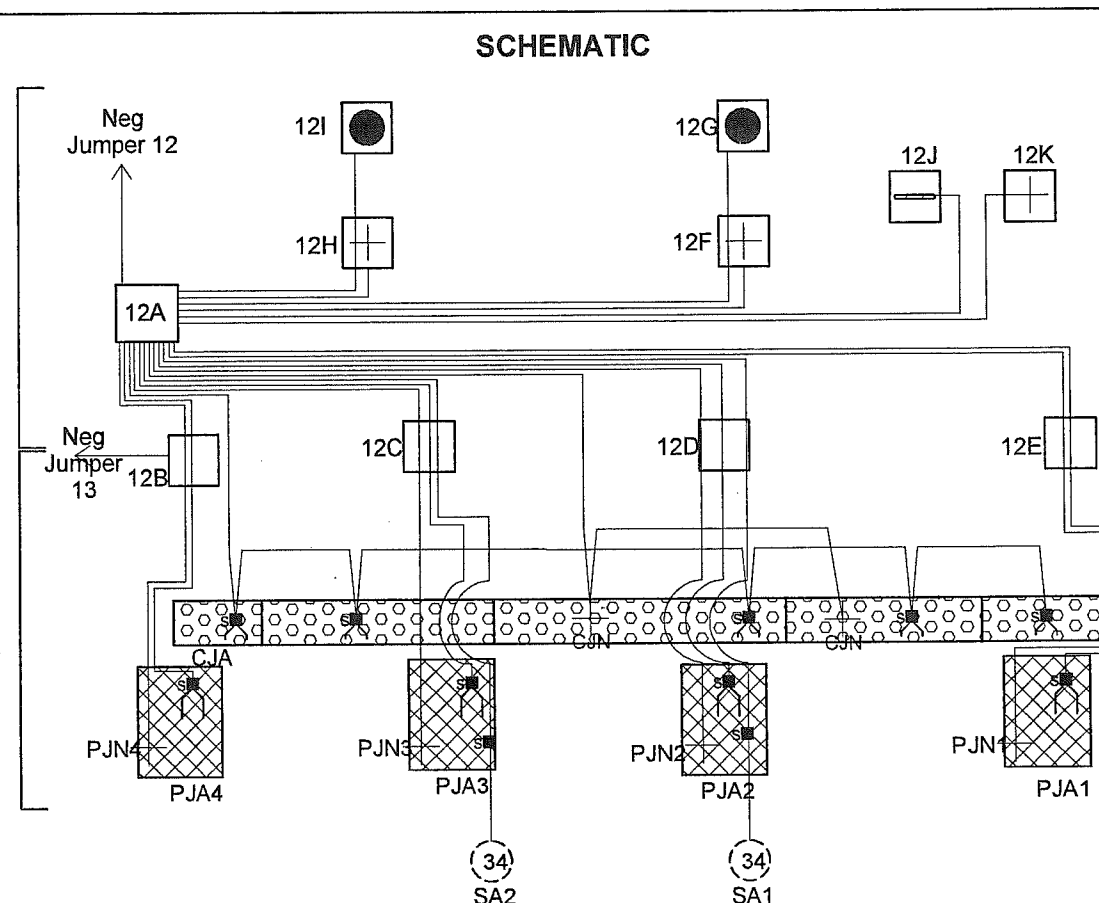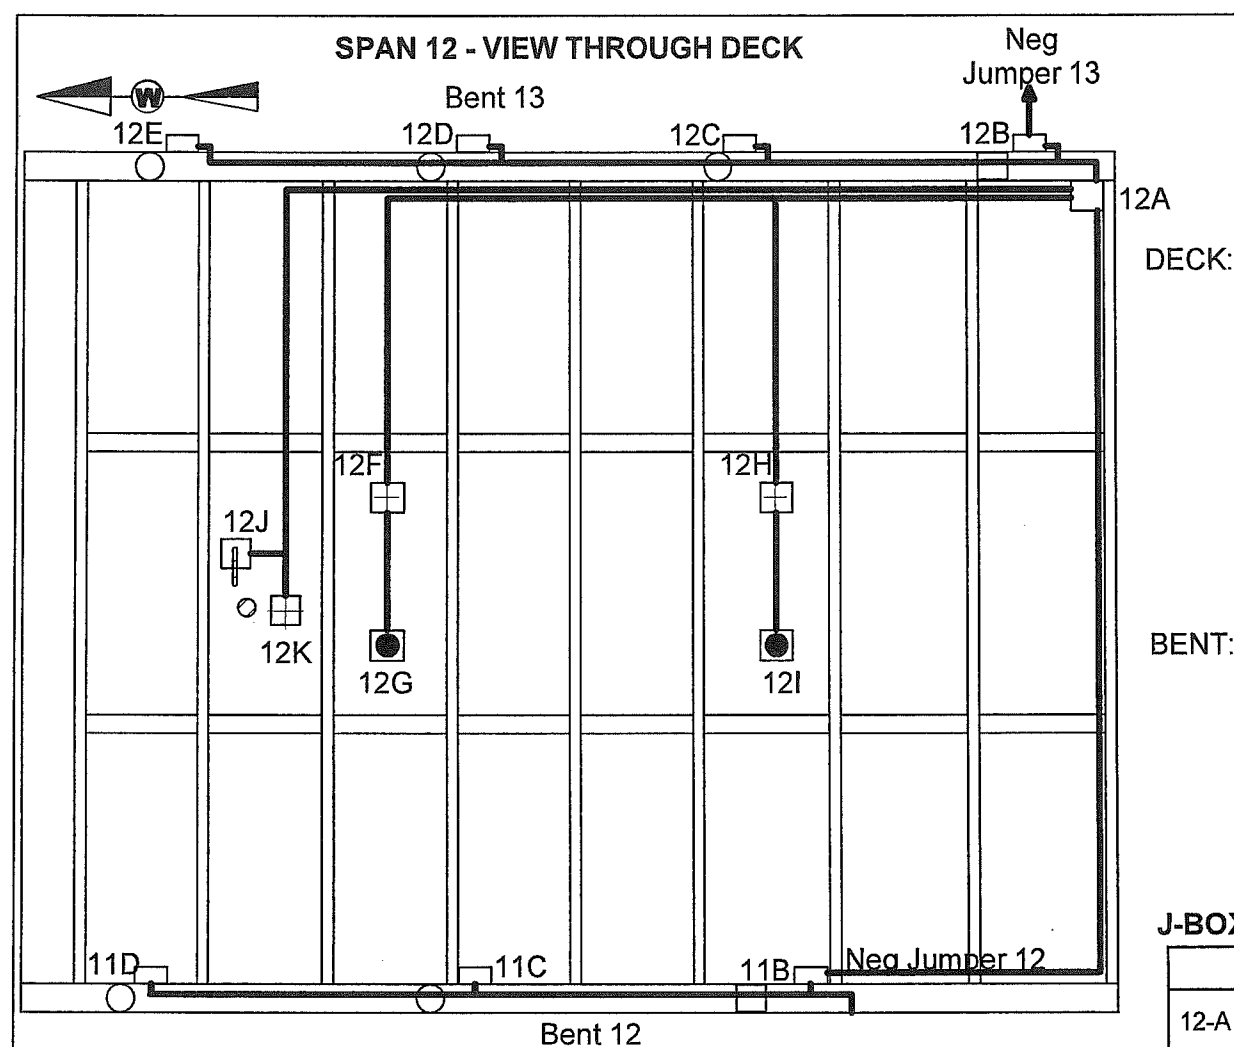

J-BOX DETAILS:

	J-Box Size	Wires or Structure
12-A	14" x 12" x 8"	MAIN J-BOX: (2) MZA; (2) MZN; (4) PJA; (4) PJN; (1) CJA; (1) CJN; (2) SA; SAN jumpered from PJN; NEG. JUMPER 12; (1) RE; (1) REN
12-B	8" x 8" x 4"	PJA4; PJN4; NEG JUMPER 13
12-C	8" x 8" x 4"	PJA3; PJN3; SA2
12-D	8" x 8" x 4"	PJA2; PJN2; SA1
12-E	8" x 8" x 4"	PJA1; PJN1
12-F	5" x 5" x 2"	Structure Negative (MZN); (1) MZA
12-G	5" x 5" x 2"	Primary Anode Terminal Plate (MZA)
12-H	5" x 5" x 2"	Structure Negative (MZN); (1) MZA
12-I	5" x 5" x 2"	Primary Anode Terminal Plate (MZA)


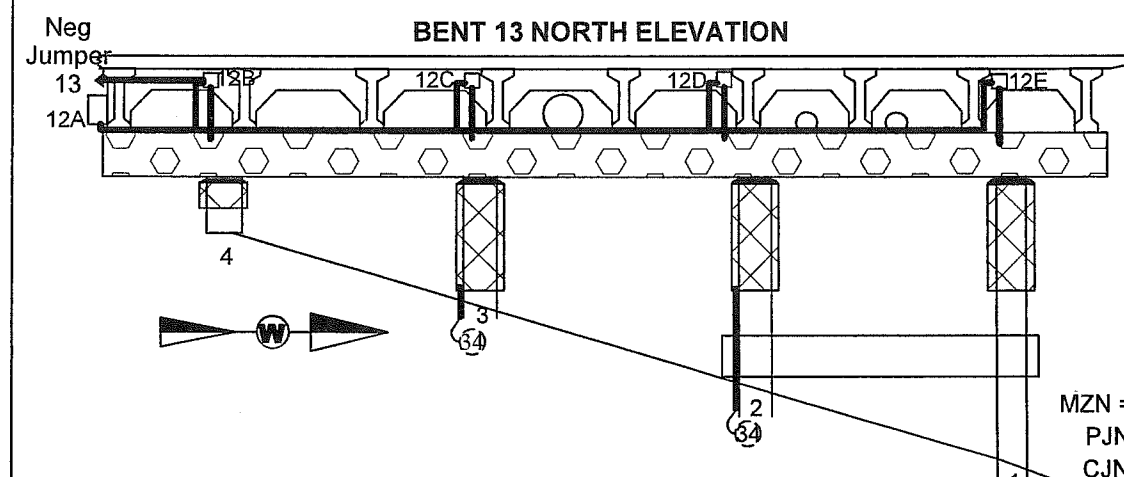


TYPICAL WIRE SIZES & COLORS AS FOLLOWS:
 MZA & PJA = #10 Red
 MZN; PJN = #10 Blue
 SA = #8 Black
 RE/REN: #16 Twisted Pair Red/Black

ABBREVIATIONS:
 MZN = Metallized Zinc Negative
 PJN = Pile Jacket Negative
 CJN = Cap Jacket Negative
 SAN = Submerged Anode Negative
 MZA = Metallized Zinc Anode
 PJA = Pile Jacket Anode
 CJA = Cap Jacket Anode
 SA = Submerged Anode
 RE = Reference Electrode
 REN = Reference Electrode Negative

LEGEND
 (X) Submerged Anode
 x = Weight in LBS
 [X] Pile Jacket
 [X] Cap Jacket
 ● Primary Anode Terminal
 + Negative Connection
 [X] Encapsulated Splice
 — Reference Electrode

Tongass Ave Bent 13 North Elevation & Span 12		
SCALE: NONE	Field Sketch As-Built	DRAWN BY KRH
DATE: 10-26-11		REVISED 10-27-11
GREAT WESTERN CORPORATION		
Ketchikan Viaduct II Repair & C.P.		DRAWING NUMBER T-12

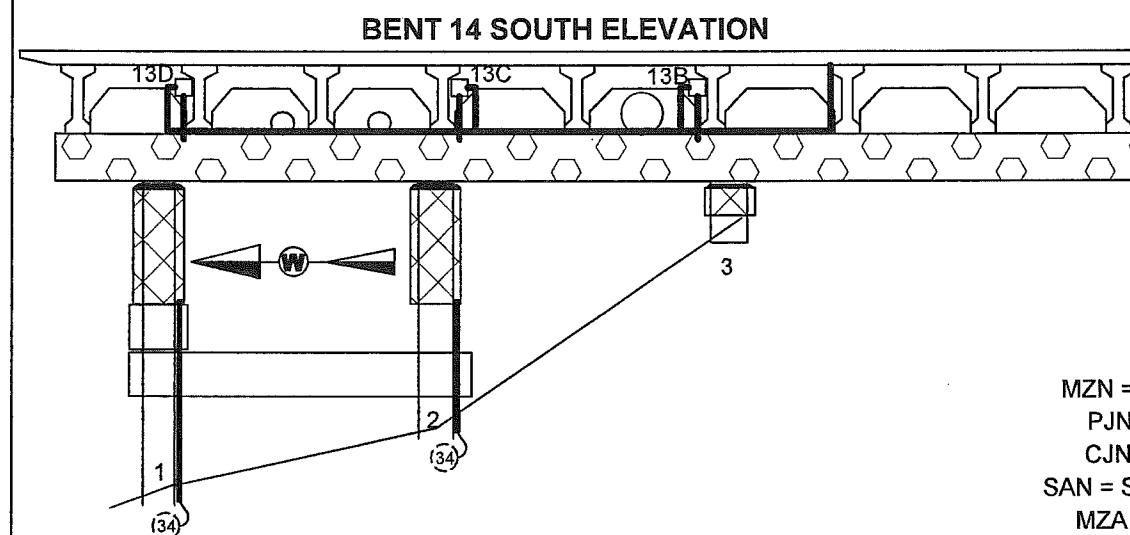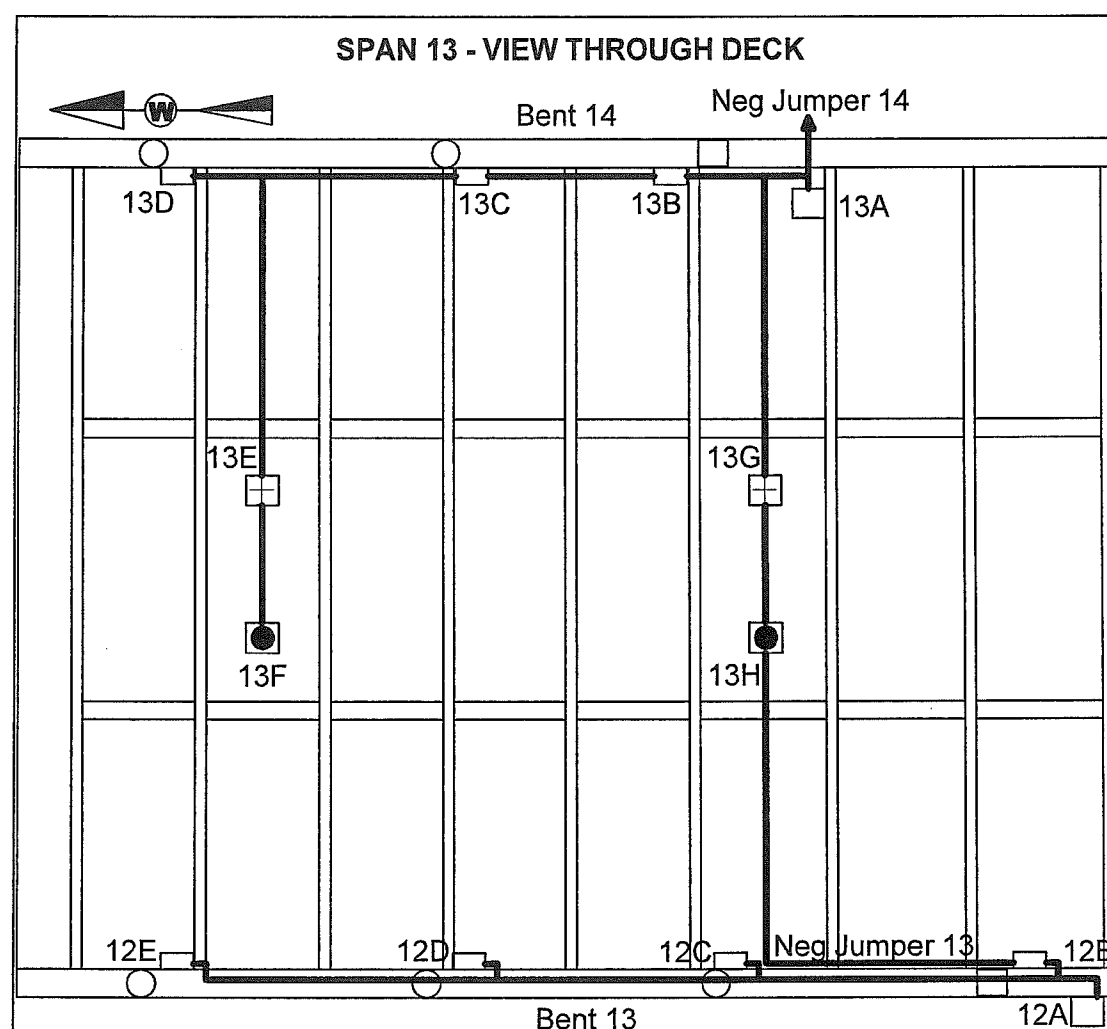


TYPICAL WIRE SIZES & COLORS AS FOLLOWS:
 MZA & PJA = #10 Red
 MZN; PJN = #10 Blue
 SA = #8 Black
 RE/REN: #16 Twisted Pair Red/Black

ABBREVIATIONS:
 MZN = Metallized Zinc Negative
 PJN = Pile Jacket Negative
 CJN = Cap Jacket Negative
 SAN = Submerged Anode Negative
 MZA = Metallized Zinc Anode
 PJA = Pile Jacket Anode
 CJA = Cap Jacket Anode
 SA = Submerged Anode
 RE = Reference Electrode
 REN = Reference Electrode Negative

LEGEND

(X) Submerged Anode
 x = Weight in LBS
 [X] Pile Jacket
 [X] Cap Jacket
 ● Primary Anode Terminal
 + Negative Connection
 [X] Encapsulated Splice
 — Reference Electrode

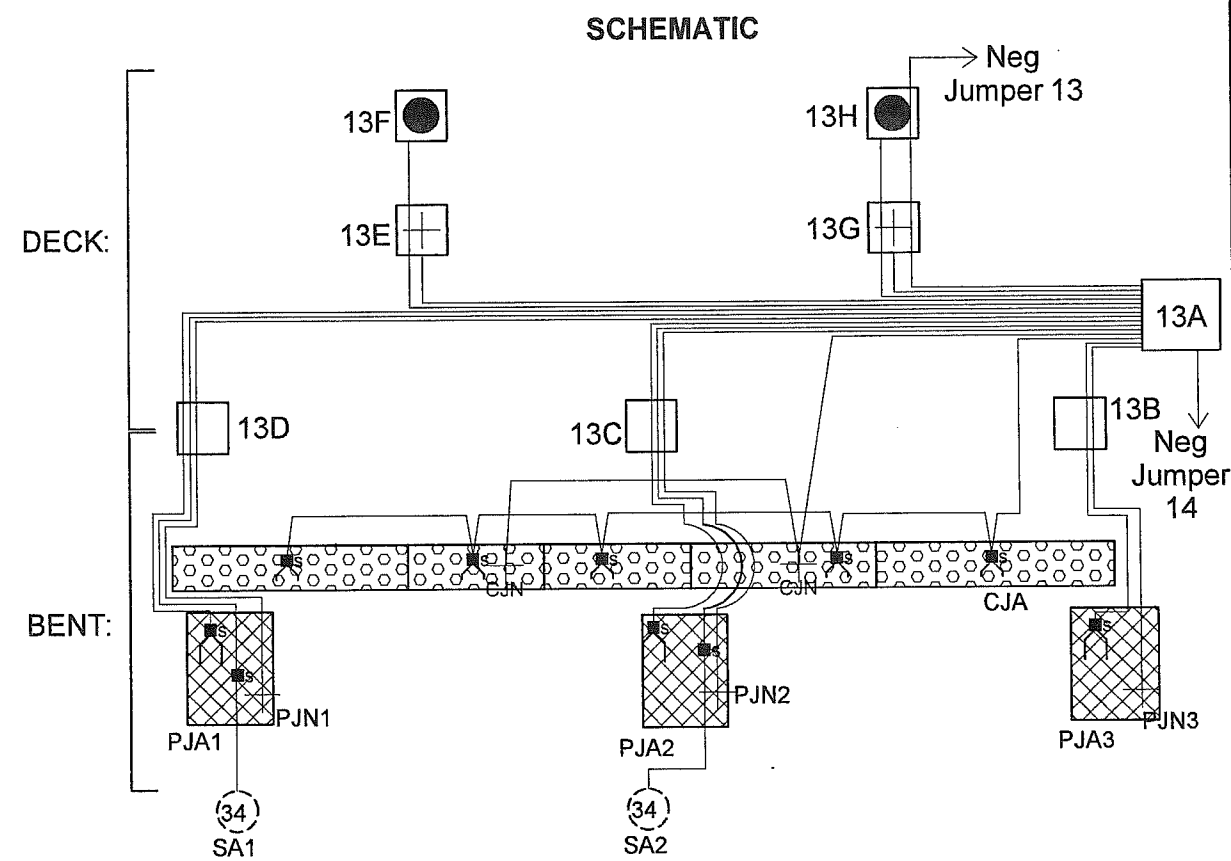


J-BOX DETAILS:


	J-Box Size	Wires or Structure
13-A	14" x 12" x 8"	MAIN J-BOX: (2) MZA; (2) MZN; (3) PJA; (3) PJN; (1) CJA; (1) CJN; (2) SA; SAN jumpered from PJN; NEG. JUMPER 14
13-B	8" x 8" x 4"	PJA3; PJN3
13-C	8" x 8" x 4"	PJA2; PJN2; SA2
13-D	8" x 8" x 4"	PJA1; PJN1; SA1
13-E	5" x 5" x 2"	Structure Negative (MZN); (1) MZA
13-F	5" x 5" x 2"	Primary Anode Terminal Plate (MZA)
13-G	5" x 5" x 2"	Structure Negative (MZN); (1) MZA; NEG JUMPER 13
13-H	5" x 5" x 2"	Primary Anode Terminal Plate (MZA); (1) NEG JUMPER

Tongass Ave Bent 14 South Elevation & Span 13		
SCALE: NONE	Field Sketch	DRAWN BY KRH
DATE: 10-27-11	As-Built	REVISED
GREAT WESTERN CORPORATION		
Ketchikan Viaduct II Repair & C.P.		DRAWING NUMBER T-13


SPAN 15 - VIEW THROUGH DECK

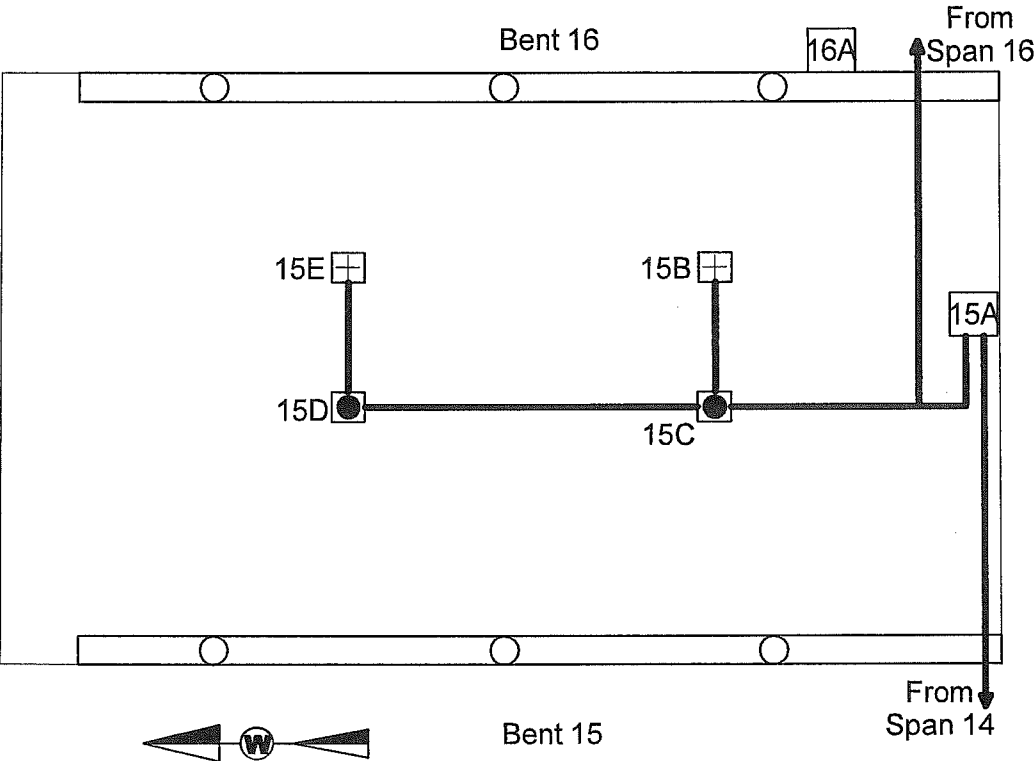

SCHEMATIC

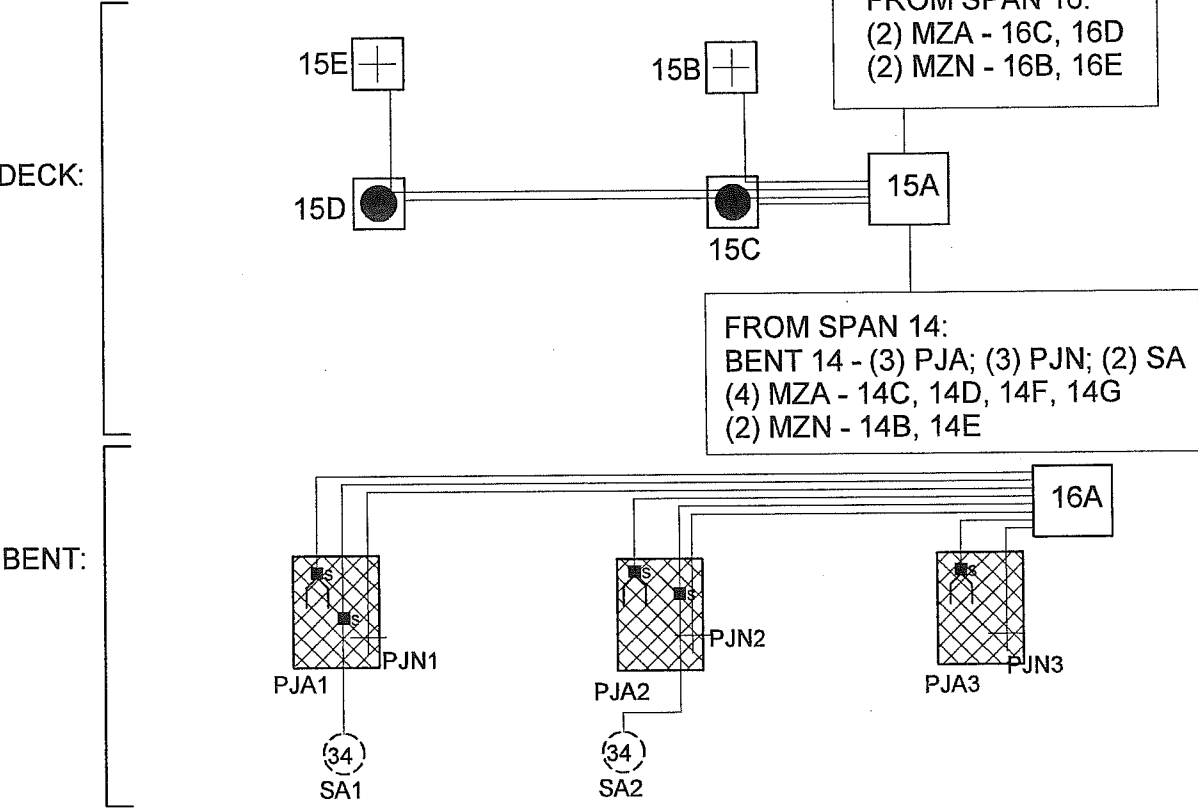

BENT 16 SOUTH ELEVATION

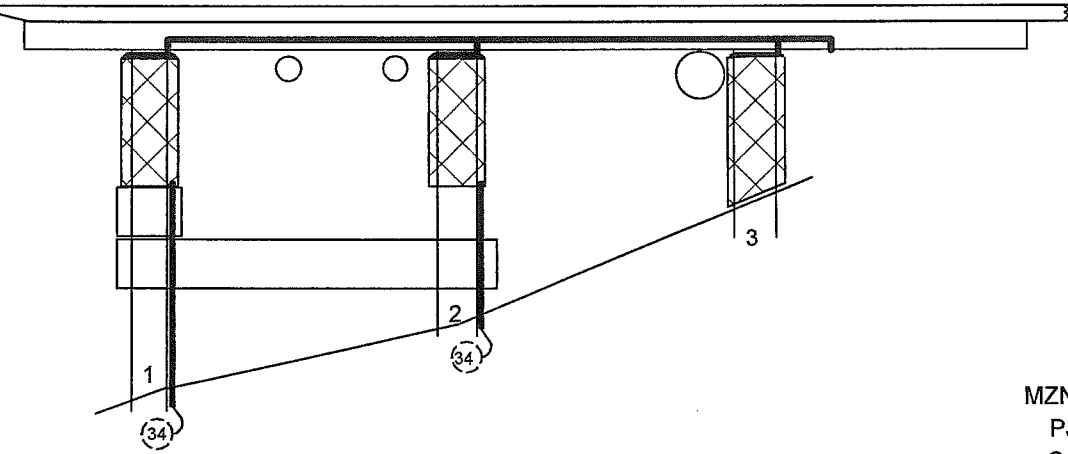

J-BOX DETAILS:

	J-Box Size	Wires or Structure
16-A	14" x 12" x 8"	BENT 16 MAIN J-BOX: (3) PJA; (3) PJN; (2) SA; SAN jumpered from PJN
15-A	14" x 12" x 8"	MAIN J-BOX: (2) MZA; (2) MZN
15-B	5" x 5" x 2"	Structure Negative (MZN)
15-C	5" x 5" x 2"	Primary Anode Terminal Plate (MZA); (1) MZN
15-D	5" x 5" x 2"	Primary Anode Terminal Plate (MZA); (1) MZN
15-E	5" x 5" x 2"	Structure Negative (MZN)

ABBREVIATIONS:

MZN = Metallized Zinc Negative
 PJN = Pile Jacket Negative
 CJN = Cap Jacket Negative
 SAN = Submerged Anode Negative
 MZA = Metallized Zinc Anode
 PJA = Pile Jacket Anode
 CJA = Cap Jacket Anode
 SA = Submerged Anode
 RE = Reference Electrode
 REN = Reference Electrode Negative

LEGEND

- (x) Submerged Anode
 x = Weight in LBS
- ⊠ Pile Jacket
- ⊡ Cap Jacket
- Primary Anode Terminal
- + Negative Connection
- ⊞ Encapsulated Splice
- Reference Electrode

Tongass Ave Bent 16 South Elevation
 & Span 15


SCALE: NONE
 DATE: 10-27-11
 Field Sketch
 As-Built
 DRAWN BY: KRH
 REVISED:

GREAT WESTERN CORPORATION


Ketchikan Viaduct II
 Repair & C.P.
 DRAWING NUMBER
 T-15

TYPICAL WIRE SIZES & COLORS AS FOLLOWS:
 MZA & PJA = #10 Red
 MZN; PJN = #10 Blue
 SA = #8 Black
 RE/REN: #16 Twisted Pair Red/Black

SPAN 16 - VIEW THROUGH DECK

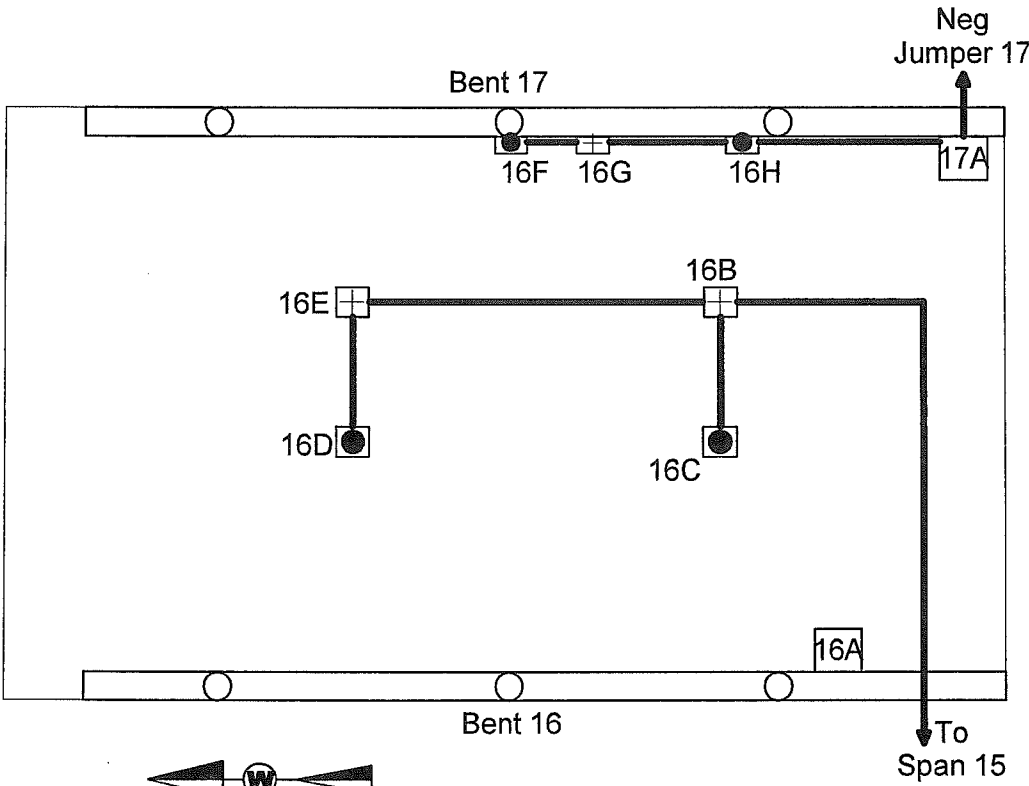


BENT 17 SOUTH ELEVATION

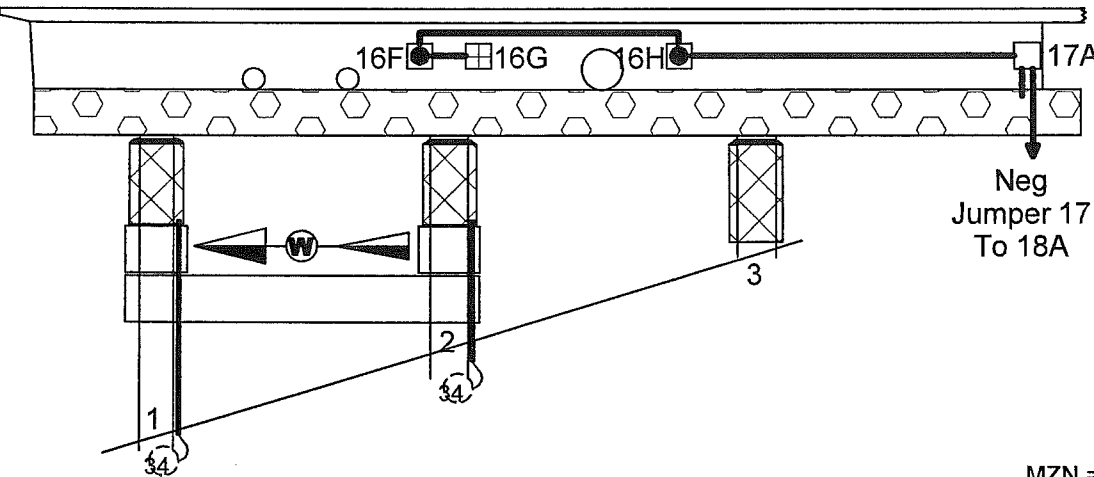

TYPICAL WIRE SIZES & COLORS AS FOLLOWS:
MZA & PJA = #10 Red
MZN; PJN = #10 Blue
SA = #8 Black
RE/REN: #16 Twisted Pair Red/Black

SCHEMATIC

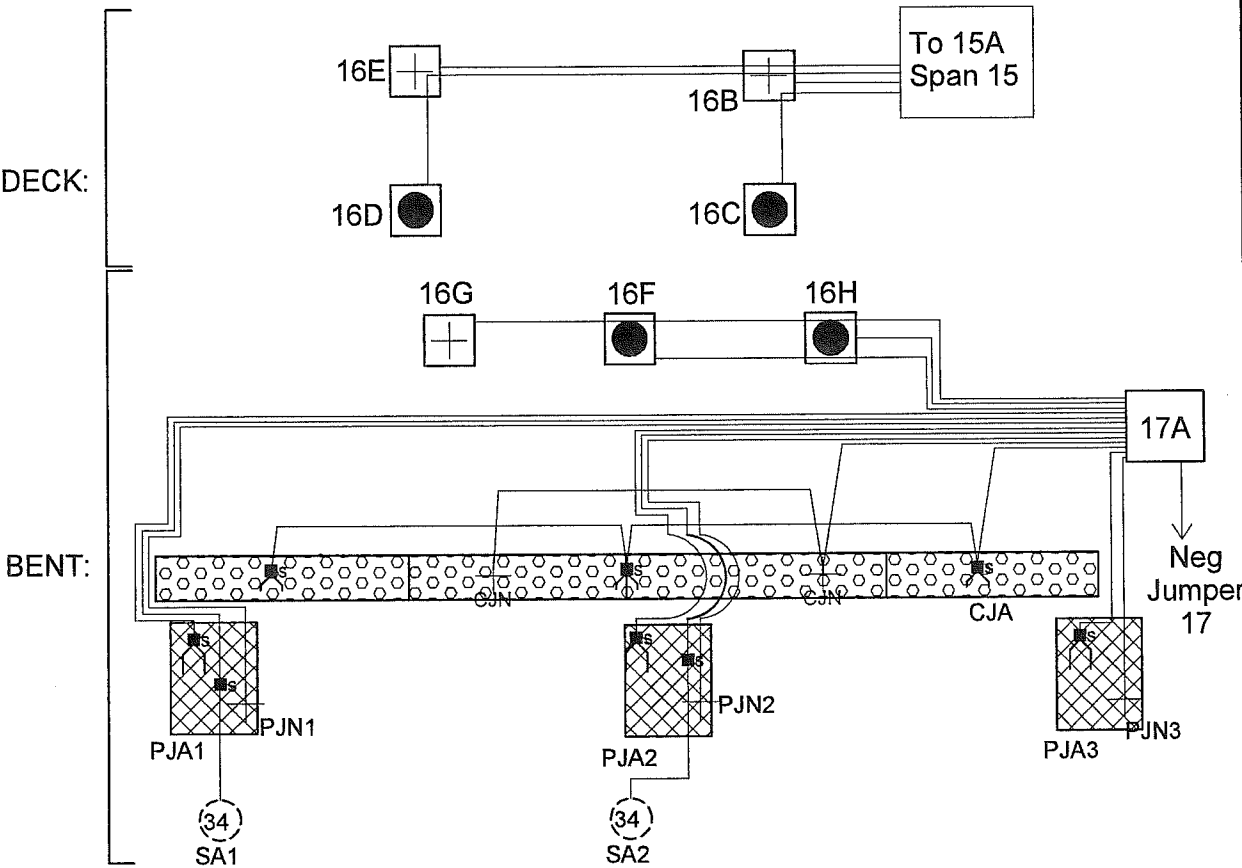


J-BOX DETAILS:

	J-Box Size	Wires or Structure
17-A	14" x 12" x 8"	BENT 17 MAIN J-BOX: (2) MZA; (1) MZN; (3) PJA; (3) PJN; (2) SA; SAN jumpered from PJN; Neg Jumper to Span 17
16-A	14" x 12" x 8"	BENT 16 MAIN J-BOX: (3) PJA; (3) PJN; (2) SA; SAN jumpered from PJN
16-B	5" x 5" x 2"	Structure Negative (MZN); (2) MZA; (1) MZN
16-C	5" x 5" x 2"	Primary Anode Terminal Plate (MZA)
16-D	5" x 5" x 2"	Primary Anode Terminal Plate (MZA)
16-E	5" x 5" x 2"	Primary Anode Terminal Plate (MZA); (1) MZN
16-F	5" x 5" x 2"	Primary Anode Terminal Plate (MZA); (1) MZN
16-G	5" x 5" x 2"	Structure Negative (MZN)
16-H	5" x 5" x 2"	Primary Anode Terminal Plate (MZA); (1) MZN; (1) MZA

ABBREVIATIONS:
MZN = Metallized Zinc Negative
PJN = Pile Jacket Negative
CJN = Cap Jacket Negative
SAN = Submerged Anode Negative
MZA = Metallized Zinc Anode
PJA = Pile Jacket Anode
CJA = Cap Jacket Anode
SA = Submerged Anode
RE = Reference Electrode
REN = Reference Electrode Negative

LEGEND
⊗ Submerged Anode
x = Weight in LBS
⊠ Pile Jacket
⊡ Cap Jacket
● Primary Anode Terminal
+ Negative Connection
⊞ Encapsulated Splice
— Reference Electrode

Tongass Ave Bent 17 South Elevation & Span 16			
SCALE: NONE	Field Sketch	DRAWN BY KRH	
DATE: 10-27-11	As-Built	REVISED	
GREAT WESTERN CORPORATION			
Ketchikan Viaduct II Repair & C.P.		DRAWING NUMBER T-16	

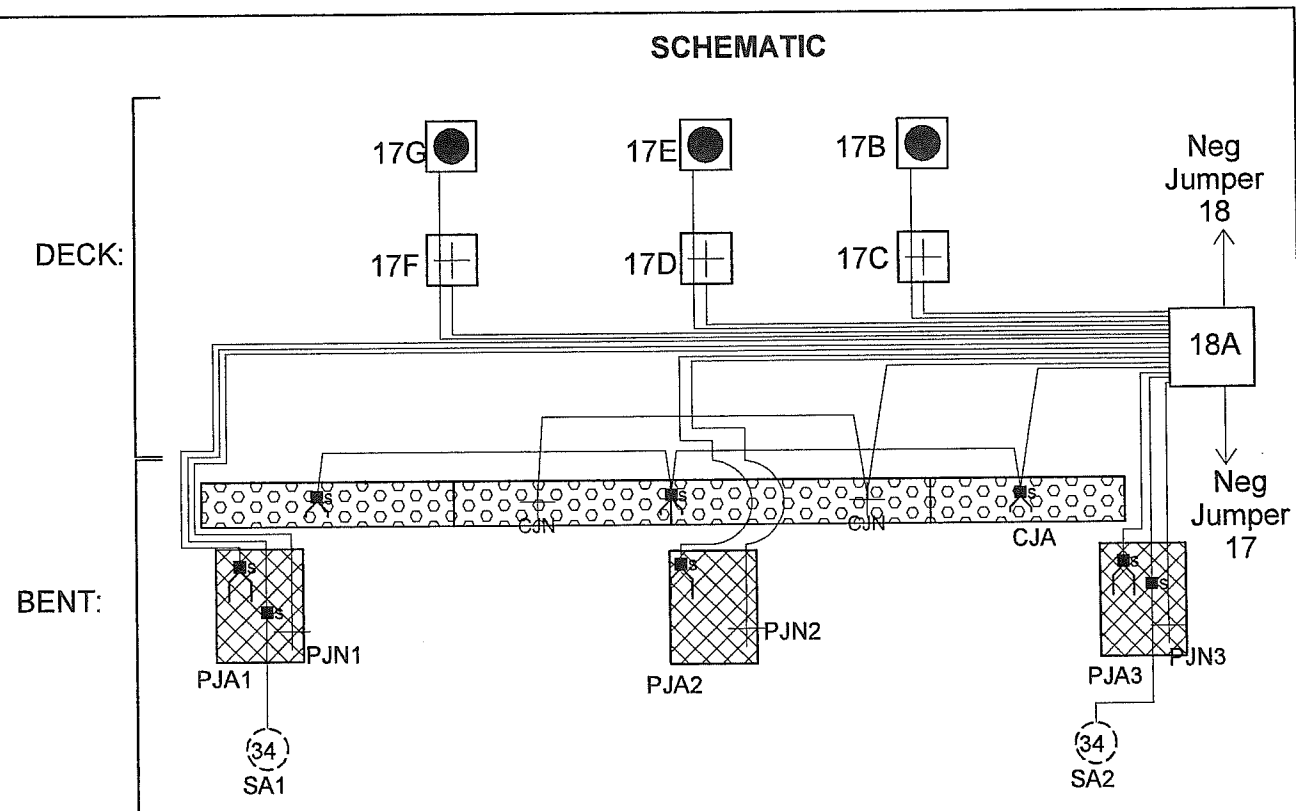

	J-Box Size	Wires or Structure
17-A	14" x 12" x 8"	MAIN J-BOX: (3) PJA; (3) PJN; (1) CJA; (1) CJA; (2) SA; SAN Jumpered from PJN; (3) MZA; (3) MZN; (2) MZN Jumpers
17-B	5" x 5" x 2"	Primary Anode Terminal Plate (MZA)
17-C	5" x 5" x 2"	Structure Negative (MZN)
17-D	5" x 5" x 2"	Structure Negative (MZN); (1) MZA
17-E	5" x 5" x 2"	Primary Anode Terminal Plate (MZA)
17-F	5" x 5" x 2"	Structure Negative (MZN); (1) MZA
17-G	5" x 5" x 2"	Primary Anode Terminal Plate (MZA)




ABBREVIATIONS:
MZN = Metallized Zinc Negative
PJN = Pile Jacket Negative
CJN = Cap Jacket Negative
SAN = Submerged Anode Negative
MZA = Metallized Zinc Anode
PJA = Pile Jacket Anode
CJA = Cap Jacket Anode
SA = Submerged Anode
RE = Reference Electrode
REN = Reference Electrode Negative


-  Submerged Anode
x = Weight in LBS
-  Pile Jacket
-  Cap Jacket
-  Primary Anode Terminal
-  Negative Connection
-  Encapsulated Splice
-  Reference Electrode

Tongass Ave Bent 18 South Elevation & Span 17		
SCALE: NONE	Field Sketch As-Built	DRAWN BY KRH
DATE: 10-07-11		REVISED
GREAT WESTERN CORPORATION		
Ketchikan Viaduct II Repair & C.P.		DRAWING NUMBER T-17

SPAN 18 - VIEW THROUGH DECK

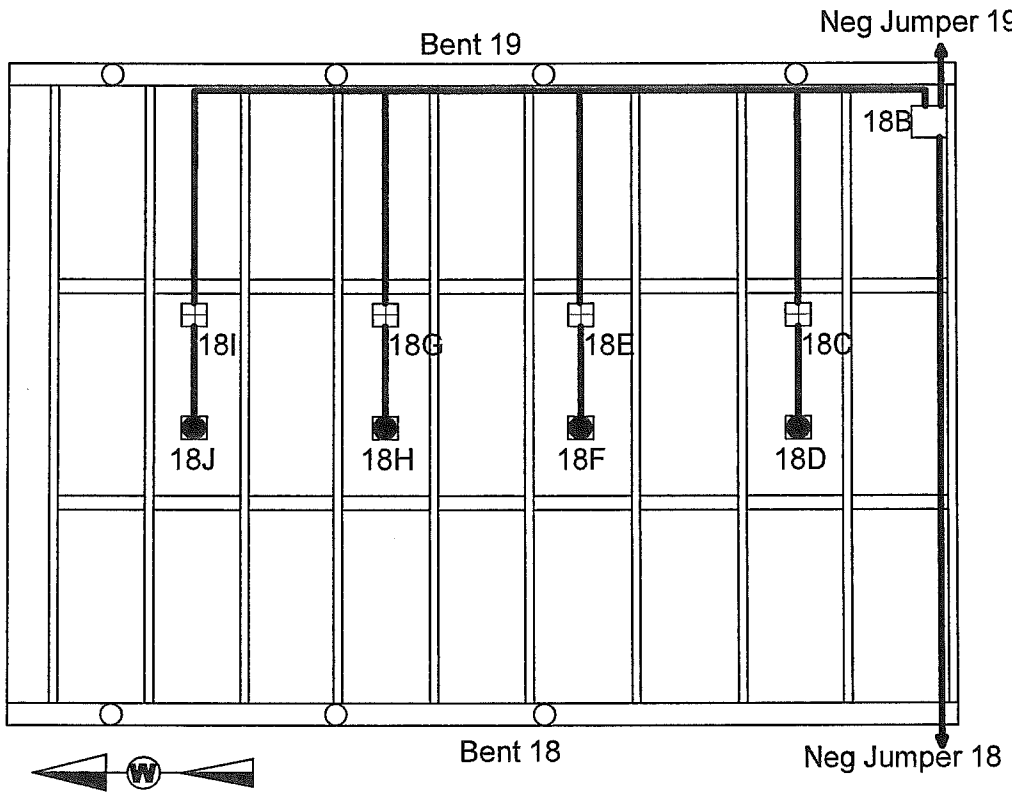

SCHEMATIC

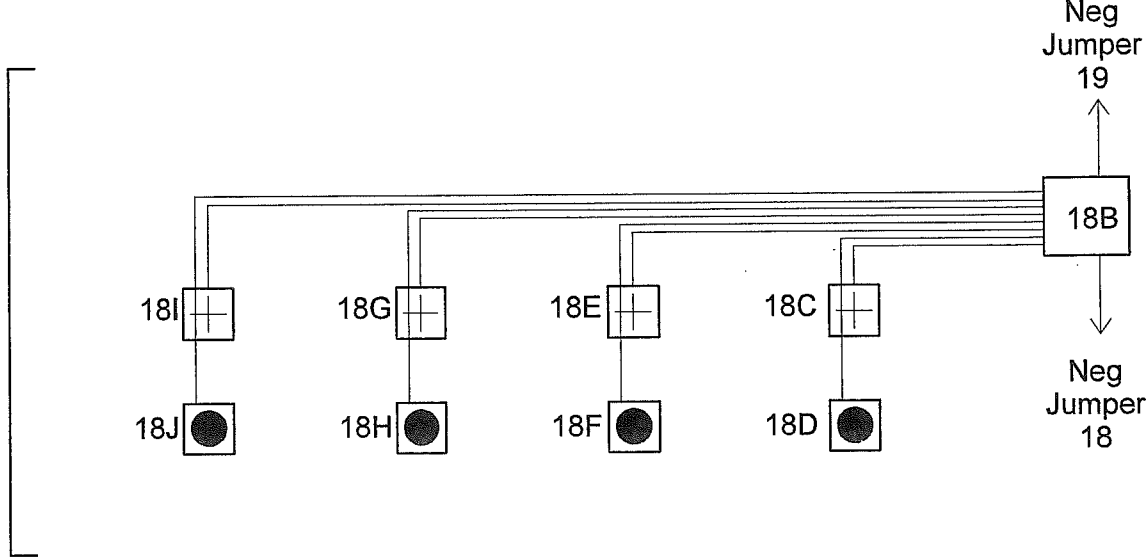

J-BOX DETAILS:

	J-Box Size	Wires or Structure
18-B	14" x 12" x 8"	MAIN J-BOX: (4) MZA; (4) MZN
18-C	5" x 5" x 2"	Structure Negative (MZN); (1) MZA
18-D	5" x 5" x 2"	Primary Anode Terminal Plate (MZA)
18-E	5" x 5" x 2"	Structure Negative (MZN); (1) MZA
18-F	5" x 5" x 2"	Primary Anode Terminal Plate (MZA)
18-G	5" x 5" x 2"	Structure Negative (MZN); (1) MZA
18-H	5" x 5" x 2"	Primary Anode Terminal Plate (MZA)
18-I	5" x 5" x 2"	Structure Negative (MZN); (1) MZA
18-J	5" x 5" x 2"	Primary Anode Terminal Plate (MZA)


TYPICAL WIRE SIZES & COLORS AS FOLLOWS:
MZA & PJA = #10 Red
MZN; PJN = #10 Blue
SA = #8 Black
RE/REN: #16 Twisted Pair Red/Black

ABBREVIATIONS:
MZN = Metallized Zinc Negative
PJN = Pile Jacket Negative
CJN = Cap Jacket Negative
SAN = Submerged Anode Negative
MZA = Metallized Zinc Anode
PJA = Pile Jacket Anode
CJA = Cap Jacket Anode
SA = Submerged Anode
RE = Reference Electrode
REN = Reference Electrode Negative


LEGEND
⊗ Submerged Anode
x = Weight in LBS
⊠ Pile Jacket
⊡ Cap Jacket
● Primary Anode Terminal
+ Negative Connection
⊞ Encapsulated Splice
— Reference Electrode

Tongass Ave Span 18			
SCALE:	NONE	Field Sketch	DRAWN BY KRH
DATE:	10-27-11	As-Built	REVISED
GREAT WESTERN CORPORATION			
Ketchikan Viaduct II Repair & C.P.			DRAWING NUMBER T-18


SPAN 19 - VIEW THROUGH DECK

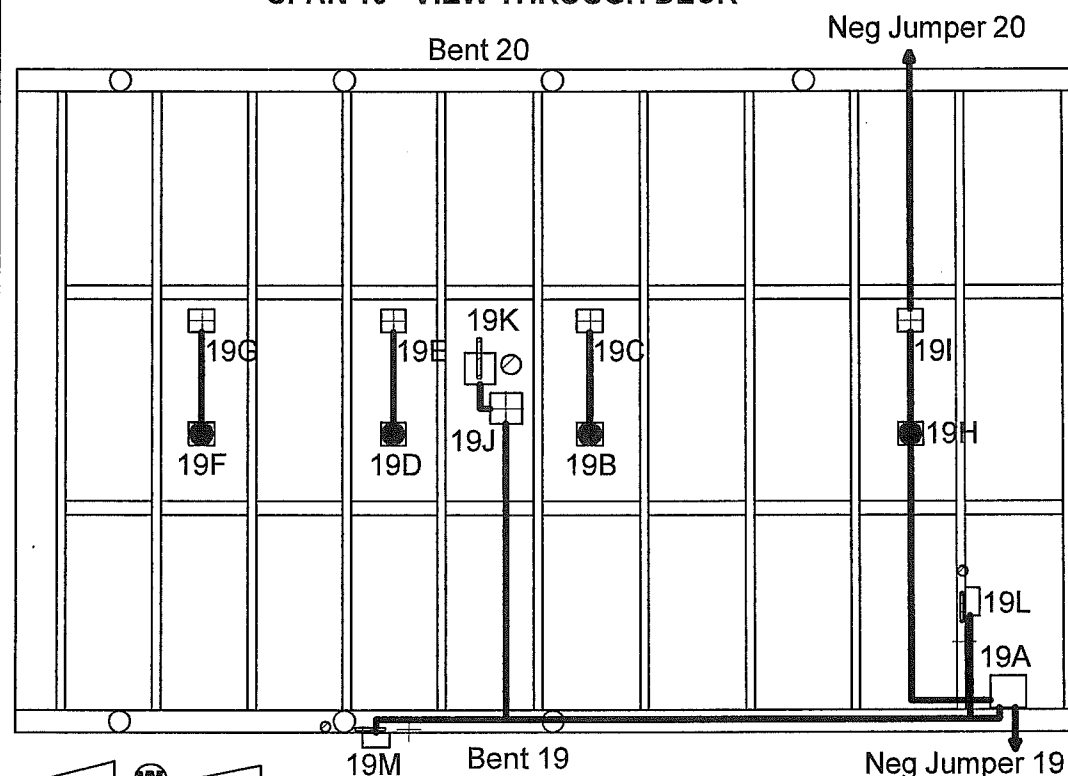

SCHEMATIC

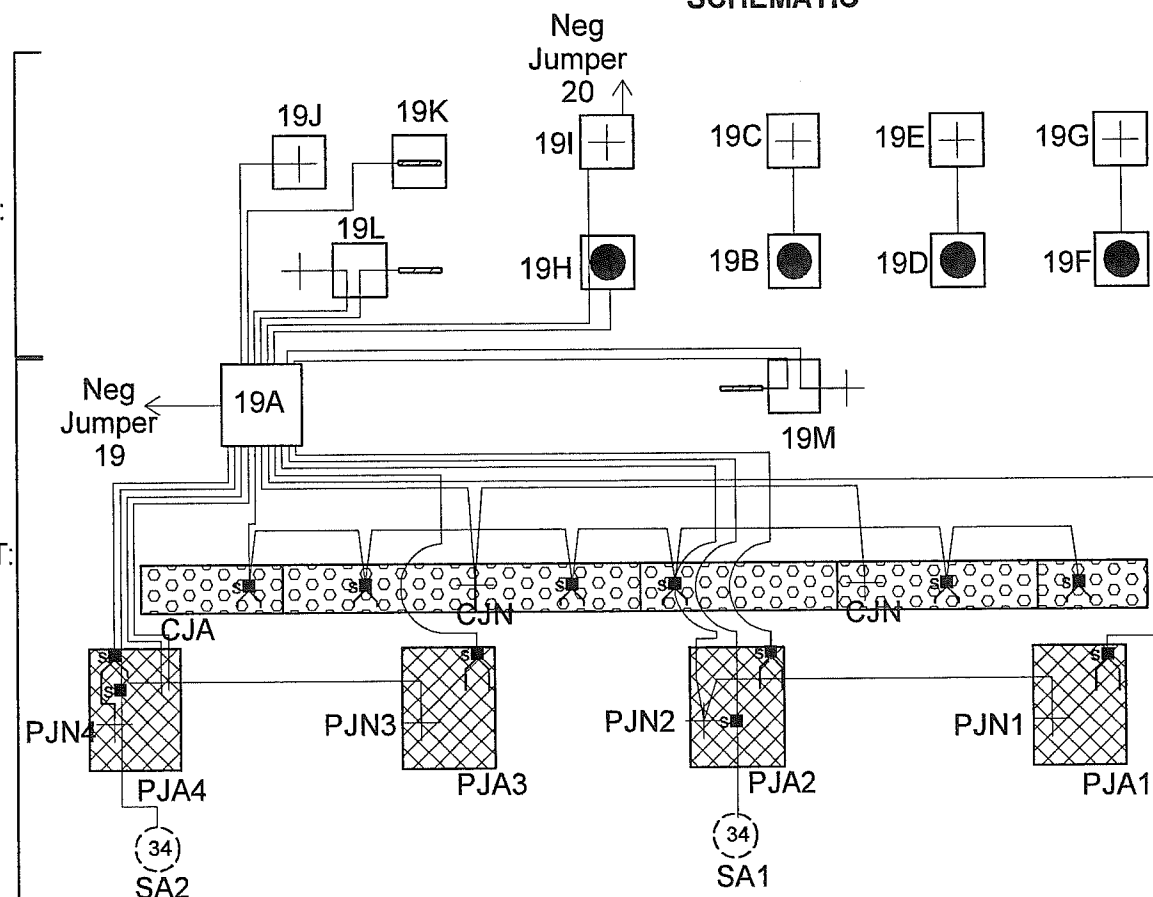

BENT 19 NORTH ELEVATION

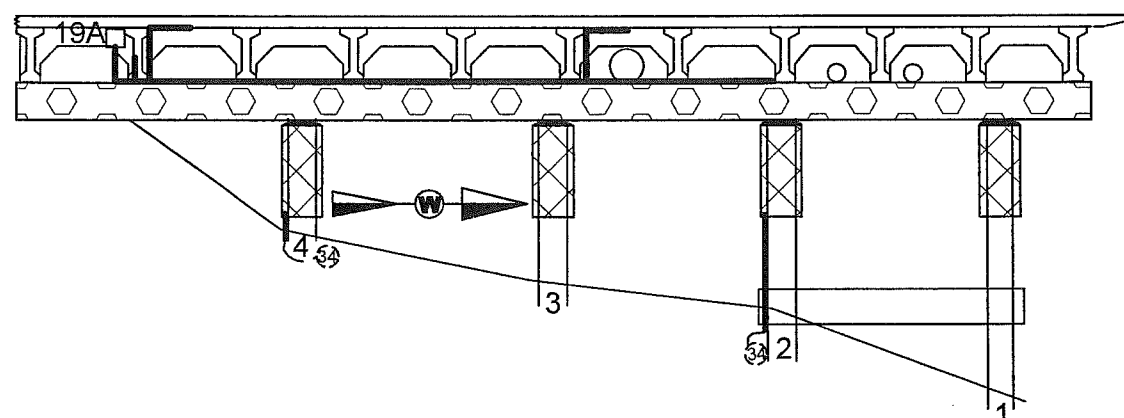

J-BOX DETAILS:

	J-Box Size	Wires or Structure
19-A	14" x 12" x 8"	MAIN J-BOX: (4) PJA; (2) PJN; (1) CJA; (1) CJN; (2) SA; SAN Jumpered from PJN; (1) MZA; (1) MZN; (3) RE; (3) REN; Neg Jumper 19
19-B	5" x 5" x 2"	Primary Anode Terminal Plate (MZA)
19-C	5" x 5" x 2"	Structure Negative (MZN)
19-D	5" x 5" x 2"	Primary Anode Terminal Plate (MZA)
19-E	5" x 5" x 2"	Structure Negative (MZN)
19-F	5" x 5" x 2"	Primary Anode Terminal Plate (MZA)
19-G	5" x 5" x 2"	Structure Negative (MZN)
19-H	5" x 5" x 2"	Primary Anode Terminal Plate (MZA); (1) MZN
19-I	5" x 5" x 2"	Structure Negative (MZN) - NEG Jumper 20
19-J	5" x 5" x 2"	Reference Electrode Negative (REN)
19-K	5" x 5" x 2"	Reference Electrode (RE)
19-L	5" x 5" x 2"	Reference Electrode (RE); (1) REN
19-M	5" x 5" x 2"	Reference Electrode (RE); (1) REN

ABBREVIATIONS:

MZN = Metallized Zinc Negative
 PJN = Pile Jacket Negative
 CJN = Cap Jacket Negative
 SAN = Submerged Anode Negative
 MZA = Metallized Zinc Anode
 PJA = Pile Jacket Anode
 CJA = Cap Jacket Anode
 SA = Submerged Anode
 RE = Reference Electrode
 REN = Reference Electrode Negative


LEGEND

- (x) Submerged Anode
- x = Weight in LBS
- ⊠ Pile Jacket
- ⊞ Cap Jacket
- Primary Anode Terminal
- + Negative Connection
- ⊞ Encapsulated Splice
- Reference Electrode


TYPICAL WIRE SIZES & COLORS AS FOLLOWS:
 MZA & PJA = #10 Red
 MZN; PJN = #10 Blue
 SA = #8 Black
 RE/REN: #16 Twisted Pair Red/Black

Tongass Ave Bent 19 North Elevation & Span 19			
SCALE:	NONE	Field Sketch	DRAWN BY KRH
DATE:	10-27-11	As-Built	REVISED 10-31-11
GREAT WESTERN CORPORATION			
Ketchikan Viaduct II Repair & C.P.			DRAWING NUMBER T-19


SPAN 20 - VIEW THROUGH DECK

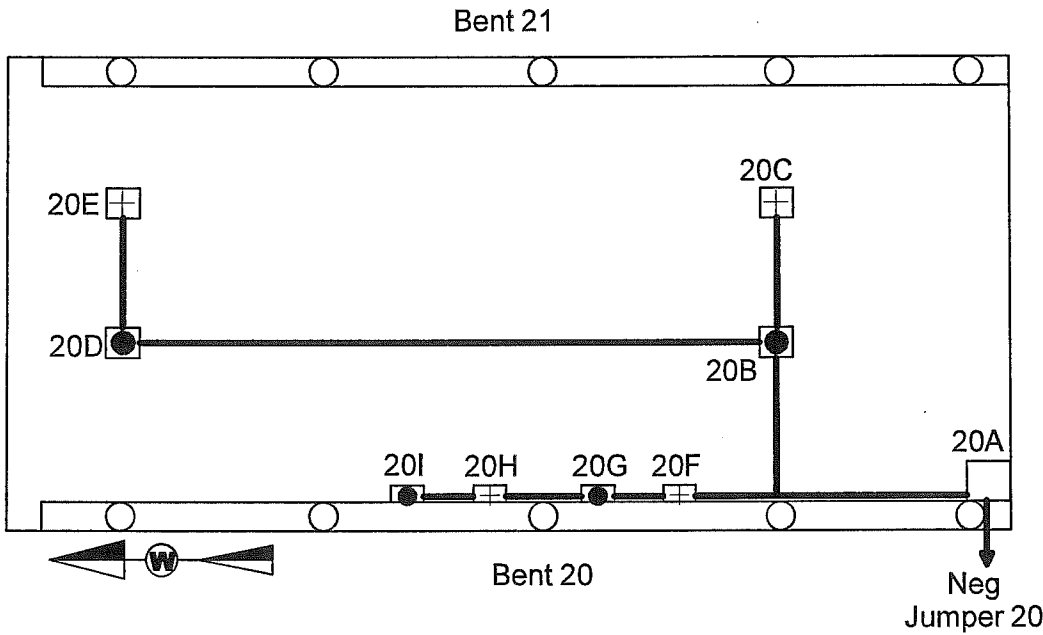

SCHEMATIC

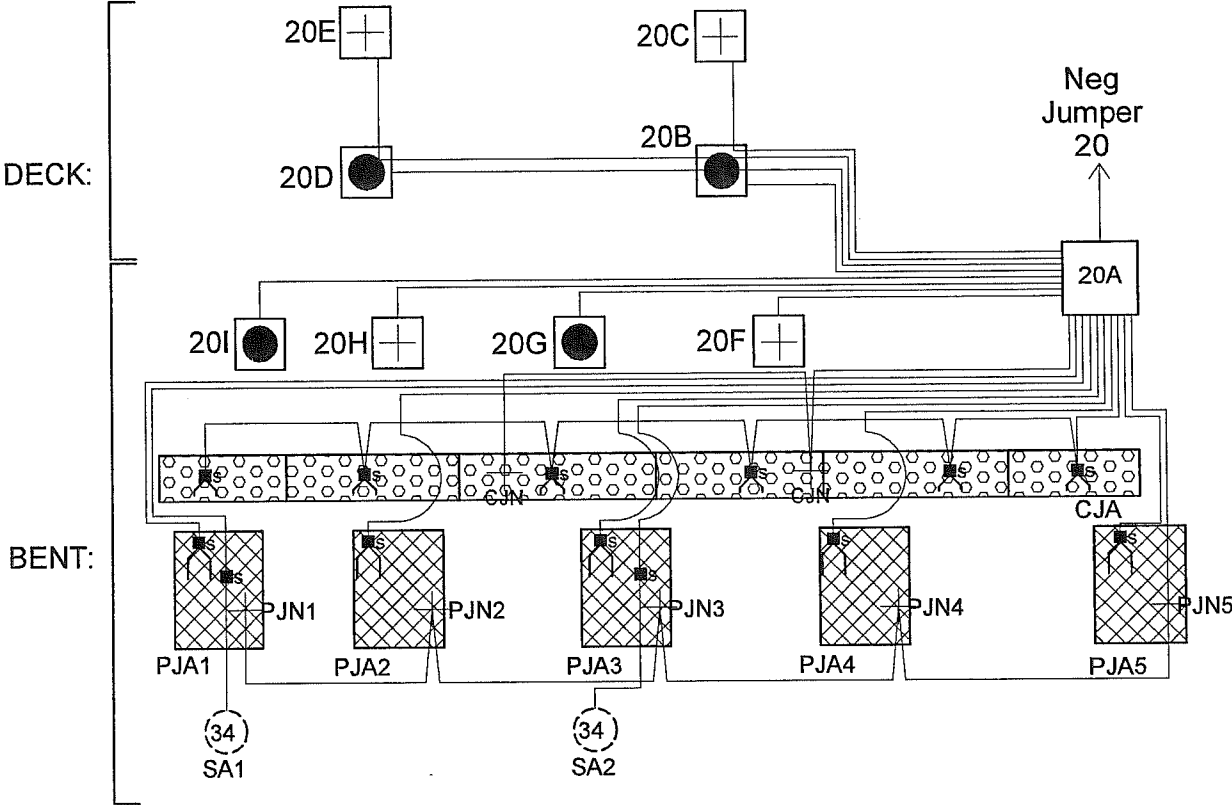

BENT 20 NORTH ELEVATION

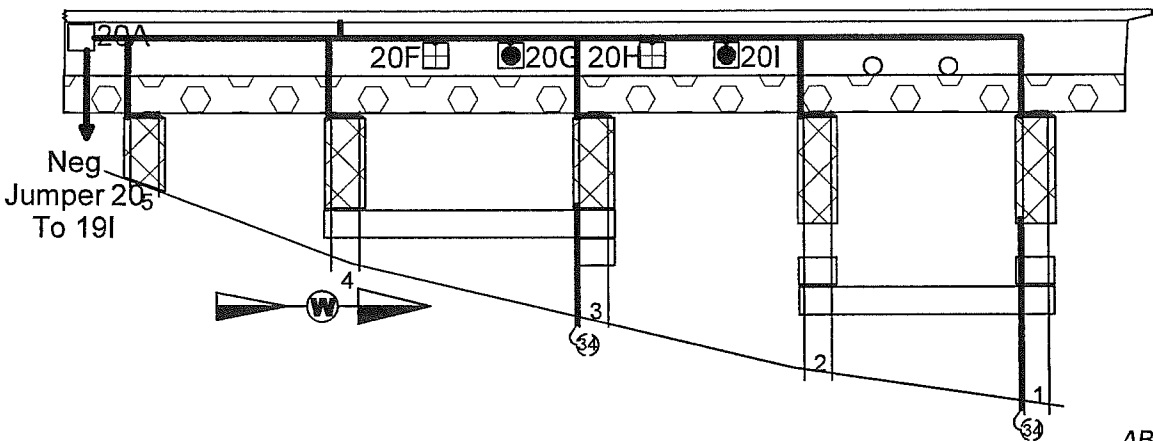

J-BOX DETAILS:

	J-Box Size	Wires or Structure
20-A	14" x 12" x 8"	MAIN J-BOX: (5) PJA; (1) PJN; (1) CJA; (1) CJN; (2) SA; SAN Jumpered from PJN; (4) MZA; (4) MZN; (1) MZN Jumpers
20-B	5" x 5" x 2"	Primary Anode Terminal Plate (MZA); (1) MZA; (2) MZN
20-C	5" x 5" x 2"	Structure Negative (MZN)
20-D	5" x 5" x 2"	Primary Anode Terminal Plate (MZA); (1) MZN
20-E	5" x 5" x 2"	Structure Negative (MZN)
20-F	5" x 5" x 2"	Structure Negative (MZN)
20-G	5" x 5" x 2"	Primary Anode Terminal Plate (MZA)
20-H	5" x 5" x 2"	Structure Negative (MZN)
20-I	5" x 5" x 2"	Primary Anode Terminal Plate (MZA)

ABBREVIATIONS:

MZN = Metallized Zinc Negative
PJN = Pile Jacket Negative
CJN = Cap Jacket Negative
SAN = Submerged Anode Negative
MZA = Metallized Zinc Anode
PJA = Pile Jacket Anode
CJA = Cap Jacket Anode
SA = Submerged Anode
RE = Reference Electrode
REN = Reference Electrode Negative

LEGEND

(x) Submerged Anode
x = Weight in LBS
⊗ Pile Jacket
⊕ Cap Jacket
● Primary Anode Terminal
+ Negative Connection
⊗ Encapsulated Splice
— Reference Electrode

Tongass Ave Bent 20 North Elevation
& Span 20

SCALE: NONE
DATE: 10-31-11
Field Sketch
As-Built
DRAWN BY: KRH
REVISED:


GREAT WESTERN CORPORATION

Ketchikan Viaduct II
Repair & C.P.


DRAWING NUMBER
T-20

TYPICAL WIRE SIZES & COLORS AS FOLLOWS:
MZA & PJA = #10 Red
MZN; PJN = #10 Blue
SA = #8 Black
RE/REN: #16 Twisted Pair Red/Black


SPAN 21 - VIEW THROUGH DECK

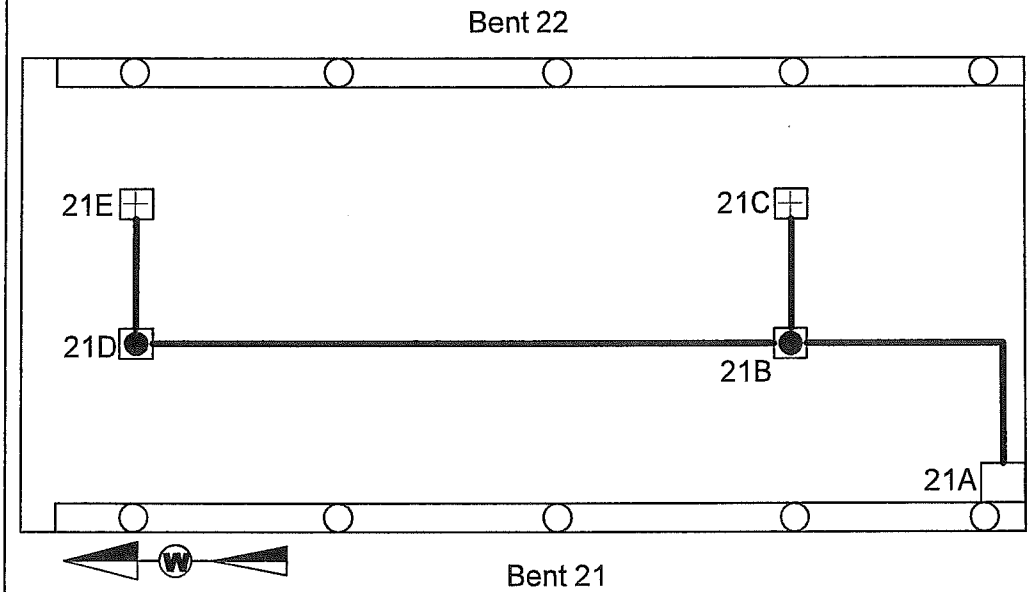

SCHEMATIC

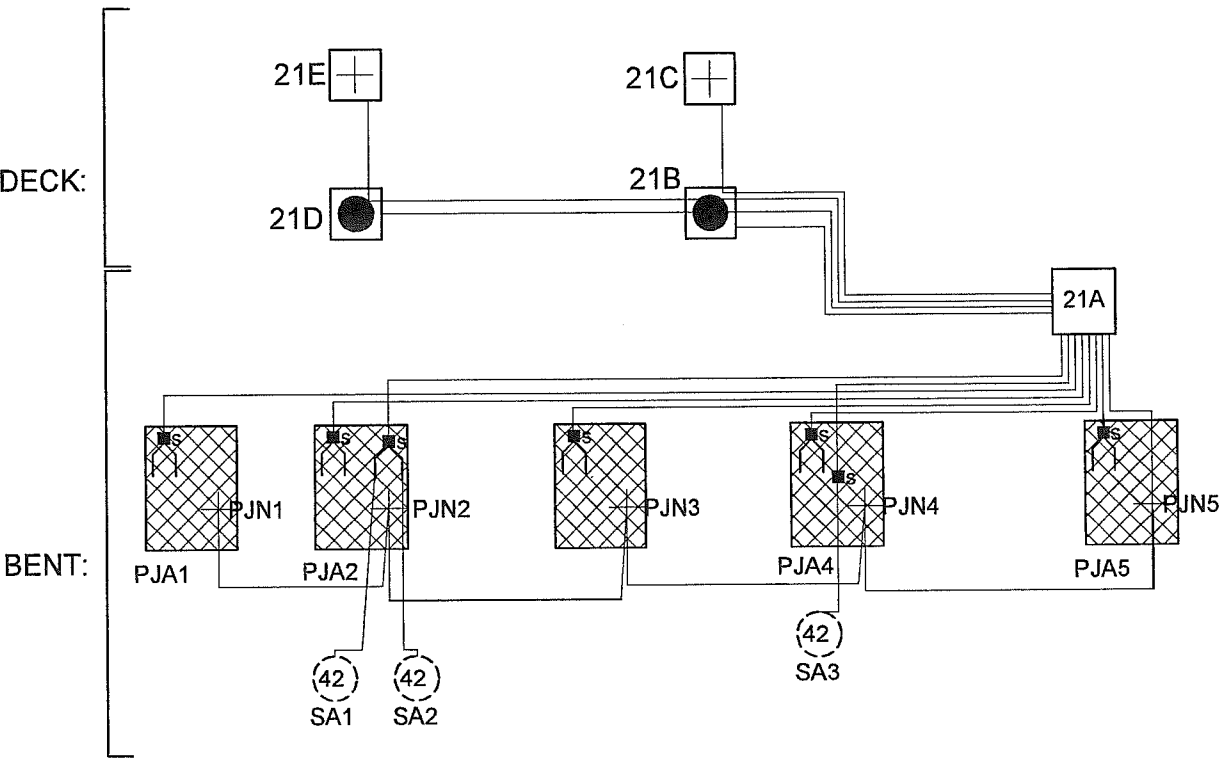

BENT 21 NORTH ELEVATION

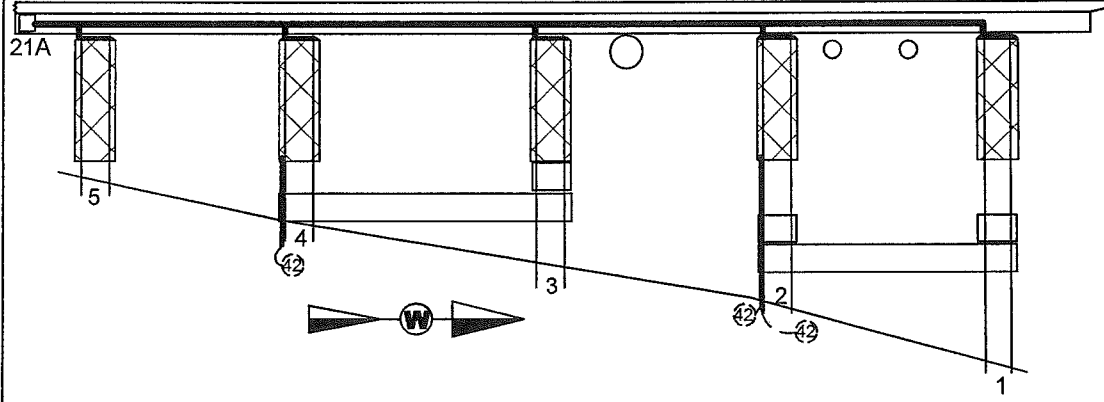

J-BOX DETAILS:

	J-Box Size	Wires or Structure
21-A	14" x 12" x 8"	MAIN J-BOX: (5) PJA; (1) PJN; (2) SA; SAN Jumpered from PJN; (2) MZA; (2) MZN
21-B	5" x 5" x 2"	Primary Anode Terminal Plate (MZA); (1) MZA; (2) MZN
21-C	5" x 5" x 2"	Structure Negative (MZN)
21-D	5" x 5" x 2"	Primary Anode Terminal Plate (MZA); (1) MZN
21-E	5" x 5" x 2"	Structure Negative (MZN)

ABBREVIATIONS:

MZN = Metallized Zinc Negative
PJN = Pile Jacket Negative
CJN = Cap Jacket Negative
SAN = Submerged Anode Negative
MZA = Metallized Zinc Anode
PJA = Pile Jacket Anode
CJA = Cap Jacket Anode
SA = Submerged Anode
RE = Reference Electrode
REN = Reference Electrode Negative


LEGEND

- Submerged Anode
x = Weight in LBS
- Pile Jacket
- Cap Jacket
- Primary Anode Terminal
- Negative Connection
- Encapsulated Splice
- Reference Electrode


TYPICAL WIRE SIZES & COLORS AS FOLLOWS:
MZA & PJA = #10 Red
MZN; PJN = #10 Blue
SA = #8 Black
RE/REN: #16 Twisted Pair Red/Black

Tongass Ave Bent 21 North Elevation & Span 21		
SCALE: NONE	Field Sketch	DRAWN BY KRH
DATE: 10-31-11	As-Built	REVISED
GREAT WESTERN CORPORATION		
Ketchikan Viaduct II Repair & C.P.		DRAWING NUMBER T-21


SPAN 22 - VIEW THROUGH DECK

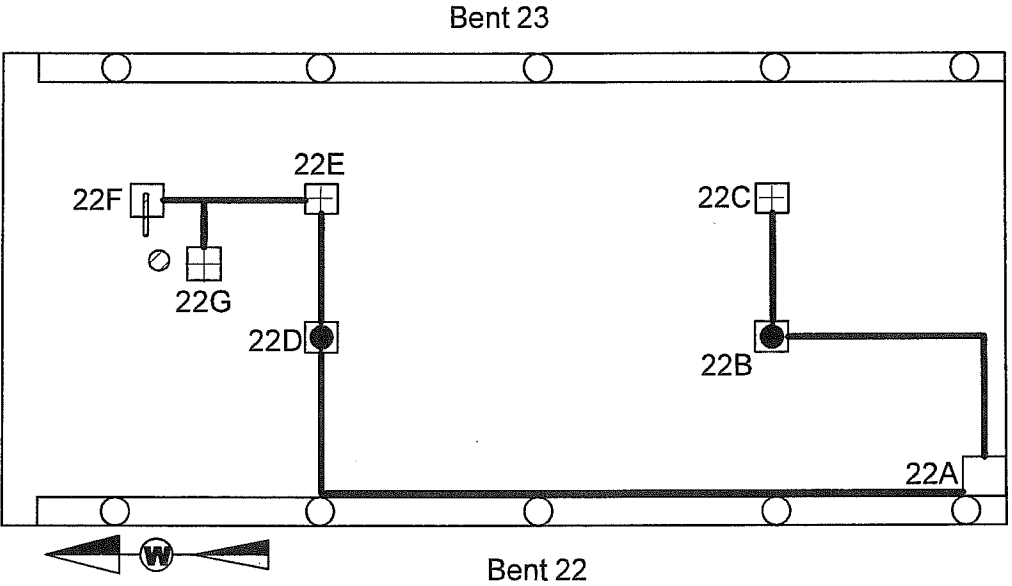

SCHEMATIC

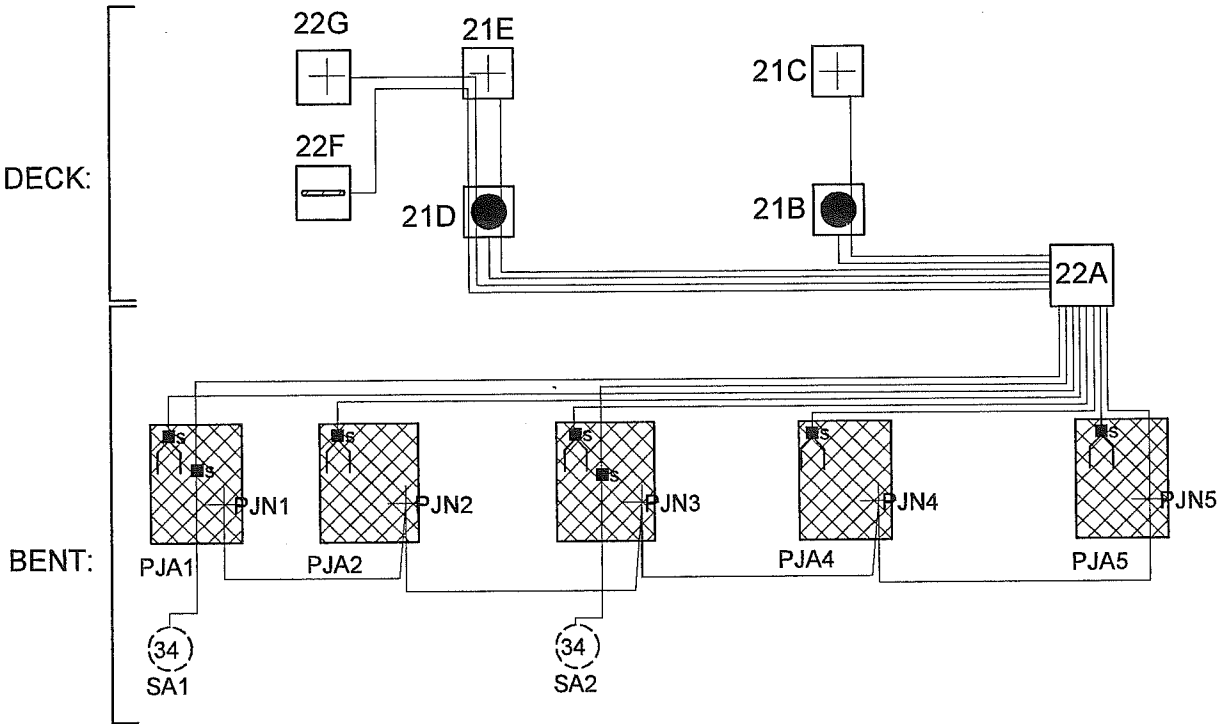

BENT 22 NORTH ELEVATION

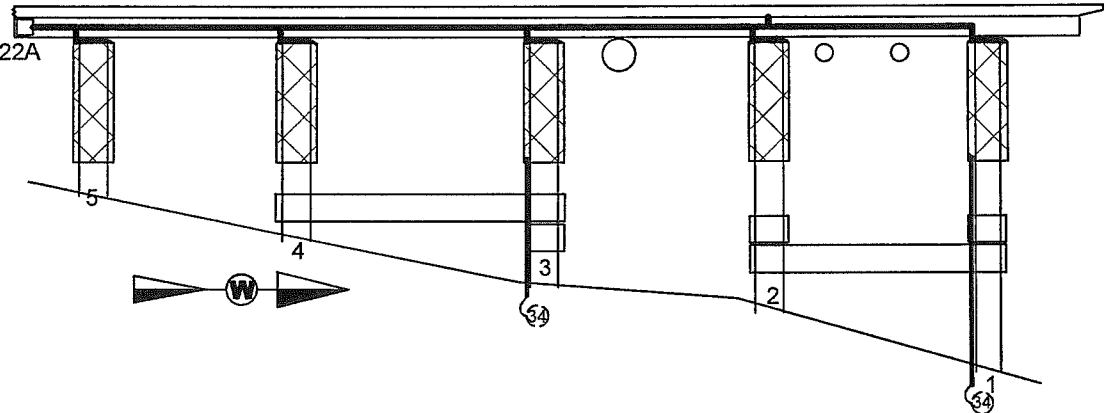

J-BOX DETAILS:

	J-Box Size	Wires or Structure
22-A	14" x 12" x 8"	MAIN J-BOX: (5) PJA; (1) PJN; (2) SA; SAN Jumpered from PJN; (2) MZA; (2) MZN; (1) RE; (1) REN
22-B	5" x 5" x 2"	Primary Anode Terminal Plate (MZA); (1) MZN
22-C	5" x 5" x 2"	Structure Negative (MZN)
22-D	5" x 5" x 2"	Primary Anode Terminal Plate (MZA); (1) MZN; (1) RE; (1) REN
22-E	5" x 5" x 2"	Structure Negative (MZN); (1) RE; (1) REN
22-F	5" x 5" x 2"	Reference Electrode (RE)
22-G	5" x 5" x 2"	Reference Electrode Negative (REN)


TYPICAL WIRE SIZES & COLORS AS FOLLOWS:
MZA & PJA = #10 Red
MZN; PJN = #10 Blue
SA = #8 Black
RE/REN: #16 Twisted Pair Red/Black

ABBREVIATIONS:
MZN = Metallized Zinc Negative
PJN = Pile Jacket Negative
CJN = Cap Jacket Negative
SAN = Submerged Anode Negative
MZA = Metallized Zinc Anode
PJA = Pile Jacket Anode
CJA = Cap Jacket Anode
SA = Submerged Anode
RE = Reference Electrode
REN = Reference Electrode Negative


LEGEND
⊗ Submerged Anode
x = Weight in LBS
⊠ Pile Jacket
⊞ Cap Jacket
● Primary Anode Terminal
+ Negative Connection
⊞ Encapsulated Splice
— Reference Electrode

Tongass Ave Bent 22 North Elevation & Span 22			
SCALE:	NONE	Field Sketch	DRAWN BY KRH
DATE:	10-31-11	As-Built	REVISED
GREAT WESTERN CORPORATION			
Ketchikan Viaduct II Repair & C.P.			DRAWING NUMBER T-22


SPAN 23 - VIEW THROUGH DECK

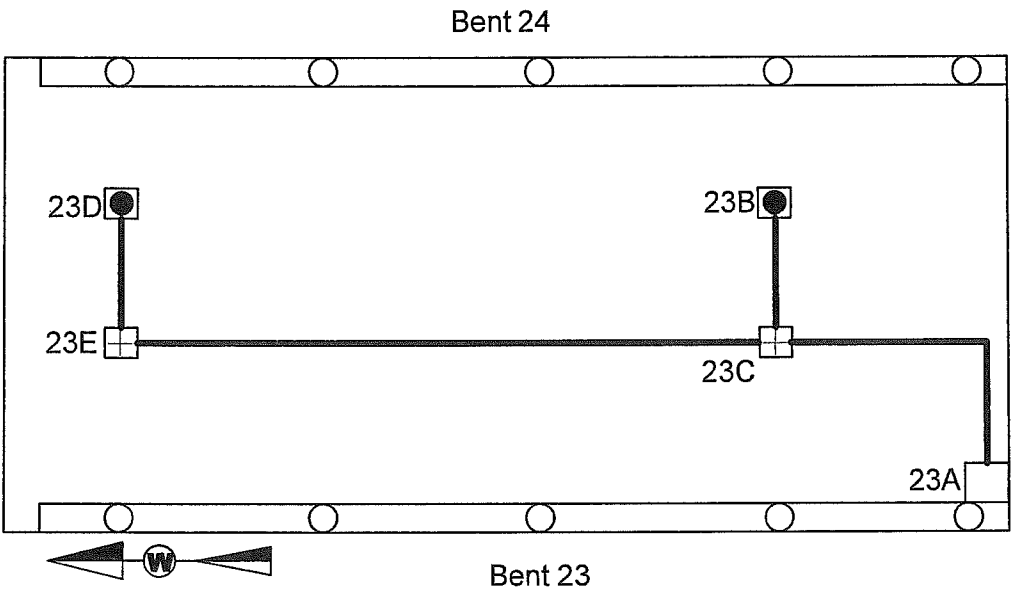

SCHEMATIC

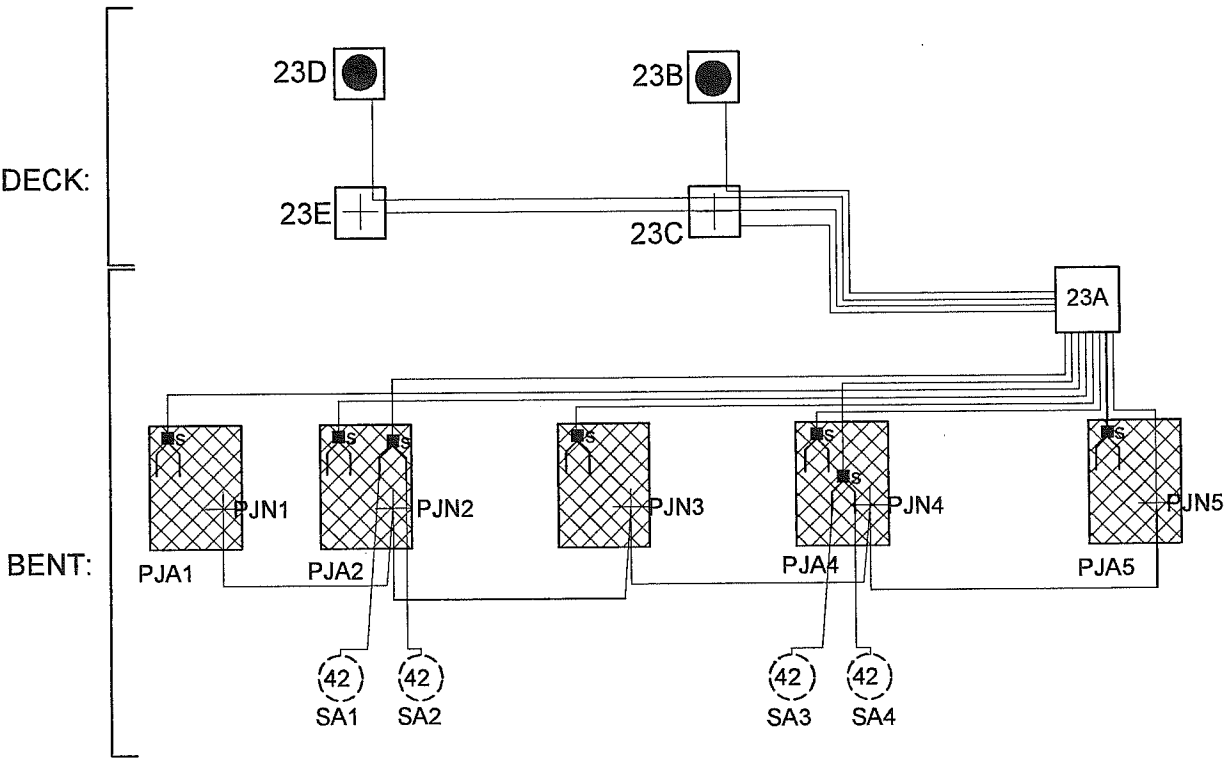

BENT 23 NORTH ELEVATION

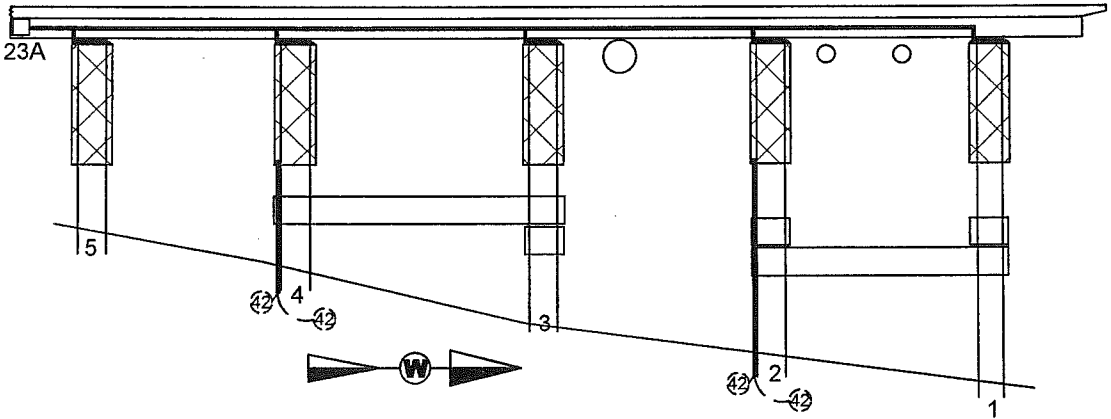

J-BOX DETAILS:

	J-Box Size	Wires or Structure
23-A	14" x 12" x 8"	MAIN J-BOX: (5) PJA; (1) PJN; (2) SA; SAN Jumpered from PJN; (2) MZA; (2) MZN
23-B	5" x 5" x 2"	Primary Anode Terminal Plate (MZA)
23-C	5" x 5" x 2"	Structure Negative (MZN); (2) MZA; (1) MZN
23-D	5" x 5" x 2"	Primary Anode Terminal Plate (MZA)
23-E	5" x 5" x 2"	Structure Negative (MZN); (1) MZA

ABBREVIATIONS:

MZN = Metallized Zinc Negative
PJN = Pile Jacket Negative
CJN = Cap Jacket Negative
SAN = Submerged Anode Negative
MZA = Metallized Zinc Anode
PJA = Pile Jacket Anode
CJA = Cap Jacket Anode
SA = Submerged Anode
RE = Reference Electrode
REN = Reference Electrode Negative

LEGEND

(x) Submerged Anode
x = Weight in LBS
[X] Pile Jacket
[C] Cap Jacket
● Primary Anode Terminal
+ Negative Connection
■ Encapsulated Splice
— Reference Electrode

Tongass Ave Bent 23 North Elevation
& Span 23

SCALE: NONE
DATE: 10-31-11
Field Sketch
As-Built
DRAWN BY: KRH
REVISED:


GREAT WESTERN CORPORATION

Ketchikan Viaduct II
Repair & C.P.


DRAWING NUMBER
T-23

TYPICAL WIRE SIZES & COLORS AS FOLLOWS:
MZA & PJA = #10 Red
MZN; PJN = #10 Blue
SA = #8 Black
RE/REN: #16 Twisted Pair Red/Black


SPAN 24 - VIEW THROUGH DECK

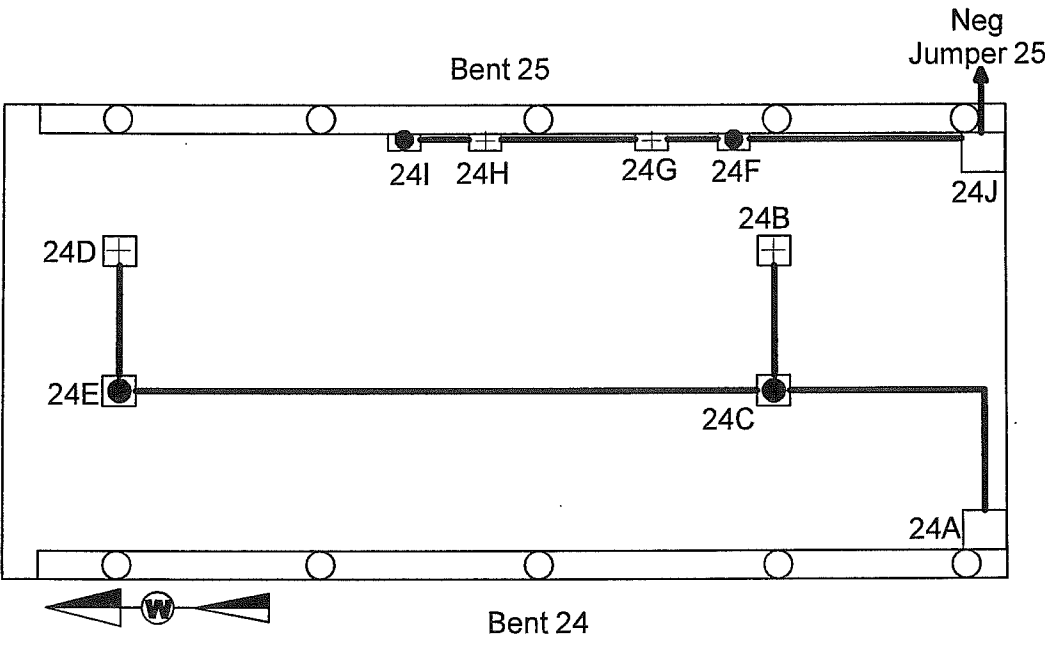

SCHEMATIC

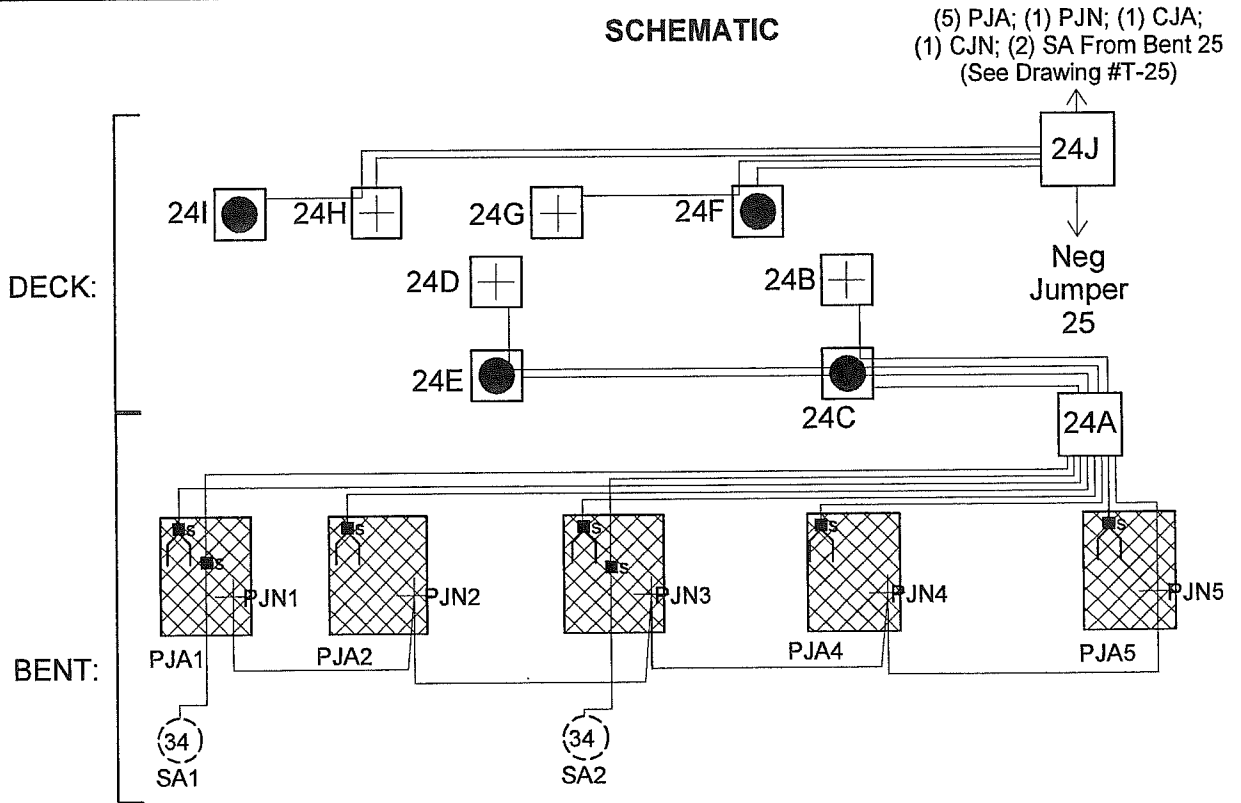

BENT 24 NORTH ELEVATION

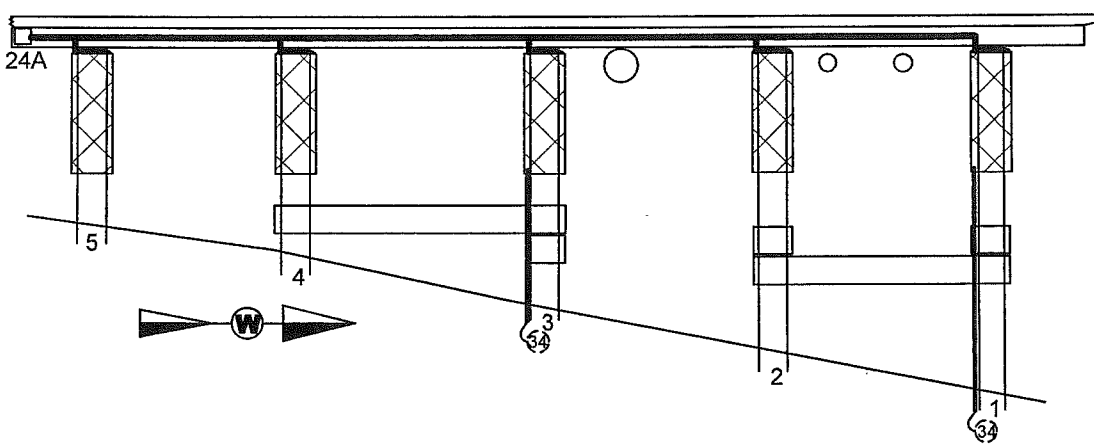

J-BOX DETAILS:

	J-Box Size	Wires or Structure
24-A	14" x 12" x 8"	MAIN J-BOX: (5) PJA; (1) PJN; (2) SA; SAN Jumpered from PJN; (2) MZA; (2) MZN
24-B	5" x 5" x 2"	Structure Negative (MZN)
24-C	5" x 5" x 2"	Primary Anode Terminal Plate (MZA); (2) MZN; (1) MZA
24-D	5" x 5" x 2"	Structure Negative (MZN)
24-E	5" x 5" x 2"	Primary Anode Terminal Plate (MZA); (1) MZN
24-F	5" x 5" x 2"	Primary Anode Terminal Plate (MZA); (1) MZN
24-G	5" x 5" x 2"	Structure Negative (MZN)
24-H	5" x 5" x 2"	Structure Negative (MZN); (1) MZA
24-I	5" x 5" x 2"	Primary Anode Terminal Plate (MZA)
24-J	14" x 12" x 8"	MAIN J-BOX BENT 25: (See Drawing #T-25) (5) PJA; (1) PJN; (1) CJA; (1) CJN; (2) SA; SAN Jumpered from PJN; (2) MZA; (2) MZN

ABBREVIATIONS:

MZN = Metallized Zinc Negative
PJN = Pile Jacket Negative
CJN = Cap Jacket Negative
SAN = Submerged Anode Negative
MZA = Metallized Zinc Anode
PJA = Pile Jacket Anode
CJA = Cap Jacket Anode
SA = Submerged Anode
RE = Reference Electrode
REN = Reference Electrode Negative

LEGEND

- Submerged Anode
- x = Weight in LBS
- Pile Jacket
- Cap Jacket
- Primary Anode Terminal
- Negative Connection
- Encapsulated Splice
- Reference Electrode

TYPICAL WIRE SIZES & COLORS AS FOLLOWS:
MZA & PJA = #10 Red
MZN; PJN = #10 Blue
SA = #8 Black
RE/REN: #16 Twisted Pair Red/Black


Tongass Ave Bent 24 North Elevation
& Span 24

SCALE: NONE	Field Sketch	DRAWN BY KRH
DATE: 10-31-11	As-Built	REVISED 11-1-11


GREAT WESTERN CORPORATION

Ketchikan Viaduct II Repair & C.P.	DRAWING NUMBER T-24
---------------------------------------	------------------------

SPAN 25 - VIEW THROUGH DECK

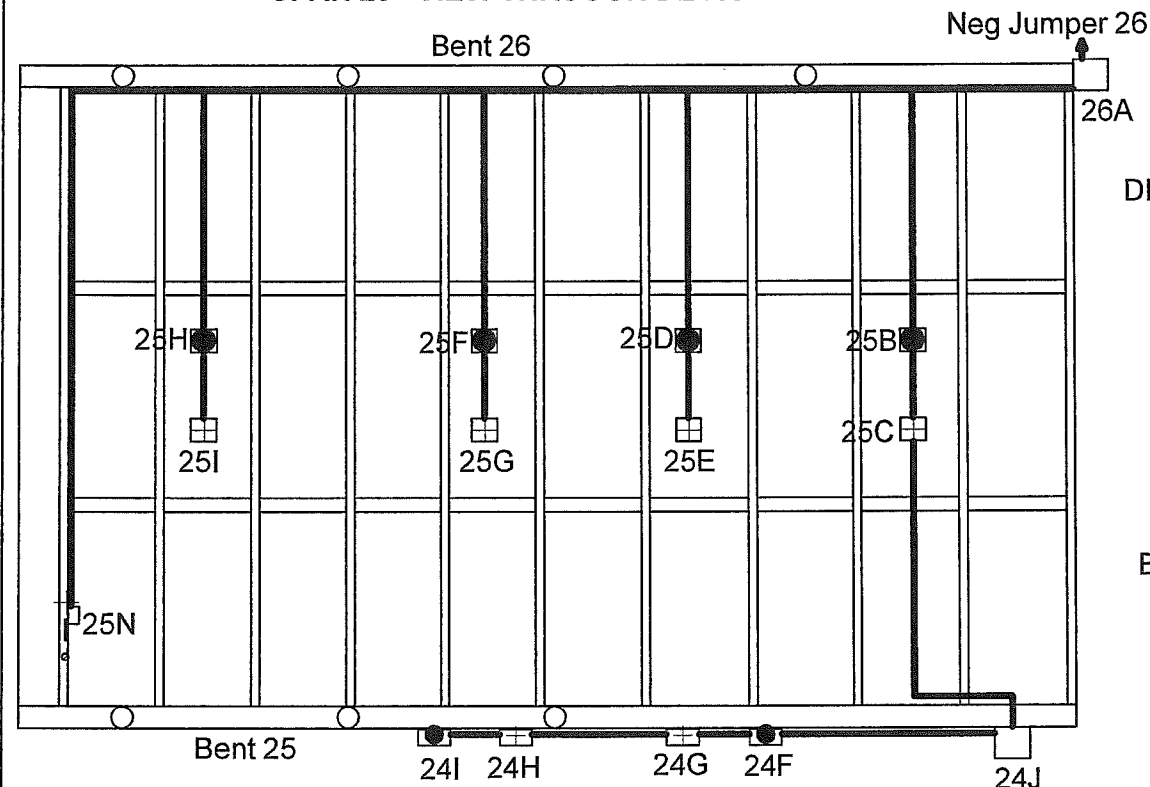


BENT 25 SOUTH ELEVATION

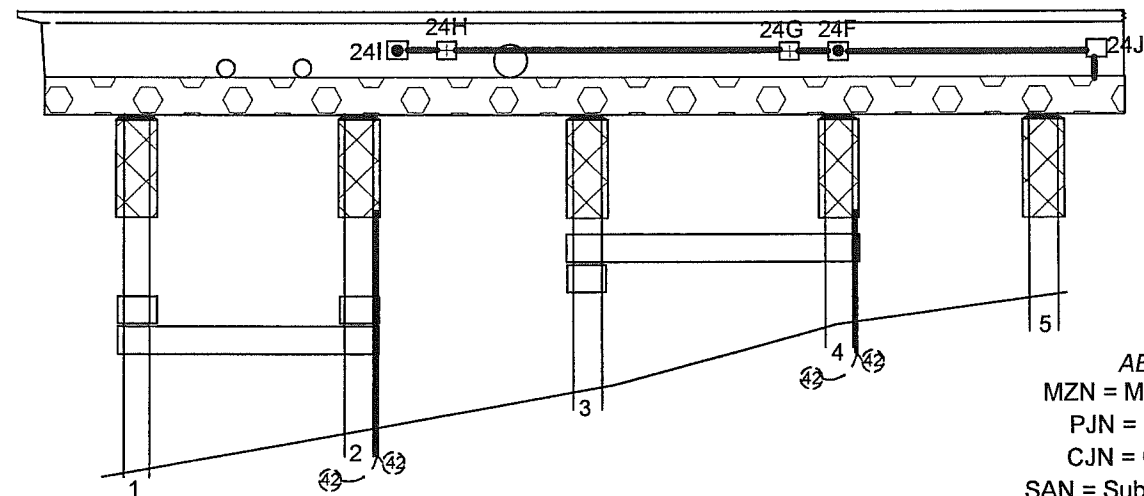

TYPICAL WIRE SIZES & COLORS AS FOLLOWS:
MZA & PJA = #10 Red
MZN; PJN = #10 Blue
SA = #8 Black
RE/REN: #16 Twisted Pair Red/Black

ABBREVIATIONS:
MZN = Metallized Zinc Negative
PJN = Pile Jacket Negative
CJN = Cap Jacket Negative
SAN = Submerged Anode Negative
MZA = Metallized Zinc Anode
PJA = Pile Jacket Anode
CJA = Cap Jacket Anode
SA = Submerged Anode
RE = Reference Electrode
REN = Reference Electrode Negative

SCHEMATIC

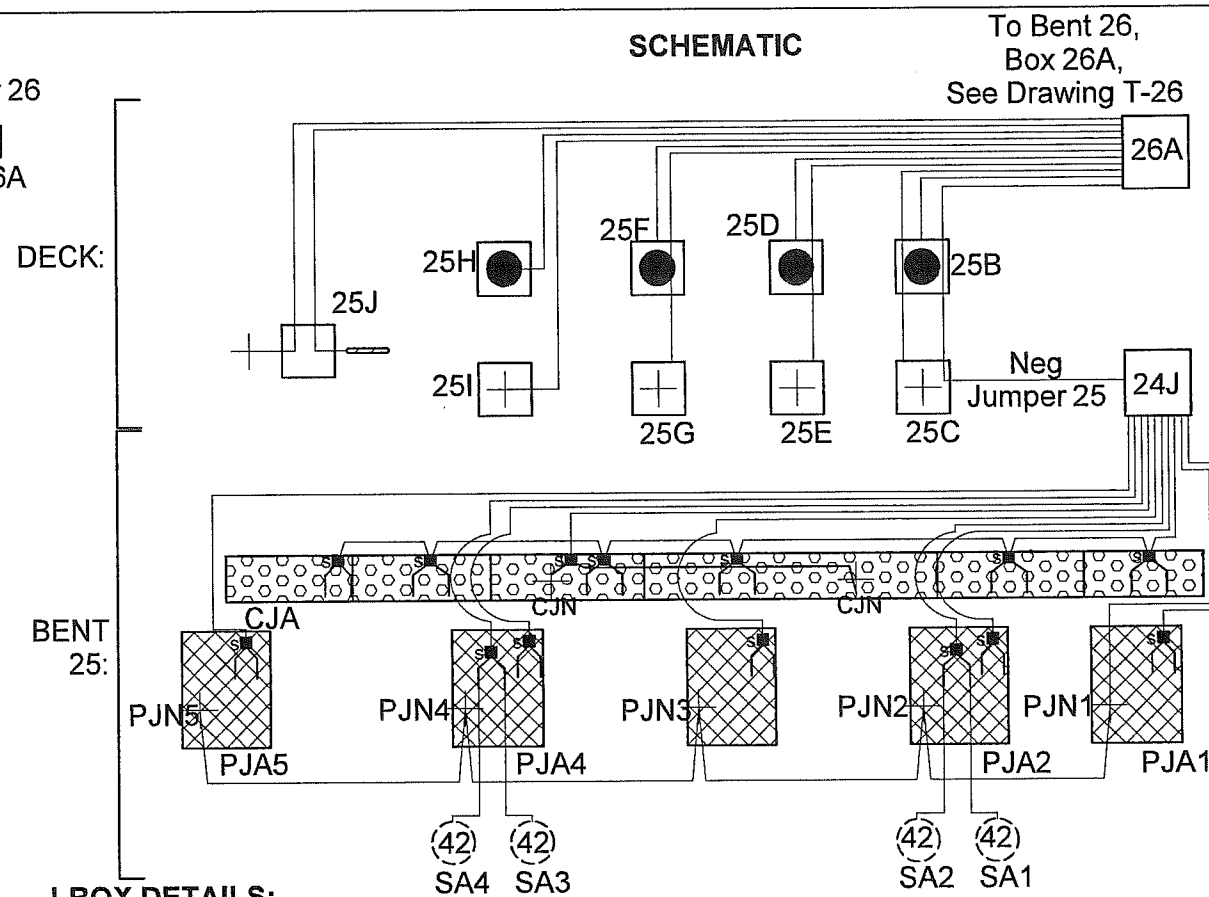

J-BOX DETAILS:

J-Box Size	Wires or Structure
26-A 14" x 12" x 8"	MAIN J-BOX Bent 26 (See Drawing #T-26): (5) PJA; (1) PJN; (1) CJA; (1) CJN; (2) SA; SAN Jumpered from PJN; (8) MZA; (8) MZN; (2) RE; (2) REN
25-B 5" x 5" x 2"	Primary Anode Terminal Plate (MZA); (1) MZN; (1) NEG JUMPER 25
25-C 5" x 5" x 2"	Structure Negative (MZN); (1) NEG JUMPER 25
25-D 5" x 5" x 2"	Primary Anode Terminal Plate (MZA); (1) MZN
25-E 5" x 5" x 2"	Structure Negative (MZN)
25-F 5" x 5" x 2"	Primary Anode Terminal Plate (MZA); (1) MZN
25-G 5" x 5" x 2"	Structure Negative (MZN)
25-H 5" x 5" x 2"	Primary Anode Terminal Plate (MZA); (1) MZN
25-I 5" x 5" x 2"	Structure Negative (MZN)
25-J 8" x 8" x 4"	Reference Electrode (RE); Reference Electrode Negative (REN)
24-F 5" x 5" x 2"	Primary Anode Terminal Plate (MZA); (1) MZN
24-G 5" x 5" x 2"	Structure Negative (MZN)
24-H 5" x 5" x 2"	Structure Negative (MZN); (1) MZA
24-I 5" x 5" x 2"	Primary Anode Terminal Plate (MZA)
24-J 14" x 12" x 8"	MAIN J-BOX BENT 25: (5) PJA; (1) PJN; (1) CJA; (1) CJN; (2) SA; SAN Jumpered from PJN; (2) MZA; (2) MZN

LEGEND




- (x) Submerged Anode
- x = Weight in LBS
- ⊠ Pile Jacket
- ⊡ Cap Jacket
- Primary Anode Terminal
- + Negative Connection
- Encapsulated Splice
- Reference Electrode

Tongass Ave Bent 25 South Elevation
& Span 25

SCALE: NONE
DATE: 10-31-11
Field Sketch
As-Built
DRAWN BY: KRH
REVISED: 11-1-11

GREAT WESTERN CORPORATION

Ketchikan Viaduct II
Repair & C.P.
DRAWING NUMBER
T-25

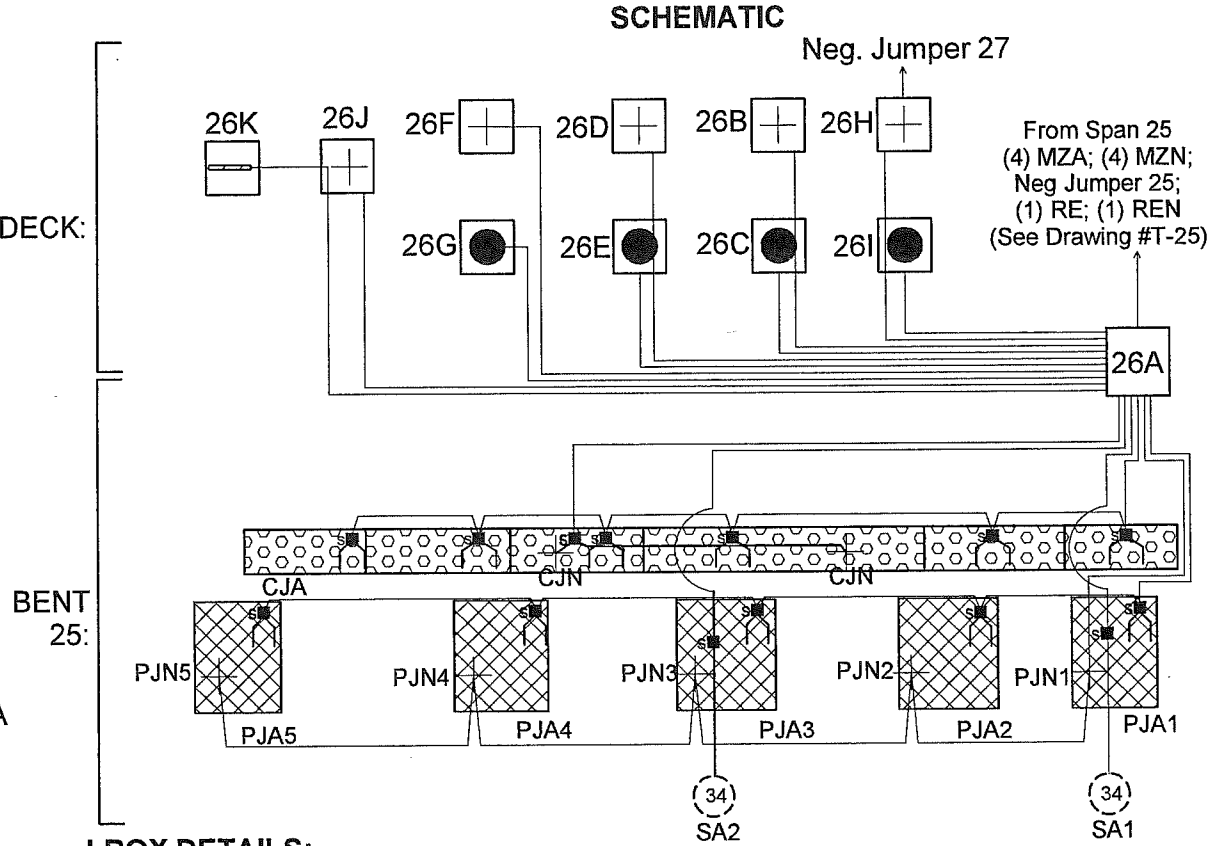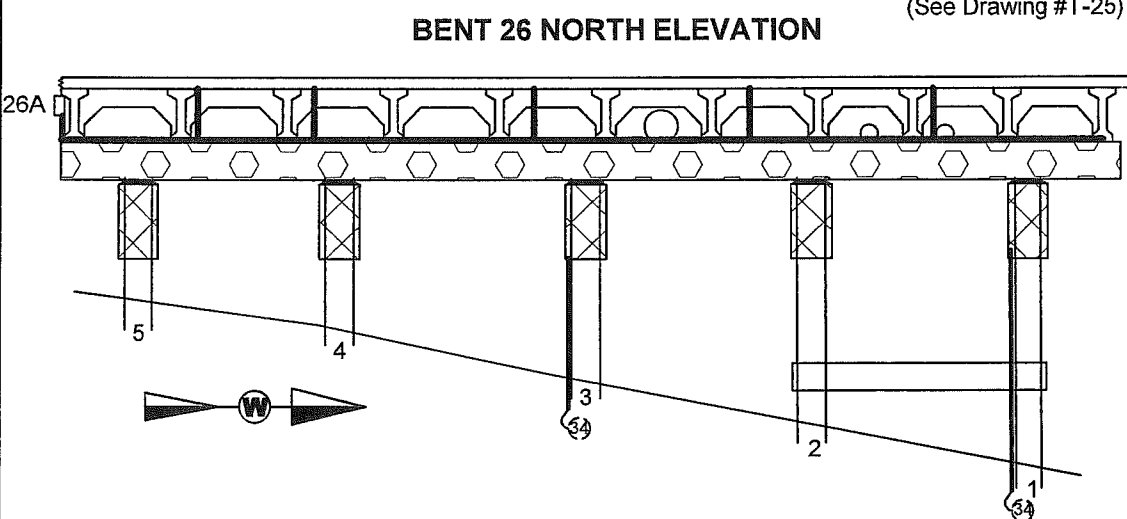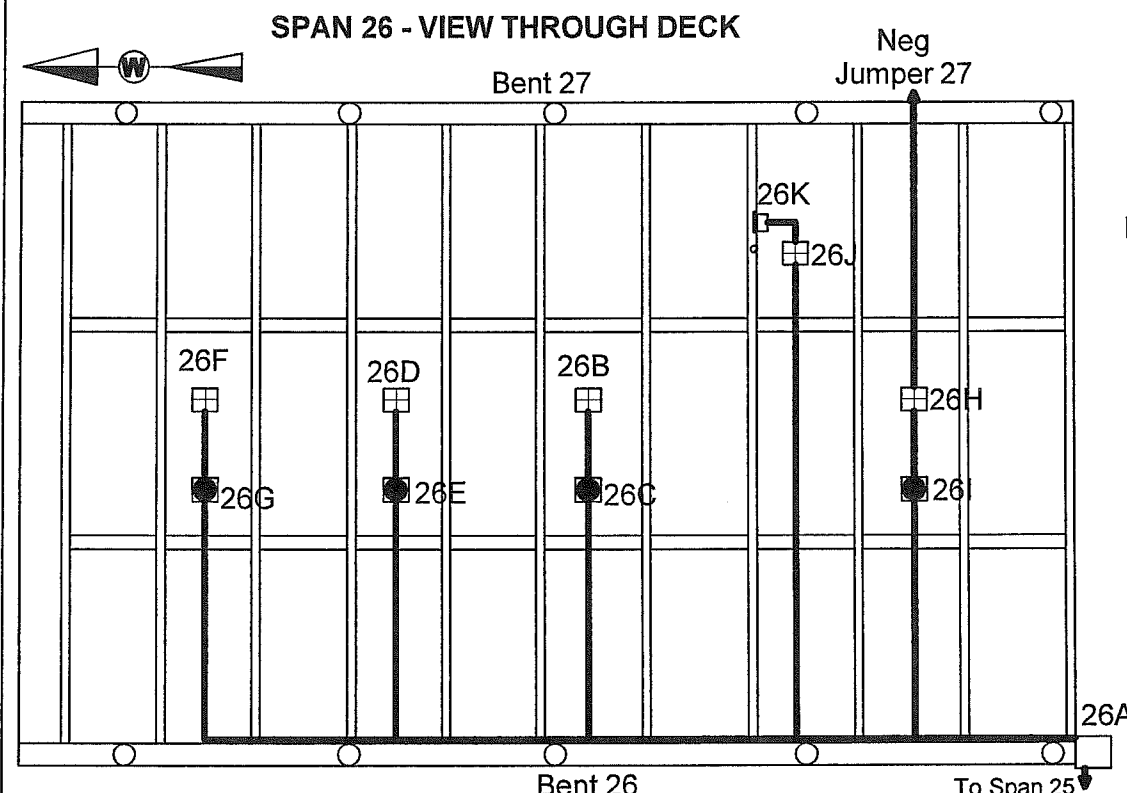

J-BOX DETAILS:

	J-Box Size	Wires or Structure
26-A	14" x 12" x 8"	MAIN J-BOX: (5) PJA; (1) PJN; (1) CJA; (1) CJN; (2) SA; SAN Jumpered from PJN; (8) MZA; (8) MZN; (2) RE; (2) REN
26-B	5" x 5" x 2"	Structure Negative (MZN)
26-C	5" x 5" x 2"	Primary Anode Terminal Plate (MZA); (1) MZN
26-D	5" x 5" x 2"	Structure Negative (MZN)
26-E	5" x 5" x 2"	Primary Anode Terminal Plate (MZA); (1) MZN
26-F	5" x 5" x 2"	Structure Negative (MZN)
26-G	5" x 5" x 2"	Primary Anode Terminal Plate (MZA); (1) MZN
26-H	5" x 5" x 2"	Structure Negative (MZN); NEG JUMPER 27
26-I	5" x 5" x 2"	Primary Anode Terminal Plate (MZA); (1) MZN
26-J	8" x 8" x 4"	Reference Electrode Negative (REN); (1) RE
26-K	5" x 5" x 2"	Reference Electrode (RE)

ABBREVIATIONS:

MZN = Metallized Zinc Negative
 PJN = Pile Jacket Negative
 CJN = Cap Jacket Negative
 SAN = Submerged Anode Negative
 MZA = Metallized Zinc Anode
 PJA = Pile Jacket Anode
 CJA = Cap Jacket Anode
 SA = Submerged Anode
 RE = Reference Electrode
 REN = Reference Electrode Negative

LEGEND

- (x) Submerged Anode
- x = Weight in LBS
- ⊠ Pile Jacket
- ⊞ Cap Jacket
- Primary Anode Terminal
- + Negative Connection
- Encapsulated Splice
- Reference Electrode

TYPICAL WIRE SIZES & COLORS AS FOLLOWS:
 MZA & PJA = #10 Red
 MZN; PJN = #10 Blue
 SA = #8 Black
 RE/REN: #16 Twisted Pair Red/Black

Tongass Ave Bent 26 North Elevation
& Span 26

SCALE: NONE	Field Sketch	DRAWN BY: KRH
DATE: 11-1-11	As-Built	REVISED

GREAT WESTERN CORPORATION

Ketchikan Viaduct II Repair & C.P.	DRAWING NUMBER T-26
---------------------------------------	------------------------

Diagram illustrating the bridge deck layout for Bent 27 and Bent 28. The layout shows the bridge deck structure, including the main spans and the location of various components labeled 27A through 27I. A north arrow and a 'W' symbol are present at the top left. The label 'Neg Jumper 27' is located at the bottom right.

The diagram illustrates the internal wiring of the 27A Jumper, divided into two main sections: DECK and BENT.

DECK: This section contains several components labeled 27F, 27G, 27C, 27B, 27H, 27E, 27D, and 27A. Components 27F, 27H, 27B, and 27D are represented by squares with a solid black circle. Components 27G, 27C, and 27E are represented by squares with a cross symbol. Component 27A is a square with a cross symbol. Wires connect these components, with a specific path leading from 27A to a "Neg Jumper 27" terminal.

BENT: This section shows a horizontal strip with a dotted pattern, labeled CJA, which is connected to a series of five cross-hatched squares labeled PJN1 through PJN5. Below these are five circular components labeled PJA1 through PJA5. PJN1, PJN3, and PJN5 are connected to a terminal labeled (34) SA1. PJN2 and PJN4 are connected to a terminal labeled (34) SA2. PJN5 is also connected to the "Neg Jumper 27" terminal. The BENT section is connected to the DECK section via a series of wires.


	J-Box Size	Wires or Structure
27-A	14" x 12" x 8"	MAIN J-BOX: (5) PJA; (1) PJN; (1) CJA; (1) CJN; (2) SA; SAN Jumpered from PJN; (4) MZA; (4) MZN
27-B	5" x 5" x 2"	Primary Anode Terminal Plate (MZA); (2) MZN; (1) MZA
27-C	5" x 5" x 2"	Structure Negative (MZN); (1) MZA; (1) MZN
27-D	5" x 5" x 2"	Primary Anode Terminal Plate (MZA); (2) MZN; (1) MZA
27-E	5" x 5" x 2"	Structure Negative (MZN)
27-F	5" x 5" x 2"	Primary Anode Terminal Plate (MZA)
27-G	5" x 5" x 2"	Structure Negative (MZN); (1) MZA
27-H	5" x 5" x 2"	Primary Anode Terminal Plate (MZA); (1) MZN
27-I	5" x 5" x 2"	Structure Negative (MZN)

MZN = Metallized Zinc Negative
 PJN = Pile Jacket Negative
 CJN = Cap Jacket Negative
 SAN = Submerged Anode Negative
 MZA = Metallized Zinc Anode
 PJA = Pile Jacket Anode
 CJA = Cap Jacket Anode
 SA = Submerged Anode
 RE = Reference Electrode
 REN = Reference Electrode Negative


- Submerged Anode
x = Weight in LBS
- Pile Jacket
- Cap Jacket
- Primary Anode Terminal
- Negative Connection
- Encapsulated Splice
- Reference Electrode

Tongass Ave Bent 27 North Elevation & Span 27			
SCALE:	NONE	Field Sketch As-Built	DRAWN BY KRH
DATE:	11-1-11		REVISED
GREAT WESTERN CORPORATION			
Ketchikan Viaduct II Repair & C.P.			DRAWING NUMBER T-27


SPAN 28 - VIEW THROUGH DECK

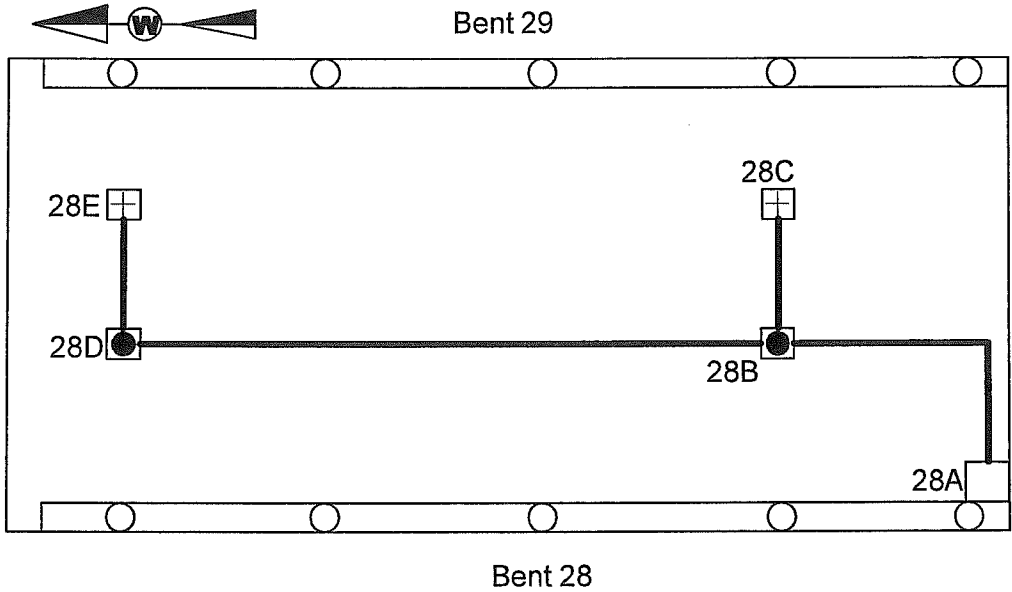

SCHEMATIC

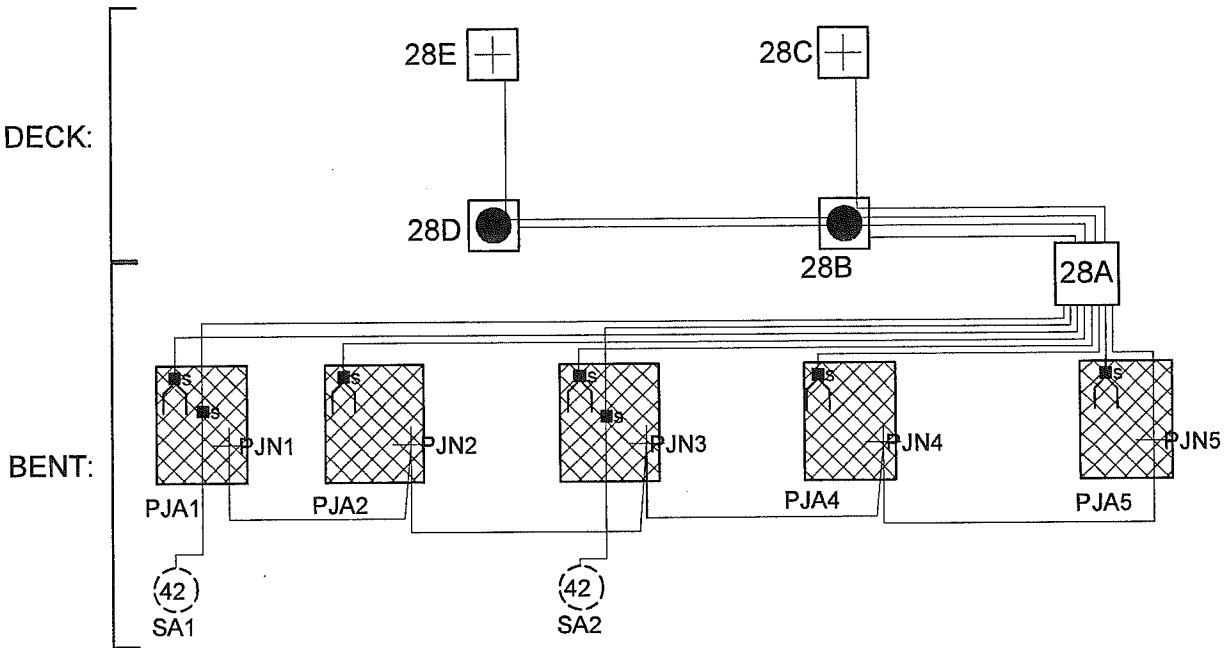

BENT 28 NORTH ELEVATION

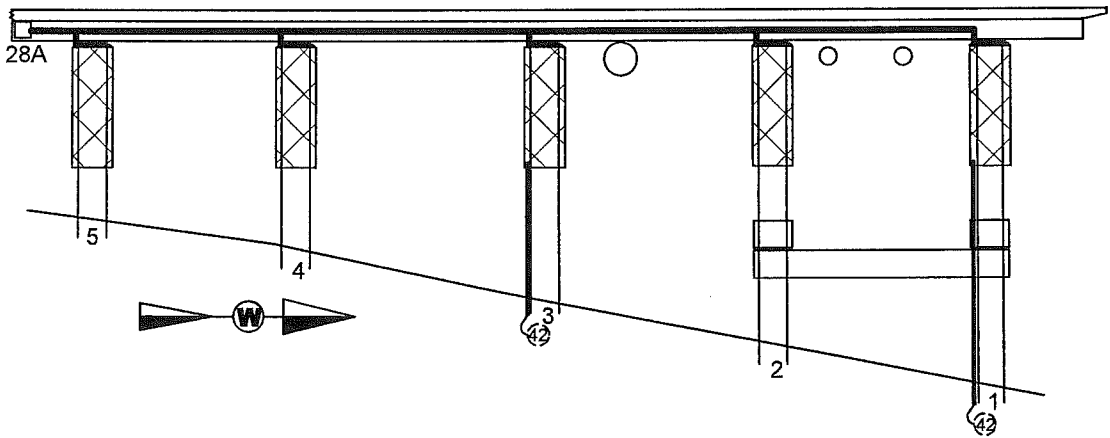

J-BOX DETAILS:

	J-Box Size	Wires or Structure
28-A	14" x 12" x 8"	MAIN J-BOX: (5) PJA; (1) PJN; (2) SA; SAN Jumpered from PJN; (2) MZA; (2) MZN
28-B	5" x 5" x 2"	Primary Anode Terminal Plate (MZA); (2) MZN; (1) MZA
28-C	5" x 5" x 2"	Structure Negative (MZN)
28-D	5" x 5" x 2"	Primary Anode Terminal Plate (MZA); (1) MZN
28-E	5" x 5" x 2"	Structure Negative (MZN)


TYPICAL WIRE SIZES & COLORS AS FOLLOWS:
MZA & PJA = #10 Red
MZN; PJN = #10 Blue
SA = #8 Black
RE/REN: #16 Twisted Pair Red/Black

ABBREVIATIONS:
MZN = Metallized Zinc Negative
PJN = Pile Jacket Negative
CJN = Cap Jacket Negative
SAN = Submerged Anode Negative
MZA = Metallized Zinc Anode
PJA = Pile Jacket Anode
CJA = Cap Jacket Anode
SA = Submerged Anode
RE = Reference Electrode
REN = Reference Electrode Negative


LEGEND
⊗ Submerged Anode
x = Weight in LBS
⊠ Pile Jacket
⊡ Cap Jacket
● Primary Anode Terminal
+ Negative Connection
■ Encapsulated Splice
— Reference Electrode

Tongass Ave Bent 28 North Elevation & Span 28		
SCALE: NONE	Field Sketch	DRAWN BY KRH
DATE: 11-1-11	As-Built	REVISED
GREAT WESTERN CORPORATION		
Ketchikan Viaduct II Repair & C.P.		DRAWING NUMBER T-28


SPAN 29 - VIEW THROUGH DECK

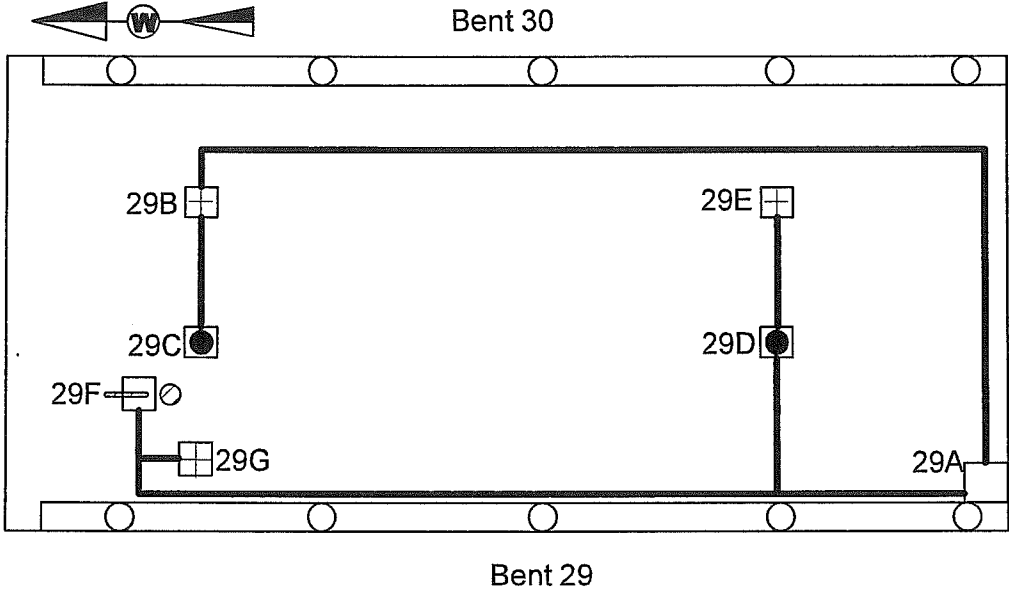

SCHEMATIC

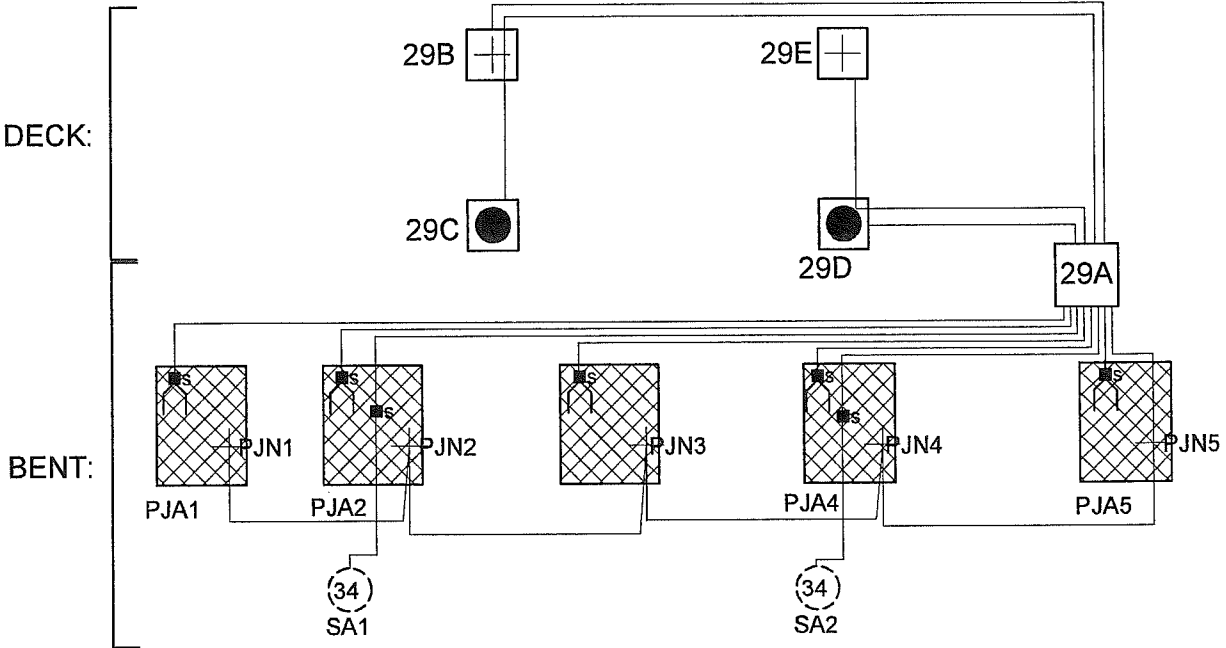

BENT 29 NORTH ELEVATION

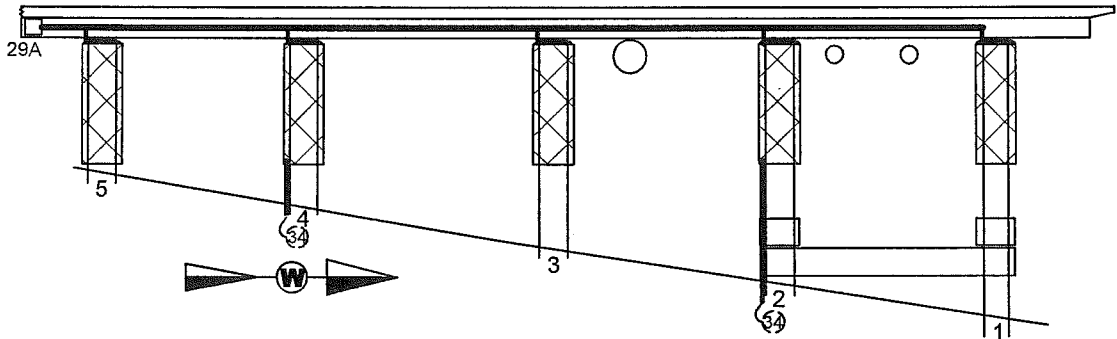

J-BOX DETAILS:

	J-Box Size	Wires or Structure
29-A	14" x 12" x 8"	MAIN J-BOX: (5) PJA; (1) PJN; (2) SA; SAN Jumpered from PJN; (2) MZA; (2) MZN
29-B	5" x 5" x 2"	Structure Negative (MZN); (1) MZA
29-C	5" x 5" x 2"	Primary Anode Terminal Plate (MZA)
29-D	5" x 5" x 2"	Primary Anode Terminal Plate (MZA); (1) MZN
29-E	5" x 5" x 2"	Structure Negative (MZN)

TYPICAL WIRE SIZES & COLORS AS FOLLOWS:
MZA & PJA = #10 Red
MZN; PJN = #10 Blue
SA = #8 Black
RE/REN: #16 Twisted Pair Red/Black

ABBREVIATIONS:
MZN = Metallized Zinc Negative
PJN = Pile Jacket Negative
CJN = Cap Jacket Negative
SAN = Submerged Anode Negative
MZA = Metallized Zinc Anode
PJA = Pile Jacket Anode
CJA = Cap Jacket Anode
SA = Submerged Anode
RE = Reference Electrode
REN = Reference Electrode Negative

LEGEND
⊗ Submerged Anode
x = Weight in LBS
⊠ Pile Jacket
⊞ Cap Jacket
● Primary Anode Terminal
+ Negative Connection
■ Encapsulated Splice
— Reference Electrode

Tongass Ave Bent 29 North Elevation & Span 29			
SCALE:	NONE	Field Sketch	DRAWN BY KRH
DATE:	11-1-11	As-Built	REVISED
GREAT WESTERN CORPORATION			
Ketchikan Viaduct II Repair & C.P.			DRAWING NUMBER T-29


	J-Box Size	Wires or Structure
30-A	14" x 12" x 8"	MAIN J-BOX: (5) PJA; (1) PJN; (2) SA; SAN Jumpered from PJN; (2) MZA; (2) MZN; (1) RE; (1) REN
30-B	5" x 5" x 2"	Primary Anode Terminal Plate (MZA); (2) MZN; (1) MZA
30-C	5" x 5" x 2"	Structure Negative (MZN); (1) MZA; (1) MZN
30-D	5" x 5" x 2"	Structure Negative (MZN); (1) MZA
30-E	5" x 5" x 2"	Primary Anode Terminal Plate (MZA)
30-F	5" x 5" x 2"	Reference Electrode Negative (REN); (1) RE
30-G	5" x 5" x 2"	Reference Electrode (RE)

MZN = Metallized Zinc Negative
 PJN = Pile Jacket Negative
 CJN = Cap Jacket Negative
 SAN = Submerged Anode Negative
 MZA = Metallized Zinc Anode
 PJA = Pile Jacket Anode
 CJA = Cap Jacket Anode
 SA = Submerged Anode
 RE = Reference Electrode
 REN = Reference Electrode Negative


- Submerged Anode
x = Weight in LBS
- Pile Jacket
- Cap Jacket
- Primary Anode Terminal
- Negative Connection
- Encapsulated Splice
- Reference Electrode

Tongass Ave Bent 30 North Elevation & Span 30		
SCALE: NONE	Field Sketch As-Built	DRAWN BY KRH
DATE: 11-1-11		REVISED
GREAT WESTERN CORPORATION		
Ketchikan Viaduct II Repair & C.P.		DRAWING NUMBER T-30


SPAN 31 - VIEW THROUGH DECK

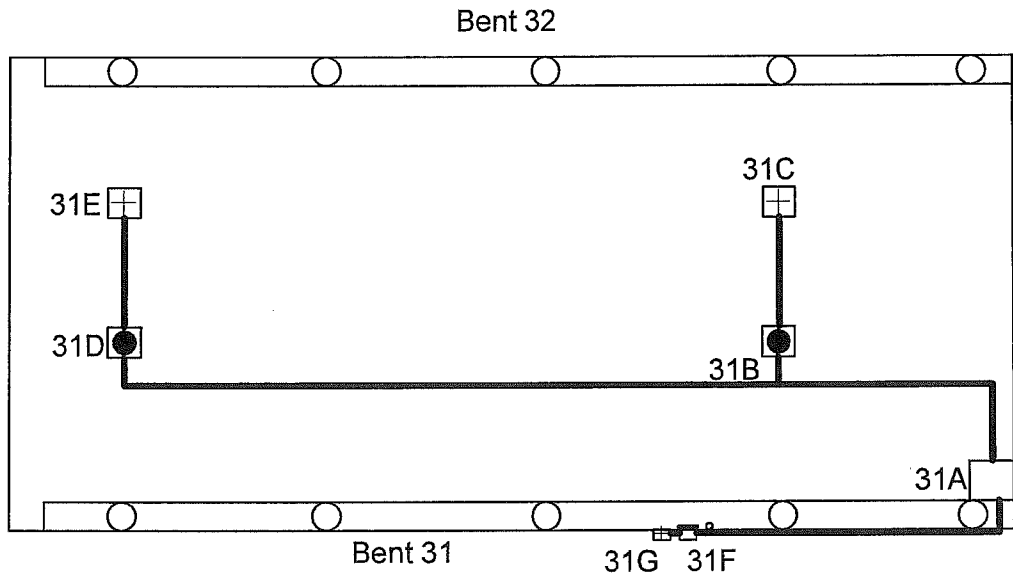

SCHEMATIC

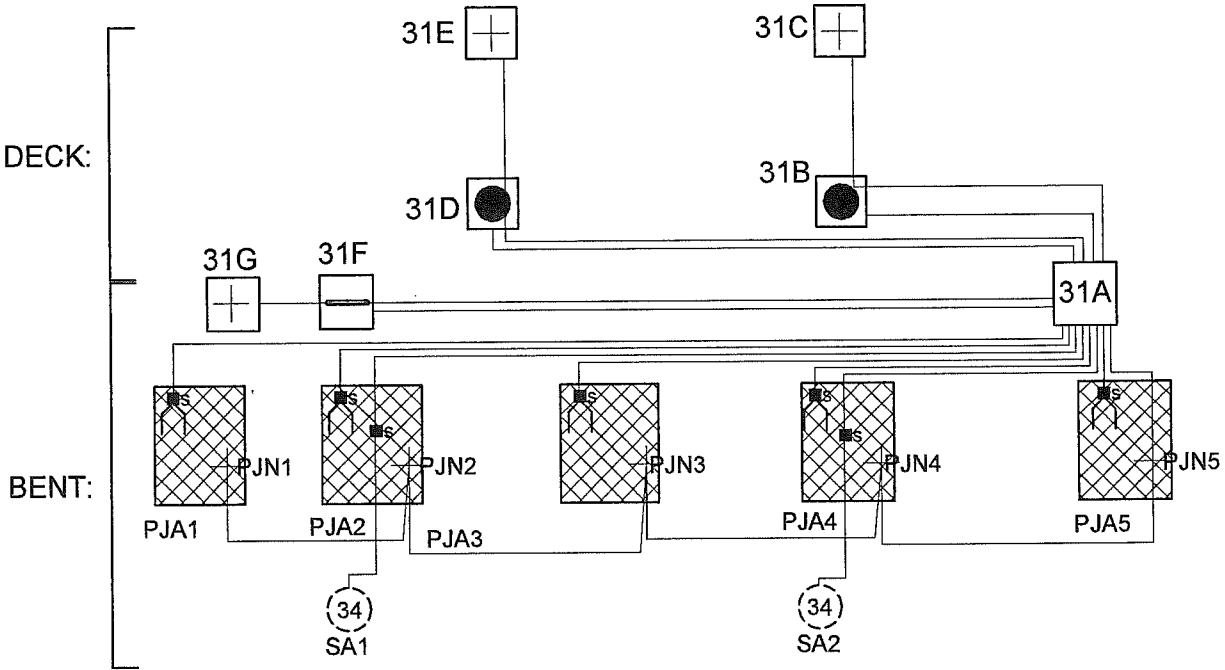

BENT 31 SOUTH ELEVATION

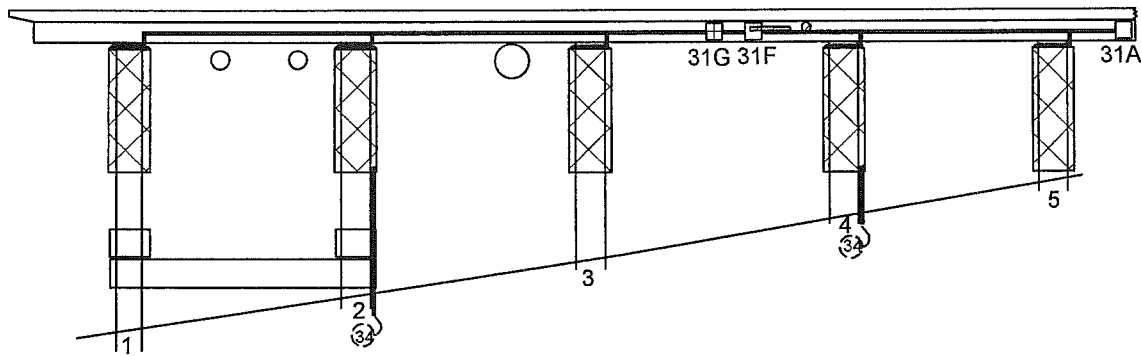

J-BOX DETAILS:

	J-Box Size	Wires or Structure
31-A	14" x 12" x 8"	MAIN J-BOX: (5) PJA; (1) PJN; (2) SA; SAN Jumpered from PJN; (2) MZA; (2) MZN; (1) RE; (1) REN
31-B	5" x 5" x 2"	Primary Anode Terminal Plate (MZA); (1) MZN
31-C	5" x 5" x 2"	Structure Negative (MZN)
31-D	5" x 5" x 2"	Primary Anode Terminal Plate (MZA); (1) MZN
31-E	5" x 5" x 2"	Structure Negative (MZN)
31-F	8" x 8" x 4"	Reference Electrode (RE); (1) REN
31-G	5" x 5" x 2"	Reference Electrode Negative (REN)


TYPICAL WIRE SIZES & COLORS AS FOLLOWS:
MZA & PJA = #10 Red
MZN; PJN = #10 Blue
SA = #8 Black
RE/REN: #16 Twisted Pair Red/Black

ABBREVIATIONS:
MZN = Metallized Zinc Negative
PJN = Pile Jacket Negative
CJN = Cap Jacket Negative
SAN = Submerged Anode Negative
MZA = Metallized Zinc Anode
PJA = Pile Jacket Anode
CJA = Cap Jacket Anode
SA = Submerged Anode
RE = Reference Electrode
REN = Reference Electrode Negative


LEGEND
⊗ Submerged Anode
x = Weight in LBS
⊠ Pile Jacket
⊡ Cap Jacket
● Primary Anode Terminal
+ Negative Connection
■ Encapsulated Splice
— Reference Electrode

Tongass Ave Bent 31 North Elevation & Span 31		
SCALE: NONE	Field Sketch	DRAWN BY KRH
DATE: 11-1-11	As-Built	REVISED
GREAT WESTERN CORPORATION		
Ketchikan Viaduct II Repair & C.P.		DRAWING NUMBER T-31


SPAN 32 - VIEW THROUGH DECK

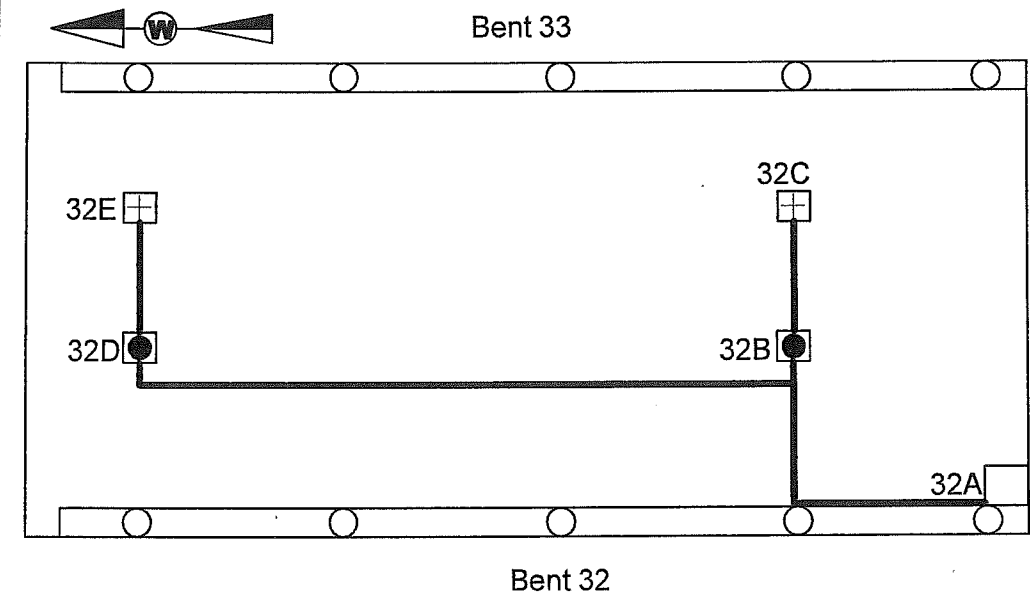

SCHEMATIC

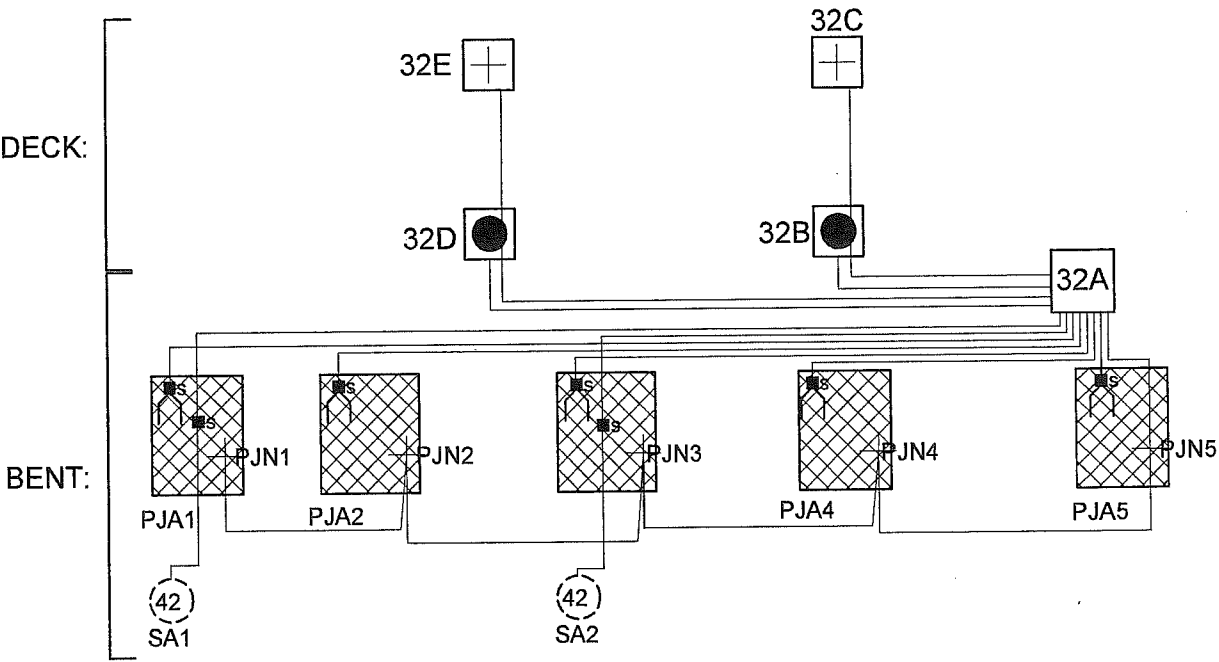

BENT 32 NORTH ELEVATION

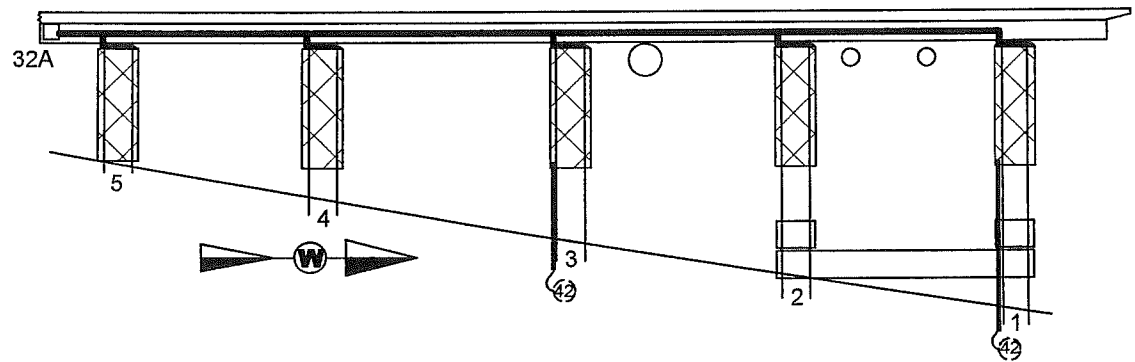

J-BOX DETAILS:

	J-Box Size	Wires or Structure
32-A	14" x 12" x 8"	MAIN J-BOX: (5) PJA; (1) PJN; (2) SA; SAN Jumpered from PJN; (2) MZA; (2) MZN
32-B	5" x 5" x 2"	Primary Anode Terminal Plate (MZA); (1) MZN
32-C	5" x 5" x 2"	Structure Negative (MZN)
32-D	5" x 5" x 2"	Primary Anode Terminal Plate (MZA); (1) MZN
32-E	5" x 5" x 2"	Structure Negative (MZN)


TYPICAL WIRE SIZES & COLORS AS FOLLOWS:
MZA & PJA = #10 Red
MZN; PJN = #10 Blue
SA = #8 Black
RE/REN: #16 Twisted Pair Red/Black

ABBREVIATIONS:
MZN = Metallized Zinc Negative
PJN = Pile Jacket Negative
CJN = Cap Jacket Negative
SAN = Submerged Anode Negative
MZA = Metallized Zinc Anode
PJA = Pile Jacket Anode
CJA = Cap Jacket Anode
SA = Submerged Anode
RE = Reference Electrode
REN = Reference Electrode Negative


LEGEND
⊗ Submerged Anode
x = Weight in LBS
⊠ Pile Jacket
⊡ Cap Jacket
● Primary Anode Terminal
+ Negative Connection
⊞ Encapsulated Splice
— Reference Electrode

Tongass Ave Bent 32 North Elevation & Span 32		
SCALE: NONE	Field Sketch	DRAWN BY KRH
DATE: 11-1-11	As-Built	REVISED
GREAT WESTERN CORPORATION		
Ketchikan Viaduct II Repair & C.P.		DRAWING NUMBER T-32


SPAN 33 - VIEW THROUGH DECK

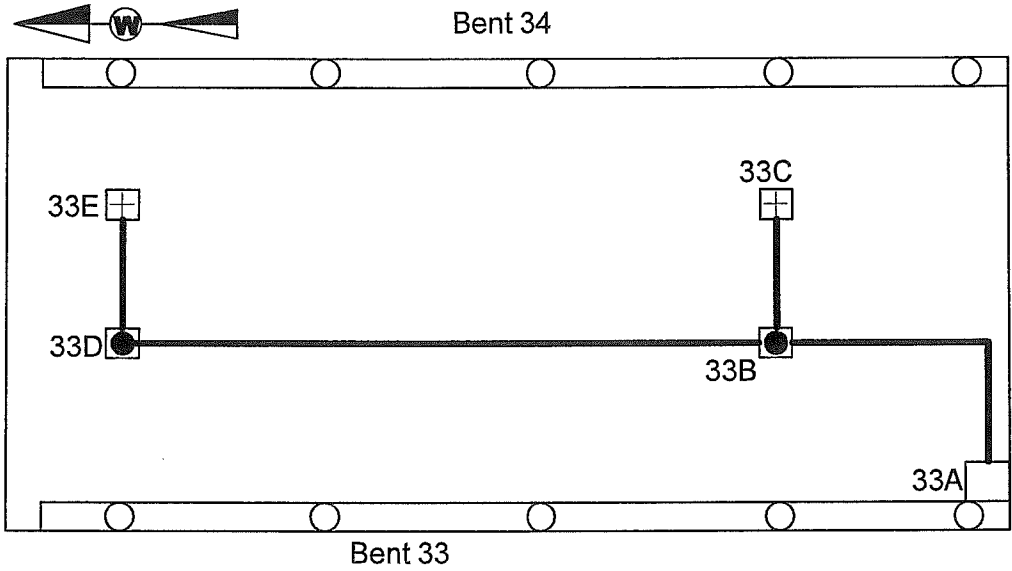

SCHEMATIC

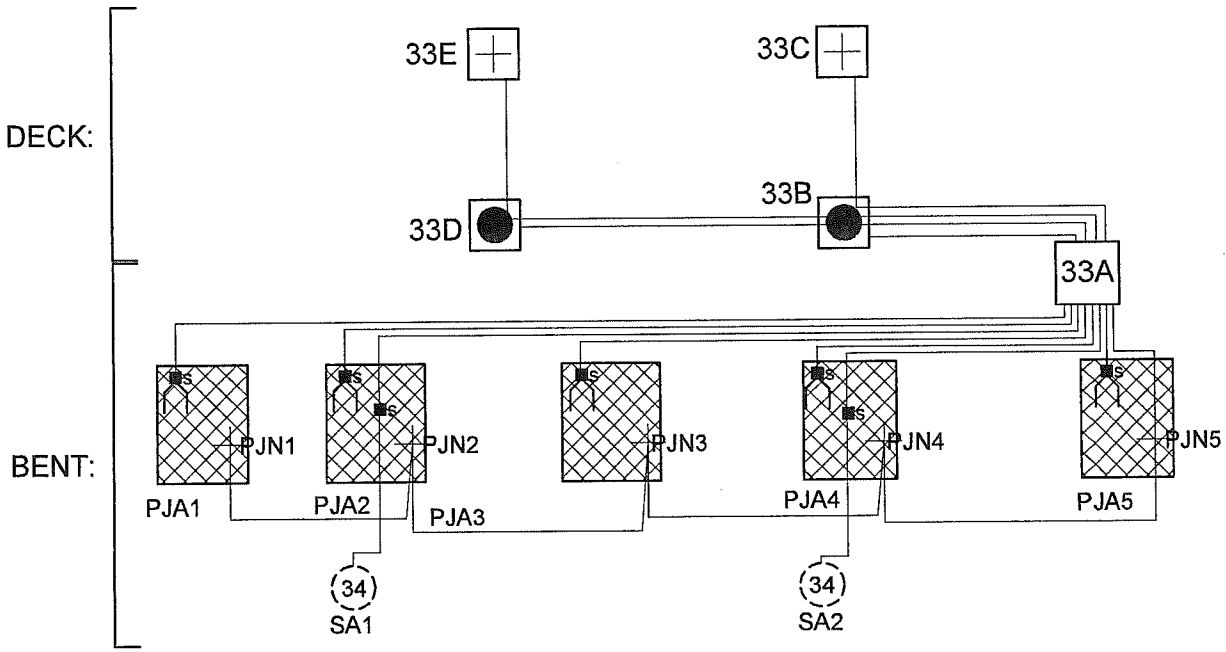

BENT 33 NORTH ELEVATION

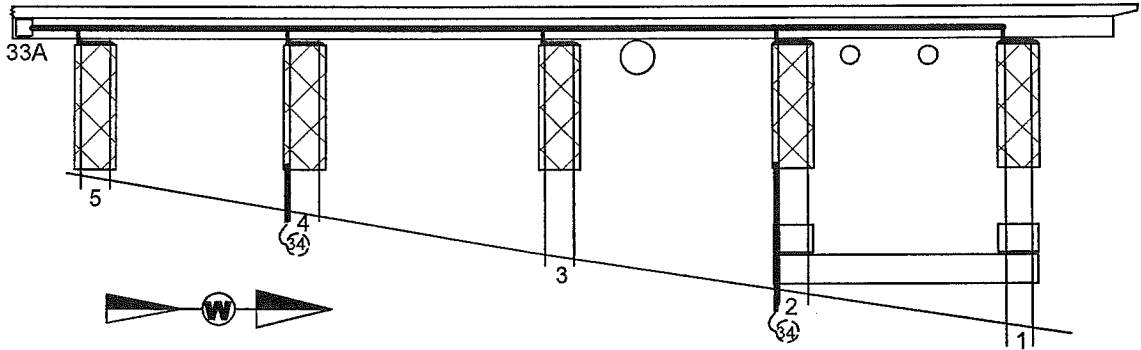

J-BOX DETAILS:

	J-Box Size	Wires or Structure
33-A	14" x 12" x 8"	MAIN J-BOX: (5) PJA; (1) PJN; (2) SA; SAN Jumped from PJN; (2) MZA; (2) MZN
33-B	5" x 5" x 2"	Primary Anode Terminal Plate (MZA); (2) MZN; (1) MZA
33-C	5" x 5" x 2"	Structure Negative (MZN)
33-D	5" x 5" x 2"	Primary Anode Terminal Plate (MZA); (1) MZN
33-E	5" x 5" x 2"	Structure Negative (MZN)


TYPICAL WIRE SIZES & COLORS AS FOLLOWS:
MZA & PJA = #10 Red
MZN; PJN = #10 Blue
SA = #8 Black
RE/REN: #16 Twisted Pair Red/Black

ABBREVIATIONS:
MZN = Metallized Zinc Negative
PJN = Pile Jacket Negative
CJN = Cap Jacket Negative
SAN = Submerged Anode Negative
MZA = Metallized Zinc Anode
PJA = Pile Jacket Anode
CJA = Cap Jacket Anode
SA = Submerged Anode
RE = Reference Electrode
REN = Reference Electrode Negative


LEGEND
(x) Submerged Anode
x = Weight in LBS
[X] Pile Jacket
[X] Cap Jacket
● Primary Anode Terminal
+ Negative Connection
[S] Encapsulated Splice
— Reference Electrode

Tongass Ave Bent 33 North Elevation & Span 33			
SCALE: NONE	Field Sketch	DRAWN BY KRH	
DATE: 11-1-11	As-Built	REVISED	
GREAT WESTERN CORPORATION			
Ketchikan Viaduct II Repair & C.P.		DRAWING NUMBER T-33	


SPAN 34 - VIEW THROUGH DECK

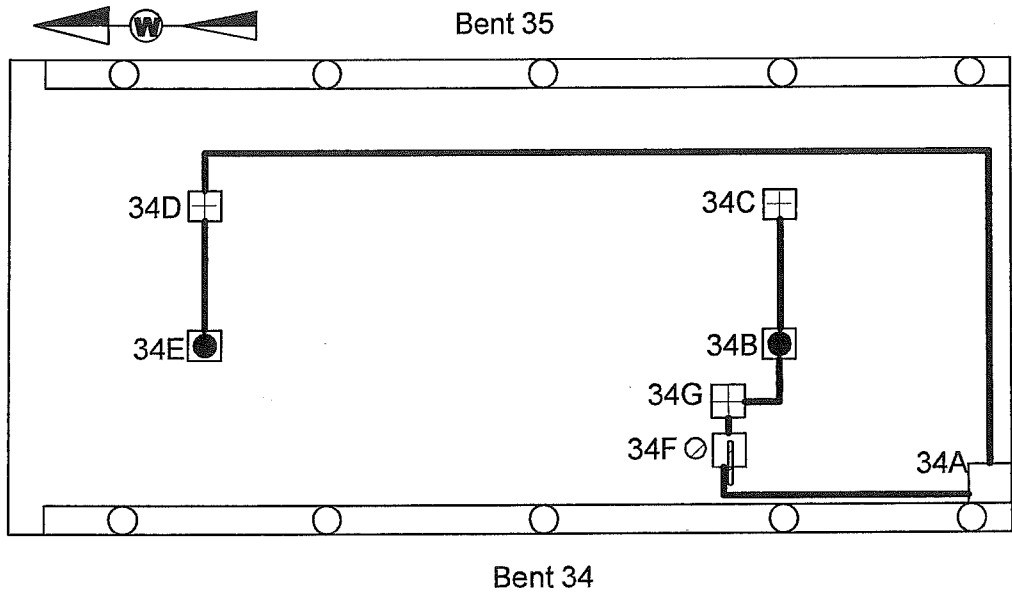

SCHEMATIC

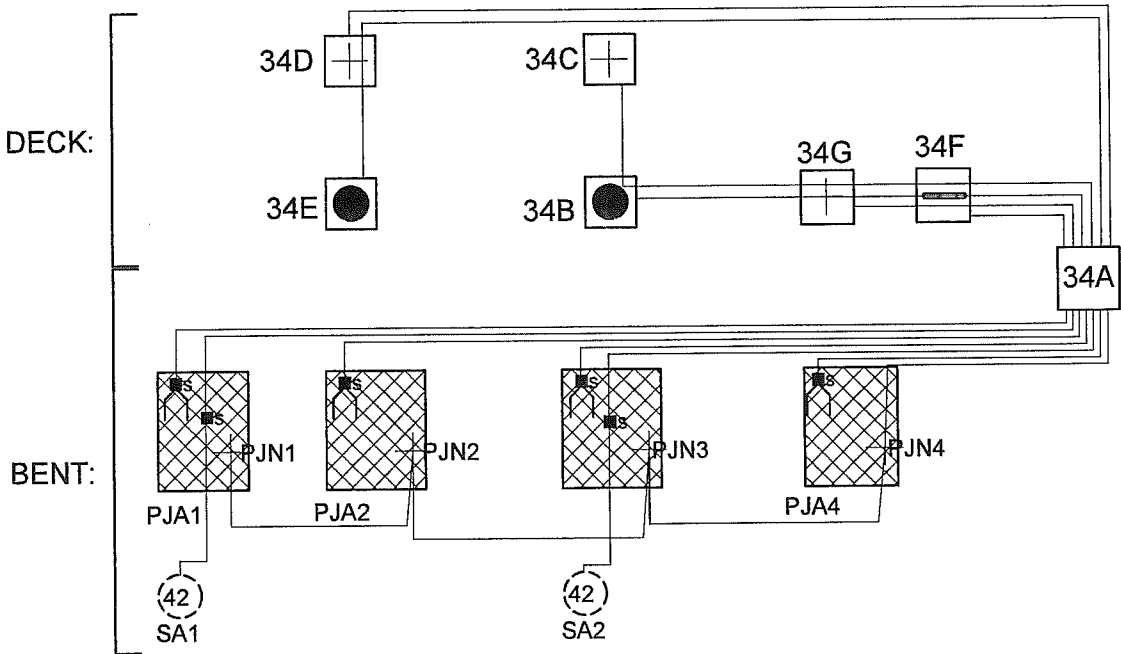

BENT 34 NORTH ELEVATION

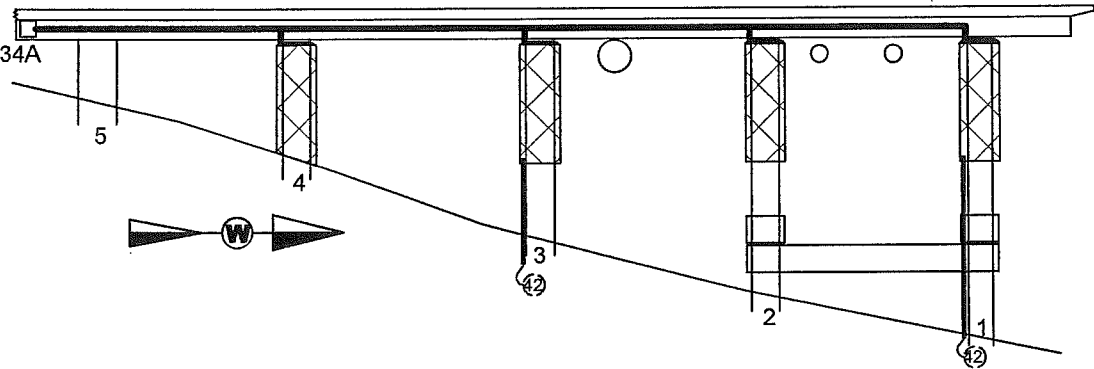

J-BOX DETAILS:

	J-Box Size	Wires or Structure
34-A	14" x 12" x 8"	MAIN J-BOX: (4) PJA; (1) PJN; (2) SA; SAN Jumpered from PJN; (2) MZA; (2) MZN; (1) RE; (1) REN
34-B	5" x 5" x 2"	Primary Anode Terminal Plate (MZA); (1) MZN
34-C	5" x 5" x 2"	Structure Negative (MZN)
34-D	5" x 5" x 2"	Structure Negative (MZN); (1) MZA
34-E	5" x 5" x 2"	Primary Anode Terminal Plate (MZA)
34-F	5" x 5" x 2"	Reference Electrode (RE); (1) REN; (1) MZA; (1) MZN
34-G	8" x 8" x 2"	Reference Electrode Negative (REN); (1) MZA; (1) MZN


TYPICAL WIRE SIZES & COLORS AS FOLLOWS:
MZA & PJA = #10 Red
MZN; PJN = #10 Blue
SA = #8 Black
RE/REN: #16 Twisted Pair Red/Black

ABBREVIATIONS:
MZN = Metallized Zinc Negative
PJN = Pile Jacket Negative
CJN = Cap Jacket Negative
SAN = Submerged Anode Negative
MZA = Metallized Zinc Anode
PJA = Pile Jacket Anode
CJA = Cap Jacket Anode
SA = Submerged Anode
RE = Reference Electrode
REN = Reference Electrode Negative


LEGEND
⊗ Submerged Anode
x = Weight in LBS
⊠ Pile Jacket
⊡ Cap Jacket
● Primary Anode Terminal
+ Negative Connection
■ Encapsulated Splice
— Reference Electrode

Tongass Ave Bent 34 North Elevation & Span 34		
SCALE: NONE	Field Sketch	DRAWN BY KRH
DATE: 11-1-11	As-Built	REVISED
GREAT WESTERN CORPORATION		
Ketchikan Viaduct II Repair & C.P.		DRAWING NUMBER T-34


SPAN 35 - VIEW THROUGH DECK

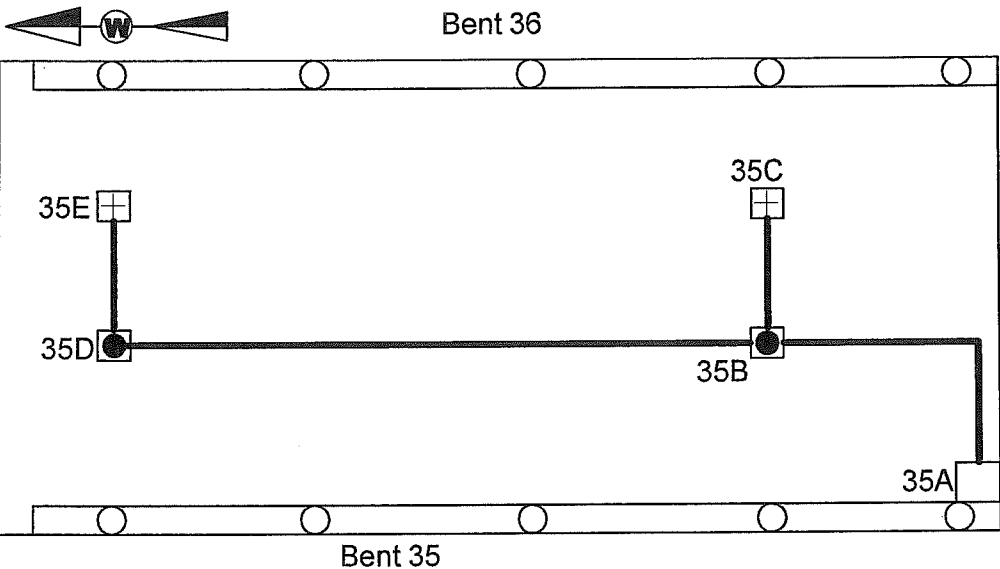

SCHEMATIC

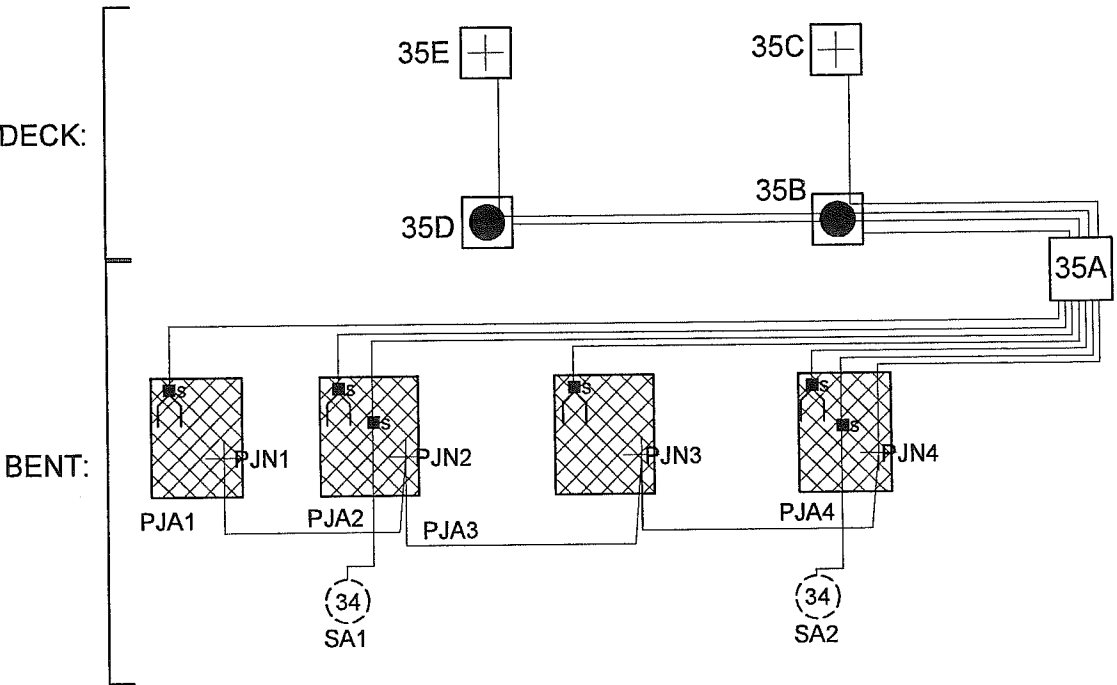

BENT 35 NORTH ELEVATION

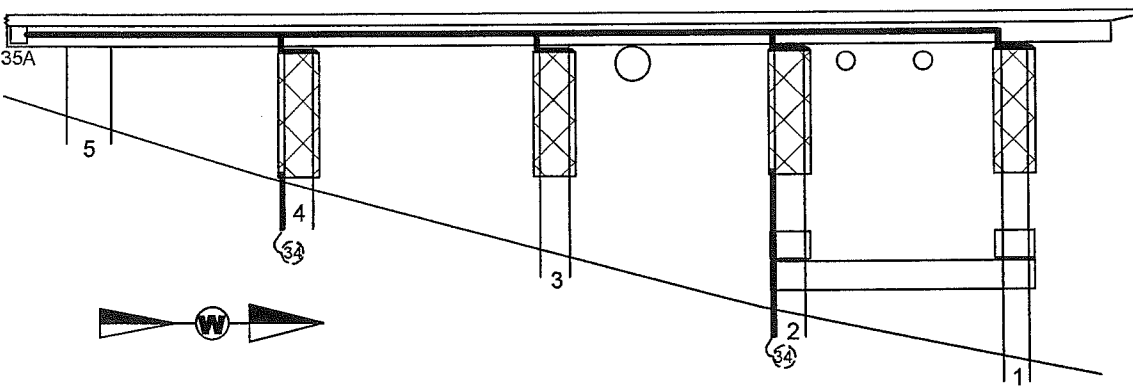

J-BOX DETAILS:

	J-Box Size	Wires or Structure
35-A	14" x 12" x 8"	MAIN J-BOX: (4) PJA; (1) PJN; (2) SA; SAN Jumpered from PJN; (2) MZA; (2) MZN
35-B	5" x 5" x 2"	Primary Anode Terminal Plate (MZA); (2) MZN; (1) MZA
35-C	5" x 5" x 2"	Structure Negative (MZN)
35-D	5" x 5" x 2"	Primary Anode Terminal Plate (MZA); (1) MZN
35-E	5" x 5" x 2"	Structure Negative (MZN)


TYPICAL WIRE SIZES & COLORS AS FOLLOWS:
MZA & PJA = #10 Red
MZN; PJN = #10 Blue
SA = #8 Black
RE/REN: #16 Twisted Pair Red/Black

ABBREVIATIONS:
MZN = Metallized Zinc Negative
PJN = Pile Jacket Negative
CJN = Cap Jacket Negative
SAN = Submerged Anode Negative
MZA = Metallized Zinc Anode
PJA = Pile Jacket Anode
CJA = Cap Jacket Anode
SA = Submerged Anode
RE = Reference Electrode
REN = Reference Electrode Negative


LEGEND
⊗ Submerged Anode
x = Weight in LBS
⊠ Pile Jacket
⊡ Cap Jacket
● Primary Anode Terminal
+ Negative Connection
⊞ Encapsulated Splice
— Reference Electrode

Tongass Ave Bent 35 North Elevation & Span 35			
SCALE: NONE	Field Sketch	DRAWN BY KRH	
DATE: 11-1-11	As-Built	REVISED	
GREAT WESTERN CORPORATION			
Ketchikan Viaduct II Repair & C.P.		DRAWING NUMBER T-35	


SPAN 36 - VIEW THROUGH DECK

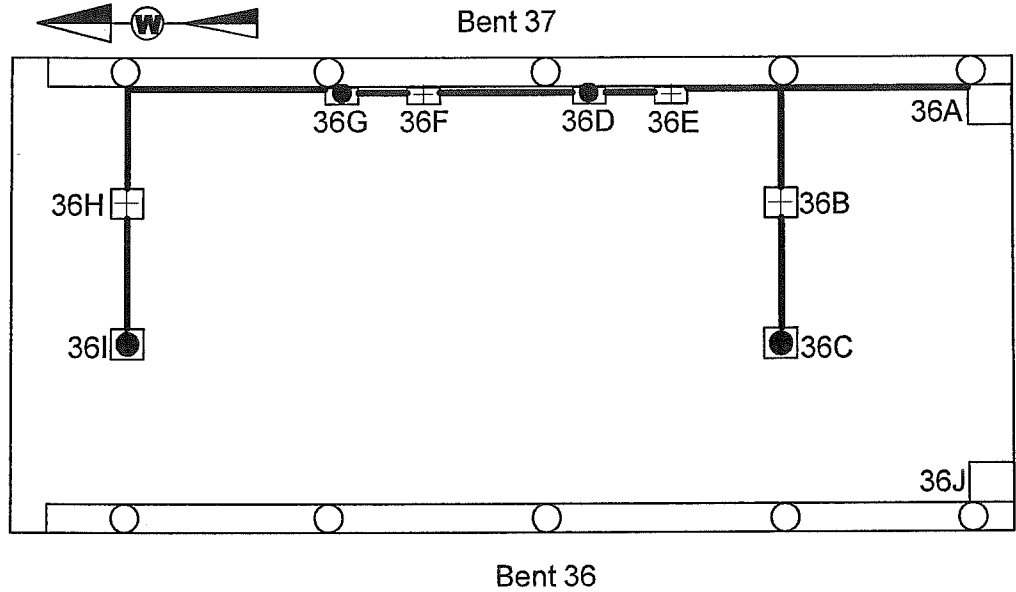

SCHEMATIC

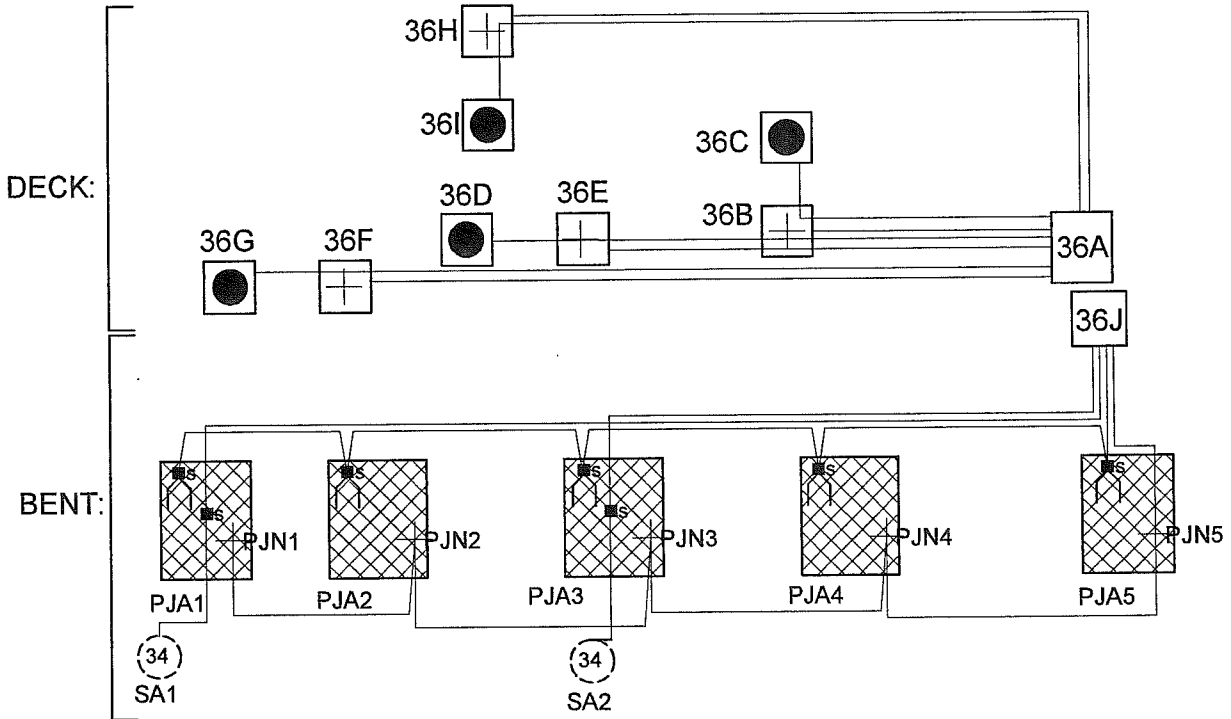

BENT 36 NORTH ELEVATION

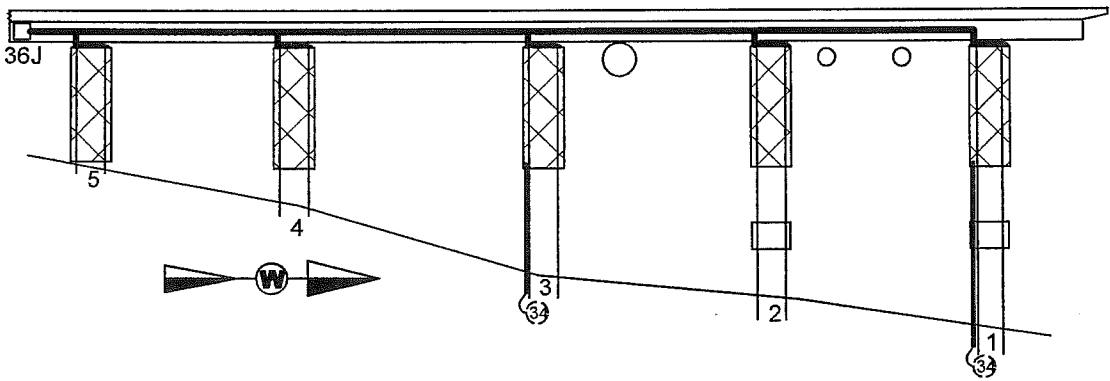

J-BOX DETAILS:

	J-Box Size	Wires or Structure
36-A	14" x 12" x 8"	MAIN J-BOX Bent 37: (5) PJA; (1) PJN; (1) CJA; (1) CJN; (2) SA; SAN Jumpered from PJN; (4) MZA; (4) MZN
36-J	14" x 12" x 8"	MAIN J-BOX Bent 36: (1) PJA; (1) PJN; (2) SA; SAN Jumpered from PJN
36-B	5" x 5" x 2"	Structure Negative (MZN); (2) MZA; (1) MZN
36-C	5" x 5" x 2"	Primary Anode Terminal Plate (MZA)
36-D	5" x 5" x 2"	Primary Anode Terminal Plate (MZA)
36-E	5" x 5" x 2"	Structure Negative (MZN); (1) MZA
36-F	5" x 5" x 2"	Structure Negative (MZN); (1) MZA
36-G	5" x 5" x 2"	Primary Anode Terminal Plate (MZA)
36-H	5" x 5" x 2"	Structure Negative (MZN); (1) MZA
36-I	5" x 5" x 2"	Primary Anode Terminal Plate (MZA)

ABBREVIATIONS:

MZN = Metallized Zinc Negative
PJN = Pile Jacket Negative
CJN = Cap Jacket Negative
SAN = Submerged Anode Negative
MZA = Metallized Zinc Anode
PJA = Pile Jacket Anode
CJA = Cap Jacket Anode
SA = Submerged Anode
RE = Reference Electrode
REN = Reference Electrode Negative

LEGEND

- ⊗ Submerged Anode
- x = Weight in LBS
- ⊠ Pile Jacket
- ⊡ Cap Jacket
- Primary Anode Terminal
- + Negative Connection
- Encapsulated Splice
- Reference Electrode


TYPICAL WIRE SIZES & COLORS AS FOLLOWS:
MZA & PJA = #10 Red
MZN; PJN = #10 Blue
SA = #8 Black
RE/REN: #16 Twisted Pair Red/Black

Tongass Ave Bent 36 North Elevation
& Span 36

SCALE: NONE	Field Sketch	DRAWN BY: KRH
DATE: 11-1-11	As-Built	REVISED:


GREAT WESTERN CORPORATION

Ketchikan Viaduct II Repair & C.P.	DRAWING NUMBER T-36
---------------------------------------	------------------------

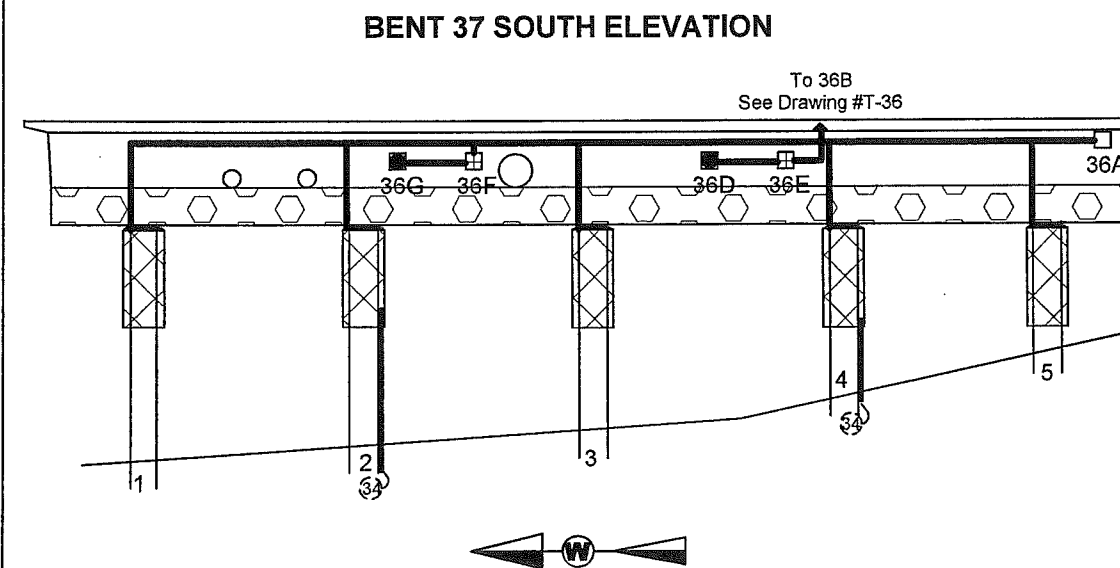

DECK
SPAN 36:

BENT:

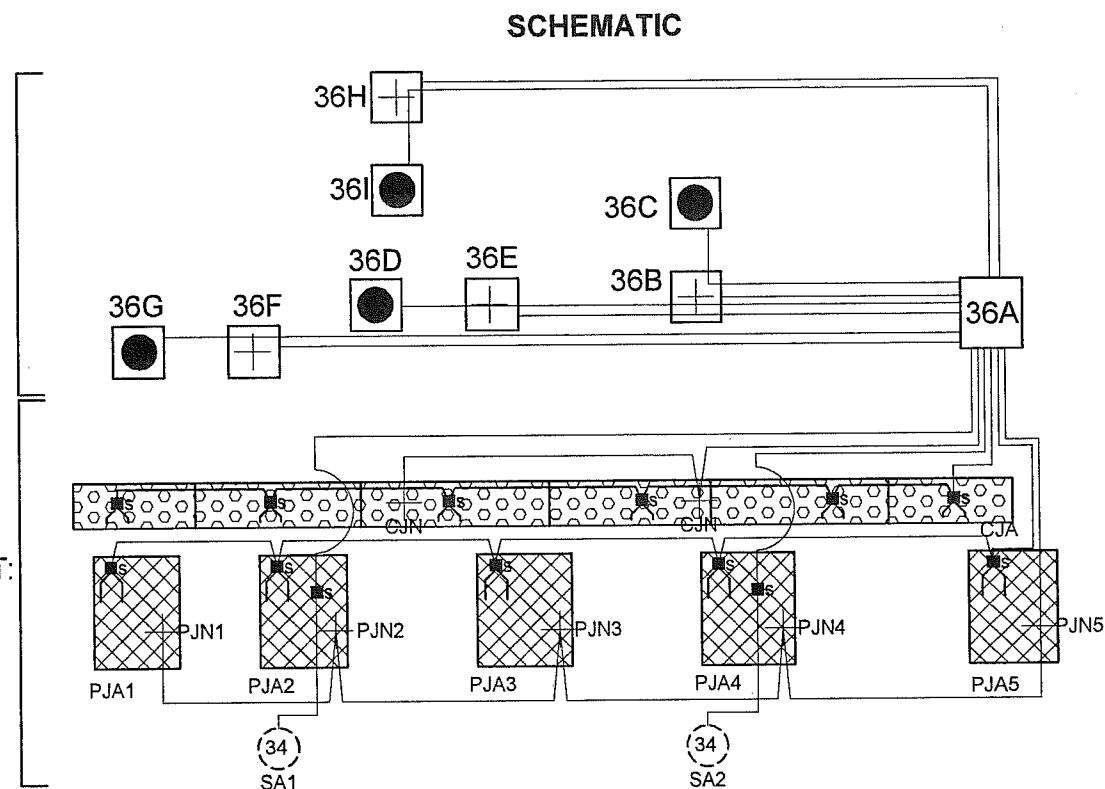

J-BOX DETAILS:

	J-Box Size	Wires or Structure
36-A	14" x 12" x 8"	MAIN J-BOX Bent 37: (5) PJA; (1) PJN; (1) CJA; (1) CJN; (2) SA; SAN Jumpered from PJN; (4) MZA; (4) MZN
36-B	5" x 5" x 2"	Structure Negative (MZN); (2) MZA; (1) MZN
36-C	5" x 5" x 2"	Primary Anode Terminal Plate (MZA)
36-D	5" x 5" x 2"	Primary Anode Terminal Plate (MZA)
36-E	5" x 5" x 2"	Structure Negative (MZN); (1) MZA
36-F	5" x 5" x 2"	Structure Negative (MZN); (1) MZA
36-G	5" x 5" x 2"	Primary Anode Terminal Plate (MZA)
36-H	5" x 5" x 2"	Structure Negative (MZN); (1) MZA
36-I	5" x 5" x 2"	Primary Anode Terminal Plate (MZA)

TYPICAL WIRE SIZES & COLORS AS FOLLOWS:
MZA & PJA = #10 Red
MZN; PJN = #10 Blue
SA = #8 Black
RE/REN: #16 Twisted Pair Red/Black


ABBREVIATIONS:
MZN = Metallized Zinc Negative
PJN = Pile Jacket Negative
CJN = Cap Jacket Negative
SAN = Submerged Anode Negative
MZA = Metallized Zinc Anode
PJA = Pile Jacket Anode
CJA = Cap Jacket Anode
SA = Submerged Anode
RE = Reference Electrode
REN = Reference Electrode Negative

LEGEND
⊗ Submerged Anode
x = Weight in LBS
⊠ Pile Jacket
⊞ Cap Jacket
● Primary Anode Terminal
+ Negative Connection
■ Encapsulated Splice
— Reference Electrode


Tongass Ave Bent 37 South Elevation		
SCALE: NONE	Field Sketch	DRAWN BY KRH
DATE: 11-1-11	As-Built	REVISED
GREAT WESTERN CORPORATION		
Ketchikan Viaduct II Repair & C.P.		DRAWING NUMBER T-37

W


SPAN 24 - VIEW THROUGH DECK

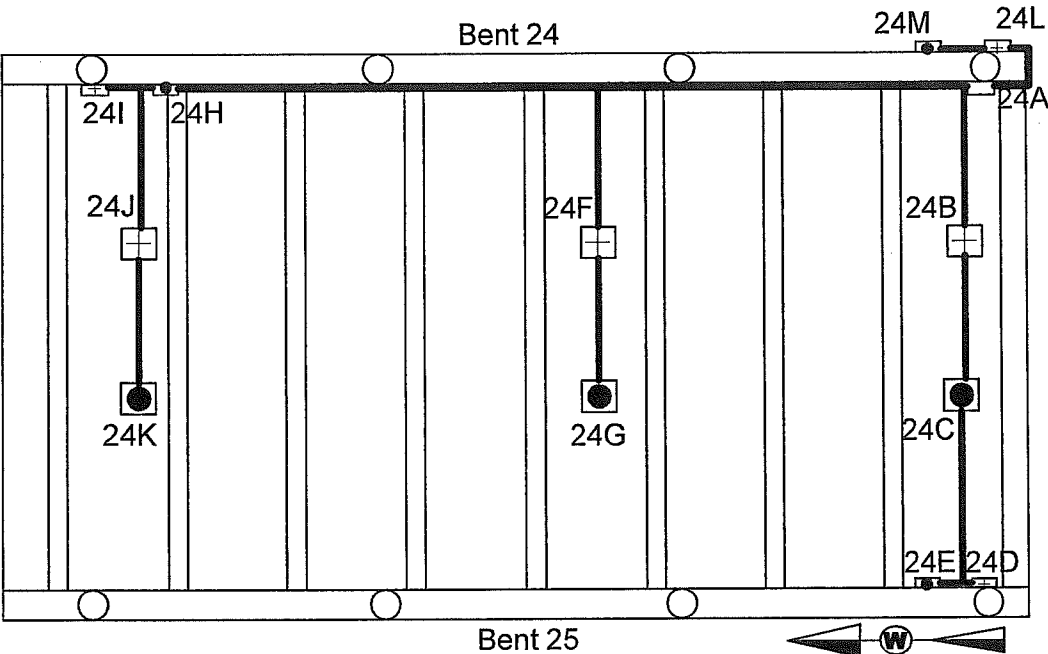

SCHEMATIC

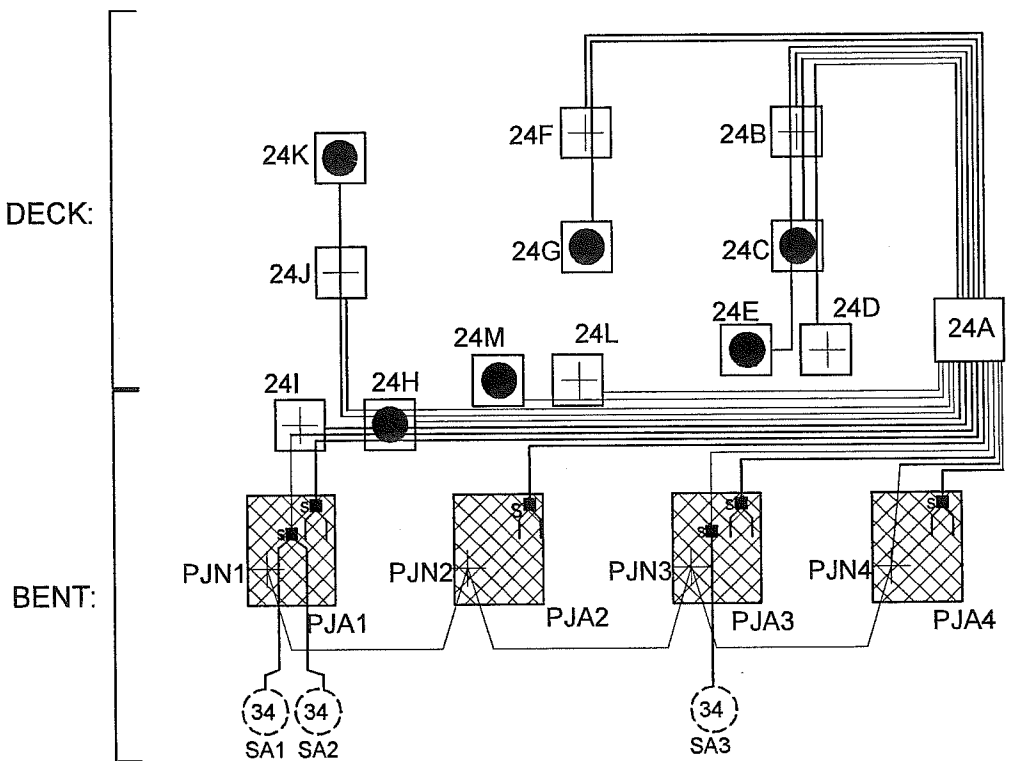

WATER BENT 24 SOUTH ELEVATION

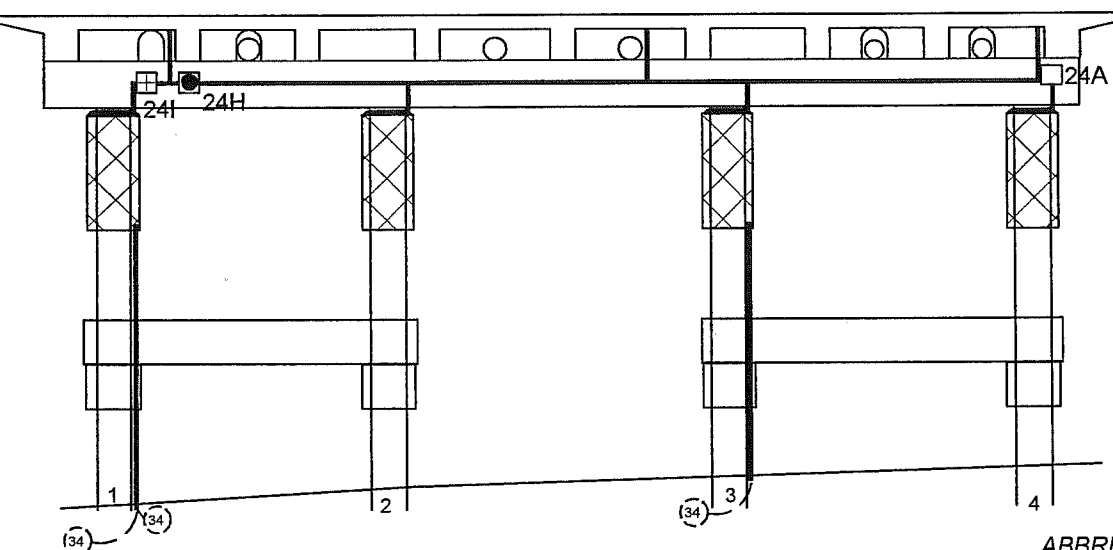

J-BOX DETAILS:

	J-Box Size	Wires or Structure
24-A	14" x 12" x 8"	MAIN J-BOX: (6) MZA; (6) MZN; (4) PJA; (1) PJN; (2) SA; SAN jumpered from PJN
24-B	5" x 5" x 2"	Structure Negative (MZN); (2) MZA; (1) MZN
24-C	5" x 5" x 2"	Primary Anode Terminal Plate (MZA); (1) MZN; (1) MZA
24-D	5" x 5" x 2"	Structure Negative (MZN)
24-E	5" x 5" x 2"	Primary Anode Terminal Plate (MZA)
24-F	5" x 5" x 2"	Structure Negative (MZN); (1) MZA
24-G	5" x 5" x 2"	Primary Anode Terminal Plate (MZA)
24-H	5" x 5" x 2"	Primary Anode Terminal Plate (MZA); (2) MZN; (1) MZA; (1) PJA; (1) SA
24-I	5" x 5" x 2"	Structure Negative (MZN); (1) PJA; (1) SA
24-J	5" x 5" x 2"	Structure Negative (MZN); (1) MZA
24-K	5" x 5" x 2"	Primary Anode Terminal Plate (MZA)
24-L	5" x 5" x 2"	Structure Negative (MZN); (1) MZA
24-M	5" x 5" x 2"	Primary Anode Terminal Plate (MZA)

ABBREVIATIONS:
MZN = Metallized Zinc Negative
PJN = Pile Jacket Negative
CJN = Cap Jacket Negative
SAN = Submerged Anode Negative
MZA = Metallized Zinc Anode
PJA = Pile Jacket Anode
CJA = Cap Jacket Anode
SA = Submerged Anode
RE = Reference Electrode
REN = Reference Electrode Negative

TYPICAL WIRE SIZES & COLORS AS FOLLOWS:
MZA & PJA = #10 Red
MZN; PJN = #10 Blue
SA = #8 Black
RE/REN: #16 Twisted Pair Red/Black

LEGEND	
(x)	Submerged Anode
x =	Weight in LBS
⊗	Pile Jacket
⊠	Cap Jacket
●	Primary Anode Terminal
+	Negative Connection
■	Encapsulated Splice
—	Reference Electrode

Water Street Bent 24 South Elevation & Span 24		
SCALE: NONE	Field Sketch	DRAWN BY KRH
DATE: 10-21-11	As-Built	REVISED
GREAT WESTERN CORPORATION		
Ketchikan Viaduct II Repair & C.P.		DRAWING NUMBER W-24


Diagram of Bent 25 showing reinforcement details. The bent is a rectangular frame with vertical and horizontal reinforcement bars. Labels include 25I, 25H, 25J, 25K, 25F, 25G, 25B, 25C, 25E, and 25D. A north arrow and a 'W' symbol are also present.

	J-Box Size	Wires or Structure
25-A	14" x 12" x 8"	MAIN J-BOX: (5) MZA; (5) MZN; (4) PJA; (1) PJN; (2) SA; SAN jumpered from PJN
25-B	5" x 5" x 2"	Structure Negative (MZN); (2) MZA; (1) MZN
25-C	5" x 5" x 2"	Primary Anode Terminal Plate (MZA); (1) MZN; (1) MZA
25-D	5" x 5" x 2"	Structure Negative (MZN)
25-E	5" x 5" x 2"	Primary Anode Terminal Plate (MZA)
25-F	5" x 5" x 2"	Structure Negative (MZN); (1) MZA
25-G	5" x 5" x 2"	Primary Anode Terminal Plate (MZA)
25-H	5" x 5" x 2"	Primary Anode Terminal Plate (MZA); (2) MZN; (1) MZA; (1) PJA
25-I	5" x 5" x 2"	Structure Negative (MZN); (1) PJA
25-J	5" x 5" x 2"	Structure Negative (MZN); (1) MZA
25-K	5" x 5" x 2"	Primary Anode Terminal Plate (MZA); MZN Jumper to 26I

MZN = Metallized Zinc Negative
 PJN = Pile Jacket Negative
 CJN = Cap Jacket Negative
 SAN = Submerged Anode Negative
 MZA = Metallized Zinc Anode
 PJA = Pile Jacket Anode
 CJA = Cap Jacket Anode
 SA = Submerged Anode
 RE = Reference Electrode
 REN = Reference Electrode Negative

- Submerged Anode
x = Weight in LBS
- Pile Jacket
- Cap Jacket
- Primary Anode Terminal
- Negative Connection
- Encapsulated Splice
- Reference Electrode


Water Street Bent 25 South Elevation & Span 25		
SCALE: NONE	Field Sketch As-Built	DRAWN BY KRH
DATE: 10-21-11		REVISED
GREAT WESTERN CORPORATION		
Ketchikan Viaduct II Repair & C.P.		DRAWING NUMBER W-25

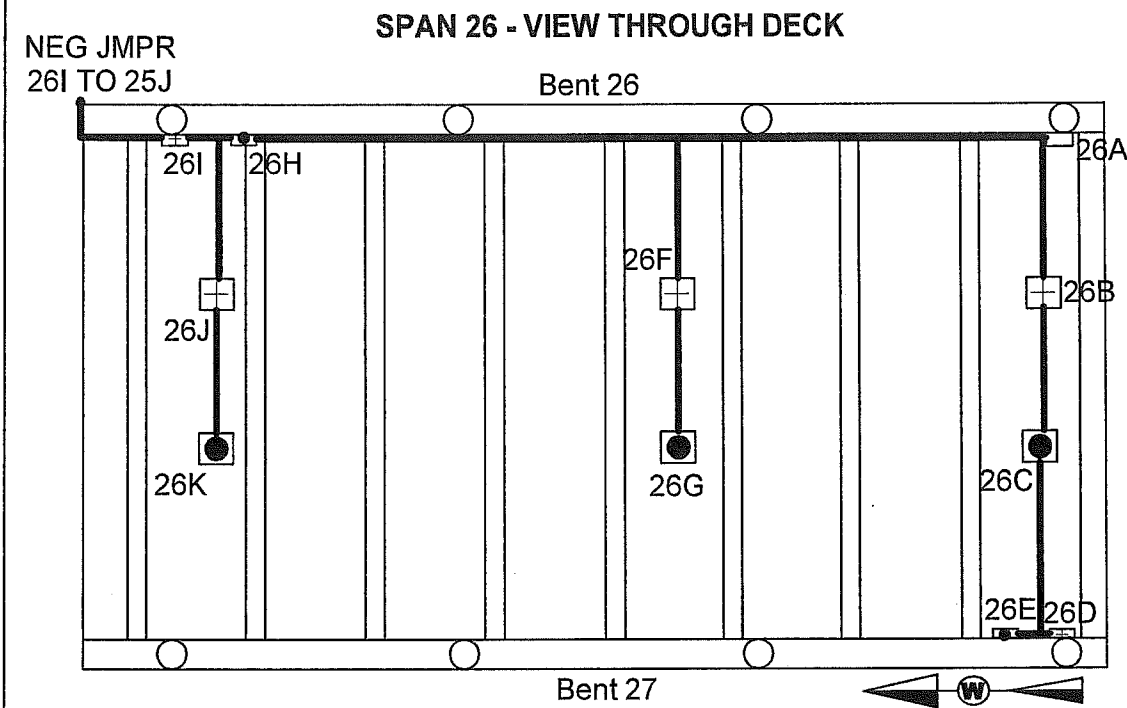


DECK:

BENT:

SCHEMATIC

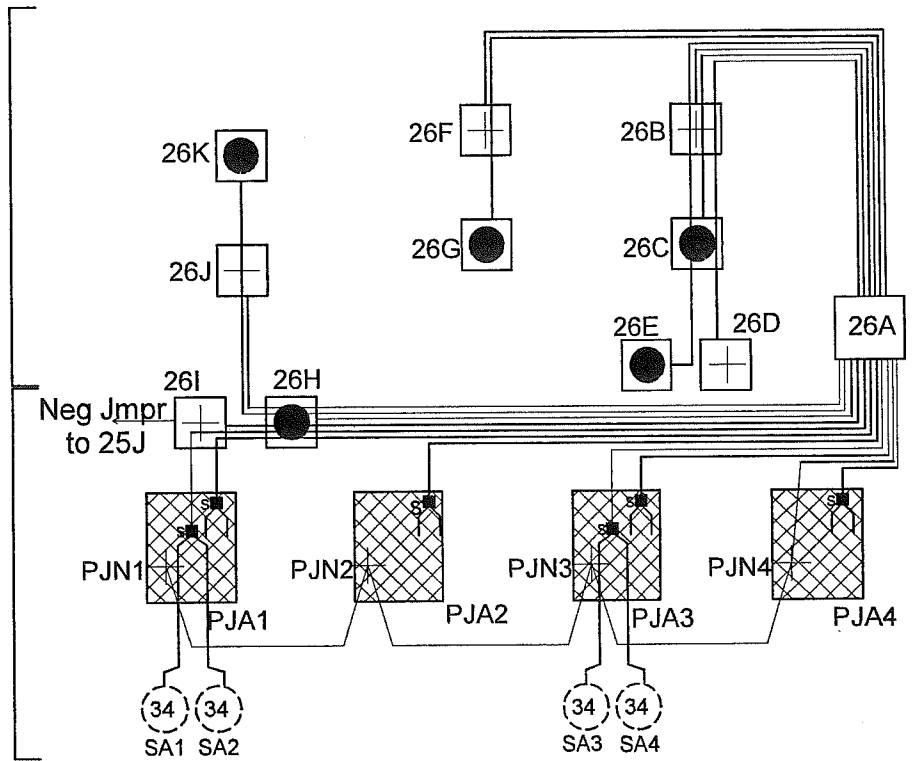

WATER BENT 26 SOUTH ELEVATION

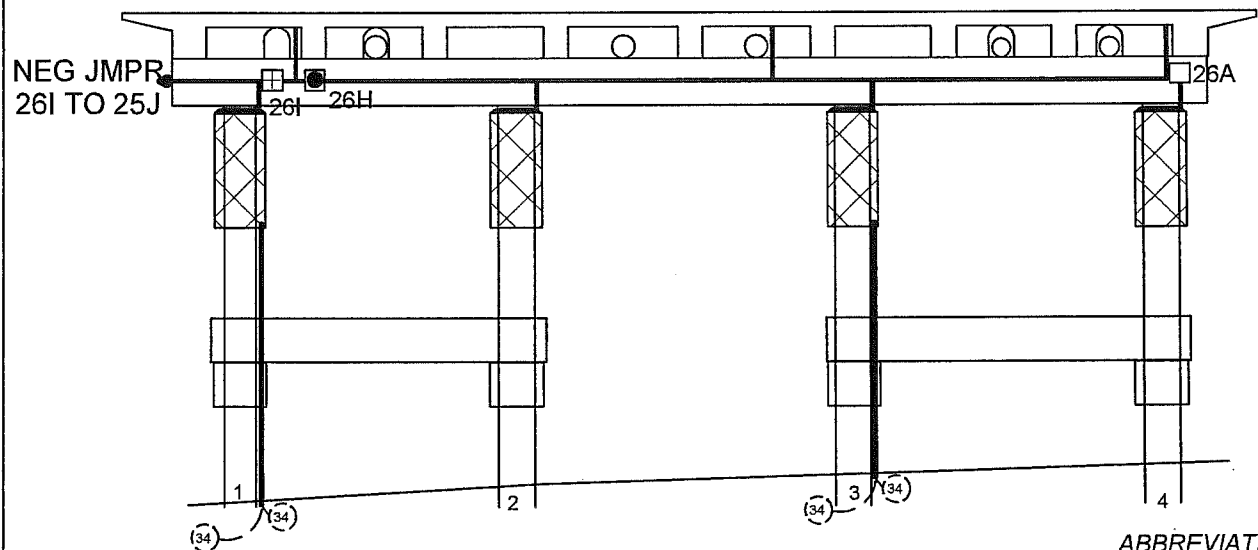

J-BOX DETAILS:

	J-Box Size	Wires or Structure
26-A	14" x 12" x 8"	MAIN J-BOX (5) MZA; (5) MZN; (4) PJA; (1) PJN; (2) SA; SAN jumpered from PJN
26-B	5" x 5" x 2"	Structure Negative (MZN); (2) MZA; (1) MZN
26-C	5" x 5" x 2"	Primary Anode Terminal Plate (MZA); (1) MZN; (1) MZA
26-D	5" x 5" x 2"	Structure Negative (MZN)
26-E	5" x 5" x 2"	Primary Anode Terminal Plate (MZA)
26-F	5" x 5" x 2"	Structure Negative (MZN); (1) MZA
26-G	5" x 5" x 2"	Primary Anode Terminal Plate (MZA)
26-H	5" x 5" x 2"	Primary Anode Terminal Plate (MZA); (2) MZN; (1) MZA; (1) PJA; (1) SA
26-I	5" x 5" x 2"	Structure Negative (MZN); MZN Jumper to 25J; (1) PJA; (1) SA
26-J	5" x 5" x 2"	Structure Negative (MZN); (1) MZA
26-K	5" x 5" x 2"	Primary Anode Terminal Plate (MZA)

ABBREVIATIONS:

MZN = Metallized Zinc Negative
 PJN = Pile Jacket Negative
 CJN = Cap Jacket Negative
 SAN = Submerged Anode Negative
 MZA = Metallized Zinc Anode
 PJA = Pile Jacket Anode
 CJA = Cap Jacket Anode
 SA = Submerged Anode
 RE = Reference Electrode
 REN = Reference Electrode Negative

LEGEND

- (x) Submerged Anode
- x = Weight in LBS
- ⊠ Pile Jacket
- ⊞ Cap Jacket
- Primary Anode Terminal
- + Negative Connection
- Encapsulated Splice
- Reference Electrode

TYPICAL WIRE SIZES & COLORS AS FOLLOWS:
 MZA & PJA = #10 Red
 MZN; PJN = #10 Blue
 SA = #8 Black
 RE/REN: #16 Twisted Pair Red/Black


Water Street Bent 26 South Elevation & Span 26			
SCALE: NONE	Field Sketch	DRAWN BY: KRH	
DATE: 10-21-11	As-Built	REVISED:	
GREAT WESTERN CORPORATION			
Ketchikan Viaduct II Repair & C.P.		DRAWING NUMBER: W-26	

Bent 27




BENT:

114

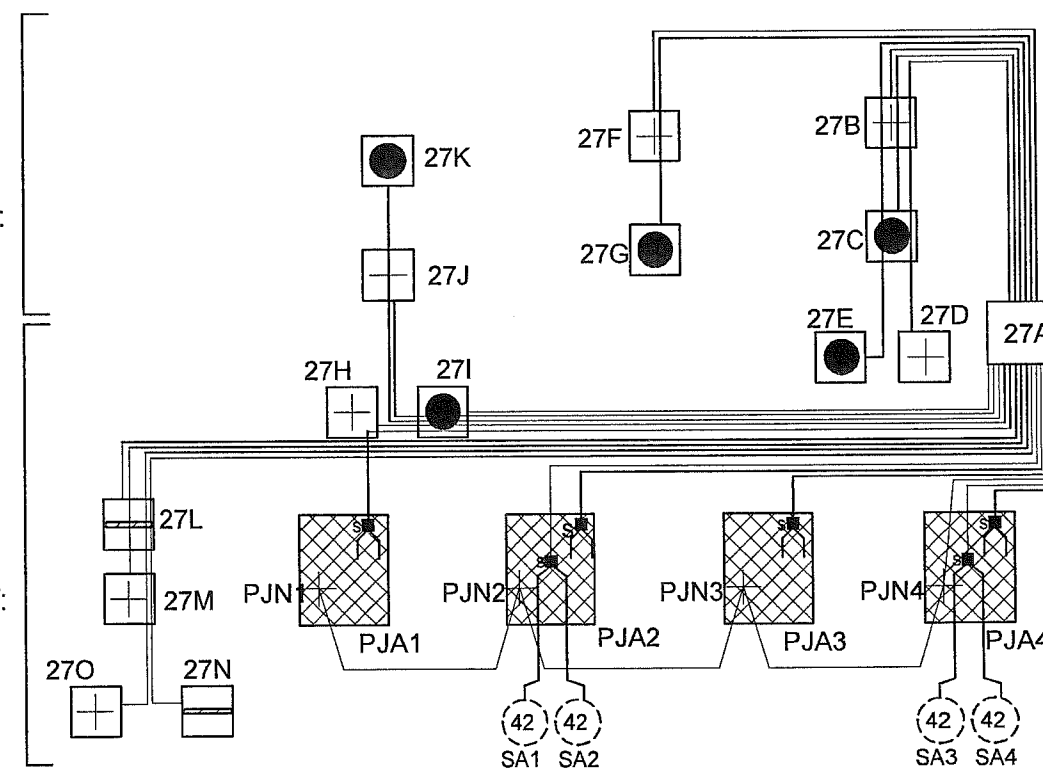

--	--	--	--	--

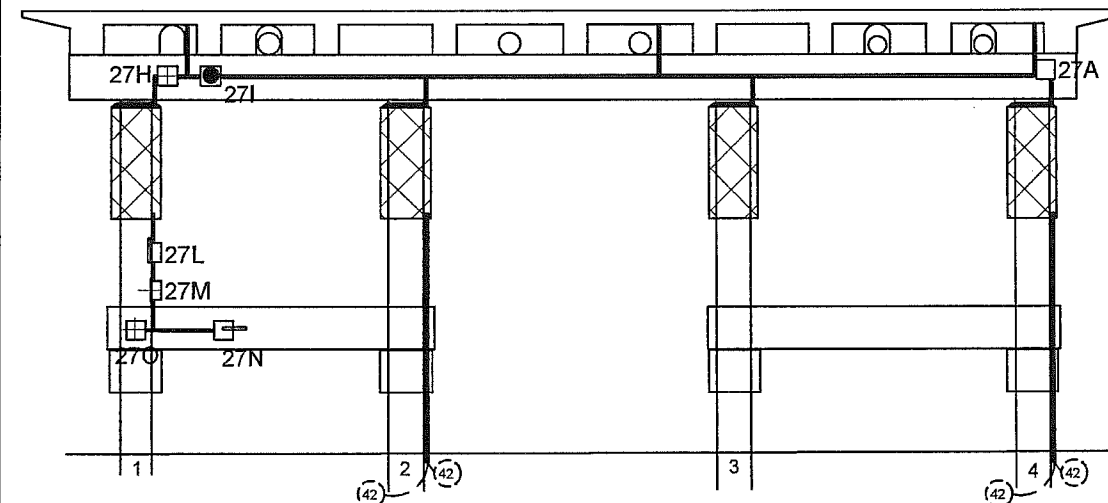

	J-Box Size	Wires or Structure
27-A	14" x 12" x 8"	MAIN J-BOX: (5) MZA; (5) MZN; (4) PJA; (1) PJN; (2) SA; SAN jumpered from PJN; (2) RE; (2) REN
27-B	5" x 5" x 2"	Structure Negative (MZN); (2) MZA; (1) MZN
27-C	5" x 5" x 2"	Primary Anode Terminal Plate (MZA); (1) MZN; (1) MZA
27-D	5" x 5" x 2"	Structure Negative (MZN)
27-E	5" x 5" x 2"	Primary Anode Terminal Plate (MZA)
27-F	5" x 5" x 2"	Structure Negative (MZN); (1) MZA
27-G	5" x 5" x 2"	Primary Anode Terminal Plate (MZA)
27-H	5" x 5" x 2"	Structure Negative (MZN); (1) PJA
27-I	5" x 5" x 2"	Primary Anode Terminal Plate (MZA); (2) MZN; (1) MZA; (1) PJA
27-J	5" x 5" x 2"	Structure Negative (MZN); (1) MZA
27-K	5" x 5" x 2"	Primary Anode Terminal Plate (MZA)
27-L	5" x 5" x 2"	Reference Electrode (RE); (2) REN; (1) RE
27-M	5" x 5" x 2"	Reference Electrode Negative (REN); (1) RE; (1) REN
27-N	5" x 5" x 2"	Reference Electrode (RE)
27-O	5" x 5" x 2"	Reference Electrode Negative (REN)

N = Bare Jacket Negative

MZN = Metallized Zinc Negative
 PJN = Pile Jacket Negative
 CJN = Cap Jacket Negative
 SAN = Submerged Anode Negative
 MZA = Metallized Zinc Anode
 PJA = Pile Jacket Anode
 CJA = Cap Jacket Anode
 SA = Submerged Anode
 RE = Reference Electrode
 REN = Reference Electrode Negative

Submerged A
= Weight in

-  Submerged Anode
x = Weight in LBS
-  Pile Jacket
-  Cap Jacket
-  Primary Anode Terminal
-  Negative Connection
-  Encapsulated Splice
-  Reference Electrode

TYPICAL WIRE SIZES & COLORS AS FOLLOWS:
MZA & PJA = #10 Red
MZN; PJN = #10 Blue
SA = #8 Black
RE/REN: #16 Twisted Pair Red/Black

Water Street Bent 27 South Elevation
& Span 27


SCALE: NONE	Field Sketch As-Built	DRAWN BY KRH
DATE: 10-21-11		REVISED

GREAT WESTERN CORPORATION


Ketchikan Viaduct II
Repair & C.P.

DRAWING NUMBER	W-27
----------------	------


SPAN 28 - VIEW THROUGH DECK

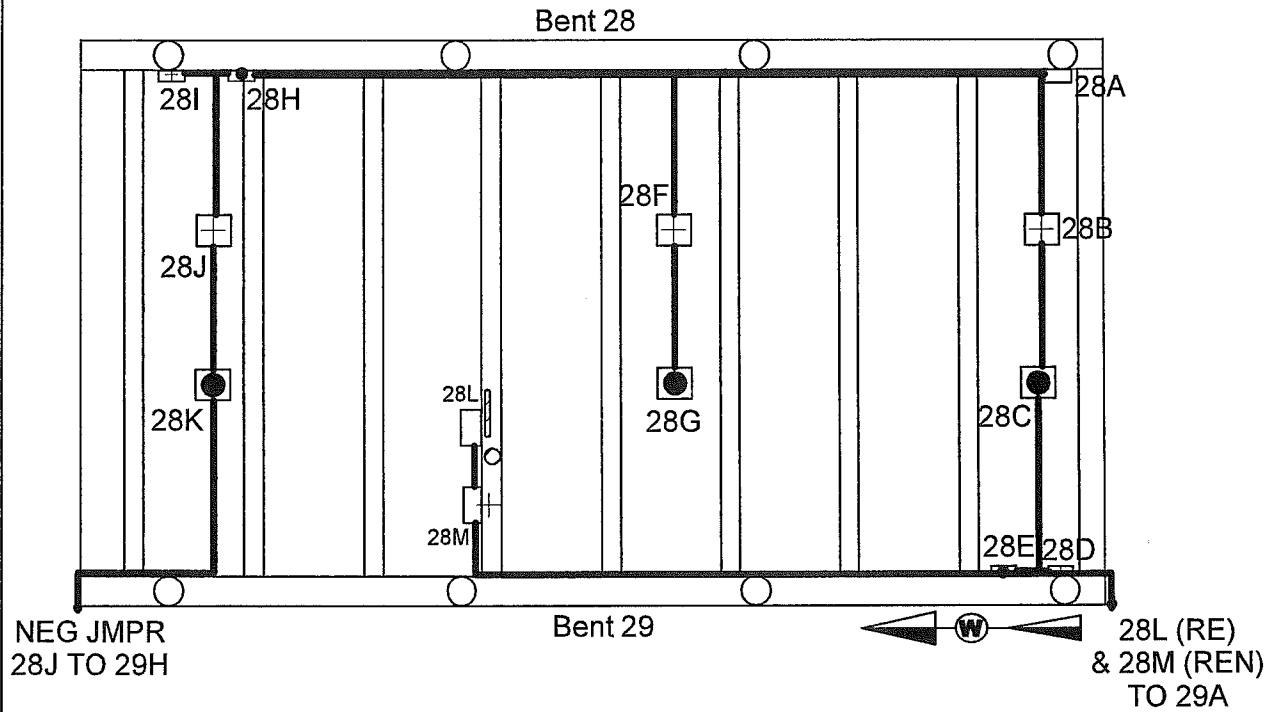

SCHEMATIC

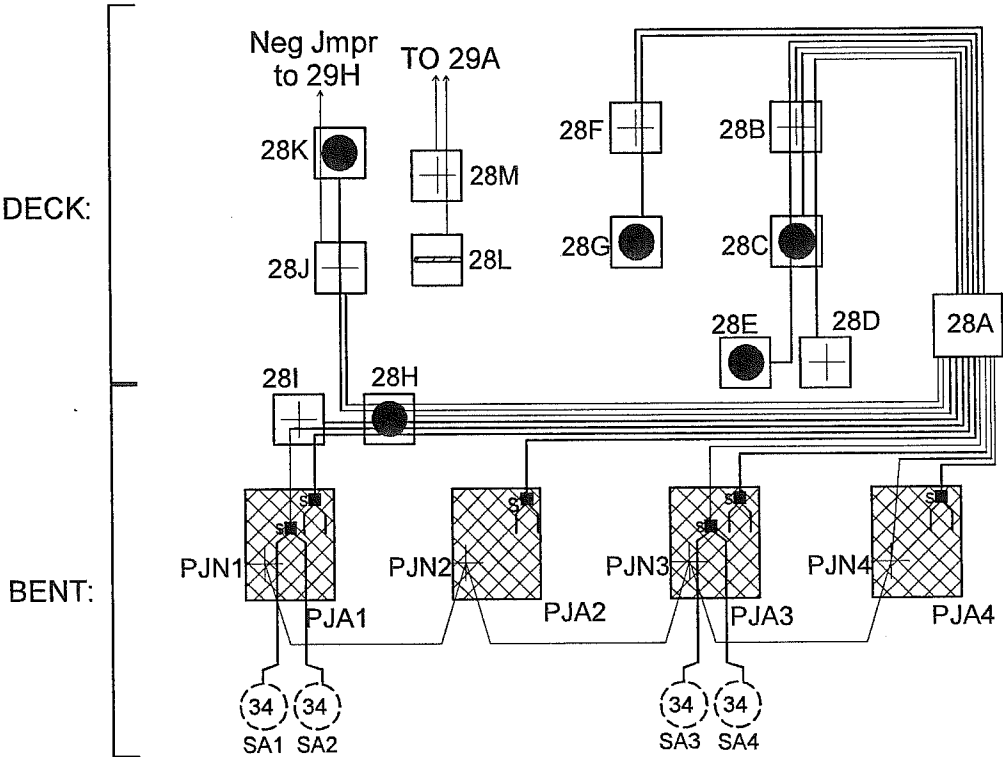

WATER BENT 28 SOUTH ELEVATION

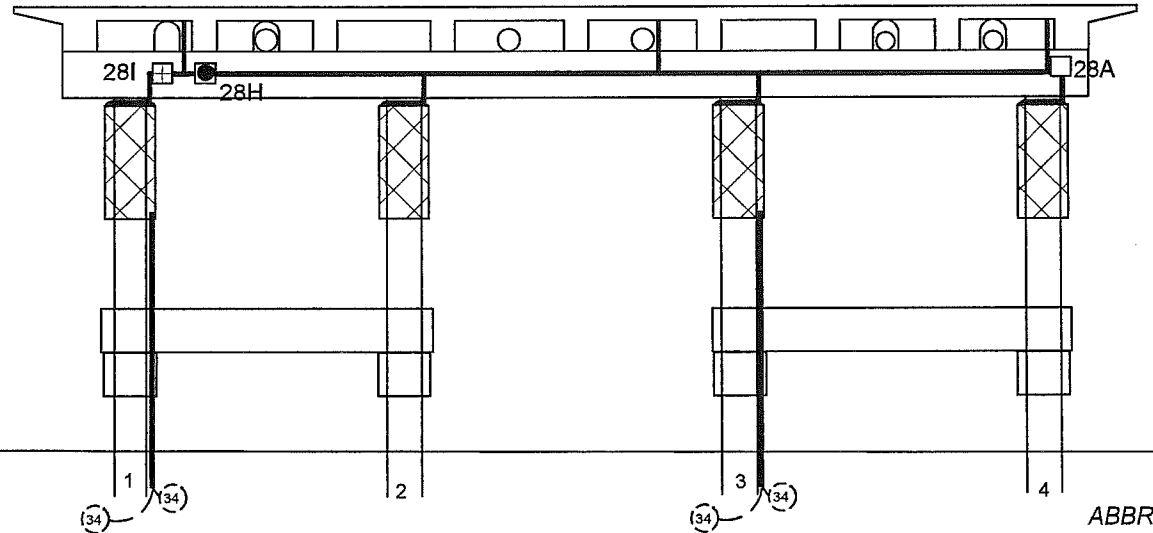

J-BOX DETAILS:

	J-Box Size	Wires or Structure
28-A	14" x 12" x 8"	MAIN J-BOX: (5) MZA; (5) MZN; (4) PJA; (1) PJN; (2) SA; SAN jumpered from PJN
28-B	5" x 5" x 2"	Structure Negative (MZN); (2) MZA; (1) MZN
28-C	5" x 5" x 2"	Primary Anode Terminal Plate (MZA); (1) MZN; (1) MZA
28-D	5" x 5" x 2"	Structure Negative (MZN)
28-E	5" x 5" x 2"	Primary Anode Terminal Plate (MZA)
28-F	5" x 5" x 2"	Structure Negative (MZN); (1) MZA
28-G	5" x 5" x 2"	Primary Anode Terminal Plate (MZA)
28-H	5" x 5" x 2"	Primary Anode Terminal Plate (MZA); (2) MZN; (1) MZA; (1) PJA; (1) SA
28-I	5" x 5" x 2"	Structure Negative (MZN); (1) PJA; (1) SA
28-J	5" x 5" x 2"	Structure Negative (MZN); MZN Jumper to 29H; (1) MZA
28-K	5" x 5" x 2"	Primary Anode Terminal Plate (MZA)
28-L	5" x 5" x 2"	Reference Electrode (RE)
28-M	5" x 5" x 2"	Reference Electrode Negative (REN); (1) RE

ABBREVIATIONS:

MZN = Metallized Zinc Negative
PJN = Pile Jacket Negative
CJN = Cap Jacket Negative
SAN = Submerged Anode Negative
MZA = Metallized Zinc Anode
PJA = Pile Jacket Anode
CJA = Cap Jacket Anode
SA = Submerged Anode
RE = Reference Electrode
REN = Reference Electrode Negative

LEGEND

- (x) Submerged Anode
- x = Weight in LBS
- ⊠ Pile Jacket
- ⊞ Cap Jacket
- Primary Anode Terminal
- + Negative Connection
- Encapsulated Splice
- Reference Electrode

TYPICAL WIRE SIZES & COLORS AS FOLLOWS:
MZA & PJA = #10 Red
MZN; PJN = #10 Blue
SA = #8 Black
RE/REN: #16 Twisted Pair Red/Black


Water Street Bent 28 South Elevation
& Span 28

SCALE: NONE	Field Sketch	DRAWN BY KRH
DATE: 10-21-11	As-Built	REVISED

GREAT WESTERN CORPORATION

Ketchikan Viaduct II
Repair & C.P.



DRAWING NUMBER
W-28

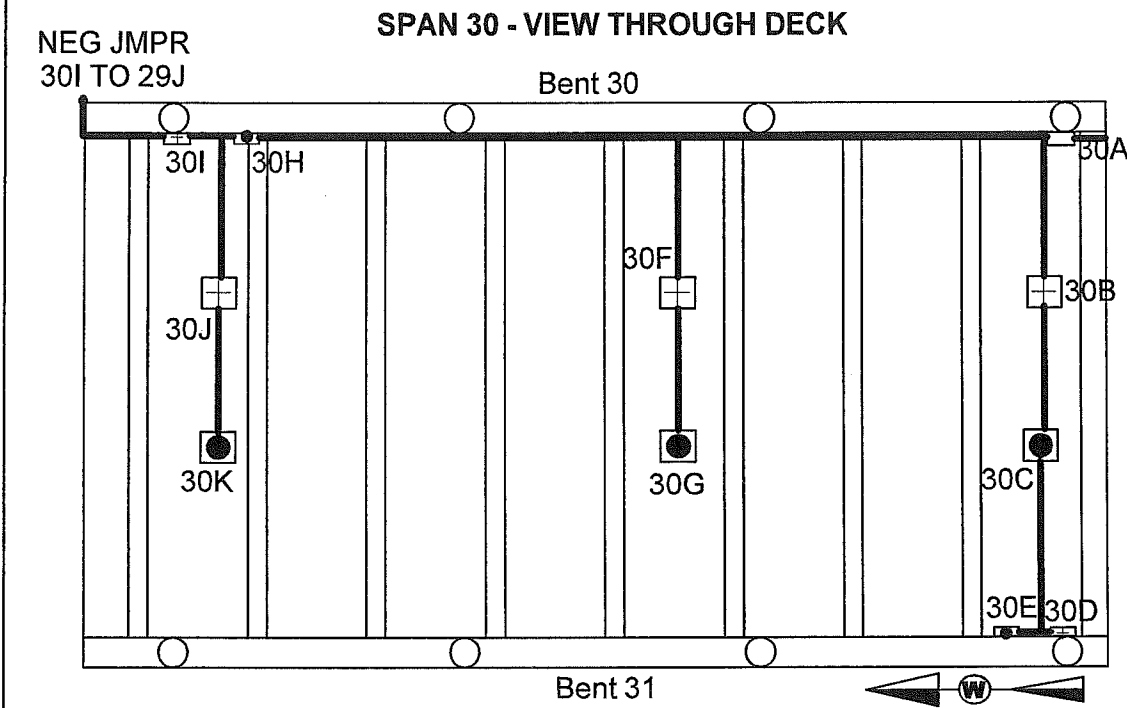

DECK:

BENT:

SCHEMATIC

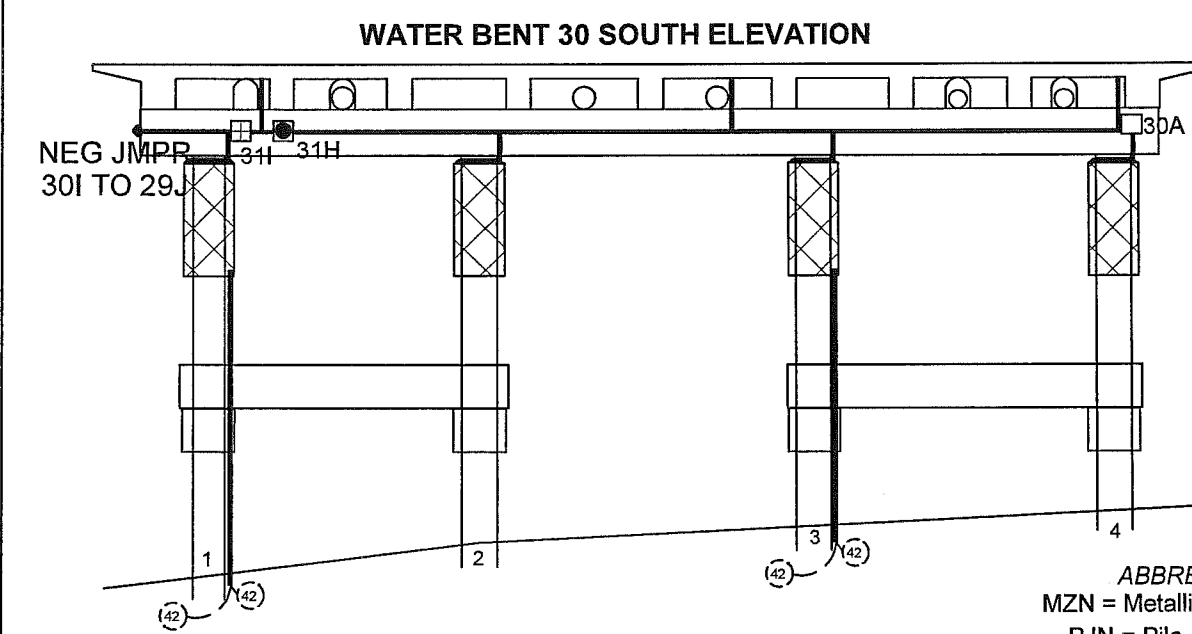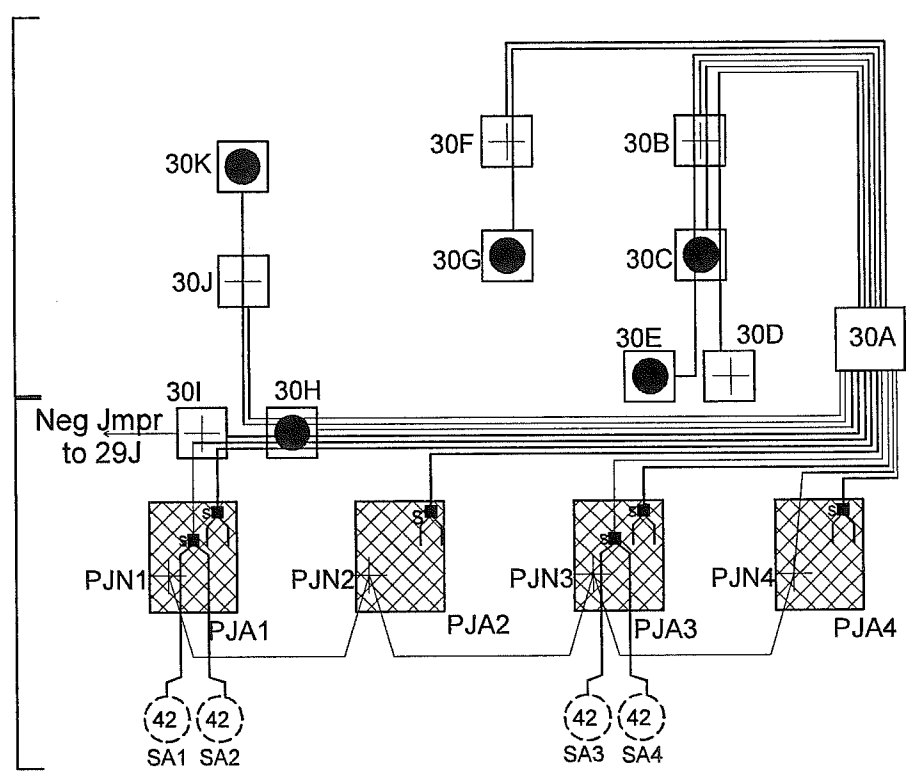

J-BOX DETAILS:

J-Box Size	Wires or Structure
30-A 14" x 12" x 8"	MAIN J-BOX: (5) MZA; (5) MZN; (4) PJA; (1) PJN; (2) SA; SAN jumpered from PJN
30-B 5" x 5" x 2"	Structure Negative (MZN); (2) MZA; (1) MZN
30-C 5" x 5" x 2"	Primary Anode Terminal Plate (MZA); (1) MZN; (1) MZA
30-D 5" x 5" x 2"	Structure Negative (MZN)
30-E 5" x 5" x 2"	Primary Anode Terminal Plate (MZA)
30-F 5" x 5" x 2"	Structure Negative (MZN); (1) MZA
30-G 5" x 5" x 2"	Primary Anode Terminal Plate (MZA)
30-H 5" x 5" x 2"	Primary Anode Terminal Plate (MZA); (2) MZN; (1) MZA; (1) PJA; (1) SA
30-I 5" x 5" x 2"	Structure Negative (MZN); (1) PJA; (1) SA; MZN Jumper to 29J
30-J 5" x 5" x 2"	Structure Negative (MZN); (1) MZA
30-K 5" x 5" x 2"	Primary Anode Terminal Plate (MZA)



ABBREVIATIONS:
 MZN = Metallized Zinc Negative
 PJN = Pile Jacket Negative
 CJN = Cap Jacket Negative
 SAN = Submerged Anode Negative
 MZA = Metallized Zinc Anode
 PJA = Pile Jacket Anode
 CJA = Cap Jacket Anode
 SA = Submerged Anode
 RE = Reference Electrode
 REN = Reference Electrode Negative

TYPICAL WIRE SIZES & COLORS AS FOLLOWS:
 MZA & PJA = #10 Red
 MZN; PJN = #10 Blue
 SA = #8 Black
 RE/REN: #16 Twisted Pair Red/Black


LEGEND	
(x)	Submerged Anode
x	Weight in LBS
⊗	Pile Jacket
⊠	Cap Jacket
●	Primary Anode Terminal
+	Negative Connection
■	Encapsulated Splice
—	Reference Electrode

Water Street Bent 30 South Elevation & Span 30			
SCALE: NONE	Field Sketch	DRAWN BY: KRH	
DATE: 10-14-11	As-Built	REVISED:	
GREAT WESTERN CORPORATION			
Ketchikan Viaduct II Repair & C.P.		DRAWING NUMBER W-30	

SPAN 31 - VIEW THROUGH DECK

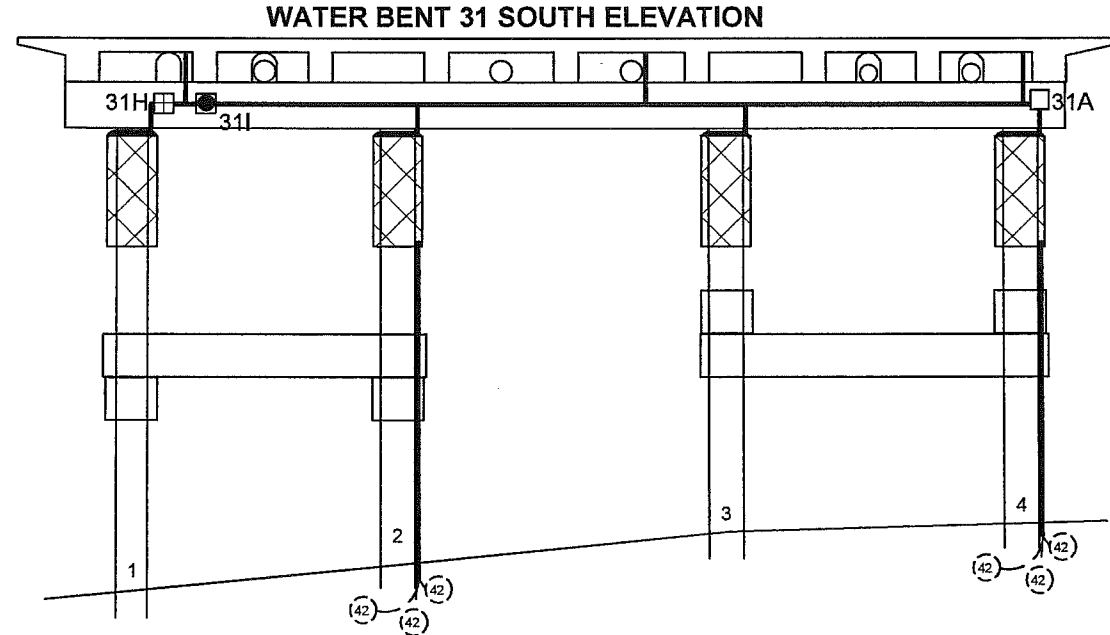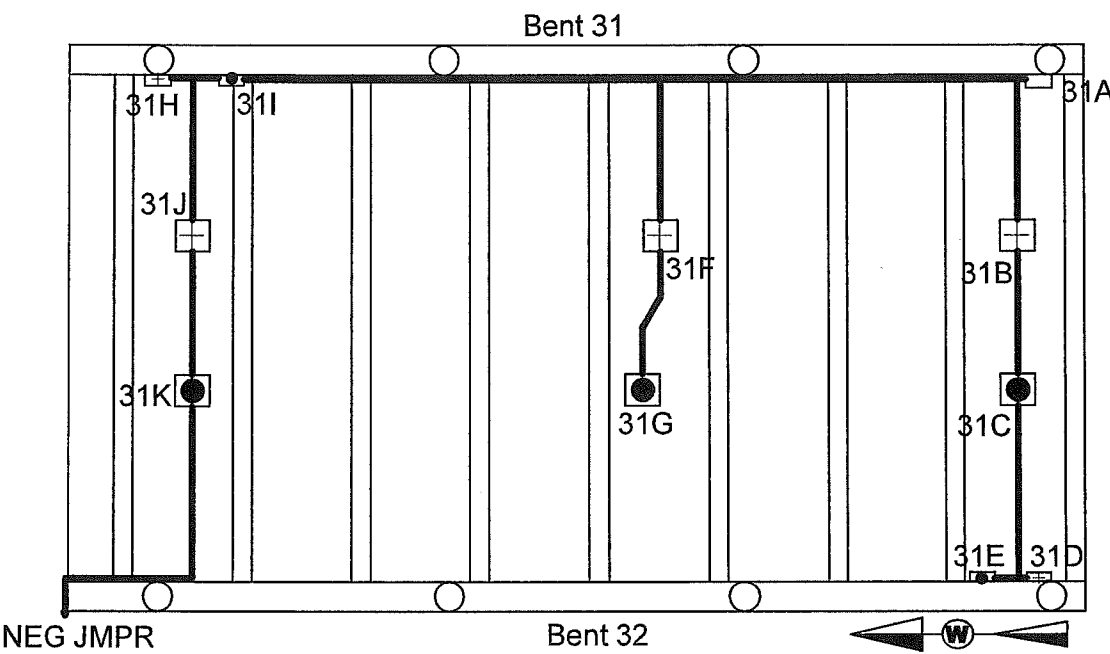

SCHEMATIC

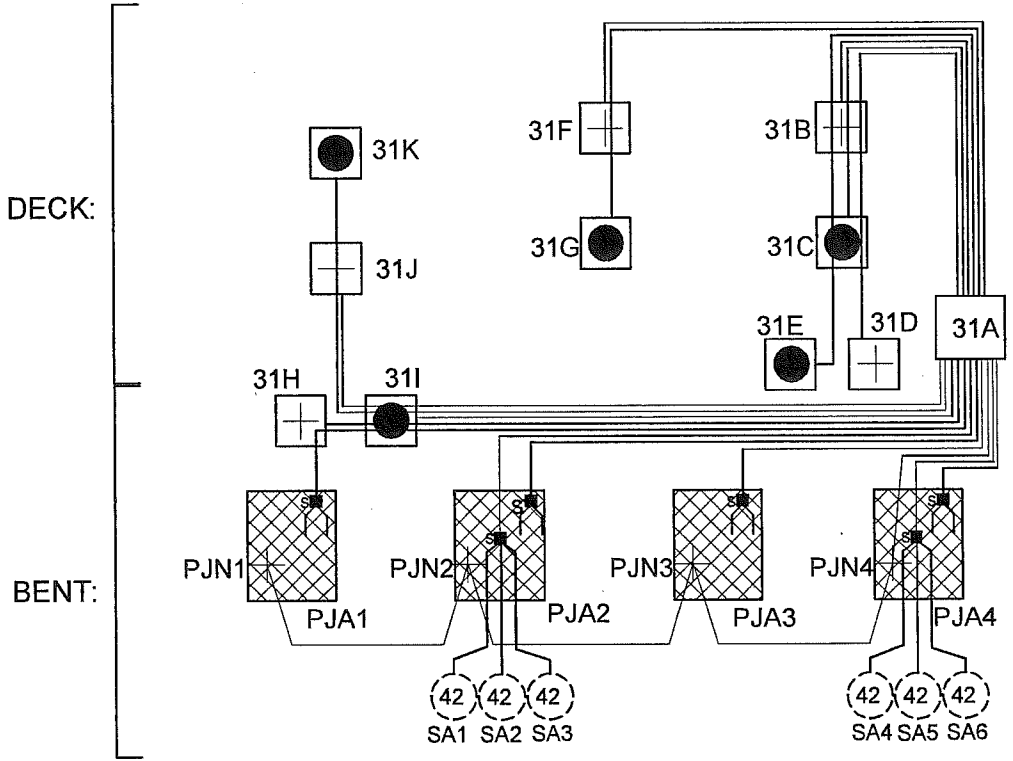

J-BOX DETAILS:

	J-Box Size	Wires or Structure
31-A	14" x 12" x 8"	MAIN J-BOX (5) MZA; (5) MZN; (4) PJA; (1) PJN; (2) SA; SAN jumpered from PJN
31-B	5" x 5" x 2"	Structure Negative (MZN); (2) MZA; (1) MZN
31-C	5" x 5" x 2"	Primary Anode Terminal Plate (MZA); (1) MZN; (1) MZA
31-D	5" x 5" x 2"	Structure Negative (MZN)
31-E	5" x 5" x 2"	Primary Anode Terminal Plate (MZA)
31-F	5" x 5" x 2"	Structure Negative (MZN); (1) MZA
31-G	5" x 5" x 2"	Primary Anode Terminal Plate (MZA)
31-H	5" x 5" x 2"	Structure Negative (MZN); (1) PJA
31-I	5" x 5" x 2"	Primary Anode Terminal Plate (MZA); (2) MZN; (1) MZA; (1) PJA
31-J	5" x 5" x 2"	Structure Negative (MZN); (1) MZA
31-K	5" x 5" x 2"	Primary Anode Terminal Plate (MZA)

TYPICAL WIRE SIZES & COLORS AS FOLLOWS:
MZA & PJA = #10 Red
MZN; PJN = #10 Blue
SA = #8 Black
RE/REN: #16 Twisted Pair Red/Black

ABBREVIATIONS:
MZN = Metallized Zinc Negative
PJN = Pile Jacket Negative
CJN = Cap Jacket Negative
SAN = Submerged Anode Negative
MZA = Metallized Zinc Anode
PJA = Pile Jacket Anode
CJA = Cap Jacket Anode
SA = Submerged Anode
RE = Reference Electrode
REN = Reference Electrode Negative

LEGEND

(X) Submerged Anode
X = Weight in KG

[Cross-hatched box] Pile Jacket

[Dotted box] Cap Jacket

● Primary Anode Terminal

— Negative Connection


■ Encapsulated Splice

Water Street Bent 31 South Elevation
& Span 31



SCALE: NONE	Field Sketch	DRAWN BY KRH
DATE: 10-14-11	As-Built	REVISED

GREAT WESTERN CORPORATION

Ketchikan Viaduct II Repair & C.P.	DRAWING NUMBER W-31
---------------------------------------	------------------------

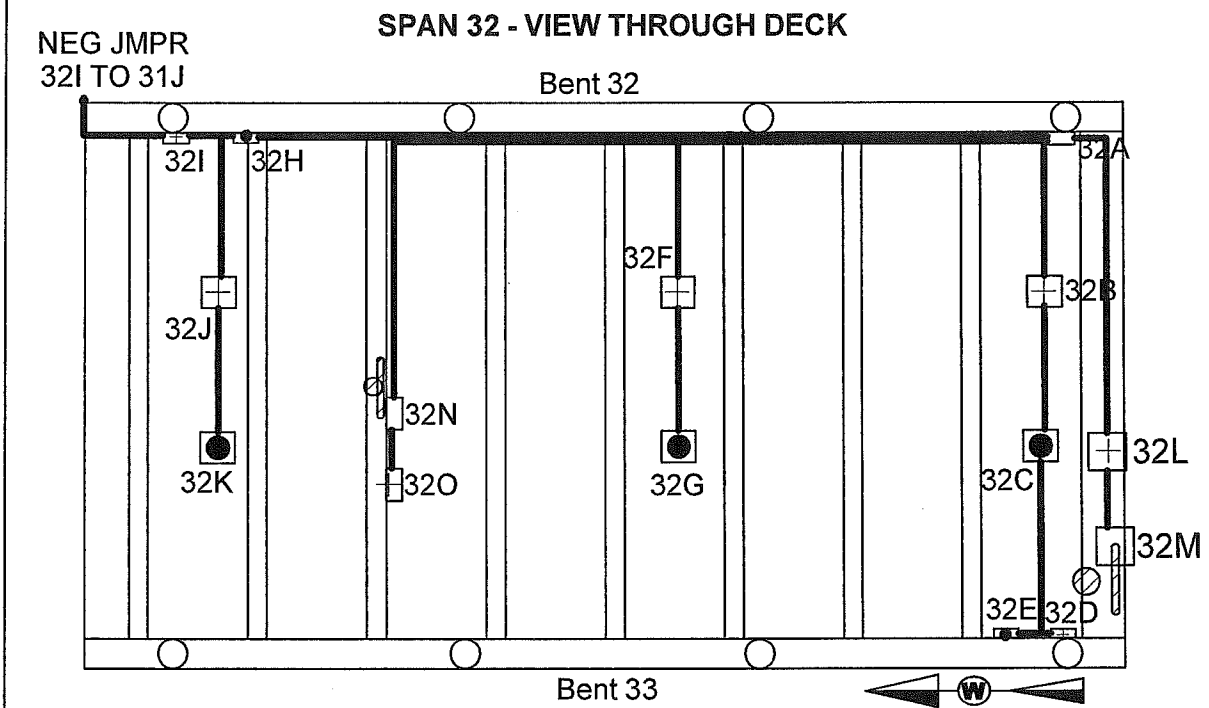

DECK:
BENT:

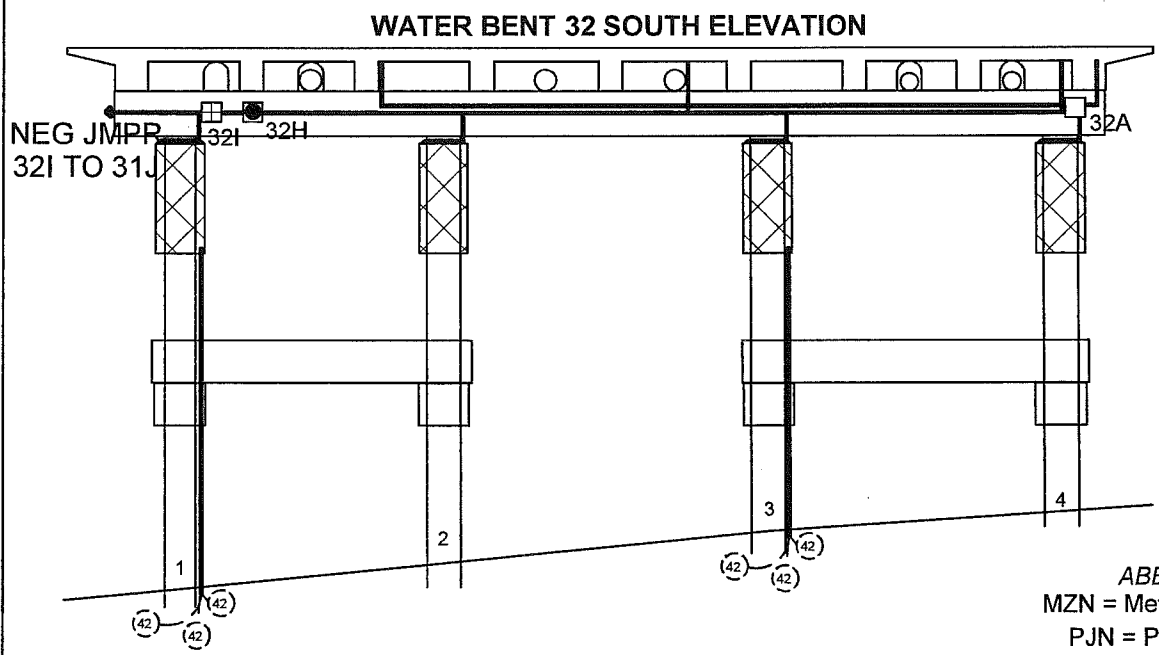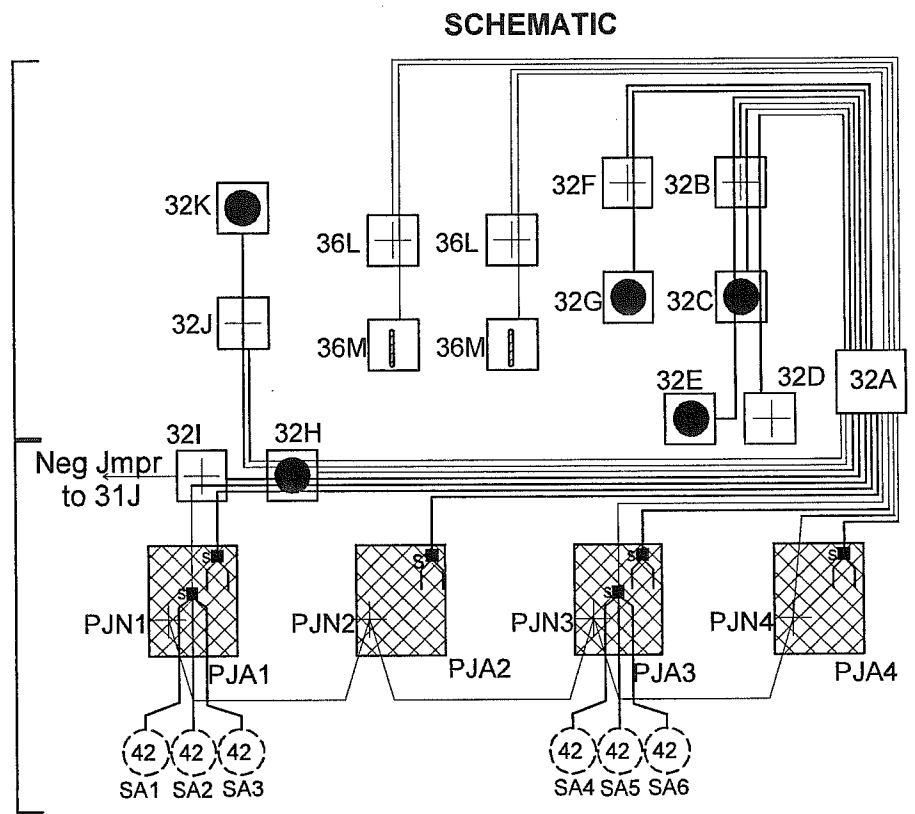

J-BOX DETAILS:

J-Box Size	Wires or Structure
32-A	14" x 12" x 8" MAIN J-BOX: (5) MZA; (5) MZN; (4) PJA; (1) PJN; (2) SA; SAN jumpered from PJN; (2) RE; (2) REN
32-B	5" x 5" x 2" Structure Negative (MZN); (2) MZA; (1) MZN
32-C	5" x 5" x 2" Primary Anode Terminal Plate (MZA); (1) MZN; (1) MZA
32-D	5" x 5" x 2" Structure Negative (MZN)
32-E	5" x 5" x 2" Primary Anode Terminal Plate (MZA)
32-F	5" x 5" x 2" Structure Negative (MZN); (1) MZA
32-G	5" x 5" x 2" Primary Anode Terminal Plate (MZA)
32-H	5" x 5" x 2" Primary Anode Terminal Plate (MZA); (2) MZN; (1) MZA; (1) PJA; (1) SA
32-I	5" x 5" x 2" Structure Negative (MZN); (1) PJA; (1) SA; MZN Jumper to 31J
32-J	5" x 5" x 2" Structure Negative (MZN); (1) MZA
32-K	5" x 5" x 2" Primary Anode Terminal Plate (MZA)
32-L	5" x 5" x 2" Reference Electrode Negative (REN) (1) RE
32-M	5" x 5" x 2" Reference Electrode (RE)
32-N	5" x 5" x 2" Reference Electrode (RE); (1) REN
32-O	5" x 5" x 2" Reference Electrode Negative (REN)

ABBREVIATIONS:

MZN = Metallized Zinc Negative
 PJN = Pile Jacket Negative
 CJN = Cap Jacket Negative
 SAN = Submerged Anode Negative
 MZA = Metallized Zinc Anode
 PJA = Pile Jacket Anode
 CJA = Cap Jacket Anode
 SA = Submerged Anode
 RE = Reference Electrode
 REN = Reference Electrode Negative


LEGEND

- (x) Submerged Anode
- x = Weight in LBS
- ⊠ Pile Jacket
- ⊞ Cap Jacket
- Primary Anode Terminal
- + Negative Connection
- Encapsulated Splice
- Reference Electrode


TYPICAL WIRE SIZES & COLORS AS FOLLOWS:
 MZA & PJA = #10 Red
 MZN; PJN = #10 Blue
 SA = #8 Black
 RE/REN: #16 Twisted Pair Red/Black

Water Street Bent 32 South Elevation & Span 32			
SCALE: NONE	Field Sketch	DRAWN BY: KRH	
DATE: 10-14-11	As-Built	REVISED:	
GREAT WESTERN CORPORATION			
Ketchikan Viaduct II Repair & C.P.		DRAWING NUMBER W-32	


SPAN 33 - VIEW THROUGH DECK

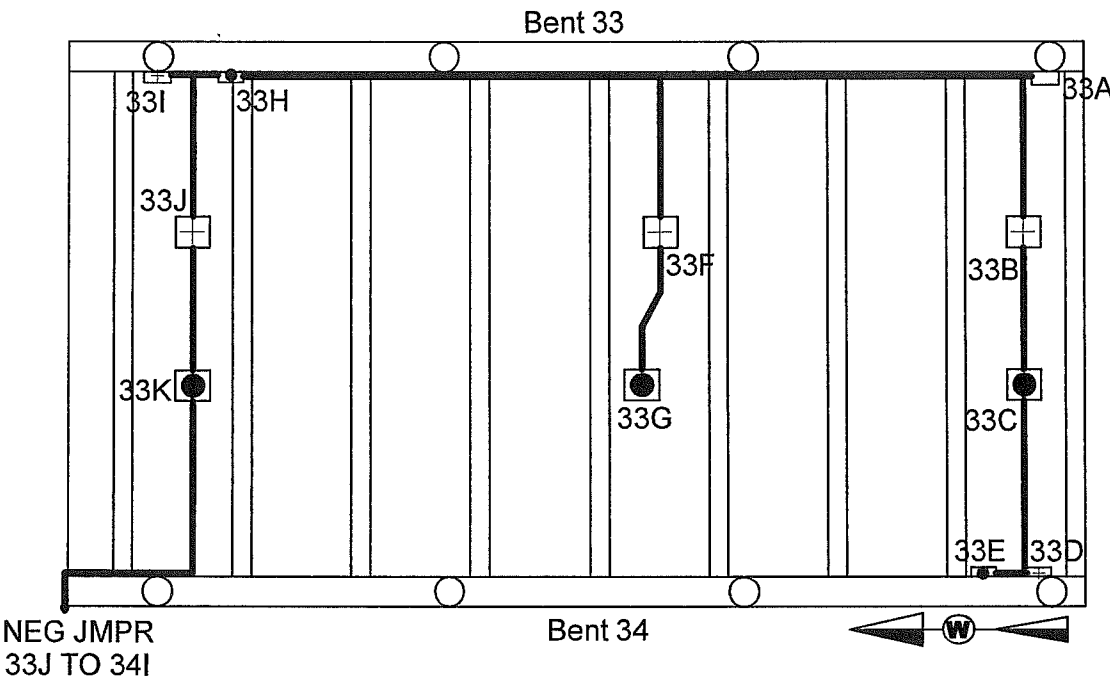

WATER BENT 33 SOUTH ELEVATION

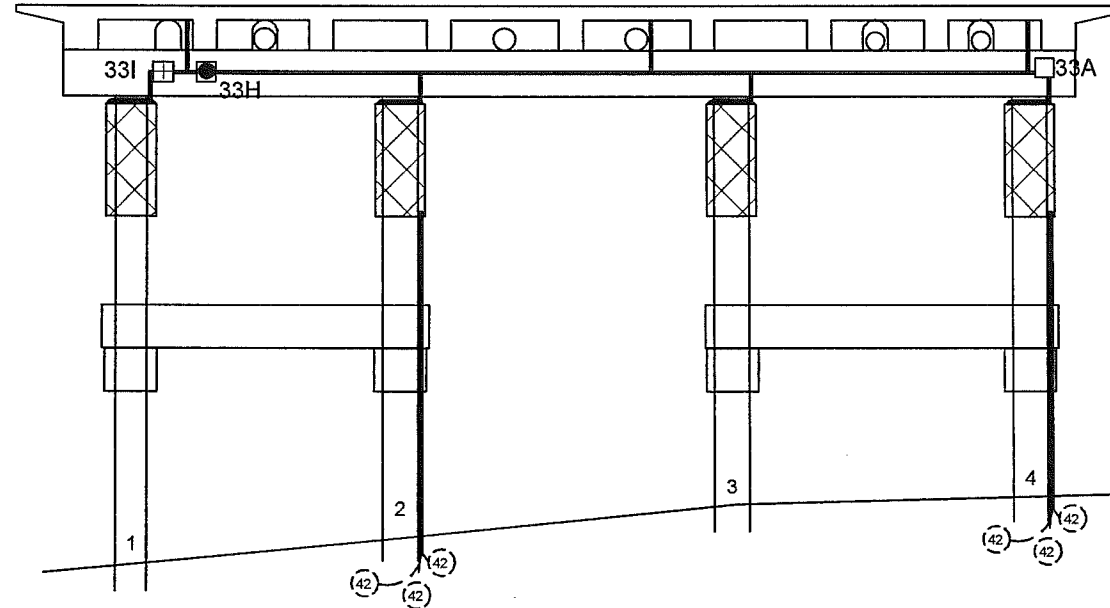

SCHEMATIC

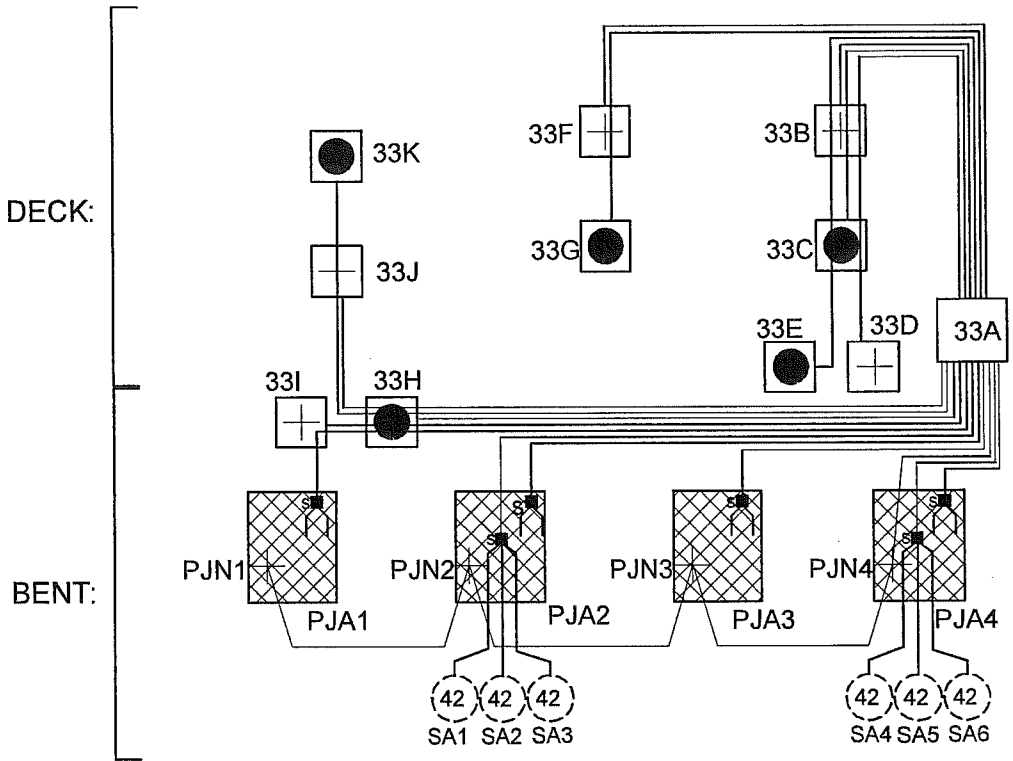

J-BOX DETAILS:

	J-Box Size	Wires or Structure
33-A	14" x 12" x 8"	MAIN J-BOX: (5) MZA; (5) MZN; (4) PJA; (1) PJN; (2) SA; SAN jumpered from PJN
33-B	5" x 5" x 2"	Structure Negative (MZN); (2) MZA; (1) MZN
33-C	5" x 5" x 2"	Primary Anode Terminal Plate (MZA); (1) MZN; (1) MZA
33-D	5" x 5" x 2"	Structure Negative (MZN)
33-E	5" x 5" x 2"	Primary Anode Terminal Plate (MZA)
33-F	5" x 5" x 2"	Structure Negative (MZN); (1) MZA
33-G	5" x 5" x 2"	Primary Anode Terminal Plate (MZA)
33-H	5" x 5" x 2"	Primary Anode Terminal Plate (MZA); (2) MZN; (1) MZA; (1) PJA
33-I	5" x 5" x 2"	Structure Negative (MZN); (1) PJA
33-J	5" x 5" x 2"	Structure Negative (MZN); (1) MZA
33-K	5" x 5" x 2"	Primary Anode Terminal Plate (MZA)

TYPICAL WIRE SIZES & COLORS AS FOLLOWS:
MZA & PJA = #10 Red
MZN; PJN = #10 Blue
SA = #8 Black
RE/REN: #16 Twisted Pair Red/Black

ABBREVIATIONS:
MZN = Metallized Zinc Negative
PJN = Pile Jacket Negative
CJN = Cap Jacket Negative
SAN = Submerged Anode Negative
MZA = Metallized Zinc Anode
PJA = Pile Jacket Anode
CJA = Cap Jacket Anode
SA = Submerged Anode
RE = Reference Electrode
REN = Reference Electrode Negative

LEGEND




- (X) Submerged Anode
X = Weight in KG
- [Cross-hatched box] Pile Jacket
- [Dotted box] Cap Jacket
- Primary Anode Terminal
- + Negative Connection
- Encapsulated Splice

Water Street Bent 33 South Elevation
& Span 33

SCALE: NONE	Field Sketch	DRAWN BY KRH
DATE: 10-14-11	As-Built	REVISED

GREAT WESTERN CORPORATION

Ketchikan Viaduct II Repair & C.P.	DRAWING NUMBER W-33
---------------------------------------	------------------------

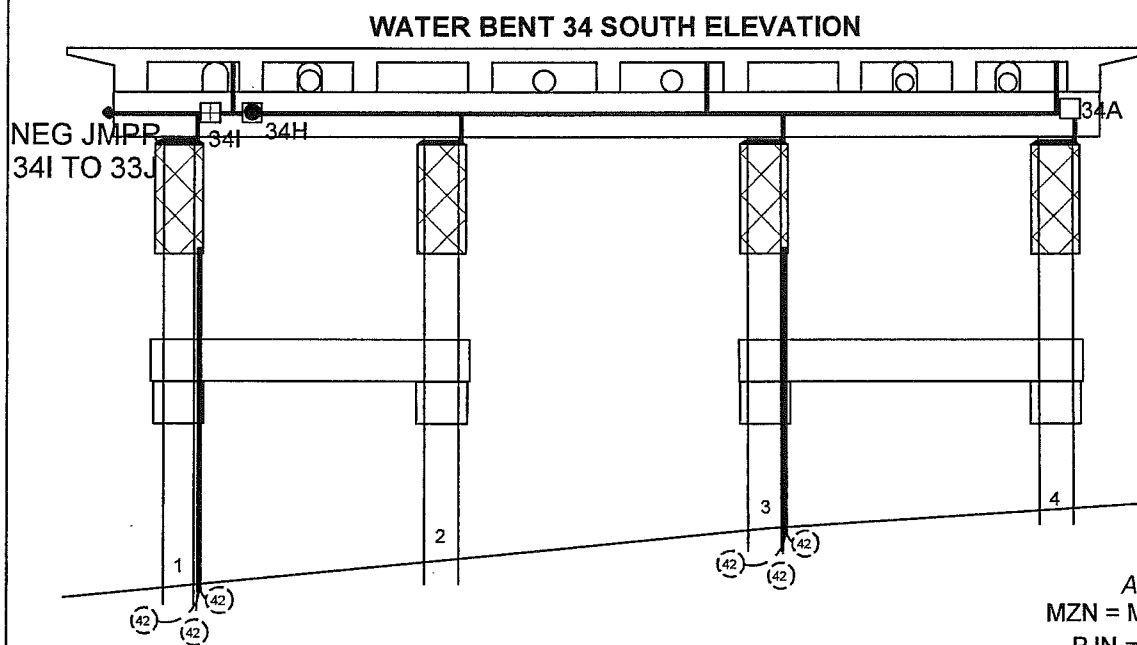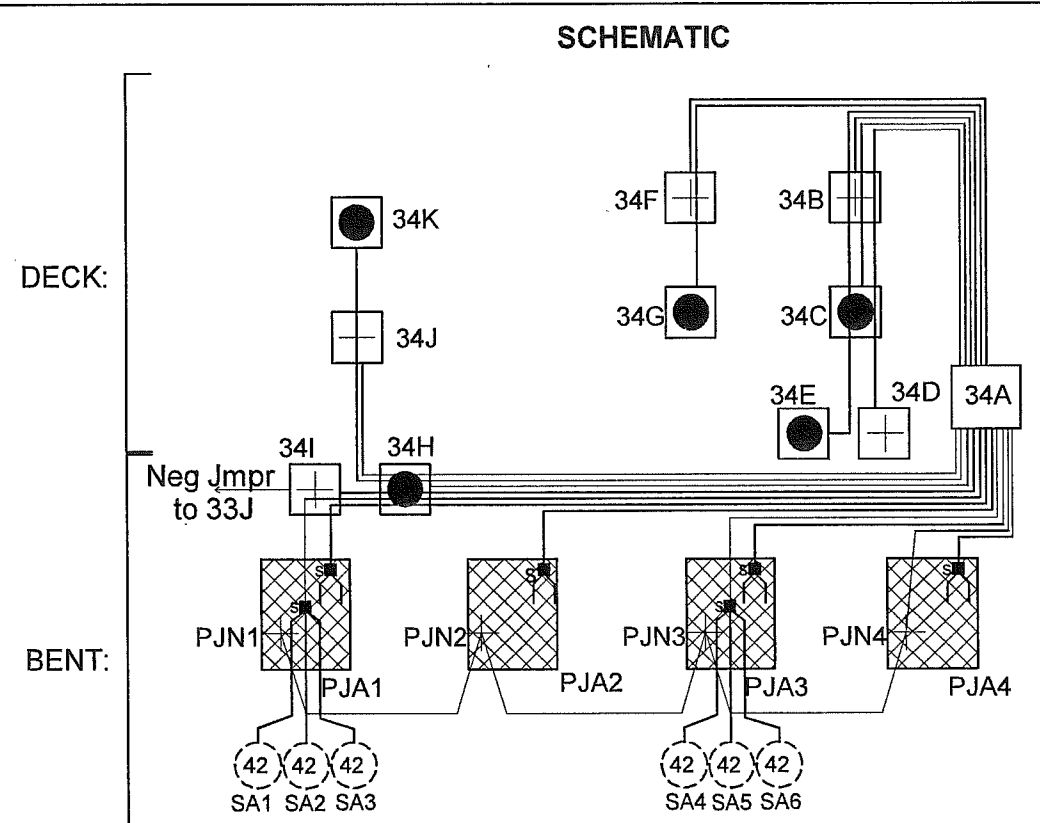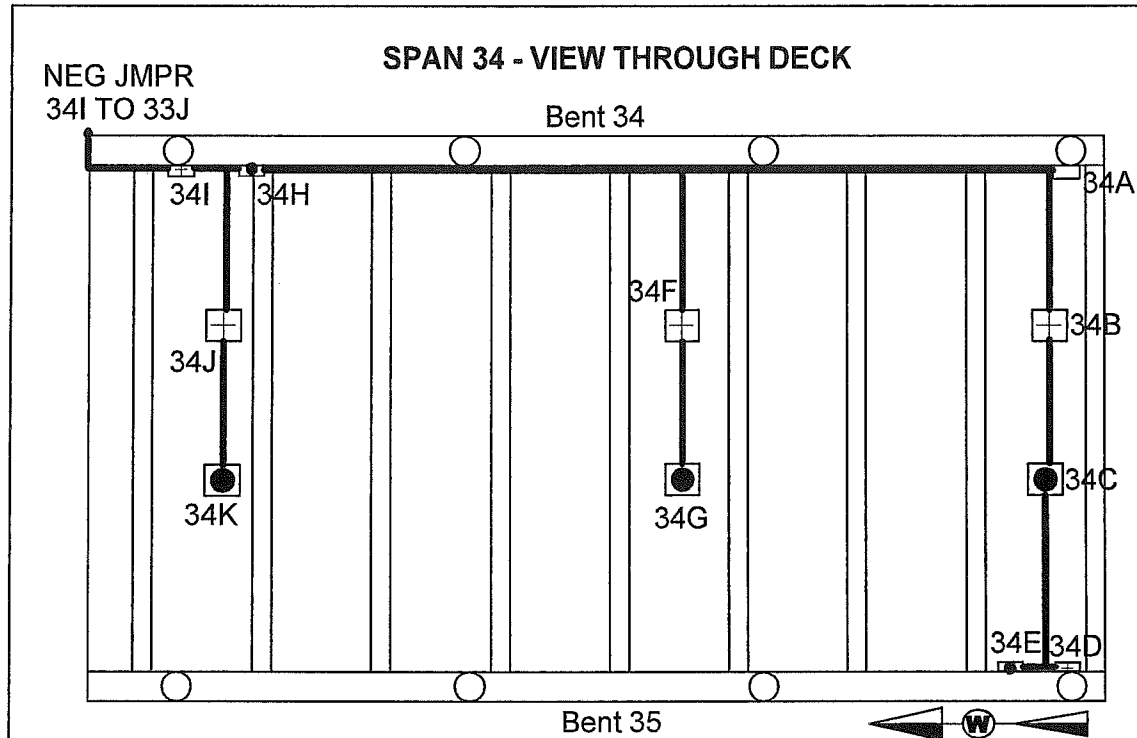

J-BOX DETAILS:

	J-Box Size	Wires or Structure
34-A	14" x 12" x 8"	MAIN J-BOX: (5) MZA; (5) MZN; (4) PJA; (1) PJN; (2) SA; SAN jumpered from PJN
34-B	5" x 5" x 2"	Structure Negative (MZN); (2) MZA; (1) MZN
34-C	5" x 5" x 2"	Primary Anode Terminal Plate (MZA); (1) MZN; (1) MZA
34-D	5" x 5" x 2"	Structure Negative (MZN)
34-E	5" x 5" x 2"	Primary Anode Terminal Plate (MZA)
34-F	5" x 5" x 2"	Structure Negative (MZN); (1) MZA
34-G	5" x 5" x 2"	Primary Anode Terminal Plate (MZA)
34-H	5" x 5" x 2"	Primary Anode Terminal Plate (MZA); (2) MZN; (1) MZA; (1) PJA; (1) SA
34-I	5" x 5" x 2"	Structure Negative (MZN); (1) PJA; (1) SA; MZN Jumper to 33J
34-J	5" x 5" x 2"	Structure Negative (MZN); (1) MZA
34-K	5" x 5" x 2"	Primary Anode Terminal Plate (MZA)

ABBREVIATIONS:

MZN = Metallized Zinc Negative
 PJN = Pile Jacket Negative
 CJN = Cap Jacket Negative
 SAN = Submerged Anode Negative
 MZA = Metallized Zinc Anode
 PJA = Pile Jacket Anode
 CJA = Cap Jacket Anode
 SA = Submerged Anode
 RE = Reference Electrode
 REN = Reference Electrode Negative


LEGEND

(x) Submerged Anode
 x = Weight in LBS
 [X] Pile Jacket
 [C] Cap Jacket
 ● Primary Anode Terminal
 + Negative Connection
 ■ Encapsulated Splice
 — Reference Electrode


TYPICAL WIRE SIZES & COLORS AS FOLLOWS:
 MZA & PJA = #10 Red
 MZN; PJN = #10 Blue
 SA = #8 Black
 RE/REN: #16 Twisted Pair Red/Black

Water Street Bent 34 South Elevation & Span 34		
SCALE: NONE	Field Sketch	DRAWN BY KRH
DATE: 10-14-11	As-Built	REVISED
GREAT WESTERN CORPORATION		
Ketchikan Viaduct II Repair & C.P.		DRAWING NUMBER W-34


SPAN 35 - VIEW THROUGH DECK

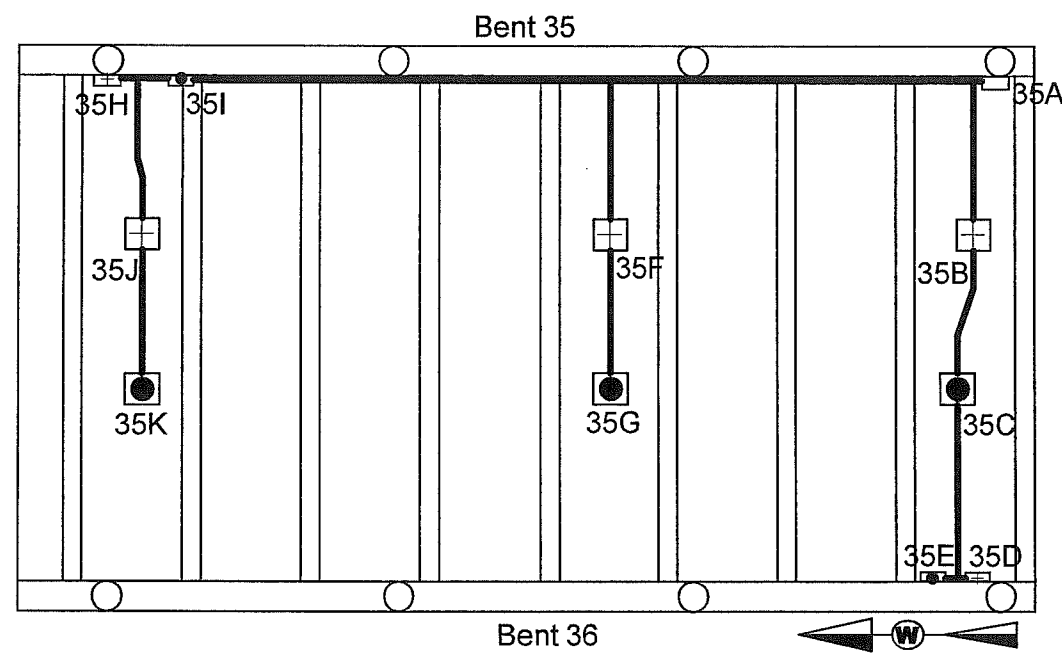

SCHEMATIC

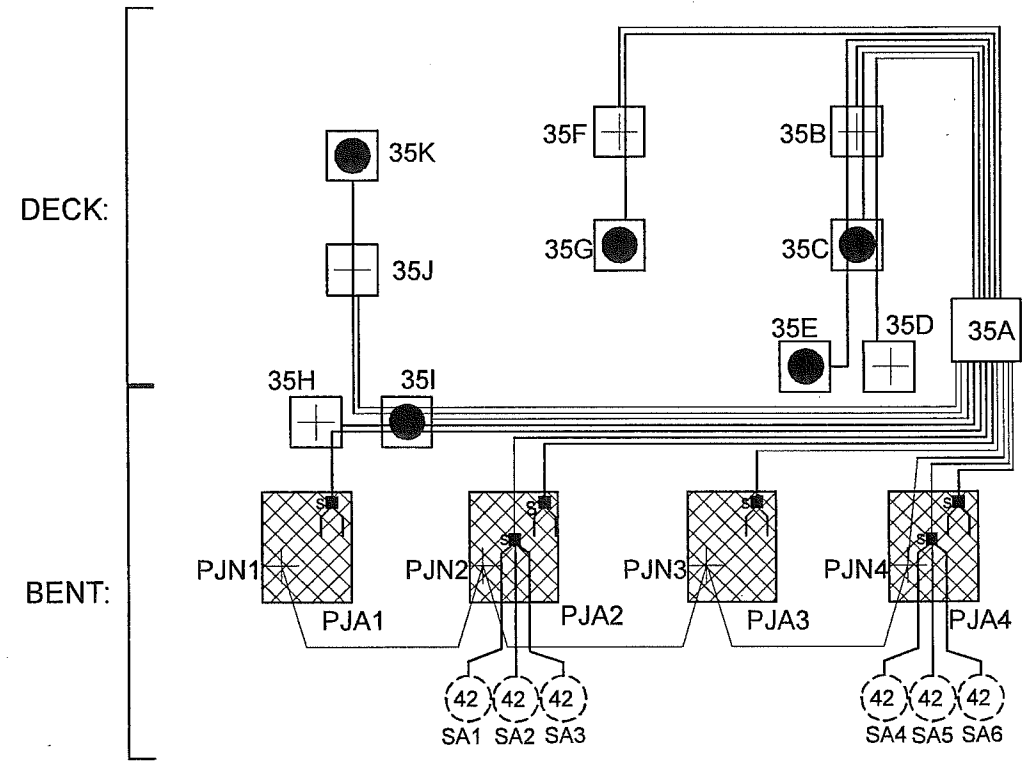

WATER BENT 35 SOUTH ELEVATION

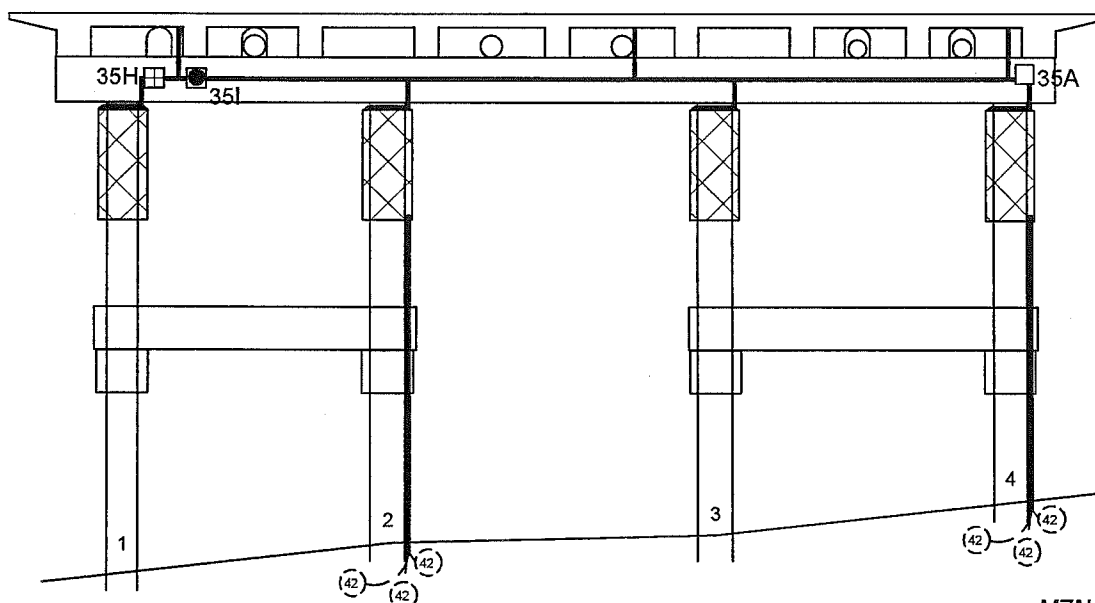

J-BOX DETAILS:

	J-Box Size	Wires or Structure
35-A	14" x 12" x 8"	MAIN J-BOX: (5) MZA; (5) MZN; (4) PJA; (1) PJN; (2) SA; SAN jumpered from PJN
35-B	5" x 5" x 2"	Structure Negative (MZN); (2) MZA; (1) MZN
35-C	5" x 5" x 2"	Primary Anode Terminal Plate (MZA); (1) MZN; (1) MZA
35-D	5" x 5" x 2"	Structure Negative (MZN)
35-E	5" x 5" x 2"	Primary Anode Terminal Plate (MZA)
35-F	5" x 5" x 2"	Structure Negative (MZN); (1) MZA
35-G	5" x 5" x 2"	Primary Anode Terminal Plate (MZA)
35-H	5" x 5" x 2"	Structure Negative (MZN); (1) PJA
35-I	5" x 5" x 2"	Primary Anode Terminal Plate (MZA); (2) MZN; (1) MZA; (1) PJA
35-J	5" x 5" x 2"	Structure Negative (MZN); (1) MZA
35-K	5" x 5" x 2"	Primary Anode Terminal Plate (MZA)

TYPICAL WIRE SIZES & COLORS AS FOLLOWS:
MZA & PJA = #10 Red
MZN; PJN = #10 Blue
SA = #8 Black
RE/REN: #16 Twisted Pair Red/Black


ABBREVIATIONS:
MZN = Metallized Zinc Negative
PJN = Pile Jacket Negative
CJN = Cap Jacket Negative
SAN = Submerged Anode Negative
MZA = Metallized Zinc Anode
PJA = Pile Jacket Anode
CJA = Cap Jacket Anode
SA = Submerged Anode
RE = Reference Electrode
REN = Reference Electrode Negative

LEGEND


- (X) Submerged Anode
X = Weight in KG
- [Cross-hatched box] Pile Jacket
- [Dotted box] Cap Jacket
- Primary Anode Terminal
- + Negative Connection
- Encapsulated Splice

Water Street Bent 35 South Elevation & Span 35			
SCALE: NONE	Field Sketch	DRAWN BY: KRH	
DATE: 10-14-11	As-Built	REVISED:	
GREAT WESTERN CORPORATION			
Ketchikan Viaduct II Repair & C.P.		DRAWING NUMBER W-35	


SPAN 36 - VIEW THROUGH DECK

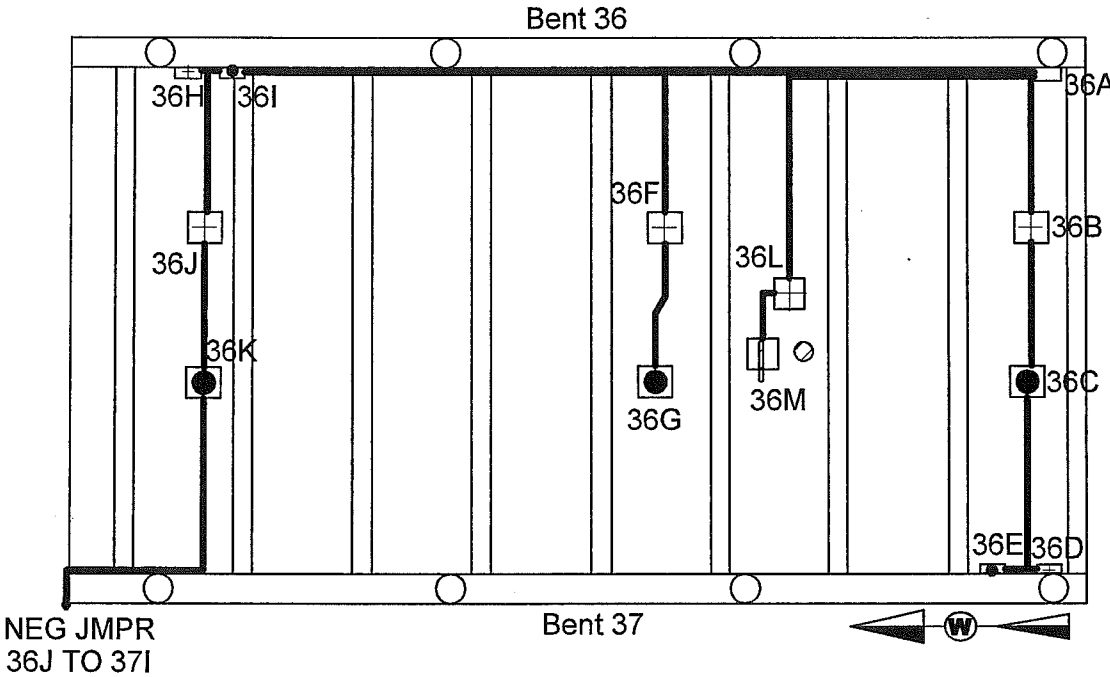

SCHEMATIC

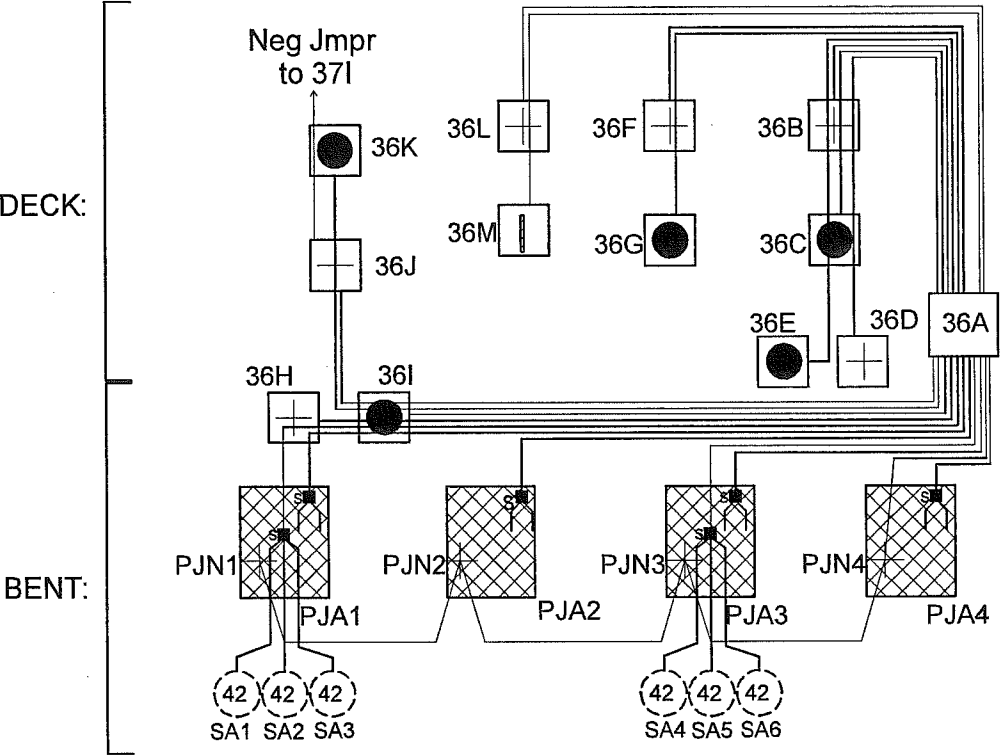

WATER BENT 36 SOUTH ELEVATION

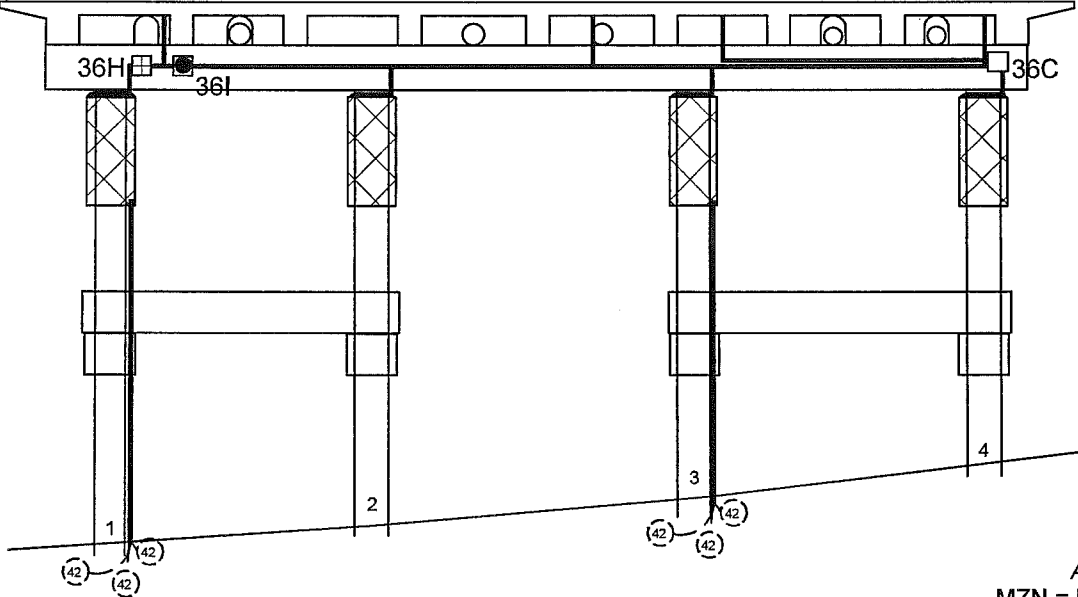

J-BOX DETAILS:


	J-Box Size	Wires or Structure
36-A	14" x 12" x 8"	MAIN J-BOX: (5) MZA; (5) MZN; (4) PJA; (1) PJN; (2) SA; SAN jumpered from PJN; (1) RE; (1) REN
36-B	5" x 5" x 2"	Structure Negative (MZN); (2) MZA; (1) MZN
36-C	5" x 5" x 2"	Primary Anode Terminal Plate (MZA); (1) MZN; (1) MZA
36-D	5" x 5" x 2"	Structure Negative (MZN)
36-E	5" x 5" x 2"	Primary Anode Terminal Plate (MZA)
36-F	5" x 5" x 2"	Structure Negative (MZN); (1) MZA
36-G	5" x 5" x 2"	Primary Anode Terminal Plate (MZA)
36-H	5" x 5" x 2"	Structure Negative (MZN); (1) PJA; (1) SA
36-I	5" x 5" x 2"	Primary Anode Terminal Plate (MZA); (2) MZN; (1) MZA; (1) PJA; (1) SA
36-J	5" x 5" x 2"	Structure Negative (MZN); (1) MZA; MZN Jumper to 37I
36-K	5" x 5" x 2"	Primary Anode Terminal Plate (MZA); (1) MZN Jumper
36-L	5" x 5" x 2"	Reference Electrode Negative (REN) (1) RE
36-M	5" x 5" x 2"	Reference Electrode (RE)

TYPICAL WIRE SIZES & COLORS AS FOLLOWS:
MZA & PJA = #10 Red
MZN; PJN = #10 Blue
SA = #8 Black
RE/REN: #16 Twisted Pair Red/Black

ABBREVIATIONS:
MZN = Metallized Zinc Negative
PJN = Pile Jacket Negative
CJN = Cap Jacket Negative
SAN = Submerged Anode Negative
MZA = Metallized Zinc Anode
PJA = Pile Jacket Anode
CJA = Cap Jacket Anode
SA = Submerged Anode
RE = Reference Electrode
REN = Reference Electrode Negative

LEGEND
⊗ Submerged Anode
x = Weight in LBS
⊠ Pile Jacket
⊞ Cap Jacket
● Primary Anode Terminal
+ Negative Connection
■ Encapsulated Splice
— Reference Electrode


Water Street Bent 36 South Elevation & Span 36		
SCALE: NONE	Field Sketch	DRAWN BY KRH
DATE: 10-14-11	As-Built	REVISED
GREAT WESTERN CORPORATION		
Ketchikan Viaduct II Repair & C.P.		DRAWING NUMBER W-36

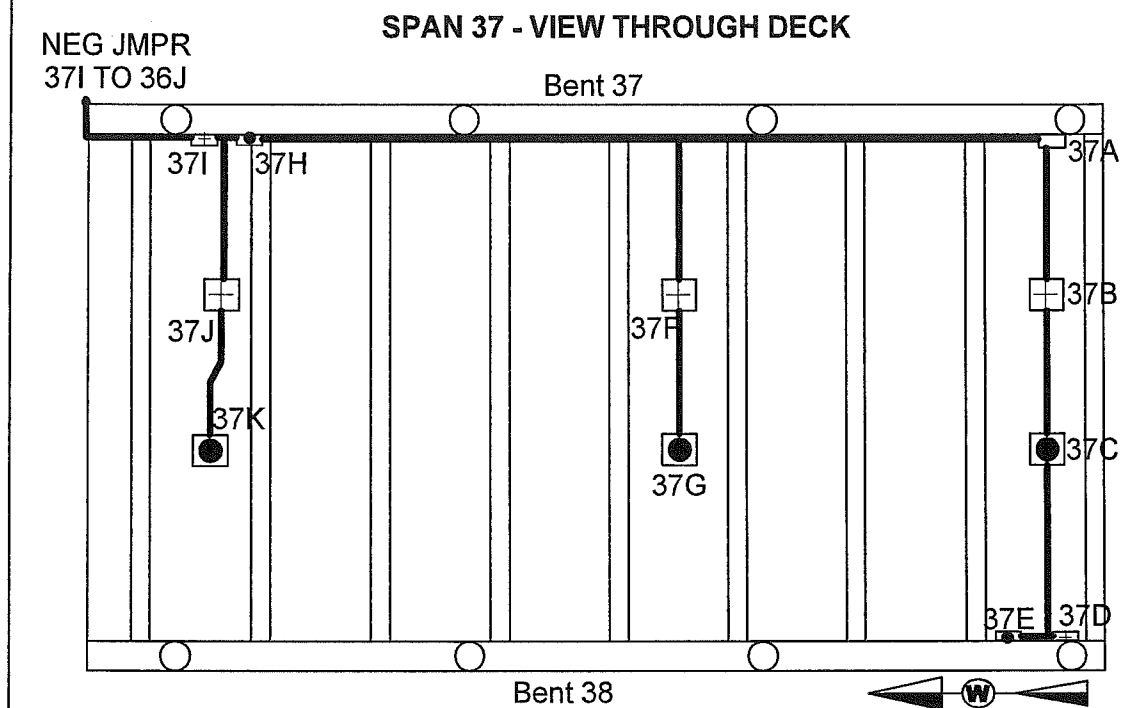


DECK:

BENT:

SCHEMATIC

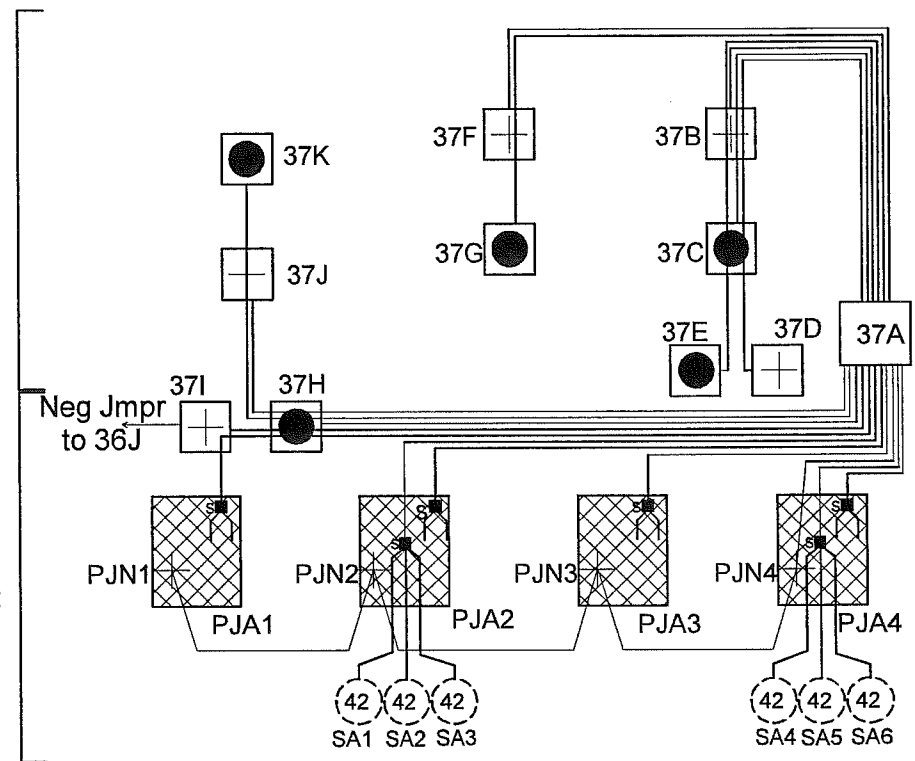

WATER BENT 37 SOUTH ELEVATION

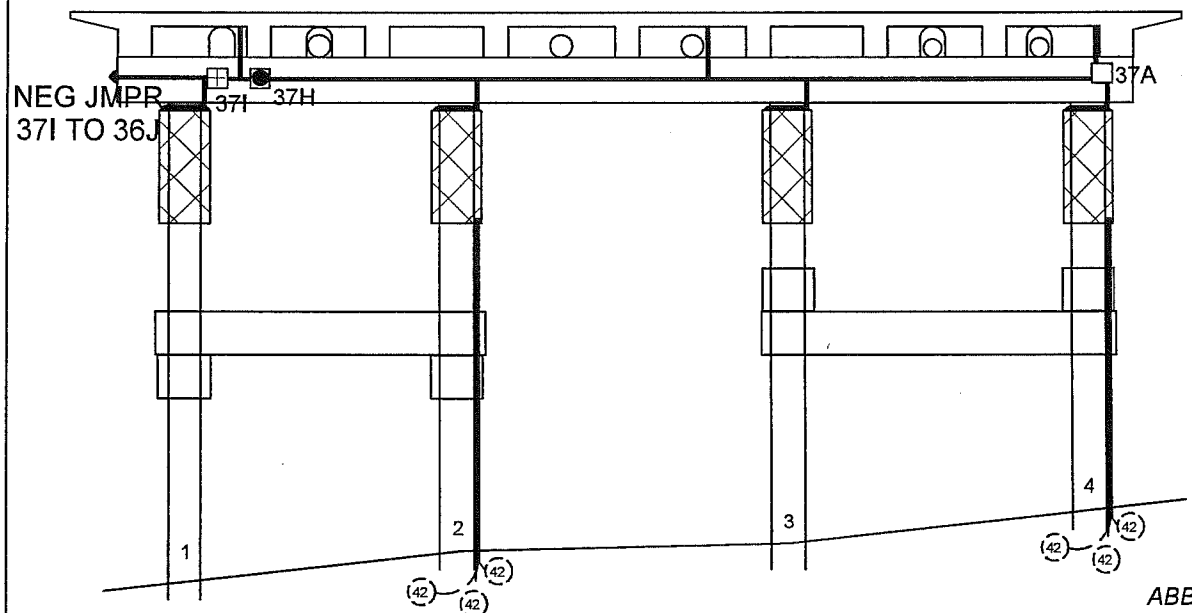

J-BOX DETAILS:

	J-Box Size	Wires or Structure
37-A	14" x 12" x 8"	MAIN J-BOX: (5) MZA; (5) MZN; (4) PJA; (1) PJN; (2) SA; SAN jumpered from PJN
37-B	5" x 5" x 2"	Structure Negative (MZN); (2) MZA; (1) MZN
37-C	5" x 5" x 2"	Primary Anode Terminal Plate (MZA); (1) MZN; (1) MZA
37-D	5" x 5" x 2"	Structure Negative (MZN)
37-E	5" x 5" x 2"	Primary Anode Terminal Plate (MZA)
37-F	5" x 5" x 2"	Structure Negative (MZN); (1) MZA
37-G	5" x 5" x 2"	Primary Anode Terminal Plate (MZA)
37-H	5" x 5" x 2"	Primary Anode Terminal Plate (MZA); (2) MZN; (1) MZA; (1) PJA
37-I	5" x 5" x 2"	Structure Negative (MZN); MZN Jumper to 36J; (1) PJA
37-J	5" x 5" x 2"	Structure Negative (MZN); (1) MZA
37-K	5" x 5" x 2"	Primary Anode Terminal Plate (MZA)

ABBREVIATIONS:

MZN = Metallized Zinc Negative
 PJN = Pile Jacket Negative
 CJN = Cap Jacket Negative
 SAN = Submerged Anode Negative
 MZA = Metallized Zinc Anode
 PJA = Pile Jacket Anode
 CJA = Cap Jacket Anode
 SA = Submerged Anode
 RE = Reference Electrode
 REN = Reference Electrode Negative


LEGEND

- (X) Submerged Anode
X = Weight in KG
- [Cross-hatched box] Pile Jacket
- [Dotted box] Cap Jacket
- Primary Anode Terminal
- ⊕ Negative Connection
- Encapsulated Splice


TYPICAL WIRE SIZES & COLORS AS FOLLOWS:
 MZA & PJA = #10 Red
 MZN; PJN = #10 Blue
 SA = #8 Black
 RE/REN: #16 Twisted Pair Red/Black

Water Street Bent 37 South Elevation & Span 37		
SCALE: NONE	Field Sketch	DRAWN BY KRH
DATE: 10-14-11	As-Built	REVISED
GREAT WESTERN CORPORATION		
Ketchikan Viaduct II Repair & C.P.		DRAWING NUMBER W-37


SPAN 40 - VIEW THROUGH DECK

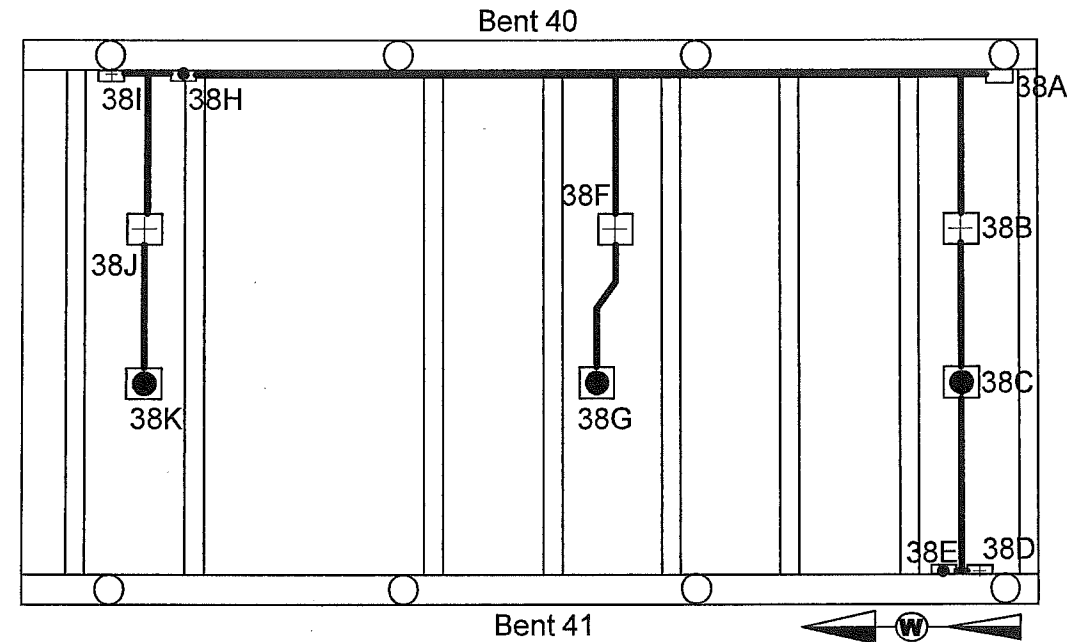

SCHEMATIC

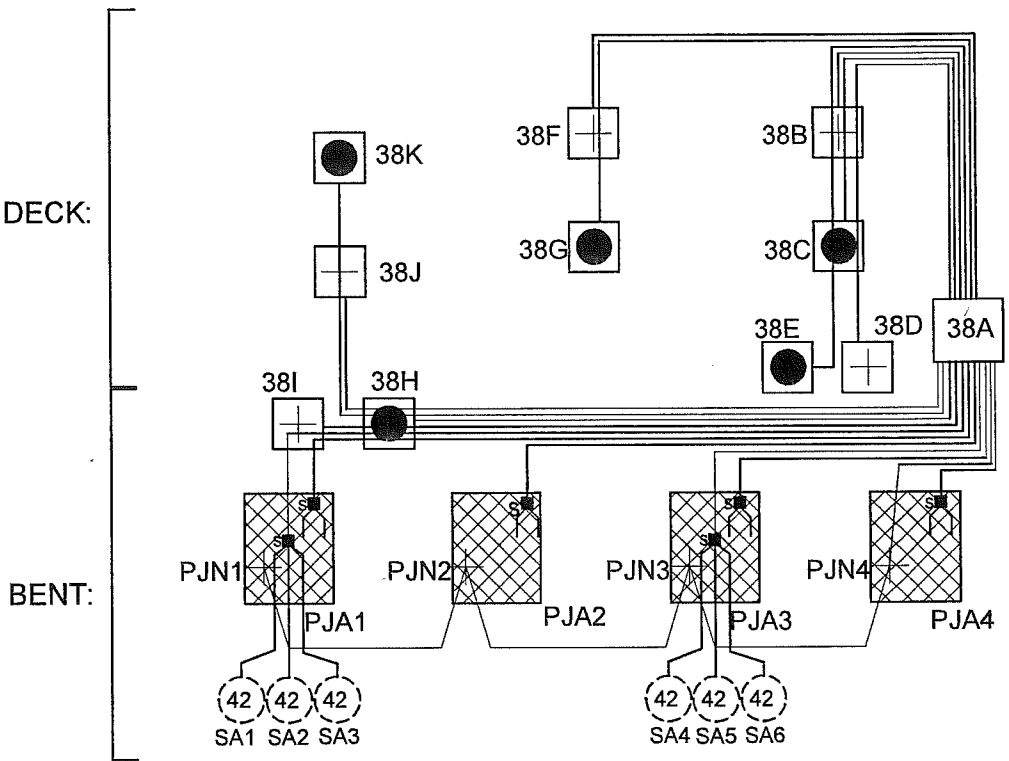

WATER BENT 38 SOUTH ELEVATION

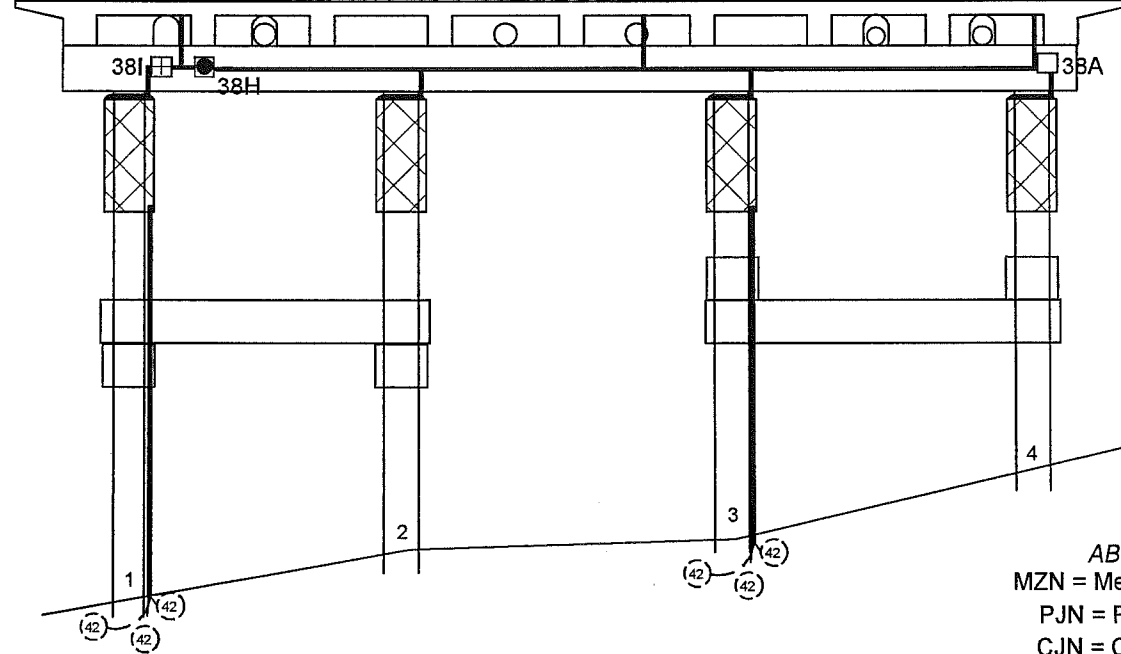

J-BOX DETAILS:

	J-Box Size	Wires or Structure
38-A	14" x 12" x 8"	MAIN J-BOX: (5) MZA; (5) MZN; (4) PJA; (1) PJN; (2) SA; SAN jumpered from PJN
38-B	5" x 5" x 2"	Structure Negative (MZN); (2) MZA; (1) MZN
38-C	5" x 5" x 2"	Primary Anode Terminal Plate (MZA); (1) MZN; (1) MZA
38-D	5" x 5" x 2"	Structure Negative (MZN)
38-E	5" x 5" x 2"	Primary Anode Terminal Plate (MZA)
38-F	5" x 5" x 2"	Structure Negative (MZN); (1) MZA
38-G	5" x 5" x 2"	Primary Anode Terminal Plate (MZA)
38-H	5" x 5" x 2"	Primary Anode Terminal Plate (MZA); (2) MZN; (1) MZA; (1) PJA; (1) SA
38-I	5" x 5" x 2"	Structure Negative (MZN); (1) PJA; (1) SA
38-J	5" x 5" x 2"	Structure Negative (MZN); (1) MZA
38-K	5" x 5" x 2"	Primary Anode Terminal Plate (MZA)

TYPICAL WIRE SIZES & COLORS AS FOLLOWS:
MZA & PJA = #10 Red
MZN; PJN = #10 Blue
SA = #8 Black
RE/REN: #16 Twisted Pair Red/Black

ABBREVIATIONS:
MZN = Metallized Zinc Negative
PJN = Pile Jacket Negative
CJN = Cap Jacket Negative
SAN = Submerged Anode Negative
MZA = Metallized Zinc Anode
PJA = Pile Jacket Anode
CJA = Cap Jacket Anode
SA = Submerged Anode
RE = Reference Electrode
REN = Reference Electrode Negative

LEGEND

- (x) Submerged Anode
- x = Weight in LBS
- ⊠ Pile Jacket
- ⊞ Cap Jacket
- Primary Anode Terminal
- + Negative Connection
- Encapsulated Splice
- Reference Electrode

Water Street Bent 38 South Elevation
& Span 38


SCALE: NONE	Field Sketch	DRAWN BY KRH
DATE: 10-14-11	As-Built	REVISED

GREAT WESTERN CORPORATION


Ketchikan Viaduct II
Repair & C.P.

DRAWING NUMBER
W-38


SPAN 39 - VIEW THROUGH DECK

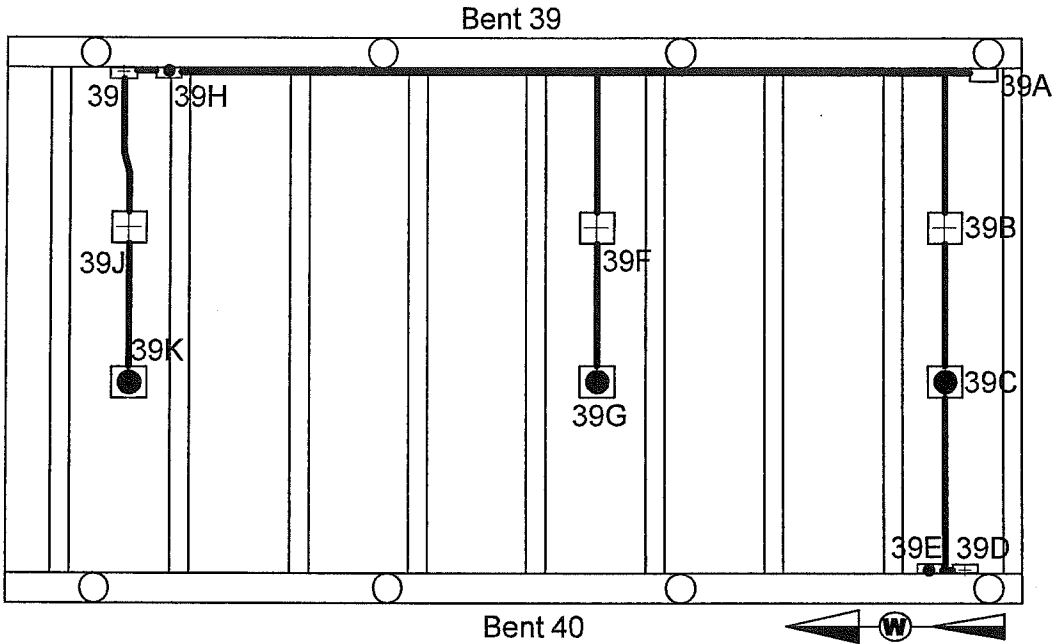

SCHEMATIC

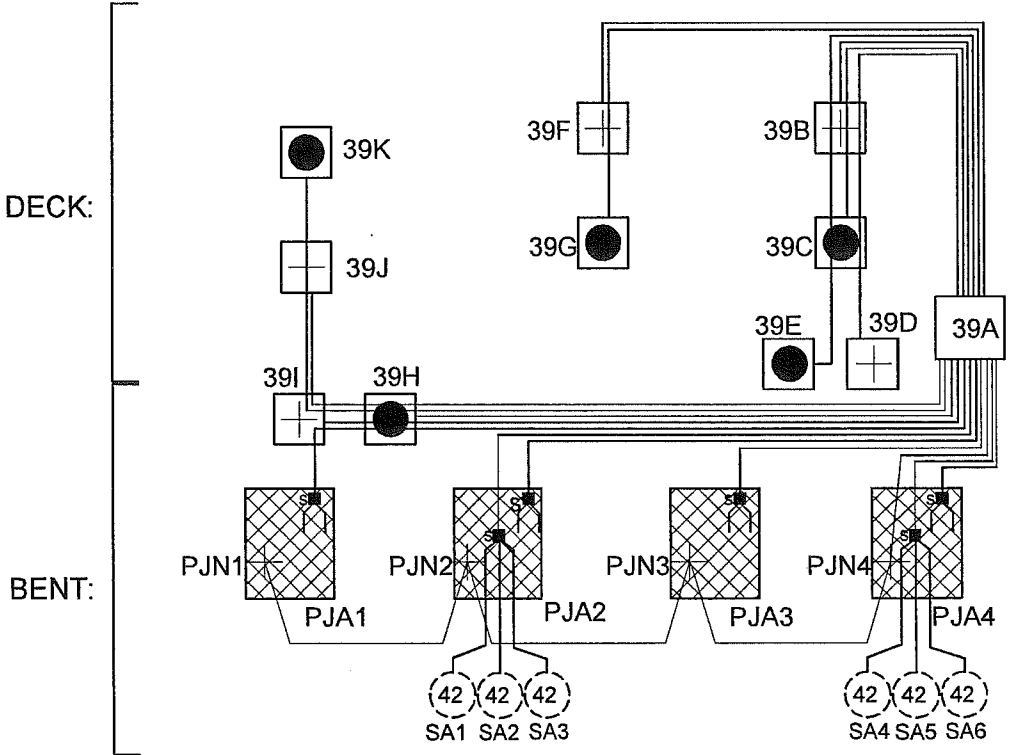

WATER BENT 39 SOUTH ELEVATION

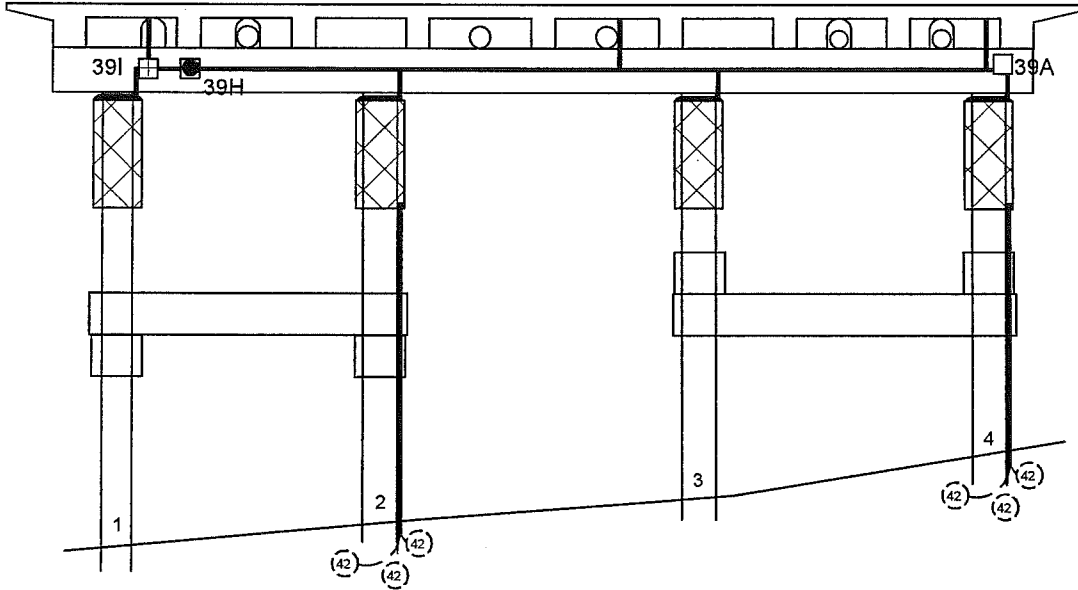


J-BOX DETAILS:

	J-Box Size	Wires or Structure
39-A	14" x 12" x 8"	MAIN J-BOX: (5) MZA; (5) MZN; (4) PJA; (1) PJN; (2) SA; SAN jumpered from PJN
39-B	5" x 5" x 2"	Structure Negative (MZN); (2) MZA; (1) MZN
39-C	5" x 5" x 2"	Primary Anode Terminal Plate (MZA); (1) MZN; (1) MZA
39-D	5" x 5" x 2"	Structure Negative (MZN)
39-E	5" x 5" x 2"	Primary Anode Terminal Plate (MZA)
39-F	5" x 5" x 2"	Structure Negative (MZN); (1) MZA
39-G	5" x 5" x 2"	Primary Anode Terminal Plate (MZA)
39-H	5" x 5" x 2"	Primary Anode Terminal Plate (MZA); (2) MZN; (1) MZA; (1) PJA
39-I	5" x 5" x 2"	Structure Negative (MZN); (1) MZA; (1) MZN; (1) PJA
39-J	5" x 5" x 2"	Structure Negative (MZN); (1) MZA
39-K	5" x 5" x 2"	Primary Anode Terminal Plate (MZA)

TYPICAL WIRE SIZES & COLORS AS FOLLOWS:
MZA & PJA = #10 Red
MZN; PJN = #10 Blue
SA = #8 Black
RE/REN: #16 Twisted Pair Red/Black

ABBREVIATIONS:
MZN = Metallized Zinc Negative
PJN = Pile Jacket Negative
CJN = Cap Jacket Negative
SAN = Submerged Anode Negative
MZA = Metallized Zinc Anode
PJA = Pile Jacket Anode
CJA = Cap Jacket Anode
SA = Submerged Anode
RE = Reference Electrode
REN = Reference Electrode Negative


LEGEND

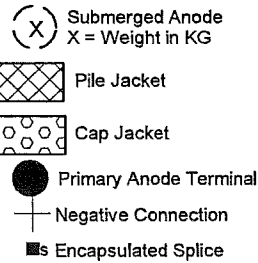


Water Street Bent 39 South Elevation
& Span 39

SCALE: NONE	Field Sketch	DRAWN BY KRH
DATE: 10-14-11	As-Built	REVISED
GREAT WESTERN CORPORATION		
Ketchikan Viaduct II Repair & C.P.		DRAWING NUMBER W-39


SPAN 40 - VIEW THROUGH DECK

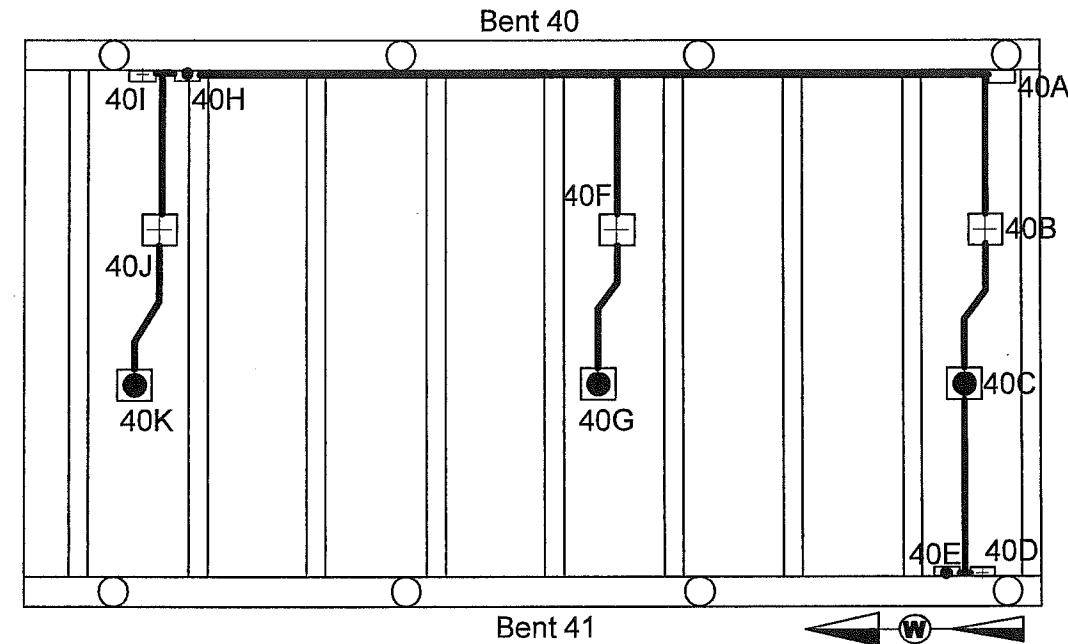

SCHEMATIC

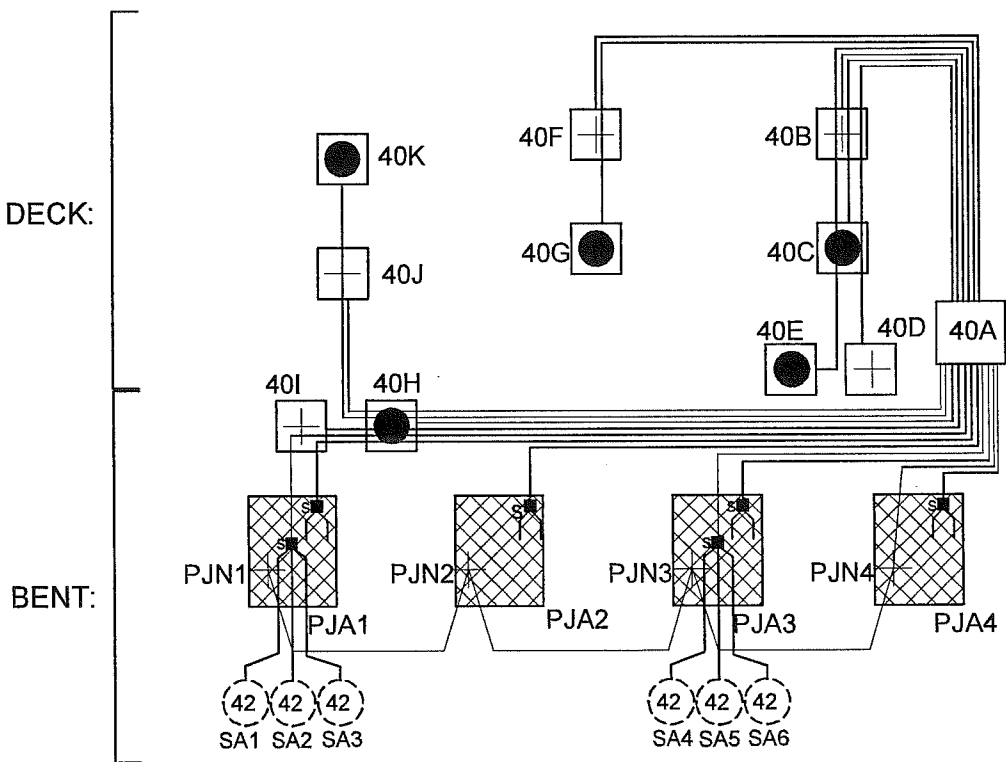

WATER BENT 40 SOUTH ELEVATION

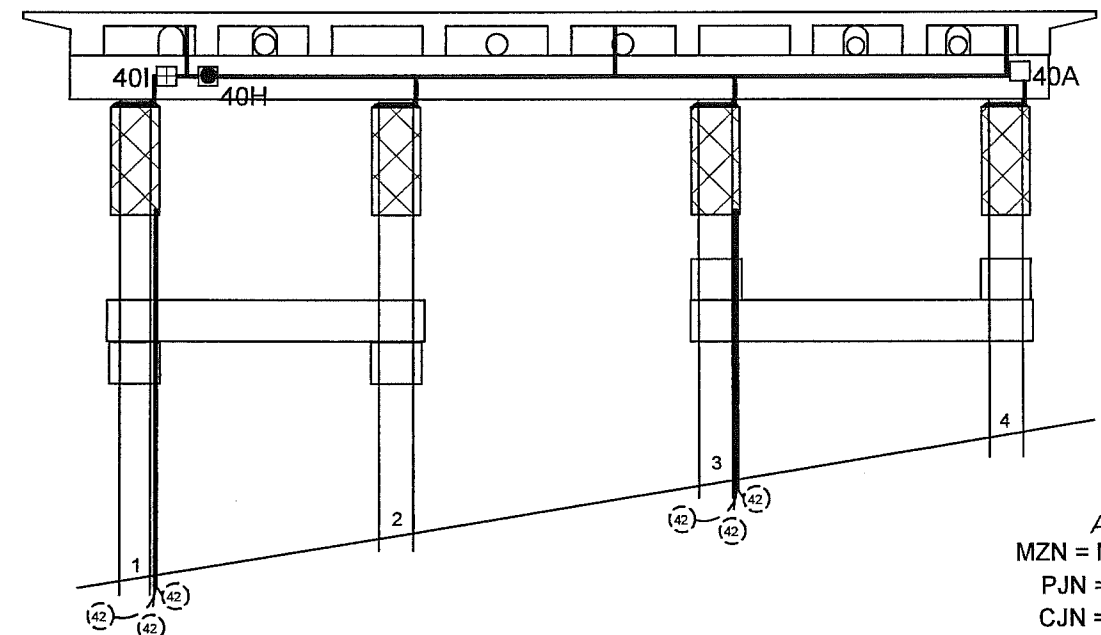

J-BOX DETAILS:

	J-Box Size	Wires or Structure
40-A	14" x 12" x 8"	MAIN J-BOX: (5) MZA; (5) MZN; (4) PJA; (1) PJN; (2) SA; SAN jumpered from PJN
40-B	5" x 5" x 2"	Structure Negative (MZN); (2) MZA; (1) MZN
40-C	5" x 5" x 2"	Primary Anode Terminal Plate (MZA); (1) MZN; (1) MZA
40-D	5" x 5" x 2"	Structure Negative (MZN)
40-E	5" x 5" x 2"	Primary Anode Terminal Plate (MZA)
40-F	5" x 5" x 2"	Structure Negative (MZN); (1) MZA
40-G	5" x 5" x 2"	Primary Anode Terminal Plate (MZA)
40-H	5" x 5" x 2"	Primary Anode Terminal Plate (MZA); (2) MZN; (1) MZA; (1) PJA; (1) SA
40-I	5" x 5" x 2"	Structure Negative (MZN); (1) PJA; (1) SA
40-J	5" x 5" x 2"	Structure Negative (MZN); (1) MZA
40-K	5" x 5" x 2"	Primary Anode Terminal Plate (MZA)

ABBREVIATIONS:

MZN = Metallized Zinc Negative
PJN = Pile Jacket Negative
CJN = Cap Jacket Negative
SAN = Submerged Anode Negative
MZA = Metallized Zinc Anode
PJA = Pile Jacket Anode
CJA = Cap Jacket Anode
SA = Submerged Anode
RE = Reference Electrode
REN = Reference Electrode Negative

LEGEND

- (x) Submerged Anode
- x = Weight in LBS
- ⊠ Pile Jacket
- ⊞ Cap Jacket
- Primary Anode Terminal
- + Negative Connection
- Encapsulated Splice
- Reference Electrode

TYPICAL WIRE SIZES & COLORS AS FOLLOWS:
MZA & PJA = #10 Red
MZN; PJN = #10 Blue
SA = #8 Black
RE/REN: #16 Twisted Pair Red/Black

Water Street Bent 40 South Elevation & Span 40		
SCALE: NONE	Field Sketch	DRAWN BY KRH
DATE: 10-13-11	As-Built	REVISED 10-14-11
GREAT WESTERN CORPORATION		
Ketchikan Viaduct II Repair & C.P.		DRAWING NUMBER W-40

Plan view of Bent 41 showing pile layout and instrumentation. The bent is rectangular, oriented horizontally. Piles are labeled 41A through 41K. Instrumentation points are marked with squares (41I, 41J, 41F, 41B) and circles (41H, 41K, 41G, 41C). A compass rose indicates North (N) is towards the top right, and a scale bar shows 0 to 10 meters. The bent is labeled "Bent 41" at the top and "Bent 42" at the bottom.

The diagram illustrates the electrical layout of a detector system, divided into two main sections: DECK and BENT.

DECK Section:

- Components 41A through 41K are arranged in a network.
- 41A is a square with a cross, connected to a multi-line bus.
- 41B, 41C, 41D, 41E, 41F, 41G, 41H, 41I, 41J, and 41K are various components (squares with crosses or circles) connected to the bus and each other.

BENT Section:

- Components PJA1 through PJA4 are square boxes with a cross-hatch pattern.
- PJN1 through PJN4 are square boxes with a cross-hatch pattern and a cross, connected to the DECK section.
- SA1 through SA6 are circular components connected to the BENT section.

The diagram shows a complex network of connections between these components, including a central horizontal bus line.

Technical drawing of a building frame structure. The drawing shows a cross-section of a frame with columns and beams. A curved line is drawn across the lower part of the frame, labeled with numbers 1, 2, 3, and 4. The columns are labeled 41H and 41A. The beams are labeled 41H and 41A. The curved line is labeled with (42) at points 1, 2, 3, and 4. The drawing is a technical drawing of a building frame structure.


	J-Box Size	Wires or Structure
41-A	14" x 12" x 8"	MAIN J-BOX: (5) MZA; (5) MZN; (4) PJA; (1) PJN; (2) SA; SAN jumpered from PJN
41-B	5" x 5" x 2"	Structure Negative (MZN); (2) MZA; (1) MZN
41-C	5" x 5" x 2"	Primary Anode Terminal Plate (MZA); (1) MZN; (1) MZA
41-D	5" x 5" x 2"	Structure Negative (MZN)
41-E	5" x 5" x 2"	Primary Anode Terminal Plate (MZA)
41-F	5" x 5" x 2"	Structure Negative (MZN); (1) MZA
41-G	5" x 5" x 2"	Primary Anode Terminal Plate (MZA)
41-H	5" x 5" x 2"	Primary Anode Terminal Plate (MZA); (2) MZN; (1) MZA; (1) PJA
41-I	5" x 5" x 2"	Structure Negative (MZN); (1) PJA
41-J	5" x 5" x 2"	Structure Negative (MZN); (1) MZA
41-K	5" x 5" x 2"	Primary Anode Terminal Plate (MZA)

ABBREVIATIONS:
MZN = Metallized Zinc Negative
PJN = Pile Jacket Negative
CJN = Cap Jacket Negative
SAN = Submerged Anode Negative
MZA = Metallized Zinc Anode
PJA = Pile Jacket Anode
CJA = Cap Jacket Anode
SA = Submerged Anode
RE = Reference Electrode
REN = Reference Electrode Negative


 Submerged Anode
 X = Weight in KG
 Pile Jacket
 Cap Jacket
 Primary Anode Terminal
 Negative Connection
 Encapsulated Splice

Water Street Bent 41 South Elevation & Span 41		
SCALE: NONE	Field Sketch As-Built	DRAWN BY KRH
DATE: 10-13-11		REVISED 10-14-11
GREAT WESTERN CORPORATION		
Ketchikan Viaduct II Repair & C.P.		DRAWING NUMBER W-41

SPAN 42 - VIEW THROUGH DECK

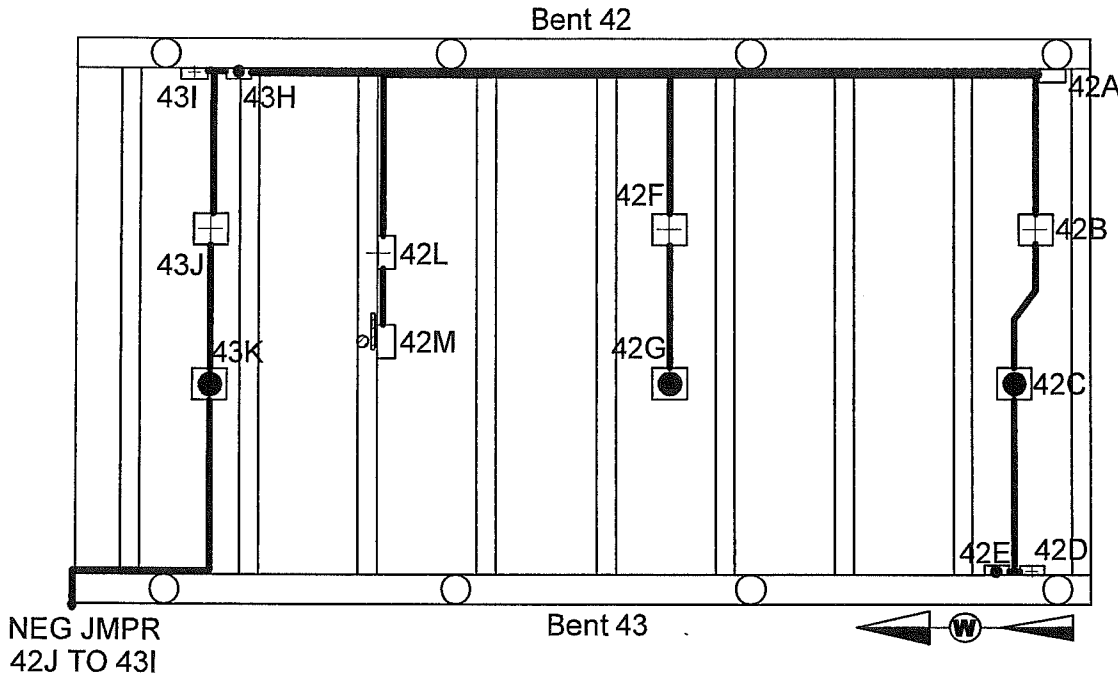


WATER BENT 42 SOUTH ELEVATION

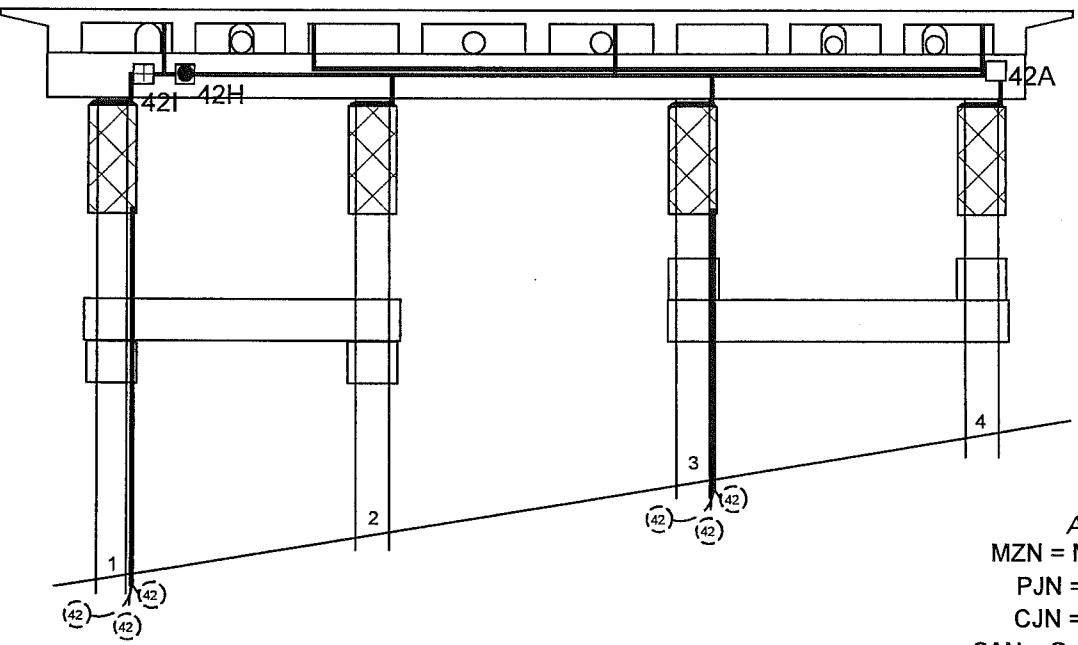

TYPICAL WIRE SIZES & COLORS AS FOLLOWS:
MZA & PJA = #10 Red
MZN; PJN = #10 Blue
SA = #8 Black
RE/REN: #16 Twisted Pair Red/Black

ABBREVIATIONS:
MZN = Metallized Zinc Negative
PJN = Pile Jacket Negative
CJN = Cap Jacket Negative
SAN = Submerged Anode Negative
MZA = Metallized Zinc Anode
PJA = Pile Jacket Anode
CJA = Cap Jacket Anode
SA = Submerged Anode
RE = Reference Electrode
REN = Reference Electrode Negative

SCHEMATIC

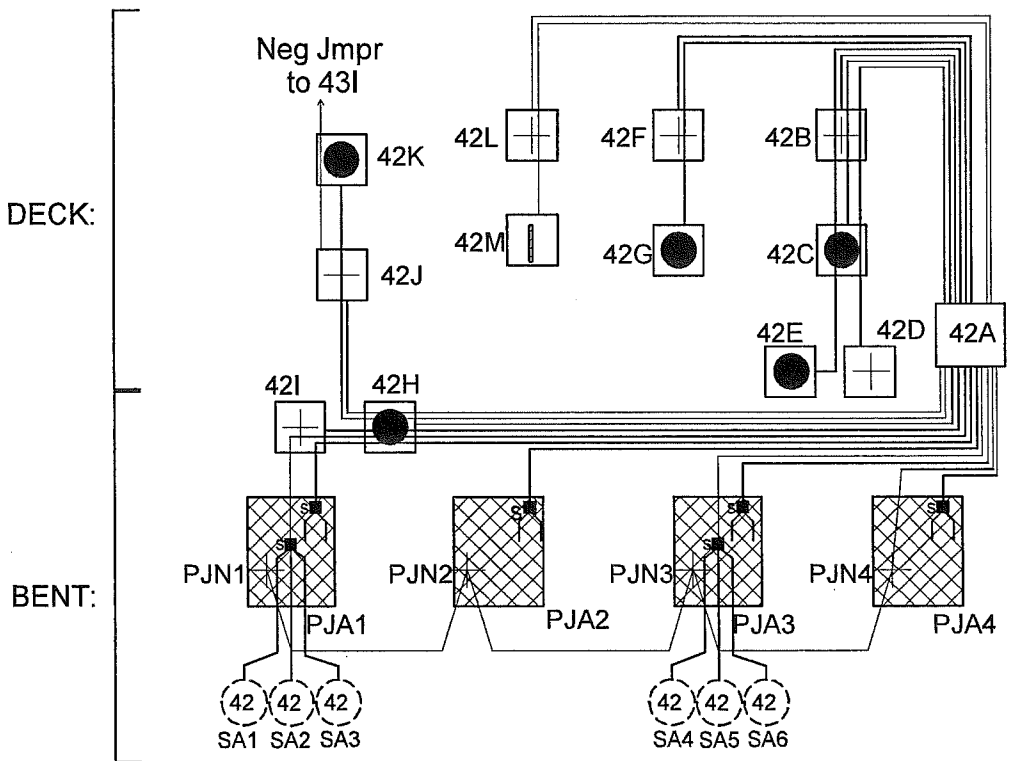


J-BOX DETAILS:

J-Box Size	Wires or Structure
42-A 14" x 12" x 8"	MAIN J-BOX: (5) MZA; (5) MZN; (4) PJA; (1) PJN; (2) SA; SAN jumpered from PJN; (1) RE; (1) REN
42-B 5" x 5" x 2"	Structure Negative (MZN); (2) MZA; (1) MZN
42-C 5" x 5" x 2"	Primary Anode Terminal Plate (MZA); (1) MZN; (1) MZA
42-D 5" x 5" x 2"	Structure Negative (MZN)
42-E 5" x 5" x 2"	Primary Anode Terminal Plate (MZA)
42-F 5" x 5" x 2"	Structure Negative (MZN); (1) MZA
42-G 5" x 5" x 2"	Primary Anode Terminal Plate (MZA)
42-H 5" x 5" x 2"	Primary Anode Terminal Plate (MZA); (2) MZN; (1) MZA; (1) PJA; (1) SA
42-I 5" x 5" x 2"	Structure Negative (MZN); MZN Jumper to 42J; (1) PJA; (1) SA
42-J 5" x 5" x 2"	Structure Negative (MZN); (1) MZA; MZN Jumper to 43I
42-K 5" x 5" x 2"	Primary Anode Terminal Plate (MZA); (1) MZN Jumper
42-L 5" x 5" x 2"	Reference Electrode Negative (REN) (1) RE
42-M 5" x 5" x 2"	Reference Electrode (RE)

LEGEND



- Submerged Anode
- x = Weight in LBS
- Pile Jacket
- Cap Jacket
- Primary Anode Terminal
- Negative Connection
- Encapsulated Splice
- Reference Electrode

Water Street Bent 42 South Elevation & Span 42		
SCALE: NONE	Field Sketch	DRAWN BY KRH
DATE: 10-13-11	As-Built	REVISED 10-14-11
GREAT WESTERN CORPORATION		
Ketchikan Viaduct II Repair & C.P.		DRAWING NUMBER W-42

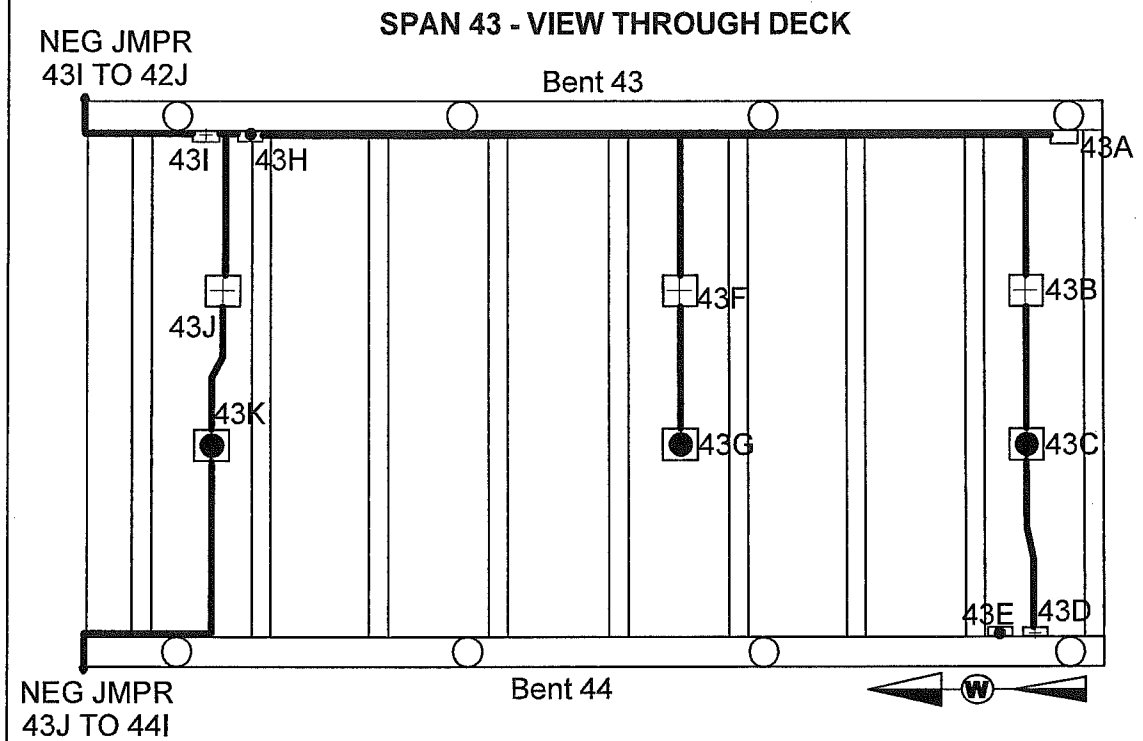

DECK:

BENT:

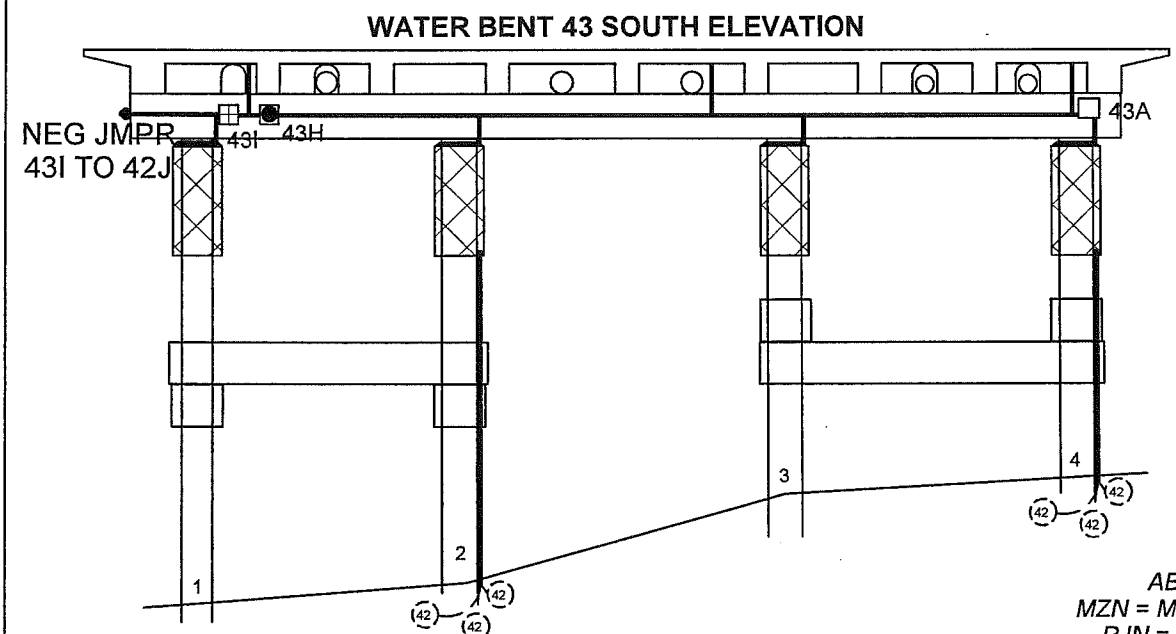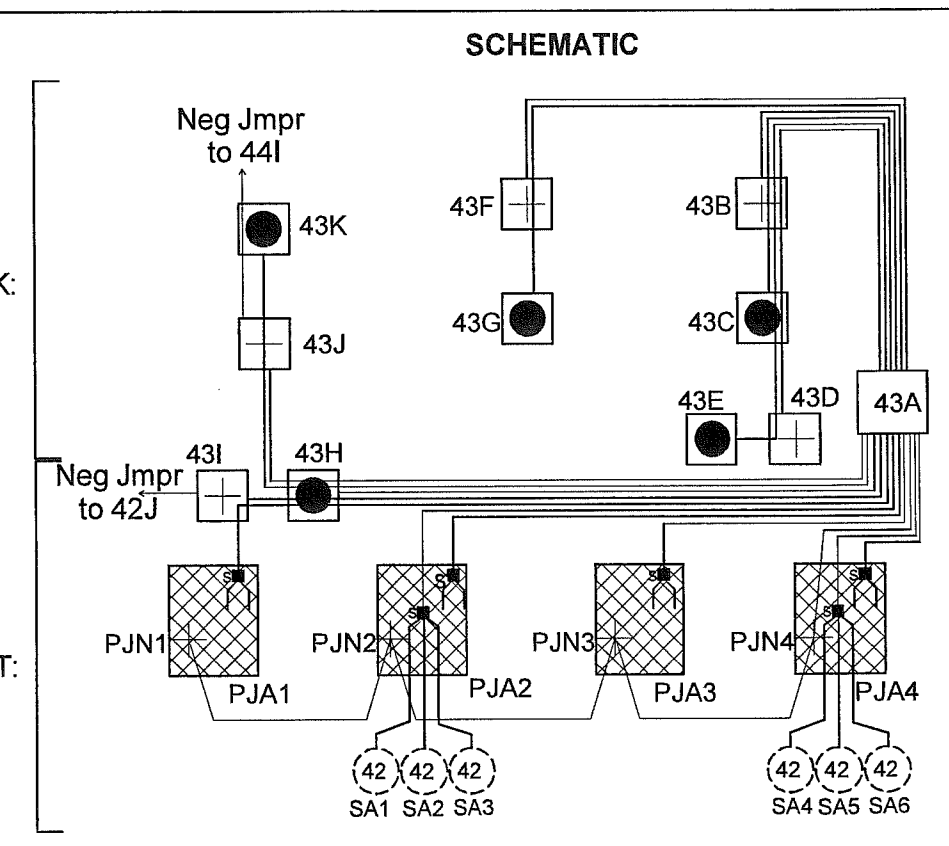

J-BOX DETAILS:



J-Box Size	Wires or Structure
43-A 14" x 12" x 8"	MAIN J-BOX: (5) MZA; (5) MZN; (4) PJA; (1) PJN; (2) SA; SAN jumpered from PJN
43-B 5" x 5" x 2"	Structure Negative (MZN); (2) MZA; (1) MZN
43-C 5" x 5" x 2"	Primary Anode Terminal Plate (MZA); (1) MZN; (1) MZA
43-D 5" x 5" x 2"	Structure Negative (MZN); (1) MZA
43-E 5" x 5" x 2"	Primary Anode Terminal Plate (MZA)
43-F 5" x 5" x 2"	Structure Negative (MZN); (1) MZA
43-G 5" x 5" x 2"	Primary Anode Terminal Plate (MZA)
43-H 5" x 5" x 2"	Primary Anode Terminal Plate (MZA); (2) MZN; (1) MZA; (1) PJA
43-I 5" x 5" x 2"	Structure Negative (MZN); MZN Jumper to 42J; (1) PJA
43-J 5" x 5" x 2"	Structure Negative (MZN); (1) MZA; MZN Jumper to 44I
43-K 5" x 5" x 2"	Primary Anode Terminal Plate (MZA); (1) MZN Jumper

TYPICAL WIRE SIZES & COLORS AS FOLLOWS:
MZA & PJA = #10 Red
MZN; PJN = #10 Blue
SA = #8 Black
RE/REN: #16 Twisted Pair Red/Black

ABBREVIATIONS:
MZN = Metallized Zinc Negative
PJN = Pile Jacket Negative
CJN = Cap Jacket Negative
SAN = Submerged Anode Negative
MZA = Metallized Zinc Anode
PJA = Pile Jacket Anode
CJA = Cap Jacket Anode
SA = Submerged Anode
RE = Reference Electrode
REN = Reference Electrode Negative

LEGEND
(X) Submerged Anode
X = Weight in KG
Pile Jacket
Cap Jacket
Primary Anode Terminal
Negative Connection
Encapsulated Splice


Water Street Bent 43 South Elevation & Span 43		
SCALE: NONE	Field Sketch	DRAWN BY KRH
DATE: 10-13-11	As-Built	REVISED 10-14-11
GREAT WESTERN CORPORATION		
Ketchikan Viaduct II Repair & C.P.		DRAWING NUMBER W-43

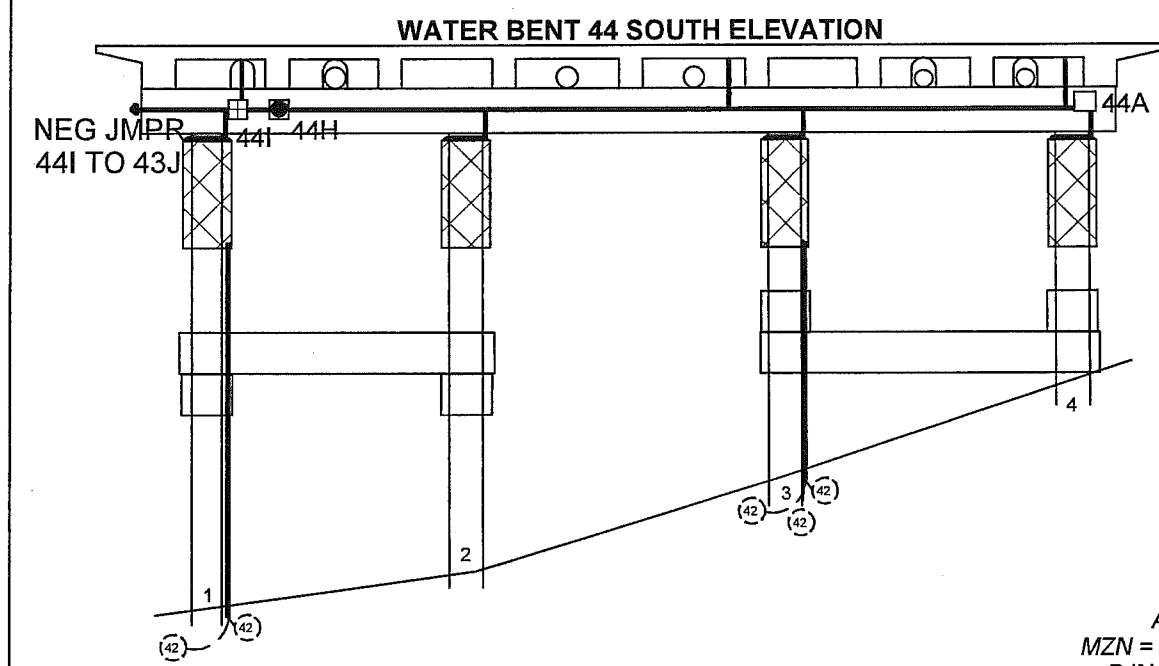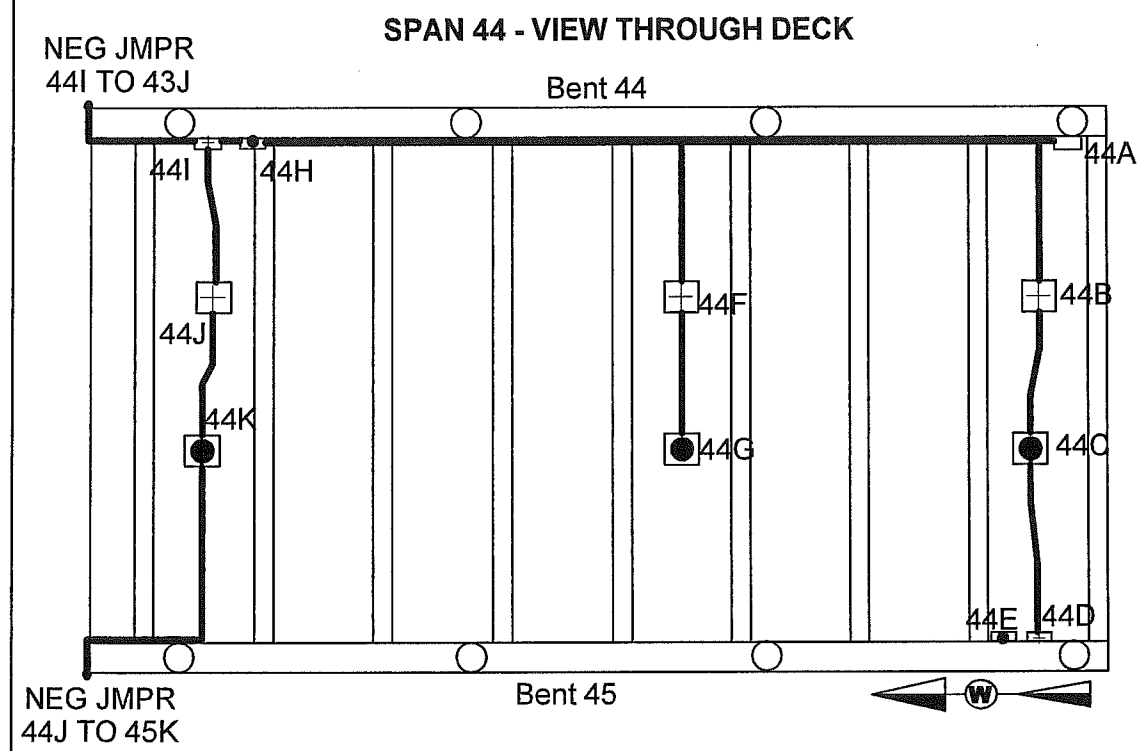

DECK:

BENT:

SCHEMATIC

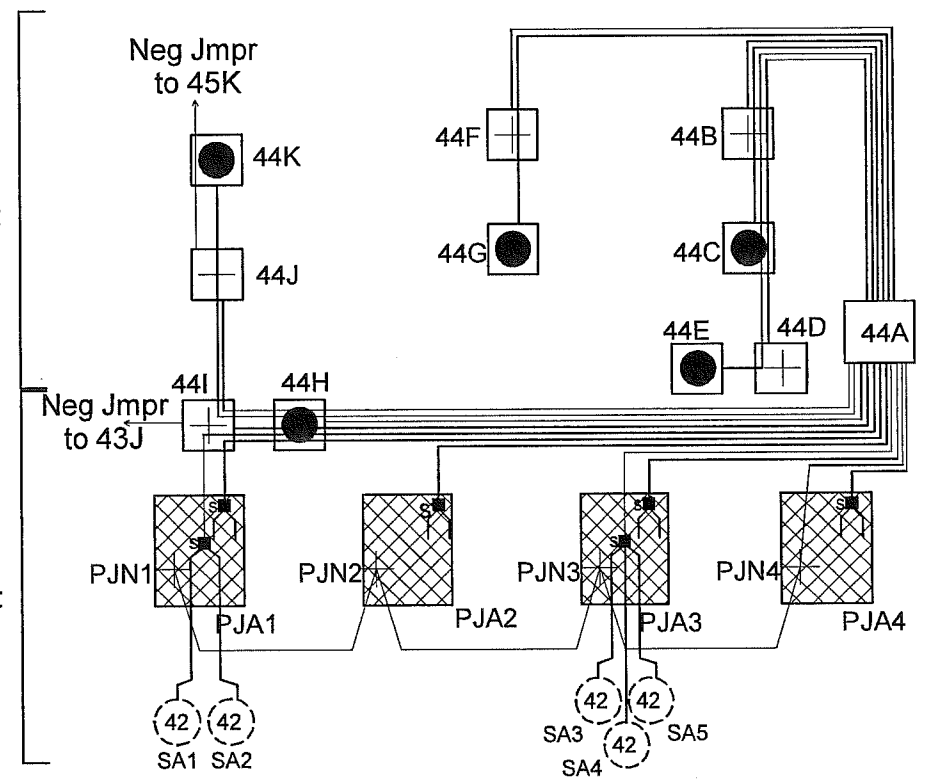

J-BOX DETAILS:

	J-Box Size	Wires or Structure
44-A	14" x 12" x 8"	MAIN J-BOX: (5) MZA; (5) MZN; (4) PJA; (1) PJN; (2) SA; SAN jumpered from PJN
44-B	5" x 5" x 2"	Structure Negative (MZN); (2) MZA; (1) MZN
44-C	5" x 5" x 2"	Primary Anode Terminal Plate (MZA); (1) MZN; (1) MZA
44-D	5" x 5" x 2"	Structure Negative (MZN); (1) MZA
44-E	5" x 5" x 2"	Primary Anode Terminal Plate (MZA)
44-F	5" x 5" x 2"	Structure Negative (MZN); (1) MZA
44-G	5" x 5" x 2"	Primary Anode Terminal Plate (MZA)
44-H	5" x 5" x 2"	Primary Anode Terminal Plate (MZA); (2) MZN; (1) MZA; (1) PJA; (1) SA
44-I	5" x 5" x 2"	Structure Negative (MZN); (1) MZA; (1) MZN; MZN Jumper to 43J; (1) PJA; (1) SA
44-J	5" x 5" x 2"	Structure Negative (MZN); (1) MZA; MZN Jumper to 45K
44-K	5" x 5" x 2"	Primary Anode Terminal Plate (MZA); (1) MZN Jumper

ABBREVIATIONS:


MZN = Metallized Zinc Negative
 PJN = Pile Jacket Negative
 CJN = Cap Jacket Negative
 SAN = Submerged Anode Negative
 MZA = Metallized Zinc Anode
 PJA = Pile Jacket Anode
 CJA = Cap Jacket Anode
 SA = Submerged Anode
 RE = Reference Electrode
 REN = Reference Electrode Negative

LEGEND

- (X) Submerged Anode
X = Weight in KG
- [Cross-hatched box] Pile Jacket
- [Dotted box] Cap Jacket
- Primary Anode Terminal
- ⊕ Negative Connection
- Encapsulated Splice

TYPICAL WIRE SIZES & COLORS AS FOLLOWS:
 MZA & PJA = #10 Red
 MZN; PJN = #10 Blue
 SA = #8 Black
 RE/REN: #16 Twisted Pair Red/Black


Water Street Bent 44 South Elevation & Span 44		
SCALE: NONE	Field Sketch	DRAWN BY KRH
DATE: 10-13-11	As-Built	REVISED 10-14-11
GREAT WESTERN CORPORATION		
Ketchikan Viaduct II Repair & C.P.		DRAWING NUMBER W-44

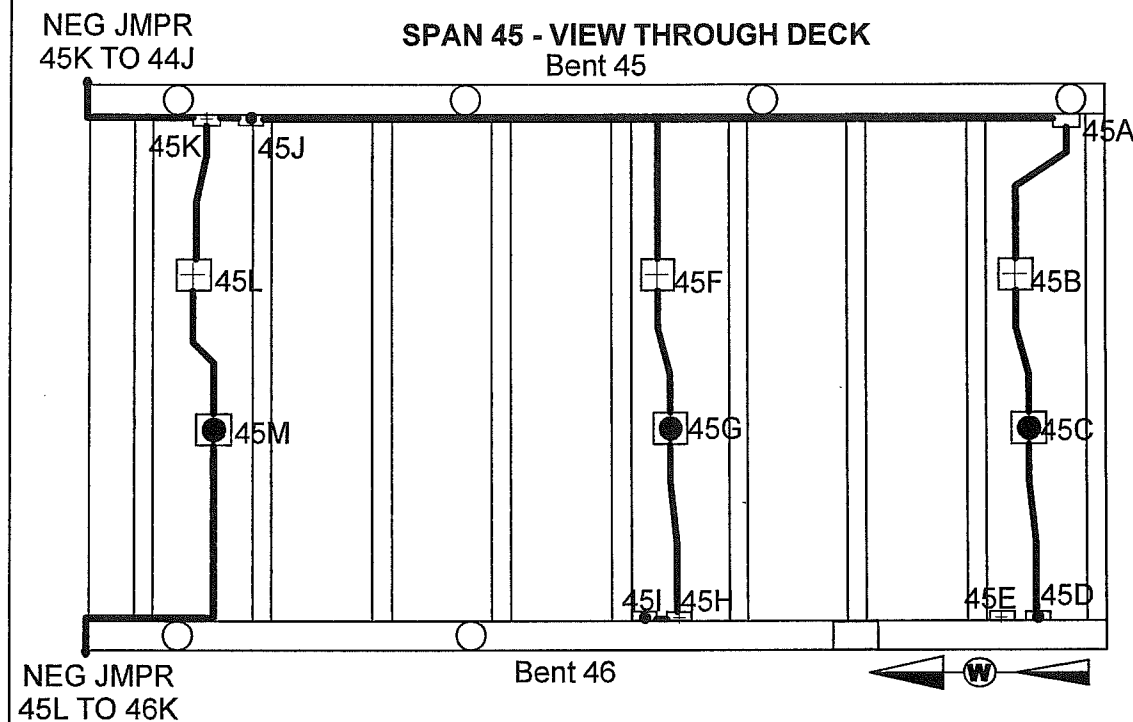

DECK:

BENT:

SCHEMATIC

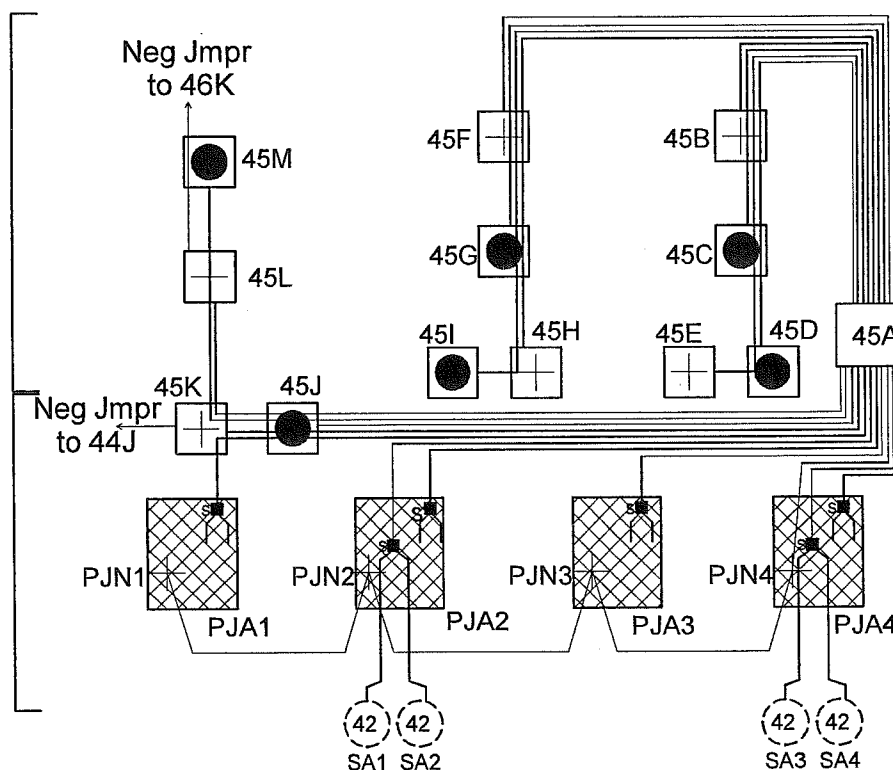


J-BOX DETAILS:

	J-Box Size	Wires or Structure
45-A	14" x 12" x 8"	MAIN J-BOX: (6) MZA; (6) MZN; (4) PJA; (1) PJN; (2) SA; SAN jumpered from PJN
45-B	5" x 5" x 2"	Structure Negative (MZN); (2) MZA; (1) MZN
45-C	5" x 5" x 2"	Primary Anode Terminal Plate (MZA); (1) MZN; (1) MZA
45-D	5" x 5" x 2"	Primary Anode Terminal Plate (MZA); (1) MZN
45-E	5" x 5" x 2"	Structure Negative (MZN)
45-F	5" x 5" x 2"	Structure Negative (MZN); (2) MZA; (1) MZN
45-G	5" x 5" x 2"	Primary Anode Terminal Plate (MZA); (1) MZN; (1) MZA
45-H	5" x 5" x 2"	Structure Negative (MZN); (1) MZA
45-I	5" x 5" x 2"	Primary Anode Terminal Plate (MZA)
45-J	5" x 5" x 2"	Primary Anode Terminal Plate (MZA); (2) MZN; (1) MZA; (1) PJA
45-K	5" x 5" x 2"	Structure Negative (MZN); (1) MZA; (1) MZN; MZN Jumper to 44J; (1) PJA
45-L	5" x 5" x 2"	Structure Negative (MZN); (1) MZA; MZN Jumper to 46K
45-M	5" x 5" x 2"	Primary Anode Terminal Plate (MZA); (1) MZN Jumper


ABBREVIATIONS:

MZN = Metallized Zinc Negative
 PJN = Pile Jacket Negative
 CJN = Cap Jacket Negative
 SAN = Submerged Anode Negative
 MZA = Metallized Zinc Anode
 PJA = Pile Jacket Anode
 CJA = Cap Jacket Anode
 SA = Submerged Anode
 RE = Reference Electrode
 REN = Reference Electrode Negative

LEGEND

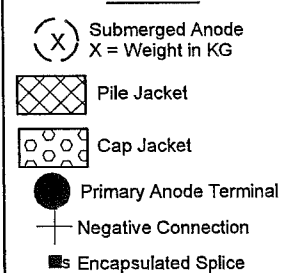

WATER BENT 45 SOUTH ELEVATION

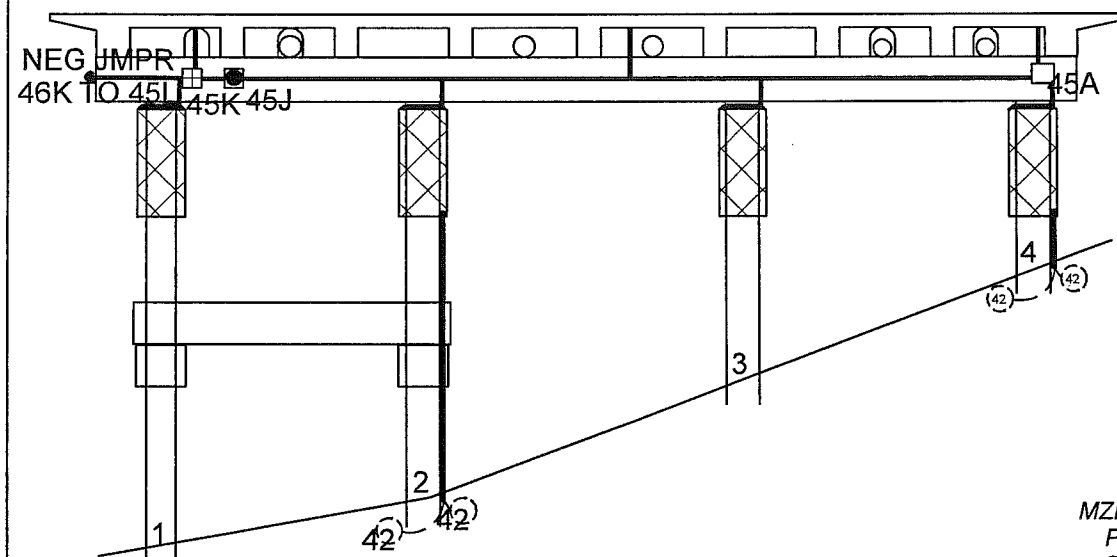



TYPICAL WIRE SIZES & COLORS AS FOLLOWS:
 MZA & PJA = #10 Red
 MZN; PJN = #10 Blue
 SA = #8 Black
 RE/REN: #16 Twisted Pair Red/Black

Water Street Bent 45 South Elevation & Span 45


SCALE: NONE Field Sketch DRAWN BY KRH
 DATE: 10-13-11 As-Built REVISED

GREAT WESTERN CORPORATION

Ketchikan Viaduct II
 Repair & C.P. DRAWING NUMBER
 W-45

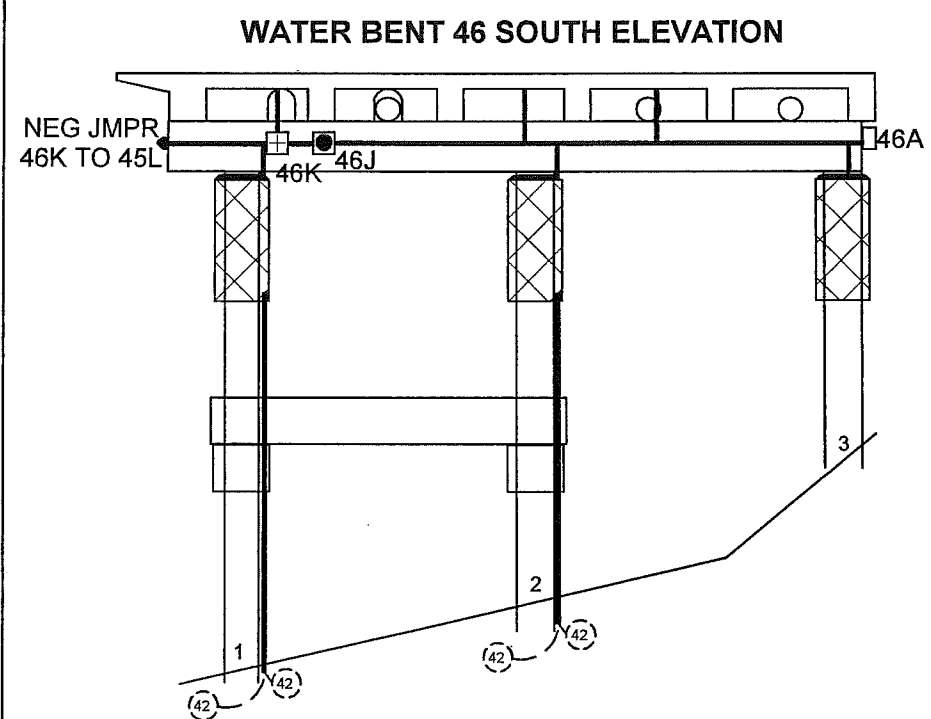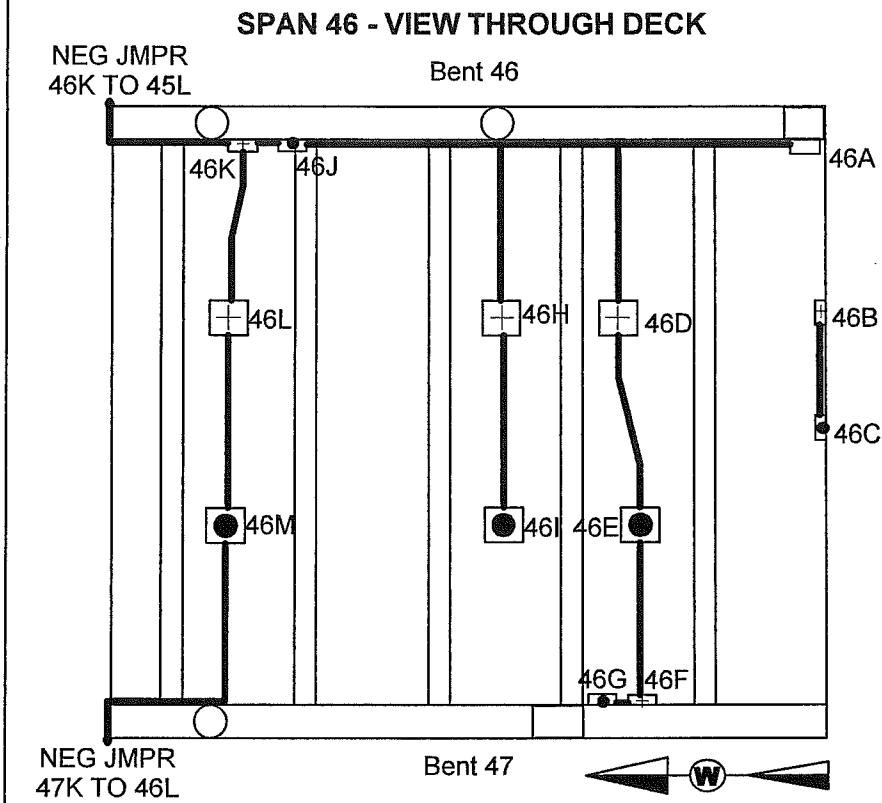


TYPICAL WIRE SIZES & COLORS AS FOLLOWS:
 MZA & PJA = #10 Red
 MZN; PJN = #10 Blue
 SA = #8 Black
 RE/REN: #16 Twisted Pair Red/Black

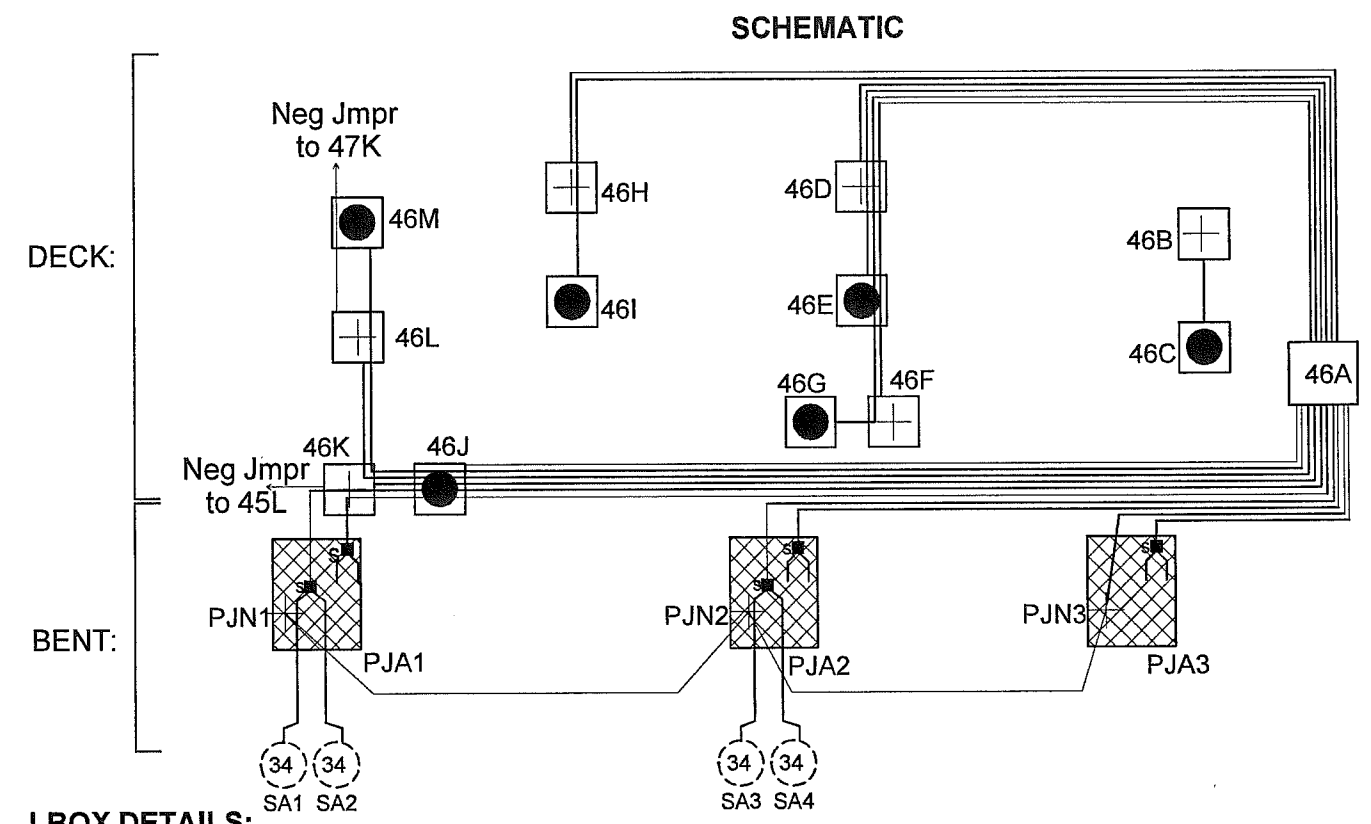

J-BOX DETAILS:


	J-Box Size	Wires or Structure
46-A	14" x 12" x 8"	MAIN J-BOX: (5) MZA; (5) MZN; (3) PJA; (1) PJN; (2) SA; SAN jumpered from PJN
46-B	5" x 5" x 2"	Structure Negative (MZN)
46-C	5" x 5" x 2"	Primary Anode Terminal Plate (MZA)
46-D	5" x 5" x 2"	Structure Negative (MZN); (2) MZA; (1) MZN
46-E	5" x 5" x 2"	Primary Anode Terminal Plate (MZA); (1) MZN; (1) MZA
46-F	5" x 5" x 2"	Structure Negative (MZN); (1) MZA
46-G	5" x 5" x 2"	Primary Anode Terminal Plate (MZA)
46-H	5" x 5" x 2"	Structure Negative (MZN); (1) MZA
46-I	5" x 5" x 2"	Primary Anode Terminal Plate (MZA)
46-J	5" x 5" x 2"	Primary Anode Terminal Plate (MZA); (2) MZN; (1) MZA; (1) PJA; (1) SA
46-K	5" x 5" x 2"	Structure Negative (MZN); (1) MZA; (1) MZN; MZN Jumper to 45L; (1) PJA; (1) SA
46-L	5" x 5" x 2"	Structure Negative (MZN); (1) MZA; MZN Jumper to 47K
46-M	5" x 5" x 2"	Primary Anode Terminal Plate (MZA); (1) MZN Jumper

ABBREVIATIONS:
 MZN = Metallized Zinc Negative
 PJN = Pile Jacket Negative
 CJN = Cap Jacket Negative
 SAN = Submerged Anode Negative
 MZA = Metallized Zinc Anode
 PJA = Pile Jacket Anode
 CJA = Cap Jacket Anode
 SA = Submerged Anode
 RE = Reference Electrode
 REN = Reference Electrode Negative

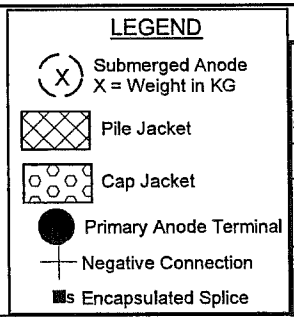


Water Street Bent 46 South Elevation & Span 46		
SCALE: NONE	Field Sketch	DRAWN BY KRH
DATE: 10-4-11	As-Built	REVISED
GREAT WESTERN CORPORATION		
Ketchikan Viaduct II Repair & C.P.		DRAWING NUMBER W-46

SPAN 47 - VIEW THROUGH DECK

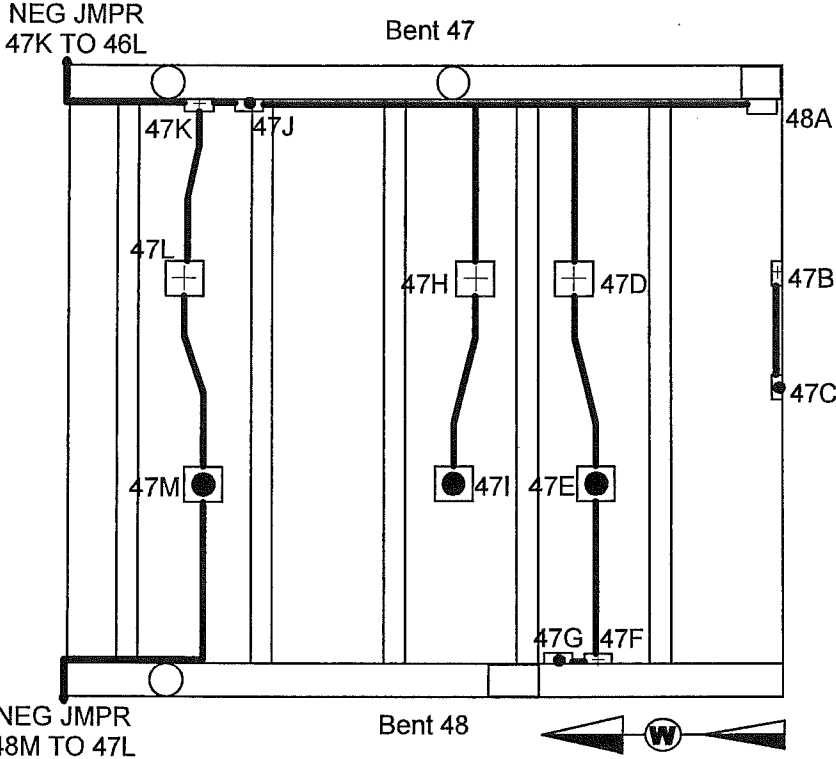


WATER BENT 47 SOUTH ELEVATION

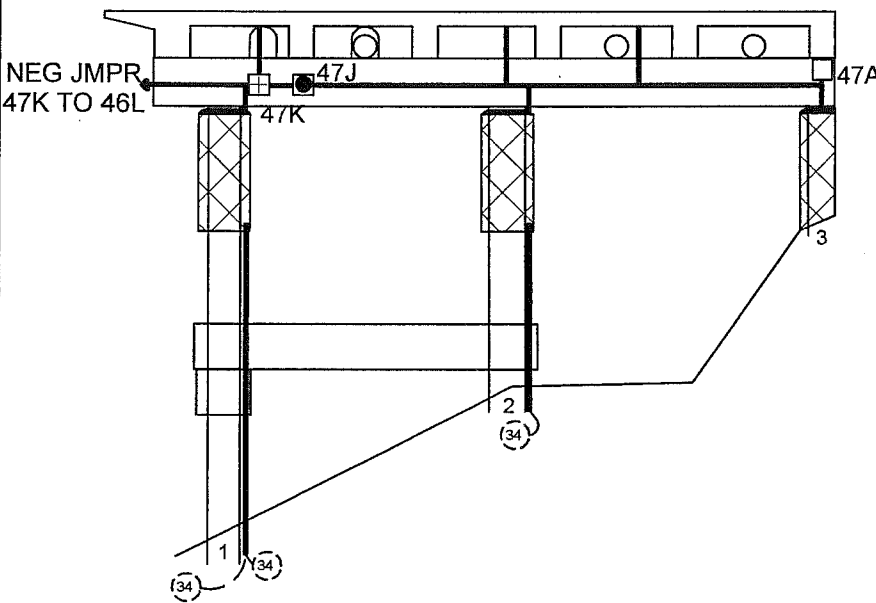

TYPICAL WIRE SIZES & COLORS AS FOLLOWS:
MZA & PJA = #10 Red
MZN; PJN = #10 Blue
SA = #8 Black
RE/REN: #16 Twisted Pair Red/Black

SCHEMATIC

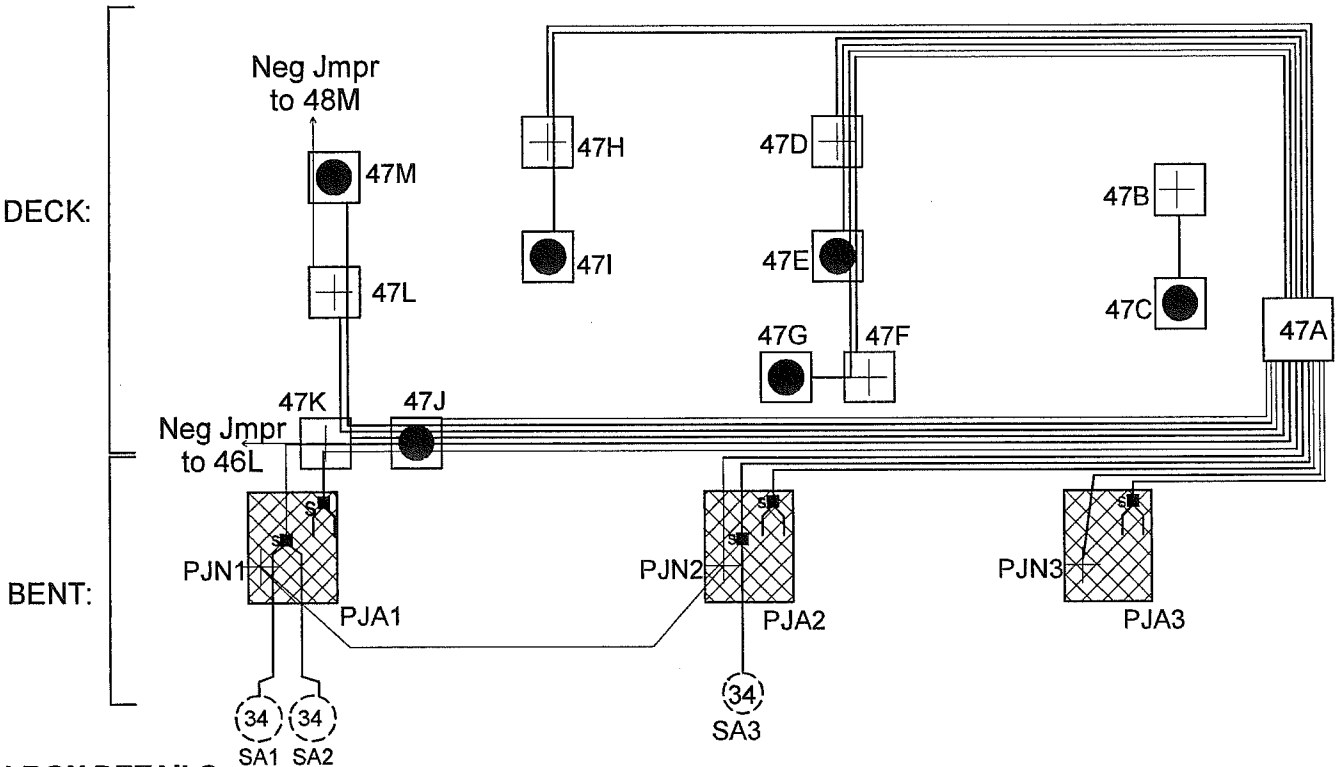


J-BOX DETAILS:

	J-Box Size	Wires or Structure
47-A	14" x 12" x 8"	MAIN J-BOX: (5) MZA; (5) MZN; (3) PJA; (2) PJN; (2) SA; SAN jumpered from PJN
47-B	5" x 5" x 2"	Structure Negative (MZN)
47-C	5" x 5" x 2"	Primary Anode Terminal Plate (MZA)
47-D	5" x 5" x 2"	Structure Negative (MZN); (2) MZA; (1) MZN
47-E	5" x 5" x 2"	Primary Anode Terminal Plate (MZA); (1) MZN; (1) MZA
47-F	5" x 5" x 2"	Structure Negative (MZN); (1) MZA
47-G	5" x 5" x 2"	Primary Anode Terminal Plate (MZA)
47-H	5" x 5" x 2"	Structure Negative (MZN); (1) MZA
47-I	5" x 5" x 2"	Primary Anode Terminal Plate (MZA)
47-J	5" x 5" x 2"	Primary Anode Terminal Plate (MZA); (2) MZN; (1) MZA; (1) PJA; (1) SA
47-K	5" x 5" x 2"	Structure Negative (MZN); (1) MZA; (1) MZN; MZN Jumper to 46L; (1) PJA; (1) SA
47-L	5" x 5" x 2"	Structure Negative (MZN); (1) MZA; MZN Jumper to 48M
47-M	5" x 5" x 2"	Primary Anode Terminal Plate (MZA); (1) MZN Jumper

ABBREVIATIONS:
MZN = Metallized Zinc Negative
PJN = Pile Jacket Negative
CJN = Cap Jacket Negative
SAN = Submerged Anode Negative
MZA = Metallized Zinc Anode
PJA = Pile Jacket Anode
CJA = Cap Jacket Anode
SA = Submerged Anode
RE = Reference Electrode
REN = Reference Electrode Negative

LEGEND

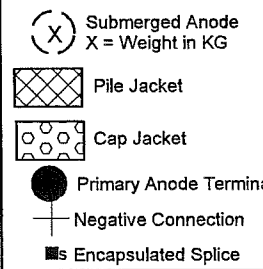


Water Street Bent 47 South Elevation & Span 47

SCALE: NONE	Field Sketch	DRAWN BY KRH
DATE: 10-4-11	As-Built	REVISED
GREAT WESTERN CORPORATION		
Ketchikan Viaduct II Repair & C.P.		DRAWING NUMBER W-47

SPAN 48 - VIEW THROUGH DECK

NEG JMPR
48M TO 47L


Bent 48

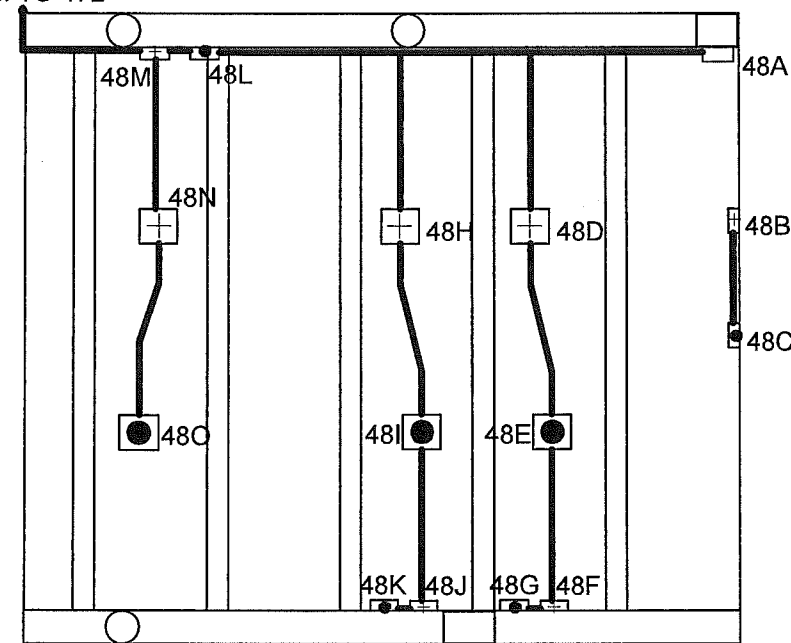

Bent 49


WATER BENT 48 SOUTH ELEVATION

NEG JMPR
48M TO 47L

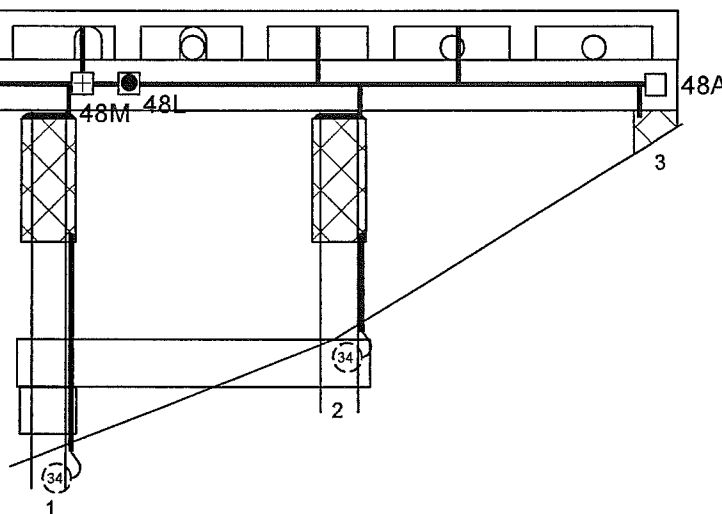

TYPICAL WIRE SIZES & COLORS AS FOLLOWS:
MZA & PJA = #10 Red
MZN; PJN = #10 Blue
SA = #8 Black
RE/REN: #16 Twisted Pair Red/Black

SCHEMATIC

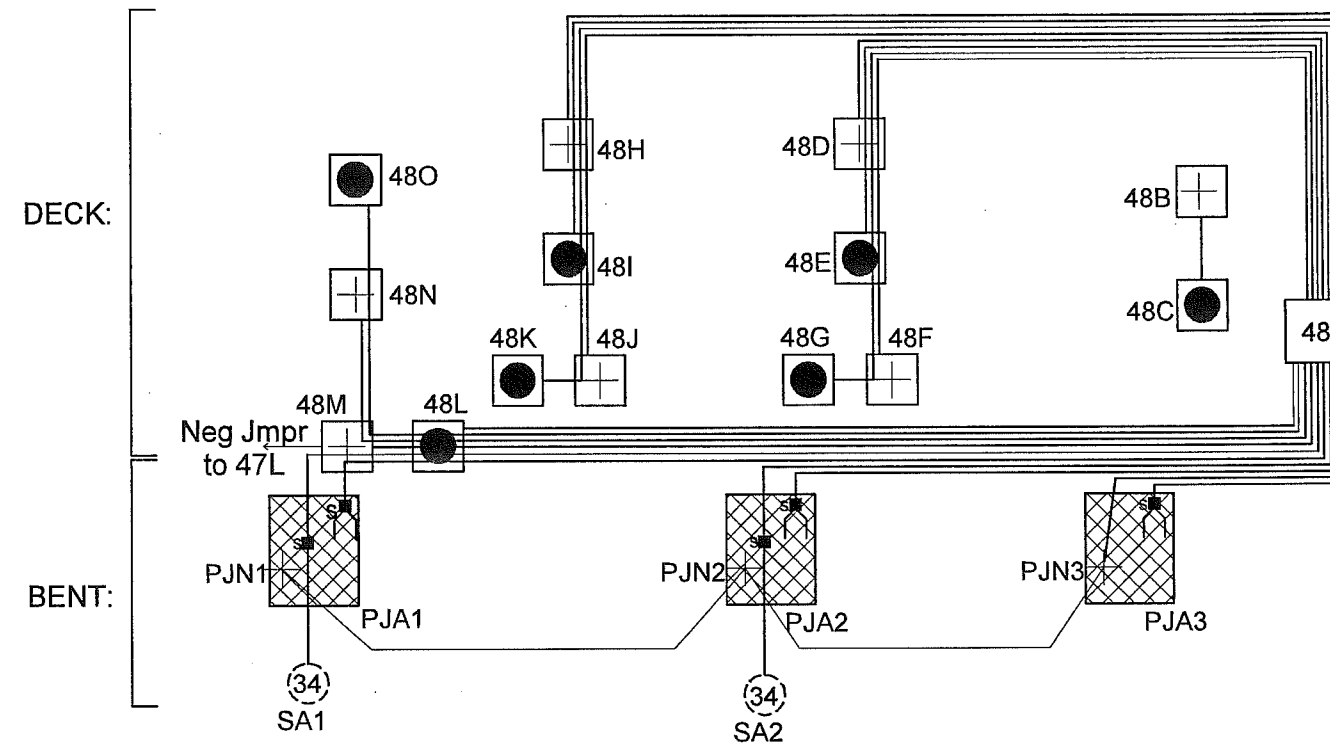


J-BOX DETAILS:

	J-Box Size	Wires or Structure
48-A	14" x 12" x 8"	MAIN J-BOX: (6) MZA; (6) MZN; (3) PJA; (1) PJN; (2) SA; SAN jumpered from PJN
48-B	5" x 5" x 2"	Structure Negative (MZN)
48-C	5" x 5" x 2"	Primary Anode Terminal Plate (MZA)
48-D	5" x 5" x 2"	Structure Negative (MZN); (2) MZA; (1) MZN
48-E	5" x 5" x 2"	Primary Anode Terminal Plate (MZA); (1) MZN; (1) MZA
48-F	5" x 5" x 2"	Structure Negative (MZN); (1) MZA
48-G	5" x 5" x 2"	Primary Anode Terminal Plate (MZA)
48-H	5" x 5" x 2"	Structure Negative (MZN); (2) MZA; (1) MZN
48-I	5" x 5" x 2"	Primary Anode Terminal Plate (MZA); (1) MZN; (1) MZA
48-J	5" x 5" x 2"	Structure Negative (MZN); (1) MZA
48-K	5" x 5" x 2"	Primary Anode Terminal Plate (MZA)
48-L	5" x 5" x 2"	Primary Anode Terminal Plate (MZA); (2) MZN; (1) MZA; (1) PJA; (1) SA
48-M	5" x 5" x 2"	Structure Negative (MZN); (1) MZA; (1) MZN; MZN Jumper to 47L; (1) PJA; (1) SA
48-N	5" x 5" x 2"	Structure Negative (MZN); (1) MZA
48-O	5" x 5" x 2"	Primary Anode Terminal Plate (MZA)

ABBREVIATIONS:

MZN = Metallized Zinc Negative
PJN = Pile Jacket Negative
CJN = Cap Jacket Negative
SAN = Submerged Anode Negative
MZA = Metallized Zinc Anode
PJA = Pile Jacket Anode
CJA = Cap Jacket Anode
SA = Submerged Anode
RE = Reference Electrode
REN = Reference Electrode Negative

LEGEND

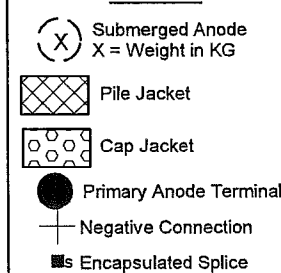

Water Street Bent 48 South Elevation & Span 48


SCALE: NONE	Field Sketch	DRAWN BY KRH
DATE: 10-4-11	As-Built	REVISED

GREAT WESTERN CORPORATION


Ketchikan Viaduct II
Repair & C.P.

DRAWING NUMBER
W-48

SPAN 49 - VIEW THROUGH DECK

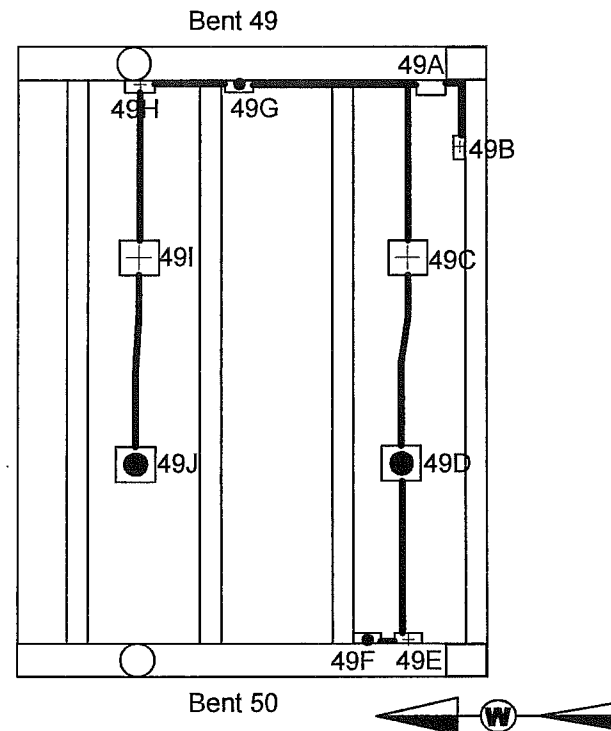


WATER BENT 49 SOUTH ELEVATION

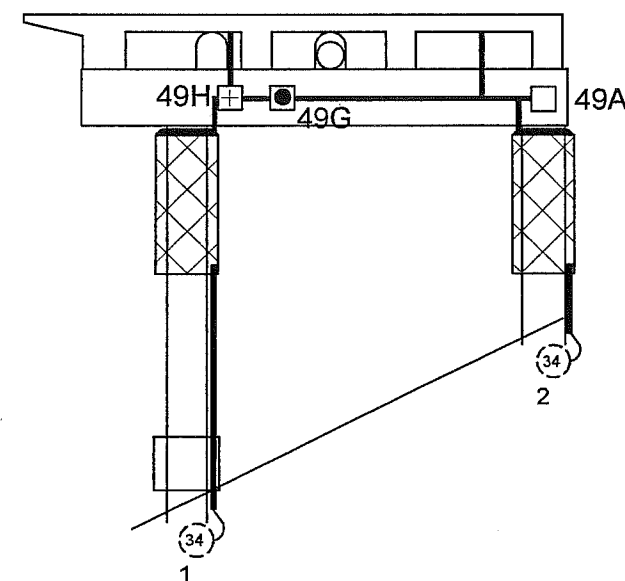

TYPICAL WIRE SIZES & COLORS AS FOLLOWS:
MZA & PJA = #10 Red
MZN; PJN = #10 Blue
SA = #8 Black
RE/REN: #16 Twisted Pair Red/Black

SCHEMATIC

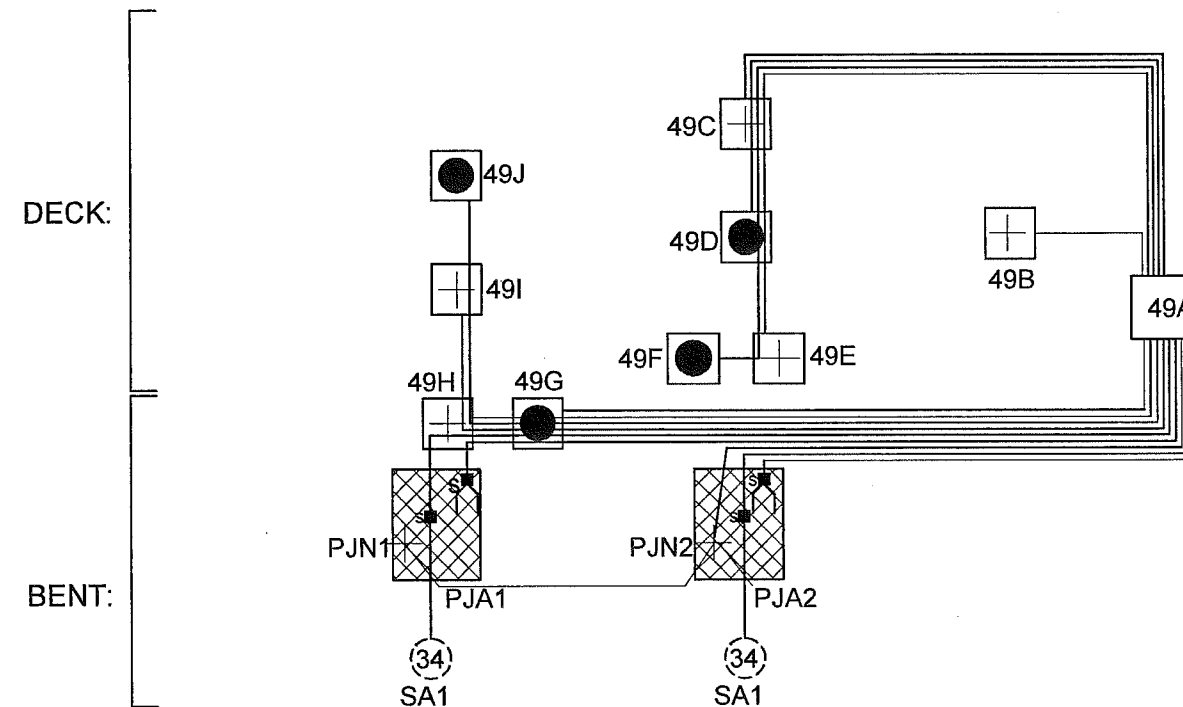

J-BOX DETAILS:


	J-Box Size	Wires or Structure
49-A	14" x 12" x 8"	MAIN J-BOX: (4) MZA; (5) MZN; (2) PJA; (1) PJN; (2) SA; SAN jumpered from PJN
49-B	5" x 5" x 2"	Structure Negative (MZN)
49-C	5" x 5" x 2"	Structure Negative (MZN); (2) MZA; (1) MZN
49-D	5" x 5" x 2"	Primary Anode Terminal Plate (MZA); (1) MZN; (1) MZA
49-E	5" x 5" x 2"	Structure Negative (MZN); (1) MZA
49-F	5" x 5" x 2"	Primary Anode Terminal Plate (MZA)
49-G	5" x 5" x 2"	Primary Anode Terminal Plate (MZA); (2) MZN; (1) MZA; (1) PJA; (1) SA
49-H	5" x 5" x 2"	Structure Negative (MZN); (1) MZA; (1) MZN; (1) PJA; (1) SA
49-I	5" x 5" x 2"	Structure Negative (MZN); (1) MZA
49-J	5" x 5" x 2"	Primary Anode Terminal Plate (MZA)

ABBREVIATIONS:
MZN = Metallized Zinc Negative
PJN = Pile Jacket Negative
CJN = Cap Jacket Negative
SAN = Submerged Anode Negative
MZA = Metallized Zinc Anode
PJA = Pile Jacket Anode
CJA = Cap Jacket Anode
SA = Submerged Anode
RE = Reference Electrode
REN = Reference Electrode Negative


LEGEND
(X) Submerged Anode
X = Weight in KG
Pile Jacket
Cap Jacket
Primary Anode Terminal
Negative Connection
Encapsulated Splice

Water Street Bent 49 South Elevation & Span 49		
SCALE: NONE	Field Sketch	DRAWN BY KRH
DATE: 10-4-11	As-Built	REVISED
GREAT WESTERN CORPORATION		
Ketchikan Viaduct II Repair & C.P.		DRAWING NUMBER W-49


SPAN 50 - VIEW THROUGH DECK

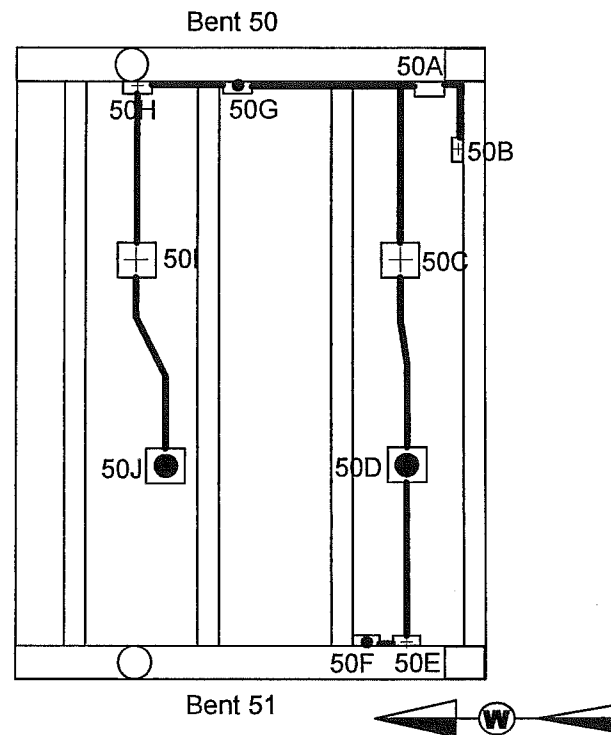

SCHEMATIC

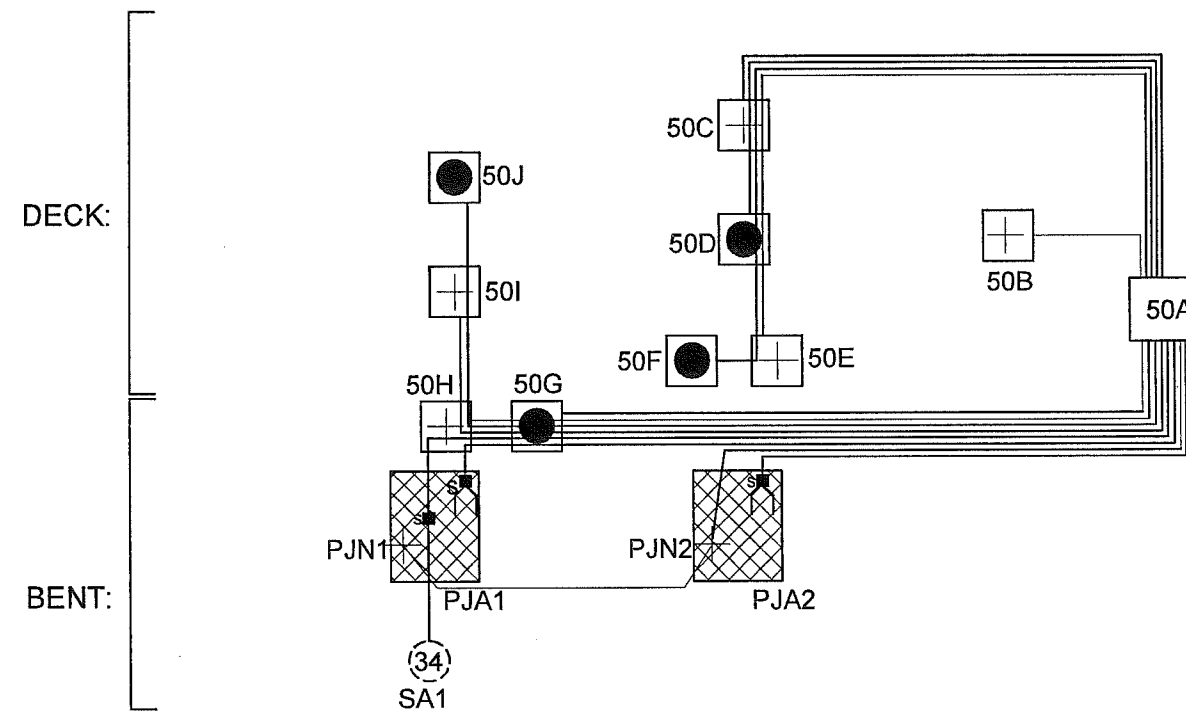

WATER BENT 50 SOUTH ELEVATION

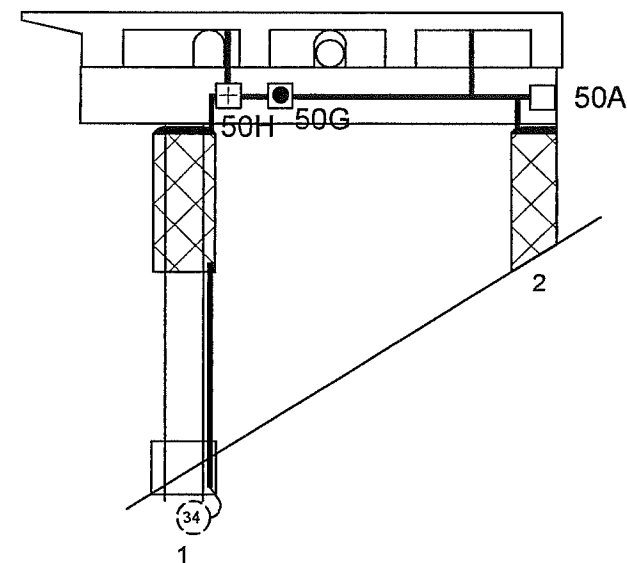

J-BOX DETAILS:

	J-Box Size	Wires or Structure
50-A	14" x 12" x 8"	MAIN J-BOX (4) MZA; (5) MZN; (2) PJA; (1) PJN; (1) SA; SAN jumpered from PJN
50-B	5" x 5" x 2"	Structure Negative (MZN)
50-C	5" x 5" x 2"	Structure Negative (MZN); (2) MZA; (1) MZN
50-D	5" x 5" x 2"	Primary Anode Terminal Plate (MZA); (1) MZN; (1) MZA
50-E	5" x 5" x 2"	Structure Negative (MZN); (1) MZA
50-F	5" x 5" x 2"	Primary Anode Terminal Plate (MZA)
50-G	5" x 5" x 2"	Primary Anode Terminal Plate (MZA); (2) MZN; (1) MZA; (1) PJA; (1) SA
50-H	5" x 5" x 2"	Structure Negative (MZN); (1) MZA; (1) MZN; (1) PJA (1) SA
50-I	5" x 5" x 2"	Structure Negative (MZN); (1) MZA
50-J	5" x 5" x 2"	Primary Anode Terminal Plate (MZA)

ABBREVIATIONS:
MZN = Metallized Zinc Negative
PJN = Pile Jacket Negative
CJN = Cap Jacket Negative
SAN = Submerged Anode Negative
MZA = Metallized Zinc Anode
PJA = Pile Jacket Anode
CJA = Cap Jacket Anode
SA = Submerged Anode
RE = Reference Electrode
REN = Reference Electrode Negative

LEGEND
(X) Submerged Anode
X = Weight in KG
Pile Jacket
Cap Jacket
Primary Anode Terminal
Negative Connection
Encapsulated Splice

Water Street Bent 50 South Elevation & Span 50		
SCALE: NONE	Field Sketch	DRAWN BY KRH
DATE: 09-30-11	As-Built	REVISED 10-4-11
GREAT WESTERN CORPORATION		
Ketchikan Viaduct II Repair & C.P.		DRAWING NUMBER W-50

TYPICAL WIRE SIZES & COLORS AS FOLLOWS:
MZA & PJA = #10 Red
MZN; PJN = #10 Blue
SA = #8 Black
RE/REN: #16 Twisted Pair Red/Black

The diagram shows two vertical sections, Bent 51 and Bent 52, connected by a horizontal line at the top. Bent 51 is on the left and Bent 52 is on the right. Various components are labeled with codes like 51A, 51B, 51C, 51D, 51E, 51F, 51G, 51H, 51I, 51J, and 52A. A compass rose at the bottom right indicates North (N) and South (S) directions.

Fig. 1 is a schematic diagram of a mechanical assembly. It shows a horizontal beam with a cross-hatched support on the left and a vertical support on the right. A diagonal line passes through the assembly. Labels include 51H, 51G, 51A, 34, 2, and 1.

DECK:

BENT:

SA1

SA2

PJA1

PJA2

PJN1

PJN2

51A

51B

51C

51D

51E

51F

51G

51H

51I

51J

SCHEMATIC


	J-Box Size	Wires or Structure
51-A	14" x 12" x 8"	MAIN J-BOX: (4) MZA; (5) MZN; (2) PJA; (1) PJN; (2) SA; SAN jumpered from PJN
51-B	5" x 5" x 2"	Structure Negative (MZN)
51-C	5" x 5" x 2"	Structure Negative (MZN); (2) MZA; (1) MZN
51-D	5" x 5" x 2"	Primary Anode Terminal Plate (MZA); (1) MZN; (1) MZA
51-E	5" x 5" x 2"	Structure Negative (MZN)
51-F	5" x 5" x 2"	Primary Anode Terminal Plate (MZA)
51-G	5" x 5" x 2"	Primary Anode Terminal Plate (MZA); (2) MZN; (1) MZA; (1) PJA; (1) SA
51-H	5" x 5" x 2"	Structure Negative (MZN); (1) MZA; (1) MZN; (1) PJA (1) SA
51-I	5" x 5" x 2"	Structure Negative (MZN); (1) MZA
51-J	5" x 5" x 2"	Primary Anode Terminal Plate (MZA)

LEGEND


- Submerged Anode
X = Weight in KG
- Pile Jacket
- Cap Jacket
- Primary Anode Terminal
- Negative Connection
- Encapsulated Splice

Water Street Bent 51 South Elevation & Span 51		
SCALE: NONE	Field Sketch As-Built	DRAWN BY KRH
DATE: 05-12-11		REVISED 10-4-11
GREAT WESTERN CORPORATION		
Ketchikan Viaduct II Repair & C.P.		DRAWING NUMBER W-51

SPAN 52 - VIEW THROUGH DECK

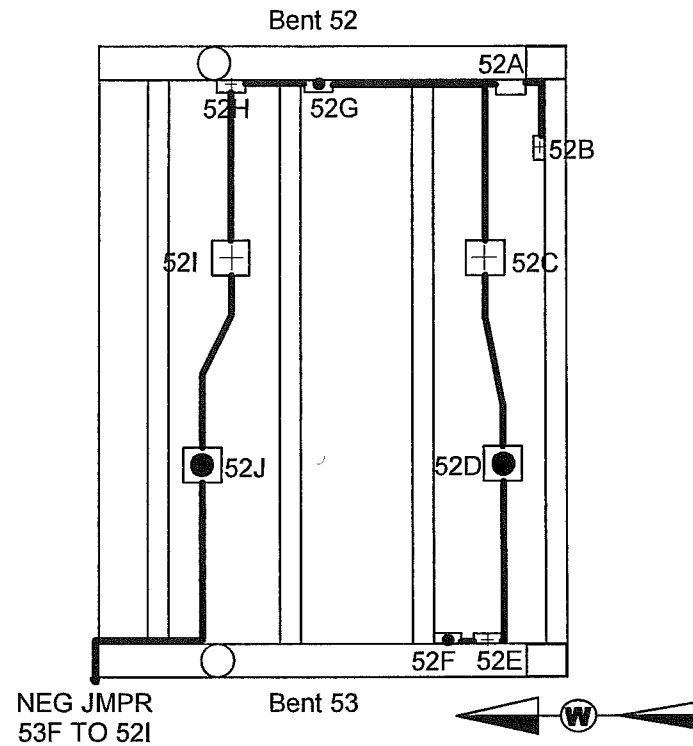


WATER BENT 52 SOUTH ELEVATION

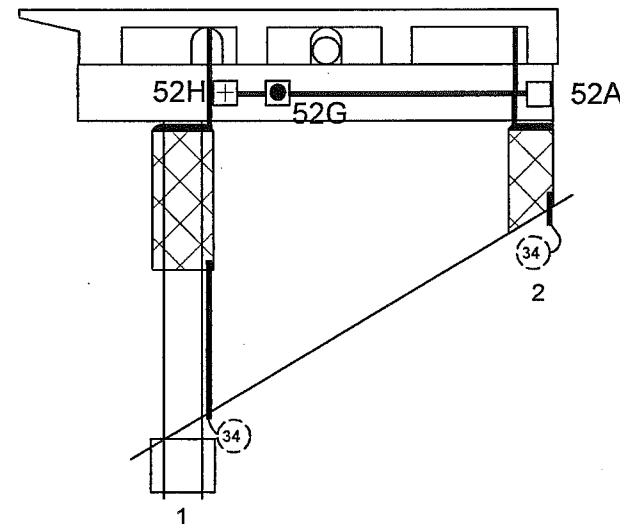

TYPICAL WIRE SIZES & COLORS AS FOLLOWS:
 MZA & PJA = #10 Red
 MZN; PJN = #10 Blue
 SA = #8 Black
 RE/REN: #16 Twisted Pair Red/Black

SCHEMATIC

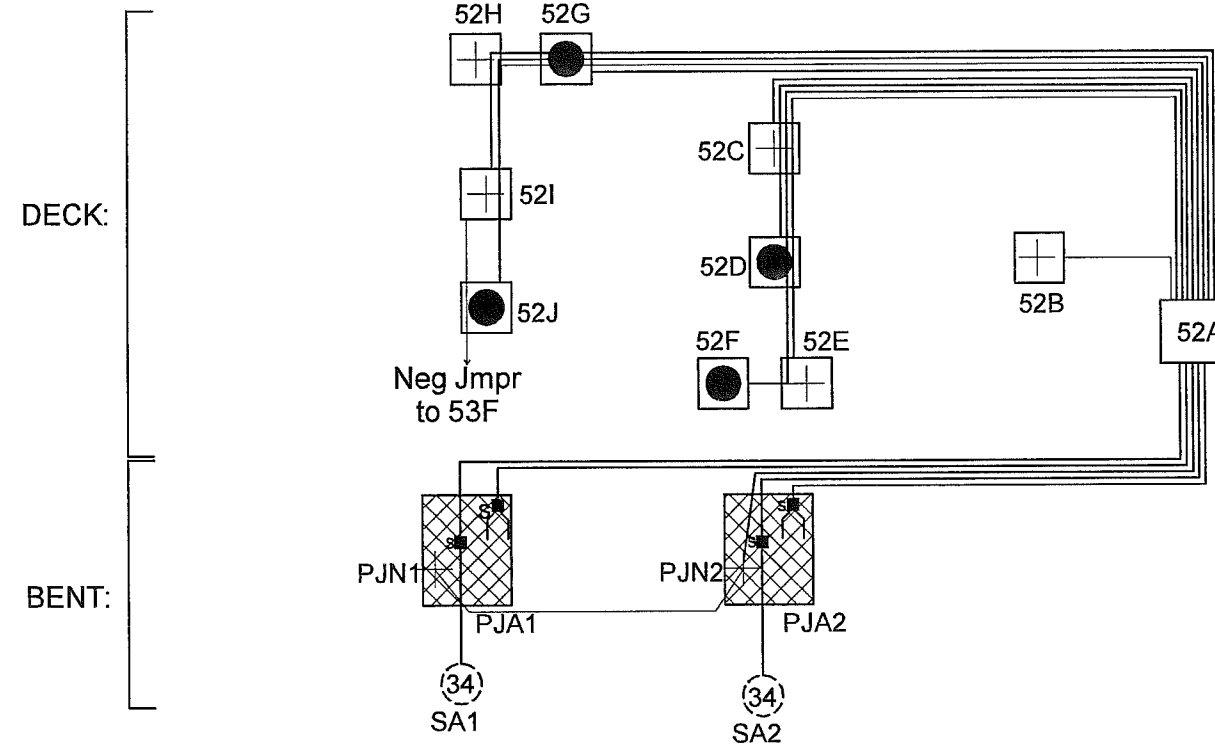


J-BOX DETAILS:

	J-Box Size	Wires or Structure
52-A	14" x 12" x 8"	MAIN J-BOX: (4) MZA; (5) MZN; (2) PJA; (1) PJN; (2) SA; SAN jumpered from PJN
52-B	5" x 5" x 2"	Structure Negative (MZN)
52-C	5" x 5" x 2"	Structure Negative (MZN); (2) MZA; (1) MZN
52-D	5" x 5" x 2"	Primary Anode Terminal Plate (MZA); (1) MZN; (1) MZA
52-E	5" x 5" x 2"	Structure Negative (MZN); (1) MZA
52-F	5" x 5" x 2"	Primary Anode Terminal Plate (MZA)
52-G	5" x 5" x 2"	Primary Anode Terminal Plate (MZA); (2) MZN; (1) MZA
52-H	5" x 5" x 2"	Structure Negative (MZN); (1) MZA; (1) MZN
52-I	5" x 5" x 2"	Structure Negative (MZN); (1) MZA; MZN Jumper to 53F
52-J	5" x 5" x 2"	Primary Anode Terminal Plate (MZA); (1) MZN Jumper to 53F

ABBREVIATIONS:
 MZN = Metallized Zinc Negative
 PJN = Pile Jacket Negative
 CJN = Cap Jacket Negative
 SAN = Submerged Anode Negative
 MZA = Metallized Zinc Anode
 PJA = Pile Jacket Anode
 CJA = Cap Jacket Anode
 SA = Submerged Anode
 RE = Reference Electrode
 REN = Reference Electrode Negative

LEGEND

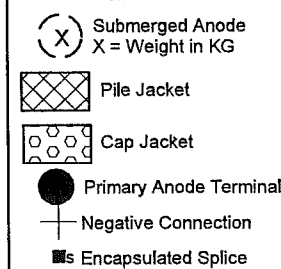

Water Street Bent 52 South Elevation
 & Span 52


SCALE: NONE
 DATE: 05-12-11
 Field Sketch
 As-Built
 DRAWN BY: KRH
 REVISED: 09-29-11

GREAT WESTERN CORPORATION


Ketchikan Viaduct II
 Repair & C.P.

DRAWING NUMBER
 W-52


SPAN 53 - VIEW THROUGH DECK

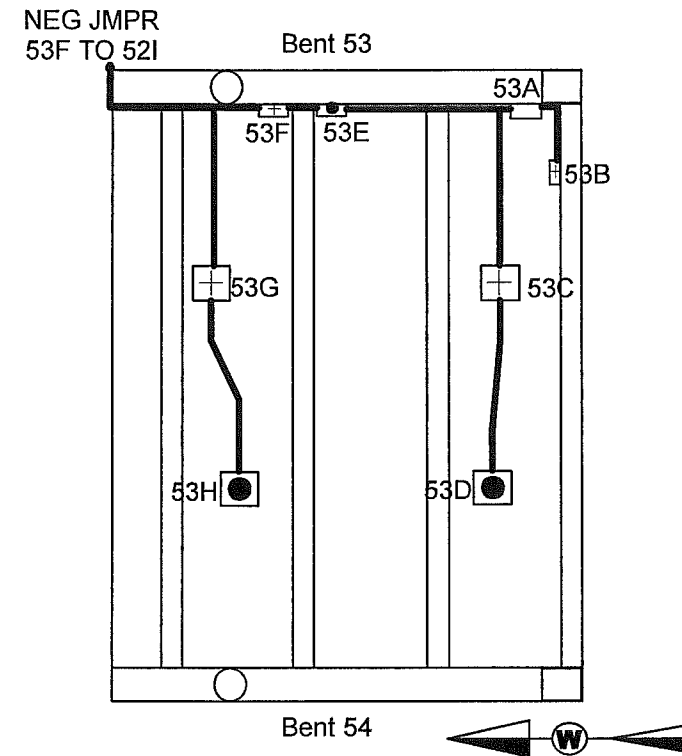

SCHEMATIC

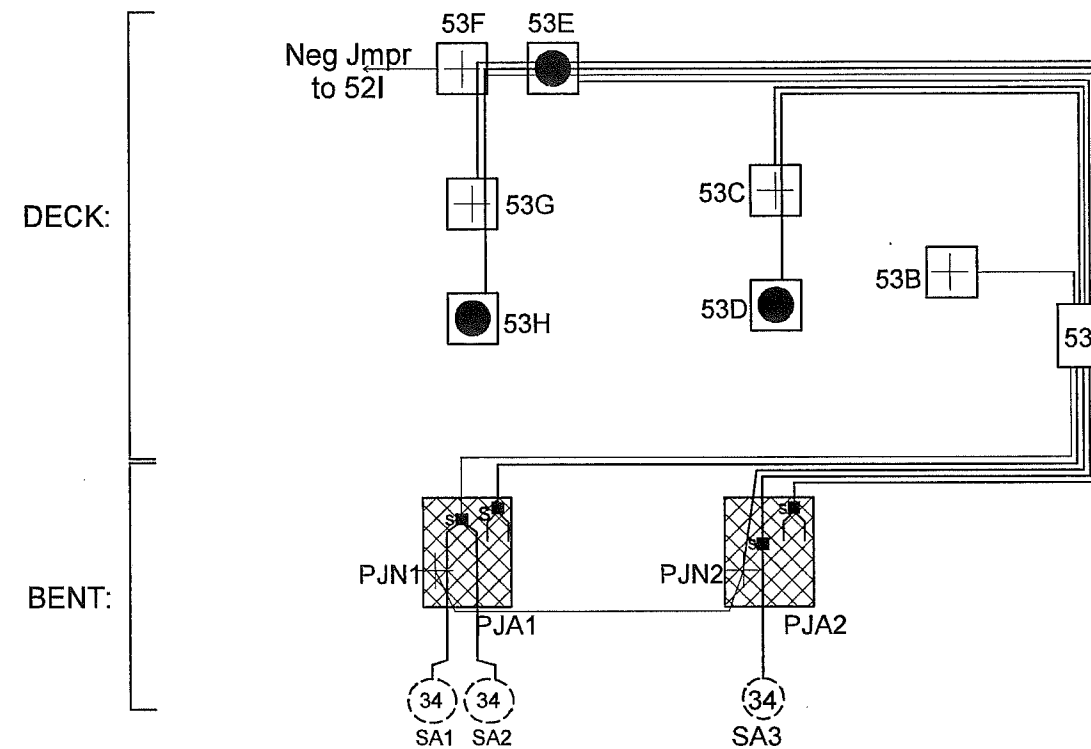

WATER BENT 53 SOUTH ELEVATION

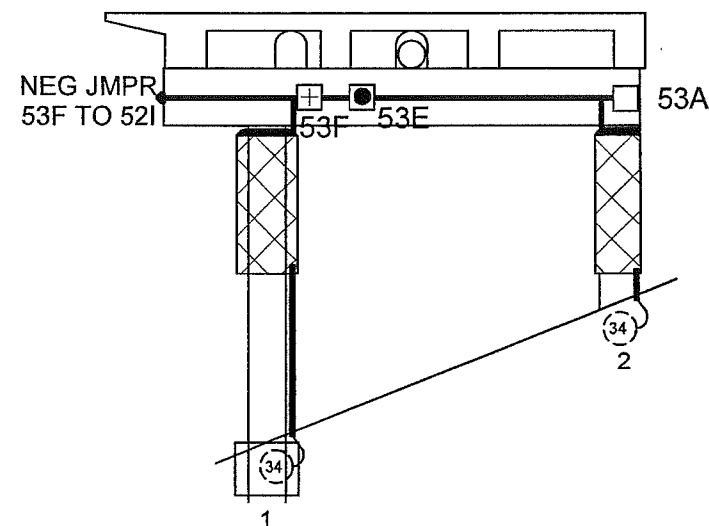

J-BOX DETAILS:

	J-Box Size	Wires or Structure
53-A	14" x 12" x 8"	MAIN J-BOX: (3) MZA; (4) MZN; (2) PJA; (1) PJN; (2) SA; SAN jumpered from PJN
53-B	5" x 5" x 2"	Structure Negative (MZN)
53-C	5" x 5" x 2"	Structure Negative (MZN); (1) MZA
53-D	5" x 5" x 2"	Primary Anode Terminal Plate (MZA)
53-E	5" x 5" x 2"	Primary Anode Terminal Plate (MZA); (2) MZN; (1) MZA
53-F	5" x 5" x 2"	Structure Negative (MZN); (1) MZA; (1) MZN; MZN Jumper to 52I
53-G	5" x 5" x 2"	Structure Negative (MZN); (1) MZA
53-H	5" x 5" x 2"	Primary Anode Terminal Plate (MZA)


TYPICAL WIRE SIZES & COLORS AS FOLLOWS:
MZA & PJA = #10 Red
MZN; PJN = #10 Blue
SA = #8 Black
RE/REN: #16 Twisted Pair Red/Black

ABBREVIATIONS:
MZN = Metallized Zinc Negative
PJN = Pile Jacket Negative
CJN = Cap Jacket Negative
SAN = Submerged Anode Negative
MZA = Metallized Zinc Anode
PJA = Pile Jacket Anode
CJA = Cap Jacket Anode
SA = Submerged Anode
RE = Reference Electrode
REN = Reference Electrode Negative


LEGEND
(X) Submerged Anode
X = Weight in KG
Pile Jacket
Cap Jacket
Primary Anode Terminal
Negative Connection
Encapsulated Splice

Water Street Bent 53 South Elevation & Span 53			
SCALE: NONE	Field Sketch	DRAWN BY KRH	
DATE: 05-12-11	As-Built	REVISED 09-29-11	
GREAT WESTERN CORPORATION			
Ketchikan Viaduct II Repair & C.P.		DRAWING NUMBER W-53	

SPAN 54 - VIEW THROUGH DECK

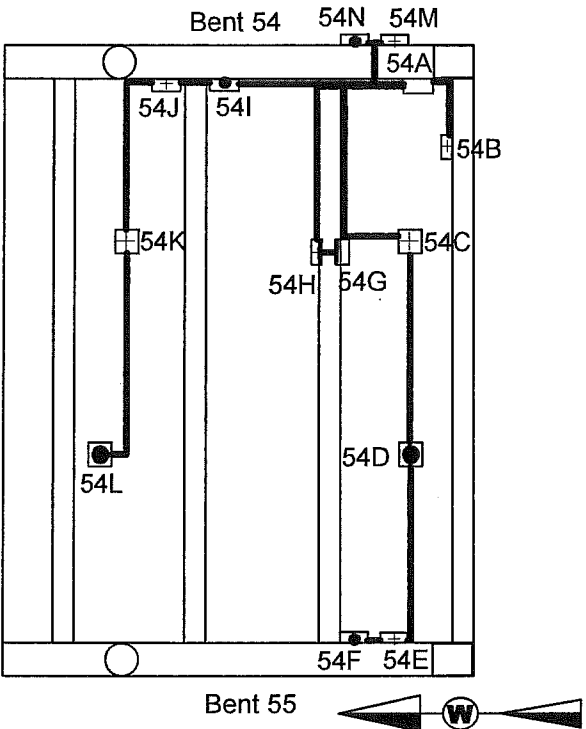


WATER BENT 54 SOUTH ELEVATION

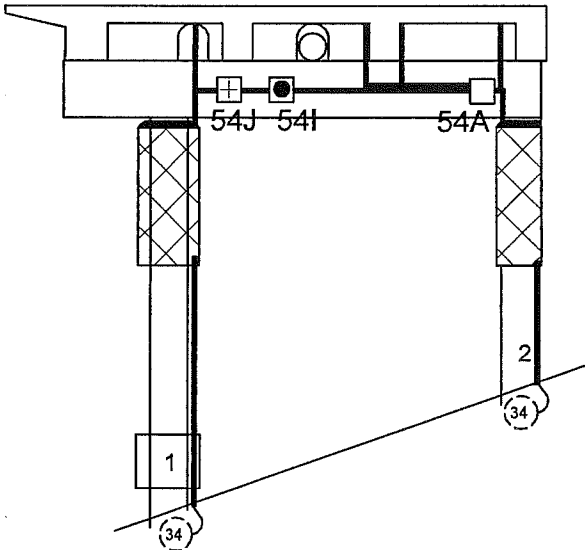

TYPICAL WIRE SIZES & COLORS AS FOLLOWS:
MZA & PJA = #10 Red
MZN; PJN = #10 Blue
SA = #8 Black
RE/REN: #16 Twisted Pair Red/Black

SCHEMATIC

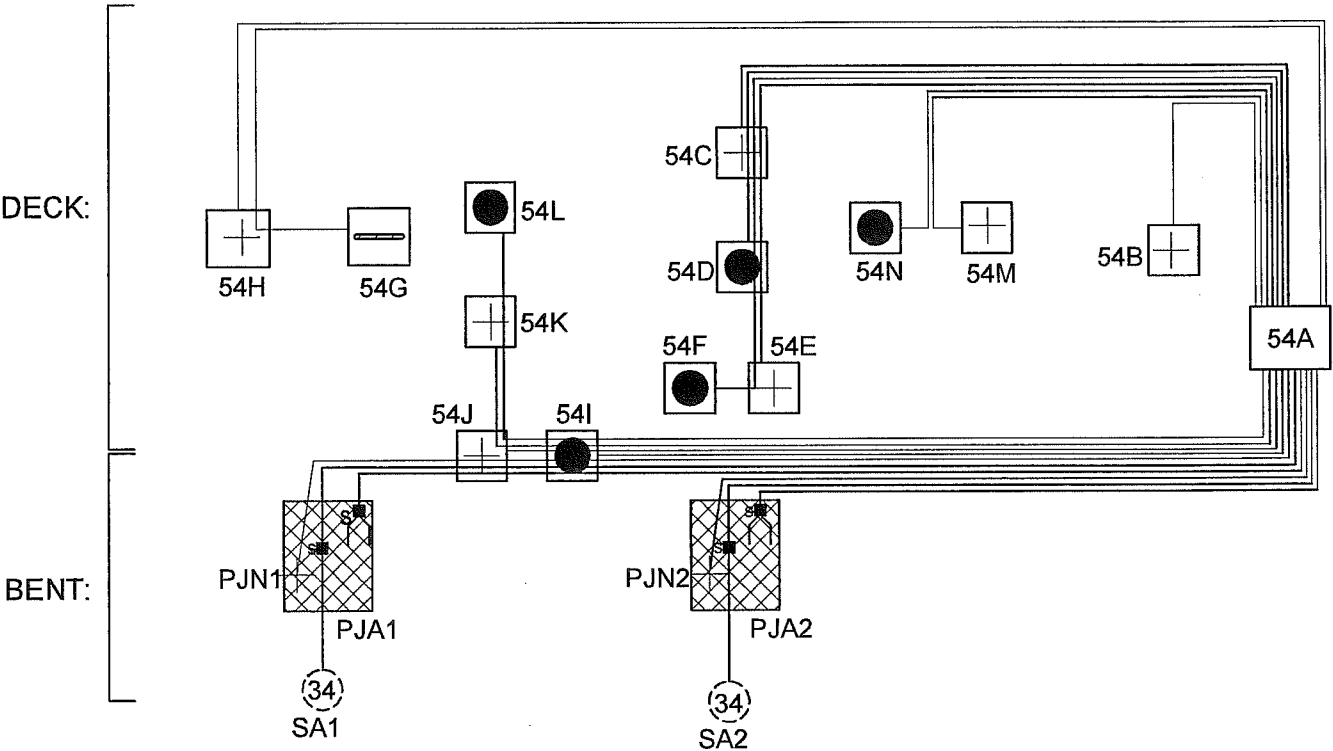

J-BOX DETAILS:

	J-Box Size	Wires or Structure
54-A	14" x 12" x 8"	MAIN J-BOX: (5) MZA; (6) MZN; (2) PJA; (2) PJN; (2) SA; SAN jumpered from PJN; (1) RE; (1) REN
54-B	5" x 5" x 2"	Structure Negative (MZN)
54-C	5" x 5" x 2"	Structure Negative (MZN); (2) MZA; (1) MZN
54-D	5" x 5" x 2"	Primary Anode Terminal Plate (MZA); (1) MZN; (1) MZA
54-E	5" x 5" x 2"	Structure Negative (MZN); (1) MZA
54-F	5" x 5" x 2"	Primary Anode Terminal Plate (MZA)
54-G	5" x 5" x 2"	Reference Electrode (RE) S/N 1000096
54-H	5" x 5" x 2"	Reference Electrode Negative (REN) (1) RE
54-I	5" x 5" x 2"	Primary Anode Terminal Plate (MZA); (2) MZN; (1) MZA; (1) PJA; (1) PJN; (1) SA
54-J	5" x 5" x 2"	Structure Negative (MZN); (1) MZA; (1) MZN; (1) PJA; (1) PJN; (1) SA
54-K	5" x 5" x 2"	Structure Negative (MZN); (1) MZA
54-L	5" x 5" x 2"	Primary Anode Terminal Plate (MZA)

ABBREVIATIONS:
MZN = Metallized Zinc Negative
PJN = Pile Jacket Negative
CJN = Cap Jacket Negative
SAN = Submerged Anode Negative
MZA = Metallized Zinc Anode
PJA = Pile Jacket Anode
CJA = Cap Jacket Anode
SA = Submerged Anode
RE = Reference Electrode
REN = Reference Electrode Negative

LEGEND

- Submerged Anode
- x = Weight in LBS
- Pile Jacket
- Cap Jacket
- Primary Anode Terminal
- Negative Connection
- Encapsulated Splice
- Reference Electrode

Water Street Bent 54 South Elevation
& Span 54


SCALE: NONE	Field Sketch	DRAWN BY KRH
DATE: 05-12-11	As-Built	REVISED 10-4-11

GREAT WESTERN CORPORATION


Ketchikan Viaduct II
Repair & C.P.

DRAWING NUMBER
W-54

SPAN 55 - VIEW THROUGH DECK

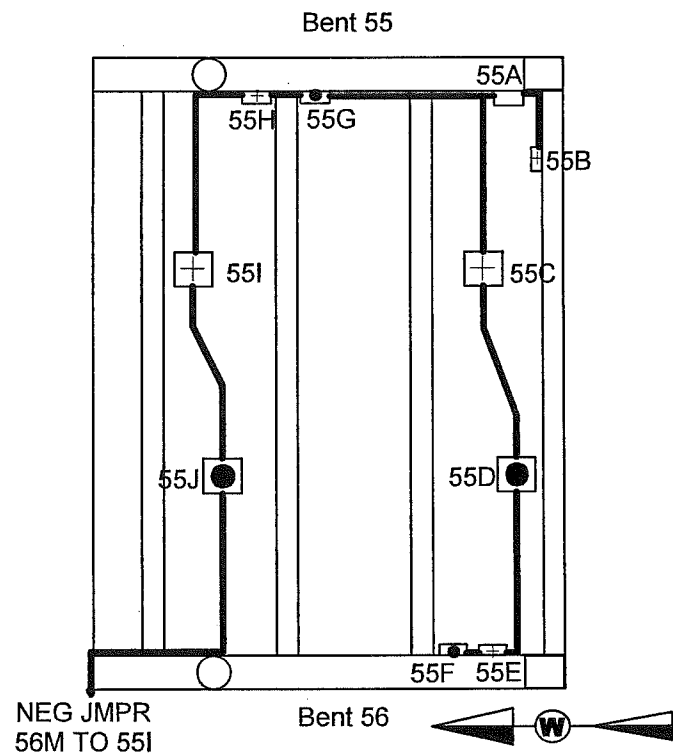


WATER BENT 55 SOUTH ELEVATION

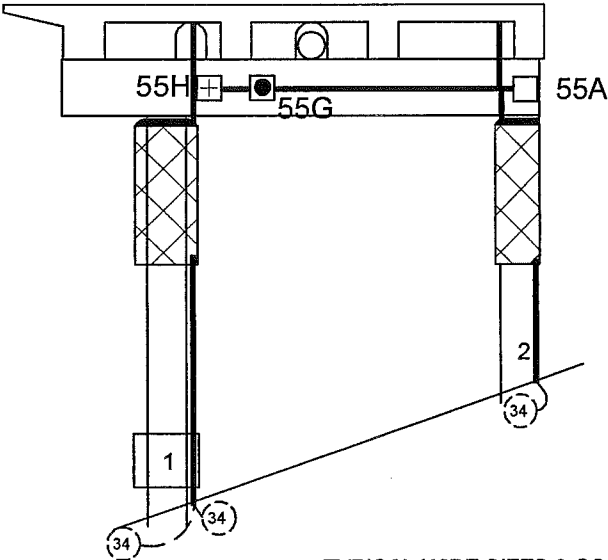

TYPICAL WIRE SIZES & COLORS AS FOLLOWS:
MZA & PJA = #10 Red
MZN; PJN = #10 Blue
SA = #8 Black
RE/REN: #16 Twisted Pair Red/Black

SCHEMATIC

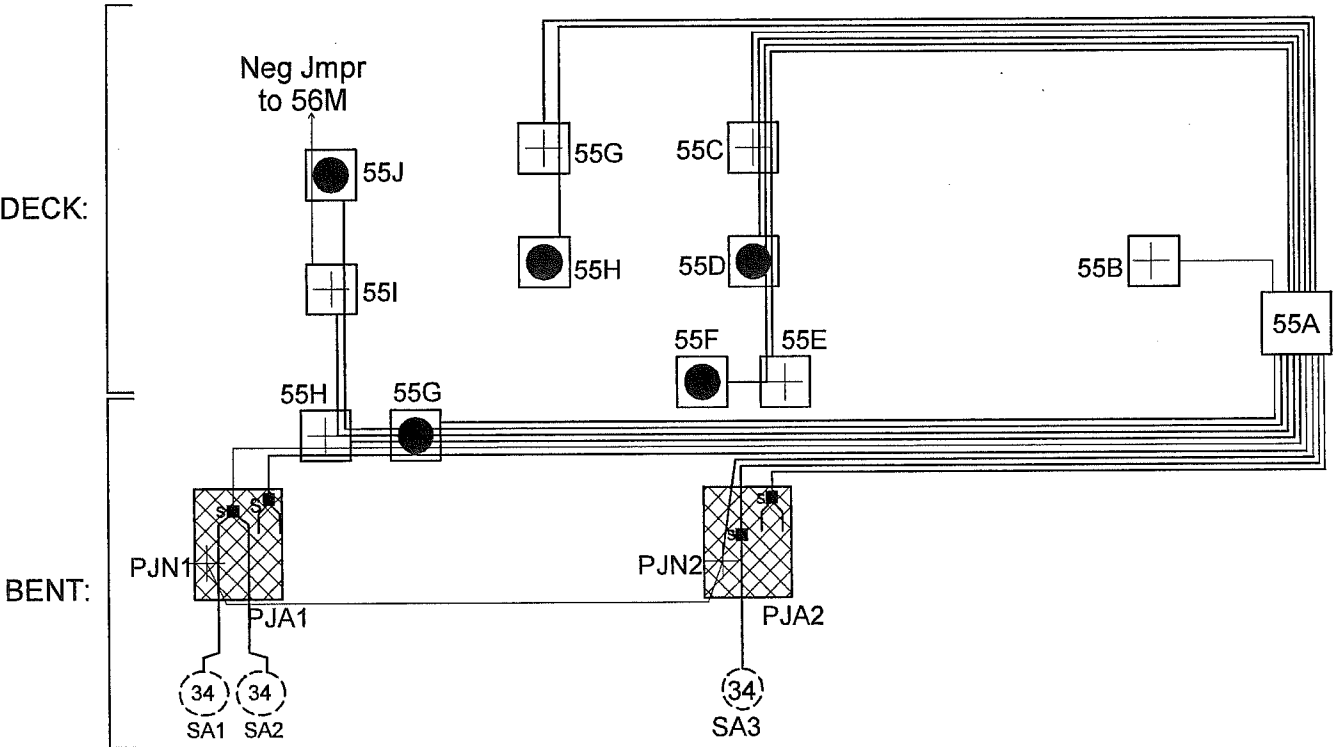

J-BOX DETAILS:

	J-Box Size	Wires or Structure
55-A	14" x 12" x 8"	MAIN J-BOX: (4) MZA; (5) MZN; (2) PJA; (1) PJN; (2) SA; SAN jumpered from PJN
55-B	5" x 5" x 2"	Structure Negative (MZN)
55-C	5" x 5" x 2"	Structure Negative (MZN); (2) MZA; (1) MZN
55-D	5" x 5" x 2"	Primary Anode Terminal Plate (MZA); (1) MZN; (1) MZA
55-E	5" x 5" x 2"	Structure Negative (MZN); (1) MZA
55-F	5" x 5" x 2"	Primary Anode Terminal Plate (MZA)
55-G	5" x 5" x 2"	Primary Anode Terminal Plate (MZA); (2) MZN; (1) MZA; (1) PJA; (1) SA
55-H	5" x 5" x 2"	Structure Negative (MZN); (1) MZA; (1) MZN; (1) PJA; (1) SA
55-I	5" x 5" x 2"	Structure Negative (MZN); (1) MZA; MZN Jumper to 56M
55-J	5" x 5" x 2"	Primary Anode Terminal Plate (MZA); (1) MZN Jumper

ABBREVIATIONS:
MZN = Metallized Zinc Negative
PJN = Pile Jacket Negative
CJN = Cap Jacket Negative
SAN = Submerged Anode Negative
MZA = Metallized Zinc Anode
PJA = Pile Jacket Anode
CJA = Cap Jacket Anode
SA = Submerged Anode
RE = Reference Electrode
REN = Reference Electrode Negative

LEGEND

- (X) Submerged Anode
X = Weight in KG
- [Cross-hatched box] Pile Jacket
- [Dotted box] Cap Jacket
- Primary Anode Terminal
- Negative Connection
- Encapsulated Splice


Water Street Bent 55 South Elevation
& Span 55

SCALE: NONE	Field Sketch	DRAWN BY KRH
DATE: 05-12-11	As-Built	REVISED 10-4-11


GREAT WESTERN CORPORATION

Ketchikan Viaduct II Repair & C.P.	DRAWING NUMBER W-55
---------------------------------------	------------------------

SPAN 56 - VIEW THROUGH DECK

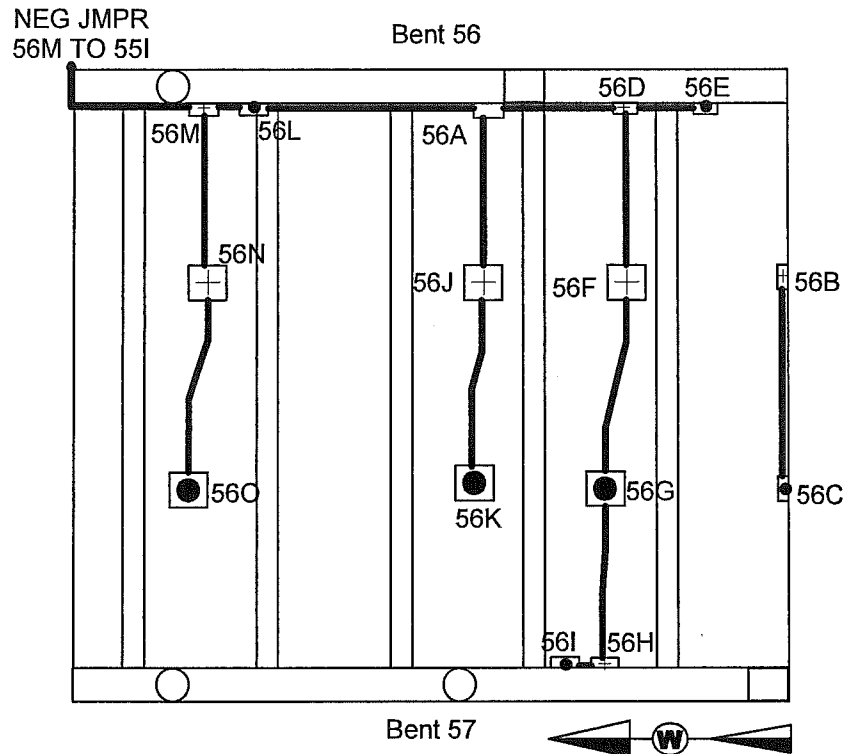


WATER BENT 56 SOUTH ELEVATION

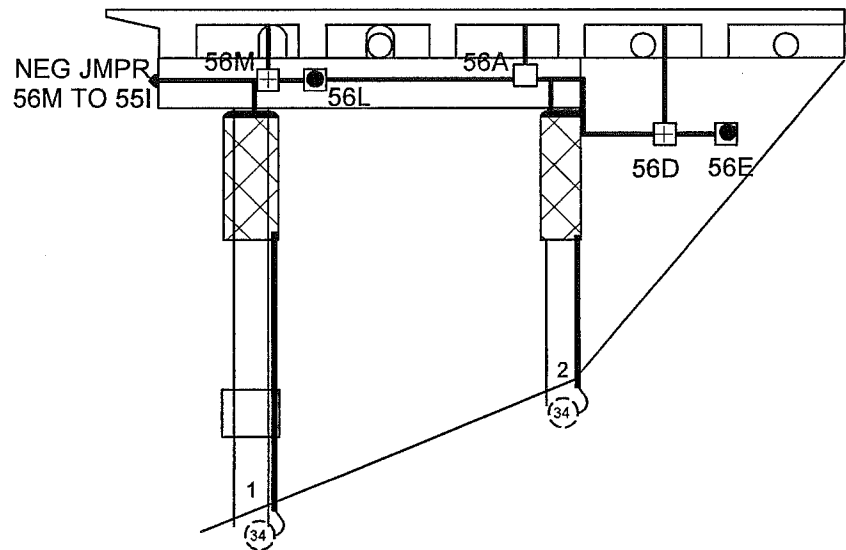

TYPICAL WIRE SIZES & COLORS AS FOLLOWS:
MZA & PJA = #10 Red
MZN; PJN = #10 Blue
SA = #8 Black
RE/REN: #16 Twisted Pair Red/Black

SCHEMATIC

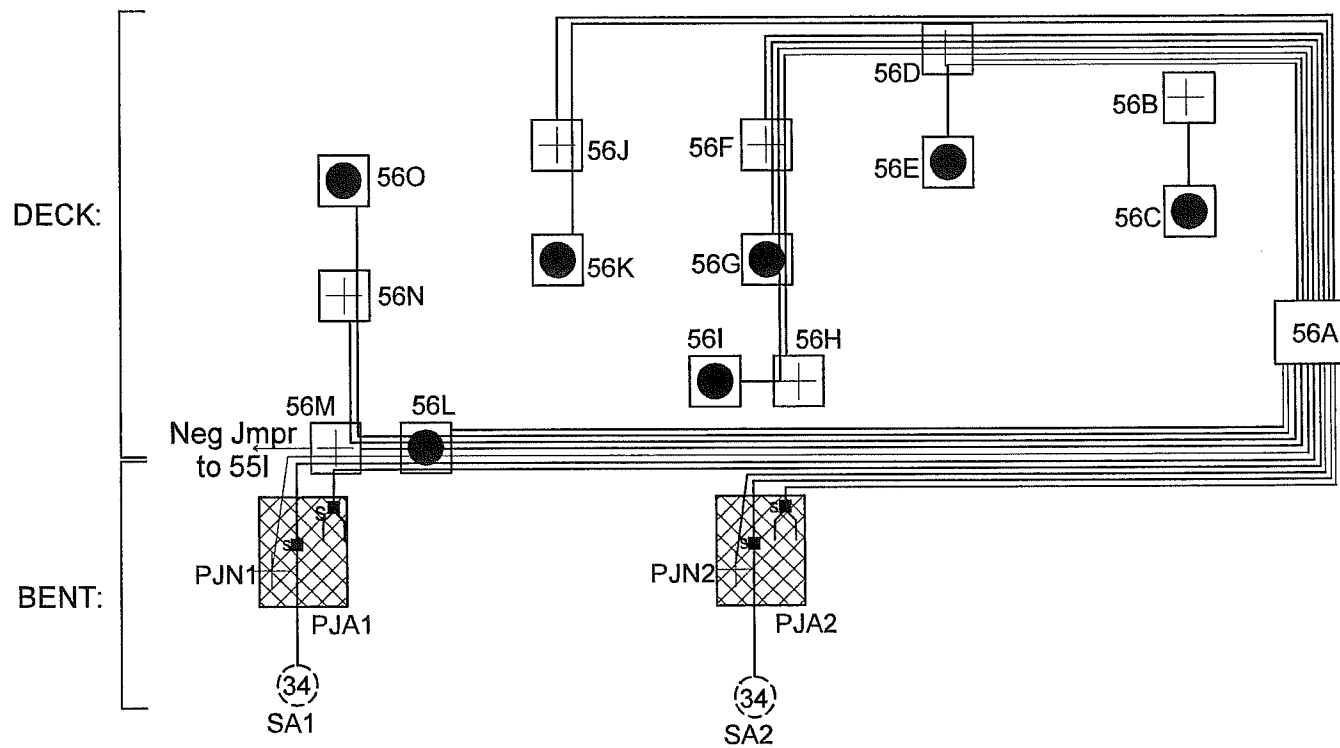

J-BOX DETAILS:

	J-Box Size	Wires or Structure
56-A	14" x 12" x 8"	MAIN J-BOX: (6) MZA; (6) MZN; (2) PJA; (2) PJN; (2) SA; SAN jumpered from PJN
56-B	5" x 5" x 2"	Structure Negative (MZN)
56-C	5" x 5" x 2"	Primary Anode Terminal Plate (MZA)
56-D	5" x 5" x 2"	Structure Negative (MZN); (3) MZA; (2) MZN
56-E	5" x 5" x 2"	Primary Anode Terminal Plate (MZA)
56-F	5" x 5" x 2"	Structure Negative (MZN); (2) MZA; (1) MZN
56-G	5" x 5" x 2"	Primary Anode Terminal Plate (MZA); (1) MZN; (1) MZA
56-H	5" x 5" x 2"	Structure Negative (MZN); (1) MZA
56-I	5" x 5" x 2"	Primary Anode Terminal Plate (MZA)
56-J	5" x 5" x 2"	Structure Negative (MZN); (1) MZA
56-K	5" x 5" x 2"	Primary Anode Terminal Plate (MZA)
56-L	5" x 5" x 2"	Primary Anode Terminal Plate (MZA); (2) MZN; (1) MZA; (1) PJA; (1) PJN; (1) SA
56-M	5" x 5" x 2"	Structure Negative (MZN); (1) MZA; (1) MZN; MZN Jumper to 55I; (1) PJA; (1) PJN; (1) SA
56-N	5" x 5" x 2"	Structure Negative (MZN); (1) MZA
56-O	5" x 5" x 2"	Primary Anode Terminal Plate (MZA)

ABBREVIATIONS:

MZN = Metallized Zinc Negative
PJN = Pile Jacket Negative
CJN = Cap Jacket Negative
SAN = Submerged Anode Negative
MZA = Metallized Zinc Anode
PJA = Pile Jacket Anode
CJA = Cap Jacket Anode
SA = Submerged Anode
RE = Reference Electrode
REN = Reference Electrode Negative

LEGEND

(X) Submerged Anode
X = Weight in KG
Pile Jacket
Cap Jacket
Primary Anode Terminal
Negative Connection
Encapsulated Splice

Water Street Bent 56 South Elevation
& Span 56


SCALE: NONE
DATE: 05-12-11
Field Sketch
As-Built
DRAWN BY: KRH
REVISED: 10-4-11

GREAT WESTERN CORPORATION


Ketchikan Viaduct II
Repair & C.P.

DRAWING NUMBER
W-56

SPAN 57 - VIEW THROUGH DECK

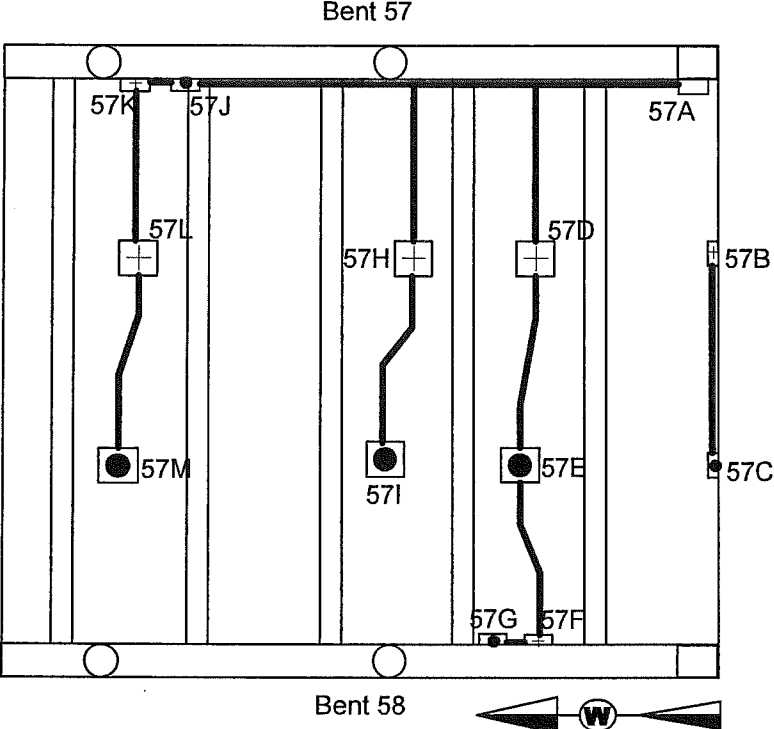


WATER BENT 57 SOUTH ELEVATION

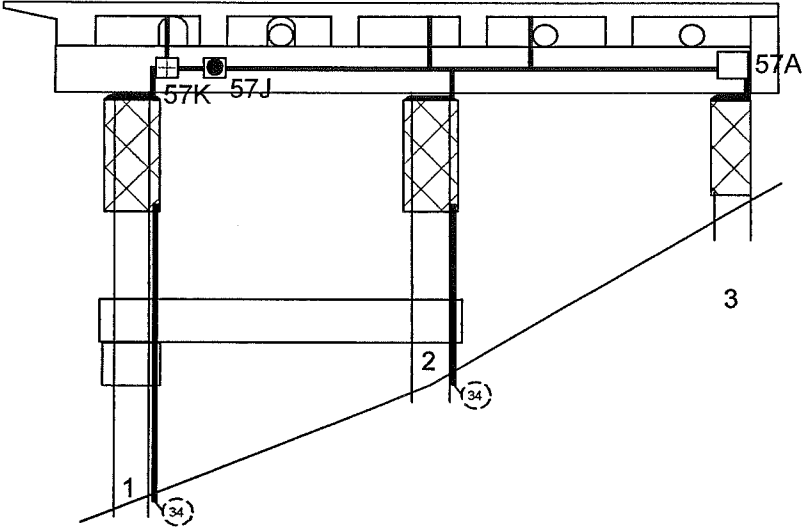

TYPICAL WIRE SIZES & COLORS AS FOLLOWS:
MZA & PJA = #10 Red
MZN; PJN = #10 Blue
SA = #8 Black
RE/REN: #16 Twisted Pair Red/Black

SCHEMATIC

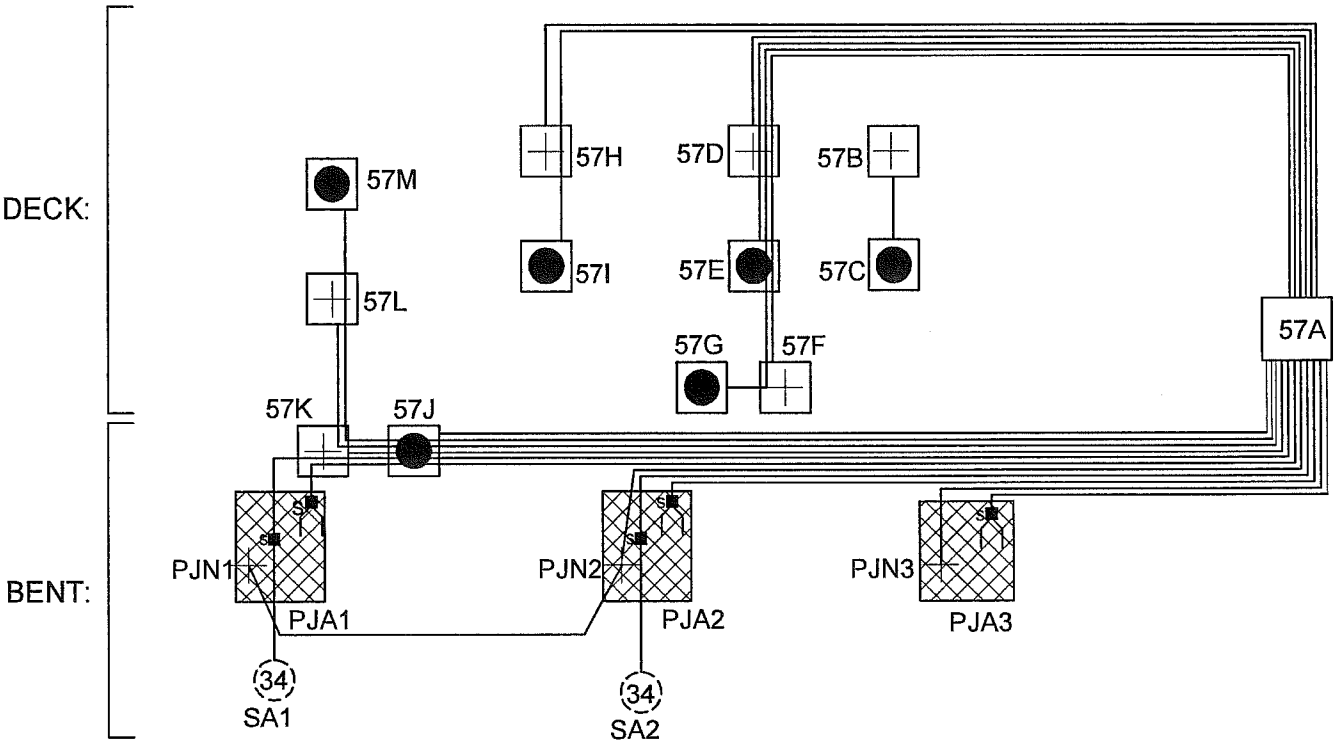


J-BOX DETAILS:

	J-Box Size	Wires or Structure
57-A	14" x 12" x 8"	MAIN J-BOX: (5) MZA; (5) MZN; (3) PJA; (2) PJN; (2) SA; SAN jumpered from PJN
57-B	5" x 5" x 2"	Structure Negative (MZN)
57-C	5" x 5" x 2"	Primary Anode Terminal Plate (MZA)
57-D	5" x 5" x 2"	Structure Negative (MZN); (2) MZA; (1) MZN
57-E	5" x 5" x 2"	Primary Anode Terminal Plate (MZA); (1) MZN; (1) MZA
57-F	5" x 5" x 2"	Structure Negative (MZN); (1) MZA
57-G	5" x 5" x 2"	Primary Anode Terminal Plate (MZA)
57-H	5" x 5" x 2"	Structure Negative (MZN); (1) MZA
57-I	5" x 5" x 2"	Primary Anode Terminal Plate (MZA)
57-J	5" x 5" x 2"	Primary Anode Terminal Plate (MZA); (2) MZN; (1) MZA; (1) PJA; (1) SA
57-K	5" x 5" x 2"	Structure Negative (MZN); (1) MZA; (1) MZN; (1) PJA; (1) SA
57-L	5" x 5" x 2"	Structure Negative (MZN); (1) MZA
57-M	5" x 5" x 2"	Primary Anode Terminal Plate (MZA)

ABBREVIATIONS:
MZN = Metallized Zinc Negative
PJN = Pile Jacket Negative
CJN = Cap Jacket Negative
SAN = Submerged Anode Negative
MZA = Metallized Zinc Anode
PJA = Pile Jacket Anode
CJA = Cap Jacket Anode
SA = Submerged Anode
RE = Reference Electrode
REN = Reference Electrode Negative


LEGEND

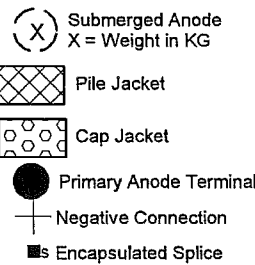


Water Street Bent 57 South Elevation & Span 57

SCALE: NONE	Field Sketch	DRAWN BY KRH
DATE: 05-12-11	As-Built	REVISED 10-4-11
GREAT WESTERN CORPORATION		
Ketchikan Viaduct II Repair & C.P.		DRAWING NUMBER W-57


SPAN 58 - VIEW THROUGH DECK

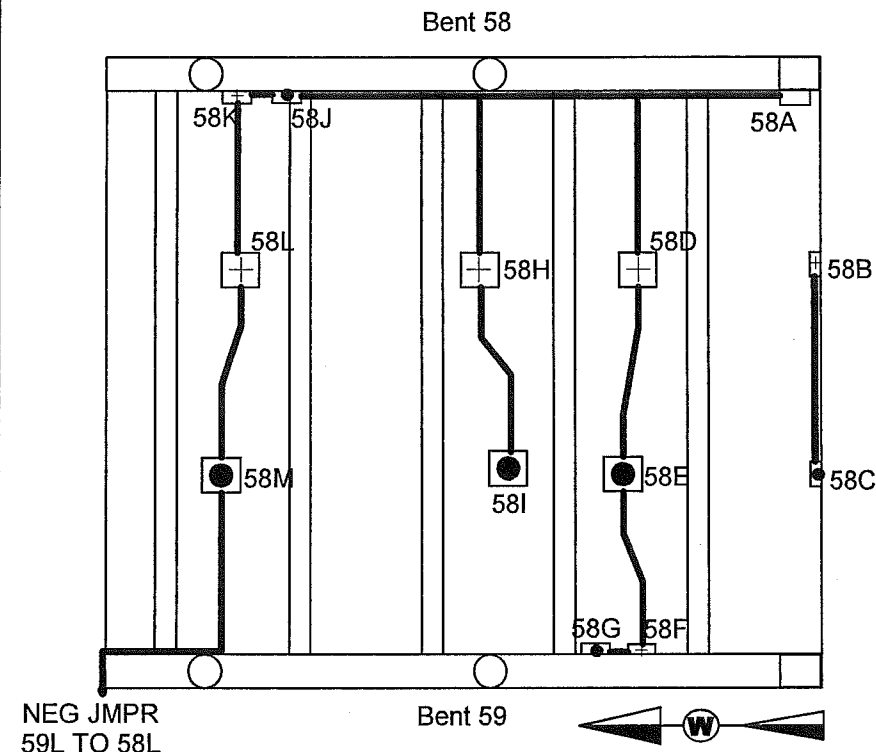

SCHEMATIC

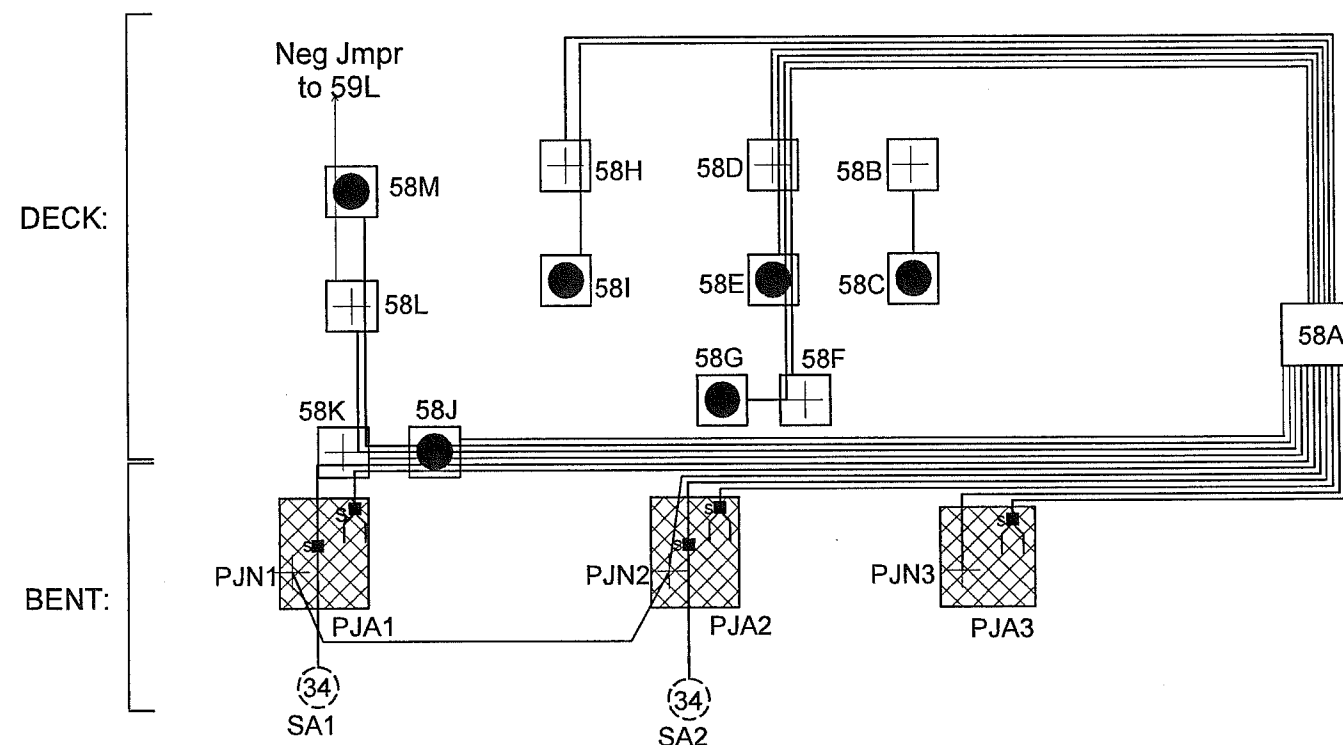

WATER BENT 58 SOUTH ELEVATION

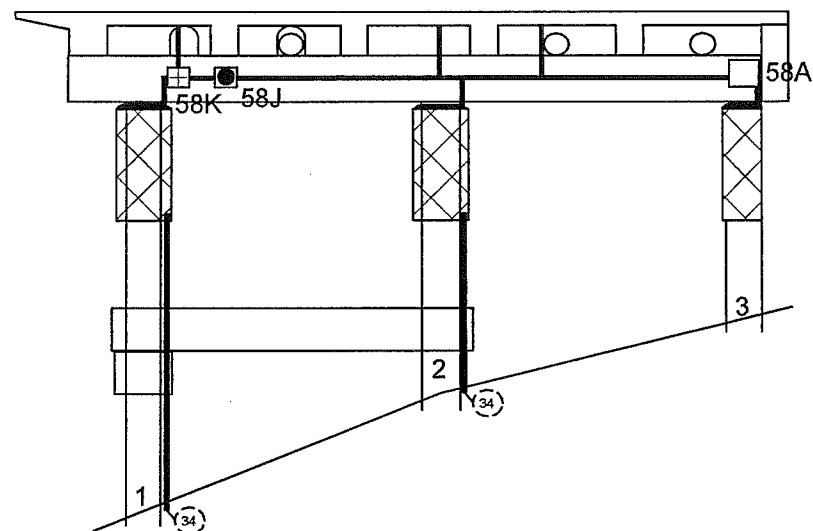


TYPICAL WIRE SIZES & COLORS AS FOLLOWS:
MZA & PJA = #10 Red
MZN; PJN = #10 Blue
SA = #8 Black
RE/REN: #16 Twisted Pair Red/Black

J-BOX DETAILS:

J-Box Size	Wires or Structure
58-A	14" x 12" x 8" MAIN J-BOX: (5) MZA; (5) MZN; (3) PJA; (2) PJN; (2) SA; SAN jumpered from PJN
58-B	5" x 5" x 2" Structure Negative (MZN)
58-C	5" x 5" x 2" Primary Anode Terminal Plate (MZA)
58-D	5" x 5" x 2" Structure Negative (MZN); (2) MZA; (1) MZN
58-E	5" x 5" x 2" Primary Anode Terminal Plate (MZA); (1) MZN; (1) MZA
58-F	5" x 5" x 2" Structure Negative (MZN); (1) MZA
58-G	5" x 5" x 2" Primary Anode Terminal Plate (MZA)
58-H	5" x 5" x 2" Structure Negative (MZN); (1) MZA
58-I	5" x 5" x 2" Primary Anode Terminal Plate (MZA)
58-J	5" x 5" x 2" Primary Anode Terminal Plate (MZA); (2) MZN; (1) MZA; (1) PJA; (1) SA
58-K	5" x 5" x 2" Structure Negative (MZN); (1) MZA; (1) MZN; (1) PJA; (1) SA
58-L	5" x 5" x 2" Structure Negative (MZN); (1) MZA; MZN Jumper to 59L
58-M	5" x 5" x 2" Primary Anode Terminal Plate (MZA); (1) MZN jumper

ABBREVIATIONS:
MZN = Metallized Zinc Negative
PJN = Pile Jacket Negative
CJN = Cap Jacket Negative
SAN = Submerged Anode Negative
MZA = Metallized Zinc Anode
PJA = Pile Jacket Anode
CJA = Cap Jacket Anode
SA = Submerged Anode
RE = Reference Electrode
REN = Reference Electrode Negative

LEGEND

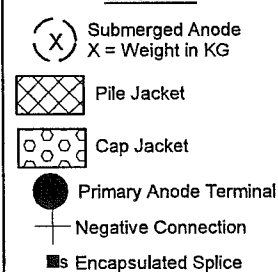

Water Street Bent 58 South Elevation & Span 58


SCALE: NONE	Field Sketch	DRAWN BY KRH
DATE: 05-12-11	As-Built	REVISED 10-4-11

GREAT WESTERN CORPORATION


Ketchikan Viaduct II
Repair & C.P.

DRAWING NUMBER
W-58

SPAN 59 - VIEW THROUGH DECK

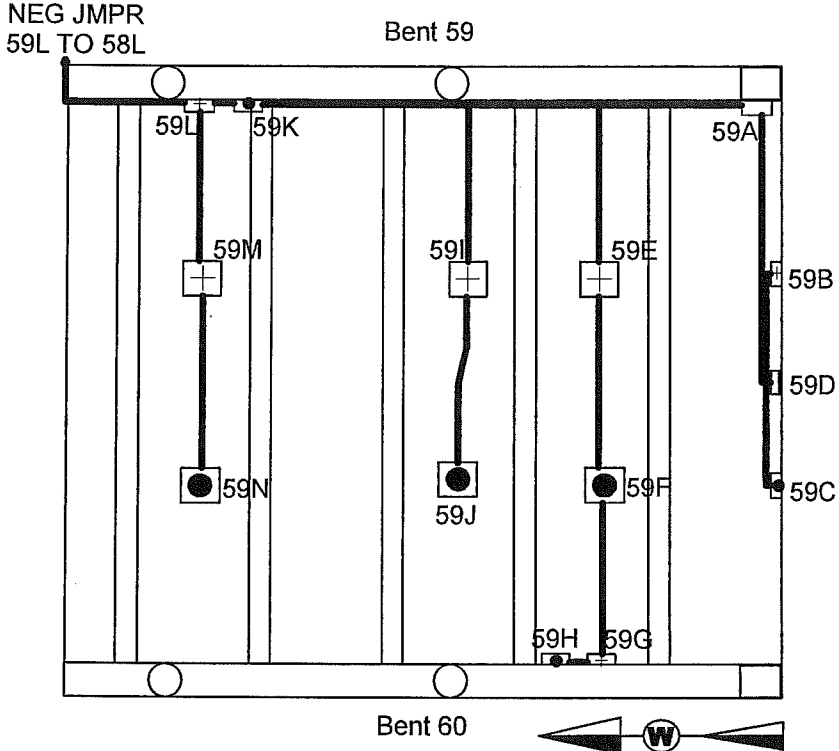


WATER BENT 59 SOUTH ELEVATION

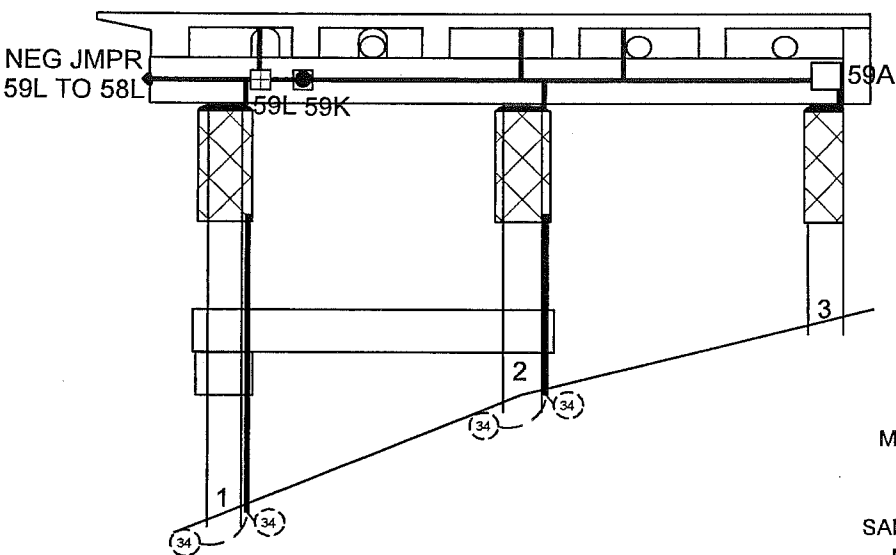

TYPICAL WIRE SIZES & COLORS AS FOLLOWS:
MZA & PJA = #10 Red
MZN; PJN = #10 Blue
SA = #8 Black
RE/REN: #16 Twisted Pair Red/Black

ABBREVIATIONS:
MZN = Metallized Zinc Negative
PJN = Pile Jacket Negative
CJN = Cap Jacket Negative
SAN = Submerged Anode Negative
MZA = Metallized Zinc Anode
PJA = Pile Jacket Anode
CJA = Cap Jacket Anode
SA = Submerged Anode
RE = Reference Electrode
REN = Reference Electrode Negative

SCHEMATIC

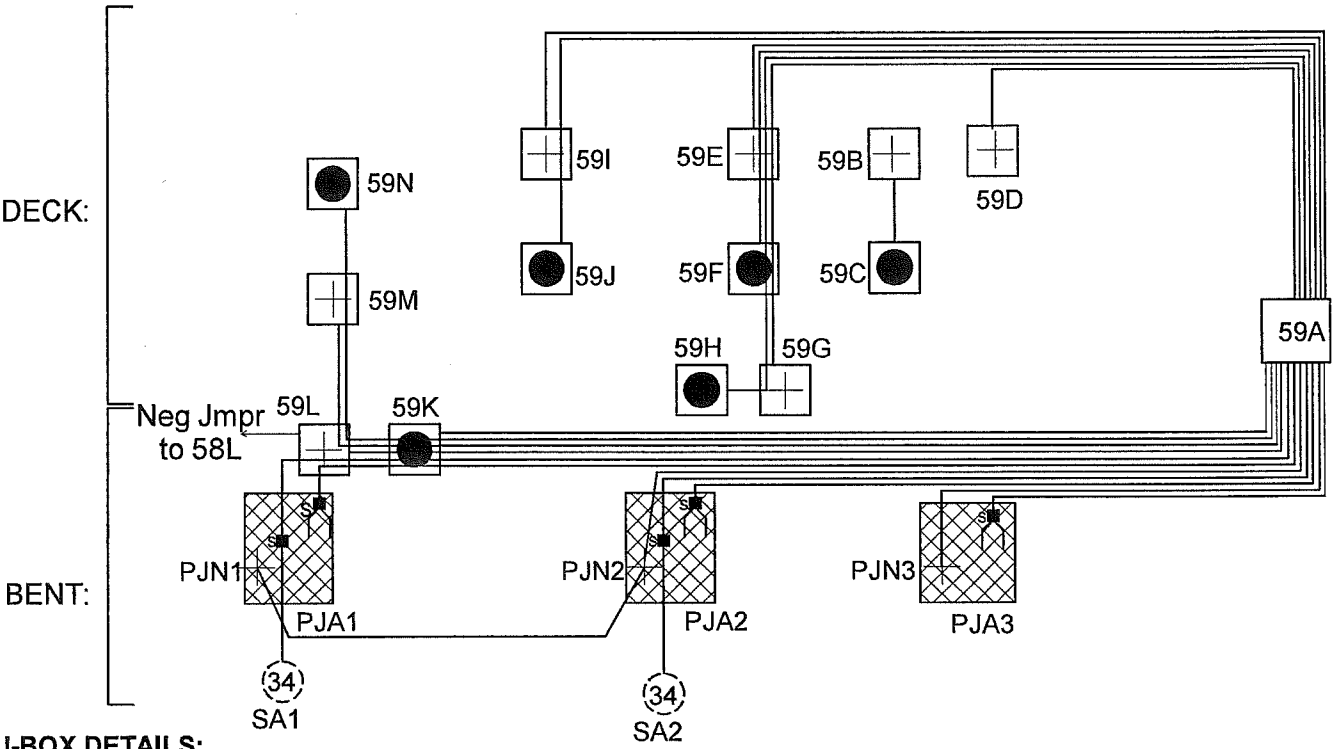

J-BOX DETAILS:

	J-Box Size	Wires or Structure
59-A	14" x 12" x 8"	MAIN J-BOX: (5) MZA; (5) MZN; (3) PJA; (2) PJN; (2) SA; SAN jumpered from PJN
59-B	5" x 5" x 2"	Structure Negative (MZN)
59-C	5" x 5" x 2"	Primary Anode Terminal Plate (MZA)
59-D	5" x 5" x 2"	Structure Negative (MZN)
59-E	5" x 5" x 2"	Structure Negative (MZN); (2) MZA; (1) MZN
59-F	5" x 5" x 2"	Primary Anode Terminal Plate (MZA); (1) MZN; (1) MZA
59-G	5" x 5" x 2"	Structure Negative (MZN); (1) MZA
59-H	5" x 5" x 2"	Primary Anode Terminal Plate (MZA)
59-I	5" x 5" x 2"	Structure Negative (MZN); (1) MZA
59-J	5" x 5" x 2"	Primary Anode Terminal Plate (MZA)
59-K	5" x 5" x 2"	Primary Anode Terminal Plate (MZA); (2) MZN; (1) MZA; (1) PJA; (1) SA
59-L	5" x 5" x 2"	Structure Negative (MZN); (1) MZA; (1) MZN; MZN Jumper to 58L; (1) PJA; (1) SA
59-M	5" x 5" x 2"	Structure Negative (MZN); (1) MZA
59-N	5" x 5" x 2"	Primary Anode Terminal Plate (MZA)

LEGEND

(x) Submerged Anode
x = Weight in LBS

⊠ Pile Jacket

⊡ Cap Jacket

● Primary Anode Terminal

⊕ Negative Connection

⊞ Encapsulated Splice

— Reference Electrode


Water Street Bent 61 South Elevation & Span 59

SCALE: NONE	Field Sketch	DRAWN BY KRH
DATE: 05-11-11	As-Built	REVISED 10-4-11


GREAT WESTERN CORPORATION

Ketchikan Viaduct II Repair & C.P.	DRAWING NUMBER W-59
---------------------------------------	------------------------

SPAN 60 - VIEW THROUGH DECK

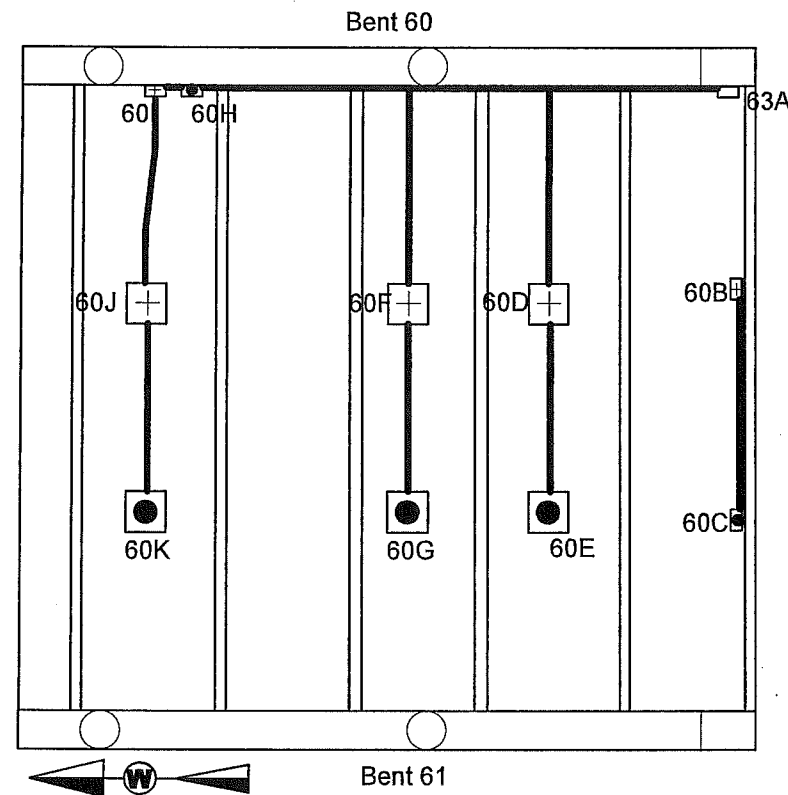


WATER BENT 60 SOUTH ELEVATION

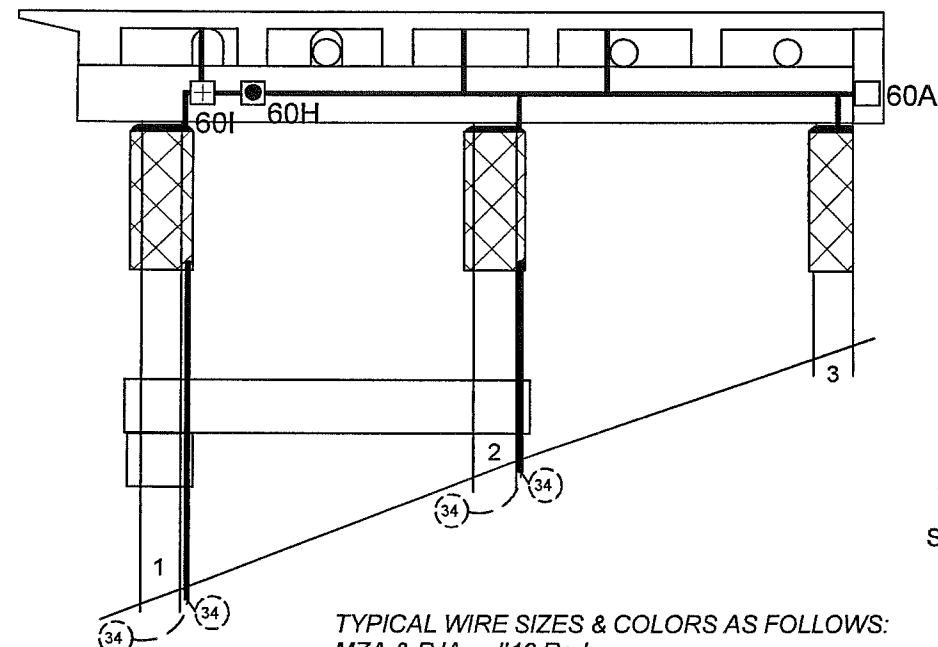

TYPICAL WIRE SIZES & COLORS AS FOLLOWS:
MZA & PJA = #10 Red
MZN; PJN = #10 Blue
SA = #8 Black
RE/REN: #16 Twisted Pair Red/Black

SCHEMATIC

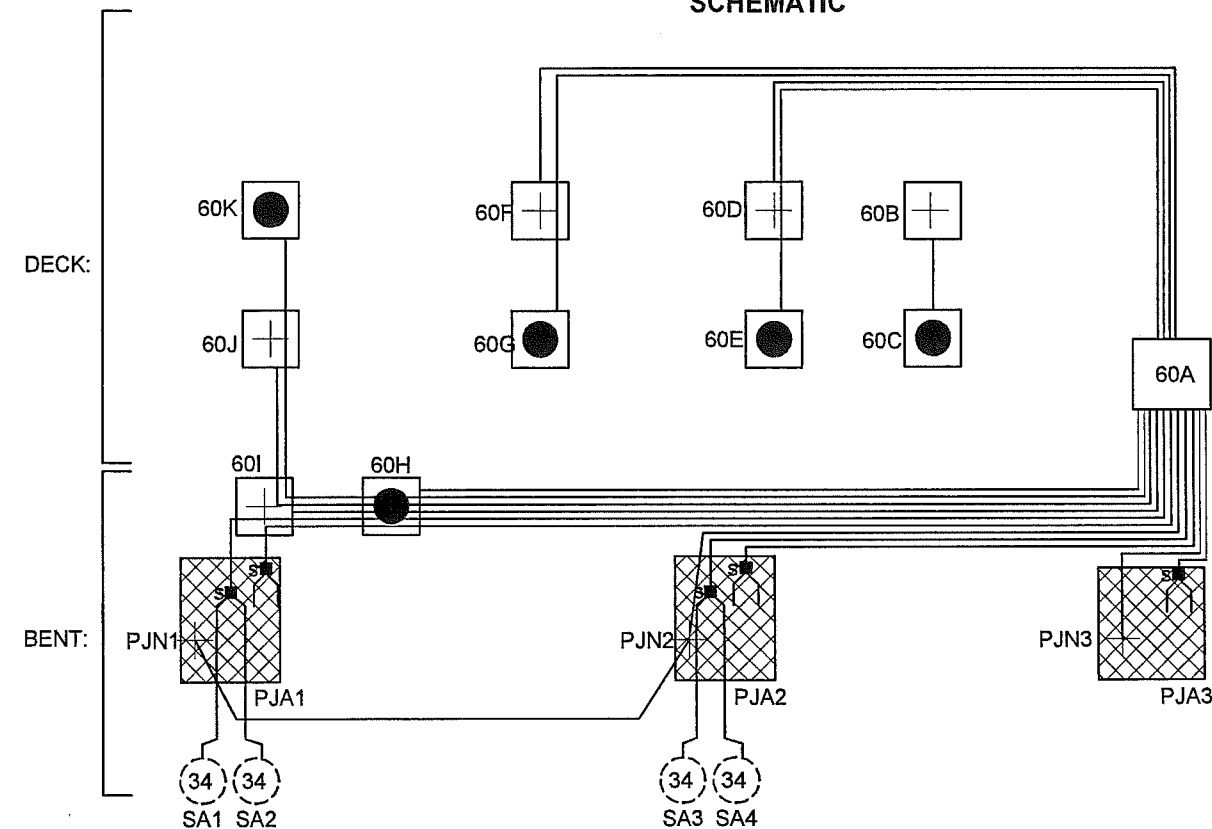

J-BOX DETAILS:

	J-Box Size	Wires or Structure
60-A	14" x 12" x 8"	MAIN J-BOX: (4) MZA; (4) MZN; (3) PJA; (2) PJN; (2) SA; SAN jumpered from PJN
60-B	5" x 5" x 2"	Structure Negative (MZN)
60-C	5" x 5" x 2"	Primary Anode Terminal Plate (MZA)
60-D	5" x 5" x 2"	Structure Negative (MZN); (1) MZA
60-E	5" x 5" x 2"	Primary Anode Terminal Plate (MZA)
60-F	5" x 5" x 2"	Structure Negative (MZN); (1) MZA
60-G	5" x 5" x 2"	Primary Anode Terminal Plate (MZA)
60-H	5" x 5" x 2"	Primary Anode Terminal Plate (MZA); (2) MZN; (1) MZA; (1) PJA; (1) SA
60-I	5" x 5" x 2"	Structure Negative (MZN); (1) MZA; (1) MZN; (1) PJA; (1) SA
60-J	5" x 5" x 2"	Structure Negative (MZN); (1) MZA
60-K	5" x 5" x 2"	Primary Anode Terminal Plate (MZA)

ABBREVIATIONS:

MZN = Metallized Zinc Negative
PJN = Pile Jacket Negative
CJN = Cap Jacket Negative
SAN = Submerged Anode Negative
MZA = Metallized Zinc Anode
PJA = Pile Jacket Anode
CJA = Cap Jacket Anode
SA = Submerged Anode
RE = Reference Electrode
REN = Reference Electrode Negative

LEGEND

- (x) Submerged Anode
- x = Weight in LBS
- ⊗ Pile Jacket
- ⊠ Cap Jacket
- Primary Anode Terminal
- + Negative Connection
- Encapsulated Splice
- Reference Electrode


Water Street Bent 60 South Elevation & Span 60

SCALE: NONE
DATE: 05-11-11
Field Sketch
As-Built
DRAWN BY KRH
REVISED 10-4-11


GREAT WESTERN CORPORATION

Ketchikan Viaduct II
Repair & C.P.
DRAWING NUMBER
W-60


SPAN 61 - VIEW THROUGH DECK

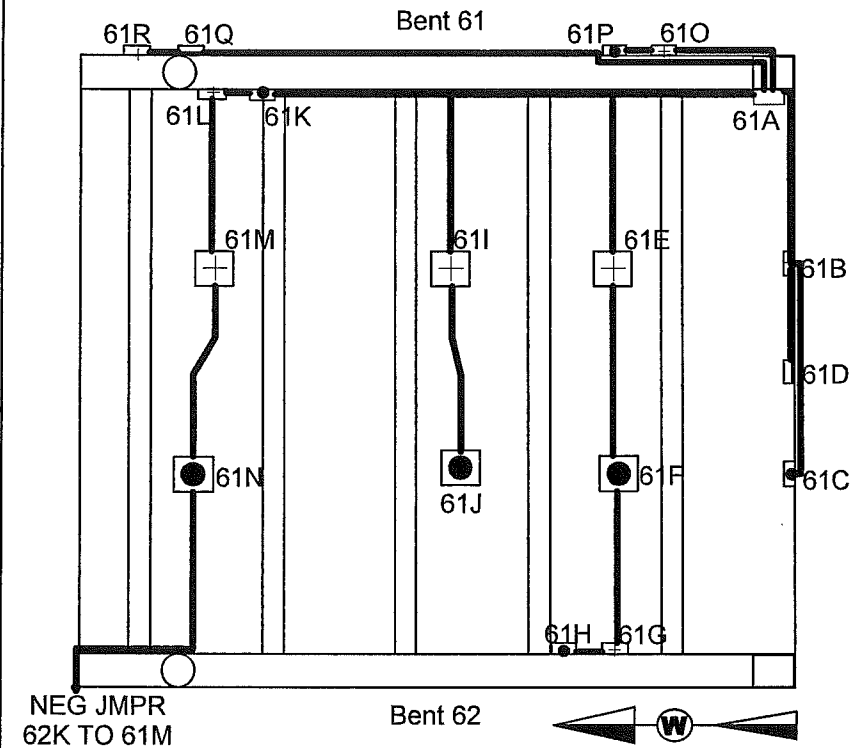

WATER BENT 61 SOUTH ELEVATION

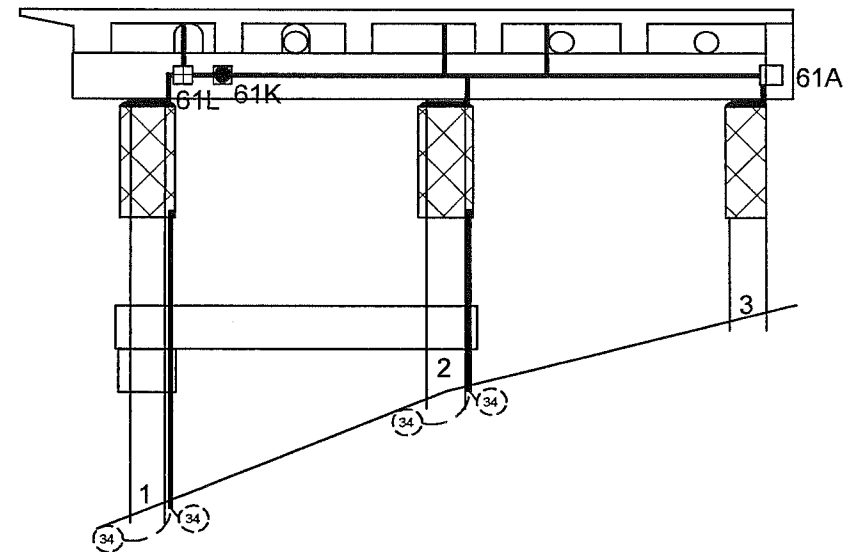

TYPICAL WIRE SIZES & COLORS AS FOLLOWS:
MZA & PJA = #10 Red
MZN; PJN = #10 Blue
SA = #8 Black
RE/REN: #16 Twisted Pair Red/Black

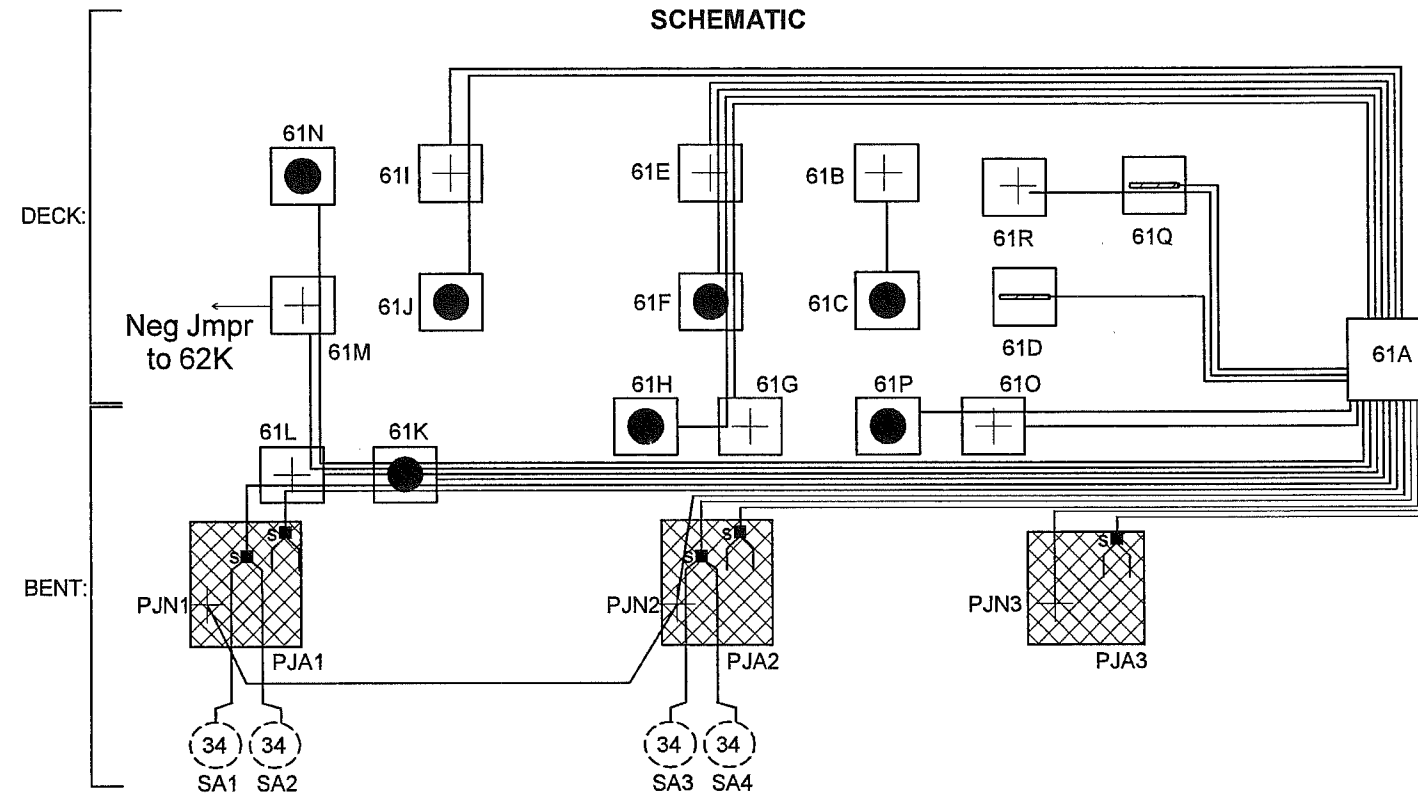

J-BOX DETAILS:

	J-Box Size	Wires or Structure
61-A	14" x 12" x 8"	MAIN J-BOX: (6) MZA; (7) MZN; (3) PJA; (2) PJN; (2) SA; SAN jumpered from PJN
61-B	5" x 5" x 2"	Structure Negative (MZN); (1) MZA
61-C	5" x 5" x 2"	Primary Anode Terminal Plate (MZA)
61-D	5" x 5" x 2"	Reference Electrode (RE) S/N 1000101
61-E	5" x 5" x 2"	Structure Negative (MZN); (2) MZA; (1) MZN
61-F	5" x 5" x 2"	Primary Anode Terminal Plate (MZA); (1) MZN; (1) MZA
61-G	5" x 5" x 2"	Structure Negative (MZN); (1) MZA
61-H	5" x 5" x 2"	Primary Anode Terminal Plate (MZA)
61-I	5" x 5" x 2"	Structure Negative (MZN); (1) MZA
61-J	5" x 5" x 2"	Primary Anode Terminal Plate (MZA)
61-K	5" x 5" x 2"	Primary Anode Terminal Plate (MZA); (2) MZN; (1) MZA; (1) PJA; (1) SA
61-L	5" x 5" x 2"	Structure Negative (MZN); (1) MZA; (1) MZN; (1) PJA; (1) SA
61-M	5" x 5" x 2"	Structure Negative (MZN); (1) MZA; (1) MZN JMPR 62
61-N	5" x 5" x 2"	Primary Anode Terminal Plate (MZA); (1) MZN JMPR 62
61-O	5" x 5" x 2"	Structure Negative (MZN); (1) MZA
61-P	5" x 5" x 2"	Primary Anode Terminal Plate (MZA)
61-Q	5" x 5" x 2"	Reference Electrode (RE) S/N 1000100
61-R	5" x 5" x 2"	Reference Electrode Negative (REN)

ABBREVIATIONS:

MZN = Metallized Zinc Negative
PJN = Pile Jacket Negative
CJN = Cap Jacket Negative
SAN = Submerged Anode Negative
MZA = Metallized Zinc Anode
PJA = Pile Jacket Anode
CJA = Cap Jacket Anode
SA = Submerged Anode
RE = Reference Electrode
REN = Reference Electrode Negative

LEGEND

⊗ Submerged Anode
x = Weight in LBS
⊠ Pile Jacket
⊡ Cap Jacket
● Primary Anode Terminal
+ Negative Connection
⊞ Encapsulated Splice
— Reference Electrode

Water Street Bent 61 South Elevation & Span 61


SCALE: NONE
DATE: 05-11-11
Field Sketch
As-Built
DRAWN BY: KRH
REVISED: 10-4-11

GREAT WESTERN CORPORATION


Ketchikan Viaduct II
Repair & C.P.

DRAWING NUMBER
W-61

SPAN 62 - VIEW THROUGH DECK

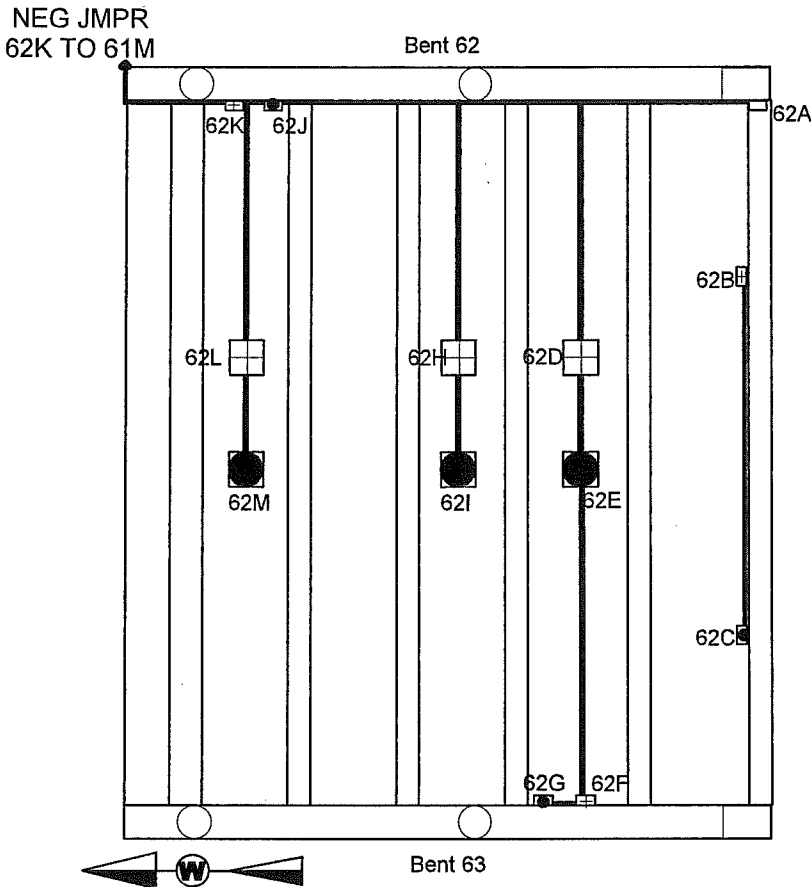


WATER BENT 62 SOUTH ELEVATION

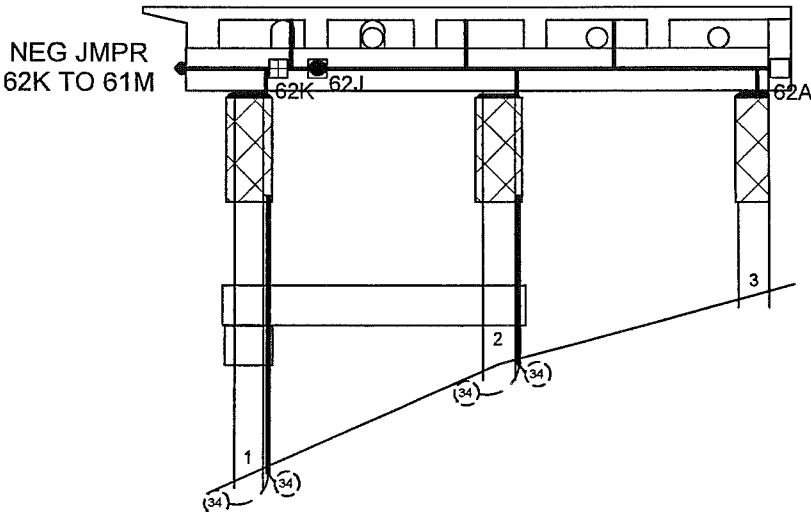

TYPICAL WIRE SIZES & COLORS AS FOLLOWS:
MZA & PJA = #10 Red
MZN; PJN = #10 Blue
SA = #8 Black
RE/REN: #16 Twisted Pair Red/Black

ABBREVIATIONS:
MZN = Metallized Zinc Negative
PJN = Pile Jacket Negative
CJN = Cap Jacket Negative
SAN = Submerged Anode Negative
MZA = Metallized Zinc Anode
PJA = Pile Jacket Anode
CJA = Cap Jacket Anode
SA = Submerged Anode
RE = Reference Electrode
REN = Reference Electrode Negative

SCHEMATIC

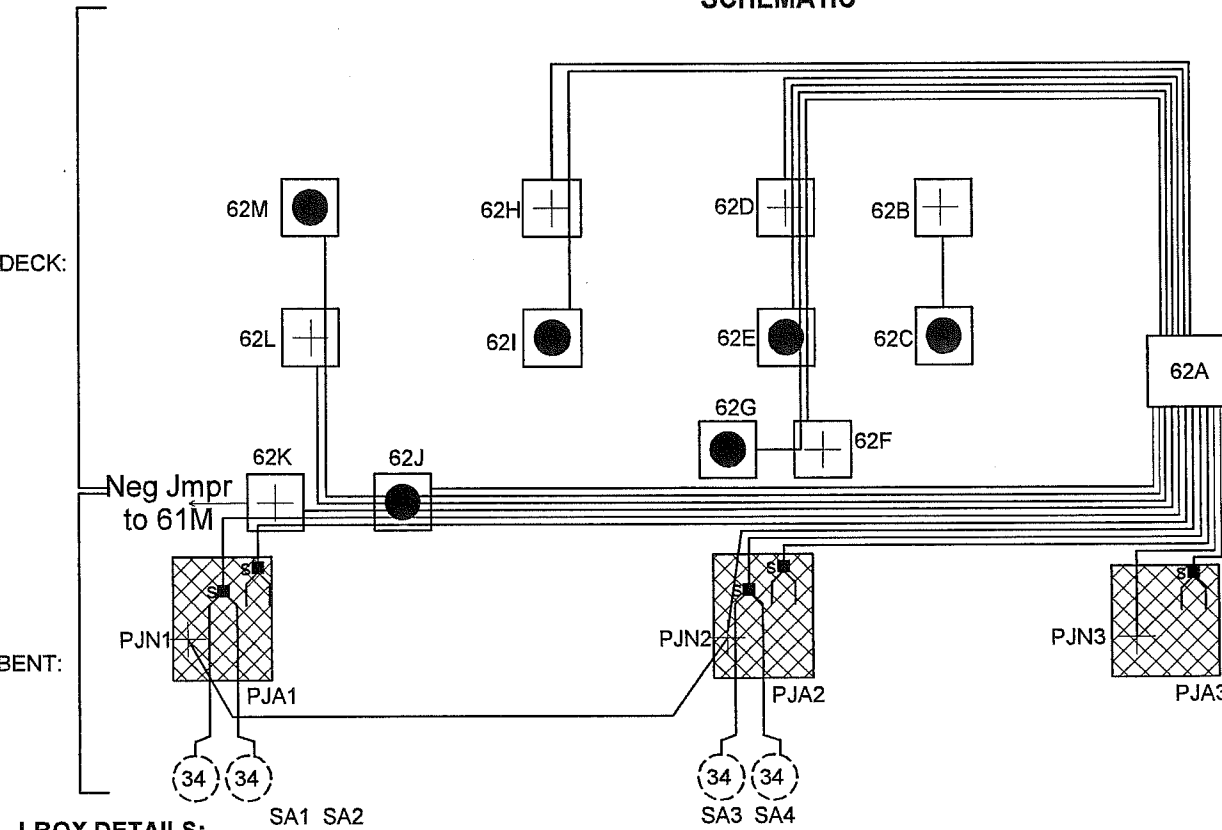

J-BOX DETAILS:


	J-Box Size	Wires or Structure
62-A	14" x 12" x 8"	MAIN J-BOX: (5) MZA; (5) MZN; (3) PJA; (2) PJN; (2) SA; SAN jumpered from PJN
62-B	5" x 5" x 2"	Structure Negative (MZN)
62-C	5" x 5" x 2"	Primary Anode Terminal Plate (MZA)
62-D	5" x 5" x 2"	Structure Negative (MZN); (2) MZA; (1) MZN
62-E	5" x 5" x 2"	Primary Anode Terminal Plate (MZA); (1) MZN; (1) MZA
62-F	5" x 5" x 2"	Structure Negative (MZN); (1) MZA
62-G	5" x 5" x 2"	Primary Anode Terminal Plate (MZA)
62-H	5" x 5" x 2"	Structure Negative (MZN); (1) MZA
62-I	5" x 5" x 2"	Primary Anode Terminal Plate (MZA)
62-J	5" x 5" x 2"	Primary Anode Terminal Plate (MZA); (2) MZN; (1) MZA; (1) PJA; (1) SA
62-K	5" x 5" x 2"	Structure Negative (MZN); MZN Jumper to 61M; (1) PJA; (1) SA
62-L	5" x 5" x 2"	Structure Negative (MZN); (1) MZA
62-M	5" x 5" x 2"	Primary Anode Terminal Plate (MZA)

LEGEND


- ⊗ Submerged Anode
- x = Weight in LBS
- ⊠ Pile Jacket
- ⊡ Cap Jacket
- Primary Anode Terminal
- + Negative Connection
- Encapsulated Splice
- Reference Electrode

Water Street Bent 62 South Elevation & Span 62		
SCALE: NONE	Field Sketch	DRAWN BY KRH
DATE: 05-11-11	As-Built	REVISED 10-4-11
GREAT WESTERN CORPORATION		
Ketchikan Viaduct II Repair & C.P.		DRAWING NUMBER W-62

SPAN 63 - VIEW THROUGH DECK

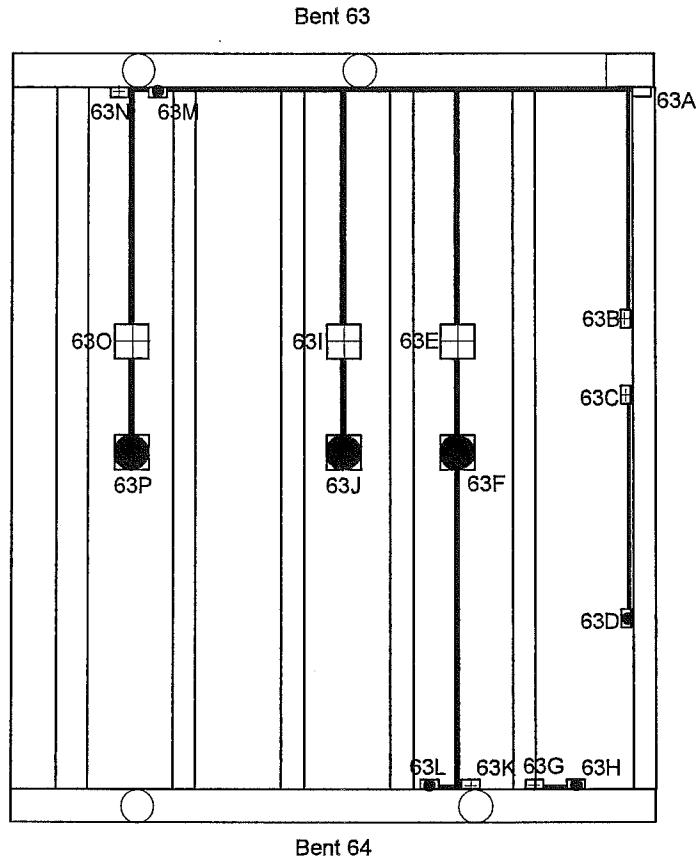


WATER BENT 63 SOUTH ELEVATION

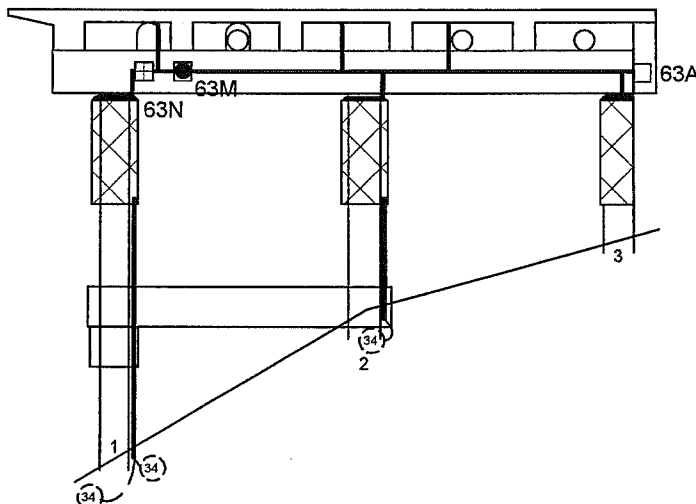

TYPICAL WIRE SIZES & COLORS AS FOLLOWS:
MZA & PJA = #10 Red
MZN; PJN = #10 Blue
SA = #8 Black
RE/REN: #16 Twisted Pair Red/Black

SCHEMATIC

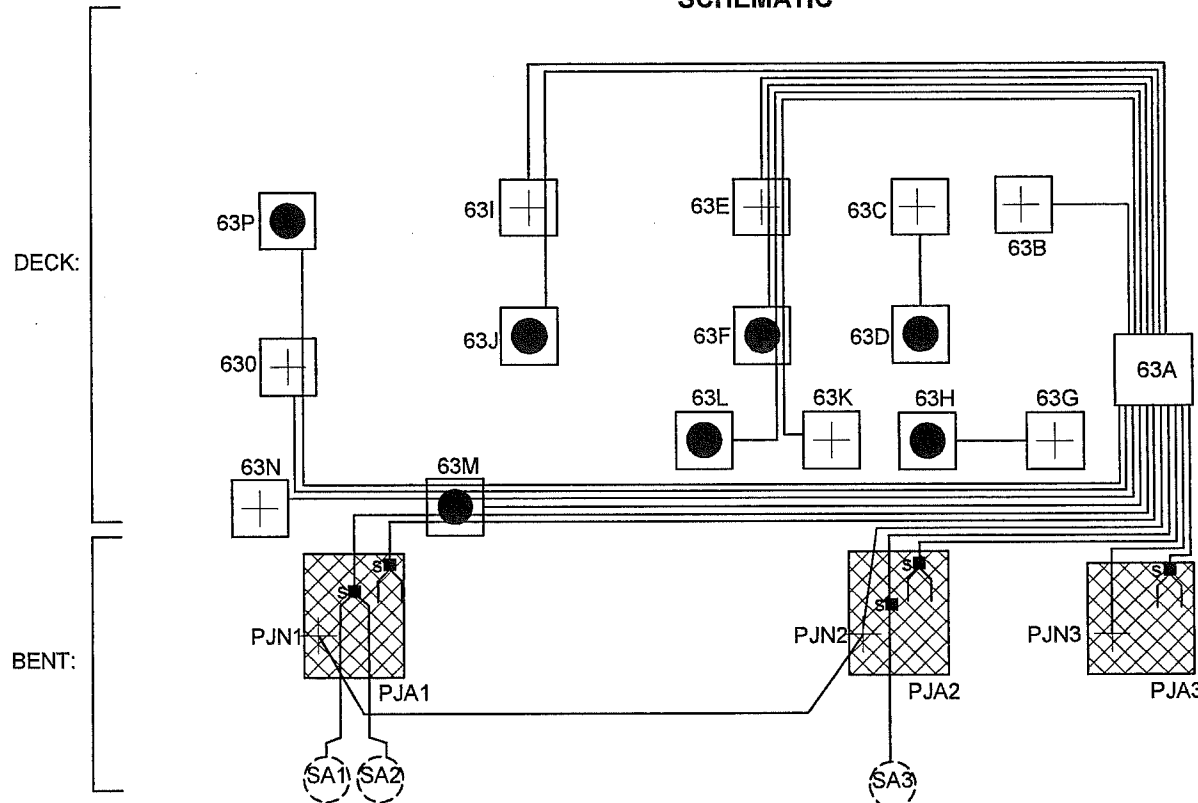

J-BOX DETAILS:

	J-Box Size	Wires or Structure
63-A	14" x 12" x 8"	MAIN J-BOX: (6) MZA; (7) MZN; (3) PJA; (2) PJN; (2) SA; SAN jumpered from PJN
63-B	5" x 5" x 2"	Structure Negative (MZN)
63-C	5" x 5" x 2"	Structure Negative (MZN)
63-D	5" x 5" x 2"	Prim ary Anode Term inal Plate (MZA)
63-E	5" x 5" x 2"	Structure Negative (MZN); (2) MZA; (1) MZN
63-F	5" x 5" x 2"	Prim ary Anode Term inal Plate (MZA); (1) MZN; (1) MZA
63-G	5" x 5" x 2"	Structure Negative (MZN)
63-H	5" x 5" x 2"	Prim ary Anode Term inal Plate (MZA)
63-I	5" x 5" x 2"	Structure Negative (MZN); (1) MZA
63-J	5" x 5" x 2"	Prim ary Anode Term inal Plate (MZA)
63-K	5" x 5" x 2"	Structure Negative (MZN)
63-L	5" x 5" x 2"	Prim ary Anode Term inal Plate (MZA)
63-M	5" x 5" x 2"	Prim ary Anode Term inal Plate (MZA); (2) MZN; (1) MZA; (1) PJA; (1) SA
63-N	5" x 5" x 2"	Structure Negative (MZN)
63-O	5" x 5" x 2"	Structure Negative (MZN); (1) MZA
63-P	5" x 5" x 2"	Prim ary Anode Term inal Plate (MZA)

ABBREVIATIONS:

MZN = Metallized Zinc Negative
 PJN = Pile Jacket Negative
 CJN = Cap Jacket Negative
 SAN = Submerged Anode Negative
 MZA = Metallized Zinc Anode
 PJA = Pile Jacket Anode
 CJA = Cap Jacket Anode
 SA = Submerged Anode
 RE = Reference Electrode
 REN = Reference Electrode Negative

LEGEND

-  Submerged Anode
x = Weight in LBS
-  Pile Jacket
-  Cap Jacket
-  Primary Anode Terminal
-  Negative Connection
-  Encapsulated Splice
-  Reference Electrode

Water Street Bent 63 South Elevation
& Span 63


SCALE: NONE	Field Sketch As-Built	DRAWN BY KRH
DATE: 05-11-11		REVISED 10-4-11

GREAT WESTERN CORPORATION


Ketchikan Viaduct II Repair & C.P.

DRAWING NUMBER	W-63
----------------	------

SPAN 64 - VIEW THROUGH DECK

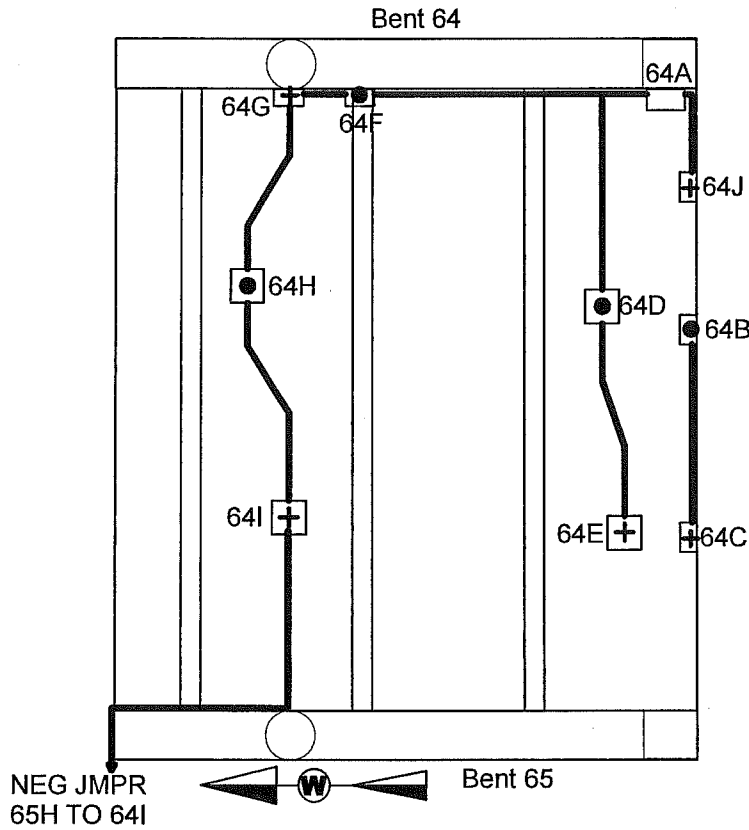


WATER BENT 64 SOUTH ELEVATION

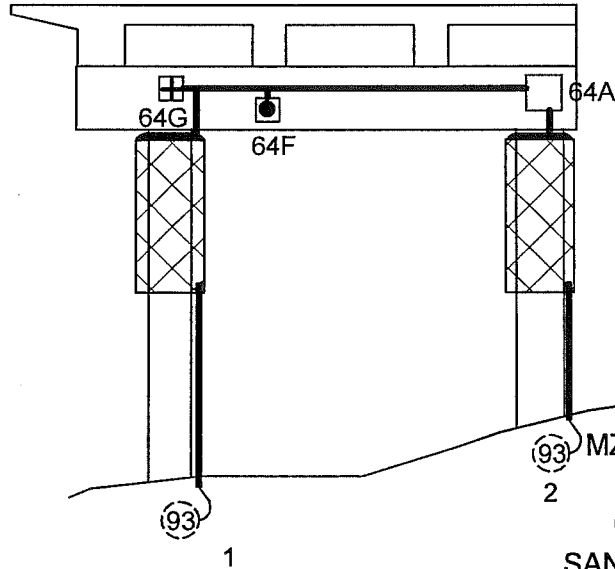

TYPICAL WIRE SIZES & COLORS AS FOLLOWS:
MZA & PJA = #10 Red
MZN; PJN = #10 Blue
SA = #8 Black
RE/REN: #16 Twisted Pair Red/Black

ABBREVIATIONS:
MZN = Metallized Zinc Negative
PJN = Pile Jacket Negative
CJN = Cap Jacket Negative
SAN = Submerged Anode Negative
MZA = Metallized Zinc Anode
PJA = Pile Jacket Anode
CJA = Cap Jacket Anode
SA = Submerged Anode
RE = Reference Electrode
REN = Reference Electrode Negative

SCHEMATIC

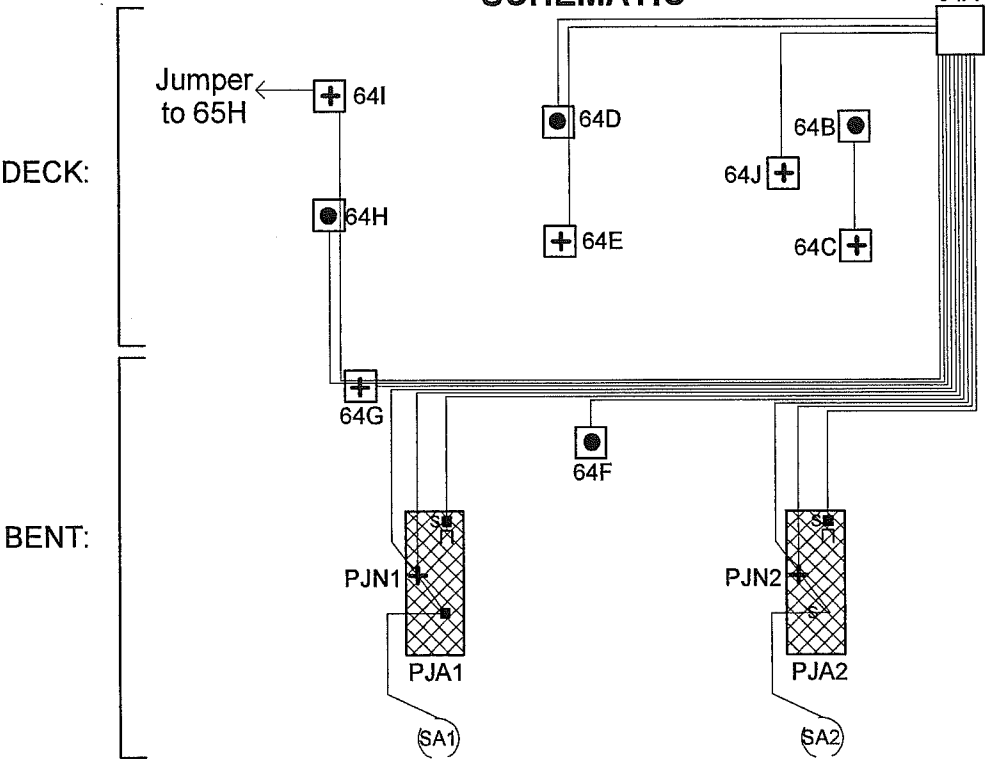

J-BOX DETAILS:



	J-Box Size	Wires or Structure
64-A	14" x 12" x 8"	MAIN J-BOX: (3) MZA; (4) MZN; (2) PJA; (2) PJN; (2) SA; SAN jumpered from PJN
64-B	5" x 5" x 2"	Primary Anode Terminal Plate (MZA)
64-C	5" x 5" x 2"	Structure Negative (MZN)
64-D	5" x 5" x 2"	Primary Anode Terminal Plate (MZA); (1) MZN
64-E	5" x 5" x 2"	Structure Negative (MZN)
64-F	5" x 5" x 2"	Primary Anode Terminal Plate (MZA)
64-G	5" x 5" x 2"	Structure Negative (MZN); (1) MZA; (1) MZN
64-H	5" x 5" x 2"	Primary Anode Terminal Plate (MZA); (1) MZN
64-I	5" x 5" x 2"	Structure Negative (MZN) - NEG JMPR 64
64-J	5" x 5" x 2"	Structure Negative (MZN)

LEGEND

- (X) Submerged Anode
x = Weight in LBS
- ⊠ Pile Jacket
- ⊡ Cap Jacket
- Primary Anode Terminal
- + Negative Connection
- Encapsulated Splice
- Reference Electrode


Water Street Bent 64 South Elevation
& Span 64

SCALE: NONE	Field Sketch	DRAWN BY KRH
DATE: 9-14-11	As-Built	REVISED
GREAT WESTERN CORPORATION		
Ketchikan Viaduct II Repair & C.P.		DRAWING NUMBER W64

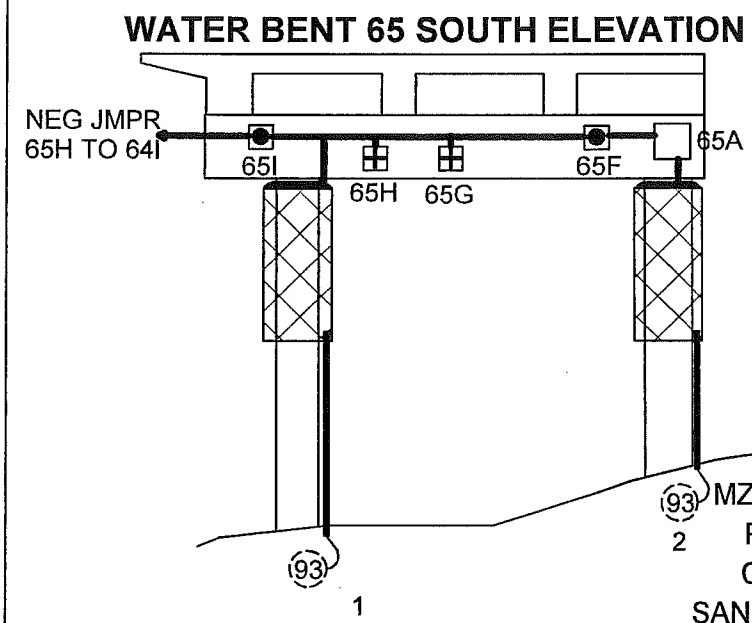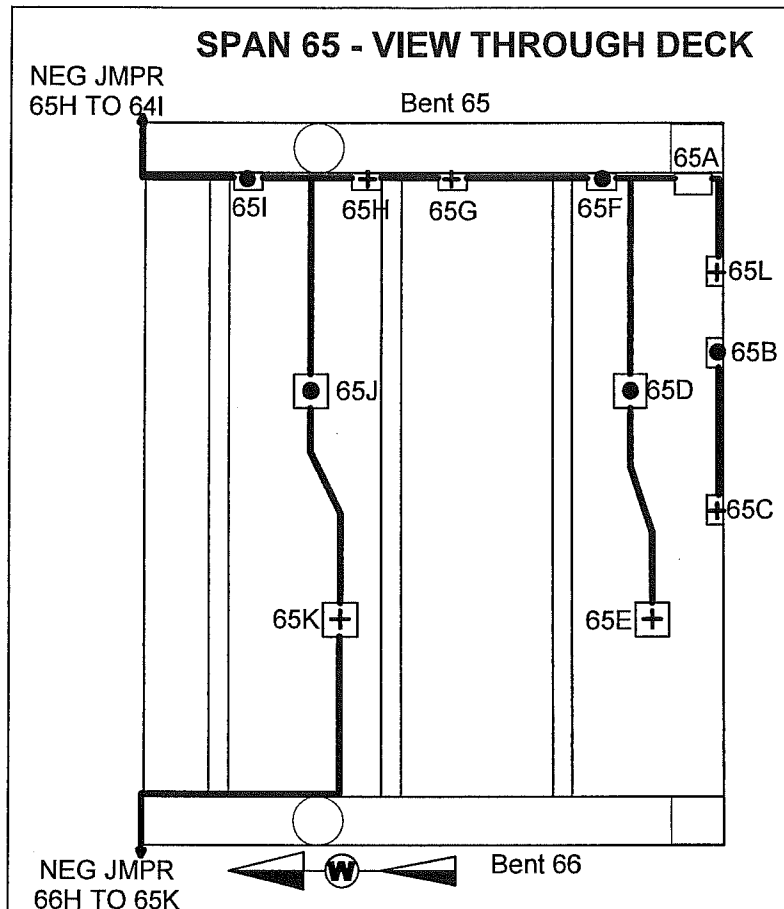

TYPICAL WIRE SIZES & COLORS AS FOLLOWS:
 MZA & PJA = #10 Red
 MZN; PJN = #10 Blue
 SA = #8 Black
 RE/REN: #16 Twisted Pair Red/Black

ABBREVIATIONS:
 MZN = Metallized Zinc Negative
 PJN = Pile Jacket Negative
 CJN = Cap Jacket Negative
 SAN = Submerged Anode Negative
 MZA = Metallized Zinc Anode
 PJA = Pile Jacket Anode
 CJA = Cap Jacket Anode
 SA = Submerged Anode
 RE = Reference Electrode
 REN = Reference Electrode Negative

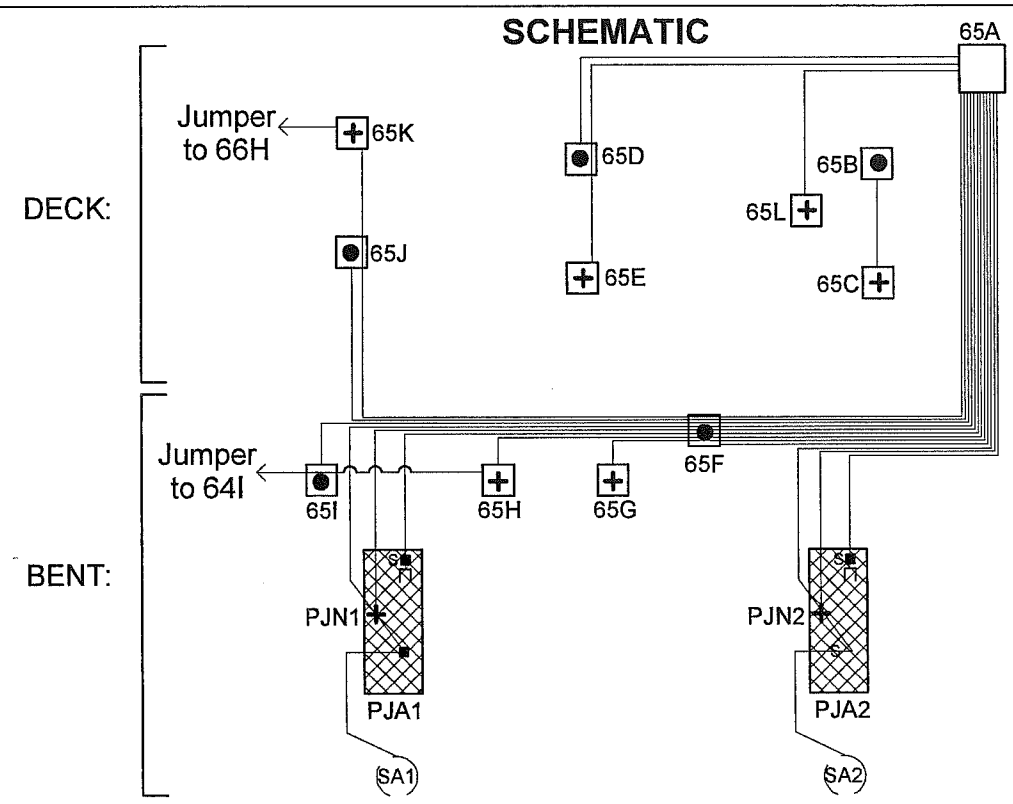

J-BOX DETAILS:


J-Box Size	Wires or Structure
65-A 14" x 12" x 8"	MAIN J-BOX: (4) MZA; (5) MZN; (2) PJA; (2) PJN; (2) SA; SAN jumpered from PJN
65-B 5" x 5" x 2"	Primary Anode Terminal Plate (MZA)
65-C 5" x 5" x 2"	Structure Negative (MZN)
65-D 5" x 5" x 2"	Primary Anode Terminal Plate (MZA); (1) MZN
65-E 5" x 5" x 2"	Structure Negative (MZN)
65-F 5" x 5" x 2"	Primary Anode Terminal Plate (MZA); (2) MZA; (3) MZN; (1) PJA; (1) PJN; (1) SA
65-G 5" x 5" x 2"	Structure Negative (MZN)
65-H 5" x 5" x 2"	Structure Negative (MZN) - NEG JMPR 65
65-I 5" x 5" x 2"	Primary Anode Terminal Plate (MZA); (1) MZN JMPR 65
65-J 5" x 5" x 2"	Primary Anode Terminal Plate (MZA); (1) MZN
65-K 5" x 5" x 2"	Structure Negative (MZN); (1) MZN JMPR 66
65-L 5" x 5" x 2"	Structure Negative (MZN)

LEGEND

(x)	Submerged Anode x = Weight in LBS
⊠	Pile Jacket
⊡	Cap Jacket
●	Primary Anode Terminal
+	Negative Connection
■	Encapsulated Splice
—	Reference Electrode


Water Street Bent 65 South Elevation & Span 65		
SCALE: NONE	Field Sketch	DRAWN BY KRH
DATE: 9-14-11	As-Built	REVISED
GREAT WESTERN CORPORATION		
Ketchikan Viaduct II Repair & C.P.		DRAWING NUMBER W65

SPAN 66 - VIEW THROUGH DECK

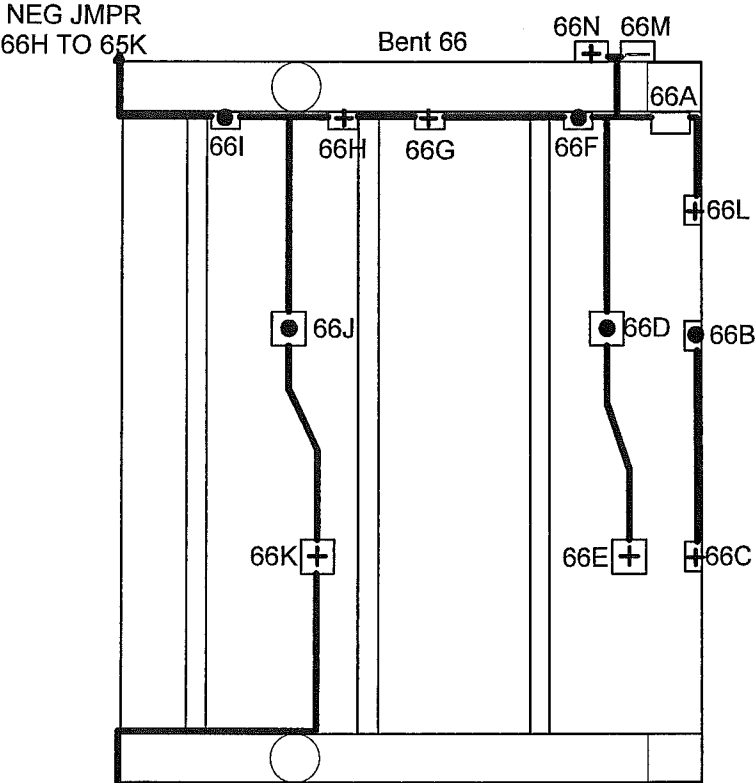

NEG JMPR
66H TO 65K


WATER BENT 66 SOUTH ELEVATION

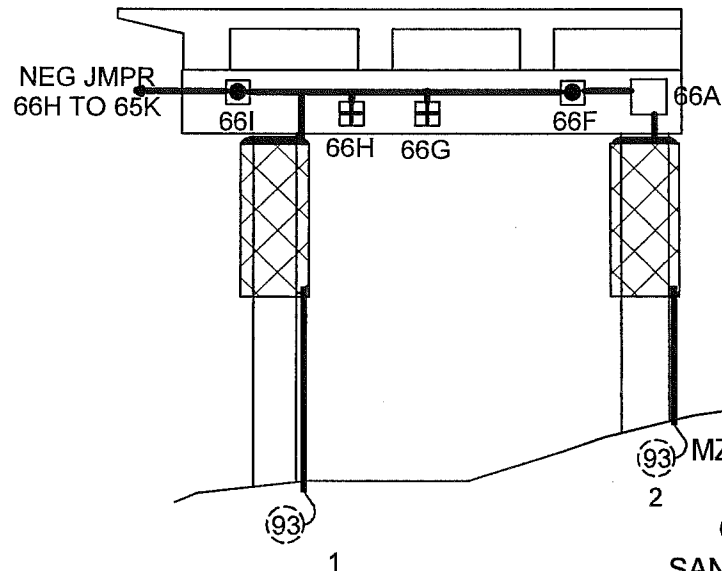

TYPICAL WIRE SIZES & COLORS AS FOLLOWS:
MZA & PJA = #10 Red
MZN; PJN = #10 Blue
SA = #8 Black
RE/REN: #16 Twisted Pair Red/Black

ABBREVIATIONS:
MZN = Metallized Zinc Negative
PJN = Pile Jacket Negative
CJN = Cap Jacket Negative
SAN = Submerged Anode Negative
MZA = Metallized Zinc Anode
PJA = Pile Jacket Anode
CJA = Cap Jacket Anode
SA = Submerged Anode
RE = Reference Electrode
REN = Reference Electrode Negative

SCHEMATIC

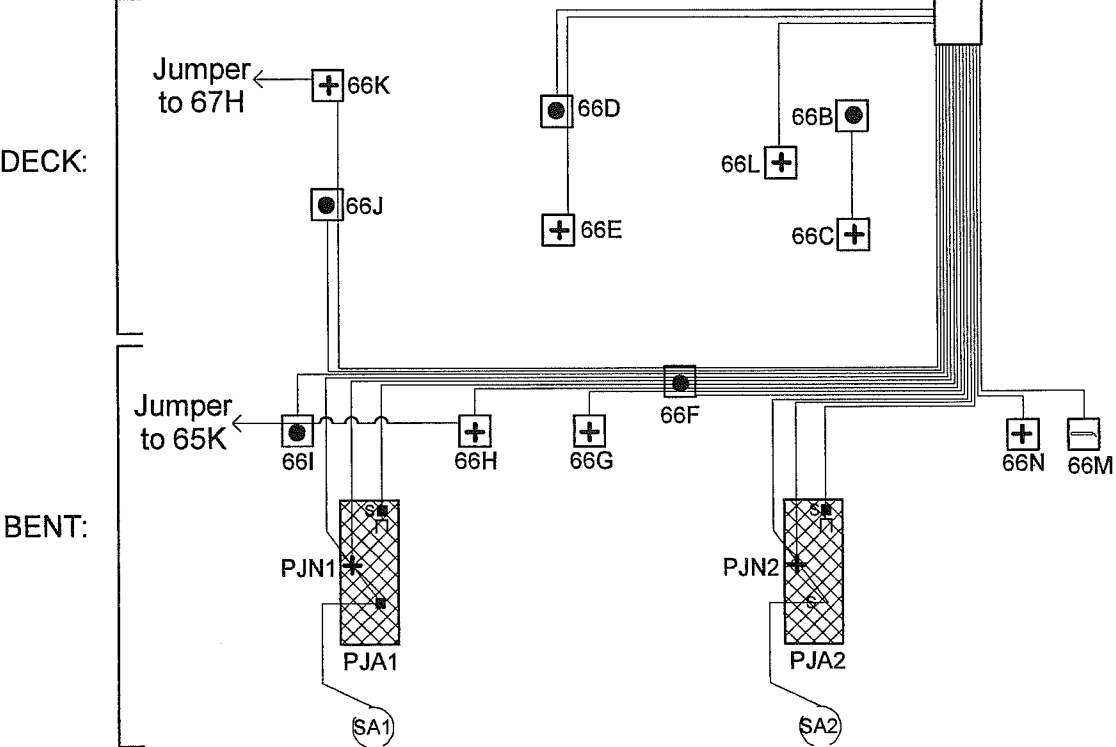

J-BOX DETAILS:

	J-Box Size	Wires or Structure
66-A	14" x 12" x 8"	MAIN J-BOX: (4) MZA; (5) MZN; (2) PJA; (2) PJN; (2) SA; SAN jumpered from PJN; (1) RE; (1) REN
66-B	5" x 5" x 2"	Primary Anode Terminal Plate (MZA)
66-C	5" x 5" x 2"	Structure Negative (MZN)
66-D	5" x 5" x 2"	Primary Anode Terminal Plate (MZA); (1) MZN
66-E	5" x 5" x 2"	Structure Negative (MZN)
66-F	5" x 5" x 2"	Primary Anode Terminal Plate (MZA); (2) MZA; (3) MZN; (1) PJA; (1) PJN; (1) SA
66-G	5" x 5" x 2"	Structure Negative (MZN)
66-H	5" x 5" x 2"	Structure Negative (MZN) - NEG JMPR 66
66-I	5" x 5" x 2"	Primary Anode Terminal Plate (MZA); (1) MZN JMPR 66
66-J	5" x 5" x 2"	Primary Anode Terminal Plate (MZA); (1) MZN
66-K	5" x 5" x 2"	Structure Negative (MZN); (1) MZN JMPR 67
66-L	5" x 5" x 2"	Structure Negative (MZN)
66-M	5" x 5" x 2"	Reference Electrode (RE) S/N 509044
66-N	5" x 5" x 2"	Reference Electrode Negative (REN)

LEGEND

- (x) Submerged Anode
x = Weight in LBS
- ⊠ Pile Jacket
- ⊡ Cap Jacket
- Primary Anode Terminal
- + Negative Connection
- ⊞ Encapsulated Splice
- Reference Electrode

Water Street Bent 66 South Elevation
& Span 66


SCALE: NONE	Field Sketch	DRAWN BY KRH
DATE: 9-14-11	As-Built	REVISED

GREAT WESTERN CORPORATION


Ketchikan Viaduct II
Repair & C.P.

DRAWING NUMBER
W66

SPAN 67 - VIEW THROUGH DECK

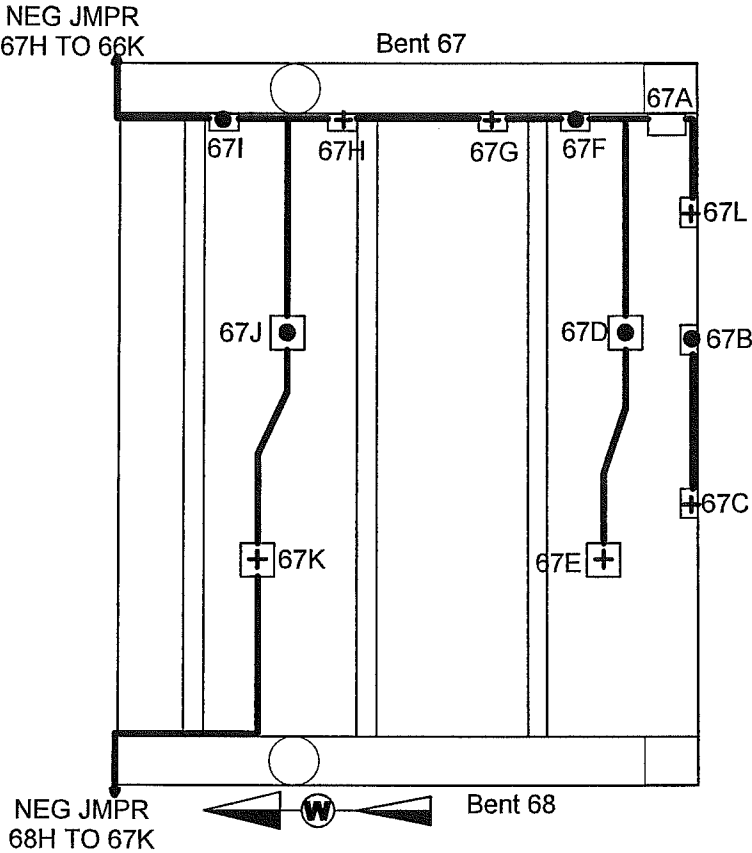


WATER BENT 67 SOUTH ELEVATION

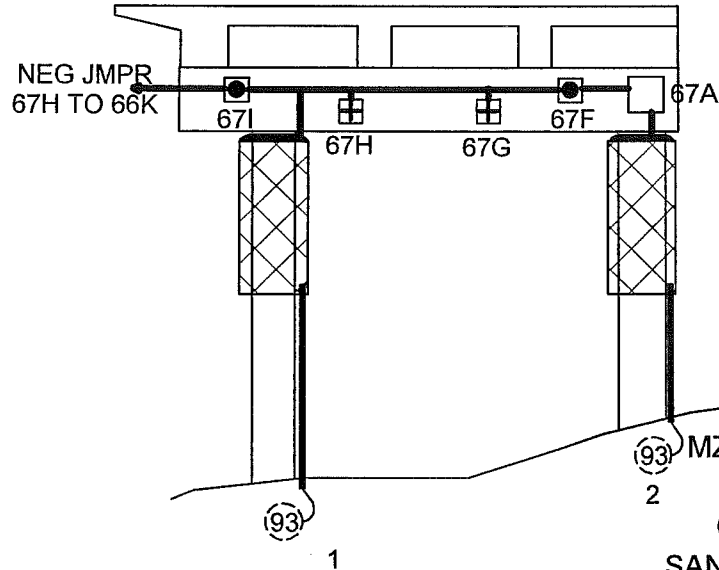

TYPICAL WIRE SIZES & COLORS AS FOLLOWS:
MZA & PJA = #10 Red
MZN; PJN = #10 Blue
SA = #8 Black
RE/REN: #16 Twisted Pair Red/Black

ABBREVIATIONS:
MZN = Metallized Zinc Negative
PJN = Pile Jacket Negative
CJN = Cap Jacket Negative
SAN = Submerged Anode Negative
MZA = Metallized Zinc Anode
PJA = Pile Jacket Anode
CJA = Cap Jacket Anode
SA = Submerged Anode
RE = Reference Electrode
REN = Reference Electrode Negative

SCHEMATIC

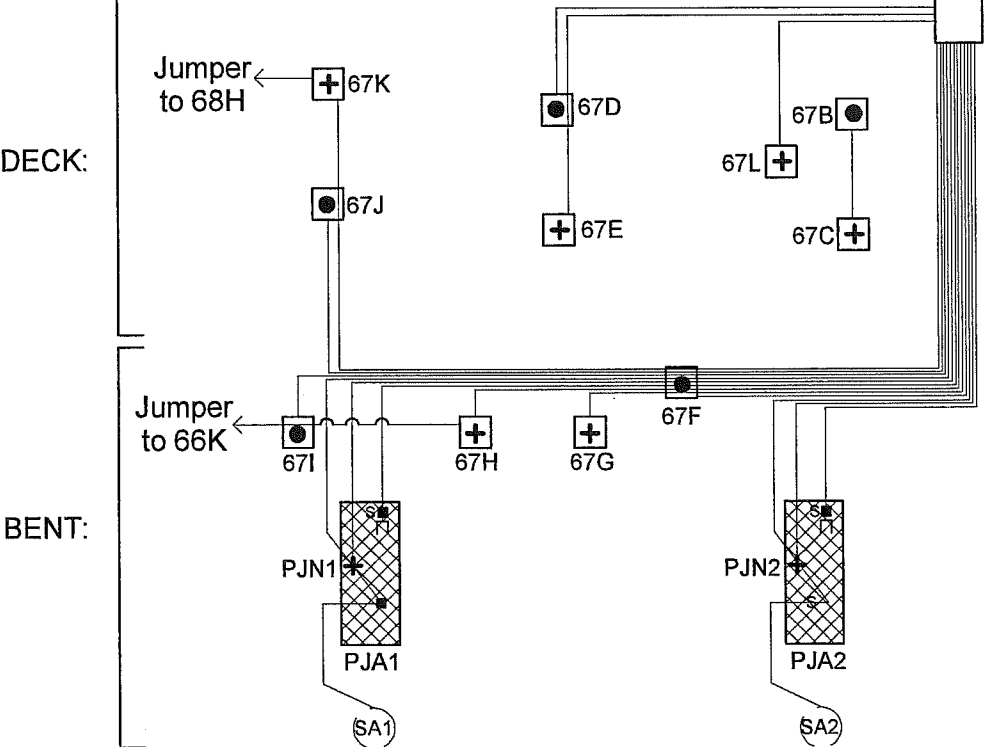

J-BOX DETAILS:

	J-Box Size	Wires or Structure
67-A	14" x 12" x 8"	MAIN J-BOX: (4) MZA; (5) MZN; (2) PJA; (2) PJN; (2) SA; SAN jumpered from PJN
67-B	5" x 5" x 2"	Primary Anode Terminal Plate (MZA)
67-C	5" x 5" x 2"	Structure Negative (MZN)
67-D	5" x 5" x 2"	Primary Anode Terminal Plate (MZA); (1) MZN
67-E	5" x 5" x 2"	Structure Negative (MZN)
67-F	5" x 5" x 2"	Primary Anode Terminal Plate (MZA); (2) MZA; (3) MZN; (1) PJA; (1) PJN; (1) SA
67-G	5" x 5" x 2"	Structure Negative (MZN)
67-H	5" x 5" x 2"	Structure Negative (MZN) - NEG JMPR 67
67-I	5" x 5" x 2"	Primary Anode Terminal Plate (MZA); (1) MZN JMPR 67
67-J	5" x 5" x 2"	Primary Anode Terminal Plate (MZA); (1) MZN
67-K	5" x 5" x 2"	Structure Negative (MZN); (1) MZN JMPR 68
67-L	5" x 5" x 2"	Structure Negative (MZN)

LEGEND

- (x) Submerged Anode
x = Weight in LBS
- ⊠ Pile Jacket
- ⊡ Cap Jacket
- Primary Anode Terminal
- + Negative Connection
- Encapsulated Splice
- Reference Electrode



Water Street Bent 67 South Elevation
& Span 67

SCALE: NONE	Field Sketch	DRAWN BY KRH
DATE: 9-14-11	As-Built	REVISED

GREAT WESTERN CORPORATION


Ketchikan Viaduct II
Repair & C.P.

DRAWING NUMBER
W67

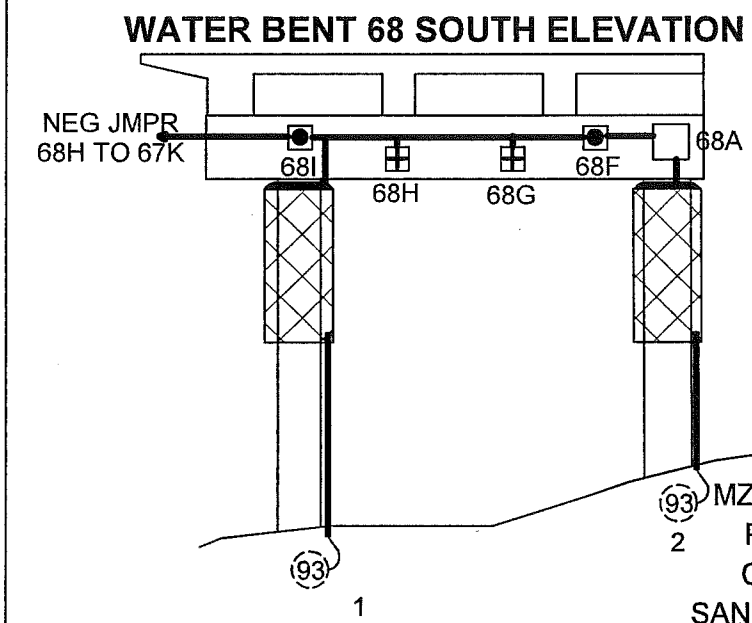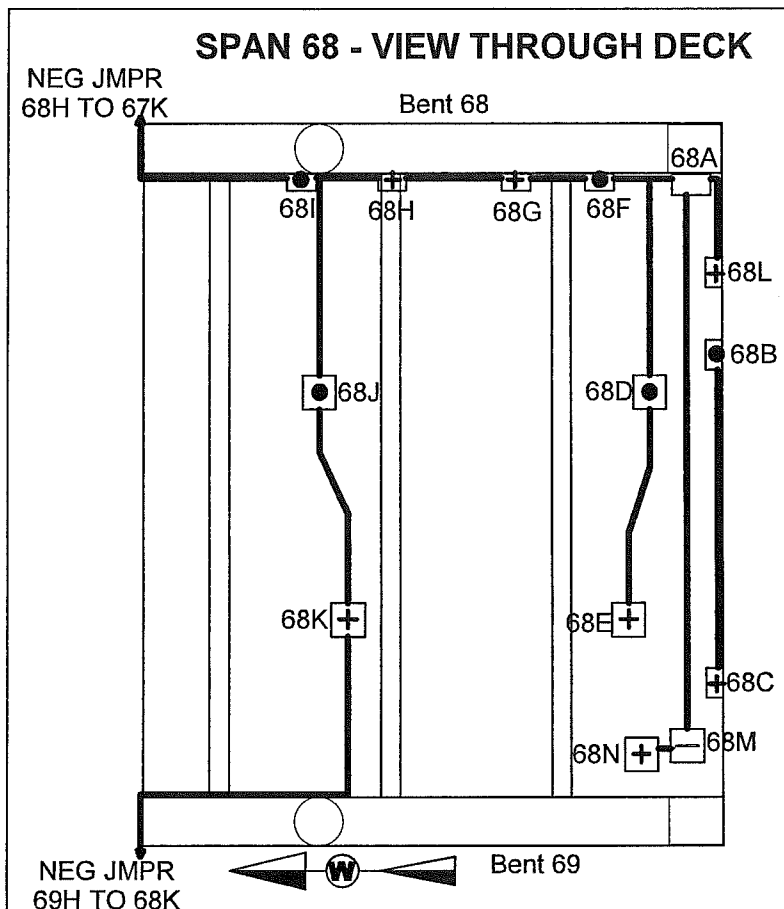

TYPICAL WIRE SIZES & COLORS AS FOLLOWS:
 MZA & PJA = #10 Red
 MZN; PJN = #10 Blue
 SA = #8 Black
 RE/REN: #16 Twisted Pair Red/Black

ABBREVIATIONS:
 MZN = Metallized Zinc Negative
 PJN = Pile Jacket Negative
 CJN = Cap Jacket Negative
 SAN = Submerged Anode Negative
 MZA = Metallized Zinc Anode
 PJA = Pile Jacket Anode
 CJA = Cap Jacket Anode
 SA = Submerged Anode
 RE = Reference Electrode
 REN = Reference Electrode Negative

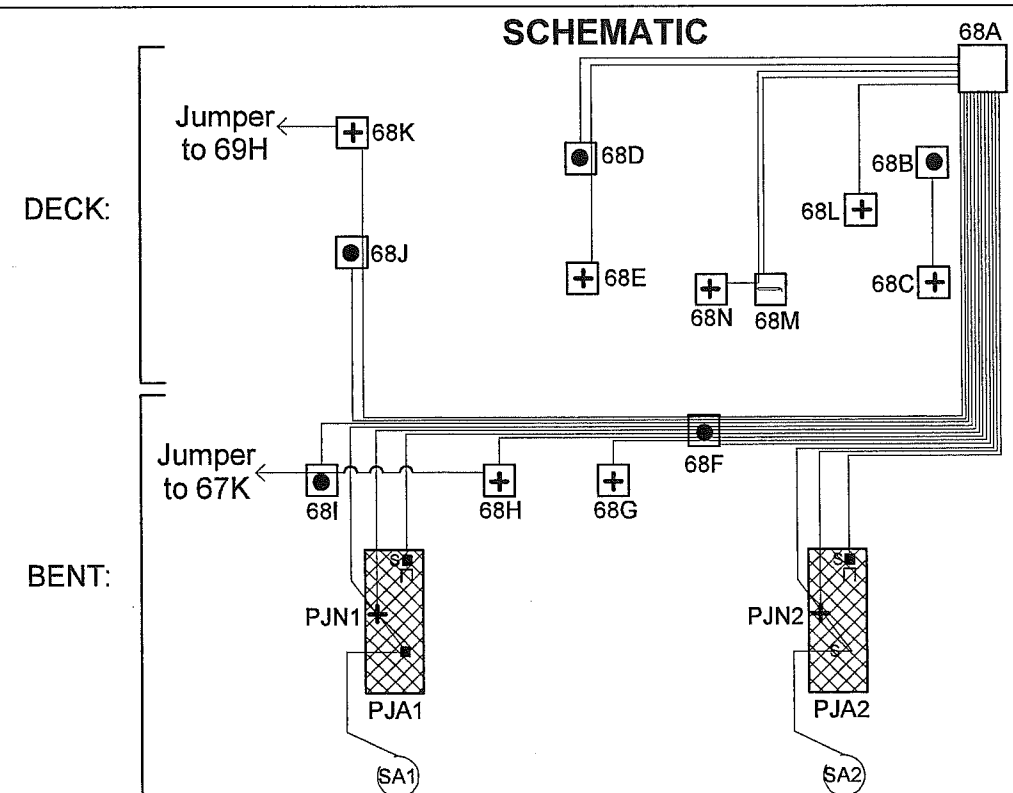




J-BOX DETAILS:

	J-Box Size	Wires or Structure
68-A	14" x 12" x 8"	MAIN J-BOX: (4) MZA; (5) MZN; (2) PJA; (2) PJN; (2) SA; SAN jumpered from PJN; (1) RE; (1) REN
68-B	5" x 5" x 2"	Primary Anode Terminal Plate (MZA)
68-C	5" x 5" x 2"	Structure Negative (MZN)
68-D	5" x 5" x 2"	Primary Anode Terminal Plate (MZA); (1) MZN
68-E	5" x 5" x 2"	Structure Negative (MZN)
68-F	5" x 5" x 2"	Primary Anode Terminal Plate (MZA); (3) MZA; (2) MZN; (1) PJA; (1) PJN; (1) SA
68-G	5" x 5" x 2"	Structure Negative (MZN)
68-H	5" x 5" x 2"	Structure Negative (MZN) - NEG JMPR 68
68-I	5" x 5" x 2"	Primary Anode Terminal Plate (MZA); (1) MZN JMPR 68
68-J	5" x 5" x 2"	Primary Anode Terminal Plate (MZA); (1) MZN
68-K	5" x 5" x 2"	Structure Negative (MZN); (1) MZN JMPR 69
68-L	5" x 5" x 2"	Structure Negative (MZN)
68-M	5" x 5" x 2"	Reference Electrode (RE) S/N 509037
68-N	5" x 5" x 2"	Reference Electrode Negative (REN)

LEGEND

(x)	Submerged Anode x = Weight in LBS
⊠	Pile Jacket
⊡	Cap Jacket
●	Primary Anode Terminal
+	Negative Connection
■	Encapsulated Splice
—	Reference Electrode

Water Street Bent 68 South Elevation & Span 68		
SCALE: NONE	Field Sketch	DRAWN BY KRH
DATE: 9-14-11	As-Built	REVISED
GREAT WESTERN CORPORATION		
Ketchikan Viaduct II Repair & C.P.		DRAWING NUMBER W68

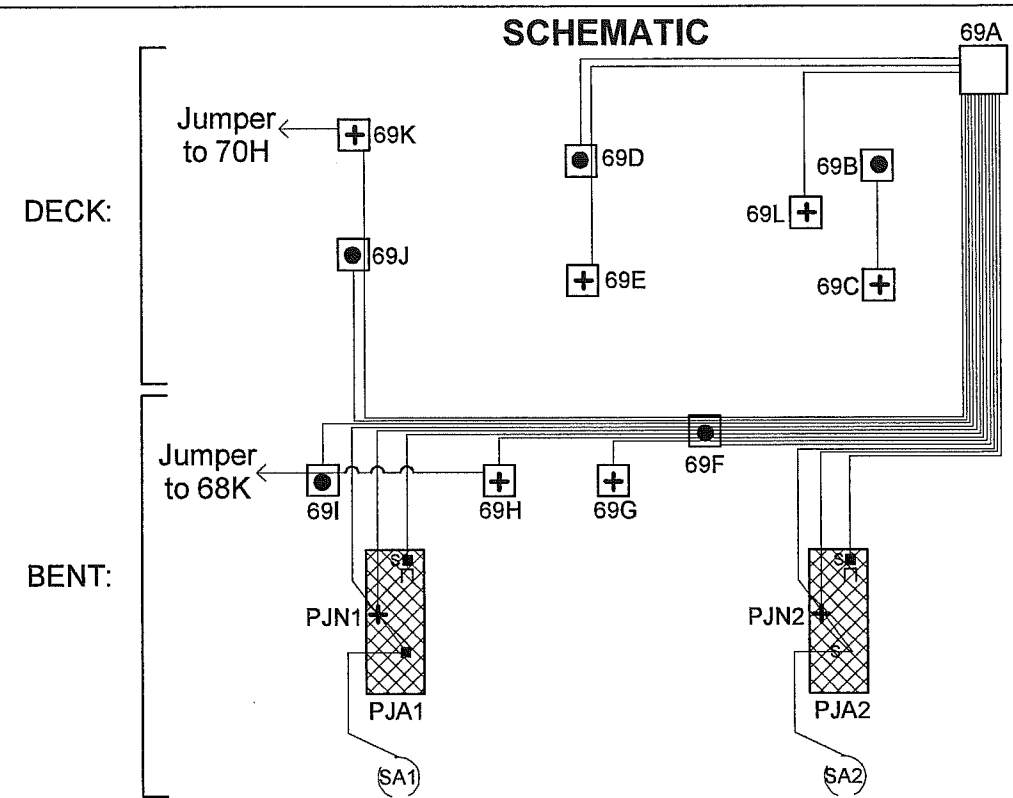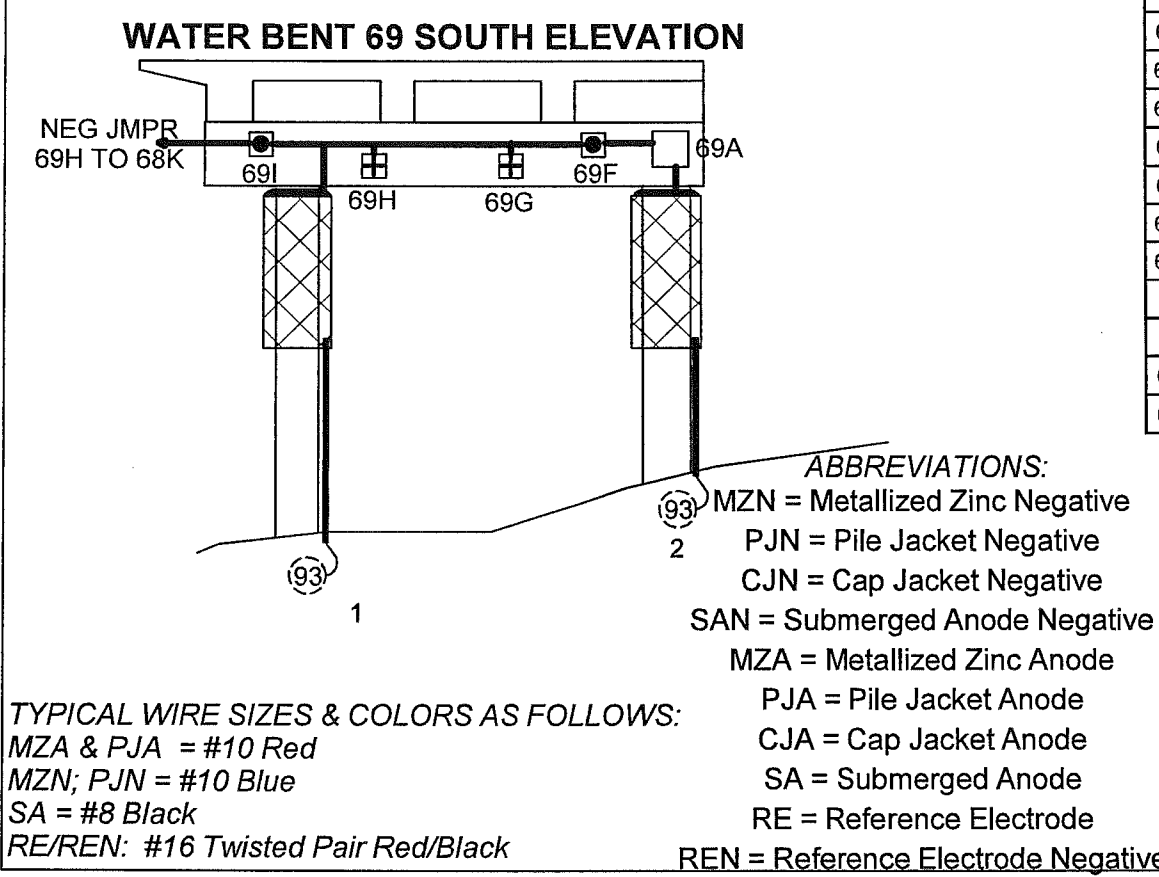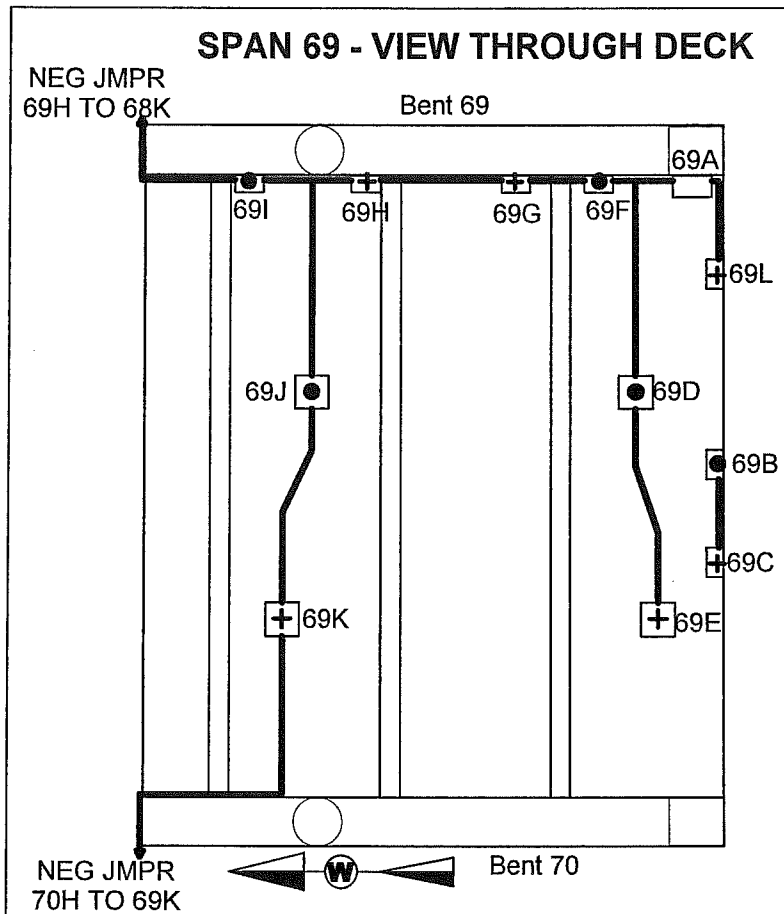

J-BOX DETAILS:


	J-Box Size	Wires or Structure
69-A	14" x 12" x 8"	MAIN J-BOX: (4) MZA; (5) MZN; (2) PJA; (2) PJN; (2) SA; SAN jumpered from PJN
69-B	5" x 5" x 2"	Primary Anode Terminal Plate (MZA)
69-C	5" x 5" x 2"	Structure Negative (MZN)
69-D	5" x 5" x 2"	Primary Anode Terminal Plate (MZA); (1) MZN
69-E	5" x 5" x 2"	Structure Negative (MZN)
69-F	5" x 5" x 2"	Primary Anode Terminal Plate (MZA); (2) MZA; (3) MZN; (1) PJA; (1) PJN; (1) SA
69-G	5" x 5" x 2"	Structure Negative (MZN)
69-H	5" x 5" x 2"	Structure Negative (MZN) - NEG JMPR 69
69-I	5" x 5" x 2"	Primary Anode Terminal Plate (MZA); (1) MZN JMPR 69
69-J	5" x 5" x 2"	Primary Anode Terminal Plate (MZA); (1) MZN
69-K	5" x 5" x 2"	Structure Negative (MZN); (1) MZN JMPR 70
69-L	5" x 5" x 2"	Structure Negative (MZN)

LEGEND


(x)	Submerged Anode
x	Weight in LBS
⊠	Pile Jacket
⊡	Cap Jacket
●	Primary Anode Terminal
+	Negative Connection
■	Encapsulated Splice
—	Reference Electrode

Water Street Bent 69 South Elevation & Span 69		
SCALE: NONE	Field Sketch	DRAWN BY KRH
DATE: 9-14-11	As-Built	REVISED
GREAT WESTERN CORPORATION		
Ketchikan Viaduct II Repair & C.P.	DRAWING NUMBER W69	


SPAN 70 - VIEW THROUGH DECK

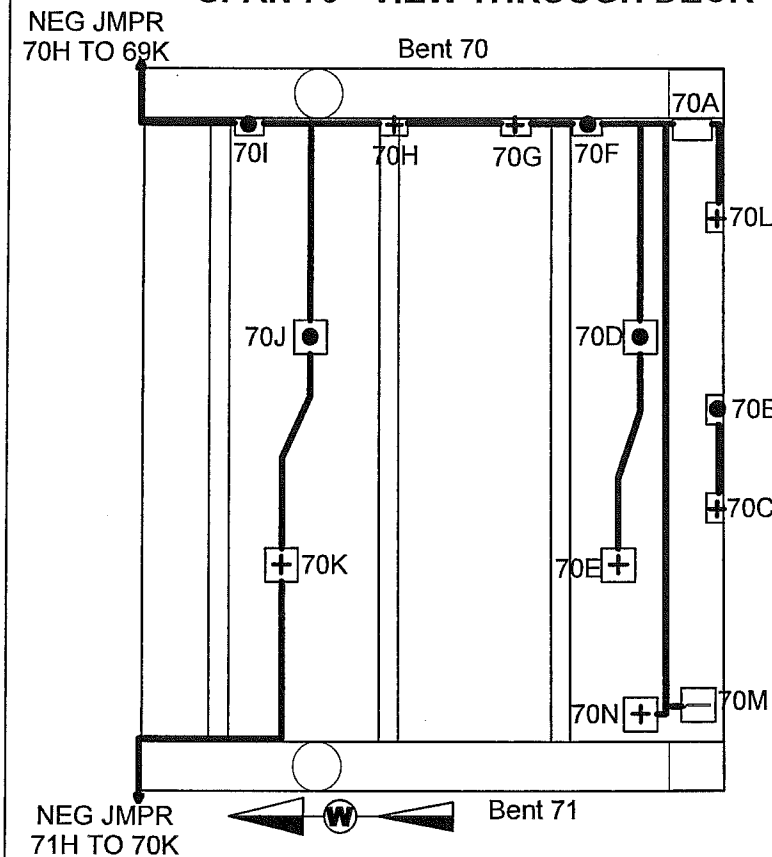

WATER BENT 70 SOUTH ELEVATION

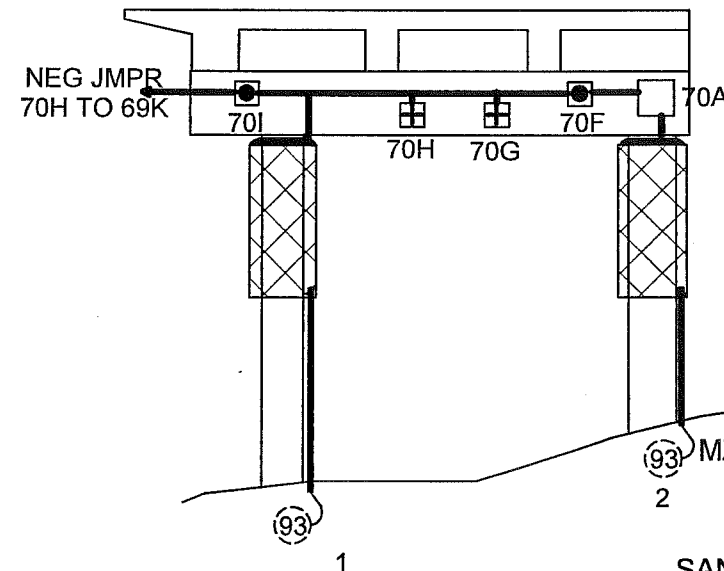

SCHEMATIC

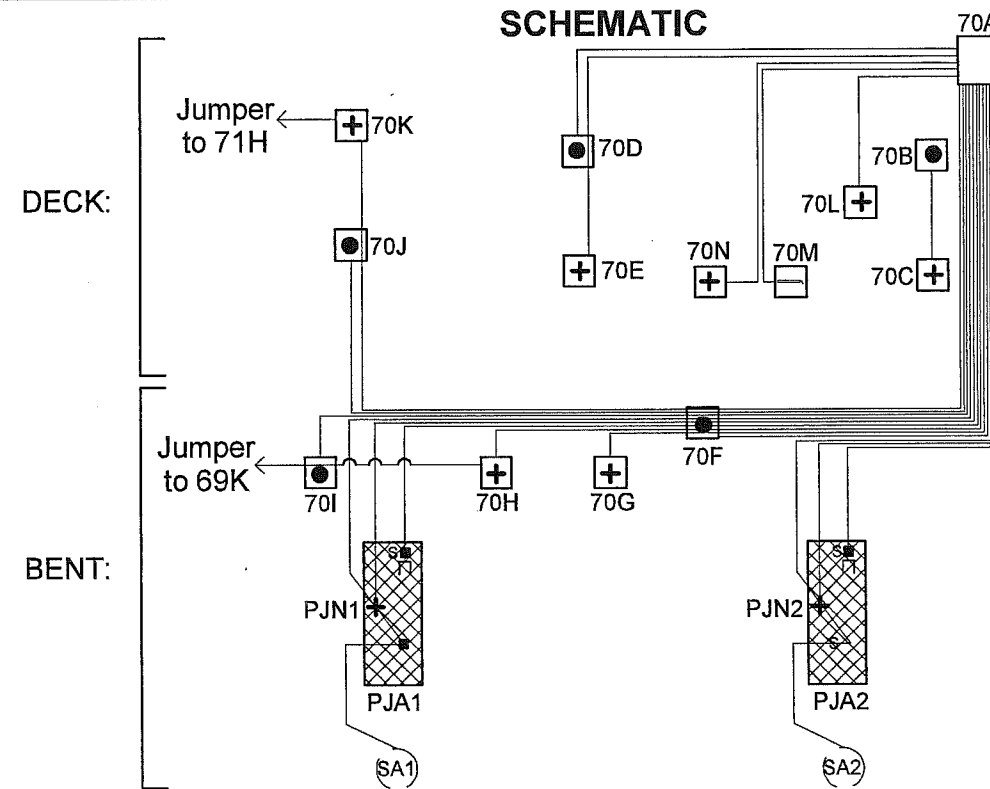

J-BOX DETAILS:

J-Box Size	Wires or Structure
70-A	14" x 12" x 8" MAIN J-BOX: (4) MZA; (5) MZN; (2) PJA; (2) PJN; (2) SA; SAN jumpered from PJN; (1) RE; (1) REN
70-B	5" x 5" x 2" Primary Anode Terminal Plate (MZA)
70-C	5" x 5" x 2" Structure Negative (MZN)
70-D	5" x 5" x 2" Primary Anode Terminal Plate (MZA); (1) MZN
70-E	5" x 5" x 2" Structure Negative (MZN)
70-F	5" x 5" x 2" Primary Anode Terminal Plate (MZA); (2) MZA; (3) MZN; (1) PJA; (1) PJN; (1) SA
70-G	5" x 5" x 2" Structure Negative (MZN)
70-H	5" x 5" x 2" Structure Negative (MZN) - NEG JMPR 70
70-I	5" x 5" x 2" Primary Anode Terminal Plate (MZA); (1) MZN JMPR 70
70-J	5" x 5" x 2" Primary Anode Terminal Plate (MZA); (1) MZN
70-K	5" x 5" x 2" Structure Negative (MZN); (1) MZN JMPR 71
70-L	5" x 5" x 2" Structure Negative (MZN)
70-M	5" x 5" x 2" Reference Electrode (RE) S/N 509033
70-N	5" x 5" x 2" Reference Electrode Negative (REN)

LEGEND

- (x) Submerged Anode
- x = Weight in LBS
- ⊠ Pile Jacket
- ⊡ Cap Jacket
- Primary Anode Terminal
- + Negative Connection
- Encapsulated Splice
- Reference Electrode

Water Street Bent 70 South Elevation & Span 70

SCALE: NONE	Field Sketch	DRAWN BY KRH
DATE: 9-14-11	As-Built	REVISED

GREAT WESTERN CORPORATION

Ketchikan Viaduct II
Repair & C.P.

DRAWING NUMBER
W70

TYPICAL WIRE SIZES & COLORS AS FOLLOWS:

MZA & PJA = #10 Red



MZN; PJN = #10 Blue

SA = #8 Black

RE/REN: #16 Twisted Pair Red/Black


ABBREVIATIONS:

- MZN = Metallized Zinc Negative
- PJN = Pile Jacket Negative
- CJN = Cap Jacket Negative
- SAN = Submerged Anode Negative
- MZA = Metallized Zinc Anode
- PJA = Pile Jacket Anode
- CJA = Cap Jacket Anode
- SA = Submerged Anode
- RE = Reference Electrode
- REN = Reference Electrode Negative

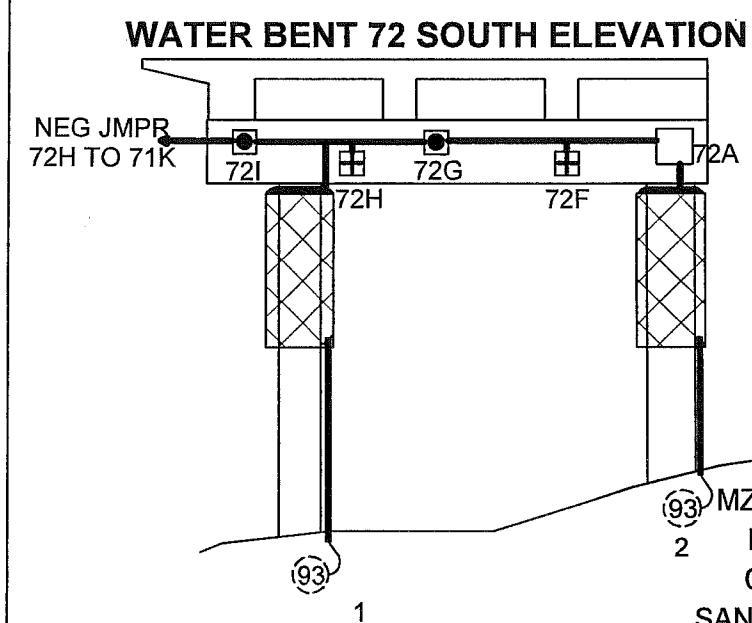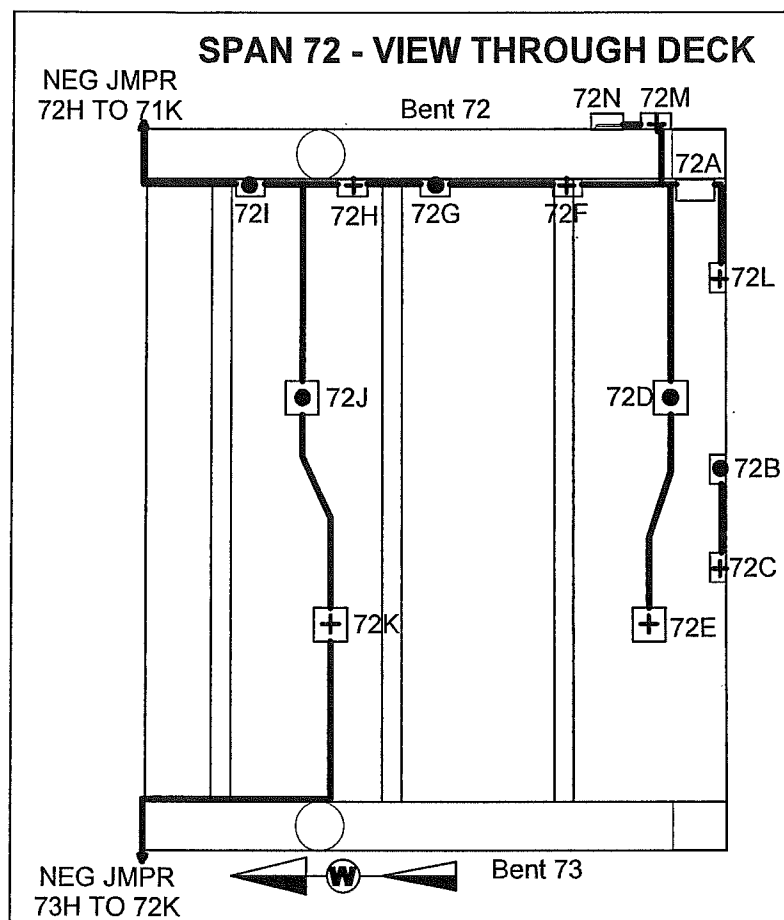

TYPICAL WIRE SIZES & COLORS AS FOLLOWS:
 MZA & PJA = #10 Red
 MZN; PJN = #10 Blue
 SA = #8 Black
 RE/REN: #16 Twisted Pair Red/Black

ABBREVIATIONS:
 MZN = Metallized Zinc Negative
 PJN = Pile Jacket Negative
 CJN = Cap Jacket Negative
 SAN = Submerged Anode Negative
 MZA = Metallized Zinc Anode
 PJA = Pile Jacket Anode
 CJA = Cap Jacket Anode
 SA = Submerged Anode
 RE = Reference Electrode
 REN = Reference Electrode Negative

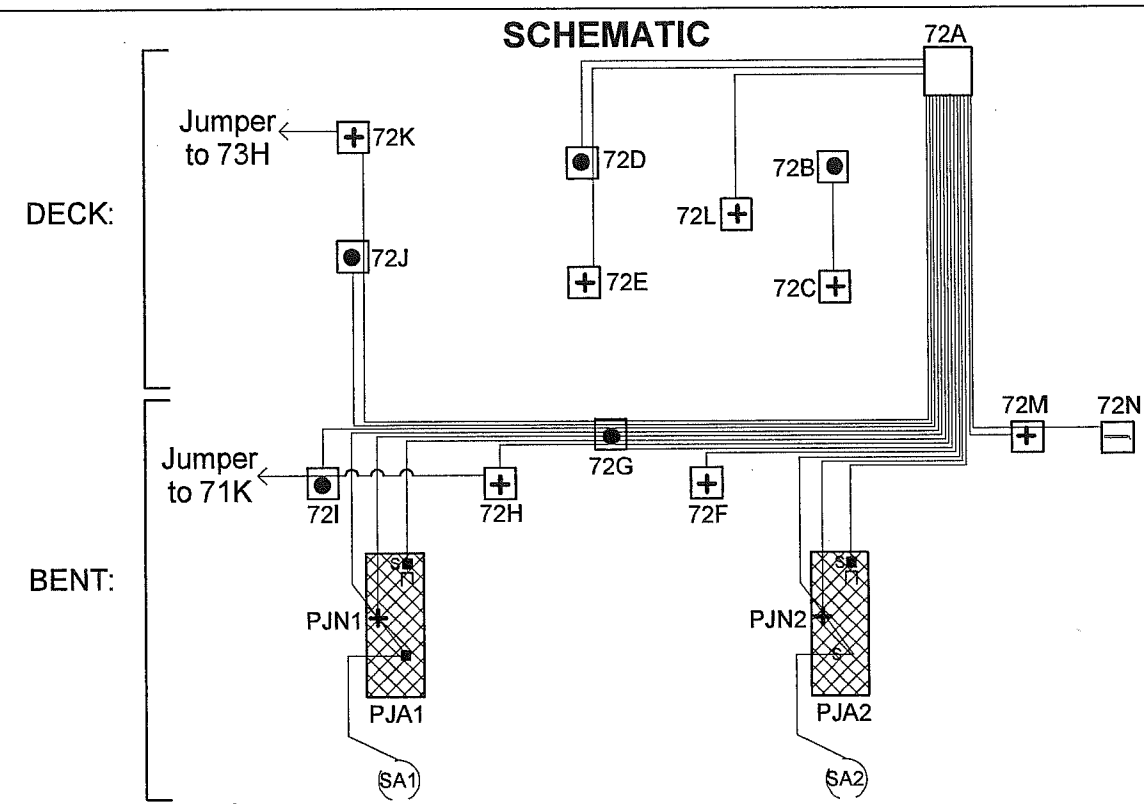

J-BOX DETAILS:


J-Box Size	Wires or Structure
72-A	14" x 12" x 8" MAIN J-BOX: (4) MZA; (5) MZN; (2) PJA; (2) PJN; (2) SA; SAN jumpered from PJN; (1) RE; (1) REN
72-B	5" x 5" x 2" Primary Anode Terminal Plate (MZA)
72-C	5" x 5" x 2" Structure Negative (MZN)
72-D	5" x 5" x 2" Primary Anode Terminal Plate (MZA); (1) MZN
72-E	5" x 5" x 2" Structure Negative (MZN)
72-F	5" x 5" x 2" Structure Negative (MZN)
72-G	5" x 5" x 2" Primary Anode Terminal Plate (MZA); (2) MZA; (2) MZN; (1) PJA; (1) PJN; (1) SA
72-H	5" x 5" x 2" Structure Negative (MZN) - NEG JMPR 72
72-I	5" x 5" x 2" Primary Anode Terminal Plate (MZA); (1) MZN JMPR 72
72-J	5" x 5" x 2" Primary Anode Terminal Plate (MZA); (1) MZN
72-K	5" x 5" x 2" Structure Negative (MZN); (1) MZN JMPR 73
72-L	5" x 5" x 2" Structure Negative (MZN)
72-M	5" x 5" x 2" Reference Electrode Negative (REN)
72-N	5" x 5" x 2" Reference Electrode (RE) S/N 509046

LEGEND

- (x) Submerged Anode
- x = Weight in LBS
- ⊠ Pile Jacket
- ⊞ Cap Jacket
- Primary Anode Terminal
- + Negative Connection
- Encapsulated Splice
- Reference Electrode

Water Street Bent 72 South Elevation & Span 72		
SCALE: NONE	Field Sketch	DRAWN BY KRH
DATE: 9-14-11	As-Built	REVISED
GREAT WESTERN CORPORATION		
Ketchikan Viaduct II Repair & C.P.		DRAWING NUMBER W72

Bent 73

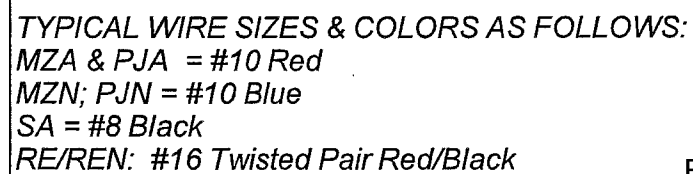

ABBREVIATIONS:

93) 2) **MZN = Metallized Zinc Negative**
PJN = Pile Jacket Negative
CJN = Cap Jacket Negative
SAN = Submerged Anode Negative
MZA = Metallized Zinc Anode
PJA = Pile Jacket Anode
CJA = Cap Jacket Anode
SA = Submerged Anode
RE = Reference Electrode
REN = Reference Electrode Negative

Diagram of the rear panel of the 7300 system. The panel features several connectors and components labeled as follows:

- 73D**: A square connector with a solid black circle.
- 73B**: A square connector with a solid black circle.
- 73L**: A square connector with a plus sign (+).
- 73E**: A square connector with a plus sign (+).
- 73C**: A square connector with a plus sign (+).
- 73G**: A square connector with a solid black circle.
- 73F**: A square connector with a plus sign (+).
- 73H**: A square connector with a plus sign (+).
- PJN2**: A rectangular connector with a cross-hatch pattern, containing a plus sign (+).
- PJA2**: A rectangular connector with a cross-hatch pattern, located below PJN2.
- SA2**: A circular connector with a plus sign (+), located at the bottom right.


The diagram shows a complex arrangement of lines connecting these components, with a dense bundle of lines on the right side of the panel.

	J-Box Size	Wires or Structure
73-A	14" x 12" x 8"	MAIN J-BOX: (4) MZA; (5) MZN; (2) PJA; (2) PJN; (2) SA; SAN jumpered from PJN
73-B	5" x 5" x 2"	Primary Anode Terminal Plate (MZA)
73-C	5" x 5" x 2"	Structure Negative (MZN)
73-D	5" x 5" x 2"	Primary Anode Terminal Plate (MZA); (1) MZN
73-E	5" x 5" x 2"	Structure Negative (MZN)
73-F	5" x 5" x 2"	Structure Negative (MZN)
73-G	5" x 5" x 2"	Primary Anode Terminal Plate (MZA); (2) MZA; (2) MZN; (1) PJA; (1) PJN; (1) SA
73-H	5" x 5" x 2"	Structure Negative (MZN) - NEG JMPR 73
73-I	5" x 5" x 2"	Primary Anode Terminal Plate (MZA); (1) MZN JMPR 73
73-J	5" x 5" x 2"	Primary Anode Terminal Plate (MZA); (1) MZN
73-K	5" x 5" x 2"	Structure Negative (MZN); (1) MZN JMPR 74
73-L	5" x 5" x 2"	Structure Negative (MZN)


- Submerged Anode
x = Weight in LBS
- Pile Jacket
- Cap Jacket
- Primary Anode Terminal
- Negative Connection
- Encapsulated Splice
- Reference Electrode

166

SPAN 74 - VIEW THROUGH DECK

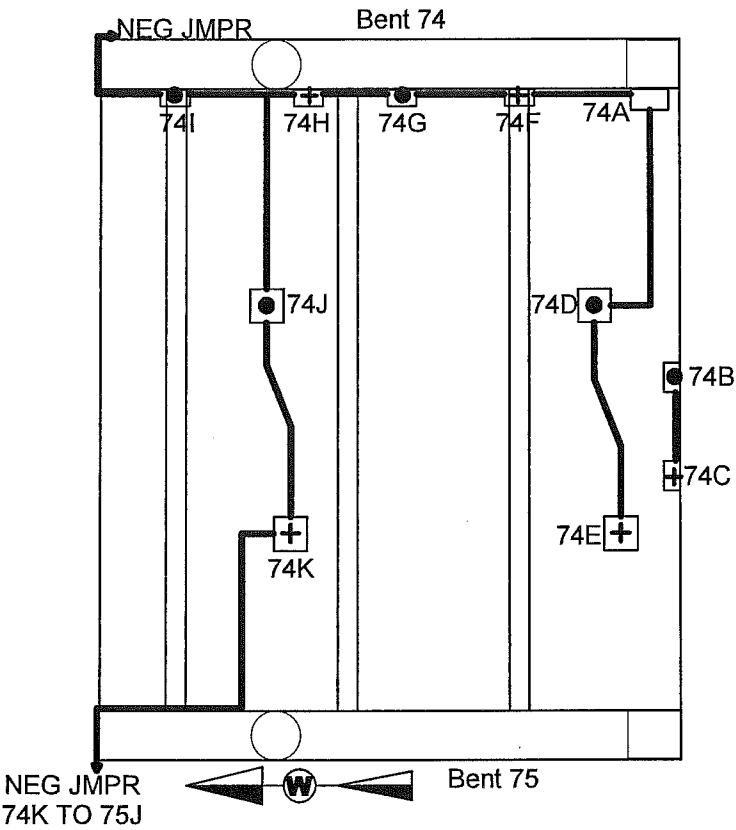


WATER BENT 74 SOUTH ELEVATION

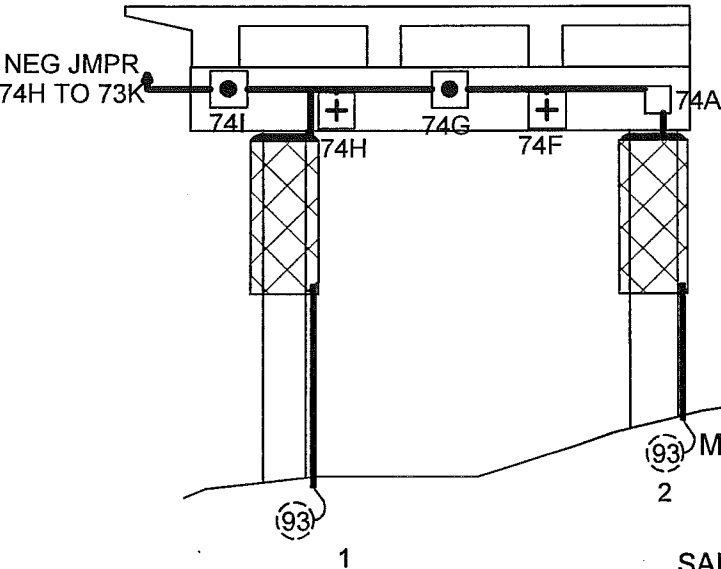

TYPICAL WIRE SIZES & COLORS AS FOLLOWS:
MZA & PJA = #10 Red
MZN; PJN = #10 Blue
SA = #8 Black
RE/REN: #16 Twisted Pair Red/Black

ABBREVIATIONS:
MZN = Metallized Zinc Negative
PJN = Pile Jacket Negative
CJN = Cap Jacket Negative
SAN = Submerged Anode Negative
MZA = Metallized Zinc Anode
PJA = Pile Jacket Anode
CJA = Cap Jacket Anode
SA = Submerged Anode
RE = Reference Electrode
REN = Reference Electrode Negative

SCHEMATIC

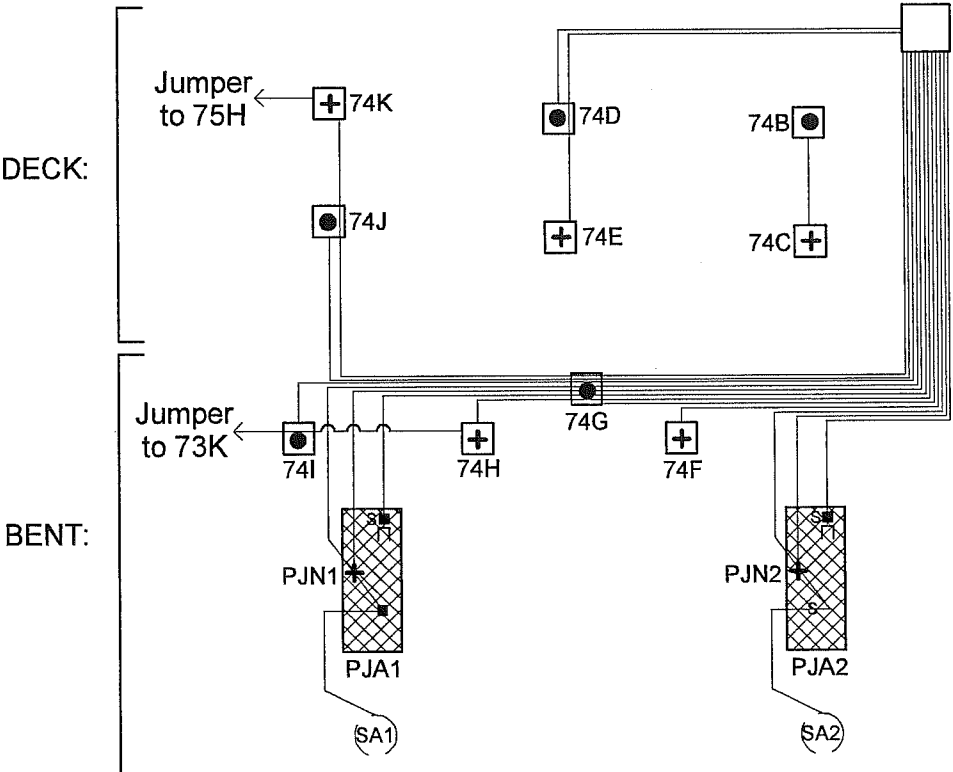

J-BOX DETAILS:

	J-Box Size	Wires or Structure
74-A	14" x 12" x 8"	MAIN J-BOX: (4) MZA; (4) MZN; (2) PJA; (2) PJN; (2) SA; SAN jumpered from PJN
74-B	5" x 5" x 2"	Primary Anode Terminal Plate (MZA)
74-C	5" x 5" x 2"	Structure Negative (MZN)
74-D	5" x 5" x 2"	Primary Anode Terminal Plate (MZA); (1) MZN
74-E	5" x 5" x 2"	Structure Negative (MZN)
74-F	5" x 5" x 2"	Structure Negative (MZN)
74-G	5" x 5" x 2"	Primary Anode Terminal Plate (MZA); (2) MZA; (2) MZN; (1) PJA; (1) PJN; (1) SA
74-H	5" x 5" x 2"	Structure Negative (MZN) - NEG JMPR 74
74-I	5" x 5" x 2"	Primary Anode Terminal Plate (MZA); (1) MZN JMPR 74
74-J	5" x 5" x 2"	Primary Anode Terminal Plate (MZA); (1) MZN
74-K	5" x 5" x 2"	Structure Negative (MZN); (1) MZN JMPR 75


LEGEND

- (x) Submerged Anode
x = Weight in LBS
- ⊠ Pile Jacket
- ⊞ Cap Jacket
- Primary Anode Terminal
- + Negative Connection
- Encapsulated Splice
- Reference Electrode


Water Street Bent 74 South Elevation
& Span 74

SCALE: NONE	Field Sketch	DRAWN BY KRH
DATE: 9-13-11	As-Built	REVISED
GREAT WESTERN CORPORATION		
Ketchikan Viaduct II Repair & C.P.		DRAWING NUMBER W74

SPAN 75 - VIEW THROUGH DECK

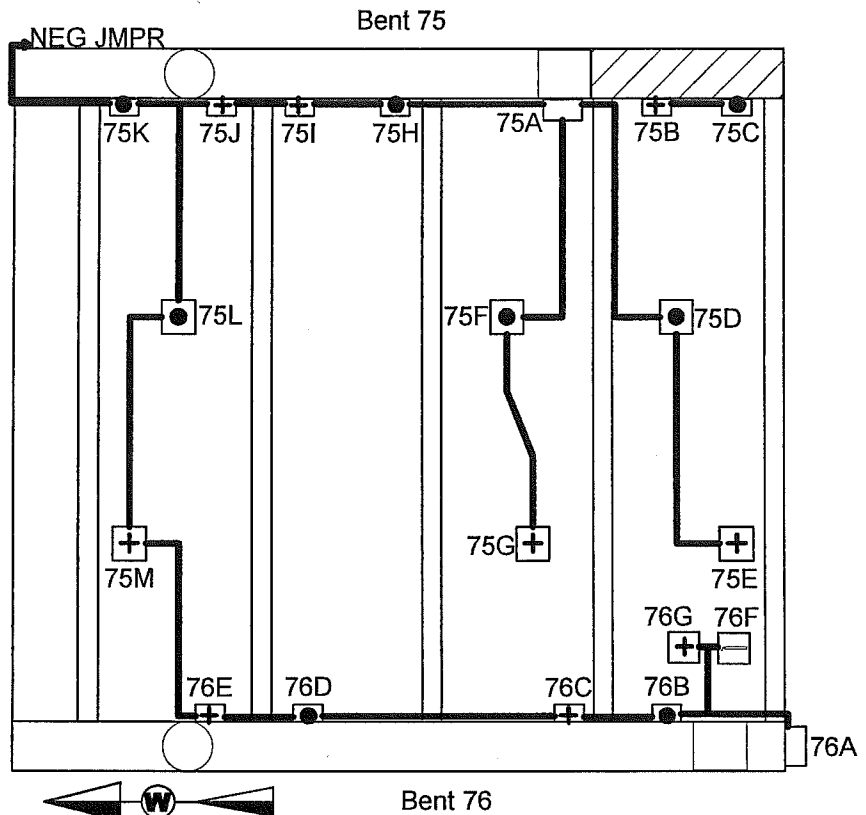


WATER BENT 75 SOUTH ELEVATION

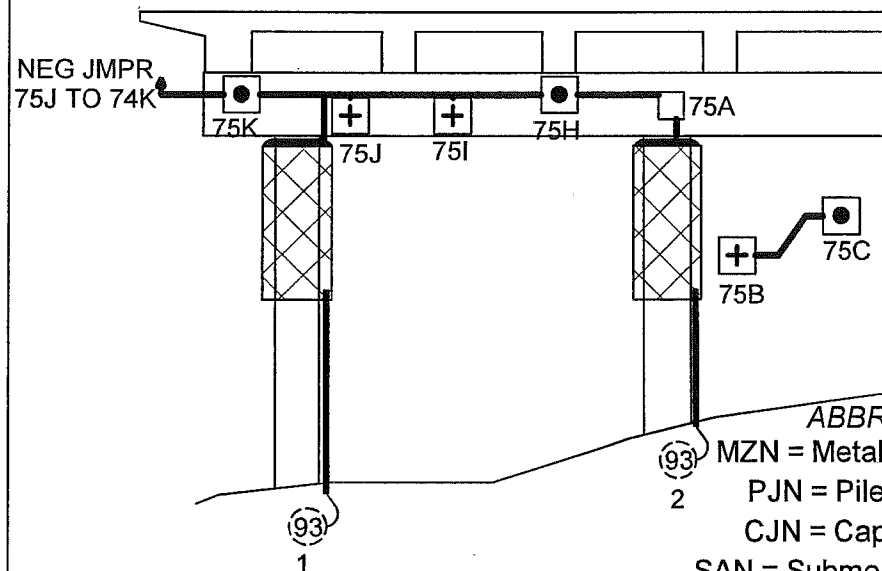

TYPICAL WIRE SIZES & COLORS AS FOLLOWS:
MZA & PJA = #10 Red
MZN; PJN = #10 Blue
SA = #8 Black
RE/REN: #16 Twisted Pair Red/Black

ABBREVIATIONS:
MZN = Metallized Zinc Negative
PJN = Pile Jacket Negative
CJN = Cap Jacket Negative
SAN = Submerged Anode Negative
MZA = Metallized Zinc Anode
PJA = Pile Jacket Anode
CJA = Cap Jacket Anode
SA = Submerged Anode
RE = Reference Electrode
REN = Reference Electrode Negative

SCHEMATIC

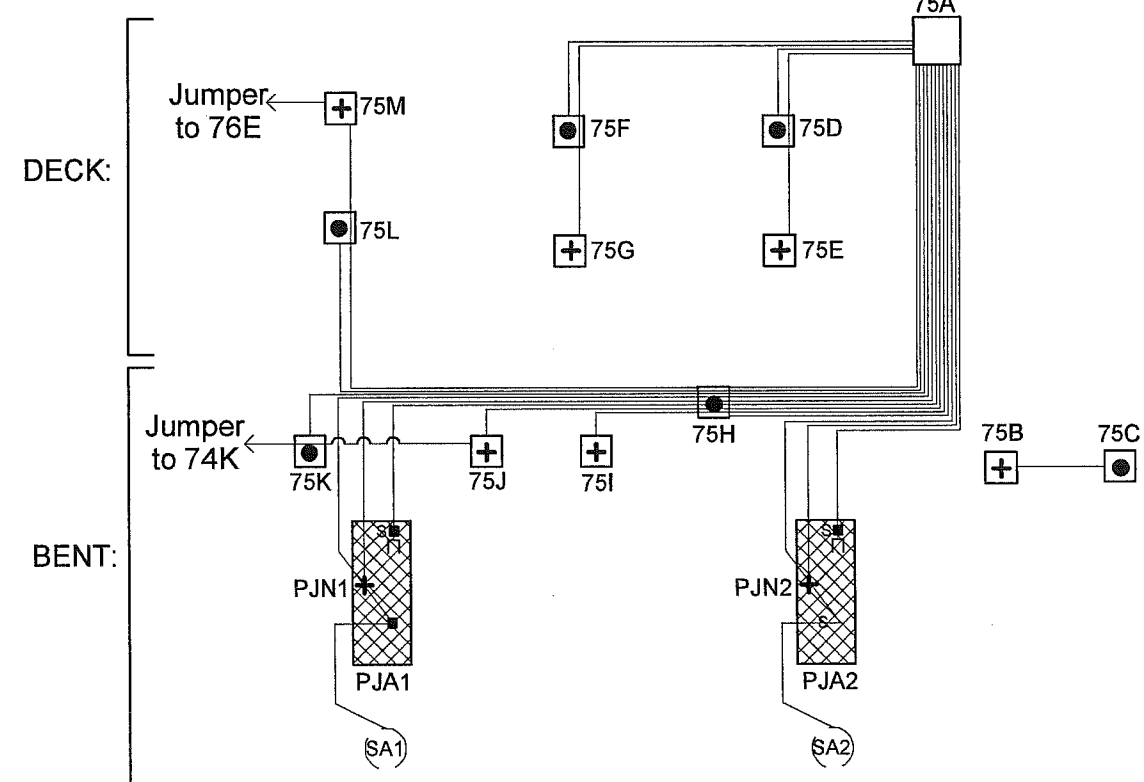

J-BOX DETAILS:

	J-Box Size	Wires or Structure
75-A	14" x 12" x 8"	MAIN J-BOX: (5) MZA; (5) MZN; (2) PJA; (2) PJN; (2) SA; SAN jumpered from PJN
75-B	5" x 5" x 2"	Structure Negative (MZN)
75-C	5" x 5" x 2"	Primary Anode Terminal Plate (MZA)
75-D	5" x 5" x 2"	Primary Anode Terminal Plate (MZA); (1) MZN
75-E	5" x 5" x 2"	Structure Negative (MZN)
75-F	5" x 5" x 2"	Primary Anode Terminal Plate (MZA); (1) MZN
75-G	5" x 5" x 2"	Structure Negative (MZN)
75-H	5" x 5" x 2"	Primary Anode Terminal Plate (MZA); (2) MZA; (3) MZN; (1) PJA; (1) PJN; (1) SA
75-I	5" x 5" x 2"	Structure Negative (MZN)
75-J	5" x 5" x 2"	Structure Negative (MZN) - NEG JMPR 75
75-K	5" x 5" x 2"	Primary Anode Terminal Plate (MZA); (1) MZN JMPR 75
75-L	5" x 5" x 2"	Primary Anode Terminal Plate (MZA)
75-M	5" x 5" x 2"	Structure Negative (MZN); (1) MZN JMPR 76

LEGEND

- (x) Submerged Anode
x = Weight in LBS
- ⊠ Pile Jacket
- ⊡ Cap Jacket
- Primary Anode Terminal
- + Negative Connection
- Encapsulated Splice
- Reference Electrode


Water Street Bent 75 South Elevation & Span 75

SCALE: NONE	Field Sketch	DRAWN BY KRH
DATE: 9-13-11	As-Built	REVISED


GREAT WESTERN CORPORATION

Ketchikan Viaduct II Repair & C.P.	DRAWING NUMBER W75
---------------------------------------	-----------------------


BENT 76 - VIEW THROUGH DECK

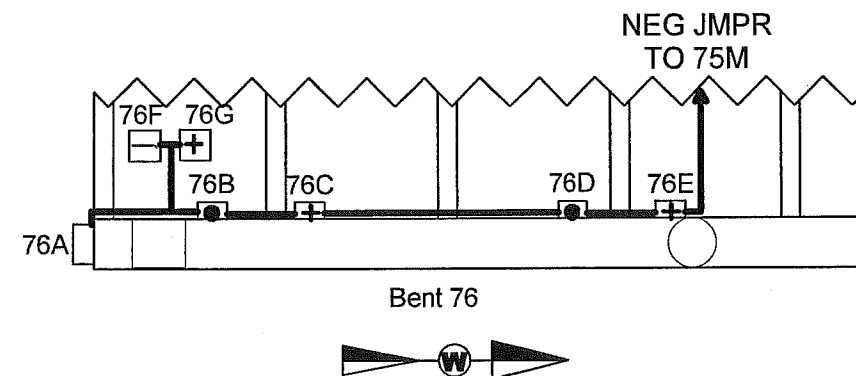

SCHEMATIC

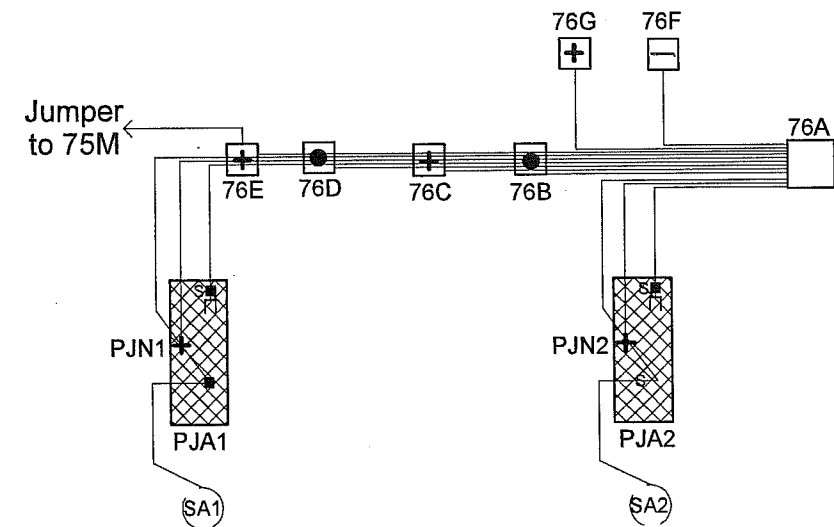

WATER BENT 76 NORTH ELEVATION

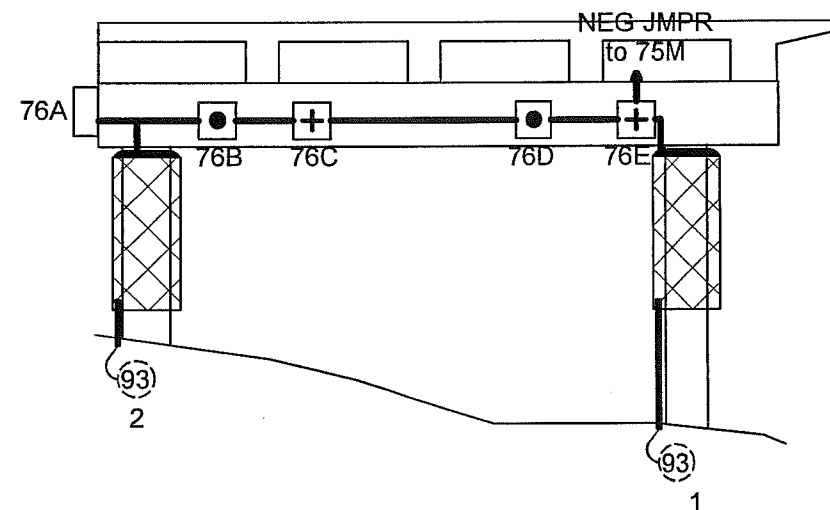

J-BOX DETAILS:

	J-Box Size	Wires or Structure
76-A	14" x 12" x 8"	MAIN J-BOX: (2) MZA; (2) MZN; (2) PJA; (2) PJN; (2) SA; SAN jumpered from PJN; (1) RE; (1) REN
76-B	5" x 5" x 2"	Primary Anode Terminal Plate (MZA); (1) MZA; (2) MZN; (1) PJA; (1) PJN; (1) SA
76-C	5" x 5" x 2"	Structure Negative (MZN); (1) MZA; (1) MZN; (1) PJA; (1) PJN; (1) SA
76-D	5" x 5" x 2"	Primary Anode Terminal Plate (MZA); (1) MZN; (1) PJA; (1) PJN; (1) SA
76-E	5" x 5" x 2"	Structure Negative (MZN) - MZN JUMPER 76; (1) PJA; (1) PJN; (1) SA
76-F	5" x 5" x 2"	Reference Electrode (RE)
76-G	5" x 5" x 2"	Reference Electrode Negative (REN)

ABBREVIATIONS:

MZN = Metallized Zinc Negative
PJN = Pile Jacket Negative
CJN = Cap Jacket Negative
SAN = Submerged Anode Negative
MZA = Metallized Zinc Anode
PJA = Pile Jacket Anode
CJA = Cap Jacket Anode
SA = Submerged Anode
RE = Reference Electrode
REN = Reference Electrode Negative

LEGEND

- (x) Submerged Anode
x = Weight in LBS
- ⊠ Pile Jacket
- ⊡ Cap Jacket
- Primary Anode Terminal
- + Negative Connection
- Encapsulated Splice
- Reference Electrode

TYPICAL WIRE SIZES & COLORS AS FOLLOWS:

MZA & PJA = #10 Red
MZN; PJN = #10 Blue
SA = #8 Black
RE/REN: #16 Twisted Pair Red/Black

Water Street Bent 76 North Elevation

SCALE: NONE	Field Sketch	DRAWN BY KRH
DATE: 9-13-11	As-Built	REVISED

GREAT WESTERN CORPORATION

Ketchikan Viaduct II
Repair & C.P.

DRAWING NUMBER
W76

