


State of Alaska

Department of Transportation
and Public Facilities

Design and Engineering Services Division-Southeast Region

KETCHIKAN, ALASKA KETCHIKAN SHIPYARD BERTH ONE RELIEVING SLAB


PROJECT No. TI-0003(126)-68715

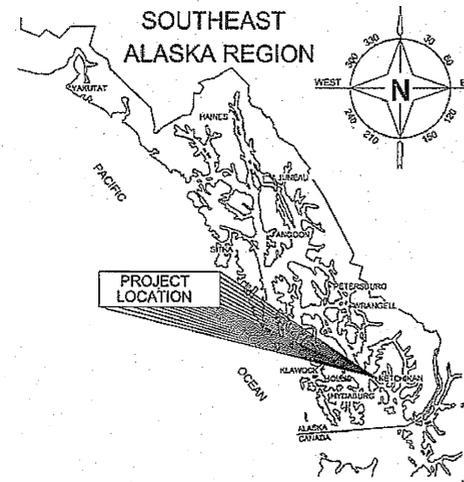

INDEX	
SHEET NO.	DESCRIPTION
G1	TITLE SHEET
G2	ABBREVIATIONS AND SYMBOLS
G3	PROJECT LIMITS
G4	SURVEY CONTROL
C0	ESTIMATE OF QUANTITIES & BASIS OF EST.
C1	SITE LAYOUT & DEMOLITION PLAN
C2	EROSION & SEDIMENT CONTROL PLAN
C3	NOT USED
C4	NOT USED
C5	NOT USED
C6	SLAB CROSS SECTIONS
C7	SEWER RELOCATION PLAN & PROFILE
C8	SEWER AND WATER SERVICE
C9	CIVIL DETAILS
C10	CIVIL DETAILS
S0	GENERAL NOTES
S1-S9	NOT USED
S10	SITE PLAN
S11	RELIEVING SLAB DETAILS
S12	UTILIDOR PLAN & SECTION
S13	CONCRETE SLAB SECTIONS
S14	RAIL BEAM & MISC DETAILS
S15	UTILIDOR PIT PLAN & DETAILS
S16	MISC SECTIONS & DETAILS
S17	MISC SECTIONS & DETAILS
S18	SHEET PILE DETAILS
S19	TROLLEY BEAM PLAN & DETAILS
S20	CIVIL DETAILS & SECTIONS
E1	ELECTRICAL PLAN
E2	ELECTRICAL ONE LINE & DETAILS
RF1	SITE PLAN
RF2	CIVIL DETAILS

THE FOLLOWING STANDARD DRAWINGS
APPLY TO THIS PROJECT

- C-03.10,
- D-01.02, D-20.03, D-22.01
- E-13.00,
- M-13.01

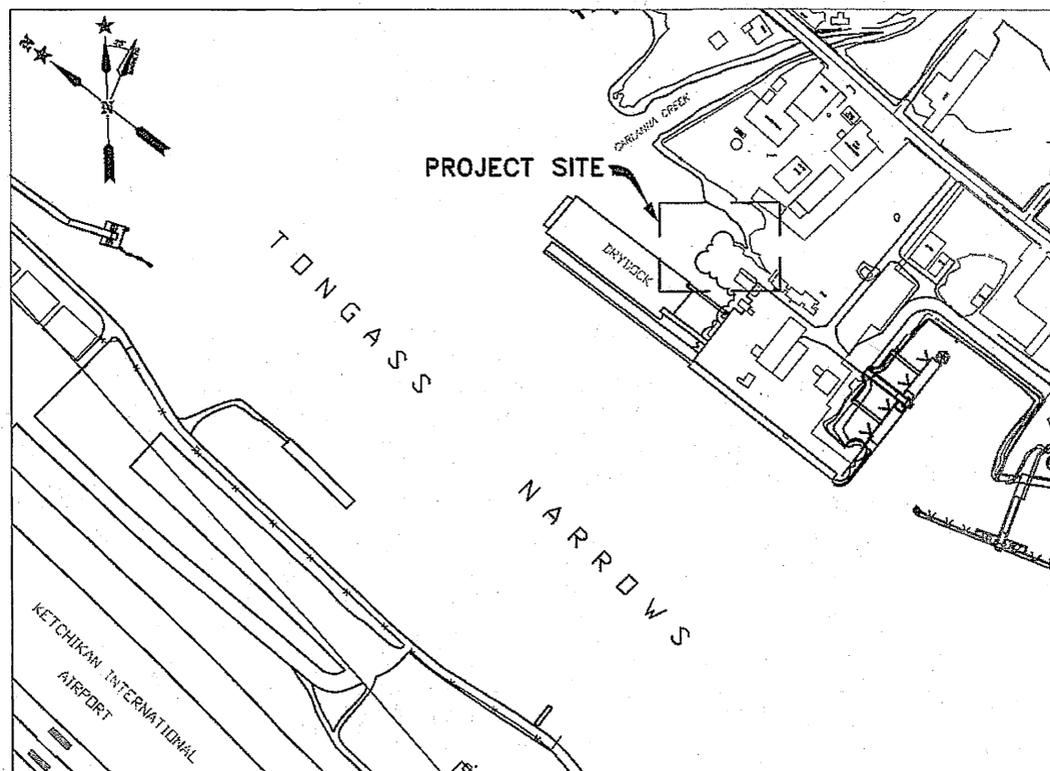

VICINITY MAP
NOT TO SCALE

AS-BUILT PLANS

Initials: KET Date: 3/10/09
 Contractor: Dawson Construction
 Date Started: August 2007
 Date Completed: April 2008
 Project Engineer* (printed): Karen R. Tony
 Project Engineer* (signature): Karen R. Tony

*I certify that revisions to these plans made during construction are noted in RED and therefore the plans are an accurate record of construction.

STATE OF ALASKA
DEPARTMENT OF TRANSPORTATION
& PUBLIC FACILITIES
DESIGN & ENGINEERING SERVICES DIVISION-SOUTHEAST REGION



PLANS DEVELOPED BY:
TRYCK NYMAN HAYES, INC.
APPROVED: Jack D. Beedle 5/8/07
REGIONAL PRE-CONSTRUCTION ENGINEER DATE
JACK D. BEEDLE, P.E.

APPROVED: Malcolm A. Menzies 5.8.07
DIRECTOR, SOUTHEAST REGION DATE
MALCOLM A. MENZIES, P.E., U.S.

CERTIFIED TRUE & CORRECT AS-BUILT OF ACTUAL FIELD
CONDITION:

CONSTRUCTION PROJECT MANAGER DATE

STATE	PROJECT DESIGNATION	YEAR	SHEET NO.	TOTAL SHEETS
ALASKA	68715	2007	G1	28

CIVIL + PILING AS-BUILT
SEE ALSO R+M CITY SEWER AS-BUILT

ABBREVIATIONS

&	AND	E	EASTING	MH	MANHOLE	SCH	SCHEDULE
⊙	AT	E-W	EAST-WEST	MAX	MAXIMUM	SD	STORM DRAIN
AMP	AMPLITUDE	EA	EACH	MIN	MINIMUM	SEC	SECTION
APPROX	APPROXIMATE	EL/ELEV	ELEVATION	MLLW	MEAN LOW LOW WATER	SHN	SHOWN
BLDG	BUILDING	ELEC	ELECTRICAL	N	NORTHING	SIM	SIMILAR
BLK	BLOCK	EQ	EQUAL	NIC	NOT IN CONTRACT	SOG	SLAB ON GRADE
BM,BMS	BEAM	ES	EACH SIDE	NO	NUMBER	SP	SPACE(S)
BOC	BOTTOM OF CONCRETE	EW	EACH WAY	NS	NEAR SIDE	SQ	SQUARE
BOT	BOTTOM	EXIST	EXISTING	NS/FS	NEAR SIDE/FAR SIDE	STD	STANDARD
BTWN	BETWEEN	FH	FIRE HYDRANT	NTS	NOT TO SCALE	STL	STEEL
CB	CATCH BASIN	FIN	FINISH	OC	ON CENTER	STRG	STRONG
CI	CAST IRON	FB	FLOOR BASIN	OG	ORIGINAL GROUND	SUPP'T	SUPPORT
CIP	CAST IN PLACE	FLG,FL	FLANGE	OPNG	OPENING	T&B	TOP AND BOTTOM
CW-NIC	CIVIL WORK NOT IN CONTRACT	FS	FAR SIDE	OPP	OPPOSITE	T&G	TONGUE AND GROOVE
⊙,C	CENTERLINE	FT,	FEET	PC	PRE-CAST	TELE	TELEPHONE
CL,R,CL	CLEAR	GA	GAGE, GAUGE	PE	POLYETHYLENE	THD	THREADED
CJ	CONSTRUCTION JOINT	GALV	GALVANIZE(D)	PL,PL	PLATE (STEEL OR WOOD)	THK	THICK
CMP	CORRAGATED METAL PIPE	GR	GRADE(ING)	PLCS	PLACES	TOC	TOP OF CONCRETE
CONC	CONCRETE	HR	HANDRAIL	POL	PETROLEUM OIL LUBRICANT	TOG	TOP OF GROUND
COORD	COORDINATE	HDPE	HIGH DENSITY POLYETHELENE	PSI	POUNDS PER SQUARE INCH	TOS	TOP OF STEEL
CTR	CENTER	HP	HP STEEL SHAPE	PT	POST TENSION	TOT	TOTAL
CTRSK	COUNTERSINK(SUNK)	HSS	HOLLOW STEEL SECTION	PVC	POLYVINYL CHLORIDE	TYP	TYPICAL
DIA,φ,DI	DIAMETER	IN	INCH	R/RAD	RADIUS	UHMW	ULTRA HIGH MOLECULAR WEIGHT
DN	DOWN	INV	INVERT	REF	REFERENCE	UNGALV	UNGALVANIZED
DWG	DRAWING	JT	JOINT	REQD	REQUIRED	UNO	UNLESS NOTED OTHERWISE
		KSI	KIPPS PER SQUARE INCH	REINF	REINFORCED	VERT	VERTICAL
		LF	LINEAR FOOT	RF	REFERENCE POINT	W/	WITH
		LOC	LOCATION			WP	WORK POINT

EXISTING UTILITIES—CONTACT INFORMATION

SEWER AND STORM DRAIN SYSTEMS:
CITY OF KETCHIKAN, HARVEY HANSEN, (907) 228-4720

WATER SYSTEM:
CITY OF KETCHIKAN, JOHN KLEINEGGER, (907)228-5499

FUEL LINES AND ELECTRICAL LINES:
KETCHIKAN PUBLIC UTILITIES, JAY HANSEN, (907) 228-5447

SYMBOLS

— E —	ELECTRICAL (EXISTING)	⊙ B-3	BORING LOG	⊙ 18.0'	ELEVATION
— T —	TELEPHONE (EXISTING)	⊙ B-II	BORING LOG	— 18.0'	SPOT ELEVATION
— S —	SANITARY SEWER (EXISTING)	⊙ B-5	BORING LOG	●	TOP CONCRETE PIPES
— SD —	STORM DRAIN (EXISTING)	□	SIGN	●	TOP PVC CONDUIT ELEVATION
— W —	WATER LINE (EXISTING)	□	UTILITY VAULTS	●	TOP SEWER ELEVATION
— B —	BILGE LINE (EXISTING)	○	UTILITY POLE	▽	VALVE
— A —	AIR LINE (EXISTING)	○	LIGHT POLE	●	SHEET PILE CORNER
— E —	ELECTRICAL (PROPOSED)	□	UTILITY VAULTS	★	INLET PROTECTION
— S —	SANITARY SEWER (PROPOSED)	□	UTILITY VAULTS	— SC — SC —	SILT CURTAIN (IN WATER)
— SD —	STORM DRAIN (PROPOSED)	□	UTILITY VAULTS	— SF — SF —	SILT FENCE
— W —	WATER LINE (PROPOSED)	□	UTILITY VAULTS		
— — — — —	PROPERTY LINE				
— x —	FENCE				
— — — — —	BURIED FUEL LINE				
— — — — —	EASEMENT				
— — — — —	EDGE OF ASPHALT				
▨	CONTOUR LINE				
▨	LIMITS OF DEMOLITION				
▨	CONCRETE				
▨	LIMITS OF ASPHALT RECONSTRUCTION				

TIDAL INFORMATION	
HIGHEST OBSERVED WATER LEVEL	21.3'
HIGH TIDE LEVEL (HTL)	19.4'
MEAN HIGHER HIGH WATER (MHHW)	15.4'
MEAN HIGH WATER (MHW)	14.4'
MEAN TIDE LINE (MTL)	8.1'
MEAN LOWER LOW WATER (MLLW)	0.0'
LOWEST OBSERVED WATER LEVEL	-5.2'



AS-BUILT PLANS

INITIALS *KRT* DATE *3/10/09*

PLANS DEVELOPED BY:
TRYCK NYMAN HAYES, INC

DO NOT SCALE FROM THESE DRAWINGS USE DIMENSIONS

CHECKED BY: PC	STATE OF ALASKA DEPARTMENT OF TRANSPORTATION & PUBLIC FACILITIES DESIGN & ENGINEERING SERVICES DIVISION-SOUTHEAST REGION
DESIGNED BY: CF	KETCHIKAN SHIPYARD BERTH ONE RELIEVING SLAB
DRAWN BY: WEH	PROJECT #68715 ABBREVIATIONS & SYMBOLS
PATH: M:\02158\001_Ketchikan Uplands Slab\400 Drawings\401 Working Drawings\2158_G2.DWG	REVISIONS
TAB: 2 5-8-07	NO. DATE DESCRIPTION
	PROJECT DESIGNATION YEAR SHEET NO. TOTAL SHEETS
	68715 2007 G2 28

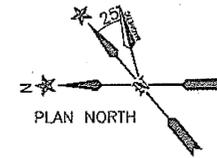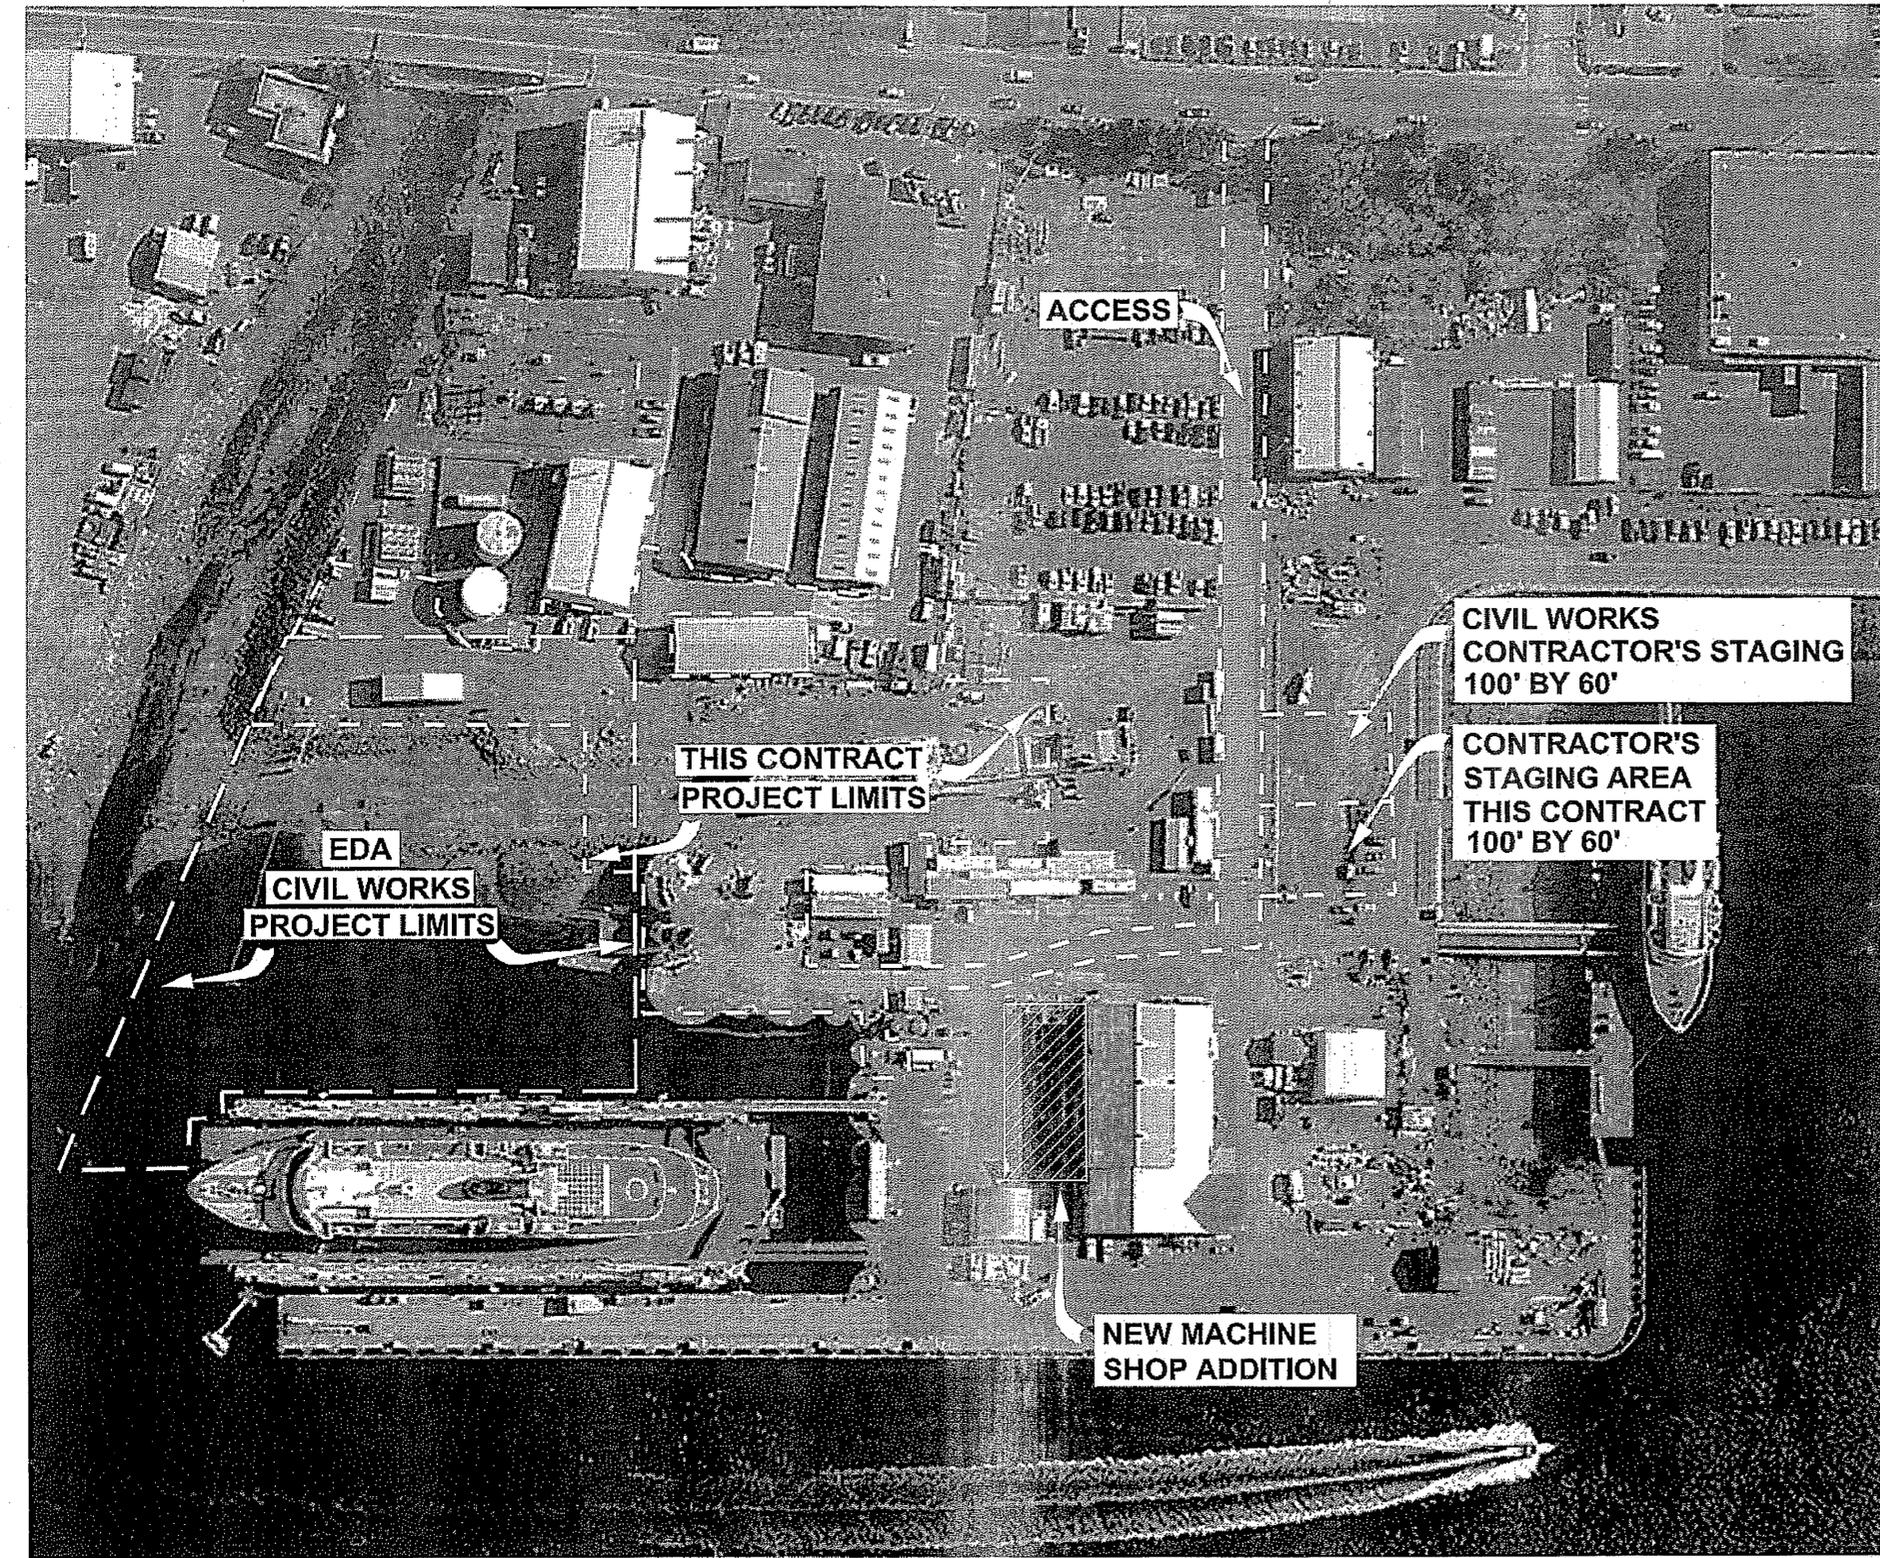

KETCHIKAN SHIPYARD IS EMBARKING ON A MULTI-YEAR EXPANSION PROJECT. THE FIRST SERIES OF CONSTRUCTION CONTRACTS ARE AS FOLLOWS:

- * EDA CIVIL WORKS: CONSTRUCTION OF SHEET PILE BULKHEADS, DREDGING, CONSTRUCTION OF AN IN-WATER GROUNDING GRID, AND DEMOLITION AND RECONSTRUCTION OF A FUEL BARGE BERTH. (N.I.C.)
- * UPLANDS SLAB: CONSTRUCTION OF A 250-FT BY 90-FOOT CONCRETE SLAB, ADJACENT SHEET PILE BULKHEAD, AND UTILITY RELOCATIONS. (THIS PROJECT)

THESE PROJECTS WILL BE CONSTRUCTED WITHIN THE EXISTING SHIPYARD WHERE VESSEL REPAIRS AND FABRICATION WILL BE ON-GOING. ACCESS INTO THE SITE WILL BE SHARED BY ALL THESE ACTIVITIES. THE EXACT SCHEDULE FOR THE VARIOUS PROJECTS IS UNCERTAIN AT THIS TIME. THE UPLANDS SLAB PROJECT ADJOINS THE EDA CIVIL WORKS PROJECT NEAR THE SOUTH BULKHEAD. CLOSE COORDINATION BETWEEN THE EDA AND UPLANDS SLAB CONTRACTORS IS REQUIRED.

IF ADDITIONAL STAGING AREAS ARE REQUIRED THE CONTRACTOR MUST PROVIDE THEM OFF-SITE.

AS-BUILT PLANS

INITIALS *KRT* DATE *3/10/09*

PLANS DEVELOPED BY:
TRYCK NYMAN HAYES, INC

DO NOT SCALE FROM THESE DRAWINGS USE DIMENSIONS		STATE OF ALASKA DEPARTMENT OF TRANSPORTATION & PUBLIC FACILITIES DESIGN & ENGINEERING SERVICES DIVISION-SOUTHEAST REGION	
		KETCHIKAN SHIPYARD BERTH ONE RELIEVING SLAB	
		PROJECT #68715	
DESIGNED BY: CF		PROJECT LIMITS	
DRAWN BY: WEH		PATH: M:\02158.001_Ketchikan Uplands Slab\400 Drawings\401 Working Drawings\2158.001_G3.DWG	
TAB: 3		SONIAJ	
REVISIONS		PROJECT DESIGNATION	YEAR
NO.	DATE	DESCRIPTION	YEAR
			2007
			G3
			28

PROJECT CONTROL

Northing	Easting	Elev.	Name	Point Description
10089.6015	8419.8709	25.12	DRY-2	LEAD PLUG & TACK
10449.7362	7991.4511	24.89	DRY-3	LEAD PLUG & TACK

SHEET PILE LAYOUT

NUMBER	NORTHING	EASTING
P1	11058.05	7950.13
P2	11099.02	7984.51
P3	10945.82	8167.09
P4	10859.76	8094.89
P5	10830.41	8129.87


LINE TABLE

LINE	DIRECTION	DISTANCE
L1	N 38°42'44" E	6.29'
L2	N 40°00'00" E	36.00'
L3	S 49°59'53" E	60.04'
	(S 50°01'20" E)	(59.97')
L4	S 40°03'19" W	49.94'
	(S 39°58'40" W)	(50.00')
L5	S 49°58'23" E	20.02'
	(S 50°01'20" E)	(20.00')
L6	S 39°58'40" W	50.00'
L7	S 50°01'20" E	26.63'
L8	S 39°58'40" W	47.47'
	(47.40')	
L9	N 40°00'00" E	36.00'
L10	N 50°12'40" W	81.00'
L11	S 50°40'00" W	20.00'
L12	N 46°10'00" W	57.50'
L13	N 01°20'00" W	20.69'
L14	N 50°12'40" W	78.26'



VICINITY MAP

SCALE: 1 INCH = 1 MILE

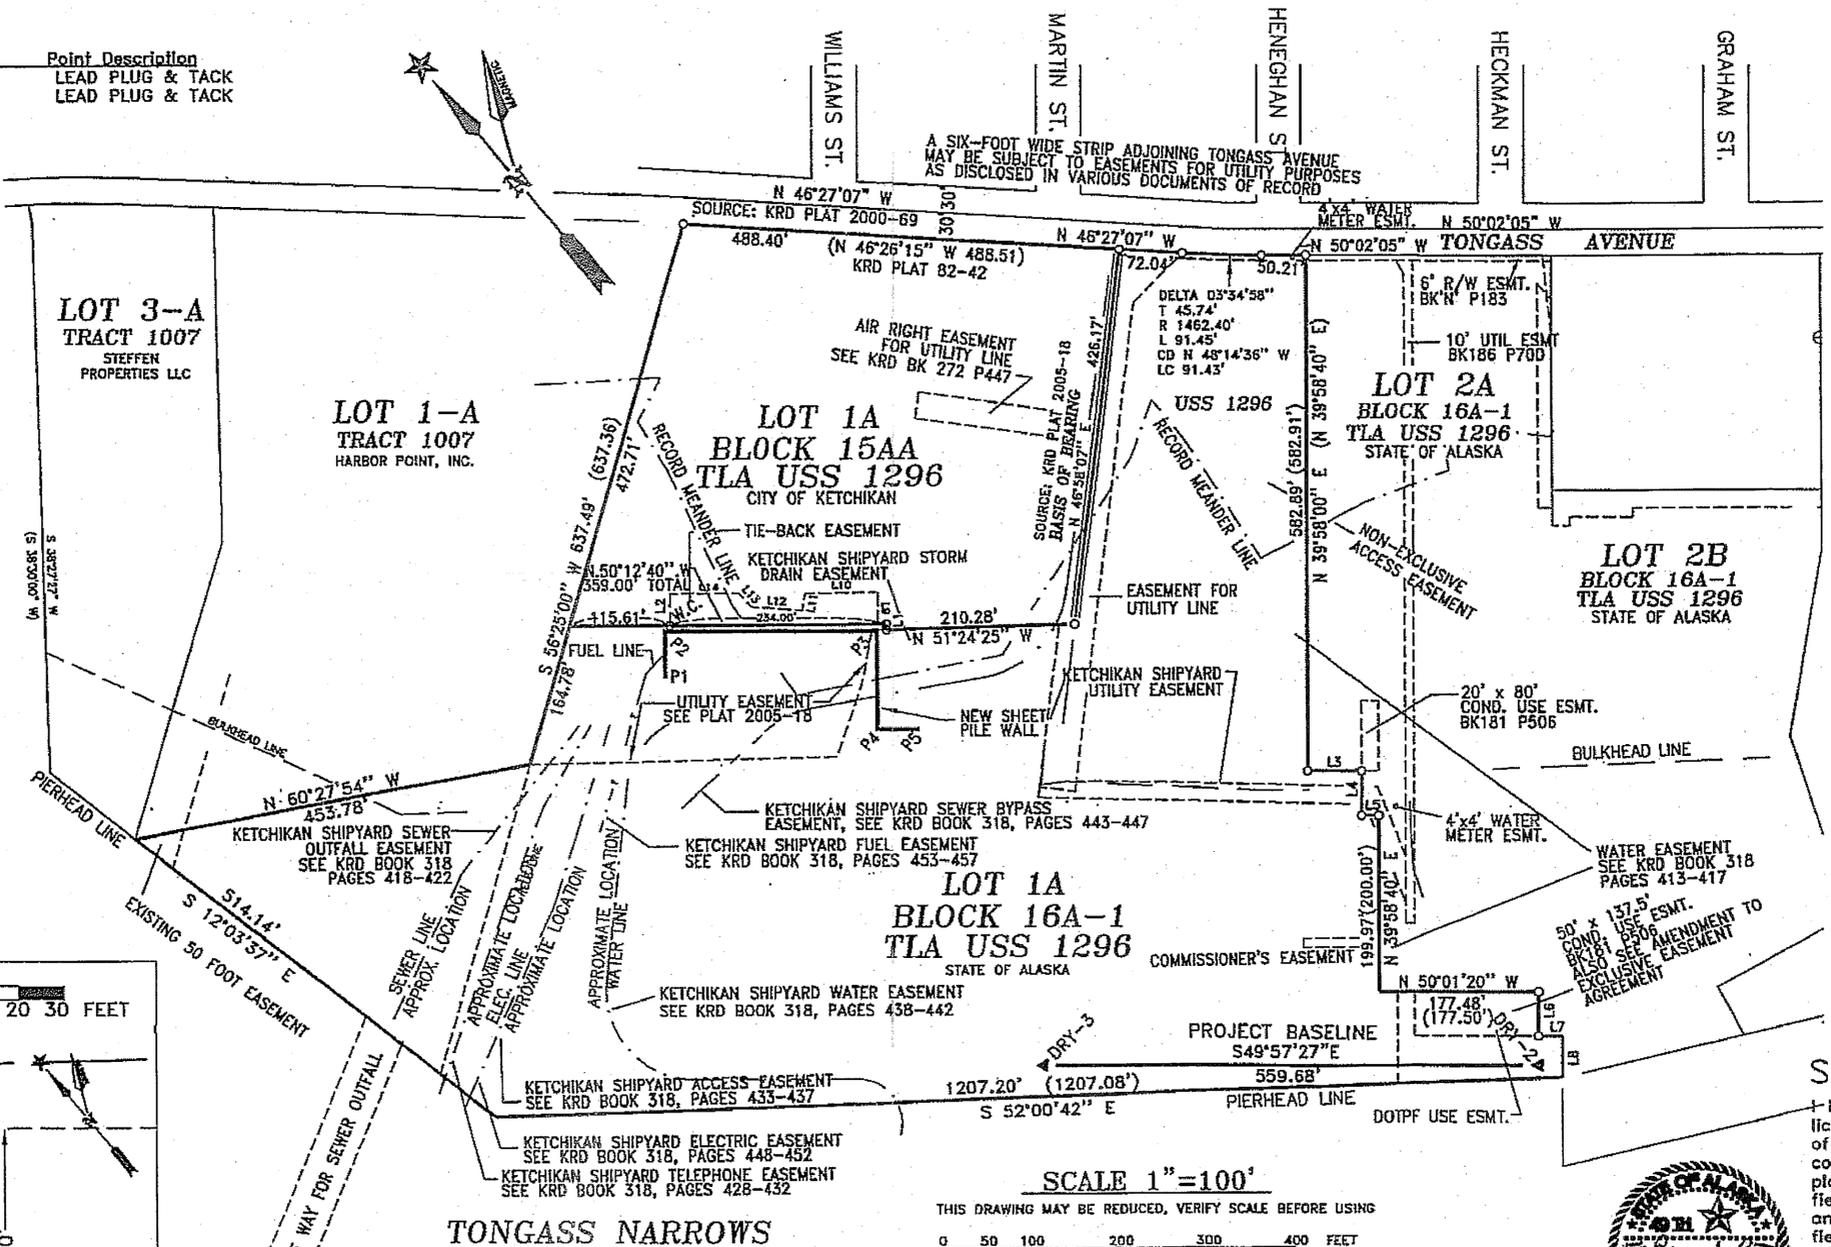

SYMBOLS



- △ LEAD PLUG AND TACK SET IN CONCRETE
- FOUND 2" ALUMINUM CAP
- () INDICATES RECORD DATA
- KRD KETCHIKAN RECORDING DISTRICT

SURVEYOR'S CERTIFICATE

I hereby certify that I am a registered surveyor, licensed in the State of Alaska, and that in April, of 2005, a survey of the herein described lands was conducted under my direct supervision and that this plat is a true and correct representation of the field notes of said survey, and that the dimensions and other details are correct according to said field notes.

5/8/07

Date
 Signature *Ray J. Roth*

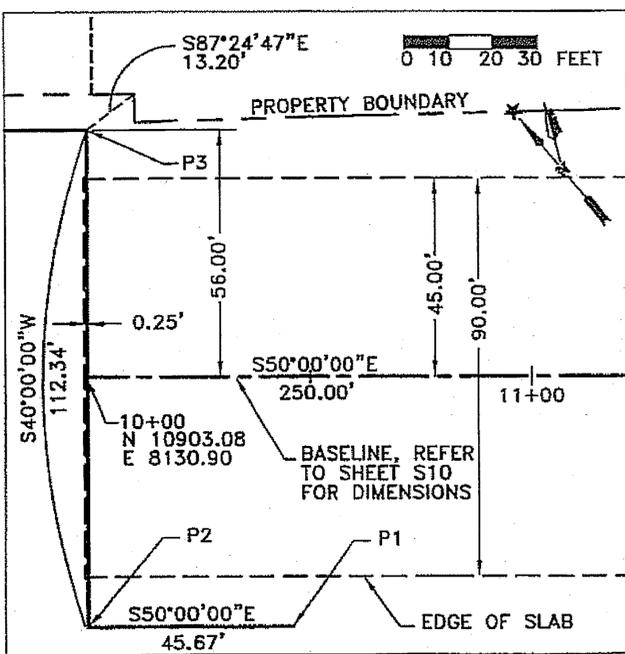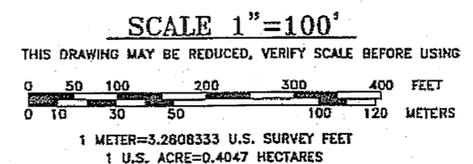

RELIEVING SLAB BASELINE

VERTICAL CONTROL

Elevation datum is based on Mean Lower Low Water (MLLW) = 0.00' (feet). The highest observed water level is 21.30'. Mean Higher High Water (MHHW) is 14.45'. Mean High Water (MHW) is 14.54'.

The elevation bench mark for this project is a rounded brass cap found in the sidewalk at the U.S. Post Office. The elevation of this mark is 25.78' above MLLW.

HORIZONTAL CONTROL

The Basis of Bearing for this project is the Plat reference for the Lot 1A, BLOCK 16A-1 of the Ketchikan Shipyard Plat No. 2005-18.

The basis of horizontal control for this project are lead plug and tacks in the concrete pier labeled as "Dry-2" and "Dry-3".

AS-BUILT PLANS

INITIALS *KET* DATE 3/10/09

DO NOT SCALE FROM THESE DRAWINGS USE DIMENSIONS

CHECKED BY: S. MENZIES	STATE OF ALASKA DEPARTMENT OF TRANSPORTATION & PUBLIC FACILITIES DESIGN & ENGINEERING SERVICES DIVISION-SOUTHEAST REGION				
DESIGNED BY: T. SANDE	KETCHIKAN SHIPYARD BERTH ONE RELIEVING SLAB				
DRAWN BY: T. SANDE					
PROJECT #68715					
SURVEY CONTROL					
PATH: SERVER\PROJECTS\032314\TNDWDG\SURVEY CONTROL.DWG					
TAB: LAYOUT1					
NO.	REVISIONS	PROJECT DESIGNATION	YEAR	SHEET NO.	SHEETS
		HRPM-003(121)	2007	G4	28

ESTIMATE OF QUANTITIES

ITEM NO.	ITEM	UNIT	TOTAL
202 (1)	REMOVAL OF STRUCTURE AND OBSTRUCTIONS	LUMP SUM	ALL REQUIRED
202 (2)	REMOVAL OF PAVEMENT	SQUARE YARD	1,500 7,486.0
202 (4)	REMOVAL OF CULVERT PIPE	LINEAR FOOT	275 83.0
202 (6)	REMOVAL OF MANHOLE	EACH	2
203 (3)	UNCLASSIFIED EXCAVATION	CUBIC YARD	3,701 3,797
203 (28)	CONTAMINATED SOIL EXCAVATION AND DISPOSAL	CONTINGENT SUM	ALL REQUIRED
301 (1)	AGGREGATE BASE COURSE, GRADING D-1	TON	5,485 7,680
401 (4)	ASPHALT CONCRETE, TYPE 2; CLASS B	SQUARE YARD	860 829
501 (2)	CLASS A-A CONCRETE	LUMP SUM	ALL REQUIRED
501 (4)	CLASS A CONCRETE	CUBIC YARD	58 69.25
501 (7A)	PRECAST CONCRETE MEMBER (RAIL BEAM)	EACH	64
501 (7B)	PRECAST CONCRETE MEMBER (UTILIDOR)	LUMP SUM	ALL REQUIRED
501 (7C)	PRECAST CONCRETE MEMBER (UTILIDOR PIT)	EACH	8 4
501 (8)	CONCRETE PRICE ADJUSTMENT	CONTINGENT SUM	ALL REQUIRED
504 (3)	STRUCTURAL STEEL (RAIL)	LUMP SUM	ALL REQUIRED
505 (9)	STRUCTURAL STEEL SHEET PILE PZ 27	SQUARE FOOT	5,805 6,525
505 (12)	FURNISH PILES HP 10X57	LINEAR FOOT	3,700 6,561
505 (13)	FURNISH PIPE PILE 16X0.5	LINEAR FOOT	280 198
505 (14)	DRIVE PILE HP 10X57	EACH	2 CO#5
505 (15)	DRIVE PILE PIPE PILE 16X0.5	EACH	2
505 (16)	SPECIAL PILE EXCAVATION	CONTINGENT SUM	ALL REQUIRED CO#1
603 (22-12)	12 INCH HDPE PIPE	LINEAR FOOT	281 188
603 (22-18)	18 INCH HDPE PIPE	LINEAR FOOT	240 239
603 (22-30)	30 INCH HDPE PIPE	LINEAR FOOT	180 137
604 (1-48)	STORM SEWER MANHOLE, 48" DIAMETER	EACH	4
604 (8)	UTILITY VAULT 10'x14' see CO#4	EACH	1 CO#4
604 (9)	UTILITY VAULT	EACH	4
604 (10A)	6" HDPE SLAB DRAIN PIPE	LINEAR FOOT	134 137
604 (10B)	12" HDPE SLAB DRAIN PIPE	LINEAR FOOT	108 105
604 (14)	STORM WATER INTERCEPTOR	LUMP SUM	1
626 (1A)	SANITARY SEWER CONDUIT, 4 INCH HDPE	LINEAR FOOT	285 651
626 (1B)	SANITARY SEWER CONDUIT 20 INCH SDR17 HDPE	LINEAR FOOT	227 274
626 (1C)	SANITARY SEWER CONDUIT 24 INCH SDR17 HDPE	LINEAR FOOT	327 CO#9
626 (2)	SEWER SERVICE CONNECTION	EACH	1
626 (3)	VALVES AND FITTINGS (OUTFALL VAULT)	LUMP SUM	ALL REQUIRED
626 (4)	SANITARY SEWER PRESSURE SERVICE CONNECTION	EACH	2
627 (3)	INSTALL VALVE BOX	EACH	1
627 (8)	WATER SERVICE CONNECTION	EACH	1
627 (11)	WATER SERVICE, 8 INCH HDPE PIPE	LINEAR FOOT	380 609.5
627 (12)	WATER SERVICE PIER CONNECTION	EACH	2
633 (1)	SILT FENCE	LINEAR FOOT	600 740.5
638 (2)	IMPERMEABLE LINER	LUMP SUM	ALL REQUIRED
640 (1)	MOBILIZATION AND DEMOBILIZATION	LUMP SUM	ALL REQUIRED

ESTIMATE OF QUANTITIES (CONT.)

ITEM NO.	ITEM	UNIT	TOTAL
640 (4)	WORKER MEALS AND LODGING, OR PER DIEM	LUMP SUM	ALL REQUIRED
641 (1)	EROSION AND POLLUTION CONTROL ADMINISTRATION	LUMP SUM	ALL REQUIRED
641 (2)	TEMPORARY EROSION AND POLLUTION CONTROL	CONTINGENT SUM	ALL REQUIRED
641 (4)	TEMPORARY EROSION AND POLLUTION CONTROL AMENDMENTS	CONTINGENT SUM	ALL REQUIRED
641 (9)	INLET PROTECTION	EACH	2 7
641 (10)	SILT CURTAIN	LINEAR FOOT	350 200
642 (1)	CONSTRUCTION SURVEYING	LUMP SUM	ALL REQUIRED
642 (3A)	THREE PERSON SURVEY PARTY	CONTINGENT SUM	ALL REQUIRED
643 (2)	TRAFFIC MAINTENANCE	LUMP SUM	ALL REQUIRED
643 (8)	PLASTIC SAFETY FENCE	LINEAR FOOT	1000 990
643 (12)	PORTABLE CONCRETE BARRIER	EACH	10
644 (1)	FIELD OFFICE	LUMP SUM	ALL REQUIRED
644 (6)	VEHICLES	LUMP SUM	ALL REQUIRED
644 (10)	SECURITY	CONTINGENT SUM	ALL REQUIRED
646 (1)	CPM SCHEDULING	LUMP SUM	ALL REQUIRED
662 (1)	ELECTRICAL	LUMP SUM	ALL REQUIRED
	(ADDITIVE ALTERNATE I)		
680 (1A)	TRANSFER CRADLES	LUMP SUM	ALL REQUIRED

DRAINAGE STRUCTURE SUMMARY

SHEET NO.	MH NO.	DRAINAGE STRUCTURE TYPE	CASTING TYPE
C7	1	STORM SEWER MANHOLE, 48" DIAMETER	FRAME & GRATE
C7	2	STORM SEWER MANHOLE, 48" DIAMETER	FRAME & COVER
S10	3	STORM SEWER MANHOLE, 48" DIAMETER	FRAME & COVER
S10	4	STORM SEWER MANHOLE, 48" DIAMETER	FRAME & COVER

NOTES:

- SEE C7 AND S10 FOR LOCATION, INVERT ELEVATIONS AND RIM ELEVATIONS OF MANHOLES.
- MH#2 HAS AN OIL/WATER SEPARATOR PLATE, SEE DETAIL ON C9.

BASIS OF ESTIMATE

ITEM NO.	ITEM	QUANTITY
301 (1)	AGGREGATE BASE COURSE, GRADING D-1	1.96 TONS/CUBIC YARD
401 (4)	ASPHALT CONCRETE, TYPE 2; CLASS B	120 LB./SQ. YARD/IN. DEPTH

New Items By Change Order


ITEM NO.	DESCRIPTION	UNIT
505(16a)	Special Pile Excavation and Backfill	LS
680(1b)	Transfer Cradles	LS
108(1)	Extended OH Costs	LS
604(8a)	Additional Vault Costs	LS
505(14a)	Drive Pile HP 10x57	LS
504(3b)	Continuity Strips	LS
502(2)	Grout Costs	LS
604(14a)	Tideflex for Stormwater Int	LS
626(12)	24 inch Sewer Conflicts	LS
504(3a)	Structural Steel Rail Alignment	LS

AS-BUILT PLANS


INITIALS *KRT* DATE *3/10/09*

PLANS DEVELOPED BY:
TRYCK NYMAN HAYES, INC

	CHECKED BY: PC DESIGNED BY: CF DRAWN BY: WEH	STATE OF ALASKA DEPARTMENT OF TRANSPORTATION & PUBLIC FACILITIES DESIGN & ENGINEERING SERVICES DIVISION-SOUTHEAST REGION KETCHIKAN SHIPYARD BERTH ONE RELIEVING SLAB PROJECT #68715 ESTIMATE OF QUANTITIES & BASIS OF ESTIMATE
	PATH: M:\02158.001_Ketchikan Uplands Slab\400 Drawings\401 Working Drawings\2158.001_CO TAB: 5 5-8-07 MATHEWS	PROJECT DESIGNATION 68715
REVISIONS NO. DATE DESCRIPTION	SHEET NO. C0	TOTAL SHEETS 28

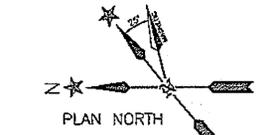


LOT 1
TRACT 1007

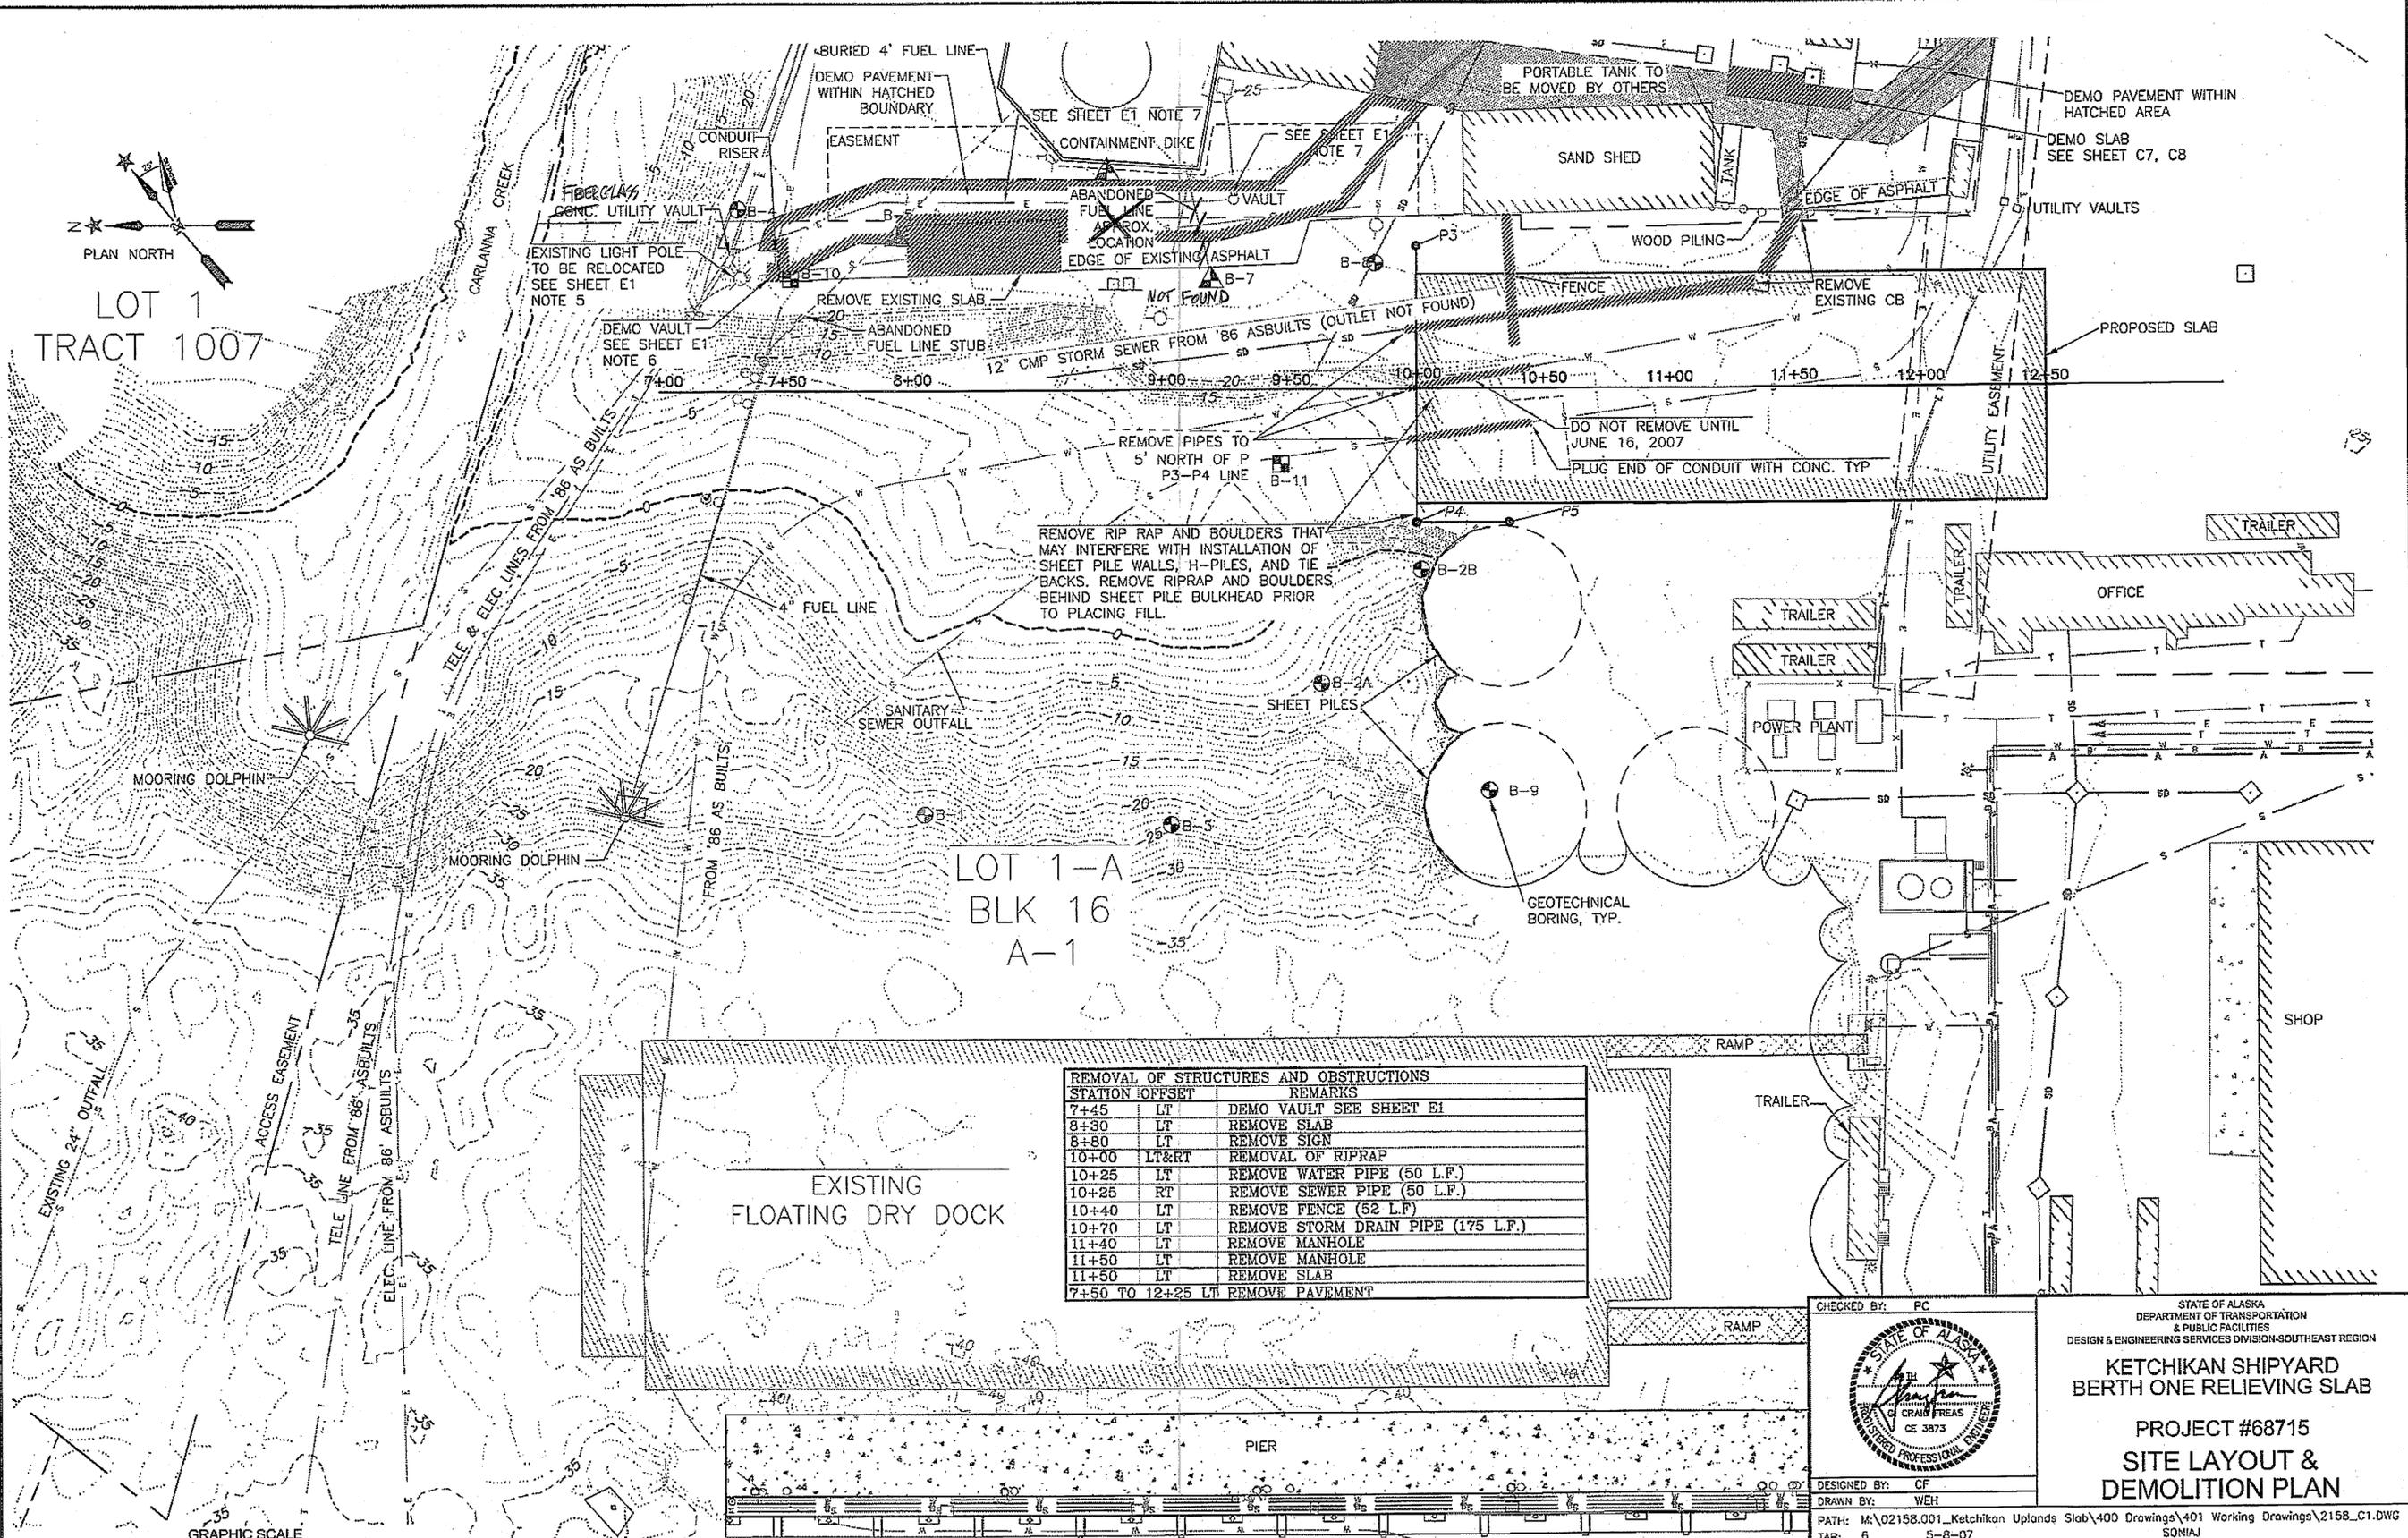


REMOVAL OF STRUCTURES AND OBSTRUCTIONS		
STATION	OFFSET	REMARKS
7+45	LT	DEMO VAULT SEE SHEET E1
8+30	LT	REMOVE SLAB
8+80	LT	REMOVE SIGN
10+00	LT&RT	REMOVAL OF RIPRAP
10+25	LT	REMOVE WATER PIPE (50 L.F.)
10+25	RT	REMOVE SEWER PIPE (50 L.F.)
10+40	LT	REMOVE FENCE (52 L.F.)
10+70	LT	REMOVE STORM DRAIN PIPE (175 L.F.)
11+40	LT	REMOVE MANHOLE
11+50	LT	REMOVE MANHOLE
11+50	LT	REMOVE SLAB
7+50 TO 12+25	LT	REMOVE PAVEMENT

EXISTING
FLOATING DRY DOCK

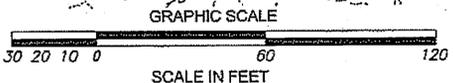

AS-BUILT PLANS

PLANS DEVELOPED BY:
TRYCK NYMAN HAYES, INC

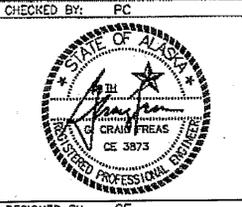


CHECKED BY: PC
DESIGNED BY: CF
DRAWN BY: WEH
PATH: M:\02158.001_Ketchikan Uplands Slab\400 Drawings\401 Working Drawings\2158_C1.DWG
TAB: 6 5-8-07
SONIAJ

STATE OF ALASKA
DEPARTMENT OF TRANSPORTATION
& PUBLIC FACILITIES
DESIGN & ENGINEERING SERVICES DIVISION-SOUTHEAST REGION
**KETCHIKAN SHIPYARD
BERTH ONE RELIEVING SLAB**

**PROJECT #68715
SITE LAYOUT &
DEMOLITION PLAN**

REVISIONS			PROJECT DESIGNATION	YEAR	SHEET NO.	TOTAL SHEETS
NO.	DATE	DESCRIPTION				
			68715	2007	C1	28

INITIALS *KET* DATE *3/10/09*

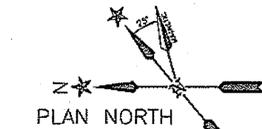

LOT 1
TRACT 1007

CITY OF KETCHIKAN
LOT 1, BLK 15AA-1


LOT 1-A
BLK 16
A-1

LEGEND:


- ★ INLET PROTECTION
- SC—SC— SILT CURTAIN (IN WATER)
- SF—SF— SILT FENCE

NOTES:

1. SEE THE SPECIFICATION APPENDICES FOR THE EROSION SEDIMENT CONTROL PLAN NARRATIVE, INLET PROTECTION DETAILS, AND THE CONTAMINATED SOIL HOLDING CELL DETAILS.
2. THE CONTRACTOR SHALL PROVIDE A SILT FENCE BETWEEN ANY EXCAVATION OR FILL AND NATURAL OR MANMADE DRAINAGE COURSES TO PREVENT DIRECT RUNOFF OF PRECIPITATION INTO CARLANNA CREEK OR TONGASS NARROWS. NOTE THAT TIDES AS HIGH AS 21.3 FEET MEAN LOWER LOW WATER (MLLW) MAY OCCUR AT THIS SITE. ACCORDINGLY, SILT FENCES WILL HAVE TO BE ADVANCED AS EXCAVATION PROCEEDS TOWARDS THE WATERFRONT. THE SILT CURTAINS ALONE SHOULD NOT BE CONSIDERED ADEQUATE TO PREVENT SILTING OF EITHER CARLANNA CREEK OR TONGASS NARROWS. ONCE ALL OF THE SOUTH BULKHEAD SHEET PILES HAVE BEEN DRIVEN (P3 TO P5), THE SHEETS MAY SUBSTITUTE AS A SILT FENCE AT THAT LOCATION.

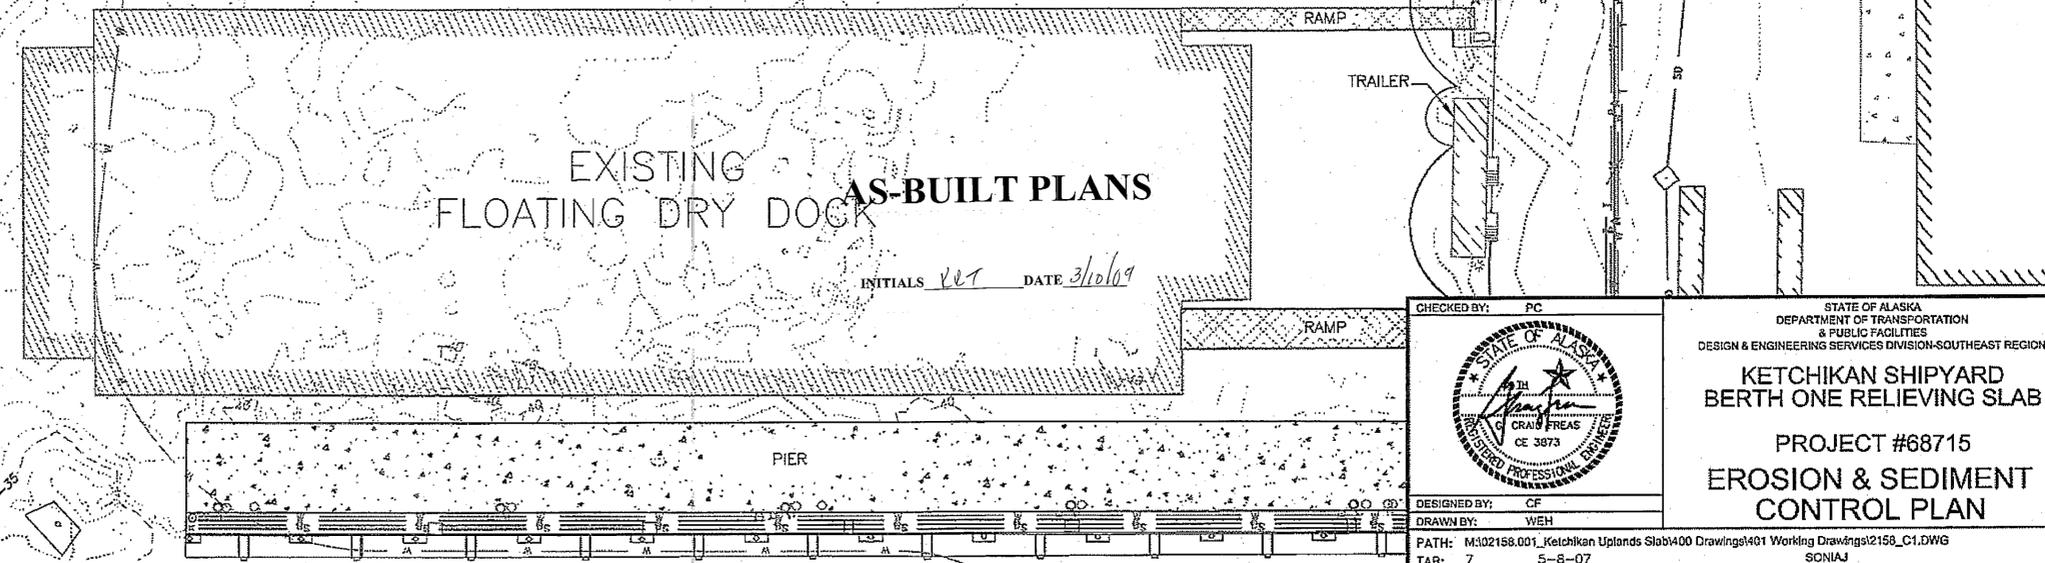

INITIALS *vet* DATE *3/10/09*

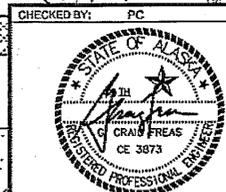

CHECKED BY: PC
DESIGNED BY: CF
DRAWN BY: WEH
PATH: M:\02158.001_Ketchikan Uplands Slab\400 Drawings\401 Working Drawings\2158_C1.DWG
TAB: 7 5-8-07 SONIAJ



STATE OF ALASKA
DEPARTMENT OF TRANSPORTATION
& PUBLIC FACILITIES
DESIGN & ENGINEERING SERVICES DIVISION-SOUTHEAST REGION

**KETCHIKAN SHIPYARD
BERTH ONE RELIEVING SLAB**



**PROJECT #68715
EROSION & SEDIMENT
CONTROL PLAN**

PLANS DEVELOPED BY:
TRYCK NYMAN HAYES, INC

REVISIONS			PROJECT DESIGNATION	YEAR	SHEET NO.	TOTAL SHEETS
NO.	DATE	DESCRIPTION	68715	2007	C2	28

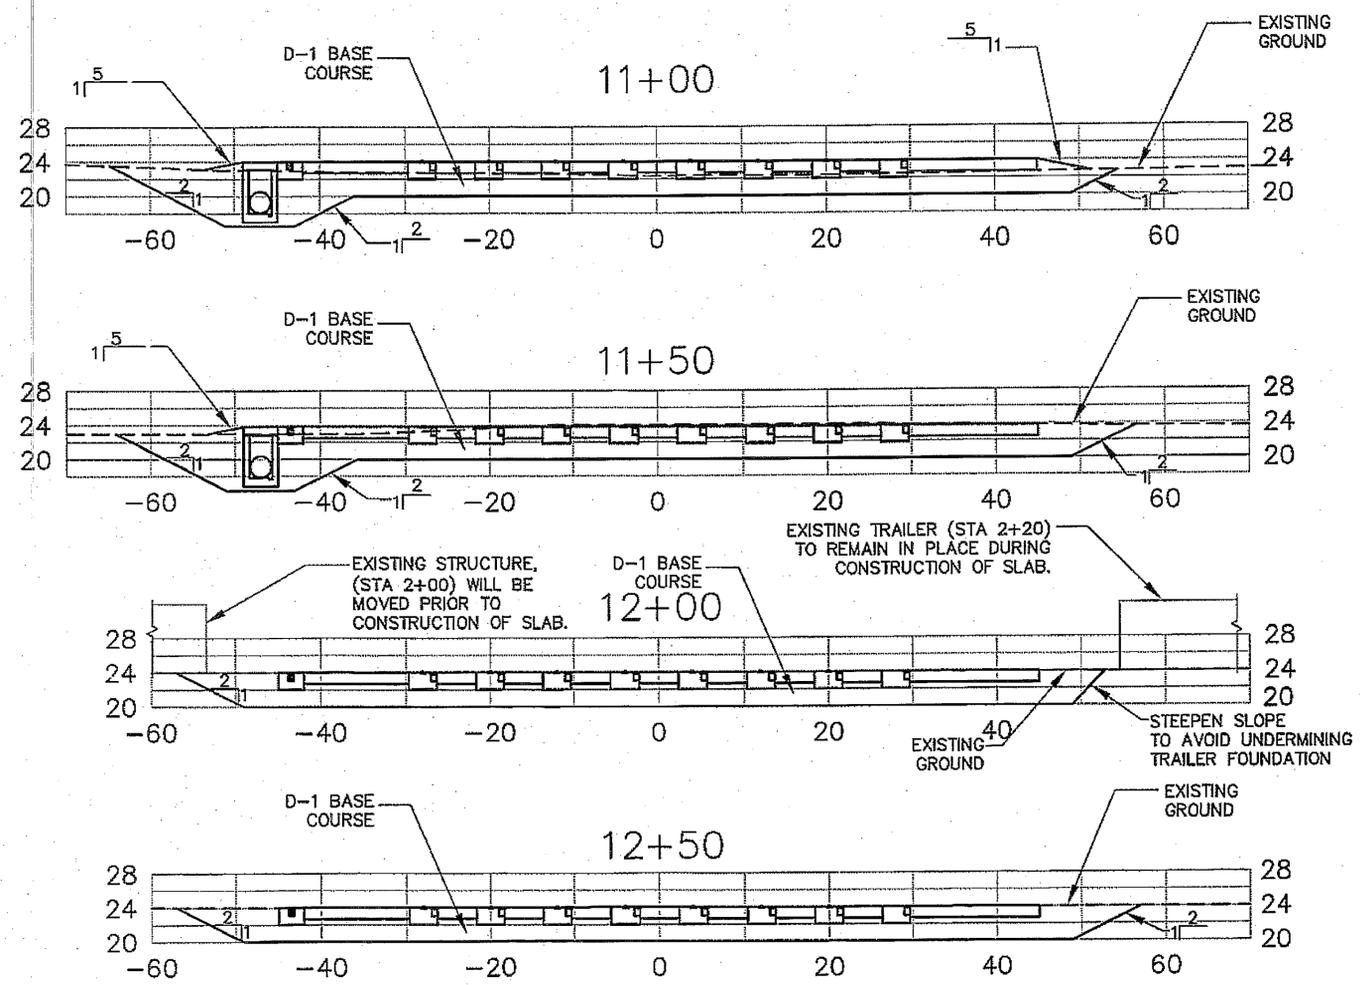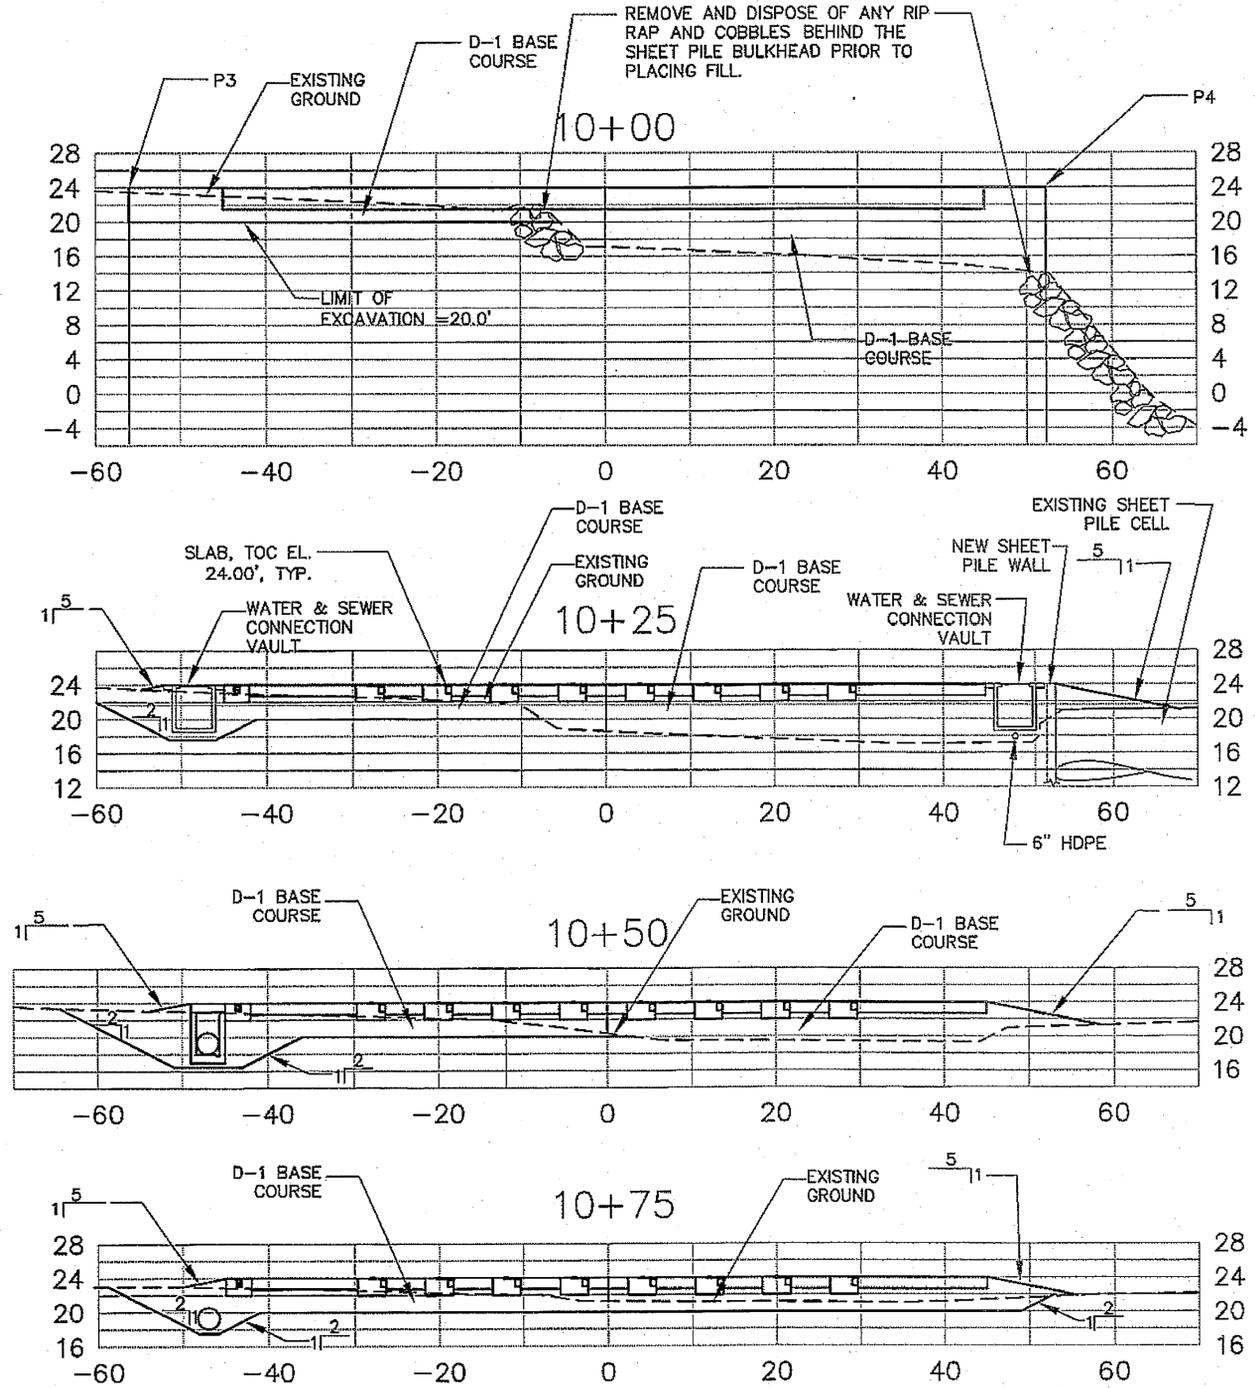

PARTIAL SECTION 20 FT RIGHT

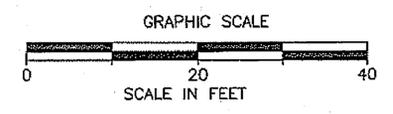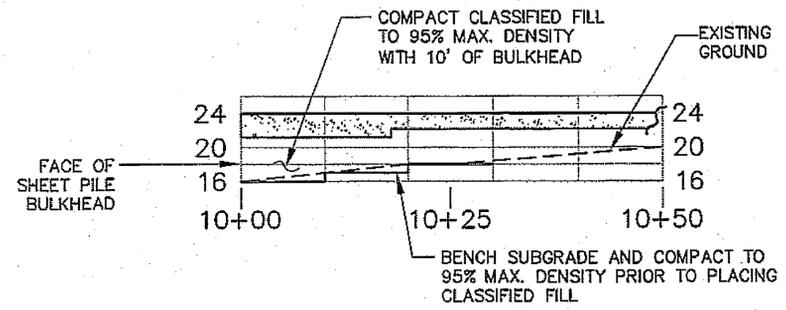


AS-BUILT PLANS


INITIALS *WET* DATE *3/10/07*

PLANS DEVELOPED BY:
TRYCK NYMAN HAYES, INC.


CHECKED BY: PC		STATE OF ALASKA DEPARTMENT OF TRANSPORTATION & PUBLIC FACILITIES DESIGN & ENGINEERING SERVICES DIVISION-SOUTHEAST REGION				
DESIGNED BY: CF		KETCHIKAN SHIPYARD BERTH ONE RELIEVING SLAB PROJECT #68715 SLAB CROSS SECTIONS				
DRAWN BY: PC						
PATH: M:\02158.001_Ketchikan Uplands Slab\400 Drawings\401 Working Drawings\2158.001_C6.DWG						
TAB: 8 5-8-07						
REVISIONS		PROJECT DESIGNATION	YEAR	SHEET NO.	TOTAL SHEETS	
NO.	DATE	DESCRIPTION	68715	2007	C6	28

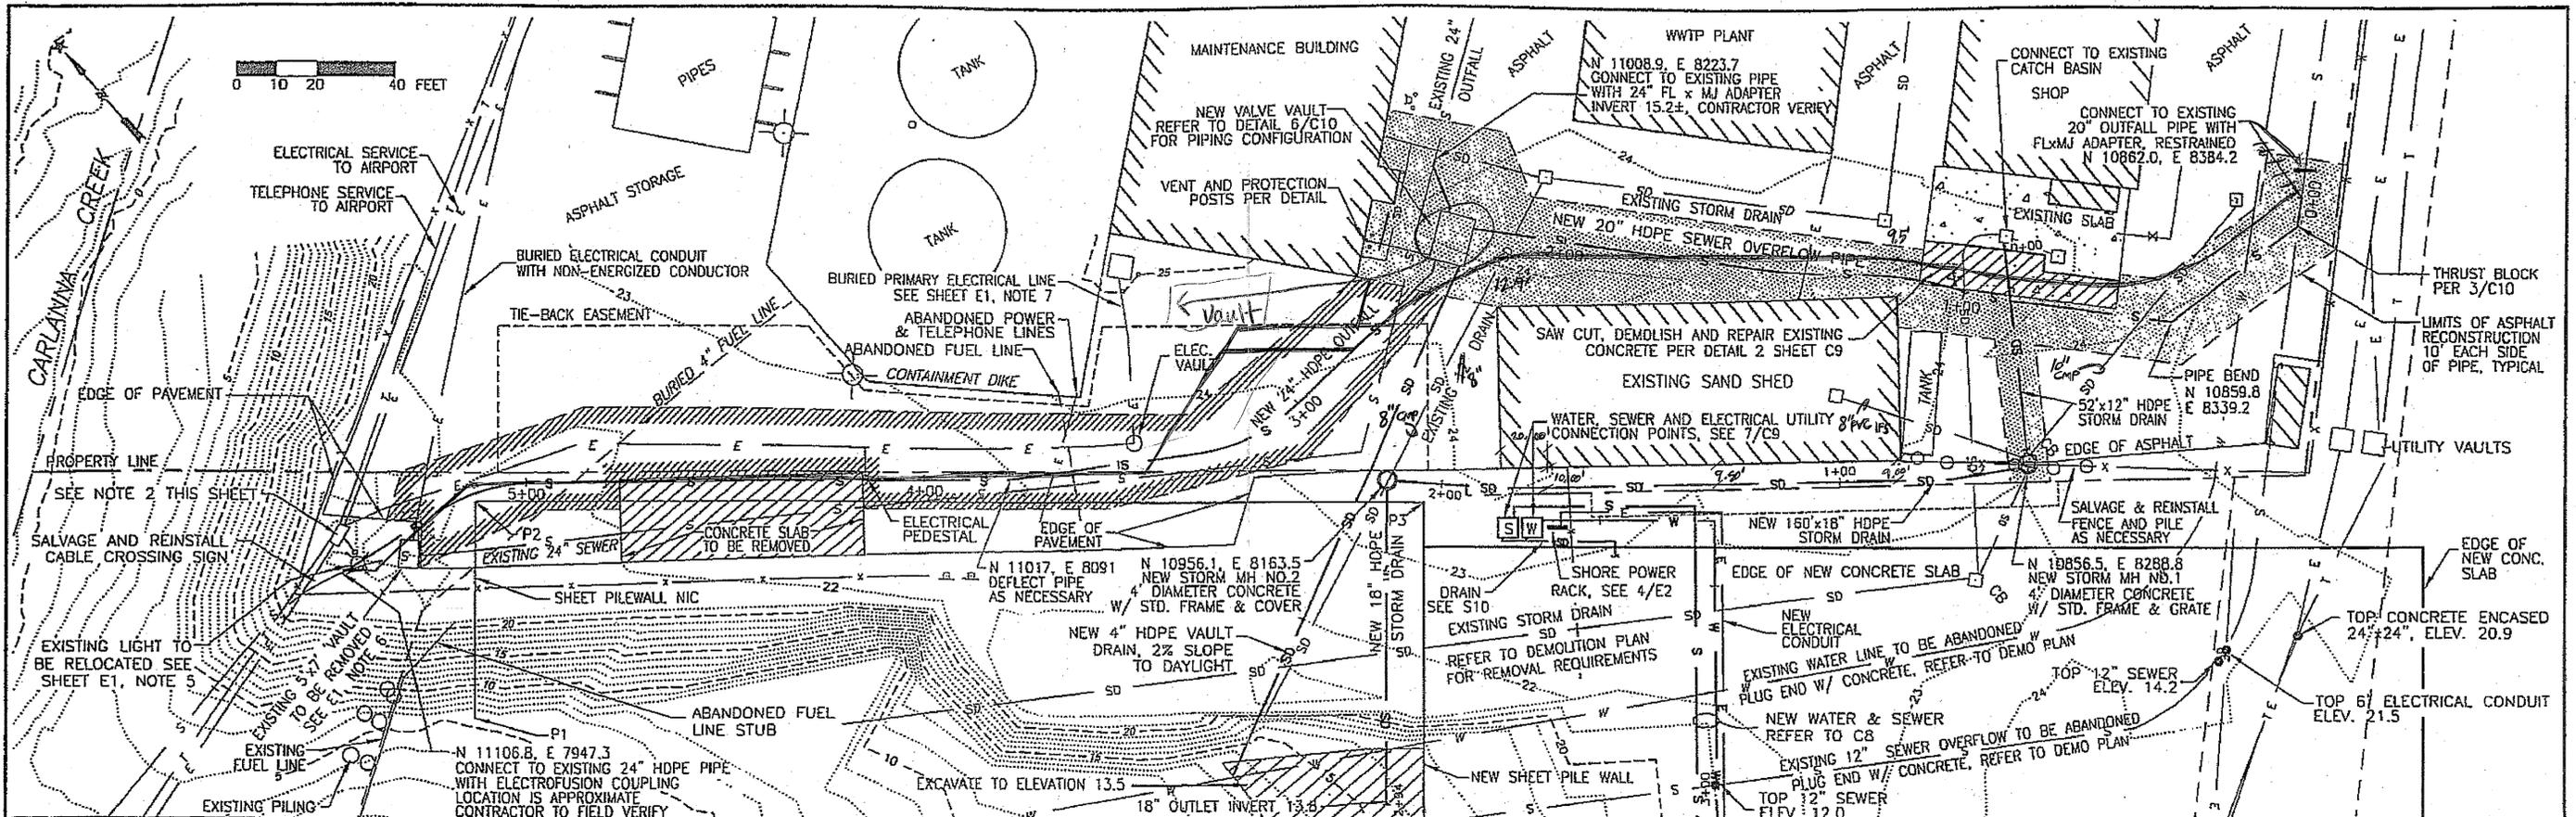

PLAN VIEW

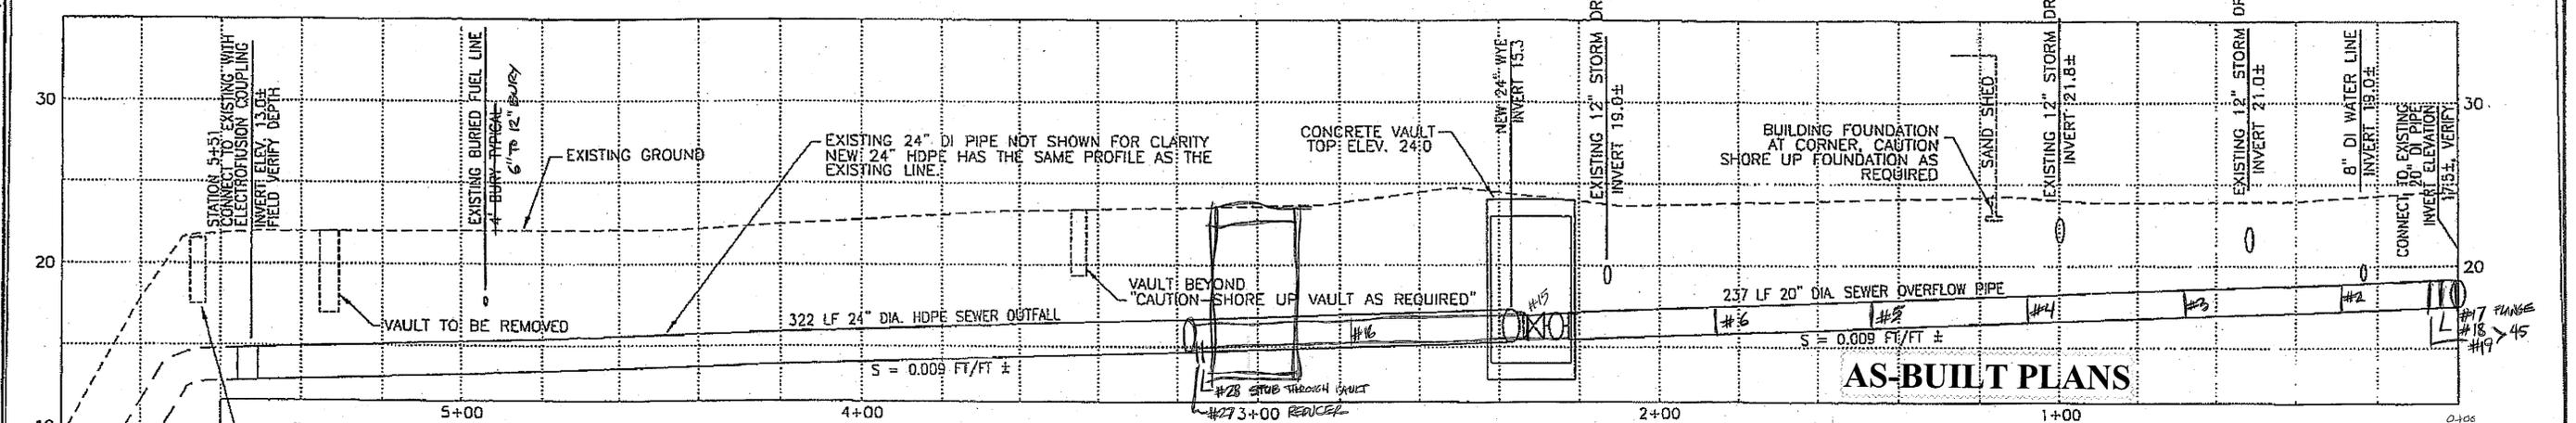

SEWER OUTFALL PROFILE VIEW

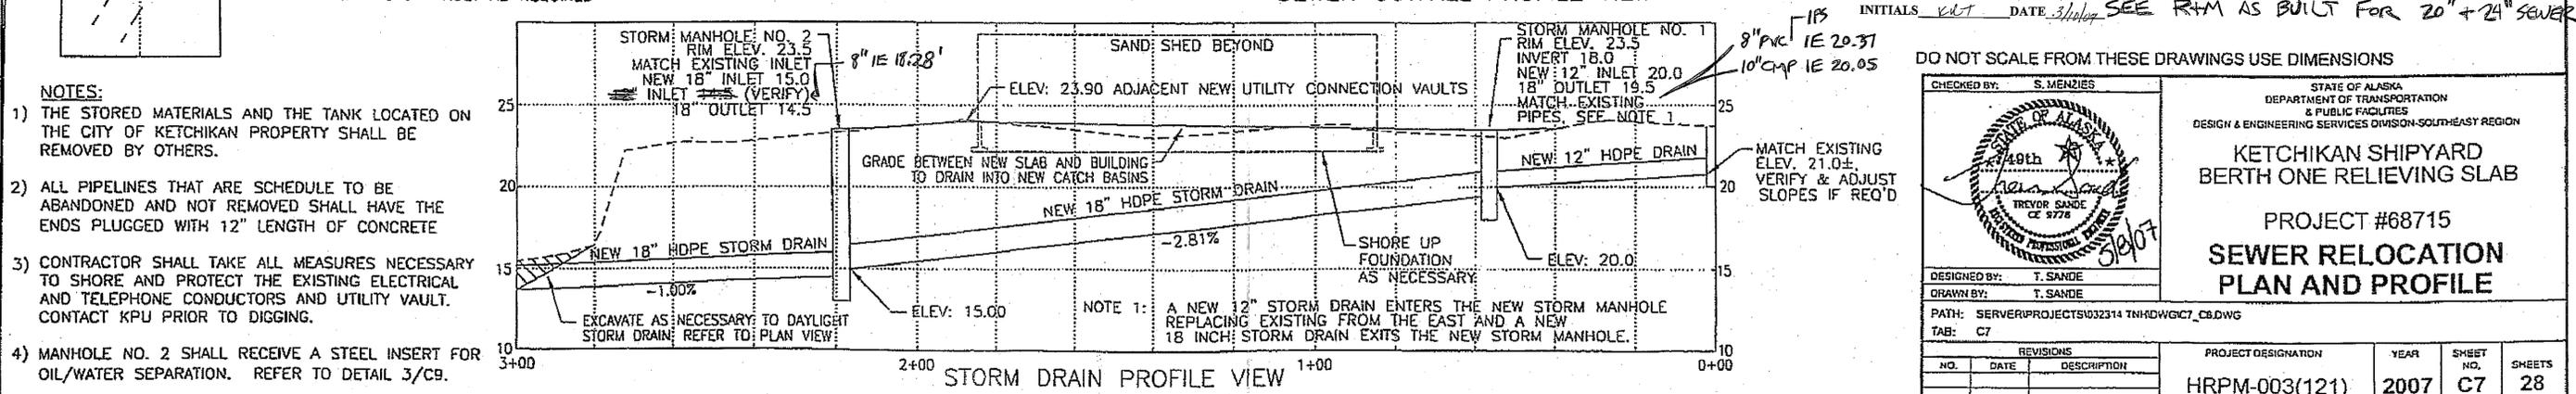



STORM DRAIN PROFILE VIEW

- NOTES:**
- 1) THE STORED MATERIALS AND THE TANK LOCATED ON THE CITY OF KETCHIKAN PROPERTY SHALL BE REMOVED BY OTHERS.
 - 2) ALL PIPELINES THAT ARE SCHEDULE TO BE ABANDONED AND NOT REMOVED SHALL HAVE THE ENDS PLUGGED WITH 12" LENGTH OF CONCRETE
 - 3) CONTRACTOR SHALL TAKE ALL MEASURES NECESSARY TO SHORE AND PROTECT THE EXISTING ELECTRICAL AND TELEPHONE CONDUCTORS AND UTILITY VAULT. CONTACT KPU PRIOR TO DIGGING.
 - 4) MANHOLE NO. 2 SHALL RECEIVE A STEEL INSERT FOR OIL/WATER SEPARATION. REFER TO DETAIL 3/C9.

INITIALS *KLT* DATE *3/1/07* SEE R4M AS BUILT FOR 20" + 24" SEWER

DO NOT SCALE FROM THESE DRAWINGS USE DIMENSIONS

CHECKED BY: S. MENZIES		STATE OF ALASKA DEPARTMENT OF TRANSPORTATION & PUBLIC FACILITIES DESIGN & ENGINEERING SERVICES DIVISION-SOUTH/EAST REGION																			
DESIGNED BY: T. SANDE																					
DRAWN BY: T. SANDE																					
PATH: SERVER\PROJECTS\032314\TND\DWG\T7_CB.DWG		KETCHIKAN SHIPYARD BERTH ONE RELIEVING SLAB PROJECT #68715 SEWER RELOCATION PLAN AND PROFILE																			
TAB: C7																					
<table border="1"> <thead> <tr> <th colspan="2">REVISIONS</th> <th>PROJECT DESIGNATION</th> <th>YEAR</th> <th>SHEET NO.</th> <th>SHEETS</th> </tr> <tr> <th>NO.</th> <th>DATE</th> <th>DESCRIPTION</th> <th></th> <th></th> <th></th> </tr> </thead> <tbody> <tr> <td></td> <td></td> <td></td> <td>2007</td> <td>C7</td> <td>28</td> </tr> </tbody> </table>		REVISIONS		PROJECT DESIGNATION	YEAR	SHEET NO.	SHEETS	NO.	DATE	DESCRIPTION							2007	C7	28		
REVISIONS		PROJECT DESIGNATION	YEAR	SHEET NO.	SHEETS																
NO.	DATE	DESCRIPTION																			
			2007	C7	28																

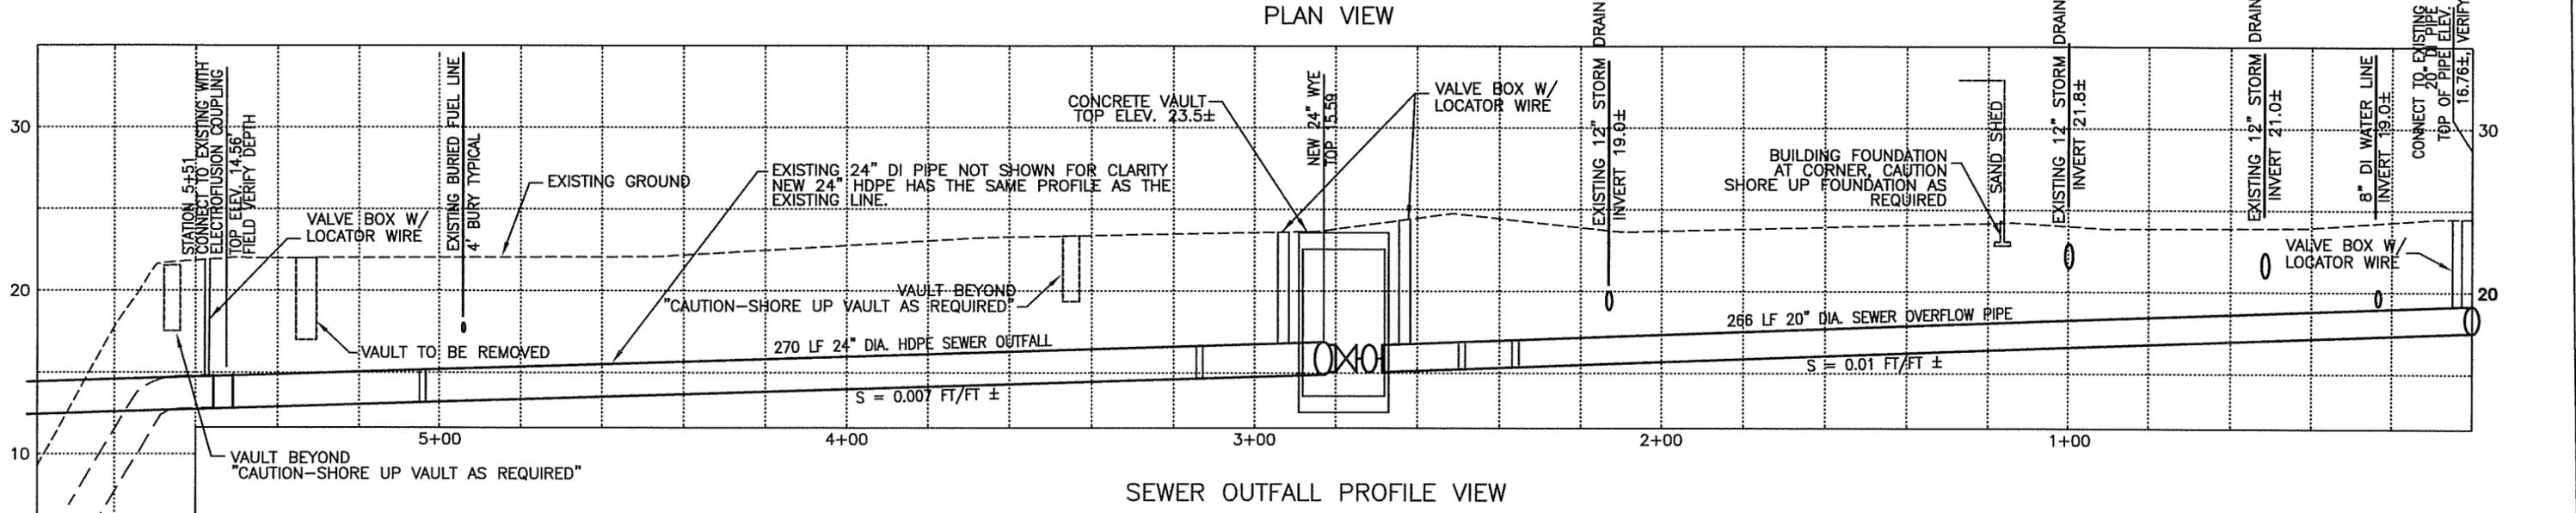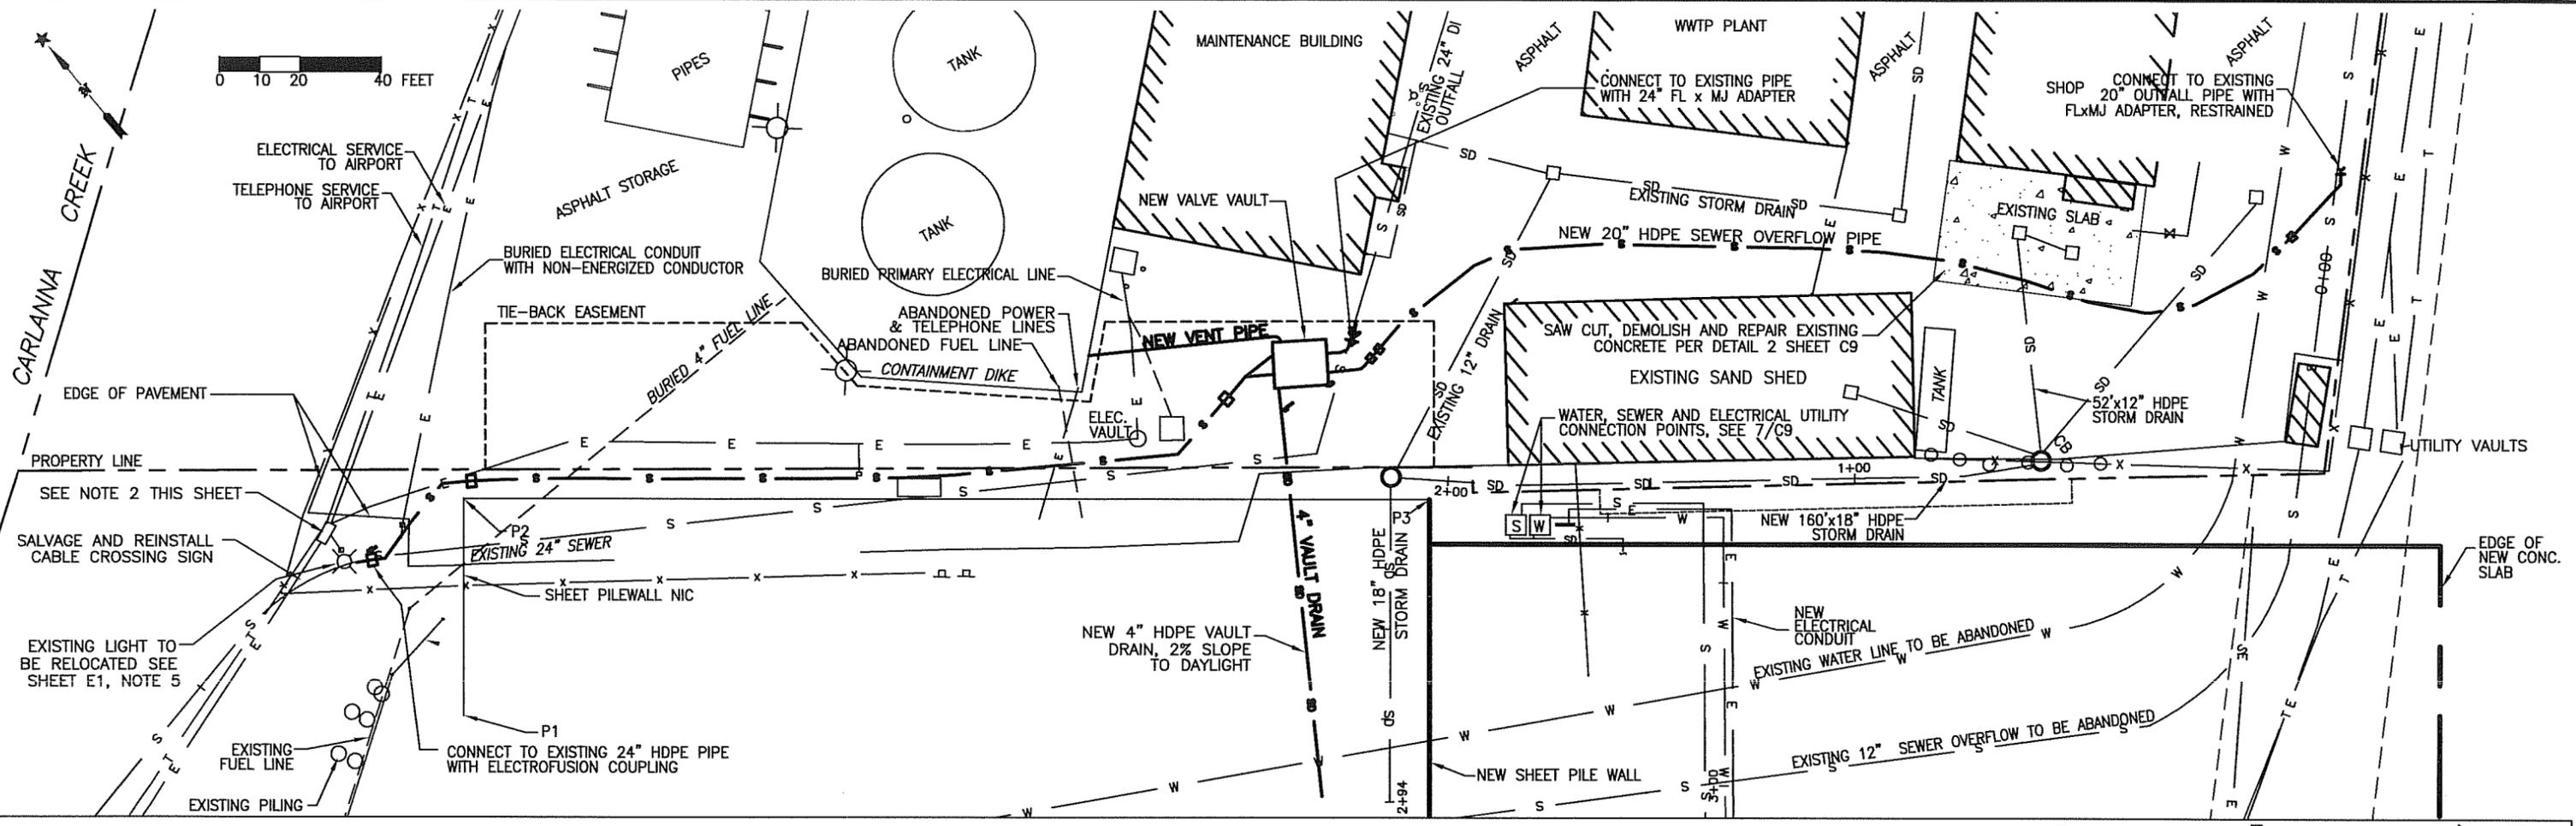


DO NOT SCALE FROM THESE DRAWINGS USE DIMENSIONS


CHECKED BY: S. MENZIES		STATE OF ALASKA DEPARTMENT OF TRANSPORTATION & PUBLIC FACILITIES DESIGN & ENGINEERING SERVICES DIVISION SOUTHEAST REGION							
		KETCHIKAN SHIPYARD BERTH ONE RELIEVING SLAB							
		PROJECT #68715 SEWER RELOCATION PLAN AND PROFILE							
DESIGNED BY: T. SANDE		YEAR: 2007							
DRAWN BY: T. SANDE		SHEET NO: C7							
PATH: SERVER\PROJECTS\1032314 TN-HDWG\C7_C8.DWG		PROJECT DESIGNATION: HRP-003(121)							
TAB: C7		SHEETS: 28							
<table border="1"> <thead> <tr> <th>NO</th> <th>DATE</th> <th>DESCRIPTION</th> </tr> </thead> <tbody> <tr> <td>1</td> <td>9/7/07</td> <td>REVISED VAULT</td> </tr> </tbody> </table>		NO	DATE	DESCRIPTION	1	9/7/07	REVISED VAULT		
NO	DATE	DESCRIPTION							
1	9/7/07	REVISED VAULT							

RECORD DRAWINGS

RECORD DRAWING INFORMATION
PROVIDED BY THE CITY OF KETCHIKAN
AND DAWSON CONSTRUCTION

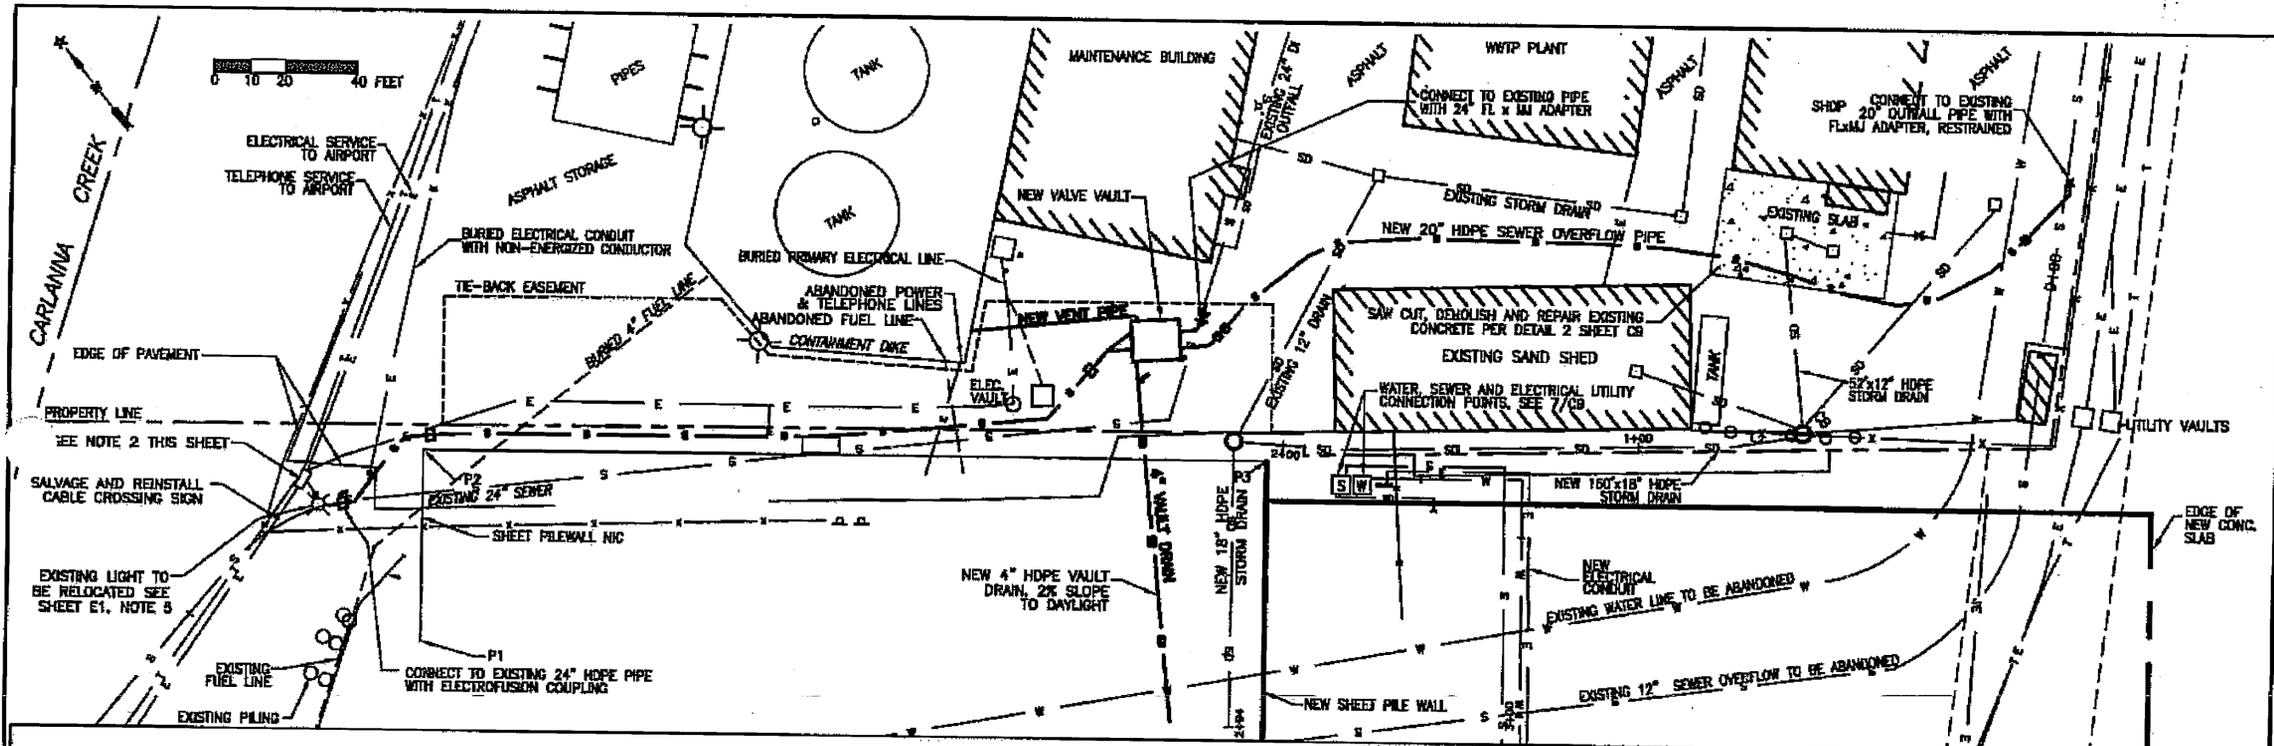

PLAN VIEW

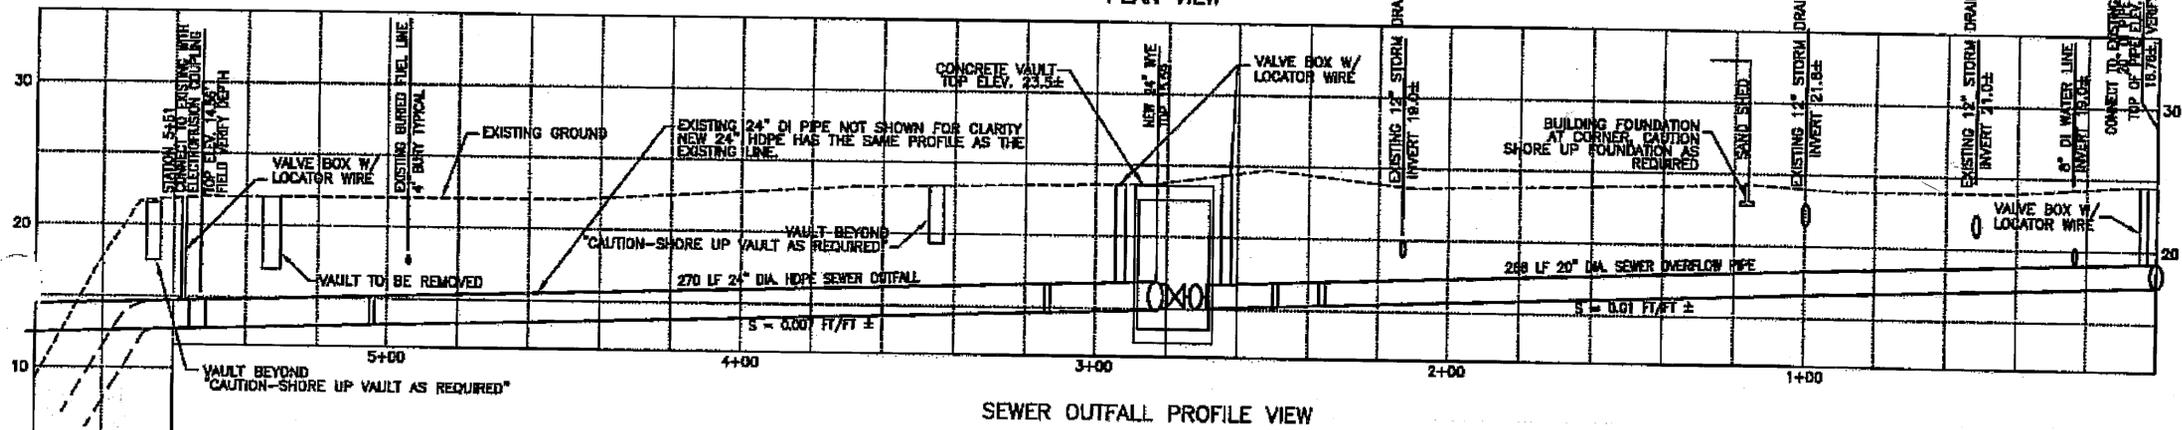

SEWER OUTFALL PROFILE VIEW

AS-BUILT PLANS


INITIALS *KRT* DATE *3/9/09*

RECORD DRAWINGS

RECORD DRAWING INFORMATION
PROVIDED BY THE CITY OF KETCHIKAN
AND DAWSON CONSTRUCTION


DO NOT SCALE FROM THESE DRAWINGS USE DIMENSIONS

CHECKED BY: S. HENNER 		STATE OF ALASKA DEPARTMENT OF TRANSPORTATION & PUBLIC FACILITIES DESIGN & ENGINEERING SERVICES DIVISION (SOUTHEAST REGION)				
DESIGNED BY: T. SANCHEZ DRAWN BY: T. SANCHEZ		KETCHIKAN SHIPYARD BERTH ONE RELIEVING SLAB				
PATH: \\SERVER\PROJECTS\072314\114240027_CADDWG		PROJECT #88715 SEWER RELOCATION PLAN AND PROFILE				
NO.	DATE	DESCRIPTION	PROJECT DESIGNATION	YEAR	SHEET NO.	SHEETS
1	8/22/07	REVISED VAULT	HRPM-003/1211	2007	57	28

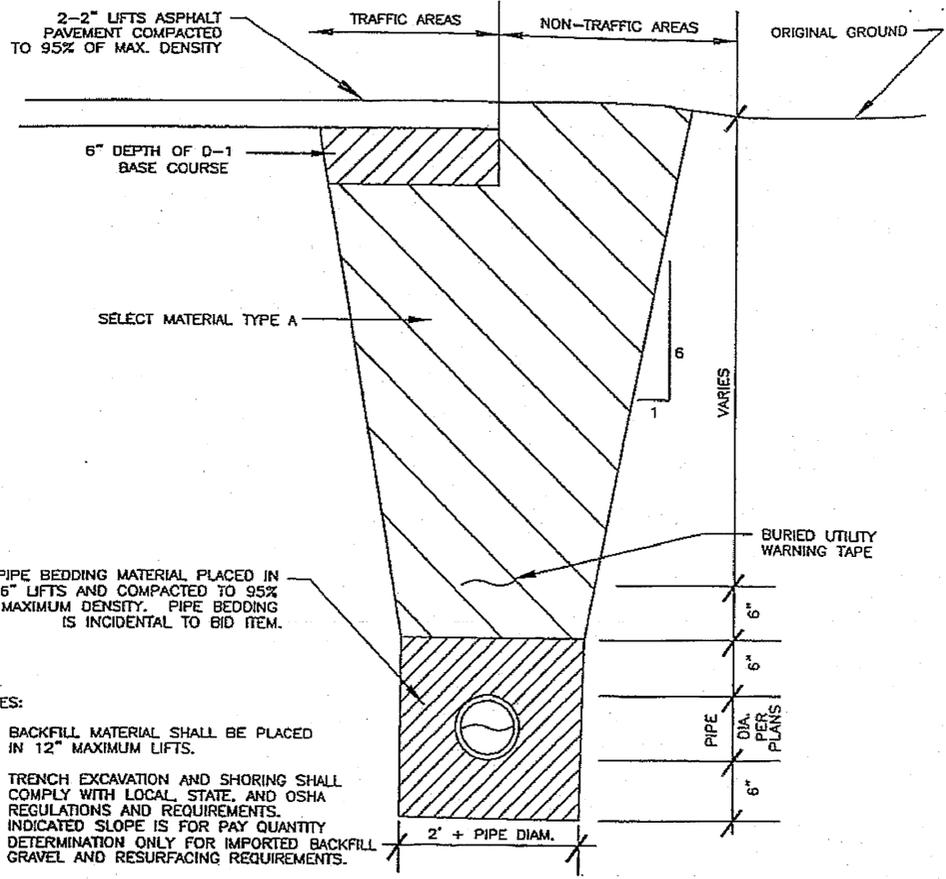


- NOTES:
- BACKFILL MATERIAL SHALL BE PLACED IN 12" MAXIMUM LIFTS.
 - TRENCH EXCAVATION AND SHORING SHALL COMPLY WITH LOCAL, STATE, AND OSHA REGULATIONS AND REQUIREMENTS. INDICATED SLOPE IS FOR PAY QUANTITY DETERMINATION ONLY FOR IMPORTED BACKFILL GRAVEL AND RESURFACING REQUIREMENTS.
 - IF UNSUITABLE PIPE FOUNDATION MATERIAL IS ENCOUNTERED DURING EXCAVATION, ENGINEER MAY DIRECT THE CONTRACTOR TO OVER-EXCAVATE AND BACKFILL WITH SUITABLE MATERIAL.
 - THE DITCH LINE, IF ONE EXISTS, SHALL BE RESHAPED IN SUCH A MANNER TO ALLOW POSITIVE DRAINAGE TO MATCH PRE-CONSTRUCTION CONDITIONS.
 - TRENCHING SEAWARD OF ELEVATION 19.4 WILL ENCOUNTER CONTAMINATED MATERIALS. REFER TO SECTION 203-2.01 FOR HANDLING AND DISPOSAL REQUIREMENTS.


1 TYPICAL UPLAND TRENCH SECTION
C9 NOT TO SCALE

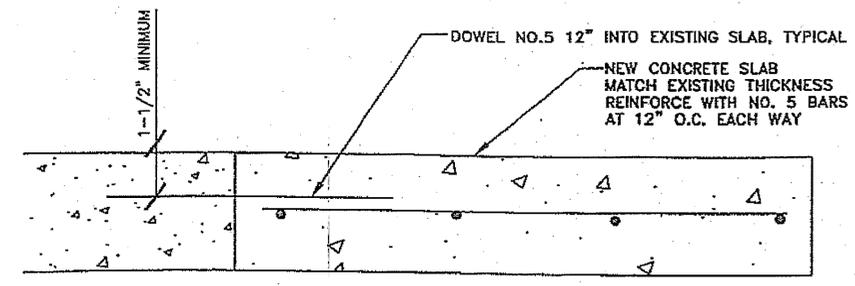

2 CONCRETE SLAB REPAIR
C9 NOT TO SCALE

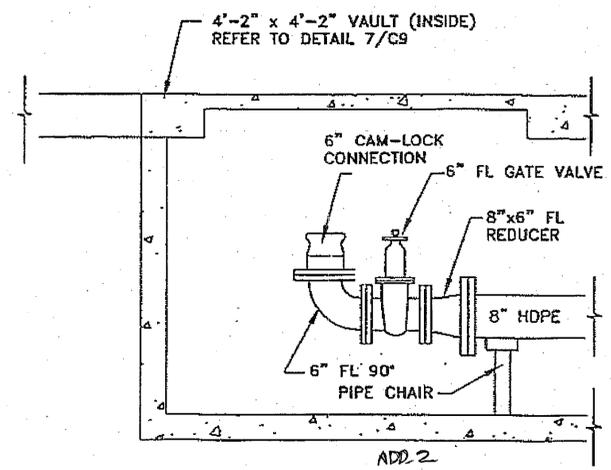


3 OIL/WATER SEPARATOR
C9 NOT TO SCALE

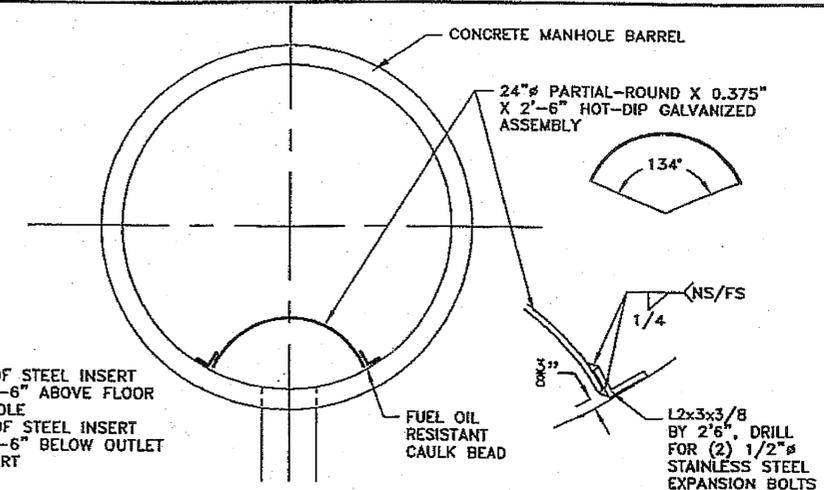


- NOTES:
- BOTTOM OF STEEL INSERT TO BE 1'-6" ABOVE FLOOR OF MANHOLE
 - BOTTOM OF STEEL INSERT TO BE 0'-6" BELOW OUTLET PIPE INVERT

4 WATER SERVICE CONNECTION
C9 NOT TO SCALE

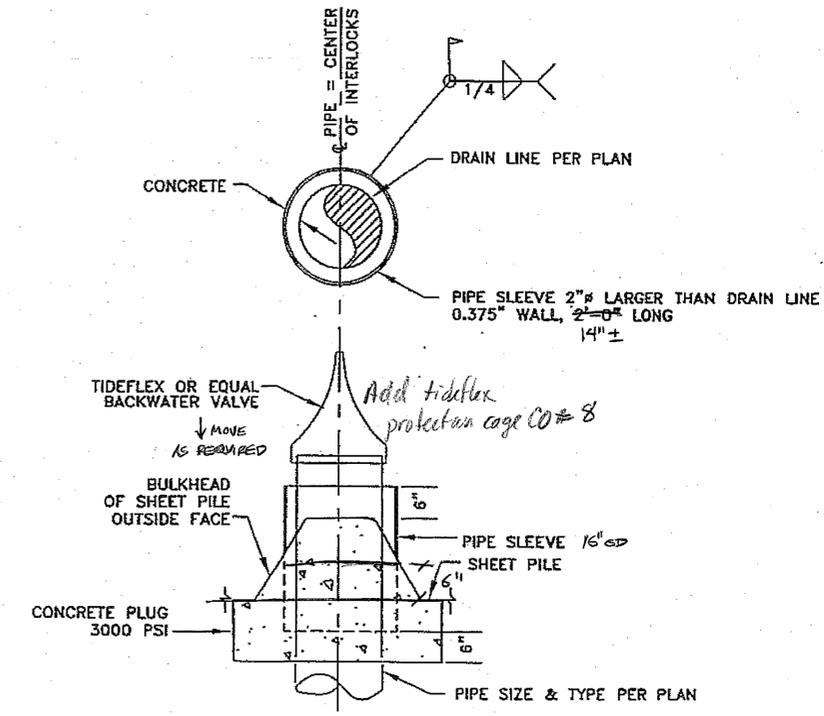

- NOTE:
CONTRACTOR SHALL EXPOSE THE EXISTING BILGE AND AIR LINES PRIOR TO BEGINNING WORK TO DETERMINE LOCATION, PIPE TYPE, DEPTH AND LOCATION. BILGE AND AIR LINES SHALL BE REMOVED AND PLACED BELOW THE WATER LINE IF CONFLICTS EXIST.

5 BURIED WATER SERVICE
C9 NOT TO SCALE

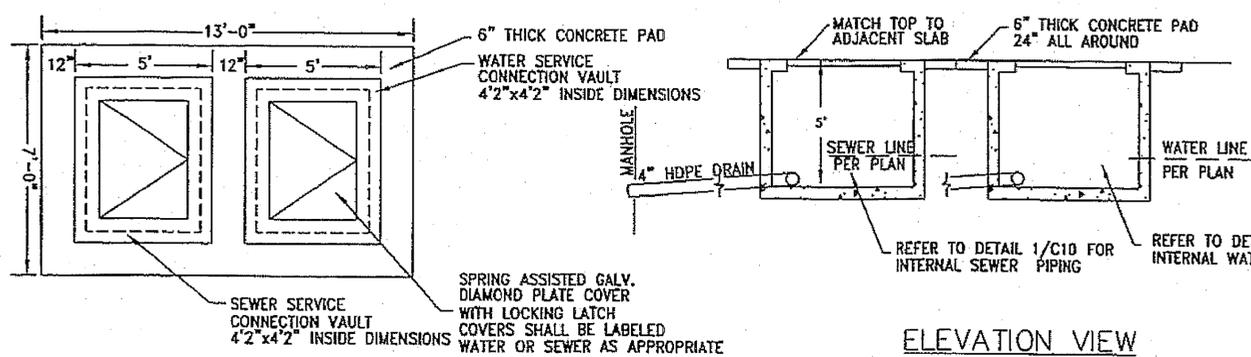

- NOTE: 1) REFER TO SHEETS C7, C8 AND S10 FOR DRAIN LOCATIONS
2) CONNECT BOTH VAULTS INTO SINGLE PIPE PENETRATION OF SLAB DRAIN MANHOLE
3) EXCAVATE A MINIMUM OF 12" BELOW PLANNED BOTTOM OF VAULT & BACKFILL WITH D-1 COMPACTED 95% OF MAXIMUM DENSITY

6 SERVICE CONNECTION DETAIL
C9 NOT TO SCALE

7 STORM DRAIN WALL PENETRATION
C9 NOT TO SCALE

ELEVATION VIEW

PLAN VIEW

AS-BUILT PLANS

INITIALS *KRT* DATE 3/10/09

DO NOT SCALE FROM THESE DRAWINGS USE DIMENSIONS

CHECKED BY: S. MENZIES

DESIGNED BY: T. SANDE
DRAWN BY: T. SANDE


STATE OF ALASKA
DEPARTMENT OF TRANSPORTATION & PUBLIC FACILITIES
DESIGN & ENGINEERING SERVICES DIVISION-SOUTHEAST REGION

KETCHIKAN SHIPYARD
BERTH ONE RELIEVING SLAB


PROJECT #68715
CIVIL
DETAILS

PATH: SERVER\PROJECTS\1032314\TIN\DWG\C9_C10.DWG
TAB: C9


REVISIONS			PROJECT DESIGNATION	YEAR	SHEET NO.	SHEETS
NO.	DATE	DESCRIPTION				
			HRPM-003(121)	2007	C9	28

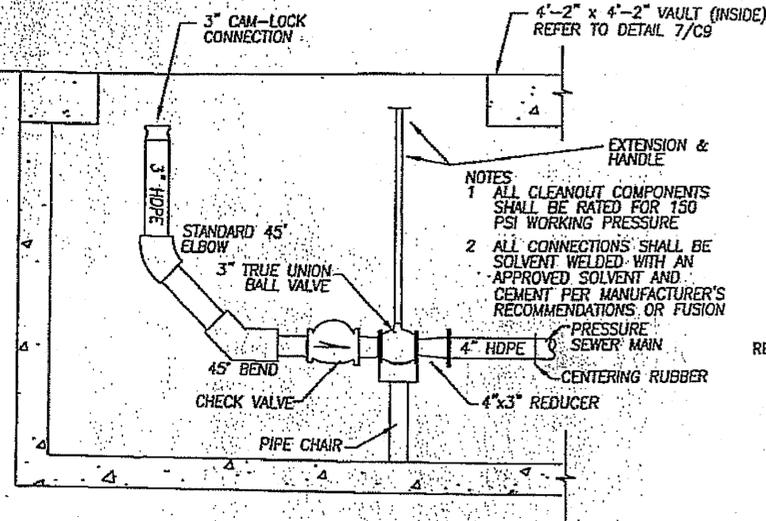

1 PRESSURE SEWER SERVICE CONNECTION
C10 NOT TO SCALE

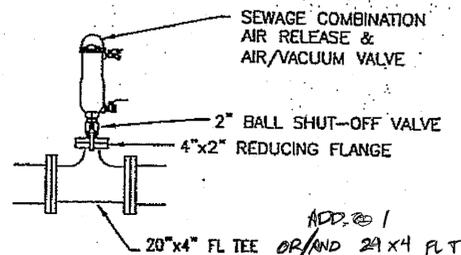


2 SEWAGE AIR RELEASE ASSEMBLY
C10 NOT TO SCALE

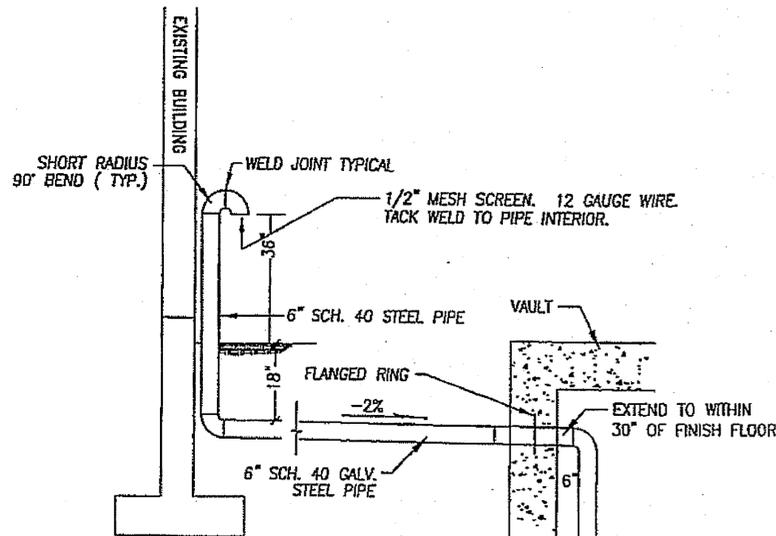

NOTES: 1) HOT DIP GALVANIZE VENT ASSEMBLY AFTER FABRICATION
2) VENT SHALL HAVE TWO PROTECTION POST PER DETAIL 5 THIS SHEET
3) REFER TO SHEET C7 FOR VENT LOCATION


4 VAULT VENT DETAIL
C10 NOT TO SCALE

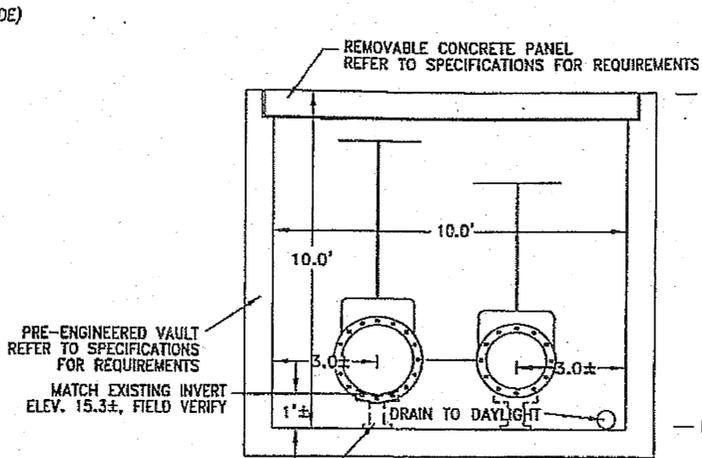


NOTE: EXCAVATE A MINIMUM OF 12" BELOW PLANNED BOTTOM OF VAULT & BACKFILL WITH D-1 COMPACTED 95% OF MAXIMUM DENSITY

SECTION A-A

3 20" SEWER BYPASS THRUST BLOCK
C10 NOT TO SCALE

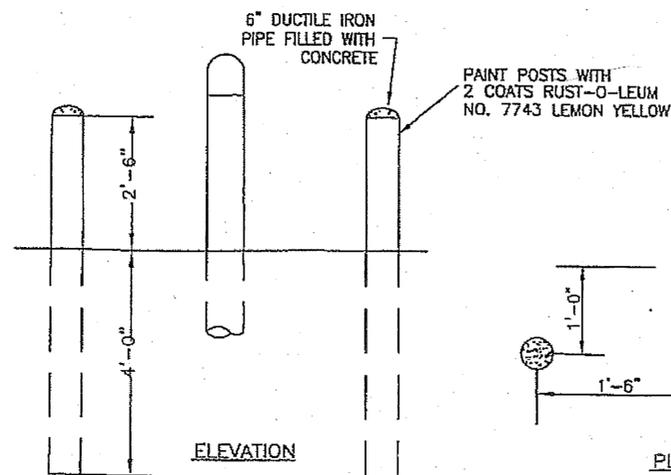

5 VENT PROTECTION POST DETAIL
C10 NOT TO SCALE

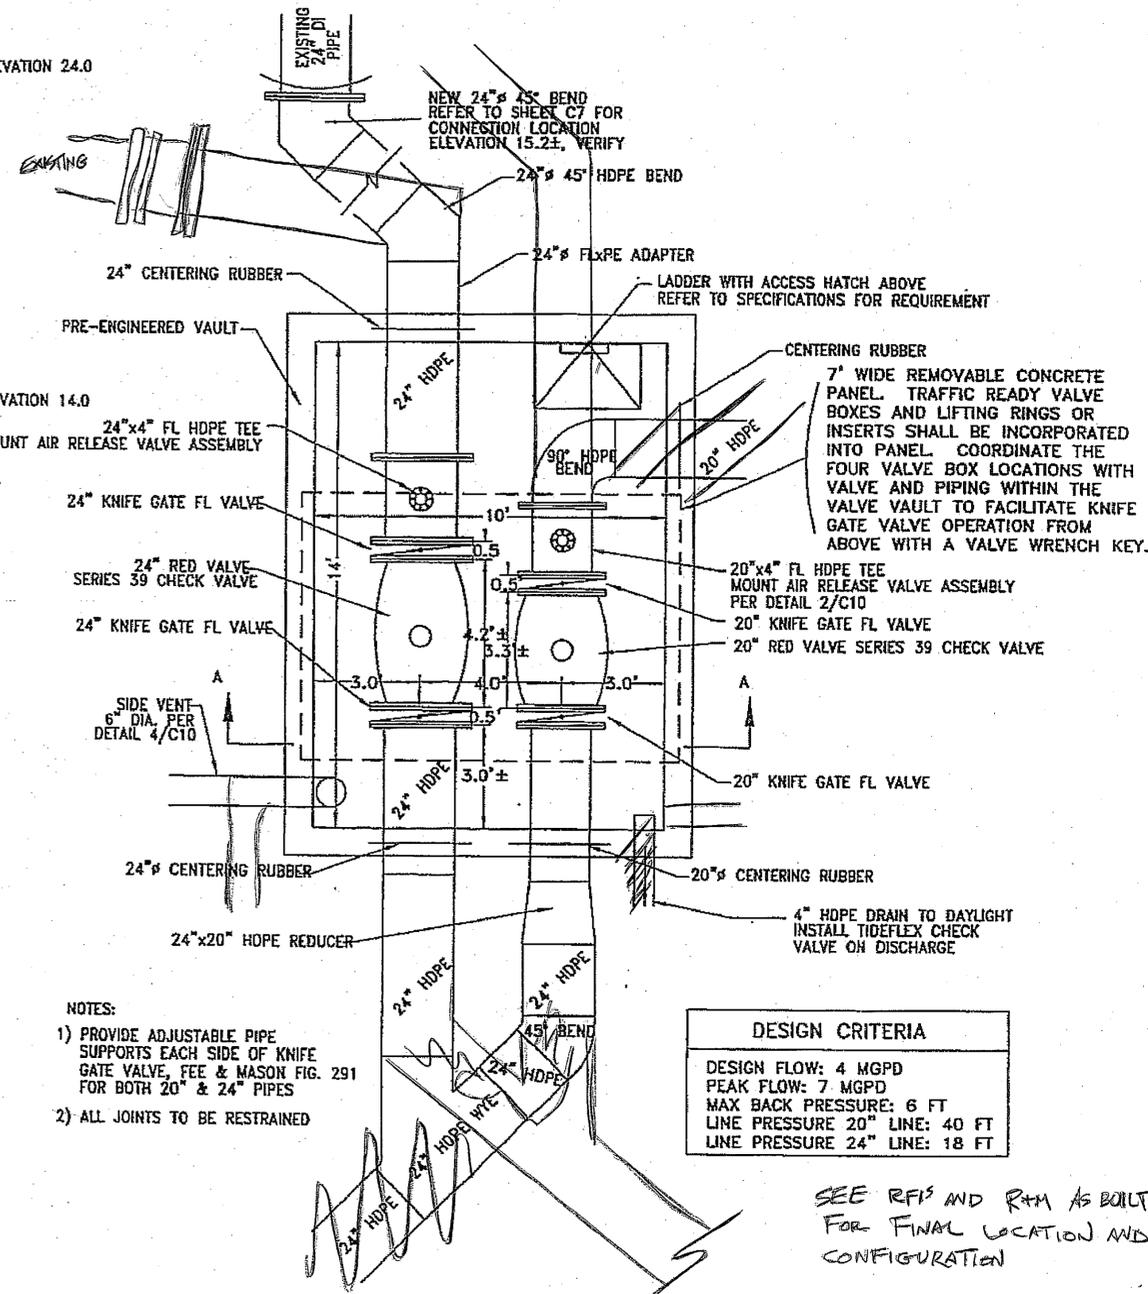


NOTES:
1) PROVIDE ADJUSTABLE PIPE SUPPORTS EACH SIDE OF KNIFE GATE VALVE, FEE & MASON FIG. 291 FOR BOTH 20" & 24" PIPES
2) ALL JOINTS TO BE RESTRAINED

DESIGN CRITERIA	
DESIGN FLOW:	4 MGPD
PEAK FLOW:	7 MGPD
MAX BACK PRESSURE:	6 FT
LINE PRESSURE 20" LINE:	40 FT
LINE PRESSURE 24" LINE:	18 FT

SEE RFI'S AND R4M AS BUILT FOR FINAL LOCATION AND CONFIGURATION

6 BYPASS / OUTFALL VAULT
C10 NOT TO SCALE

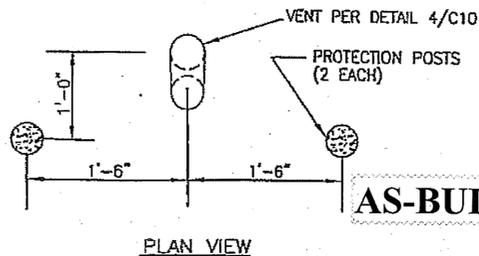

AS-BUILT PLANS
by Dawson Inc.

INITIALS *KRT* DATE 3/10/09
A0071PF

DO NOT SCALE FROM THESE DRAWINGS USE DIMENSIONS

CHECKED BY: S. MENZIES

STATE OF ALASKA
DEPARTMENT OF TRANSPORTATION & PUBLIC FACILITIES
DESIGN & ENGINEERING SERVICES DIVISION-SOUTHEAST REGION


KETCHIKAN SHIPYARD
BERTH ONE RELIEVING SLAB

PROJECT #68715
CIVIL
DETAILS

DESIGNED BY: T. SANDE
DRAWN BY: T. SANDE

PATH: SERVER\PROJECTS\032314\TND\DWG\C10.DWG
TAB: C10


NO.	DATE	DESCRIPTION	PROJECT DESIGNATION	YEAR	SHEET NO.	SHEETS
			HRPM-003(121)	2007	C10	28

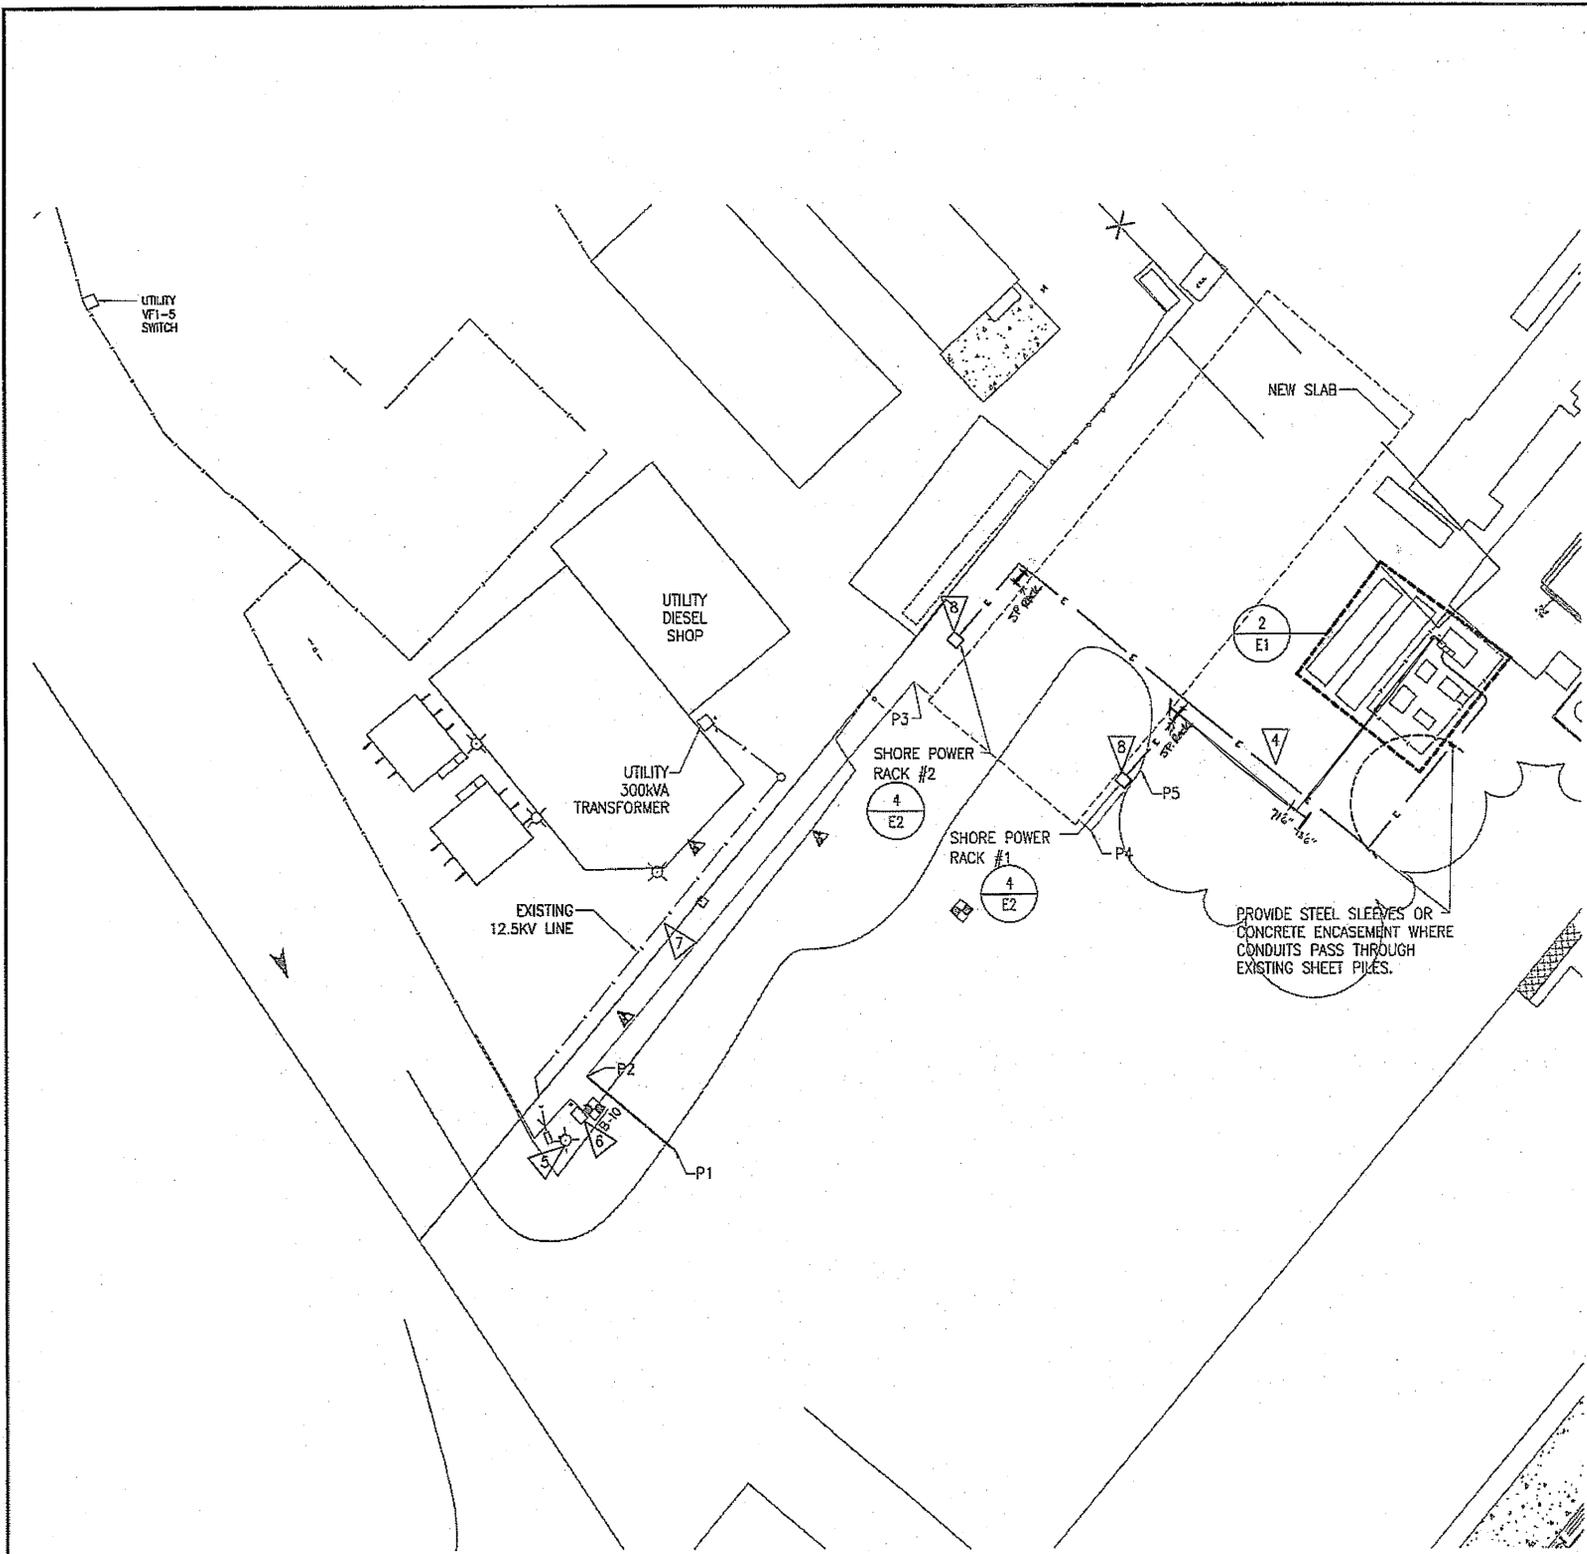

1 ELECTRICAL SITE PLAN
 E1 0 20 40 80 120

NOTES:

1. PROVIDE 1-1200A, 480V, 3Ø, 4-W CIRCUIT FROM THE MAIN SWITCHGEAR, TO THE SHORE POWER RACK ATTACHMENT POINTS. REFER TO 2/E1.
2. INSTALL 2-400A RECEPTACLES AND DISCONNECTS AT LOCATION-1 (LOC#1), EXTEND CIRCUIT TO LOCATION-2 AND INSTALL A SECOND SET OF TWO 400A RECEPTACLES, REFER TO 4/E2.
3. INSTALL NEW BREAKER FOR THE CIRCUIT IN THE EXISTING SWITCHGEAR, REFER TO ONE-LINE DIAGRAM 1/E2.
4. UNDERGROUND FEEDER RUNS FROM EXISTING SWITCHGEAR TO SHORE POWER POINTS. (4) 3" CONDUITS FROM THE EXISTING SWITCHGEAR BUILDING RACK #1, (4) 3" CONDUITS FROM RACK #1 TO RACK #2. REFER TO 4/E2 AND 5/E2 FOR FURTHER DETAILS. THE CONDUIT SHALL BE SITUATED ALONG SIDE THE WATER AND SEWER LINES, TO THE SOUTH AND THE EAST OF THESE LINES. WHERE THE CONDUIT IS REQUIRED TO CROSS THE WATER AND SEWER LINES, IT SHALL CROSS ABOVE THESE LINES. REFER TO C8 FOR FURTHER DETAILS ON WATER AND SEWER LINE ROUTING.
5. REMOVE AND RELOCATE EXISTING LIGHT MOUNTED ON WOODEN POLE FOR INSTALLATION OF SEWER LINE. RINSTALL EXISTING POLE AND FIXTURE AS CLOSE TO ORIGINAL LOCATION AS POSSIBLE. RECONNECT TO THE EXISTING CIRCUIT.
6. EXISTING VAULT HAS AN UNENERGIZED DISTRIBUTION CABLE. COORDINATE WITH KETCHIKAN PUBLIC UTILITIES TO REMOVE THIS CABLE. DEMO THE EXISTING VAULT.
7. EXISTING 12.5KV LINE WITHIN AREA OF TIE-BACKS. COORDINATE WITH THE UTILITY FOR LINE LOCATE AND EXERCISE CAUTION EXCAVATING AROUND THIS LINE.
8. REFER TO SHEET S10 FOR SPECIFIC LOCATION OF THE SHORE POWER ATTACHMENT RACKS.

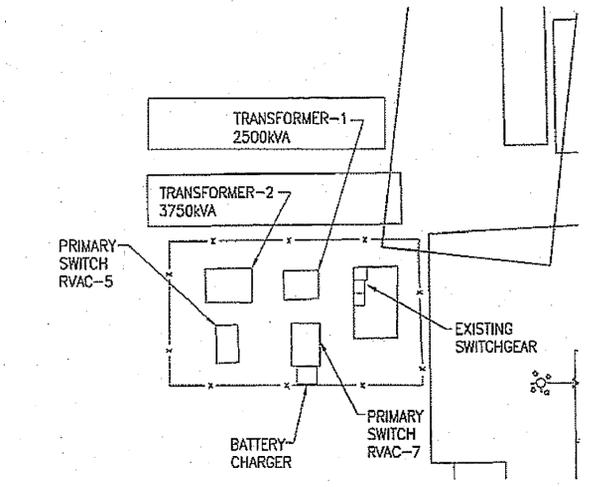



2 ENLARGED SITE PLAN
 E1 0 10 20 40 60

AS-BUILT PLANS


INITIALS *KLT* DATE *3/16/07*

DO NOT SCALE FROM THESE DRAWINGS USE DIMENSIONS

		STATE OF ALASKA DEPARTMENT OF TRANSPORTATION & PUBLIC FACILITIES DESIGN & ENGINEERING SERVICES DIVISION-SOUTHEAST REGION										
DESIGNED BY: TJP DRAWN BY: TAH		KETCHIKAN SHIPYARD BERTH ONE RELIEVING SLAB PROJECT #68715 ELECTRICAL PLAN										
PATH: P:\03199 SHIPLIFT FOR KETCHIKAN SHIPYARD\DRAWINGS\02158.001 DWG\03138E1.DWG TAB: E1 5-9-07 MORROW, ANDREA		PROJECT DESIGNATION 68715	YEAR 2007									
<table border="1"> <thead> <tr> <th colspan="3">REVISIONS</th> </tr> <tr> <th>NO.</th> <th>DATE</th> <th>DESCRIPTION</th> </tr> </thead> <tbody> <tr> <td>1</td> <td>10/20/06</td> <td>REVISION #1</td> </tr> </tbody> </table>		REVISIONS			NO.	DATE	DESCRIPTION	1	10/20/06	REVISION #1	SHEET NO. E1	TOTAL SHEETS 28
REVISIONS												
NO.	DATE	DESCRIPTION										
1	10/20/06	REVISION #1										

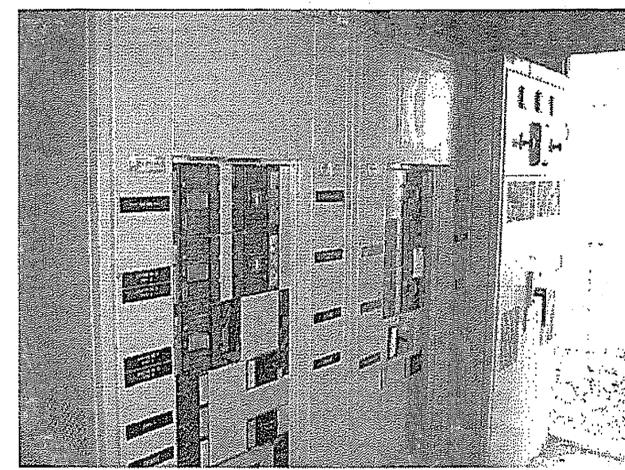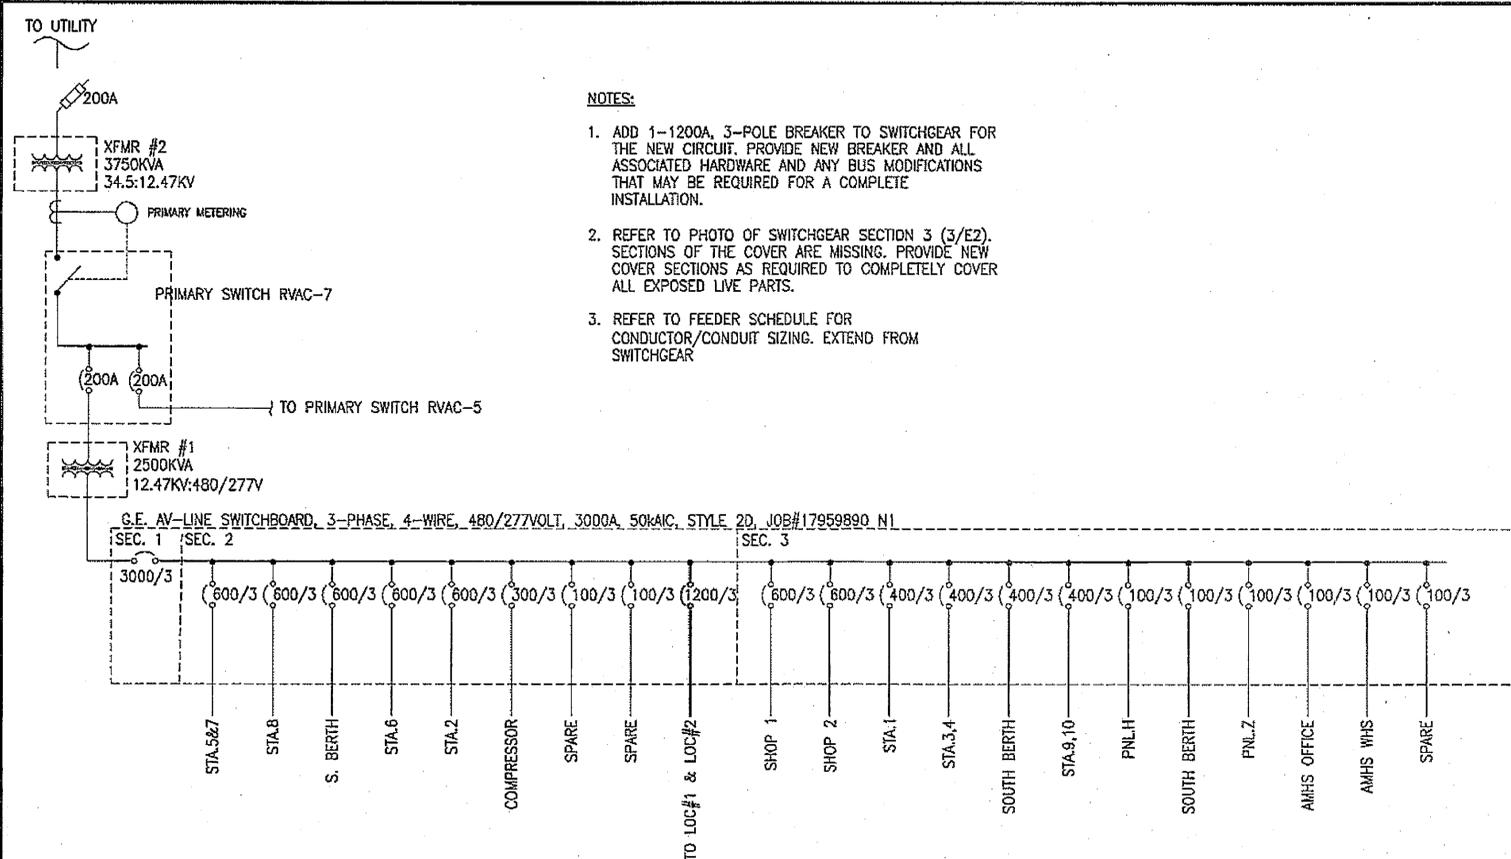


2 PHOTO OF EXISTING SWITCHGEAR
E2 NTS

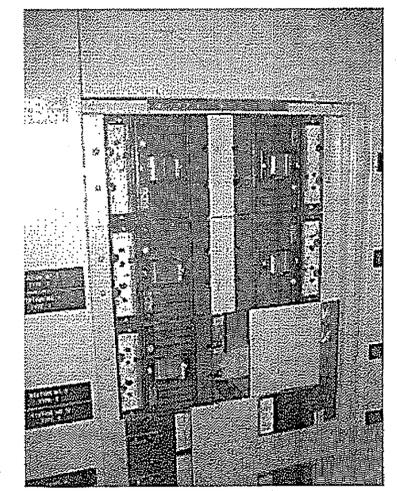


3 PHOTO OF SECTION 3
E2 NTS

FEEDER SCHEDULE			
CONDUCTORS	EQUIPMENT GROUNDING CONDUCTOR	CONDUIT	REMARKS
(4)3-350 kcmil Cu. XHHW	1- 3/0 Cu.	(4) 3" GRC	FEEDER FROM NEW 1200A CIRCUIT BREAKER TO SHORE POWER RACKS LOC#1 & LOC#2 CONSISTS OF FOUR PARALLEL RUNS
3-500 kcmil Cu. XHHW	1- 3/0 Cu.	3 1/2" GRC	TAPS FROM MAIN FEEDER TO EACH DISCONNECT

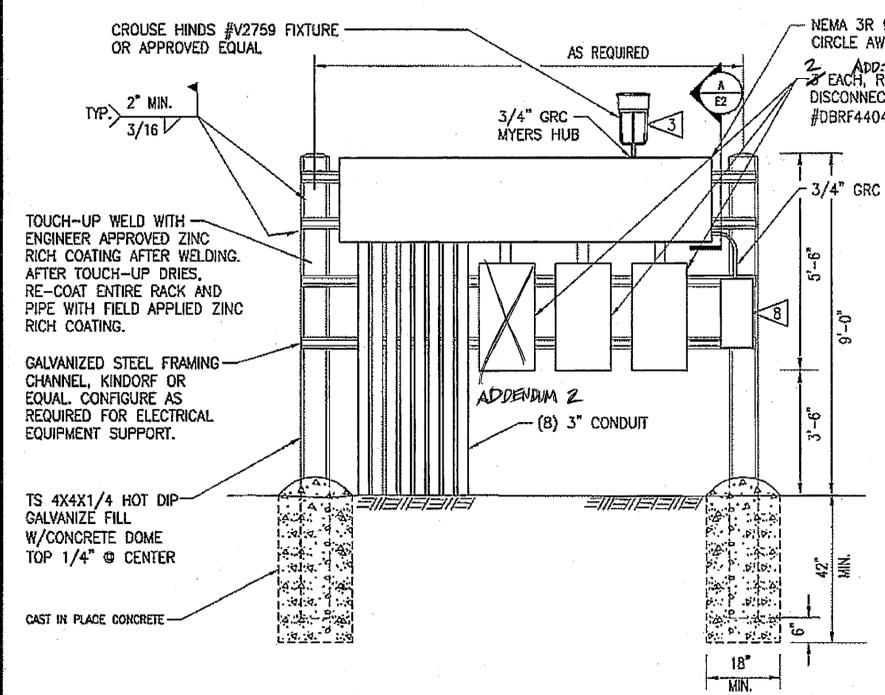

- NOTES:**
1. REFER TO FEEDER SCHEDULE FOR FEEDER CIRCUIT SIZING.
 2. SHORE POWER RACK #1 HAS 8 CONDUITS, 4 FROM SWITCHGEAR, 4 TO SHORE POWER RACK #2 FROM SHORE POWER RACK #1. THE RACK AT LOCATION TWO IS SIMILAR.
 3. FIXTURE MOUNTED 1'-0" IN FRONT OF EQUIPMENT, BRACE AS NECESSARY.
 4. INSTALL GROUNDING BUSHINGS AT ALL CONDUITS AND NIPPLES AND BOND TO ENCLOSURE WITH #1AWG Cu.
 5. USE DUCT SEAL TO PLUG THE CONDUIT ENTRIES BETWEEN THE BUSSED GUTTER AND THE NIPPLES TO THE DISCONNECTS.
 6. ALSO PROVIDE THE FOLLOWING FOR EACH SHORE POWER ATTACHMENT POINT:
 7. 2- 70' SECTIONS, AMERICAN INSULATED WIRE CORP. TYPE W, PORTABLE POWER CABLE 4-CONDUCTOR, 500kcmil, 2- MALE PLUG, RUSSELL STOLL #DS4404MFP000
 8. 2- FEMALE PLUG, RUSSELL STOLL #DF404FP000
 9. USE IRREVERSIBLE CRIMP TYPE CONNECTORS FOR ALL CONNECTION TO BUS.
 10. PROVIDE SQUARE D FAL14015, 1-POLE, 15AMP BREAKER IN FA1000S ENCLOSURE (NEMA 4X) FOR SWITCHING THE LIGHT FIXTURE. TAP FEEDERS FOR POWERING CIRCUIT.

A SECTION
E2 NTS

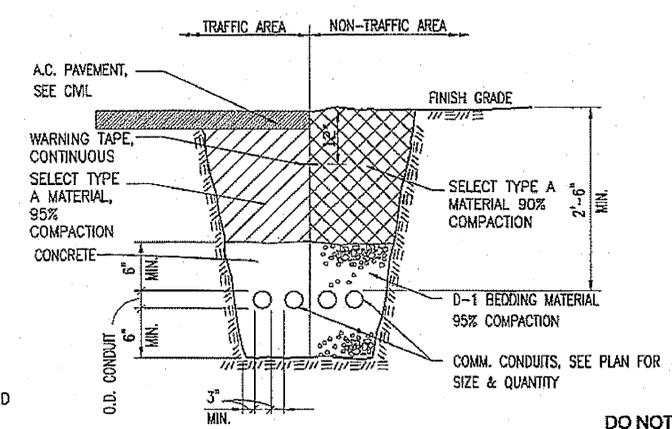

- NOTES:**
1. TRENCH WALL SLOPES WILL VARY WITH SOIL STRENGTH AND CHARACTERISTICS, SLOPE OR SHORE TO CONFORM TO SAFETY STANDARDS.
 2. THE CONTRACTOR SHALL NOTIFY THE ENGINEER IMMEDIATELY WHEN ODORS OR SHEENS ARE DISCOVERED THAT MIGHT INDICATE CONTAMINATION IN ANY EXCAVATED SOILS MOVED THROUGH DREDGING, EXCAVATION, TRENCHING OR GRADING.

AS-BUILT PLANS
by Dawson

INITIALS *ket* DATE *Sholat*

DO NOT SCALE FROM THESE DRAWINGS USE DIMENSIONS

CHECKED BY: DJJ

DESIGNED BY: TJP
DRAWN BY: TAH


STATE OF ALASKA
DEPARTMENT OF TRANSPORTATION & PUBLIC FACILITIES
DESIGN & ENGINEERING SERVICES DIVISION-SOUTHEAST REGION

KETCHIKAN SHIPYARD BERTH ONE RELIEVING SLAB

PROJECT #68715
ELECTRICAL ONE-LINE AND DETAILS

PATH: P:\03139 SHIPYARD\DRAWINGS\02158.001 DWG\03139E2.DWG
MORROW, ANDREA

NO.	DATE	REVISIONS DESCRIPTION	PROJECT DESIGNATION	YEAR	SHEET NO.	TOTAL SHEETS
1	10/23/06	REVISION #1	68715	2007	E2	28

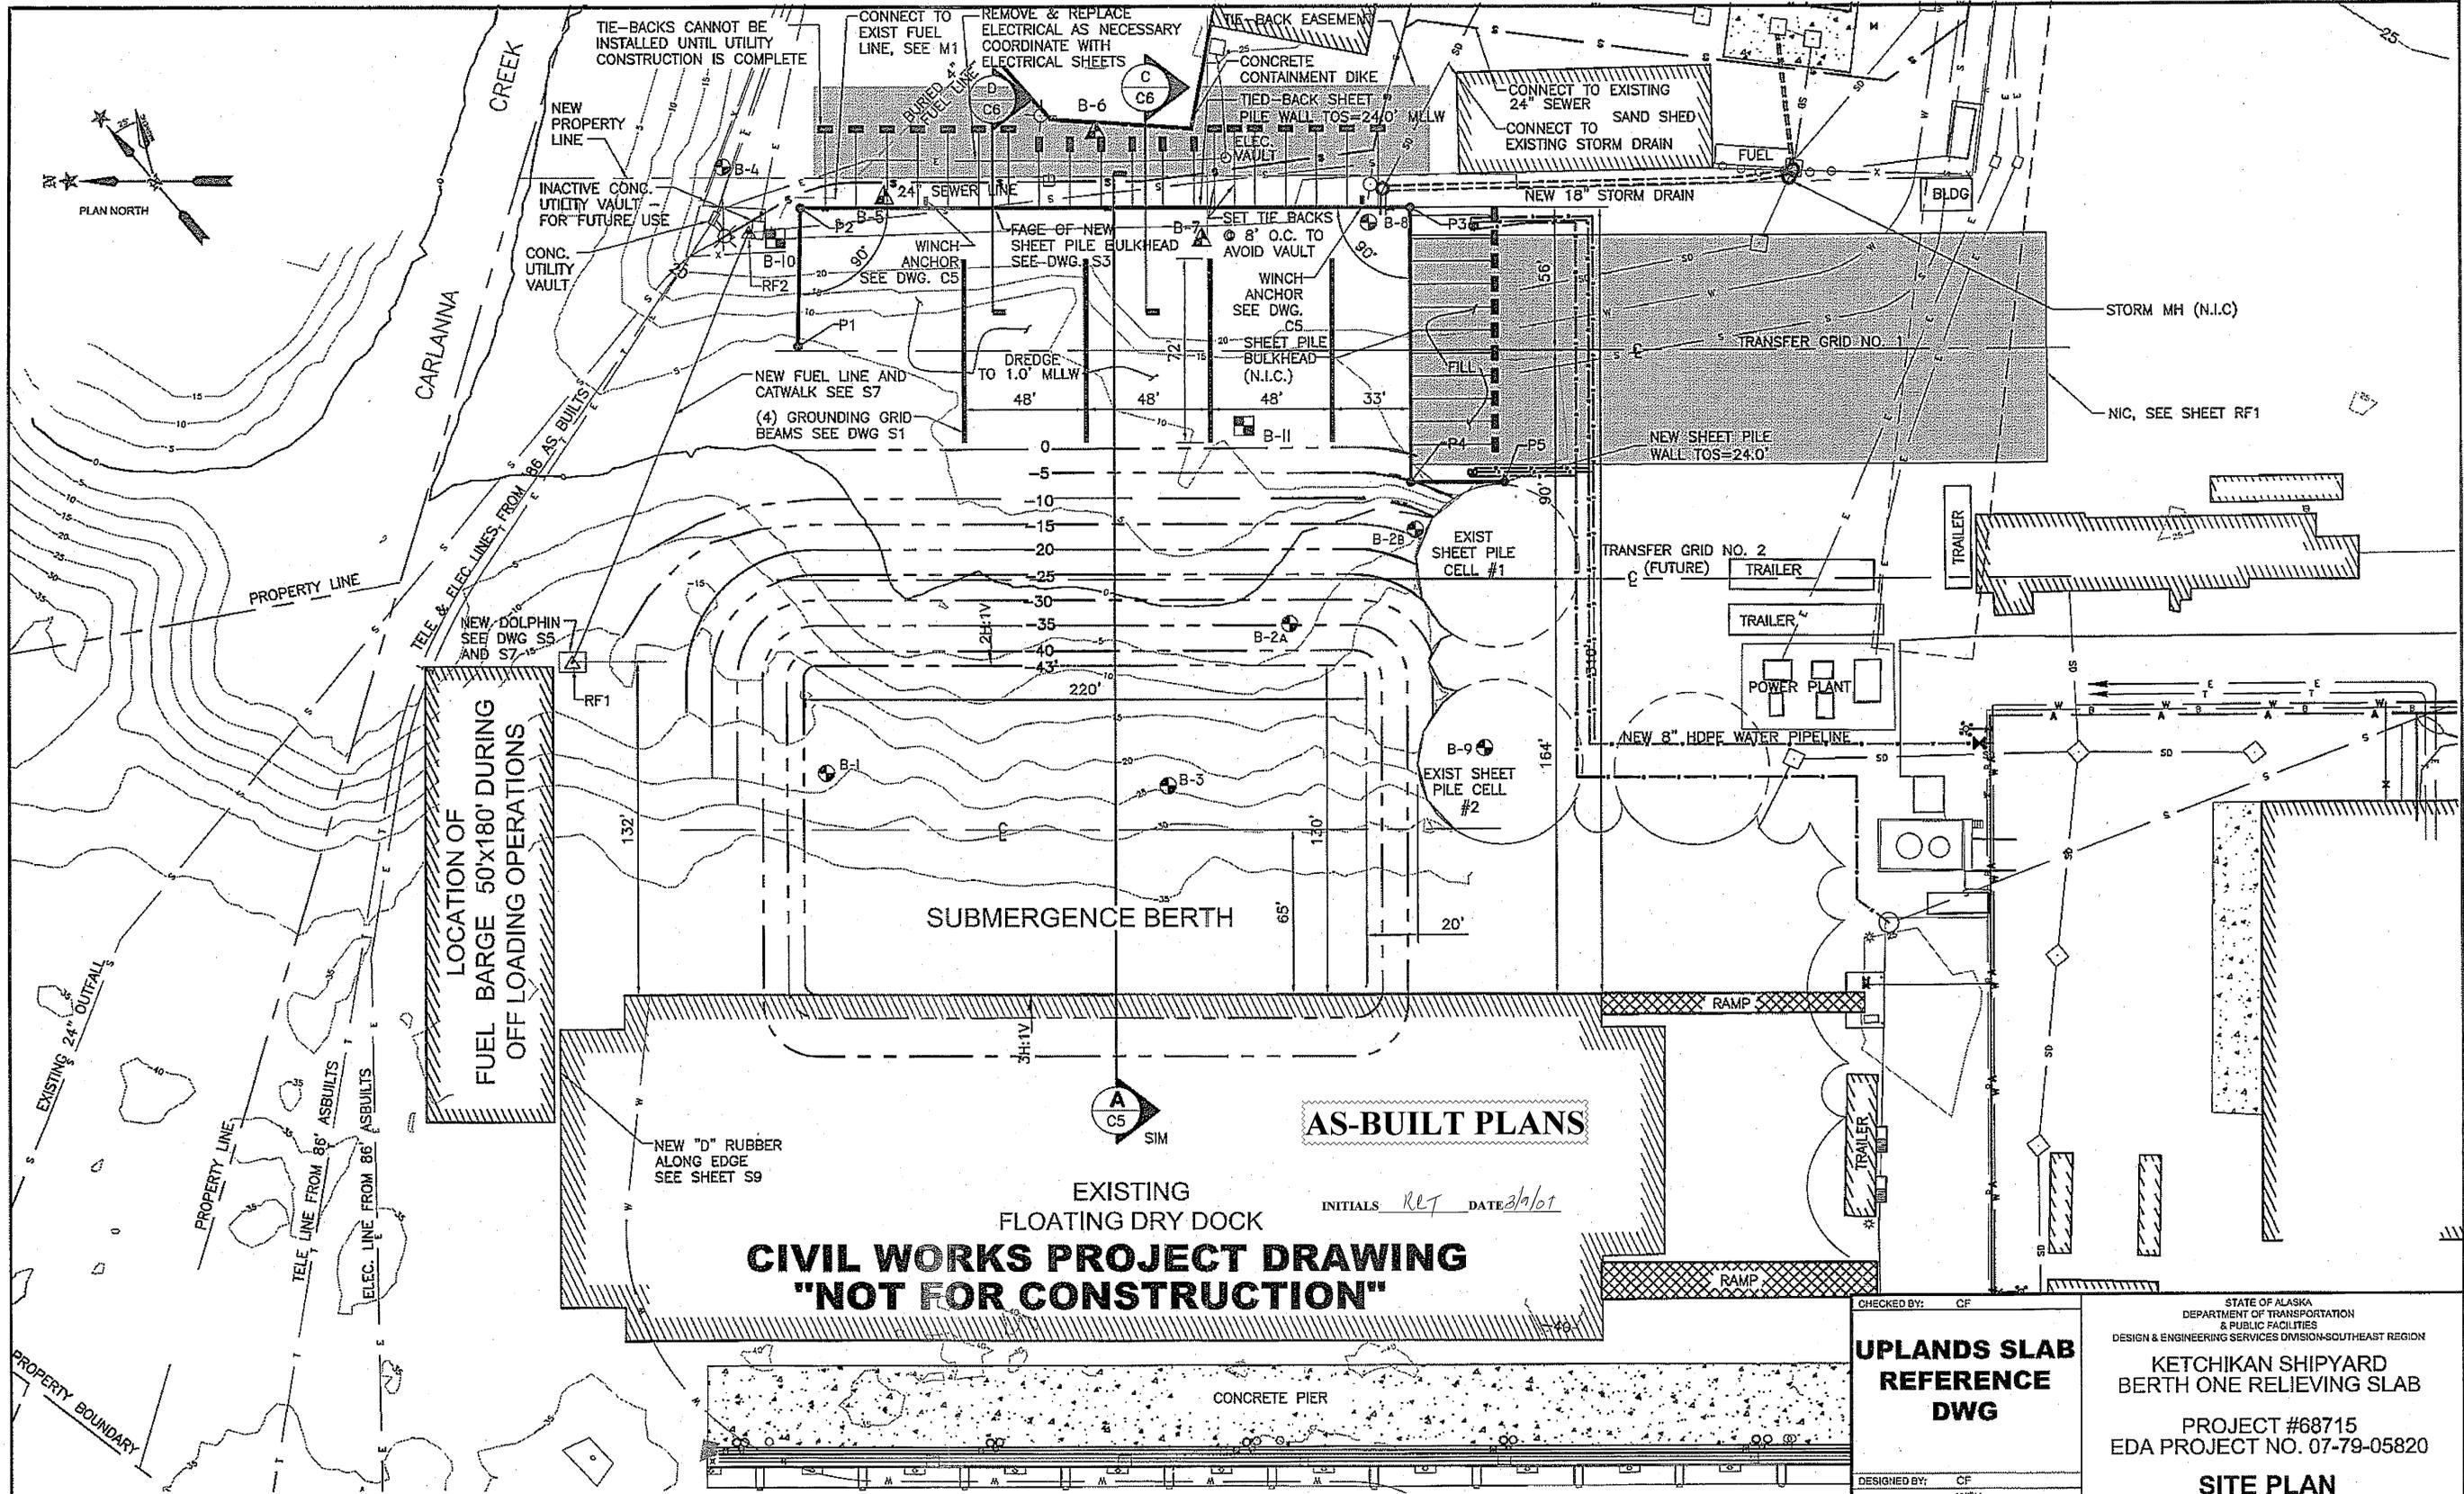

GENERAL NOTES:

1. ALL CONSTRUCTION LINES & GRADES ARE TO BE ESTABLISHED BY A LAND SURVEYOR REGISTERED IN THE STATE OF ALASKA.
2. SEE E1 AND C7 THRU C9 FOR BURIED UTILITIES.



CIVIL WORKS PROJECT DRAWING
"NOT FOR CONSTRUCTION"

AS-BUILT PLANS

INITIALS *RET* DATE *2/19/07*

CHECKED BY: CF
UPLANDS SLAB
REFERENCE
DWG

DESIGNED BY: CF
 WEH
 PATH: M:\02158.001_Ketchikan Uplands Slab\400 Drawings\401 Working Drawings\2158.001_RF1.DWG
 TAB: 27 5-8-07 SONIAJ

STATE OF ALASKA
 DEPARTMENT OF TRANSPORTATION
 & PUBLIC FACILITIES
 DESIGN & ENGINEERING SERVICES DIVISION-SOUTHEAST REGION
KETCHIKAN SHIPYARD
BERTH ONE RELIEVING SLAB
 PROJECT #68715
 EDA PROJECT NO. 07-79-05820

SITE PLAN

REVISIONS	PROJECT DESIGNATION	YEAR	SHEET NO.	TOTAL SHEETS
DATE DESCRIPTION	68715	2007	RF1	28

PLANS DEVELOPED BY:
 TRYCK NYMAN HAYES, INC.

GENERAL NOTES

1. DESIGN CRITERIA

THE SLAB DESIGN IS BASED ON THE FOLLOWING LOAD ASSUMPTIONS:
 -MANITOWOC 4100W S2 CRANE WITH 150' BOOM.
 -THE CRANE MAY WALK UNLOADED PARALLEL TO THE RAIL BEAMS WITHOUT TIMBER MATS. THE CRAWLERS ARE TO BE POSITIONED DIRECTLY ON THE CAST-IN-PLACE SLAB AND NOT ON THE RAIL BEAMS.
 -THE CRANE MAY WALK PERPENDICULAR TO THE RAIL BEAMS BUT ONLY WITH TIMBER MATS AT LEAST 12" THICK.
 -WHEN PICKING LOADS THE CRANE MUST BE ON TIMBER MATS AT LEAST 12" THICK. THE CRANE MAY PICK LOADS UP TO 42,500 POUNDS.

2. PARTIAL SEQUENCE OF STRUCTURAL CONSTRUCTION

KETCHIKAN SHIPYARD IS EMBARKING ON A MULTI-YEAR EXPANSION PROJECT. THE FIRST SERIES OF CONSTRUCTION CONTRACTS ARE AS FOLLOWS

- A. EDA CIVIL WORKS: CONSTRUCTION OF SHEET PILE BULKHEADS, DREDGING, CONSTRUCTION OF AN IN-WATER GROUNDING GRID, AND DEMOLITION AND RECONSTRUCTION OF A FUEL BARGE BERTH.
- B. THIS PROJECT WHICH INVOLVES CONSTRUCTION OF A 250-FT BY 90-FOOT CONCRETE SLAB AND UTILITY RELOCATIONS.

THESE PROJECTS WILL BE CONSTRUCTED WITHIN THE EXISTING SHIPYARD WHERE VESSEL REPAIRS AND FABRICATION WILL BE ON-GOING. ACCESS INTO THE SITE WILL BE SHARED BY ALL THESE ACTIVITIES. THE EXACT SCHEDULE FOR THE VARIOUS PROJECTS IS UNCERTAIN AT THIS TIME. THE UPLANDS SLAB PROJECT OVERLAPS THE EDA CIVIL WORKS PROJECT NEAR THE SOUTH BULKHEAD. CLOSE COORDINATION BETWEEN THE EDA AND UPLANDS SLAB CONTRACTORS IS REQUIRED.

-PILES FOR THE PILE-SUPPORTED SLAB (SOG) MUST BE DRIVEN IN ADVANCE OF PLACING ANY CONCRETE OR PRECAST CONCRETE.
 -IF BOTH SECTIONS OF THE SOG (NON-PILE SUPPORTED SLAB) ARE CONSTRUCTED AT THE SAME TIME, THE PT SPLICE LOCATED 57' SOUTH OF THE PILE-SUPPORTED SLAB IS TO BE ELIMINATED AND THE ENTIRE LENGTH OF THE RAIL BEAMS POST-TENSIONED IN ONE OPERATION.
 -FOR THE SOG, THE RAIL BEAMS ARE TO BE SET AND POST-TENSIONED PRIOR TO CASTING ADJACENT CIP SECTIONS.
 -CIP SPLICES BETWEEN THE PRECAST RAIL BEAMS MUST REACH A CONCRETE STRENGTH OF $f_c = 3000$ PSI BEFORE COMMENCING POST-TENSIONING.
 -THE CONTRACTOR SHALL SUBMIT THE RAIL BEAM STRESSING SEQUENCE FOR REVIEW 30-DAYS PRIOR TO STRESSING.
 -THE JOINT BETWEEN THE PRECAST RAIL BEAMS AND THE PILE-SUPPORTED SLAB MAY NOT BE CAST UNTIL 21 DAYS FOLLOWING POST-TENSIONING.
 -SLABS ADJACENT TO THE RAIL BEAMS MAY NOT BE CAST UNTIL 7 DAYS FOLLOWING POST-TENSIONING.
 -PT DUCTS MUST BE GROUTED WITHIN 7 DAYS OF POST-TENSIONING.

3. CAST-IN-PLACE CONCRETE

ALL CAST-IN-PLACE CONCRETE SHALL HAVE A MINIMUM COMPRESSIVE STRENGTH $f_c = 5,000$ PSI. ALL CONCRETE SHALL BE AIR-ENTRAINED AND CONTAIN DCI CORROSION INHIBITOR.
 -ALL ITEMS EMBEDDED IN CONCRETE SHALL BE HOT DIP GALVANIZED. (EXCEPT REBAR & PILING ARE TO BE BARE)

4. PRECAST CONCRETE

-ALL CONCRETE SHALL BE AIR ENTRAINED AND CONTAIN DCI CORROSION INHIBITOR.
 -PRECAST POST-TENSIONED CONCRETE SHALL HAVE A MINIMUM COMPRESSIVE STRENGTH $f_c = 7,000$ PSI. USE 0.60-INCH DIAMETER, SEVEN-WIRE LOW RELAXATION STRAND CONFORMING TO ASTM A-421 AND ASTM A-416, GRADE 270.
 -THE STRESSING METHOD FOR THE RAIL BEAMS SHALL MAINTAIN A UNIFORM STRESS IN THE CONCRETE SECTION. THE STRESSING METHOD SHALL BE DESIGNED TO ACHIEVE A COMPRESSIVE FORCE OF 575 KIPS IN THE CONCRETE RAIL BEAM AFTER ALL LOSSES. INCLUDE LOSSES DUE TO FRICTION ON THE BOTTOM OF THE CONCRETE RAIL BEAM IN THE LOSS CALCULATIONS. STRESS FROM BOTH ENDS.
 -OTHER PRECAST CONCRETE SHALL HAVE A MINIMUM COMPRESSIVE STRENGTH $f_c = 5,000$ PSI. THE WATER-CEMENT RATIO W/C SHALL NOT EXCEED 0.40.
 -THE SUPPLIER SHALL PROVIDE DETAILED BUNKING REQUIREMENTS FOR TRANSPORTATION AND ONSITE STORAGE. HANDLING AND BUNKING DIAGRAMS ARE TO BE INCLUDED ON THE SHOP DRAWINGS.

-UTILIDORS, PITS AND RAIL BEAMS ARE SHOWN AS PRECAST CONCRETE ELEMENTS. IN LIEU OF PRECASTING, THE CONTRACTOR MAY CAST THESE ITEMS IN PLACE. CONCRETE STRENGTHS AND REINFORCING REQUIREMENTS WILL BE THE SAME FOR CAST-IN-PLACE (CIP) CONCRETE AS FOR THE PRECAST CONCRETE. THE PRECAST CONCRETE SUPPLIER MAY HAVE TO ADD ADDITIONAL REINFORCEMENT AND INSERTS FOR HANDLING AND SHALL DEMONSTRATE THAT THE PROPOSED METHODS OF HANDLING WILL NOT OVERSTRESS THE ELEMENTS.
 -REMOVABLE LIDS FOR PITS AND UTILIDORS SHALL BE MATCH CAST ON SITE.

5. STRUCTURAL STEEL

-STEEL PLATE AND SHAPES SHALL BE ASTM A-36 UNLESS OTHERWISE NOTED OR APPROVED BY THE OWNER. ALL BOLTS SHALL BE ASTM A-307 UNLESS OTHERWISE NOTED. BOLTS SHALL BE INSTALLED "SNUG TIGHT". HOLES MAY NOT BE BURNED; THEY MUST BE PUNCHED OR DRILLED.

6. WELDING

-ALL WELDING SHALL BE IN ACCORDANCE WITH AWS D1.1. USE ELECTRODES WITH 70 KSI TENSILE STRENGTH U.O.N.

7. STEEL PILING

-HP PILES SHALL BE ASTM A572 GRADE 50. ALL PILING SHALL BE FITTED WITH CAST-STEEL CUTTING SHOES. SPLICE PILES WITH COMPLETE JOINT PENETRATION WELDS IN ACCORDANCE WITH AWS D1.1.
 -ALL PILES SHALL BE DRIVEN TO A MINIMUM DRIVING RESISTANCE AND MINIMUM PENETRATION FOR BOTH IMPACT AND VIBRATORY HAMMERS. WHERE A VIBRATORY HAMMER IS USED THE PILE MUST BE PROOFED WITH AN IMPACT HAMMER.
 -A CONTINUOUS DRIVING RECORD IN BLOWS PER FOOT OR INCHES PER MINUTE SHALL BE TAKEN FOR THE ENTIRE LENGTH OF ALL PILES. THE WAVE EQUATION WILL BE USED TO DETERMINE THE MINIMUM DRIVING RESISTANCE.
 -IF THE MINIMUM PENETRATION IS NOT OBTAINED THE PILE SHALL BE DRIVEN TO 2 TIMES THE RECOMMENDED MINIMUM DRIVING RESISTANCE. IF THE REQUIRED MINIMUM DEPTH IS STILL NOT OBTAINED IT IS LIKELY THAT AN OBSTRUCTION HAS BEEN ENCOUNTERED AND THE PILE SHALL BE PULLED AND RE-DRIVEN, OR PRE-DRILLED AND THEN DRIVEN.
 -HARD DRIVING IS ANTICIPATED IN THE TILLS AND PRE-DRILLING MAY BE REQUIRED. SCATTERED BOULDERS AND COBBLES MAY ALSO BE ENCOUNTERED. PRE-DRILL ONLY WITH WRITTEN AUTHORIZATION FROM OWNERS REPRESENTATIVE.
 -THE CONTRACTOR IS TO EXPOSE THE ADJACENT TIE-RODS PRIOR TO DRIVING EVERY PILE. THE TIP OF THE PILE MUST BE PLACED BELOW THE TIE-ROD ELEVATION AT THE START OF DRIVING.

8. STEEL TIE RODS

TIE RODS SHALL ALL-THREAD-BAR WITH A MINIMUM YIELD STRENGTH OF 150 KSI CONFORMING TO ASTM A-722-95. THE BARS SHALL BE COATED WITH FUSION BONDED EPOXY CONFORMING TO ASTM A-775. USE SPRAY EPOXY COATING IN THE FIELD TO REPAIR NICKS OR SCRATCHED SURFACES. AT A MINIMUM, ALL TENSION COMPONENTS OF THE SYSTEM MUST DEVELOP 100% OF THE BARS PUBLISHED ULTIMATE STRENGTH. THE BARS MAY NOT BE WELDED. FIELD CUTTING MUST BE DONE WITH AN ABRASIVE WHEEL OR BAND SAW; THEY MAY NOT BE TORCH CUT. BEARING PLATES, NUTS, AND WASHERS SHALL BE FURNISHED BY THE BAR SUPPLIER AND BE SIZED FOR THE CAPACITY OF THE BAR AND THE INTENDED APPLICATION. ALL OF THE HARDWARE SHALL BE FUSION BONDED EPOXY COATED LIKE THE TIE RODS. WHERE BARS ARE ANGLED, BEVELED WASHERS OR DISHED PLATES WITH ROUNDED NUTS SHALL BE PROVIDED. BARS MAY NOT BE SPLICED. PLATE WASHERS SHALL CONFORM TO ASTM F-436, TYP 1 HEAVY DUTY HEX NUTS FOR GRADE 150 ALL-THREAD-BAR SHALL CONFORM TO ASTM A-29, GRADE C-1045.

PILE CRITERIA

LOCATION	PILE SIZE	WORKING LOAD (KIPS)	ESTIMATED LENGTH (FEET)	MINIMUM PENETRATION (FEET)
RELIEVING SLAB HP10		190 C	77 126-144	39 <i>SEE PILE LOSS FOR ACTUAL LENGTH (ALL PILING TO REFUSAL TO REACH REQUIRED CAPACITY)</i>
TROLLEY BEAM	16	30 C	88 90	30 (BELOW FUTURE DREDGE LINE)

C=COMPRESSION

REQUIRED ULTIMATE CAPACITY = 2X WORKING LOAD. ESTIMATED LENGTH IS THE LENGTH FROM CUT-OFF TO TIP, THAT IS EXPECTED TO ACHIEVE THE REQUIRED ULTIMATE CAPACITY. MINIMUM PENETRATION IS THE LENGTH FROM BOTTOM OF RELIEVING SLAB CONCRETE TO TIP, REQUIRED FOR UPLIFT OR LATERAL LOADS.

9. HEAVY TIMBER

TIMBER PRESSURE TREATED NO. 1 OR BETTER DOUG-FIR. PRESSURE TREATMENT SHALL BE PERFORMED AFTER ALL CUTTING, DRILLING, DAPPING, AND COUNTERSINKING IS COMPLETED. PRESSURE TREATING SHALL CONFORM TO THE AMERICAN WOOD-PRESERVERS ASSOCIATION STANDARD C18. TREATMENT SHALL CONSIST OF CREOSOTE AT A MINIMUM RETENTION OF 26 POUNDS PER CUBIC FOOT. ALL BOLTS, RODS, WASHERS, NUTS AND OTHER HARDWARE SHALL BE HOT DIP GALVANIZED.

10. CORRUGATED METAL PIPE HOPE *APP. 2*

-~~THE 30" DIAMETER CORRUGATED METAL PIPE BETWEEN THE PITS SHALL BE GALVANIZED STEEL WITH 2 3/8" X 1/2" CORRUGATIONS AND A MINIMUM THICKNESS OF 0.064".~~
 -THE CONTRACTOR SHALL KEEP CONSTRUCTION DEBRIS OUT OF THE UNDER SLAB DRAINS.

11. STEEL RAILS

-STEEL FOR RAILS: (SEE SPECS) THE RAILS ARE TO BE INSTALLED STRAIGHT, PARALLEL AND LEVEL AND MATCH THE POSITION OF THE RAILS ON THE DRAWINGS.
 -~~GROUNDING SHIP-LIFT:~~ THE RAILS MAY NOT VARY MORE THAN 1/8" (0.016") FROM CENTERLINE OR MORE THAN 1/8" (0.016") FROM GRADE. THE HORIZONTAL AND VERTICAL GAP BETWEEN RAILS AND A TEN FOOT STRAIGHT-EDGE SHALL NOT EXCEED 3/32" (0.078"). ADJOINING SECTIONS OF RAIL MAY NOT VARY MORE THAN 1/32" (0.0313") VERTICALLY. THE CONTRACTOR SHALL USE STEEL SHIMS TO SUPPORT THE RAILS TO THESE TOLERANCES OR BETTER BEFORE GROUTING. GROUT THE RAILS WITH SIKAGROUT 212, OR APPROVED EQUAL, MIXED TO A FLOWABLE CONSISTENCY IN ACCORDANCE WITH THE MANUFACTURERS PRINTED INSTRUCTIONS. THE GROUT SHALL BE EXTENDED WITH 3/4" PEA GRAVEL CONFORMING TO ASTM C33 SIZE NUMBER 8 PER TABLE 2 AND IN ACCORDANCE WITH SIKA'S APPROVED MIXING PROCEDURES. APPLY A CURING COMPOUND CONFORMING TO ASTM C-309 ON EXPOSED SURFACES. SEE ALSO 2/S14 AND 5/S14. NOTE: RAILS ARE NOT DESIGNED FOR UPLIFT.


SHIFTLIFT RAILS ARE NOT SPACED W/ SAME TOLERANCE

AS-BUILT PLANS


INITIALS *WLT* DATE *3/10/07*

CHECKED BY: <i>DE</i> 		STATE OF ALASKA DEPARTMENT OF TRANSPORTATION & PUBLIC FACILITIES DESIGN & ENGINEERING SERVICES DIVISION-SOUTHEAST REGION KETCHIKAN SHIPYARD BERTH ONE RELIEVING SLAB PROJECT #68715	
DESIGNED BY: <i>CF</i> DRAWN BY: <i>WEH</i>		GENERAL NOTES	
PATH: M:\02158.001_Ketchikan Uplands Slab\400 Drawings\401 Working Drawings\2158.001_S0 TAB: 13 5-8-07 SONIAJ		PROJECT DESIGNATION: 68715 YEAR: 2007 SHEET NO.: S0 TOTAL SHEETS: 28	
REVISIONS NO. DATE DESCRIPTION			
PLANS DEVELOPED BY: TRYCK NYMAN HAYES, INC			

Concrete for rails were cast in place

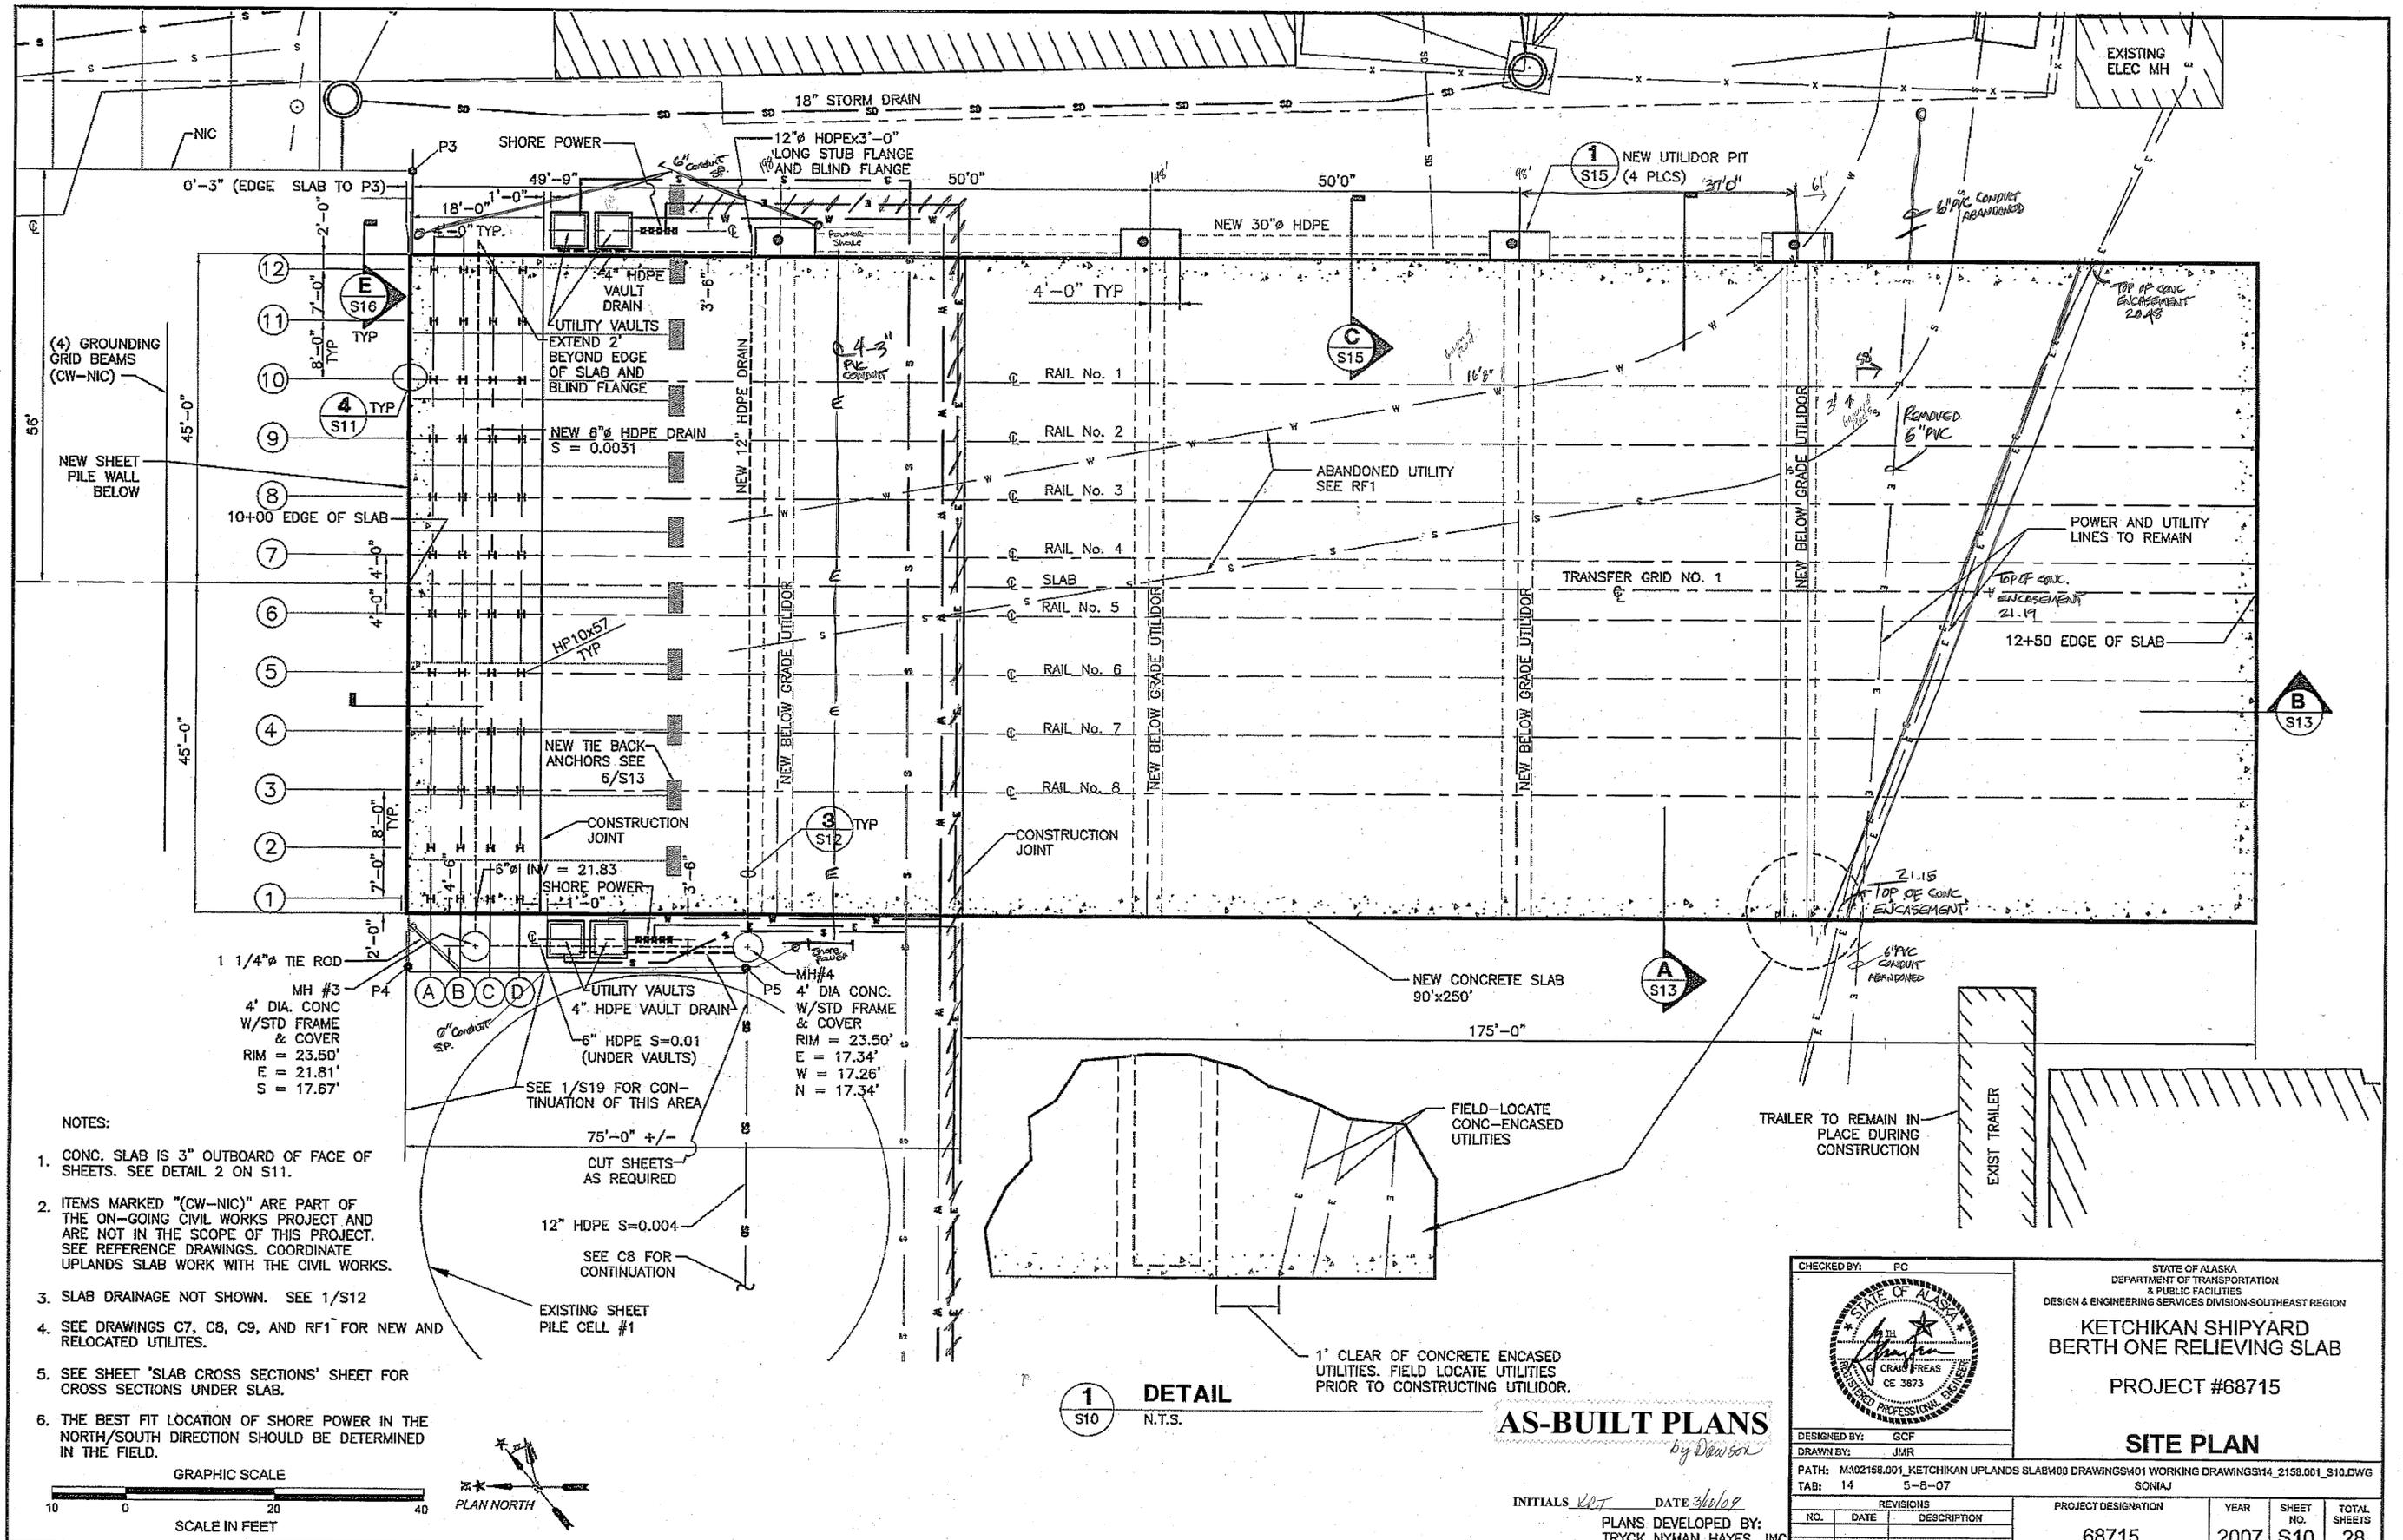

- NOTES:
1. CONC. SLAB IS 3" OUTBOARD OF FACE OF SHEETS. SEE DETAIL 2 ON S11.
 2. ITEMS MARKED "(CW-NIC)" ARE PART OF THE ON-GOING CIVIL WORKS PROJECT AND ARE NOT IN THE SCOPE OF THIS PROJECT. SEE REFERENCE DRAWINGS. COORDINATE UPLANDS SLAB WORK WITH THE CIVIL WORKS.
 3. SLAB DRAINAGE NOT SHOWN. SEE 1/S12
 4. SEE DRAWINGS C7, C8, C9, AND RF1 FOR NEW AND RELOCATED UTILITIES.
 5. SEE SHEET 'SLAB CROSS SECTIONS' SHEET FOR CROSS SECTIONS UNDER SLAB.
 6. THE BEST FIT LOCATION OF SHORE POWER IN THE NORTH/SOUTH DIRECTION SHOULD BE DETERMINED IN THE FIELD.

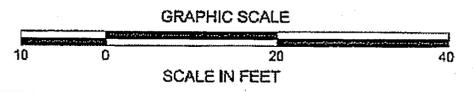



1
S10

DETAIL
N.T.S.

AS-BUILT PLANS
by Dawson


INITIALS *ket* DATE *3/6/07*
PLANS DEVELOPED BY:
TRYCK NYMAN HAYES, INC

CHECKED BY: PC 		STATE OF ALASKA DEPARTMENT OF TRANSPORTATION & PUBLIC FACILITIES DESIGN & ENGINEERING SERVICES DIVISION-SOUTHEAST REGION KETCHIKAN SHIPYARD BERTH ONE RELIEVING SLAB PROJECT #68715							
DESIGNED BY: GCF DRAWN BY: JMR PATH: M\02158.001_KETCHIKAN UPLANDS SLAB\00 DRAWINGS\01 WORKING DRAWINGS\14_2158.001_S10.DWG TAB: 14 5-8-07 SONIAJ		SITE PLAN							
REVISIONS <table border="1"> <thead> <tr> <th>NO.</th> <th>DATE</th> <th>DESCRIPTION</th> </tr> </thead> <tbody> <tr> <td> </td> <td> </td> <td> </td> </tr> </tbody> </table>		NO.	DATE	DESCRIPTION				PROJECT DESIGNATION 68715	
NO.	DATE	DESCRIPTION							
YEAR 2007		SHEET NO. S10							
TOTAL SHEETS 28									

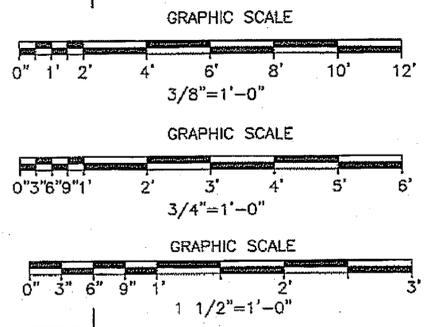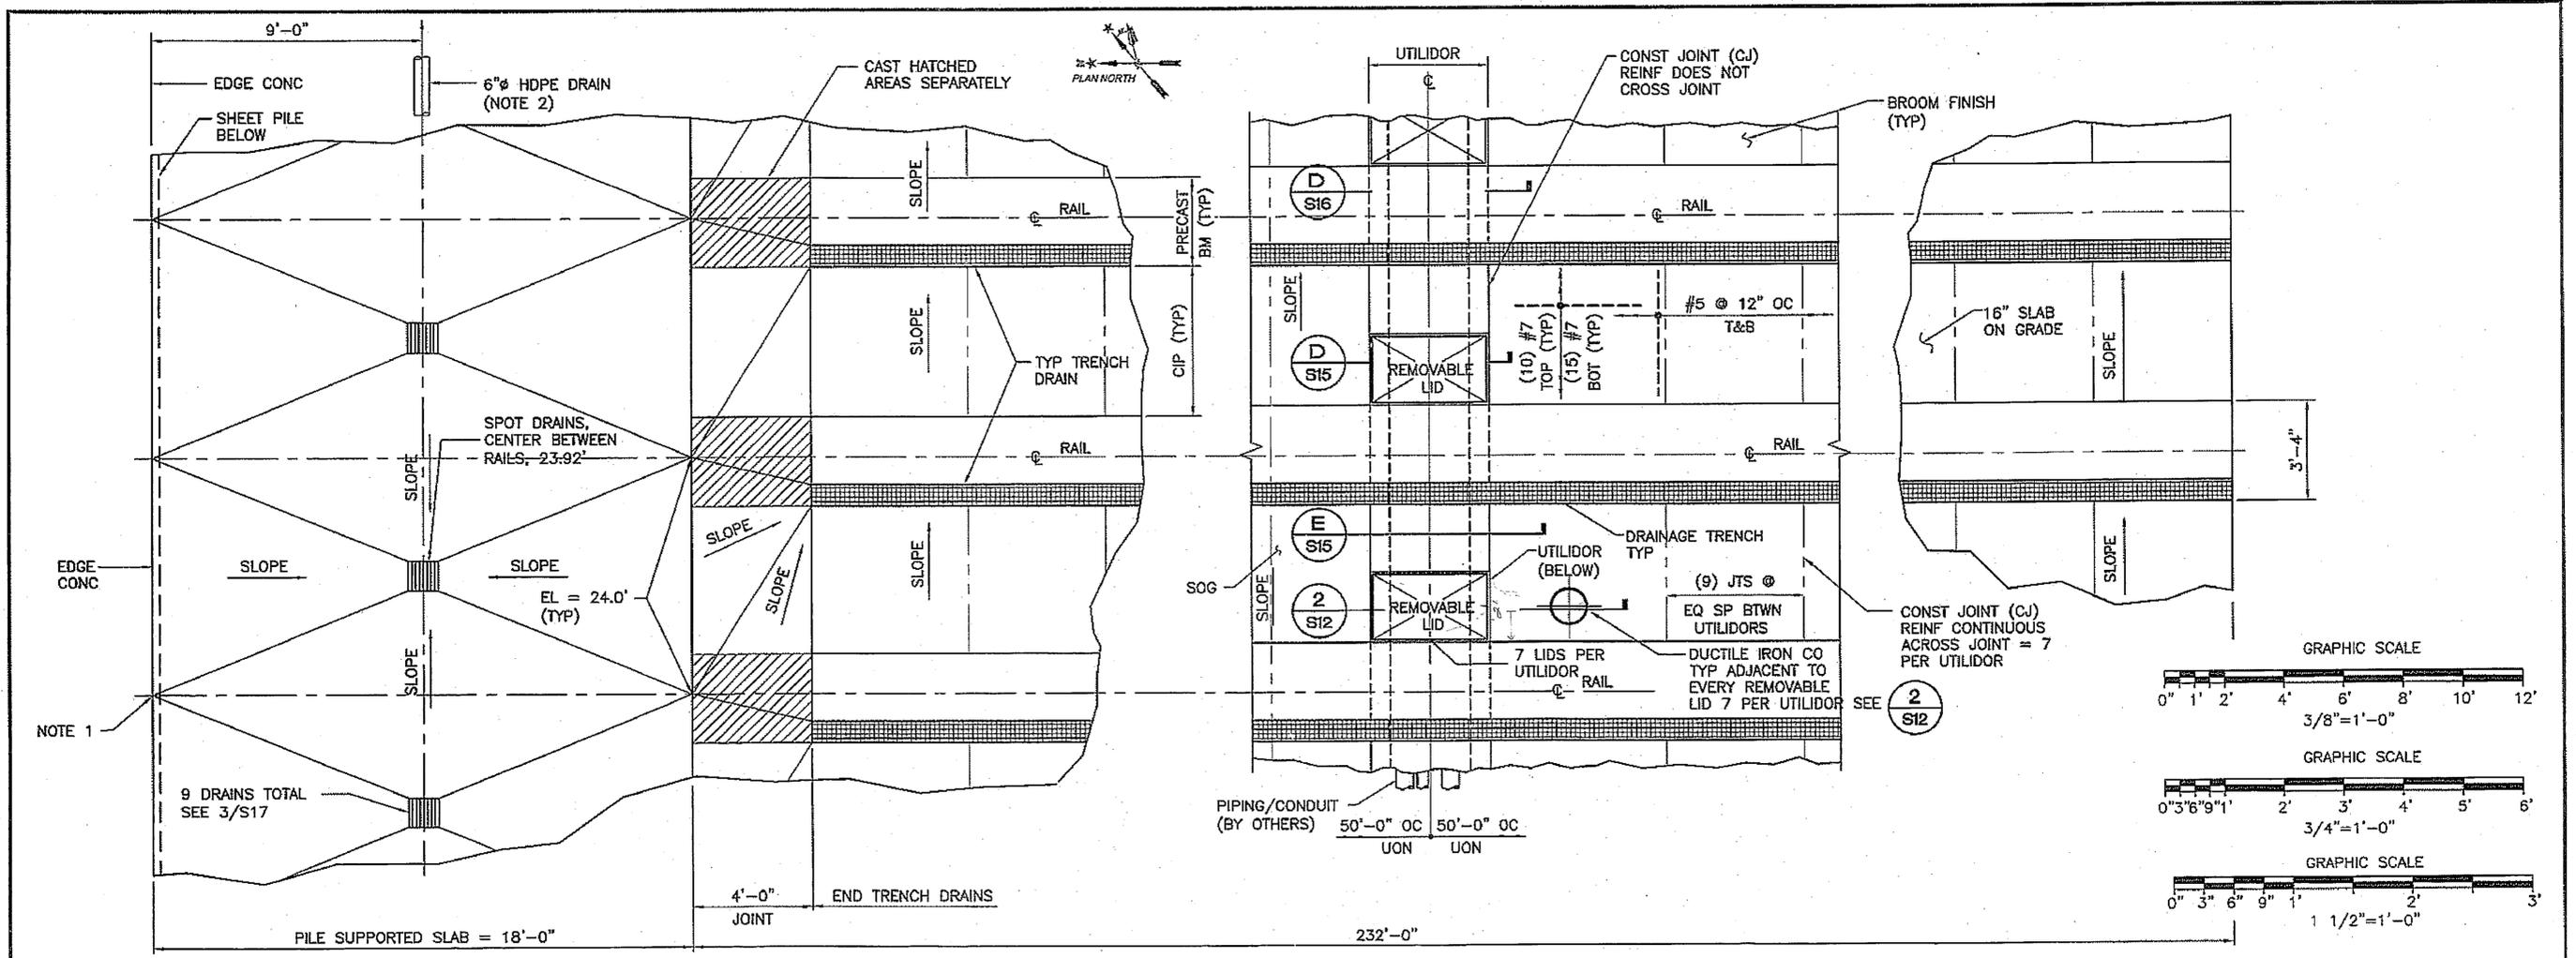


- NOTES:**
- TRANSFER BRIDGE POCKETS NOT SHOWN. SEE S11.
 - 6" DRAIN SLOPE = 0.003, ENCASE IN CIP SLAB. EXTEND 4' BEYOND EAST & WEST EDGES OF SLAB & CAP BOTH ENDS (EAST END SHALL BE FLANGED). CONNECT 4" DOWN DRAINS TO 6" WITH TEES.


1 PARTIAL PLAN
SCALE: 3/8" = 1'-0"

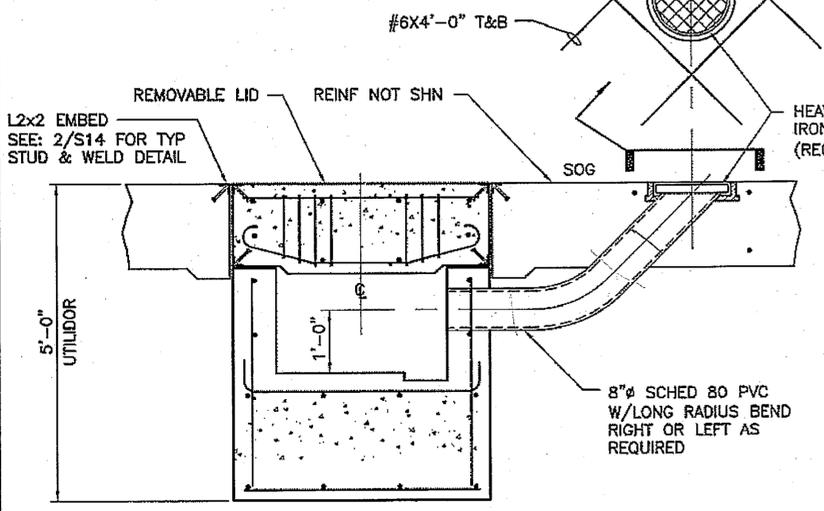


2 UTILITY SERVICE ACCESS
SCALE: 3/4" = 1'-0"
(28 REQ'D)

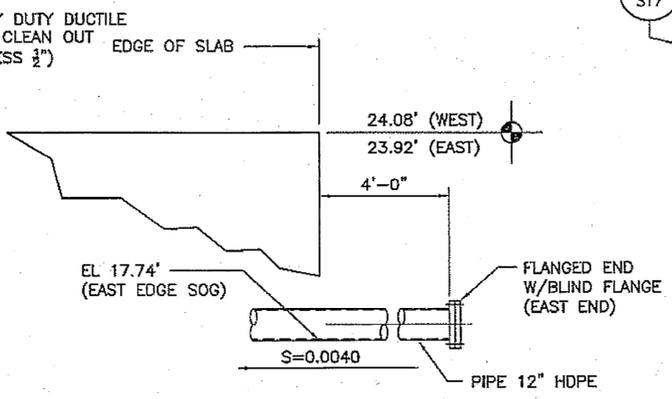

3 12" HDPE DRAIN TERMINATION
SCALE: 3/4" = 1'-0"

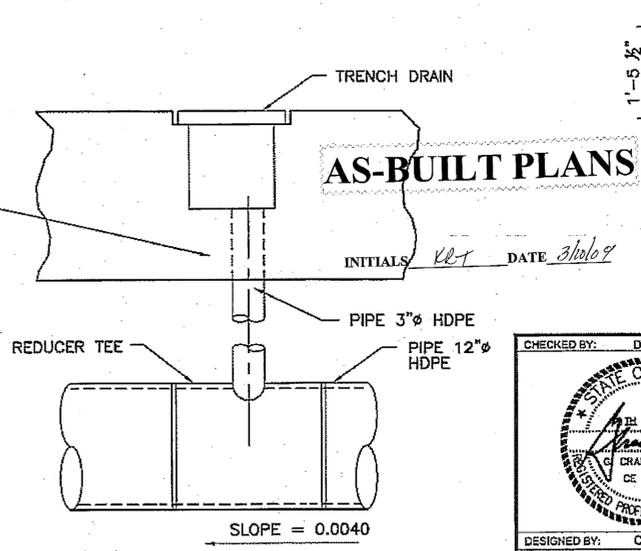

5 TYP DRAIN DETAIL
SCALE: 1 1/2" = 1'-0"

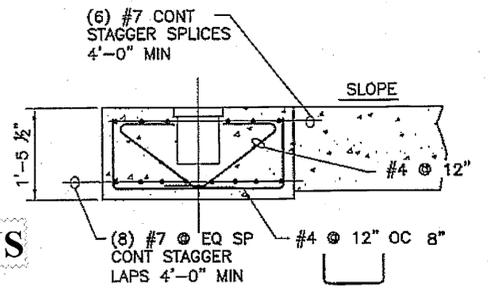


4 DETAIL
SCALE: 3/4" = 1'-0"


AS-BUILT PLANS

CHECKED BY: DE 		STATE OF ALASKA DEPARTMENT OF TRANSPORTATION & PUBLIC FACILITIES DESIGN & ENGINEERING SERVICES DIVISION-SOUTHEAST REGION	
KETCHIKAN SHIPYARD BERTH ONE RELIEVING SLAB			
PROJECT #68715 UTILIDOR PLAN & SECTION			
DESIGNED BY: CF	PROJECT DESIGNATION: 68715	YEAR: 2007	SHEET NO.: S12
DRAWN BY: WEH	YEAR: 2007	SHEET NO.: S12	TOTAL SHEETS: 28
PATH: M:\02158.001_Ketchikan Uplands Stab\400 Drawings\401 Working Drawings\2158.001_S12.DWG TAB: 16 5-8-07 SONIAJ			


PLANS DEVELOPED BY:
TRYCK NYMAN HAYES, INC

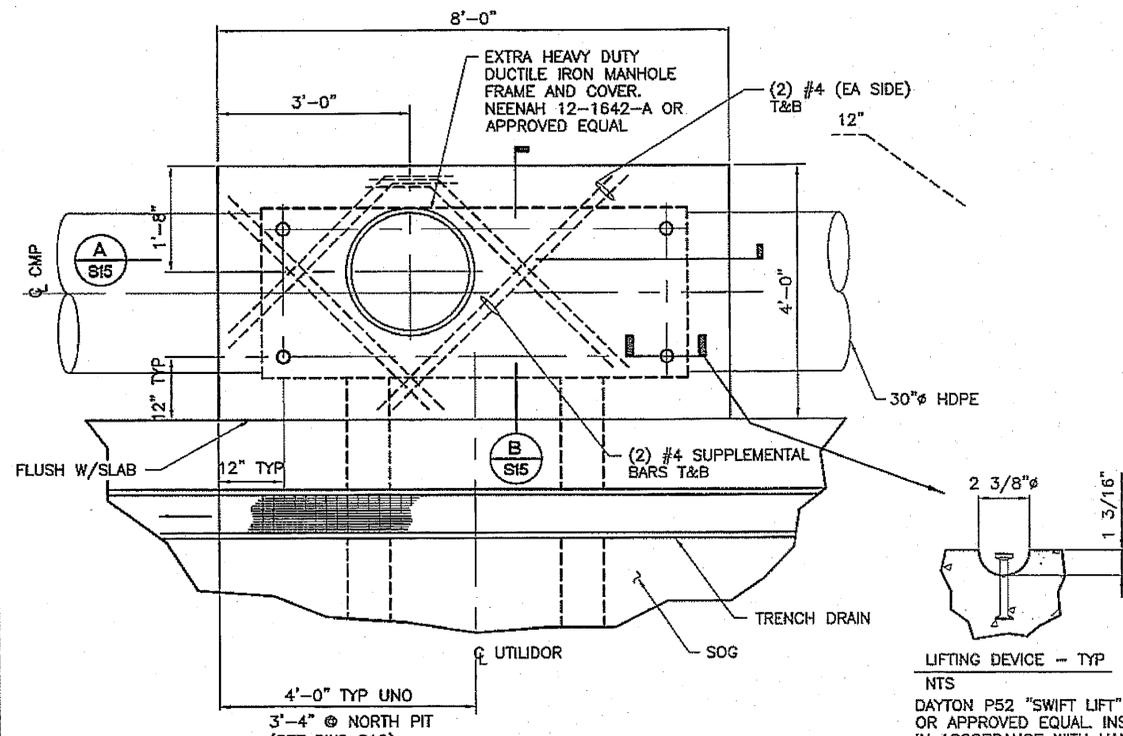


1 PIT LID PLAN
S15 SCALE: 3/4" = 1'-0"

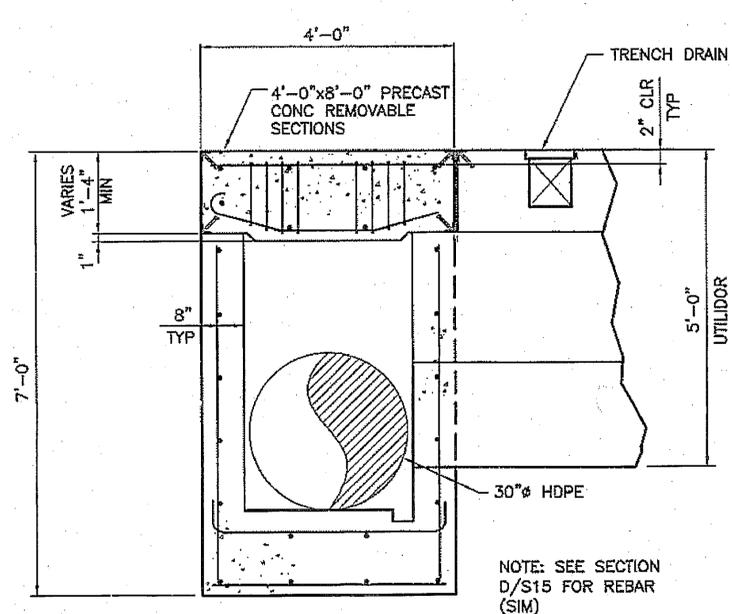

B SECTION
S15 SCALE: 3/4" = 1'-0"

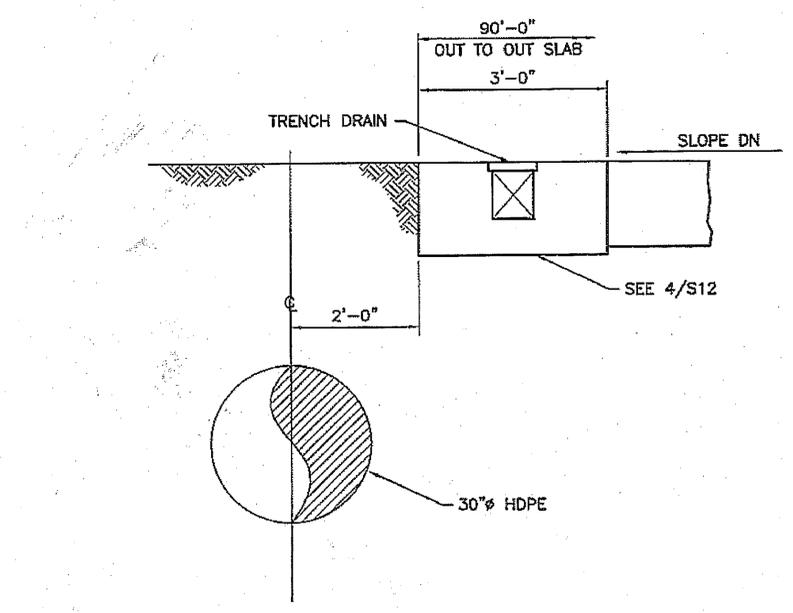


C SECTION
S15 SCALE: 3/4" = 1'-0"

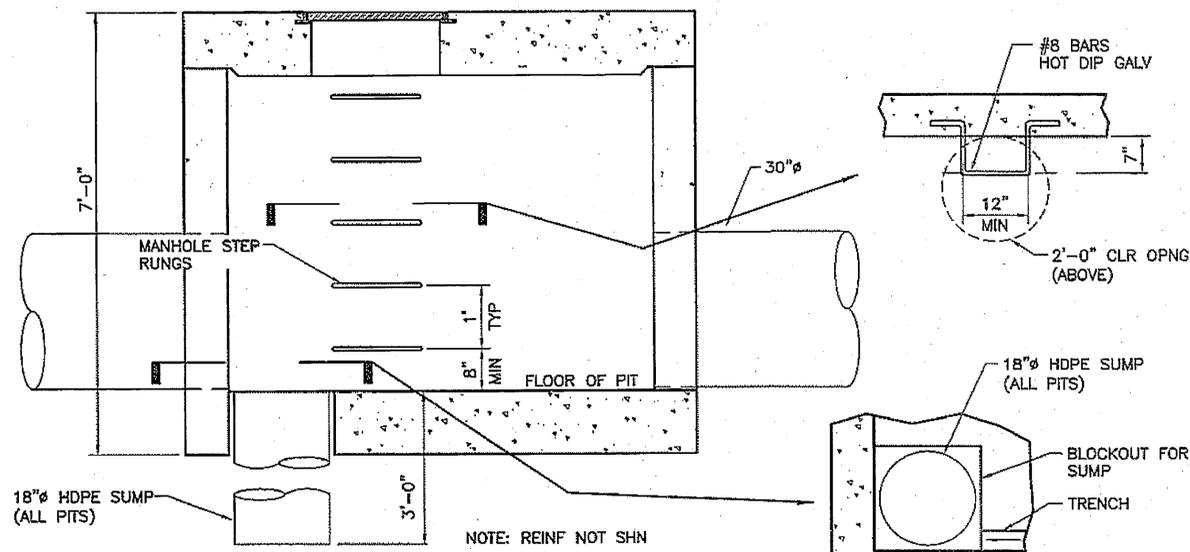


A SECTION
S15 SCALE: 3/4" = 1'-0"


LIFTING DEVICE - TYP
NTS
DAYTON P52 "SWIFT LIFT" OR APPROVED EQUAL INSTALL IN ACCORDANCE WITH MANF WRITTEN INSTRUCTION. SAFE CAPACITY = 1 TON. PROVIDE ONE DOZEN (12) MP50 "SWIFT LIFT" 1 TON UNIVERSAL LIFTING EYES.

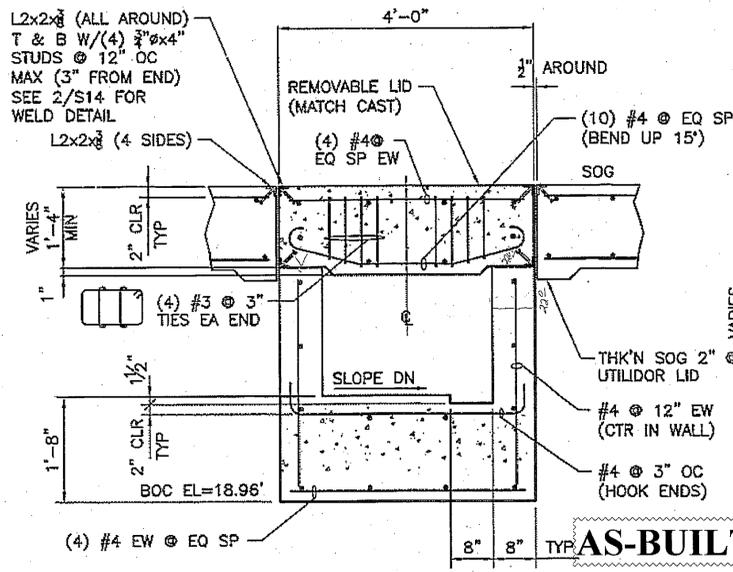


D SECTION THRU 5'-0" UTILIDOR
S15 SCALE: 3/4" = 1'-0"

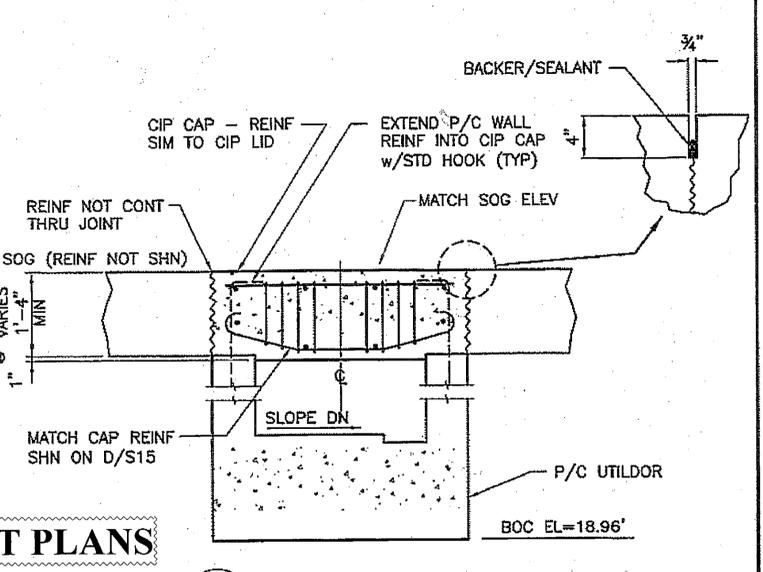

E SECTION @ CIP CAP
S15 SCALE: 3/4" = 1'-0"

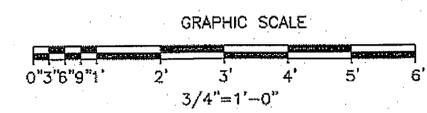

INITIALS *WRT* DATE *3/11/07*

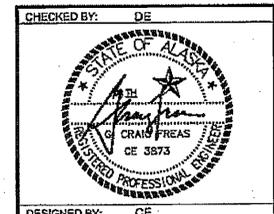


STATE OF ALASKA
DEPARTMENT OF TRANSPORTATION & PUBLIC FACILITIES
DESIGN & ENGINEERING SERVICES DIVISION-SOUTHEAST REGION
KETCHIKAN SHIPYARD BERTH ONE RELIEVING SLAB

PROJECT #68715
UTILIDOR PIT PLAN & DETAILS



DESIGNED BY: GP	PROJECT DESIGNATION: 68715	YEAR: 2007	SHEET NO.: S15	TOTAL SHEETS: 28
DRAWN BY: WEH				
PATH: M:\02158.001_Ketchikan Uplands Slab\400 Drawings\401 Working Drawings\2158.001_S15.DWG				
TAB: 19				
REVISIONS				
NO.	DATE	DESCRIPTION		

PLANS DEVELOPED BY:
TRYCK NYMAN HAYES, INC

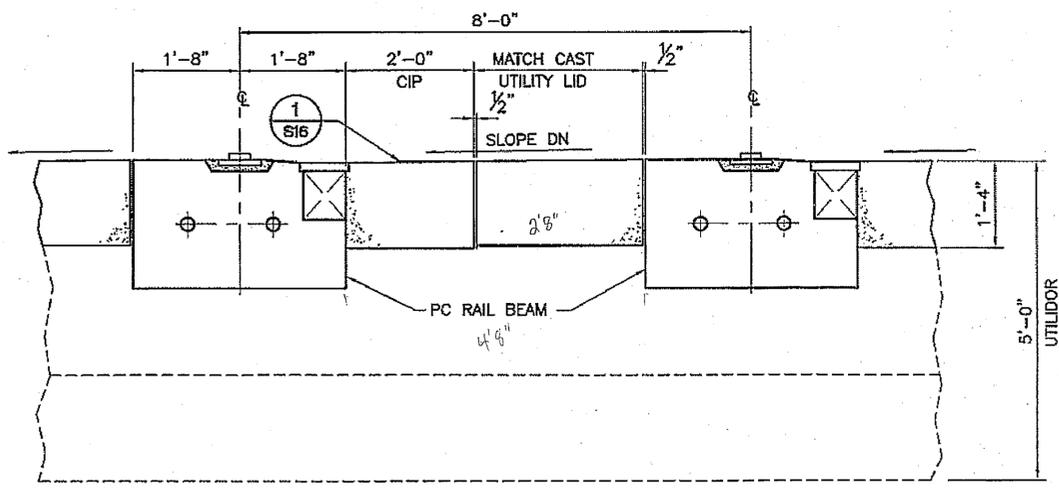

NOTE: REBAR NOT SHN

FLUSH BUTT JT (NO WELD) PL 1
1/8" RAIL &
PL 1" BASE

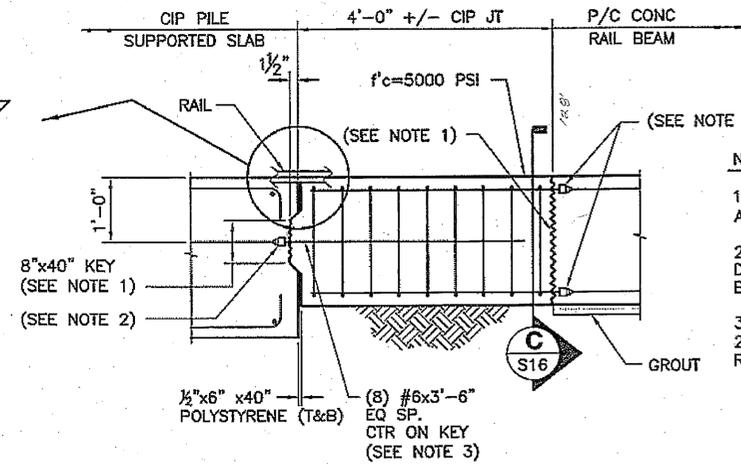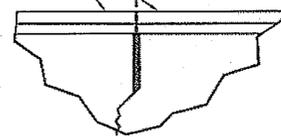


NOTE:

1. ROUGHEN TO FULL AMPLITUDE OF 1/4"
2. COUPLERS TO DEVELOP 125% OF BAR YIELD
3. CAST JT AT LEAST 21 DAYS AFTER P/T RAIL BEAM.


A SECTION THRU RAIL BEAMS

S16 SCALE: 3/4" = 1'-0"

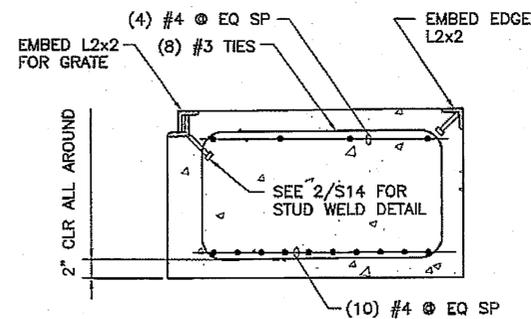

1 CIP DETAIL

S16 SCALE: 1 1/2" = 1'-0"

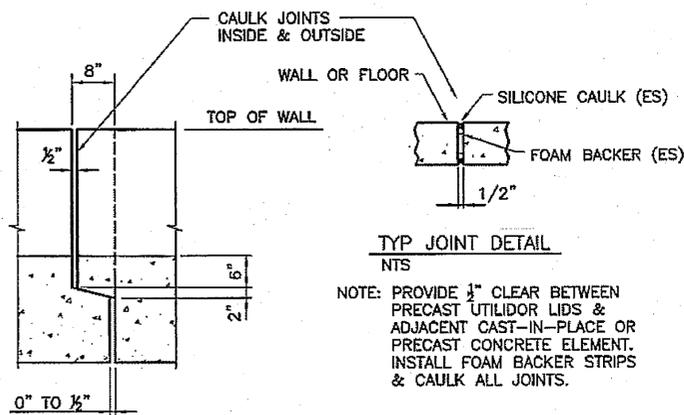


TYP JOINT DETAIL
NTS

NOTE: PROVIDE 1/4" CLEAR BETWEEN PRECAST UTILIDOR LIDS & ADJACENT CAST-IN-PLACE OR PRECAST CONCRETE ELEMENT. INSTALL FOAM BACKER STRIPS & CAULK ALL JOINTS.


2 UTILIDOR JOINT DETAIL (IF PRECAST)

S16 SCALE 3/4" = 1'-0"

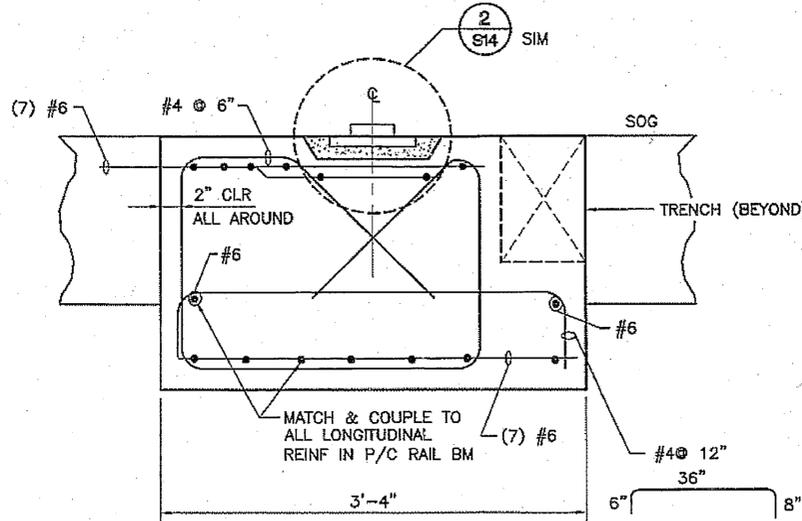

C SECTION

S16 SCALE: 1 1/2" = 1'-0"

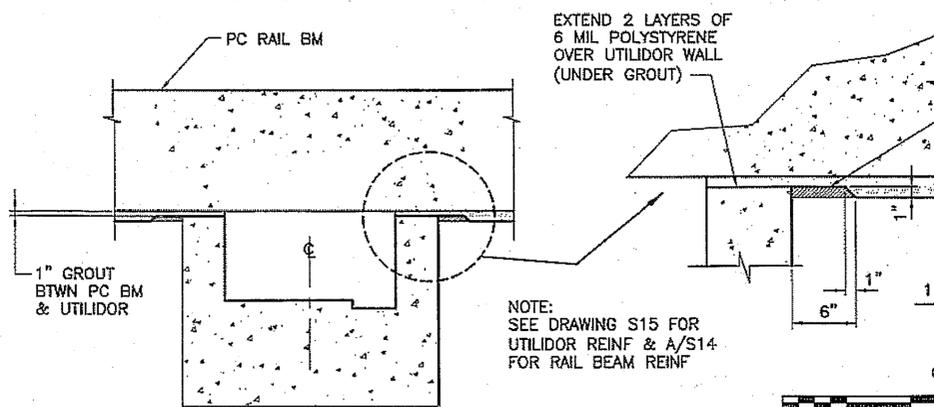


NOTE: SEE DRAWING S15 FOR UTILIDOR REINF & A/S14 FOR RAIL BEAM REINF

D SECTION

S16 SCALE 3/4" = 1'-0"

B LONG SECTION THRU RAIL BEAMS

S16 SCALE: 3/4" = 1'-0"


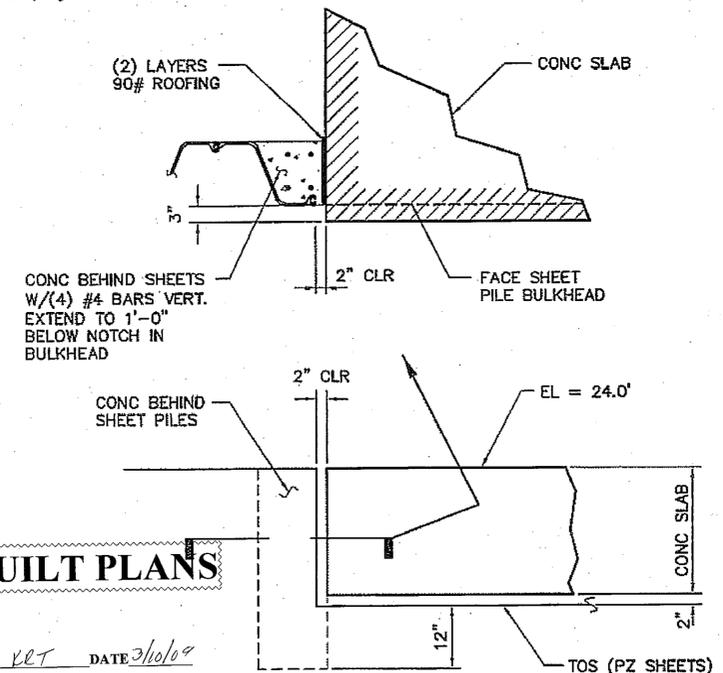


AS-BUILT PLANS

INITIALS *RET* DATE 3/10/09


E TYPICAL CLOSURE SECTION

S16 SCALE: 3/4" = 1'-0"

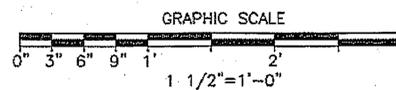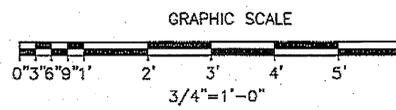


PLANS DEVELOPED BY:
TRYCK NYMAN HAYES, INC.


CHECKED BY: DE		STATE OF ALASKA DEPARTMENT OF TRANSPORTATION & PUBLIC FACILITIES DESIGN & ENGINEERING SERVICES DIVISION-SOUTHEAST REGION				
DESIGNED BY: CF						
DRAWN BY: WEH						
PATH: M:\02158.001_Ketchikan Uplands Slab\400 Drawings\401 Working Drawings\2158.001_S16.DWG		KETCHIKAN SHIPYARD BERTH ONE RELIEVING SLAB PROJECT #68715				
TAB: 20 5-8-07 SONIAJ						
REVISIONS		PROJECT DESIGNATION	YEAR	SHEET NO.	TOTAL SHEETS	
NO.	DATE	DESCRIPTION	68715	2007	S16	28

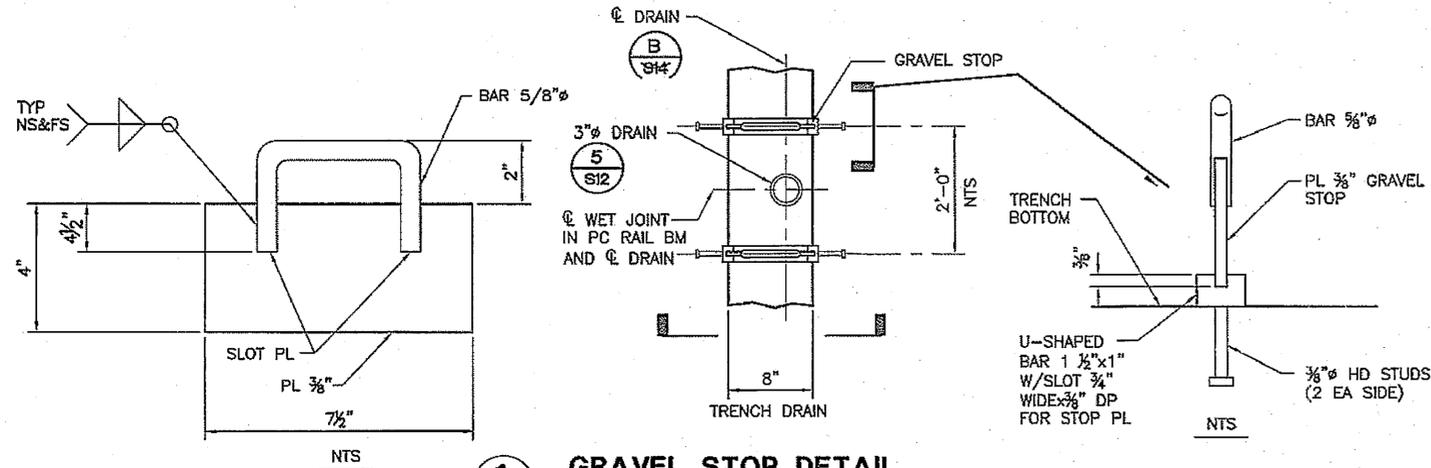


1 GRAVEL STOP DETAIL
S17 SCALE: 1 1/2" = 1'-0"

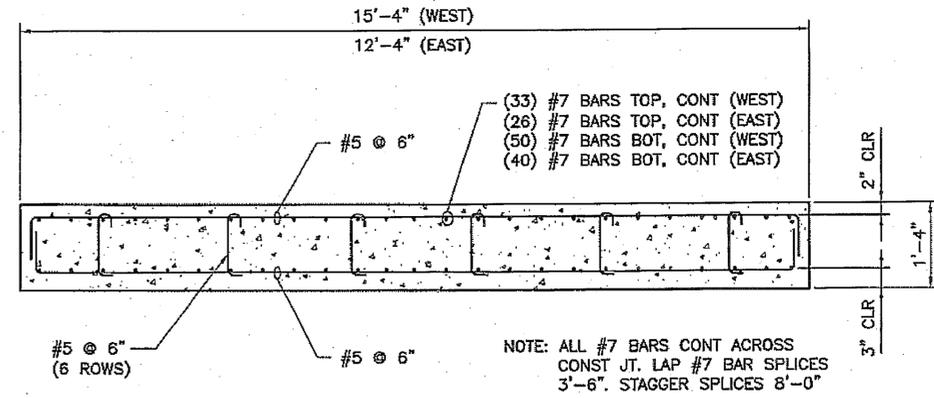


A SOG SECTION (EAST & WEST)
S17 SCALE: 3/4" = 1'-0" (f_c = 5,000 PSI)

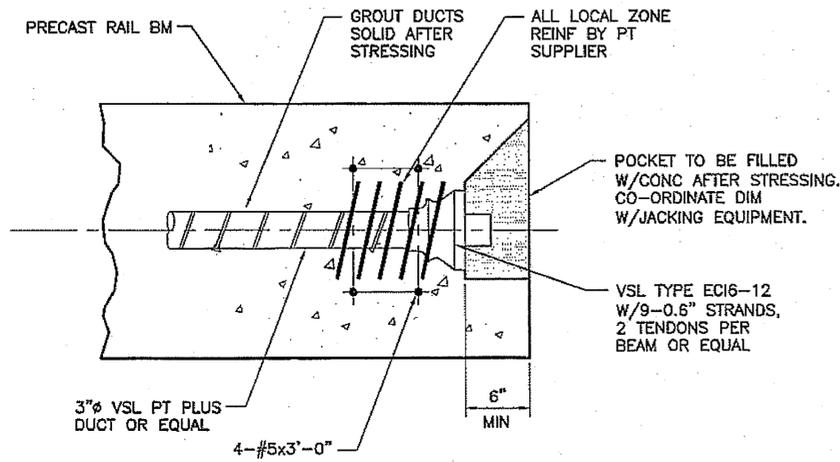



2 PT ANCHOR DETAIL
S17 SCALE: 1 1/2" = 1'-0"

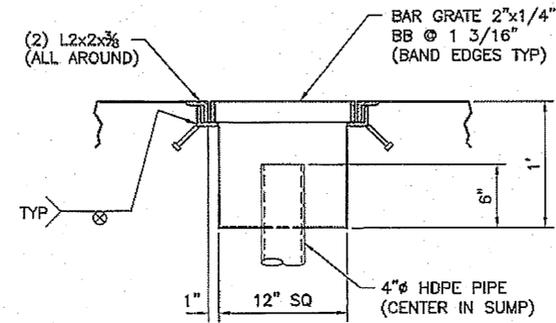


3 SPOT DRAIN DETAIL (9 LOCATIONS)
S17 SCALE: 1 1/2" = 1'-0"

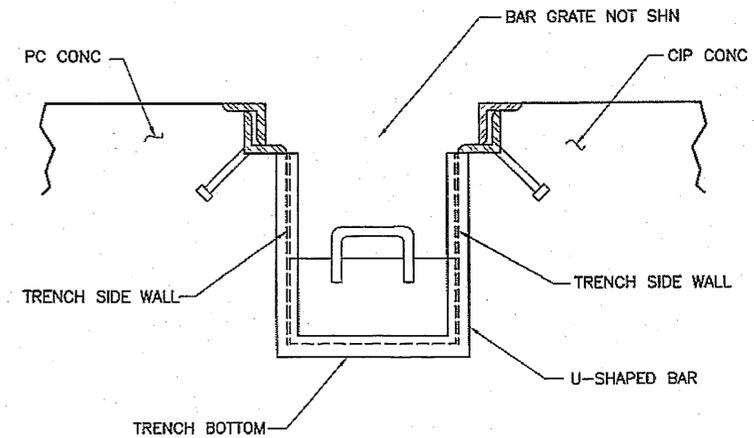


B GRAVEL STOP SECTION (9 LOCATIONS)
S17 SCALE: 3" = 1'-0"

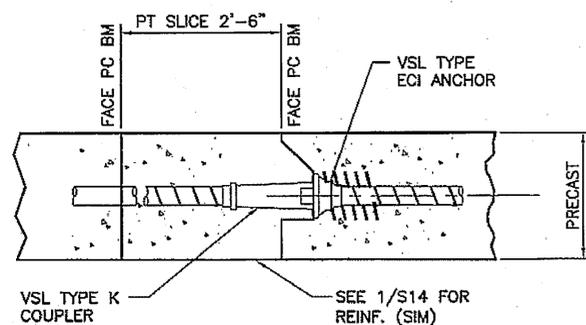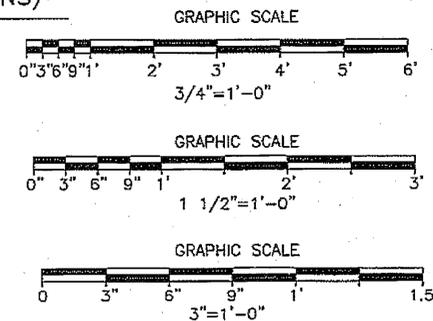

4 PT ANCHOR DETAIL
S17 SCALE: 3/4" = 1'-0" (OPTIONAL - NOT REQUIRED SEE ADD. B.)

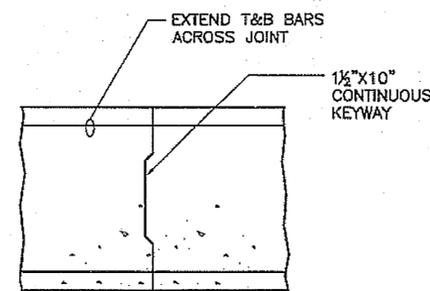

5 CONSTRUCTION JOINT FOR PILE SUPPORTED SLAB
S17 SCALE: 3/4" = 1'-0"

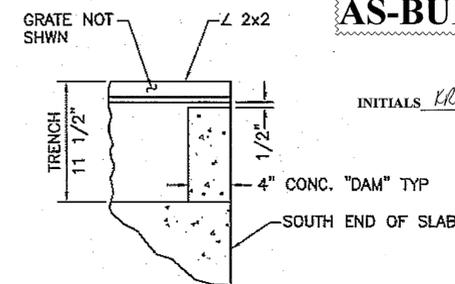

6 TRENCH DETAIL
S17 SCALE: 1 1/2" = 1'-0"

AS-BUILT PLANS


INITIALS *KRT* DATE *3/10/09*

CHECKED BY: DE 		STATE OF ALASKA DEPARTMENT OF TRANSPORTATION & PUBLIC FACILITIES DESIGN & ENGINEERING SERVICES DIVISION-SOUTHEAST REGION KETCHIKAN SHIPYARD BERTH ONE RELIEVING SLAB PROJECT #68715 MISC SECTIONS & DETAILS								
DESIGNED BY: CF DRAWN BY: WEH		PROJECT DESIGNATION: 68715 YEAR: 2007 SHEET NO.: S17 TOTAL SHEETS: 28								
PATH: M:\02158.001_Ketchikan Upland Slab\400 Drawings\401 Working Drawings\2158.001_S17.DWG TAB: 21 5-5-07 SONIAJ		REVISIONS <table border="1"> <thead> <tr> <th>NO.</th> <th>DATE</th> <th>DESCRIPTION</th> </tr> </thead> <tbody> <tr> <td> </td> <td> </td> <td> </td> </tr> </tbody> </table>			NO.	DATE	DESCRIPTION			
NO.	DATE	DESCRIPTION								


PLANS DEVELOPED BY:
TRYCK NYMAN HAYES, INC.

GENERAL NOTES


STRUCTURAL STEEL:
 STEEL PLATE AND SHAPES EXCEPT ANGLES AND CHANNELS SHALL BE ASTM A572 GR. 50 UNLESS OTHERWISE NOTED OR APPROVED BY THE OWNER. ALL ANGLES AND CHANNELS SHALL BE A36. ALL BOLTS SHALL BE ASTM A-490 UNLESS OTHERWISE NOTED. BOLTS SHALL BE INSTALLED "SNUG TIGHT". HOLES MAY NOT BE BURNED; THEY MUST BE PUNCHED OR DRILLED.

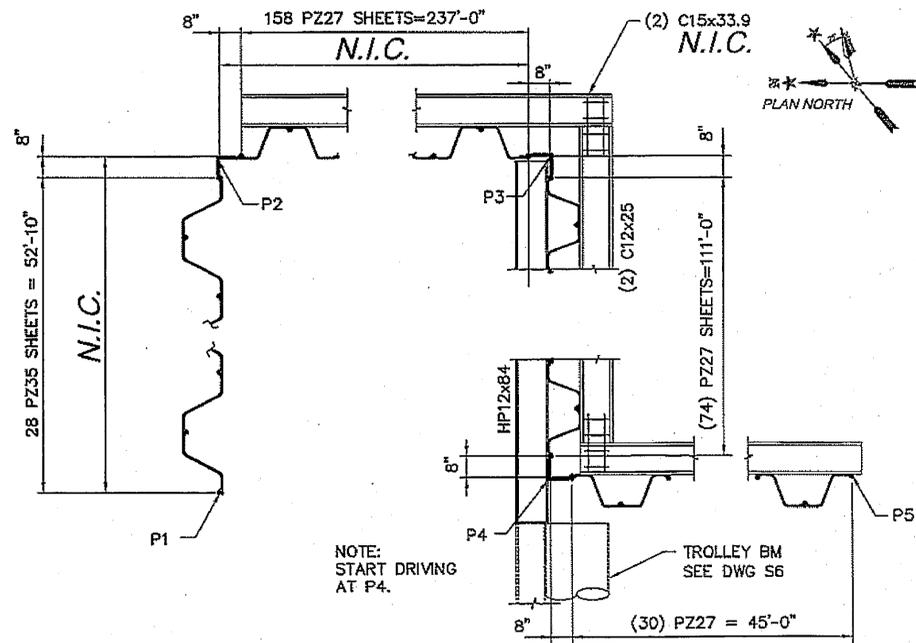


1 SHEET PILE LAYOUT
 S18 SCALE: 3/8" = 1'-0"

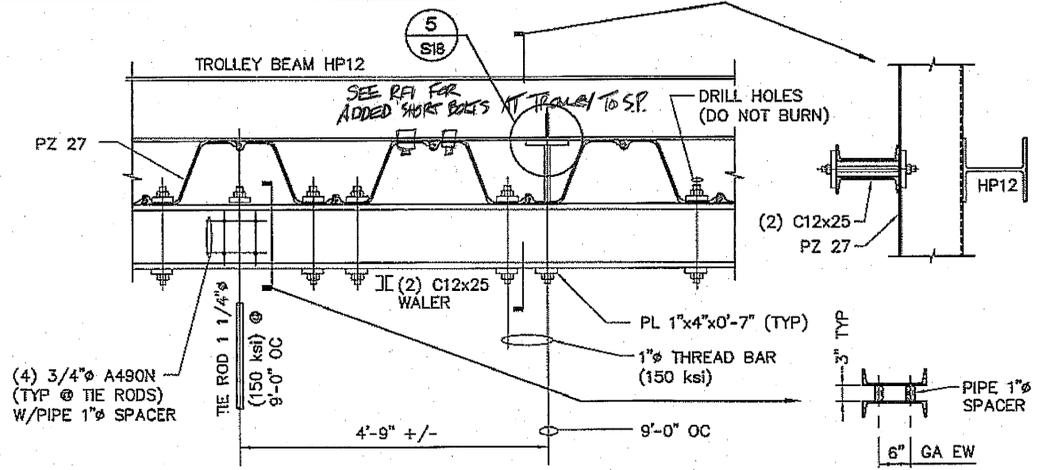


3 SHEET PILE PLAN-SOUTH BULKHEAD
 S18 SCALE: 3/4" = 1'-0"

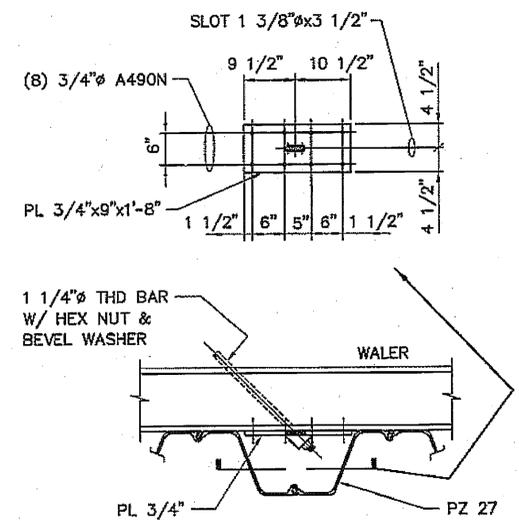


8 DETAIL
 S18 SCALE: 3/4" = 1'-0"

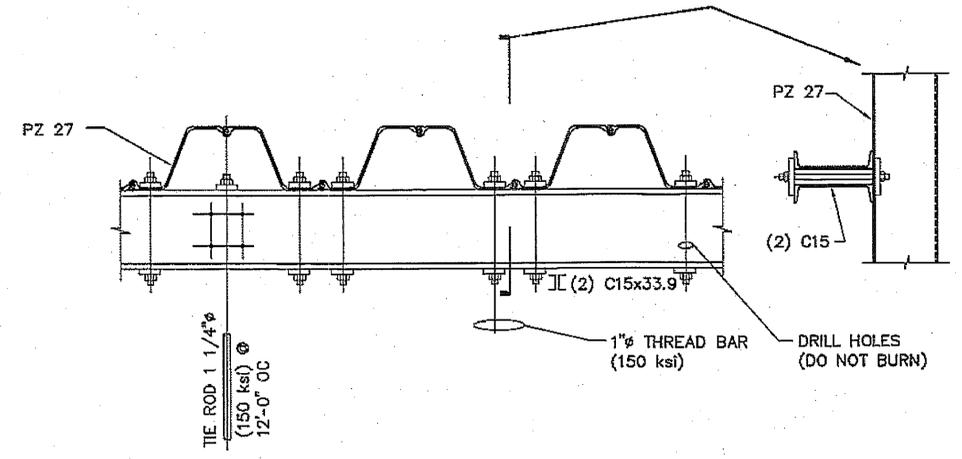


4 SHEET PILE PLAN-EAST BULKHEAD (N.I.C.)
 S18 SCALE: 3/4" = 1'-0"

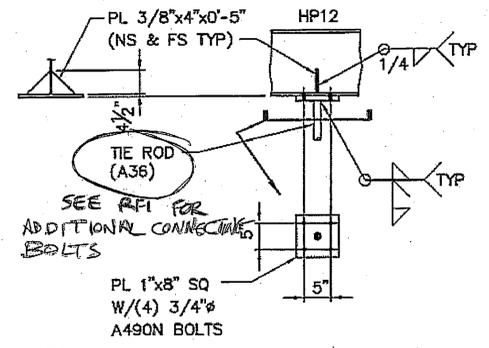


5 DETAIL
 S18 SCALE: 3/4" = 1'-0"

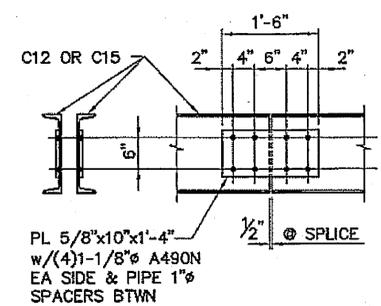

6 TYP SPLICE DETAIL
 S18 SCALE: 3/4" = 1'-0"

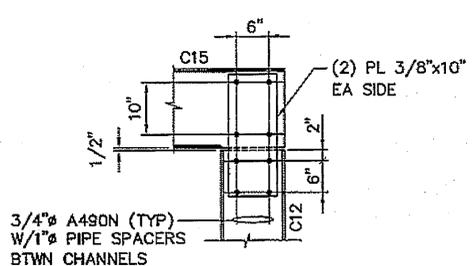


7 WHALER CORNER SPLICE (N.I.C.)
 S18 SCALE: 3/4" = 1'-0"

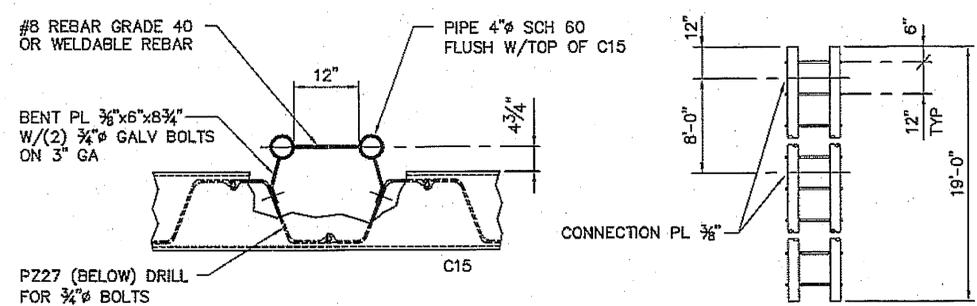

9 LADDER DETAIL - 3 REQ'D (N.I.C.)
 S18 SCALE: 3/4" = 1'-0"



LADDER ELEVATION
 NTS

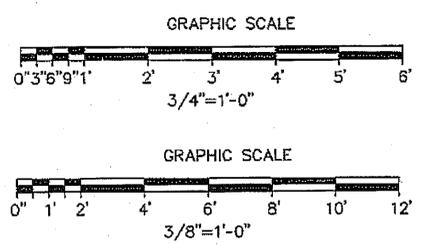


AS-BUILT PLANS
by Dawson


INITIALS *RET* DATE *3/10/09*

PLANS DEVELOPED BY:
 TRYCK NYMAN HAYES, INC.


CHECKED BY: DE 		STATE OF ALASKA DEPARTMENT OF TRANSPORTATION & PUBLIC FACILITIES DESIGN & ENGINEERING SERVICES DIVISION-SOUTHEAST REGION KETCHIKAN SHIPYARD BERTH ONE RELIEVING SLAB PROJECT #68715	
DESIGNED BY: DE DRAWN BY: WEH		SHEET PILE DETAILS	
PATH: M:\02158.001_KETCHIKAN UPLANDS SLAB\400 DRAWINGS\401 WORKING DRAWINGS\02_2158.001_S18.DWG TAB: 22 5-8-07 SONIAJ		PROJECT DESIGNATION 68715	YEAR 2007
REVISIONS NO. DATE DESCRIPTION	SHEET NO. S18	TOTAL SHEETS 28	

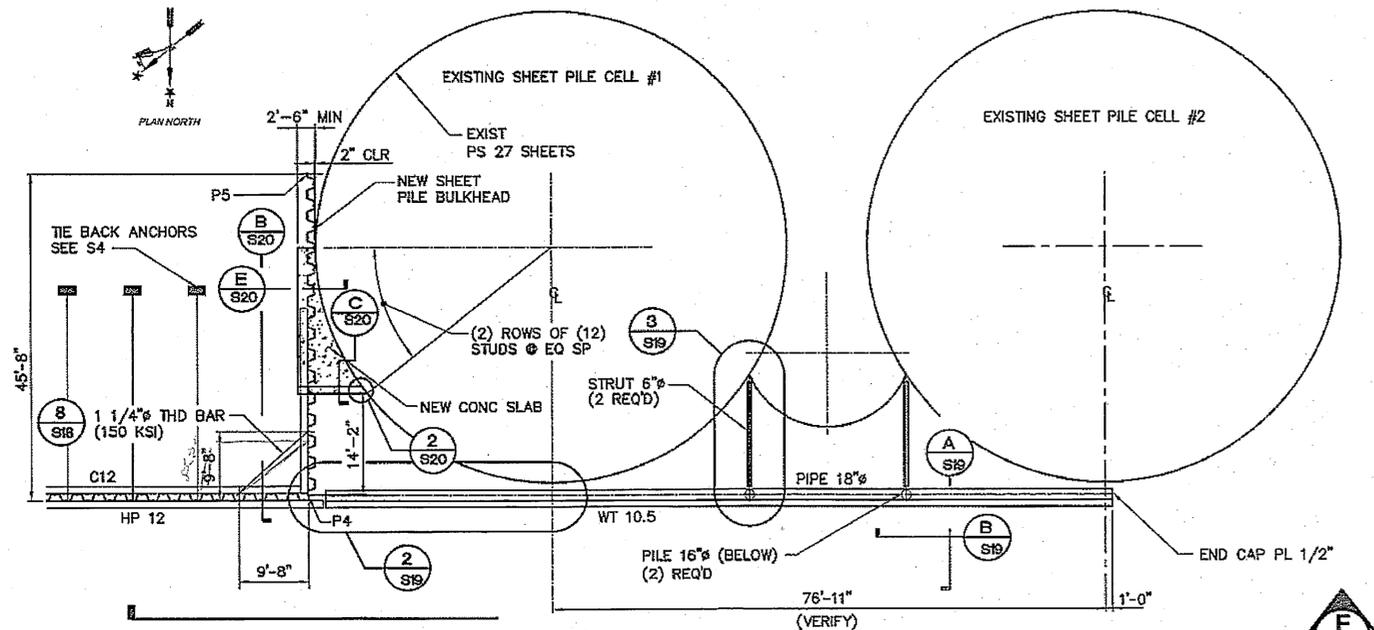


1 TROLLEY BEAM PLAN
S19 SCALE: 3/32" = 1'-0"

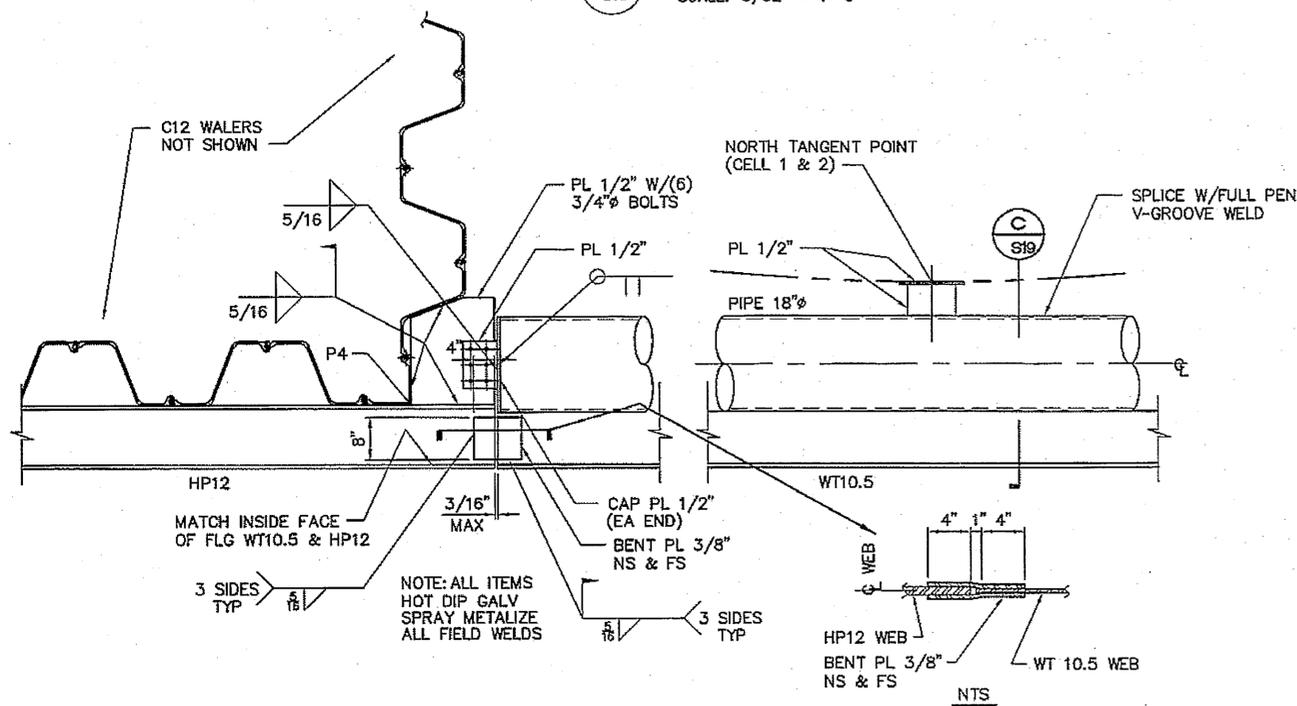


2 DETAIL
S19 SCALE: 3/4" = 1'-0"

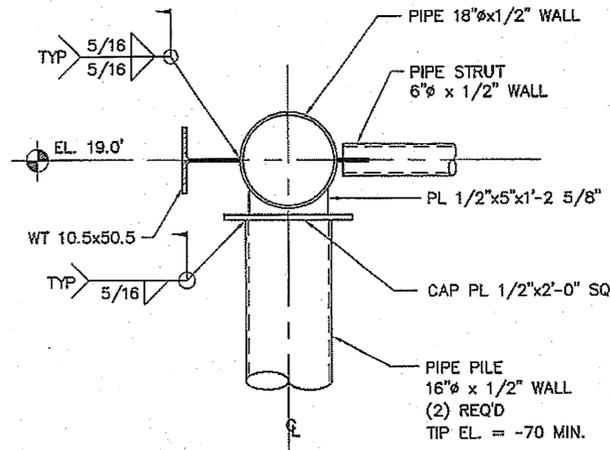


A SECTION
S19 SCALE: 3/4" = 1'-0"

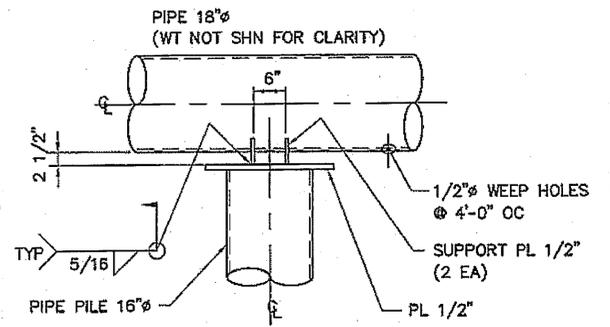

B SECTION
S19 SCALE: 3/4" = 1'-0"

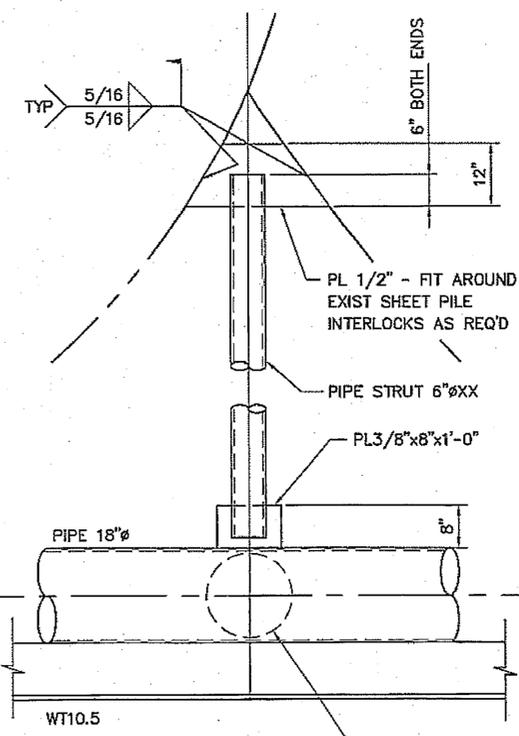


3 DETAIL
S19 SCALE: 3/4" = 1'-0"

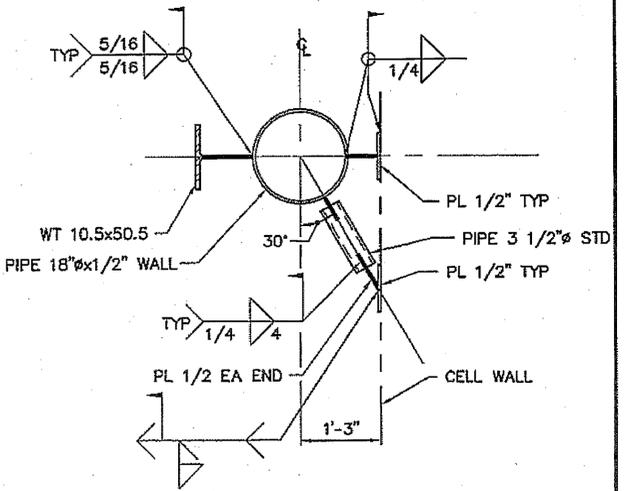

C SECTION
S19 SCALE: 3/4" = 1'-0"

NOTE: ALL ITEMS HOT DIP GALVANIZED EXCEPT PORTION OF OUTER FLANGE OF TROLLEY BEAM.

AS-BUILT PLANS

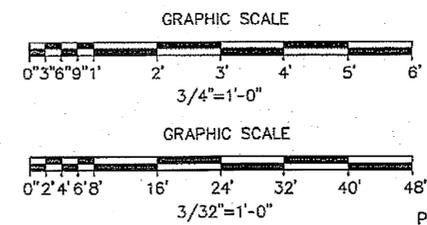

PLANS DEVELOPED BY:
TRYCK NYMAN HAYES, INC.

INITIALS *VET* DATE *3/10/07*

CHECKED BY: DE
DESIGNED BY: CF
DRAWN BY: WEH

STATE OF ALASKA
DEPARTMENT OF TRANSPORTATION
& PUBLIC FACILITIES
DESIGN & ENGINEERING SERVICES DIVISION-SOUTHEAST REGION


KETCHIKAN SHIPYARD
BERTH ONE RELIEVING SLAB

PROJECT #68715
TROLLEY BEAM PLAN & DETAILS


PATH: M:\02158.001_KETCHIKAN UPLANDS SLAB\400 DRAWINGS\401 WORKING DRAWINGS\23_2158.001_S19.DWG
TAB: 23 5-8-07 WALTH

REVISIONS			PROJECT DESIGNATION	YEAR	SHEET NO.	TOTAL SHEETS
NO.	DATE	DESCRIPTION	68715	2007	S19	28


NOTE: COMPLETE AND CURE CONCRETE PRIOR TO PLACING FILL AGAINST SHEET PILE BULKHEAD

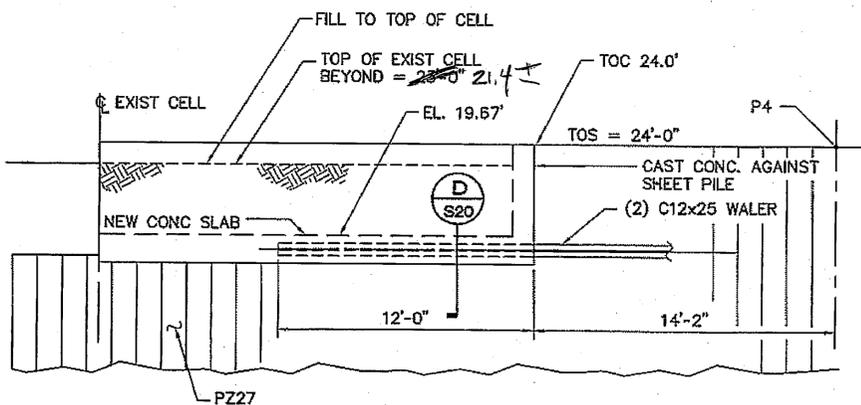


B SECTION
S20 SCALE: 1/4" = 1'-0"

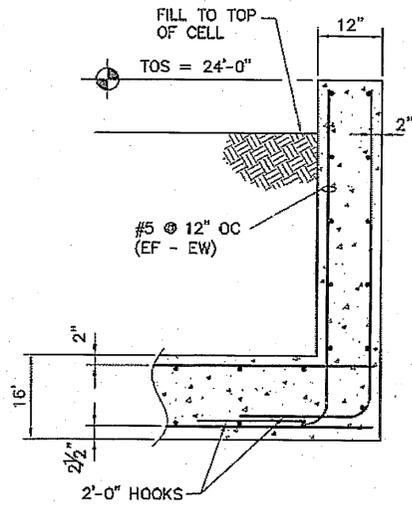


C SECTION
S20 SCALE: 3/4" = 1'-0" (f'c = 4,000 PSI)

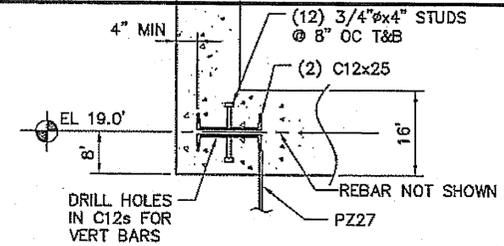


D SECTION
S20 SCALE: 3/4" = 1'-0"

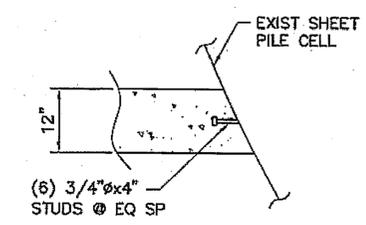

2 SECTION
S20 SCALE: 3/4" = 1'-0"

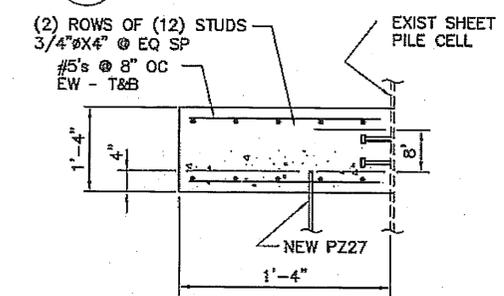


E SECTION
S20 SCALE: 3/4" = 1'-0"

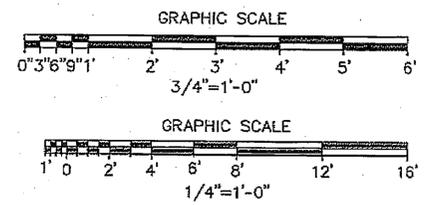


TIE ROD LOCATIONS
SOUTH BULKHEAD
3.7
12.7
21.7
30.7
39.7
48.7
57.7
66.7
75.7
85.2**
93.7
102.7*


SEE SHEET PILE SHOPS AND WALER SHOPS AND RFI'S FOR ACTUAL LOCATIONS

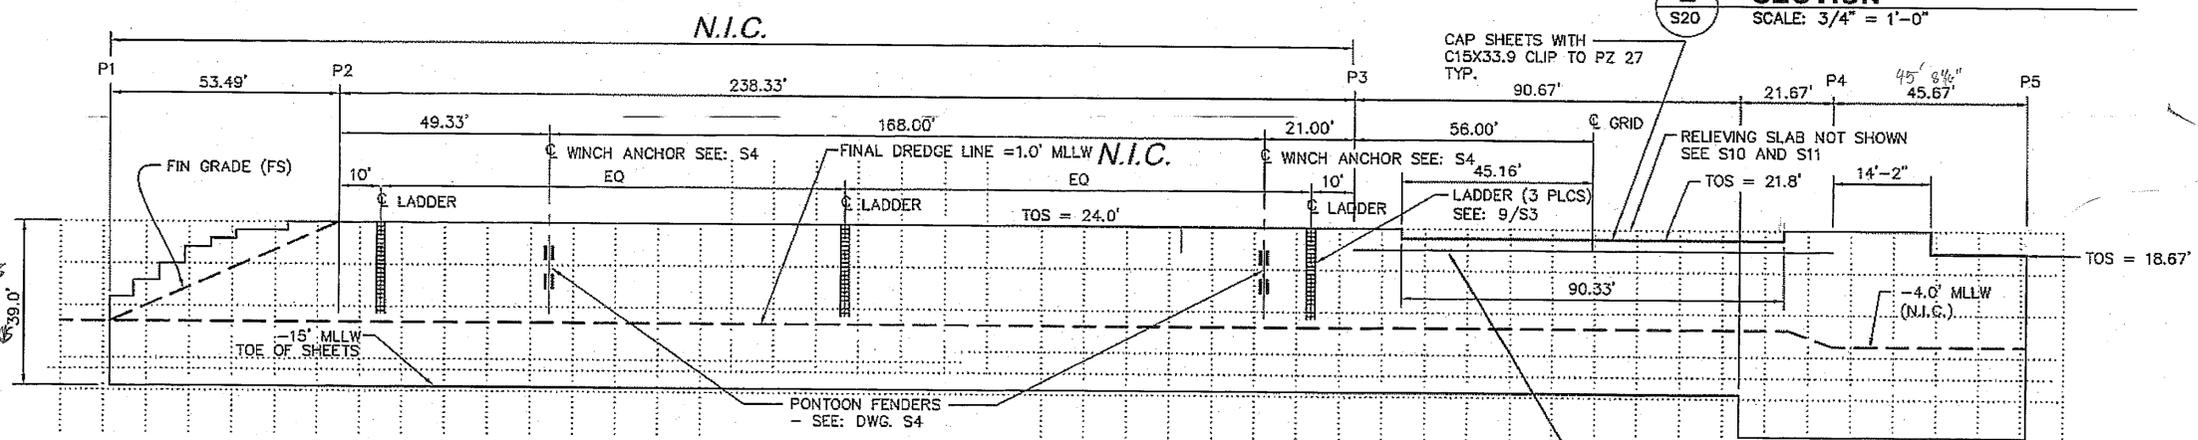

A SHEET PILE PROFILE
S20 SCALE: 1" = 20'

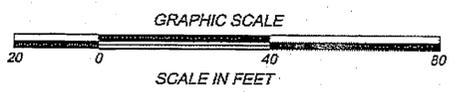

NOTE:
DISTANCES ARE IN FEET FROM P3.
* - ANGLED RODS
** - SPECIAL LOCATION TO AVOID FUTURE PILING.

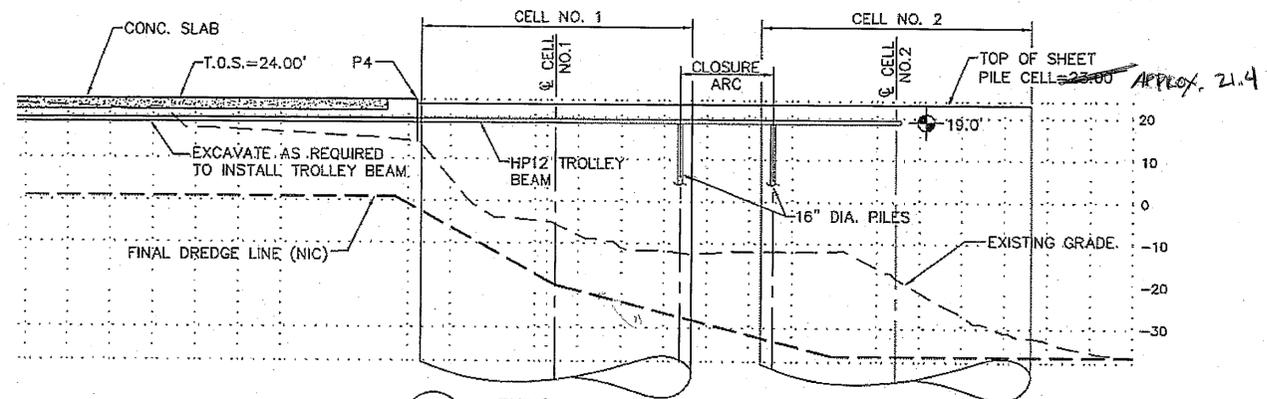

F TROLLEY BEAM SECTION
S20 SCALE: 1" = 20'

AS-BUILT PLANS
by Dawson Inc

INITIALS *VRT* DATE *3/10/04*

	CHECKED BY: DE DESIGNED BY: CF DRAWN BY: WEH	STATE OF ALASKA DEPARTMENT OF TRANSPORTATION & PUBLIC FACILITIES DESIGN & ENGINEERING SERVICES DIVISION-SOUTHEAST REGION KETCHIKAN SHIPYARD BERTH ONE RELIEVING SLAB PROJECT #68715 CIVIL DETAILS & SECTIONS
	PATH: M:\02158.001_KETCHIKAN UPLANDS SLAB\004 DRAWINGS\401 WORKING DRAWINGS\24_2158.001_S20.DWG TAB: 24 5-8-07 SONIAJ	REVISIONS NO. DATE DESCRIPTION

PLANS DEVELOPED BY:
TRYCK NYMAN HAYES, INC.