


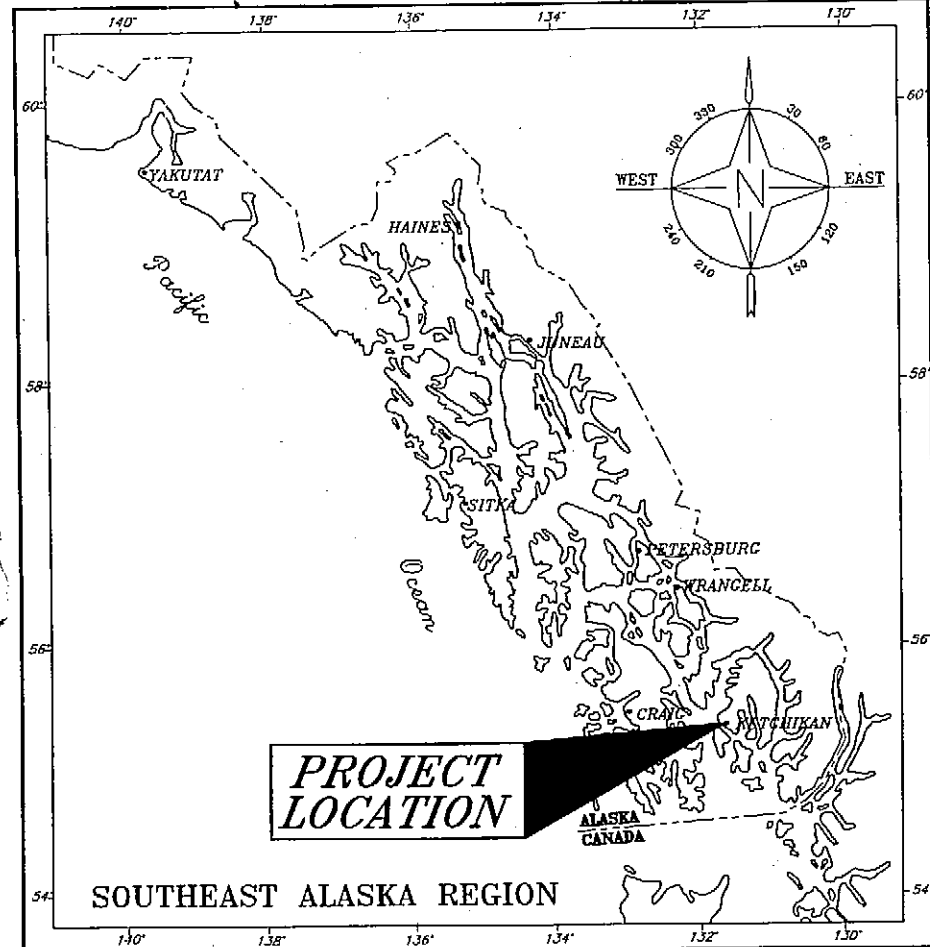


STATE OF ALASKA
DEPARTMENT OF TRANSPORTATION
AND
PUBLIC FACILITIES
SOUTHEAST REGION
DESIGN AND CONSTRUCTION DIVISION

KETCHIKAN, ALASKA
**KETCHIKAN AIRPORT
SEAPLANE FLOAT
RECONSTRUCTION**

PROJECT NO. 68742


INDEX OF SHEETS	
SHEET NO.	DESCRIPTION
1	TITLE SHEET
2	QUANTITIES & GENERAL NOTES
3	EXISTING PLAN
4	PROJECT LAYOUT
5	BRIDGE SUPPORT FLOAT FRAME LAYOUT
6	BRIDGE SUPPORT FLOAT HULL REINFORCEMENT
7	BRIDGE SUPPORT FLOAT FRAME DETAILS
8	BRIDGE SUPPORT FLOAT MISC. DETAILS
9	RESTRAINT FLOAT PLAN
10	RESTRAINT FLOAT DETAILS
11	MISC. DETAILS
12	AS-BUILT, PEDESTRIAN & VEHICLE BRIDGE DETAILS
13	AS-BUILT, BRIDGE SECTION DETAILS
14	AS-BUILT, BRIDGE SUPPORT FLOAT
15	AS-BUILT, TYPICAL FLOAT MODULE DETAILS
16	AS-BUILT, FLOAT CONNECTION DETAILS

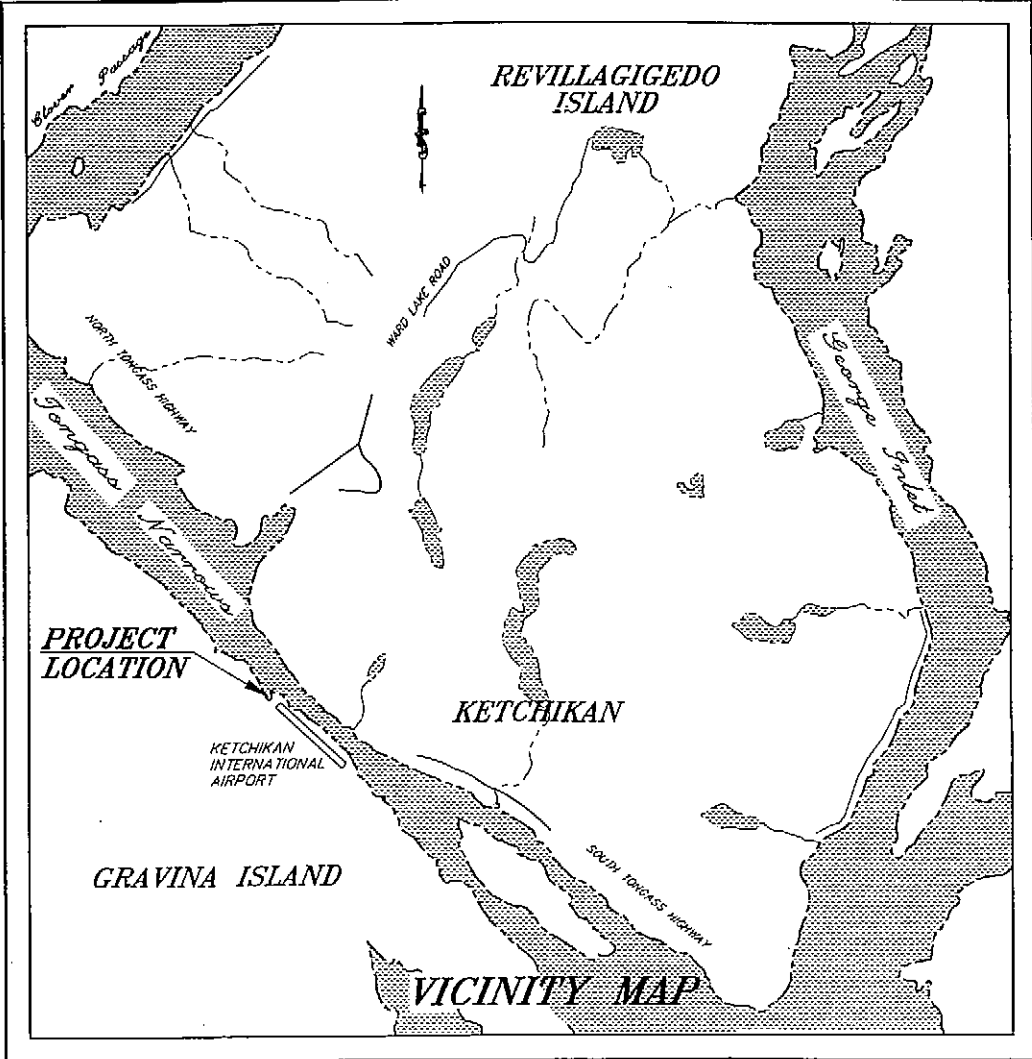


AS-Built Plans

Begin: 10-11-04 END: 10-16-04
Project Engineer: Jack Lee
Contractor: Western Dock & Bridge

STATE OF ALASKA
DEPARTMENT OF TRANSPORTATION
AND
PUBLIC FACILITIES
SOUTHEAST REGION DESIGN SECTION

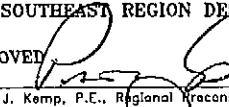APPROVED  Date 5/13/04
Patrick J. Kemp, P.E., Regional Reconstruction Engineer
APPROVED  Date 5/13/04
Gary L. Paxton, Director, S.E. Region

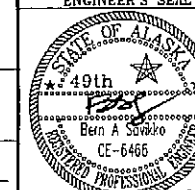PROJECT NUMBER: 68742	ENGINEER'S SEAL 
DATE: 2004	
SHEET 1 OF 16	

ESTIMATE OF QUANTITIES

KETCHIKAN SEAPLANE BRIDGE FLOAT REPAIR

ITEM NO.	ITEM	ESTIMATED QUANTITIES	UNIT
G-100a	Mobilization and Demobilization	All Req'd	L.S.
M-300a	New Steel Bridge Support Float	All Req'd	L.S.
M-300b	New Steel Pipe Restraint Float	All Req'd	L.S.
P-158a	Erosion and Pollution Control Administration	All Req'd	L.S.
P-158b	Temporary Erosion and Pollution Control	All Req'd	C.S.
P-165a	Removal of Structures and Obstructions	All Req'd	L.S.

GENERAL NOTES

Specifications: Per Contract Documents for Project No. 68742

Construction: Per Contract Documents for Project No. 68742

Design Standards: AKDOT/PF & SOUTHEAST REGION MARINE ENGINEERING DESIGN STANDARDS

Design Loads: Float Restraint Structures: Current @ 2 knots
Wave Loading: 4' x 4 sec wave
Wind Load: 25 psf x Projected Area of Bridge

Seaplane Float: Current @ 2 knots
Wave Loading: 4' x 4 sec wave
AASHTO H10-44

Vehicle Bridge AASHTO H10-44
Pedestrian Ramps: LL - 85 psf

Design Unit Stresses:

Steel: A36 $F_y = 20 \text{ Ksi}$
A252 Gr. 2 $F_y = 19.25 \text{ Ksi}$
A500 Gr. B $F_y = 25 \text{ Ksi}$
A572 $F_y = 27 \text{ Ksi}$
A108 $F_y = 29 \text{ Ksi}$
A608 Gr. D $F_y = 30 \text{ Ksi}$

Materials:

Steel: Tube Sections A500 Gr. B
Pile A252 Gr. 2 (with A36 properties), A501 or A53, Gr. B, type E or S
Pipe A53, Gr. B, type E or S
Stainless Type 302, 304 or 316
All other shall be A36 or A572 as noted.

Protective Coatings:

All steel shall be galvanized after fabrication unless specified otherwise

Glulam Timbers: Repair per specifications.

Steel float exterior shall be coated per System 1 of the technical specifications.

As-Built Drawings :

Are Available For Inspection By Prospective Bidders At The Southeast Region D & C Offices, 6860 Glacier Highway, In Juneau, AK. Contact Bern Savikko or Bill Nelson At (907)465-8945.

NOTE: The new steel bridge support float is a replacement for the existing glulam timber float. The steel float as detailed has six watertight compartments for leveling with fresh water ballast.
A fabricated steel float with similar design characteristics may be an acceptable option. If the Contractor elects to utilize a another steel float design, he shall submit design computations, plans and specifications for approval. The float must not be pile restrained. If the alternate is not accepted the contractor must construct the float as designed at the bid amount. If an alternate system is used, there shall be no increased cost to the State.

NOTE: DO NOT SCALE FROM THESE PLANS, USE DIMENSIONS

PATH: Q:\Marine\Ktn Seaplane Repair 2002\PlanSet\002 Ktn SP Brdg Flt - Quant.dwg

BY: DATE: DESCRIPTION OF CHANGE:

RECORD OF REVISIONS

STATE OF ALASKA
DEPARTMENT OF TRANSPORTATION
AND PUBLIC FACILITIES
SOUTHEAST REGION DESIGN & CONSTRUCTION

KETCHIKAN

ALASKA
KETCHIKAN AIRPORT SEAPLANE FLOAT RECONSTRUCTION
PROJECT NO. 68742

QUANTITIES & GENERAL NOTES

DESIGNED BY: BN


PROJECT NO.
68742

DRAWN BY: BN

DATE:
2004

CHECKED BY: BAS

SHEET 2 OF 16

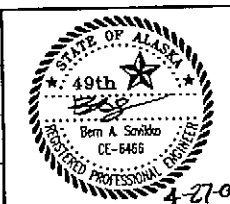

BASIS OF CONTROL


HORIZONTAL CONTROL

THE BASIS OF HORIZONTAL CONTROL FOR THIS PROJECT IS THE RECORD BEARING OF S. 44°21'58"E, BETWEEN A 3" ALUMINUM MONUMENT AT PT 234+94.89, LOCATED IN THE ASPHALT IN FRONT OF THE TERMINAL BUILDING, AND A 2" BRASS CAP AT PT 18 STA. 244+01.44, LOCATED IN THE SERVICE ROAD BY THE RAMP TO THE SEAPLANE FACILITY.

THE BASIS OF COORDINATES IS THE MONUMENT AT PT 234+94.89 WITH PROJECT COORDINATES OF N. 10648.451, E. 19365.739.

VERTICAL CONTROL

THE BASIS OF VERTICAL CONTROL FOR THIS PROJECT IS THE MONUMENT AT PT 234+94.89 WITH AN ACCEPTED ELEVATION OF 43.44' ABOVE MLLW. THIS OBSERVATION WAS DERIVED FROM A SERIES OF TIDAL OBSERVATIONS TAKEN ON OCT. 29 & 30, 1986. CONTRACTOR TO VERIFY.

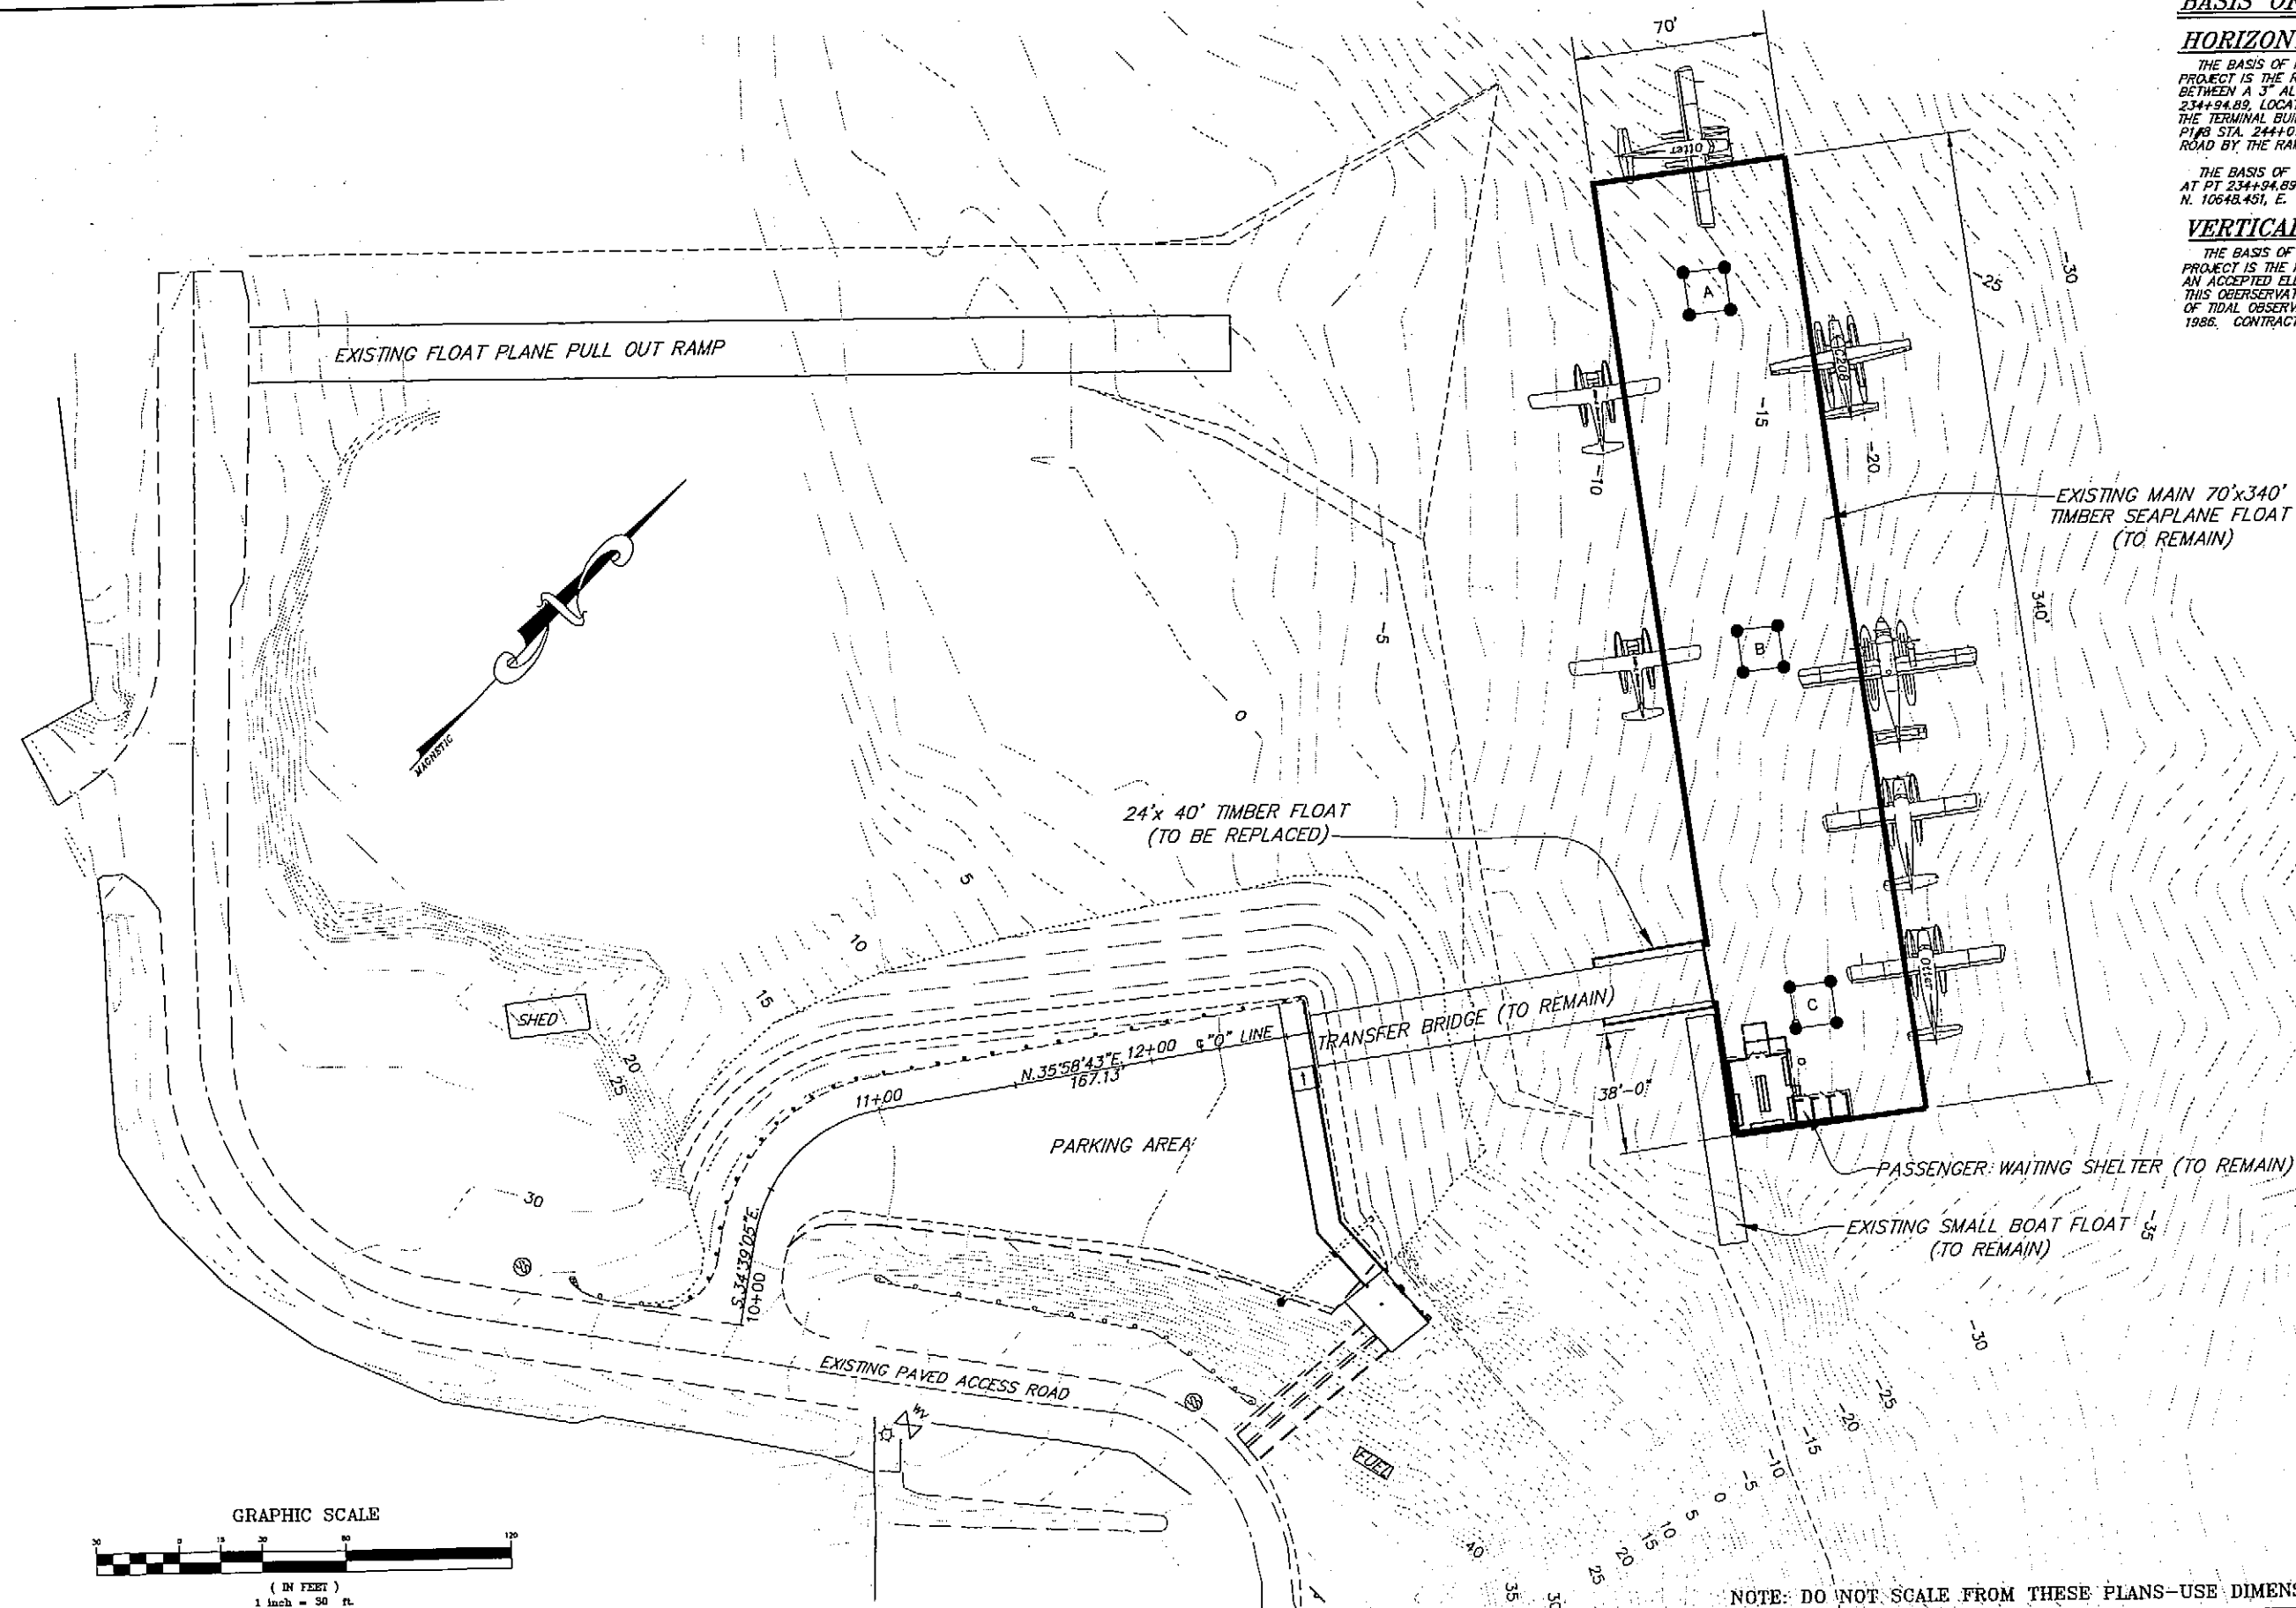

PATH: Q:\Marine\Ktn Seaplane Repair 2002\PlanSet\003 Ktn SP Brd Flt - Plan.dwg

PLOT:

BY: DATE: DESCRIPTION OF CHANGE:

RECORD OF REVISIONS

STATE OF ALASKA
DEPARTMENT OF TRANSPORTATION
AND PUBLIC FACILITIES
SOUTHEAST REGION DESIGN & CONSTRUCTION

KETCHIKAN

KETCHIKAN AIRPORT
SEAPLANE FLOAT RECONSTRUCTION
PROJECT NO. 68742

EXISTING PLAN

ALASKA

DESIGNED BY: BN


DRAWN BY: BN

CHECKED BY: BAS

PROJECT NO.
68742

DATE:
2004

SHEET 3 OF 16

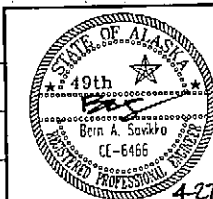

4-2701

Notes:

Electrical/Comm utilities located along the east side of the bridge will need to be disconnected and reconnected to allow removal and replacement of the existing timber bridge float.

Supply New galvanized pipe support bracket to be field welded onto the east side apron handrail. The electrical cables shall be supported by two trolling springs & stainless steel mesh strain relief grips from the new bracket. The support bracket should standoff from the handrail (brace as req'd) to allow the flexible electrical cables movement safe from binding or abrasion.


After the support float has been located, the existing steel skids on seaplane float must be relocated and secured to align with the bridge apron.

ACCESS HATCHES: New Access Hatches shall be Baier oval, flush, plain, type "C" commercial, aluminum w/ galv. steel rim or equal and installed per manufacturer's recommendations. Contact information at:
Baier Hatch Co, Inc., 16901 Wood-Red Road, Woodinville, WA 98072
Ph: 1-800-455-3917


BALLAST: Bridge support float shall be ballasted with fresh water to ~1'-6" freeboard all around with all structures installed.

PROTECTIVE COATINGS: Exterior of bridge support float shall be System 1 with non-skid deck per Technical Specifications or equal, applied after fabrication. Interior of support float shall have one coat of zinc rich primer. Support float attachments and assemblies shall be galvanized after fabrication. Restraint float members, frames & collars shall be hot-dip galvanized.

TONGASS NARROWS

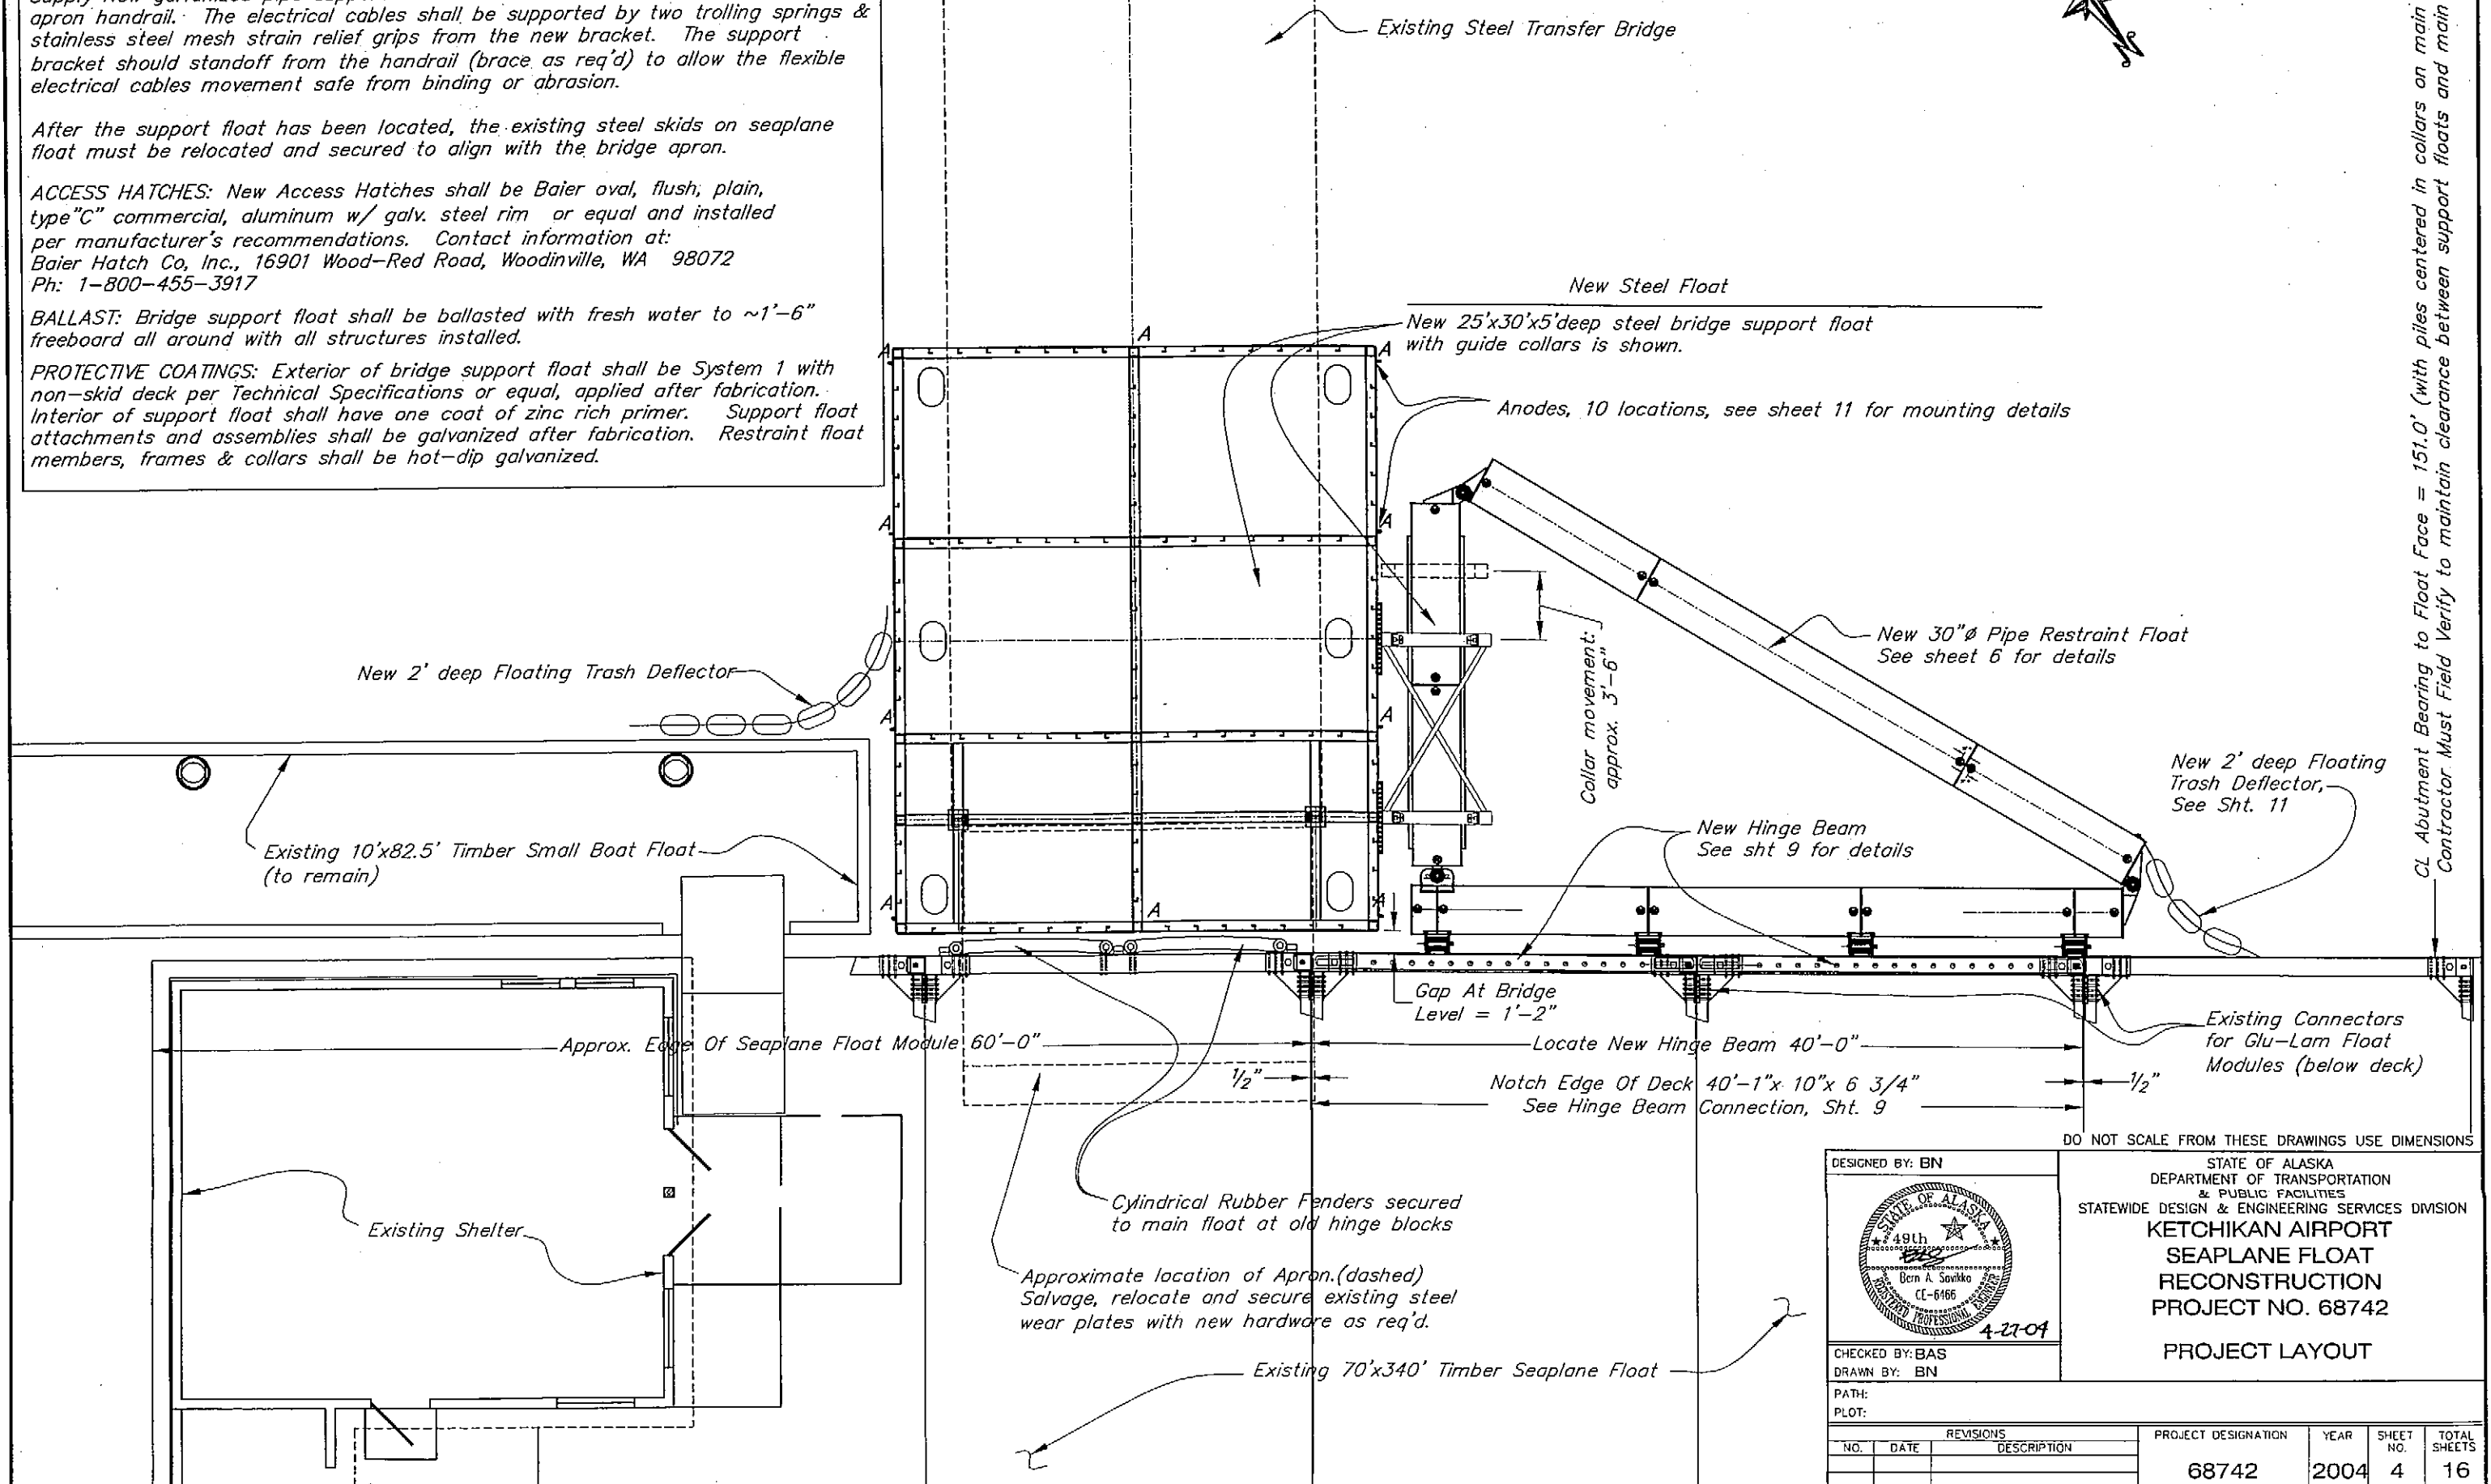

DESIGNED BY: BN

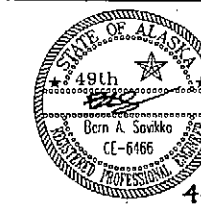

CHECKED BY: BAS

DRAWN BY: BN

PATH:

PLOT:


REVISIONS			PROJECT DESIGNATION	YEAR	SHEET NO.	TOTAL SHEETS
NO.	DATE	DESCRIPTION				
			68742	2004	4	16

DO NOT SCALE FROM THESE DRAWINGS USE DIMENSIONS


STATE OF ALASKA
DEPARTMENT OF TRANSPORTATION
& PUBLIC FACILITIES
STATEWIDE DESIGN & ENGINEERING SERVICES DIVISION

KETCHIKAN AIRPORT
SEAPLANE FLOAT
RECONSTRUCTION
PROJECT NO. 68742


PROJECT LAYOUT

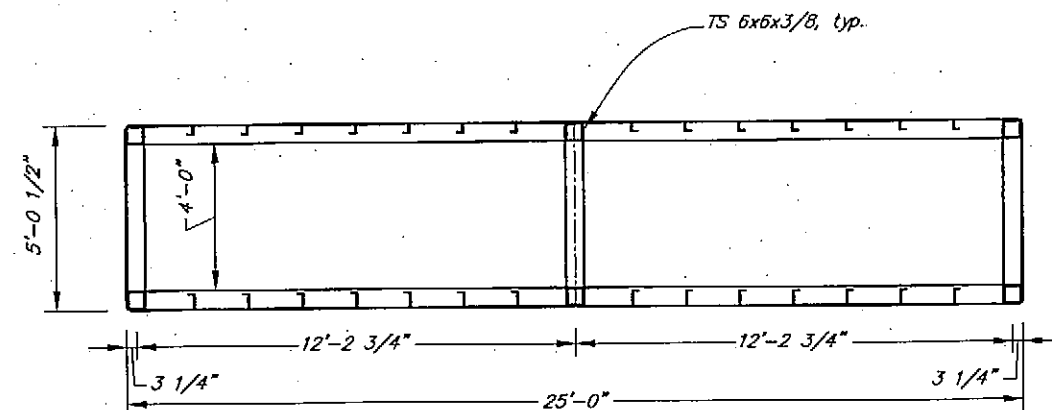


Float, Section A

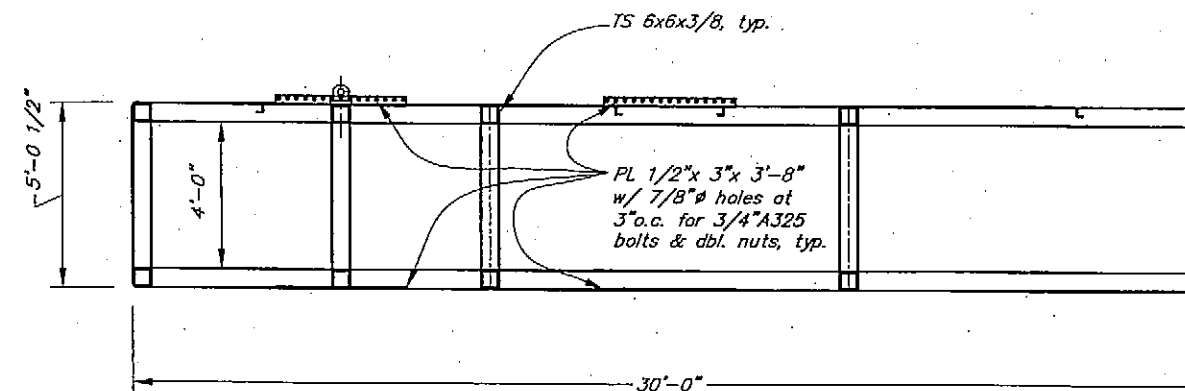


Float, Side Elevation At C

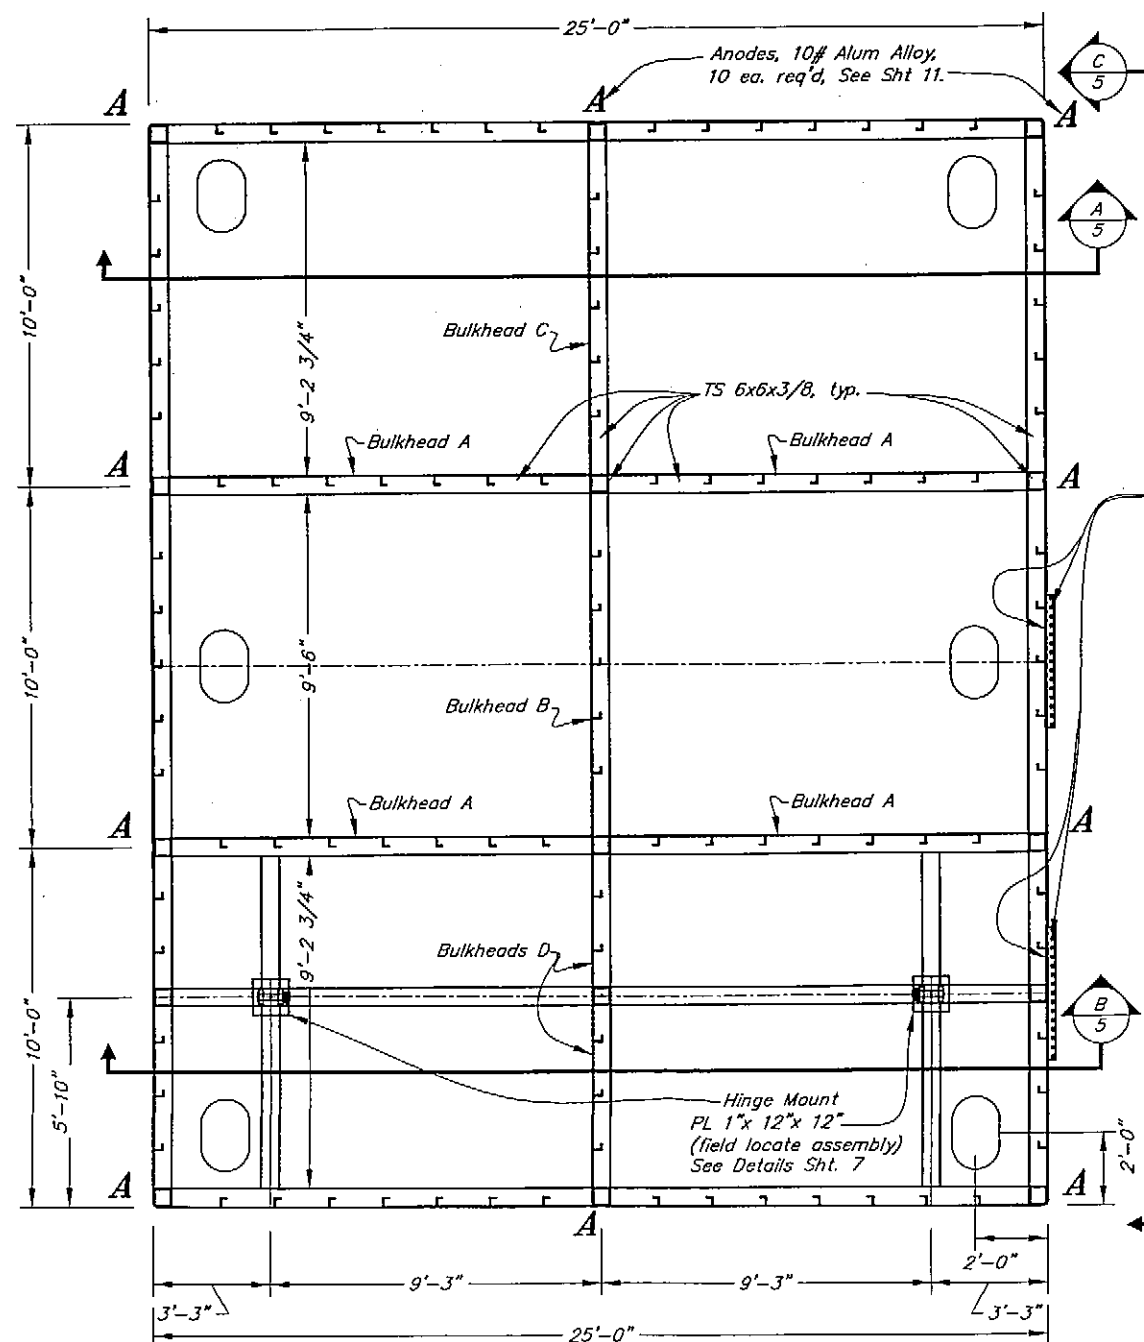

Float, Top Plan

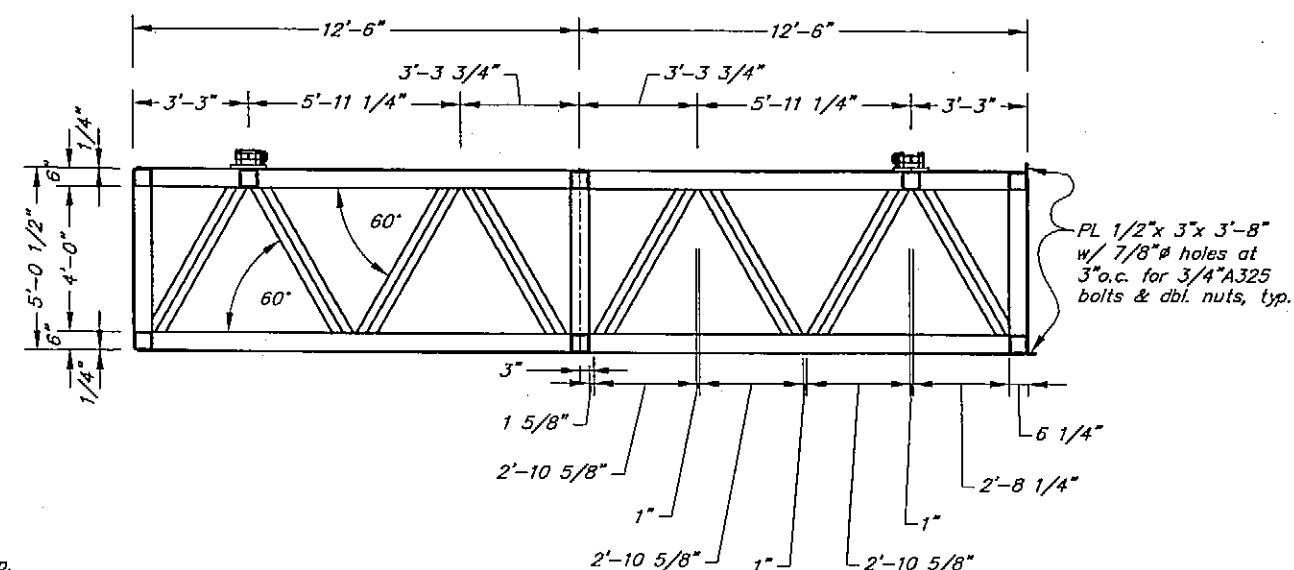

Float, Section B

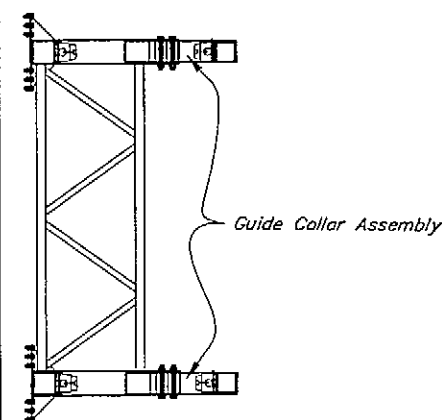


NOTES:


1. All frame members are TS 6x6x3/8
2. Where members intersect the longest member is continuous.
3. Cap all open ends with 1/4" plate and use full penetration metal backed groove welds.
4. Complete all welds for top and bottom frames before adding vertical columns.
5. The flare groove welds covered by columns Must Be Completed and shall be ground flat for fit-up.
6. Tube splices must be full penetration metal backed groove welds but are allowed at any location.

DO NOT SCALE FROM THESE DRAWINGS USE DIMENSIONS


DESIGNED BY: BN		STATE OF ALASKA DEPARTMENT OF TRANSPORTATION & PUBLIC FACILITIES STATEWIDE DESIGN & ENGINEERING SERVICES DIVISION KETCHIKAN AIRPORT SEAPLANE FLOAT RECONSTRUCTION PROJECT NO. 68742 BRIDGE SUPPORT FLOAT FRAME LAYOUT																	
CHECKED BY: BAS DRAWN BY: BN PATH: PLOT:		422-01 68742																	
<table border="1"> <thead> <tr> <th colspan="2">REVISIONS</th> <th rowspan="2">PROJECT DESIGNATION</th> <th rowspan="2">YEAR</th> <th rowspan="2">SHEET NO.</th> <th rowspan="2">TOTAL SHEETS</th> </tr> <tr> <th>NO.</th> <th>DATE</th> </tr> </thead> <tbody> <tr> <td> </td> <td> </td> <td>68742</td> <td>2004</td> <td>5</td> <td>16</td> </tr> </tbody> </table>		REVISIONS		PROJECT DESIGNATION	YEAR	SHEET NO.	TOTAL SHEETS	NO.	DATE			68742	2004	5	16				
REVISIONS		PROJECT DESIGNATION	YEAR					SHEET NO.	TOTAL SHEETS										
NO.	DATE																		
		68742	2004	5	16														

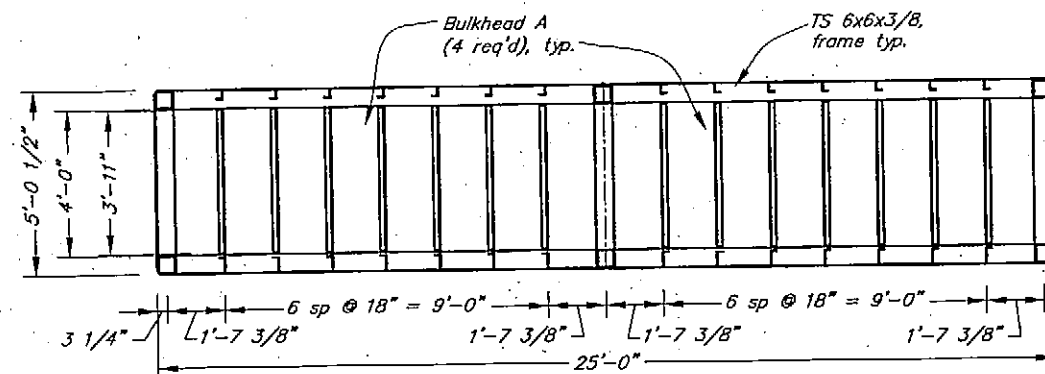


Float, Section A

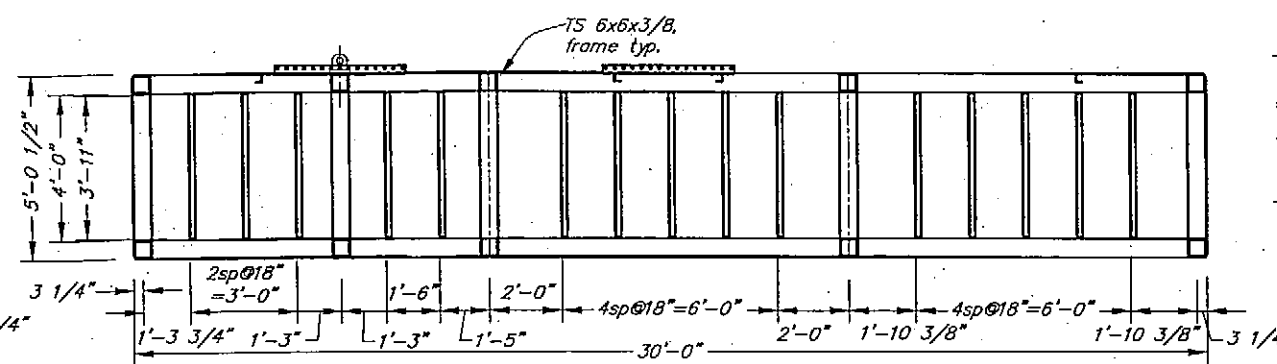


Float, Side View

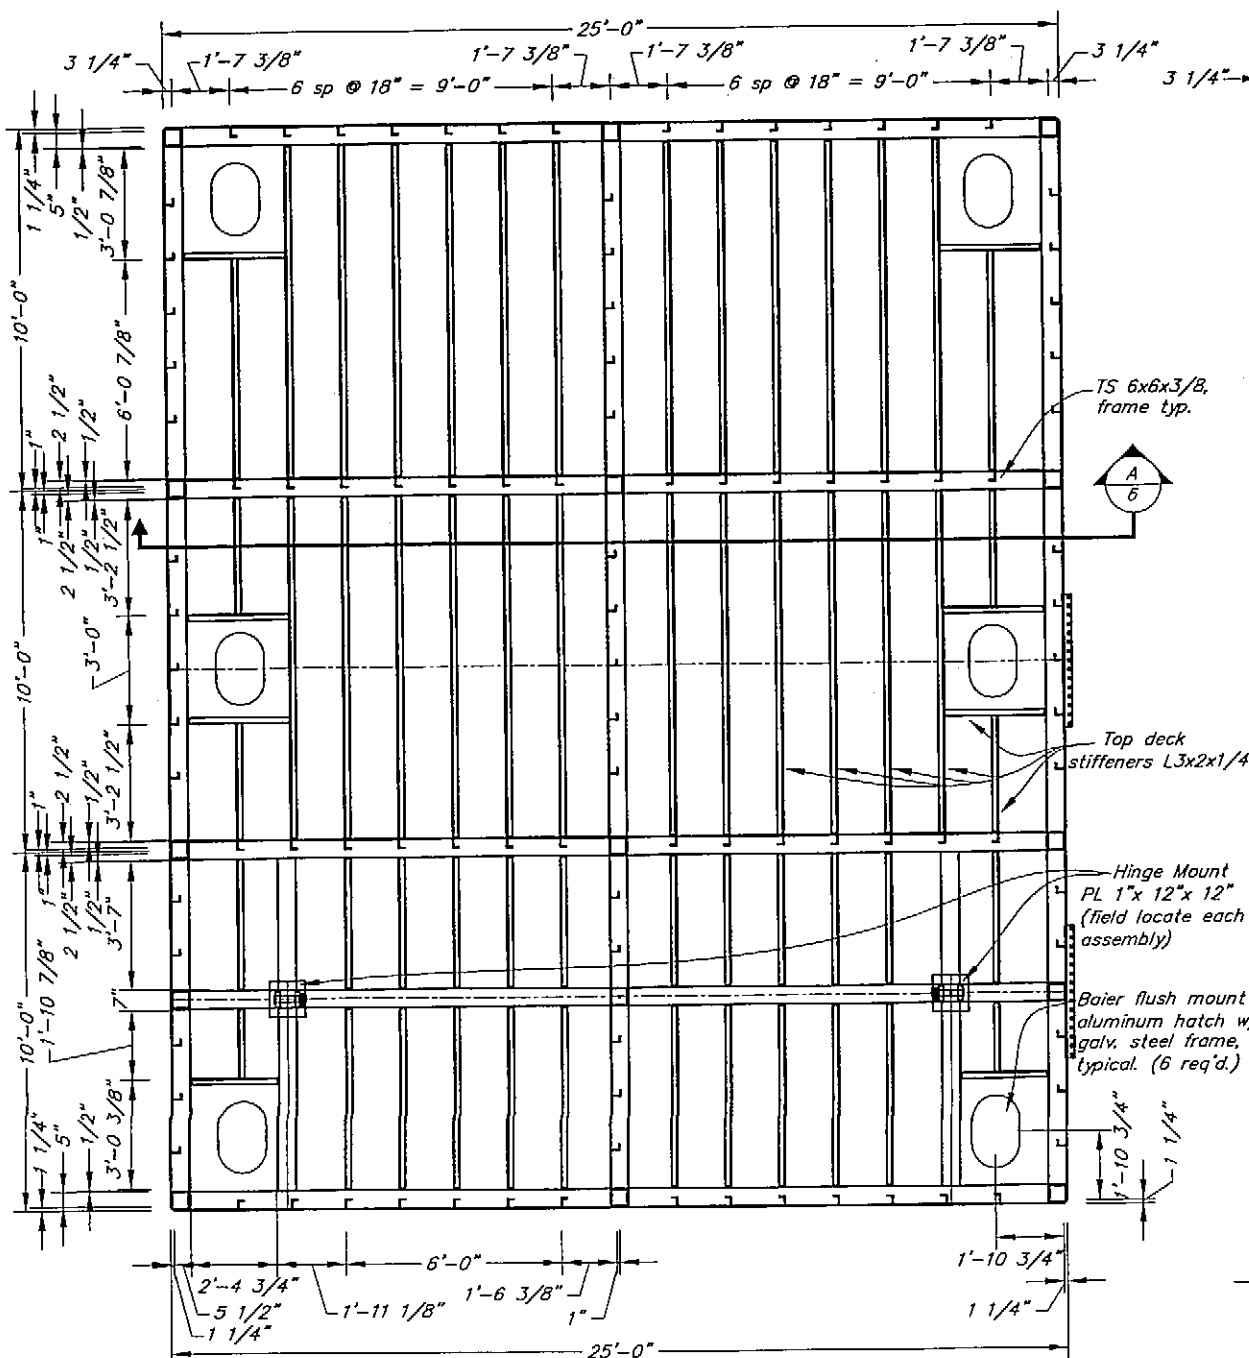


Float, Top Plan

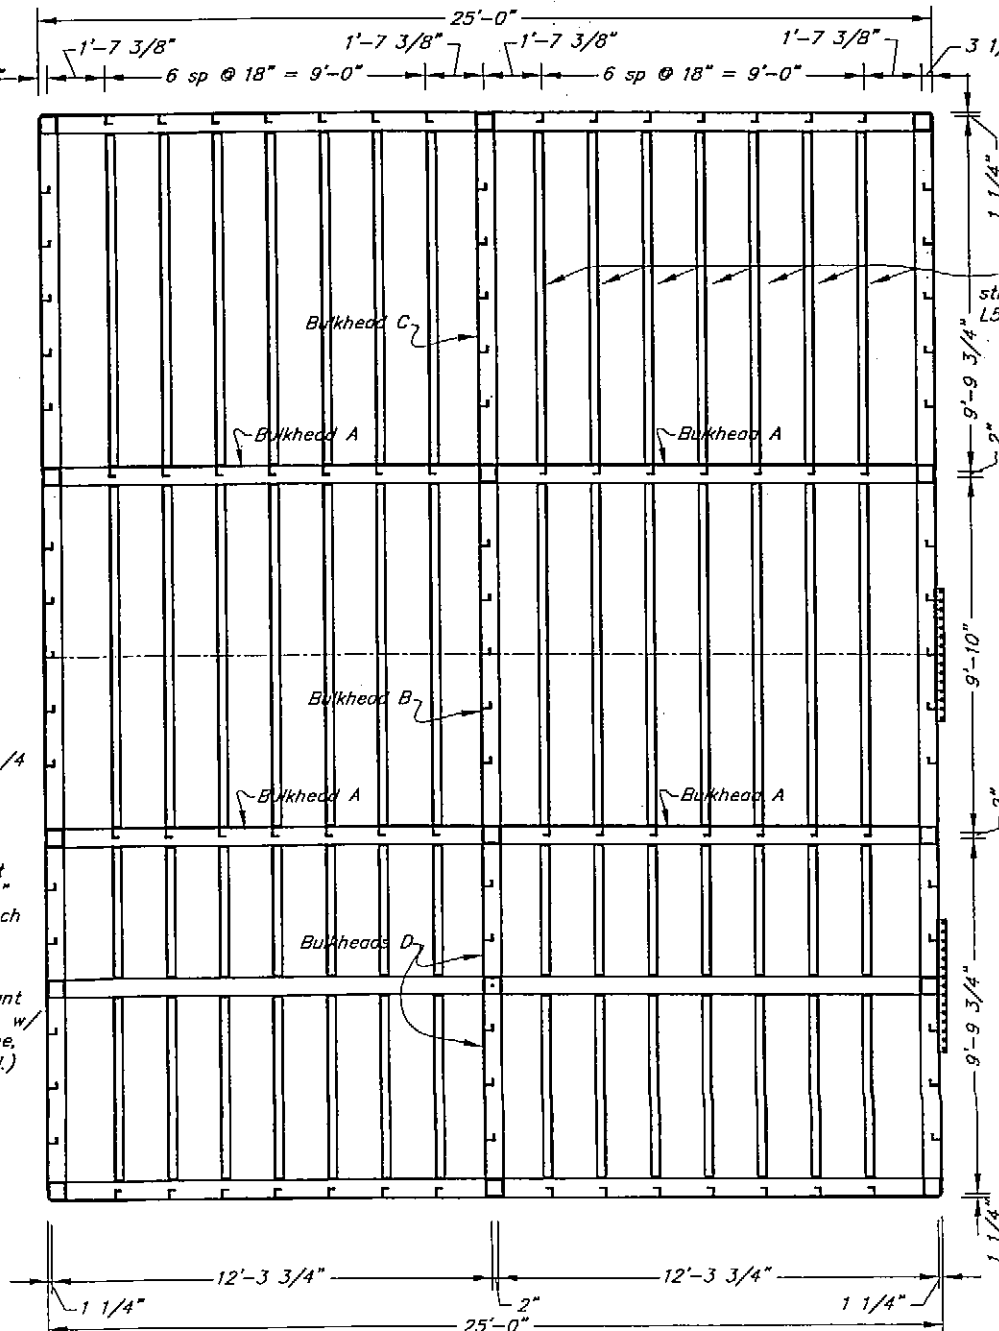


Float, Bottom Plan

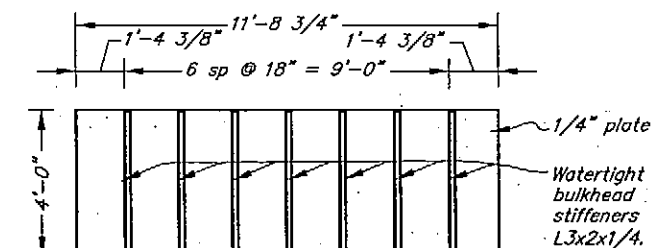


Bulkhead A (4 req'd)

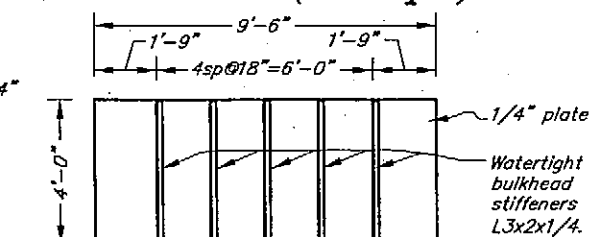

Bulkhead B (1 req'd)

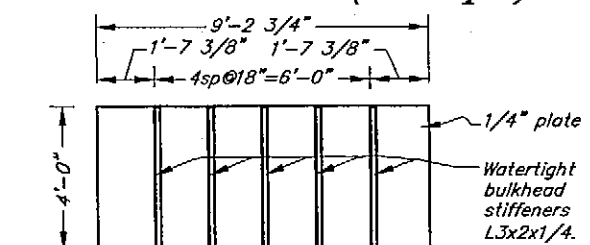

Bulkhead C (2 req'd)

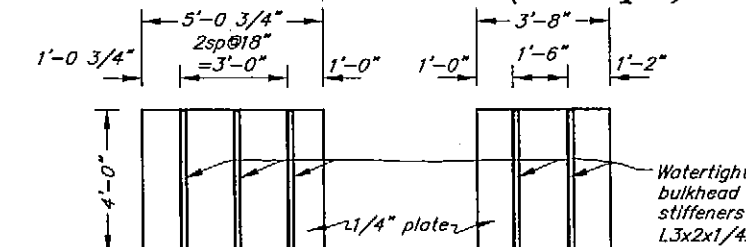

2 Pc. Bulkhead D (1 req'd)

Punch 1/2" holes at 6"oc, perimeter of Top Deck Plates Only for plug welds at 1" from inside face of frame members and adjacent to stiffeners

All sides, deck, bottom & bulkheads are 1/4" plate.

deck, end, side and bulkhead stiffeners L3x2x1/4, bottom deck stiffeners are L5x3x1/4

TS 6x6x3/8, frame typ.

1/4" SEAL, TYP

1/4" SEAL, TYP


1/4" SEAL, TYP

1/4" SEAL, TYP

Stiffener Detail

DO NOT SCALE FROM THESE DRAWINGS USE DIMENSIONS

DESIGNED BY: BAS

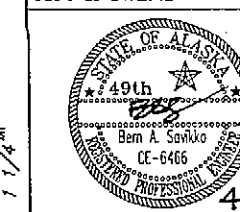

CHECKED BY: BAS

DRAWN BY: BN

PATH:

PLOT:

NO. DATE DESCRIPTION


NO. DATE DESCRIPTION

NO. DATE DESCRIPTION


NO. DATE DESCRIPTION

STATE OF ALASKA
DEPARTMENT OF TRANSPORTATION
& PUBLIC FACILITIES
STATEWIDE DESIGN & ENGINEERING SERVICES DIVISION
KETCHIKAN AIRPORT
SEAPLANE FLOAT
RECONSTRUCTION
PROJECT NO. 68742
BRIDGE SUPPORT FLOAT
HULL REINFORCEMENT

PROJECT DESIGNATION
68742
YEAR
2004
SHEET NO.
6
TOTAL SHEETS
16

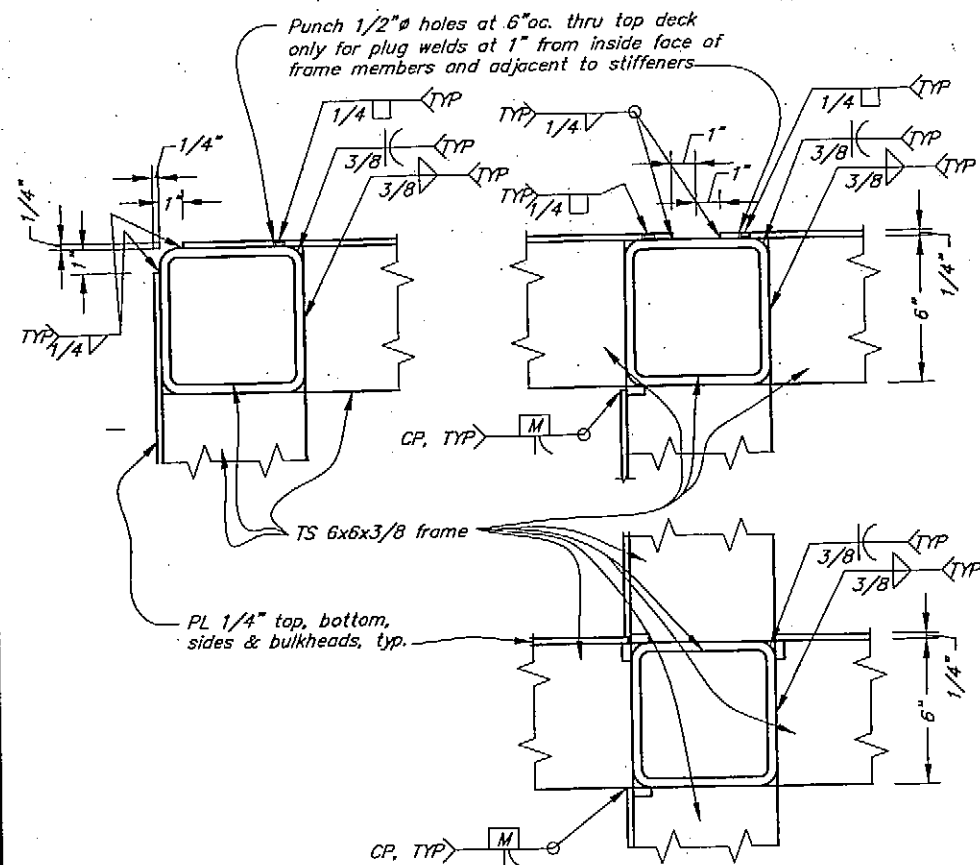


Bridge Float Frame Details

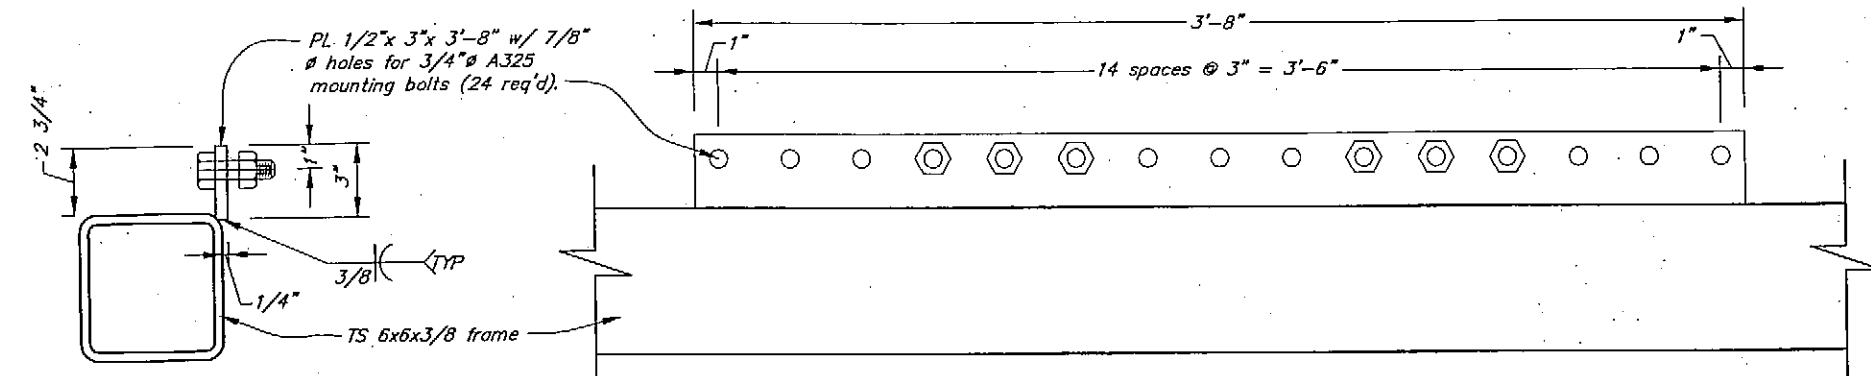

Top Mounting Plate, End View


Top Mounting Plate, Side View

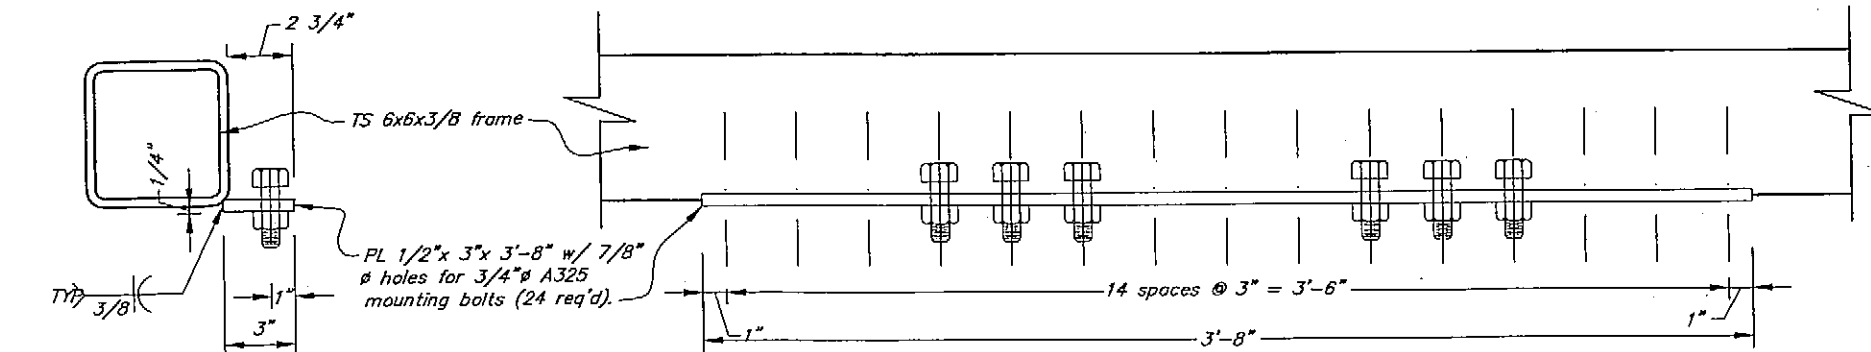

Lower Mounting Plate, End View

Lower Mounting Plate, Side View






Bridge Float Guide Collar, Mounting Plate Detail

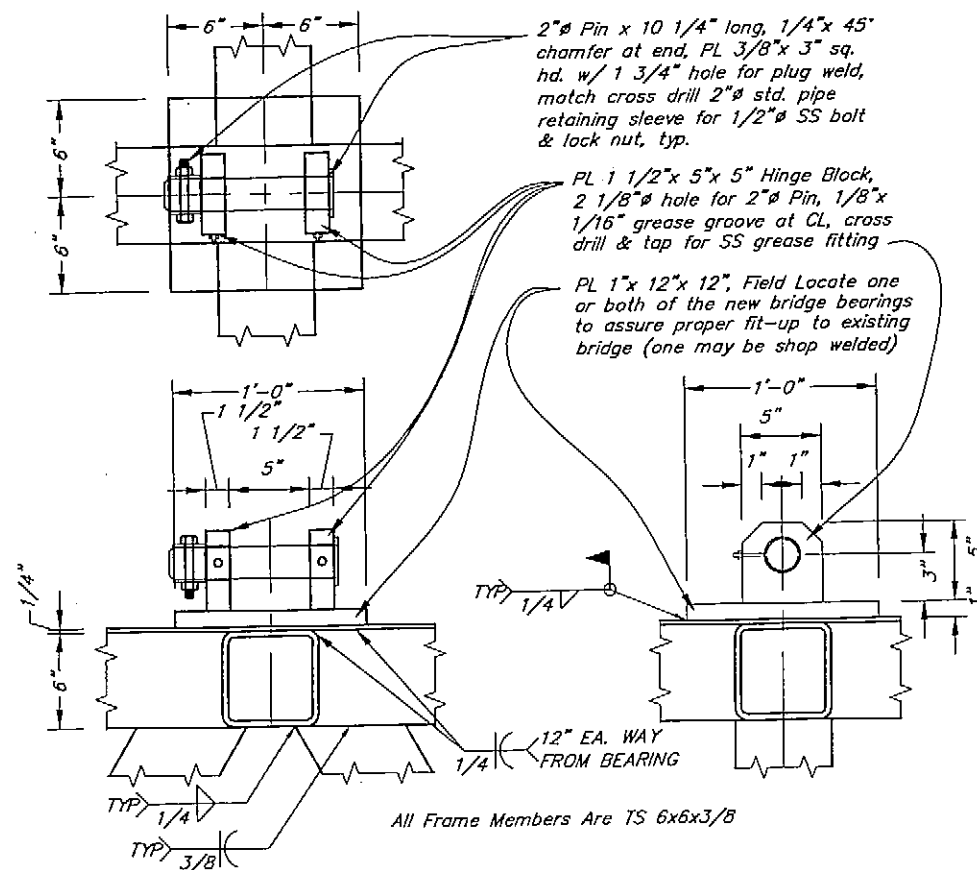


Bridge Bearing & Internal Truss Detail

DO NOT SCALE FROM THESE DRAWINGS USE DIMENSIONS


DESIGNED BY: BN		STATE OF ALASKA DEPARTMENT OF TRANSPORTATION & PUBLIC FACILITIES STATEWIDE DESIGN & ENGINEERING SERVICES DIVISION KETCHIKAN AIRPORT SEAPLANE FLOAT RECONSTRUCTION PROJECT NO. 68742 BRIDGE SUPPORT FLOAT FRAME DETAILS																		
CHECKED BY: BAS DRAWN BY: BN																				
PATH: PLOT:																				
<table border="1"> <thead> <tr> <th colspan="2">REVISIONS</th> <th rowspan="2">PROJECT DESIGNATION</th> <th rowspan="2">YEAR</th> <th rowspan="2">SHEET NO.</th> <th rowspan="2">TOTAL SHEETS</th> </tr> <tr> <th>NO.</th> <th>DATE</th> <th>DESCRIPTION</th> </tr> </thead> <tbody> <tr> <td> </td> <td> </td> <td> </td> <td> </td> <td> </td> <td> </td> </tr> </tbody> </table>		REVISIONS		PROJECT DESIGNATION	YEAR	SHEET NO.	TOTAL SHEETS	NO.	DATE	DESCRIPTION							68742	2004	7	16
REVISIONS		PROJECT DESIGNATION	YEAR					SHEET NO.	TOTAL SHEETS											
NO.	DATE			DESCRIPTION																

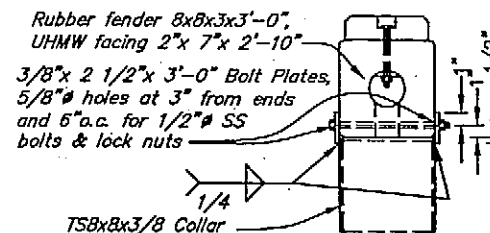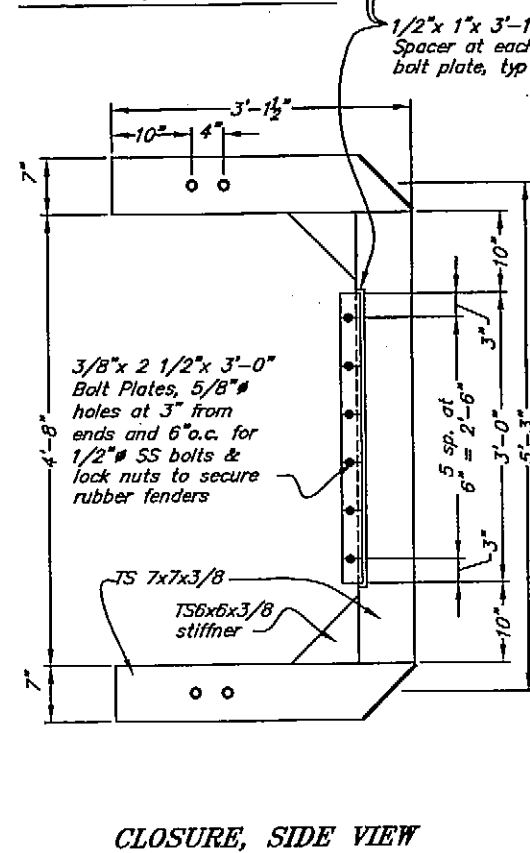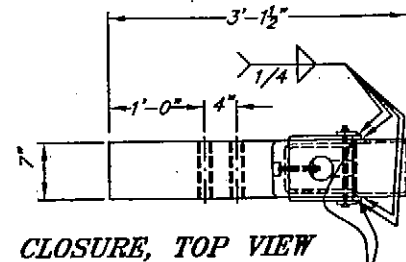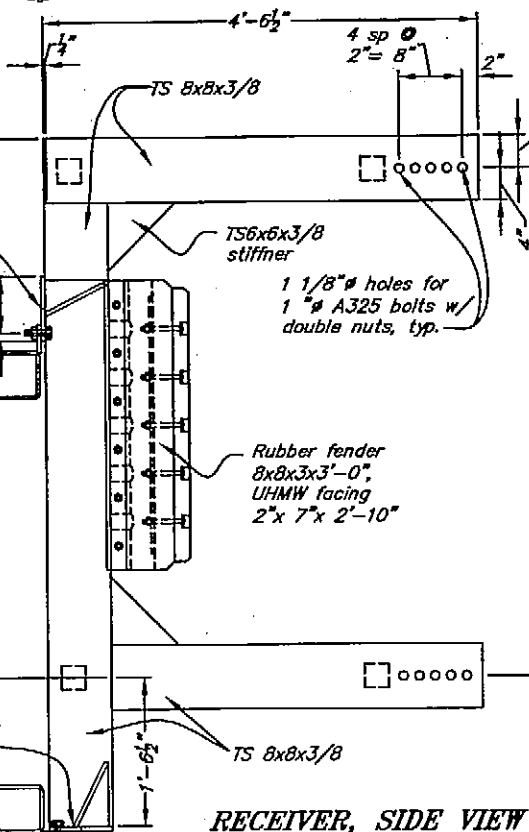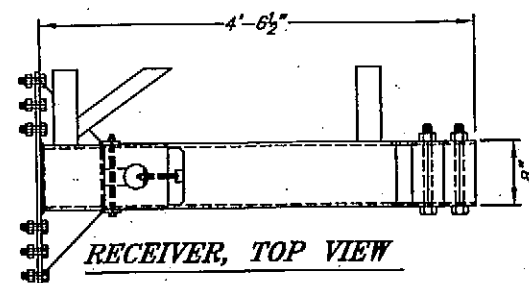


RUBBER FENDER
CONNECTION DETAIL

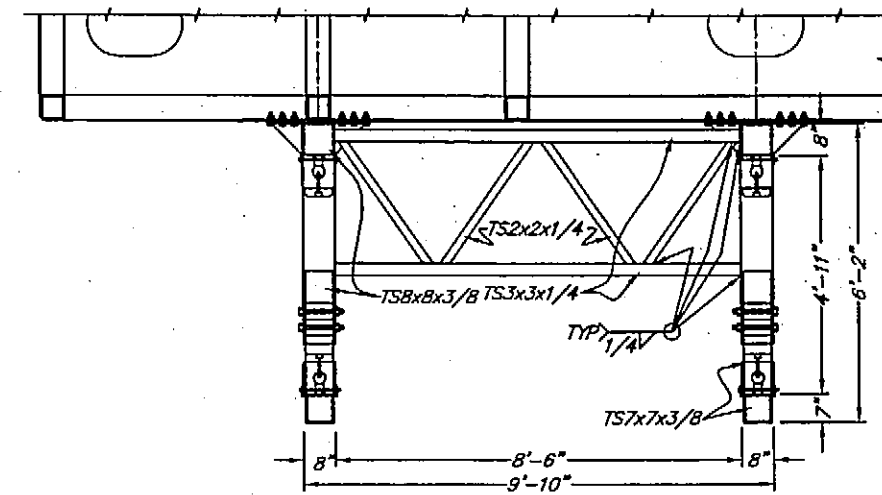

PLAN VIEW

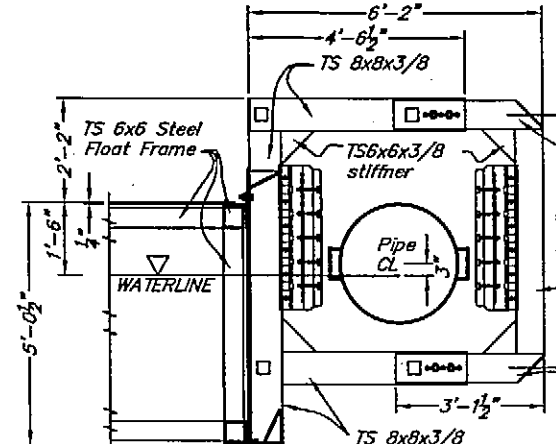


SIDE VIEW

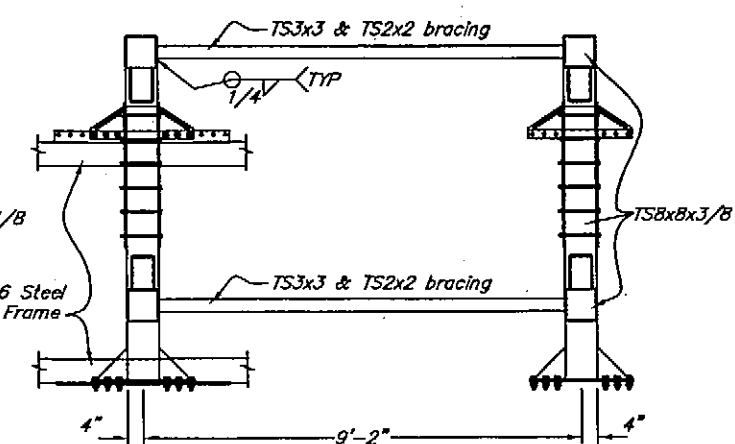


FRONT VIEW


STEEL FLOAT GUIDE COLLAR ASSEMBLY

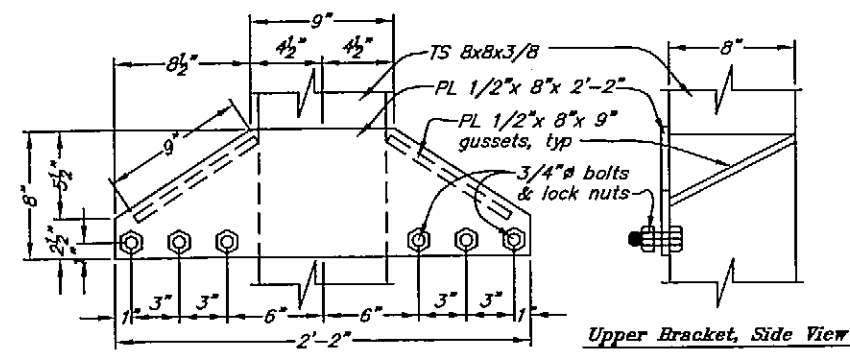


Upper Bracket, Side View

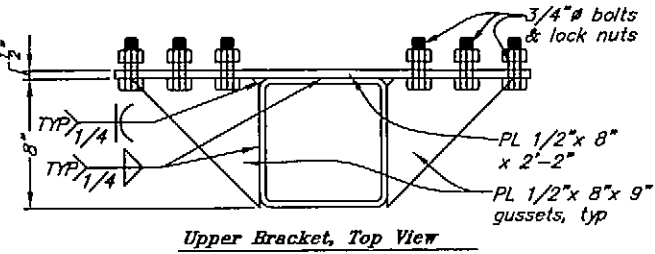

Upper Bracket, Top View

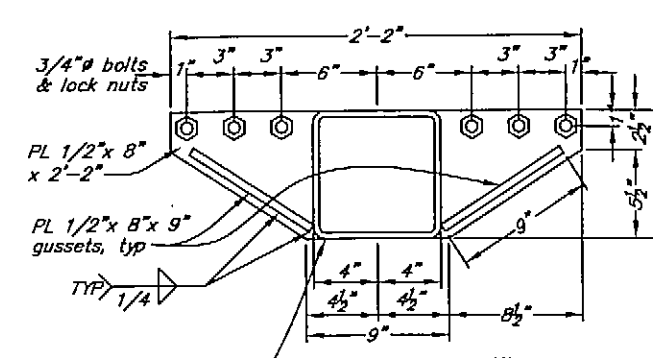


Lower Bracket, Top View

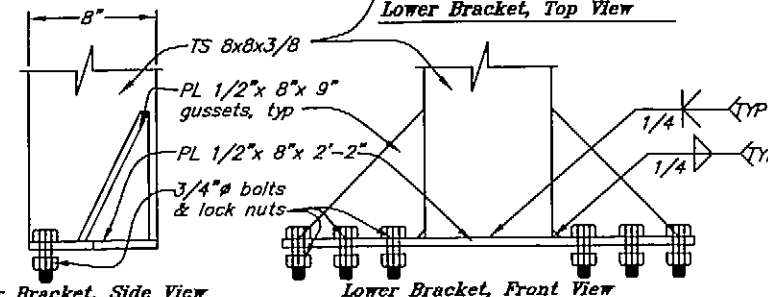

Lower Bracket, Side View

Lower Bracket, Front View



Guide Collar Mount Brackets

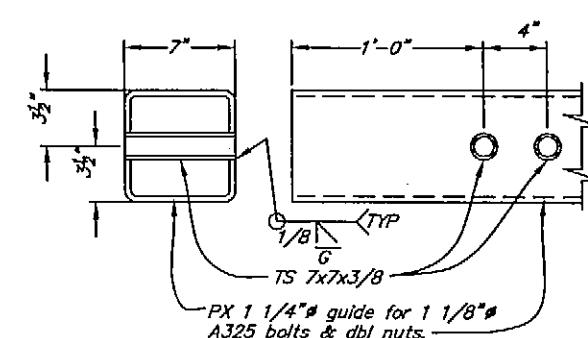


Collar Bolt Guide Detail

DO NOT SCALE FROM THESE DRAWINGS USE DIMENSIONS


DESIGNED BY: BN		STATE OF ALASKA DEPARTMENT OF TRANSPORTATION & PUBLIC FACILITIES STATEWIDE DESIGN & ENGINEERING SERVICES DIVISION KETCHIKAN AIRPORT SEAPLANE FLOAT RECONSTRUCTION PROJECT NO. 68742 BRIDGE SUPPORT FLOAT MISC. DETAILS																					
CHECKED BY: BAS		<table border="1"> <thead> <tr> <th colspan="2">REVISIONS</th> <th rowspan="2">PROJECT DESIGNATION</th> <th rowspan="2">YEAR</th> <th rowspan="2">SHEET NO.</th> <th rowspan="2">TOTAL SHEETS</th> </tr> <tr> <th>NO.</th> <th>DATE</th> </tr> </thead> <tbody> <tr> <td> </td> <td> </td> <td rowspan="3">68742</td> <td rowspan="3">2004</td> <td rowspan="3">8</td> <td rowspan="3">16</td> </tr> <tr> <td> </td> <td> </td> </tr> <tr> <td> </td> <td> </td> </tr> </tbody> </table>				REVISIONS		PROJECT DESIGNATION	YEAR	SHEET NO.	TOTAL SHEETS	NO.	DATE			68742	2004	8	16				
REVISIONS						PROJECT DESIGNATION	YEAR					SHEET NO.	TOTAL SHEETS										
NO.	DATE																						
						68742	2004	8	16														
DRAWN BY: BN																							
PATH:																							
PLOT:																							

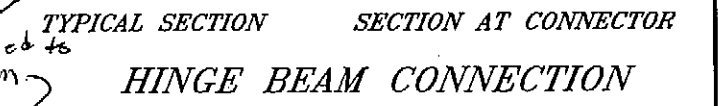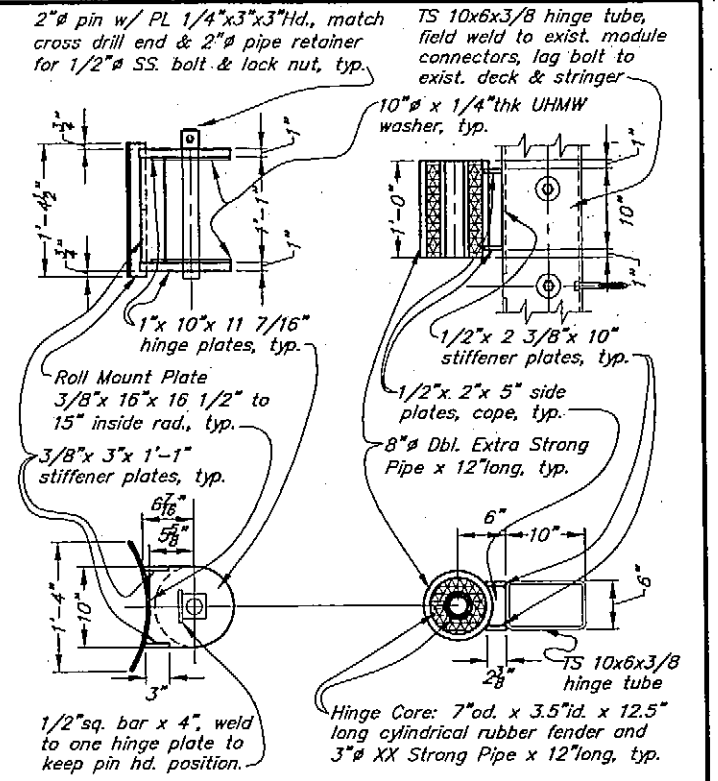

DESIGNED BY: BN		DO NOT SCALE FROM THESE DRAWINGS USE DIMENSIONS STATE OF ALASKA DEPARTMENT OF TRANSPORTATION & PUBLIC FACILITIES STATEWIDE DESIGN & ENGINEERING SERVICES DIVISION KETCHIKAN AIRPORT SEAPLANE FLOAT RECONSTRUCTION PROJECT NO. 68742			
 4-27-01		RESTRAINT FLOAT PLAN			
CHECKED BY: BAS					
DRAWN BY: BN					
PATH: G:\Marine\Kln Seaplane Repair 2002\Planset\003 Kln SP Brdg Flt - Restraint Flt Plan.dwg PLOT:					
REVISIONS		PROJECT DESIGNATION	YEAR	SHEET NO.	TOTAL SHEETS
NO.	DATE				
		68742	2004	9	16


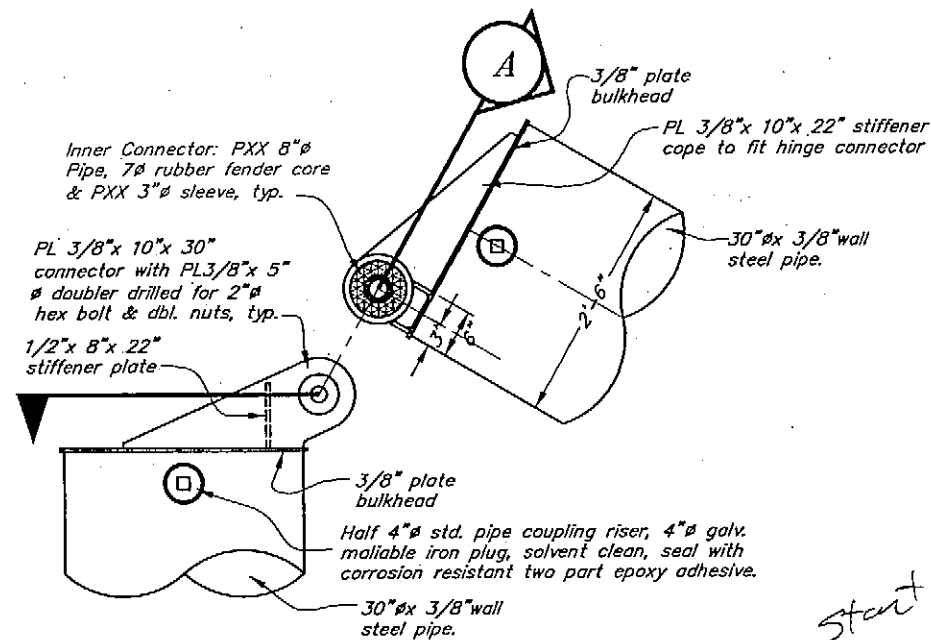


CONNECTOR HINGE
DETAIL 2

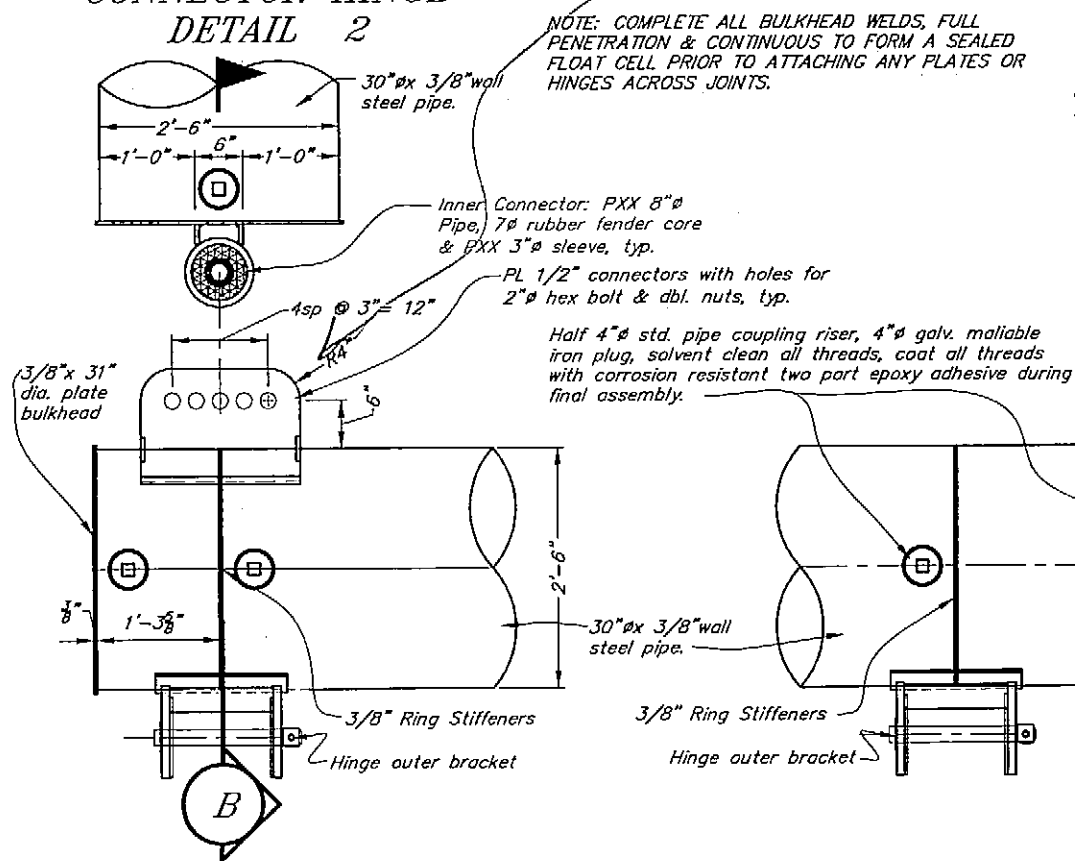


CONNECTOR HINGE
DETAIL 1


CONNECTOR HINGE
DETAIL 3

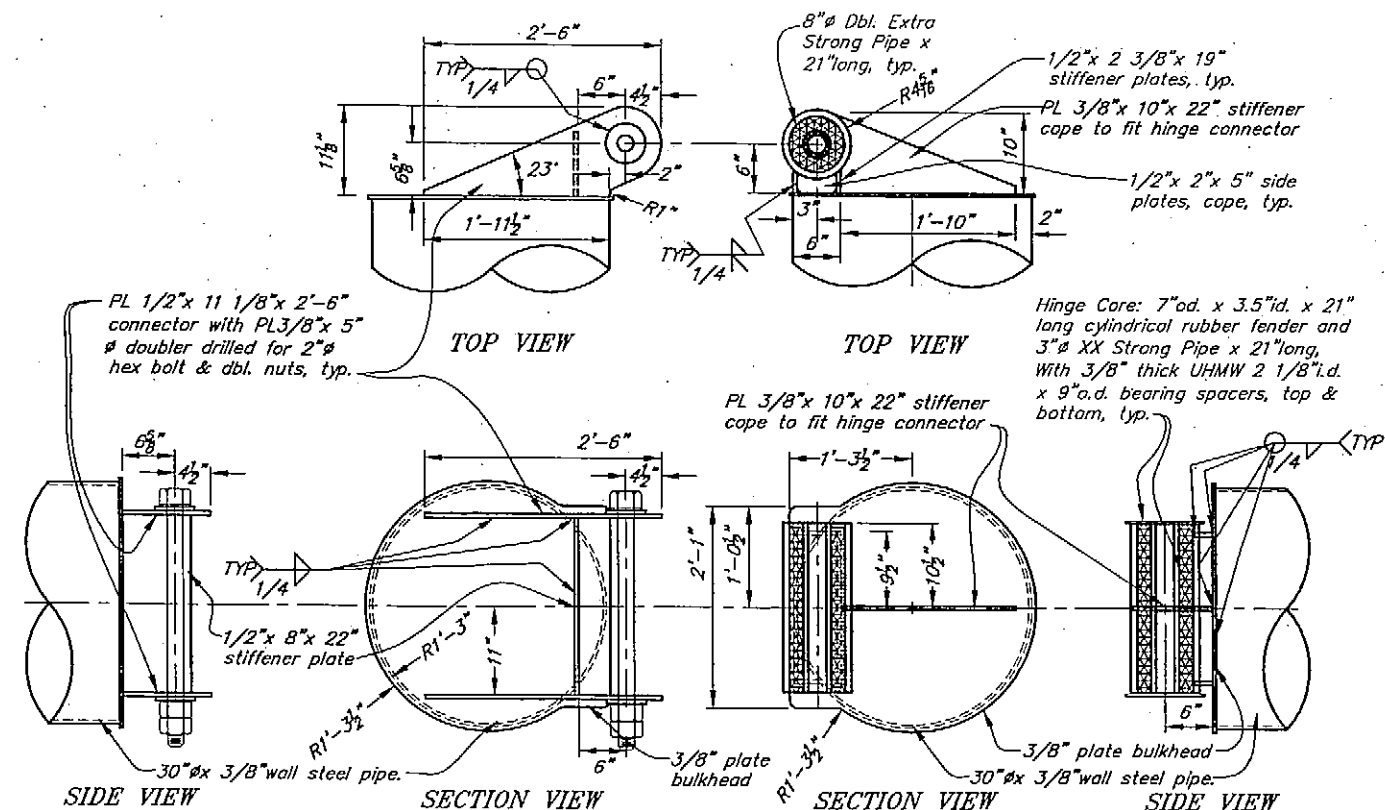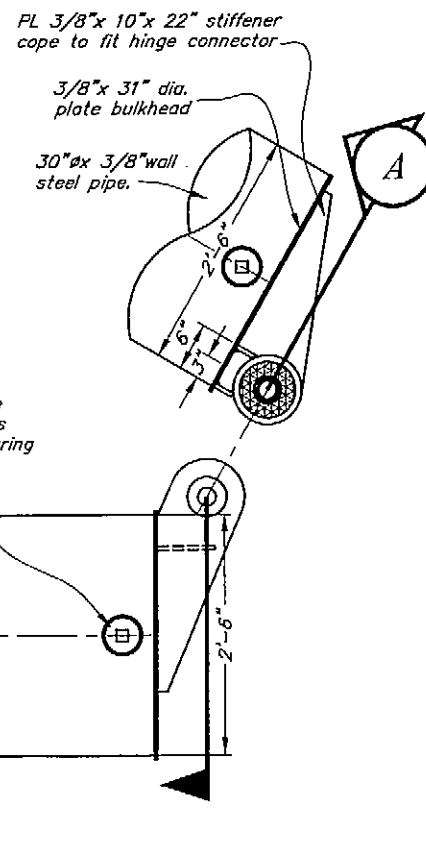

SECTION (A)

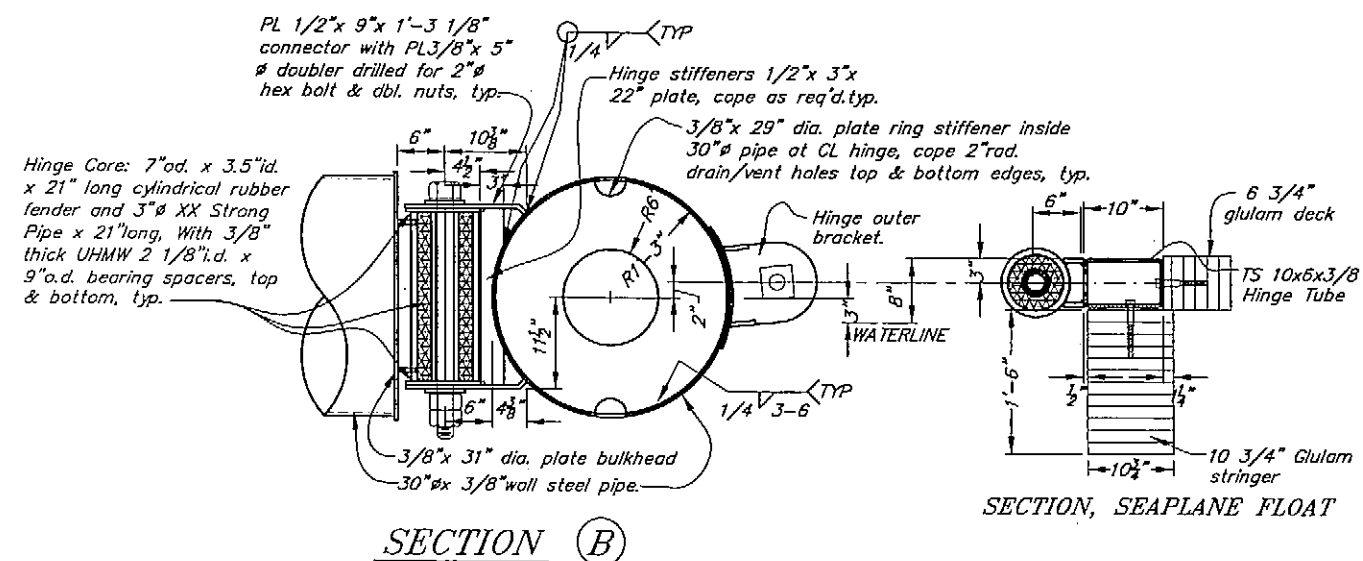


SECTION (B)

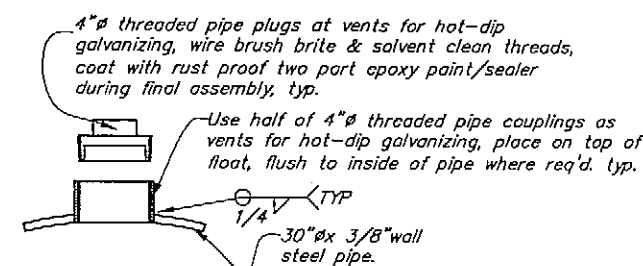


BALAST & GALV. VENT DETAIL

DO NOT SCALE FROM THESE DRAWINGS USE DIMENSIONS


DESIGNED BY: BN		STATE OF ALASKA DEPARTMENT OF TRANSPORTATION & PUBLIC FACILITIES STATEWIDE DESIGN & ENGINEERING SERVICES DIVISION KETCHIKAN AIRPORT SEAPLANE FLOAT RECONSTRUCTION PROJECT NO. 68742															
CHECKED BY: BAS DRAWN BY: BN		RESTRAINT FLOAT DETAILS															
PATH: Q:\Marine\Ktn Seaplane Repair 2002\PlanSet\010 Ktn SP Brdg Flt - Restraint Flt Dtls.dwg PLOT:																	
<table border="1"> <thead> <tr> <th colspan="2">REVISIONS</th> <th rowspan="2">PROJECT DESIGNATION</th> <th rowspan="2">YEAR</th> <th rowspan="2">SHEET NO.</th> <th rowspan="2">TOTAL SHEETS</th> </tr> <tr> <th>NO.</th> <th>DATE</th> </tr> </thead> <tbody> <tr> <td></td> <td></td> <td>68742</td> <td>2004</td> <td>10</td> <td>16</td> </tr> </tbody> </table>		REVISIONS		PROJECT DESIGNATION	YEAR	SHEET NO.	TOTAL SHEETS	NO.	DATE			68742	2004	10	16		
REVISIONS		PROJECT DESIGNATION	YEAR					SHEET NO.	TOTAL SHEETS								
NO.	DATE																
		68742	2004	10	16												

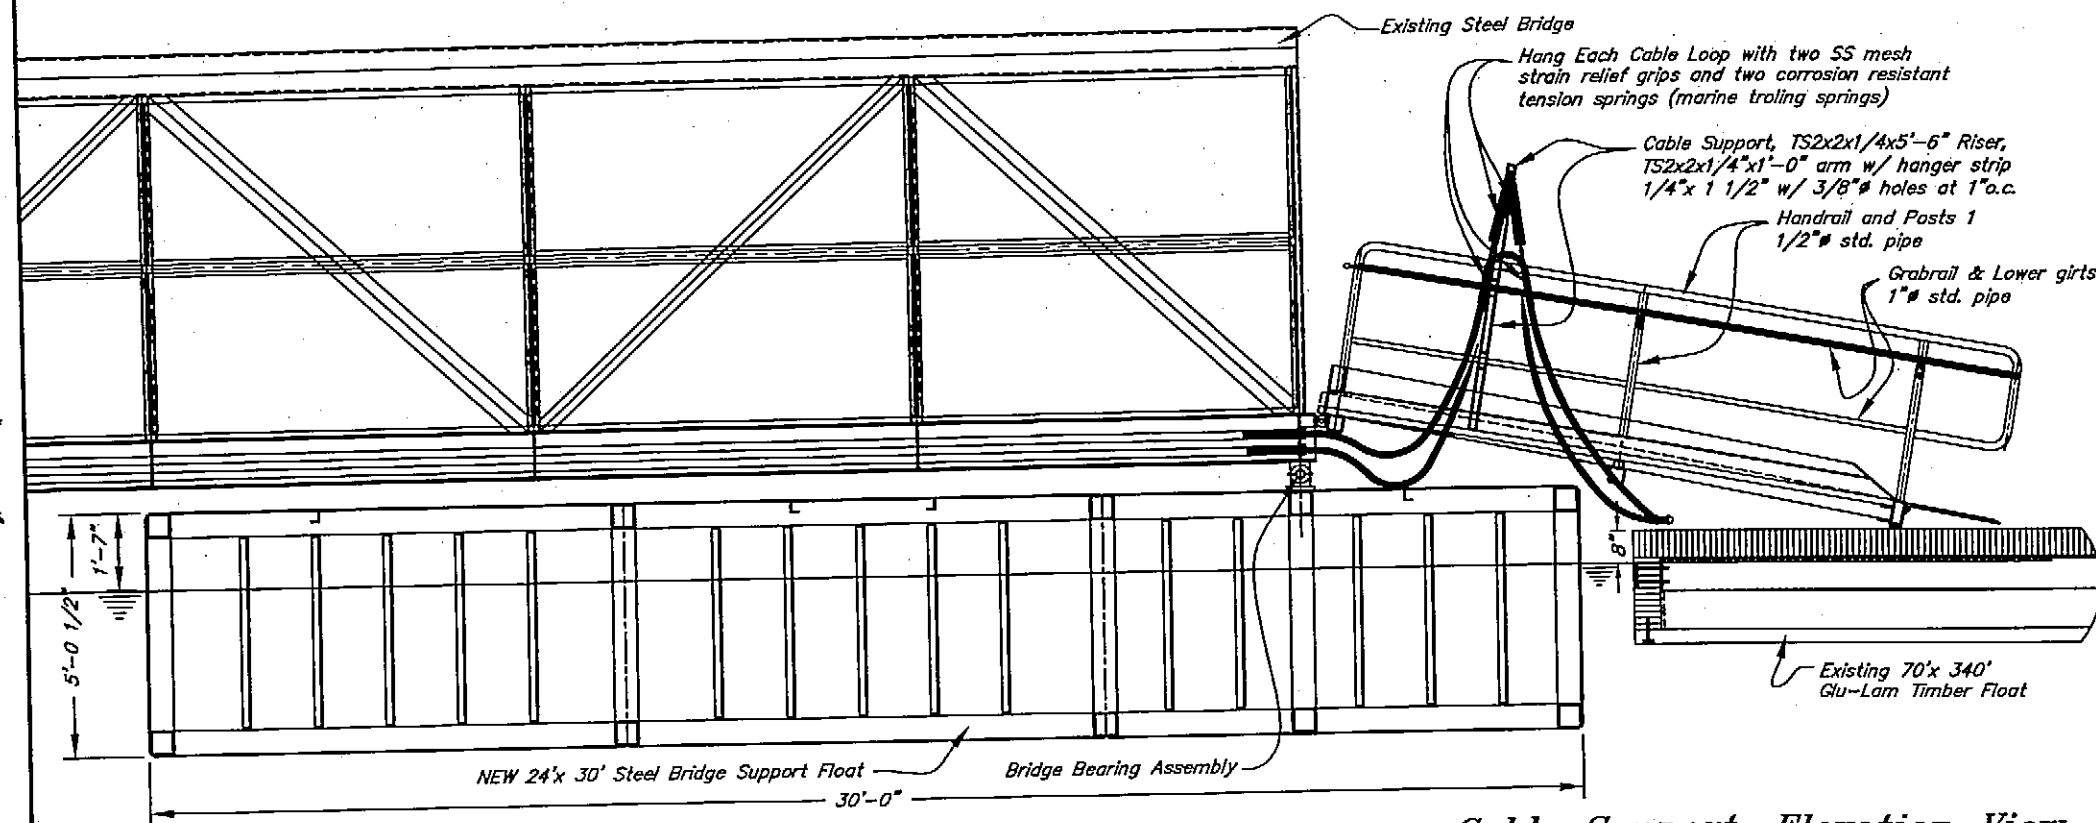


Cable Support, Elevation View

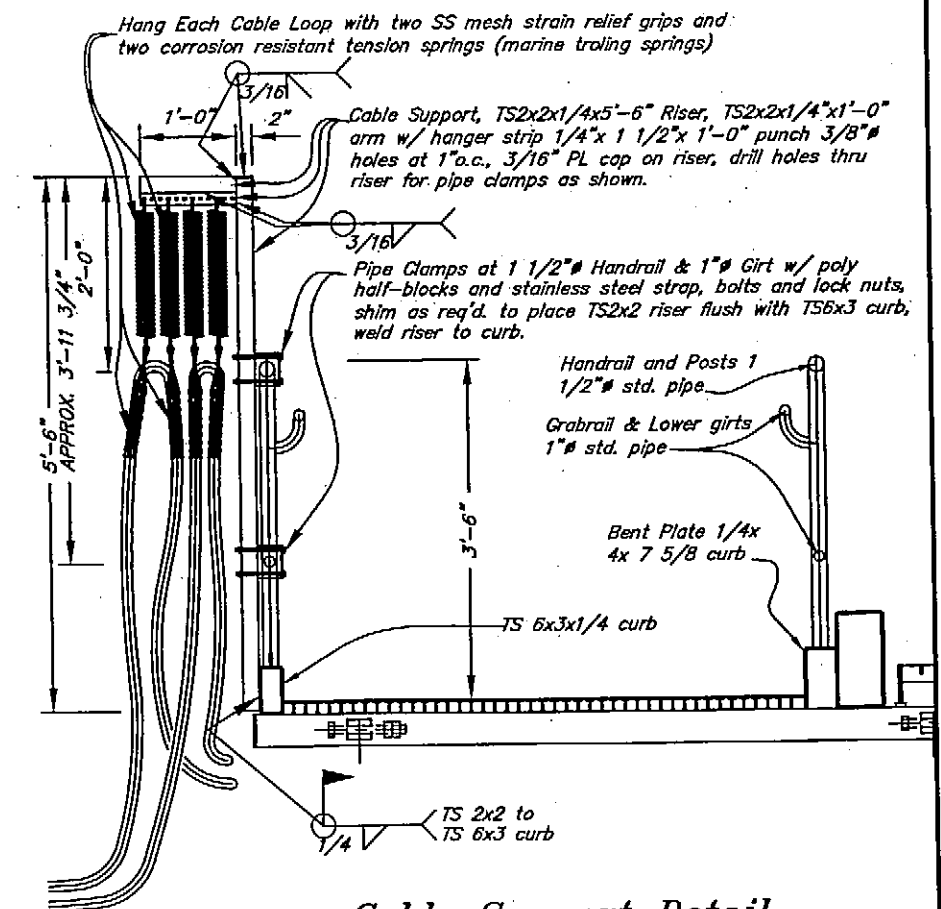


Cable Support Detail

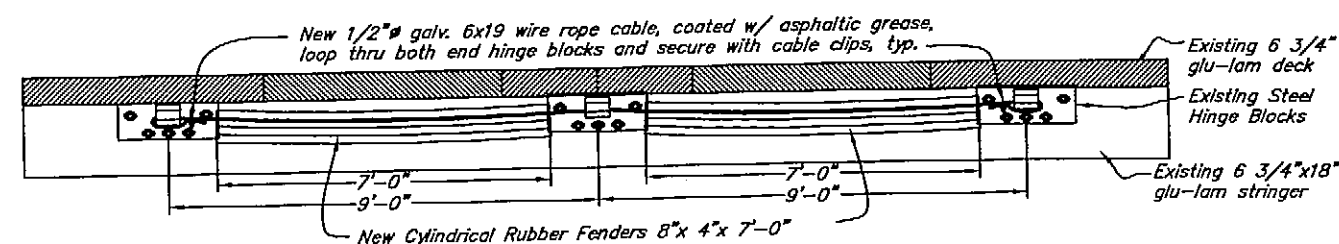


SEAPLANE FLOAT HINGE BUMPER DETAIL

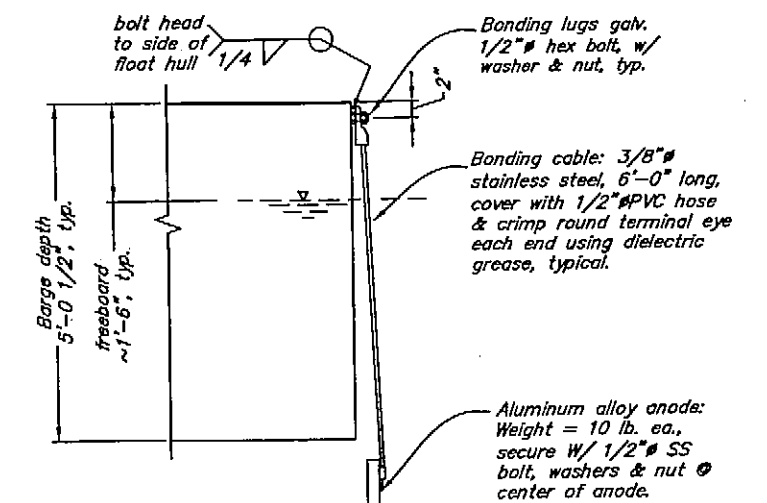

Steel Float Anode Detail (10 req'd.)

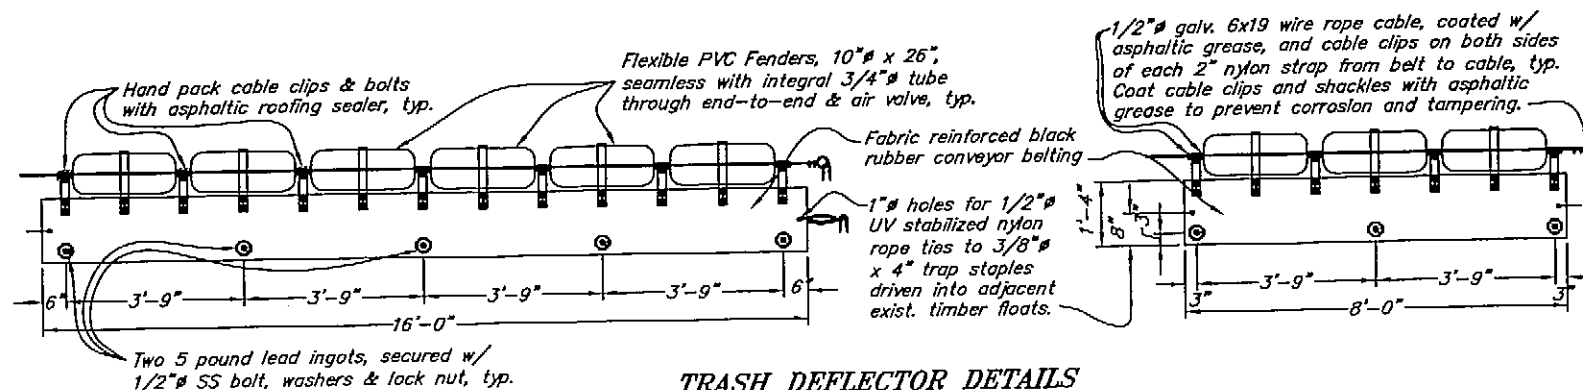




TRASH DEFLECTOR DETAILS

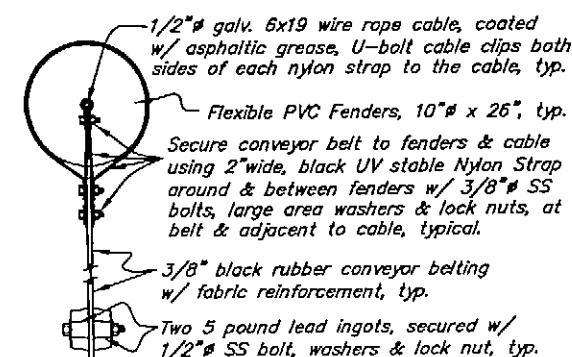


TRASH DEFLECTOR - END VIEW

DO NOT SCALE FROM THESE DRAWINGS USE DIMENSIONS


DESIGNED BY: BN		STATE OF ALASKA DEPARTMENT OF TRANSPORTATION & PUBLIC FACILITIES STATEWIDE DESIGN & ENGINEERING SERVICES DIVISION KETCHIKAN AIRPORT SEAPLANE FLOAT RECONSTRUCTION PROJECT NO. 68742			
CHECKED BY: BAS DRAWN BY: BN		MISC. DETAILS			
PATH: PLOT:					
REVISIONS		PROJECT DESIGNATION	YEAR	SHEET NO.	TOTAL SHEETS
NO. DATE DESCRIPTION		68742	2004	11	16

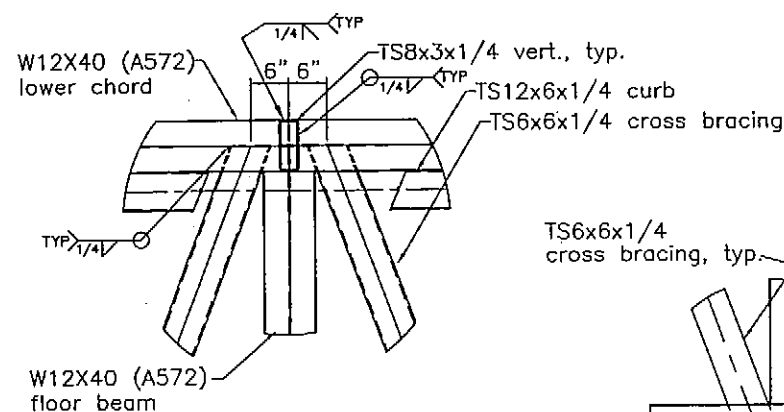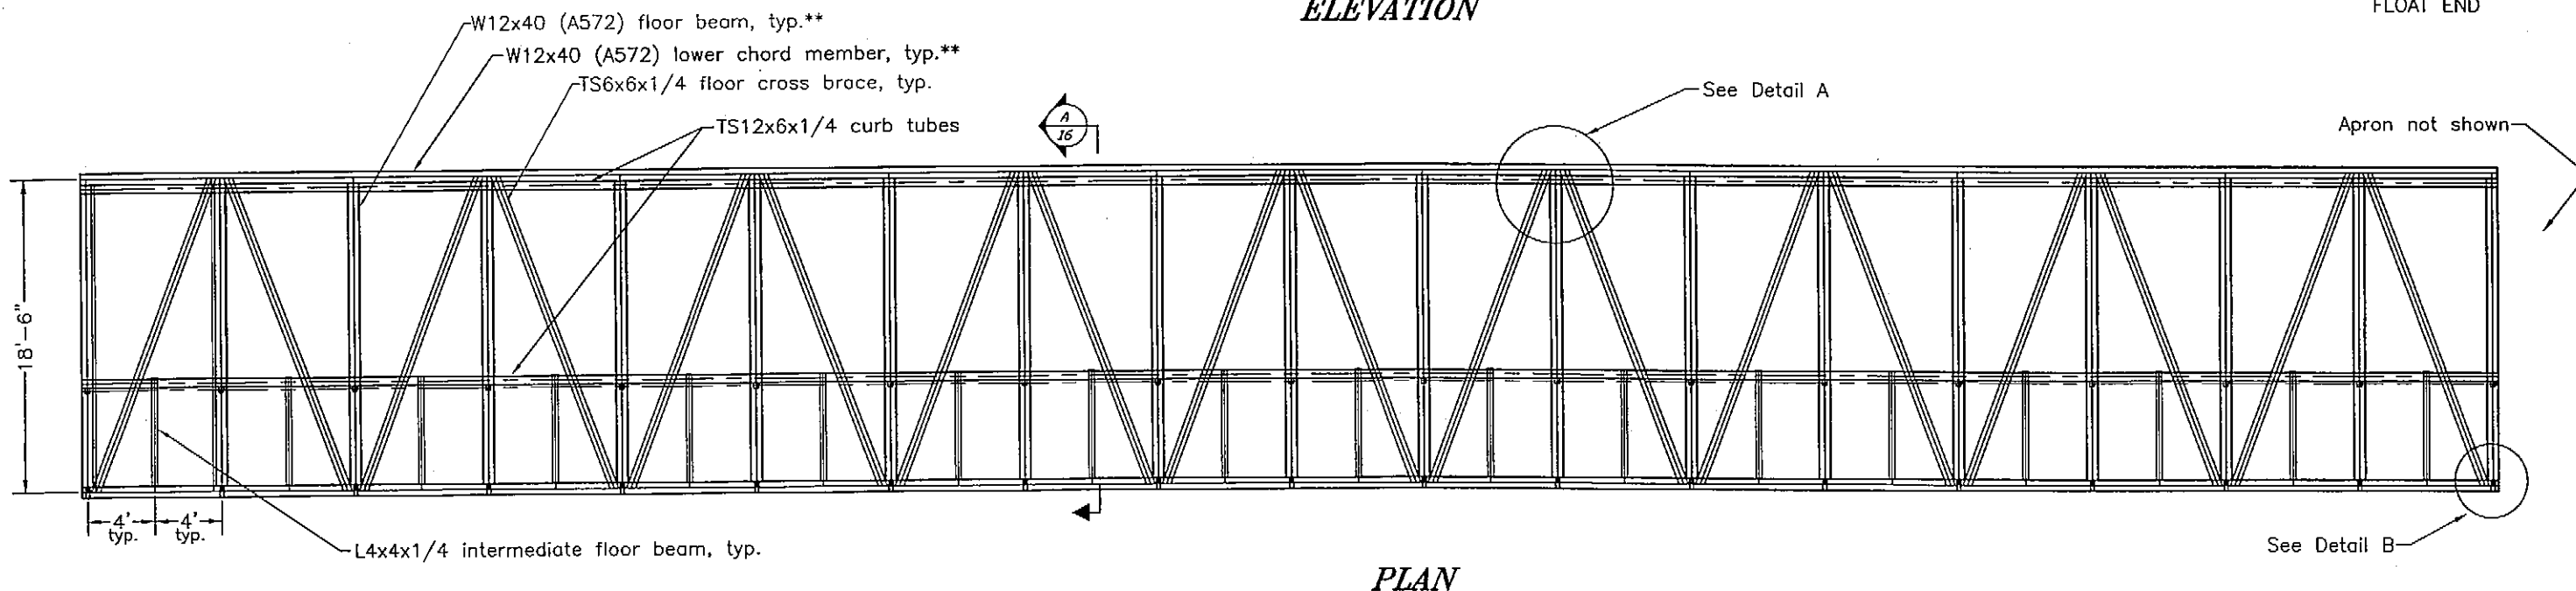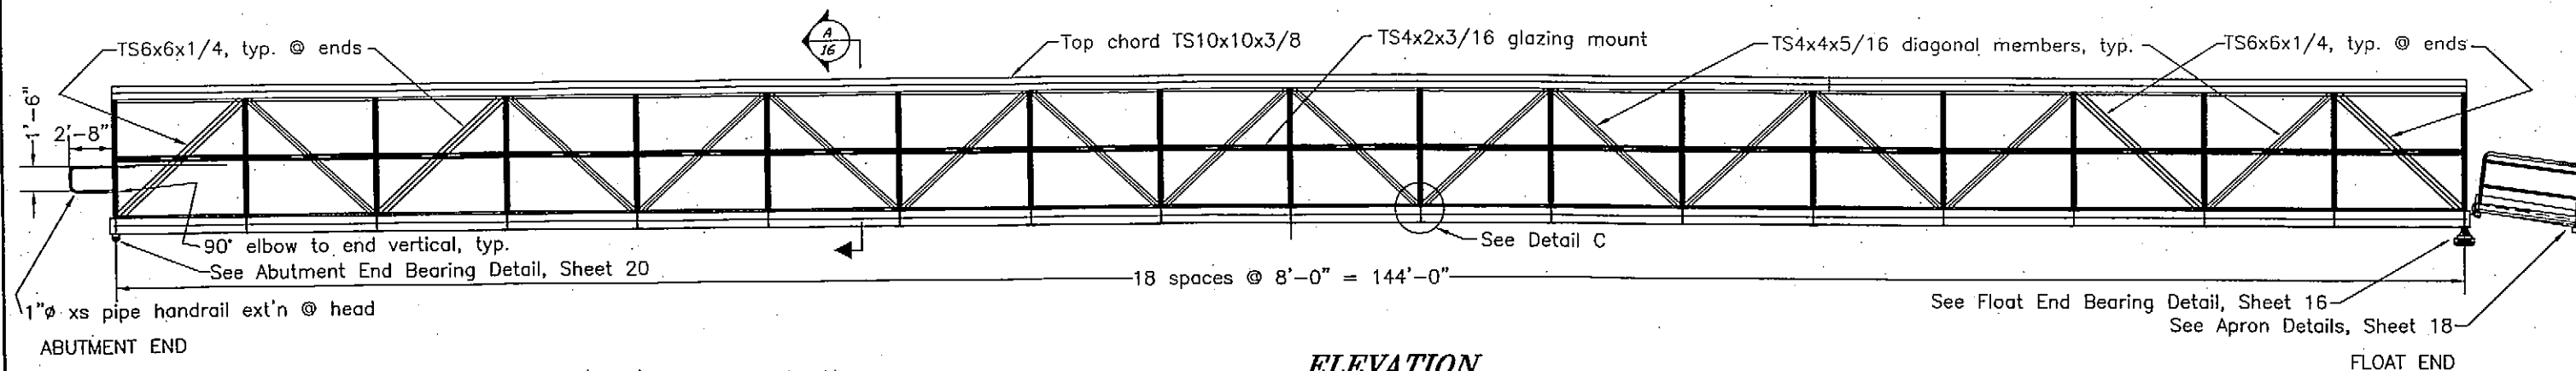

DETAIL A - PLAN

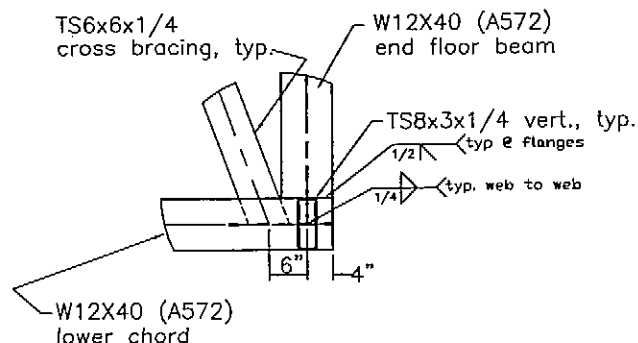

DETAIL B - PLAN

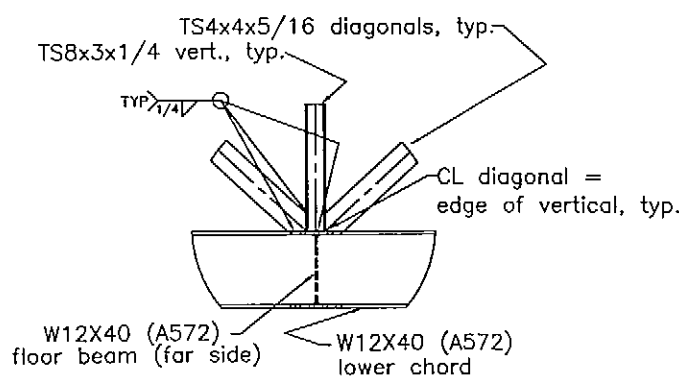

DETAIL C - ELEVATION

NOTES

- Design live load = 85 psf pedestrian live load and H10 vehicle load
 - Design wind load = 40 psf transverse to the structure
 - All seamless pipe shall conform to ASTM A-53, Grade B or ASTM A-500 and shall be painted, unless specified to be galvanized
 - All shapes and plates shall conform to ASTM A36 (unless specified otherwise) and shall be galvanized.
 - Ship assembled.
 - No stringer or pipe splices may be located in middle third of gangway.
 - Camber to compensate for dead load deflection (approx. +2.25" @ midspan).
 - Approx. weight = 120,000 lbs.
 - Paint entire structure after assembly and prior to installation of glazing. Paint shall be System 5, Section 303.
 - All welds joining tubular members and cover or end plates to be seal weld.
 - The following members are considered main members subject to tensile stress and require Charpy Impact Testing. See Section 302 of the specifications.
 - A. Lower chord members
 - B. Floor beams
- In addition, the lower chord members are considered fracture critical and require a fracture control plan. See Section 302 of the specifications.

AS-BUILT INFORMATION

PROJECT NO. 68742

SHEET 12 OF 16

NOTE: DO NOT SCALE FROM THESE PLANS-USE DIMENSIONS

PATH: C:\Marine\Win Section Report 2002\Project\012 Kln SP Bdy Pl - As-Blt Bridge.dwg		
BY:	DATE:	DESCRIPTION OF CHANGE:
RECORD OF REVISIONS		

STATE OF ALASKA
DEPARTMENT OF TRANSPORTATION
AND PUBLIC FACILITIES
SOUTHEAST REGION DESIGN & CONSTRUCTION

KETCHIKAN


KETCHIKAN AIRPORT
SEAPLANE FACILITY RECONSTRUCTION
PROJECT NO. A.I.P. 3-02-0144-0996/71952

ALASKA


PEDESTRIAN AND VEHICLE ACCESS BRIDGE

DESIGNED BY:	PROJECT NO.
BAS	71952
DRAWN BY:	DATE:
BAS	MARCH, 1998
CHECKED BY:	SHEET 12 OF 16
JAL	




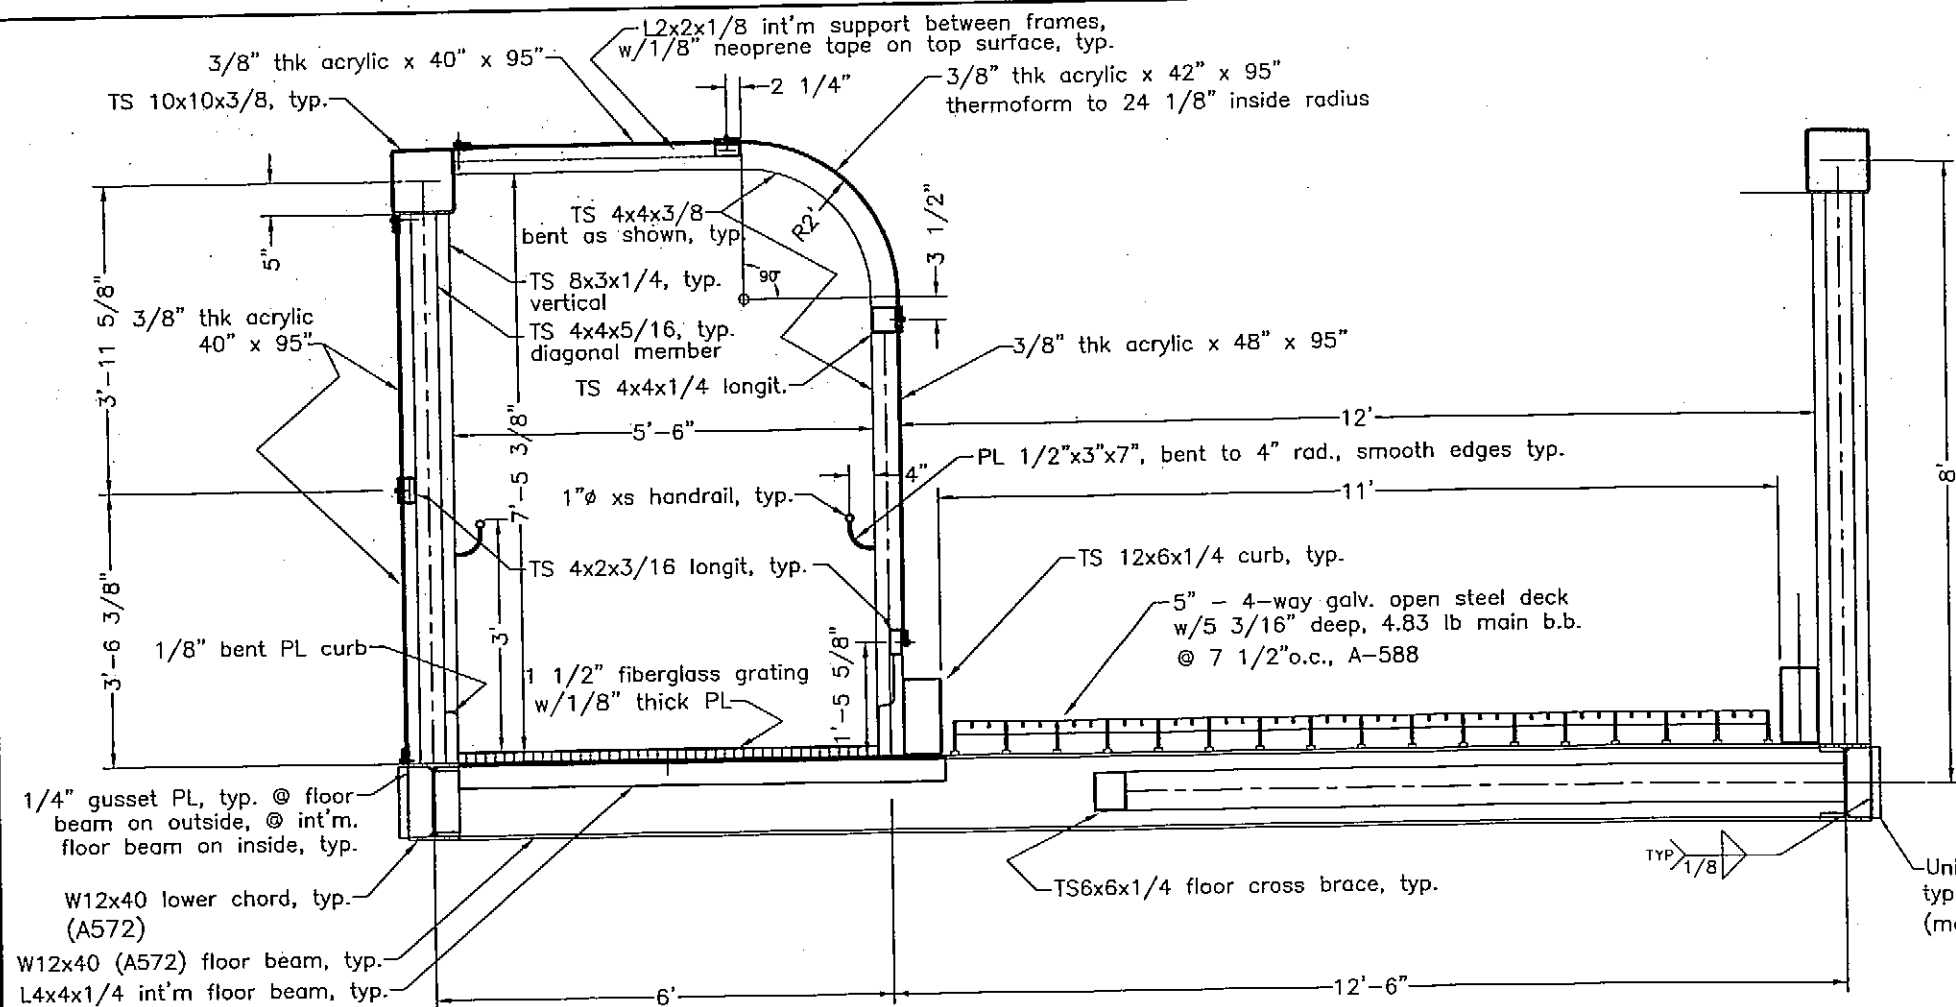

TYPICAL SECTION A

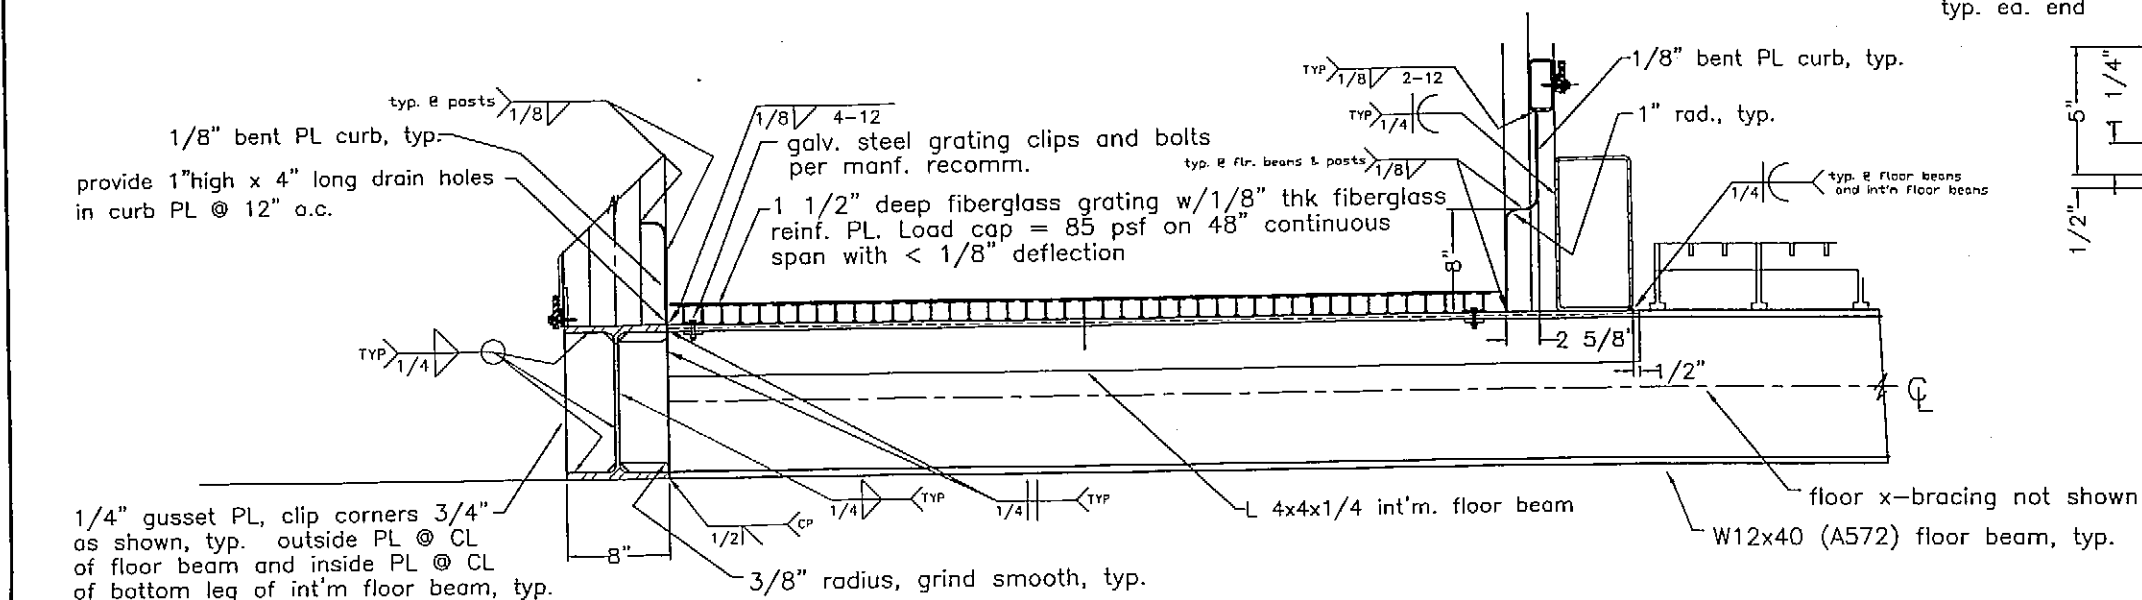

FLOOR BEAM DETAILS - ELEVATION

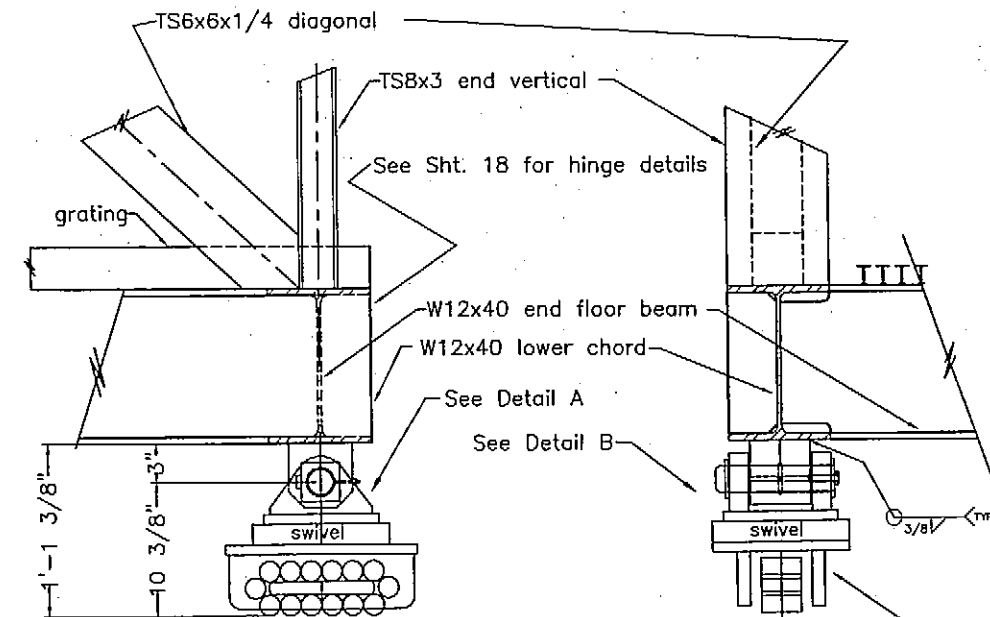

SIDE VIEW

FRONT END VIEW

Unistrut, L=11", @ 8'o.c.
typ. both sides
(mount to 1/4" stiff'r PLs)


PL 1/4"x2 3/4"x2 3/4"

3/8" sq. bar, 1" long
typ. ea. end

steel block 5"x5"x4 3/4". Drill for
1/4" x 28 thd. stls. stl. straight grease fitting.
1/8" deep grease grooves, two longitudinal
and one about inside circumference @
midpoint, typ.

side PL 1 1/2"x4 1/2"x8", typ.

1/8" or 1/16"x 3" UHMW
washers, typ.

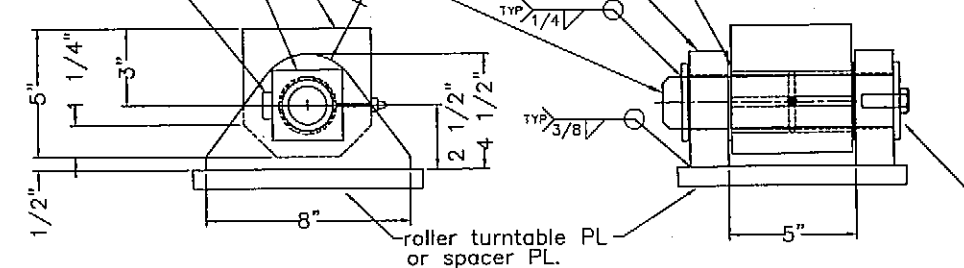

DETAIL A

DETAIL B

FLOAT END BEARING DETAIL
(one bearing w/turntable, other w/spacer)

AS-BUILT INFORMATION

PROJECT NO. 88742

SHEET 13 OF 16

NOTE: DO NOT SCALE FROM THESE PLANS-USE DIMENSIONS

PATH: D:\BAS\sheet16.DWG	BY:	DATE:	DESCRIPTION OF CHANGE:
RECORD OF REVISIONS			

STATE OF ALASKA
DEPARTMENT OF TRANSPORTATION
AND PUBLIC FACILITIES
SOUTHEAST REGION DESIGN & CONSTRUCTION


KETCHIKAN

KETCHIKAN AIRPORT
SEAPLANE FACILITY RECONSTRUCTION
PROJECT NO. A.I.P. 3-63-0144-0006/71062
SECTION DETAILS


ALASKA

DESIGNED BY:	BAS	PROJECT NO.	71900
DRAWN BY:	BAS	DATE:	MARCH, 1998
CHECKED BY:	JAL	SHEET	16 OF 44



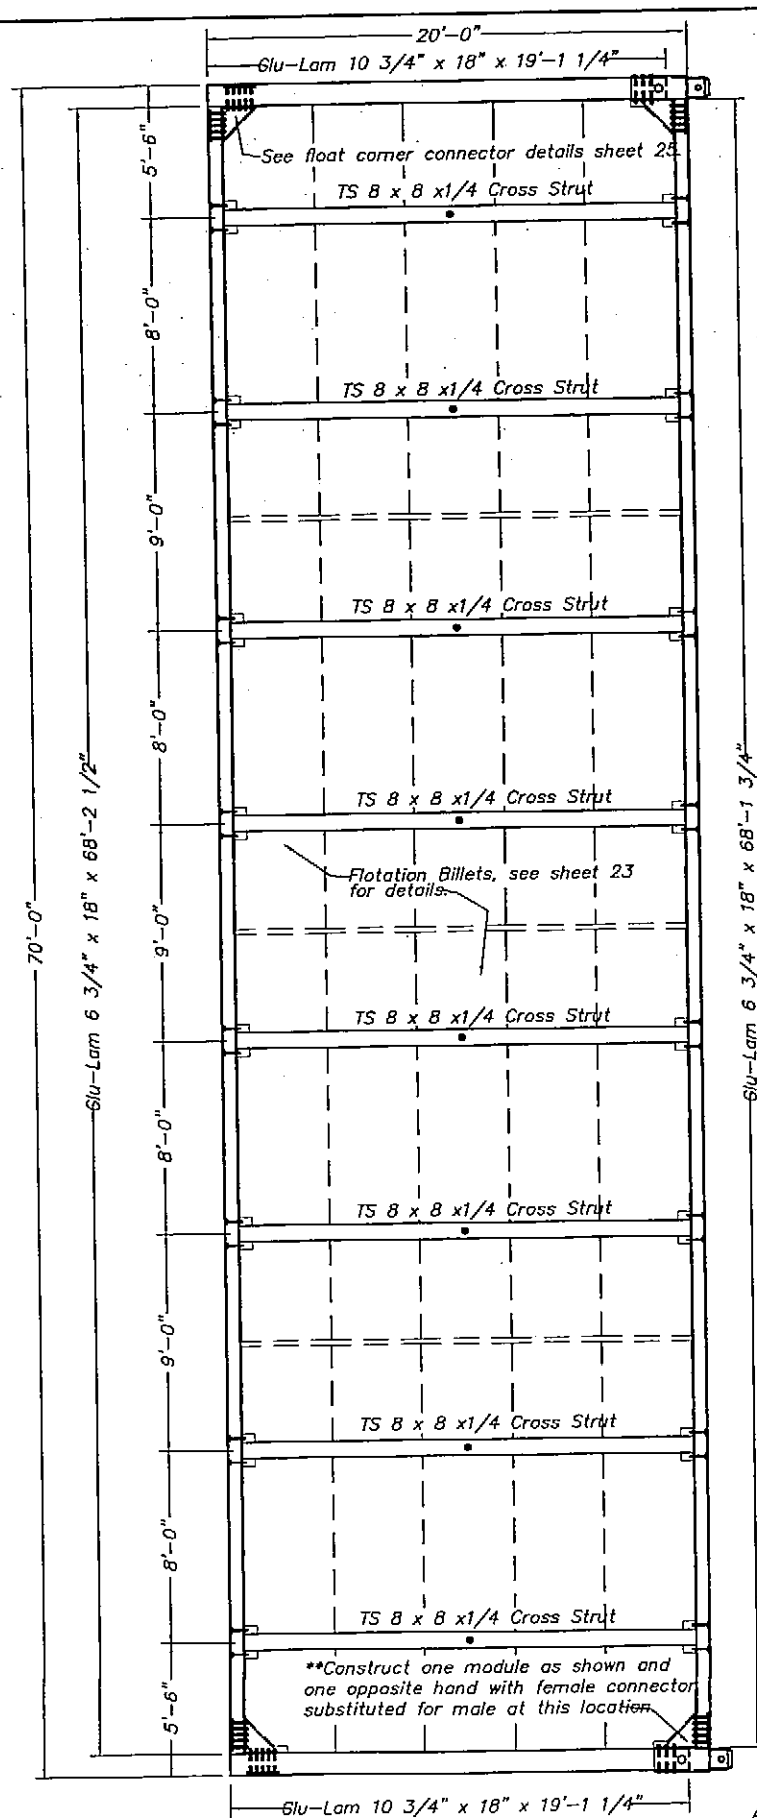


END FLOAT MODULE
(**2 Required)

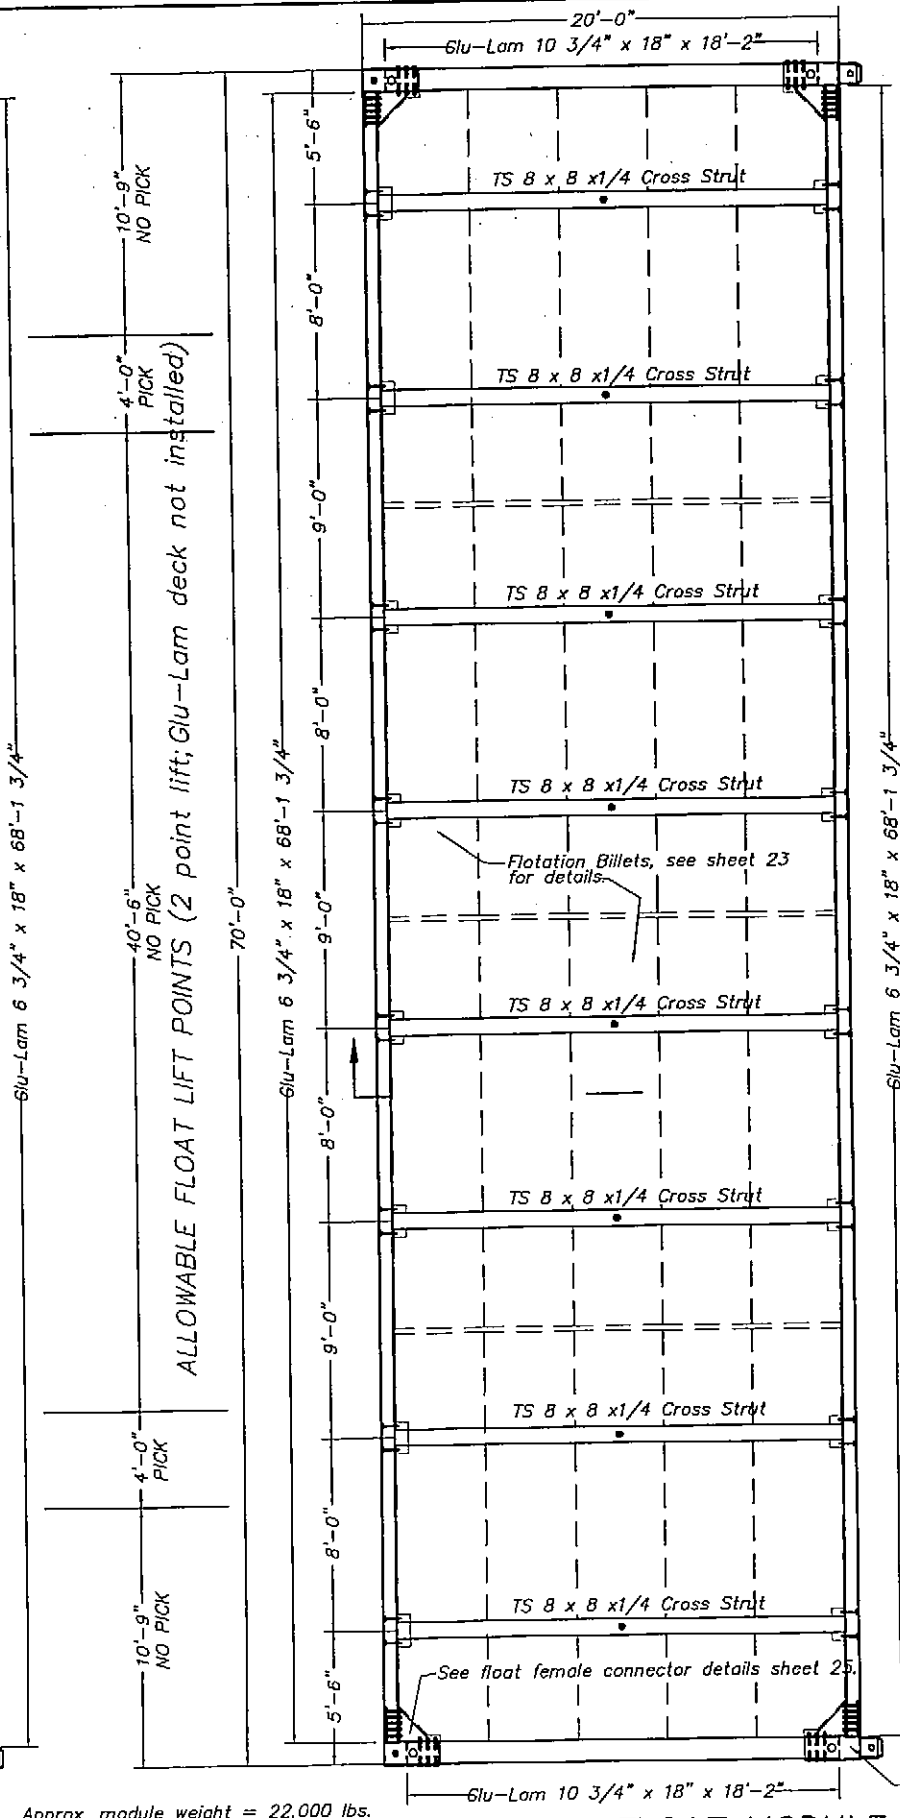


INTERIOR FLOAT MODULE
(15 Required)


Approx. module weight = 22,000 lbs.

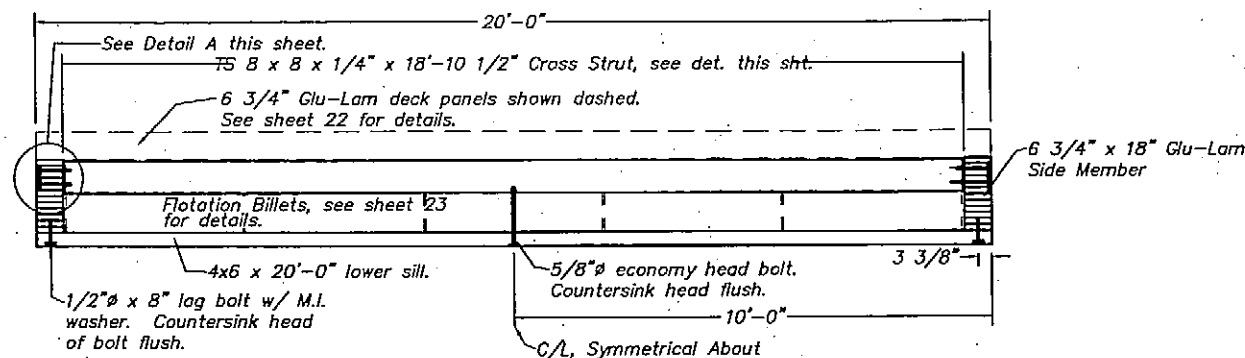


SECTION A

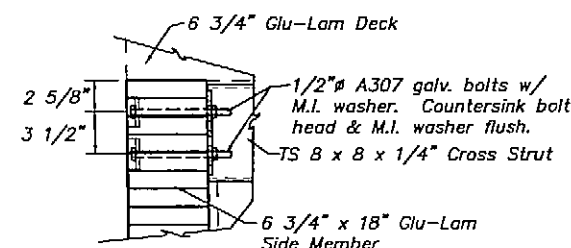

DETAIL A

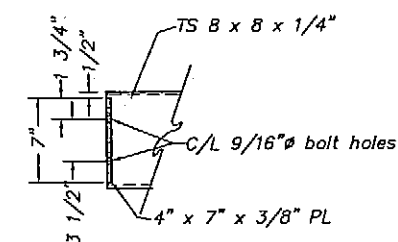

SECTIONAL ELEV. B

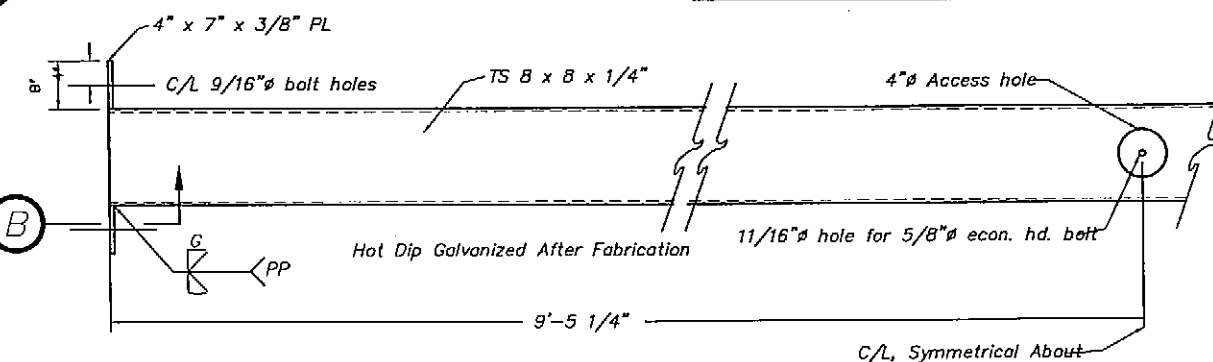

CROSS STRUT - PLAN

Contractor Note: Float prefabrication details shown may or may not reflect fabrication details required by other attachments. This drawing should be coordinated with other sheets and details found elsewhere.

AS-BUILT INFORMATION

PROJECT NO. 68742

SHEET 15 OF 16

PATH: P:\KTN\71952\MF\SHEET24	STATE OF ALASKA	KETCHIKAN	ALASKA
BY: DATE: DESCRIPTION OF CHANGE:	DEPARTMENT OF TRANSPORTATION AND PUBLIC FACILITIES	KETCHIKAN AIRPORT SEAPLANE FACILITY RECONSTRUCTION	DESIGNED BY: JAL
	SOUTHEAST REGION DESIGN & CONSTRUCTION	PROJECT NO. A.I.P. 3-02-0144-0996/71952	DRAWN BY: JAL
		TYPICAL FLOAT MODULE DETAILS	CHECKED BY: JDB
			PROJECT NO. 49th
			DATE: MAY 1990
			SHEET 15 OF 17

STATE OF ALASKA
DEPARTMENT OF TRANSPORTATION
AND PUBLIC FACILITIES
SOUTHEAST REGION DESIGN & CONSTRUCTION

KETCHIKAN
KETCHIKAN AIRPORT SEAPLANE FACILITY RECONSTRUCTION
PROJECT NO. A.I.P. 3-02-0144-0996/71952
TYPICAL FLOAT MODULE DETAILS

NOTE: DO NOT SCALE FROM THESE PLANS-USE DIMENSIONS

DESIGNED BY: JAL
DRAWN BY: JAL
CHECKED BY: JDB

PROJECT NO. 49th
DATE: MAY 1990
SHEET 15 OF 17

