

State of Alaska


Department of Transportation
and Public Facilities
Southeast Region

KETCHIKAN, ALASKA WATER STREET


KETCHIKAN ADVANCE WATER STREET
TRUNK RELOCATION
PROJECT NO BR-000S(735)~~~69548~~

The undersigned hereby certifies that this duplicated document is an exact and true copy of the original.
Cody Sutter

February 2, 2015

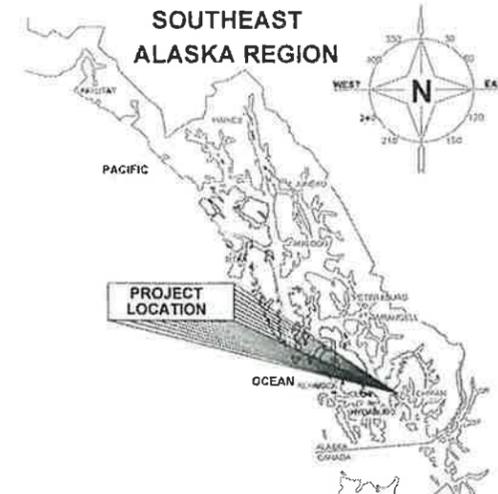

**PROJECT NUMBER IS:
69548**

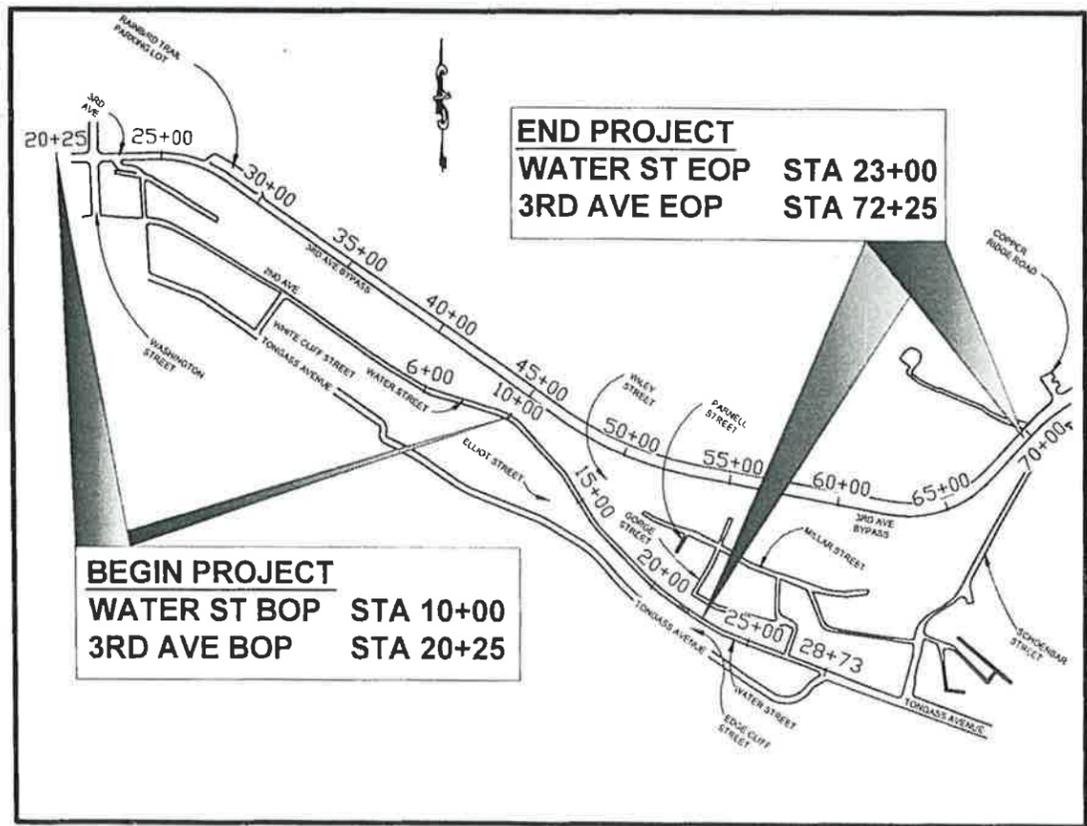

VICINITY MAP

DESIGN DESIGNATION
(WATER STREET)
FUNCTIONAL CLASS: URBAN LOCAL

ADT 2010	=	726
ADT 2034	=	818
DHV (10.7%) 2010	=	60
DHV (10.7%) 2034	=	70
% T	=	5.5
V	=	25
ESAL	=	50,000

PROJECT SUMMARY
(WATER STREET)

CDS ROUTE NO	=	291404
CDS MILEPOINT	=	MP 0.035 TO MP 0.574
LENGTH OF PROJECT	=	1300 FT
LENGTH OF BRIDGE	=	981 FT
LENGTH OF PAVING	=	1300 FT
WIDTH OF PAVING	=	18 FT

DESIGN DESIGNATION
(3RD AVENUE)
FUNCTIONAL CLASS: ARTERIAL

ADT 2012	=	4085
ADT 2023	=	4600
DHV (10.7%) 2012	=	230
DHV (10.7%) 2023	=	460
% T	=	5.5
V	=	35
ESAL	=	<500,000

PROJECT SUMMARY
(3RD AVENUE)

CDS ROUTE NO	=	291433
CDS MILEPOINT	=	MP 0.035 TO MP 0.574
LENGTH OF PROJECT	=	4900 FT

THE FOLLOWING STANDARD DRAWINGS APPLY TO THIS PROJECT:

- A-1 G-00.02 G-46.11
- C-04.12 G-04.10S
- L-30.10 G-04.10W
- T-05.10 G-10.01
- U-03.00 G-27.11
- G-28.00

INDEX

SHEET NO.	DESCRIPTION
A01	TITLE SHEET
A02	SCHEMATIC LAYOUT
A03 - A06	SURVEY CONTROL
B01	TYPICAL SECTIONS
C01	ESTIMATE OF QUANTITIES
D01 - D02	SUMMARY TABLES
E01	DETAILS
P01 - P05	ESCP & DETAILS
T01 - T02	TRAFFIC CONTROL PLANS
U01 - U35	UTILITY PLANS
V01 - V19	TELEPHONE CABLE LAYOUT

Asbuilt Plans
Project Engineer: Marali Bolshakoff
Contractor: City Electric

Project As Built Drawings Have Been Reviewed By The Project Engineer & Represent, To The Best Of My Knowledge, The Project As Constructed.

Proj. Eng. *MS* Date *1.5.16*

PATH: Z:\PROJECT\1744.00 DOT_SE WATER STREET VIA DUCT\G\M\LACAD\ADV UTILITY
REL\1744.00-A01(AUR).DWG TAB:A01
Tuesday, October 22, 2013 3:40:59 PM
PLOT: PSPACE OR MSPACE: 1=1(F)

STATE OF ALASKA
DEPARTMENT OF TRANSPORTATION
& PUBLIC FACILITIES
SOUTHEAST REGION




APPROVED: *Pat Carroll* *9/2/14*
REGIONAL PRE-CONSTRUCTION ENGINEER DATE
L. PAT CARROLL, P.E.

APPROVED: *Chuck Correa* *9/2/14*
DIRECTOR OF DESIGN AND CONSTRUCTION, SOUTHEAST REGION
CHUCK CORREA, P.E.

CERTIFIED TRUE & CORRECT AS-BUILT OF ACTUAL FIELD CONDITION:

CONSTRUCTION PROJECT MANAGER DATE

STATE	PROJECT DESIGNATION	YEAR	SHEET NO.	TOTAL SHEETS
ALASKA	BR-000S(735) ~ 69548	2014	A01	78

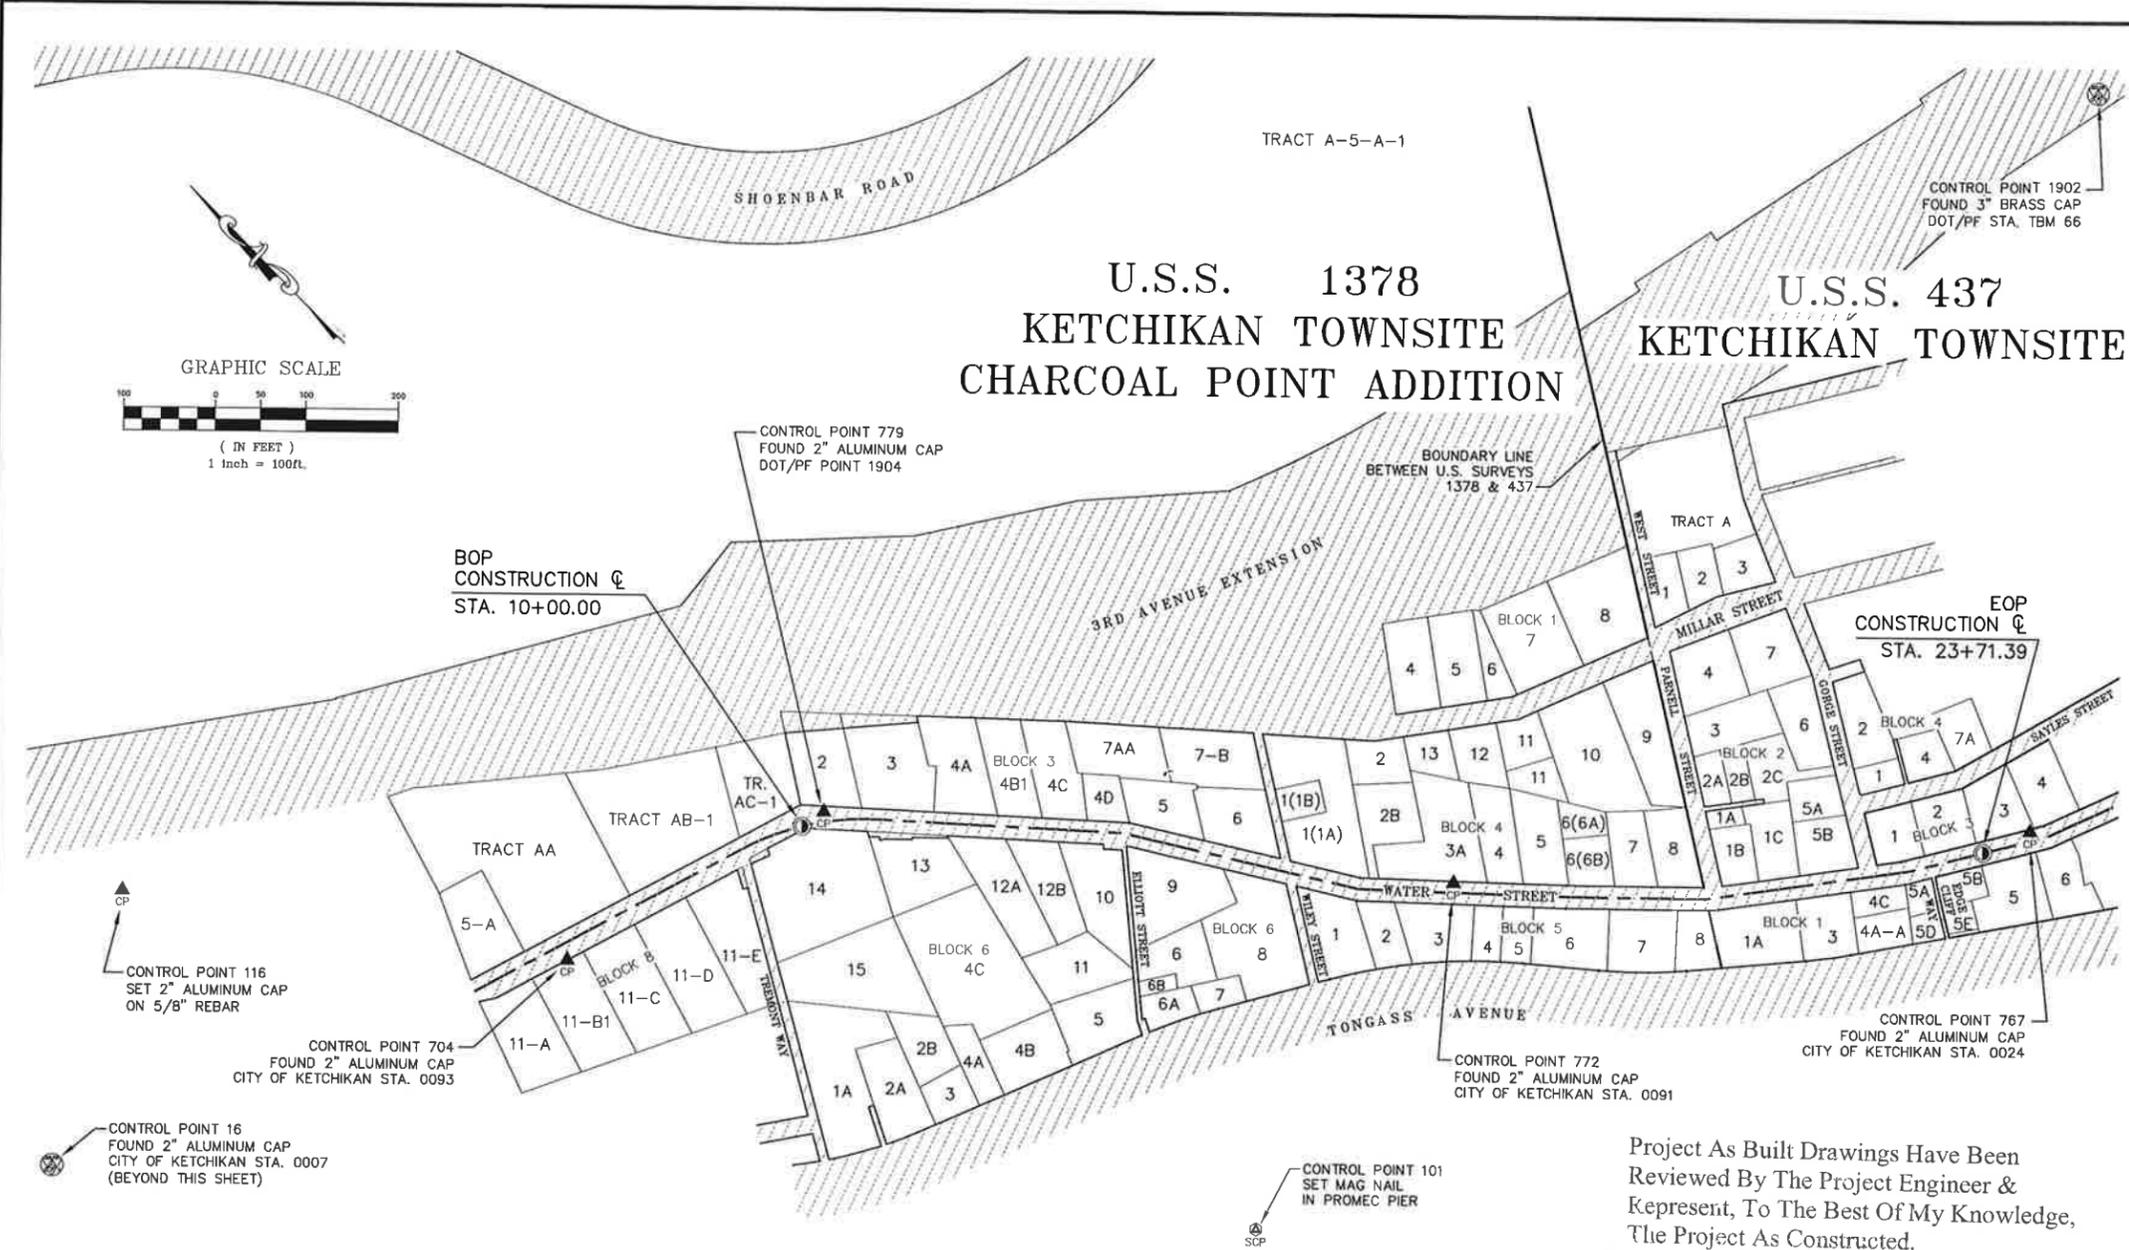

VERTICAL CONTROL STATEMENT

Historical Basis of Vertical Control Statement:
 KGB control monument 1015 (Tongass Ave. Project point No. 3012), a DOH monument in a case in front of 2324 Tongass Ave. was held as the Basis of Vertical Control with an elevation of 21.90' above MLLW from the Ketchikan Gateway Borough Control Network of 1984 (KGBCN84).

Historical Vertical Control Note:
 KGBCN84 monument 1015 is also Monument "I", a Tongass Avenue centerline monument originally depicted on "Coordinate Map of Ketchikan, Alaska", Plat V1-112 (see note Basis of Bearing). The monument no longer exists. Much of Tongass Avenue has experienced recent re-construction.

Basis of Vertical Control:
 Basis of Vertical Control is vertical datum KGBCN84. DOT&PF drawing "tongass_ave09.dwg" shows point nos. 1648-1650, along Tongass Avenue, near this project and with KGBCN84 elevations. 1648-1650 are R&M Eng. Ketchikan monuments TA-19, TA-20 & TA-21, respectively. All three 2" aluminum cap monuments were recovered and examined for relative elevations with respect to record. Station TA-21 (1650) was held for elevation: Elev. = 21.94'. Note: additional stations shown in "tongass_ave09.dwg" southeast of TA-19 (1648) and within the project area were not found and are assumed destroyed by recent construction.

Station	Measured Elev.	Record Elev.
TA-21 (1650)	21.940'	21.940' (Held)
TA-20 (1649)	21.764'	21.760'
TA-19 (1648)	21.530'	21.540'

Elevations were transferred to primary horizontal control and benchmarks using differential levels. Topography and planimetrics were measured using optical instrumentation and trigonometric methods.

NOTES

- Whether listed or not, All monuments or property markers, corners, or accessories, which will be disturbed or buried, shall be referenced or re-established in their original position (A.S. 19.10.260) and recorded (A.S. 34.65.040).
- ROW location is shown for orientation purpose only. Refer to AKDOT ROW Maps for ROW information.
- Horizontal and Vertical Control must be field verified by the contractor. Discrepancies of note will be reported to the contracting agency.

LEGEND

- ⊕ DOT&PF GPS CONTROL
- ⊕ PRIMARY PROPERTY MONUMENT
- ▲ CP PRIMARY PROJECT CONTROL
- ⊙ SECONDARY PROPERTY MONUMENT
- ⊙ SCP SECONDARY PROJECT CONTROL
- ⊙ CONSTRUCTION C (NOT SET)
- ⊕ BLM/GLO MONUMENT
- Ⓜ SURVEY POINT NUMBER

SURVEYOR'S CERTIFICATE

I hereby certify that I am properly registered and licensed to practice land surveying in the State of Alaska, and that this plat was made by me or under my direct supervision. I declare that this plat is based on information compiled from record data and controlled by recovered monuments, and that all dimensions and other details are correct.

Randal H. Brinker 8/28/14
 RANDAL H. BRINKER, L.S. 8852 Date

HORIZONTAL CONTROL STATEMENT

Control Methodology:
 Primary horizontal control was established using Static GPS techniques with Trimble dual frequency receivers. The GPS vectors were adjusted by simultaneous least squares methods using Trimble Business Center software. All vectors were constrained to DOT&PF Control Stations #1902 and #16. Note: A free adjustment, holding #1902 produced a radial error at #16 of 0.020' (5 ppm).

Coordinate System:
 This project is located entirely within the "Gravina" coordinate system; a U.S. Survey Feet, local grid established by State of Alaska, Department of Transportation and Public Facilities, Southeast Region, Right-of-Way Section, for a select, specific area of Ketchikan, Alaska. All measurements, dimensions, coordinates and elevations on this map are in U.S. Survey Feet as related to, and associated with Gravina Grid.

Basis of Coordinates:
 Basis of Coordinates is Point "TBM-66" (a 3" diameter domed brass disk grouted flush on a bedrock outcrop along the southerly side of 3rd Avenue Extension). Said point has Gravina Grid coordinates of 89745.1673 N, 104488.6036 E. (DOT reference point #1902.)

Basis of Bearings:
 Basis of Bearings is the "Ketchikan Gateway Borough Control Network of 1984" (KGBCN84) NAD27 bearing between monuments "J" and "I" (KGBCN84 pt. nos. 1014 & 1015). Monuments "J" and "I" are Tongass Avenue monuments originally depicted on "Coordinate Map of Ketchikan, Alaska", Plat V1-112. Said KGBCN84 NAD27 bearing between monuments "J" and "I" is S88°29'20"W.

Translation Parameters:
 To convert Alaska State Plane Zone 1, NAD83(CORS96)(EPOCH:2003.0000), U.S. Survey Feet coordinates to the local project U.S. Survey Feet coordinates:
 Step 1: Scale by 1.000099310 (1/.9999007) (base point 0,0).
 Step 2: Rotate -00°00'18" (base point 0,0).
 Step 3: Translate using -1199866.83352 N, -3000134.77840 E.
 To convert local project coordinates to Alaska State Plane Zone 1, NAD83(CORS96)- (EPOCH:2003.0000), U.S. Survey Feet coordinates:
 Step 1: Scale by .9999007 (base point 0,0).
 Step 2: Rotate +00°00'18" (base point 0,0).
 Step 3: Translate using +1199485.89702 N, +2999941.55133 E.

Project As Built Drawings Have Been Reviewed By The Project Engineer & Represent, To The Best Of My Knowledge, The Project As Constructed.
 Proj. Eng. *NB* Date *11/16/16*

POINT	LOCAL COORDINATES		AKSPC ZONE 1		GEOGRAPHIC COORDINATES		ELEVATION
	NORTHING	EASTING	NORTHING	EASTING	NORTH LATITUDE	WEST LONGITUDE	
16	90429.1907	100406.7659	1289897.3465	3100346.2371	55° 20' 57.87348"	131° 40' 31.30090"	22.28
101	89506.0125	102969.0892	1288974.0364	3102908.2254	55° 20' 48.04424"	131° 39' 47.46419"	
116	90634.5691	102342.0505	1290102.5356	3102281.3474	55° 20' 59.34278"	131° 39' 57.73657"	
704	90240.4331	102635.4499	1289708.4131	3102574.6834	55° 20' 55.37555"	131° 39' 52.86230"	136.80
767	89225.4608	103874.0745	1288693.4336	3103813.0963	55° 20' 45.01992"	131° 39' 31.95998"	74.84
772	89624.4952	103386.3961	1289092.4709	3103325.5012	55° 20' 49.09154"	131° 39' 40.18970"	92.68
779	90159.7075	102948.6286	1289627.6683	3102887.8239	55° 20' 54.49028"	131° 39' 47.48828"	128.80
1902	89745.1673	104488.6036	1289213.0348	3104427.6098	55° 20' 49.96293"	131° 39' 21.07280"	

DO NOT SCALE FROM THESE DRAWINGS USE DIMENSIONS

CHECKED BY: *RHB*

DESIGNED BY: *RHB*

DRAWN BY: *RHB*

TAB: A04 Thursday, August 28, 2014 12:31:14 PM HANK BRINKER

STATE OF ALASKA
 DEPARTMENT OF TRANSPORTATION
 & PUBLIC FACILITIES
 SOUTHEAST REGION


**KTN - WATER STREET:
 REHABILITATION/REPLACEMENT
 OF OFF SYSTEM CITY BRIDGES
 PROJECT # 69534**

SURVEY CONTROL SHEET

PROJECT DESIGNATION: BR-000S(735) YEAR: 2014 SHEET NO: A04 TOTAL SHEETS: 78


PATH: Z:\PROJECT\1744.00_DOT_SE WATER STREET VIADUCT\SURVEY\ACAD\WATER STREET_SCS V2014.DWG

PATH: Z:\PROJECT\1744_00_DOT_SE WATER STREET VADUCT\SURVEY\CAD\WATER STREET_SCS V2014.DWG

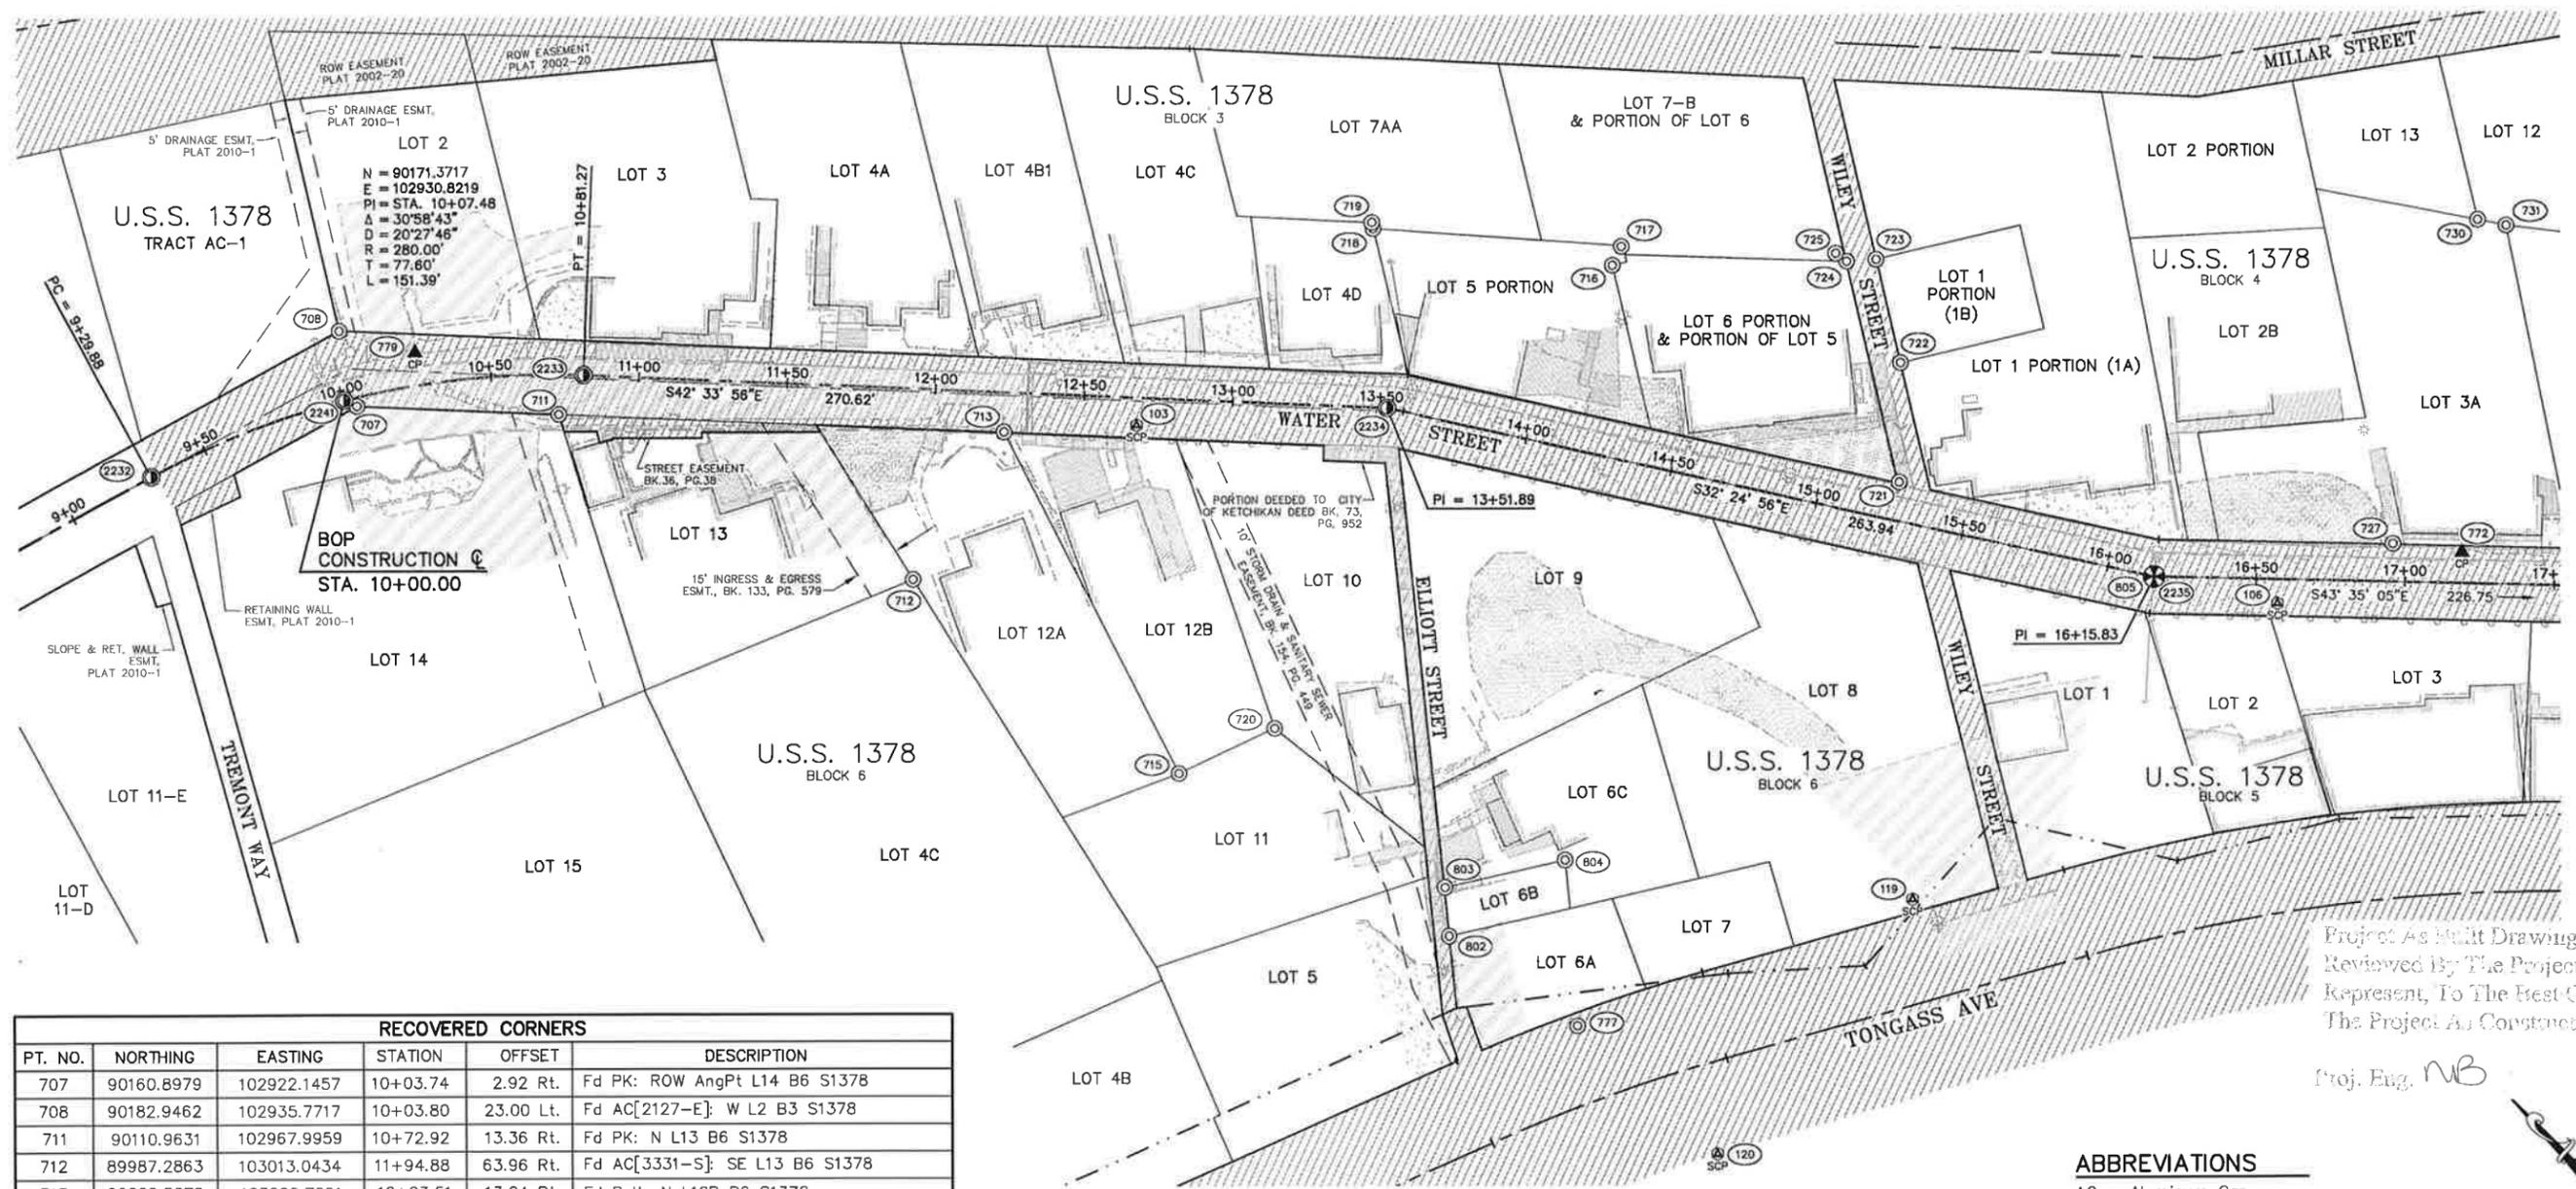

Project As Built Drawings Have Been Reviewed By The Project Engineer & Represent, To The Best Of My Knowledge, The Project As Constructed.

Proj. Eng. NB Date 1/16/16

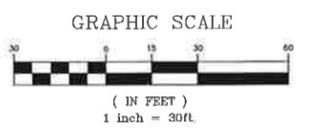

RECOVERED CORNERS					
PT. NO.	NORTHING	EASTING	STATION	OFFSET	DESCRIPTION
707	90160.8979	102922.1457	10+03.74	2.92 Rt.	Fd PK: ROW AngPt L14 B6 S1378
708	90182.9462	102935.7717	10+03.80	23.00 Lt.	Fd AC[2127-E]: W L2 B3 S1378
711	90110.9631	102967.9959	10+72.92	13.36 Rt.	Fd PK: N L13 B6 S1378
712	89987.2863	103013.0434	11+94.88	63.96 Rt.	Fd AC[3331-S]: SE L13 B6 S1378
713	90000.5076	103069.7691	12+23.51	13.24 Rt.	Fd Bolt: N L12B B6 S1378
715	89877.9560	103029.9934	12+86.86	125.44 Rt.	Fd PC[4110-S]: SE 12A B6 S1378
720	89865.8062	103063.5305	13+18.50	108.95 Rt.	Fd Rbr: SE 12B B6 S1378
719	89962.4293	103206.8921	13+44.31	61.99 Lt.	Fd PC[3408-S]: E L4D B3 S1378
718	89960.6878	103205.7150	13+44.80	59.95 Lt.	Fd PC[3408-S]: N L5 B3 S1378
803	89787.5449	103066.0335	14+05.63	152.97 Rt.	Fd Nail/Washer[6269-S]: N L6B B6 S1378
802	89775.0241	103055.4475	14+10.52	168.62 Rt.	Fd Rbr: N L6A S1378
716	89894.7884	103253.9246	14+15.82	63.13 Lt.	Fd Rbr: NNW L6 B3 S1378
717	89897.1232	103260.5275	14+17.38	69.96 Lt.	Fd IP: E L5 B3 S1378
804	89765.2997	103101.1812	14+43.25	135.23 Rt.	Fd PlgTk: E L6B B6 S1378
777	89723.8986	103065.5515	14+59.10	187.50 Rt.	Fd AC[3491-S]: WC2 C1 TRE ATS 1641
725	89844.4545	103309.7335	14+88.22	83.26 Lt.	Fd IP: S L7B B3 S1378
724	89839.9281	103310.4230	14+92.41	81.42 Lt.	Fd Rbr: E L6 B3 S1378
723	89833.4241	103317.8035	15+01.86	84.16 Lt.	Fd PC[3248-S]: N L1B B4 S1378
722	89803.1136	103299.0295	15+17.39	52.06 Lt.	Fd PC[3248-S]: W L1B B4 S1378
721	89775.1845	103270.3755	15+25.60	12.90 Lt.	Fd PK: S L6 B3 S1378
805	89692.1009	103307.8478	16+15.83	0.00 Rt.	Fd Bc[GLO]: CL Water Street PI
727	89642.9834	103372.1650	16+95.75	12.73 Lt.	Fd PC: ROW L3A B4 S1378
730	89699.7260	103469.0986	17+21.47	122.06 Lt.	Fd IP: S L13 B4 S1378
731	89691.6394	103474.4735	17+31.04	120.38 Lt.	Fd IP: N L4 B4 S1378

PROJECT CONTROL POINTS						
PT. NO.	NORTHING	EASTING	STATION	OFFSET	ELEVATION	DESCRIPTION
779	90159.7076	102948.6286	10+26.08	10.86 Lt.	128.80	Fd AC[DOT]: DOT Pt.No. 1904
103	89970.5539	103102.8251	12+67.93	9.16 Rt.		Set MAG: CP103
120	89659.1832	103067.3977	15+14.72	220.63 Rt.	21.90	Set Survey Spike: CP120
119	89673.1207	103174.1836	15+60.20	123.01 Rt.	21.74	Set MAG: CP119
106	89656.3965	103330.5564	16+57.35	8.17 Rt.		Set MAG: CP106
772	89624.4952	103386.3961	17+18.95	10.29 Lt.	92.68	Fd AC [COK]: Pt. No. 0091

CONSTRUCTION CENTERLINE ALIGNMENT						
POINT	NORTHING	EASTING	STATION	OFFSET	DESCRIPTION	
2232	90193.3525	102856.4058	9+29.88	0.00 Rt.	Not Set: Construction CL PC	
2241	90165.3212	102920.4758	10+00.00	0.00 Rt.	Not Set: Construction CL BOP	
2233	90114.2229	102983.3094	10+81.27	0.00 Rt.	Not Set: Construction CL PT	
2234	89914.9125	103166.3630	13+51.89	0.00 Rt.	Not Set: Construction CL PI	
2235	89692.1009	103307.8478	16+15.83	0.00 Rt.	Not Set: Construction CL PI (see no. 805)	

ABBREVIATIONS
 AC = Aluminum Cap
 BC = Brass Cap
 GLO = General Land Office
 IP = Iron Pipe
 MAG = Mag Nail
 PC = Plastic Cap
 PK = PK Nail
 PlgTk = Lead Plug with Tack
 POR = Portion
 Rbr = Rebar
 SI = Street Intersection

DO NOT SCALE FROM THESE DRAWINGS USE DIMENSIONS

CHECKED BY: RHB

DESIGNED BY: RHB
 DRAWN BY: RHB


STATE OF ALASKA
 DEPARTMENT OF TRANSPORTATION
 & PUBLIC FACILITIES
 SOUTHEAST REGION

**KTN - WATER STREET:
 REHABILITATION/REPLACEMENT
 OF OFF SYSTEM CITY BRIDGES
 PROJECT # 69534**

SURVEY CONTROL SHEET

TAB: A05 Thursday, August 28, 2014 12:25:06 PM HANK BRINKER

REVISIONS		PROJECT DESIGNATION	YEAR	SHEET NO.	TOTAL SHEETS
NO.	DATE	DESCRIPTION			
			2014	A05	78

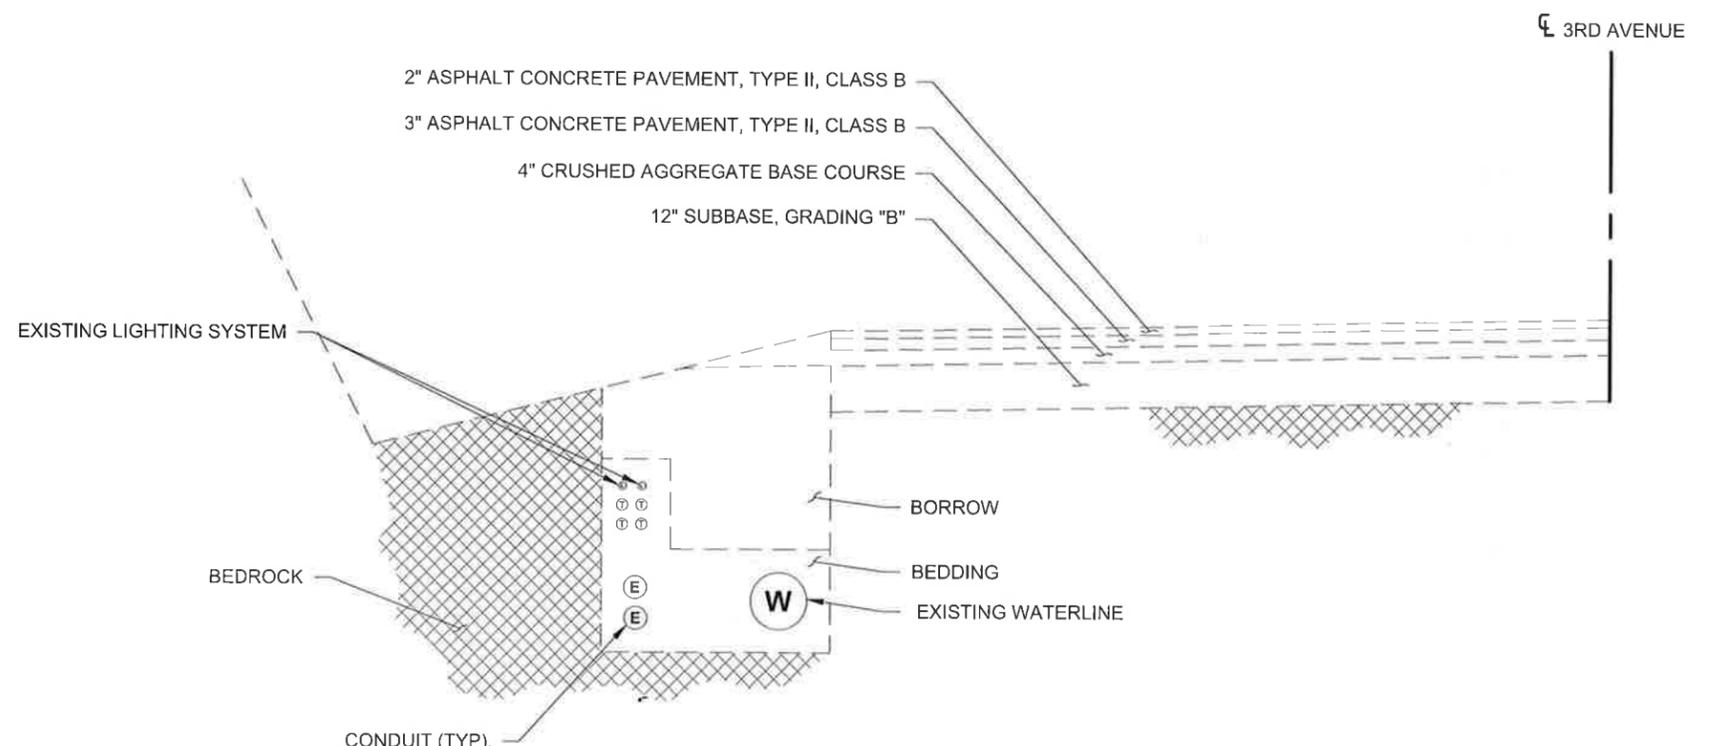


NOTES:

- 1) THERE IS AN EXISTING UTILITY TRENCH THAT WAS CONSTRUCTED (2003) ALONG THE LEFT SIDE OF 3RD AVENUE. CONDUITS WERE INSTALLED FOR A PORTION OF THE LENGTH. THIS PROJECT COMPLETES THE RELOCATION OF UTILITIES TO 3RD AVENUE.
- 2) ALL EXCAVATION WILL BE PERFORMED USING MECHANICAL METHODS, BLASTING WILL NOT BE PERMITTED.
- 3) REPLACE ANY REMOVED OR DISTURBED MATERIALS WITH EXISTING MATERIAL PRIOR TO IMPORTING MATERIAL PER THE PROJECT SPECIFICATIONS.
- 4) PROVIDE TRENCH SHORING OR SUPPORT SYSTEM TO ENSURE THE TRENCH WIDTH DOES NOT DAMAGE THE EXISTING ROADWAY.
- 5) EXISTING LIGHTING SYSTEM TO REMAIN AND WILL NEED TO BE TEMPORARY PULLED TO THE SIDE OF TRENCH, PROTECTED, AND WORKED AROUND.
- 6) PLACE BONDED FIBER MATRIX (BFM) AND SEED ON ALL GROUND DISTURBED BY CONSTRUCTION ACTIVITIES.
- 7) SEE SHEET E01 FOR SIDEWALK DETAIL.

EXISTING 3RD AVENUE CONDUITS / TRENCH

STA 22+50 TO STA 30+00

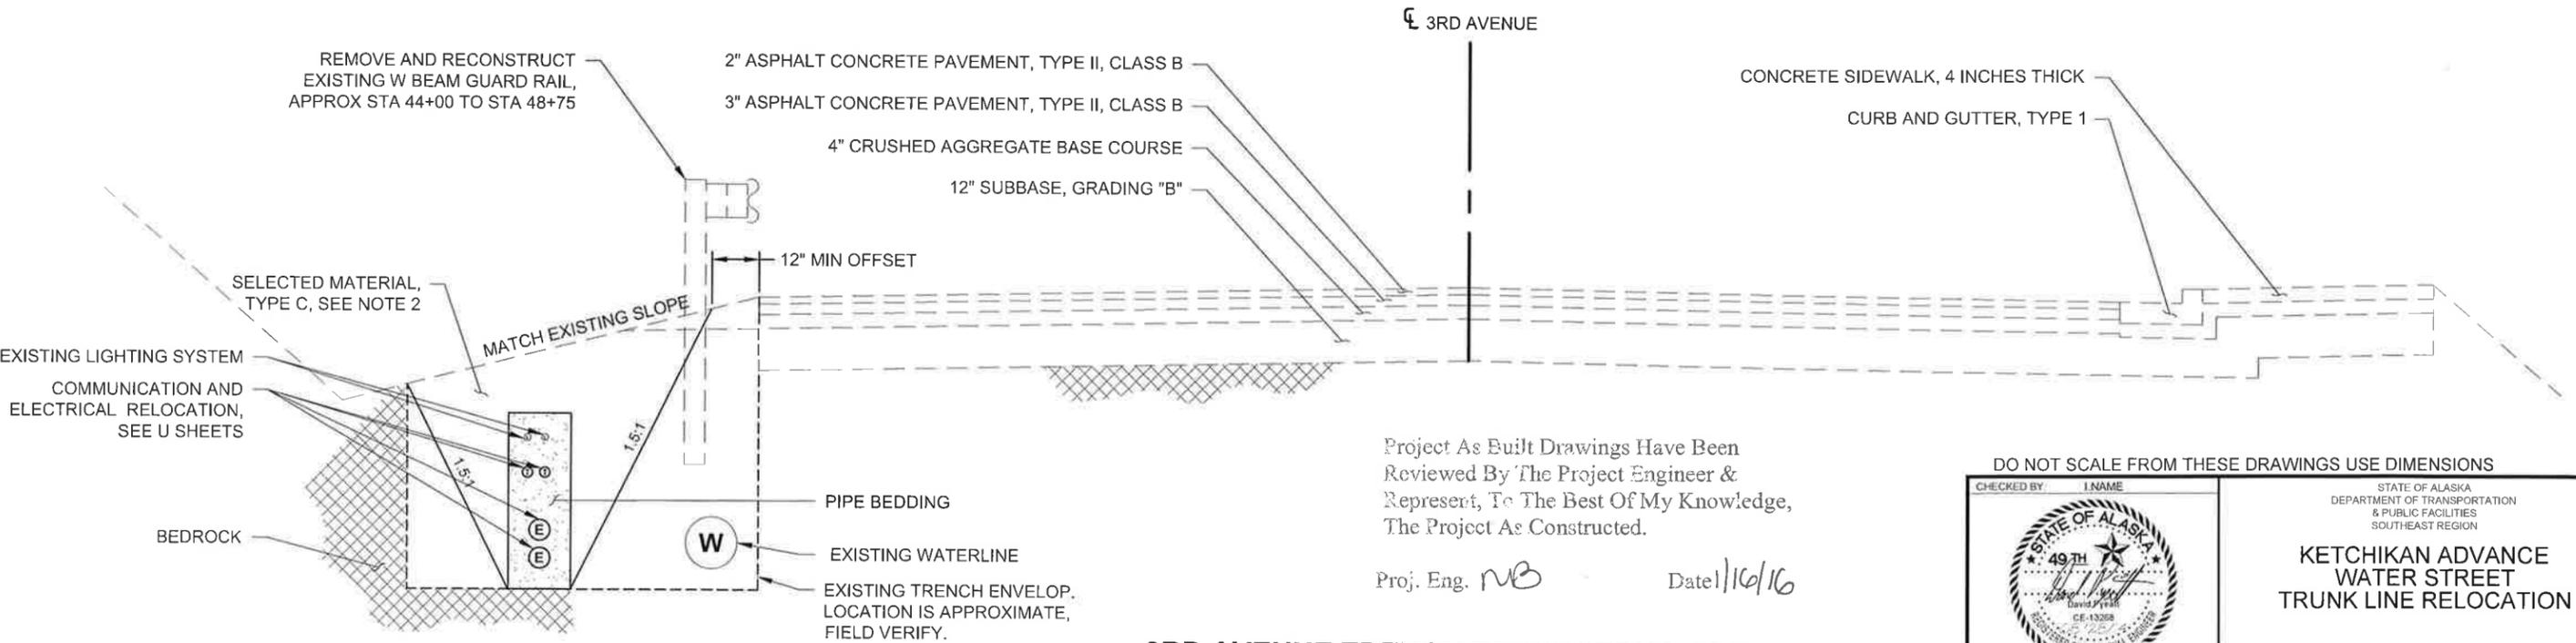

3RD AVENUE TRENCH RECONSTRUCTION

STA 30+00 TO STA 69+25

DO NOT SCALE FROM THESE DRAWINGS USE DIMENSIONS

CHECKED BY: I. NAME	STATE OF ALASKA DEPARTMENT OF TRANSPORTATION & PUBLIC FACILITIES SOUTHEAST REGION	
DESIGNED BY: I. NAME	KETCHIKAN ADVANCE WATER STREET TRUNK LINE RELOCATION	
DRAWN BY: I. NAME		
PATH: Z:\PROJECT\1744.00 DOT_SE WATER STREET VIADUCT\CIVIL\CAD\ADV UTILITY RELO\1744.00-B SHEETS(AUR) PLOT DATE: 8/28/2014 12:05 PM		
REVISIONS		
NO.	DATE	DESCRIPTION
PROJECT DESIGNATION		YEAR
BR-000S(735) ~ 69548		2014
SHEET NO.	TOTAL SHEETS	
B01	78	

202 (2) REMOVAL OF PAVEMENT				
SHEET	STATION RANGE		AREA (SY)	REMARKS
U02	3RD AVE 28+00		5	FIRE HYDRANT ACCESS
U03	3RD AVE 37+00		7.05	FIRE HYDRANT ACCESS
U03	3RD AVE 41+80		5.6	FIRE HYDRANT ACCESS
U04	3RD AVE 47+00		5.23	FIRE HYDRANT ACCESS
U04	3RD AVE 52+00		6.19	FIRE HYDRANT ACCESS
U05	3RD AVE 66+00		4.26	FIRE HYDRANT ACCESS
U05	3RD AVE 70+50		25.7	3RD AVENUE CROSSING
	" " 70+00 4.		2.21	FIRE Hydrant
	SUBTOTAL			
	CONTINGENCY (20%)			
	TOTAL		81.49	

301 (1) AGGREGATE BASE COURSE				
SHEET	STATION RANGE		TON	REMARKS
U02	3RD AVE 28+00		1	FIRE HYDRANT ACCESS
U03	3RD AVE 37+00		1	FIRE HYDRANT ACCESS
U03	3RD AVE 41+80		1	FIRE HYDRANT ACCESS
U04	3RD AVE 47+00		1	FIRE HYDRANT ACCESS
U04	3RD AVE 52+00		1	FIRE HYDRANT ACCESS
U05	3RD AVE 66+00		1	FIRE HYDRANT ACCESS
U05	3RD AVE 69+20		10	3RD AVENUE CROSSING
	SUBTOTAL		16	
	CONTINGENCY (25%)		4	
	TOTAL		20	

202 (3) REMOVAL OF SIDEWALK				
SHEET	STATION RANGE		AREA (SY)	REMARKS
U05	3RD AVE 70+40		12.6	3RD AVENUE CROSSING
	52+50 4.		5.9	
	SUBTOTAL			
	CONTINGENCY (100%)			
	TOTAL		18.41	

401 (1) ASPHALT CONCRETE, TYPE II; CLASS B				
SHEET	STATION RANGE		TON	REMARKS
U02	3RD AVE 28+00		2.5	FIRE HYDRANT ACCESS
U03	3RD AVE 37+00		2.5	FIRE HYDRANT ACCESS
U03	3RD AVE 41+80		2.5	FIRE HYDRANT ACCESS
U04	3RD AVE 47+00		2.5	FIRE HYDRANT ACCESS
U04	3RD AVE 52+00		2.5	FIRE HYDRANT ACCESS
U05	3RD AVE 66+00		2.5	FIRE HYDRANT ACCESS
U05	3RD AVE 70+50		10	3RD AVENUE CROSSING
	69+75 Lt.			Approach HYDRANT
	70+00 Lt.			
	SUBTOTAL		25	
	CONTINGENCY (20%)		5	
	TOTAL		30	

202 (9) REMOVAL OF CURB AND GUTTER				
SHEET	STATION RANGE		LENGTH (LF)	REMARKS
U05	3RD AVE 70+40		20.10	3RD AVENUE CROSSING
	3RD AVE 70+60			
	SUBTOTAL			
	CONTINGENCY (50%)			
	TOTAL		20.10	

204 (2) STRUCTURE TRENCH EXCAVATION				
SHEET	STATION RANGE		LENGTH (LF)	REMARKS
U02	3RD AVE 30+00		275	
U03	3RD AVE 32+75		1,225	
U04	3RD AVE 45+00		1,360	
U05	3RD AVE 58+60		1,060	
U05			220	3RD AVENUE CROSSING TO RISER POLE
	SUBTOTAL			
	CONTINGENCY (5%)			
	TOTAL		4,265	


Project As Built Drawings Have Been Reviewed By The Project Engineer & Represent, To The Best Of My Knowledge, The Project As Constructed.

Proj. Eng. NB


Date 1/16/16

DO NOT SCALE FROM THESE DRAWINGS USE DIMENSIONS

CHECKED BY: I. NAME		STATE OF ALASKA DEPARTMENT OF TRANSPORTATION & PUBLIC FACILITIES SOUTHEAST REGION	
		KETCHIKAN ADVANCE WATER STREET TRUNK LINE RELOCATION	
DESIGNED BY: I. NAME		PROJECT DESIGNATION	
DRAWN BY: I. NAME		YEAR	
PATH: Z:\PROJECT\1744.00 DOT_SE WATER STREET VIADUCT\CIVIL\CAD\ADV UTILITY RELO\1744.00-D SHEETS(AUR)		PLOT DATE: 8/28/2014 12:05 PM	
REVISIONS		SHEET NO.	
NO.	DATE	DESCRIPTION	TOTAL SHEETS
			BR-000S(735) ~ 69548 2014 D01 78

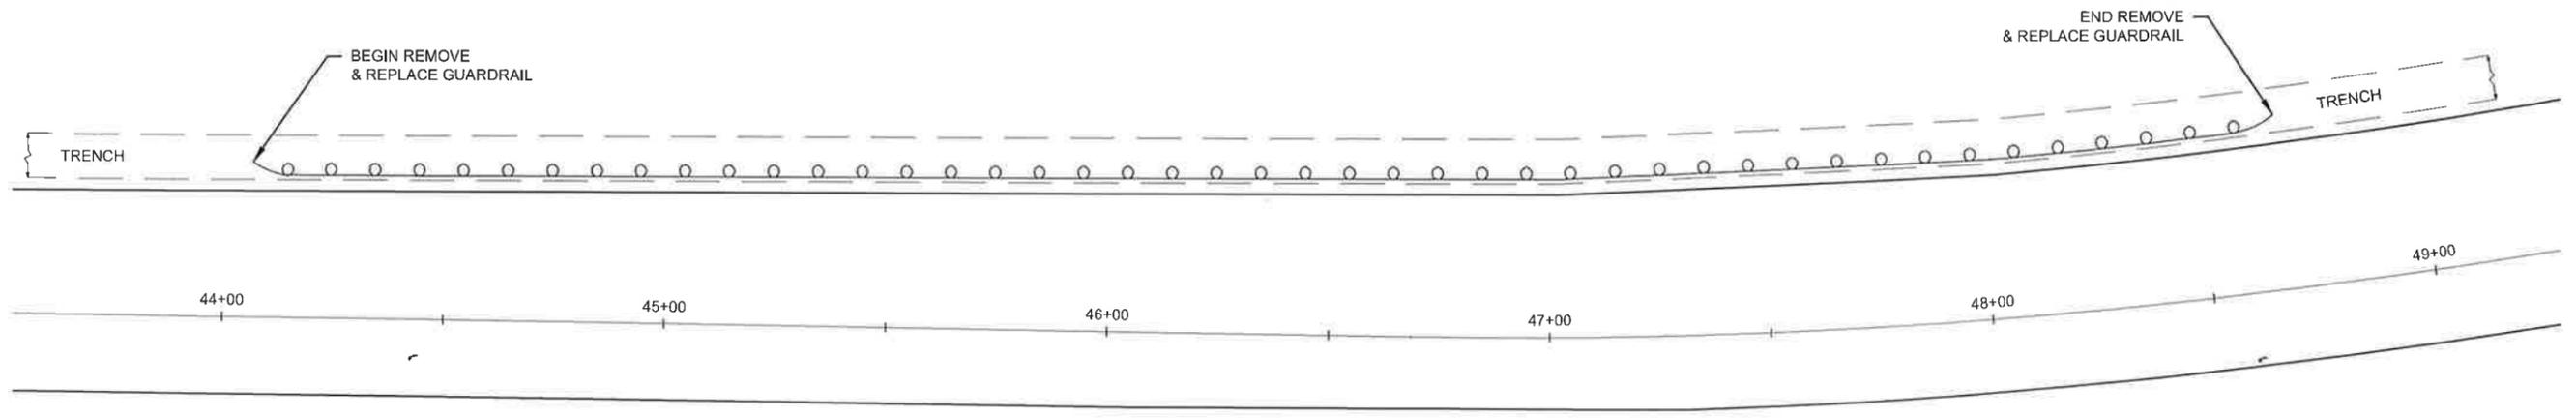


REMOVE & REPLACE GUARDRAIL
3RD AVE STA 44+00 TO STA 48+75

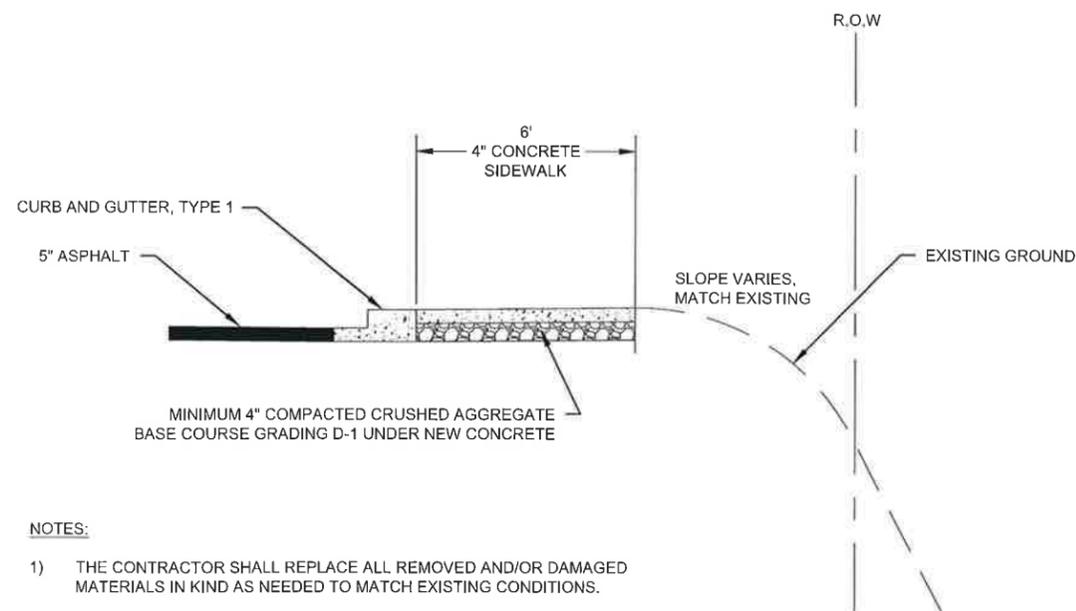

NOTES:

- 1) THE CONTRACTOR SHALL REPLACE ALL REMOVED AND/OR DAMAGED MATERIALS IN KIND AS NEEDED TO MATCH EXISTING CONDITIONS.

SIDEWALK AND CURB AND GUTTER REPLACEMENT SECTION
3RD AVE STA 69+10 TO STA 69+30

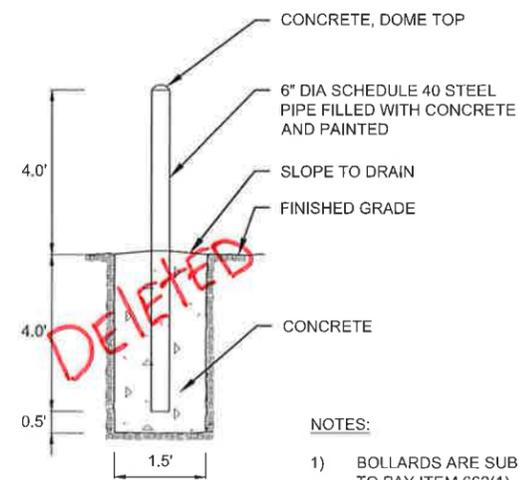

NOTES:

- 1) BOLLARDS ARE SUBSIDIARY TO PAY ITEM 662(1)

Project As Built Drawings Have Been Reviewed By The Project Engineer & Represent, To The Best Of My Knowledge, The Project As Constructed.

Proj. Eng. *MB*

Date *1/16/16*


DO NOT SCALE FROM THESE DRAWINGS USE DIMENSIONS

CHECKED BY: I NAME 		STATE OF ALASKA DEPARTMENT OF TRANSPORTATION & PUBLIC FACILITIES SOUTHEAST REGION	
DESIGNED BY: I NAME DRAWN BY: I NAME		KETCHIKAN ADVANCE WATER STREET TRUNK LINE RELOCATION	
PATH: Z:\PROJECT\1744.00 DOT_SE WATER STREET VIADUCT\CIVIL\CAD\ADV UTILITY RELO\1744.00-E SHEETS(AUR)		PROJECT DESIGNATION BR-000S(735) ~ 69548	YEAR 2014
SHEET NO. E01	TOTAL SHEETS 78	PLOT DATE: 8/28/2014 12:06 PM	

~~**BOLLARD DETAIL**~~


LEGEND

-  **DISTURBED AREA**
-  **BONDED FIBER MATRIX**
-  **FIBER ROLL**
-  **INLET PROTECTION**

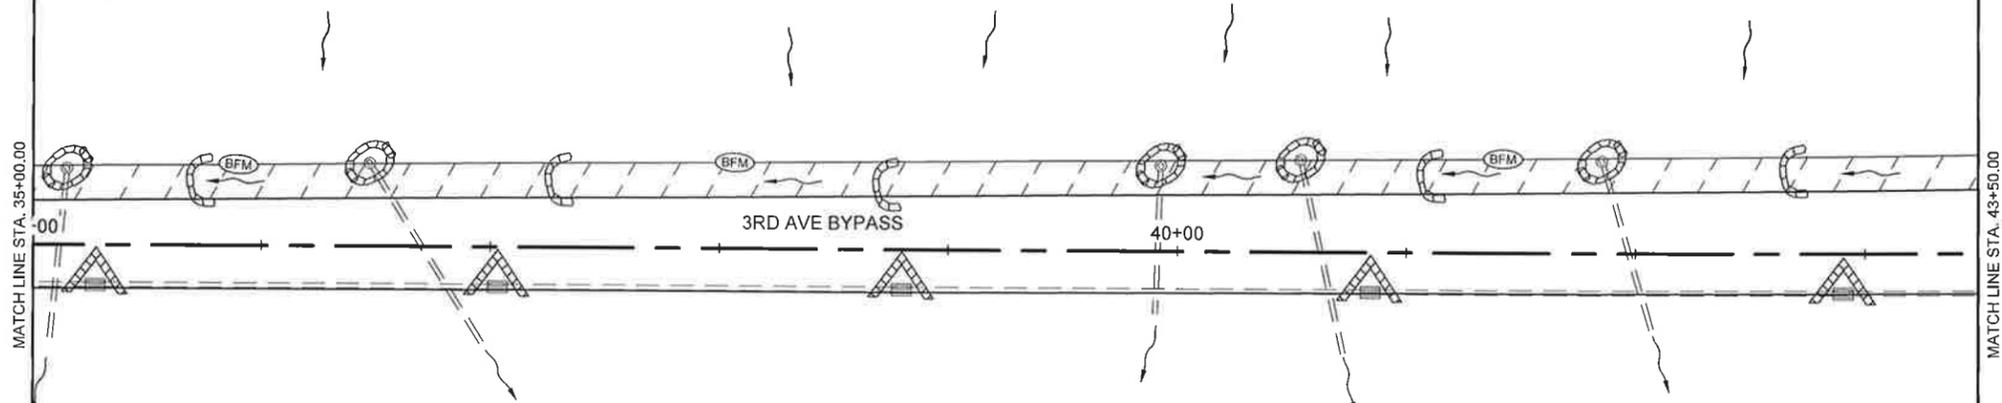

NOTES:

- 1) SEE SHEET P05 FOR BEST MANAGEMENT PLAN (BMP) DETAILS.
- 2) PLACE BONDED FIBER MATRIX (BFM) AND SEED ON ALL GROUND DISTURBED BY CONSTRUCTION ACTIVITIES.

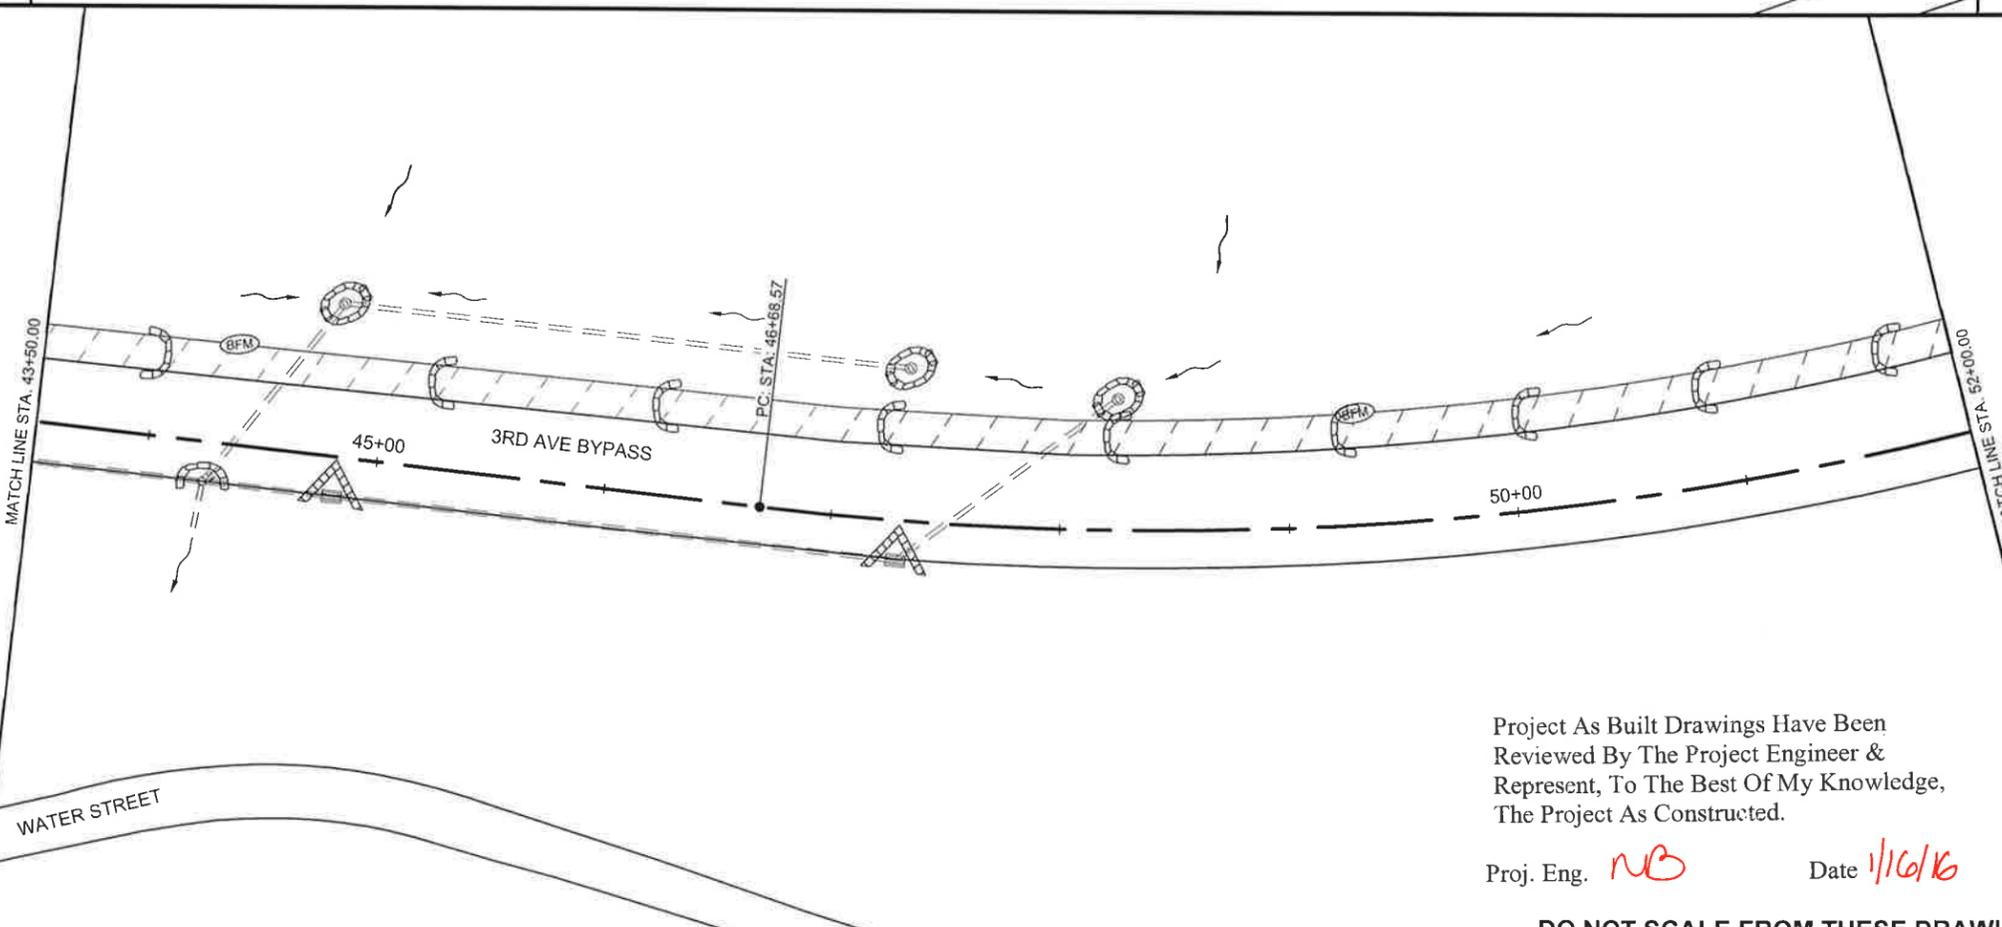

Project As Built Drawings Have Been Reviewed By The Project Engineer & Represent, To The Best Of My Knowledge, The Project As Constructed.

Proj. Eng. *MB* Date *1/16/16*

DO NOT SCALE FROM THESE DRAWINGS USE DIMENSIONS

PATH:Z:\PROJECT\1744.00 DOT_SE WATER STREET VIADUCT\CIVIL\CAD\ADV UTILITY RELO\1744.00-P SHEETS(AUR).DWG


RYAN REDICK
TAB: P02 8/29/2014 3:55 PM

ADDENDUM NUMBER

ATTACHMENT NUMBER

RECORD OF REVISIONS

No.	DATE	DESCRIPTION

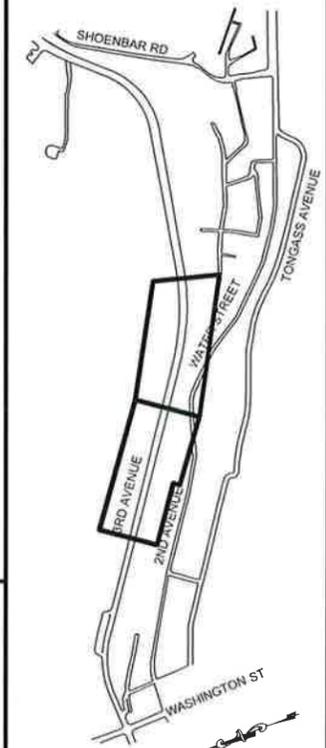

PLAN LEGEND

CHECKED BY: I.NAME



DESIGNED BY: I.NAME

DRAWN BY: I.NAME

STATE OF ALASKA
DEPARTMENT OF TRANSPORTATION
& PUBLIC FACILITIES
SOUTHEAST REGION

KETCHIKAN ADVANCE
WATER STREET TRUNK LINE
RELOCATION


EROSION SEDIMENT CONTROL PLAN

PROJECT DESIGNATION

BR-000S(735) ~ 69548

STATE	YEAR
ALASKA	2014

SHEET NUMBER	TOTAL SHEETS
P02	73

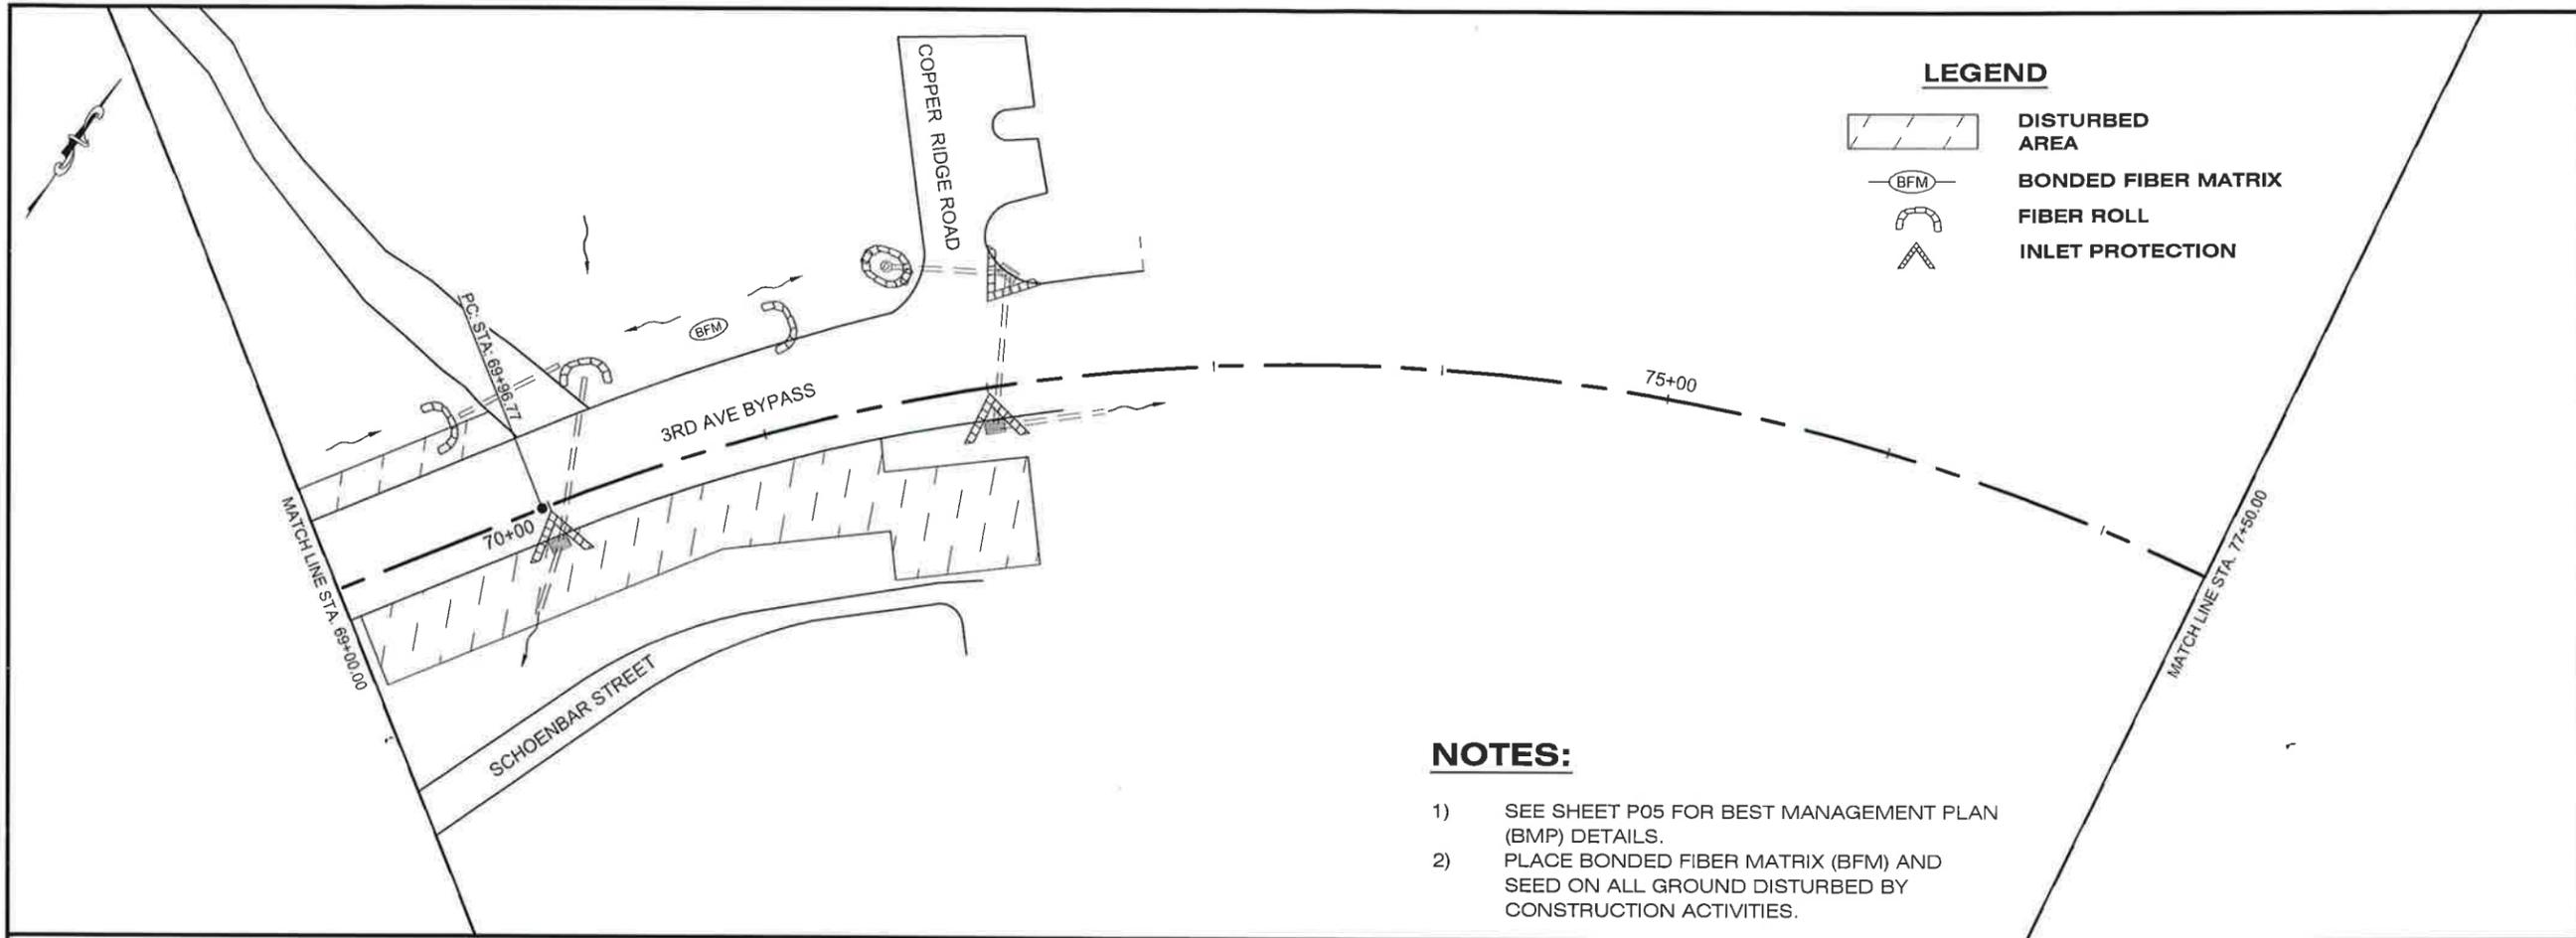

LEGEND

-  **DISTURBED AREA**
-  **BONDED FIBER MATRIX**
-  **FIBER ROLL**
-  **INLET PROTECTION**



NOTES:

- 1) SEE SHEET P05 FOR BEST MANAGEMENT PLAN (BMP) DETAILS.
- 2) PLACE BONDED FIBER MATRIX (BFM) AND SEED ON ALL GROUND DISTURBED BY CONSTRUCTION ACTIVITIES.

PATH: Z:\PROJECT\1744.00 DOT_SE WATER STREET VIADUCT\CIVIL\CAD\ADV UTILITY RELO\1744.00-P SHEETS(AUR).DWG

RYAN REDICK
TAB: P04 8/29/2014 3:55 PM

ADDENDUM NUMBER		
ATTACHMENT NUMBER		
RECORD OF REVISIONS		
No.	DATE	DESCRIPTION

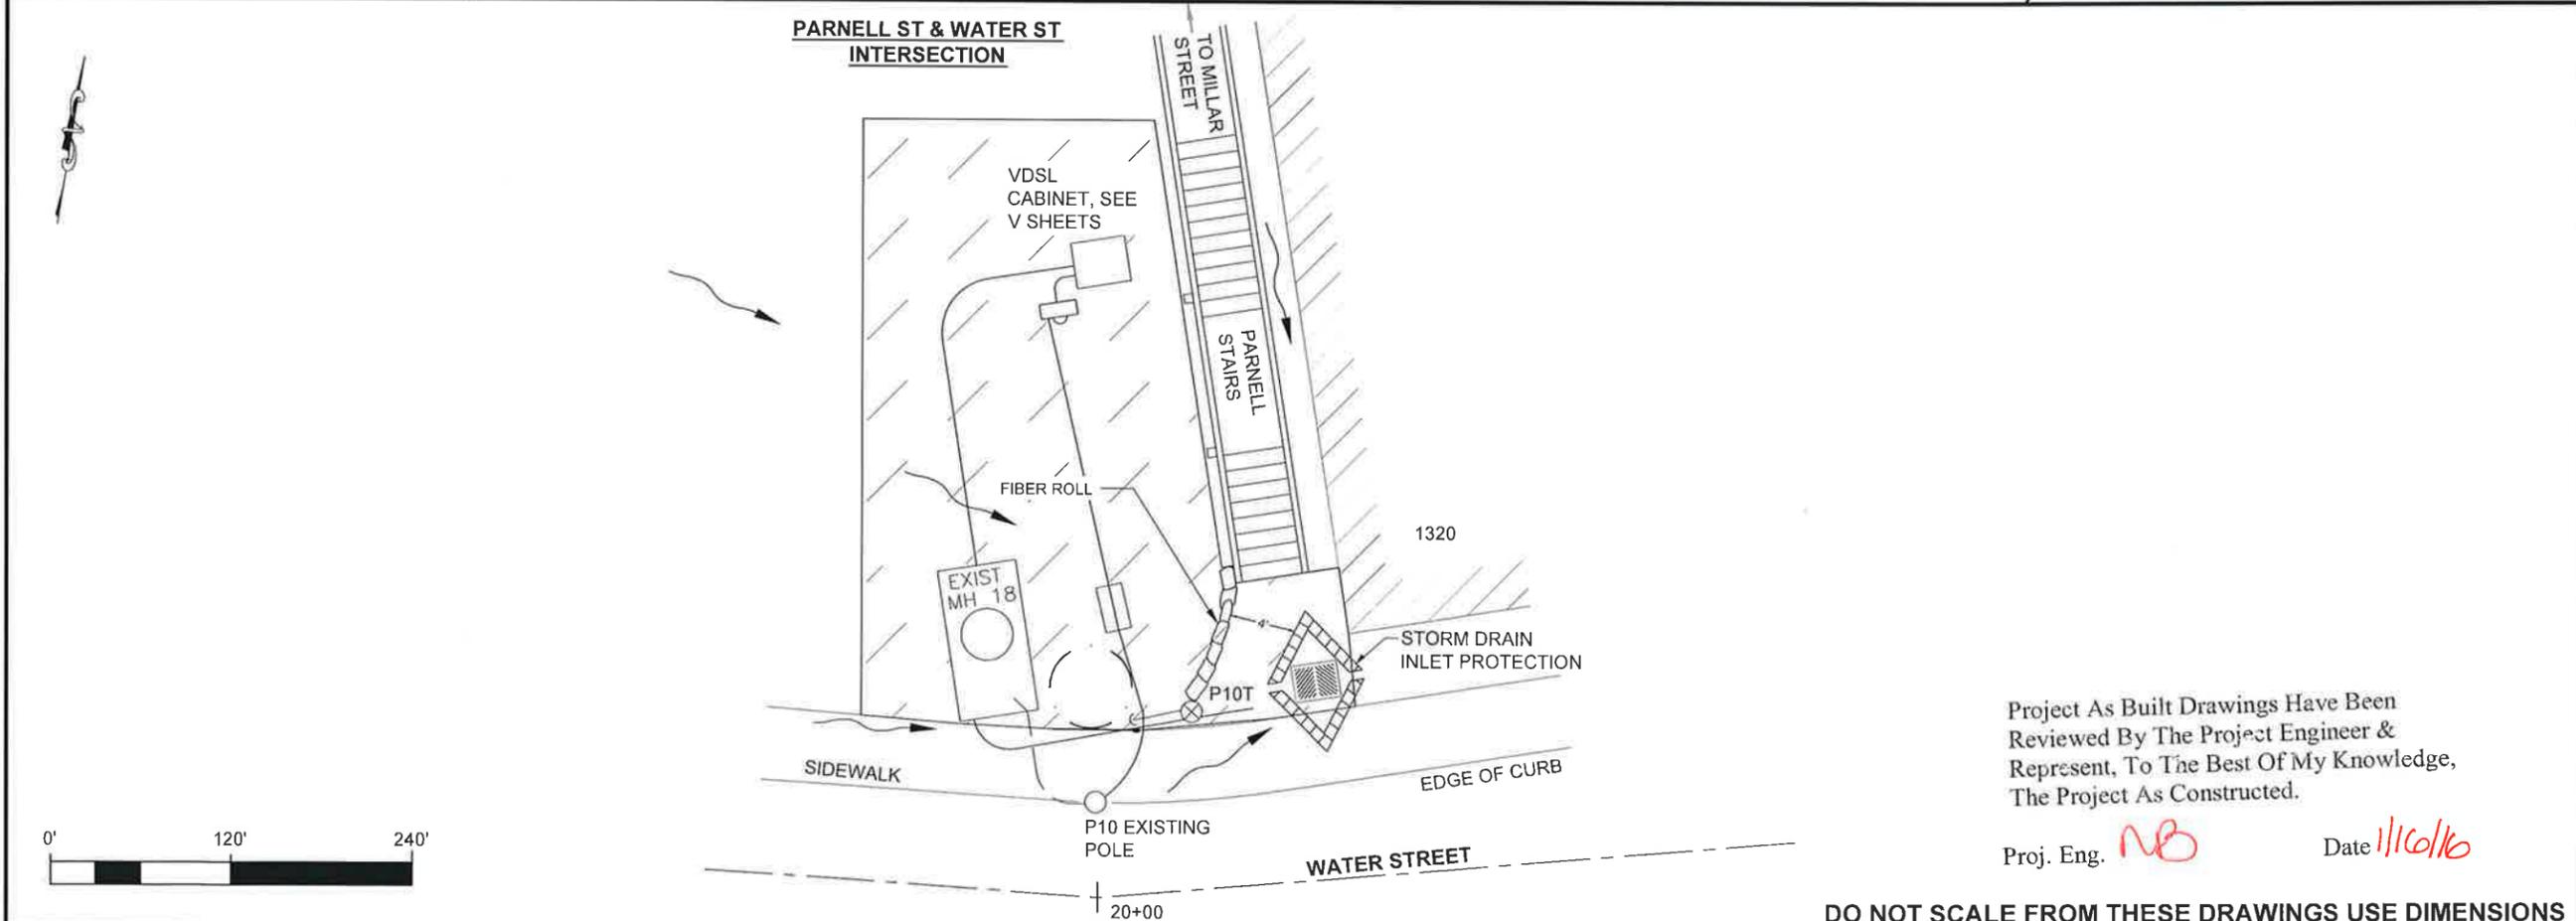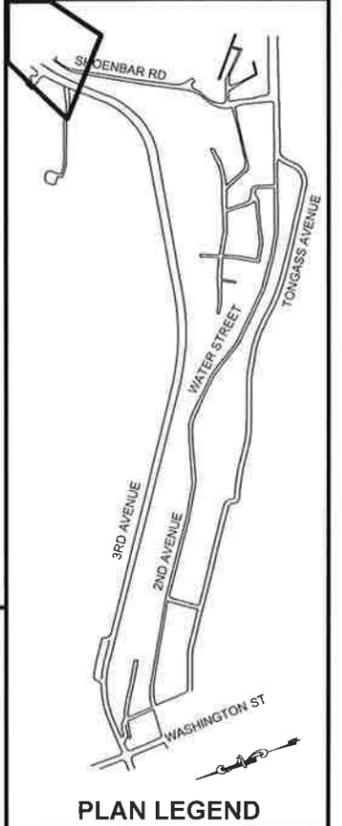

Project As Built Drawings Have Been Reviewed By The Project Engineer & Represent, To The Best Of My Knowledge, The Project As Constructed.

Proj. Eng. *NR* Date *11/16/16*

DO NOT SCALE FROM THESE DRAWINGS USE DIMENSIONS

CHECKED BY: I.NAME



DESIGNED BY: I.NAME
DRAWN BY: I.NAME

STATE OF ALASKA
DEPARTMENT OF TRANSPORTATION & PUBLIC FACILITIES
SOUTHEAST REGION

KETCHIKAN ADVANCE
WATER STREET TRUNK LINE
RELOCATION


EROSION SEDIMENT CONTROL PLAN

PROJECT DESIGNATION
BR-000S(735) ~ 69548

STATE	YEAR
ALASKA	2014
SHEET NUMBER	TOTAL SHEETS
P04	78

TRAFFIC CONTROL NOTES

- 1) IT IS THE INTENT OF THIS TRAFFIC CONTROL PLAN (TCP) TO ILLUSTRATE SOME BUT NOT ALL OF THE TRAFFIC CONTROL CONFIGURATIONS REQUIRED BY THIS PROJECT. TCPs FOR CONFIGURATIONS NOT COVERED BY THIS TCP SHALL BE DEVELOPED BY THE CONTRACTOR AND SUBMITTED TO THE ENGINEER FOR APPROVAL PRIOR TO USE.
- 2) THE CONTRACTOR SHALL KEEP THE PUBLIC INFORMED OF ONGOING CONSTRUCTION ACTIVITIES THROUGH THE USE OF THE LOCAL NEWS MEDIA. NEWS RELEASES SHALL BE APPROVED BY THE ENGINEER PRIOR TO THE RELEASE.
- 3) MAINTAIN PEDESTRIAN ACCESS SIMILAR TO THE EXISTING PEDESTRIAN ROUTES.
- 4) MAINTAIN A MINIMUM OF ONE LANE AT ALL TIMES, THROUGH ALL WORK AREAS.
- 5) MAINTAIN TWO LANES AT ALL TIMES IN NON-WORK AREAS AND DURING NON-WORK HOURS.
- 6) TEMPORARY DRIVING LANES SHALL HAVE A MINIMUM WIDTH OF 10'-0".
- 7) USE WORK ZONE DOUBLE TRAFFIC FINES AS DIRECTED BY THE ENGINEER AND PER STANDARD DRAWING C-04.12.
- 8) USE WARNING LIGHTS ON ALL CHANNELIZING DEVICES PLACED ALONG OR AROUND ROADWAY HAZARDS.
- 9) THE LENGTH OF A TWO-WAY ONE LANE WORK AREA MAY BE REDUCED TO AVOID EXCESSIVE TRAFFIC DELAYS AS DIRECTED BY THE ENGINEER.

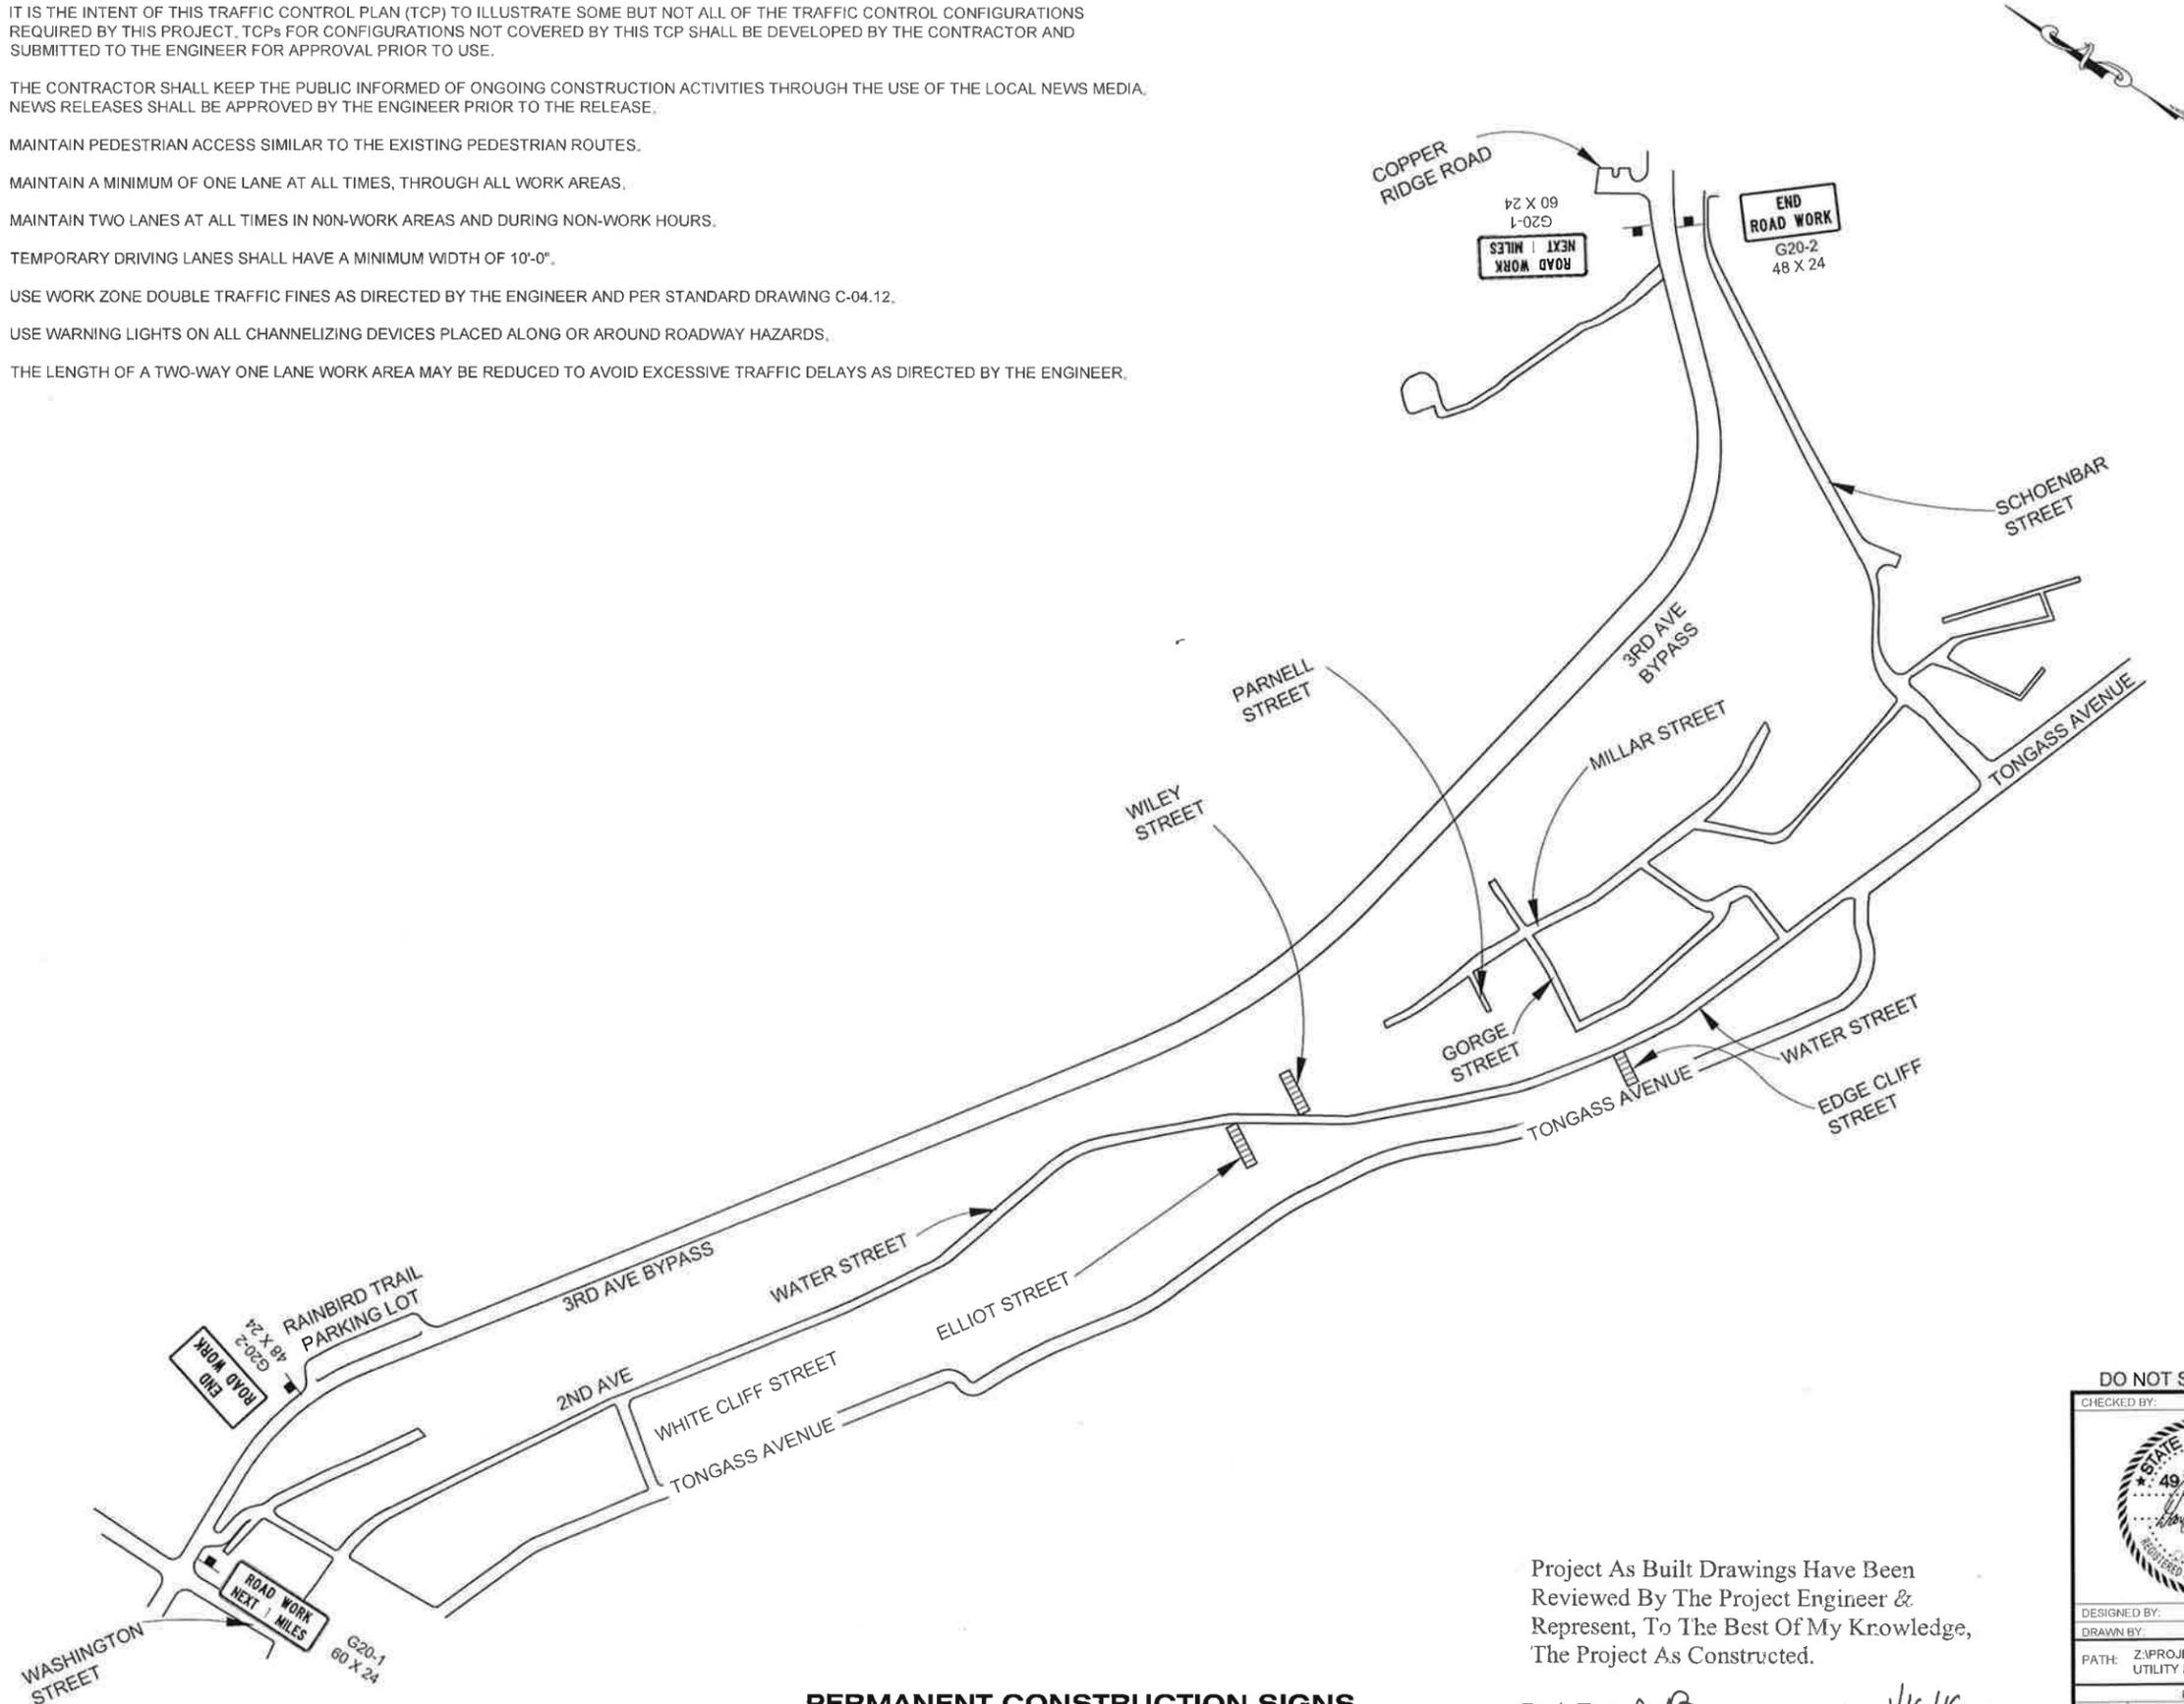


PERMANENT CONSTRUCTION SIGNS

Project As Built Drawings Have Been Reviewed By The Project Engineer & Represent, To The Best Of My Knowledge, The Project As Constructed.


Proj. Eng. *NB* Date *1/16/16*

DO NOT SCALE FROM THESE DRAWINGS USE DIMENSIONS

CHECKED BY: I NAME 		STATE OF ALASKA DEPARTMENT OF TRANSPORTATION & PUBLIC FACILITIES SOUTHEAST REGION									
DESIGNED BY: I NAME DRAWN BY: I NAME		KETCHIKAN ADVANCE WATER STREET TRUNK LINE RELOCATION									
PATH: Z:\PROJECT\1744.00 DOT_SE WATER STREET VIADUCT\CIVIL\CAD\ADV UTILITY\REL\1744.00-T SHEETS(AUR)		PLOT DATE: 8/28/2014 12:07 PM									
<table border="1"> <thead> <tr> <th>NO.</th> <th>DATE</th> <th>DESCRIPTION</th> </tr> </thead> <tbody> <tr> <td> </td> <td> </td> <td> </td> </tr> </tbody> </table>		NO.	DATE	DESCRIPTION				PROJECT DESIGNATION BR-000S(735) ~ 69548	YEAR 2014	SHEET NO. T01	TOTAL SHEETS 78
NO.	DATE	DESCRIPTION									

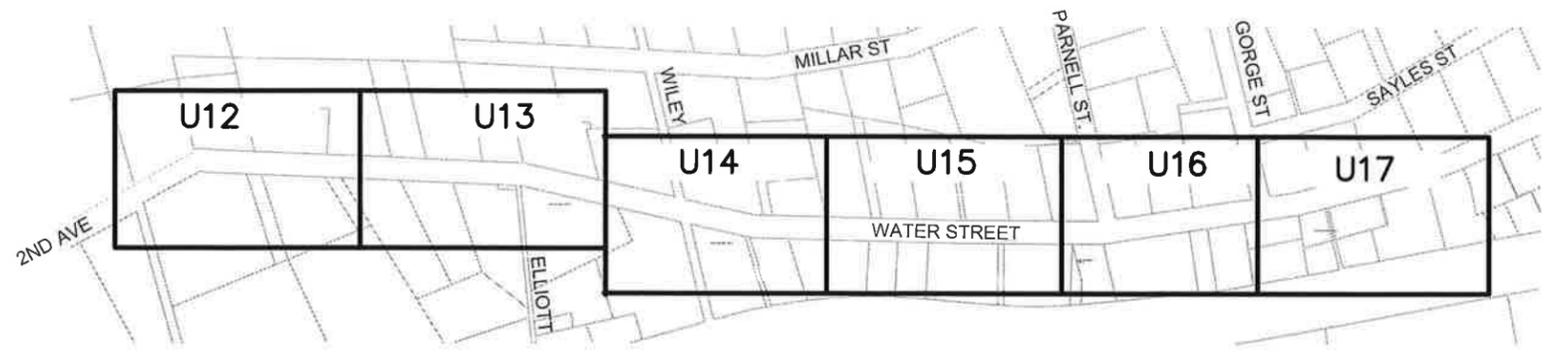

WATER STREET BRIDGE KEY PLAN

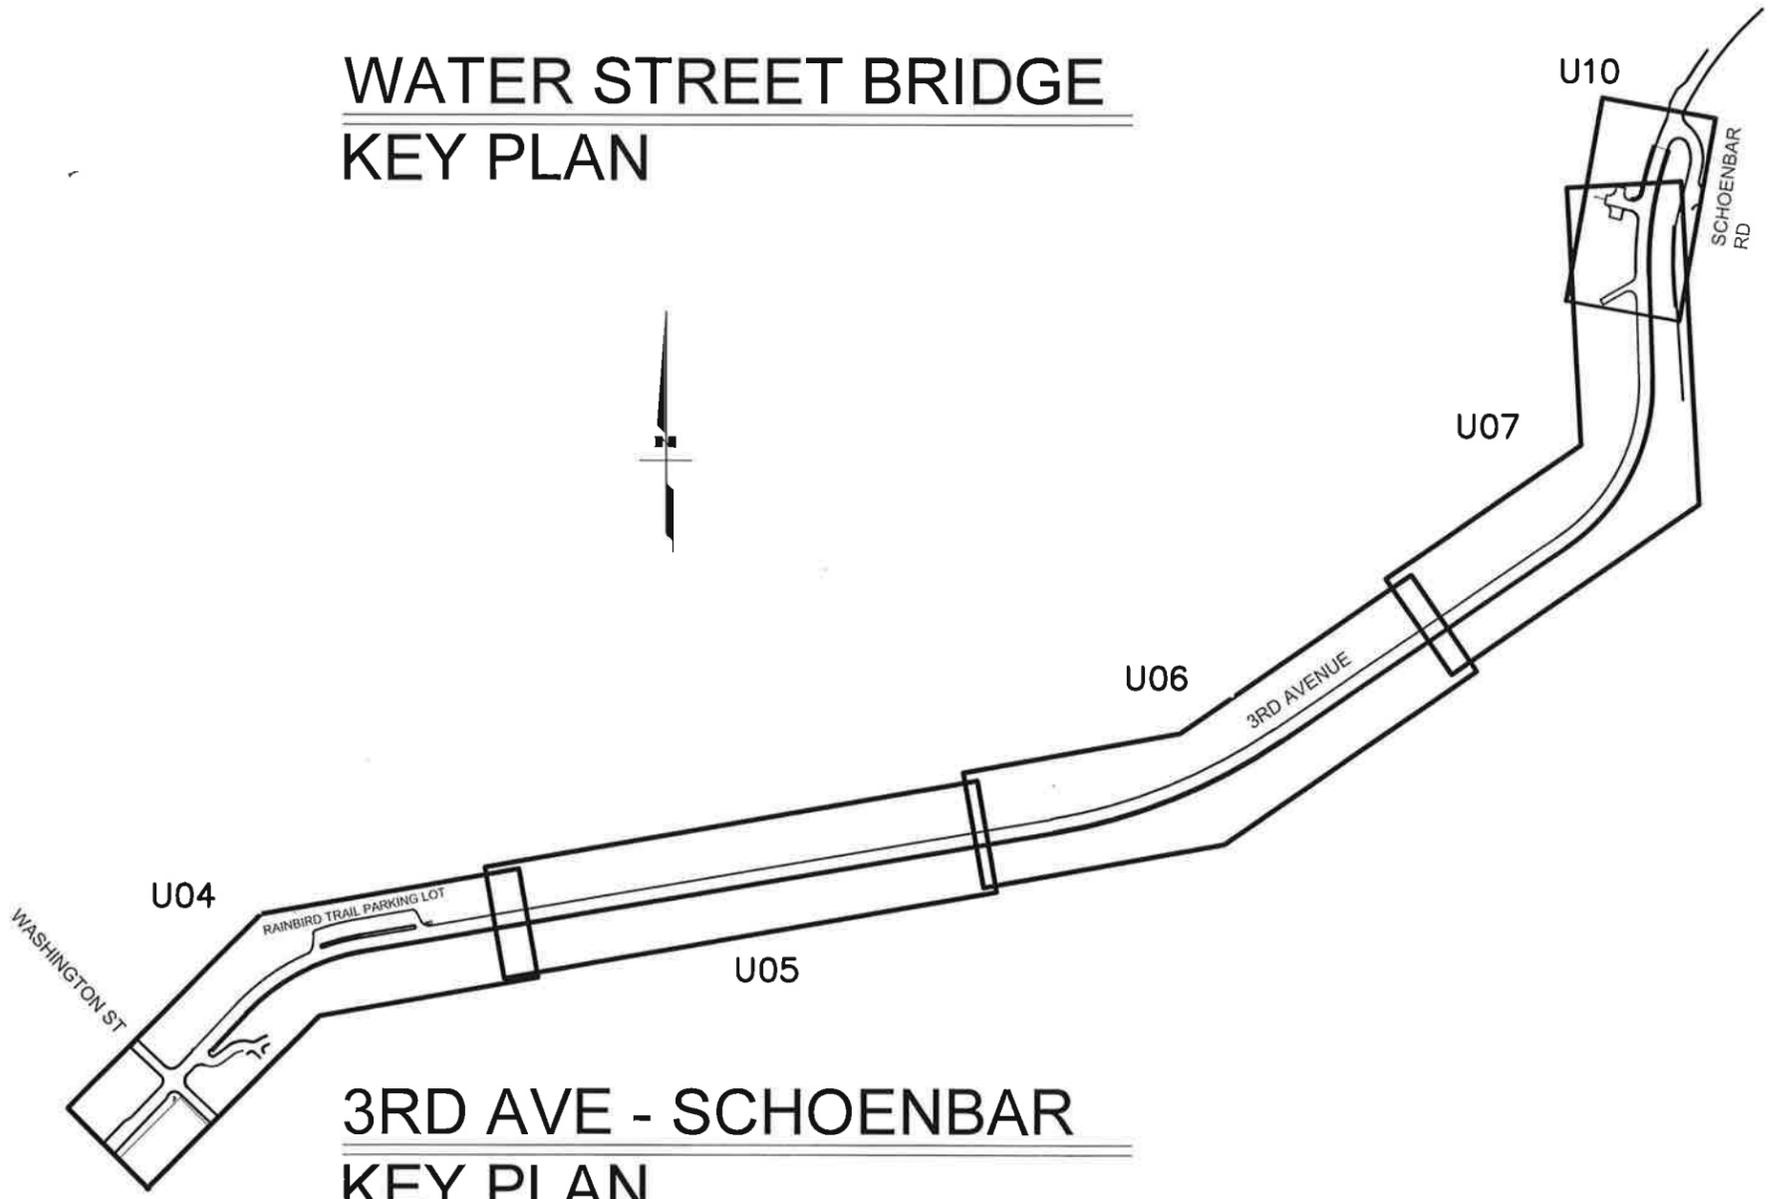


3RD AVE - SCHOENBAR KEY PLAN

Project As Built Drawings Have Been Reviewed By The Project Engineer & Represent, To The Best Of My Knowledge, The Project As Constructed.

Proj. Eng. *NO* Date *1/16/16*

DO NOT SCALE FROM THESE DRAWINGS USE DIMENSIONS

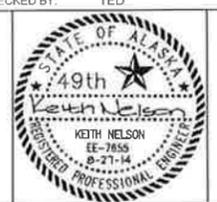	STATE OF ALASKA DEPARTMENT OF TRANSPORTATION & PUBLIC FACILITIES SOUTHEAST REGION KETCHIKAN - WATER STREET: BRIDGE PROJECT #69548 ADVANCE UTILITY RELOCATION																	
DESIGNED BY: KCN DRAWN BY: KCN	UTILITY KEY PLAN																	
PATH: C:\USERS\KCN12_000\DOCUMENTS\0-KNEE\2013\WSB DESIGN\3RD AVE - SCHOENBAR TRUNK RELOCATION\WSB AUR U01-12-17 BRIDGE.DWG TAB:																		
<table border="1" style="width: 100%; border-collapse: collapse;"> <thead> <tr> <th colspan="3">REVISIONS</th> </tr> <tr> <th>NO.</th> <th>DATE</th> <th>DESCRIPTION</th> </tr> </thead> <tbody> <tr> <td> </td> <td> </td> <td> </td> </tr> </tbody> </table>	REVISIONS			NO.	DATE	DESCRIPTION				<table border="1" style="width: 100%; border-collapse: collapse;"> <tr> <td>PROJECT DESIGNATION</td> <td>YEAR</td> <td>SHEET NO.</td> <td>TOTAL SHEETS</td> </tr> <tr> <td>BR-000S(735) ~69548</td> <td>2014</td> <td>U01</td> <td>78</td> </tr> </table>	PROJECT DESIGNATION	YEAR	SHEET NO.	TOTAL SHEETS	BR-000S(735) ~69548	2014	U01	78
REVISIONS																		
NO.	DATE	DESCRIPTION																
PROJECT DESIGNATION	YEAR	SHEET NO.	TOTAL SHEETS															
BR-000S(735) ~69548	2014	U01	78															

INSTALL UNDERGROUND CONDUITS RUN IN EXISTING TRENCH FROM RAINBIRD PARKING LOT TO 3RD AVE CROSSING, NEW TRENCH ACROSS 3RD TO SCHOENBAR ISLAND. CONDUITS INCLUDE
 662(1) = 6" C FOR NEW 34.5KV UNDERGROUND CIRCUIT,
 (1) 6" SPARE FOR FUTURE ELECTRIC CIRCUIT
 662(2) = (1) 4" C SPARE KPU-T
 662(3) = (2) 4" C SPARE KPU-T & 1 4" KPU-E

INSTALL KPU SCHOENBAR RISER POLE P2SR, INSTALL NEW (2) 6" C ONE W/ NEW 34.5KV UNDERGROUND CABLING. TIE INTO EXISTING 34.5KV AERIAL DISTRIBUTION AT POLE P2S.

EXISTING RUN (2) 6" C, (4) 4", & (2) 2" FROM KPU RISER POLE P1W ON WASHINGTON STREET TO RAINBIRD PARKING LOT.

AFTER THE NEW 35KV CIRCUIT IS ENERGIZED, REMOVE THE 34.5KV LINE FROM P1M TO POLE P10, REMOVE THE CROSSARMS FROM P1M AND P10. REMOVE INSULATORS FROM P10B.

NEW UNDERGROUND 34.5KV CUT NEW TRENCH ACROSS 3RD AVE & SCHOENBAR ISLAND

EXISTING KPU-T CABINETS INSTALL PULL BOX W/ NEW CONDUITS, VDSL HARDWARE IN EXISTING CABINET, NEW CABLING IN EXIST CONDUIT, AND RESPLICE AERIAL TERMINALS, SEE V SHEETS

NEW UNDERGROUND CIRCUIT: 6" C W/ (3) 350MCM 35KV CABLES & 6" C SPARE RUN IN EXISTING 6" FROM WASHINGTON P1R TO RAINBIRD & NEW CONDUITS RAINBIRD TO SHOENBAR P2R

EXISTING KPU AERIAL 34.5KV SUBTRANSMISSION LINE ALONG SCHOENBAR RD, LINE RUNS TO POLE P10 AT THE BASE OF PARNELL, THEN WEST ON WATER STREET.

START OF NEW 35KV CIRCUIT AT EXISTING WASHINGTON STREET KPU RISER POLE, P1W

EXISTING KPU 34.5KV AERIAL TO BETHE SUBSTATION

EXISTING 34.5KV AERIAL TO RISER POLE AT PLAZA MALL (WASHINGTON & TONGASS)

SEE V SHEETS FOR ADDITIONAL COMM WIRING INCLUDING NEW VDSL CABINET AT PARNELL STAIRS AND NEW HARDWARE IN SCHOENBAR VDSL CABINET WITH CABLE TO P2S PULLED IN EXISTING CONDUIT

EXISTING OVERHEAD POLE LINE ALONG WATER STREET:


- A DEADENDS AND GUYS AT POLE P1 AND P10
- B COMMUNICATION GUYS AT POLES P3 AND P12
- C JUMPER 12.47KV TO TOP TIER (FORMERLY 34.5KV) AT POLES P1 AND P10 REMOVE EXISTING 12.47KV TIER P3-P10 CROSSARMS, CONDUCTORS P1-P10.
- D MOVE 120/240V DISTRIBUTION, SYSTEM NEUTRAL, STREET LIGHTS, TRANSFORMERS UP POLES P4-P11. EXTEND OVHD SERVICE DROPS AS NEEDED.
- E
- F INSTALL NEW VDSL CABINET AT PARNELL AND INSTALL HARDWARE IN EXISTING SCHOENBAR VDSL CABINET
- G INSTALL NEW STRAND P3-P10 & P10T-P12,
- H RELOCATE KPU-T FIBER OPTIC DISTRIBUTION CABLE P3-P10. INSTALL NEW FIBER DROPS AND ONTs TO THE HOME. DEMO COPPER SERVICE DROPS & NIDs.
- I REMOVE EXISTING KPU-T COPPER DISTRIBUTION UNDERBRIDGE AND AERIAL P3-P12.
- J COORD W/ GCI TO HAVE THEM RAISE THEIR INFRASTRUCTURE & DROPS P3-P13

Project As Built Drawings Have Been Reviewed By The Project Engineer & Represent, To The Best Of My Knowledge, The Project As Constructed.

Proj. Eng. *NB*

Date *1/16/16*

DO NOT SCALE FROM THESE DRAWINGS USE DIMENSIONS

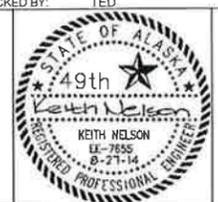CHECKED BY: TED 		STATE OF ALASKA DEPARTMENT OF TRANSPORTATION & PUBLIC FACILITIES SOUTHEAST REGION KETCHIKAN ADVANCE WATER STREET TRUNK LINE RELOCATION PROJECT #69548	
DESIGNED BY: KCN DRAWN BY: KCN		ELECTRICAL SITE PLAN	
PATH: C:\USER\KCN12_000\DOCUMENTS\0-KNE\2013\WB DESIGN\13\DWG10-NTP9 TRUNK RELOCATION\WB APR U03 OVERALL PLAN.DWG TAB: U03 KCN12_000		PROJECT DESIGNATION: BR-000S(735) 2014 U03	
REVISIONS NO. DATE DESCRIPTION		YEAR: 2014	SHEET NO.: U03
		TOTAL SHEETS: 78	





GENERAL NOTES:

A. EXISTING ELECTRICAL EQUIPMENT AND CIRCUITING IS TO REMAIN UNLESS OTHERWISE NOTED. THE DRAWINGS SHOW EXISTING TRENCH, ELECTRICAL CIRCUITS AND WATER LINE BASED ON AS-BUILT INFO. FIELD CONFIRM ALL INFO.

B. THERE ARE TWO EXISTING 6" RUN FROM THE WASHINGTON STREET RISER POLE TO THE RAINBIRD PARKING LOT JBOX. EXTEND THE (2) EXISTING 6" FROM THE RAINBIRD PARKING LOT JBOX TO SCHOENBAR W/ (2) NEW 6". ONE CONDUIT IS A SPARE. IN THE OTHER CONDUIT INSTALL #350MCM 35KV 3/C CABLING FROM THE WASHINGTON STREET RISER POLE TO THE SCHOENBAR RISER POLE. CONNECT NEW CABLE TO EXISTING 34.5KV OVERHEAD DISTRIBUTION SYSTEM.

C. AN EXISTING TRENCH, WHICH WAS BLASTED OUT OF A ROCK SUBSTRATE, RUNS FROM THE RAINBIRD PARKING LOT TO SCHOENBAR ON THE UPHILL SIDE OF 3RD AVE. DIG INTO THE EXISTING TRENCH TO INSTALL NEW CONDUIT RUNS. FIELD LOCATE ALL EXISTING WATER LINE VALVES, HYDRANTS, UNDERGROUND CONDUIT RUNS, HANDHOLES, LIGHT FIXTURES, ETC. SEE TRENCH DETAILS U5. SEE SPEC SECTION 204 FOR TRENCH EXCAVATION AND OTHER CONSTRUCTION REQUIREMENTS.

D. SEE 2/U26, U18 & U19 FOR PULL BOX INSTALLATION INFO, 2/U11 FOR HYDRANT INFO. ADDITIONAL INFO ON 3RD AVE BYPASS CONSTRUCTION IS AVAILABLE ON DOT AS-BUILT DRAWINGS, SEE SPEC 662-1.02

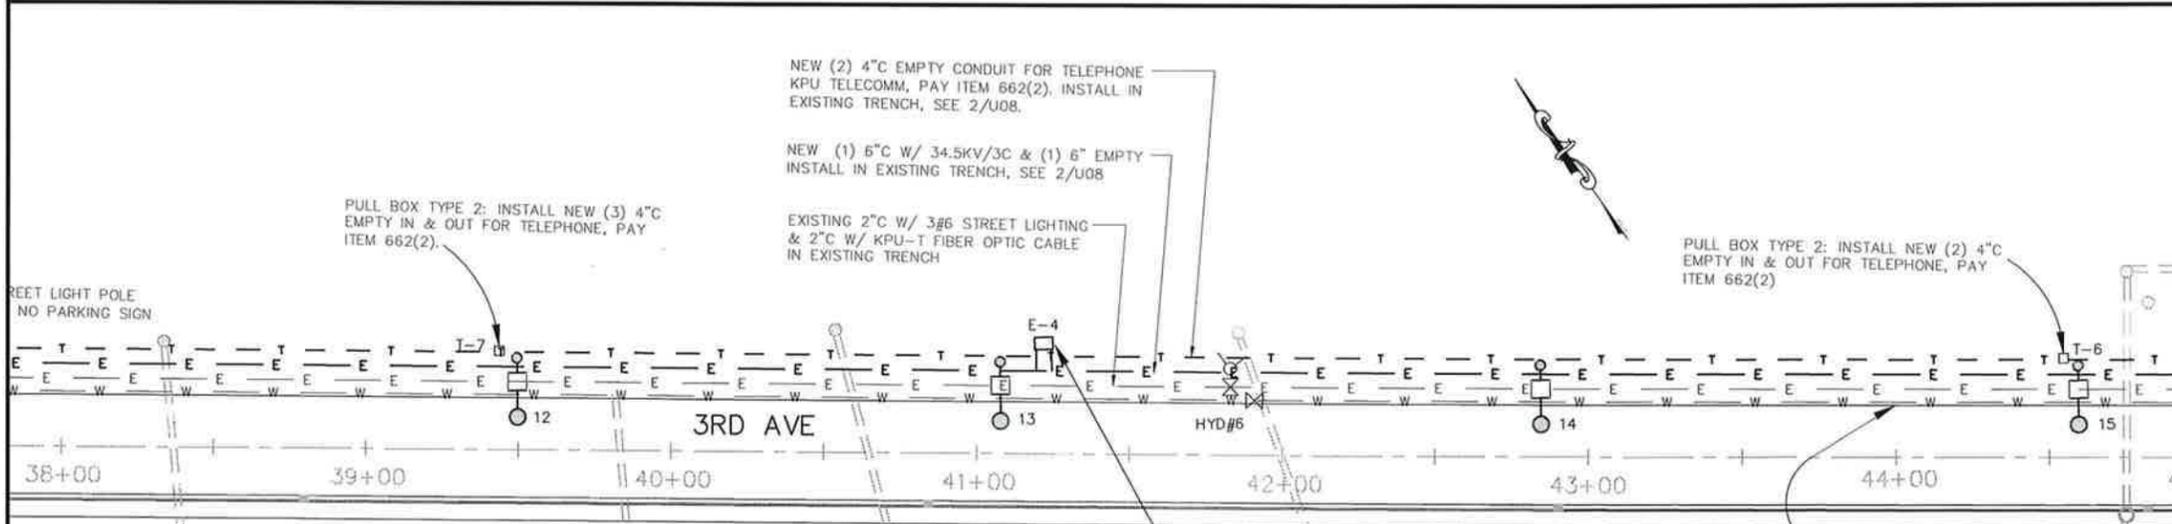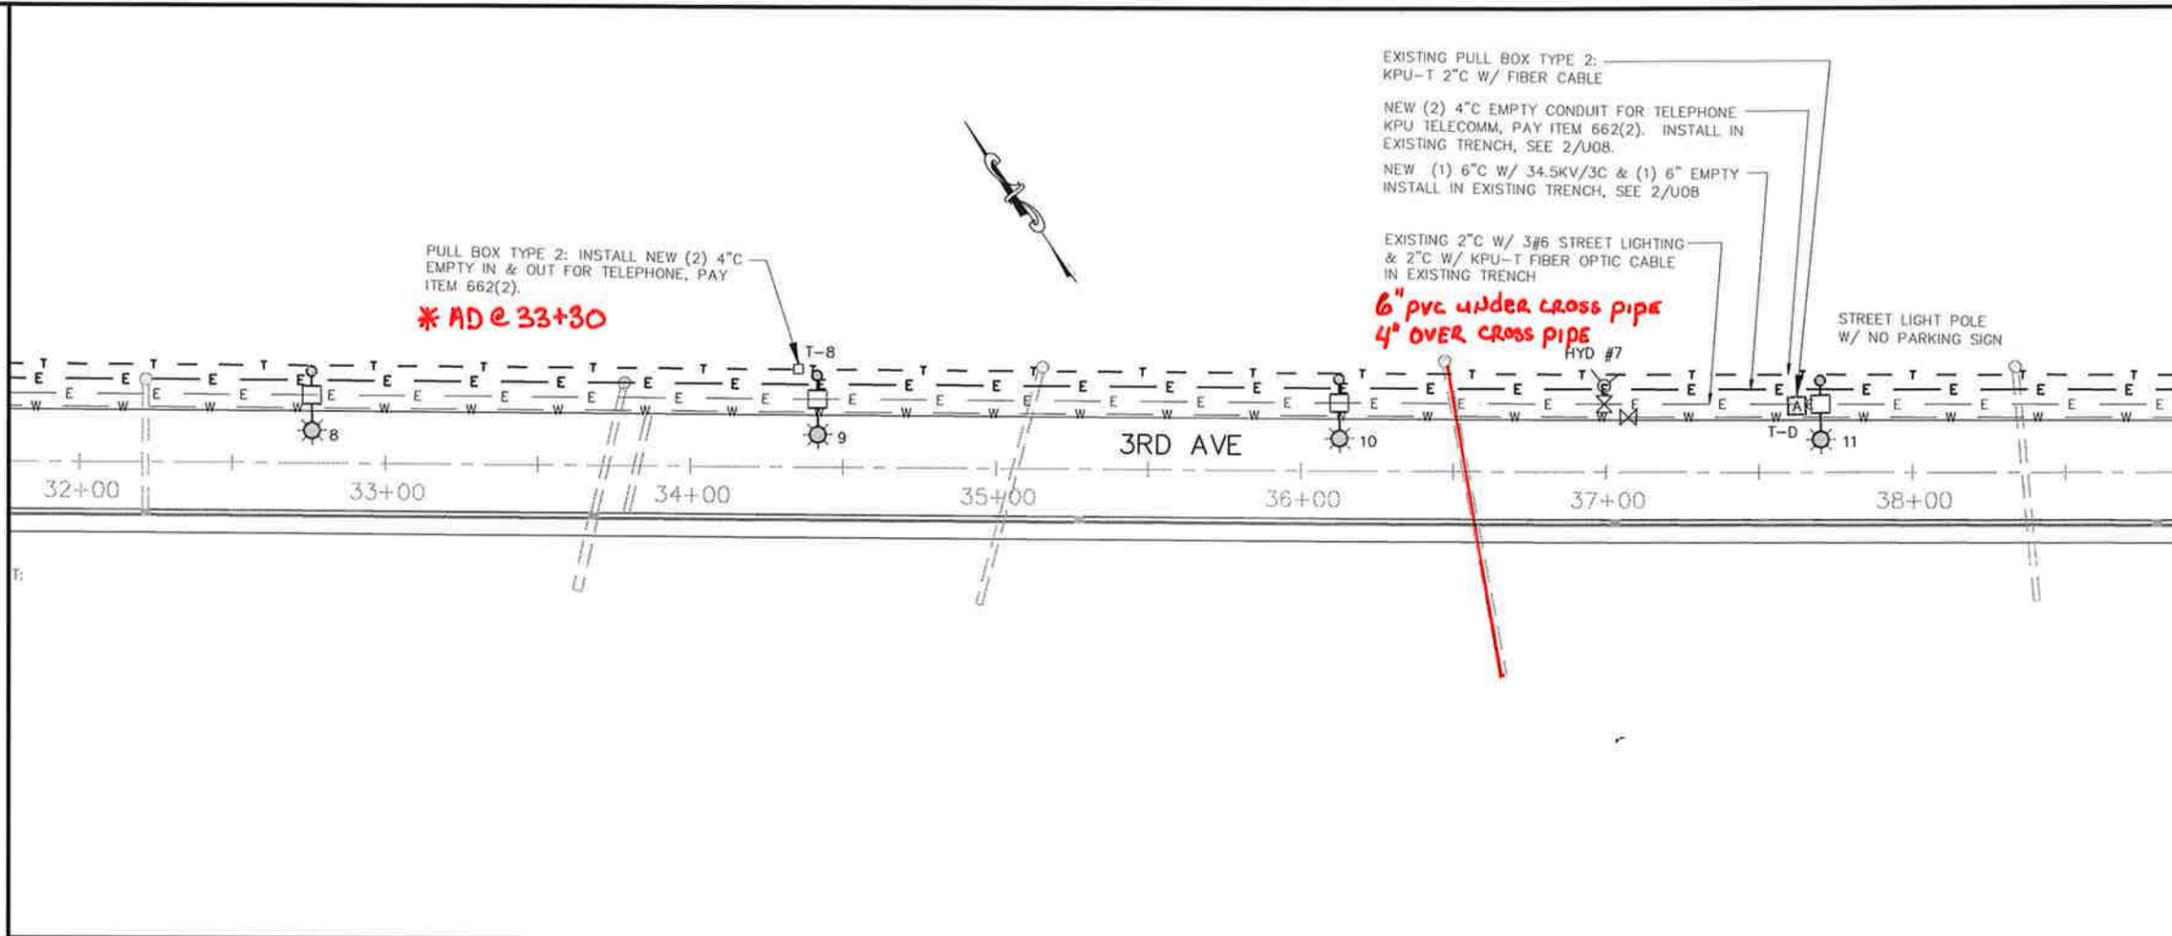

Project As Built Drawings Have Been Reviewed By The Project Engineer & Represent, To The Best Of My Knowledge, The Project As Constructed.


Proj. Eng. *MB* Date *1/16/16*

DO NOT SCALE FROM THESE DRAWINGS USE DIMENSIONS

PATH:XXX

KCN12_000
TAB: U05 8/28/2014 10:45 AM

ADDENDUM NUMBER		
ATTACHMENT NUMBER		
RECORD OF REVISIONS		
No	DATE	DESCRIPTION

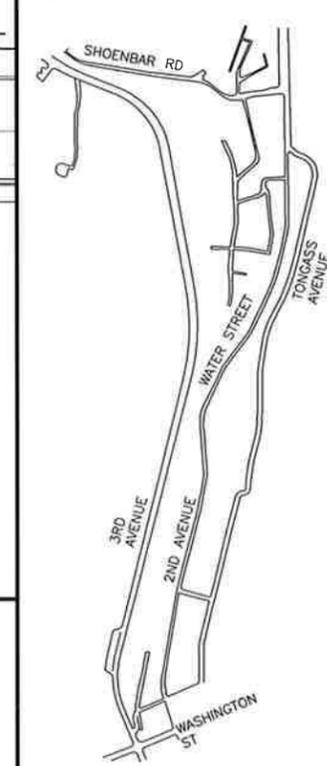

PLAN LEGEND

CHECKED BY: TED

DESIGNED BY: KCN
DRAWN BY: KCN

STATE OF ALASKA
DEPARTMENT OF TRANSPORTATION & PUBLIC FACILITIES
SOUTHEAST REGION

KETCHIKAN ADVANCE
WATER STREET TRUNK LINE
RELOCATION
PROJECT # 69548

UTILITY PLAN ELECTRICAL 3rd AVE

PROJECT DESIGNATION	
BR-000S(735) ~ 69548	
STATE	YEAR
ALASKA	2014
SHEET NUMBER	TOTAL SHEETS
U05	78

GENERAL NOTES:

A. EXISTING ELECTRICAL EQUIPMENT AND CIRCUITING IS TO REMAIN UNLESS OTHERWISE NOTED. THE DRAWINGS SHOW EXISTING TRENCH, ELECTRICAL CIRCUITS AND WATER LINE BASED ON AS-BUILT INFO. FIELD CONFIRM ALL INFO.

B. THERE ARE TWO EXISTING 6" C RUN FROM THE WASHINGTON STREET RISER POLE TO THE RAINBIRD PARKING LOT JBOX. EXTEND THE (2) EXISTING 6" C FROM THE RAINBIRD PARKING LOT JBOX TO SCHOENBAR W/ (2) NEW 6" C. ONE CONDUIT IS A SPARE. IN THE OTHER CONDUIT INSTALL #350MCM 35KV 3/C CABLING FROM THE WASHINGTON STREET RISER POLE TO THE SCHOENBAR RISER POLE. CONNECT NEW CABLE TO EXISTING 34.5KV OVERHEAD DISTRIBUTION SYSTEM.

C. AN EXISTING TRENCH, WHICH WAS BLASTED OUT OF A ROCK SUBSTRATE, RUNS FROM THE RAINBIRD PARKING LOT TO SCHOENBAR ON THE UPHILL SIDE OF 3RD AVE. DIG INTO THE EXISTING TRENCH TO INSTALL NEW CONDUIT RUNS. FIELD LOCATE ALL EXISTING WATER LINE VALVES, HYDRANTS, UNDERGROUND CONDUIT RUNS, HANDHOLES, LIGHT FIXTURES, ETC. SEE TRENCH DETAILS U5. SEE SPEC SECTION 204 FOR TRENCH EXCAVATION AND OTHER CONSTRUCTION REQUIREMENTS.


D. SEE 2/U26, U18 & U19 FOR PULL BOX INSTALLATION INFO, 2/U11 FOR HYDRANT INFO. ADDITIONAL INFO ON 3RD AVE BYPASS CONSTRUCTION IS AVAILABLE ON DOT AS-BUILT DRAWINGS, SEE SPEC 662-1.02

ELECTRICAL NOTES:

1. INSTALL 35KV RISER POLE P2SR PER KPU DETAIL AND TERMINATE THE UNDERGROUND CIRCUIT 35KV CABLES. INSTALL AERIAL CONDUCTOR TO CONNECT TO EXISTING POLE P2SC.
2. EXISTING MANHOLE MH3 (KPU-T) WITH EXISTING 2" C W/ FIBER CABLE FROM WASHINGTON RISER POLE AND (3) 4" C TO POLE P1S.
3. LOCATION OF THE STREET LIGHTING CIRCUIT CROSSING 3RD AVE PER AS-BUILT DRAWINGS. CONFIRM LOCATION
4. LOCATION OF THE WATER LINE CROSSING 3RD AVE PER AS-BUILT DRAWINGS. CONFIRM LOCATION
5. INSTALL NEW PULL BOX AND INSTALL (3) SETS OF CONDUITS IN AND OUT OF BOX: (1) 4" C FOR 662(2) & (2) 4" C FOR 662(3). CONDUITS TERMINATING ON P1S SHALL MATCH EXISTING RISER CONDUIT INSTALLATION.
6. INSTALL NEW CROSSARM W/ 34.5KV HARDWARE AND 34.5KV 3 PHASE OVERHEAD CONDUCTORS CONNECTING TO POLE P2SR.

Project As Built Drawings Have Been Reviewed By The Project Engineer & Represent, To The Best Of My Knowledge, The Project As Constructed.


Proj. Eng. **NB** Date **11/10/16**

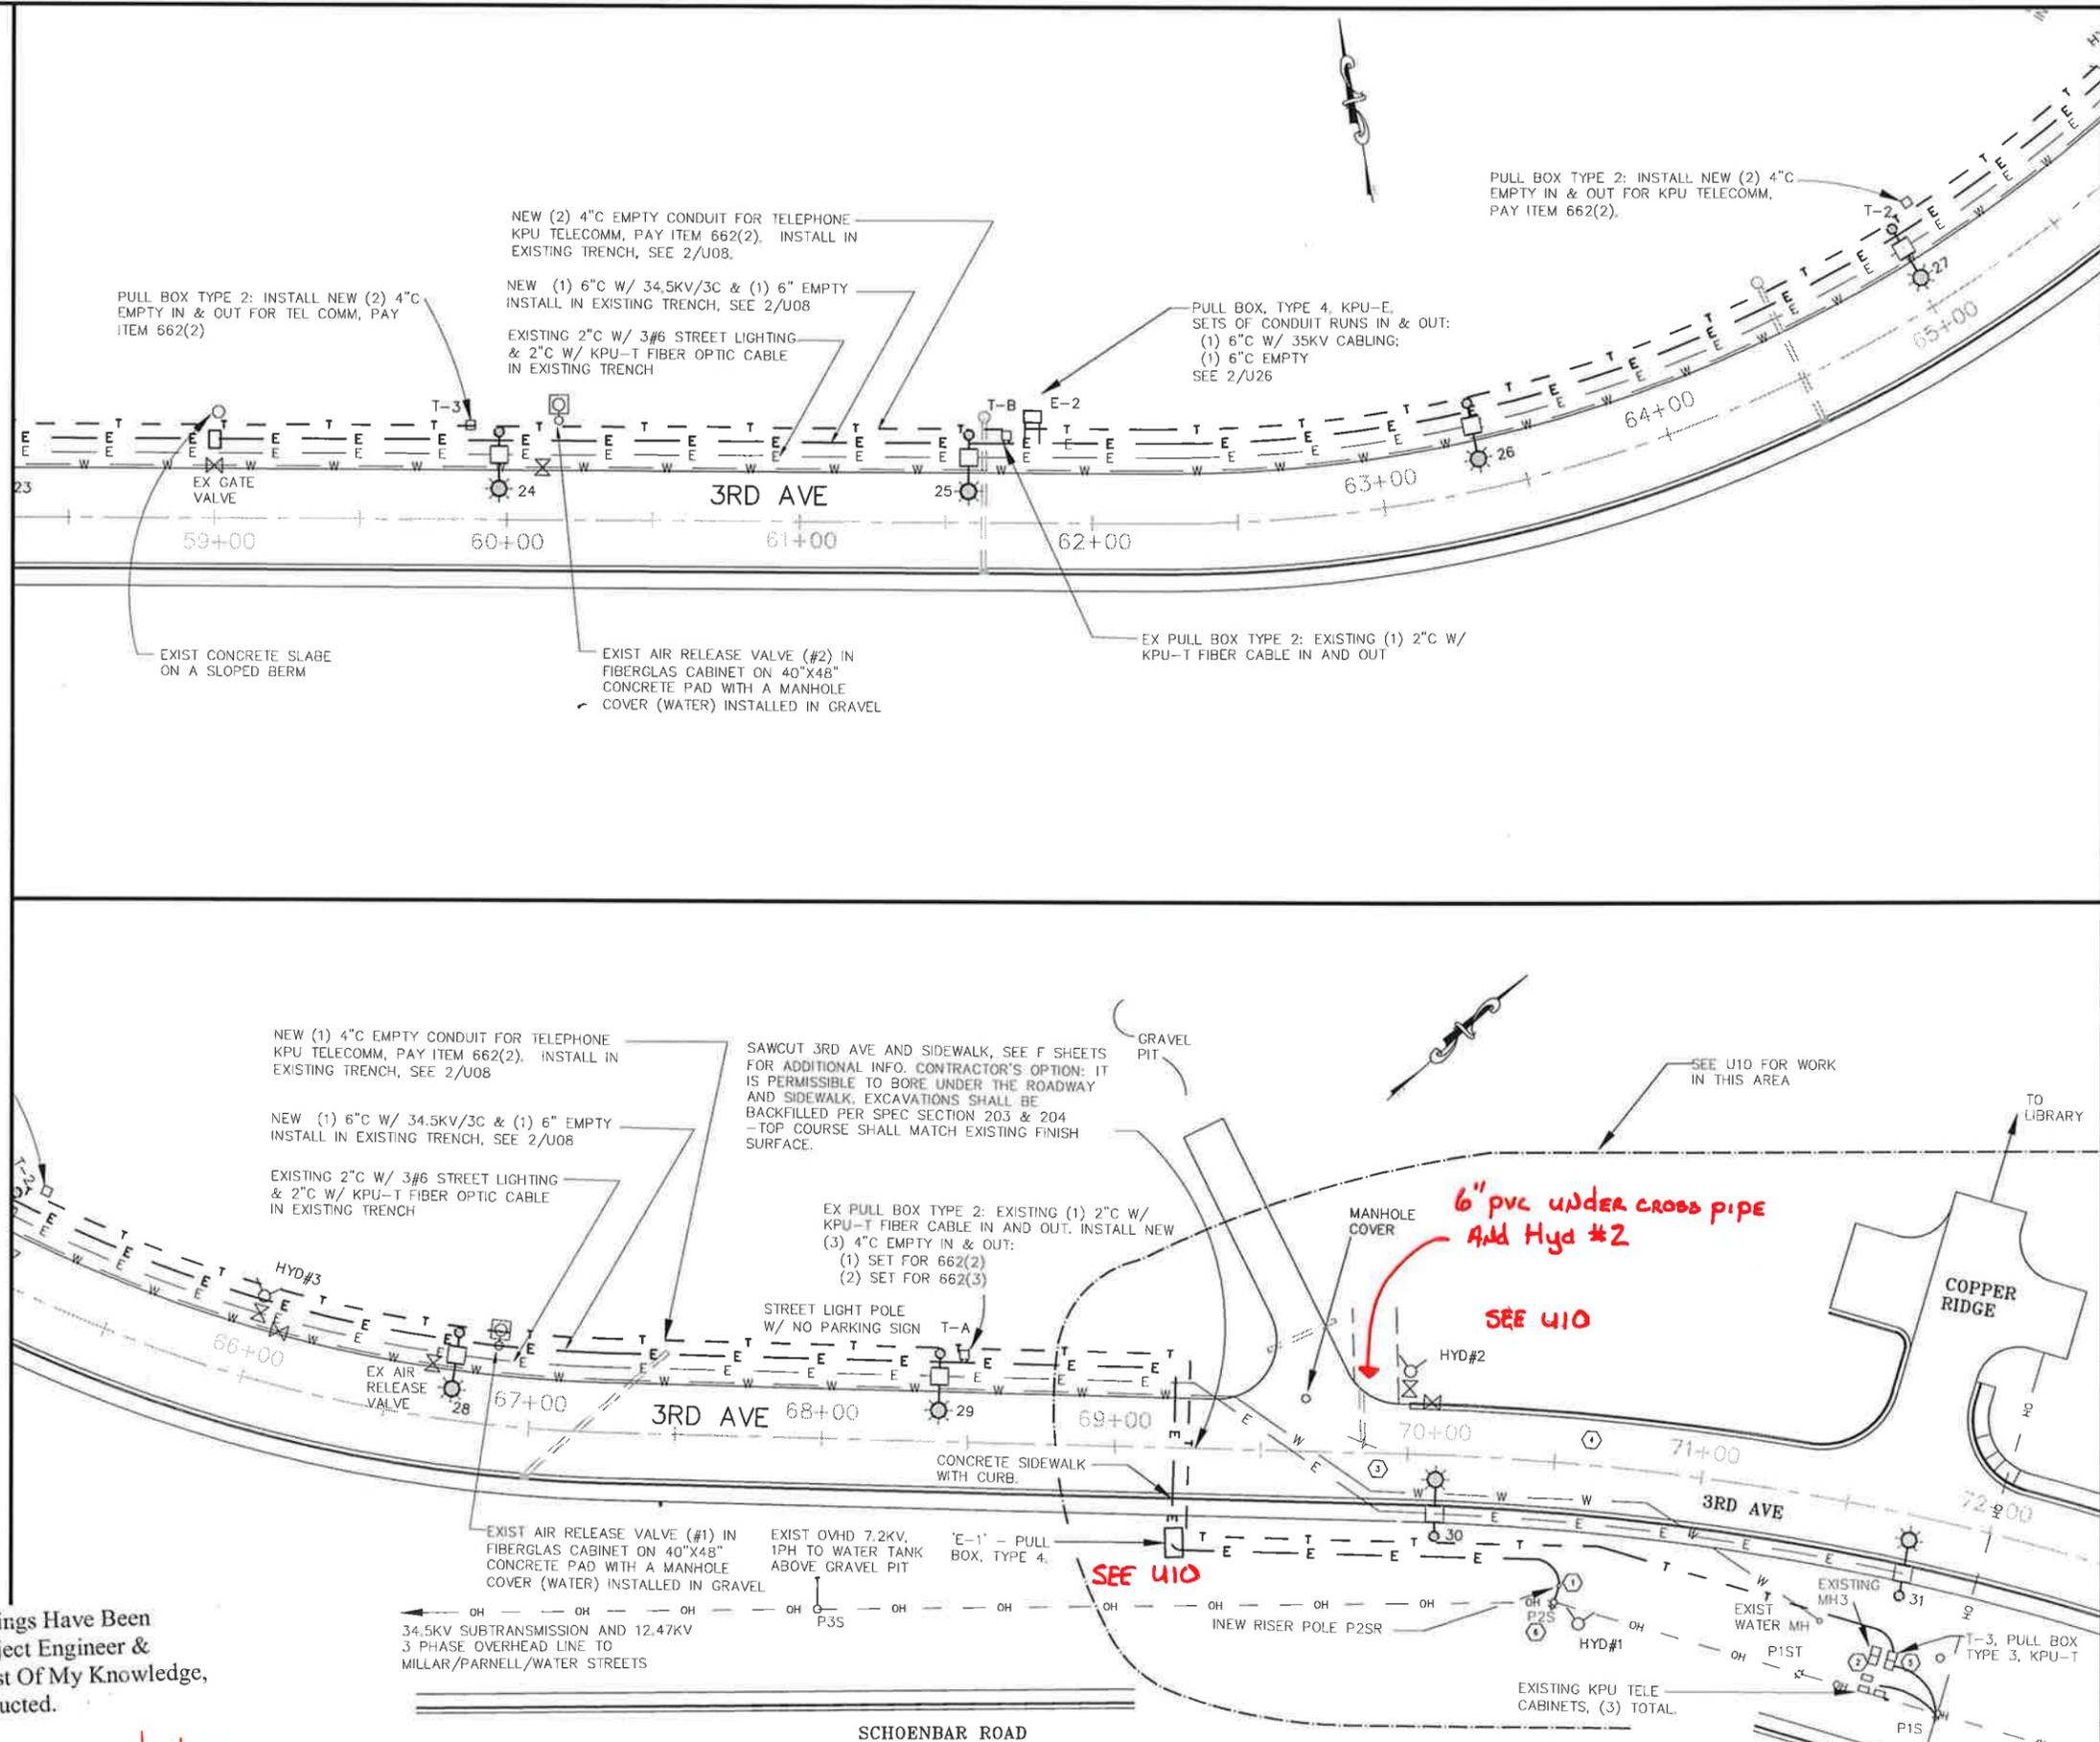

DO NOT SCALE FROM THESE DRAWINGS USE DIMENSIONS

PATH:XXX

KCN12_000	8/28/2014 10:45 AM	
TAB: U07		
ADDENDUM NUMBER		
ATTACHMENT NUMBER		
RECORD OF REVISIONS		
No.	DATE	DESCRIPTION

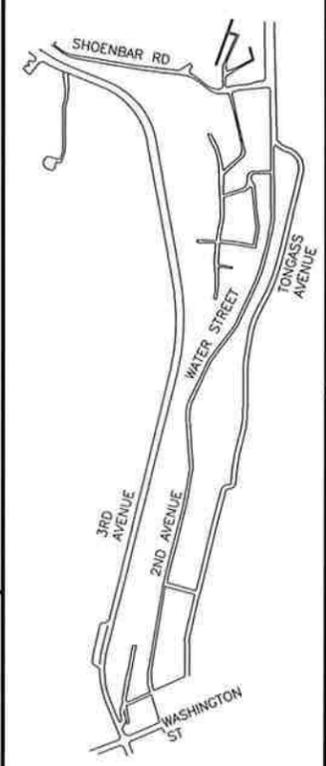

PLAN LEGEND

CHECKED BY: TED

DESIGNED BY: KCN
 DRAWN BY: KCN


STATE OF ALASKA
 DEPARTMENT OF TRANSPORTATION & PUBLIC FACILITIES
 SOUTHEAST REGION

KETCHIKAN ADVANCE
 WATER STREET TRUNK LINE
 RELOCATION
 PROJECT # 69548

UTILITY PLAN ELECTRICAL 3RD AVE

PROJECT DESIGNATION	
BR-000S(735) ~ 69548	
STATE	YEAR
ALASKA	2014
SHEET NUMBER	TOTAL SHEETS
U07	78

No.	DATE	DESCRIPTION

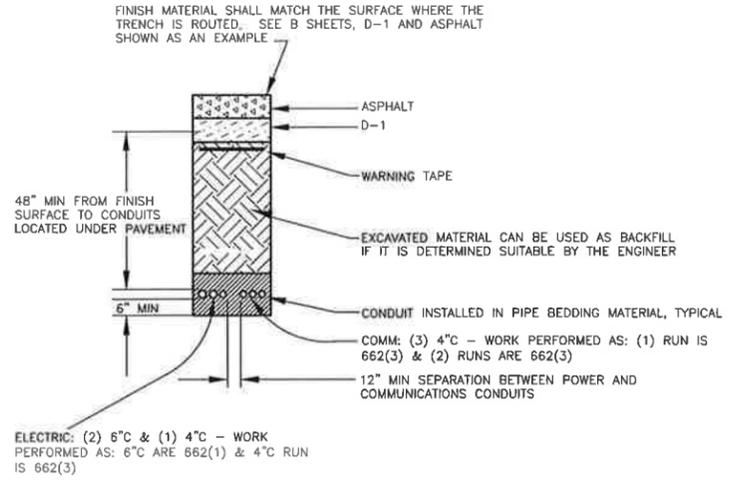

DETAIL NOTES:


- A LOCATE THE 3RD AVE CROSSINGS OF THE WATER LINE AND STREET LIGHTING CIRCUIT AND KPU-T FIBER OPTIC LINE. AVOID EXISTING EXISTING UNDERGROUND PIPING AND CONDUIT RUNS IN THE SCHOENBAR ISLAND AREA, HAND DIGGING MAY BE REQUIRED.
- B SEE SPEC 205 REQUIREMENTS FOR THE MAX. LENGTH OF TRENCH THAT CAN BE OPEN, DEWATERING REQUIREMENTS.



1 TRENCH DETAIL - 3RD AVE CROSSING + SCHOENBAR
NO SCALE

THIS DETAIL IS SIMILAR FOR THE TRENCH TO THE PULL BOXES IN THE 3RD AVE WORK (SHEETS U04-U07) AND VDSL CABINET AT PARNELL STAIRS (SHEET U20).

2 EXISTING TRENCH CONSTRUCTION
NO SCALE

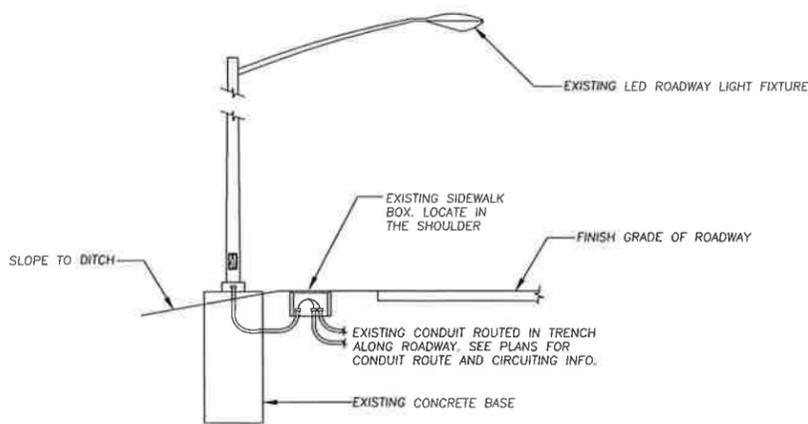

3 EXISTING LIGHT POLE DETAIL - 3RD AVE.
NO SCALE

Project As Built Drawings Have Been Reviewed By The Project Engineer & Represent, To The Best Of My Knowledge, The Project As Constructed.

Proj. Eng. NB Date: 10/16

DO NOT SCALE FROM THESE DRAWINGS USE DIMENSIONS

CHECKED BY: TED



DESIGNED BY: KCN

DRAWN BY: KCN

STATE OF ALASKA
DEPARTMENT OF TRANSPORTATION & PUBLIC FACILITIES
SOUTHEAST REGION
KETCHIKAN ADVANCE
WATER STREET TRUNK LINE
RELOCATION
PROJECT # 69534

3rd AVE DETAILS


PROJECT DESIGNATION
BR-000S(735) ~ 69354

STATE	YEAR
ALASKA	2014


SHEET NUMBER	TOTAL SHEETS
U09	78



(3) 4" PVC EMPTY FROM WASHINGTON STREET RISER POLE


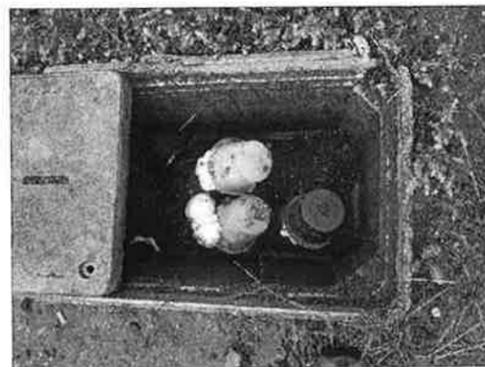


(1) 4" PVC W/KPU-T FIBER CABLE (LEFT SIDE OF BOX) FROM WASHINGTON STREET RISER POLE. THE FIBER CONTINUES IN 2" C (RIGHT SIDE OF BOX) TO MANHOLE 3 AT SCHOENBAR ISLAND.

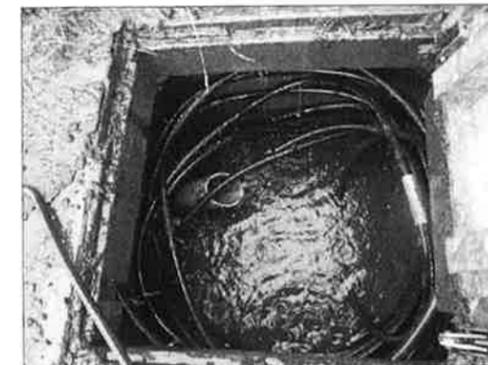

1 EXISTING PULL BOXES AT RAINBIRD
NO SCALE SEE 3/U11 FOR ADDITIONAL INFO

A = EXISTING BERM AROUND CATCH BASIN, REMOVE AND REPLACE AFTER EXCAVATION OF EXISTING TRENCH. NOTE PER AS-BUILT DRAWINGS: THE EDGE OF THE EXISTING TRENCH & EXISTING WATER LINE IS LOCATED EVEN WITH THE EDGE OF THE SHOULDER

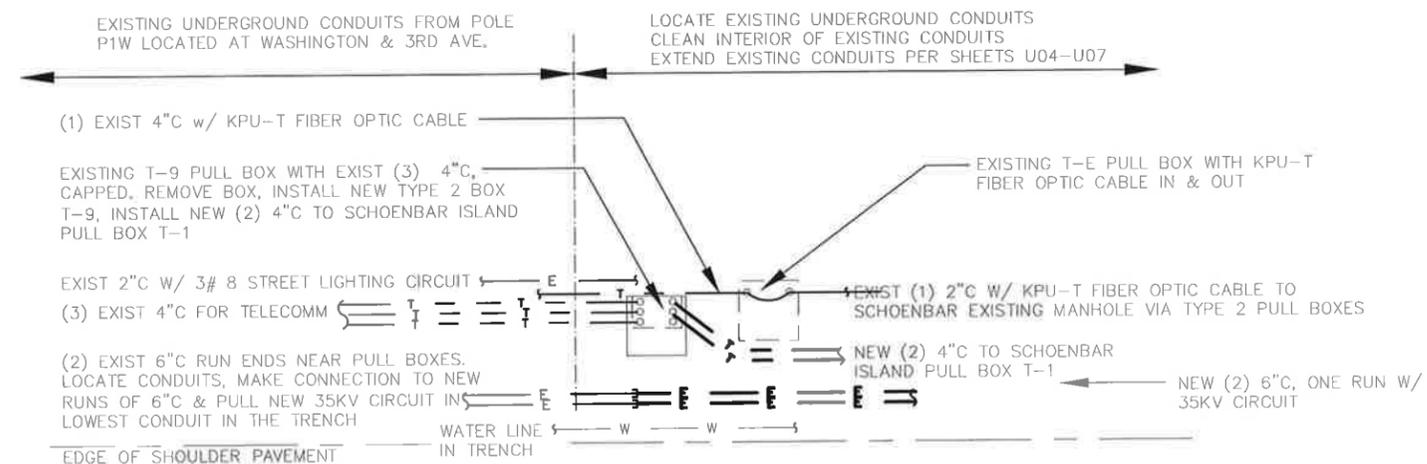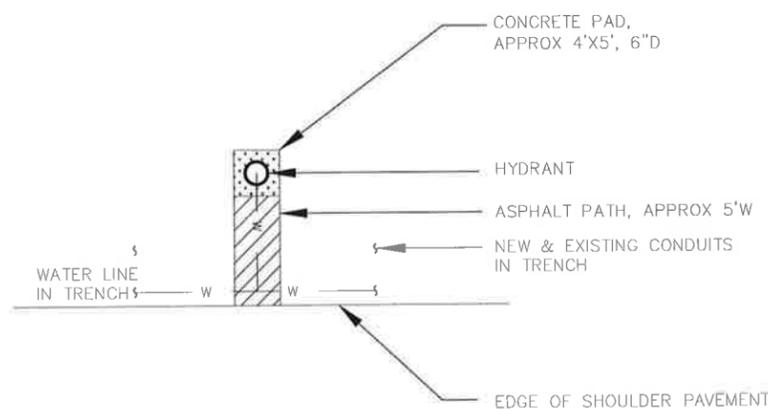

2 EXISTING HYDRANT DETAIL - 3RD AVE.
NO SCALE

DETAIL NOTES:

- A THE DETAIL SHOWS GENERAL LAYOUT INFO FOR INSTALLING NEW CONDUITS AT LOCATIONS WITH HYDRANTS, PATCH SURFACES TO MATCH EXISTING.
- B HAND DIG IN TRENCH TO EXPOSE WATER LINE PIPING AND VALVES FEEDING THE HYDRANT. SUPPORT EXISTING PIPING AND CONDUITS. ROUTE NEW CONDUITS TO AVOID EXISTING PIPING, VALVES, EQUIPMENT AND CONDUITS
- C FIELD CONFIRM EXISTING CONDITIONS PRIOR TO EXCAVATING. COORDINATE INSTALLATION WITH WATER DEPT.
- D THE DETAIL IS SIMILAR AT LOCATIONS WITH FIBERGLASS CABINETS

3 3RD AVE. RAINBIRD PULL BOXES - PLAN VIEW
NO SCALE

DETAIL NOTES:

- A THE DETAIL SHOWS GENERAL LAYOUT INFO FOR INSTALLING NEW CONDUITS AND PULL BOX NEAR THE RAINBIRD PARKING LOT NEAR STATION 30+00. PATCH SURFACES TO MATCH EXISTING.
- B HAND DIG IN TRENCH TO EXPOSE WATER LINE PIPING AND (2) 6" CONDUITS. SUPPORT EXISTING PIPING AND CONDUITS. ROUTE NEW CONDUITS TO AVOID EXISTING PIPING, VALVES, EQUIPMENT AND CONDUITS
- C FIELD CONFIRM EXISTING CONDITIONS PRIOR TO EXCAVATING. COORDINATE INSTALLATION WITH WATER DEPT.

Project As Built Drawings Have Been Reviewed By The Project Engineer & Represent, To The Best Of My Knowledge, The Project As Constructed.

Proj. Eng. MB

Date 1/16/16

DO NOT SCALE FROM THESE DRAWINGS USE DIMENSIONS

PATH:XXX

KCN12_000
TAB: U11 8/28/2014 10:46 AM


ADDENDUM NUMBER

ATTACHMENT NUMBER

RECORD OF REVISIONS

No.	DATE	DESCRIPTION

CHECKED BY: TED

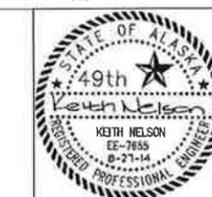

DESIGNED BY: KCN

DRAWN BY: KCN

STATE OF ALASKA
DEPARTMENT OF TRANSPORTATION
& PUBLIC FACILITIES
SOUTHEAST REGION


KETCHIKAN ADVANCE
WATER STREET TRUNK LINE
RELOCATION
PROJECT # 69534

3rd AVE DETAILS


PROJECT DESIGNATION
BR-000S(735) ~ 69534

STATE	YEAR
ALASKA	2014

SHEET NUMBER	TOTAL SHEETS
U11	78

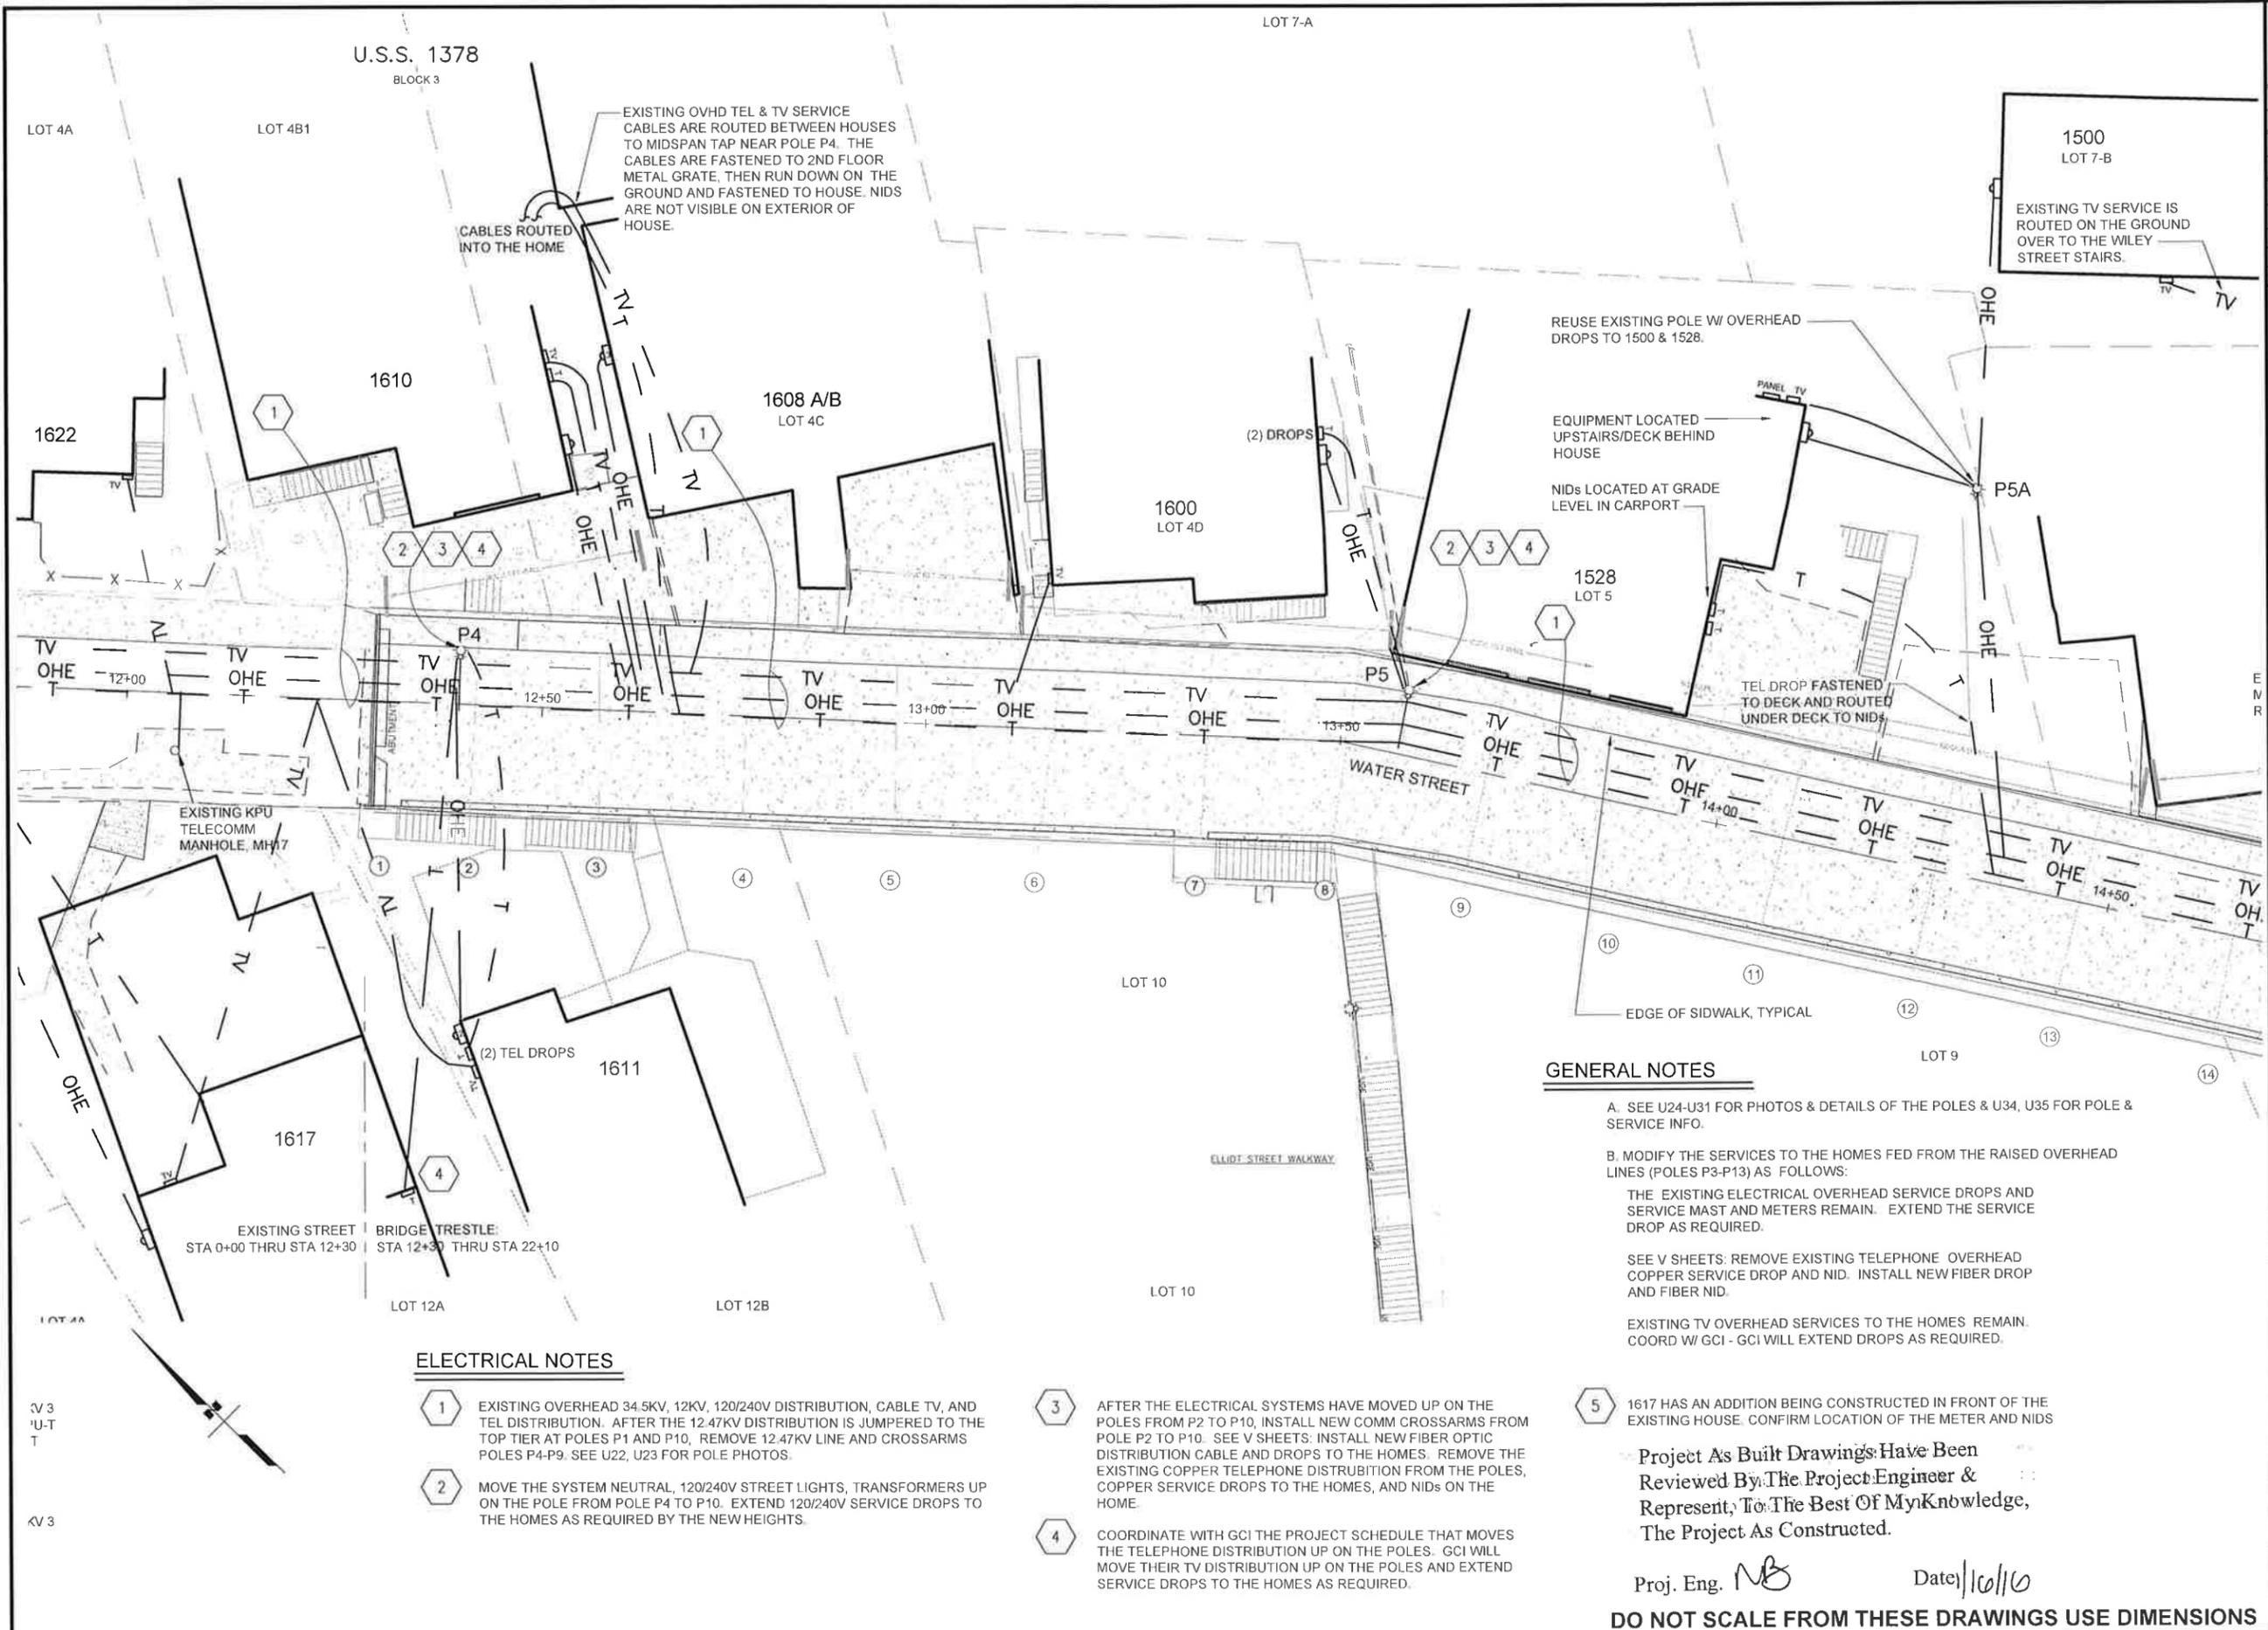

ADDENDUM NUMBER		
ATTACHMENT NUMBER		
RECORD OF REVISIONS		
No.	DATE	DESCRIPTION

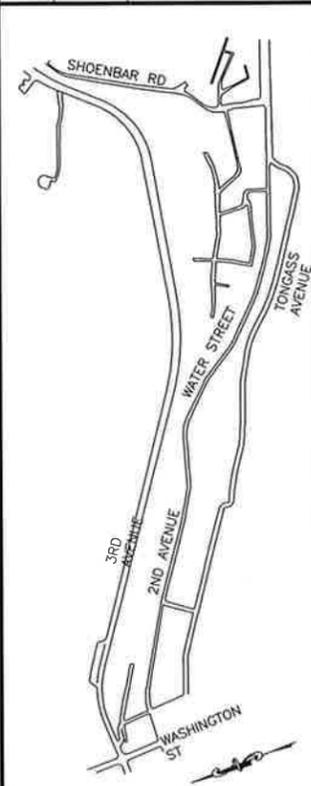

PLAN LEGEND

CHECKED BY: TED



DESIGNED BY: KCN
 DRAWN BY: KCN

STATE OF ALASKA
 DEPARTMENT OF TRANSPORTATION
 & PUBLIC FACILITIES
 SOUTHEAST REGION

**KETCHIKAN ADVANCE
 WATER STREET TRUNK LINE
 RELOCATION
 PROJECT # 69548**

**UTILITY PLAN
 WATER ST. ELECT**

PROJECT DESIGNATION	
BR-00S(735) ~69548	
STATE	YEAR
ALASKA	2014
SHEET NUMBER	TOTAL SHEETS
U13	78

GENERAL NOTES

- A. SEE U24-U31 FOR PHOTOS & DETAILS OF THE POLES & U34, U35 FOR POLE & SERVICE INFO.
- B. MODIFY THE SERVICES TO THE HOMES FED FROM THE RAISED OVERHEAD LINES (POLES P3-P13) AS FOLLOWS:
 THE EXISTING ELECTRICAL OVERHEAD SERVICE DROPS AND SERVICE MAST AND METERS REMAIN. EXTEND THE SERVICE DROP AS REQUIRED.

 SEE V SHEETS: REMOVE EXISTING TELEPHONE OVERHEAD COPPER SERVICE DROP AND NID. INSTALL NEW FIBER DROP AND FIBER NID.

 EXISTING TV OVERHEAD SERVICES TO THE HOMES REMAIN. COORD W/ GCI - GCI WILL EXTEND DROPS AS REQUIRED.

ELECTRICAL NOTES

- 1 EXISTING OVERHEAD 34.5KV, 12KV, 120/240V DISTRIBUTION, CABLE TV, AND TEL DISTRIBUTION. AFTER THE 12.47KV DISTRIBUTION IS JUMPED TO THE TOP TIER AT POLES P1 AND P10. REMOVE 12.47KV LINE AND CROSSARMS POLES P4-P9. SEE U22, U23 FOR POLE PHOTOS.
- 2 MOVE THE SYSTEM NEUTRAL, 120/240V STREET LIGHTS, TRANSFORMERS UP ON THE POLE FROM POLE P4 TO P10. EXTEND 120/240V SERVICE DROPS TO THE HOMES AS REQUIRED BY THE NEW HEIGHTS.

- 3 AFTER THE ELECTRICAL SYSTEMS HAVE MOVED UP ON THE POLES FROM P2 TO P10, INSTALL NEW COMM CROSSARMS FROM POLE P2 TO P10. SEE V SHEETS: INSTALL NEW FIBER OPTIC DISTRIBUTION CABLE AND DROPS TO THE HOMES. REMOVE THE EXISTING COPPER TELEPHONE DISTRIBUTION FROM THE POLES, COPPER SERVICE DROPS TO THE HOMES, AND NIDS ON THE HOME.
- 4 COORDINATE WITH GCI THE PROJECT SCHEDULE THAT MOVES THE TELEPHONE DISTRIBUTION UP ON THE POLES. GCI WILL MOVE THEIR TV DISTRIBUTION UP ON THE POLES AND EXTEND SERVICE DROPS TO THE HOMES AS REQUIRED.



5 1617 HAS AN ADDITION BEING CONSTRUCTED IN FRONT OF THE EXISTING HOUSE. CONFIRM LOCATION OF THE METER AND NIDS

Project As Built Drawings Have Been Reviewed By The Project Engineer & Represent, To The Best Of My Knowledge, The Project As Constructed.

Proj. Eng. *NB* Date *1/10/16*

DO NOT SCALE FROM THESE DRAWINGS USE DIMENSIONS

ADDENDUM NUMBER		
ATTACHMENT NUMBER		
RECORD OF REVISIONS		
No.	DATE	DESCRIPTION

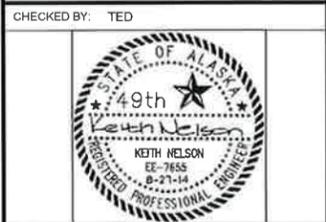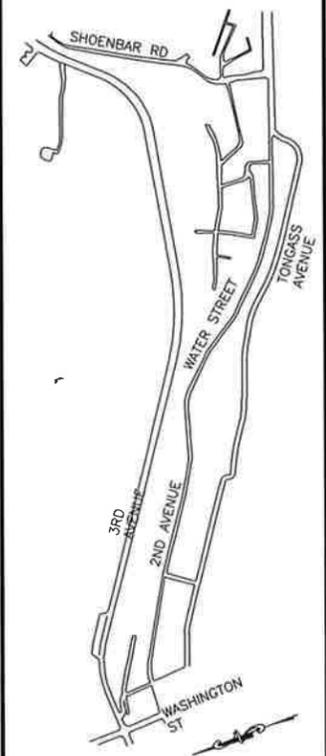

DESIGNED BY: KCN
 DRAWN BY: KCN

STATE OF ALASKA
 DEPARTMENT OF TRANSPORTATION
 & PUBLIC FACILITIES
 SOUTHEAST REGION

KETCHIKAN ADVANCE
 WATER STREET TUNK LINE
 RELOCATION
 PROJECT # 69548

PROJECT DESIGNATION	
BR-000S(735) ~69548	
STATE	YEAR
ALASKA	2014
SHEET NUMBER	TOTAL SHEETS
U15	78



ELECTRICAL NOTES

- 1 EXISTING OVERHEAD 34.5KV, 12KV, 120/240V DISTRIBUTION, CABLE TV, AND TEL DISTRIBUTION. AFTER THE 12.47KV DISTRIBUTION IS JUMPED TO THE TOP TIER AT POLES P1 AND P10, REMOVE 12.47KV LINE AND CROSSARMS POLES P4-P9. SEE U22, U23 FOR POLE PHOTOS.
- 2 MOVE THE SYSTEM NEUTRAL, 120/240V STREET LIGHTS, TRANSFORMERS UP ON THE POLE FROM POLE P4 TO P10. EXTEND 120/240V SERVICE DROPS TO THE HOMES AS REQUIRED BY THE NEW HEIGHTS.

- 3 AFTER THE ELECTRICAL SYSTEMS HAVE MOVED UP ON THE POLES FROM P2 TO P10, INSTALL NEW COMM CROSSARMS FROM POLE P4 TO P10. SEE V SHEETS: INSTALL NEW FIBER OPTIC DISTRIBUTION CABLE AND DROPS TO THE HOMES. REMOVE THE EXISTING COPPER TELEPHONE DISTRIBUTION FROM THE POLES, COPPER SERVICE DROPS TO THE HOMES, AND NIDs ON THE HOME.
- 4 COORDINATE WITH GCI THE PROJECT SCHEDULE THAT MOVES THE TELEPHONE DISTRIBUTION UP ON THE POLES. GCI WILL MOVE THEIR TV DISTRIBUTION UP ON THE POLES AND EXTEND SERVICE DROPS TO THE HOMES AS REQUIRED.

GENERAL NOTES

- A. SEE U24-U31 FOR PHOTOS & DETAILS OF THE POLES & U34, U35 FOR POLE SERVICE INFO.
- B. MODIFY THE SERVICES TO THE HOMES FED FROM THE RAISED OVERHEAD LINES (POLES P3-P13) AS FOLLOWS:
 THE EXISTING ELECTRICAL OVERHEAD SERVICE DROPS AND SERVICE MAST AND METERS REMAIN. EXTEND THE SERVICE DROP AS REQUIRED.
 SEE V SHEETS: REMOVE EXISTING TELEPHONE OVERHEAD COPPER SERVICE DROP AND NID. INSTALL NEW FIBER DROP AND FIBER NID.
 EXISTING TV OVERHEAD SERVICES TO THE HOMES REMAIN. COORD W/ GCI - GCI WILL EXTEND DROPS AS REQUIRED.

Project As Built Drawings Have Been Reviewed By The Project Engineer & Represent, To The Best Of My Knowledge, The Project As Constructed.

Proj. Eng. *NB* Date *1/16/16*

DO NOT SCALE FROM THESE DRAWINGS USE DIMENSIONS

INSTALL UNDERGROUND CONDUITS RUN IN EXISTING TRENCH FROM RAINBIRD PARKING LOT TO 3RD AVE CROSSING, NEW TRENCH ACROSS 3RD TO SCHOENBAR ISLAND. CONDUITS INCLUDE

- 662(1) = 6" C FOR NEW 34.5KV UNDERGROUND CIRCUIT.
- (1) 6" SPARE FOR FUTURE ELECTRIC CIRCUIT
- 662(2) = (1) 4" C SPARE KPU-T
- 662(3) = (2) 4" C SPARE KPU-T & 1 4" KPU-E

EXISTING RUN (2) 6" C, (4) 4", & (2) 2" FROM KPU RISER POLE P1W ON WASHINGTON STREET TO RAINBIRD PARKING LOT.

INSTALL KPU SCHOENBAR RISEF. POLE P2SR. INSTALL NEW (2) 6" C ONE W/ NEW 34.5KV UNDERGROUND CABLING. TIE INTO EXISTING 34.5KV AERIAL DISTRIBUTION AT POLE P2S.

AFTER THE NEW 35KV CIRCUIT IS ENERGIZED, REMOVE THE 34.5KV LINE FROM P1M TO POLE P10, REMOVE THE CROSSARMS FROM P1M AND P10. REMOVE INSULATORS FROM P10B.

NEW UNDERGROUND 34.5KV CUT NEW TRENCH ACROSS 3RD AVE & SCHOENBAR ISLAND

EXISTING KPU-T CABINETS INSTALL PULL BOX W/ NEW CONDUITS, VDSL HARDWARE IN EXISTING CABINET, NEW CABLING IN EXIST CONDUIT, AND REFLICE AERIAL TERMINALS, SEE V SHEETS

EXISTING KPU AERIAL 34.5KV SUBTRANSMISSION LINE ALONG SCHOENBAR RD, LINE RUNS TO POLE P10 AT THE BASE OF PARNELL, THEN WEST ON WATER STREET.

NEW UNDERGROUND CIRCUIT: 6" C W/ (3) 350MCM 35KV CABLES & 0" C SPARE RUN IN EXISTING 6" FROM WASHINGTON P1R TO RAINBIRD & NEW CONDUITS RAINBIRD TO SCHOENBAR P2R

START OF NEW 35KV CIRCUIT AT EXISTING WASHINGTON STREET KPU RISER POLE, P1W

EXISTING KPU 34.5KV AERIAL TO BETHE SUBSTATION

EXISTING 34.5KV AERIAL TO RISER POLE AT PLAZA MALL (WASHINGTON & TONGASS)

SEE V SHEETS FOR ADDITIONAL COMM WIRING INCLUDING NEW VDSL CABINET AT PARNELL STAIRS AND NEW HARDWARE IN SCHOENBAR VDSL CABINET WITH CABLE TO P2S PULLED IN EXISTING CONDUIT

EXISTING OVERHEAD POLE LINE ALONG WATER STREET:

- A DEADENDS AND GUYS AT POLE P1 AND P10
- B COMMUNICATION GUYS AT POLES P3 AND P12
- C JUMPER 12.47KV TO TOP TIER (FORMERLY 34.5KV) AT POLES P1 AND P10. REMOVE EXISTING 12.47KV TIER P3-P10 CROSSARMS, CONDUCTORS P1-P10.
- D MOVE 120/240V DISTRIBUTION, SYSTEM NEUTRAL, STREET LIGHTS, TRANSFORMERS UP POLES P4-P11. EXTEND OVHD SERVICE DROPS AS NEEDED.
- E
- F INSTALL NEW VDSL CABINET AT PARNELL AND INSTALL HARDWARE IN EXISTING SCHOENBAR VDSL CABINET
- G INSTALL NEW STRAND P3-P10 & P10T-P12.
- H RELOCATE KPU-T FIBER OPTIC DISTRIBUTION CABLE P3-P10. INSTALL NEW FIBER DROPS AND ONTs TO THE HOME. DEMO COPPER SERVICE DROPS & NIDs.
- I REMOVE EXISTING KPU-T COPPER DISTRIBUTION UNDERBRIDGE AND AERIAL P3-P12.
- J COORD W/ GC1 TO HAVE THEM RAISE THEIR INFRASTRUCTURE & DROPS P3-P13

Project As Built Drawings Have Been Reviewed By The Project Engineer & Represent, To The Best Of My Knowledge, The Project As Constructed.

Proj. Eng. *NB*

Date *1/10/16*

DO NOT SCALE FROM THESE DRAWINGS USE DIMENSIONS

CHECKED BY: TED 		STATE OF ALASKA DEPARTMENT OF TRANSPORTATION & PUBLIC FACILITIES SOUTHEAST REGION KETCHIKAN ADVANCE WATER STREET TRUNK LINE RELOCATION PROJECT #69548	
DESIGNED BY: KCN DRAWN BY: KCN		ELECTRICAL SITE PLAN	
PATH: G:\SERV\K12_000\DOCUMENTS\KNEE\2013\WB DESIGN\SDWG\NTPS TRUNK RELOCATION\WB AUR U03 OVERALL PLAN.DWG TAB: U03		PROJECT DESIGNATION: KCN12_000	
REVISIONS NO. DATE DESCRIPTION		PROJECT DESIGNATION BR-000S(735)	YEAR 2014
		SHEET NO. U03	TOTAL SHEETS 78

1 ELECTRICAL SITE PLAN
 SCALE: 1/16" = 1'-0"

 PLAN NORTH



GENERAL NOTES:

A. EXISTING ELECTRICAL EQUIPMENT AND UTILITIES IS TO REMAIN UNLESS OTHERWISE NOTED. THE DRAWINGS SHOW EXISTING TRENCH, ELECTRICAL CIRCUITS AND WATER LINE BASED ON AS-BUILT INFO, FIELD CONFIRM ALL INFO.

B. THERE ARE TWO EXISTING 6" CONDUIT FROM THE WASHINGTON STREET RISER POLE TO THE RAINBIRD PARKING LOT JUNCTION. EXTEND THE (2) EXISTING 6" CONDUIT FROM THE RAINBIRD PARKING LOT JUNCTION TO SCHOENBAR W/ (2) NEW 6" CONDUIT IS A SPARE. IN THE OTHER CONDUIT INSTALL #35001CM 35KV 3/C CABLING FROM THE WASHINGTON STREET RISER POLE TO THE SCHOENBAR STREET RISER POLE. CONNECT NEW CABLE TO EXISTING 34.5KV OVERHEAD DISTRIBUTION SYSTEM.

C. AN EXISTING TRENCH, WHICH WAS BLASTED OUT OF A ROCK SUBSTRATE, RUNS FROM THE RAINBIRD PARKING LOT TO SCHOENBAR ON THE UPHILL SIDE OF 3RD AVE. DIG INTO THE EXISTING TRENCH TO INSTALL NEW CONDUIT RUNS. FIELD LOCATE ALL EXISTING WATER LINE VALVES, HYDRANTS, UNDERGROUND CONDUIT RUNS, HANDHOLES, LIGHT FIXTURES, ETC. SEE TRENCH DETAILS U5. SEE SPEC SECTION 204 FOR TRENCH EXCAVATION AND OTHER CONSTRUCTION REQUIREMENTS.

D. SEE 2/U26, U13 & U10 FOR FULL PULL BOX INSTALLATION INFO, 2/U11 FOR HYDRANT INFO. ADDITIONAL INFO ON 3RD AVE BYPASS CONSTRUCTION IS AVAILABLE ON DOT AS-BUILT DRAWINGS. SEE SPEC 662-1.02

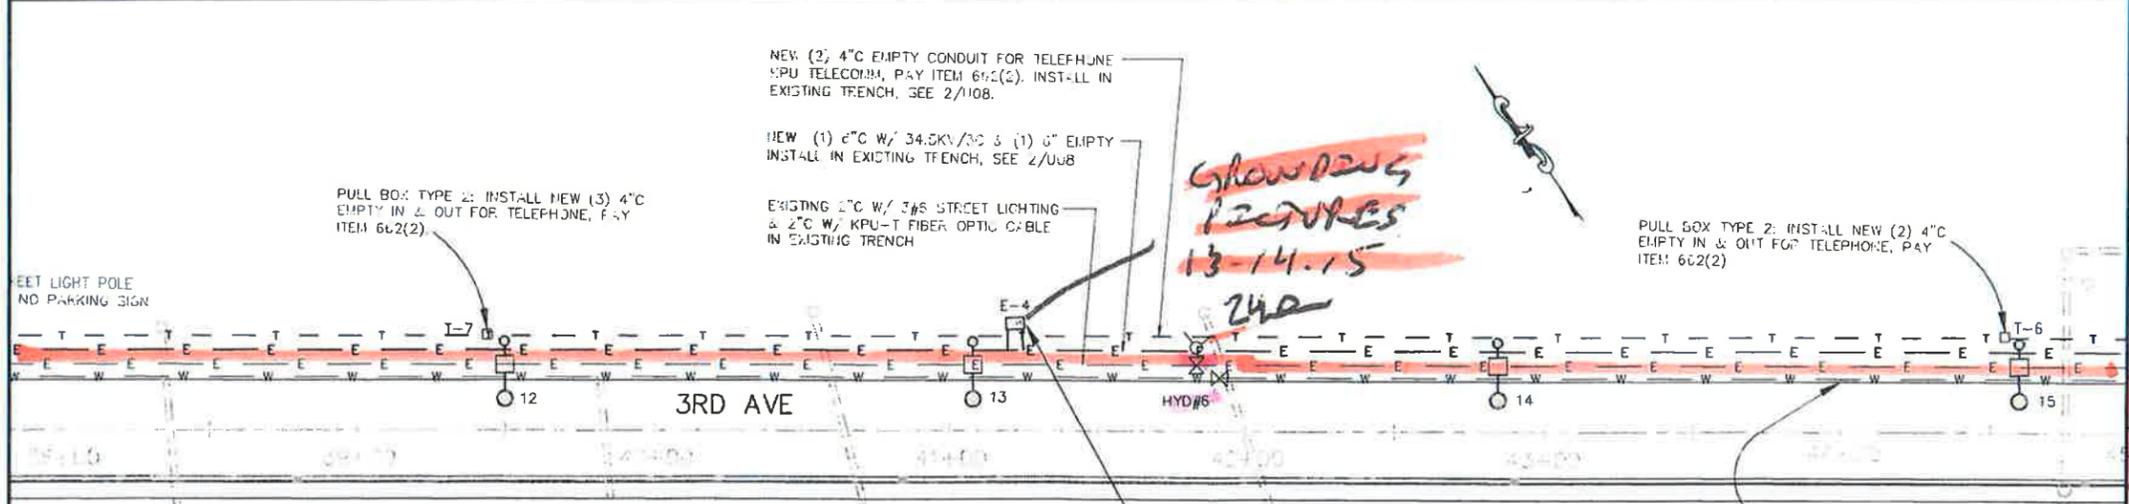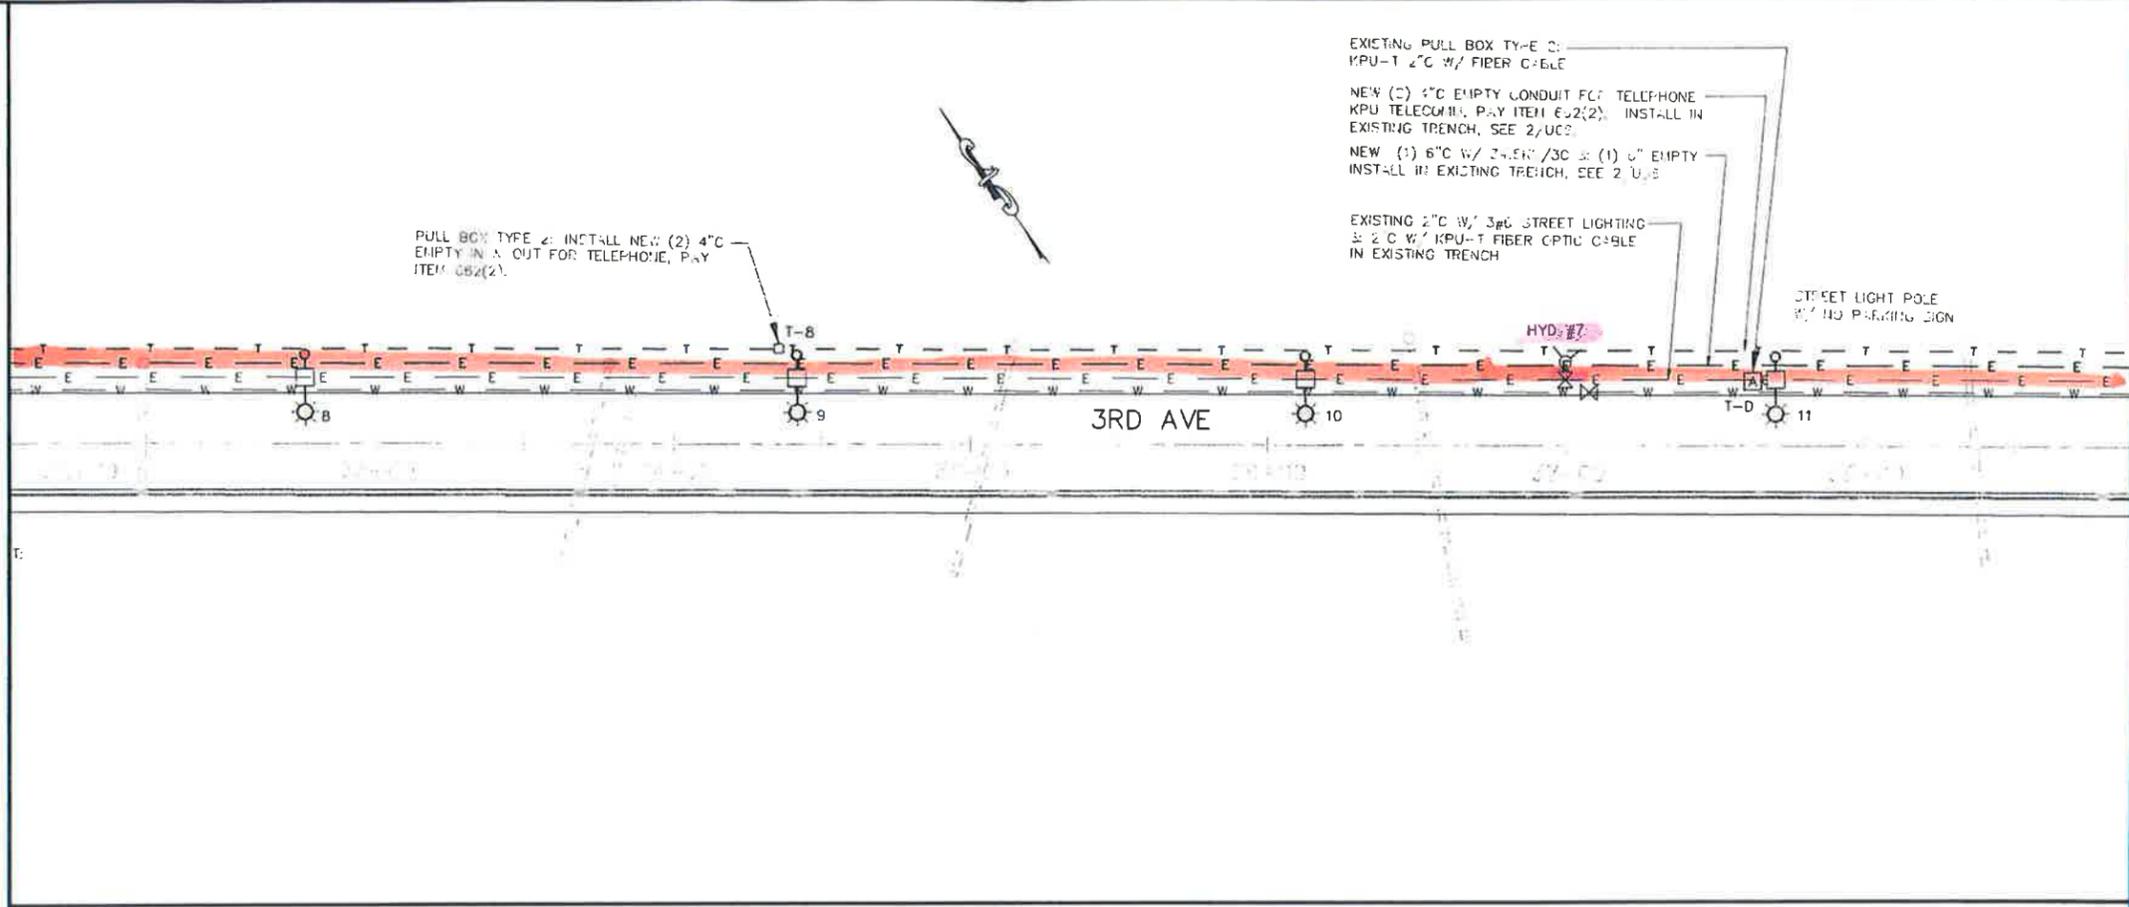

Project As Built Drawings Have Been Reviewed By The Project Engineer & Represent, To The Best Of My Knowledge, The Project As Constructed.


Proj. Eng. *NS* Date *11/6/16*

DO NOT SCALE FROM THESE DRAWINGS USE DIMENSIONS

PC-114 XXX

KCN12_000
T-S U05 8/28/2014 10:45 AM

RECORD OF REVISIONS		
No	DATE	DESCRIPTION

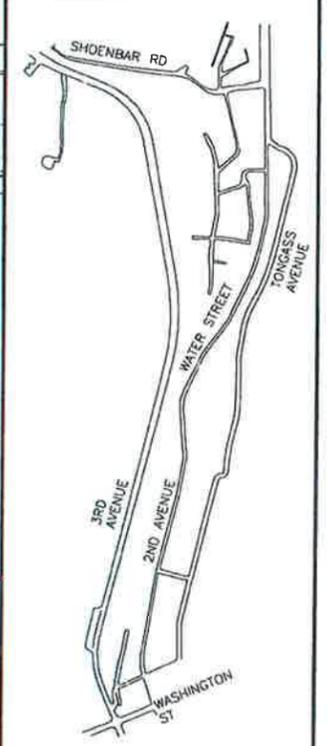

PLAN LEGEND

CHECKED BY: TED

DESIGNED BY: KCN
DRAWN BY: KCN

STATE OF ALASKA
DEPARTMENT OF TRANSPORTATION & PUBLIC FACILITIES
SOUTHEAST REGION

KETCHIKAN ADVANCE
WATER STREET TRUNK LINE
RELOCATION
PROJECT # 69548

UTILITY PLAN ELECTRICAL 3RD AVE

PROJECT DESIGNATION
BR-000S(735) ~ 69548

STATE	YEAR
ALASKA	2014
SHEET NUMBER	TOTAL SHEETS
U05	78



GENERAL NOTES:

A. EXISTING ELECTRICAL EQUIPMENT AND CIRCUITING IS TO REMAIN UNLESS OTHERWISE NOTED. THE DRAWINGS SHOW EXISTING TRENCH, ELECTRICAL CIRCUITS AND WATER LINE EXPOSED ON AS-BUILT INFO. FIELD CONFIRM ALL INFO.

B. THERE ARE TWO EXISTING 6" C RUN FROM THE WASHINGTON STREET RISER POLE TO THE RAINEIRD PARKING LOT JOY. EXTEND THE (2) EXISTING 6" C FROM THE RAINEIRD PARKING LOT JOY TO SCHOENBAR W/ (2) NEW 6" C. ONE CONDUIT IS A SPARE. IN THE OTHER CONDUIT INSTALL #750MCH 35KV 3 C CABLING FROM THE WASHINGTON STREET RISER POLE TO THE SCHOENBAR RISER POLE. CONNECT NEW CABLE TO EXISTING 34.5KV OVERHEAD DISTRIBUTION SYSTEM.

C. AN EXISTING TRENCH, WHICH WAS BLASTED OUT OF A ROCK SUBSTRATE, RUNS FROM THE RAINEIRD PARKING LOT TO SCHOENBAR ON THE UPHILL SIDE OF 3RD AVE. DIG INTO THE EXISTING TRENCH TO INSTALL NEW CONDUIT RUNS. FIELD LOCATE ALL EXISTING WATER LINE VALVES, HYDRANTS, UNDERGROUND CONDUIT RUNS, HANDHOLES, LIGHT FIXTURES, ETC. SEE TRENCH DETAILS US. SEE SPEC SECTION 204 FOR TRENCH EXCAVATION AND OTHER CONSTRUCTION REQUIREMENTS.

D. SEE 2/U26, U18 & U19 FOR PULL BOX INSTALLATION INFO, 2/U11 FOR HYDRANT INFO. ADDITIONAL INFO ON 3RD AVE BYPASS CONSTRUCTION IS AVAILABLE ON DOT AS-BUILT DRAWINGS. SEE SPEC 602-1.02.

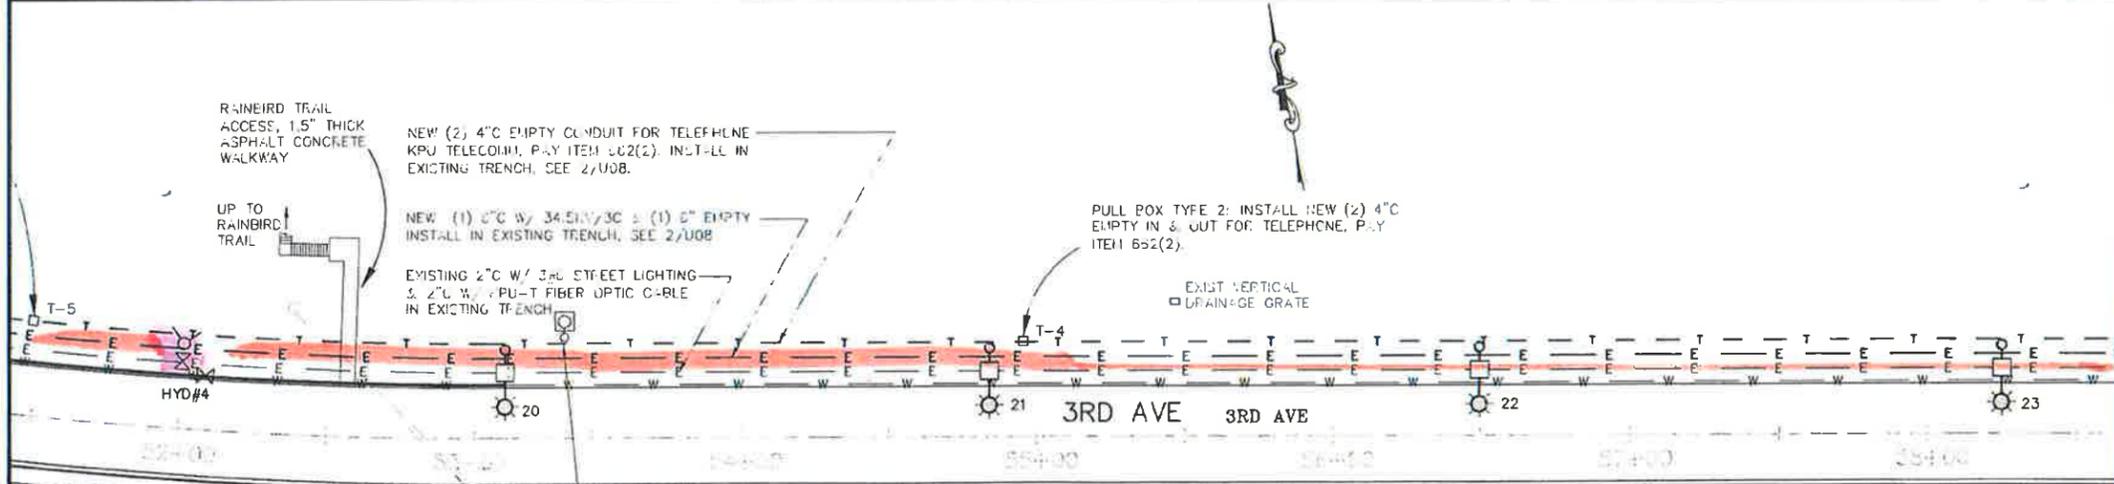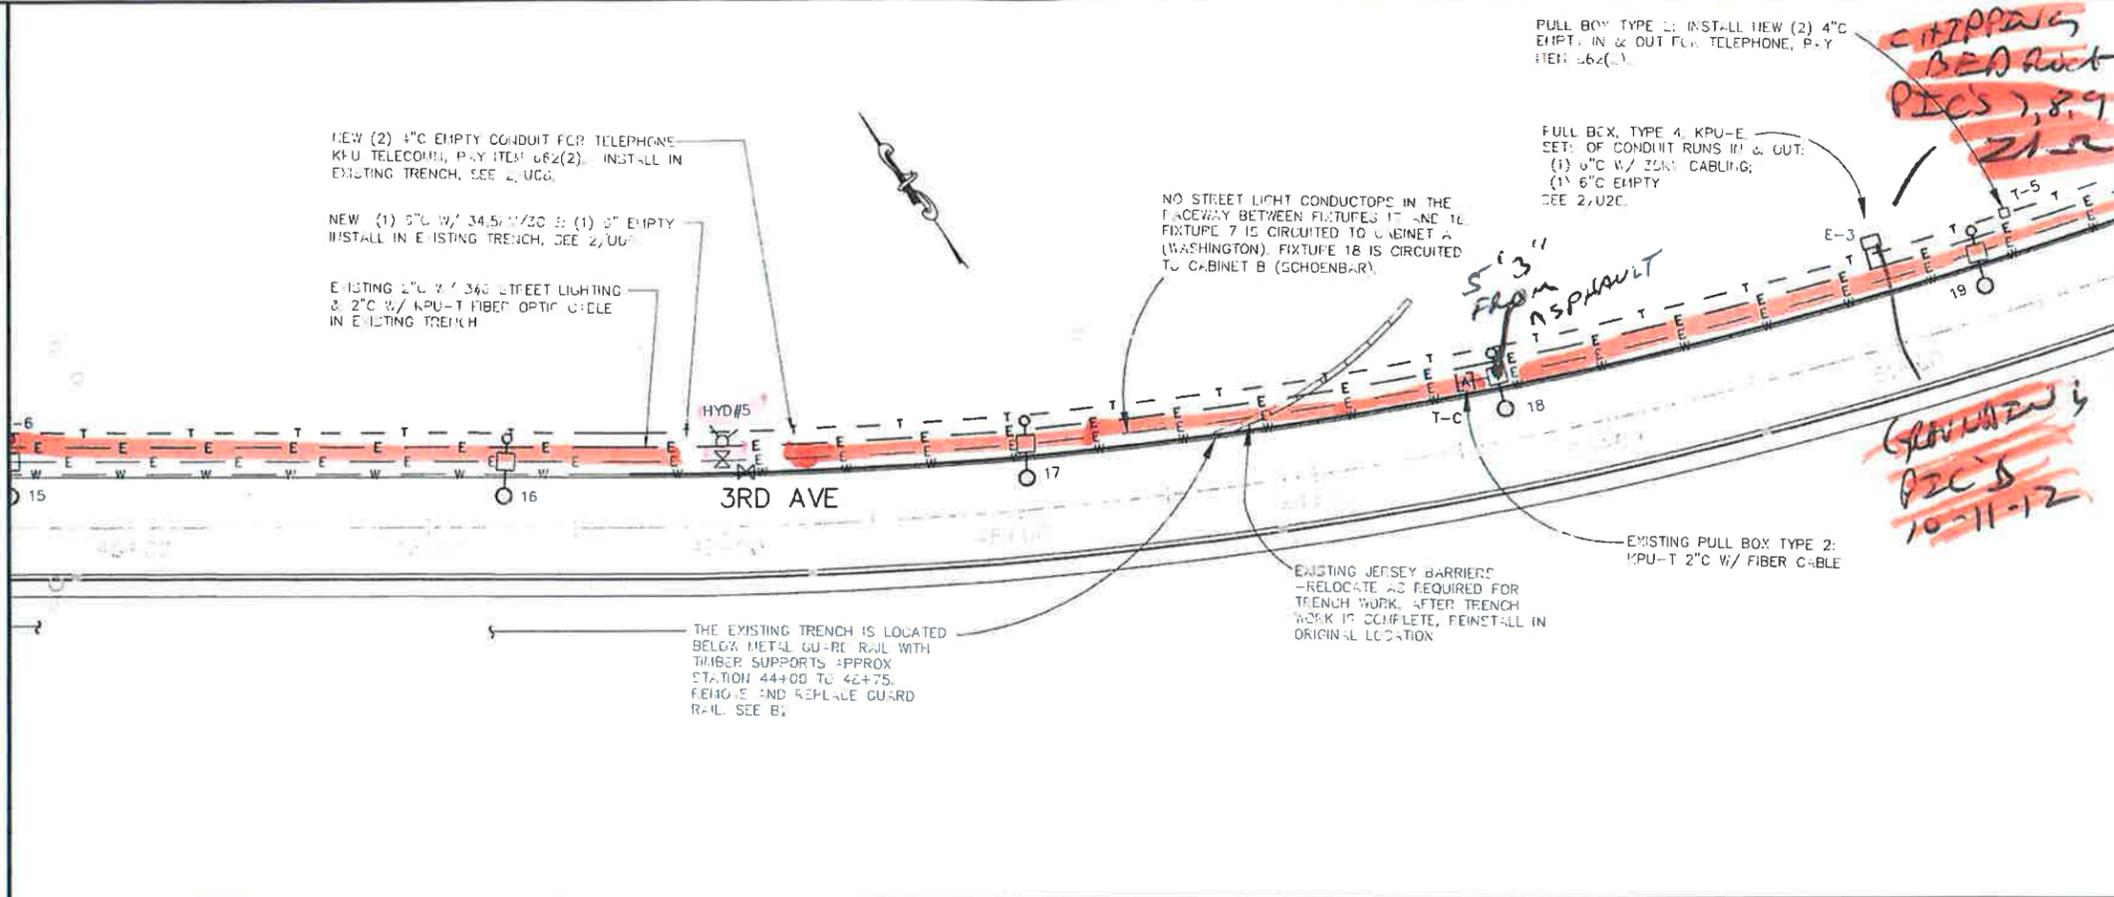

Project As Built Drawings Have Been Reviewed By The Project Engineer & Represent, To The Best Of My Knowledge, The Project As Constructed.

Proj. Eng. **NB** Date **11/16/16**

DO NOT SCALE FROM THESE DRAWINGS USE DIMENSIONS

P:TH XXX

KCN12_000


T-B U06 8/28/2014 10:46 AM

DEPENDENT NUMBER

ATTACHMENT NUMBER

RECORD OF REVISIONS

No	DATE	DESCRIPTION

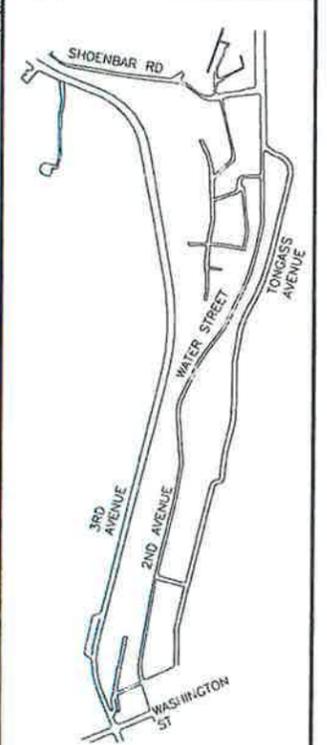

PLAN LEGEND

CHECKED BY TED



DESIGNED BY KCN

DRAWN BY KCN

STATE OF ALASKA
DEPARTMENT OF TRANSPORTATION
& PUBLIC FACILITIES
SOUTHEAST REGION

KETCHIKAN ADVANCE
WATER STREET TRUNK LINE
RELOCATION
PROJECT # 69548

**UTILITY PLAN
ELECTRICAL 3rd AVE**

PROJECT DESIGNATION
BR-000S(735) ~ 69548



STATE	YEAR
ALASKA	2014
SHEET NUMBER	TOTAL SHEETS
U06	78

GENERAL NOTES:

- A. EXISTING ELECTRICAL EQUIPMENT AND CIRCUITING IS TO REMAIN UNLESS OTHERWISE NOTED. THE DRAWINGS SHOW EXISTING TRENCH, ELECTRICAL CIRCUITS AND WATER LINE BASED ON AS-BUILT INFO. FIELD CONFIRM ALL INFO.
- B. THERE ARE TWO EXISTING 4" RUN FROM THE WASHINGTON STREET RISER POLE TO THE RAINBIRD PARKING LOT JBOX. EXTEND THE (2) EXISTING 6" FROM THE RAINBIRD PARKING LOT JBOX TO SCHOENBAR W/ (2) NEW 6". ONE CONDUIT IS A SPARE. IN THE OTHER CONDUIT INSTALL #350MCM 35KV 3/C CABLE FROM THE WASHINGTON STREET RISER POLE TO THE SCHOENBAR RISER POLE. CONNECT NEW CABLE TO EXISTING 34.5KV OVERHEAD DISTRIBUTION SYSTEM.
- C. AN EXISTING TRENCH, WHICH WAS BLASTED OUT OF A ROCK SUBSTRATE, RUNS FROM THE RAINBIRD PARKING LOT TO SCHOENBAR ON THE UPHILL SIDE OF 3RD AVE. DIG INTO THE EXISTING TRENCH TO INSTALL NEW CONDUIT RUNS. FIELD LOCATE ALL EXISTING WATER LINE VALVES, HYDRANTS, UNDERGROUND CONDUIT RUNS, HANDHOLES, LIGHT FIXTURES, ETC. SEE TRENCH DETAILS US. SEE SPEC SECTION 204 FOR TRENCH EXCAVATION AND OTHER CONSTRUCTION REQUIREMENTS.
- D. SEE 2/U26, U18 & U19 FOR PULL BOX INSTALLATION INFO, 2/U11 FOR HYDRANT INFO. ADDITIONAL INFO ON 3RD AVE BYPASS CONSTRUCTION IS AVAILABLE ON DOT AS-BUILT DRAWING. SEE SPEC 662-1.02

ELECTRICAL NOTES:

1. INSTALL 35KV RISER POLE P2SR PER KPU DETAIL AND TERMINATE THE UNDERGROUND CIRCUIT 35KV CABLES. INSTALL AERIAL CONDUCTOR TO CONNECT TO EXISTING POLE P23C.
2. EXISTING MANHOLE MH3 (KPU-T) WITH EXISTING 2" W/ FIBER CABLE FROM WASHINGTON RISER POLE AND (3) 4" TO POLE P15.
3. LOCATION OF THE STREET LIGHTING CIRCUIT CROSSING 3RD AVE PER AS-BUILT DRAWINGS. CONFIRM LOCATION.
4. LOCATION OF THE WATER LINE CROSSING 3RD AVE PER AS-BUILT DRAWINGS. CONFIRM LOCATION.
5. INSTALL NEW PULL BOX AND INSTALL (3) SETS OF CONDUITS IN AND OUT OF BOX: (1) 4" FOR 662(2) & (2) 4" FOR 662(3). CONDUITS TERMINATING ON P15 SHALL MATCH EXISTING RISER CONDUIT INSTALLATION.
6. INSTALL NEW CROSSARM W/ 34.5KV HARDWARE AND 34.5KV 3 PHASE OVERHEAD CONDUCTORS CONNECTING TO POLE P23R.

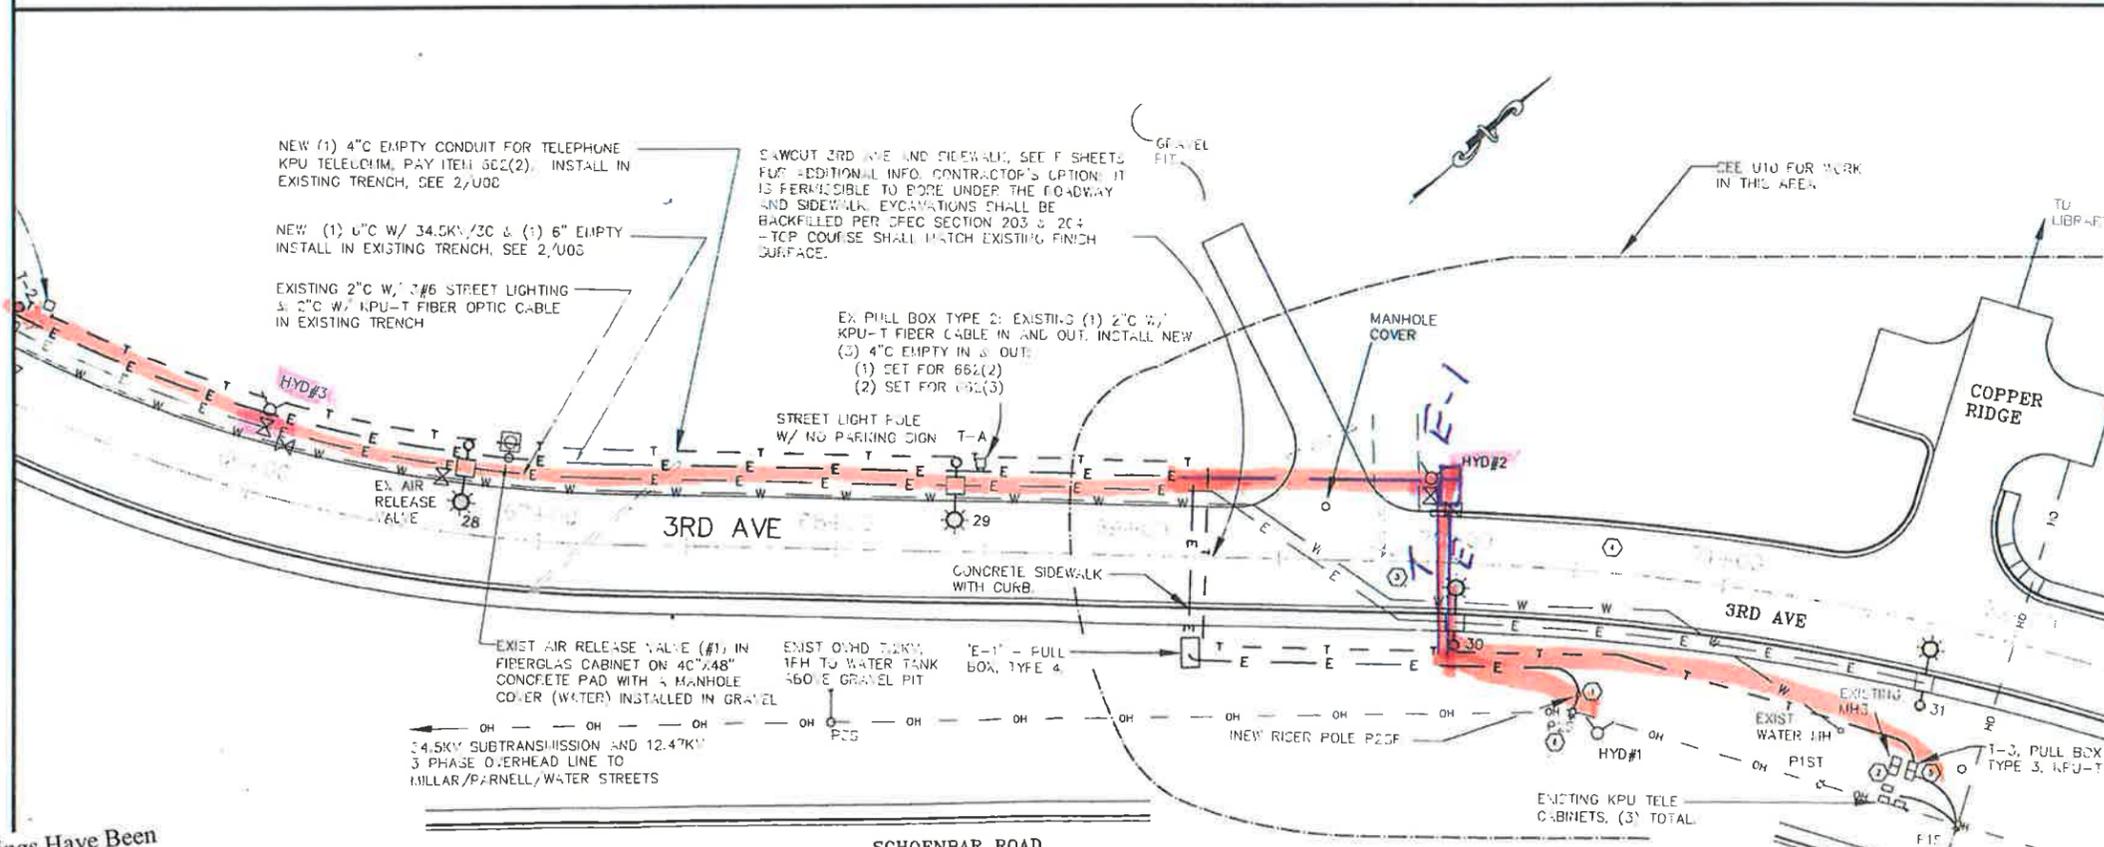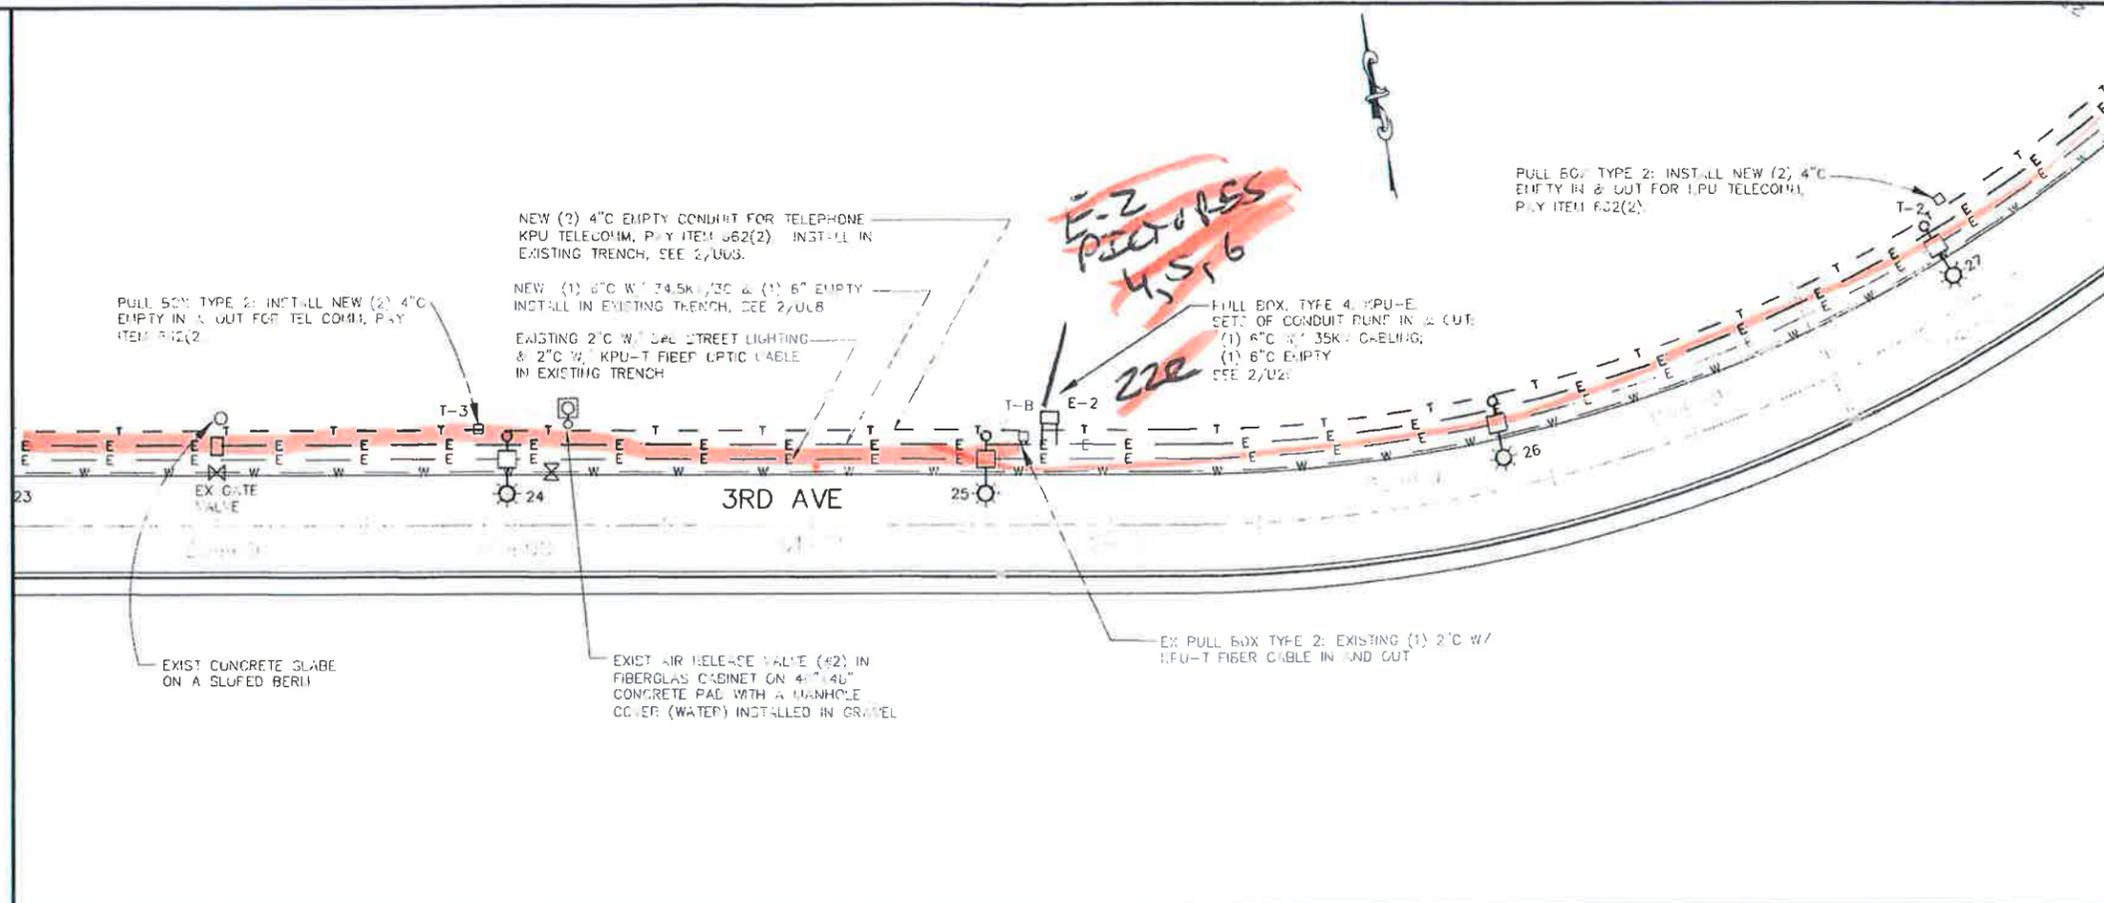

Project As Built Drawings Have Been Reviewed By The Project Engineer & Represent, To The Best Of My Knowledge, The Project As Constructed.

Proj. Eng. NB

Date 1/16/10

DO NOT SCALE FROM THESE DRAWINGS USE DIMENSIONS

PATH XXX

KCN12_000


T-E U07 8/28/2014 10:45 AM

ADDENDUM NUMBER

ATTACHMENT NUMBER

RECORD OF REVISIONS

No	DATE	DESCRIPTION

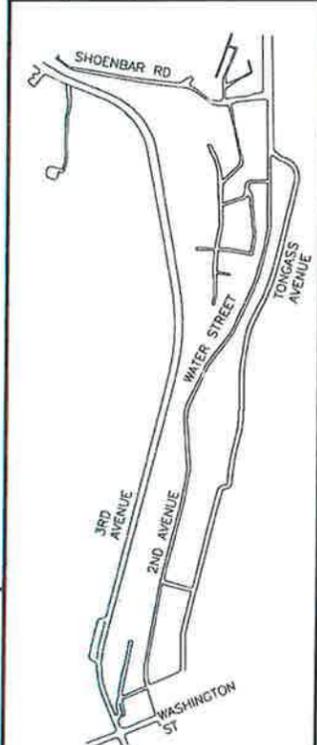

CHECKED BY TED

DESIGNED BY: KCN

DRAWN BY: KCN

STATE OF ALASKA
DEPARTMENT OF TRANSPORTATION & PUBLIC FACILITIES
SOUTHEAST REGION


KETCHIKAN ADVANCE
WATER STREET TRUNK LINE
RELOCATION
PROJECT # 69548

UTILITY PLAN
ELECTRICAL 3RD AVE

PROJECT DESIGNATION
BR-000S(735) ~ 69548

STATE	YEAR
ALASKA	2014

SHEET NUMBER	TOTAL SHEETS
U07	78

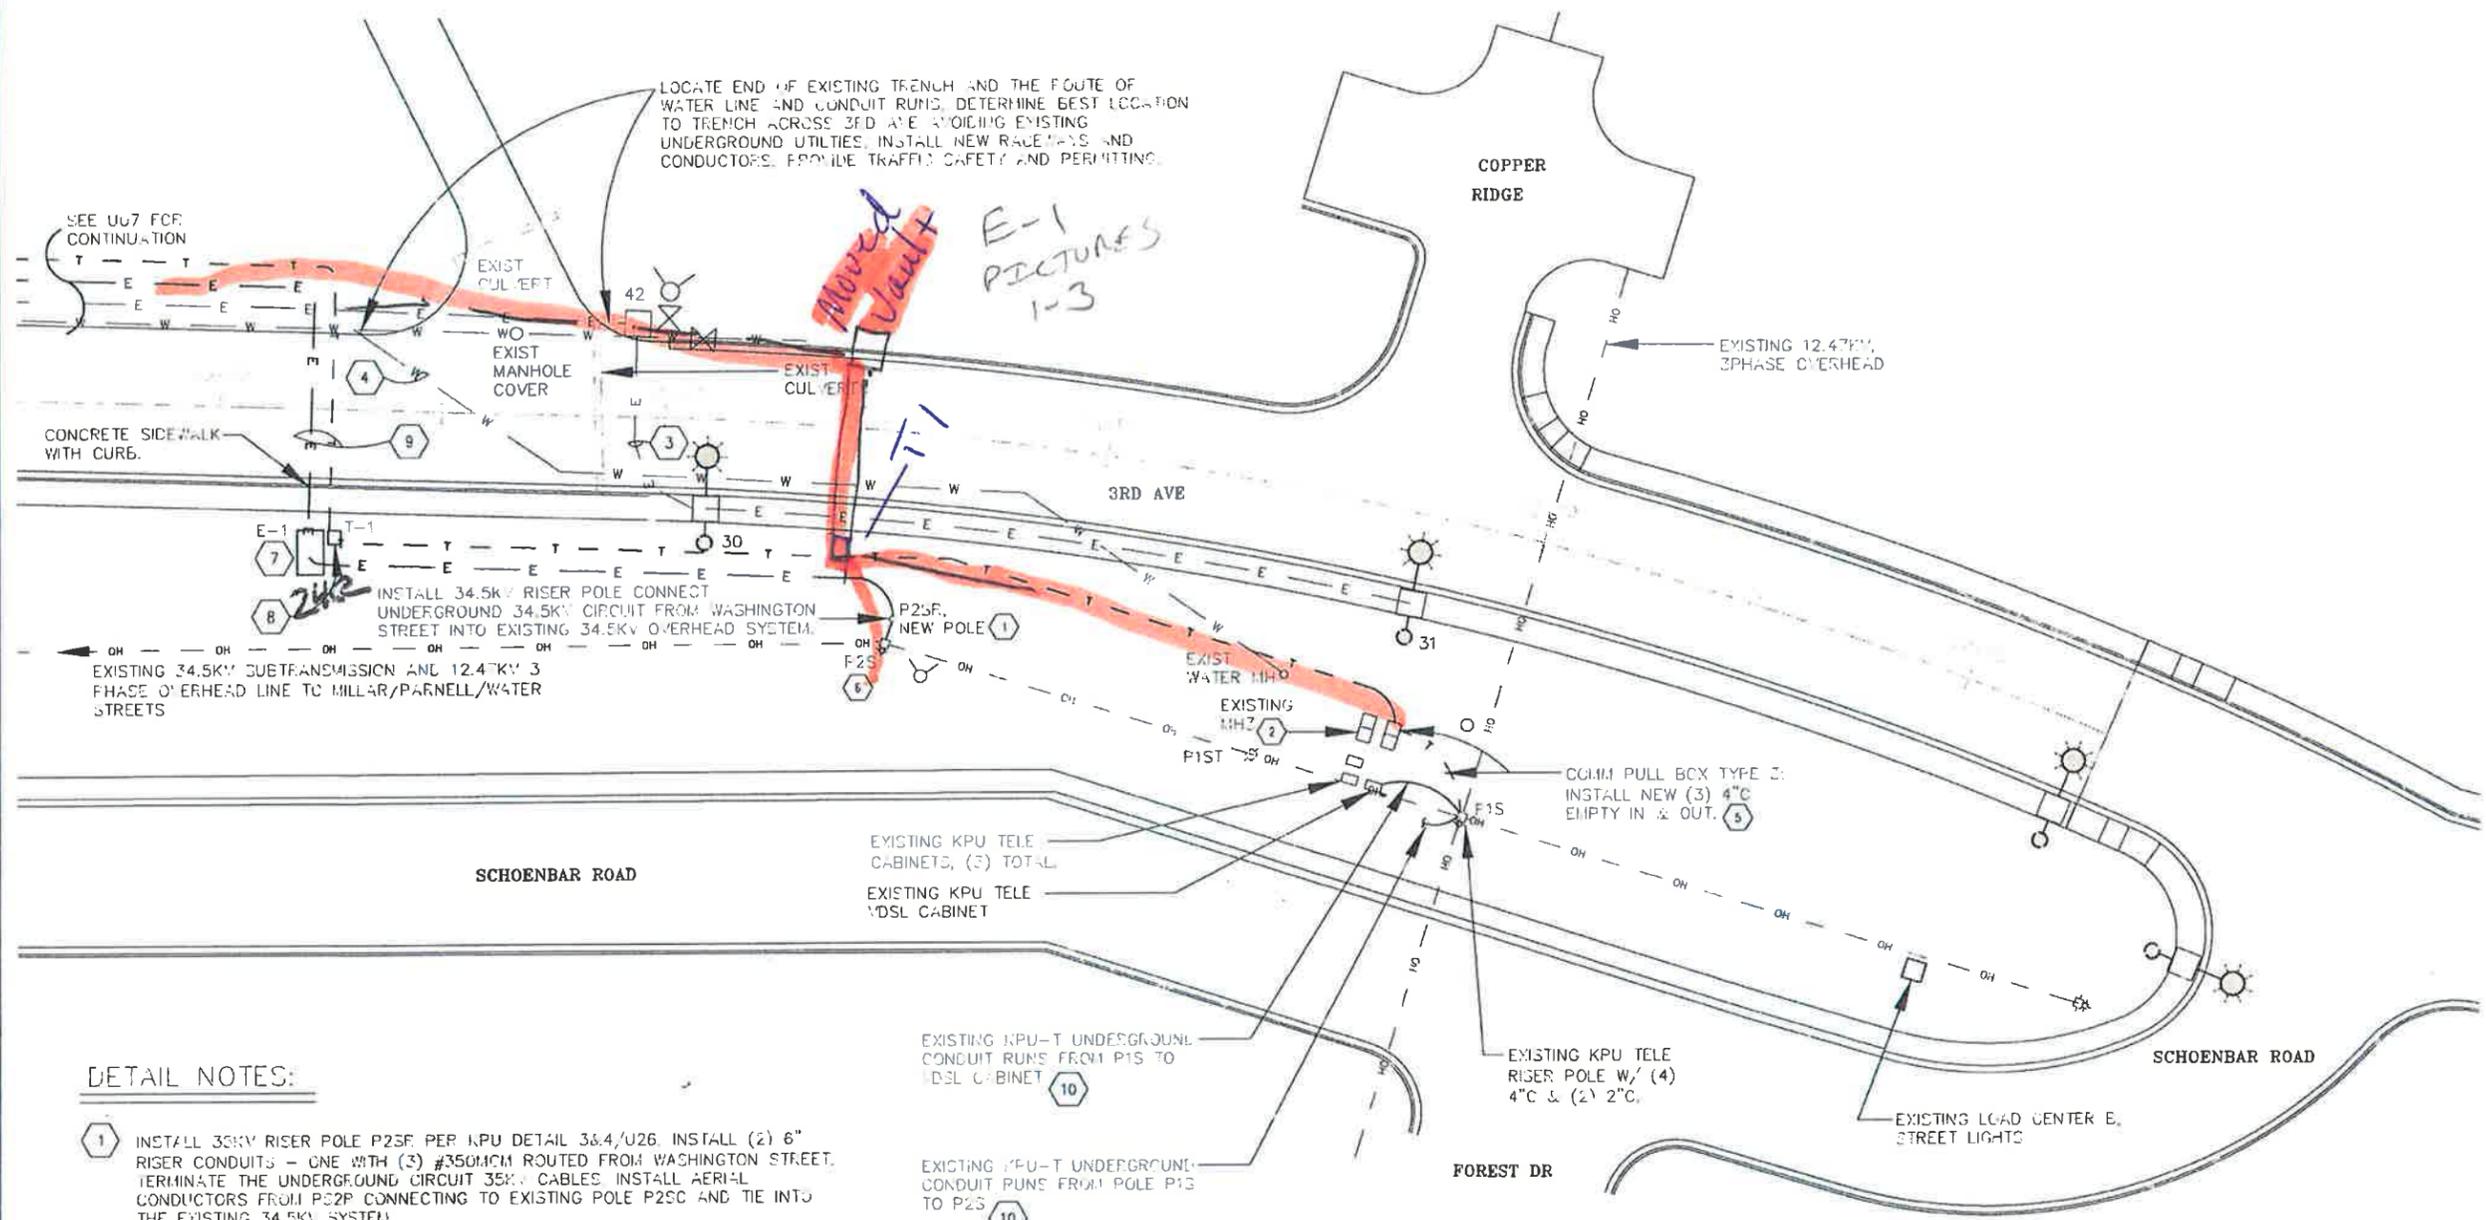

LOCATE END OF EXISTING TRENCH AND THE ROUTE OF WATER LINE AND CONDUIT RUNS. DETERMINE BEST LOCATION TO TRENCH ACROSS 3RD AVE AVOIDING EXISTING UNDERGROUND UTILITIES. INSTALL NEW RACEWAYS AND CONDUCTORS. PROVIDE TRAFFIC SAFETY AND PERMITTING.

Altered Utility
E-1 PICTURES 1-3

SEE U07 FOR CONTINUATION

INSTALL 34.5KV RISER POLE CONNECT UNDERGROUND 34.5KV CIRCUIT FROM WASHINGTON STREET INTO EXISTING 34.5KV OVERHEAD SYSTEM.

EXISTING 34.5KV SUBTRANSMISSION AND 12.4KV 3 PHASE OVERHEAD LINE TO MILLAR/PARNELL/WATER STREETS

EXISTING KPU TELE CABINETS, (2) TOTAL
 EXISTING KPU TELE DSL CABINET

EXISTING KPU-T UNDERGROUND CONDUIT RUNS FROM P15 TO DSL CABINET

EXISTING KPU-T UNDERGROUND CONDUIT RUNS FROM POLE P13 TO P25

EXISTING KPU TELE RISER POLE W/ (4) 4" C & (2) 2" C.

COMM PULL BOX TYPE 2: INSTALL NEW (3) 4" C EMPTY IN & OUT.

DETAIL NOTES:

- 1 INSTALL 35KV RISER POLE P25F PER KPU DETAIL 3&4/U26. INSTALL (2) 6" RISER CONDUITS - ONE WITH (3) #350MCM ROUTED FROM WASHINGTON STREET. TERMINATE THE UNDERGROUND CIRCUIT 35KV CABLES. INSTALL AERIAL CONDUCTORS FROM P25P CONNECTING TO EXISTING POLE P25C AND TIE INTO THE EXISTING 34.5KV SYSTEM.
- 2 EXISTING KPU-T MANHOLE (MH3) WITH EXISTING 2" C W/ FIBER CABLE FROM WASHINGTON RISER POLE AND (3) 4" C TO POLE P15.
- 3 LOCATION OF THE STREET LIGHTING CIRCUIT CROSSING 3RD AVE PER AS-BUILT DRAWINGS. CONFIRM LOCATION.
- 4 LOCATION OF THE WATER LINE CROSSING 3RD AVE PER AS-BUILT DRAWINGS. CONFIRM LOCATION.
- 5 INSTALL NEW PULL BOX AND INSTALL (3) SETS OF CONDUITS IN AND OUT OF BOX: (1) 4" C FOR 662(2) & (2) 4" C FOR 662(3). THE CONDUITS TERMINATING ON P15 SHALL MATCH EXISTING RISER CONDUIT INSTALLATION.
- 6 INSTALL NEW CROSSARM W/ 34.5KV DEADEND HARDWARE AND 34.5KV 3 PHASE OVERHEAD CONDUCTORS CONNECTING TO NEW RISER POLE P25. ALSO JUMPER NEW OVERHEAD CONDUCTORS TO THE EXISTING 34.5KV LINE LOCATED ON THE TOP TIER OF P25.
- 7 PULL BOX, TYPE 4 FOR ELECTRIC (KPU-E). SETS OF CONDUIT RUNS IN & OUT: (1) 6" C W/ 35KV CABLING; (1) 2" C EMPTY; (1) 4" C EMPTY, WORK IN 662(3)
- 8 PULL BOX, TYPE 2 FOR TELECOM: INSTALL NEW (3) 4" C EMPTY IN & OUT: (1) SET FOR 662(2); (2) SET FOR 662(3)

- 9 SAWCUT 3RD AVE AND SIDEWALK, SEE 1/U09 & F SHEETS FOR ADDITIONAL INFO. CONTRACTOR'S OPTION: IT IS PERMISSIBLE TO BORE UNDER THE ROADWAY AND SIDEWALK. EXCAVATIONS SHALL BE BACKFILLED PER SPEC SECTION 203 & 204 -TOP COURSE SHALL MATCH EXISTING FINISH SURFACE.
- 10 INSTALL NEW 25 F AIR C-BLE IN EXISTING CONDUIT FROM EXISTING DSL CABINET TO POLE P25. TERMINATE IN CABINET AND NEW AERIAL TERMINAL ON POLE P25, SEE F SHEETS.

1 SCHOENBAR ISLAND PLAN
 SCALE: 1" = 20'

Project As Built Drawings Have Been Reviewed By The Project Engineer & Represent, To The Best Of My Knowledge, The Project As Constructed.


Proj. Eng. *NB* Date *11/16/16*

DO NOT SCALE FROM THESE DRAWINGS USE DIMENSIONS

PATH XXX

KCN12_000
 TAB U10 8/28/2014 10:57 AM

APPENDIX NUMBER		
ATTACHMENT NUMBER		
RECORD OF REVISIONS		
No.	DATE	DESCRIPTION

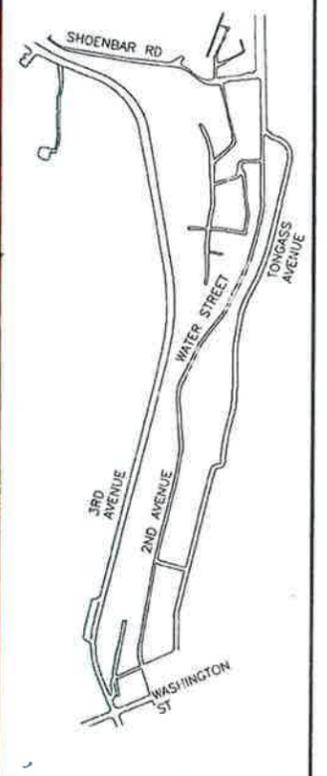

CHECKED BY: TED

DESIGNED BY: KCN
 DRAWN BY: KCN


STATE OF ALASKA
 DEPARTMENT OF TRANSPORTATION & PUBLIC FACILITIES
 SOUTHEAST REGION

KETCHIKAN ADVANCE WATER STREET TRUNK LINE RELOCATION
 PROJECT #69534

SCHOENBAR PLAN

PROJECT DESIGNATION	
BR-000S(735) ~ 69354	
STATE	YEAR
ALASKA	2014
SHEET NUMBER	TOTAL SHEETS
U10	78

ADDENDUM NUMBER		
ATTACHMENT NUMBER		
RECORD OF REVISIONS		
No.	DATE	DESCRIPTION

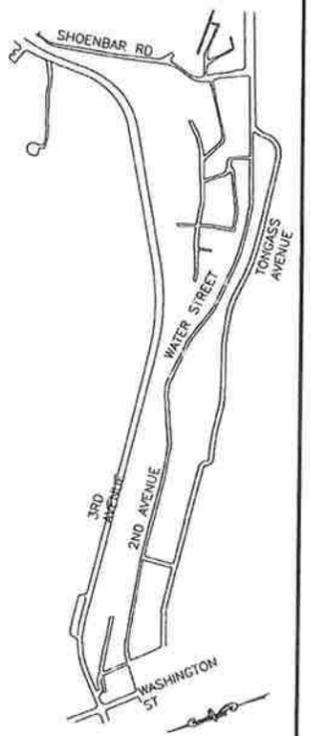

PLAN LEGEND

CHECKED BY: TED



DESIGNED BY: KCN

DRAWN BY: KCN

STATE OF ALASKA
 DEPARTMENT OF TRANSPORTATION
 & PUBLIC FACILITIES
 SOUTHEAST REGION


KETCHIKAN ADVANCE
 WATER STREET TRUNKLINE
 RELOCATION
 PROJECT #69548

**UTILITY PLAN
 WATER ST. ELECTRIC**

PROJECT DESIGNATION

BR-000S(735) ~69458

STATE	YEAR
ALASKA	2014
SHEET NUMBER	TOTAL SHEETS
U12	78

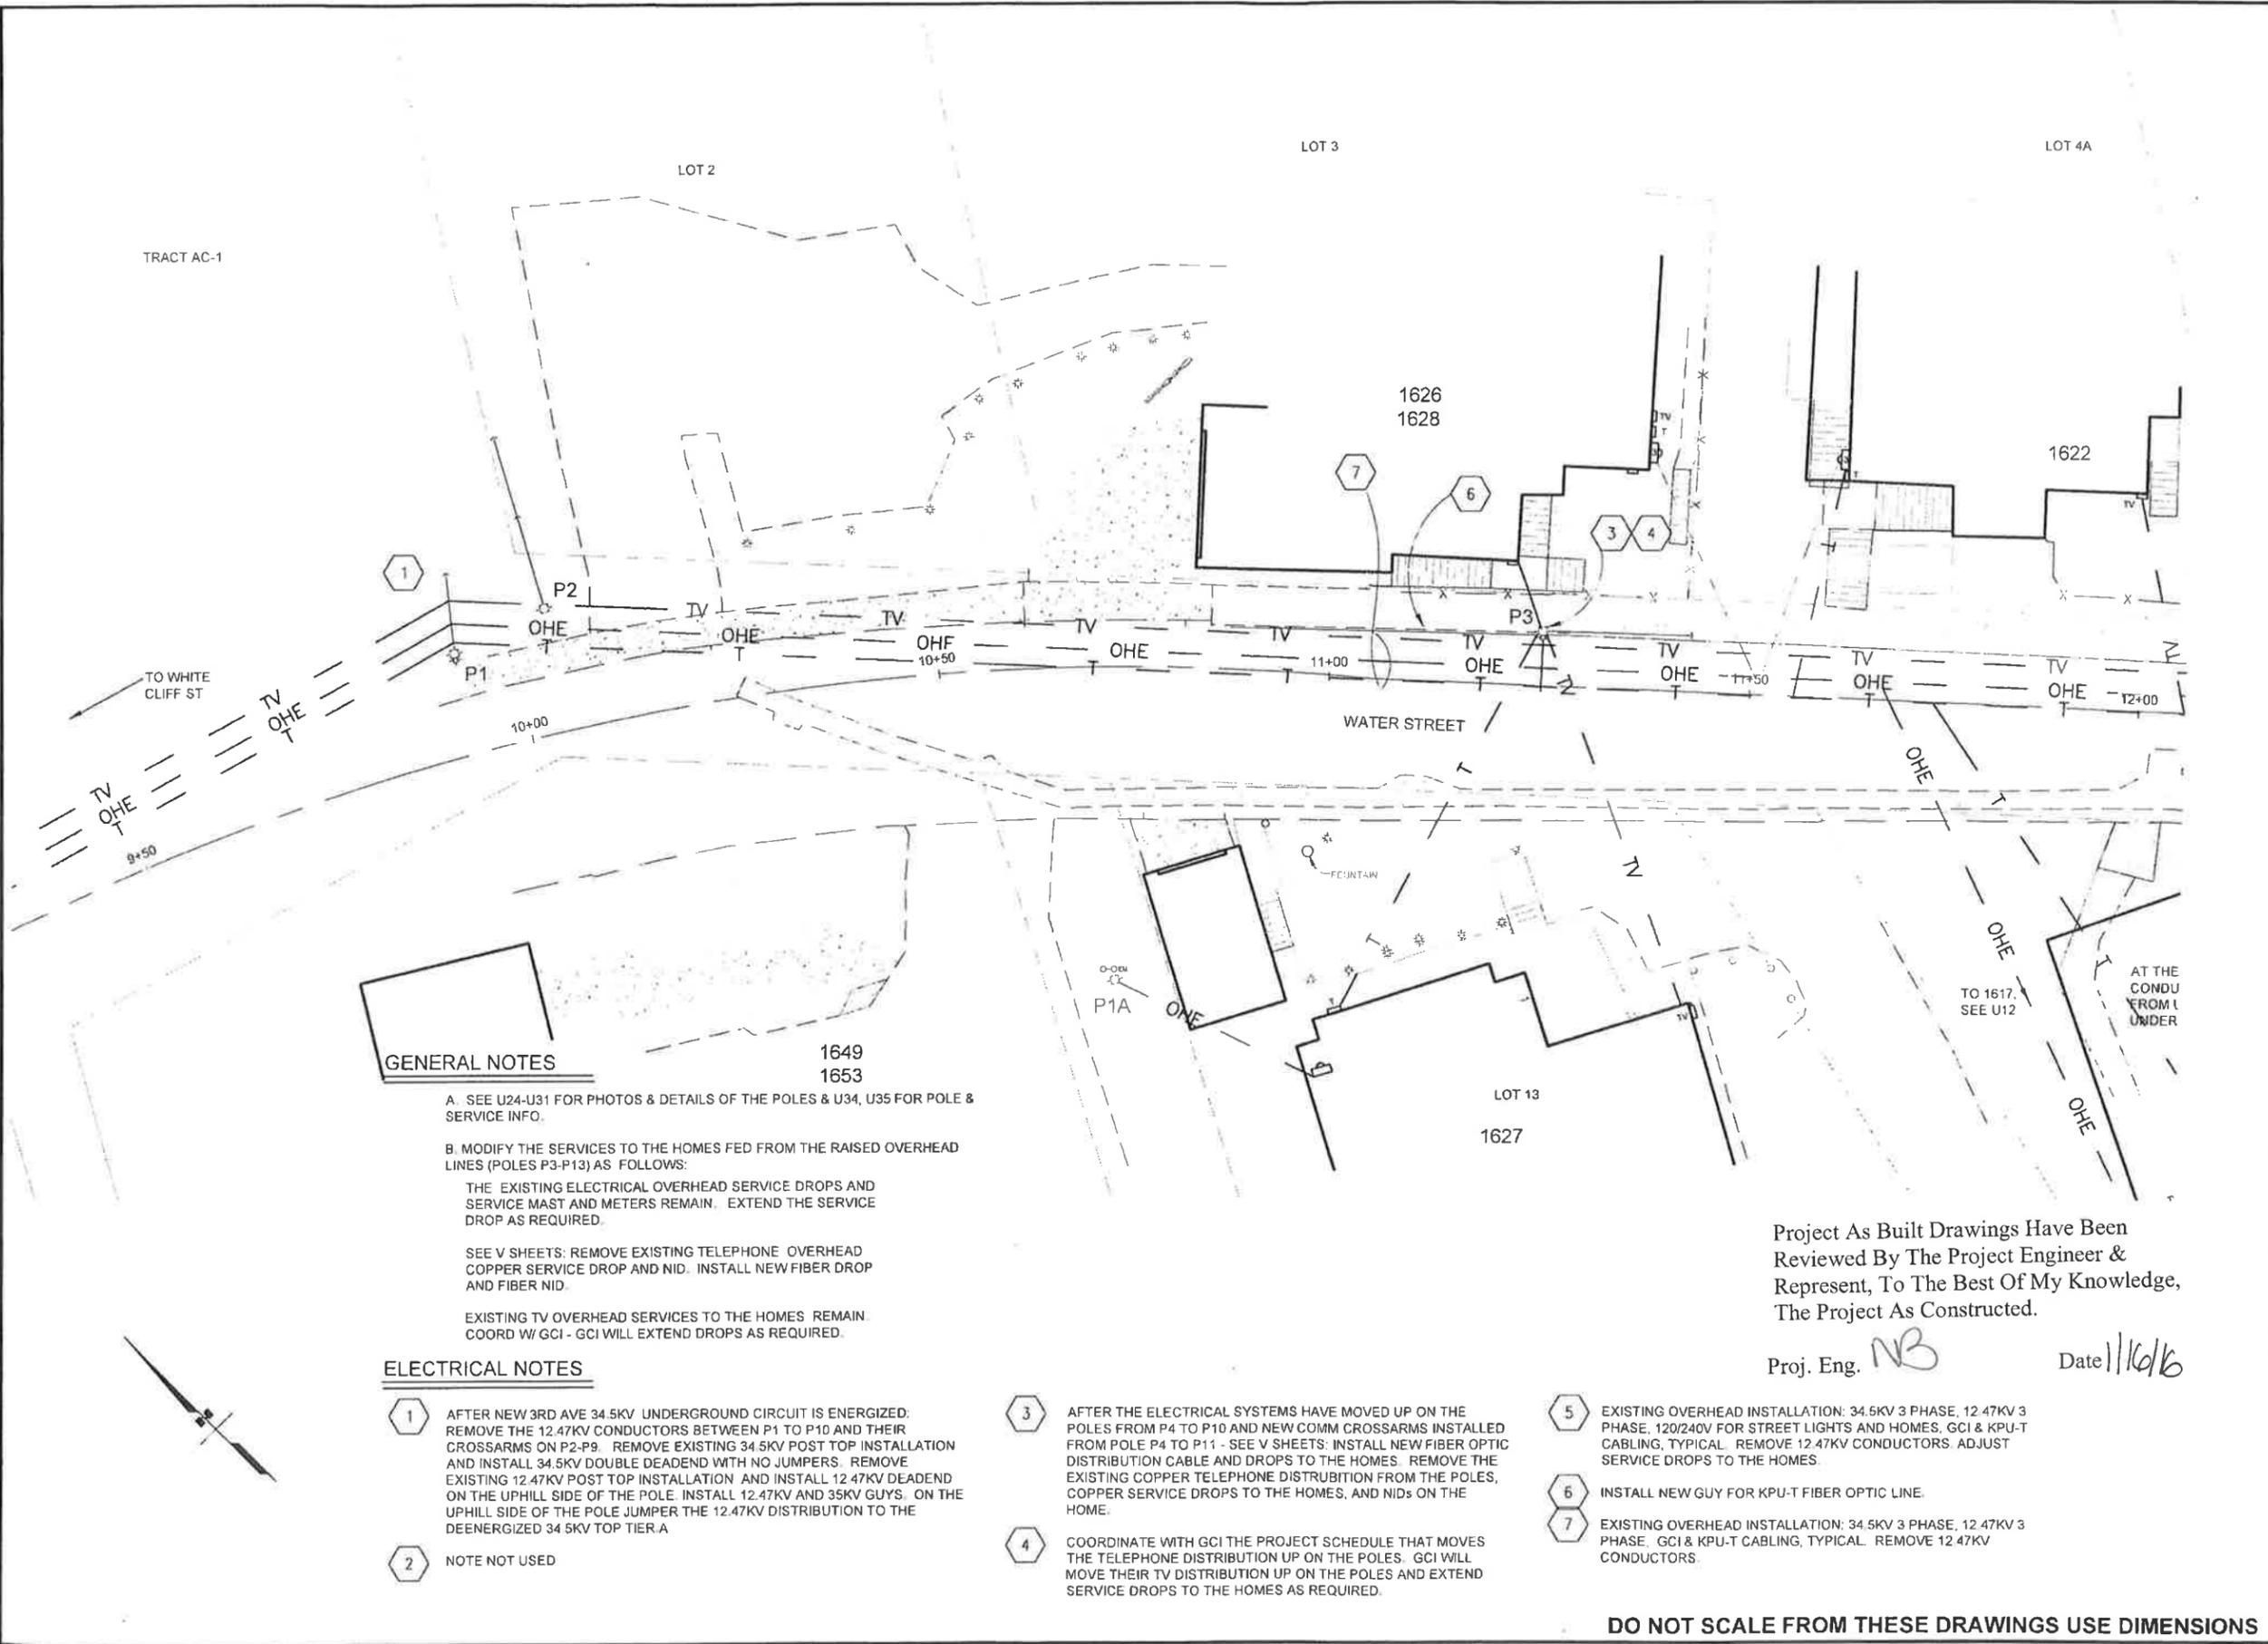

GENERAL NOTES

- A. SEE U24-U31 FOR PHOTOS & DETAILS OF THE POLES & U34, U35 FOR POLE & SERVICE INFO.
- B. MODIFY THE SERVICES TO THE HOMES FED FROM THE RAISED OVERHEAD LINES (POLES P3-P13) AS FOLLOWS:
 THE EXISTING ELECTRICAL OVERHEAD SERVICE DROPS AND SERVICE MAST AND METERS REMAIN. EXTEND THE SERVICE DROP AS REQUIRED.
- SEE V SHEETS: REMOVE EXISTING TELEPHONE OVERHEAD COPPER SERVICE DROP AND NID. INSTALL NEW FIBER DROP AND FIBER NID.
- EXISTING TV OVERHEAD SERVICES TO THE HOMES REMAIN. COORD W/ GCI - GCI WILL EXTEND DROPS AS REQUIRED.



ELECTRICAL NOTES

- 1 AFTER NEW 3RD AVE 34.5KV UNDERGROUND CIRCUIT IS ENERGIZED: REMOVE THE 12.47KV CONDUCTORS BETWEEN P1 TO P10 AND THEIR CROSSARMS ON P2-P9. REMOVE EXISTING 34.5KV POST TOP INSTALLATION AND INSTALL 34.5KV DOUBLE DEADEND WITH NO JUMPERS. REMOVE EXISTING 12.47KV POST TOP INSTALLATION AND INSTALL 12.47KV DEADEND ON THE UPHILL SIDE OF THE POLE. INSTALL 12.47KV AND 35KV GUYS. ON THE UPHILL SIDE OF THE POLE JUMPER THE 12.47KV DISTRIBUTION TO THE DEENERGIZED 34.5KV TOP TIER A.
- 2 NOTE NOT USED
- 3 AFTER THE ELECTRICAL SYSTEMS HAVE MOVED UP ON THE POLES FROM P4 TO P10 AND NEW COMM CROSSARMS INSTALLED FROM POLE P4 TO P11 - SEE V SHEETS: INSTALL NEW FIBER OPTIC DISTRIBUTION CABLE AND DROPS TO THE HOMES. REMOVE THE EXISTING COPPER TELEPHONE DISTRIBUTION FROM THE POLES, COPPER SERVICE DROPS TO THE HOMES, AND NIDS ON THE HOME.
- 4 COORDINATE WITH GCI THE PROJECT SCHEDULE THAT MOVES THE TELEPHONE DISTRIBUTION UP ON THE POLES. GCI WILL MOVE THEIR TV DISTRIBUTION UP ON THE POLES AND EXTEND SERVICE DROPS TO THE HOMES AS REQUIRED.
- 5 EXISTING OVERHEAD INSTALLATION: 34.5KV 3 PHASE, 12.47KV 3 PHASE, 120/240V FOR STREET LIGHTS AND HOMES, GCI & KPU-T CABLING, TYPICAL. REMOVE 12.47KV CONDUCTORS. ADJUST SERVICE DROPS TO THE HOMES.
- 6 INSTALL NEW GUY FOR KPU-T FIBER OPTIC LINE.
- 7 EXISTING OVERHEAD INSTALLATION: 34.5KV 3 PHASE, 12.47KV 3 PHASE, GCI & KPU-T CABLING, TYPICAL. REMOVE 12.47KV CONDUCTORS.

Project As Built Drawings Have Been Reviewed By The Project Engineer & Represent, To The Best Of My Knowledge, The Project As Constructed.

Proj. Eng. NB Date 1/16/16

DO NOT SCALE FROM THESE DRAWINGS USE DIMENSIONS

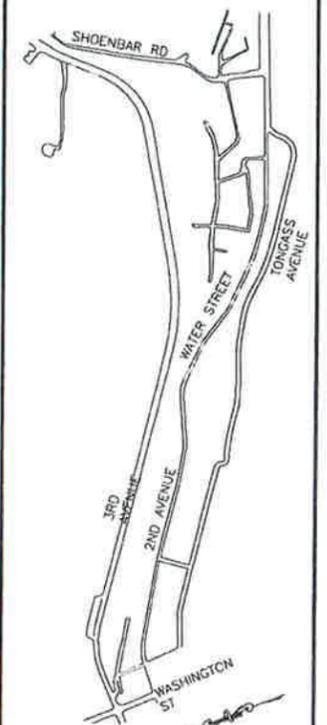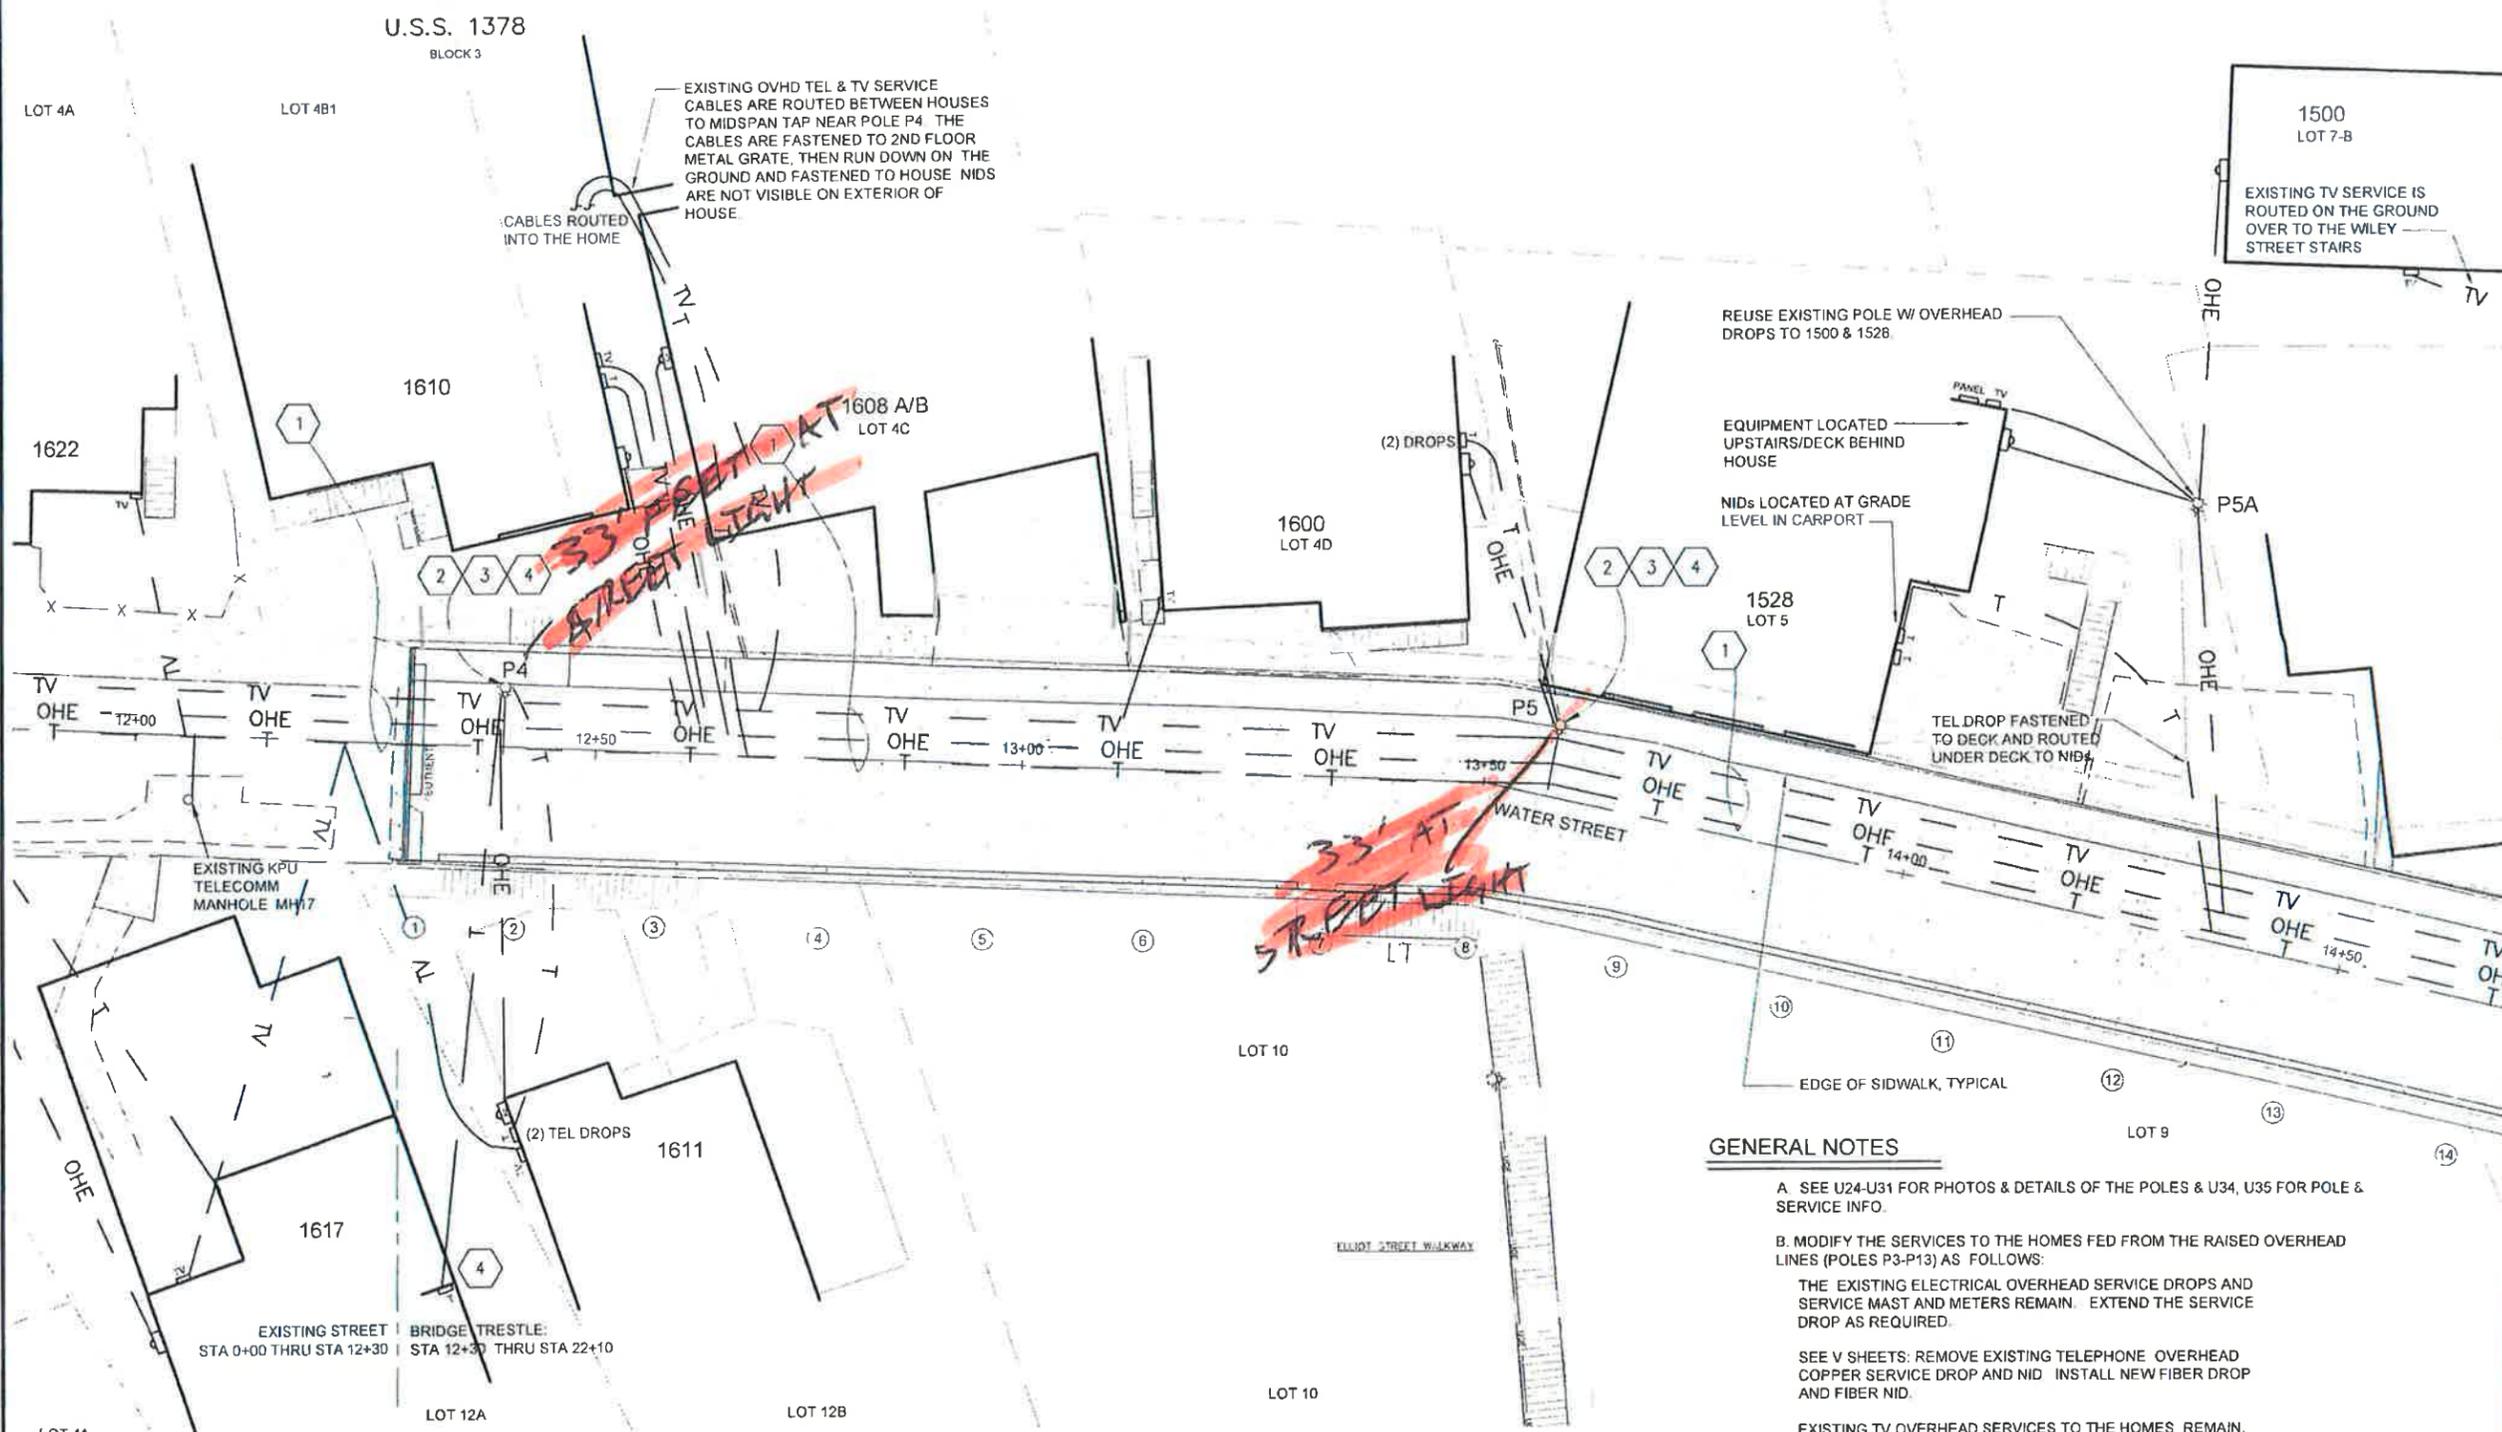

PLAN LEGEND

GENERAL NOTES

- A. SEE U24-U31 FOR PHOTOS & DETAILS OF THE POLES & U34, U35 FOR POLE & SERVICE INFO.
- B. MODIFY THE SERVICES TO THE HOMES FED FROM THE RAISED OVERHEAD LINES (POLES P3-P13) AS FOLLOWS:
 THE EXISTING ELECTRICAL OVERHEAD SERVICE DROPS AND SERVICE MAST AND METERS REMAIN. EXTEND THE SERVICE DROP AS REQUIRED.
 SEE V SHEETS: REMOVE EXISTING TELEPHONE OVERHEAD COPPER SERVICE DROP AND NID. INSTALL NEW FIBER DROP AND FIBER NID.
 EXISTING TV OVERHEAD SERVICES TO THE HOMES REMAIN. COORD W/ GCI - GCI WILL EXTEND DROPS AS REQUIRED.

ELECTRICAL NOTES

- 1. EXISTING OVERHEAD 34.5KV, 12KV, 120/240V DISTRIBUTION, CABLE TV, AND TEL DISTRIBUTION. AFTER THE 12.47KV DISTRIBUTION IS JUMPED TO THE TOP TIER AT POLES P1 AND P10, REMOVE 12.47KV LINE AND CROSSARMS POLES P4-P9. SEE U22, U23 FOR POLE PHOTOS.
- 2. MOVE THE SYSTEM NEUTRAL, 120/240V STREET LIGHTS, TRANSFORMERS UP ON THE POLE FROM POLE P4 TO P10. EXTEND 120/240V SERVICE DROPS TO THE HOMES AS REQUIRED BY THE NEW HEIGHTS.
- 3. AFTER THE ELECTRICAL SYSTEMS HAVE MOVED UP ON THE POLES FROM P2 TO P10, INSTALL NEW COMM CROSSARMS FROM POLE P2 TO P10. SEE V SHEETS: INSTALL NEW FIBER OPTIC DISTRIBUTION CABLE AND DROPS TO THE HOMES. REMOVE THE EXISTING COPPER TELEPHONE DISTRIBUTION FROM THE POLES, COPPER SERVICE DROPS TO THE HOMES, AND NIDS ON THE HOME.
- 4. COORDINATE WITH GCI THE PROJECT SCHEDULE THAT MOVES THE TELEPHONE DISTRIBUTION UP ON THE POLES. GCI WILL MOVE THEIR TV DISTRIBUTION UP ON THE POLES AND EXTEND SERVICE DROPS TO THE HOMES AS REQUIRED.
- 5. 1617 HAS AN ADDITION BEING CONSTRUCTED IN FRONT OF THE EXISTING HOUSE. CONFIRM LOCATION OF THE METER AND NIDS

Project As Built Drawings Have Been Reviewed By The Project Engineer & Represent, To The Best Of My Knowledge, The Project As Constructed.

Proj. Eng. **NB** Date **11/16/16**

DO NOT SCALE FROM THESE DRAWINGS USE DIMENSIONS

CHECKED BY TED



DESIGNED BY KCN

DRAWN BY KCN

STATE OF ALASKA
 DEPARTMENT OF TRANSPORTATION & PUBLIC FACILITIES
 SOUTHEAST REGION


KETCHIKAN ADVANCE
 WATER STREET TRUNK LINE
 RELOCATION
 PROJECT # 69548

UTILITY PLAN
 WATER ST. ELECT

PROJECT DESIGNATION
BR-000S(735) -69548

STATE	YEAR
ALASKA	2014
SHEET NUMBER	TOTAL SHEETS
U13	78

ADDENDUM NUMBER		
ATTACHMENT NUMBER		
RECORD OF REVISIONS		
No	DATE	DESCRIPTION

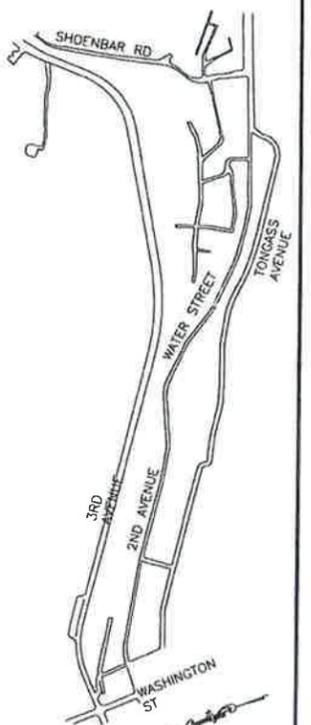

PLAN LEGEND

CHECKED BY TED



DESIGNED BY: KCN
 DRAWN BY: KCN


STATE OF ALASKA
 DEPARTMENT OF TRANSPORTATION
 & PUBLIC FACILITIES
 SOUTHEAST REGION

KETCHIKAN ADVANCE
 WATER STREET TRUNK LINE
 RELOCATION
 PROJECT # 69548

**UTILITY PLAN
 WATER ST. ELECT**

PROJECT DESIGNATION
BR-000S(735) ~69548

STATE	YEAR
ALASKA	2014
SHEET NUMBER	TOTAL SHEETS
U14	78

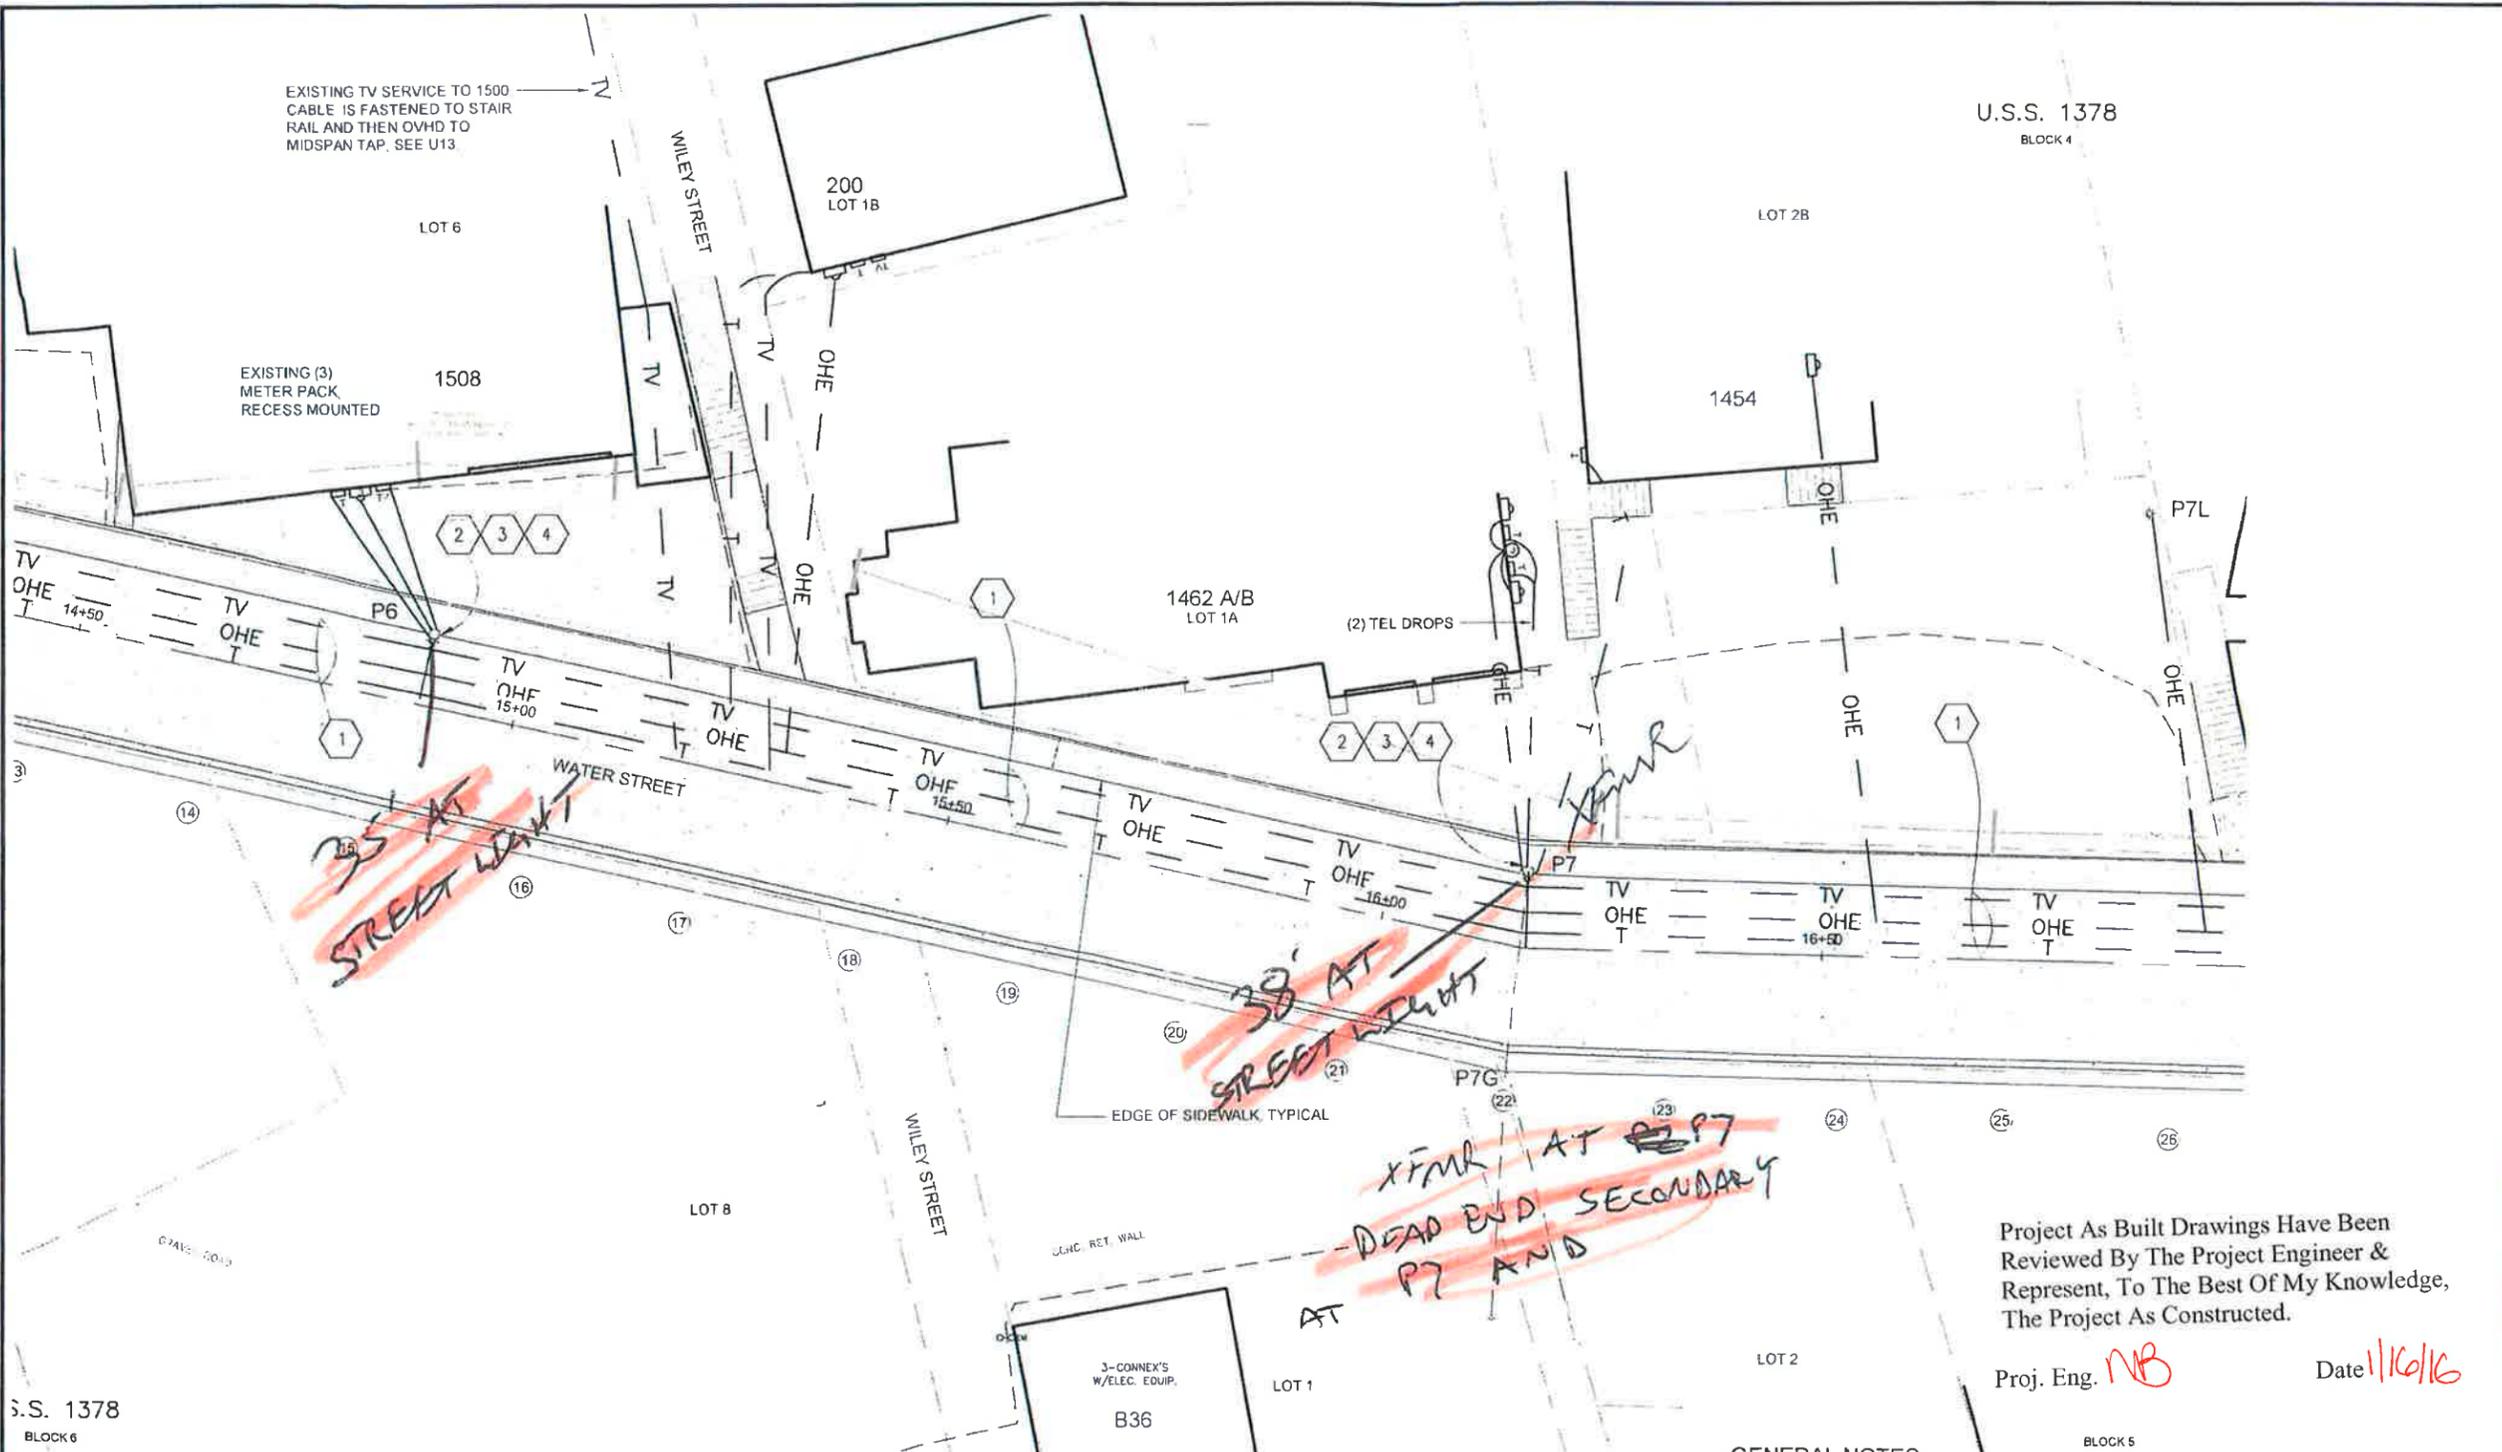

U.S.S. 1378
 BLOCK 4

U.S.S. 1378
 BLOCK 6

THE NIDS



ELECTRICAL NOTES

- 1 EXISTING OVERHEAD 34.5KV, 12KV, 120/240V DISTRIBUTION, CABLE TV, AND TEL DISTRIBUTION. AFTER THE 12.47KV DISTRIBUTION IS JUMPED TO THE TOP TIER AT POLES P1 AND P10. REMOVE 12.47KV LINE AND CROSSARMS POLES P4-P9. SEE U22, U23 FOR POLE PHOTOS.
- 2 MOVE THE SYSTEM NEUTRAL, 120/240V STREET LIGHTS, TRANSFORMERS UP ON THE POLE FROM POLE P4 TO P10. EXTEND 120/240V SERVICE DROPS TO THE HOMES AS REQUIRED BY THE NEW HEIGHTS.
- 3 AFTER THE ELECTRICAL SYSTEMS HAVE MOVED UP ON THE POLES FROM P2 TO P10, INSTALL NEW COMM CROSSARMS FROM POLE P4 TO P10. SEE V SHEETS: INSTALL NEW FIBER OPTIC DISTRIBUTION CABLE AND DROPS TO THE HOMES. REMOVE THE EXISTING COPPER TELEPHONE DISTRIBUTION FROM THE POLES. COPPER SERVICE DROPS TO THE HOMES, AND NIDS ON THE HOME.
- 4 COORDINATE WITH GCI THE PROJECT SCHEDULE THAT MOVES THE TELEPHONE DISTRIBUTION UP ON THE POLES. GCI WILL MOVE THEIR TV DISTRIBUTION UP ON THE POLES AND EXTEND SERVICE DROPS TO THE HOMES AS REQUIRED.

GENERAL NOTES

- A SEE U24-U31 FOR PHOTOS & DETAILS OF THE POLES & U34, U35 FOR POLE & SERVICE INFO.
- B MODIFY THE SERVICES TO THE HOMES FED FROM THE RAISED OVERHEAD LINES (POLES P3-P13) AS FOLLOWS:
 THE EXISTING ELECTRICAL OVERHEAD SERVICE DROPS AND SERVICE MAST AND METERS REMAIN. EXTEND THE SERVICE DROP AS REQUIRED.
 SEE V SHEETS: REMOVE EXISTING TELEPHONE OVERHEAD COPPER SERVICE DROP AND NID. INSTALL NEW FIBER DROP AND FIBER NID.
 EXISTING TV OVERHEAD SERVICES TO THE HOMES REMAIN. COORD W/ GCI. GCI WILL EXTEND DROPS AS REQUIRED.

Project As Built Drawings Have Been Reviewed By The Project Engineer & Represent, To The Best Of My Knowledge, The Project As Constructed.


Proj. Eng. **NB** Date **11/16/16**

DO NOT SCALE FROM THESE DRAWINGS USE DIMENSIONS



PATH: C:\USERS\KCN12\DR\DOCUMENTS\18-KNEE\2013\WSB DESIGN\210\DWG\NTP8 TRUNK RELOCATION\WSB AUR U01+12+17 BRIDGE.DWG
KCN12_000
TAB: U15

ADDENDUM NUMBER		
ATTACHMENT NUMBER		
RECORD OF REVISIONS		
No	DATE	DESCRIPTION

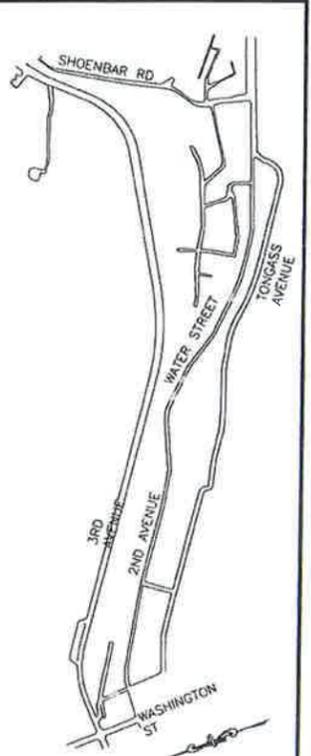

PLAN LEGEND

Project As Built Drawings Have Been Reviewed By The Project Engineer & Represent, To The Best Of My Knowledge, The Project As Constructed.

Proj. Eng. **NB** Date **1/16/16**

CHECKED BY: TED



DESIGNED BY: KCN
DRAWN BY: KCN

STATE OF ALASKA
DEPARTMENT OF TRANSPORTATION & PUBLIC FACILITIES
SOUTHEAST REGION

KETCHIKAN ADVANCE
WATER STREET TUNK LINE
RELOCATION
PROJECT # 69548

**UTILITY PLAN
WATER ST. ELECT**

PROJECT DESIGNATION
BR-000S(735) ~69548

STATE	YEAR
ALASKA	2014
SHEET NUMBER	TOTAL SHEETS
U15	78

ELECTRICAL NOTES

- 1 EXISTING OVERHEAD 34 5KV, 12KV, 120/240V DISTRIBUTION, CABLE TV, AND TEL DISTRIBUTION. AFTER THE 12.47KV DISTRIBUTION IS JUMPERED TO THE TOP TIER AT POLES P1 AND P10, REMOVE 12.47KV LINE AND CROSSARMS POLES P4-P9, SEE U22, U23 FOR POLE PHOTOS.
- 2 MOVE THE SYSTEM NEUTRAL, 120/240V STREET LIGHTS, TRANSFORMERS UP ON THE POLE FROM POLE P4 TO P10. EXTEND 120/240V SERVICE DROPS TO THE HOMES AS REQUIRED BY THE NEW HEIGHTS.

- 3 AFTER THE ELECTRICAL SYSTEMS HAVE MOVED UP ON THE POLES FROM P2 TO P10, INSTALL NEW COMM CROSSARMS FROM POLE P4 TO P10. SEE V SHEETS. INSTALL NEW FIBER OPTIC DISTRIBUTION CABLE AND DROPS TO THE HOMES. REMOVE THE EXISTING COPPER TELEPHONE DISTRIBUTION FROM THE POLES, COPPER SERVICE DROPS TO THE HOMES, AND NIDS ON THE HOME.
- 4 COORDINATE WITH GCI THE PROJECT SCHEDULE THAT MOVES THE TELEPHONE DISTRIBUTION UP ON THE POLES. GCI WILL MOVE THEIR TV DISTRIBUTION UP ON THE POLES AND EXTEND SERVICE DROPS TO THE HOMES AS REQUIRED.

GENERAL NOTES

- A. SEE U24-U31 FOR PHOTOS & DETAILS OF THE POLES & U34, U35 FOR POLE SERVICE INFO.
- B. MODIFY THE SERVICES TO THE HOMES FED FROM THE RAISED OVERHEAD LINES (POLES P3-P13) AS FOLLOWS:
THE EXISTING ELECTRICAL OVERHEAD SERVICE DROPS AND SERVICE MAST AND METERS REMAIN. EXTEND THE SERVICE DROP AS REQUIRED.
SEE V SHEETS: REMOVE EXISTING TELEPHONE OVERHEAD COPPER SERVICE DROP AND NID. INSTALL NEW FIBER DROP AND FIBER NID.
EXISTING TV OVERHEAD SERVICES TO THE HOMES REMAIN. COORD W/ GCI - GCI WILL EXTEND DROPS AS REQUIRED.

DO NOT SCALE FROM THESE DRAWINGS USE DIMENSIONS

Ketchikan Advance Water Street Truck Line Relocation Project #69548

As-Built
Pole
Photos



P0



P1 & P2



P3



P4



P5



P6



P7



P8



P9



P10



P10



P11

Mid Span Height
Pole to Pole

10	9	KPU	26' 6"
		GCI	26' 6"
9	8	KPU	25' 6"
		GCI	26' 10"
8	7	KPU	26' 2"
		GCI	25'
7	6	KPU	26' 2"
		GCI	25' 9"
6	5	KPU	25' 2"
		KPU *	26' 6"
		GCI	24' 9"
5	4	KPU	25' 1"
		GCI	24' 3"
4	3	KPU	26'
		GCI	26' 8"

* Measurement taken at pole

Project As Built Drawings Have Been
Reviewed By The Project Engineer &
Represent, To The Best Of My Knowledge,
The Project As Constructed.

Proj. Eng. *NB*

Date *1/10/16*


Project As Built Drawings Have Been Reviewed By The Project Engineer & Represent, To The Best Of My Knowledge, The Project As Constructed.

Proj. Eng. **MB**

Date **1/16/16**

P:\TH\C\USERS\KCN\12_000\DOCUMENTS\12-000-KNEE\2013\WSB
 DESIGN\150\DWG-ATPS TRUNK
 RELOCATION\WSB_AUR_U01-12-17
 BRIDGE.DWG
 KCN12_000
 TAB U16

ADDENDUM NUMBER		
ATTACHMENT NUMBER		
RECORD OF REVISIONS		
No	DATE	DESCRIPTION

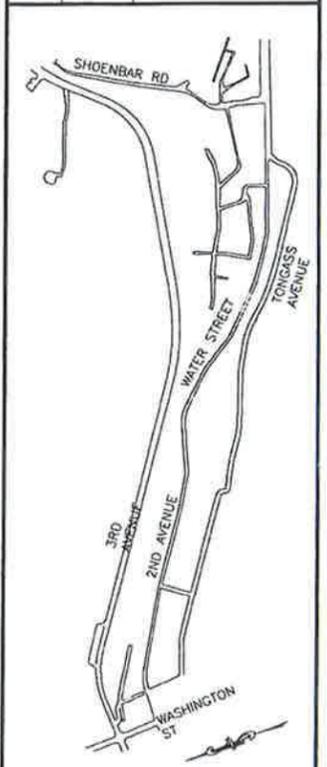

PLAN LEGEND

CHECKED BY: TED



DESIGNED BY: KCN

DRAWN BY: KCN

STATE OF ALASKA
 DEPARTMENT OF TRANSPORTATION
 & PUBLIC FACILITIES
 SOUTHEAST REGION


KETCHIKAN ADVANCE
 WATER STREET TRUNK LINE
 RELOCATION
 PROJECT # 69548

**UTILITY PLAN
 WATER ST. ELECT**

PROJECT DESIGNATION
BR-000S(735) ~69548

STATE: **ALASKA** YEAR: **2014**

SHEET NUMBER: **U16** TOTAL SHEETS: **78**

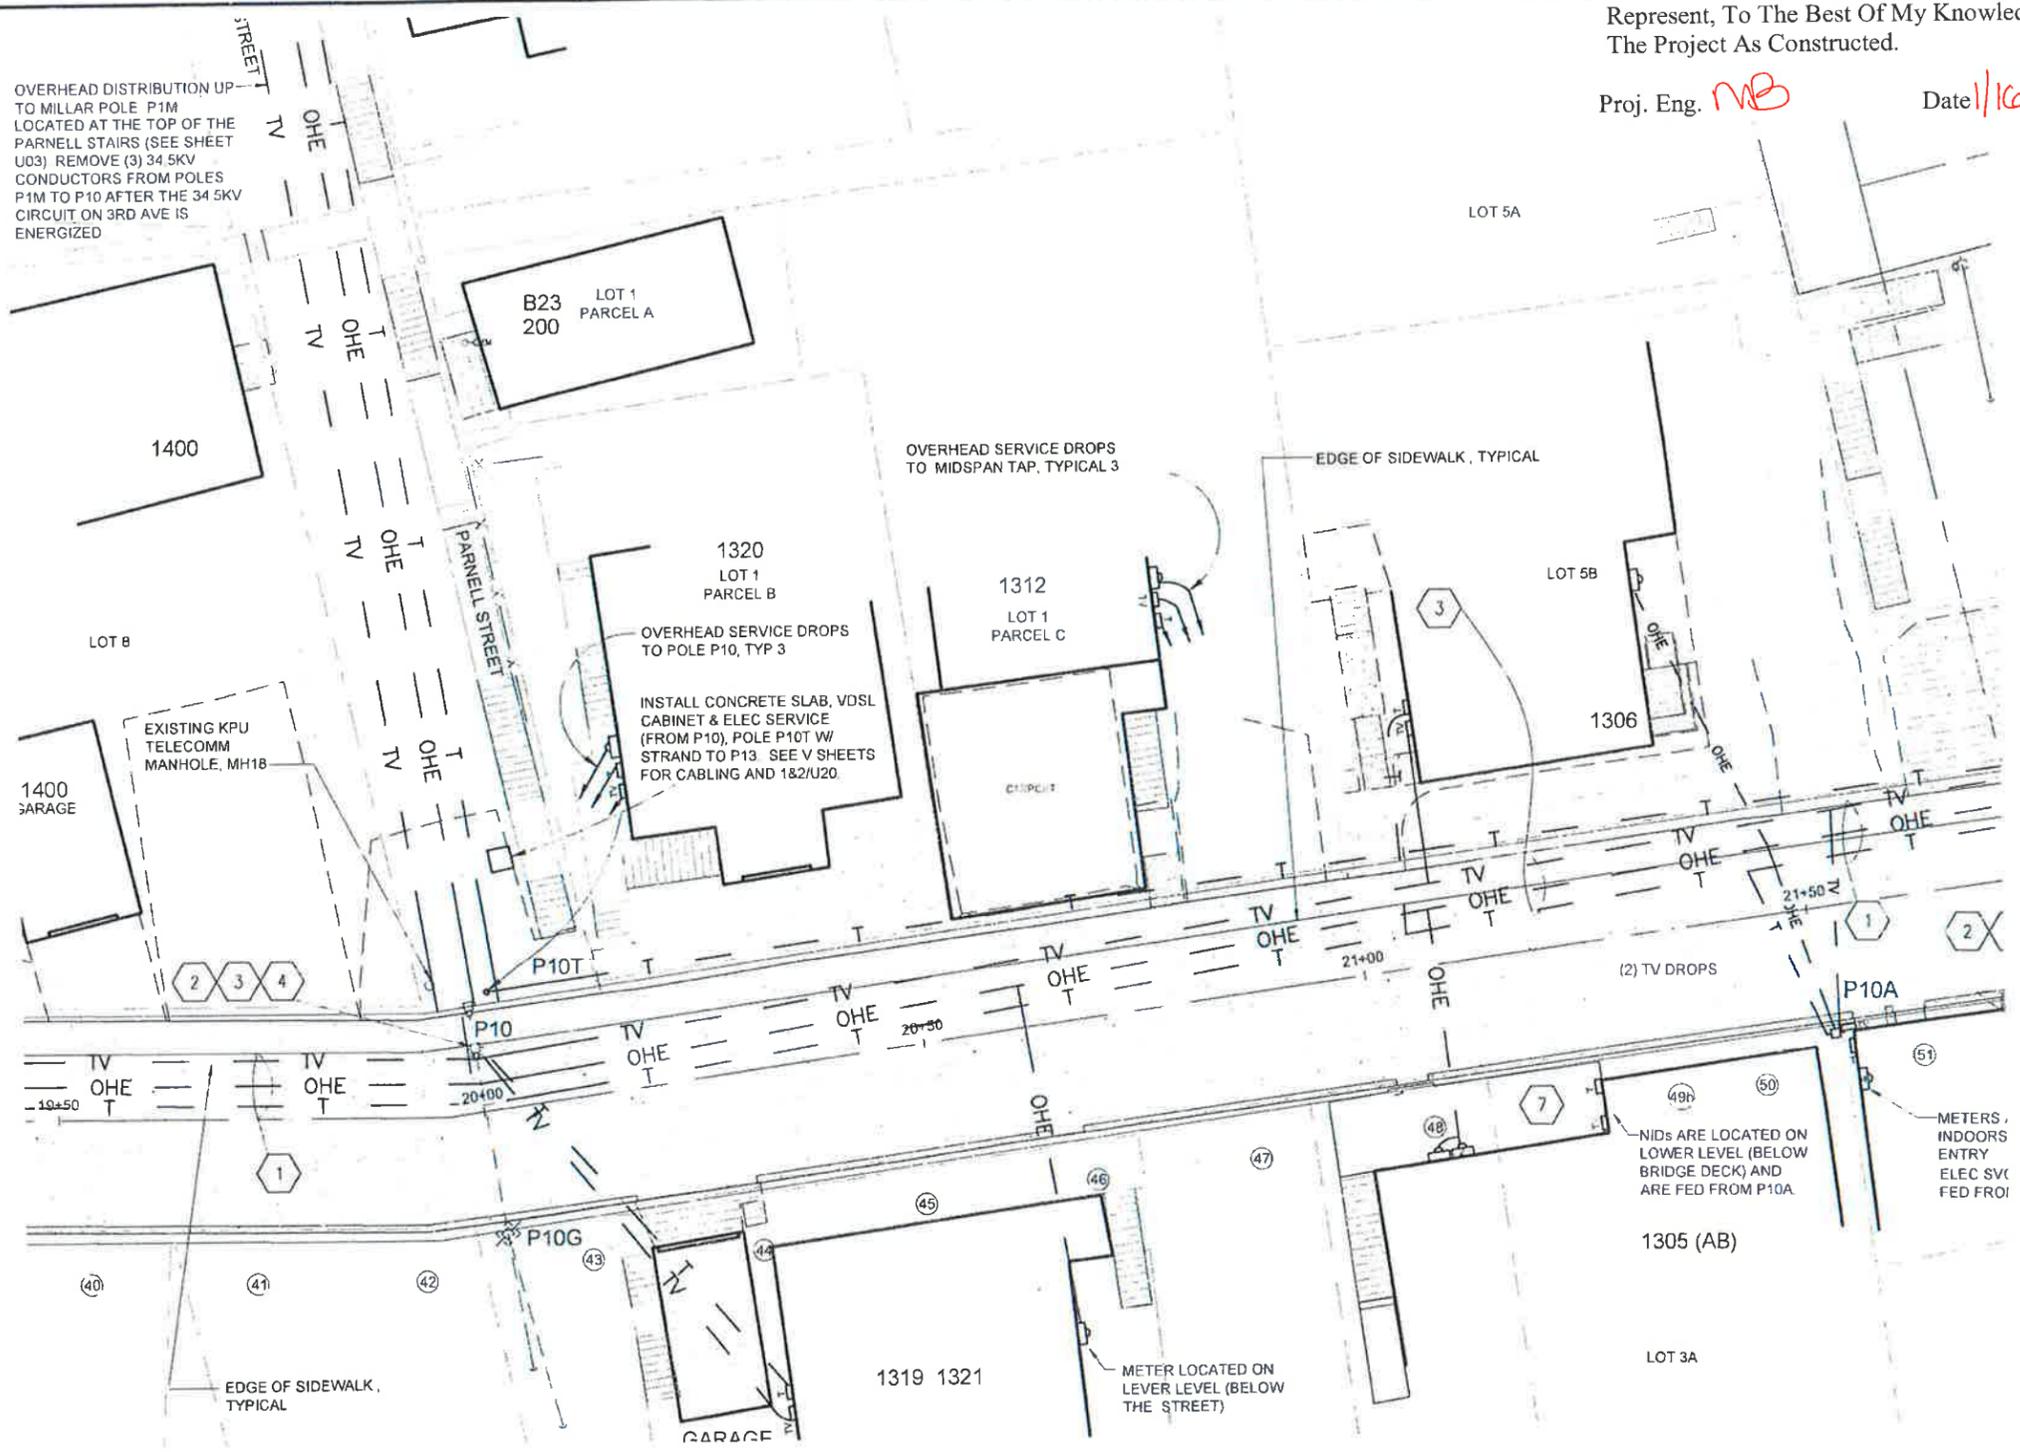

ELECTRICAL NOTES

- 1 EXISTING OVERHEAD 34.5KV, 12KV, 120/240V DISTRIBUTION, CABLE TV, AND TEL DISTRIBUTION. AFTER THE 12.47KV DISTRIBUTION IS JUMPED TO THE TOP TIER AT POLES P1 AND P10, REMOVE 12.47KV LINE BETWEEN P3-P10 AND CROSSARMS ON POLES P4-P9. SEE U22, U23 FOR POLE PHOTOS.
- 2 MOVE THE SYSTEM NEUTRAL, 120/240V STREET LIGHTS, TRANSFORMERS UP ON THE POLE FROM POLE P3 TO P10. EXTEND 120/240V SERVICE DROPS TO THE HOMES AS REQUIRED BY THE NEW HEIGHTS.

- 3 AFTER THE ELECTRICAL SYSTEMS HAVE MOVED UP ON THE POLES FROM P2 TO P10, INSTALL NEW COMM CROSSARMS FROM POLE P2 TO P10. SEE V SHEETS. INSTALL NEW FIBER OPTIC DISTRIBUTION CABLE AND DROPS TO THE HOMES. REMOVE THE EXISTING COPPER TELEPHONE DISTRIBUTION FROM THE POLES, COPPER SERVICE DROPS TO THE HOMES, AND NIDS ON THE HOME.
- 4 COORDINATE WITH GCI THE PROJECT SCHEDULE THAT MOVES THE TELEPHONE DISTRIBUTION UP ON THE POLES. GCI WILL MOVE THEIR TV DISTRIBUTION UP ON THE POLES AND EXTEND SERVICE DROPS TO THE HOMES AS REQUIRED.

GENERAL NOTES

- A SEE U FOR PHOTOS OF THE POLES
- B MODIFY THE SERVICES TO THE HOMES FED FROM THE RAISED OVERHEAD LINES (P3-P13) AS FOLLOWS:
 THE EXISTING ELECTRICAL OVERHEAD SERVICE DROPS AND SERVICE MAST AND METERS REMAIN. EXTEND THE SERVICE DROP AS REQUIRED.

 SEE V SHEETS. REMOVE EXISTING TELEPHONE OVERHEAD COPPER SERVICE DROP AND NID. INSTALL NEW FIBER DROP AND FIBER NID.

 EXISTING TV OVERHEAD SERVICES TO THE HOMES REMAIN. COORD W/ GCI - GCI WILL EXTEND DROPS AS REQUIRED.

DO NOT SCALE FROM THESE DRAWINGS USE DIMENSIONS

OVERHEAD DISTRIBUTION UP TO MILLAR POLE P1M LOCATED AT THE TOP OF THE PARNELL STAIRS (SEE SHEET U03) REMOVE (3) 34.5KV CONDUCTORS FROM POLES P1M TO P10 AFTER THE 34.5KV CIRCUIT ON 3RD AVE IS ENERGIZED

OVERHEAD SERVICE DROPS TO MIDSPAN TAP, TYPICAL 3

EDGE OF SIDEWALK, TYPICAL


OVERHEAD SERVICE DROPS TO POLE P10, TYP 3
 INSTALL CONCRETE SLAB, VDSL CABINET & ELEC SERVICE (FROM P10), POLE P10T W/ STRAND TO P13. SEE V SHEETS FOR CABLING AND 1&2/U20.

NIDS ARE LOCATED ON LOWER LEVEL (BELOW BRIDGE DECK) AND ARE FED FROM P10A.

METERS, INDOORS ENTRY ELEC SVC FED FROM


METER LOCATED ON LOWER LEVEL (BELOW THE STREET)



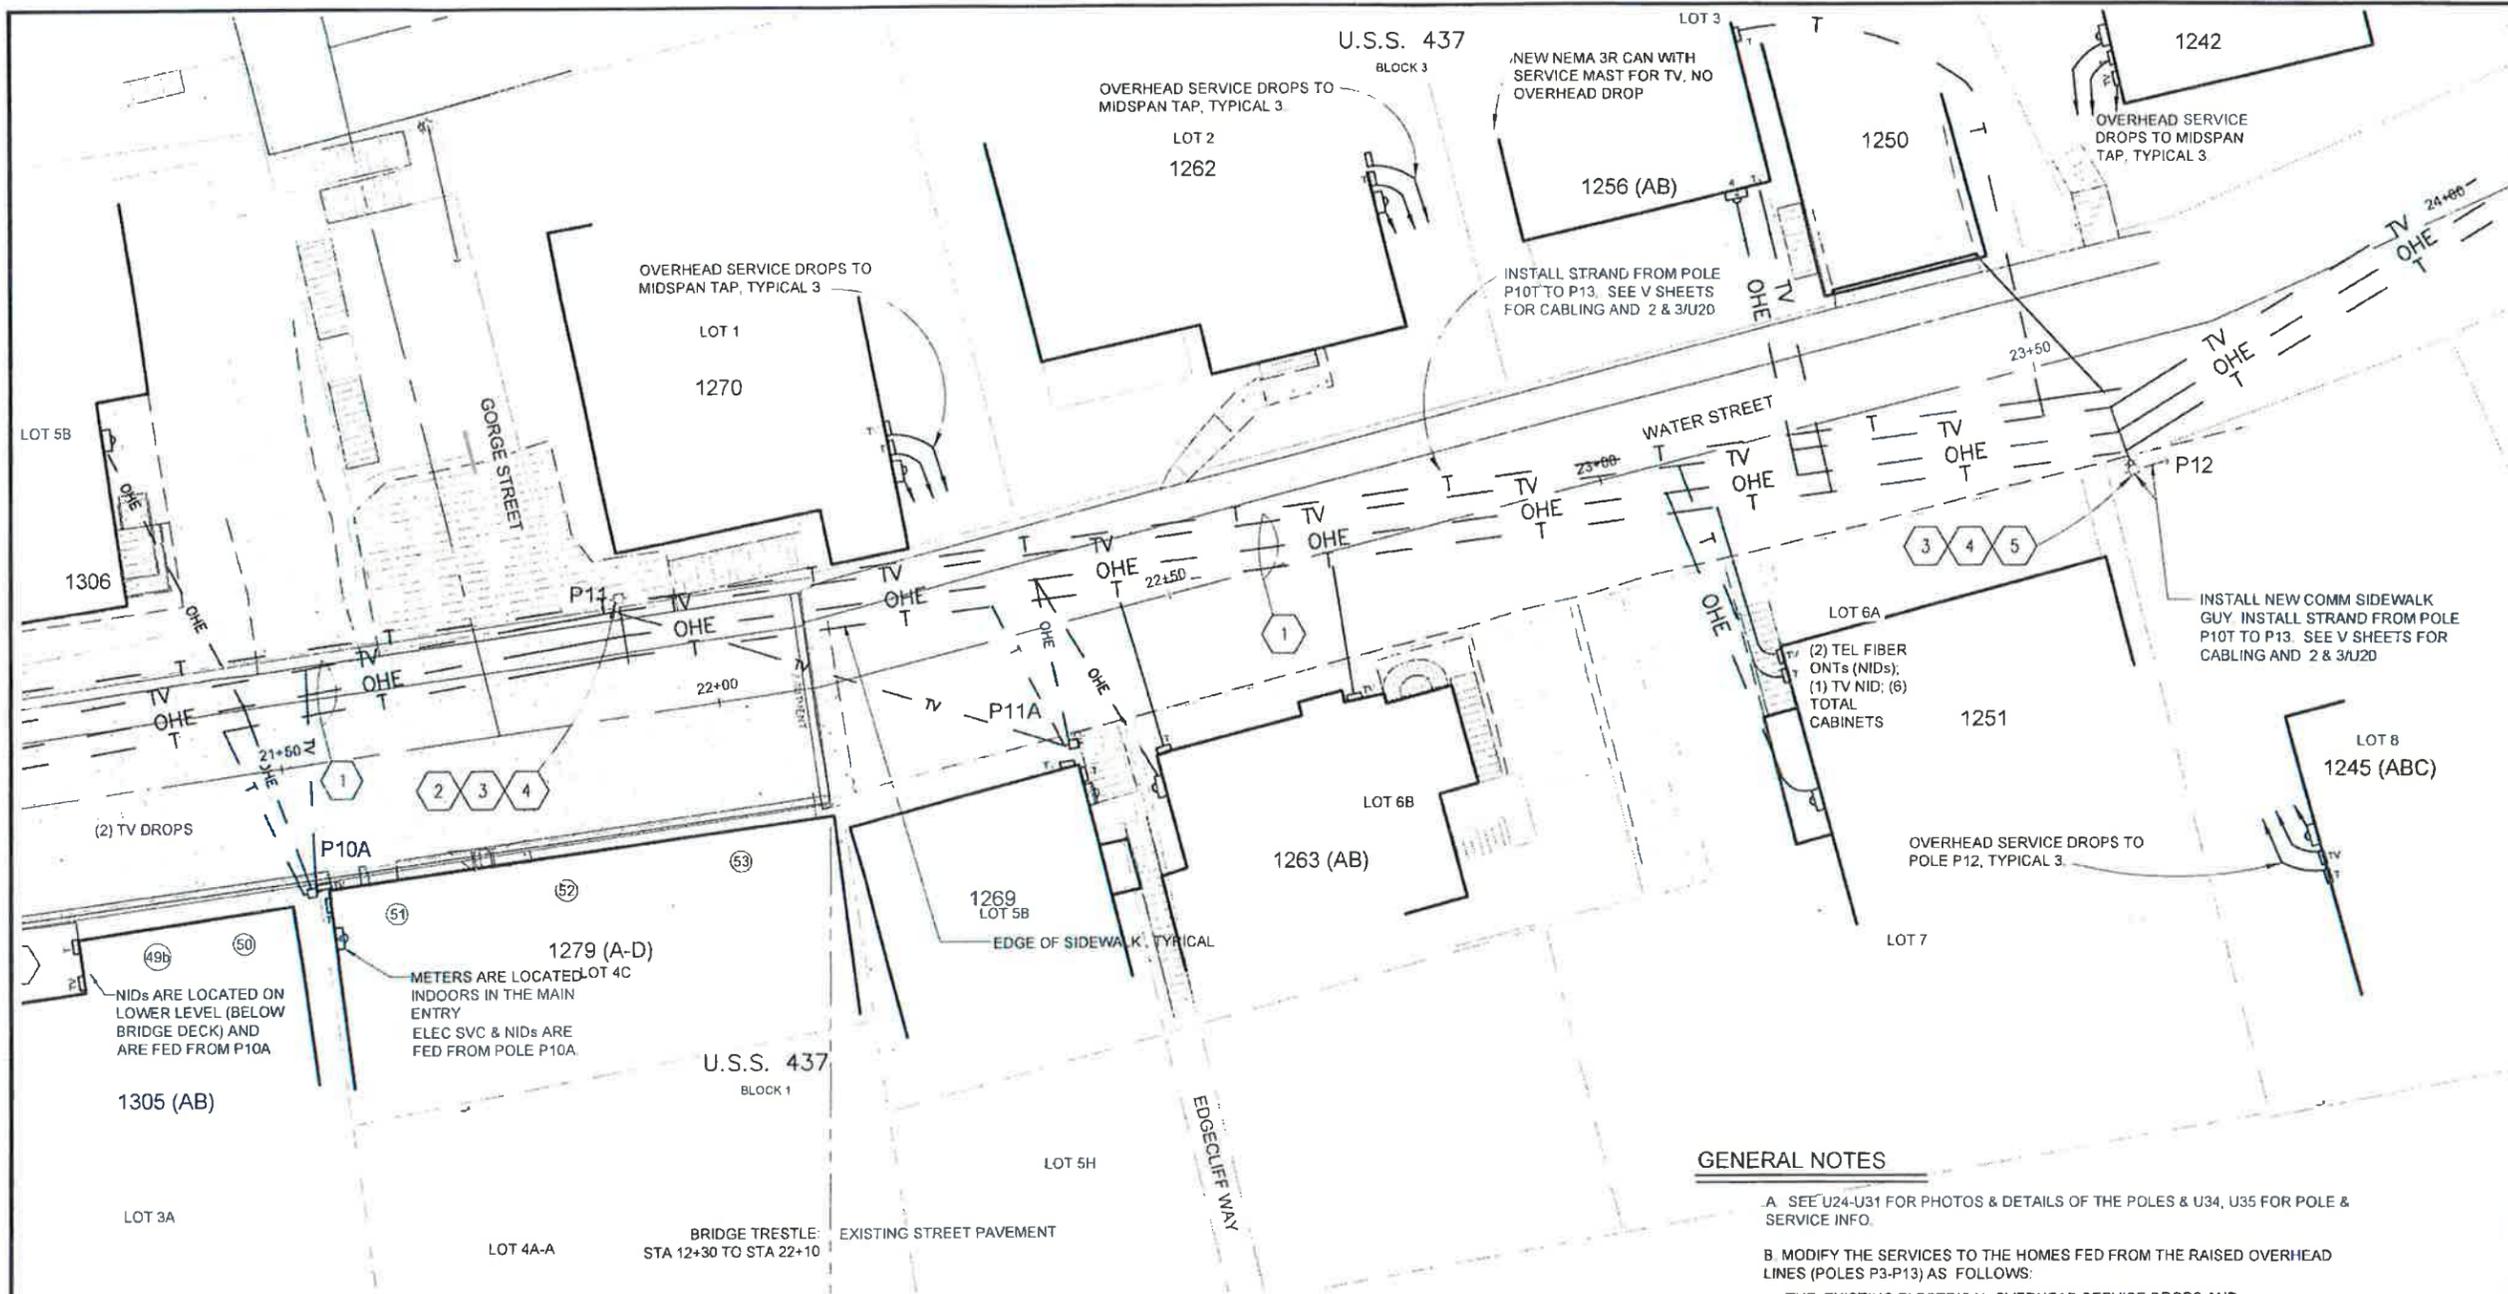

PATH: C:\USERS\KCN12_000\DOCUMENTS\10-KNEE\1013\WB8
 DESIGN: 12/20/10
 RELOCATION: WB8 AUR U11-12-17
 BRIDGE.DWG
 KCN12_000
 TAB: U17

ADDENDUM NUMBER		
ATTACHMENT NUMBER		
RECORD OF REVISIONS		
No.	DATE	DESCRIPTION

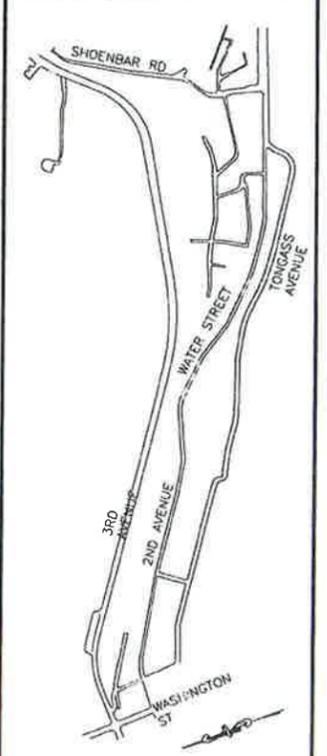

PLAN LEGEND

CHECKED BY: TED



DESIGNED BY: KCN

DRAWN BY: KCN

STATE OF ALASKA
 DEPARTMENT OF TRANSPORTATION
 & PUBLIC FACILITIES
 SOUTHEAST REGION

KETCHIKAN ADVANCE
 WATER STREET TRUNK LINE
 RELOCATION
 PROJECT # 69548

**UTILITY PLAN
 WATER ST. ELECT**

PROJECT DESIGNATION
BR-000S(735) ~69548

STATE	YEAR
ALASKA	2014

SHEET NUMBER	TOTAL SHEETS
U17	78

GENERAL NOTES

- A. SEE U24-U31 FOR PHOTOS & DETAILS OF THE POLES & U34, U35 FOR POLE & SERVICE INFO.
- B. MODIFY THE SERVICES TO THE HOMES FED FROM THE RAISED OVERHEAD LINES (POLES P3-P13) AS FOLLOWS:
 THE EXISTING ELECTRICAL OVERHEAD SERVICE DROPS AND SERVICE MAST AND METERS REMAIN. EXTEND THE SERVICE DROP AS REQUIRED.
 SEE V SHEETS: REMOVE EXISTING TELEPHONE OVERHEAD COPPER SERVICE DROP AND NID. INSTALL NEW FIBER DROP AND FIBER NID.
 EXISTING TV OVERHEAD SERVICES TO THE HOMES REMAIN. COORD W/ GCI - GCI WILL EXTEND DROPS AS REQUIRED.

Project As Built Drawings Have Been Reviewed By The Project Engineer & Represent, To The Best Of My Knowledge, The Project As Constructed.


Proj. Eng. *NB* Date *1/16/16*

ELECTRICAL NOTES

- 1. EXISTING OVERHEAD MOUNTED ON ALLEY ARMS: 12.47KV, 120/240V DISTRIBUTION, CABLE TV, AND TEL DISTRIBUTION. AFTER THE 12.47KV DISTRIBUTION IS JUMPED TO THE TOP TIER AT POLES P1 AND P10, INSTALL 120/240V AND COMM SYSTEMS HIGHER ON THE POLE. WHEN THEY ARE OPERATIONAL DEMO THE EXISTING SYSTEMS. SEE U22, U23 FOR POLE PHOTOS.
- 2. INSTALL NEW 120/240V CROSSARM, SYSTEM NEUTRAL, 120/240V DISTRIBUTION UP ON THE POLE AT POLE P11. EXTEND 120/240V SERVICE DROPS TO THE HOMES AS REQUIRED BY THE NEW HEIGHTS.
- 3. AFTER THE 120/240V SYSTEMS HAVE MOVED UP ON THE POLE P11, INSTALL NEW COMM CROSSARM. SEE V SHEETS: INSTALL NEW FIBER OPTIC DISTRIBUTION CABLE AND DROPS TO THE HOMES, NEW 900 PAIR CU. REMOVE THE EXISTING COPPER TELEPHONE DISTRIBUTION FROM THE POLES, COPPER SERVICE DROPS TO THE HOMES, AND NIDS ON THE HOME.
- 4. COORDINATE WITH GCI THE PROJECT SCHEDULE THAT MOVES THE TELEPHONE DISTRIBUTION UP ON THE POLES. GCI WILL MOVE THEIR TV DISTRIBUTION UP ON THE POLES AND EXTEND SERVICE DROPS TO THE HOMES AS REQUIRED.
- 5. EXISTING OVERHEAD MOUNTED ON ALLEY ARMS: 12.47KV, 120/240V DISTRIBUTION, CABLE TV, AND TEL DISTRIBUTION. AFTER THE 12.47KV DISTRIBUTION IS JUMPED TO THE TOP TIER AT POLES P1 AND P10, INSTALL COMM SYSTEMS HIGHER ON THE POLE. WHEN THEY ARE OPERATIONAL DEMO THE EXISTING SYSTEMS. SEE U23 FOR POLE PHOTOS.
- 6. INSTALL NEW COMM CROSSARM DOUBLE ARM 10 PIN ALLEY. SEE V SHEETS FOR RAISING EXISTING COPPER & FIBER OPTIC CABLES, INSTALL NEW 900 PAIR, ADJUST TEL SERVICE DROPS DISTRIBUTION CABLE AND DROPS TO THE HOMES, NEW 900 PAIR CU. REMOVE THE EXISTING COPPER TELEPHONE DISTRIBUTION

DO NOT SCALE FROM THESE DRAWINGS USE DIMENSIONS

No.	DATE	DESCRIPTION

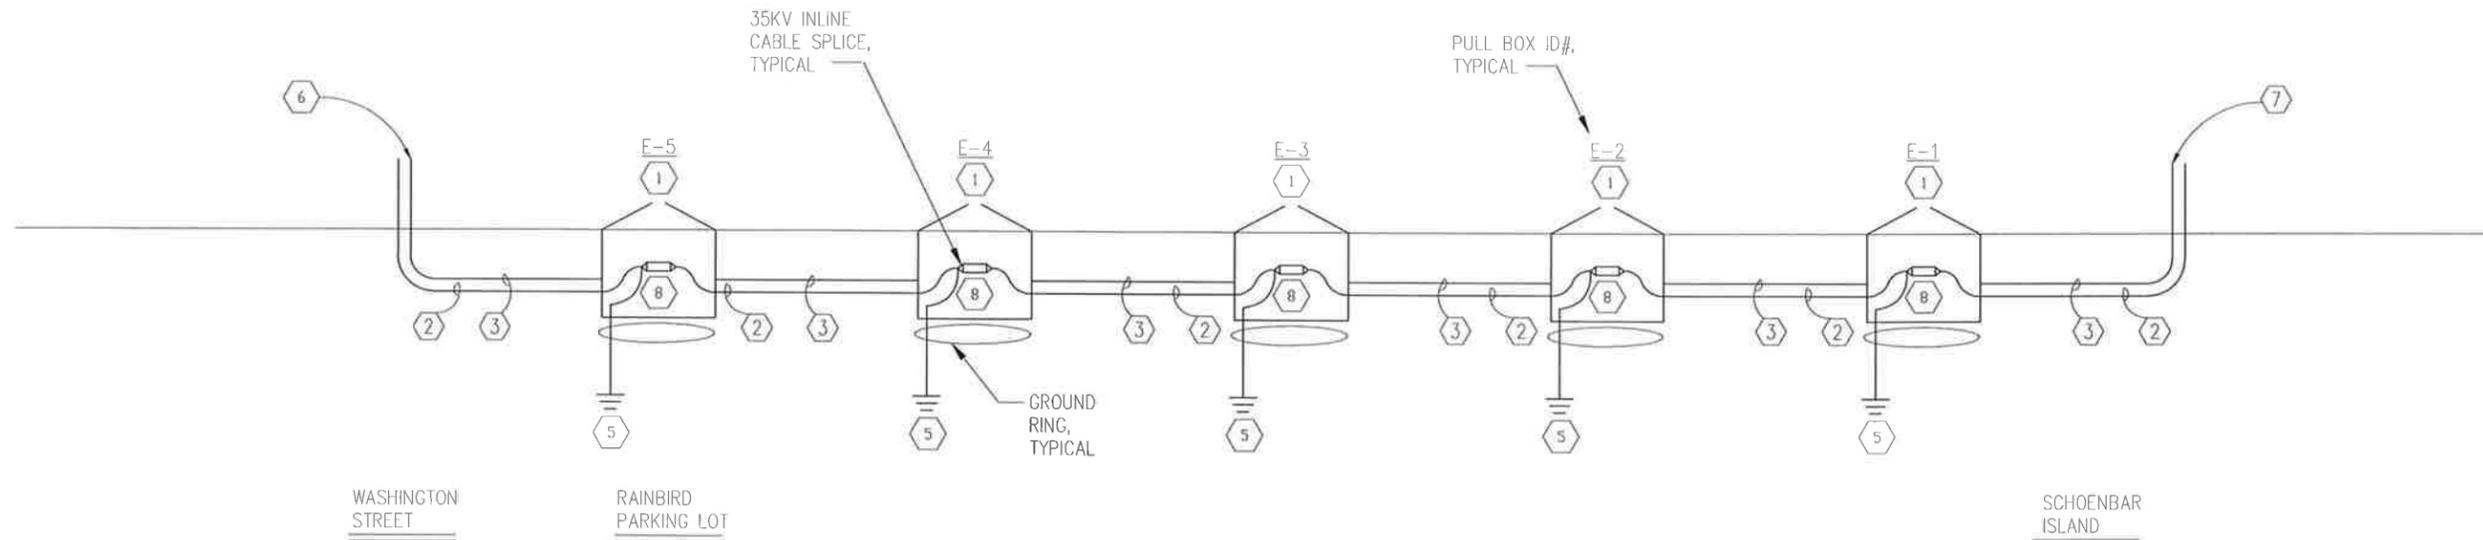

1 ELECTRICAL 35KV ONE LINE DIAGRAM -3RD AVENUE
 NO SCALE

DETAIL GENERAL NOTES:

- A COORDINATE THE ENTIRE 34.5KV CABLE INSTALLATION INCLUDING CONNECTIONS TO THE EXISTING OVERHEAD 35KV SYSTEM WITH KPU.
- B SEE U04-U07 & U10 FOR EQUIPMENT LOCATIONS.

DETAIL ELECTRICAL NOTES

- ① TYPE 4 PULL BOX, ELECTRICAL 4'X6'X 3'D, SEE 3/U26
- ② NEW (1) 6" PVC SCH80 W/ (3) 3350MCM 35KV CABLES WITH CONCENTRIC NEUTRAL
- ③ NEW (1) 6" PVC SCH80 WITH PULL STRINGS AND LABELS, SPARE CONDUIT
- ④ NOTE NOT USED
- ⑤ INSTALL NEW GROUNDING ELECTRODE SYSTEM: GROUND ROD, #4/0 BARE CU CONNECTED TO GROUND RING LOOPED AROUND THE PERIMETER OF THE BOX. TIE THE 35KV CONDUCTOR'S CONCENTRIC NEUTRALS TOGETHER AND CONNECT THEM TO THE GROUND ELECTRODE SYSTEM W/ #4 BARE CU, SEE 2/U26 FOR ADDITIONAL DETAIL.
- ⑥ (2) 6" PVC EXISTING CONDUITS ON RISER POLE P1W ON STANDOFF BRACKETS, EXTEND ONE CONDUIT, PULL NEW (3) 3350MCM 35KV CABLES WITH CONCENTRIC NEUTRAL AND CONNECT INTO EXISTING 35KV OVERHEAD DISTRIBUTION SYSTEM. SEE 35KV RISER POLE DETAIL. THE OTHER 6" CONDUIT SHALL HAVE TWO FULL STICKS OF CONDUIT INSTALLED ON THE EXISTING BRACKET AND CAPPED. SEE U04 FOR LOCATION & 2/U21 FOR PHOTO OF EXISTING P1W INSTALLATION.
- ⑦ INSTALL CONDUITS ON NEW RISER POLE P2SR MOUNTED ON STANDOFF BRACKETS, THE CONDUIT WITH CONDUCTORS: TERMINATE HV CABLE PER 35KV RISER POLE DETAIL. THE OTHER 6" CONDUIT SHALL HAVE TWO FULL STICKS OF CONDUIT INSTALLED ON THE BRACKET AND CAPPED.
- ⑧ INSTALL INLINE SPLICE & COLD SEAL ON EACH CABLE IN PULL BOX. SUPPORT FINISHED CABLE INSTALLATION IN THE PULL BOX

Project As Built Drawings Have Been Reviewed By The Project Engineer & Represent, To The Best Of My Knowledge, The Project As Constructed.

Proj. Eng. NB Date 1/10/16

CHECKED BY: TED



DESIGNED BY: KCN

DRAWN BY: KCN

STATE OF ALASKA
 DEPARTMENT OF TRANSPORTATION
 & PUBLIC FACILITIES
 SOUTHEAST REGION

KETCHIKAN ADVANCE
 WATER STREET TRUNK LINE
 RELOCATION
 PROJECT #69548

**ELECTRICAL ONE
 LINE DIAGRAM**

PROJECT DESIGNATION

BR000(735) ~ 69548

STATE	YEAR
ALASKA	2014

SHEET NUMBER	TOTAL SHEETS
U18	78


KCN12_000
 TAB. U19

ADDENDUM NUMBER

ATTACHMENT NUMBER

RECORD OF REVISIONS

No.	DATE	DESCRIPTION

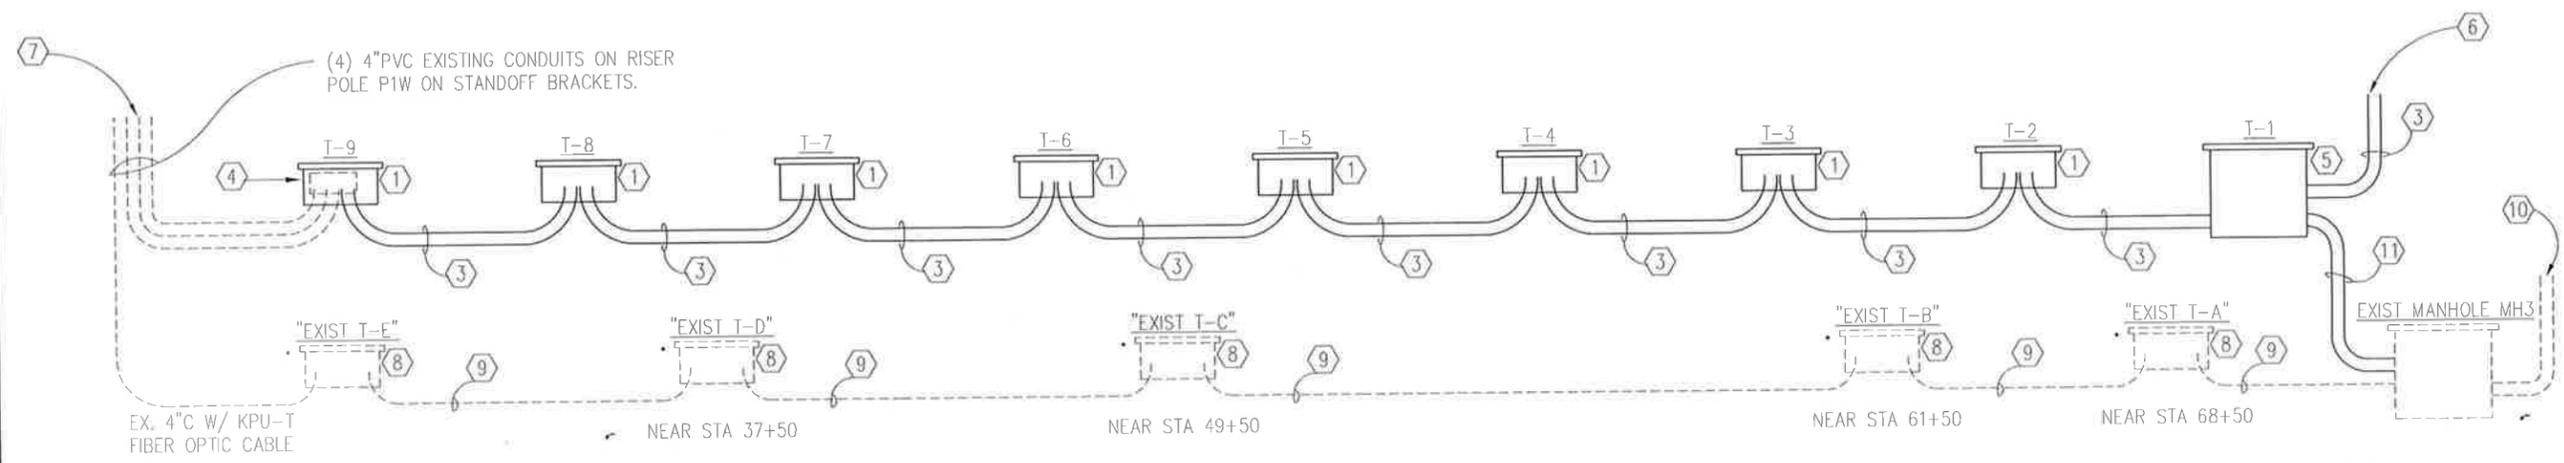

1 TELECOMM ONE LINE DIAGRAM -3RD AVENUE
 NO SCALE

DETAIL ELECTRICAL NOTES

- ① TYPE 2 TELECOM PULL BOX
- ② NOTE NOT USED
- ③ NEW (2) 4" PVC SCH80 INSTALL AS 662(2) WITH PULL STRINGS AND LABELS.
- ④ REMOVE EXISTING PB T-F QUARZITE HANDHOLE, INSTALL NEW TYPE 2 PULL BOX.
- ⑤ TYPE 3 TELECOM PULL BOX
- ⑥ INSTALL CONDUITS ON TELECOMM RISER POLE P1S MOUNTED ON NEW STANDOFF BRACKETS. SEE U10 FOR LOCATION & 3/U21 FOR PHOTO OF EXISTING INSTALLATION.
- ⑦ (3) 4" PVC EXISTING CONDUITS ON RISER POLE P1W ON STANDOFF BRACKETS. SEE U04 FOR LOCATION & 2/U21 FOR PHOTO OF EXISTING INSTALLATION.
- ⑧ EXISTING TYPE 3 TELECOM PULL BOX
- ⑨ EXISTING 2" PVC EXISTING CONDUIT W/ KPU-T FIBER OPTIC CABLE (WASHINGTON ST TO SCHOENBAR)
- ⑩ EXISTING CONDUITS ON TELECOMM RISER POLE P1S.
- ⑪ (2) 4" PVC SCH80 CONNECT EXIST MANHOLE MH3 TO NEW T-1 PULL BOX.


DETAIL GENERAL NOTES:

- A COORDINATE THE RACEWAY SYSTEM INSTALLATION WITH KPU-T.
- B SEE U04-U07 & U10 FOR EQUIPMENT LOCATIONS.

Project As Built Drawings Have Been Reviewed By The Project Engineer & Represent, To The Best Of My Knowledge, The Project As Constructed.

Proj. Eng. NB Date 1/16/16

CHECKED BY: TED

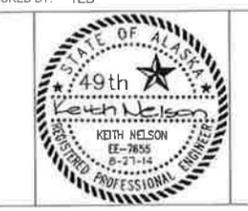

DESIGNED BY: KCN
 DRAWN BY: KCN

STATE OF ALASKA
 DEPARTMENT OF TRANSPORTATION & PUBLIC FACILITIES
 SOUTHEAST REGION

KETCHIKAN ADVANCE
 WATER STREET TRUNK LINE
 RELOCATION
 PROJECT #69548

TELECOMM ONE LINE DIAGRAM

PROJECT DESIGNATION
BR-000S(735) ~ 69548

STATE	YEAR
ALASKA	2014
SHEET NUMBER	TOTAL SHEETS
U19	78



Electrical Vault E-1 70+50 LT



Electrical Vault E-1 70+50 LT



Electrical Vault E-4 41+25 LT



Electrical Vault E-2 62+80 LT



Electrical Vault E-2 62+80 LT



Electrical Vault E-4 41+25 LT



Electrical Vault E-3 51+00 LT



Electrical Vault E-3 51+00 LT



Electrical Vault E-5 30+60 LT

Ketchikan Advance Water Street
Truck Line Relocation
Project #69548



Project As Built Drawings Have Been
Reviewed By The Project Engineer &
Represent, To The Best Of My Knowledge,
The Project As Constructed.

Proj. Eng. *NB* Date *1/16/16*




Electrical Vault E-5 30+60 LT

No.	DATE	DESCRIPTION

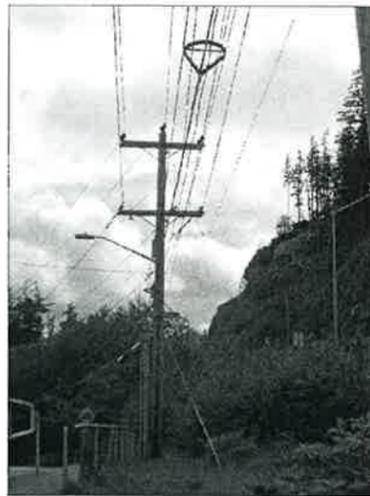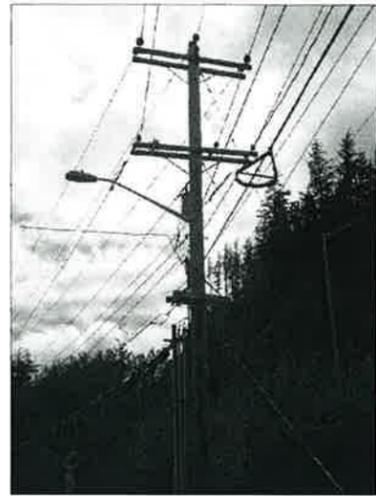


INSTALL NEW CROSS BUCK ARMS (SIMILAR TO EXISTING P1W INSTALLATION) FOR CONNECTING 34.5KV, THREE PHASE TO THE NEW P2SR RISER POLE.

1 POLE P2S
NONE

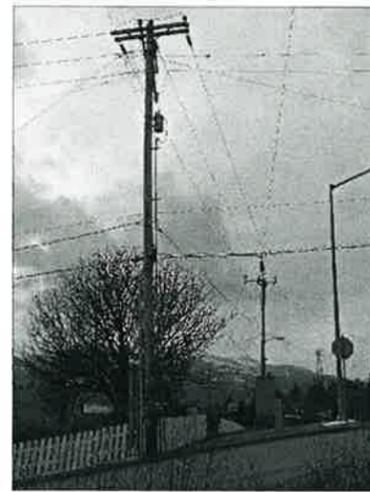


2 POLE P1W
NONE

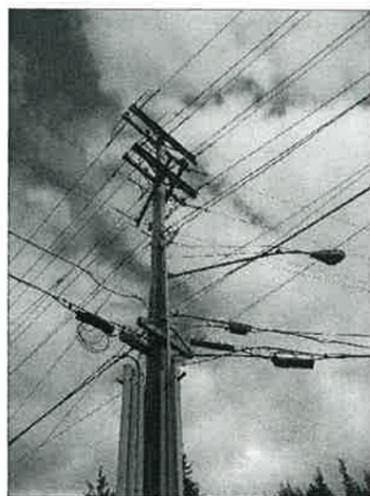

INSTALL NEW 4" CONDUITS (EMPTY) ON STANDOFF BRACKETS FOR TELECOMM FOR FUTURE USE; MATCH EXISTING INSTALLATION. THE NEW CONDUIT RUNS ARE FROM THE NEW PULL BOX TO THE POLE.

3 POLE P1S
NONE
A = EXISTING KPU-T VDSL CABINET

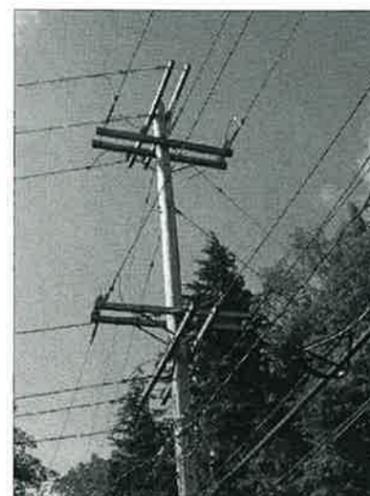

4 POLE P1M
NONE
MILLAR STREET AT THE TOP OF PARNELL STAIRS

Project As Built Drawings Have Been Reviewed By The Project Engineer & Represent, To The Best Of My Knowledge, The Project As Constructed.

Proj. Eng: *NB*

Date *11/6/16*

CHECKED BY: TED



DESIGNED BY: KCN

DRAWN BY: KCN

STATE OF ALASKA
DEPARTMENT OF TRANSPORTATION
& PUBLIC FACILITIES
SOUTHEAST REGION

KETCHIKAN ADVANCE
WATER STREET TRUNK LINE
RELOCATION
PROJECT #69548

**POLE
PHOTOS**

PROJECT DESIGNATION

BR-000S(735) ~ 69548

STATE	YEAR
ALASKA	2014
SHEET NUMBER	TOTAL SHEETS
U21	78

ADDENDUM NUMBER

ATTACHMENT NUMBER

RECORD OF REVISIONS


No.	DATE	DESCRIPTION




1 POLE P8
NO SCALE



2 POLE P9
NO SCALE

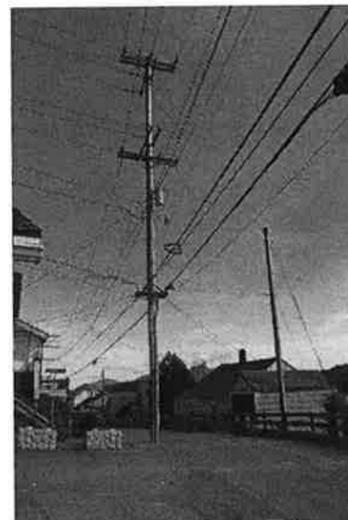

3 POLE P10
NO SCALE

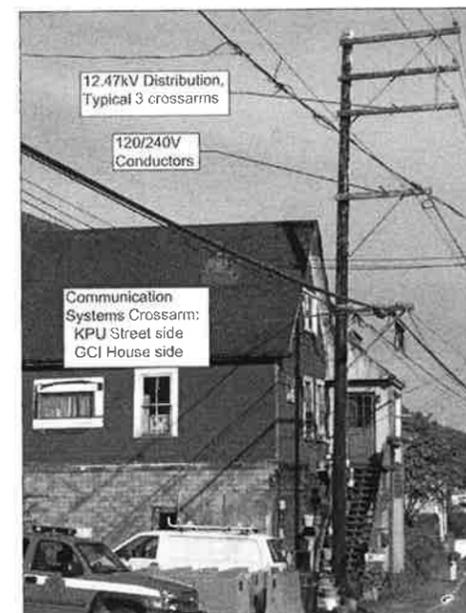

4 POLE P11
NO SCALE



5 POLE P12
NO SCALE



6 POLE P13
NO SCALE



7 POLE P10A
NO SCALE



8 POLE P11A
NO SCALE

Project As Built Drawings Have Been Reviewed By The Project Engineer & Represent, To The Best Of My Knowledge, The Project As Constructed.

Proj. Eng. NB

Date 1/16/16

CHECKED BY: TED



DESIGNED BY: KCN

DRAWN BY: KCN

STATE OF ALASKA
DEPARTMENT OF TRANSPORTATION
& PUBLIC FACILITIES
SOUTHEAST REGION

KETCHIKAN ADVANCE
WATER STREET TRUNK LINE
RELOCATION
PROJECT #69548

**POLE
PHOTOS**

PROJECT DESIGNATION

BR-000S(735) ~ 69548

STATE	YEAR
ALASKA	2014
SHEET NUMBER	TOTAL SHEETS
U23	78

KCN12_000
TAB: U25

ADDENDUM NUMBER

ATTACHMENT NUMBER

RECORD OF REVISIONS

No.	DATE	DESCRIPTION

34.5KV CROSSARM
W/ 34,5KV CONDUCTORS DE-ENERGIZED, JUMPER 12,47KV TO TOP TIER

20' RADIUS
CLEARANCE
BUBBLE

10' RADIUS
CLEARANCE
BUBBLE

12.47KV CROSSARM
-CONDUCTORS
DE-ENERGIZED

TRANSFORMER

SYSTEM NEUTRAL
W/ 120/240V BELOW

STREET LIGHT

COMMUNICATIONS
CROSSARM


A B C D



1 OSHA CLEARANCE BUBBLE @ POLE P10
SCALE: 1/4" = 1'-0"
EXISTING INSTALLATION

Conductor Heights Above The Street

	At Pole P10	Midspan P9-P10	Midspan P10-P11
A (Communication Lines)	19'-10"	15'-10"	16'-11"
B (System Neutral)	33'-8"	28'-4"	27'-6"
C (12.47kV)	40'-8"		
D (34.5kV)	48'-8"		

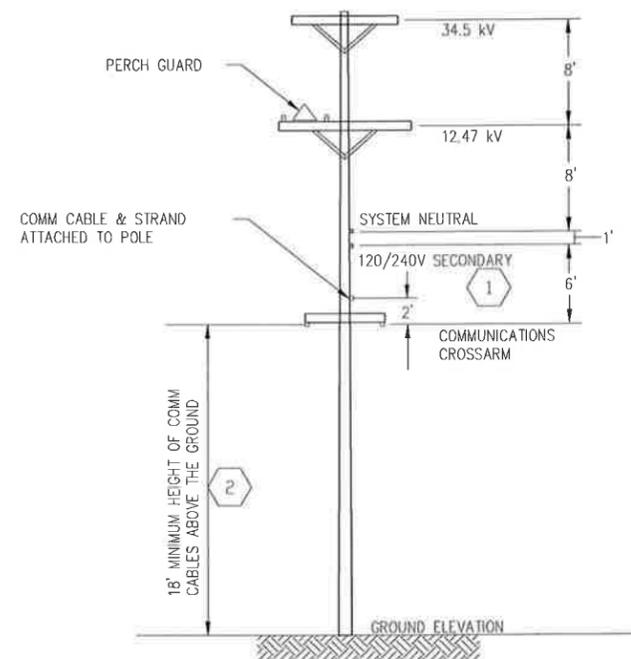

THE DETAIL SHOWS THE GENERAL FRAMING REQUIREMENTS FOR KPU POWER POLES.

2 KPU GENERAL FRAMING GUIDE
NO SCALE

ELECTRICAL NOTES

- 1** ALONG WATER STREET WHERE THE OVERHEAD SYSTEM IS BEING RAISED, THE MINIMUM DISTANCE BETWEEN ANY OF THE COMM LINES AND THE 120/240V DISTRIBUTION SYSTEM IS 48"
- 2** RAISE THE COMM LINES ALONG WATER STREET TO THE MAXIMUM LEVEL WHILE MAINTAINING 48" SEPARATION BETWEEN ANY OF THE COMM LINES AND THE 120/240V DISTRIBUTION SYSTEM

Project As Built Drawings Have Been Reviewed By The Project Engineer & Represent, To The Best Of My Knowledge, The Project As Constructed.

Proj. Eng. **NB**

Date **1/16/16**

CHECKED BY: TED



DESIGNED BY: KCN

DRAWN BY: KCN

STATE OF ALASKA
DEPARTMENT OF TRANSPORTATION
& PUBLIC FACILITIES
SOUTHEAST REGION

KETCHIKAN -ADVANCE
WATER STREET TRUNK LINE
RELOCATION
PROJECT #69548


**POLE
DETAILS**

PROJECT DESIGNATION

BR-000S(735) ~ 69548


STATE	YEAR
ALASKA	2014
SHEET NUMBER	TOTAL SHEETS
U25	78

No.	DATE	DESCRIPTION

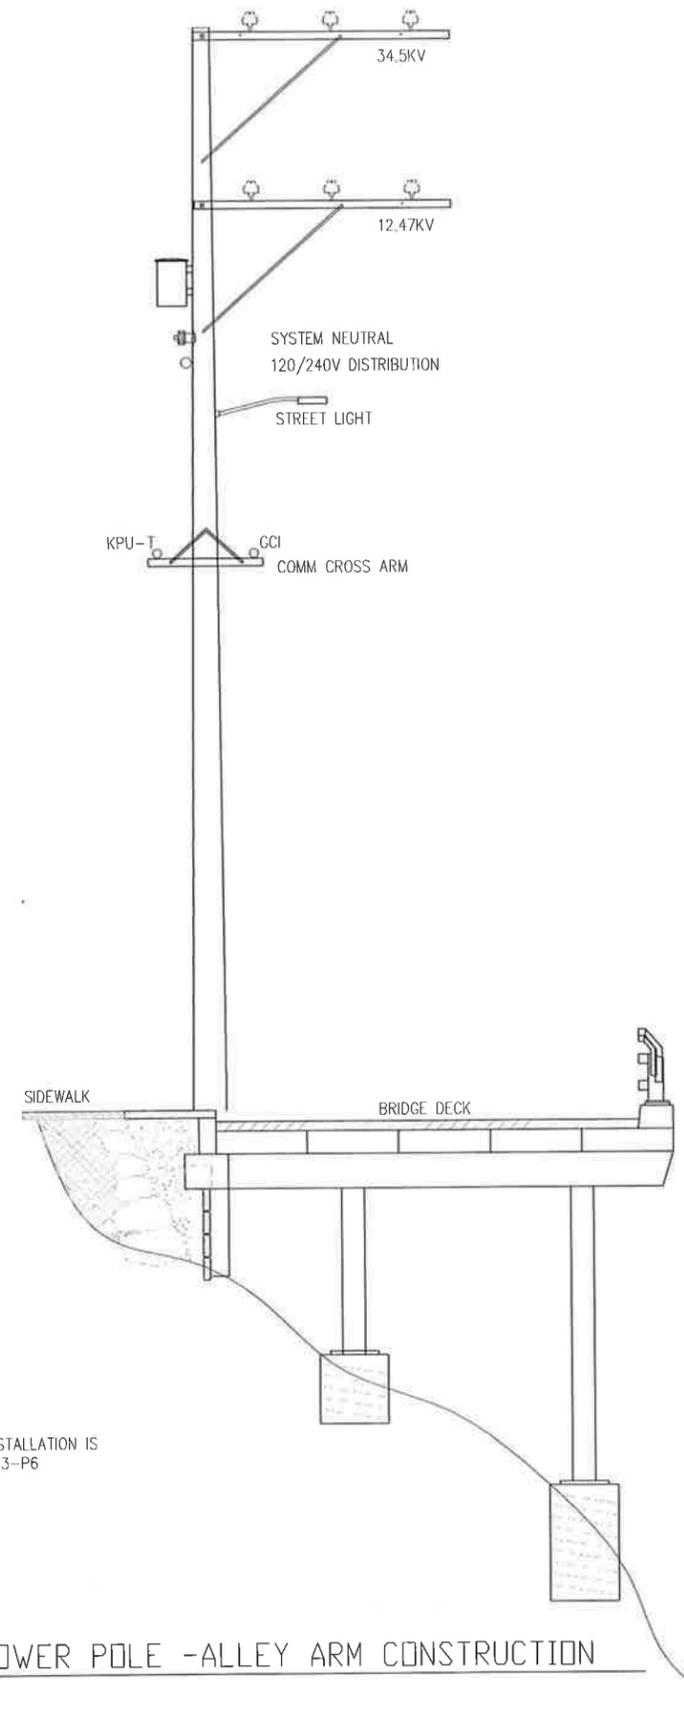

POLE P5 SHOWN. INSTALLATION IS SIMILAR FOR POLE P3-P6

1 EXISTING POWER POLE -ALLEY ARM CONSTRUCTION
NO SCALE

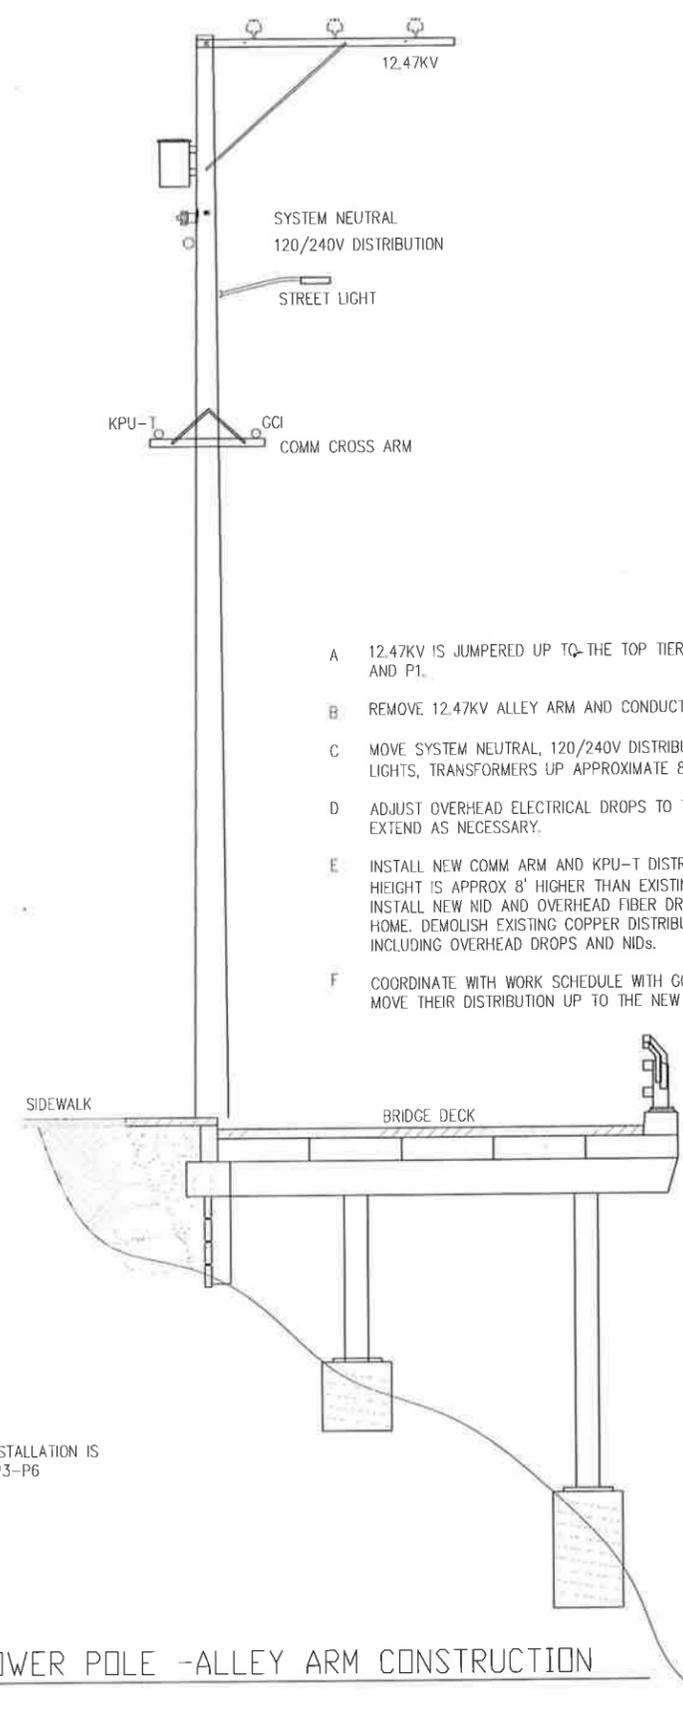

POLE P5 SHOWN. INSTALLATION IS SIMILAR FOR POLE P3-P6

2 REVISED POWER POLE -ALLEY ARM CONSTRUCTION
NO SCALE

- A 12.47KV IS JUMPERED UP TO THE TOP TIER AT POLE P10 AND P1.
- B REMOVE 12.47KV ALLEY ARM AND CONDUCTORS.
- C MOVE SYSTEM NEUTRAL, 120/240V DISTRIBUTION, STREET LIGHTS, TRANSFORMERS UP APPROXIMATE 8'
- D ADJUST OVERHEAD ELECTRICAL DROPS TO THE HOMES, EXTEND AS NECESSARY.
- E INSTALL NEW COMM ARM AND KPU-T DISTRIBUTION. NEW HEIGHT IS APPROX 8' HIGHER THAN EXISTING COMM ARM. INSTALL NEW NID AND OVERHEAD FIBER DROPS TO EACH HOME. DEMOLISH EXISTING COPPER DISTRIBUTION SYSTEM INCLUDING OVERHEAD DROPS AND NIDS.
- F COORDINATE WITH WORK SCHEDULE WITH GCI - GCI WILL MOVE THEIR DISTRIBUTION UP TO THE NEW COMM ARM.

Project As Built Drawings Have Been Reviewed By The Project Engineer & Represent, To The Best Of My Knowledge, The Project As Constructed.

Proj. Eng. **MB**

Date **1/16/16**

CHECKED BY: TED



DESIGNED BY: KCN
DRAWN BY: KCN


STATE OF ALASKA
DEPARTMENT OF TRANSPORTATION & PUBLIC FACILITIES
SOUTHEAST REGION
KETCHIKAN -ADVANCE
WATER STREET TRUNK LINE
RELOCATION
PROJECT #69548

POLE DETAILS


PROJECT DESIGNATION
BR-000S(735) ~ 69548

STATE	YEAR
ALASKA	2014
SHEET NUMBER	TOTAL SHEETS
U27	78

No.	DATE	DESCRIPTION

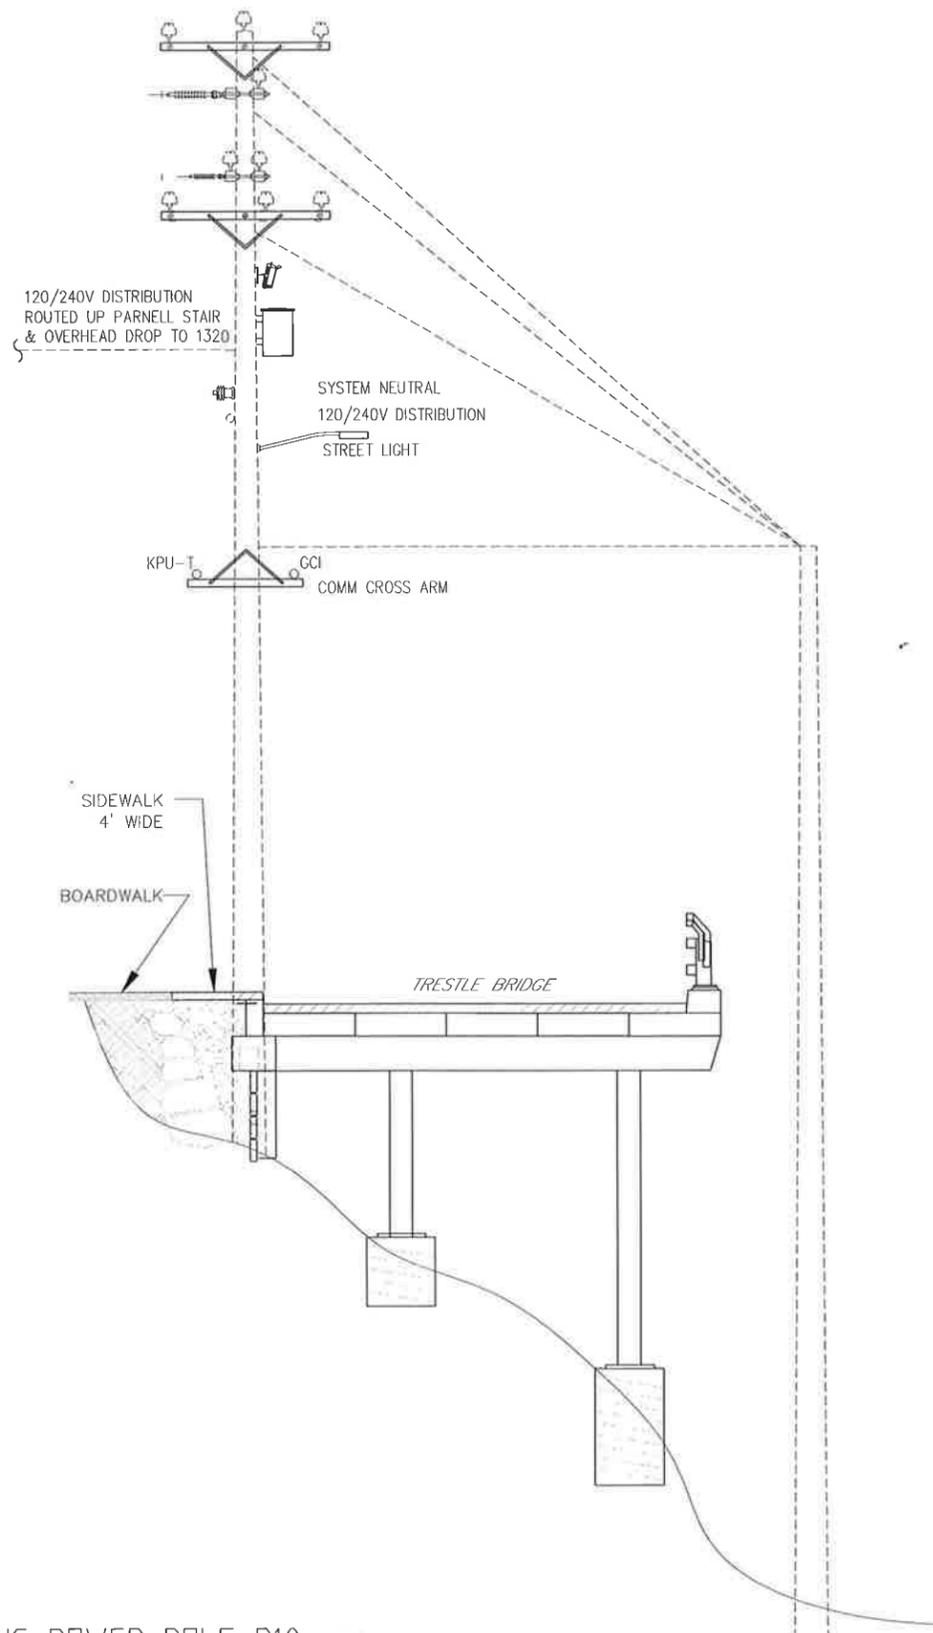

1 EXISTING POWER POLE P10
 NO SCALE

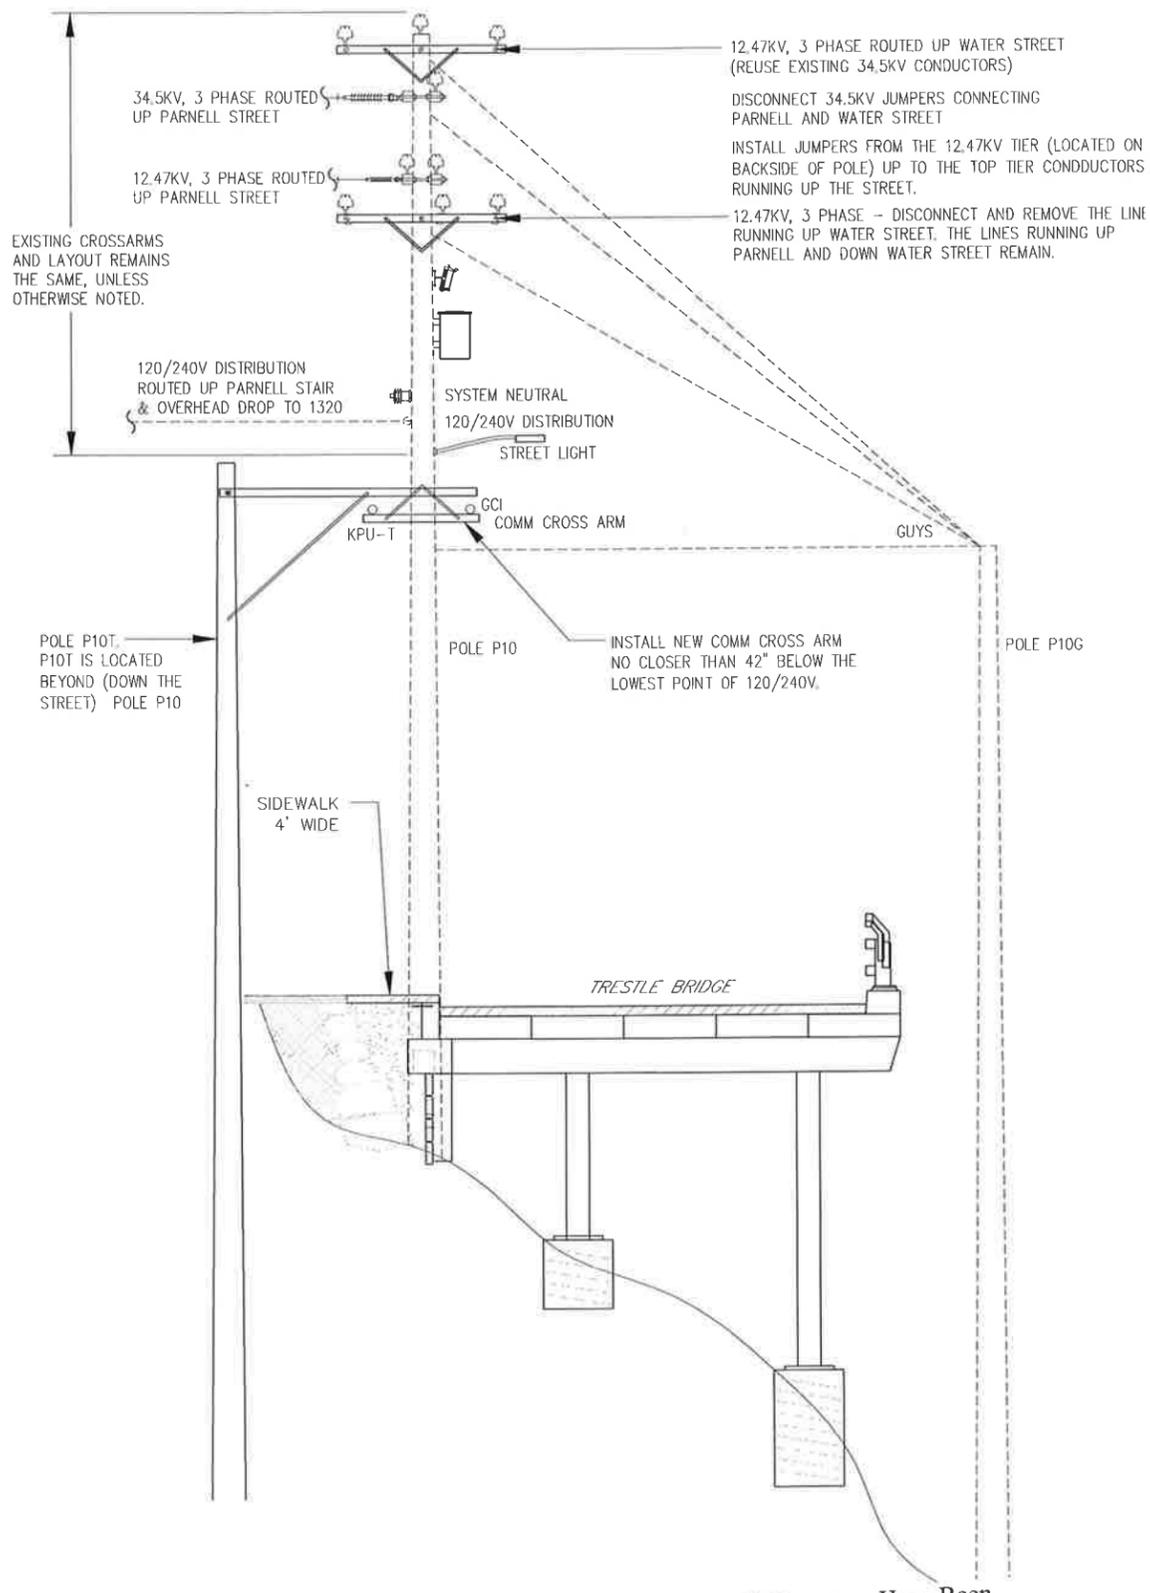

2 REVISED POWER POLE P10
 NO SCALE

Project As Built Drawings Have Been Reviewed By The Project Engineer & Represent, To The Best Of My Knowledge, The Project As Constructed.

Proj. Eng. *NB*

Date *1/16/16*

CHECKED BY: TED



DESIGNED BY: KCN
 DRAWN BY: KCN

STATE OF ALASKA
 DEPARTMENT OF TRANSPORTATION
 & PUBLIC FACILITIES
 SOUTHEAST REGION
 KETCHIKAN - ADVANCE
 WATER STREET TRUNK LINE
 RELOCATION
 PROJECT #69548



**POLE
 DETAILS**

PROJECT DESIGNATION

BR-000S(735) ~ 69548

STATE	YEAR
ALASKA	2014
SHEET NUMBER	TOTAL SHEETS
U29	78

No.	DATE	DESCRIPTION

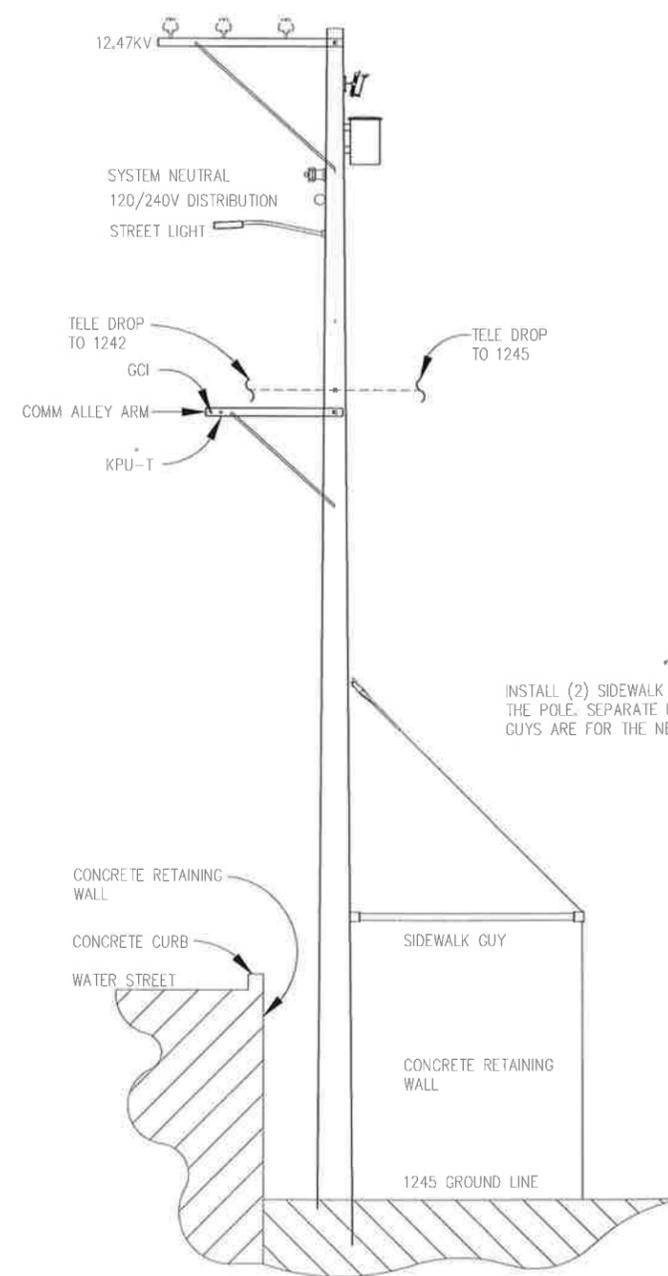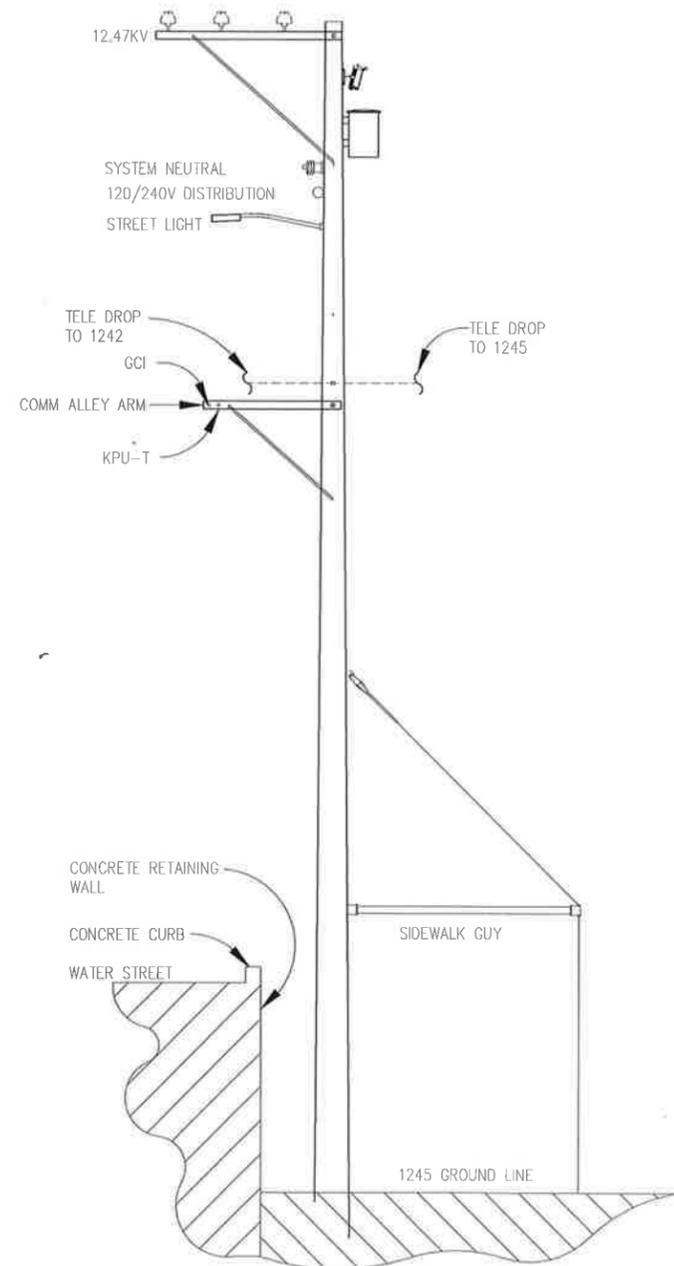

AFTER THE NEW COMM ALLEY ARM (SEE
 DETAIL 2 THIS SHEET), NEW STRAND,
 TELECOM DISTRIBUTION AND GUYS ARE
 INSTALLED, DISCONNECT AND REMOVE THE
 EXISTING INSTALLATION.

INSTALL (2) SIDEWALK GUYS ON DOWN STREET SIDE OF
 THE POLE. SEPARATE BY AT 10 DEGREES. THE NEW
 GUYS ARE FOR THE NEW TELE STRAND CABLE

Project As Built Drawings Have Been
 Reviewed By The Project Engineer &
 Represent, To The Best Of My Knowledge,
 The Project As Constructed.

Proj. Eng. *NB* Date *1/16/16*

1 EXISTING POWER POLE P12
 NO SCALE

2 REVISED POWER POLE P12
 NO SCALE

CHECKED BY: TED




DESIGNED BY: KCN
 DRAWN BY: KCN

STATE OF ALASKA
 DEPARTMENT OF TRANSPORTATION
 & PUBLIC FACILITIES
 SOUTHEAST REGION
 KETCHIKAN -ADVANCE
 WATER STREET TRUNK LINE
 RELOCATION
 PROJECT #69548

**POLE
 DETAILS**

PROJECT DESIGNATION
BR-000S(735) ~ 69548

STATE	YEAR
ALASKA	2014
SHEET NUMBER	TOTAL SHEETS
U31	78

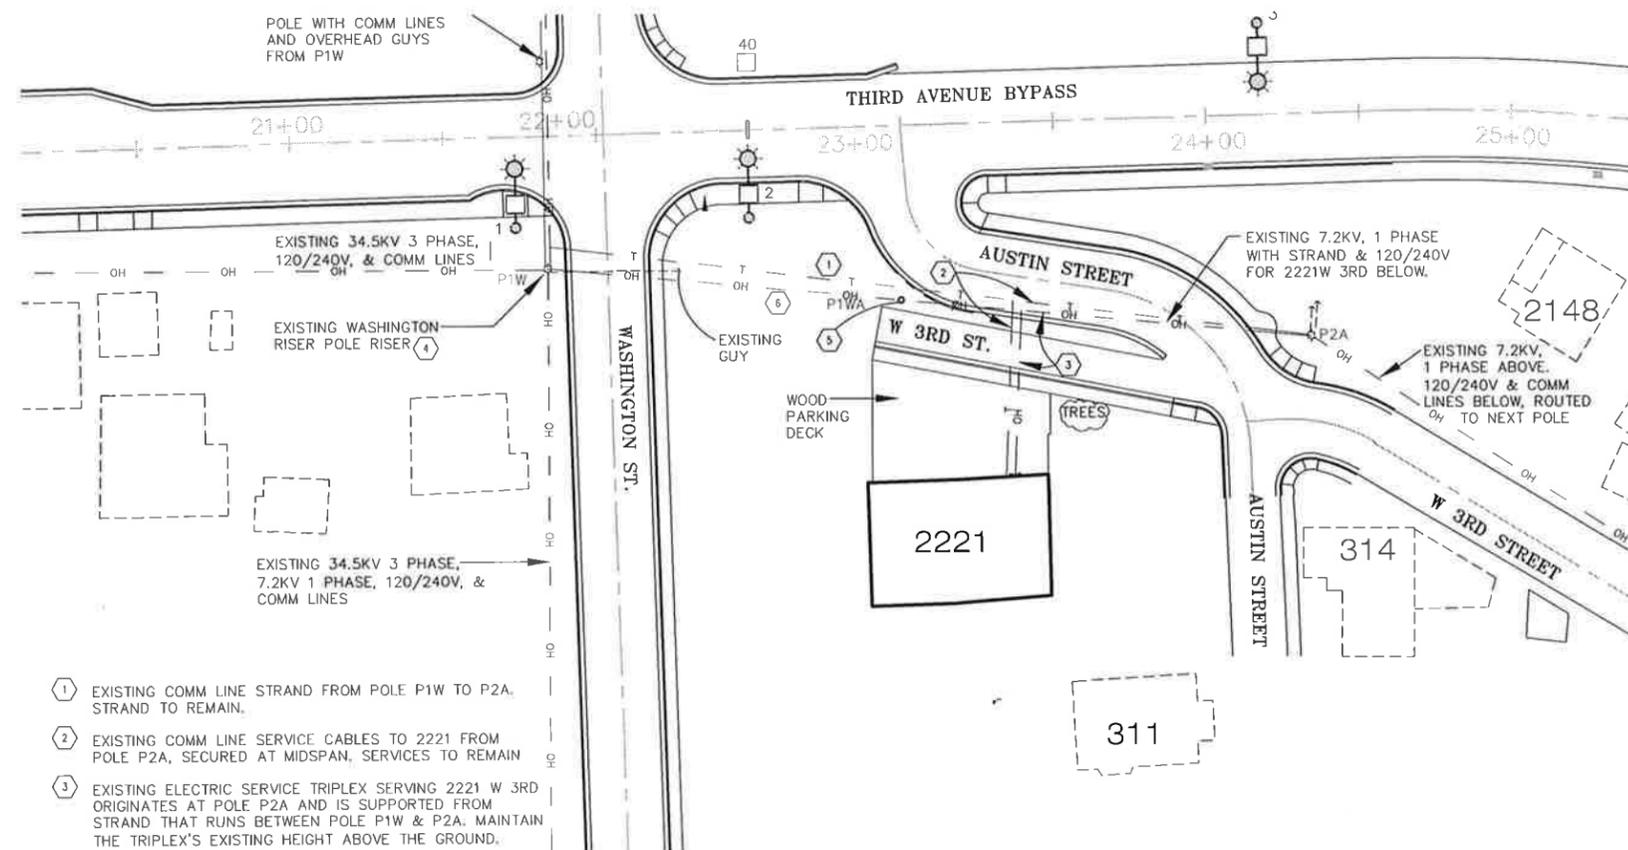

- ① EXISTING COMM LINE STRAND FROM POLE P1W TO P2A. STRAND TO REMAIN.
- ② EXISTING COMM LINE SERVICE CABLES TO 2221 FROM POLE P2A, SECURED AT MIDSPAN, SERVICES TO REMAIN
- ③ EXISTING ELECTRIC SERVICE TRIPLEX SERVING 2221 W 3RD ORIGINATES AT POLE P2A AND IS SUPPORTED FROM STRAND THAT RUNS BETWEEN POLE P1W & P2A. MAINTAIN THE TRIPLEX'S EXISTING HEIGHT ABOVE THE GROUND.
- ④ LOWER THE EXISTING EQUIPMENT AND LINES ON POLE P1W AS REQUIRED TO INSTALL NEW 35KV RISER MATERIALS. SEE U04.
- ⑤ INSTALL NEW POLE P1WA AND ATTACH EXISTING: 7.2KV (1 PHASE), SYSTEM NEUTRAL, AND STRAND TO THE NEW POLE SO AS TO MAINTAIN THE EXISTING 2221 W 3RD SERVICE DROP'S HEIGHT ABOVE THE GROUND. COORDINATE LOCATION OF POLE, TENSION/SAG AND ATTACHMENT REQUIREMENTS WITH KPU PRIOR TO INSTALLATION.
- ⑥ EXISTING STRAND LINE FROM POLE P1W TO P2A FOR ELECTRICAL SERVICE TO 2221 W 3RD. EXISTING 7.2KV 1 PHASE AND SYSTEM NEUTRAL ARE LOCATED ABOVE THE STRAND LINE. REUSE EXISTING CONDUCTORS AND STRAND: LOWER THEIR LOCATION ON POLE P1W (INSTALL SPLICES ONLY IF NEEDED), FASTEN TO NEW POLE P1WA, ADJUST SAG & TENSION TO MATCH EXISTING OR AS DIRECTED BY KPU.

AT THE TIME THIS DRAWING SET WAS ISSUED FOR BID, KPU-E WAS GOING TO PERFORM THE WORK TO INSTALL NEW POLE P1WA AND REVISE THE SERVICE TO 2221 W 3RD AVE AS SHOWN ON THIS DETAIL AND THE ASSOCIATED WORK ON POLE P1W, SEE U04. FOR THE BID PHASE, ASSUME THIS WORK WILL BE COMPLETED BEFORE THE ADVANCE RELOCATION CONTRACT IS ISSUED. FIELD CONFIRM THAT THE INSTALLATION IS COMPLETE PRIOR TO THE START OF CONSTRUCTION. NOTE ANY ISSUES WITH THE ENGINEER AT THAT TIME.

① **NEW POLE P1WA FOR SERVICE TO 2221 W 3RD**
 SCALE: 1" = 30'
 SEE 2/U32 FRO ADDITIONAL INFO

② **SERVICE TO 2221 W 3RD**
 NO SCALE

Project As Built Drawings Have Been Reviewed By The Project Engineer & Represent, To The Best Of My Knowledge, The Project As Constructed.

Proj. Eng. *NB* Date *1/16/16*

DO NOT SCALE FROM THESE DRAWINGS USE DIMENSIONS

CHECKED BY: TED

DESIGNED BY: KCN
 DRAWN BY: KCN

STATE OF ALASKA
 DEPARTMENT OF TRANSPORTATION & PUBLIC FACILITIES
 SOUTHEAST REGION

KETCHIKAN ADVANCE
 WATER STREET TRUNK LINE
 RELOCATION
 PROJECT # 69548

ELECTRICAL DETAILS

PROJECT DESIGNATION
BR-000S(735) ~ 69548

STATE	YEAR
ALASKA	2014
SHEET NUMBER	TOTAL SHEETS
U33	78

ADDENDUM NUMBER

ATTACHMENT NUMBER

RECORD OF REVISIONS

No	DATE	DESCRIPTION

Pole	KPU #	Height	Class	Xfm	Information for the Existing Installation					34.5kV	12.47kV	120/240V Distribution	Comments
					Xfm #	Xfm Phas	RUS Xfm	Street Light	Guy				
0	T-111	60	2	50	3023			Y	N	336MCM ACSR	4/0 CU WP	#4/0 Triplex	Exist. 34.5 & 12.47kV alley arms
1	1334-B3-1	60	2	N				Y	Y	336MCM ACSR	4/0 CU WP	#4/0 Triplex	Exist. 34.5 & 12.47kV double crossarm, post top insulators. Install deadend insulators; remove post top insulators; jumper the 12.47kV top tier back down to middle tier
2	1334-B3-?	?	2	N				N	Y	336MCM ACSR	4/0 CU WP		Telecomm pole; no power
3		60	2	N				Y	Y	336MCM ACSR	4/0 CU WP		Exist. 34.5 & 12.47kV alley arms; pole located on a raised sidewalk; install comm guy line.
4	1342-D3-2	60	2	50	1404	B	G39	Y	N	336MCM ACSR	4/0 CU WP	#4/0 Triplex	Exist. 34.5 & 12.47kV alley arms
5		60	2	N				Y	N	336MCM ACSR	4/0 CU WP	#4/0 Triplex	Exist. 34.5 & 12.47kV alley arms
6	1342-C4-4	60	2	N				Y	N	336MCM ACSR	4/0 CU WP	#4/0 Triplex	Exist. 34.5 & 12.47kV alley arms
7	E00465	60	2	50	1405	C	G39	Y	Y	336MCM ACSR	4/0 CU WP	#4/0 Triplex	Exist. 34.5 & 12.47kV double crossarm, post top insulators
7G													Guy Pole for P7 with guys over the roadway
8	1342-B4-5	55	2	N				Y	N	336MCM ACSR	4/0 CU WP	#4/0 Triplex	Ex. 34.5 & 12.47kV double crossarm, post top insulators; hydrant uphill
9	1342-B4-4	55	2	25	2110	A	G39	Y	N	336MCM ACSR	4/0 CU WP	#4/0 Triplex	Ex. 34.5 & 12.47kV double crossarm, post top insulators; hydrant uphill
10	1342-B4-3	70	2	50	3536	NA	G39	Y	3	336MCM ACSR	4/0 CU WP	#4/0 Triplex	Exist. 34.5 & 12.47kV double crossarm deadends; (2) riser conduits up hill side; Tel count 4, TV 3, FO 2 Jumper 12.47kV to the top tier. Install 120/240V service to VDSL cabinet. Install new conduits from manhole MH2.
10G	E00461		2										Guy Pole for P10 with guy over the roadway
10T	New Pole	45	2	N		NA		N	Y				Install new temporary telephone pole with sidewalk guy & 900 pair CU cable down Water Street & 200 pair up Parnell Stairs;
10A				N				N	Y			#1/0 Triplex	Service pole; Mid tap 120/240 to 1305 lands on pole; 1279 direct to svc mast; GCI & KPU-Tel drops on pole for both houses
11	T-117	50	2	N				N	N		4/0 CU WP	#4/0 Triplex	Alley arms: (3) 12.47kV, (1) 120/240V & (1) Comm.
11A	T-278			N				Y	N			#1/0 Triplex	Square wood service pole; (House address 102/103 services are fed from Tongass St)
12	2116	65	2	75	3762	A	G39	Y	2		4/0 CU WP	#4/0 Triplex	Tangent Pole -Opposite side of road; New sidewalk guy for communications
P1W	1241-A5-2	60	2	10	1507		G39	Y	Y	336MCM ACSR	4/0 CU WP	#4/0 Triplex	Washington 34.5kV riser pole; install 35kV riser assembly
P1S	E00462	65	2	N				Y	Y	336MCM ACSR	4/0 CU WP	#4/0 Triplex	Schoenbar telecomm riser pole; install new 4" comm riser conduits from pull box T-1.
P2S		60	2	Y				Y	Y	336MCM ACSR	4/0 CU WP	#4/0 Triplex	Schoenbar telecomm riser pole. New 34.5kV crossarm, connect 34.5kV 3 phase to P2SR
P2SR	New Pole	60	2	N						336MCM ACSR			New 34.5kV riser pole; connect new 3rd Ave 34.5kV underground circuit into overhead system.
P1M			2	N				Y	Y	336MCM ACSR	4/0 CU WP	#4/0 Triplex	Millar Street at top Parnell Stairs

ISNSTALL POLE CAPS ON ALL NEW POLES P10T, P2SR

Project As Built Drawings Have Been Reviewed By The Project Engineer & Represent, To The Best Of My Knowledge, The Project As Constructed.

Proj. Eng. *NB* Date *1/16/16*

CHECKED BY: TED



DESIGNED BY: KCN

DRAWN BY: KCN

STATE OF ALASKA
 DEPARTMENT OF TRANSPORTATION & PUBLIC FACILITIES
 SOUTHEAST REGION
 KETCHIKAN -ADVANCE
 WATER STREET TRUNK LINE
 RELOCATION
 PROJECT #69548

POLE INFORMATION

PROJECT DESIGNATION
BR-000S(735) ~ 69548

STATE	YEAR
ALASKA	2014
SHEET NUMBER	TOTAL SHEETS
U35	78

CONSTRUCTION NOTES

- THE CONTRACTOR SHALL INSTALL NEW 2-ADTRAN VDSL SYSTEM & REMOVE THE FOLLOWING EXISTING VARIOUS AERIAL & UG TEL. CABLE FACILITIES FOR THE REHABILITATION OF WATER STREET BRIDGE
 - AERIAL FIBER OPTIC CABLE 48FOC, FWAT, 37-60+24D'd
 - AERIAL COPPER CABLE AEF100PR-26GA, K37, 801-900
 - UG COPPER CABLE AEB50-22, T02, 1-25+51-75
 - UG COPPER CABLE AE1200-26, K37, 1-800+1000'd+901-1075+125D'd, AND
 - UG COPPER CABLE AE1800-26, C03, 1-1800
- NO REMOVAL/MIGRATION OF EXISTING TELEPHONE COPPER AND FIBER CABLES OR SERVICES SHALL BE DONE UNLESS THE PROPOSED VDSL SYSTEM AT PARNELL ST AND BEAR VALLEY ARE IN FULL OPERATION
- THE CONTRACTOR SHALL BE RESPONSIBLE TO CONSTRUCT A PAD MOUNT OF 72"x30" AT PARNELL ST AND TO INSTALL ADTRAN VDSL CABINET TA5000 INCLUDING PLACEMENT OF EACH 17"x30" (TIER 2) HANDHOLE AS SHOWN IN PROPOSED VDSL LOCATION DETAIL, PRINT V18.
- THE CONTRACTOR SHALL BE RESPONSIBLE TO SET UP THE PROPOSED VDSL CABINET TA5000 SHELL & ITS ELECTRONIC DEVICES AT PARNELL ST INCLUDING TERMINATION OF PROPOSED 600 COPPER PAIRS INTO VDSL TERMINATION BLOCK.
- THE CONTRACTOR SHALL BE RESPONSIBLE TO INSTALL ELECTRONIC VDSL CARDS IN EXISTING CABINET SHELL AT SCHEONBAR RD & 3RD AVENUE BYPASS. UPON INSTALLATION OF ADTRAN ELECTRONIC CARDS, THE CONTRACTOR SHALL DO THE CUTOVER OF ALL EXISTING ACTIVE LINES SERVING BEAR VALLEY HOMES FROM EXISTING COPPER CABLE C03, WHICH IS TO BE REMOVED, INTO NEW VDSL SYSTEM, CABINET X021.
- THE CONTRACTOR SHALL INSTALL NEW POWER METER AND SHALL BE RESPONSIBLE TO COORDINATE W/ KPU ELECTRIC ABOUT INSTALLATION STANDARDS & ITS PROPER LOCATION.
- THE CONTRACTOR SHALL INSTALL NEW 45' POLE AT PARNELL ST CORNER WATER ST INCLUDING ITS PROPOSED RISER PIPES
- THE CONTRACTOR SHALL INSTALL VARIOUS SIZES OF NEW CONDUITS FROM NEW VDSL CABINET THROUGH EX. MH-18 & NEW HHT (17"x30") TO NEW 45' POLE RISER. SEE NEW VDSL LOCATION ON PRINT V18.
- THE CONTRACTOR SHALL INSTALL NEW 16M STRAND WIRE FROM POLE 1334-B4-1 TO 1341-D4-5 AT A HEIGHT OF 26' MIN TO 30' MAX ALONG WATER ST.
- THE CONTRACTOR SHALL CONSTRUCT 1 EACH OF 16M DOWN GUY ON POLE 1334-B4-1 AND 2-EACH OF 16M SIDEWALK GUY ON POLE 1341-D4-5 ALONG WATER ST. SEE PRINTS V16 & V17.
- THE CONTRACTOR SHALL RE-LASH (DOUBLE LASH) EXISTING FIBER CABLE 48FOC, F02, AT A NEW HEIGHT OF 26' (MIN) TO 30' (MAX) CLEARANCE AND TO MAKE 150' SPLICE LOOPS ON POLES 1334-A4-1 & 1334-A5-4 AT WATER ST AFTER THE CABLE IS CUT AT SCHEONBAR ROAD, AS SHOWN ON PRINT V16, TO SPLICE IN NEW 6-PORT FIBER TERMINALS.
- THE CONTRACTOR SHALL INSTALL 8 EACH OF NEW 6-PORT FIBER POLE TERMINAL AND SPLICE INTO EXISTING FIBER CABLE 48FOC, F02, AS SHOWN ON PRINTS V16 TO V17.
- THE CONTRACTOR SHALL INSTALL 1500' NEW AIR PIPE AS SHOWN ON PRINTS V15 TO V17. THE CONTRACTOR SHALL ALSO BE RESPONSIBLE TO SPLICE IN THE NEW AIR PIPE TO EXISTING CABLE PRESSURIZATION SYSTEM INCLUDING THE TESTING. THE CONTRACTOR SHALL COORDINATE WITH KEN BERRY, KPU-TELECOM SPLICE HEAD CREW, OF ANY ATTACHMENT TO EXISTING KPU-TELECOM CABLE PRESSURIZATION SYSTEM.
- DUE TO CONSTRUCTION, AS A TEMP. SERVICE TO WATER STREET BRIDGE RESIDENTS, THE CONTRACTOR SHALL INSTALL NEW FIBER DROPS & ONT (30 UNITS, PER TABLE V2) TO ALL ACTIVE COPPER CUSTOMERS IN THE VICINITY TO CONVERT THEIR SERVICE TO FIBER PER V16 & V17. THE CONTRACTOR SHALL ALSO BE RESPONSIBLE TO REMOVE THEIR EX. COPPER DROPS & NIDS (21 UNITS). SEE CONST. NOTE No. 25. THE CONTRACTOR SHALL COORDINATE WITH JOHN BECK, KPU-TELECOM OSP FOREMAN, ABOUT KPU-TELECOM GUIDELINES IN THE INSTALLATION OF FIBER DROPS.
- THE CONTRACTOR SHALL COORDINATE WITH KPU-TELECOM INSPECTOR IN TRANSFERRING EXISTING TELEPHONE AERIAL CABLE FACILITIES FROM A HEIGHT OF 18-FOOT CLEARANCE TO A NEW HEIGHT OF 26- TO 30-FOOT HIGH AT WATER ST. THE CONTRACTOR SHALL ALSO REPLACE EXISTING COPPER & FIBER DROPS FROM EX. 18-FOOT HIGH EXISTING TERMINALS TO NEW HEIGHT OF COPPER & FIBER TERMINALS.
- THE CONTRACTOR SHALL COORDINATE WITH KPU-TELECOM BEFORE MIGRATING/CONVERTING ANY TELEPHONE SERVICE TO NEW SERVICE BOTH IN VDSL OR FIBER SYSTEM INCLUDING SERVICE DROPS REMOVAL THAT THERE SHALL BE NO SERVICE INTERRUPTIONS IN THE AREA.

KPU-TELECOM STAFF TO BE CONTACTED FOR MAINTENANCE WINDOW:

 - KEITH WADLEY - PLANT MANAGER
 - JOHN BECK - OSP FOREMAN
 - CARYN HOMAN - ISP FOREMAN
 - JEFF HENDRICKSON - SENIOR C.O.N.T.
 - KEN BERRY - SPLICER HEAD CREW
- THE CONTRACTOR SHALL BE RESPONSIBLE FOR ALL THE REMOVAL OF CUT CABLES (BOTH COPPER & FIBER) BUT NOT LIMITED TO SERVICE DROPS, WIRE STRAND WIRES AND OTHER POLE LINE HARDWARES.
- THE CONTRACTOR SHALL SPLICE THE FOLLOWING (AS CALL OUT IN PRINTS V3-V17 FROM BOAT 1 TO 60):
 - SPLICING OF NEW UG COPPER CABLES (900PR-24, 600PR-24G, AND 200PR-24GA) IN MH-18.
 - SPLICING OF NEW 200PR-24 CABLE TO EXISTING COPPER CABLES AT MILLAR ST CORNER PARNELL ST.
 - RE-SPLICING OF ALL EXISTING COPPER CABLES AND TERMINALS WHICH ARE AFFECTED BY CUTOVER FROM EXISTING K37 COPPER CABINET TO NEW X019 VDSL CABINET
 - RE-SPLICING OF EXISTING FIBER CABLE, F02, AT SCHEONBAR RD AFTER THE CUT.
 - SPLICING OF NEW LONG TAIL FIBER TERMINALS (6-PORT) INTO EXISTING 48FOC, F02, ALONG WATER STREET
- ALL NEW INSTALLED TELEPHONE FACILITIES INCLUDING ALL NEW SPLICED CABLES (COPPER & FIBER) SHALL BE DONE PER KPU-TELECOM STANDARD.
- THE CONTRACTOR SHALL BE RESPONSIBLE TO VERIFY AND TEST IN THE FIELD ALL CABLE PAIRS/COUNTS IF THERE'S NO ACTIVE WORKER(S) IN THE CABLE BEFORE CUTTING IT OFF FOR REMOVAL
- THE CONTRACTOR SHALL INSTALL NEW DOUBLE ARM 10-PIN ALLEY ON THE FOLLOWING POLES (SEE PRINT V17):
 - PROPOSED 45' HIGH POLE AT PARNELL AND WATER STREETS,
 - POLE 1342-A4-3 AT WATER AND GORGE STREETS, AND
 - POLE 1341-D4-5 IN FRONT OF 1251 WATER STREET.
- THE CONTRACTOR SHALL BE RESPONSIBLE FOR THE CONVERSION OF SERVICE DROPS OF HOUSES ALONG WATER STREET BRIDGE FROM COPPER TO FIBER AS MENTIONED IN CONST. NOTE No. 26 & TABLE V2, RESPECTIVELY. ALL DROPS FED FROM EXISTING COPPER TERMINAL OF CABLE K37 WILL BE REMOVED AND NEW FIBER DROPS WILL BE INSTALLED FROM FIBER CABLE F02 AS SHOWN ON PRINTS V16 & V17. THIS INCLUDES THE MIGRATION OF EXISTING FIBER DROPS FROM FWAT CABLE TO F02.
- UPON COMPLETION OF THIS PROJECT, THE CONTRACTOR SHALL PERFORM A CABLE (COPPER & FIBER) TESTING WITH KPU-TELECOM INSPECTOR AND A 100% PASSED ON CABLE TESTING SHALL BE SUBMITTED TO KPU-TELECOM FOR ACCEPTANCE & APPROVAL OF THE PROJECT INCLUDING REDLINE AS-BUILT PLANS SIGNED BY THE KPU-TELECOM INSPECTOR, CONTRACTOR MANAGER AND DOT PROJECT ENGINEER/REPRESENTATIVE.
- WHERE NEW CABLE LENGTHS ARE CALLED OUT, THIS IS A PRELIMINARY LENGTH - ADD 10% SPARE LENGTH FOR ESTIMATING PURPOSES. PROVIDE ACTUAL CABLE LENGTH AS REQUIRED FOR CONSTRUCTION.
- THE CONTRACTOR SHALL BE RESPONSIBLE FOR THE REMOVAL OF EX. 6-PAIR COPPER SERVICE DROPS FROM THE FOLLOWING ADDRESS PER TERMINAL NO.:
 - TWTR-1626 ON POLE 1334-B4-1:**
 - 1628 WATER STREET
 - 1626 WATER STREET
 - 1627 WATER STREET
 - 1622 WATER STREET APT. MID.
 - TWTR-1610 ON POLE 1334-A4-2:**
 - 1617 WATER STREET
 - 1611 WATER STREET
 - 1610 WATER STREET
 - 1608 WATER STREET APT. UPR
 - TWTR-1600 ON POLE 1334-A4-1:**
 - 1600 WATER STREET
 - 1528 WATER STREET
 - TWTR-1508 ON POLE 1334-A5-5:**
 - 1508 WATER STREET APT. UPR 2
 - 200 WILEY STREET
 - TWTR-1462 ON POLE 1334-A5-4:**
 - 1462 WATER STREET APT. UPR
 - 1454 WATER STREET
 - TWTR-1446 ON POLE 1342-B4-5:**
 - 1442 WATER STREET
 - TWTR-1418 ON POLE 1342-B4-4:**
 - 1426 WATER STREET
 - 1418 WATER STREET
 - TWTR-1400 ON POLE 1342-B4-3 (WHICH IS TO BE REMOVED):**
 - 1412 WATER STREET
 - 1400 WATER STREET
 - 1320 WATER STREET
 - 1321 WATER STREET
- THE CONTRACTOR SHALL ALSO BE RESPONSIBLE FOR PLACEMENT OF FIBER DROPS FROM NEW TERMINALS TO ALL HOUSES INDICATED ON TABLE V2. THIS WORKS INCLUDE THE INSTALLATION OF ONT (OPTICAL NETWORK TERMINAL) PER ADDRESS TO TERMINATE THE FIBER DROP
- FROM ONT, KPU TELECOM WILL BE RESPONSIBLE TO MIGRATE THE SERVICES TO HOUSE NUMBERS SHOWN ON TABLE V2.
- FOR INFORMATION ONLY, DOT & KPU TELECOM WILL ADDRESS THE CONNECTIVITY BETWEEN MH-17 & MH-18 IN THE NEXT PHASE OF THE PROJECT (WATER STREET BRIDGE).
- SEE NOTE IN NOMENCLATURE FOR THE WORD "PROP." OR "PROPOSED".

2421.1 PROP. POLE TERM. FWTR-1626 6P 41-44 +2D'd

TERMINAL SYMBOLS: () MEANS COPPER FACILITIES & DOT () MEANS FIBER SYSTEM. PROP. POLE TERM. A DESCRIPTION OF PROPOSED TERMINAL TYPE TO BE USED. DATE-1626, PROPOSED ASSIGNED TERMINAL NUMBER. THE VERY FIRST LETTER "T" MEANS COPPER. 6P, NUMBER OF TERMINAL FIBER PORT. 41-44+2D's, FIBER COUNTS 41 TO 44 TO BE SPLICED WITH THE TERMINAL & 2 PORTS ABOVE NOT BE USED.

2421.2 PROP. POLE TERM. TWTR-1320 25 17D'd+ 393-400

2421.2, A 2421 NUMBER IS AN FCC CODE THAT MEANS AERIAL FACILITIES & DOT () 2 MEANS COPPER SYSTEM. PROP. POLE TERM. A DESCRIPTION OF PROPOSED TERMINAL TYPE TO BE USED. DATE-1320, PROPOSED ASSIGNED TERMINAL NUMBER. THE VERY FIRST LETTER "T" MEANS COPPER. 25, A 25-PAIR COPPER TERMINAL. 17D's+393-400, 17 PAIRS DEAD MEANS WILL NOT BE USED & COPPER PAIRS 393 TO 400 TO BE SPLICED INTO THE TERMINAL.

SYMBOL FOR CABLE PULL STUD, EP-1041

NOMENCLATURE

NOTE: ALL STATEMENTS WITH THE WORD "PROP." OR "PROPOSED" IN THIS ENG'G. PLAN MEAN NEW AND NEED TO BE INSTALLED.

2 - SYMBOL FOR CABLE PULL STUD, EP-1041

[FWTR-1626 4 53-56] TO BE REMOVED

[2422.2 AE1800-26 (16M) C03,1-1800] TO BE REMOVED

[MB AEF25-24 [K37,251-268+D'd] X019,20D'd+171-175]

MB AEF25-24 TYPE OF EXISTING CABLE, SIZE & INCH TO BE RE-SPLICED TO NEW CABLE NUMBER OF PAIRS.

[K37,251-268+D'd] EXISTING CABLE NUMBER & PAIRS TO BE CHANGED. X019,20D'd+171-175 FROM CABLE NUMBER & PAIRS TO BE USED.

11/15-APPROVAL: KPU: [Signature] DOT: [Signature] CONT: [Signature]

TABLE V2 - COVERED ADDRESSES PER NEW & EXISTING FIBER TERMINAL

NEW TERMINAL NO.	TERM. LOCATION	COVERED ADDRESSES	NEW TERMINAL NO.	TERM. LOCATION	COVERED ADDRESSES
FWTR-1626 (6-PORT) F02, 41-46	POLE 1334-B4-1 ALONG WATER STREET	1628 WATER STREET	FWTR-1462 (6-PORT) F02, 25-28+2D'd	POLE 1334-A5-4 ALONG WATER STREET	1462-A WATER STREET
		1626 WATER STREET			1462-B WATER STREET
		1627 WATER STREET			1454 WATER STREET
		1622-A WATER STREET			
		1622-B WATER STREET			
FWTR-1610 (6-PORT) F02, 35-40+2D'd	POLE 1334-A4-2 ALONG WATER STREET	1617 WATER STREET	FWTR-1446 (6-PORT) F02, 29-32+2D'd	POLE 1342-B4-5 ALONG WATER STREET	1446-A WATER STREET
		1611 WATER STREET			1446-B WATER STREET
		1610 WATER STREET			1442 WATER STREET
		1608-A WATER STREET			
		1608-B WATER STREET			
FWTR-1600 (6-PORT) F02, 45-48+4D'd	POLE 1334-A4-1 ALONG WATER STREET	1600 WATER STREET	FWTR-1418 (6-PORT) F02, 21-24+2D'd	POLE 1342-B4-4 ALONG WATER STREET	1426 WATER STREET
		1528 WATER STREET			1418 WATER STREET
		1412 WATER STREET			1418.5 WATER STREET
		1400 WATER STREET			
		1320 WATER STREET			
FWTR-1508 (6-PORT) F02, 33-36+2D'd	POLE 1334-A5-5 ALONG WATER STREET	1508-A WATER STREET	FWTR-1400 (6-PORT) F02, 17-20+2D'd	NEW POLE 45' ALONG WATER STREET	1412 WATER STREET
		1508-B WATER STREET			1320 WATER STREET
		200 WILEY STREET			1321 WATER STREET
					NEW VDSL CABINET
FWTR-1505 (6-PORT) F02, 33-36+2D'd	POLE 1334-A5-5 ALONG WATER STREET	1508-A WATER STREET	FPAR-0302 (4-PORT) FWAT, 1D'd-146 +155-155	POLE 1342-A4-1 ALONG PARNELL STREET	210 PARNELL STREET
		1508-B WATER STREET			1400 WATER STREET

F02, 24+ 1-3+ 2 D'd

F02, 37-39+ 3 D'd

F02, 15-19+ 1 D'd

F02, 9-12+ 2 D'd

1412 WATER

F02, 47-48+ 4 D'd

F02, 4-8+ 1 D'd

1312 WATER

F02, 20-23+ 2 D'd

PATH: CHUSERS\KCN12_000\DOCUMENTS\0-KNEE 0113
 DESIGN: 13-DWG-0-NTPS TRUNK
 RELOCATION: KPU-T-PSE 140827 DOT
 CERTIFIED FILE FOR WSDWG FILE FOR
 WSDW PLACEMENT OF VDSL CABINETS FOR
 DOT WSDW PROJECT #69548
 DATE: 11/15/10 11:47:26 PM

ADDENDUM NUMBER

ATTACHMENT NUMBER

RECORD OF REVISIONS

NO.	DATE	DESCRIPTION

--- PROP. AERIAL FOC
 --- PROP. FOC LONG TAIL TERM.
 --- PROP. AERIAL COPPER CA.
 --- EXISTING AERIAL FOC
 --- EX. FOC LONG TAIL TERM.
 --- EX. AERIAL COPPER CA.
 --- EX. AER. FOC TO BE REMOVED
 --- EX. FOC LONG TAIL TO BE REMOVED
 --- EX. COPPER CABLE TO BE REMOVED
 ⊗ PROPOSED POLE
 ⊗ EXISTING POLE
 ⊗ PROP. DOUBLE X-ARM ON PROP. POLE
 ⊗ EX. POLE & EX. DOUBLE X-ARM TO BE REMOVED
 ⊗ EX. POLE & EX. SINGLE X-ARM OR ALLEY-ARM TO BE REMOVED
 ⊗ EX. DOUBLE X-ARM ON EX. POLE
 ⊗ EX. SINGLE X-ARM OR ALLEY-ARM ON EX. POLE
 ⊗ EX. GUY & ANCHOR TO BE REMOVED
 ⊗ PROP. GUY & ANCHOR WITH PROP. LEAD
 ⊗ EXISTING FIBER SLACK LOOP
 ⊗ PROP. FIBER SLACK LOOP
 ⊗ EX. AER. FIBER TERMINAL
 ⊗ EX. AER. COPPER TERMINAL
 --- EX. FOC SPLICE POINT
 --- PROP. SPLICE ON EX. FIBER SPLICE POINT

PLAN LEGEND

CHECKED BY: KCN

DESIGNED BY: R MOJE
 DRAWN BY: R MOJE

STATE OF ALASKA
 DEPARTMENT OF TRANSPORTATION
 & PUBLIC FACILITIES
 SOUTHEAST REGION

KETCHIKAN ADVANCE
 WATER STREET TRUNK LINE
 RELOCATION
 PROJECT # 69548

TELEPHONE
 CABLE LAYOUT

PROJECT DESIGNATION:
 BR-000S(735) ~ 69548

STATE	YEAR
ALASKA	2014

SHEET NUMBER: V2 TOTAL SHEETS: 78

Project As Built Drawings Have Been Reviewed By The Project Engineer & Represent, To The Best Of My Knowledge, The Project As Constructed.

Proj. Eng. NB Date 11/16/10

APPENDIX NUMBER		
ATTACHMENT NUMBER		
RECORD OF REVISIONS		
NO.	DATE	DESCRIPTION

- PROP. AERIAL FOC
- PROP. FOC LONG TAIL TERM
- PROP. AERIAL COPPER CA
- EXISTING AERIAL FOC
- EX. FOC LONG TAIL TERM
- EX. AERIAL COPPER CA
- *--- EX. AER. FOC TO BE REMOVED
- *--- EX. FOC LONG TAIL TO BE REMOVED
- *--- EX. COPPER CABLE TO BE REMOVED
- ⊗ PROPOSED POLE
- ⊗ EXISTING POLE
- ⊗ PROP. DOUBLE X-ARM ON PROP. POLE
- ⊗ EX. POLE & EX. DOUBLE X-ARM TO BE REMOVED
- ⊗ EX. POLE & EX. SINGLE X-ARM OR ALLEY-ARM TO BE REMOVED
- ⊗ EX. DOUBLE X-ARM ON EX. POLE
- ⊗ EX. SINGLE X-ARM OR ALLEY-ARM ON EX. POLE
- ⊗ EX. GUY & ANCHOR TO BE REMOVED
- Y PROP. GUY & ANCHOR WITH PROP. LEAD
- ⊗ EXISTING FIBER SLACK LOOP
- ⊗ PROP. FIBER SLACK LOOP
- ⊗ EX. AER. FIBER TERMINAL
- ⊗ EX. AER. COPPER TERMINAL
- EX. FOC SPICE POINT
- PROP. SPICE ON EX. FIBER SPICE POINT

PLAN LEGEND

CHECKED BY: KCN


DESIGNED BY: R MOJE
 DRAWN BY: R MOJE

STATE OF ALASKA
 DEPARTMENT OF TRANSPORTATION
 & PUBLIC FACILITIES
 SOUTHEAST REGION

**KETCHIKAN ADVANCE
 WATER STREET TRUNK LINE
 RELOCATION
 PROJECT # 69548**

**TELEPHONE
 CABLE LAYOUT**


PROJECT DESIGNATION	
BR-000S(735) ~ 69548	
STATE	YEAR
ALASKA	2014
SHEET NUMBER	TOTAL SHEETS
V3	78

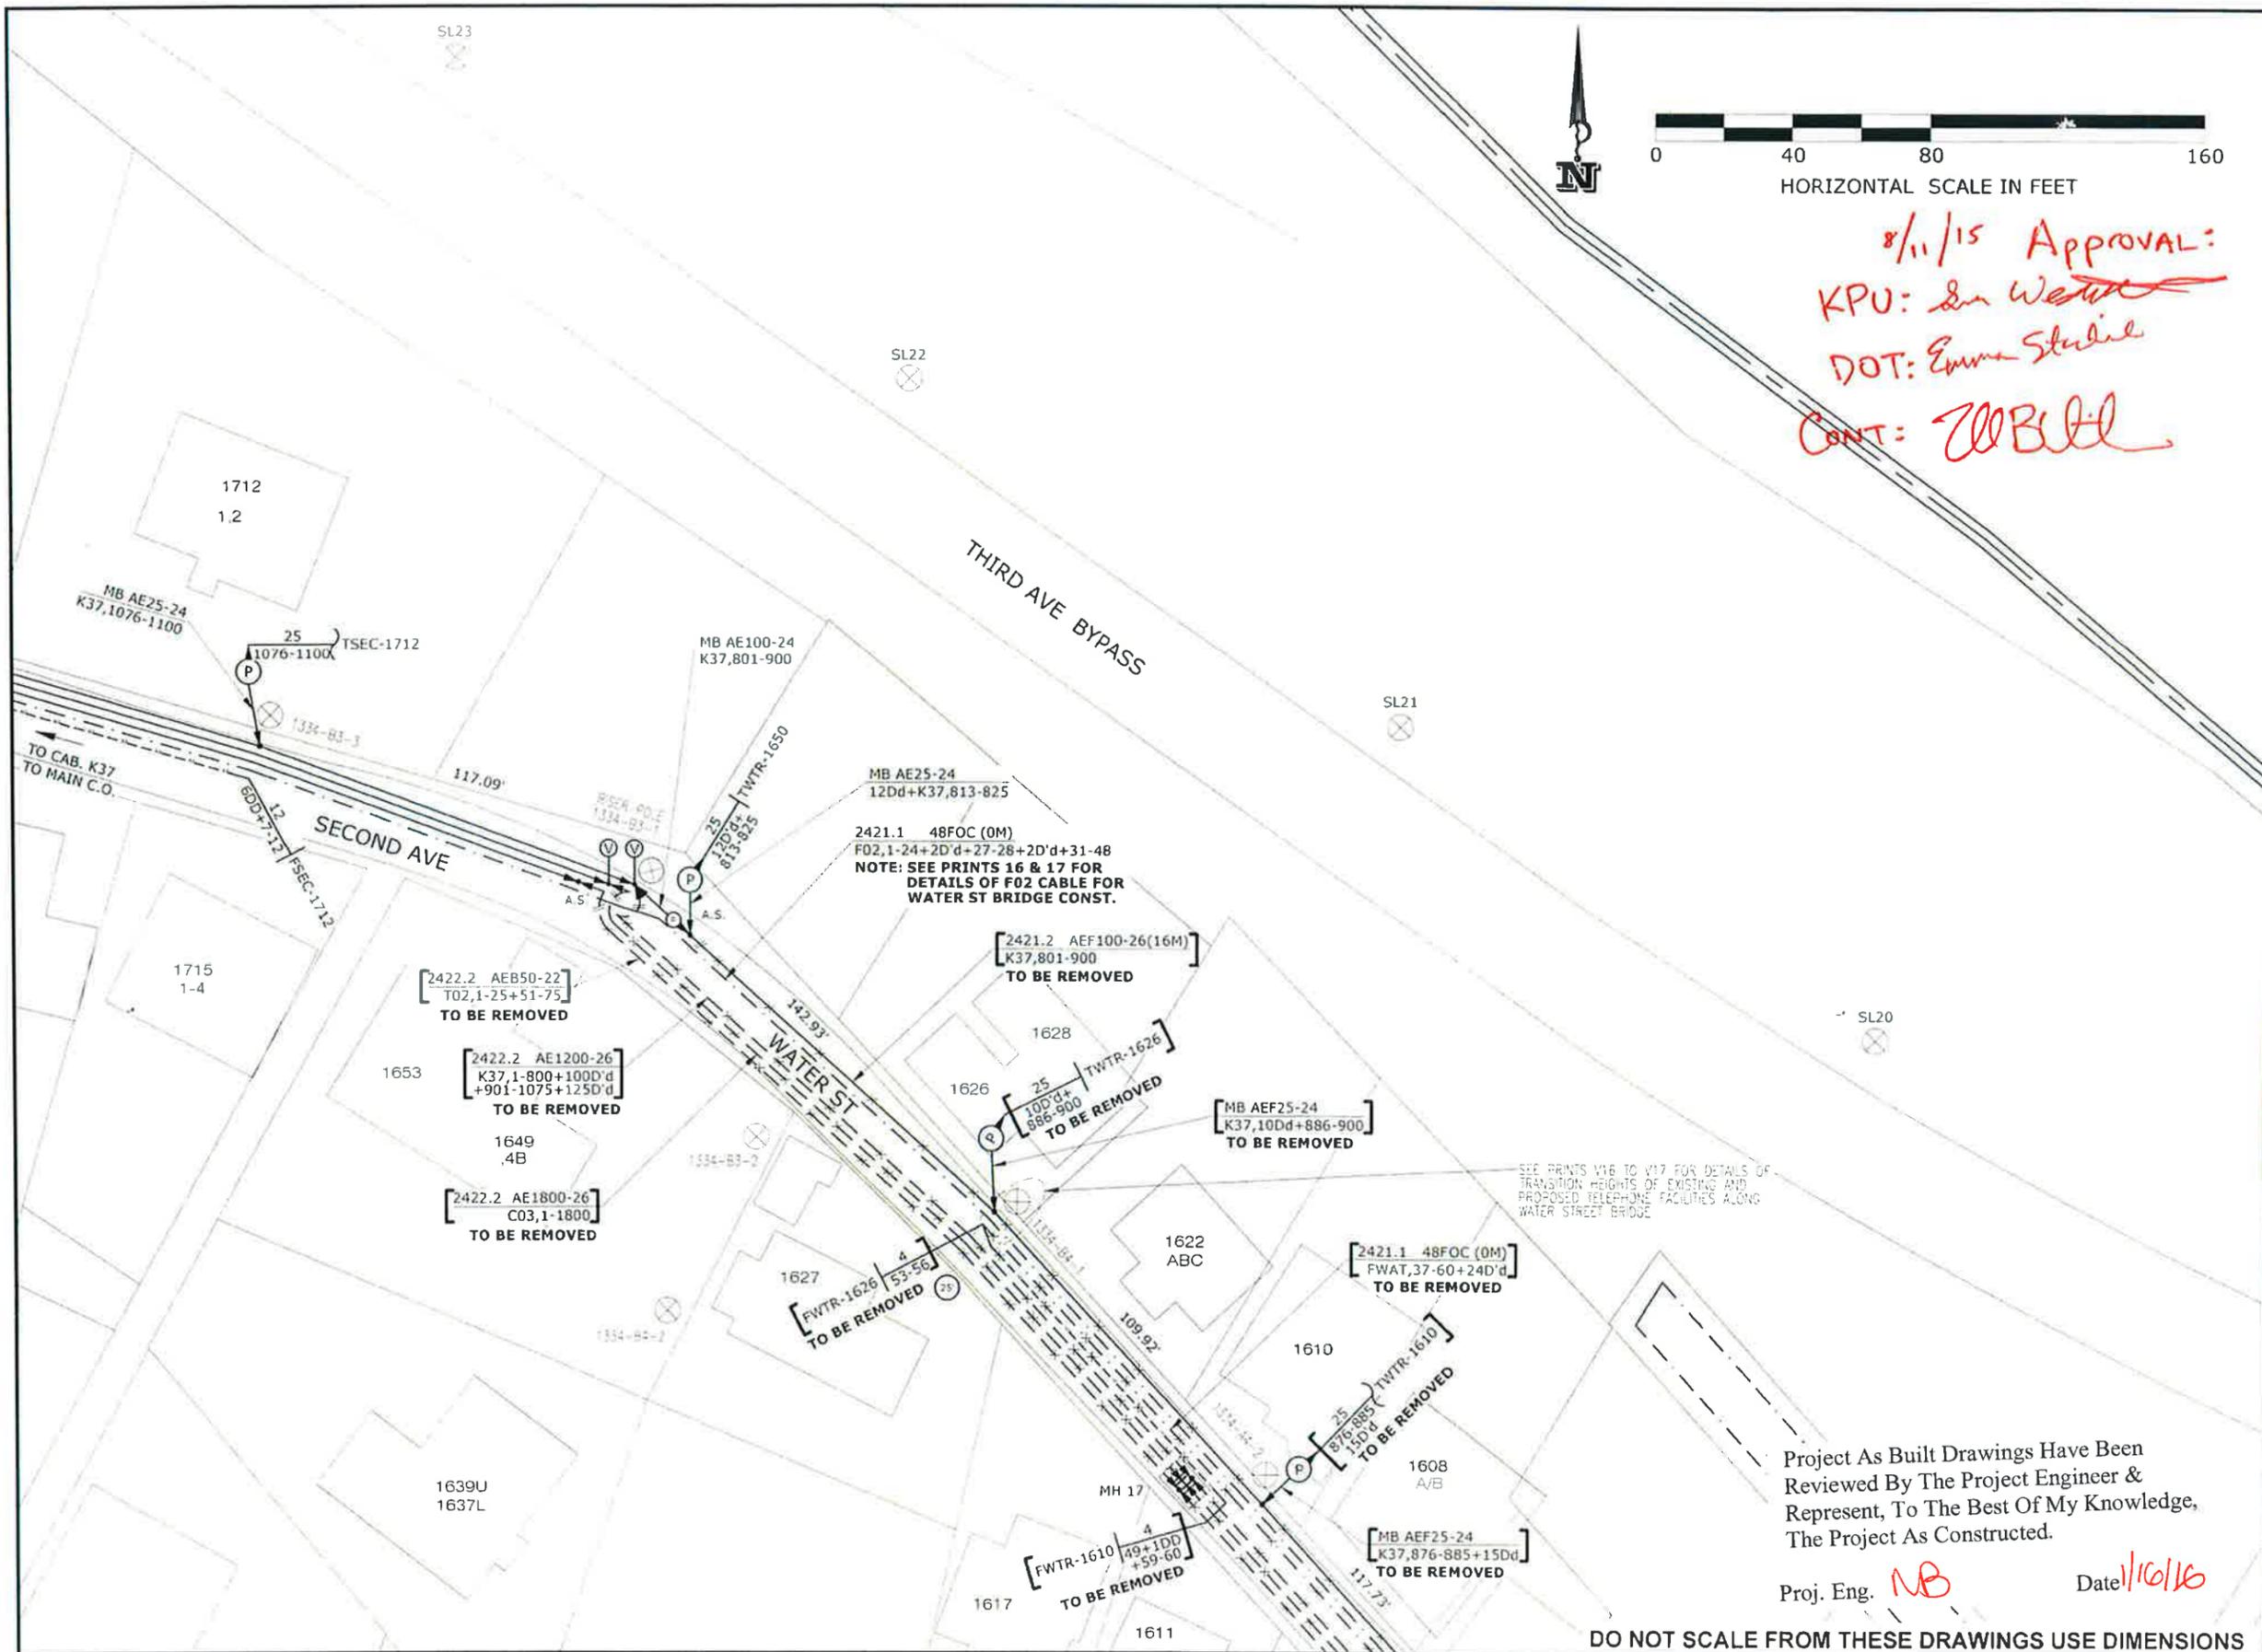

Project As Built Drawings Have Been Reviewed By The Project Engineer & Represent, To The Best Of My Knowledge, The Project As Constructed.

Proj. Eng. *NB* Date *11/6/16*

DO NOT SCALE FROM THESE DRAWINGS USE DIMENSIONS

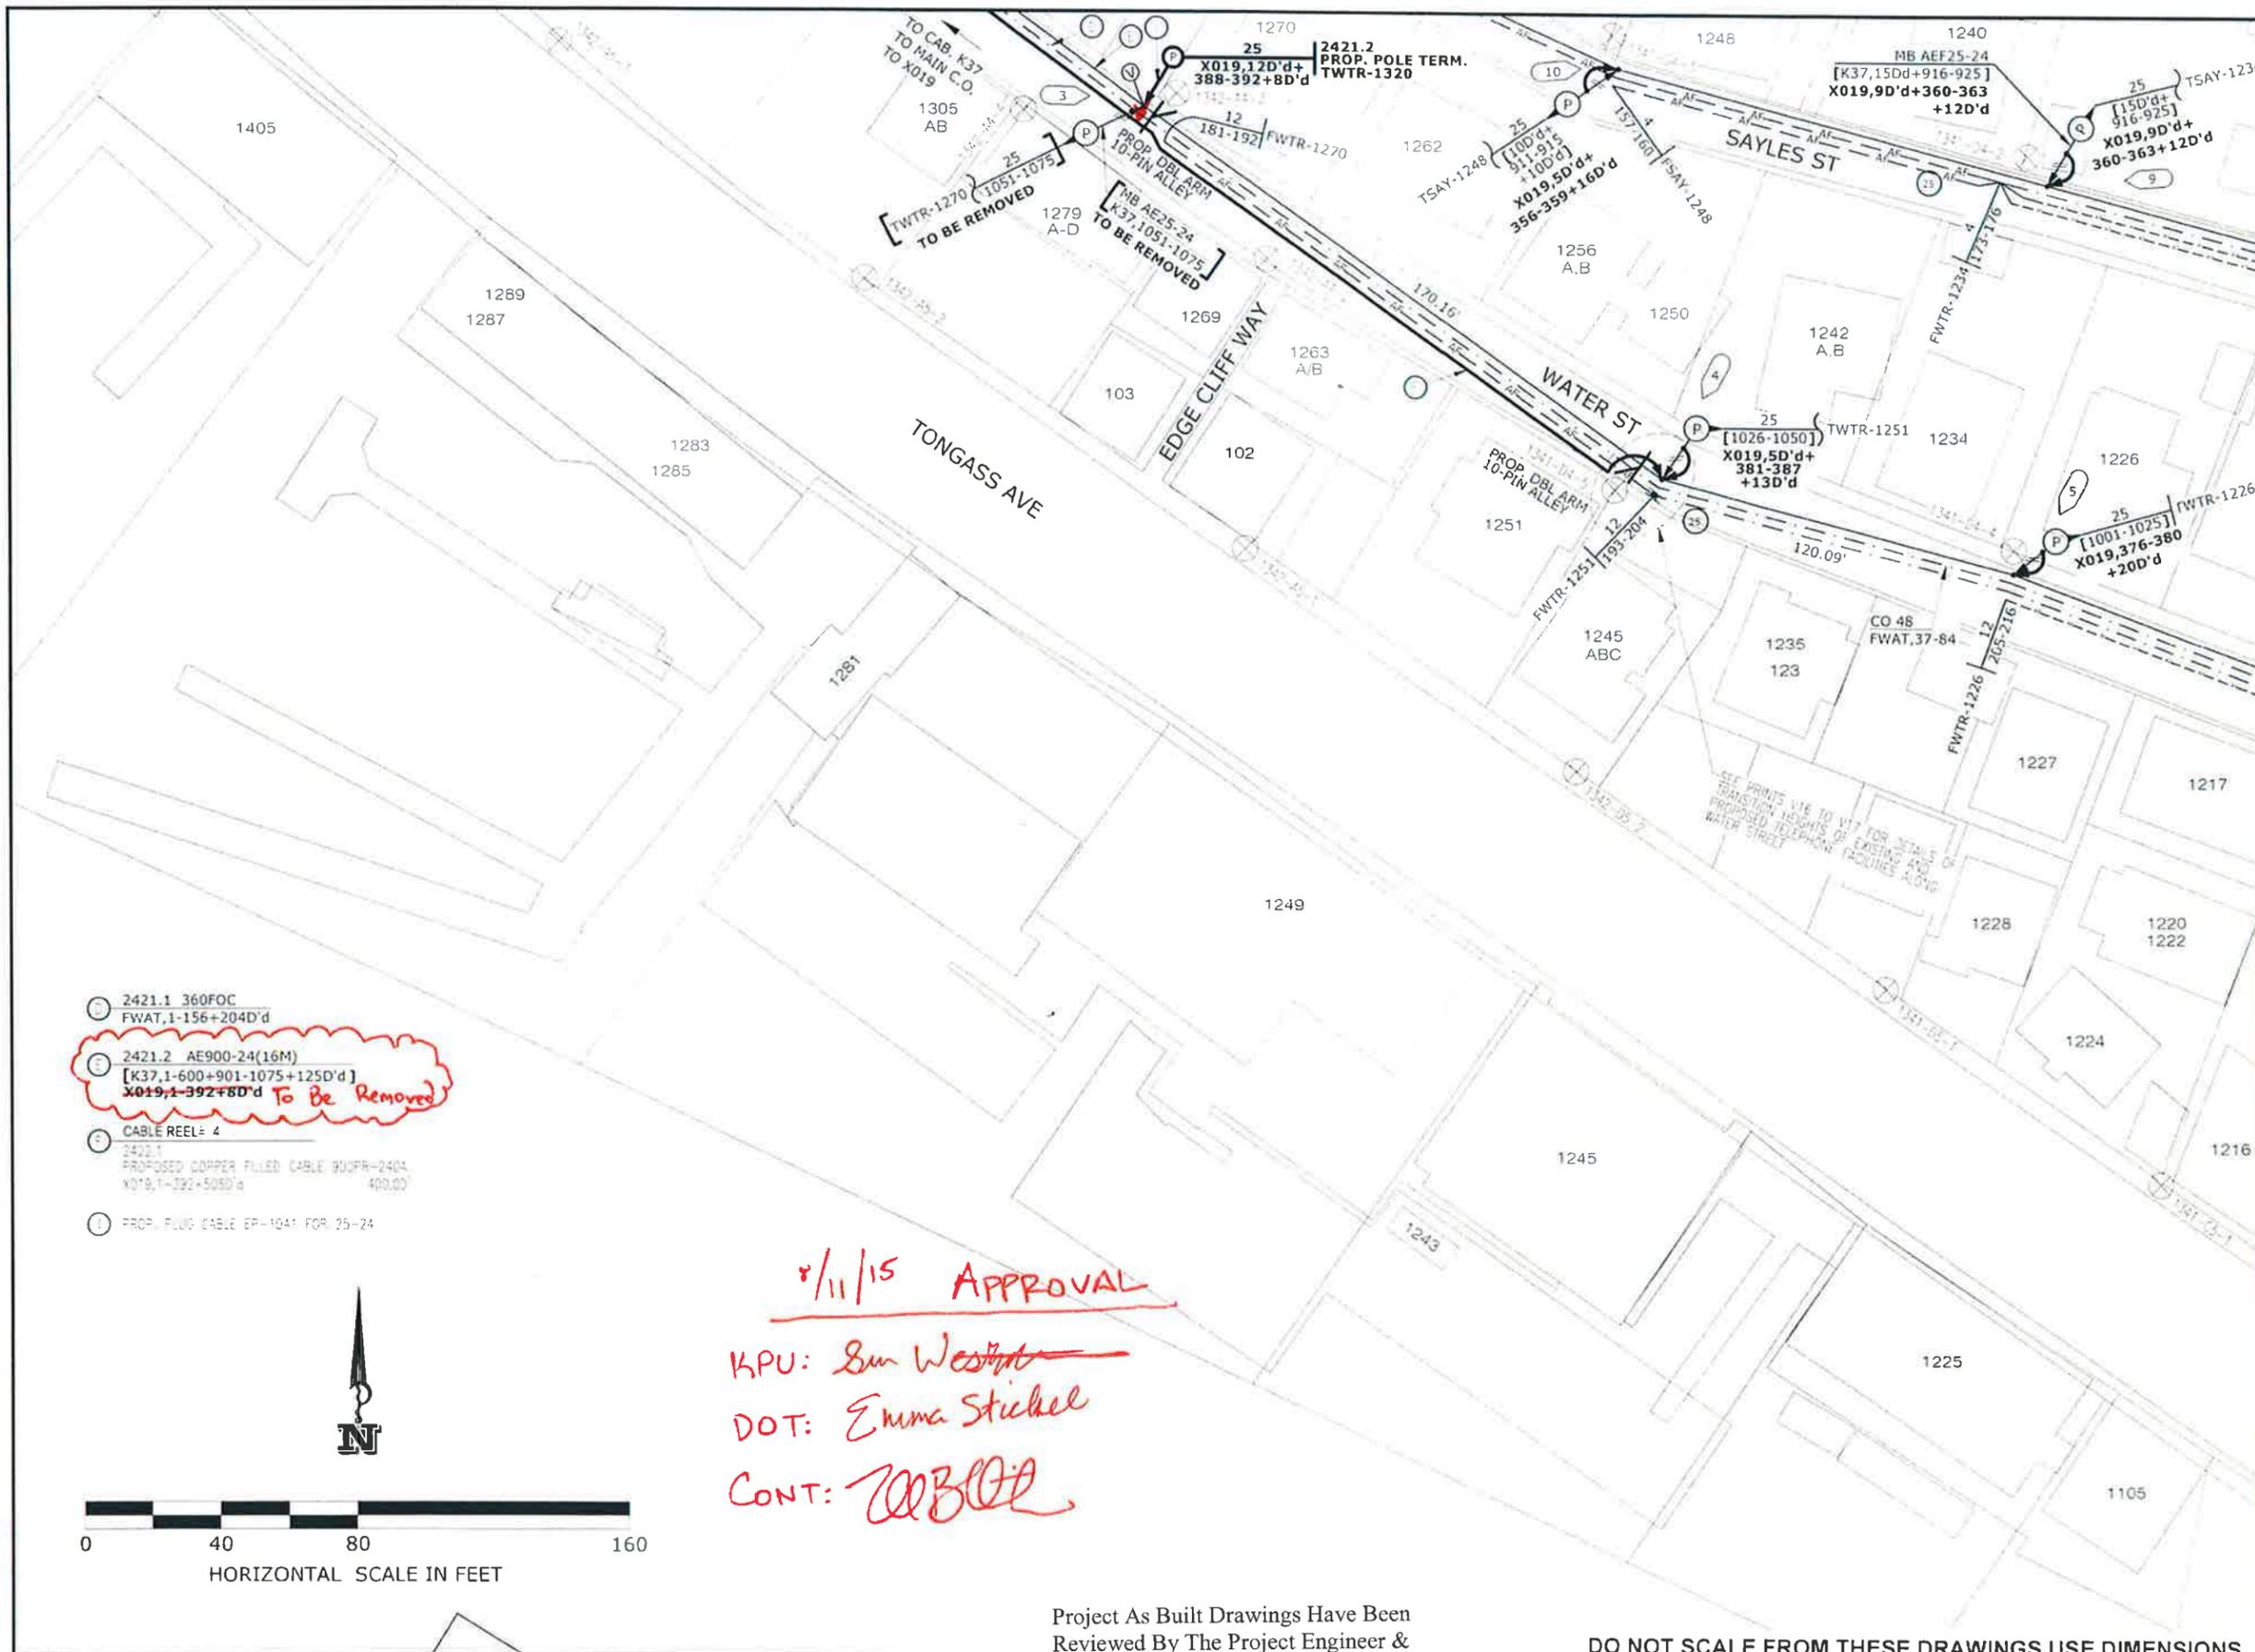

- 2421.1 360FOC
FWAT,1-156+204D'd
- 2421.2 AE900-24(16M)
[K37,1-600+901-1075+125D'd]
X019,1-392+8D'd *To Be Removed*
- CABLE REEL= 4
- 2421.1
PROPOSED COPPER FILLED CABLE 903PR-2401
X019,1-392+50SD'd 400.00'
- 2421.1
PROP. FLOC CABLE EP-1041 FOR 25-24

2/11/15 APPROVAL

KPU: Sam West

DOT: Emma Stichel

CONT: [Signature]

Project As Built Drawings Have Been Reviewed By The Project Engineer & Represent, To The Best Of My Knowledge, The Project As Constructed.

Proj. Eng. *NB* Date *1/16/16*

DO NOT SCALE FROM THESE DRAWINGS USE DIMENSIONS

PATH: C:\USERS\KCN12_000\DOCUMENTS\KNEE 2013
 DESIGN\3D\DWG\NTP3 TRUNK
 RELOCATION\KPU-T PSE 140827.DOT
 CERTIFIED FILE FOR WSD\DWG FILE FOR
 KVS\PLACEMENT OF VOISL CABINETS FOR
 BOTH WSD PROJECTS
 2/11/16 1:32 PM

ADDENDUM NUMBER

ATTACHMENT NUMBER

RECORD OF REVISIONS

No	DATE	DESCRIPTION

--- PROP. AERIAL FOC
 --- PROP. FOC LONG TAIL TERM.
 --- PROP. AERIAL COPPER CA.
 - - - EXISTING AERIAL FOC
 - - - EX. FOC LONG TAIL TERM.
 - - - EX. AERIAL COPPER CA.
 * - * EX. AER. FOC TO BE REMOVED
 * - * EX. FOC LONG TAIL TO BE REMOVED
 * - * EX. COPPER CABLE TO BE REMOVED

⊗ PROPOSED POLE
 ⊗ EXISTING POLE
 ⊗ PROP. DOUBLE X-ARM ON PROP. POLE
 ⊗ EX. POLE & EX. DOUBLE X-ARM TO BE REMOVED
 ⊗ EX. POLE & EX. SINGLE X-ARM OR ALLEY-ARM TO BE REMOVED
 ⊗ EX. DOUBLE X-ARM ON EX. POLE
 ⊗ EX. SINGLE X-ARM OR ALLEY-ARM ON EX. POLE
 ⊗ EX. GUY & ANCHOR TO BE REMOVED
 ⊗ PROP. GUY & ANCHOR with PROP. LEAD
 ⊗ EXISTING FIBER SLACK LOOP
 ⊗ PROP. FIBER SLACK LOOP
 ⊗ EX. AER. FIBER TERMINAL
 ⊗ EX. AER. COPPER TERMINAL
 ⊗ EX. FOC SPLICE POINT
 ⊗ PROP. SPLICE ON EX. FIBER SPLICE POINT

PLAN LEGEND

CHECKED BY KCN

DESIGNED BY R. MOJE
 DRAWN BY R. MOJE

STATE OF ALASKA
 DEPARTMENT OF TRANSPORTATION & PUBLIC FACILITIES
 SOUTHEAST REGION


KETCHIKAN ADVANCE
 WATER STREET TRUNK LINE
 RELOCATION
 PROJECT # 69548

**TELEPHONE
 CABLE LAYOUT**


PROJECT DESIGNATION
BR-000S(735) ~ 69548

STATE	YEAR
ALASKA	2014

SHEET NUMBER	TOTAL SHEETS
V6	78

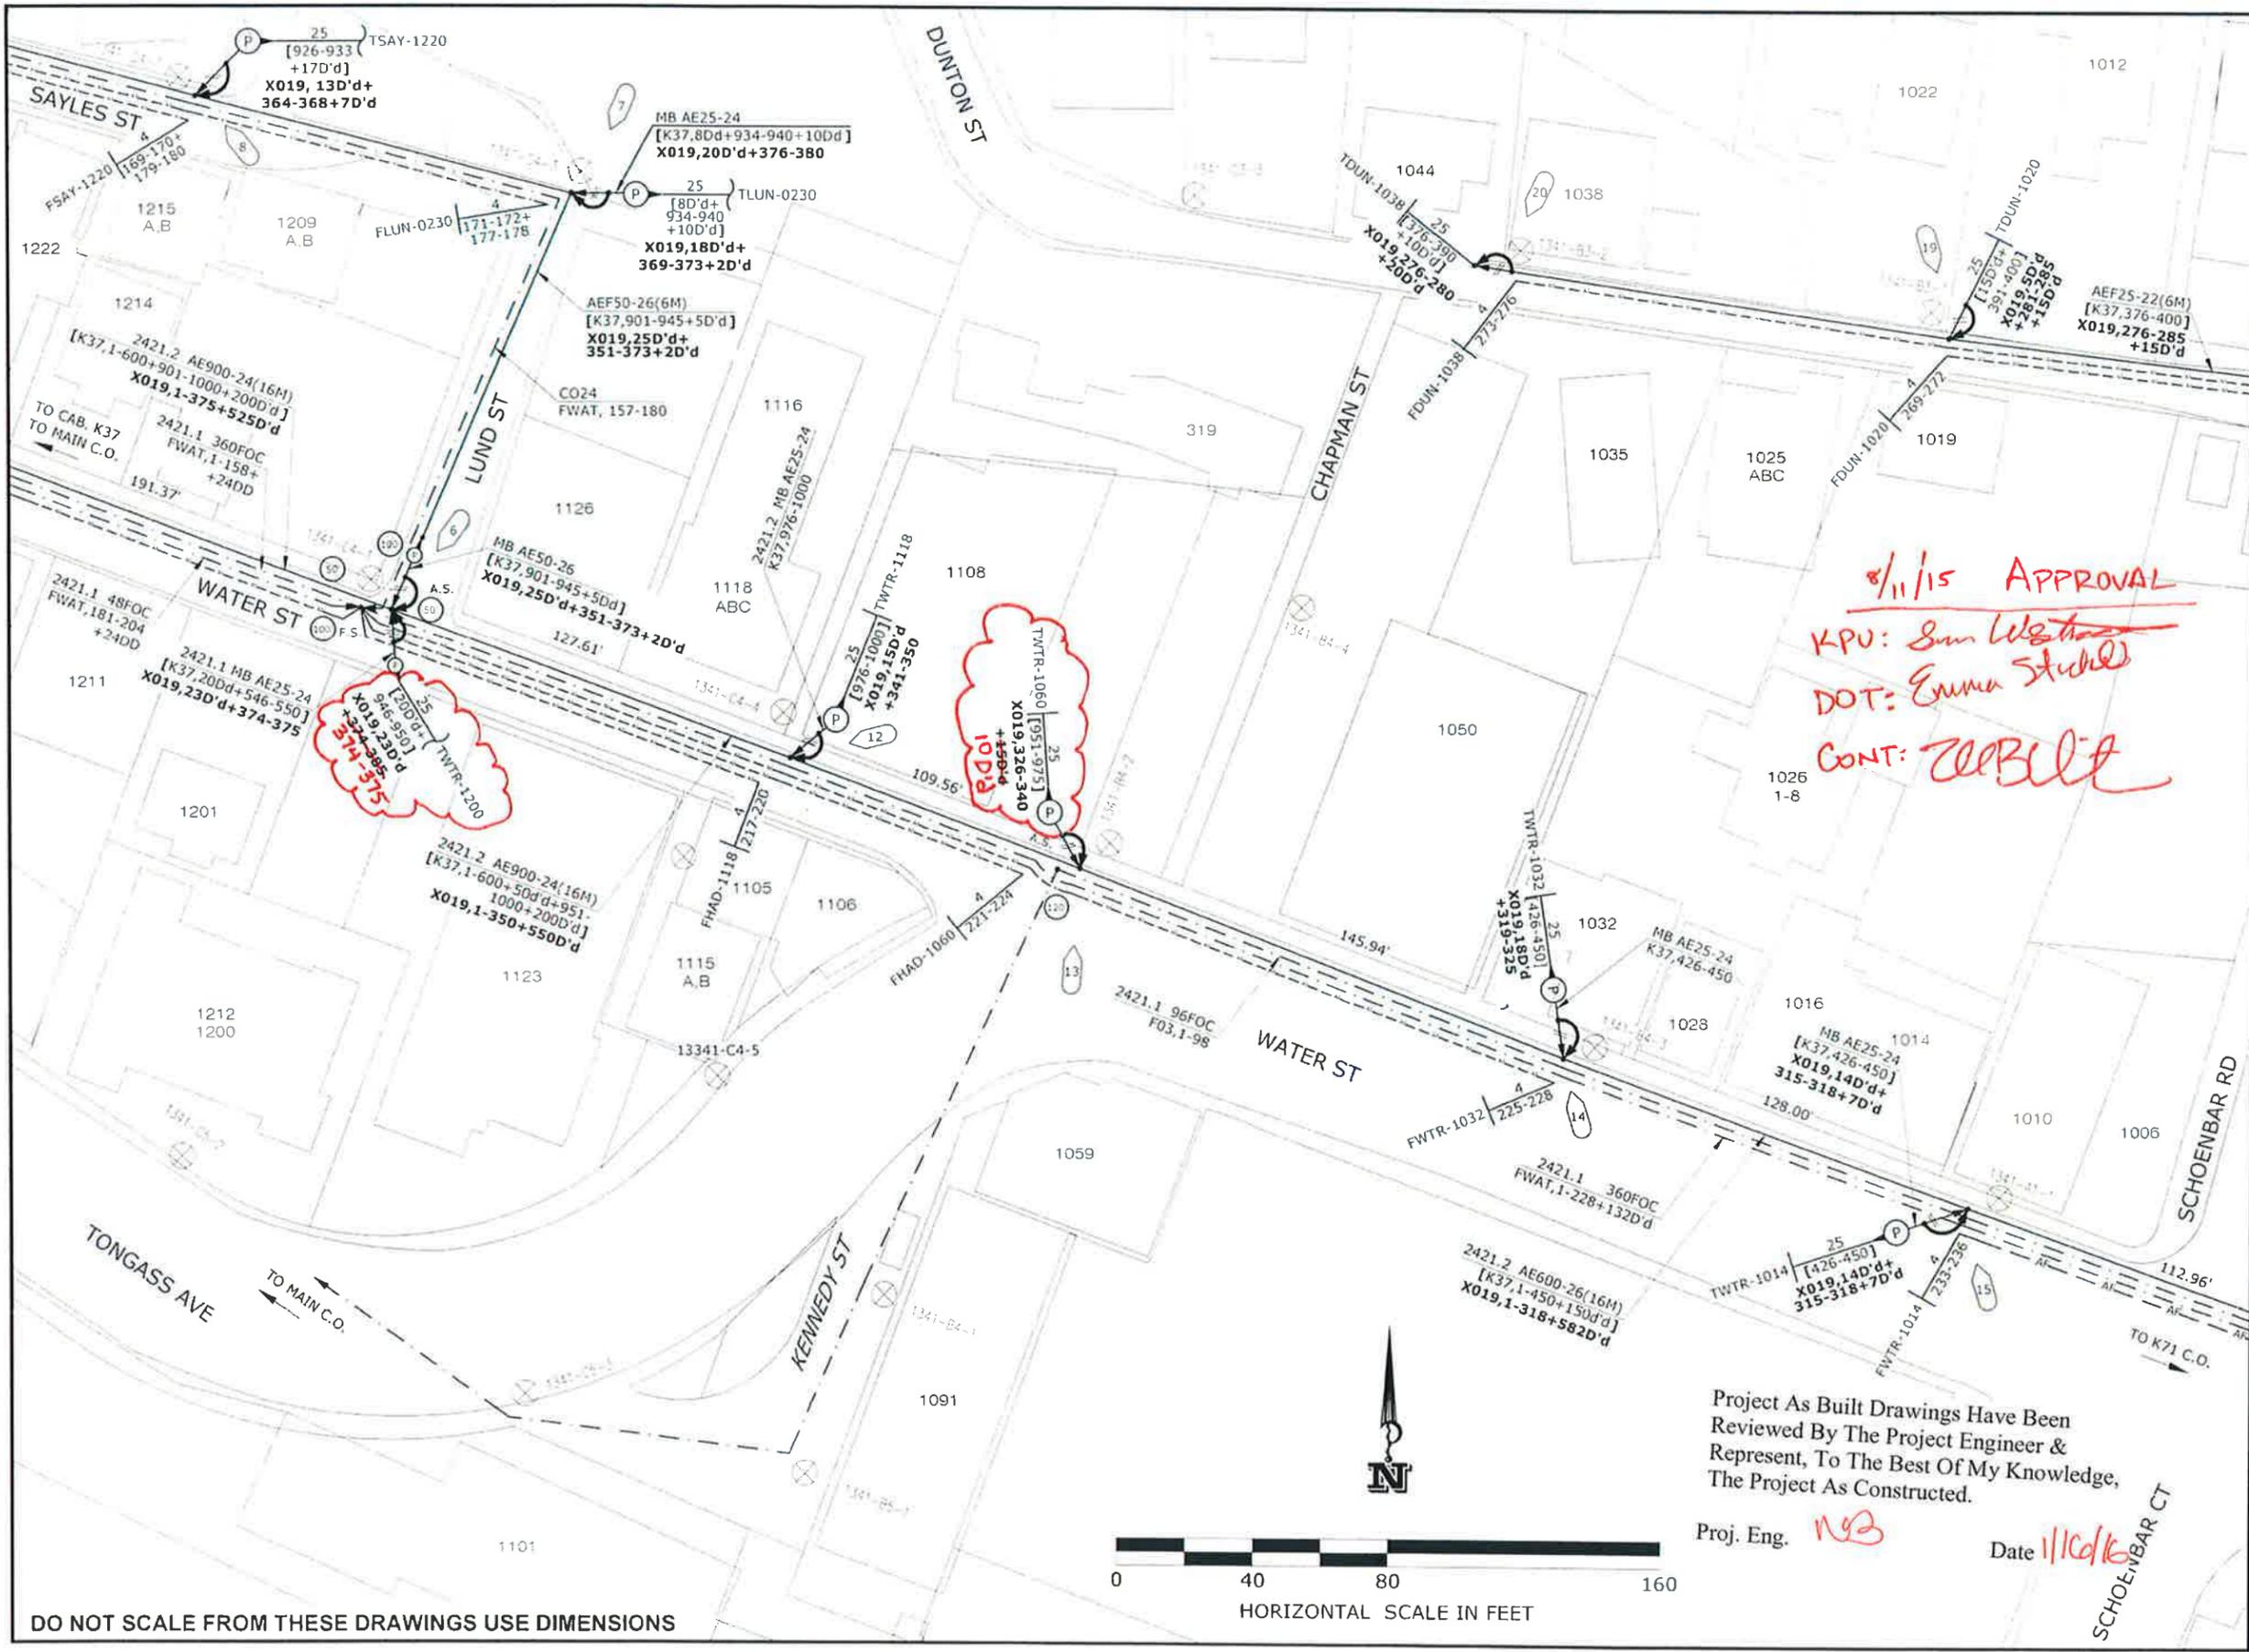

DO NOT SCALE FROM THESE DRAWINGS USE DIMENSIONS

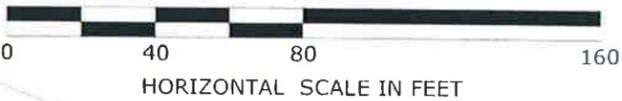

Project As Built Drawings Have Been Reviewed By The Project Engineer & Represent, To The Best Of My Knowledge, The Project As Constructed.
 Proj. Eng. *NSB* Date *11/16/16*

PATH: C:\USERS\KCN12_000\DOCUMENTS\10-KNEE\1013
 DESIGN\13\DWG\10-NTP9 TRUNK
 RELOCATION\KPU-T PSE 140827 DOT
 CERTIFYING FILE FOR W5B\DWG FILE FOR
 W5B\PLACEMENT OF VDSL CABINETS FOR
 DOT\W5B\PROJ\140827\1013.DWG
 10/13/16 1:33 PM

ADDENDUM NUMBER
 ATTACHMENT NUMBER

RECORD OF REVISIONS

No.	DATE	DESCRIPTION

--- PROP. AERIAL FOC
 - - - PROP. FOC LONG TAIL TERM
 - - - PROP. AERIAL COPPER CA
 - - - EXISTING AERIAL FOC
 - - - EX. FOC LONG TAIL TERM
 - - - EX. AERIAL COPPER CA
 - - - EX. AER. FOC TO BE REMOVED
 - - - EX. FOC LONG TAIL TO BE REMOVED
 - - - EX. COPPER CABLE TO BE REMOVED
 ⊗ PROPOSED POLE
 ⊗ EXISTING POLE
 ⊗ PROP. DOUBLE X-ARM ON PROP. POLE
 ⊗ EX. POLE & EX. DOUBLE X-ARM TO BE REMOVED
 ⊗ EX. POLE & EX. SINGLE X-ARM OR ALLEY-ARM TO BE REMOVED
 ⊗ EX. DOUBLE X-ARM ON EX. POLE
 ⊗ EX. SINGLE X-ARM OR ALLEY-ARM ON EX. POLE
 ⊗ EX. GUY & ANCHOR TO BE REMOVED
 ⊗ PROP. GUY & ANCHOR WITH PROP. LEAD
 ⊗ EXISTING FIBER SLACK LOOP
 ⊗ PROP. FIBER SLACK LOOP
 ⊗ EX. AER. FIBER TERMINAL
 ⊗ EX. AER. COPPER TERMINAL
 ⊗ EX. FDC SPLICE POINT
 ⊗ PROP. SPLICE ON EX. FIBER SPLICE POINT

PLAN LEGEND

CHECKED BY: KCN

DESIGNED BY: R MOJE
 DRAWN BY: R MOJE

STATE OF ALASKA
 DEPARTMENT OF TRANSPORTATION & PUBLIC FACILITIES
 SOUTHEAST REGION

KEITH NELSON
 PE-7883
 8-27-14
 PROFESSIONAL ENGINEER

STATE OF ALASKA
 DEPARTMENT OF TRANSPORTATION & PUBLIC FACILITIES
 SOUTHEAST REGION

KETCHIKAN ADVANCE
 WATER STREET TRUNK LINE
 RELOCATION
 PROJECT # 69548

**TELEPHONE
 CABLE LAYOUT**

PROJECT DESIGNATION
 BR-000S(735) ~ 69548

STATE	YEAR
ALASKA	2014

SHEET NUMBER	TOTAL SHEETS
V8	78

8/11/15 APPROVAL
KPU: Sam Westman
DOT: Emma Stichel
CONT: Zellert



Project As Built Drawings Have Been Reviewed By The Project Engineer & Represent, To The Best Of My Knowledge, The Project As Constructed.

Proj. Eng. **NB**

Date **11/6/16**

K35 CROSS CONNECT
 5400 PR X BOX
 [IN: CO3,1-300+CO3,901-1100+100DD+CO3,1201-1800+P35,1-200+K71,5201-5250+5301-5325+5451-5475+300DD]
 3IN: X021,1-200+K71,5201-5250+5301-5325+5451-5475+300DD
 OUT: K35,1-2000+1600DD

1800 D'd + X021, 201-300 + 50 D'd + K71, 5201-5250 + 5301-5325 + 5451-5475 + X021, 1-200 + 100 D'd

NOTE: INSTALL ADTRAN CARDS A5000 COMBO V2 24 PORT ACCESS (10 EACH) IN EXISTING CABINET AND ALL NECESSARY ELECTRONICS ITEMS FOR VDSL SERVICE OPERATION

X021
 ADTRAN VDSL CABINET
 200-PR COPPER DIST. CAPACITY
 AT 3RD AVE/SCHOENBAR RD EXCHANGE: K71 C.O.

NOTE TO CONTRACTOR:
 COORDINATE WITH KPU TELECOM OSP FOREMAN, JOHN BECK, OR SPLICER HEAD CREW, KEN BERRY, THE REMOVAL OF AIR PRESSURE SYSTEM ON CO3 AT CROSS CABINET K35

8/11/15 APPROVAL
 KPU: *Sam W...*
 DOT: *Emma Stichel*
 CONT: *ALBERT*

Project As Built Drawings Have Been Reviewed By The Project Engineer & Represent, To The Best Of My Knowledge, The Project As Constructed.

Proj. Eng.

Date

DO NOT SCALE FROM THESE DRAWINGS USE DIMENSIONS

PAT: C:\USERS\KCN12_000\DOCUMENTS\9-KNEE\2013 DESIGN\1306\1306-ATPS TRUNK RELOCATION\KPU-T-PS-148827.DOT
 C:\USERS\KCN12_000\DOCUMENTS\9-KNEE\2013 DESIGN\1306\1306-ATPS TRUNK RELOCATION\KPU-T-PS-148827.DOT
 DATE: 11/6/16 10:47 PM

ADDENDUM NUMBER

ATTACHMENT NUMBER

RECORD OF REVISIONS

NO.	DATE	DESCRIPTION

- PROP. AERIAL FOC
- PROP. FOC LONG TAIL TERM.
- PROP. AERIAL COPPER CA.
- EXISTING AERIAL FOC
- EX. FOC LONG TAIL TERM.
- EX. AERIAL COPPER CA.
- X - X EX. AER. FOC TO BE REMOVED
- X - X EX. FOC LONG TAIL TO BE REMOVED
- X - X EX. COPPER CABLE TO BE REMOVED
- PROPOSED POLE
- EXISTING POLE
- PROP. DOUBLE X-ARM ON PROP. POLE
- EX. POLE & EX. DOUBLE X-ARM TO BE REMOVED
- EX. POLE & EX. SINGLE X-ARM OR ALLEY-ARM TO BE REMOVED
- EX. DOUBLE X-ARM ON EX. POLE
- EX. SINGLE X-ARM OR ALLEY-ARM ON EX. POLE
- EX. GUY & ANCHOR TO BE REMOVED
- PROP. GUY & ANCHOR WITH PROP. LEAD
- EXISTING FIBER SLACK LOOP
- PROP. FIBER SLACK LOOP
- EX. AER. FIBER TERMINAL
- EX. AER. COPPER TERMINAL
- EX. FOC SPLICE POINT
- PROP. SPLICE ON EX. FIBER SPLICE POINT

PLAN LEGEND

CHECKED BY: KCN

DESIGNED BY: R MOJE

DRAWN BY: R MOJE

STATE OF ALASKA
 DEPARTMENT OF TRANSPORTATION & PUBLIC FACILITIES
 SOUTHEAST REGION

KETCHIKAN ADVANCE WATER STREET TRUNK LINE RELOCATION PROJECT # 69548

TELEPHONE CABLE LAYOUT

PROJECT DESIGNATION:
BR-000S(735) ~ 69548

STATE	YEAR
ALASKA	2014

SHEET NUMBER	TOTAL SHEETS
V9	78

RECORD OF REVISIONS		
NO.	DATE	DESCRIPTION

- PROP. AERIAL FOC
- PROP. FOC LONG TAIL TERM.
- PROP. AERIAL COPPER CA.
- EXISTING AERIAL FOC
- EX. FOC LONG TAIL TERM.
- EX. AERIAL COPPER CA.
- EX. AER. FOC TO BE REMOVED
- EX. FOC LONG TAIL TO BE REMOVED
- EX. COPPER CABLE TO BE REMOVED
- ⊗ PROPOSED POLE
- ⊗ EXISTING POLE
- ⊗ PROP. DOUBLE X-ARM ON PROP. POLE
- ⊗ EX. POLE & EX. DOUBLE X-ARM TO BE REMOVED
- ⊗ EX. POLE & EX. SINGLE X-ARM OR ALLEY-ARM TO BE REMOVED
- ⊗ EX. DOUBLE X-ARM ON EX. POLE
- ⊗ EX. SINGLE X-ARM OR ALLEY-ARM ON EX. POLE
- ⊗ EX. GUY & ANCHOR TO BE REMOVED
- ⊗ PROP. GUY & ANCHOR WITH PROP. LEAD
- ⊗ EXISTING FIBER SLACK LOOP
- ⊗ PROP. FIBER SLACK LOOP
- ⊗ EX. AER. FIBER TERMINAL
- ⊗ EX. AER. COPPER TERMINAL
- ⊗ EX. FOC SPlice POINT
- ⊗ PROP. SPlice ON EX. FIBER SPlice POINT

PLAN LEGEND

CHECKED BY: KCN



DESIGNED BY: R MOJE



DRAWN BY: R MOJE

STATE OF ALASKA
 DEPARTMENT OF TRANSPORTATION
 & PUBLIC FACILITIES
 SOUTHEAST REGION
 KETCHIKAN ADVANCE
 WATER STREET TRUNK LINE
 RELOCATION
 PROJECT # 69548

TELEPHONE CABLE LAYOUT

PROJECT DESIGNATION
BR-000S(735) ~ 69548

STATE	YEAR
ALASKA	2014
SHEET NUMBER	TOTAL SHEETS
V11	78

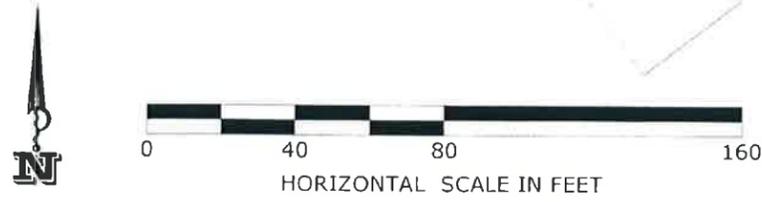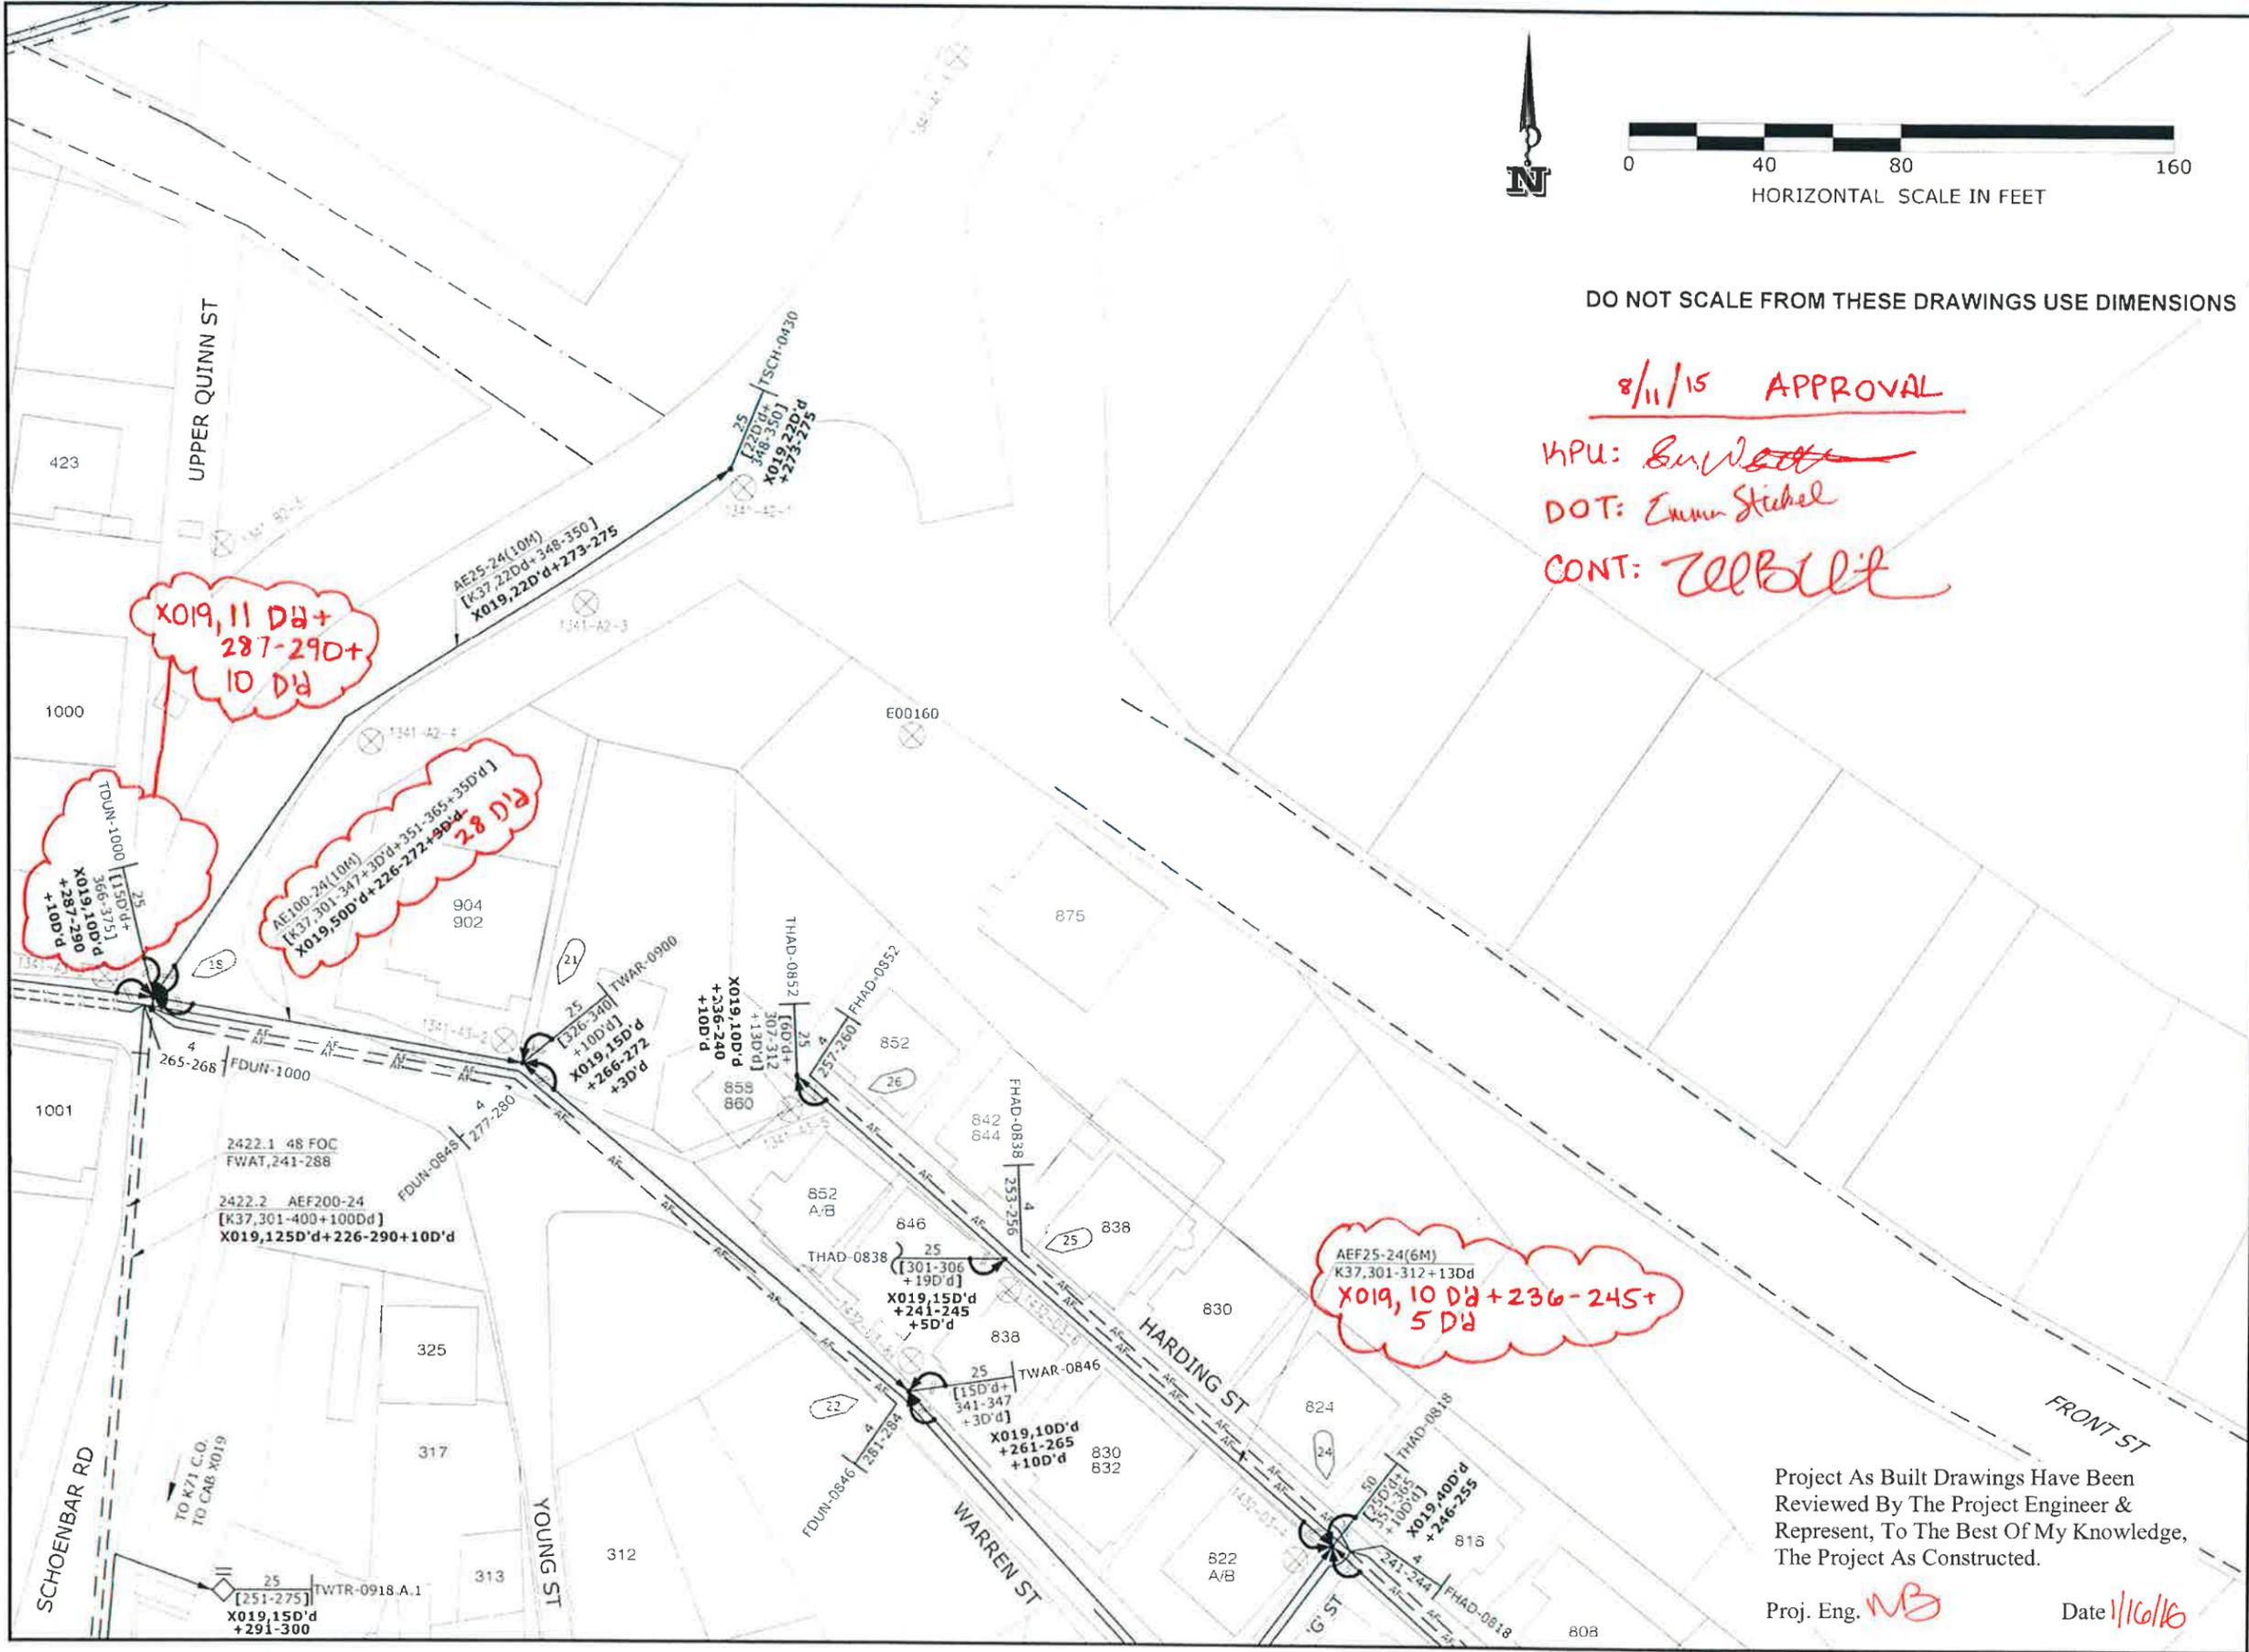


DO NOT SCALE FROM THESE DRAWINGS USE DIMENSIONS

8/11/15 APPROVAL
 KPU: *[Signature]*
 DOT: Emma Stichel
 CONT: Zellbit

AEF25-24(6M)
 K37.301-312+13Dd
 X019, 10 Dd + 236-245 +
 5 Dd

Project As Built Drawings Have Been
 Reviewed By The Project Engineer &
 Represent, To The Best Of My Knowledge,
 The Project As Constructed.

Proj. Eng. *[Signature]* Date 11/6/16

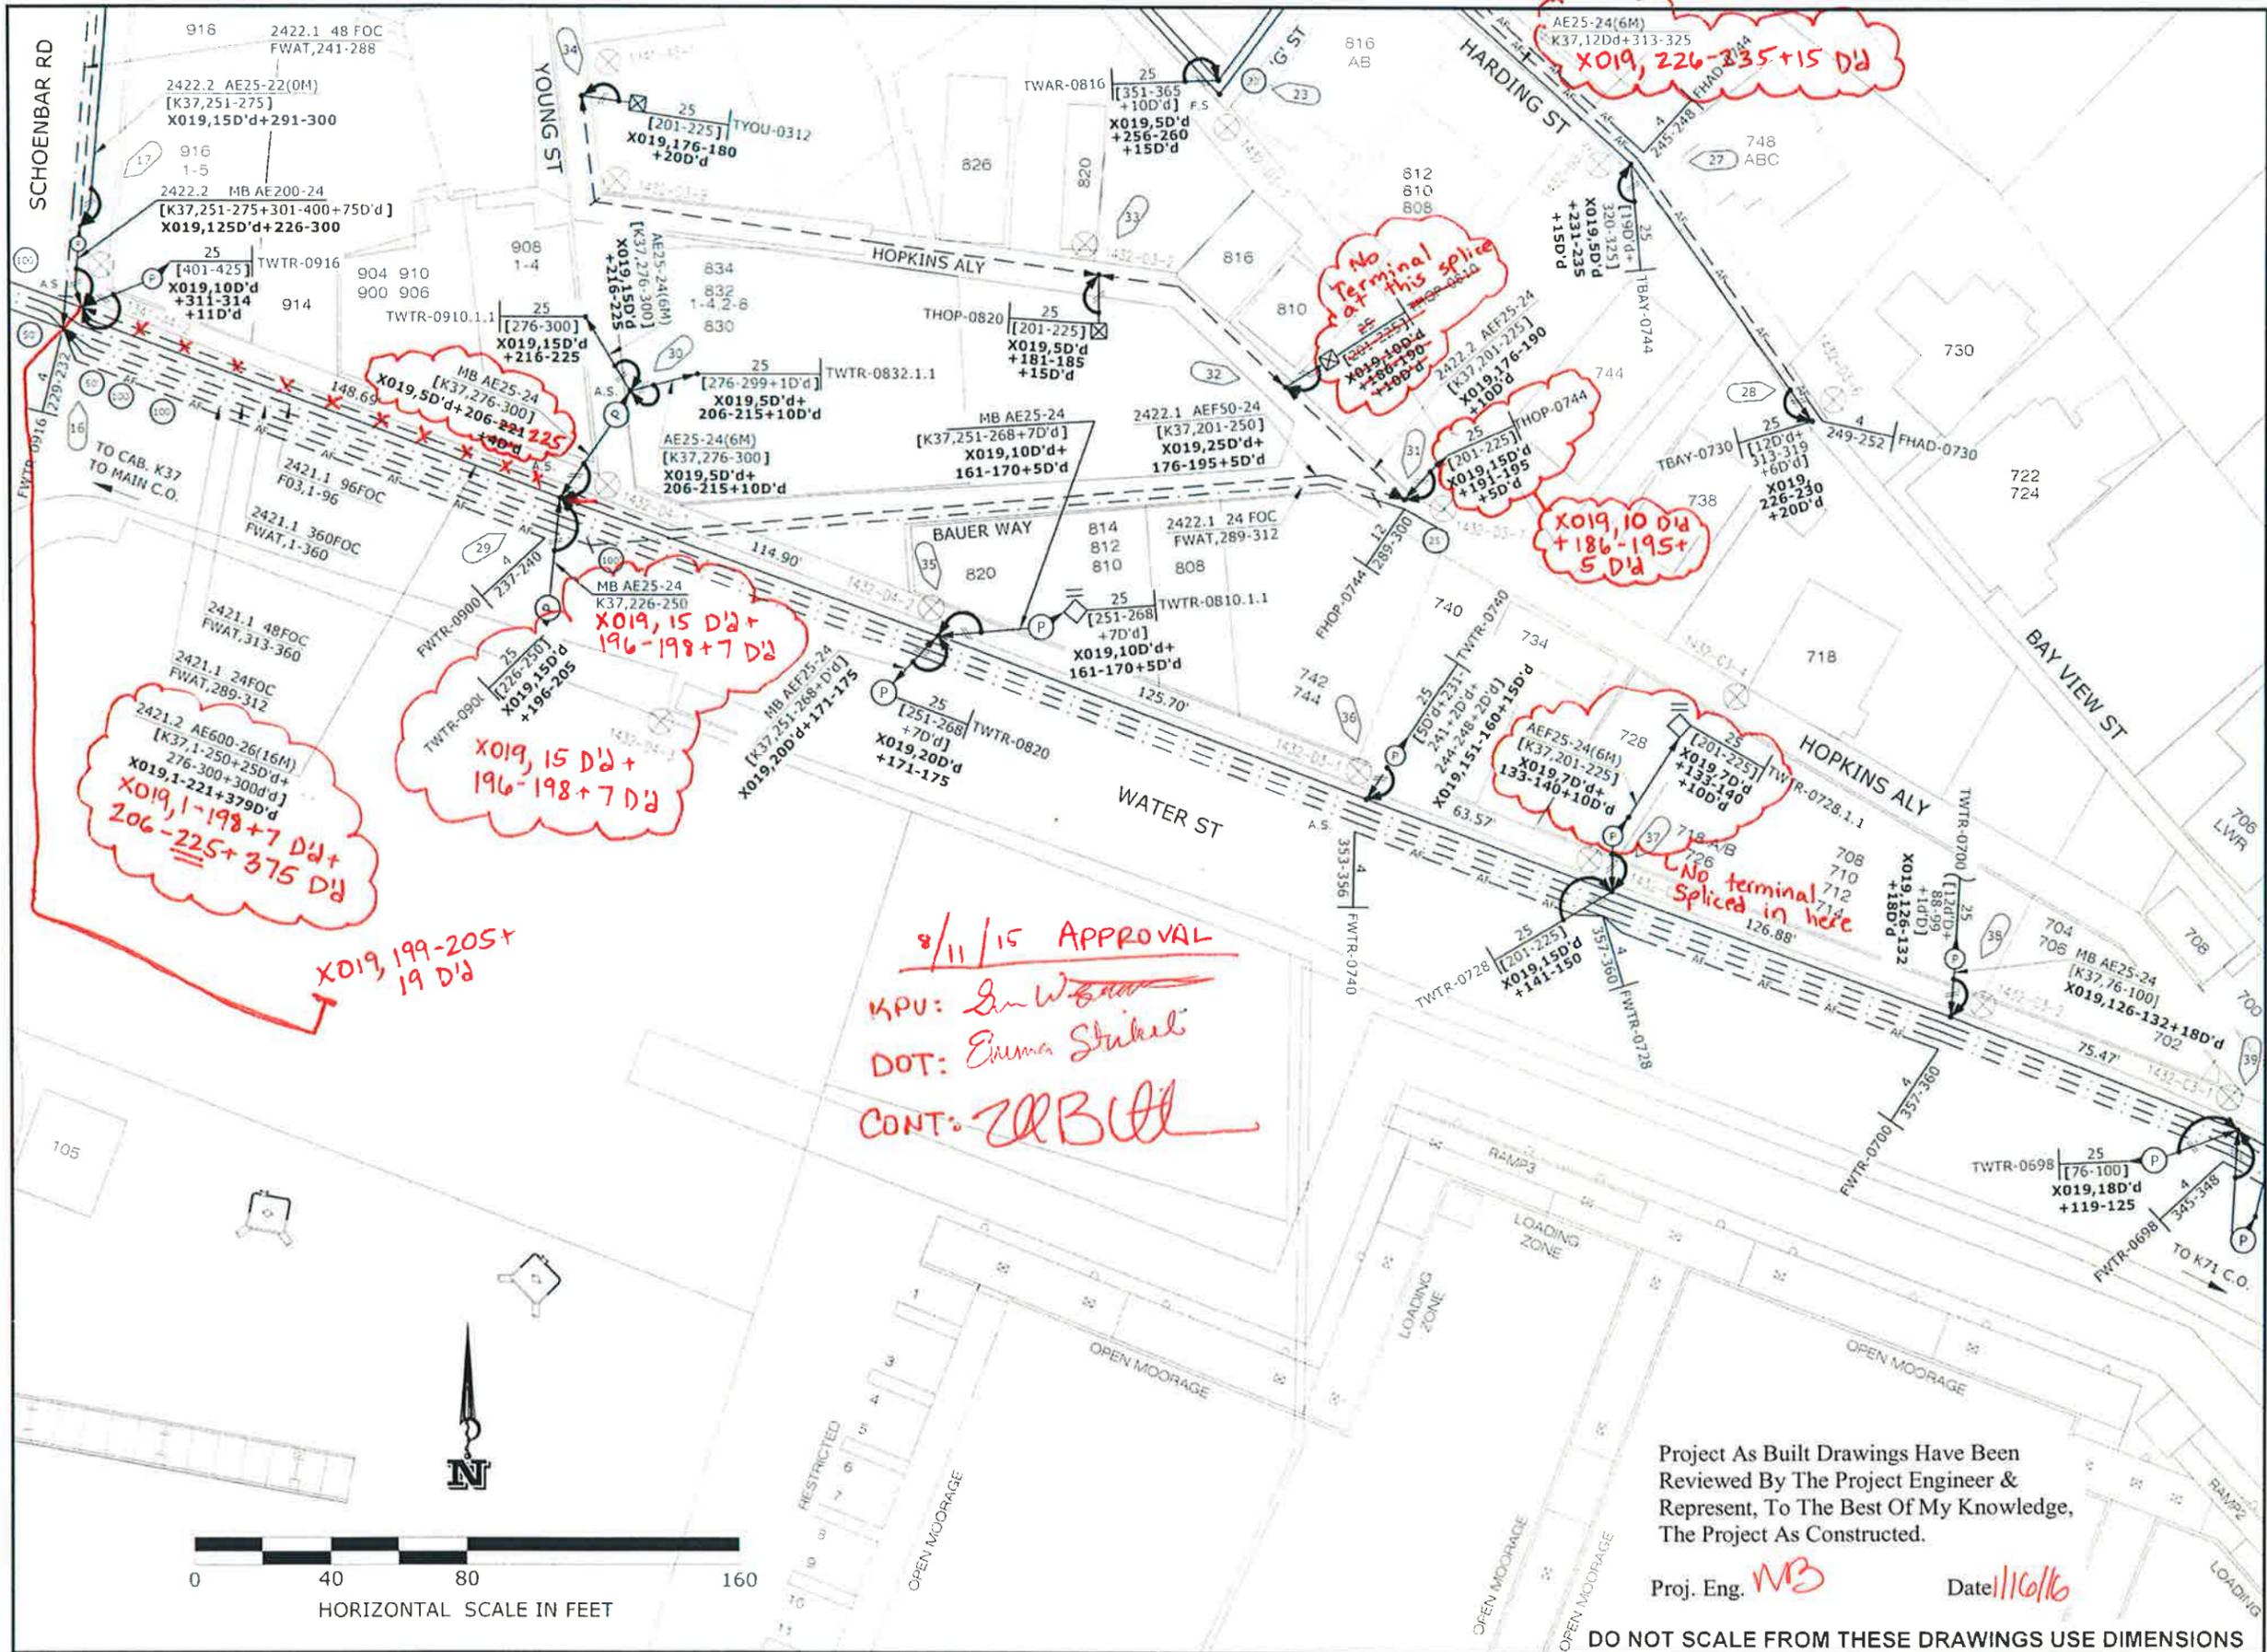

8/11/15 APPROVAL
 KPU: *[Signature]*
 DOT: *[Signature]*
 CONT: *[Signature]*

Project As Built Drawings Have Been Reviewed By The Project Engineer & Represent, To The Best Of My Knowledge, The Project As Constructed.

Proj. Eng. *MB* Date *11/6/16*

DO NOT SCALE FROM THESE DRAWINGS USE DIMENSIONS

PATH: CAUSERS\KCN12_000\DOCUMENTS\0-KNEE\013
 DESIGN: DWG\KPU-TSE 140827.DOT
 RELOCATION\KPU-TSE 140827.DOT
 KETCHIKAN ADVANCE WATER STREET TRUNK LINE RELOCATION PROJECT # 69548
 DATE: 11/16/16 11:46 AM

ADDENDUM NUMBER: _____
 ATTACHMENT NUMBER: _____

RECORD OF REVISIONS

NO	DATE	DESCRIPTION

--- PROP. AERIAL FOC
 --- PROP. FOC LONG TAIL TERM.
 --- PROP. AERIAL COPPER CA.
 --- EXISTING AERIAL FOC
 --- EX. FOC LONG TAIL TERM.
 --- EX. AERIAL COPPER CA.
 -X-X- EX. AER. FOC TO BE REMOVED
 -X-X- EX. FOC LONG TAIL TO BE REMOVED
 -X-X- EX. COPPER CABLE TO BE REMOVED
 ⊗ PROPOSED POLE
 ⊗ EXISTING POLE
 ⊗ PROP. DOUBLE X-ARM ON PROP. POLE
 ⊗ EX. POLE & EX. DOUBLE X-ARM TO BE REMOVED
 ⊗ EX. POLE & EX. SINGLE X-ARM OR ALLEY-ARM TO BE REMOVED
 ⊗ EX. DOUBLE X-ARM ON EX. POLE
 ⊗ EX. SINGLE X-ARM OR ALLEY-ARM ON EX. POLE
 ⊗ EX. GUY & ANCHOR TO BE REMOVED
 ⊗ PROP. GUY & ANCHOR WITH PROP. LEAD
 ⊗ EXISTING FIBER SLACK LOOP
 ⊗ PROP. FIBER SLACK LOOP
 ⊗ EX. AER. FIBER TERMINAL
 ⊗ EX. AER. COPPER TERMINAL
 ⊗ EX. FOC SPLICE POINT
 ⊗ PROP. SPLICE ON EX. FIBER SPLICE POINT

PLAN LEGEND


CHECKED BY: KCN

DESIGNED BY: R MOJE
 DRAWN BY: R MOJE

STATE OF ALASKA
 DEPARTMENT OF TRANSPORTATION & PUBLIC FACILITIES
 SOUTHEAST REGION
 KETCHIKAN ADVANCE WATER STREET TRUNK LINE RELOCATION PROJECT # 69548
TELEPHONE CABLE LAYOUT
 PROJECT DESIGNATION
BR-000S(735) ~ 69548

STATE	YEAR
ALASKA	2014

SHEET NUMBER	TOTAL SHEETS
V12	78

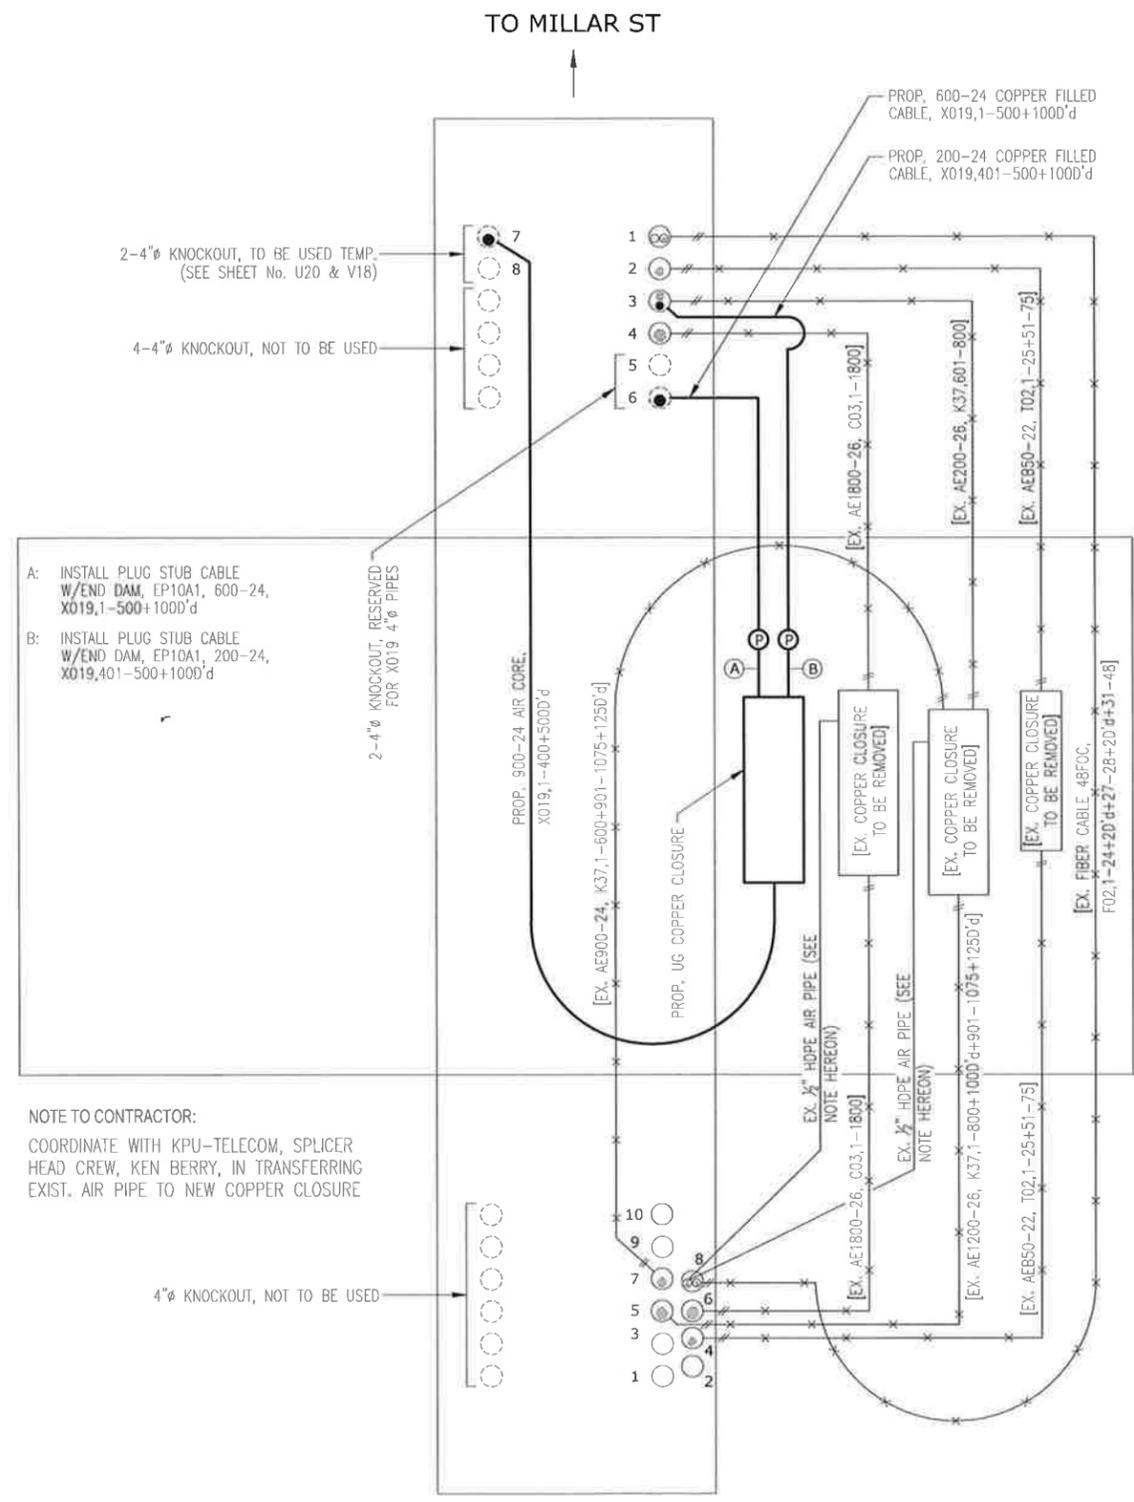


A: INSTALL PLUG STUB CABLE
 W/END DAM, EP10A1, 600-24,
 X019,1-500+1000'd
 B: INSTALL PLUG STUB CABLE
 W/END DAM, EP10A1, 200-24,
 X019,401-500+1000'd

NOTE TO CONTRACTOR:
 COORDINATE WITH KPU-TELECOM, SPLICER
 HEAD CREW, KEN BERRY, IN TRANSFERRING
 EXIST. AIR PIPE TO NEW COPPER CLOSURE

EXISTING VACANT CONDUITS AT SOUTH END
 (TO RISER/TO MAIN C.O.)

- 1 ○ NO CONDUIT PLUG
- 2 ○ NO CONDUIT PLUG
- 3 ○ NO CONDUIT PLUG
- 9 ○ WITH CONDUIT PLUG
- 10 ○ WITH CONDUIT PLUG

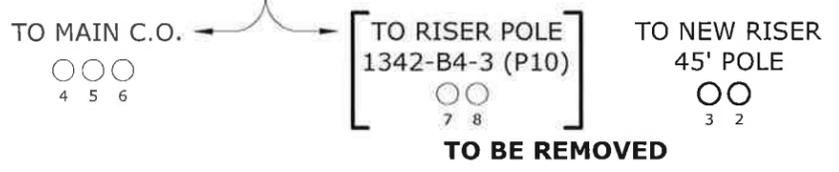

MANHOLE-18 FOLDOUT
 NOT TO SCALE

Project As Built Drawings Have Been
 Reviewed By The Project Engineer &
 Represent, To The Best Of My Knowledge,
 The Project As Constructed.

Proj. Eng. *MB* Date *11/10/10*

DO NOT SCALE FROM THESE DRAWINGS USE DIMENSIONS

ADDENDUM NUMBER

ATTACHMENT NUMBER

RECORD OF REVISIONS

No	DATE	DESCRIPTION

PLAN LEGEND

- PROP. AERIAL FOC
- PROP. FOC LONG TAIL TERM.
- PROP. AERIAL COPPER CA.
- EXISTING AERIAL FOC
- EX. FOC LONG TAIL TERM.
- EX. AERIAL COPPER CA.
- EX. AER. FOC TO BE REMOVED
- EX. FOC LONG TAIL TO BE REMOVED
- EX. COPPER CABLE TO BE REMOVED
- ⊗ PROPOSED POLE
- ⊗ EXISTING POLE
- ⊗ PROP. DOUBLE X-ARM ON PROP. POLE
- ⊗ EX. POLE & EX. DOUBLE X-ARM TO BE REMOVED
- ⊗ EX. POLE & EX. SINGLE X-ARM OR ALLEY-ARM TO BE REMOVED
- ⊗ EX. DOUBLE X-ARM ON EX. POLE
- ⊗ EX. SINGLE X-ARM OR ALLEY-ARM ON EX. POLE
- ⊗ EX. GUY & ANCHOR TO BE REMOVED
- ⊗ PROP. GUY & ANCHOR with PROP. LEAD
- ⊗ EXISTING FIBER SLACK LOOP
- ⊗ PROP. FIBER SLACK LOOP
- ⊗ EX. AER. FIBER TERMINAL
- ⊗ EX. AER. COPPER TERMINAL
- EX. FOC SPLICE POINT
- PROP. SPLICE ON EX. FIBER SPLICE POINT

CHECKED BY: KCN



DESIGNED BY: R. MOJE

DRAWN BY: R. MOJE

STATE OF ALASKA
 DEPARTMENT OF TRANSPORTATION
 & PUBLIC FACILITIES
 SOUTHEAST REGION


KETCHIKAN ADVANCE
 WATER STREET TRUNK LINE
 RELOCATION
 PROJECT # 69548

**TELEPHONE
 CABLE LAYOUT**


PROJECT DESIGNATION

BR-000S(735) ~ 69548

STATE	YEAR
ALASKA	2014
SHEET NUMBER	TOTAL SHEETS
V19	78

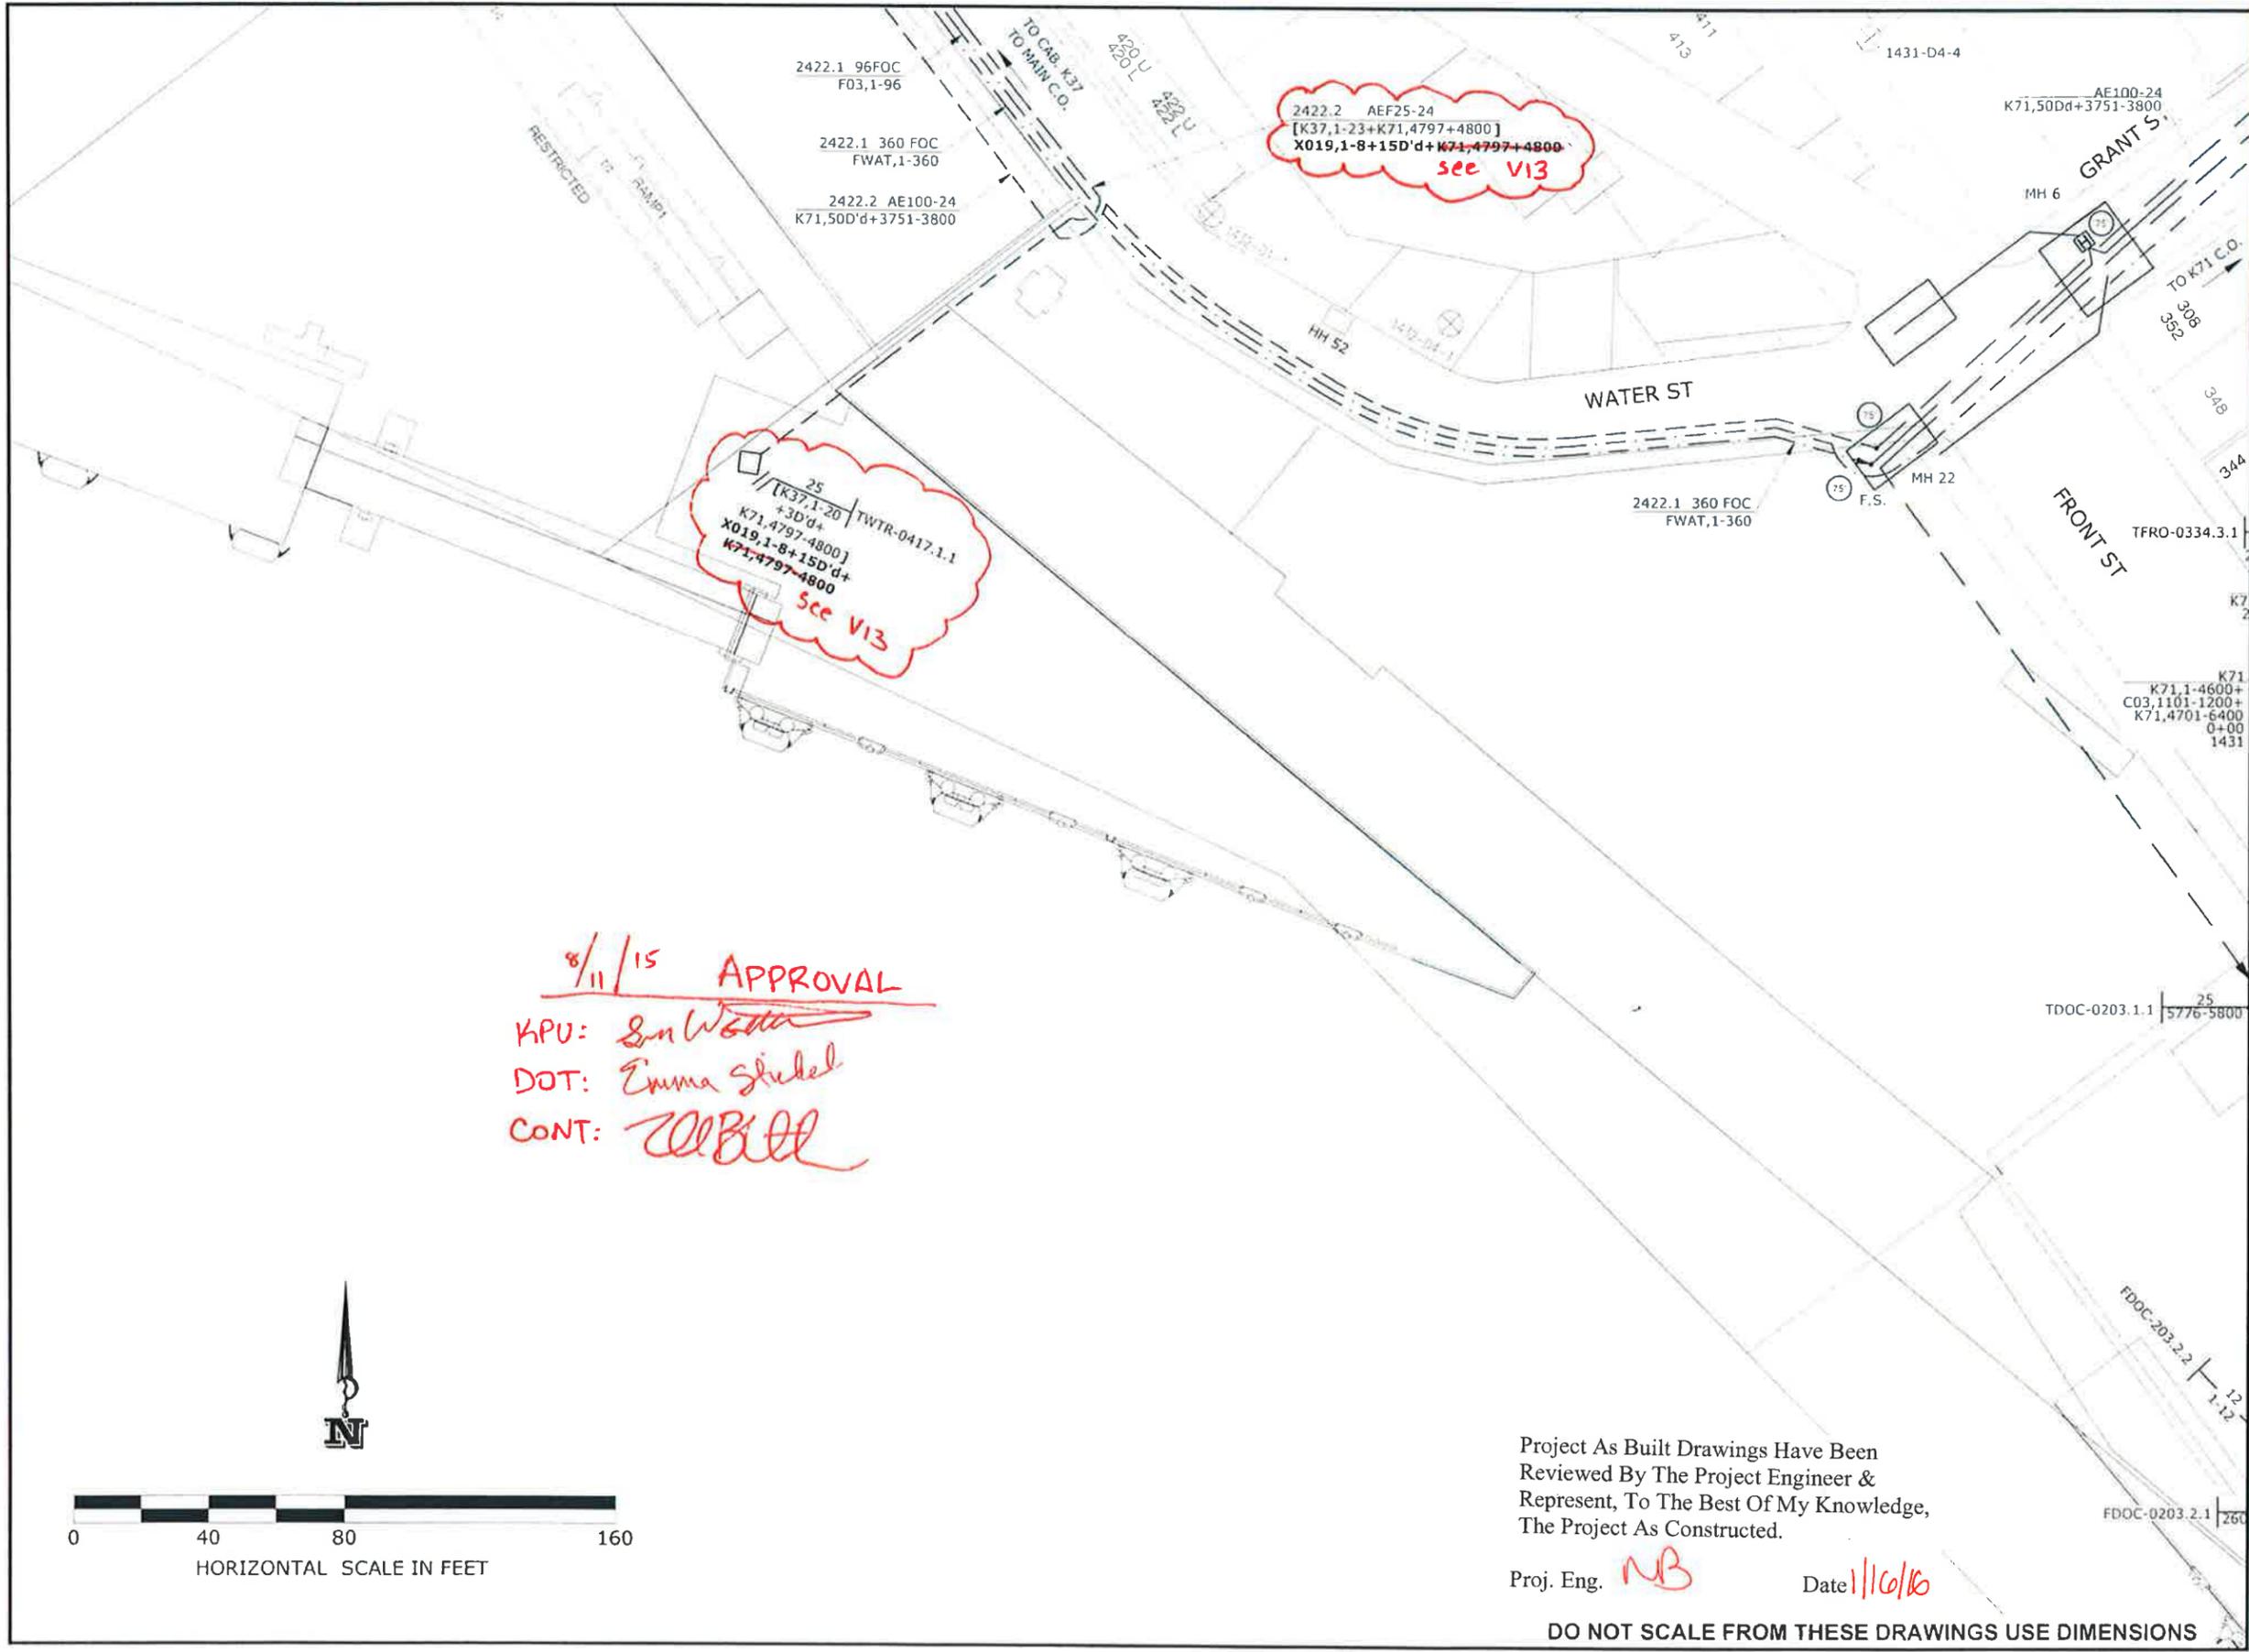

8/11/15 APPROVAL
 KPU: *[Signature]*
 DOT: *[Signature]*
 CONT: *[Signature]*

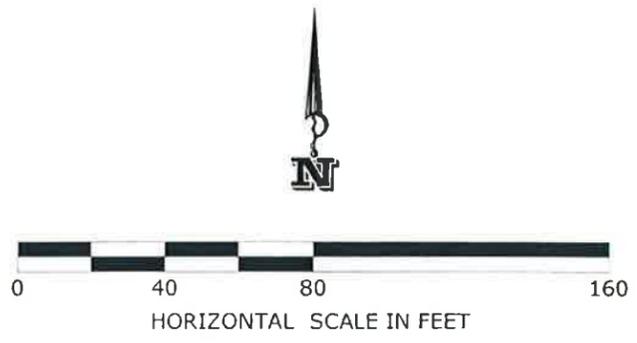

Project As Built Drawings Have Been Reviewed By The Project Engineer & Represent, To The Best Of My Knowledge, The Project As Constructed.

Proj. Eng. *NB* Date *11/6/16*

DO NOT SCALE FROM THESE DRAWINGS USE DIMENSIONS

PATH: C:\USERS\KCN12_000\DOCUMENTS\10-KNEE 2013
 DESIGN: 13D\WG10-NTP9 TRUNK
 RELOCATION\KPU-T PSE 140827.DOT
 KETCHIKAN FILE FOR WSB\DWG FILE FOR
 REPLACEMENT OF VDSL CABINETS FOR
 VDSL PROJECT # 69548
 DATE: 11/06/16 05:05 PM

ADDENDUM NUMBER

ATTACHMENT NUMBER

RECORD OF REVISIONS

No.	DATE	DESCRIPTION

--- PROP. AERIAL FOC
 --- PROP. FOC LONG TAIL TERM.
 --- PROP. AERIAL COPPER CA.
 --- EXISTING AERIAL FOC
 --- EX. FOC LONG TAIL TERM.
 --- EX. AERIAL COPPER CA.
 -X-X- EX. AER. FOC TO BE REMOVED
 -X-X- EX. FOC LONG TAIL TO BE REMOVED
 -X-X- EX. COPPER CABLE TO BE REMOVED
 ⊗ PROPOSED POLE
 ⊗ EXISTING POLE
 ⊗ PROP. DOUBLE X-ARM ON PROP. POLE
 ⊗ EX. POLE & EX. DOUBLE X-ARM TO BE REMOVED
 ⊗ EX. POLE & EX. SINGLE X-ARM OR ALLEY-ARM TO BE REMOVED
 ⊗ EX. DOUBLE X-ARM ON EX. POLE
 ⊗ EX. SINGLE X-ARM OR ALLEY-ARM ON EX. POLE
 ⊗ EX. GUY & ANCHOR TO BE REMOVED
 ⊗ PROP. GUY & ANCHOR with PROP. LEAD
 ⊗ EXISTING FIBER SLACK LOOP
 ⊗ PROP. FIBER SLACK LOOP
 ⊗ EX. AER. FIBER TERMINAL
 ⊗ EX. AER. COPPER TERMINAL
 --- EX. FOC SPLICE POINT
 --- PROP. SPLICE ON EX. FIBER SPLICE POINT

PLAN LEGEND

CHECKED BY: KCN

DESIGNED BY: R MOJE
 DRAWN BY: R MOJE

STATE OF ALASKA
 DEPARTMENT OF TRANSPORTATION & PUBLIC FACILITIES
 SOUTHEAST REGION

**KETCHIKAN ADVANCE
 WATER STREET TRUNK LINE
 RELOCATION
 PROJECT # 69548**

**TELEPHONE
 CABLE LAYOUT**

PROJECT DESIGNATION
BR-000S(735) ~ 69548

STATE	YEAR
ALASKA	2014

SHEET NUMBER	TOTAL SHEETS
V14	78

PATH: C:\USERS\KCN12_000\DOCUMENTS\10-KNEE_013
 DESIGN\13\DWG\10-NTP\ TRUNK
 RELOCATION\KPU-T PSE 140827.DOT
 CERTIFYING FILE FOR VSD\DWG FILE FOR
 VSD\PLACEMENT OF VDSL CABINETS FOR
 TAB: VSD\10\PROV\140827\140827.DOT 10:16 PM

ADDENDUM NUMBER

ATTACHMENT NUMBER

RECORD OF REVISIONS

No.	DATE	DESCRIPTION

--- PROP. AERIAL FOC
 - - - PROP. FOC LONG TAIL TERM.
 --- PROP. AERIAL COPPER CA
 - - - EXISTING AERIAL FOC
 - - - EX. FOC LONG TAIL TERM.
 --- EX. AERIAL COPPER CA
 * - * - * EX. AER. FOC TO BE REMOVED
 * - * - * EX. FOC LONG TAIL TO BE REMOVED
 * - * - * EX. COPPER CABLE TO BE REMOVED
 ⊗ PROPOSED POLE
 ⊗ EXISTING POLE
 PROP. DOUBLE X-ARM ON PROP. POLE
 EX. POLE & EX. DOUBLE X-ARM TO BE REMOVED
 EX. POLE & EX. SINGLE X-ARM OR ALLEY-ARM TO BE REMOVED
 EX. DOUBLE X-ARM ON EX. POLE
 EX. SINGLE X-ARM OR ALLEY-ARM ON EX. POLE
 EX. GUY & ANCHOR TO BE REMOVED
 PROP. GUY & ANCHOR WITH PROP. LEAD
 EXISTING FIBER SLACK LOOP
 PROP. FIBER SLACK LOOP
 EX. AER. FIBER TERMINAL
 EX. AER. COPPER TERMINAL
 EX. FOC SPLICE POINT
 PROP. SPLICE ON EX. FIBER SPLICE POINT

PLAN LEGEND

CHECKED BY: KCN

DESIGNED BY: R MOJE

DRAWN BY: R MOJE

STATE OF ALASKA
DEPARTMENT OF TRANSPORTATION
& PUBLIC FACILITIES
SOUTHEAST REGION


**KETCHIKAN ADVANCE
WATER STREET TRUNK LINE
RELOCATION
PROJECT # 69548**


**TELEPHONE
CABLE LAYOUT**

PROJECT DESIGNATION
BR-000S(735) ~ 69548

STATE	YEAR
ALASKA	2014

SHEET NUMBER	TOTAL SHEETS
V15	78

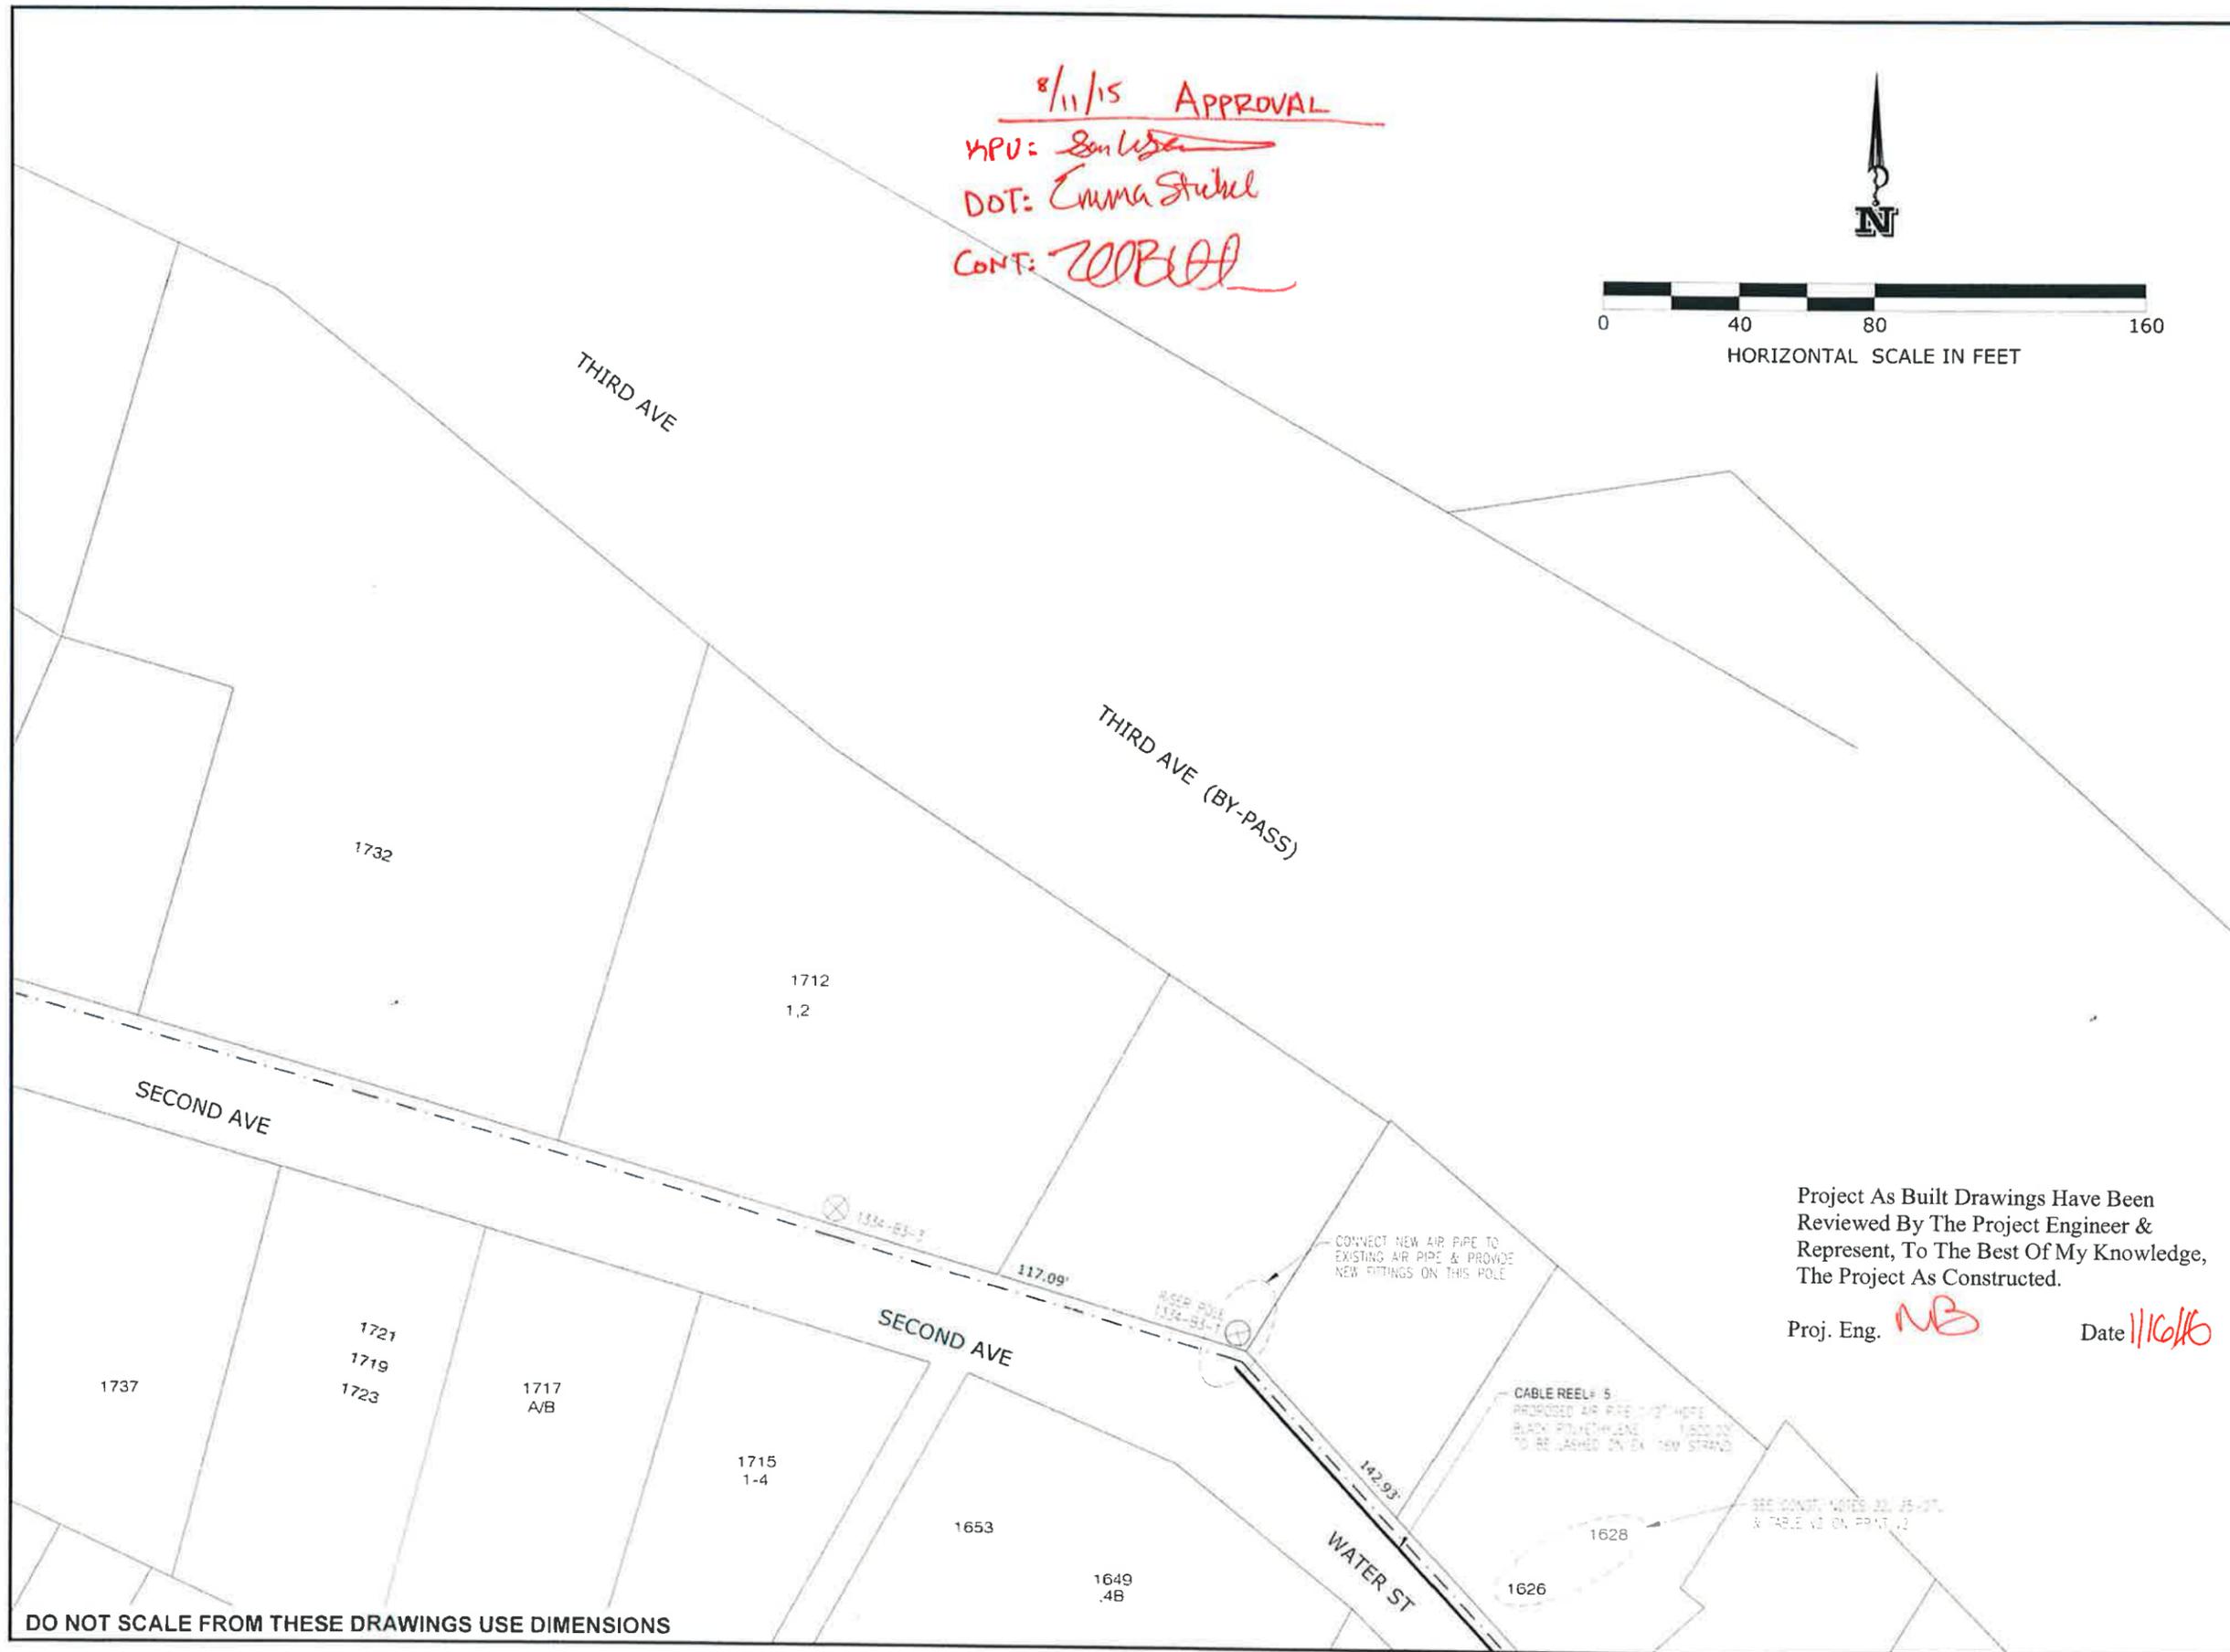

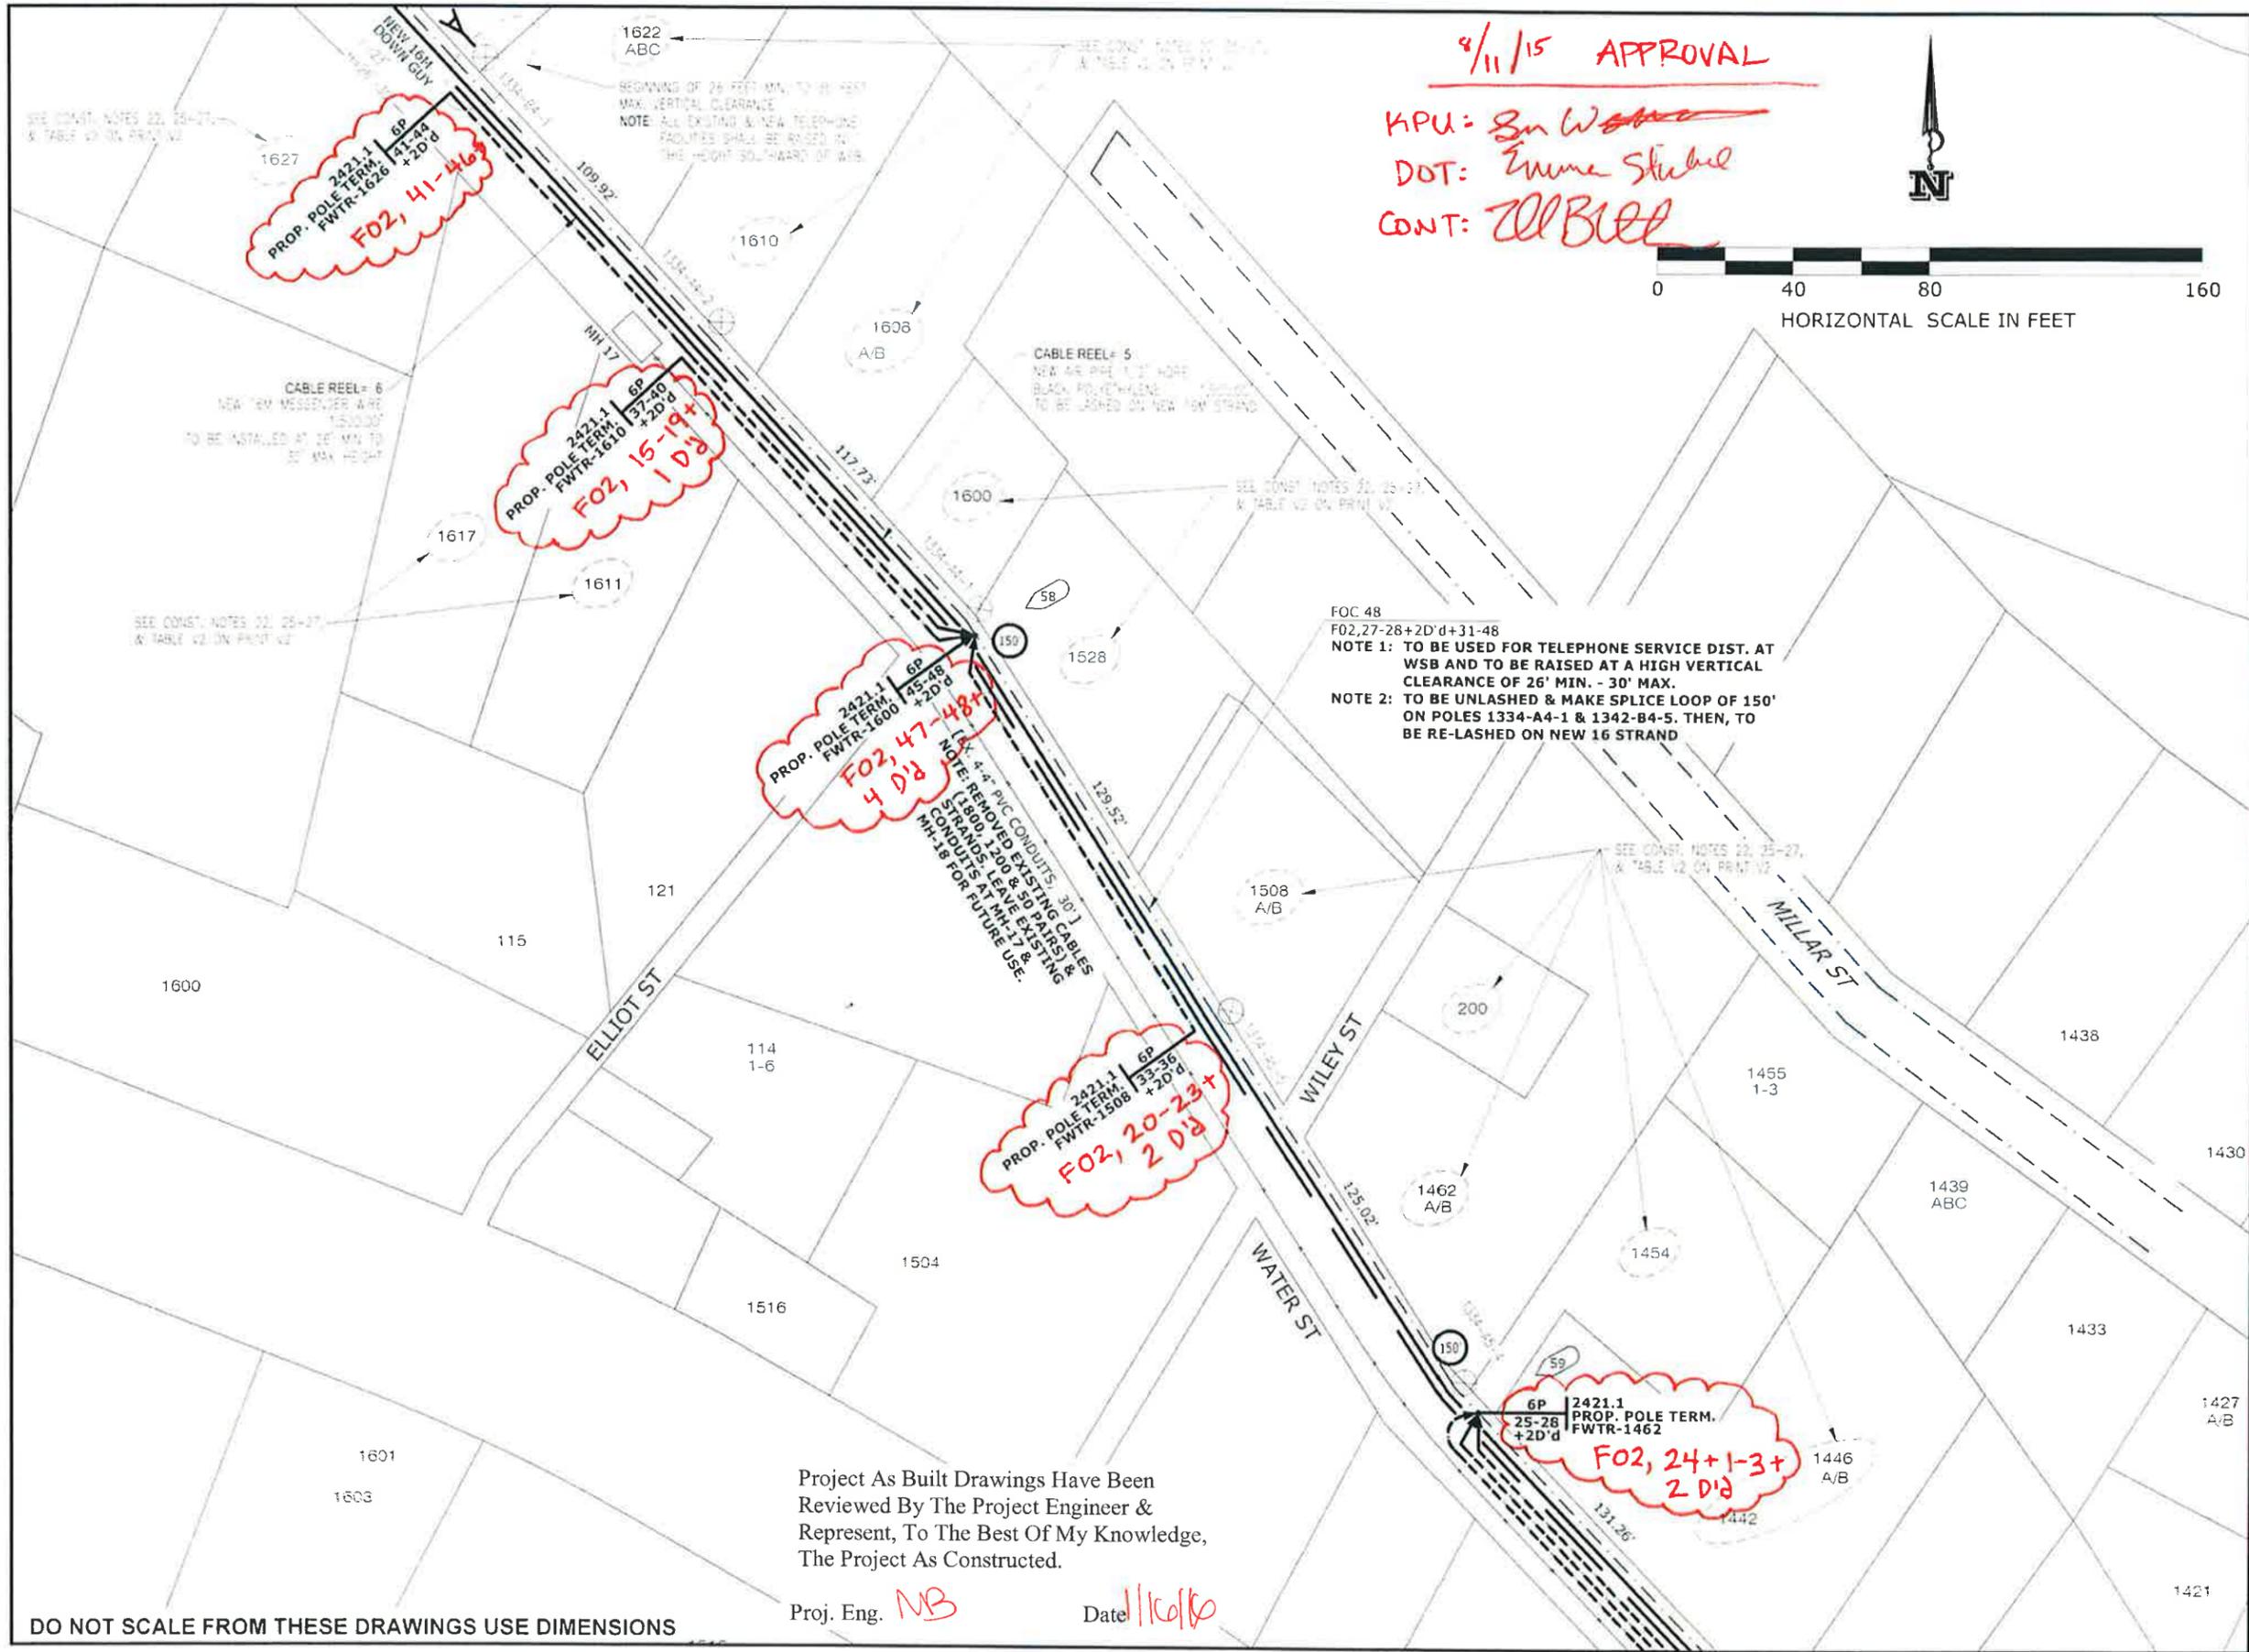

Project As Built Drawings Have Been Reviewed By The Project Engineer & Represent, To The Best Of My Knowledge, The Project As Constructed.
 Proj. Eng. *NB* Date *11/16/16*

PATH: CAUSERS\KCN12_000\DOCUMENTS\0-KNEE 2013
 DESIGN\130-NTP3 ADV RELOC PSE DOT
 CERT 140828\DOC-DWG-XLS
 PROJECT DWG FILE FOR VSB DWG FILE
 FOR REPLACEMENT OF VDSL CABINETS
 FOR DOT USE PROJ 774048.F016

ADDENDUM NUMBER

ATTACHMENT NUMBER

RECORD OF REVISIONS

No	DATE	DESCRIPTION

--- PROP. AERIAL FOC
 --- PROP. FOC LONG TAIL TERM.
 --- PROP. AERIAL COPPER CA
 --- EXISTING AERIAL FOC
 --- EX. FOC LONG TAIL TERM.
 --- EX. AERIAL COPPER CA
 * * * EX. AER. FOC TO BE REMOVED
 * * * EX. FOC LONG TAIL TO BE REMOVED
 * * * EX. COPPER CABLE TO BE REMOVED
 ⊗ PROPOSED POLE
 ⊗ EXISTING POLE
 ⊗ PROP. DOUBLE X-ARM ON PROP. POLE
 ⊗ EX. POLE & EX. DOUBLE X-ARM TO BE REMOVED
 ⊗ EX. POLE & EX. SINGLE X-ARM OR ALLEY-ARM TO BE REMOVED
 ⊗ EX. DOUBLE X-ARM ON EX. POLE
 ⊗ EX. SINGLE X-ARM OR ALLEY-ARM ON EX. POLE
 ⊗ EX. GUY & ANCHOR TO BE REMOVED
 ⊗ PROP. GUY & ANCHOR with PROP. LEAD
 ⊗ EXISTING FIBER SLACK LOOP
 ⊗ PROP. FIBER SLACK LOOP
 ⊗ EX. AER. FIBER TERMINAL
 ⊗ EX. AER. COPPER TERMINAL
 ⊗ EX. FOC SPLICE POINT
 ⊗ PROP. SPLICE ON EX. FIBER SPLICE POINT

PLAN LEGEND

CHECKED BY

DESIGNED BY R. MOJE
 DRAWN BY R. MOJE

STATE OF ALASKA
 DEPARTMENT OF TRANSPORTATION & PUBLIC FACILITIES
 SOUTHEAST REGION

KETCHIKAN ADVANCE
 WATER STREET TRUNK LINE
 RELOCATION
 PROJECT # 69548

**TELEPHONE
 CABLE LAYOUT**

PROJECT DESIGNATION
 BR-000S(735) ~ 69548





STATE	YEAR
ALASKA	2014

SHEET NUMBER	TOTAL SHEETS
V16	78

8/11/15 APPROVAL
 KPU: *En Wytka*
 DOT: *Zume Stehe*
 CONT: *700 B/C*

NOTE ON THE VDSL LOCATION AREA:
 THE GROUND IS ROCK AND ITS HEIGHT IS APPROX. 3.5' HIGH FROM BRIDGE LEVEL.

NOTE TO CONTRACTOR:
 1. ALL CONDUITS SHOWN IN THIS DETAIL WILL BE INSTALLED PER ELECTRICAL PLAN SHEET No. U20.

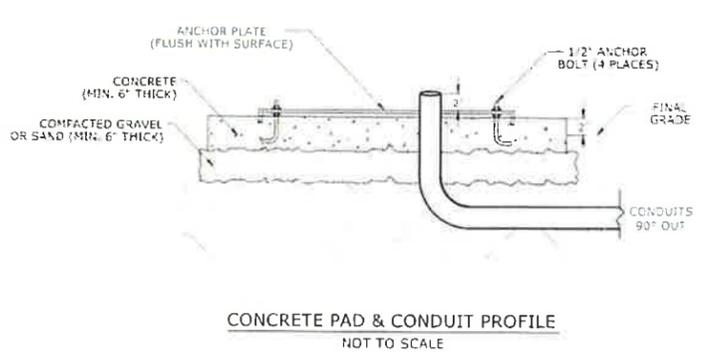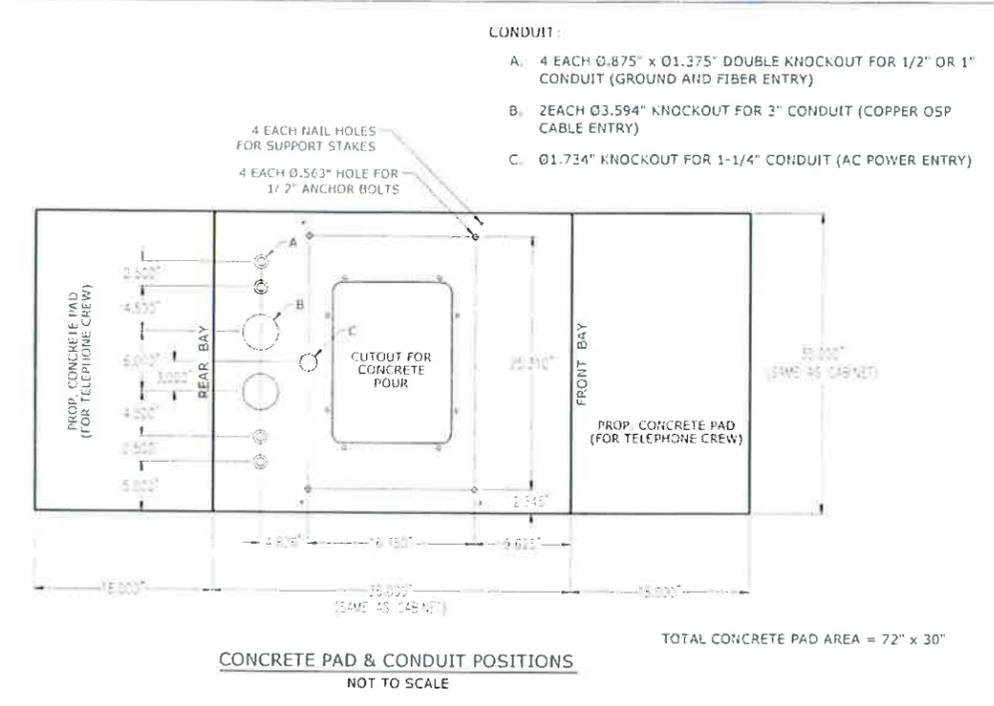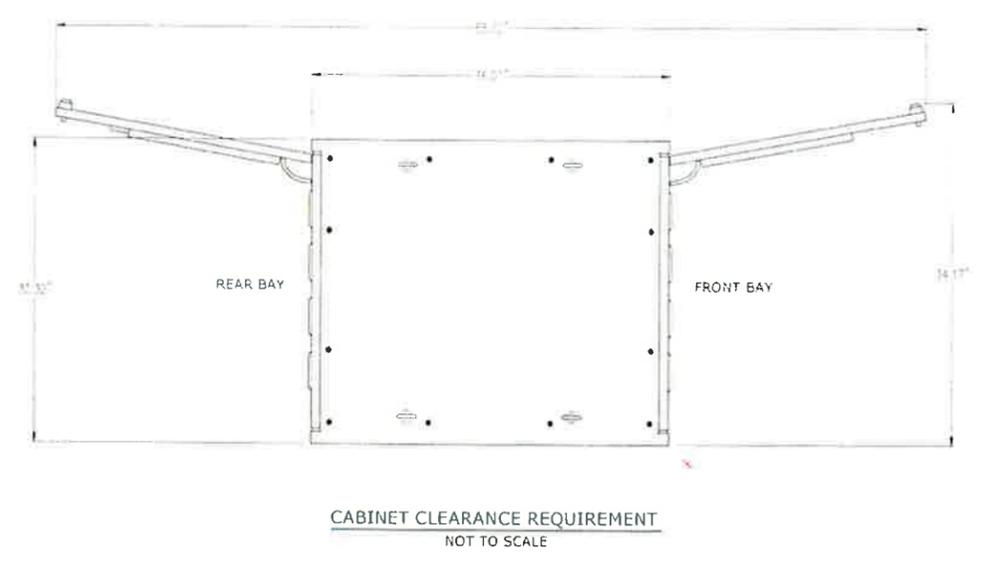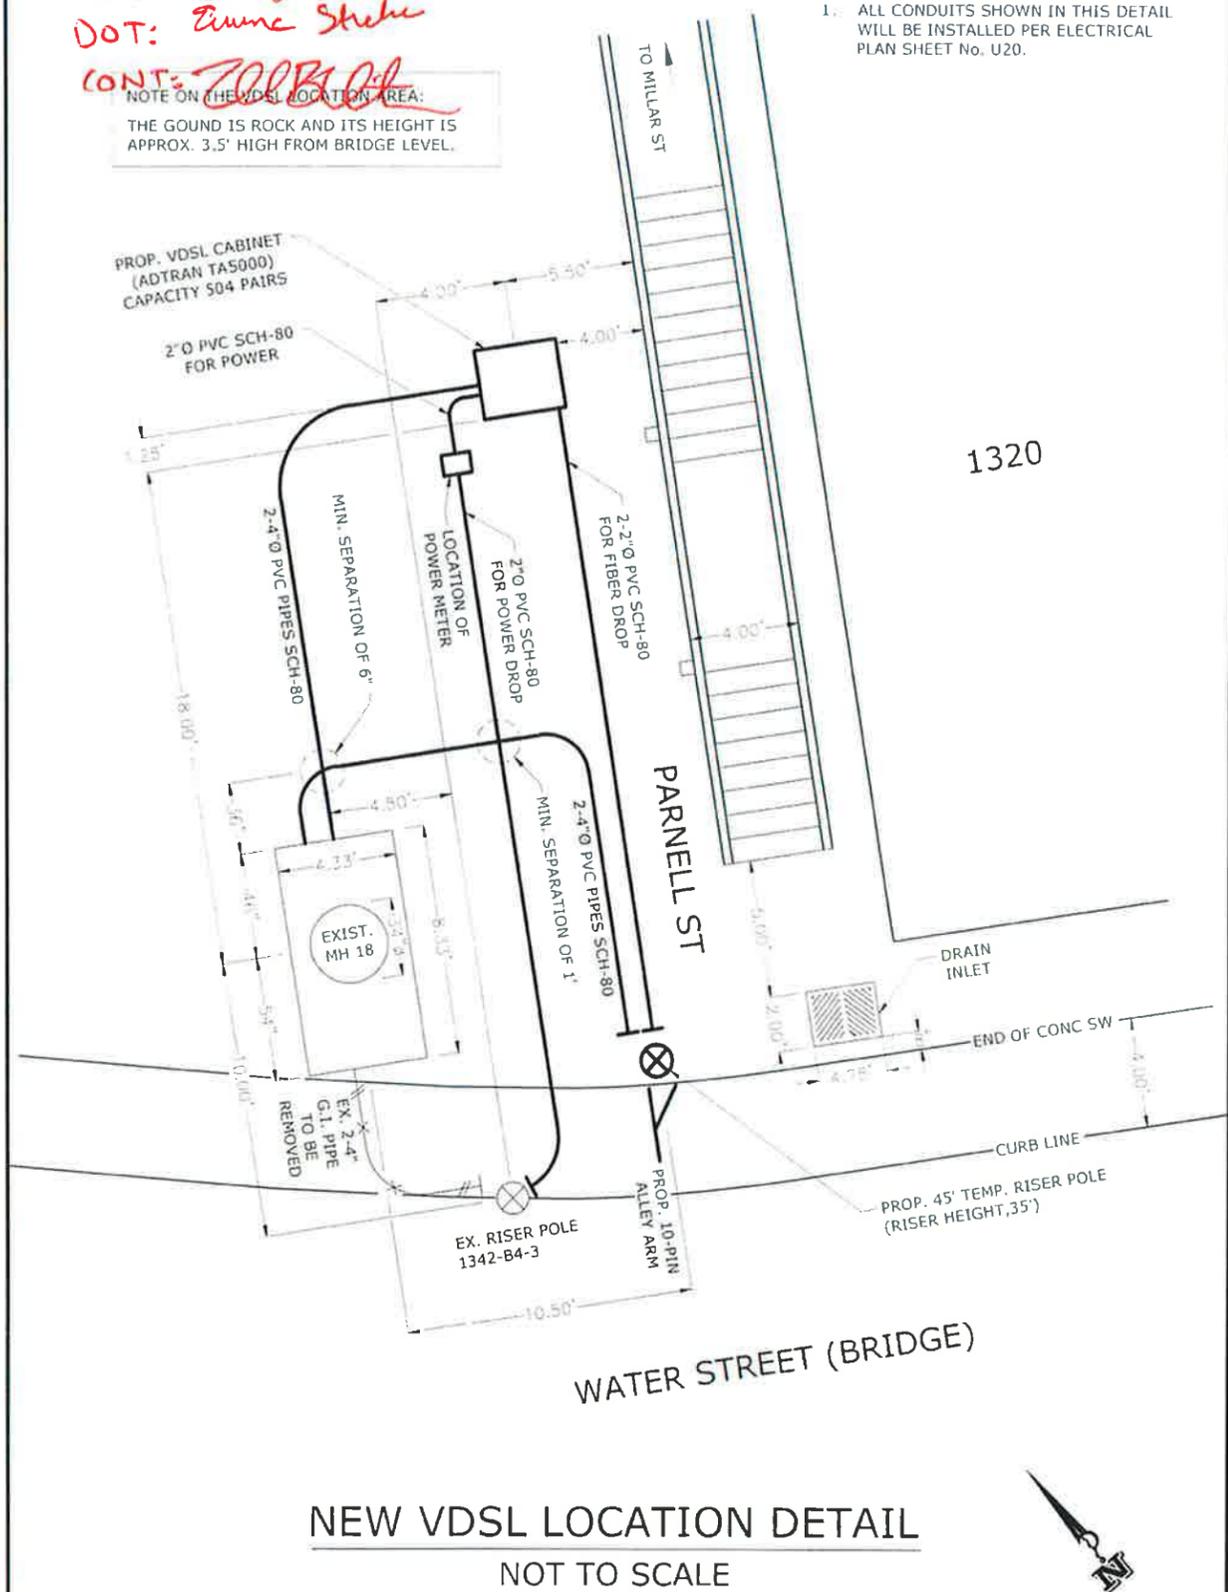

- CONDUIT:
- A. 4 EACH Ø.875" x Ø1.375" DOUBLE KNOCKOUT FOR 1/2" OR 1" CONDUIT (GROUND AND FIBER ENTRY)
 - B. 2 EACH Ø3.594" KNOCKOUT FOR 3" CONDUIT (COPPER OSP CABLE ENTRY)
 - C. Ø1.734" KNOCKOUT FOR 1-1/4" CONDUIT (AC POWER ENTRY)

PATH C:\USERS\KCN12_000\DOCUMENTS\10-KNEE_2013
 DESIGN\10DWG10-NTP3 TRUNK
 RELOCATION\KPU-T PSE 140827 DOT
 CERTIFIED FILE FOR WSDWG FILE FOR
 WSDWG FILE FOR VDSL CABINETS FOR
 VDSL PROJECT # 69548
 8/27/14 10:46 PM

ADDENDUM NUMBER

ATTACHMENT NUMBER

RECORD OF REVISIONS

No	DATE	DESCRIPTION

- PROP. AERIAL FOC
- PROP. FOC LONG TAIL TERM.
- PROP. AERIAL COPPER CA
- EXISTING AERIAL FOC
- EX. FOC LONG TAIL TERM.
- EX. AERIAL COPPER CA
- *- EX. AER. FOC TO BE REMOVED
- *- EX. FOC LONG TAIL TO BE REMOVED
- *- EX. COPPER CABLE TO BE REMOVED
- ⊗ PROPOSED POLE
- ⊗ EXISTING POLE
- ⊗ PROP. DOUBLE X-ARM ON PROP. POLE
- ⊗ EX. POLE & EX. DOUBLE X-ARM TO BE REMOVED
- ⊗ EX. POLE & EX. SINGLE X-ARM OR ALLEY-ARM TO BE REMOVED
- ⊗ EX. DOUBLE X-ARM ON EX. POLE
- ⊗ EX. SINGLE X-ARM OR ALLEY-ARM ON EX. POLE
- ⊗ EX. GUY & ANCHOR TO BE REMOVED
- ⊗ PROP. GUY & ANCHOR WITH PROP. LEAD
- ⊗ EXISTING FIBER SLACK LOOP
- ⊗ PROP. FIBER SLACK LOOP
- ⊗ EX. AER. FIBER TERMINAL
- ⊗ EX. AER. COPPER TERMINAL
- ⊗ EX. FOC SPLICE POINT
- ⊗ PROP. SPLICE ON EX. FIBER SPLICE POINT

CHECKED BY: KCN

DESIGNED BY: R. MOJE

DRAWN BY: R. MOJE

STATE OF ALASKA
 DEPARTMENT OF TRANSPORTATION & PUBLIC FACILITIES
 SOUTHEAST REGION

KETCHIKAN ADVANCE
 WATER STREET TRUNK LINE
 RELOCATION
 PROJECT # 69548

TELEPHONE
 CABLE LAYOUT

PROJECT DESIGNATION:
 BR-000S(735) ~ 69548

STATE	YEAR
ALASKA	2014


SHEET NUMBER	TOTAL SHEETS
V18	78

DO NOT SCALE FROM THESE DRAWINGS USE DIMENSIONS

Project As Built Drawings Have Been Reviewed By The Project Engineer & Represent, To The Best Of My Knowledge, The Project As Constructed.

Proj. Eng. *MB* Date *11/16/15*

8/11/15 APPROVAL
 KPU: *[Signature]*
 DOT: *Emme Stichel*
 CONT: *[Signature]*

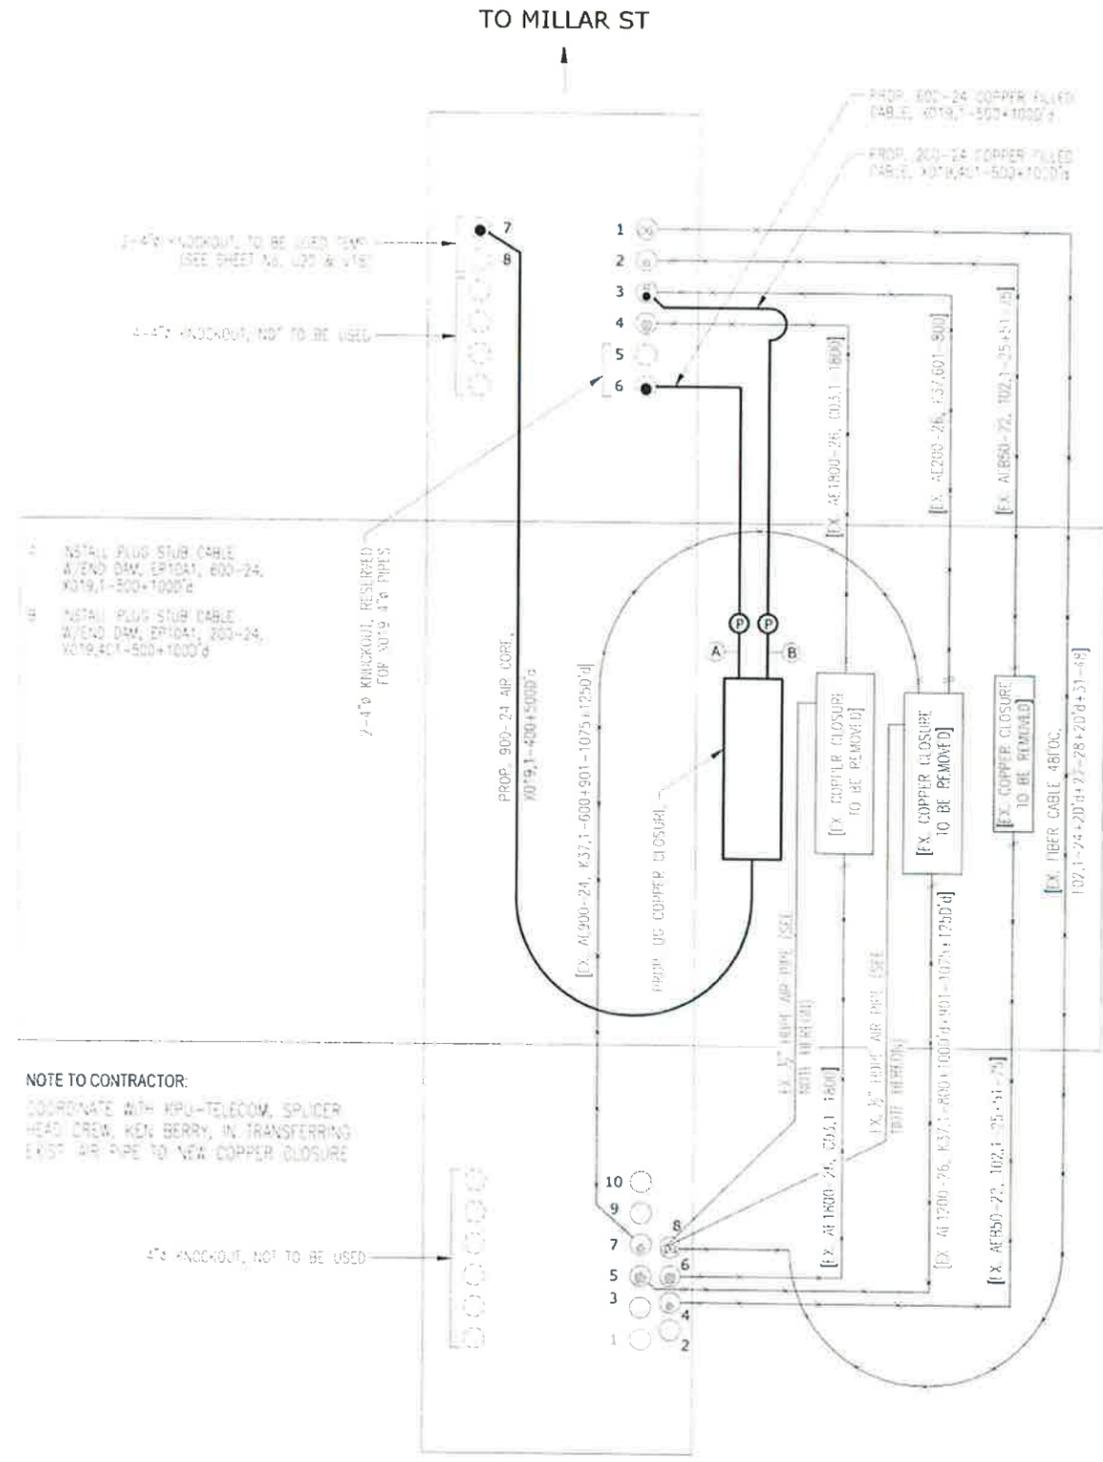

RECORD OF REVISIONS

No.	DATE	DESCRIPTION

- PLAN LEGEND**
- PROP. AERIAL FOC
 - PROP. FOC LONG TAIL TERM.
 - PROP. AERIAL COPPER CA.
 - EXISTING AERIAL FOC
 - EX. FOC LONG TAIL TERM.
 - EX. AERIAL COPPER CA.
 - EX. AER. FOC TO BE REMOVED
 - EX. FOC LONG TAIL TO BE REMOVED
 - EX. COPPER CABLE TO BE REMOVED
 - ⊗ PROPOSED POLE
 - ⊗ EXISTING POLE
 - ⊗ PROP. DOUBLE X-ARM ON PROP. POLE
 - ⊗ EX. POLE & EX. DOUBLE X-ARM TO BE REMOVED
 - ⊗ EX. POLE & EX. SINGLE X-ARM OR ALLEY-ARM TO BE REMOVED
 - ⊗ EX. DOUBLE X-ARM ON EX. POLE
 - ⊗ EX. SINGLE X-ARM OR ALLEY-ARM ON EX. POLE
 - ⊗ EX. GUY & ANCHOR TO BE REMOVED
 - ⊗ PROP. GUY & ANCHOR WITH PROP. LEAD
 - ⊗ EXISTING FIBER SLACK LOOP
 - ⊗ PROP. FIBER SLACK LOOP
 - ⊗ EX. AER. FIBER TERMINAL
 - ⊗ EX. AER. COPPER TERMINAL
 - ⊗ EX. FOC SPLICE POINT
 - ⊗ PROP. SPLICE ON EX. FIBER SPLICE POINT

CHECKED BY KCN

DESIGNED BY R MOJE
 DRAWN BY R MOJE

STATE OF ALASKA
 DEPARTMENT OF TRANSPORTATION
 & PUBLIC FACILITIES
 SOUTHEAST REGION

**KETCHIKAN ADVANCE
 WATER STREET TRUNK LINE
 RELOCATION
 PROJECT # 69548**

**TELEPHONE
 CABLE LAYOUT**

PROJECT DESIGNATION
BR-000S(735) ~ 69548

STATE	YEAR
ALASKA	2014
SHEET NUMBER	TOTAL SHEETS
V19	78

Project As Built Drawings Have Been
 Reviewed By The Project Engineer &
 Represent, To The Best Of My Knowledge,
 The Project As Constructed.






Proj. Eng. *MB* Date *11/10/16*

DO NOT SCALE FROM THESE DRAWINGS USE DIMENSIONS

Project As Built Drawings Have Been Reviewed By The Project Engineer & Represent, To The Best Of My Knowledge, The Project As Constructed.

Proj. Eng. MB Date 1/16/16

SHEET 1 of 1

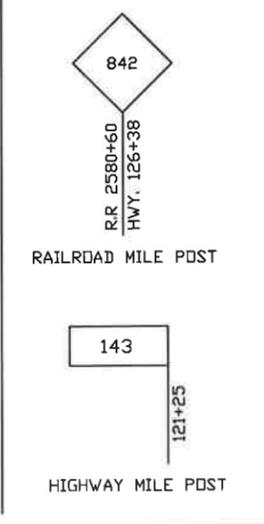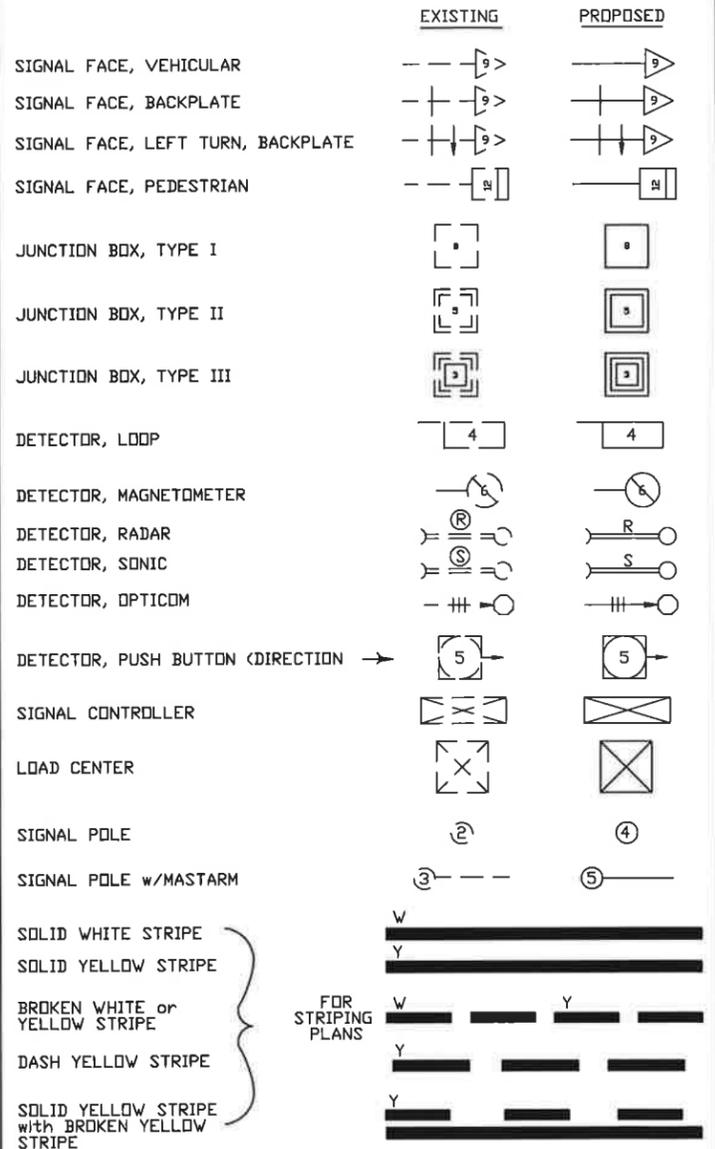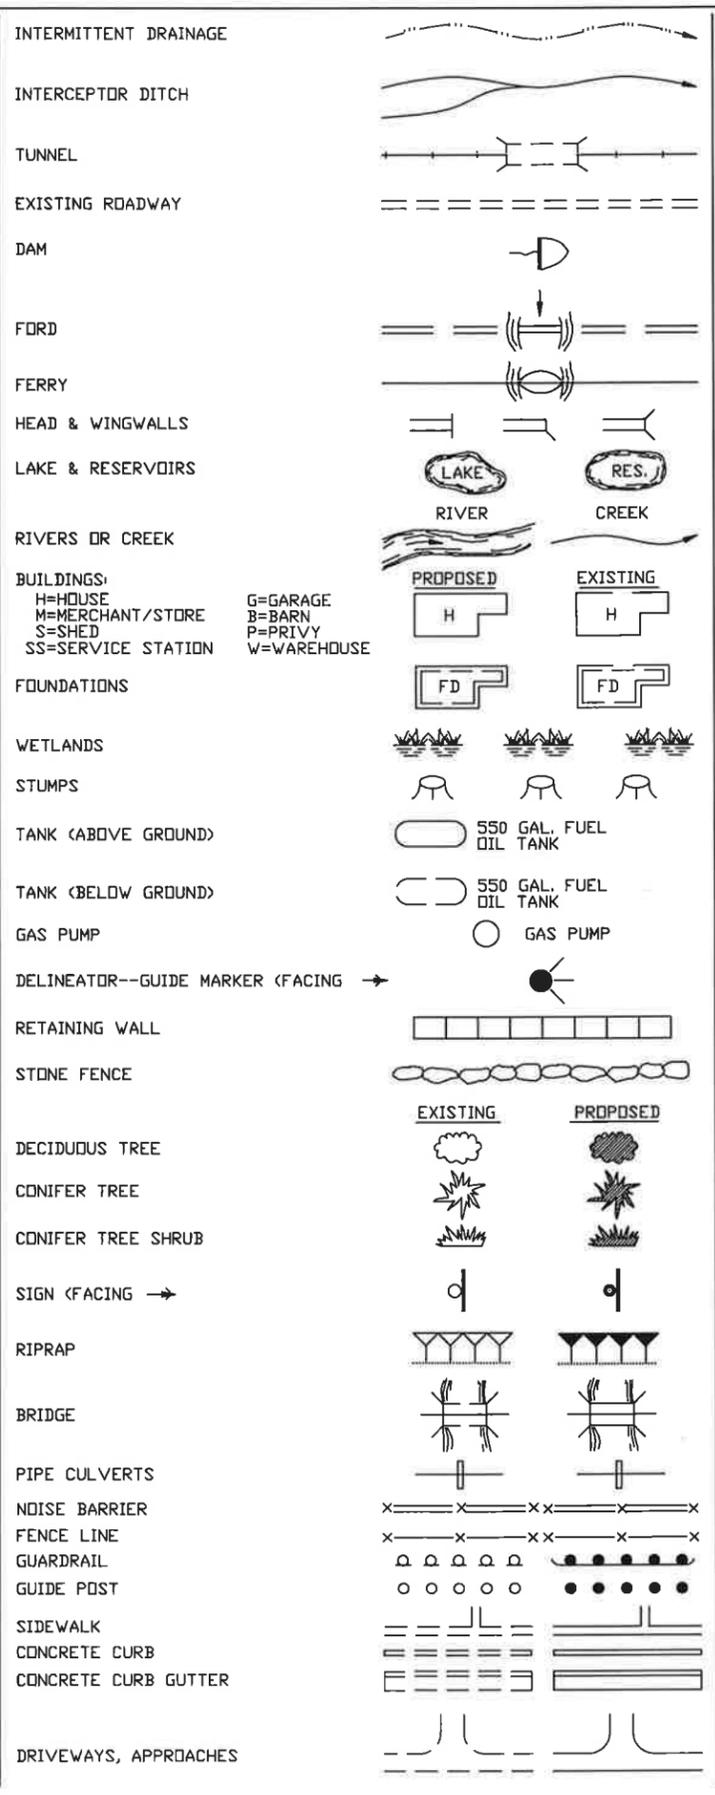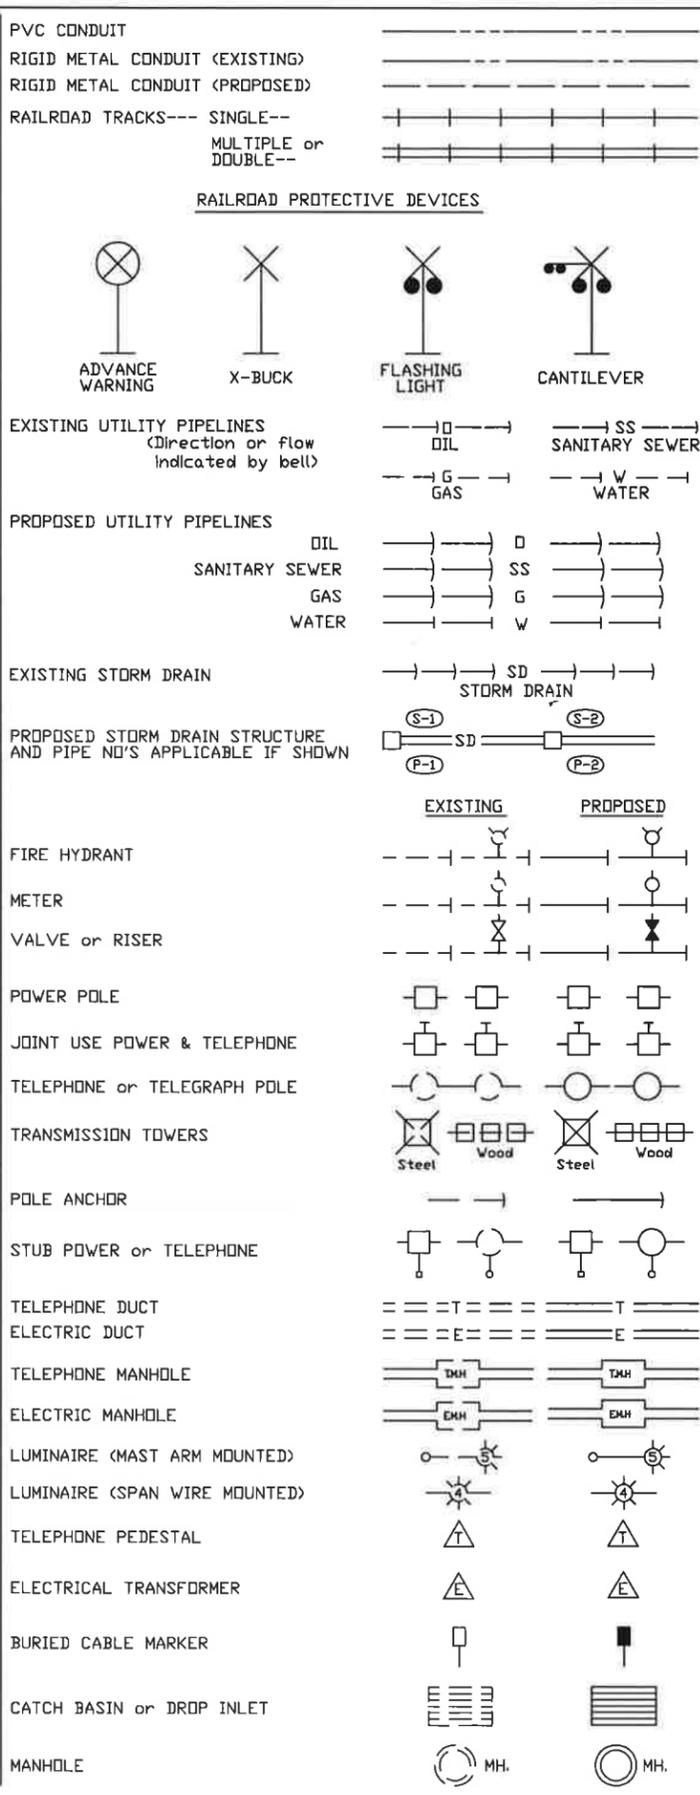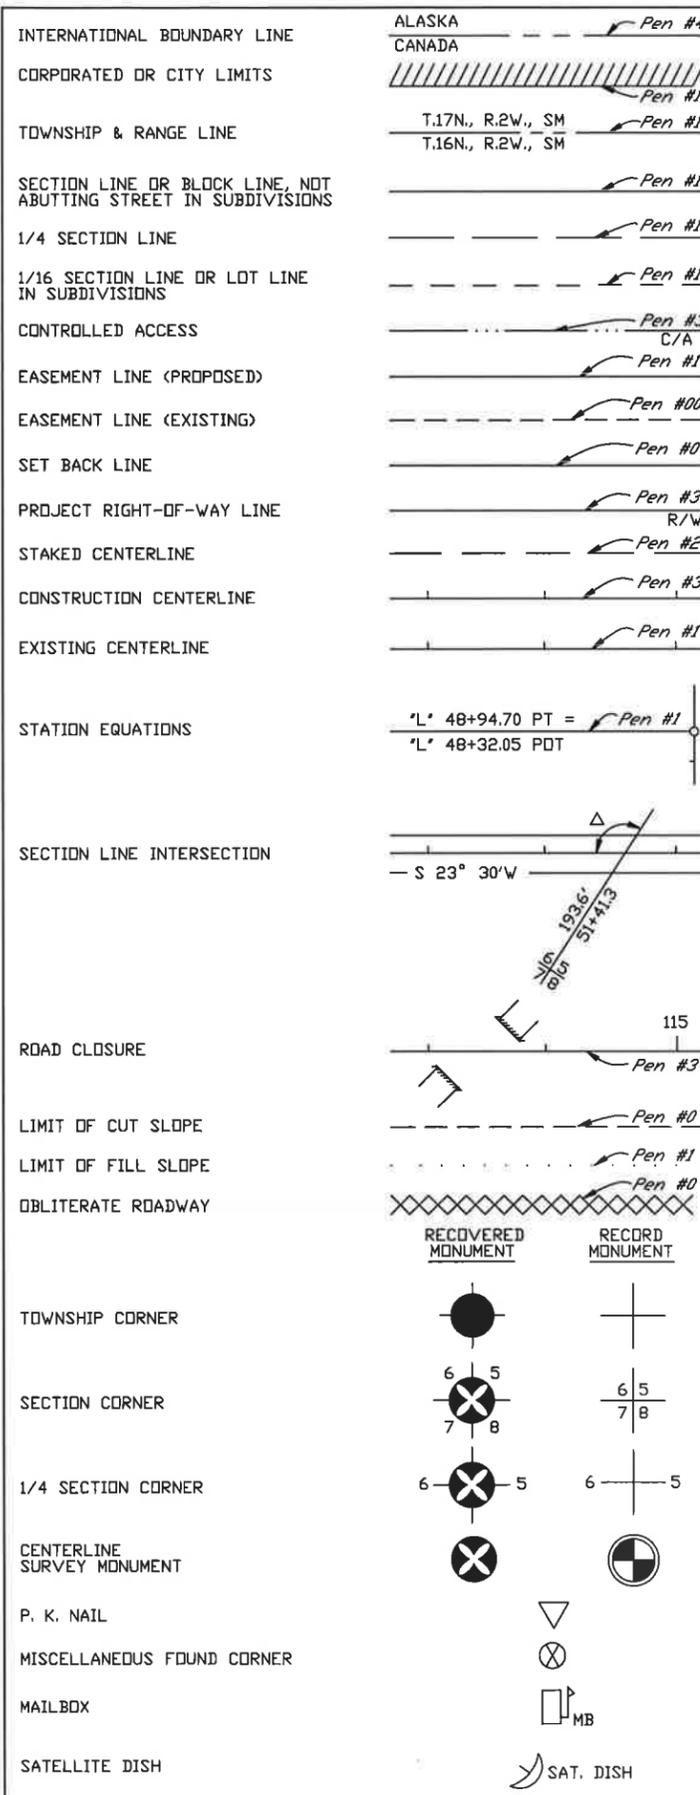

REVISIONS		
Date	Description	By

State of Alaska
Department of Transportation
& Public Facilities


SYMBOLS

APPROVED

Date _____


GENERAL NOTES:

- All covered hardware shall comply with the AASHTO/AGC/ARTBA "A Guide to Standardized Highway Barrier Hardware", latest edition.

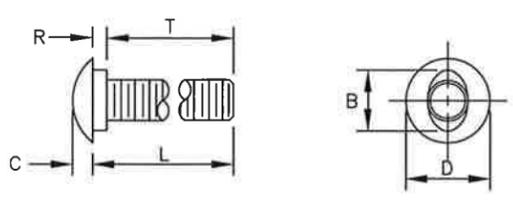


B	C	D	L (Length)	R	T (Thread Length)
15/16"	5/16"	1 5/16" or 1 7/16"	As Required	7/32"	As Required

5/8" BUTTONHEAD BOLT

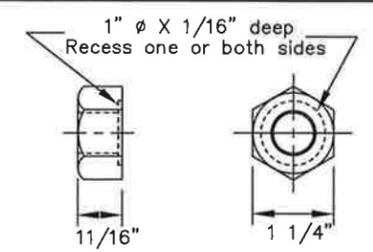


5/8" Dia. RECESSED HEX NUT

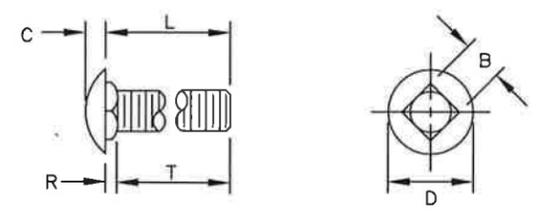


B	C	D	L (Length)	R	T (Thread Length)
5/8"	5/16"	1 5/16"	As Required	3/16"	As Required

5/8" Dia. CARRIAGE BOLT

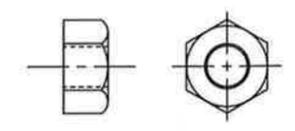


STANDARD HEX NUT

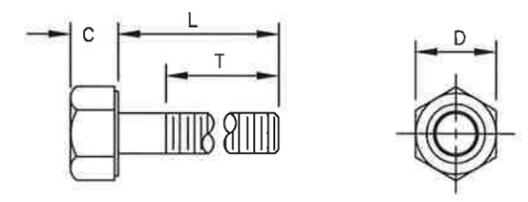


Bolt Size	C	D	L (Length)	T (Thread Length)
5/16"	—	—	1 1/2"	7/8"
5/16"	—	—	1"	1"
3/8"	—	—	7 1/2"	1 1/2"
1/2"	—	—	1 1/2"	1 1/2"
1/2"	—	—	1 1/4"	1 1/4"
5/8" H.S.	5/16"	7/8"	8"	1 1/2"
5/8"-11	—	—	1 1/2"	1 1/2"
3/4"	—	—	1 1/2"	1 1/2"
3/4"	—	—	As Required	2"
3/4" H.S.	15/32"	1 1/4"	2"	1 1/2"

STANDARD HEX BOLTS

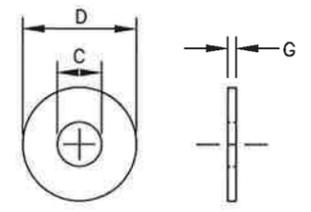


For Bolt ϕ	C	D	G
3/8"	7/16"	1"	5/64"
1/2"	17/32"	1 1/16"	3/32"
1/2" H.S.	17/32"	1 1/16"	3/32"
5/8"	11/16"	1 3/4"	9/64"
3/4"	13/16"	1 15/32"	9/64"
3/4" H.S.	13/16"	2"	5/32"
1"	1 1/16"	2"	9/64"


STANDARD STEEL WASHERS

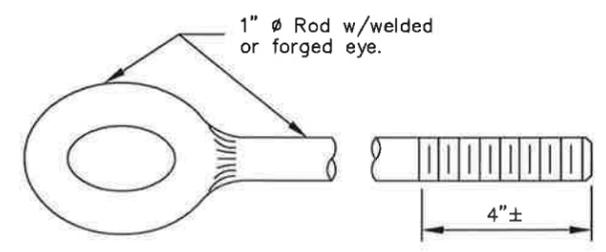


EYE BOLT

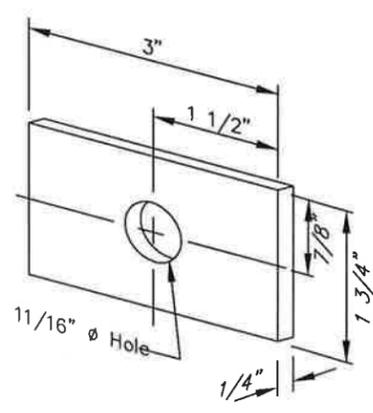

FLAT PLATE WASHER

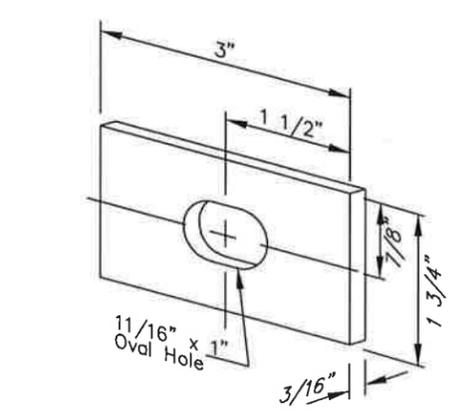

RECTANGULAR POST BOLT WASHER

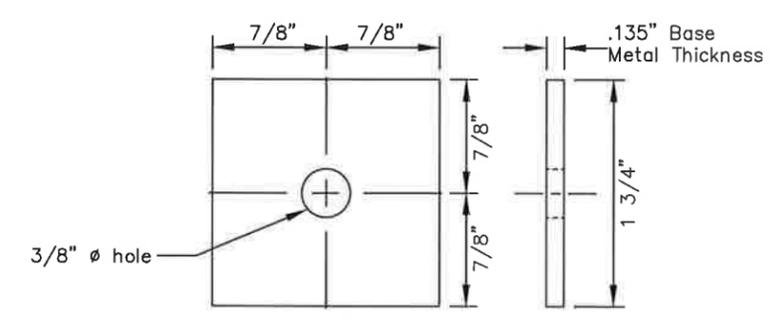

SQUARE STEEL WASHER

Project As Built Drawings Have Been Reviewed By The Project Engineer & Represent To The Best Of My Knowledge, The Project As Constructed.

Proj. Eng. *MB* Date *11/10/16*

REVISIONS		
Date	Description	By
3/15/99	Delete BCT Hardware	KJS


State of Alaska
Department of Transportation
& Public Facilities
**STANDARD GUARDRAIL
HARDWARE
(NUTS, BOLTS, WASHERS)**




Date *5/31/12*

GENERAL NOTES:


1. W-Beam and Thrie Beam Terminal Connectors shall conform to AASHTO M180, Class B, Type 2.
2. W-Beam end sections shall conform to AASHTO M180, Class A, Type 2.
3. All covered hardware shall comply with the AASHTO/AGC/ARTBA "A Guide to Standardized Highway Barrier Hardware", latest edition.

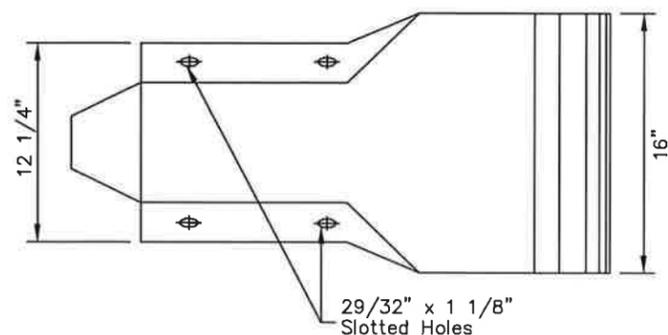

PROFILE

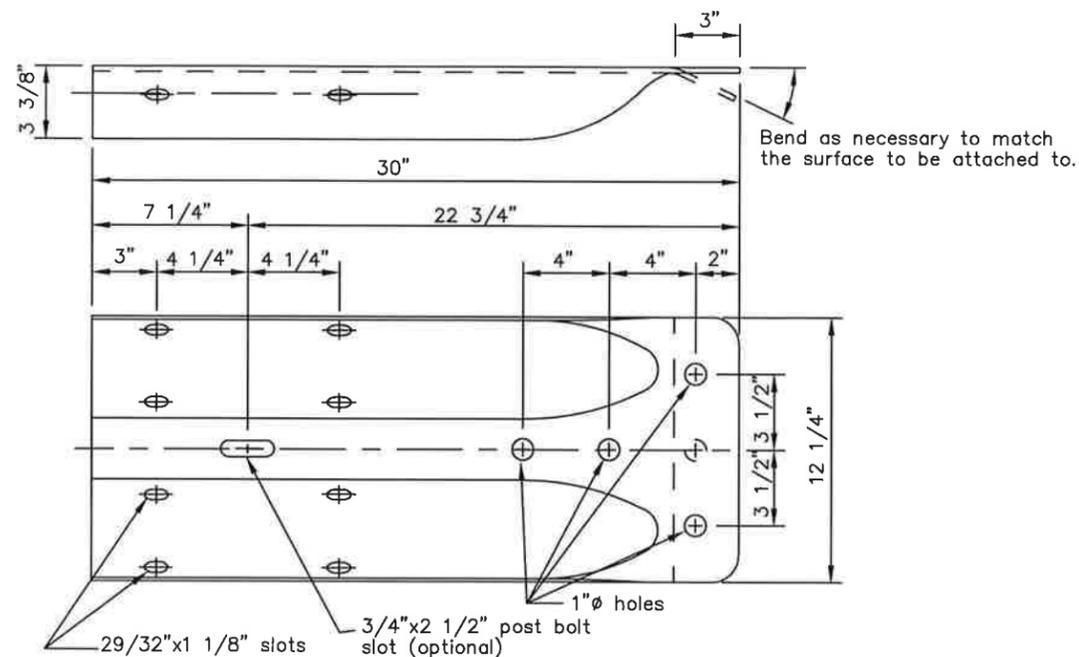


STANDARD W-BEAM TERMINAL CONNECTOR

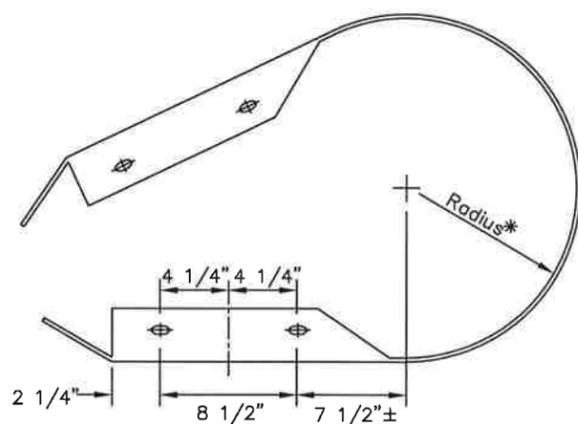

W-BEAM PLAN VIEW

*Radius to be specified on the plans

STANDARD W-BEAM END SECTION

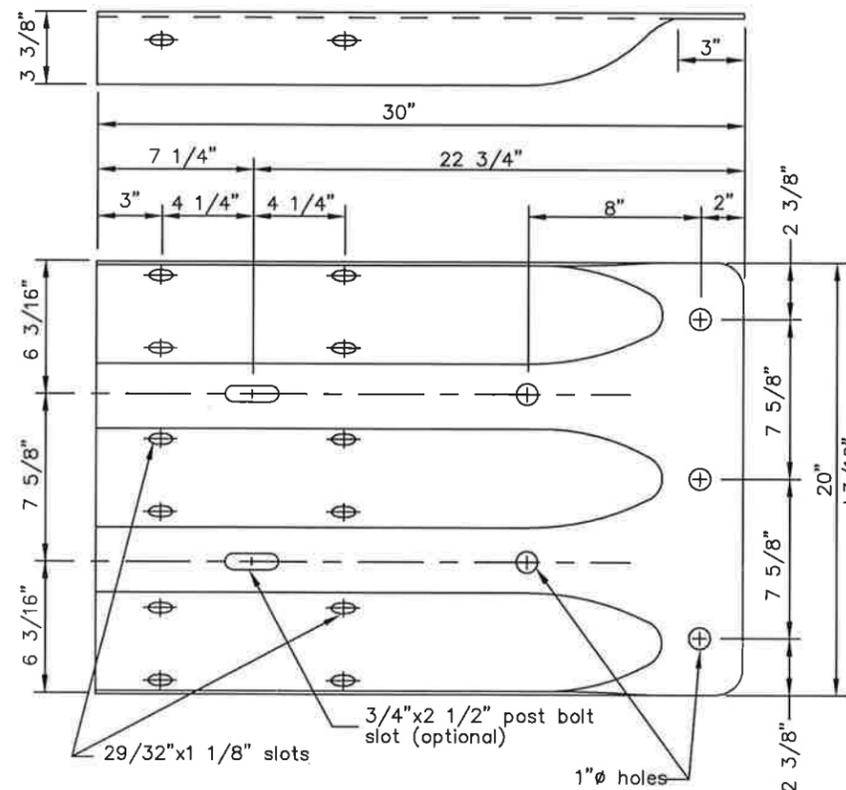

STANDARD THRIE BEAM TERMINAL CONNECTOR

Project As-Built Drawings Have Been Reviewed By The Project Engineer & Represent, To The Best Of My Knowledge, The Project As Constructed.

Proj. Eng. *NS*

Date *1/16/12*


REVISIONS		
Date	Description	By
<i>3/15/99</i>	<i>Delete Thrie End Sect.</i>	<i>KJS</i>

State of Alaska
Department of Transportation
& Public Facilities
**STANDARD GUARDRAIL
HARDWARE
(TERMINAL CONNECTORS)**


APPROVED



Date *5/31/12*

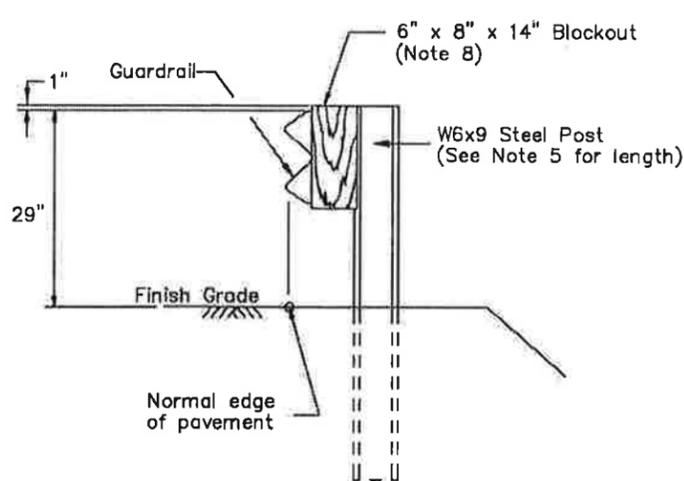


TYPE I POST INSTALLATION

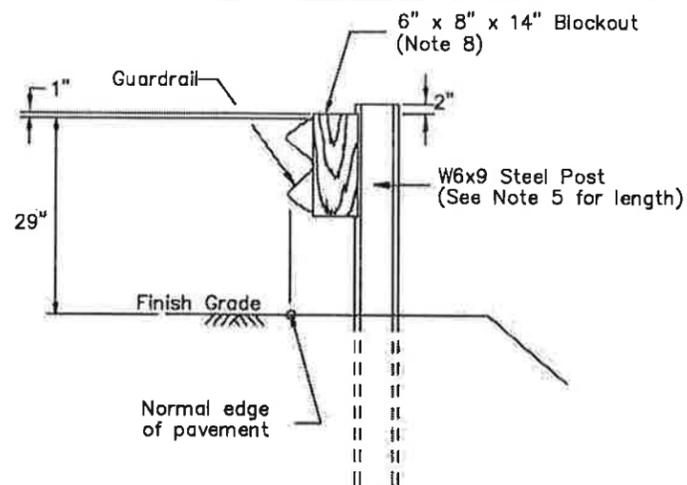

TYPE II POST INSTALLATION

(Facilitates raising rail for future overlays.)

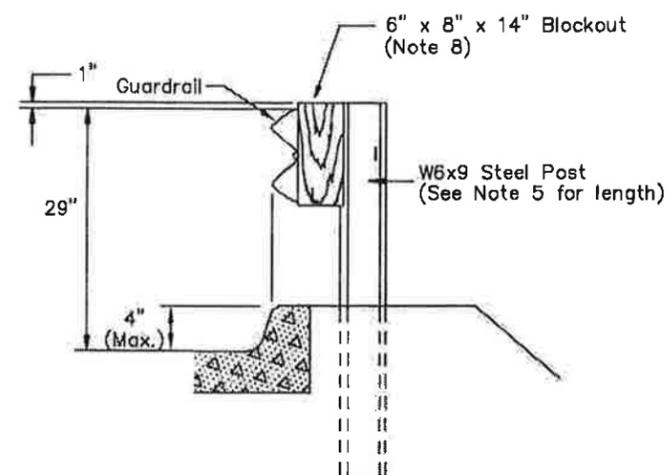

CURB DETAIL


TYPE III POST INSTALLATION

NOTE: Curb should not be installed with guardrail when the speed limit exceeds 40 mph.


GENERAL NOTES:

1. Attach guardrail reflectors at 50' centers beginning with the first post. Use Type A reflectors unless specified otherwise.
2. Provide hardware compliant with the AASHTO/AGC/ARTBA "A Guide to Standardized Highway Barrier Hardware," latest edition.
3. See Standard Drawing G-00 for hardware details.
4. Mount rail to block with bolt on approaching traffic side of block web.
5. See Standard Drawing G-10 for post lengths corresponding to different combinations of slope and behind-post embankment width.
6. Typical post spacing is 6'-3" center to center.
7. This barrier is acceptable under NCHRP 350, TL-3.
8. Use wood, rubber, plastic, or other NCHRP 350 or MASH approved blockouts designed to be used with steel posts.
9. Use 25 linear foot transition to match height of existing or new rail elements and end treatments.
10. W6x8.5 steel post may be substituted for W6x9 steel post.

Project Eng. *NB* Date *11/6/16*

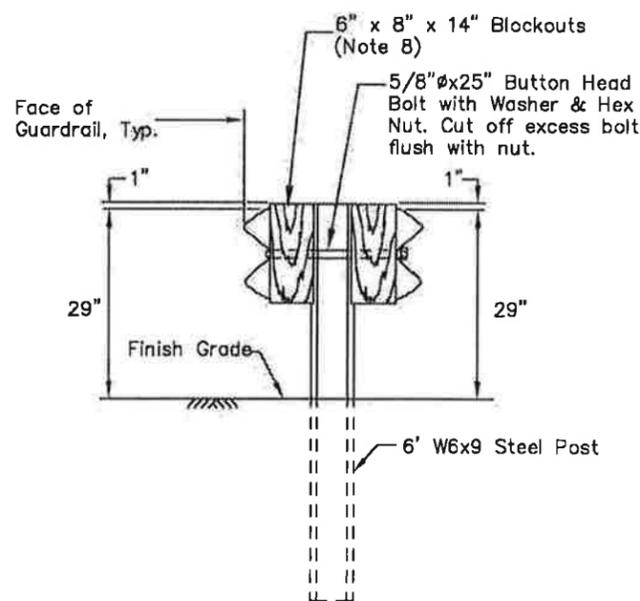


TYPE IV DOUBLE SIDED INSTALLATION

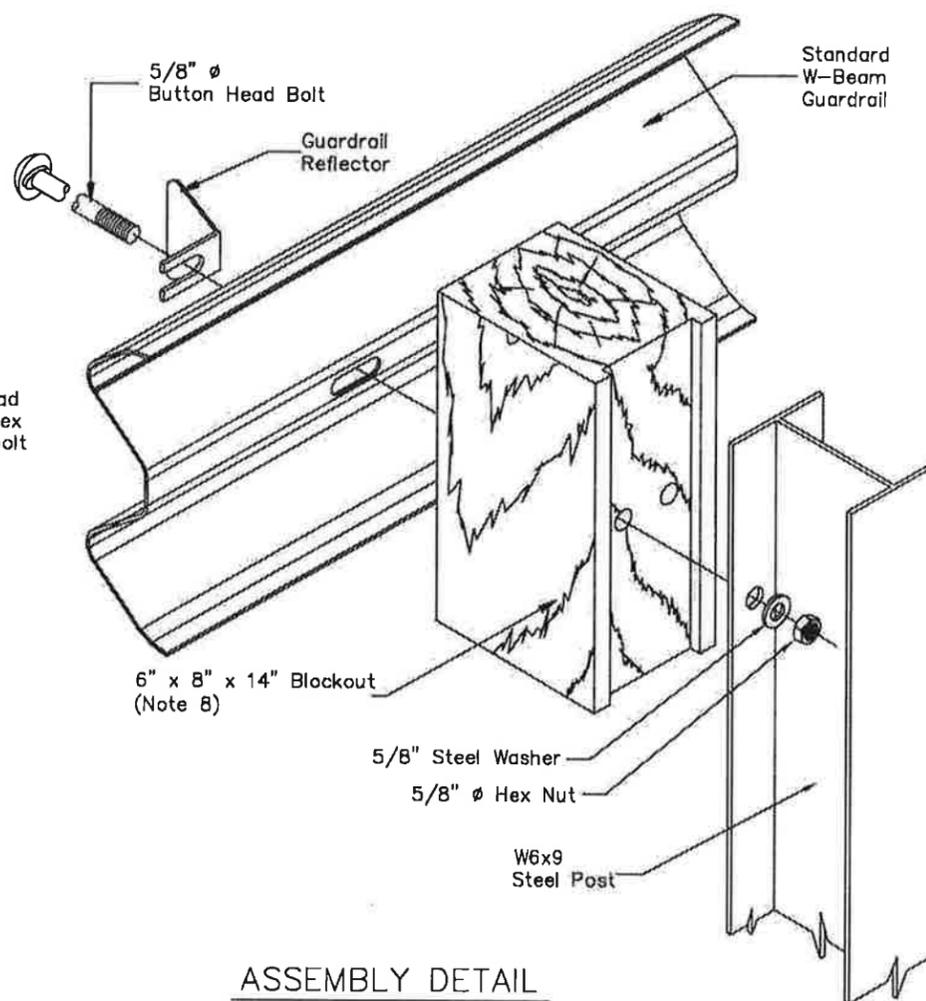

ASSEMBLY DETAIL

(Type I post shown)

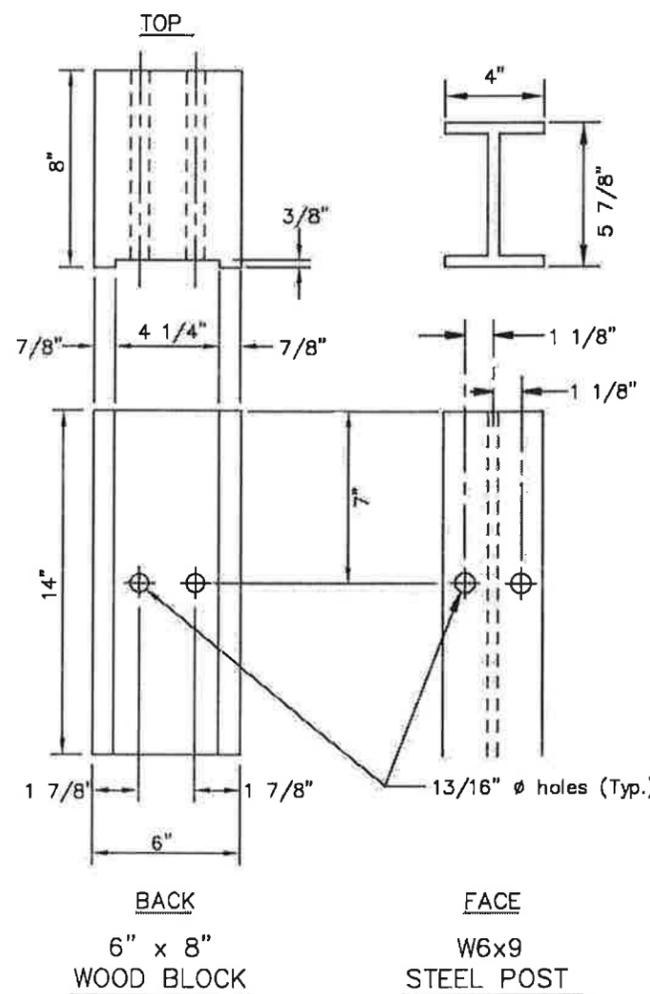

REVISIONS		
Date	Description	By
3/1/83	Revised gen. notes	Gdo
1/1/86	Revised hanger detail	Gdo
3/15/99	Block and post length	KJS
4/1/13	Add double-sided detail and increase g.r. height	JCJ

State of Alaska
Department of Transportation
& Public Facilities

**STEEL POST
W-BEAM GUARDRAIL**


APPROVED



Date *05/15/13*


GENERAL NOTES:

1. This drawing is to be used for post length determination only. See the plans for slopes and behind-post embankment widths.
2. To determine post length, identify the case that matches site conditions and read the length corresponding to the pertinent guardrail type.
3. These dimensions apply to both curbed and uncurbed sections.

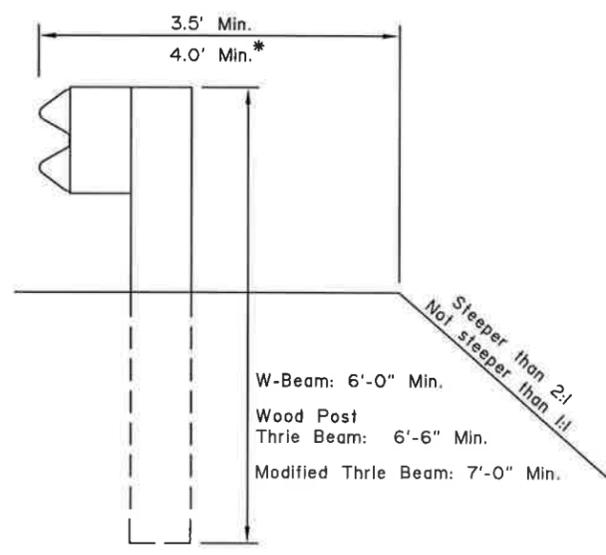


CASE 1

* with Modified Thrie Beam'

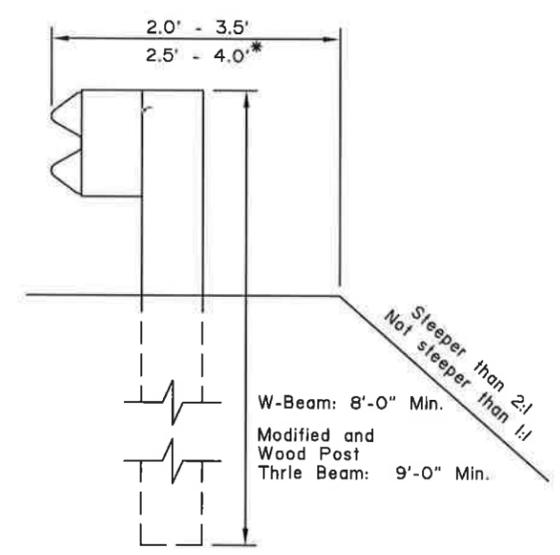

CASE 2

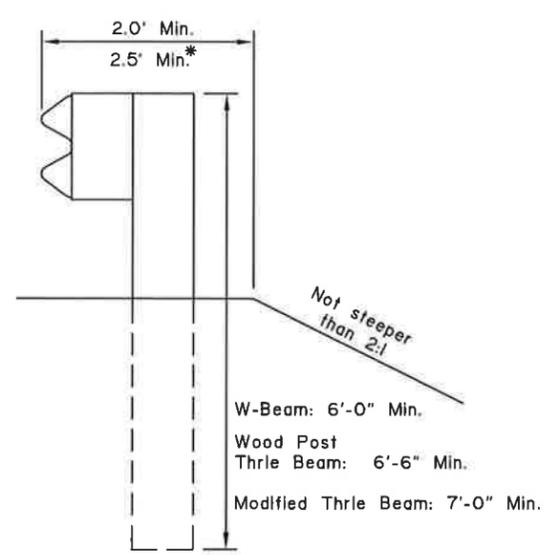

CASE 3

Project As Built Drawings Have Been Reviewed By The Project Engineer & Represent, To The Best Of My Knowledge, The Project As Constructed.

Proj. Eng. NB

Date: 1/10/16

REVISIONS		
Date	Description	By
12/2/99	Delete Case 4, 5, and 6	KJS

State of Alaska
Department of Transportation
& Public Facilities

BEAM GUARDRAIL
POST INSTALLATION




Date 3/15/99


G-27.11

GENERAL NOTES:


1. Post spacings shall be per sheet 1 of 2.
2. The 12'-6" section of guardrail immediately adjacent to the obstacle rail shall be nested.
3. See standard drawing G-10, "Beam Guardrail Post Installation" for post lengths corresponding to different combinations of slope and behind-post embankment widths.
4. Hardware details not shown here shall conform to drawings G-04 & G-00.
5. Blockouts shall conform to Standard Drawing G-04, except that no notch is required on W8x13 steel posts.

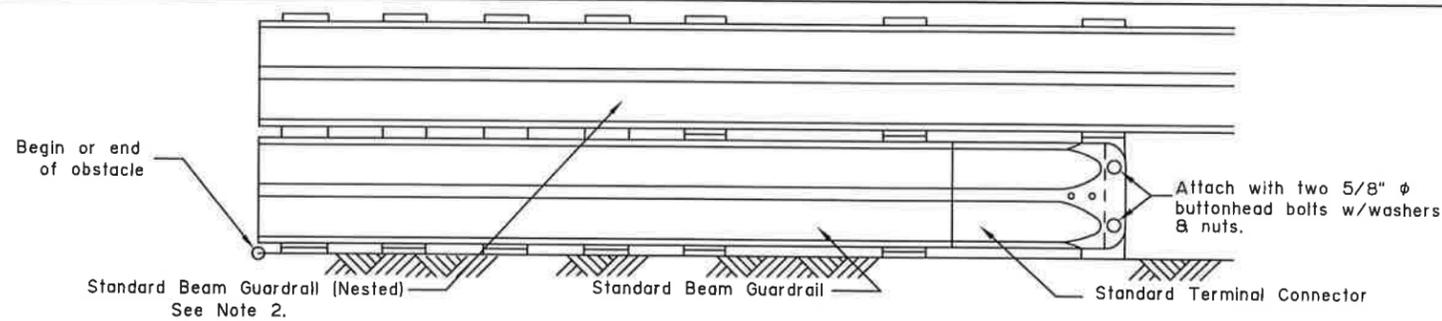

RUBRAIL TRANSITION ELEVATION (STEEL & WOOD POST)


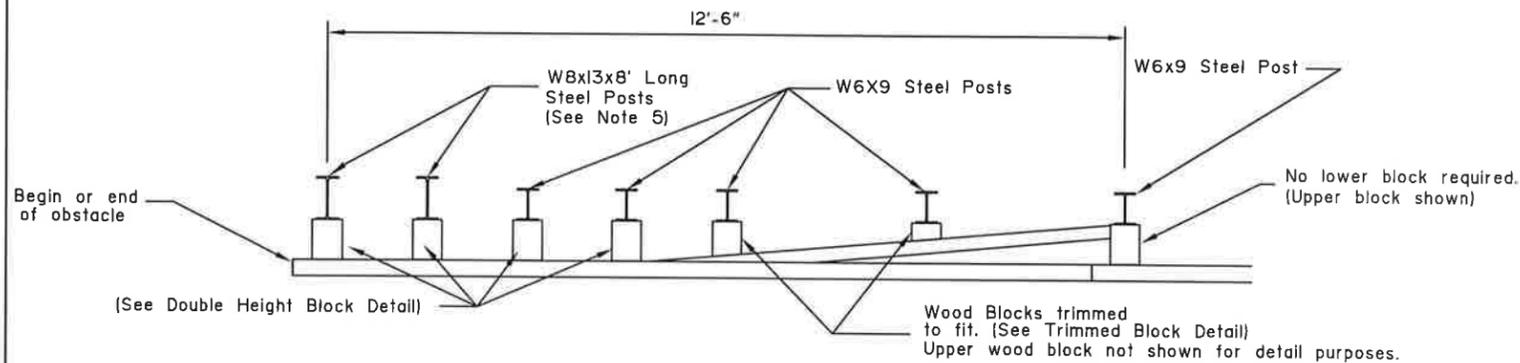


RUBRAIL TRANSITION PLAN (STEEL POST)

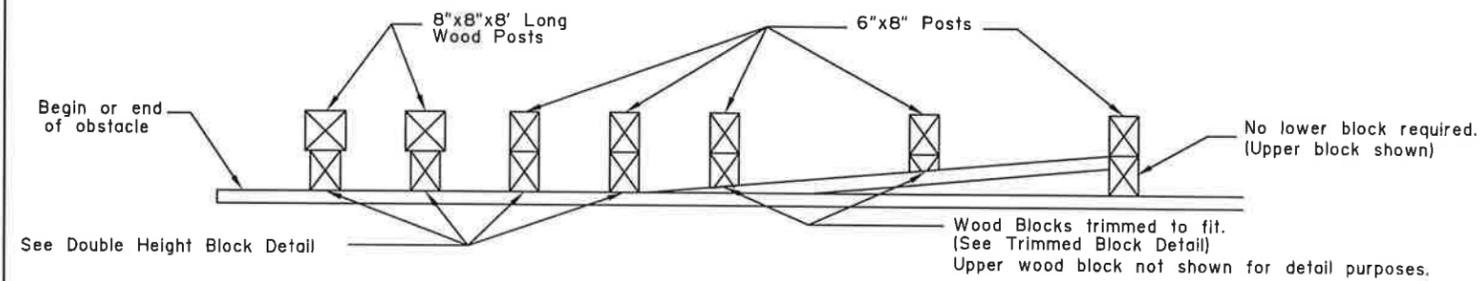

RUBRAIL TRANSITION PLAN (WOOD POST)




STEEL POST DETAILS

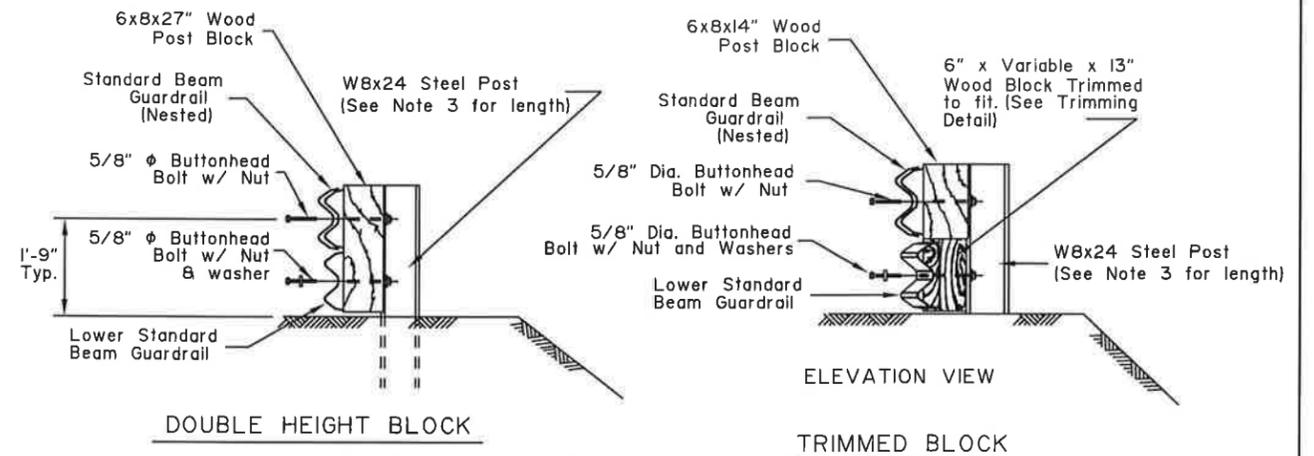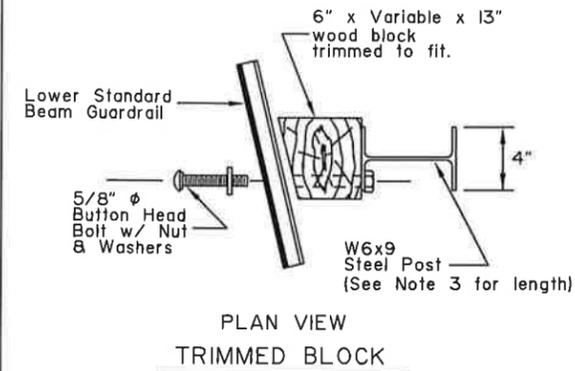

Project As Built Drawings Have Been Reviewed By The Project Engineer & Represent, To The Best Of My Knowledge, The Project As Constructed.

Proj. Eng. *NR* Date 1/10/16

WOOD POST DETAILS

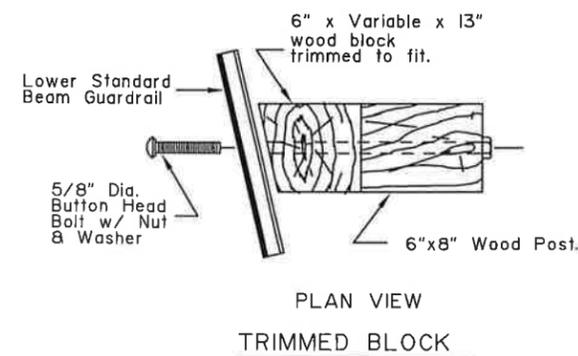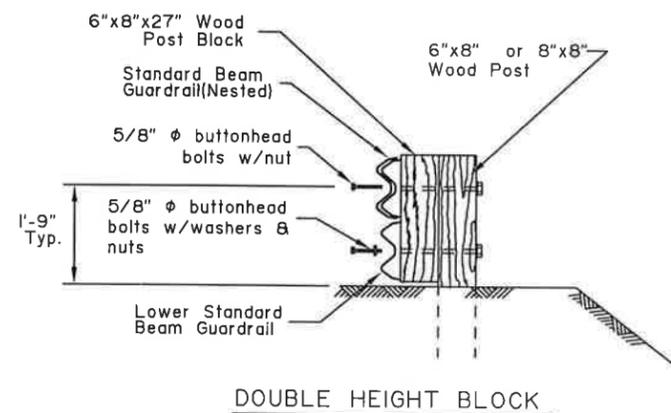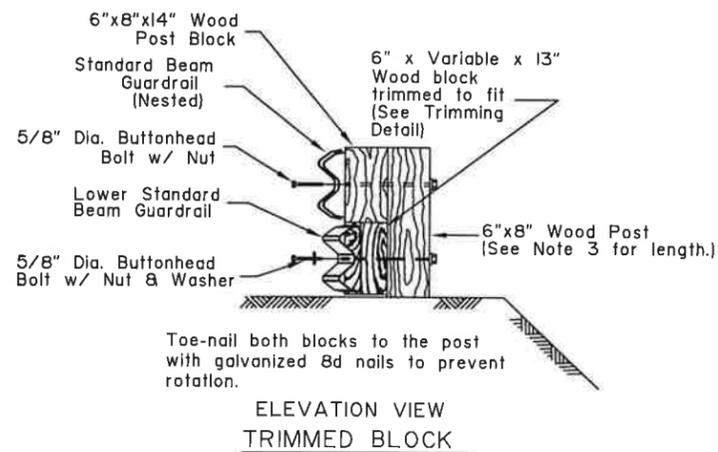

REVISIONS		
Date	Description	By
10/31/03	Added Sheet 2 For Rubrail transition	LRG

Sheet 2 of 2

State of Alaska
Department of Transportation & Public Facilities
GUARDRAIL STIFFENING
AT OBSTACLES







NOT TO SCALE Date 10/31/03








G-46.11

GENERAL NOTES

1. Barriers may be used for temporary and permanent applications.
2. Provide 36" unobstructed smooth deflection area behind barrier for unanchored applications. Provide 12" unobstructed smooth deflection area behind barrier for anchored applications.
3. When anchored, install anchor pins on the side facing traffic. Precast barrier used as permanent median barrier in medians less than 8' in width shall be anchored to the roadway. When anchored in medians, install anchor pins on both sides of the barrier.
4. Provide 2" clearance between all metal reinforcement and the nearest face of concrete unless otherwise shown.
5. Normal use of precast barrier units is restricted to curvatures with radii greater than 770'.
6. Use narrow base shoulder barrier only at locations with full height backfill or equivalent structural support placed behind barrier.
7. When scuppers are not required plug them with a minimum 2" of grout.
8. Concrete grout for grouting over pins, pinning holes or grouting of scuppers shall be a non-shrinking grout, weak in strength and of thick consistency.
9. This precast concrete barrier is NCHRP 350 TL-3 approved.

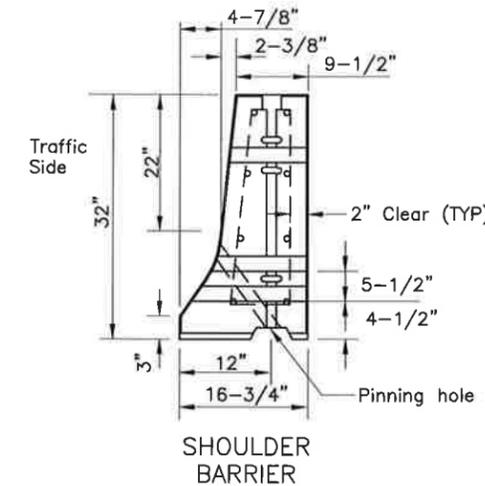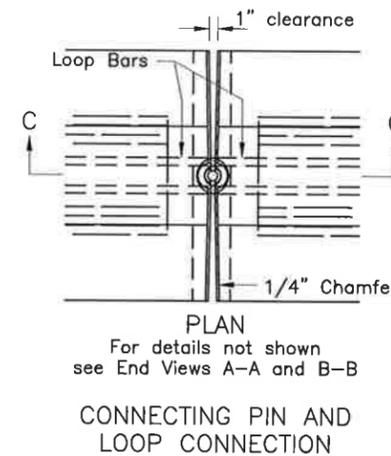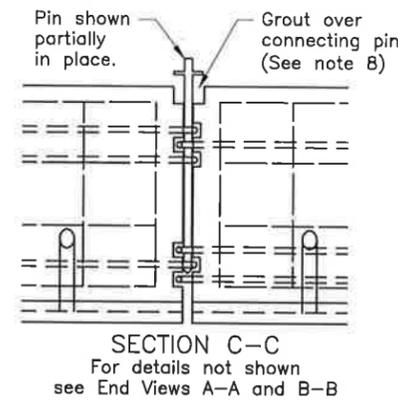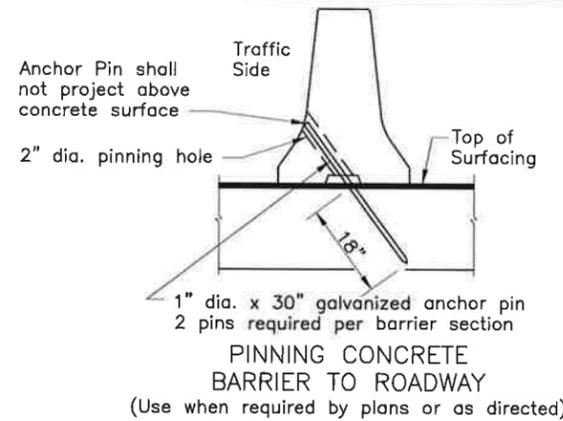

* Dimensions marked thus are to the intersection point of the barrier slopes.

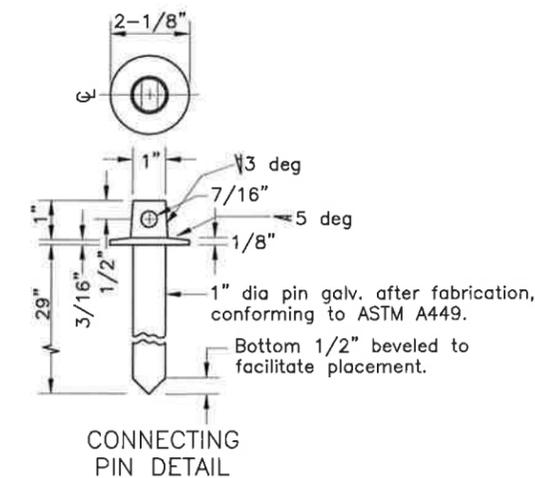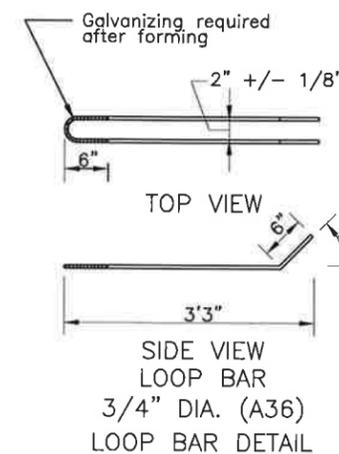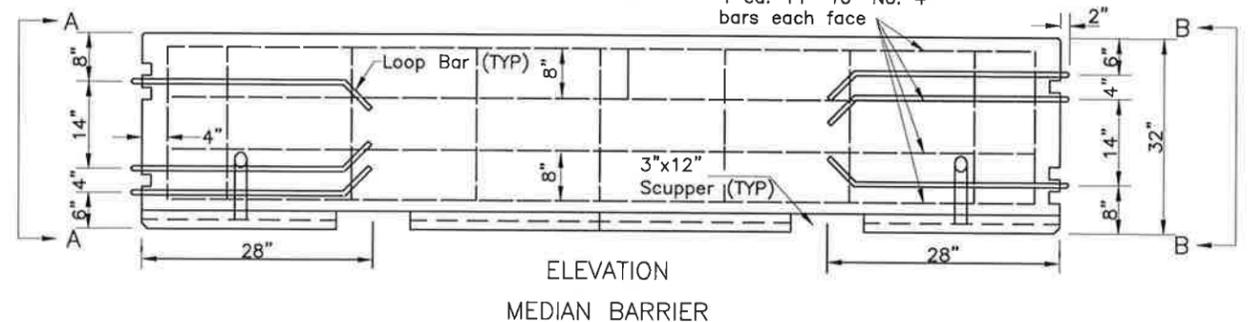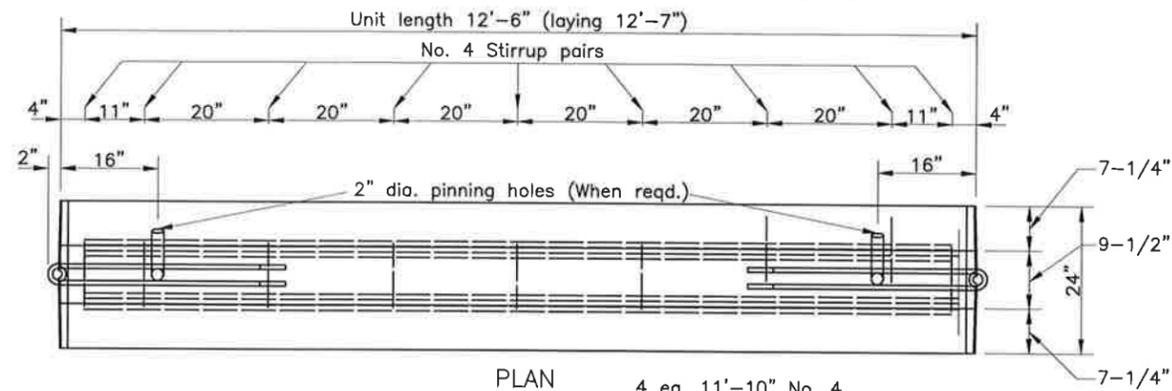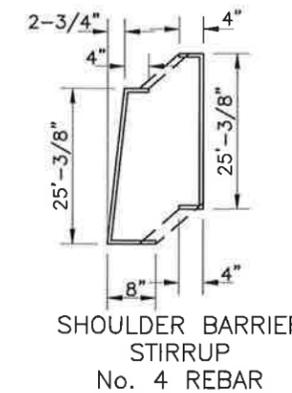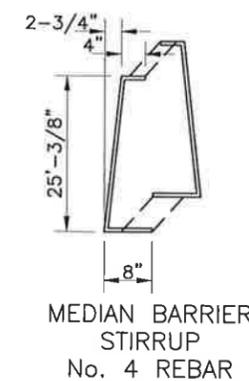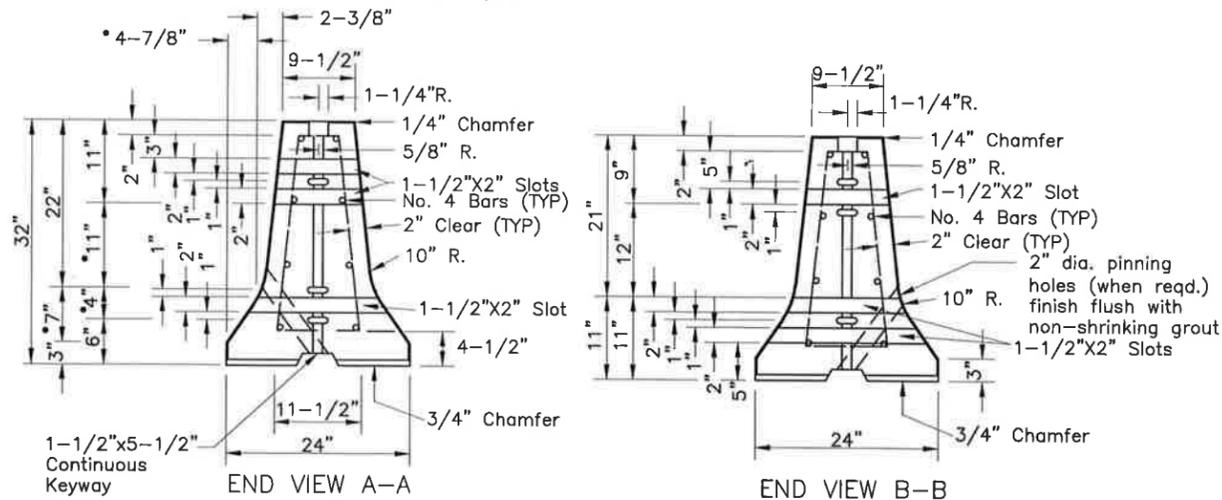

Project As Built Drawings Have Been Reviewed By The Project Engineer & Represent, To The Best Of My Knowledge, The Project As Constructed.

Proj. Eng. NB

Date: 1/10/16

REVISIONS		
Date	Description	By
4/28/10	Correct Dims, Note 1	KJS

Sheet 1 of 2

State of Alaska
Department of Transportation
& Public Facilities

PRECAST CONCRETE "F" SHAPE BARRIER



Date: 5/31/12

G-46.11 Sheet 1 of 2

DESIGN NOTES:

- Design Standard: 2001 Standard Specifications for Structural Supports for Highway Signs, Luminaires and Traffic Signals with 2006 interim.
- Design Load: 1,000 lbs axial, 2,000 lbs shear, 50,000 ft-lbs moment.
- Construction Standard: Latest edition of the State Of Alaska Standard Specifications for Highway Construction with Special Provisions.

NOTES:

- This foundation is approved for electrolier and breakaway traffic signal applications in cohesionless soils with an N1-60 value of 10 or greater per AASHTO T-206, "Standard Penetration Test" (SPT). This foundation shall not be used if any of the following are encountered; water table above the bottom of foundation, very loose soils, organic soils, cohesive soils (clay), or soils susceptible to frost jacking. If any of these conditions are encountered, stop foundation work and contact the Engineer.
- Place foundation in drilled or excavated hole with centerline of foundation located at the station, offset, and elevation specified in plans. Set foundation to satisfy the conditions depicted in clearance detail.
- Form the foundation in corrugated metal pipe conforming to Subsection 707-2.01 of the Specifications.
- Provide 1.5 extra turns at each end of the spiral reinforcing steel. Reinforcing steel shall not be spliced. Tie vertical reinforcing steel to each intersection of the spiral reinforcing steel.
- Connect ground wire near the top of spiral reinforcing steel with two irreversible connectors as shown. Fasten connectors according to the manufacturers' recommendations including the use of manufacturer specified tools. The ground wire may be bare solid, stranded, or braided copper. Protect ground wire with protective sleeve as shown and fill with silicon sealant.
- Complete all concrete work in conformance with Sections 501, 503, and 660 of the Specifications. Use a tube with a hopper head or other approved device when dropping concrete more than 5 feet per Subsection 501-3.08. Vibrate concrete during placement by mechanical vibration per Subsection 501-3.08. Ensure anchor threads are protected from contact with concrete during pour.
- Backfill and compact according to Section 205, and Subsections 203-3.04 and 660-3.01 of the Specifications. Use select material, Type A or sand slurry as backfill material. Ensure area below foundation meets compaction requirements and is free of loose material and debris prior to concrete work.
- Install all anchors according to the manufacturer's written installation instructions. Anchors shall be installed plumb. Anchors greater than 1:40 out-of-plumb will result in foundation rejection.
- When used for electrolier reduce the foundation depth 1 foot when there is no luminaire arm or the luminaire arm is less than or equal to 12 feet.
- Grade in depth table refers to fill slopes. If foundation is in a cut slope assume flat grade in table. To determine grade in fill slopes, use the most severe grade found within an 8 foot radius of the center of the foundation. Slopes steeper than 1.5:1 require engineered depth calculation.

MATERIAL REQUIREMENTS		
Concrete	Class A	$f'c = 4000$ psi
CMP	AASHTO M218	14 ga.
Vertical Reinforcing Steel	AASHTO M31 #11	GR 60
Spiral Reinforcing Steel	AASHTO M31 #5	GR 60
Ground Wire		#4 awg
Frangible Coupling	NCHRP 350 TL3 Frangible Coupling	$V_u = 5.5$ kips $T_u = 43.2$ kips
Anchor	NCHRP 350 TL3 Frangible Coupling Anchor	
Conduit	Sch 40	RMC
Protective Sleeve	Sch 40	PVC



GRADE	FOUNDATION DEPTH BY APPLICATION (ft.)	
	ELECTROLIER * SEE NOTE 9	BREAKAWAY TRAFFIC SIGNAL
Flat to 6:1	8	6
>=6:1 to 3:1	9	7
>=3:1 to 1.5:1	10	8

SAND SLURRY MIX DESIGN		
ITEM	BATCHING QUANTITIES PER CYD BATCH (lbs.)	APPLICABLE SPECS.
Portland Cement Concrete	188	701-2.01
Water (52.1 gal.)	435	712-2.01
Fine Aggregate SSD	3041	703-2.01
Admixture: Microair	2.0 oz.	711-2.02
Total	3664	



BOLT CIRCLE	
REGION	DIAMETER
Northern Region Projects	14.5"
Central Region Projects	15.5"
Southeast Region Projects	15.5"

Project As Built Drawings Have Been Reviewed By The Project Engineer & Represent, To The Best Of My Knowledge, The Project As Constructed.

Proj. Eng. *MB* Date 11/6/16

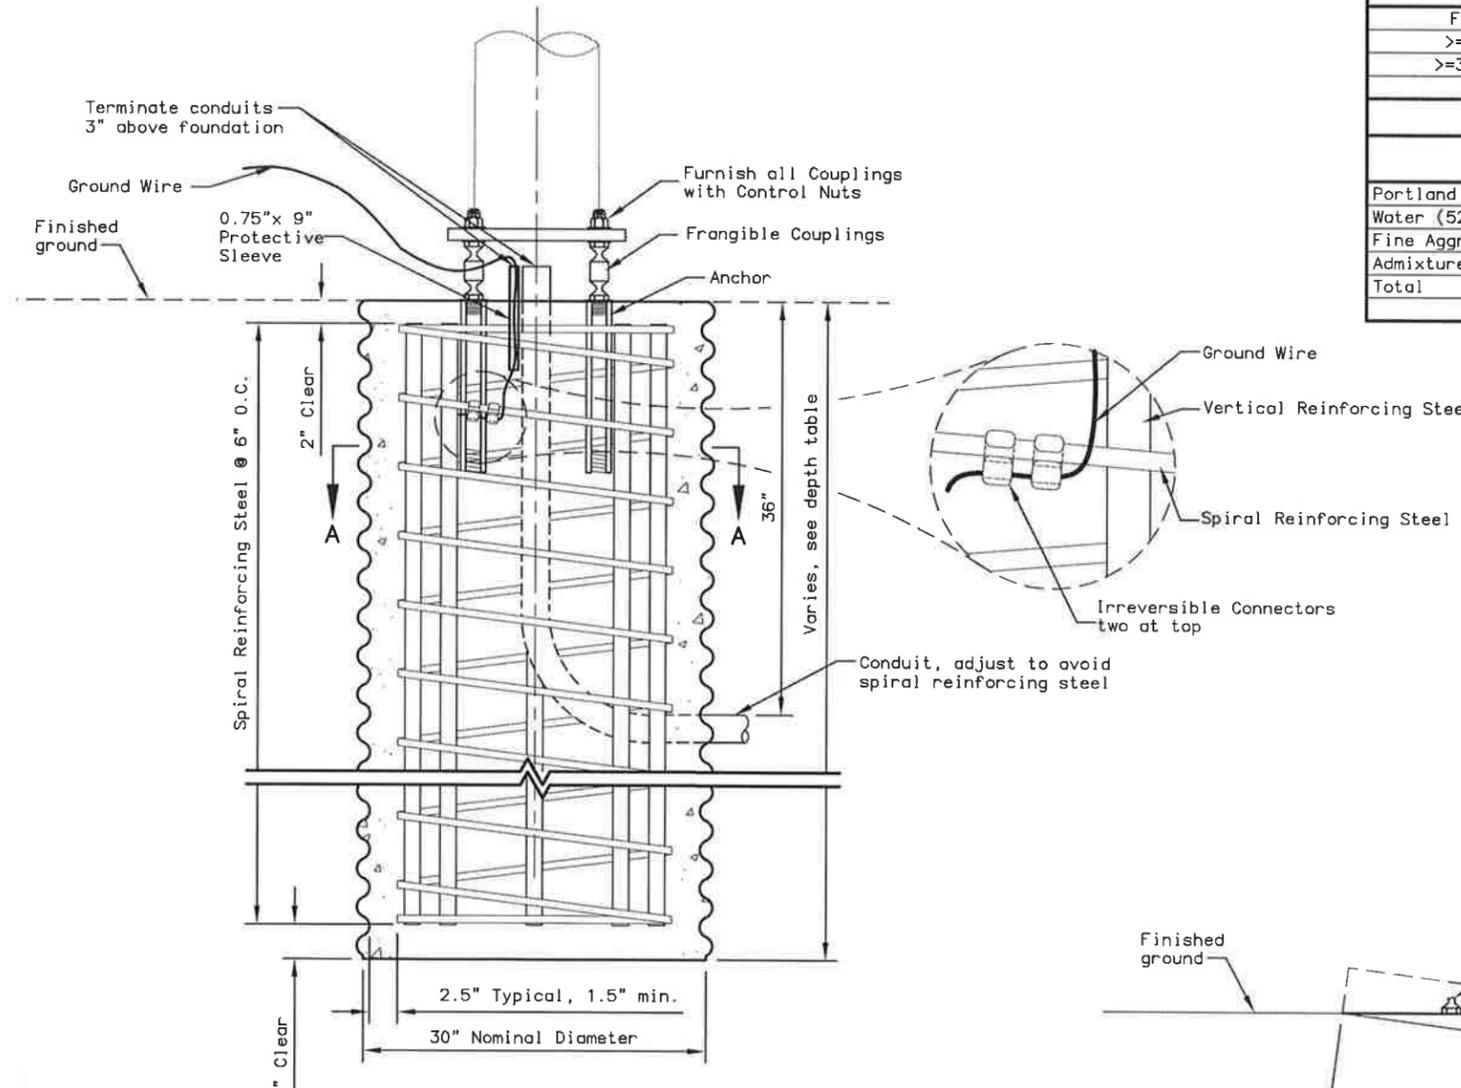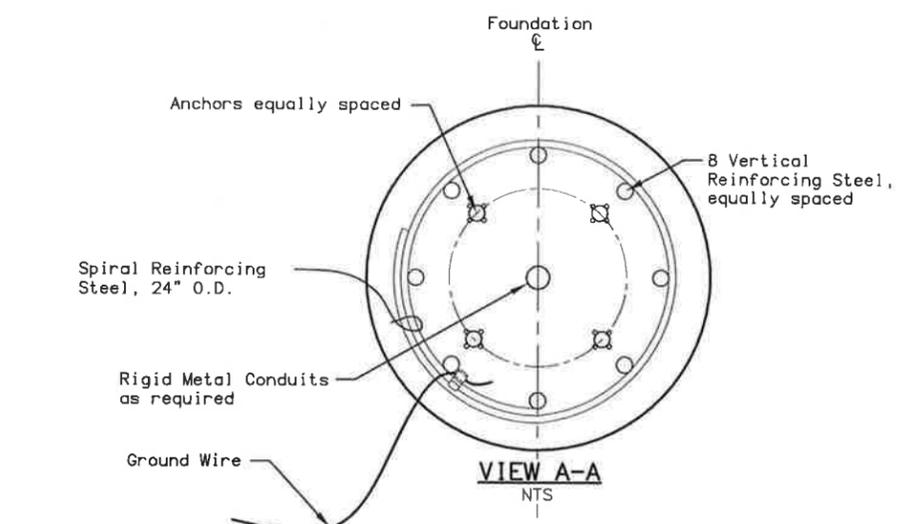

FOUNDATION DETAILS
NTS
(Skirt omitted for clarity)

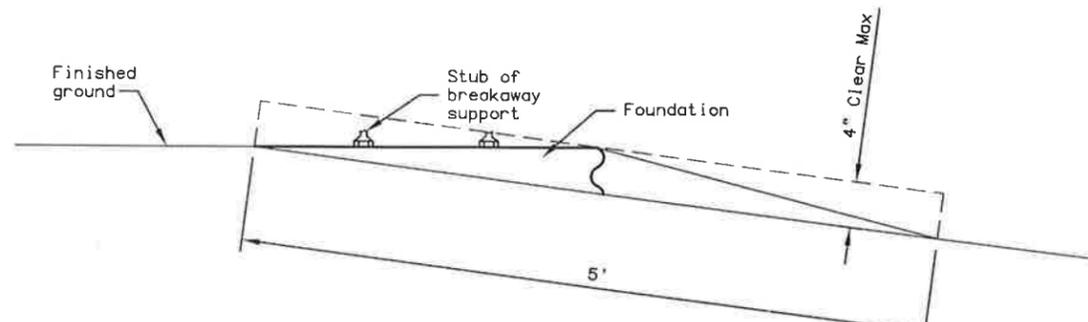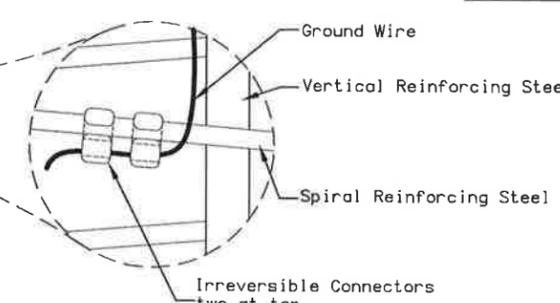

CLEARANCE DETAIL
NTS

REVISIONS		
Date	Description	By

SHEET 1 OF 1
State of Alaska
Department of Transportation & Public Facilities
CONCRETE STREET LIGHT POLE FOUNDATION


APPROVED
Date 05/31/12

THRUST BLOCK MINIMUM SIZE TABLE						
For Bends Greater Than 45°, Tee Branches & Crosses						
Pipe Diam. (In.)	Water Pressure in Pipe (P.S.I.)					
	50		150		250	
	Bearing Area (Sq. Ft.)	Concrete Volume (Cu. Ft.)	Bearing Area (Sq. Ft.)	Concrete Volume (Cu. Ft.)	Bearing Area (Sq. Ft.)	Concrete Volume (Cu. Ft.)
2	0.5	0.5	0.8	1.0	1.0	1.3
3	0.6	0.8	1.0	1.3	1.1	1.5
4	0.8	1.0	1.6	3.1	1.5	3.0
6	1.0	1.3	1.9	4.0	3.2	7.0
8	1.1	1.5	3.2	7.0	5.4	11.0
10	1.7	3.2	4.9	10.0	8.3	19.0
12	2.4	5.2	7.1	17.0	11.8	24.3
14	3.2	7.0	9.8	21.0	16.1	32.0
16	4.1	8.0	12.3	25.0	20.5	40.0
18	5.4	11.0	16.2	32.0	27.1	50.0
20	6.8	15.0	20.6	40.0	34.4	70.0
24	8.2	19.0	25.3	50.0	42.0	80.0


For Bends 45° or Less						
Pipe Diam. (In.)	Bearing Area (Sq. Ft.)	Concrete Volume (Cu. Ft.)	Bearing Area (Sq. Ft.)	Concrete Volume (Cu. Ft.)	Bearing Area (Sq. Ft.)	Concrete Volume (Cu. Ft.)
2	0.5	0.5	0.5	0.5	0.6	0.8
3	0.5	0.5	0.7	0.9	0.8	1.0
4	0.5	0.5	0.9	1.1	1.0	1.5
6	0.6	0.8	1.2	2.0	1.7	3.2
8	0.8	1.0	1.8	3.6	2.9	6.0
10	1.0	1.3	2.7	5.8	4.5	9.0
12	1.3	2.5	3.8	7.5	6.4	14.0
14	1.7	3.2	5.2	11.0	8.6	19.0
16	2.2	4.5	6.7	15.0	11.2	24.0
18	2.8	5.9	8.5	19.0	14.1	30.0
20	3.5	7.0	10.5	22.2	17.5	35.0
24	4.2	8.0	12.8	26.0	21.5	40.0

VALVES REQUIRING ANCHORAGE	
WORKING PRESSURE (P.S.I.)	VALVES REQUIRING ANCHORAGE
50 - 100	12 Inch and up
101 - 150	8 Inch and up
151 - 200	All Sizes


THRUST AT VERTICAL BEND PER DEGREE DEFLECTION AT 100 P.S.I. WATER PRESSURE			
PIPE SIZE	THRUST (LB.)	PIPE SIZE	THRUST (LB.)
4"	35	10"	197
6"	72	12"	278
8"	122	14"	377
		16"	486

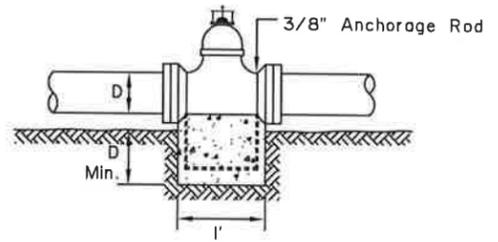

ANCHORAGE OF VALVES

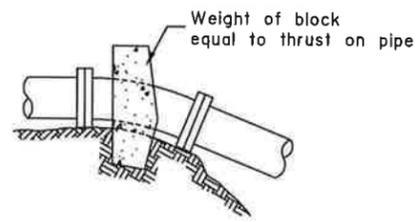

VERTICAL BENDS






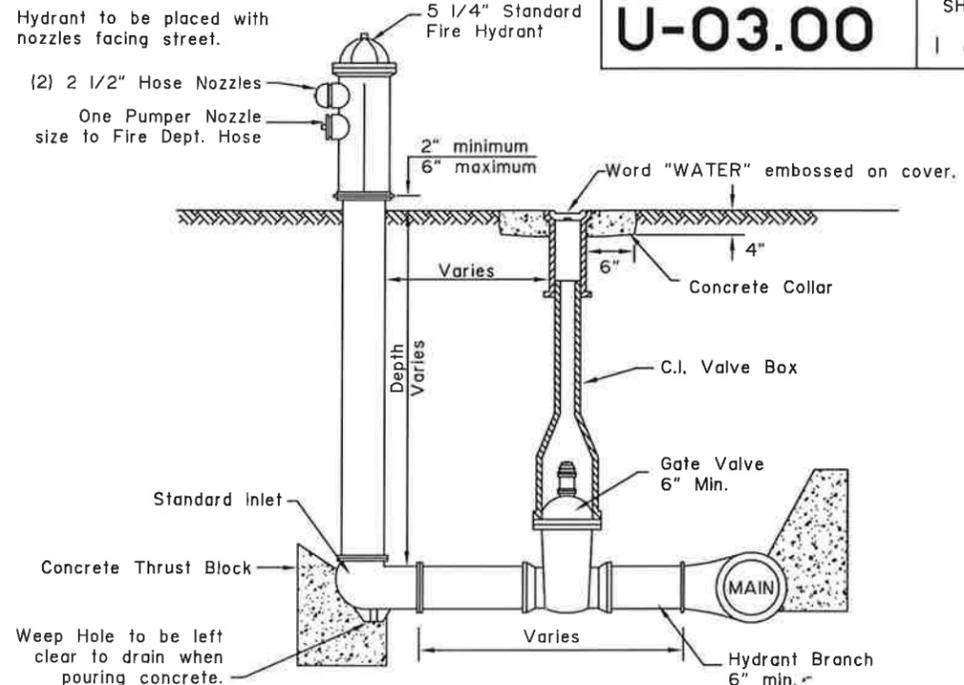


No bends shall exceed 11 1/4" between the hydrant and the main.

STANDARD HYDRANT

GENERAL NOTES:

1. Thrust blocks are to be concrete poured in place between the fitting and undisturbed trench wall.
2. Concrete shall be kept behind bell of fitting so as not to obstruct the joint.
3. Thrust blocks are required whenever pipe-line changes direction, changes size, dead ends, or develops thrust at valves.
4. Material, behind the thrust blocks, deemed inadequate by the engineer shall be removed and replaced by a ballast material, the extent and quality of replacement material to be determined by the engineer.
5. In impervious soils, a hole shall be dug beneath the hydrant thrust block to a minimum volume of 7 cubic feet. The hole shall be backfilled and compacted with a porous material acceptable to the engineer.
6. Refer to AWWA C600-64 Section II for placement of hydrant.
7. Concrete class shall be as directed by the engineer.

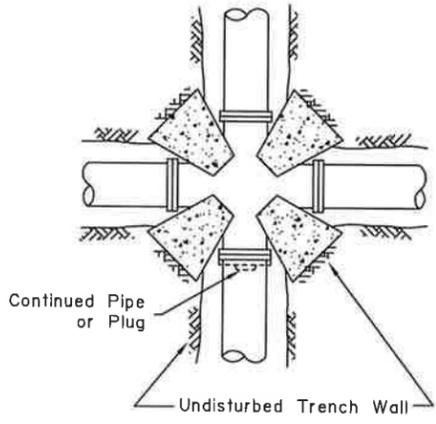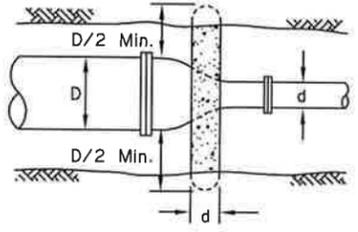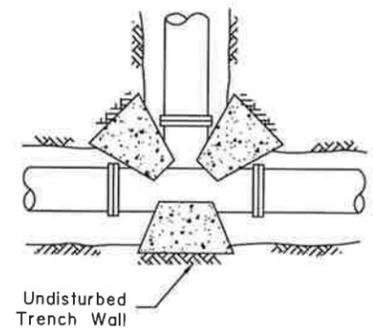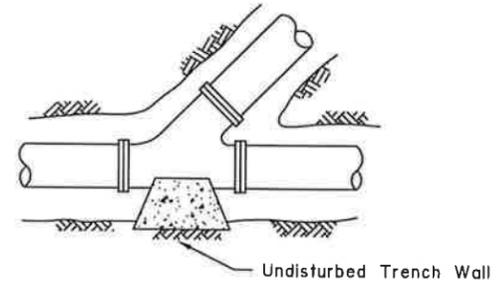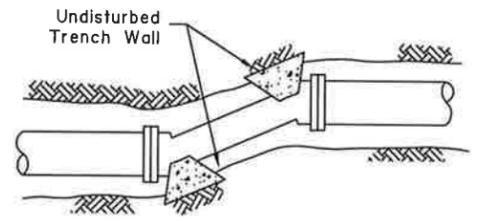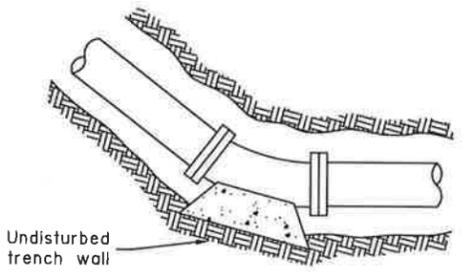

PLACEMENT OF THRUST BLOCKS

REVISIONS		
Date	Description	By

State of Alaska
Department of Transportation & Public Facilities
THRUST BLOCKS FOR WATER MAIN & HYDRANT

Project As Built Drawings Have Been Reviewed By The Project Engineer & Represent, To The Best Of My Knowledge, The Project As Constructed.

Proj. Eng. NB

Date 1/16/16

APPROVED

Date 7/15/82

CONSTRUCTION NOTES

- THE CONTRACTOR SHALL INSTALL NEW 2-ADTRAN VDSL SYSTEM & REMOVE THE FOLLOWING EXISTING VARIOUS AERIAL & UG TEL. CABLE FACILITIES FOR THE REHABILITATION OF WATER STREET BRIDGE:
 - AERIAL FIBER OPTIC CABLE, 48FOC, FWAT,37-60+24D'd;
 - AERIAL COPPER CABLE AEF100PR-26GA, K37,801-900;
 - UG COPPER CABLE AEB50-22, T02,1-25+51-75
 - UG COPPER CABLE AE1200-26, K37,1-800+100D'd+901-1075+125D'd; AND
 - UG COPPER CABLE AE1800-26, C03,1-1800.
- NO REMOVAL/MIGRATION OF EXISTING TELEPHONE COPPER AND FIBER CABLES OR SERVICES SHALL BE DONE UNLESS THE PROPOSED VDSL SYSTEM AT PARNELL ST AND BEAR VALLEY ARE IN FULL OPERATION.
- THE CONTRACTOR SHALL BE RESPONSIBLE TO CONSTRUCT A PAD MOUNT OF 72"x30" AT PARNELL ST AND TO INSTALL ADTRAN VDSL CABINET TA5000 INCLUDING PLACEMENT OF 1 EACH 17"x30" (TIER 22) HANDHOLE AS SHOWN IN PROPOSED VDSL LOCATION DETAIL, PRINT V18.
- THE CONTRACTOR SHALL BE RESPONSIBLE TO SET UP THE PROPOSED VDSL CABINET TA5000 SHELL & ITS ELECTRONIC DEVICES AT PARNELL ST INCLUDING TERMINATION OF PROPOSED 600 COPPER PAIRS INTO VDSL TERMINATION BLOCK.
- THE CONTRACTOR SHALL BE RESPONSIBLE TO INSTALL ELECTRONIC VDSL CARDS IN EXISTING CABINET SHELL AT SCHEONBAR RD & 3RD AVENUE BYPASS. UPON INSTALLATION OF ADTRAN ELECTONIC CARDS, THE CONTRACTOR SHALL DO THE CUTOVER OF ALL EXISTING ACTIVE LINES SERVING BEAR VALLEY HOMES FROM EXISTING COPPER CABLE C03, WHICH IS TO BE REMOVED, INTO NEW VDSL SYSTEM, CABINET X021.
- THE CONTRACTOR SHALL INSTALL NEW POWER METER AND SHALL BE RESPONSIBLE TO COORDINATE W/ KPU ELECTRIC ABOUT INSTALLATION STANDARDS & ITS PROPER LOCATION.
- THE CONTRACTOR SHALL INSTALL NEW 45' POLE AT PARNELL ST CORNER WATER ST INCLUDING ITS PROPOSED RISER PIPES.
- THE CONTRACTOR SHALL INSTALL VARIOUS SIZES OF NEW CONDUITS FROM NEW VDSL CABINET THROUGH EX. MH-18 & NEW HH (17"x30") TO NEW 45' POLE RISER, SEE NEW VDSL LOCATION ON PRINT V18.
- THE CONTRACTOR SHALL INSTALL NEW 16M STRAND WIRE FROM POLE 1334-B4-1 TO 1341-D4-5 AT A HEIGHT OF 26' MIN TO 30' MAX ALONG WATER ST.
- THE CONTRACTOR SHALL CONSTRUCT 1 EACH OF 16M DOWN GUY ON POLE 1334-B4-1 AND 2-EACH OF 16M SIDEWALK GUY ON POLE 1341-D4-5 ALONG WATER ST. SEE PRINTS V16 & V17.
- THE CONTRACTOR SHALL RE-LASH (DOUBLE LASH) EXISTING FIBER CABLE 48FOC, F02, AT A NEW HEIGHT OF 26' (MIN) TO 30' (MAX) CLEARANCE AND TO MAKE 150' SPLICE LOOPS ON POLES 1334-A4-1 & 1334-A5-4 AT WATER ST AFTER THE CABLE IS CUT AT SCHEONBAR ROAD, AS SHOWN ON PRINT V16, TO SPLICE IN NEW 6-PORT FIBER TERMINALS.
- THE CONTRACTOR SHALL INSTALL 8 EACH OF NEW 6-PORT FIBER POLE TERMINAL AND SPLICE INTO EXISTING FIBER CABLE 48FOC, F02, AS SHOWN ON PRINTS V16 TO V17.
- THE CONTRACTOR SHALL INSTALL 1500' NEW AIR PIPE AS SHOWN ON PRINTS V15 TO V17. THE CONTRACTOR SHALL ALSO BE RESPONSIBLE TO SPLICE IN THE NEW AIR PIPE TO EXISTING CABLE PRESSURIZATION SYSTEM INCLUDING THE TESTING. THE CONTRACTOR SHALL COORDINATE WITH KEN BERRY, KPU-TELECOM SPLICE HEAD CREW, OF ANY ATTACHMENT TO EXISTING KPU-TELECOM CABLE PRESSURIZATION SYSTEM.
- DUE TO CONSTRUCTION, AS A TEMP. SERVICE TO WATER STREET BRIDGE RESIDENTS, THE CONTRACTOR SHALL INSTALL NEW FIBER DROPS & ONT (30 UNITS, PER TABLE V2) TO ALL ACTIVE COPPER CUSTOMERS IN THE VICINITY TO CONVERT THEIR SERVICE TO FIBER PER V16 & V17. THE CONTRACTOR SHALL ALSO BE RESPONSIBLE TO REMOVE THEIR EX. COPPER DROPS & NIDS (21 UNITS), SEE CONST. NOTE No. 25. THE CONTRACTOR SHALL COORDINATE WITH JOHN BECK, KPU-TELECOM OSP FOREMAN, ABOUT KPU-TELECOM GUIDELINES IN THE INSTALLATION OF FIBER DROPS.
- THE CONTRACTOR SHALL COORDINATE WITH KPU-TELECOM INSPECTOR IN TRANSFERRING EXISTING TELEPHONE AERIAL CABLE FACILITIES FROM A HEIGHT OF 18-FOOT CLEARANCE TO A NEW HEIGHT OF 26- TO 30-FOOT HIGH AT WATER ST. THE CONTRACTOR SHALL ALSO REPLACE EXISTING COPPER & FIBER DROPS FROM EX. 18-FOOT HIGH EXISTING TERMINALS TO NEW HEIGHT OF COPPER & FIBER TERMINALS.
- THE CONTRACTOR SHALL COORDINATE WITH KPU-TELECOM BEFORE MIGRATING/CONVERTING ANY TELEPHONE SERVICE TO NEW SERVICE BOTH IN VDSL OR FIBER SYSTEM INCLUDING SERVICE DROPS REMOVAL THAT THERE **SHALL BE NO SERVICE INTERRUPTIONS** IN THE AREA.

KPU-TELECOM STAFF TO BE CONTACTED FOR MAINTENANCE WINDOW:

 - KEITH WADLEY - PLANT MANAGER
 - JOHN BECK - OSP FOREMAN
 - CARYN HOMAN - ISP FORMAN
 - JEFF HENDRICKSON - SENIOR C.O.N.T.
 - KEN BERRY - SPLICER HEAD CREW
- THE CONTRACTOR SHALL BE RESPONSIBLE FOR ALL THE REMOVAL OF CUT CABLES (BOTH COPPER & FIBER) BUT NOT LIMITED TO SERVICE DROPPINGS, STRAND WIRES AND OTHER POLE LINE HARDWARES.
- THE CONTRACTOR SHALL SPLICE THE FOLLOWING (AS CALL OUT IN PRINTS V3-V17 FROM BOAT 1 TO 60):
 - SPLICING OF NEW UG COPPER CABLES (900PR-24, 600PR-24G, AND 200PR-24GA) IN MH-18.
 - SPLICING OF NEW 200PR-24 CABLE TO EXISTING COPPER CABLES AT MILLAR ST CORNER PARNELL ST.
 - RE-SPLICING OF ALL EXISTING COPPER CABLES AND TERMINALS WHICH ARE AFFECTED BY CUTOVER FROM EXISTING K37 COPPER CABINET TO NEW X019 VDSL CABINET.
 - RE-SPLICING OF EXISTING FIBER CABLE, F02, AT SCHEONBAR RD AFTER THE CUT.
 - SPLICING OF NEW LONG TAIL FIBER TERMINALS (6-PORT) INTO EXISTING 48FOC, F02, ALONG WATER STREET
- ALL NEW INSTALLED TELEPHONE FACILITIES INCLUDING ALL NEW SPLICED CABLES (COPPER & FIBER) SHALL BE DONE PER KPU-TELECOM STANDARD.
- THE CONTRACTOR SHALL BE RESPONSIBLE TO VERIFY AND TEST IN THE FIELD ALL CABLE PAIRS/COUNTS IF THERE'S NO ACTIVE WORKER(S) IN THE CABLE BEFORE CUTTING IT OFF FOR REMOVAL.
- THE CONTRACTOR SHALL INSTALL NEW DOUBLE ARM 10-PIN ALLEY ON THE FOLLOWING POLES (SEE PRINT V17):
 - PROPOSED 45' HIGH POLE AT PARNELL AND WATER STREETS;
 - POLE 1342-A4-3 AT WATER AND GORGE STREETS; AND
 - POLE 1341-D4-5 IN FRONT OF 1251 WATER STREET.
- THE CONTRACTOR SHALL BE RESPONSIBLE FOR THE CONVERSION OF SERVICE DROPS OF HOUSES ALONG WATER STREET BRIDGE FROM COPPER TO FIBER AS MENTIONED IN CONST. NOTE No. 26 & TABLE V2, RESPECTIVELY. ALL DROPS FED FROM EXISTING COPPER TERMINAL OF CABLE K37 WILL BE REMOVED AND NEW FIBER DROPS WILL BE INSTALL FROM FIBER CABLE F02 AS SHOWN ON PRINTS V16 & V17. THIS INCLUDES THE MIGRATION OF EXISTING FIBER DROPS FROM FWAT CABLE TO F02.
- UPON COMPLETION OF THIS PROJECT, THE CONTRACTOR SHALL PERFORM A CABLE (COPPER & FIBER) TESTING WITH KPU-TELECOM INSPECTOR AND A 100% PASSED ON CABLE TESTING SHALL BE SUBMITTED TO KPU-TELECOM FOR ACCEPTANCE & APPROVAL OF THE PROJECT INCLUDING REDLINE AS-BUILT PLANS SIGNED BY THE KPU-TELECOM INSPECTOR, CONTRACTOR MANAGER AND DOT PROJECT ENGINEER/REPRESENTATIVE.
- WHERE NEW CABLE LENGTHS ARE CALLED OUT, THIS IS A PRELIMINARY LENGTH - ADD 10% SPARE LENGTH FOR ESTIMATING PURPOSES, PROVIDE ACTUAL CABLE LENGTH AS REQUIRED FOR CONSTRUCTION.
- THE CONTRACTOR SHALL BE RESPONSIBLE FOR THE REMOVAL OF EX. 6-PAIR COPPER SERVICE DROPS FROM THE FOLLOWING ADDRESS PER TERMINAL NO.:
 - TWTR-1626 ON POLE 1334-B4-1:**
 - 1628 WATER STREET
 - 1626 WATER STREET
 - 1627 WATER STREET
 - 1622 WATER STREET APT. MID.
 - TWTR-1610 ON POLE 1334-A4-2:**
 - 1617 WATER STREET
 - 1611 WATER STREET
 - 1610 WATER STREET
 - 1608 WATER STREET APT. UPR
 - TWTR-1600 ON POLE 1334-A4-1:**
 - 1600 WATER STREET
 - 1528 WATER STREET
 - 1610 WATER STREET
 - TWTR-1508 ON POLE 1334-A5-5:**
 - 1508 WATER STREET APT. UPR 2
 - 200 WILEY STREET
 - TWTR-1462 ON POLE 1334-A5-4:**
 - 1462 WATER STREET APT. UPR
 - 1454 WATER STREET
 - TWTR-1446 ON POLE 1342-B4-5:**
 - 1442 WATER STREET
 - TWTR-1418 ON POLE 1342-B4-4:**
 - 1426 WATER STREET
 - 1418 WATER STREET
 - TWTR-1400 ON POLE 1342-B4-3 (WHICH IS TO BE REMOVED):**
 - 1412 WATER STREET
 - 1400 WATER STREET
 - 1320 WATER STREET
 - 1321 WATER STREET
- THE CONTRACTOR SHALL ALSO BE RESPONSIBLE FOR PLACEMENT OF FIBER DROPS FROM NEW TERMINALS TO ALL HOUSES INDICATED ON TABLE V2. THIS WORKS INCLUDE THE INSTALLATION OF ONT (OPTICAL NETWORK TERMINAL) PER ADDRESS TO TERMINATE THE FIBER DROP.
- FROM ONT, KPU TELECOM WILL BE RESPONSIBLE TO MIGRATE THE SERVICES TO HOUSE NUMBERS SHOWN ON TABLE V2.
- FOR INFORMATION ONLY, DOT & KPU TELECOM WILL ADDRESS THE CONNECTIVITY BETWEEN MH-17 & MH-18 IN THE NEXT PHASE OF THE PROJECT (WATER SHEET BRIDGE).
- SEE NOTE IN NOMENCLATURE FOR THE WORD "PROP." OR "PROPOSED".

NOMENCLATURE

NOTE: ALL STATEMENTS WITH THE WORD "PROP." OR "PROPOSED" IN THIS ENG'G. PLAN MEAN NEW AND NEED TO BE INSTALLED.

2421.1 6P
PROP. POLE TERM. FWTR-1626 41-44 +2D'd

—, TERMINAL SYMBOL; BOLD LINE MEANS PROPOSED.

2421.1, A 2421 NUMBER IS AN FCC CODE THAT MEANS AERIAL FACILITIES & DOT (.) 1 MEANS FIBER SYSTEM.

PROP. POLE TERM., A DESCRIPTION OF PROPOSED TERMINAL TYPE TO BE INSTALLED.

FWTR-1626, ASSIGNED TERMINAL NUMBER, THE VERY FIRST LETTER "F" MEANS FIBER.

6P, NUMBER OF TERMINAL FIBER PORT

41-44+2D'd, FIBER COUNTS 41 TO 44 TO BE SPLICED INTO THE TERMINAL & 2 PORTS WOULD NOT BE USED.

2421.2 25
PROP. POLE TERM. TWTR-1320 17D'd+ 393-400

2421.2, A 2421 NUMBER IS AN FCC CODE THAT MEANS AERIAL FACILITIES & DOT (.) 2 MEANS COPPER SYSTEM.

PROP. POLE TERM., A DESCRIPTION OF PROPOSED TERMINAL TYPE TO BE USED.

TWTR-1320, PROPOSED ASSIGNED TERMINAL NUMBER, THE VERY FIRST LETTER "T" MEANS COPPER.

25, A 25-PAIR COPPER TERMINAL

17D'd+393-400, 17 PAIRS DEAD MEANS WILL NOT BE USED & COPPER PAIRS 393 TO 400 TO BE SPLICED INTO THE TERMINAL.

P, SYMBOL FOR CABLE PLUG STUB, EP-10A1.

2, SPLICING ACTIVITY NUMBER

FWTR-1626 4 53-56
TO BE REMOVED, EX. TERMINAL TO BE REMOVED OR TAKEN DOWN.

2422.2 AE1800-26 (16M)
C03,1-1800
TO BE REMOVED

2422.2, A 2422 NUMBER IS AN FCC CODE THAT MEANS U.G. FACILITIES & DOT (.) 1 MEANS FIBER CABLE; 2 MEANS COPPER.

AE1800-26, EXISTING CABLE SIZE & GAUGE TO BE REMOVED.

(16M), MESSENGER WIRE SIZE WHERE CABLE IS PRESENTLY LASHED.

C03,1-1800, C03 IS CABLE NUMBER & 1-1800 WORKING PAIRS.

[], BOLD BRACKETS MEANS FOR REMOVAL.

MB AEF25-24
[K37,251-268+D'd]
X019,20D'd+171-175

MB AEF25-24, TYPE OF EXISTING CABLE, SIZE & GAGE TO BE RE-SPLICED TO NEW CABLE NUMBER OR PAIRS.

[K37,251-268+D'd], EXISTING CABLE NUMBER & PAIRS TO BE CHANGED.

X019,20D'd+171-175, PROP. CABLE NUMBER & PAIRS TO BE USED.

TABLE V2 - COVERED ADDRESSES PER NEW & EXISTING FIBER TERMINAL

NEW TERMINAL NO.	TERM. LOCATION	COVERED ADDRESSES
FWTR-1626 (6-PORT) F02, 41-46	POLE 1334-B4-1 ALONG WATER STREET	1628 WATER STREET
		1626 WATER STREET
		1627 WATER STREET
		1622-A WATER STREET
		1622-B WATER STREET
		1622-C WATER STREET

NEW TERMINAL NO.	TERM. LOCATION	COVERED ADDRESSES
FWTR-1610 (6-PORT) F02, 35-40+2D'd	POLE 1334-A4-2 ALONG WATER STREET	1617 WATER STREET
		1611 WATER STREET
		1610 WATER STREET
		1608-A WATER STREET
		1608-B WATER STREET

NEW TERMINAL NO.	TERM. LOCATION	COVERED ADDRESSES
FWTR-1600 (6-PORT) F02, 45-48+4D'd	POLE 1334-A4-1 ALONG WATER STREET	1600 WATER STREET
		1528 WATER STREET

NEW TERMINAL NO.	TERM. LOCATION	COVERED ADDRESSES
FWTR-1508 (6-PORT) F02, 33-36+2D'd	POLE 1334-A5-5 ALONG WATER STREET	1508-A WATER STREET
		1508-B WATER STREET
		200 WILEY STREET

NEW TERMINAL NO.	TERM. LOCATION	COVERED ADDRESSES
FWTR-1462 (6-PORT) F02, 25-28+2D'd	POLE 1334-A5-4 ALONG WATER STREET	1462-A WATER STREET
		1462-B WATER STREET
		1454 WATER STREET

NEW TERMINAL NO.	TERM. LOCATION	COVERED ADDRESSES
FWTR-1446 (6-PORT) F02, 29-32+2D'd	POLE 1342-B4-5 ALONG WATER STREET	1446-A WATER STREET
		1446-B WATER STREET
		1442 WATER STREET

NEW TERMINAL NO.	TERM. LOCATION	COVERED ADDRESSES
FWTR-1418 (6-PORT) F02, 21-24+2D'd	POLE 1342-B4-4 ALONG WATER STREET	1426 WATER STREET
		1418 WATER STREET
		1418.5 WATER STREET

NEW TERMINAL NO.	TERM. LOCATION	COVERED ADDRESSES
FWTR-1400 (6-PORT) F02, 17-20+2D'd	NEW POLE 45' ALONG WATER STREET	1412 WATER STREET
		1320 WATER STREET
		1321 WATER STREET
		NEW VDSL CABINET

EXISTING TERMINAL NO.	TERM. LOCATION	COVERED ADDRESSES
FPAR-0302 (4-PORT) FWAT, 1D'd+146 +155-156	POLE 1342-A4-1 ALONG PARNELL STREET	210 PARNELL STREET
		1400 WATER STREET

PATH: CAUSERS\KCN12_000\DOCUMENTS\10-KNEE\2013 DESIGN\13DWG\10-NTPS TRUNK RELOCATION\KPU-T PSE 140827 DOT PERFORM FILE FOR WSBIDWG FILE FOR REPLACEMENT OF VDSL CABINETS FOR DOT WSBIDWG\10-NTPS TRUNK PSE 140827.DWG

Project As Built Drawings Have Been Reviewed By The Project Engineer & Represent, To The Best Of My Knowledge, The Project As Constructed.

Proj. Eng. NB

Date 1/10/16

SYMBOL	DESCRIPTION
---	PROP. AERIAL FOC
---	PROP. FOC LONG TAIL TERM.
---	PROP. AERIAL COPPER CA.
---	EXISTING AERIAL FOC
---	EX. FOC LONG TAIL TERM.
---	EX. AERIAL COPPER CA.
---	EX. AER. FOC TO BE REMOVED
---	EX. FOC LONG TAIL TO BE REMOVED
---	EX. COPPER CABLE TO BE REMOVED
⊗	PROPOSED POLE
⊗	EXISTING POLE
⊗	PROP. DOUBLE X-ARM ON PROP. POLE
⊗	EX. POLE & EX. DOUBLE X-ARM TO BE REMOVED
⊗	EX. POLE & EX. SINGLE X-ARM OR ALLEY-ARM TO BE REMOVED
⊗	EX. DOUBLE X-ARM ON EX. POLE
⊗	EX. SINGLE X-ARM OR ALLEY-ARM ON EX. POLE
⊗	EX. GUY & ANCHOR TO BE REMOVED
⊗	PROP. GUY & ANCHOR WITH PROP. LEAD
⊗	EXISTING FIBER SLACK LOOP
⊗	PROP. FIBER SLACK LOOP
⊗	EX. AER. FIBER TERMINAL
⊗	EX. AER. COPPER TERMINAL
⊗	EX. FOC SPLICE POINT
⊗	PROP. SPLICE ON EX. FIBER SPLICE POINT

CHECKED BY: KCN



DESIGNED BY: R. MOJE

DRAWN BY: R. MOJE

STATE OF ALASKA DEPARTMENT OF TRANSPORTATION & PUBLIC FACILITIES SOUTHEAST REGION


KETCHIKAN ADVANCE WATER STREET TRUNK LINE RELOCATION PROJECT # 69548

TELEPHONE CABLE LAYOUT

PROJECT DESIGNATION BR-000S(735) ~ 69548

STATE ALASKA YEAR 2014

SHEET NUMBER V2 TOTAL SHEETS 78

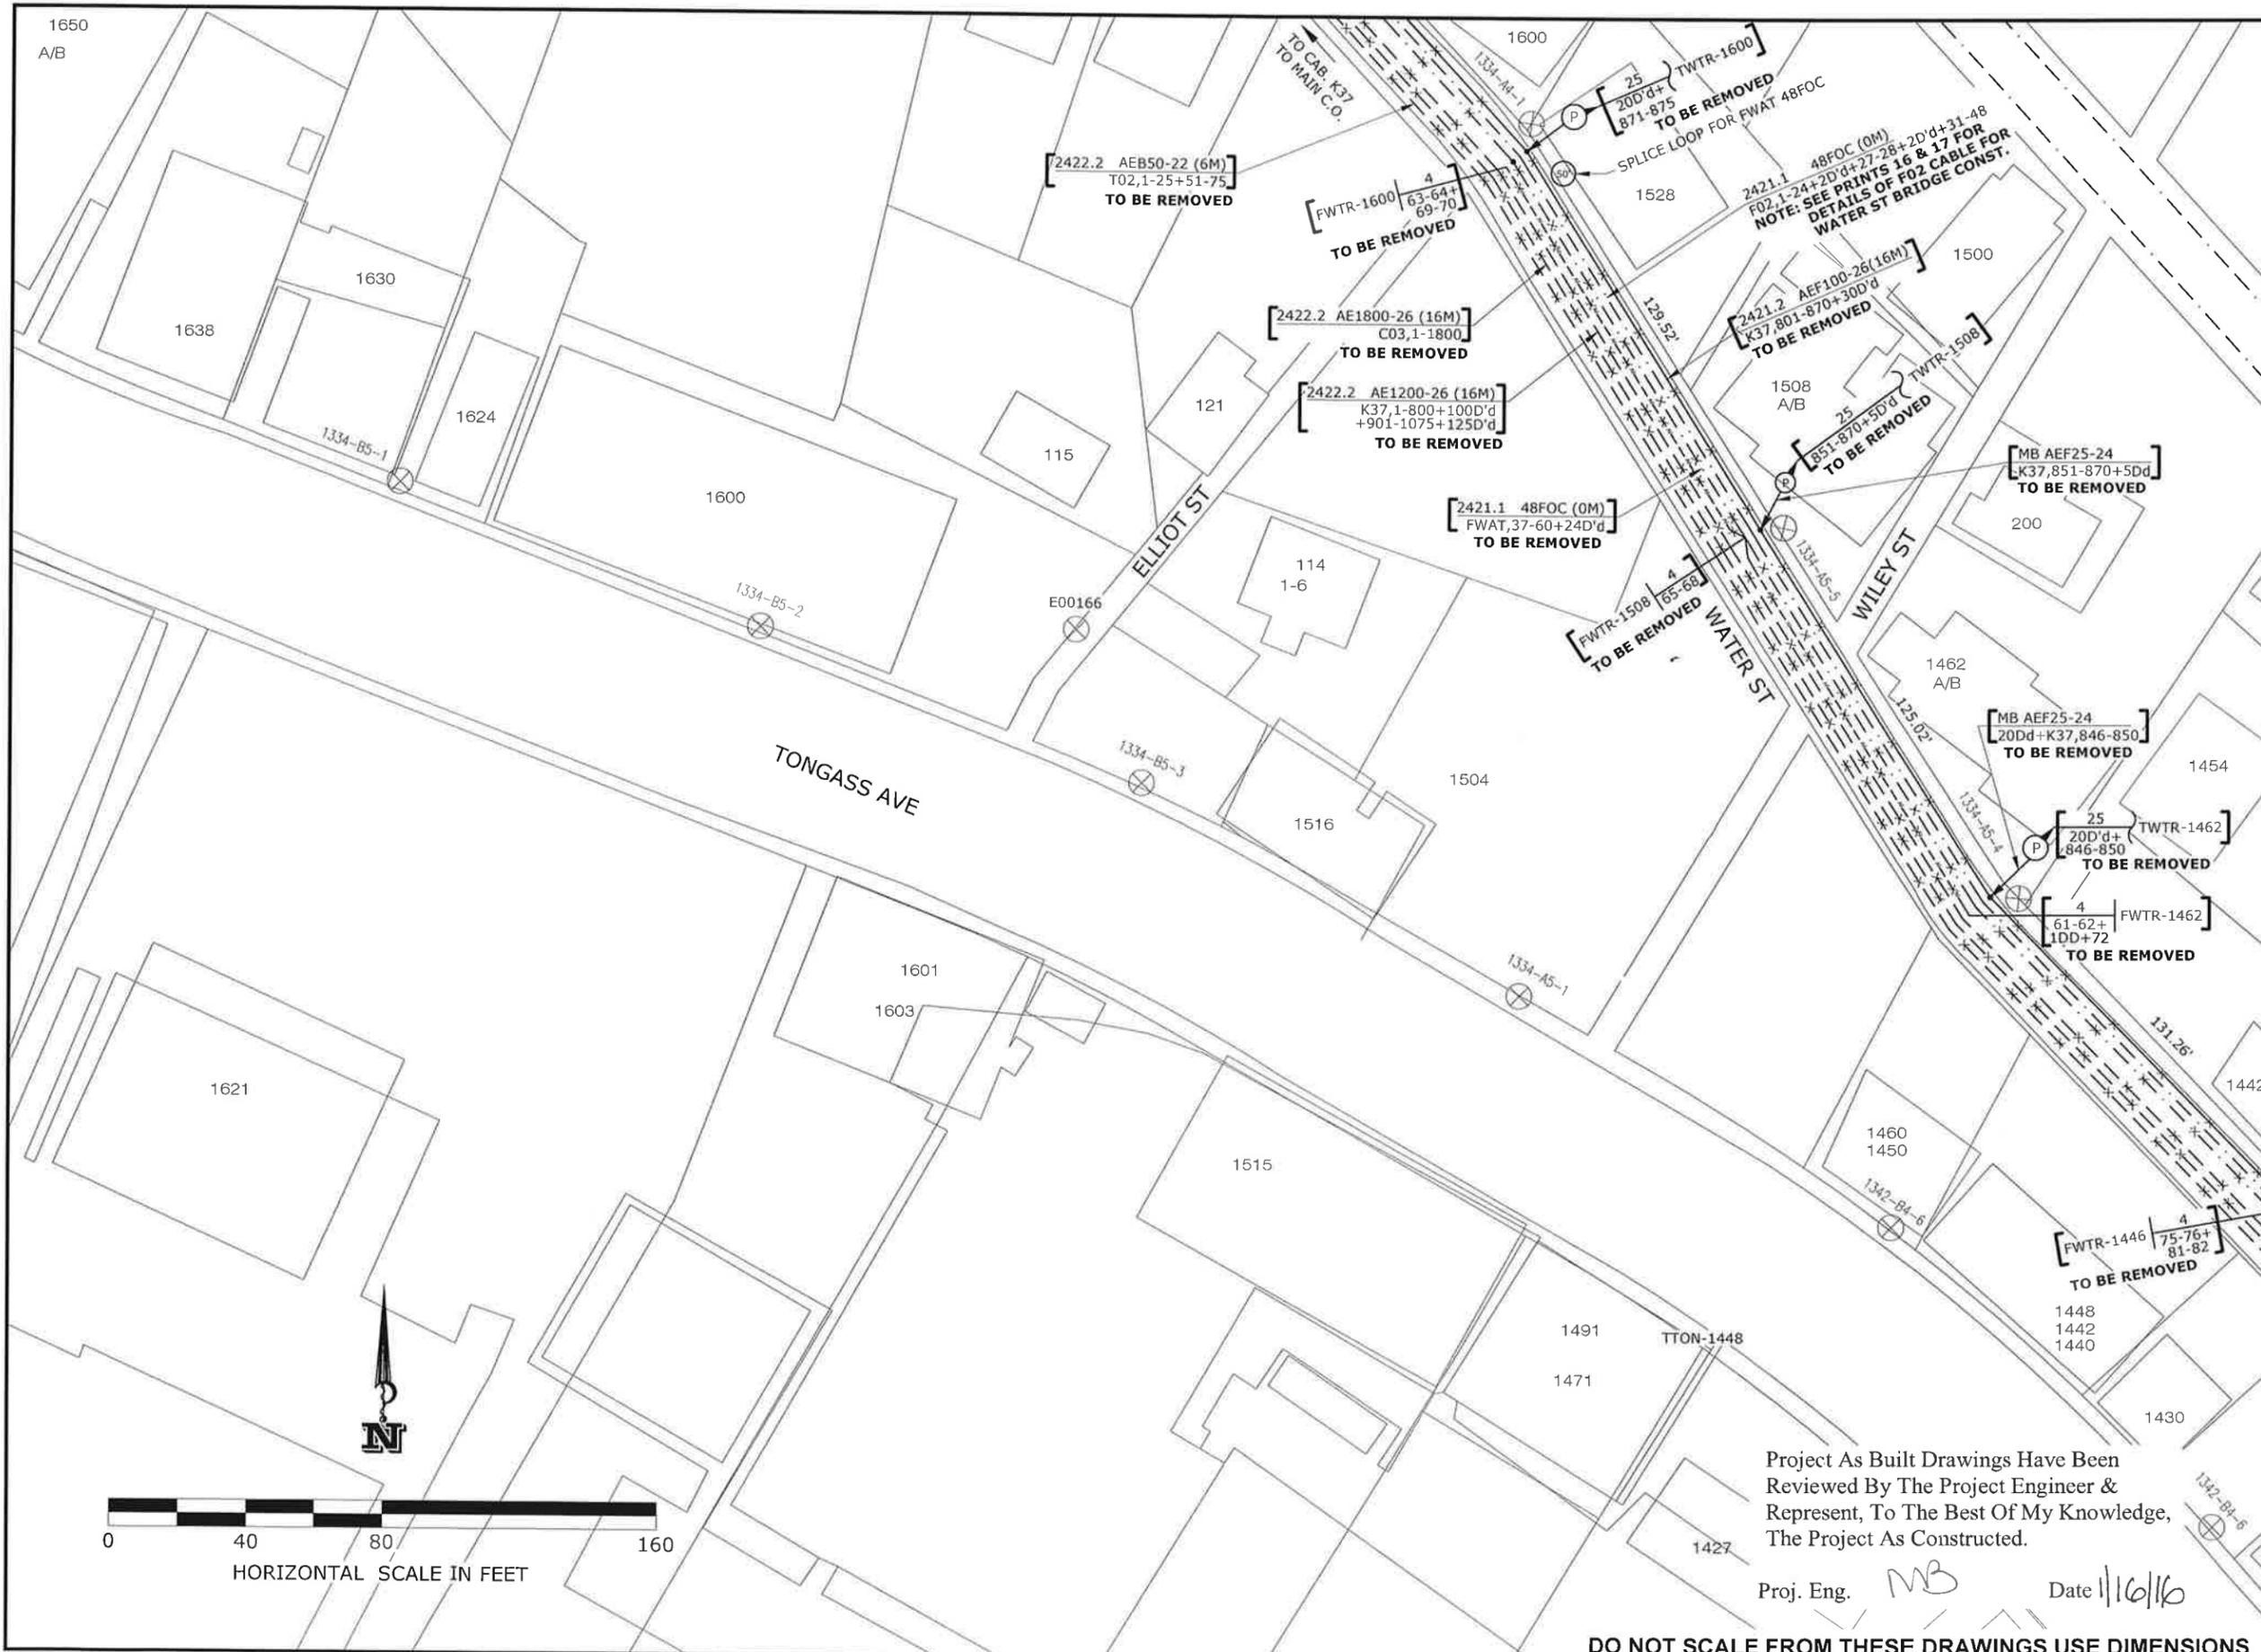

PATH: C:\USERS\KCN12_000\DOCUMENTS\10-KNEE\013
 DESIGN: 3D\DWG\10-NTP8 TRUNK
 RELOCATION\KPL1-T PE 140827.DOT
 KETCHIKAN FILE FOR WSBID\DWG FILE FOR
 WSBID\PLACEMENT OF VDSL CABINETS FOR
 DOT WSBID PROJECTS
 TAB: WSBID PROJECTS

ADDENDUM NUMBER		
ATTACHMENT NUMBER		
RECORD OF REVISIONS		
No.	DATE	DESCRIPTION

- PLAN LEGEND**
- PROP. AERIAL FOC
 - PROP. FOC LONG TAIL TERM.
 - PROP. AERIAL COPPER CA.
 - EXISTING AERIAL FOC
 - EX. FOC LONG TAIL TERM.
 - EX. AERIAL COPPER CA.
 - EX. AER. FOC TO BE REMOVED
 - EX. FOC LONG TAIL TO BE REMOVED
 - EX. COPPER CABLE TO BE REMOVED
 - ⊗ PROPOSED POLE
 - ⊗ EXISTING POLE
 - ⊗ PROP. DOUBLE X-ARM ON PROP. POLE
 - ⊗ EX. POLE & EX. DOUBLE X-ARM TO BE REMOVED
 - ⊗ EX. POLE & EX. SINGLE X-ARM OR ALLEY-ARM TO BE REMOVED
 - ⊗ EX. DOUBLE X-ARM ON EX. POLE
 - ⊗ EX. SINGLE X-ARM OR ALLEY-ARM ON EX. POLE
 - ⊗ EX. GUY & ANCHOR TO BE REMOVED
 - ⊗ PROP. GUY & ANCHOR with PROP. LEAD
 - ⊗ EXISTING FIBER SLACK LOOP
 - ⊗ PROP. FIBER SLACK LOOP
 - ⊗ EX. AER. FIBER TERMINAL
 - ⊗ EX. AER. COPPER TERMINAL
 - EX. FOC SPICE POINT
 - PROP. SPICE ON EX. FIBER SPICE POINT

CHECKED BY: KCN

DESIGNED BY: R. MOJE
 DRAWN BY: R. MOJE

STATE OF ALASKA
 DEPARTMENT OF TRANSPORTATION
 & PUBLIC FACILITIES
 SOUTHEAST REGION

KETCHIKAN ADVANCE
 WATER STREET TRUNK LINE
 RELOCATION
 PROJECT # 69548


**TELEPHONE
 CABLE LAYOUT**

PROJECT DESIGNATION	
BR-000S(735) ~ 69548	
STATE	YEAR
ALASKA	2014
SHEET NUMBER	TOTAL SHEETS
V4	78


Project As Built Drawings Have Been Reviewed By The Project Engineer & Represent, To The Best Of My Knowledge, The Project As Constructed.

Proj. Eng. *MB* Date *11/6/16*

DO NOT SCALE FROM THESE DRAWINGS USE DIMENSIONS

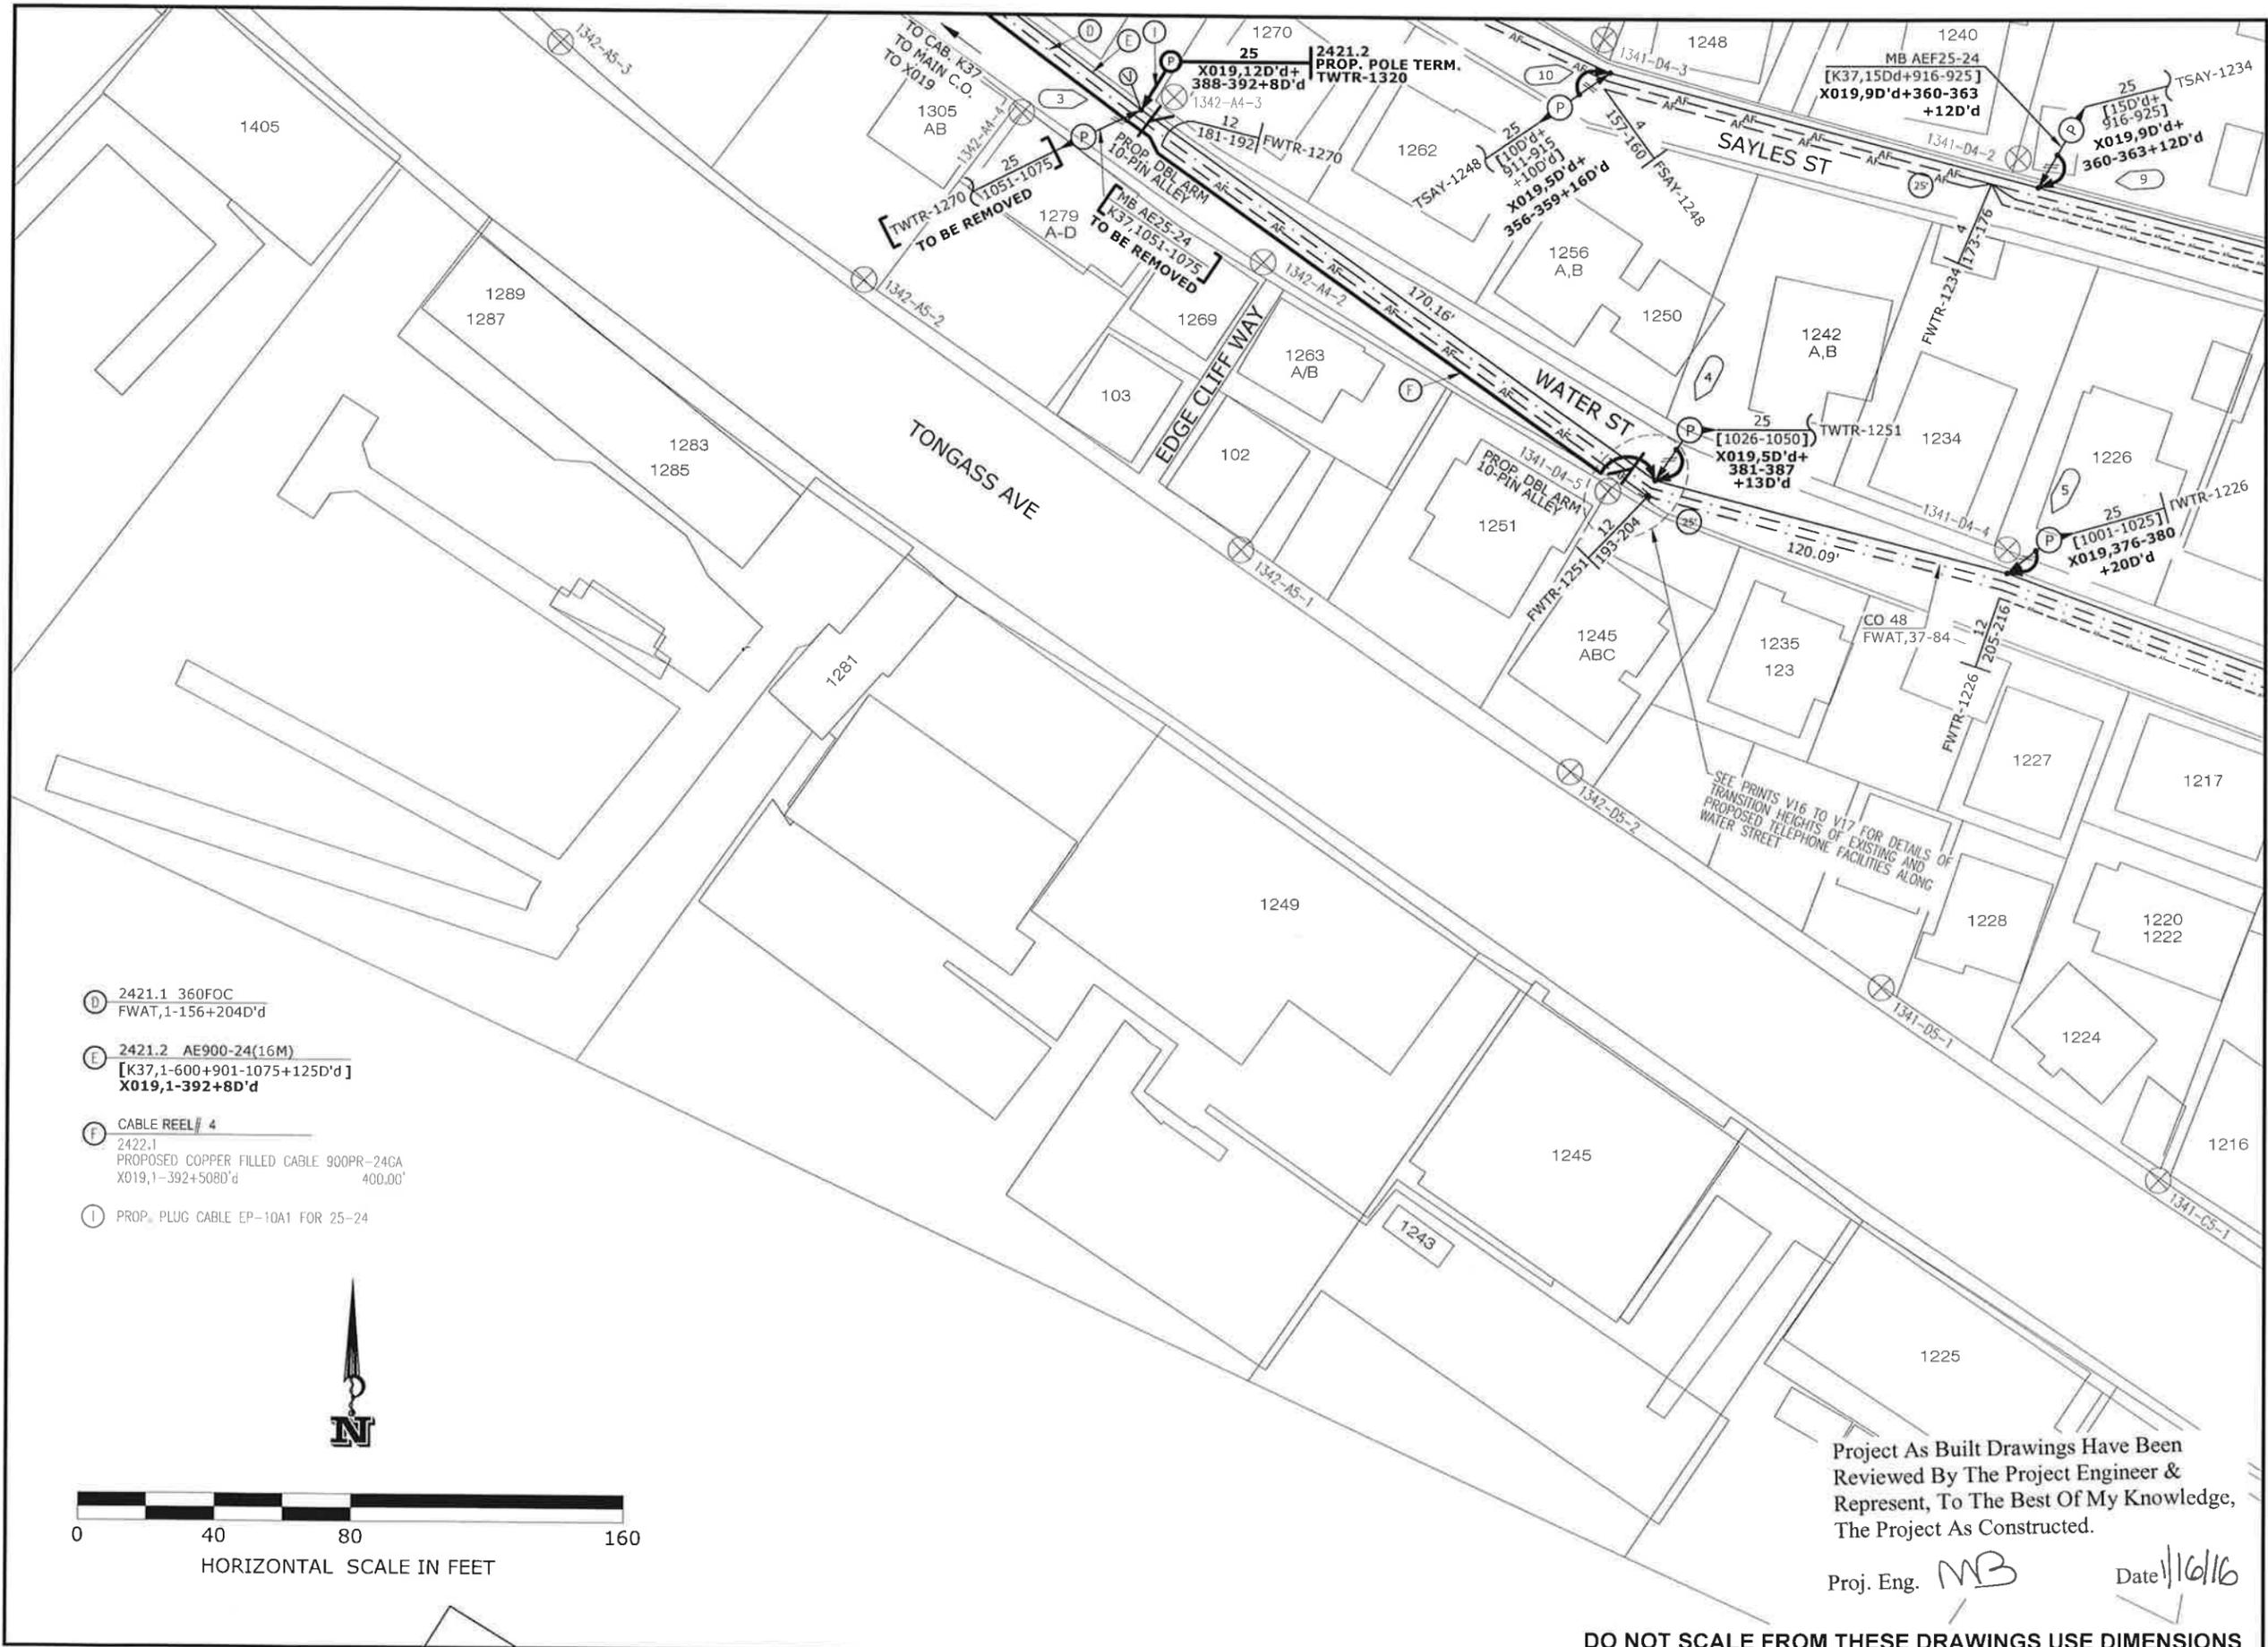

- D 2421.1 360FOC
FWAT,1-156+204D'd
- E 2421.2 AE900-24(16M)
[K37,1-600+901-1075+125D'd]
X019,1-392+8D'd
- F CABLE REEL # 4
2422.1
PROPOSED COPPER FILLED CABLE 900PR-24GA
X019,1-392+508D'd 400.00'
- I PROP. PLUG CABLE EP-10A1 FOR 25-24

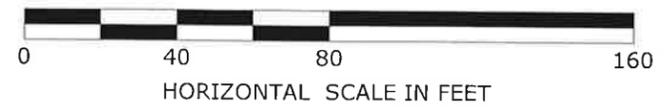

Project As Built Drawings Have Been Reviewed By The Project Engineer & Represent, To The Best Of My Knowledge, The Project As Constructed.

Proj. Eng. *MB* Date *1/16/16*

DO NOT SCALE FROM THESE DRAWINGS USE DIMENSIONS

PATH: C:\USERS\KCN12_000\DOCUMENTS\16-KNEE\013
 DESIGN\3\DWG\0-NTP9 TRUNK
 RELOCATION\KIP-T PSE 140827 DOT
 CABLE FILE FOR WSL\DWG FILE FOR
 KIP-T PSE\PLACEMENT OF VDSL CABINETS FOR
 KIP-T PSE PROJECT\DWG
 TAB: V6
 1/16/2016 12:49:32 PM

ADDENDUM NUMBER		
ATTACHMENT NUMBER		
RECORD OF REVISIONS		
No.	DATE	DESCRIPTION

- PROP. AERIAL FOC
- PROP. FOC LONG TAIL TERM.
- PROP. AERIAL COPPER CA.
- EXISTING AERIAL FOC
- EX. FOC LONG TAIL TERM.
- EX. AERIAL COPPER CA.
- x-x-x- EX. AER. FOC TO BE REMOVED
- x-x-x- EX. FOC LONG TAIL TO BE REMOVED
- x-x-x- EX. COPPER CABLE TO BE REMOVED
- ⊗ PROPOSED POLE
- ⊗ EXISTING POLE
- ⊗ PROP. DOUBLE X-ARM ON PROP. POLE
- ⊗ EX. POLE & EX. DOUBLE X-ARM TO BE REMOVED
- ⊗ EX. POLE & EX. SINGLE X-ARM OR ALLEY-ARM TO BE REMOVED
- ⊗ EX. DOUBLE X-ARM ON EX. POLE
- ⊗ EX. SINGLE X-ARM OR ALLEY-ARM ON EX. POLE
- ⊗ EX. GUY & ANCHOR TO BE REMOVED
- ⊗ PROP. GUY & ANCHOR with PROP. LEAD
- ⊗ EXISTING FIBER SLACK LOOP
- ⊗ PROP. FIBER SLACK LOOP
- ⊗ EX. AER. FIBER TERMINAL
- ⊗ EX. AER. COPPER TERMINAL
- EX. FOC SPLICE POINT
- PROP. SPLICE ON EX. FIBER SPLICE POINT

PLAN LEGEND

CHECKED BY: KCN



DESIGNED BY: R. MOJE
 DRAWN BY: R. MOJE

STATE OF ALASKA
 DEPARTMENT OF TRANSPORTATION
 & PUBLIC FACILITIES
 SOUTHEAST REGION

KETCHIKAN ADVANCE
 WATER STREET TRUNK LINE
 RELOCATION
 PROJECT # 69548

**TELEPHONE
 CABLE LAYOUT**

PROJECT DESIGNATION
BR-000S(735) ~ 69548

STATE	YEAR
ALASKA	2014

SHEET NUMBER	TOTAL SHEETS
V6	78

ADDENDUM NUMBER		
ATTACHMENT NUMBER		
RECORD OF REVISIONS		
No.	DATE	DESCRIPTION

- PROP. AERIAL FOC
- PROP. FOC LONG TAIL TERM.
- PROP. AERIAL COPPER CA.
- EXISTING AERIAL FOC
- EX. FOC LONG TAIL TERM.
- EX. AERIAL COPPER CA.
- *- EX. AER. FOC TO BE REMOVED
- *- EX. FOC LONG TAIL TO BE REMOVED
- *- EX. COPPER CABLE TO BE REMOVED
- ⊗ PROPOSED POLE
- ⊗ EXISTING POLE
- ⊗ PROP. DOUBLE X-ARM ON PROP. POLE
- ⊗ EX. POLE & EX. DOUBLE X-ARM TO BE REMOVED
- ⊗ EX. POLE & EX. SINGLE X-ARM OR ALLEY-ARM TO BE REMOVED
- ⊗ EX. DOUBLE X-ARM ON EX. POLE
- ⊗ EX. SINGLE X-ARM OR ALLEY-ARM ON EX. POLE
- ⊗ EX. GUY & ANCHOR TO BE REMOVED
- ⊗ PROP. GUY & ANCHOR with PROP. LEAD
- ⊗ L=21'
- ⊗ EXISTING FIBER SLACK LOOP
- ⊗ PROP. FIBER SLACK LOOP
- ⊗ EX. AER. FIBER TERMINAL
- ⊗ EX. AER. COPPER TERMINAL
- ⊗ EX. FOC SPLICE POINT
- ⊗ PROP. SPLICE ON EX. FIBER SPLICE POINT

PLAN LEGEND

CHECKED BY: KCN




DESIGNED BY: R. MOJE
 DRAWN BY: R. MOJE

STATE OF ALASKA
 DEPARTMENT OF TRANSPORTATION
 & PUBLIC FACILITIES
 SOUTHEAST REGION

KETCHIKAN ADVANCE
 WATER STREET TRUNK LINE
 RELOCATION
 PROJECT # 69548


**TELEPHONE
 CABLE LAYOUT**

PROJECT DESIGNATION	
BR-000S(735) ~ 69548	
STATE	YEAR
ALASKA	2014
SHEET NUMBER	TOTAL SHEETS
V8	78

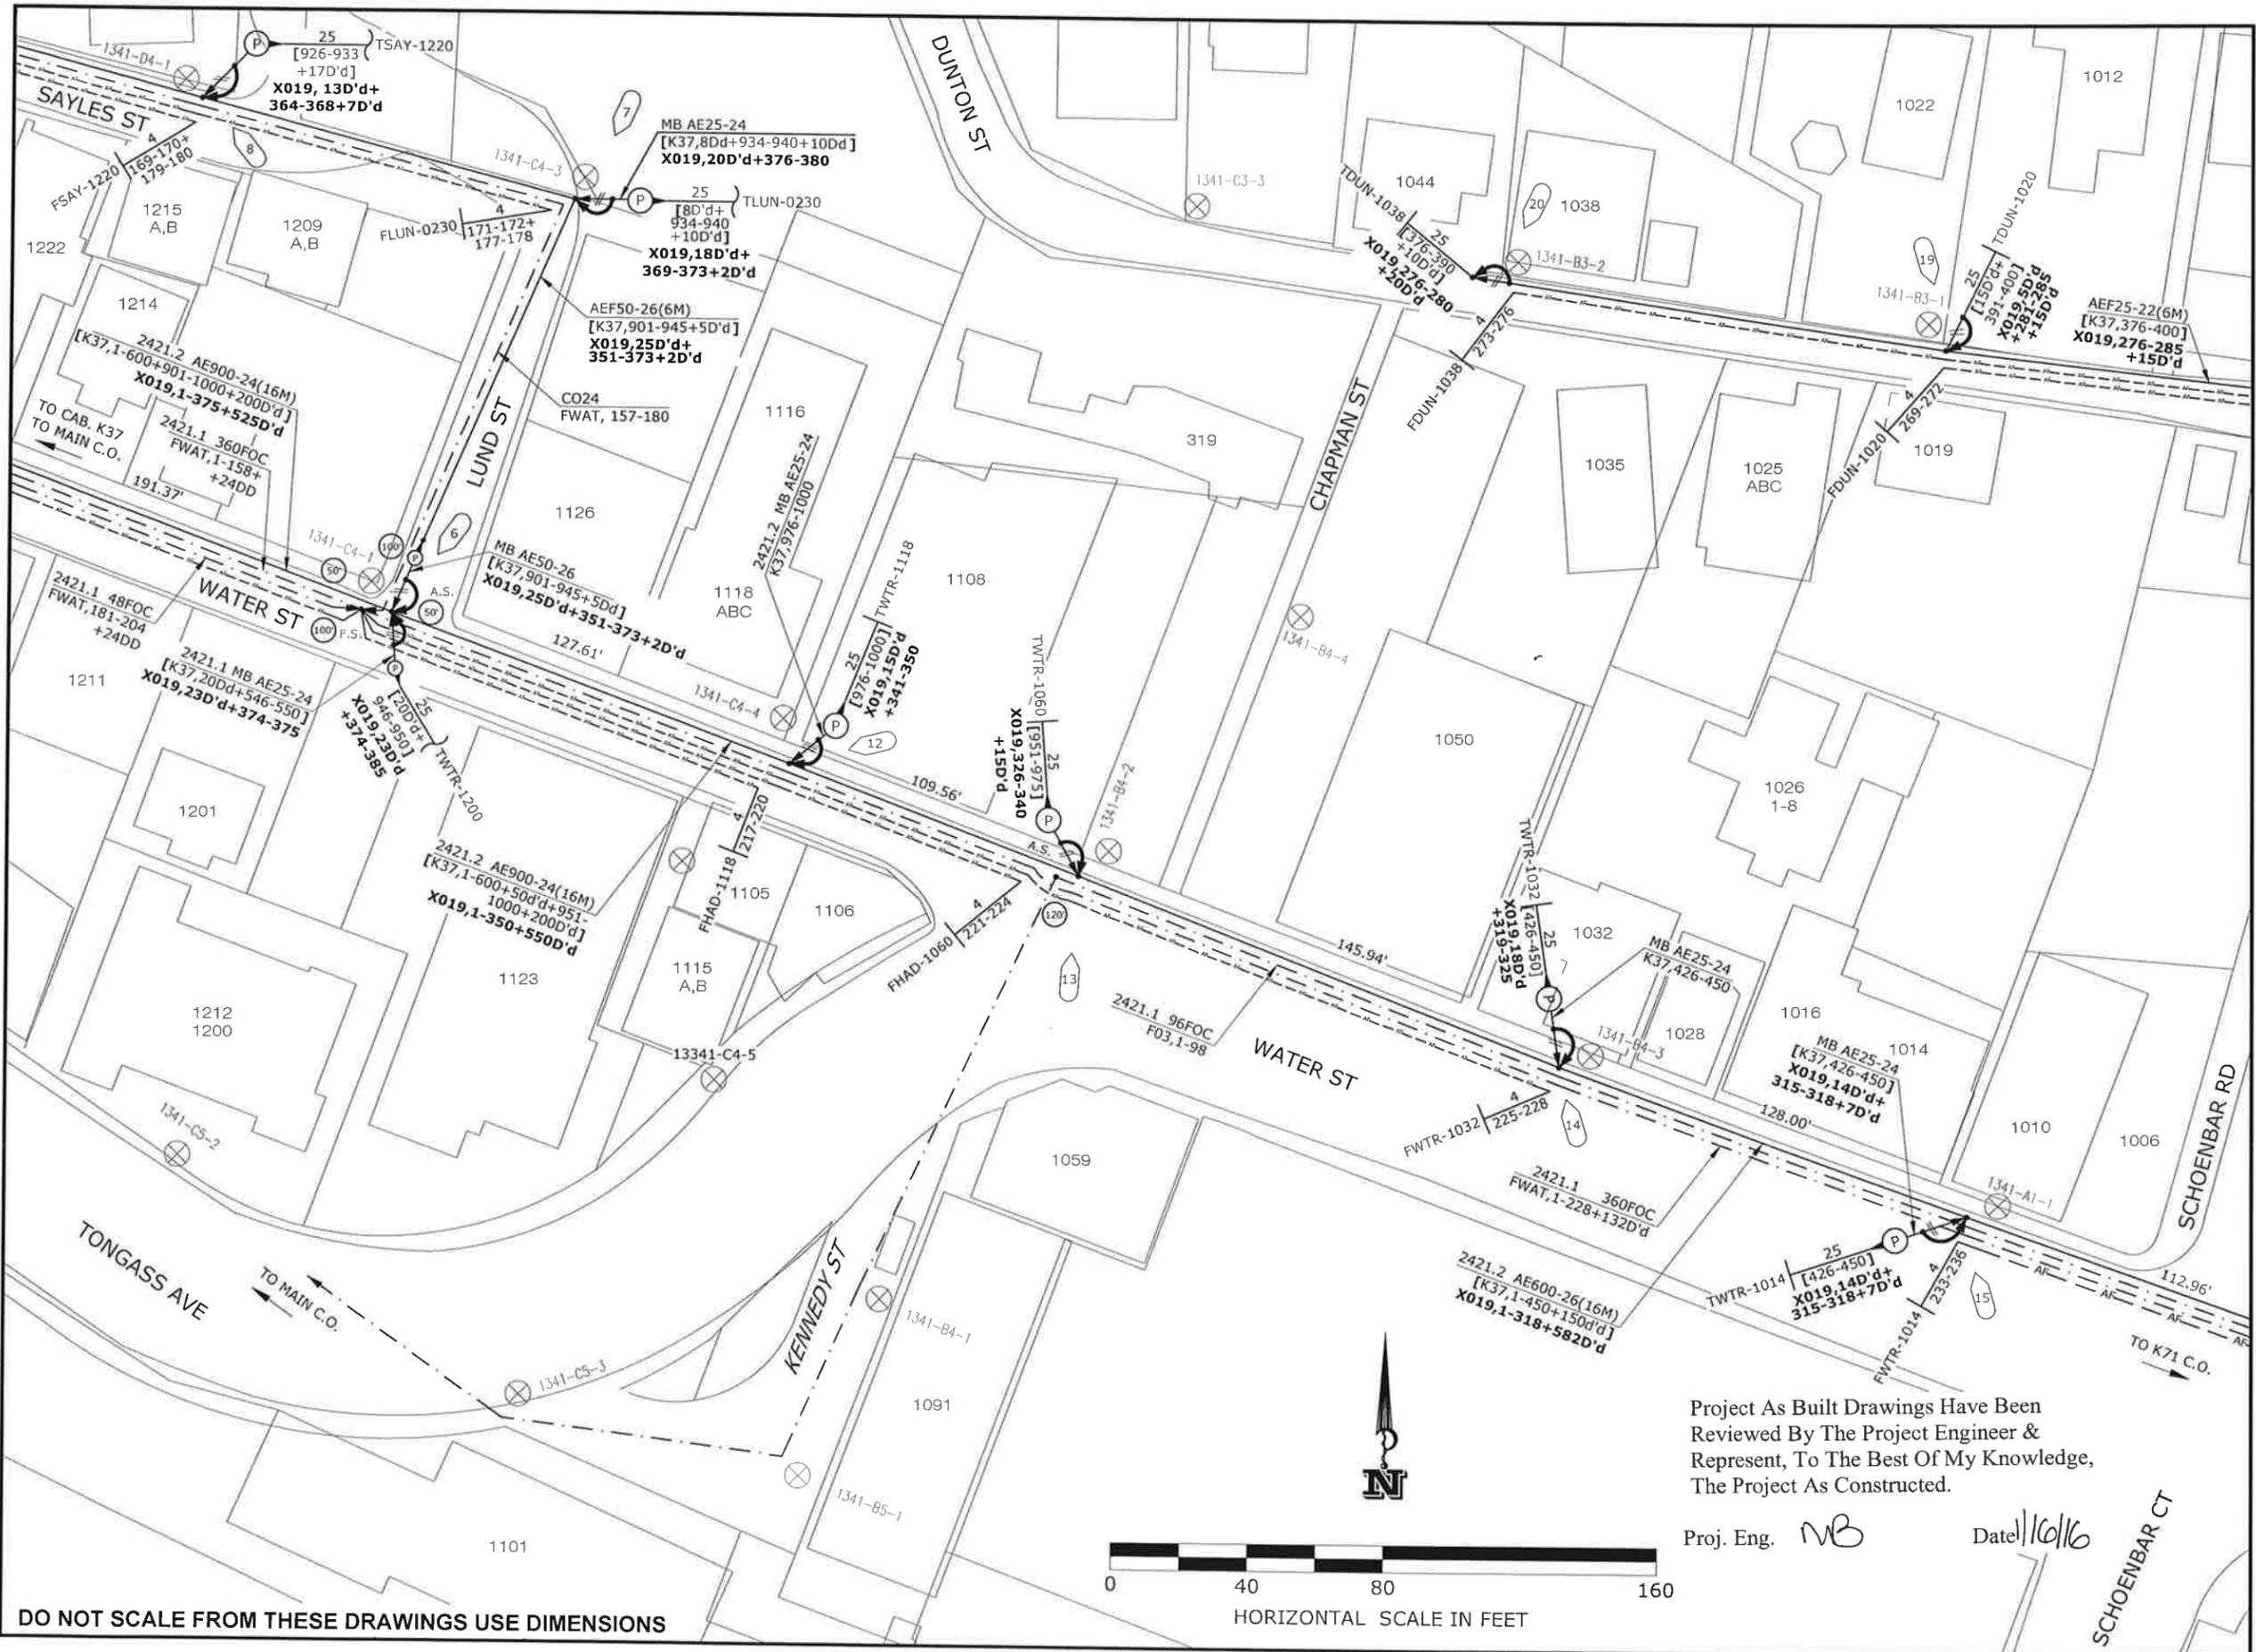

Project As Built Drawings Have Been
 Reviewed By The Project Engineer &
 Represent, To The Best Of My Knowledge,
 The Project As Constructed.

Proj. Eng. MB Date 1/16/16

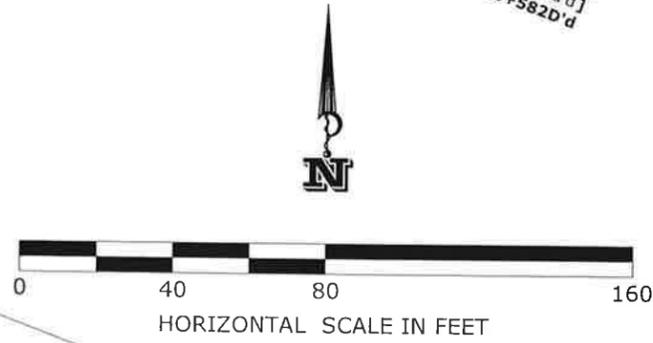

DO NOT SCALE FROM THESE DRAWINGS USE DIMENSIONS

APPENDUM NUMBER		
ATTACHMENT NUMBER		
RECORD OF REVISIONS		
No.	DATE	DESCRIPTION

	PROP. AERIAL FOC
	PROP. FOC LONG TAIL TERM.
	PROP. AERIAL COPPER CA.
	EXISTING AERIAL FOC
	EX. FOC LONG TAIL TERM.
	EX. AERIAL COPPER CA.
	EX. AER. FOC TO BE REMOVED
	EX. FOC LONG TAIL TO BE REMOVED
	EX. COPPER CABLE TO BE REMOVED
	PROPOSED POLE
	EXISTING POLE
	PROP. DOUBLE X-ARM ON PROP. POLE
	EX. POLE & EX. DOUBLE X-ARM TO BE REMOVED
	EX. POLE & EX. SINGLE X-ARM OR ALLEY-ARM TO BE REMOVED
	EX. DOUBLE X-ARM ON EX. POLE
	EX. SINGLE X-ARM OR ALLEY-ARM ON EX. POLE
	EX. GUY & ANCHOR TO BE REMOVED
	PROP. GUY & ANCHOR with PROP. LEAD
	EXISTING FIBER SLACK LOOP
	PROP. FIBER SLACK LOOP
	EX. AER. FIBER TERMINAL
	EX. AER. COPPER TERMINAL
	EX. FOC SPLICE POINT
	PROP. SPLICE ON EX. FIBER SPLICE POINT

CHECKED BY: KCN




DESIGNED BY: R. MOJE
 DRAWN BY: R. MOJE


STATE OF ALASKA
 DEPARTMENT OF TRANSPORTATION & PUBLIC FACILITIES
 SOUTHEAST REGION

KETCHIKAN ADVANCE
 WATER STREET TRUNK LINE
 RELOCATION
 PROJECT # 69548

**TELEPHONE
 CABLE LAYOUT**

PROJECT DESIGNATION	
BR-000S(735) ~ 69548	
STATE	YEAR
ALASKA	2014
SHEET NUMBER	TOTAL SHEETS
V10	78

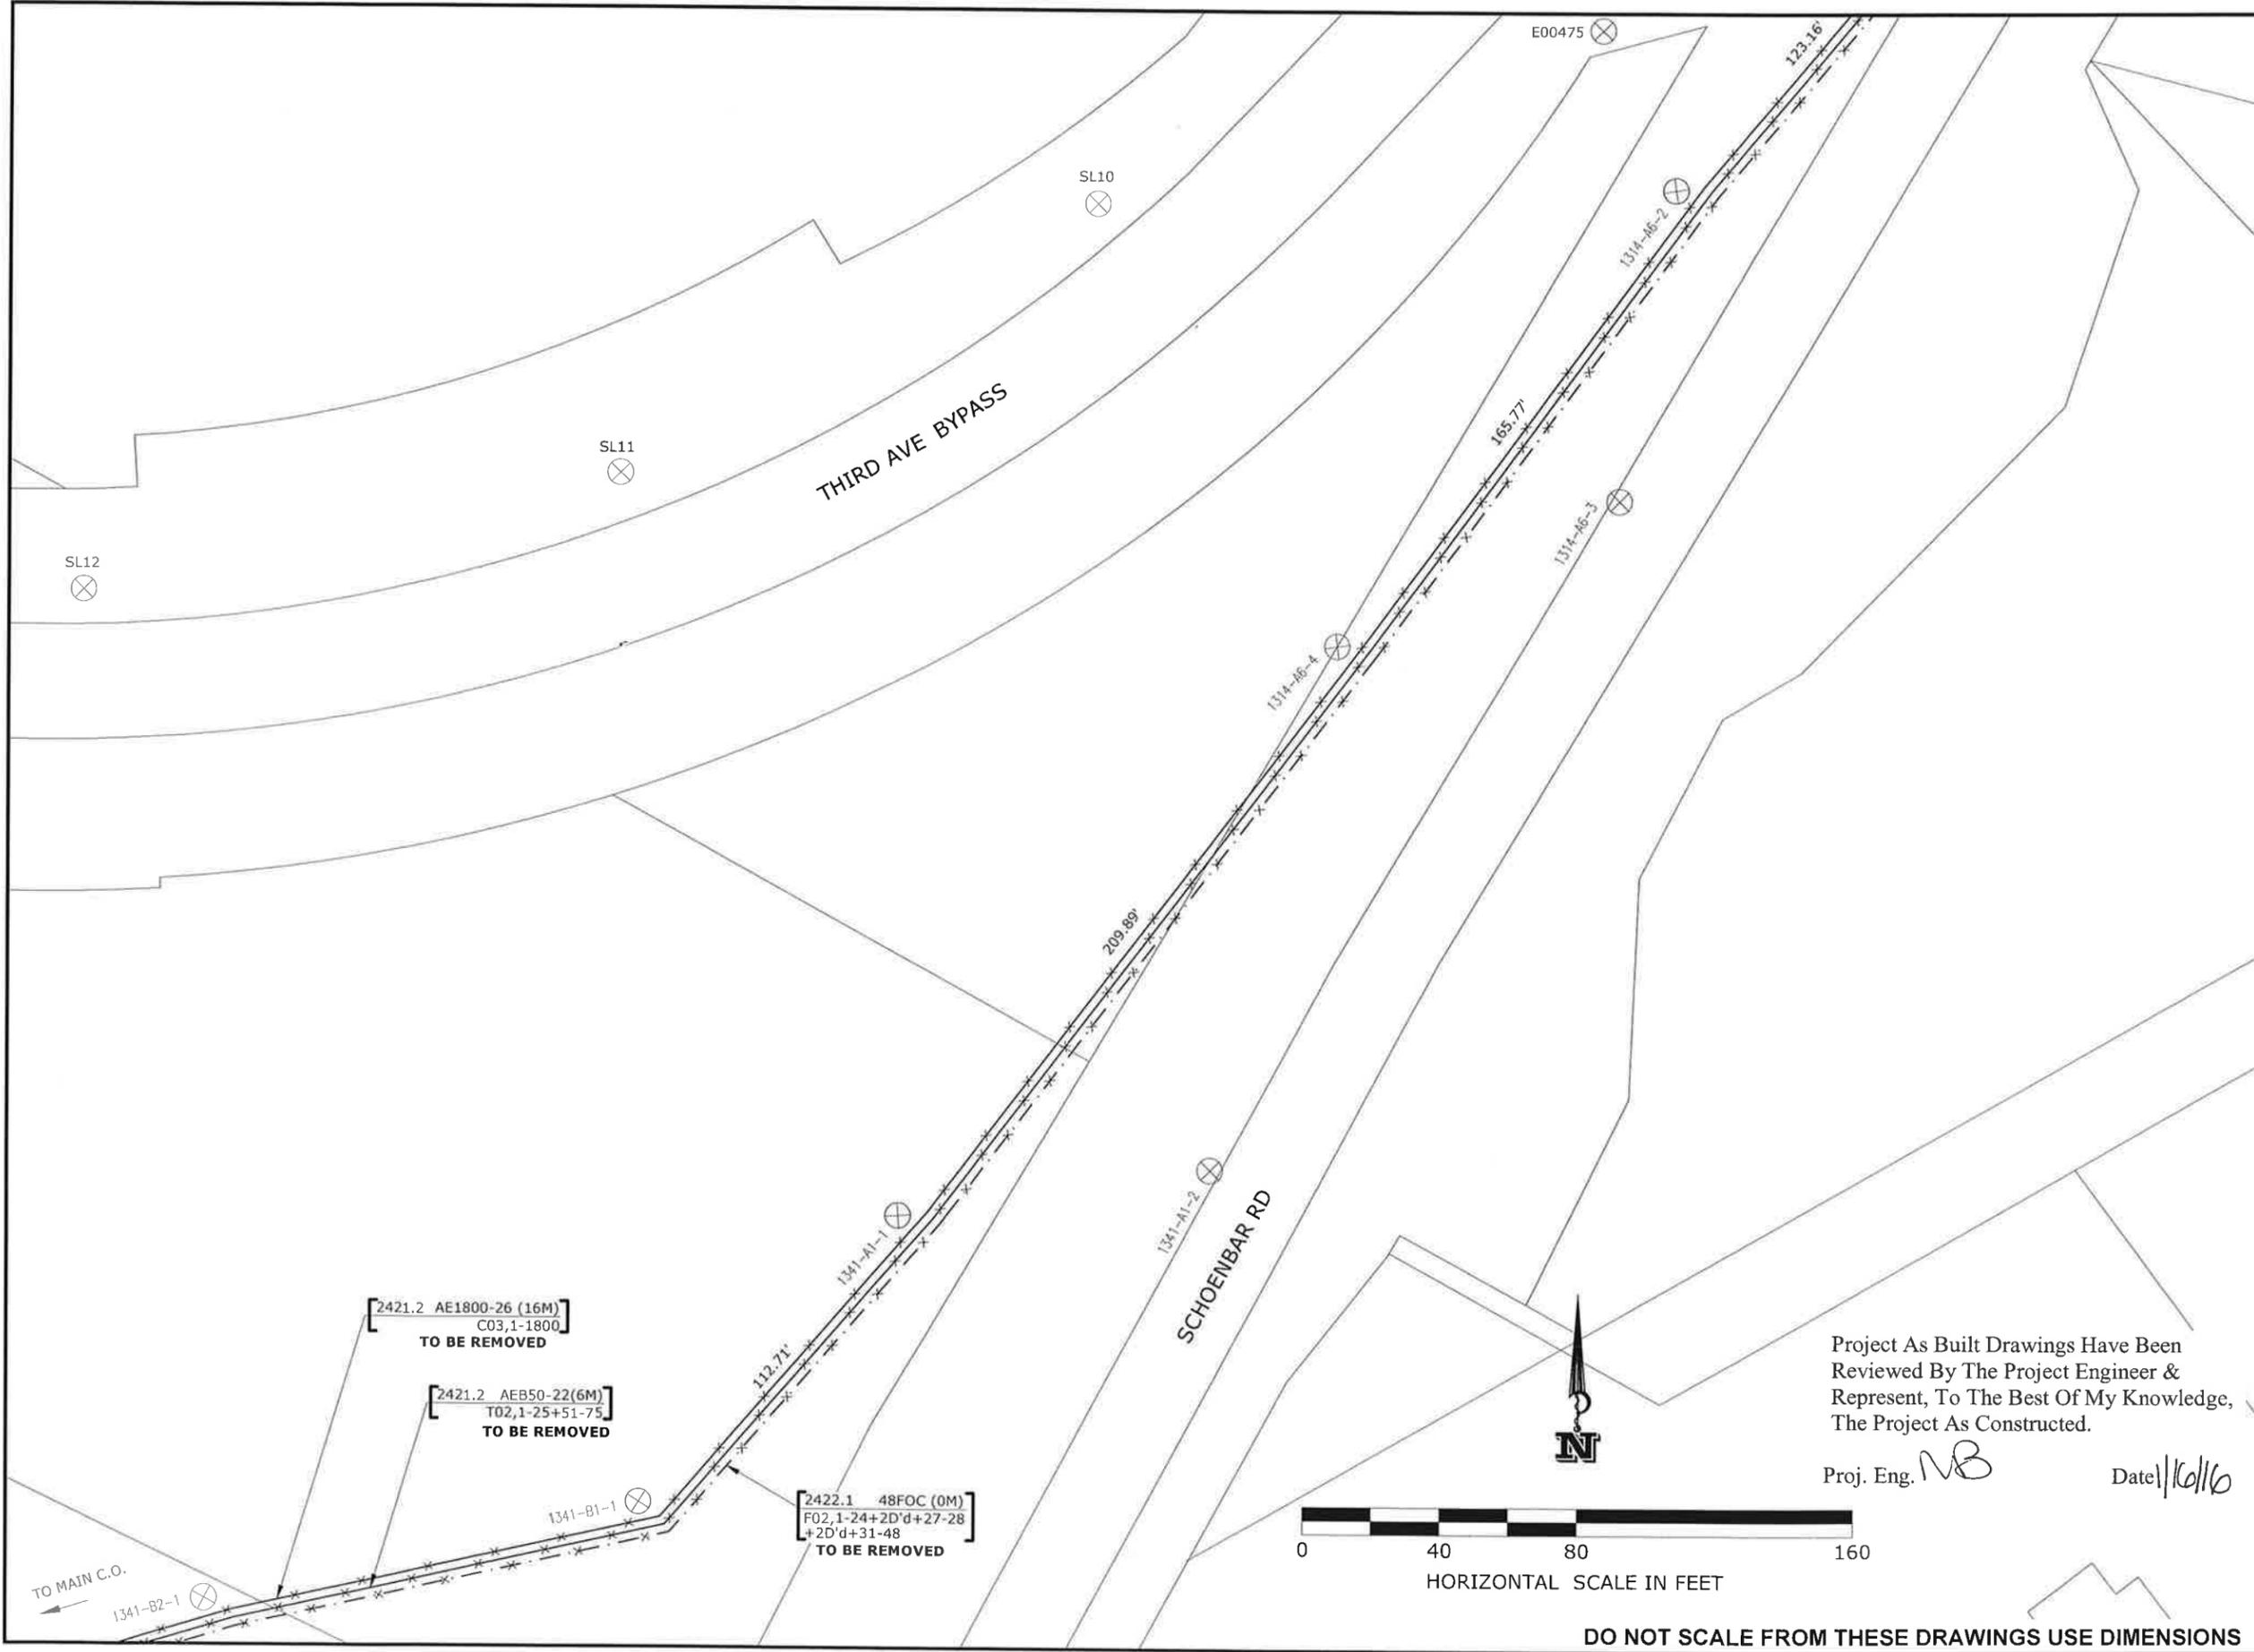

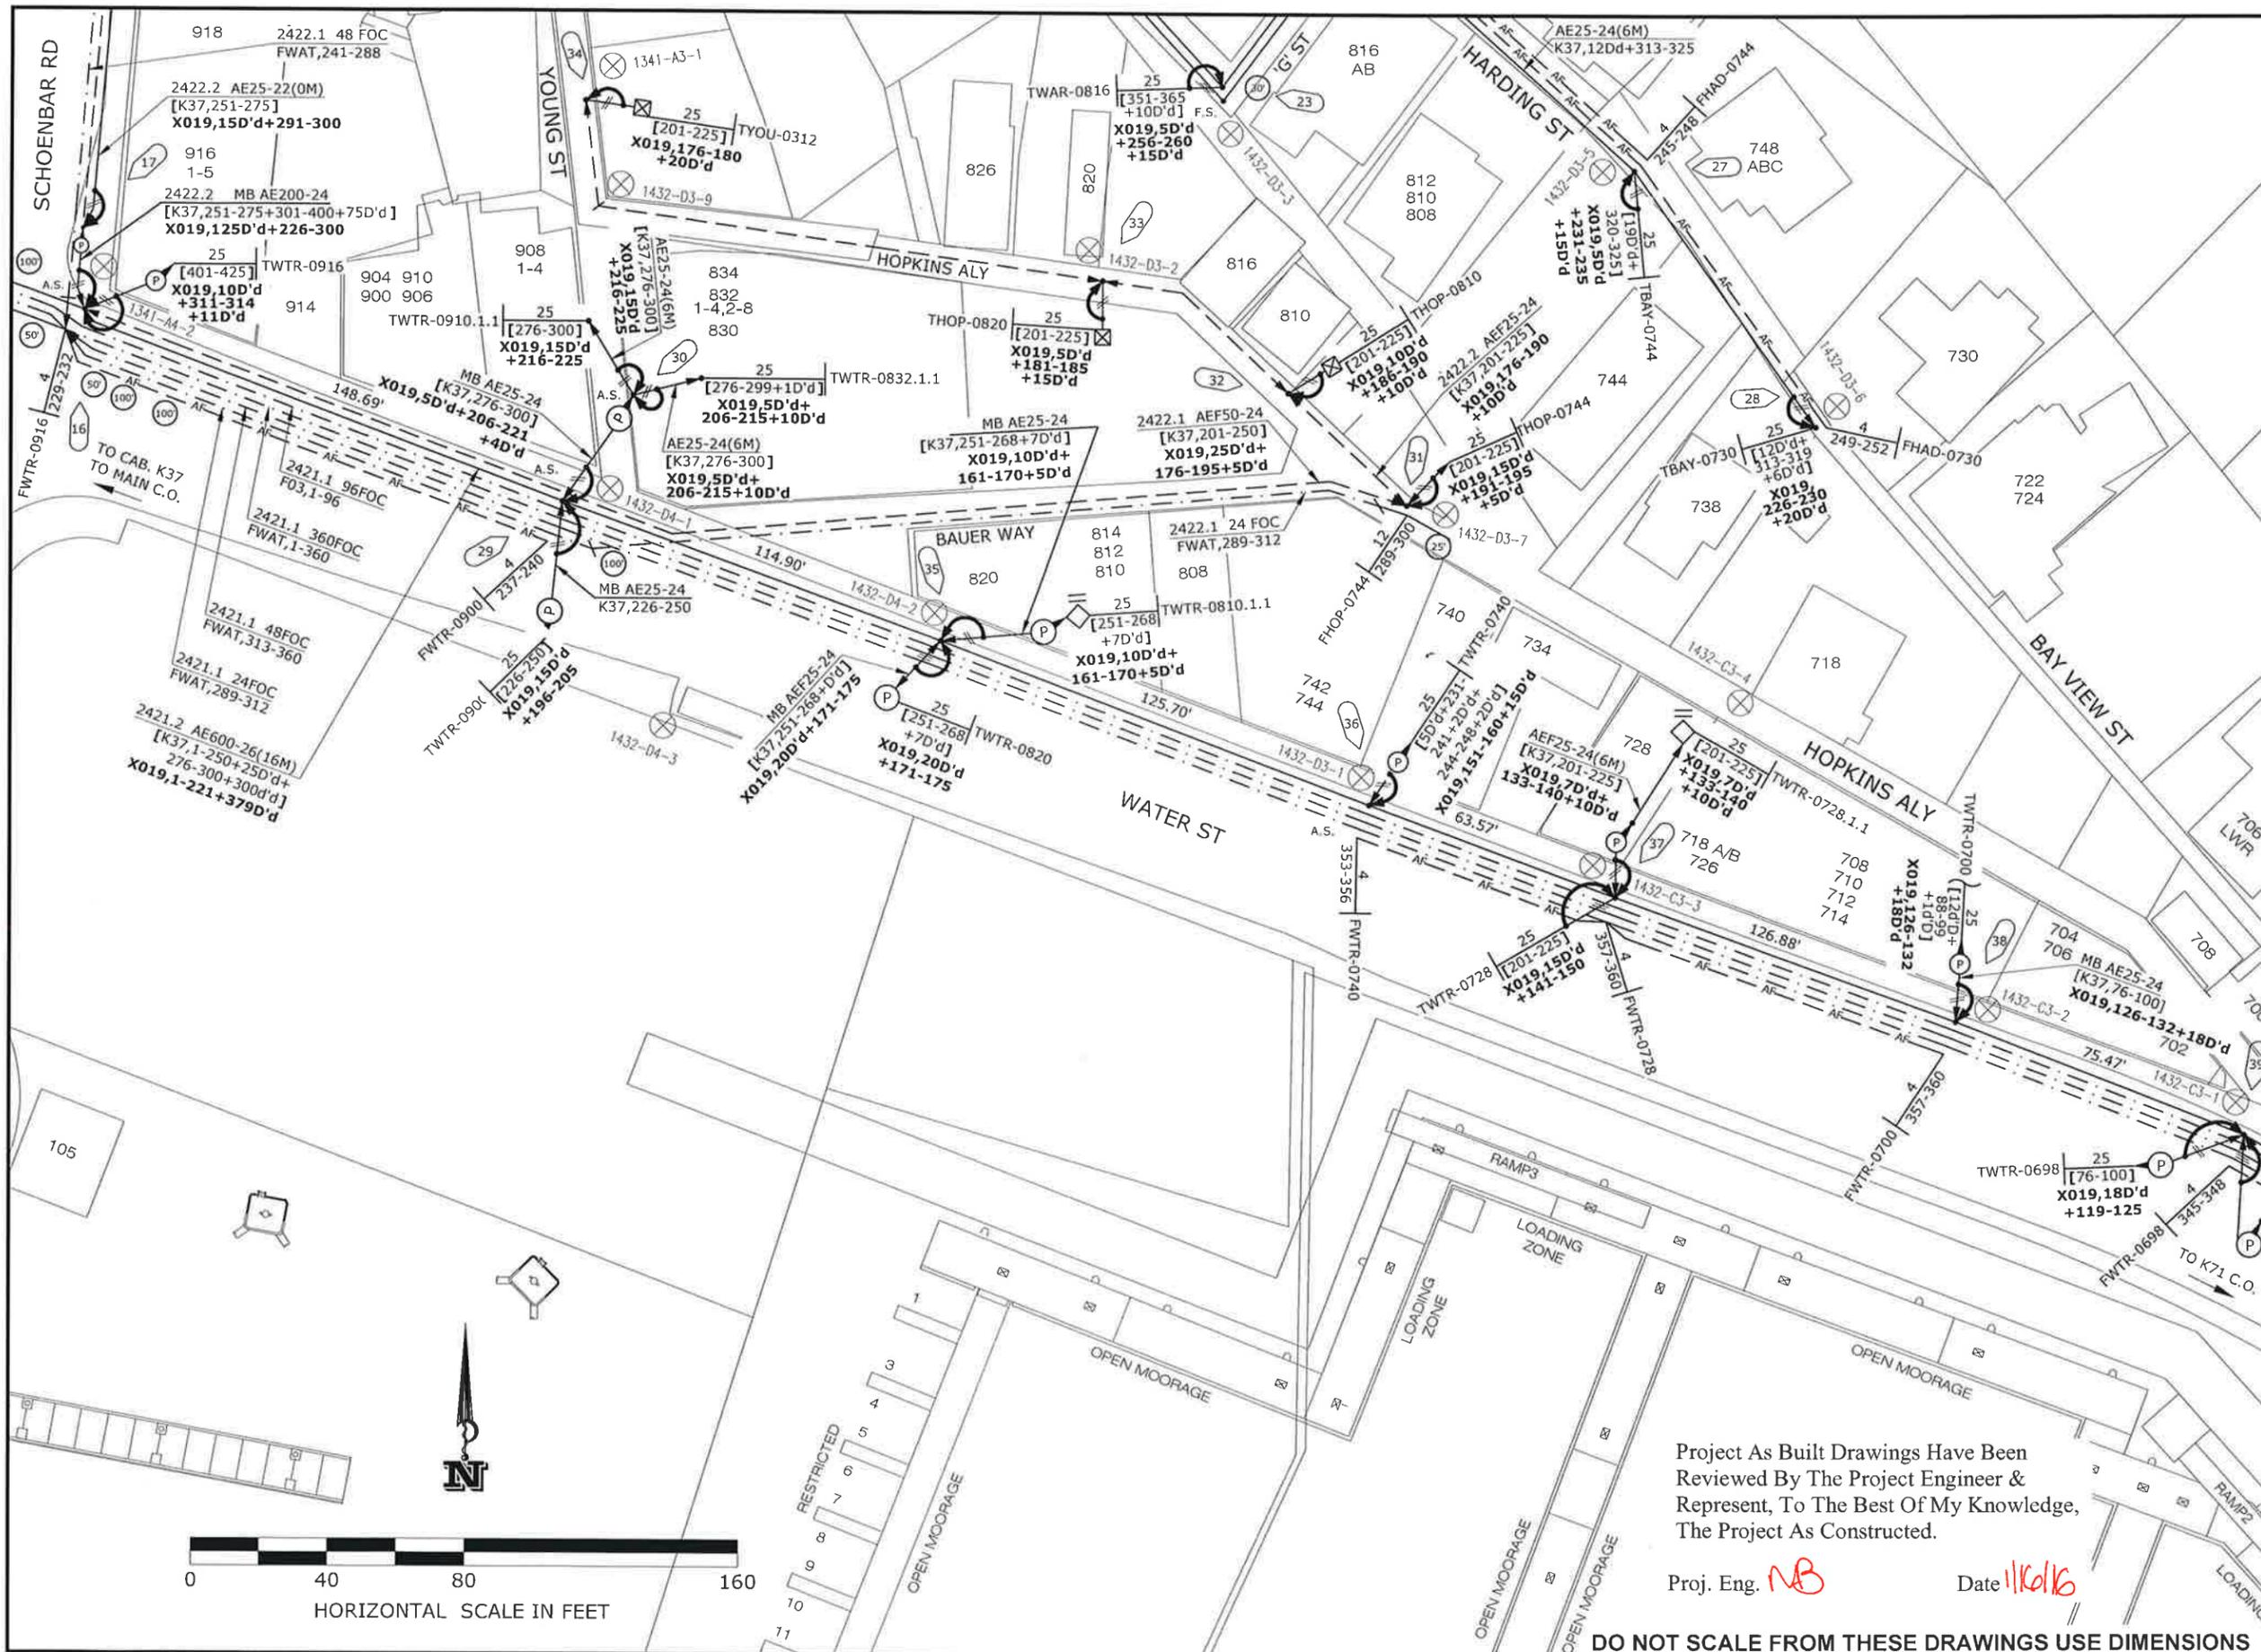

PATH: C:\USERS\KCN12\000\DOCUMENTS\10-KNEE\013
 DESIGN\3D\DWG\0-NTP9 TRUNK
 RELOCATION\KPU-T PSE 140827.DOT
 CERTIFIED FILE FOR WSDWG FILE FOR
 WSDWG PLACEMENT OF VDSL CABINETS FOR
 TAB: VDSL CABINETS FOR WSDWG
 10/17/2016 10:46:20 AM

ADDENDUM NUMBER		
ATTACHMENT NUMBER		
RECORD OF REVISIONS		
No.	DATE	DESCRIPTION

- PROP. AERIAL FOC
- PROP. FOC LONG TAIL TERM.
- PROP. AERIAL COPPER CA.
- EXISTING AERIAL FOC
- EX. FOC LONG TAIL TERM.
- EX. AERIAL COPPER CA.
- EX. AER. FOC TO BE REMOVED
- EX. FOC LONG TAIL TO BE REMOVED
- EX. COPPER CABLE TO BE REMOVED
- ⊗ PROPOSED POLE
- ⊗ EXISTING POLE
- ⊗ PROP. DOUBLE X-ARM ON PROP. POLE
- ⊗ EX. POLE & EX. DOUBLE X-ARM TO BE REMOVED
- ⊗ EX. POLE & EX. SINGLE X-ARM OR ALLEY-ARM TO BE REMOVED
- ⊗ EX. DOUBLE X-ARM ON EX. POLE
- ⊗ EX. SINGLE X-ARM OR ALLEY-ARM ON EX. POLE
- ⊗ EX. GUY & ANCHOR TO BE REMOVED
- ⊗ PROP. GUY & ANCHOR with PROP. LEAD
- ⊗ EXISTING FIBER SLACK LOOP
- ⊗ PROP. FIBER SLACK LOOP
- ⊗ EX. AER. FIBER TERMINAL
- ⊗ EX. AER. COPPER TERMINAL
- ⊗ EX. FOC SPLICE POINT
- ⊗ PROP. SPLICE ON EX. FIBER SPLICE POINT

PLAN LEGEND

CHECKED BY: KCN



DESIGNED BY: R. MOJE
 DRAWN BY: R. MOJE

STATE OF ALASKA
 DEPARTMENT OF TRANSPORTATION
 & PUBLIC FACILITIES
 SOUTHEAST REGION
 KETCHIKAN ADVANCE
 WATER STREET TRUNK LINE
 RELOCATION
 PROJECT # 69548


TELEPHONE CABLE LAYOUT

PROJECT DESIGNATION	
BR-000S(735) ~ 69548	
STATE	YEAR
ALASKA	2014
SHEET NUMBER	TOTAL SHEETS
V12	78

Project As Built Drawings Have Been Reviewed By The Project Engineer & Represent, To The Best Of My Knowledge, The Project As Constructed.

Proj. Eng. *NB* Date *11/16/16*

DO NOT SCALE FROM THESE DRAWINGS USE DIMENSIONS

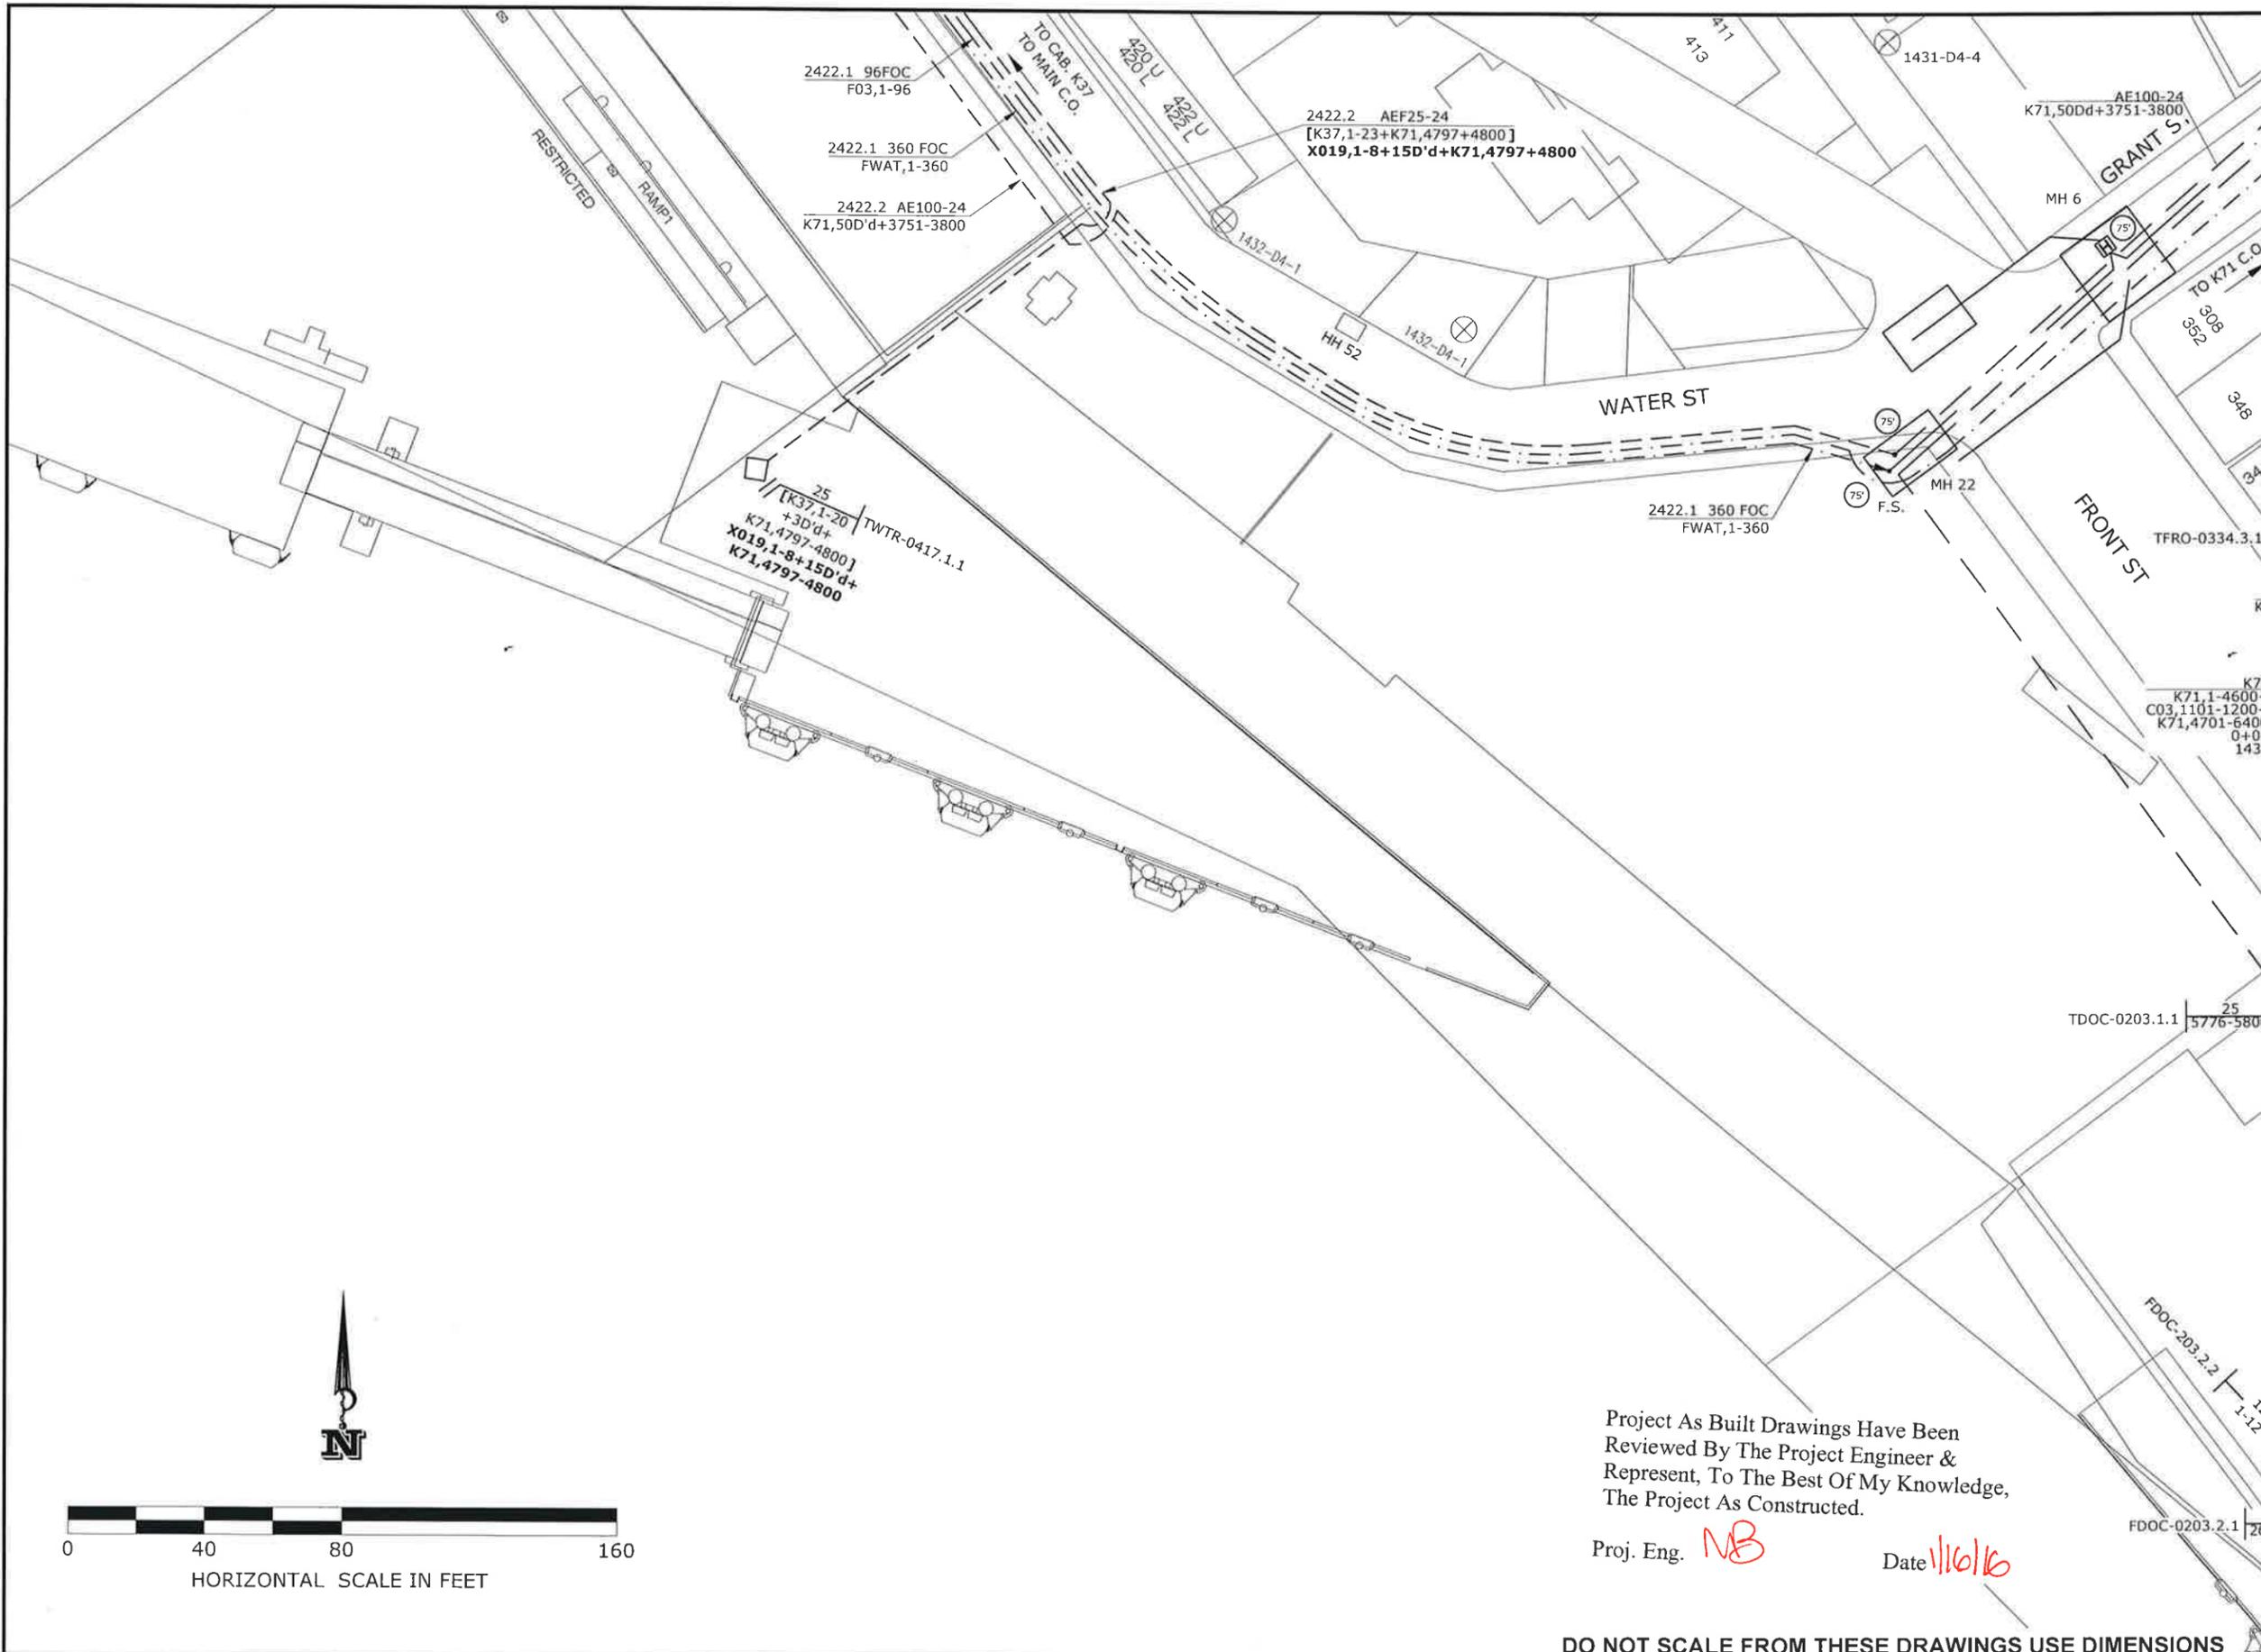

Project As Built Drawings Have Been Reviewed By The Project Engineer & Represent, To The Best Of My Knowledge, The Project As Constructed.

Proj. Eng. *NB* Date *11/6/16*

DO NOT SCALE FROM THESE DRAWINGS USE DIMENSIONS

PATH: C:\USERS\KCN12_000\DOCUMENTS\10-KNEE\013
 DESIGN\13\DWG\0-NT\9 TRUNK
 RELOCATION\KPU-T PSE 140827 DOT
 CERTIFIED FILE FOR WSDWG FILE FOR
 WSDWG PLACEMENT OF VDSL CABINETS FOR
 TAB: 10/15/16 10:06 PM

ADDENDUM NUMBER		
ATTACHMENT NUMBER		
RECORD OF REVISIONS		
No.	DATE	DESCRIPTION

- PLAN LEGEND**
- PROP. AERIAL FOC
 - PROP. FOC LONG TAIL TERM.
 - PROP. AERIAL COPPER CA.
 - EXISTING AERIAL FOC
 - EX. FOC LONG TAIL TERM.
 - EX. AERIAL COPPER CA.
 - EX. AER. FOC TO BE REMOVED
 - EX. FOC LONG TAIL TO BE REMOVED
 - EX. COPPER CABLE TO BE REMOVED
 - ⊗ PROPOSED POLE
 - ⊗ EXISTING POLE
 - ⊗ PROP. DOUBLE X-ARM ON PROP. POLE
 - ⊗ EX. POLE & EX. DOUBLE X-ARM TO BE REMOVED
 - ⊗ EX. POLE & EX. SINGLE X-ARM OR ALLEY-ARM TO BE REMOVED
 - ⊗ EX. DOUBLE X-ARM ON EX. POLE
 - ⊗ EX. SINGLE X-ARM OR ALLEY-ARM ON EX. POLE
 - ⊗ EX. GUY & ANCHOR TO BE REMOVED
 - ⊗ PROP. GUY & ANCHOR with PROP. LEAD
 - ⊗ EXISTING FIBER SLACK LOOP
 - ⊗ PROP. FIBER SLACK LOOP
 - ⊗ EX. AER. FIBER TERMINAL
 - ⊗ EX. AER. COPPER TERMINAL
 - EX. FOC SPLICE POINT
 - PROP. SPLICE ON EX. FIBER SPLICE POINT


CHECKED BY: KCN

DESIGNED BY: R. MOJE
 DRAWN BY: R. MOJE

STATE OF ALASKA
 DEPARTMENT OF TRANSPORTATION & PUBLIC FACILITIES
 SOUTHEAST REGION

KETCHIKAN ADVANCE
 WATER STREET TRUNK LINE
 RELOCATION
 PROJECT # 69548

TELEPHONE CABLE LAYOUT	
PROJECT DESIGNATION	
BR-000S(735) ~ 69548	
STATE	YEAR
ALASKA	2014
SHEET NUMBER	TOTAL SHEETS
V14	78

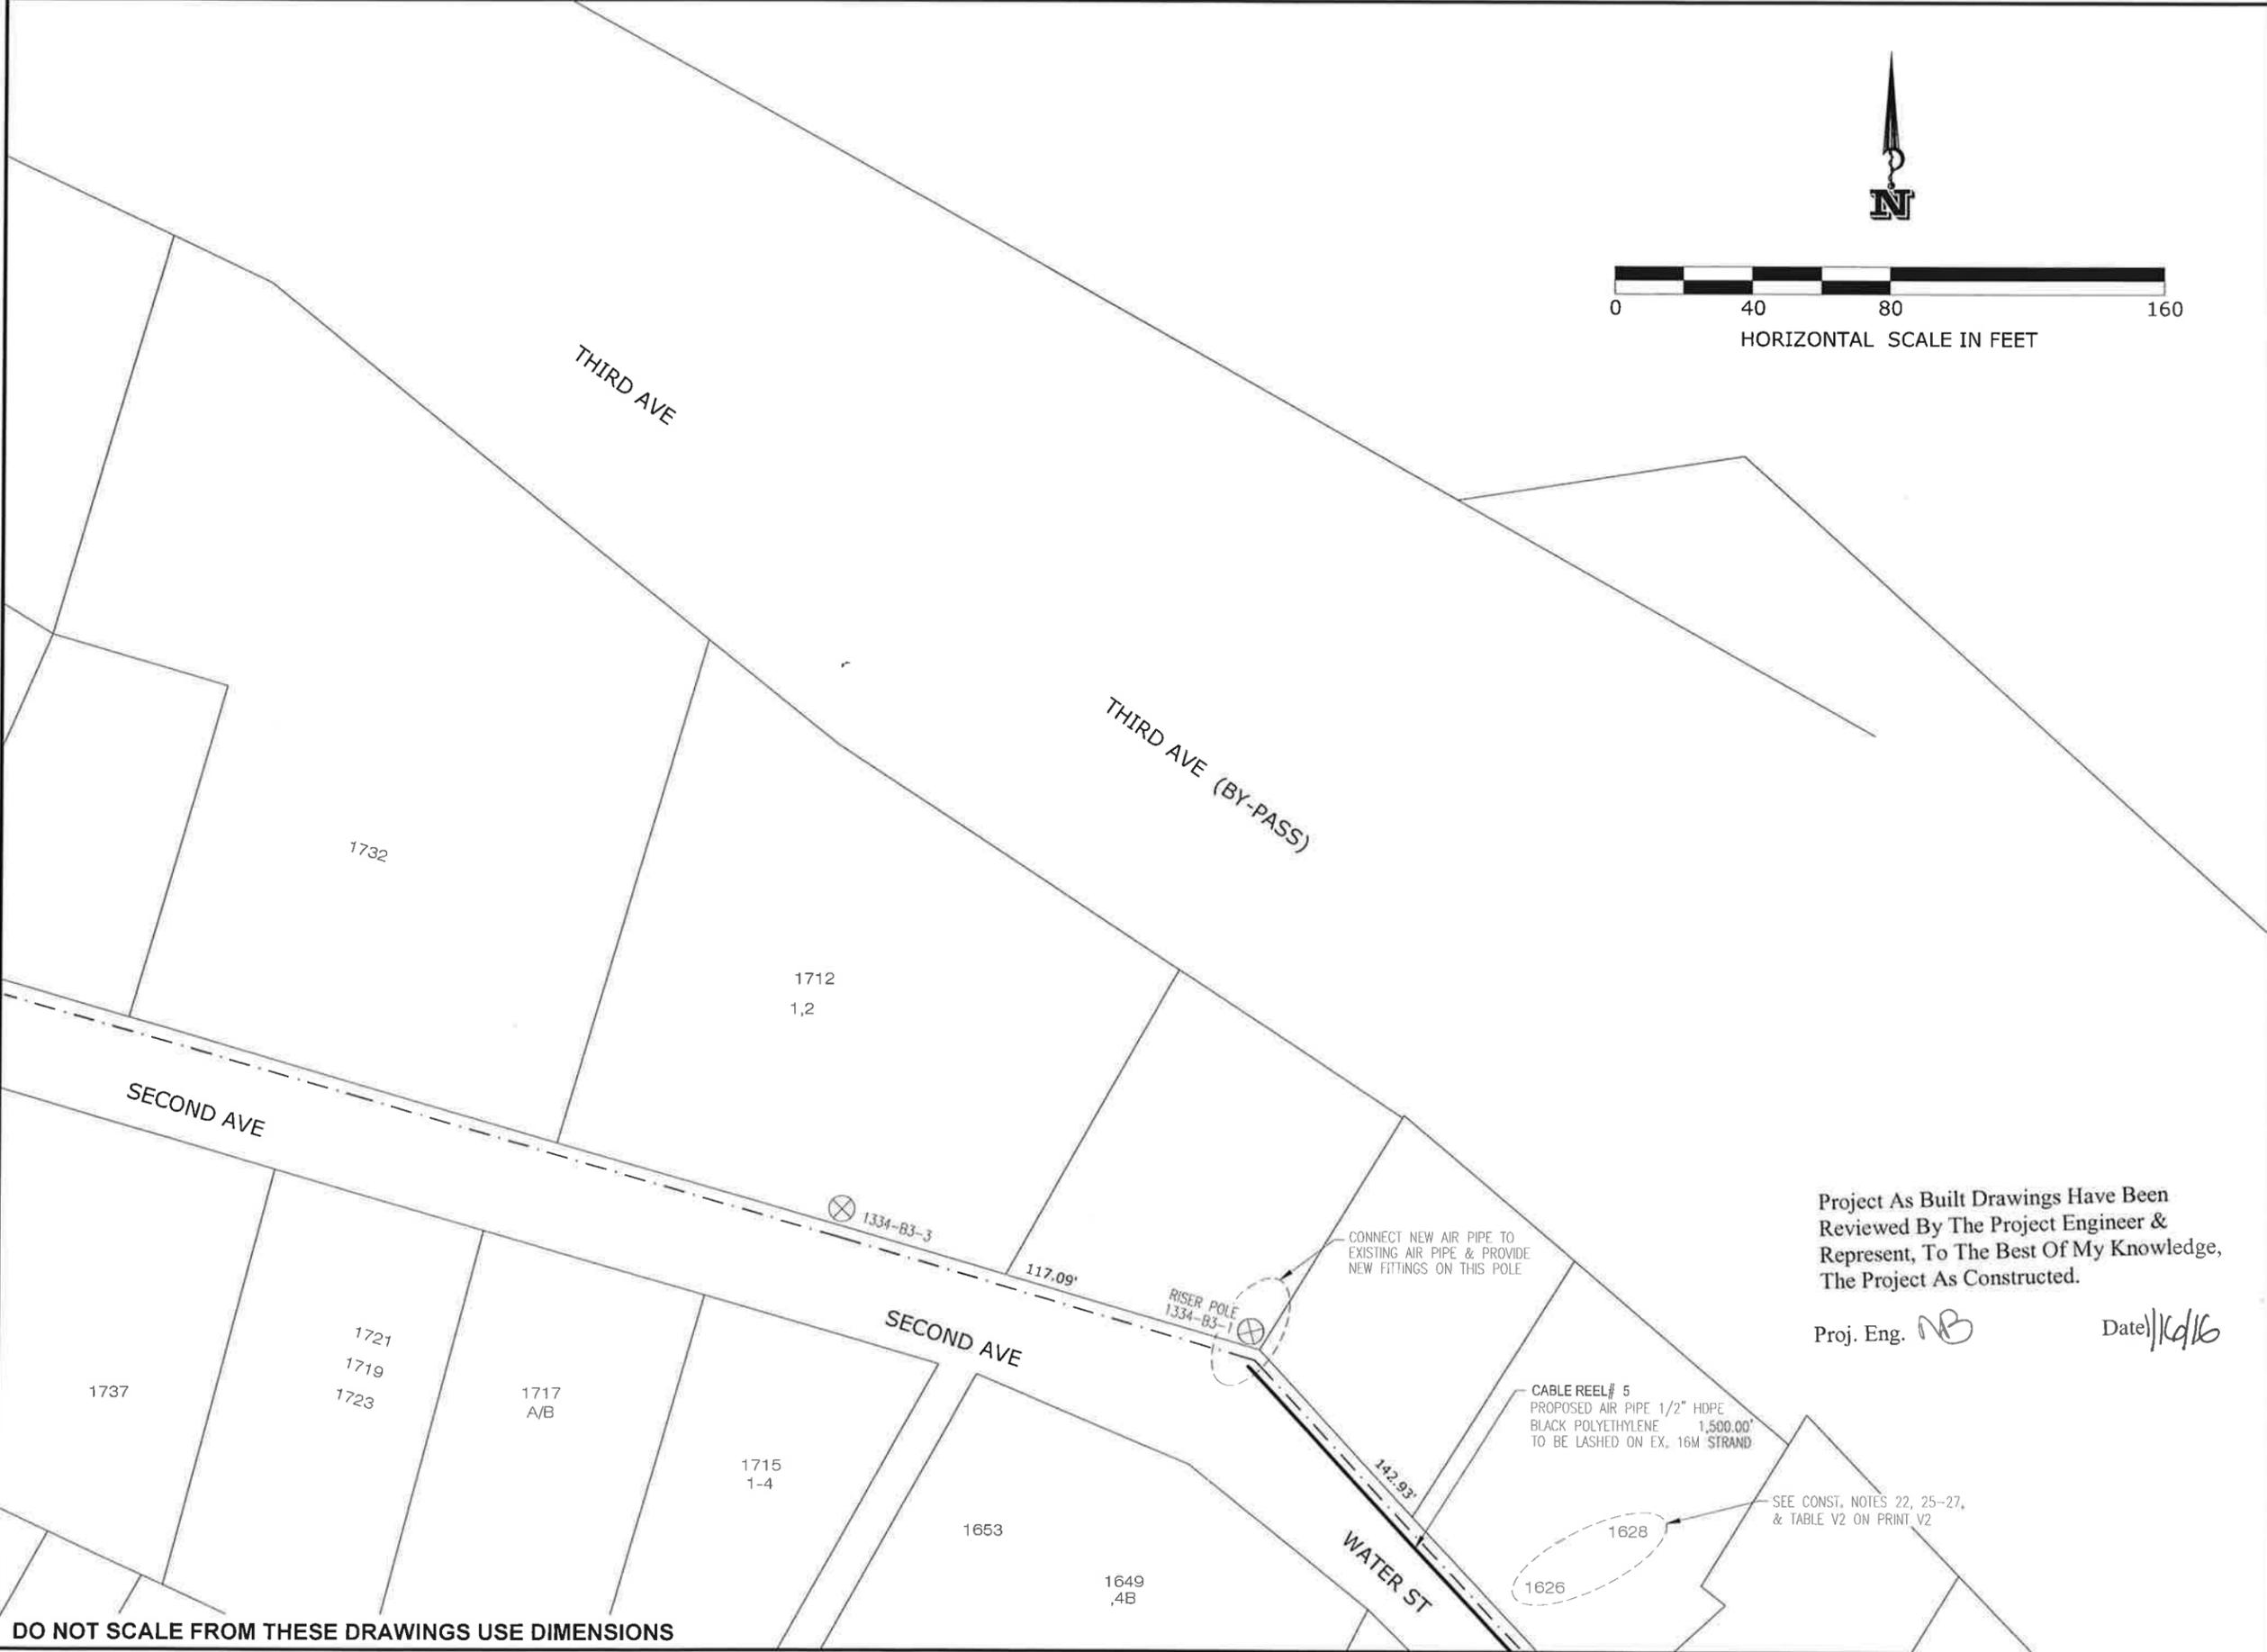

DO NOT SCALE FROM THESE DRAWINGS USE DIMENSIONS

ADDENDUM NUMBER

ATTACHMENT NUMBER

RECORD OF REVISIONS

No.	DATE	DESCRIPTION

- PROP. AERIAL FOC
- PROP. FOC LONG TAIL TERM.
- PROP. AERIAL COPPER CA.
- EXISTING AERIAL FOC
- EX. FOC LONG TAIL TERM.
- EX. AERIAL COPPER CA.
- x-x-x- EX. AER. FOC TO BE REMOVED
- x-x-x- EX. FOC LONG TAIL TO BE REMOVED
- x-x-x- EX. COPPER CABLE TO BE REMOVED
- ⊗ PROPOSED POLE
- ⊗ EXISTING POLE
- ⊗ PROP. DOUBLE X-ARM ON PROP. POLE
- ⊗ EX. POLE & EX. DOUBLE X-ARM TO BE REMOVED
- ⊗ EX. POLE & EX. SINGLE X-ARM OR ALLEY-ARM TO BE REMOVED
- ⊗ EX. DOUBLE X-ARM ON EX. POLE
- ⊗ EX. SINGLE X-ARM OR ALLEY-ARM ON EX. POLE
- ⊗ EX. GUY & ANCHOR TO BE REMOVED
- ⊗ PROP. GUY & ANCHOR WITH PROP. LEAD
- ⊗ EXISTING FIBER SLACK LOOP
- ⊗ PROP. FIBER SLACK LOOP
- ⊗ EX. AER. FIBER TERMINAL
- ⊗ EX. AER. COPPER TERMINAL
- EX. FOC SPLICE POINT
- PROP. SPLICE ON EX. FIBER SPLICE POINT

PLAN LEGEND

CHECKED BY: KCN



DESIGNED BY: R. MOJE

DRAWN BY: R. MOJE

Project As Built Drawings Have Been Reviewed By The Project Engineer & Represent, To The Best Of My Knowledge, The Project As Constructed.

Proj. Eng. *MB* Date *11/16/16*

STATE OF ALASKA
 DEPARTMENT OF TRANSPORTATION & PUBLIC FACILITIES
 SOUTHEAST REGION


KETCHIKAN ADVANCE
 WATER STREET TRUNK LINE
 RELOCATION
 PROJECT # 69548

TELEPHONE CABLE LAYOUT

PROJECT DESIGNATION

BR-000S(735) ~ 69548

STATE	YEAR
ALASKA	2014
SHEET NUMBER	TOTAL SHEETS
V15	78

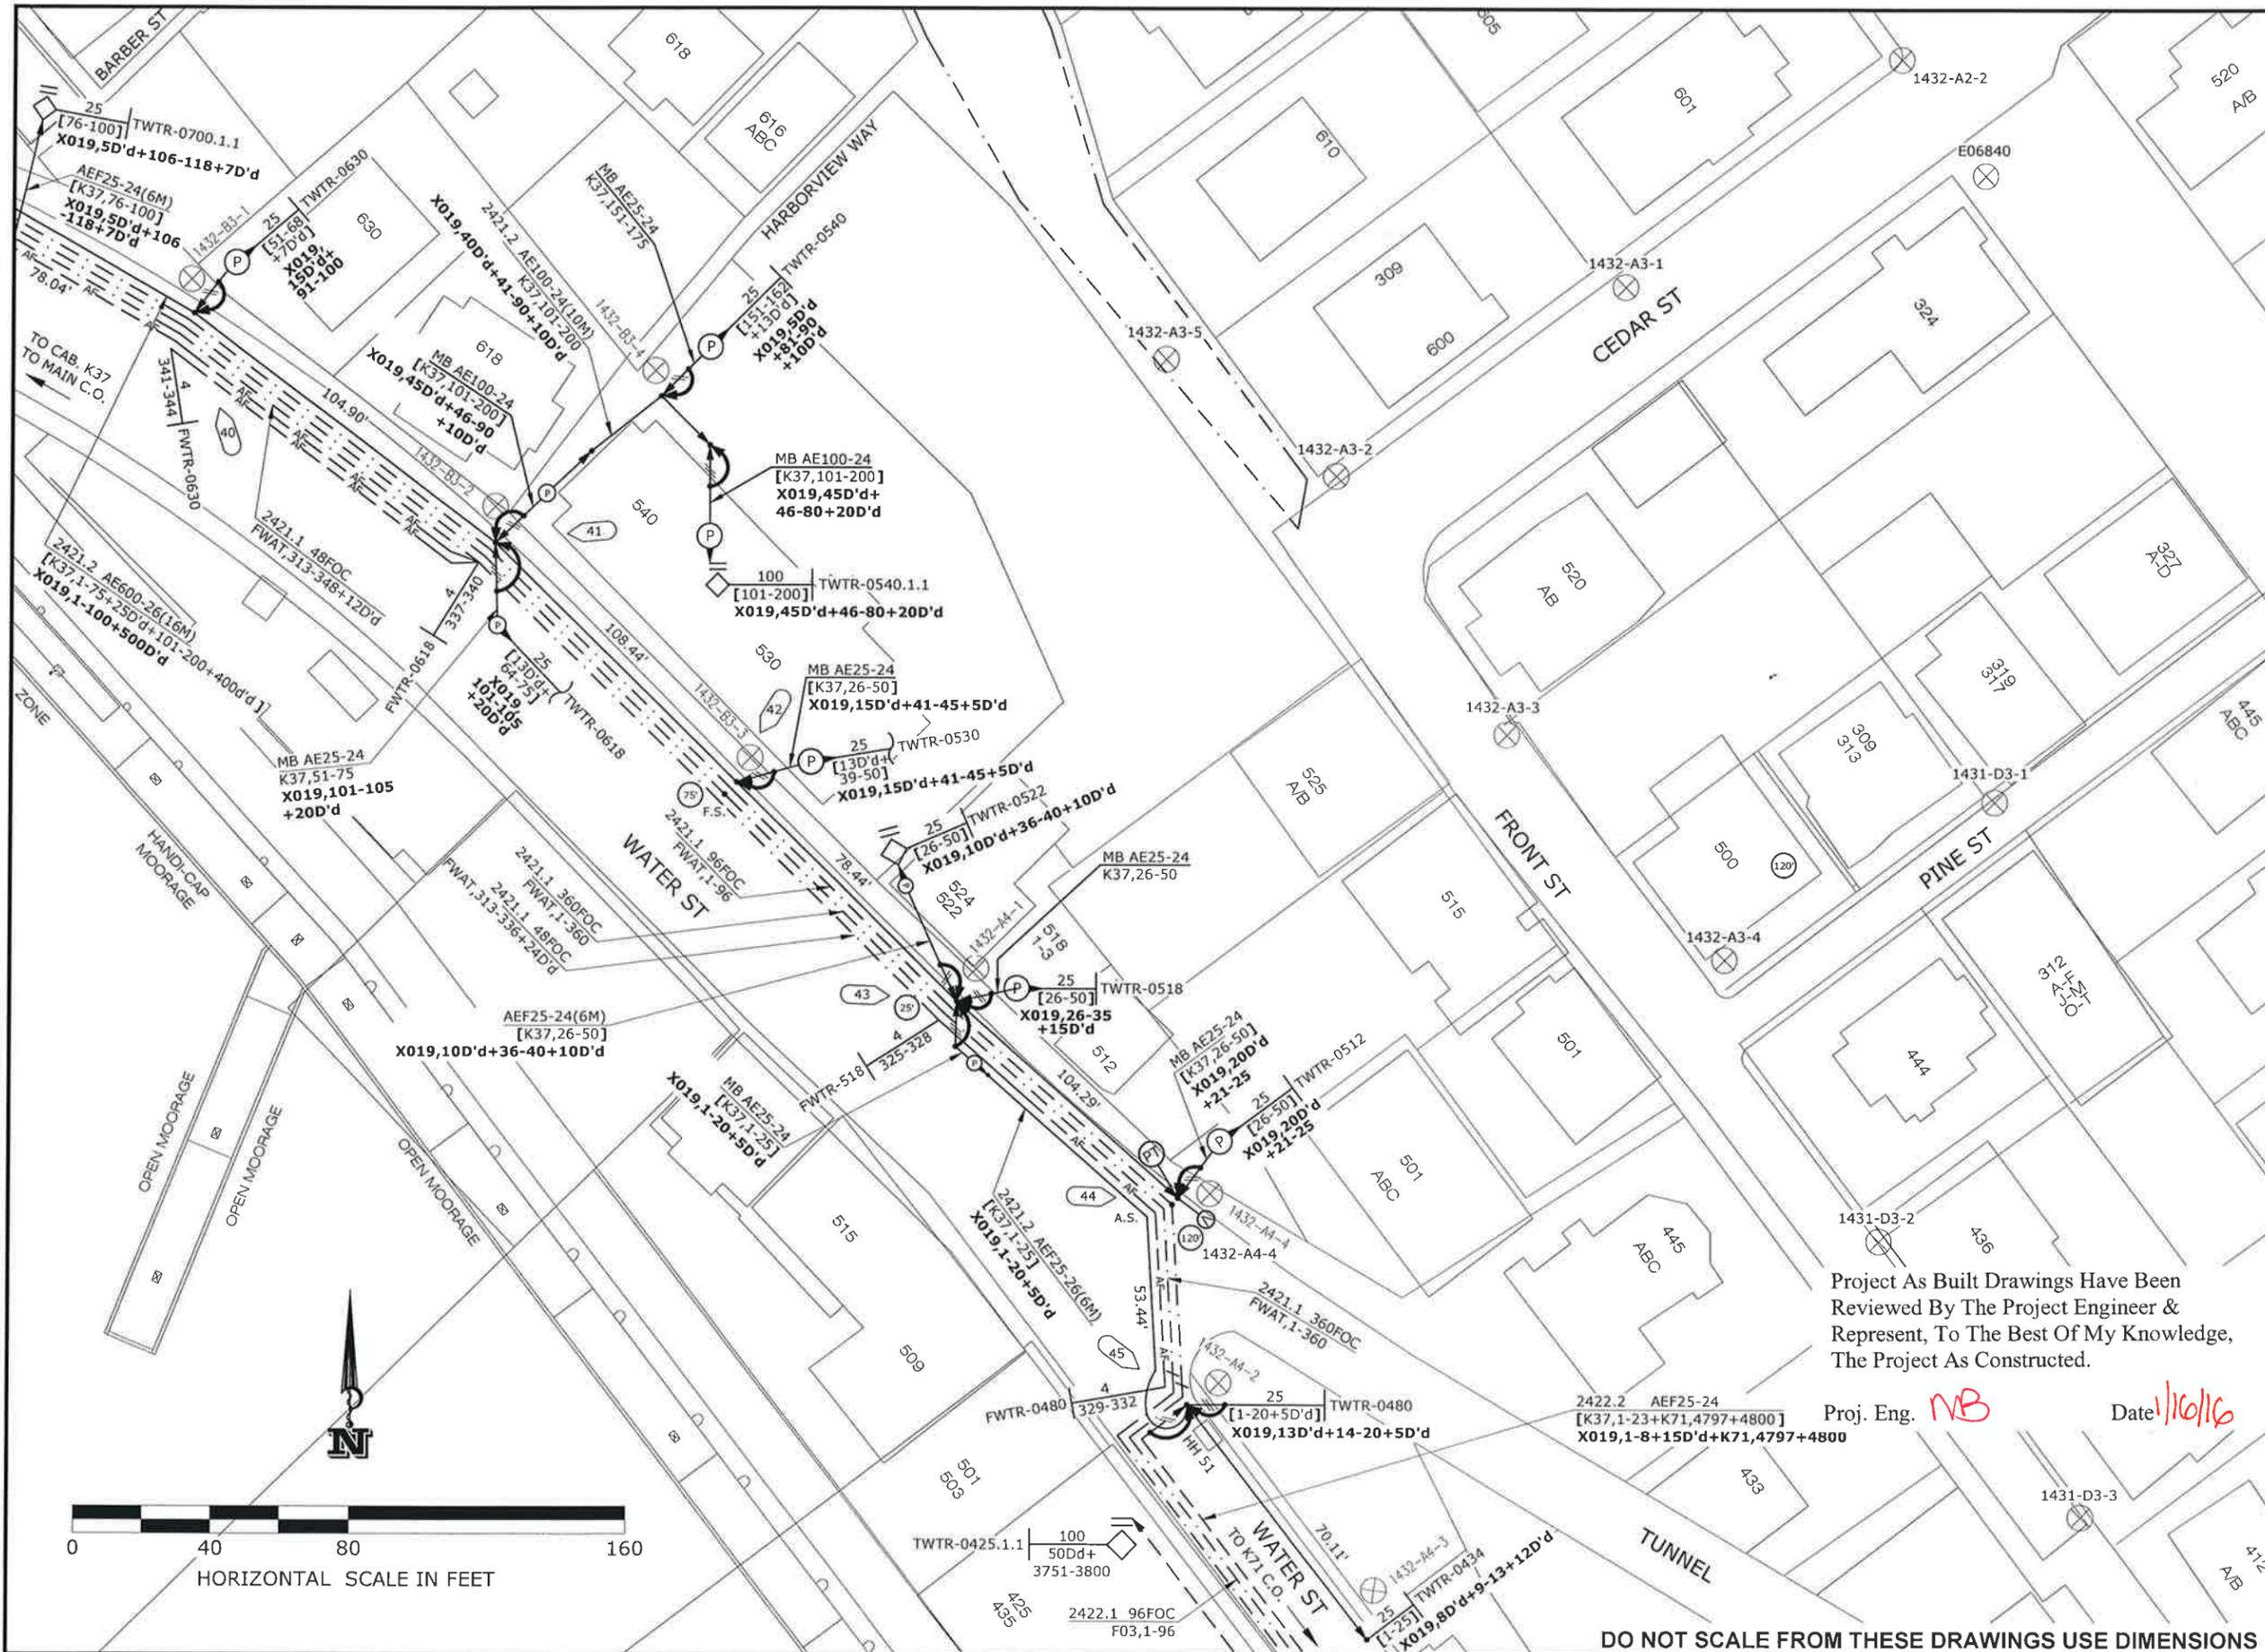

PATH: C:\USERS\KCN12_00\DOCUMENTS\0-KNEE\013
 DESIGN\13\DWG\0-NTP9 TRUNK
 RELOCATION\KPU-T PSE 140827.DOT
 CERTIFIED FILE FOR WSDWG FILE FOR
 VSDP\PLACEMENT OF VDSL CABINETS FOR
 TAB: 140827.DWG
 11/16/16 9:56 PM

ADDENDUM NUMBER	
ATTACHMENT NUMBER	

RECORD OF REVISIONS		
No.	DATE	DESCRIPTION

- PROP. AERIAL FOC
- PROP. FOC LONG TAIL TERM.
- PROP. AERIAL COPPER CA.
- EXISTING AERIAL FOC
- EX. FOC LONG TAIL TERM.
- EX. AERIAL COPPER CA.
- x-x-x- EX. AER. FOC TO BE REMOVED
- x-x-x- EX. FOC LONG TAIL TO BE REMOVED
- x-x-x- EX. COPPER CABLE TO BE REMOVED
- ⊗ PROPOSED POLE
- ⊗ EXISTING POLE
- ⊗ PROP. DOUBLE X-ARM ON PROP. POLE
- ⊗ EX. POLE & EX. DOUBLE X-ARM TO BE REMOVED
- ⊗ EX. POLE & EX. SINGLE X-ARM OR ALLEY-ARM TO BE REMOVED
- ⊗ EX. DOUBLE X-ARM ON EX. POLE
- ⊗ EX. SINGLE X-ARM OR ALLEY-ARM ON EX. POLE
- ⊗ EX. GUY & ANCHOR TO BE REMOVED
- ⊗ PROP. GUY & ANCHOR WITH PROP. LEAD
- ⊗ EXISTING FIBER SLACK LOOP
- ⊗ PROP. FIBER SLACK LOOP
- ⊗ EX. AER. FIBER TERMINAL
- ⊗ EX. AER. COPPER TERMINAL
- EX. FOC SPLICE POINT
- PROP. SPLICE ON EX. FIBER SPLICE POINT

PLAN LEGEND

CHECKED BY: KCN

DESIGNED BY: R. MOJE
 DRAWN BY: R. MOJE

STATE OF ALASKA
 DEPARTMENT OF TRANSPORTATION & PUBLIC FACILITIES
 SOUTHEAST REGION

KETCHIKAN ADVANCE
 WATER STREET TRUNK LINE
 RELOCATION
 PROJECT # 69548

TELEPHONE CABLE LAYOUT


PROJECT DESIGNATION	
BR-000S(735) ~ 69548	
STATE	YEAR
ALASKA	2014
SHEET NUMBER	TOTAL SHEETS
V13	78

Project As Built Drawings Have Been Reviewed By The Project Engineer & Represent, To The Best Of My Knowledge, The Project As Constructed.

Proj. Eng. *MB* Date *11/16/16*



DO NOT SCALE FROM THESE DRAWINGS USE DIMENSIONS

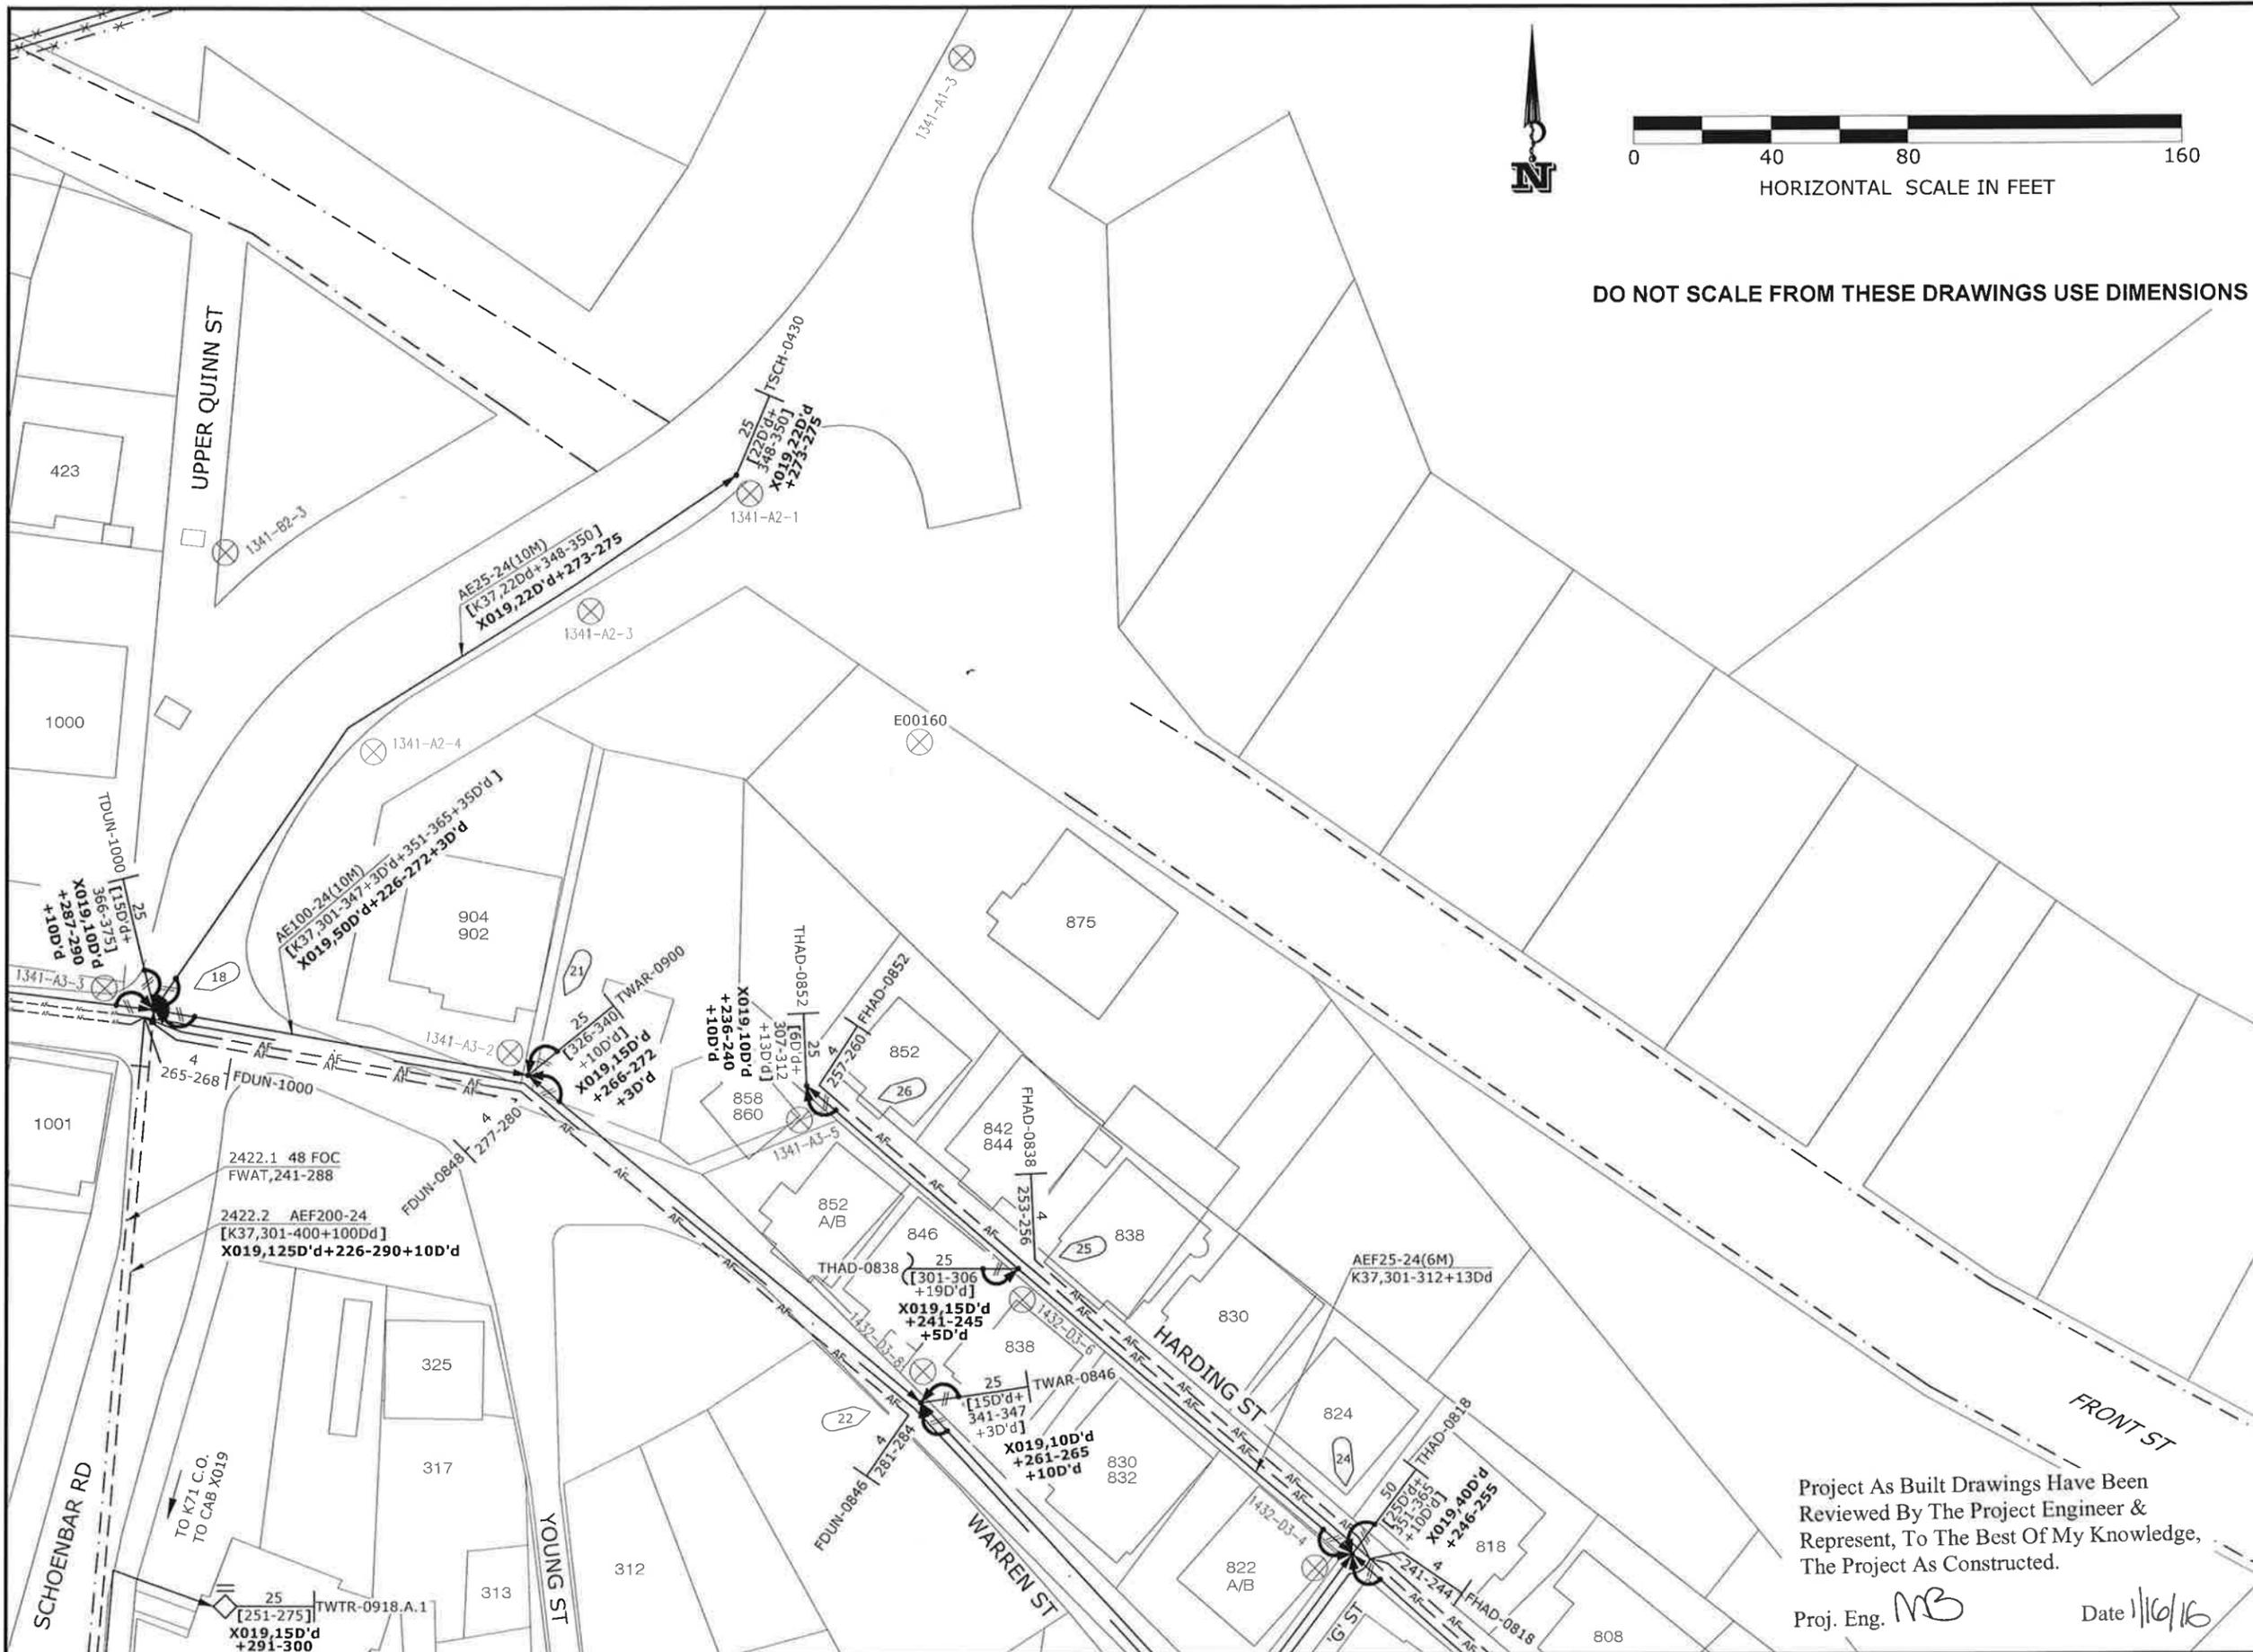

DO NOT SCALE FROM THESE DRAWINGS USE DIMENSIONS

Project As Built Drawings Have Been Reviewed By The Project Engineer & Represent, To The Best Of My Knowledge, The Project As Constructed.

Proj. Eng. *MB* Date *1/16/16*

PATH: C:\USERS\KCN12_000\DOCUMENTS\10-KNEE\2013
 DESIGN\310\DWG\10-NTP9 TRUNK
 RELOCATION\PLT-PTSE 140827 DOT
 KETCHIKAN FILE FOR WSD\DWG FILE FOR
 WSD\REPLACEMENT OF VDSL CABINETS FOR
 DOT WSD PROJECTS\140827 DOT
 TAB: 10-11-14 10:36 PM

ADDENDUM NUMBER
 ATTACHMENT NUMBER

RECORD OF REVISIONS

No.	DATE	DESCRIPTION

- PLAN LEGEND**
- PROP. AERIAL FOC
 - - - PROP. FOC LONG TAIL TERM.
 - PROP. AERIAL COPPER CA.
 - EXISTING AERIAL FOC
 - - - EX. FOC LONG TAIL TERM.
 - EX. AERIAL COPPER CA.
 - * - * - EX. AER. FOC TO BE REMOVED
 - * - * - EX. FOC LONG TAIL TO BE REMOVED
 - * - * - EX. COPPER CABLE TO BE REMOVED
 - ⊗ PROPOSED POLE
 - ⊗ EXISTING POLE
 - ⊗ PROP. DOUBLE X-ARM ON PROP. POLE
 - ⊗ EX. POLE & EX. DOUBLE X-ARM TO BE REMOVED
 - ⊗ EX. POLE & EX. SINGLE X-ARM OR ALLEY-ARM TO BE REMOVED
 - ⊗ EX. DOUBLE X-ARM ON EX. POLE
 - ⊗ EX. SINGLE X-ARM OR ALLEY-ARM ON EX. POLE
 - ⊗ EX. GUY & ANCHOR TO BE REMOVED
 - ⊗ PROP. GUY & ANCHOR WITH PROP. LEAD
 - ⊗ L=21'
 - ⊗ EXISTING FIBER SLACK LOOP
 - ⊗ PROP. FIBER SLACK LOOP
 - F120-002 305+48 25 EX. AER. FIBER TERMINAL
 - T120-002 305+48 25 EX. AER. COPPER TERMINAL
 - EX. FOC SPLICE POINT
 - PROP. SPLICE ON EX. FIBER SPLICE POINT

CHECKED BY: KCN



DESIGNED BY: R. MOJE
 DRAWN BY: R. MOJE


STATE OF ALASKA
 DEPARTMENT OF TRANSPORTATION
 & PUBLIC FACILITIES
 SOUTHEAST REGION

KETCHIKAN ADVANCE
 WATER STREET TRUNK LINE
 RELOCATION
 PROJECT # 69548



**TELEPHONE
 CABLE LAYOUT**

PROJECT DESIGNATION
BR-000S(735) ~ 69548

STATE	YEAR
ALASKA	2014
SHEET NUMBER	TOTAL SHEETS
V11	78

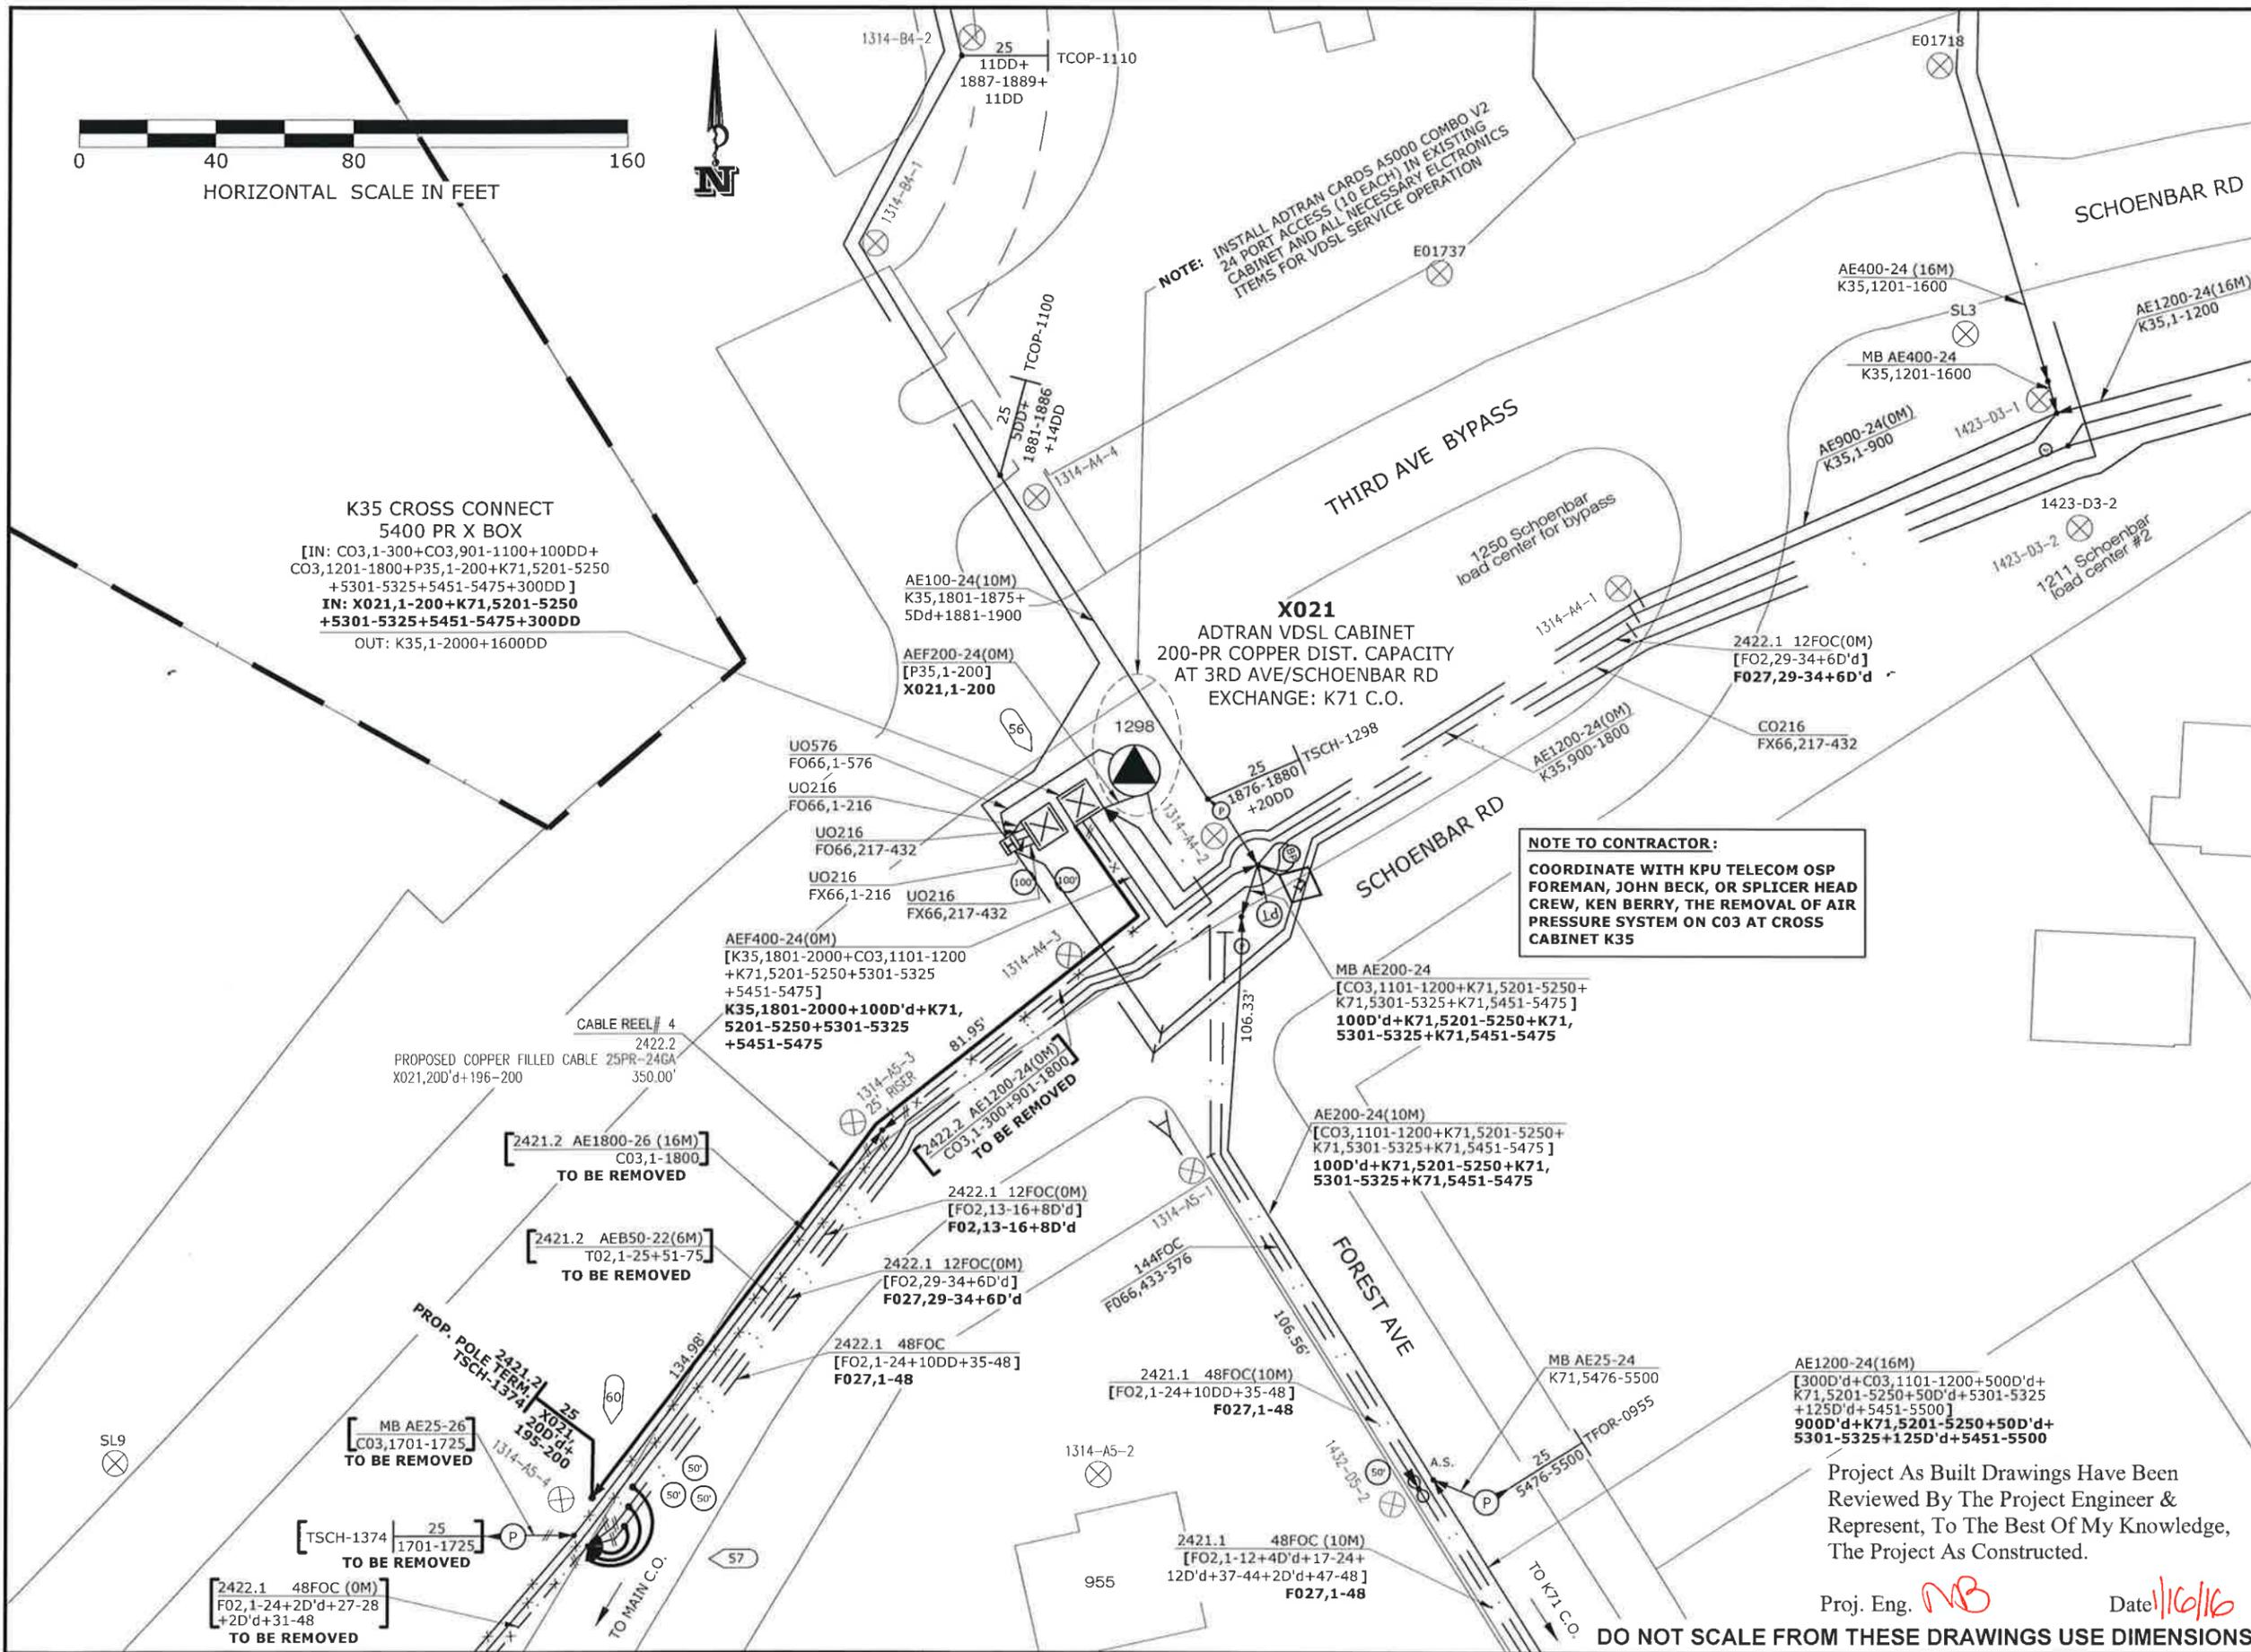

PATH C:\USERS\KCN12_000\DOCUMENTS\10-KNEE\2013
 DESIGN\3D\WG10-NTP9 TRUNK
 RELOCATION\KPU-T PSE 140827 DOT
 CERTIFYING FILE FOR WSDWG FILE FOR
 REPLACEMENT OF VDSL CABINETS FOR
 DOT WSDWG PROJECT 140827 DOT
 ATTENDUM NUMBER
 ATTACHMENT NUMBER
 RECORD OF REVISIONS
 No. DATE DESCRIPTION
 PROJECT DESIGNATION
BR-000S(735) ~ 69548
 STATE ALASKA YEAR 2014
 SHEET NUMBER V9 TOTAL SHEETS 78
 PROJECT # 69548
TELEPHONE CABLE LAYOUT
 KETCHIKAN ADVANCE WATER STREET TRUNK LINE RELOCATION
 DESIGNED BY: R. MOJE
 DRAWN BY: R. MOJE
 STATE OF ALASKA
 DEPARTMENT OF TRANSPORTATION & PUBLIC FACILITIES
 SOUTHEAST REGION
 KETH NELSON
 EE-7855
 8-21-14
 REGISTERED PROFESSIONAL ENGINEER
 Project As Built Drawings Have Been Reviewed By The Project Engineer & Represent, To The Best Of My Knowledge, The Project As Constructed.
 Proj. Eng. *MB* Date: *11/6/16*
DO NOT SCALE FROM THESE DRAWINGS USE DIMENSIONS

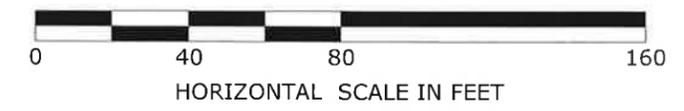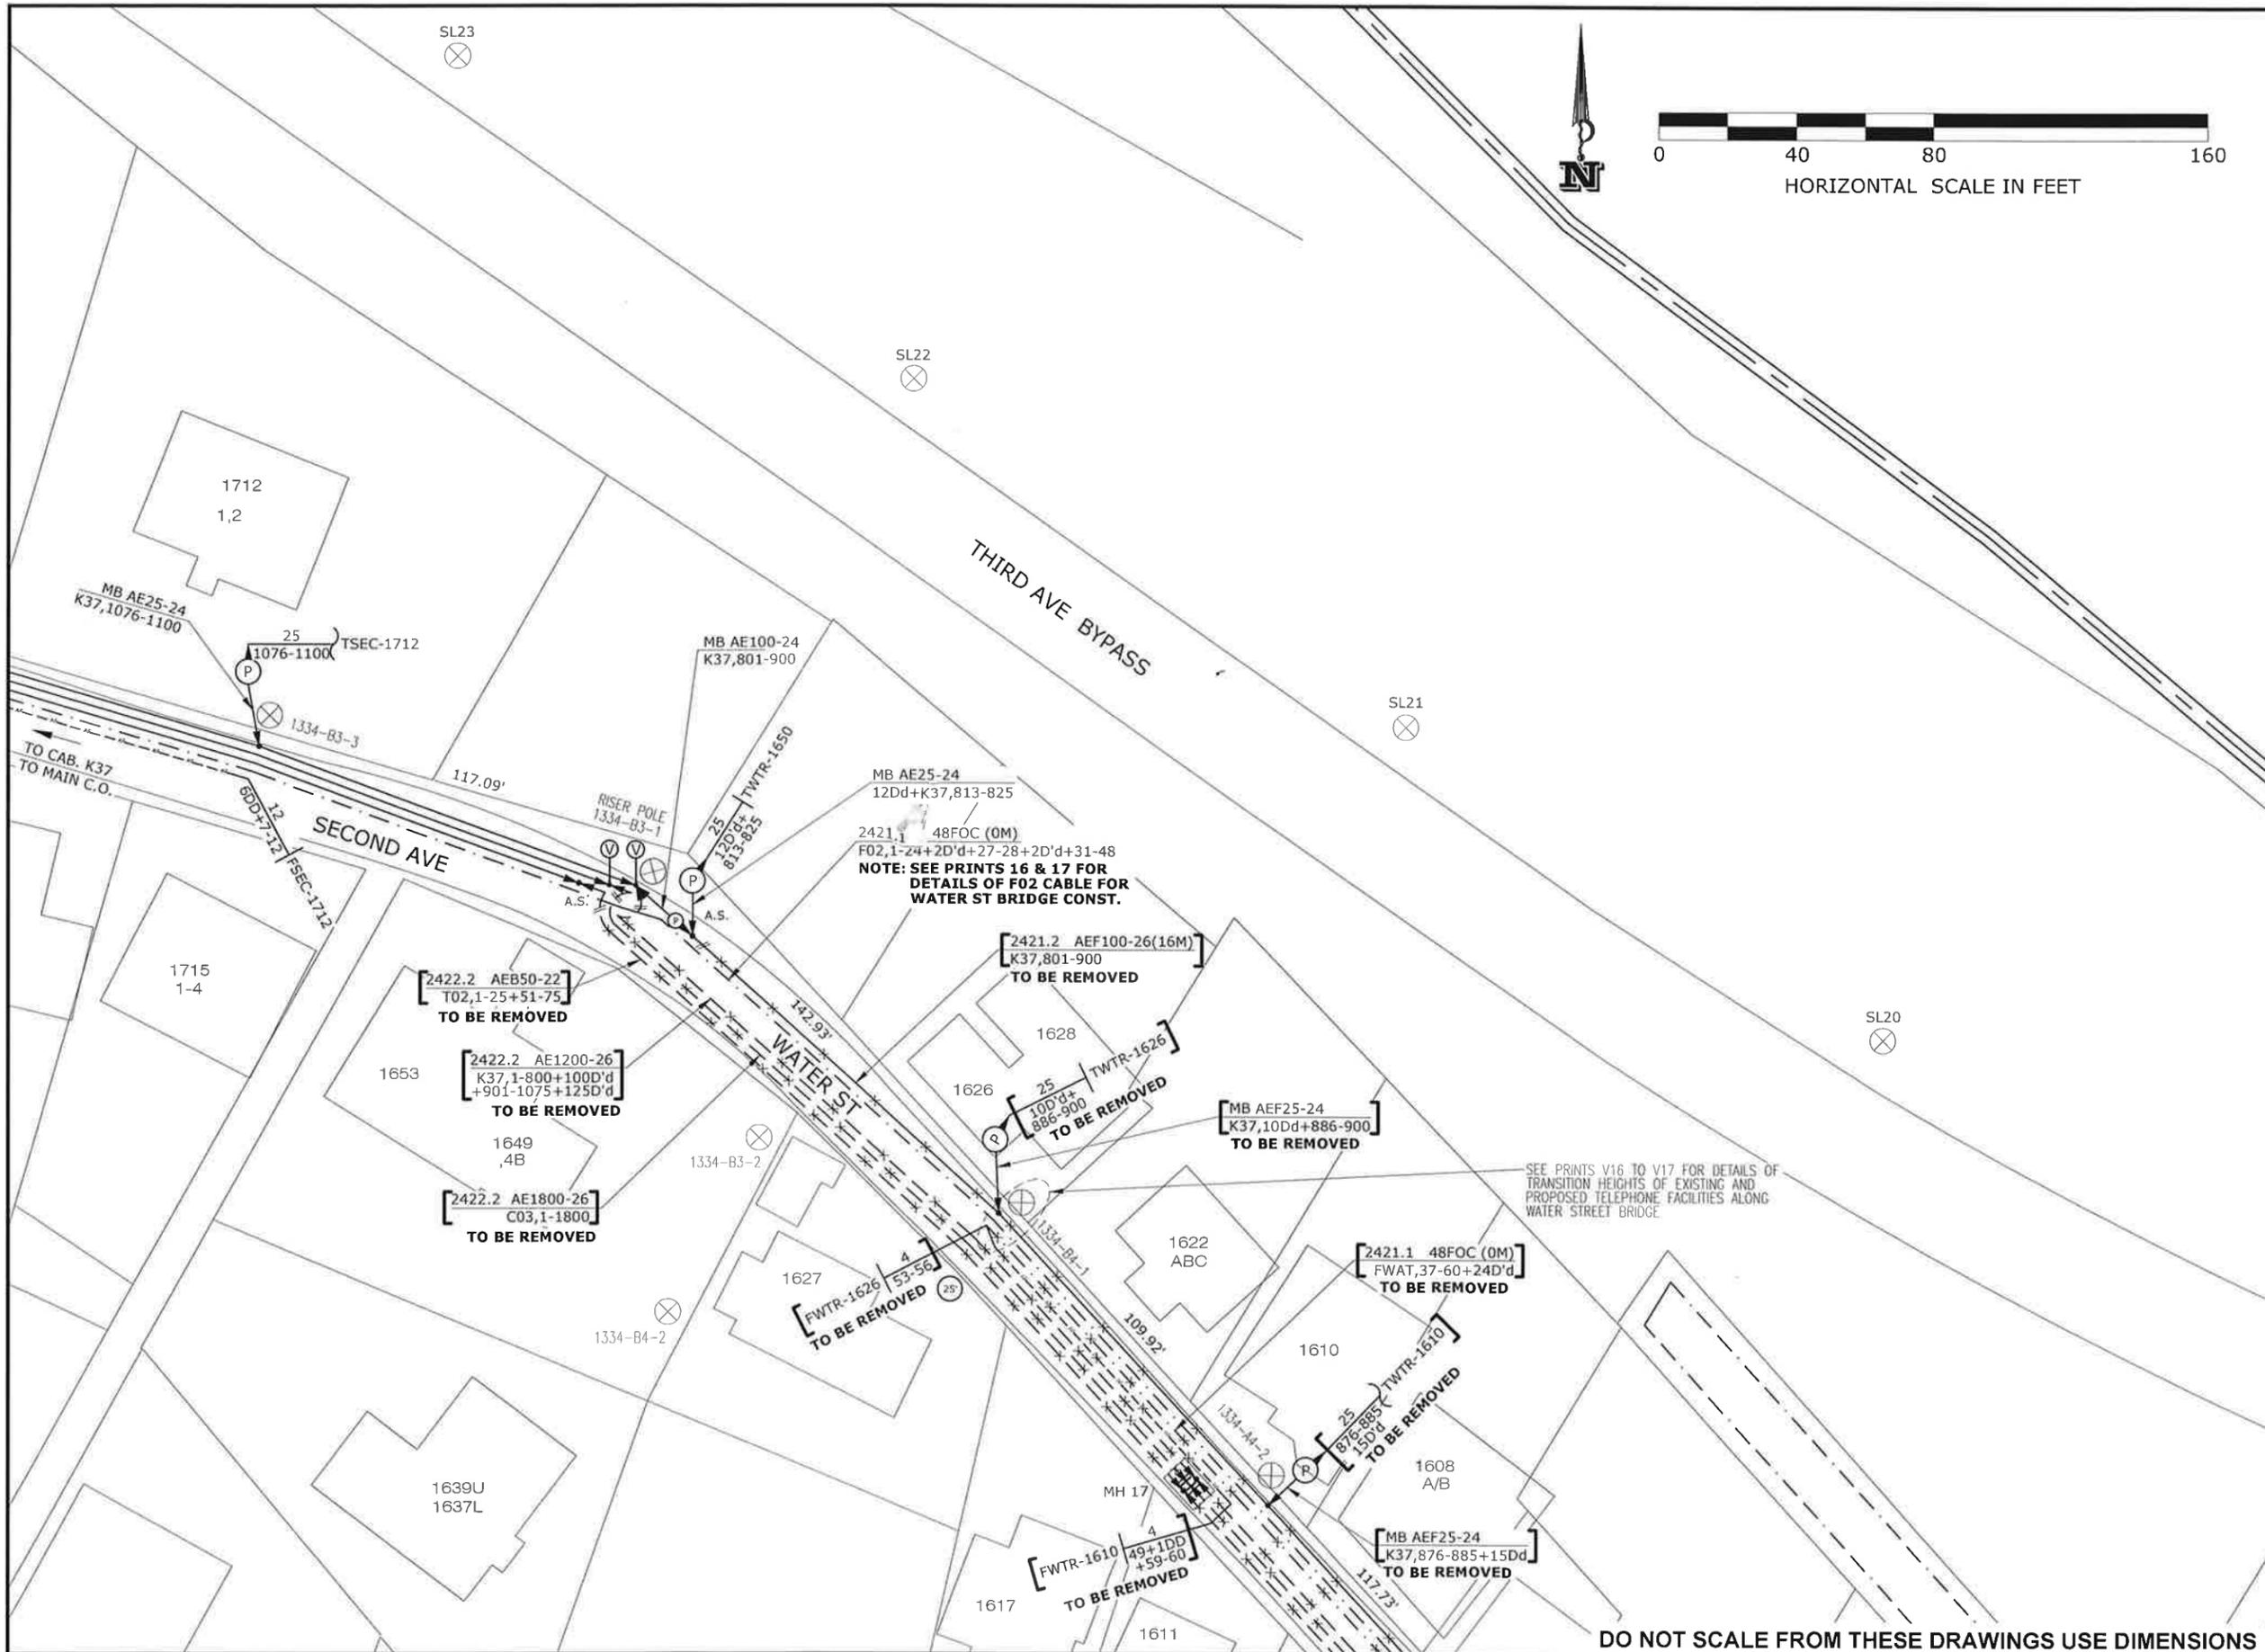

PATH: C:\USERS\KCN12_000\DOCUMENTS\10-KNEE\013
 DESIGN\13\DWG\10-NTP9 TRUNK
 RELOCATION\KPU-T PSE 140827.DOT
 CERTIFYING FILE FOR WSDWG FILE FOR
 WSDWG PLACEMENT OF VDSL CABINETS FOR
 TAB: 10/13/2014 10:46 PM

ADDENDUM NUMBER		
ATTACHMENT NUMBER		
RECORD OF REVISIONS		
No.	DATE	DESCRIPTION

	PROP. AERIAL FOC
	PROP. FOC LONG TAIL TERM.
	PROP. AERIAL COPPER CA.
	EXISTING AERIAL FOC
	EX. FOC LONG TAIL TERM.
	EX. AERIAL COPPER CA.
	EX. AER. FOC TO BE REMOVED
	EX. FOC LONG TAIL TO BE REMOVED
	EX. COPPER CABLE TO BE REMOVED
	PROPOSED POLE
	EXISTING POLE
	PROP. DOUBLE X-ARM ON PROP. POLE
	EX. POLE & EX. DOUBLE X-ARM TO BE REMOVED
	EX. POLE & EX. SINGLE X-ARM OR ALLEY-ARM TO BE REMOVED
	EX. DOUBLE X-ARM ON EX. POLE
	EX. SINGLE X-ARM OR ALLEY-ARM ON EX. POLE
	EX. GUY & ANCHOR TO BE REMOVED
	PROP. GUY & ANCHOR with PROP. LEAD
	EXISTING FIBER SLACK LOOP
	PROP. FIBER SLACK LOOP
	EX. AER. FIBER TERMINAL
	EX. AER. COPPER TERMINAL
	EX. FOC SPLICE POINT
	PROP. SPLICE ON EX. FIBER SPLICE POINT

PLAN LEGEND

CHECKED BY: KCN

DESIGNED BY: R. MOJE
 DRAWN BY: R. MOJE


STATE OF ALASKA
 DEPARTMENT OF TRANSPORTATION
 & PUBLIC FACILITIES
 SOUTHEAST REGION

KETCHIKAN ADVANCE
 WATER STREET TRUNK LINE
 RELOCATION
 PROJECT # 69548





**TELEPHONE
 CABLE LAYOUT**

PROJECT DESIGNATION	
BR-000S(735) ~ 69548	
STATE	YEAR
ALASKA	2014
SHEET NUMBER	TOTAL SHEETS
V3	78

DO NOT SCALE FROM THESE DRAWINGS USE DIMENSIONS

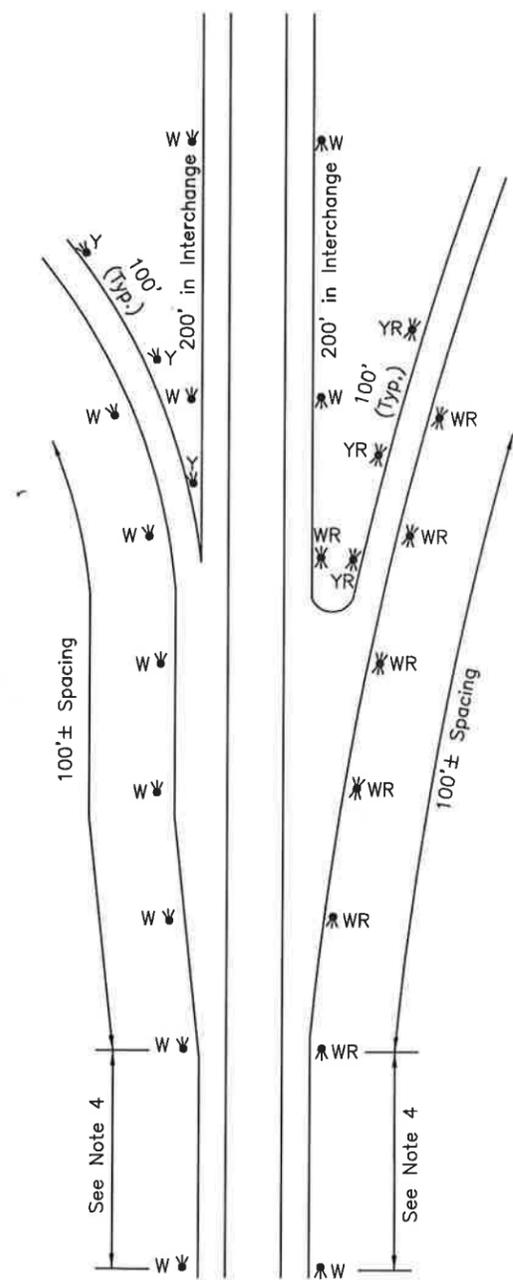

FREEWAY RAMPS

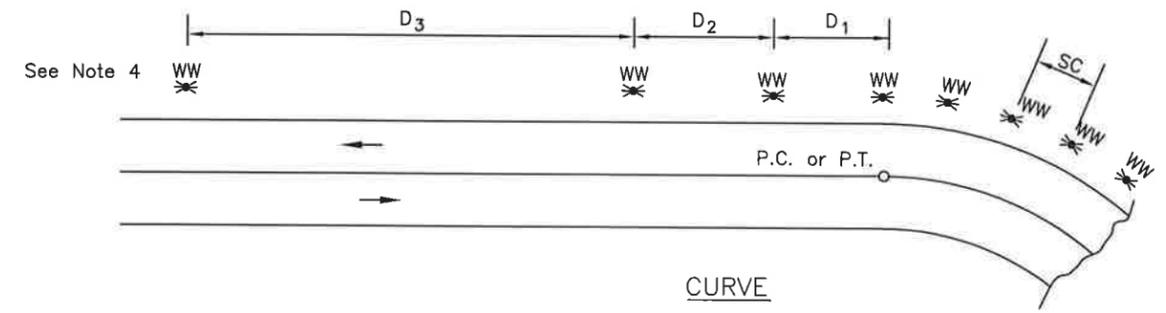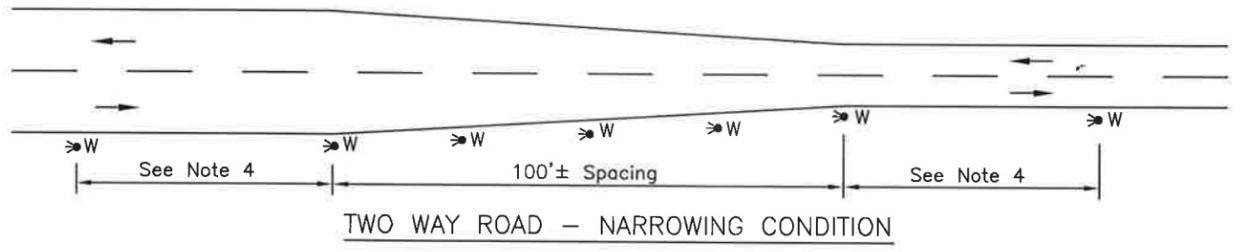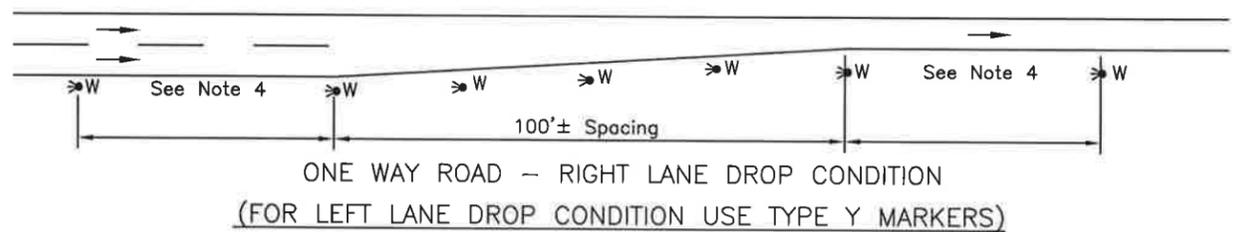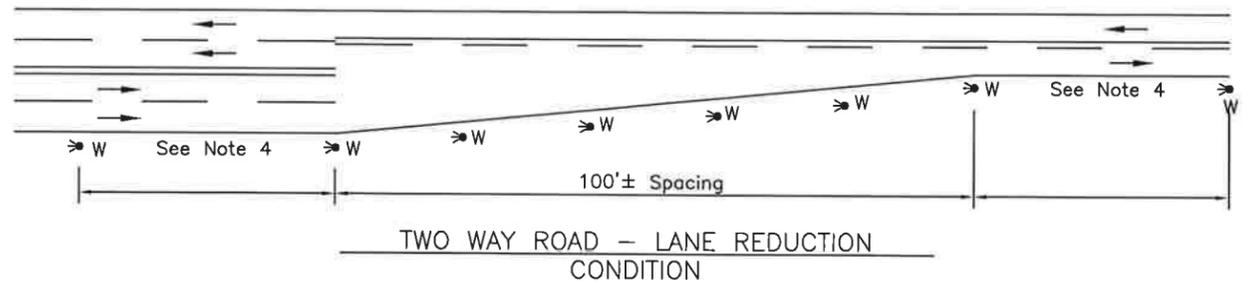

SPACING ON CURVES				
RADIUS FT	SPACING ON CURVE	SPACING IN ADVANCE AND BEYOND CURVE		
		FIRST	SECOND	THIRD
R	SC	D ₁	D ₂	D ₃
1,000'	90'	160'	270'	300'
900'	85'	155'	250'	300'
800'	80'	145'	240'	300'
700'	75'	135'	225'	300'
600'	70'	125'	210'	300'
500'	65'	115'	195'	300'
400'	55'	100'	165'	300'
300'	50'	90'	150'	300'
250'	40'	70'	120'	240'
180'	35'	65'	105'	210'
115'	25'	55'	90'	180'
50'	20'	35'	60'	120'

GUIDE MARKER REFLECTORS		
TYPE	FRONT COLOR	BACK COLOR
WW	WHITE	WHITE
W	WHITE	--
Y	YELLOW	--
YY	YELLOW	YELLOW
WR	WHITE	RED
YR	YELLOW	RED

- GENERAL NOTES**
1. Maximum spacing on tapers, speed change lanes, pavement transitions, and ramps should be 100'±.
 2. On roads with continuous delineation, adjust existing guide marker locations to tie into these configurations.
 3. Marker spacing in table has been rounded for ease of calculation and field layout.
 4. Spacing on tangents should be approximately 500', 530' maximum. See table for spacing on curves.

Project As Built Drawings Have Been Reviewed By The Project Engineer & Represent, To The Best Of My Knowledge, The Project As Constructed.

Proj. Eng. *MB* Date 11/10/10

REVISIONS		
Date	Description	By

Sheet 1 of 1

State of Alaska
Department of Transportation
& Public Facilities

**GUIDE MARKER
PLACEMENT**

WILLIAM J. SMITH
CE-7847

APPROVED

TIMOTHY G. MILLER
CE-8548

Date 2/28/03

G-46.11

GENERAL NOTES

- Use tapered end sections only where:
 - Barriers terminate outside the clear zone, or
 - The regulatory speed limit is 25 MPH or below, or 30 MPH if the Engineer determines NCHRP 350 or MASH compliant end treatments are unfeasible.
- Use air entrained concrete with minimum compressive strength of 3,000 p.s.i.
- Provide a minimum of two inches clear cover for reinforcing steel bars except as shown otherwise.
- Galvanize all exposed hardware in accordance with AASHTO M 232.
- Provide reinforcing steel bars conforming to AASHTO M 31-86, grade 60.
- Provide anchor pins conforming to AASHTO M 183 steel.
- Provide connecting pins conforming to AASHTO M 164-86.
- Provide four anchor pins per unit.

REVISIONS		
Date	Description	By
4/28/10	Correct dimensioning	KJS






Sheet 2 of 2

State of Alaska
Department of Transportation
& Public Facilities





**PRECAST CONCRETE
"F" SHAPE BARRIER
TAPERED END SECTION**



Date 5/31/12

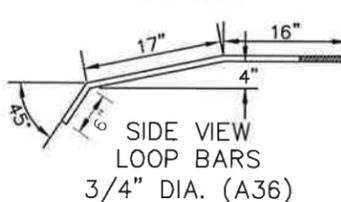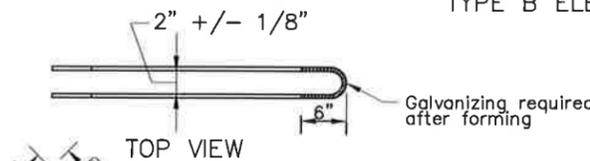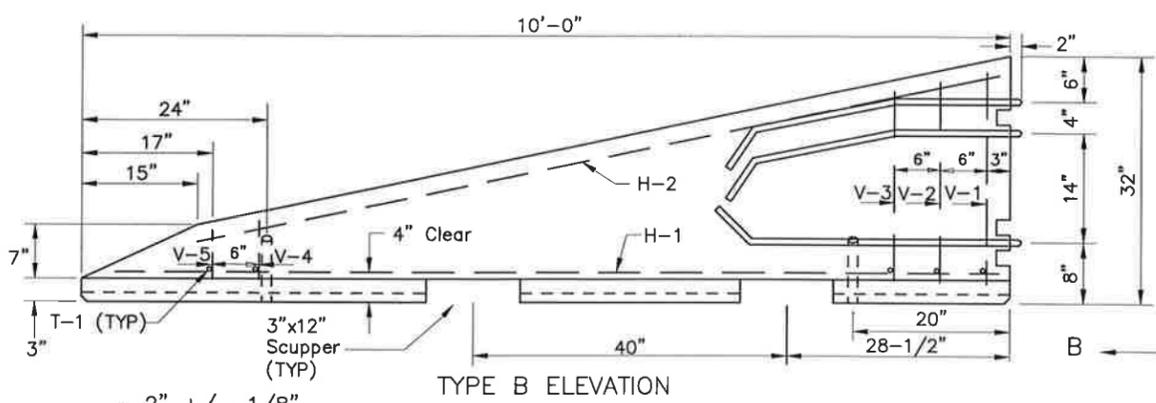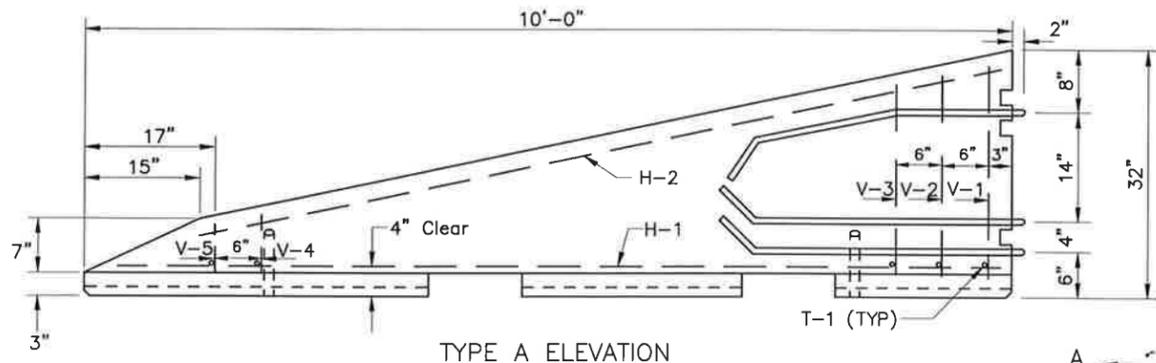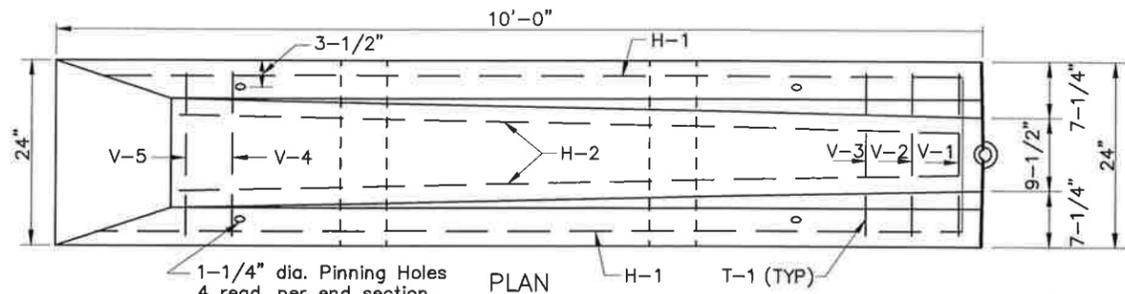


REINFORCEMENT DETAIL

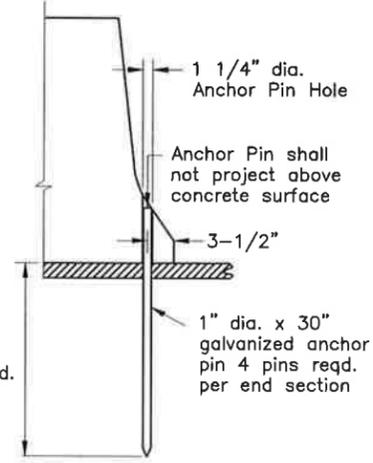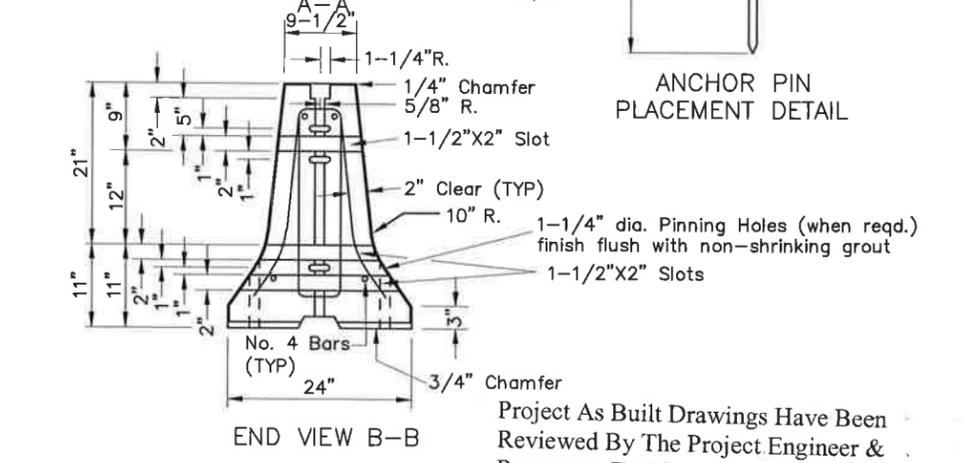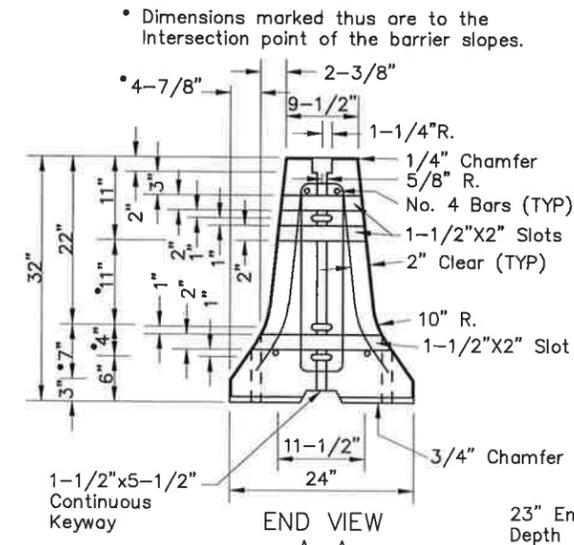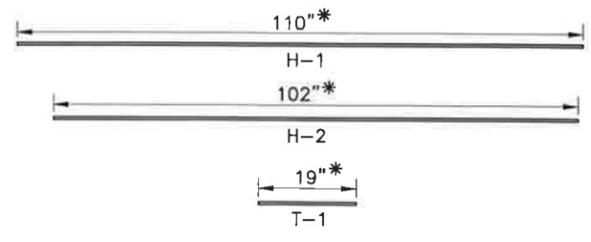


Project As Built Drawings Have Been Reviewed By The Project Engineer & Represent, To The Best Of My Knowledge, The Project As Constructed.


Proj. Eng. *NB* Date 1/16/16

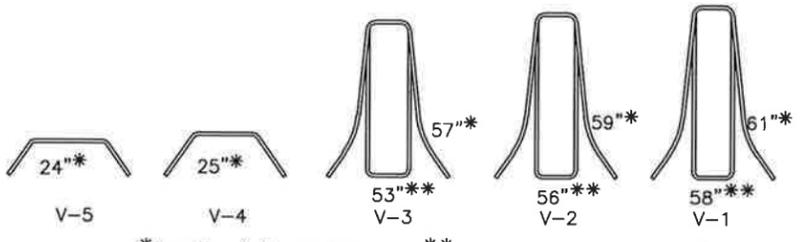


*Length of No. 4 Rebar **Length of No. 4 Rebar (Inner Core)
REINFORCING STEEL

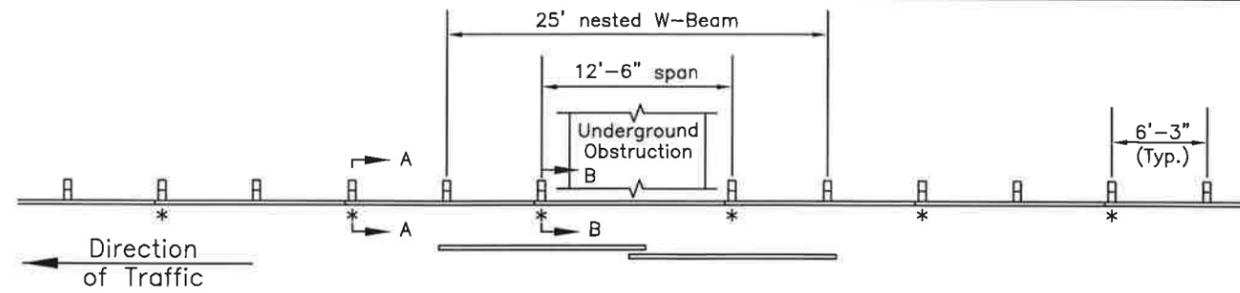


CASE A - ONE POST OMITTED (NESTED RAIL SPLICE AT OMITTED POST)
For obstruction widths up to 10'-6"

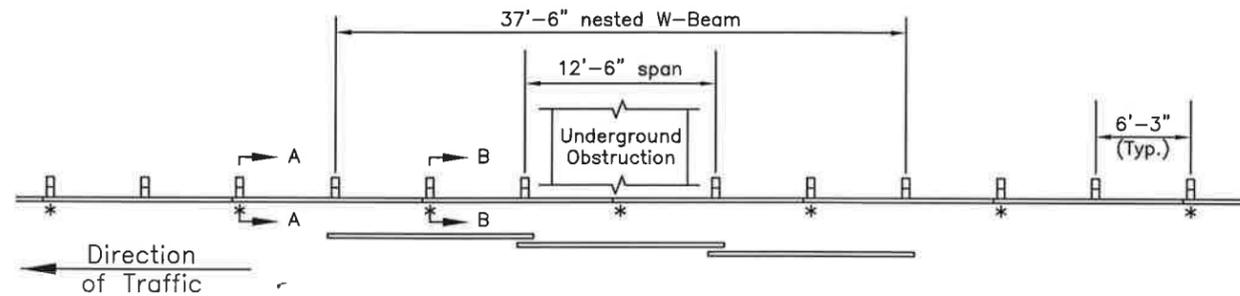

CASE B - ONE POST OMITTED (NESTED RAIL SPANS OMITTED POST)
For obstruction widths up to 10'-6"

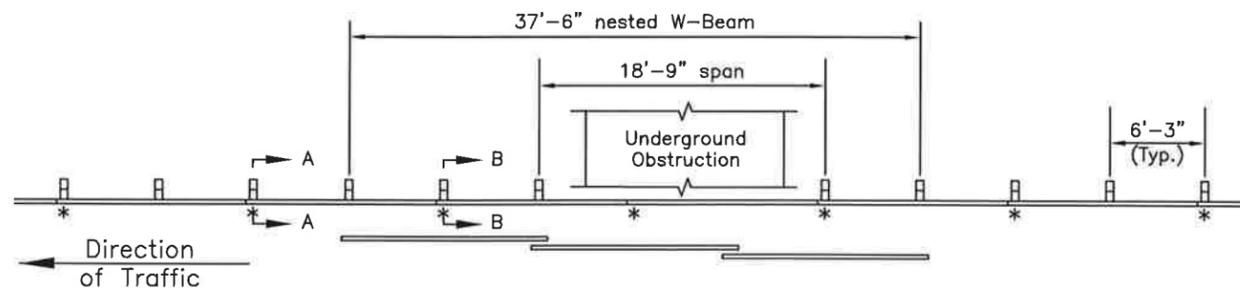


CASE C - TWO POSTS OMITTED
For obstruction widths from 10'-6" to 16'-9"

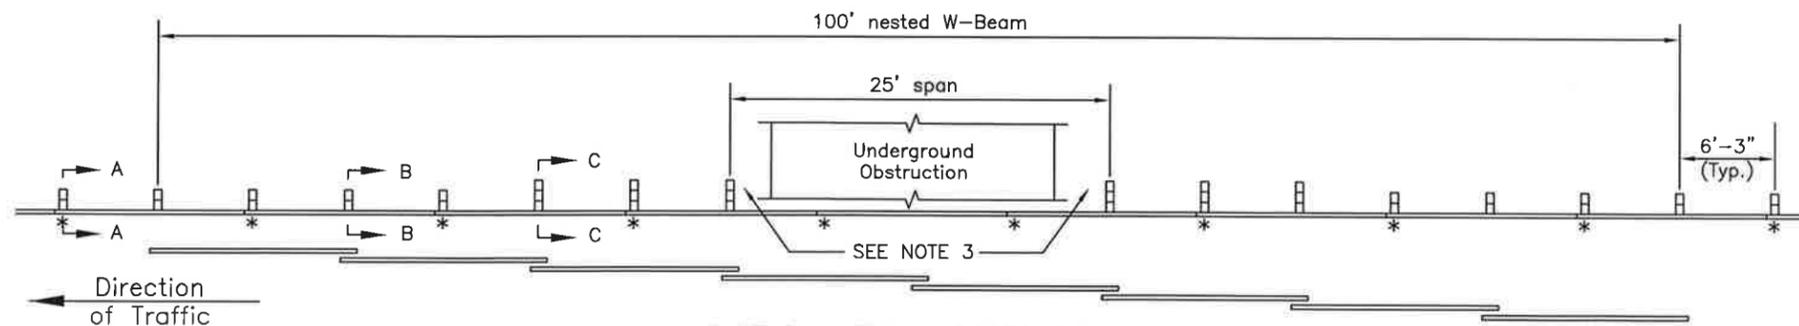


CASE D - THREE POSTS OMITTED
For obstruction widths from 16'-9" to 20'-6"


* Designates Splice Location

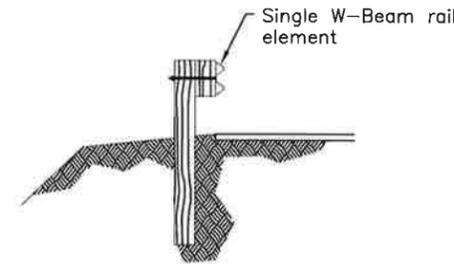

SECTION A-A

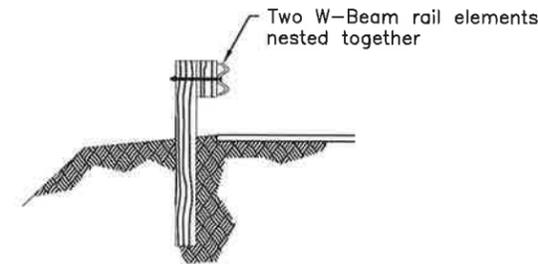

SECTION B-B

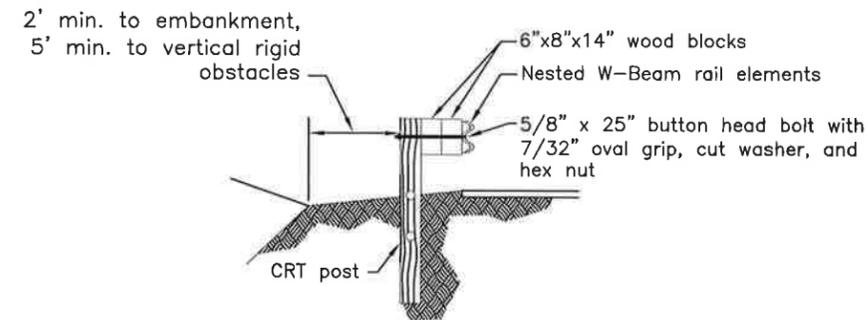

SECTION C-C

CROSS SECTIONS

GENERAL NOTES

1. See Standard Drawings G-00, G-04, G-10 for additional details, and G-25 Sheet 1 of 3 for CRT post details.
2. For one-way traffic locations Case D may be modified so that only the posts trailing the span are CRT posts with double blocks.
3. In Case D only, provide 2' minimum clearance between posts and underground obstruction.
4. Standard steel posts with standard wood blocks (or NCHRP 350 compliant synthetic blocks) may be used for all posts except those indicated to be CRT posts.
5. Install nested rail element with leading edge lapped behind primary rail element.
6. Cases A and B were tested under NCHRP 230 guidelines but the FHWA considers them equivalent to an NCHRP 350 Test Level 2 design. Case C has not been tested (as of March, 03) but the FHWA considers it equivalent to an NCHRP 350 Test Level 3 design. Case D is NCHRP 350 Test Level 3 tested and approved.

Project As Built Drawings Have Been Reviewed By The Project Engineer & Represent, To The Best Of My Knowledge, The Project As Constructed.

Proj. Eng. *NR*

Date 1/16/16

REVISIONS		
Date	Description	By


Sheet 1 of 1

State of Alaska
Department of Transportation
& Public Facilities


LONG SPAN
W BEAM GUARDRAIL




Date 2/28/03

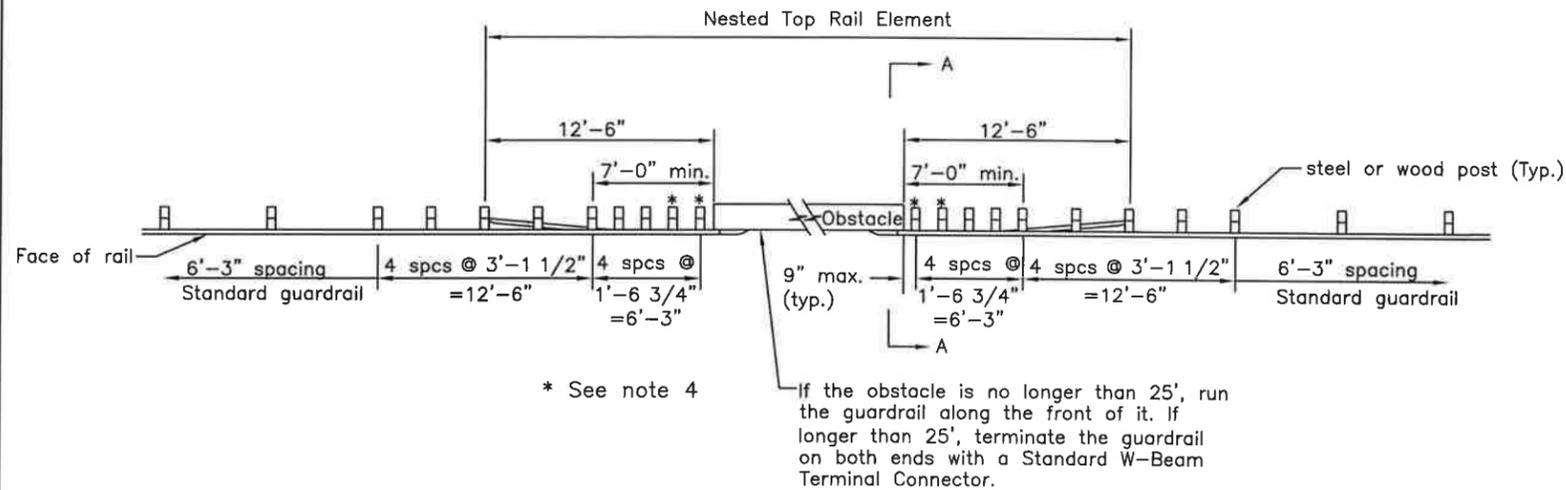




CASE A - OBSTACLE AT BACK OF W-BEAM

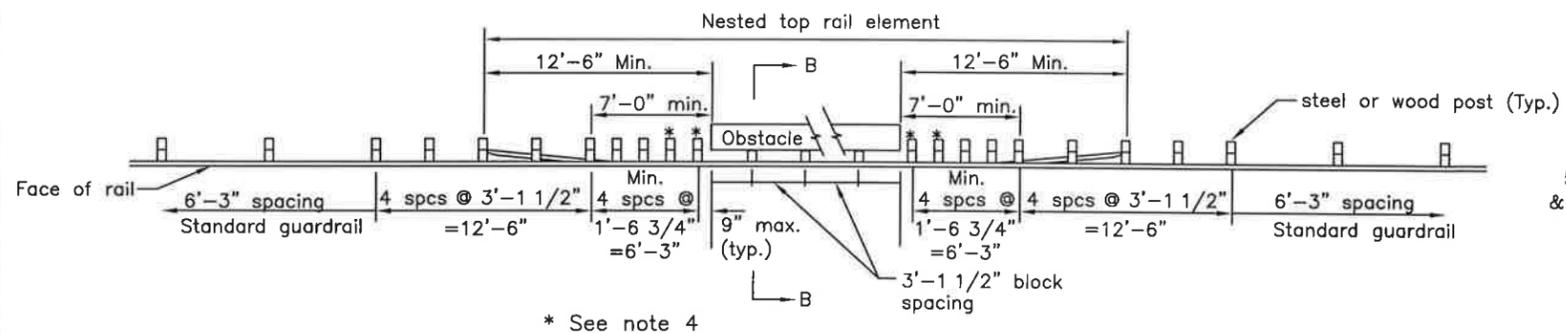

CASE B - OBSTACLE AT BACK OF BLOCK-OUT

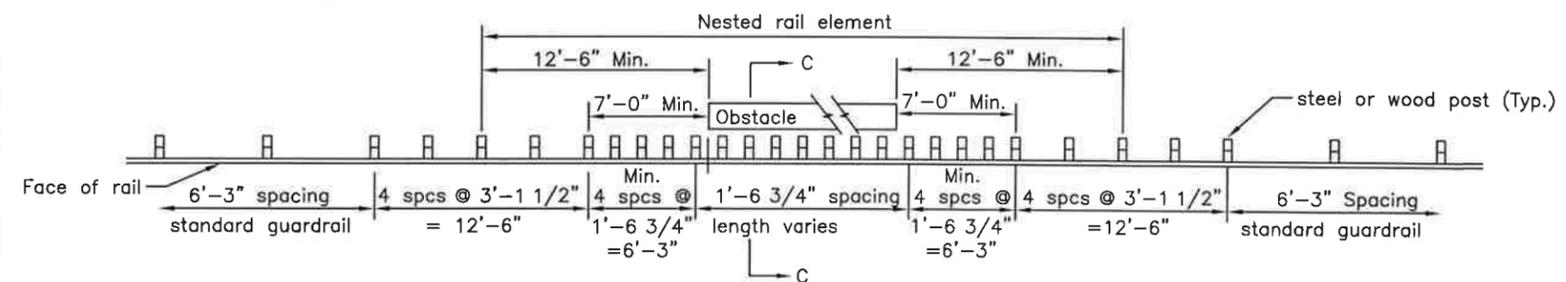

CASE C - LESS THAN THREE FEET OF CLEARANCE TO BACK OF POST

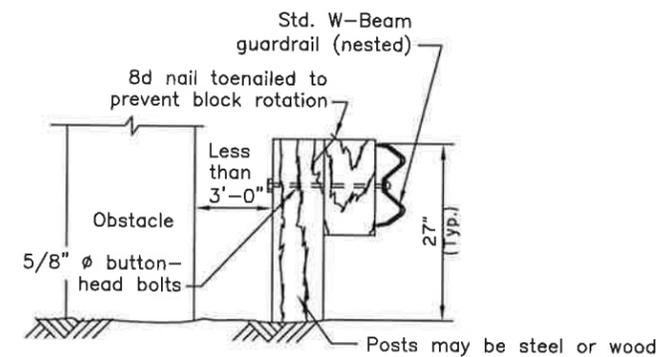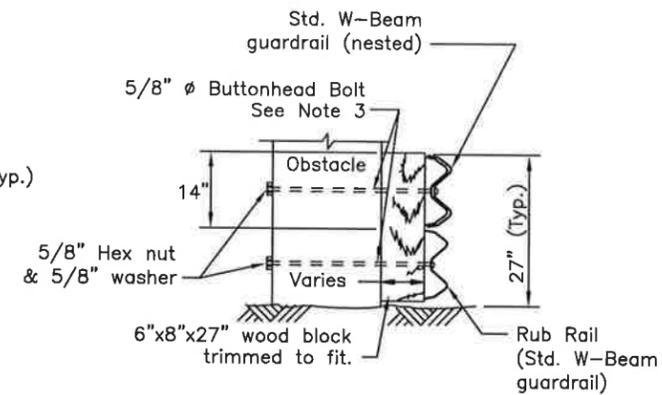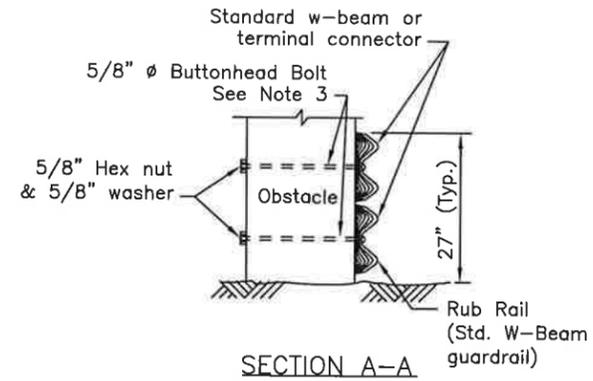

Use Std. W-Beam rail, post, wood block and hardware (See G-04S and G-04W).

SECTION C-C

GENERAL NOTES:

- Hardware details not shown here shall conform to drawings G-04, G-00, & G-10.
- No stiffening is required if the clearance between the back of post and the obstacle is 3 feet or greater.
- Guardrail that is connected to an obstacle shall be through-bolted or shall have an alternate connection that develops the full tensile strength of the bolt. Alternate connections must be approved by the Engineer.
- Posts marked with * shall be 8' long W8x13 steel or 8"x8" wood with blockouts as shown on G-04 (without notches).
- Install nested rail inside standard rail elements. Ensure that exposed ends of lapped rail elements face away from approaching traffic.
- These barriers are NCHRP 350, TL 3 approved.

Project As Built Drawings Have Been Reviewed By The Project Engineer & Represent, To The Best Of My Knowledge, The Project As Constructed.

Proj. Eng. *NB* Date *11/6/16*

REVISIONS		
Date	Description	By
10/31/03	Added Sheet 2 For Rubrail Transition	LRG


Sheet 1 of 2

State of Alaska
Department of Transportation
& Public Facilities
**GUARDRAIL STIFFENING
AT OBSTACLES**




NOT TO SCALE

Date 10/31/03

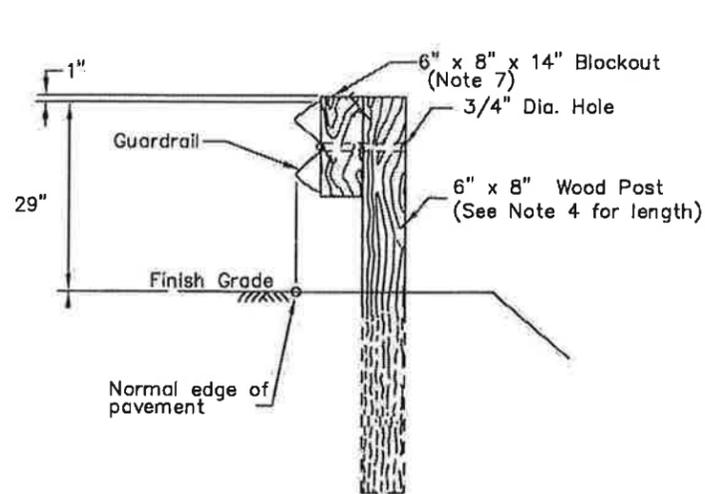


TYPE I POST INSTALLATION

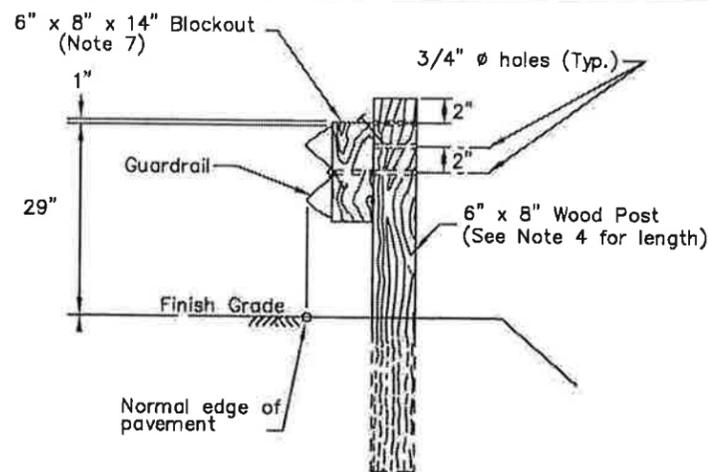

TYPE II POST INSTALLATION

(Facilitates raising rail for future overlays.)

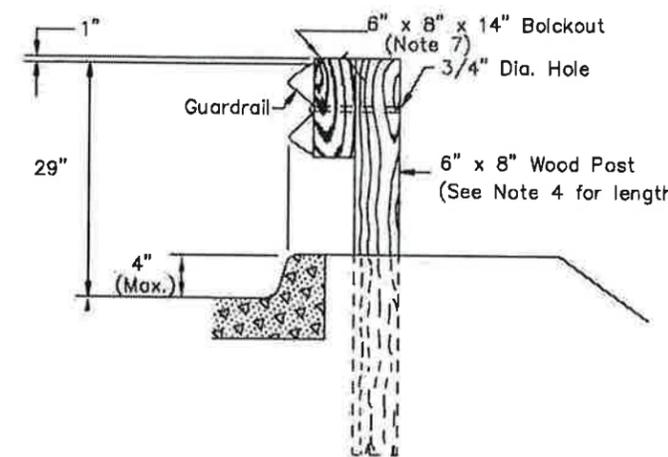

CURB DETAIL


TYPE III POST INSTALLATION

NOTE: Curb should not be installed with guardrail when the speed limit exceeds 40 mph.


- GENERAL NOTES:**
1. Attach guardrail reflectors at 50' centers beginning with the first post. Use Type A reflectors unless specified otherwise.
 2. Provide hardware compliant with the AASHTO/AGC/ARTBA "A Guide to Standardized Highway Barrier Hardware," latest edition.
 3. See Standard Drawing G-00 for hardware details.
 4. See Standard Drawing G-10 for post lengths corresponding to different combinations of slope and behind-post embankment width.
 5. Typical post spacing is 6'-3" center to center.
 6. This barrier is acceptable under NCHRP 350, TL-3.
 7. Use wood, rubber, plastic, or other NCHRP 350 or MASH approved blockouts designed to be used with wood posts.
 8. Use 25 linear foot transition to match height of existing or new rail elements and end treatments.

Project As Built Drawings Have Been Reviewed By The Project Engineer & Represent, To The Best Of My Knowledge, The Project As Constructed.

Proj. Eng. *NB* Date *1/16/16*

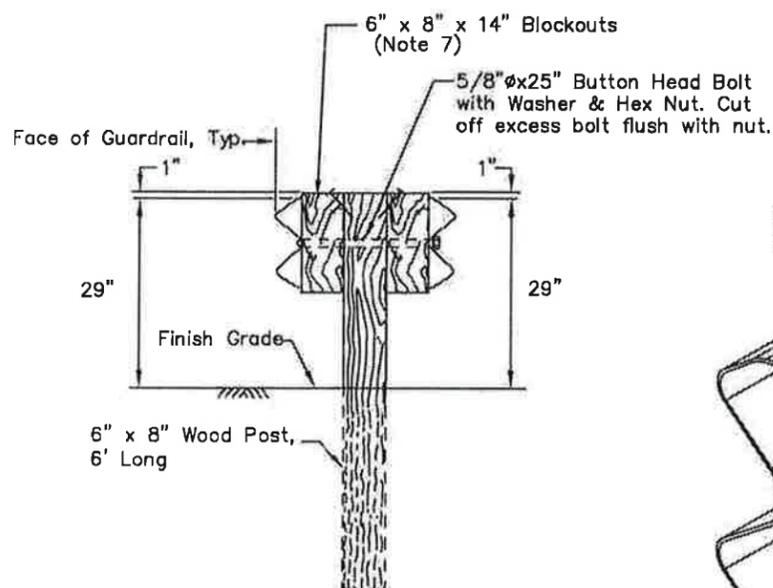

TYPE IV DOUBLE SIDED INSTALLATION

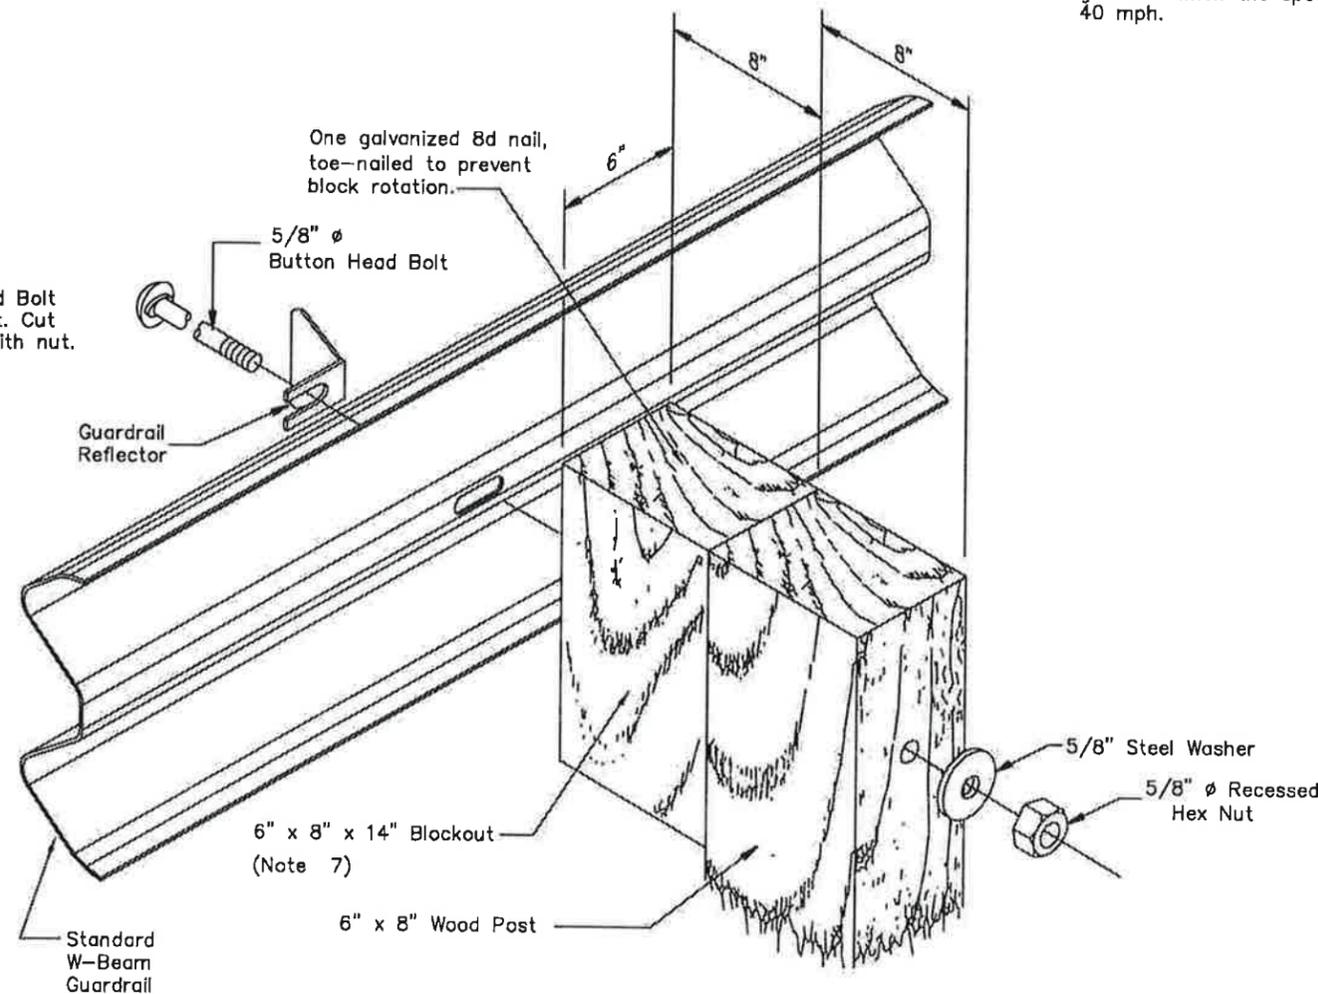

ASSEMBLY DETAIL

(Type I post shown)

REVISIONS		
Date	Description	By
12/1/87	2'-0" behind post	Gdo
5/15/89	Ref S4S to rough sawn	Gdo
4/1/93	Hinge point note	Gdo
1/1/96	Del. hardware/ add type II	Gdo
3/15/99	Post length and misc	Gdo
4/1/13	Double-sided detail and increase g.r. height	JCJ

State of Alaska
Department of Transportation
& Public Facilities

**WOOD POST
W-BEAM GUARDRAIL**



Date *05/15/13*

GENERAL NOTES:

1. Cable Anchor Plate may be formed in single unit or welded fabrication.
2. Anchor Cable Assembly shall conform to AASHTO M-30 with Type II Wire Rope.
3. Sleeve for Wood Posts shall conform to the requirements of ASTM A120 and shall be of 2-inch galvanized standard pipe. Sleeve shall be a tight, pressed fit in post.
4. Bolts, nuts and washers shall conform to ASTM A-325 and galvanized in accordance with ASTM A-153.
5. Radius ID plates shall be attached to all shop-bent guardrail sections. They shall be bolted to the back side of the guardrail panel with the lower splice bolt nearest the P.C. of the radius.
6. Rail bend radius in feet shall be shown as "XX" on the radius ID plate. Digits shall be etched or stamped and have a min. height of 1 1/2" and a max. width of 3/4". The plate shall be galvanized after digits are marked.
7. All covered hardware shall comply with the AASHTO/AGC/ARTBA "A Guide to Standardized Highway Barrier Hardware", latest edition.

Project As Built Drawings Have Been Reviewed By The Project Engineer & Represent, To The Best Of My Knowledge, The Project As Constructed.

Proj. Eng. *NR* Date *11/6/16*


REVISIONS		
Date	Description	By
3/15/99	Delete BCT Hardware	KJS

State of Alaska
Department of Transportation
& Public Facilities


**STANDARD GUARDRAIL
HARDWARE
(MISCELLANEOUS)**

Type	Color	Reflectors
A	White	Front & Rear
B	White	Front
C	Yellow	Front
D	Yellow	Front & Rear


APPROVED
Date *5/31/12*

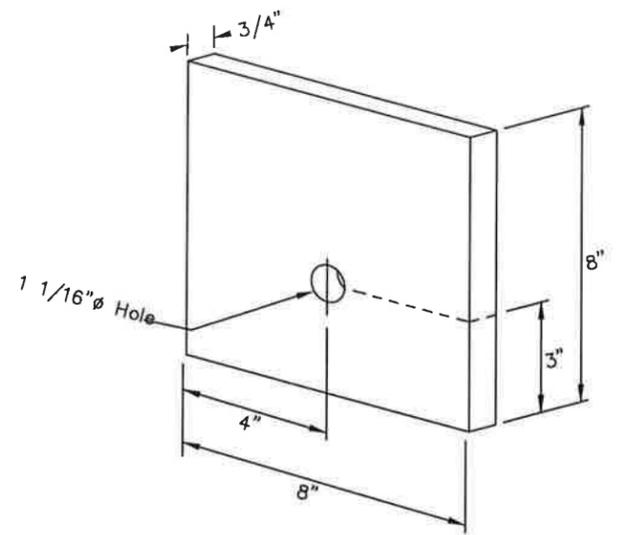


BEARING PLATE for CRT TERMINAL ANCHOR

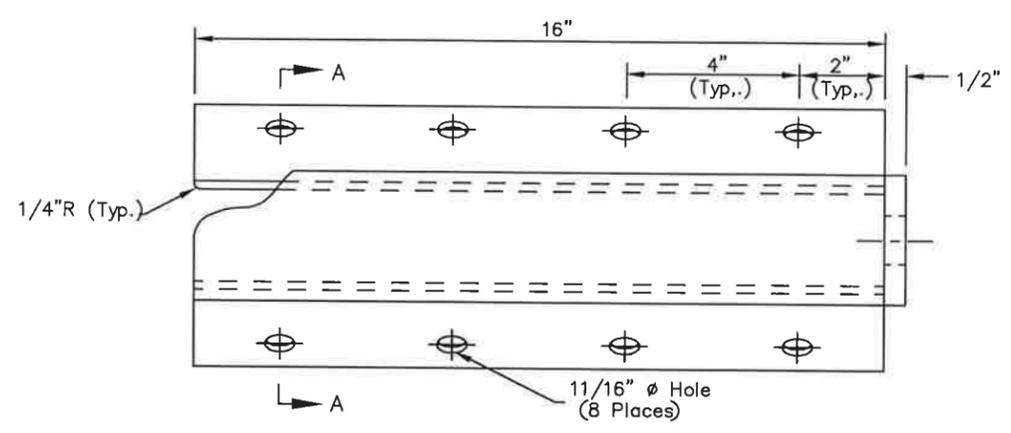


CABLE ANCHOR PLATE

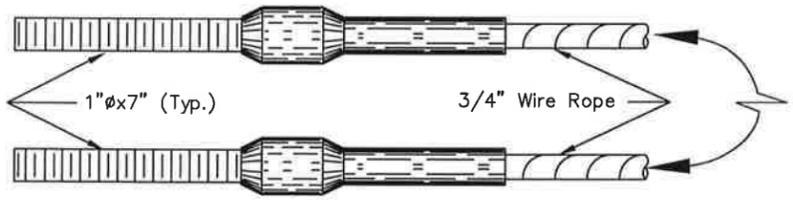

SWAGED FITTING DETAIL

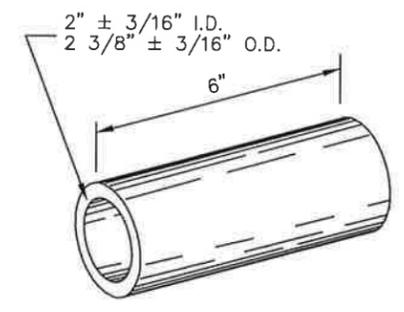


SLEEVE DETAIL

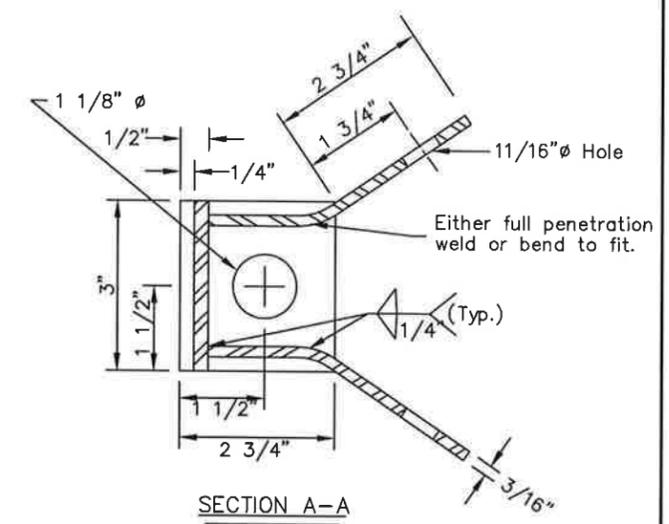


SECTION A-A


CONTROLLED RELEASE TERMINAL HARDWARE DETAILS

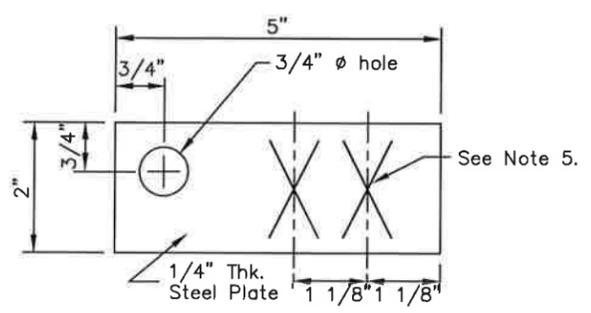

RADIUS I.D. PLATE

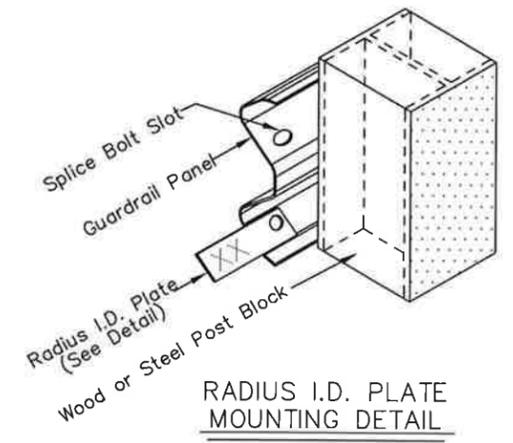


RADIUS I.D. PLATE MOUNTING DETAIL

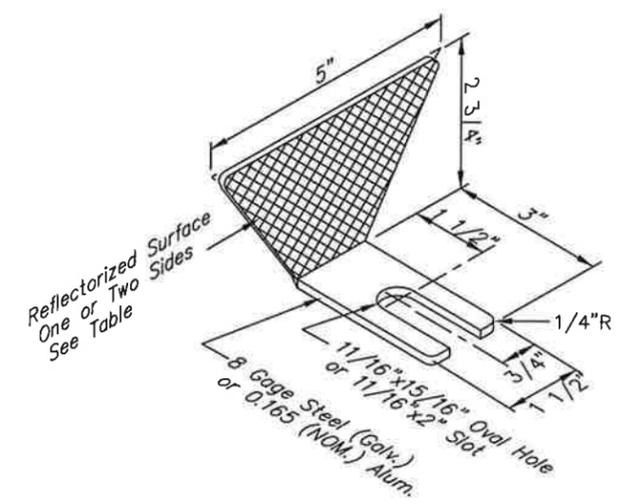


GUARDRAIL REFLECTOR

GENERAL NOTES:


1. Provide hardware compliant with the AASHTO/AGC/ARTBA "A Guide to Standardized Highway Barrier Hardware, latest edition.
2. Install back-up plates between blockouts and w-beam or thrie-beam rail at intermediate (non-splice) posts when steel blockouts are used but not with wood, rubber, plastic, or other approved blockouts.
3. Provide Thrie beam and W-beam compliant with AASHTO M180A. Use 12 gauge (0.105") thick steel for both.

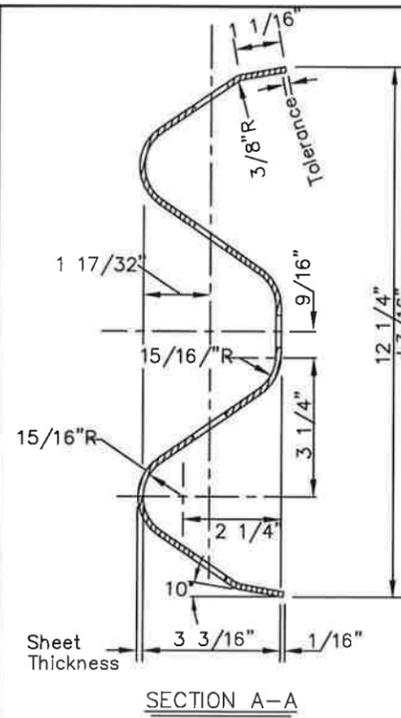


SECTION A-A

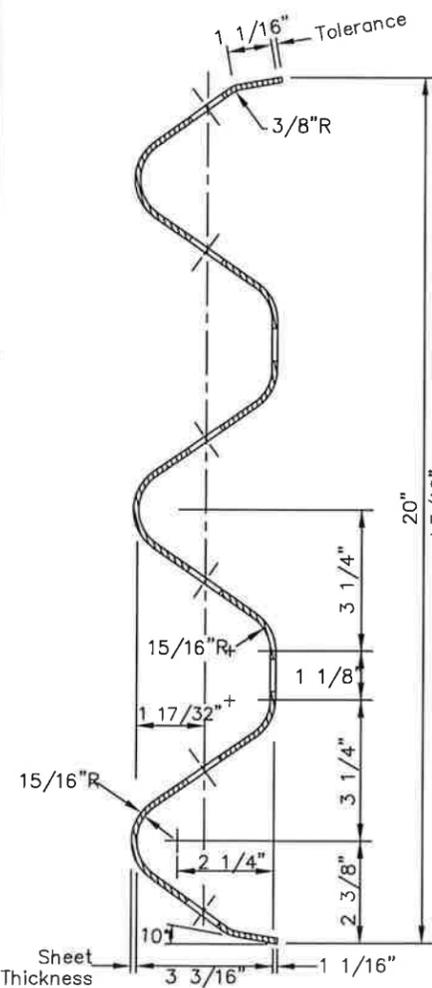


SECTION C-C

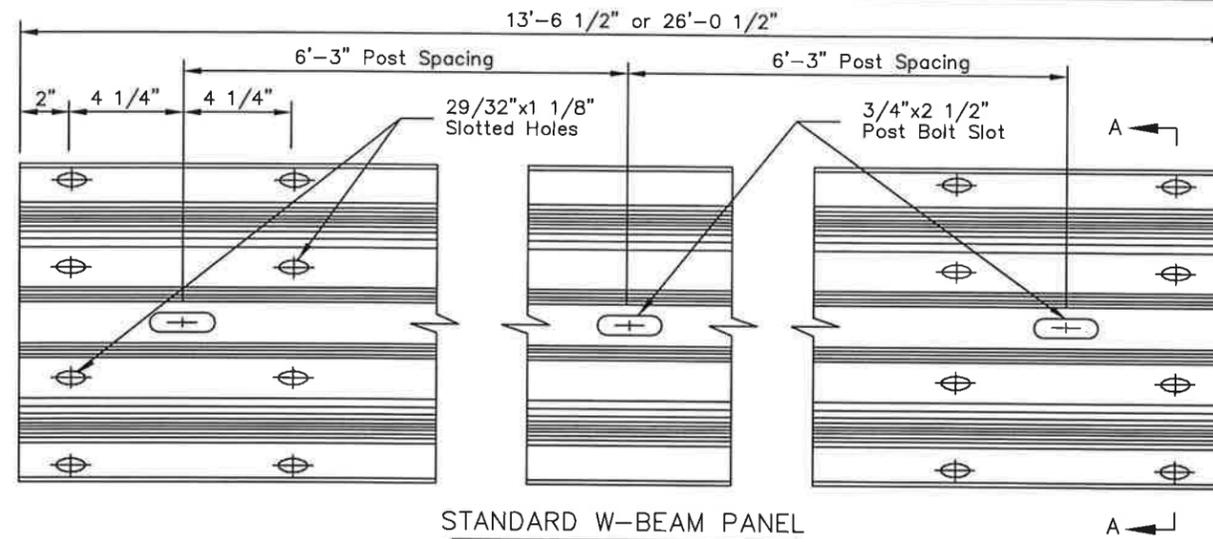


STANDARD W-BEAM PANEL

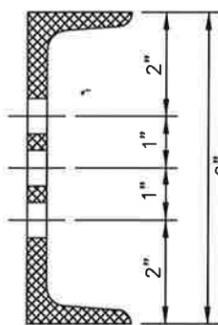


SECTION B-B

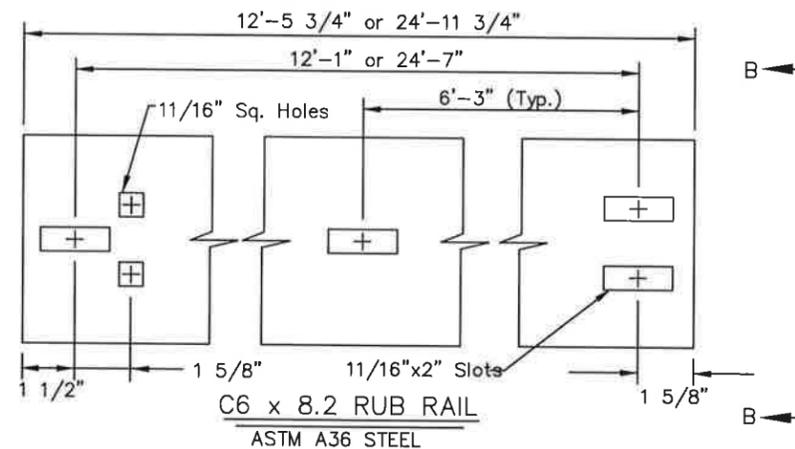


C6 x 8.2 RUB RAIL
ASTM A36 STEEL

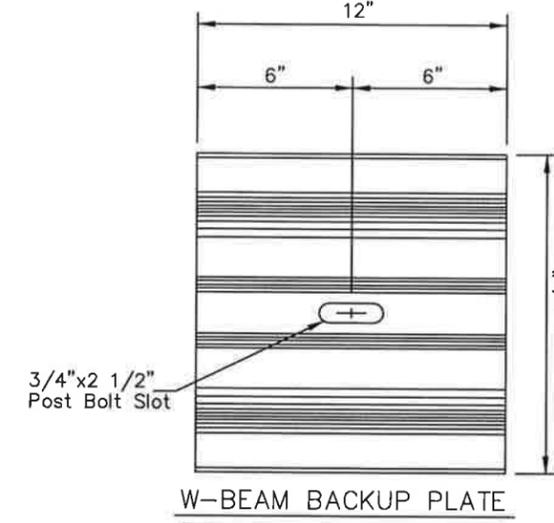


W-BEAM BACKUP PLATE

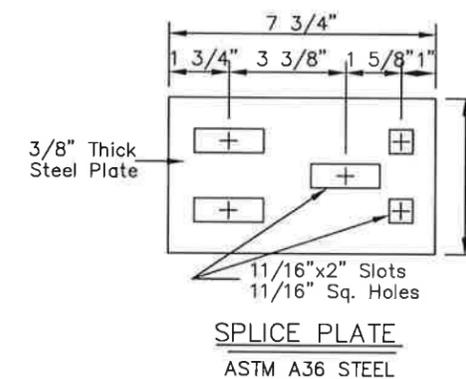

SPLICE PLATE
ASTM A36 STEEL

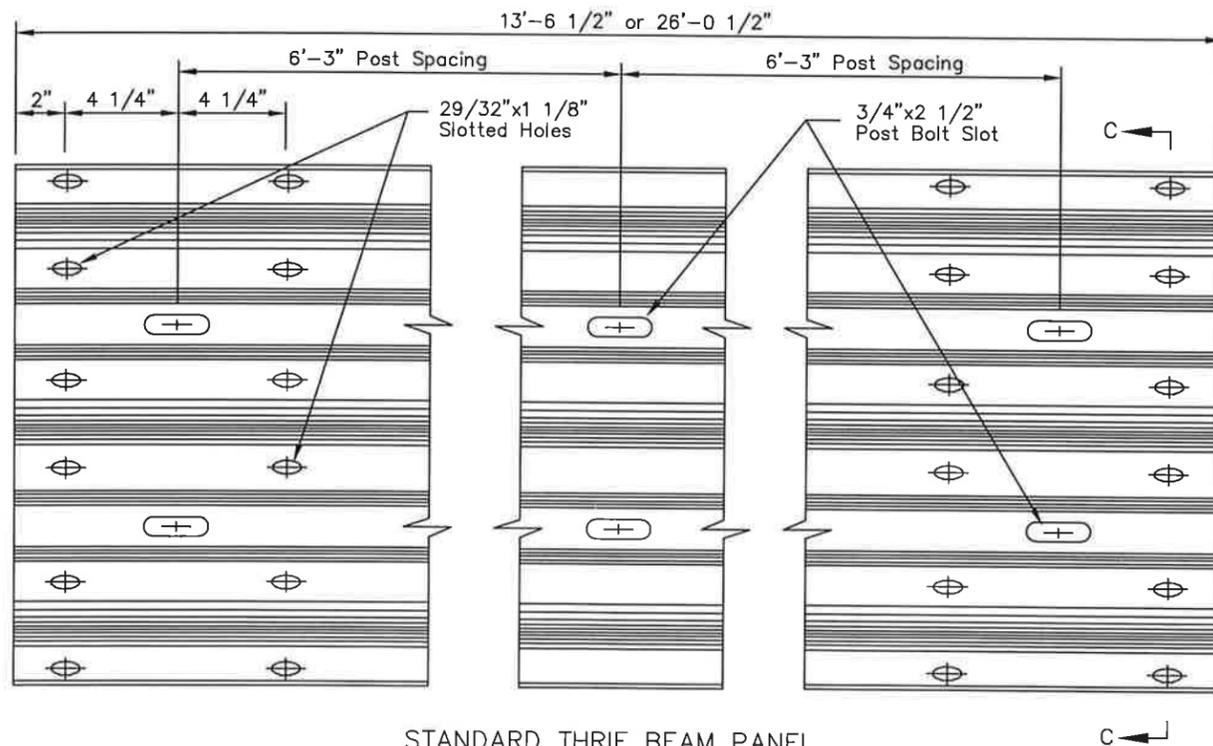

STANDARD THRIE BEAM PANEL

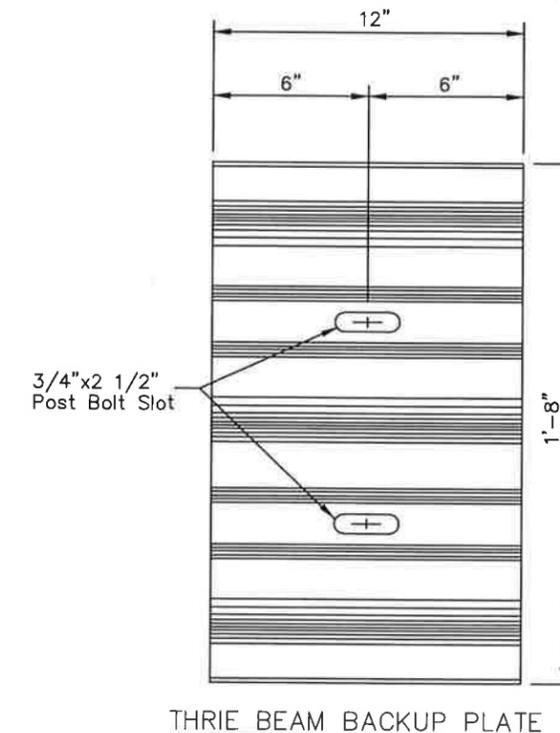

THRIE BEAM BACKUP PLATE

Project As Built Drawings Have Been Reviewed By The Project Engineer & Represent, To The Best Of My Knowledge, The Project As Constructed.


Proj. Eng. *NB* Date *1/16/10*

REVISIONS		
Date	Description	By
4/28/10	Revise General Notes	KJS

State of Alaska
Department of Transportation
& Public Facilities
**STANDARD GUARDRAIL
HARDWARE
(RAILS AND SPLICES)**



Date *5/31/12*

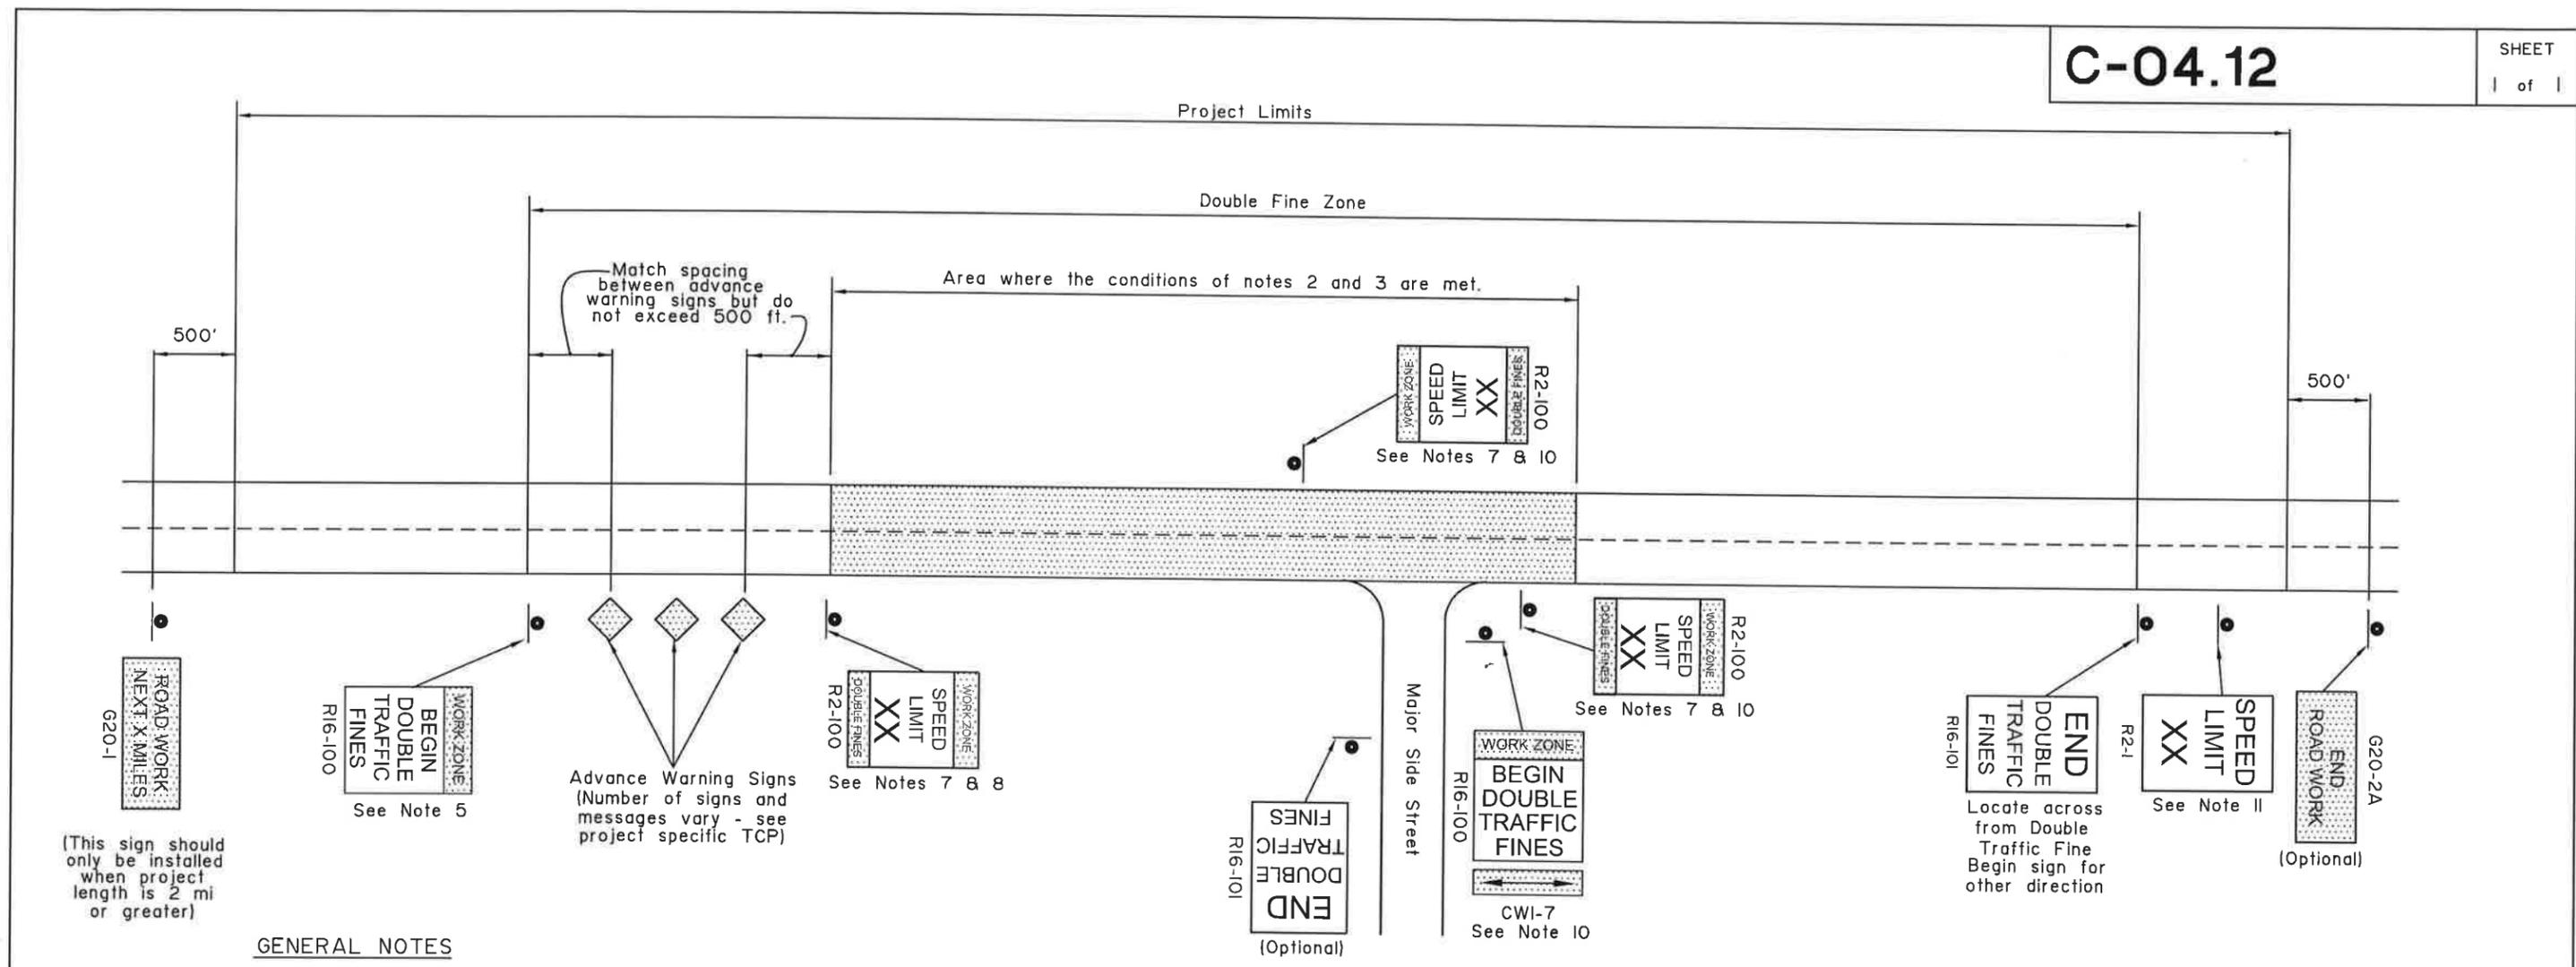

GENERAL NOTES

1. Signs are shown for one direction only (with one exception). Signs for the other direction mirror those shown.
2. Double fine signs shall be used only where one or more of the following conditions exist:
 - a. Active work areas (where road workers and/or machines are presently working on or adjacent to a road)
 - b. Detours on new temporary roads built for that purpose (this does not include detours on existing streets)
 - c. Sections of paved roads where pavement has been removed.
 - d. Roads being paved where unmatched asphalt lifts result in a vertical lip between lanes.
3. Double fine signs shall be confined to the areas where the above conditions exist, with the following exceptions:
 - a. If the project is 2 miles or shorter in length, the entire project may be posted for double fines when the above conditions exist on any part of the project.
 - b. When the above conditions exist at multiple locations separated by less than 2 miles, the locations and the intervening segments may be posted as a single double fine zone.
4. Double fine signs shall be removed or covered when work activity ceases for more than two days and conditions b, c, or d of note 2 are not met.
5. The R16-100 "BEGIN" sign may be used in place of the first advance warning sign. However, when this is done, the appropriate advance warning sign must be reinstalled when the double fine sign is taken down or covered.
6. When a double fine zone is longer than 2 miles, work zone speed limit signs shall be posted at spacings not greater than 2 miles within the double fine zone.
7. "Work zone speed limit signs", as used here, refer either to 1) R2-100 signs or 2) standard R2-1 regulatory speed limit signs with CW20-102 "DOUBLE FINES" plates mounted below.
8. The limit shown on work zone speed limit signs shall be either the existing limit before construction or, if a work zone speed limit order has been approved in accordance with ADOT&PF Procedure 05.05.020 PDR, a reduced limit.
9. All existing regulatory speed limit signs within double fine zones shall either be replaced with R2-100 signs or supplemented with CW20-102 plates.
10. Signs shall be installed at major intersections within the double fine zone to warn entering drivers of double fines. This may be done with a R16-100 sign with a CWI-7 arrow panel on the side street or with two work zone speed limit signs on the main street on either side of the intersection. Use of R16-100 signs on side streets eliminates the need for "Road Work Ahead" signs on those streets. If the speed limit has been reduced, the two work zone speed limit signs are mandatory.
- II. At the end of each double fine zone, install an R2-1 sign showing the speed limit for the road beyond the double fine zone.

(This sign should only be installed when project length is 2 mi or greater)

Advance Warning Signs (Number of signs and messages vary - see project specific TCP)

REVISIONS		
Date	Description	By
6/11/99	Revised Notes	KJS
2/28/03	Rev. Notes & Sign No's	KJS

State of Alaska
Department of Transportation
& Public Facilities

**LOCATION OF
DOUBLE TRAFFIC
FINE SIGNS**

APPROVED

Date 3/31/99

Project As Built Drawings Have Been Reviewed By The Project Engineer & Represent, To The Best Of My Knowledge, The Project As Constructed.

Proj. Eng. *NG* Date 11/6/16

ADDENDUM NUMBER		
ATTACHMENT NUMBER		
RECORD OF REVISIONS		
No.	DATE	DESCRIPTION

	PROP. AERIAL FOC
	PROP. FOC LONG TAIL TERM.
	PROP. AERIAL COPPER CA.
	EXISTING AERIAL FOC
	EX. FOC LONG TAIL TERM.
	EX. AERIAL COPPER CA.
	EX. AER. FOC TO BE REMOVED
	EX. FOC LONG TAIL TO BE REMOVED
	EX. COPPER CABLE TO BE REMOVED
	PROPOSED POLE
	EXISTING POLE
	PROP. DOUBLE X-ARM ON PROP. POLE
	EX. POLE & EX. DOUBLE X-ARM TO BE REMOVED
	EX. POLE & EX. SINGLE X-ARM OR ALLEY-ARM TO BE REMOVED
	EX. DOUBLE X-ARM ON EX. POLE
	EX. SINGLE X-ARM OR ALLEY-ARM ON EX. POLE
	EX. GUY & ANCHOR TO BE REMOVED
	PROP. GUY & ANCHOR with PROP. LEAD
	EXISTING FIBER SLACK LOOP
	PROP. FIBER SLACK LOOP
	EX. AER. FIBER TERMINAL
	EX. AER. COPPER TERMINAL
	EX. FOC SPLICE POINT
	PROP. SPLICE ON EX. FIBER SPLICE POINT

CHECKED BY: KCN

DESIGNED BY: R. MOJE
 DRAWN BY: R. MOJE

STATE OF ALASKA
 DEPARTMENT OF TRANSPORTATION & PUBLIC FACILITIES
 SOUTHEAST REGION

KETCHIKAN ADVANCE
 WATER STREET TRUNK LINE
 RELOCATION
 PROJECT # 69548


**TELEPHONE
 CABLE LAYOUT**

PROJECT DESIGNATION
BR-000S(735) ~ 69548

STATE	YEAR
ALASKA	2014
SHEET NUMBER	TOTAL SHEETS
V18	78


NOTE TO CONTRACTOR:
 1. ALL CONDUITS SHOWN IN THIS DETAIL WILL BE INSTALLED PER ELECTRICAL PLAN SHEET No. U20.

NOTE ON THE VDSL LOCATION AREA:
 THE GROUND IS ROCK AND ITS HEIGHT IS APPROX. 3.5' HIGH FROM BRIDGE LEVEL.

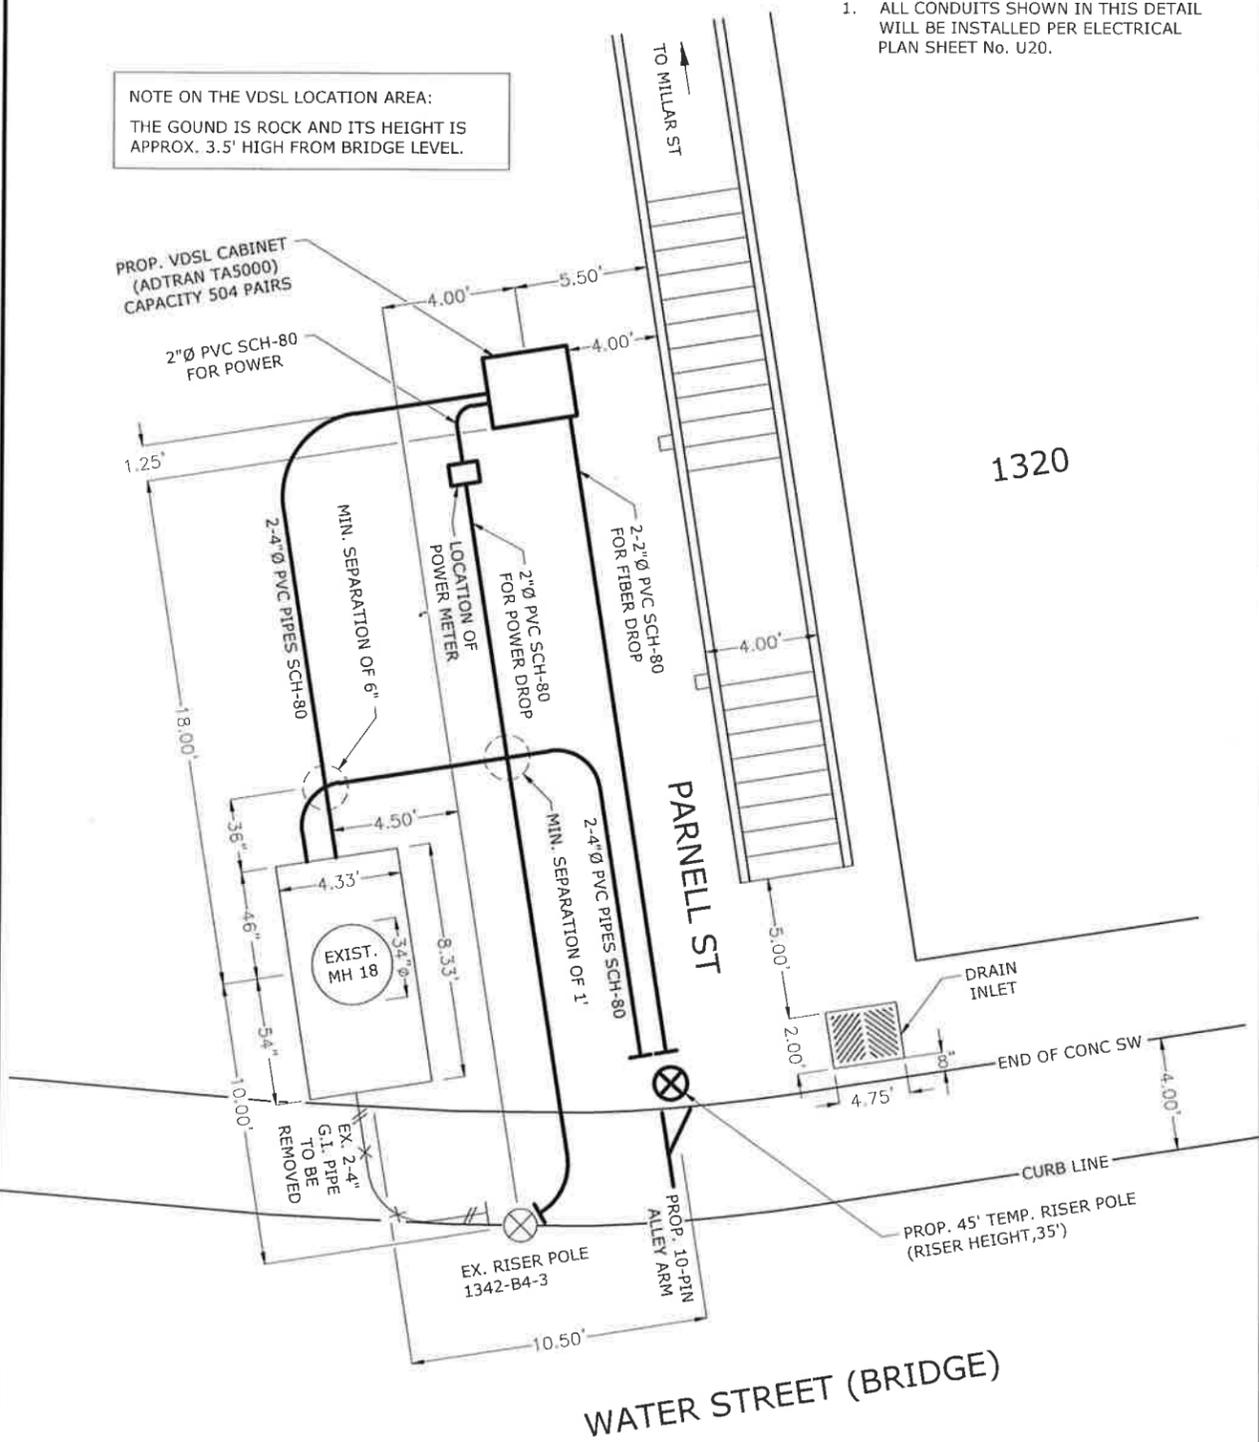


NEW VDSL LOCATION DETAIL
 NOT TO SCALE

DO NOT SCALE FROM THESE DRAWINGS USE DIMENSIONS

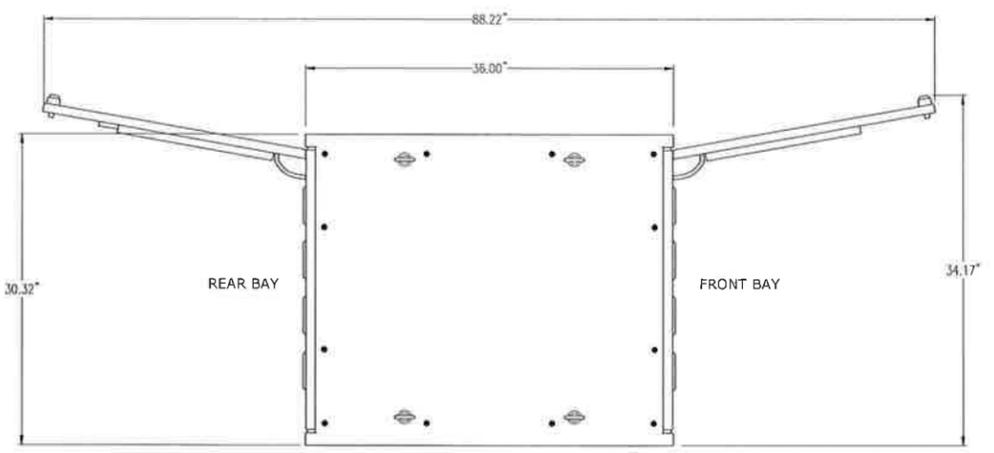


CABINET CLEARANCE REQUIREMENT
 NOT TO SCALE

- CONDUIT:
- A. 4 EACH Ø.875" x Ø1.375" DOUBLE KNOCKOUT FOR 1/2" OR 1" CONDUIT (GROUND AND FIBER ENTRY)
 - B. 2 EACH Ø3.594" KNOCKOUT FOR 3" CONDUIT (COPPER OSP CABLE ENTRY)
 - C. Ø1.734" KNOCKOUT FOR 1-1/4" CONDUIT (AC POWER ENTRY)

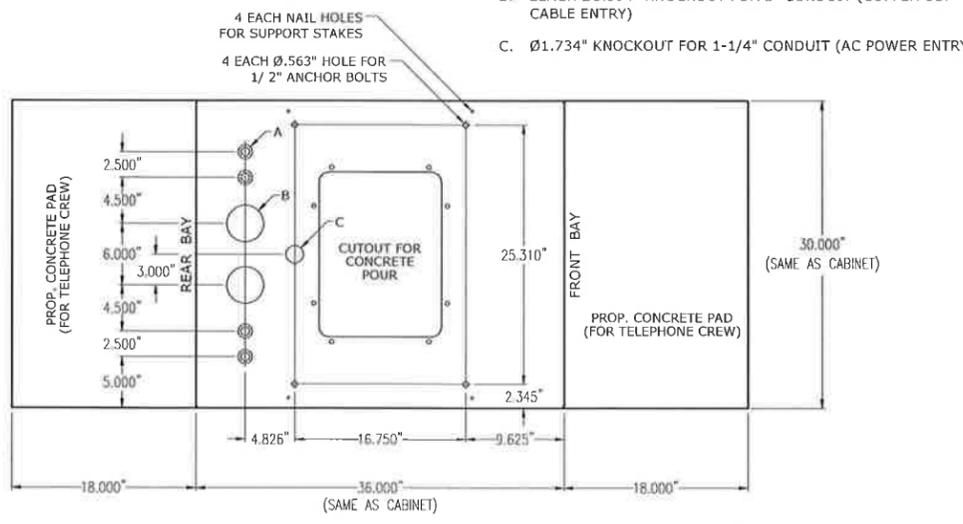


CONCRETE PAD & CONDUIT POSITIONS
 NOT TO SCALE

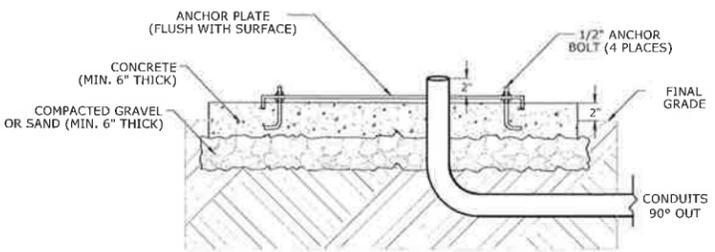

CONCRETE PAD & CONDUIT PROFILE
 NOT TO SCALE

Project As Built Drawings Have Been Reviewed By The Project Engineer & Represent, To The Best Of My Knowledge, The Project As Constructed.

VICINITY MAP

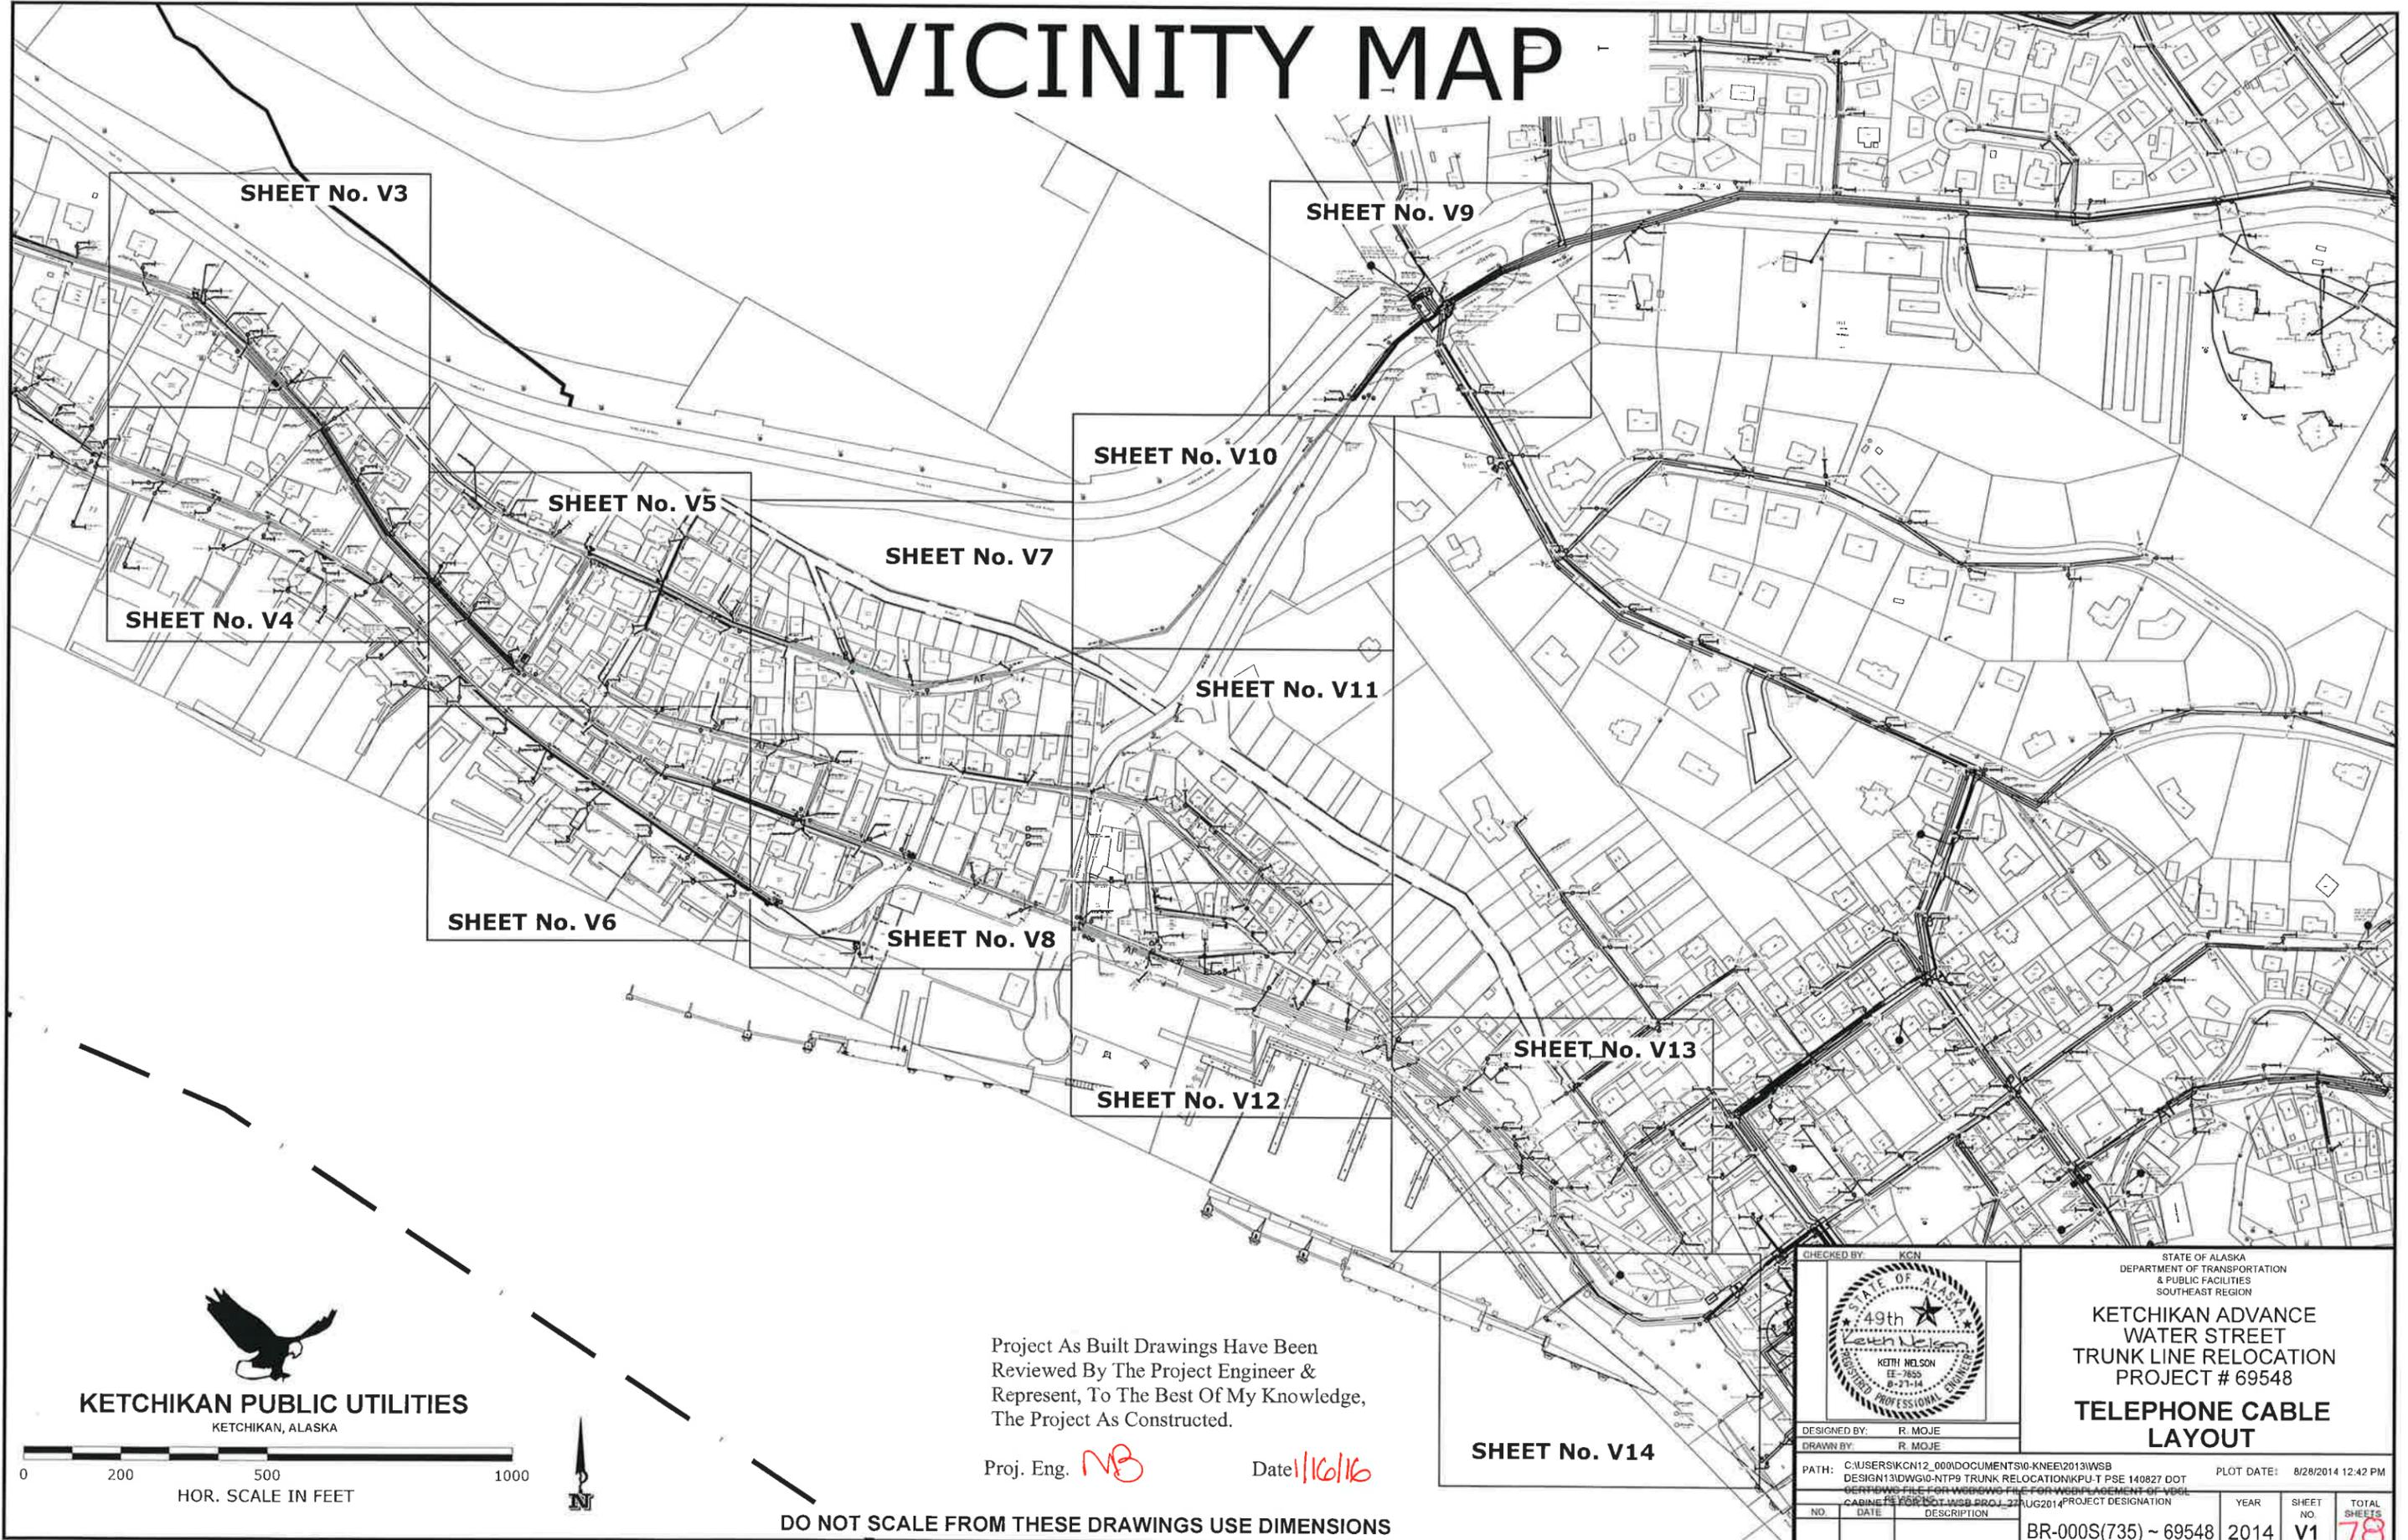

0 200 500 1000
HOR. SCALE IN FEET

Project As Built Drawings Have Been Reviewed By The Project Engineer & Represent, To The Best Of My Knowledge, The Project As Constructed.

Proj. Eng. *MB* Date *11/6/16*

DO NOT SCALE FROM THESE DRAWINGS USE DIMENSIONS

CHECKED BY: KCN

DESIGNED BY: R. MOJE
DRAWN BY: R. MOJE

PATH: C:\USERS\KCN\2_000\DOCUMENTS\10-KNEE\2013\WSB DESIGN\3D\WG10-NT\9 TRUNK RELOCATION\KPU-T PSE 140827.DOT
C:\USERS\KCN\2_000\DOCUMENTS\10-KNEE\2013\WSB PROJECT DESIGNATION

STATE OF ALASKA
DEPARTMENT OF TRANSPORTATION & PUBLIC FACILITIES
SOUTHEAST REGION

KETCHIKAN ADVANCE WATER STREET TRUNK LINE RELOCATION PROJECT # 69548

TELEPHONE CABLE LAYOUT

NO.	DATE	DESCRIPTION	YEAR	SHEET NO.	TOTAL SHEETS
		BR-000S(735) ~ 69548	2014	V1	78

PLOT DATE: 8/28/2014 12:42 PM

OVERHEAD SERVICE DROP INFORMATION						
120/240V, Single Phase, Three Wire Distribution						
	Address	Street	# Existing Meters	Existing Triplex (Alum)	Feed	Comments
1	1628 / 1626	Water Street	AB	#2	Midspan tap	
2	1627	Water Street		#2	Pole P1A	Fed from Pole P1A, no work required on overhead drop
3	1622	Water Street	ABC	#2	Midspan tap	
4	1617	Water Street		#2	Midspan tap	
5	1611	Water Street		#2	Pole P4	
6	1610	Water Street		#2	Pole P4	
7	1608	Water Street	AB	#2	Pole P4	
8	1600	Water Street		#2	Midspan tap	
9	1528	Water Street		#1/0	Midspan Tap to Pole P5A	#1/0 midspan to Pole 5A; adjust drop to Pole P5A; #2 from P5A to mast
10	1508	Water Street	AB	#2	Midspan tap	
11	1500	Water Street		#2	Midspan Tap to Pole P5A	House is located above 1528 Water; adjust drop to Pole P5A; #2 P5A to mast
12	200	Wiley Stairs		#2	Midspan tap	House is located above 1462 Water
13	1462	Water Street	AB	#1/0	P7	
14	1454	Water Street		#2	Midspan tap	
15	Near 1454	Water Street		#4 Duplex	Midspan tap	Security Street Light; Pole P7L; adjust drop to Pole P7L
16	1446	Water Street	AB	See Comments	P8	#4/0 drop parlayed: 1446 = #2 Triplex; 1442 = #1/0 Triplex.
17	1442	Water Street		See Comments	P8	#1/0 tapped from a #4/0 drop (see 1446 comment)
18	1426	Water Street		#2	P9	
19	1418.5	Water Street		#2	P9	Located above 1418
20	1418	Water Street		#2	P9	
21	1412	Water Street		#2	Midspan tap	
22	1400	Water Street		#4	Midspan tap	Fed from Parnell Stairs Overhead
23	200	Parnell Stairs		#2	Midspan tap	Fed from Parnell Stairs Overhead
24	Base of Parnell Stairs	Water Street		#2	P10	New service for VDSL Cabinet; install service mast on pole.
25	1320	Water Street		#2	P10	
26	1319	Water Street		#2	Midspan tap	
27	1312	Water Street		#2	Midspan tap	
28	1306	Water Street		#2	Midspan tap	
29	1305	Water Street	ABC	#2	Midspan tap	Two combination meter mains; one overhead service drop
30	1279	Water Street	A-D	#1/0	Midspan tap	Meters located in the street level entry hallway
31	1269	Water Street		#1/0	Midspan tap	Adjust drop to mast; drop is attached to Pole P11A
32	1263	Water Street		#1/0	Midspan tap	No service mast; drop attached to the eaves; then conduit from eaves to meters
33	1262	Water Street		#2	Midspan tap	
34	1256	Water Street		#2	Midspan tap	
35	1251	Water Street		#2	Midspan tap	Adjust drop to mast; drop is attached to Pole P10A
36	1250	Water Street		#2	P12	
37	1245	Water Street	ABC	#1/0	P12	
38	1242	Water Street		#4/0	P12	4/0 is parlayed


UNLESS NOTED OTHERWISE WHEREVER THE DISTRIBUTION SYSTEMS ARE RAISED ON THE POLES, ADJUST ALL OVERHEAD DROPS TO ACCOMMODATE THE NEW HEIGHT,

Project As Built Drawings Have Been Reviewed By The Project Engineer & Represent, To The Best Of My Knowledge, The Project As Constructed.

Proj. Eng. *MB* Date *10/16*

PATH: C:\USERS\KCH2_000\DOCUMENTS\KNEE\213W55 DESIGN\150W00-ATP3 TRUNK RELOCATION\W55 AUR U18-05 FOTOS POLES.DWG
 KCN12_000
 TAB: U34
 ADDENDUM NUMBER
 ATTACHMENT NUMBER
 RECORD OF REVISIONS

No.	DATE	DESCRIPTION

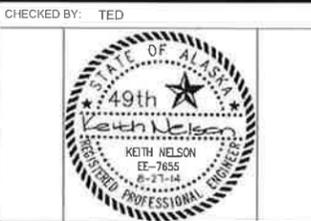


CHECKED BY: TED
 DESIGNED BY: KCN
 DRAWN BY: KCN

STATE OF ALASKA
 DEPARTMENT OF TRANSPORTATION & PUBLIC FACILITIES
 SOUTHEAST REGION
 KETCHIKAN -ADVANCE
 WATER STREET TRUNK LINE
 RELOCATION
 PROJECT #69548

SERVICE DROP INFORMATION
 PROJECT DESIGNATION
BR-000S(735) ~ 69548


STATE	YEAR
ALASKA	2014
SHEET NUMBER	TOTAL SHEETS
U34	78

No.	DATE	DESCRIPTION

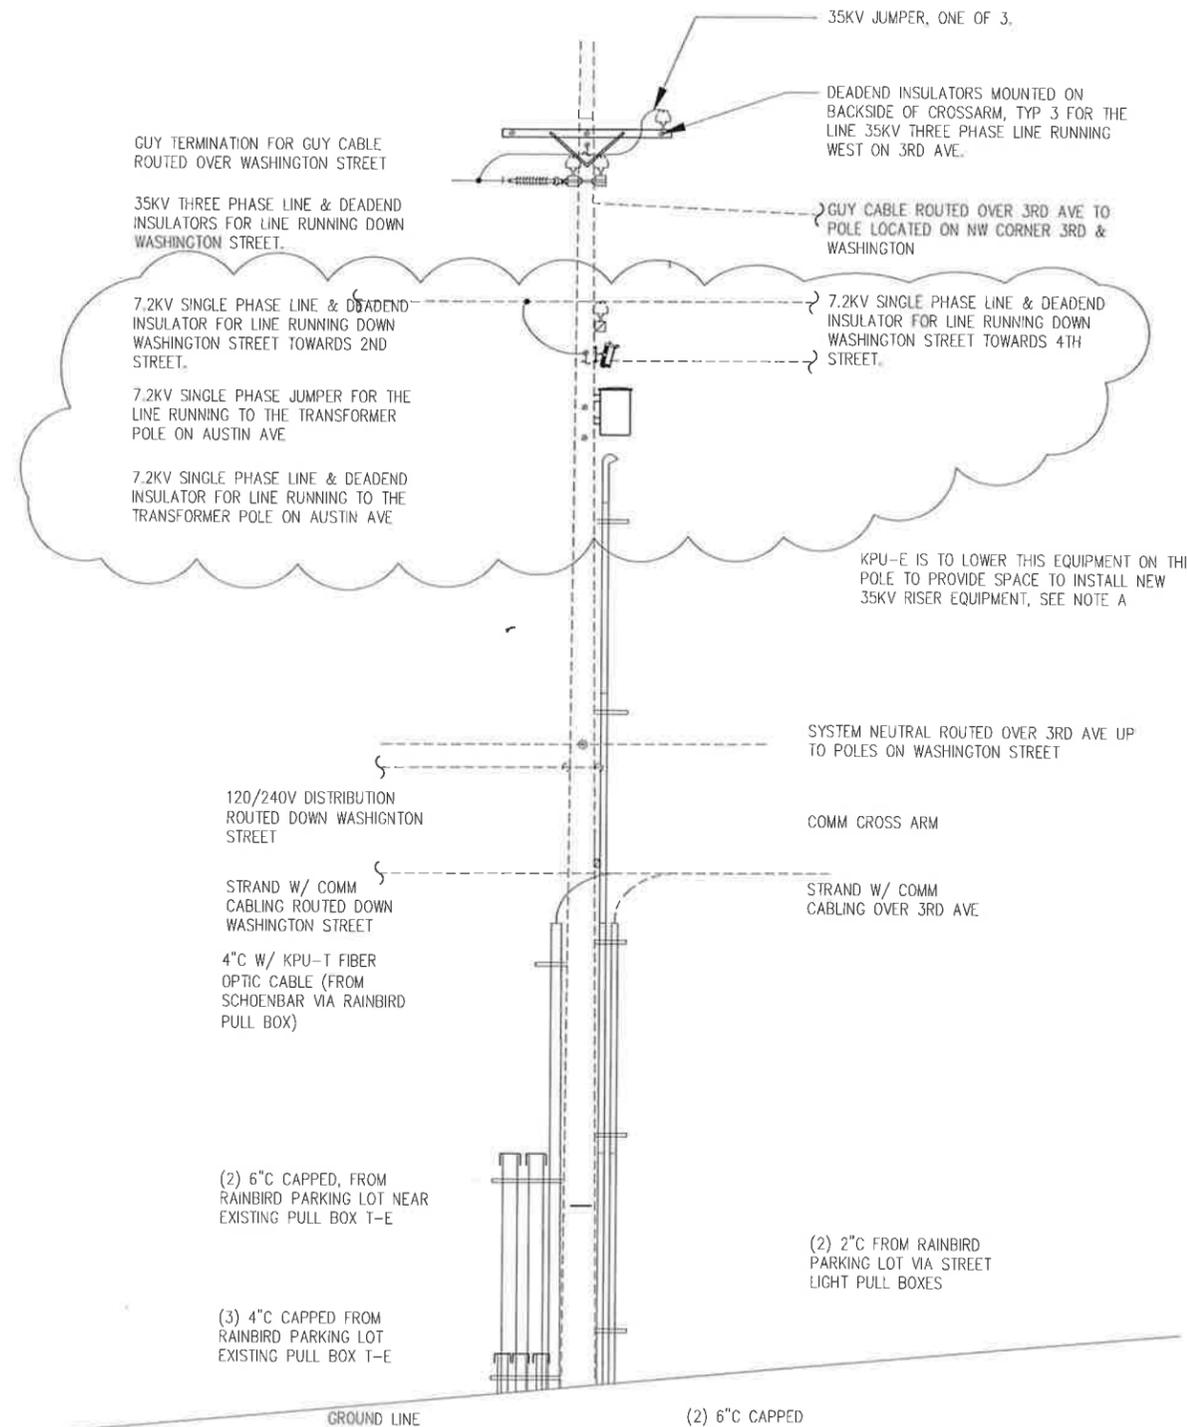

1 EXISTING POWER POLE P1W
NO SCALE

A AT THE TIME THIS DRAWING SET WAS ISSUED FOR BID, KPU-E WAS GOING TO PERFORM THE WORK TO LOWER THE 12.47KV & 7.2KV SYSTEMS, STREET LIGHT, TRANSFORMER AND EQUIPMENT ON THE POLE TO PROVIDE THE NECESSARY SPACE FOR THE CONTRACTOR TO INSTALL THE 35KV RISER POLE EQUIPMENT SHOWN IN 3/U26. FOR THE BID PHASE, ASSUME THE SPACE ON THE POLE IS ADEQUATE TO INSTALL

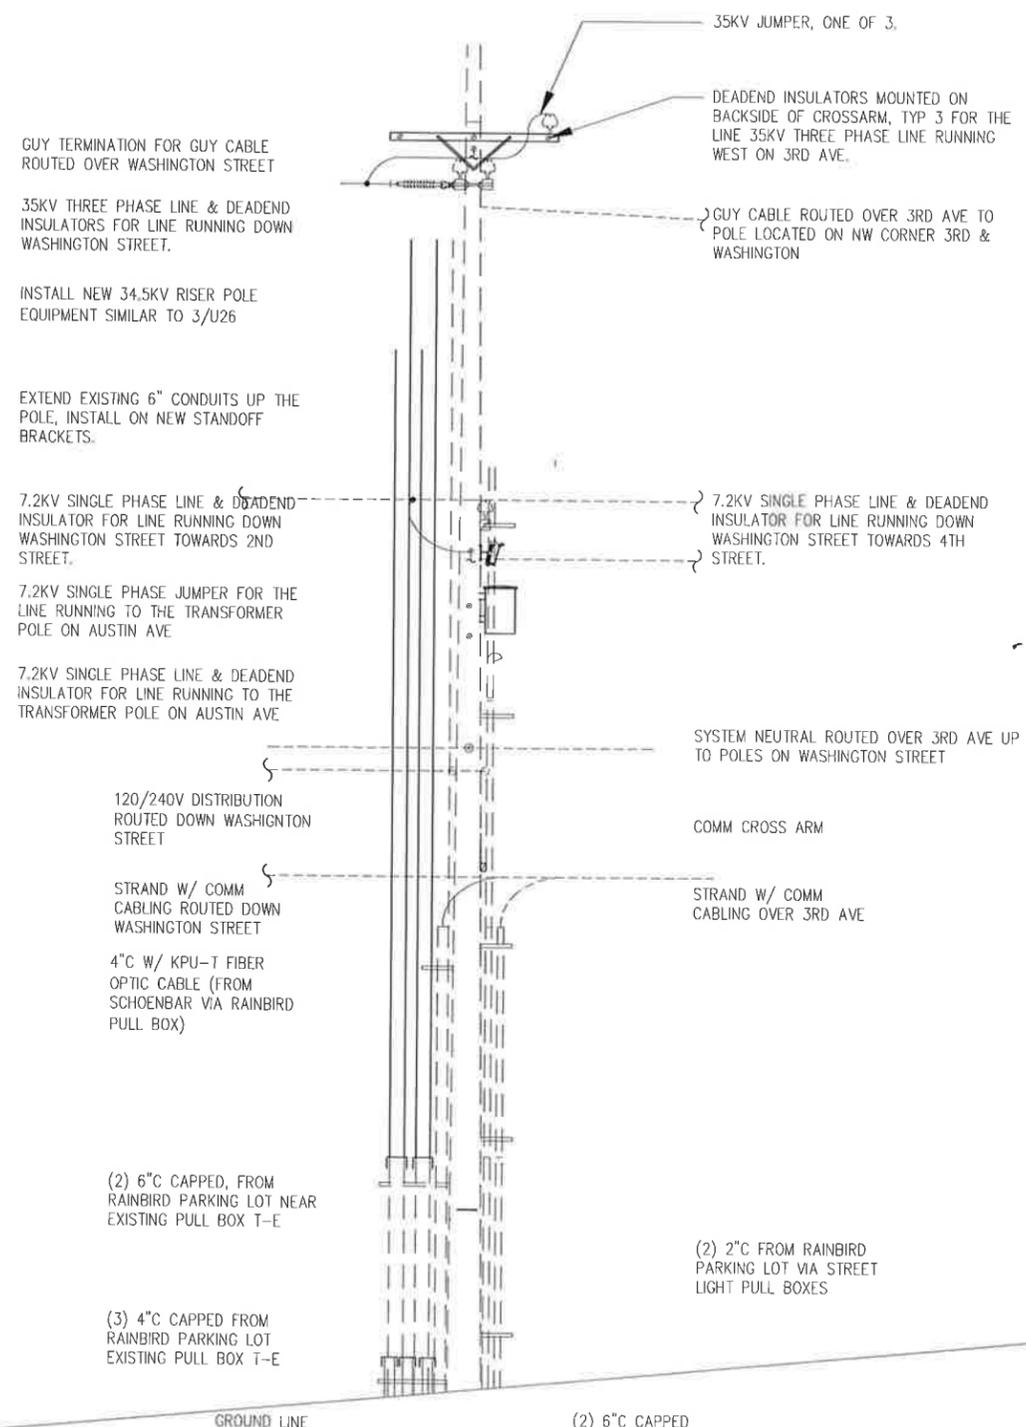

2 REVISED POWER POLE P1W
NO SCALE

Project As Built Drawings Have Been Reviewed By The Project Engineer & Represent, To The Best Of My Knowledge, The Project As Constructed.

Proj. Eng. NB Date 1/16/16

CHECKED BY: TED



DESIGNED BY: KCN

DRAWN BY: KCN

STATE OF ALASKA
DEPARTMENT OF TRANSPORTATION & PUBLIC FACILITIES
SOUTHEAST REGION

KETCHIKAN - ADVANCE
WATER STREET TRUNK LINE
RELOCATION
PROJECT #69548


POLE
DETAILS

PROJECT DESIGNATION
BR-000S(735) ~ 69548

STATE	YEAR
ALASKA	2014
SHEET NUMBER	TOTAL SHEETS
U32	78


KCN12_000
TAB: U30

ADDENDUM NUMBER		
ATTACHMENT NUMBER		
RECORD OF REVISIONS		
No	DATE	DESCRIPTION

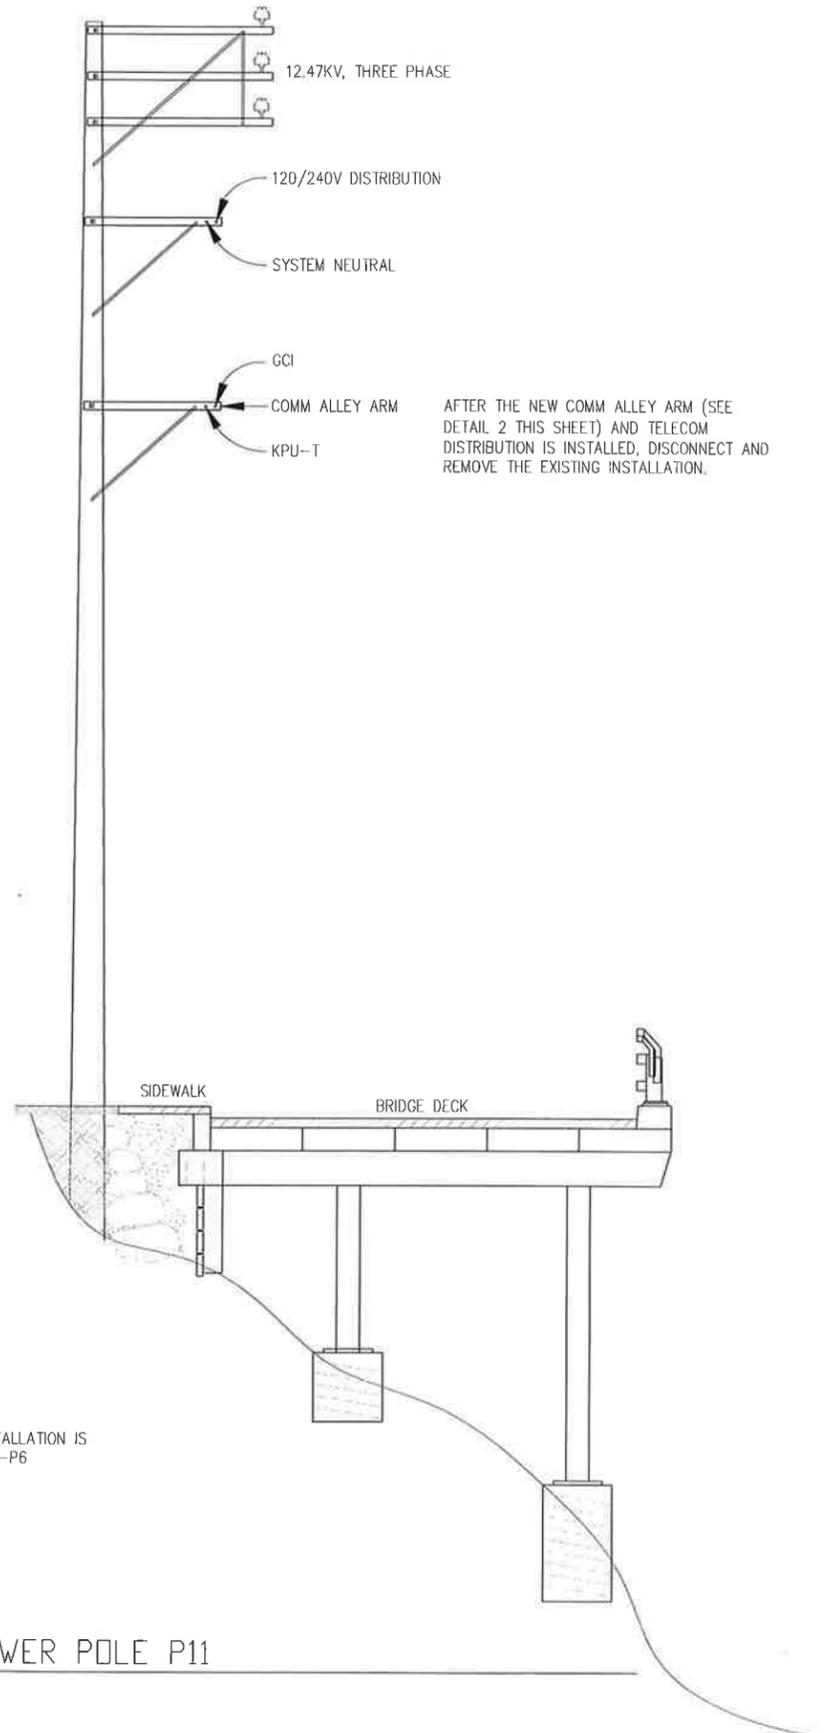

POLE P5 SHOWN. INSTALLATION IS SIMILAR FOR POLE P3-P6

1 EXISTING POWER POLE P11
NO SCALE

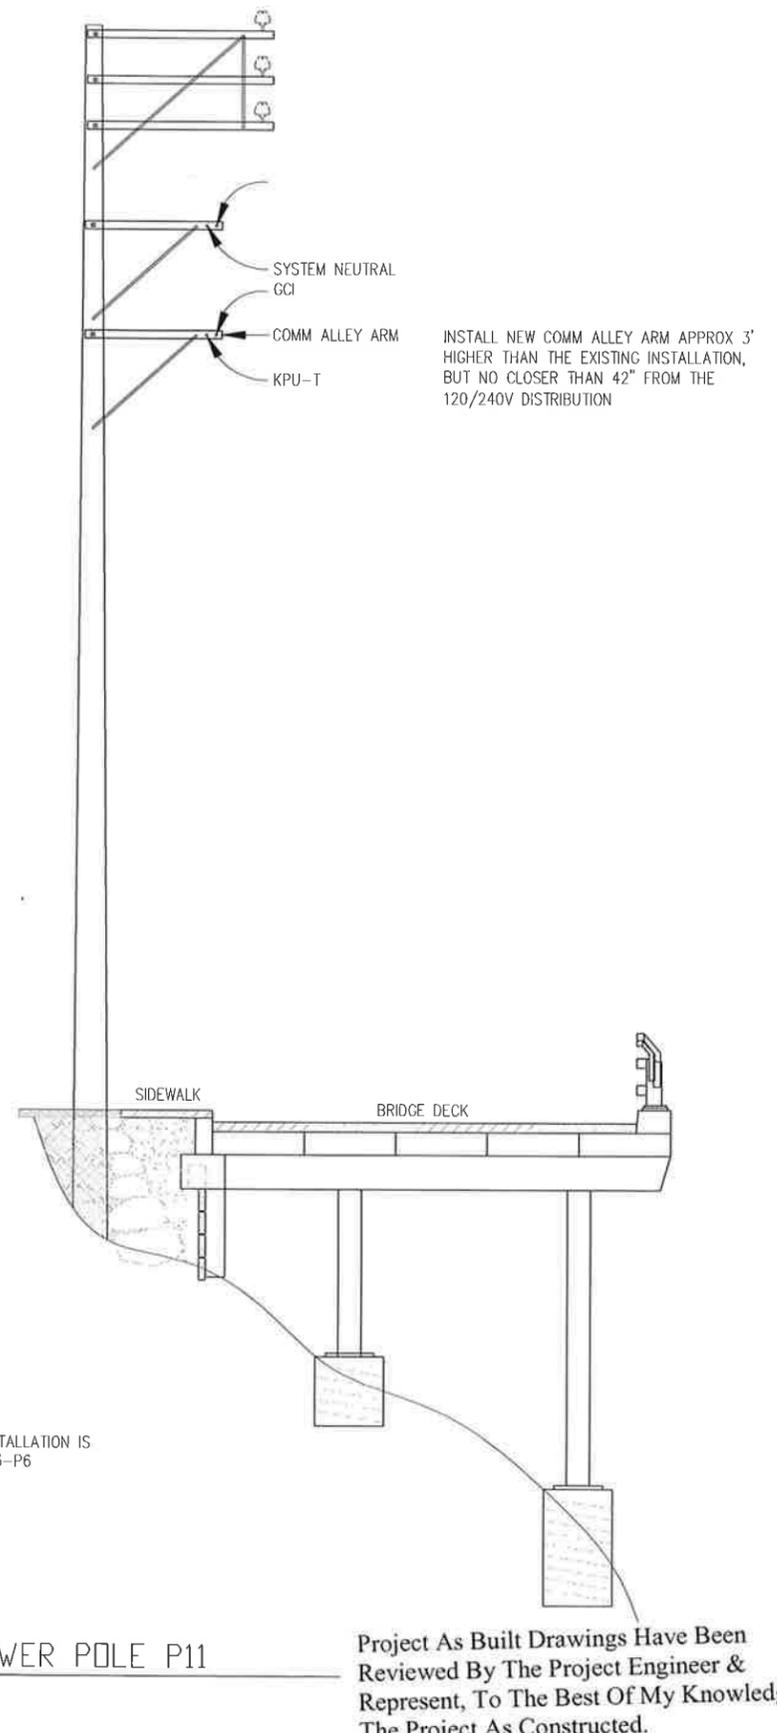


POLE P5 SHOWN. INSTALLATION IS SIMILAR FOR POLE P3-P6

2 REVISED POWER POLE P11
NO SCALE

Project As Built Drawings Have Been Reviewed By The Project Engineer & Represent, To The Best Of My Knowledge, The Project As Constructed.

Proj. Eng. *NS* Date *1/16/16*

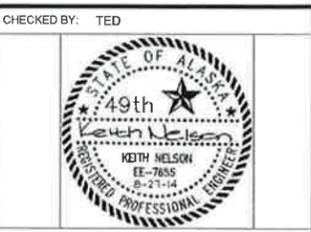

DESIGNED BY: KCN
DRAWN BY: KCN

STATE OF ALASKA
DEPARTMENT OF TRANSPORTATION & PUBLIC FACILITIES
SOUTHEAST REGION
KETCHIKAN -ADVANCE
WATER STREET TRUNK LINE
RELOCATION
PROJECT #69548

POLE DETAILS

PROJECT DESIGNATION
BR-000S(735) ~ 69548

STATE	YEAR
ALASKA	2014
SHEET NUMBER	TOTAL SHEETS
U30	78


KCN12_000
 TAB U28

ADDENDUM NUMBER

ATTACHMENT NUMBER


RECORD OF REVISIONS

No.	DATE	DESCRIPTION

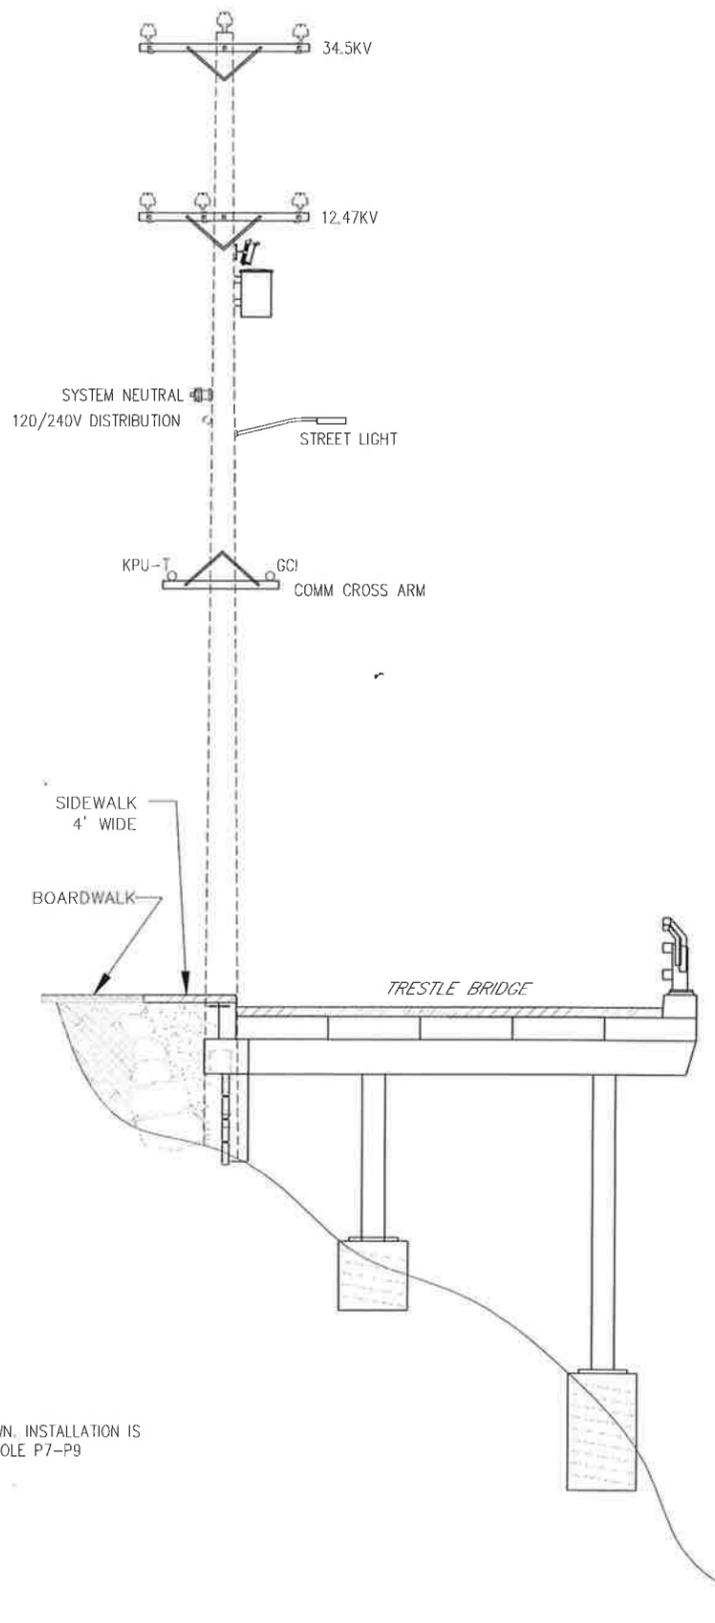

POLE P8 SHOWN. INSTALLATION IS
 SIMILAR FOR POLE P7-P9

1 EXISTING POWER POLE P8
 NO SCALE

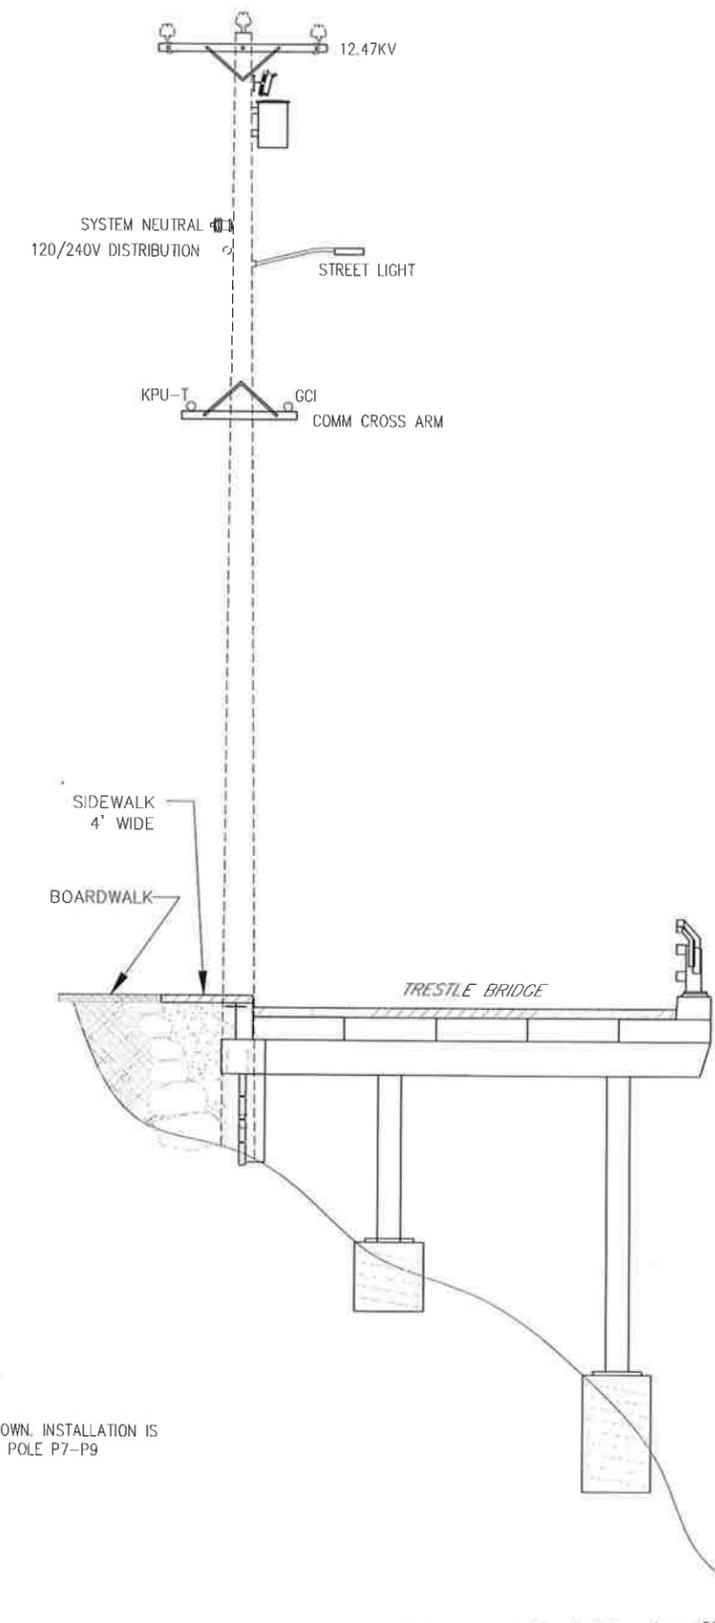


POLE P8 SHOWN. INSTALLATION IS
 SIMILAR FOR POLE P7-P9

2 REVISED POWER POLE P8
 NO SCALE

Project As Built Drawings Have Been
 Reviewed by The Project Engineer &
 Represent, To The Best Of My Knowledge,
 The Project As Constructed.

Proj. Eng. NB Date 1/16/16

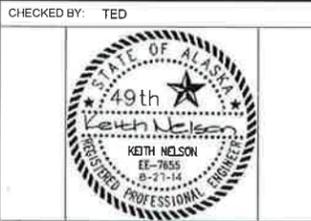

DESIGNED BY: KCN
 DRAWN BY: KCN

STATE OF ALASKA
 DEPARTMENT OF TRANSPORTATION
 & PUBLIC FACILITIES
 SOUTHEAST REGION


KETCHIKAN -ADVANCE
 WATER STREET TRUNK LINE
 RELOCATION
 PROJECT #69548

**POLE
 DETAILS**


PROJECT DESIGNATION
BR-000S(735) ~ 69548

STATE	YEAR
ALASKA	2014
SHEET NUMBER	TOTAL SHEETS
U28	78

ADDENDUM NUMBER		
ATTACHMENT NUMBER		
RECORD OF REVISIONS		
No.	DATE	DESCRIPTION

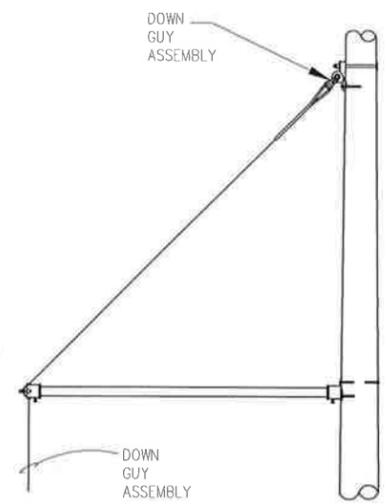

1 SIDEWALK GUY
NO SCALE

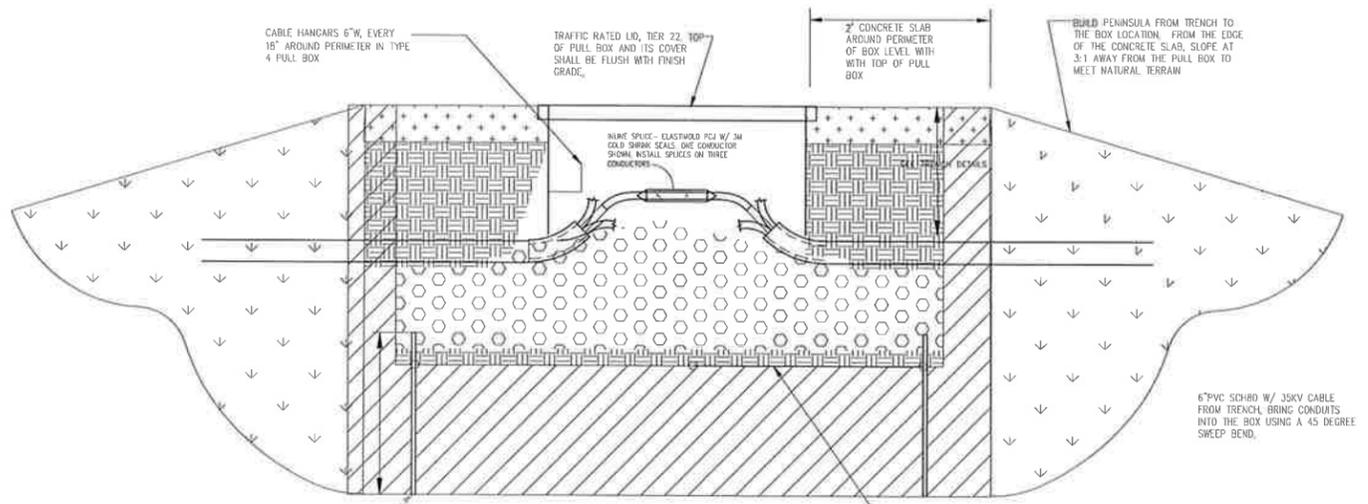


COPPER CLAD GROUND ROD (6)
OK to place rod in bottom of new vault's hole. Must be at least 24" from side of vault. Rod shall be approx. 1" above clean backfill covering copper ground grid.

2 PULL BOX - GENERAL INSTALLATION
NO SCALE


THE DETAIL SHOWS THE GENERAL INSTALLATION REQUIREMENTS FOR THE TYPE 1-4 PULL BOXES.
TIE THE (3) CONCENTRIC NEUTRALS TOGETHER WITH #4 CU GROUND WIRE AND CONNECT TO GROUND ROD IN THE BOX.
SEE U FOR GROUNDING AND ADDITIONAL INSTALLATION INFORMATION

4/0 BARE COPPER WIRE
It is OK to bury 1/8" cu wire in bottom of vault hole if must be 24" from the sides of vault. Cover with clean backfill before adding gravel.

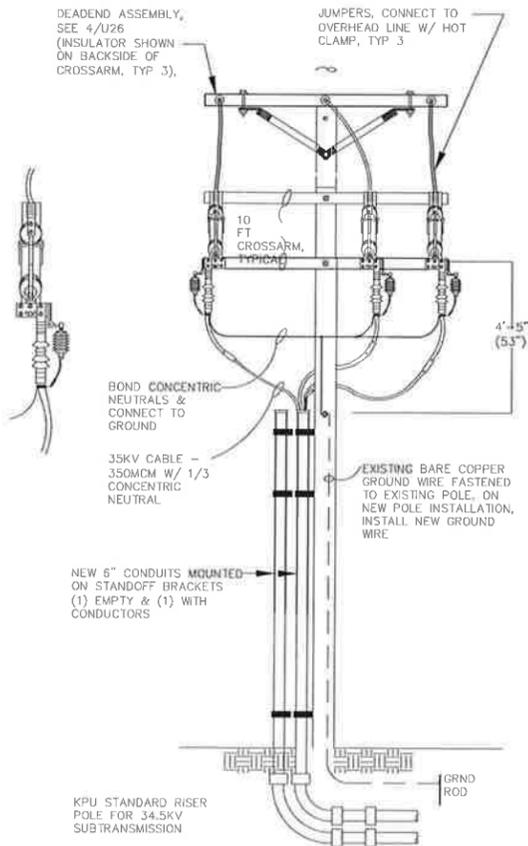

3 KPU 34.5KV RISER POLE
NO SCALE

ITEM	KPU NUMBER	QTY	DESCRIPTION
	17173.5B	3	TERMINATION KIT FOR 350 MCM (TYCO RAYCHEM cat#TF1-353E)
	17897.10	3	SOLID BLADE SWITCH (S&C cat#4943R9-E-D2-U)
	11612	3	POWER TAP GRIP (UTILCO cat#SCH-397)
	19240		INSULATED JUMPER 350MCM (TO LENGTH) (use 2 or RHH or RH-W-2 INSULATION)
	10828	2	BOLT MACHINE 5/8" x 14" (or as reqd)
	18358	4	WASHER, 2 1/4"x2 1/4"x2 1/4"x 9/16" hole
	10354	2	CROSS ARM, LIGHT 3 3/4"x4 3/4"x10'-0" (HUGHES BRO. TYPE 5 DRILL PATTERN)
		3	KELLEMS GRIP (HUBBELL cat#02206013)
	12052		CONDUIT 6" SCH 80 (as req)
	12052.30		CONDUIT 6" 90 ELBOW (as req)
	16388		STAND-OFF BRACKETS 12" (2 PER SECTION CONDUIT)
	10456.30	3	LIGHTNING ARRESTER 36KV (COOPER cat#JURS3614-0A1A-0A1A)
	18220.10	3	1/2" GROUNDED BRAID WITH EYELETS (ELECTRIC MOTION cat#EM12435)
	11613	3	#8-2/0 STR CU ARRESTER LINE CONNECTORS (HUBBELL/FARGO cat#GH-201D)
	NOI		UNDERGROUND 35KV CONCENTRIC NEUTRAL CABLE 350 MCM
	NOI	3	BRONZE TAP LUG (1-BOLTS) 1/0-500 (ANDERSON cat#ILD-52-L)
	13114	3	LUGS-500 1/2" BOLT (T&B HOMAC cat#AL-500-NTN)
	16566	1	GROUND ROD (JOSLYN cat#J8338)
		3	PLATE PARALLEL CIRCUIT CU BUS
		3	ARRESTER FLAG BRACKET P/L 600AMP
		3	DISCONNECT SW LEAD COVER

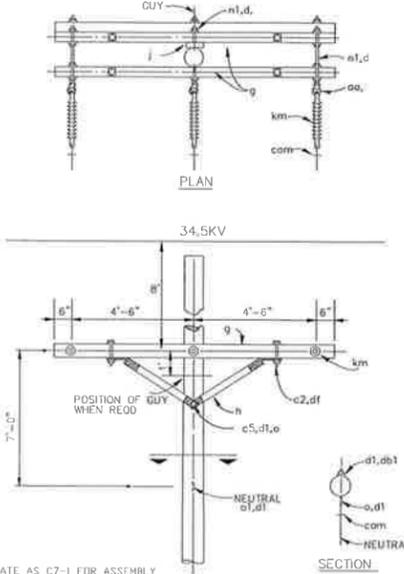


NOTES:
1 DESIGNATE AS C7-1 FOR ASSEMBLY WITH THREE CROSSARMS.
2 SIMILAR LAYOUT FOR 35KV CROSSARM DEADEND. ITEM km BECOMES SEDIVER 001-35-70-29-C7-SIL

4 KPU 7.2/12.5KV CROSSARM DEADEND, C7, C7-1
NO SCALE 35KV INSTALLATION IS SIMILAR

ITEM	KPU NUMBER	QTY	DESCRIPTION
aa	15690	3	Nut, eye 5/8" JOSLYN: J1092
c2	10770	4	Bolt, machine 1/2" x 8" (or as reqd)
c5	10828	1	Bolt, machine 5/8" x 14" (or as reqd)
cam	11610	3	Deadend Assm-primary, Anderson336-3/OADE70N
cam	11610	1	Deadend Assm-neutral, Anderson336-3/OADE70N
d1	18358	12	Washer, 2 1/4"x2 1/4"x2 1/4"x 9/16" hole
g	10355	2	Crossarm, heavy 5 3/4"x 43/4"x 10'-0"
h	11180	4	Brace, wood, HUGHES BROS 2045045-11-13
j	14999	1	Arm Gain Plastic Radar Enterprises #601
km	15730	3	Ins, Supen SEDIVER ODI-15-70-28-CT-SIL
n1	10861	3	Bolt, double arming, 5/8" x 24" (or as reqd)
o1	10690	2	Bolt, Eye 5/8" x 12" (or as reqd)
df		4	1/2" flat washers

Project As Built Drawings Have Been Reviewed By The Project Engineer & Represent, To The Best Of My Knowledge, The Project As Constructed.

Proj. Eng. NB Date 1/16/16

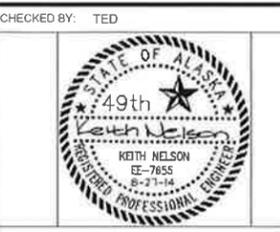

DESIGNED BY: KCN
DRAWN BY: KCN

STATE OF ALASKA
DEPARTMENT OF TRANSPORTATION & PUBLIC FACILITIES
SOUTHEAST REGION
KETCHIKAN - ADVANCE WATER STREET TRUNK LINE RELOCATION PROJECT #69548


POLE DETAILS

PROJECT DESIGNATION
BR-000S(735) ~ 69548

STATE	YEAR
ALASKA	2014
SHEET NUMBER	TOTAL SHEETS
U26	78

KCN12_000
 TAB U24

ADDENDUM NUMBER		
ATTACHMENT NUMBER		
RECORD OF REVISIONS		
No	DATE	DESCRIPTION

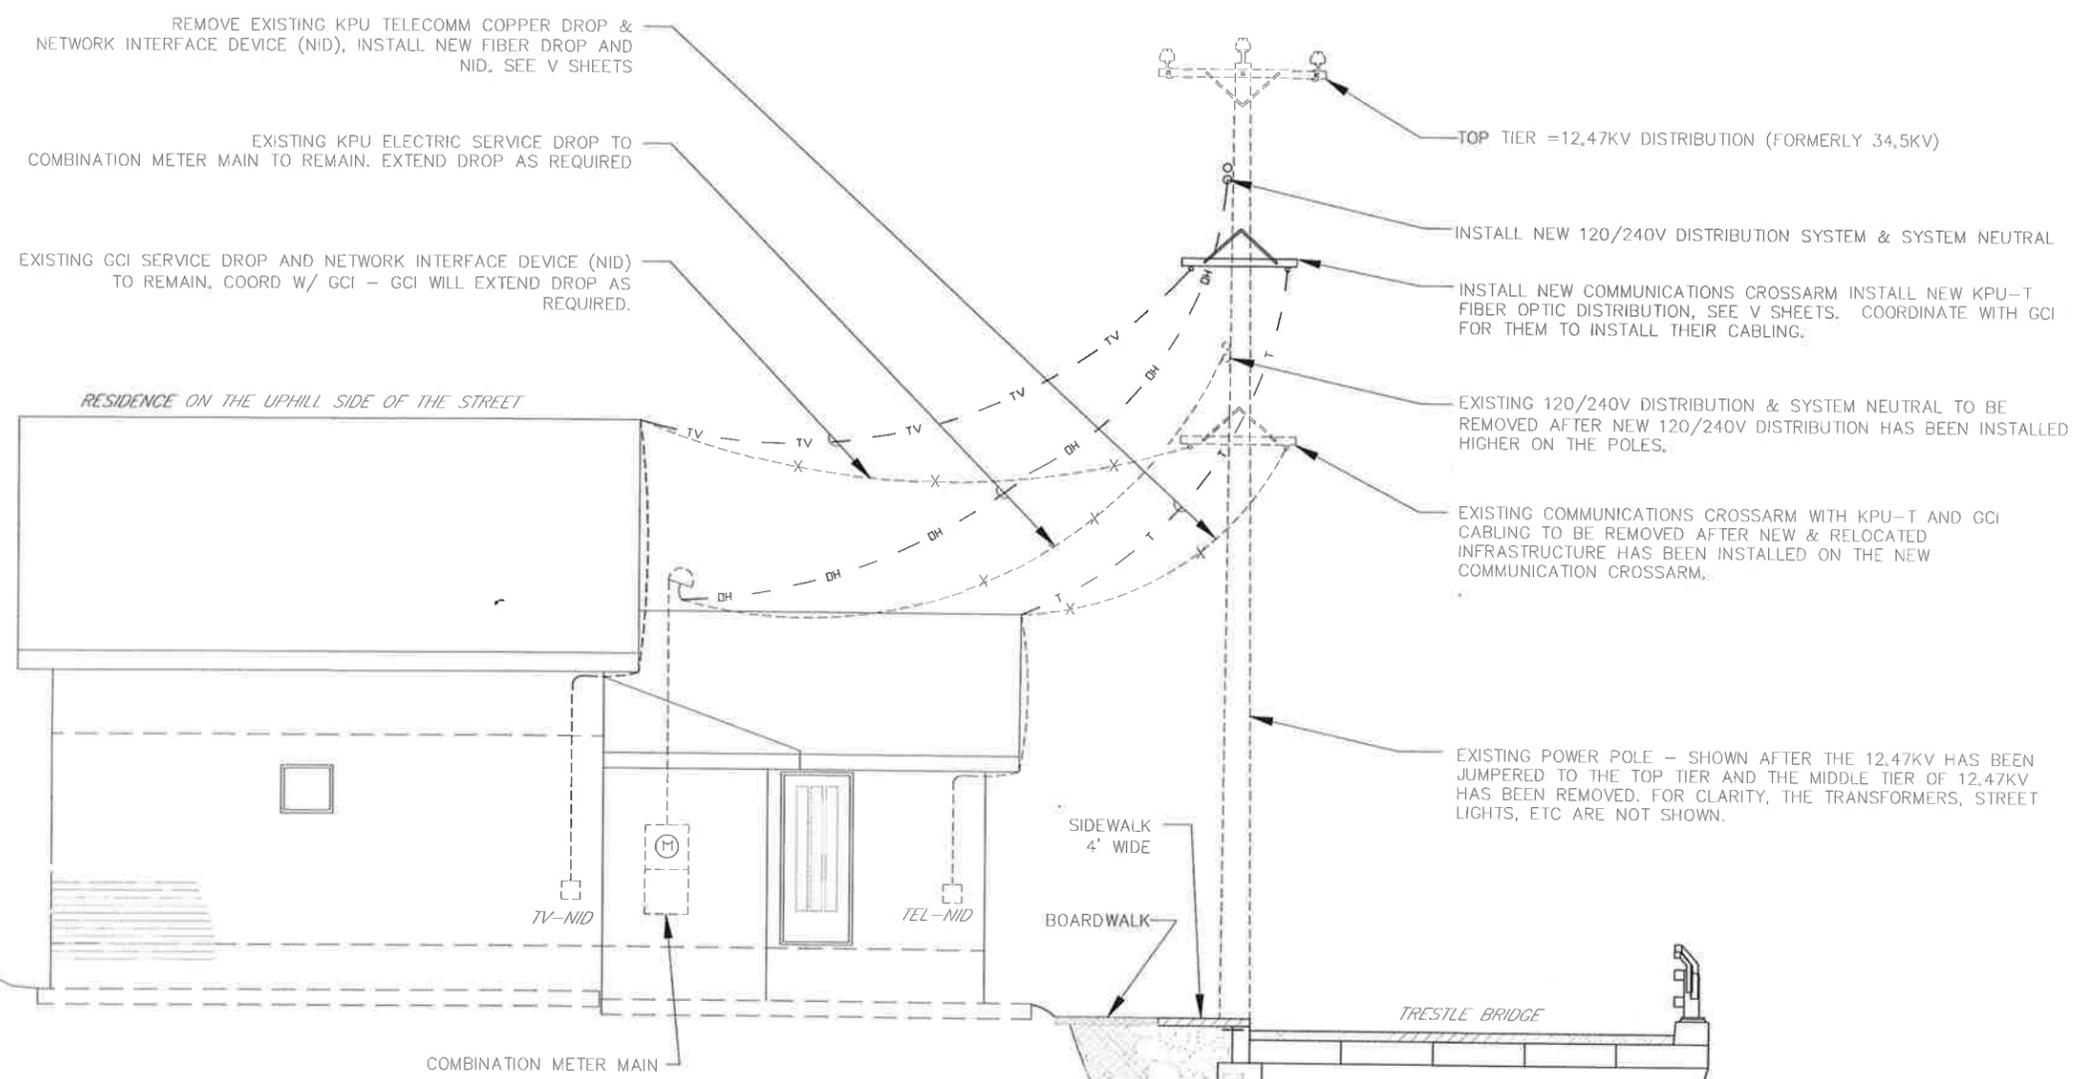


GENERAL NOTES:

A THE DETAIL SHOWS THE GENERAL INTENT OF RAISING THE OVERHEAD 120/240V, TEL, TV LINES AND MODIFICATIONS TO THE SERVICE DROPS

1 HOUSE SERVICE - ELEVATION
 NO SCALE

Project As Built Drawings Have Been Reviewed By The Project Engineer & Represent, To The Best Of My Knowledge, The Project As Constructed.

Proj. Eng. NB Date 1/10/16

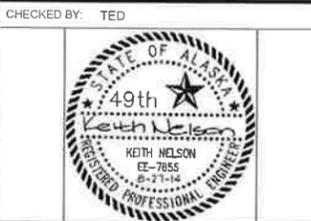

DESIGNED BY: KCN
 DRAWN BY: KCN

STATE OF ALASKA
 DEPARTMENT OF TRANSPORTATION & PUBLIC FACILITIES
 SOUTHEAST REGION

KETCHIKAN ADVANCE
 WATER STREET TRUNK LINE
 RELOCATION
 PROJECT #69548

POLE DETAILS


PROJECT DESIGNATION
BR-00S(735) ~ 69548

STATE	YEAR
ALASKA	2014
SHEET NUMBER	TOTAL SHEETS
U24	78

ADDENDUM NUMBER		
ATTACHMENT NUMBER		
RECORD OF REVISIONS		
No.	DATE	DESCRIPTION



1 POLE P0
 NO SCALE

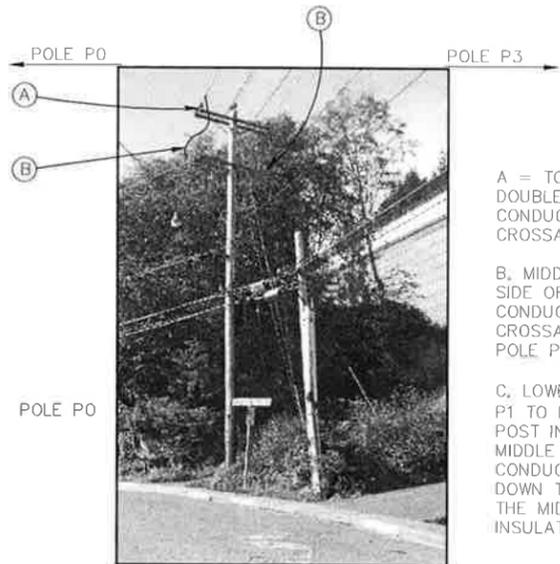

2 POLE P1 & P2
 NO SCALE


A = TOP TIER: INSTALL DEADEND INSULATORS ON DOUBLE DEADEND CROSSARMS AND TERMINATE CONDUCTORS, REMOVE EXISTING POST INSULATORS FROM CROSSARMS.

B, MIDDLE TIER: INSTALL DEADEND INSULATORS THE P0 SIDE OF THE EXISTING CROSSARM AND TERMINATE CONDUCTORS, REMOVE EXISTING POST INSULATORS FROM CROSSARMS, DISCONNECT OVERHEAD CONDUCTORS TO POLE P3

C, LOWER THE 12.47KV ON THE TOP TIER (RUNNING FROM P1 TO P10) BACK DOWN TO THE MIDDLE TIER: INSTALL POST INSULATORS ON POLE BETWEEN THE TOP AND MIDDLE TIER, INSTALL JUMPERS CONNECTING THE CONDUCTORS ON THE POLE P2 SIDE OF THE TOP TIER DOWN TO THE CONDUCTORS ON THE POLE P0 SIDE OF THE MIDDLE TIER, TIE OFF THE JUMPERS TO THE NEW INSULATORS ON THE POLE.



3 POLE P3
 NO SCALE

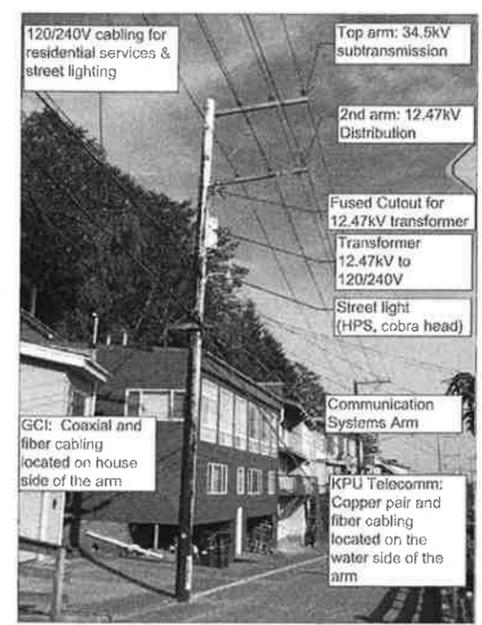

4 POLE P4
 NO SCALE

120/240V cabling for residential services & street lighting

Top arm: 34.5kV subtransmission

2nd arm: 12.47kV Distribution

Fused Cutout for 12.47kV transformer

Transformer 12.47kV to 120/240V

Street light (HPS, cobra head)

GCI: Coaxial and fiber cabling located on house side of the arm

Communication Systems Arm

KPU Telecomm: Copper pair and fiber cabling located on the water side of the arm



5 POLE P5
 NO SCALE



6 POLE P6
 NO SCALE



7 POLE P7
 NO SCALE

Project As Built Drawings Have Been Reviewed By The Project Engineer & Represent, To The Best Of My Knowledge, The Project As Constructed.

Proj. Eng. NB Date 1/10/16



DESIGNED BY: KCN
 DRAWN BY: KCN

STATE OF ALASKA
 DEPARTMENT OF TRANSPORTATION & PUBLIC FACILITIES
 SOUTHEAST REGION


KETCHIKAN ADVANCE
 WATER STREET TRUNK LINE
 RELOCATION
 PROJECT #69548

POLE PHOTOS

PROJECT DESIGNATION
BR-000S(735) ~ 69548


STATE	YEAR
ALASKA	2014

SHEET NUMBER	TOTAL SHEETS
U22	78

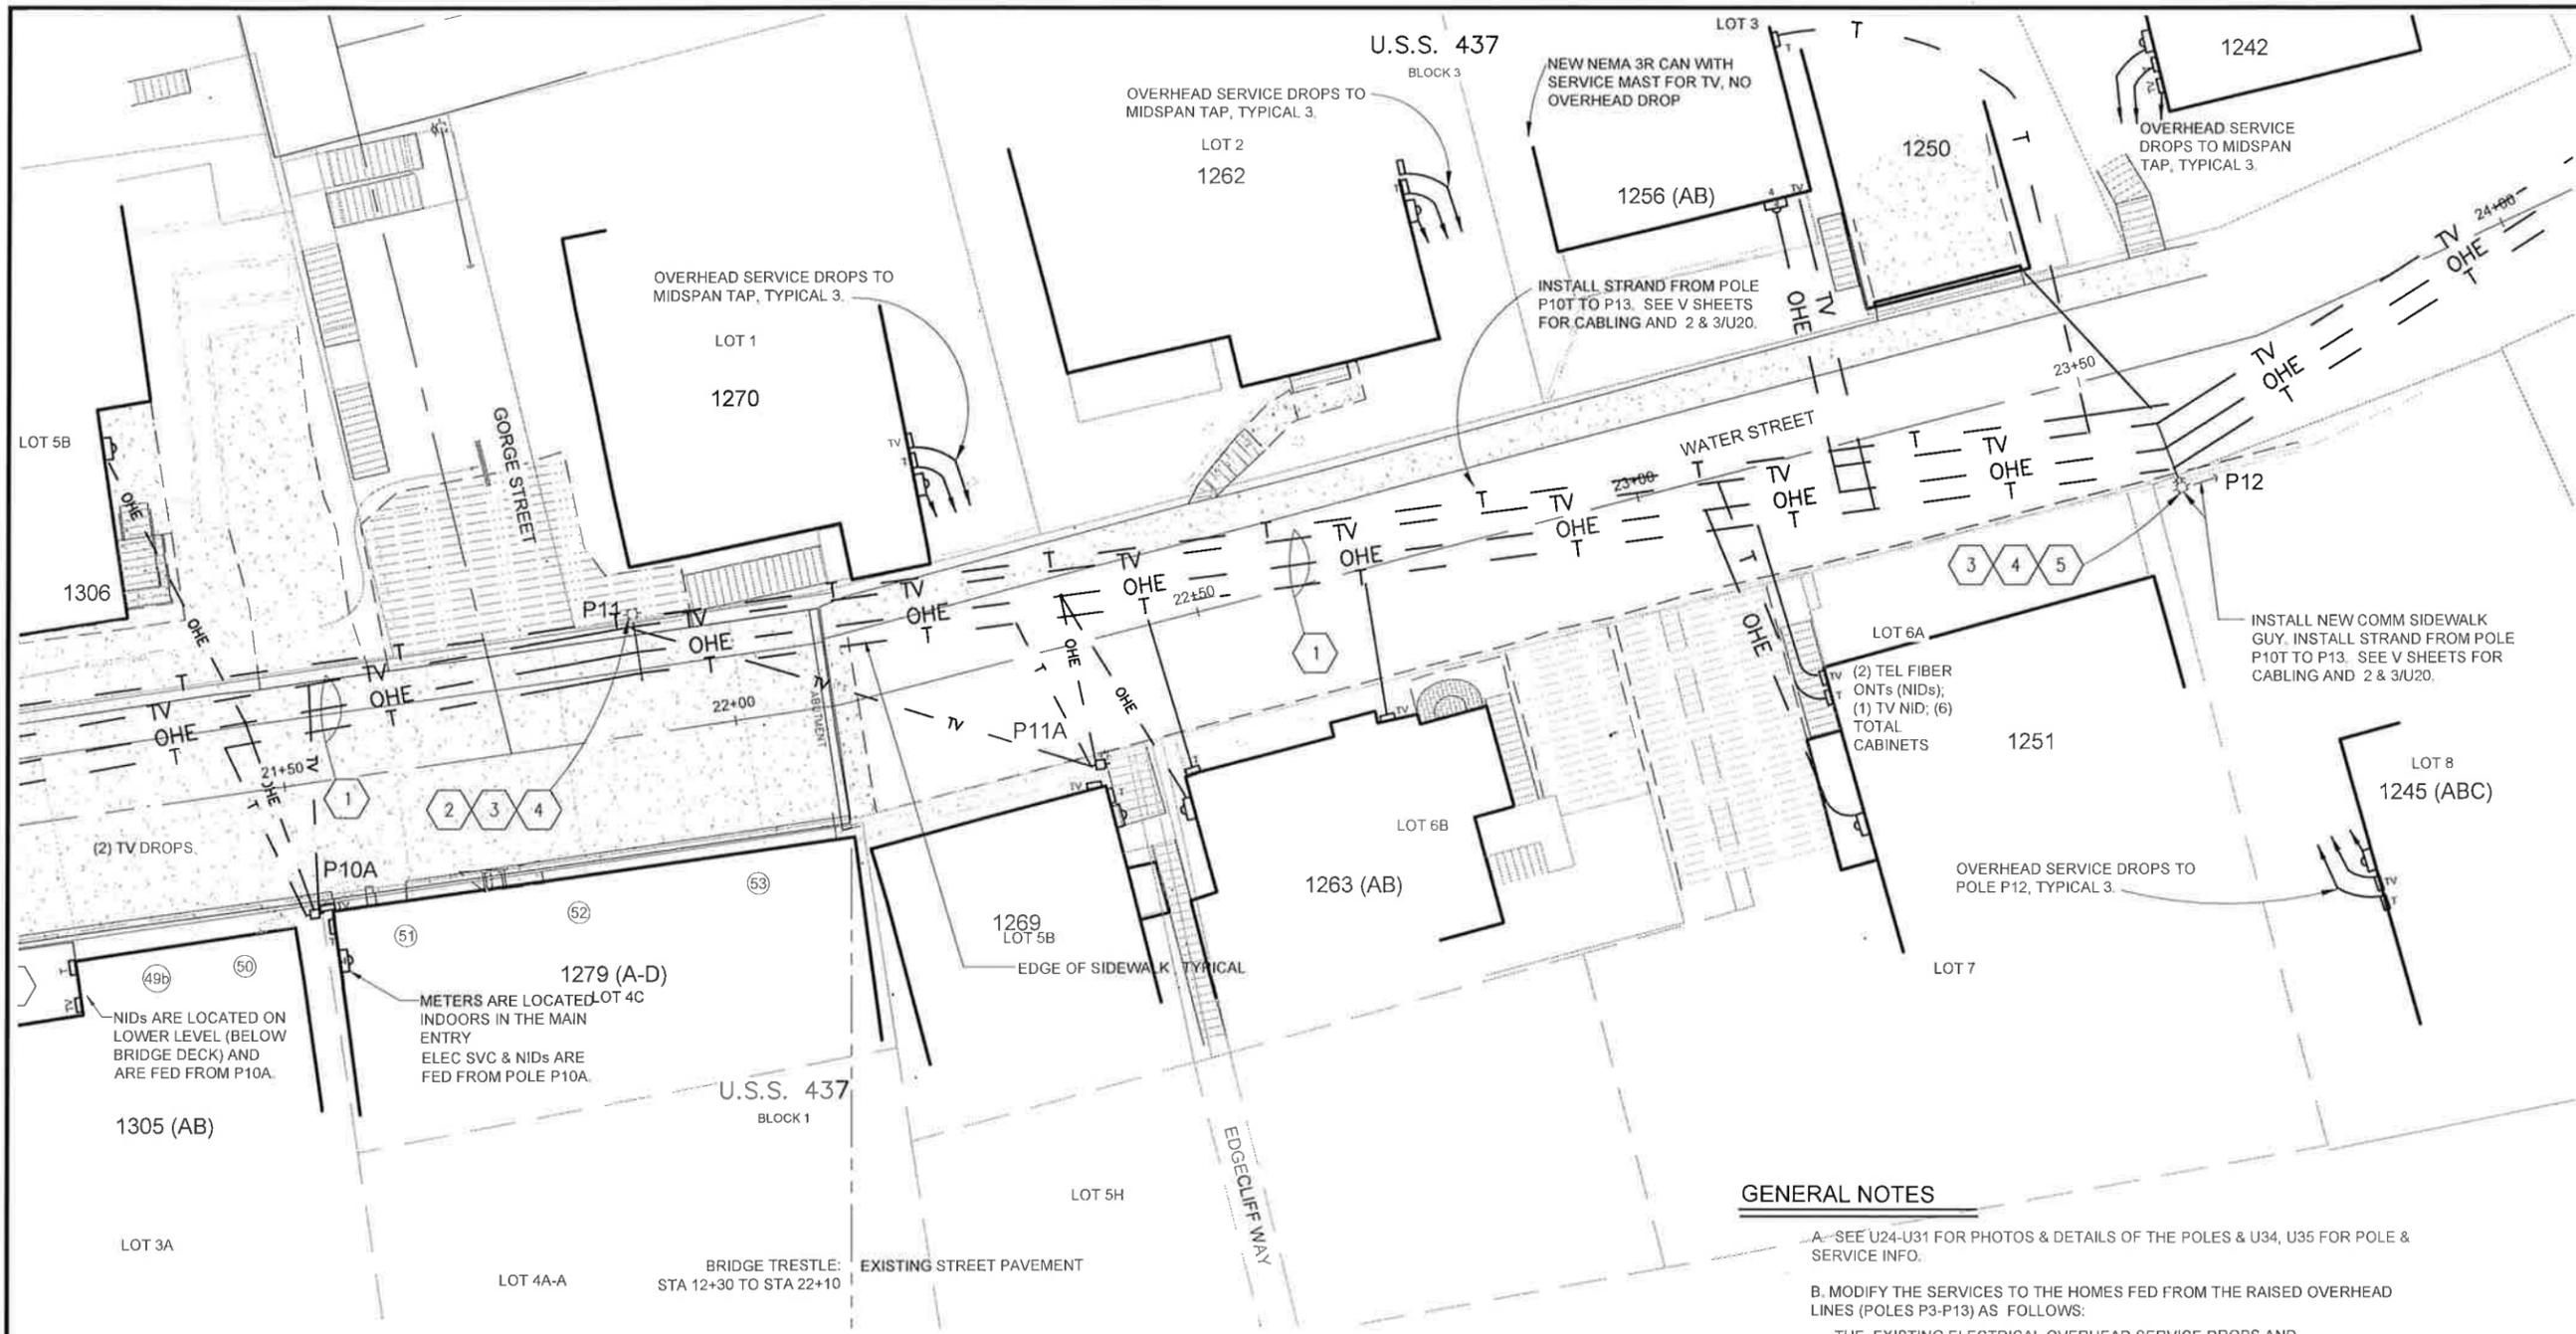

PATH: C:\USERS\KCN12_000\DOCUMENTS\10-KNEE\2013\WSB DESIGN\13IDWG10-NTP3 TRUNK RELOCATION\WSB AUR U01+12-17 BRIDGE.DWG
 KCN12_000
 TAB: U17

ADDENDUM NUMBER		
ATTACHMENT NUMBER		
RECORD OF REVISIONS		
No.	DATE	DESCRIPTION

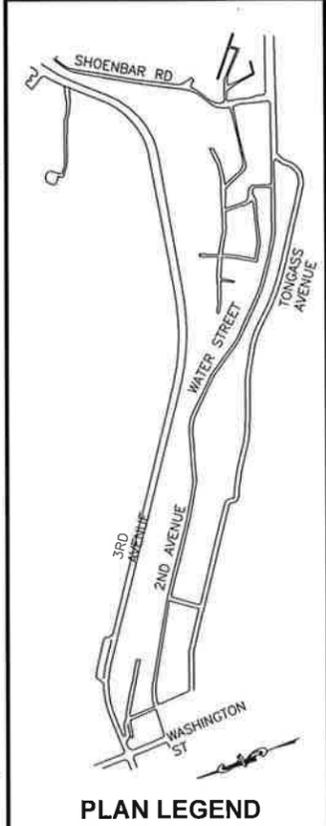

CHECKED BY: TED

DESIGNED BY: KCN
 DRAWN BY: KCN

STATE OF ALASKA
 DEPARTMENT OF TRANSPORTATION & PUBLIC FACILITIES
 SOUTHEAST REGION

KETCHIKAN ADVANCE WATER STREET TRUNK LINE RELOCATION PROJECT # 69548

UTILITY PLAN WATER ST. ELECT

PROJECT DESIGNATION
BR-000S(735) ~69548

STATE	YEAR
ALASKA	2014
SHEET NUMBER	TOTAL SHEETS
U17	78

GENERAL NOTES

A. SEE U24-U31 FOR PHOTOS & DETAILS OF THE POLES & U34, U35 FOR POLE & SERVICE INFO.

B. MODIFY THE SERVICES TO THE HOMES FED FROM THE RAISED OVERHEAD LINES (POLES P3-P13) AS FOLLOWS:

THE EXISTING ELECTRICAL OVERHEAD SERVICE DROPS AND SERVICE MAST AND METERS REMAIN. EXTEND THE SERVICE DROP AS REQUIRED.

SEE V SHEETS: REMOVE EXISTING TELEPHONE OVERHEAD COPPER SERVICE DROP AND NID. INSTALL NEW FIBER DROP AND FIBER NID.

EXISTING TV OVERHEAD SERVICES TO THE HOMES REMAIN. COORD W/ GCI - GCI WILL EXTEND DROPS AS REQUIRED.

Project As Built Drawings Have Been Reviewed By The Project Engineer & Represent, To The Best Of My Knowledge, The Project As Constructed.

Proj. Eng. *NB* Date 1/16/16


ELECTRICAL NOTES

- 1 EXISTING OVERHEAD MOUNTED ON ALLEY ARMS: 12.47KV, 120/240V DISTRIBUTION, CABLE TV, AND TEL DISTRIBUTION. AFTER THE 12.47KV DISTRIBUTION IS JUMPERED TO THE TOP TIER AT POLES P1 AND P10, INSTALL 120/240V AND COMM SYSTEMS HIGHER ON THE POLE, WHEN THEY ARE OPERATIONAL DEMO THE EXISTING SYSTEMS. SEE U22, U23 FOR POLE PHOTOS.
- 2 INSTALL NEW 120/240V CROSSARM, SYSTEM NEUTRAL, 120/240V DISTRIBUTION UP ON THE POLE AT POLE P11. EXTEND 120/240V SERVICE DROPS TO THE HOMES AS REQUIRED BY THE NEW HEIGHTS.
- 3 AFTER THE 120/240V SYSTEMS HAVE MOVED UP ON THE POLE P11, INSTALL NEW COMM CROSSARM. SEE V SHEETS: INSTALL NEW FIBER OPTIC DISTRIBUTION CABLE AND DROPS TO THE HOMES, NEW 900 PAIR CU. REMOVE THE EXISTING COPPER TELEPHONE DISTRIBUTION FROM THE POLES, COPPER SERVICE DROPS TO THE HOMES, AND NIDS ON THE HOME.
- 4 COORDINATE WITH GCI THE PROJECT SCHEDULE THAT MOVES THE TELEPHONE DISTRIBUTION UP ON THE POLES. GCI WILL MOVE THEIR TV DISTRIBUTION UP ON THE POLES AND EXTEND SERVICE DROPS TO THE HOMES AS REQUIRED.
- 5 EXISTING OVERHEAD MOUNTED ON ALLEY ARMS: 12.47KV, 120/240V DISTRIBUTION, CABLE TV, AND TEL DISTRIBUTION. AFTER THE 12.47KV DISTRIBUTION IS JUMPERED TO THE TOP TIER AT POLES P1 AND P10, INSTALL COMM SYSTEMS HIGHER ON THE POLE. WHEN THEY ARE OPERATIONAL DEMO THE EXISTING SYSTEMS. SEE U23 FOR POLE PHOTOS.
- 6 INSTALL NEW COMM CROSSARM DOUBLE ARM 10 PIN ALLEY. SEE V SHEETS FOR RAISING EXISTING COPPER & FIBER OPTIC CABLES, INSTALL NEW 900 PAIR, ADJUST TEL SERVICE DROPS

DISTRIBUTION CABLE AND DROPS TO THE HOMES, NEW 900 PAIR CU. REMOVE THE EXISTING COPPER TELEPHONE DISTRIBUTION

DO NOT SCALE FROM THESE DRAWINGS USE DIMENSIONS

ADDENDUM NUMBER		
ATTACHMENT NUMBER		
RECORD OF REVISIONS		
No	DATE	DESCRIPTION

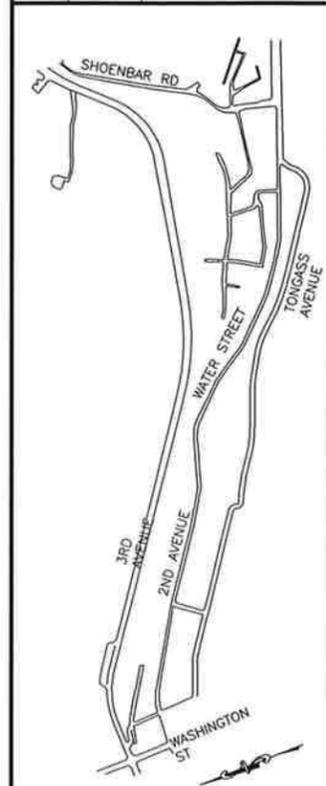

PLAN LEGEND

CHECKED BY: TED



DESIGNED BY: KCN

DRAWN BY: KCN

STATE OF ALASKA
 DEPARTMENT OF TRANSPORTATION
 & PUBLIC FACILITIES
 SOUTHEAST REGION


KETCHIKAN ADVANCE
 WATER STREET TRUNK LINE
 RELOCATION
 PROJECT # 69548

**UTILITY PLAN
 WATER ST. ELECT**

PROJECT DESIGNATION
BR-000S(735) ~69548

STATE	YEAR
ALASKA	2014

SHEET NUMBER	TOTAL SHEETS
U16	78

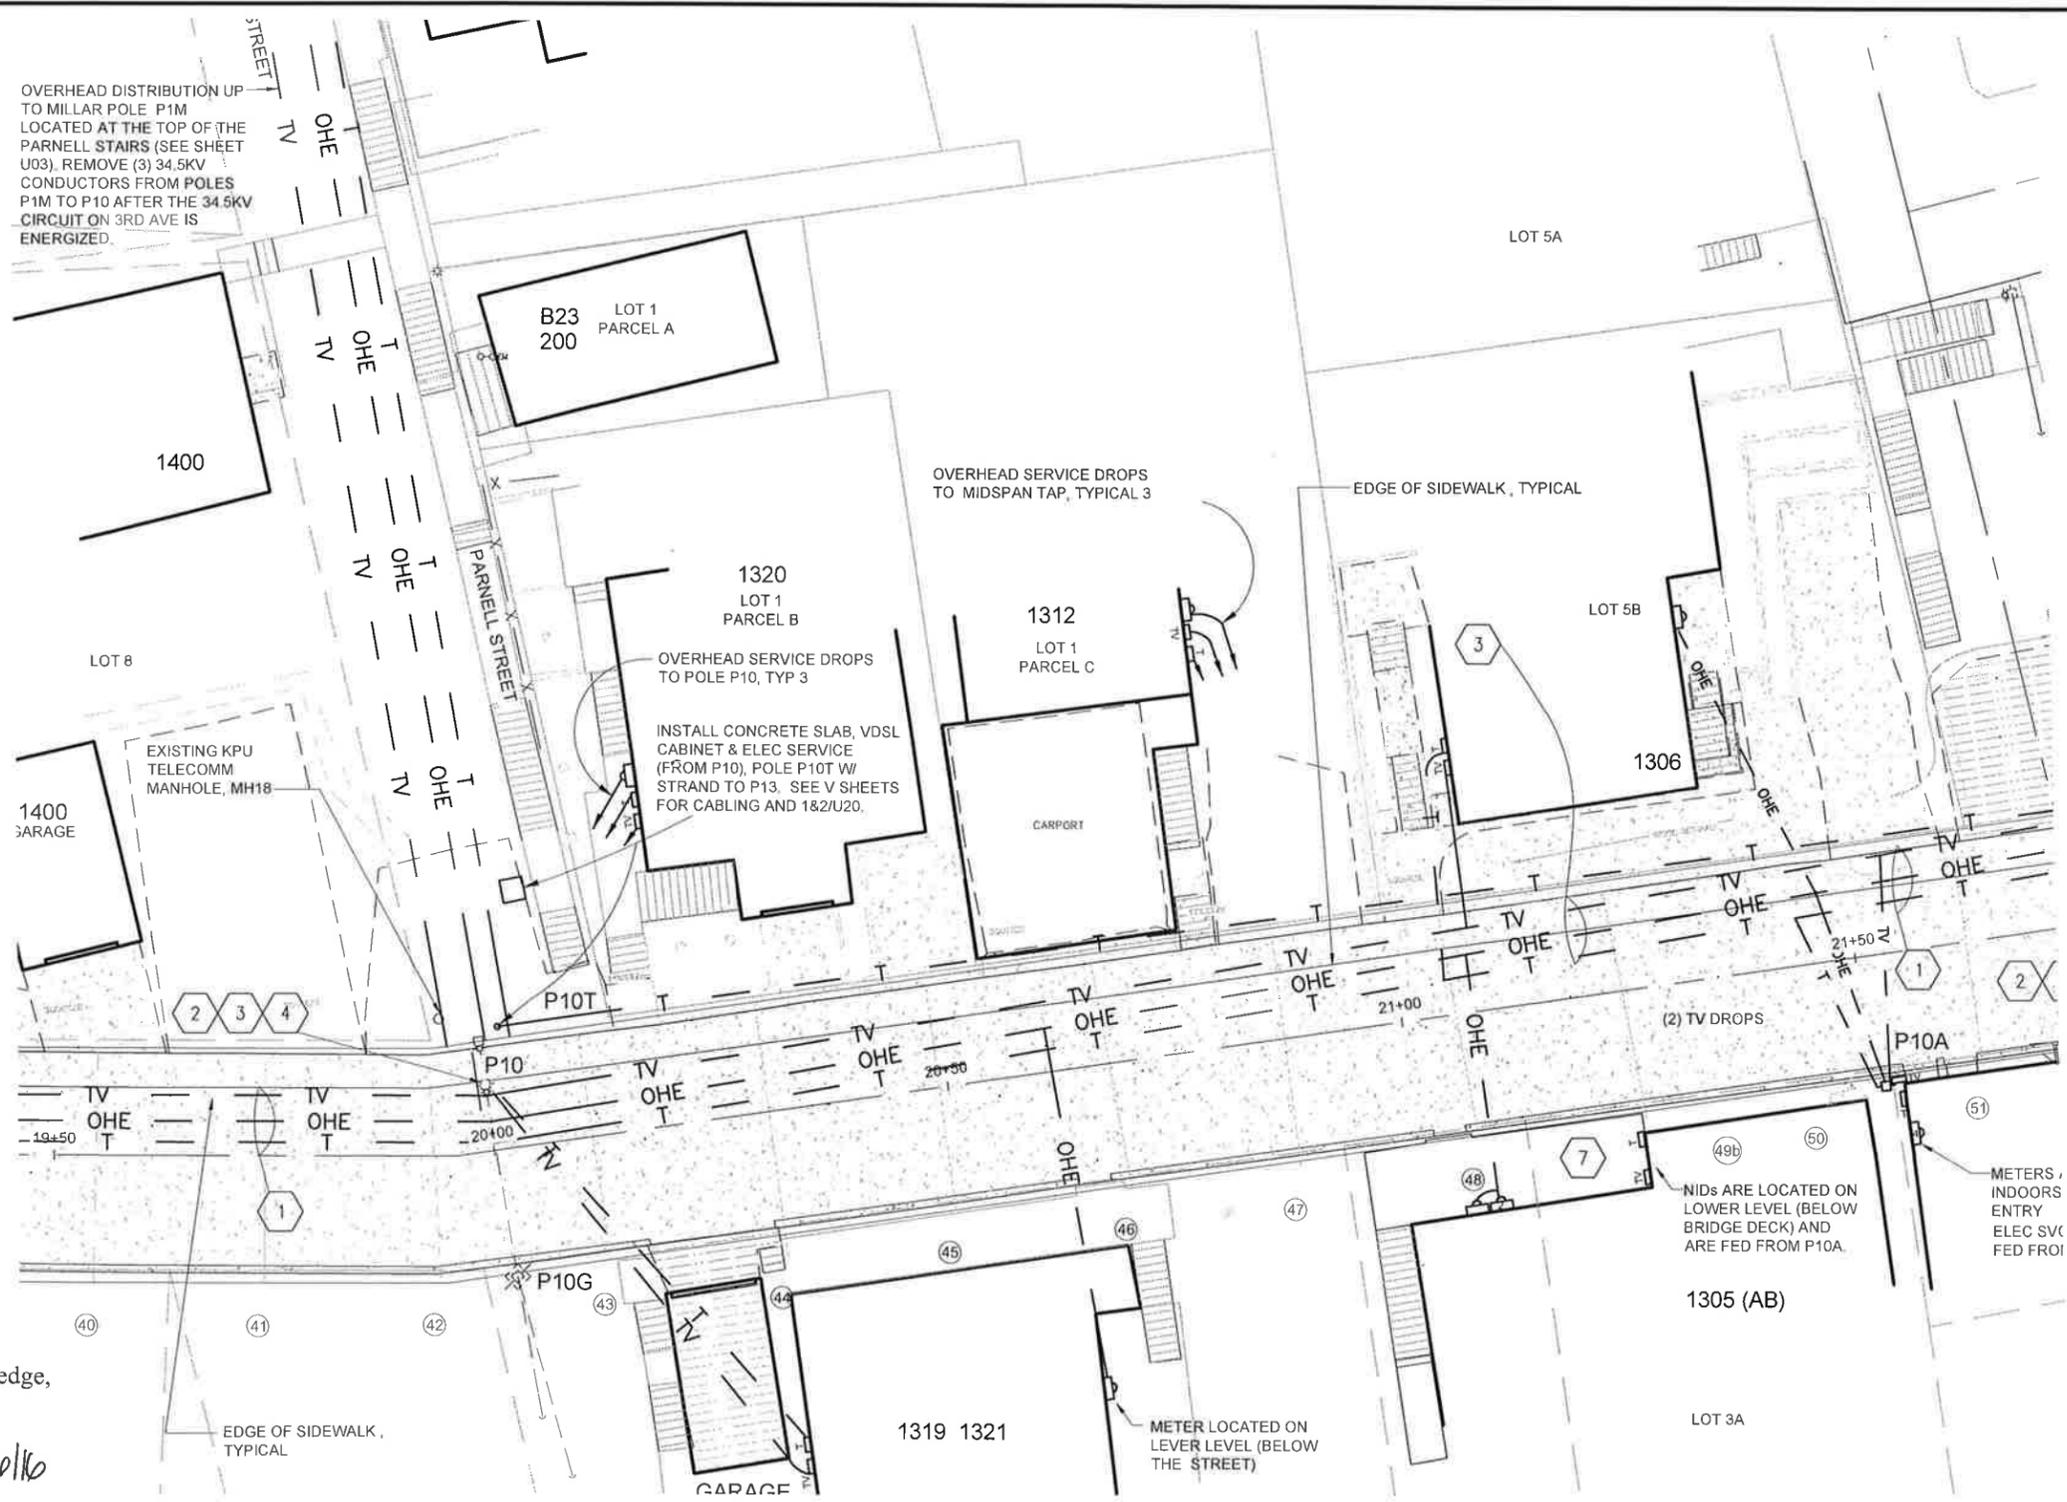

OVERHEAD DISTRIBUTION UP TO MILLAR POLE P1M LOCATED AT THE TOP OF THE PARNELL STAIRS (SEE SHEET U03). REMOVE (3) 34.5KV CONDUCTORS FROM POLES P1M TO P10 AFTER THE 34.5KV CIRCUIT ON 3RD AVE IS ENERGIZED.

OVERHEAD SERVICE DROPS TO MIDSPAN TAP, TYPICAL 3

OVERHEAD SERVICE DROPS TO POLE P10, TYP 3
 INSTALL CONCRETE SLAB, VDSL CABINET & ELEC SERVICE (FROM P10), POLE P10T W/ STRAND TO P13. SEE V SHEETS FOR CABLING AND 1&2/U20.

NIDs ARE LOCATED ON LOWER LEVEL (BELOW BRIDGE DECK) AND ARE FED FROM P10A.
 METERS / INDOORS ENTRY ELEC SVC FED FROM

Project As Built Drawings Have Been Reviewed By The Project Engineer & Represent, To The Best Of My Knowledge, The Project As Constructed.

Proj. Eng. NB Date 1/16/16

ELECTRICAL NOTES

- 1 EXISTING OVERHEAD 34.5KV, 12KV, 120/240V DISTRIBUTION, CABLE TV, AND TEL DISTRIBUTION. AFTER THE 12.47KV DISTRIBUTION IS JUMPED TO THE TOP TIER AT POLES P1 AND P10, REMOVE 12.47KV LINE BETWEEN P3-P10 AND CROSSARMS ON POLES P4-P9. SEE U22, U23 FOR POLE PHOTOS.
- 2 MOVE THE SYSTEM NEUTRAL, 120/240V STREET LIGHTS, TRANSFORMERS UP ON THE POLE FROM POLE P3 TO P10. EXTEND 120/240V SERVICE DROPS TO THE HOMES AS REQUIRED BY THE NEW HEIGHTS.


- 3 AFTER THE ELECTRICAL SYSTEMS HAVE MOVED UP ON THE POLES FROM P2 TO P10, INSTALL NEW COMM CROSSARMS FROM POLE P2 TO P10. SEE V SHEETS: INSTALL NEW FIBER OPTIC DISTRIBUTION CABLE AND DROPS TO THE HOMES. REMOVE THE EXISTING COPPER TELEPHONE DISTRIBUTION FROM THE POLES, COPPER SERVICE DROPS TO THE HOMES, AND NIDs ON THE HOME.
- 4 COORDINATE WITH GCI THE PROJECT SCHEDULE THAT MOVES THE TELEPHONE DISTRIBUTION UP ON THE POLES. GCI WILL MOVE THEIR TV DISTRIBUTION UP ON THE POLES AND EXTEND SERVICE DROPS TO THE HOMES AS REQUIRED.

GENERAL NOTES

- A. SEE U FOR PHOTOS OF THE POLES.
- B. MODIFY THE SERVICES TO THE HOMES FED FROM THE RAISED OVERHEAD LINES (P3-P13) AS FOLLOWS:
 THE EXISTING ELECTRICAL OVERHEAD SERVICE DROPS AND SERVICE MAST AND METERS REMAIN. EXTEND THE SERVICE DROP AS REQUIRED.
 SEE V SHEETS: REMOVE EXISTING TELEPHONE OVERHEAD COPPER SERVICE DROP AND NID. INSTALL NEW FIBER DROP AND FIBER NID.
 EXISTING TV OVERHEAD SERVICES TO THE HOMES REMAIN. COORD W/ GCI - GCI WILL EXTEND DROPS AS REQUIRED.

DO NOT SCALE FROM THESE DRAWINGS USE DIMENSIONS

ADDENDUM NUMBER		
ATTACHMENT NUMBER		
RECORD OF REVISIONS		
No.	DATE	DESCRIPTION

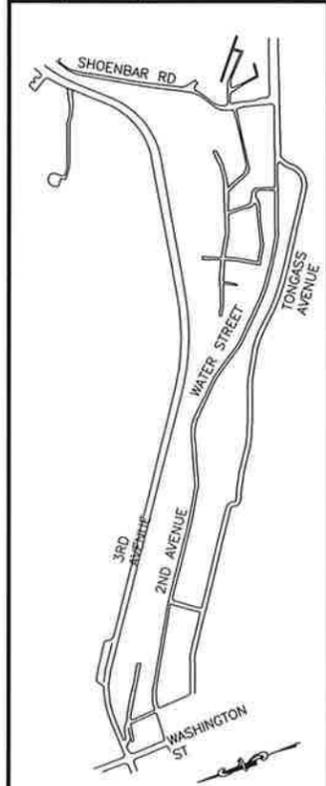

PLAN LEGEND

CHECKED BY: TED



DESIGNED BY: KCN
 DRAWN BY: KCN

STATE OF ALASKA
 DEPARTMENT OF TRANSPORTATION
 & PUBLIC FACILITIES
 SOUTHEAST REGION


KETCHIKAN ADVANCE
 WATER STREET TRUNK LINE
 RELOCATION
 PROJECT # 69548

**UTILITY PLAN
 WATER ST. ELECT**

PROJECT DESIGNATION
BR-000S(735) ~69548

STATE	YEAR
ALASKA	2014

SHEET NUMBER	TOTAL SHEETS
U14	78

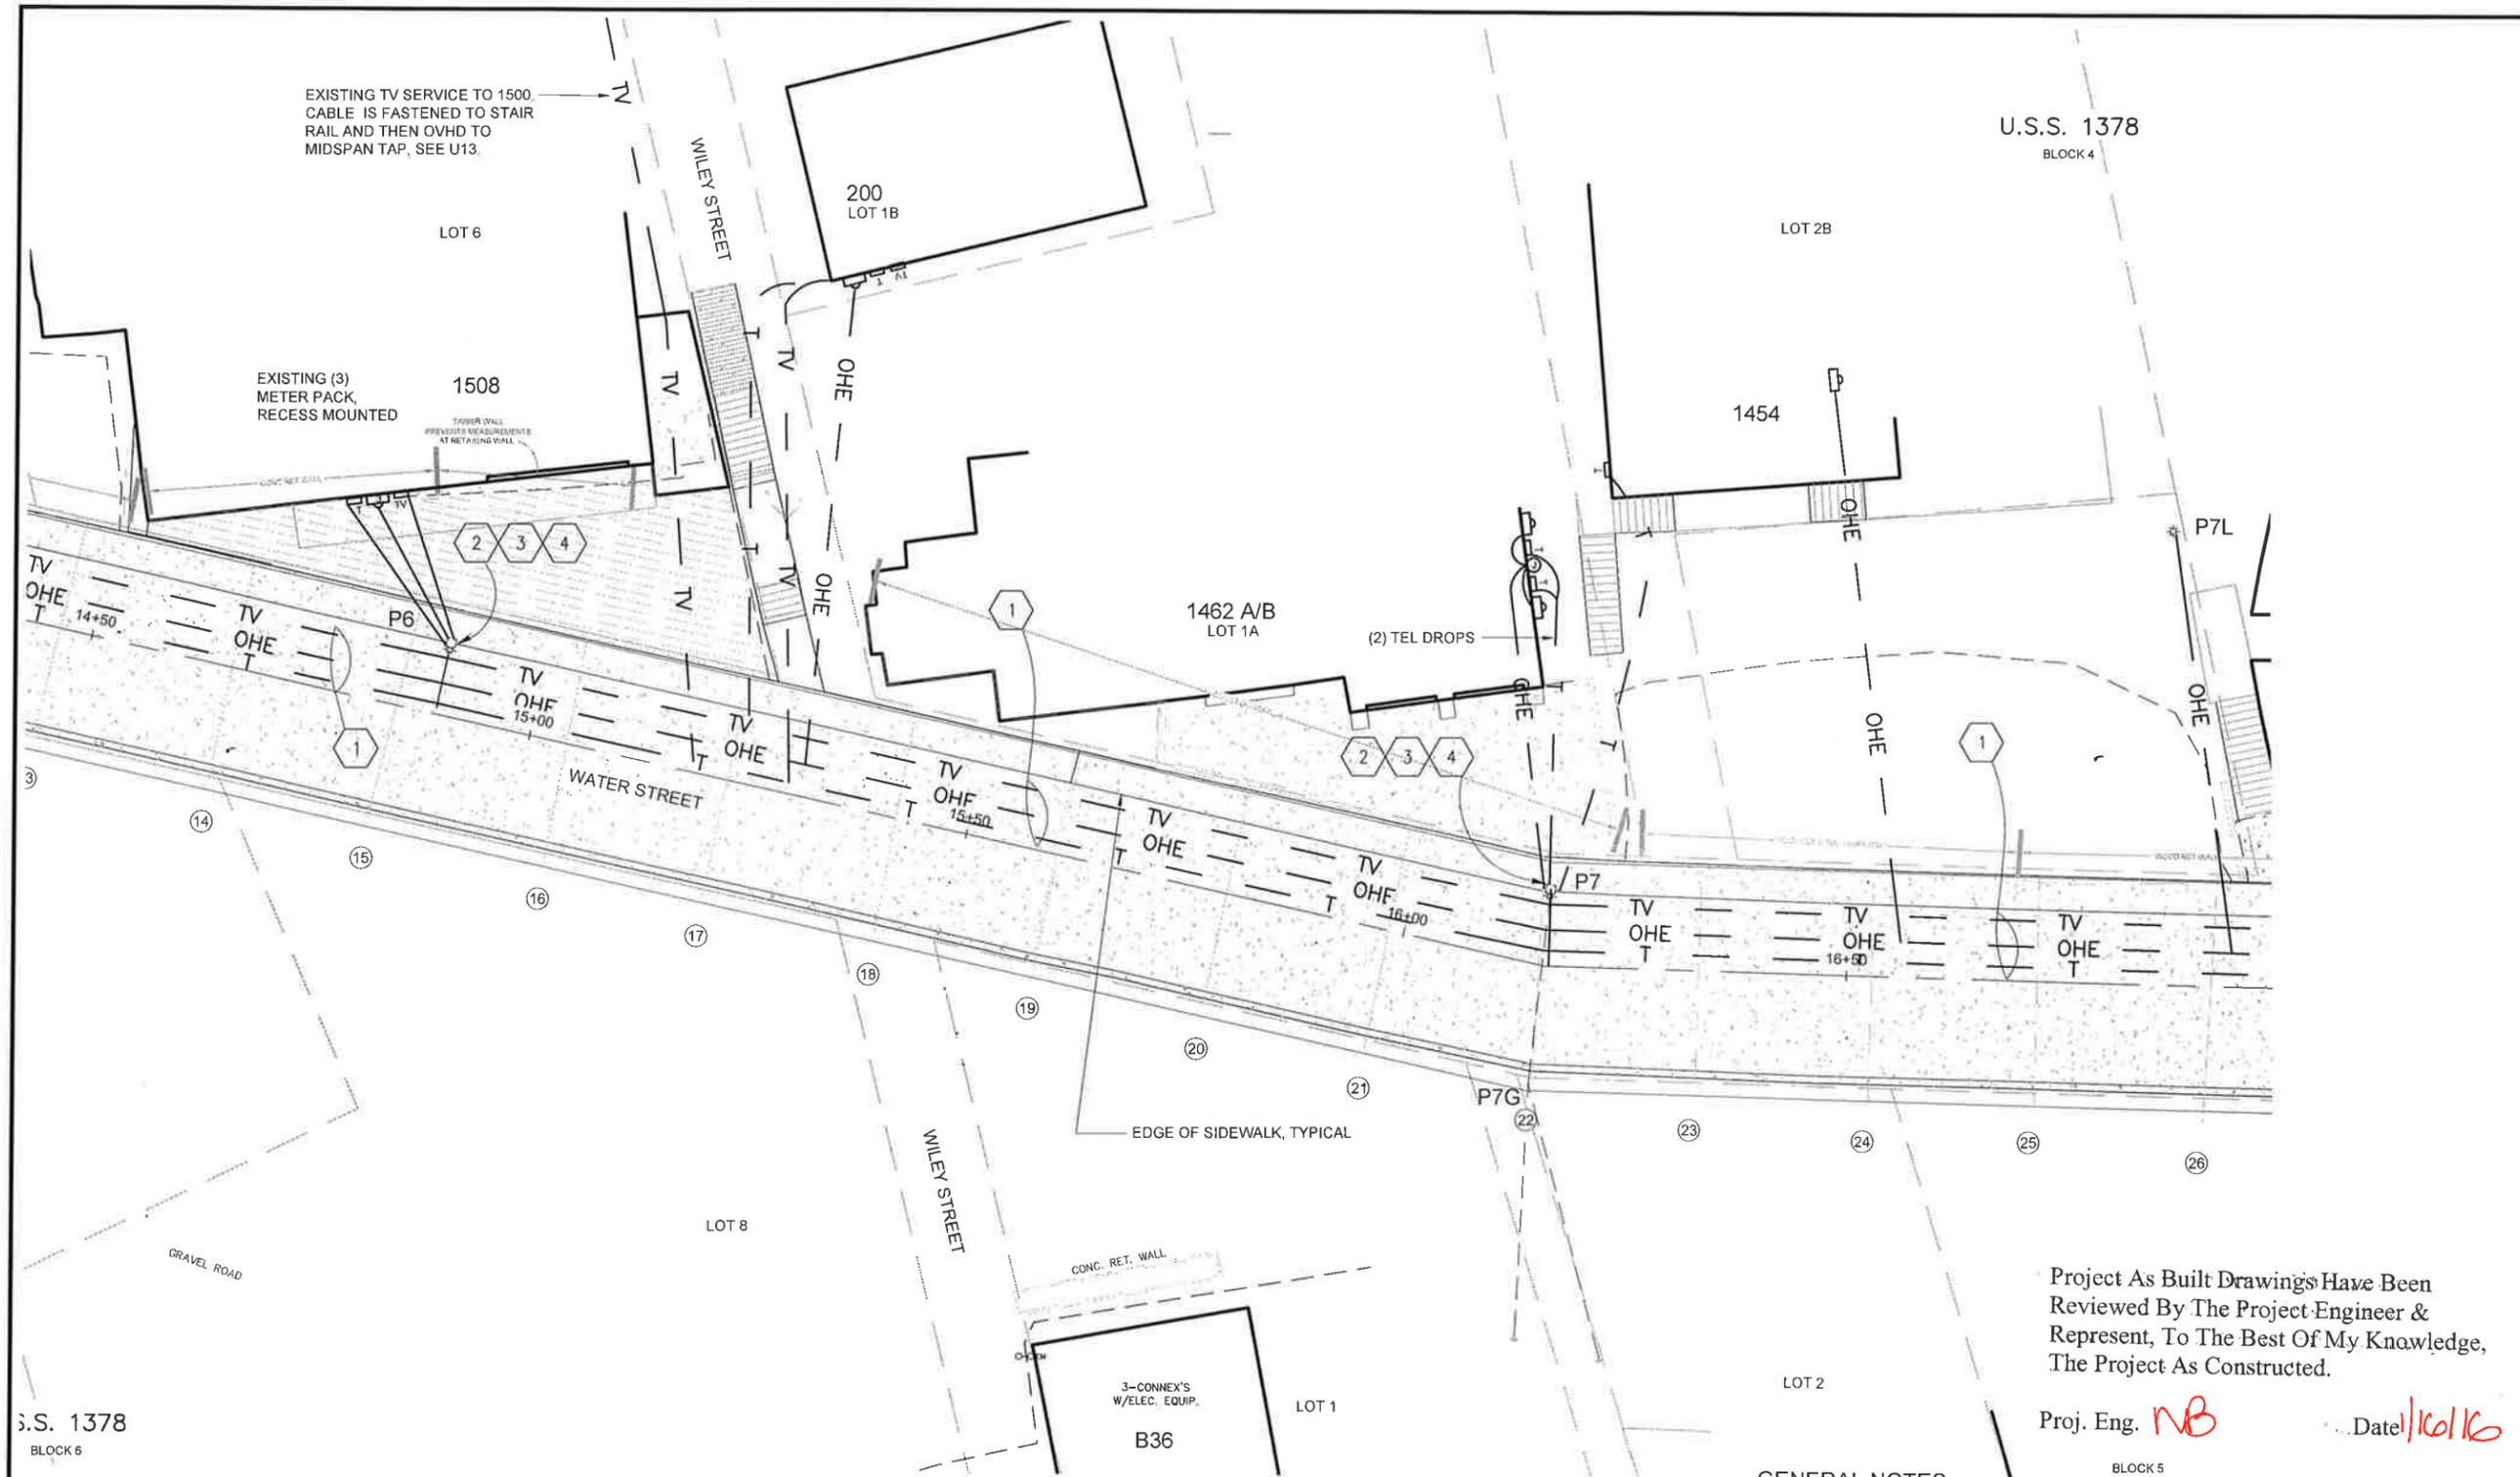

ELECTRICAL NOTES

- 1 EXISTING OVERHEAD 34.5KV, 12KV, 120/240V DISTRIBUTION, CABLE TV, AND TEL DISTRIBUTION. AFTER THE 12.47KV DISTRIBUTION IS JUMPERED TO THE TOP TIER AT POLES P1 AND P10, REMOVE 12.47KV LINE AND CROSSARMS POLES P4-P9. SEE U22, U23 FOR POLE PHOTOS.
- 2 MOVE THE SYSTEM NEUTRAL, 120/240V STREET LIGHTS, TRANSFORMERS UP ON THE POLE FROM POLE P4 TO P10. EXTEND 120/240V SERVICE DROPS TO THE HOMES AS REQUIRED BY THE NEW HEIGHTS.

- 3 AFTER THE ELECTRICAL SYSTEMS HAVE MOVED UP ON THE POLES FROM P2 TO P10, INSTALL NEW COMM CROSSARMS FROM POLE P4 TO P10. SEE V SHEETS; INSTALL NEW FIBER OPTIC DISTRIBUTION CABLE AND DROPS TO THE HOMES. REMOVE THE EXISTING COPPER TELEPHONE DISTRIBUTION FROM THE POLES, COPPER SERVICE DROPS TO THE HOMES, AND NIDS ON THE HOME.
- 4 COORDINATE WITH GCI THE PROJECT SCHEDULE THAT MOVES THE TELEPHONE DISTRIBUTION UP ON THE POLES. GCI WILL MOVE THEIR TV DISTRIBUTION UP ON THE POLES AND EXTEND SERVICE DROPS TO THE HOMES AS REQUIRED.

GENERAL NOTES

- A. SEE U24-U31 FOR PHOTOS & DETAILS OF THE POLES & U34, U35 FOR POLE & SERVICE INFO.
- B. MODIFY THE SERVICES TO THE HOMES FED FROM THE RAISED OVERHEAD LINES (POLES P3-P13) AS FOLLOWS:
 THE EXISTING ELECTRICAL OVERHEAD SERVICE DROPS AND SERVICE MAST AND METERS REMAIN. EXTEND THE SERVICE DROP AS REQUIRED.
 SEE V SHEETS: REMOVE EXISTING TELEPHONE OVERHEAD COPPER SERVICE DROP AND NID. INSTALL NEW FIBER DROP AND FIBER NID.
 EXISTING TV OVERHEAD SERVICES TO THE HOMES REMAIN. COORD W/ GCI - GCI WILL EXTEND DROPS AS REQUIRED.

Project As Built Drawings Have Been Reviewed By The Project Engineer & Represent, To The Best Of My Knowledge, The Project As Constructed.

Proj. Eng. *NB* Date *1/10/16*



DO NOT SCALE FROM THESE DRAWINGS USE DIMENSIONS

U.S. 1378
 BLOCK 6

THE NIDS



ADDENDUM NUMBER		
ATTACHMENT NUMBER		
RECORD OF REVISIONS		
No.	DATE	DESCRIPTION

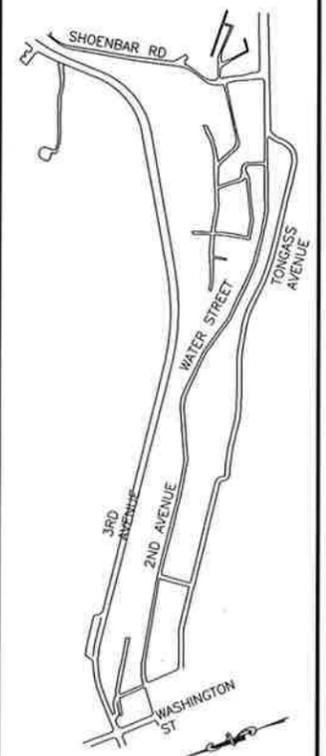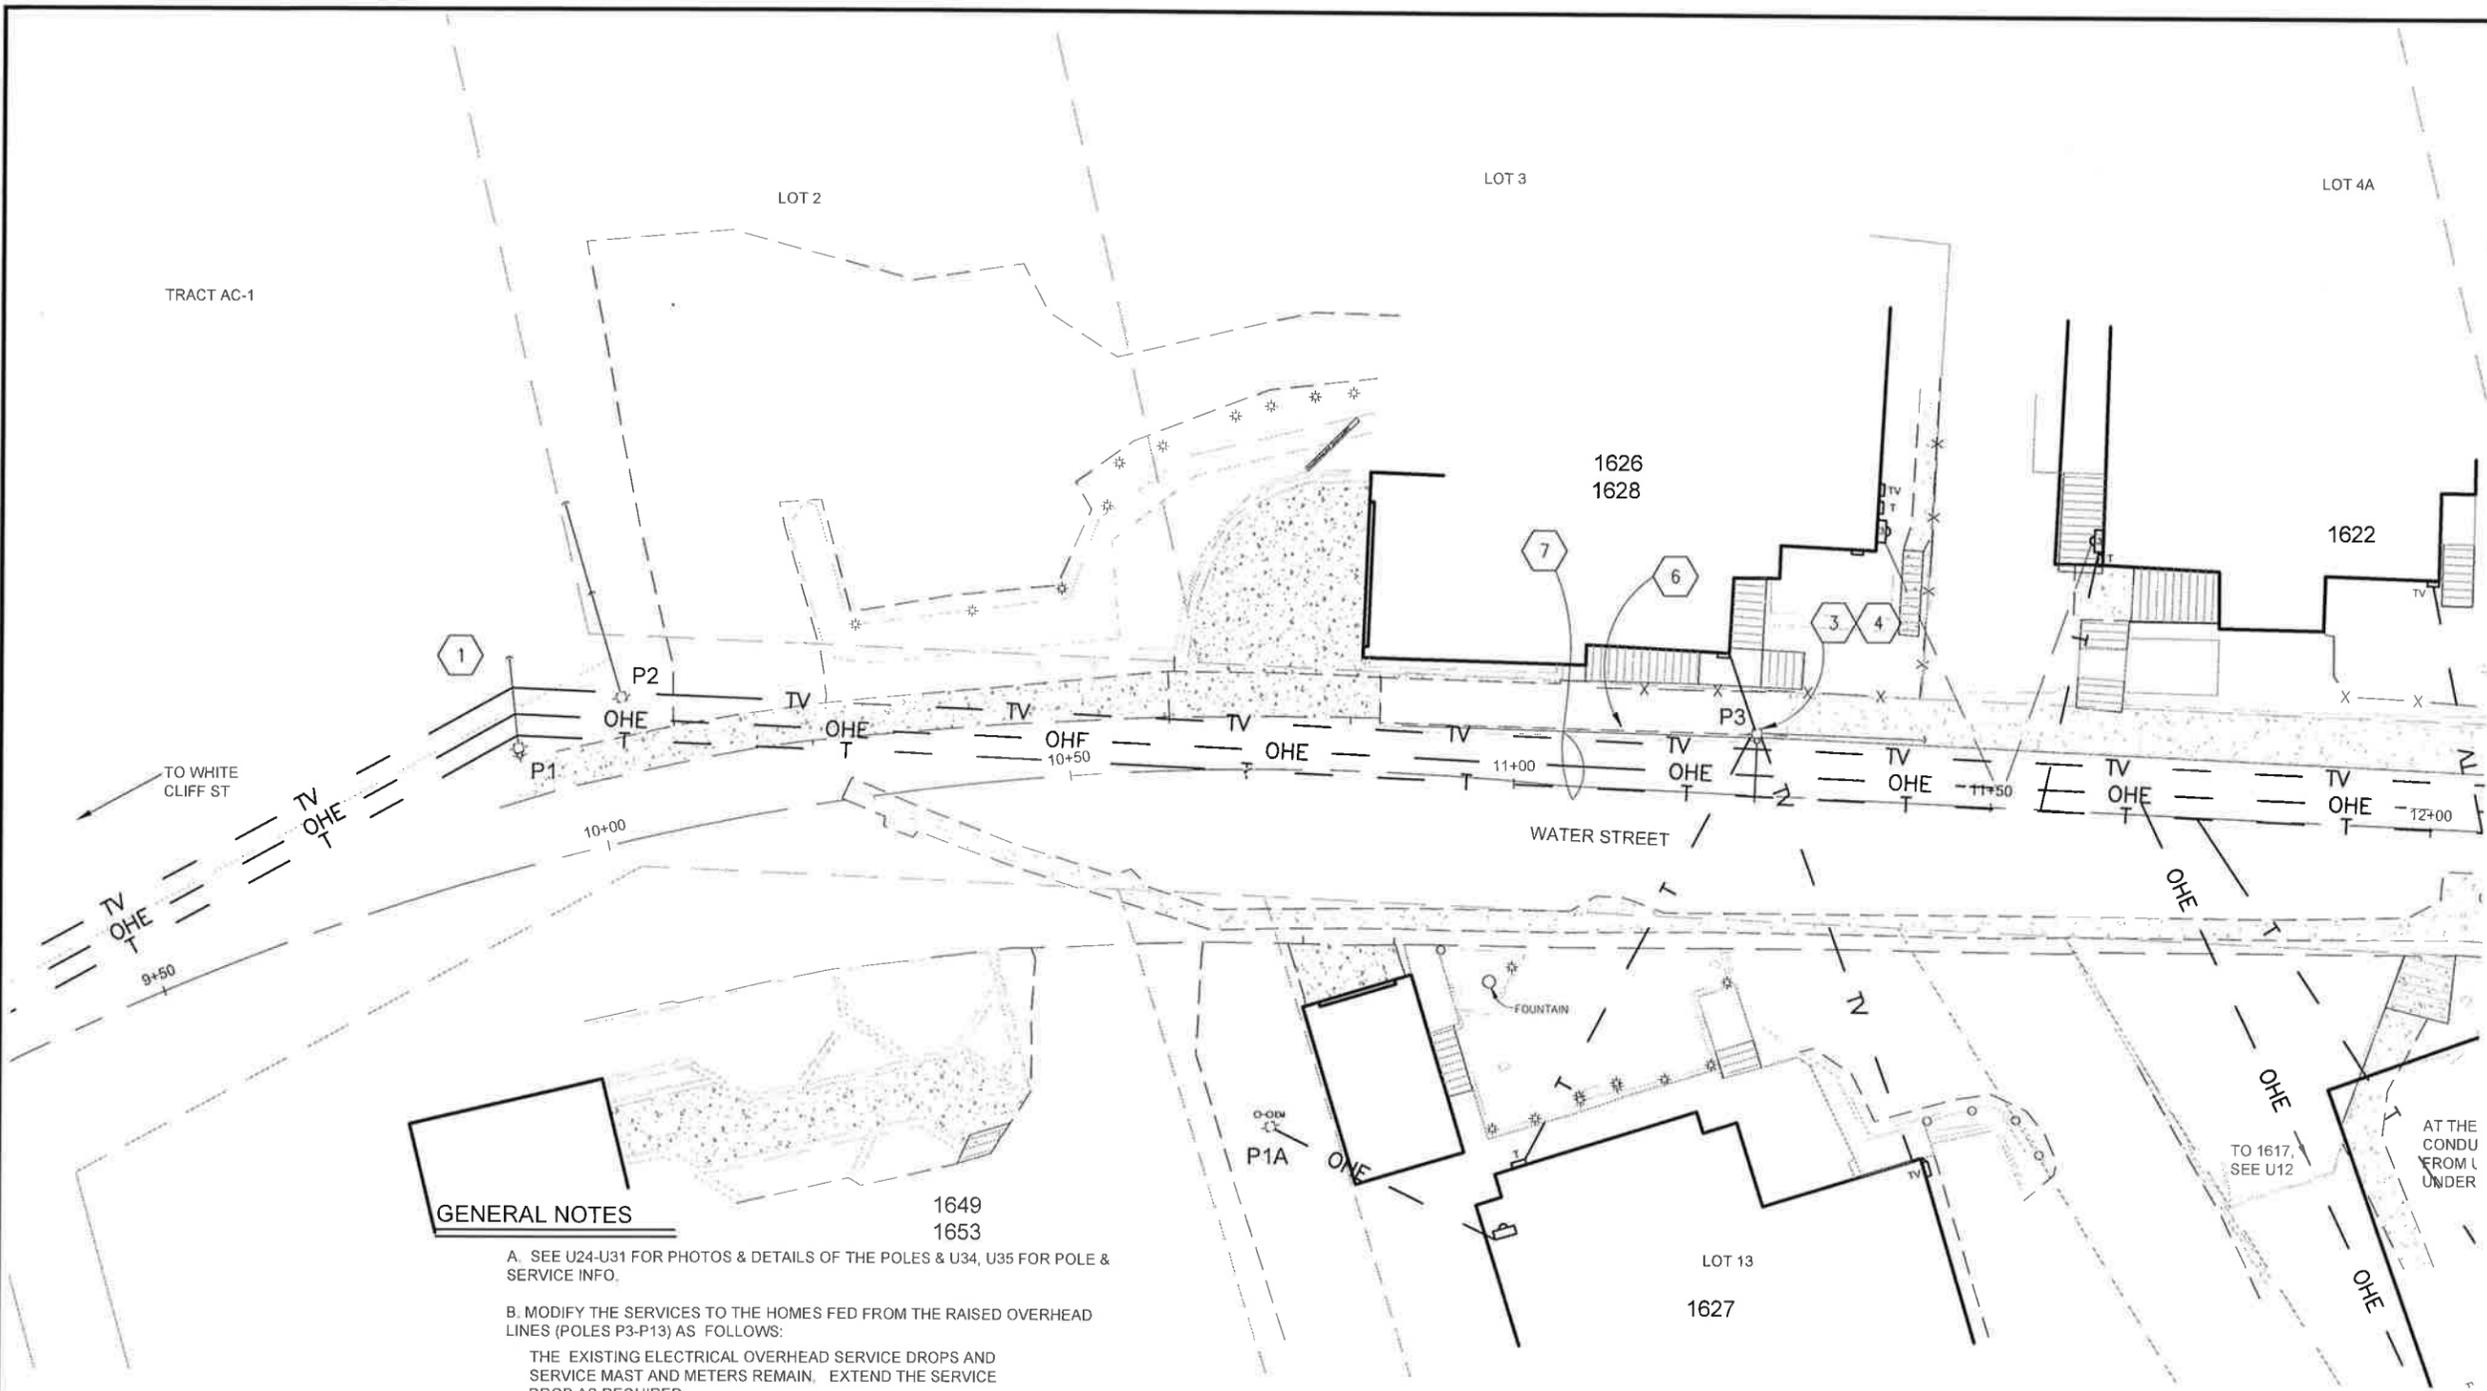

GENERAL NOTES

- 1649
1653
- A. SEE U24-U31 FOR PHOTOS & DETAILS OF THE POLES & U34, U35 FOR POLE & SERVICE INFO.
 - B. MODIFY THE SERVICES TO THE HOMES FED FROM THE RAISED OVERHEAD LINES (POLES P3-P13) AS FOLLOWS:
 THE EXISTING ELECTRICAL OVERHEAD SERVICE DROPS AND SERVICE MAST AND METERS REMAIN. EXTEND THE SERVICE DROP AS REQUIRED.

 SEE V SHEETS: REMOVE EXISTING TELEPHONE OVERHEAD COPPER SERVICE DROP AND NID. INSTALL NEW FIBER DROP AND FIBER NID.

 EXISTING TV OVERHEAD SERVICES TO THE HOMES REMAIN. COORD W/ GCI - GCI WILL EXTEND DROPS AS REQUIRED.

ELECTRICAL NOTES

- 1 AFTER NEW 3RD AVE 34.5KV UNDERGROUND CIRCUIT IS ENERGIZED: REMOVE THE 12.47KV CONDUCTORS BETWEEN P1 TO P10 AND THEIR CROSSARMS ON P2-P9. REMOVE EXISTING 34.5KV POST TOP INSTALLATION AND INSTALL 34.5KV DOUBLE DEADEND WITH NO JUMPERS. REMOVE EXISTING 12.47KV POST TOP INSTALLATION AND INSTALL 12.47KV DEADEND ON THE UPHILL SIDE OF THE POLE. INSTALL 12.47KV AND 35KV GUYS. ON THE UPHILL SIDE OF THE POLE JUMPER THE 12.47KV DISTRIBUTION TO THE DEENERGIZED 34.5KV TOP TIER.A
- 2 NOTE NOT USED
- 3 AFTER THE ELECTRICAL SYSTEMS HAVE MOVED UP ON THE POLES FROM P4 TO P10 AND NEW COMM CROSSARMS INSTALLED FROM POLE P4 TO P11 - SEE V SHEETS: INSTALL NEW FIBER OPTIC DISTRIBUTION CABLE AND DROPS TO THE HOMES. REMOVE THE EXISTING COPPER TELEPHONE DISTRIBUTION FROM THE POLES, COPPER SERVICE DROPS TO THE HOMES, AND NIDS ON THE HOME.
- 4 COORDINATE WITH GCI THE PROJECT SCHEDULE THAT MOVES THE TELEPHONE DISTRIBUTION UP ON THE POLES. GCI WILL MOVE THEIR TV DISTRIBUTION UP ON THE POLES AND EXTEND SERVICE DROPS TO THE HOMES AS REQUIRED.
- 5 EXISTING OVERHEAD INSTALLATION: 34.5KV 3 PHASE, 12.47KV 3 PHASE, 120/240V FOR STREET LIGHTS AND HOMES, GCI & KPU-T CABLING, TYPICAL. REMOVE 12.47KV CONDUCTORS. ADJUST SERVICE DROPS TO THE HOMES.
- 6 INSTALL NEW GUY FOR KPU-T FIBER OPTIC LINE.
- 7 EXISTING OVERHEAD INSTALLATION: 34.5KV 3 PHASE, 12.47KV 3 PHASE, GCI & KPU-T CABLING, TYPICAL. REMOVE 12.47KV CONDUCTORS.

Project As Built Drawings Have Been Reviewed By The Project Engineer & Represent, To The Best Of My Knowledge, The Project As Constructed.

Proj. Eng. *NS* Date 1/10/16

PLAN LEGEND

CHECKED BY: TED UNDER



DESIGNED BY: KCN

DRAWN BY: KCN

STATE OF ALASKA
 DEPARTMENT OF TRANSPORTATION & PUBLIC FACILITIES
 SOUTHEAST REGION


KETCHIKAN ADVANCE
 WATER STREET TRUNKLINE
 RELOCATION
 PROJECT #69548

**UTILITY PLAN
 WATER ST. ELECTRIC**

PROJECT DESIGNATION
BR-000S(735) ~69458

STATE	YEAR
ALASKA	2014
SHEET NUMBER	TOTAL SHEETS
U12	78

DO NOT SCALE FROM THESE DRAWINGS USE DIMENSIONS

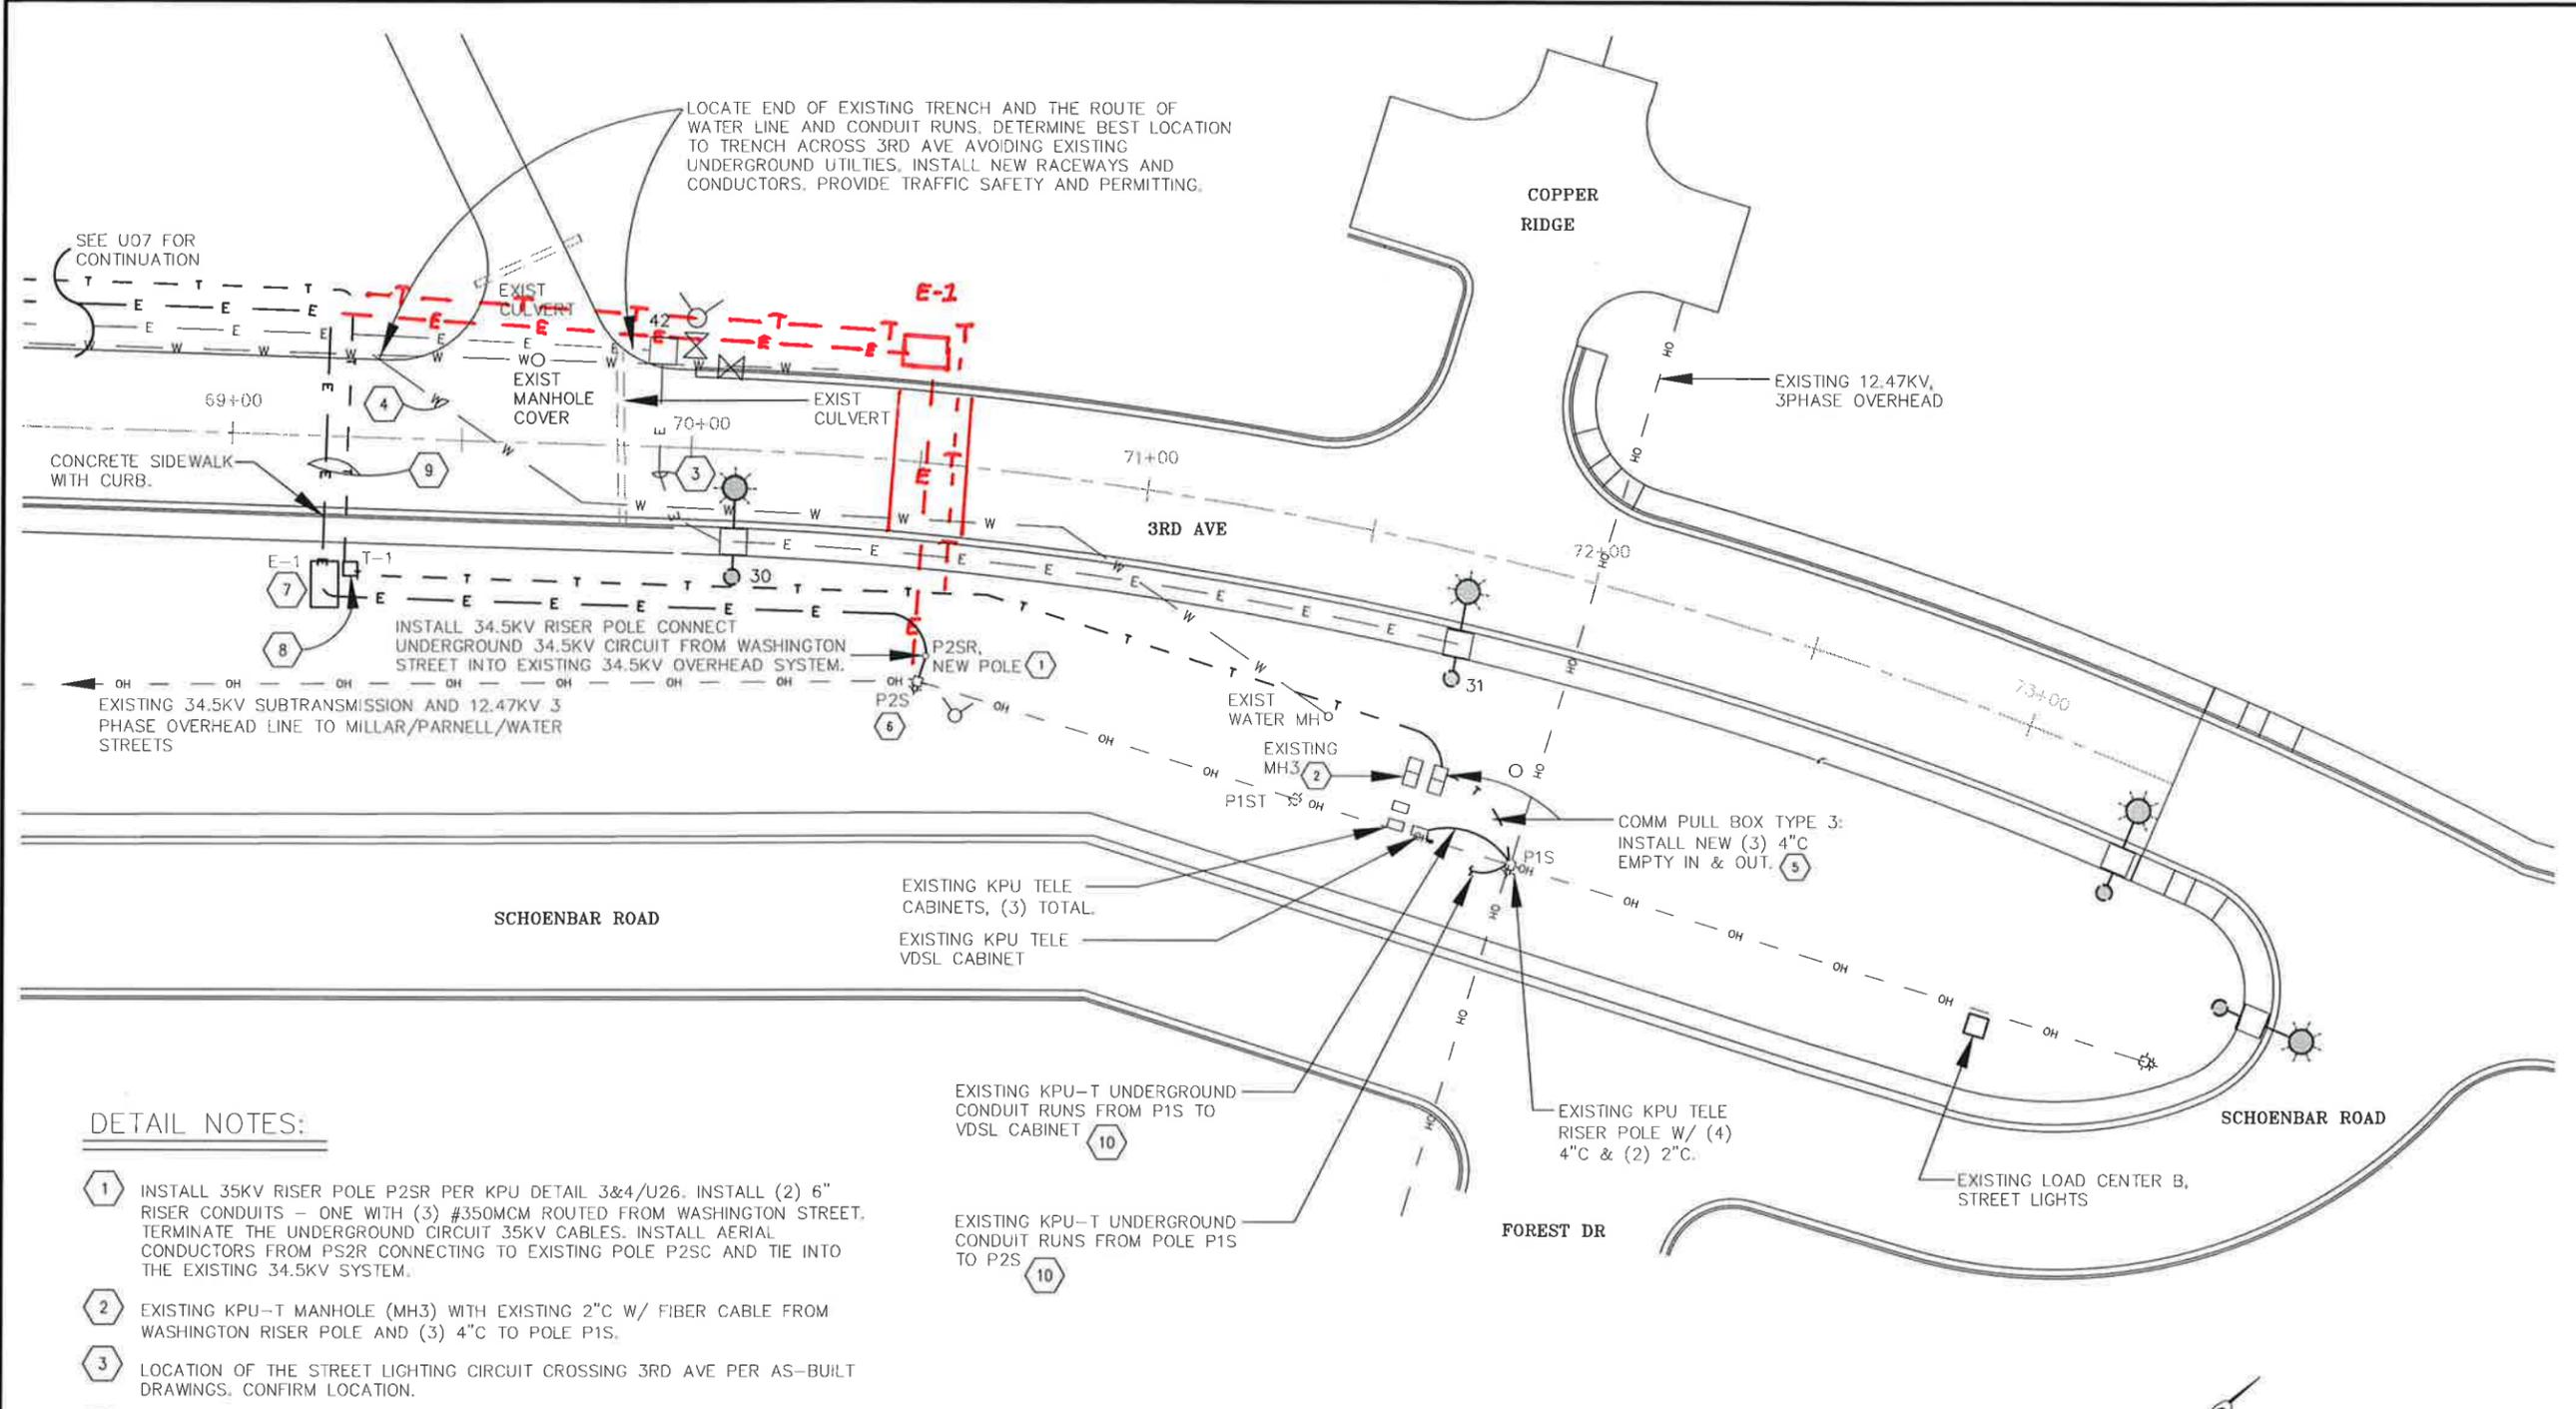

DETAIL NOTES:

- 1 INSTALL 35KV RISER POLE P2SR PER KPU DETAIL 3&4/U26. INSTALL (2) 6" RISER CONDUITS - ONE WITH (3) #350MCM ROUTED FROM WASHINGTON STREET. TERMINATE THE UNDERGROUND CIRCUIT 35KV CABLES. INSTALL AERIAL CONDUCTORS FROM P2SR CONNECTING TO EXISTING POLE P2SC AND TIE INTO THE EXISTING 34.5KV SYSTEM.
- 2 EXISTING KPU-T MANHOLE (MH3) WITH EXISTING 2" C W/ FIBER CABLE FROM WASHINGTON RISER POLE AND (3) 4" C TO POLE P1S.
- 3 LOCATION OF THE STREET LIGHTING CIRCUIT CROSSING 3RD AVE PER AS-BUILT DRAWINGS. CONFIRM LOCATION.
- 4 LOCATION OF THE WATER LINE CROSSING 3RD AVE PER AS-BUILT DRAWINGS. CONFIRM LOCATION
- 5 INSTALL NEW PULL BOX AND INSTALL (3) SETS OF CONDUITS IN AND OUT OF BOX: (1) 4" C FOR 662(2) & (2) 4" C FOR 662(3). THE CONDUITS TERMINATING ON P1S SHALL MATCH EXISTING RISER CONDUIT INSTALLATION.
- 6 INSTALL NEW CROSSARM W/ 34.5KV DEADEND HARDWARE AND 34.5KV 3 PHASE OVERHEAD CONDUCTORS CONNECTING TO NEW RISER POLE P2S. ALSO JUMPER NEW OVERHEAD CONDUCTORS TO THE EXISTING 34.5KV LINE LOCATED ON THE TOP TIER OF P2S.
- 7 PULL BOX, TYPE 4 FOR ELECTRIC (KPU-E), SETS OF CONDUIT RUNS IN & OUT: (1) 6" C W/ 35KV CABLING; (1) 6" C EMPTY (1) 4" C EMPTY, WORK IN 662(3)
- 8 PULL BOX, TYPE 2 FOR TELECOMM: INSTALL NEW (3) 4" C EMPTY IN & OUT: (1) SET FOR 662(2) (2) SET FOR 662(3)

- 9 SAWCUT 3RD AVE AND SIDEWALK, SEE 1/U09 & F SHEETS FOR ADDITIONAL INFO. CONTRACTOR'S OPTION: IT IS PERMISSIBLE TO BORE UNDER THE ROADWAY AND SIDEWALK. EXCAVATIONS SHALL BE BACKFILLED PER SPEC SECTION 203 & 204 -TOP COURSE SHALL MATCH EXISTING FINISH SURFACE.
- 10 INSTALL NEW 25 PAIR CABLE IN EXISTING CONDUIT FROM EXISTING VDSL CABINET TO POLE P2S. TERMINATE IN CABINET AND NEW AERIAL TERMINAL ON POLE P2S, SEE V SHEETS.

1 SCHOENBAR ISLAND PLAN
SCALE: 1" = 20'

Project As Built Drawings Have Been Reviewed By The Project Engineer & Represent, To The Best Of My Knowledge, The Project As Constructed.

Proj. Eng. *NB* Date *1/16/16*

DO NOT SCALE FROM THESE DRAWINGS USE DIMENSIONS

PATH:XXX


KCN12_000
TAB: U10 8/28/2014 10:57 AM

ADDENDUM NUMBER

ATTACHMENT NUMBER

RECORD OF REVISIONS

No.	DATE	DESCRIPTION

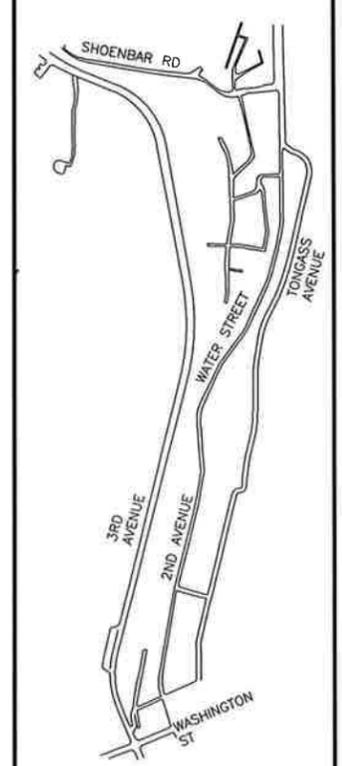

CHECKED BY: TED

DESIGNED BY: KCN
DRAWN BY: KCN

STATE OF ALASKA
DEPARTMENT OF TRANSPORTATION & PUBLIC FACILITIES
SOUTHEAST REGION

KETCHIKAN ADVANCE WATER STREET TRUNK LINE RELOCATION PROJECT #69534

SCHOENBAR PLAN

PROJECT DESIGNATION
BR-000S(735) ~ 69354

STATE	YEAR
ALASKA	2014
SHEET NUMBER	TOTAL SHEETS
U10	78

PATH:XXX


KCN12_000
TAB: U08 8/28/2014 10:45 AM

ADDENDUM NUMBER

ATTACHMENT NUMBER

RECORD OF REVISIONS

No.	DATE	DESCRIPTION

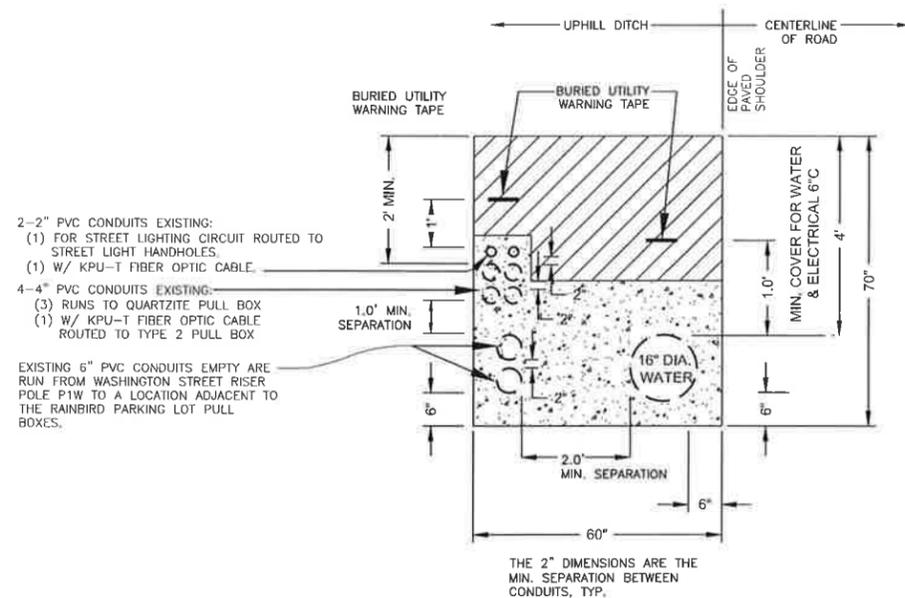

EXISTING LAYOUT


DETAIL NOTES:

- A THE DETAIL SHOWS THE EXISTING TRENCH CONSTRUCTION PER A DOT AS-BUILT.
- B THE EXISTING TRENCH ALONG 3RD AVENUE WAS BLASTED OUT OF A BEDROCK SUBSTRATE. SEE 2/U09 FOR PHOTO OF EXISTING CONSTRUCTION.
- C DOT AS-BUILTS INDICATE THAT FROM WASHINGTON ST TO RAINBIRD PARKING AREA NEAR STA 30+00 THE WATER LINE IS RUN UNDER THE 3RD AVE PAVEMENT. THE ELECTRICAL CONDUITS ARE RUN IN A SEPARATE TRENCH ALONG SIDE 3RD AVE, SEE U04.

1 TRENCH DETAIL - NEAR RAINBIRD PARKING LOT

NO SCALE

THESE DETAILS PROVIDE INFO ABOUT THE TRENCH INSTALLATION FROM WASHINGTON & 3RD TO RAINBIRD PARKING AREA NEAR STA 30+00

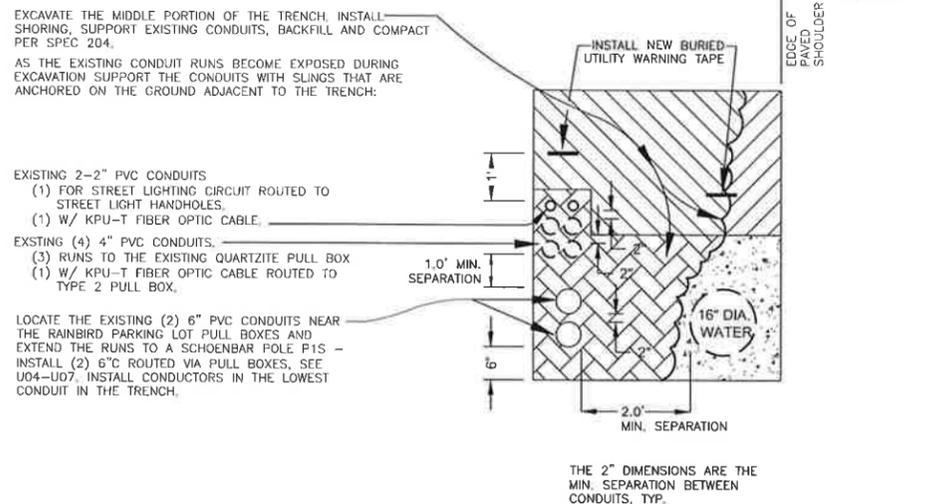


NEW WORK NEAR RAINBIRD PARKING LOT

DETAIL NOTES:

- A BACKHOE AND HAND DIGGING IN THE TRENCH AREA ARE PERMISSIBLE. ROCK HAMMER DRILL, SAWCUT, AND DITCH WITCH ARE PERMISSIBLE IN AREAS OUTSIDE THE EXISTING TRENCH AREA. BLASTING IS NOT PERMITTED.
- B SEE SHEET B01 FOR ADDITIONAL TRENCH INFO AND SPEC 204 FOR ADDITIONAL REQUIREMENTS INCLUDING 204-3.01 FOR THE MAX. LENGTH OF TRENCH THAT CAN BE OPEN AT ONE TIME, SHORING AND DEWATERING REQUIREMENTS.

Project As Built Drawings Have Been Reviewed By The Project Engineer & Represent, To The Best Of My Knowledge, The Project As Constructed.

Proj. Eng. *MB* Date *1/16/16*

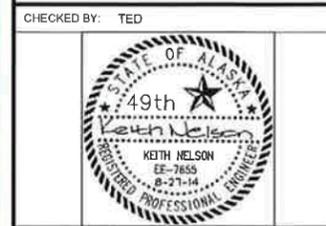

DESIGNED BY: KCN
DRAWN BY: KCN

STATE OF ALASKA
DEPARTMENT OF TRANSPORTATION & PUBLIC FACILITIES
SOUTHEAST REGION


KETCHIKAN ADVANCE
WATER STREET TRUNK LINE
RELOCATION
PROJECT # 69534

3rd AVE DETAILS

PROJECT DESIGNATION

BR-000S(735) ~ 69354

STATE	YEAR
ALASKA	2014
SHEET NUMBER	TOTAL SHEETS
U08	78

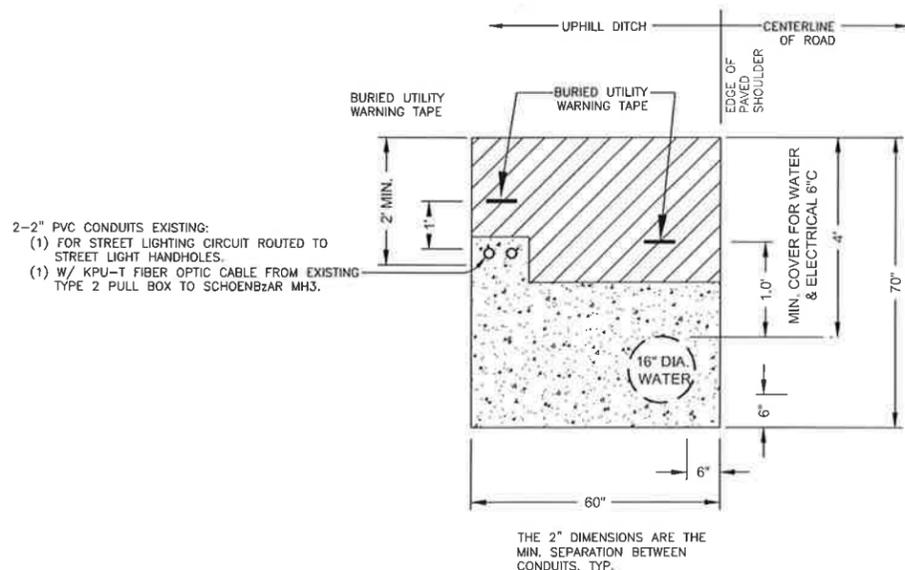


EXISTING LAYOUT

DETAIL NOTES:

- A THE DETAIL SHOWS THE EXISTING TRENCH CONSTRUCTION PER A DOT AS-BUILT.
- B THE EXISTING TRENCH ALONG 3RD AVENUE WAS BLASTED OUT OF A BEDROCK SUBSTRATE. SEE 2/U09 FOR PHOTO OF EXISTING CONSTRUCTION.

2 TRENCH DETAIL - RAINBIRD TO SCHOENBAR


NO SCALE

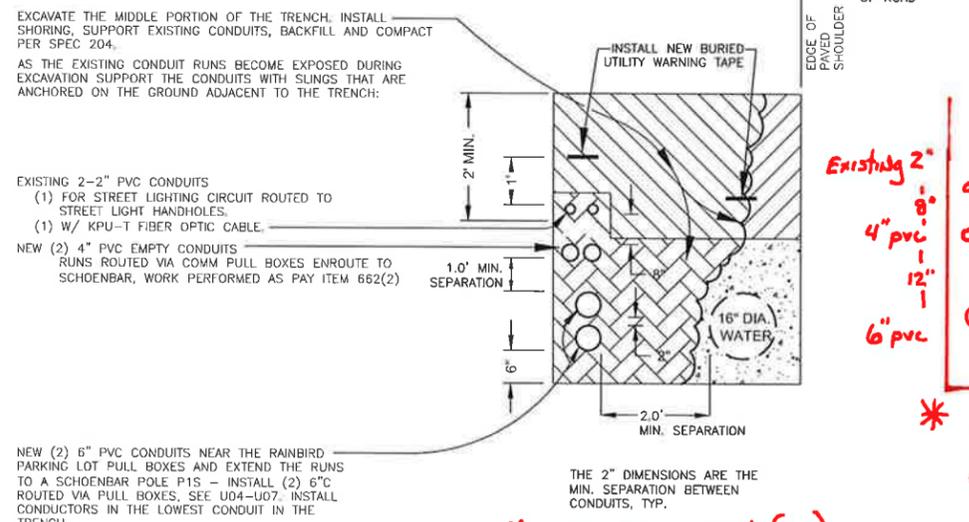

NEW WORK

DETAIL NOTES:

- A BACKHOE AND HAND DIGGING IN THE TRENCH AREA ARE PERMISSIBLE. ROCK HAMMER DRILL, SAWCUT, AND DITCH WITCH ARE PERMISSIBLE IN AREAS OUTSIDE THE EXISTING TRENCH AREA. BLASTING IS NOT PERMITTED.
- B SEE SHEET B01 FOR ADDITIONAL TRENCH INFO AND SPEC 204 FOR ADDITIONAL REQUIREMENTS INCLUDING 204-3.01 FOR THE MAX. LENGTH OF TRENCH THAT CAN BE OPEN AT ONE TIME, SHORING AND DEWATERING REQUIREMENTS.

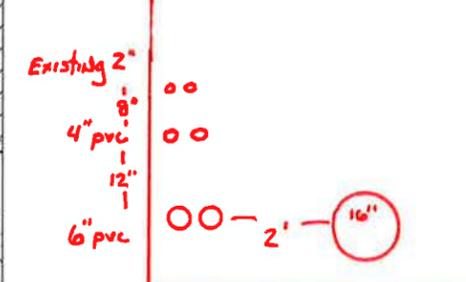

*** ALTERNATE LAYOUT (AL)**

*** AS DESIGNED (AD)**

DO NOT SCALE FROM THESE DRAWINGS USE DIMENSIONS



GENERAL NOTES:

A. EXISTING ELECTRICAL EQUIPMENT AND CIRCUITING IS TO REMAIN UNLESS OTHERWISE NOTED. THE DRAWINGS SHOW EXISTING TRENCH, ELECTRICAL CIRCUITS AND WATER LINE BASED ON AS-BUILT INFO, FIELD CONFIRM ALL INFO.

B. THERE ARE TWO EXISTING 6" C RUN FROM THE WASHINGTON STREET RISER POLE TO THE RAINBIRD PARKING LOT JBOX. EXTEND THE (2) EXISTING 6" C FROM THE RAINBIRD PARKING LOT JBOX TO SCHOENBAR W/ (2) NEW 6" C, ONE CONDUIT IS A SPARE. IN THE OTHER CONDUIT INSTALL #350MCM 35KV 3/C CABLING FROM THE WASHINGTON STREET RISER POLE TO THE SCHOENBAR RISER POLE, CONNECT NEW CABLE TO EXISTING 34.5KV OVERHEAD DISTRIBUTION SYSTEM.

C. AN EXISTING TRENCH, WHICH WAS BLASTED OUT OF A ROCK SUBSTRATE, RUNS FROM THE RAINBIRD PARKING LOT TO SCHOENBAR ON THE UPHILL SIDE OF 3RD AVE. DIG INTO THE EXISTING TRENCH TO INSTALL NEW CONDUIT RUNS. FIELD LOCATE ALL EXISTING WATER LINE VALVES, HYDRANTS, UNDERGROUND CONDUIT RUNS, HANDHOLES, LIGHT FIXTURES, ETC. SEE TRENCH DETAILS U5. SEE SPEC SECTION 204 FOR TRENCH EXCAVATION AND OTHER CONSTRUCTION REQUIREMENTS.

D. SEE 2/U26, U18 & U19 FOR PULL BOX INSTALLATION INFO, 2/U11 FOR HYDRANT INFO. ADDITIONAL INFO ON 3RD AVE BYPASS CONSTRUCTION IS AVAILABLE ON DOT AS-BUILT DRAWINGS, SEE SPEC 662-1.02

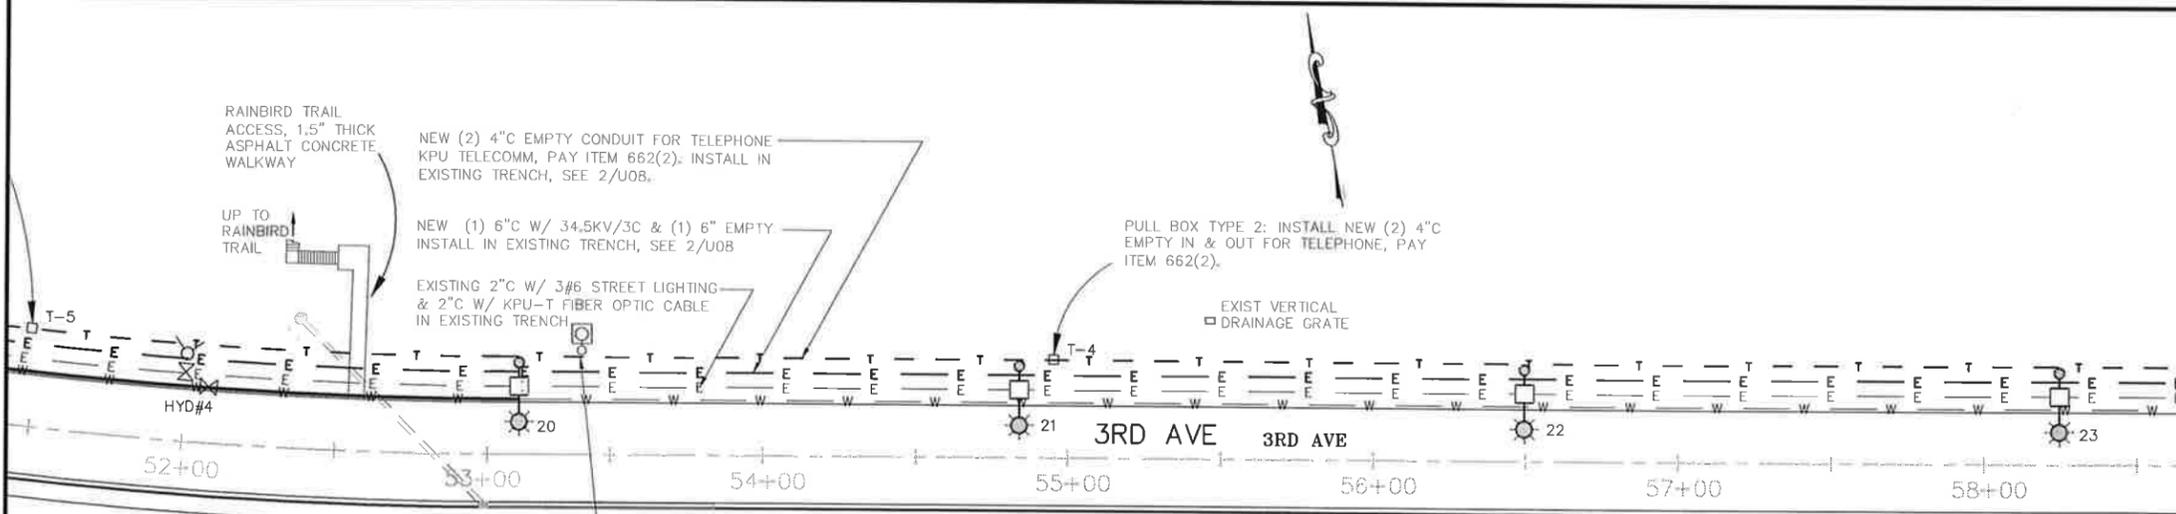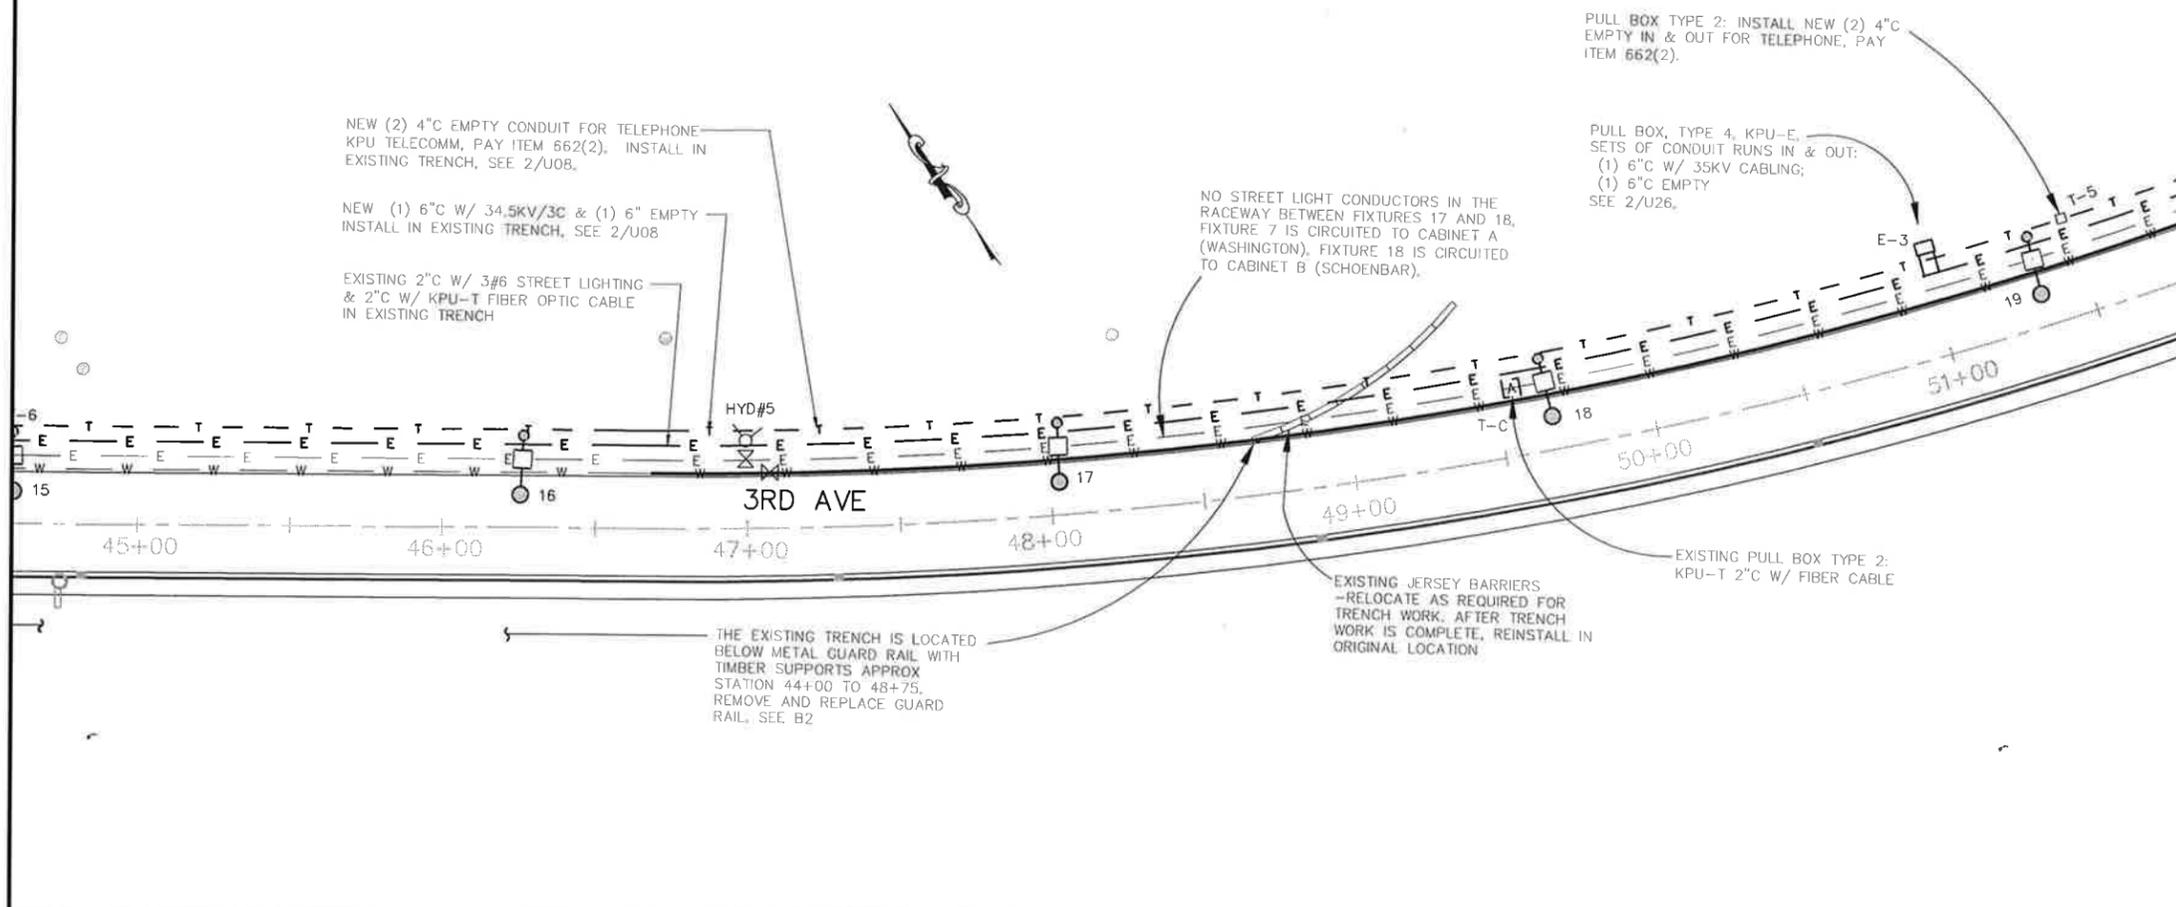

PATH:XXX


KCN12_000
TAB: U06 8/28/2014 10:45 AM

ADDENDUM NUMBER

ATTACHMENT NUMBER

RECORD OF REVISIONS

No.	DATE	DESCRIPTION

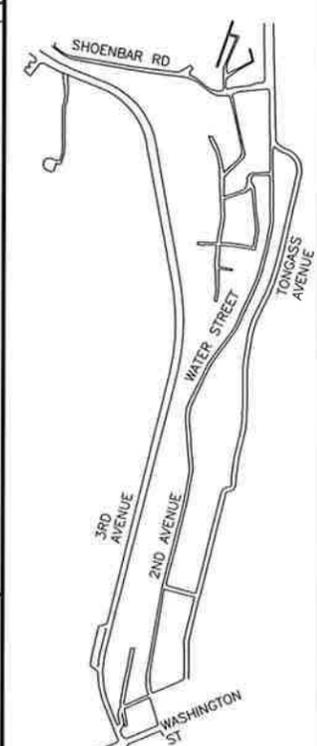

PLAN LEGEND

CHECKED BY: TED

DESIGNED BY: KCN

DRAWN BY: KCN

STATE OF ALASKA
DEPARTMENT OF TRANSPORTATION & PUBLIC FACILITIES
SOUTHEAST REGION

KETCHIKAN ADVANCE
WATER STREET TRUNK LINE
RELOCATION
PROJECT # 69548

**UTILITY PLAN
ELECTRICAL 3rd AVE**

PROJECT DESIGNATION
BR-000S(735) ~ 69548

STATE	YEAR
ALASKA	2014
SHEET NUMBER	TOTAL SHEETS
U06	70

Project As Built Drawings Have Been Reviewed By The Project Engineer & Represent, To The Best Of My Knowledge, The Project As Constructed.

Proj. Eng. MB Date 1/16/16

DO NOT SCALE FROM THESE DRAWINGS USE DIMENSIONS

GENERAL NOTES:

A. EXISTING ELECTRICAL EQUIPMENT AND CIRCUITING IS TO REMAIN UNLESS OTHERWISE NOTED. THE DRAWINGS SHOW EXISTING TRENCH, ELECTRICAL CIRCUITS AND WATER LINE BASED ON AS-BUILT INFO. FIELD CONFIRM ALL INFO.

B. THERE ARE TWO EXISTING 6" C RUN FROM THE WASHINGTON STREET RISER POLE TO THE RAINBIRD PARKING LOT JBOX. EXTEND THE (2) EXISTING 6" C FROM THE RAINBIRD PARKING LOT JBOX TO SCHOENBAR W/ (2) NEW 6" C. ONE CONDUIT IS A SPARE. IN THE OTHER CONDUIT INSTALL #350MCM 35KV 3/C CABLING FROM THE WASHINGTON STREET RISER POLE TO THE SCHOENBAR RISER POLE. CONNECT NEW CABLE TO EXISTING 34.5KV OVERHEAD DISTRIBUTION SYSTEM.

C. AN EXISTING TRENCH, WHICH WAS BLASTED OUT OF A ROCK SUBSTRATE, RUNS FROM THE RAINBIRD PARKING LOT TO SCHOENBAR ON THE UPHILL SIDE OF 3RD AVE. DIG INTO THE EXISTING TRENCH TO INSTALL NEW CONDUIT RUNS. FIELD LOCATE ALL EXISTING WATER LINE VALVES, HYDRANTS, UNDERGROUND CONDUIT RUNS, HANDHOLES, LIGHT FIXTURES, ETC. SEE TRENCH DETAILS U5. SEE SPEC SECTION 204 FOR TRENCH EXCAVATION AND OTHER CONSTRUCTION REQUIREMENTS.

D. SEE 2/U26, U18 & U19 FOR PULL BOX INSTALLATION INFO, 2/U11 FOR HYDRANT INFO. ADDITIONAL INFO ON 3RD AVE BYPASS CONSTRUCTION IS AVAILABLE ON DOT AS-BUILT DRAWINGS. SEE SPEC 662-1.02



ELECTRICAL NOTES:

1. INSTALL 35KV RISER POLE PER KPU DETAIL (3/U26) AND TERMINATE THE UNDERGROUND CIRCUIT 35KV CABLES TO THE AERIAL 35KV SUBTRANSMISSION CIRCUIT LOCATED ON THE TOP TIER OF THE POLE. DISCONNECT (3) EXISTING JUMPERS AND ASSOCIATED CONNECTORS AT 2ND AND WASHINGTON WHICH CONNECT THE WASHINGTON STREET AND WATER STREET AVE 35KV AERIAL LINES, SEE U03.

2. EXISTING TRENCH FROM RAINBIRD TO WASHINGTON STREET RISER POLE P1W. SEE DETAIL 1/U08.


3. EXISTING TRENCH FROM RAINBIRD TO SCHOENBAR. SEE DETAIL 2/U08.

4. THE EXISTING 2" C W/ THE STREET LIGHTING CIRCUIT BYPASSES THE EXISTING PULL BOXES. THE (2) 6" C EMPTY FROM THE WASHINGTON STREET RISER POLE P1W TERMINATE NEAR THE EXISTING PULL BOXES -LOCATE THE ENDS OF THE CONDUITS AND EXTEND THE TWO RUNS TO SCHOENBAR RISER POLE P2SR.

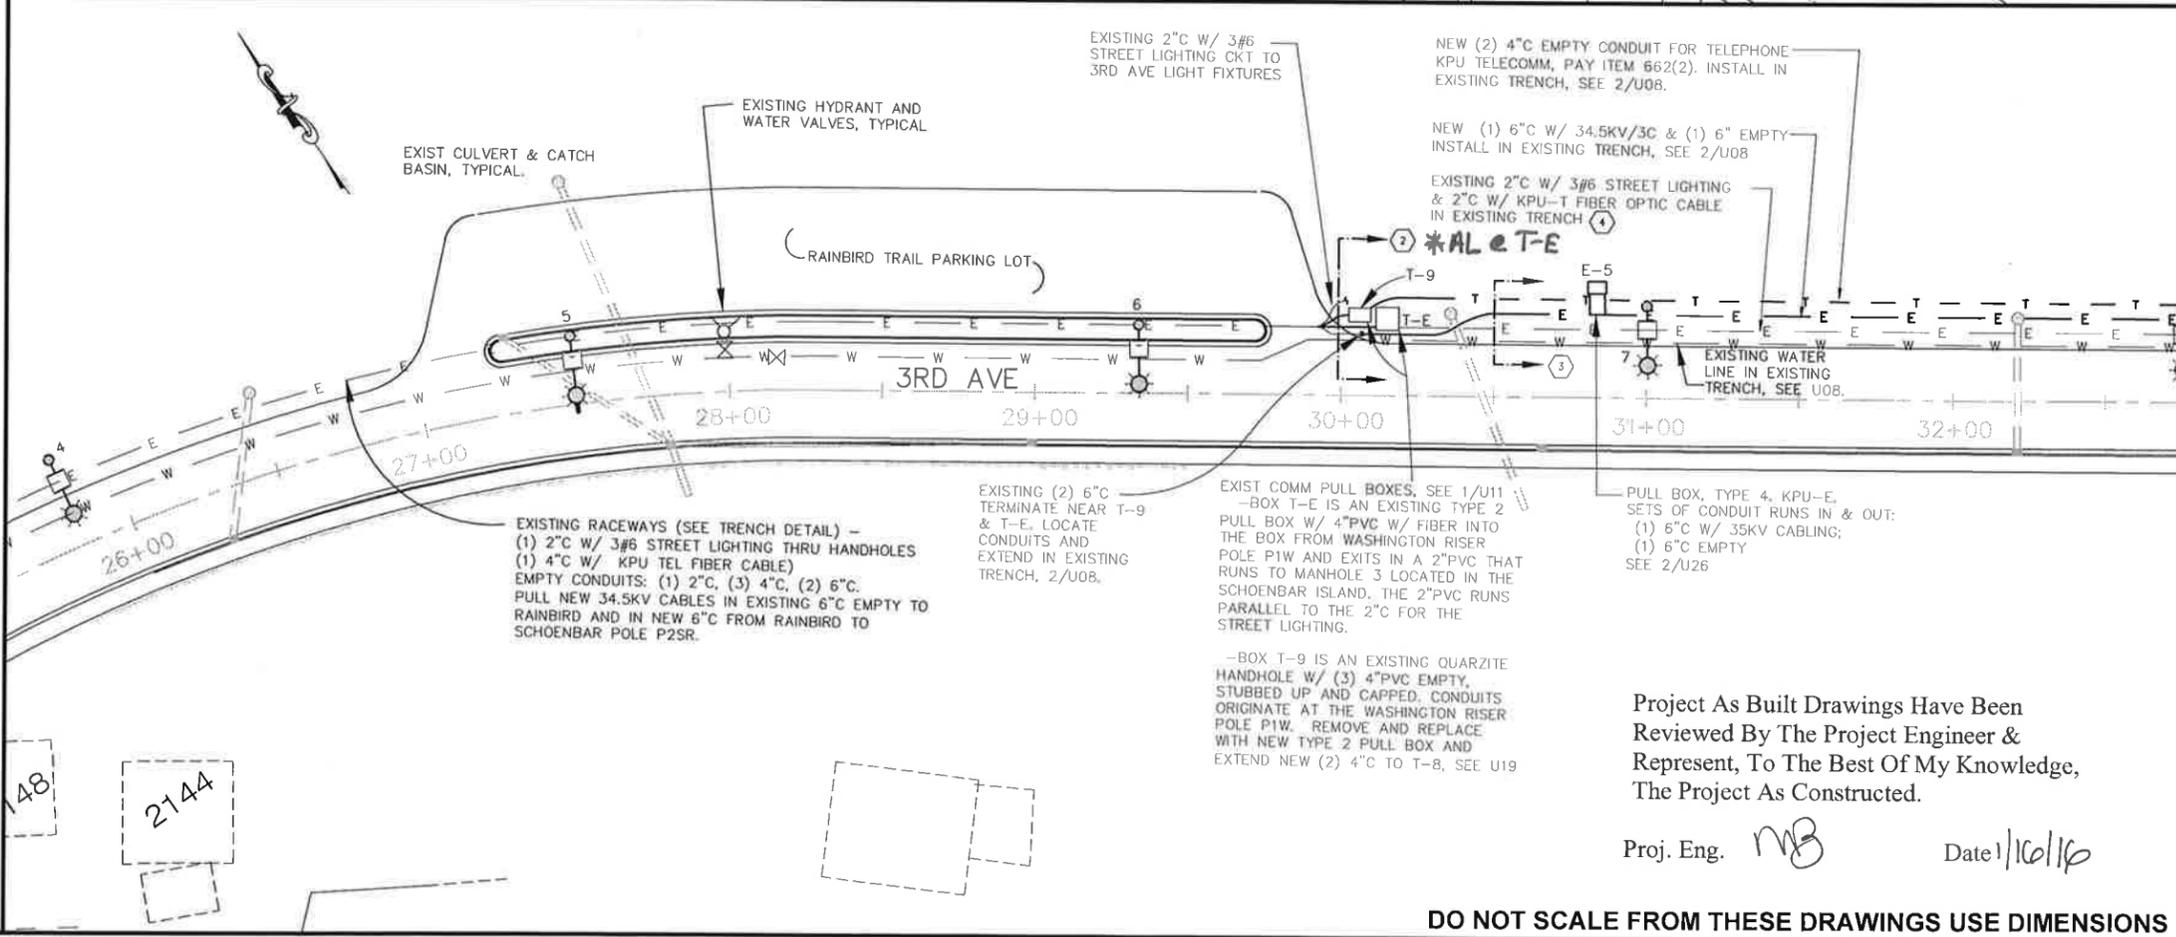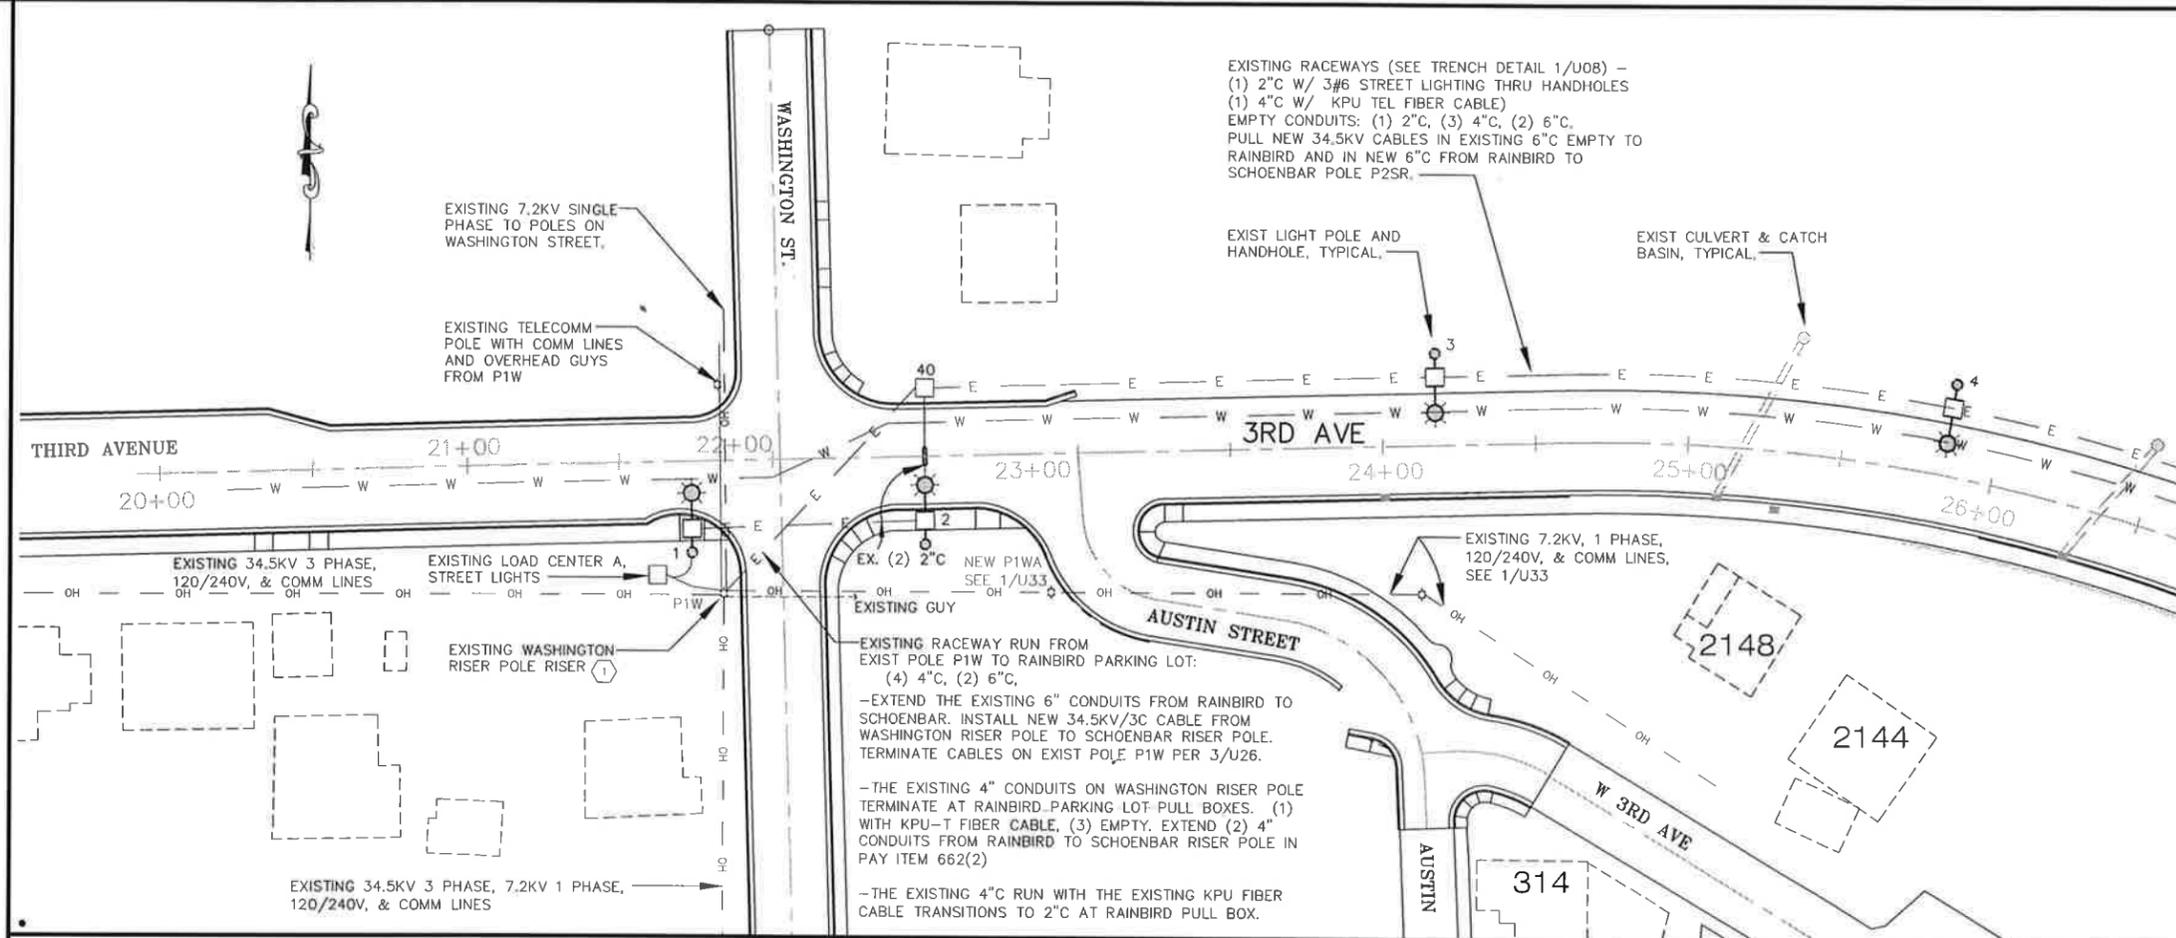

PATH:XXX

KCN12_000	TAB: U04	8/28/2014 10:45 AM
ADDENDUM NUMBER		
ATTACHMENT NUMBER		
RECORD OF REVISIONS		
No.	DATE	DESCRIPTION

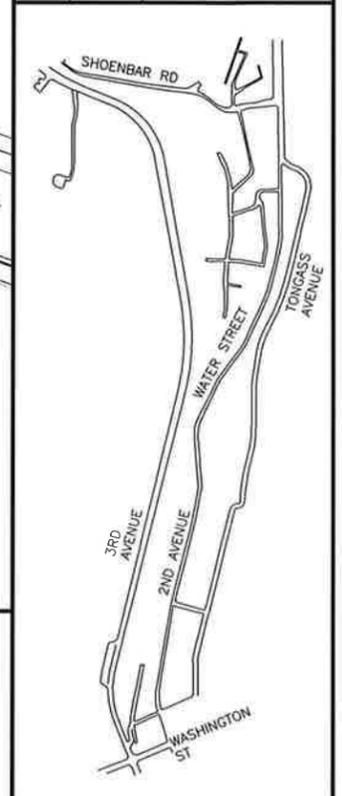

PLAN LEGEND

CHECKED BY: TED

DESIGNED BY: KCN
 DRAWN BY: KCN

STATE OF ALASKA
 DEPARTMENT OF TRANSPORTATION
 & PUBLIC FACILITIES
 SOUTHEAST REGION

KETCHIKAN ADVANCE
 WATER STREET TRUNK LINE
 RELOCATION
 PROJECT # 69548

**UTILITY PLAN
ELECTRICAL 3rd AVE**

PROJECT DESIGNATION
BR-000S(735) ~ 69548

STATE	YEAR
ALASKA	2014
SHEET NUMBER	TOTAL SHEETS
U04	78

Project As Built Drawings Have Been Reviewed By The Project Engineer & Represent, To The Best Of My Knowledge, The Project As Constructed.

Proj. Eng. *MJB* Date: 1/16/16

DO NOT SCALE FROM THESE DRAWINGS USE DIMENSIONS

SYMBOLS AND LEGEND

○-OEM ELECTRIC METER	— TV — CABLE TELEVISION LINE =GCI
□ NETWORK INTERFACE DEVICE, NID T = TELEPHONE, TV = CABLE TV	— E — ELECTRIC UNDERGROUND = KPU ELECTRIC
⊠ PADMOUNT TRANSFORMER	— OH — ELECTRIC OVERHEAD = KPU ELECTRIC
⊠ COMBINATION METER MAIN / METER PACK	— T — TELEPHONE = KPU TELECOMM
⊠ / POWER POLE / POWER POLE W/LIGHT	— W — WATER LINE
PS ⊠ / POWER POLE W/ SIDEWALK ARM & POLE #	⊙ JUNCTION BOX
⊠ / EXIST LIGHT POLE W/ SIDEWALK BOX & POLE #	□ PULL BOX
⊠ / EXIST LIGHT POLE / LIGHT POLE W/MASTARM	⊗ WATER VALVE
← GUY	— CULVERT
	⊙ HYDRANT
	— FENCE
⊠ BOLLARD / POST	— GUARDRAIL
⊠ BRIDGE BENT No. (TYP.)	— SURVEY LIMITS
⊠ BUILDING DESIGNATION (TYP.)	— TREE / BRUSH LINE
⊠ CATCH BASIN	— UNDERGROUND FUEL LINE
⊠ / / DECIDUOUS / CONIFER / BUSH	— UNDERGROUND SANITARY SEWER LINE
⊠ GATE POST	— UNDERGROUND STORM DRAIN
⊠ GUTTER / DOWNSPOUT	— SANITARY SEWER CLEANOUT
⊠ GUTTER - UNDERGROUND	— SANITARY SEWER MANHOLE
⊠ MAIL BOX	— STORM DRAIN MANHOLE
⊠ SIGN	

HATCH PATTERN LEGEND

	ASPHALT
	BEDROCK
	BUILDING
	CONCRETE
	DRIVEWAY - WOOD
	GRAVEL
	LANDING PLATFORM / DECK
	STAIRS - BRICK
	STAIRS - METAL / WOOD

ABBREVIATIONS

CoK	CITY OF KETCHIKAN
GCI	GCI (CABLE TV COMPANY)
KPU-E	KPU ELECTRICAL DIVISION
KPU-T	KPU TELECOMMUNICATIONS DIVISION
KV	KILOVOLT
NID	NETWORK INTERFACE DEVICE

U and V Sheets Project Notes:

General Information:

- The intent of the AUR project is to relocate 34.5kV aerial circuit out of the project work area and arrange the remaining existing Water Street aerial infrastructure to provide additional working clearance for the heavy equipment to operate during the next phase of work, bridge construction.
- Prior to the start of the work the Contractor shall meet with the DOT, KPU-E, KPU-T, GCI and the City to discuss project schedule, sequence of work, and methods to handle outages. Work cannot proceed until the issues are agreed upon.
- All electrical work shall comply with KPU safety programs including OSHA clearances and fire protective clothing policy. All electrical installation work shall comply with KPU and RUS construction details and specifications. Coordinate with KPU to obtain their latest requirements.
- GCI will perform all work associated with their infrastructure. The contractor shall coordinate the project work schedules with GC to allow GCI adequate time to perform their work.
- The bridge will be shored up in work administered by the City of Ketchikan and is scheduled to be completed prior to the start of work in the Advance Utility Relocation (AUR) project. The new load ratings will be posted along the bridge, but in general it will be 50,000 pounds. Specific load rating information can be obtained from the R&M Engineering.

**Electrical Scope of Work:
3rd Avenue**

- Open the existing 3rd Ave trench; shore and stabilize the trench; see Section 204 for additional trenching info. Maintain service for the existing street lighting circuits, telephone fiber optic system and water line that are installed in the trench. Install new conduit systems, pull boxes and 35kV circuit:
 - (1) 6" conduit system with 34.5kV circuit
 - (1) 6" conduit system for future power from Rainbird to Schoenbar
 - (2) 4" conduit system for future telephone from Rainbird to Schoenbar (installed in Pay Item 662(2))
- Install 35kv risers at existing pole P1W and new pole P2SR, Pull new 35kv triplex in 6" conduit and make connection to the existing 35kV aerial system at Washington and Schoenbar Streets.
- After the 3rd Ave 34.5kV work is energized and accepted by the KPU and DOT, disconnect 34.5kV jumpers at Washington Street and 2nd Ave(see U03) and Schoenbar P1S. Disconnect and remove 35kV conductors, crossarms, insulators and jumpers from Millar pole P1M and Water Street pole P10. All remaining 34.5kV demolition will be done in the future by KPU Electric.
- Water Street - Raise aerial infrastructure to provide additional clearance for bridge construction project.
- Install jumpers from the 12.47kV up to the 34.5kV aerial system at Poles P1 and P10.
- Remove the 12.47kV tier (conductors, crossarms) from poles P1 to P10.
- Move transformers, 120/240 volt circuits, system neutral, and street lights up on the pole into the spaces formerly occupied by the 12.47kV tier. Adjust overhead electrical service drops to the homes; splice in new cabling if required
- Move telecomm infrastructure up on the poles into the spaces formerly occupied 120/240V circuits. Install new telecomm crossarms and fiber optic cable for telephone distribution. Install new fiber optic ONT on the homes and fiber drop to the homes per the V sheets for telephone work and cabling info.
- Coordinate with GCI to have them move their cable plant up onto the new crossarms and adjust overhead drops to their NIDs on the homes.
- Install guys at existing poles P3, P12 and new pole P10T
- Install VDSL cabinet at Parnell; provide power to the cabinet, conduits and telephone cabling. See U20 & V18 sheets for additional info.
- Install hardware in existing VDSL cabinet at Schoenbar; install conduits and telephone cabling. See V sheets for additional info.
- Install new air core pipe and tie into existing air system. Test system per spec 663 requirements. See V sheets for additional info.
- Work with KPU Telecomm to determine the active pairs in 900 pair cable originating in KPU Telecomm Manhole 18. Reterminate cable pairs in (60) aerial terminals to free up cable pairs for the Water Street VDSL.
- Demo KPU-T telephone cables per V sheets.
 - Underground and under the bridge from Pole P1 to P10 via Manholes MH1 and MH2 (1800, 1200, 50 pair copper);
 - Water Street aerial (48 strand fiber, 100 pair copper distribution and overhead service drop copper cables);
 - Parnell Stairs, Millar to Schoenbar aerial systems (1800 and 200 pair copper)
- Coordinate with GCI to have them relocate their cable plant; adjust service drops to the home; remove unused equipment and conductors.

Project As Built Drawings Have Been Reviewed By The Project Engineer & Represent, To The Best Of My Knowledge, The Project As Constructed.

Proj. Eng. *NB* Date *1/10/16*

DO NOT SCALE FROM THESE DRAWINGS USE DIMENSIONS

PATH:XXX

KCN12_000
TAB: U02 8/28/2014 11:21 AM

ADDENDUM NUMBER

ATTACHMENT NUMBER

RECORD OF REVISIONS

No.	DATE	DESCRIPTION

CHECKED BY: TED

DESIGNED BY: KCN

DRAWN BY: KCN


STATE OF ALASKA
DEPARTMENT OF TRANSPORTATION & PUBLIC FACILITIES
SOUTHEAST REGION

KETCHIKAN ADVANCE
WATER STREET TRUNK LINE
RELOCATION
PROJECT # 69548


SYMBOL & NOTES

PROJECT DESIGNATION
BR-00S(735) ~ 69548

STATE	YEAR
ALASKA	2014
SHEET NUMBER	TOTAL SHEETS
U02	78

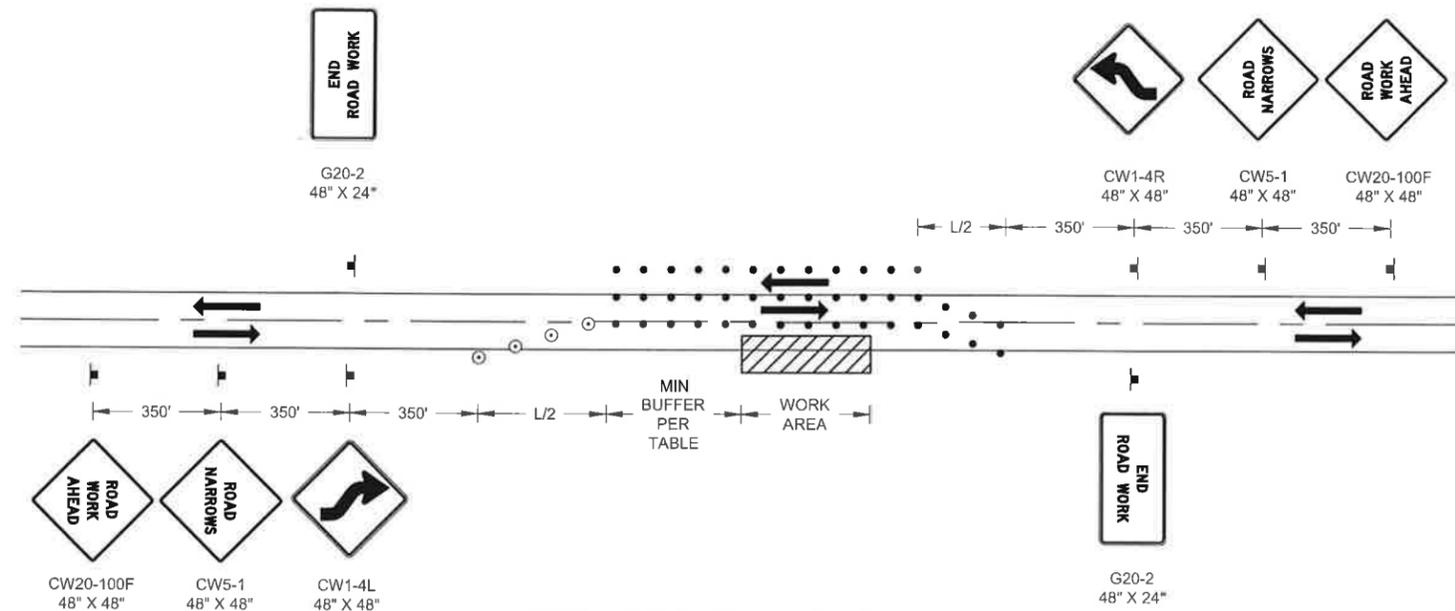

TWO LANE ROAD - SHOULDER CLOSURE

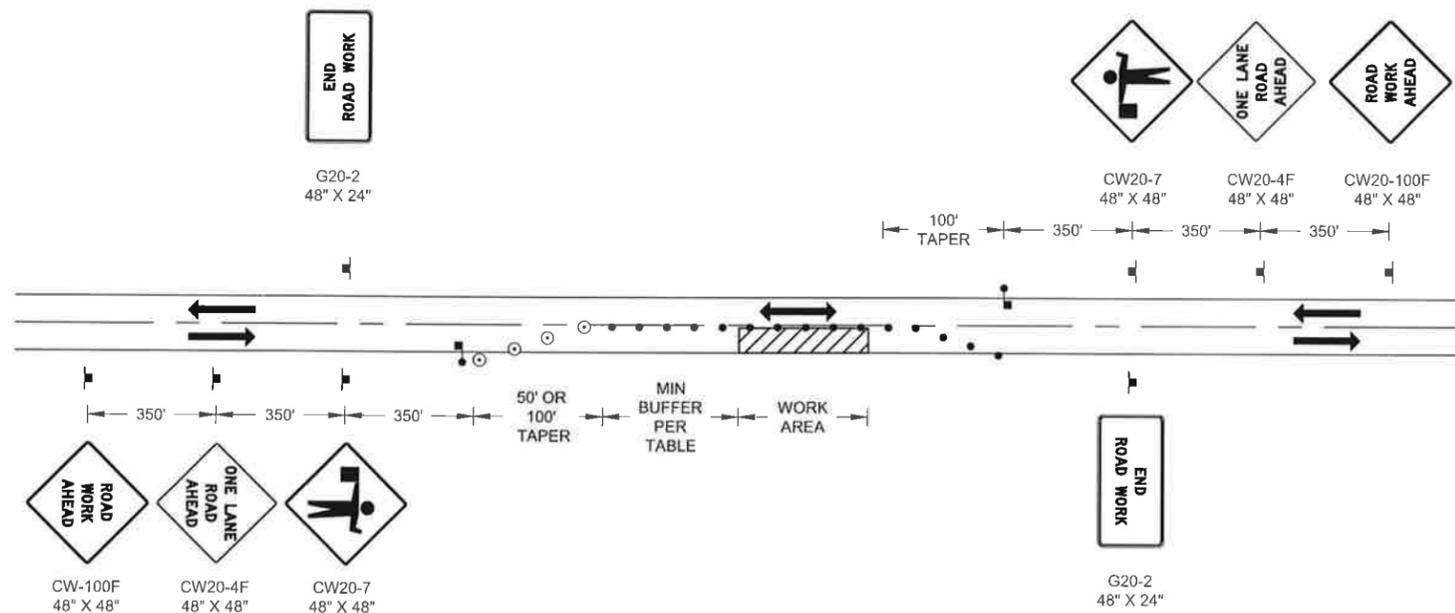

TWO LANE ROAD - SINGLE LANE CLOSURE

LEGEND

- ▬ SIGN
- CONE
- DRUM
- ▬ TYPE III BARRICADE
- ⚠ FLAGGING STATION
- ++ TYPE II BARRICADE OR TUBULAR MARKER
- +++ TYPE III BARRICADE
- - - - SAFETY FENCE
- ▨ WORK AREA


Project As Built Drawings Have Been Reviewed By The Project Engineer & Represent, To The Best Of My Knowledge, The Project As Constructed.

Proj. Eng. NB


Date 1/16/16

NOTES:

- 1) TAPERS ARE 6 DEVICES EVENLY SPACED.
- 2) PROVIDE PEDESTRIAN TRAFFIC CONTROL DEVICES WHEN SIDEWALKS OR PATHWAYS ARE CLOSED TO PEDESTRIANS AND WHERE REQUIRED BY THE PLANS OR SPECIFICATIONS.
- 3) AVOID ROUTING PEDESTRIANS ACROSS ROADS UNNECESSARILY.
- 4) MAINTAIN A MINIMUM PEDESTRIAN FACILITY WIDTH OF 5 FEET OR THE WIDTH OF THE FACILITY THAT EXISTED BEFORE CONSTRUCTION, WHICHEVER IS LESS.
- 5) WHEN PEDESTRIAN TRAFFIC CONTROL DEVICES REQUIRED BY THE CURRENT TRAFFIC CONTROL PLAN ARE NOT IN PLACE OR ARE TEMPORARILY REMOVED, PROVIDE A WORKER TO DIRECT PEDESTRIANS THROUGH THE WORK AREA.

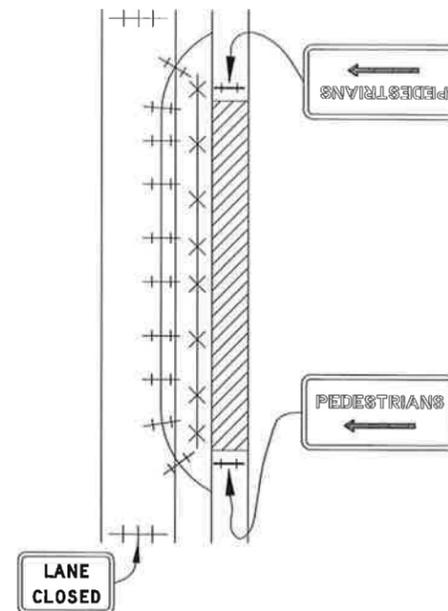

**DETAIL A:
DETOUR TO SHOULDER OR
TRAVEL LANE**

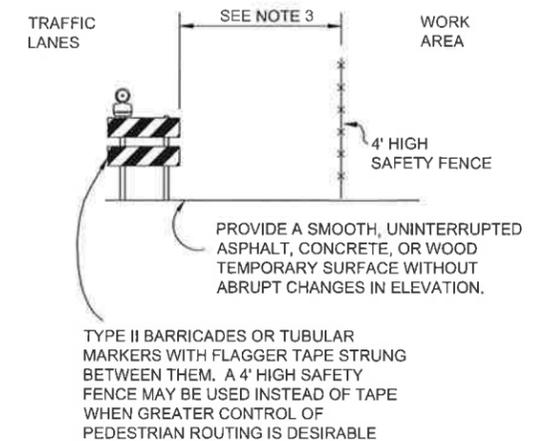

**DETAIL B:
PEDESTRIAN DETOUR
TYPICAL SECTION**

MID-BLOCK SIDEWALK, PATHWAY OR SHOULDER CLOSURE


DESIGN SPEED (MPH)	TCP SETUP TABLE								
	MIN MERGING TAPER LENGTH(L) IN FEET			MIN NUMBER OF DEVICES WIDTH OF OFFSET(W) IN FEET			MAX DEVICE SPACING IN FEET		BUFFER SPACE (FT)
	10'	11'	12'	10'	11'	12'	ALONG TAPER	ALONG TANGENT	
25 OR BELOW	105	115	125	6	6	6	25	50	155
30	150	165	180	6	7	7	30	60	200
35	205	225	245	7	8	8	35	70	250
40	270	295	320	8	9	9	40	80	305
45	450	495	540	11	12	13	45	90	360
50	500	550	600	11	12	13	50	100	425
55	550	605	660	11	12	13	55	110	495
60	600	660	720	11	12	13	60	120	570

DO NOT SCALE FROM THESE DRAWINGS USE DIMENSIONS


CHECKED BY: I NAME		STATE OF ALASKA DEPARTMENT OF TRANSPORTATION & PUBLIC FACILITIES SOUTHEAST REGION	
		KETCHIKAN ADVANCE WATER STREET TRUNK LINE RELOCATION	
		TRAFFIC CONTROL PLAN	
DESIGNED BY: I NAME		PROJECT DESIGNATION	
DRAWN BY: I NAME		YEAR	
PATH: Z:\PROJECT\1744.00 DOT_SE WATER STREET VIADUCT\CIVIL\ACAD\ADV UTILITY RELO\1744.00-T SHEETS(AUR)		PLOT DATE: 8/28/2014 12:07 PM	
REVISIONS		PROJECT DESIGNATION	
NO.	DATE	DESCRIPTION	YEAR
			2014
		BR-000S(735) ~ 69548	TOTAL SHEETS
			78

EROSION & SEDIMENT CONTROL NOTES:

- 1) REFER TO THE CONTRACT DOCUMENTS FOR THE ENVIRONMENTAL COMMITMENTS
- 2) THE LOCATIONS OF TEMPORARY EROSION & SEDIMENT POLLUTION CONTROLS SHOWN ON THE P SHEETS ARE RECOMMENDATIONS. IT IS THE RESPONSIBILITY OF THE CONTRACTOR TO PREPARE AND IMPLEMENT A STORM WATER POLLUTION PREVENTION PLAN (SWPPP) ACCORDING TO SECTION 641 OF THE SPECIFICATIONS
- 3) INSTALL EROSION AND SEDIMENT CONTROL DEVICES BEFORE BEGINNING EARTH DISTURBING ACTIVITIES
- 4) IF INSPECTION REVEALS SEDIMENT IS DISCHARGED BEYOND THE PROJECT WORK LIMITS, IMMEDIATELY IMPLEMENT CORRECTIVE ACTION. ADDITIONAL BMP'S MAY BE REQUIRED

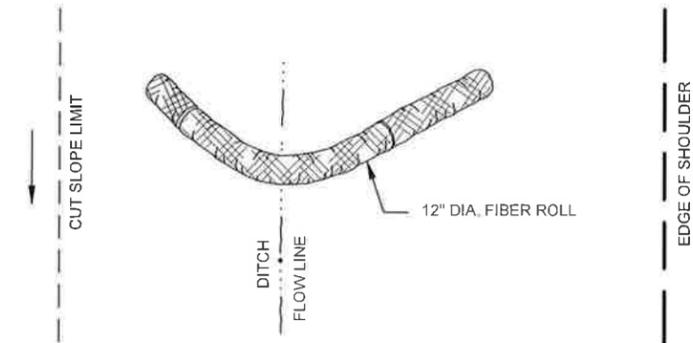


**FIBER ROLL CHECK DAM
PLAN VIEW**
NTS

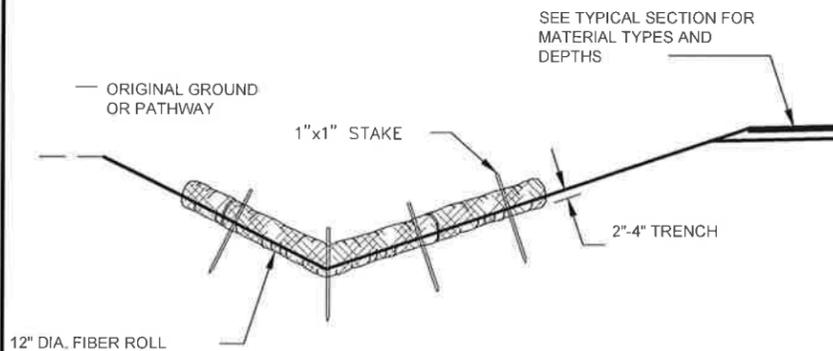


**FIBER ROLL CHECK DAM
ELEVATION VIEW**
NTS

NOTES:

- 1) FIBER ROLL CHECK DAMS SHALL BE CONSTRUCTED AT LOCATIONS AS INDICATED ON PLANS OR AS REQUIRED BY THE SWPPP IMMEDIATELY AFTER THE DITCH FLOW LINE HAS BEEN ESTABLISHED
- 2) SPACE CHECK DAMS ON 100 FOOT CENTERS FOR GRADES BETWEEN 2% AND 5%. USE CLOSER SPACING FOR STEEPER GRADES UP TO 5% AS REQUIRED BY THE SWPPP
- 3) FIBER ROLL INSTALLATION FOR CHECK DAMS REQUIRES THE PLACEMENT AND SECURE STAKING OF THE ROLL IN A TRENCH 2"-4" DEEP. RUNOFF MUST NOT BE ALLOWED TO FLOW UNDER THE ROLL

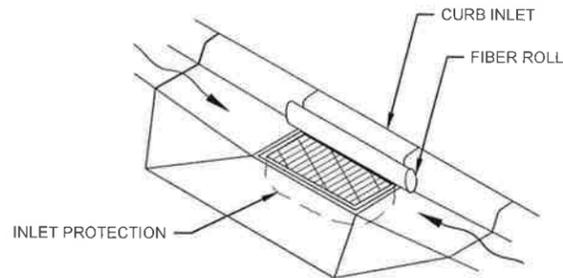

**ABOVE GRATE
INLET PROTECTION DETAIL**
NTS

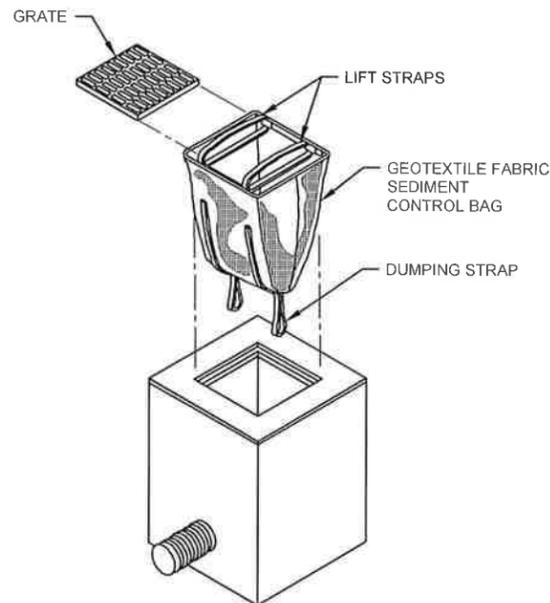

**BELOW GRATE
INLET PROTECTION DETAIL**
NTS


INLET PROTECTION INSTALLATION AND MAINTENANCE:

- 1) INSTALLATION: REMOVE THE GRATE FROM CATCH BASIN. IF USING OPTIONAL OIL ABSORBENT; PLACE ABSORBENT PILLOW IN UNIT. STAND THE GRATE ON END. MOVE THE LIFT STRAPS OUT OF THE WAY AND PLACE THE GRATE INTO THE SEDIMENT BAGS SO THAT THE GRATE IS BELOW THE TOP STRAPS AND ABOVE THE LOWER STRAPS. HOLDING THE LIFTING DEVICES, INSERT THE GRATE INTO THE INLET
- 2) MAINTENANCE: REMOVE ALL ACCUMULATED SEDIMENT AND DEBRIS FROM VICINITY OF UNIT AFTER EACH STORM EVENT. AFTER EACH STORM EVENT AND AT REGULAR INTERVALS, LOOK INTO THE SEDIMENT BAG. IF THE CONTAINMENT AREA IS MORE THAT 1/3 FULL OF SEDIMENT, THE UNIT MUST BE EMPTIED. TO EMPTY UNIT, LIFT THE UNIT OUT OF THE INLET USING THE LIFTING STRAPS AND REMOVE THE GRATE. IF USING OPTIONAL OIL ABSORBENTS; REPLACE ABSORBENT WHEN NEAR SATURATION
- 3) INSTALL INLET PROTECTION AT LOCATIONS PRIOR TO EARTH DISTURBING ACTIVITIES


Project As Built Drawings Have Been Reviewed By The Project Engineer & Represent, To The Best Of My Knowledge, The Project As Constructed.

Proj. Eng. NB


Date: 10/16

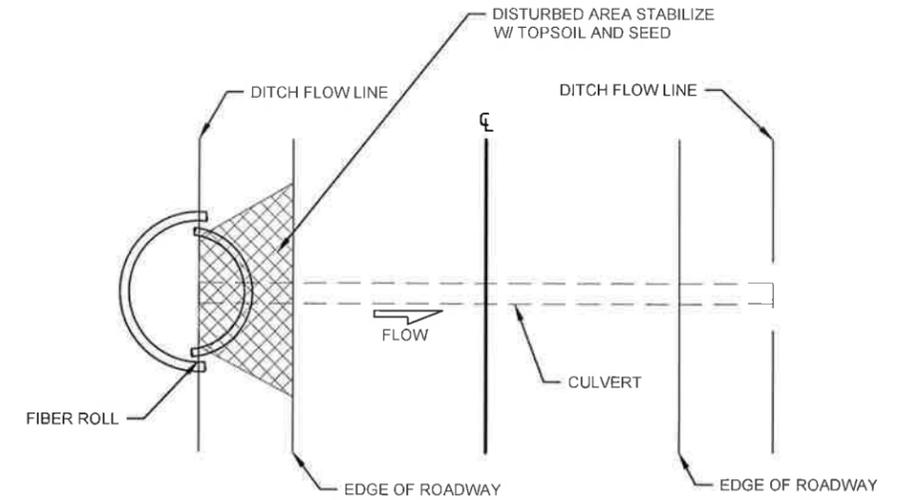

FIBER ROLL PLACEMENT AT CULVERT REPAIRS
NTS

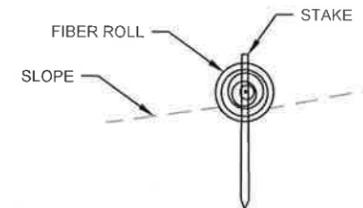

SECTION

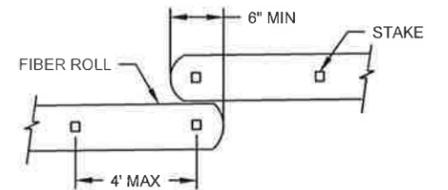

FIBER ROLL

FIBER ROLL
NTS


NOTES:

- 1) THE LOCATION AND LENGTH OF FIBER ROLLS IS DEPENDENT ON THE CONDITION OF THE SITE
- 2) LAP ADJACENT FIBER ROLLS TO PREVENT SEDIMENT BYPASS
- 3) ANCHOR AS NECESSARY TO FIRMLY SECURE FIBER ROLLS AND PROVIDE CONTINUOUS CONTACT WITH THE SURFACE ON WHICH IT IS INSTALLED

DO NOT SCALE FROM THESE DRAWINGS USE DIMENSIONS

CHECKED BY: I NAME  DESIGNED BY: I NAME DRAWN BY: I NAME		STATE OF ALASKA DEPARTMENT OF TRANSPORTATION & PUBLIC FACILITIES SOUTHEAST REGION KETCHIKAN ADVANCE WATER STREET TRUNK LINE RELOCATION EROSION SEDIMENT CONTROL PLAN DETAILS			
PATH: Z:\PROJECT\1744.00 DOT_SE WATER STREET VIADUCT\CIVIL\CAD\ADV UTILITY RELO\1744.00-P SHEETS(AUR) PLOT DATE: 8/29/2014 3:55 PM		PROJECT DESIGNATION BR-000S(735) ~ 69548	YEAR 2014	SHEET NO. P05	TOTAL SHEETS 18

No.	DATE	DESCRIPTION

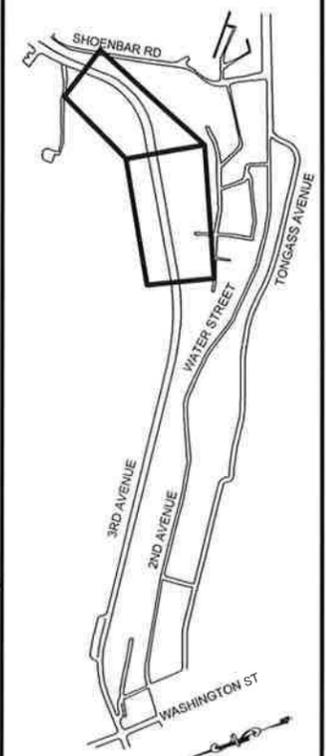

PLAN LEGEND

CHECKED BY: I, NAME



DESIGNED BY: I, NAME

DRAWN BY: I, NAME

STATE OF ALASKA
DEPARTMENT OF TRANSPORTATION
& PUBLIC FACILITIES
SOUTHEAST REGION

KETCHIKAN ADVANCE
WATER STREET TRUNK LINE
RELOCATION


EROSION SEDIMENT CONTROL PLAN

PROJECT DESIGNATION

BR-000S(735) ~ 69548



STATE	YEAR
ALASKA	2014

SHEET NUMBER	TOTAL SHEETS
P03	78

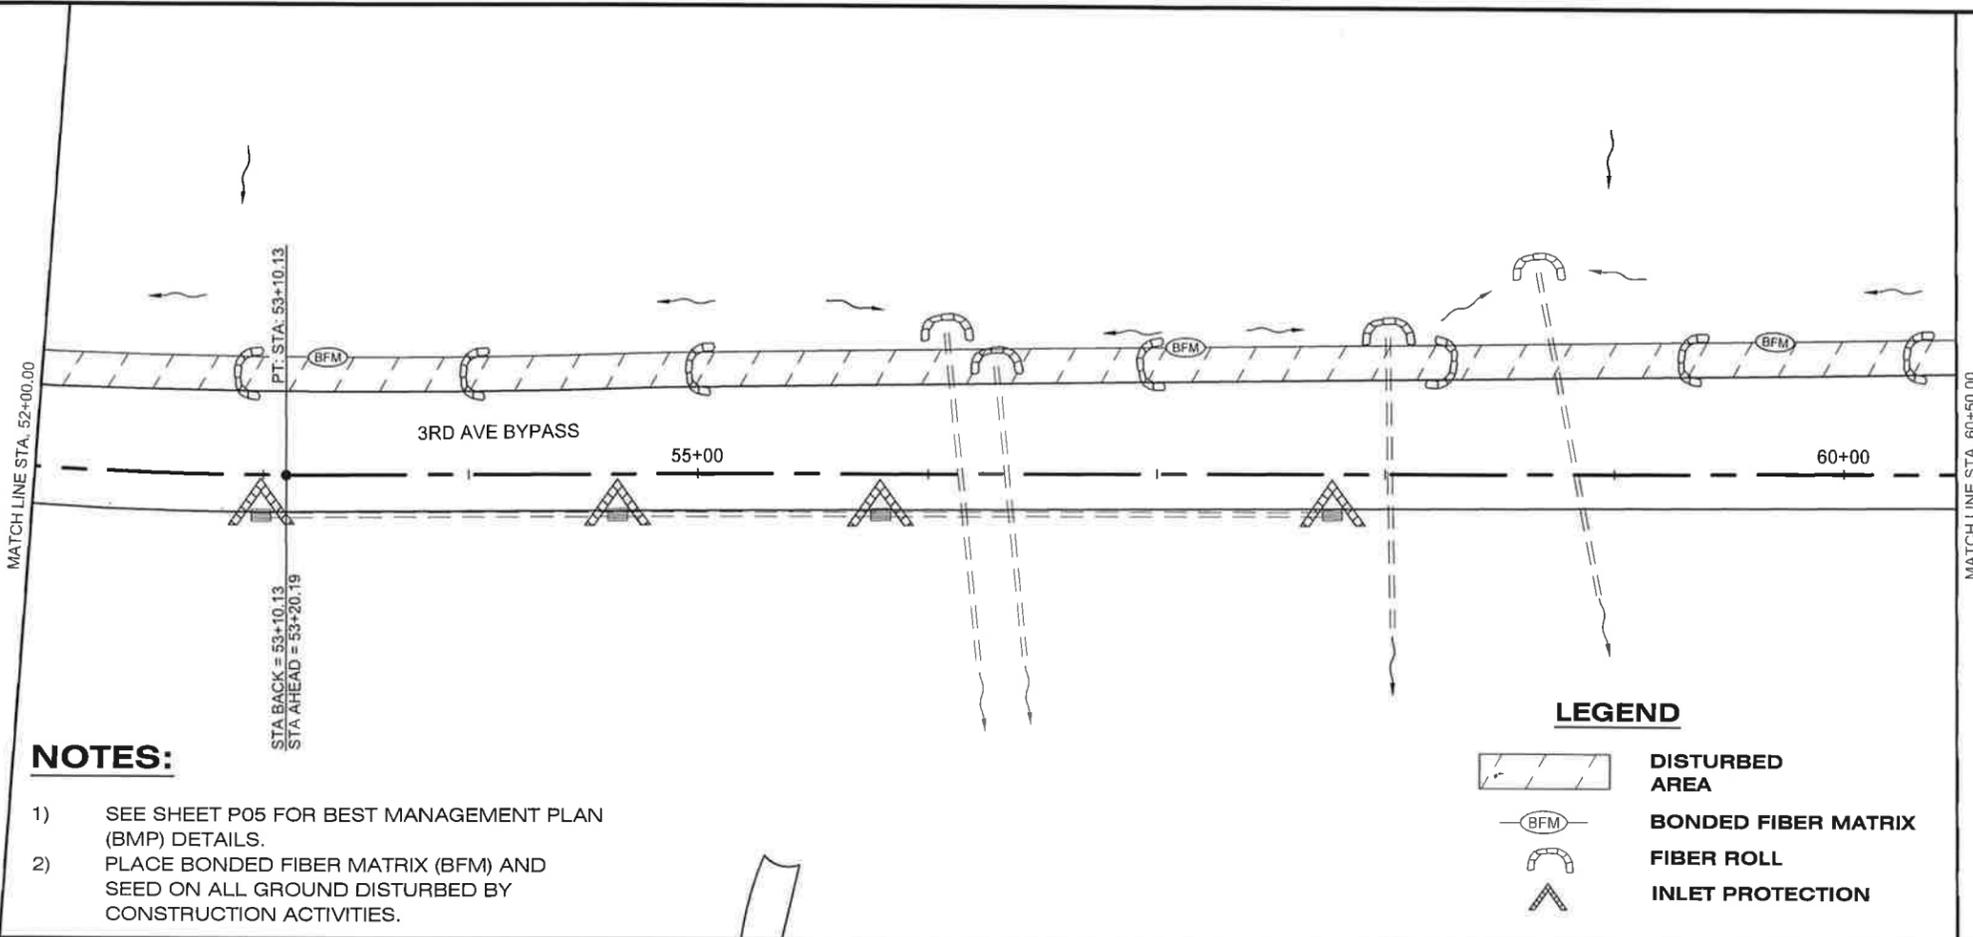

NOTES:

- 1) SEE SHEET P05 FOR BEST MANAGEMENT PLAN (BMP) DETAILS.
- 2) PLACE BONDED FIBER MATRIX (BFM) AND SEED ON ALL GROUND DISTURBED BY CONSTRUCTION ACTIVITIES.

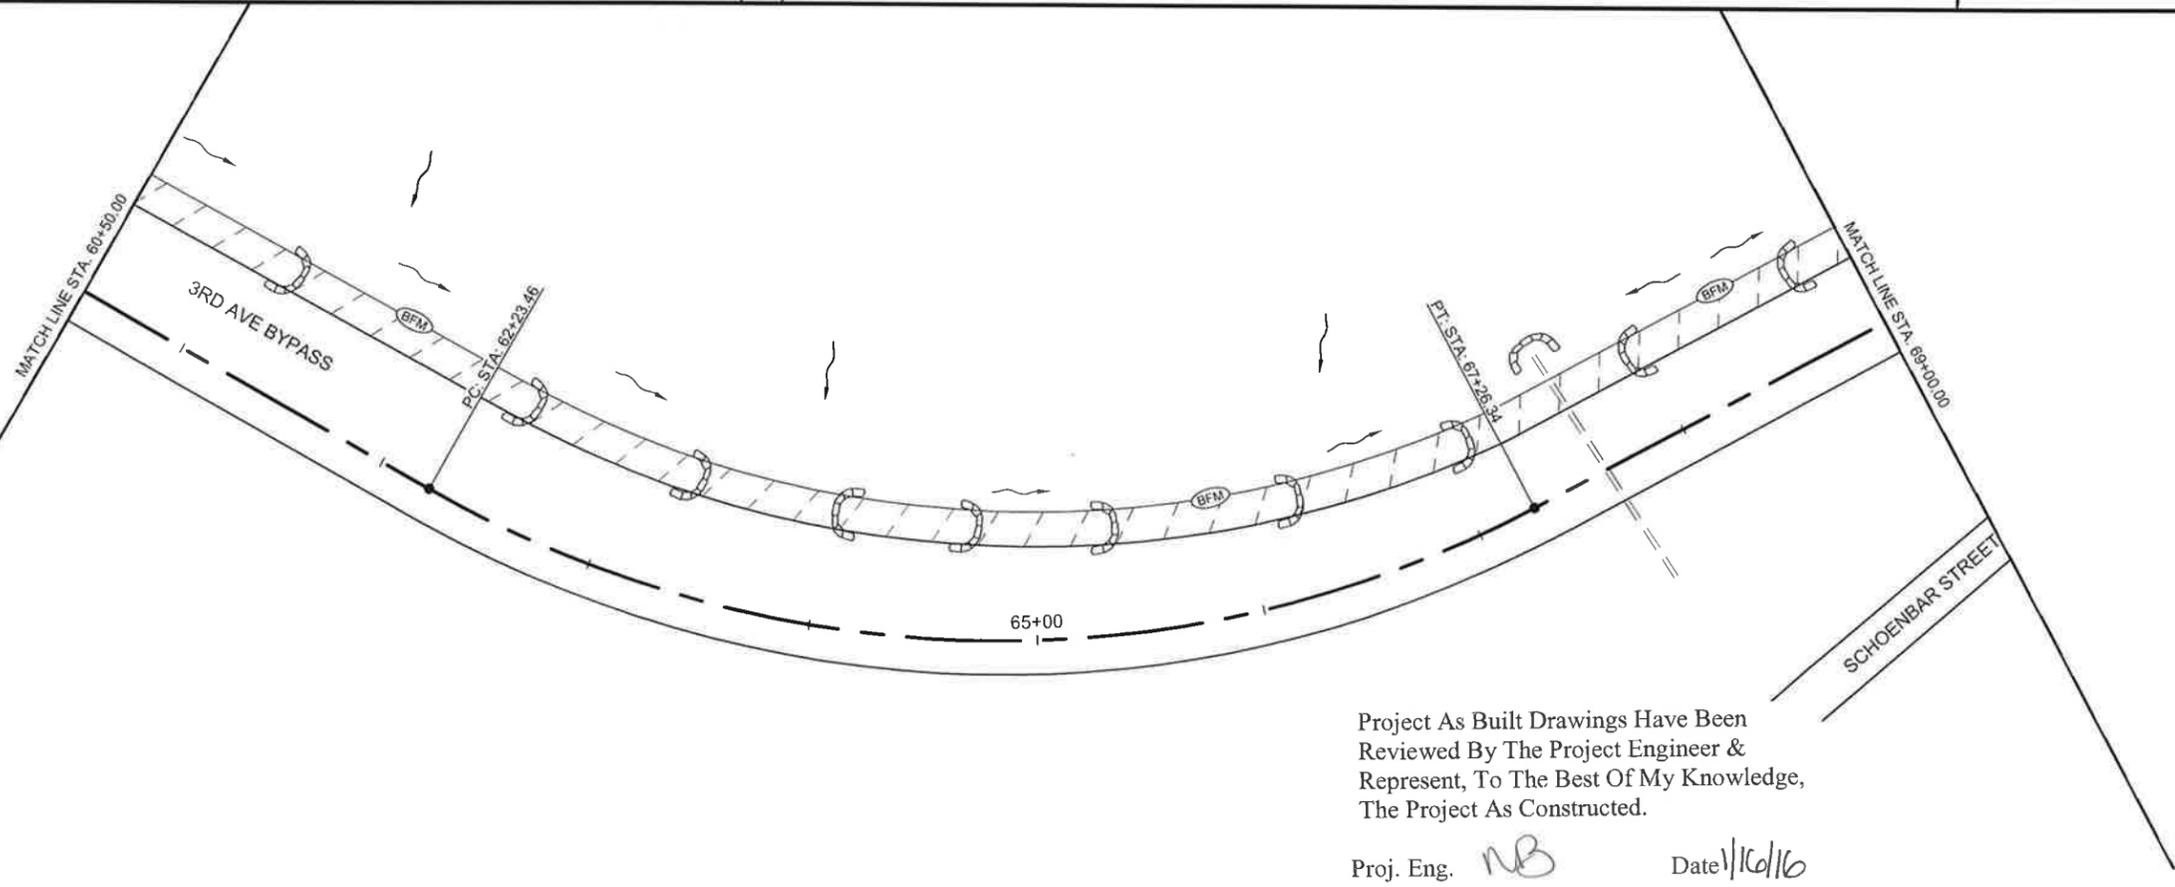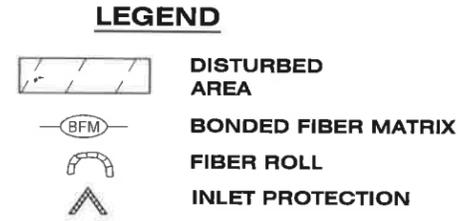


Project As Built Drawings Have Been Reviewed By The Project Engineer & Represent, To The Best Of My Knowledge, The Project As Constructed.

Proj. Eng. *NB* Date *1/16/16*

DO NOT SCALE FROM THESE DRAWINGS USE DIMENSIONS

No	DATE	DESCRIPTION

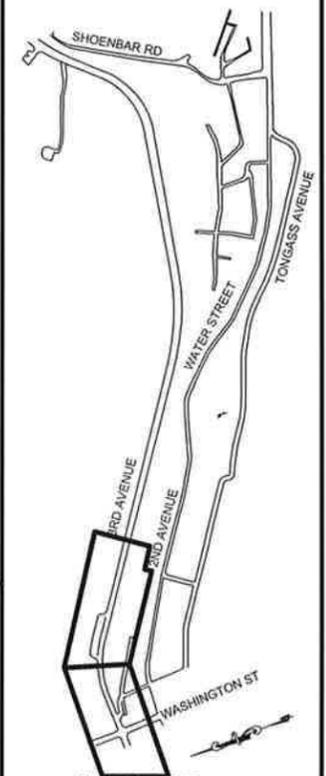

PLAN LEGEND

CHECKED BY: I.NAME



DESIGNED BY: I.NAME

DRAWN BY: I.NAME

STATE OF ALASKA
DEPARTMENT OF TRANSPORTATION
& PUBLIC FACILITIES
SOUTHEAST REGION
KETCHIKAN ADVANCE
WATER STREET TRUNK LINE
RELOCATION

EROSION SEDIMENT CONTROL PLAN

PROJECT DESIGNATION
BR-000S(735) ~ 69548



STATE	YEAR
ALASKA	2014
SHEET NUMBER	TOTAL SHEETS
P01	78

LEGEND

-  **DISTURBED AREA**
-  **BONDED FIBER MATRIX**
-  **FIBER ROLL**
-  **INLET PROTECTION**

NOTES:

- 1) SEE SHEET P05 FOR BEST MANAGEMENT PLAN (BMP) DETAILS.
- 2) PLACE BONDED FIBER MATRIX (BFM) AND SEED ON ALL GROUND DISTURBED BY CONSTRUCTION ACTIVITIES.

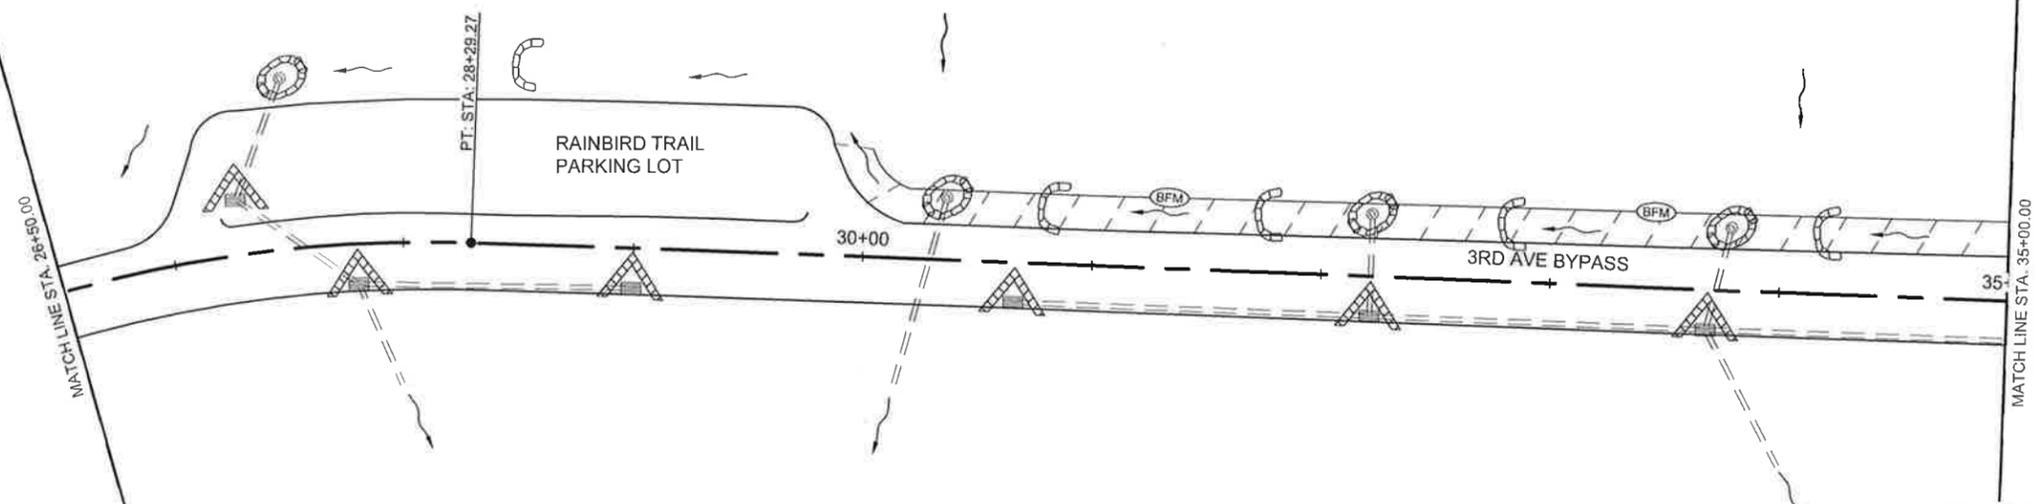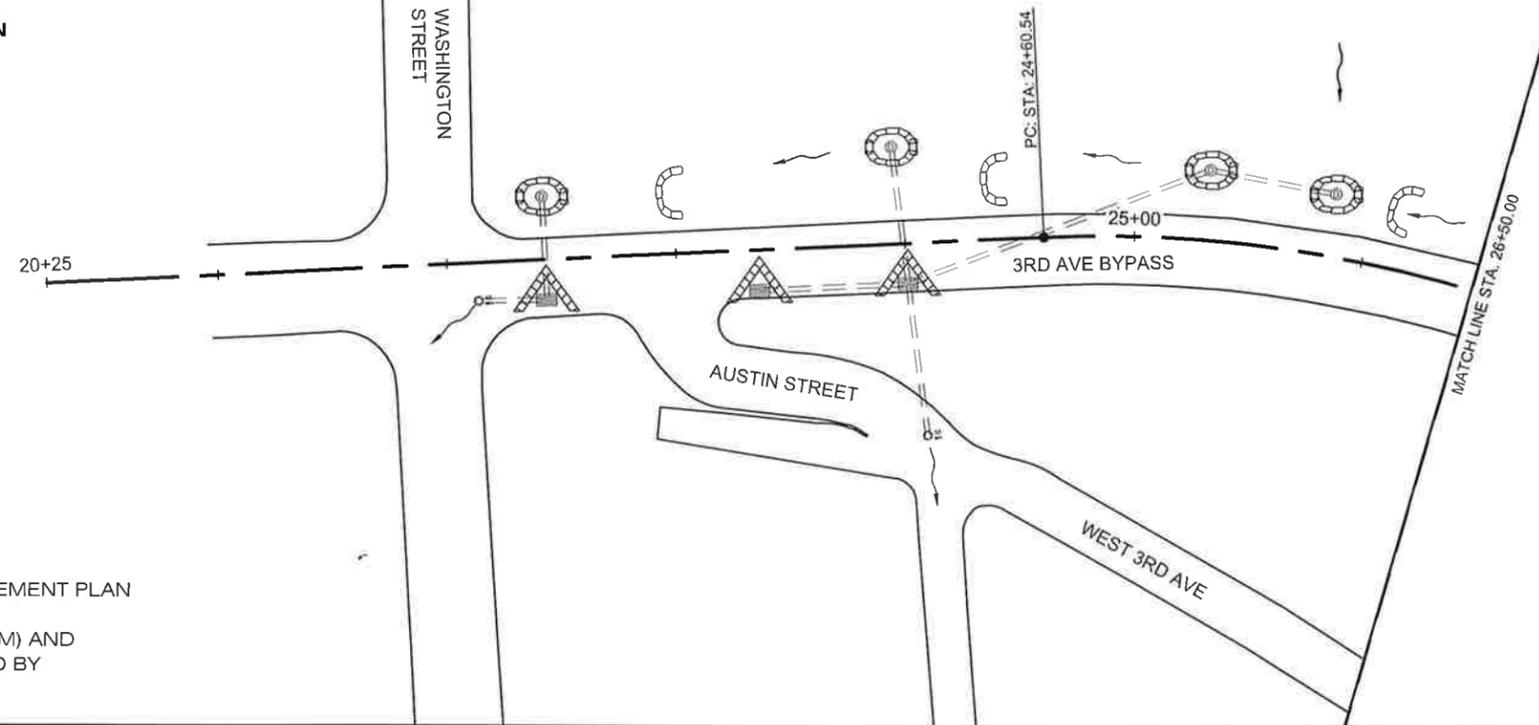

Project As Built Drawings Have Been Reviewed By The Project Engineer & Represent, To The Best Of My Knowledge, The Project As Constructed.

Proj. Eng. *MB* Date *11/10/16*

DO NOT SCALE FROM THESE DRAWINGS USE DIMENSIONS

ESTIMATE OF QUANTITIES			
ITEM NO	ITEM DESCRIPTION	PAY UNIT	QUANTITY
202 (2)	REMOVAL OF PAVEMENT	SQUARE YARD	81.49
202 (3)	REMOVAL OF SIDEWALK	SQUARE YARD	18.41
202 (9)	REMOVAL OF CURB AND GUTTER	LINEAR FOOT	20.10
204 (2)	STRUCTURE TRENCH EXCAVATION	LINEAR FOOT	4,255
204(3)	TRENCH Rock Excavation	CS	AR
301 (1)	AGGREGATE BASE COURSE, GRADING D-1	LUMP SUM	ALL REQUIRED
401 (1)	ASPHALT CONCRETE, TYPE II: CLASS B	LUMP SUM	ALL REQUIRED
606 (5)	REMOVING AND RECONSTRUCTING GUARDRAIL	LINEAR FOOT	482
608 (1A)	CONCRETE SIDEWALK 4 INCHES THICK	SQUARE YARD	12.51
609 (2)	CURB AND GUTTER, TYPE 1	LINEAR FOOT	20.10
618 (2)	SEEDING	POUND	68.60
619 (3)	BONDED FIBER MATRIX (BFM)	POUND	4,400
633 (2)	SEDIMENT BARRIER	LINEAR FOOT	950
640 (1)	MOBILIZATION AND DEMOBILIZATION	LUMP SUM	ALL REQUIRED
640 (4)	WORKER MEALS AND LODGING, OR PER DIEM	LUMP SUM	ALL REQUIRED
641 (1)	EROSION, SEDIMENT, AND POLLUTION CONTROL ADMINISTRATION	LUMP SUM	ALL REQUIRED
641 (3)	TEMPORARY EROSION, SEDIMENT, AND POLLUTION CONTROL	LUMP SUM	ALL REQUIRED
641 (4)	TEMPORARY EROSION, SEDIMENT, AND POLLUTION CONTROL ADDITIVE	CONTINGENT SUM	ALL REQUIRED
641 (6)	WITHOLDING	CONTINGENT SUM	ALL REQUIRED
641 (7)	SWPPP MANAGER	LUMP SUM	ALL REQUIRED
642 (1)	CONSTRUCTION SURVEYING	LUMP SUM	ALL REQUIRED
643 (2)	TRAFFIC MAINTENANCE	LUMP SUM	ALL REQUIRED
643(3)	PERMANENT CONSTRUCTION SIGNS	LUMP SUM	ALL REQUIRED
643 (15)	FLAGGING	CONTINGENT SUM	ALL REQUIRED
643 (23)	TRAFFIC PRICE ADJUSTMENT	CONTINGENT SUM	ALL REQUIRED
643 (25)	TRAFFIC CONTROL	CONTINGENT SUM	ALL REQUIRED
644 (6)	VEHICLES	LUMP SUM	ALL REQUIRED
646 (1)	CPM SCHEDULING	LUMP SUM	ALL REQUIRED
662 (1)	POWER DISTRIBUTION SYSTEM CONSTRUCTION	LUMP SUM	ALL REQUIRED
662 (2)	POWER DISTRIBUTION SYSTEM CONSTRUCTION - KPU TELECOMM	LUMP SUM	ALL REQUIRED
663 (1)	TELECOMMUNICATIONS CONSTRUCTION	LUMP SUM	ALL REQUIRED
890 (1)	BELOW GRATE INLET PROTECTION	EACH	28

TABLE OF ESTIMATING FACTORS			
ITEM NO	ITEM DESCRIPTION	FACTOR	
301(1)	AGGREGATE BASE COURSE, GRADING D-1	145	LB / FT3
401(1)	ASPHALT CONCRETE, TYPE II: CLASS B	150	LB / FT3
401(2)	ASPHALT CEMENT, GRADE PG 58-28	6%	of 401(1)
402	STE-1 ASPHALT FOR TACK COAT	0.10, 243	GAL/SY, GAL/TON
608(1A)	CONCRETE SIDEWALK 4 INCHES THICK	9.1	SY/CY
618(2)	SEEDING	33	LB / ACRE
619(3)	BONDED FIBER MATRIX (BFM)	3,500	LB / ACRE

Project As Built Drawings Have Been Reviewed By The Project Engineer & Represent, To The Best Of My Knowledge, The Project As Constructed.


Proj. Eng. *NB*

Date: *11/16/16*

DO NOT SCALE FROM THESE DRAWINGS USE DIMENSIONS

		STATE OF ALASKA DEPARTMENT OF TRANSPORTATION & PUBLIC FACILITIES SOUTHEAST REGION	
DESIGNED BY: I NAME DRAWN BY: I NAME		KETCHIKAN ADVANCE WATER STREET TRUNK LINE RELOCATION	
		ESTIMATE OF QUANTITIES	
PATH: Z:\PROJECT\1744.00 DOT_SE WATER STREET VIADUCT\CIVIL\CAD\ADV UTILITY RELO\1744.00-C SHEETS(AUR) PLOT DATE: 8/29/2014 3:19 PM			
REVISIONS NO. DATE DESCRIPTION		PROJECT DESIGNATION BR-000S(735) ~ 69548	YEAR 2014
		SHEET NO. C01	TOTAL SHEETS 78

NOTE: 3RD AVENUE ASBUILT SURVEY CONTROL

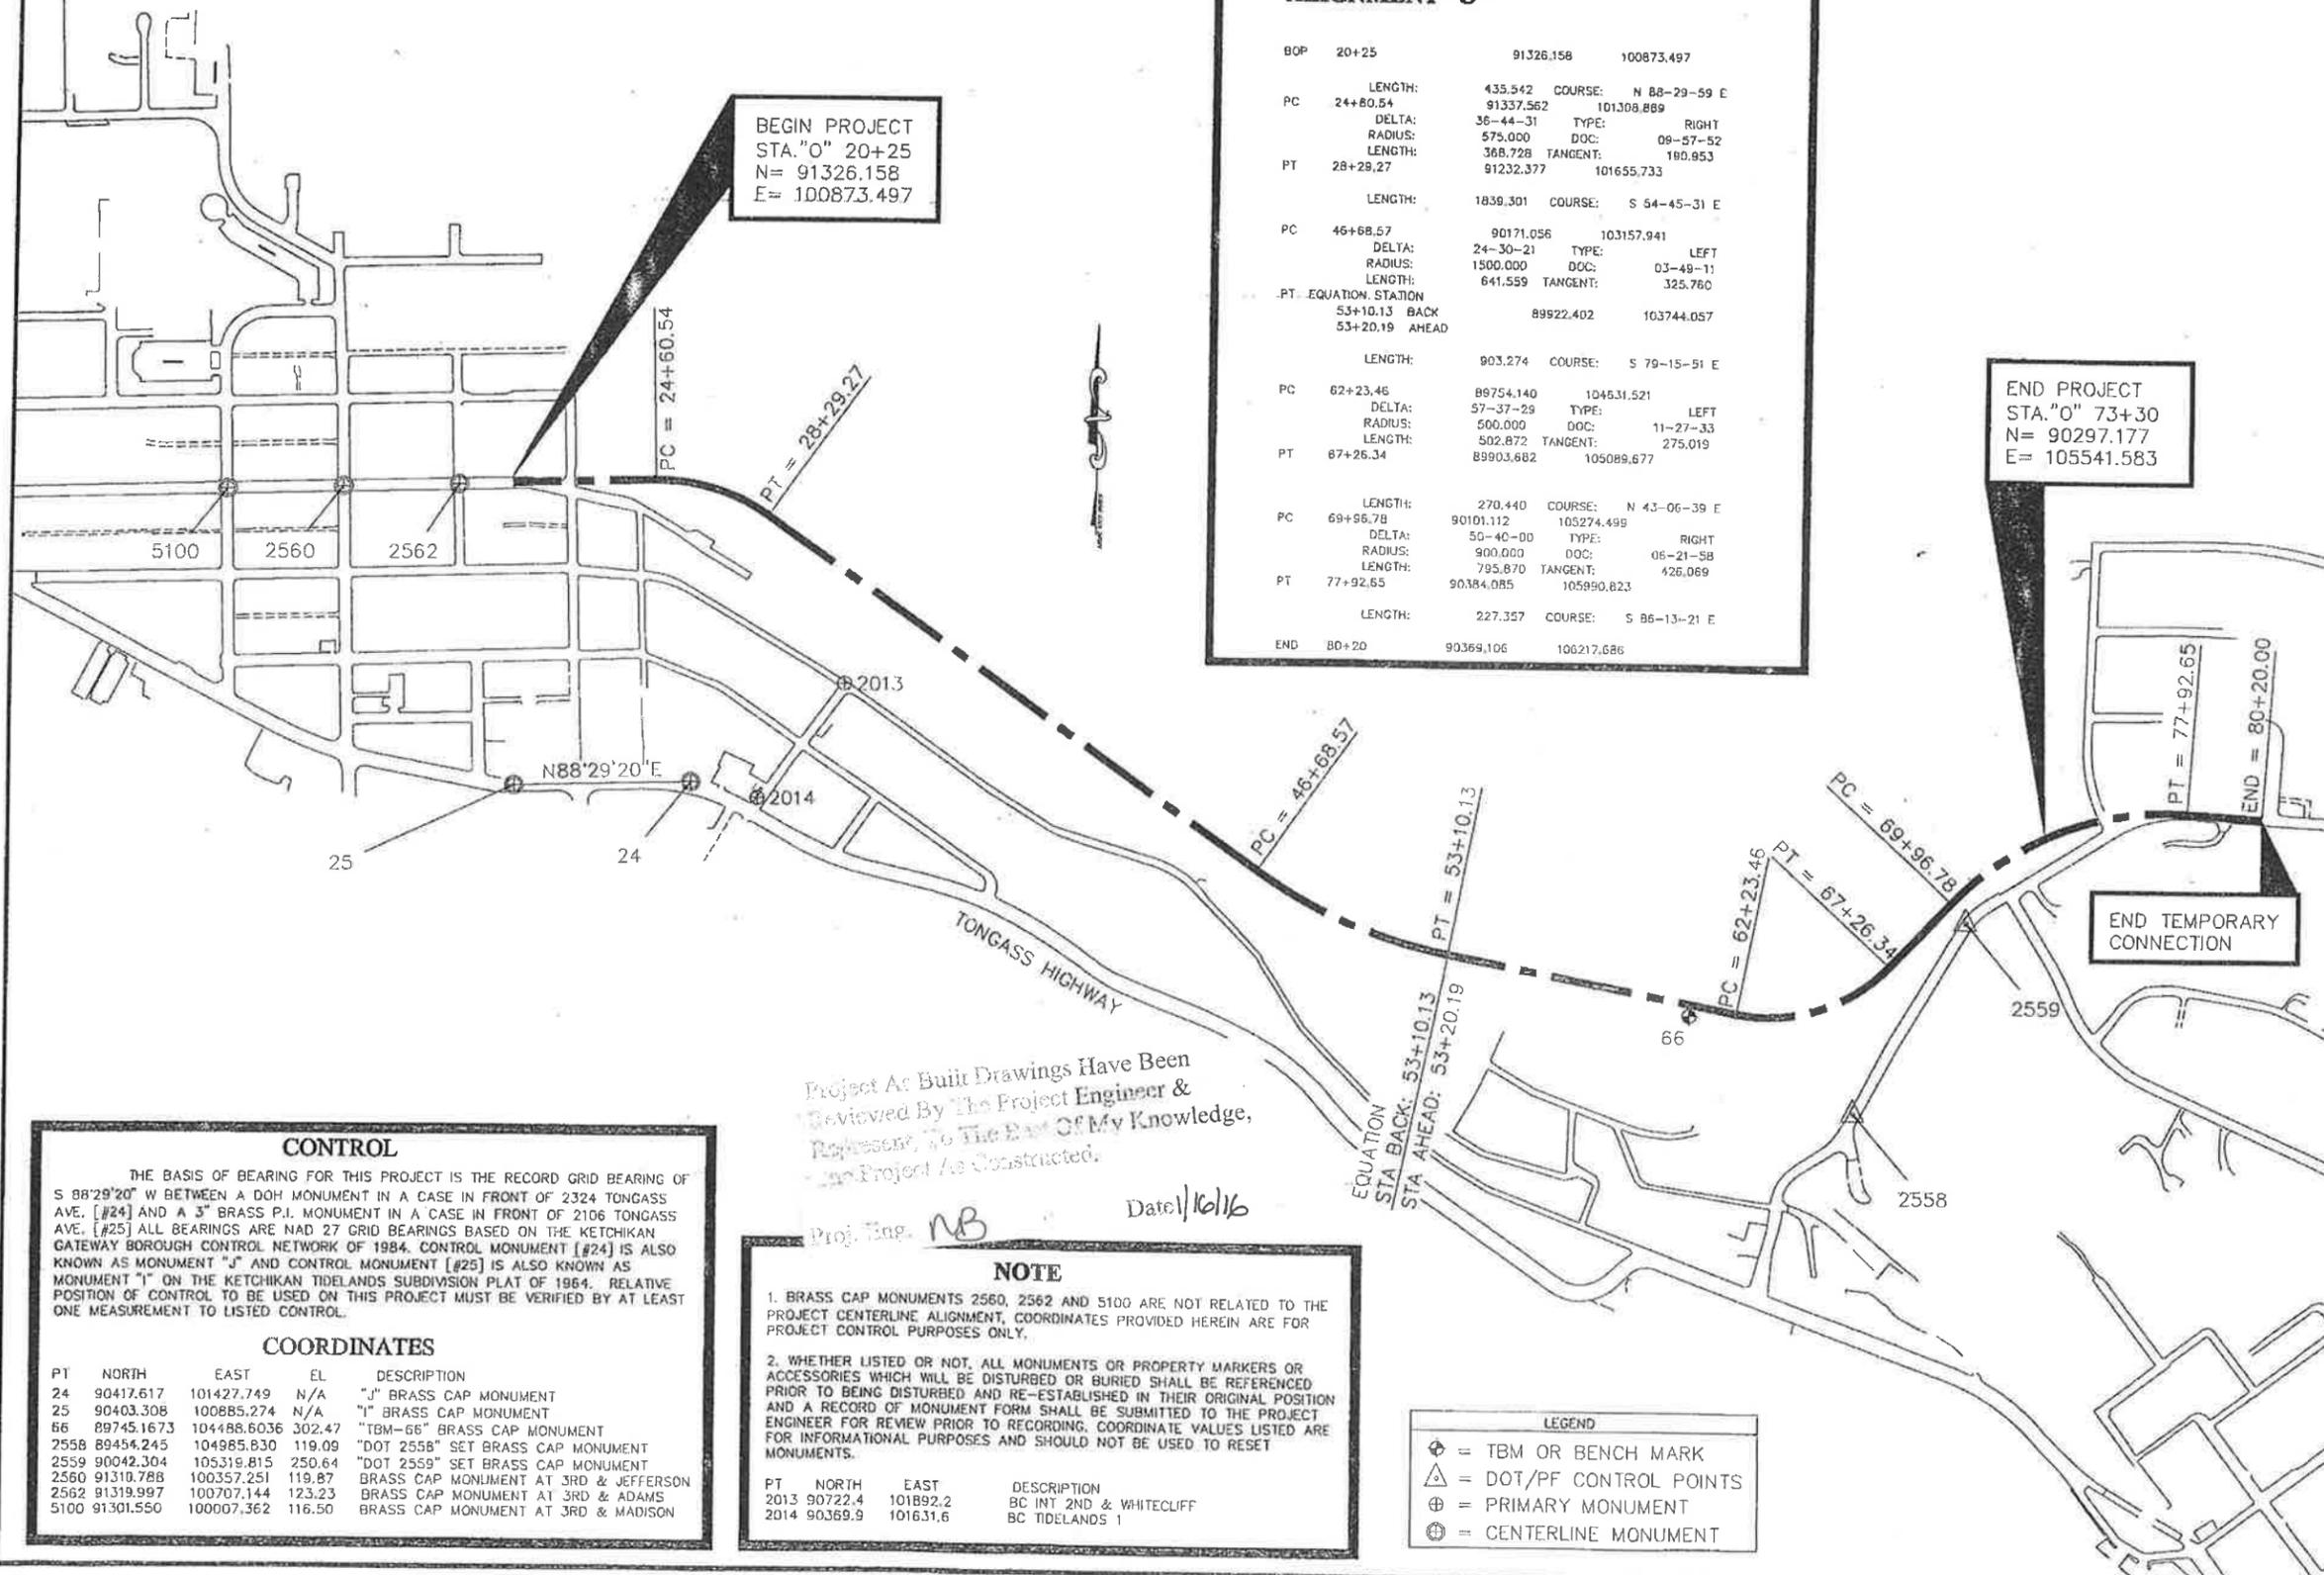

ALIGNMENT "O"

BOP	20+25	91326.158	100873.497
PC	24+80.54	91337.562	101308.889
PT	28+29.27	91232.377	101655.733
PC	46+68.57	90171.056	103157.941
PT	53+10.13	89922.402	103744.057
PC	62+23.46	89754.140	104631.521
PT	67+26.34	89903.682	105089.677
PC	69+96.78	90101.112	105274.499
PT	77+92.65	90384.085	105990.823
END	80+20	90369.106	106217.686

BEGIN PROJECT
STA. "O" 20+25
N= 91326.158
E= 100873.497

END PROJECT
STA. "O" 73+30
N= 90297.177
E= 105541.583

PATH:
Q:\Ktn\71811A\Plans\AZ_Control.dwg
Mon, 05/May/02 10:01AM Michael Limbough
PLOT:
PSPACE 1=(F) OR MSPACE 1=(F)
TAB: PLANVIEW

ADDENDUM NUMBER		
ATTACHMENT NUMBER		
RECORD OF REVISIONS		
No.	DATE	DESCRIPTION

KTN-THIRD AVENUE EXTENSION
PROJECT NO. 68490

Survey Control Layout Plan

DESIGNED BY: C. HOWARD

CHECKED BY: T. MOORE
DRAWN BY: K.K.

STATE OF ALASKA
DEPARTMENT OF TRANSPORTATION
& PUBLIC FACILITIES
STATEWIDE DESIGN & ENGINEERING
SERVICES DIVISION
**THIRD AVENUE EXTENSION
PROJECT NO. 68490**

**Survey Control
Layout Plan**

PROJECT DESIGNATION NUMBER	
STP-MG-0904(2)	
STATE	YEAR
ALASKA	2002
SHEET NUMBER	TOTAL SHEETS
A2 A03	78 2

CONTROL

THE BASIS OF BEARING FOR THIS PROJECT IS THE RECORD GRID BEARING OF S 88°29'20" W BETWEEN A DOH MONUMENT IN A CASE IN FRONT OF 2324 TONGASS AVE. [#24] AND A 3" BRASS P.I. MONUMENT IN A CASE IN FRONT OF 2106 TONGASS AVE. [#25] ALL BEARINGS ARE NAD 27 GRID BEARINGS BASED ON THE KETCHIKAN GATEWAY BOROUGH CONTROL NETWORK OF 1984. CONTROL MONUMENT [#24] IS ALSO KNOWN AS MONUMENT "J" AND CONTROL MONUMENT [#25] IS ALSO KNOWN AS MONUMENT "I" ON THE KETCHIKAN TIDELANDS SUBDIVISION PLAT OF 1964. RELATIVE POSITION OF CONTROL TO BE USED ON THIS PROJECT MUST BE VERIFIED BY AT LEAST ONE MEASUREMENT TO LISTED CONTROL.

COORDINATES

PT	NORTH	EAST	EL	DESCRIPTION
24	90417.617	101427.749	N/A	"J" BRASS CAP MONUMENT
25	90403.308	100885.274	N/A	"I" BRASS CAP MONUMENT
66	89745.1673	104488.6036	302.47	"TBM-66" BRASS CAP MONUMENT
2558	89454.245	104985.830	119.09	"DOT 2558" SET BRASS CAP MONUMENT
2559	90042.304	105319.815	250.64	"DOT 2559" SET BRASS CAP MONUMENT
2560	91310.788	100357.251	119.87	BRASS CAP MONUMENT AT 3RD & JEFFERSON
2562	91319.997	100707.144	123.23	BRASS CAP MONUMENT AT 3RD & ADAMS
5100	91301.550	100007.362	116.50	BRASS CAP MONUMENT AT 3RD & MADISON

Project As Built Drawings Have Been
Reviewed By The Project Engineer &
Represent To The Best Of My Knowledge,
In Project As Constructed.

Proj. Eng. NB Date 1/6/16

NOTE

- BRASS CAP MONUMENTS 2560, 2562 AND 5100 ARE NOT RELATED TO THE PROJECT CENTERLINE ALIGNMENT, COORDINATES PROVIDED HEREIN ARE FOR PROJECT CONTROL PURPOSES ONLY.
- WHETHER LISTED OR NOT, ALL MONUMENTS OR PROPERTY MARKERS OR ACCESSORIES WHICH WILL BE DISTURBED OR BURIED SHALL BE REFERENCED PRIOR TO BEING DISTURBED AND RE-ESTABLISHED IN THEIR ORIGINAL POSITION AND A RECORD OF MONUMENT FORM SHALL BE SUBMITTED TO THE PROJECT ENGINEER FOR REVIEW PRIOR TO RECORDING. COORDINATE VALUES LISTED ARE FOR INFORMATIONAL PURPOSES AND SHOULD NOT BE USED TO RESET MONUMENTS.


PT	NORTH	EAST	DESCRIPTION
2013	90722.4	101892.2	BC INT 2ND & WHITECLIFF
2014	90369.9	101631.6	BC TIDELANDS 1

LEGEND

- ⊕ = TBM OR BENCH MARK
- △ = DOT/PF CONTROL POINTS
- ⊙ = PRIMARY MONUMENT
- ⊕ = CENTERLINE MONUMENT

GENERAL NOTES:

- 1) EXISTING STRUCTURES SHOWN ON PLANS ARE BASED ON AS-BUILT DRAWINGS. LOCATIONS SHOWN ON THESE PLANS ARE APPROXIMATE. POTENTIAL CONFLICTS SHALL BE FIELD VERIFIED PRIOR TO CONSTRUCTION.
- 2) ALL EXCAVATION WILL BE PERFORMED USING MECHANICAL METHODS, BLASTING WILL NOT BE PERMITTED.
- 3) PLACE BONDED FIBER MATRIX (BFM) AND SEED ON ALL GROUND DISTURBED BY CONSTRUCTION ACTIVITIES.

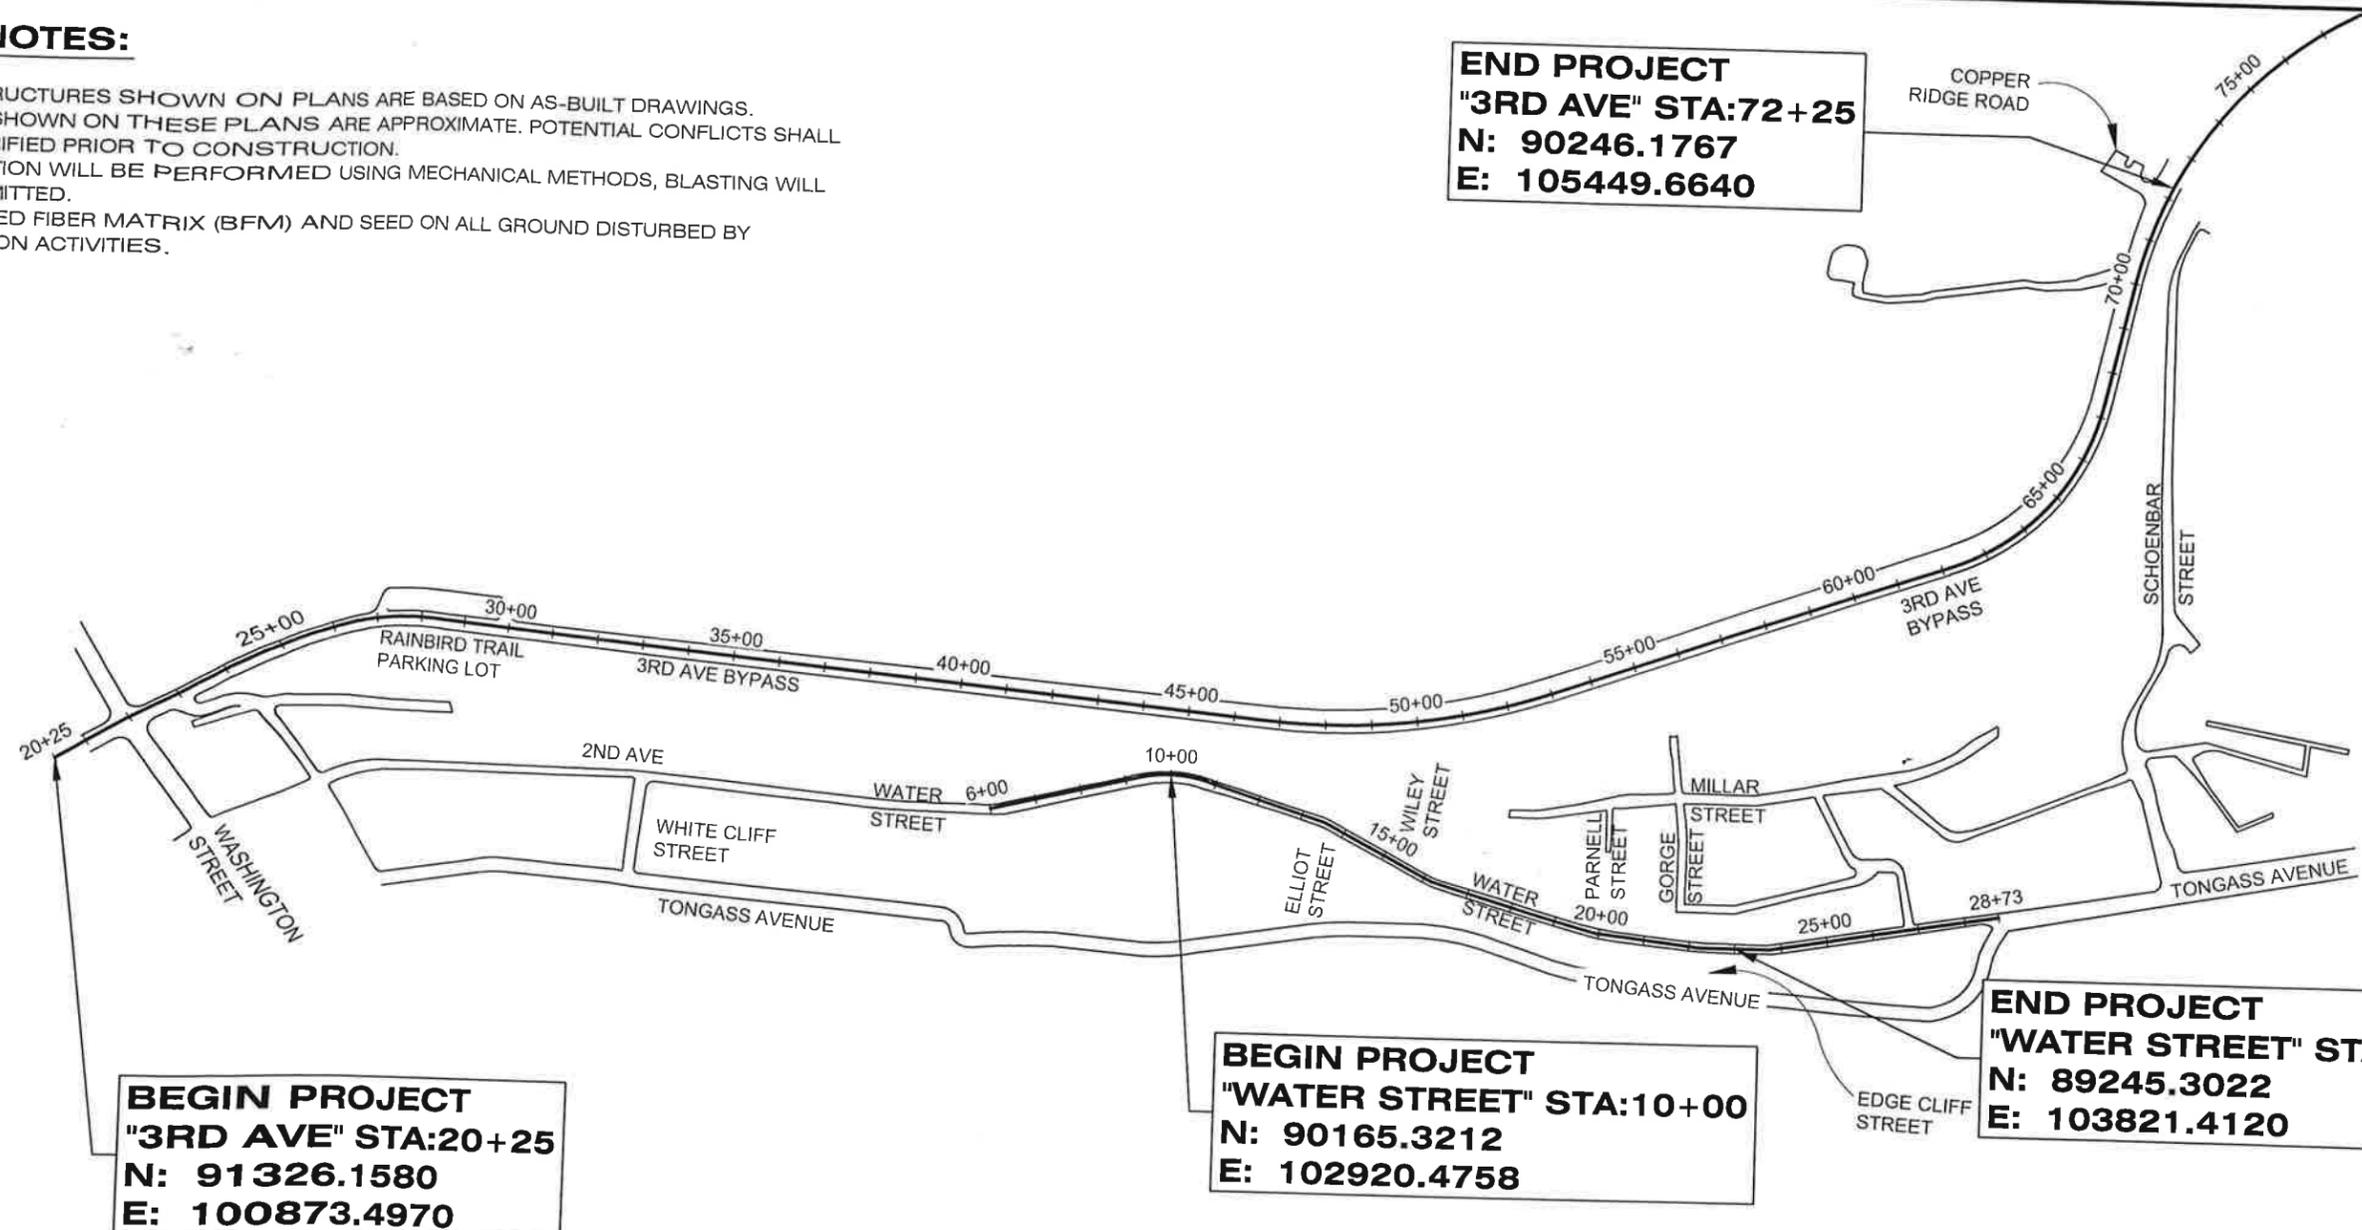

BEGIN PROJECT
"3RD AVE" STA:20+25
N: 91326.1580
E: 100873.4970

BEGIN PROJECT
"WATER STREET" STA:10+00
N: 90165.3212
E: 102920.4758

END PROJECT
"3RD AVE" STA:72+25
N: 90246.1767
E: 105449.6640

END PROJECT
"WATER STREET" STA:23+00
N: 89245.3022
E: 103821.4120

Project As Built Drawings Have Been Reviewed By The Project Engineer & Represent, To The Best Of My Knowledge, The Project As Constructed.

Proj. Eng. *MB* Date *1/16/16*

LEGEND

BOLLARD / POST	TREE / BRUSH LINE	STORM DRAIN MANHOLE
BUILDING DESIGNATION (TYP.)	OVERHEAD CABLE TELEVISION LINE	TELEPHONE MANHOLE
ELECTRIC METER	OVERHEAD ELECTRIC LINE	OVERHEAD TELEPHONE
FIRE HYDRANT	OVERHEAD ELECTRIC / TELEPHONE LINE	OVERHEAD TELEPHONE / TELEVISION LINE
GATE POST	STORM DRAIN INLET	UNDERGROUND CABLE TELEVISION LINE
GUTTER / DOWNSPOUT	GUY WIRE	UNDERGROUND ELECTRIC LINE
GUTTER UNDERGROUND	LIGHT POLE / LIGHT POLE W/MASTARM	UNDERGROUND FUEL LINE
TELEPHONE PEDESTAL	MAIL BOX	UNDERGROUND SANITARY SEWER LINE
WATER VALVE / KEYBOX	POWER POL / POWER POLE W/LIGHT	UNDERGROUND STORM DRAIN
INLET PROTECTION	SANITARY SEWER CLEANOUT	UNDERGROUND TELEPHONE LINE
FLOW LINE	SANITARY SEWER MANHOLE	UNDERGROUND WATER LINE
EXISTING CULVERT	SIGN	BONDED FIBER MATRIX
GUARDRAIL	SPOT ELEVATION	FIBER ROLL

ABBREVIATIONS

AVENUE	AVE	LINEAR FOOT	LF
AVERAGE DAILY TRAFFIC	ADT	MILEPOST	MP
BEGINNING OF PROJECT	BOP	NORTH, NORTHING	N
CENTERLINE	CL	NOT TO SCALE	NTS
COORDINATED DATA SYSTEM	CDS	POINT OF CURVATURE	PC
DESIGN HOURLY VOLUME	DHV	POINT OF INTERSECTION	PI
DESIGN SPEED	V	POINT OF TANGENT	PT
EACH	EA	RIGHT OF WAY	ROW
EAST, EASTING	E	SQUARE YARDS	SY
END OF PROJECT	EOP	STATION	STA
EQUIVALENT SINGLE AXLE LOAD	ESAL	TYPICAL	TYP
EROSION SEDIMENT CONTROL PLAN	ESCP		
FEET, FOOT	FT		

DO NOT SCALE FROM THESE DRAWINGS USE DIMENSIONS

CHECKED BY: I NAME		STATE OF ALASKA DEPARTMENT OF TRANSPORTATION & PUBLIC FACILITIES SOUTHEAST REGION											
		KETCHIKAN ADVANCE WATER STREET TRUNK LINE RELOCATION											
				SCHEMATIC LAYOUT									
DESIGNED BY: I NAME	PROJECT DESIGNATION	YEAR	SHEET NO.			TOTAL SHEETS							
DRAWN BY: I NAME	BR-000S(735) ~ 69548	2014	A02	78									
PATH: Z:\PROJECT\1744.00 DOT_SE WATER STREET VIADUCT\CIVIL\CAD\ADV UTILITY RELO\1744.00-A02(AUR)		PLOT DATE: 8/28/2014 12:03 PM											
<table border="1"> <thead> <tr> <th colspan="3">REVISIONS</th> </tr> <tr> <th>NO.</th> <th>DATE</th> <th>DESCRIPTION</th> </tr> </thead> <tbody> <tr> <td> </td> <td> </td> <td> </td> </tr> </tbody> </table>					REVISIONS			NO.	DATE	DESCRIPTION			
REVISIONS													
NO.	DATE	DESCRIPTION											