

State of Alaska


Department of Transportation
and Public Facilities
Southcoast Region

KETCHIKAN, ALASKA GRAVINA ISLAND HIGHWAY

KTN GRAVINA-MILL ACCESS ROAD
PROJECT NO. Z699220000

The undersigned hereby certifies that this duplicated document is an exact and true copy of the original.

Cody Sutter

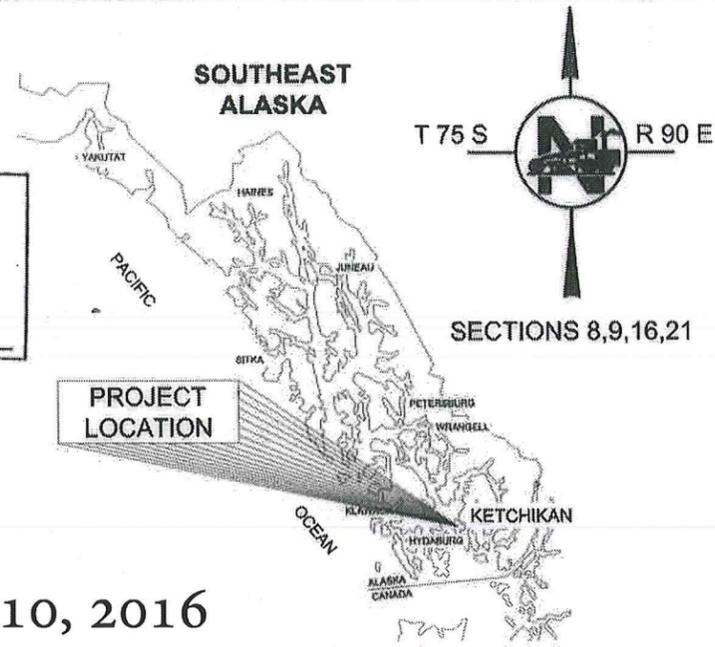

May 10, 2016

*Asbuits
Contractor: Glacier State Contractors
Start Date: 6/7/16
End Date: 10/27/16*

**DESIGN DESIGNATION
GRAVINA MILL ROAD**

A.D.T 2015	=	50
A.D.T 2035	=	75
D.H.V. 2015	=	5
%T	=	15%
V	=	25 M.P.H.

Project Engineer: Mandi Pelham

PROJECT SUMMARY

LENGTH OF PROJECT	=	1.59 MILES
LENGTH OF RESURFACING	=	1.05 MILES
WIDTH OF RESURFACING	=	±14 FEET
LENGTH OF NEW CONSTRUCTION	=	0.54 MILES
WIDTH OF NEW CONSTRUCTION	=	16-27 FEET

**THE FOLLOWING STANDARD DRAWINGS
APPLY TO THIS PROJECT:**

D-01.02	E-00.00	S-00.11
D-04.21	E-09.00	S-01.00
	E-13.00	S-05.01
		S-30.03

INDEX	
SHEET NO.	DESCRIPTION
A1	TITLE SHEET
A2	ABBREVIATIONS & LEGEND
A3	KEY MAP
A4	SURVEY CONTROL DIAGRAM
A5-A6	ALIGNMENT DATA
B1-B3	TYPICAL SECTIONS
C1-C2	ESTIMATE OF QUANTITIES
D1-D2	SUMMARY TABLES
E1	DETAILS
E2-E4	SITE EXHIBITS
EX2A-EX3	PIPE CONSTRUCTION SEQUENCING
F1-F3	PLAN & PROFILE
G1	APPROACH PLAN
H1-H2	SIGNING
J1-J11	CROSS SECTIONS <i>See Total/Cut/Fill sheets</i>
J12	PIPE PROFILES
J13	PIPE PLAN & PROFILE
N1-N3	STRUCTURES
P1-P5	EROSION CONTROL
T1	TRAFFIC CONTROL

Z1-Z10 Revised Site 3 & 1 (9/03)

PATH: P:\53(ADOT)\53-02(Gravina)\Design\Plans\53-02 A1-A2_Title Sheets.dwg

Friday, February 26, 2016 11:09:31 AM

PLOT: PSPACE OR MSPACE : 1=1(F)

STATE OF ALASKA
DEPARTMENT OF TRANSPORTATION
& PUBLIC FACILITIES
SOUTHCOAST REGION



Project As Built Drawings Have Been Reviewed By the Project Engineer & Represent, To the Best of My Knowledge, the Project as Constructed.

Project Eng. *MP* *8.28.17* Date

APPROVED: *Pat Carroll* 3/30/16
REGIONAL PRE-CONSTRUCTION ENGINEER DATE
L. PAT CARROLL, P.E.


CONCUR: *Michael J. Coffey* 3/30/16
DIRECTOR, SOUTHCOAST REGION DATE
MICHAEL J. COFFEY

CERTIFIED TRUE & CORRECT AS-BUILT OF ACTUAL FIELD CONDITION:

CONSTRUCTION PROJECT MANAGER DATE

PLANS DEVELOPED BY:
LEI ENGINEERING & SURVEYING, LLC

STATE	PROJECT DESIGNATION	YEAR	SHEET NO.	TOTAL SHEETS
ALASKA	Z699220000	2016	A1	48

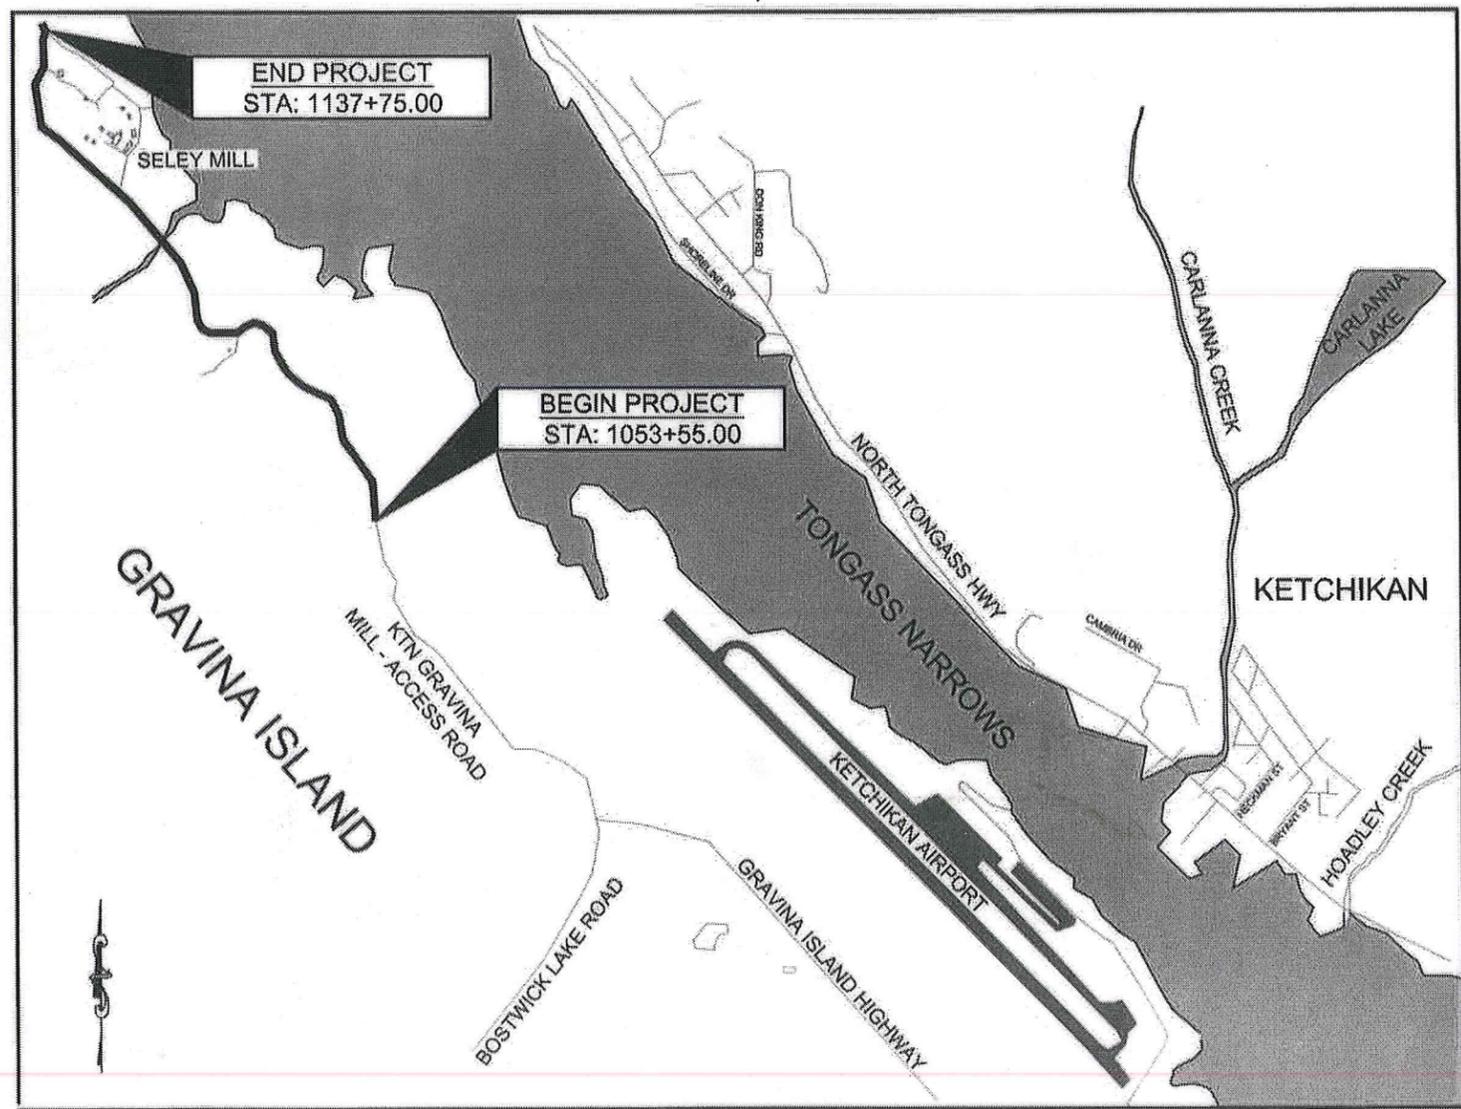

VICINITY MAP

DRAWING LOCATION: P:\53(ADOT)\53-02(Gravina)\Design\Plans\53-02 A1-A2_Title Sheets.dwg

DATE: 2/26/2016 10:56 AM

LAYOUT: AT


SCALE: NTS

DESIGNED BY: M. DUMAN, CHECKED BY: B. MARTIN, DRAWN BY: P. BERGER

ABBREVIATIONS

%T	PERCENTAGE TRUCK TRAFFIC DURING PEAK HOURS	INTL.	INTERNATIONAL	RD	ROAD
&	AND	I.E.	INVERT ELEVATION	REF	REFER OR REFERENCE
(TYP.)	TYPICAL	JT	JOINT	REINF	REINFORCED, REINFORCING
@	AT	KTN	KETCHIKAN INTERNATIONAL AIRPORT	ROW	RIGHT-OF-WAY
A.D.T.	AVERAGE DAILY TRAFFIC	L	LENGTH	R	RANGE, RADIUS
AC	ASPHALT CONCRETE	LB	POUNDS	RT	RIGHT
AKDOT&PF	ALASKA DEPARTMENT OF TRANSPORTATION & PUBLIC FACILITIES	LB/CU FT	POUNDS PER CUBIC FOOT	S	SOUTH
AL	ALUMINUM	LF	LINEAR FOOT	SB	SOUTHBOUND
B.O.P.	BEGINNING OF PROJECT	LS	LUMP SUM	SHT	SHEET
BM	BENCH MARK	LT	LEFT	SHLD	SHOULDER
BOP	BOTTOM OF PIPE	M GAL	1000 GALLONS (ROMAN NUMERAL M = 1000)	SPECS	SPECIFICATIONS
BRG	BEARING	MAX	MAXIMUM	SQ. FT.	SQUARE FEET
CL	CENTER LINE	MI	MILE	ST	STREET
CLR	CLEAR	MIN	MINIMUM	STA	STATION
CY	CUBIC YARD	MISC	MISCELLANEOUS	STD	STANDARD
D.H.V.	DESIGN HOURLY VOLUME	MUTCD	MANUAL ON UNIFORM TRAFFIC CONTROL DEVICES	SPA	STRUCTURAL PLATE ARCH
DIA	DIAMETER	N	NORTH	T	TANGENT, TOWNSHIP
DWG	DRAWING	NB	NORTHBOUND	T&B	TOP AND BOTTOM
E	EAST	NO	NUMBER	TEMP	TEMPERATURE
E.A.L.	EQUIVALENT AXLE LOAD	NTS	NOT TO SCALE	THKN.	THICKNESS
E.O.P.	END OF PROJECT	O.D.	OUTER DIAMETER	TSS	TEMPORARY SIGN SUPPORT
EA	EACH	O.C.	ON CENTER	UG	UNDERGROUND
EB	EASTBOUND	OFF	OFFSET	UNK	UNKNOWN
ELEV.	ELEVATION	OHW	ORDINARY HIGH WATER	V	DESIGN SPEED (VELOCITY)
EP	EDGE OF PAVEMENT	P.C.	POINT OF CURVATURE	V.C.	VERTICAL CURVE
EX	EXISTING	PI	POINT OF INTERSECTION	VERT	VERTICAL
FG	FINISH GRADE	PL	PLACE, PLATE, PROPERTY LINE	VPI	VERTICAL POINT OF INTERSECTION
FIG	FIGURE	PSI	POUNDS PER SQUARE INCH	W	WEST, WATER
FT	FOOT OR FEET	PSST	PERFORATED STEEL SQUARE TUBE	W/	WITH
GA	GAUGE	P.T.	POINT OF TANGENCY	WB	WESTBOUND
HORIZ	HORIZONTAL	PT	POINT	WL	WATER LINE
I.D.	INSIDE DIAMETER	PVC	POLYVINYL CHLORIDE PLASTIC	WS	WATER SURFACE, WATER STOP
IN	INCH	PVI	POINT OF VERTICAL INTERSECTION	WT	WEIGHT
INT.	INTERSECTION	PVMT	PAVEMENT		

LEGEND

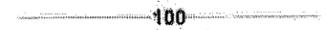PRIMARY MONUMENT (BRASS/AL CAP)	
TEST PIT	
DRAINAGE PATHWAY	
CHECK DAM	
SEDIMENT BARRIER	
CENTERLINE	
CULTURALLY MODIFIED TREE	
PIPE CULVERT	
STRUCTURE	
SIGN POST	
PUMP	
EXISTING ROADWAY	
PROPOSED ROADWAY	
DITCH LINE	
MAJOR CONTOUR	
MINOR CONTOUR	
RESURFACING	
FULL DEPTH CONSTRUCTION	
REMOVED EXISTING	
BORROW MATERIAL	
RIPRAP	
FILL	
CUT	



Michael L. Duman
No. 13756

STATE OF ALASKA
DEPARTMENT OF TRANSPORTATION
& PUBLIC FACILITIES
SOUTHCOST REGION

**KTN GRAVINA - MILL
ACCESS ROAD**

ABBREVIATIONS & LEGEND

DESIGNED BY: M. DJUMAN
DRAWN BY: R. BERGER



PATH: P:\53(ADOT)\53-02(Gravina)\Design\Plan\53-02 A1-A2_Title Sheets.dwg
TAB: A2 Wednesday, February 17, 2016 11:38:50 AM Ryan Berger

REVISIONS			PROJECT DESIGNATION	YEAR	SHEET NO.	TOTAL SHEETS
NO.	DATE	DESCRIPTION				
			Z699220000	2016	A2	48

Project As Built Drawings Have Been Reviewed
By the Project Engineer & Represent, To the
Best of My Knowledge, the Project as
Constructed.


Project Eng. *Mandi Peckham* Date *8/23/17*

DRAWING LOCATION: P:\53\ADOT\53-02\Gravina\Design\Drawings\53-02-A3-A5-A6_General.dwg
 DATE: 11/27/2015 4:41 PM
 LAYOUT: A3
 SCALE: 1" = 1000'
 SHEET: 3 OF 3

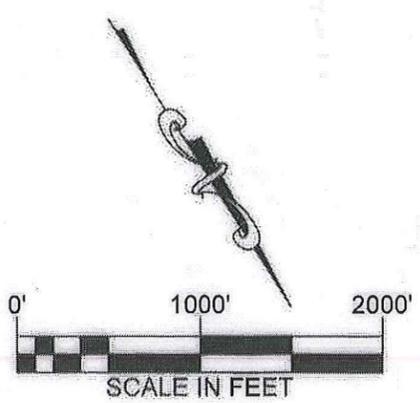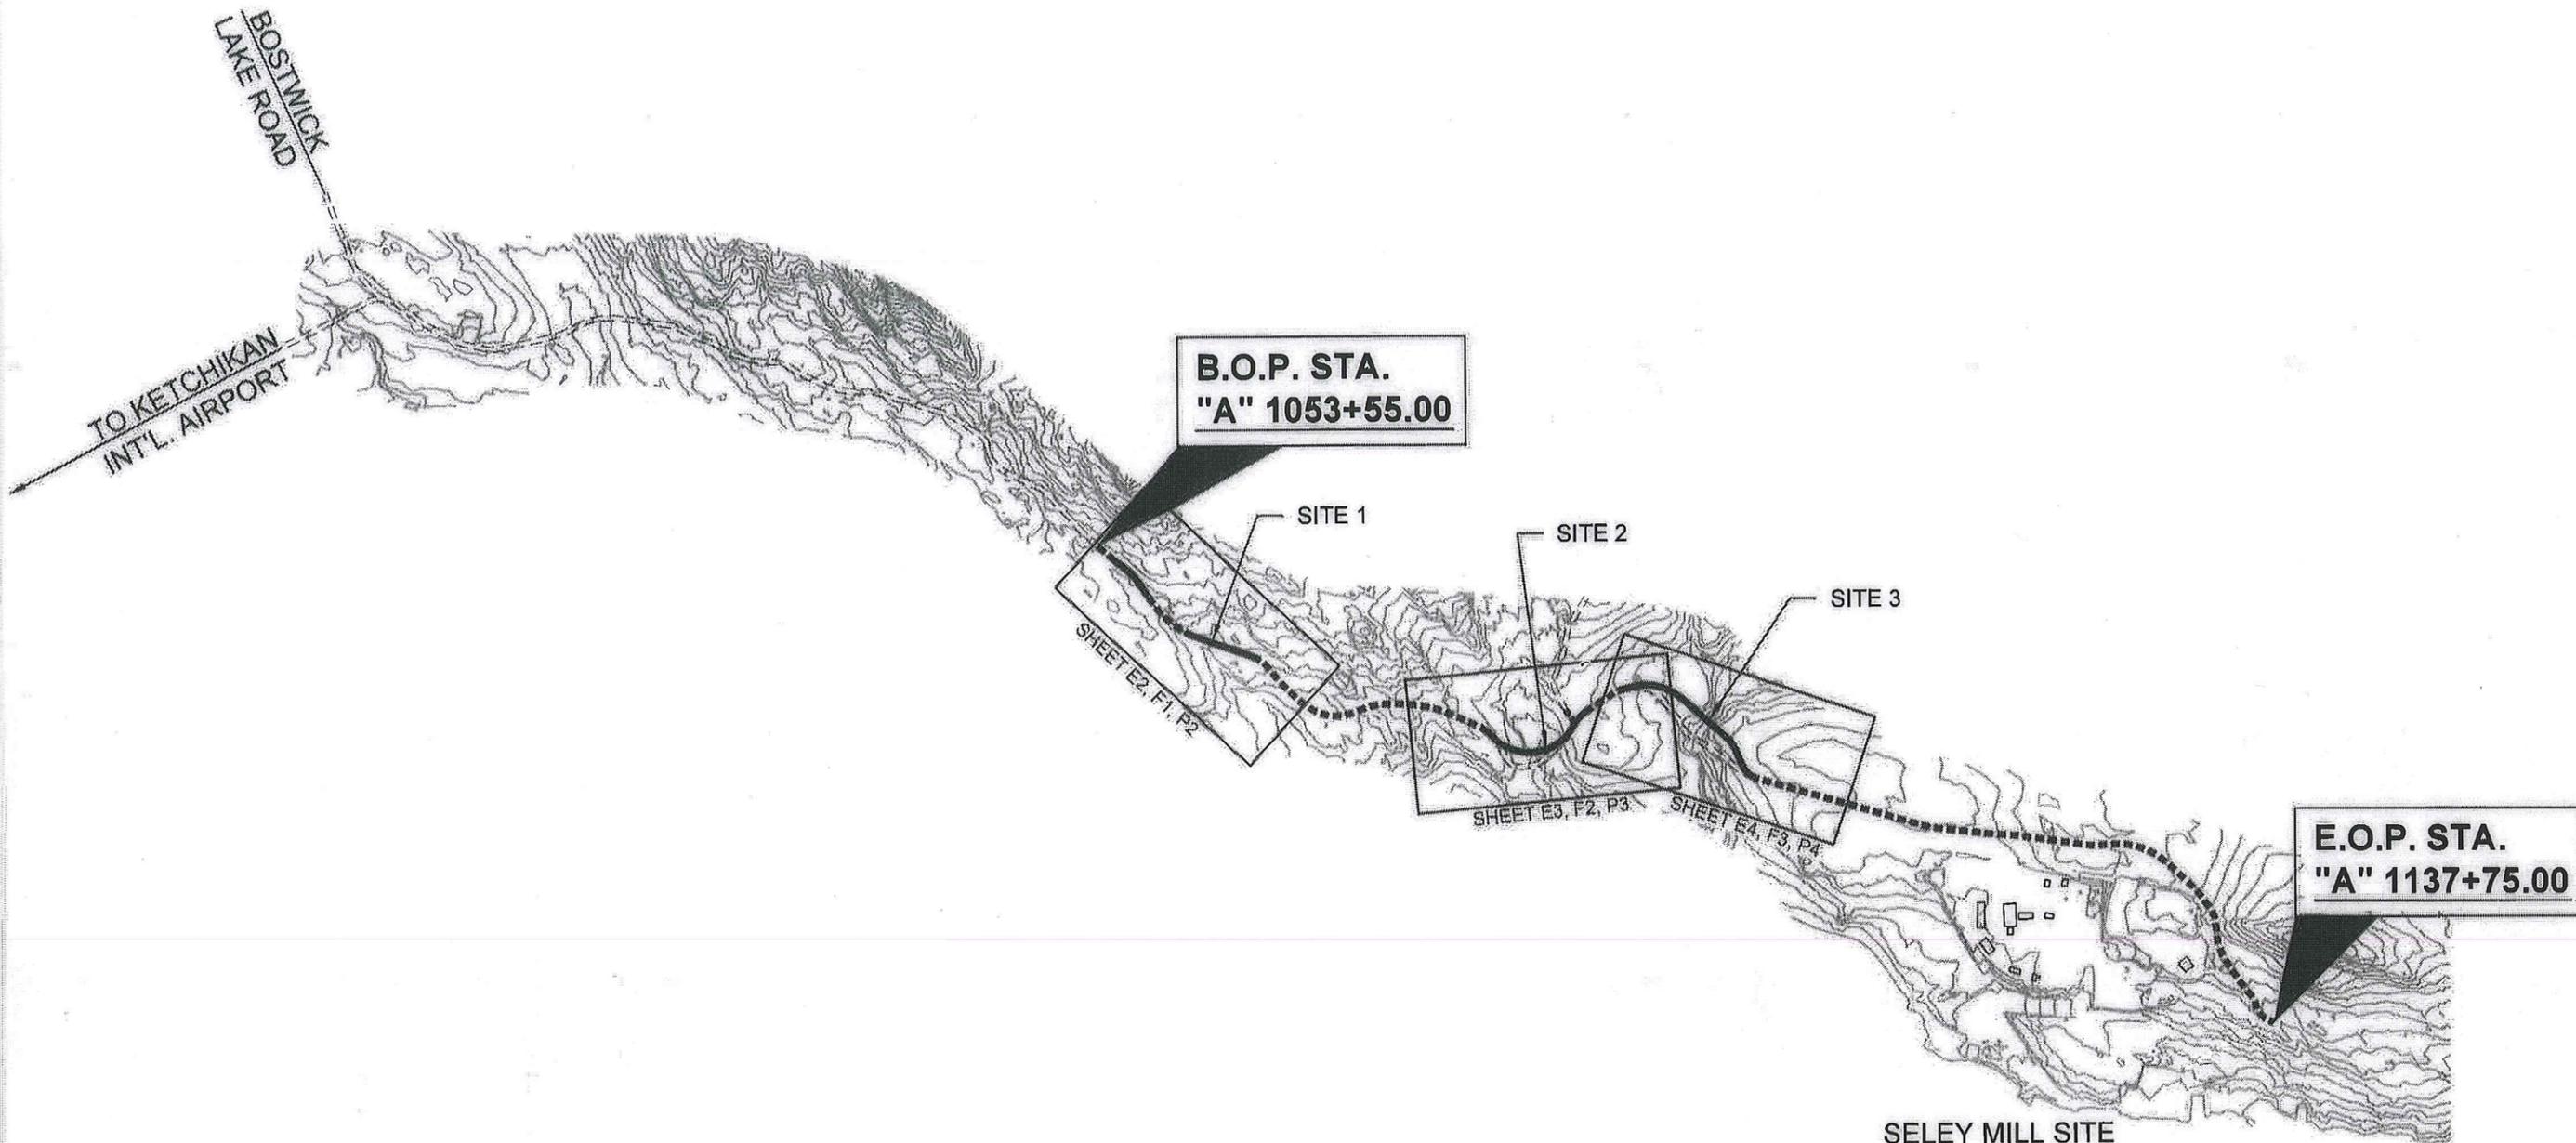

LEGEND				
----	EXISTING ROADWAY			
=====	EXISTING ROADWAY TO BE RESURFACED			
—————	ROADWAY FULL DEPTH CONSTRUCTION			
		STATE OF ALASKA DEPARTMENT OF TRANSPORTATION & PUBLIC FACILITIES SOUTHCOAST REGION		
		KTN GRAVINA - MILL ACCESS ROAD		
KEY MAP				
DESIGNED BY: M. DUMAN DRAWN BY: R. BERGER		PROJECT DESIGNATION: Z699220000 YEAR: 2016 SHEET NO.: A3 TOTAL SHEETS: 48		
PATH: P:\53\ADOT\53-02\Gravina\Design\Drawings\53-02-A3-A5-A6_General.dwg TAB: A3 DATE: Wednesday, February 17, 2016 11:38:51 AM PROJECT ENGINEER: <i>Nardo Pacham</i>		REVISIONS NO. DATE DESCRIPTION 1 8/23/16		

Project As Built Drawings Have Been Reviewed
 By the Project Engineer & Represent, To the
 Best of My Knowledge, the Project as
 Constructed.
 Project Eng: *Nardo Pacham* Date: *8/23/16*

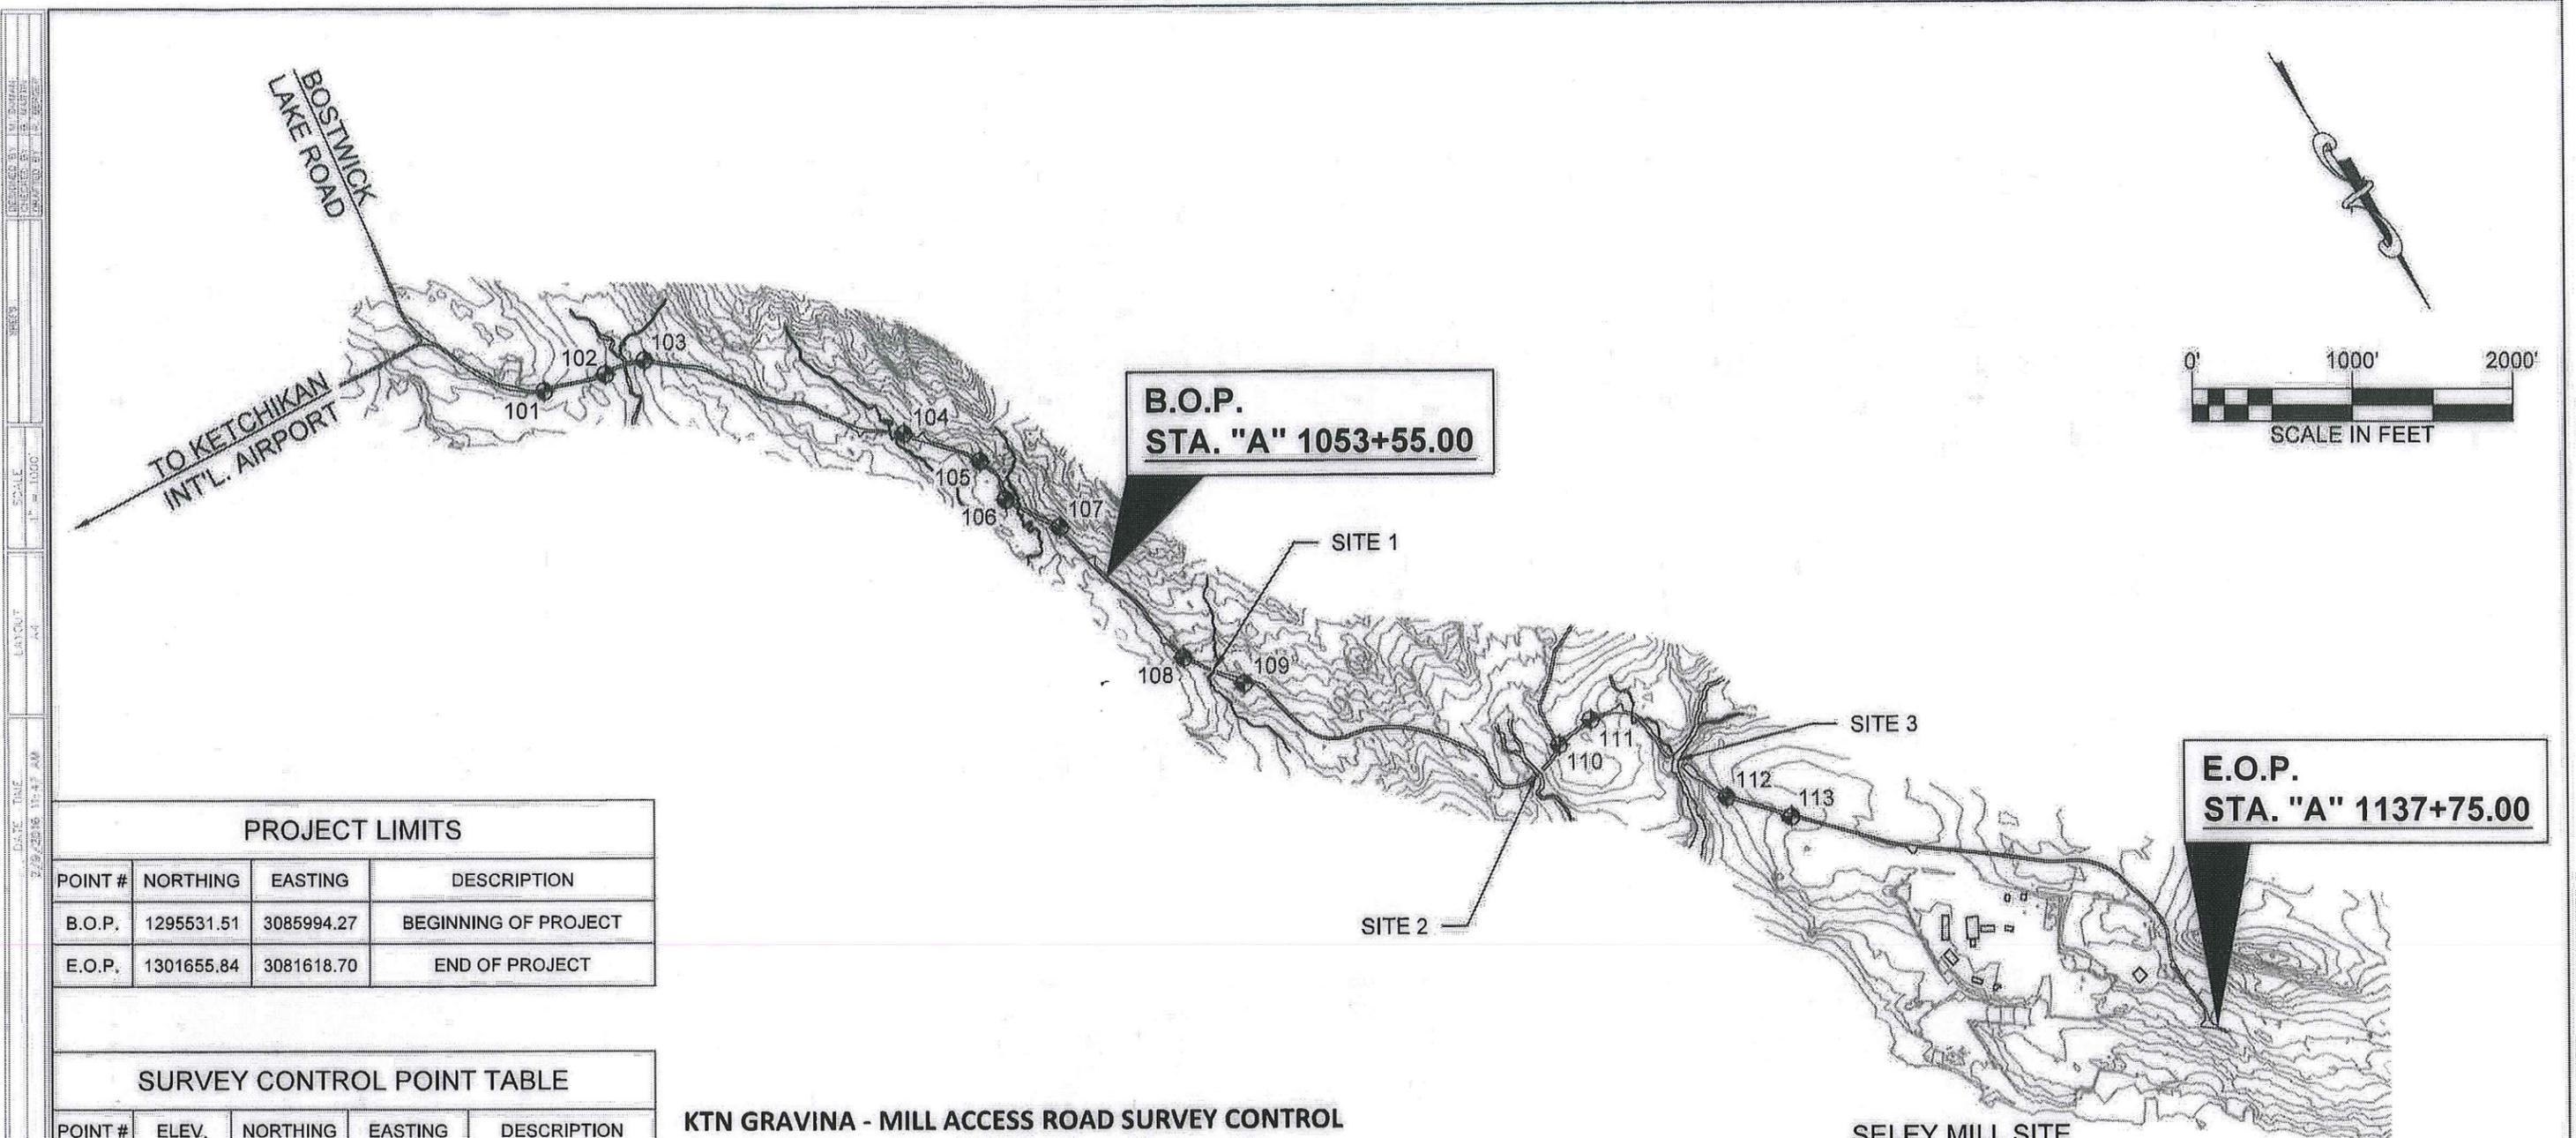

PROJECT LIMITS

POINT #	NORTHING	EASTING	DESCRIPTION
B.O.P.	1295531.51	3085994.27	BEGINNING OF PROJECT
E.O.P.	1301655.84	3081618.70	END OF PROJECT

SURVEY CONTROL POINT TABLE

POINT #	ELEV.	NORTHING	EASTING	DESCRIPTION
101	151.68	1292685.94	3088333.62	ALCAP2_DOT_SET
102	132.65	1292802.23	3087955.45	ALCAP2_DOT_SET
103	141.07	1292858.33	3087702.57	ALCAP2_DOT_SET
104	193.52	1294109.91	3086574.45	ALCAP2_DOT_SET
105	189.07	1294507.82	3086264.61	ALCAP2_DOT_SET
106	178.92	1294793.69	3086257.44	ALCAP2_DOT_SET
107	193.75	1295114.24	3086072.00	ALCAP2_DOT_SET
108	143.83	1296208.96	3085852.45	ALCAP2_DOT_SET
109	136.90	1296545.62	3085620.08	ALCAP2_DOT_SET
110	79.28	1297917.10	3084173.08	ALCAP2_DOT_SET
111	76.17	1297893.03	3083924.69	ALCAP2_DOT_SET
112	63.62	1298752.66	3083464.78	ALCAP2_DOT_SET
113	76.44	1299069.89	3083190.93	ALCAP2_DOT_SET

KTN GRAVINA - MILL ACCESS ROAD SURVEY CONTROL

THE HORIZONTAL DATUM USED FOR THE SURVEY CONTROL IS NAD83(2011) 2010.00 ALASKA STATE PLANE ZONE 1. ALL COORDINATES, DISTANCES, AND BEARINGS ARE GRID.

THE VERTICAL DATUM USED IS NAVD88 DERIVED FROM STATIC GPS OBSERVATIONS TO THE NATIONAL SPATIAL REFERENCE SYSTEM AND USING THE GEOID MODEL 12A AS DETERMINED BY THE NATIONAL GEODETIC SURVEY.

AKDOT&PF HAS SUPPLIED THE FOLLOWING GROUND MARKS TO BE USED FOR ANY ADDITIONAL SURVEY. SEE ACAD C3D V 2014 DWG FILE "MILL_ROAD_EGA" FOR COGO POINTS AND CORRESPONDING LOCATIONS, COORDINATES, AND DESCRIPTIONS.

- 101 - 113 ARE 2" ALUMINUM CAPS ON REBAR SET ALONG PROJECT CORRIDOR FOR USE IN ADDITIONAL MAPPING.

MONUMENT NOTES

IF ANY PAIR OF CONTROL POINTS DISAGREES FROM PUBLISHED VALUE BY MORE THAN 1:10,000 HORIZONTALLY OR VERTICALLY THEN A THIRD NETWORK POINT MUST BE TIED TO ASCERTAIN WHICH POINT IS IN ERROR OR HAS BEEN DISTURBED.

WHETHER LISTED OR NOT, ALL PROPERTY MONUMENTS, PROPERTY MARKERS, OR ACCESSORIES THAT WILL BE DISTURBED OR BURIED SHALL BE REFERENCED PRIOR TO BEING DISTURBED, AND RE-ESTABLISHED IN THEIR ORIGINAL POSITION AND A RECORD OF MONUMENT FORM IN ACCORDANCE WITH A.S.34.65.040 SHALL BE SUBMITTED TO THE CONSTRUCTION ENGINEER FOR REVIEW PRIOR TO RECORDING.

MONUMENTS 101-113 ARE FOR CONSTRUCTION CONTROL ONLY AND NEED NOT BE REPLACED IF DESTROYED.

Project As Built Drawings Have Been Reviewed By the Project Engineer & Represent, To the Best of My Knowledge, the Project as Constructed.

Project Eng. *M. Duman* Date *8-23-17*

	STATE OF ALASKA DEPARTMENT OF TRANSPORTATION & PUBLIC FACILITIES SOUTHCOST REGION													
	KTN GRAVINA - MILL ACCESS ROAD SURVEY CONTROL DIAGRAM													
DESIGNED BY: M. DUMAN DRAWN BY: R. BERGER	PATH: P:\53(ADOT)\53-02(Gravina)\Design\Plans\53-02 Survey Diagram.dwg TAB: A4			Wednesday, February 17, 2016 11:38:52 AM										
<table border="1"> <thead> <tr> <th colspan="3">REVISIONS</th> </tr> <tr> <th>NO.</th> <th>DATE</th> <th>DESCRIPTION</th> </tr> </thead> <tbody> <tr> <td> </td> <td> </td> <td> </td> </tr> </tbody> </table>		REVISIONS			NO.	DATE	DESCRIPTION				PROJECT DESIGNATION	YEAR	SHEET NO.	TOTAL SHEETS
REVISIONS														
NO.	DATE	DESCRIPTION												
		Z699220000	2016	A4	48									

DRAWING: 02A-110
 P:\53(ADOT)\53-02(Gravina)\Design\Plans\53-02 Survey Diagram.dwg
 DATE: 2/17/2016 11:47 AM
 SCALE: 1" = 1000'
 LAYOUT: A4

DATE: 11/24/2015 4:41 PM
 LAYOUT: 15
 SCALE: 1/8" = 1'-0"
 PROJECT: P:\31\ADOT\53-02(Gravina)\Plan\53-02-A3-A5-A6_General.dwg

SITE 1 ("B" LINE)

Number	Segment	Station	Northing	Easting	Bearing	Length	Radius	Delta
L1	Tangent	100+00.00	1295664.69	3085949.89	N20° 04' 56.27"W	83.3		
C1	Curve	100+83.34	1295742.96	3085921.27	N11° 27' 58.69"W	75.2	250	17
L2	Tangent	101+58.53	1295816.37	3085906.38	N2° 51' 01.11"W	188.7		
C2	Curve	103+47.24	1296004.86	3085897.00	N20° 44' 23.16"W	312.2	500	36
L3	Tangent	106+59.47	1296292.13	3085788.22	N38° 37' 45.22"W	338.2		
C3	Curve	109+97.69	1296556.35	3085577.07	N37° 13' 08.19"W	12.3	250	3

SITE 2 ("C" LINE)

Number	Segment	Station	Northing	Easting	Bearing	Length	Radius	Delta
L1	Tangent	200+00.00	1297705.77	3084630.35	N10° 20' 03.10"W	14.4		
C1	Curve	200+14.45	1297719.99	3084627.76	N65° 54' 18.09"W	591.6	305	111
L2	Tangent	206+06.08	1297925.40	3084168.45	S58° 31' 26.92"W	1.3		
C2	Curve	206+07.37	1297924.73	3084167.36	S73° 35' 20.44"W	78.9	150	30
L3	Tangent	206+86.25	1297902.70	3084092.56	S88° 39' 13.97"W	9.7		

SITE 3 ("D" LINE)

Number	Segment	Station	Northing	Easting	Bearing	Length	Radius	Delta
L1	Tangent	300+00.00	1297916.30	3083806.53	N75° 23' 33.04"W	29.0		
C1	Curve	300+29.00	1297923.61	3083778.46	N46° 10' 37.41"W	305.9	300	58
L2	Tangent	303+34.95	1298126.40	3083567.17	N16° 57' 41.79"W	361.1		
C2	Curve	306+96.04	1298471.79	3083461.83	N3° 59' 05.26"W	90.6	200	26
L3	Tangent	307+86.64	1298561.39	3083455.59	N8° 59' 31.26"E	113.1		
C3	Curve	308+99.70	1298673.06	3083473.26	N10° 33' 55.94"W	75.1	110	39
L4	Tangent	309+74.79	1298745.46	3083459.75	N30° 07' 23.15"W	8.4		
C4	Curve	309+83.17	1298752.71	3083455.55	N30° 31' 41.67"W	2.8	200	1

SITE STATIONING TABLE

			LF
"A" ALIGNMENT	"A" 1053+55.00	"A" 1137+75.00	8420
"B" SITE 1	"A" 1054+95.38 = "B" 100+00.00	"A" 1065+06.80 = "B" 110+10.00	1010
"C" SITE 2	"A" 1080+84.00 = "C" 200+00.00	"A" 1088+84.38 = "C" 206+96.00	696
"D" SITE 3	"A" 1091+63.31 = "D" 300+00.00	"A" 1101+15.21 = "D" 309+86.00	986
"FR" FOREST ROAD	"A" 1088+05.98 = "FR" 0+00.00	"FR" 0+90.69	90.7

FOREST ROAD ("FR" LINE)

Number	Segment	Station	Northing	Easting	Bearing	Length	Radius	Delta
L1	Tangent	0+00.00	1297919.97	3084158.99	S28° 33' 50.30"E	5.9		
C1	Curve	0+05.86	1297914.82	3084161.79	S13° 50' 13.70"E	51.4	100	29
L2	Tangent	0+57.27	1297865.45	3084173.95	S0° 53' 22.91"W	33.4		

Project As Built Drawings Have Been Reviewed
By the Project Engineer & Represent, To the
Best of My Knowledge, the Project as
Constructed.


Project Eng. *Mandi Pelhorn* Date *8-23-17*

NOTE: SEE SHEET A6 FOR ILLUSTRATION

	STATE OF ALASKA DEPARTMENT OF TRANSPORTATION & PUBLIC FACILITIES SOUTHCOAST REGION			
	KTN GRAVINA - MILL ACCESS ROAD			
ALIGNMENT DATA				
DESIGNED BY: M. DUMAN DRAWN BY: R. BERGER	PATH: P:\53(ADOT)\53-02(Gravina)\Design\Plans\53-02-A3-A5-A6_General.dwg TAB: A5 Wednesday, February 17, 2016 11:38:56 AM Ryan Berger			
REVISIONS NO. DATE DESCRIPTION		PROJECT DESIGNATION Z699220000	YEAR 2016	SHEET NO. A5
				TOTAL SHEETS 48


11/14/2015 4:41 PM
 SCALE NO SCALE
 LA TOUT AB
 11/14/2015 4:41 PM
 P:\3\ADOT\3-02\Gravina\Gravina_VPlans\53-02\A3-A5-A6_Schematic.dwg

BEGIN "B" LINE
STA. "B" 100+00.00

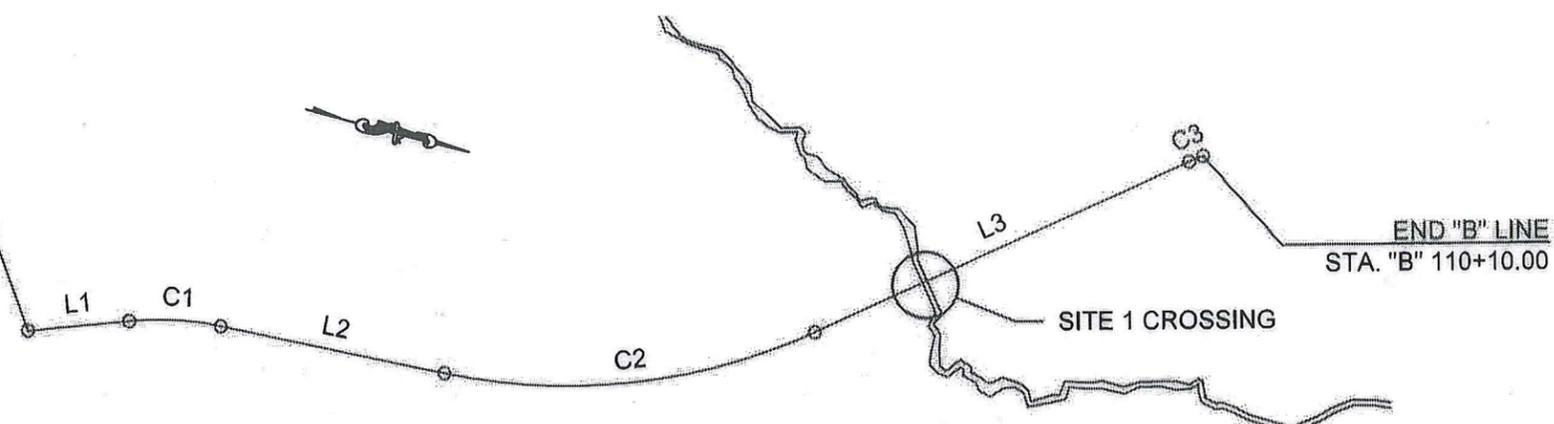


SITE 1

BEGIN "C" LINE
STA. "C" 200+00.00

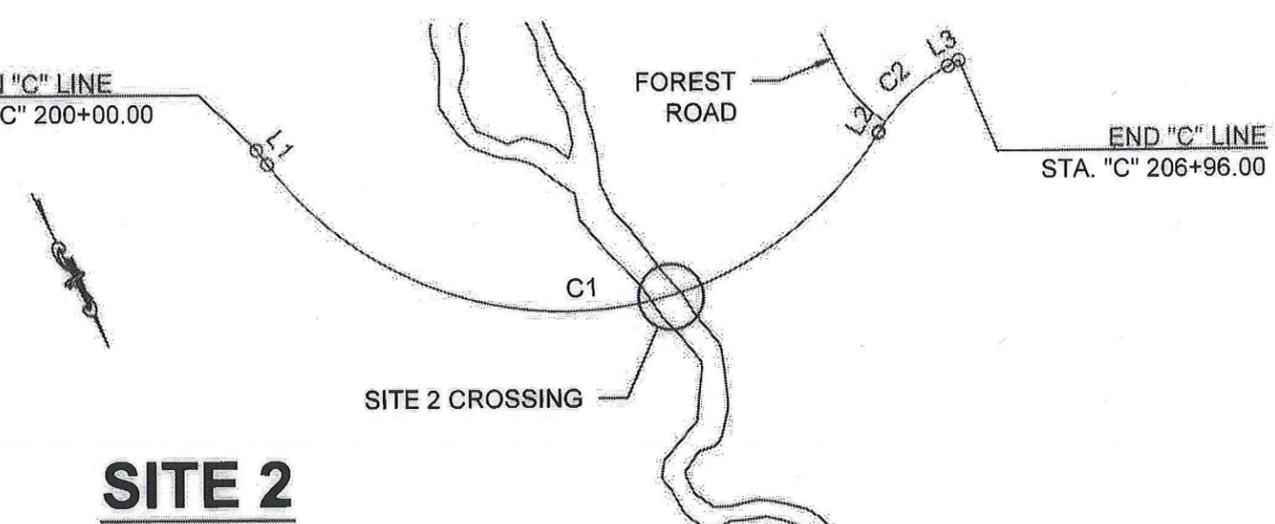


SITE 2

END "FR" LINE
STA. "FR" 0+90.69

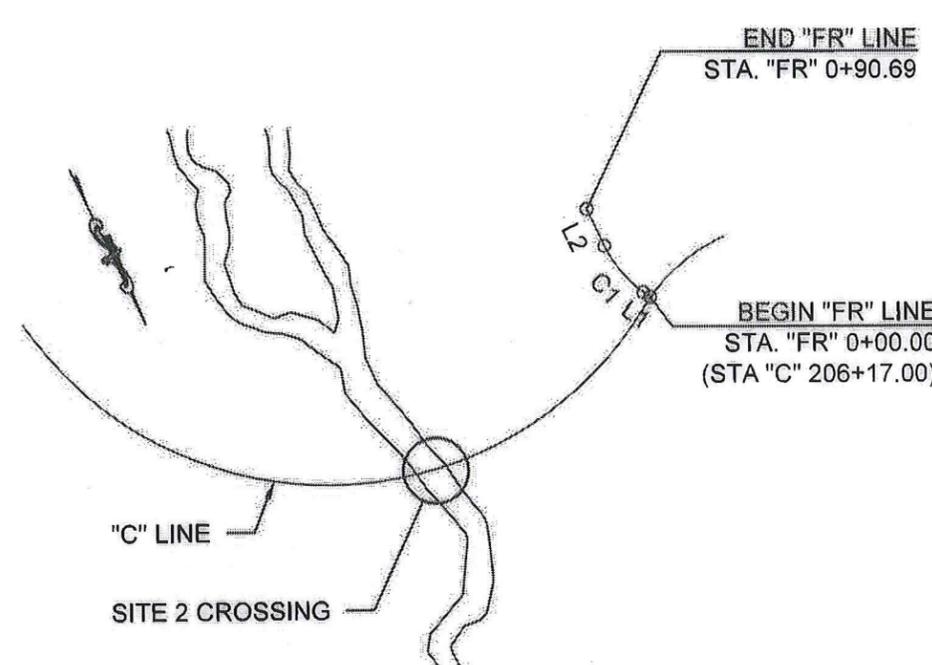

FOREST ROAD

BEGIN "D" LINE
STA. "D" 300+00.00

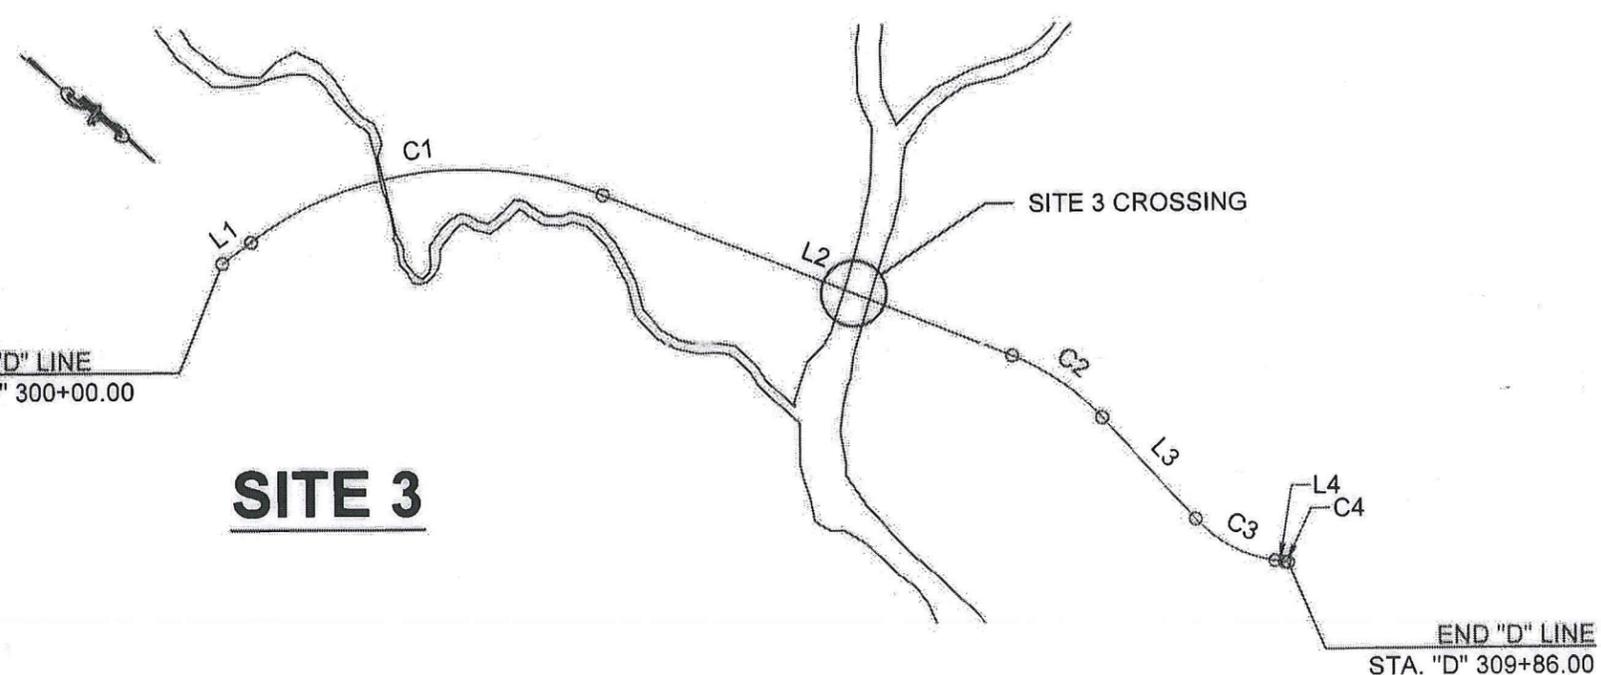

SITE 3

Project As Built Drawings Have Been Reviewed
By the Project Engineer & Represent, To the
Best of My Knowledge, the Project as
Constructed.

Project Eng. *Mandi Pelham* Date *8.23.17*




STATE OF ALASKA
DEPARTMENT OF TRANSPORTATION
& PUBLIC FACILITIES
SOUTHCOST REGION

KTN GRAVINA - MILL
ACCESS ROAD

ALIGNMENT DATA


DESIGNED BY: M. DUMAN	PROJECT DESIGNATION					
DRAWN BY: R. BERGER	YEAR					
PATH: P:\53\ADOT\53-02\Gravina\DesignPlans\53-02 A3-A5-A6_General.dwg	SHEET NO.					
TAB: A6	TOTAL SHEETS					
NO.	DATE	DESCRIPTION	Z699220000	2016	A6	48

DATE: 2/12/2016 12:55 PM
 LAYOUT: B1
 SCALE: INTS
 DESIGNED BY: M. DUMAN
 CHECKED BY: R. BERGER
 DRAWN BY: R. BERGER
 P: P:\ADOT\153-02\Gravina\Design\Plans\53-02_Typical Section.dwg

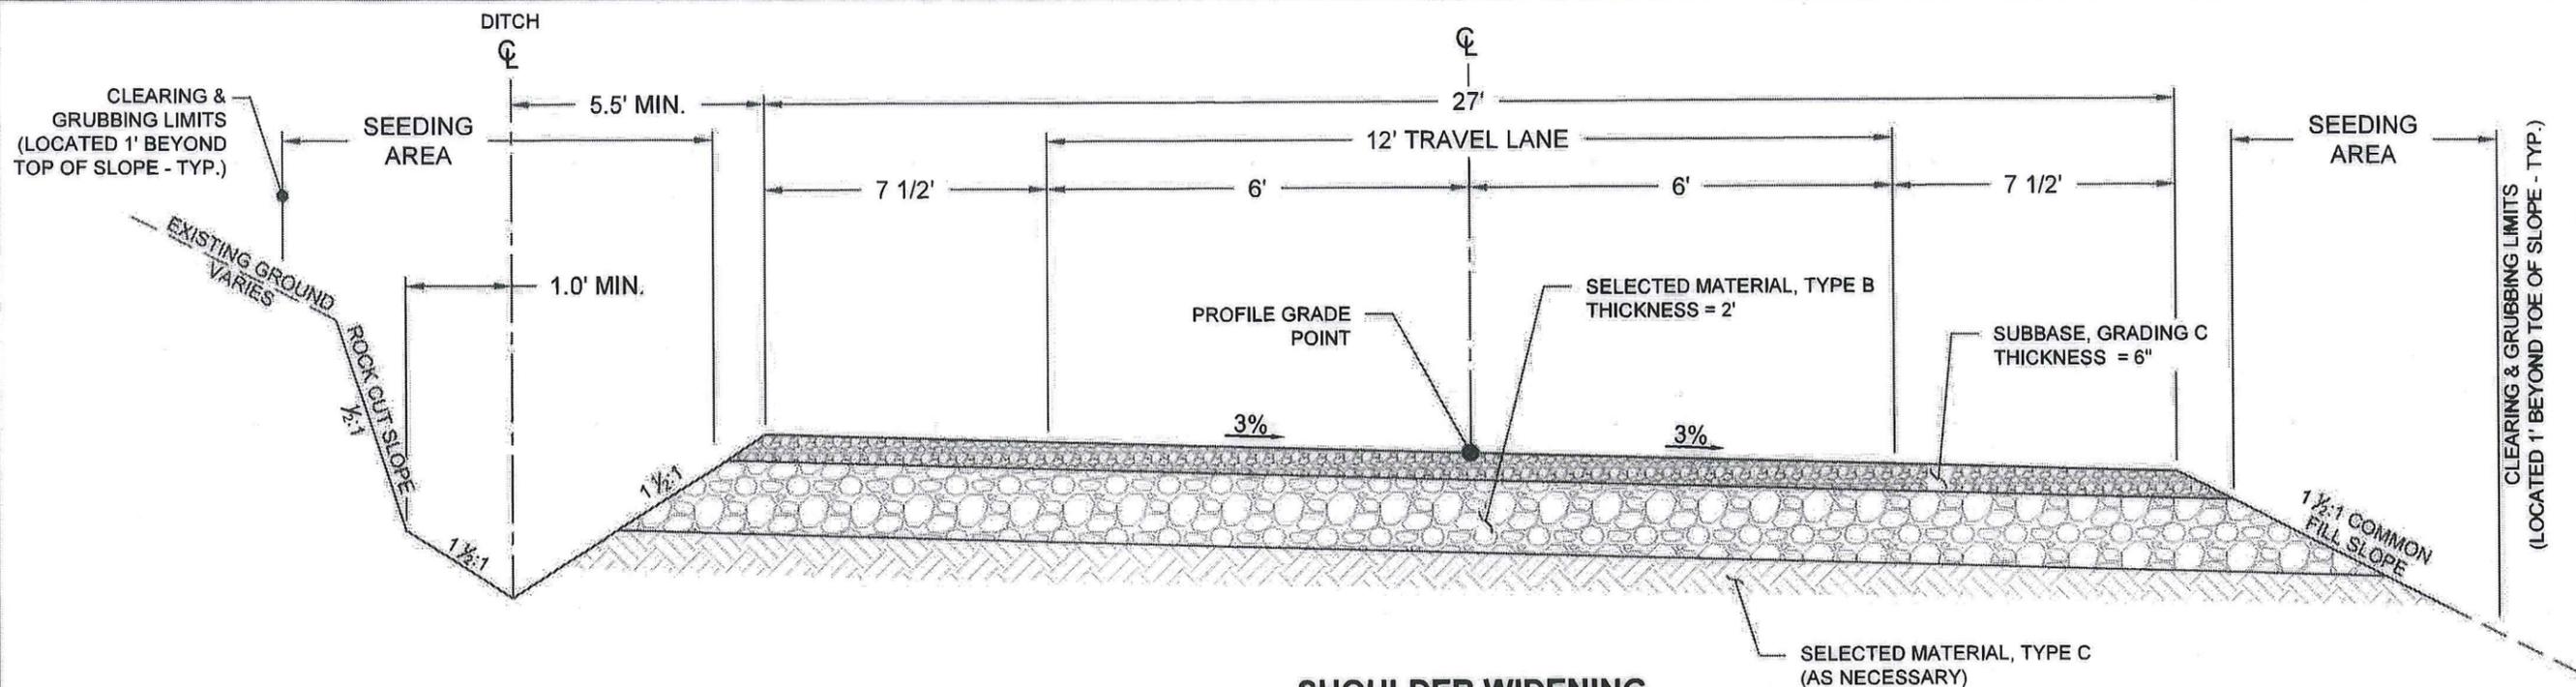

SHOULDER WIDENING

SITE 2: STA "C" 203+52.12-TO "C" 204+07.12
 SITE 3: STA "D" 305+24.30 TO "D" 305+90.36

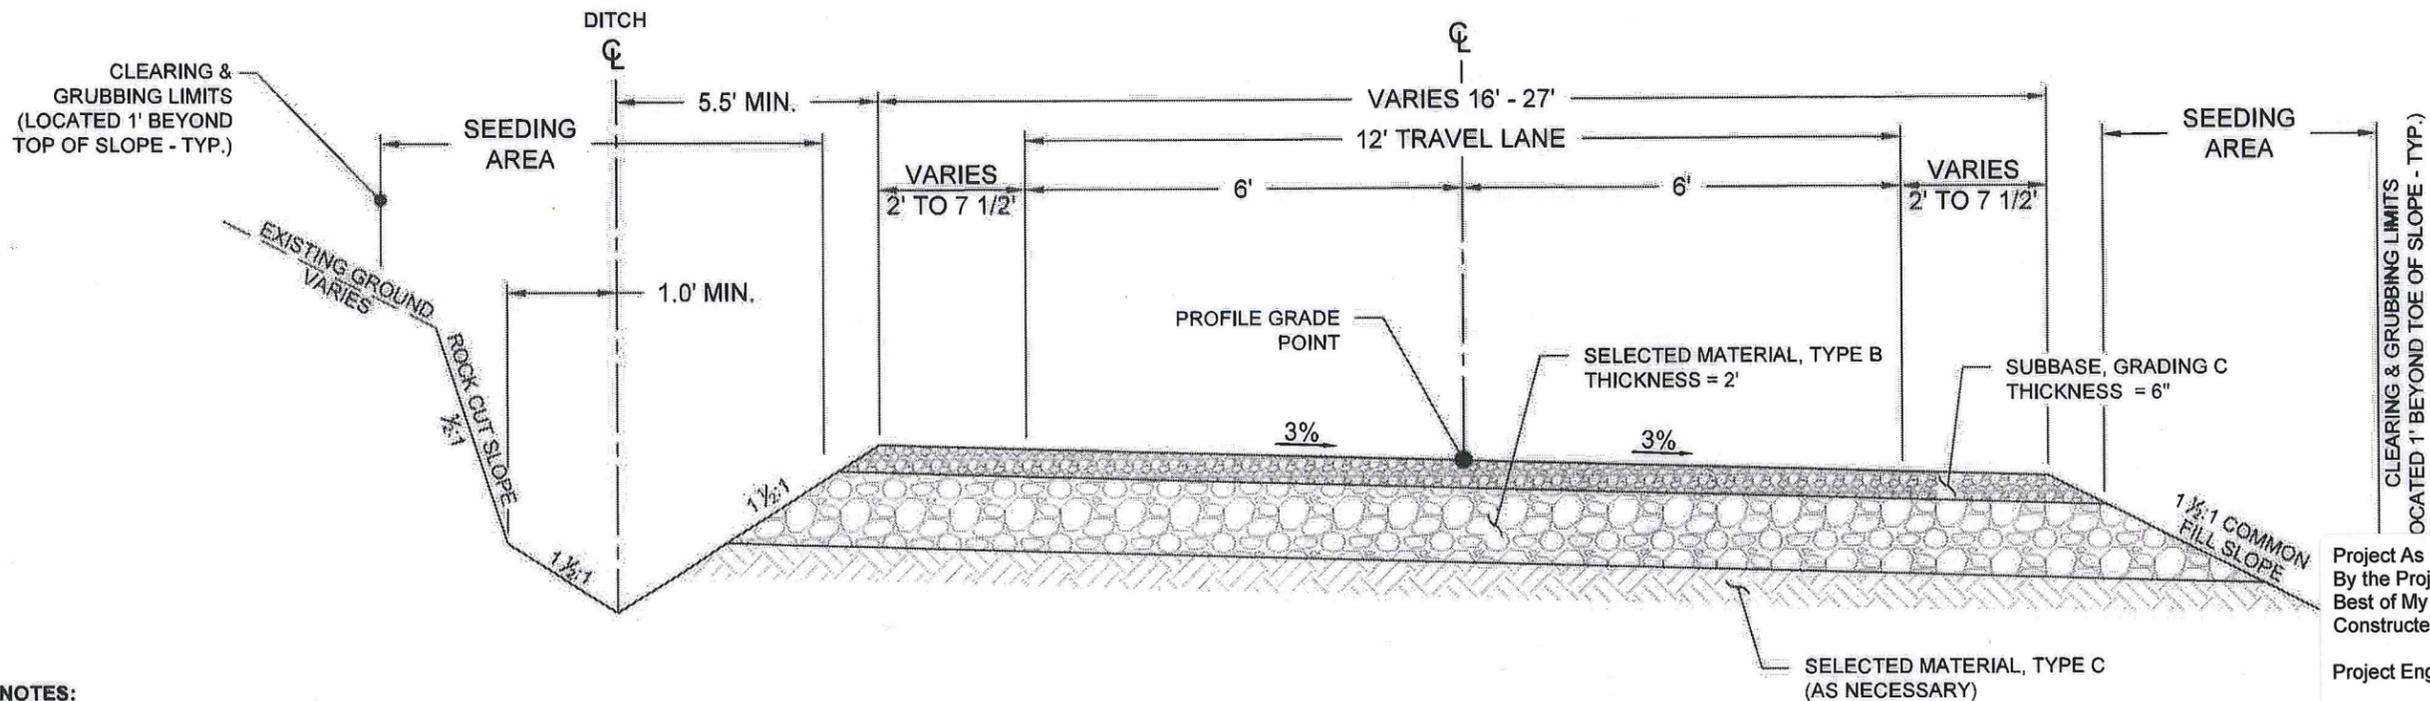

SHOULDER WIDENING TRANSITION

SITE 2: STA "C" 202+96.12 TO "C" 203+52.12
 STA "C" 204+07.12 TO "C" 204+63.12
 SITE 3: STA "D" 304+69.26 TO "D" 305+24.30
 STA "D" 305+90.36 TO "D" 306+45.40

NOTES:


- CLEARING & GRUBBING LIMITS SHALL BE LOCATED 1' BEYOND TOP / TOE OF SLOPE AS ESTABLISHED BY THE GRADING LIMITS.
- SEEDING AREA SHALL EXTEND FROM THE EDGE OF SUBBASE TO CLEARING & GRUBBING LIMITS, AND SHALL INCLUDE ANY OTHER CONSTRUCTION DISTURBED AREAS OFF THE ROADWAY.
- ROCK WITHIN THE PROJECT LIMITS IS SOFT, AND IS EXPECTED TO BE RIPABLE.
- ROCK SLOPES WILL NOT BE SEEDED.

Project As Built Drawings Have Been Reviewed By the Project Engineer & Represent, To the Best of My Knowledge, the Project as Constructed.

Project Eng. *MP* 8-23-17 Date

		STATE OF ALASKA DEPARTMENT OF TRANSPORTATION & PUBLIC FACILITIES SOUTHCOAST REGION	
		KTN GRAVINA - MILL ACCESS ROAD	
DESIGNED BY: M. DUMAN		TYPICAL SECTIONS	
DRAWN BY: R. BERGER		PROJECT DESIGNATION	
PATH: P:\53(ADOT)\53-02(Gravina)\Design\Plans\53-02_Typical Section.dwg		YEAR	SHEET NO.
TAB: B1		2016	B1
REVISIONS		TOTAL SHEETS	48
NO.	DATE	DESCRIPTION	
		Z699220000	


SCALE: N.T.S.
 DATE: 2/12/2016 12:53 PM
 DRAWING LOCATION: P:\303\30311\303-02\Drawings\Design\Plan\303-02_Typical Section.dwg

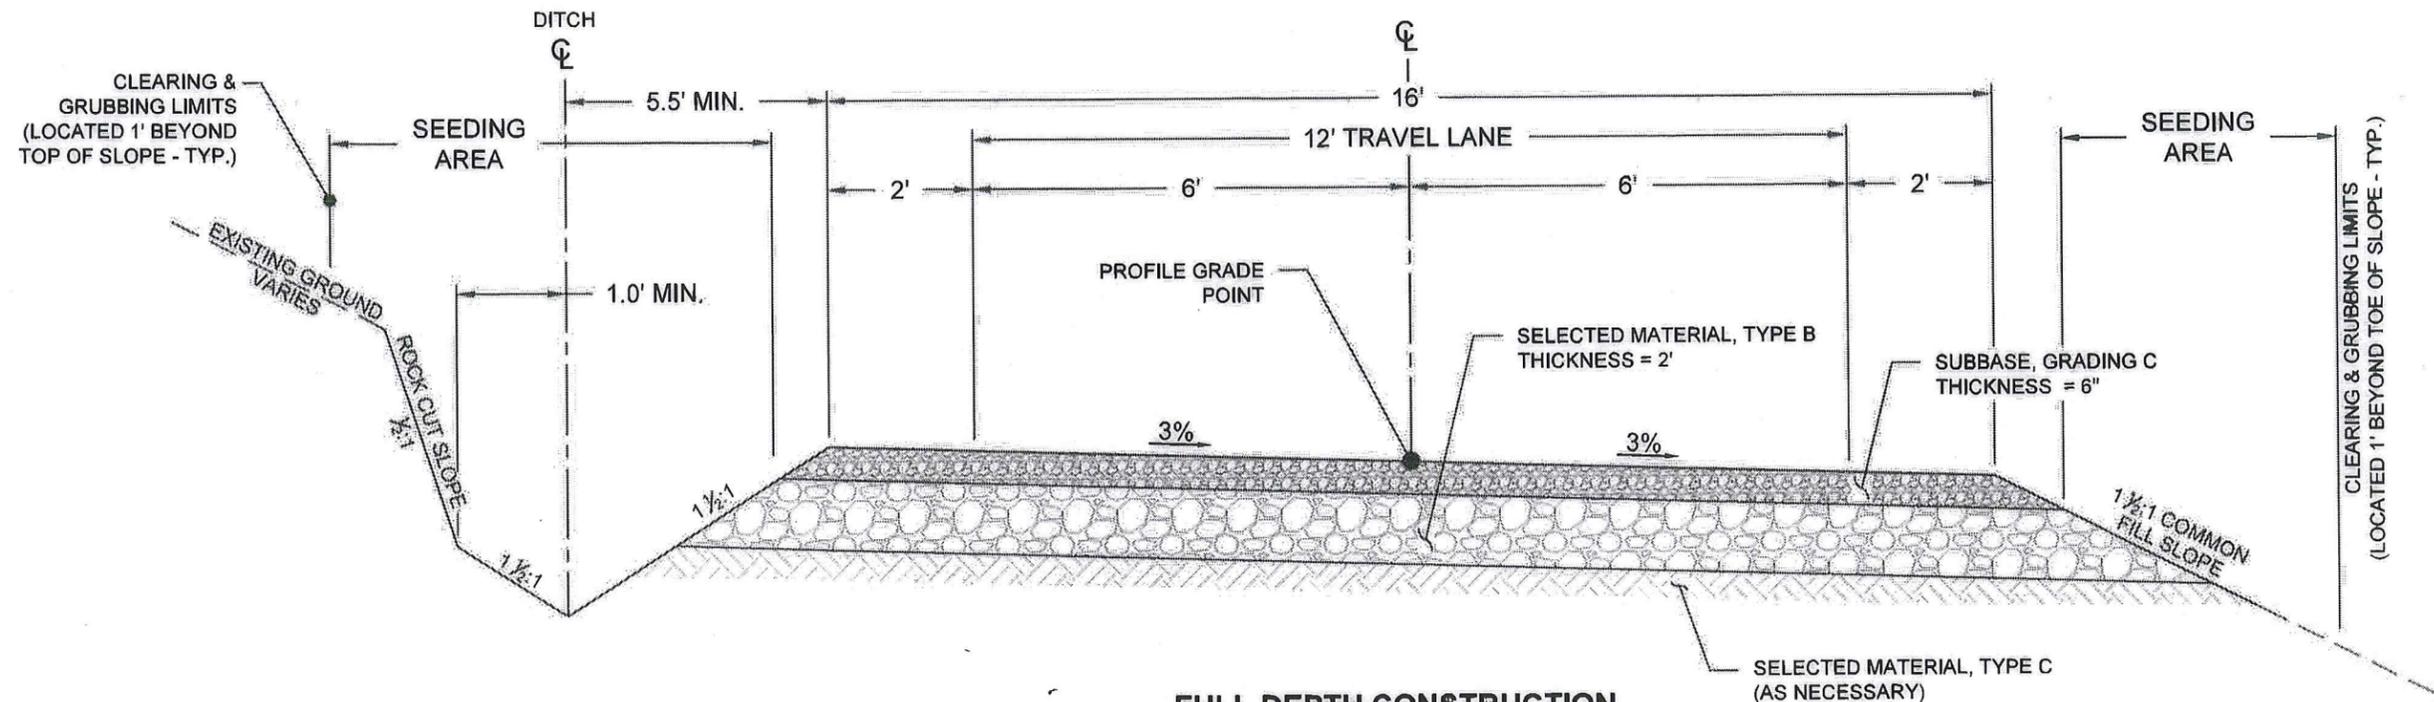

FULL DEPTH CONSTRUCTION

- SITE 1: STA "B" 100+00.00 TO "B" 102+15.00
 STA "B" 106+40.00 TO "B" 110+10.00
- SITE 2: STA "C" 200+00.00 TO "C" 202+96.12
 STA "C" 205+13.12 TO "C" 206+96.00
- SITE 3: STA "D" 300+00.00 TO "D" 304+69.26
 STA "D" 306+45.40 TO "D" 309+86.00

*Revision: See 2 sheets
 STN 300+00 - 309+86
 lay back slopes to 1.5:1
 to adjust from a rock cut
 to a soil cut*

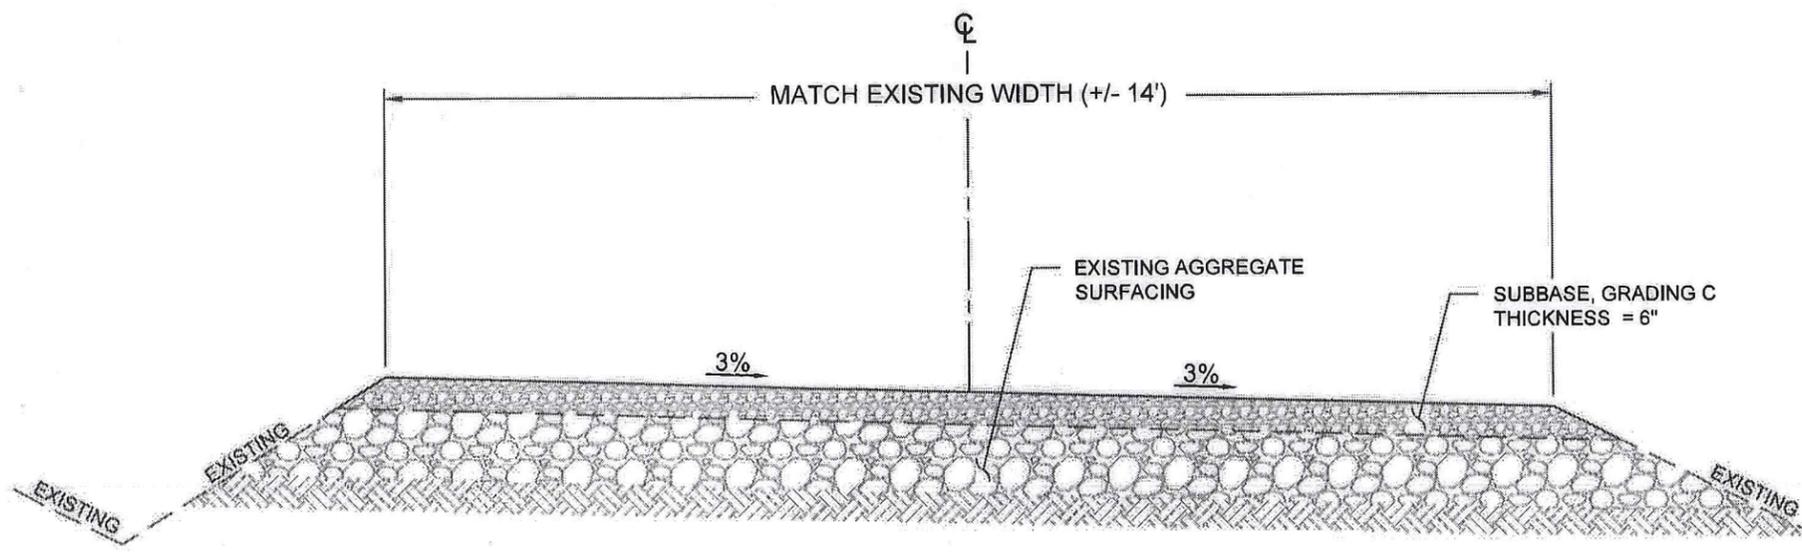

RESURFACING

- STA "A" 1053+55.00 TO "A" 1054+95.38
- STA "A" 1065+06.80 TO "A" 1080+84.00
- STA "A" 1088+84.38 TO "A" 1091+63.31
- STA "A" 1101+15.21 TO "A" 1137+75.00
- STA "B" 102+15.00 TO "B" 106+40.00
- STA "FR" 0+08.00 TO "FR" 0+90.69

NOTES:


- CLEARING & GRUBBING LIMITS SHALL BE LOCATED 1' BEYOND TOP / TOE OF SLOPE AS ESTABLISHED BY THE GRADING LIMITS.
- SEEDING AREA SHALL EXTEND FROM THE EDGE OF SUBBASE TO CLEARING & GRUBBING LIMITS, AND SHALL INCLUDE ANY OTHER CONSTRUCTION DISTURBED AREAS OFF THE ROADWAY.
- ROCK WITHIN THE PROJECT LIMITS IS SOFT, AND IS EXPECTED TO BE RIPABLE.
- ROCK SLOPES WILL NOT BE SEEDDED.



STATE OF ALASKA DEPARTMENT OF TRANSPORTATION & PUBLIC FACILITIES SOUTHCOST REGION			
KTN GRAVINA - MILL ACCESS ROAD			
TYPICAL SECTIONS			
DESIGNED BY: M. DUMAN	PROJECT DESIGNATION	YEAR	TOTAL SHEETS
DRAWN BY: R. BERGER	Z699220000	2016	48
PATH: P:\53\ADOT\53-02\Gravina\Design\Plan\53-02_Typical Section.dwg			
TAB: B2	Wednesday, February 17, 2016 11:40:26 AM	Ryan Berger	
NO.	DATE	DESCRIPTION	


Project As Built Drawings Have Been Reviewed By the Project Engineer & Represent, To the Best of My Knowledge, the Project as Constructed.
 Project Eng. *MP*
 Date *8-23-17*

DESIGNED BY: M. DUMAN
 DRAWN BY: R. BERGER
 CHECKED BY: R. BERGER
 SCALE: NTS
 LAYOUT: B3
 DATE: 3/14/2016 3:35 PM
 DRAWING LOCATION: F:\AS\ADOT\53-02\Gravina\Design\Plans\53-02_Typical Section.dwg

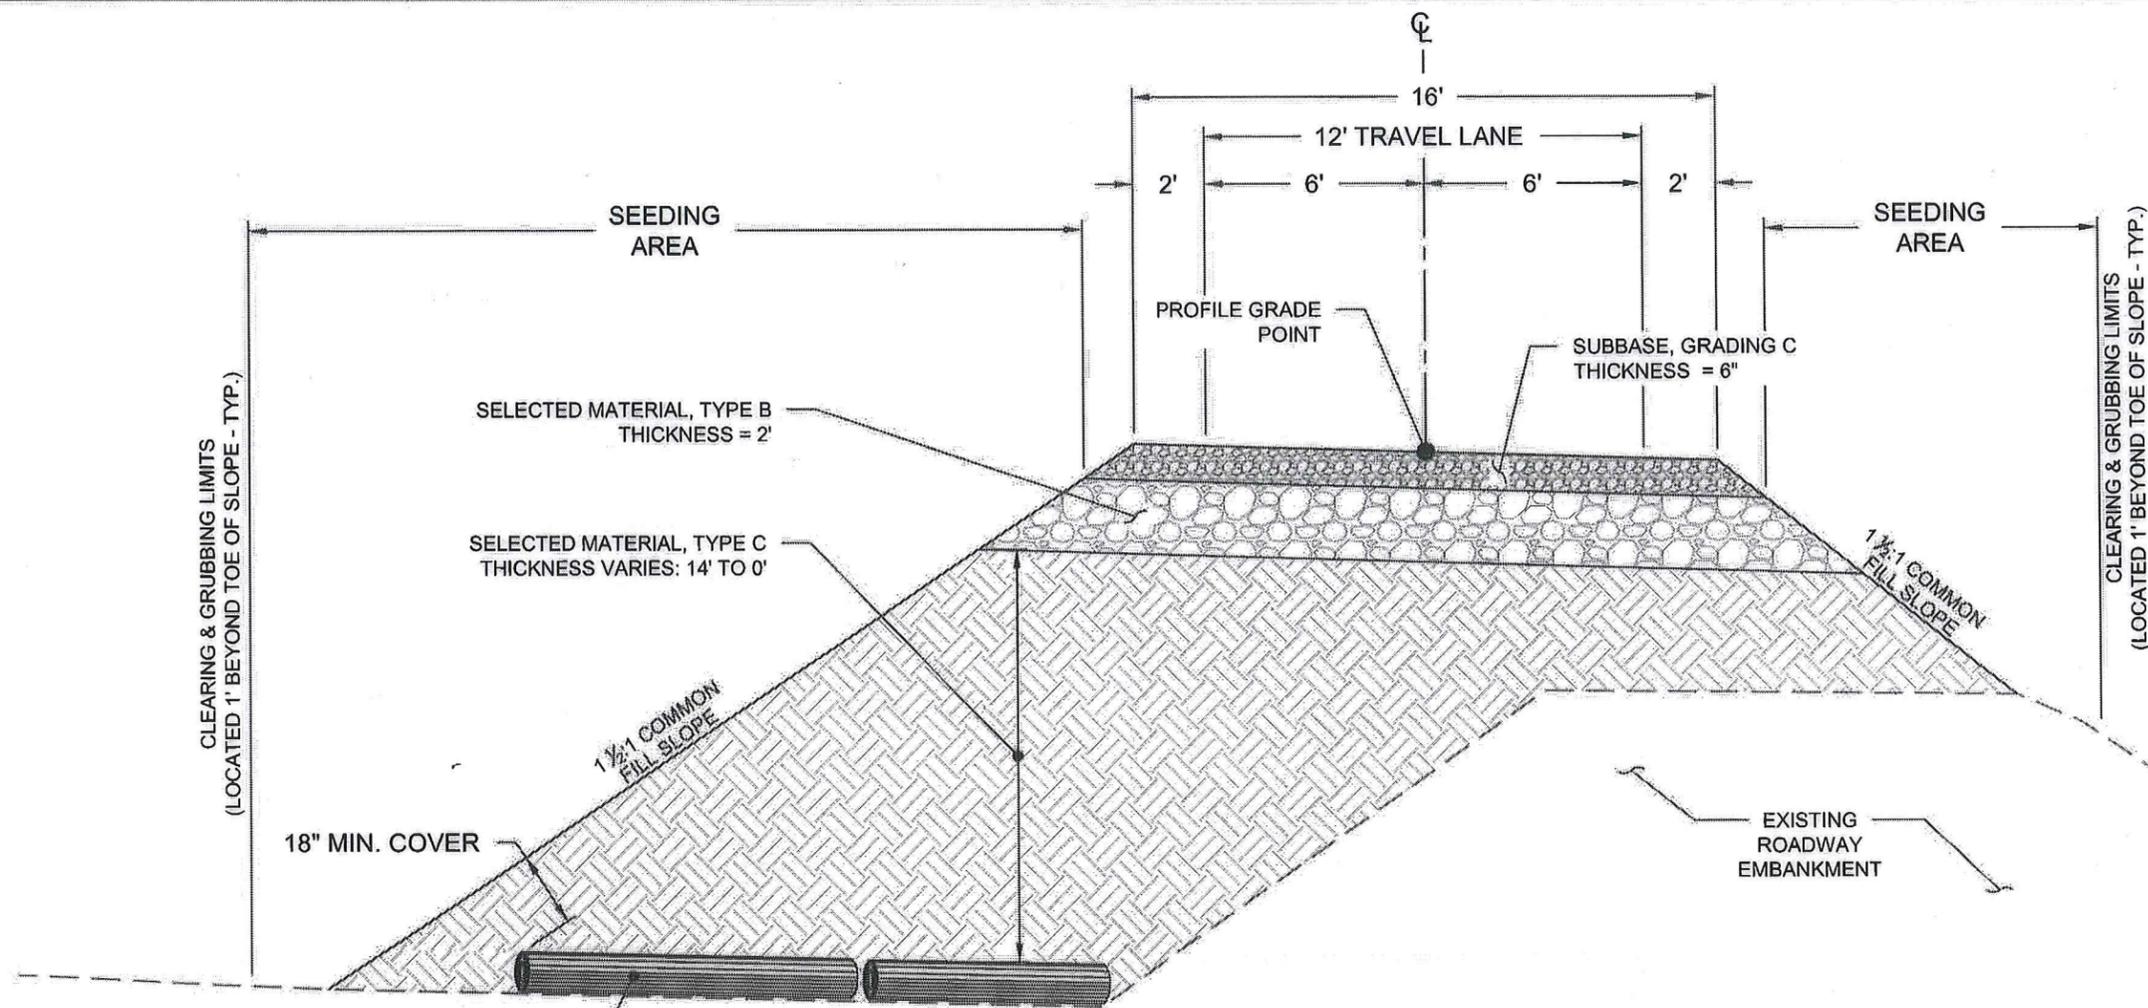

- NOTES:**
- CLEARING & GRUBBING LIMITS SHALL BE LOCATED 1' BEYOND TOP / TOE OF SLOPE AS ESTABLISHED BY THE GRADING LIMITS.
 - SEEDING AREA SHALL EXTEND FROM THE EDGE OF SUBBASE TO CLEARING & GRUBBING LIMITS, AND SHALL INCLUDE ANY OTHER CONSTRUCTION DISTURBED AREAS OFF THE ROADWAY.
 - ROCK WITHIN THE PROJECT LIMITS IS SOFT, AND IS EXPECTED TO BE RIPABLE. *See cjo # 6*
 - COMPLETELY ENCAPSULATE THE CORDUROY WITHIN THE EMBANKMENT. THE CORDUROY SHALL NOT PROTRUDE OUTSIDE THE FILL SLOPE.
 - SEE SUBSECTION 2.03-3.01 AND REFERENCE THE ENVIRONMENTAL COMMITMENTS IN APPENDIX B OF THE SPECIAL PROVISIONS.

CORDUROY STABILIZED SECTION
 SITE 2: STA "C" 204+63.12 TO "C" 205+13.12

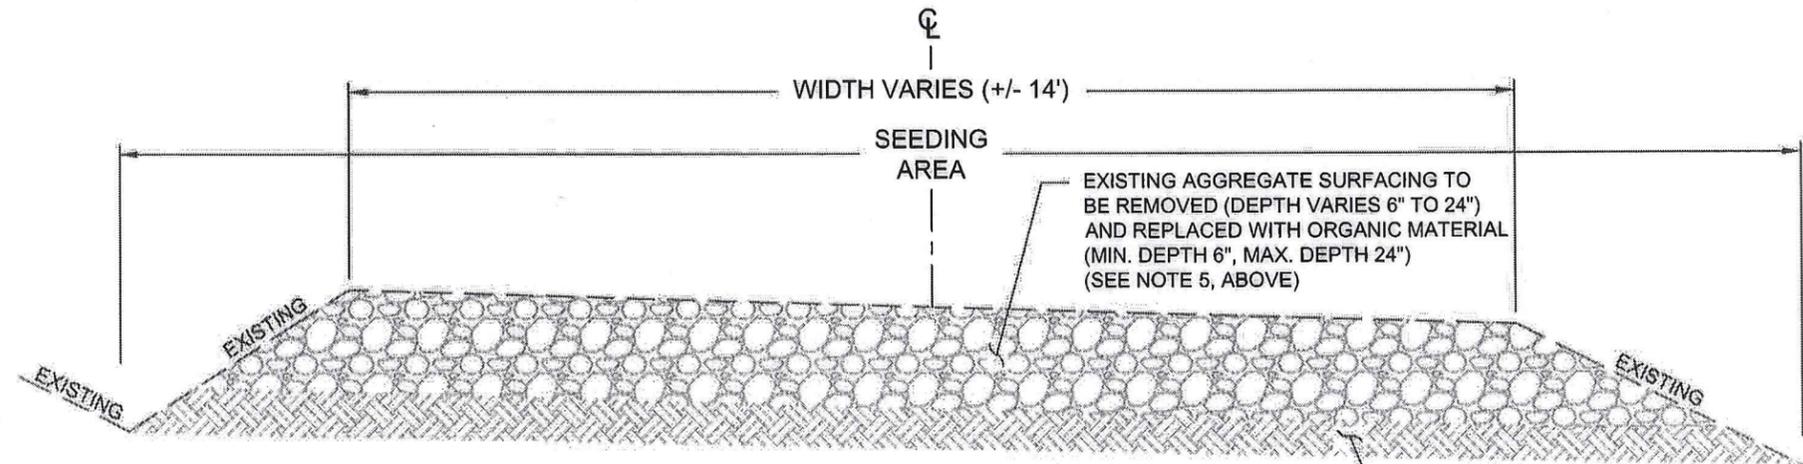

ROADWAY REMOVAL

- SITE 1: STA "A" 1061+35.86 TO "A" 1062+32.03
 STA "A" 1062+75.60 TO "A" 1065+06.80
- SITE 2: STA "A" 1081+23.54 TO "A" 1085+37.78
 STA "A" 1086+07.18 TO "A" 1087+22.25
- SITE 3: STA "A" 1091+70.91 TO "A" 1096+76.69
 STA "A" 1097+61.54 TO "A" 1101+15.21

Project As Built Drawings Have Been Reviewed by the Project Engineer & Represent, To the Best of My Knowledge, the Project as Constructed.
 Project Eng. *MP* Date *8.23.17*

		STATE OF ALASKA DEPARTMENT OF TRANSPORTATION & PUBLIC FACILITIES SOUTHCOST REGION	
		KTN GRAVINA - MILL ACCESS ROAD	
DESIGNED BY: M. DUMAN DRAWN BY: R. BERGER DATE: 3-15-2016		PROJECT DESIGNATION: Z699220000 YEAR: 2016	
PATH: P:\53\ADOT\53-02\Gravina\Design\Plans\53-02_Typical Section.dwg TAB: B3 Monday, March 14, 2016 3:37:17 PM		SHEET NO.: B3	TOTAL SHEETS: 48

EARTHWORK SUMMARY - ADDITIVE ALTERNATE A

SITE	STATION TO STATION	EXCAVATION							EMBANKMENT							
									TOTAL REQUIRED MATERIAL		ONSITE AVAILABLE		BORROW MATERIAL		BALANCE	
		TOTAL UNCLASSIFIED EXCAVATION (CY)	MUCK EXCAVATION (CY)	ROCK EXCAVATION (CY)	COMMON EXCAVATION (CY)	RECLAIMED ROADWAY MATERIAL FROM ABANDONED ROADWAY SEGMENTS (CY)	TOTAL UNUSABLE EXCAVATION (CY)	TOTAL USABLE EXCAVATION (CY)	SELECTED MATERIAL TYPE B (CY)	SELECTED MATERIAL TYPE C (CY)	SELECTED MATERIAL TYPE B (CY)	SELECTED MATERIAL TYPE C (CY)	SELECTED MATERIAL TYPE B (CY)	SELECTED MATERIAL TYPE C (CY)	TOTAL EMBANKMENT (CY)	EXCESS MATERIAL (CY)
1	"B" 100+00.00 to "B" 110+10.00	784	314	329	141	52*	314**	522*	919	81	0	522*	919	0	1000	441*

EARTHWORK NOTES:

- * - USED AN ASSUMED DEPTH OF 6" OF USABLE MATERIAL FROM RECLAIMED ROADWAY.
- ** - MATERIAL VOLUME MAY BE MORE OR LESS THAN LISTED VALUE, BASED ON SITE CONDITIONS AT THE TIME OF CONSTRUCTION.

CULVERT INSTALLATION SUMMARY - ADDITIVE ALTERNATE A

PIPE	INLET			OUTLET			LENGTH (FT)	SIZE	REMARKS	APPROX GRADE
	STATION	OFFSET	INVERT	STATION	OFFSET	INVERT				
P-1	"B" 107+59.00	17' LEFT	132.13	"B" 107+59.00	22' RIGHT	128.66	38'	48" CORRUGATED ALUMINUM PIPE		9.13%

REMOVAL OF STRUCTURES AND OBSTRUCTIONS - ADDITIVE ALTERNATE (SITE 1)

STATION	OFFSET	DESCRIPTION	REMARKS
"B" 107+57	13.5' RT	STEEL I-BEAMS WITH SHEET METAL COVERING	APPROXIMATE DIMENSIONS 20' X 14'

Project As Built Drawings Have Been Reviewed By the Project Engineer & Represent, To the Best of My Knowledge, the Project as Constructed.

Project Eng. *MP*

8-23-17
Date



STATE OF ALASKA
DEPARTMENT OF TRANSPORTATION & PUBLIC FACILITIES
SOUTHCOST REGION

KTN GRAVINA - MILL
ACCESS ROAD

SUMMARY TABLES
ADD ALTERNATE A

DESIGNED BY: M. DUMAN
DRAWN BY: R. BERGER

PATH: P:\53(ADOT)\53-02(Gravina)\Design\Plane\53-02 C1 & D1.dwg
TAB: D1 Wednesday, February 17, 2016 11:43:27 AM Ryan Berger

REVISIONS			PROJECT DESIGNATION	YEAR	SHEET NO.	TOTAL SHEETS
NO.	DATE	DESCRIPTION				
			Z699220000	2016	D1	48

EARTHWORK SUMMARY - BASIC BID

SITE	STATION TO STATION	EXCAVATION							EMBANKMENT							
		TOTAL UNCLASSIFIED EXCAVATION (CY)	MUCK EXCAVATION (CY)	ROCK EXCAVATION (CY)	COMMON EXCAVATION (CY)	RECLAIMED ROADWAY MATERIAL FROM ABANDONED ROADWAY SEGMENTS (CY)	TOTAL UNUSABLE EXCAVATION (CY)	TOTAL USABLE EXCAVATION (CY)	TOTAL REQUIRED MATERIAL		ONSITE AVAILABLE		BORROW MATERIAL		BALANCE	
									SELECTED MATERIAL TYPE B (CY)	SELECTED MATERIAL TYPE C (CY)	SELECTED MATERIAL TYPE B (CY)	SELECTED MATERIAL TYPE C (CY)	SELECTED MATERIAL TYPE B (CY)	SELECTED MATERIAL TYPE C (CY)	TOTAL EMBANKMENT (CY)	EXCESS MATERIAL (CY)
2	"C" 200+00.00 TO "C" 206+96.00	268	107	38	123	125*	107**	286*	3824	7386	0	286*	3824	4045***	11210	0
3	"D" 300+00.00 TO "D" 309+86.00	6180	2472	2595	1113	315*	2472**	4023*	3216	968	0	4023*	3216	0	4184	3055***
TOTAL		6448	2579	2633	1236	440*	2579**	4309*	7040	8354	0	4309*	7040	4045***	15394	3055***

EARTHWORK NOTES:

- * - USED AN ASSUMED DEPTH OF 6" OF USEABLE MATERIAL FROM RECLAIMED ROADWAY.
- ** - MATERIAL VOLUME MAY BE MORE OR LESS THAN LISTED VALUE, BASED ON SITE CONDITIONS AT THE TIME OF CONSTRUCTION.
- *** - EXCESS MATERIAL FROM SITE #3 APPLIED TO BORROW VALUE FOR SELECT MATERIAL, TYPE C ON SITE #2.

CULVERT INSTALLATION SUMMARY - BASIC BID

PIPE	INLET			OUTLET			LENGTH (FT)	SIZE	REMARKS	APPROX GRADE
	STATION	OFFSET	INVERT	STATION	OFFSET	INVERT				
P-2	"D" 301+50.00	18' LEFT	50.49	"D" 301+50.00	19' RIGHT	49.75	36'	24" CORRUGATED ALUMINUM PIPE		2.05%
P-3	"D" 309+20.10	14' LEFT	55.87	"D" 309+20.10	13' RIGHT	55.33	26'	24" CORRUGATED ALUMINUM PIPE		2.07%
P-4	"FR" 0+22.73	37' RIGHT	77.22	"FR" 0+26.61	28' LEFT	74.82	65'	24" CORRUGATED ALUMINUM PIPE		3.70%

REMOVAL OF STRUCTURES AND OBSTRUCTIONS - BASIC BID

STATION	OFFSET	DESCRIPTION	REMARKS
"C" 203+93	30' RT	TWO STEEL RAIL CARS PLACED SIDE BY SIDE	APPROXIMATE DIMENSION: 70' X 18'
"D" 301+49	32' RT	24" CULVERT	APPROXIMATE LENGTH: 31'
"D" 305+76	124' RT	TWO STEEL RAIL CARS PLACED SIDE BY SIDE	APPROXIMATE DIMENSION: 70' X 18'

STANDARD SIGN SUMMARY - BASIC BID

SIGN NO.	STA	OFFSET		ASDS CODE	LEGEND	TRAFFIC TRAVELING	HEIGHT (IN)	WIDTH (IN)	AREA (SQ FT)	POST			REMARKS
		L	R							NO.	SIZE (IN)	TYPE	
1	"A" 1054+00		X	R2-1	SPEED LIMIT 25	NB	30"	24"	5.00	1	2.5"X2.5"	PSST	
2	"A" 1080+25		X	W1-1L	(SYMBOL) TURN LEFT	NB	36"	36"	9.00	1	2.5"X2.5"	PSST	
3	"C" 203+52		X	CUSTOM	EAST FORK LEWIS REEF CREEK	NB	2'-6"	6'-6"	16.25	2	2.5"X2.5"	PSST	SEE CUSTOM SIGN DETAIL, SHT. H1
4	"C" 204+08	X		CUSTOM	EAST FORK LEWIS REEF CREEK	SB	2'-6"	6'-6"	16.25	2	2.5"X2.5"	PSST	SEE CUSTOM SIGN DETAIL, SHT. H1
5	"C" 205+32	X		R1-2	YIELD	EB (FOREST ROAD)	24"	24"	4.00	1	2.5"X2.5"	PSST	INTERSECTION "FR" LINE @ "C" LINE
6	"A" 1088+94	X		W1-1R	(SYMBOL) TURN RIGHT	SB	36"	36"	9.00	1	2.5"X2.5"	PSST	
7	"D" 304+92		X	CUSTOM	WEST FORK LEWIS REEF CREEK	NB	2'-6"	6'-6"	16.25	2	2.5"X2.5"	PSST	SEE CUSTOM SIGN DETAIL, SHT. H2. MAINTAIN 100' FROM SIGN #8.
8	"D" 305+92		X	W1-3R	(SYMBOL) REVERSE TURN RIGHT	NB	36"	36"	9.00	1	2.5"X2.5"	PSST	
9	"D" 306+19	X		CUSTOM	WEST FORK LEWIS REEF CREEK	SB	2'-6"	6'-6"	16.25	2	2.5"X2.5"	PSST	SEE CUSTOM SIGN DETAIL, SHT. H2
10	"A" 1102+68	X		W1-3R	(SYMBOL) REVERSE TURN RIGHT	SB	36"	36"	9.00	1	2.5"X2.5"	PSST	
11	"A" 1135+57	X		R2-1	SPEED LIMIT 25	SB	30"	24"	5.00	1	2.5"X2.5"	PSST	
12	"A" 1137+70		X	W14-1	DEAD END	NB	36"	36"	9.00	1	2.5"X2.5"	PSST	

Project As Built Drawings Have Been Reviewed By the Project Engineer & Represent, To the Best of My Knowledge, the Project as Constructed.

Project Eng. *MP*

8.23.17
Date





STATE OF ALASKA
DEPARTMENT OF TRANSPORTATION & PUBLIC FACILITIES
SOUTHCOST REGION

KTN GRAVINA - MILL
ACCESS ROAD

SUMMARY TABLES

DESIGNED BY: M. DUMAN	PROJECT DESIGNATION		YEAR	SHEET NO.	TOTAL SHEETS
DRAWN BY: R. BERGER	Z699220000		2016	D2	48
PATH: P:\53(ADOT)\53-02(Gravina)\DesignPlans\53-02 C1 & D1.dwg		DATE: Wednesday, February 17, 2016 11:43:27 AM		DRAWN BY: Ryan Berger	
TAB: D2	REVISIONS				
NO.	DATE	DESCRIPTION			

ADDITIVE ALTERNATE A "B" LINE PLAN

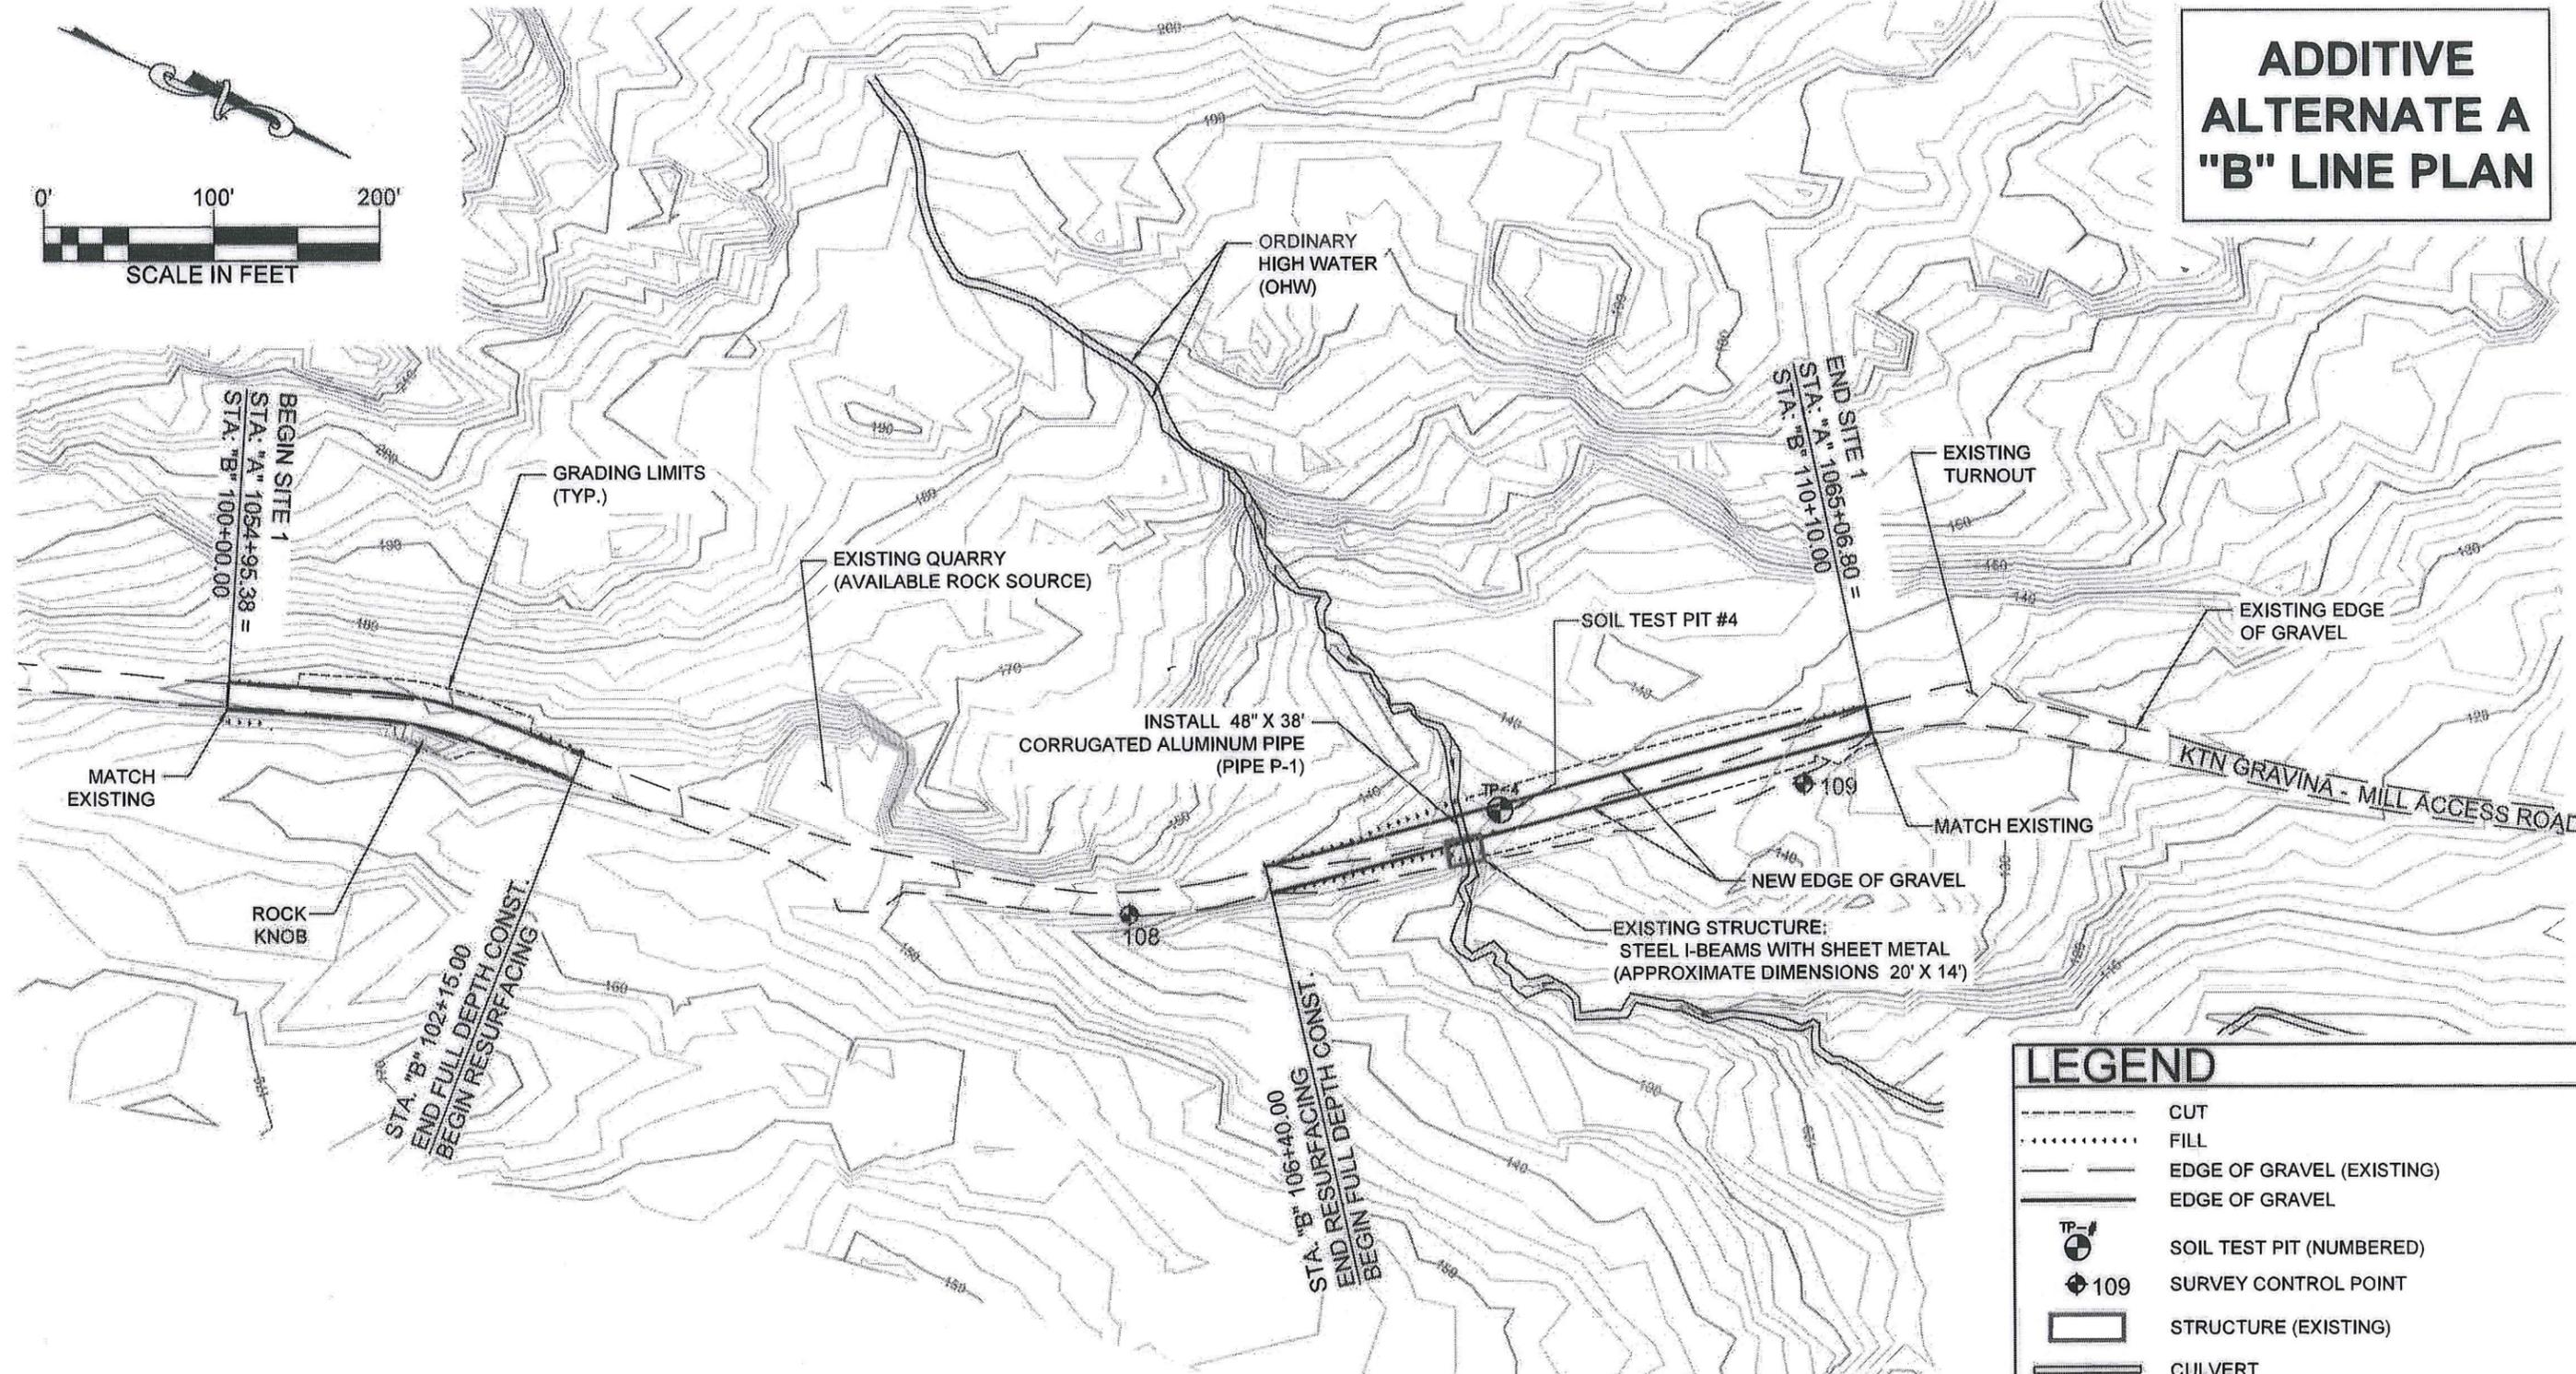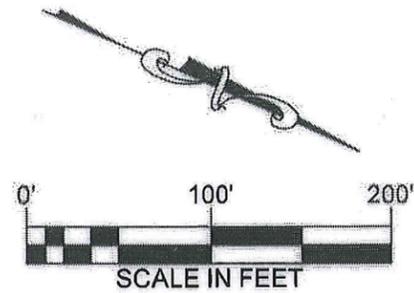

LEGEND

- CUT
- FILL
- EDGE OF GRAVEL (EXISTING)
- EDGE OF GRAVEL
- SOIL TEST PIT (NUMBERED)
- SURVEY CONTROL POINT
- STRUCTURE (EXISTING)
- CULVERT

Project As Built Drawings Have Been Reviewed
By the Project Engineer & Represent, To the
Best of My Knowledge, the Project as
Constructed.

Project Eng. *MP* Date *8.23.17*

SURVEY CONTROL POINTS				
POINT #	NORTHING	EASTING	ELEVATION	DESCRIPTION
109	1296545.6190	3085620.0830	136.9000	2" AL. CAP SET BY DOT
108	1296208.9630	3085852.4460	143.8320	2" AL. CAP SET BY DOT

*HORIZONTAL DATUM IS NAD83(2011) 2010.00 ALASKA STATE PLANE ZONE 1. VERTICAL DATUM IS NAD88.

DESIGNED BY: M. DUMAN
DRAWN BY: R. BERGER

PATH: P:\53(ADOT)\53-02(Gravina)\Design\Plans\53-02 Site Exhibits.dwg
TAB: E2 Wednesday, February 17, 2016 11:46:31 AM Ryan Berger

2-23-2016

STATE OF ALASKA
DEPARTMENT OF TRANSPORTATION
& PUBLIC FACILITIES
SOUTHCOST REGION

**KTN GRAVINA - MILL
ACCESS ROAD**



**ADDITIVE ALTERNATE A
SITE EXHIBIT SITE 1**

NO.	DATE	DESCRIPTION

PROJECT DESIGNATION	YEAR	SHEET NO.	TOTAL SHEETS
Z699220000	2016	E2	48

DRAWING: 05A102a
 P:\53(ADOT)\53-02(Gravina)\Design\Plans\53-02 Site Exhibits.dwg
 DATE: 2/8/2016 11:54 AM
 SCALE: 1" = 100'
 LAYOUT: E2

DRAWING LOCATION: P:\53\ADOT\53-02\Gravina\Design\Plans\53-02_Site Exhibits.dwg
 DATE TIME: 2/9/2016 11:54 AM
 SCALE: 1" = 100'
 LAYOUT: E3

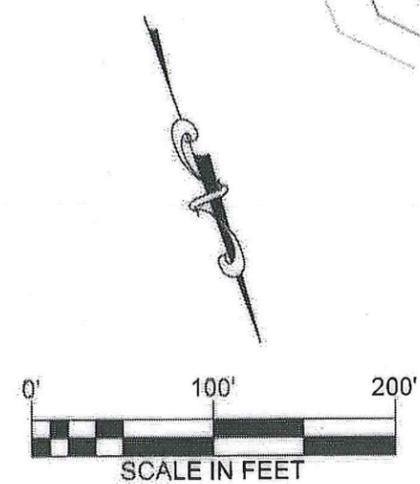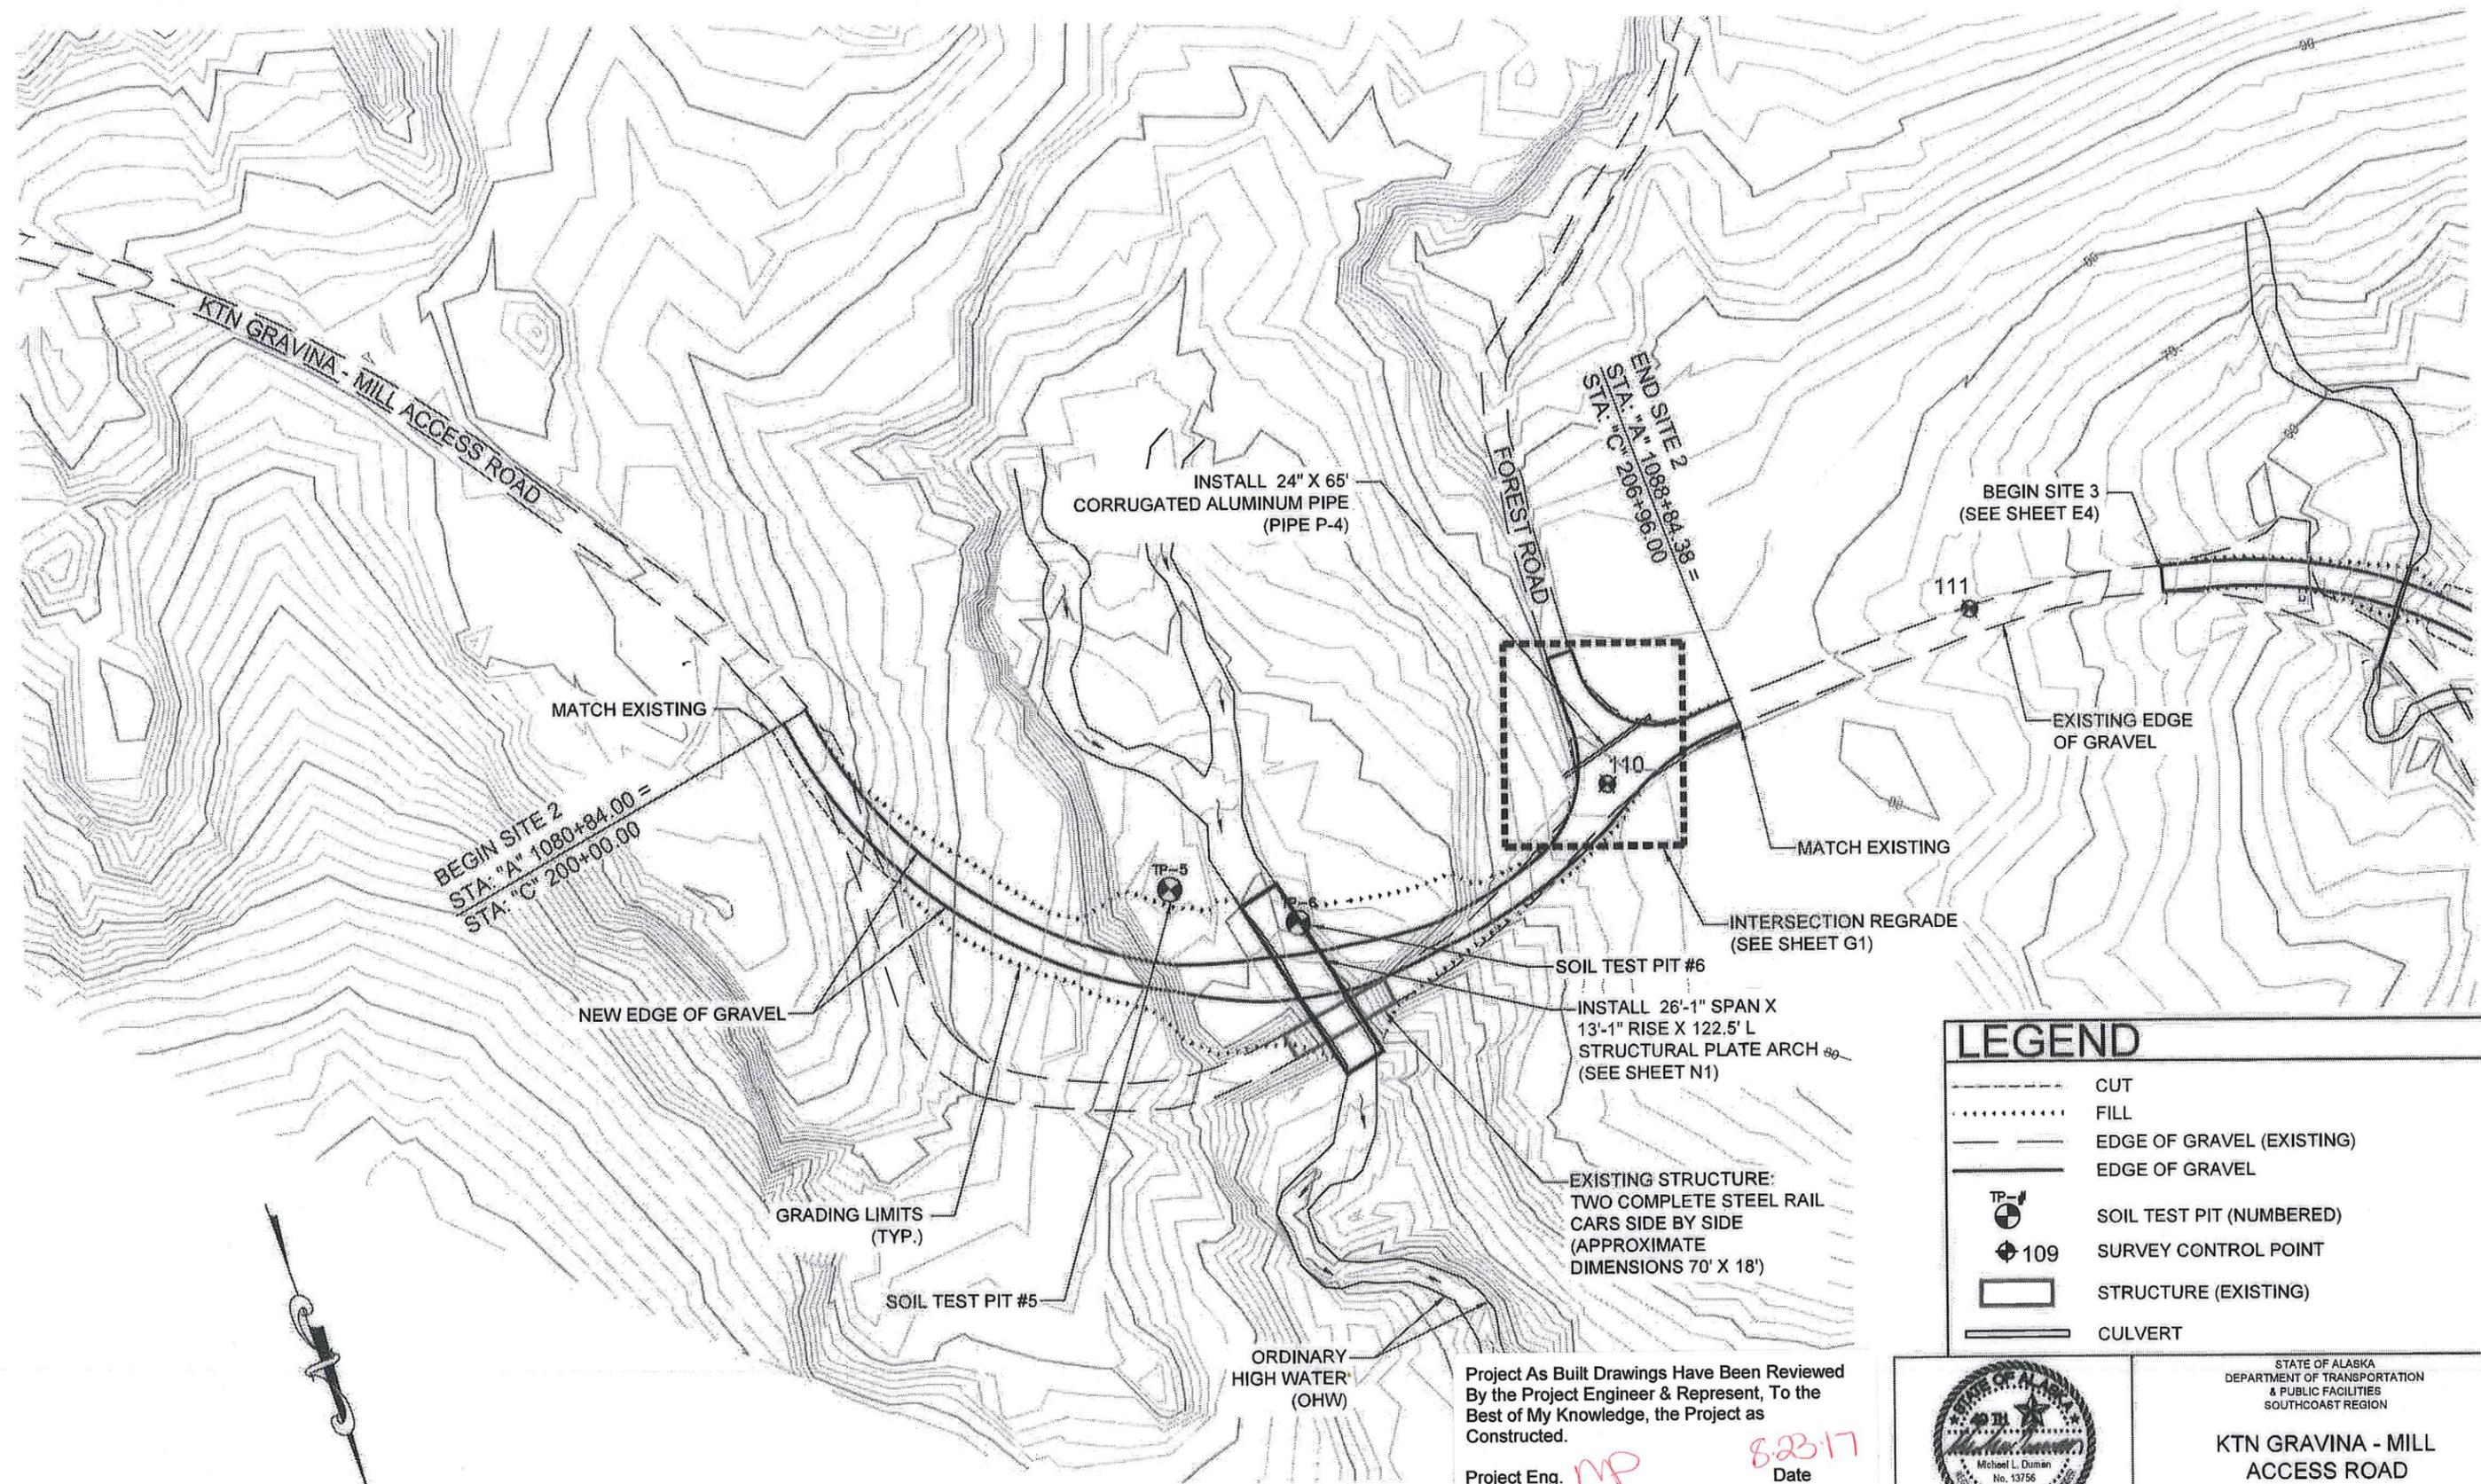

LEGEND	
	CUT
	FILL
	EDGE OF GRAVEL (EXISTING)
	EDGE OF GRAVEL
	SOIL TEST PIT (NUMBERED)
	SURVEY CONTROL POINT
	STRUCTURE (EXISTING)
	CULVERT

Project As Built Drawings Have Been Reviewed By the Project Engineer & Represent, To the Best of My Knowledge, the Project as Constructed.

Project Eng. *MP* Date *8-23-17*

SURVEY CONTROL POINTS				
POINT #	NORTHING	EASTING	ELEVATION	DESCRIPTION
111	1297893.0330	3083924.6920	76.1700	2" AL. CAP SET BY DOT
110	1297917.1020	3084173.0810	79.2820	2" AL. CAP SET BY DOT

*HORIZONTAL DATUM IS NAD83(2011) 2010.00 ALASKA STATE PLANE ZONE 1. VERTICAL DATUM IS NAD88.

DESIGNED BY: M. DUMAN
DRAWN BY: R. BERGER

2-22-2016



PATH: P:\53\ADOT\53-02\Gravina\Design\Plans\53-02_Site Exhibits.dwg
TAB: E3
Wednesday, February 17, 2016 11:46:33 AM

STATE OF ALASKA
DEPARTMENT OF TRANSPORTATION
& PUBLIC FACILITIES
SOUTHCOST REGION

**KTN GRAVINA - MILL
ACCESS ROAD**

**SITE EXHIBIT
SITE 2**

NO.	DATE	DESCRIPTION	PROJECT DESIGNATION	YEAR	SHEET NO.	TOTAL SHEETS
			Z699220000	2016	E3	48

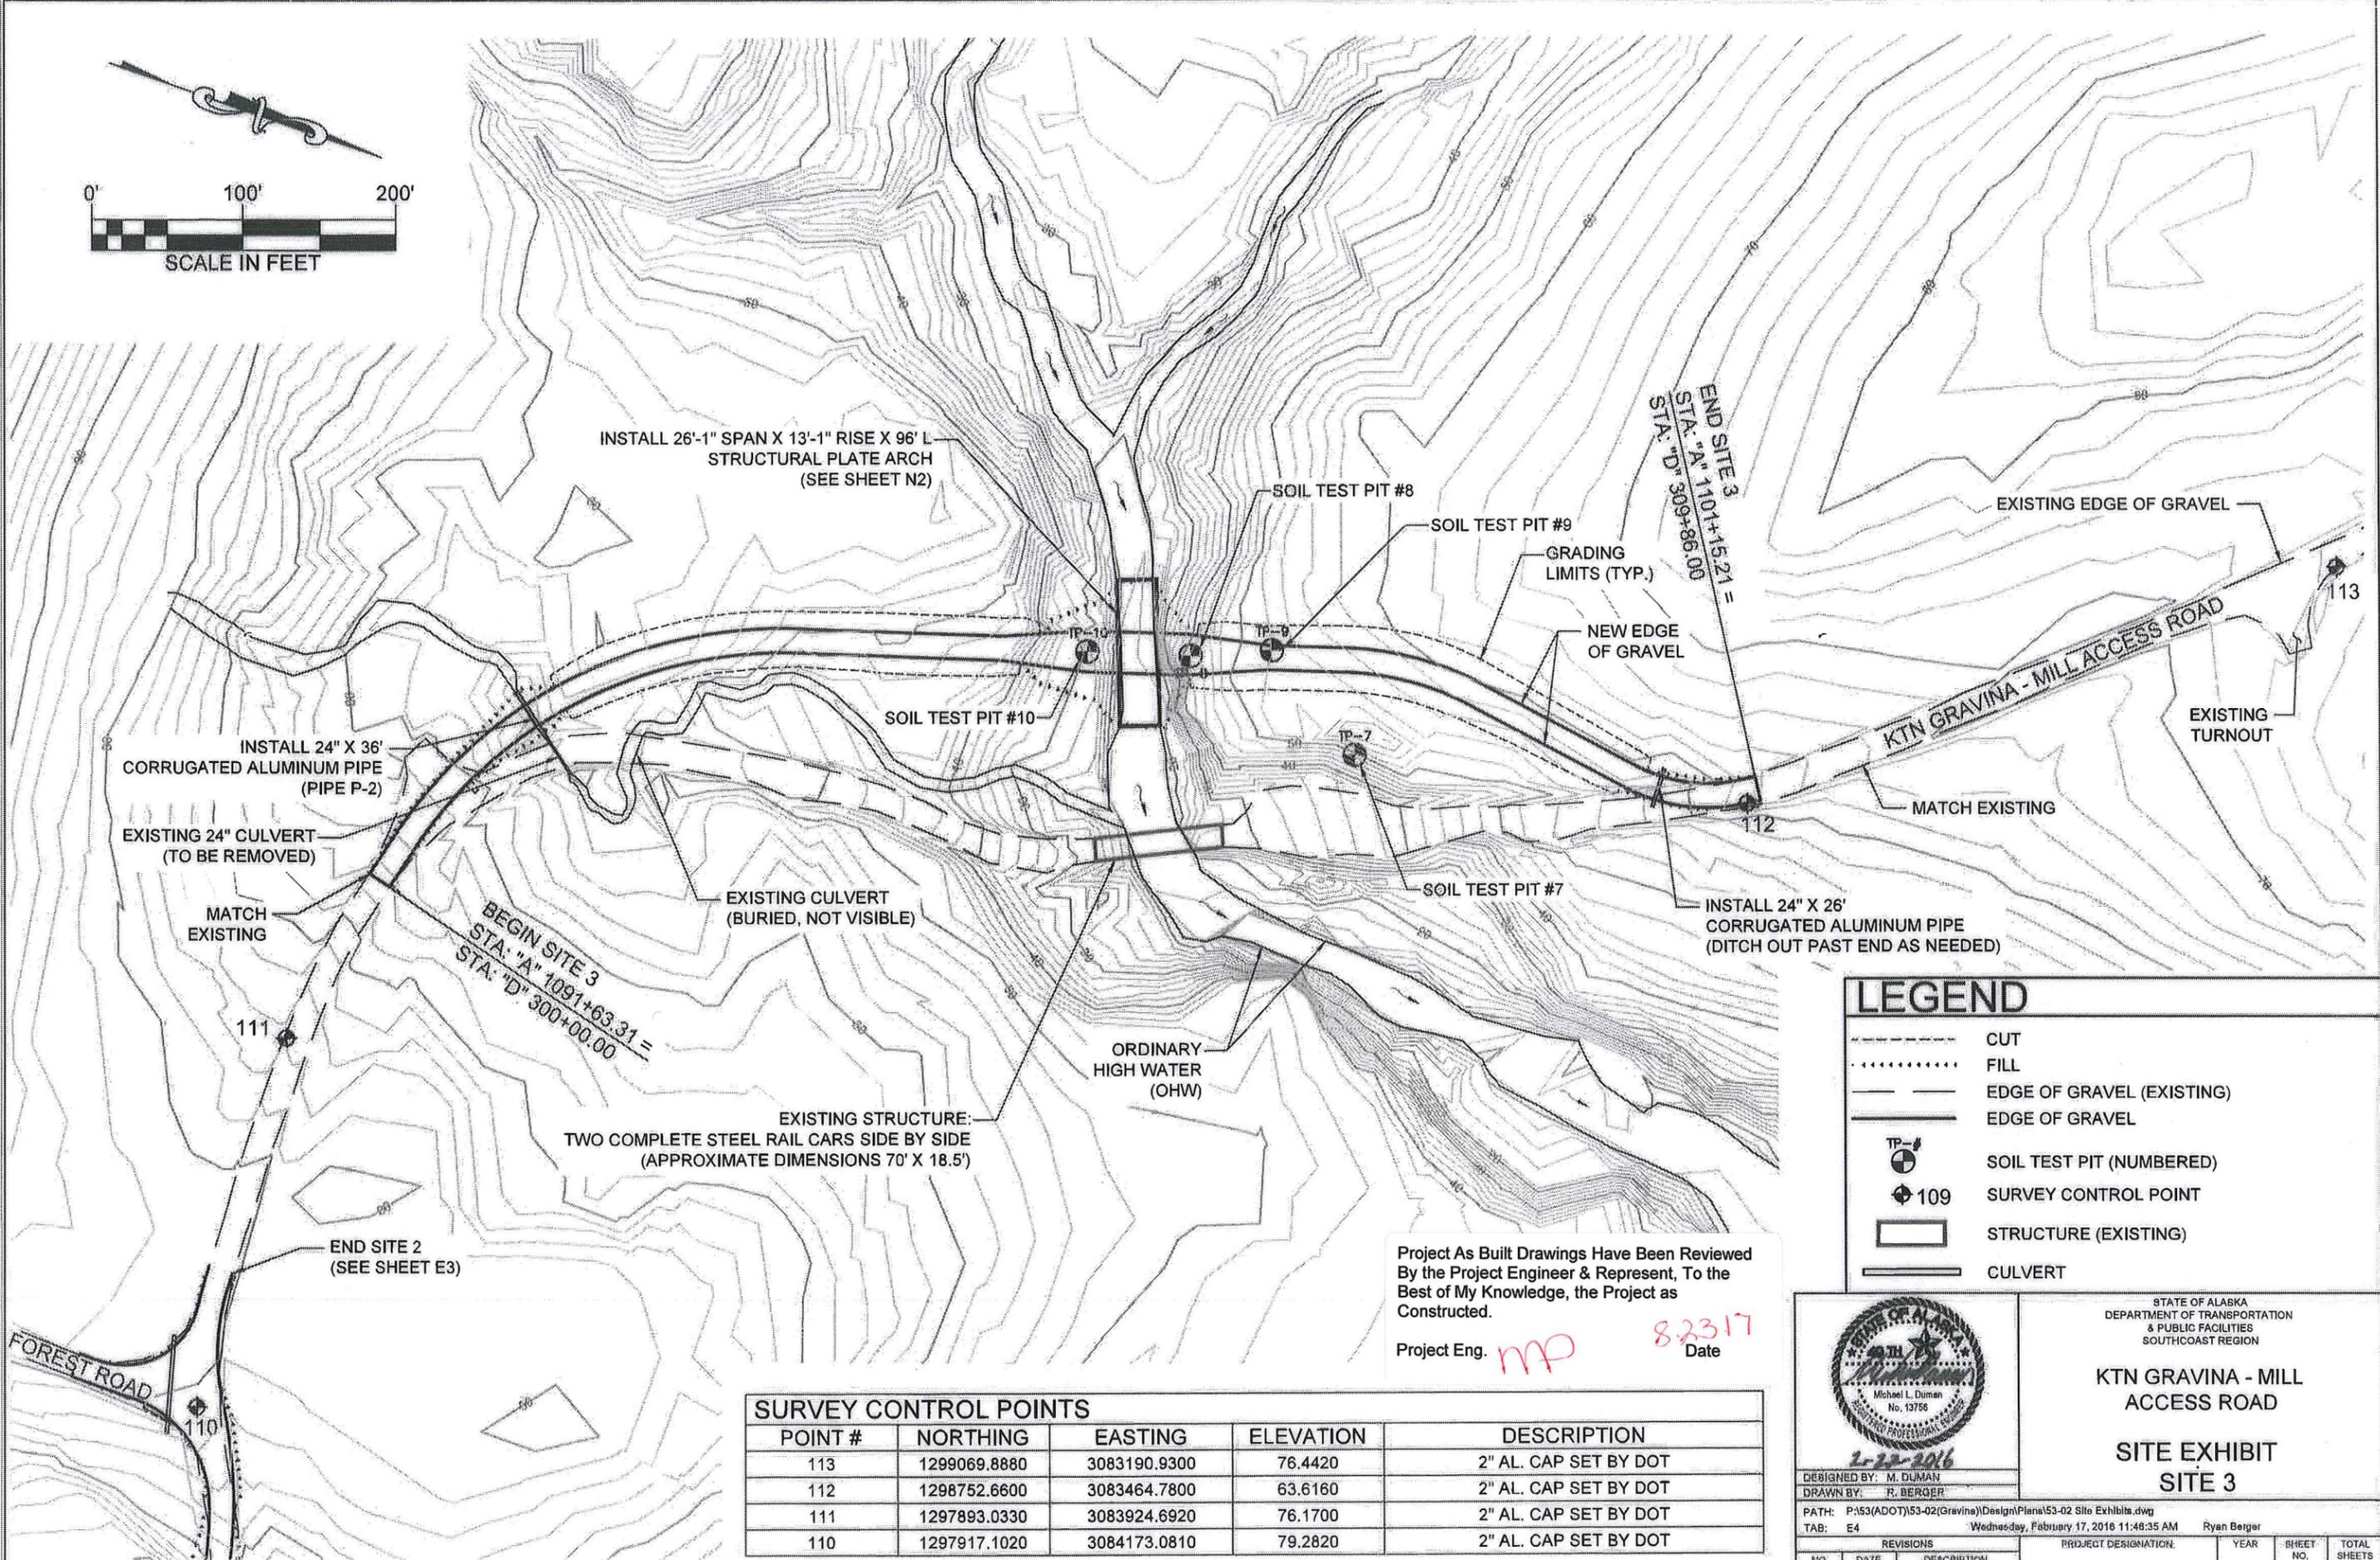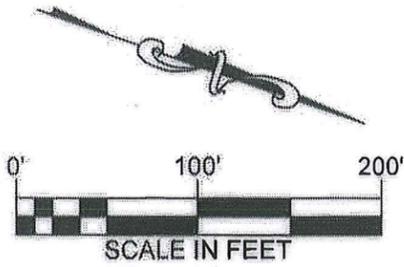

LEGEND

- CUT
- FILL
- EDGE OF GRAVEL (EXISTING)
- EDGE OF GRAVEL
- SOIL TEST PIT (NUMBERED)
- SURVEY CONTROL POINT
- STRUCTURE (EXISTING)
- CULVERT

Project As Built Drawings Have Been Reviewed By the Project Engineer & Represent, To the Best of My Knowledge, the Project as Constructed.

Project Eng. *MP* 8.23.17
Date

SURVEY CONTROL POINTS				
POINT #	NORTHING	EASTING	ELEVATION	DESCRIPTION
113	1299069.8880	3083190.9300	76.4420	2" AL. CAP SET BY DOT
112	1298752.6600	3083464.7800	63.6160	2" AL. CAP SET BY DOT
111	1297893.0330	3083924.6920	76.1700	2" AL. CAP SET BY DOT
110	1297917.1020	3084173.0810	79.2820	2" AL. CAP SET BY DOT

*HORIZONTAL DATUM IS NAD83(2011) 2010.00 ALASKA STATE PLANE ZONE 1. VERTICAL DATUM IS NAD88.

DESIGNED BY: M. DUMAN
DRAWN BY: R. BERGER

PATH: P:\53(ADOT)\53-02(Gravina)\Design\Plans\53-02 Site Exhibits.dwg
TAB: E4
Wednesday, February 17, 2016 11:48:35 AM Ryan Berger

STATE OF ALASKA
DEPARTMENT OF TRANSPORTATION
& PUBLIC FACILITIES
SOUTHCOST REGION


**KTN GRAVINA - MILL
ACCESS ROAD**

**SITE EXHIBIT
SITE 3**

REVISIONS			PROJECT DESIGNATION:	YEAR	SHEET NO.	TOTAL SHEETS
NO.	DATE	DESCRIPTION	Z699220000	2016	E4	48

DRAWING LOCATION: P:\53(ADOT)\53-02(Gravina)\Design\Plans\53-02 Site Exhibits.dwg
 DATE/TIME: 2/17/2016 11:54 AM
 SCALE: 1" = 100'
 LAYOUT: E4


DRAWING LOCATION: P:\531(ADOT)\53-02(Gravina)\Design\Plans\53-02 Details_Pipe Sequencing.dwg
 DATE: 2/27/2016 9:47 AM
 SCALE: 1" = 20'
 LAYOUT: EX2A

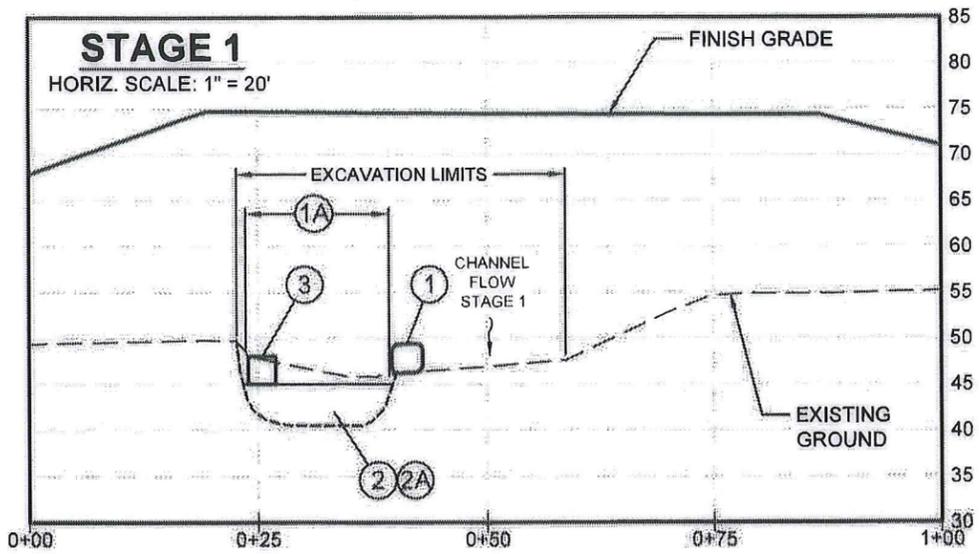

NOTE: ALL IN-WATER WORK MUST BE COMPLETED WITHIN THE DATES LISTED IN THE FISH HABITAT PERMITS. SEE APPENDIX B OF THE SPECIFICATIONS.


STAGE 1 NOTES

- ① INSTALL SUPERSACK ISOLATION BAGS WITH IMPERMEABLE MEMBRANE TO ISOLATE STREAM ON THE EAST SIDE OF THE CHANNEL. FLOW IS ON THE WEST SIDE OF THE CHANNEL.
- ①A REMOVE FISH FROM THE ISOLATED SIDE OF THE CHANNEL.
- ② REMOVE RIVERBED COBBLE DOWN TO THE BOTTOM OF PROPOSED RIPRAP SCOUR PAD.
- ②A INSTALL 54" THICK RIPRAP SCOUR PAD BELOW FOOTING FOR THE WIDTH OF EXCAVATION IN THIS STAGE.
- ③ INSTALL PRECAST FOOTING ON BEDDING IN RIPRAP.
- ④ ALLOW WATER BACK INTO STAGE 1 ISOLATION.

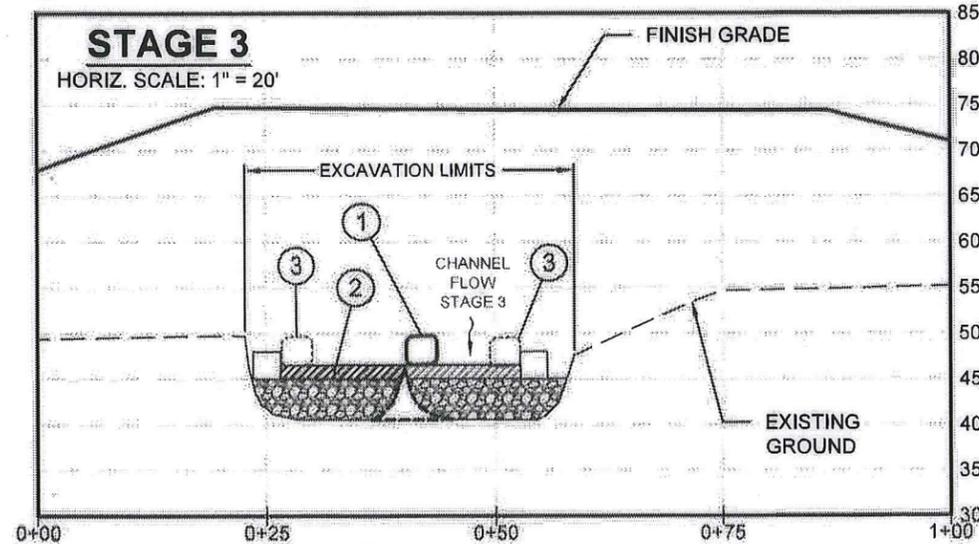


STAGE 3 NOTES

- ① ISOLATE STREAM TO STAGE 1 CONDITION. REMOVE FISH FROM ISOLATION.
- ② INSTALL 12" THICK NATIVE BEDLOAD CONSERVED FROM EXCAVATION BACK OVER THE RIPRAP ON THE EAST SIDE OF THE CHANNEL. FLOW IS ON THE WEST SIDE OF THE CHANNEL.
- ③ AT THE COMPLETION OF THIS STAGE, MOVE AND INSTALL ADDITIONAL SUPERSACKS OUT NEAR THE PRECAST FOOTINGS TO ISOLATE EACH FOOTING RESULTING IN CHANNEL FLOW TO THE CENTER OF THE STREAM.

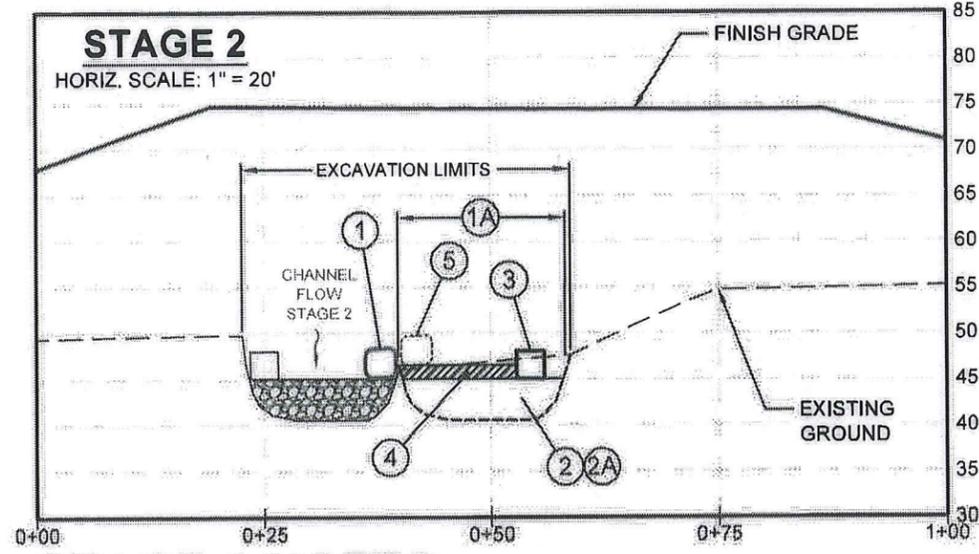

STAGE 2 NOTES

- ① MOVE SUPERSACKS & MEMBRANE OVER ONTO RIPRAP BEDDING TO SHIFT LIVE FLOW TO THE EAST SIDE OF THE CHANNEL.
- ①A REMOVE FISH FROM THE ISOLATED SIDE OF THE CHANNEL.
- ② REMOVE RIVERBED COBBLE DOWN TO THE BOTTOM OF PROPOSED RIPRAP SCOUR PAD.
- ②A INSTALL 54" THICK RIPRAP SCOUR PAD BELOW FOOTING FOR THE WIDTH OF EXCAVATION IN THIS STAGE.
- ③ INSTALL PRECAST FOOTING ON BEDDING IN RIPRAP.
- ④ INSTALL 12" THICK NATIVE BEDLOAD CONSERVED FROM EXCAVATION BACK OVER THE RIPRAP.
- ⑤ MOVE SUPERSACKS & MEMBRANE BACK TO STAGE 1 PLACEMENT.

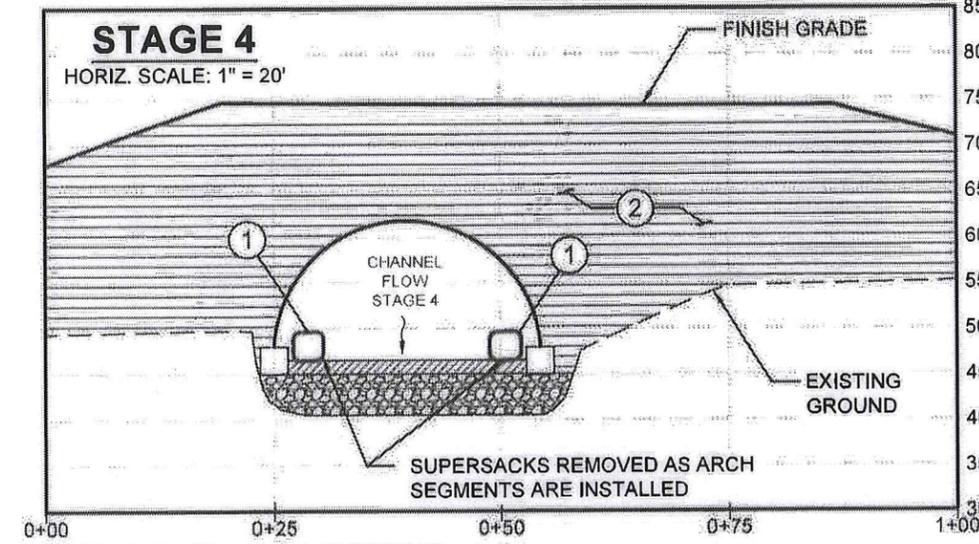


STAGE 4 NOTES

- ① IT IS RECOMMENDED TO HAVE THE ARCH COMPLETELY ASSEMBLED WITH BOLTS TIGHTENED PRIOR TO PLACEMENT ONTO FOOTINGS. THE ARCH CAN BE DISASSEMBLED INTO WORKABLE SEGMENT LENGTHS (20') FOR EASE OF PLACEMENT ONTO THE FOOTINGS. FOR EASE OF MATCHING BOLT HOLES, AND ACCESS FOR REMOVAL OF SUPERSACKS. BEGIN INSTALLING SEGMENTS AT THE DOWNSTREAM END. AS EACH SEGMENT IS INSTALLED, REMOVE THE SUPERSACKS WITHIN THE SEGMENT PRIOR TO INSTALLING THE SUBSEQUENT SEGMENT. ACCESS INTO THE COMPLETED ARCH TO REMOVE SUPERSACKS IS NOT ALLOWED.
- ② COMMENCE BACKFILL ON BOTH SIDES OF ARCH IN EQUAL LIFTS. BACKFILL STRUCTURAL PLATE ARCH. INSTALL RIPRAP ARMOR ON THE FACE OF BOTH ENDS OF THE STRUCTURE TO ABOVE THE ORDINARY HIGH WATER ELEVATION TO COMPLETE THE IN-WATER WORK.

Project As Built Drawings Have Been Reviewed By the Project Engineer & Represent, To the Best of My Knowledge, the Project as Constructed.
 Project Eng. *MP* Date *8-23-17*

		STATE OF ALASKA DEPARTMENT OF TRANSPORTATION & PUBLIC FACILITIES SOUTHWEST REGION	
		KTN GRAVINA - MILL ACCESS ROAD PIPE CONSTRUCTION SEQUENCING	
DESIGNED BY: M. DUMAN		PROJECT DESIGNATION	
DRAWN BY: R. BERGER		YEAR	
PATH: P:\53(ADOT)\53-02(Gravina)\Design\Plans\53-02 Details_Pipe Sequencing.dwg		SHEET NO.	
TAB: EX2A		TOTAL SHEETS	
Wednesday, February 17, 2016 11:46:38 AM		2699220000	
Ryan Berger		2016	
REVISIONS		EX2A	
NO.	DATE	DESCRIPTION	48

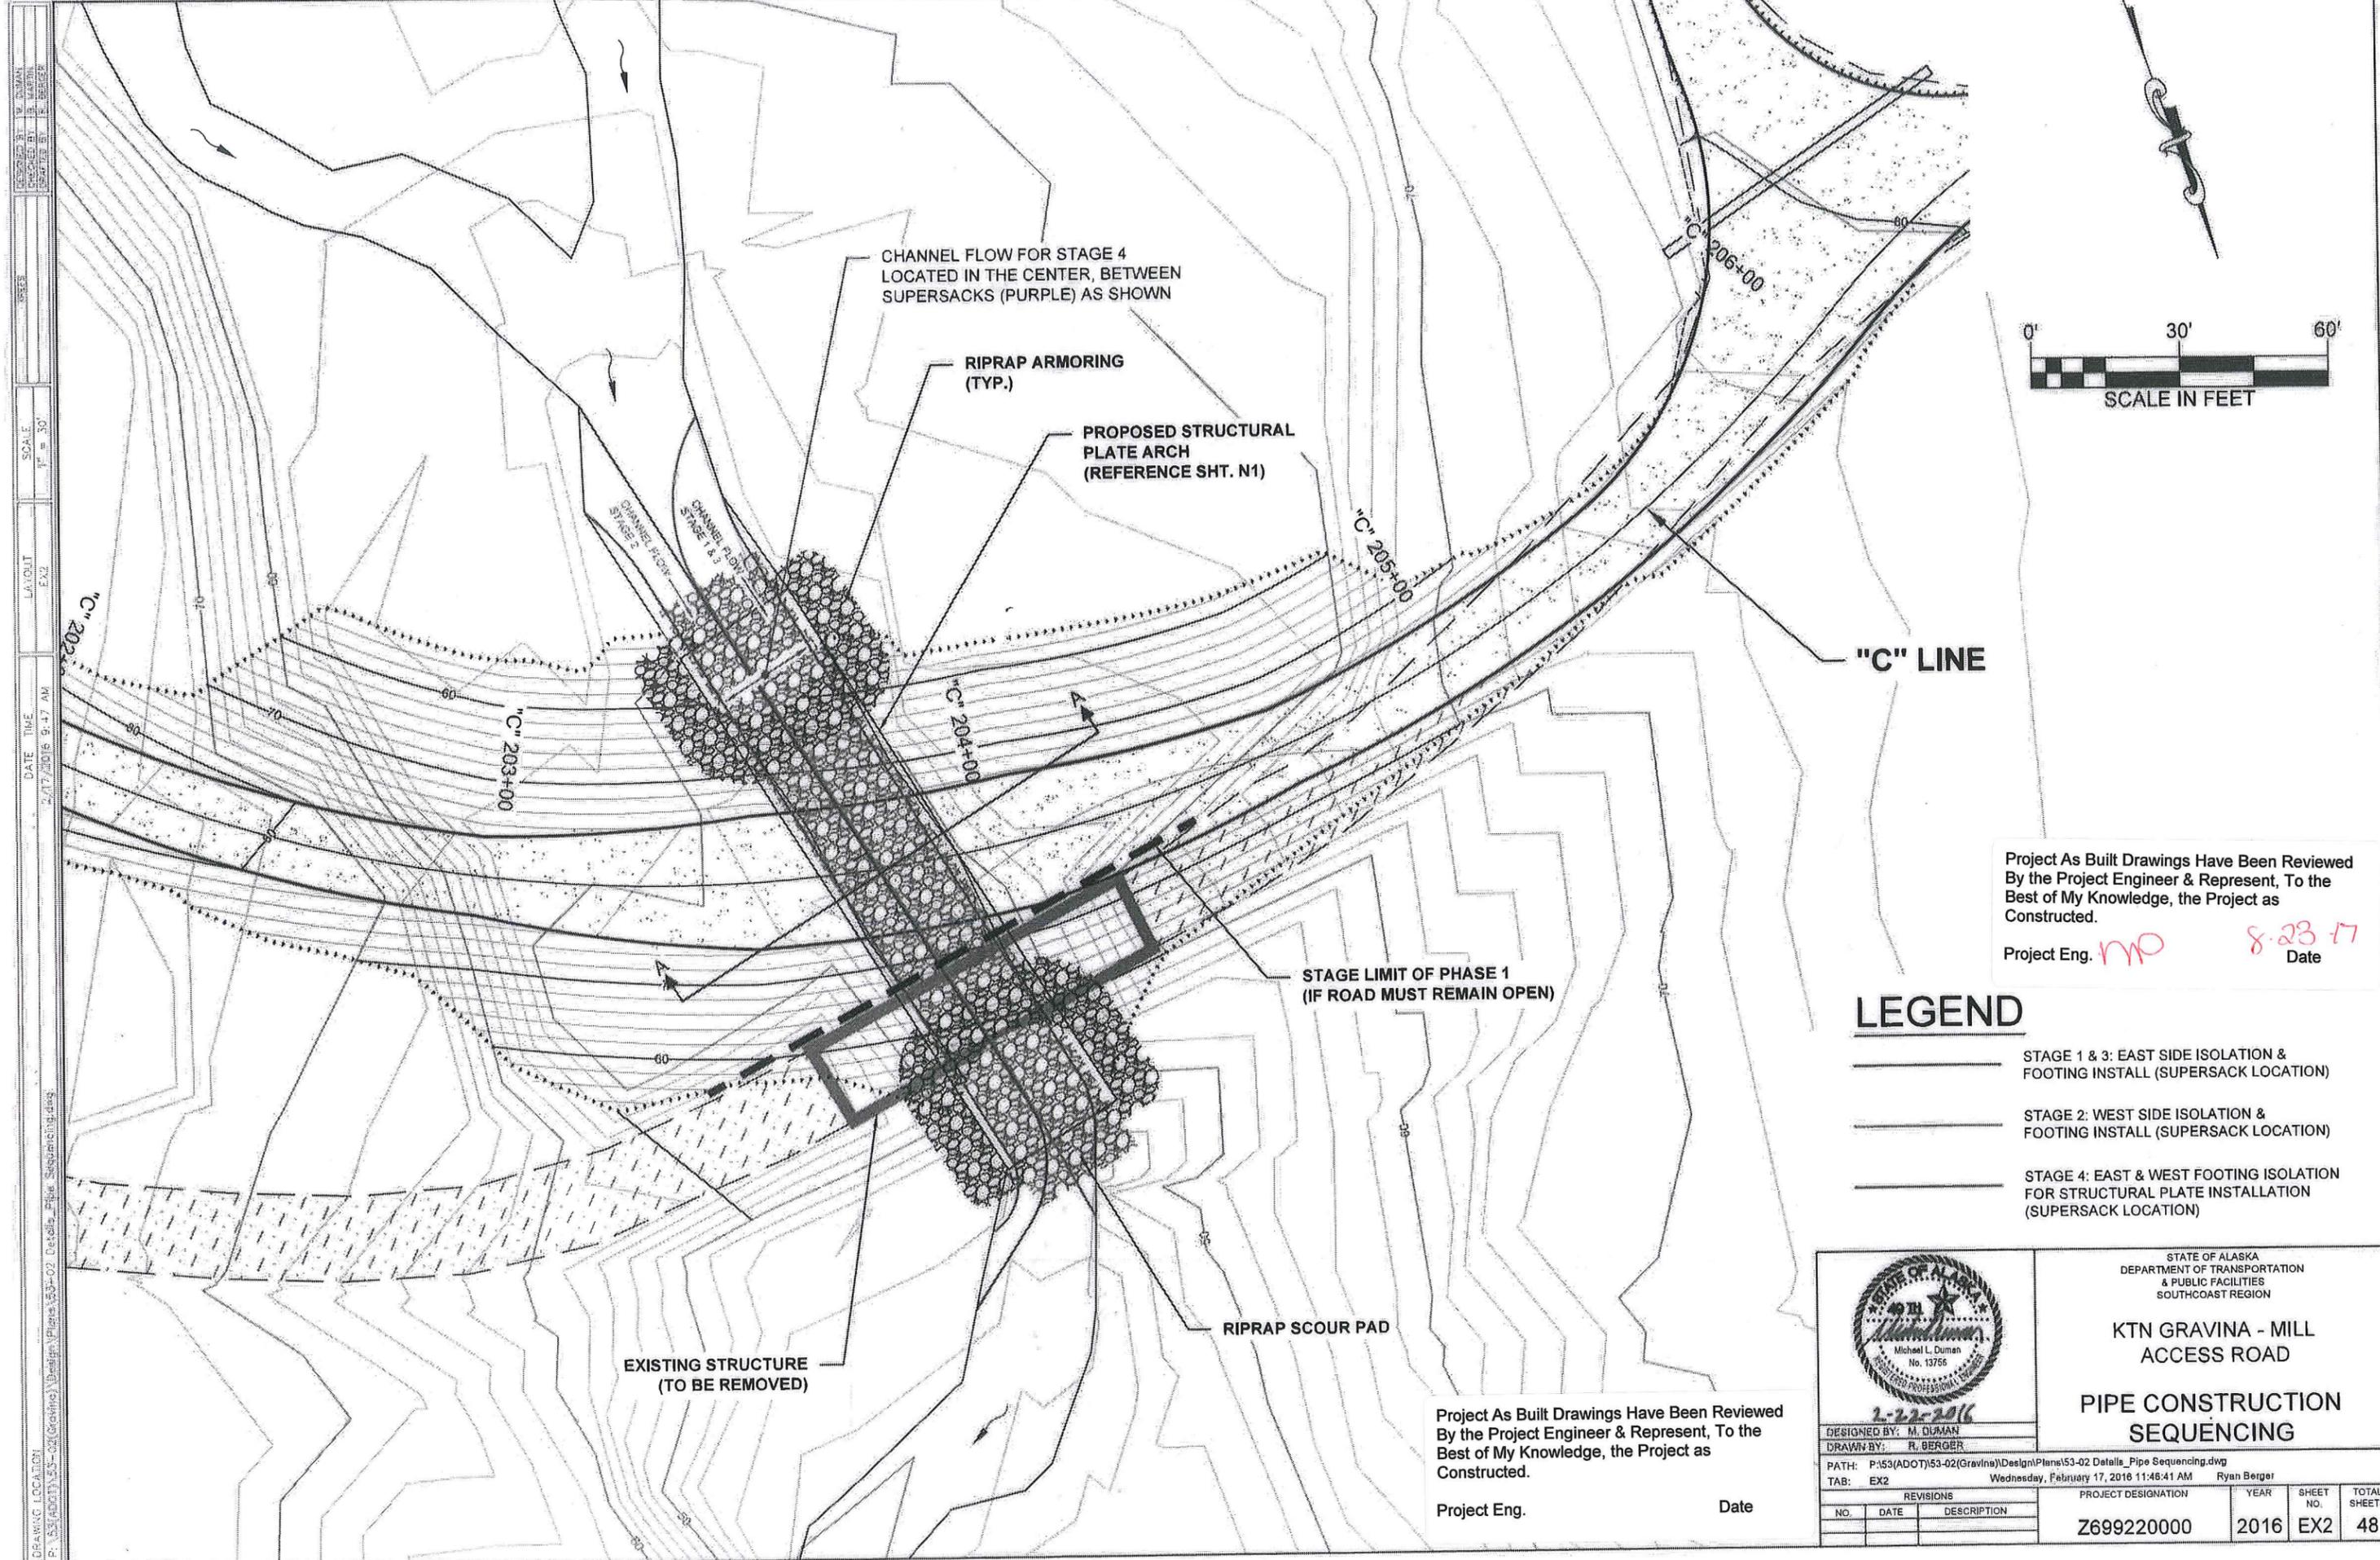

DRAWING LOCATION: P:\53\ADOT\53-02\Gravina\Detail\Pipe Sequencing.dwg
 DATE TIME: 2/17/2016 11:47:17 AM
 LAYOUT: EX2
 SCALE: 1" = 30'
 SHEETS: 48

Project As Built Drawings Have Been Reviewed By the Project Engineer & Represent, To the Best of My Knowledge, the Project as Constructed.

Project Eng. *MP* *8.23.17*
 Date

LEGEND


	STAGE 1 & 3: EAST SIDE ISOLATION & FOOTING INSTALL (SUPERSACK LOCATION)
	STAGE 2: WEST SIDE ISOLATION & FOOTING INSTALL (SUPERSACK LOCATION)
	STAGE 4: EAST & WEST FOOTING ISOLATION FOR STRUCTURAL PLATE INSTALLATION (SUPERSACK LOCATION)

Project As Built Drawings Have Been Reviewed By the Project Engineer & Represent, To the Best of My Knowledge, the Project as Constructed.

Project Eng. _____ Date _____

	STATE OF ALASKA DEPARTMENT OF TRANSPORTATION & PUBLIC FACILITIES SOUTHCOAST REGION			
	KTN GRAVINA - MILL ACCESS ROAD PIPE CONSTRUCTION SEQUENCING			
DESIGNED BY: M. DUMAN DRAWN BY: R. BERGER DATE: 2-22-2016		PROJECT DESIGNATION: Z699220000 YEAR: 2016		
PATH: P:\53\ADOT\53-02\Gravina\Design\Plans\53-02 Detalls_Pipe Sequencing.dwg TAB: EX2 Wednesday, February 17, 2016 11:46:41 AM Ryan Berger		SHEET NO. EX2	TOTAL SHEETS 48	


DRAWING NO. 2016-02
 PROJECT: KTN GRAVINA - MILL ACCESS ROAD
 SHEET: PIPE CONSTRUCTION SEQUENCING
 DATE: 2/17/2016 9:47 AM
 DRAWN BY: R. BERGER
 CHECKED BY: M. DUMAN
 PROJECT ENGINEER: RYAN BERGER

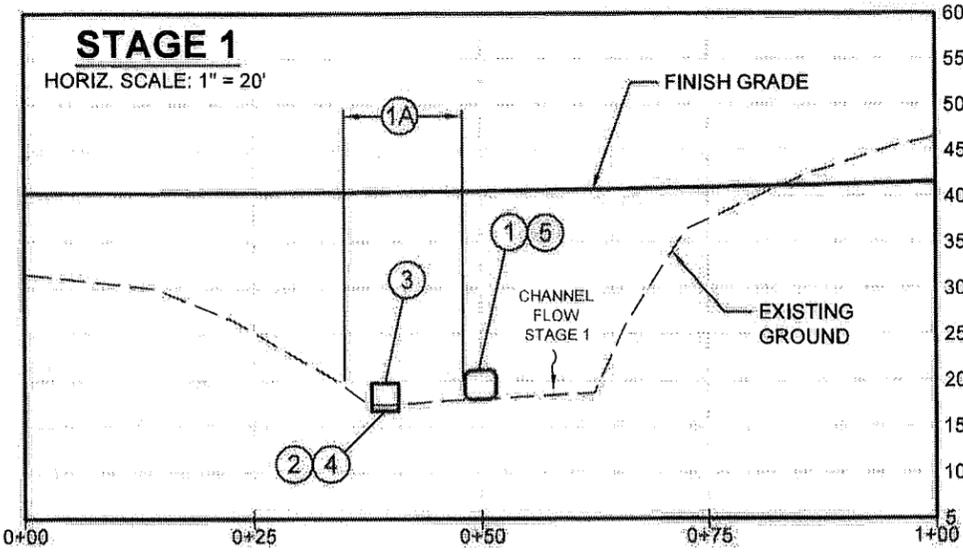

NOTE: ALL IN-WATER WORK MUST BE COMPLETED WITHIN THE DATES LISTED IN THE FISH HABITAT PERMITS. SEE APPENDIX B OF THE SPECIFICATIONS.

STAGE 1 NOTES

- ① INSTALL SUPERSACK ISOLATION BAGS WITH IMPERMEABLE LAYER FABRIC ON FACE.
- 1A REMOVE FISH FROM ISOLATION.
- ② "HOE-PICK" OUT FOOTING BASE FOR PRECAST FOUNDATION.
- ③ INSTALL PRECAST FOUNDATION OVER BEDROCK BEDDING.
- ④ GROUT PRECAST FOOTING TO BEDROCK. (CURE TIME: 3 DAYS)
- ⑤ MOVE INLET/OUTLET OF ISOLATION OVER TO ISOLATE NORTH SIDE OF CHANNEL.

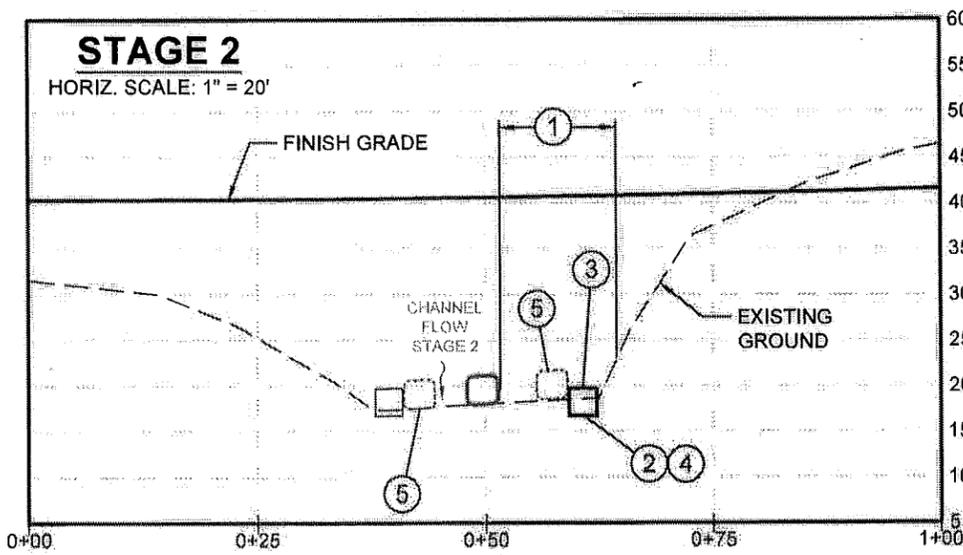


STAGE 2 NOTES

- ① REMOVE FISH FROM ISOLATION.
- ② "HOE-PICK" OUT FOOTING BASE FOR PRECAST FOUNDATION.
- ③ INSTALL PRECAST FOUNDATION OVER BEDROCK BEDDING.
- ④ GROUT PRECAST FOOTING TO BEDROCK. (CURE TIME: 3 DAYS)
- ⑤ AT THE CONCLUSION OF THIS STAGE, MOVE AND INSTALL ADDITIONAL SUPERSACKS OUT NEAR THE PRECAST FOOTINGS TO ISOLATE EACH FOOTING RESULTING IN CHANNEL FLOW TO THE CENTER OF THE STREAM.


Project As Built Drawings Have Been Reviewed By the Project Engineer & Represent, To the Best of My Knowledge, the Project as Constructed.

Project Eng. _____ Date _____

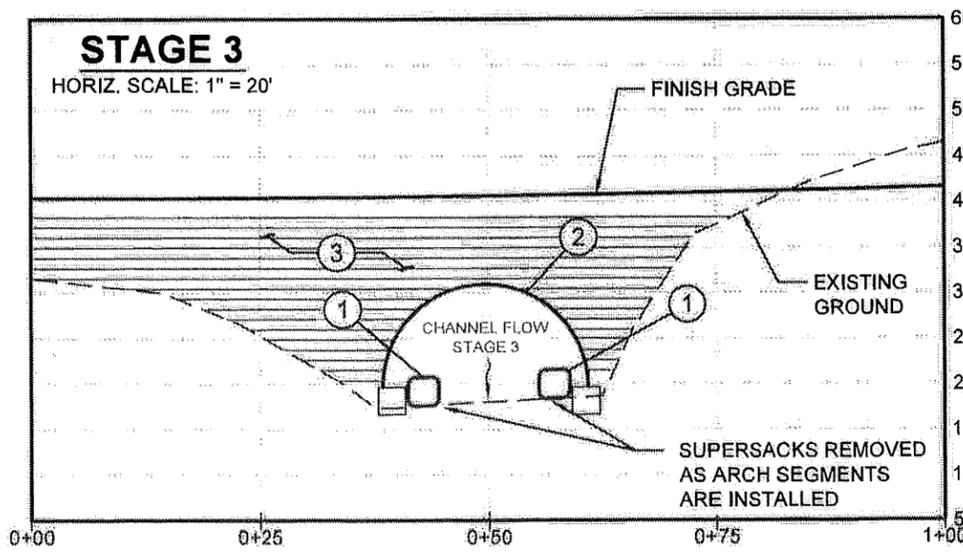

STAGE 3 NOTES

- ① IT IS RECOMMENDED TO HAVE THE ARCH COMPLETELY ASSEMBLED WITH BOLTS TIGHTENED PRIOR TO PLACEMENT ONTO FOOTINGS. THE ARCH CAN BE DISASSEMBLED INTO WORKABLE SEGMENT LENGTHS (20') FOR EASE OF PLACEMENT ONTO THE FOOTINGS, FOR EASE OF MATCHING BOLT HOLES, AND ACCESS FOR REMOVAL OF SUPERSACKS. BEGIN INSTALLING SEGMENTS AT THE DOWNSTREAM END. AS EACH SEGMENT IS INSTALLED, REMOVE THE SUPERSACKS WITHIN THE SEGMENT PRIOR TO INSTALLING THE SUBSEQUENT SEGMENT. ACCESS INTO THE COMPLETED ARCH TO REMOVE SUPERSACKS IS NOT ALLOWED.
- ② INSTALL STRUCTURAL PLATE ARCH. (BOLT TO PRECAST FOOTING)
- ③ COMMENCE BACKFILL ON BOTH SIDES OF ARCH IN EQUAL LIFTS. BACKFILL STRUCTURAL PLATE ARCH AND INSTALL RIPRAP ARMOR ON THE FACE OF BOTH ENDS OF THE STRUCTURE TO ABOVE THE ORDINARY HIGH WATER ELEVATION TO COMPLETE THE IN-WATER WORK.

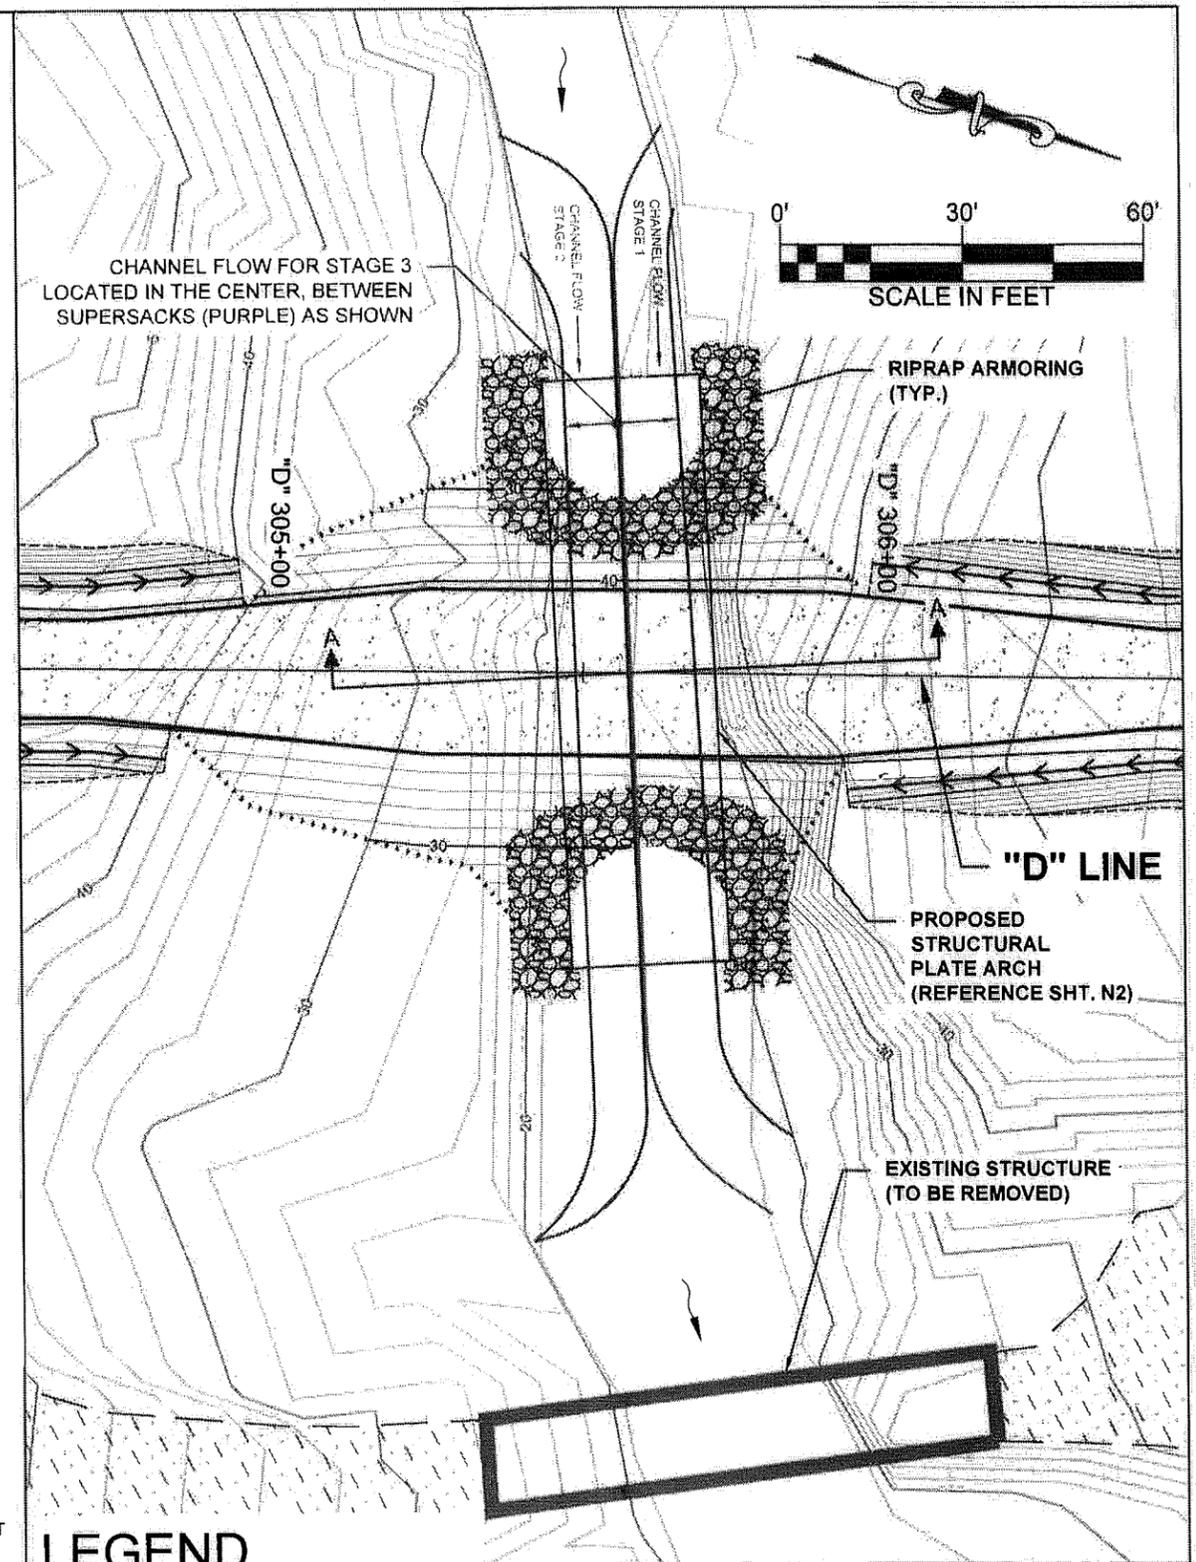

LEGEND

- STAGE 1: SOUTH SIDE ISOLATION & FOOTING INSTALL (SUPERSACK LOCATION)
- STAGE 2: NORTH SIDE ISOLATION & FOOTING INSTALL (SUPERSACK LOCATION)
- STAGE 3: NORTH AND SOUTH FOOTING ISOLATION FOR STRUCTURAL PIPE ARCH INSTALLATION (SUPERSACK LOCATION)



STATE OF ALASKA
DEPARTMENT OF TRANSPORTATION & PUBLIC FACILITIES
SOUTHCOAST REGION


KTN GRAVINA - MILL ACCESS ROAD

PIPE CONSTRUCTION SEQUENCING


DESIGNED BY: M. DUMAN
DRAWN BY: R. BERGER
DATE: 2-22-2016

PATH: P:\53(ADOT)\53-02(Gravina)\Design\Plans\53-02 Details_Pipe Sequencing.dwg
TAB: EX3
Wednesday, February 17, 2016 11:46:44 AM
Ryan Berger

NO.	DATE	DESCRIPTION	PROJECT DESIGNATION	YEAR	SHEET NO.	TOTAL SHEETS
			Z699220000	2016	EX3	48

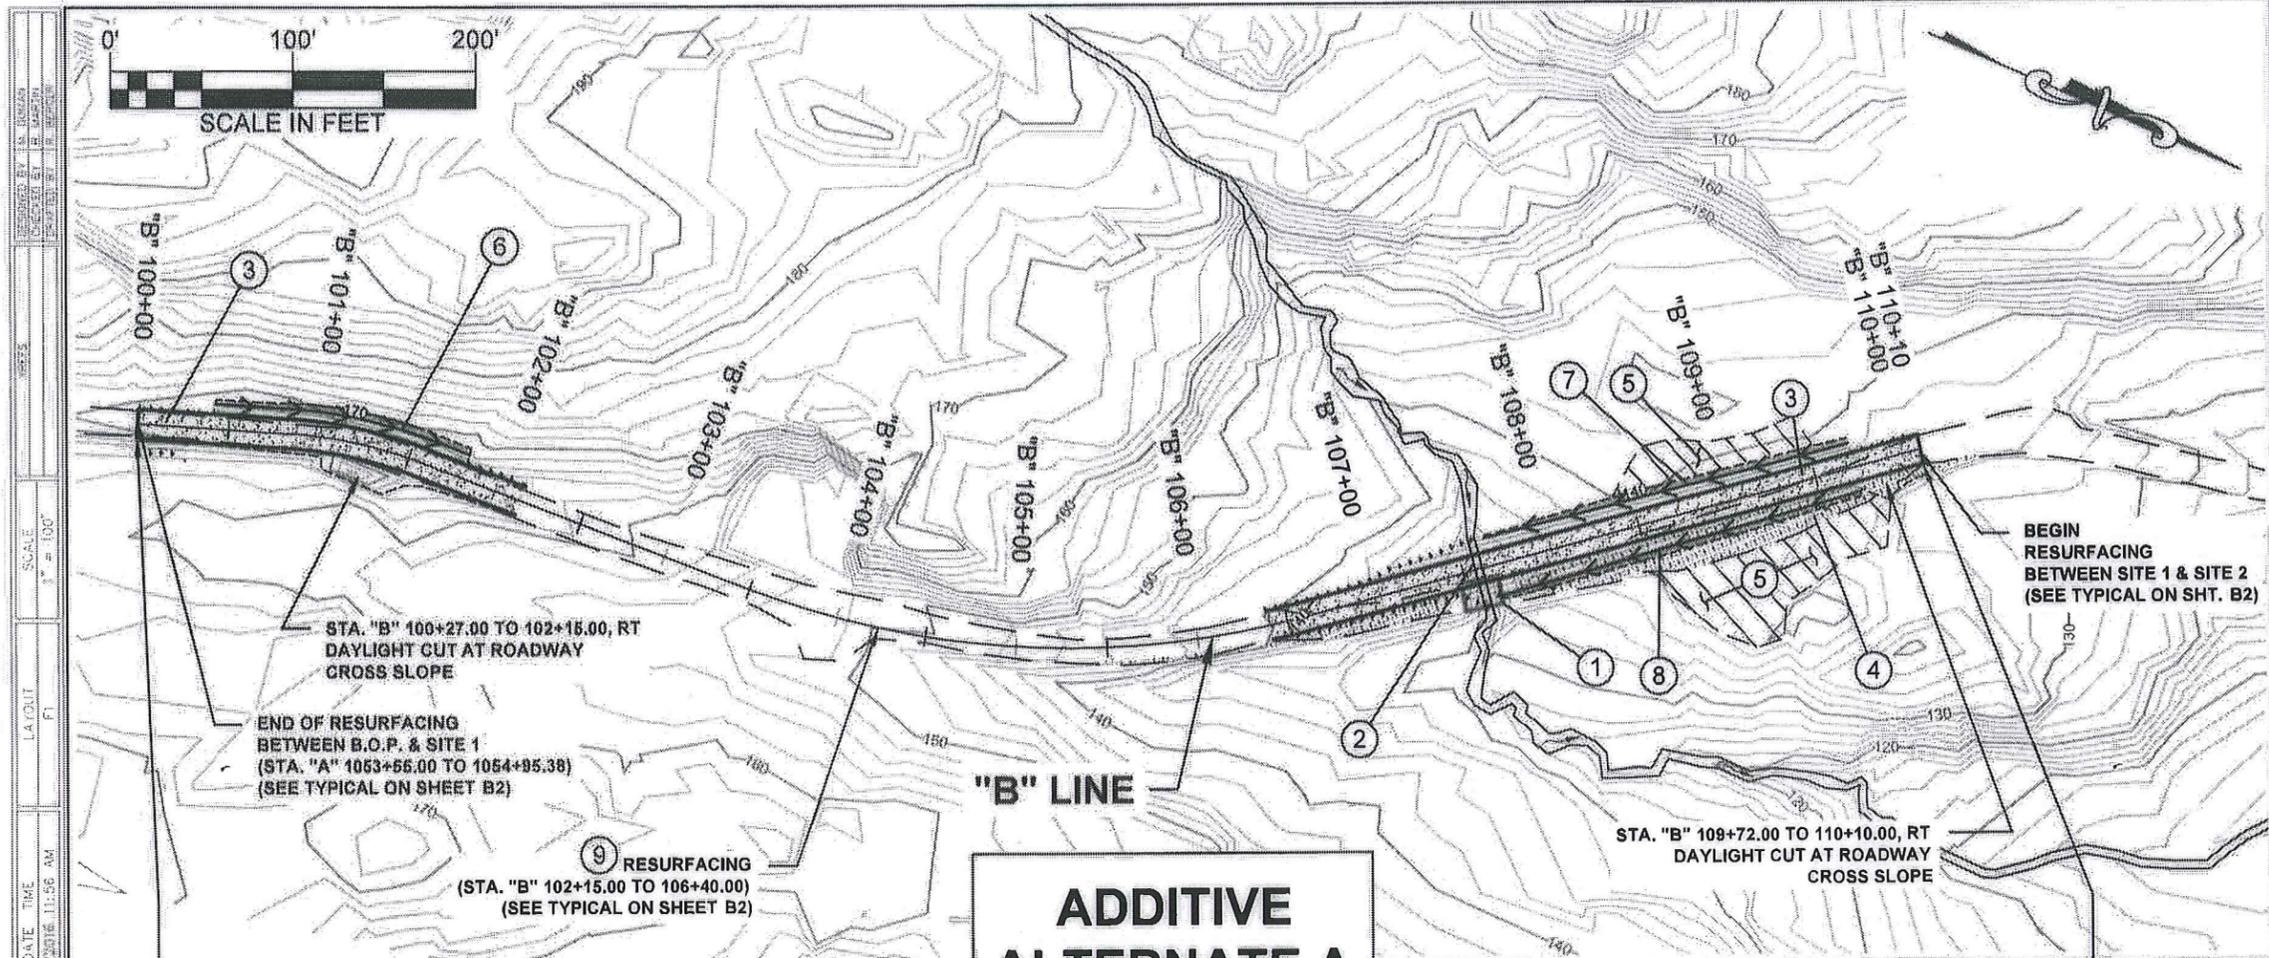

**ADDITIVE
ALTERNATE A
"B" LINE PLAN**

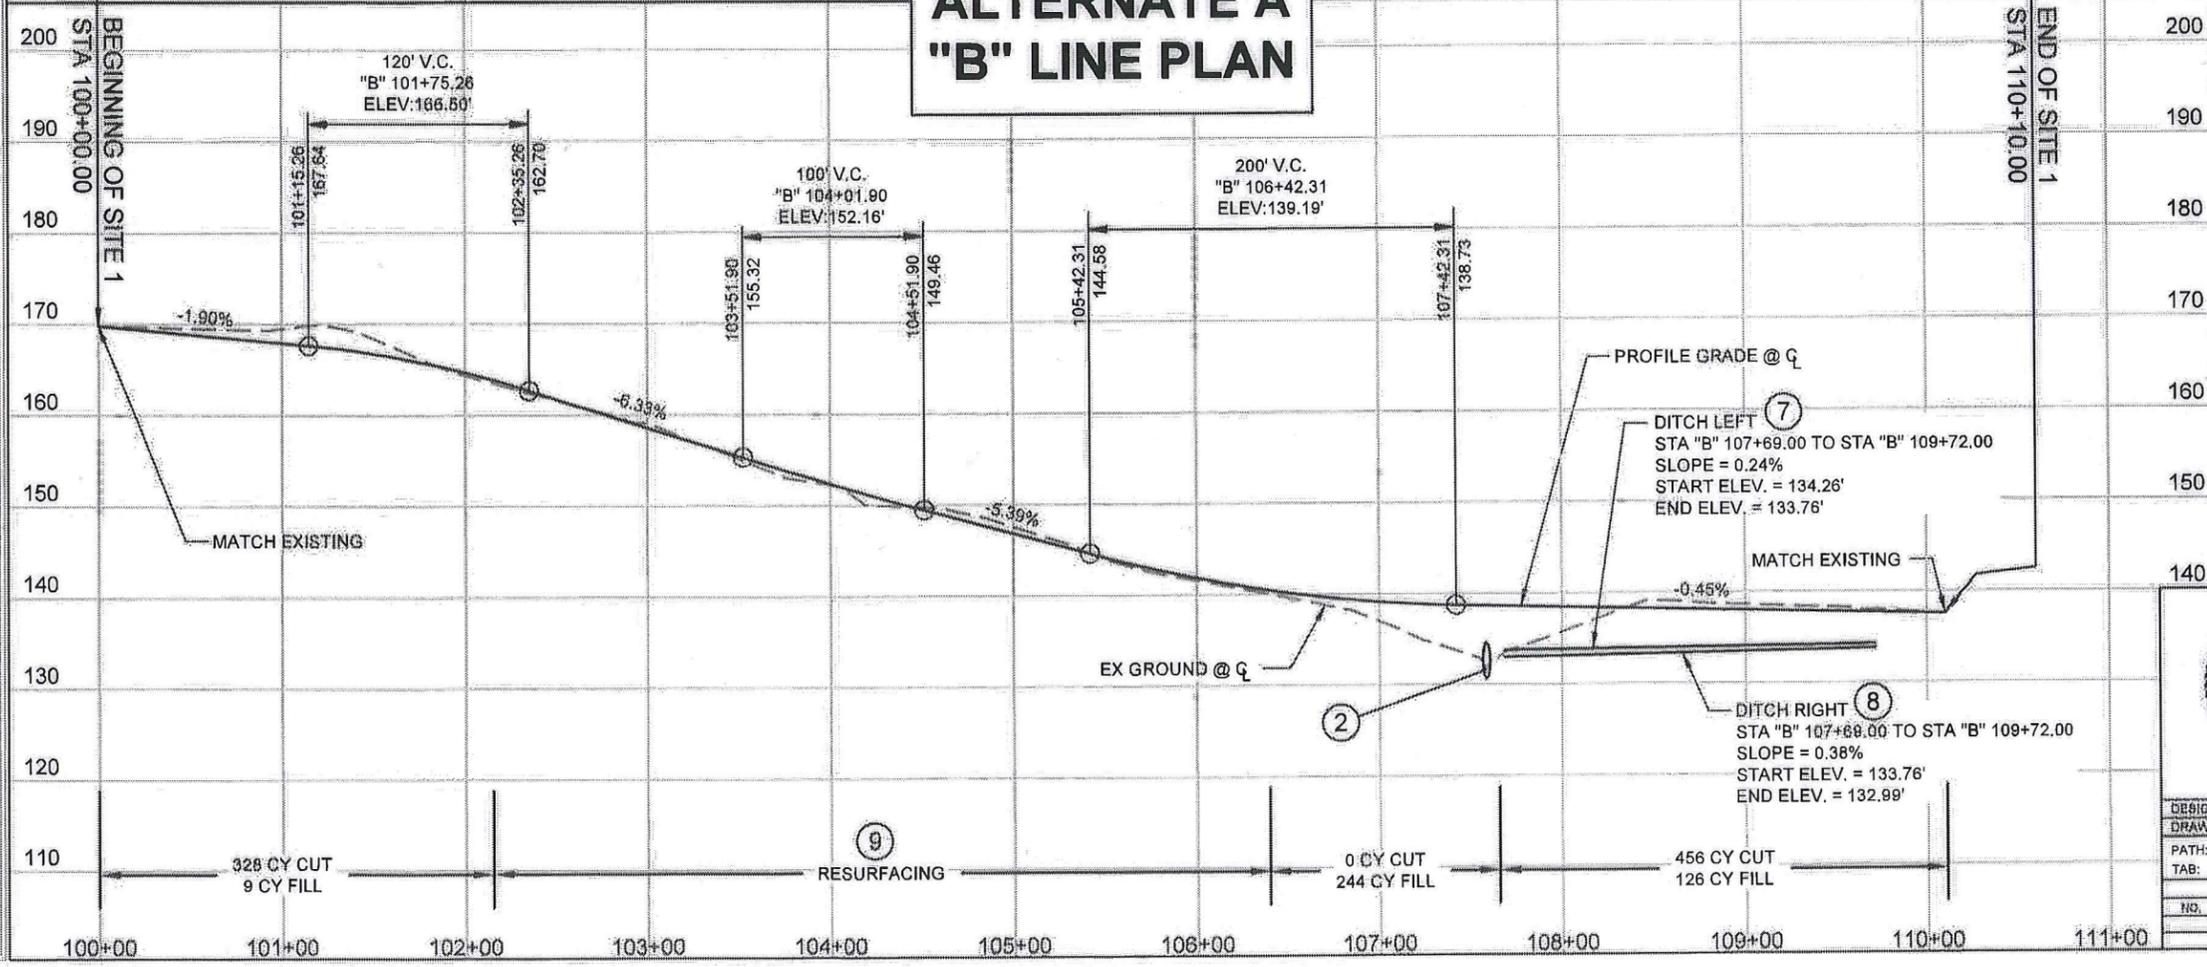

CONSTRUCTION NOTES


- ① REMOVE AND DISPOSE OF EXISTING STRUCTURE. STEEL I-BEAMS WITH SHEET METAL COVERING. APPROXIMATE DIMENSION: 20' X 14'
- ② STA 107+59.00: INSTALL 48" X 38" CORRUGATED ALUMINUM PIPE AS SHOWN. (PIPE P-1)
I.E. IN: 132.13' 17' LT, STA: 107+59.00
I.E. OUT: 128.66' 22' RT, STA: 107+59.00
SLOPE: 9.13%
- ③ STA 100+00.00 TO 102+15.00
STA 106+40.00 TO 110+10.00:
FULL DEPTH CONSTRUCTION AS SHOWN.
(SEE SHEET B2 FOR TYPICAL SECTION)
- ④ REMOVE EXISTING SURFACING.
(DEPTH VARIES 6" TO 2.0')
(SEE SHEET B3 FOR TYPICAL SECTION)
- ⑤ WASTE DISPOSAL AREA FOR SOIL AND ORGANICS.
- ⑥ STA. "B" 100+42.00 TO 101+80.00, LEFT
CONSTRUCT V-BOTTOM DITCH AS SHOWN (L = 138')
(SEE SHEET B1 & B2 FOR TYPICAL SECTIONS)
- ⑦ STA. "B" 107+69.00 TO 109+72.00, LEFT
CONSTRUCT V-BOTTOM DITCH AS SHOWN (L = 203')
(SEE SHEET B1 & B2 FOR TYPICAL SECTIONS)
- ⑧ STA. "B" 107+69.00 TO 109+72.00, RIGHT
CONSTRUCT V-BOTTOM DITCH AS SHOWN (L = 203')
(SEE SHEET B1 & B2 FOR TYPICAL SECTIONS)
- ⑨ MATCH EXISTING ALIGNMENT & PROFILE GRADE FOR RESURFACING. PROPOSED ALIGNMENT SHOWN IS FOR FUTURE PROJECT.

Project As Built Drawings Have Been Reviewed
By the Project Engineer & Represent, To the
Best of My Knowledge, the Project as
Constructed.

Project Eng. *MP* 8-23-17
Date

LEGEND

- EXISTING SURFACING
- PROPOSED FINISH GRADE
- WASTE DISPOSAL AREA FOR ORGANICS
- CUT
- FILL
- DITCH LINE

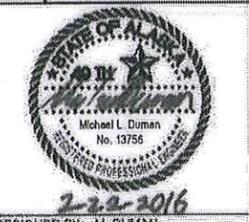

STATE OF ALASKA
DEPARTMENT OF TRANSPORTATION
& PUBLIC FACILITIES
SOUTHCOST REGION

**KTN GRAVINA - MILL
ACCESS ROAD**


**ADDITIVE ALTERNATE A
PLAN AND PROFILE SITE 1**

DESIGNED BY: M. DUMAN
DRAWN BY: R. BERGER

PATH: P:\53\ADOT\53-02\Gravina\Design\Plans\53-02 Plan and Profile.dwg
TAB: F1 Wednesday, February 17, 2016 11:48:50 AM Ryan Berger

REVISIONS			PROJECT DESIGNATION	YEAR	SHEET NO.	TOTAL SHEETS
NO.	DATE	DESCRIPTION	Z699220000	2016	F1	48

DRAWING LOCATION: P:\53\ADOT\53-02\Gravina\Design\Plans\53-02 Plan and Profile.dwg
 DATE/TIME: 2/17/2016 11:56 AM
 SCALE: 3" = 100'
 LA/OUT: F1

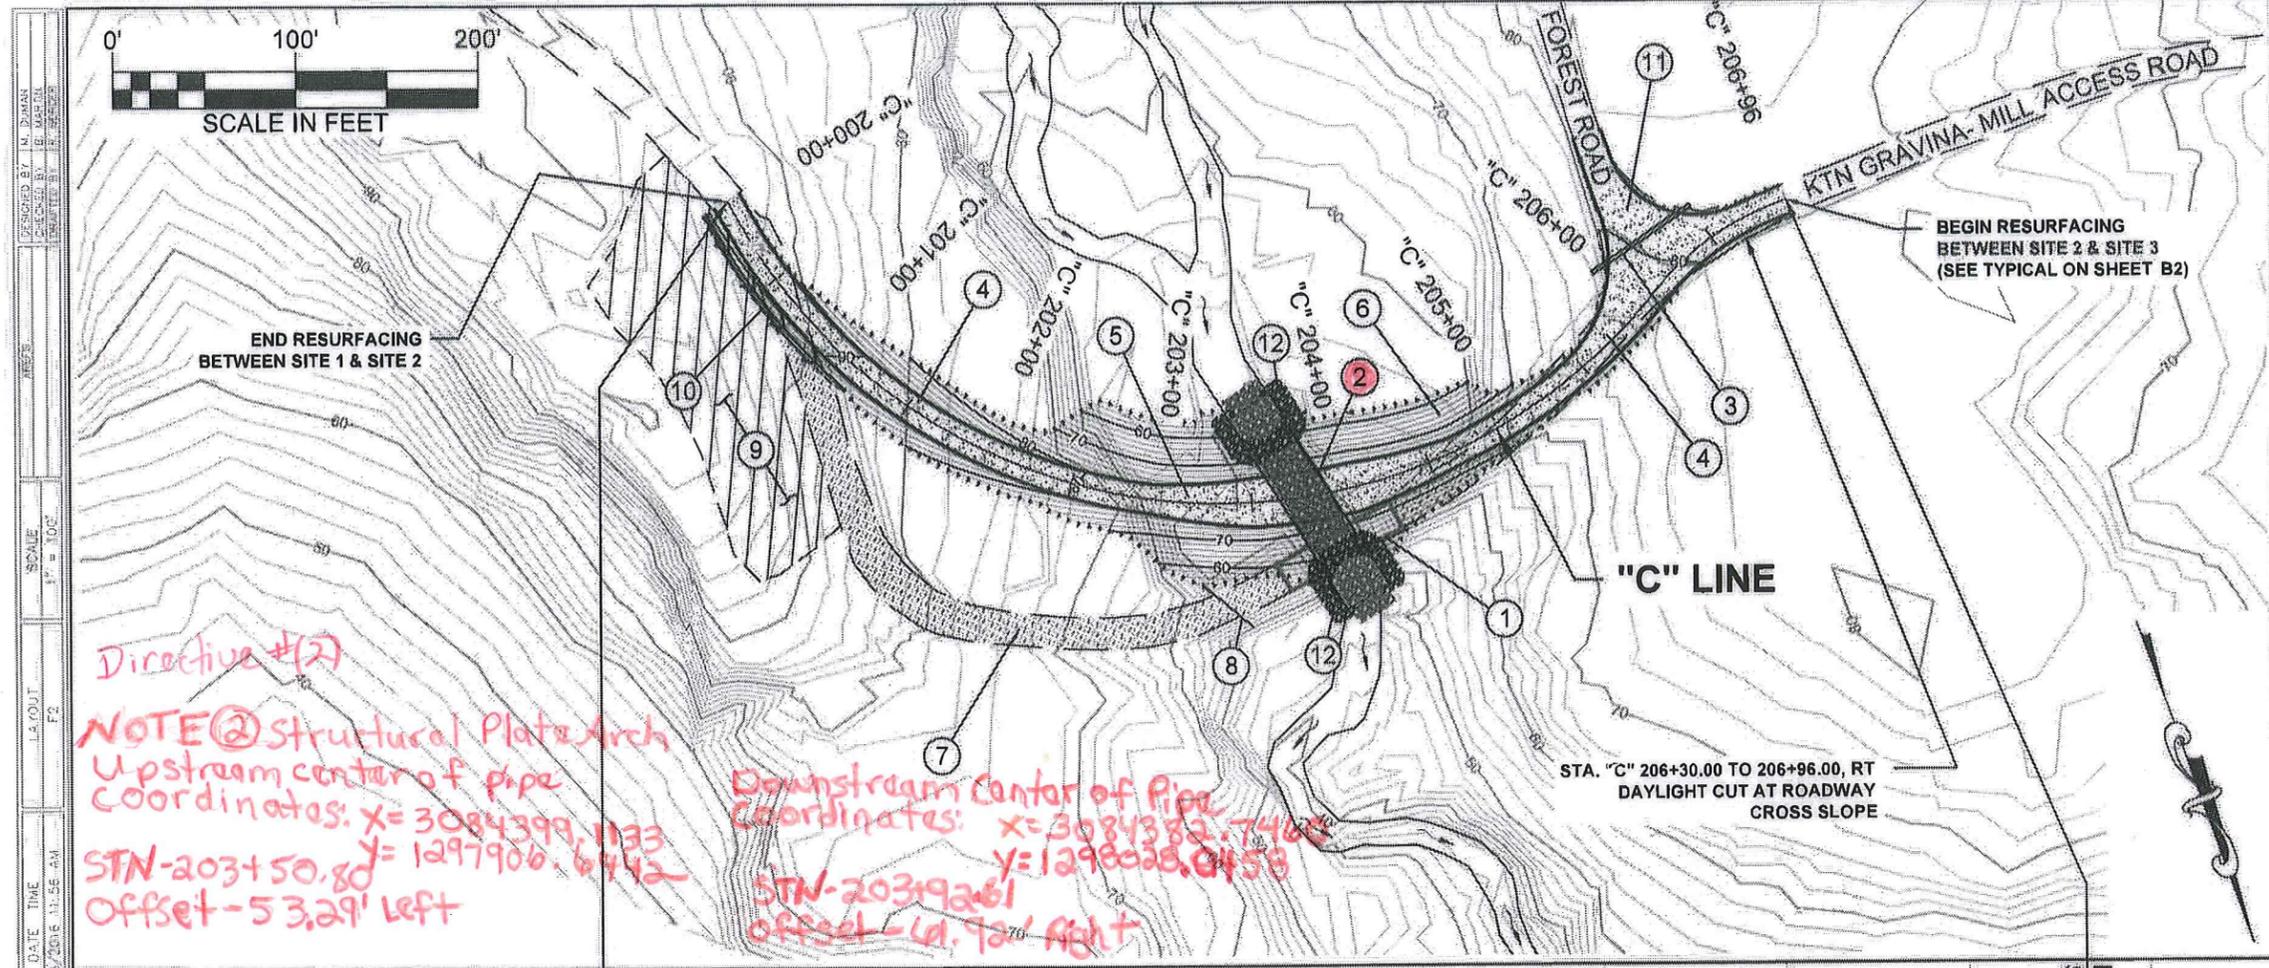

Directive #12

NOTE @ Structural Plate Arch
 Upstream center of pipe
 Coordinates: $x = 3084399.1133$
 $y = 1297906.6942$
 STN-203+50.80
 Offset - 53.29' left


Downstream center of pipe
 Coordinates: $x = 3084382.7468$
 $y = 1298028.0458$
 STN-203+92.61
 Offset - 41.92' right

CONSTRUCTION NOTES

- ① REMOVE AND DISPOSE OF EXISTING STRUCTURE:
TWO STEEL RAIL CARS PLACED SIDE BY SIDE.
APPROXIMATE DIMENSION: 70' X 18'
- ② STA 203+79.62: CONSTRUCT 26'-1" SPAN X 13'-1" RISE X 122.5' L
STRUCTURAL PLATE ARCH AS SHOWN.
(SEE SHEET N1 FOR DETAIL)
THALWEG IN: 49.50' 52' LT, STA: 203+51.40
THALWEG OUT: 43.37' 60' RT, STA: 204+01.16
CHANNEL BED SLOPE: 5.00%
- ③ STA 0+25.60: INSTALL 24" X 65' CORRUGATED ALUMINUM PIPE
AS SHOWN (PIPE P-4).
I.E. IN: 77.22' 37' RT, STA: 0+22.73
I.E. OUT: 74.82' 28' LT, STA: 0+26.61
SLOPE: 3.70%
GRADE INLET AND OUTLET TO DRAIN AS SHOWN IN PROFILE,
SHT. J12.
- ④ STA 200+00.00 TO 202+96.12
STA 205+13.12 TO 206+96.00
FULL DEPTH CONSTRUCTION AS SHOWN.
(SEE SHEET B2 FOR TYPICAL SECTION)
- ⑤ SHOULDER WIDENING SHALL BE CONSTRUCTED AS SHOWN.
(SEE SHEET B1 FOR TYPICAL SECTION)
TRANSITION: STA 202+96.12 TO 203+52.12
FULL: STA 203+52.12 TO 204+07.12
TRANSITION: STA 204+07.12 TO 204+63.12
- ⑥ STA 204+63.12 TO 205+13.12:
INSTALL CORDUROY FOUNDATION STABILIZATION.
(SEE SHEET B3 FOR TYPICAL SECTION)
- ⑦ REMOVE EXISTING SURFACING.
(DEPTH VARIES 6" TO 2.0')
(SEE SHEET B3 FOR TYPICAL SECTION)
- ⑧ DITCH RELIEF SHALL BE CONSTRUCTED AS SHOWN.
- ⑨ EXISTING ORGANIC WOOD WASTE AREA MAY BE USED FOR
WASTE DISPOSAL AREA FOR ORGANICS.
- ⑩ STA. "C" 200+00.00 TO 201+17.00, RIGHT
CONSTRUCT V-BOTTOM DITCH AS SHOWN (L = 117')
(SEE SHEET B2 FOR TYPICAL SECTION)
- ⑪ REGRADE INTERSECTION. (SEE APPROACH PLAN, SHEET G1)
- ⑫ CONSTRUCT CLASS 2 RIPRAP ARMORING AS SHOWN.
(SEE SHEET N1)

Project As Built Drawings Have Been Reviewed
 By the Project Engineer & Represent, To the
 Best of My Knowledge, the Project as
 Constructed.

Project Eng. *MPD* 8-23-17
Date

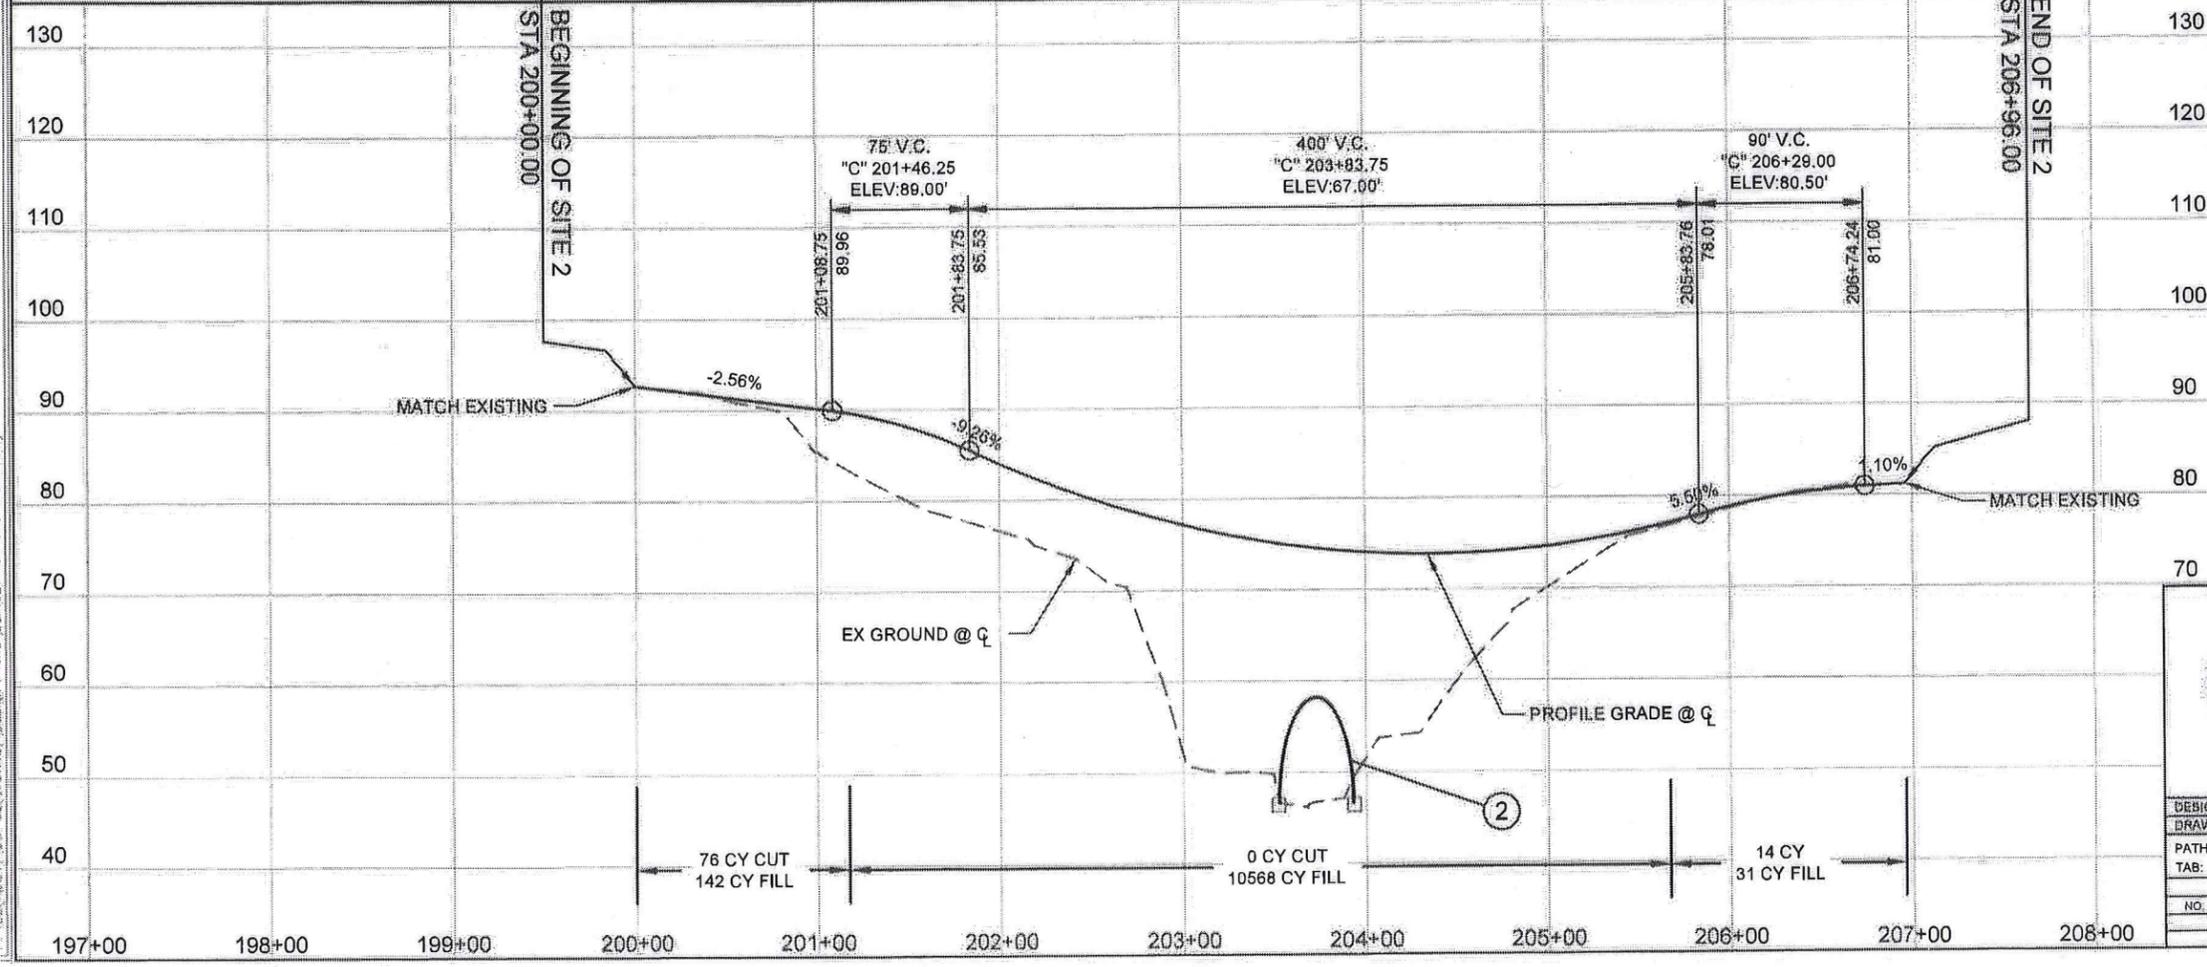

LEGEND

- EXISTING SURFACING
- PROPOSED FINISH GRADE
- WASTE DISPOSAL AREA FOR ORGANICS
- CUT
- FILL
- DITCH LINE




STATE OF ALASKA
 DEPARTMENT OF TRANSPORTATION
 & PUBLIC FACILITIES
 SOUTHCOAST REGION

**KTN GRAVINA - MILL
 ACCESS ROAD**


**PLAN AND PROFILE
 SITE 2**

DESIGNED BY: M. DUMAN	PROJECT DESIGNATION			YEAR	SHEET NO.	TOTAL SHEETS
DRAWN BY: R. BERGER	Z699220000			2016	F2	48
PATH: P:\53\ADOT\53-02(Gravina)\Design\Plans\53-02 Plan and Profile.dwg	REVISIONS					
TAB: F2	NO.	DATE	DESCRIPTION			
Wednesday, February 17, 2016 11:48:54 AM						

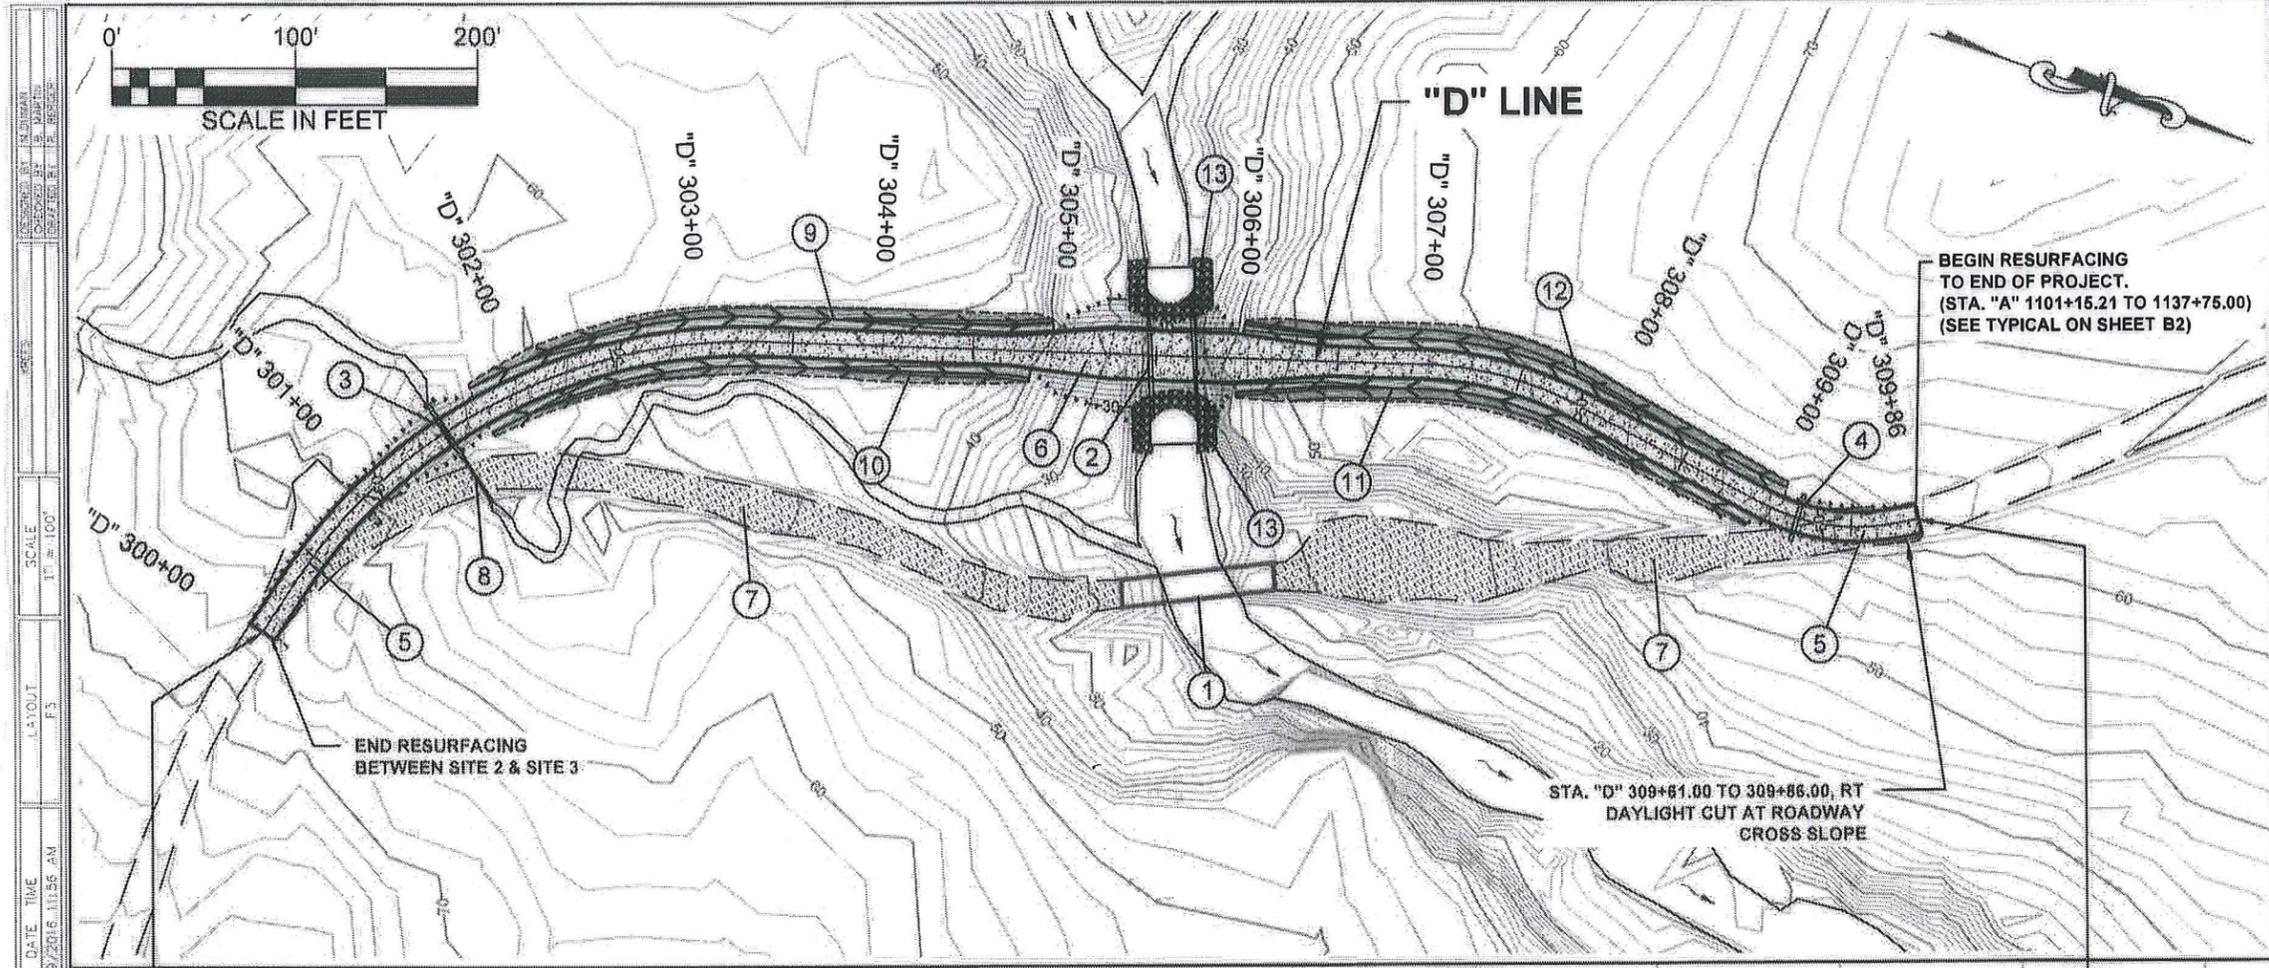

CONSTRUCTION NOTES

- 1 REMOVE AND DISPOSE OF EXISTING STRUCTURE: TWO STEEL RAIL CARS PLACED SIDE BY SIDE. APPROXIMATE DIMENSION: 70' X 18'
- 2 STA 305+58.68: CONSTRUCT 26'-1" SPAN X 13'-1" RISE X 96' L STRUCTURAL PLATE ARCH AS SHOWN. (SEE SHEET N2 FOR DETAIL)
THALWEG IN: 17.97' 48' LT, STA: 305+55.90
THALWEG OUT: 17.43' 48' RT, STA: 305+61.43
CHANNEL BED SLOPE: 0.56%
- 3 STA 301+50.00: INSTALL 24" X 36" CORRUGATED ALUMINUM PIPE AS SHOWN (PIPE P-2).
I.E. IN: 50.49' 18' LT, STA: 301+50.00
I.E. OUT: 49.75' 19' RT, STA: 301+50.00
SLOPE: 2.05%
GRADE OUTLET TO DRAIN AS SHOWN IN PROFILE, SHT. J12.
- 4 STA 309+20.10: INSTALL 24" X 26" CORRUGATED ALUMINUM PIPE AS SHOWN (PIPE P-3).
I.E. IN: 55.87' 14' LT, STA: 309+20.10
I.E. OUT: 55.33' 13' RT, STA: 309+20.10
SLOPE: 2.07%
GRADE INLET & OUTLET TO DRAIN AS SHOWN IN PROFILE, SHT. J12.
- 5 STA 300+00.00 TO 304+69.26
STA 306+45.40 TO 309+86.00:
FULL DEPTH CONSTRUCTION AS SHOWN. (SEE SHEET B2 FOR TYPICAL SECTION)
- 6 CONTRACTOR SHALL CONSTRUCT SHOULDER WIDENING AS SHOWN. (SEE SHEET B1 FOR TYPICAL SECTION)
TRANSITION: STA 304+69.26 TO 305+24.30
FULL: STA 305+24.30 TO 305+90.36
TRANSITION: STA 305+90.36 TO 306+45.40
- 7 REMOVE EXISTING SURFACING. (DEPTH VARIES 6" TO 2.0') (SEE SHEET B3 FOR TYPICAL SECTION)
- 8 REMOVE & DISPOSE OF EXISTING CULVERT. RE-OPEN CHANNEL ACROSS EXISTING ROADWAY & RESTORE NATURAL FLOW.
- 9 STA. "D" 301+73.00 TO 304+93.00, LEFT CONSTRUCT V-BOTTOM DITCH AS SHOWN (L = 320') (SEE SHEET B1 & B2 FOR TYPICAL SECTIONS)
- 10 STA. "D" 301+72.00 TO 304+81.00, RIGHT CONSTRUCT V-BOTTOM DITCH AS SHOWN (L = 309') (SEE SHEET B1 & B2 FOR TYPICAL SECTIONS)
- 11 STA. "D" 305+94.00 TO 308+96.00, RIGHT CONSTRUCT V-BOTTOM DITCH AS SHOWN (L = 302') (SEE SHEET B1 & B2 FOR TYPICAL SECTIONS)
- 12 STA. "D" 305+98.00 TO 309+08.00, LEFT CONSTRUCT V-BOTTOM DITCH AS SHOWN (L = 310') (SEE SHEET B1 & B2 FOR TYPICAL SECTIONS)
- 13 CONSTRUCT CLASS 2 RIPRAP ARMORING AS SHOWN. (SEE SHEET N2 FOR DETAILS)

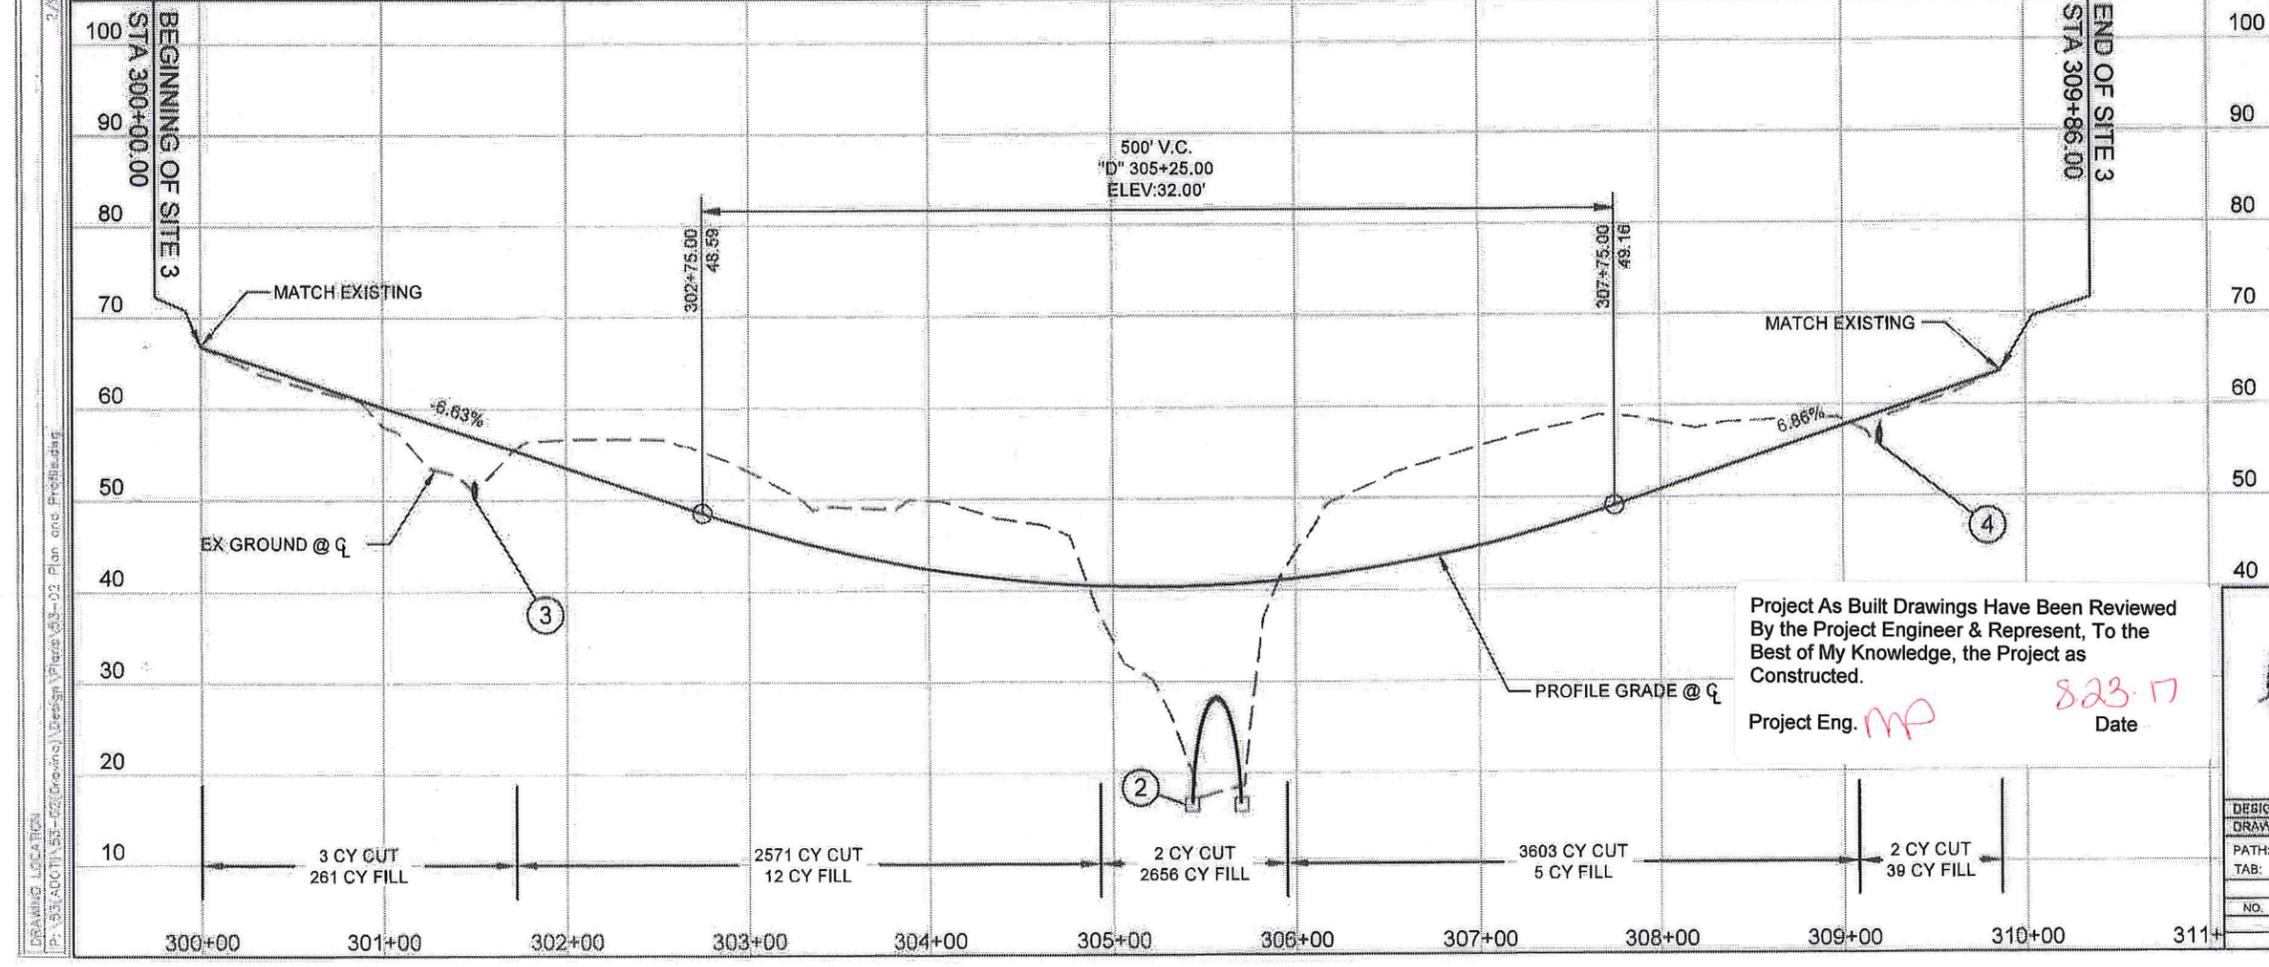

LEGEND

- EXISTING SURFACING
- PROPOSED FINISH GRADE
- WASTE DISPOSAL AREA FOR ORGANICS
- CUT
- FILL
- DITCH LINE

Project As Built Drawings Have Been Reviewed By the Project Engineer & Represent, To the Best of My Knowledge, the Project as Constructed.
Project Eng. *MP* Date *8-23-17*



STATE OF ALASKA
DEPARTMENT OF TRANSPORTATION & PUBLIC FACILITIES
SOUTHCOST REGION

KTN GRAVINA - MILL ACCESS ROAD

PLAN AND PROFILE SITE 3

DESIGNED BY: M. DUMAN
DRAWN BY: R. BERGER



PATH: P:\53\ADOT\53-02\Gravina\Design\Plans\53-02 Plan and Profile.dwg
TAB: F3 Wednesday, February 17, 2016 11:46:59 AM Ryan Berger

REVISIONS		PROJECT DESIGNATION	YEAR	SHEET NO.	TOTAL SHEETS	
NO.	DATE	DESCRIPTION				
			Z699220000	2016	F-3	48

DRAWING LOCATION: P:\53\ADOT\53-02\Gravina\Design\Plans\53-02 Plan and Profile.dwg
 DATE: 2/2/2016 11:56 AM
 SCALE: 1" = 100'
 LAYOUT: F3


CONSTRUCTION NOTES

- ① FOR "C" LINE ALIGNMENT DATA, REFERENCE SHT. A5 & A6.
- ② FOR "FR" LINE ALIGNMENT DATA, REFERENCE SHT. A5 & A6.
- ③ 24" X 65" CORRUGATED ALUMINUM PIPE
SEE NOTE 3, SHEET F2.

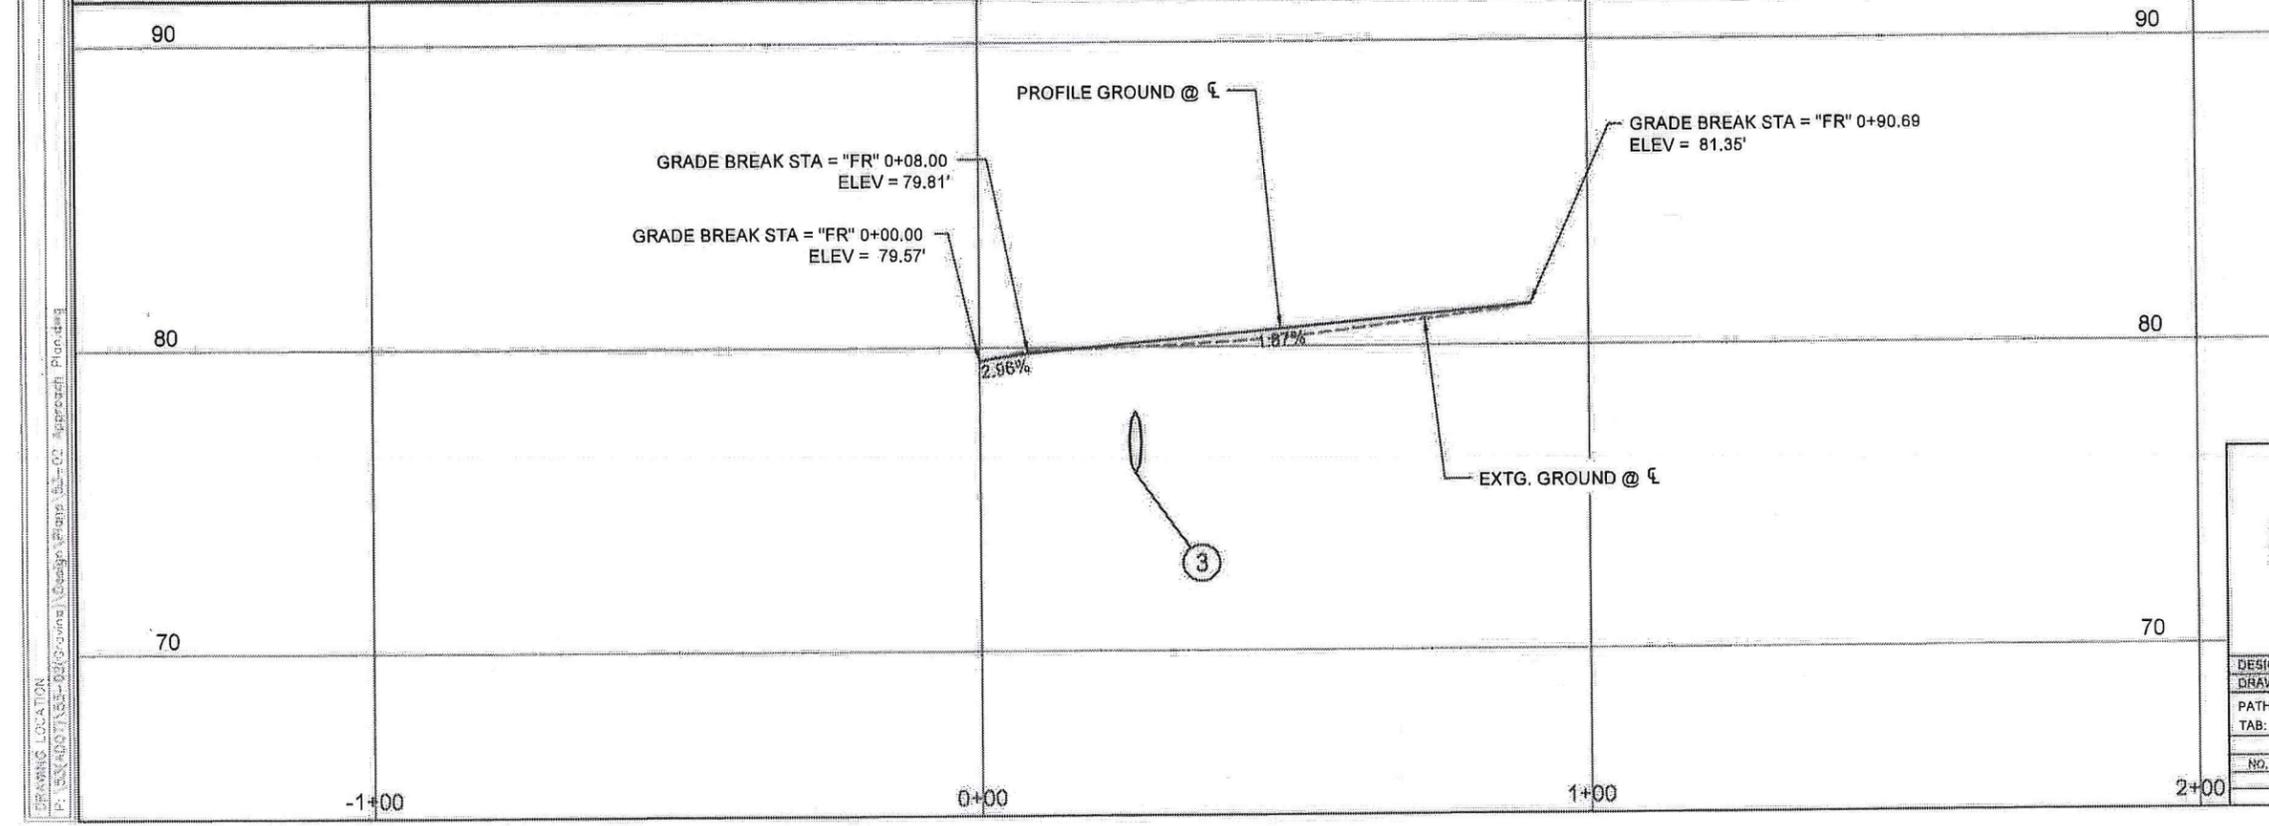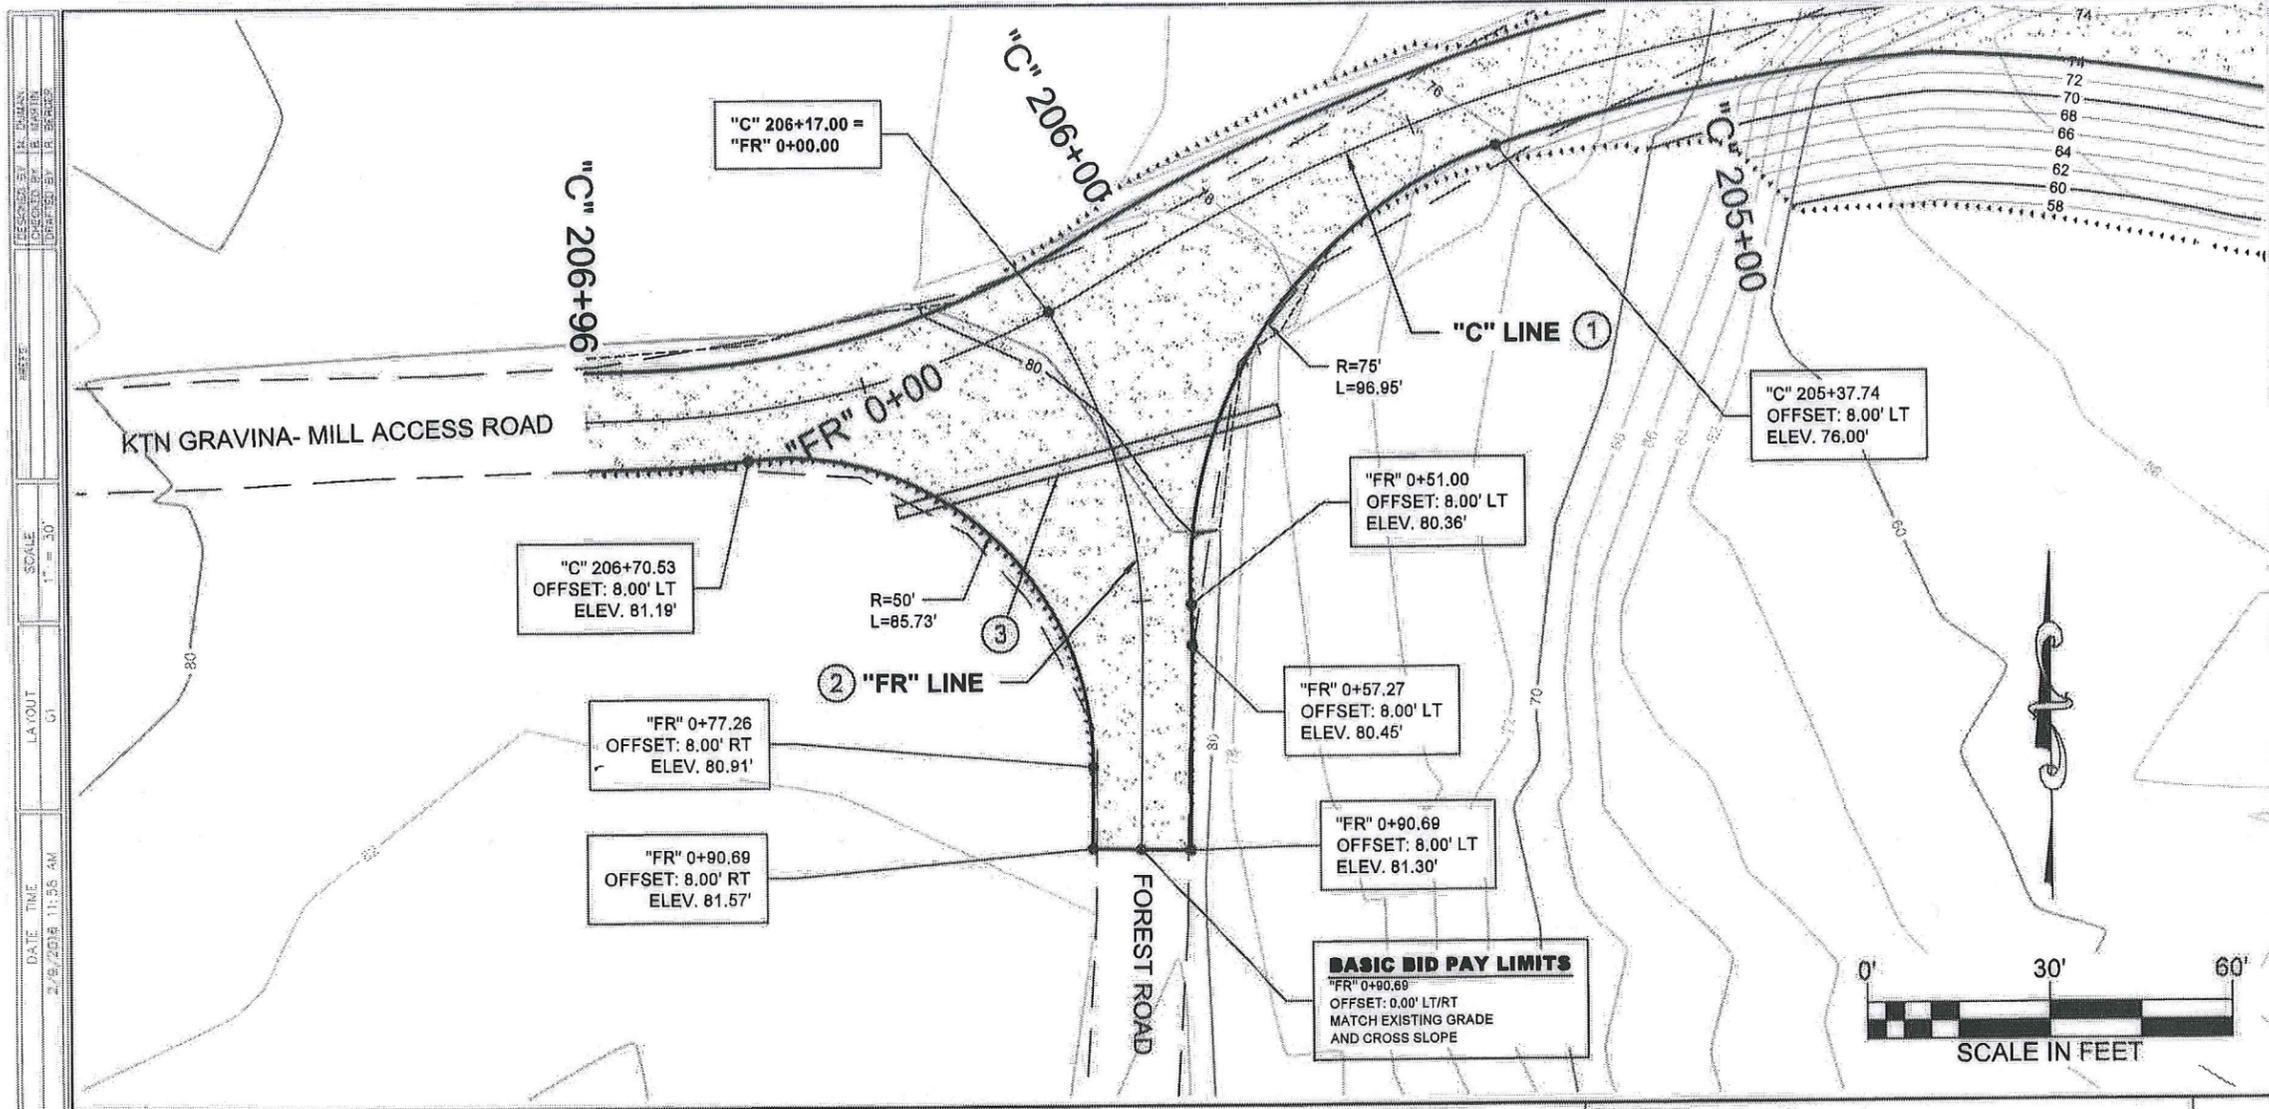

Project As Built Drawings Have Been Reviewed
By the Project Engineer & Represent, To the
Best of My Knowledge, the Project as
Constructed.

Project Eng. *MP* Date *8-23-17*

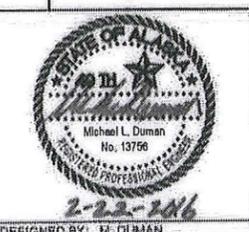

STATE OF ALASKA
DEPARTMENT OF TRANSPORTATION
& PUBLIC FACILITIES
SOUTHCOST REGION

**KTN GRAVINA - MILL
ACCESS ROAD**




**APPROACH PLAN
FOREST ROAD INT.**

DESIGNED BY: M. DUMAN	PROJECT DESIGNATION			YEAR	SHEET NO.	TOTAL SHEETS
DRAWN BY: R. BERGER	Z699220000			2016	G1	48
PATH: P:\53(ADOT)\53-02(Gravina)\Design\Plane\53-02 Approach Plan.dwg	REVISIONS					
TAB: G1	NO.	DATE	DESCRIPTION			

DRAWING LOCATION: P:\53(ADOT)\53-02(Gravina)\Design\Plane\53-02 Approach Plan.dwg
 DATE TIME: 2/9/2016 11:35 AM
 SCALE: 1" = 30'
 LA OUT: G1
 REVISIONS: 1. BERGER 2/9/16 11:35 AM

GENERAL NOTES

1. INSTALL ALL SIGNS ON GALVANIZED 2 1/2" X 2 1/2" PSST. REFERENCE AKDOT&PF STD. DWG. S-00.11 AND S-01.00.
2. FOR SIGN INSTALLATION OFFSET, REFERENCE AKDOT&PF STD. DWG. S-05.01
3. FOR SIGN POST FOUNDATIONS, REFERENCE AKDOT&PF STD. DWG. S-30.03.
4. REFERENCE STANDARD SIGN SUMMARY TABLE, SHT. D2.

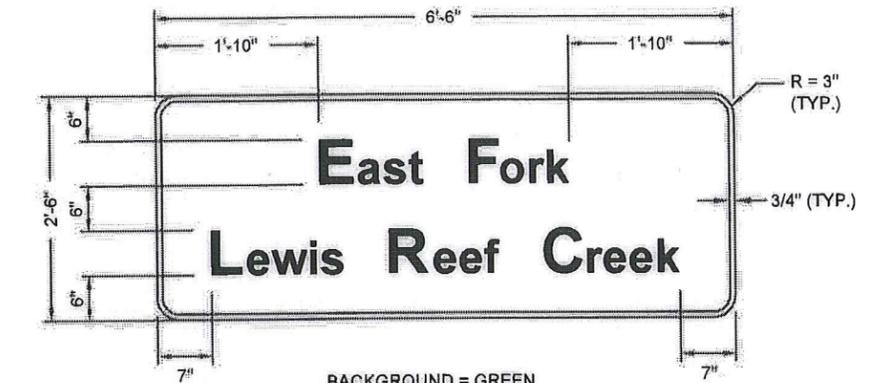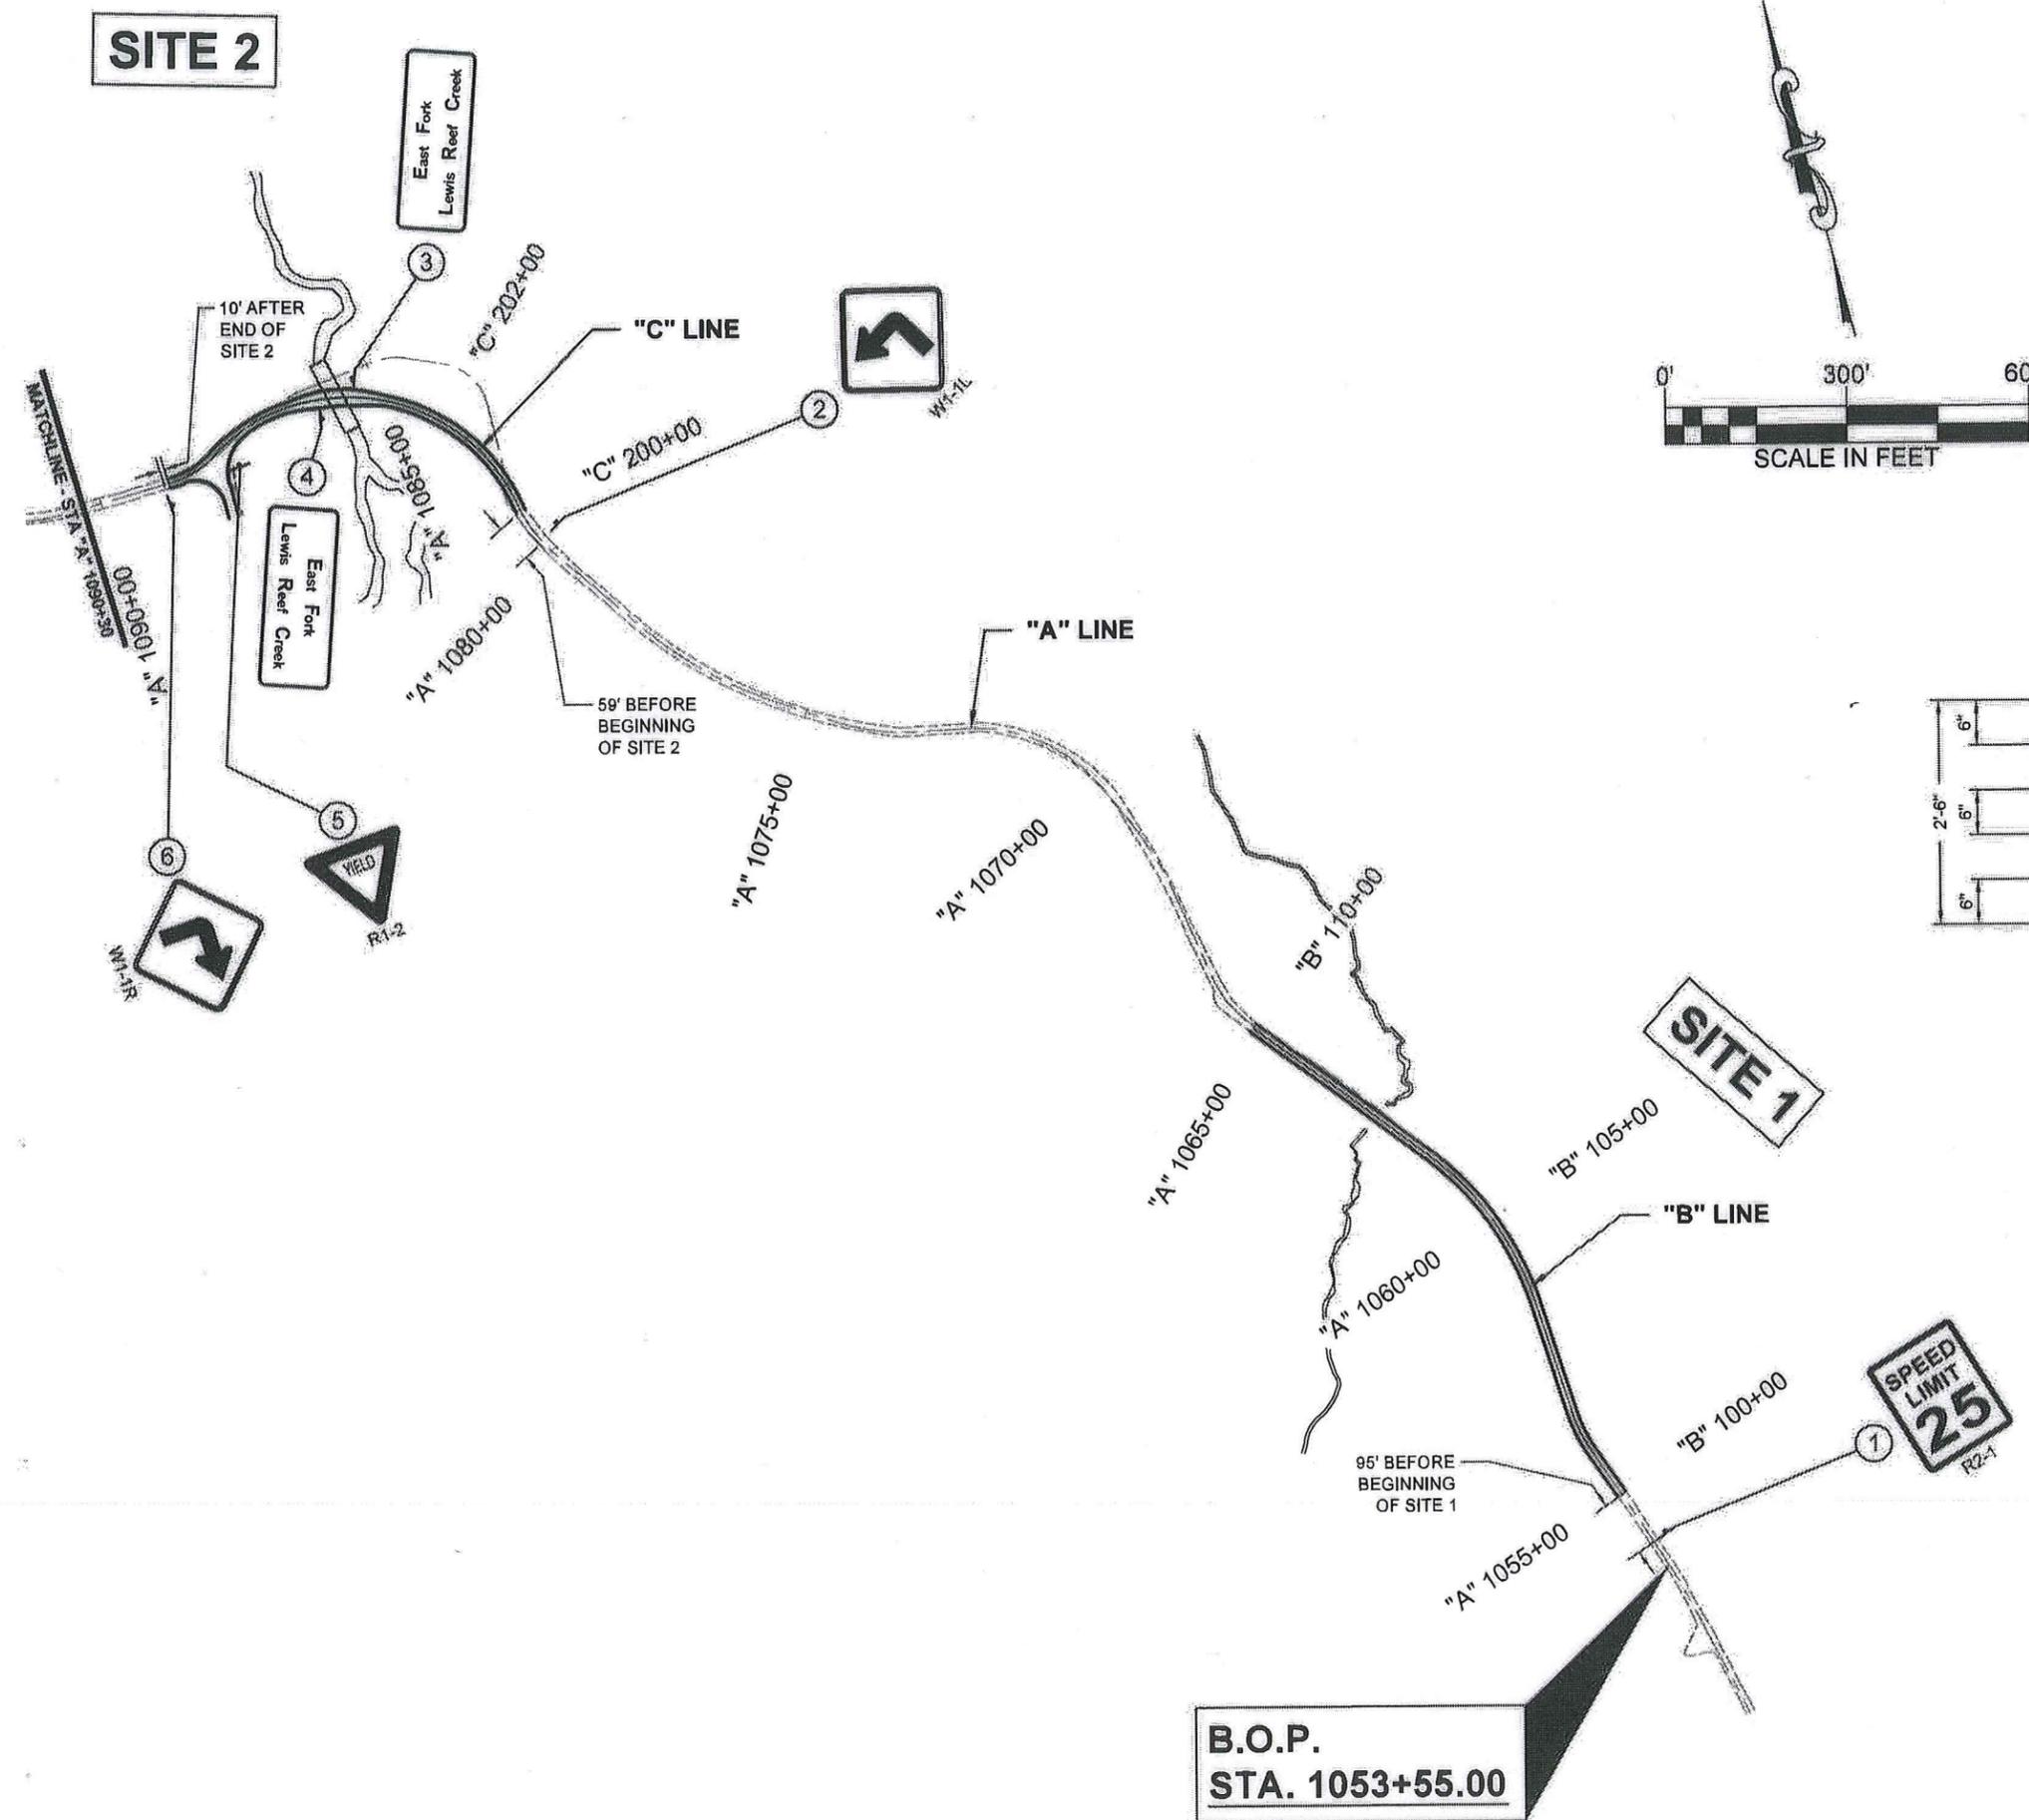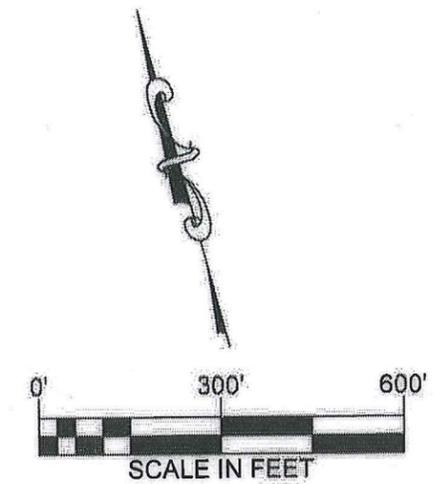

BACKGROUND = GREEN
 BORDER = WHITE
 LEGEND = WHITE
 FIRST LETTER = 6" C UPPERCASE
 AFTER LETTERS = 4 1/2" C LOWERCASE

CUSTOM SIGN DETAIL "EAST FORK LEWIS REEF CREEK"

N.T.S.

Project As Built Drawings Have Been Reviewed By the Project Engineer & Represent, To the Best of My Knowledge, the Project as Constructed.

Project Eng. *MP* Date *8.23.17*



STATE OF ALASKA
 DEPARTMENT OF TRANSPORTATION
 & PUBLIC FACILITIES
 SOUTHCOAST REGION

KTN GRAVINA - MILL
 ACCESS ROAD

SIGNING PLAN


DESIGNED BY: M. DUMAN	PROJECT DESIGNATION			YEAR	SHEET NO.	TOTAL SHEETS
DRAWN BY: R. BERGER	Z699220000			2016	H1	48
PATH: P:\53(ADOT)\53-02(Gravina)\Design\Plans\53-02 Signing Plan.dwg	REVISIONS					
TAB: H1	NO.	DATE	DESCRIPTION			
Wednesday, February 17, 2016 11:51:34 AM				Ryan Berger		

**B.O.P.
 STA. 1053+55.00**

DRAWING LOCATION: P:\53(ADOT)\53-02(Gravina)\Design\Plans\53-02 Signing Plan.dwg
 DATE: 2/29/2016 11:59 AM
 SCALE: 1" = 300'
 LAYOUT: H1
 TIME: 11:59 AM
 PROJECT: KTN GRAVINA - MILL ACCESS ROAD
 SHEET: 48 OF 48

GENERAL NOTES

1. INSTALL ALL SIGNS ON GALVANIZED 2 1/2" X 2 1/2" PSST. REFERENCE AKDOT&PF STD. DWG. S-00.11 AND S-01.00.
2. FOR SIGN INSTALLATION OFFSET, REFERENCE AKDOT&PF STD. DWG. S-05.01
3. FOR SIGN POST FOUNDATIONS, REFERENCE AKDOT&PF STD. DWG. S-30.03.
4. REFERENCE STANDARD SIGN SUMMARY TABLE, SHT. D2.

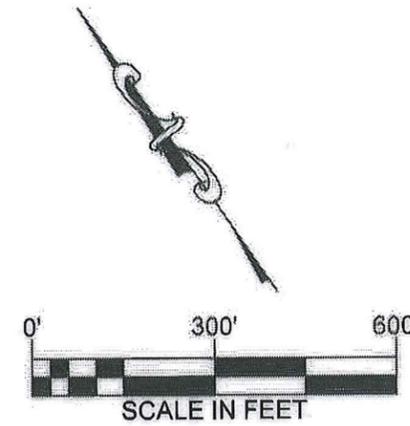

E.O.P.
STA. 1137+75.00

5' BACK FROM E.O.P.



11

"A" 1135+00



W14-1

SELEY MILL SITE

"A" 1130+00

"A" 1125+00

"A" 1120+00

"A" 1115+00

"A" 1110+00

"A" LINE

"D" 310+00

"A" 1105+00

"A" 1100+00

394' BEFORE END OF SITE 3



W11-3R

West Fork Lewis Reef Creek

8

7

"D" 300+00

152' AFTER END OF SITE 3




West Fork Lewis Reef Creek

9

SITE 3

"A" 1095+00

"D" LINE

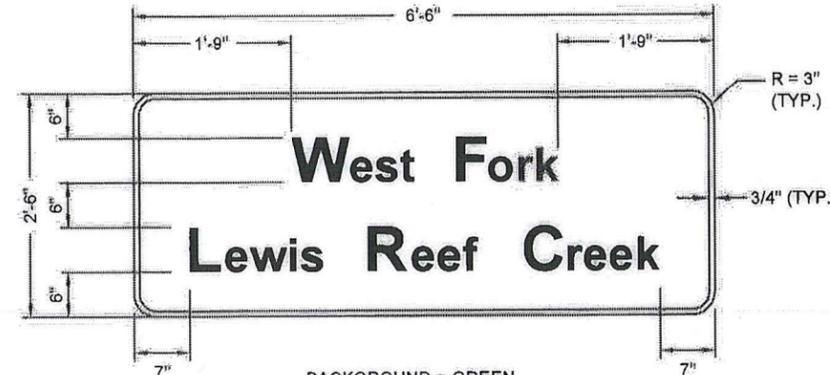

BACKGROUND = GREEN
BORDER = WHITE
LEGEND = WHITE
FIRST LETTER = 6" C UPPERCASE
AFTER LETTERS = 4 1/2" C LOWERCASE

CUSTOM SIGN DETAIL
"WEST FORK LEWIS REEF CREEK"
N.T.S.

Project As Built Drawings Have Been Reviewed by the Project Engineer & Represent, To the Best of My Knowledge, the Project as Constructed.

Project Eng. *MAP*

Date *8.24.17*



DESIGNED BY: M. DURAN
DRAWN BY: R. BERGER

PATH: P:\53(ADOT)\53-02(Gravina)\Design\Plans\53-02 Signing Plan.dwg

TAB: H2 Wednesday, February 17, 2016 11:51:35 AM Ryan Berger

REVISIONS		
NO.	DATE	DESCRIPTION













STATE OF ALASKA
DEPARTMENT OF TRANSPORTATION
& PUBLIC FACILITIES
SOUTHCOST REGION

KTN GRAVINA - MILL
ACCESS ROAD

SIGNING PLAN

PROJECT DESIGNATION	YEAR	SHEET NO.	TOTAL SHEETS
Z699220000	2016	H2	48

DRAWING LOCATION: P:\333\ADOT\53-02\Gravina\Design\Plans\53-02 Cross Sections_Site 1.dwg
 DATE/TIME: 8/23/2016 8:42 AM
 LAYOUT: II
 SCALE: 1" = 50'
 SHEETS: 48

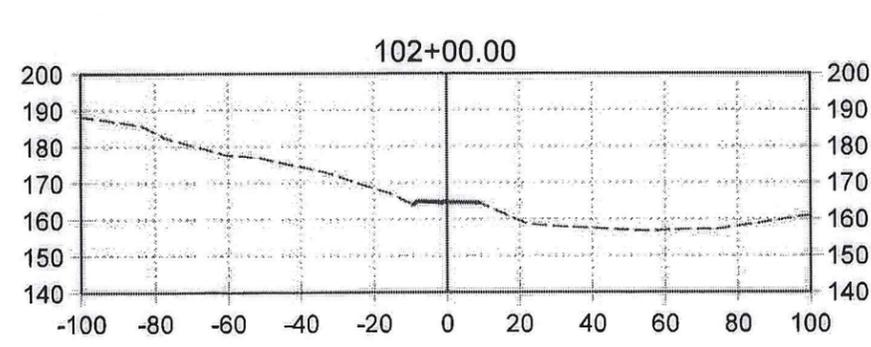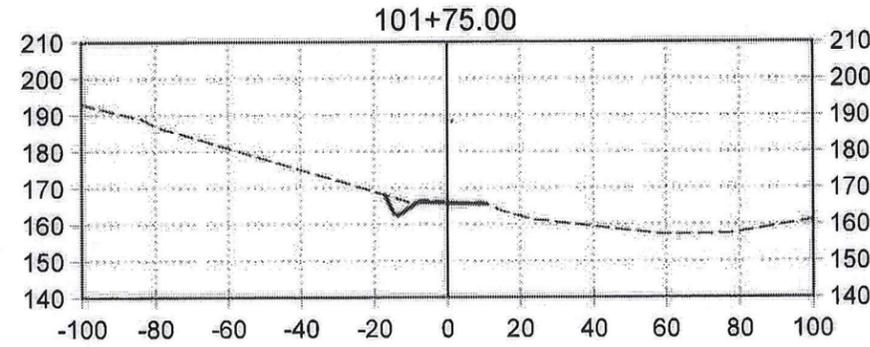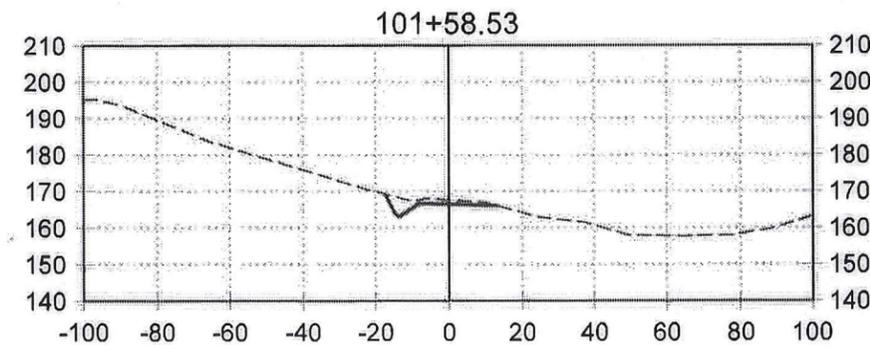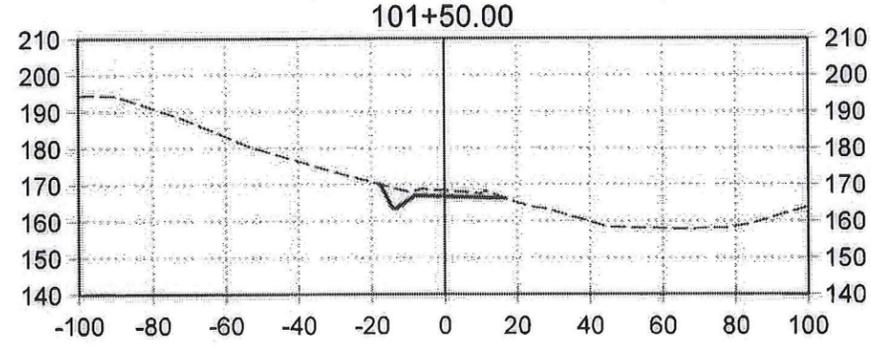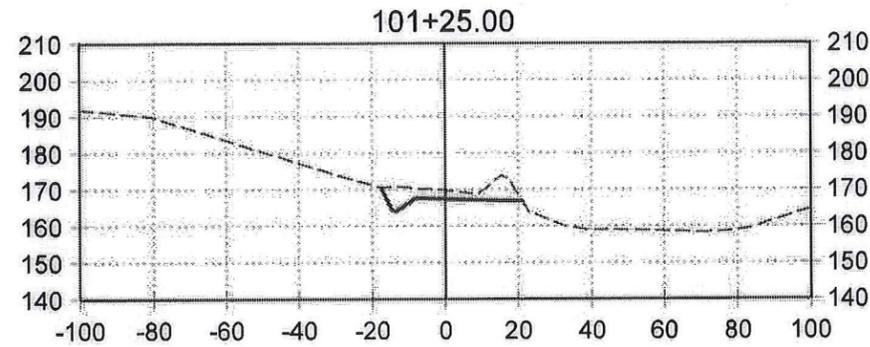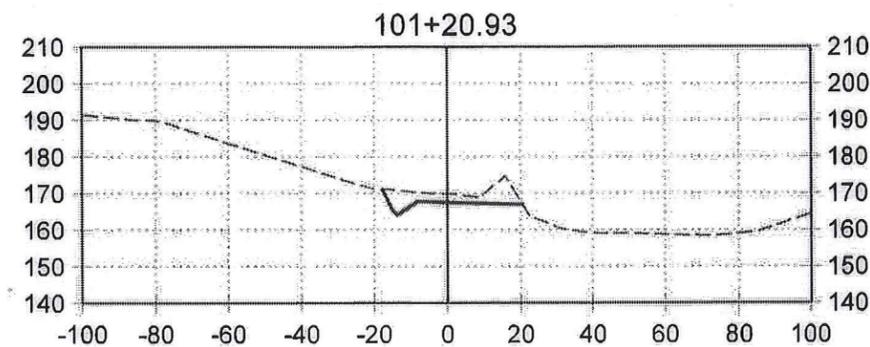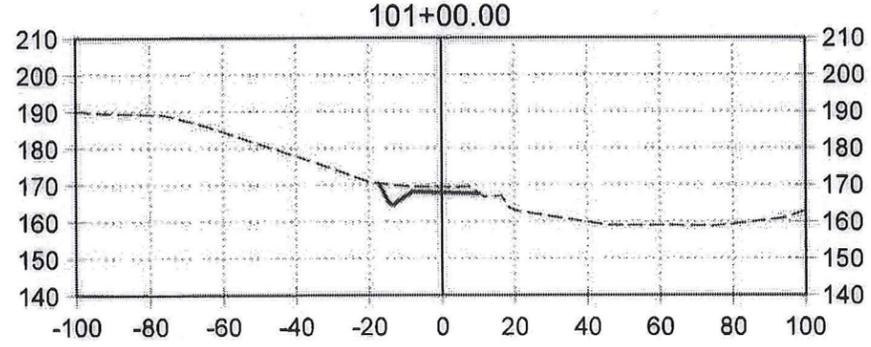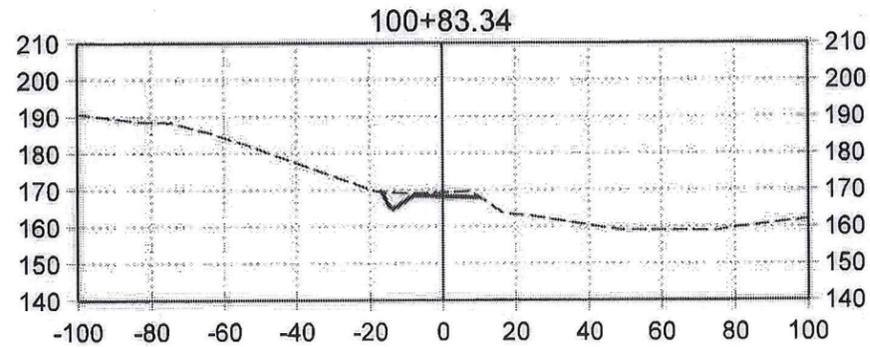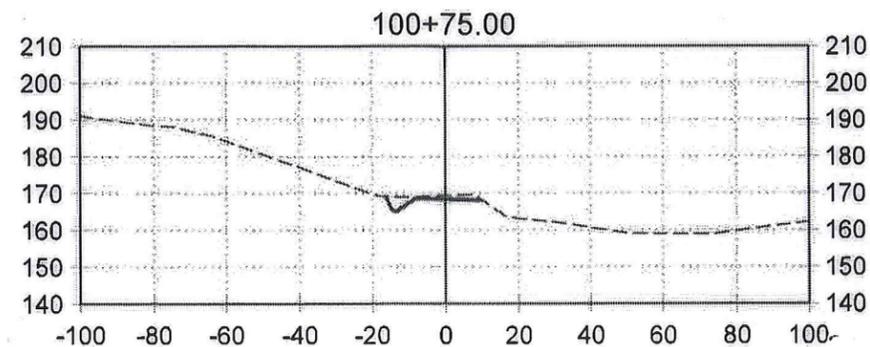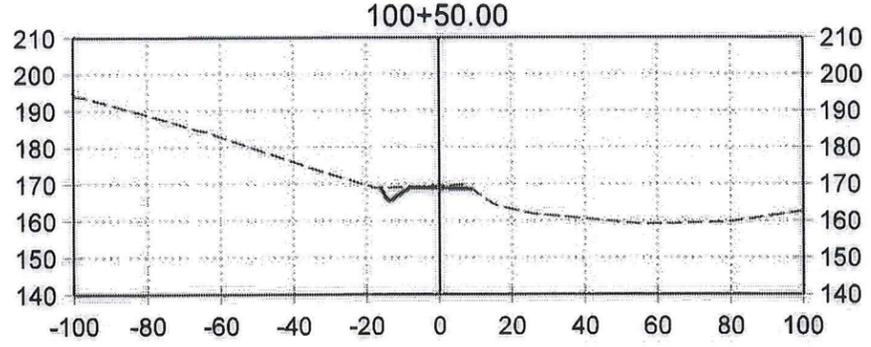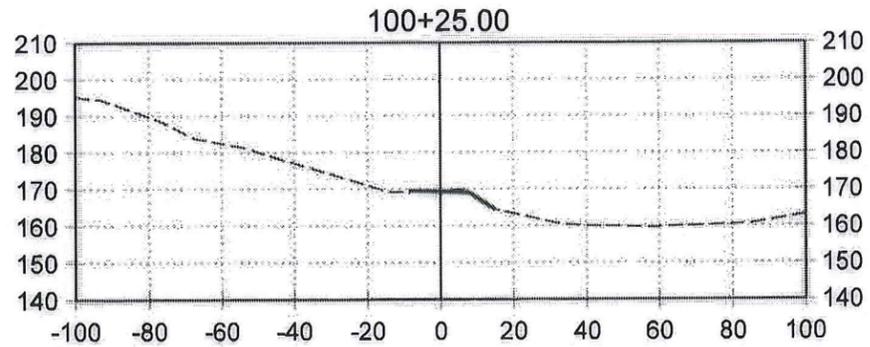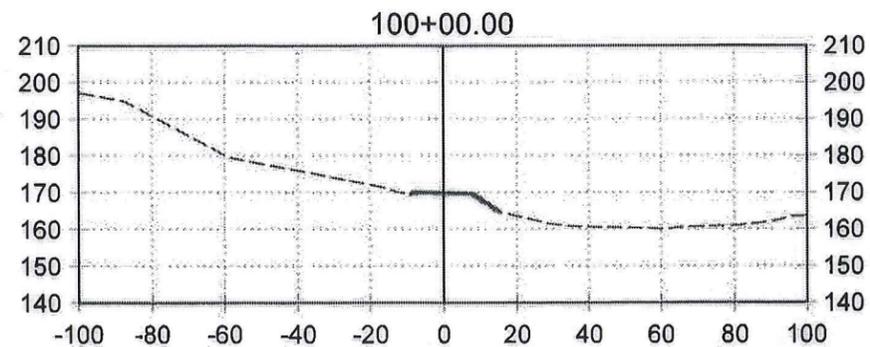

**ADDITIVE
ALTERNATE A
"B" LINE PLAN**

Project As Built Drawings Have Been Reviewed
 By the Project Engineer & Represent, To the
 Best of My Knowledge, the Project as
 Constructed.
 Project Eng. *MP* Date *8-23-16*

LEGEND













- EXISTING GROUND
- FINISHED GROUND
- ALIGNMENT CENTERLINE

DESIGNED BY: M. DUMAN
 DRAWN BY: R. BERGER
 PATH: P:\53(ADOT)\53-02(Gravina)\Design\Plans\53-02 Cross Sections_Site 1.dwg
 TAB: J1
 Wednesday, February 17, 2016 11:53:46 AM Ryan Berger

STATE OF ALASKA DEPARTMENT OF TRANSPORTATION & PUBLIC FACILITIES SOUTHCOAST REGION			
KTN GRAVINA - MILL ACCESS ROAD ADDITIVE ALTERNATE A SITE 1 CROSS SECTIONS 100+00 - 102+00			
PROJECT DESIGNATION	YEAR	SHEET NO.	TOTAL SHEETS
Z699220000	2016	J1	48

See Total Cut/Fill Quantities Sheets

DRAWING LOCATION: P:\AS3\ADOT\53-02\Gravina\Design\Plans\53-02_Cross Sections_Site 1.dwg
 DATE/TIME: 9/29/2015 8:42 AM
 LAYOUT: 02
 SCALE: 1" = 50'
 DESIGNED BY: M. DUMAN
 DRAWN BY: R. BERGER

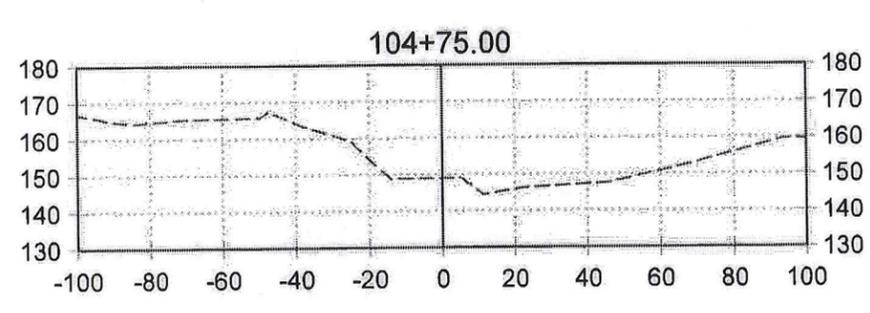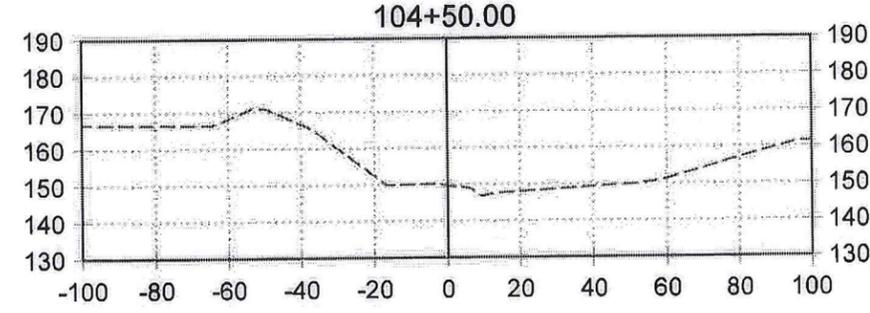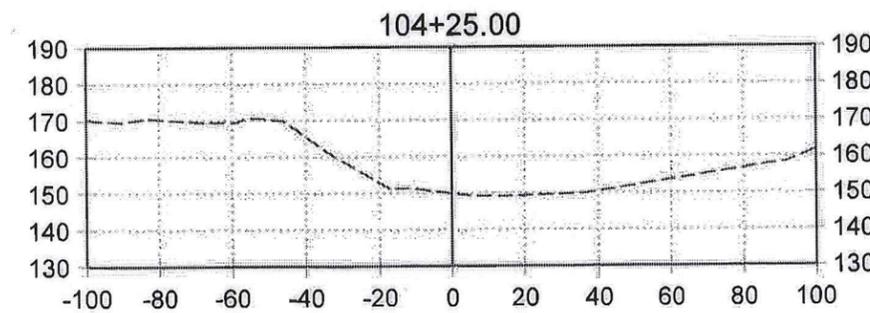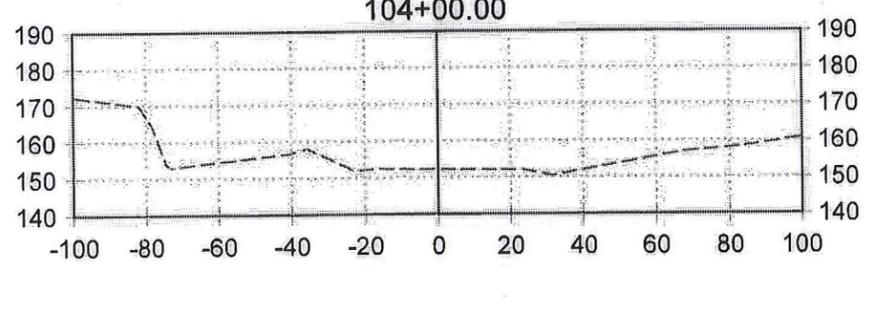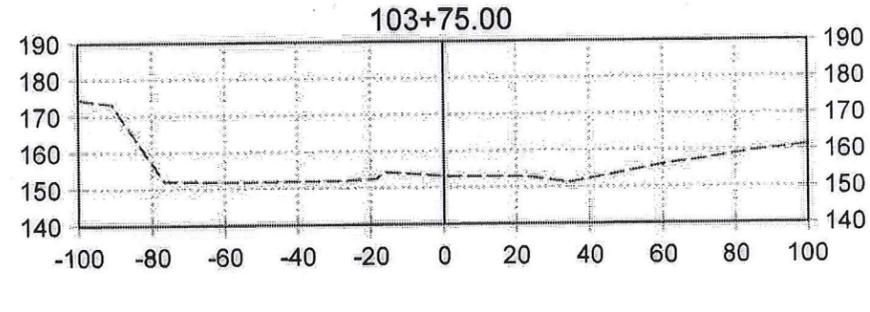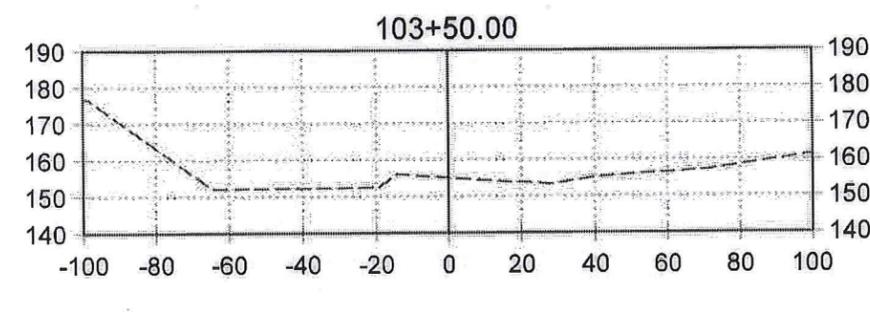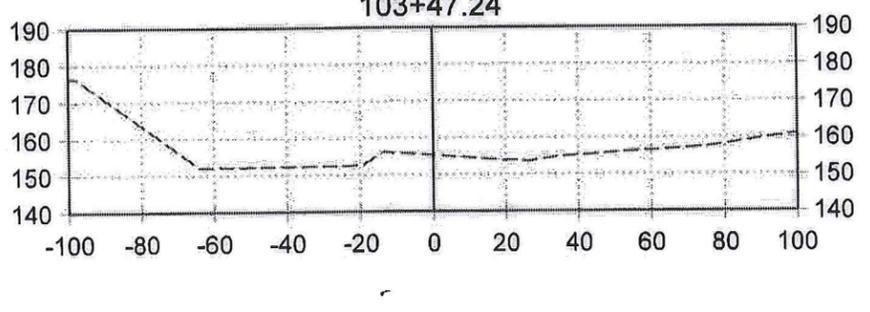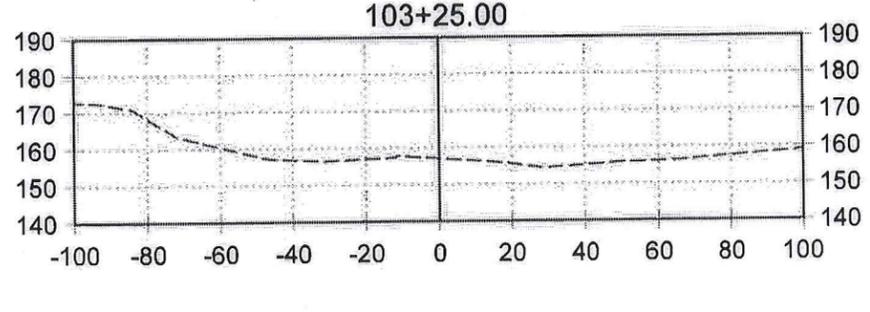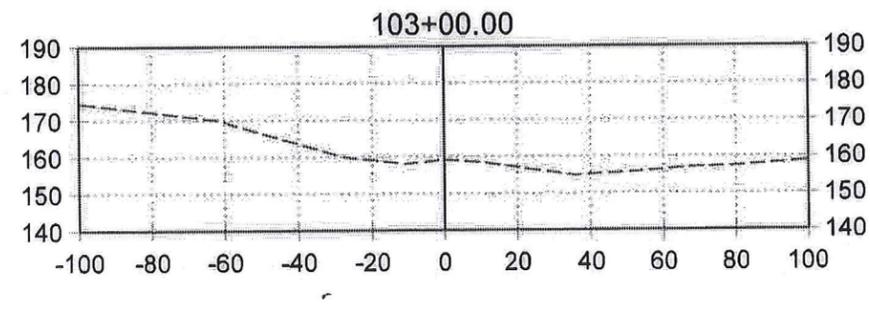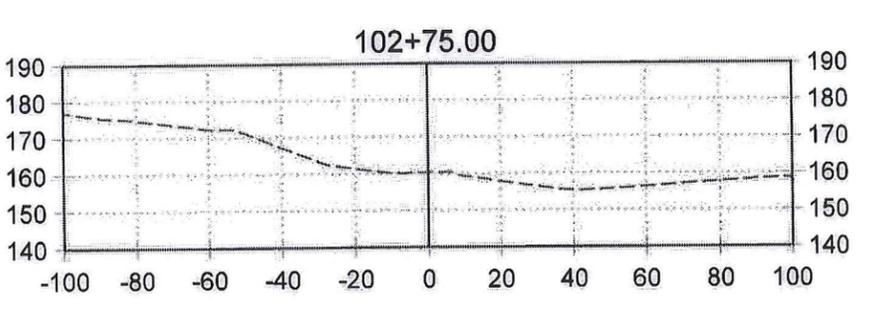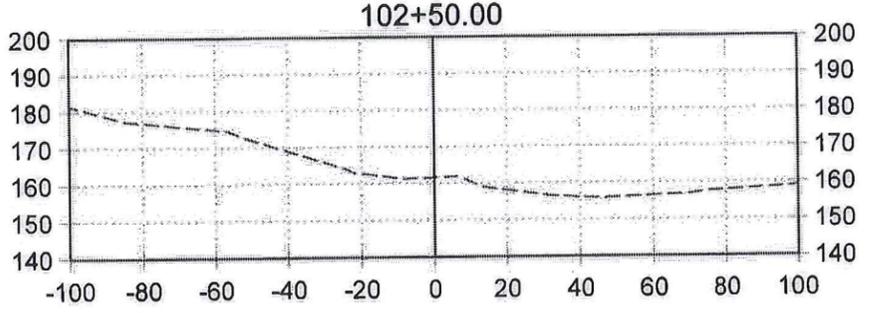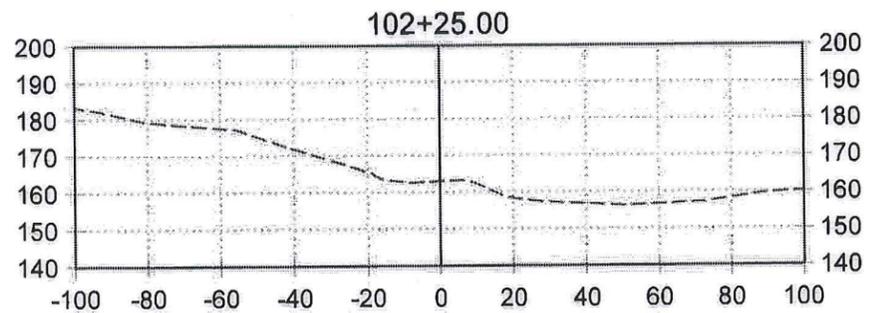

**ADDITIVE
ALTERNATE A
"B" LINE PLAN**

NOTE:
RESURFACING
STA "B" 102+15.00 TO 106+40.00

Project As Built Drawings Have Been Reviewed
By the Project Engineer & Represent, To the
Best of My Knowledge, the Project as
Constructed.
Project Eng. *MP* Date *8/23/17*

LEGEND

- EXISTING GROUND
- FINISHED GROUND
- ALIGNMENT CENTERLINE















DESIGNED BY: M. DUMAN		PROJECT DESIGNATION		YEAR	SHEET NO.	TOTAL SHEETS
DRAWN BY: R. BERGER		Z699220000		2016	J2	48
PATH: P:\AS3\ADOT\53-02\Gravina\Design\Plans\53-02_Cross Sections_Site 1.dwg TAB: J2 Wednesday, February 17, 2016 11:53:48 AM Ryan Berger						

STATE OF ALASKA
 DEPARTMENT OF TRANSPORTATION
 & PUBLIC FACILITIES
 SOUTHCOAST REGION

**KTN GRAVINA - MILL
 ACCESS ROAD
 ADDITIVE ALTERNATE A
 SITE 1 CROSS SECTIONS
 102+25 - 104+75**

See Total Cut/Fill Quantities Sheets

DRAWING LOCATION: P:\53\ADOT\53-02\Gravina\Design\Plan\53-02 Cross Sections_Site 1.dwg
 DATE TIME: 9/22/2015 8:47 AM
 LAYOUT: J3
 SCALE: 1" = 50'
 DESIGNED BY: M. DUMAN
 DRAWN BY: R. BERGER
 CHECKED BY: R. BERGER

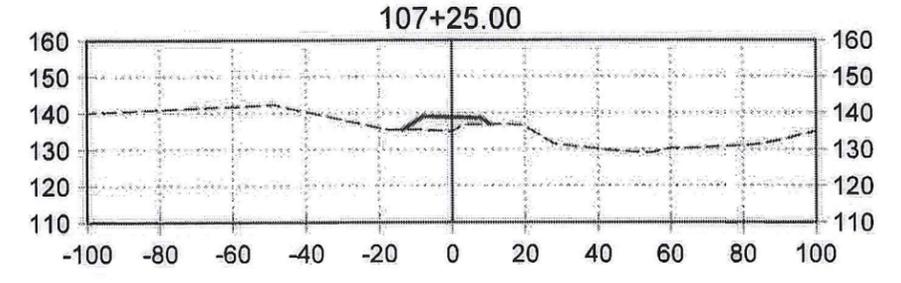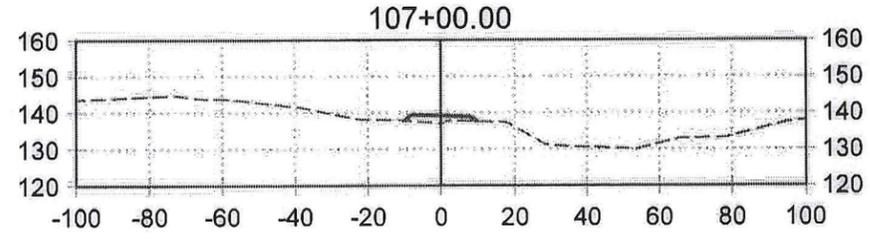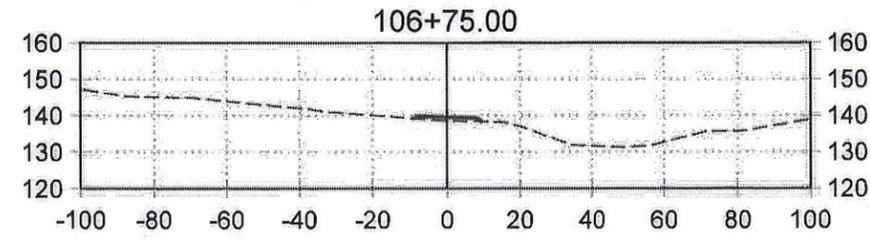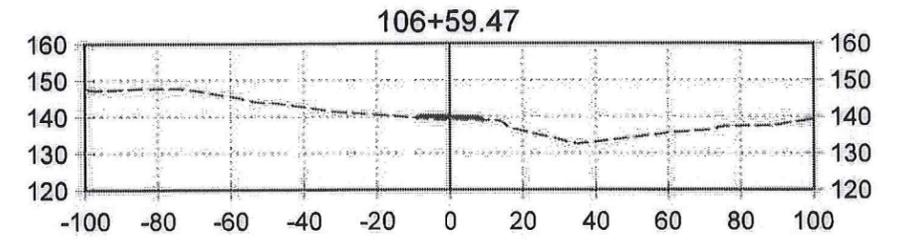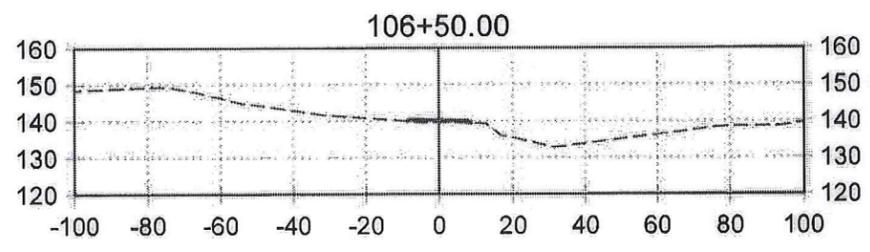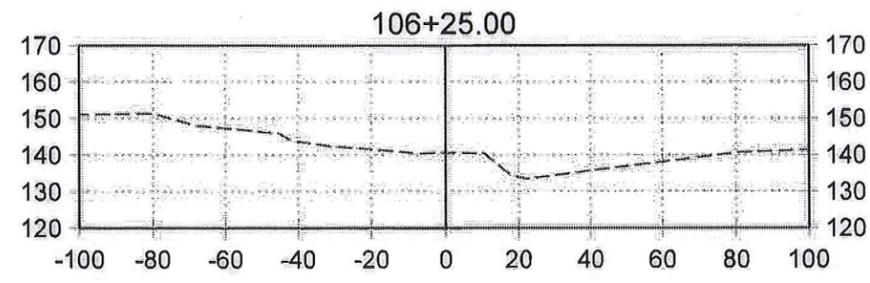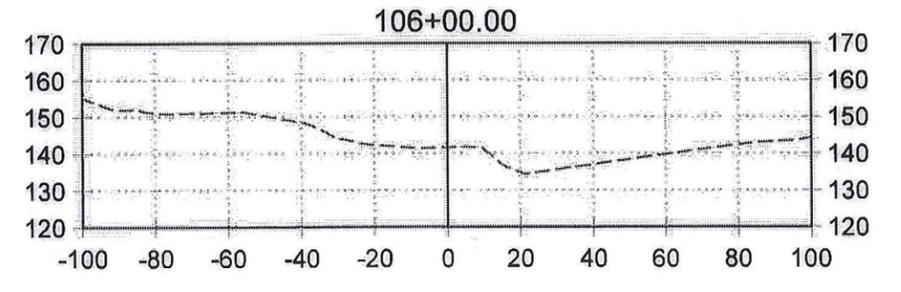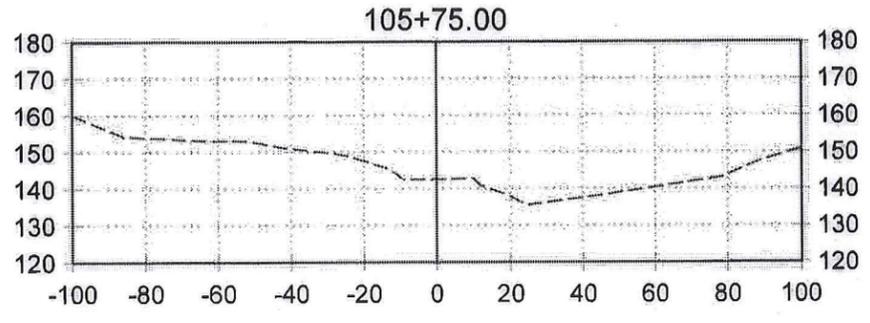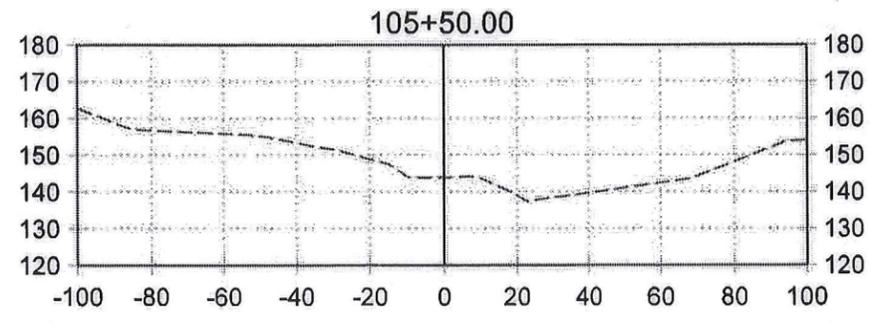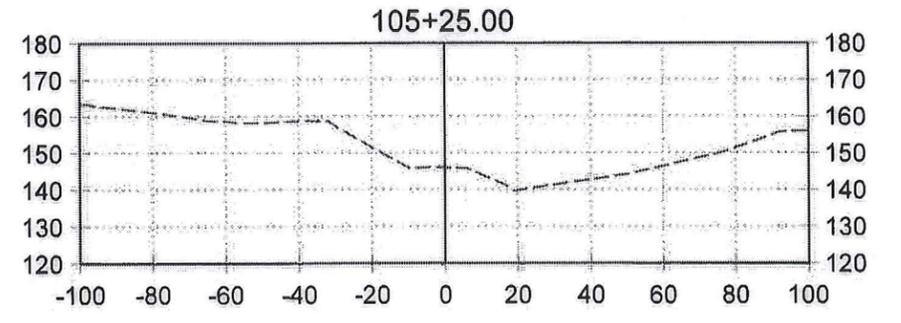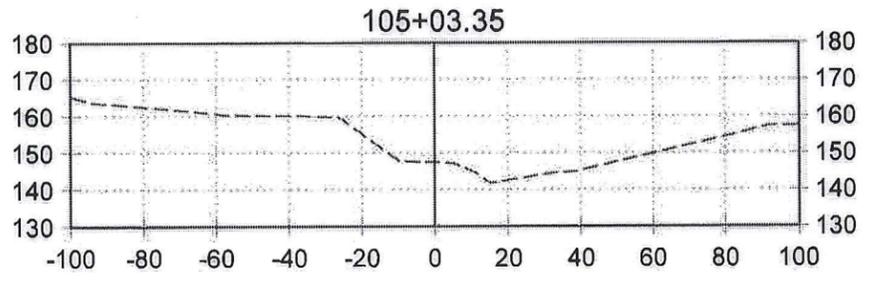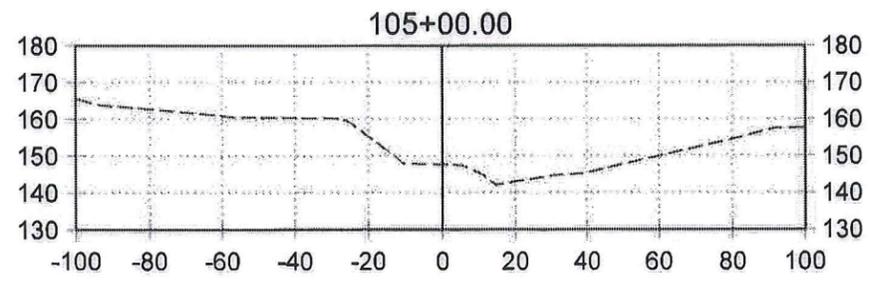

**ADDITIVE
ALTERNATE A
"B" LINE PLAN**

NOTE:
RESURFACING
STA "B" 102+15.00 TO 106+40.00

Project As Built Drawings Have Been Reviewed
By the Project Engineer & Represent, To the
Best of My Knowledge, the Project as
Constructed.
Project Eng. *MP* Date *8.23.17*

LEGEND













- EXISTING GROUND
- FINISHED GROUND
- ALIGNMENT CENTERLINE



DESIGNED BY: M. DUMAN DRAWN BY: R. BERGER DATE: 2-22-2016		STATE OF ALASKA DEPARTMENT OF TRANSPORTATION & PUBLIC FACILITIES SOUTHCOAST REGION	
KTN GRAVINA - MILL ACCESS ROAD ADDITIVE ALTERNATE A SITE 1 CROSS SECTIONS 105+00 - 107+25			
PATH: P:\53\ADOT\53-02\Gravina\Design\Plan\53-02 Cross Sections_Site 1.dwg TAB: J3 Wednesday, February 17, 2016 11:53:58 AM Ryan Berger		PROJECT DESIGNATION Z699220000	YEAR 2016
SHEET NO. J3	TOTAL SHEETS 48		

See Total Cut/Fill Quantities Sheets

DRAWING LOCATION: P:\S\ADOT\153-02(Gravina)\Design\Plans\153-02 Cross Sections_Site 1.dwg
 DATE TIME: 9/29/2015 8:42 AM
 LAYOUT: J4
 SCALE: 1" = 50'
 DESIGNED BY: M. DUMAN
 DRAWN BY: R. BERGER
 CHECKED BY: R. BERGER
 APPROVED BY: R. BERGER

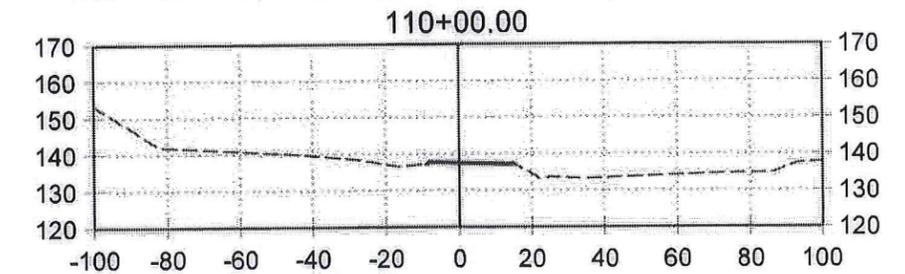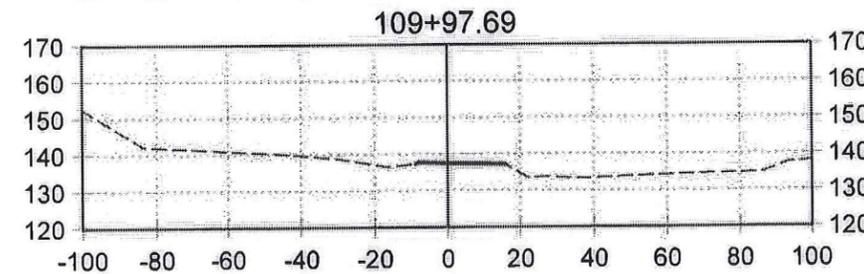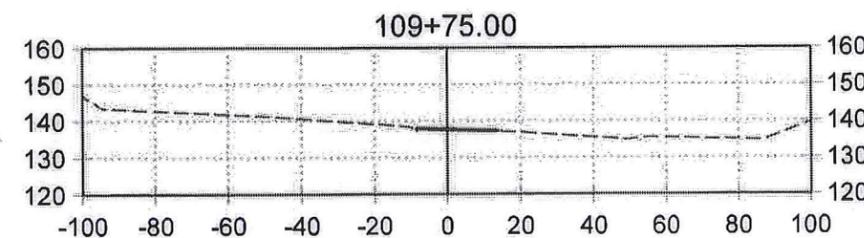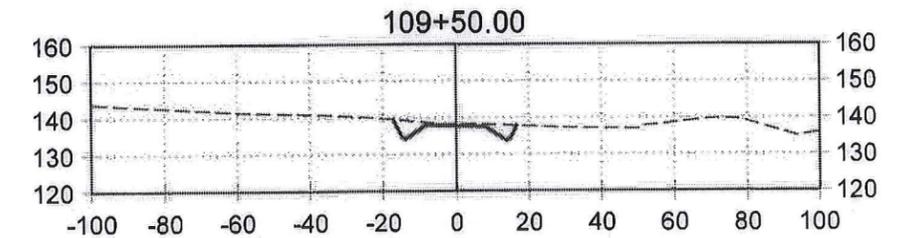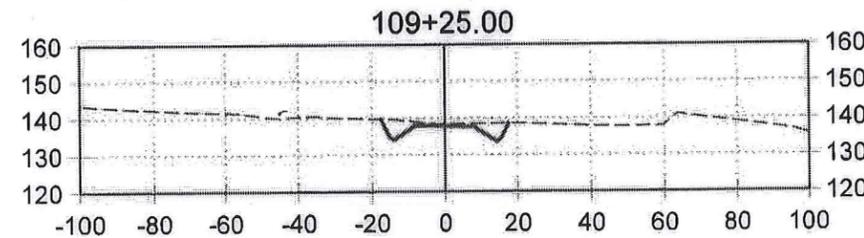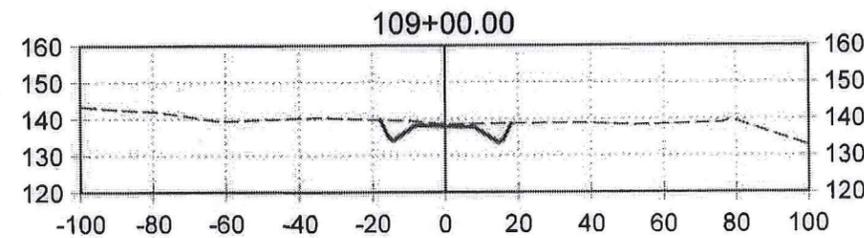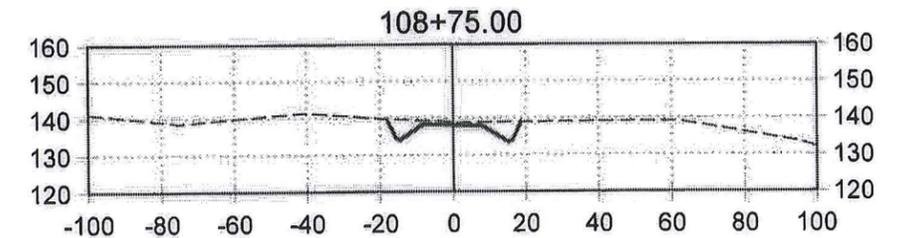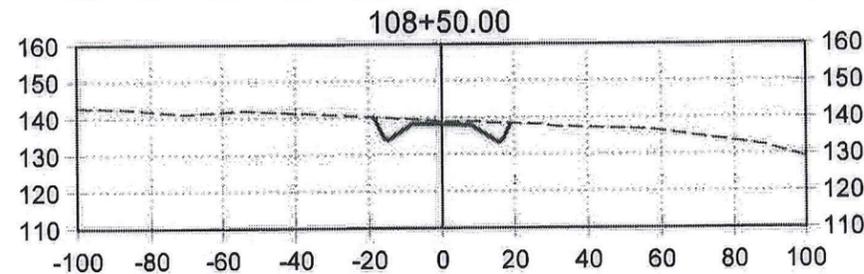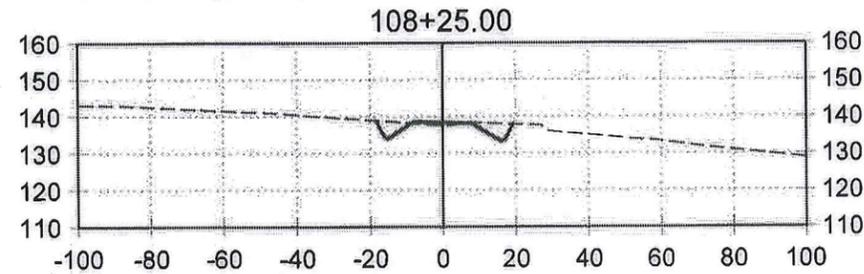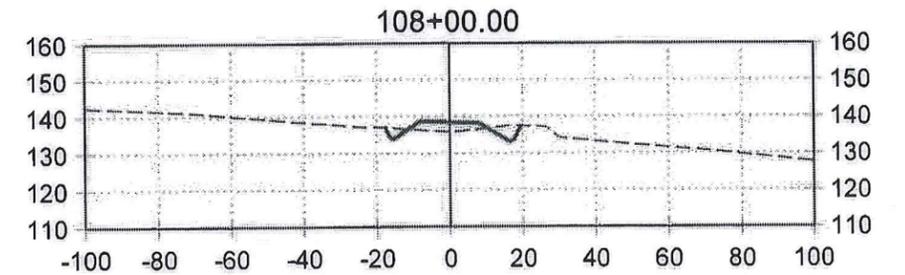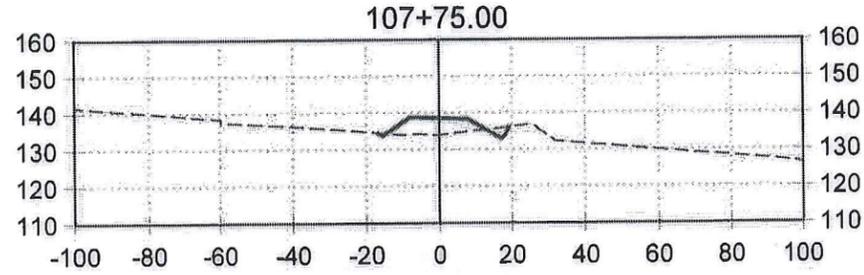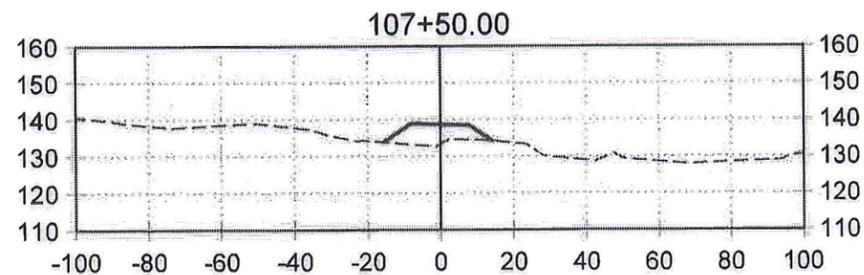

**ADDITIVE
ALTERNATE A
"B" LINE PLAN**


Project As Built Drawings Have Been Reviewed
By the Project Engineer & Represent, To the
Best of My Knowledge, the Project as
Constructed.

Project Eng. *MP*

8.23.17
Date

LEGEND

	EXISTING GROUND
	FINISHED GROUND
	ALIGNMENT CENTERLINE

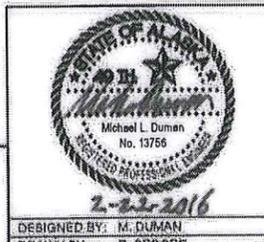













DESIGNED BY: M. DUMAN		PROJECT DESIGNATION		YEAR	SHEET NO.	TOTAL SHEETS
DRAWN BY: R. BERGER		Z699220000		2016	J4	48
PATH: P:\S\ADOT\153-02(Gravina)\Design\Plans\153-02 Cross Sections_Site 1.dwg TAB: J4 Wednesday, February 17, 2016 11:53:52 AM Ryan Berger						

STATE OF ALASKA
 DEPARTMENT OF TRANSPORTATION
 & PUBLIC FACILITIES
 SOUTHCOAST REGION

**KTN GRAVINA - MILL
 ACCESS ROAD
 ADDITIVE ALTERNATE A
 SITE 1 CROSS SECTIONS
 107+50 - 110+10**

See Total Cut/Fill Quantities Sheets

DRAWING LOCATION: P:\53\4003\53-02\Gravina\Design\Plans\53-02 Cross Sections_Site 2.dwg
 DATE/TIME: 9/27/2015 12:09 PM
 LAYOUT: J5
 SCALE: 1" = 50'
 USER: M. DULMAN

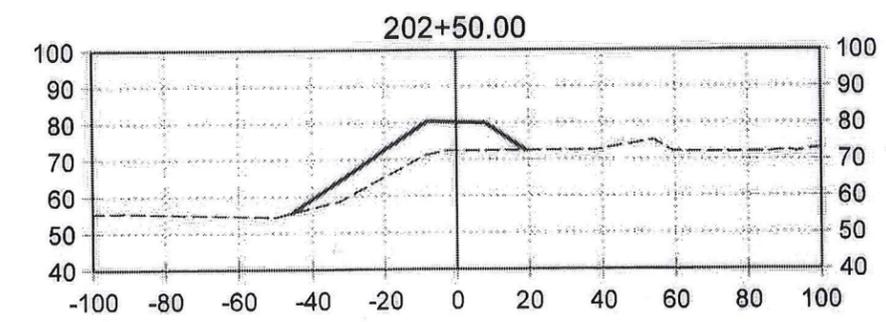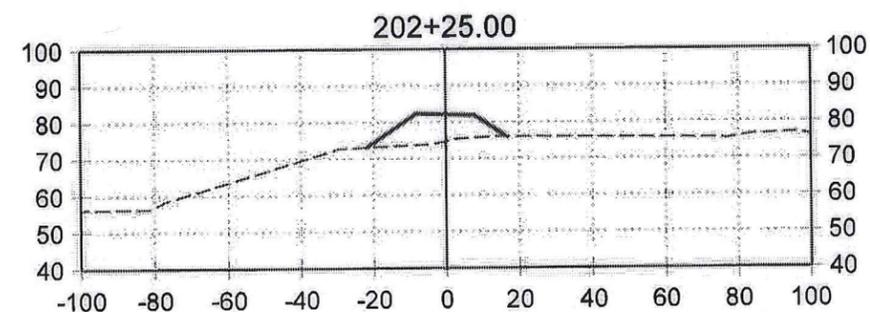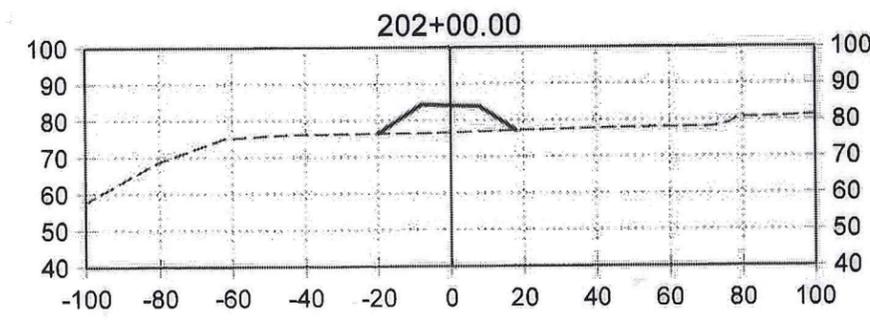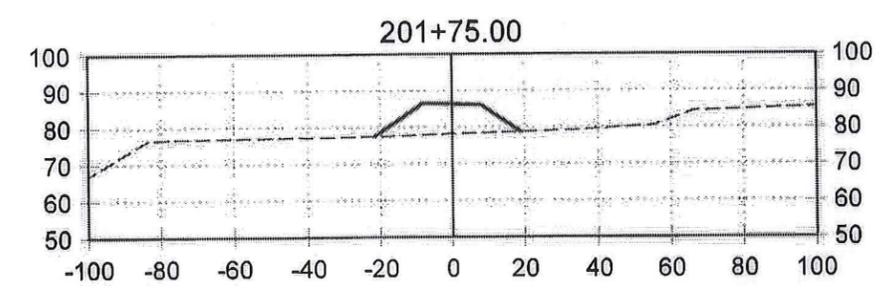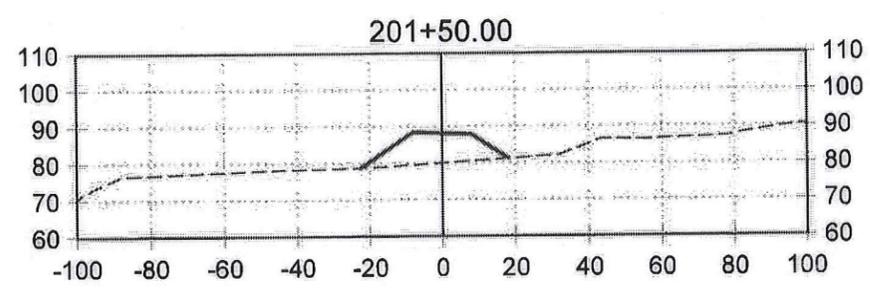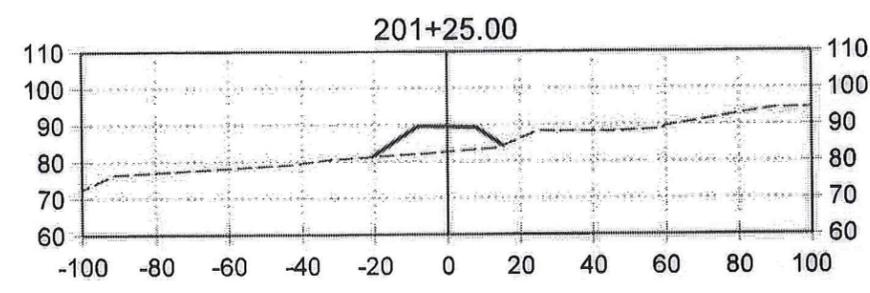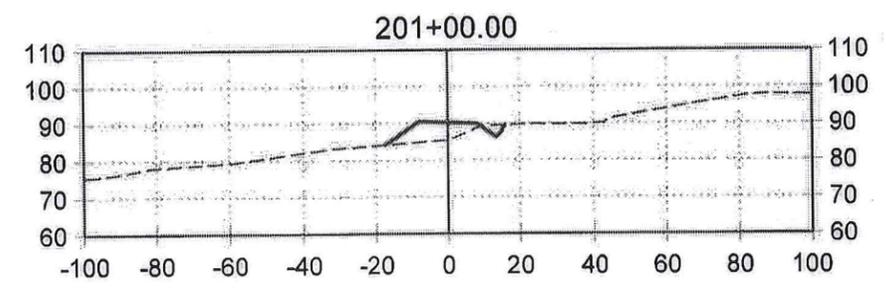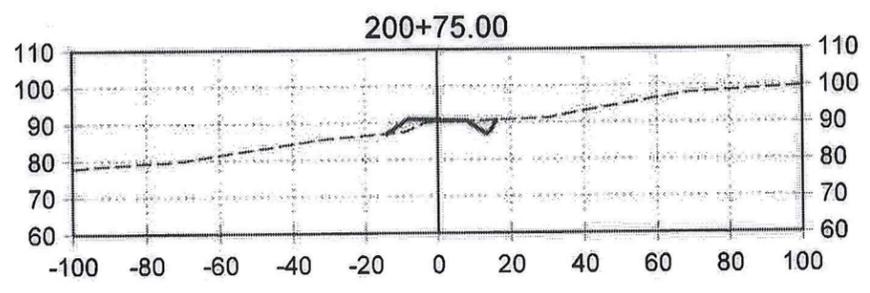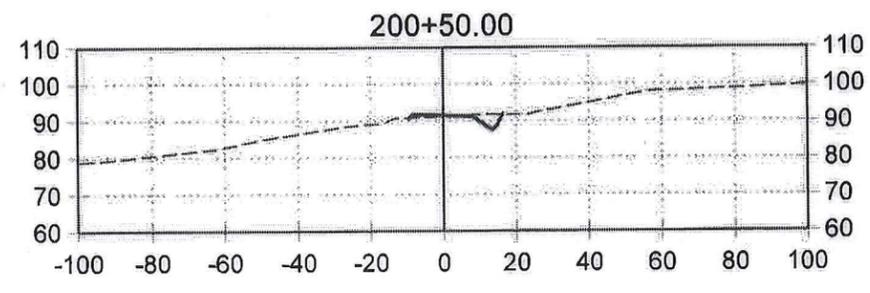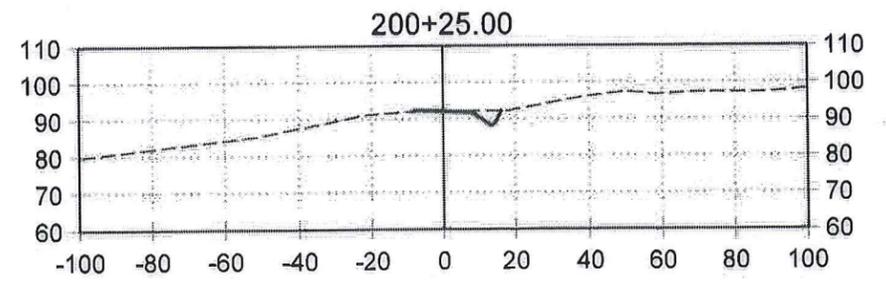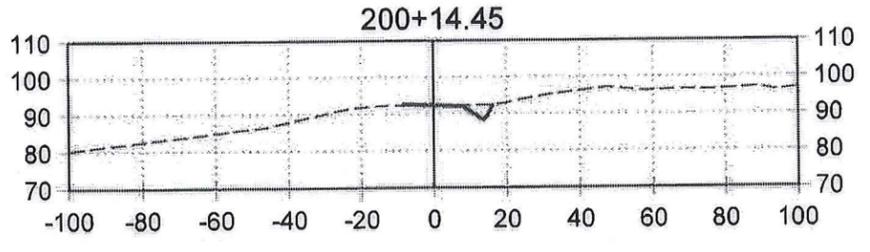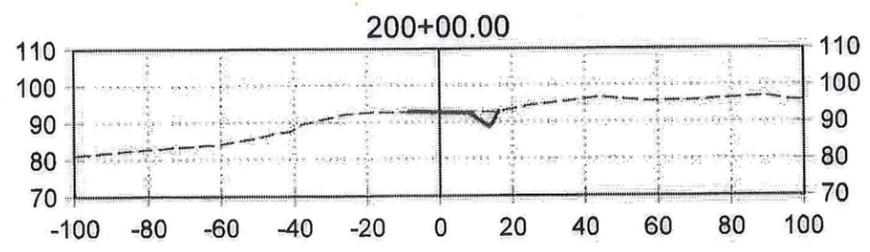

Project As Built Drawings Have Been Reviewed By the Project Engineer & Represent, To the Best of My Knowledge, the Project as Constructed.

Project Eng. *MP* Date *8.23.17*

LEGEND













- EXISTING GROUND
- FINISHED GROUND
- ALIGNMENT CENTERLINE

DESIGNED BY: M. DULMAN
 DRAWN BY: R. BERGER
 PATH: P:\53\ADOT\53-02\Gravina\Design\Plans\53-02 Cross Sections_Site 2.dwg
 TAB: J5 Wednesday, February 17, 2016 11:53:55 AM Ryan B#100

STATE OF ALASKA DEPARTMENT OF TRANSPORTATION & PUBLIC FACILITIES SOUTHCOAST REGION			
KTN GRAVINA - MILL ACCESS ROAD			
SITE 2 CROSS SECTIONS 200+00 - 202+75			
PROJECT DESIGNATION	YEAR	SHEET NO.	TOTAL SHEETS
Z699220000	2016	J5	48

See Total Cut/Fill Quantities Sheets

DRAWING LOCATION: P:\3\ADOT\15-02\Gravina\Design\Plans\3-22 Cross Sections_Site 2.dwg
 DATE/TIME: 9/21/2015 12:09 PM
 LAYOUT: J6
 SCALE: 1" = 50'
 DESIGNED BY: M. DUMAN
 CHECKED BY: R. BERGER
 DRAWN BY: R. BERGER

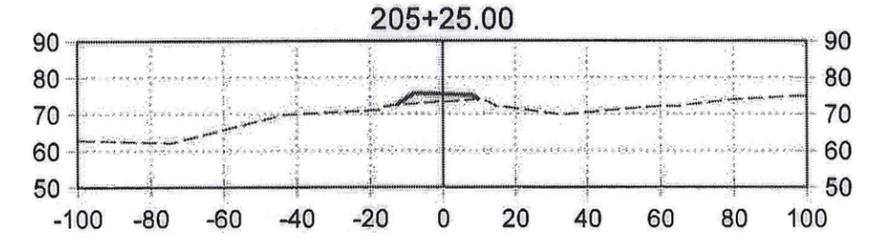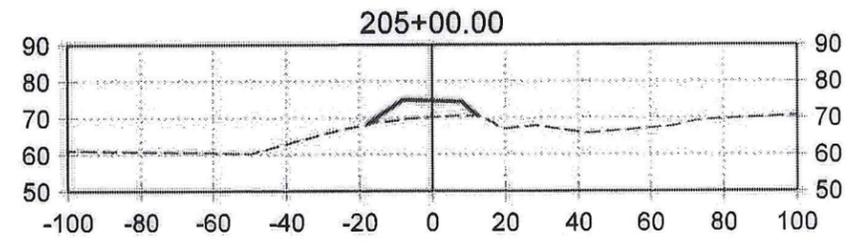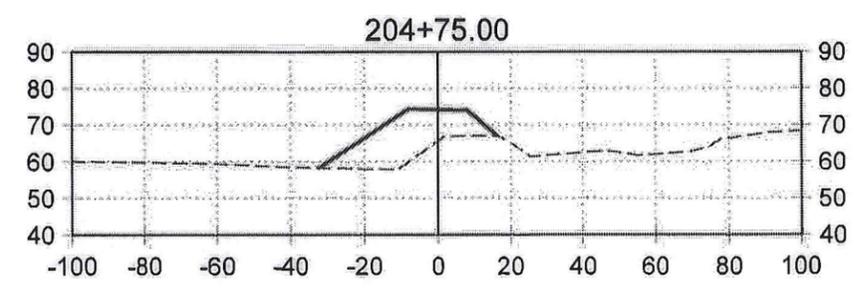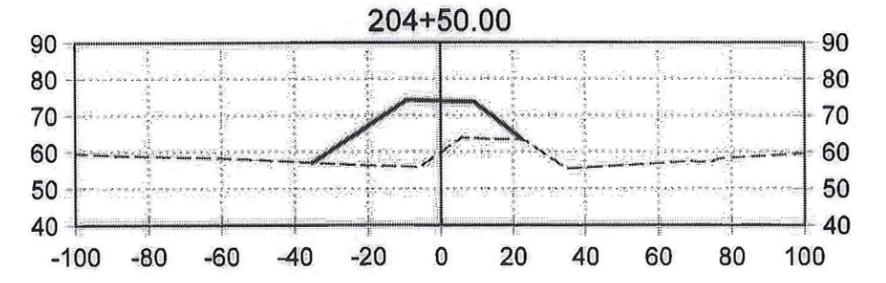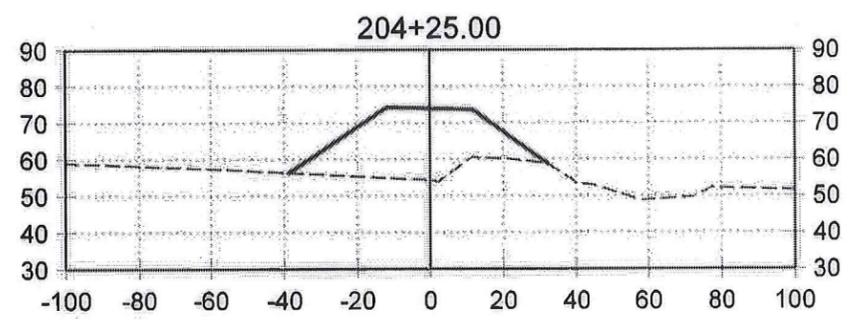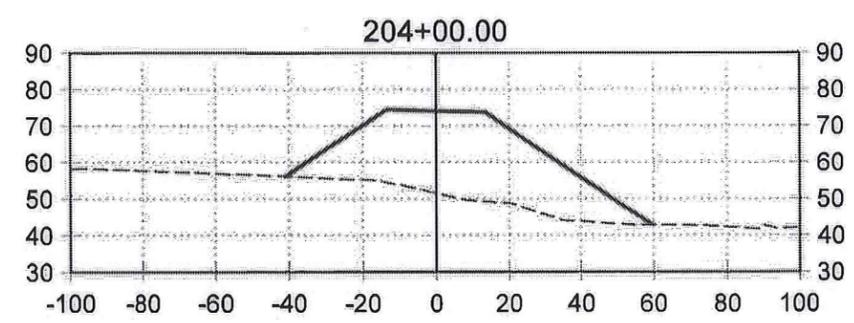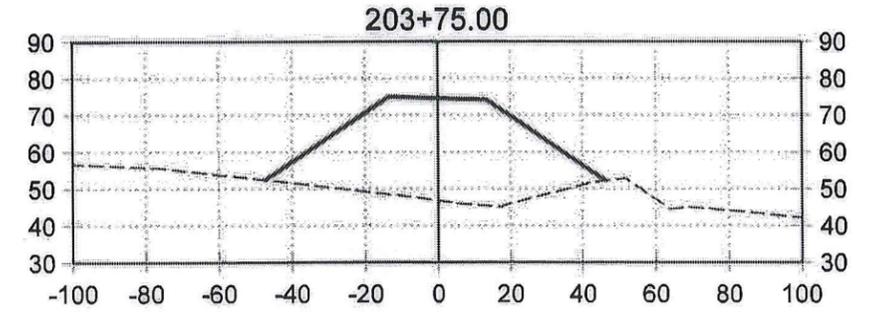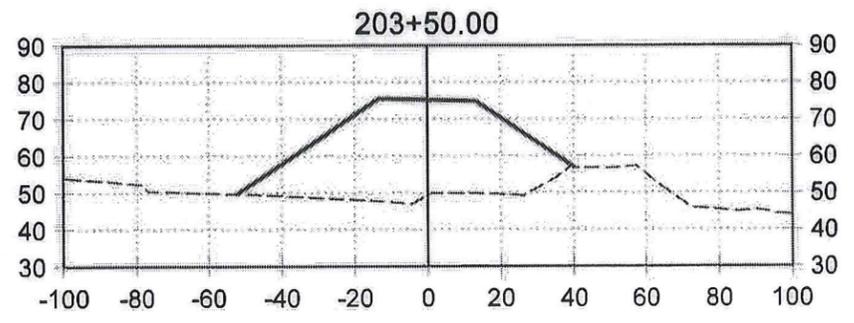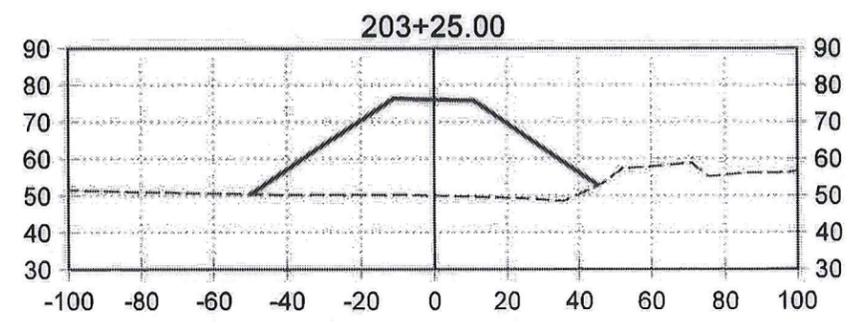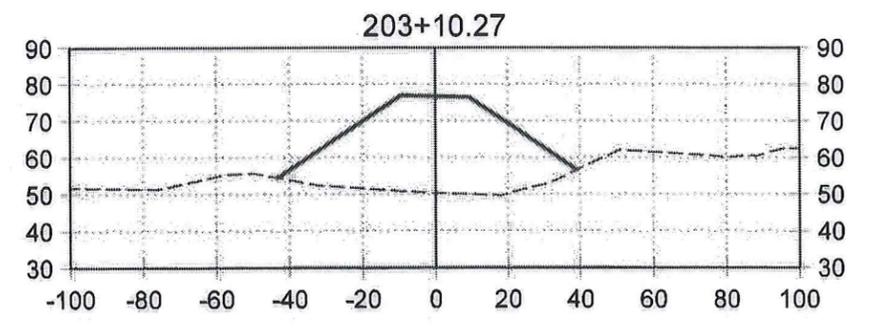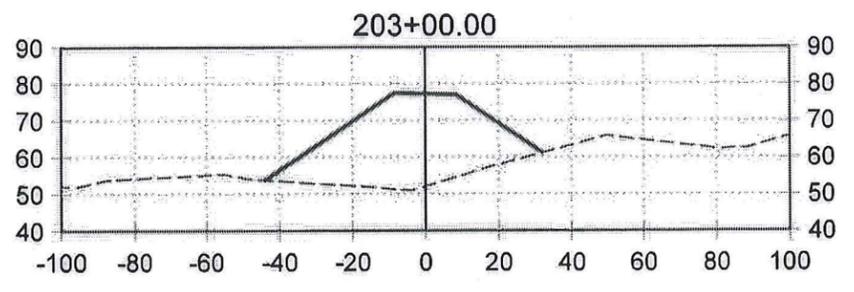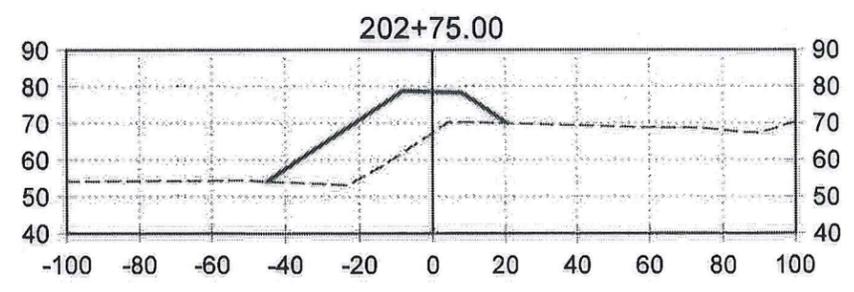

Project As Built Drawings Have Been Reviewed
 By the Project Engineer & Represent, To the
 Best of My Knowledge, the Project as
 Constructed.

Project Eng. *MD* Date *8-23-17*

LEGEND

- EXISTING GROUND
- FINISHED GROUND
- ALIGNMENT CENTERLINE



DESIGNED BY: M. DUMAN
 DRAWN BY: R. BERGER
 PATH: P:\53(ADOT)\53-02(Gravina)\Design\Plans\53-02 Cross Sections_Site 2.dwg
 TAB: J6 Wednesday, February 17, 2016 11:53:57 AM Ryan Berger

STATE OF ALASKA
 DEPARTMENT OF TRANSPORTATION
 & PUBLIC FACILITIES
 SOUTHCOAST REGION












**KTN GRAVINA - MILL
 ACCESS ROAD**

**SITE 2 CROSS SECTIONS
 203+00 - 205+25**

REVISIONS			PROJECT DESIGNATION	YEAR	SHEET NO.	TOTAL SHEETS
NO.	DATE	DESCRIPTION				
			Z699220000	2016	J6	48

See Total Cut/Fill Quantities Sheets

DRAWING LOCATION: P:\53\ADOT\53-02\Gravina\Design\Plans\53-02 Cross Sections_Site 2.dwg
 DATE/TIME: 9/27/2016 12:59 PM
 LAYOUT: J7
 SCALE: 1" = 50'
 DESIGNED BY: M. DUMAN
 DRAWN BY: R. BERGER

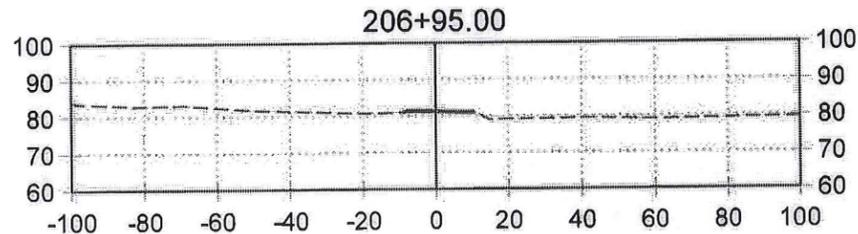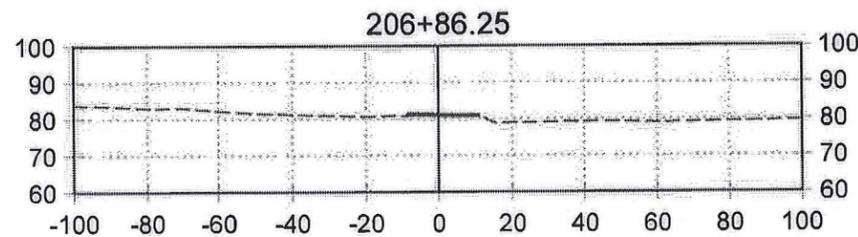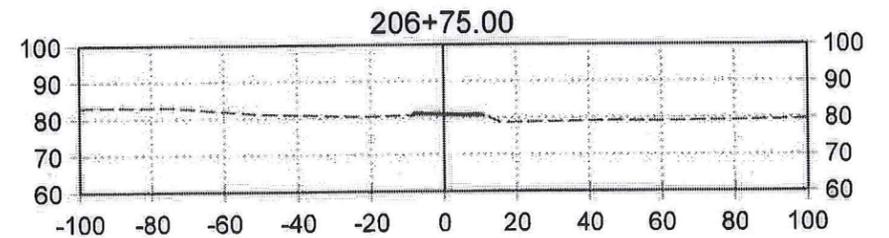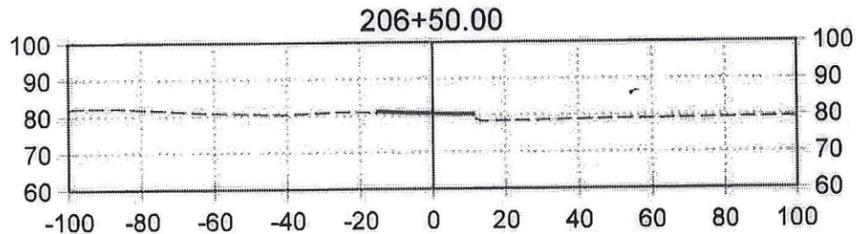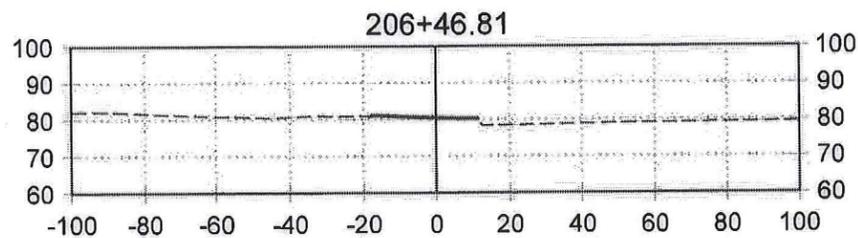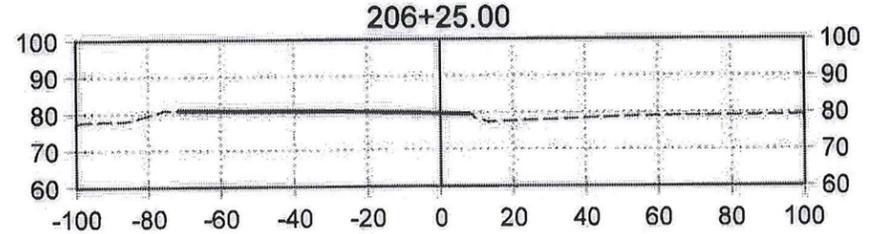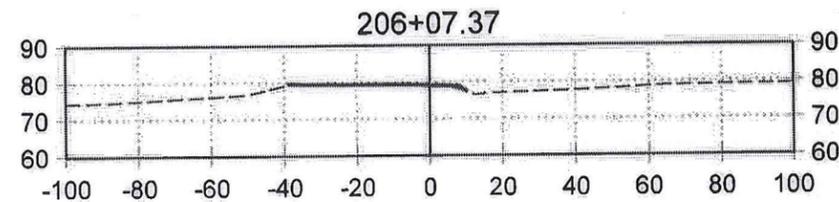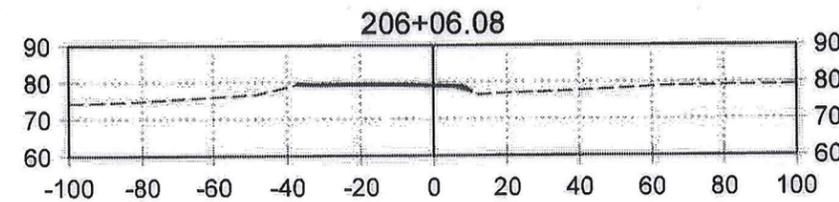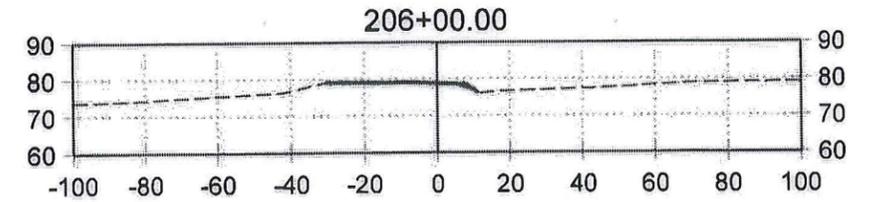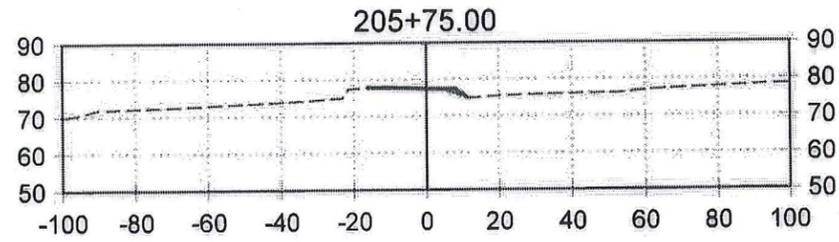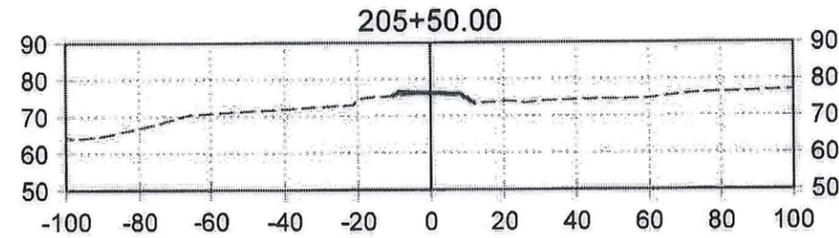

Project As Built Drawings Have Been Reviewed
 By the Project Engineer & Represent, To the
 Best of My Knowledge, the Project as
 Constructed.

Project Eng. *MP* Date *8.23.17*

LEGEND
















- EXISTING GROUND
- FINISHED GROUND
- ALIGNMENT CENTERLINE



DESIGNED BY: M. DUMAN
 DRAWN BY: R. BERGER
 PATH: P:\53\ADOT\53-02\Gravina\Design\Plans\53-02 Cross Sections_Site 2.dwg
 TAB: J7
 REVISIONS

STATE OF ALASKA DEPARTMENT OF TRANSPORTATION & PUBLIC FACILITIES SOUTHCOST REGION			
KTN GRAVINA - MILL ACCESS ROAD			
SITE 2 CROSS SECTIONS 205+50 - 206+95			
PROJECT DESIGNATION	YEAR	SHEET NO.	TOTAL SHEETS
Z699220000	2016	J7	48

DRAWING LOCATION: P:\33\ADOT\153-02(Gravina)\Design\Plans\153-02 Cross Sections_Site 3.dwg
 DATE: 2/22/2016 12:03 PM
 SCALE: 1" = 50'
 LAYOUT: JB

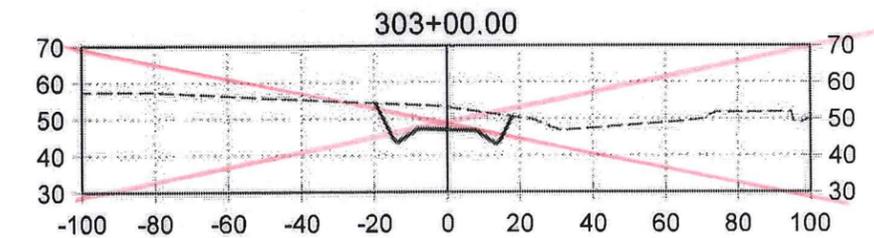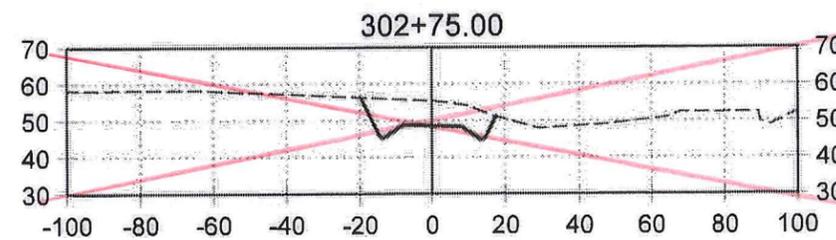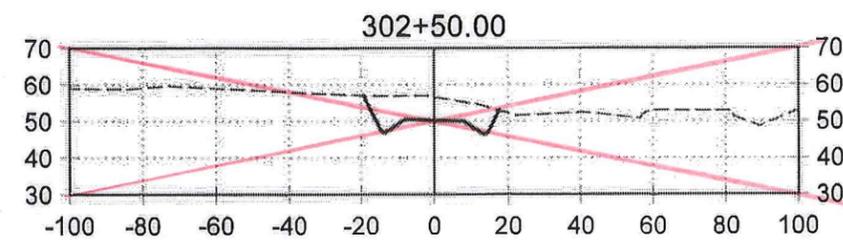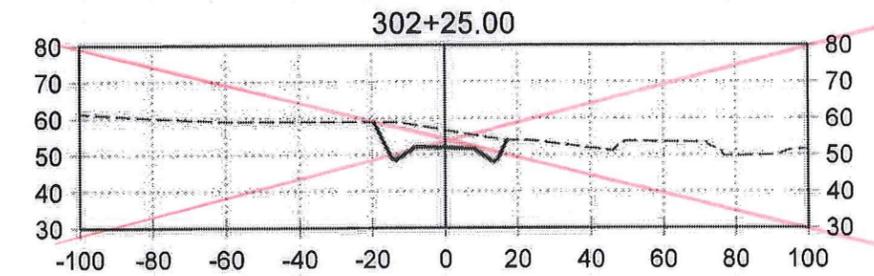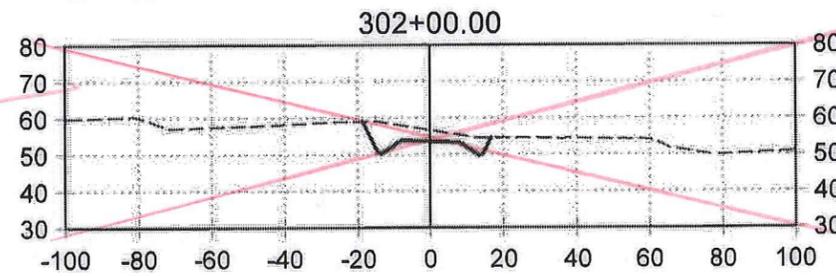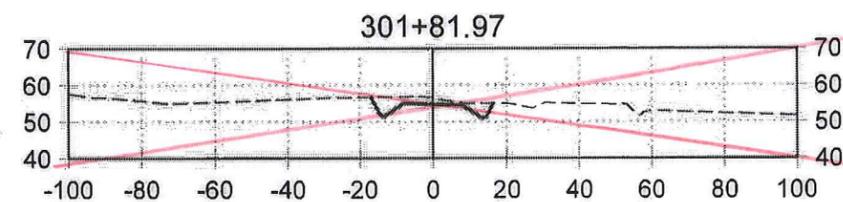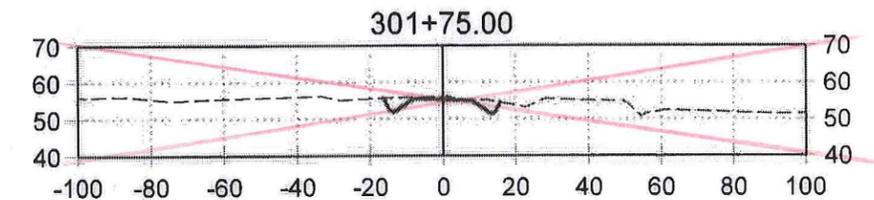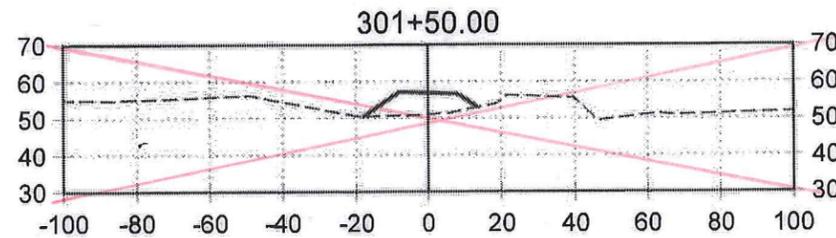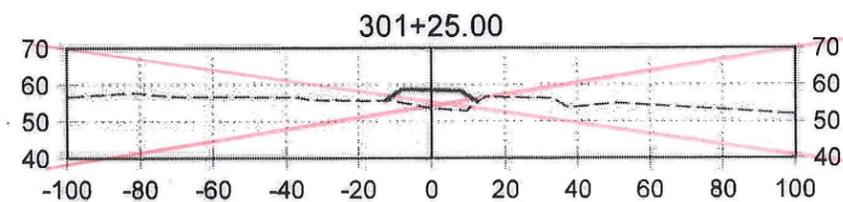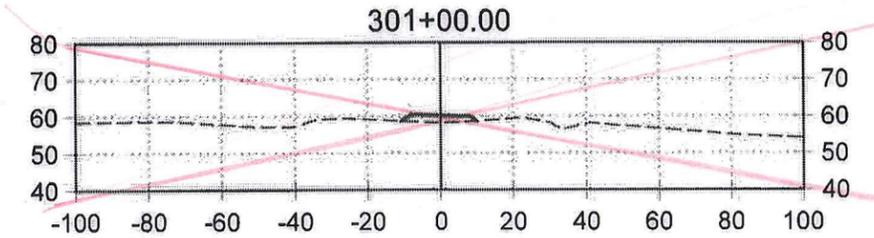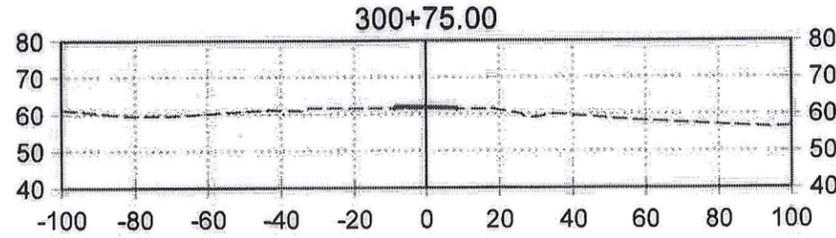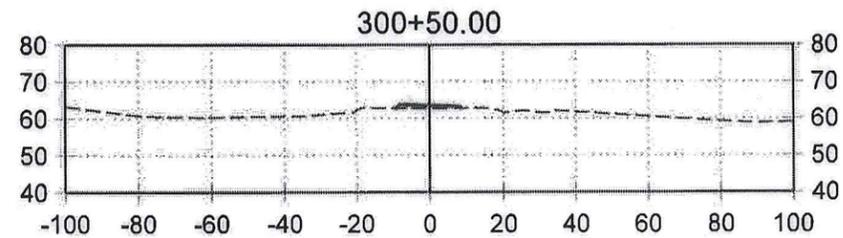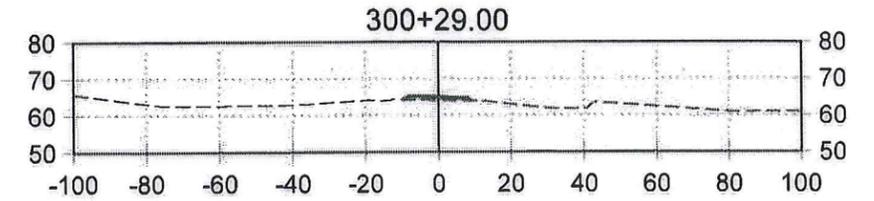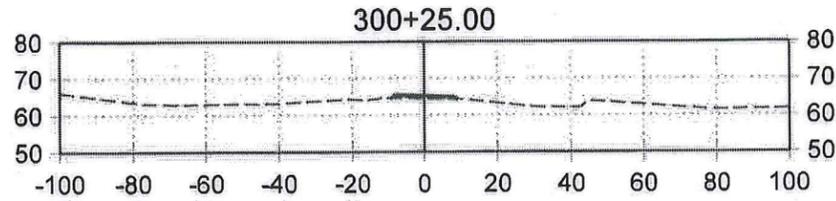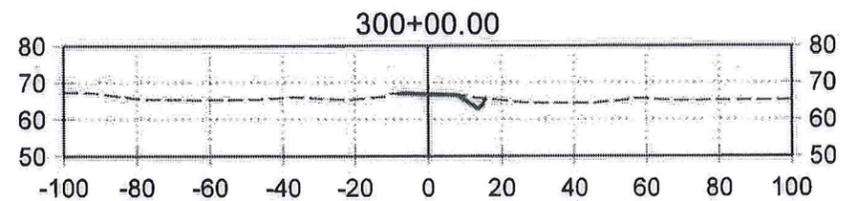

See plan sheet 2:3

Project As Built Drawings Have Been Reviewed
 By the Project Engineer & Represent, To the
 Best of My Knowledge, the Project as
 Constructed.

Project Eng. *MO*

8-23-17
 Date

LEGEND

- EXISTING GROUND
- FINISHED GROUND
- ALIGNMENT CENTERLINE



DESIGNED BY: M. DUMAN

DRAWN BY: R. BERGER

PATH: P:\53\ADOT\153-02(Gravina)\Design\Plans\153-02 Cross Sections_Site 3.dwg

TAB: JB Wednesday, February 17, 2016 11:54:01 AM Ryan Beiger













REVISIONS			PROJECT DESIGNATION	YEAR	SHEET NO.	TOTAL SHEETS
NO.	DATE	DESCRIPTION				
			Z699220000	2016	J8	48

STATE OF ALASKA
 DEPARTMENT OF TRANSPORTATION
 & PUBLIC FACILITIES
 SOUTHCOAST REGION

KTN GRAVINA - MILL
 ACCESS ROAD

SITE 3 CROSS SECTIONS
 300+00 - 303+00

DRAWING LOCATION: P:\S\ADDITIONAL\53-02\Gravina\Design\Plan\53-02 Cross Sections_Site 3.dwg
 DATE/TIME: 2/29/2016 12:03 PM
 SCALE: 1" = 50'
 SHEET NO.: J9

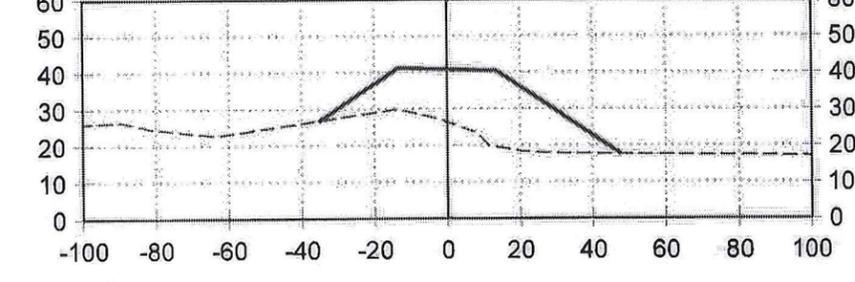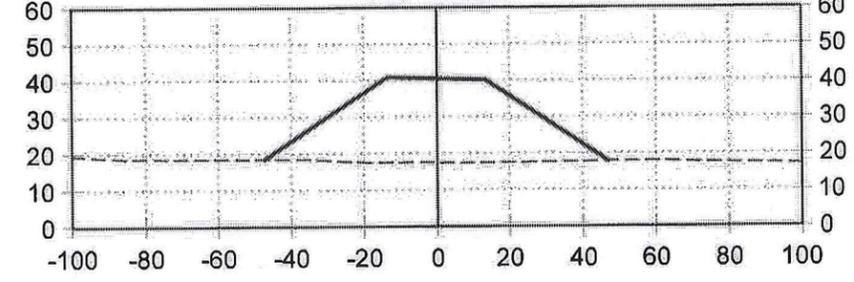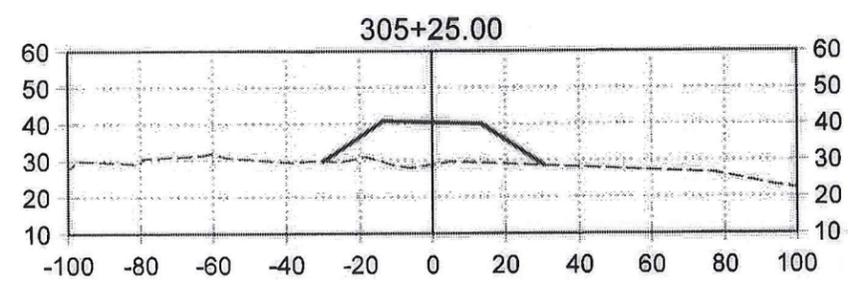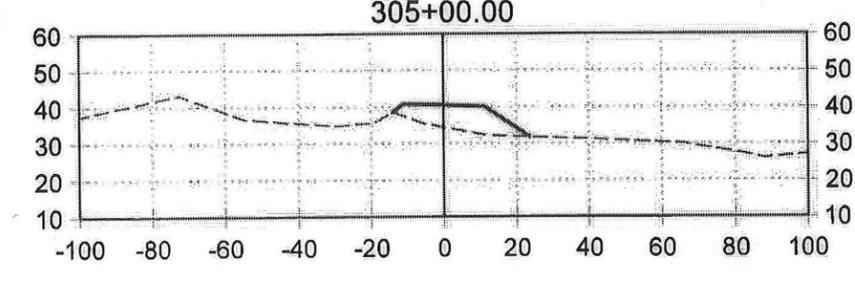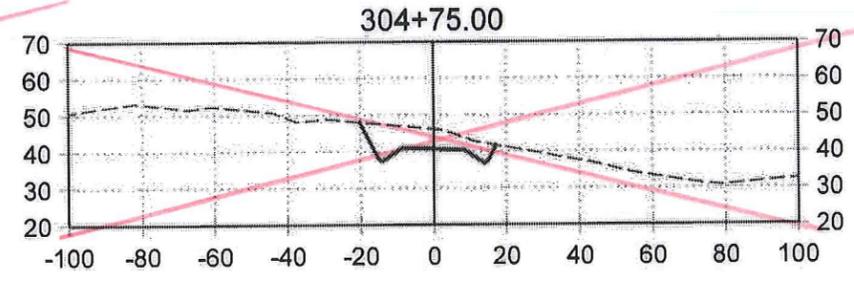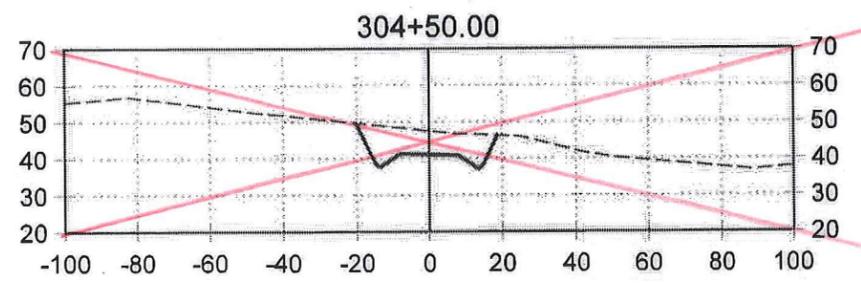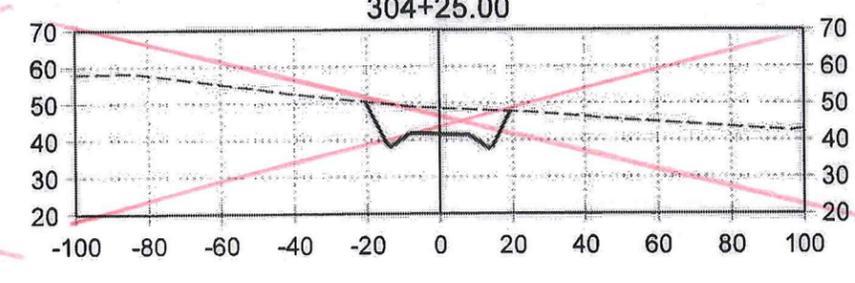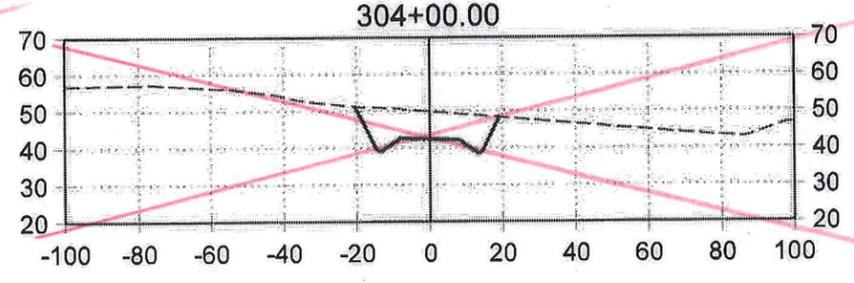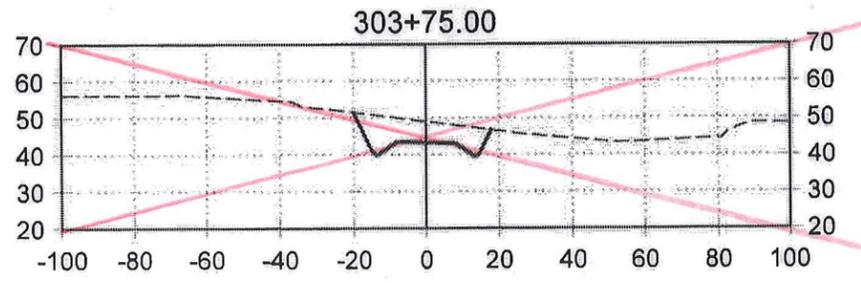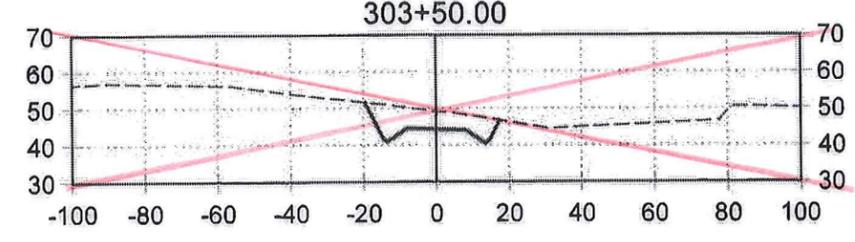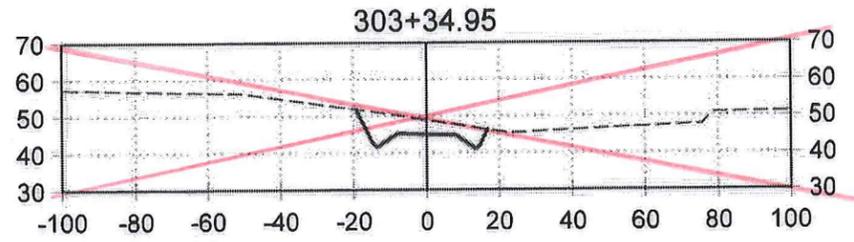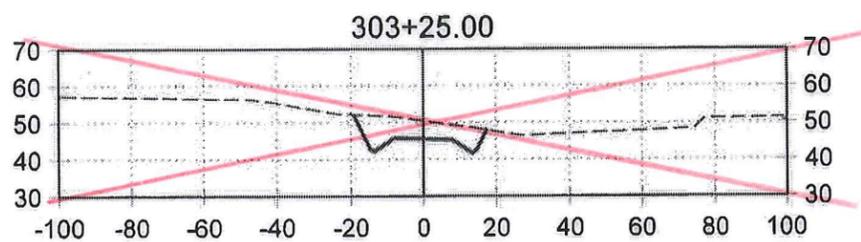

See Plan sheet Z:3

Project As Built Drawings Have Been Reviewed
 By the Project Engineer & Represent, To the
 Best of My Knowledge, the Project as
 Constructed.
 Project Eng. *MP* Date *8-23-17*

LEGEND

- EXISTING GROUND
- FINISHED GROUND
- ALIGNMENT CENTERLINE

DESIGNED BY: M. DUMAN
 DRAWN BY: R. BERGER
 2-28-2016













STATE OF ALASKA
 DEPARTMENT OF TRANSPORTATION
 & PUBLIC FACILITIES
 SOUTHCOST REGION

**KTN GRAVINA - MILL
 ACCESS ROAD**

**SITE 3 CROSS SECTIONS
 303+25 - 305+75**

PATH: P:\53(ADOT)\53-02(Gravina)\Design\Plan\53-02 Cross Sections_Site 3.dwg			YEAR	SHEET NO.	TOTAL SHEETS
TAB: J9			2016	J9	48
PROJECT DESIGNATION			Z699220000		
REVISIONS					
NO.	DATE	DESCRIPTION			

DRAWING LEGEND
 P:\53\ADOT\53-02\Gravina\Design\Plans\53-02 Cross Sections_Site 3.dwg
 DATE TIME 2/9/2016 12:03 PM
 LAYOUT J10
 SCALE 1" = 50'
 DESIGNED BY M. DUMAN
 DRAWN BY R. BERGER
 CHECKED BY P. BERGER

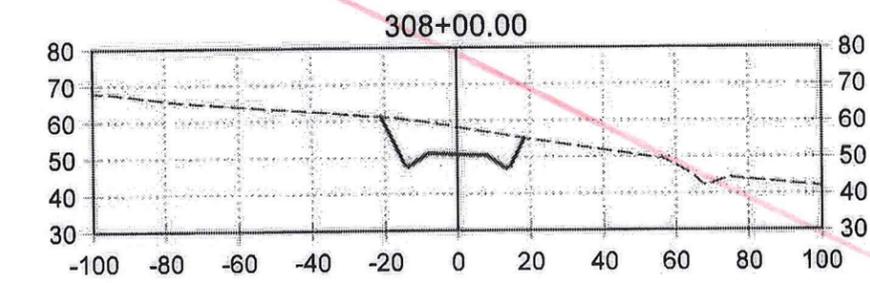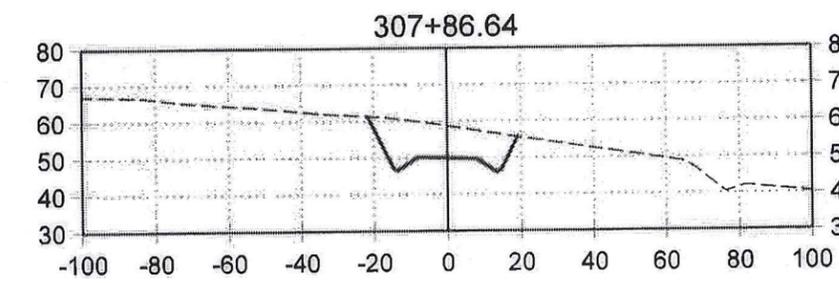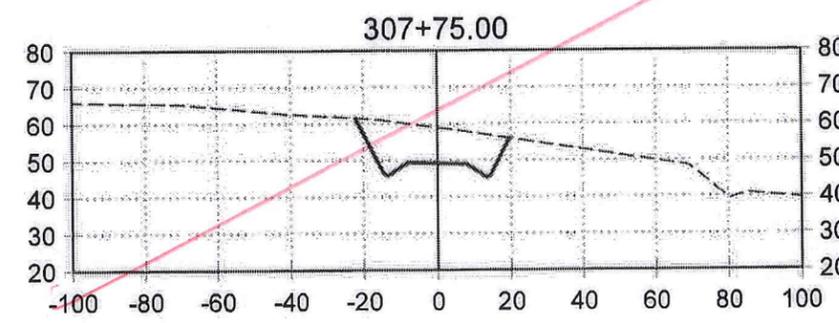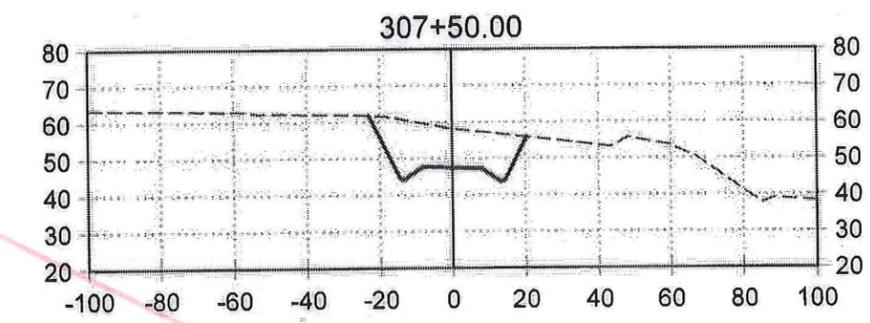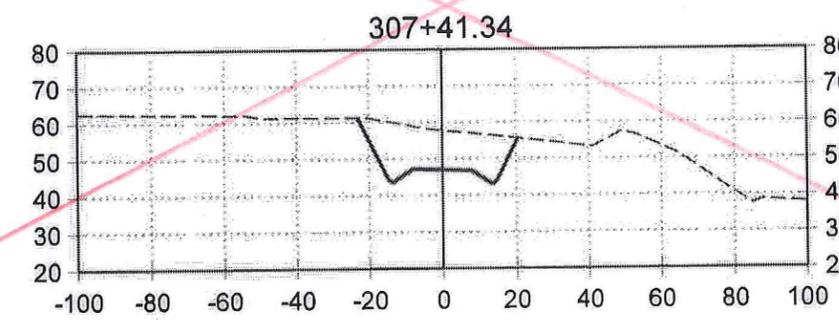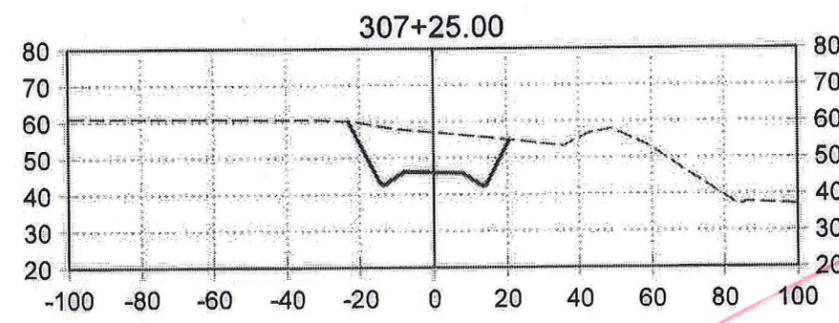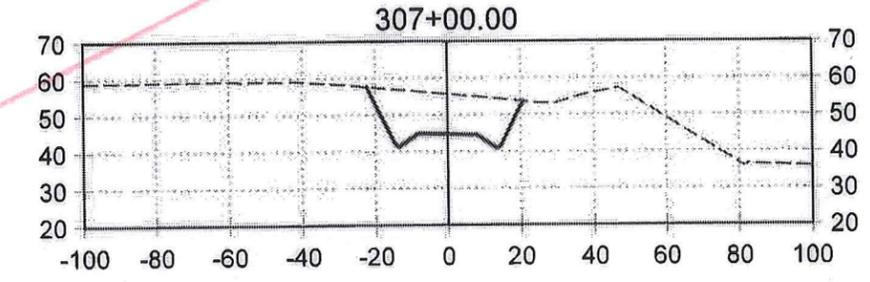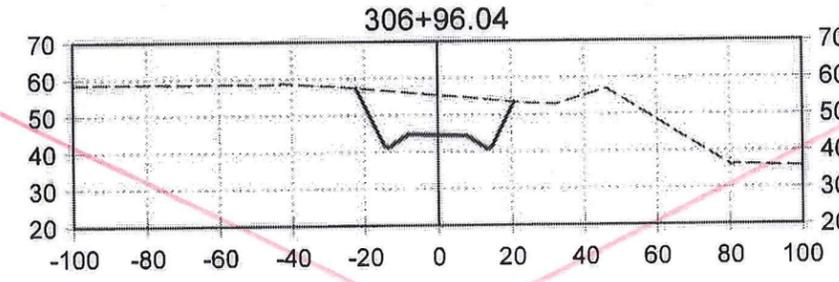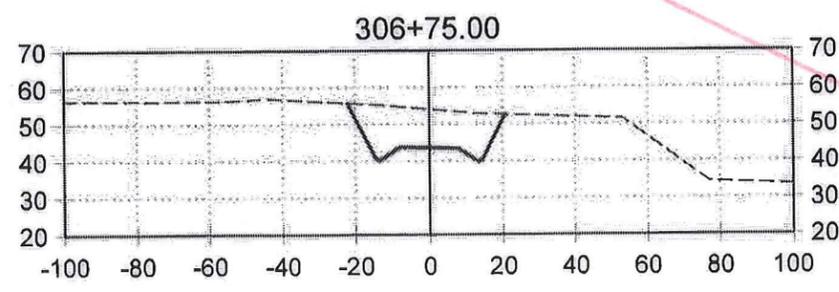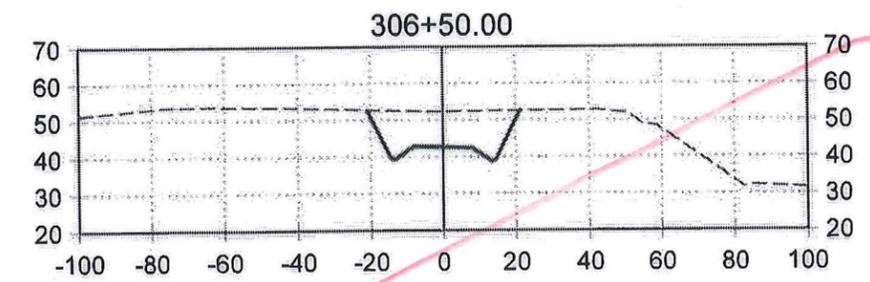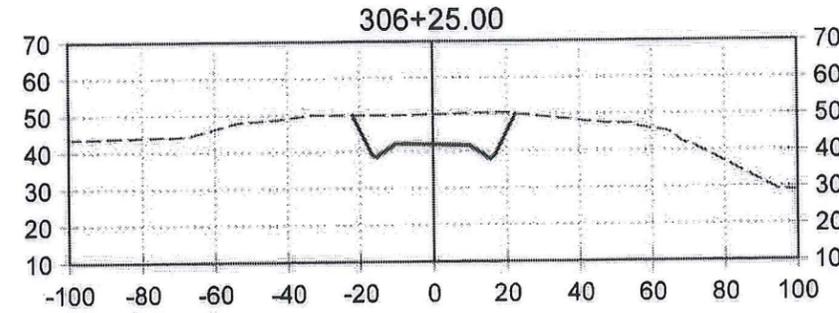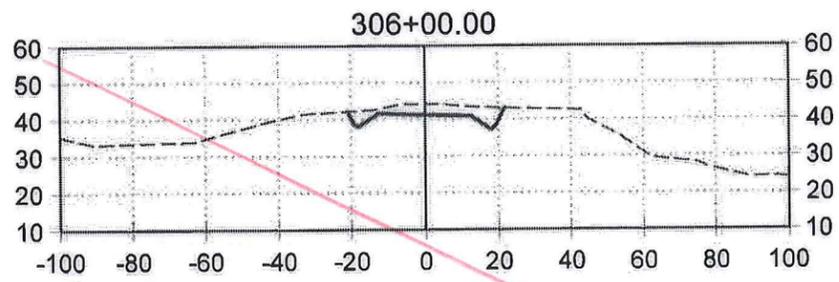

See Plan Sheet Z:4

Project As Built Drawings Have Been Reviewed By the Project Engineer & Represent, To the Best of My Knowledge, the Project as Constructed.

Project Eng. *MP* Date *8.23.14*

LEGEND

	EXISTING GROUND
	FINISHED GROUND
	ALIGNMENT CENTERLINE

DESIGNED BY: M. DUMAN
 DRAWN BY: R. BERGER
 PATH: P:\53\ADOT\53-02\Gravina\Design\Plans\53-02 Cross Sections_Site 3.dwg
 TAB: J10 Wednesday, February 17, 2016 11:54:05 AM Ryan Berger












STATE OF ALASKA
 DEPARTMENT OF TRANSPORTATION & PUBLIC FACILITIES
 SOUTHCOAST REGION

KTN GRAVINA - MILL ACCESS ROAD

SITE 3 CROSS SECTIONS
 306+00 - 308+00

REVISIONS			PROJECT DESIGNATION	YEAR	SHEET NO.	TOTAL SHEETS
NO.	DATE	DESCRIPTION	Z699220000	2016	J10	48

DRAWING LOCATION: P:\53\ADOT\53-02\Gravina\Design\Plans\13-CR_Cross Sections_Site 3.dwg
 DATE/TIME: 2/23/2016 12:03 PM
 LAYOUT: J11
 SCALE: 1" = 50'
 DESIGNED BY: M. DUMAN
 DRAWN BY: R. BERGER
 CHECKED BY: B. MURPHY
 APPROVED BY: R. BERGER

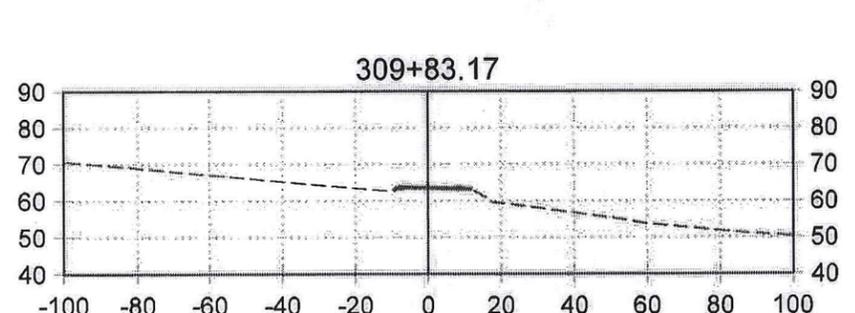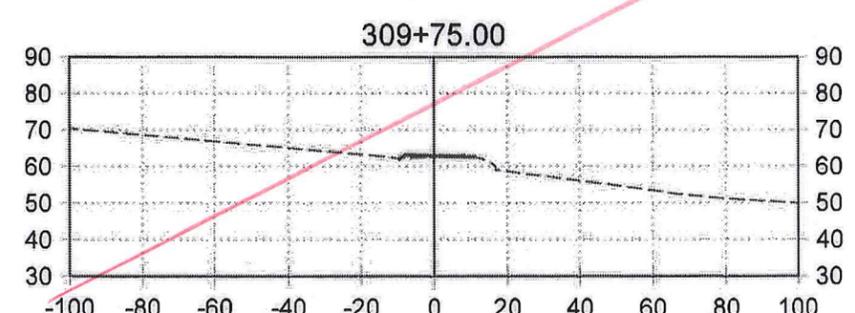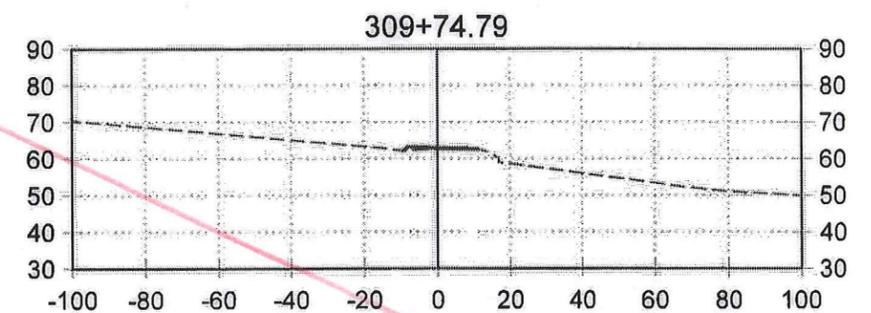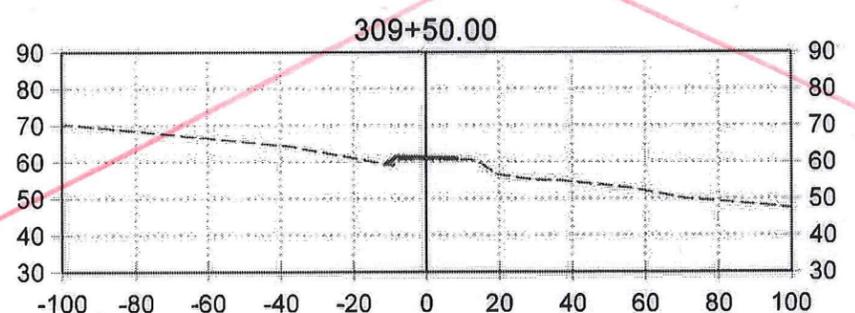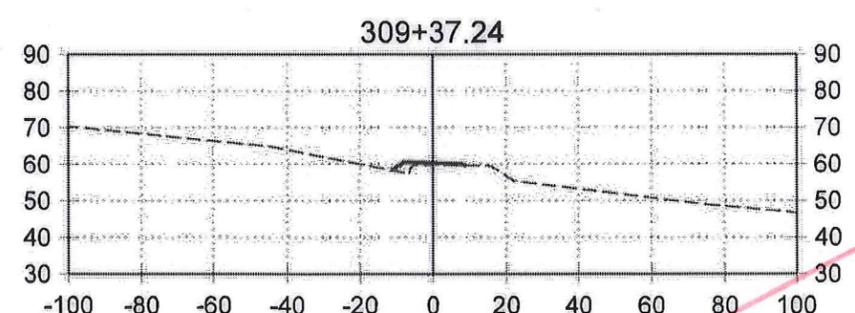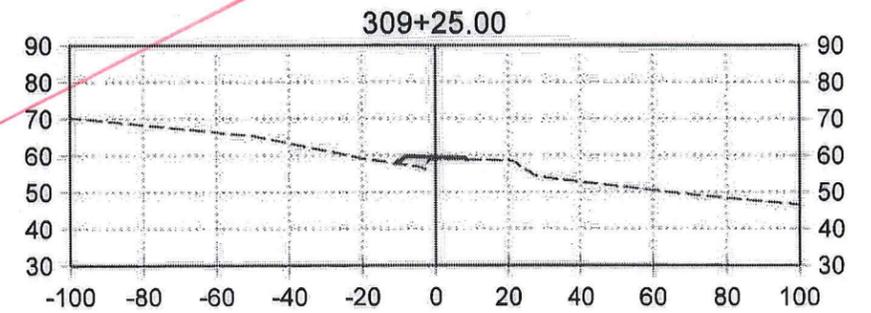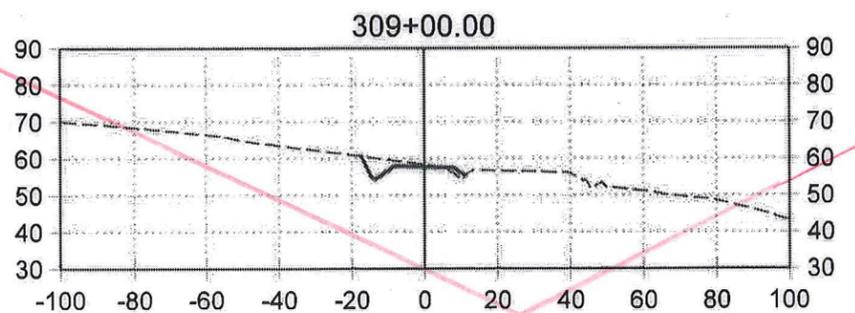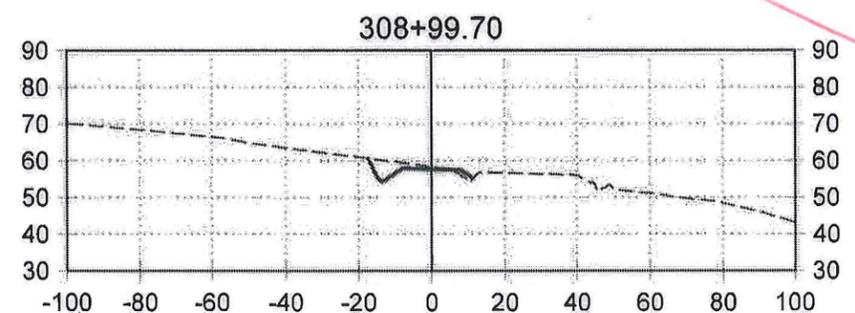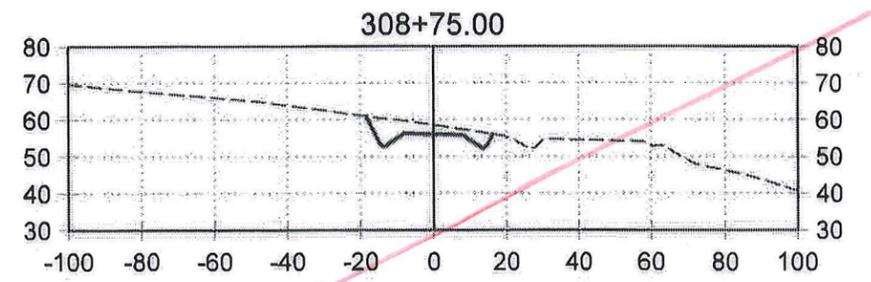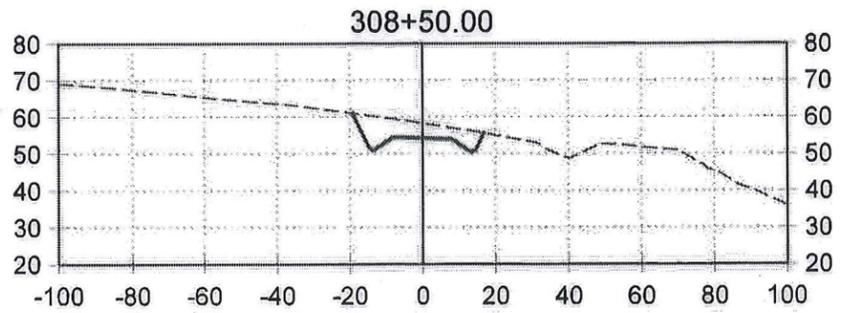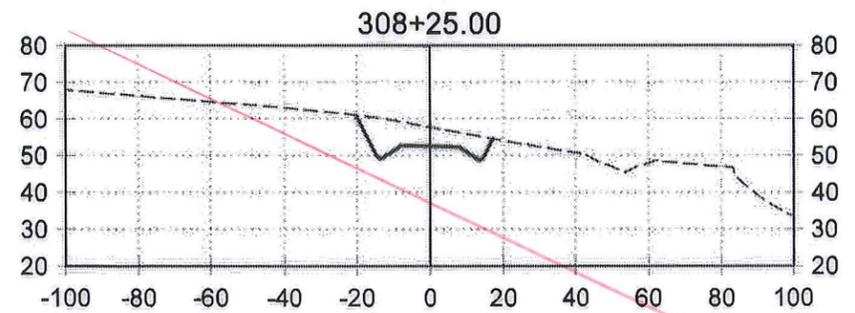

See Plan Sheet Z:4

Project As Built Drawings Have Been Reviewed By the Project Engineer & Represent, To the Best of My Knowledge, the Project as Constructed.
 Project Eng. *MP* 8.23.17 Date

LEGEND

- EXISTING GROUND
- FINISHED GROUND
- ALIGNMENT CENTERLINE




STATE OF ALASKA DEPARTMENT OF TRANSPORTATION & PUBLIC FACILITIES SOUTHCOST REGION			
KTN GRAVINA - MILL ACCESS ROAD			
SITE 3 CROSS SECTIONS 308+25 - 309+86			
DESIGNED BY:	M. DUMAN	PROJECT DESIGNATION	Z699220000
DRAWN BY:	R. BERGER	YEAR	2016
PATH:	P:\53\ADOT\53-02\Gravina\Design\Plans\53-02 Cross Sections_Site 3.dwg	SHEET NO.	J11
TAB:	J11	TOTAL SHEETS	48
DATE:	Wednesday, February 17, 2016 11:54:07 AM		
REVISIONS			
NO.	DATE	DESCRIPTION	

DRAWING LOCATION: P:\3\ADOT\53-02\Gravina\Design\Plans\53-02 Cross Sections_Site 3.dwg
 DATE TIME: 2/17/2016 12:03 PM
 LAYOUT: J12
 SCALE: 1" = 50'
 DESIGNED BY: M. DUMAN
 CHECKED BY: R. BERGER
 DATE: 2/17/2016


HYDROLOGIC & HYDRAULIC SUMMARY (SITE 1) ADDITIVE ALTERNATE "A"		
DRAINAGE AREA	0.044 SQUARE MILES	
EXCEEDANCE PROBABILITY	2%	1%
RETURN PERIOD	50-YEAR (Q50)	100-YEAR (Q100)
DESIGN DISCHARGE	52 CFS	57 CFS
DESIGN HIGH WATER ELEVATION	132.84 FT	132.91 FT
ANTICIPATED ADDITIONAL BACKWATER =	0.0 FT	

(SITE 1) STA. "B" 107+59.00

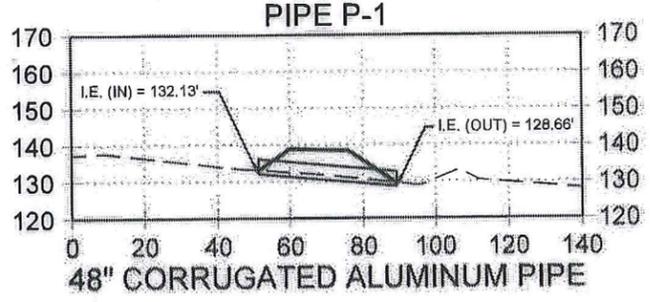


ADDITIVE ALTERNATE "A"

(SITE 2) STA. "FR" 0+22.73

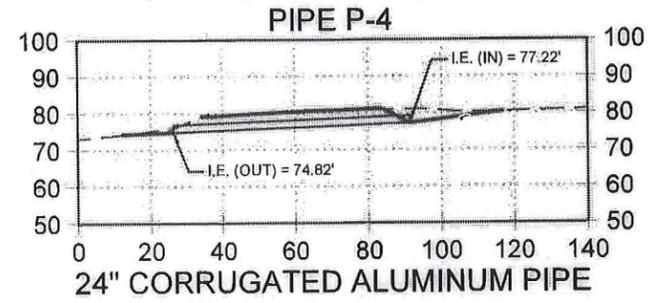


(SITE 2) STA. "C" 203+79.62

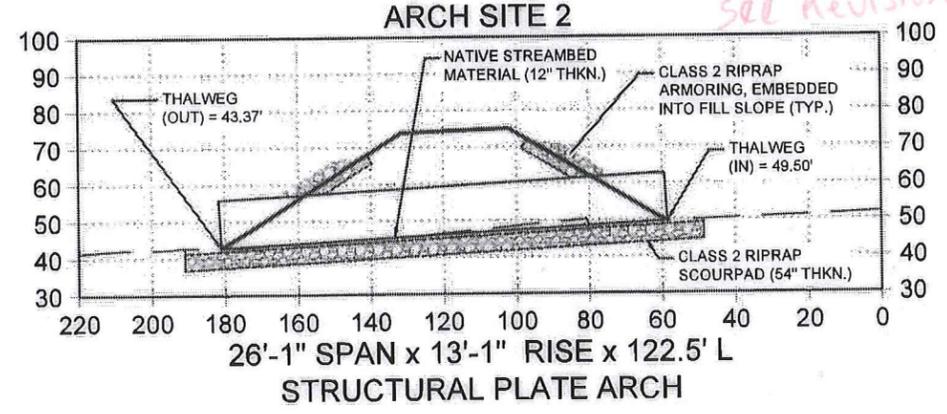


See Revision sheet F2


(SITE 3) STA. "D" 301+50.00

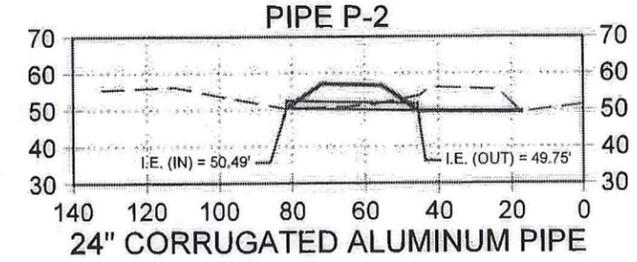

(SITE 3) STA. "D" 305+58.68

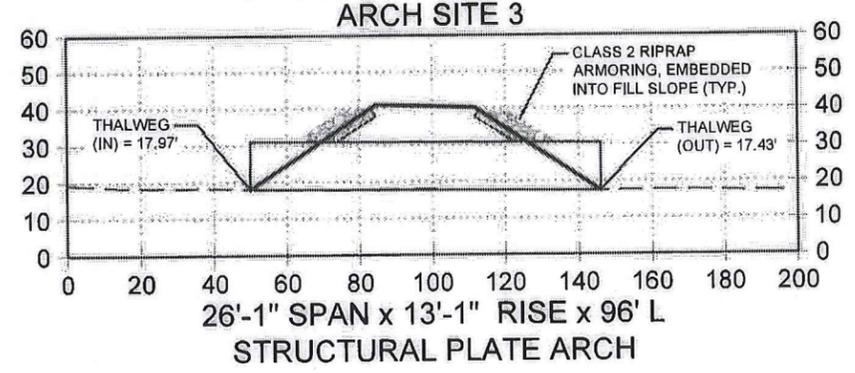

(SITE 3) STA. "D" 309+20.10

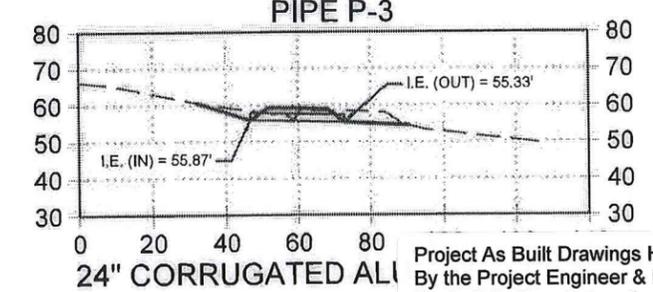

Project As Built Drawings Have Been Reviewed By the Project Engineer & Represent, To the Best of My Knowledge, the Project as Constructed.

Project Eng. *MP* Date *8.23.17*

HYDROLOGIC & HYDRAULIC SUMMARY (ARCH SITE 2)		
DRAINAGE AREA	0.87 SQUARE MILES	
EXCEEDANCE PROBABILITY	2%	1%
RETURN PERIOD	50-YEAR (Q50)	100-YEAR (Q100)
DESIGN DISCHARGE	618 CFS	677 CFS
DESIGN HIGH WATER ELEVATION	49.21 FT	50.67 FT
ANTICIPATED ADDITIONAL BACKWATER =	0.0 FT	

HYDROLOGIC & HYDRAULIC SUMMARY (ARCH SITE 3)		
DRAINAGE AREA	2.57 SQUARE MILES	
EXCEEDANCE PROBABILITY	2%	1%
RETURN PERIOD	50-YEAR (Q50)	100-YEAR (Q100)
DESIGN DISCHARGE	1510 CFS	1653 CFS
DESIGN HIGH WATER ELEVATION	21.83 FT	22.96 FT
ANTICIPATED ADDITIONAL BACKWATER =	0.0 FT	

LEGEND


- EXISTING GROUND
- FINISHED GROUND
- ALIGNMENT CENTERLINE



DESIGNED BY: M. DUMAN
 DRAWN BY: R. BERGER
 PATH: P:\53(ADOT)\53-02(Gravina)\Design\Plans\53-02 Cross Sections_Site 3.dwg
 TAB: J12
 Wednesday, February 17, 2016 11:54:10 AM Ryan Berger


STATE OF ALASKA DEPARTMENT OF TRANSPORTATION & PUBLIC FACILITIES SOUTHCOST REGION			
KTN GRAVINA - MILL ACCESS ROAD			
PIPE PROFILES			
PROJECT DESIGNATION	YEAR	SHEET NO.	TOTAL SHEETS
Z699220000	2016	J12	48

DRAWING LOCATION: P:\53\ADOT\53-02(Gravina)\Design\Plans\53-02 J13_Pipe P&P.dwg
 DATE/TIME: 2/9/2016 12:03 PM
 LAYOUT: J13
 SCALE: 1" = 20'
 SHEET: 48

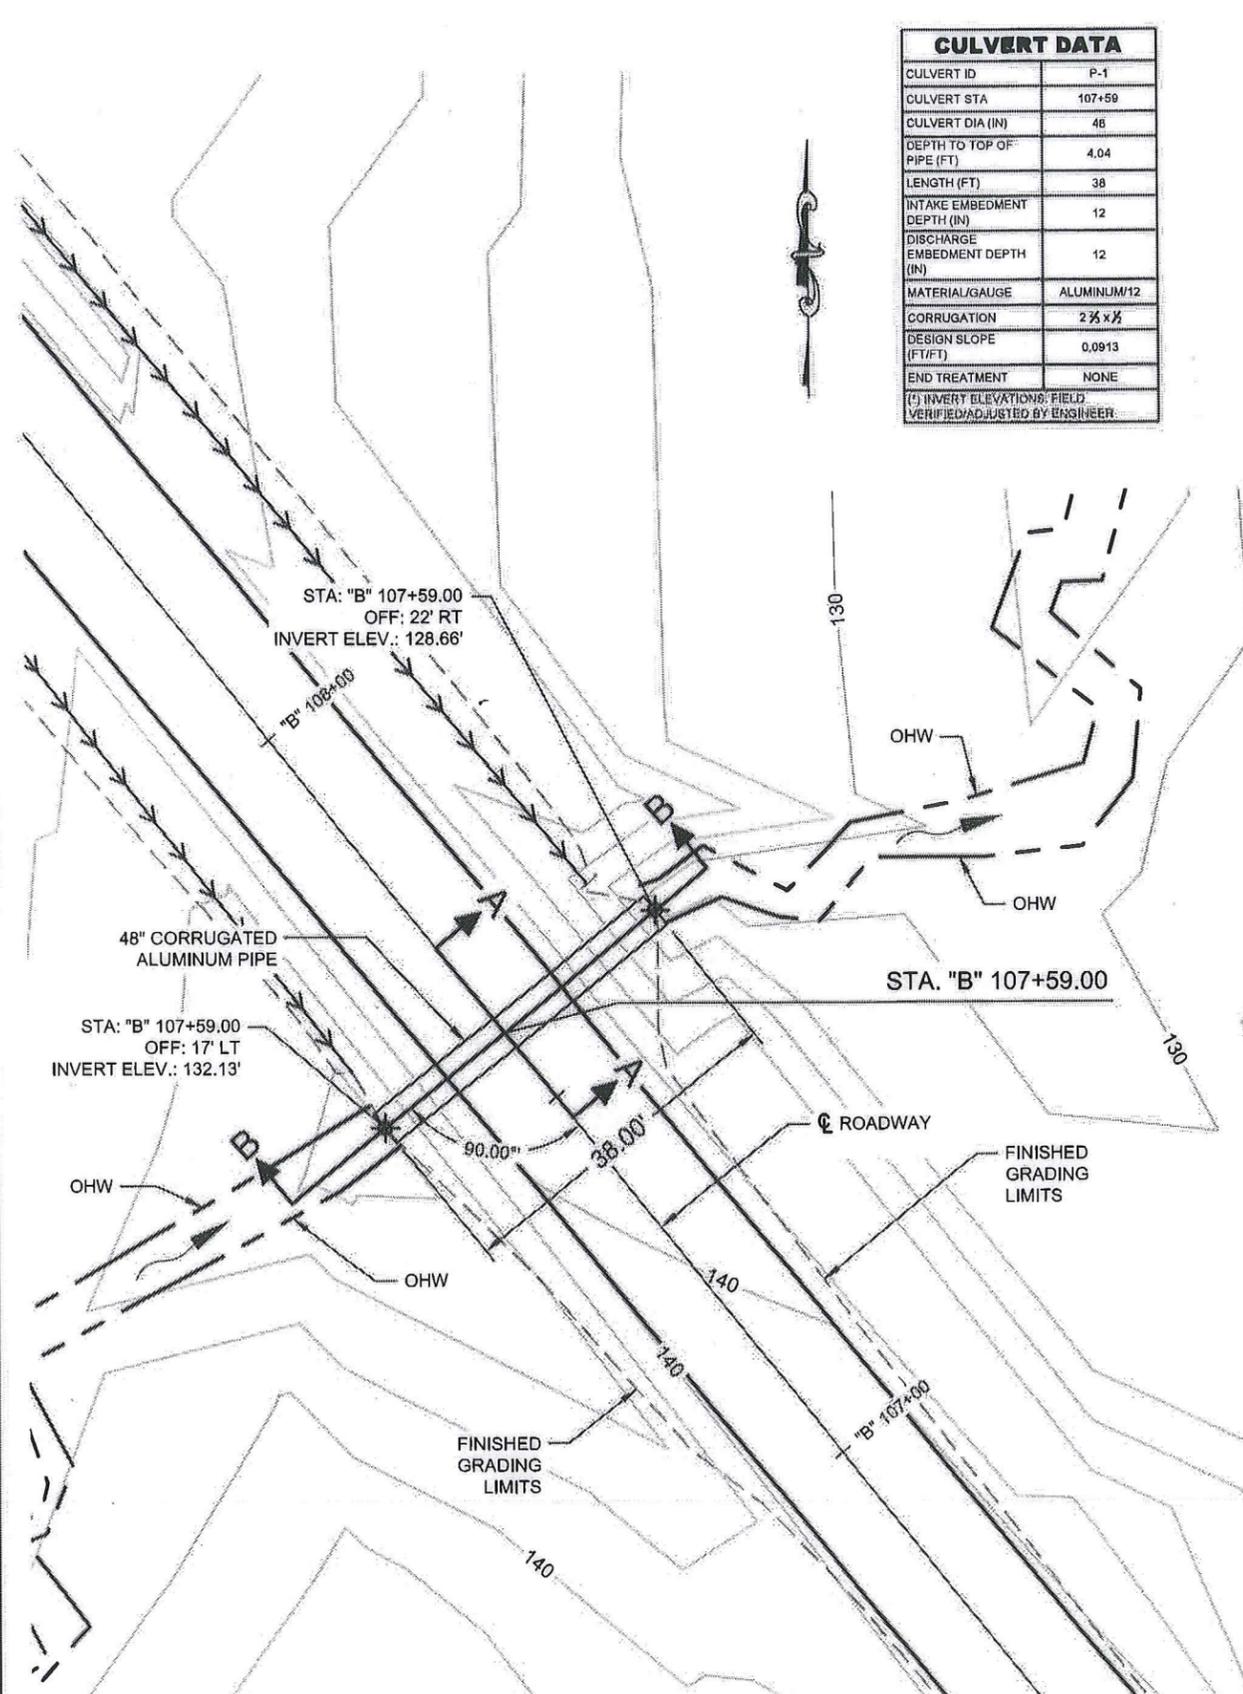


CULVERT DATA	
CULVERT ID	P-1
CULVERT STA	107+59
CULVERT DIA (IN)	48
DEPTH TO TOP OF PIPE (FT)	4.04
LENGTH (FT)	38
INTAKE EMBEDMENT DEPTH (IN)	12
DISCHARGE EMBEDMENT DEPTH (IN)	12
MATERIAL/GAUGE	ALUMINUM/12
CORRUGATION	2 3/8 x 3/8
DESIGN SLOPE (FT/FT)	0.0913
END TREATMENT	NONE
(!) INVERT ELEVATIONS: FIELD VERIFIED/ADJUSTED BY ENGINEER	

PLAN
SCALE IN FEET
0 10 20

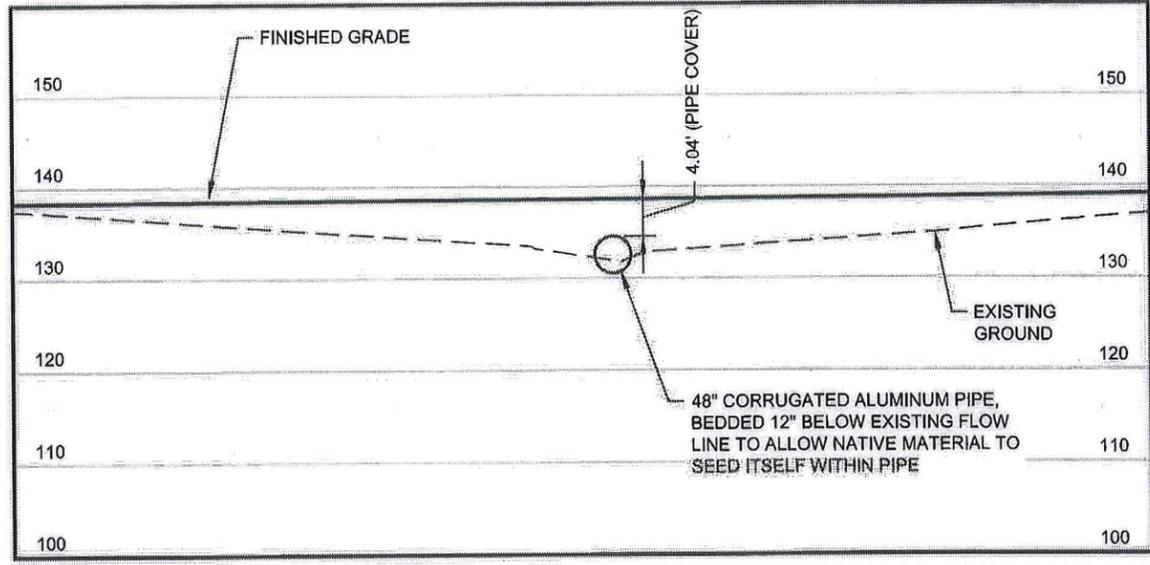

SECTION A-A
SCALE IN FEET
0 10 20

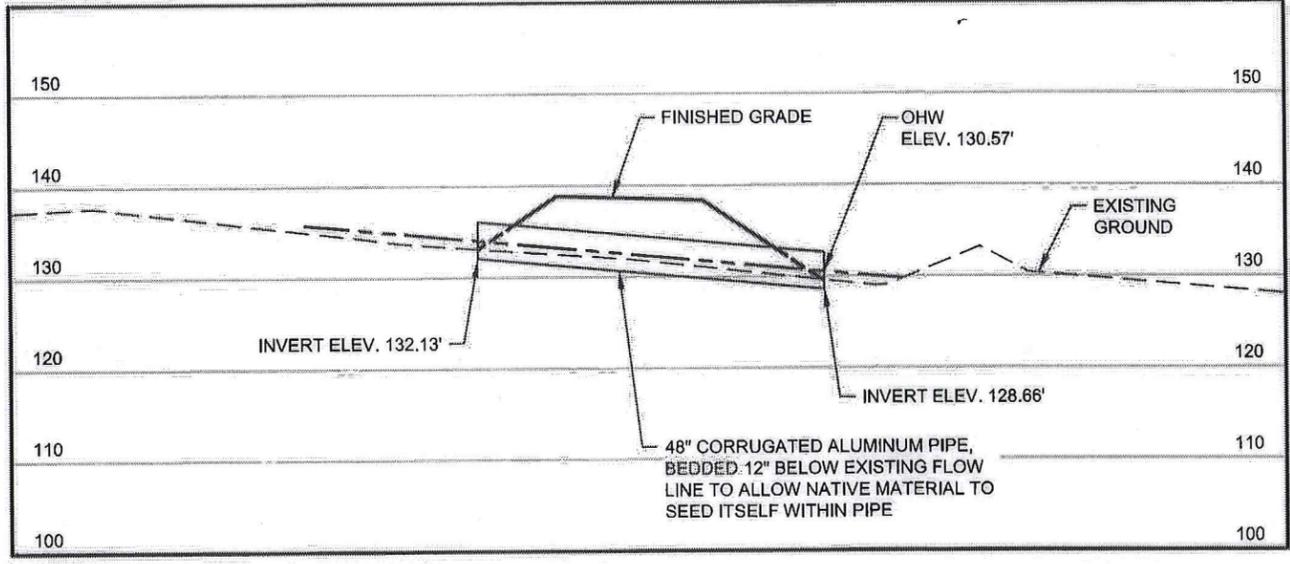

SECTION B-B
SCALE IN FEET
0 10 20


Project As Built Drawings Have Been Reviewed By the Project Engineer & Represent, To the Best of My Knowledge, the Project as Constructed.
 Project Eng. **MP** 8-23-17 Date




STATE OF ALASKA DEPARTMENT OF TRANSPORTATION & PUBLIC FACILITIES SOUTHCOST REGION							
KTN GRAVINA - MILL ACCESS ROAD							
ADDITIVE ALTERNATE A PIPE PLAN & PROFILE							
DESIGNED BY: M. DUMAN	PROJECT DESIGNATION: Z699220000						
DRAWN BY: R. BERGER	YEAR: 2016						
PATH: P:\53\ADOT\53-02(Gravina)\Design\Plans\53-02 J13_Pipe P&P.dwg	SHEET NO.: J13						
TAB: J13	TOTAL SHEETS: 48						
DATE: Wednesday, February 17, 2016 11:54:12 AM	PROJECT ENGINEER: Ryan Berger						
<table border="1"> <thead> <tr> <th colspan="2">REVISIONS</th> </tr> <tr> <th>NO.</th> <th>DESCRIPTION</th> </tr> </thead> <tbody> <tr> <td> </td> <td> </td> </tr> </tbody> </table>		REVISIONS		NO.	DESCRIPTION		
REVISIONS							
NO.	DESCRIPTION						

NOTES:
 1. FOR PIPE TRENCH DETAIL, SEE SHEET E1.


DRAWING LOCATION: P:\53\ADOT\53-02\Gravina\Design\Plans\53-02_N2_Structures_Site 3.dwg
 DATE TIME: 2/2/2016 1:54 PM
 SCALE: 1" = 20'
 LAYOUT: N2

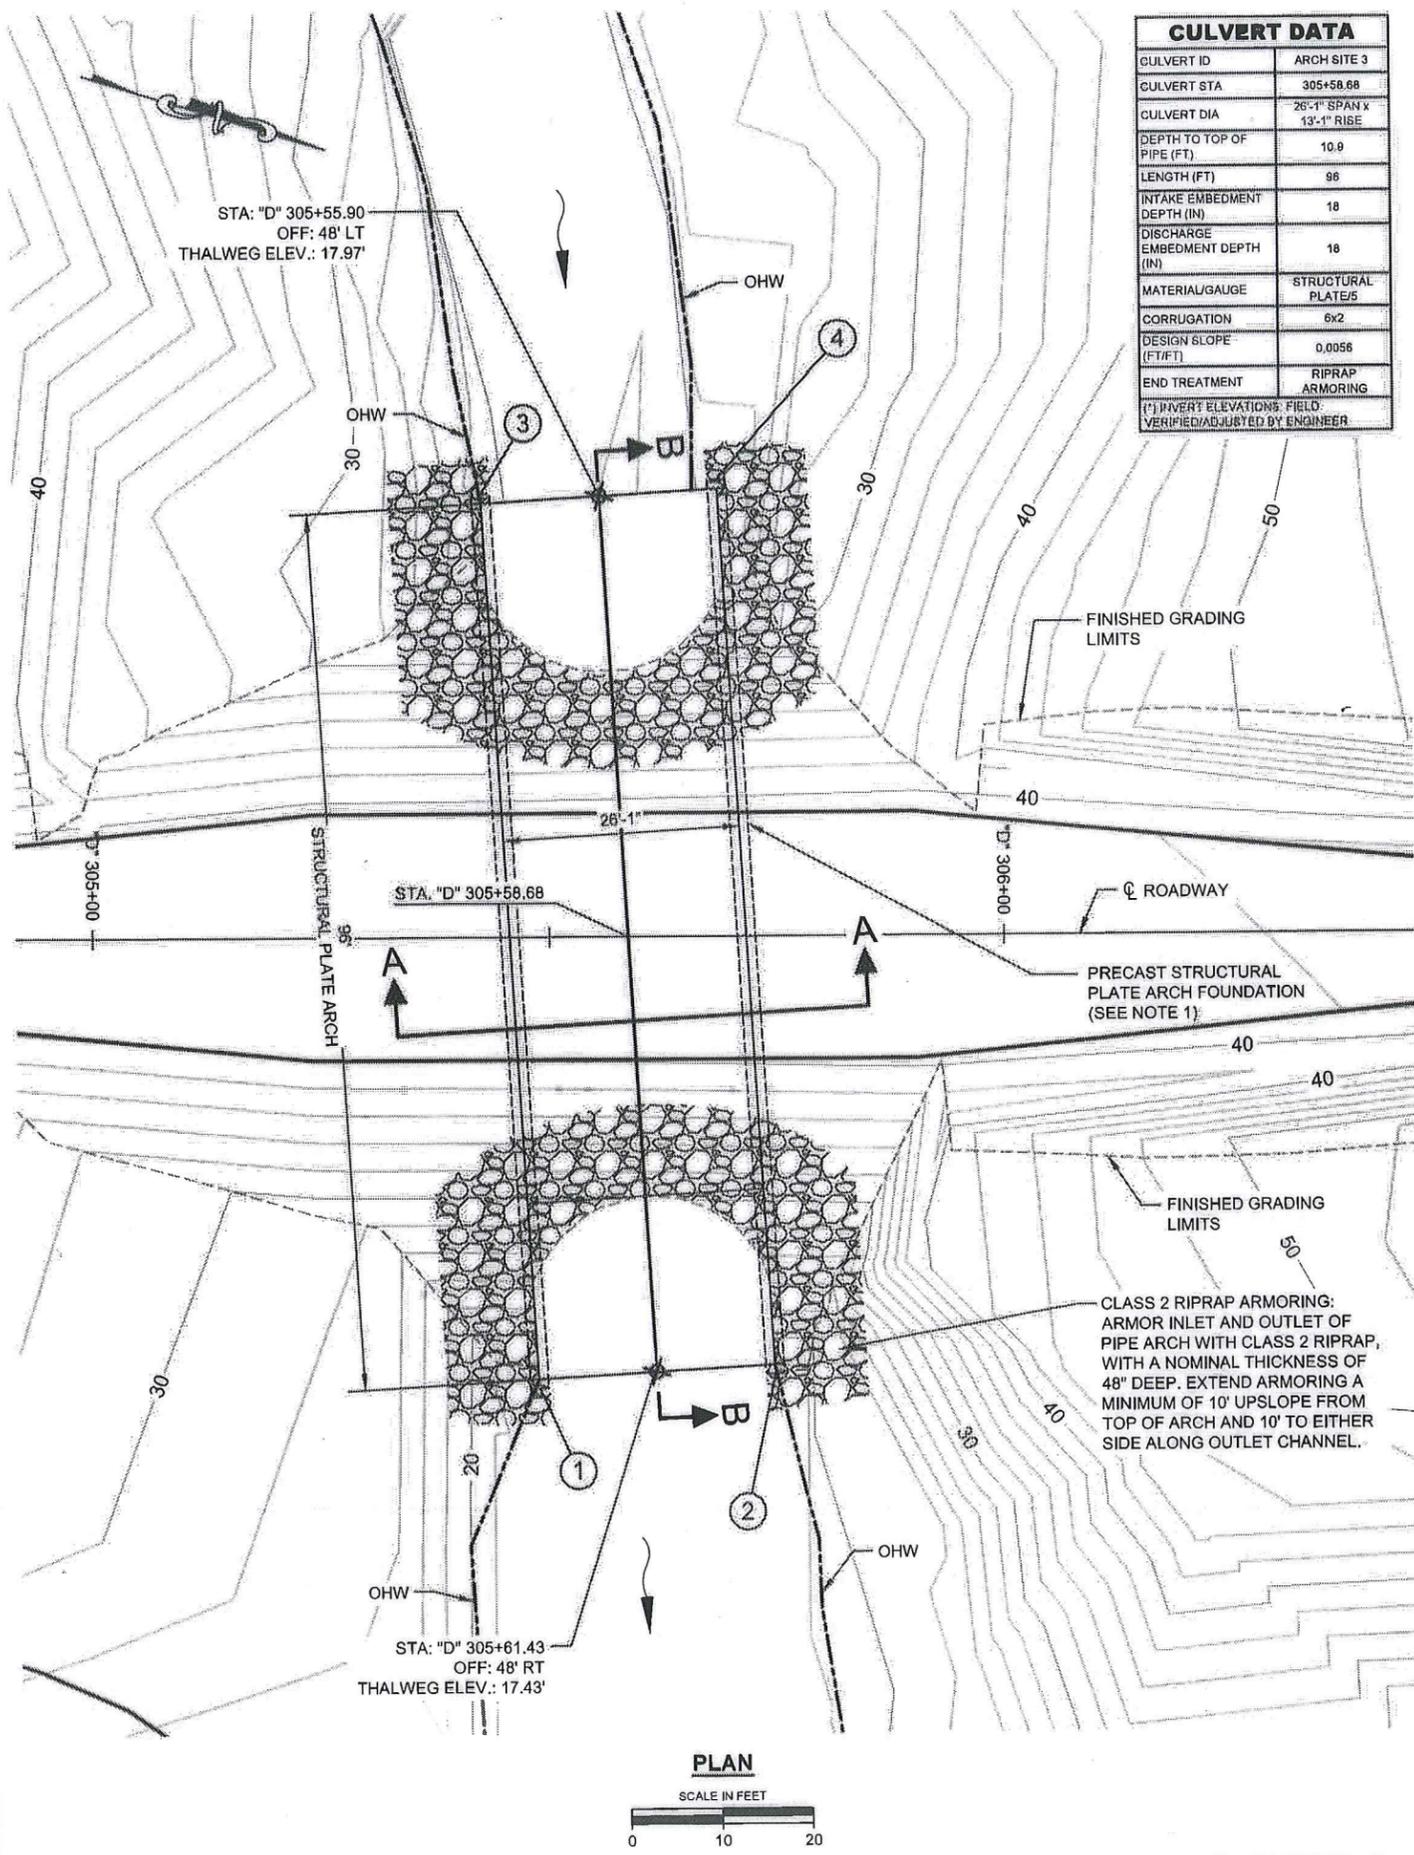

CULVERT DATA	
CULVERT ID	ARCH SITE 3
CULVERT STA	305+58.68
CULVERT DIA	26'-1" SPAN x 13'-1" RISE
DEPTH TO TOP OF PIPE (FT)	10.9
LENGTH (FT)	96
INTAKE EMBEDMENT DEPTH (IN)	18
DISCHARGE EMBEDMENT DEPTH (IN)	18
MATERIAL/GAUGE	STRUCTURAL PLATE/5
CORRUGATION	6x2
DESIGN SLOPE (F/T)	0.0058
END TREATMENT	RIPRAP ARMORING
(*) INVERT ELEVATIONS FIELD VERIFIED/ADJUSTED BY ENGINEER	

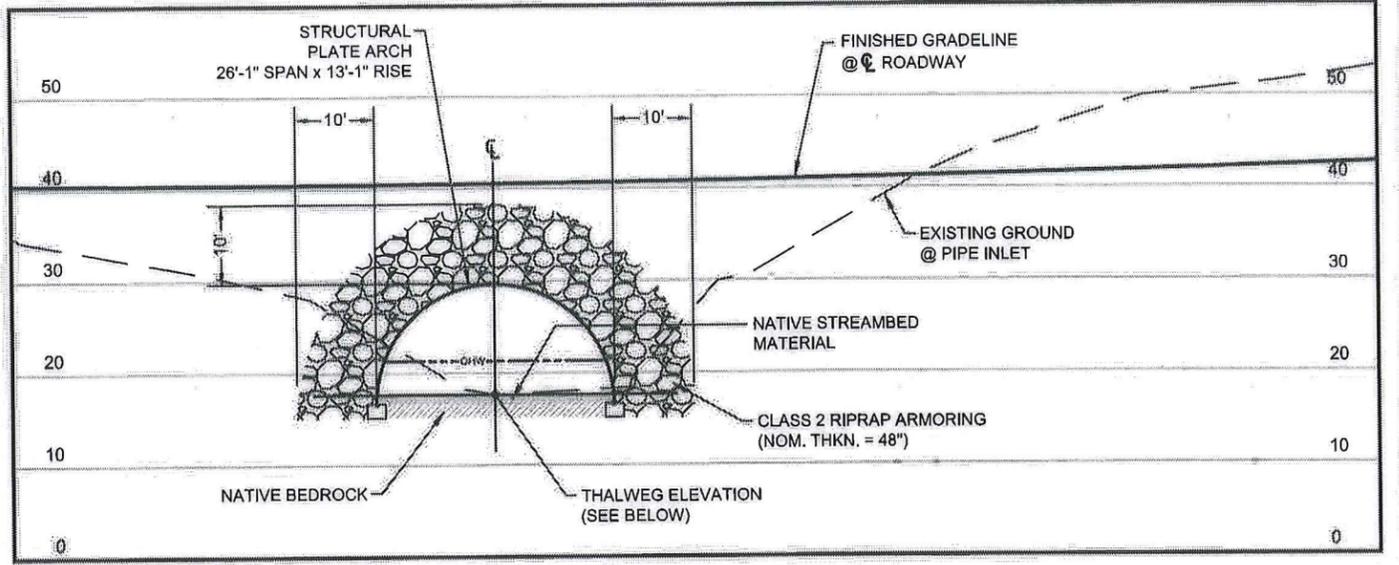

ELEVATION
SCALE IN FEET
0 10 20

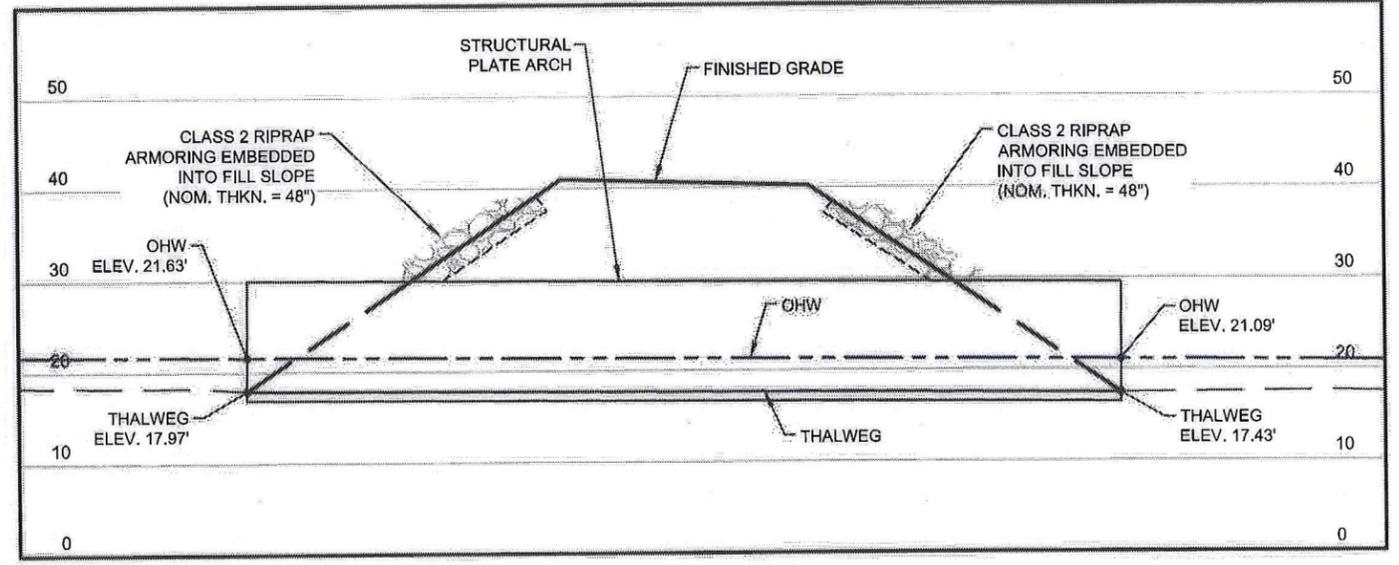

SECTION B-B
SCALE IN FEET
0 10 20

Project As Built Drawings Have Been Reviewed By the Project Engineer & Represent, To the Best of My Knowledge, the Project as Constructed.
 Project Eng. *MP* Date *8-23-17*

- NOTES:**
- FOR PRECAST STRUCTURAL PLATE ARCH FOUNDATION DETAIL, SEE SHEET N3.
 - FOR SECTION A-A, SEE SHEET N3.

FOOTING ELEVATIONS (BOTTOM)	
CORNER	ELEVATION (FT)
①	14.93
②	14.93
③	15.47
④	15.47

DESIGNED BY: M. DUMAN
DRAWN BY: R. BERGER

PATH: P:\53\ADOT\53-02\Gravina\Design\Plans\53-02_N2_Structures_Site 3.dwg
 TAB: N2 Wednesday, February 17, 2016 11:55:50 AM Ryan Berger

STATE OF ALASKA
DEPARTMENT OF TRANSPORTATION & PUBLIC FACILITIES
SOUTHCOST REGION


KTN GRAVINA - MILL ACCESS ROAD

STRUCTURES SITE 3

NO.	DATE	DESCRIPTION	PROJECT DESIGNATION	YEAR	SHEET NO.	TOTAL SHEETS
			Z699220000	2016	N2	48

PLAN
SCALE IN FEET
0 10 20


DRAWING LOCATION: P:\33\ADOT\153-02\Gravina\Design\Plans\53-02 N1 Structures Site 2.dwg
 DATE: 3/19/2016 12:04 PM
 SCALE: #1/8"=1'-0"
 LAYOUT: N3
 SHEET: 48 OF 48

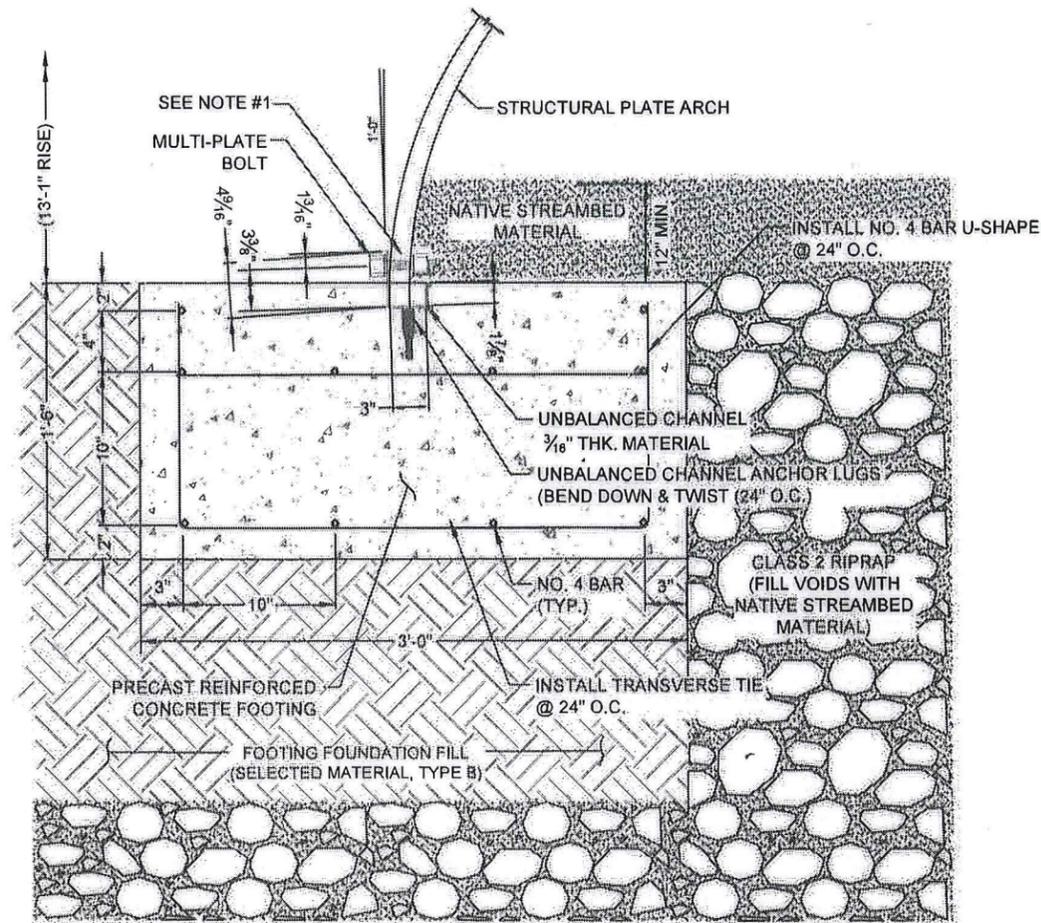


**PRECAST STRUCTURAL PLATE ARCH FOUNDATION
(SITE 2 - LEFT & RIGHT)**

GENERAL NOTES:

1. PROVIDE CLASS A CONCRETE FOR ALL PRECAST FOUNDATIONS SECTIONS.
2. PROVIDE ALL REINFORCING STEEL ACCORDING TO AASHTO M31 GRADE 60.
3. SHORT BOLT CONNECTION TO THE UNBALANCED CHANNEL SHOWN. OPPOSITE SIDE OF STRUCTURE REQUIRES 3" LONG BOLTS.
4. LENGTH OF PRECAST SECTION DETERMINED PURSUANT TO MANUFACTURER'S SPECIFICATIONS.

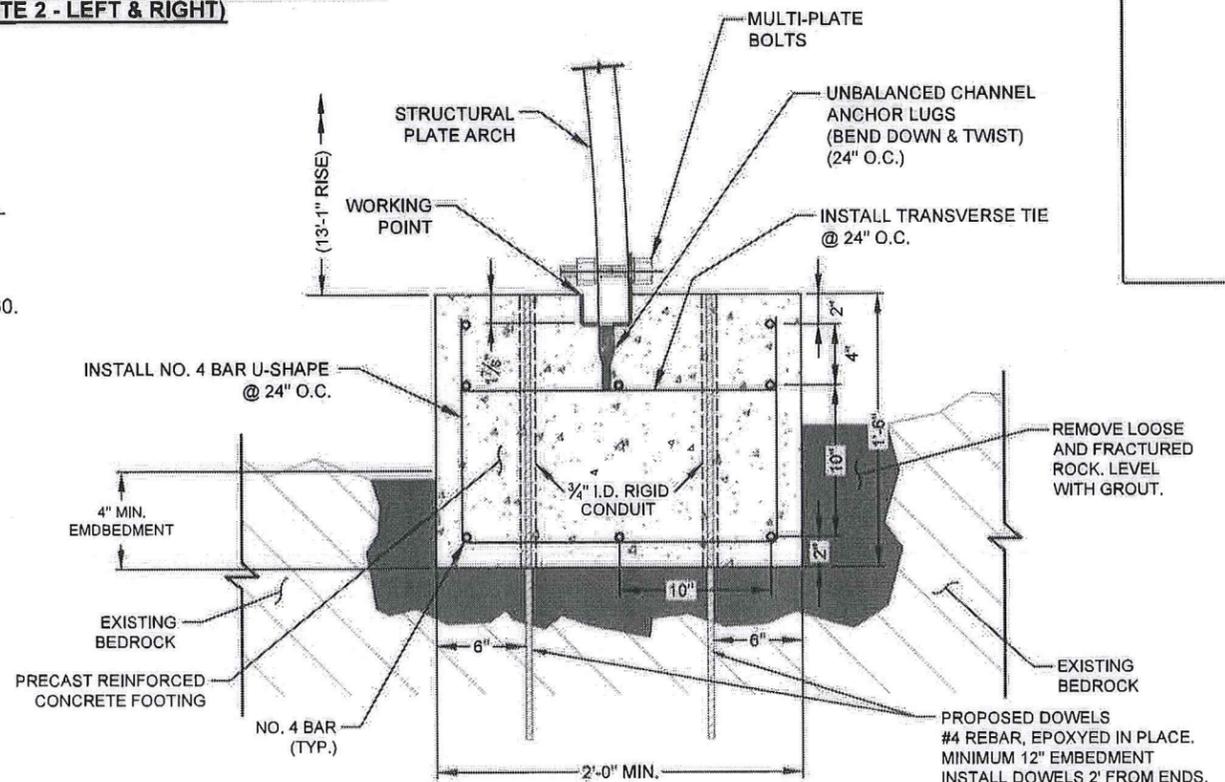


**PRECAST STRUCTURAL PLATE ARCH FOUNDATION
(SITE 3 - LEFT & RIGHT)**

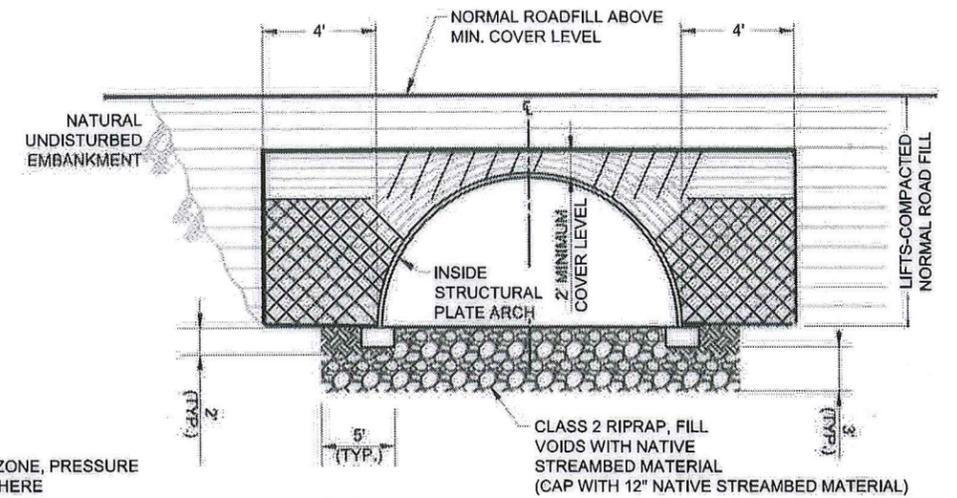

**SECTION A-A
STRUCTURAL PLATE ARCH
(SITE 2)**

NOT TO SCALE

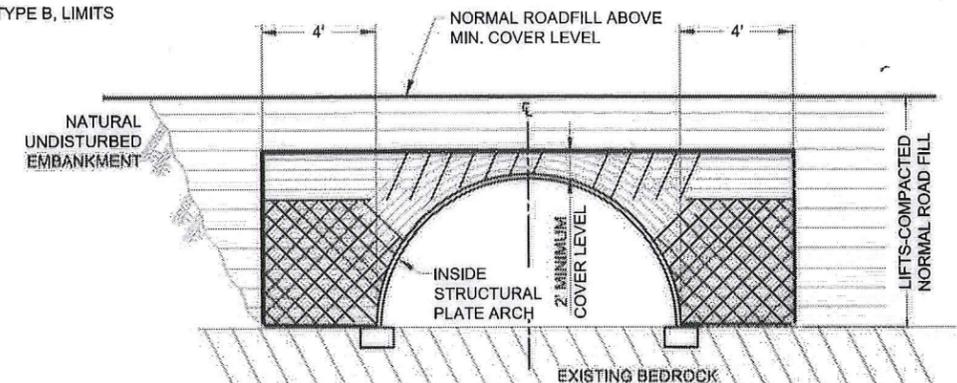

**SECTION A-A
STRUCTURAL PLATE ARCH
(SITE 3)**

NOT TO SCALE

- CRITICAL BACKFILL ZONE, PRESSURE ON SOIL GREATEST HERE
- INITIAL LIFTS OVER CROWN OF STRUCTURE AS INDICATED BY SHADED AREA TO BE COMPACTED TO REQUIRED DENSITY WITH HAND OPERATED EQUIPMENT OR WITH SMALL TRACTOR (D-4 OR SMALLER) DRAWN EQUIPMENT
- SELECT MATERIAL, TYPE B, LIMITS

Project As Built Drawings Have Been Reviewed By the Project Engineer & Represent, To the Best of My Knowledge, the Project as Constructed.

Project Eng. *MP* 8.23.17 Date



DESIGNED BY: M. DUMEN		PROJECT DESIGNATION		YEAR	SHEET NO.	TOTAL SHEETS
DRAWN BY: R. BERGER		Z699220000		2016	N3	48
PATH: P:\53\ADOT\153-02\Gravina\Design\Plans\53-02 N1 Structures Site 2.dwg		PROJECT DESIGNATION		YEAR	SHEET NO.	TOTAL SHEETS
TAB: N3		Z699220000		2016	N3	48

CONSTRUCTION NOTES

- ① CONSTRUCT SEDIMENT BARRIER. (AKDOT&PF E-13.00) (QUANTITY: 755')
- ② CONSTRUCT ROCK CHECK DAM ALONG DITCH LINE (QUANTITY: 18)
- ③ CONSTRUCT PUMP BYPASS IMPOUNDMENT. REMOVE FISH PRIOR TO COMMENCEMENT OF PUMPING. (SEE DETAIL, SHT. P5)
- ④ INSTALL SEDIMENT OUTFALL BAG TO BE USED ON ALL PUMP BYPASS.

Project As Built Drawings Have Been Reviewed By the Project Engineer & Represent, To the Best of My Knowledge, the Project as Constructed.

Project Eng. *MP* 8.23.17 Date

LEGEND

	WASTE DISPOSAL AREA FOR ORGANICS (STABILIZE WITH SEEDING & BONDED FIBER MATRIX)		FILL
	AGGREGATE CHECK DAM		CUT
	SEDIMENT BARRIER		DITCH LINE

ESCP NOT SEALED IN ACCORDANCE WITH ALASKA HIGHWAY PRE-CONSTRUCTION MANUAL SECTION 1120.7.3 DATED NOVEMBER 15, 2013



STATE OF ALASKA
DEPARTMENT OF TRANSPORTATION & PUBLIC FACILITIES
SOUTHCOST REGION

KTN GRAVINA - MILL ACCESS ROAD

ADDITIVE ALTERNATE A EROSION CONTROL SITE 1

DESIGNED BY: M. DUMAN	PROJECT DESIGNATION	YEAR	SHEET NO.	TOTAL SHEETS
DRAWN BY: R. BERGER	Z699220000	2016	P2	48
PATH: P:\53(ADOT)\53-02(Gravina)\DesignPlans\53-02 EROSION CONTROL.dwg TAB: P2 Wednesday, February 17, 2016 11:57:40 AM Ryan Baiger				

ADDITIVE ALTERNATE A "B" LINE PLAN

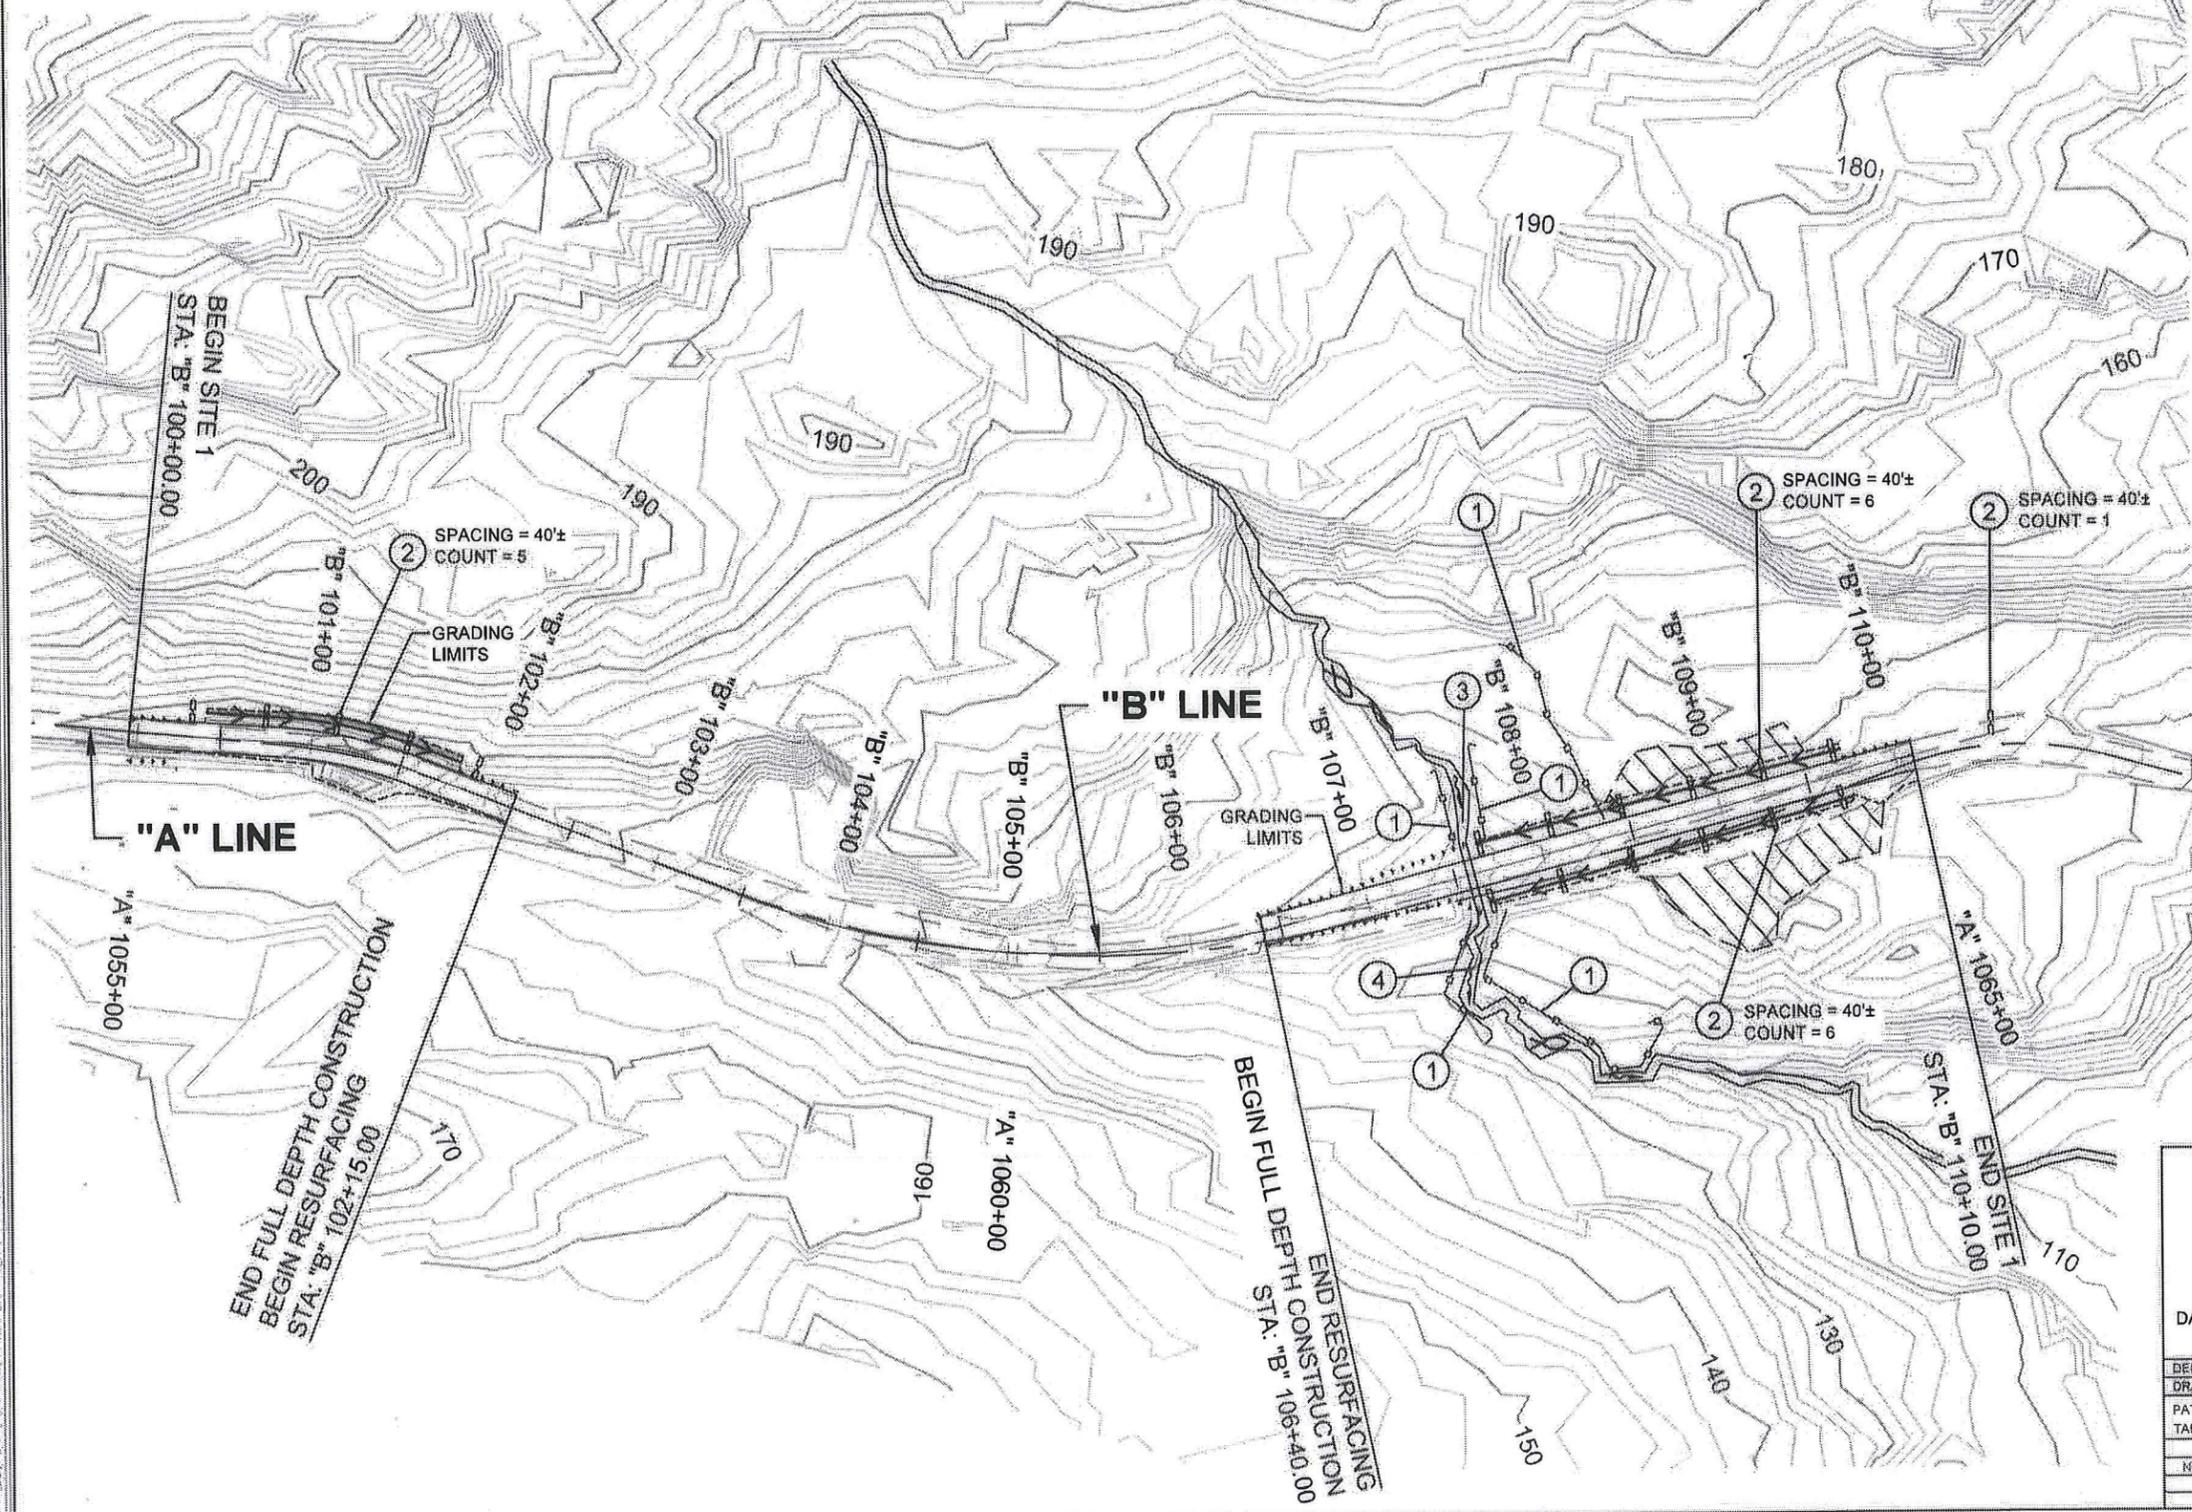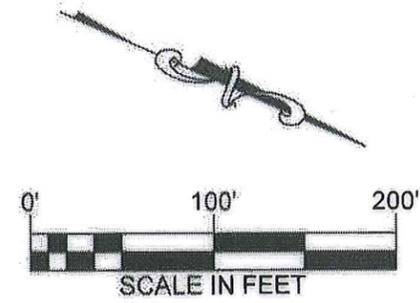

DRAWING LOCATION: P:\53(ADOT)\53-02(Gravina)\DesignPlans\53-02 EROSION CONTROL.dwg
 DATE/TIME: 2/9/2016 12:06 PM
 LAYOUT: P2
 SCALE: 1" = 100'
 DESIGNED BY: M. DUMAN
 DRAWN BY: R. BERGER



CONSTRUCTION NOTES

- ① CONSTRUCT SEDIMENT BARRIER (AKDOT&PF E-13.00)
(QUANTITY: 542')
- ② CONSTRUCT ROCK CHECK DAM ALONG DITCH LINE
(QUANTITY: 15)
- ③ INSTALL TURBIDITY CURTAIN
(QUANTITY: 360')
REMOVE FISH AFTER INSTALLATION
- ④ INSTALL PUMP BYPASS & SANDBAG BARRIER
REFERENCE DETAILS, SHEET P5.

Project As Built Drawings Have Been Reviewed
By the Project Engineer & Represent, To the
Best of My Knowledge, the Project as
Constructed.

Project Eng. *MP* 8.23.17
Date

LEGEND

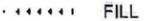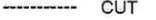	WASTE DISPOSAL AREA FOR ORGANICS (STABILIZE WITH SEEDING & BONDED FIBER MATRIX)		FILL
	AGGREGATE CHECK DAM		CUT
	SEDIMENT BARRIER		DITCH LINE

ESCP NOT SEALED
IN ACCORDANCE WITH
ALASKA HIGHWAY
PRE-CONSTRUCTION
MANUAL
SECTION 1120.7.3
DATED NOVEMBER 15, 2013


DESIGNED BY: M. DUMAN
DRAWN BY: R. BERGER
PATH: P:\53(ADOT)\53-02(Gravina)\Design\Plans\53-02 EROSION CONTROL.dwg
TAB: P3 Wednesday, February 17, 2016 11:57:43 AM Ryan Berger

REVISIONS			PROJECT DESIGNATION	YEAR	SHEET NO.	TOTAL SHEETS
NO.	DATE	DESCRIPTION				
			Z699220000	2016	P3	48

STATE OF ALASKA
DEPARTMENT OF TRANSPORTATION
& PUBLIC FACILITIES
SOUTHCOST REGION

**KTN GRAVINA - MILL
ACCESS ROAD**

**EROSION CONTROL
SITE 2**

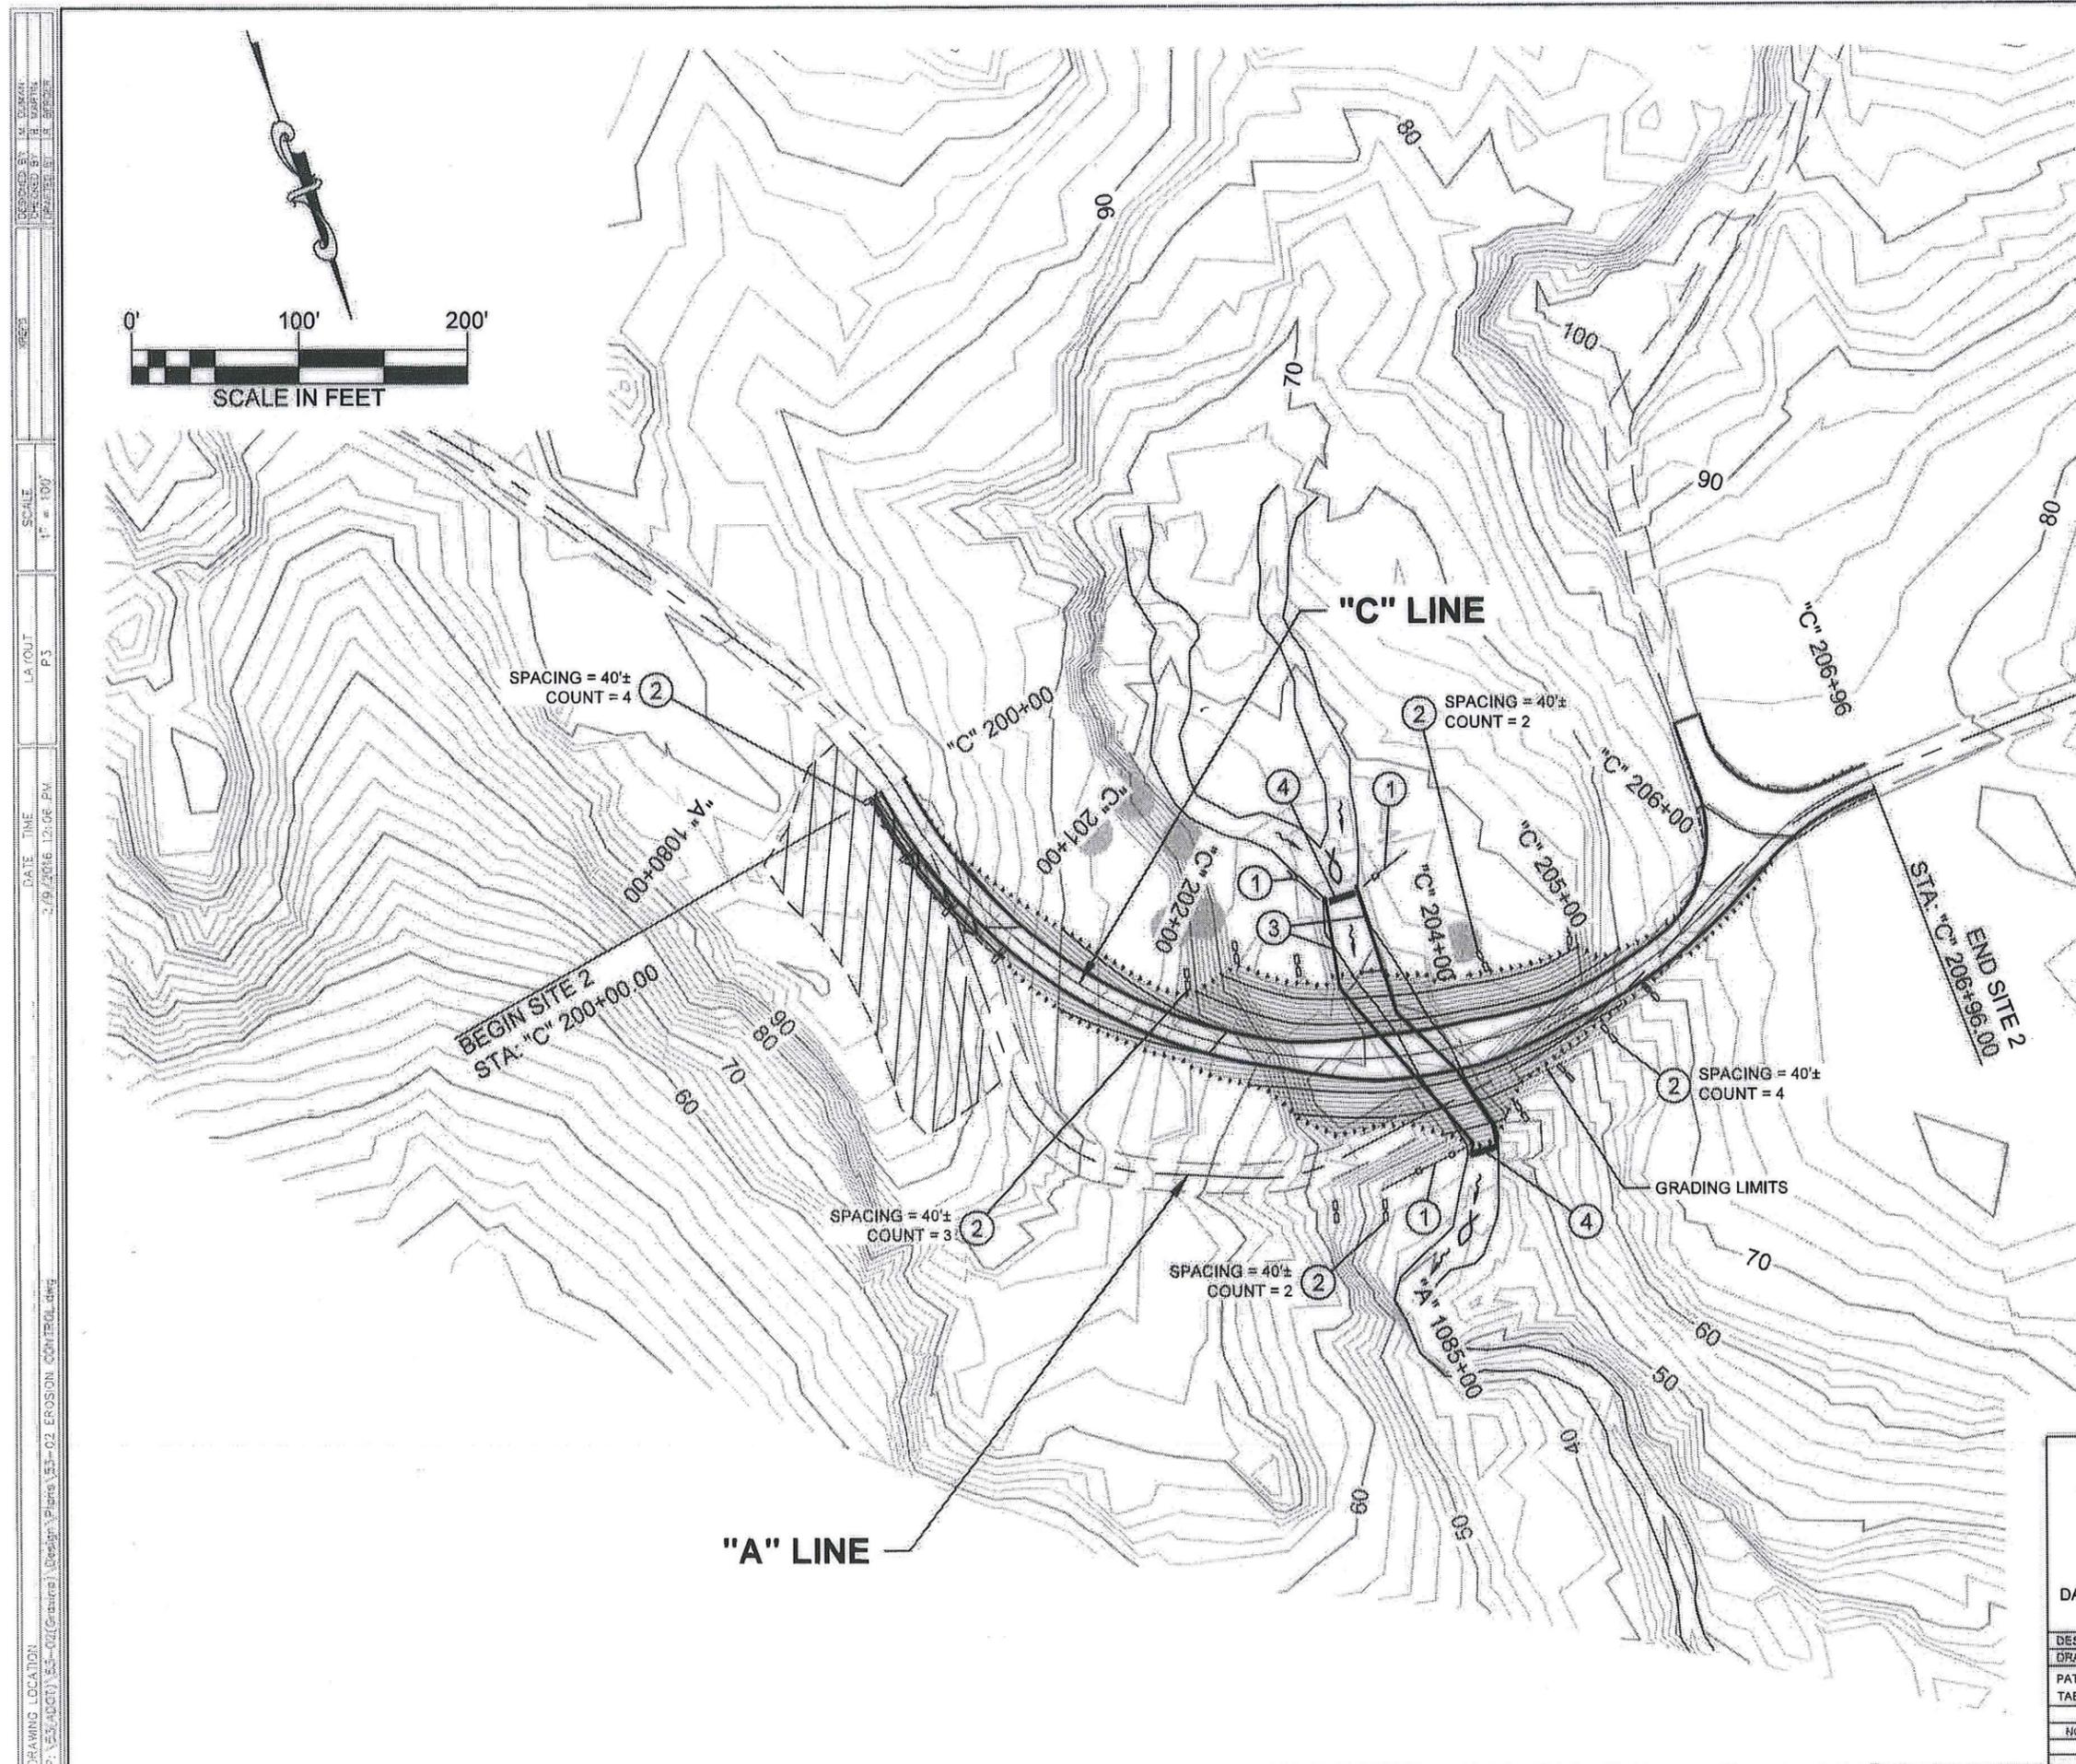

DRAWING LOCATION: P:\53(ADOT)\53-02(Gravina)\Design\Plans\53-02 EROSION CONTROL.dwg
 DATE: 2/16/16 12:46 PM
 LAYOUT: P3
 SCALE: 1" = 100'
 SHEET: 48 OF 48

CONSTRUCTION NOTES

- ① CONSTRUCT SEDIMENT BARRIER (AKDOT&PF E-13.00)
(QUANTITY: 1090')
- ② CONSTRUCT ROCK CHECK DAM ALONG DITCH LINE
(QUANTITY: 35)
- ③ INSTALL TURBIDITY CURTAIN
REMOVE FISH AFTER INSTALLATION
(QUANTITY: 300')
- ④ INSTALL PUMP BYPASS & SANDBAG BARRIER
REFERENCE DETAILS, SHEET P5.

Project As Built Drawings Have Been Reviewed
By the Project Engineer & Represent, To the
Best of My Knowledge, the Project as
Constructed.

Project Eng. *MP* Date *8-23-17*

LEGEND

	WASTE DISPOSAL AREA FOR ORGANICS (STABILIZE WITH SEEDING & BONDED FIBER MATRIX)		FILL
	AGGREGATE CHECK DAM		CUT
	SEDIMENT BARRIER		DITCH LINE

ESCP NOT SEALED
IN ACCORDANCE WITH
ALASKA HIGHWAY
PRE-CONSTRUCTION
MANUAL
SECTION 1120.7.3
DATED NOVEMBER 15, 2013

STATE OF ALASKA
DEPARTMENT OF TRANSPORTATION
& PUBLIC FACILITIES
SOUTHCOST REGION


**KTN GRAVINA - MILL
ACCESS ROAD**

**EROSION CONTROL
SITE 3**

DESIGNED BY: M. DUMAN
DRAWN BY: R. BERGER


PATH: P:\53(ADOT)\53-02(Gravina)\Design\Plane\53-02 EROSION CONTROL.dwg
TAB: P4 Wednesday, February 17, 2016 11:57:45 AM Ryan Berger

REVISIONS			PROJECT DESIGNATION	YEAR	SHEET NO.	TOTAL SHEETS
NO.	DATE	DESCRIPTION				
			Z699220000	2016	P4	48

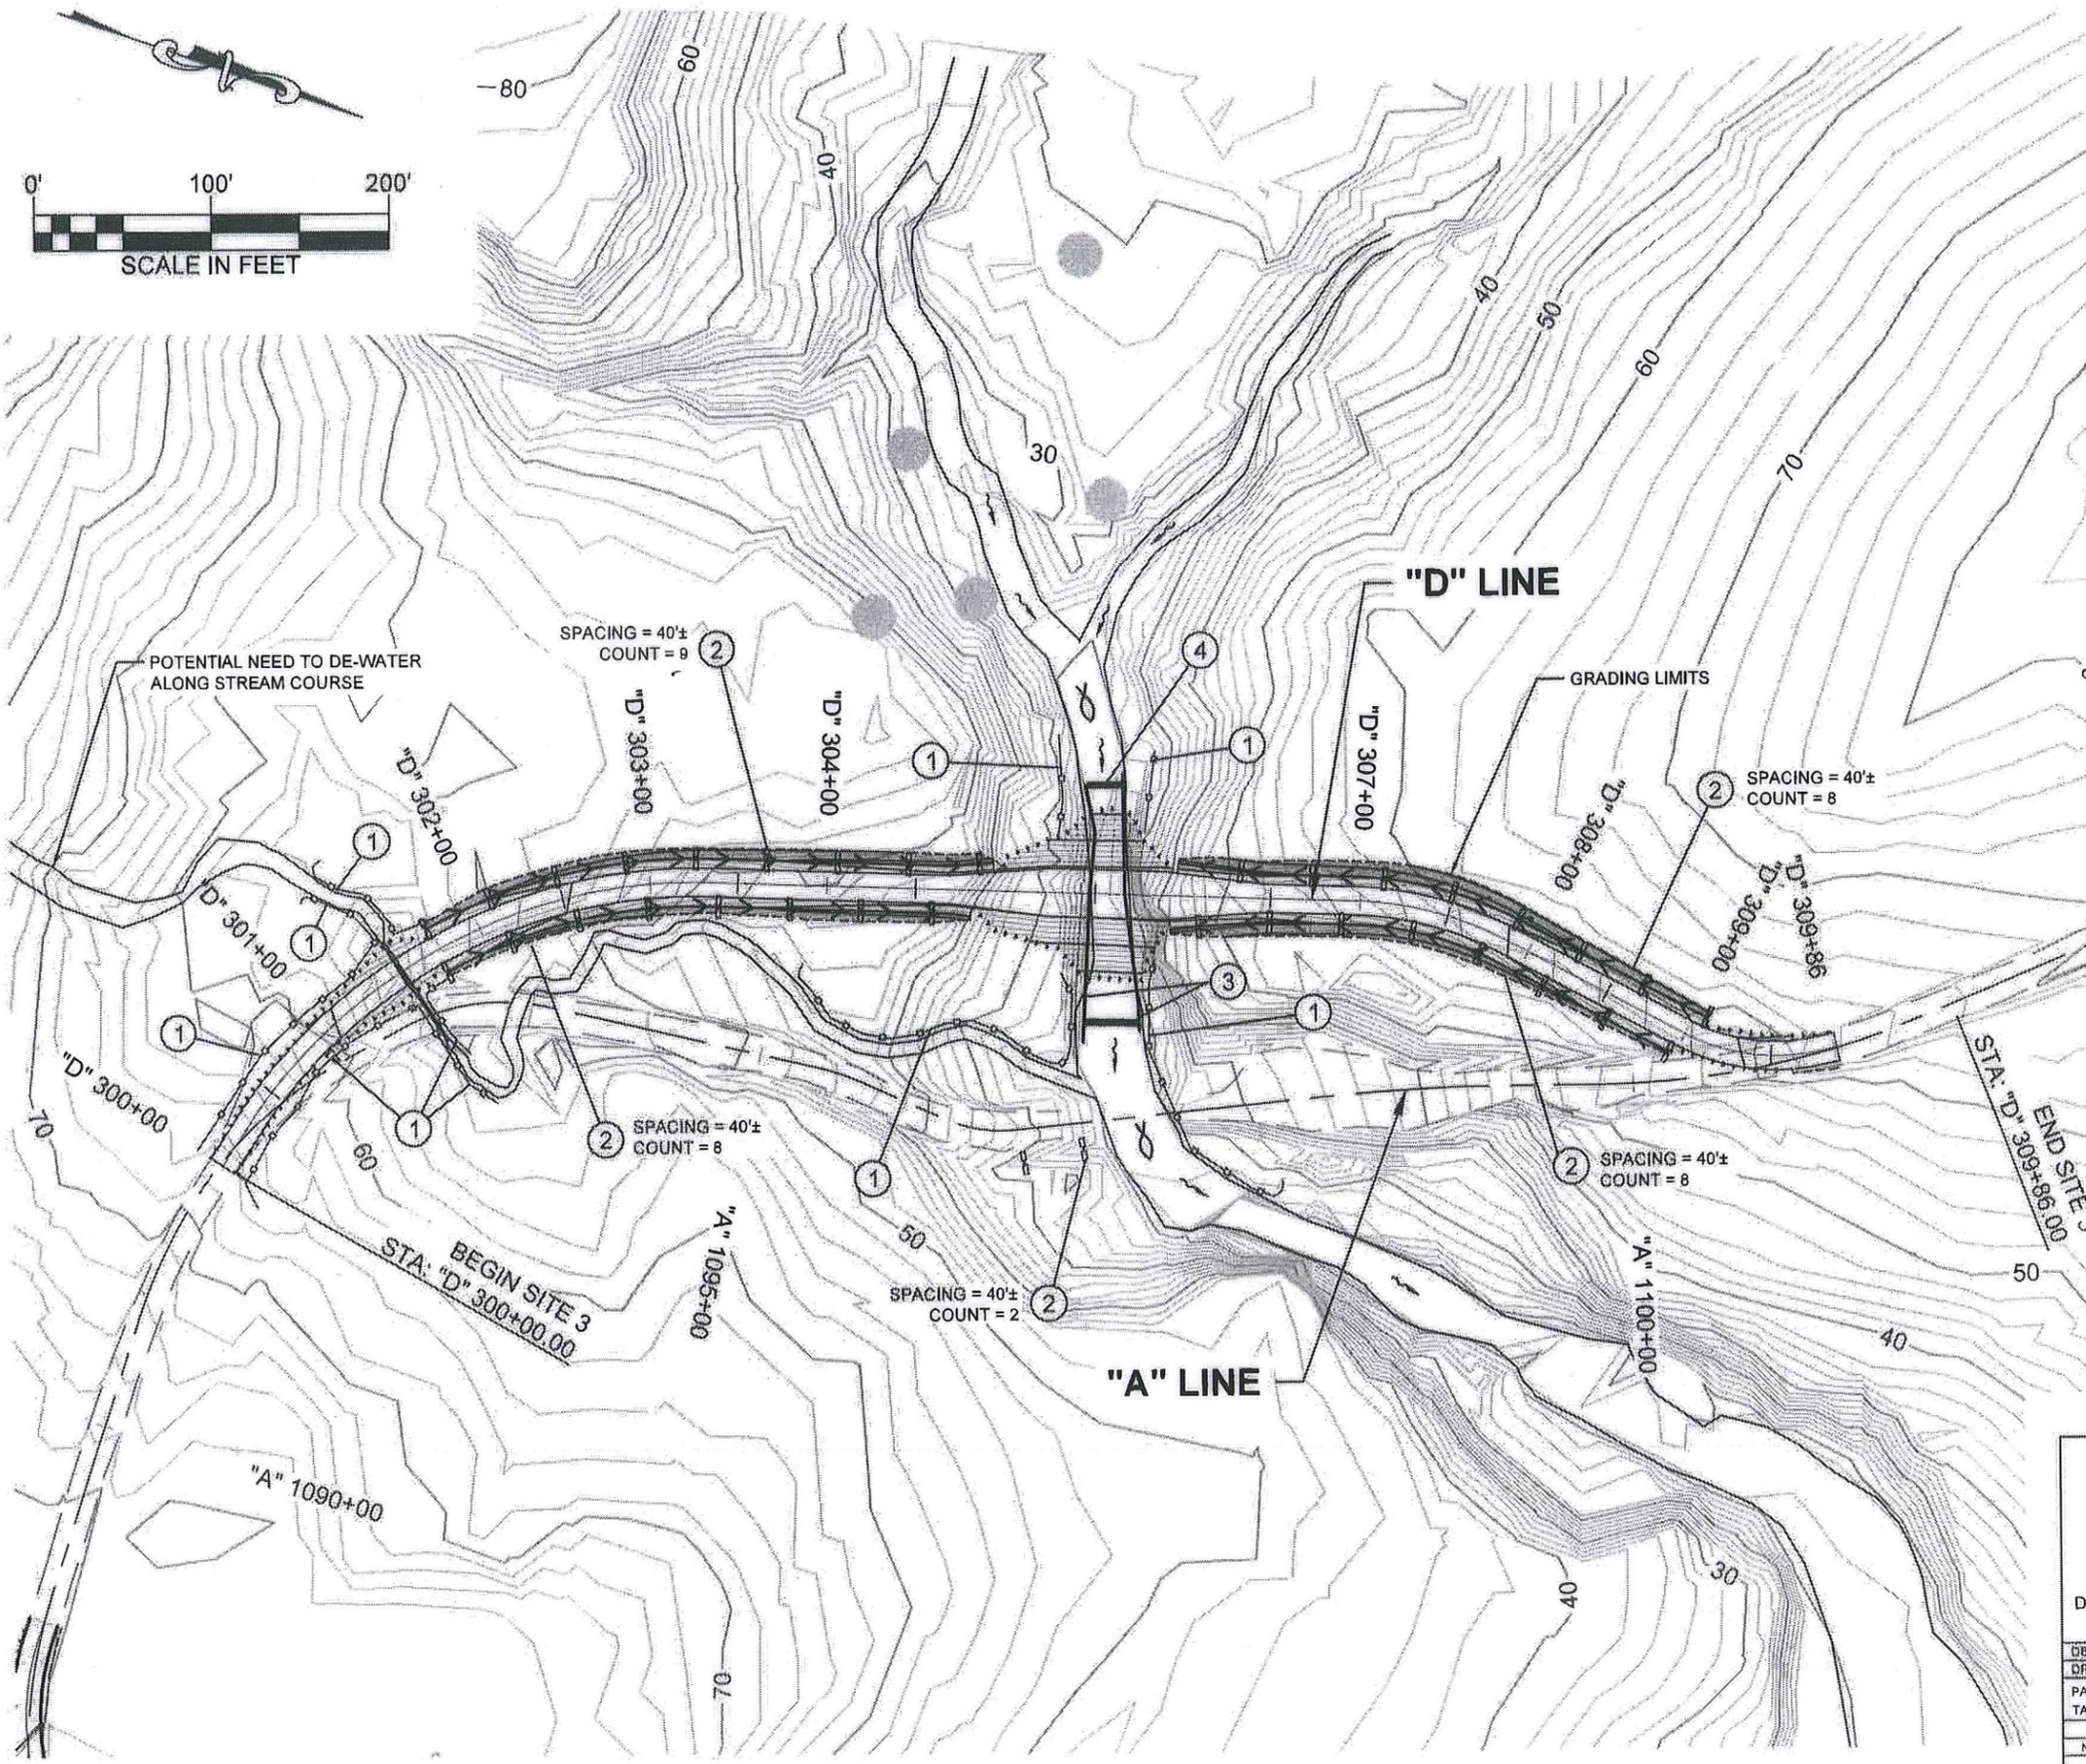


DRAWING LOCATION: P:\53(ADOT)\53-02(Gravina)\Design\Plane\53-02 EROSION CONTROL.dwg
 DATE: 2/9/2016 1:56 PM
 LAYOUT: P4
 SCALE: 1" = 100'
 DESIGNED BY: M. DUMAN
 DRAWN BY: R. BERGER


DESIGNED BY: M. GUMAN
 CHECKED BY: R. BERGER
 SCALE: AS SHOWN
 DATE: 2/7/2018 12:08:39 PM
 LAYOUT: P5
 PROJECT: ESCP NOT SEALED IN ACCORDANCE WITH ALASKA HIGHWAY PRE-CONSTRUCTION MANUAL SECTION 1120.7.3 DATED NOVEMBER 15, 2013
 FILE: P:\ESC\ADOT\53-02(Gravina)\Design\Plans\53-02 EROSION CONTROL.dwg

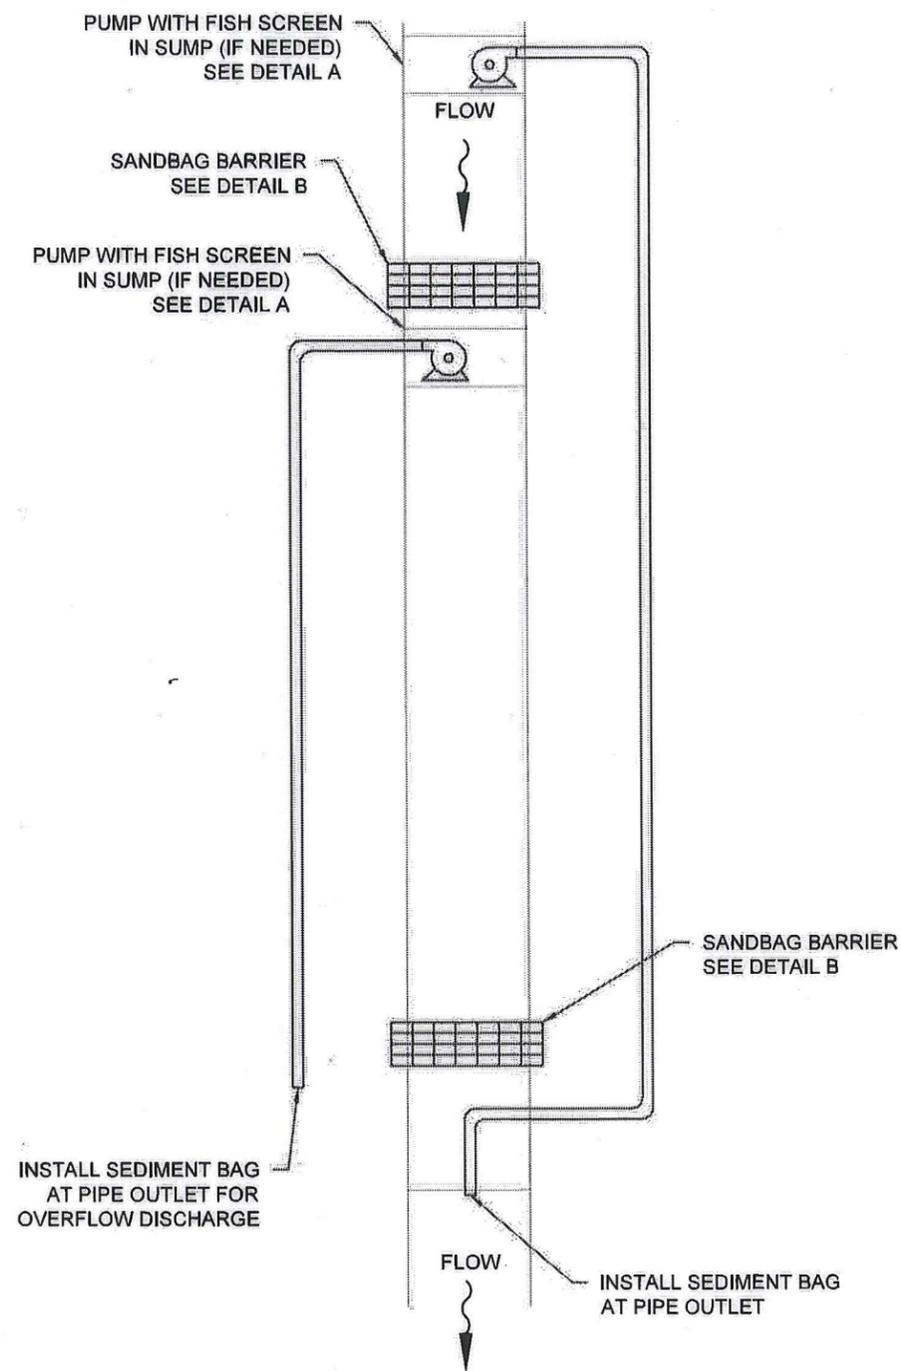

TYPICAL PUMP BYPASS DETAIL

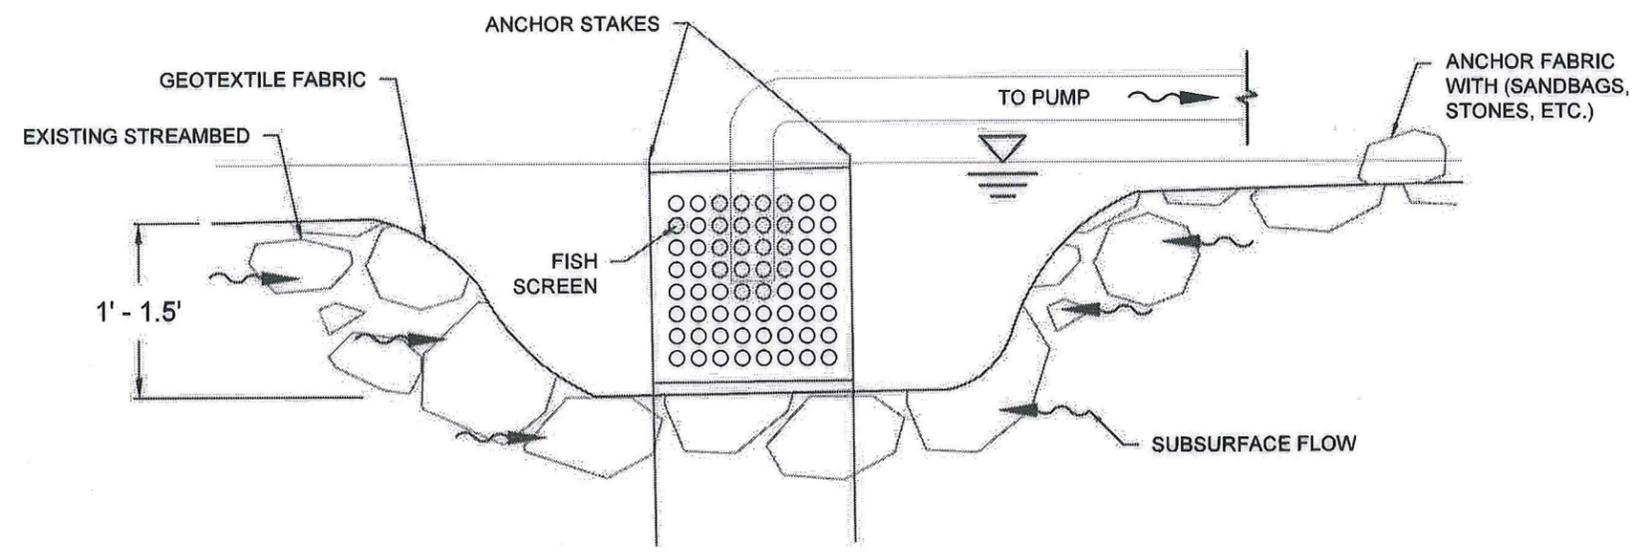

FISH SCREEN SUMP DETAIL A

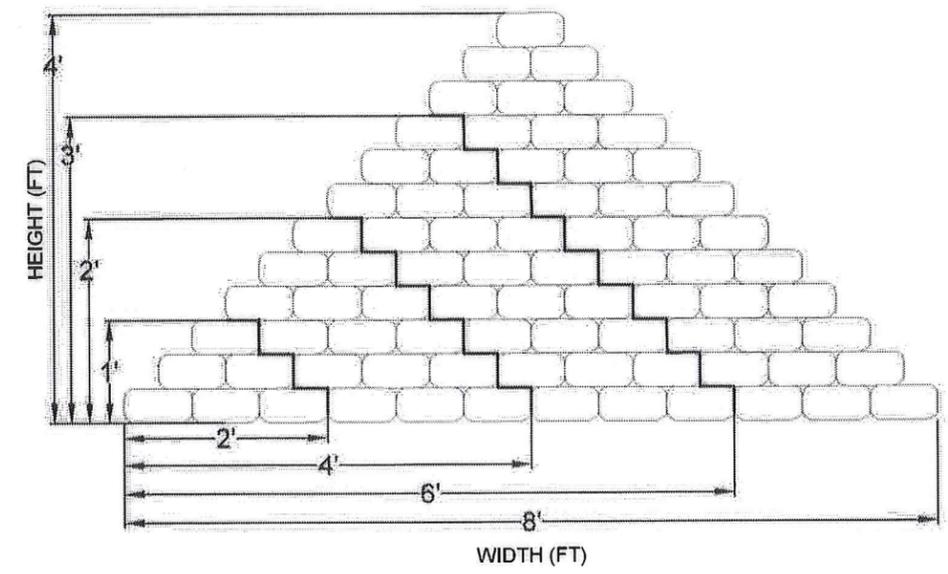

SANDBAG BARRIER DETAIL B

MAKE THE SANDBAG BARRIER TWICE AS WIDE AS ITS HEIGHT (E.G. A ONE FOOT HIGH WALL WOULD HAVE A BASE WIDTH OF 2 FEET). THIS IS THE MINIMUM WIDTH-TO-HEIGHT RATIO THAT SHOULD BE USED TO CONSTRUCT A SANDBAG BARRIER. THIS IS BASED ON EACH BAG HAVING A PLACED DIMENSION OF ABOUT 4 TO 5 INCHES HIGH BY 9 TO 10 INCHES WIDE BY 14 INCHES LONG. THIS IS A 30 LB BAG OF SAND.

THE ESTIMATED NUMBER OF BAGS NEEDED FOR 100 LINEAR FEET OF BARRIER THAT IS TWICE AS WIDE AS ITS HEIGHT IS:

HEIGHT (FT)	# BAGS
1	600
2	1700
3	3000
4	5500

Project As Built Drawings Have Been Reviewed By the Project Engineer & Represent, To the Best of My Knowledge, the Project as Constructed.

Project Eng. *MP* **8.03.17**
Date

ESCP NOT SEALED IN ACCORDANCE WITH ALASKA HIGHWAY PRE-CONSTRUCTION MANUAL SECTION 1120.7.3 DATED NOVEMBER 15, 2013		STATE OF ALASKA DEPARTMENT OF TRANSPORTATION & PUBLIC FACILITIES SOUTHCOAST REGION				
DESIGNED BY: M. GUMAN DRAWN BY: R. BERGER		KTN GRAVINA - MILL ACCESS ROAD EROSION CONTROL DETAILS				
PATH: P:\53(ADOT)\53-02(Gravina)\Design\Plans\53-02 EROSION CONTROL.dwg TAB: P5 Wednesday, February 17, 2018 11:57:47 AM Ryan Berger						
NO.	DATE	DESCRIPTION	PROJECT DESIGNATION	YEAR	SHEET NO.	TOTAL SHEETS
			Z699220000	2016	P5	48

GENERAL NOTES

1. SIGN SPACING SHOWN IS APPROXIMATE AND NOT TO SCALE. CONTRACTOR SHALL ADJUST PLACEMENT AS NECESSARY IN THE FIELD TO AVOID CONFLICTS WITH EXISTING FEATURES. ADJUSTMENT DISTANCE SHALL NOT EXCEED 50'.
2. IF THE VALLENAR BAY ROAD PROJECT IS NOT UNDER CONSTRUCTION, THE CONTRACTOR HAS THE OPTION TO CLOSE THE ROAD.

**E.O.P.
STA. 1137+75.00**

SELEY MILL

SEE DETAIL "A"

**B.O.P.
STA. 1053+55.00**

KTN GRAVINA MILL - ACCESS ROAD


SEE DETAIL "A"

BOSTWICK LAKE ROAD

GRAVINA ISLAND HIGHWAY

KETCHIKAN INTERNATIONAL AIRPORT

 UNDER TRAFFIC
 PROJECT WORK AREA

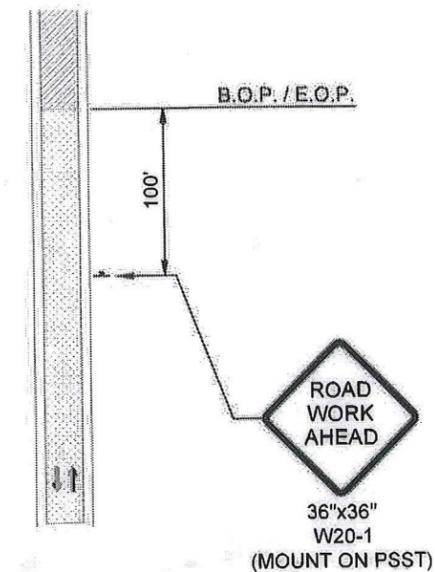

**DETAIL "A"
ADVANCED WARNING SIGN**

Project As Built Drawings Have Been Reviewed By the Project Engineer & Represent, To the Best of My Knowledge, the Project as Constructed.

Project Eng. *MP*


8-23-17
Date

TCP NOT SEALED IN ACCORDANCE WITH ALASKA HIGHWAY PRE-CONSTRUCTION MANUAL SECTION 1400.3.5 DATED JANUARY 30, 2012		STATE OF ALASKA DEPARTMENT OF TRANSPORTATION & PUBLIC FACILITIES SOUTHCOAST REGION	
DESIGNED BY: M. DUMAN DRAWN BY: R. BERGER		KTN GRAVINA - MILL ACCESS ROAD	
PATH: P:\53(ADOT)\53-02(Gravina)\Design\Plans\53-02 Traffic Control.dwg TAB: T1 Wednesday, February 17, 2016 11:58:23 AM Ryan Berger		TRAFFIC CONTROL PLAN	
REVISIONS NO. DATE DESCRIPTION		PROJECT DESIGNATION Z699220000	YEAR 2016
		SHEET NO. T1	TOTAL SHEETS 48


DRAWING LOCATION: P:\53(ADOT)\53-02(Gravina)\Design\Plans\53-02 Traffic Control.dwg
 DATE TIME: 2/17/2016 1:58 PM
 LAYOUT: T1
 SCALE: NTS
 DESIGNED BY: M. DUMAN
 DRAWN BY: R. BERGER

GENERAL NOTES:


1. Sidefill shall be placed and compacted with care under haunches of pipe and shall be brought up evenly and simultaneously on both sides of pipe to 1 foot above the top of the full length of the pipe.
2. Alternate installation methods may only be used when specified or approved by the Engineer.

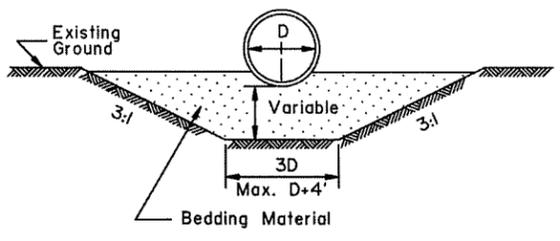


TYPE "A"
FOUNDATION STABILIZATION
To be used in unstable areas as directed by the Engineer.

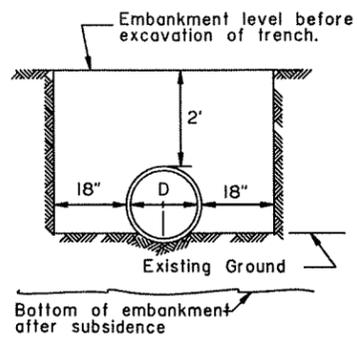


TYPE "B"

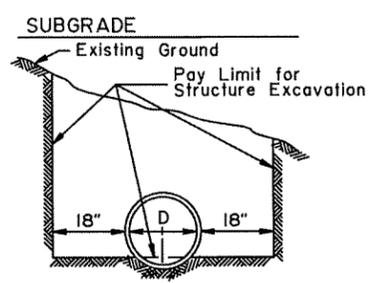


TYPE "C"

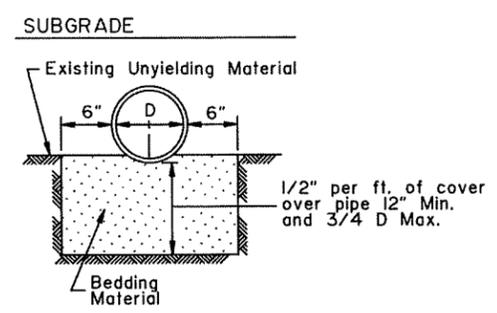


TYPE "D"
ROCK OR UNYIELDING MATERIAL

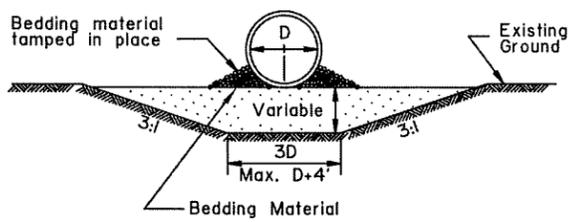


'ALTERNATE' TYPE "A"
FOUNDATION STABILIZATION
To be used in unstable areas as directed by the Engineer.

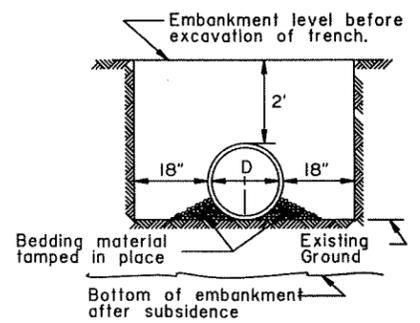

'ALTERNATE' TYPE "B"

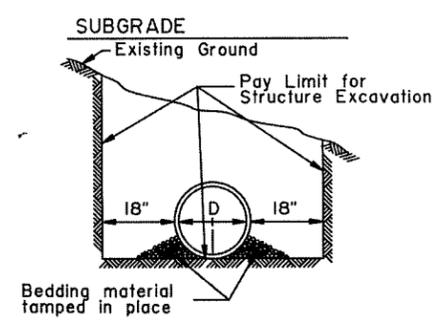


'ALTERNATE' TYPE "C"

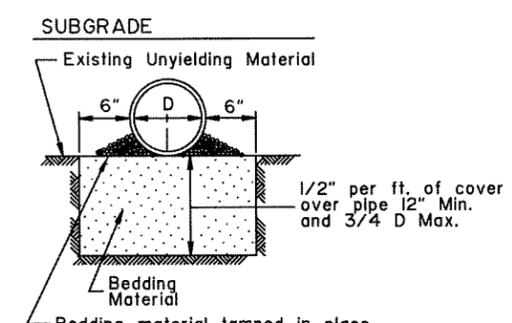


'ALTERNATE' TYPE "D"
ROCK OR UNYIELDING MATERIAL

D = Nominal Pipe Diameter

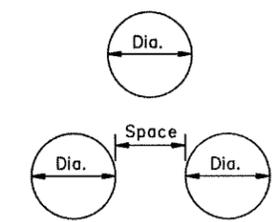


MULTIPLE INSTALLATIONS	
Dia.	Minimum Space Between Pipes
0" - 42"	24"
48" & Over	1/2 Dia. of pipe or 3', whichever is less.

S = Nominal Pipe Arch Span

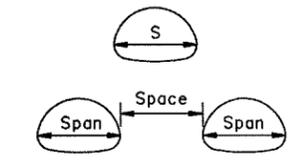


MULTIPLE INSTALLATIONS	
Dia.	Minimum Space Between Pipes
0" - 42"	24"
48" & Over	1/2 Span of pipe arch or 3', whichever is less.


CULVERT PIPE

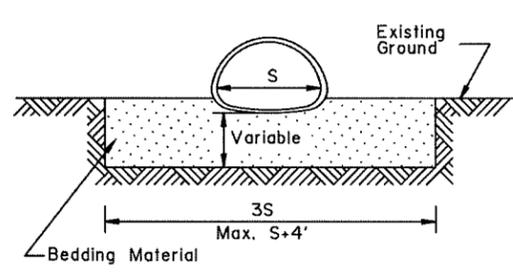


TYPE "A"
FOUNDATION STABILIZATION
To be used in unstable areas as directed by the Engineer.

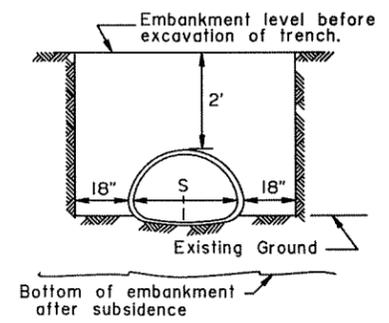

TYPE "B"

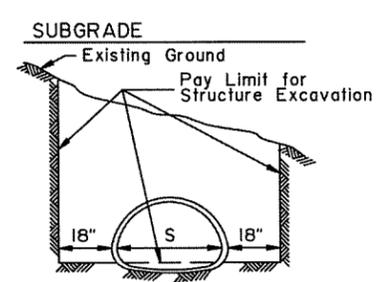

TYPE "C"

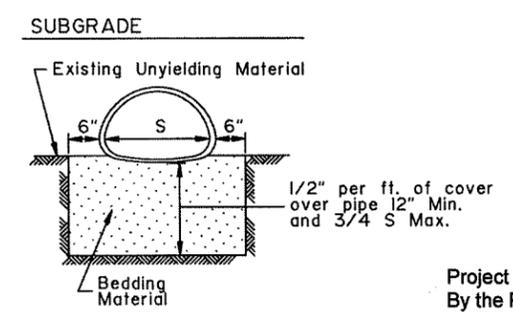

TYPE "D"
ROCK OR UNYIELDING MATERIAL

ARCH

Project As Built Drawings Have Been Reviewed By the Project Engineer & Represent, To the Best of My Knowledge, the Project as Constructed.
Project Eng. _____ Date _____

VERT PIPE & ARCH INSTALLATION DETAILS


REVISIONS		
Date	Description	By
12/1/87	Delete ref. to Specs.	Gdo
4/1/93	Delete All Arch	Gdo

State of Alaska
Department of Transportation
& Public Facilities

APPROVED
Date _____
7/15/82


GENERAL NOTES:

1. Sidefill shall be placed and compacted with care under haunches of pipe and shall be brought up evenly and simultaneously on both sides of pipe to 1 foot above the top of the full length of the pipe.
2. Alternate installation methods may only be used when specified or approved by the Engineer.

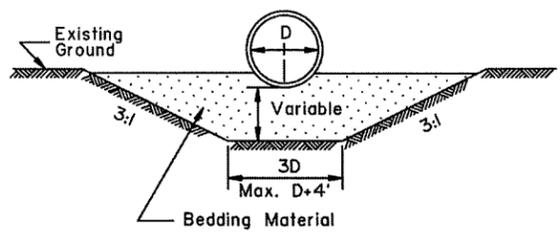


TYPE "A" FOUNDATION STABILIZATION


To be used in unstable areas as directed by the Engineer.

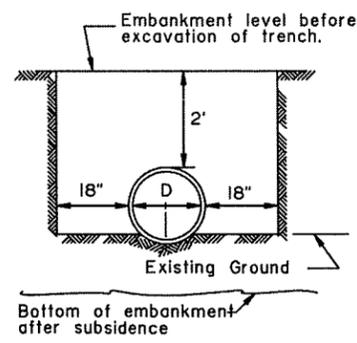


TYPE "B"

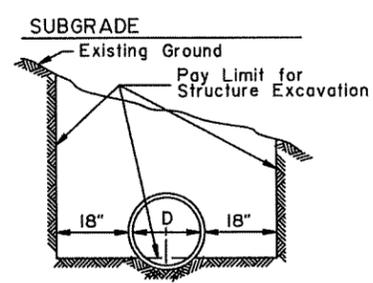

TYPE "C"

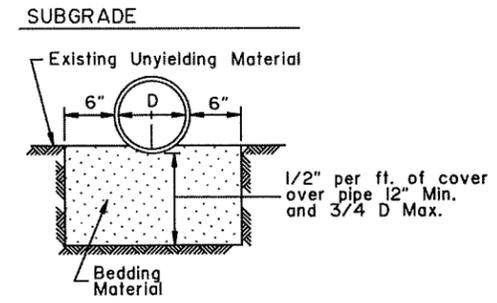


TYPE "D" ROCK OR UNYIELDING MATERIAL

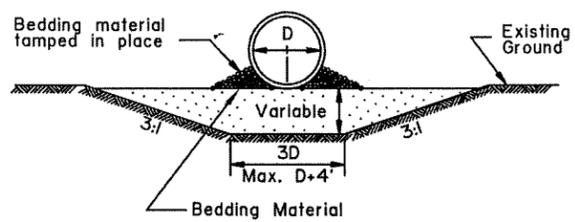


'ALTERNATE' TYPE "A" FOUNDATION STABILIZATION


To be used in unstable areas as directed by the Engineer.

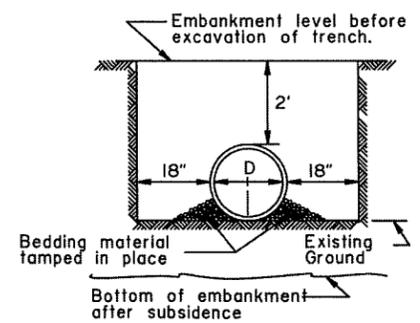

'ALTERNATE' TYPE "B"

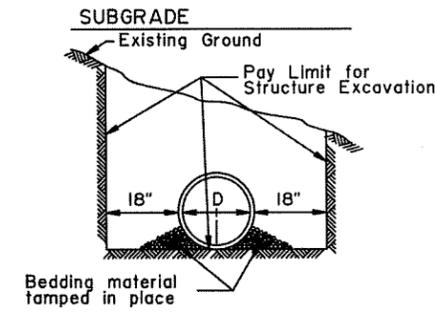


'ALTERNATE' TYPE "C"

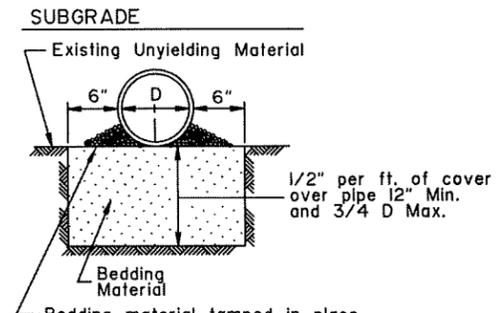


'ALTERNATE' TYPE "D" ROCK OR UNYIELDING MATERIAL

D = Nominal Pipe Diameter

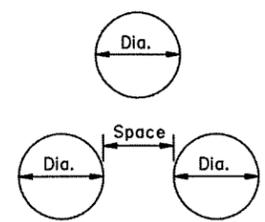


MULTIPLE INSTALLATIONS	
Dia.	Minimum Space Between Pipes
0" - 42"	24"
48" & Over	1/2 Dia. of pipe or 3', whichever is less.

S = Nominal Pipe Arch Span

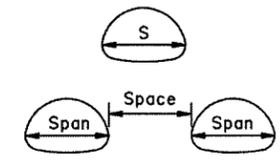


MULTIPLE INSTALLATIONS	
Dia.	Minimum Space Between Pipes
0" - 42"	24"
48" & Over	1/2 Span of pipe arch or 3', whichever is less.

CULVERT PIPE

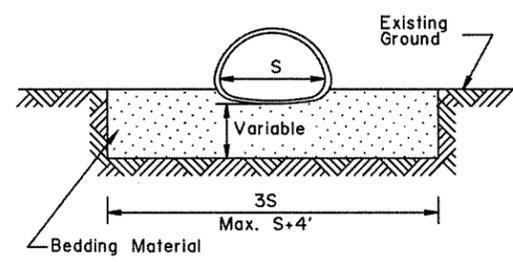


TYPE "A" FOUNDATION STABILIZATION


To be used in unstable areas as directed by the Engineer.

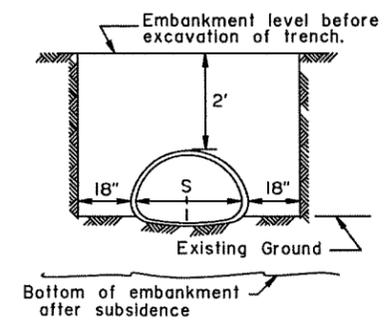

TYPE "B"

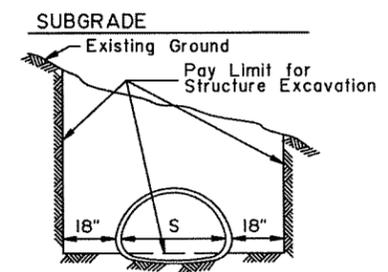

TYPE "C"

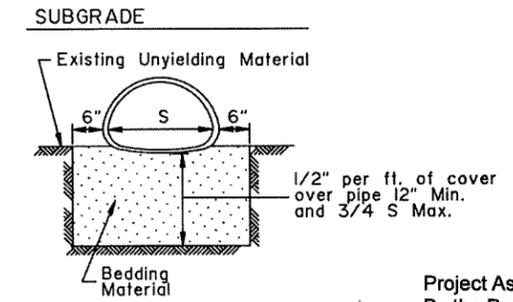

TYPE "D" ROCK OR UNYIELDING MATERIAL

ARCH

REVISIONS		
Date	Description	By
12/1/87	Delete ref. to Specs.	Gdo
4/1/93	Delete All Arch	Gdo

State of Alaska
Department of Transportation
& Public Facilities

CULVERT PIPE & ARCH INSTALLATION DETAILS

Project As Built Drawings Have Been Reviewed By the Project Engineer & Represent, To the Best of My Knowledge, the Project as Constructed.

Project Eng.

Date

Date 7/15/82



GENERAL NOTES

- All material and workmanship shall be in accordance with the State of Alaska, Standard Specifications for Highway Construction.
- The contractor shall select only pipes that meet specific height of cover criteria shown on the plans or in the special provisions.
- No more than one type of pipe may be used on any single installation or installation grouping.
- All structural plate pipes shall be placed on a pre-shaped foundation conforming to the depth of the bottom plates with clearance for assembling to the adjacent plates allowed.
- See Standard Drawing "Culvert Pipe & Arch Installation Details" for foundation and structural backfill details.
- Minimum cover shall be measured from the top of pipe to the top of rigid pavement or to the top of flexible pavement subgrade. In all cases, the minimum cover shall not be less than 12". Minimum cover during construction shall be that required to protect the pipe from damage or deflection.
- These tables have been developed for an H-20 live load and for compacted soil weighing 120 lbs. per cubic foot or less. If compacted soil cover exceeds 120 lbs. per cubic foot, the contractor shall use the depth of cover shown in the plans for the specific pipe. Where compacted soil cover exceeds 120 lbs. per cubic foot and no specific cover requirements are provided in the plans, the contractor shall determine the required minimum pipe cover in accordance with Section 12 of the 2000 AASHTO "LRFD Bridge Design Specifications"

Project As Built Drawings Have Been Reviewed
By the Project Engineer & Represent, To the
Best of My Knowledge, the Project as
Constructed.

Project Eng. _____ Date _____

GAGE	0.064"		0.079"		0.109"		0.138"		0.168"	
	Min. (In)	Max. (Ft)								
12	12	100+	12	100+	12	100+	12	100+	12	100+
15	12	100+	12	100+	12	100+	12	100+	12	100+
18	12	100+	12	100+	12	100+	12	100+	12	100+
21	12	100+	12	100+	12	100+	12	100+	12	100+
24	12	100+	12	100+	12	100+	12	100+	12	100+
27	12	100+	12	100+	12	100+	12	100+	12	100+
30	12	99	12	100+	12	100+	12	100+	12	100+
36	12	83	12	100+	12	100+	12	100+	12	100+
42	12	71	12	88	12	100+	12	100+	12	100+
48	12	62	12	77	12	100+	12	100+	12	100+
54			12	66	12	93	12	100+	12	100+
60					12	79	12	100+	12	100+
66					12	68	12	88	12	100+
72							12	75	12	93
78									12	79
84										66

GAGE	0.064"		0.079"		0.109"		0.138"		0.168"	
	Min. (In)	Max. (Ft)								
36	12		12		12	100+	12	100+	12	100+
42	12		12		12	100+	12	100+	12	100+
48	12		12	76	12	100+	12	100+	12	100+
54	12	63	12	79	12	100+	12	100+	12	100+
60	12	56	12	71	12	99	12	100+	12	100+
66	12	52	12	64	12	90	12	100+	12	100+
72	12	47	12	59	12	82	12	100+	12	100+
78	12	44	12	54	12	77	12	98	12	100+
84	12	41	12	51	12	71	12	92	12	100+
90	12	37	12	47	12	67	12	86	12	100+
96	12	35	12	44	12	62	12	80	12	98
102	18	33	18	42	18	59	18	76	18	93
108			18	40	18	55	18	71	18	87
114			18	36	18	51	18	66	18	80
120			18	34	18	46	18	61	18	75
126					18	44	18	56	18	70
132					18	41	18	53	18	64
138					18	37	18	49	18	60
144							18	44	18	55
150									18	52

GAGE	0.064"		0.079"		0.109"		0.138"		0.168"	
	Min. (In)	Max. (Ft)								
36	12	81	12	90	12	100+	12	100+	12	100+
42	12	71	12	77	12	100+	12	100+	12	100+
48	12	62	12	68	12	100+	12	100+	12	100+
54	12	56	12	70	12	98	12	100+	12	100+
60	12	50	12	63	12	88	12	100+	12	100+
66	12	46	12	57	12	80	12	100+	12	100+
72	12	42	12	52	12	73	12	95	12	100+
78	12	39	12	48	12	68	12	87	12	100+
84	12	36	12	45	12	63	12	81	12	99
90	12	33	12	42	12	59	12	76	12	93
96	12	31	12	39	12	55	12	71	12	87
102	18	29	18	37	18	52	18	67	18	82
108			18	35	18	49	18	63	18	77
114			18	32	18	45	18	58	18	71
120			18	30	18	41	18	54	18	66
126					18	39	18	50	18	62
132					18	36	18	47	18	57
138					18	33	18	43	18	53
144							18	39	18	49
150									19	47

* Table for pipe with helical lockseams or helical welded seams ONLY.

GAGE	ALL	0.111"		0.140"		0.170"		0.188"		0.218"		0.249"		0.280"	
		Min. (In)	Max. (Ft)												
60	12	46	68	90	100+	100+	100+	100+	100+	100+	100+	100+	100+	100+	100+
66	12	42	62	81	93	100+	100+	100+	100+	100+	100+	100+	100+	100+	100+
72	12	38	57	75	86	100+	100+	100+	100+	100+	100+	100+	100+	100+	100+
78	12	35	52	69	79	95	100+	100+	100+	100+	100+	100+	100+	100+	100+
84	12	33	49	64	73	88	100+	100+	100+	100+	100+	100+	100+	100+	100+
90	12	31	45	60	68	82	97	100+	100+	100+	100+	100+	100+	100+	100+
96	12	29	43	56	64	77	91	100+	100+	100+	100+	100+	100+	100+	100+
102	18	27	40	52	60	73	86	94	100+	100+	100+	100+	100+	100+	100+
108	18	25	38	50	57	69	81	88	100+	100+	100+	100+	100+	100+	100+
114	18	24	36	47	54	65	77	84	100+	100+	100+	100+	100+	100+	100+
120	18	23	34	45	51	62	73	80	100+	100+	100+	100+	100+	100+	100+
126	18	22	32	42	49	59	69	76	100+	100+	100+	100+	100+	100+	100+
132	18	21	31	40	46	56	66	72	100+	100+	100+	100+	100+	100+	100+
138	18	20	29	39	44	54	63	69	100+	100+	100+	100+	100+	100+	100+
144	18	19	28	37	43	51	61	66	100+	100+	100+	100+	100+	100+	100+
150	18	18	27	36	41	49	58	64	100+	100+	100+	100+	100+	100+	100+
156	24	17	26	34	39	47	56	61	100+	100+	100+	100+	100+	100+	100+
162	24	17	25	33	38	46	54	59	100+	100+	100+	100+	100+	100+	100+
168	24	16	24	32	36	44	52	57	100+	100+	100+	100+	100+	100+	100+
174	24	16	23	31	35	42	50	55	100+	100+	100+	100+	100+	100+	100+
180	24	15	22	30	34	41	48	53	100+	100+	100+	100+	100+	100+	100+
186	24	15	22	29	33	40	47	51	100+	100+	100+	100+	100+	100+	100+
192	24		21	28	32	38	45	50	100+	100+	100+	100+	100+	100+	100+
198	30		20	27	31	37	44	48	100+	100+	100+	100+	100+	100+	100+
204	30		20	26	30	36	43	47	100+	100+	100+	100+	100+	100+	100+
210	30		19	25	29	35	41	45	100+	100+	100+	100+	100+	100+	100+
216	30			25	28	34	40	44	100+	100+	100+	100+	100+	100+	100+
222	30			24	27	33	39	43	100+	100+	100+	100+	100+	100+	100+
228	30			23	27	32	38	42	100+	100+	100+	100+	100+	100+	100+
234	30			23	26	31	37	41	100+	100+	100+	100+	100+	100+	100+
240	30			25	31	36	40	44	100+	100+	100+	100+	100+	100+	100+
246	36			25	30	35	39	43	100+	100+	100+	100+	100+	100+	100+
252	36				29	34	38	42	100+	100+	100+	100+	100+	100+	100+
258	36				28	34	37	41	100+	100+	100+	100+	100+	100+	100+
264	36				28	33	36	40	100+	100+	100+	100+	100+	100+	100+
270	36				27	32	35	39	100+	100+	100+	100+	100+	100+	100+
276	36					31	34	37	100+	100+	100+	100+	100+	100+	100+
282	36					31	34	36	100+	100+	100+	100+	100+	100+	100+
288	42					30	33	36	100+	100+	100+	100+	100+	100+	100+
294	42							32	100+	100+	100+	100+	100+	100+	100+
300	42							31	100+	100+	100+	100+	100+	100+	100+
306	42							31	100+	100+	100+	100+	100+	100+	100+
312	42							30	100+	100+	100+	100+	100+	100+	100+

** Longitudinal seams use (4) 3/4" dia. bolts per foot.

CORRUGATED CIRCULAR STEEL PIPE

CORRUGATED STEEL PIPE-ARCH

Span x Rise (In. x In.)	Corner Radius (In)	Max. Cover (Ft)			
		Minimum Gage (In)	Min. Cover (In)	2 Tons Corner Bearing Pressure	3 Tons Corner Bearing Pressure
17 x 13	3	0.064	12	16	18
21 x 15	3	0.064	12	15	14
24 x 18	3	0.064	12	15	13
28 x 20	3	0.064	12	15	11
35 x 24	3	0.064	12	15	7
42 x 29	3 1/2	0.064	12	15	7
49 x 33	4	0.079	12	15	6
57 x 38	5	0.109	12	15	8
64 x 43	6	0.109	12	15	9
71 x 47	7	0.138	12	15	10
77 x 52	8	0.168	12	15	10
83 x 57	9	0.168	12	15	10

GENERAL NOTES

- All material and workmanship shall be in accordance with the State of Alaska, Standard Specifications for Highway Construction.
- The contractor shall select only pipes that meet specific height of cover criteria shown on the plans or in the special provisions.
- No more than one type of pipe may be used on any single installation or installation grouping.
- All structural plate pipes shall be placed on a pre-shaped foundation conforming to the depth of the bottom plates with clearance for assembling to the adjacent plates allowed.
- See Standard Drawing "Culvert Pipe & Arch Installation Details" for foundation and structural backfill details.
- Minimum cover shall be measured from the top of pipe to the top of rigid pavement or to the top of flexible pavement subgrade. In all cases, the minimum cover shall not be less than 12". Minimum cover during construction shall be that required to protect the pipe from damage or deflection.
- These tables have been developed for an H-20 live load and for compacted soil weighing 120 lbs. per cubic foot or less. If compacted soil cover exceeds 120 lbs. per cubic foot, the contractor shall use the depth of cover shown in the plans for the specific pipe. Where compacted soil cover exceeds 120 lbs. per cubic foot and no specific cover requirements are provided in the plans, the contractor shall determine the required minimum pipe cover in accordance with Section 12 of the 2000 AASHTO "LRFD Bridge Design Specifications".

GAGE	0.060"		0.075"		0.105"		0.135"	
	Min. (In)	Max. (Ft)						
12	24	35	24	50				
18	24	34	24	49				
24	24	25	24	36	24	63	24	82
30	24	19	24	28	24	50	24	65
36	24	15	24	24	24	41	24	54
42			24	19	24	35	24	46
48			24	17	24	30	24	40
54			24	14	24	27	24	35
60			24	12	24	24	24	30

* $\frac{3}{4}$ x $\frac{3}{4}$ x $\frac{7}{8}$ in. or $\frac{3}{4}$ x 1 x $\frac{1}{2}$ in. Corrugations

Span x Rise (In. x In.)	Min. Cover (In.)	Soil Corner Bearing Capacity of 2 Tons/ s.f.		
		0.060"	0.075"	0.105"
20 x 16	12	13		
23 x 19	12	14		
27 x 21	12	13		
33 x 26	12	13		
40 x 31	12	13		
46 x 36	12	14		
53 x 41	18		13	
60 x 46	18		20	
66 x 51	18		21	
73 x 55	18			21
81 x 59	18			17
87 x 63	18			17
95 x 67	18			17

* $\frac{3}{4}$ x $\frac{3}{4}$ x $\frac{7}{8}$ in. or $\frac{3}{4}$ x 1 x $\frac{1}{2}$ in. Corrugations

ALUMINUM SPIRAL RIB PIPE

STEEL SPIRAL RIB PIPE

GAGE	0.064"		0.079"		0.109"		0.138"	
	Min. (In)	Max. (Ft)						
18	12							
24	12	51	12	72	12	121		
30	12	41	12	58	12	97		
36	12	34	12	48	12	81		
42	12	29	12	41	12	69		
48	12	26	12	36	12	61		
54	18	23	18	32	18	54		
60	18	21	18	29	18	49	18	73
66	18	19	18	26	18	44	18	65
72			18	24	18	40	18	59
78			24	22	24	37	24	55
84			24	21	24	35	24	52
90			24	32	24	47		
96			24	30	24	44		
102			30	29	30	43		
108			30	27	30	41		

* $\frac{3}{4}$ x $\frac{3}{4}$ x $\frac{7}{8}$ in. or $\frac{3}{4}$ x 1 x $\frac{1}{2}$ in. Corrugations

** $\frac{3}{4}$ x $\frac{3}{4}$ x $\frac{7}{8}$ in. Corrugations Only.

Span x Rise (In. x In.)	Min. Cover (In.)	Soil Corner Bearing Capacity of 2 Tons/ s.f.		
		0.064"	0.079"	0.109"
20 x 16	12	13		
23 x 19	12	14		
27 x 21	12	13		
33 x 26	12	13		
40 x 31	12	13		
46 x 36	12	14		
53 x 41	18		13	
60 x 46	18		20	
66 x 51	18		21	
73 x 55	18			21
81 x 59	18			17
87 x 63	18			17
95 x 67	18			17

* $\frac{3}{4}$ x $\frac{3}{4}$ x $\frac{7}{8}$ in. or $\frac{3}{4}$ x 1 x $\frac{1}{2}$ in. Corrugations

Date	Description	By
8/10/00	Pipe Tables & G. Notes.	DFD
10/31/03	New Sheet 4.	LRG

Sheet 4 of 4

State of Alaska
Department of Transportation
& Public Facilities

PIPE AND ARCH TABLES

Project As Built Drawings Have Been Reviewed
By the Project Engineer & Represent, To the
Best of My Knowledge, the Project as
Constructed.

Project Eng.

Date

Date 10/31/03



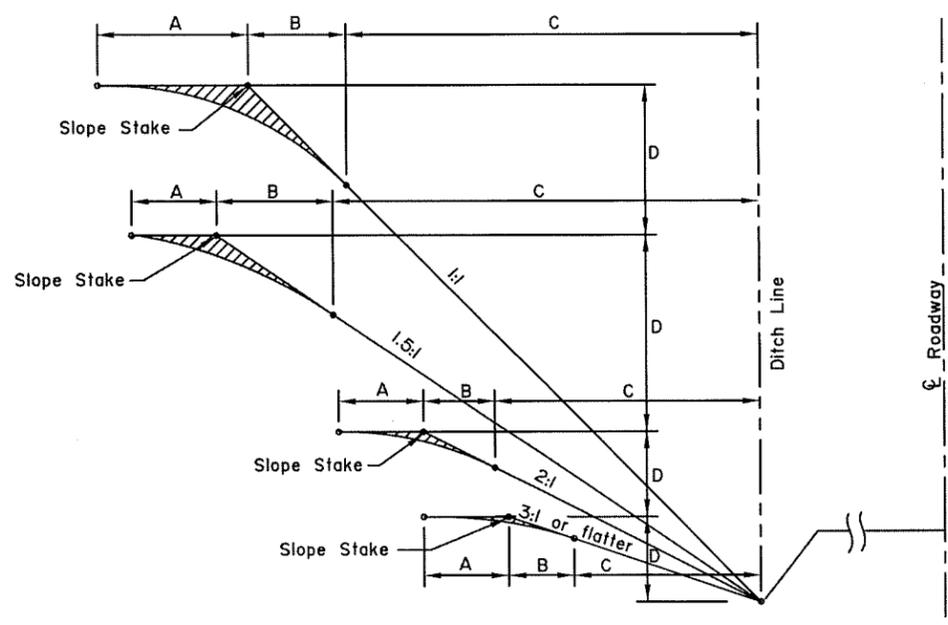


FIG. 1
TYPICAL SECTION OF ROUNDED SLOPES

TABLE OF ROUNING DIMENSIONS

Rate of Slope	A		B	
	When B's 5.0' or less	When B is more than 5.0'	When D's 15.0' or less	When D is more than 15.0'
3:1 or flatter	B	5.0'	5.0'	5.0'
2:1	B	5.0'	5.0'	D/3
1.5:1	B	5.0'	5.0'	D/3
1:1	B	$\frac{D}{3}$, Max. 10.0'		D/3

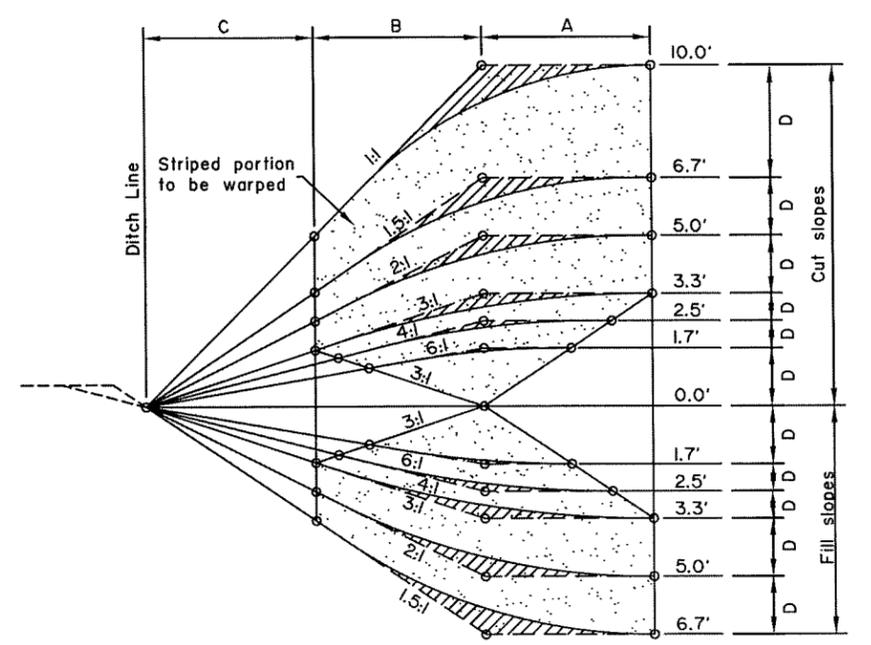


FIG. 4
TYPICAL GRADING FOR WARPING SLOPES

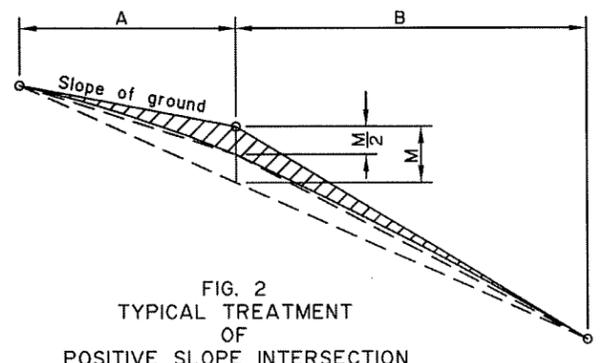


FIG. 2
TYPICAL TREATMENT OF POSITIVE SLOPE INTERSECTION

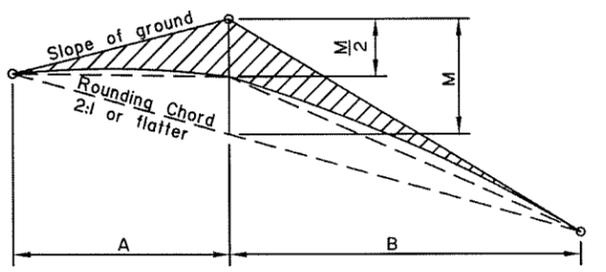


FIG. 3
TYPICAL TREATMENT OF NEGATIVE SLOPE INTERSECTION

TYPICAL SLOPE ROUNDING

GENERAL NOTES

- Cut and fill slopes shall be rounded as shown in fig. 1, 2, and 3 when required by the plans or special provisions. Rounding of fill slopes shall be done in the same manner as shown for cut slopes.
- Intersections of cut and fill slopes shall be warped as shown in fig. 4 and 5 when required by the plans or special provisions.
- Warping of cut and fill slopes is for the purpose of attaining a more pleasing appearance and to promote the growth of natural vegetation by causing the fill slope to flow smoothly into the cut slope. The length of slope warping is relatively proportional to the character of the topography, the distance between end limits of warped surfaces being lessened as the terrain steepens and lengthened as the topography flattens out. The procedure as outlined herein is typical and shall be varied to meet special conditions and shall be as staked by the Engineer.
- SUGGESTED PROCEDURE FOR WARPING SLOPING

A--Select end points for warping to fit specified slope ratios as follows:-

 - The dimensions A, B, and C shall all be constant throughout the full length of warping, E.
 - When the average depth of cut or fill is such that the dimension B+C exceeds 10 feet, the ends of warping shall be at points where B+C is 10 feet, provided the warping distance E does not exceed 100 feet. That is, as shown in fig. 4 and 5, warping shall begin at a cut or fill depth of 6.7 feet for 1.5:1 slopes, at 50 feet for 2:1 slopes, etc. if the dimension E exceeds 100 feet, the dimension B+C shall be reduced until the intersections of the prescribed slopes with the natural ground are 100 feet apart.
 - When the average depth of cut or fill is such that the distance B+C is between 5 feet and 10 feet, the ends of warping shall be at points where C is 0 feet, but such points shall not be more than 150 feet apart.
 - When the average depth of cut or fill is such that the dimension B is less than 5 feet, the ends of warping shall be 200 feet apart.

B--Set slope stakes at end of warping.
 C--Set additional slope stakes at various intervals between end stakes and at the same distance from centerline.
 D--Flatten and round warped slopes as shown in figure 4 for each section.
- A layer of earth overlying a rock cut shall be rounded as far as possible as though the total height of slope were in earth cut.

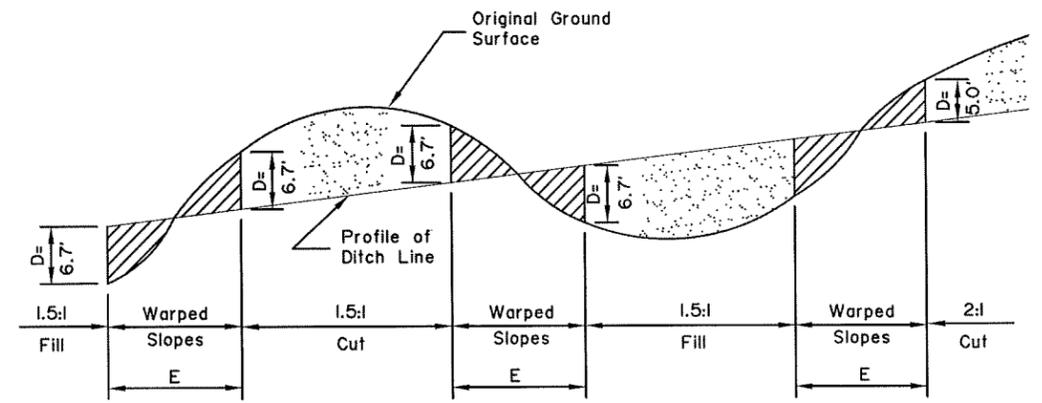


FIG. 5
TYPICAL PROFILE OF WARPED SLOPES
TYPICAL SLOPE WARPING

REVISIONS


Date	Description	By

State of Alaska
Department of Transportation
& Public Facilities

SLOPE ROUNDING & WARPING

Project As Built Drawings Have Been Reviewed By the Project Engineer & Represent, To the Best of My Knowledge, the Project as Constructed.

Project Eng. _____ Date _____

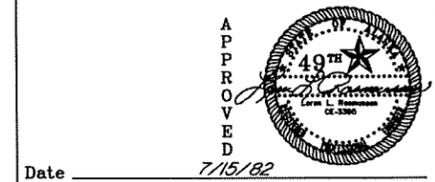

Date 7/15/82



GENERAL NOTES

- See the standard specifications for the aluminum alloys that you may use for sign sheeting and wind framing members.
- Fabricate all signs from 0.125" thick aluminum sheeting.
- Sign fabricators may use alternates to the zee shaped framing member with approval of the engineer, if the frame manufacturer certifies their design equals or exceeds the strength of the zee shaped design.
- Install one piece wind framing members on all signs up to 23.5' wide. Use one splice in each wind frame on all signs wider than 23.5'. Locate splices at least 18" from all posts and panel edges. Stagger splices in adjacent framing members at least 8.0' apart.
- Attach wind framing members with rivets or with an engineer approved, double sided, high strength, adhesive tape. Clean and handle sheeting and framing members and apply tape in accordance with the tape manufacturer's written instructions. Install two rivets in both ends of each framing member.
- Use 3/16" diameter rivets conforming to aluminum alloy 6061-T6 for cold driven rivets, or aluminum alloy 6061-T43 for hot driven rivets.
- Sign fabricators may use sign panels extruded with integral framing with approval of the engineer, if the manufacturer certifies their design equals or exceeds the strength of the 0.125" thick panel with framing attached to it.
- Frame all signs taller than 8.0' with five wind framing members located $(H-0.15)/4$ spaces. If needed, make a horizontal splice at the middle wind frame.
- Do not use round pipes for sign supports.

TUBE SIGN POST SPACING							
Sign Width (feet)	No. of Posts	Distance Between Posts	Sign Overhang	Post Type			Notes
				P.S.T.	Wood	Steel Tube	
0.5 to 4.0	1	-	0.5W	X	X	X	See Note 2.
4.5 to 10.0	2	0.6W	0.2W	X	X	X	See Note 3.
10.5 to 11.0	2	6	Varies	X	X	X	See Note 3.
11.5 to 13.0	2	8	Varies				X
13.5 to 20.0	2	0.6W	0.2W				X
20.5 to 22.5	3	8	Varies				X
23.0 to 29.5	3	0.35W	0.15W				X
30.0 to 31.5	4	8	Varies				X
32.0 to 40.0	4	0.25W	0.125W				X

SIGN POST SPACING NOTES:




- Install sign support in accordance with the table above, unless otherwise required by plans or specifications.
- Exceptions:
 - Use one post for all E5-1 gore signs, regardless of width.
 - Use one 2.5" P.S.T. for all STOP signs, with or without street name signs.
- Supports placed within 7' of each other must be acceptable for that use. See Standard Drawing S-30 for the sizes of wood posts and P.S.T.s that may be used within 7'. See Manufacturer's documentation for breakaway couplings and tubes that may be used within 7'.
- See Standard Drawing S-31 for frangible couplings, hinges, and foundations for tube and W-shape sign supports.

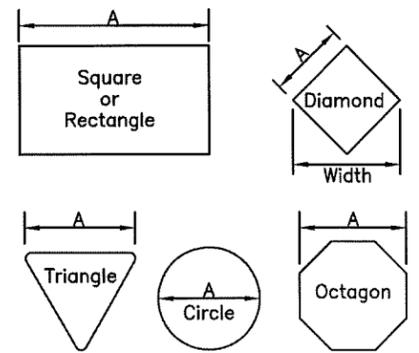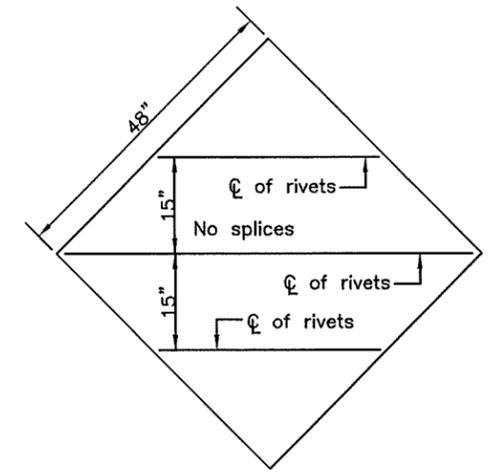


Maximum size unframed signs using 0.125" thick aluminum sheeting.	
Sign Shape	A
Squares, Shields, and Route Markers	48"
Rectangles	48"
Diamonds	48"
Triangles	48"
Rounds and Octagons	48"

Install wind framing on all signs that exceed the dimensions listed.


LIGHT SIGNS

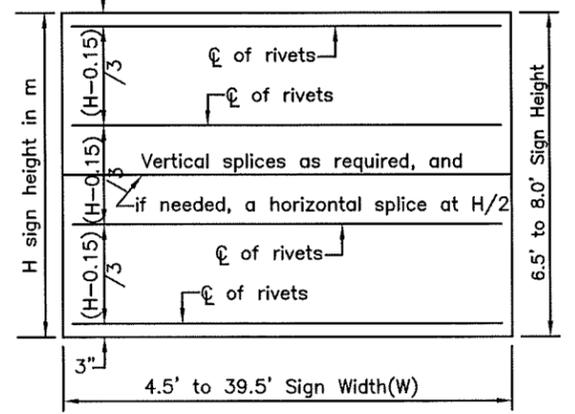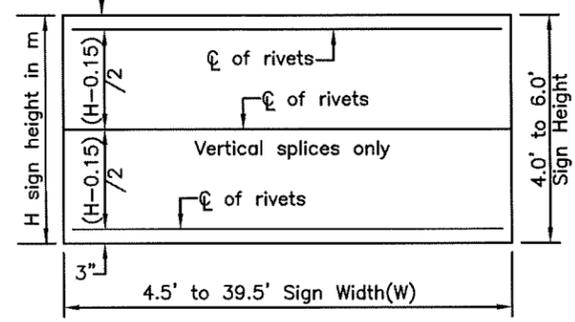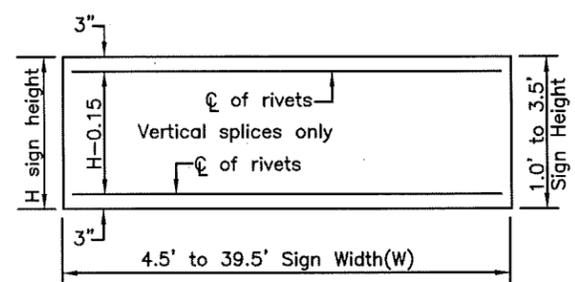

WIND FRAMING LOCATIONS

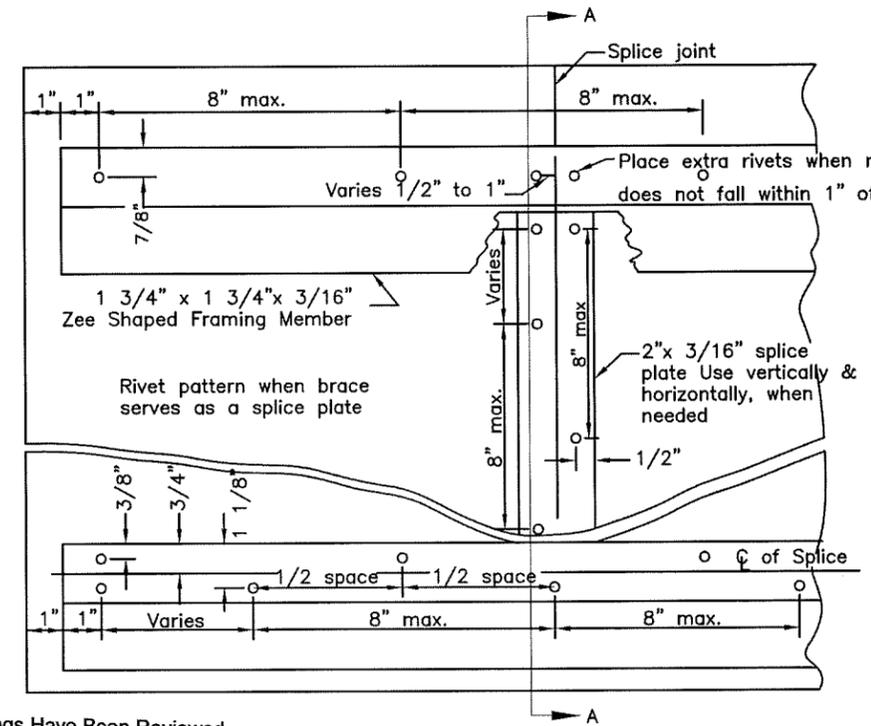

RIVET DETAIL FOR ZEE SHAPED WIND FRAMING & SPLICE PLATE

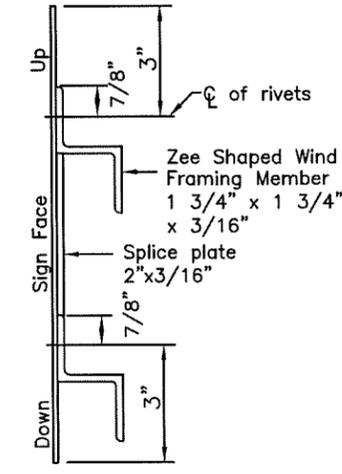

SECTION A-A

Project As Built Drawings Have Been Reviewed By the Project Engineer & Represent, To the Best of My Knowledge, the Project as Constructed.

Project Eng.

Date

REVISIONS		
Date	Description	By
4/28/10	Delete pipe, rev notes	KJS

Sheet 1 of 1

State of Alaska
Department of Transportation & Public Facilities

SIGN FRAMING AND POST SPACING

APPROVED


Arline G. Smith
4/28/10

Date 5/31/12

S-05.01


GENERAL NOTES

1. Unless shown otherwise on the plans, the standard sign offset is 12'. The minimum is 6'.
2. If signs extend over sidewalks, the minimum vertical clearance is 7'-0".
3. Add 6" to mounting height on unpaved roads.
4. If signs extend over bike paths, the minimum vertical clearance is 8' 0".
5. When signs are placed 30' or more from the edge of traveled way, mount them with the bottom of the sign at least 5' above the road surface at the near edge of the road.
6. When multiple hinged sign supports are used, mount hinges at least 7' above the ground.

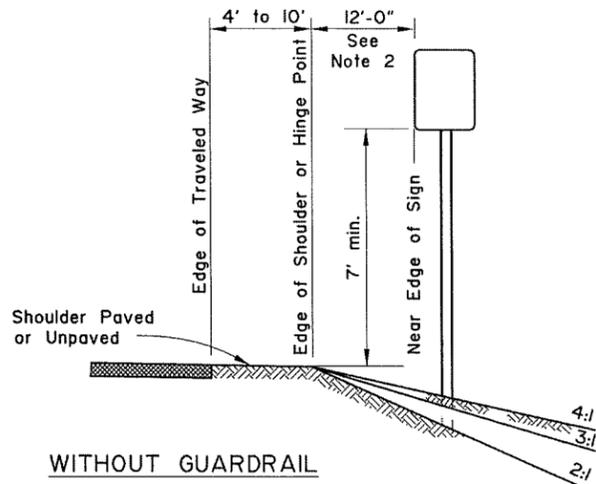


WITHOUT GUARDRAIL

SUBGRADES OVER 28', ALL SLOPES

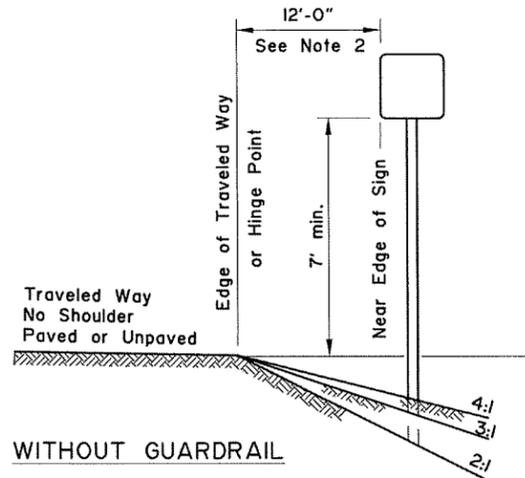


WITHOUT GUARDRAIL

SUBGRADES 24' TO 28', ALL SLOPES

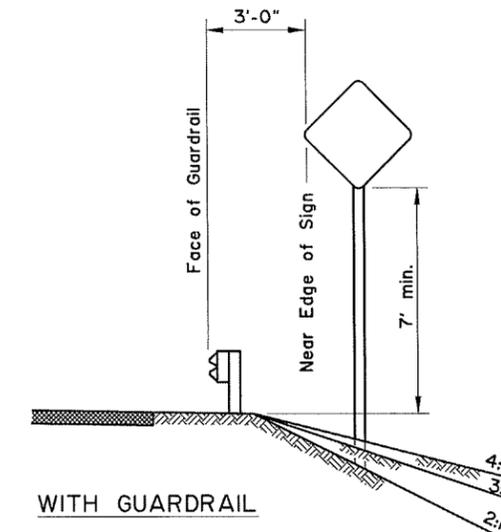


WITH GUARDRAIL

ALL SUBGRADES, ALL SLOPES

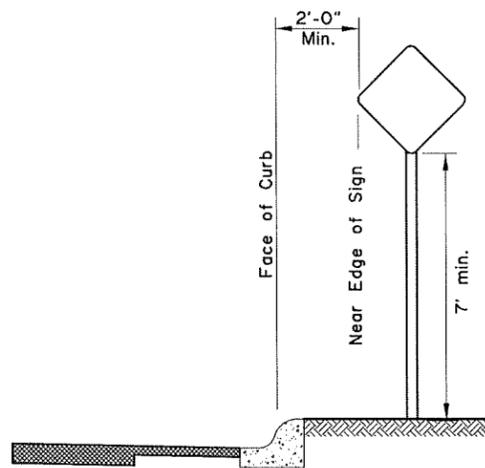


CURB WITHOUT SIDEWALK

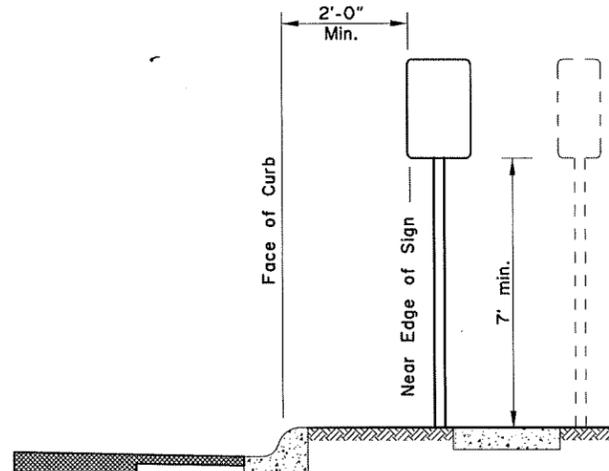


CURB WITH PARKWAY AND SIDEWALK

(If R/W width permits, signs should be placed behind sidewalk.)

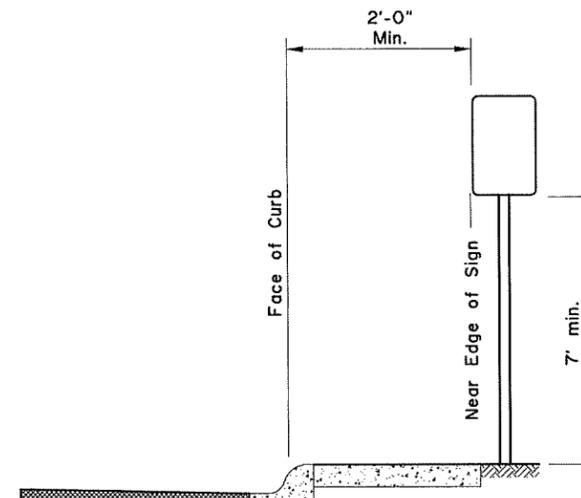


CURB WITH SIDEWALK WITHOUT PARKWAY

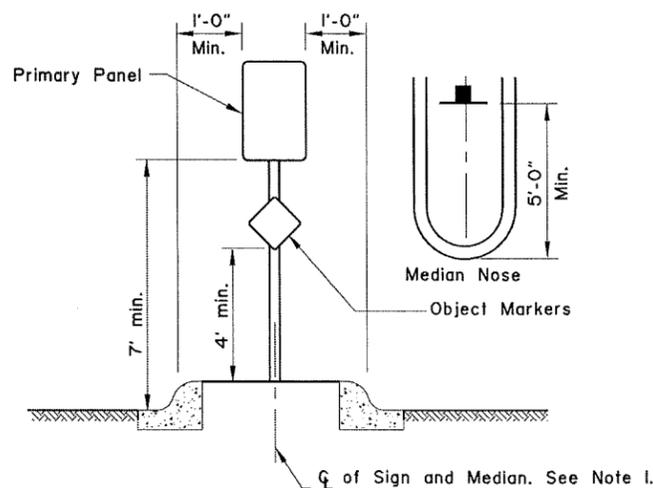


RAISED MEDIANS

Minimum 4' Width for Signing

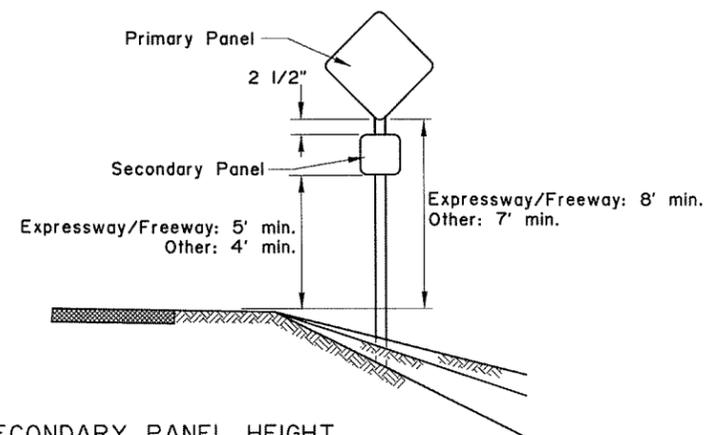

SECONDARY PANEL HEIGHT

ALL TWO PANEL MOUNTING

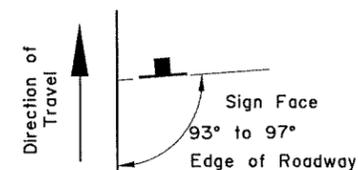

SIGN POSITIONING

Project As Built Drawings Have Been Reviewed By the Project Engineer & Represent, To the Best of My Knowledge, the Project as Constructed.

Project Eng.

Date

REVISIONS		
Date	Description	By
4/3/01	Revised Sign Heights	KJS

Sheet 1 of 1

State of Alaska
Department of Transportation
& Public Facilities

POST MOUNTED SIGN
OFFSET AND HEIGHT



Date 7/15/82

S-05.01

DESIGNED BY: M. DUMAN
 CHECKED BY: R. BERGER
 DRAFTED BY: R. BERGER

SCALE: 1" = 40'




LAYOUT: Z1

DATE: 08/22/2016

TIME: 10:23:50 AM

PROJECT: Site 3 STA 30100 TO 30475.dwg

DRAWING LOCATION: P:\53(ADOT)\53-02(Gravina)\Design\Construction Services\20160830 Revised Grading Site 3\53-02 Site Exhibit - Site 3 STA 30100 TO 30475.dwg

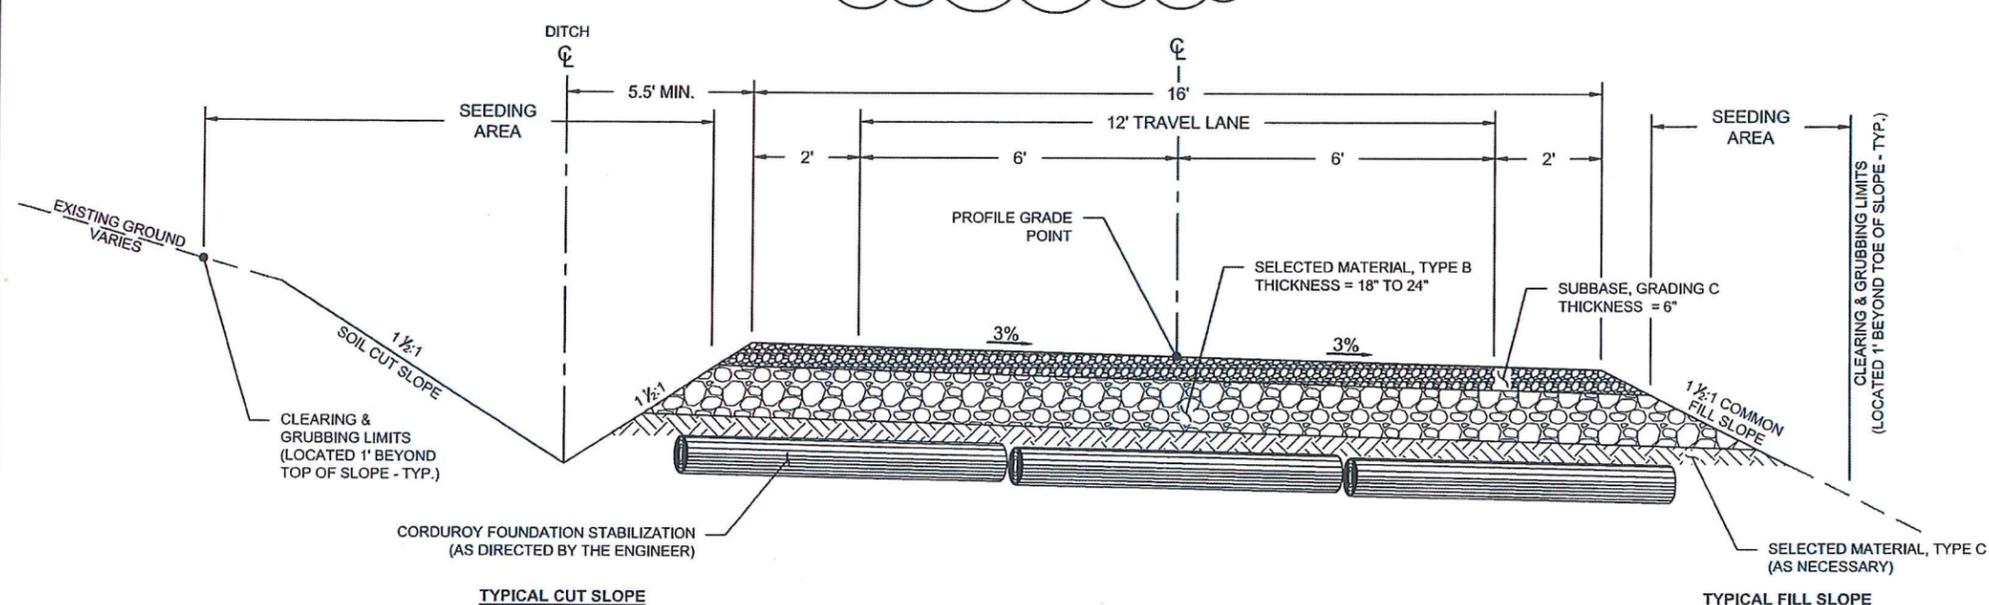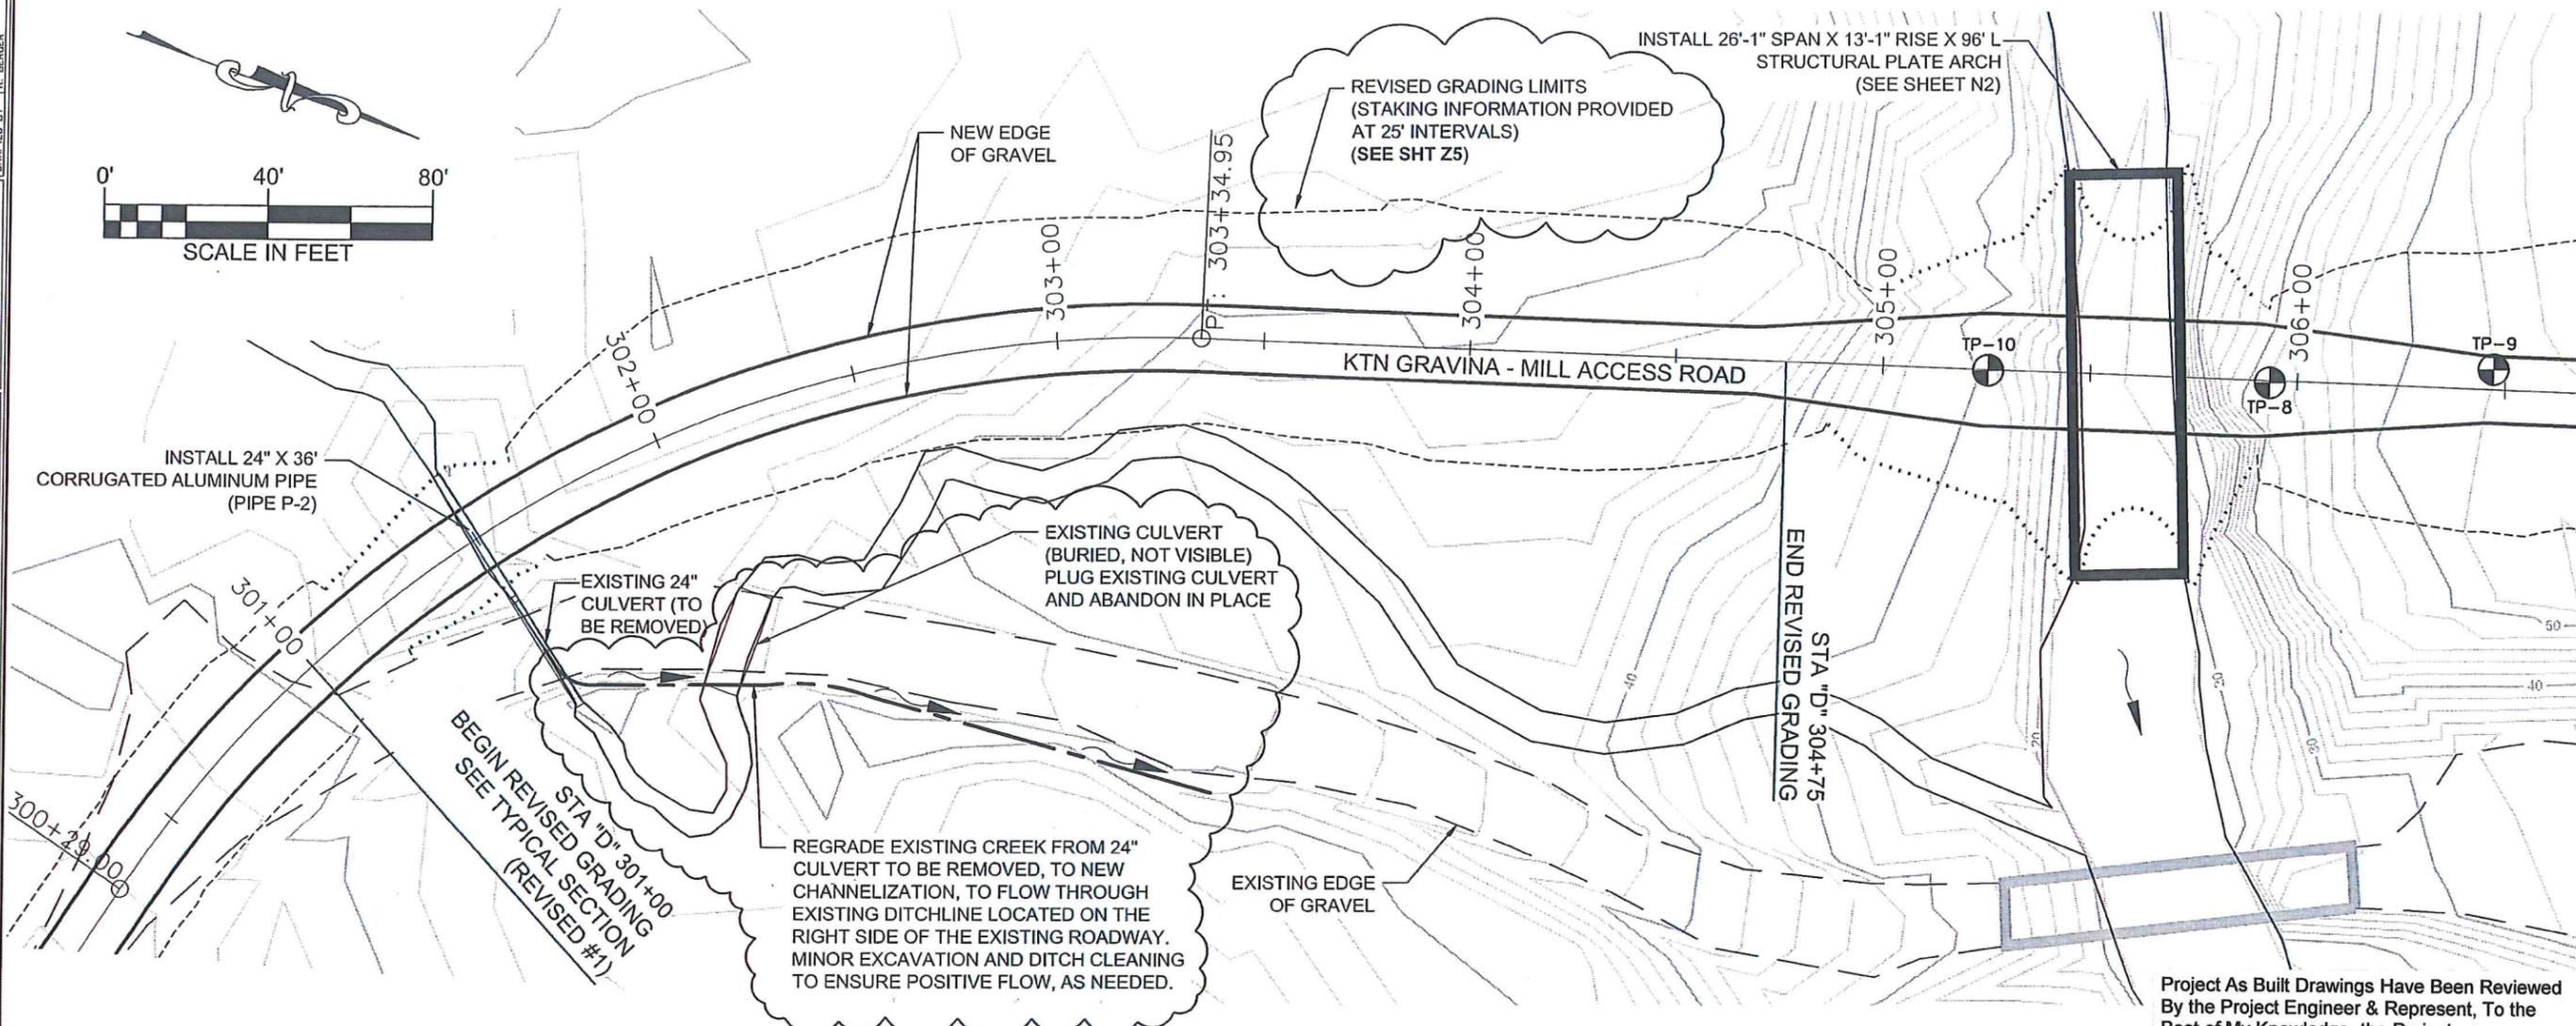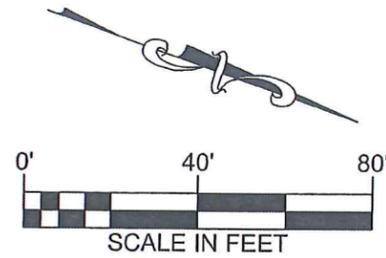

FULL DEPTH CONSTRUCTION (REVISED #1)
 SITE 3: STA "D" 300+00.00 TO "D" 309+86.00

Project As Built Drawings Have Been Reviewed By the Project Engineer & Represent, To the Best of My Knowledge, the Project as Constructed.

Project Eng. *RP* Date *8.23.17*

REVISIONS		
REV #1	07/08/2016	a. REMOVED 1:1 CUT SLOPE VARIATION BETWEEN STA 302+50 TO 303+50. b. REMOVED "FULL DEPTH CONSTRUCTION (REVISED #2)" TYPICAL SECTION. c. RECHANNELIZATION OF OUTFLOW FROM EXISTING 24" CULVERT ADDED.
REV #2	08/22/2016	a. REGRADED TO 1 1/2:1 CUT THROUGH ENTIRE SITE.






STATE OF ALASKA
 DEPARTMENT OF TRANSPORTATION & PUBLIC FACILITIES
 SOUTHCOAST REGION

KTN GRAVINA - MILL ACCESS ROAD

SITE EXHIBIT
SITE 3 - REVISED GRADING

DESIGNED BY: M. DUMAN	PROJECT DESIGNATION: Z699220000	YEAR: 2016	SHEET NO.: Z1	TOTAL SHEETS: 5
DRAWN BY: R. BERGER				
PATH: P:\53(ADOT)\53-02(Gravina)\Design\Construction Services\20160830 Revised Grading Site 3\53-02 Site Exhibit - Site 3 STA 30100 TO 30475.dwg				
TAB: Z1				
DATE: Monday, August 22, 2016 10:23:50 AM				
REVISIONS				
NO.	DATE	DESCRIPTION		
#1	07/08/2016	SEE NOTE ABOVE		
#2	08/22/2016	SEE NOTE ABOVE		

DRAWING LOCATION: P:\53(ADOT)\53-02(Gravina)\Design\Construction Services\20160630 Revised Grading Site 3\53-02 Site Exhibit - Site 3 STA 304+75 to 309+86.dwg
 DATE TIME: 08/22/2016 10:24:15 AM
 LAYOUT: Z2
 SCALE: 1" = 40'
 XREFS: DESIGNED BY: M. DUMAN, CHECKED BY: R. BERGER, DRAFTED BY: R. BERGER

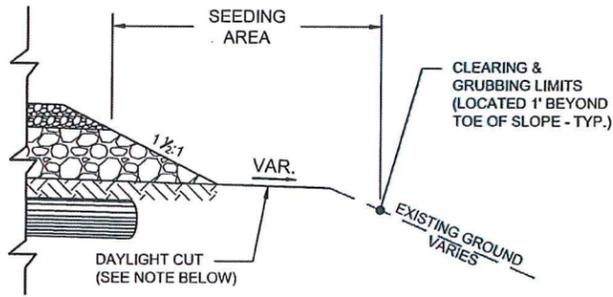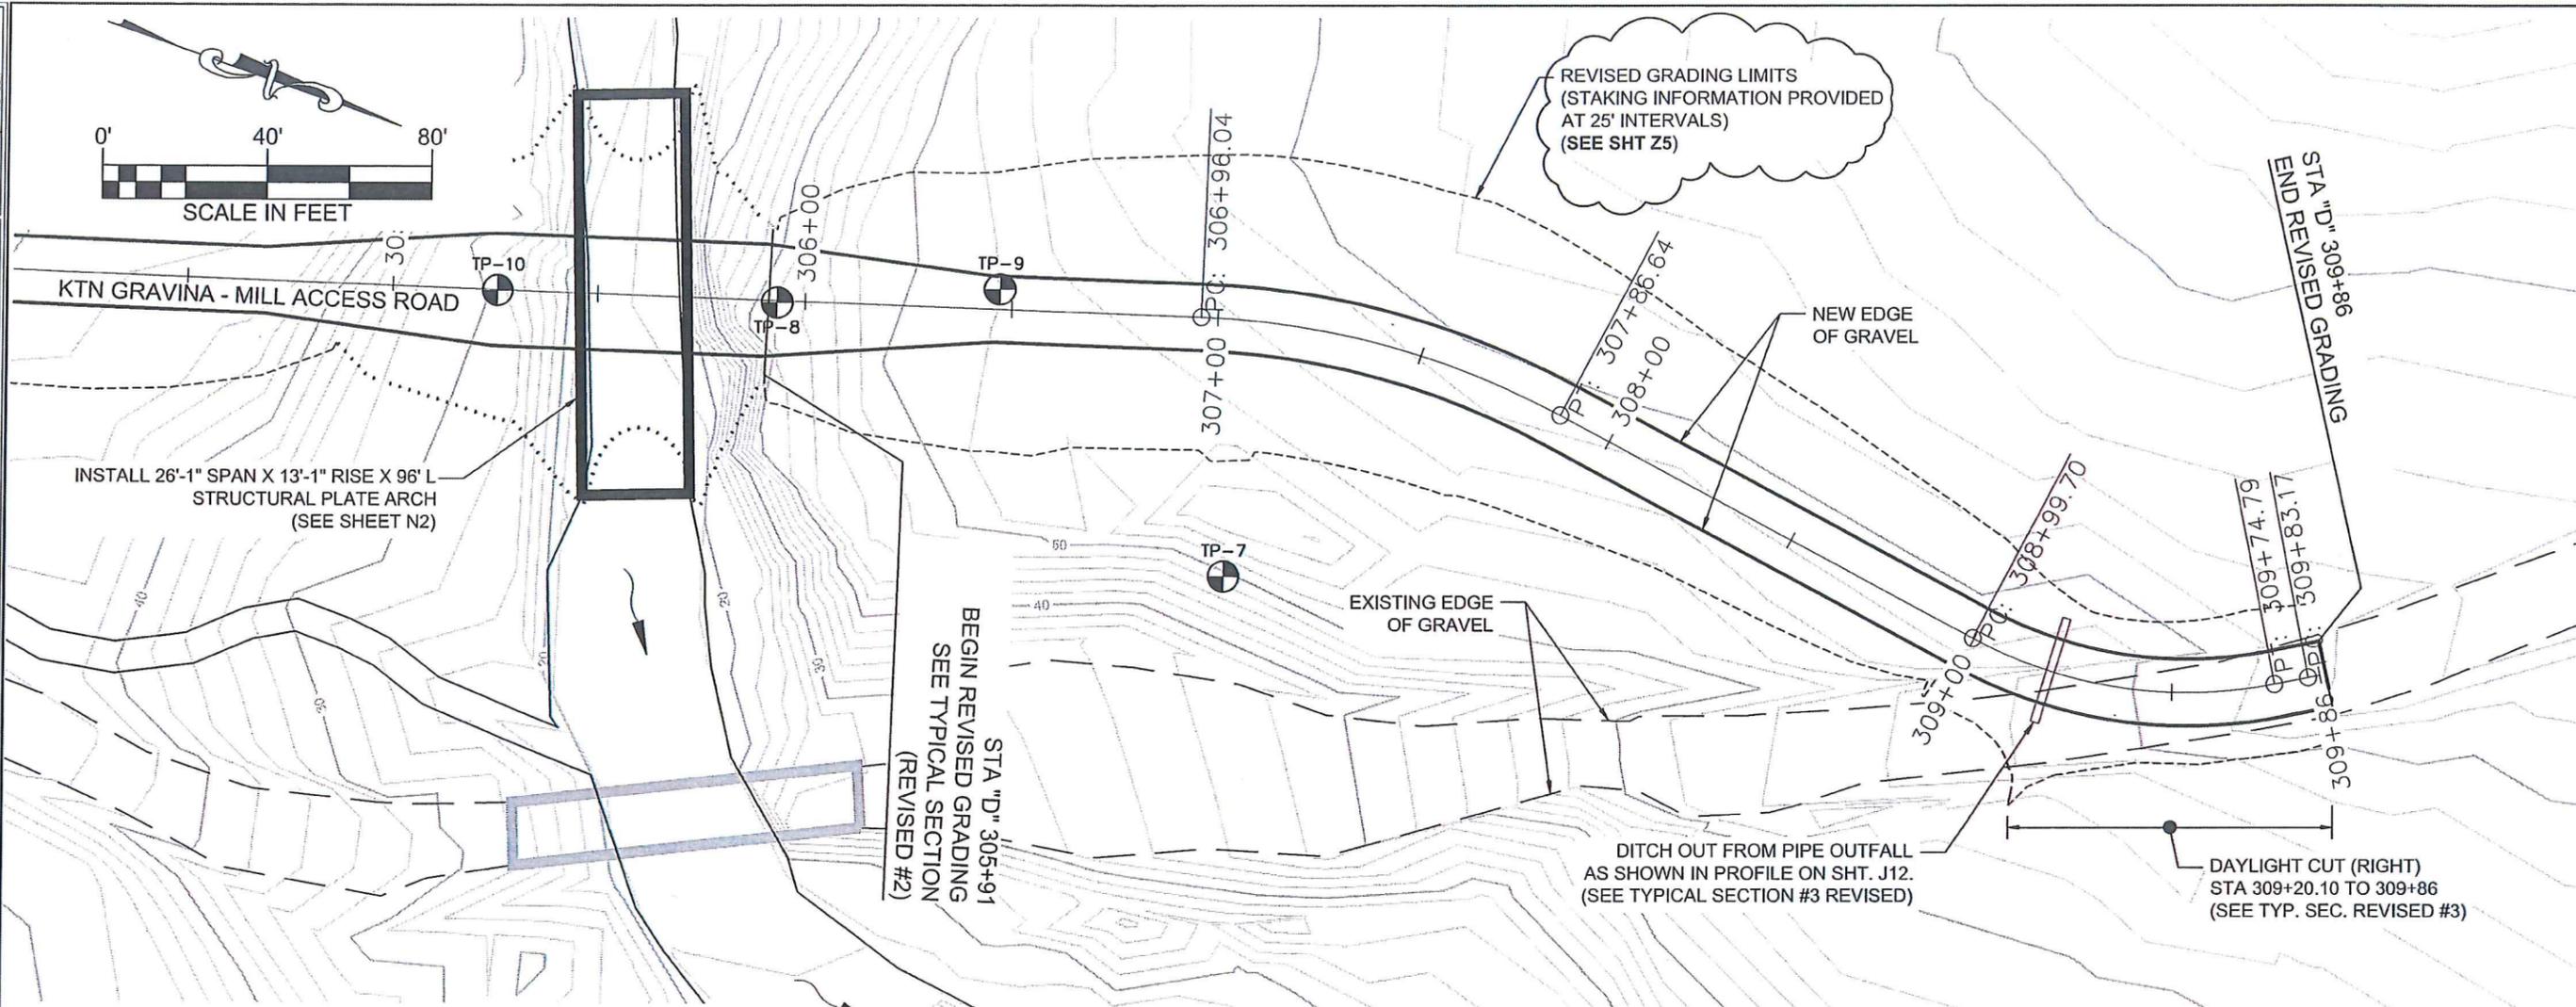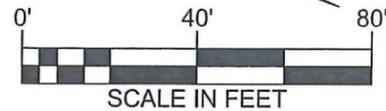

NOTE:
 DAYLIGHT CUT SLOPE VARIES FROM 6% TO 3% BETWEEN STA 309+20.10 TO 309+27, FOR THE DITCH OUT ON PIPE P-3. (SEE PIPE PROFILE, SHT. J12)
 MAINTAIN 3% CUT SLOPE TO THE END OF SITE 3.

FULL DEPTH CONSTRUCTION (REVISED #3)
 SITE 3: STA "D" 309+20.10 TO "D" 309+86.00
 (RIGHT SIDE ONLY)

Project As Built Drawings Have Been Reviewed By the Project Engineer & Represent, To the Best of My Knowledge, the Project as Constructed.

Project Eng. *RP* 8.23.17
Date

REVISIONS		
REV #1	07/08/2016	a. ADDED SHEET FOR REVISED GRADING BETWEEN STATION 304+75 TO 309+86.
REV #2	08/22/2016	a. REGRADED TO 1 1/2:1 CUT THROUGH ENTIRE SITE. b. ARCH PIPE AT SITE 2 ROTATED.

DESIGNED BY: M. DUMAN
 DRAWN BY: R. BERGER
 PATH: P:\53(ADOT)\53-02(Gravina)\Design\Construction Services\20160630 Revised Grading Site 3\53-02 Site Exhibit - Site 3 STA 304+75 to 309+86.dwg
 TAB: Z2
 Monday, August 22, 2016 10:24:15 AM

STATE OF ALASKA
 DEPARTMENT OF TRANSPORTATION & PUBLIC FACILITIES
 SOUTHCOAST REGION

KTN GRAVINA - MILL ACCESS ROAD

**SITE EXHIBIT
 SITE 3 - REVISED GRADING**

NO.	DATE	DESCRIPTION	PROJECT DESIGNATION	YEAR	SHEET NO.	TOTAL SHEETS
#1	07/08/2016	SEE NOTE ABOVE	Z699220000	2016	Z2	5
#2	08/22/2016	SEE NOTE ABOVE				

















DESIGNED BY: M. DUMAN
 CHECKED BY: R. BERGER
 DRAWN BY: R. BERGER

SCALE: #####

LAYOUT: Z3

DATE TIME: 08/22/2016 10:24:42 AM

DRAWING LOCATION: P:\315(ADOT)\33-02(Gravina)\Design\Construction Services\20160630 Revised Grading Site 3\33-02 Site Exhibit - Site 3 STA 30100 TO 30475.dwg

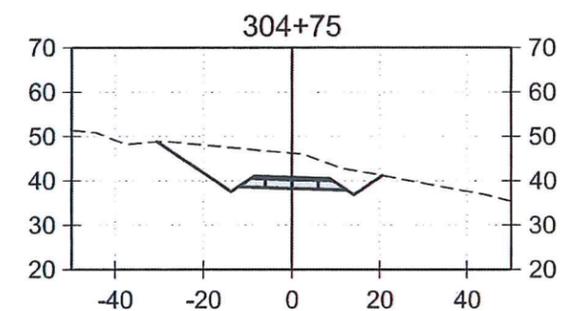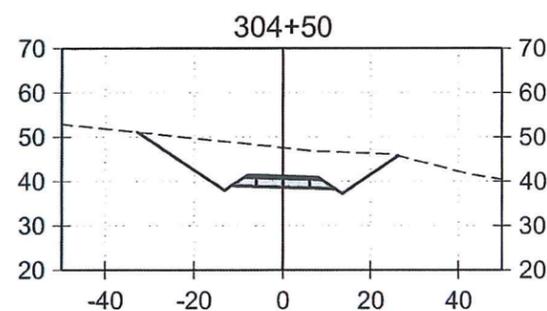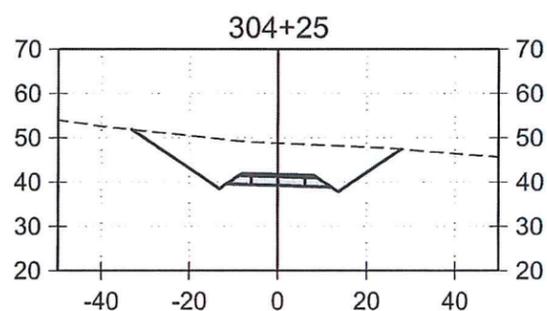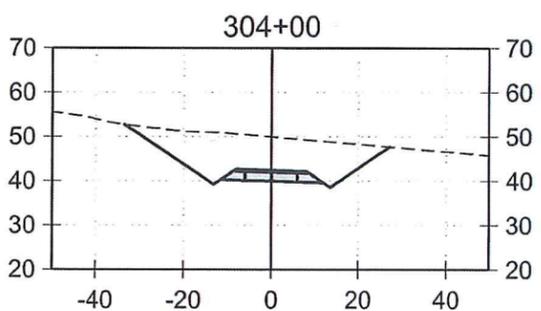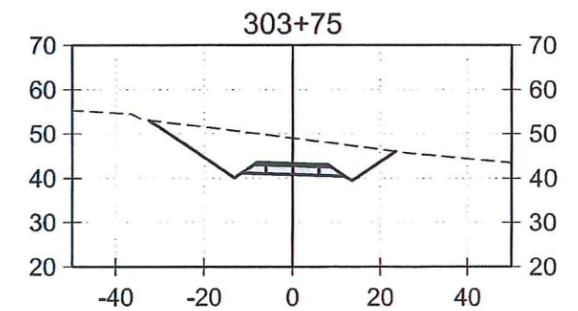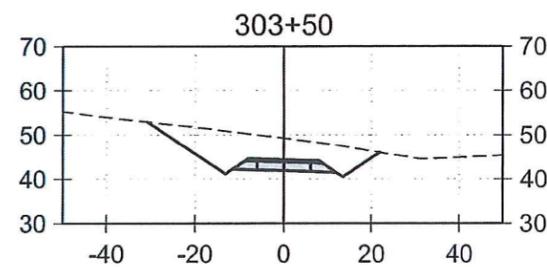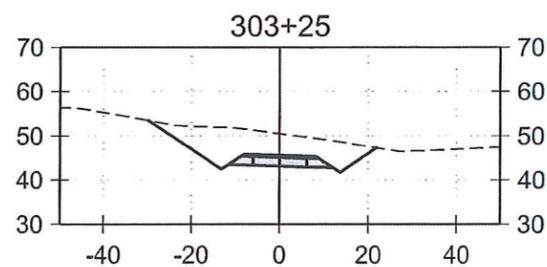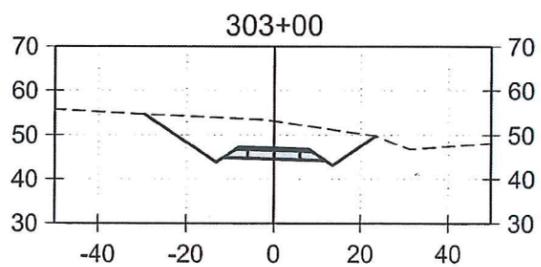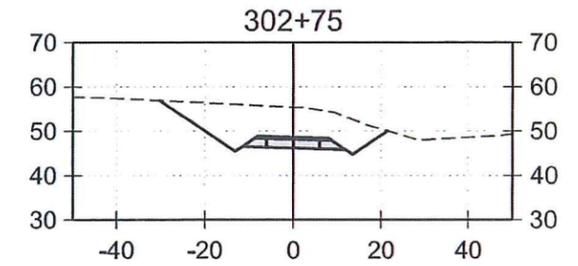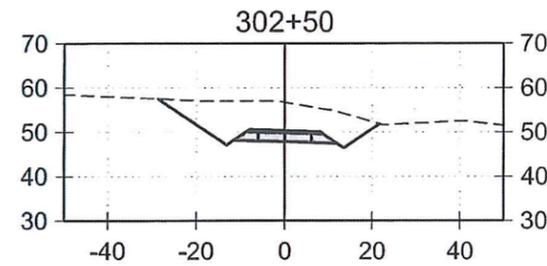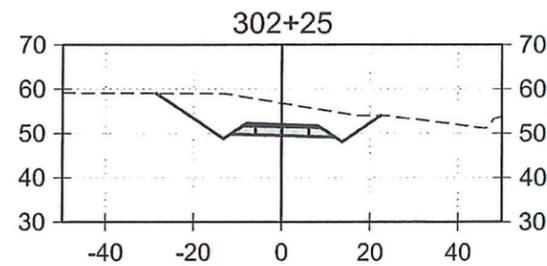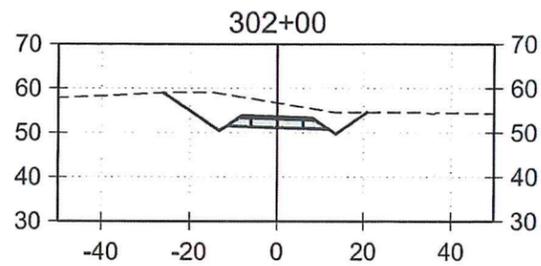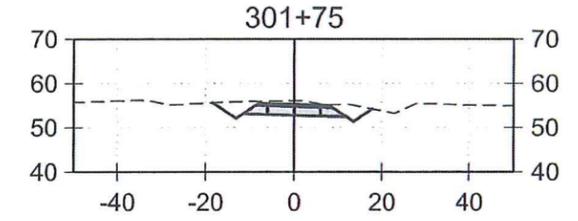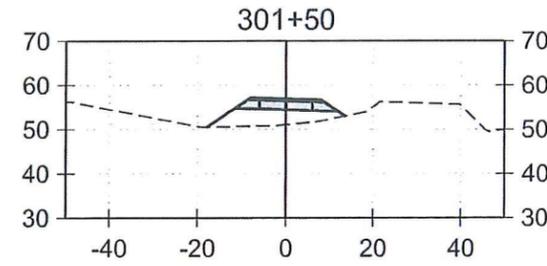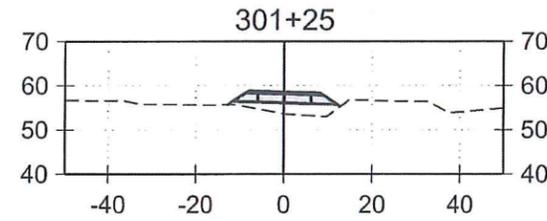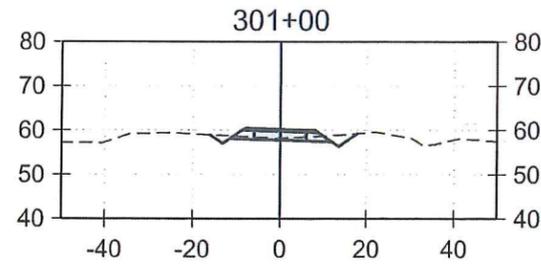

Project As Built Drawings Have Been Reviewed
 By the Project Engineer & Represent, To the
 Best of My Knowledge, the Project as
 Constructed.

Project Eng. *MP* Date *8-23-17*

REVISIONS		
REV #1	07/08/2016	a. ADDED SHEET FOR REGRADING FROM STATION 305+91 TO 309+86.
REV #2	08/22/2016	a. REVISED GRADING TO 1 1/2:1 CUT SLOPES.



DESIGNED BY: M. DUMAN		PROJECT DESIGNATION		YEAR	SHEET NO.	TOTAL SHEETS
DRAWN BY: R. BERGER		Z699220000		2016	Z3	5
PATH: P:\315(ADOT)\33-02(Gravina)\Design\Construction Services\20160630 Revised Grading Site 3\33-02 Site Exhibit - Site 3 STA 30100 TO 30475.dwg TAB: Z3 Monday, August 22, 2016 10:24:42 AM Ryan Berger						

STATE OF ALASKA
 DEPARTMENT OF TRANSPORTATION
 & PUBLIC FACILITIES
 SOUTHCOAST REGION

KTN GRAVINA - MILL
 ACCESS ROAD

SITE EXHIBIT
 SITE 3 - REVISED SECTIONS


















DESIGNED BY: M. DUMAN
 CHECKED BY: R. BERGER
 DRAWN BY: R. BERGER

SCALE: #####

LAYOUT: Z4

DATE: 08/22/2016
 TIME: 10:25:07 AM
 FILE: P:\53\ADOT\53-02\Gravina\Design\Construction Services\20160630 Revised Grading Site 3\53-02 Site Exhibit - Site 3 STA 30100 to 30475.dwg

DRAWING LOCATION: P:\53\ADOT\53-02\Gravina\Design\Construction Services\20160630 Revised Grading Site 3\53-02 Site Exhibit - Site 3 STA 30100 to 30475.dwg

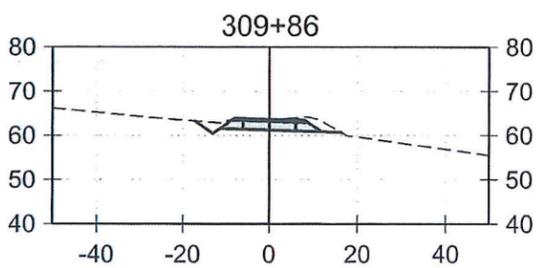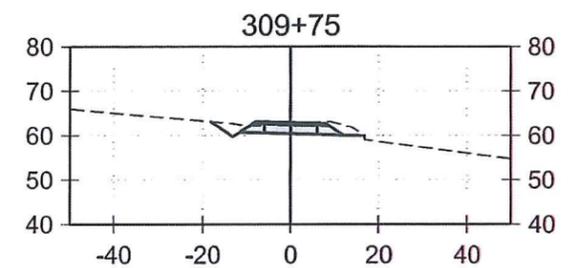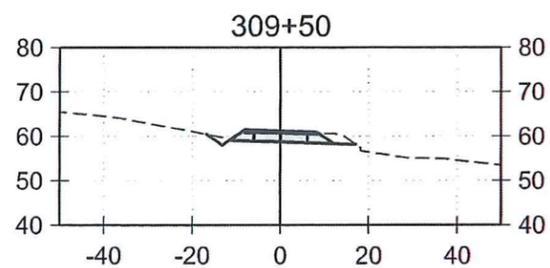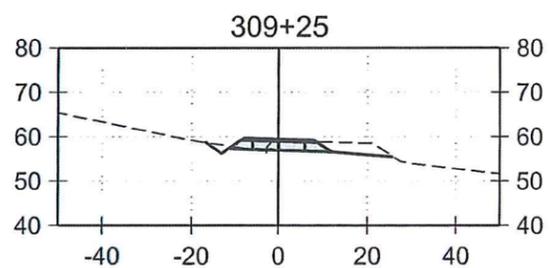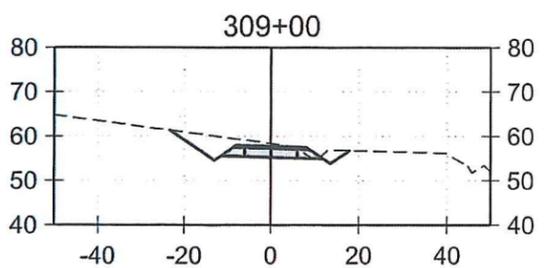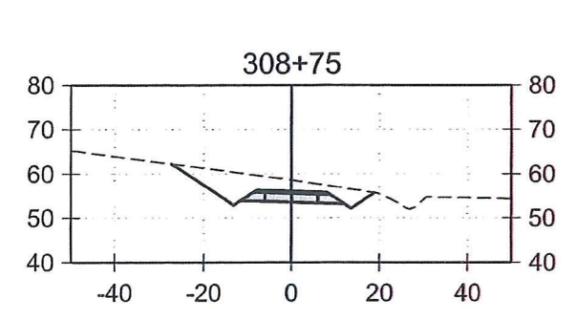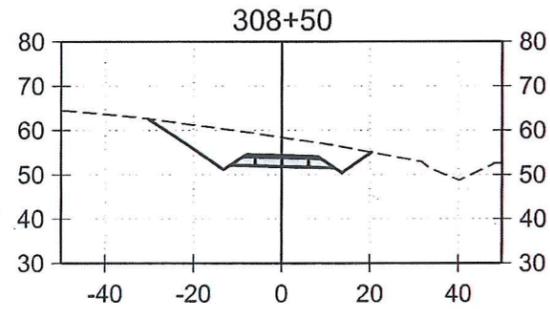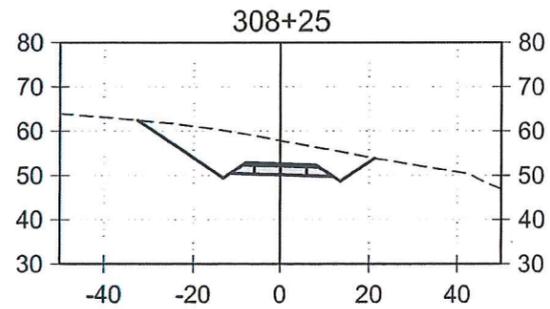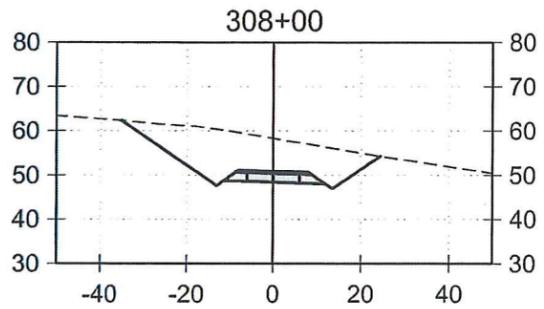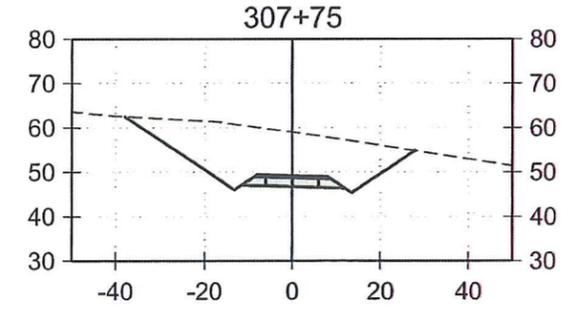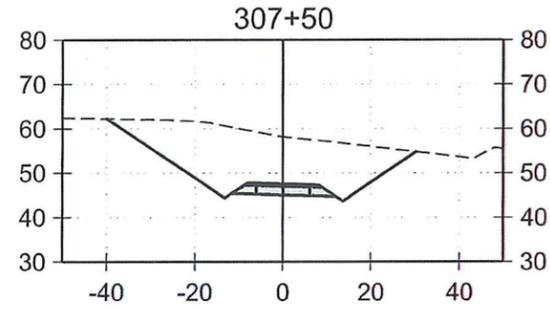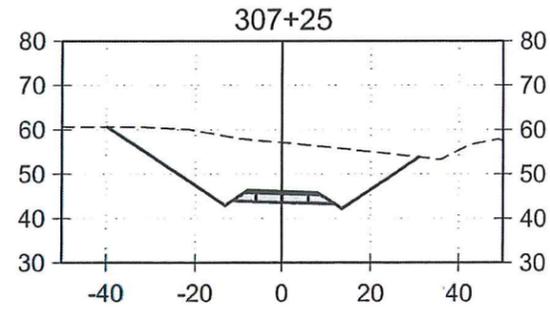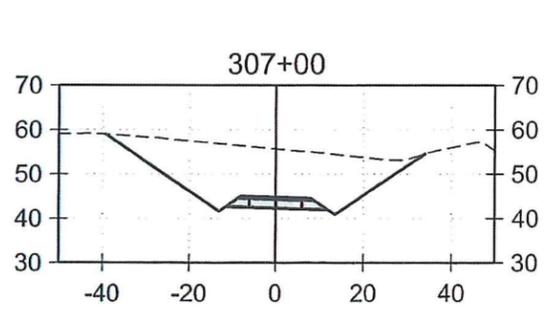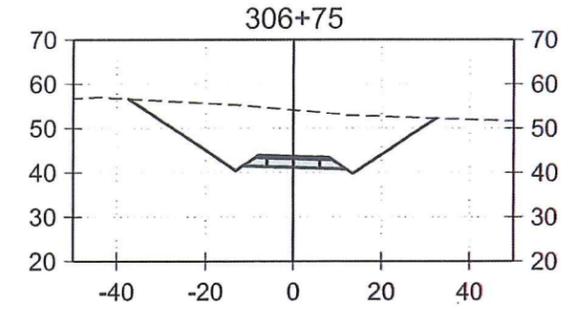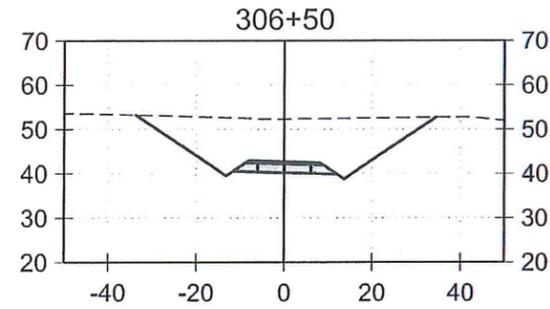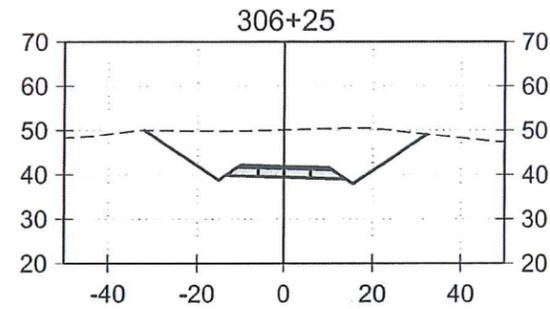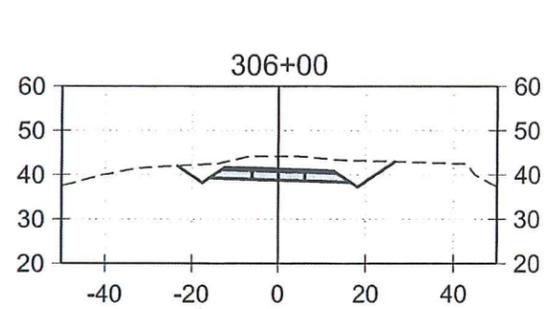

Project As Built Drawings Have Been Reviewed
 by the Project Engineer & Represent, To the
 Best of My Knowledge, the Project as
 Constructed.

Project Eng. *MP*

8-23-17
 Date

REVISIONS		
REV #1	07/08/2016	a. ADDED SHEET FOR REGRADING FROM STATION 305+91 TO 309+86.
REV #2	08/22/2016	a. REVISED GRADING TO 1 1/2:1 CUT SLOPES.



DESIGNED BY: M. DUMAN		PROJECT DESIGNATION		YEAR	SHEET NO.	TOTAL SHEETS
DRAWN BY: R. BERGER		Z699220000		2016	Z4	5
PATH: P:\53\ADOT\53-02\Gravina\Design\Construction Services\20160630 Revised Grading Site 3\53-02 Site Exhibit - Site 3 STA 30100 to 30475.dwg TAB: Z4 Monday, August 22, 2016 10:25:07 AM Ryan Berger						
NO.	DATE	DESCRIPTION				
#1	07/08/2016	SEE NOTE ABOVE				
#2	08/22/2016	SEE NOTE ABOVE				

STATE OF ALASKA
 DEPARTMENT OF TRANSPORTATION
 & PUBLIC FACILITIES
 SOUTHCOAST REGION

KTN GRAVINA - MILL
 ACCESS ROAD

SITE EXHIBIT
 SITE 3 - REVISED SECTIONS

DESIGNED BY: M. DUMAN
 CHECKED BY: B. MARTIN
 DRAFTED BY: R. BERGER

SCALE: #####

LAYOUT: Z5

DATE TIME: 8/22/2016 10:25:26 AM

DRAWING LOCATION: P:\53\ADOT\53-02\Gravina\Design\Construction Services\20160630 Revised Grading Site 3\53-02 Site Exhibit - Site 3 STA 30100 to 30475.dwg

STAKING DATA - SITE 3

STATION	OFFSET (RT)	OFFSET (LT)	CONDITION (RT)	CONDITION (LT)	NOTES
300+00	17.25'	16.35'	CUT	CUT	
300+25	16.96'	16.29'	CUT	CUT	
300+50	17.63'	16.97'	CUT	CUT	
300+75	18.61'	17.55'	CUT	CUT	
301+00	17.84'	16.02'	CUT	CUT	
301+25	12.60'	12.72'	FILL	FILL	
301+50	13.52'	17.95'	FILL	FILL	
301+75	17.77'	18.49'	CUT	CUT	
302+00	20.83'	25.99'	CUT	CUT	
302+25	22.43'	28.58'	CUT	CUT	
302+50	21.65'	28.74'	CUT	CUT	
302+75	21.44'	30.32'	CUT	CUT	
303+00	23.50'	29.50'	CUT	CUT	
303+25	21.86'	29.77'	CUT	CUT	
303+50	21.85'	30.78'	CUT	CUT	
303+75	23.43'	32.46'	CUT	CUT	
304+00	27.22'	33.35'	CUT	CUT	
304+25	27.88'	33.19'	CUT	CUT	
304+50	26.24'	32.86'	CUT	CUT	
304+75	20.56'	30.61'	CUT	CUT	
305+00	23.56'	17.18'	FILL	CUT	
305+25	30.62'	30.10'	FILL	FILL	
305+50	47.16'	36.36'	FILL	FILL	CATCHES AGAINST SPA
305+75	44.74'	38.85'	FILL	FILL	RT CATCHES AGAINST SPA
306+00	26.60'	23.40'	CUT	CUT	
306+25	32.30'	32.07'	CUT	CUT	
306+50	34.37'	33.76'	CUT	CUT	
306+75	32.24'	37.43'	CUT	CUT	
307+00	33.95'	39.21'	CUT	CUT	
307+25	30.93'	39.78'	CUT	CUT	
307+50	30.19'	39.98'	CUT	CUT	
307+75	27.78'	37.96'	CUT	CUT	
308+00	24.42'	35.09'	CUT	CUT	
308+25	21.25'	32.60'	CUT	CUT	
308+50	20.36'	30.25'	CUT	CUT	
308+75	18.83'	27.21'	CUT	CUT	
309+00	17.84'	23.38'	CUT	CUT	
309+20.10	33.65'	18.02'	DAYLIGHT CUT	CUT	DAYLIGHT SLOPE VARIES 6% TO 3%
309+25	25.54'	16.78'	DAYLIGHT CUT	CUT	
309+27	23.66'	16.38'	DAYLIGHT CUT	CUT	DAYLIGHT SLOPE 3% TO END
309+50	17.01'	16.84'	DAYLIGHT CUT	CUT	
309+75	16.80'	18.27'	DAYLIGHT CUT	CUT	
309+86	16.39'	17.32'	DAYLIGHT CUT	CUT	END SITE 3

REVISED
08/22/2016

REVISIONS		
REV #1	07/08/2016	a. REVISED STAKING DATA.
REV #2	08/22/2016	a. REVISED STAKING DATA.



STATE OF ALASKA
 DEPARTMENT OF TRANSPORTATION
 & PUBLIC FACILITIES
 SOUTHCOAST REGION

KTN GRAVINA - MILL
 ACCESS ROAD

SITE EXHIBIT
 SITE 3 - STAKING DATA

Project As Built Drawings Have Been Reviewed
 By the Project Engineer & Represent, To the
 Best of My Knowledge, the Project as
 Constructed.

Project Eng. *MP* *8.23.16*
 Date

DESIGNED BY: M. DUMAN	PROJECT DESIGNATION	YEAR	SHEET NO.	TOTAL SHEETS
DRAWN BY: R. BERGER	Z699220000	2016	Z5	5
PATH: P:\53\ADOT\53-02\Gravina\Design\Construction Services\20160630 Revised Grading Site 3\53-02 Site Exhibit - Site 3 STA 30100 to 30475.dwg				
TAB: Z5				
DATE: Monday, August 22, 2016 10:25:26 AM				
REVISIONS				
#1 07/08/2016 SEE NOTE ABOVE				
#2 08/22/2016 SEE NOTE ABOVE				




DESIGNED BY: M. DUMAN
 CHECKED BY: B. MARTIN
 DRAFTED BY: R. BERGER

SCALE: 1" = 40'

LAYOUT: 76

DATE: TIME: 8/26/2016 2:51 PM

FILE: P:\53\ADOT\53-02\Gravina\Design\Construction Services\20160826 Revised Grading Site\153-02 Site Exhibit - Site 1.dwg

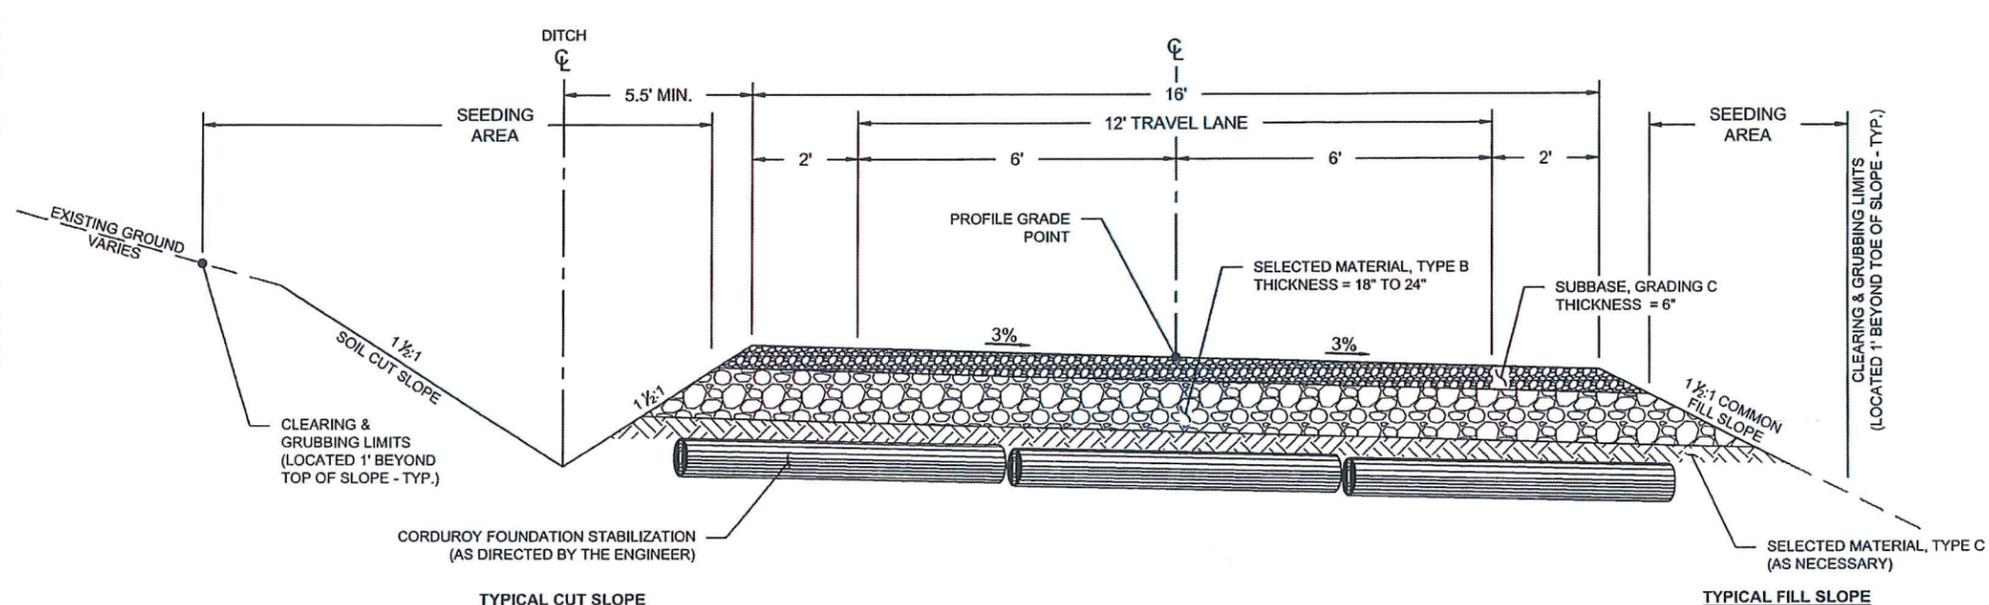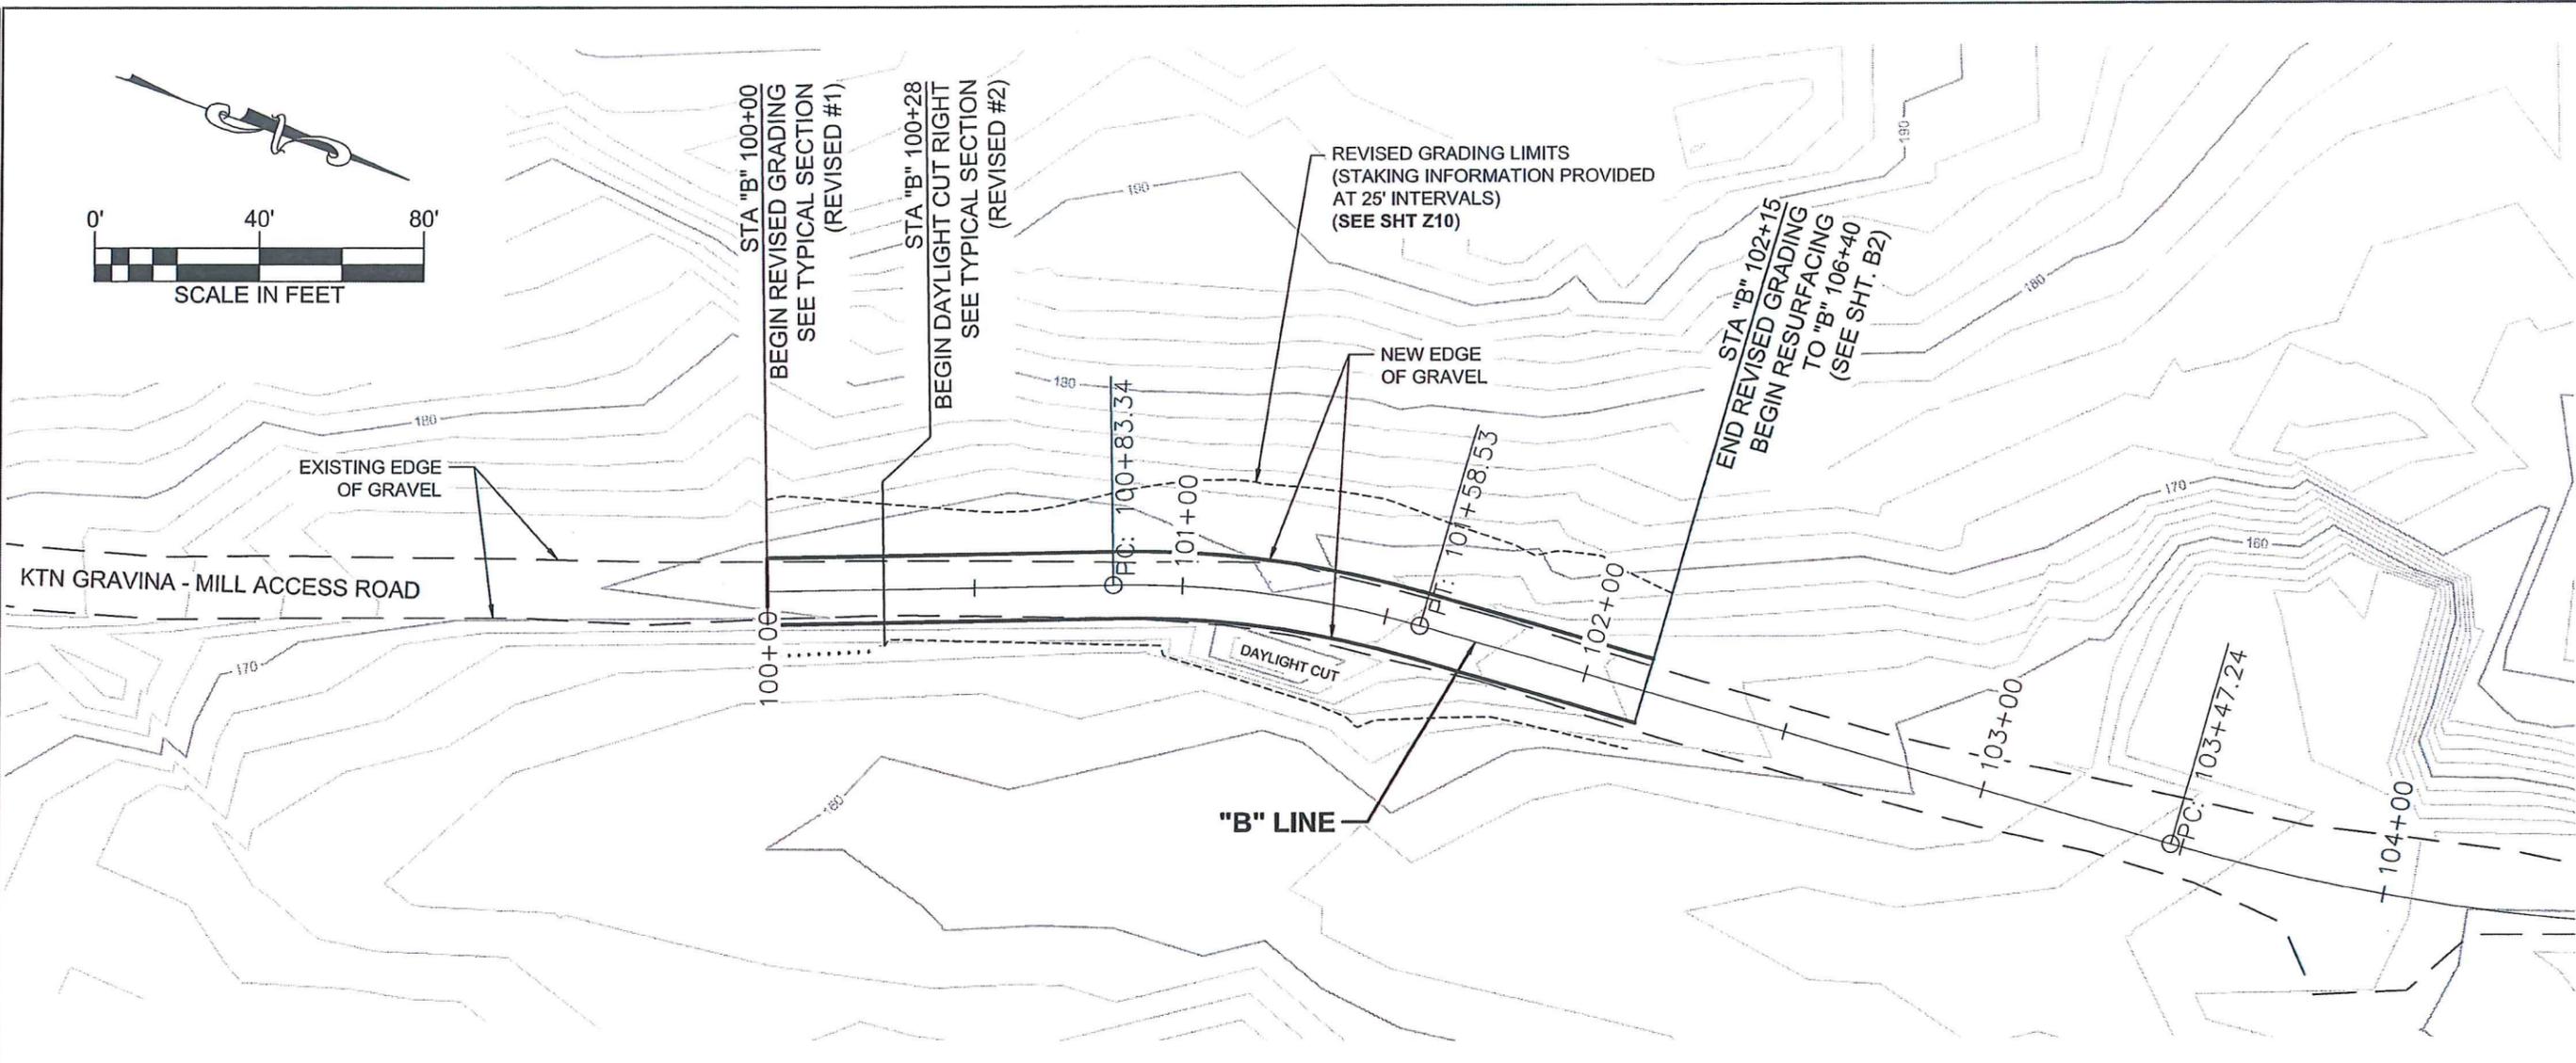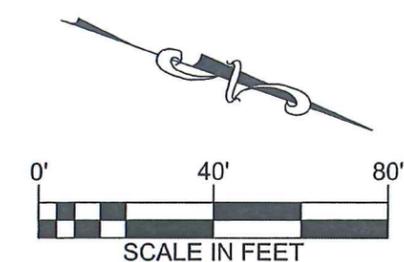


FULL DEPTH CONSTRUCTION (REVISED #1)
 SITE 1: STA "B" 100+00 TO "B" 102+15
 STA "B" 106+40 TO "B" 110+10


Project As Built Drawings Have Been Reviewed
 By the Project Engineer & Represent, To the
 Best of My Knowledge, the Project as
 Constructed.

Project Eng. *MB* 8-23-17 Date

		STATE OF ALASKA DEPARTMENT OF TRANSPORTATION & PUBLIC FACILITIES SOUTHCOAST REGION	
DESIGNED BY: M. DUMAN DRAWN BY: R. BERGER PATH: P:\53\ADOT\53-02\Gravina\Design\Construction Services\20160826 Revised Grading Site\153-02 Site Exhibit - Site 1.dwg TAB: Z6		PROJECT DESIGNATION: Z699220000 YEAR: 2016 SHEET NO.: Z6 TOTAL SHEETS: 5	

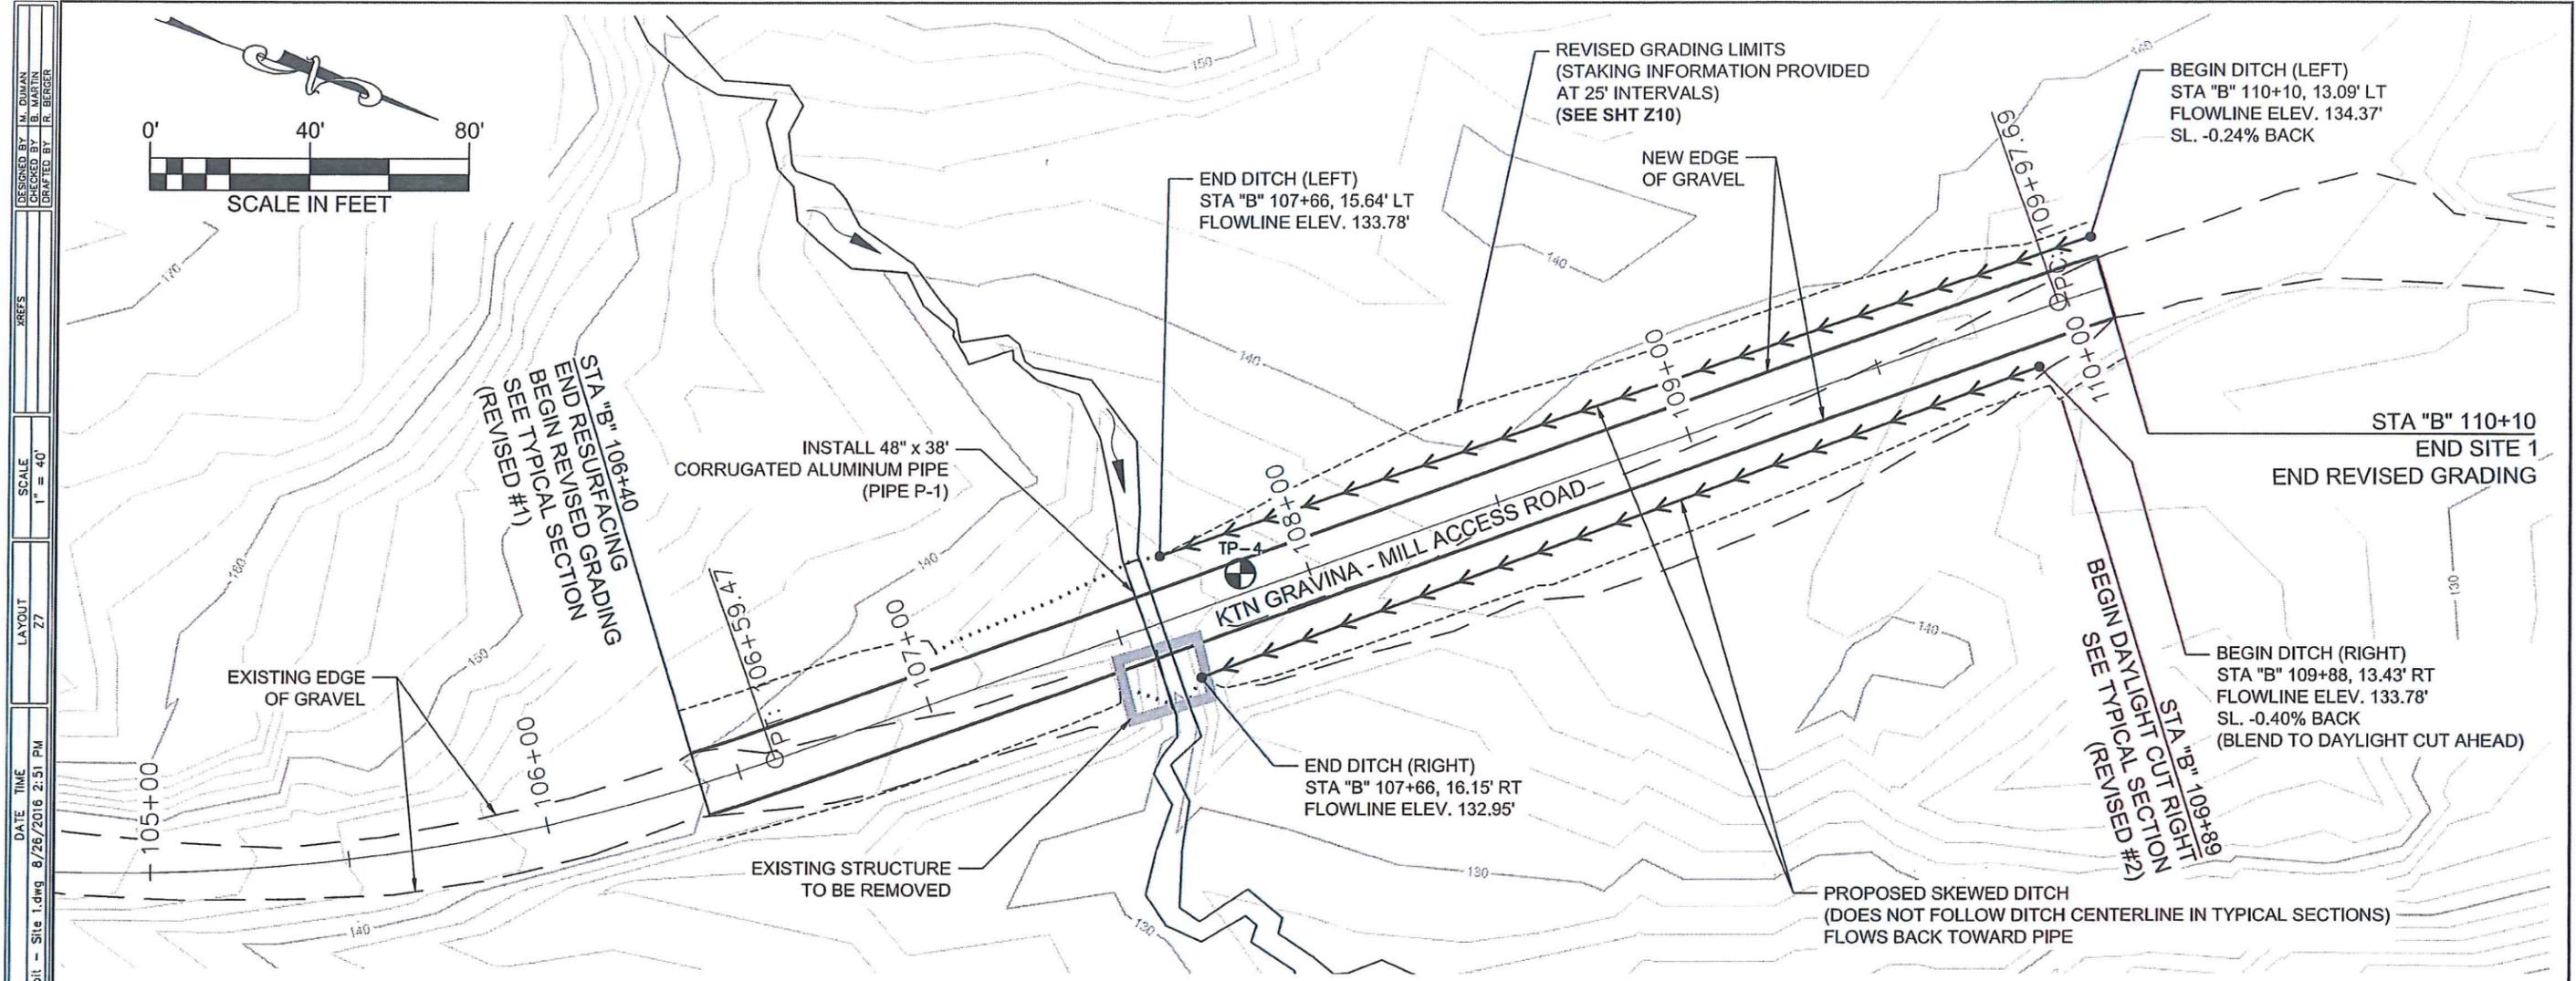

DRAWING LOCATION: P:\351(ADOT)\353-02(Gravina)\Design\Construction Services\20160826 Revised Grading Site\153-02 Site Exhibit - Site 1.dwg
 DATE TIME: 8/26/2016 2:51 PM
 LAYOUT: Z7
 SCALE: 1" = 40'
 DESIGNED BY: M. DUMAN
 CHECKED BY: B. MARTIN
 DRAFTED BY: R. BERGER

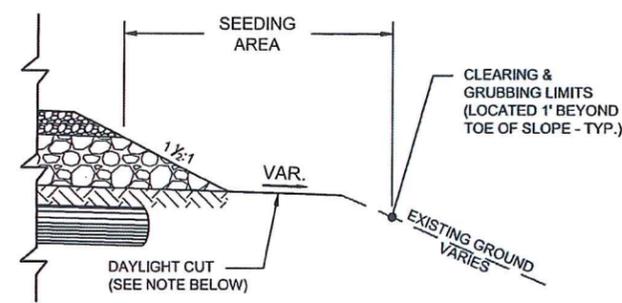










NOTE:
BLEND DAYLIGHT CUT TO FULL DITCH SECTION BETWEEN "B" 109+89 AND START OF DITCH RIGHT.

FULL DEPTH CONSTRUCTION (REVISED #2)
 SITE 1: STA "B" 100+28 TO "B" 102+15
 STA "B" 109+89 TO "B" 110+10
 (RIGHT SIDE ONLY)

Project As Built Drawings Have Been Reviewed By the Project Engineer & Represent, To the Best of My Knowledge, the Project as Constructed.
 Project Eng. *MP* 8.23.17 Date

		STATE OF ALASKA DEPARTMENT OF TRANSPORTATION & PUBLIC FACILITIES SOUTHCOST REGION	
		KTN GRAVINA - MILL ACCESS ROAD	
SITE EXHIBIT SITE 1 - REVISED GRADING			
DESIGNED BY: M. DUMAN	DRAWN BY: R. BERGER	PROJECT DESIGNATION	YEAR
PATH: P:\351(ADOT)\353-02(Gravina)\Design\Construction Services\20160826 Revised Grading Site\153-02 Site Exhibit - Site 1.dwg		Z699220000	2016
TAB: Z7	Friday, August 26, 2016 2:53:09 PM	Ryan Berger	
REVISIONS		SHEET NO.	TOTAL SHEETS
NO.	DATE	DESCRIPTION	
			Z7
			5

DRAWING LOCATION: P:\53\ADOT\53-02(Gravina)\Design\Construction Services\20160826 Revised Grading Site\53-02 Site Exhibit - Site 1.dwg
 DATE TIME: 8/26/2016 2:51 PM
 LAYOUT: ZB
 SCALE: #####
 DESIGNED BY: M. DUMAN
 DRAWN BY: R. BERGER

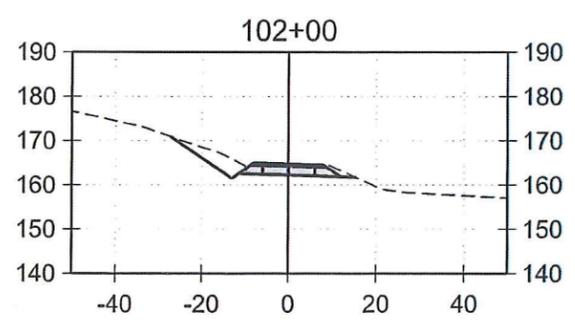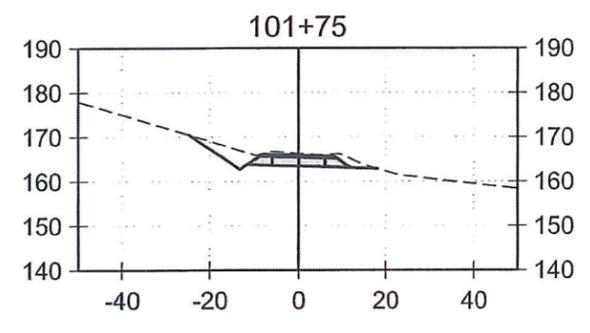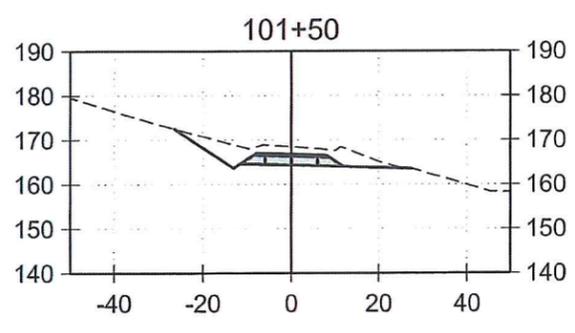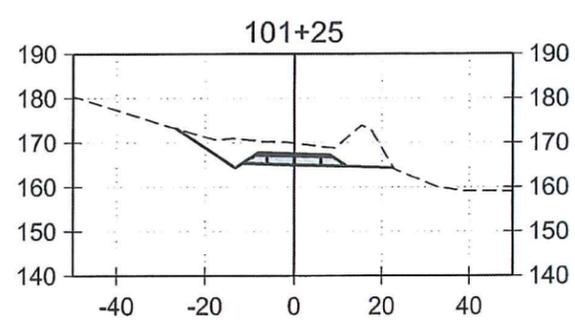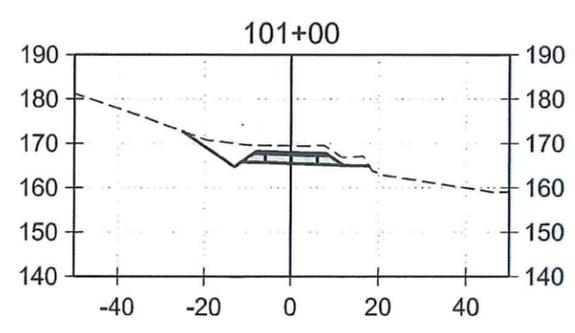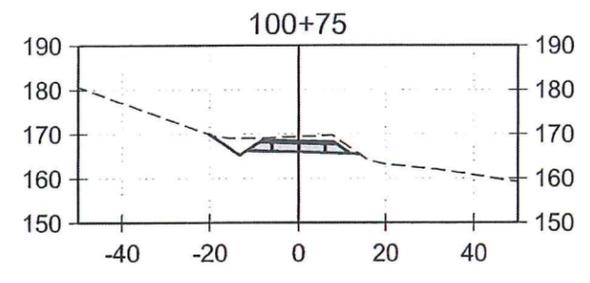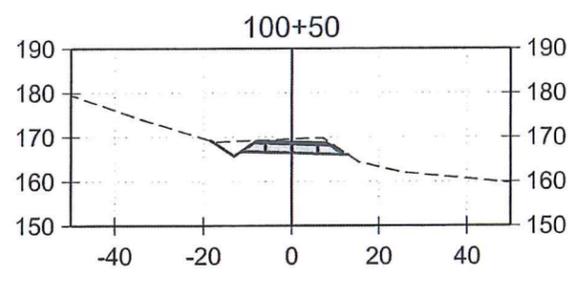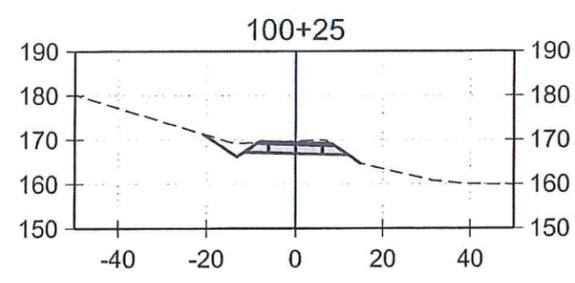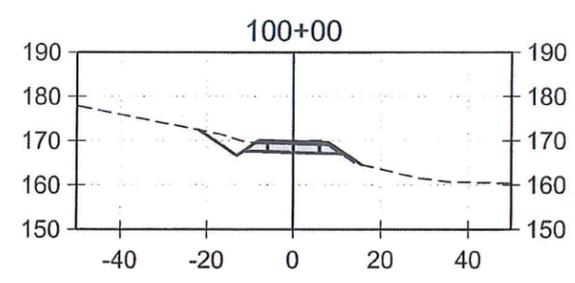

Project As Built Drawings Have Been Reviewed By the Project Engineer & Represent, To the Best of My Knowledge, the Project as Constructed.

Project Eng. *MP* 8.23.17 Date

DESIGNED BY: M. DUMAN
 DRAWN BY: R. BERGER
 PATH: P:\53\ADOT\53-02(Gravina)\Design\Construction Services\20160826 Revised Grading Site\53-02 Site Exhibit - Site 1.dwg
 TAB: ZB Friday, August 26, 2016 2:53:27 PM Ryan Berger

STATE OF ALASKA
 DEPARTMENT OF TRANSPORTATION
 & PUBLIC FACILITIES
 SOUTHCOAST REGION

KTN GRAVINA - MILL
 ACCESS ROAD

SITE EXHIBIT
 SITE 1 - REVISED SECTIONS

REVISIONS			PROJECT DESIGNATION	YEAR	SHEET NO.	TOTAL SHEETS
NO.	DATE	DESCRIPTION				
			Z699220000	2016	Z8	5

DESIGNED BY: M. DUMAN
 CHECKED BY: R. BERGER
 DRAFTED BY: R. BERGER

















XREFS

SCALE: #####

LAYOUT: Z9

DATE TIME: 8/26/2016 2:51 PM

DRAWING LOCATION: P:\53(ADOT)\53-02(Gravina)\Design\Construction Services\20160826 Revised Grading Site\1\53-02 Site Exhibit - Site 1.dwg

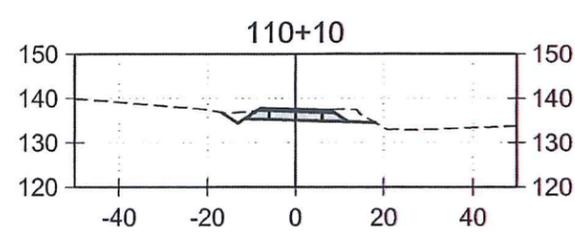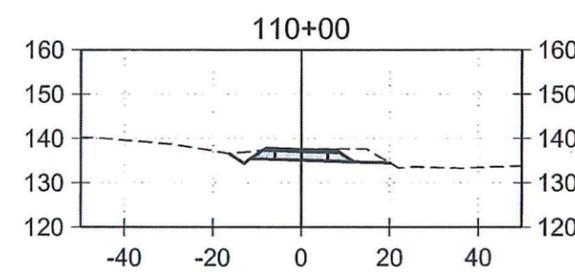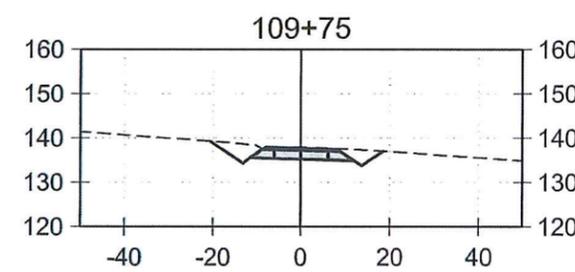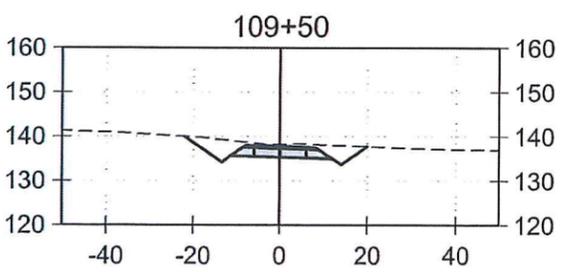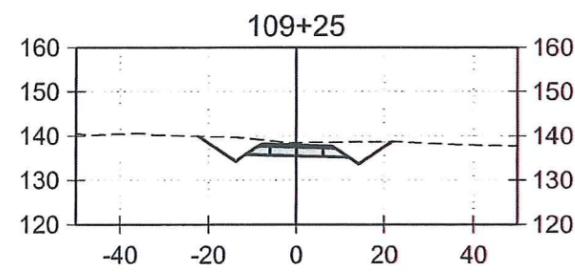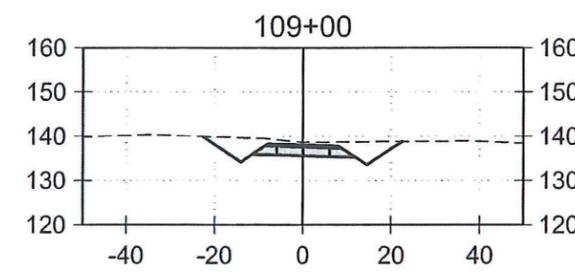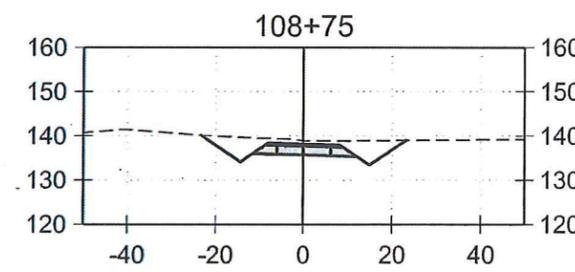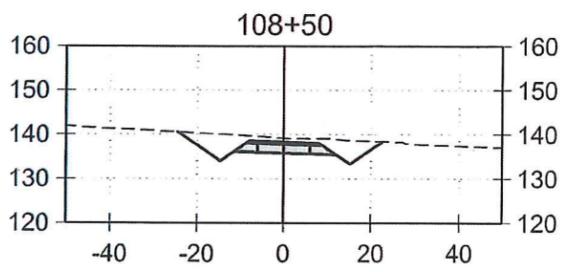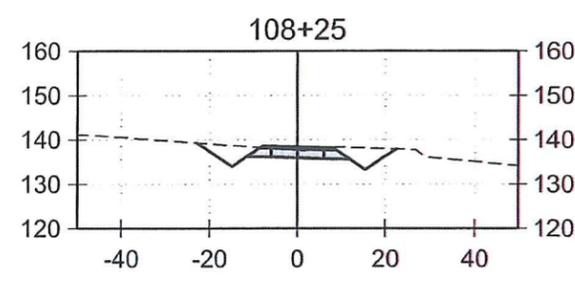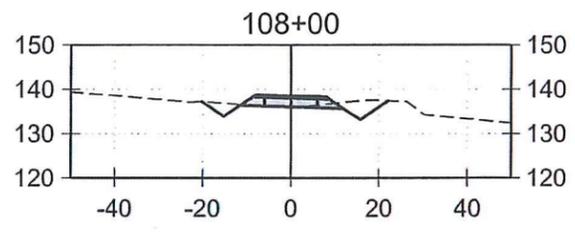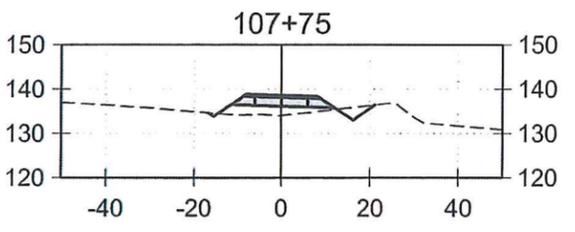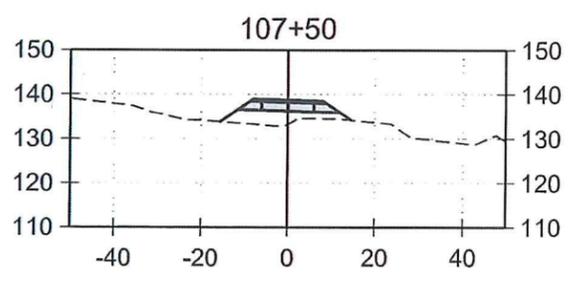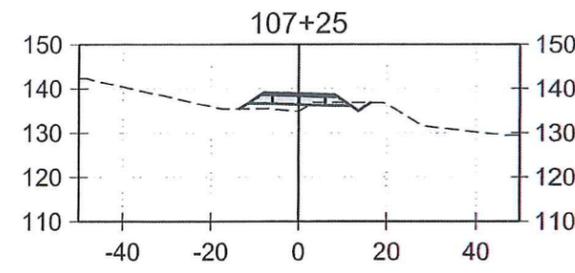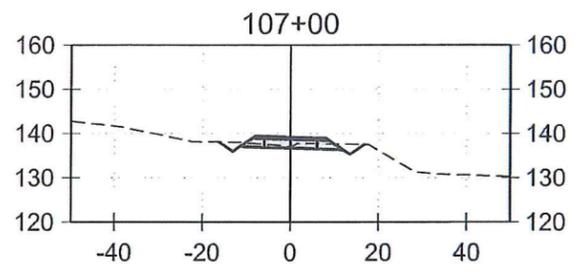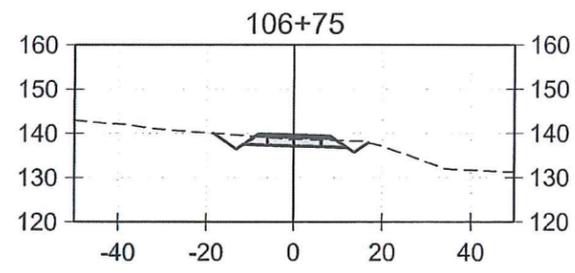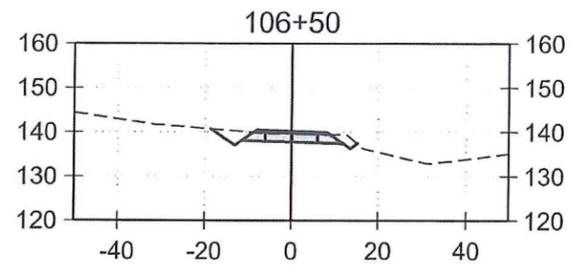

Project As Built Drawings Have Been Reviewed
 By the Project Engineer & Represent, To the
 Best of My Knowledge, the Project as
 Constructed.

Project Eng. *MB* Date *8-23-17*

DESIGNED BY: M. DUMAN
 DRAWN BY: R. BERGER
 PATH: P:\53(ADOT)\53-02(Gravina)\Design\Construction Services\20160826 Revised Grading Site\1\53-02 Site Exhibit - Site 1.dwg
 TAB: Z9 Friday, August 26, 2016 2:53:51 PM Ryan Berger

STATE OF ALASKA
 DEPARTMENT OF TRANSPORTATION
 & PUBLIC FACILITIES
 SOUTHCOAST REGION

KTN GRAVINA - MILL
 ACCESS ROAD

SITE EXHIBIT
 SITE 1 - REVISED SECTIONS

NO.	DATE	REVISIONS DESCRIPTION	PROJECT DESIGNATION	YEAR	SHEET NO.	TOTAL SHEETS
			Z699220000	2016	Z9	5

DESIGNED BY: M. DUMAN
 CHECKED BY: B. MARTIN
 DRAFTED BY: R. BERGER

XREFS

SCALE: #####

LAYOUT: Z10

DATE TIME: 8/26/2016 2:51 PM

DRAWING LOCATION: P:\33(ADD)\33-02(Gravina)\Design\Construction Services\20160826 Revised Grading Site 1\33-02 Site Exhibit - Site 1.dwg

STAKING DATA - SITE 1

STATION	OFFSET (RT)	OFFSET (LT)	CONDITION (RT)	CONDITION (LT)	NOTES
100+00	15.53'	21.84'	FILL	CUT	BEGIN SITE 1
100+25	14.76'	20.83'	FILL	CUT	
100+50	12.83'	18.40'	DAYLIGHT CUT	CUT	
100+75	13.85'	20.19'	DAYLIGHT CUT	CUT	
101+00	17.85'	25.05'	DAYLIGHT CUT	CUT	
101+25	22.68'	26.38'	DAYLIGHT CUT	CUT	
101+50	27.39'	26.50'	DAYLIGHT CUT	CUT	
101+75	18.01'	24.81'	DAYLIGHT CUT	CUT	
102+00	15.13'	27.08'	DAYLIGHT CUT	CUT	
102+15	14.47'	24.26'	DAYLIGHT CUT	CUT	END FULL DEPTH, BEGIN RESURFACE
106+40	14.56'	18.92'	CUT	CUT	END RESURFACE, BEGIN FULL DEPTH
106+50	15.10'	18.73'	CUT	CUT	
106+75	16.74'	18.51'	CUT	CUT	
107+00	16.84'	16.34'	CUT	CUT	
107+25	16.32'	13.49'	CUT	FILL	
107+50	14.44'	15.66'	FILL	FILL	
107+75	21.12'	16.74'	CUT	CUT	
108+00	22.14'	20.25'	CUT	CUT	
108+25	22.41'	22.94'	CUT	CUT	
108+50	22.68'	24.57'	CUT	CUT	
108+75	23.19'	23.57'	CUT	CUT	
109+00	22.47'	22.77'	CUT	CUT	
109+25	21.69'	22.40'	CUT	CUT	
109+50	19.93'	22.13'	CUT	CUT	
109+75	18.50'	20.61'	CUT	CUT	
109+89	18.73'	17.70'	DAYLIGHT CUT	CUT	BEGIN DAYLIGHT CUT RIGHT
110+00	20.15'	16.24'	DAYLIGHT CUT	CUT	
110+10	18.15'	16.69'	DAYLIGHT CUT	CUT	END SITE 1

Project As Built Drawings Have Been Reviewed
 By the Project Engineer & Represent, To the
 Best of My Knowledge, the Project as
 Constructed.

Project Eng. *MP*

8.28.17
 Date




DESIGNED BY: M. DUMAN
 DRAWN BY: R. BERGER
 PATH: P:\33(ADD)\33-02(Gravina)\Design\Construction Services\20160826 Revised Grading Site 1\33-02 Site Exhibit - Site 1.dwg
 TAB: Z10 Friday, August 26, 2016 2:54:04 PM Ryan Berger

STATE OF ALASKA
 DEPARTMENT OF TRANSPORTATION
 & PUBLIC FACILITIES
 SOUTHCOAST REGION


KTN GRAVINA - MILL
 ACCESS ROAD

SITE EXHIBIT
 SITE 1 - STAKING DATA


REVISIONS			PROJECT DESIGNATION	YEAR	SHEET NO.	TOTAL SHEETS
NO.	DATE	DESCRIPTION				
			Z699220000	2016	Z10	5

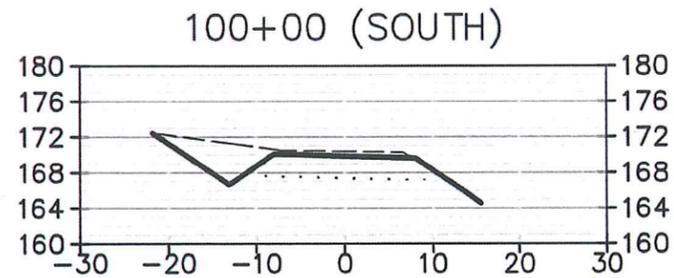


Total Volume at Station 100+00	
Cut Area	89.97 (ft ²)
Cut Vol	0.00 (yd ³)
Cum Cut Vol	0.00 (yd ³)
Fill Area	0.00 (ft ²)
Fill Volume	0.00 (yd ³)
Cum Fill Vol	0.00 (yd ³)

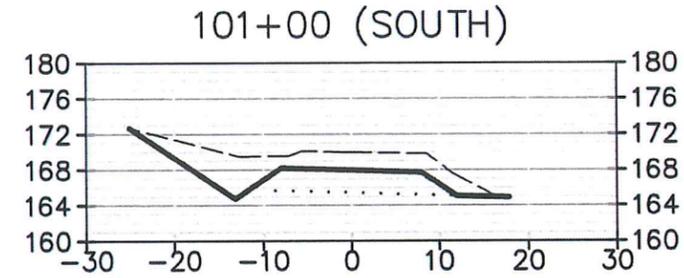


Total Volume at Station 101+00	
Cut Area	140.43 (ft ²)
Cut Vol	106.66 (yd ³)
Cum Cut Vol	327.50 (yd ³)
Fill Area	0.00 (ft ²)
Fill Volume	0.00 (yd ³)
Cum Fill Vol	0.00 (yd ³)

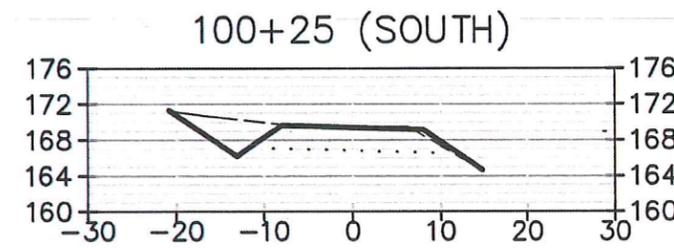


Total Volume at Station 100+25	
Cut Area	77.05 (ft ²)
Cut Vol	77.32 (yd ³)
Cum Cut Vol	77.32 (yd ³)
Fill Area	0.00 (ft ²)
Fill Volume	0.00 (yd ³)
Cum Fill Vol	0.00 (yd ³)

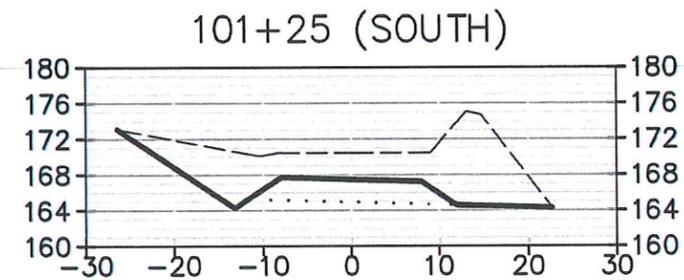


Total Volume at Station 101+25	
Cut Area	229.63 (ft ²)
Cut Vol	171.32 (yd ³)
Cum Cut Vol	498.821 (yd ³)
Fill Area	0.00 (ft ²)
Fill Volume	0.00 (yd ³)
Cum Fill Vol	0.00 (yd ³)

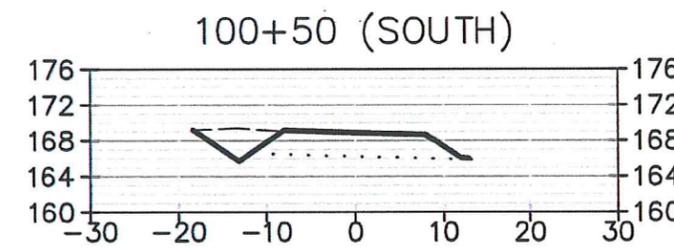

Total Volume at Station 100+50	
Cut Area	71.50 (ft ²)
Cut Vol	68.77 (yd ³)
Cum Cut Vol	146.10 (yd ³)
Fill Area	0.00 (ft ²)
Fill Volume	0.00 (yd ³)
Cum Fill Vol	0.00 (yd ³)

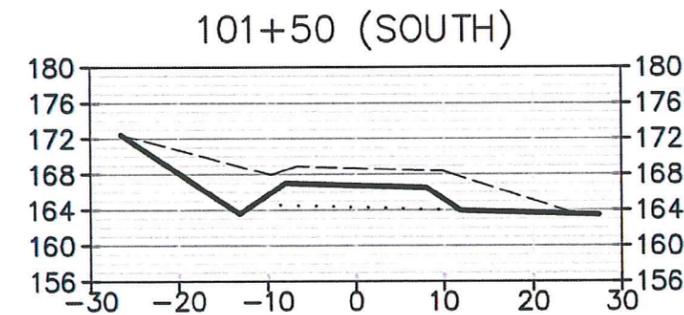

Total Volume at Station 101+50	
Cut Area	147.50 (ft ²)
Cut Vol	174.60 (yd ³)
Cum Cut Vol	673.42 (yd ³)
Fill Area	0.00 (ft ²)
Fill Volume	0.00 (yd ³)

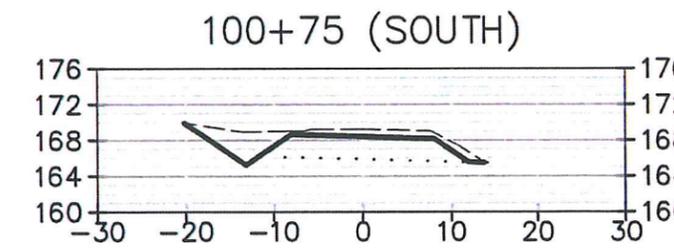


Total Volume at Station 100+75	
Cut Area	89.95 (ft ²)
Cut Vol	74.75 (yd ³)
Cum Cut Vol	220.84 (yd ³)
Fill Area	0.00 (ft ²)
Fill Volume	0.00 (yd ³)
Cum Fill Vol	0.00 (yd ³)



Project As Built Drawings Have Been Reviewed By the Project Engineer & Represent, To the Best of My Knowledge, the Project as Constructed.


Project Eng. *MD* Date *8-23-17*

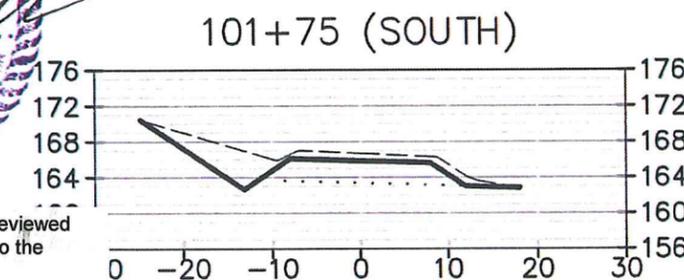

Total Volume at Station 101+75	
Cut Area	102.01 (ft ²)
Cut Vol	115.51 (yd ³)
Cum Cut Vol	788.94 (yd ³)
Fill Area	0.00 (ft ²)
Fill Volume	0.00 (yd ³)
Cum Fill Vol	0.00 (yd ³)

C Project As Built Drawings Have Been Reviewed By the Project Engineer & Represent, To the Best of My Knowledge, the Project as Constructed.

Project Eng. _____ Date _____

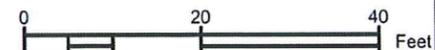

LEGEND


- PROPOSED FINISHED GRADE
- PROPOSED SUBGRADE
- EXISTING GROUND

NOTE: THESE VOLUMES ARE DERIVED FROM THE AREA CUT/FILLED FROM ORIGINAL GROUND TO PROPOSED SUBGRADE




GRAVINA - MILL ACCESS ROAD
SITE 1
TOTAL CUT/FILL QUANTITIES


PROJECT: 1227.70866
DATE: 10/29/2016
DRAWN BY: I.M.D.
CHECKED BY: J.M.L.

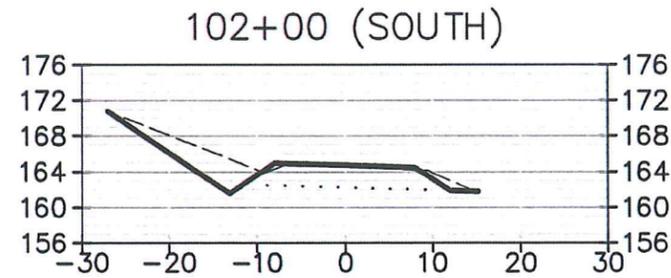


Total Volume at Station 102+00	
Cut Area	83.43 (ft ²)
Cut Vol	85.85 (yd ³)
Cum Cut Vol	874.79 (yd ³)
Fill Area	0.00 (ft ²)
Fill Volume	0.00 (yd ³)
Cum Fill Vol	0.00 (yd ³)

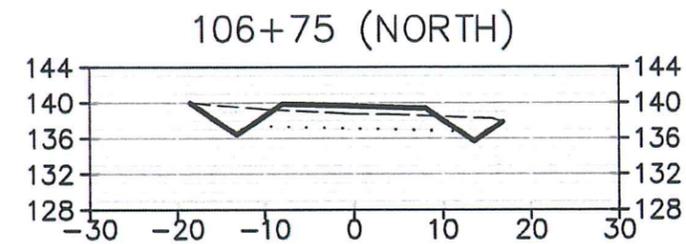

Total Volume at Station 106+75	
Cut Area	60.83 (ft ²)
Cut Vol	57.04 (yd ³)
Cum Cut Vol	80.01 (yd ³)
Fill Area	0.00 (ft ²)
Fill Volume	0.00 (yd ³)
Cum Fill Vol	0.00 (yd ³)

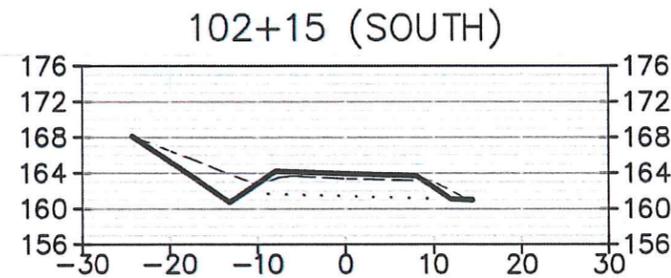


Total Volume at Station 102+15	
Cut Area	64.52 (ft ²)
Cut Vol	41.10 (yd ³)
Cum Cut Vol	915.88 (yd ³)
Fill Area	0.00 (ft ²)
Fill Volume	0.00 (yd ³)
Cum Fill Vol	0.00 (yd ³)

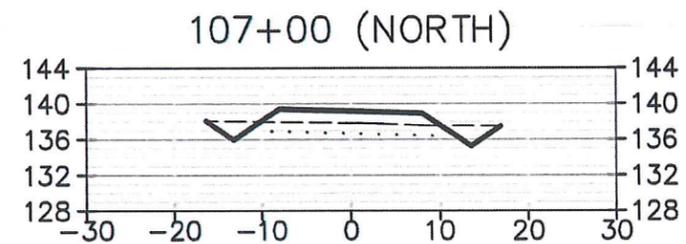


Total Volume at Station 107+00	
Cut Area	38.84 (ft ²)
Cut Vol	46.14 (yd ³)
Cum Cut Vol	126.15 (yd ³)
Fill Area	0.00 (ft ²)
Fill Volume	0.00 (yd ³)
Cum Fill Vol	0.00 (yd ³)

STA: 102+15 - 106+40 RESURFACE ONLY

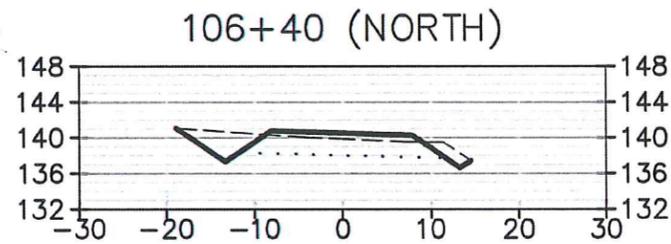


Total Volume at Station 106+40	
Cut Area	61.65 (ft ²)
Cut Vol	0.00 (yd ³)
Cum Cut Vol	0.00 (yd ³)
Fill Area	0.00 (ft ²)
Fill Volume	0.00 (yd ³)
Cum Fill Vol	0.00 (yd ³)

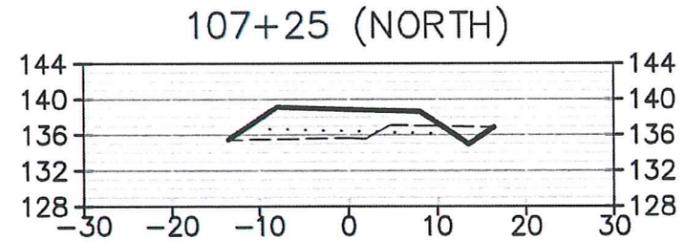

Total Volume at Station 107+25	
Cut Area	11.60 (ft ²)
Cut Vol	23.35 (yd ³)
Cum Cut Vol	149.51 (yd ³)
Fill Area	15.19 (ft ²)
Fill Volume	7.03 (yd ³)

Project As Built Drawings Have Been Reviewed By the Project Engineer & Represent, To the Best of My Knowledge, the Project as Constructed.


Project Eng. _____ Date _____

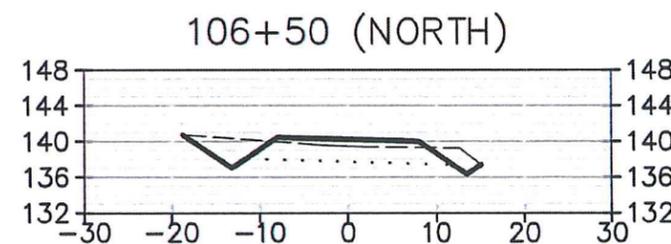


Total Volume at Station 106+50	
Cut Area	62.38 (ft ²)
Cut Vol	22.97 (yd ³)
Cum Cut Vol	22.97 (yd ³)
Fill Area	0.00 (ft ²)
Fill Volume	0.00 (yd ³)
Cum Fill Vol	0.00 (yd ³)

Project As Built Drawings Have Been Reviewed By the Project Engineer & Represent, To the Best of My Knowledge, the Project as Constructed.

Project Eng. *MP* Date *8.23.17*

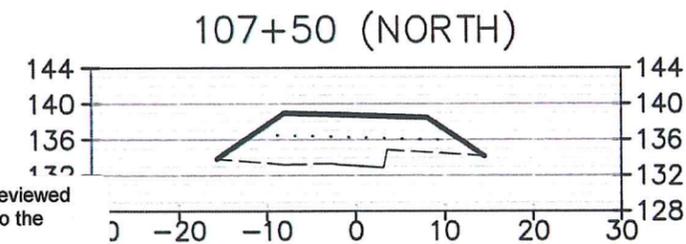

Total Volume at Station 107+50	
Cut Area	0.00 (ft ²)
Cut Vol	5.37 (yd ³)
Cum Cut Vol	154.88 (yd ³)
Fill Area	67.84 (ft ²)
Fill Volume	38.44 (yd ³)
Cum Fill Vol	45.47 (yd ³)

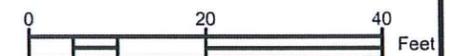

LEGEND


- PROPOSED FINISHED GRADE
- PROPOSED SUBGRADE
- EXISTING GROUND

NOTE: THESE VOLUMES ARE DERIVED FROM THE AREA CUT/FILLED FROM ORIGINAL GROUND TO PROPOSED SUBGRADE




GRAVINA - MILL ACCESS ROAD
SITE 1
TOTAL CUT/FILL QUANTITIES


PROJECT: 1227.70866
DATE: 10/29/2016
DRAWN BY: I.M.D.
CHECKED BY: J.M.L.

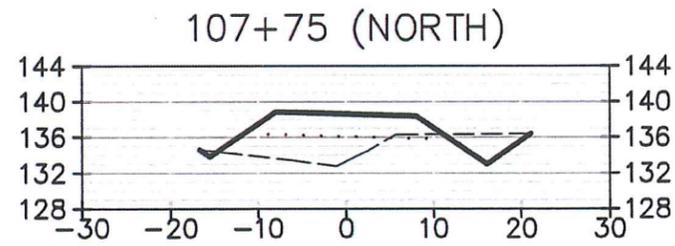


Total Volume at Station 107+75	
Cut Area	2.81 (ft ²)
Cut Vol	1.30 (yd ³)
Cum Cut Vol	156.18 (yd ³)
Fill Area	61.46 (ft ²)
Fill Volume	59.86 (yd ³)
Cum Fill Vol	105.33 (yd ³)

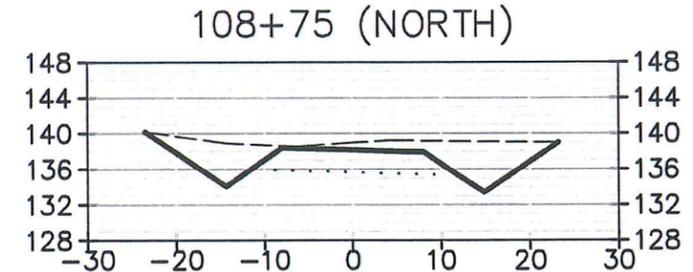


Total Volume at Station 108+75	
Cut Area	147.17 (ft ²)
Cut Vol	137.29 (yd ³)
Cum Cut Vol	499.80 (yd ³)
Fill Area	0.00 (ft ²)
Fill Volume	0.00 (yd ³)
Cum Fill Vol	145.88 (yd ³)

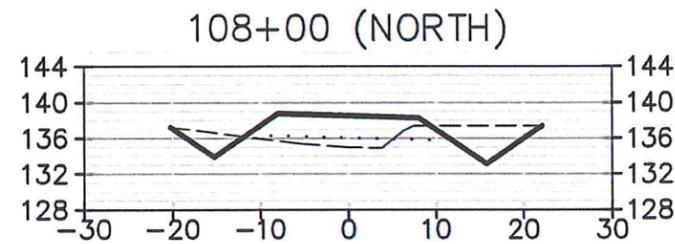


Total Volume at Station 108+00	
Cut Area	45.73 (ft ²)
Cut Vol	22.47 (yd ³)
Cum Cut Vol	178.65 (yd ³)
Fill Area	13.06 (ft ²)
Fill Volume	34.50 (yd ³)
Cum Fill Vol	139.83 (yd ³)

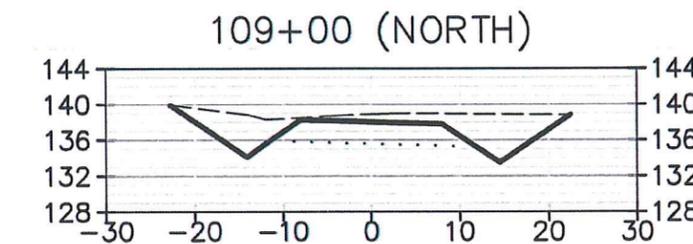

Total Volume at Station 109+00	
Cut Area	138.49 (ft ²)
Cut Vol	132.25 (yd ³)
Cum Cut Vol	632.05 (yd ³)
Fill Area	0.00 (ft ²)
Fill Volume	0.00 (yd ³)
Cum Fill Vol	145.88 (yd ³)

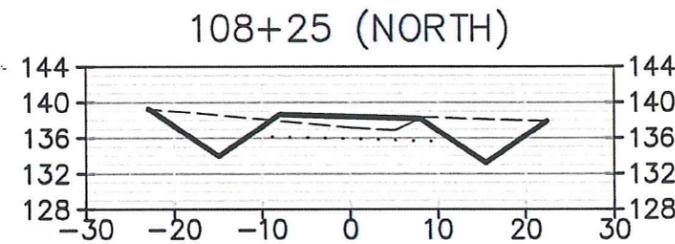


Total Volume at Station 108+25	
Cut Area	101.01 (ft ²)
Cut Vol	67.94 (yd ³)
Cum Cut Vol	246.58 (yd ³)
Fill Area	0.00 (ft ²)
Fill Volume	6.05 (yd ³)
Cum Fill Vol	145.88 (yd ³)

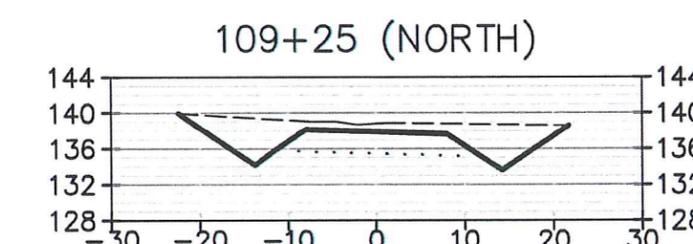

Total Volume at Station 109+25	
Cut Area	142.73 (ft ²)
Cut Vol	130.19 (yd ³)
Cum Cut Vol	762.24 (yd ³)
Fill Area	0.00 (ft ²)
Fill Volume	0.00 (yd ³)

Project As Built Drawings Have Been Reviewed By the Project Engineer & Represent, To the Best of My Knowledge, the Project as Constructed.


Project Eng. _____ Date _____

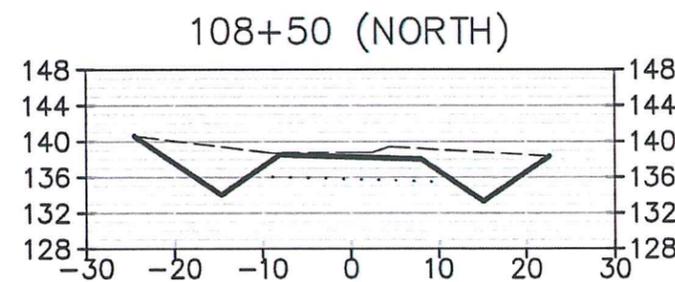


Total Volume at Station 108+50	
Cut Area	149.38 (ft ²)
Cut Vol	115.92 (yd ³)
Cum Cut Vol	362.51 (yd ³)
Fill Area	0.00 (ft ²)
Fill Volume	0.00 (yd ³)
Cum Fill Vol	145.88 (yd ³)

Project As Built Drawings Have Been Reviewed By the Project Engineer & Represent, To the Best of My Knowledge, the Project as Constructed.

Project Eng. *MD* Date *8-23-17*

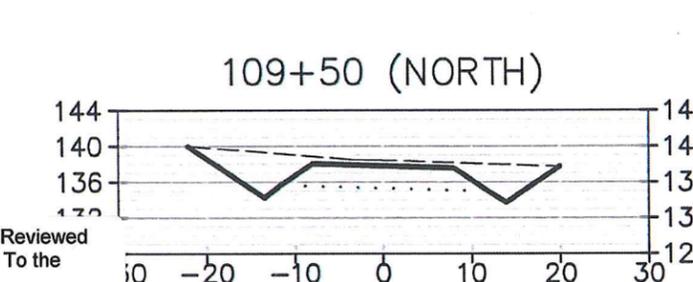

Total Volume at Station 109+50	
Cut Area	124.12 (ft ²)
Cut Vol	123.54 (yd ³)
Cum Cut Vol	885.78 (yd ³)
Fill Area	0.00 (ft ²)
Fill Volume	0.00 (yd ³)
Cum Fill Vol	145.88 (yd ³)

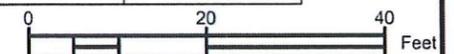

LEGEND


- PROPOSED FINISHED GRADE
- PROPOSED SUBGRADE
- EXISTING GROUND

NOTE: THESE VOLUMES ARE DERIVED FROM THE AREA CUT/FILLED FROM ORIGINAL GROUND TO PROPOSED SUBGRADE




GRAVINA - MILL ACCESS ROAD
SITE 1
TOTAL CUT/FILL QUANTITIES



PROJECT: 1227.70866
DATE: 10/29/2016
DRAWN BY: I.M.D.
CHECKED BY: J.M.L.

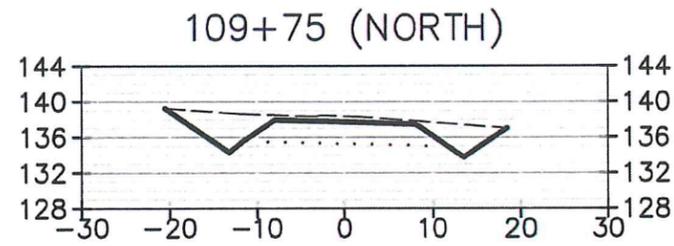

Total Volume at Station 109+75	
Cut Area	105.06 (ft ²)
Cut Vol	106.10 (yd ³)
Cum Cut Vol	991.89 (yd ³)
Fill Area	0.00 (ft ²)
Fill Volume	0.00 (yd ³)
Cum Fill Vol	145.88 (yd ³)

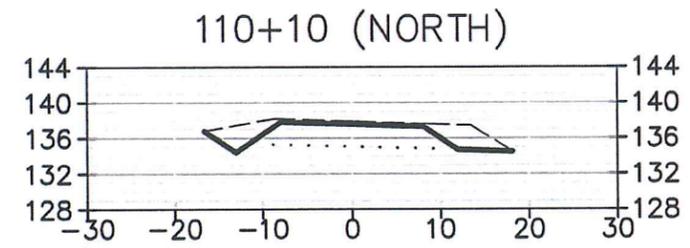


Total Volume at Station 110+10	
Cut Area	76.99 (ft ²)
Cut Vol	27.36 (yd ³)
Cum Cut Vol	1100.63 (yd ³)
Fill Area	0.00 (ft ²)
Fill Volume	0.00 (yd ³)
Cum Fill Vol	145.88 (yd ³)

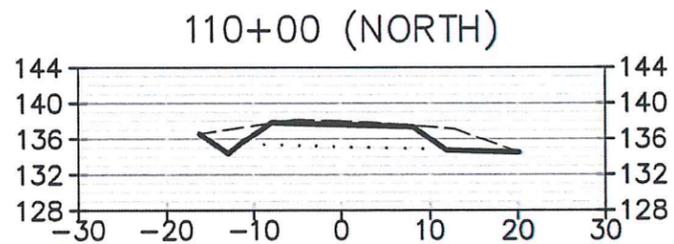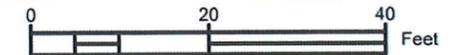

Total Volume at Station 110+00	
Cut Area	70.74 (ft ²)
Cut Vol	81.39 (yd ³)
Cum Cut Vol	1073.27 (yd ³)
Fill Area	0.00 (ft ²)
Fill Volume	0.00 (yd ³)
Cum Fill Vol	145.88 (yd ³)


SITE 1 SOUTH

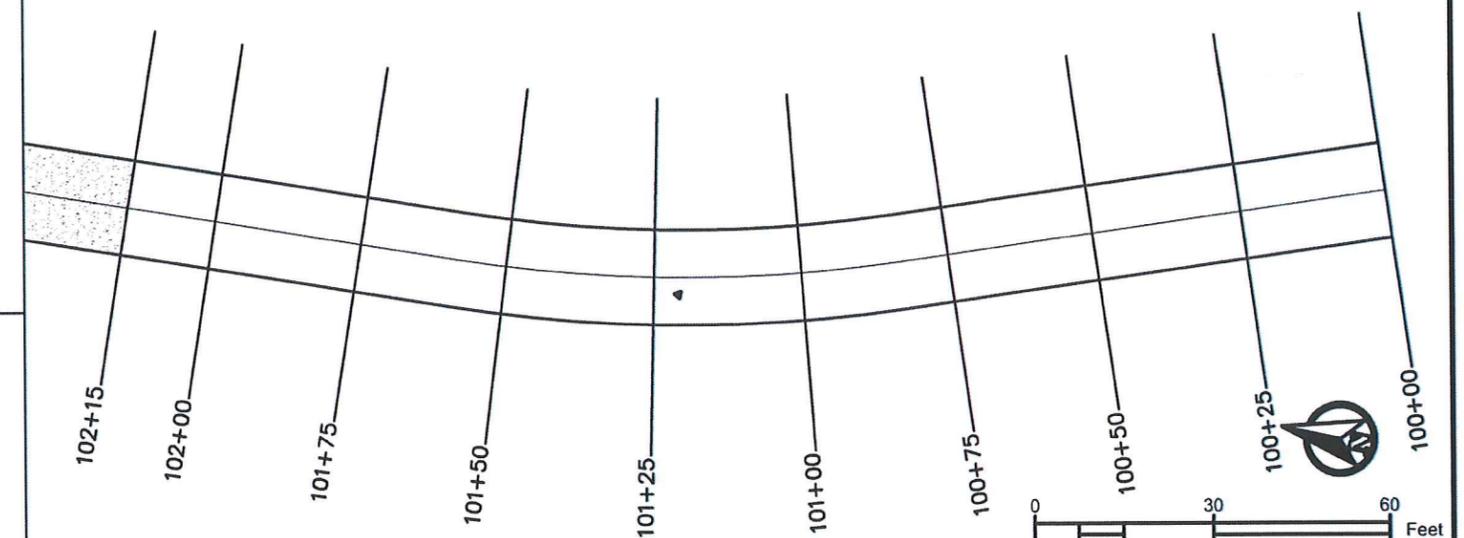

SOUTH CUM. CUT: 915.88 YD³
 NORTH CUM. CUT: 1100.63 YD³
 TOTAL CUT VOL: 2016.51 YD³

SOUTH CUM. FILL: 0.00 YD³
 NORTH CUM. FILL: 145.88 YD³
 TOTAL FILL VOL: 145.88 YD³

SITE 1 NORTH

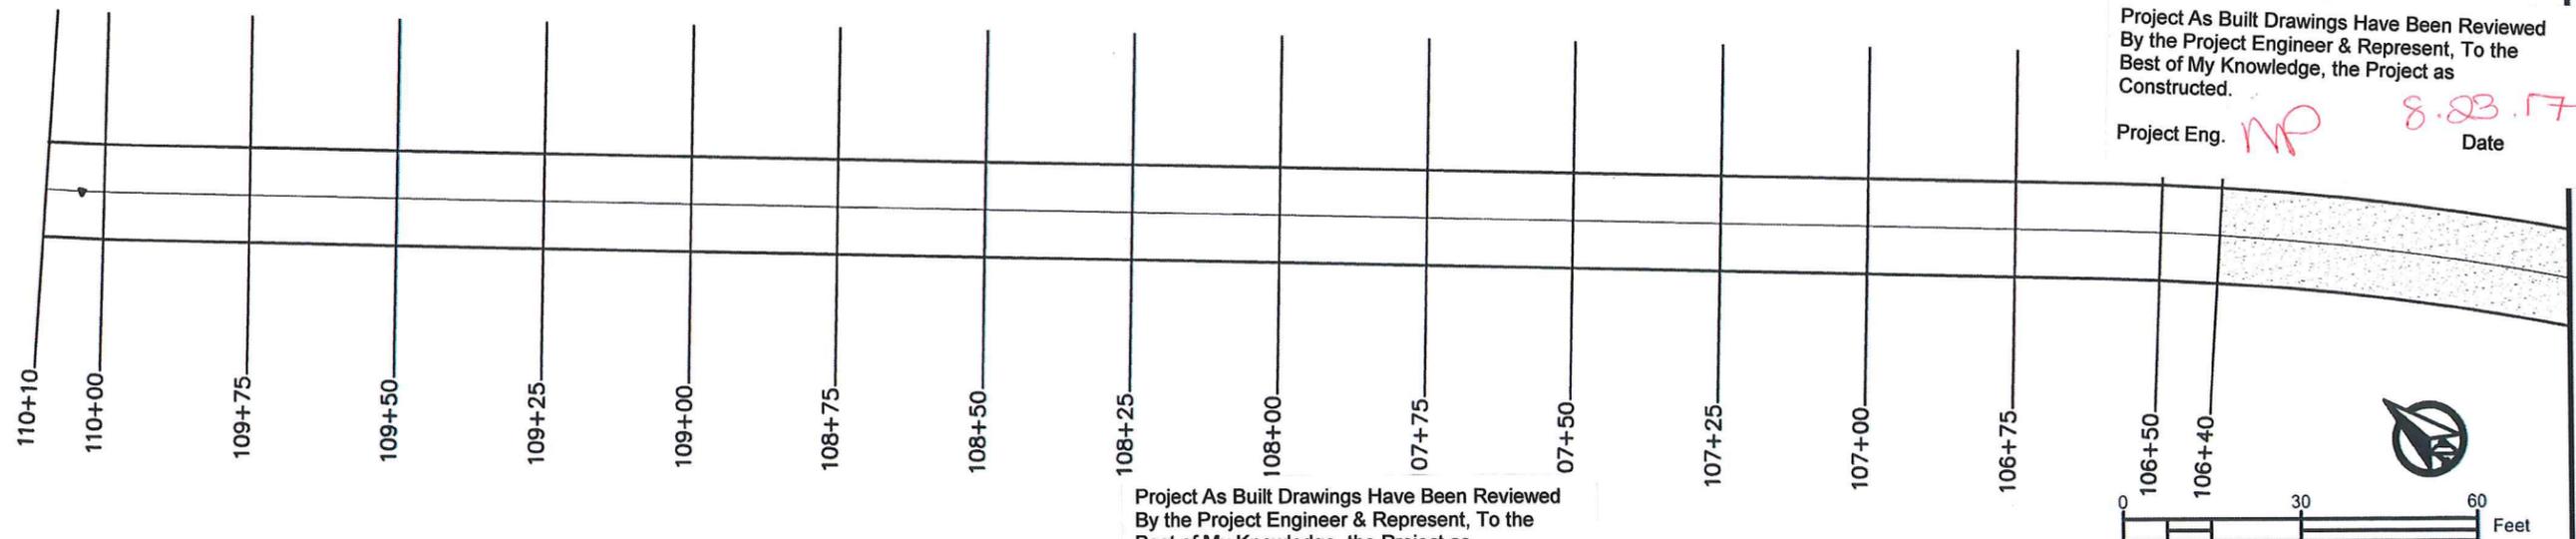

Project As Built Drawings Have Been Reviewed
 By the Project Engineer & Represent, To the
 Best of My Knowledge, the Project as
 Constructed.
 Project Eng. *MP* Date *8.23.17*

Project As Built Drawings Have Been Reviewed
 By the Project Engineer & Represent, To the
 Best of My Knowledge, the Project as
 Constructed.
 Project Eng. _____ Date _____

GRAVINA - MILL ACCESS ROAD
 SITE 1
 TOTAL CUT/FILL QUANTITIES

PROJECT: 1227.70866
 DATE: 10/29/2016
 DRAWN BY: I.M.D.
 CHECKED BY: J.M.L.

LEGEND

- PROPOSED FINISHED GRADE
- PROPOSED SUBGRADE
- EXISTING GROUND

NOTE: THESE VOLUMES ARE DERIVED FROM THE
 AREA CUT/FILLED FROM ORIGINAL GROUND TO
 PROPOSED SUBGRADE

