



GENERAL NOTES

1. Minor changes in the typical sections may be directed by the Engineer.
2. Cross slope changes shall be approved by the Engineer.
3. From the B.O.P. to Station 59+55 removal of shoulder pavement and base course shall be limited to one side of the roadway at a time.
4. Material below the excavation limits shall be recompacted in accordance with Section 301, prior to new work.
5. The typical sections shall be used as general guidelines for an area. Additional information found on the Pavement Cold Planing, sheet 6, shall be used in conjunction with the typical. The Engineer will indicate actual limits of work and transitions length between sections.
6. It shall be the contractors responsibility to set control for the paving, cold planing, temporary and permanent traffic markings and other items necessary to complete the work.
7. Summary tables are for bidding information only. All man-holes monument cases, valve boxes, etc. shall be field located by the contractor, prior to cold planing operations.
8. Project stationing is based on As-built records from prior construction projects. To differentiate between similar stationing "F" for Front Street and "MS" for Mill Street is utilized through these areas.

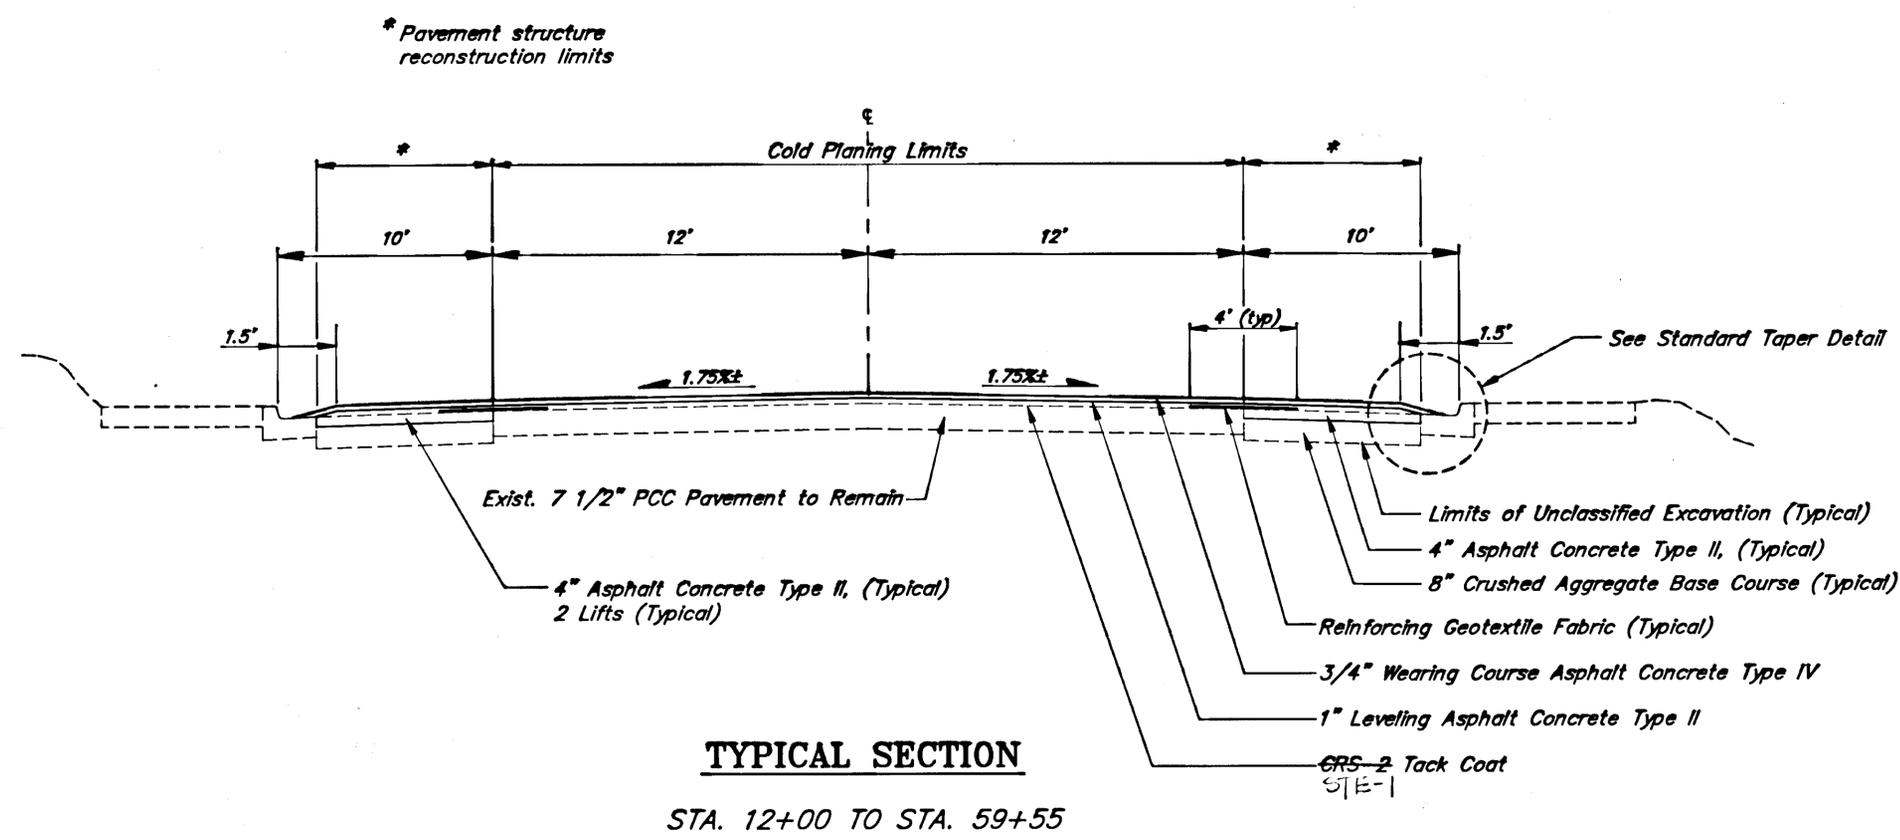

TYPICAL SECTION
STA. 12+00 TO STA. 59+55

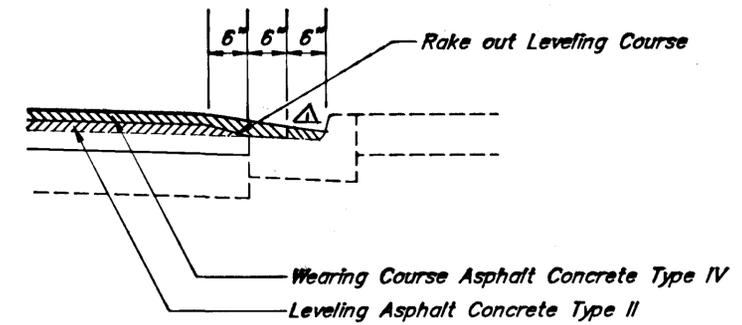

STANDARD TAPER DETAIL

AS BUILT


NOTE: DO NOT SCALE FROM THESE PLANS-USE DIMENSIONS

DATE:	DESCRIPTION OF CHANGE:
K.K 11/16/95	AS BUILT


STATE OF ALASKA
DEPARTMENT OF TRANSPORTATION
AND PUBLIC FACILITIES
SOUTHEAST REGION DESIGN & CONSTRUCTION

KETCHIKAN
TONGASS AVENUE PAVEMENT REHABILITATION
F-M-0902 (16) 70375
TYPICAL SECTION

ALASKA	DESIGNED BY: T.M.	SCALE NONE
	DRAWN BY: AUTOCADD/R.K.S.	DATE: MAY 1991
	CHECKED BY: P.J.	SHEET 2 OF 38

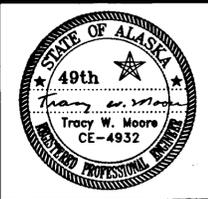


NOTES:
 ① Surface type varies.

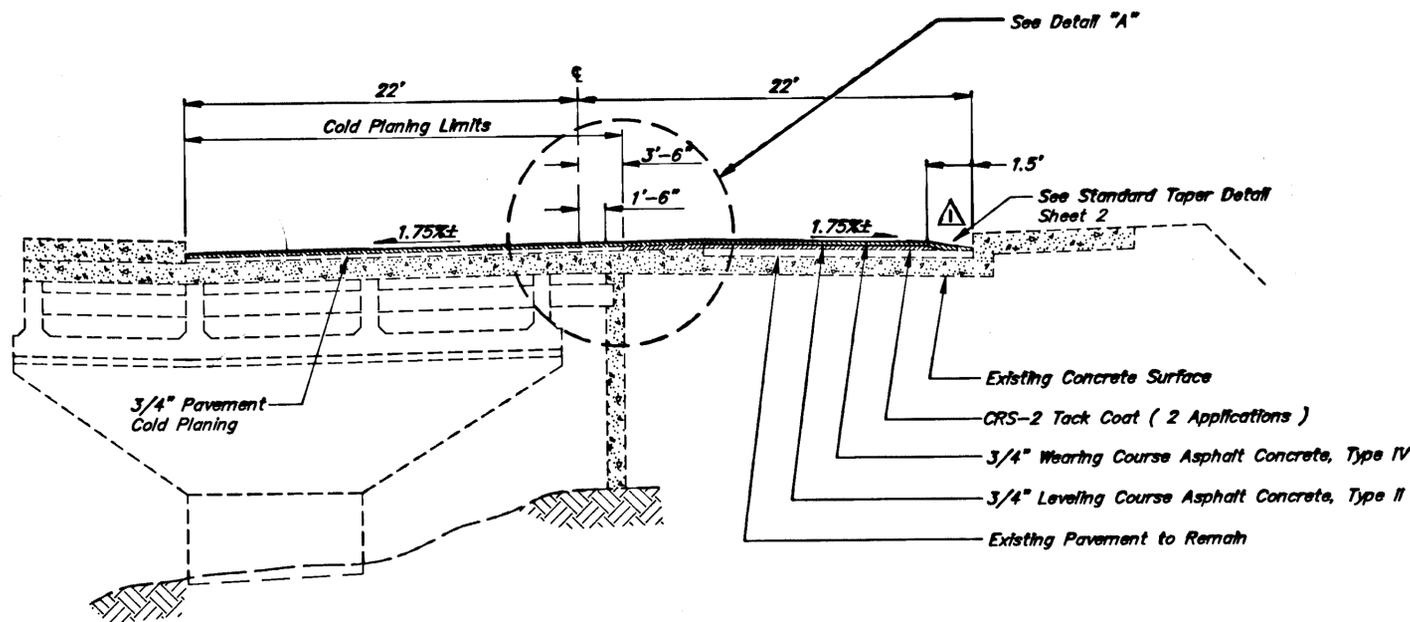


TYPICAL SECTION

"F" STA. 6+80.96 TO "F" STA. 0-23 (Front Street) 0+50 TO 1+75 NO PAVING
 "F" STA. 2+74.86 TO "F" STA. 5+21.60 (Viaduct Only, Rt.)

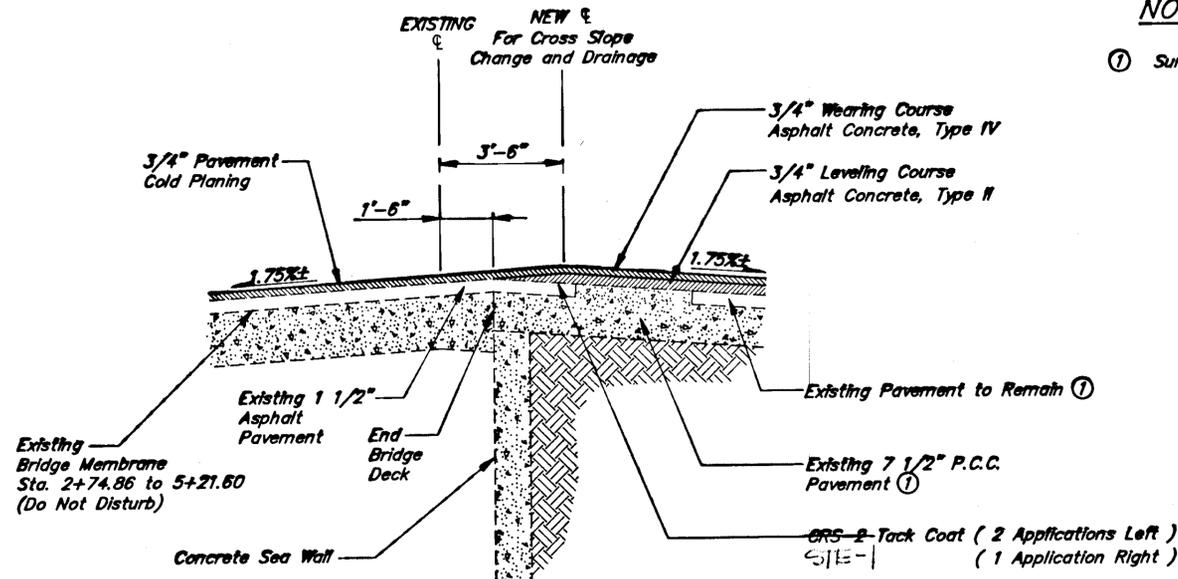


DETAIL "A"

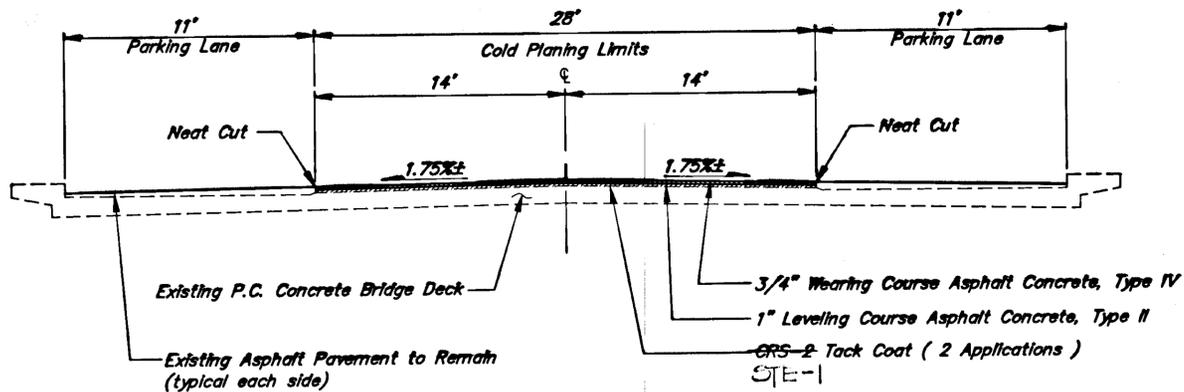

TYPICAL SECTION

STA. 100+67.78 TO STA. 117+80 AND (Tongass Avenue Viaduct)
 STA. 122+90 TO STA. 135+00 (Water Street Viaduct)

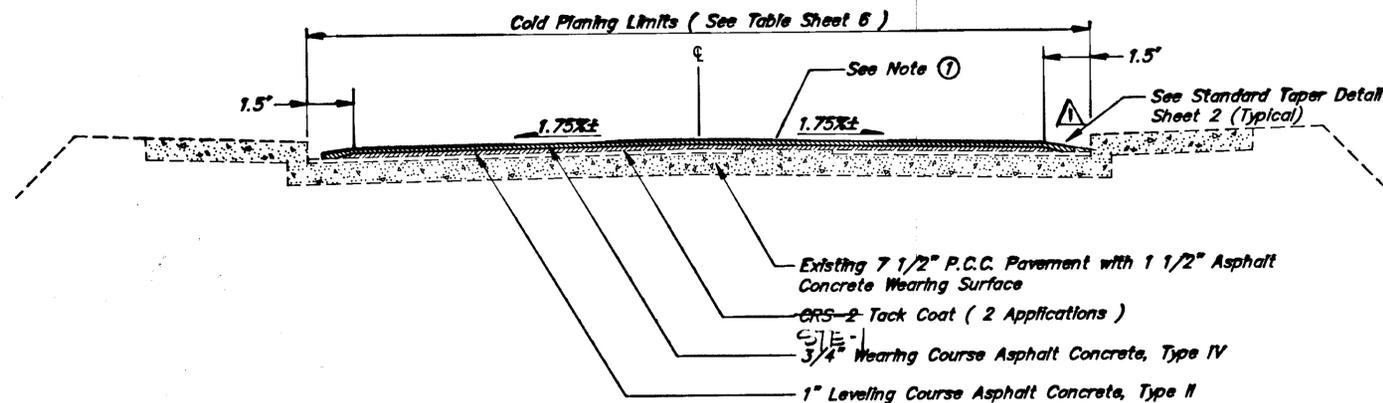

TYPICAL SECTION

STA. 117+80 TO STA. 122+90
 STA. 59+55 TO STA. 100+67.78

AS BUILT


NOTE: DO NOT SCALE FROM THESE PLANS-USE DIMENSIONS


NO.	DATE	DESCRIPTION OF CHANGE
1	11/16/95	AS BUILT

STATE OF ALASKA
 DEPARTMENT OF TRANSPORTATION
 AND PUBLIC FACILITIES
 SOUTHEAST REGION DESIGN & CONSTRUCTION

KETCHIKAN
 TONGASS AVENUE PAVEMENT REHABILITATION
 F-M-0902 (16) 70375
TYPICAL SECTION


DESIGNED BY:	T.M.	SCALE	NONE
DRAWN BY:	AUTOCADD/R.K.S.	DATE:	MAY 1991
CHECKED BY:	P.J.	SHEET	3 OF 38

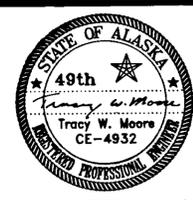

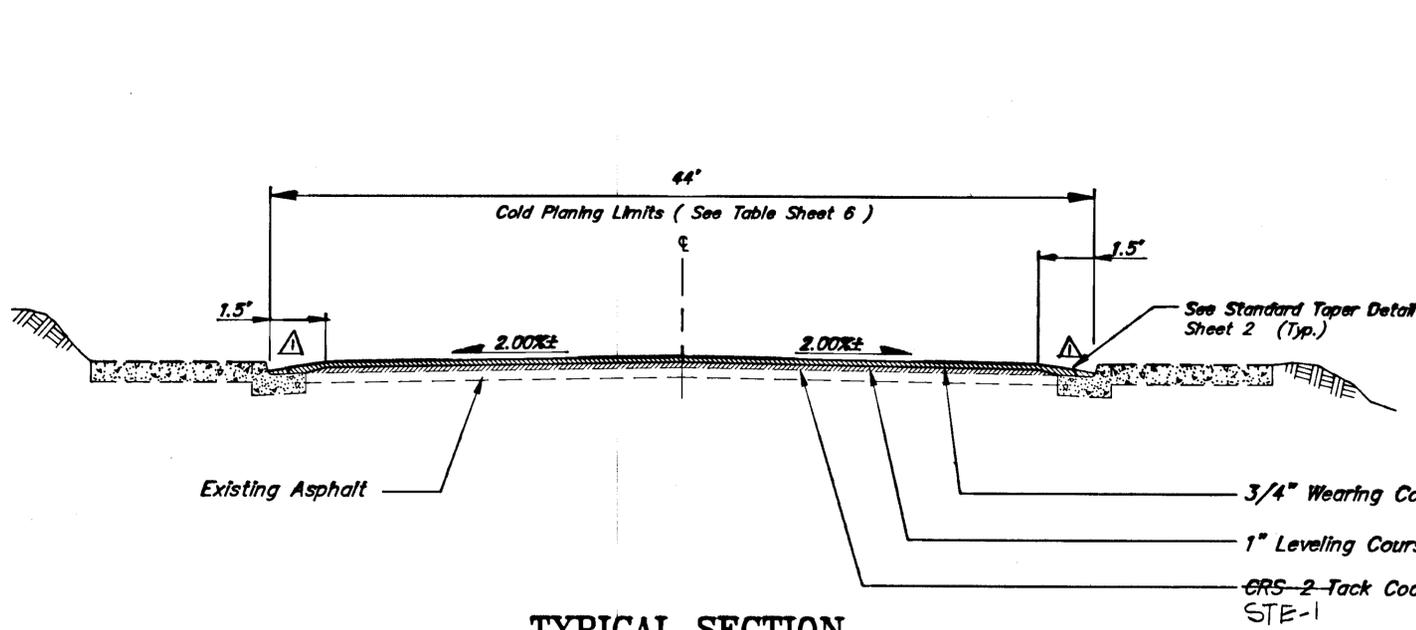


TYPICAL SECTION

"MS" STA. 3+50 TO "MS" STA. 26+00

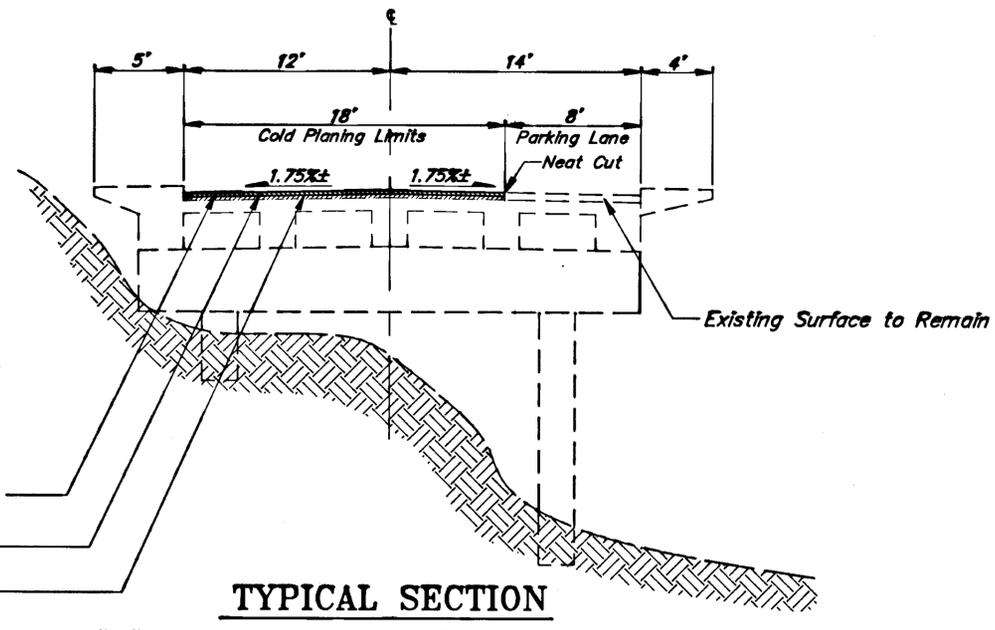


TYPICAL SECTION

"W" STA. 135+00 TO "W" STA. 139+35.44
(Water Street Viaduct)

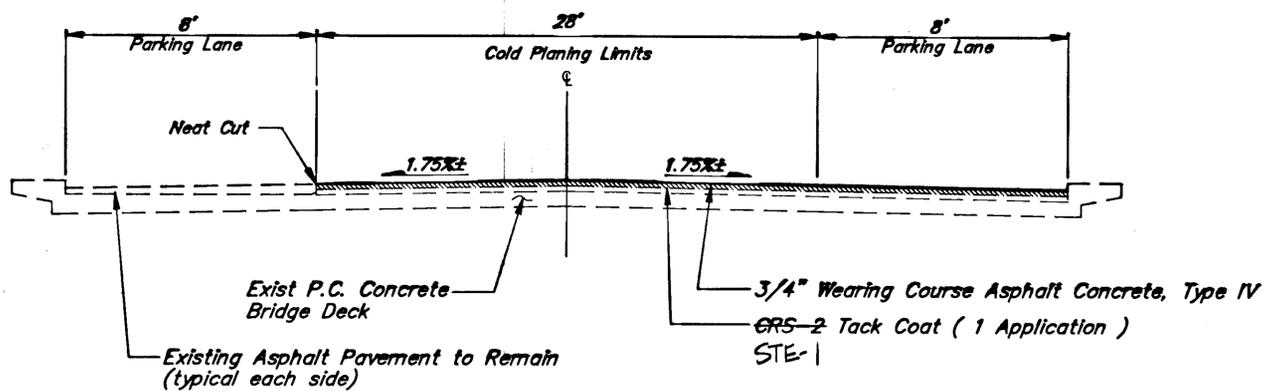

TYPICAL SECTION

"MS" STA. 0+42.64 TO "MS" STA. 3+50
Viaduct Only
(Mill Street Viaduct)

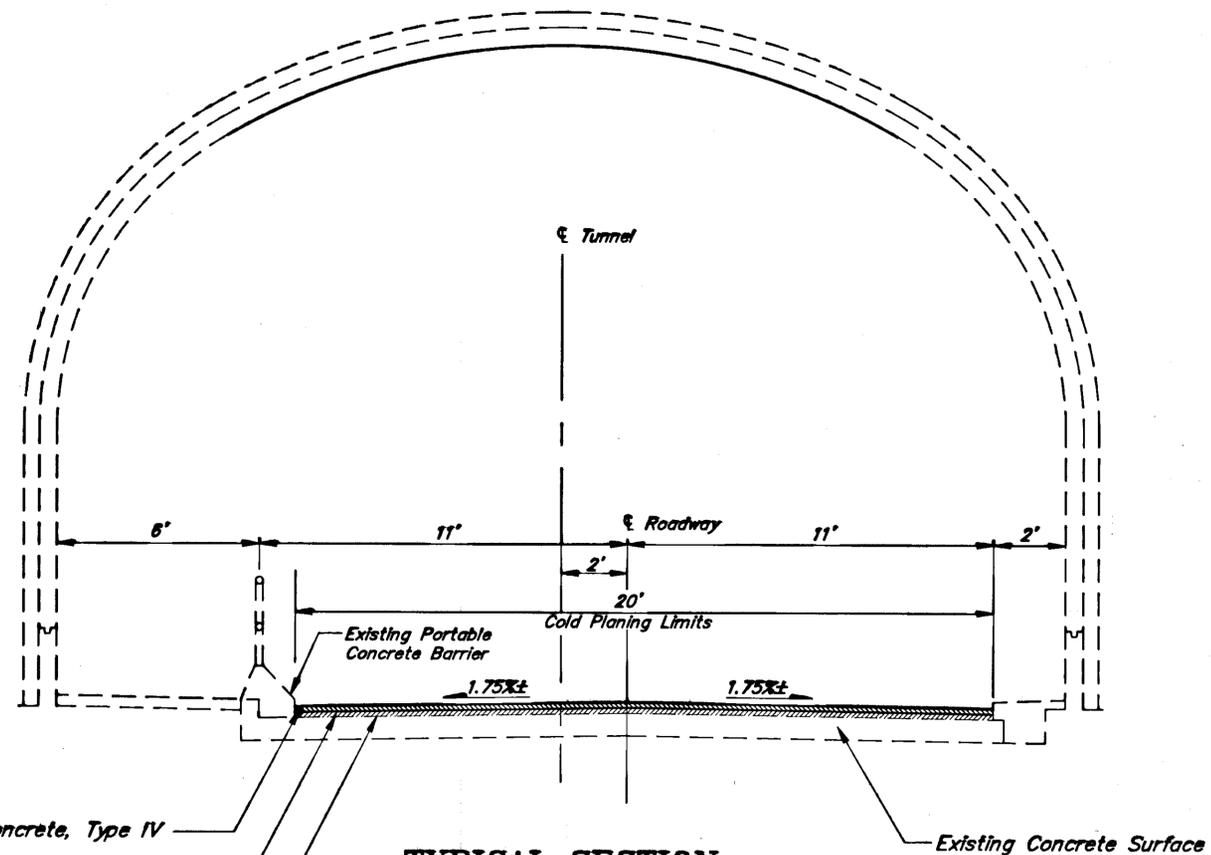

TYPICAL SECTION

"T" STA. 135+00 TO "T" STA. 138+39.80
(Tunnel)

AS BUILT


NOTE: DO NOT SCALE FROM THESE PLANS-USE DIMENSIONS

DATE:	DESCRIPTION OF CHANGE:
K. 11/16/95	ΔAG-BUILT

STATE OF ALASKA
DEPARTMENT OF TRANSPORTATION
AND PUBLIC FACILITIES
SOUTHEAST REGION DESIGN & CONSTRUCTION

KETCHIKAN
TONGASS AVENUE PAVEMENT REHABILITATION
F-M-0902 (16) 70375
TYPICAL SECTION
ALASKA

DESIGNED BY:	T.M.	SCALE	NONE
DRAWN BY:	AUTOCADD/R.K.S.	DATE:	MAY 1991
CHECKED BY:	P.J.	SHEET	4 OF 38

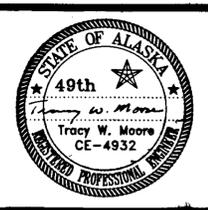

ESTIMATE OF QUANTITIES

ITEM NO.	ITEM	UNIT	TOTAL
109 (1)	JIM'S CREEK DRAINAGE (C.O.#4)	L.S.	13,192.02
120 (1)	DBE Adjustment 3,014.19	C.S.	All Req'd
202 (3)	Removal of Sidewalk (C.O.#5) 451.36	S.Y.	350
202 (9)	Removal of Curb and Gutter 651.5	L.F.	456
203 (3)	Unclassified Excavation 3046.27	C.Y.	2,370
203 (5)	BORROW (C.O.#5)	C.Y.	8.77
301 (1)	Crushed Aggregate Base Course 3,768.06	Ton	5,000
202 (12)	DRIVEWAY REMOVAL (C.O.#12)	L.S.	3,259.50
401 (1A)	Asphalt Concrete, Type II 8,168.63	Ton	8,100
401 (1B)	Asphalt Concrete, Type IV 4,273.11	Ton	3,900
401 (2)	AC-20 Asphalt Cement 702.45	Ton	764
402 (1)	CRS-2 Asphalt for Tack Coat 48.34	Ton	60
504 (4)	STRUCTURAL STEEL EXPANJT (C.O.#2)	L.S.	31,109.57
408 (1A)	Pavement Cold Planing - Asphalt (C.O.#2)	S.Y.	62,400
408 (2B)	Pavement Cold Planing - Concrete 1,850	S.Y.	1,850
409 (1)	Joint Repair 5,113.3	L.F.	7,000
501 (1)	CLASS A CONCRETE (C.O.#5)	L.S.	5,610
504 (3)	Structural Steel Expansion Joint (C.O.#2)	L.F.	50
508 (1)	Membrane Waterproofing 8,000.00	L.S.	All Req'd
508 (2)	Membrane Waterproofing for Patching	S.Y.	10
509 (1)	Concrete Patch Repair 33.32	S.Y.	60
506 (5)	TEMP. TIMBER WALKWAY (C.O.#5)	L.S.	829.41
604 (4)	Adjust Existing Manholes 80	Each	70
608 (1)	Concrete Sidewalk (C.O.#5) 603.17	S.Y.	350
608 (6)	Wheelchair Ramp (Bridge) 37	Each	8
608 (7)	Handicap Improvements 18,245.0	C.S.	All Req'd
508 (3)	BRIDGE MEMBRANE (C.O.#13)	S.Y.	335.81
609 (2)	Curb and Gutter, Type I 644.50	L.F.	456
609 (7)	Raised Median Curb 693.90	L.F.	873
614 (4A)	REPLACE EXISTING MON. CASES (C.O.#8)	EACH	19
614 (4)	Adjust Existing Monument Cases (C.O.#8)	Each	27 45
615 (1)	Standard Sign (C.O.#6) 727.6	S.F.	698
604 (B)	ADJUST EXISTING INLET (C.O.#12)	L.S.	600
627 (10A)	Type "A" Valve Box Adjustment (C.O.#7)	Each	18 25
627 (10B)	Type "B" Valve Box Adjustment	Each	20 35
627 (10C)	Type "C" Valve Box Adjustment	Each	110 210
627 (10E)	TYPE "E" VALVE BOX ADJUSTMENT (C.O.#7)	EACH	68
632 (1)	Geotextile for Pavement Reinforcement	S.Y.	4,250
604 (10)	UTILITY VAULT ADJUSTMENT (C.O.#12)	EACH	4287.12

ESTIMATE OF QUANTITIES

ITEM NO.	ITEM	UNIT	TOTAL
640 (1)	Mobilization and Demobilization	L.S.	All Req'd
641 (1)	Temporary Erosion and Pollution Control	C.S.	All Req'd
642 (1)	Construction Surveying	L.S.	All Req'd
643 (2)	Traffic Maintenance	L.S.	All Req'd
643 (3)	Permanent Construction Signing 1,636	Cal. Day	540
643 (4)	Construction Sign 886	Each Per Day	800
643 (5)	Type II Barricade 7,623	Each Per Day	700
643 (6)	Type III Barricade	Each Per Day	360 4
643 (7)	Traffic Cone	Each Per Day	10,000 13,191
643 (13)	Temporary Pavement Marking	Station	254 407.2
643 (15)	Flagging	Hour	2000 3A42.5
644 (6)	Engineering Transportation	L.S.	All Req'd
660 (11)	Conduit Enclosed Loop (C.O.#1)	Each	14
660 (12)	Saw Cut Loop	Each	8
660 (13)	Signal Head Replacement	L.S.	All Req'd
670 (1)	Painted Traffic Markings	L.S.	All Req'd
670 (8)	Recessed Pavement Markers 1,037	Each	1,500
670 (9)	Thermoplastic Pavement Markings	L.S.	All Req'd

BASIS OF ESTIMATE

ITEM NO.	ESTIMATING FACTOR
301 (1)	2.04 Tons/Cubic Yard
401 (1)	123 Lbs./Sq. Yd./Inch Depth
401 (2)	7.0% of Item 401 (1B), Type IV + 6.0% of Item 401 (1A), Type II
402 (1)	0.1 Gal./Sq. Yd. - 253 Gal./Ton @ 60' F.
508 (1)	Hoadly Creek Bridge = 300 Yd. ³

Handwritten notes and arrows pointing to specific rows in the first table, including '13,191', '407.2', and '3A42.5'.

AS BUILT


NOTE: DO NOT SCALE FROM THESE PLANS-USE DIMENSIONS


DATE	DESCRIPTION OF CHANGE
11/16/93	As Built

STATE OF ALASKA
DEPARTMENT OF TRANSPORTATION
AND PUBLIC FACILITIES
SOUTHEAST REGION DESIGN & CONSTRUCTION


KETCHIKAN TONGASS AVENUE PAVEMENT REHABILITATION
F-M-0902 (16) 70375
ESTIMATE OF QUANTITIES

DESIGNED BY: T.M.	SCALE: NONE
DRAWN BY: AUTOCADD/R.K.S.	DATE: MAY 1991
CHECKED BY: P.J.	SHEET 5 OF 38

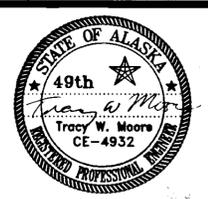


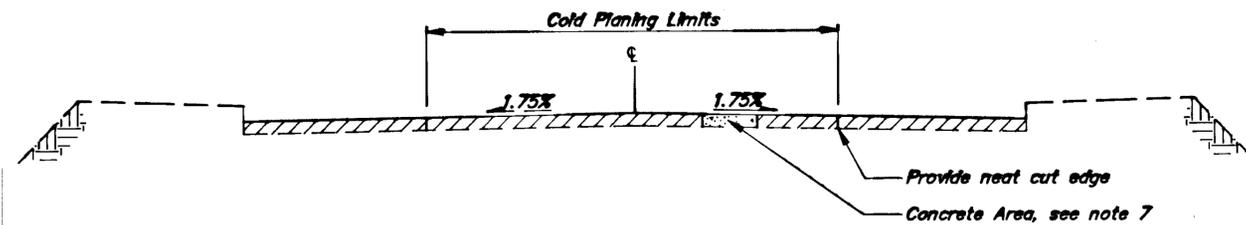

SECTION A

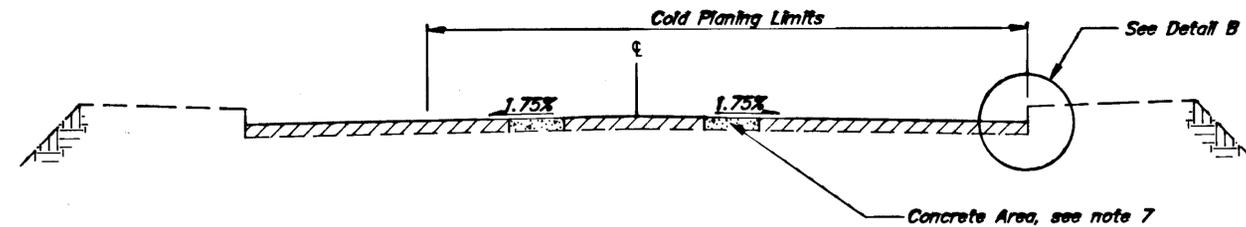


SECTION B

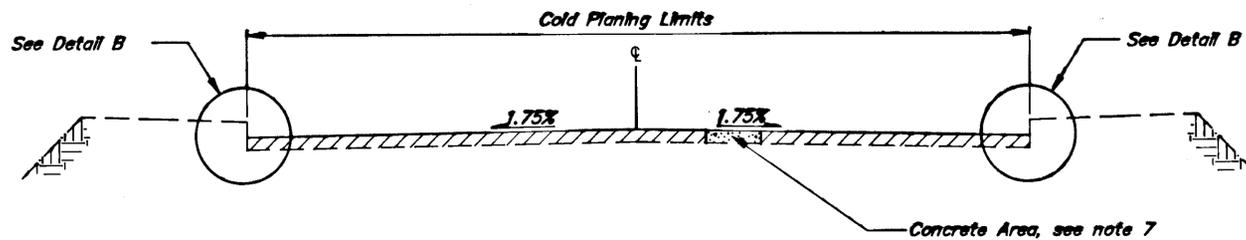


SECTION C

LOCATION	DEPTH
CARLANNA CREEK BRIDGE*	1 1/2" AVERAGE DEPTH
HOADLY CREEK BRIDGE *	1 1/2" AVERAGE DEPTH
TONGASS AVENUE VIADUCT	REMOVE ALL AC. SEE NOTE 3
WATER STREET VIADUCT	REMOVE ALL AC. SEE NOTE 3
FRONT STREET VIADUCT *	3/4" AVERAGE DEPTH
MILL STREET VIADUCT *	3/4" AVERAGE DEPTH
KETCHIKAN CREEK BRIDGE	1 1/2" MAXIMUM DEPTH

* INDICATES BRIDGE MEMBRANE AREAS. SEE DETAIL (A) AND NOTE 10 BELOW.

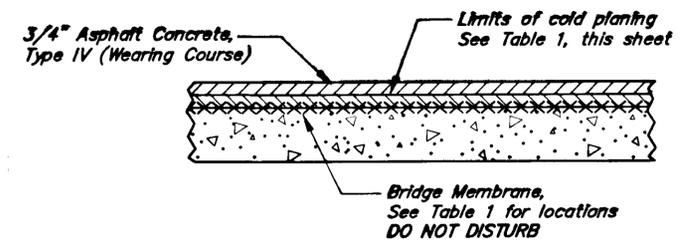

**Bridge Deck Cold Planing in Membrane Areas
DETAIL A**

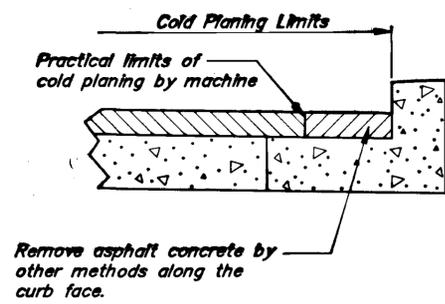

DETAIL B

STATION TO STATION	SECTION TYPE	WIDTH	DEPTH	REMARKS
BOP to 21+35	A	24'	2"	Shoulder reconstruction area-See note 9
22+25 to 59+55	A	24'	2"	Shoulder reconstruction area-See note 9
59+25 to 88+00	B	43'	1 1/2"	Omit parking area Lt
88+00 to 100+79	A	36'	2"	Omit parking areas Lt & Rt
100+79 to 118+00	A	30'	1 3/4"	Tongass Avenue Viaduct
118+00 to 125+00	C	50'	1 1/2"	Full width grinding
125+00 to 133+50	A	34'	2"	Omit parking areas-Water Street Viaduct
"W" 133+50 to "W" 139+35 Rt	B	18'	1 1/2"	Water Street Viaduct
"T" 133+50 to "T" 139+35 Lt	C	21'	1 1/2"	Tunnel area
Front Street Viaduct	C	21'	3/4"	See note 3
Mill Street Viaduct	B	36'	3/4"	See note 3
"MS" 0+42.64 to "MS" 3+50	B	36'	3/4"	
"MS" 3+50 to "MS" 6+00	C	44'	2"	
"MS" 6+00 to "MS" 8+50	B	36'	1"	Omit parking area
"MS" 8+50 to "MS" 26+50	A	28'	1"	Omit parking area

COLD PLANING NOTES

1. Cold planing widths and depths may vary and are subject to minor revisions by the Engineer.
2. The depth of cold planing shall vary according to the depth of the wheel ruts. The intent of the cold planing is to provide a uniform cross sloped surface free of ruts and edge lips for overlaying with asphalt concrete.
3. The Contractor has the option to use other techniques to remove the pavement on the Tongass Avenue and Water Street viaducts.
4. The material removed during the cold planing shall be stockpiled at DOT/PF shuttle ferry overflow parking lot.
5. Traffic loop detectors damaged during the cold planing operations shall be replaced or repaired within 36 hours of being damaged. See Section 660 of the Special Provisions.
6. When not cold planing full width (Section "C"), the limits of cold planing shall be adjusted to just outside the existing overlay lip, as directed by the Engineer.
7. Cold planing in concrete is required. Stations and areas have been estimated and shown on Sheet 7.
8. From Station 12+00 to 59+55 the asphalt shoulders require complete removal and reconstruction. See Section 203 of the Special Provisions.
9. Cold planing operations shall commence on the lower of roadway to facilitate drainage.
10. The bridge membrane on Hoadly Creek bridge is scheduled for replacement; approximately 300 square yards is required.


AS BUILT

DATE	DESCRIPTION OF CHANGE
R.K. 11/16/91	AS BUILT


STATE OF ALASKA
DEPARTMENT OF TRANSPORTATION AND PUBLIC FACILITIES
SOUTHEAST REGION DESIGN & CONSTRUCTION

KETCHIKAN
TONGASS AVENUE PAVEMENT REHABILITATION
F-M-0902 (16) 70375
ALASKA
PAVEMENT COLD PLANING DETAILS


DESIGNED BY: T.M.	SCALE: NONE
DRAWN BY: AUTOCAD/R.K.S.	DATE: MAY 1991
CHECKED BY: P.J.	SHEET 6 OF 38

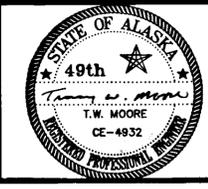

NOTE: DO NOT SCALE FROM THESE PLANS-USE DIMENSIONS

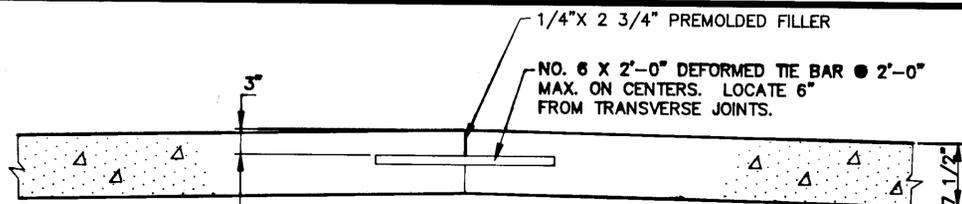


CENTERLINE CONSTRUCTION JOINT

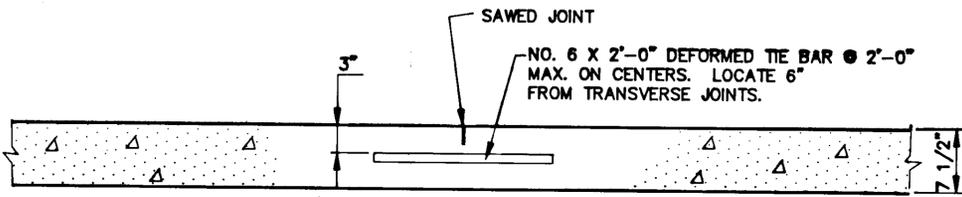


LONGITUDINAL CONTRACTION JOINT

AND


CENTERLINE JOINT - FULL WIDTH CONSTRUCTION

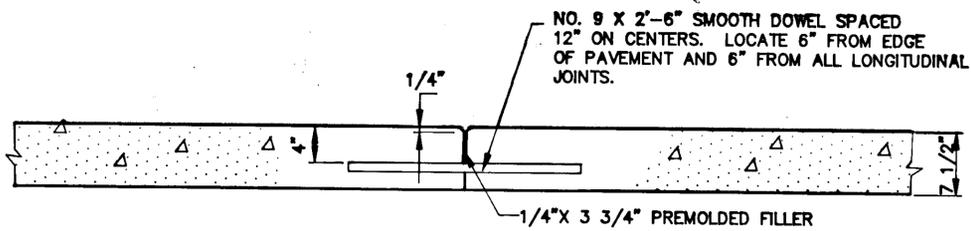

CONSTRUCTION JOINT

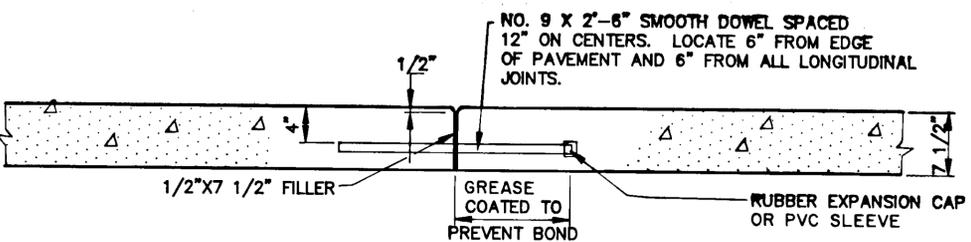


EXPANSION JOINT

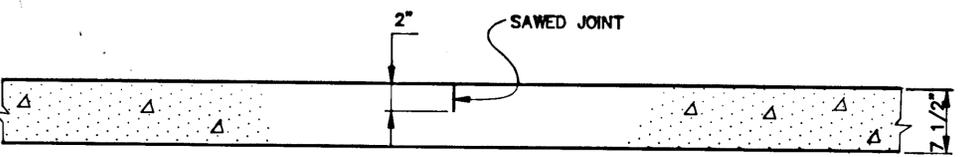


TRANSVERSE CONTRACTION JOINT

DOWELING SCHEDULE FOR CONCRETE PAVEMENT WORK

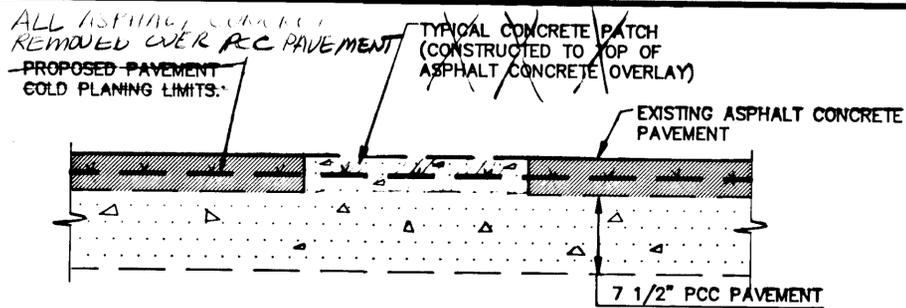

CONCRETE COLD PLANING DETAIL

1. VALVE BOX SHALL REMAIN IN FINAL POSITION TO TAPER NEW PAVEMENT AROUND VALVE BOX AS DIRECTED.
2. LEAVE A MINIMUM OF A 1 FOOT COLLAR ALL AROUND VALVE BOX IN A SQUARE PATTERN.

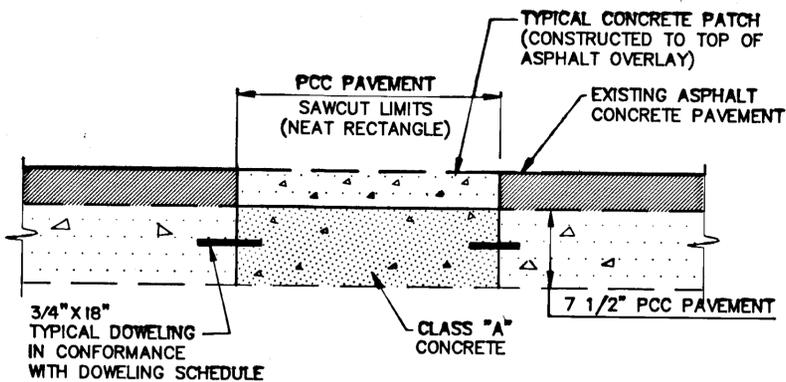

CONCRETE PATCH REPAIR DETAIL

1. COVER WORK AREA WITH STEEL PLATE TO ALLOW TRAFFIC ON PATCH AREA BEFORE CONCRETE HAS CURED.
2. RECONSTRUCT NEW CONCRETE TO TOP OF EXISTING PCC PAVEMENT.
3. IN ADDITION TO THE DOWELS SHOWN IN THE DOWELING SCHEDULE A MINIMUM OF DOWEL EVERY 2' SHALL BE USED ON ALL PATCHES.

PORTLAND CONCRETE PAVEMENT SUMMARY

ITEM 408 (1), ITEM 509 (8)

STATION	OFFSET		GRINDING AREA S.Y.	REPAIR AREA S.Y.	REMARKS
	LT.	RT.			
19+60	3'			-6	WATER LINE REPAIR AREA
27+28+1575	8' TO 20'		15.6	-11.67	WATER MAIN TO KSY
29+85	5'			-1	TWO VALVES SET IN CONCRETE
31+00			16.87	-9.8	
32+90				-2.3	ROAD REPAIR AREA
38+00			-75		
39+40		2'	3		ROAD REPAIR AREA
40+30	5' TO 20'		-27		
43+25		18'	28		CONCRETE DRIVEWAY APPROACH
48+80				2.3	CRACKED PATCH FOR WATER LINE
55				7.5	
50+90+80	2'		10.67	4	ROAD REPAIR AREA
56+75			41.267		WATER LINE REPAIR AREA
59+50		15'		-2.2	UNBONDED PATCH AT MANHOLE
67+50			-50		RUTS IN CONCRETE PAVEMENT
70+80				12.5	WATERLINE REPAIR, BOND BREAKER AT 2" DEPTH
74+90			11.66	-17	
75+60			17		VISQUEEN BOND BREAKER LOCATED AT 2" DEPTH
80+80			11.66	14	ROADWAY PATCH NEXT TO ASPHALT PATCH
93+60			2.84		MANHOLE PATCH
94+30			7.8		VISQUEEN BOND BREAKER LOCATED AT 2" DEPTH
95+50					MANHOLE PATCH
119			19.16	230	
120+10			-5.6		
121+90			-5.8		
122+30			-6.8		
122+85			-6.8		
124			1300	6.8	
126+00			2.18	4.5	
"MS" 23+00			2		
"MS" 24+00			12		
ADDED					
"O" 27+75				10.95	
100+78LT	X			2.22	

* IN AREAS WHERE REPAIRING AND PATCHING IMPACTS EXISTING JOINTS, THE NEW WORK SHALL UTILIZE THE DOWELING SCHEDULE SHOWN ON THIS SHEET, AS DIRECTED BY THE ENGINEER.

AS BUILT

DATE:	DESCRIPTION OF CHANGE:
11/16/95	AS BUILT

STATE OF ALASKA
DEPARTMENT OF TRANSPORTATION
AND PUBLIC FACILITIES
SOUTHEAST REGION DESIGN & CONSTRUCTION

KETCHIKAN

TONGASS AVENUE PAVEMENT REHABILITATION
F-M-0902 (16) 70375

ALASKA


DESIGNED BY: T.W. MOORE
DRAWN BY: AUTOCADD/C. Anderson
CHECKED BY: P. JONES

PROJECT NO. 70375
DATE: MAY, 1991
SHEET 7 OF 38



MISCELLANEOUS DETAILS

NOTE: DO NOT SCALE FROM THESE PLANS-USE DIMENSIONS

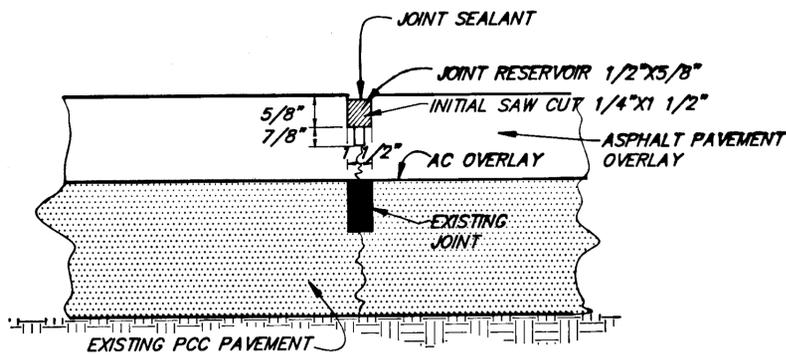

JOINT REPAIR DETAIL


SEE SECTION 409 OF THE SPECIAL PROVISIONS

JOINT CRACK REPAIR SUMMARY				
STATION TO STATION	WIDTH	INTERVAL	REMARKS	
12+00	59+55	24'	50'	
59+55	100+79	50'	50'	
100+79	117+80	50'	30'	
117+80	125+00	50'	30'	
125+00	133+50	50'	30'	
133+50 RT.	139+50 RT.	18'	30'	
133+50 LT.	139+50 LT.	21'	30'	
"MS" 0+42 LT.	"MS" 3+60	44'	50'	
"F" 0+23.00	"F" 6+80	22'	50'	

AREAS TO BE SELECTED BY THE ENGINEER. APPROXIMATELY 50% OF ROADWAY AREAS WILL BE GROOVED AND SEALED. SEE SECTION 409 OF THE SPECIFICATIONS.

WHEEL CHAIR SUMMARY			
STATION	LT.	RT.	REMARKS
0 88+15		X	STANDARD
102+55	X		BRIDGE STRUCTURE*
112+25		X	BRIDGE STRUCTURE*
112+45		X	BRIDGE STRUCTURE*
127+35	X		BRIDGE STRUCTURE*
123+70	X		STANDARD BRIDGE ST.
123+70		X	STANDARD BRIDGE ST.
130+10	X		BRIDGE STRUCTURE*
130+30	X		BRIDGE STRUCTURE*
"T" 135+05	X		STANDARD
"T" 135+05		X	STANDARD
"W" 135+07	X		STANDARD
"F" 2+20	X	X	STANDARD
"F" 2+70	X	X	BRIDGE STRUCTURE* STD
"F" 6+20		X	STANDARD
"MS" 0+45	X	X	BRIDGE STRUCTURE*
"MS" 4+67	X		STANDARD
"MS" 5+12		X	STANDARD
"MS" 5+12	X		STANDARD
"MS" 15+25	X		STANDARD
"MS" 15+25		X	STANDARD
"MS" 20+00		X	STANDARD
"MS" 20+20	X	X	STANDARD
"MS" 26+00	X		STANDARD
"MS" 26+25	X		STANDARD
"O" 64+50		X	STANDARD

* SEE BRIDGE STRUCTURE WHEELCHAIR DETAIL SHT. B

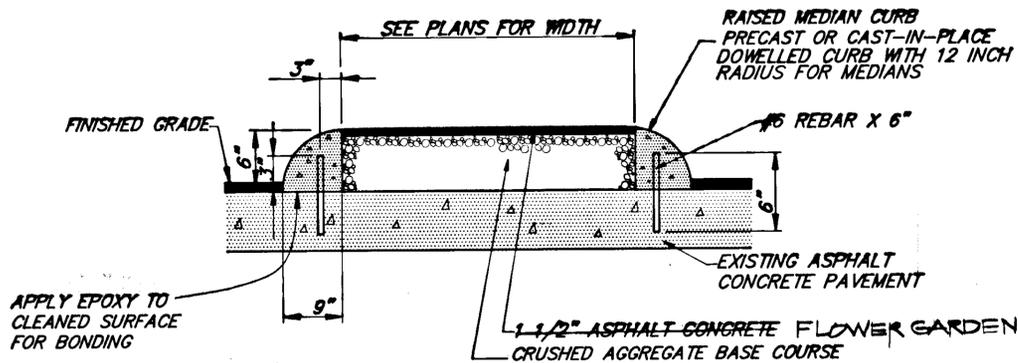


RAISED MEDIAN ISLAND DETAIL

SEE SHEET 17


DOWELED CURB NOTES

1. REBAR SHALL BE 60-INCHES O.C. EXCEPT AT ENDS OF ISLAND WHERE SPACING SHALL BE 30 INCHES O.C.
2. EPOXY CEMENT SHALL NOT BE SUBSTITUTED FOR #6 VERTICAL REBAR PINS.
3. ASPHALT MAY BE HAND PLACED AND COMPACTED AS DIRECTED BY THE ENGINEER.
4. ACTUAL DEPTH OF CURB SHALL BE 8" TO ALLOW 6" ± ABOVE FINISHED GRADE.
5. NO DOWELING WILL BE ALLOWED ON BRIDGE STRUCTURE.

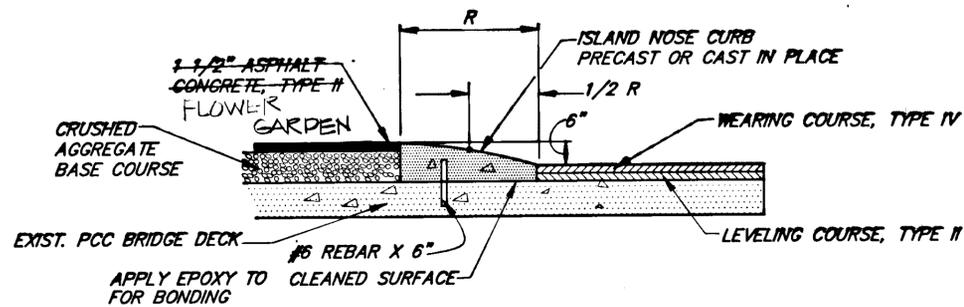


SECTION A-A ISLAND NOSE DETAIL

RAISED MEDIAN CURB

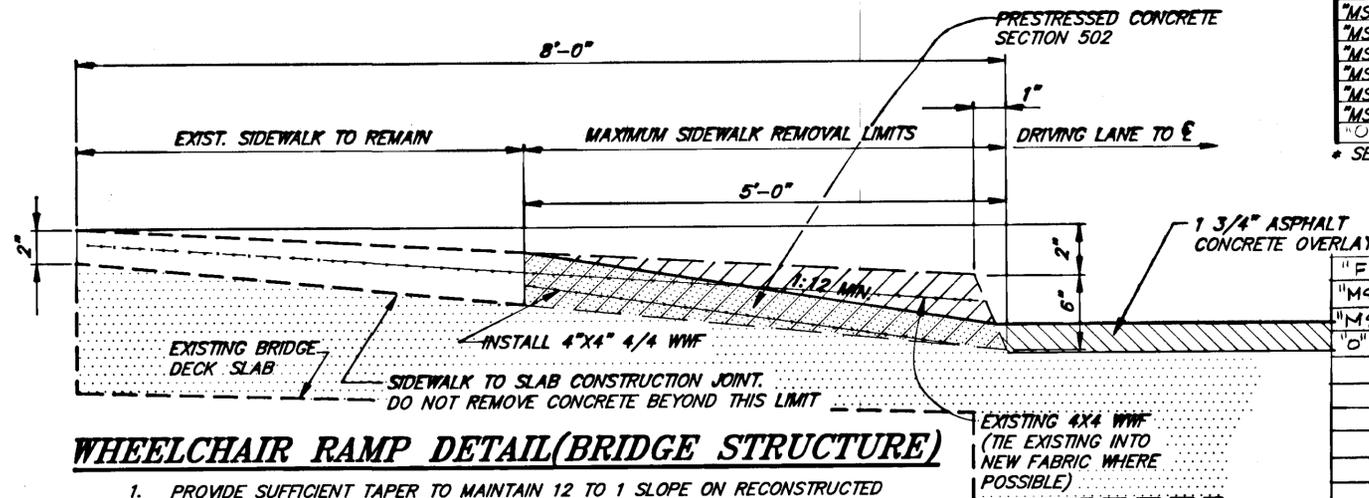

WHEELCHAIR RAMP DETAIL (BRIDGE STRUCTURE)

1. PROVIDE SUFFICIENT TAPER TO MAINTAIN 12 TO 1 SLOPE ON RECONSTRUCTED PORTION.
2. PRESSURE CLEAN SURFACE PRIOR TO PLACING CONCRETE.
3. EXISTING SIDEWALK REMOVAL SHALL BE DONE IN A MANNER AS NOT TO DAMAGE THE BRIDGE DECK SLAB BENEATH OR AROUND THE AFFECTED AREA.
4. PROVIDE NEAT SAW CUT EDGE TO FORM AGAINST.

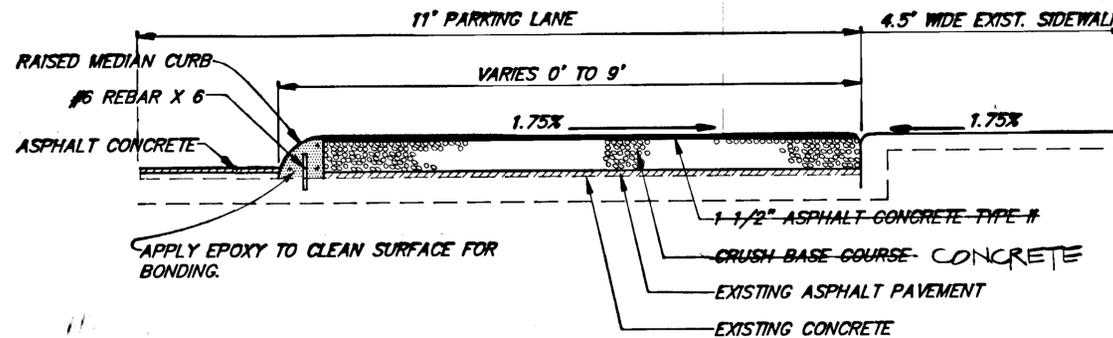

RAISED CHANNELIZATION DETAIL

SEE SHEET 17

1. NO DOWELING WILL BE ALLOWED ON BRIDGE STRUCTURE.
2. THE CONTRACTOR SHALL SLOPE THE RAISED AREA TO DRAIN ALONG EACH SIDE OF THE CURB INTERFACE. NO LIP GREATER THAN 1 1/2" WILL BE ALLOWED.

CONT'D.

STATION	LT.	RT.	REMARKS
"F" 2+70	X		STANDARD
"M" 0+45	X		STANDARD
"MS" 0+50	X		BRIDGE STRUCTURE
"O" 100+95	X		
101+20		X	
102+35		X	
102+50		X	
107+95		X	
108+05		X	
108+95		X	
109+05		X	
111+30		X	
111+50		X	
114+60		X	
114+75		X	
120+50		X	
120+60		X	
121+80		X	
121+90		X	
124+50		X	
124+60		X	
126+00	X		
127+30		X	
127+40		X	
134+00		X	
134+40		X	
134+80		X	
135+20		X	
136+50		X	
136+60		X	
137+00		X	

AS BUILT

NO.	DATE	DESCRIPTION OF CHANGE
K.K.	11/16/95	AS BUILT

STATE OF ALASKA
DEPARTMENT OF TRANSPORTATION
AND PUBLIC FACILITIES
SOUTHEAST REGION DESIGN & CONSTRUCTION

KETCHIKAN

TONGASS AVENUE PAVEMENT REHABILITATION
F-M-0902(16) 70375

MISCELLANEOUS DETAILS

NOTE: DO NOT SCALE FROM THESE PLANS-USE DIMENSIONS

ALASKA

DESIGNED BY: T.W. MOORE

DRAWN BY: AUTOCADD/C. Anderson

CHECKED BY: P. JONES

PROJECT NO. 70375

DATE: MAY, 1991


SHEET 8 OF 38

ENGINEER'S SEAL




SIDEWALK, CURB AND GUTTER NOTES


1. CURB AND GUTTER EXPANSION JOINTS SHALL BE PLACED AT EACH END OF THE CURB RETURN, AT 20' INTERVALS BETWEEN CURB RETURNS, AND CONTINUOUSLY BETWEEN THE BACK OF THE NEW CONCRETE CURB AND THE ADJACENT EDGE OF THE NEW CONCRETE SIDEWALK.
2. SIDEWALK EXPANSION JOINTS SHALL BE PLACED OPPOSITE AN ADJOINING CURB AND GUTTER EXPANSION JOINT. DUMMY JOINTS SHALL BE PLACED AT 5' INTERVALS BETWEEN EXPANSION JOINTS.

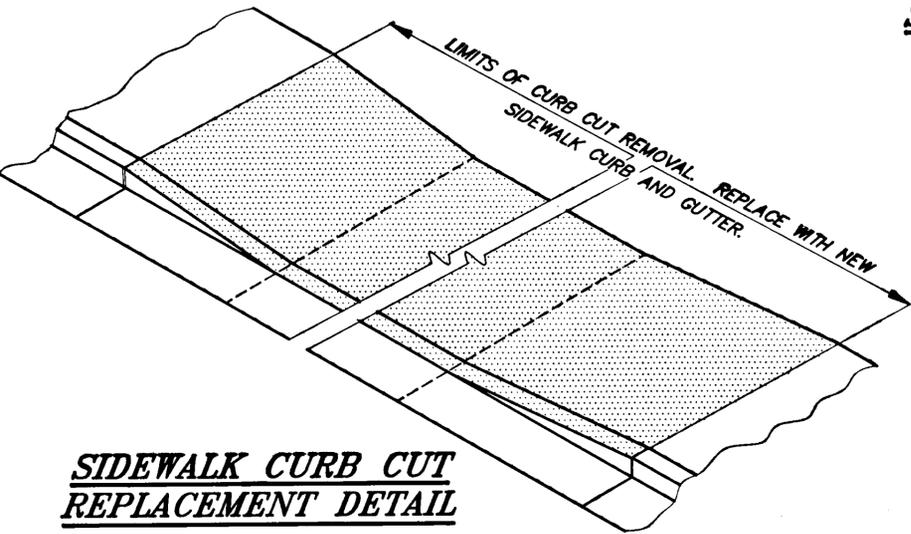

SIDEWALK CURB CUT REPLACEMENT DETAIL

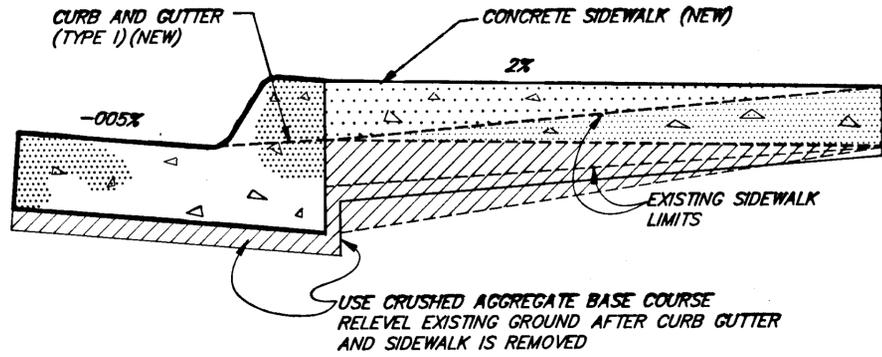


CURB-CUT REPLACEMENT DETAIL

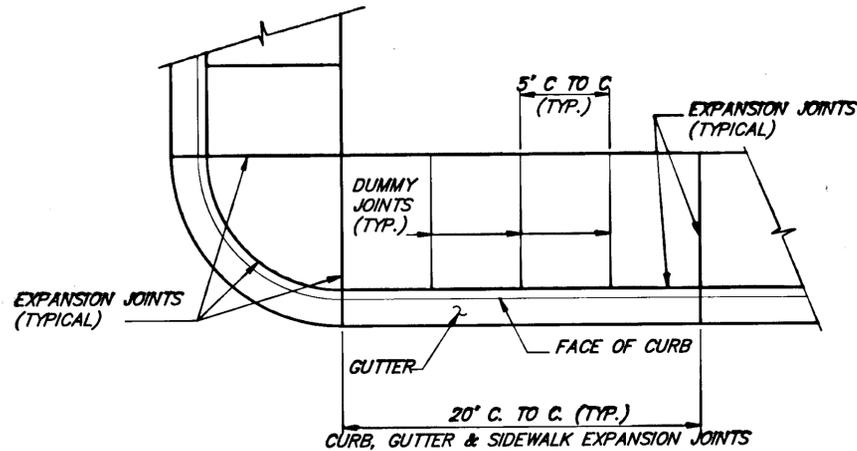


PLAN

SIDEWALK, CURB, & GUTTER JOINT DETAILS

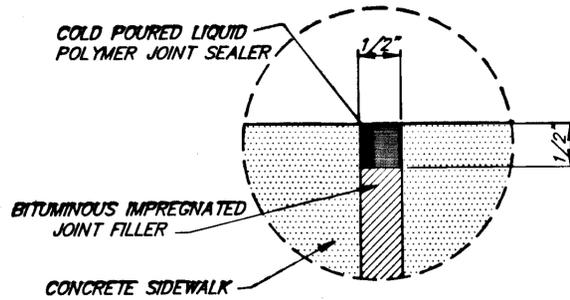


JOINT SEAL DETAIL

TYPICAL OF ALL SIDEWALK, CURB & GUTTER EXPANSION JOINTS

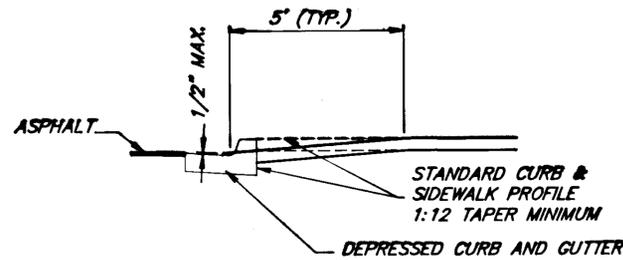

SECTION A-A

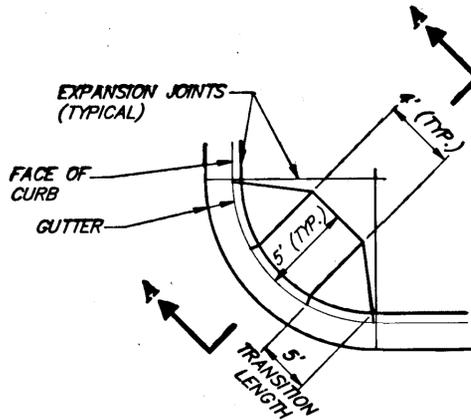

PLAN

WHEELCHAIR RAMP DETAILS


(STANDARD)

CURB CUT REPLACEMENT SUMMARY


STATION	WIDTH	LENGTH	S.Y AREA	REMARKS
62+00 RT.	7.5'	17.8'	14.85	REPLACE EXISTING CURB-CUT
62+40 RT.	7.5'	18.0'	15.19	REPLACE EXISTING CURB-CUT
65+50 RT.	7.5'	14.3'	10.84	REPLACE EXISTING CURB-CUT
73+25 RT.	0	58.0'	0	50 L.F. OF DAMAGED CURB FACE
76+25 RT.	7.5'	25.0'	21.08	REPLACE EXISTING CURB-CUT
84+25 RT.	7.5'	27.5'	23.21	REPLACE EXISTING CURB-CUT
84+80 RT.	7.5'	27.5'	23.21	REPLACE EXISTING CURB-CUT
85+20 RT.	7.5'	27.5'	23.21	REPLACE EXISTING CURB-CUT
86+40 RT.	7.5'	28.5'	24.41	REPLACE EXISTING CURB-CUT
86+60 RT.	7.5'	27.5'	23	REPLACE EXISTING SIDEWALK
86+80 RT.	7.5'	27.5'	23	REPLACE EXISTING CURB-CUT
99+70 RT.	5.0'	48.5'	27	EXISTING CURB CUT NEEDS REPAIR
100+50 RT.	5.0'	66.0'	33.49	UNNECESSARY CURB CUT NEXT TO DRIVING LANE. REPLACE SIDEWALK
122+75 RT.	4'	25'	11.2	ELIMINATE 25' OF CURB CUT & ADD 25' SIDEWALK
125+20 RT.	32'			INSTALL NEW CURBCUT IN CHANNELIZATION AREA
		TOTAL	322 S.Y.	

SIDEWALK WIDENING SUMMARY

STATION	RT.	LT.	REMARKS
23+45	X		WIDEN EXISTING SIDEWALK
25+50	X		WIDEN EXISTING SIDEWALK
30+15	X		WIDEN EXISTING SIDEWALK
36+25	X		WIDEN EXISTING SIDEWALK
45+60	X		WIDEN EXISTING SIDEWALK
47+30	X		WIDEN EXISTING SIDEWALK
57+00	X		WIDEN EXISTING SIDEWALK
57+45	X		WIDEN EXISTING SIDEWALK

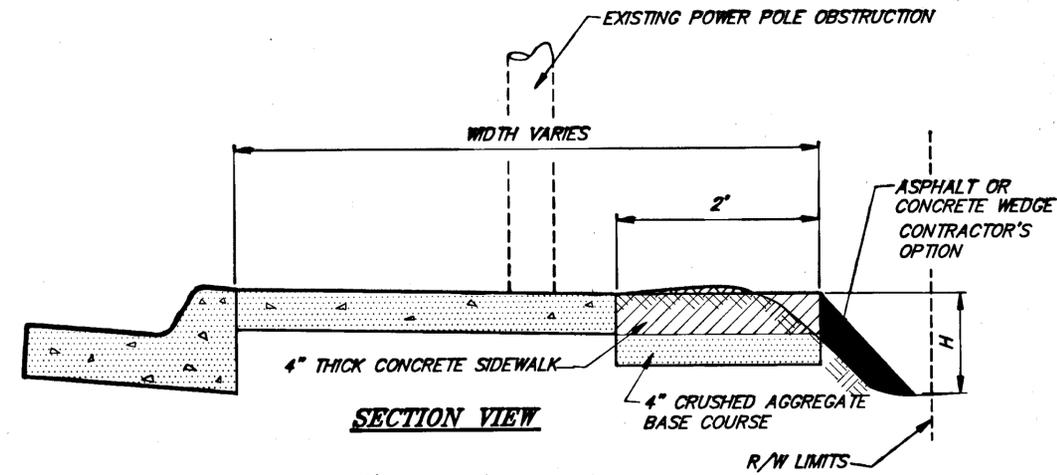

SECTION VIEW

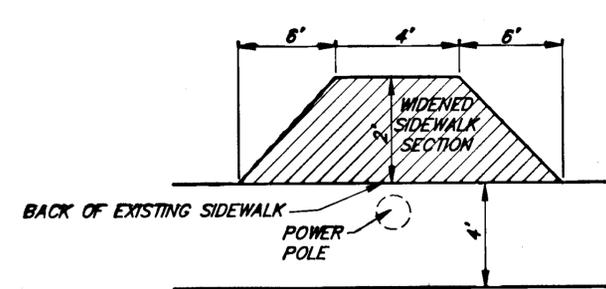

**PLAN VIEW
SIDEWALK WIDENING DETAIL**

1. THE EXISTING SIDEWALK SHALL BE WIDENED APPROX. 2 FEET OR TO THE R/W WHICHEVER IS LESS.
2. ASPHALT CONCRETE WEDGES SHALL BE REQUIRED WHEN "H" EXCEEDS 6".

AS BUILT

NOTE: DO NOT SCALE FROM THESE PLANS-USE DIMENSIONS

DATE	DESCRIPTION OF CHANGE
11/16/91	AS BUILT

STATE OF ALASKA
DEPARTMENT OF TRANSPORTATION AND PUBLIC FACILITIES
SOUTHEAST REGION DESIGN & CONSTRUCTION

KETCHIKAN

TONGASS AVENUE PAVEMENT REHABILITATION
F-M-0902(16) 70375
SIDEWALK CURB CUT DETAILS

ALASKA


DESIGNED BY: T.W. MOORE
DRAWN BY: AUTOCADD/CSA
CHECKED BY: P. JONES

PROJECT NO. 70375
DATE: MAY, 1991
SHEET 9 OF 38



ELASTOMERIC CONCRETE NOTES

1. AFTER PLACING THE LEVELING COURSE THE ASPHALT CONCRETE MATERIAL SHALL BE REMOVED AND THE EXISTING DECK SURFACE SHALL BE CLEANED BY SAND BLASTING.
2. SURFACE SHALL BE PRIMED WITH MANUFACTURER'S APPROVED PRODUCT.
3. THE JOINT AND SURFACE MUST BE DRY AT THE TIME OF INSTALLATION AND THE MINIMUM TEMPERATURE IS 45° F.
4. TRAFFIC MAY USE JOINT AFTER A 1 HOUR CURING PERIOD.
5. MIXTURE SHALL BE PREPARED AND PLACED IN ACCORDANCE WITH MANUFACTURER'S SPECIFICATIONS.

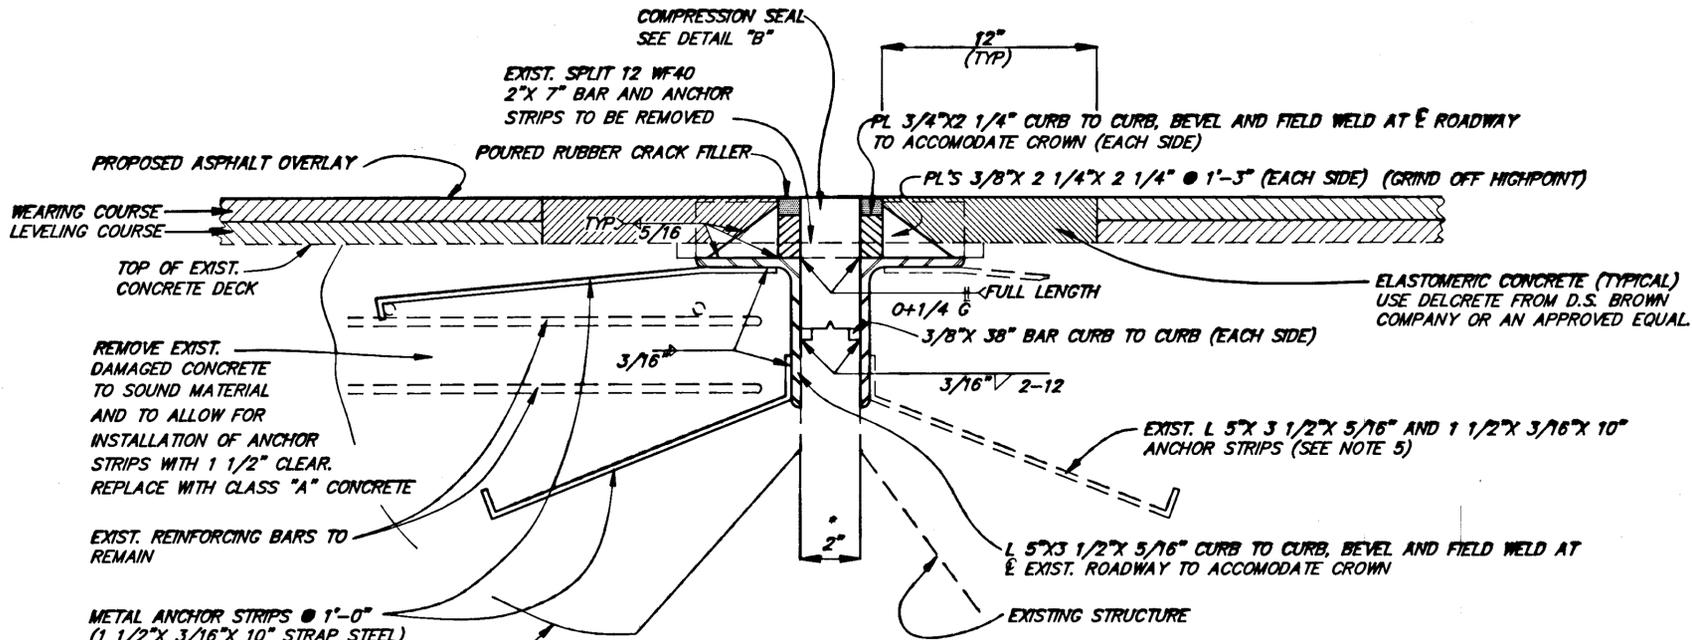


**PROPOSED EXPANSION JOINT
STA. 109+15.53**


• DIMENSIONS AT 50°F. ALLOW 3/32 EXPANSION OR CONTRACTION FOR EACH 10°F CHANGE FROM 50°F.

NOTES:

1. ALL NEW STEEL SHALL CONFORM TO ASTM A-36.
2. CONCRETE SHALL CONFORM TO CLASS A-A.
3. REPLACEMENT OF ANY DAMAGED STRUCTURAL STEEL SHAPES SHALL BE AS DIRECTED.
4. THE CONTRACTOR SHALL ASSURE THAT THE WORK IS PROTECTED FROM TRAFFIC AND SUBMIT A WORK PLAN FOR APPROVAL PRIOR TO BEGINNING WORK.
5. ONLY REMOVE DAMAGED CONCRETE TO SOUND MATERIAL.

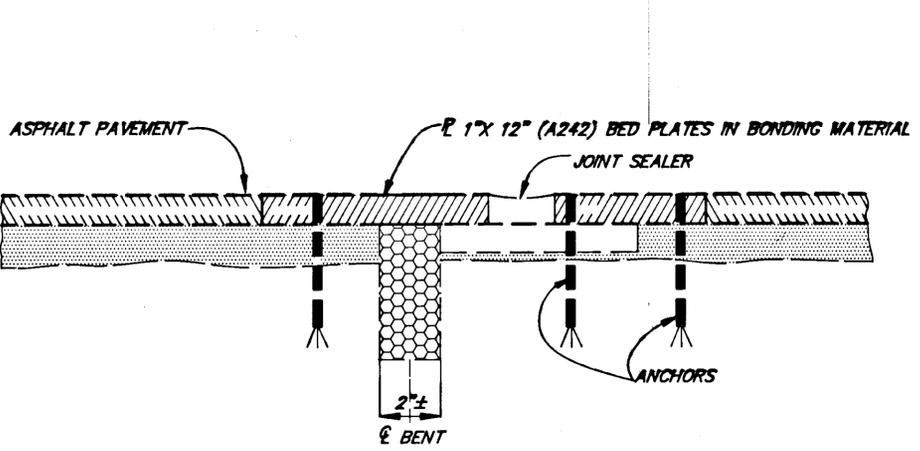

EXISTING EXPANSION JOINT

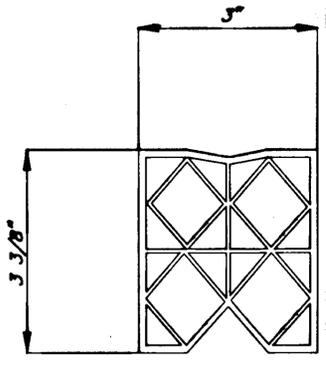

ELASTIC COMPRESSION SEAL

BRIDGE SEAL CONTINUOUS FOR LENGTH OF NEW JOINT. COMPRESS AND INSTALL IN LUBRICATED JOINT PER MANUFACTURER'S INSTRUCTIONS.

As Built

NOTE: DO NOT SCALE FROM THESE PLANS-USE DIMENSIONS

DATE:	DESCRIPTION OF CHANGE:


STATE OF ALASKA
DEPARTMENT OF TRANSPORTATION
AND PUBLIC FACILITIES
SOUTHEAST REGION DESIGN & CONSTRUCTION

KETCHIKAN


TONGASS AVENUE PAVEMENT REHABILITATION
F-M-0902 (16) 70375
EXPANSION JOINT REPAIR

ALASKA

DESIGNED BY: T.W. MOORE	PROJECT NO. 70375
DRAWN BY: AUTOCADD/ C. Anderson	DATE: MAY, 1991
CHECKED BY: P. JONES	SHEET 10 OF 38

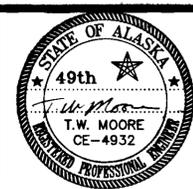


JREPAIR.DWG

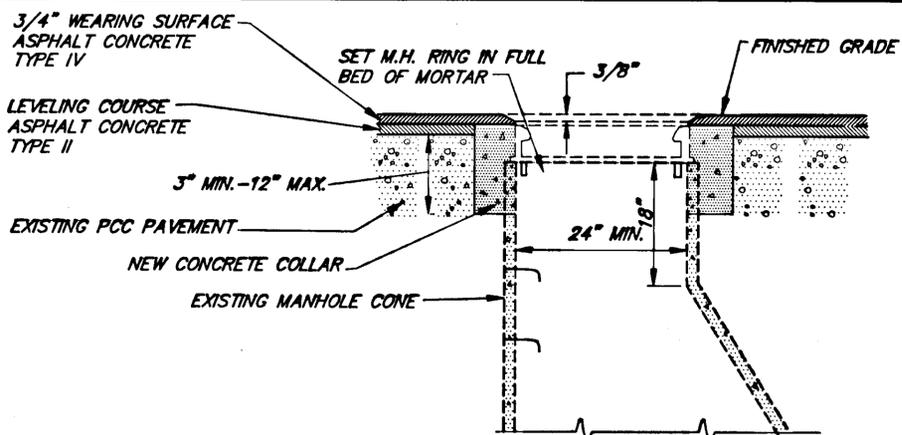


MANHOLE ADJUSTMENT DETAIL

- NOTES:
1. ALL ADJUSTMENTS SHALL BE MADE BELOW THE FRAME ON THE MANHOLE CONE FRAME & GRATE SUPPLIED NEW BY CITY.
 2. THE CONTRACTOR SHALL HAVE THE OPTION TO USE BRICKS OR ADJUSTMENT RINGS TO ADJUST THE EXISTING MANHOLES.

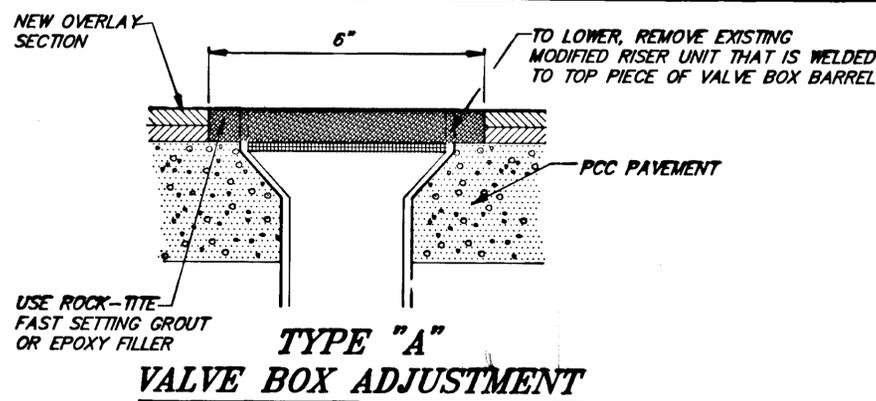

TYPE "A" VALVE BOX ADJUSTMENT



TYPE "E" VALVE BOX ADJUSTMENT C.O.#7 COMBINES TYPE "A" AND TYPE "C" INCLUDING TOTAL REMOVAL AND REPLACEMENT MATERIALS SUPPLIED BY CITY.

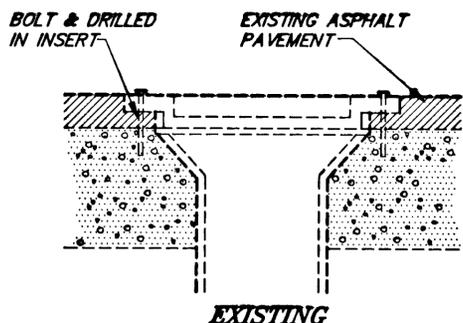


TYPE "B" VALVE BOX ADJUSTMENT

NOTES

1. PRIOR TO COLD PLANING, VALVE BOX SHALL BE LOWERED BY REMOVING THE BOLTED RISER RING AND LOWERING TO TOP OF CONCRETE.
2. AFTER THE LEVELING COURSE IS PLACED, THE CONTRACTOR SHALL CUT OUT AND ADJUST THE TOP BARREL OF THE VALVE BOX TO BE AT FINISHED LEVEL AS SHOWN, LEAVING THE FRAME STICKING UP TO ALLOW FOR FINAL WEARING COURSE.

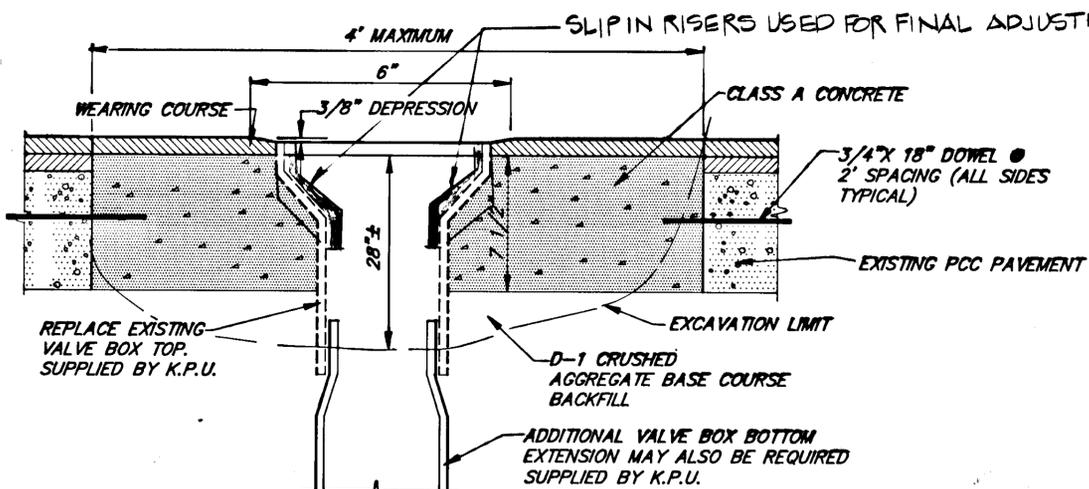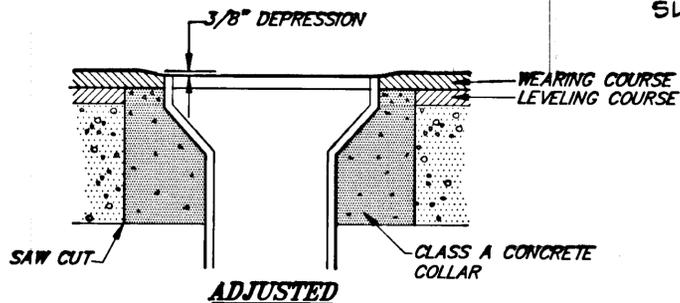

TYPE "C" VALVE BOX ADJUSTMENT

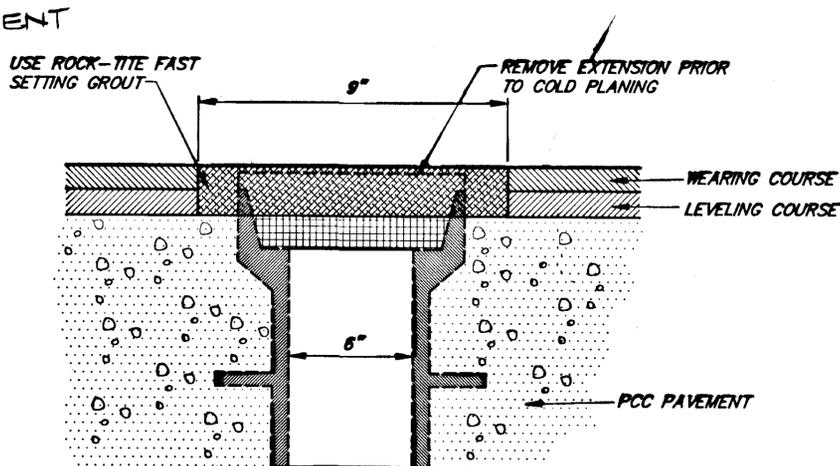

MONUMENT ADJUSTMENT DETAIL

NOTE: SOME NEARBY REPLACEMENT C.O.#8

SEE SHEET 11A ADJUSTMENT SUMMARY

LOCATION INTERSECTION	4" VALVE BOX	6" VALVE BOX	25" SEWER MH	26" SEWER MH	REMARKS
SHUTTLE TERMINAL	10	32	2	4	
BRYANT STREET	9	12	2	3	
CARLANNA LAKE ROAD	20	26	5	3	
THIRD AVENUE	16	4			
SECOND AVENUE	17	9		3	
MADISON AVENUE	7	5	2	2	
JEFFERSON STREET	10	10		3	
WASHINGTON STREET	14	9		2	
WHITECLIFF STREET	19	12	1	1	
FIRST AVENUE	4	5	1	1	
TONGASS VIADUCT		5	1	3	
WATER STREET		1	1	1	
SCHOENBAR ROAD		7	2	3	
WATER STREET VIADUCT	3	11	2		
GRANT STREET	7	10	4		
DOCK STREET		5	3	1	
MISSION STREET	2	5			
END MILL STREET VIADUCT		5	5		
BARNEY WAY		8	4	2	
DEERMOUNT					
TOTAL	140	181	35	35	

MONUMENT SUMMARY SEE SHEET 11B

INTERSECTION	MON. CASES	INTERSECTION	MON. CASES
SHUTTLE TERM		WATER STREET	
BRYANT STREET	4	SCHOENBAR ROAD	1
CARLANNA LAKE RD.	1	WATER ST. VIADUCT	1
THIRD AVENUE	3	GRANT STREET	1
SECOND AVENUE		DOCK STREET	0
MADISON AVENUE	1	MISSION STREET	1
JEFFERSON ST.	3	END VIADUCT (MILL ST.)	0
WASHINGTON ST.	2	BARNEY WAY	9
FIRST AVENUE	2	DEERMOUNT STREET	6
IGN VIADUCT	3	GAS AT LAST	0
	6	TOTAL	45

AS BUILT

RECORD OF REVISIONS

DATE:	DESCRIPTION OF CHANGE:

STATE OF ALASKA
DEPARTMENT OF TRANSPORTATION
AND PUBLIC FACILITIES
SOUTHEAST REGION DESIGN & CONSTRUCTION

KETCHIKAN


TONGASS AVENUE PAVEMENT REHABILITATION
F-M-0902(16) 70375

UTILITY ADJUSTMENT DETAILS

NOTE: DO NOT SCALE FROM THESE PLANS-USE DIMENSIONS

DESIGNED BY:
T.W. MOORE
DRAWN BY:
AUTOCADD/C. Anderson
CHECKED BY:
P. JONES

PROJECT NO.
70375
DATE:
MAY, 1991
SHEET 11 OF 38

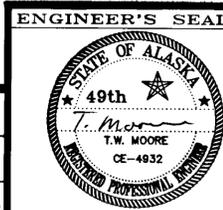

VALVE BOX ADJUSTMENT SUMMARY

Valve Box No.	Station	Box Size	Type A	Type B	Type C	Type E	Valve Box No.	Station	Box Size	Type A	Type B	Type C	Type E	Valve Box No.	Station	Box Size	Type A	Type B	Type C	Type E	Valve Box No.	Station	Box Size	Type A	Type B	Type C	Type E	Valve Box No.	Station	Box Size	Type A	Type B	Type C	Type E
0A	11+60	6"		X			75	47+27	6"			X		154	69+96.6	6"		X			230	93+01.7	DEL					303	120+66	6"		X		
1	12+77	6"			X		76	47+81	4"		X			155	70+84.6	DEL					231	93+46	DEL					303A	120+75	4"		X		
2	12+79	6"			X		77	48+11	DEL					156	70+63	4"				X	232	93+40	4"			X		303B	120+81	4"		X		
3	13+19	DEL					78	48+59	DEL					157	71+25.6	DEL					233	93+70	6"			X		304	121+52	6"		X		X
4	13+47	4"				X	79	48+60.5	DEL					158	70+81.7	6"			X		234	93+92	4"			X		305	121+65/16' LT	4"		X		X
5	13+57.7	6"			X		80	48+86	6"			X		159	71+67	6"			X		235	94+10	6"			X		306	121+77/18' LT	6"		X		
6	13+59.9	4"				X	81	49+06	DEL					160	71+71	4"			X		236	94+31	4"			X		307	122+25/16' LT	4"		X		X
7	13+80	DEL					82	49+13	DEL					160A	71+75	6"			X		237	94+40	6"		X			308	122+58/14' LT	DEL				
8	14+44.9	DEL					83	49+38	4"				X	160B	71+85	6"			X		238	95+00	4"			X		309	122+67	6"		X		X
9	14+59.8	4"				X	84	49+39	6"			X		161	72+02	4"			X	X	239	95+45	6"			X		309A	122+68	6"		X		X
10	15+40	DEL					85	49+74	DEL					162	72+04	6"			X		240	95+58	6"		X			310	122+68/16' LT	6"		X		X
11	15+43	6"			X		86	50+01	DEL					163	72+98	DEL					241	95+63	6"		X			310A	122+75/18' LT	6"		X		X
12	15+52.1	6"		X			87	50+26	6"			X		164	73+03	4"				X	242	95+65	6"		X			310B	122+74	6"		X		X
13	16+31.9	4"				X	88	50+27	6"			X		165	73+49	4"				X	243	95+67	6"		X			311	122+78/14' LT	6"		X		X
14	17+29.1	DEL					89	50+86	DEL					166	74+08.8	6"			X		244	95+92	4"		X			312	122+82/18' LT	6"		X		X
15	17+83.2	6"			X		90	52+94	4"				X	167	74+90.8	DEL				X	245	96+24	6"		X			313	122+77 RT	6"		X		X
16	17+85.3	6"			X		91	53+24	6"			X		168	75+19	4"				X	246	96+25	4"		X			314	122+90 RT	DEL				X
17	18+47.9	6"			X		92	53+68	4"				X	169	75+36.8	6"			X		246B	97+55	6"		X			500	"MS" 26+18	6"			X	
18	19+16.8	6"		X			93	54+54	4"				X	170	75+89.1	6"			X		246C	97+60	6"		X			501	"MS" 26+14	6"		X		X
19	19+64	4"		X			94	54+59	4"			X		171	75+51	DEL				X	247	98+82	6"		X			502	"MS" 26+11	6"		X		X
20	22+52	6"				X	95	55+80	6"			X		172	76+92.1	DEL				X	248	98+85	6"		X			503	"MS" 26+08	6"		X		X
21	24+39	4"				X	96	55+90	DEL					173	76+93.2	DEL				X	248B	99+11	4"		X			504	"MS" 26+11	6"		X		X
22	24+68.9	6"			X		97	56+38	6"			X		174	76+70.7	6"				X	249	100+40	6"		X			505	"MS" 26+19	4"		X		X
23	24+80.6	6"			X		97A	56+48	New					175	77+03.8	6"			X		250	100+53	6"		X			506	"MS" 26+25	6"		X		X
24	24+83.7	6"			X		98	56+72	6"			X		176	78+10.9	6"			X		251	100+58	6"		X			507	"MS" 26+30	6"		X		X
25	24+86.8	6"			X		99	57+11	6"			X		177	78+18	4"				X	251A	100+69	6"		X			508	"MS" 26+29	6"		X		X
26	27+47	6"			X		100	57+13	DEL					178	78+29	4"				X	251B	100+69.5	6"		X			509	"MS" 25+44	6"		X		X
27	27+52.6	DEL					101	57+15	6"			X		179	79+25.7	6"			X		252	100+73	6"			X		510	"MS" 24+85	6"		X		X
28	27+48.6	6"			X		102	57+79	DEL					180	79+28.9	6"			X		253	100+75	6"			X		511	"MS" 24+82	4"			X	
29	27+61.5	6"			X		103	58+49	DEL					181	79+32	6"			X		254	100+80	N/A					512	"MS" 24+02	6"				
30	27+78	6"			X		104	59+20	DEL					182	79+93	DEL				X	255	101+40	6"					513	"MS" 23+82	6"		X		
30A	29+75	DEL					105	59+38.6	6"			X		183	Unknown	DEL				X	256	101+61	DEL					514	"MS" 23+62	DEL				
31	29+92	6"		X			106	58+87.3	6"					184	80+64	4"				X	257	101+76	6"					515	"MS" 23+58	4"				
32	29+93.8	6"		X			107	59+06	4"				X	185	80+73	6"			X		258	101+94	4"					516	"MS" 23+53	4"				
33	31+07	6"			X		108	59+77.5	6"			X		186	81+20	DEL				X	259	102+71	DEL					517	"MS" 10+83	6"			X	
34	32+43	6"			X		109	59+92.4	DEL					187	80+86	DEL				X	260	102+86	4"					518	"MS" 10+79	6"		X		X
35	32+44	6"			X		110	59+56.5	6"			X		188	81+75	4"				X	261	103+58	6"					519	"MS" 10+59	6"		X		X
36	33+06	DEL					111	59+62	4"				X	189	82+25	6"			X		262	104+21	6"					520	"MS" 10+52	6"		X		X
37	34+35.8	6"		X			112	59+66	4"				X	190	82+60	6"			X		263	105+00	6"					521	"MS" 10+49	6"		X		X
38	34+58.9	DEL					113	60+14	4"			X		191	82+34	DEL				X	264	105+39	6"					522	"MS" 3+27	DEL				
39	34+60	6"			X		114	60+23.4	4"				X	192	83+04	4"				X	265	105+63	DEL					523	"MS" 3+16	6"		X		
40	34+65	6"			X		115	60+58	4"				X	193	82+89	DEL				X	266	105+96	4"					524	"MS" 3+03	DEL				
41	34+95	6"		X			116	61+46.6	DEL					194	83+87	DEL				X	267	106+35	DEL					525	"MS" 3+00	DEL				
41A	37+40	6"			X		117	61+05	4"			X		195	84+63	6"			X		268	106+68	4"					526	"MS" 2+54	DEL				
42	35+13	6"			X		118	61+21	4"			X		196	84+66	6"			X		269	107+30	6"					527	"MS" 1+56	6"		X		X
43	35+44	DEL					119	61+39	4"			X		197	84+69.1	DEL				X	270	107+96	6"					528	"MS" 1+38	6"		X		X
44	35+54	DEL					120	61+66	4"			X		198	84+85.9	DEL				X	271	108+03	6"					529	"MS" 0+95	4"		X		X
45	35+83	6"			X		121	61+76	4"			X		199	85+59	4"				X	272	109+53	6"					530	"MS" 0+21	6"				
46	36+33	4"				X	122	61+96	4"			X		200	85+86	4"				X	273	110+86	6"					531	"MS" 0+17	6"				
47	36+63	DEL					123	62+16	4"			X		201	85+63.3	DEL				X	274	111+16	6"					532	"MS" 0+15	6"				
48	37+24	DEL					124	62+53	4"				X	202	86+45	4"				X	275	111+61	6"					533	"F" 0+25 LT	6"		X		
49	37+68	6"			X		125	62+62	6"			X		203	86+34	DEL				X	276	111+76	6"					534	"F" 0+31 LT	6"			X	
50	37+80	DEL					126	63+73.2	DEL					204	87+00	6"			X		277	112+30	4"					535	"F" 0+36 LT	6"			X	
51	38+36	DEL					127	63+75	DEL					205	87+17	4"				X	278	112+48	6"					536	"F" 0+36	6"				
52	38+65	DEL					128	64+10	DEL					206	87+29	6"			X		279	112+66	4"					537	"F" 1+97	6"			X	
53	38+91	DEL					129	63+56	4"				X	207	87+04	DEL				X	280	112+81	6"					538	"F" 2+03	4"			X	
54	39+19.6	DEL					130	64+53	DEL					208	87+77																			

MONUMENT CASE SUMMARY

STATION	ITEM 614(4)	ITEM 614(4A)
"0" 12+68.12 (12+67.47)	X	
"0" 20+23.48		X
"0" 26+80.47 (26+81.07)		X
"0" 43+03.18 (43+02.21)		X
"0" 47+96.6		X
"0" 58+76.21		X
"0" 59+06.7 (59+06.43)	X	
"0" 59+63 (case no monument)		X
"O" 63+53.22 (63+52.8)		X
"O" 68+97.17		X
"O" 71+39.55		X
"0" 74+16.67 (74+16.32)		X
"0" 75+28	X	
"O" 80+49.5 (80+43.41)	X	
"O" 82+36.3	X	
"O" 84+54.78		X
"0" 95+22	X	
"0" 99+88.31/5' RT		X
"0" 99+96/4' RT	X	
"0" 100+77.73	X	
"0" 103+60.5	X	
"0" 106+28.8	X	
"0" 108+63.22	X	
"0" 110+70.45	X	
"0" 113+11.28		X
"0" 116+56.47	X	
"0" 123+02	X	
"0" 123+42	X	
"W" 134+79.78	X	
"F" 6+42		X
"MS" 0+20	X	
"MS" 3+57.79	X	
"MS" 4+90	X	
"MS" 5+20		X
"MS" 8+28.94	X	
"MS" 10+18.82	X	
"MS" 10+50 +	X	
"MS" 10+50 +	X	
"MS" 11+13.34		X
"MS" 22+04	X	
"MS" 23+10	X	
"MS" 23+88	X	
"MS" 23+90	X	
"MS" 24+16.85		X
"MS" 26+29		X

Note:
614(4) Remove riser, replace lid, core after final pavement and fill hole with grout.

614(4A) Replace broken or damaged monument case with new, core and grout.

Stationing was found on old construction plans dated 1960, 1972 and 1987

ADJUST EXISTING MANHOLES

M.H. NO.	CITY M.H. NO.	LOCATION	ADJUSTED
6	A-2	12+80 (15' RT)	X
7	A-3	14+53 (20' RT)	X
8	A-5	14+53 (18' LT)	X
8A	New	15+64 (18' LT)	X
9	A-6	17+54 (18' LT)	X
10	A-4	17+27 (20' RT)	X
11	B1-3	24+96 (14' RT)	X
12	B1-2	27+29 (20' RT)	X
13	B1-1	29+78.5 (20' RT)	X
14	B4-2	32+22 (20' RT)	X
15	2-22	34+67 (16' LT)	X
16	B4-1	34+90 (20' RT)	X
17	B2-1	37+43 (20' RT)	X
18	1-34	37+19 (16' LT)	X
19	B2-4	37+44 (25' LT)	Not in paving lane
20	B2-2	40+43 (20' RT)	X
21	B2-3	42+91 (20' RT)	X
22	B2-6	42+91 (25' LT)	X
22A		43+00 (16' LT)	X
23	B2-16	45+25 (20' RT)	X
24	C-2	47+96 (22' RT)	X
25	C-1	51+05 (20' RT)	X
26	C-1A	51+19 (12.5' RT)	X
27	C-1B	54+67.5 (12.5' RT)	X
28	C-4	55+10 (19.5' RT)	X
30	C-5A	59+44 (16' RT)	X
31	C-5B	59+45 (14' LT)	Not in paving lane
32	D-1	59+04 (16' RT)	X
33	D-9	59+04 (4' LT)	X
34	D-2	61+24.9 (15.8' RT)	X
35	D-3	63+47 (16' RT)	X
36	D-5	63+47 (9' LT)	X
37	D-4	65+32 (17' RT)	X
38	E-3	67+18.5 (17' RT)	X
39	E-2	69+45 (16.5' RT)	X
40	E-1	71+74 (17' RT)	X
41	E-9	71+70 (2' LT)	X
42	E-9A	71+58 (14' LT)	Not in paving lane
43	E-26	73+73 (17' RT)	X
44	E-26A	73+63 (12.5' LT)	Not in paving lane
45	E-27	75+13 (12' RT)	X
46	E-27A	75+12 (15' LT)	X
46A	E-27B	75+27 (20' LT)	X
47	E-28	76+51 (16' RT)	X
48	F1-24	79+43.5 (16.5' RT)	X
49	F1-15	82+39 (7' RT)	X
50	F1-9	84+49 (7.5' RT)	X
51	F1-8	86+04 (12.5' LT)	X
52	F1-8A	87+32.5 (4' RT)	X
53	F1-1	87+87 (7' RT)	X
54	F1-1A	87+72 (15' RT)	X
55	F1-2	90+70 (15' RT)	X
56	F2-2	93+60 (6.5' RT)	X
57	F2-1	95+56 (4' RT)	X
58	F2-3	97+51 (6.5' RT)	X
59	F2-4	99+58 (4.5' LT)	X
61	G-12	113+06 (4' RT)	X
62	H-1	118+50 (21.3' RT)	X
63	H-11	119+50 (4' LT)	X
64	H-10	119+90 (3' LT)	X
65	H-9	122+90 (2.5' LT)	X
66	H-5	130+65.29 (9' LT)	X
66A		131+20 C/L	X
67	I-4	132+79 (11.5' LT)	X
68	I-3	134+22 (9' LT)	X
69	I-1	134+22 (10' RT)	X
70	J-4	"F"6+38 (8' LT)	X
71	J-2	"F" 4+62 (7.5' RT)	X
72	J-2A	"F"3+25 (4' RT)	X
73	J-1	"F"2+46 (7' RT)	X
74	J-1A	"F"2+46 (3' LT)	X
75	I-2	"F"0+48 (2.5' LT)	X
76	I-2A	"F"0+48 (8' RT)	X
77	K-1	"F"0+00 (12.5' RT)	X
78	K-2	3+76 (10' LT)	X
79	K-3	4+64 (14' LT)	X
80	K-4	4+91 (27' LT)	Not in paving lane
81	K-41	10+30 (21' LT)	Not in paving lane
82	K-23	10+58 (3' LT)	X
82A	K-23A	10+90 (6' RT)	Abandon
83	K-24	11+22 (19' LT)	X
84	K-25	13+23 (14' LT)	X
85	L-6	15+24 (14' LT)	X
86	L-5	16+89 (14' LT)	X
87	L-2	20+10 (14' LT)	X
88	L-3	23+79 (4.5' LT)	X
89	L-4	26+07 (5' LT)	X

AS BUILT

SHEET 11B

STANDARD SIGN SUMMARY

LOCATION			SIGN				POST				REMARKS
SIGN NO.	LOCATION	OFFSET FT. LT. FT. RT.	CODE NO.	LEGEND	SIZE	AREA S.F.	NO. OF POSTS	SIZE	LENGTH	FACING TRAFFIC	
1	17+74	28	R2-1	SPEED LIMIT 35	30"x36"	7.5	-	-	-	SB NB	REPLACE SIGN ON EXISTING POST
2	20+53	26	EXIST. R12-5	WEIGHT LIMIT 16T,22T	30"x36"	-	1	2.0	11.0	SB	INSTALL EXISTING SIGN FROM 21+00 ON NEW POST DELETED, NO EXISTING SIGN
3	21+00	26	I-3	CARLANNA CREEK	54"x24"	9.0	2	2.0	10.0	SB	6" U.C., 4.5" L.C. REPLACE EXISTING AND REMOVE WEIGHT LIMIT SIGN
4	22+38	26	I-3	CARLANNA CREEK	54"x24"	9.0	2	2.0	10.0	NB	6" U.C., 4.5" L.C. REPLACE EXISTING AND REMOVE WEIGHT LIMIT AND TWO WAY LEFT TURN SIGNS.
5	23+50	27	EXIST. R12-5	WEIGHT LIMIT 16T,22T	30"x36"	7.5	1	2.0	11.0	NB	INSTALL EXISTING SIGN FROM 22+38 ON NEW POST DELETED, NO EXISTING SIGN
6	24+07	27	D9-12	DUMP STATION SYMBOL	24" x 24"	4.0	1	2.0	11.0	SB	REPLACE EXISTING SIGN AND POST
	24+07	27	D9-12	DUMP STATION	6"x24"	1.0	-	-	-	SB	INSTALL BELOW 8' @
	24+07	27	D9-12	ARROW RIGHT	6"x24"	1.0	-	-	-	SB	INSTALL BELOW 8' @
	24+07	27		DUMP STATION SYMBOL	24" x 24"	4.0	-	-	-	NB	
	24+07	27		DUMP STATION	6" x 24"	1.0	-	-	-	NB	
	24+07	27		ARROW LEFT	6" x 24"	1.0	-	-	-	NB	
7	24+65	28	D3-1	MARTIN ST	30"x8"	1.67	-	-	-	NB	INSTALL ABOVE EXISTING STOP SIGN. REMOVE EXISTING "MARTIN ST"
	24+65	28	D3-1	TONGASS AVE	36"x8"	2.0	-	-	-	NB	INSTALL ABOVE 9' REQUIRES SIGN BRACKET
8	25+31	27	R3-9B	TWLT LANE	24"x36"	6.0	1	2.0	11.5	SB	
	25+31	27	R3-9B	BEGIN	24"x36" @	1.0	-	-	-	SB	INSTALL ABOVE 11' SIMILAR TO D11-1K EXCEPT BLACK ON WHITE BACKGROUND
9	25+66	33	-	DO NOT ENTER	-	-	-	-	-	WB	REMOVE EXISTING DID NOT REMOVE
	25+66	33	-	STOP	-	-	-	-	-	EB	REMOVE EXISTING DID NOT REMOVE
10	25+93	28	R3-9B	TWLT LANE	24"x36"	6.0	-	2.0	11.5	NB	
	25+93	28	R3-9B	END	24"x6"	1.0	-	-	-	NB	INSTALL ABOVE 10' SAME AS D11-1M EXCEPT BLACK ON WHITE BACKGROUND. INSTALLED NEW
11	27+10	28	M1-6	ALASKA 7	24"x24"	4.0	1	2.0	10.0	NB	INSTALLED NEW POST AND BASE. POST & BASE
12	29+62	28	D3-1	TONGASS AV	36"x8"	2.0	-	-	-	WB	INSTALL ABOVE "HECKMAN ST" REQUIRES SIGN BRACKET
13	30 29+75 + 30	28	R2-1	SPEED LIMIT 25	30"x36"	7.5	1	2.0	11.0	SB	REPLACE EXISTING SIGN USED EXISTING TWLT POST
14	28+74	28	R2-1	SPEED LIMIT 35	30"x36"	7.5	1	2.0	11.0	NB	
15	30+15	28	-	SPEED LIMIT 35	-	-	-	-	-	NB	REMOVE EXISTING SIGN AND POST
16	30+30	3	OM-1	TYPE 1 OBJECT MARKER	18"x18"	2.25	1	2.0	9.0	SB	MOUNT AT 7 FEET, (TYPICAL) ABOVE ROADWAY
	30+30	3	OM-1	TYPE 1 OBJECT MARKER	18"x18"	2.25	1	-	-	NB	INSTALL BACK TO BACK
17	31+76	29	R3-9B	TWLT LANE	24"x36"	6.0	1	2.0	11.0	SB	
18	32+42	28	-	PED XING	-	-	-	-	-	-	REMOVE SIGN AND POST
19	37+73	28	R3-9B	TWLT LANE	24"x36"	6.0	1	2.0	11.0	NB	
20	38+50	28	M1-6	ALASKA 7	24"x24"	4.0	1	2.0	10.0	SB	INSTALLED ON EXISTING POST
21	42+60	37	D3-1	TONGASS AV	36"x8"	2.0	-	-	-	WB	INSTALL ABOVE "CARLANNA LK RD", REQUIRES SIGN BRACKET
22	40+09	28	R2-1	SPEED LIMIT 25	30"x36"	7.5	1	2.0	11.0	SB	
23	47+25	28	R3-9B	TWLT LANE	24"x36"	6.0	1	2.0	11.0	NB	
24	47+54	28	R3-9B	TWLT LANE	24"x36"	6.0	1	2.0	11.0	SB	
25	49+25	28	-	HOSPITAL	-	-	1	2.0	11.0	SB	INSTALL EXISTING SIGN FROM 50+19, REMOVE SPEED LIMIT 25 NO EXISTING 25 MPH. SIGN REQUIRED NEW BASE & POST
26	51+47	28	R2-1	SPEED LIMIT 25	30"x36"	7.5	-	-	-	SB	REPLACE EXISTING SIGN
27	51+48	28	-	HOSPITAL	-	-	1	2.0	11.0	NB	INSTALL EXISTING SIGN REMOVED FROM 51+19, REMOVE SPEED LIMIT 25, REMOVE POST AT 51+19
28	53+50	28	R3-9B	TWLT LANE	24"x36"	6.0	1	2.0	11.0	SB	
29	57+57	28	R3-9B	TWLT LANE	24"x36"	6.0	1	2.0	11.0	SB	
30	59+50	28	-	TWLT LANE	24"x36"	6.0	-	-	-	-	REMOVE SIGN AND POST LEFT POST FOR CITY BUS STOP SIGN
31	59+00	32	D3-1	TONGASS AV	36"x8"	2.0	-	-	-	-	INSTALL ABOVE "THIRD AV". REQUIRES SIGN BRACKET
32	60+35	28	-	TWLT LANE	-	-	-	-	-	-	REMOVE EXISTING SIGN AND POST USED POST FOR #33
33	60+35	28	R2-1	SPEED LIMIT 25	30"x36"	7.5	-	-	-	SB	REPLACE EXISTING SIGN MOVED BACK ~40' AND PLACED ON EXISTING POST
34	63+56	35	D3-1	TONGASS AV	36"x8"	2.0	-	-	-	-	INSTALL ABOVE SECOND AV. REQUIRES SIGN BRACKET

SIGNING GENERAL NOTES

1. SIGN LOCATIONS ARE APPROXIMATE AND MAY BE FIELD ADJUSTED BY THE ENGINEER.
2. SIGN NUMBERS ARE SHOWN ON THE STRIPING PLANS BY THE SYMBOL (2) (SIGN NUMBER 2).
3. ALL EXISTING STREET NAME SIGNS THAT ARE REMOVED SHALL BE DELIVERED TO THE CITY OF KETCHIKAN, DEPARTMENT OF PUBLIC WORKS, AT A LOCATION DESIGNATED BY THE PROJECT ENGINEER.
4. ALL POST LENGTHS ARE APPROXIMATE AND SHALL BE VERIFIED IN THE FIELD.
5. SIGN POSTS SHALL BE PERFORATED, SQUARE STEEL TUBE.
6. THE MOUNTING HEIGHT FOR ALL SIGNS AND SIGN COMBINATIONS SHALL BE 7 FEET.

← USED EXISTING POST FROM 51+19

AS BUILT

DATE	DESCRIPTION OF CHANGE
K. 11/16/93	AC-BUILD

STATE OF ALASKA
DEPARTMENT OF TRANSPORTATION
AND PUBLIC FACILITIES
SOUTHEAST REGION DESIGN & CONSTRUCTION

KETCHIKAN
TONGASS AVENUE PAVEMENT REHABILITATION
P-M-0902(16) 70375
SIGNING SUMMARY

DESIGNED BY: J. AHLGREN	PROJECT NO. 70375
DRAWN BY: AUTOCADD/CSA	DATE: MAY, 1991
CHECKED BY: K. SMITH	SHEET 12 OF 38



STANDARD SIGN SUMMARY

LOCATION			SIGN				POST				REMARKS	
SIGN NO.	LOCATION	OFFSET FT. LT. FT. RT.	CODE NO.	LEGEND	SIZE	AREA S.F.	NO. OF POSTS	SIZE	LENGTH	FACING TRAFFIC		
35	64+85		3	OM-1	TYPE 1 OBJECT MARKER	18"X18"	2.25	1	2.0	6.0	SB	INSTALL AT 7 FT. ABOVE ROADWAY INSTALL BACK TO BACK
	64+85		3	OM-1	TYPE 1 OBJECT MARKER	18"X18"	2.25	-	-	-	NB	
36	65+17		31	R3-9B	TWLT LANE	24"X36"	6.0	1	2.0	11.0	SB	INSTALL ABOVE "MADISON AV" REQUIRES SIGN BRACKET REMOVE SIGNS AND POSTS REMOVE SIGNS AND POSTS
37	70+86	41	D3-1	TONGASS AV	36"X8"	2.0	-	-	-	-	WB	
38	70+79	29	-	UNIVERSITY OF ALASKA	-	-	-	-	-	-	-	
39	71+60	29	-	UNIVERSITY OF ALASKA	-	-	-	-	-	-	-	
40	69+39	29	R3-9B	TWLT LANE	24"X36"	6.0	1	2.0	11.0	-	-	REMOVE
41	74+75	29	-	SPEED LIMIT 25	-	-	-	-	-	-	-	
42	74+68	1	R3-5L	R10-13	LEFT ONLY, YIELD ON GREEN	30"X36"	7.5	-	-	-	NB	REPLACE EXISTING, BAND TO OVERHEAD MAST ARM. REPLACE EXISTING, BAND TO OVERHEAD MAST ARM. REPLACE EXISTING, BAND TO OVERHEAD MAST ARM. REPLACE EXISTING, BAND TO OVERHEAD MAST ARM.
43	75+12	32	R10-13	LEFT ONLY, YIELD ON GREEN	30"X36"	7.5	-	-	-	-	WB	
44	75+57	6	R10-13	LEFT ONLY, YIELD ON GREEN	30"X36"	7.5	-	-	-	-	SB	
45	75+21	35	R10-13	LEFT ONLY, YIELD ON GREEN	30"X36"	7.5	-	-	-	-	EB	
46	79+10	31	R6-1R	ONE WAY RIGHT	36"X12"	3.0	-	-	-	-	SB	INSTALL ABOVE "ADAMS ST" REQUIRES SIGN BRACKET INSTALL ON EXISTING POST, BACK TO BACK WITH EXIST. SIGN
46	79+10	31	R6-1L	ONE WAY LEFT	36"X12"	3.0	-	-	-	-	NB	
47	79+80	35	R6-1L	ONE WAY	36"X12"	3.0	-	-	-	-	NB	REPLACE EXISTING INSTALL ABOVE "WASHINGTON ST", REQUIRES SIGN BRACKET
48	82+17	38	R6-1R	ONE WAY	36"X12"	3.0	1	2.0	12.0	-	NB	
	82+17	38	D3-1	TONGASS AV	36"X8"	2.0	-	-	-	-	WB	WB ONE WAY WAS NO GOOD, REPLACED WITH SIGN MEANT FOR #47
	82+17	38	R6-1L	ONE WAY LEFT	36"X12"	3.0	-	-	-	-	SB	
49	78+90	30	R6-1R	ONE WAY RIGHT	36"X12"	3.0	1	2.0	9.0	-	SB	INSTALL BACK TO BACK
	78+90	30	R6-1L	ONE WAY LEFT	36"X12"	3.0	-	-	-	-	WB	
50	81+85	30	R6-1L	ONE WAY LEFT	36"X12"	3.0	1	2.0	9.0	-	SB	INSTALL BACK TO BACK
	81+85	30	R6-1R	ONE WAY RIGHT	36"X12"	3.0	-	-	-	-	NB	
51	84+40	32	D3-1	TONGASS AV	36"X8"	2.0	-	-	-	-	WB	INSTALL ABOVE "AUSTIN ST", REQUIRES SIGN BRACKET REMOVE "AUSTIN ST" AND "TONGASS AV" INSTALL ABOVE "WHITE CLIFF ST", REQUIRES SIGN BRACKET
52	84+77	31	-	-	-	-	-	-	-	-	-	
53	87+55	33	D3-1	TONGASS AV	36"X8"	2.0	-	-	-	-	WB	

DELETE, NOT NEEDED EXISTING OK USED ON #48
WASHINGTON SIGN MISSING
SIGN MEANT FOR #47

AS BUILT

DATE:	DESCRIPTION OF CHANGE:
K.K. 11/16/93	ADD EDI

STATE OF ALASKA
DEPARTMENT OF TRANSPORTATION
AND PUBLIC FACILITIES
SOUTHEAST REGION DESIGN & CONSTRUCTION

KETCHIKAN
TONGASS AVENUE PAVEMENT REHABILITATION
F-M-0902(16) 70375
SIGNING SUMMARY

ALASKA

DESIGNED BY: J. AHLGREN
DRAWN BY: AUTOCADD/CSA
CHECKED BY: K. SMITH

PROJECT NO. 70375
DATE: MAY, 1991
SHEET 13 OF 38



STANDARD SIGN SUMMARY

LOCATION			SIGN				POST				REMARKS	
SIGN NO.	LOCATION	OFFSET		CODE NO.	LEGEND	SIZE	AREA S.F.	NO. OF POSTS	SIZE	LENGTH		FACING TRAFFIC
		FT. LT.	FT. RT.									
54	88+36		3	OM-1	TYPE I OBJECT MARKER	18"X18"	2.25	1	2.0	6.0	SB	
	88+36		3	OM-1	TYPE I OBJECT MARKER	18"X18"	2.25	-	-	-	NB	INSTALL BACK TO BACK
55	88+03		30	D3-1	SEALEVEL DR	36"X8"	2.0	-	-	-	SB	REPLACE EXISTING
56	86+80		30	R3-9B	TWLT LANE	24"X36"	6.0	1	2.0	12.0	SB	
	86+80		30	SPECIAL	END	24"X36"	1.0	-	-	-	SB	SIMILAR TO D11-1M EXCEPT BLACK ON WHITE. INSTALL ABOVE TWLT LANE
57	88+79		3	R4-7	KEEP RIGHT	24"X30"	5.0	1	2.0	12.0	NB	
	88+79		3	OM-1	TYPE I OBJECT MARKER	18"X18"	2.25	-	-	-	NB	INSTALL BELOW "KEEP RIGHT"
58	89+89		28	R2-1	SPEED LIMIT 25	30"X36"	7.5	-	-	-	NB	REPLACE EXISTING
59	90+00		28	R2-1	SPEED LIMIT 25	30"X36"	7.5	-	-	-	SB	REPLACE EXISTING NO EXISTING POST REQUIRED NEW POST & BASE
60	90+41		30	R6-1L	ONEWAY	36"X12"	3.0	1	2.0	9.0	SB	• INSTALLED TONGASS AVE, SIGN #61 ON TOP.
	90+41		30	R6-1R	ONEWAY	36"X12"	3.0	-	-	-	NB	INSTALL BACK TO BACK
61	90+61	41	30	R6-1L	ONEWAY	36"X12"	3.0	-	-	-	WB	INSTALL ABOVE "NADEAU ST" REQUIRES SIGN BRACKET NO ROOM FOR TONGASS AVE SIGN-INSTALLED ON #60.
	90+61		32	R6-1L	ONEWAY	36"X12"	3.0	1	2.0	9.0	NB	REMOVE LEAVE AS IS
	90+61		32	R6-1R	ONEWAY	36"X12"	3.0	-	-	-	SB	REMOVE NOT THERE
62	91+06		37	R6-1L	ONEWAY	36"X12"	3.0	-	-	-	NB	INSTALL ON EXISTING POST BACK TO BACK WITH EXISTING SIGN DELETE-
63	95+40		33	D3-1	TONGASS AV	36"X8"	2.0	-	-	-	WB	INSTALL ABOVE "FIRST AV", REQUIRES SIGN BRACKET
	95+40		33	-	ONEWAY	-	-	-	-	-	SB	REMOVE-ADJUST POST LENGTH
	95+40		33	-	ONEWAY	-	-	-	-	-	NB	REMOVE
64	95+22		29	R6-1L	ONEWAY	36"X12"	3.0	1	2.0	9.0	SB	
	95+22		29	R6-1R	ONEWAY	36"X12"	3.0	-	-	-	NB	INSTALL BACK TO BACK
65	95+83		30	R6-1L	ONEWAY	36"X12"	3.0	1	2.0	9.0	SB	
	95+83		30	R6-1R	ONEWAY	36"X12"	3.0	-	-	-	NB	INSTALL BACK TO BACK
66	99+66		37	D3-1	TREMONT ST	36"X8"	2.0	-	-	-	NB	REPLACE EXISTING
	99+66		37	D3-1	TONGASS AV	36"X8"	2.0	-	-	-	WB	REPLACE EXISTING
67	101+31		30	W11-2	PED XING SYMBOL	36"X8" 3/6"	9.0	1	2.0	11.5	NB	
68	103+63		30	W11-2	PED XING SYMBOL	36"X8" 3/6"	9.0	1	2.0	11.5	SB	
69	119+52		62	R2-1	SPEED LIMIT 15	24"X30"	5.0	-	-	-	NB	REPLACE EXISTING EXISTING POST TOO SHORT, REQUIRED NEW POST & BASE.
70	119+94		37	D3-1	CHAPMAN ST	36"X8"	2.0	-	-	-	NB	REPLACE EXISTING
71	120+21		29	R7-101	NO PARKING ANYTIME	12"X18"	1.5	-	-	-	SB	REPLACE EXISTING
72	122+83		32	D3-1	TONGASS AV	36"X8"	2.0	-	-	-	NB	INSTALL ABOVE "SCHOENBAR RD" REQUIRES SIGN BRACKET SCHOENBAR SIGN GONE
73	125+19		30	R5-1	DO NOT ENTER	36"X36" 9.0	4.5	-	-	-	-	REPLACE EXISTING
74	125+27		28	R7-101	NO PARKING ANYTIME	12"X18"	1.5	-	-	-	SB	REPLACE EXISTING
	125+27		28	R7-202M	END	12"X6"	1.5	-	-	-	SB	INSTALL ABOVE NO PARKING
75	126+31		29	W11-2	PED XING SYMBOL	36"X36"	9.0	1	2.0	11.5	SB	
76	128+24		30	W11-2	PED XING SYMBOL	36"X36"	9.0	1	2.0	11.5	NB	
77	123+84		3	OM-1	TYPE I OBJECT MARKER	18"X18"	2.25	1	2.0	10.0	SB	
	123+84		3	OM-1	TYPE I OBJECT MARKER	18"X18"	2.25	-	-	-	NB	INSTALL BACK TO BACK
78	124+18		3	R4-7	KEEP RIGHT	24"X30"	5.0	1	2.0	12.0	NB	
	124+18		3	OM-1	TYPE I OBJECT MARKER	18"X18"	2.25	-	-	-	NB	INSTALL BELOW KEEP RIGHT
	124+18		3	OM-1	TYPE I OBJECT MARKER	18"X18"	2.25	-	-	-	SB	INSTALL BACK TO BACK
79	127+17		28	-	PED XING SYMBOL	-	-	-	-	-	-	REMOVE SIGN AND POST
80	127+45		31	-	PED XING SYMBOL	-	-	-	-	-	-	REMOVE SIGN AND POST
81	130+01		32	D3-1	WATER ST	36"X8" 2.0	1.67	-	-	-	WB	REPLACE EXISTING
82	130+01		32	D3-1	HOPKINGS ST	36"X8" 2.0	1.67	-	-	-	NB	REPLACE EXISTING
83	130+26		38	D3-1	WATER ST	36"X8" 2.0	1.67	-	-	-	WB	REPLACE EXISTING
84	130+26		38	D3-1	BAYVIEW ST	36"X8" 2.0	1.67	-	-	-	NB	REPLACE EXISTING
85	133+43		28	-	SPEED LIMIT 20	24"X30" 3/6"	7.5	-	-	-	-	REPLACE EXISTING EXISTING POST TOO SHORT, REQUIRED NEW POST.
86	133+43		27	-	SPEED LIMIT 25	24"X30" 3/6"	7.5	-	-	-	-	REPLACE EXISTING EXISTING POST TOO SHORT, REQUIRED NEW POST AND BASE.

DATE:	DESCRIPTION OF CHANGE:
11/16/91	AS BUILT

STATE OF ALASKA
DEPARTMENT OF TRANSPORTATION
AND PUBLIC FACILITIES
SOUTHEAST REGION DESIGN & CONSTRUCTION

KETCHIKAN
TONGASS AVENUE PAVEMENT REHABILITATION
F-M-0902(16) 70375
ALASKA
SIGNING SUMMARY

DESIGNED BY: J. AHLGREN	PROJECT NO. 70375
DRAWN BY: AUTOCADD/CSA	DATE: MAY, 1991
CHECKED BY: K. SMITH	SHEET 14 OF 38



STANDARD SIGN SUMMARY

LOCATION			SIGN				POST				REMARKS
SIGN NO.	LOCATION	OFFSET FT. LT. FT. RT.	CODE NO.	LEGEND	SIZE	AREA S.F.	NO. OF POSTS	SIZE	LENGTH	FACING TRAFFIC	
87	"T" 134+45	14	-	-	-	-	-	-	-	NB	REMOVE EXISTING SIGN AND POST NOTHING THERE
88	"W" 135+15	20	R4-7B	KEEP RIGHT	30"X36"	7.5	-	-	-	SB	REPLACE EXISTING
	"W" 135+15	20	OM-1	TYPE I YELLOW OBJECT MARKER	18"X18"	7.5	-	-	-	SB	REPLACE EXISTING REQUIRED NEW POST AND BASE
						2.2					
89	"T" 135+36	17	R5-1	DO NOT ENTER	36"X36"	9.0	-	-	-	SB	REPLACE EXISTING
90	"T" 135+36	13	R5-1	DO NOT ENTER	36"X36"	9.0	-	-	-	SB	REPLACE EXISTING
91	"T" 138+19	20	R4-7B	KEEP RIGHT	30"X36"	7.5	-	-	-	NB	REPLACE EXISTING
	"T" 138+19	20	OM-1	TYPE I YELLOW OBJECT MARKER	18"X18"	2.25	-	-	-	NB	REPLACE EXISTING
92	"F" 6+67	29	R5-1	DO NOT ENTER	36"X36"	9.0	1	2.0	11.5	EB	INSTALLED NEW SIGN ON EXISTING #93 POST
93	"F" 6+60	32	R1-1	STOP	30"X30"	6.25	1	2.0	11.5	WB	REPLACE EXISTING SIGN AND POST
	"F" 6+60	32	-	DO NOT ENTER	-	-	-	-	-	-	REMOVE EXISTING
	"F" 6+60	32	R6-1L	ONE WAY	36"X12"	3.0	-	-	-	NB	INSTALL ABOVE "STOP"
	"F" 6+60	32	D3-1	GRANT ST	30"X8"	1.67	-	-	-	NB	INSTALL ABOVE "ONE WAY"
	"F" 6+60	32	D3-1	FRONT ST	30"X8"	1.67	-	-	-	EB	INSTALL ABOVE "GRANT ST" REQUIRES SIGN BRACKET
94	"F" 6+28	40	R5-1	DO NOT ENTER	36"X36"	9.0	-	-	-	EB	INSTALL ON EXISTING POST
	"F" 6+28	40	R1-1	STOP	30"X30"	6.25	-	-	-	WB	REPLACE EXISTING
95	"F" 6+05	12	R3-1	NO RIGHT TURN	30"X30"	6.25	-	-	-	NB	REPLACE EXISTING
96	"F" 2+70	37	R5-1	DO NOT ENTER	36"X36"	9.0	-	-	-	EB	REPLACE EXISTING
	"F" 2+70	37	R6-1L	ONE WAY	36"X12"	3.0	-	-	-	NB	REPLACE EXISTING
97	"F" 2+20	43	R5-1	DO NOT ENTER	36"X36"	9.0	-	-	-	EB	REPLACE EXISTING
	"F" 2+20	43	R6-1R	ONE WAY	36"X12"	3.0	-	-	-	SB	REPLACE EXISTING
98	"F" 2+15	18	R6-1R	ONE WAY	36"X12"	3.0	-	-	-	SB	BAND TO MAST ARM-REPLACE EXISTING.
	"F" 2+15	14	R3-2	NO LEFT TURN	30"X30"	6.25	-	-	-	SB	BAND TO MAST ARM-REPLACE EXISTING.
	"F" 2+15	22	D3-1B	DOCK ST	24"X18"	3.0	-	-	-	SB	8" U.C., 6" L.C. LETTERS-BAND TO MAST ARM. REPLACE EXISTING.
99	"F" 2+76	7	R3-2	NO LEFT TURN	30"X30"	6.25	-	-	-	NB	BAND TO MAST ARM-REPLACE EXISTING.
	"F" 2+76	14	R3-1	NO RIGHT TURN	30"X30"	6.25	-	-	-	NB	BAND TO MAST ARM-REPLACE EXISTING.
	"F" 2+76	20	D2-1B	DOCK ST	24"X18"	3.0	-	-	-	NB	8" U.C., 6" L.C. LETTERS-BAND TO MAST ARM. REPLACE EXISTING.
100	"F" 2+76	18	R6-1L	ONE WAY	36"X12"	3.0	-	-	-	SB	BAND TO POLE BETWEEN PEDESTRIAN AND SIGNAL HEADS
	"F" 2+76	18	R6-1R	ONE WAY	36"X12"	3.0	-	-	-	SB	BAND TO POLE BETWEEN PEDESTRIAN AND SIGNAL HEADS
101	"F" 0+30	30	R6-1L	ONE WAY	36"X12"	3.0	1	2.0	9.0	SB	
	"F" 0+30	30	R6-1R	ONE WAY	36"X12"	3.0	-	-	-	NB	
102	"MS" 0+44	28	D3-1	MISSION ST	30"X8"	1.67	1	2.0	10.0	NB	REPLACE EXISTING -REQUIRES BRACKET
	"MS" 0+44	28	D3-1	FRONT ST	30"X8"	1.67	-	-	-	WB	REPLACE EXISTING
	"MS" 0+44	28	R6-1R	ONE WAY	36"X12"	3.0	-	-	-	NB	INSTALL BELOW STREET NAME SIGN
	"MS" 0+44	28	R6-1L	ONE WAY	36"X12"	3.0	-	-	-	SB	INSTALL BACK TO BACK
103	"MS" 0+23	36	-	ONE WAY	-	-	-	-	-	NB-SB	REMOVE SIGNS AND POST ALREADY GONE
104	"MS" 2+19	30	R5-1	DO NOT ENTER	36"X36"	9.0	1	2.0	11.0	WB	REPLACE EXISTING SIGN AND POST
105	"MS" 2+25	30	R1-1	STOP	30"X30"	6.25	-	-	-	EB	REMOVE
	"MS" 2+25	30	-	NO LEFT TURN	30"X30"	-	-	-	-	-	REMOVE
	"MS" 2+19	30	R6-1R	ONE WAY	36"X12"	3.0	-	-	-	NB	INSTALL ABOVE "DO NOT ENTER"
	"MS" 2+19	30	R6-1L	ONE WAY	36"X12"	3.0	-	-	-	SB	INSTALL ABOVE "DO NOT ENTER"
106	"MS" 2+50	30	R1-1	STOP	30"X30"	6.25	1	2.0	11.5	EB	
107	"MS" 2+55	30	R3-2	NO LEFT TURN	30"X30"	6.25	-	-	-	EB	REPLACE EXISTING
108	"MS" 4+69	31	R1-1	STOP	30"X30"	6.25	-	-	-	SB	REPLACE EXISTING INSTALLED NEW POST AND BASE, REMOVED EXISTING POST WHEN CONSTRUCTING WHEEL CHAIR RAMP.
	"MS" 4+69	31	D3-1	MILL ST	24"X18"	1.33	-	-	-	SB	REPLACE EXISTING
	"MS" 4+69	31	D3-1	MAIN ST	24"X18"	1.33	-	-	-	WB	REPLACE EXISTING
109	"MS" 5+22	28	R2-1	SPEED LIMIT 20	30"X36"	7.5	-	-	-	WB	REPLACE EXISTING
110	"MS" 8+78	27	-	MILL ST	-	-	-	-	-	-	REMOVE EXISTING SIGN AND POST


AS BUILT

DATE:	DESCRIPTION OF CHANGE:
11/16/95	AS BUILT

STATE OF ALASKA
DEPARTMENT OF TRANSPORTATION
AND PUBLIC FACILITIES
SOUTHEAST REGION DESIGN & CONSTRUCTION

KETCHIKAN
TONGASS AVENUE PAVEMENT REHABILITATION
F-M-0902(16) 70375
ALASKA
SIGNING SUMMARY

DESIGNED BY: J. AHLGREN	PROJECT NO. 70375
DRAWN BY: AUTOCADD/CSA	DATE: MAY, 1991
CHECKED BY: K. SMITH	SHEET 15 OF 38

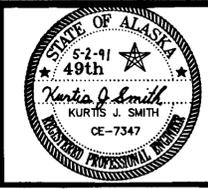

STANDARD SIGN SUMMARY

LOCATION			SIGN				POST			REMARKS	
SIGN NO.	LOCATION	OFFSET FT. LT. RT.	CODE NO.	LEGEND	SIZE	AREA S.F.	NO. OF POSTS	SIZE	LENGTH		FACING TRAFFIC
111	"MS" 9+22		W1-1R	TURN RIGHT	36"X36"	9.0	1	2.0	12.5	EB	
-	"MS" 9+22	30	W13-1	15 MPH	24"X24"	4.0	-	-	-	-	INSTALL BELOW TURN SIGN ABOVE
112	"MS" 10+18		R3-2	LEFT TURN	30"X30"	6.95	-	-	-	EB	REMOVE EXISTING SPEED LIMIT 20-BAND TO LIGHT POLE SPEED LIMIT ALREADY BANDED
113	"MS" 10+40	50	R1-2	YIELD	36"X36"X36"	7.9	1	2.0	11.5	NB	REPLACE EXISTING SIGN AND REMOVE "DO NOT ENTER"
114	"MS" 10+95	28	M1-6	ALASKA 7	24"X24"	4.0	-	-	-	NB	REPLACE EXISTING
115	"MS" 11+68	23	R2-1	SPEED LIMIT 20	30"X36"	7.5	-	-	-	NB	REPLACE EXISTING
116	"MS" 11+95		M1-6	ALASKA 7	24"X24"	4.0	-	-	-	SB	REPLACE EXISTING
117	"MS" 12+88		R2-1	SPEED LIMIT 20	30"X36"	7.5	-	-	-	SB	REPLACE EXISTING REQUIRED NEW POST AND BASE
118	"MS" 13+92		W11-2	PED XING SYMBOL	36"X36"	9.0	1	2.0	11.5	SB	REPLACE EXISTING
119	"MS" 16+38	28	W11-2	PED XING SYMBOL	36"X36"	9.0	1	2.0	11.5	NB	REPLACE EXISTING
120	"MS" 20+15		D3-1	STEDMAN ST	36"X8"	2.0	-	-	-	EB	REPLACE EXISTING
-	"MS" 20+15	30	D3-1	THOMAS ST	36"X8"	2.0	-	-	-	SB	REPLACE EXISTING
121	"MS" 21+30	38	D3-1	TATSUDA WY	36"X8"	2.0	-	-	-	NB	REPLACE EXISTING
122	"MS" 21+65		D3-1	STEDMAN ST	36"X8"	2.0	-	-	-	EB	REPLACE EXISTING
-	"MS" 21+65	27	D3-1	INMAN ST	24"X8"	1.33	-	-	-	SB	REPLACE EXISTING
123	"MS" 22+71	28	-	SPEED LIMIT 20	-	-	-	-	-	NB	REMOVE EXISTING SIGN
-	"MS" 22+71	28	1-8	FERRY SYMBOL	24"X24"	4.0	-	-	-	NB	INSTALL ON EXISTING POST
-	"MS" 22+71	28	1-8	FERRY	24"X6"	1.0	-	-	-	NB	INSTALL BELOW FERRY SYMBOL
-	"MS" 22+71	28	SPECIAL	ARROW STRAIGHT	21"X15"	2.19	-	-	-	NB	INSTALL BELOW "FERRY", SIGN SHALL BE SIMILAR TO M6-3 EXCEPT COLOR SHALL BE WHITE ON GREEN
124	"MS" 25+94	26	R2-1	SPEED LIMIT 20	30"X36"	7.5	-	-	-	NB	INSTALL ON EXISTING POST REQUIRED NEW POST AND BASE
-	"MS" 25+94	26	R2-1	FERRY	-	-	-	-	-	NB	REMOVE EXISTING SIGN
125	"MS" 26+00	28	R1-1	STOP	30"X30"	6.25	-	-	-	WB	REPLACE EXISTING
-	"MS" 26+00	28	D3-1	STEDMAN ST	36"X8"	2.0	-	-	-	WB	REPLACE EXISTING
-	"MS" 26+00	28	D3-1	DEERMOUNT ST	42"X8"	2.33	-	-	-	NB	REPLACE EXISTING
126	"MS" 26+95	30	-	SPEED LIMIT 20	-	-	-	-	-	NB	REMOVE EXISTING SIGN AND POST
127	"MS" 10+92		R1-2 R5-1	YIELD	36"X36"X36"	7.9	1	2.0	12.0	EB-SB	YIELD WAS WRONG. INSTALLED A "DO NOT ENTER"
-	"MS" 10+92	55	R6-1R	ONE WAY	36"X12"	3.0	-	-	-	SB	INSTALL ABOVE "YIELD"
-	"MS" 10+92	55	R6-1L	ONE WAY	36"X12"	3.0	-	-	-	EB	INSTALL ABOVE "YIELD"
128	"F" 0+24		-	ONE WAY	-	-	-	-	-	NB	REMOVE SIGNS AND POST
129	"F" 6+00	28	R7-101	NO PARKING ANYTIME TOW AWAY ZONE	12"X18"	1.15	-	-	-	SB	ADDED I.R.C.O. #
130	"F" 4+60	28	R7-201		12"X18"	1.15	-	-	-	SB	
131	"MS" 1+00	28					-	-	-	SB	
132	"MS" 2+00	28					-	-	-	SB	
133	"MS" 3+30	28					-	-	-	EB	
134	"MS" 4+00	28					-	-	-	EB	
135	"F" 3+50	28					-	-	-	SB	
136	"MS" 6+00	28					-	-	-	EB	

TOTAL 727.60 SF

AS BUILT



DATE:	DESCRIPTION OF CHANGE:
11/16/95	AS BUILT

STATE OF ALASKA
DEPARTMENT OF TRANSPORTATION
AND PUBLIC FACILITIES
SOUTHEAST REGION DESIGN & CONSTRUCTION




KETCHIKAN
TONGASS AVENUE PAVEMENT REHABILITATION
F-M-0902(16) 70375
ALASKA
SIGNING SUMMARY

DESIGNED BY: J. AHLGREN
DRAWN BY: AUTOCADD/CSA
CHECKED BY: K. SMITH
PROJECT NO. 70375
DATE: MAY, 1991
SHEET 16 OF 38



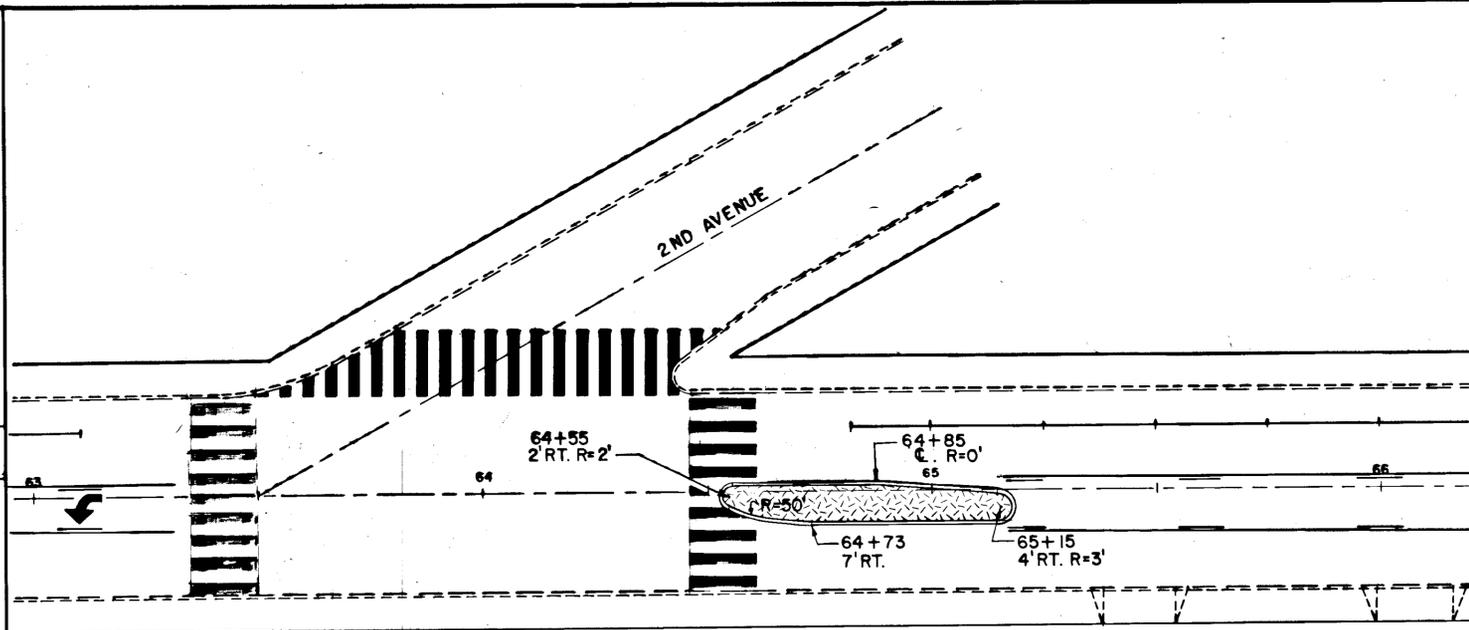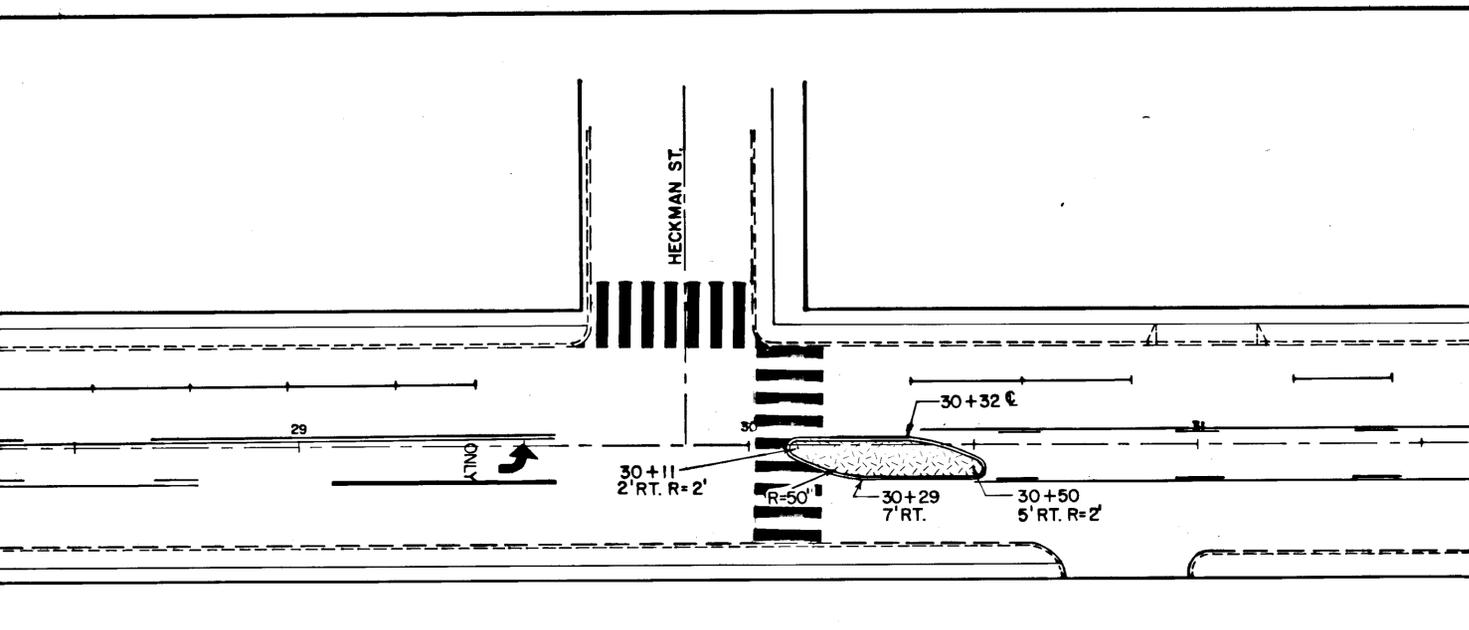


 RAISED MEDIAN ISLAND
 SEE SHEET 8 FOR DETAILS.

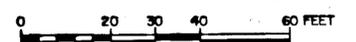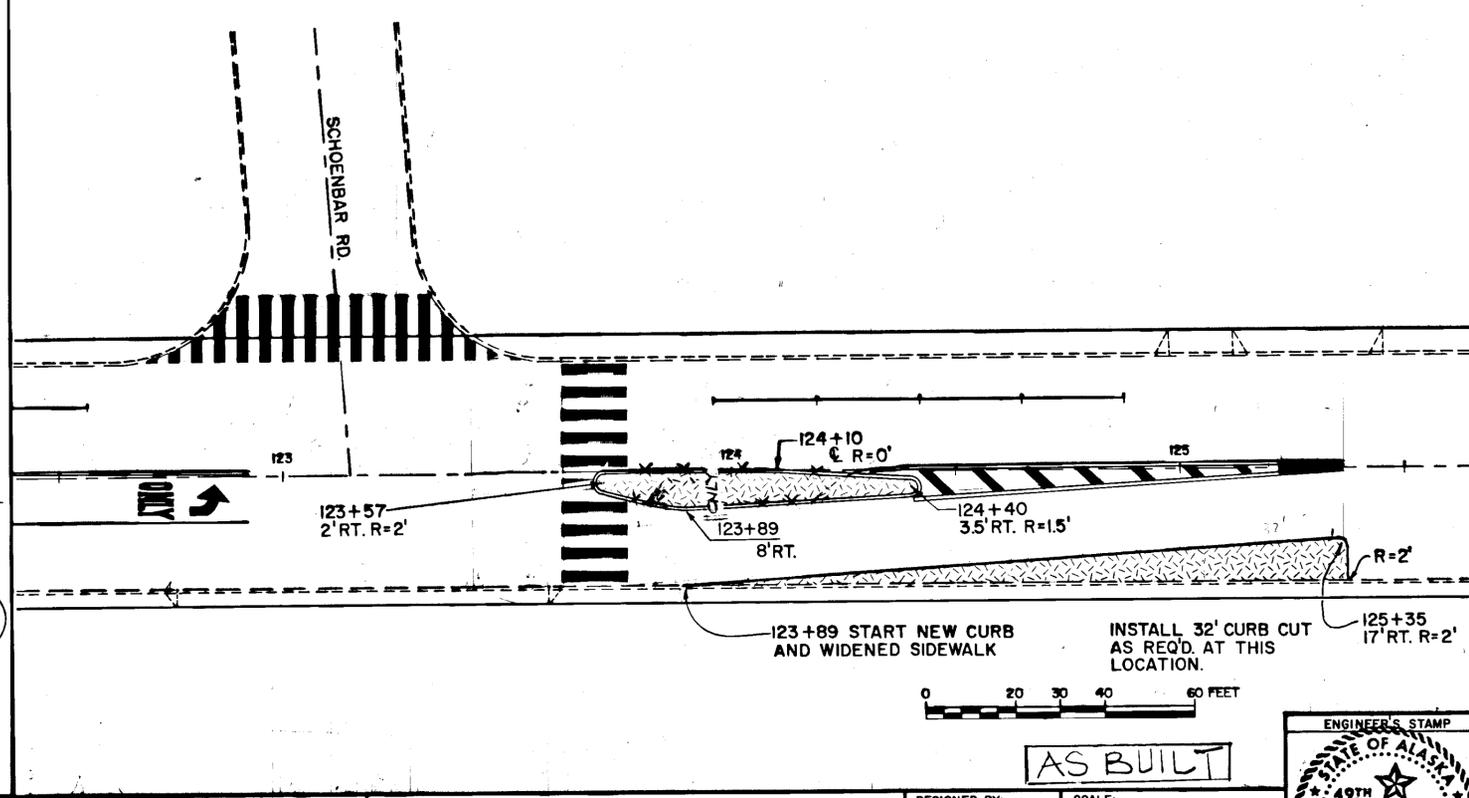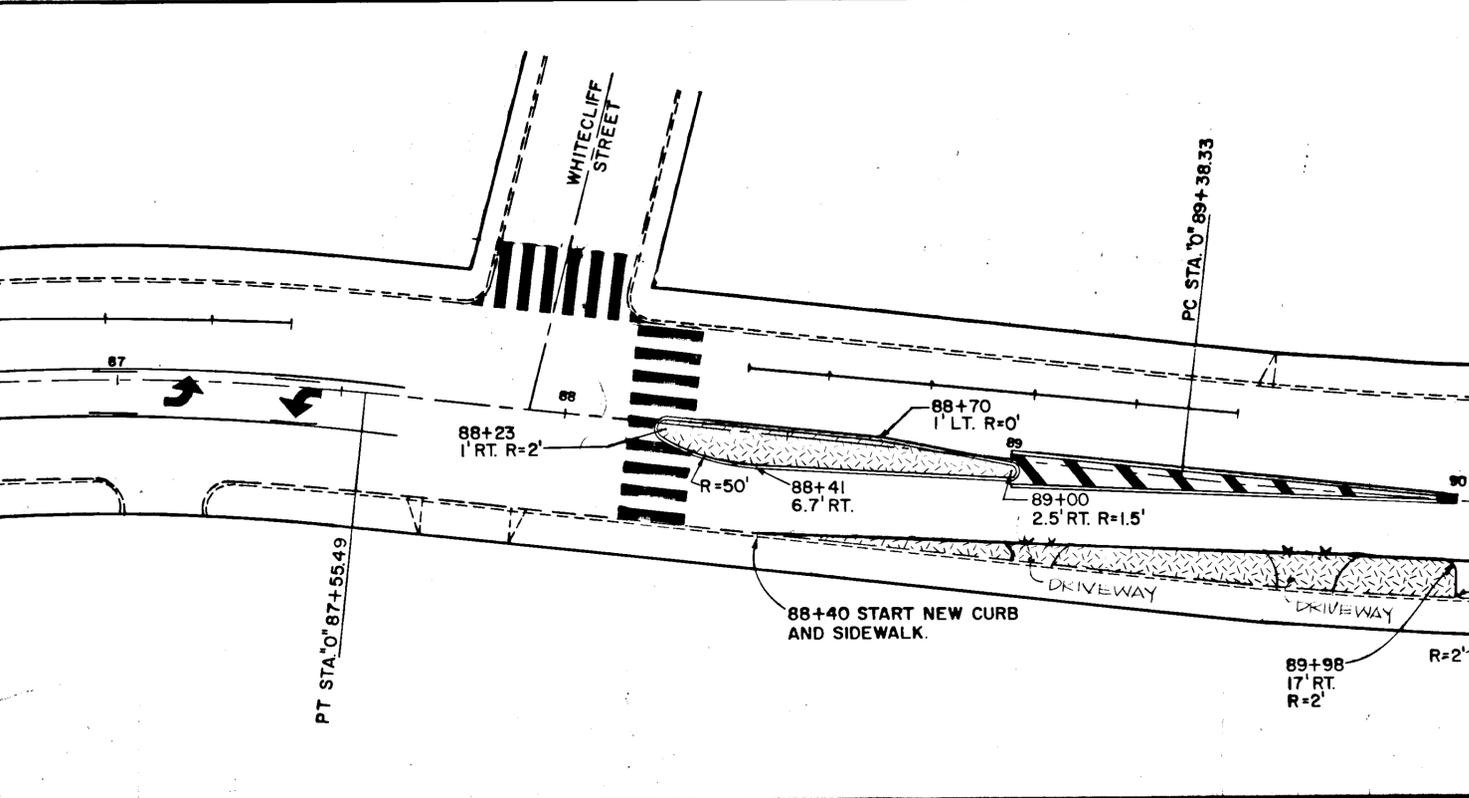

AS BUILT

BY	DATE	DESCRIPTION OF CHANGE
K.K.	11/16/95	AS BUILT
RECORD OF REVISIONS		

STATE OF ALASKA
 DEPARTMENT OF TRANSPORTATION
 & PUBLIC FACILITIES
 SOUTHEAST REGION DESIGN & CONSTRUCTION

KETCHIKAN TONGASS AVENUE PAVEMENT REHABILITATION
 F-M-0902 (16) 70375
 RAISED MEDIAN ISLAND DETAILS
 ALASKA

APPROVED BY: _____ DATE _____
 DESIGN GROUP CHIEF
 RECOMMENDED BY: _____ DATE _____
 DESIGN ENGINEER, GROUP
 PREPARED BY: _____ DATE _____
 PROJECT MANAGER LEAD DESIGNER



DESIGNED BY: T.M.
 DRAWN BY: B.A.
 CHECKED BY: P.J.
 SCALE: AS SHOWN
 DATE: MAY, 1991
 SHEET 17 OF 38



GENERAL NOTES


- All loops shall be centered laterally in their lanes.

Approx. Sta. 75+05, 33' Rt. and 75+22, 33' Lt., remove existing 5-section signal heads and install new 3-section signal heads. See Section 660 of the Special Provisions.

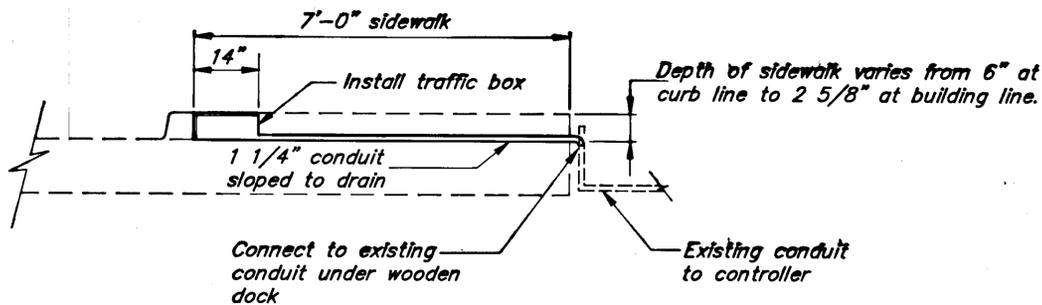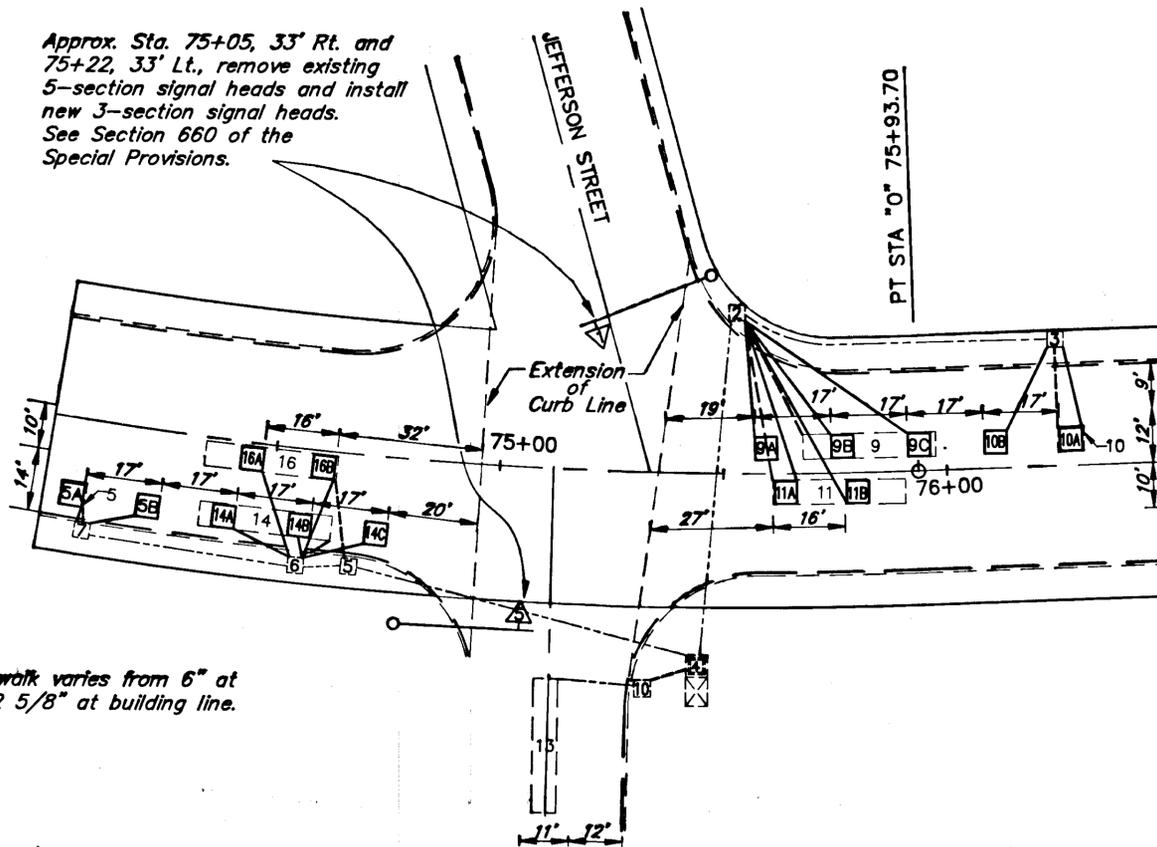

JUNCTION BOX AND CONDUIT INSTALLATION DETAIL

DOCK STREET N.T.S.

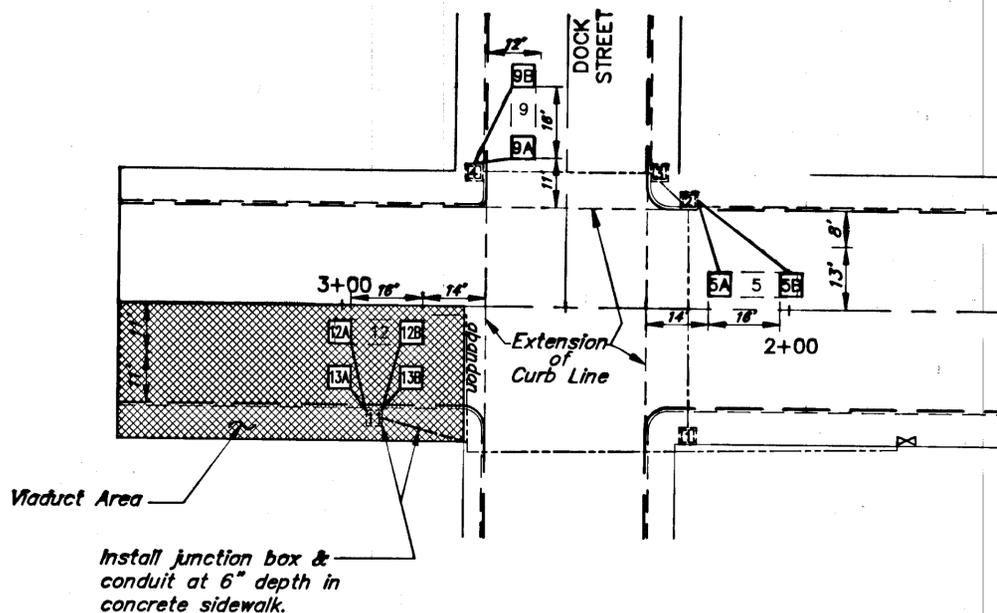

JEFFERSON STREET DETECTION NOTES

- A new terminal strip with space for at least 30 connections shall be installed in the existing signal cabinet.
- New loops 9B, 9C, 10B, 11B, 16a, 14A, 14C, 5B shall each have one new two conductor lead in cable pulled in from the controller. Loops 9A, 10A, 11A, 16B, 14B, 5A, shall be spliced to the existing lead ins for loop 9, 10, 11, 16, 14, 5.
- All loops shall be installed in a 1" x 1" groove that will be sawcut or routed onto the concrete. The loops shall be installed after cold planing and prior to paving the first asphalt lift.
- All loops will be conduit enclosed loops as per the Special Provisions.
- Loop 13 shall be cleaned and resealed wherever the loop is exposed using an approved two part epoxy sealant.

DOCK STREET DETECTION NOTES

- A new terminal strip with space for at least 20 connections shall be installed in the existing signal cabinet.
- New loops 5A, 5B shall be installed if the existing loop 5 is disturbed by grinding. If no construction activity occurs in this area the new loops will not be installed and the existing loop will be left as is.
- The conduit from the controller to the existing loop 12 shall be cut and rerouted to the new conduit going to junction box 11.
- Loop 12 shall have its lead in cable removed and a new 6 pair loop lead in cable pulled in that will connect to loop leads at junction box 11.
- A boat may be required to connect conduit from controller to new conduit connecting to junction box 11.
- Loop 5B and loop 9B shall each have one new two conductor detector lead in cable pulled in from the controller. Loops 5A and 9A, shall be spliced to the existing lead in for Loops 5 and 9.
- All loops shall be installed in a sawcut in the pavement. Loops 5A, 5B, 9A, 9B shall be installed as per standard drawing T-32, with the exception of dimensions which shall be shown to loop edge nearest the intersection. Loops 12A, 12B, 13A, 13B will be installed in a sawcut that is 1 1/4" deep. In no case shall the sawcut penetrate the bridge deck membrane.
- Splices in detector lead-ins may only be made in the curbside junction box.
- Wiring for Loops 5A, 5B, 9A, 9B shall have PVC ducts. Loops 12A, 12B, 13A, 13B shall be standard wire loops.

AS BUILT

NOTE: DO NOT SCALE FROM THESE PLANS—USE DIMENSIONS

DATE:	DESCRIPTION OF CHANGE:
11/10/95	AS BUILT

STATE OF ALASKA
DEPARTMENT OF TRANSPORTATION
AND PUBLIC FACILITIES
SOUTHEAST REGION DESIGN & CONSTRUCTION

KETCHIKAN


TONGASS AVENUE PAVEMENT REHABILITATION
F-M-0902 (16) 70375

ALASKA


DESIGNED BY:	R.P.	SCALE:	NONE
DRAWN BY:	AUTOCADD/R.K.S.	DATE:	MAY 1991
CHECKED BY:	K.S.	SHEET	18 OF 38

TRAFFIC LOOP DETECTOR DETAILS



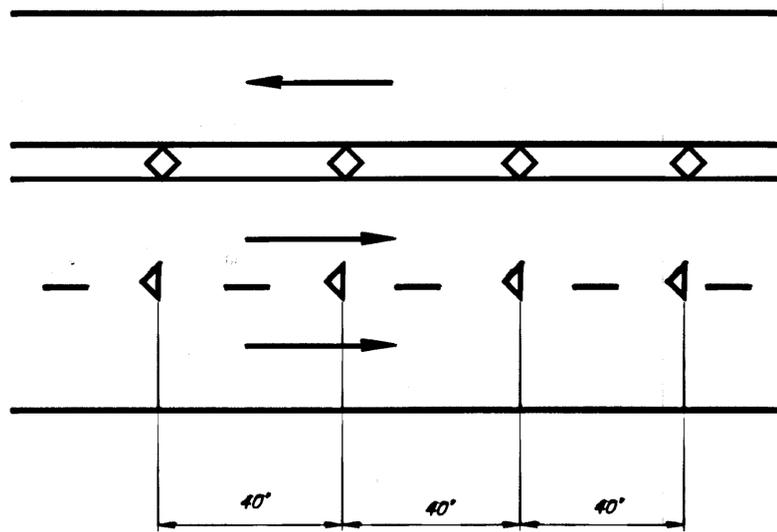


THREE THROUGH LANE MARKING DETAIL

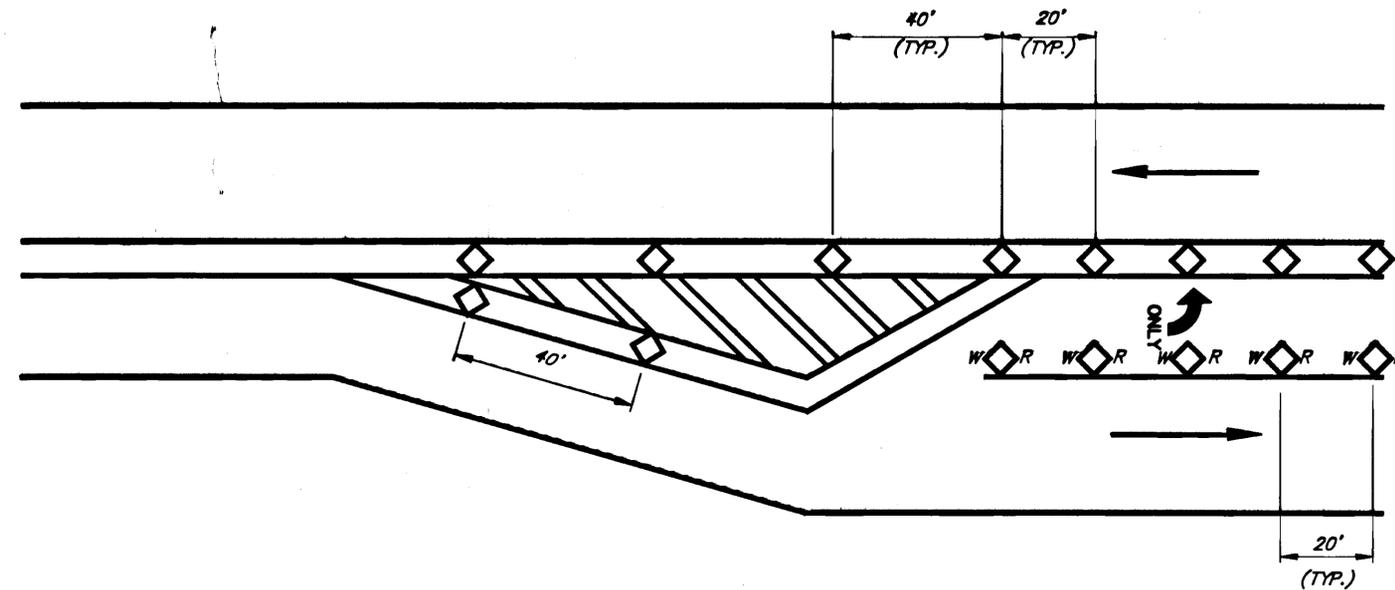

TWO LANE ONE WAY LEFT TURN LANE TRANSITION

LEGEND


- TWO WAY YELLOW REFLECTIVE PAVEMENT MARKER
- REFLECTIVE PAVEMENT MARKER WITH ONE WHITE, ONE RED FACE
- ONE WAY WHITE REFLECTIVE PAVEMENT MARKER

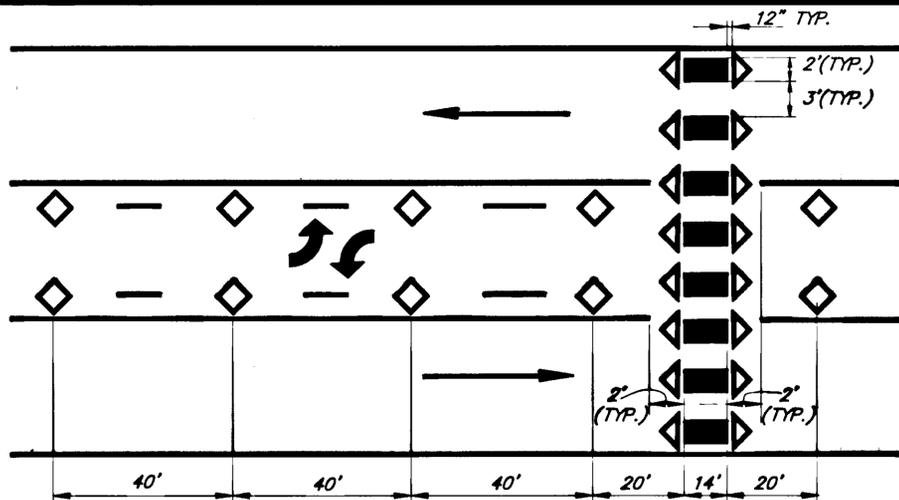

TWO-WAY LEFT TURN LANE AND CROSSWALK MARKING DETAIL

NOTES:

1. GAPS BETWEEN CROSSWALK STRIPES SHALL BE ADJUSTED AS NECESSARY TO KEEP THEM OUT OF WHEEL PATHS.
2. PARKING SHALL NOT BE ALLOWED WITHIN 20 FEET OF A CROSSWALK.
3. CROSSWALKS ARE ALSO INSTALLED IN 3 LANE SECTIONS WITH ONE WAY LEFT TURN LANES OR IN TWO LANE SECTIONS. CLEARANCES FROM LONGITUDINAL STRIPES, RPMs, AND PARKING ZONES SHALL REMAIN THE SAME IN THOSE INSTANCES.
4. ONE WAY REFLECTIVE MARKINGS SHALL NOT BE INSTALLED NEXT TO CROSSWALK MARKINGS ACROSS SIDE STREETS OR AT SIGNALIZED INTERSECTIONS.

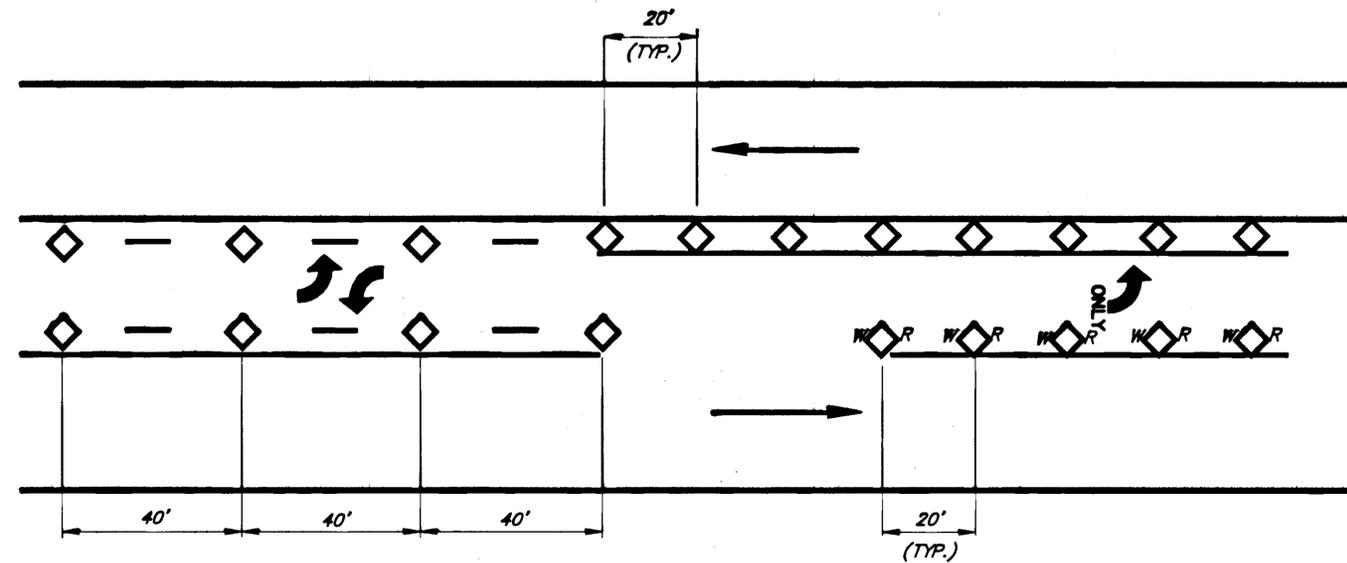

TWO-WAY ONE WAY LEFT TURN LANE TRANSITION

AS BUILT

DATE	DESCRIPTION OF CHANGE
11/16/95	AS BUILT

STATE OF ALASKA
DEPARTMENT OF TRANSPORTATION
AND PUBLIC FACILITIES
SOUTHEAST REGION DESIGN & CONSTRUCTION

KETCHIKAN


TONGASS AVENUE PAVEMENT REHABILITATION
F-M-0902(16) 70375
**REFLECTIVE PAVEMENT MARKERS
CROSSWALK MARKINGS**

ALASKA

DESIGNED BY: K. SMITH
DRAWN BY: AUTOCADD/CSA
CHECKED BY: J. AHLGREN


PROJECT NO. 70375
DATE: MAY, 1991
SHEET 19 OF 38



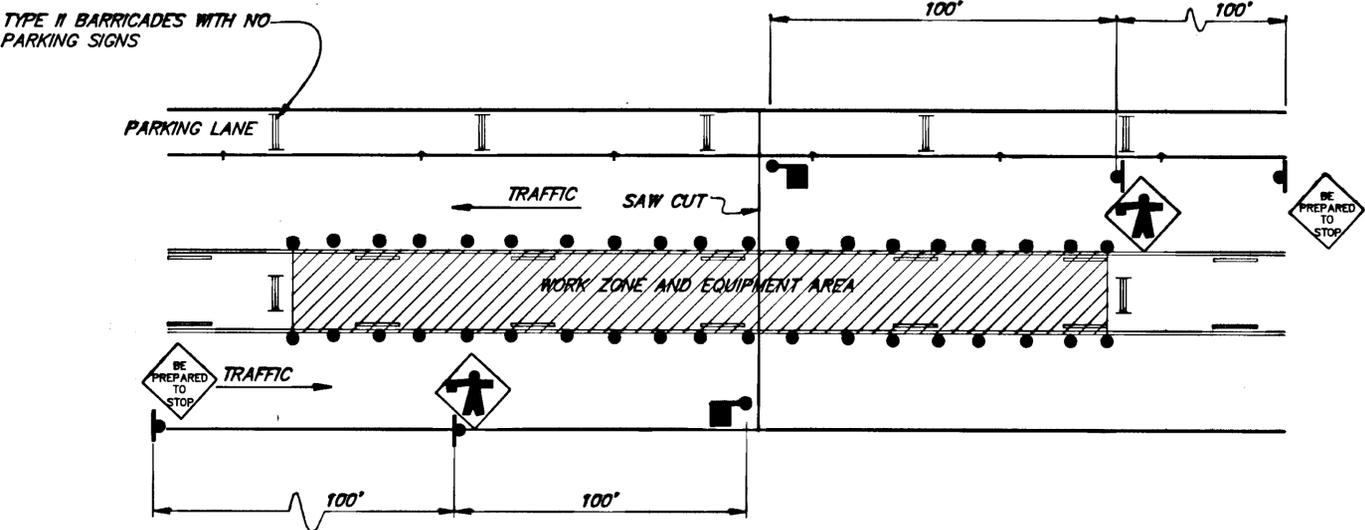


TCP FOR EXPANSION JOINT SAWING AND SEALING (TWO-WAY LEFT TURN LANE)

NOTE: FLAGGER WILL STOP TRAFFIC WHILE EQUIPMENT IS IN TRAFFIC LANE. ONE LANE MAY BE CLOSED AT A TIME FOR NO MORE THAN 5 MINUTES.

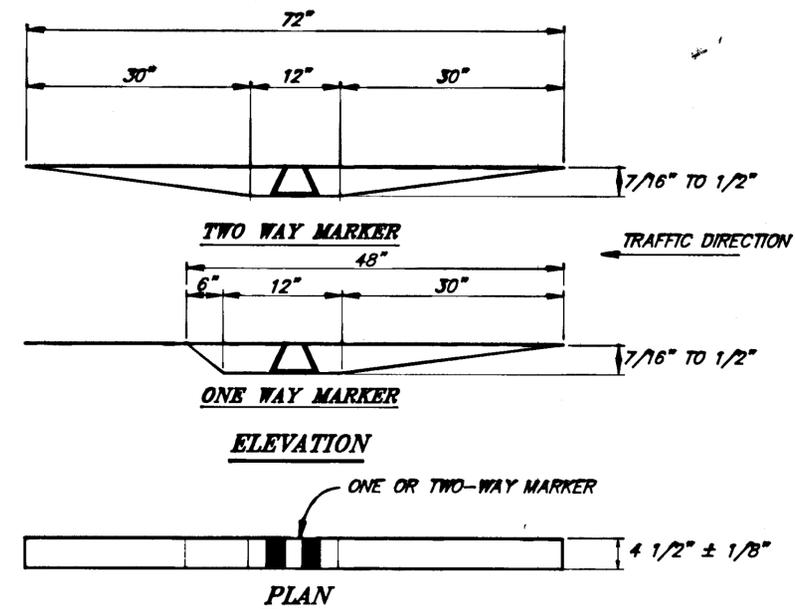


RECESSED MARKER TYPICAL

- NOTES:
- NO REFLECTIVE PAVEMENT MARKERS ARE REQUIRED IN 2 LANE SECTIONS.

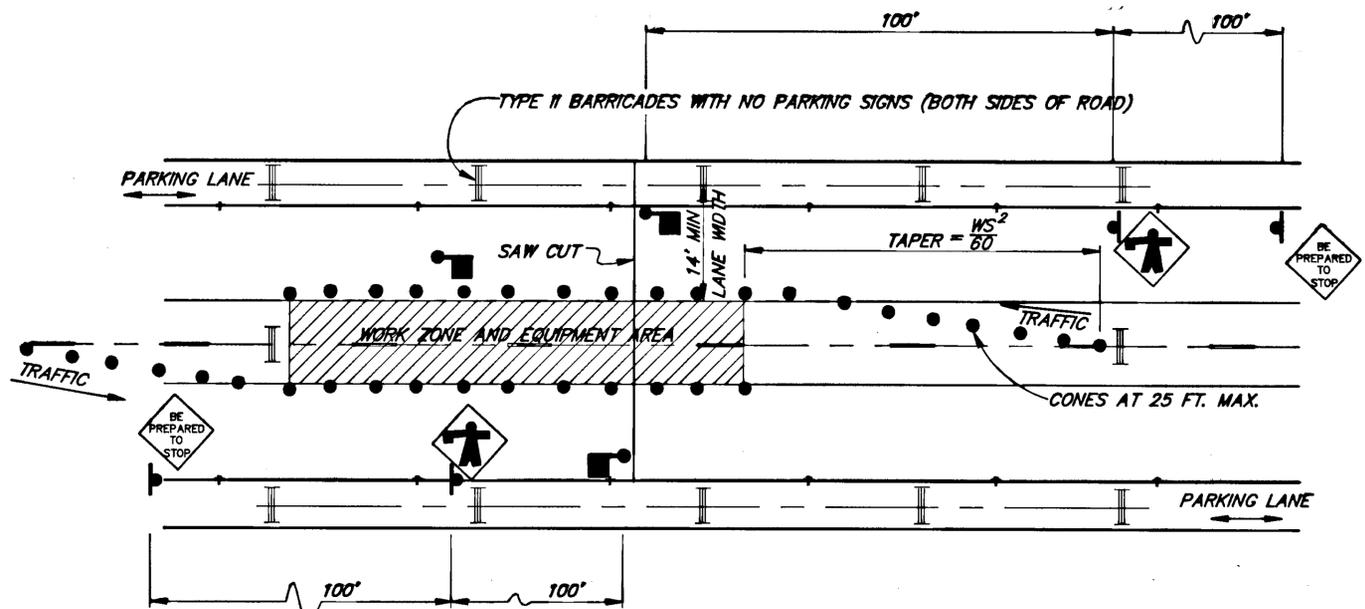

TCP FOR EXPANSION JOINT SAWING AND SEALING. (TWO-WAY WITH PARKING)

NOTE: FLAGGER WILL STOP TRAFFIC WHILE EQUIPMENT IS IN TRAFFIC LANE. ONE LANE MAY BE CLOSED AT A TIME FOR NO MORE THAN 5 MINUTES.

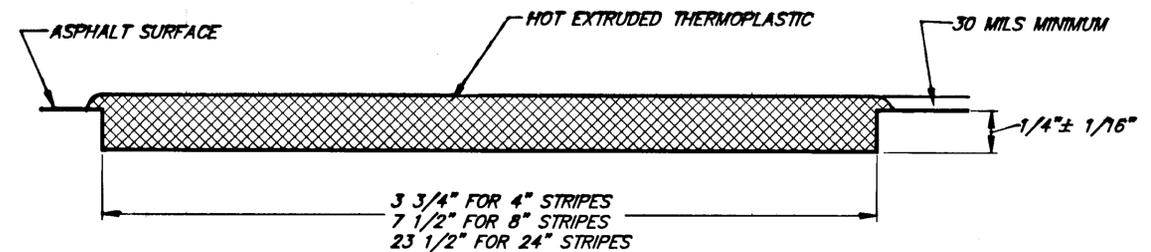

GROOVED-IN THERMOPLASTIC

SEE SECTION 670 OF THE SPECIAL PROVISIONS

DATE:	DESCRIPTION OF CHANGE:
K 11/16/95	AS BUILT

STATE OF ALASKA
DEPARTMENT OF TRANSPORTATION AND PUBLIC FACILITIES
SOUTHEAST REGION DESIGN & CONSTRUCTION

KETCHIKAN
TONGASS AVENUE PAVEMENT REHABILITATION
F-M-0802(16) 70375
ALASKA
TRAFFIC CONTROL PLAN
REFLECTIVE PAVEMENT MARKERS/GROOVED IN THERMOPLASTIC


NOTE: DO NOT SCALE FROM THESE PLANS-USE DIMENSIONS

DESIGNED BY: J. AHLGREN	PROJECT NO. 70375
DRAWN BY: AUTOCADD/C. Anderson	DATE: MAY, 1991
CHECKED BY: K. SMITH	SHEET 20 OF 38


AS BUILT

ENGINEER'S SEAL



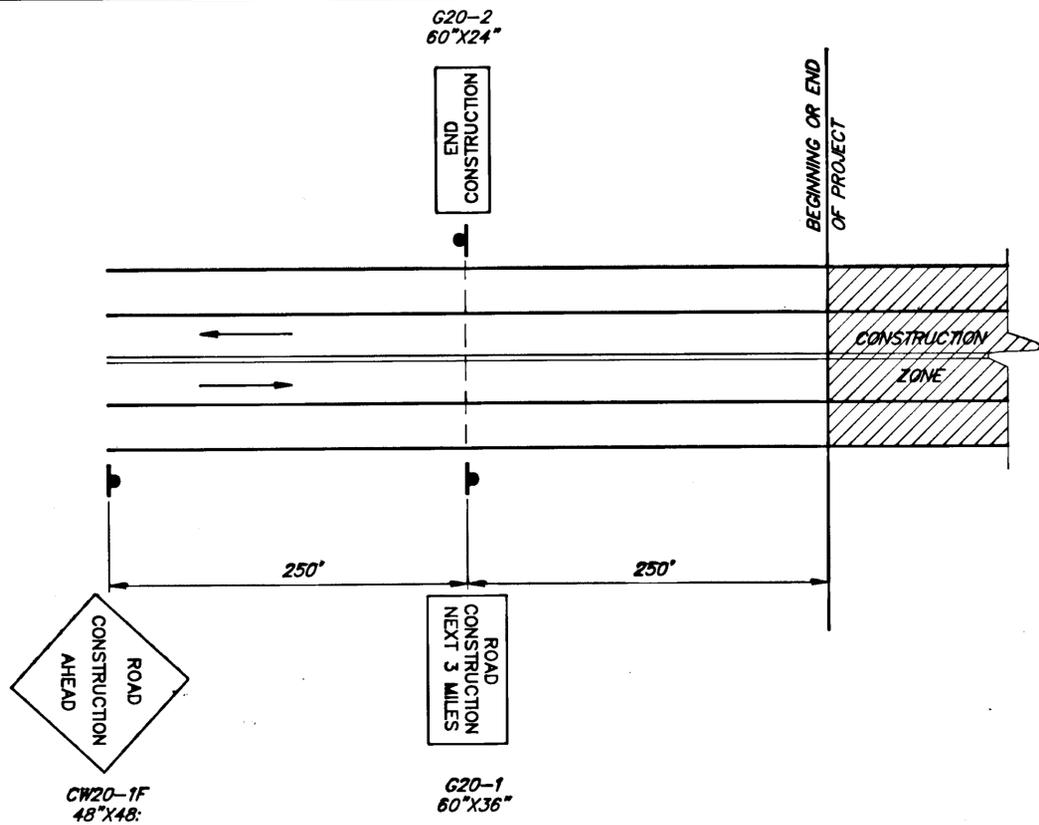

PERMANENT CONSTRUCTION SIGNING
INSTALL AT BOTH ENDS OF PROJECT

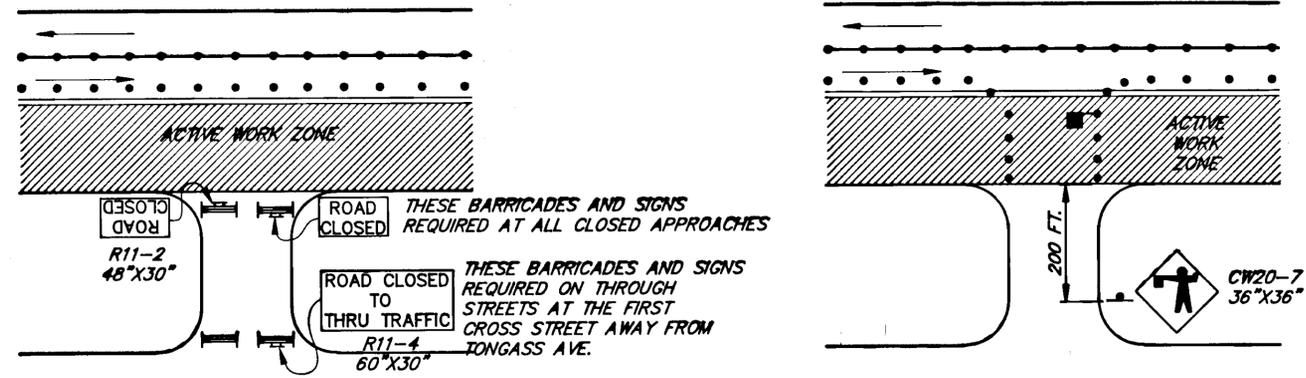

FOR SIDE STREETS WITHIN ACTIVE WORK ZONE WITH ALTERNATIVE ACCESS TO TONGASS AVE.


FOR SIDE STREETS WITHIN ACTIVE WORK ZONE WITHOUT ALTERNATIVE ACCESS TO TONGASS AVE.

NOTE: CLOSURES SHALL LAST NO LONGER THAN 2 HOURS


SIDE STREET TRAFFIC CONTROL

LEGEND

- = TYPE 3 BARRICADE
- = TUBULAR MARKERS
- = FLAGGER

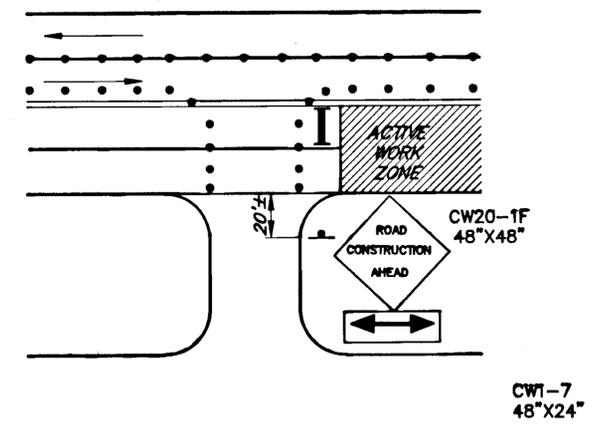

FOR SIDE STREETS WITHIN DIVERSION ZONE BUT NOT WITHIN ACTIVE WORK ZONE

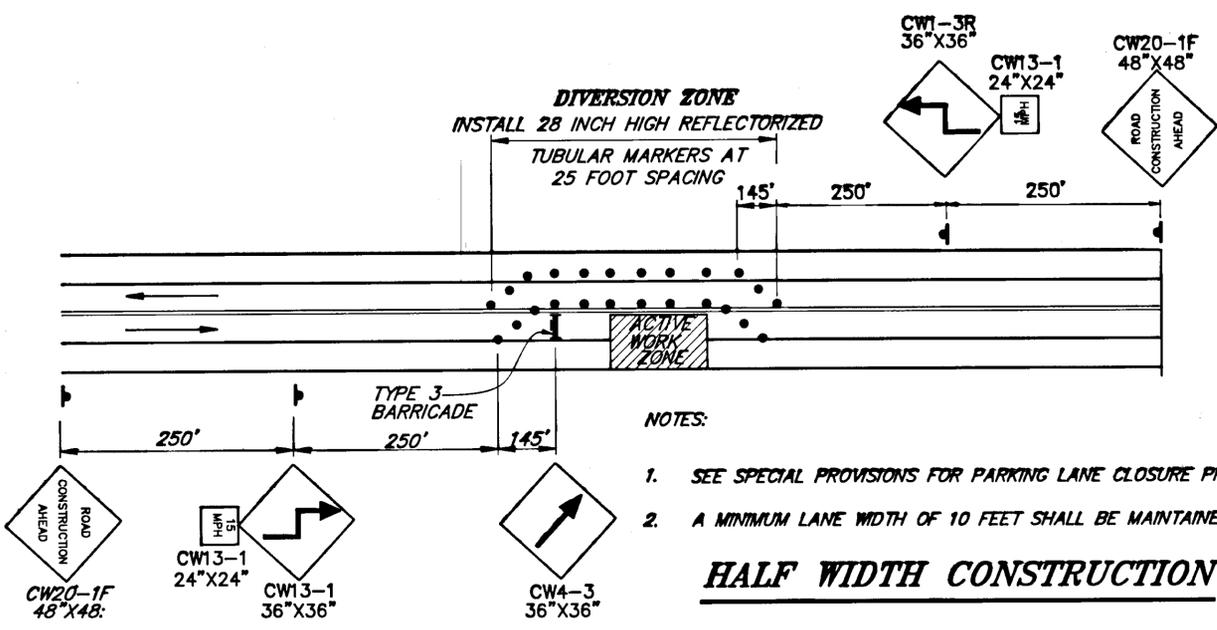

- NOTES:
- SEE SPECIAL PROVISIONS FOR PARKING LANE CLOSURE PROCEDURES.
 - A MINIMUM LANE WIDTH OF 10 FEET SHALL BE MAINTAINED.

HALF WIDTH CONSTRUCTION

AS BUILT

DATE:	DESCRIPTION OF CHANGE:
K.K. 11/16/95	AS BUILT

STATE OF ALASKA
DEPARTMENT OF TRANSPORTATION
AND PUBLIC FACILITIES
SOUTHEAST REGION DESIGN & CONSTRUCTION

KETCHIKAN

TONGASS AVENUE PAVEMENT REHABILITATION
F-M-0902(16) 70375
TRAFFIC CONTROL PLAN

ALASKA


DESIGNED BY: K. SMITH
DRAWN BY: AUTOCADD/CSA
CHECKED BY: J. AHLGREN

PROJECT NO. 70375
DATE: MAY, 1991
SHEET 21 OF 38




STRIPING NOTES

1. All markings shall conform to the latest edition of manual of uniform traffic control devices and these plans.
2. For additional striping details, see Std. Dwg. T-20.00, T-21.01, and T-22.01.
3. Parking lane striping shall begin and end a minimum of 2 feet after and before curb cuts respectively.
4. Loading Zones shall be painted on the curb face and curb top with white paint.
5. No Parking areas (ie Fire Hydrants & curb returns) shall be painted on the curb face & curb top with yellow paint, with skipped stripes.
6. Field verify the parking zone spaces at each section and adjust spacing to allow even length of stall in each section. Minimum stall length shall be 18 feet.

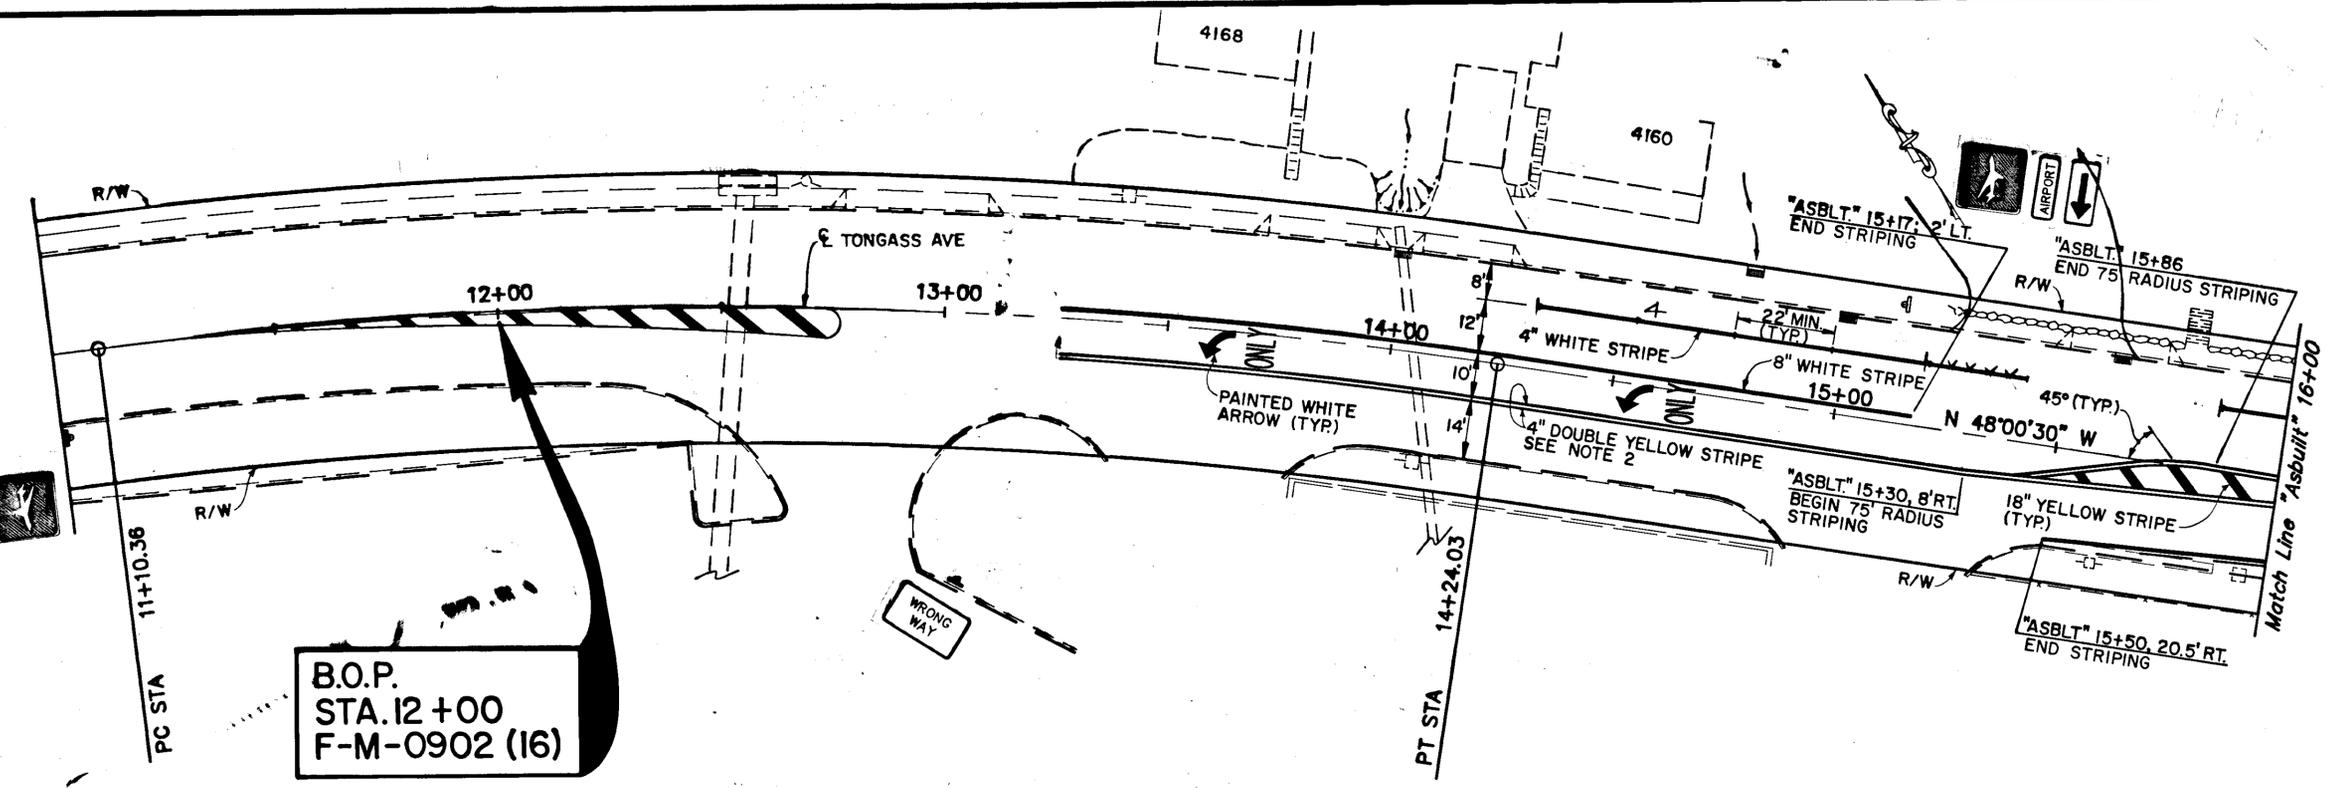

STRIPING QUANTITIES	
DESCRIPTION	QUANTITIES
4" YELLOW SOLID	17,801 LF
4" YELLOW SKIP	4,106 LF
4" WHITE SOLID	13,534 LF
4" WHITE SKIP	280 LF
8" WHITE SOLID	464 LF
18" YELLOW	573 LF
24" WHITE (CROSSWALK)	57.58 EA
ARROW SYMBOL	65 EA
LETTERING (ONLY)	11.12 EA

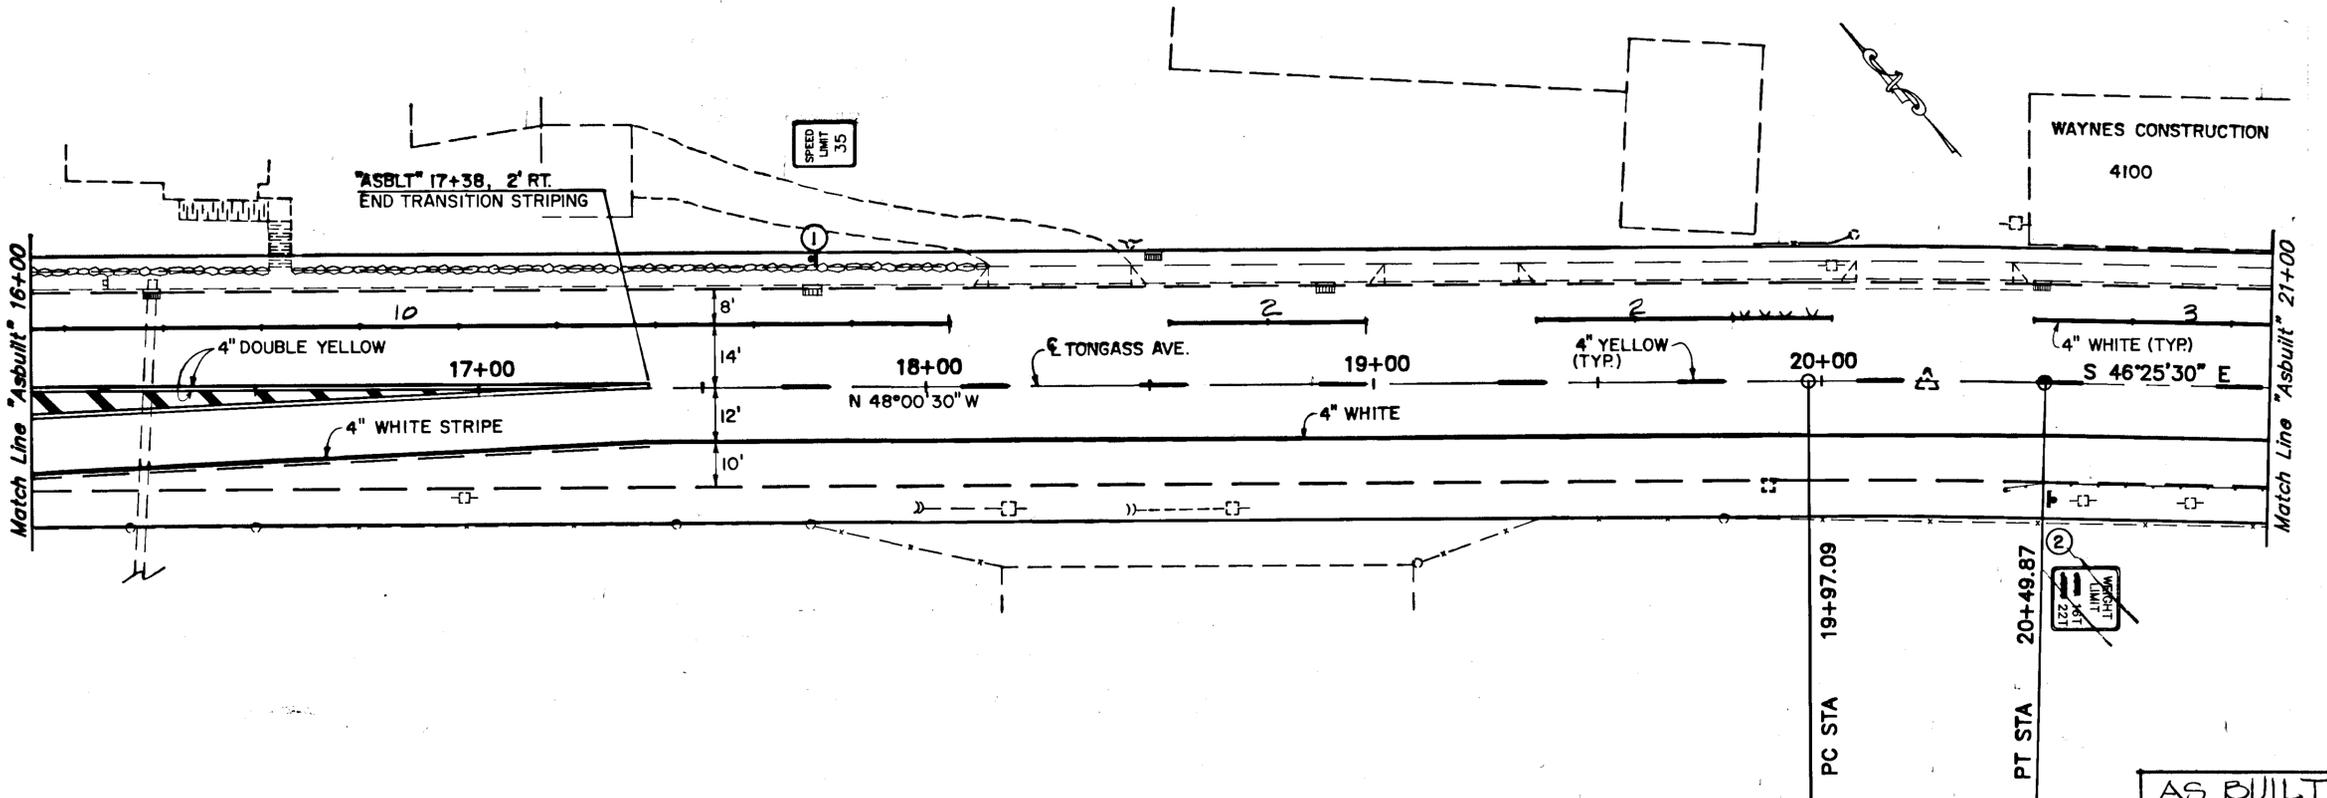

AS BUILT

NOTE: DO NOT SCALE FROM THESE PLANS-USE DIMENSIONS



BY:	DATE:	DESCRIPTION OF CHANGE:
KK	11/16/95	AS BUILT

STATE OF ALASKA
DEPARTMENT OF TRANSPORTATION AND PUBLIC FACILITIES
 SOUTHEAST REGION DESIGN & CONSTRUCTION

KETCHIKAN
 TONGASS AVENUE PAVEMENT REHABILITATION
 F-M-0902 (16) 70375
SIGNING AND STRIPING PLAN
 B.O.P. to Sta. 21+00

DESIGNED BY:	T.M.	SCALE
DRAWN BY:	AUTOCADD/R.K.S.	DATE:
CHECKED BY:	P.J.	MAY, 1991
		SHEET 22 OF 38



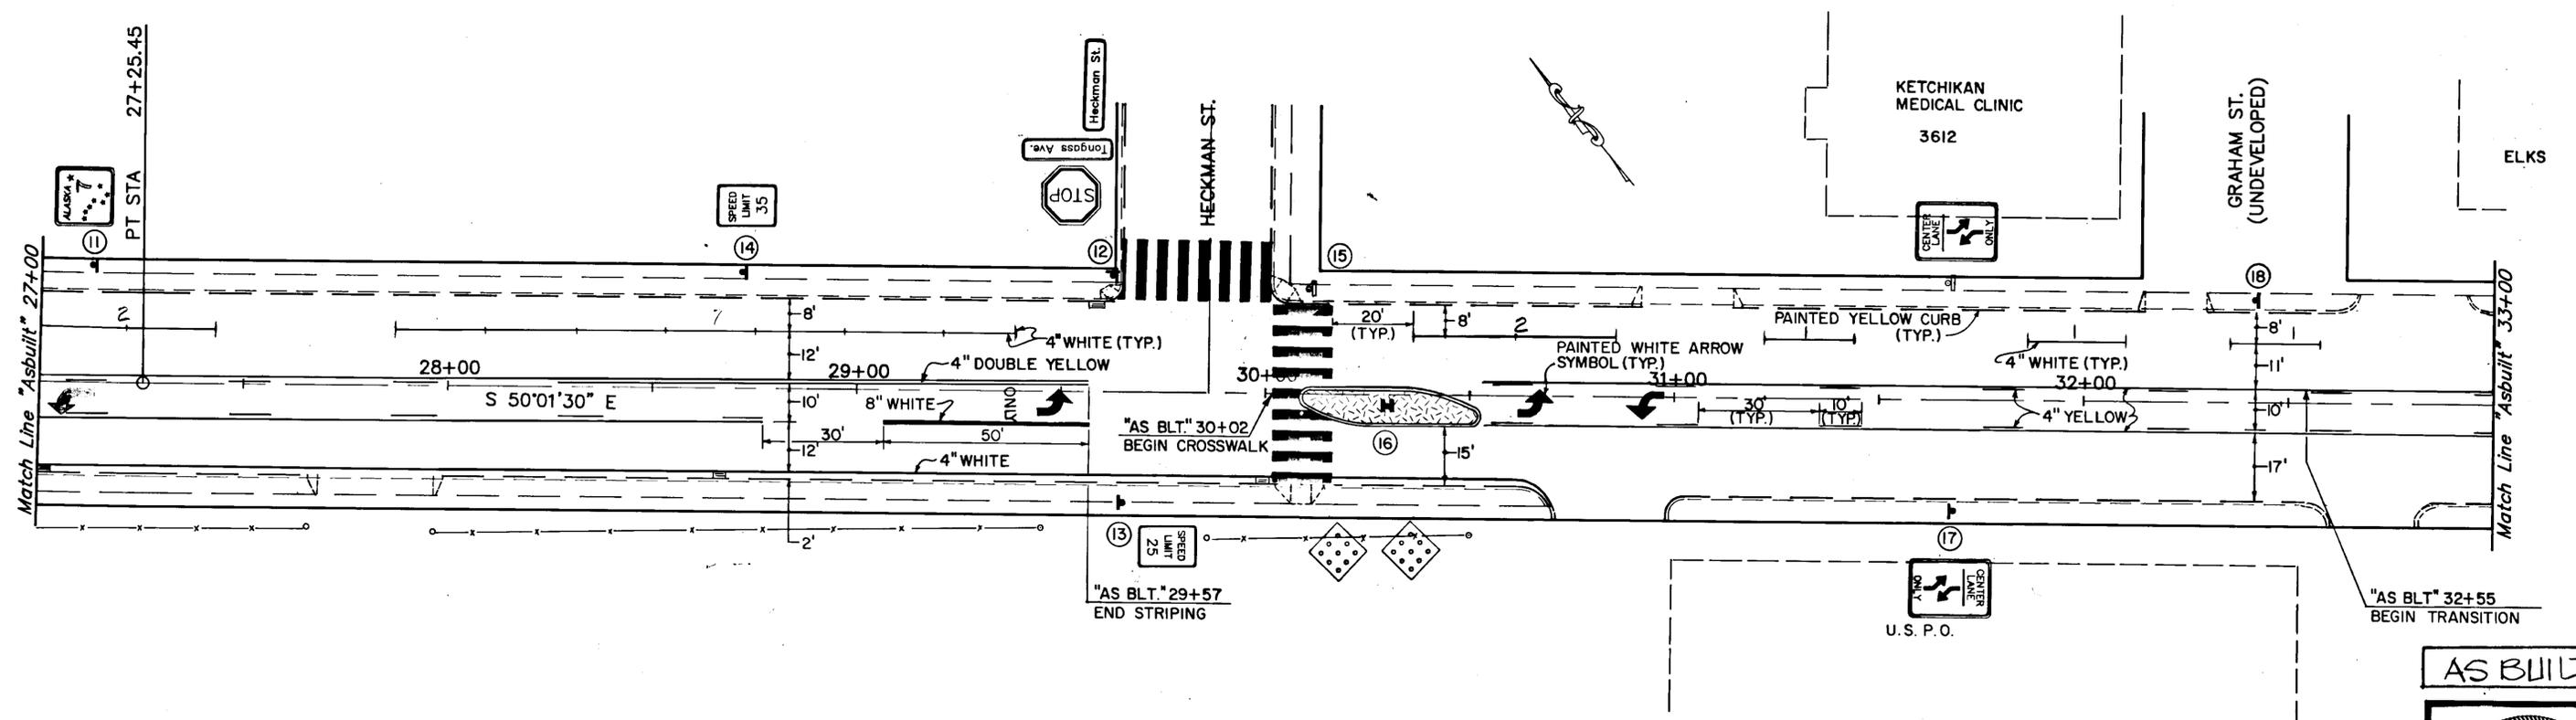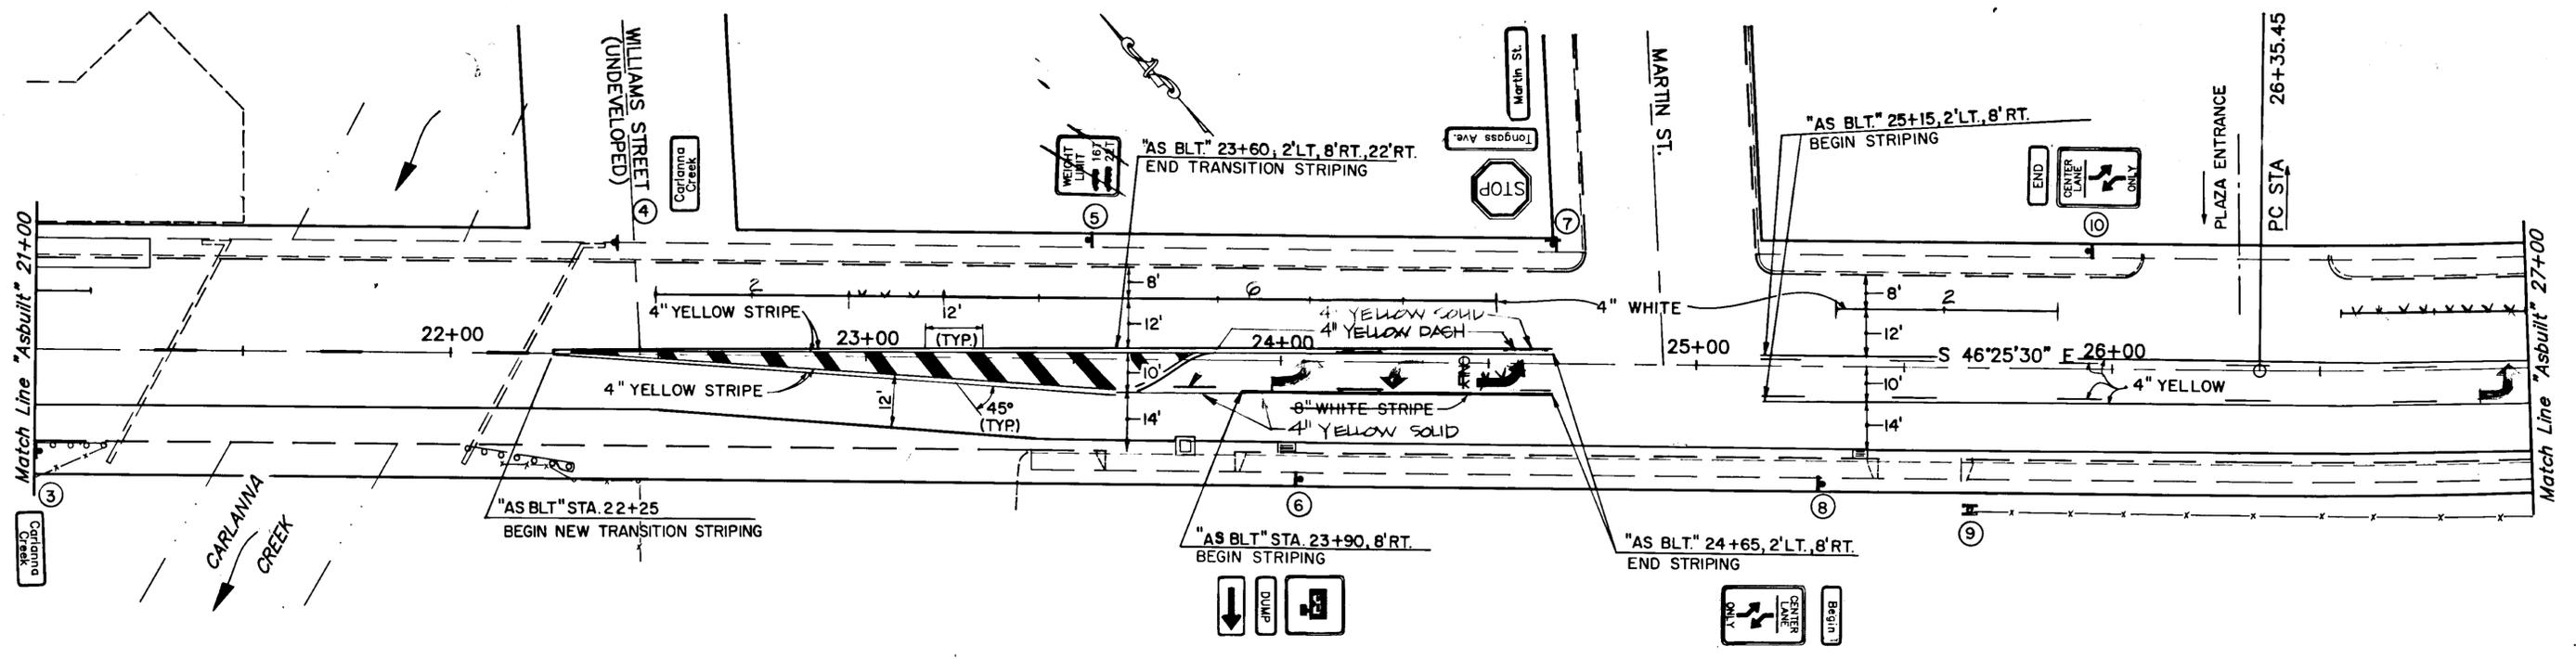

AS BUILT

NOTE: DO NOT SCALE FROM THESE PLANS-USE DIMENSIONS


DATE:	DESCRIPTION OF CHANGE:
K. 11/16/99	AS BUILT

STATE OF ALASKA
 DEPARTMENT OF TRANSPORTATION
 AND PUBLIC FACILITIES
 SOUTHEAST REGION DESIGN & CONSTRUCTION

KETCHIKAN
 TONGASS AVENUE PAVEMENT REHABILITATION
 F-M-0902 (16) 70375
SIGNING AND STRIPING PLAN
 Sta. 21+00 to Sta. 33+00

DESIGNED BY:	T.M.	SCALE
DRAWN BY:	AUTOCADD/R.K.S.	DATE:
CHECKED BY:	P.J.	MAY, 1991
		SHEET 23 OF 38



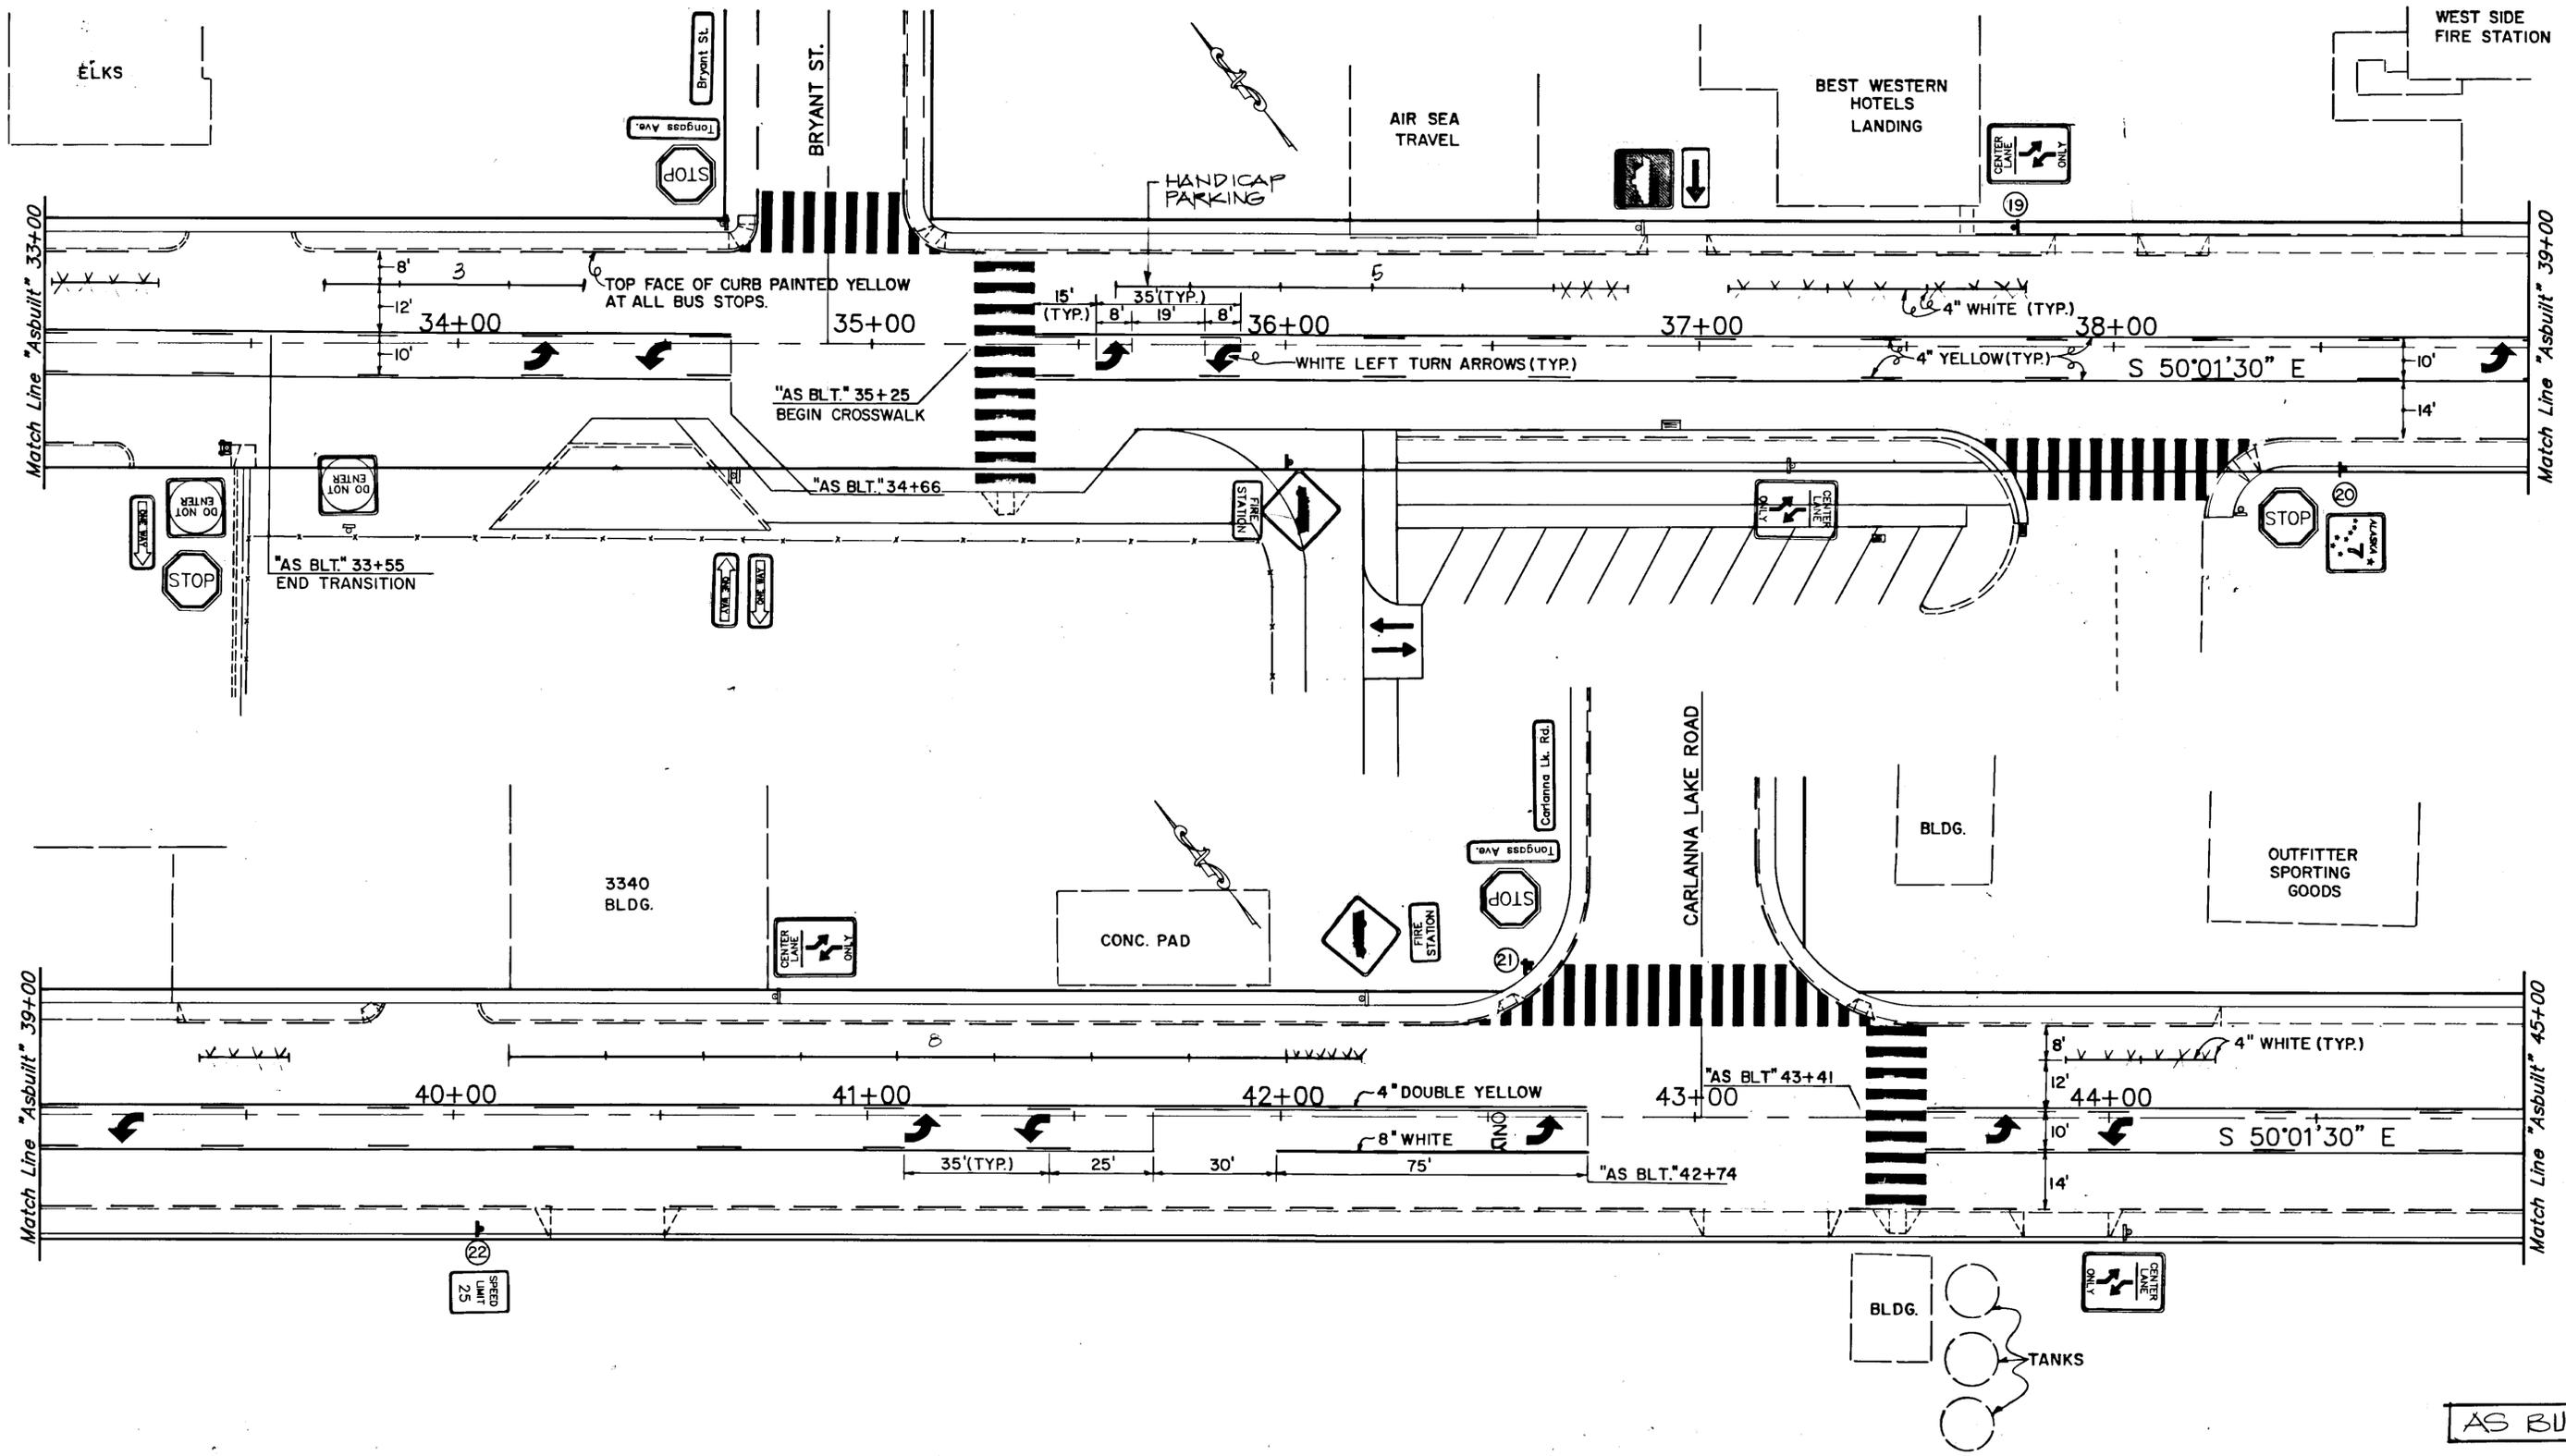

AS BUILT


NOTE: DO NOT SCALE FROM THESE PLANS—USE DIMENSIONS


DATE:	DESCRIPTION OF CHANGE:
K 11/16/95	AS-BUILT

STATE OF ALASKA
 DEPARTMENT OF TRANSPORTATION
 AND PUBLIC FACILITIES
 SOUTHEAST REGION DESIGN & CONSTRUCTION

KETCHIKAN TONGASS AVENUE PAVEMENT REHABILITATION
 F-M-0902(16) 70375
SIGNING AND STRIPING PLAN
 Sta. 33+00 to Sta. 45+00

DESIGNED BY:	T.M.	SCALE
DRAWN BY:	AUTOCADD/R.K.S.	DATE: MAY, 1991
CHECKED BY:	P.J.	SHEET 24 OF 38

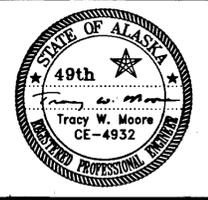

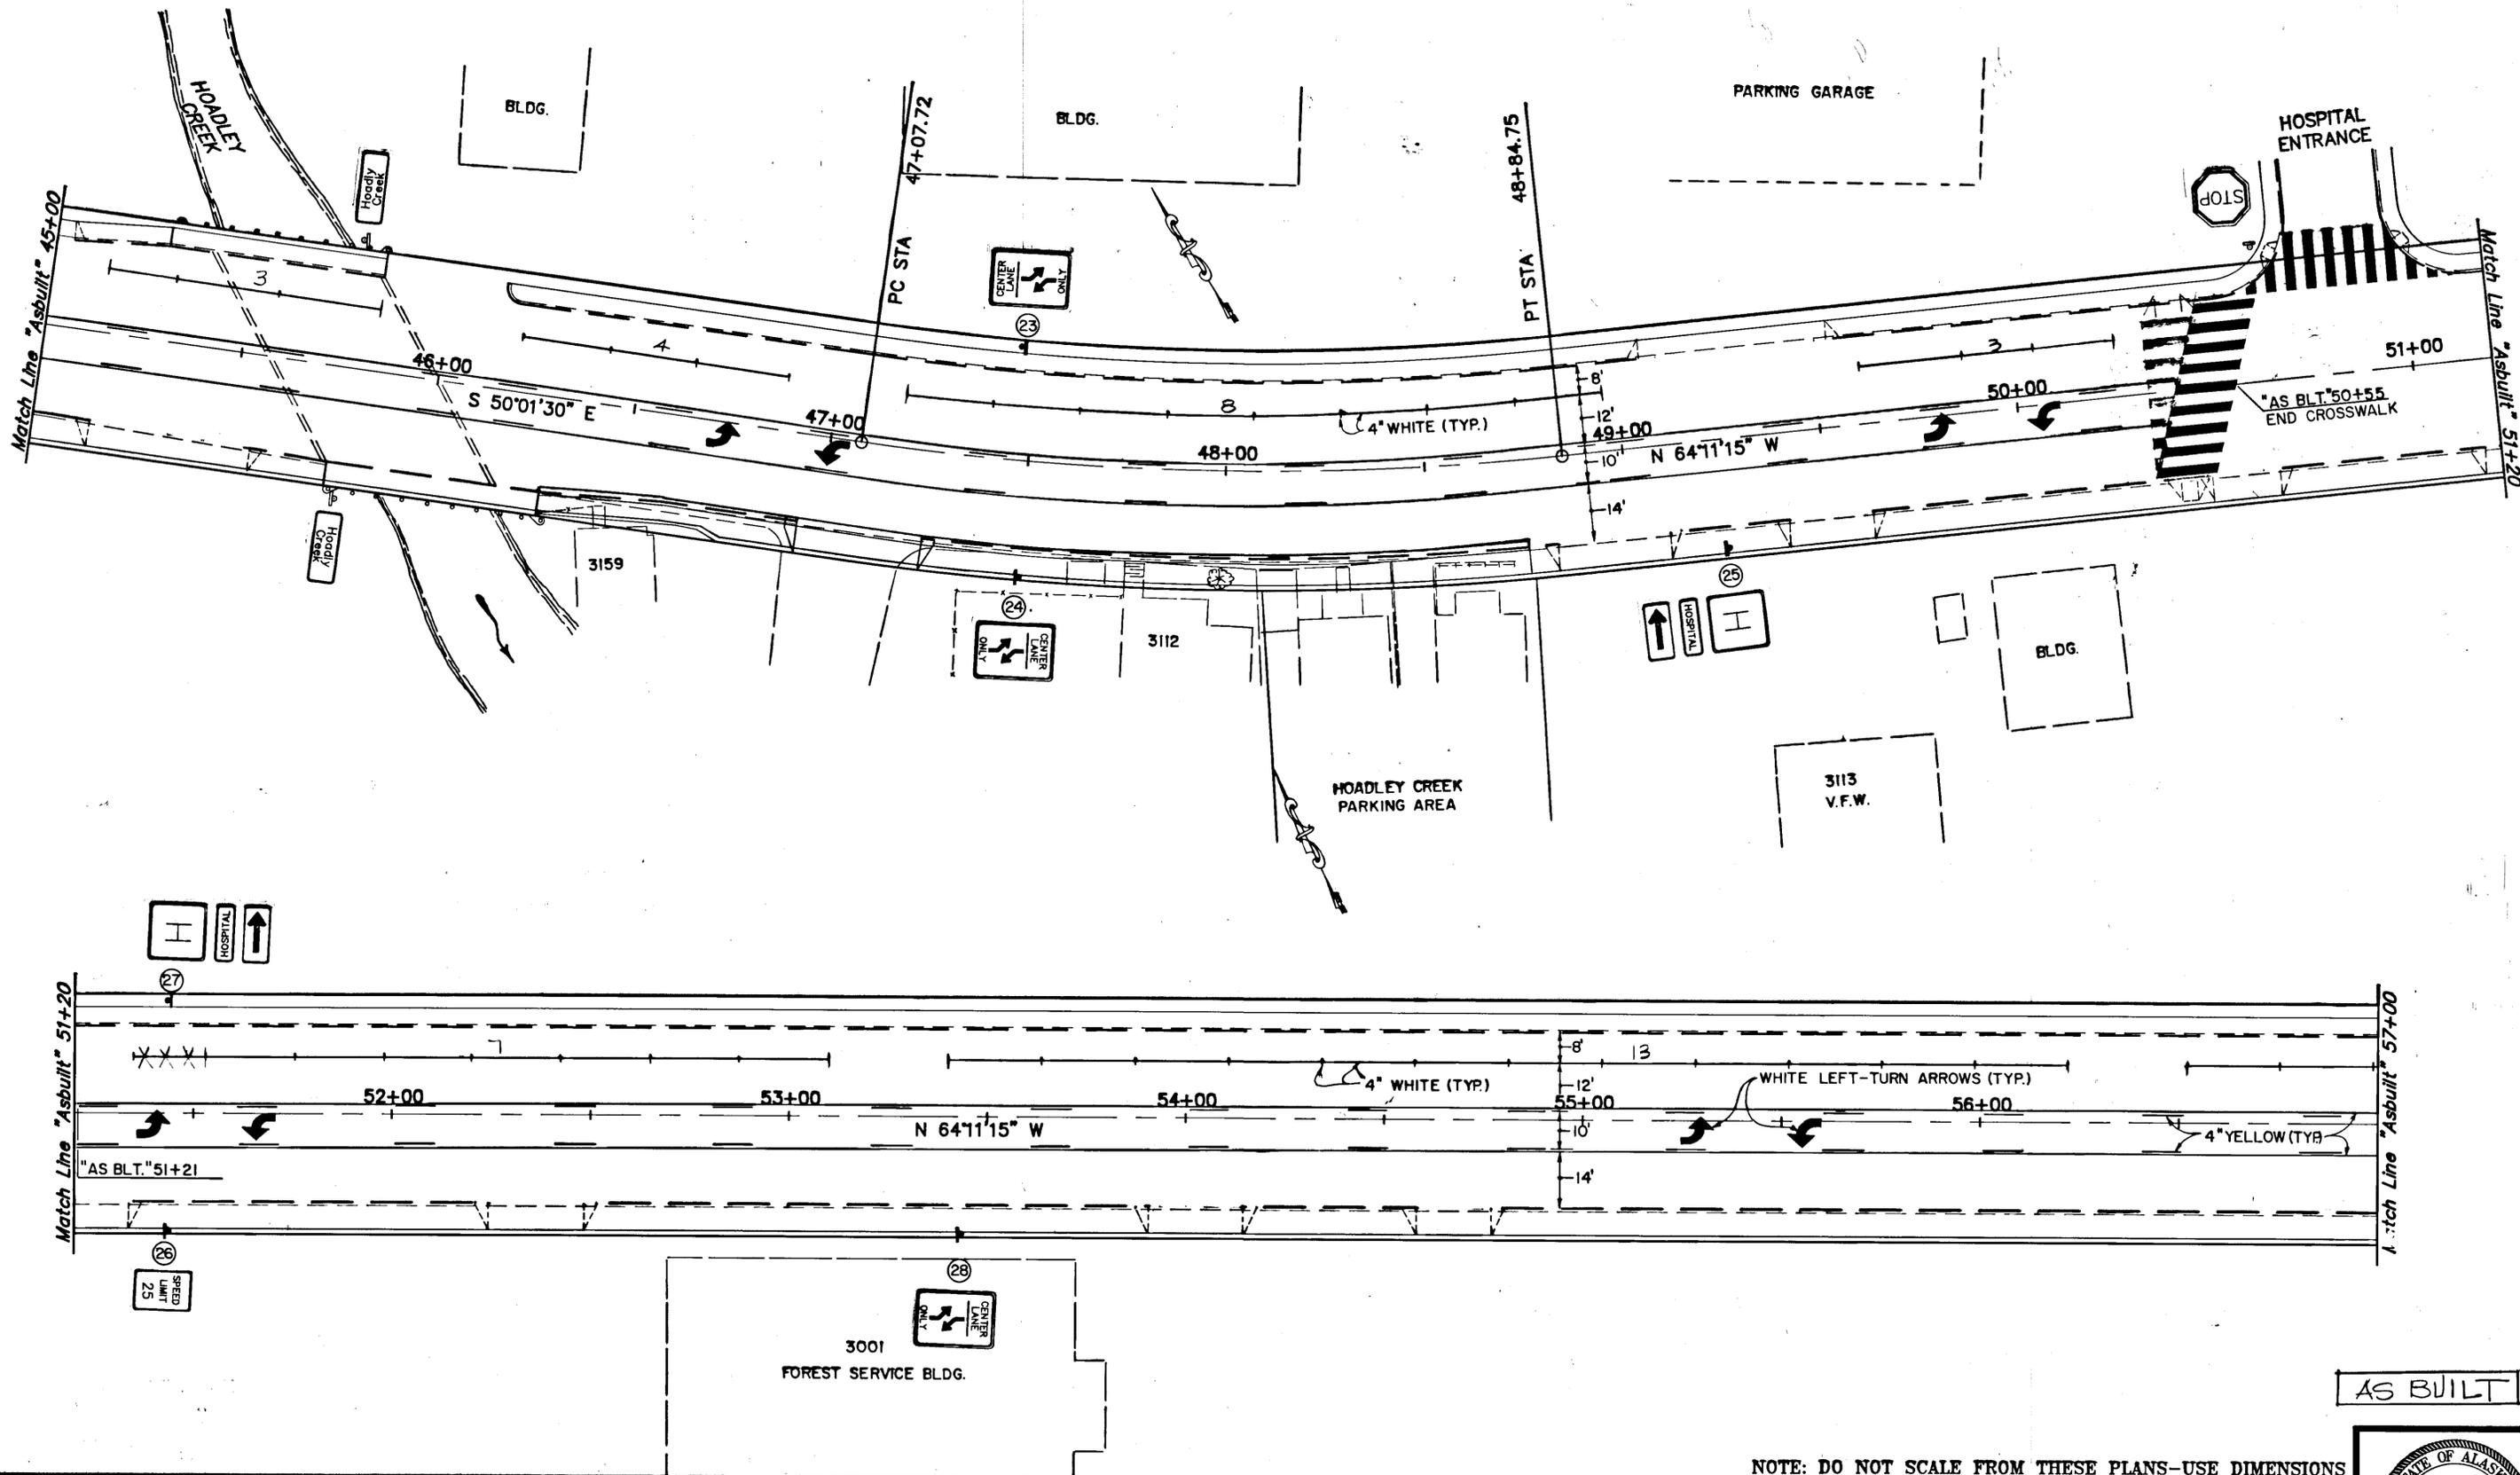

AS BUILT


NOTE: DO NOT SCALE FROM THESE PLANS—USE DIMENSIONS


NO.	DATE	DESCRIPTION OF CHANGE
1	11/16/95	AS BUILT

STATE OF ALASKA
 DEPARTMENT OF TRANSPORTATION
 AND PUBLIC FACILITIES
 SOUTHEAST REGION DESIGN & CONSTRUCTION

KETCHIKAN
 TONGASS AVENUE PAVEMENT REHABILITATION
 F-M-0902(16) 70375
SIGNING AND STRIPING PLAN
 Sta. 45+00 to Sta. 57+00

DESIGNED BY: T.M.	SCALE
DRAWN BY: AUTOCADD/R.K.S.	DATE: MAY, 1991
CHECKED BY: P.J.	SHEET 25 OF 38

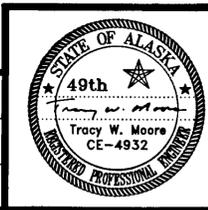

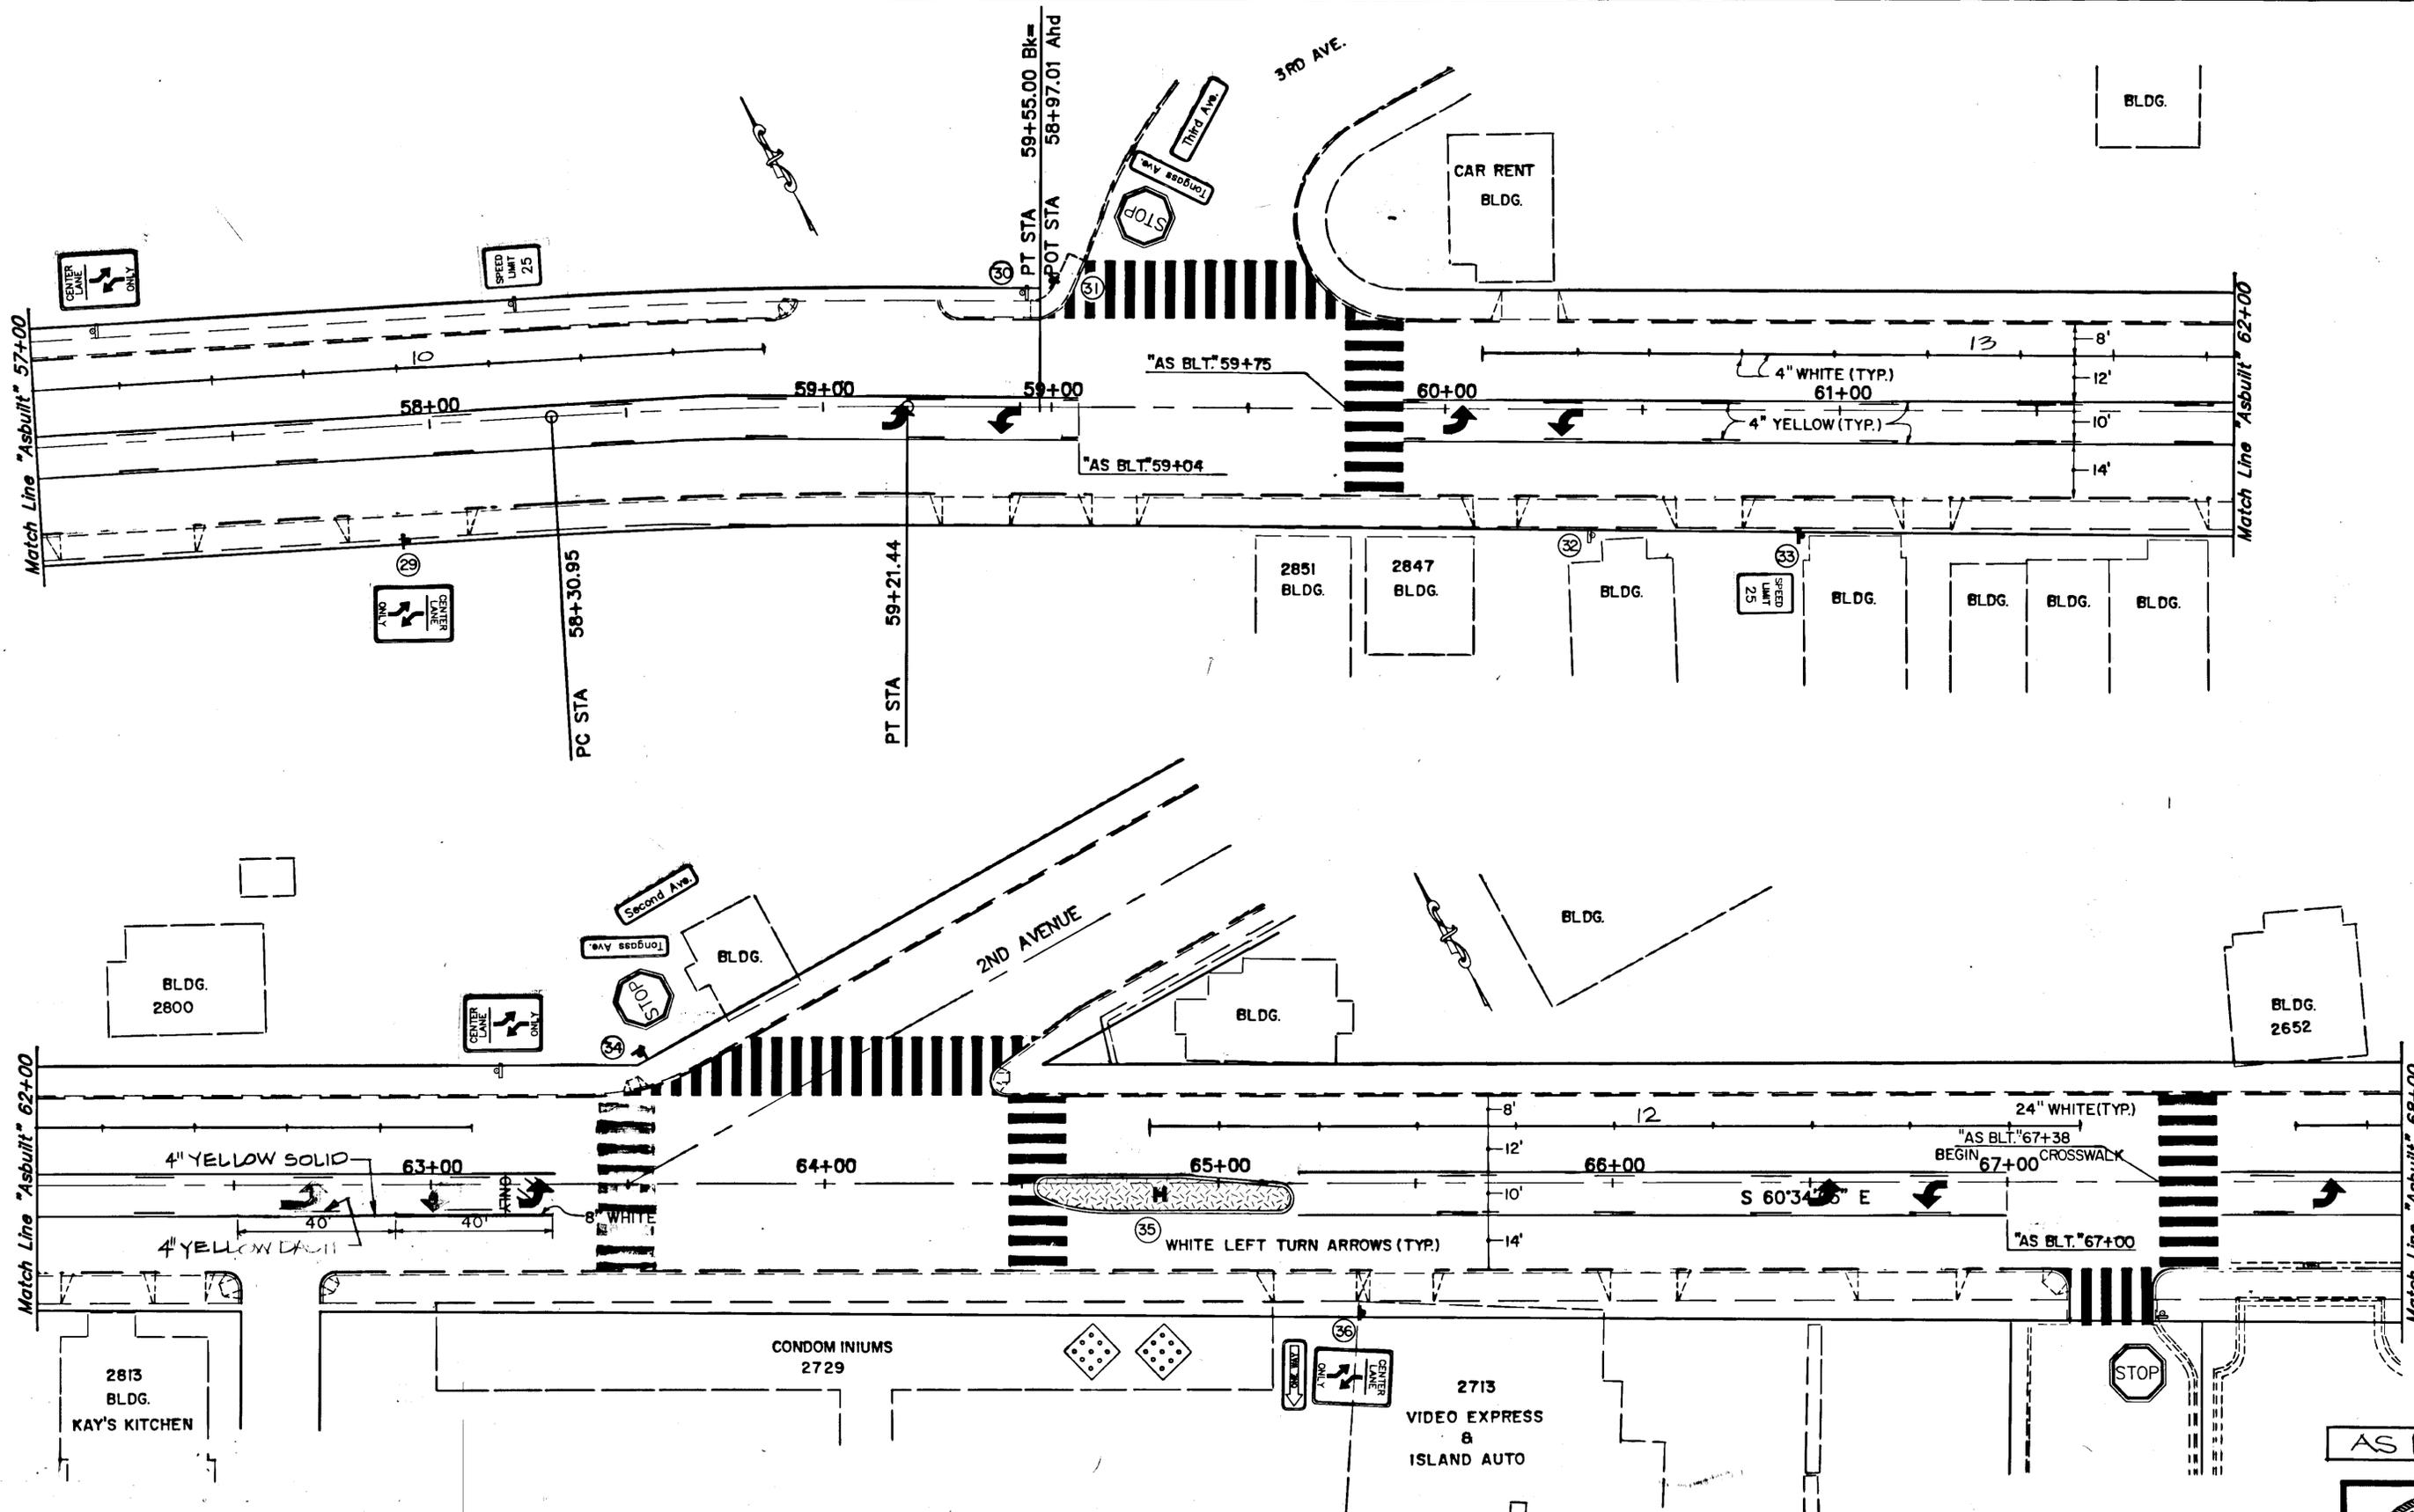

AS BUILT


NOTE: DO NOT SCALE FROM THESE PLANS-USE DIMENSIONS


DATE	DESCRIPTION OF CHANGE
11/16/95	AS BUILT

STATE OF ALASKA
 DEPARTMENT OF TRANSPORTATION
 AND PUBLIC FACILITIES
 SOUTHEAST REGION DESIGN & CONSTRUCTION

KETCHIKAN ALASKA
 TONGASS AVENUE PAVEMENT REHABILITATION
 F-M-0902 (16) 70375
SIGNING AND STRIPING PLAN
 Sta. 57+00 to Sta. 68+00

DESIGNED BY:	T.M.	SCALE
DRAWN BY:	AUTOCADD/R.K.S.	DATE:
CHECKED BY:	P.J.	MAY, 1991
		SHEET 26 OF 38

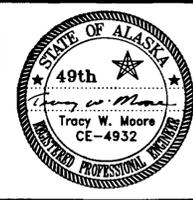

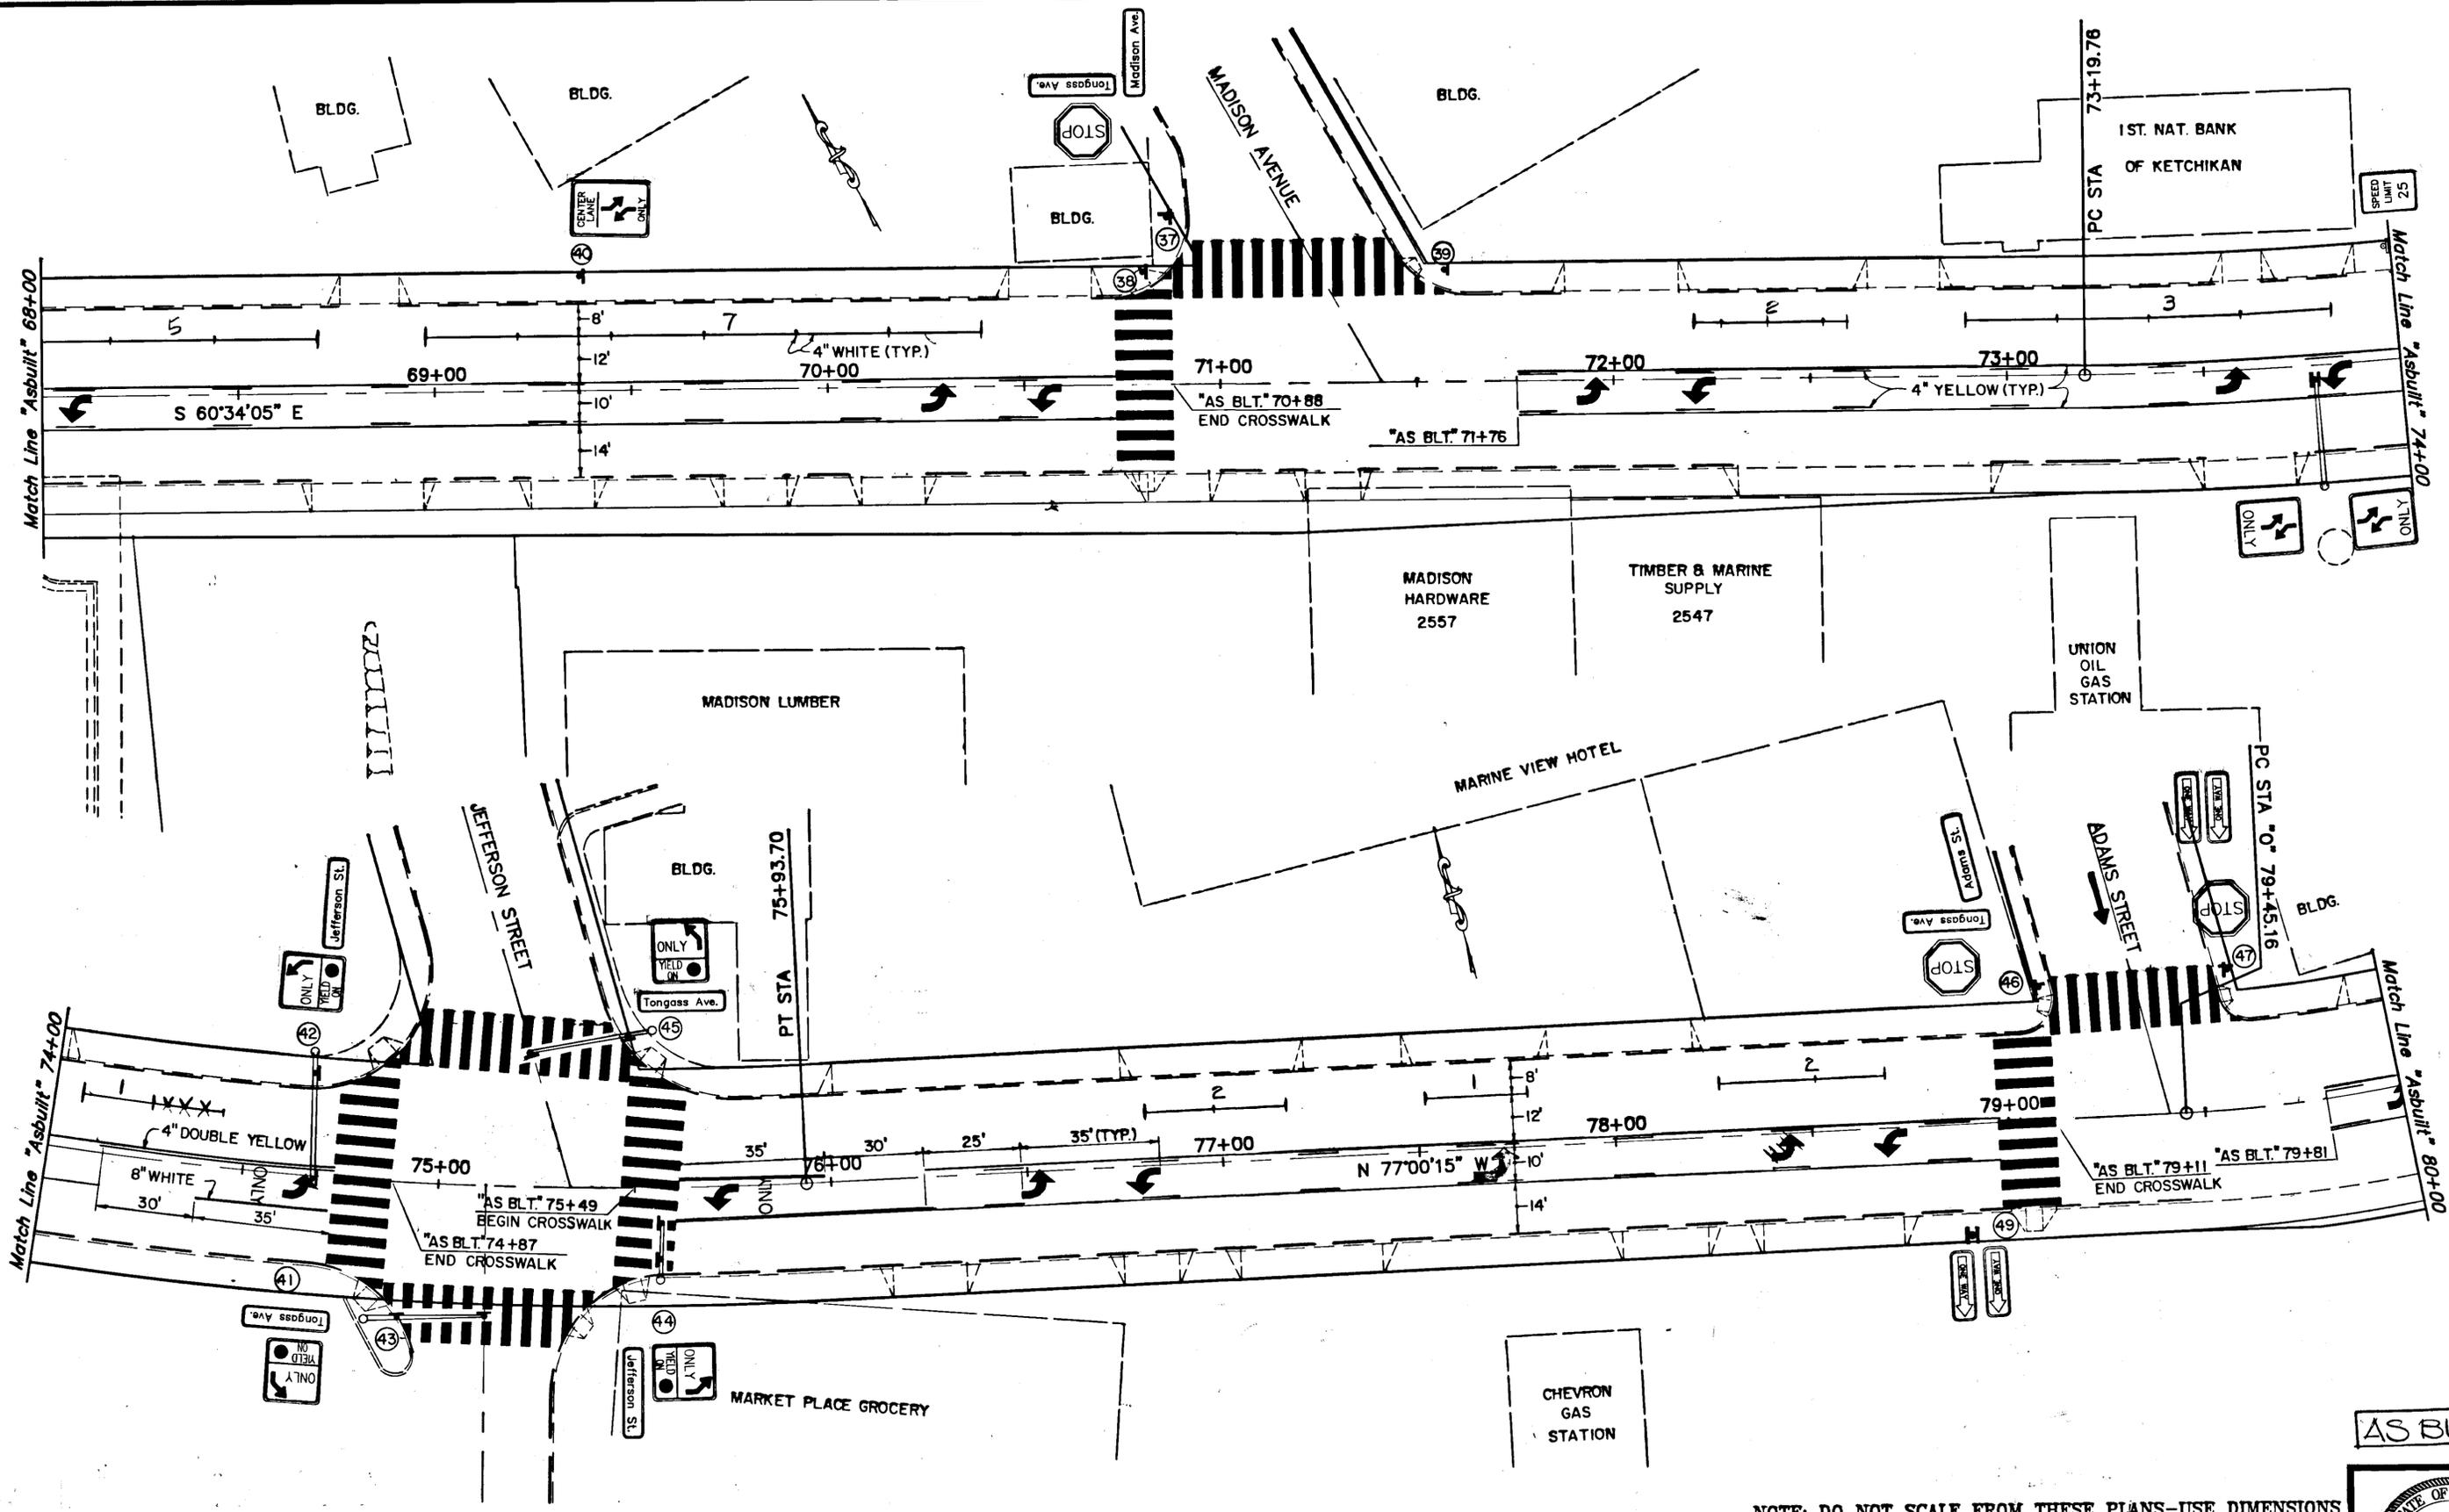

AS BUILT


NOTE: DO NOT SCALE FROM THESE PLANS-USE DIMENSIONS


BY:	DATE:	DESCRIPTION OF CHANGE:
KK	11/16/95	AS BUILT

STATE OF ALASKA
 DEPARTMENT OF TRANSPORTATION
 AND PUBLIC FACILITIES
 SOUTHEAST REGION DESIGN & CONSTRUCTION

KETCHIKAN ALASKA
 TONGASS AVENUE PAVEMENT REHABILITATION
 F-M-0902(16) 70375
SIGNING AND STRIPING PLAN
 Sta. 68+00 to Sta. 80+00

DESIGNED BY:	T.M.	SCALE
DRAWN BY:	AUTOCADD/R.K.S.	DATE: MAY, 1991
CHECKED BY:	P.J.	SHEET 27 OF 38

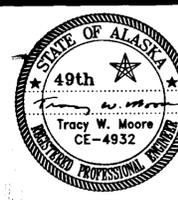

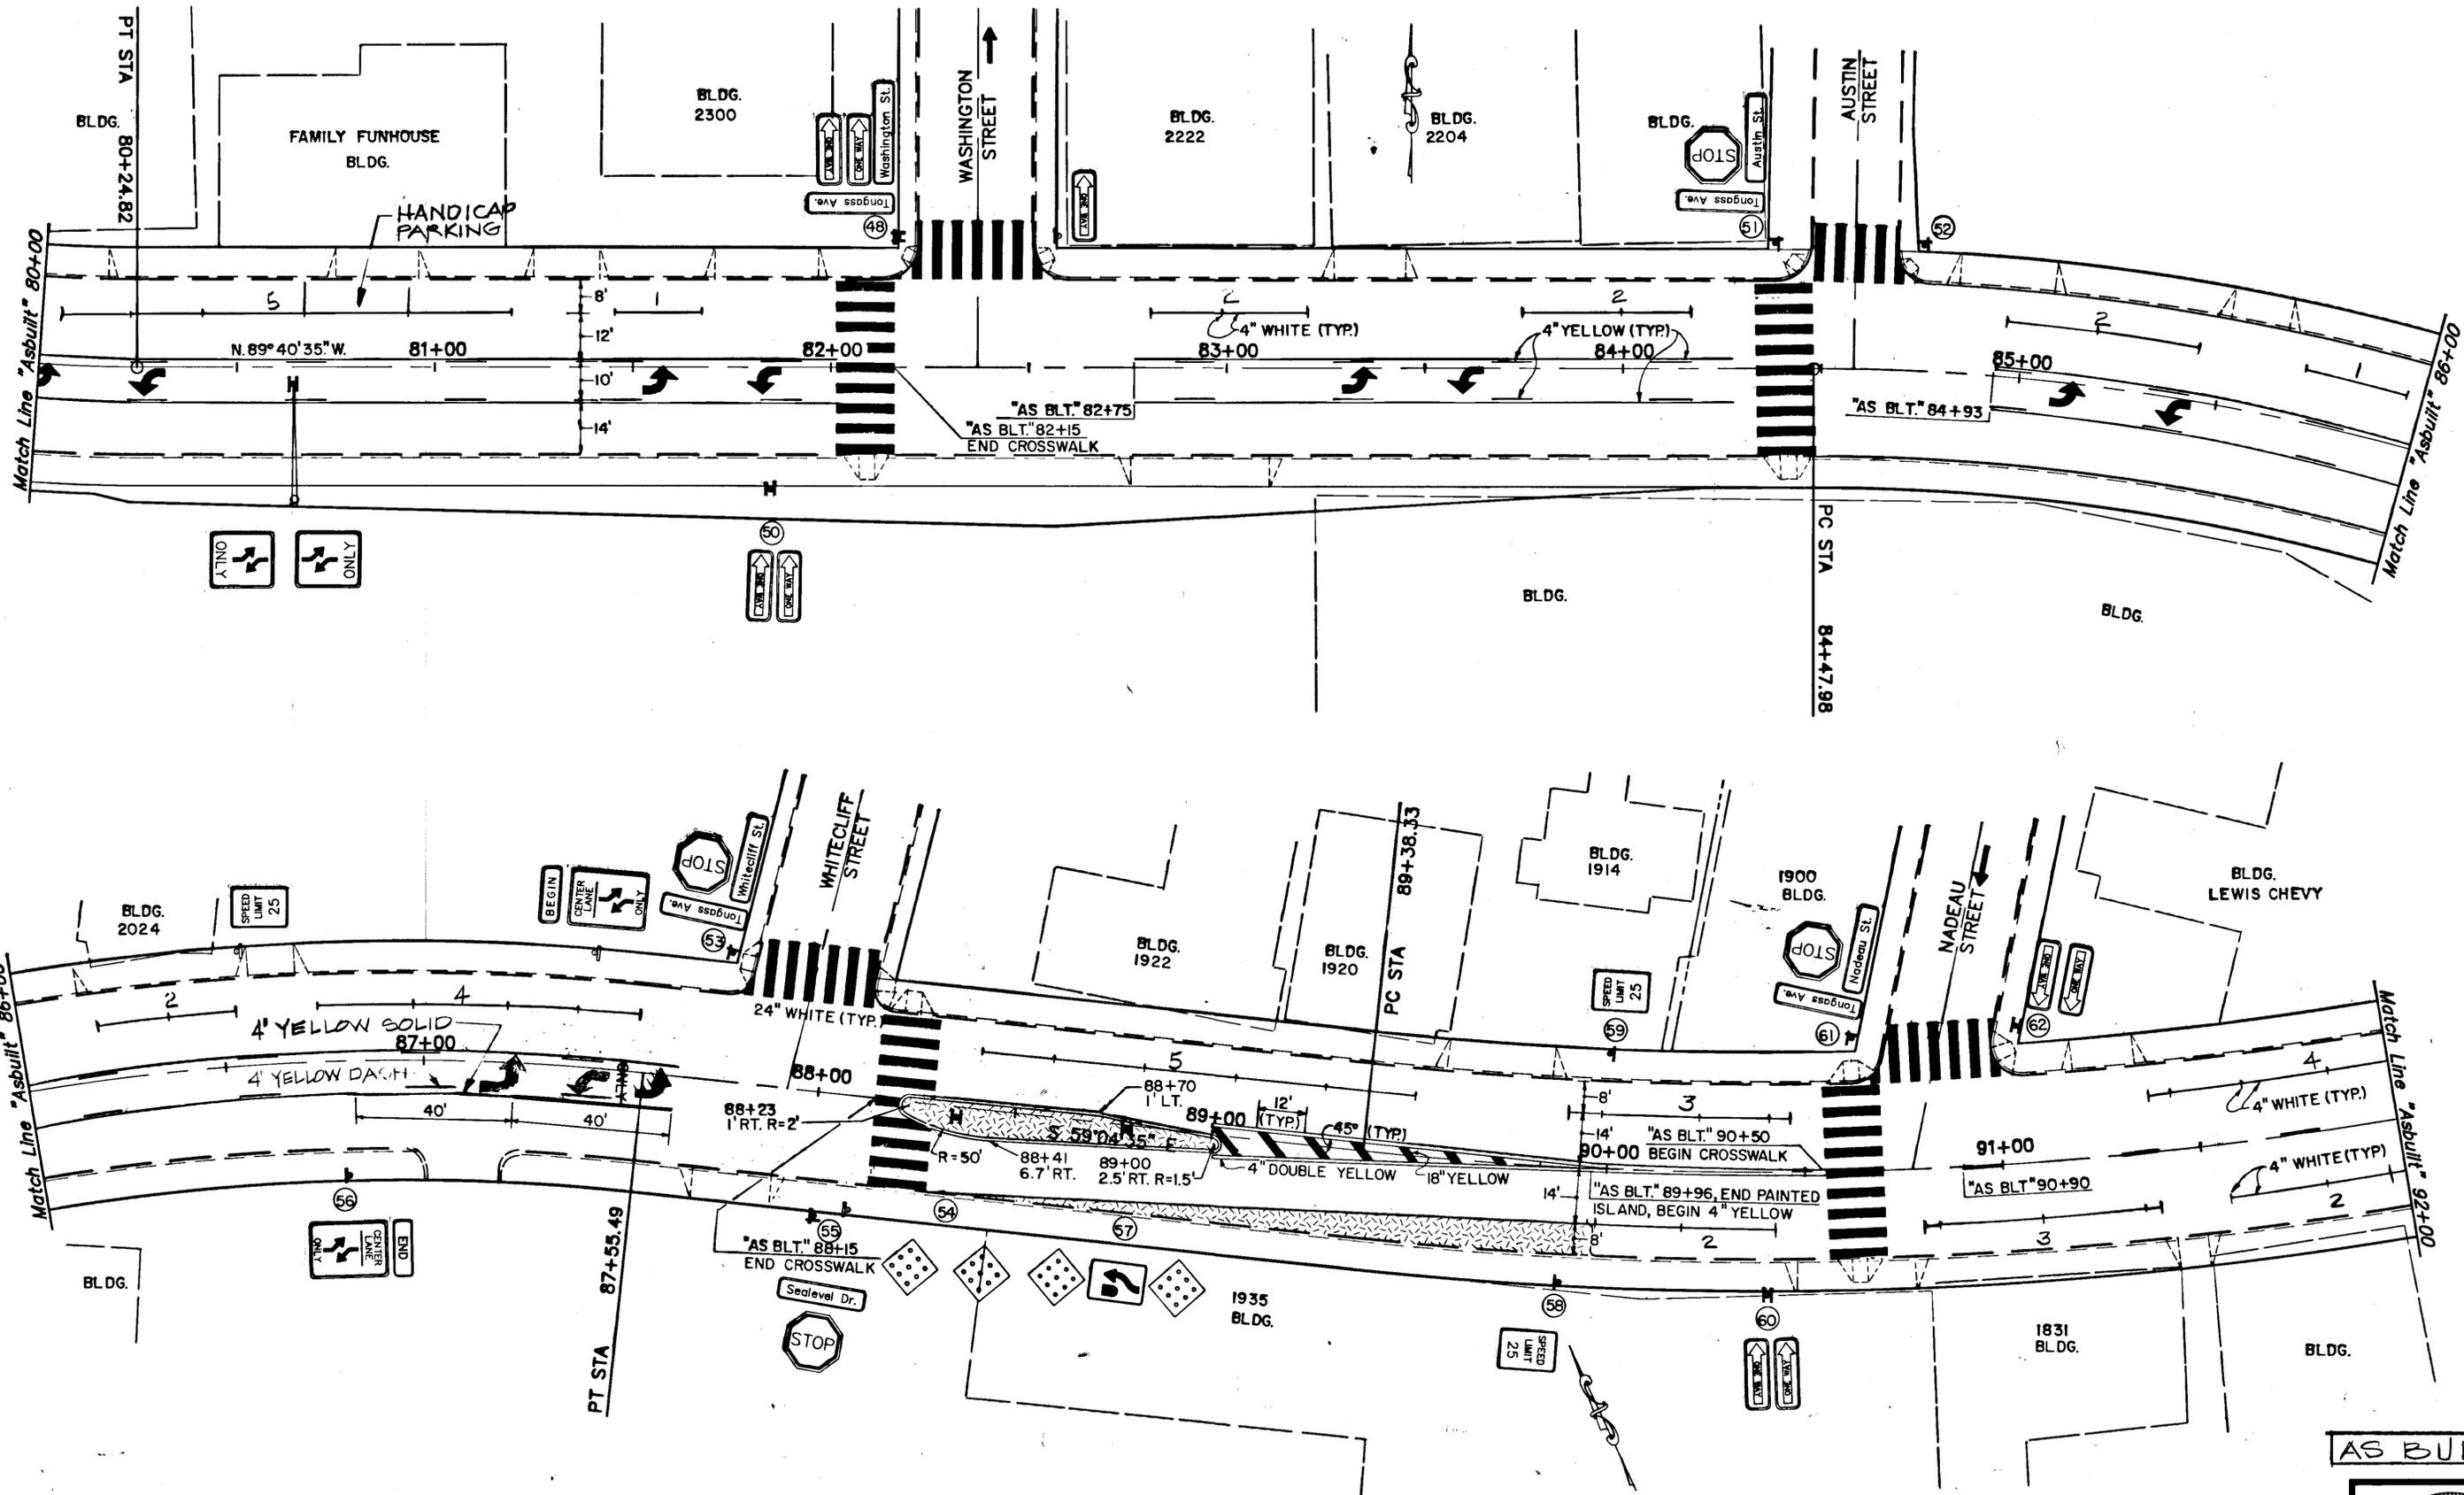

AS BUILT

NOTE: DO NOT SCALE FROM THESE PLANS-USE DIMENSIONS


BY:	DATE:	DESCRIPTION OF CHANGE:
KK	11/16/95	AS BUILT

STATE OF ALASKA
 DEPARTMENT OF TRANSPORTATION
 AND PUBLIC FACILITIES
 SOUTHEAST REGION DESIGN & CONSTRUCTION

KETCHIKAN
 TONGASS AVENUE PAVEMENT REHABILITATION
 F-M-0902 (16) 70375
SIGNING AND STRIPING PLAN
 Sta. 80+00 to Sta. 92+00

DESIGNED BY:	T.M.	SCALE
DRAWN BY:	AUTOCADD/R.K.S.	DATE: MAY, 1991
CHECKED BY:	P.J.	SHEET 28 OF 38



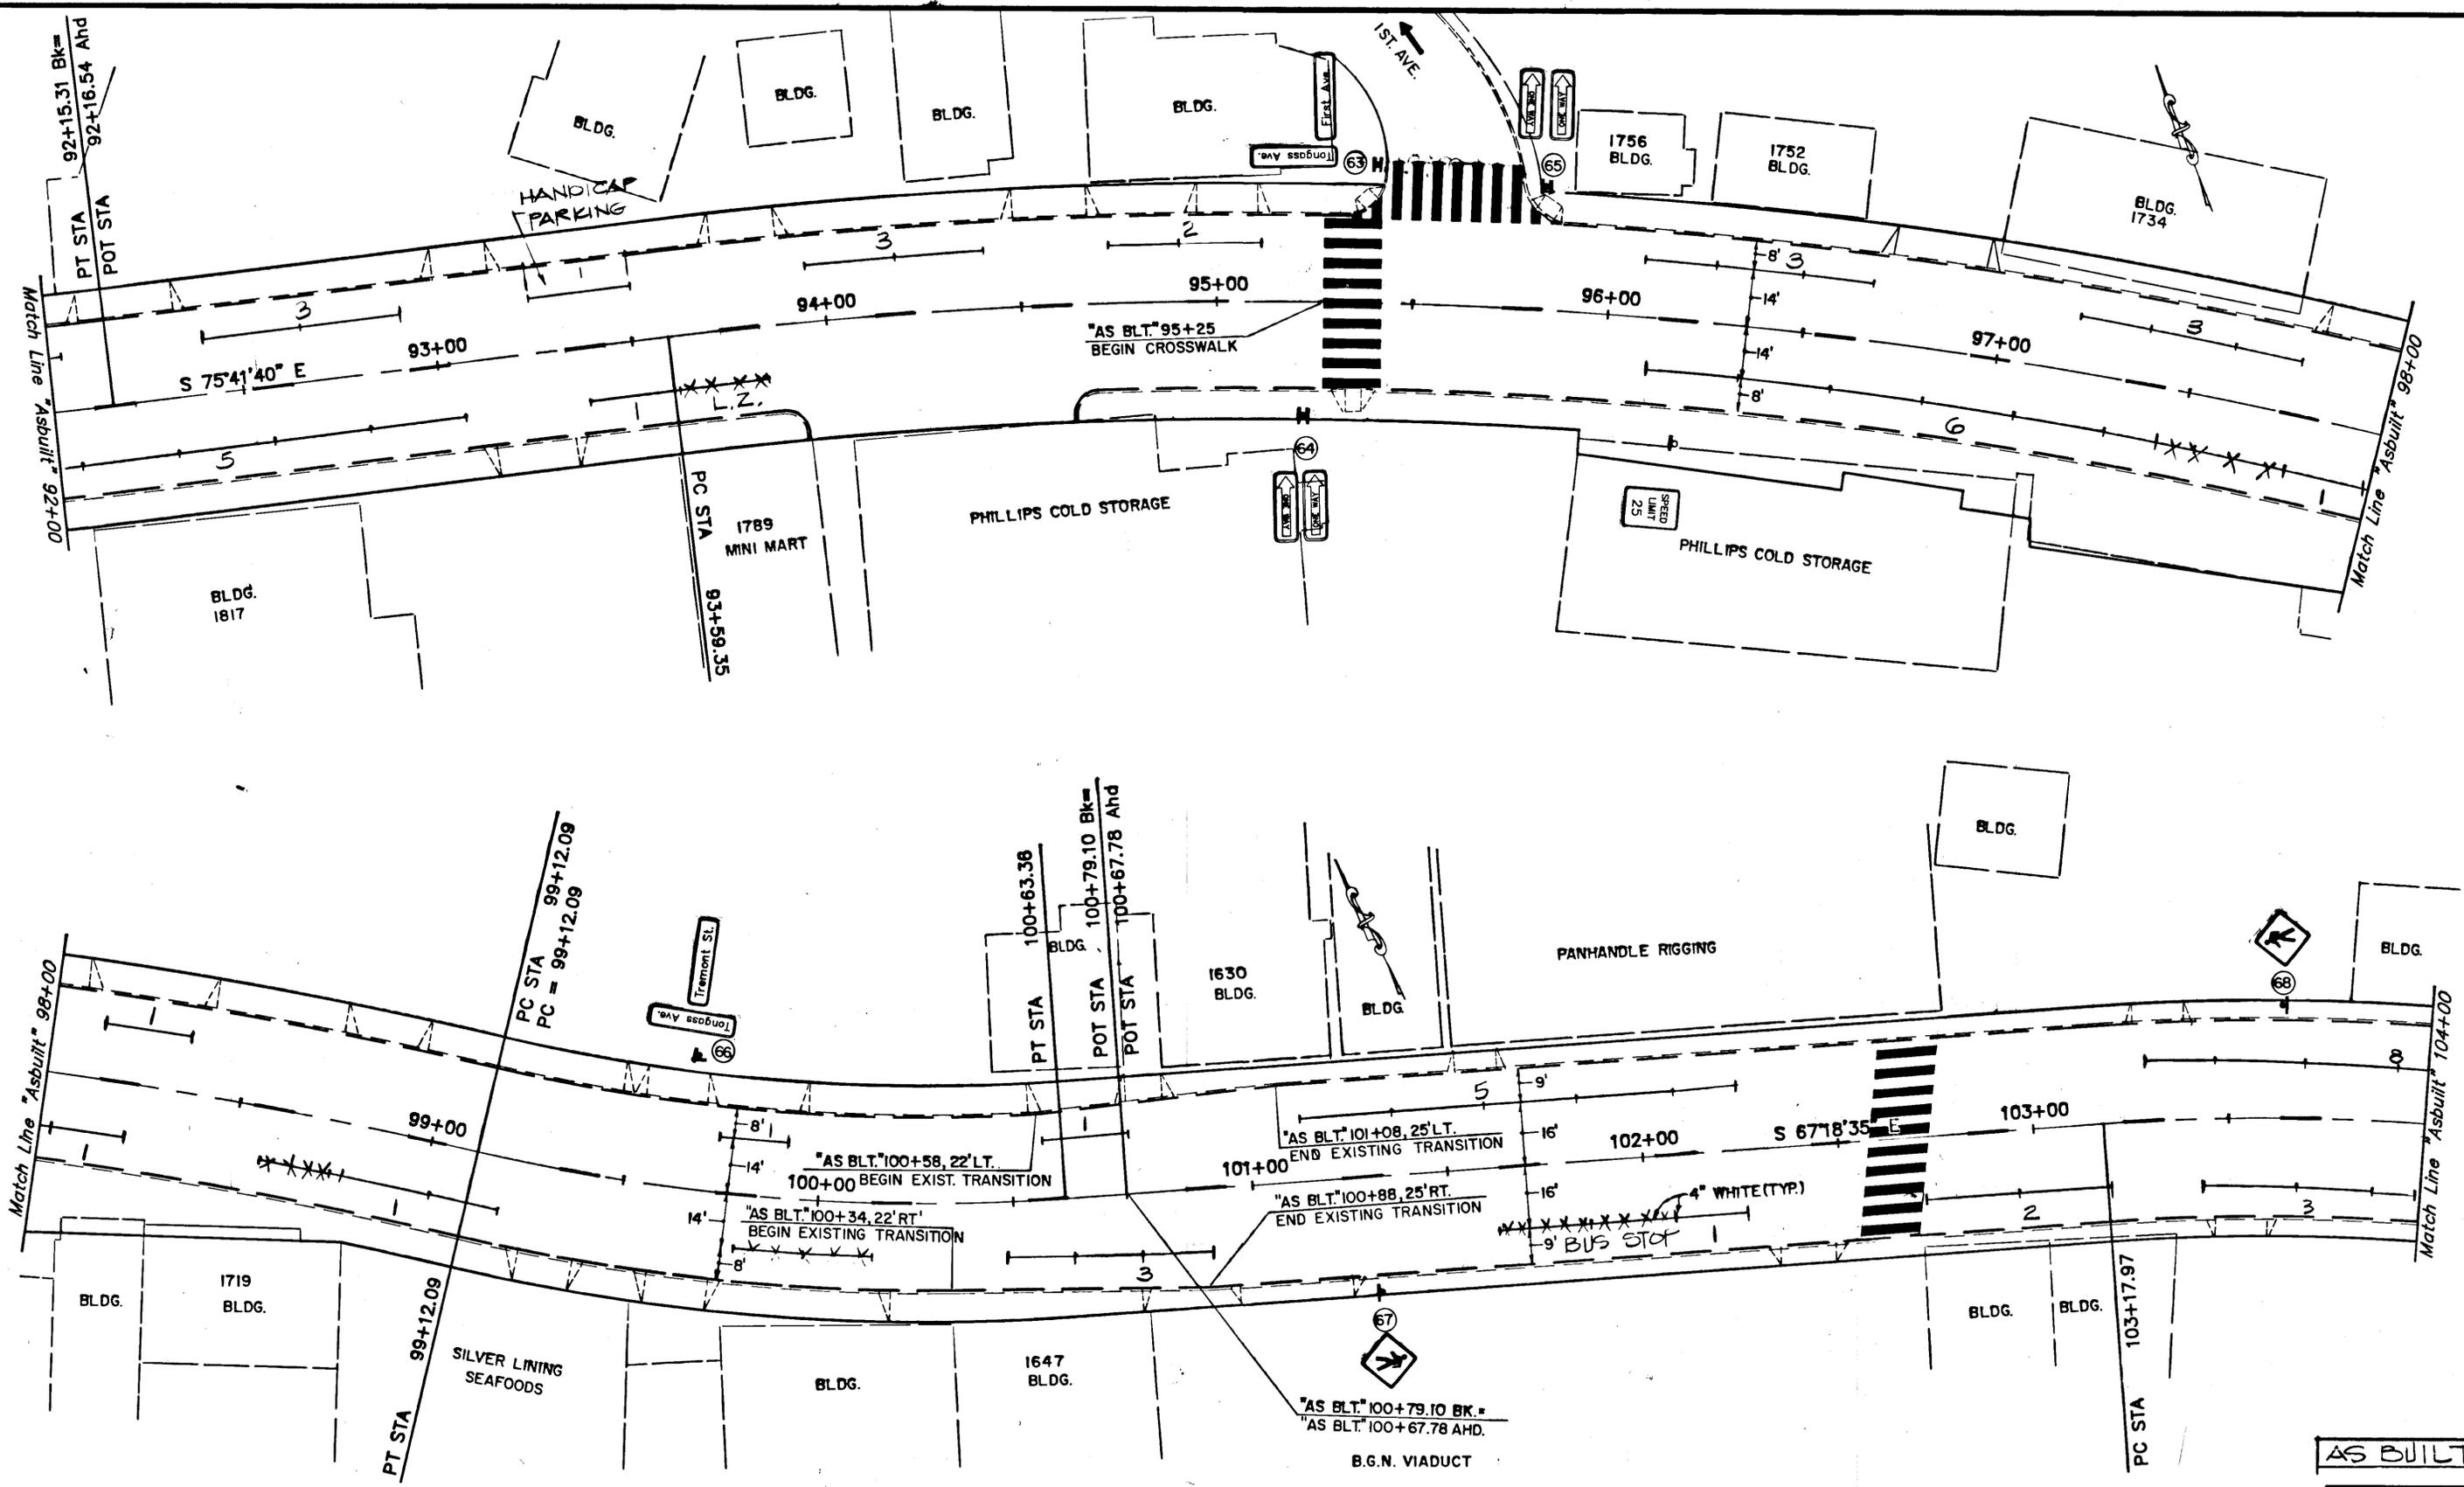

AS BUILT

NOTE: DO NOT SCALE FROM THESE PLANS—USE DIMENSIONS


DATE:	DESCRIPTION OF CHANGE:
11/16/90	AS-BUILT

STATE OF ALASKA
 DEPARTMENT OF TRANSPORTATION
 AND PUBLIC FACILITIES
 SOUTHEAST REGION DESIGN & CONSTRUCTION

KETCHIKAN ALASKA
 TONGASS AVENUE PAVEMENT REHABILITATION
 F-M-0902(16) 70375
SIGNING AND STRIPING PLAN
 Sta. 92+00 to Sta. 104+00

DESIGNED BY:	T.M.	SCALE
DRAWN BY:	AUTOCADD/R.K.S.	DATE: MAY, 1991
CHECKED BY:	P.J.	SHEET 29 OF 38



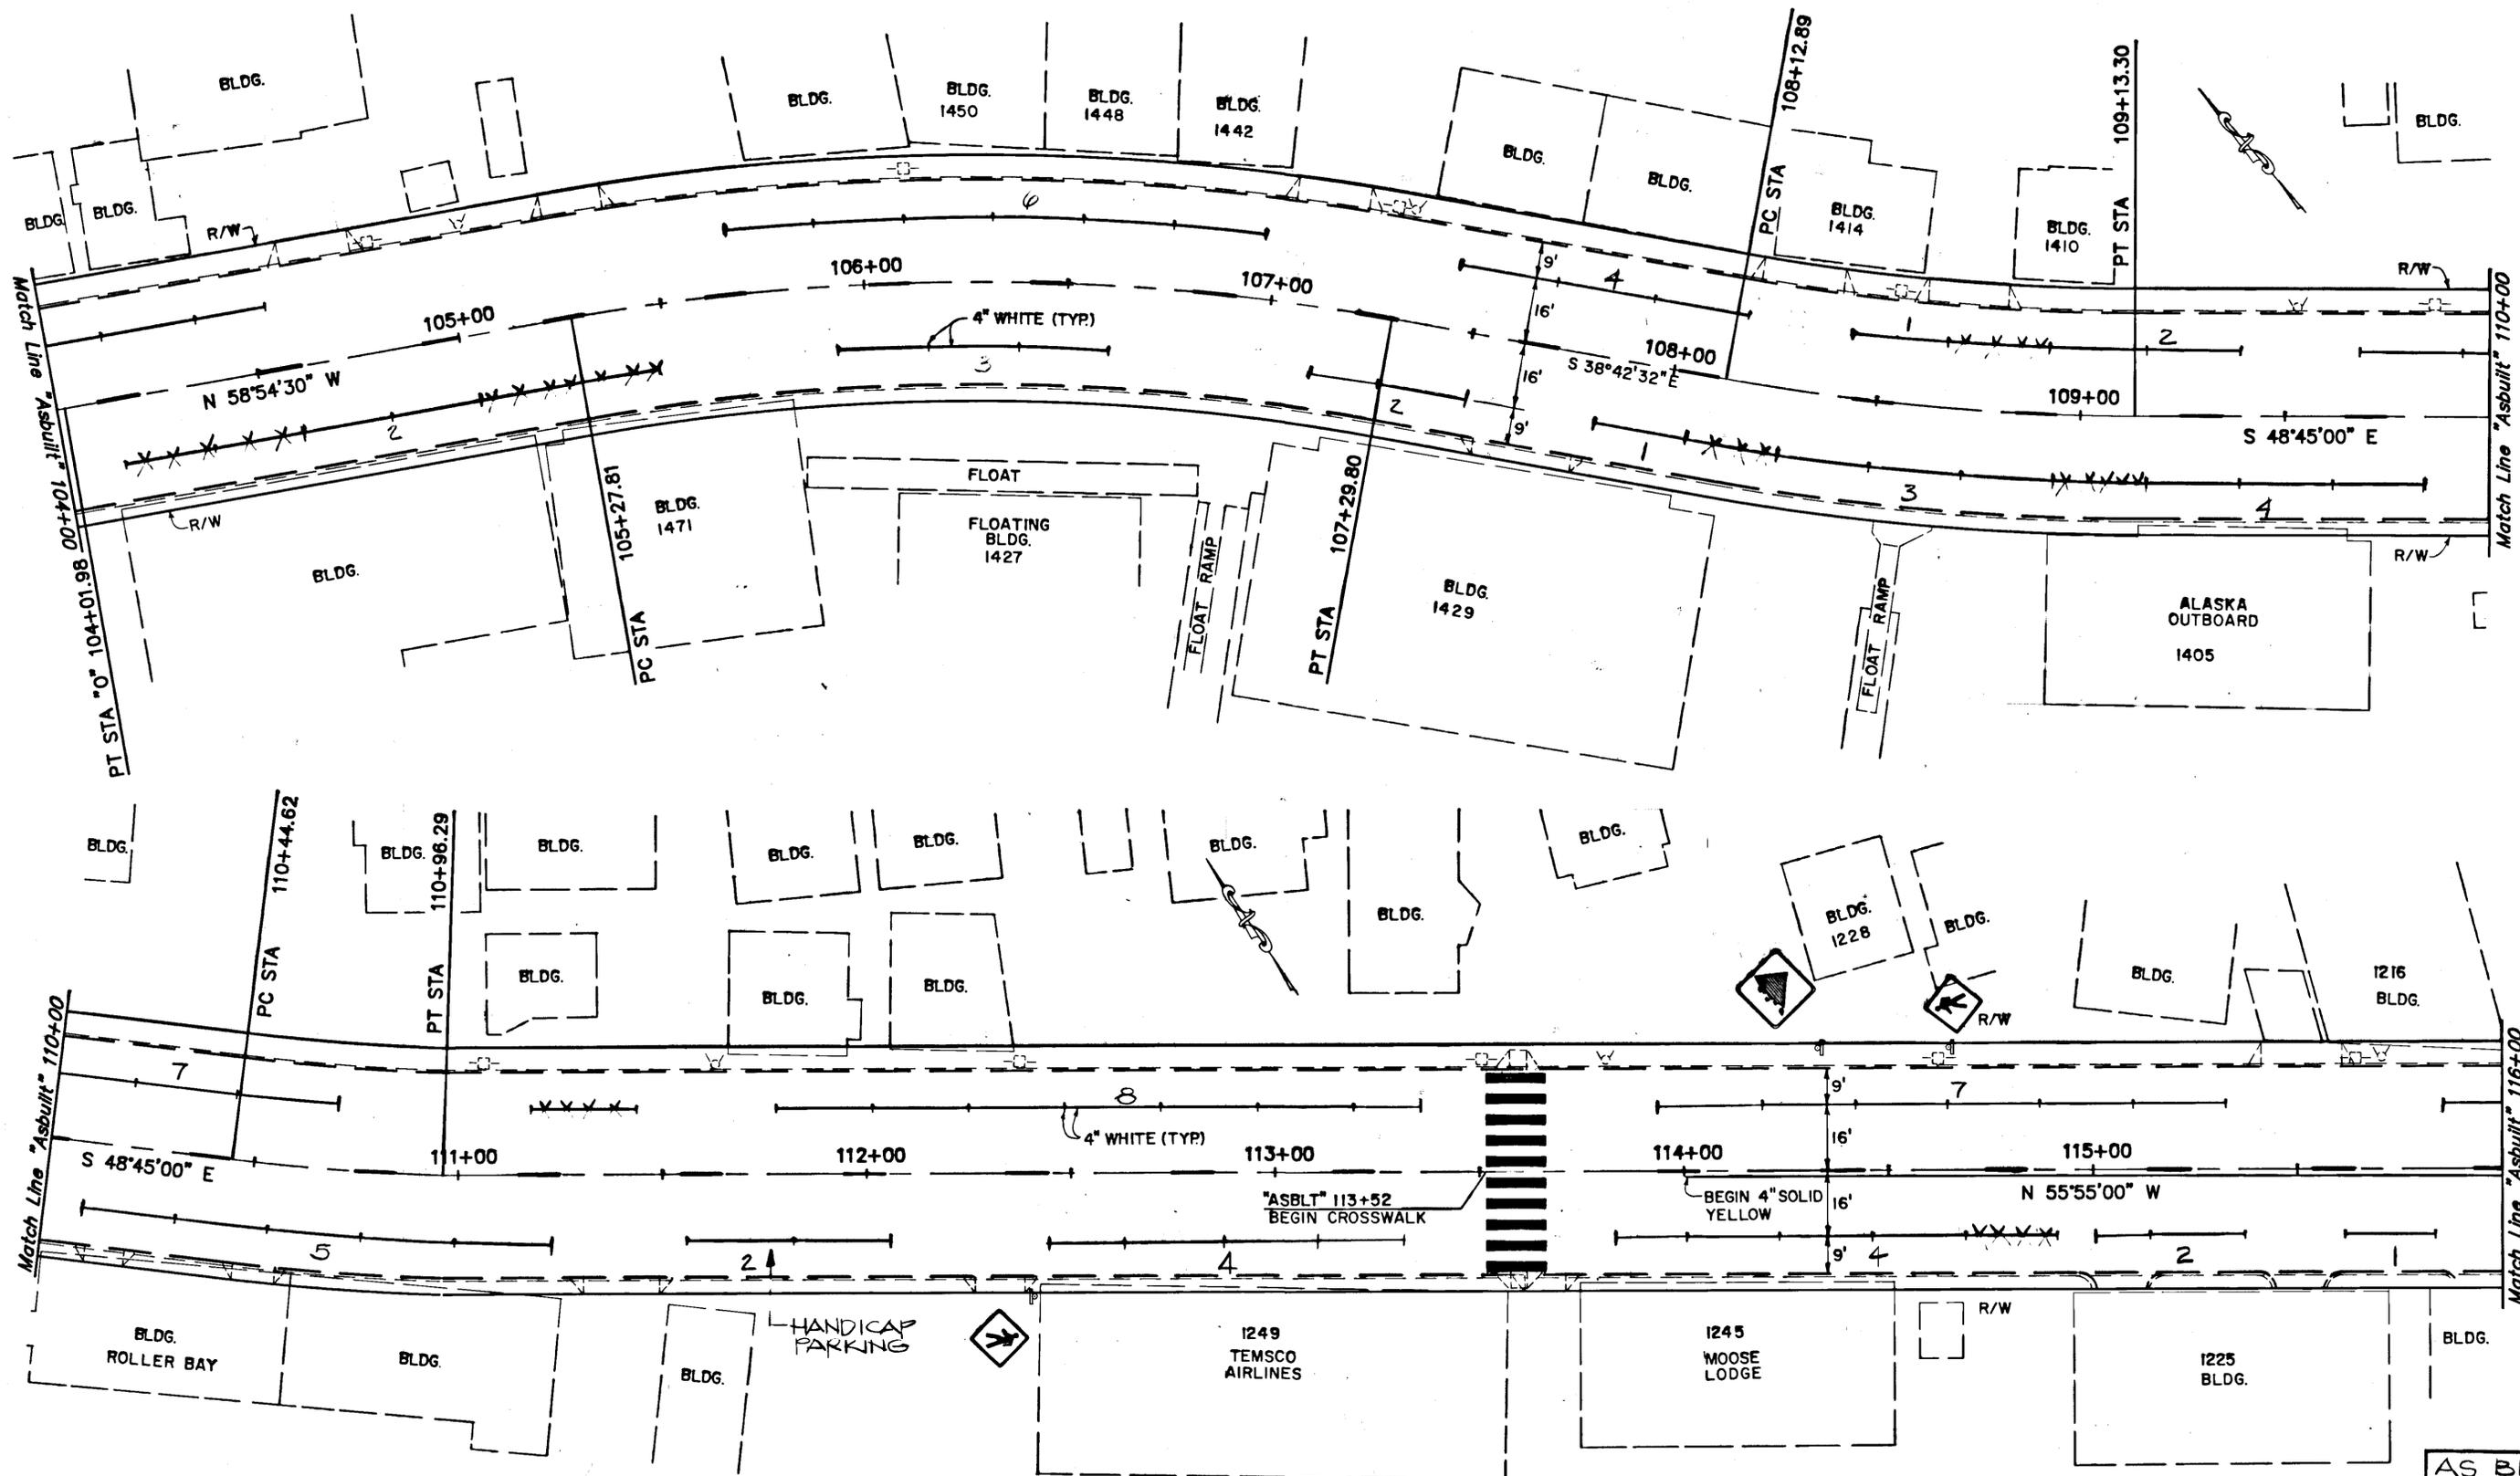

AS BUILT


NOTE: DO NOT SCALE FROM THESE PLANS—USE DIMENSIONS


DATE	DESCRIPTION OF CHANGE
11/16/95	AS BUILT

STATE OF ALASKA
**DEPARTMENT OF TRANSPORTATION
 AND PUBLIC FACILITIES**
 SOUTHEAST REGION DESIGN & CONSTRUCTION

KETCHIKAN TONGASS AVENUE PAVEMENT REHABILITATION
 F-M-0902(16) 70375
SIGNING AND STRIPING PLAN
 Sta. 104+00 to Sta. 116+00

ALASKA DESIGNED BY:	T.M.	SCALE
DRAWN BY:	AUTOCADD/R.K.S.	DATE: MAY, 1991
CHECKED BY:	P.J.	SHEET 30 OF 38

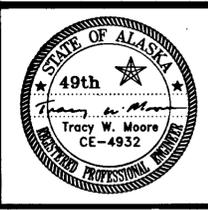

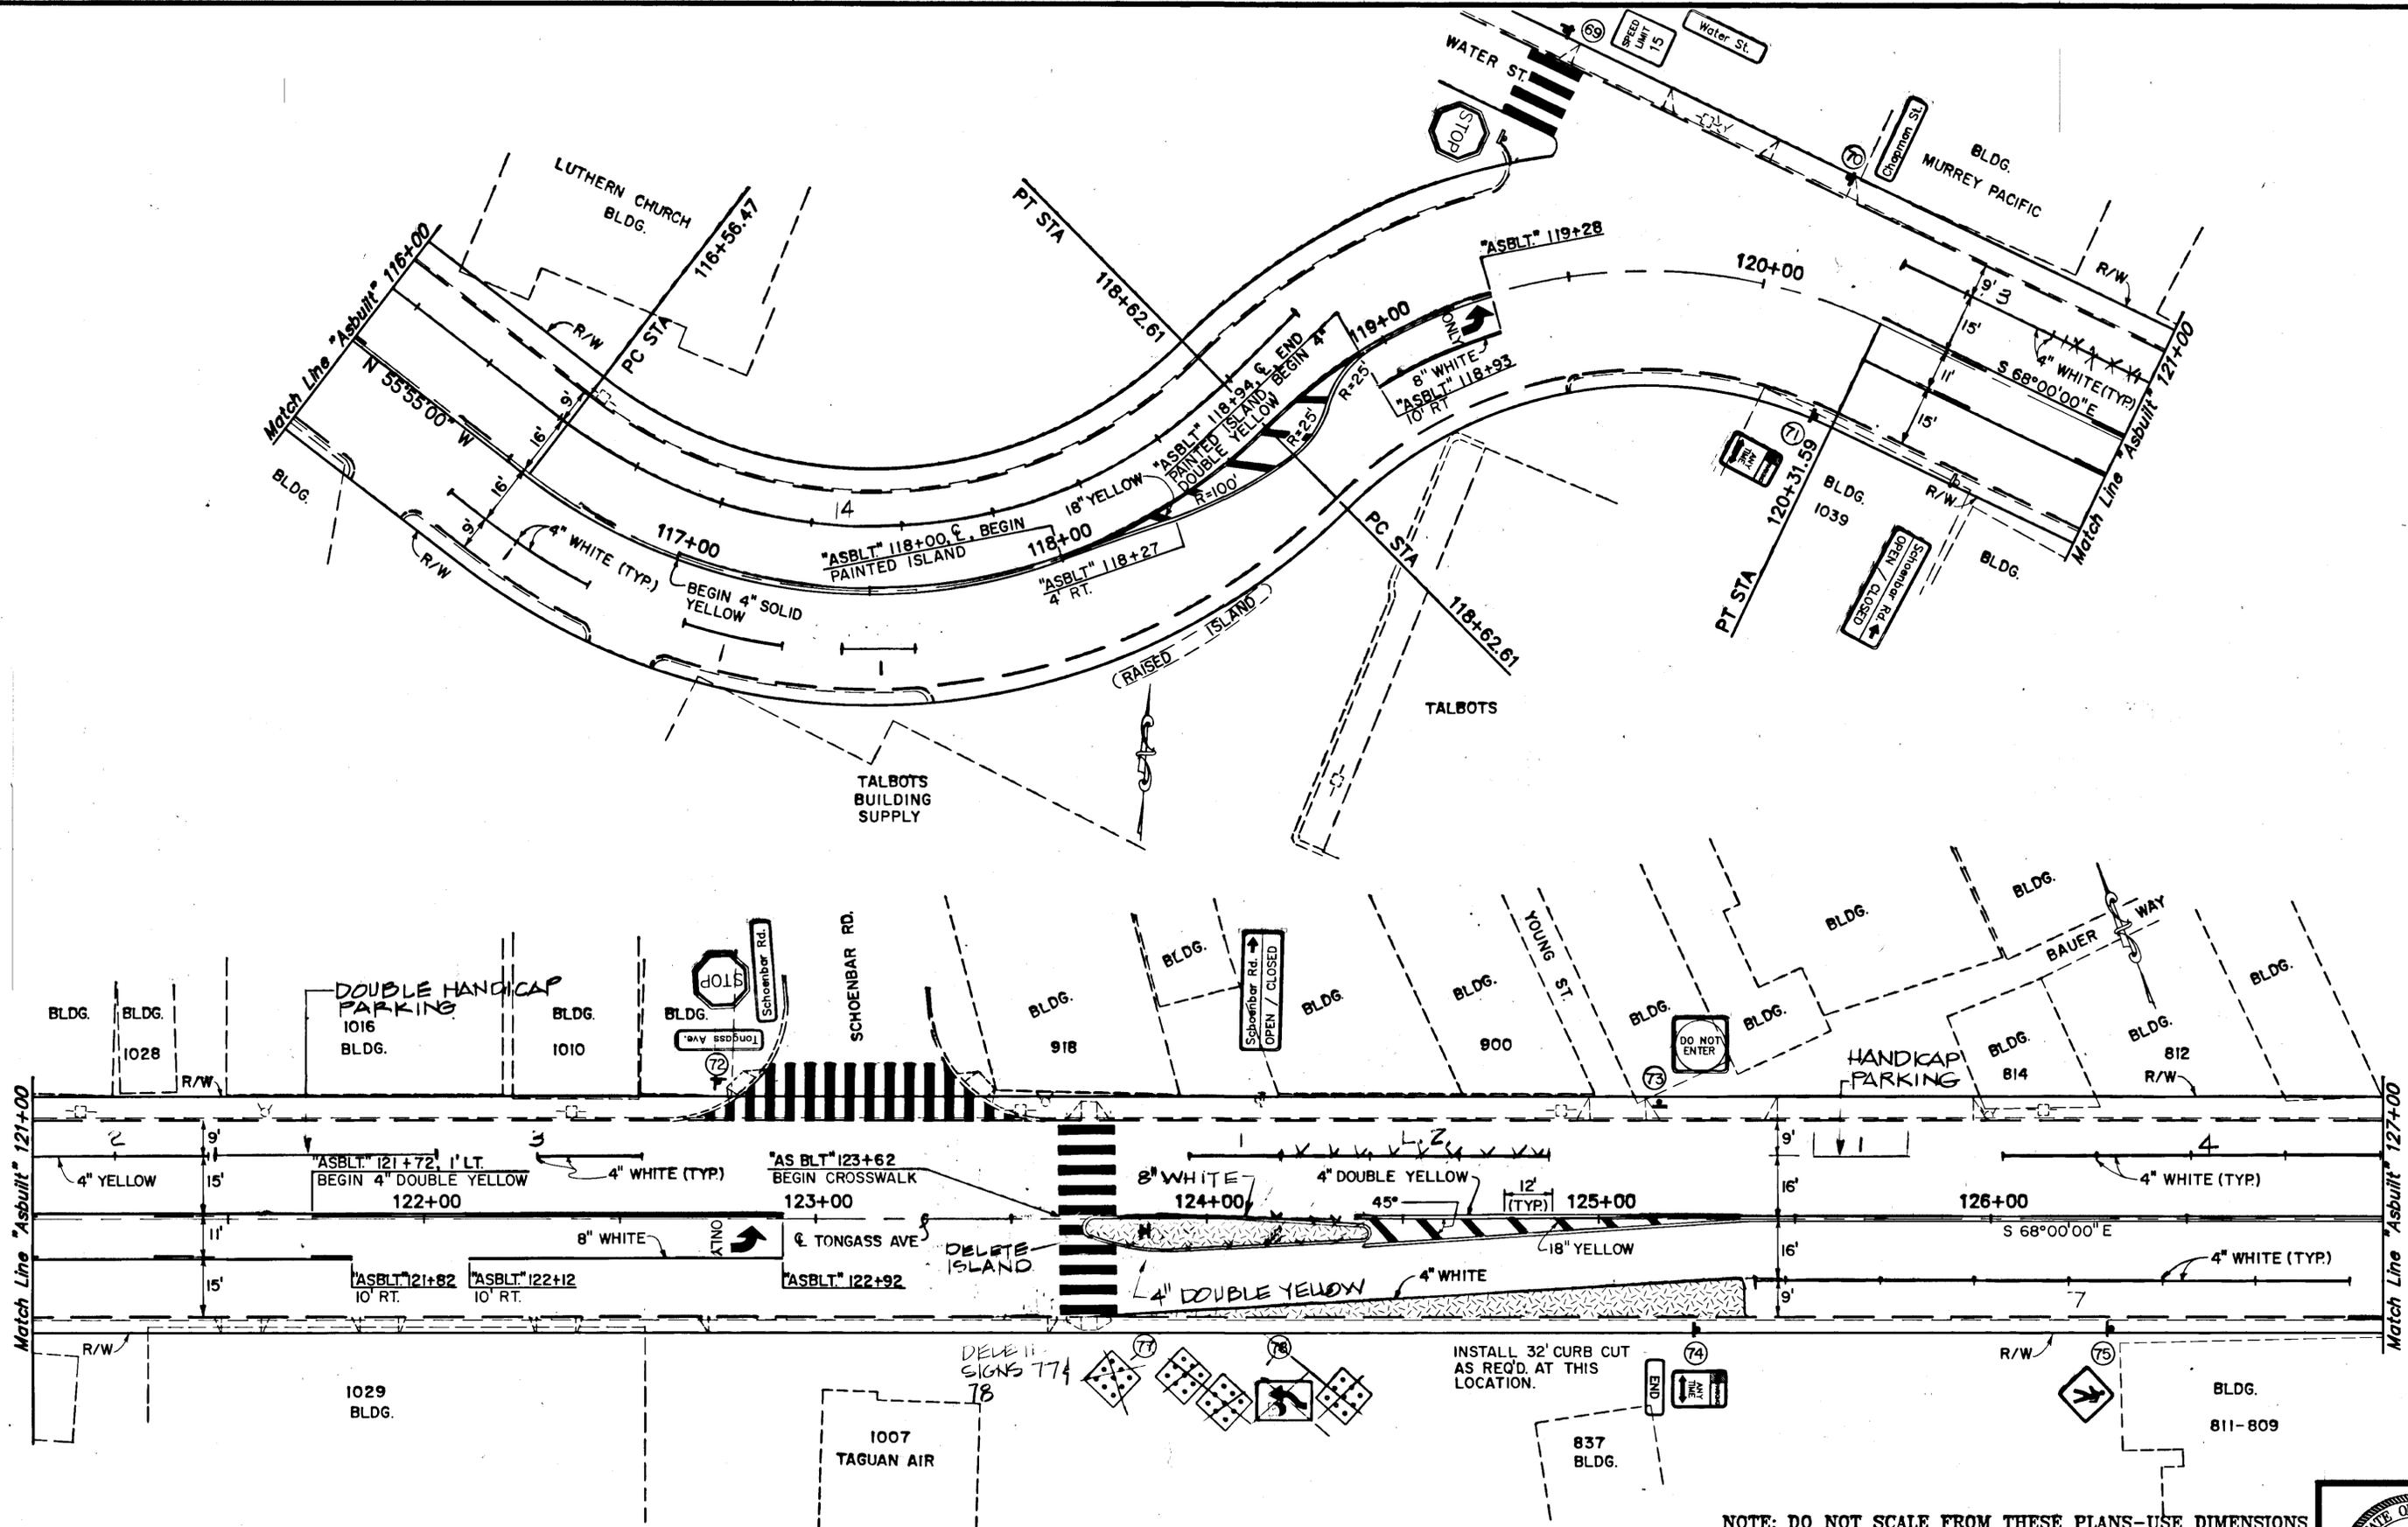

NOTE: DO NOT SCALE FROM THESE PLANS-USE DIMENSIONS


DATE:	DESCRIPTION OF CHANGE:

STATE OF ALASKA
 DEPARTMENT OF TRANSPORTATION
 AND PUBLIC FACILITIES
 SOUTHEAST REGION DESIGN & CONSTRUCTION

KETCHIKAN
 TONGASS AVENUE PAVEMENT REHABILITATION
 F-M-0902(16) 70375
SIGNING AND STRIPING PLAN
 Sta. 116+00 to Sta. 127+00

DESIGNED BY:	T.M.	SCALE
DRAWN BY:	AUTOCADD/R.K.S.	DATE: MAY, 1991
CHECKED BY:	P.J.	SHEET 31 OF 38



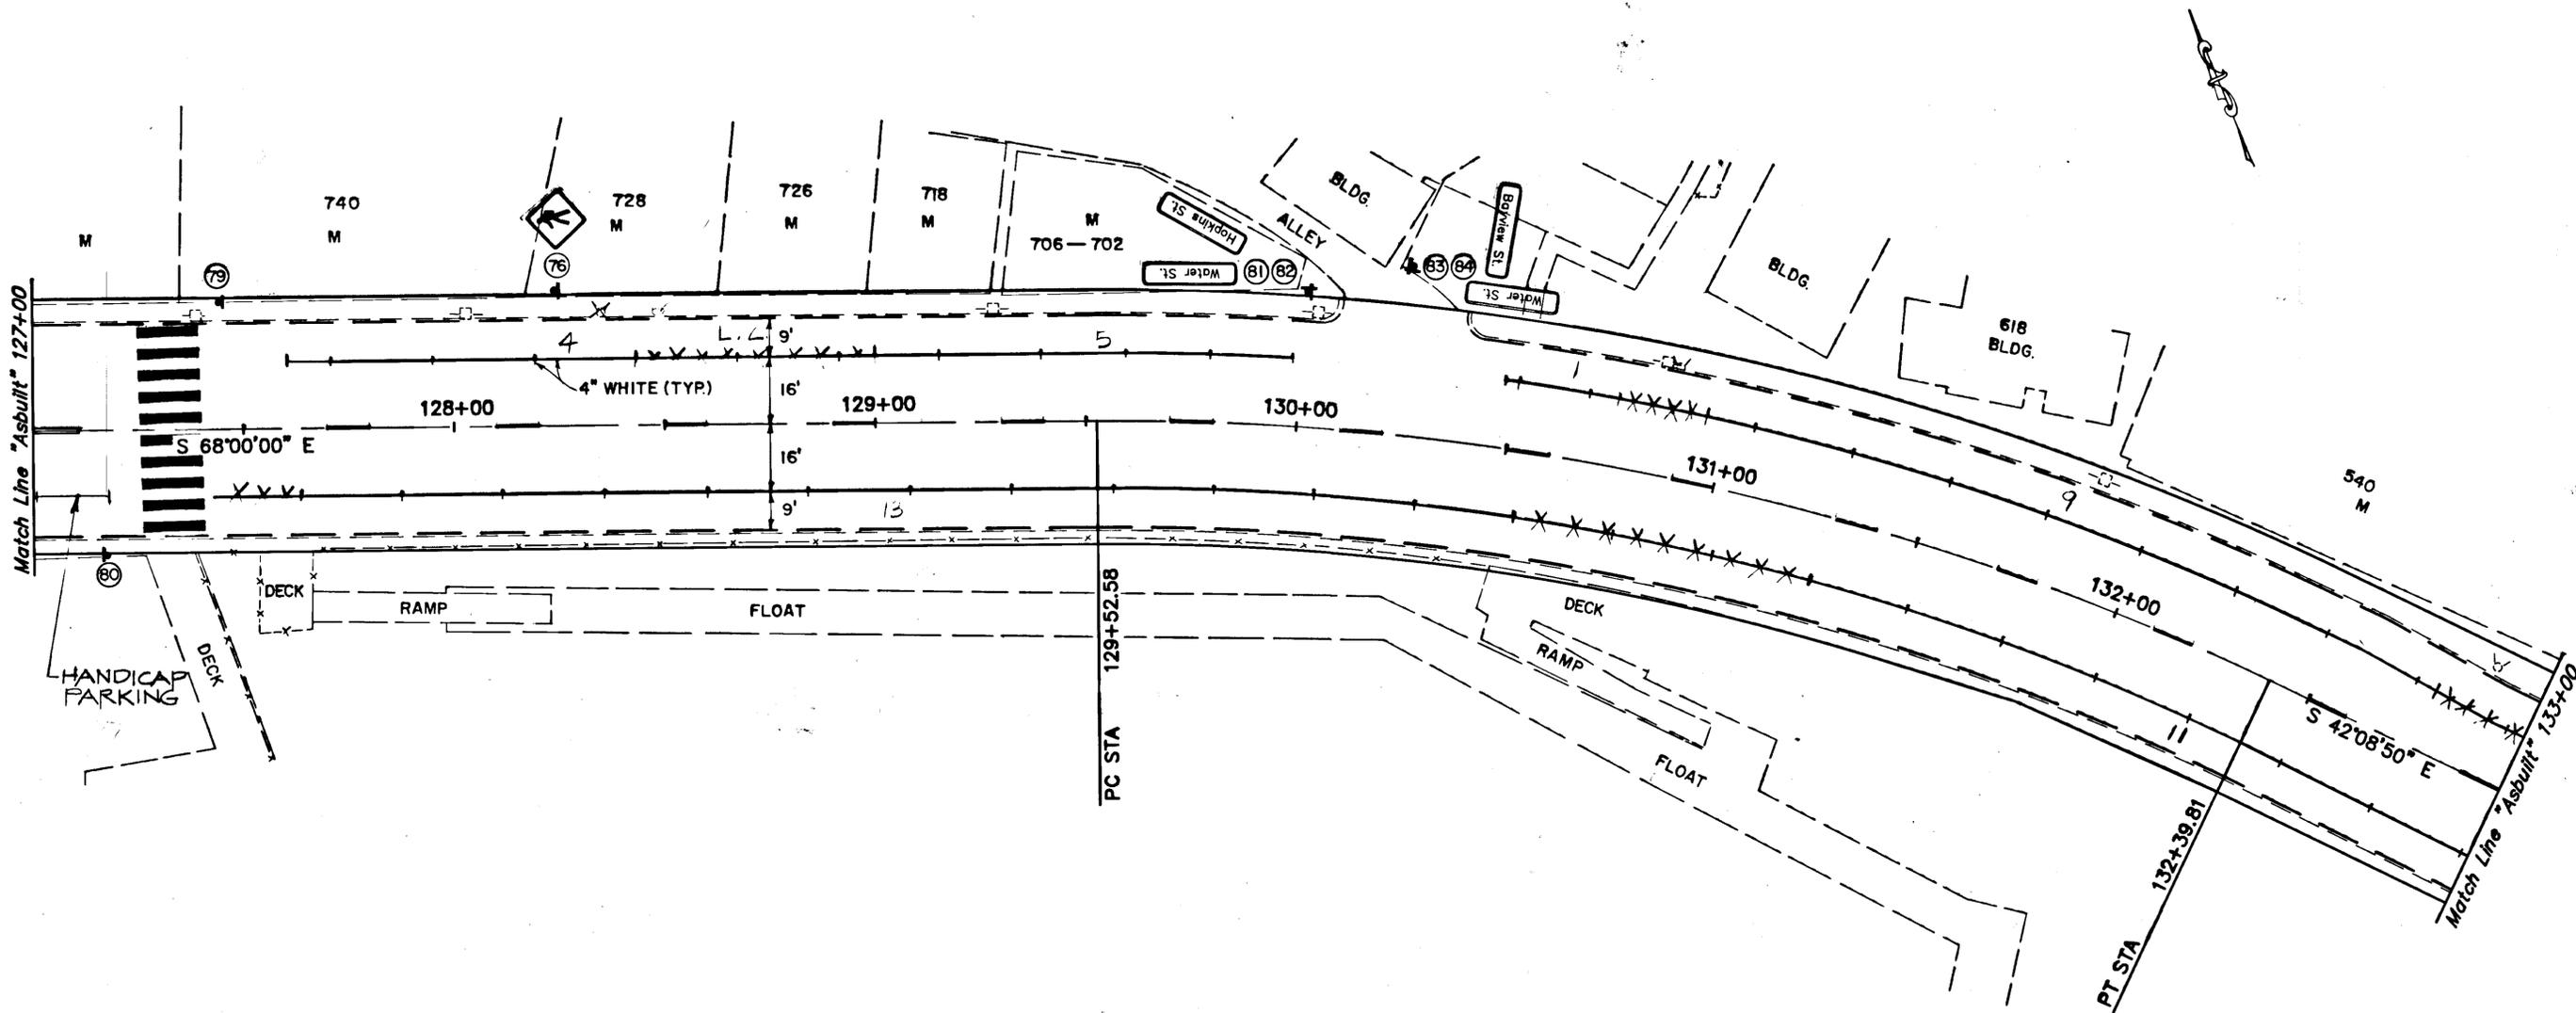

AS BUILT

NOTE: DO NOT SCALE FROM THESE PLANS—USE DIMENSIONS

DATE:	DESCRIPTION OF CHANGE:
11/16/98	AS BUILT

STATE OF ALASKA
 DEPARTMENT OF TRANSPORTATION
 AND PUBLIC FACILITIES
 SOUTHEAST REGION DESIGN & CONSTRUCTION

KETCHIKAN

TONGASS AVENUE PAVEMENT REHABILITATION
 F-M-0902 (16) 70375

ALASKA


DESIGNED BY: T.M.
 DRAWN BY: AUTOCADD/R.K.S.
 CHECKED BY: P.J.

SCALE
 DATE: MAY, 1991
 SHEET 32 OF 38

SIGNING AND STRIPING PLAN

Sta. 127+00 to Sta. 133+00



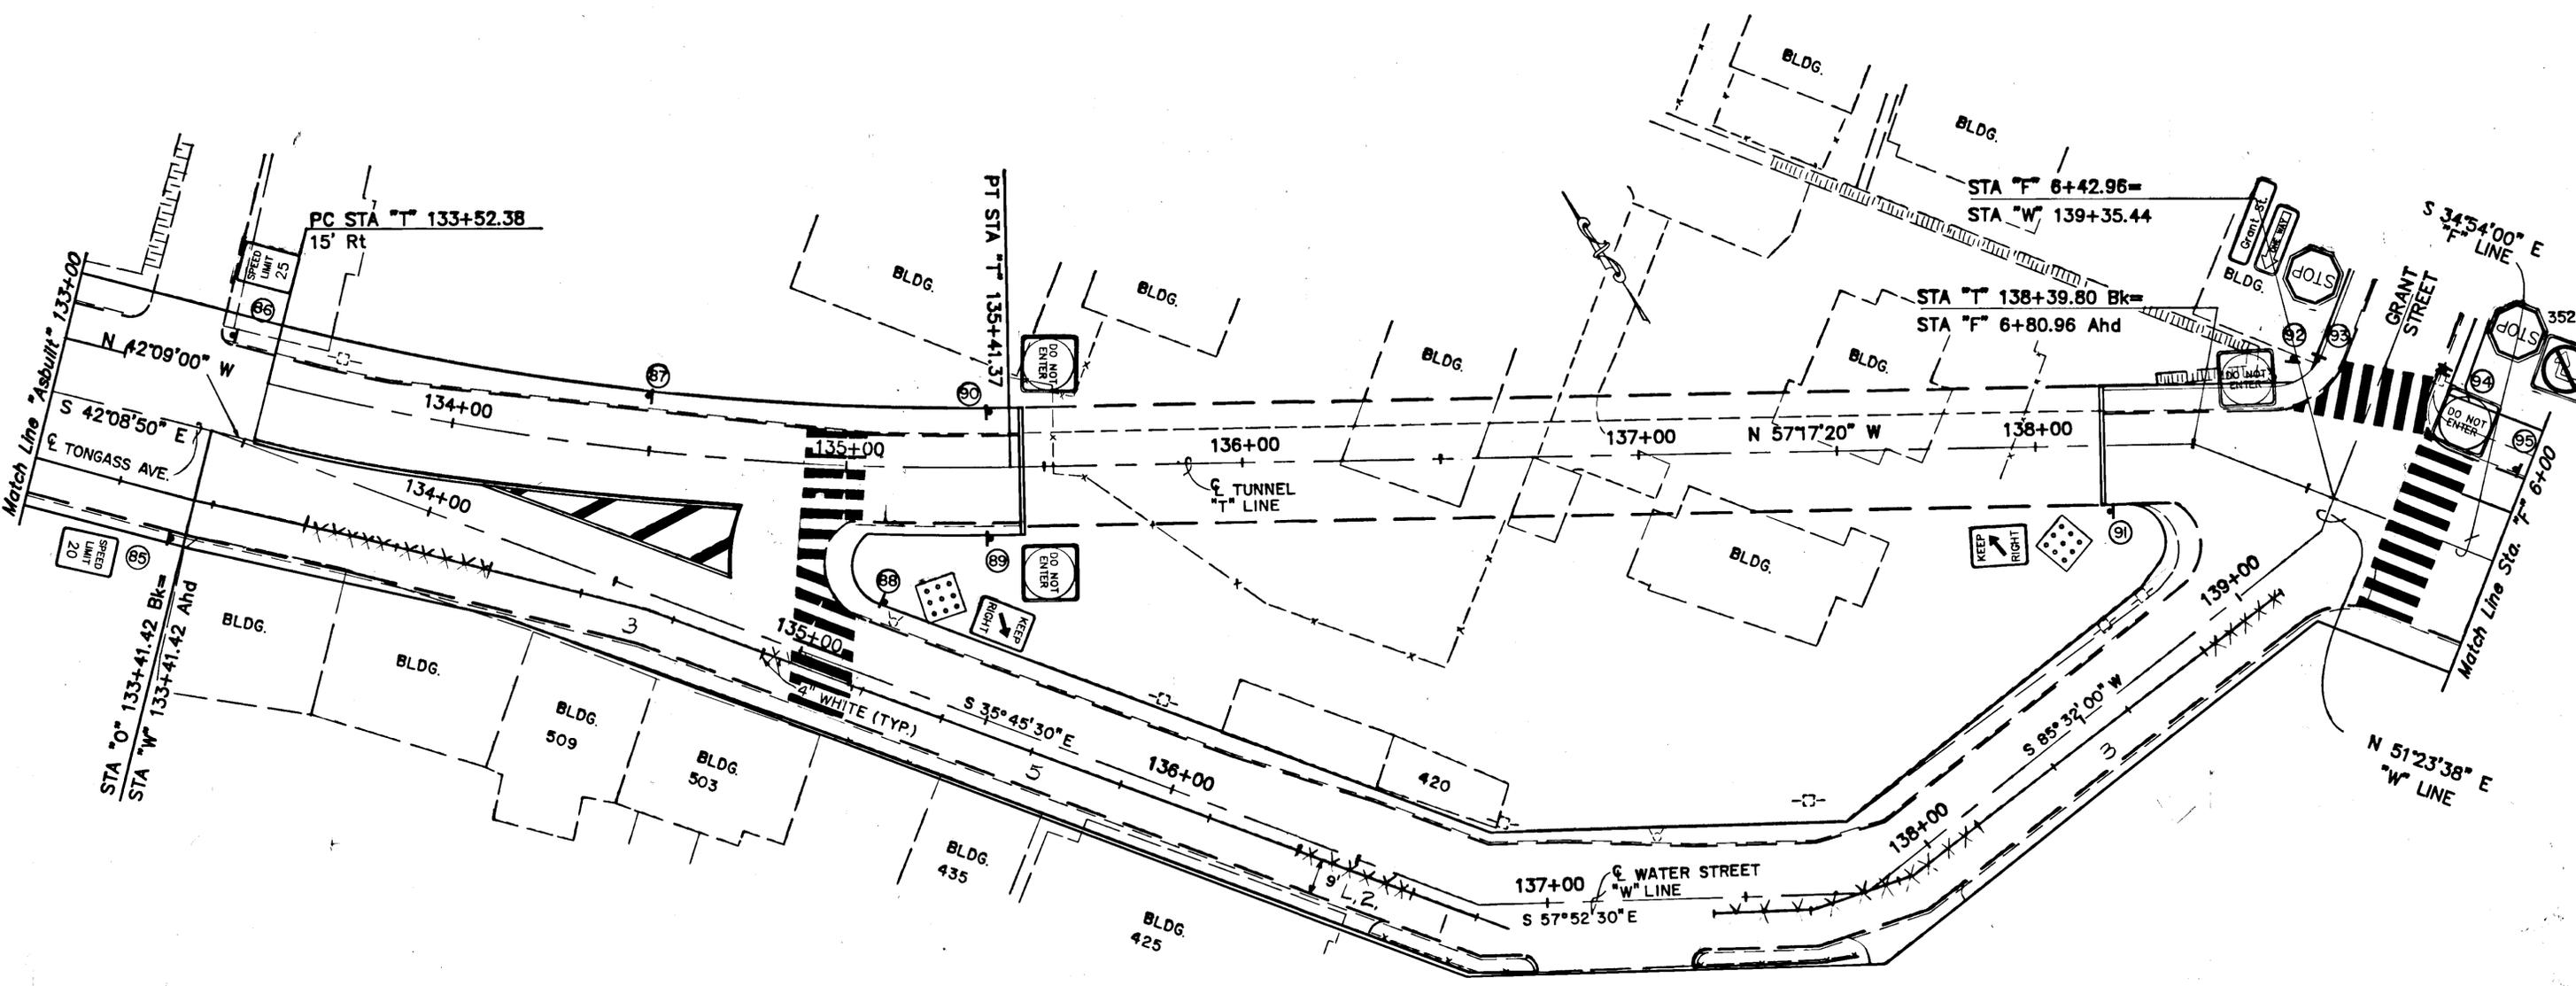

AS BUILT


NOTE: DO NOT SCALE FROM THESE PLANS—USE DIMENSIONS


DATE:	DESCRIPTION OF CHANGE:
11/16/95	AS BUILT

STATE OF ALASKA
 DEPARTMENT OF TRANSPORTATION
 AND PUBLIC FACILITIES
 SOUTHEAST REGION DESIGN & CONSTRUCTION

KETCHIKAN TONGASS AVENUE PAVEMENT REHABILITATION
 F-M-0902(16) 70375
SIGNING AND STRIPING PLAN
 Sta. 133+00 to Sta. "F" 6+00

ALASKA	DESIGNED BY: T.M.	SCALE
	DRAWN BY: AUTOCADD/R.K.S.	DATE: MAY, 1991
	CHECKED BY: P.J.	SHEET 33 OF 38

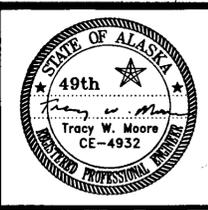

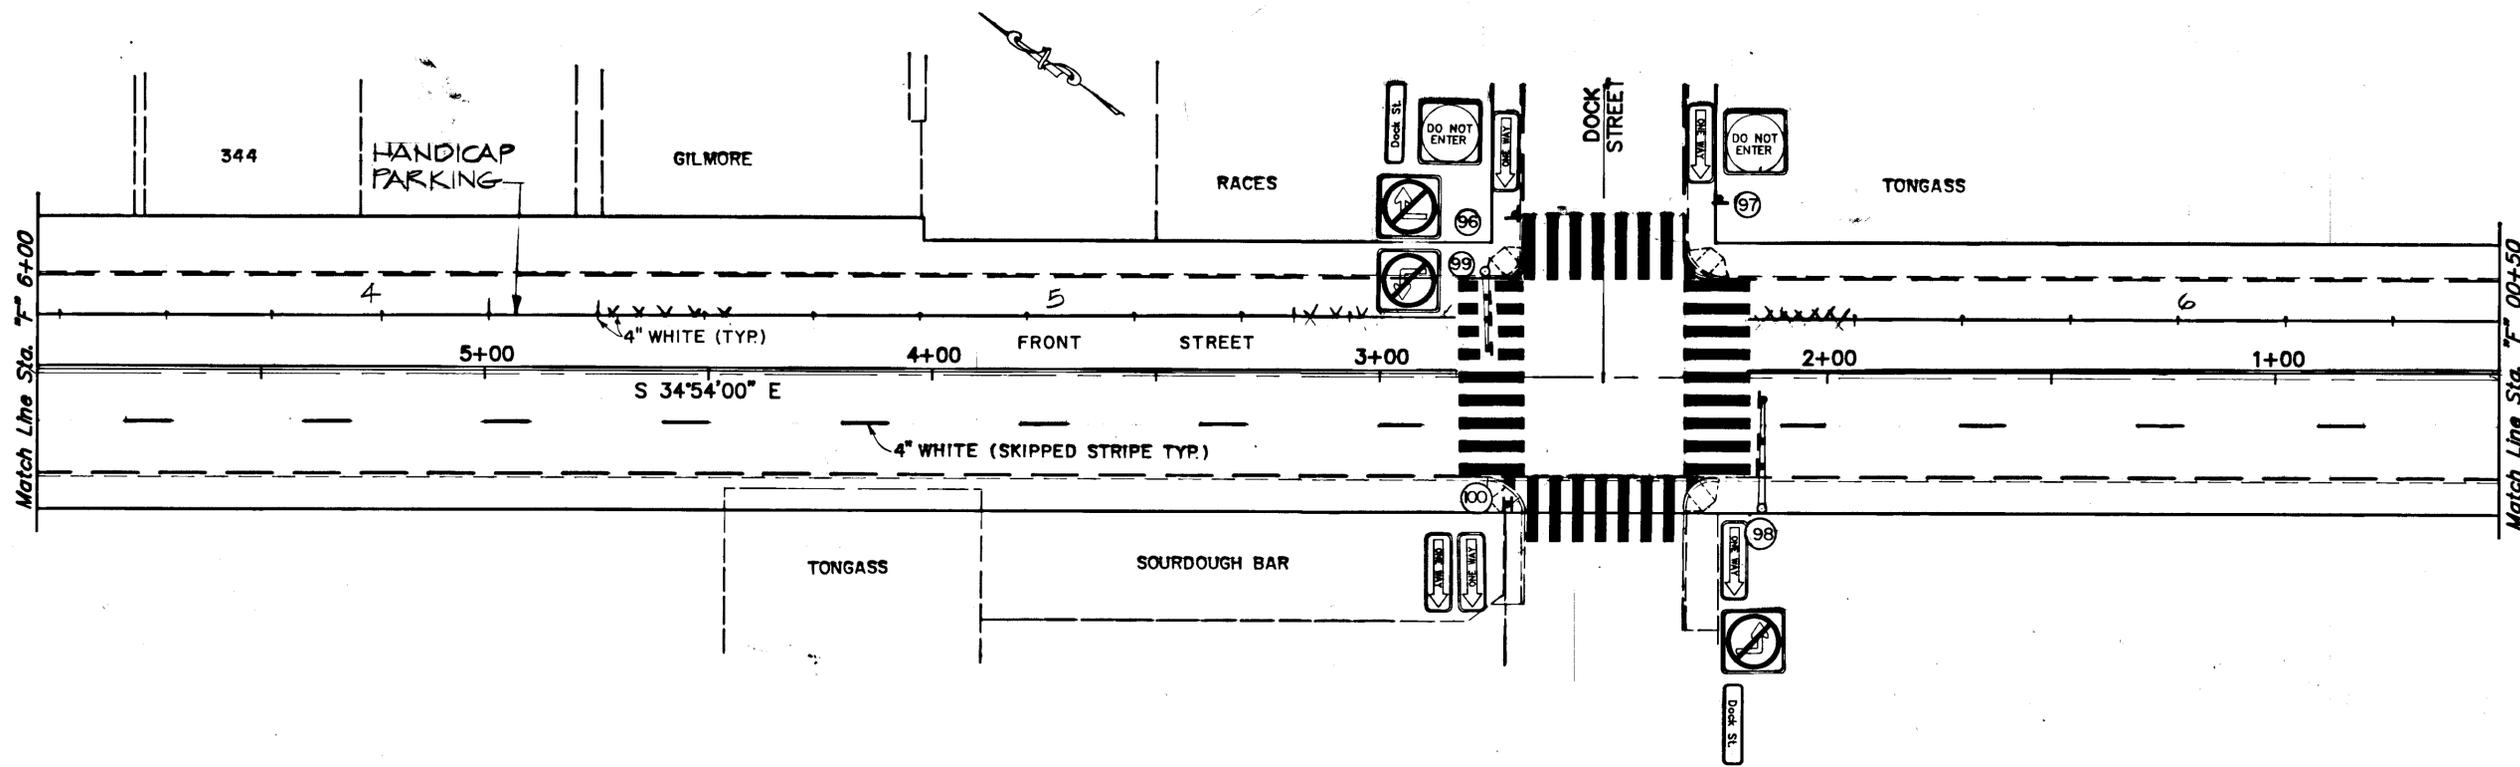

AS BUILT


NOTE: DO NOT SCALE FROM THESE PLANS—USE DIMENSIONS


DATE:	DESCRIPTION OF CHANGE:
11/16/95	AS BUILT

STATE OF ALASKA
 DEPARTMENT OF TRANSPORTATION
 AND PUBLIC FACILITIES
 SOUTHEAST REGION DESIGN & CONSTRUCTION

KETCHIKAN TONGASS AVENUE PAVEMENT REHABILITATION
 F-M-0902(16) 70375
SIGNING AND STRIPING PLAN
 Sta. "F" 6+00 to Sta. "F" 00+50

DESIGNED BY:	T.M.	SCALE
DRAWN BY:	AUTOCADD/R.K.S.	DATE: MAY, 1991
CHECKED BY:	P.J.	SHEET 34 OF 38

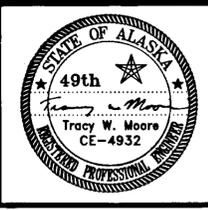

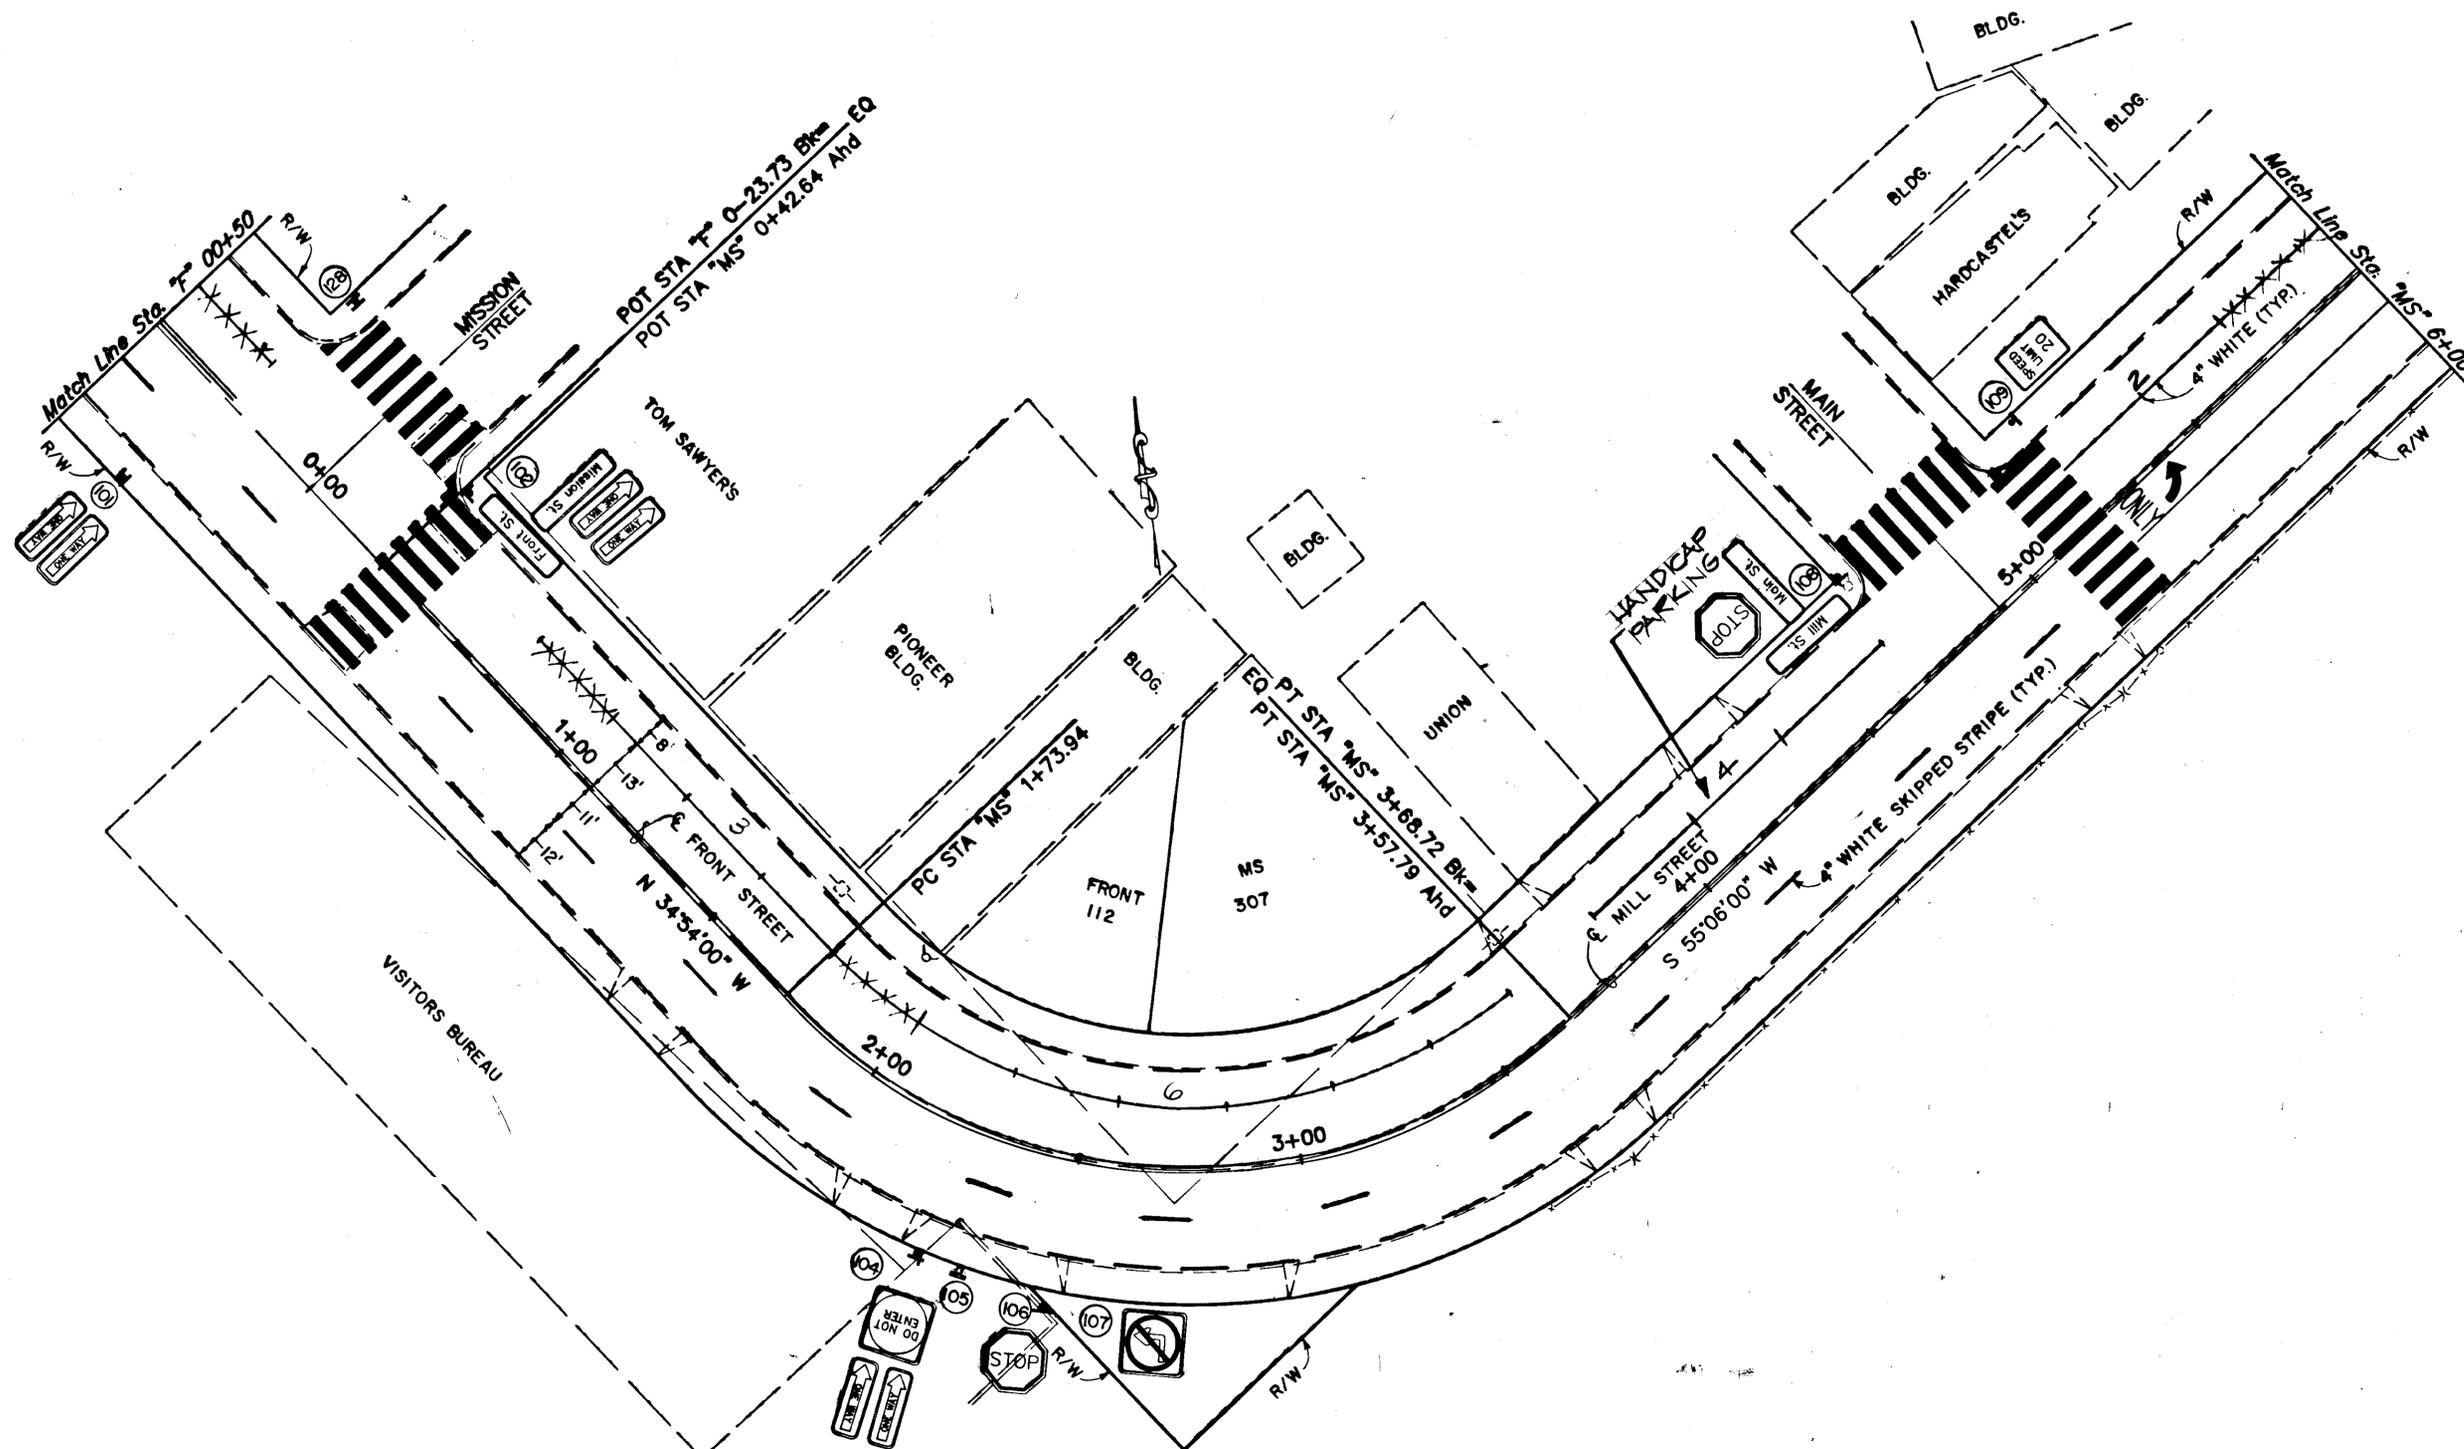

AS BUILT

NOTE: DO NOT SCALE FROM THESE PLANS—USE DIMENSIONS


DATE:	DESCRIPTION OF CHANGE:
11/16/91	AS BUILT

STATE OF ALASKA
 DEPARTMENT OF TRANSPORTATION
 AND PUBLIC FACILITIES
 SOUTHEAST REGION DESIGN & CONSTRUCTION

KETCHIKAN TONGASS AVENUE PAVEMENT REHABILITATION
 F-M-0902 (16) 70375
SIGNING AND STRIPING PLAN
 Sta. "F" 00+50 to Sta. "MS" 6+00

DESIGNED BY:	T.M.	SCALE
DRAWN BY:	AUTOCADD/R.K.S.	DATE: MAY, 1991
CHECKED BY:	P.J.	SHEET 35 OF 38



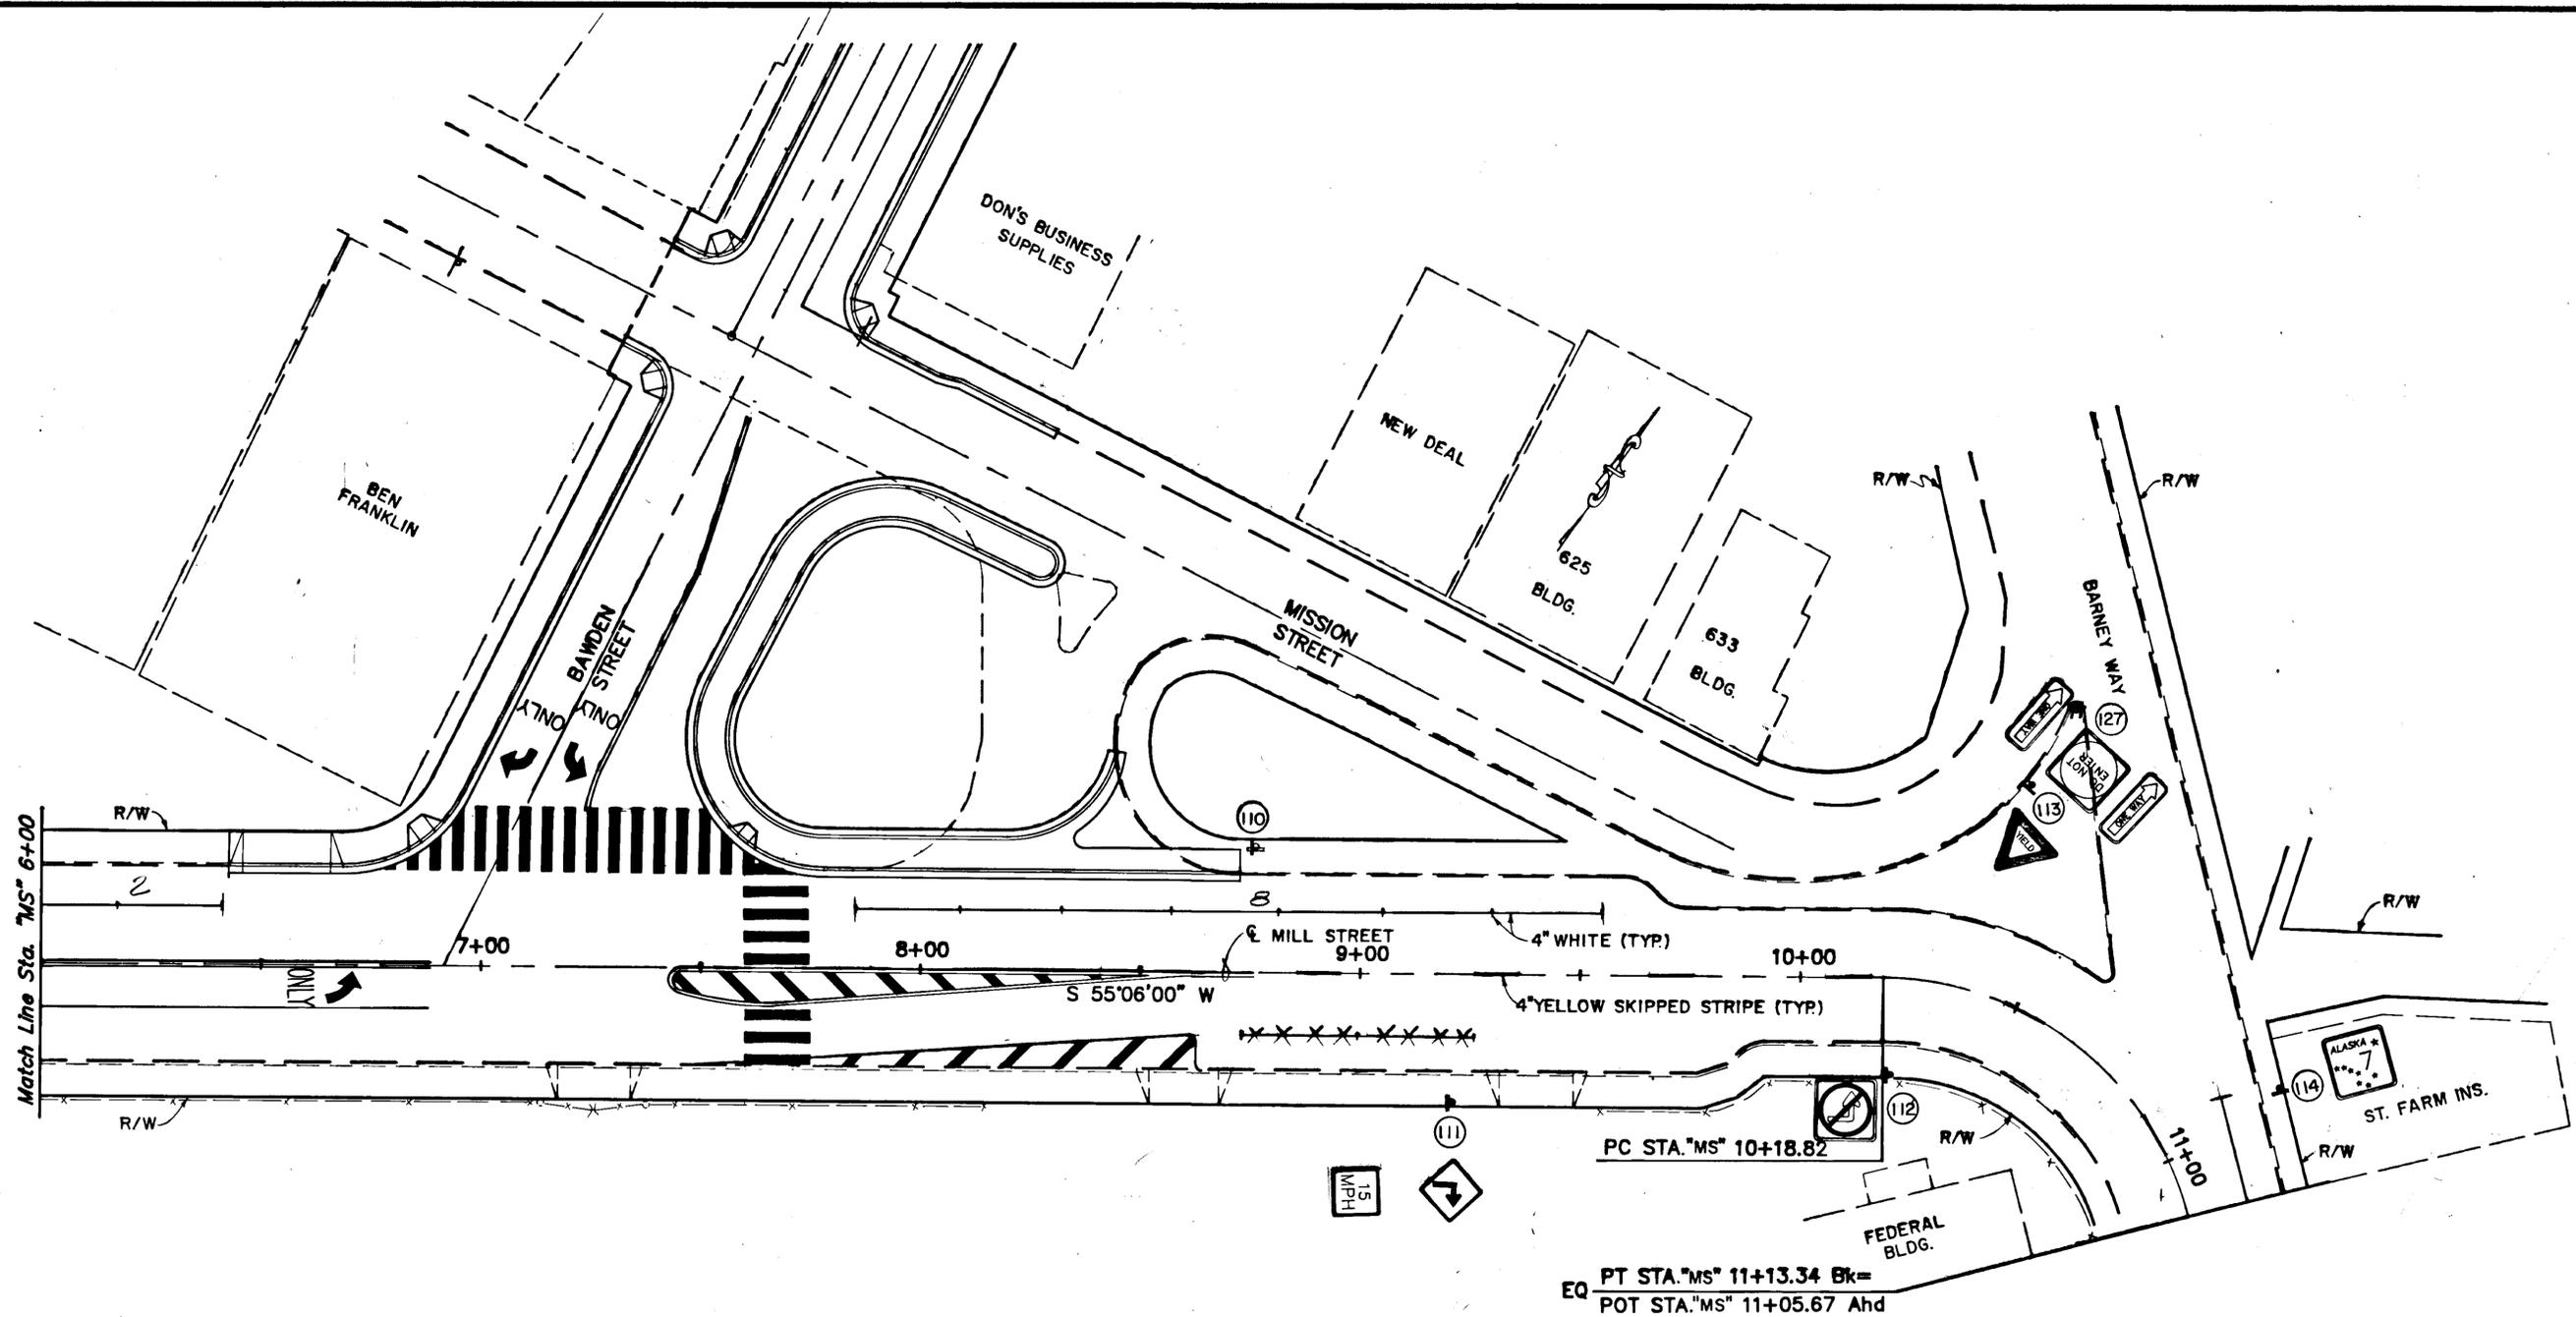


NOTE: DO NOT SCALE FROM THESE PLANS-USE DIMENSIONS


DATE:	DESCRIPTION OF CHANGE:

STATE OF ALASKA
 DEPARTMENT OF TRANSPORTATION
 AND PUBLIC FACILITIES
 SOUTHEAST REGION DESIGN & CONSTRUCTION

KETCHIKAN ALASKA
 TONGASS AVENUE PAVEMENT REHABILITATION
 F-M-0902 (16) 70375
SIGNING AND STRIPING PLAN
 Sta. "MS" 6+00 to Sta. "MS" 11+00

DESIGNED BY:	T.M.	SCALE
DRAWN BY:	AUTOCADD/R.K.S.	DATE: MAY, 1991
CHECKED BY:	P.J.	SHEET 36 OF 38

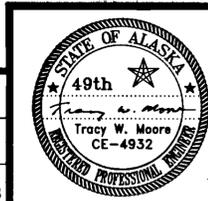

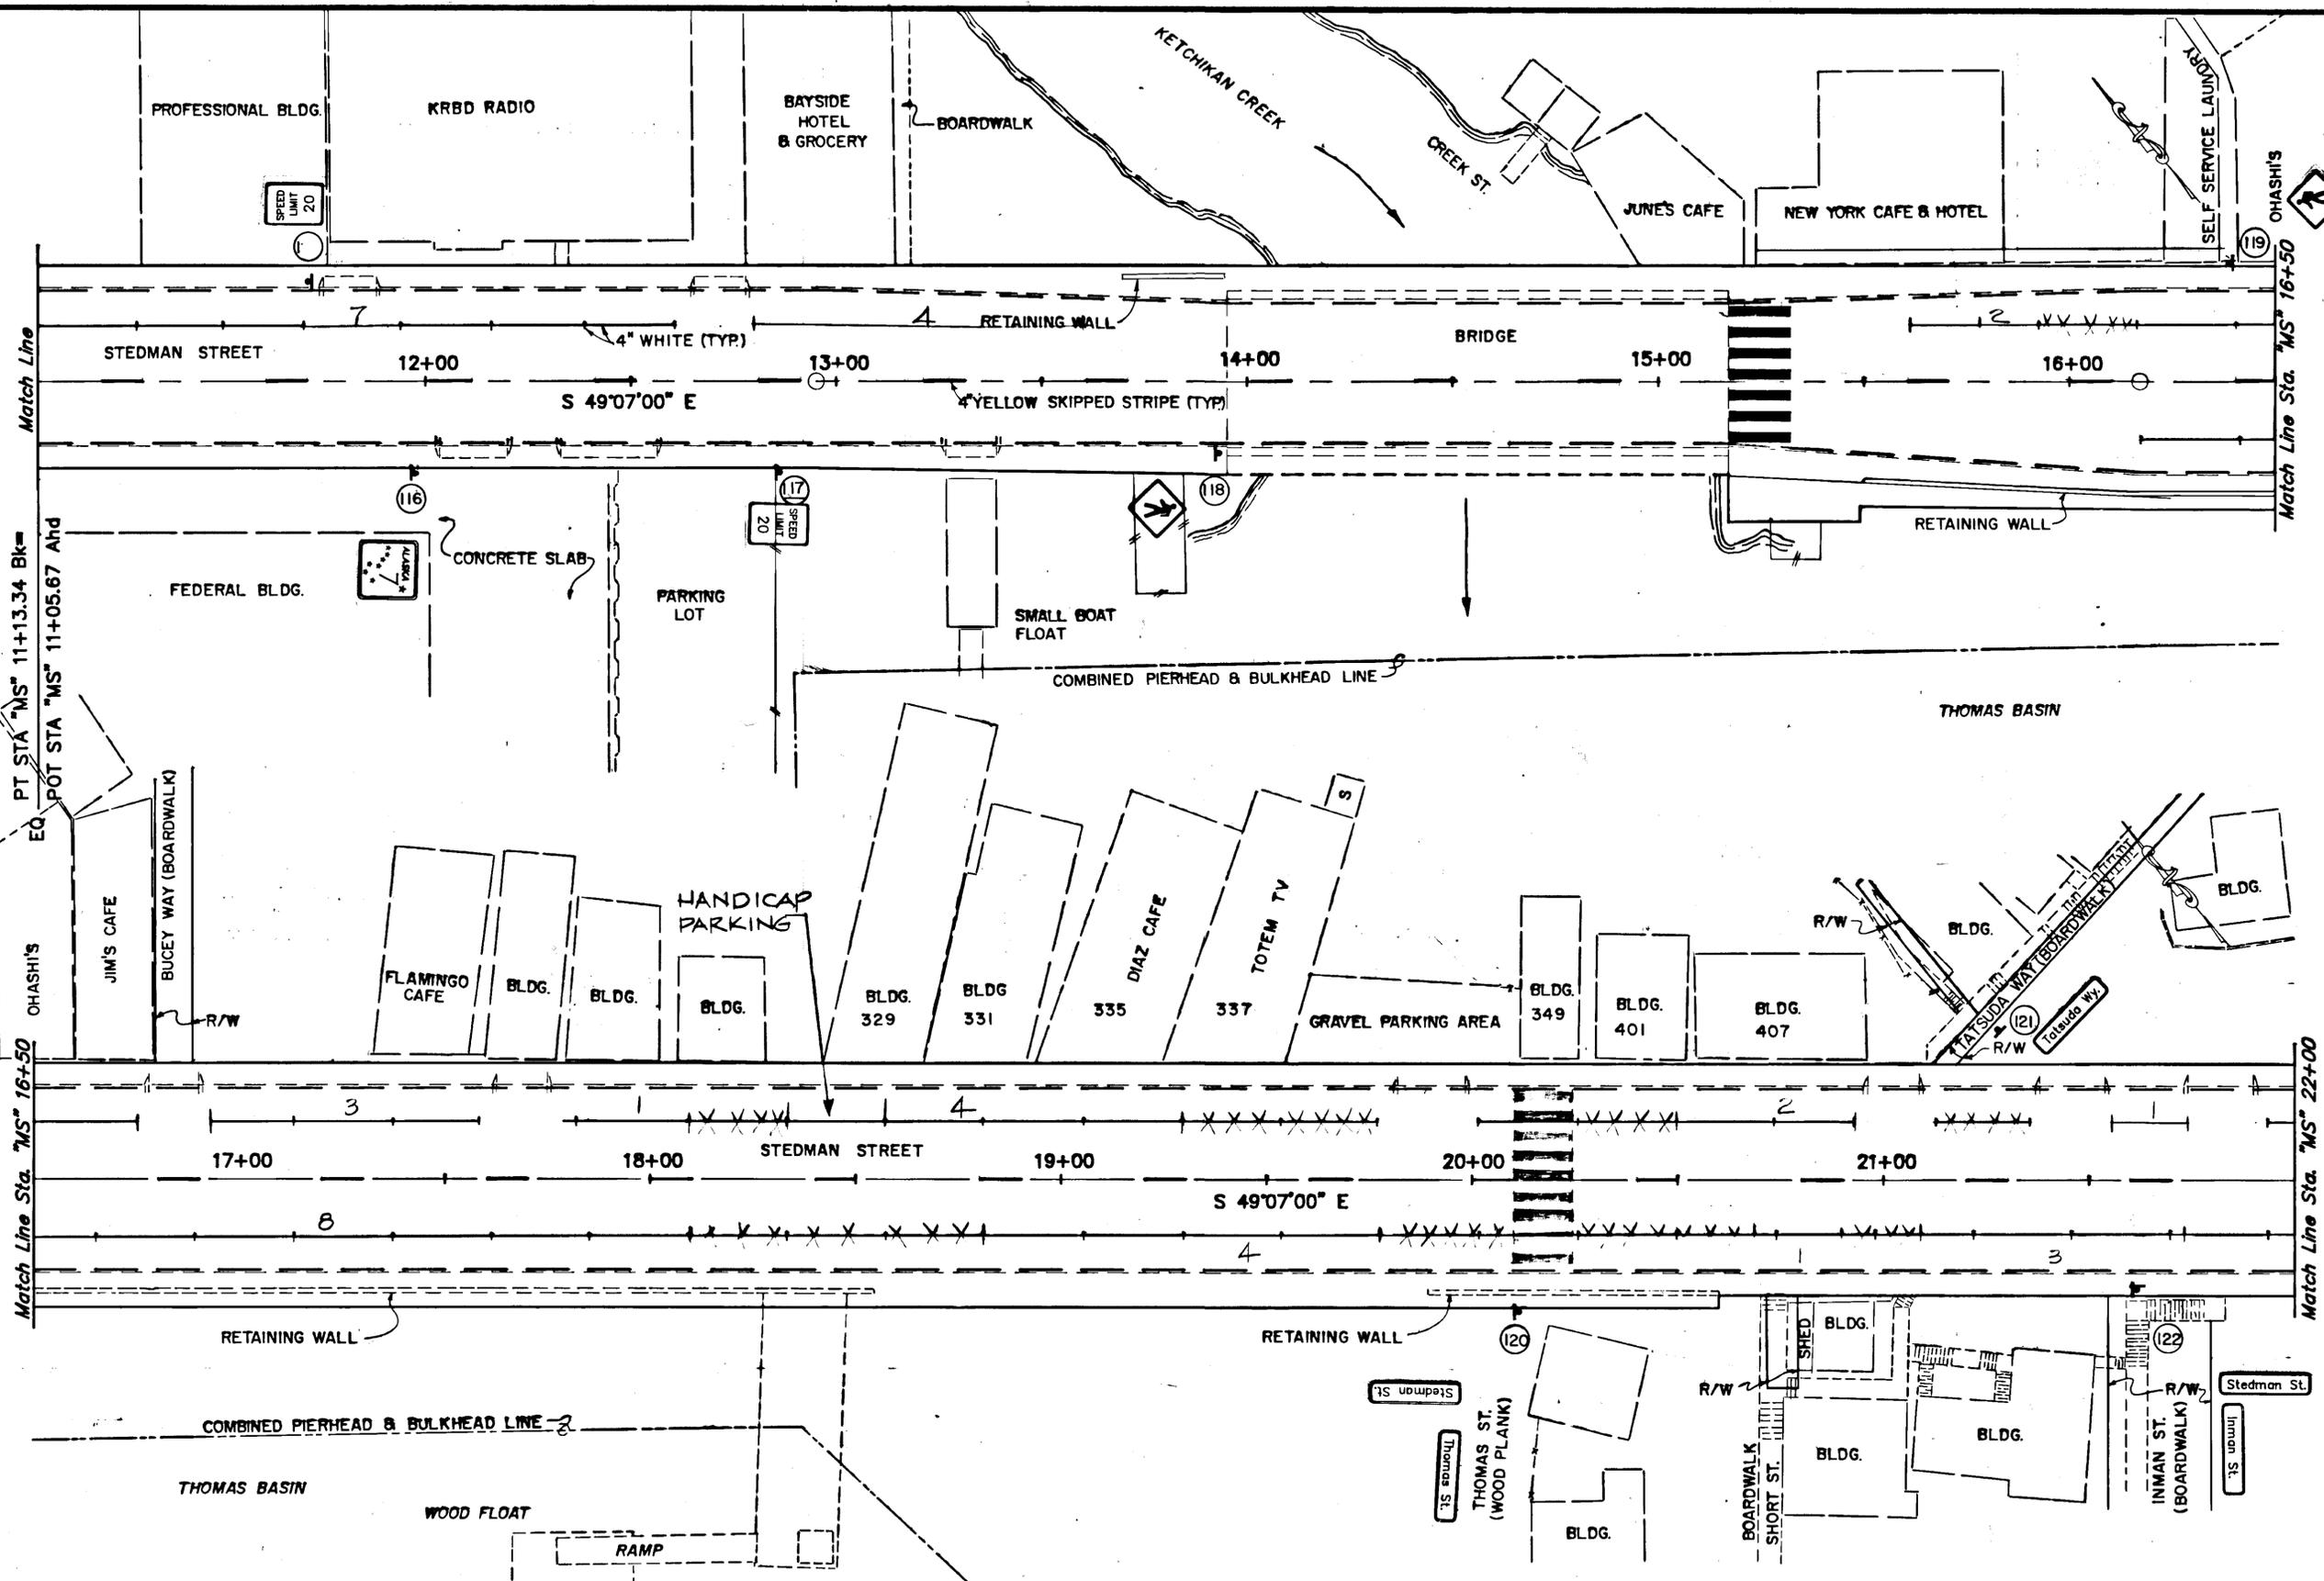

AS BUILT


NOTE: DO NOT SCALE FROM THESE PLANS-USE DIMENSIONS


DATE	DESCRIPTION OF CHANGE
11/16/91	AS BUILT

STATE OF ALASKA
 DEPARTMENT OF TRANSPORTATION
 AND PUBLIC FACILITIES
 SOUTHEAST REGION DESIGN & CONSTRUCTION

KETCHIKAN
 TONGASS AVENUE PAVEMENT REHABILITATION
 F-M-0902 (16) 70375
SIGNING AND STRIPING PLAN
 Equation to Sta. "MS" 22+00

DESIGNED BY:	T.M.	SCALE
DRAWN BY:	AUTOCADD/R.K.S.	DATE:
CHECKED BY:	P.J.	MAY, 1991
		SHEET 37 OF 38

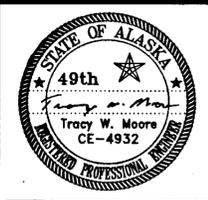

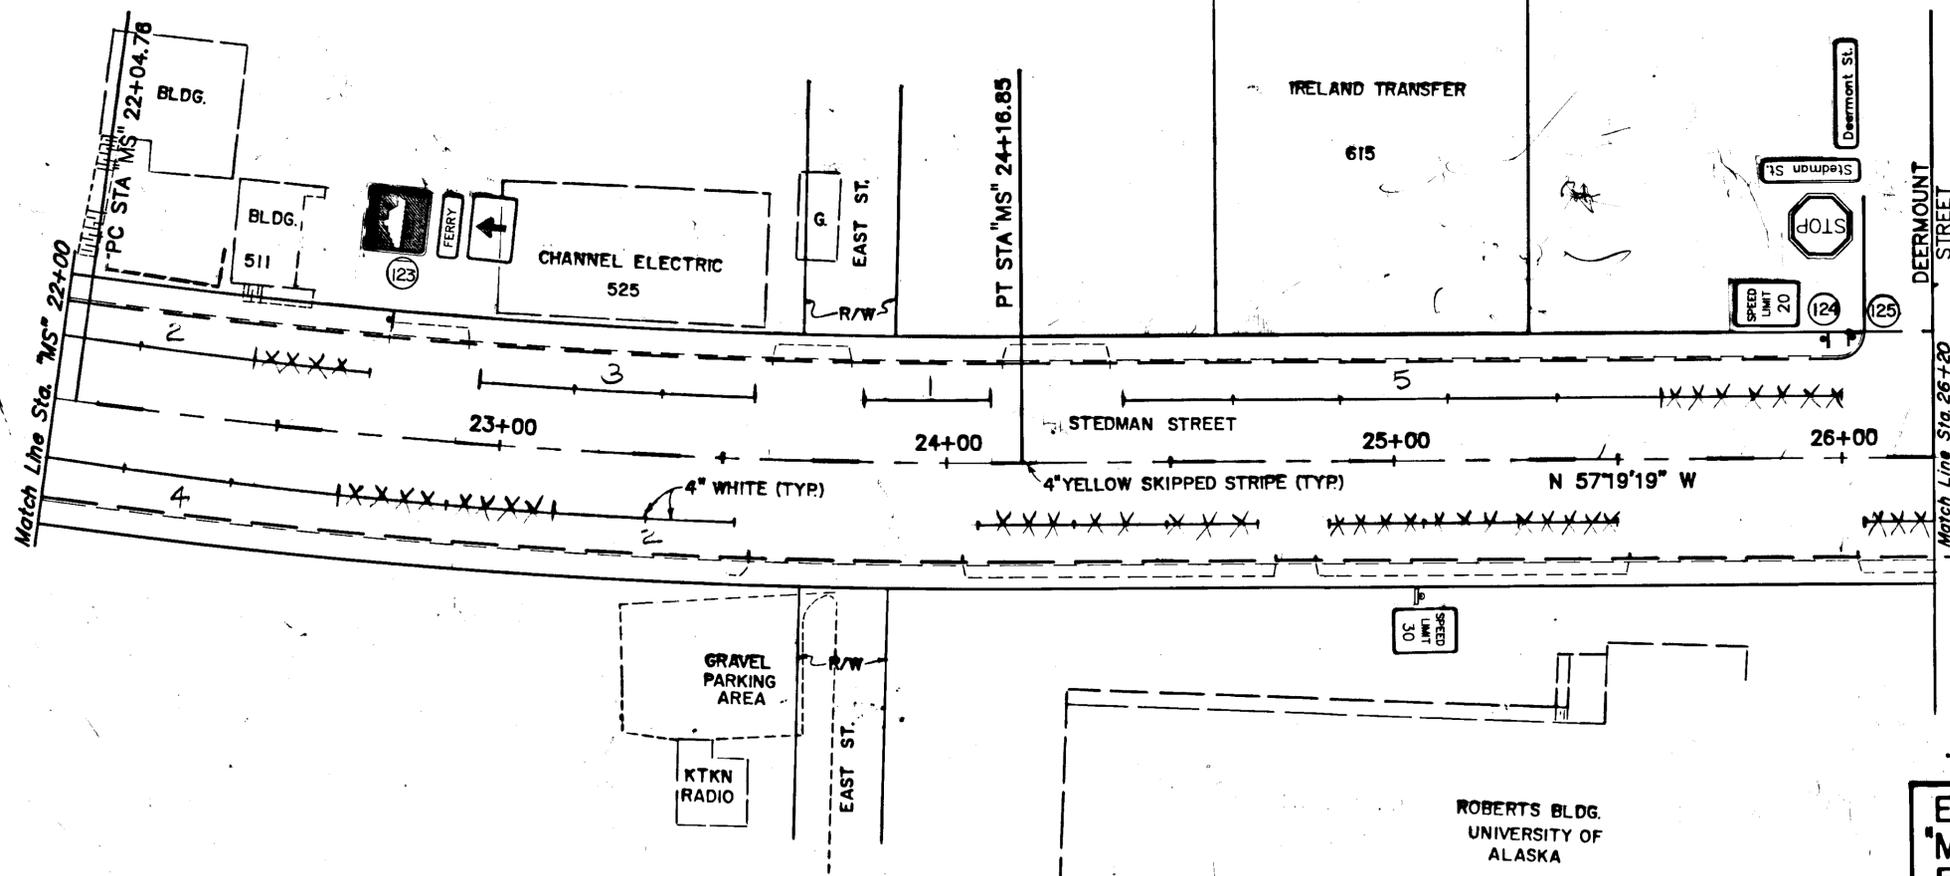

E.O.P.
 "MS" STA. 20+60
 F-M-0902 (16)

AS BUILT


NOTE: DO NOT SCALE FROM THESE PLANS-USE DIMENSIONS

BY:	DATE:	DESCRIPTION OF CHANGE:
KK	11/16/95	AS BUILT

STATE OF ALASKA
 DEPARTMENT OF TRANSPORTATION
 AND PUBLIC FACILITIES
 SOUTHEAST REGION DESIGN & CONSTRUCTION

KETCHIKAN TONGASS AVENUE PAVEMENT REHABILITATION
 F-M-0902 (16) 70375
SIGNING AND STRIPING PLAN
 Sta. "MS" 22+00 to Sta. "MS" 26+60.21

DESIGNED BY:	T.M.	SCALE
DRAWN BY:	AUTOCADD/R.K.S.	DATE:
CHECKED BY:	P.J.	MAY, 1991
		SHEET 38 OF 38

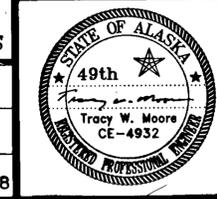

RECORD OF REVISIONS