

**STATE OF ALASKA
DEPARTMENT OF TRANSPORTATION
&
PUBLIC FACILITIES**

**PLAN AND PROFILE
PROPOSED HIGHWAY PROJECT**

B-59902

**RSG-M-0902 (II)
NORTH & SOUTH TONGASS HWY.
RAISED PAVEMENT MARKERS**

SHEET NO.	INDEX OF SHEETS
1	TITLE SHEET
2	ESTIMATE OF QUANTITIES, MISC. SUMMARY, GENERAL NOTES
3-5	PLAN SHEETS
6	TRAFFIC CONTROL PLAN

THE FOLLOWING STANDARD DRAWINGS SHALL APPLY TO THIS PROJECT:
A-1, C-00.04, C-10.01, & C-11.01


"AS-BUILT" PLANS

CONTRACTOR: ALASKA STRIPING & PAINTING

PROJECT ENGINEER: RAY DEMMERT

CONTRACT BEGIN: April 6, 1985

CONTRACT END: May 18, 1985

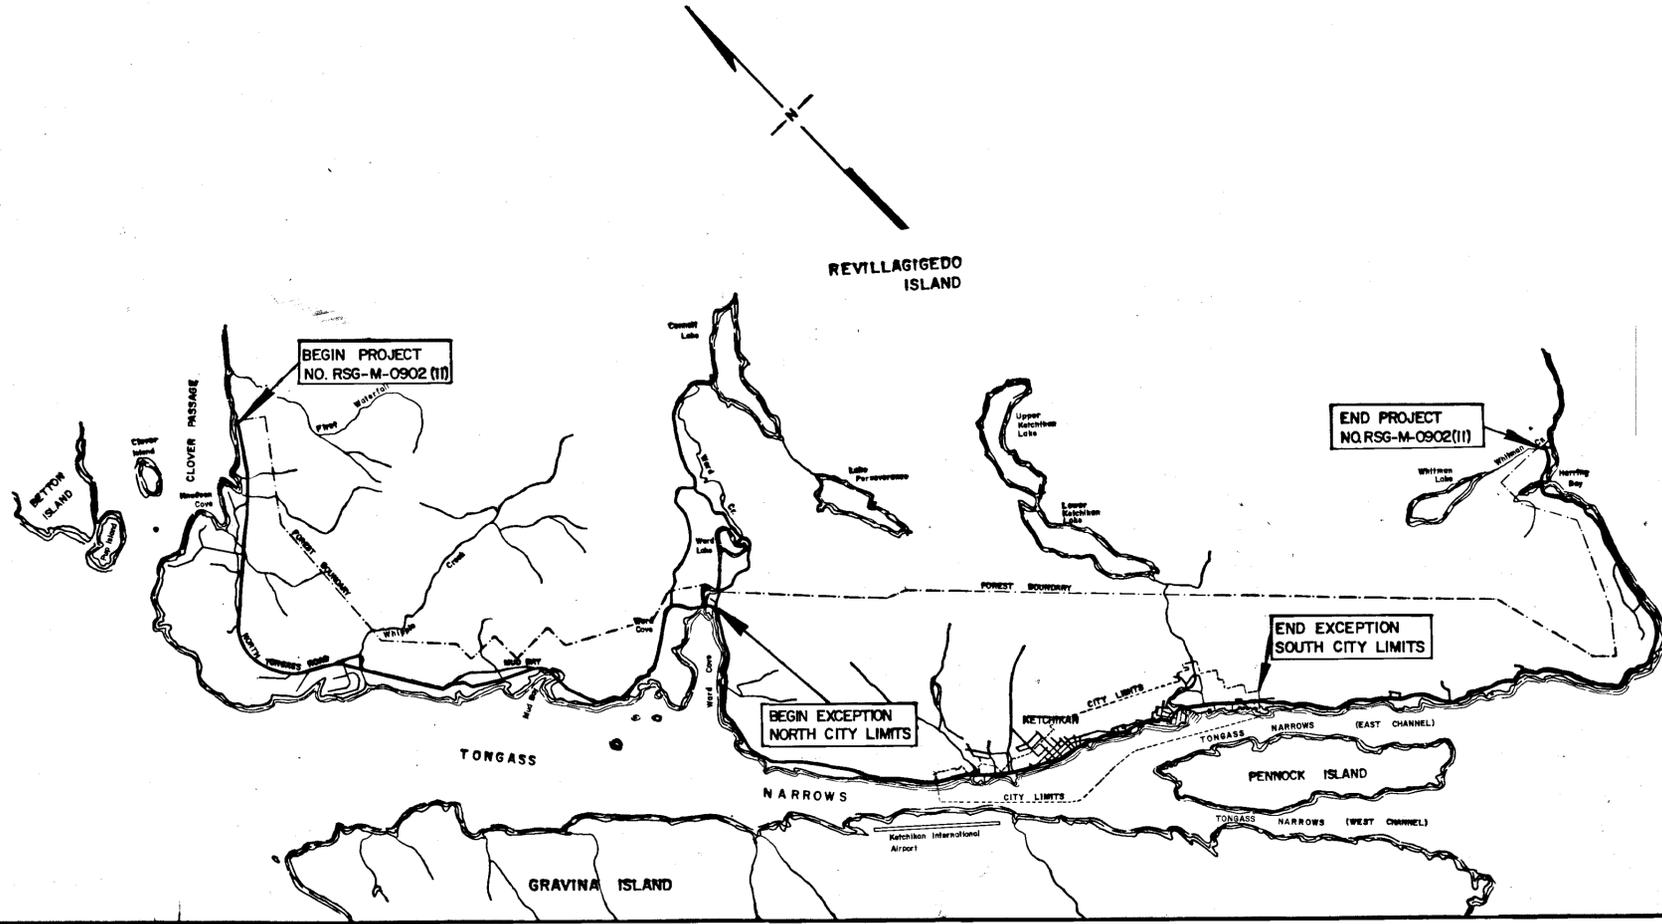

STATE OF ALASKA
DEPARTMENT OF TRANSPORTATION
&
PUBLIC FACILITIES

APPROVED
Wallace K. Williams Date *5/18/84*
SOUTHEAST REGION DESIGN/CONST. ENGINEER

STATE OF ALASKA
DEPARTMENT OF TRANSPORTATION
&
PUBLIC FACILITIES

APPROVED
R. Dickmeier Date *5/18/84*
DIRECTOR, HIGHWAY DESIGN/CONSTRUCTION

"As-Built" corrections made Sept. 11, 1985 - C. Anderson

**RAISED PAVEMENT MARKERS
NORTH TONGASS HIGHWAY**

Begin Station	End Station	Number of Markers	
		2-Way	1-Way
205+27			
204+87	217+97	145	21
245+46	251+27	30	
257+74	292+79	138	136
326+72	340+45	68	
344+61	357+79	66	
363+69	371+51	38	
397+91	418+21	104	
451+48	486+95	176	
519+10			
520+38	533+04	44	18
572+74	586+58	44	24
	587+02.24		
604+63	615+37	54	
604+56.94			

**RAISED PAVEMENT MARKERS
SOUTH TONGASS HIGHWAY**


Begin Station	End Station	Number of Markers	
		2-Way	1-Way
15+59	19+22.94	20	18
38+14	70+19	160	
75+33	88+17	64	
92+50	97+70	26	28
2910.5	317+45	14	
117+18	186+30	20	301
240+98	243+76	14	
218+00	240+98	94	20
243+76	251+89	40	
256+63	274+92	92	
303+65	317+68	70	
351+12.8			
351+53	381+31	130	148
388+22	401+56	66	
	Total =	1884	144

ESTIMATE OF QUANTITIES			
ITEM NO.	ITEM	UNIT	QUANTITY
110 (1)	Mobilization	L.S.	All Req'd
114 (1)	Construction Surveying	L.S.	All Req'd
115 (1)	Traffic Maintenance	L.S.	All Req'd
670 (7)	Raised Pavement Markers	Ea.	2,028 2046


GENERAL NOTES:

- South Tongass Highway as-built stationing is derived from project Tongass Forest Highway, Route No. 1 - Sec. C4, D7-D8, E4-E5, H2, 1949-1953.
- North Tongass Highway as-built stationing is derived from project Tongass Forest Highway, Route No. 1 - Sec. A5, B8-B7, G3-G4, J2, 1952-1953, and Project No. S-0920(4), 1967.
- Installation methods for raised pavement markers (RPMs) shall be according to manufacturers recommendations.
- Epoxy adhesive shall be standard set type. Temperature and curing times shall be as recommended by the manufacturer of the adhesive.
- Raised pavement markers will not be installed within the limits of intersecting streets.
- If concrete markers are used, mortar shall be Magnesium Phosphate Set 45 or equivalent.
- All reflectors on the RPMs shall be two-sided yellow.
- All locations for RPMs shall be approved by project engineers after staking by the contractor.
- Traffic control shall be similar to the plan shown in the U.S. Dept. of Transportation, Work Zone Traffic Control Standards And Guidelines, Part VI page 46.
- In areas of double stripe, the markers shall be set on the inside and outside of the curve with a two-inch offset from the double stripe. When the stripe is solid and dashed, the markers shall be placed between the dashes.


RAISED PAVEMENT MARKER PLACEMENT DETAIL

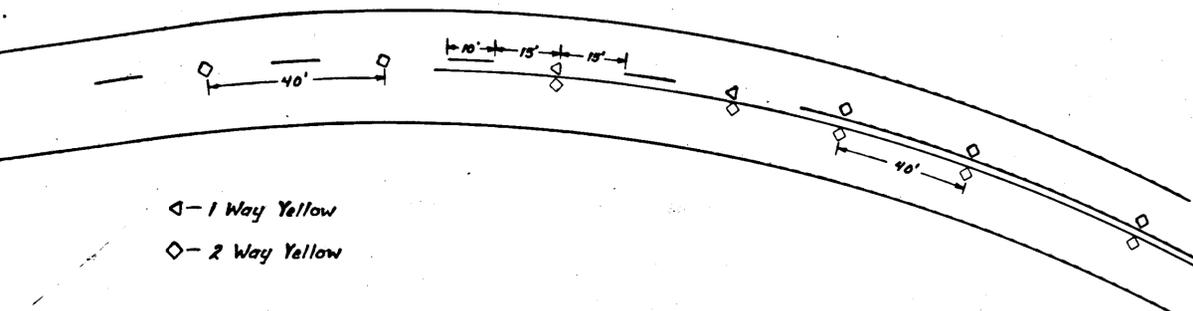


DOUBLE YELLOW PLACEMENT DETAIL

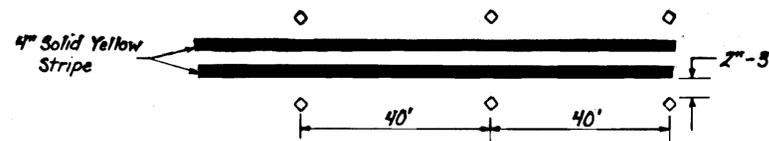




NO PASSING ZONE PLACEMENT DETAIL

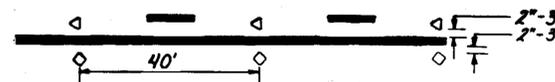

STATE	PROJECT DESIGNATION	YEAR	SHEET NO.	TOTAL SHEETS
ALASKA	RSG-M-0902 (11)	1984	3	6

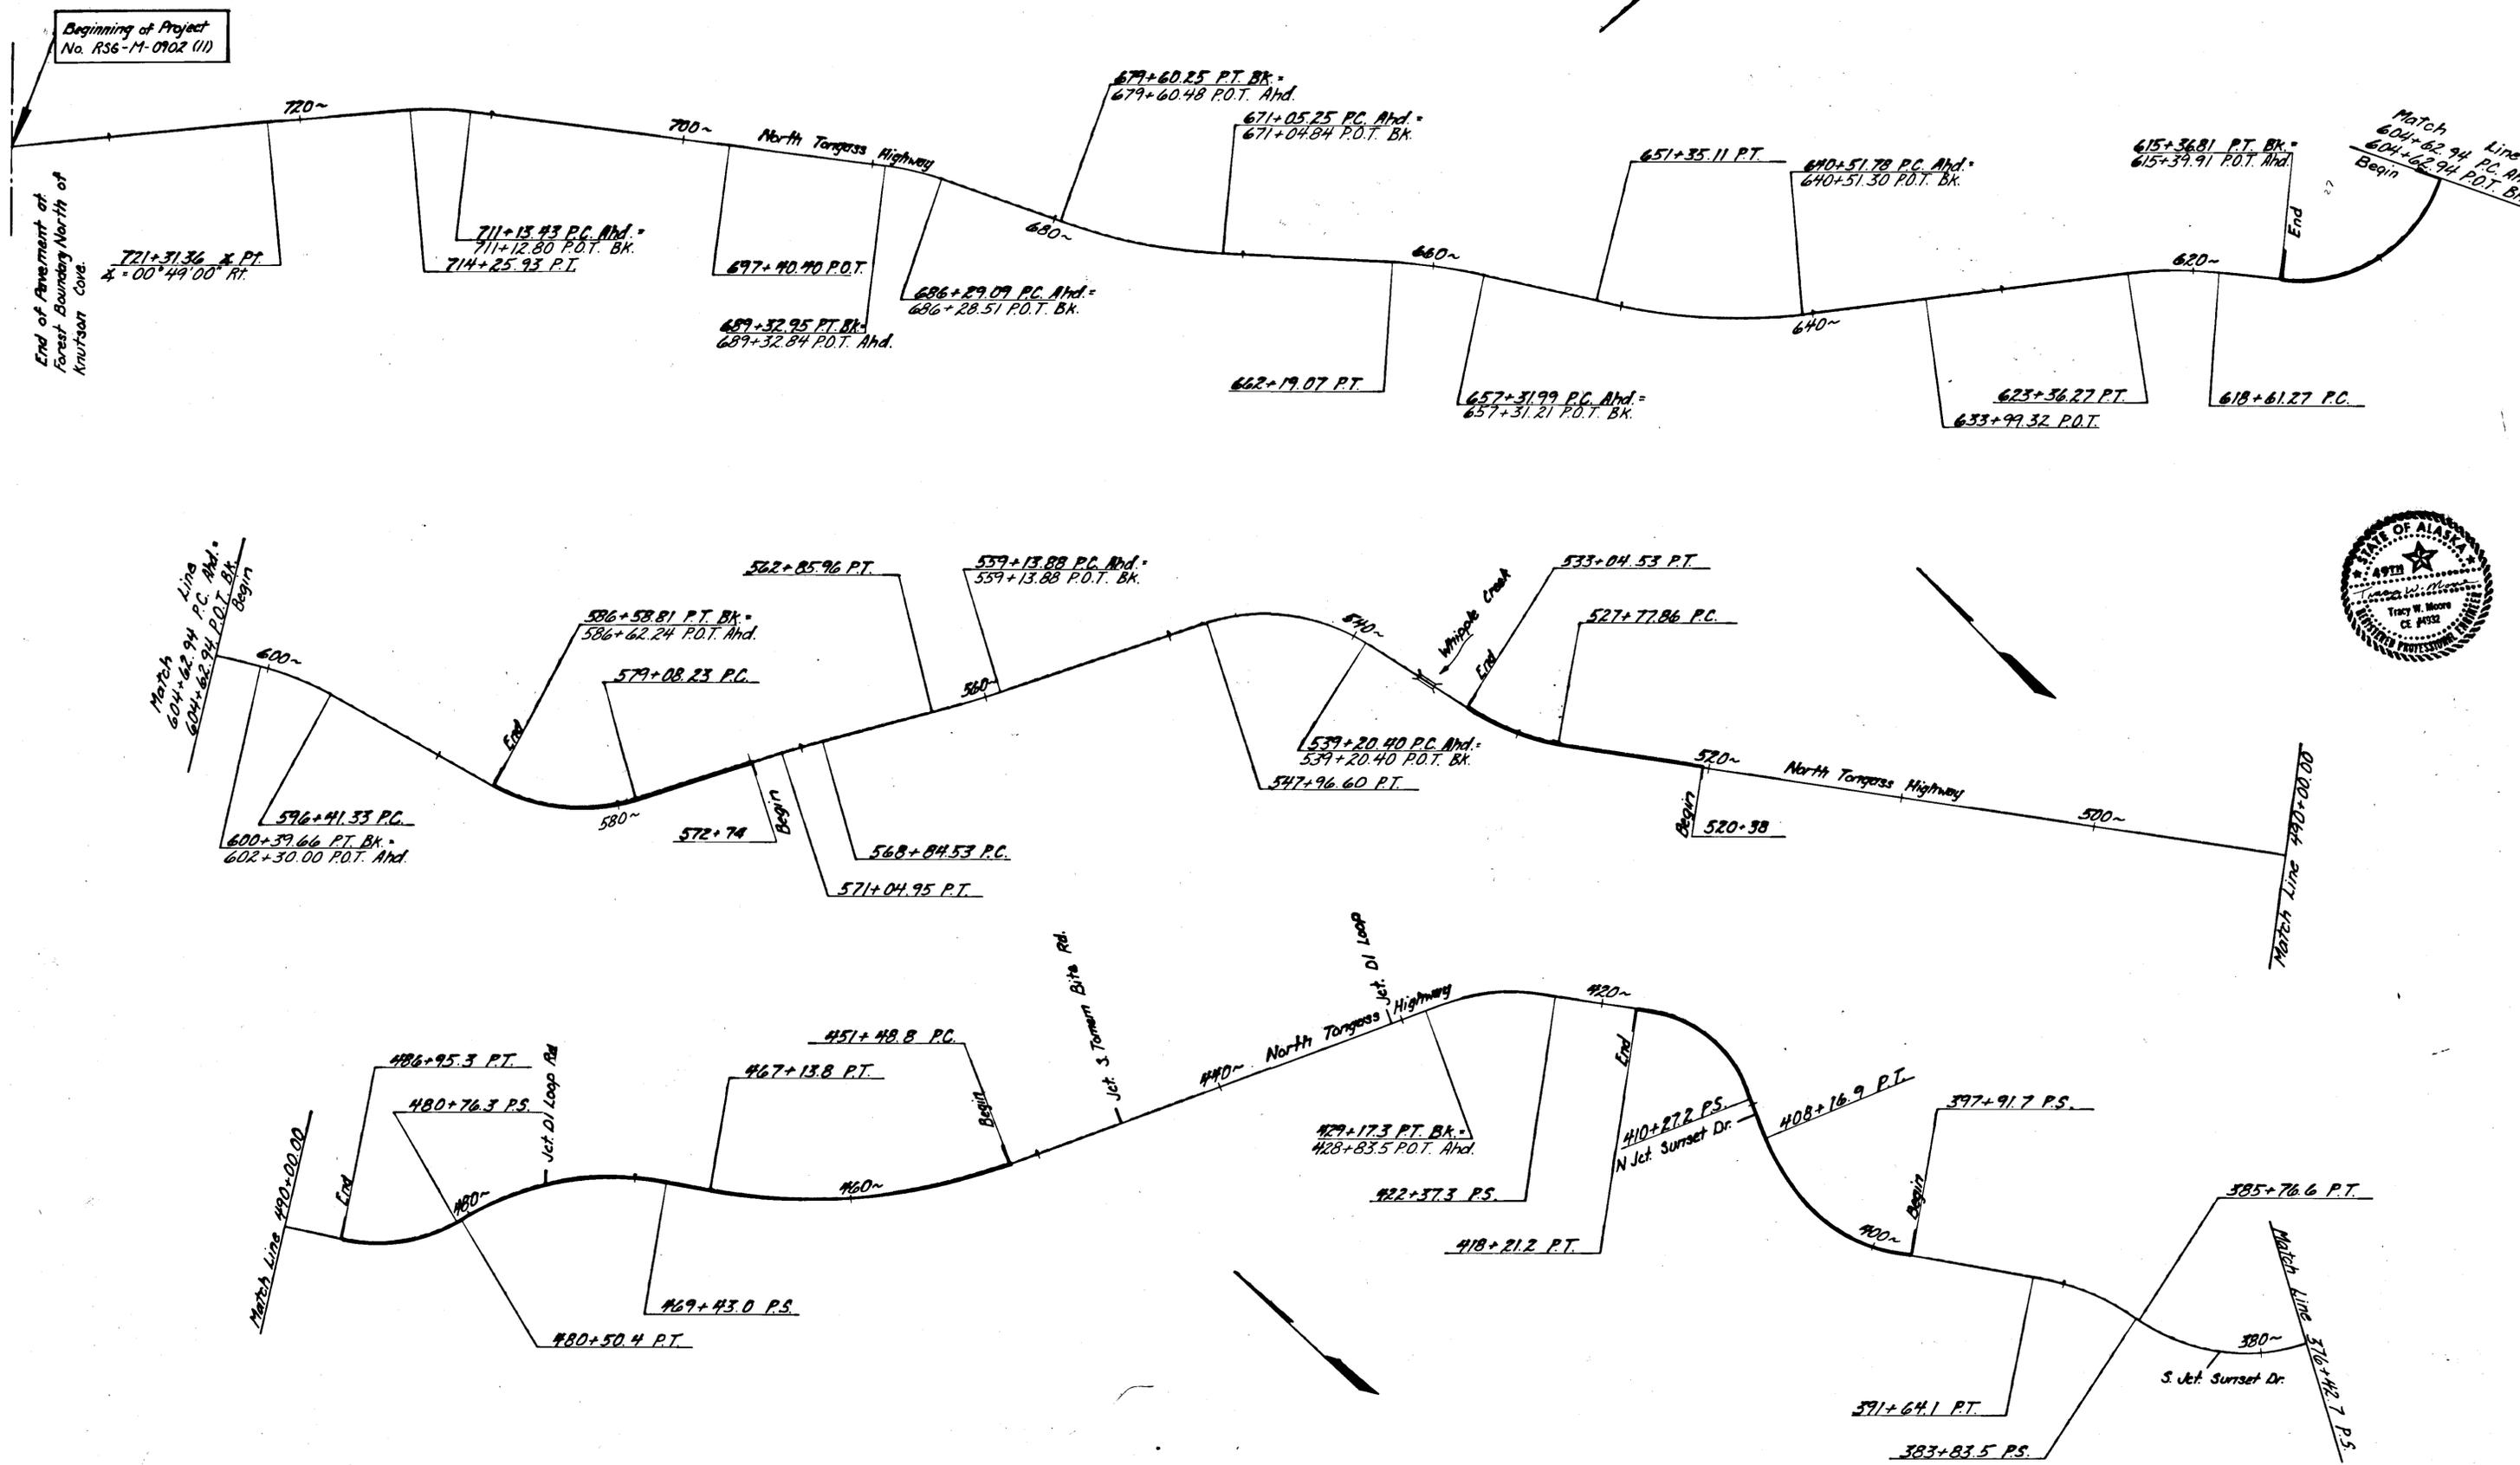


STATE	PROJECT DESIGNATION	YEAR	SHEET NO.	TOTAL SHEETS
ALASKA	RSG-M-0902 (II)	1984	4	6

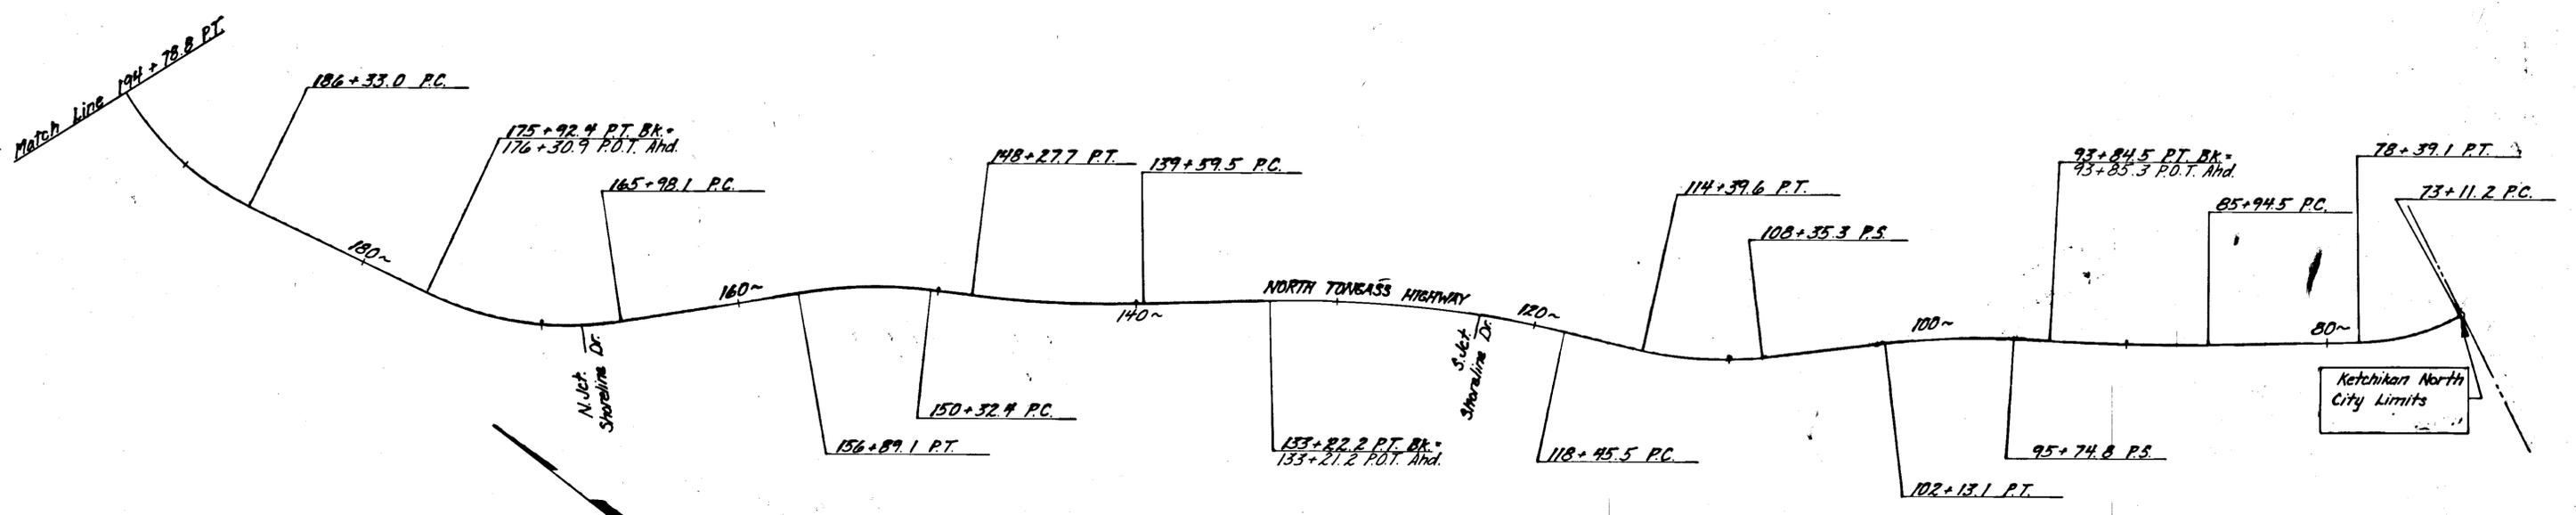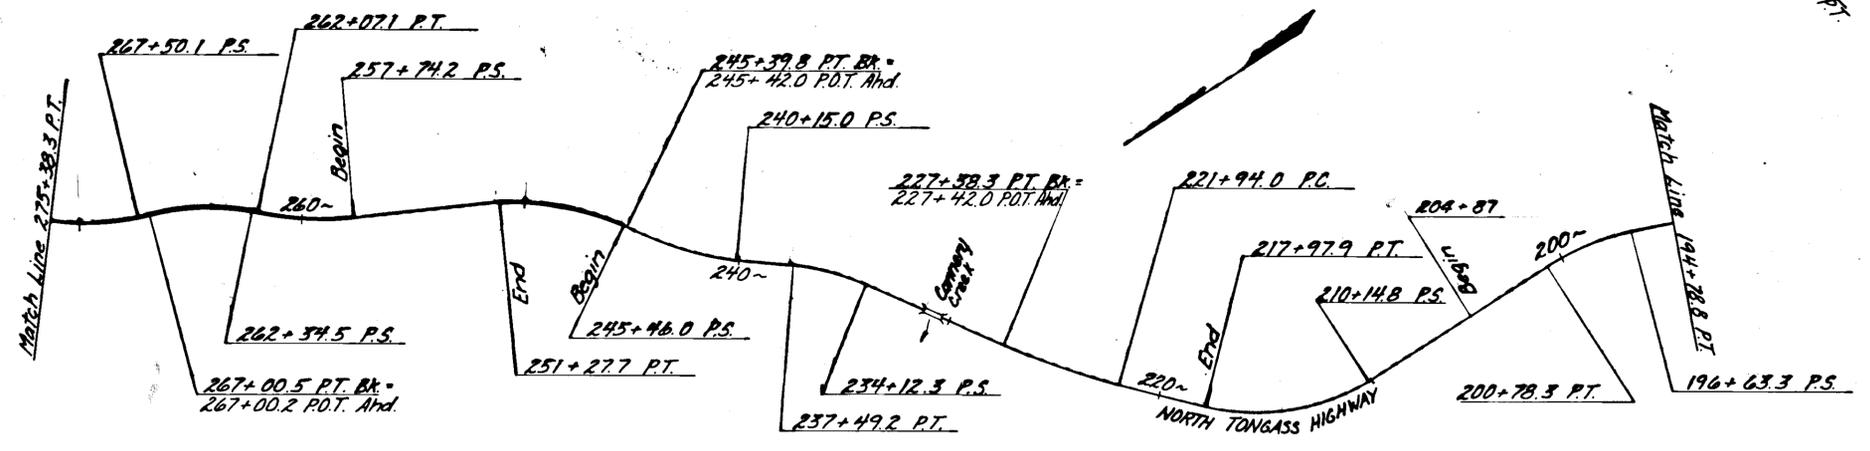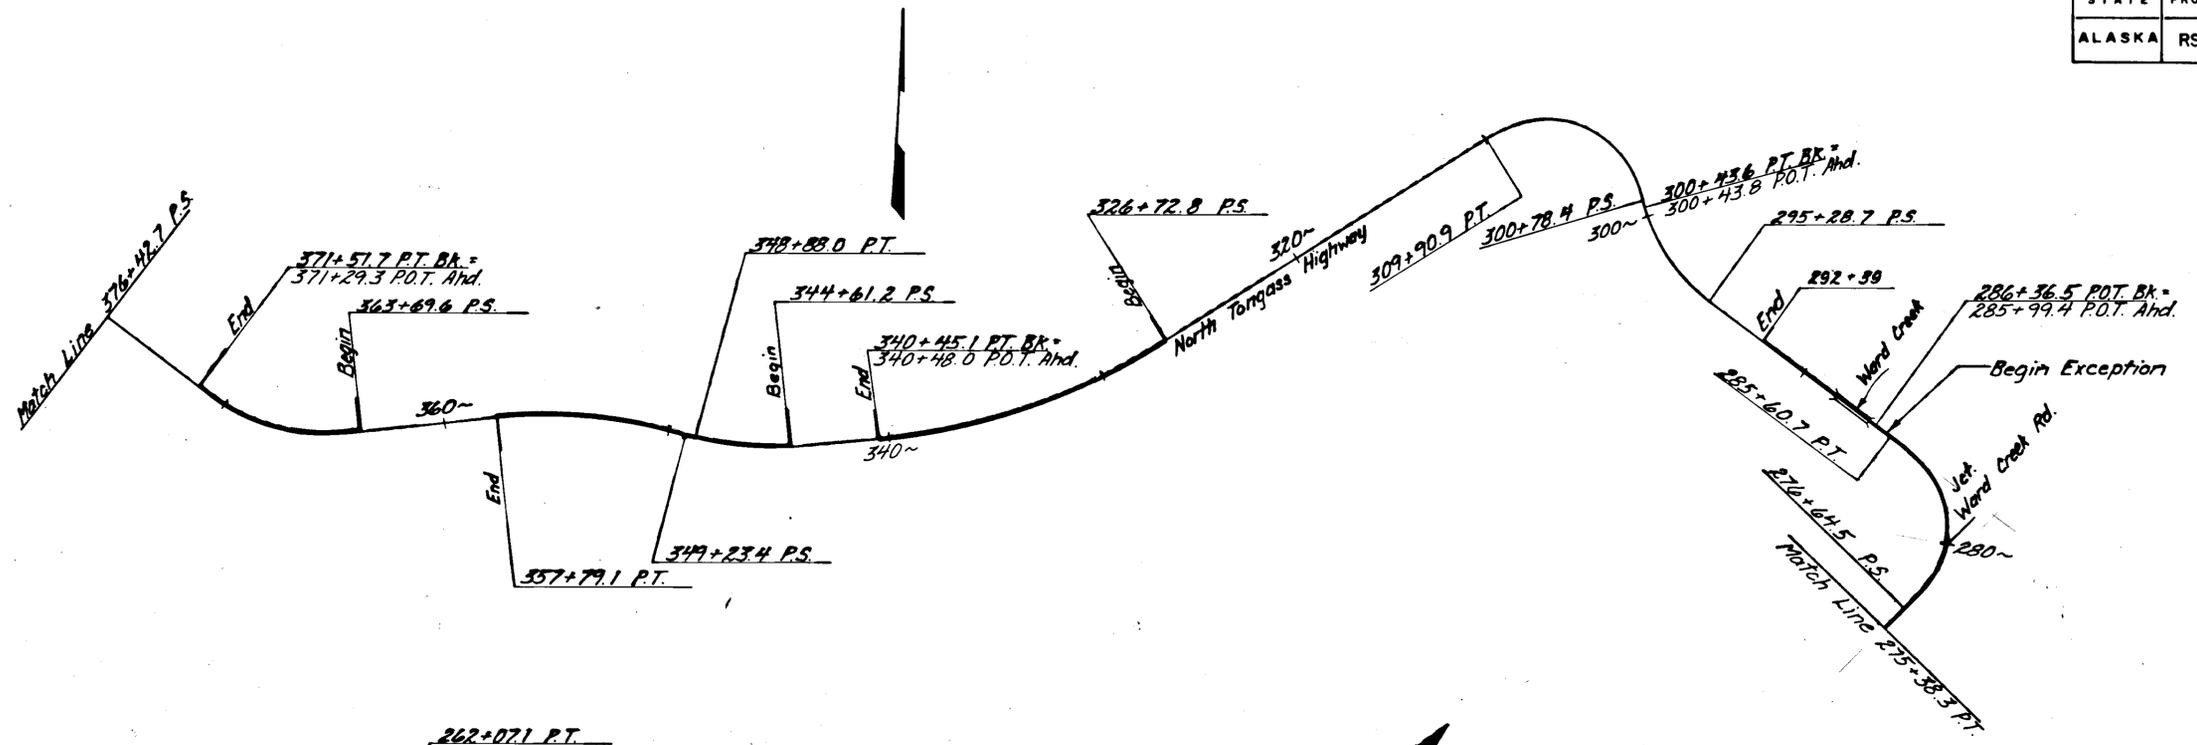

STATE	PROJECT DESIGNATION	YEAR	SHEET NO.	TOTAL SHEETS
ALASKA	RSG-M-0902 (II)	1984	6	6

TRAFFIC CONTROL PLAN

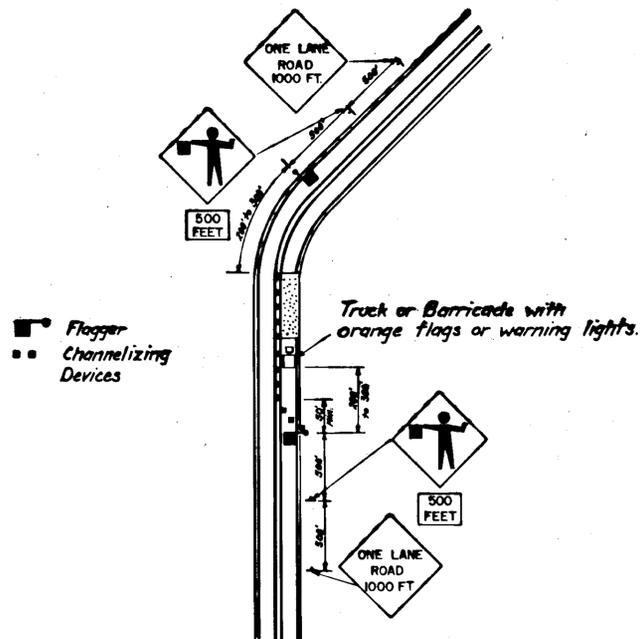

NOTES:

1. If the entire work area is visible from one station, a single flagger may be used.
2. Channelizing devices are to be extended to a point where they are visible to approaching traffic.
3. If the work area ends near the curve or hill, the transition area should be adjusted so that the flagger and the entire taper will be visible before the curve or hill for an adequate stopping sight distance.
4. A shadow or backup vehicle equipped as a sign truck, preferable equipped with a flashing arrow panel may follow the work vehicle.