

KEY MAP

STATE OF ALASKA
 DEPARTMENT OF TRANSPORTATION
 &
 PUBLIC FACILITIES

PLAN AND PROFILE
 PROPOSED HIGHWAY PROJECT

KETCHIKAN - NORTH TONGASS

HIGHWAY SIGHT DISTANCE

HES-M-0920(16)

(E-90082)

STATE	PROJECT	SHEET NO.	TOTAL SHEETS
ALASKA	HES-M-0920(16)	1	1

INDEX OF SHEETS	
1	TITLE SHEET
2	TYPICAL SECTIONS
3	ESTIMATE OF QUANTITIES, MISC. DETAILS AND SUMMARIES
4-5	PLAN SHEETS
6	RAISED PAVEMENT MARKER & STRIPING PLAN

THE FOLLOWING STANDARD DRAWINGS SHALL APPLY TO THIS PROJECT: A-1, C-00.00, C-10.01, C-11.01, D-01.01, D-04.01, D-05.01, I-40.00, I-80.00, T-20.00, T-21.00, T-22.00


PROJECT ASBUILTS
 DATE: 7-9-85
 PROJECT ENGINEER: RAY DEMME

PROJECT SUMMARY

WIDTH OF WIDENING = 0'-12"
 LENGTH OF PROJECT = 780.00' = 0.148 MI.

DESIGN DESIGNATION

A.D.T. (1983)	=	4464
A.D.T. (2004)	=	6633
D.H.V. 15%	=	995
T.	=	7%
T.I.	=	8.0
D.	=	35

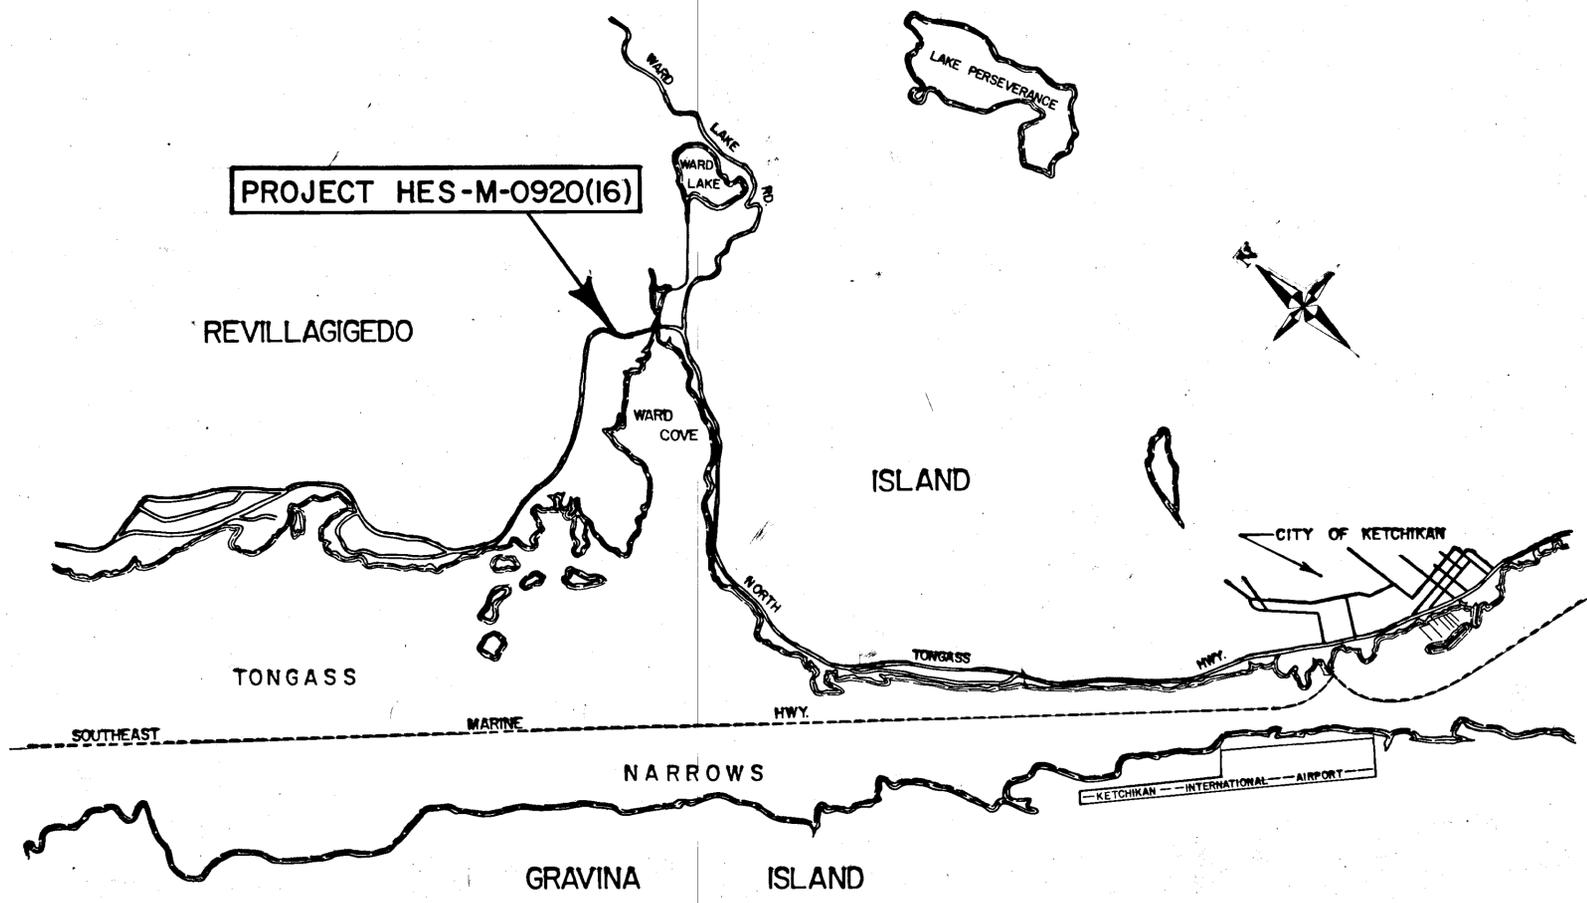

STATE OF ALASKA
 DEPARTMENT OF TRANSPORTATION
 &
 PUBLIC FACILITIES

APPROVED
Wallace Kullman Date 6/22/85
 SOUTHEASTERN REGION DESIGN ENGINEER

STATE OF ALASKA
 DEPARTMENT OF TRANSPORTATION
 &
 PUBLIC FACILITIES





APPROVED
Ray Demme Date 6/22/85
 DIRECTOR, HIGHWAY DESIGN / CONSTRUCTION

HES-M-0920(16)


TYPICAL SECTIONS OF IMPROVEMENT

GENERAL NOTES

- Alignment & Grades shown on the plans are subject to minor revisions.
- Pipe Conduit lengths and locations are subject to minor revisions as approved by the Engineer.
- Saw Cuts shall be considered incidental to Item 202 (1), Removal of Pavement. Saw Cut line may be adjusted in the field.
- The Contractor is responsible for any damage to underground or suspended utilities that is a result of his Construction.
- Clearing and Grubbing Limits shall be 10' beyond the slope limits in cut areas and 5' beyond the slope limits in fill areas or to the R/W Line or as directed by the Engineer. Clearing and Grubbing shall be considered incidental to Item 203 (8), Unclassified Excavation and Embankment.
- Excess material not used for Embankment shall be disposed of in an up-lands area outside the R/W Limits at a location selected by the Contractor and approved by the Engineer.
- The Contractor's Traffic Control Plan shall follow the guidelines set by standard Drawing C-10.01 and Part II of the Manual on Uniform Traffic Control Devices and shall be approved by the Engineer.
- It shall be the Contractor's responsibility to begin only that amount of work which can be completed by the end of the shift. There will be no drop-off at the edge of the existing pavement during non-working hours.

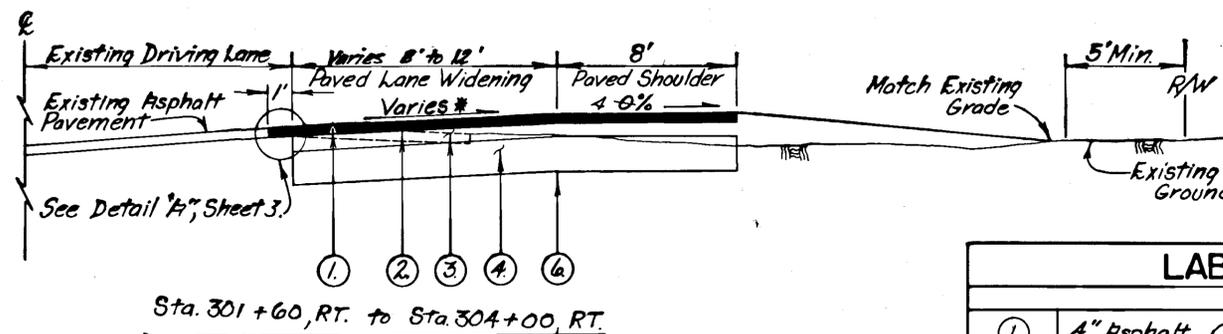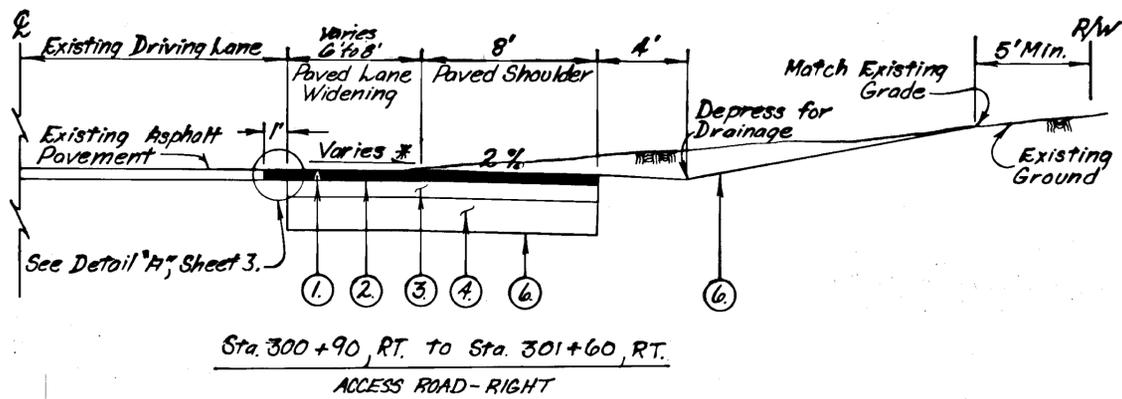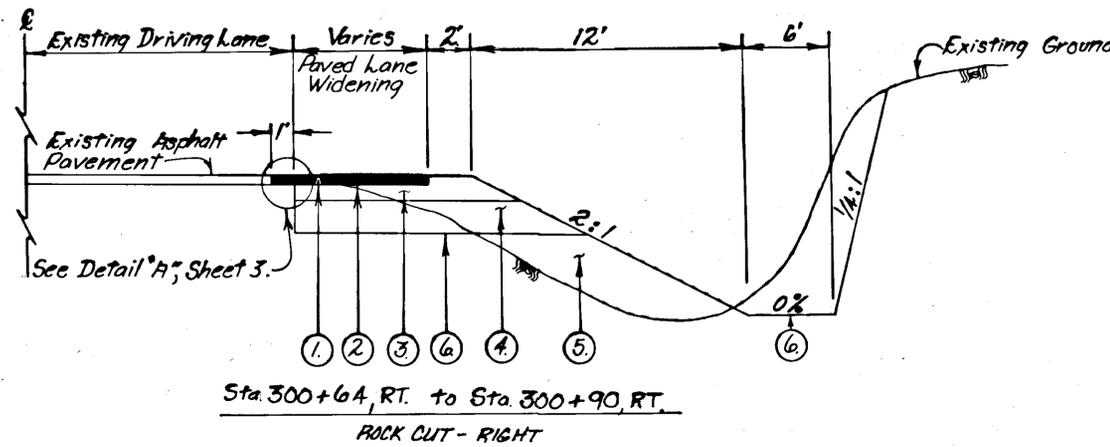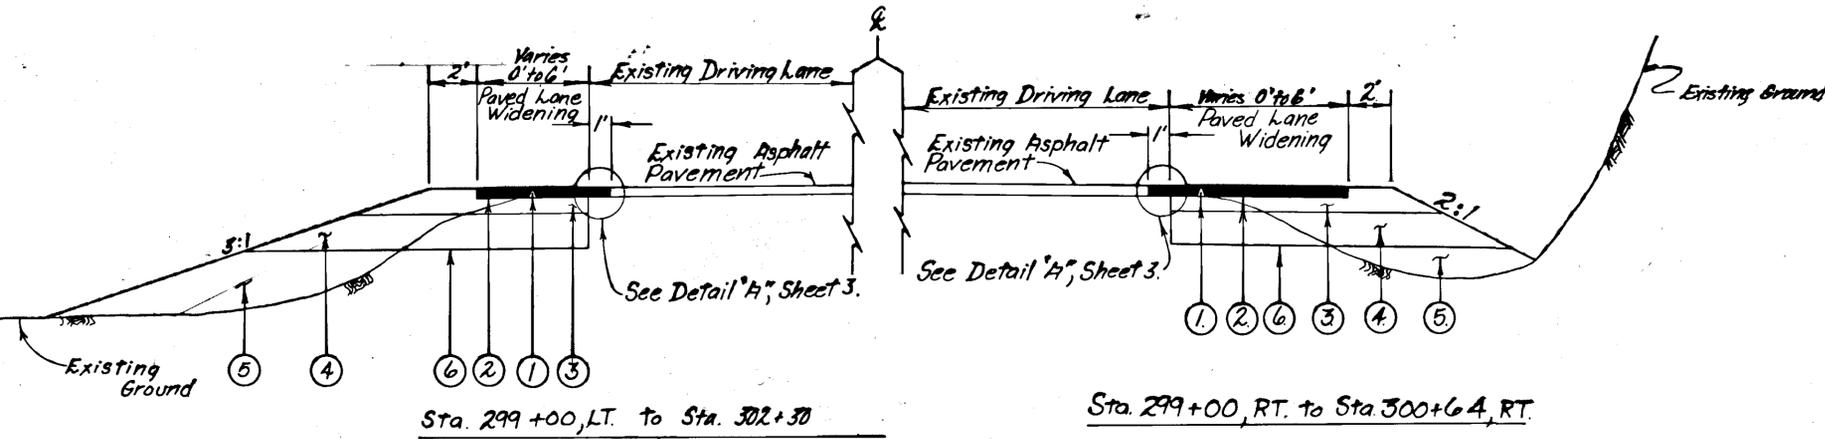

* Project Super-elevation - Not to Exceed 6%.

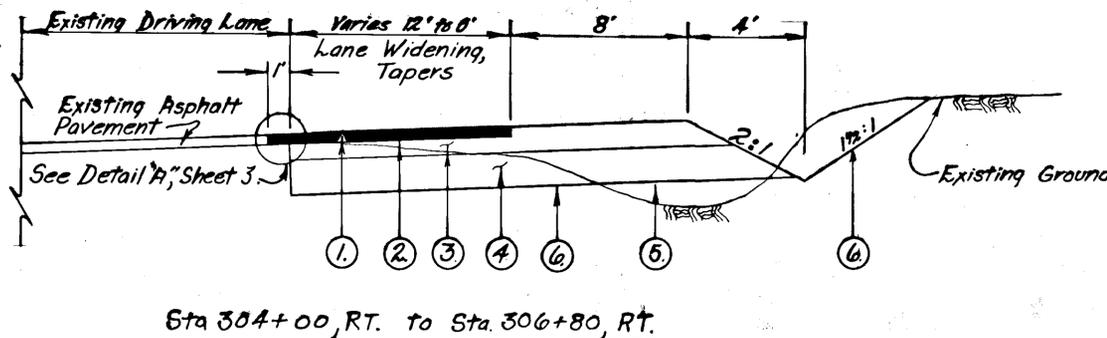


LABELING INDEX

①	4" Asphalt Concrete Type II
②	MC-30 Liquid Asphalt For Prime Coat
③	6" Crushed Aggregate Base Course
④	14" Subbase (Grading "A")
⑤	Embankment or Usable Unclassified Excavation
⑥	Limits of Unclassified Excavation



ESTIMATE OF QUANTITIES, MISC. DETAILS AND SUMMARY TABLES

ESTIMATE OF QUANTITIES			
NO.	ITEM	UNIT	QUANTITY
110(1)	Mobilization	L.S.	All Req'd
111(1)	Temporary Erosion and Pollution Control	C.S.	All Req'd
114(1)	Construction Surveying by the Contractor	L.S.	All Req'd
115(1)	Traffic Maintenance	L.S.	All Req'd
202(11)	Removal of Pavement (Est. Quantity = 410 S.Y.)	L.S.	All Req'd
203(8)	Unclassified Excavation and Embankment Estimated Unclassified Excavation = 650 C.Y. Estimated Embankment = 115 C.Y.	L.S.	All Req'd
301(1)	Crushed Aggregate Base Course	Ton	-753,1024.67
304(1)	Subbase, Grading "A"	Ton	+751,256.92
401(1)	Asphalt Concrete Type II.	Ton	-275,342.83
401(2)	Asphalt Cement	Ton	+72,18.2
402(2)	CSS-1 Asphalt for Tack Coat	L.S.	All Req'd
403(2)	MC-30 Liquid Asphalt for Prime Coat.	Ton	+2,1.1
603(1)	24-Inch Corrugated Steel Pipe	L.F.	32,49
603(22)	18-Inch Pipe	L.F.	34
604(5A)	FIELD MARK, Type A	Each	1
670(1)	Painted Traffic Markings.	L.S.	All Req'd
670(7)	Raised Pavement Markers.	Each	83,71

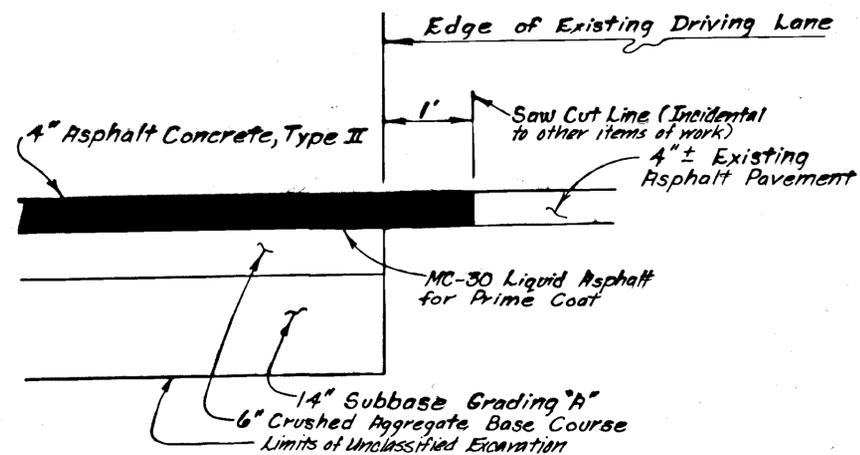


DETAIL "A"

PIPE CONDUIT SUMMARY							
STATION	PIPE LENGTH		REMARKS	STATION	PIPE LENGTH		REMARKS
	18"	24"			18"	24"	
Sta. 300+60, R		18'	EXISTING 18" PIPE APPROX 12' AC. @ 6' RT.	Sta. 304+50, 44' RT.	34'		
Sta. 300+90, 28' RT.		14'	Includes 25° Elbow				

BASIS OF ESTIMATE		
NO.	ITEM	FACTOR
301(1)	Crushed aggregate base course	1.96 Tons/Cu.yd.
304(1)	Subbase, grading "A"	1.90 Tons/Cu.yd.
401(1)	Asphalt concrete type II.	116 lbs./S.Y./Inch depth
401(2)	Asphalt MC-5	6% of Item 401(1)
402(2)	CSS-1 asphalt for tack coat.	0.04 Gal./S.Y. (Residual), 240 gal./Ton, application rate = 0.10 gal./S.Y.
403(2)	MC-30 Liquid asphalt for prime coat.	0.25 gal./S.Y./256 gal./Ton.



STATE	PROJECT DESIGNATION	YEAR	SHEET NO.	TOTAL SHEETS
ALASKA	HES-M-0920(16)	1984	4	6

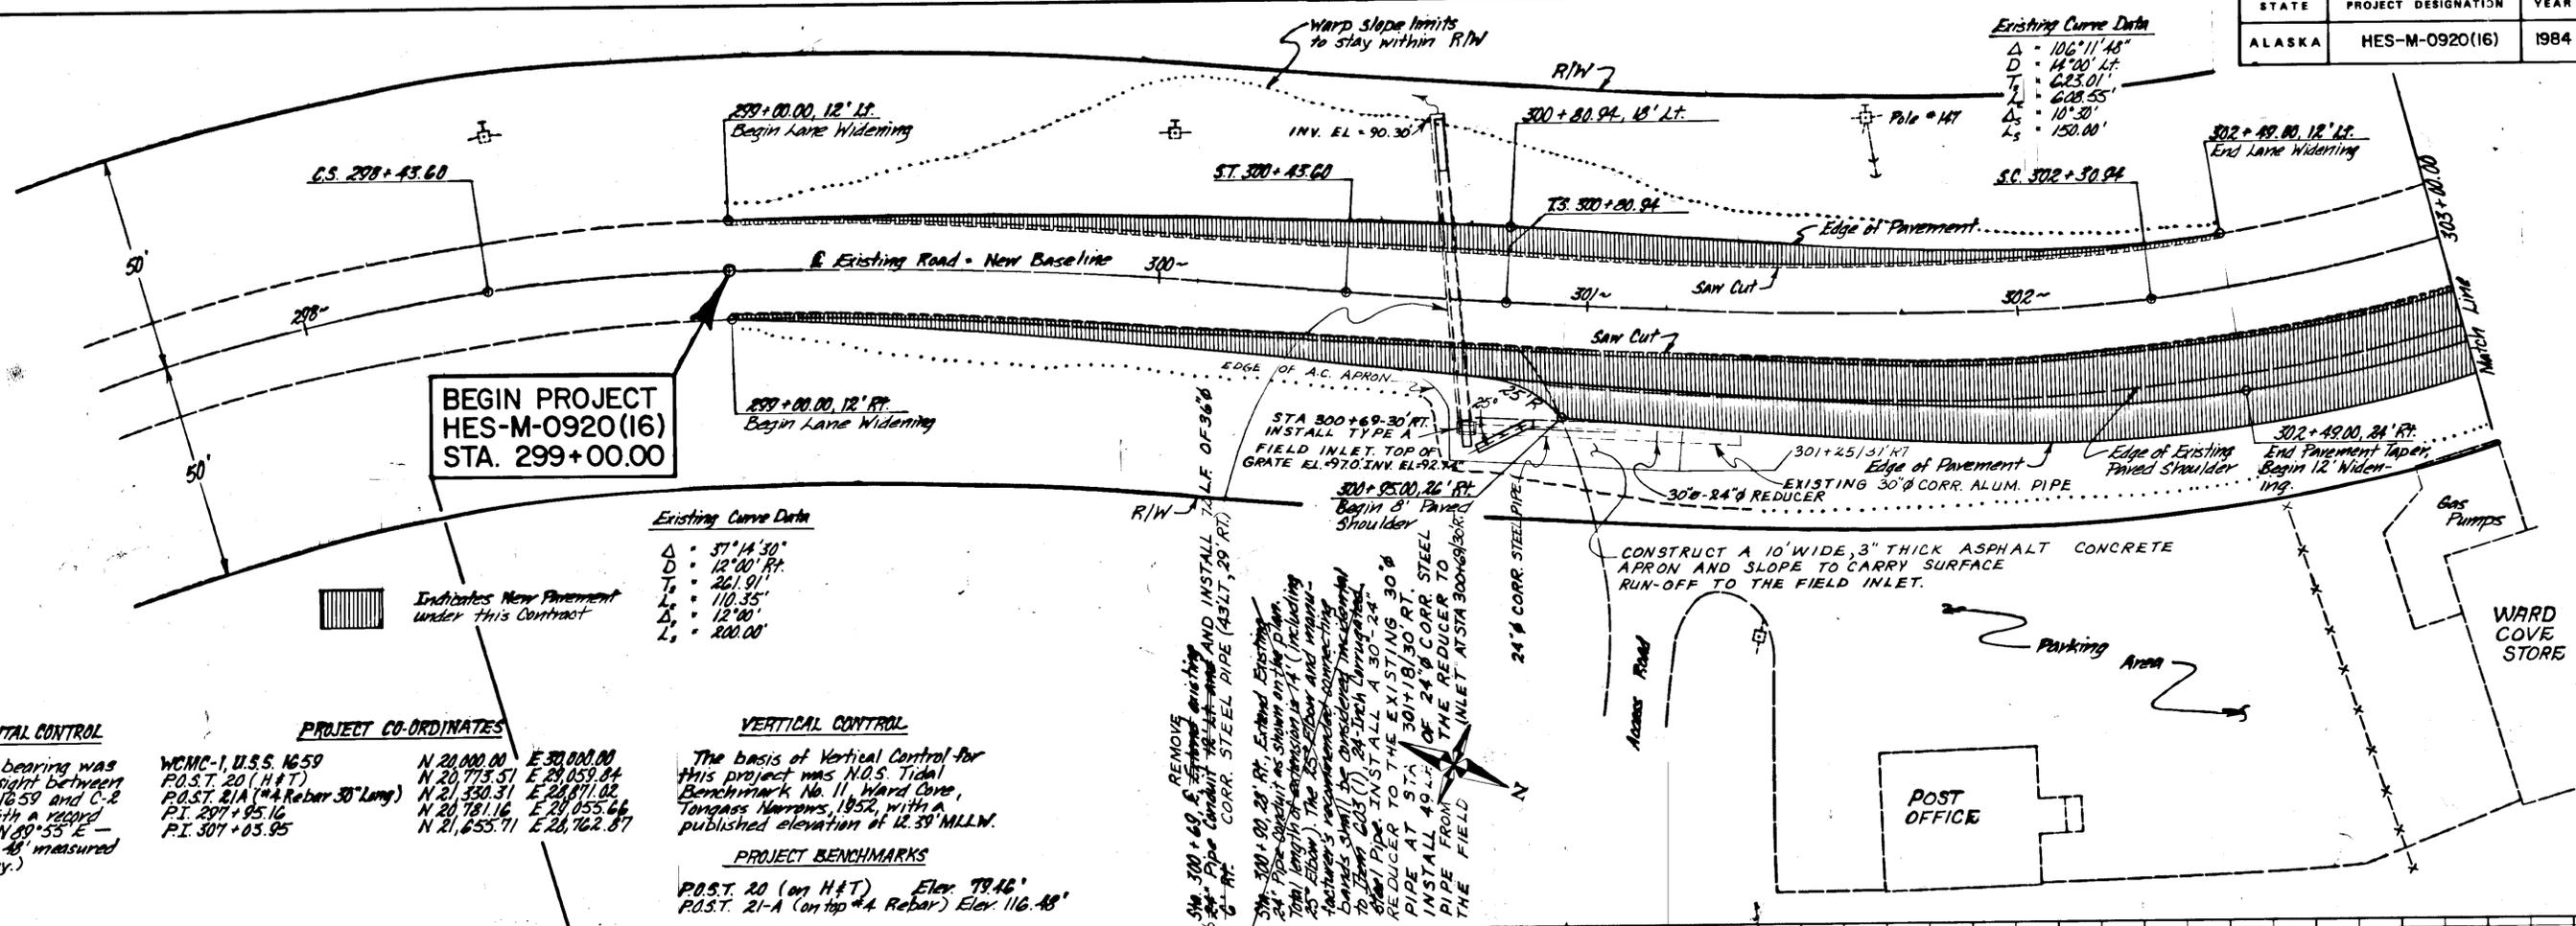

Existing Curve Data
 $\Delta = 106^{\circ}11'48''$
 $D = 14^{\circ}00' Lt.$
 $T_s = 623.01'$
 $L_s = 608.55'$
 $\Delta_s = 10^{\circ}30'$
 $L_s = 150.00'$

Existing Curve Data
 $\Delta = 57^{\circ}14'30''$
 $D = 12^{\circ}00' Rt.$
 $T_s = 261.91'$
 $L_s = 110.35'$
 $\Delta_s = 12^{\circ}00'$
 $L_s = 200.00'$



HORIZONTAL CONTROL
 The basis of bearing was the line-of-sight between W.C.M.C-1 U.S.S. 1659 and C-2 U.S.S. 1659 with a revised bearing of $N 89^{\circ}55' E - 476.52'$ (476.48' measured by this survey.)

PROJECT CO-ORDINATES
 W.C.M.C-1, U.S.S. 1659
 P.O.S.T. 20 (H&T) N 20,000.00 E 30,000.00
 P.O.S.T. 21A (#4 Rebar 30" Long) N 20,773.51 E 29,059.04
 P.I. 207+95.16 N 21,350.31 E 28,871.02
 P.I. 307+05.95 N 20,781.16 E 29,055.66
 N 21,655.71 E 28,762.87

VERTICAL CONTROL
 The basis of Vertical Control for this project was N.O.S. Tidal Benchmark No. 11, Hard Cove, Tongass Narrows, 1952, with a published elevation of 12.39' MLLW.



PROJECT BENCHMARKS
 P.O.S.T. 20 (on H&T) Elev. 79.46'
 P.O.S.T. 21-A (on top #4 Rebar) Elev. 116.48'

REMOVE STA 300+60, 6" EXISTING AND INSTALL 24" CORR. STEEL PIPE (43LT, 29 RT)
 STA 300+00, 24" CORR. STEEL PIPE (43LT, 29 RT)
 STA 300+25, 24" CORR. STEEL PIPE (43LT, 29 RT)
 STA 300+60, 24" CORR. STEEL PIPE (43LT, 29 RT)
 STA 300+95, 24" CORR. STEEL PIPE (43LT, 29 RT)
 STA 301+18, 24" CORR. STEEL PIPE (43LT, 29 RT)
 STA 301+45, 24" CORR. STEEL PIPE (43LT, 29 RT)
 STA 302+45, 24" CORR. STEEL PIPE (43LT, 29 RT)

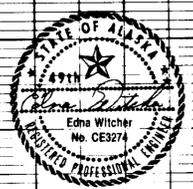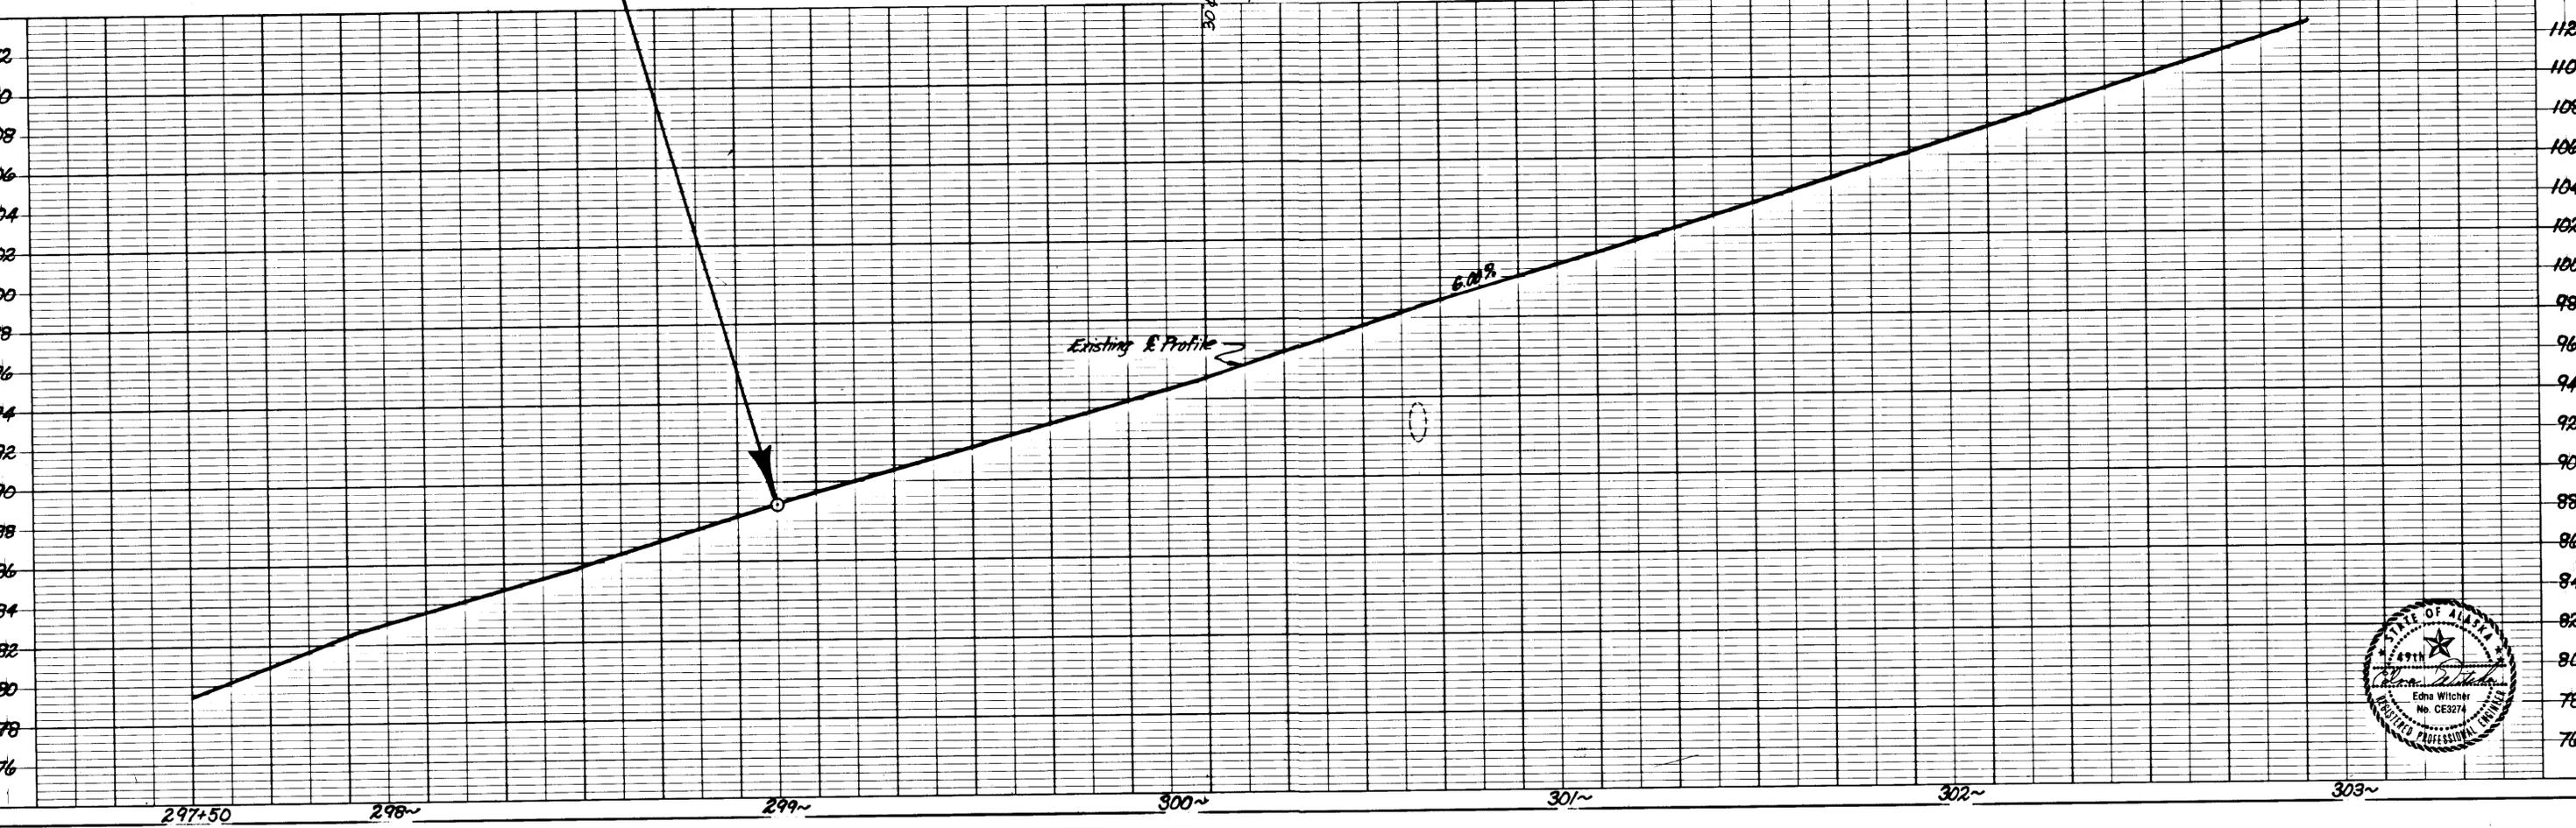


STATE	PROJECT DESIGNATION	YEAR	SHEET NO.	TOTAL SHEETS
ALASKA	HES-M-0920(16)	1984	5	6

Existing Curve Data
 $\Delta = 106^\circ 11' 45''$
 $D = 14^\circ 00' \text{ L.T.}$
 $T_1 = 623.01'$
 $L_c = 608.55'$
 $\Delta_1 = 10^\circ 30'$
 $L_2 = 150.00'$

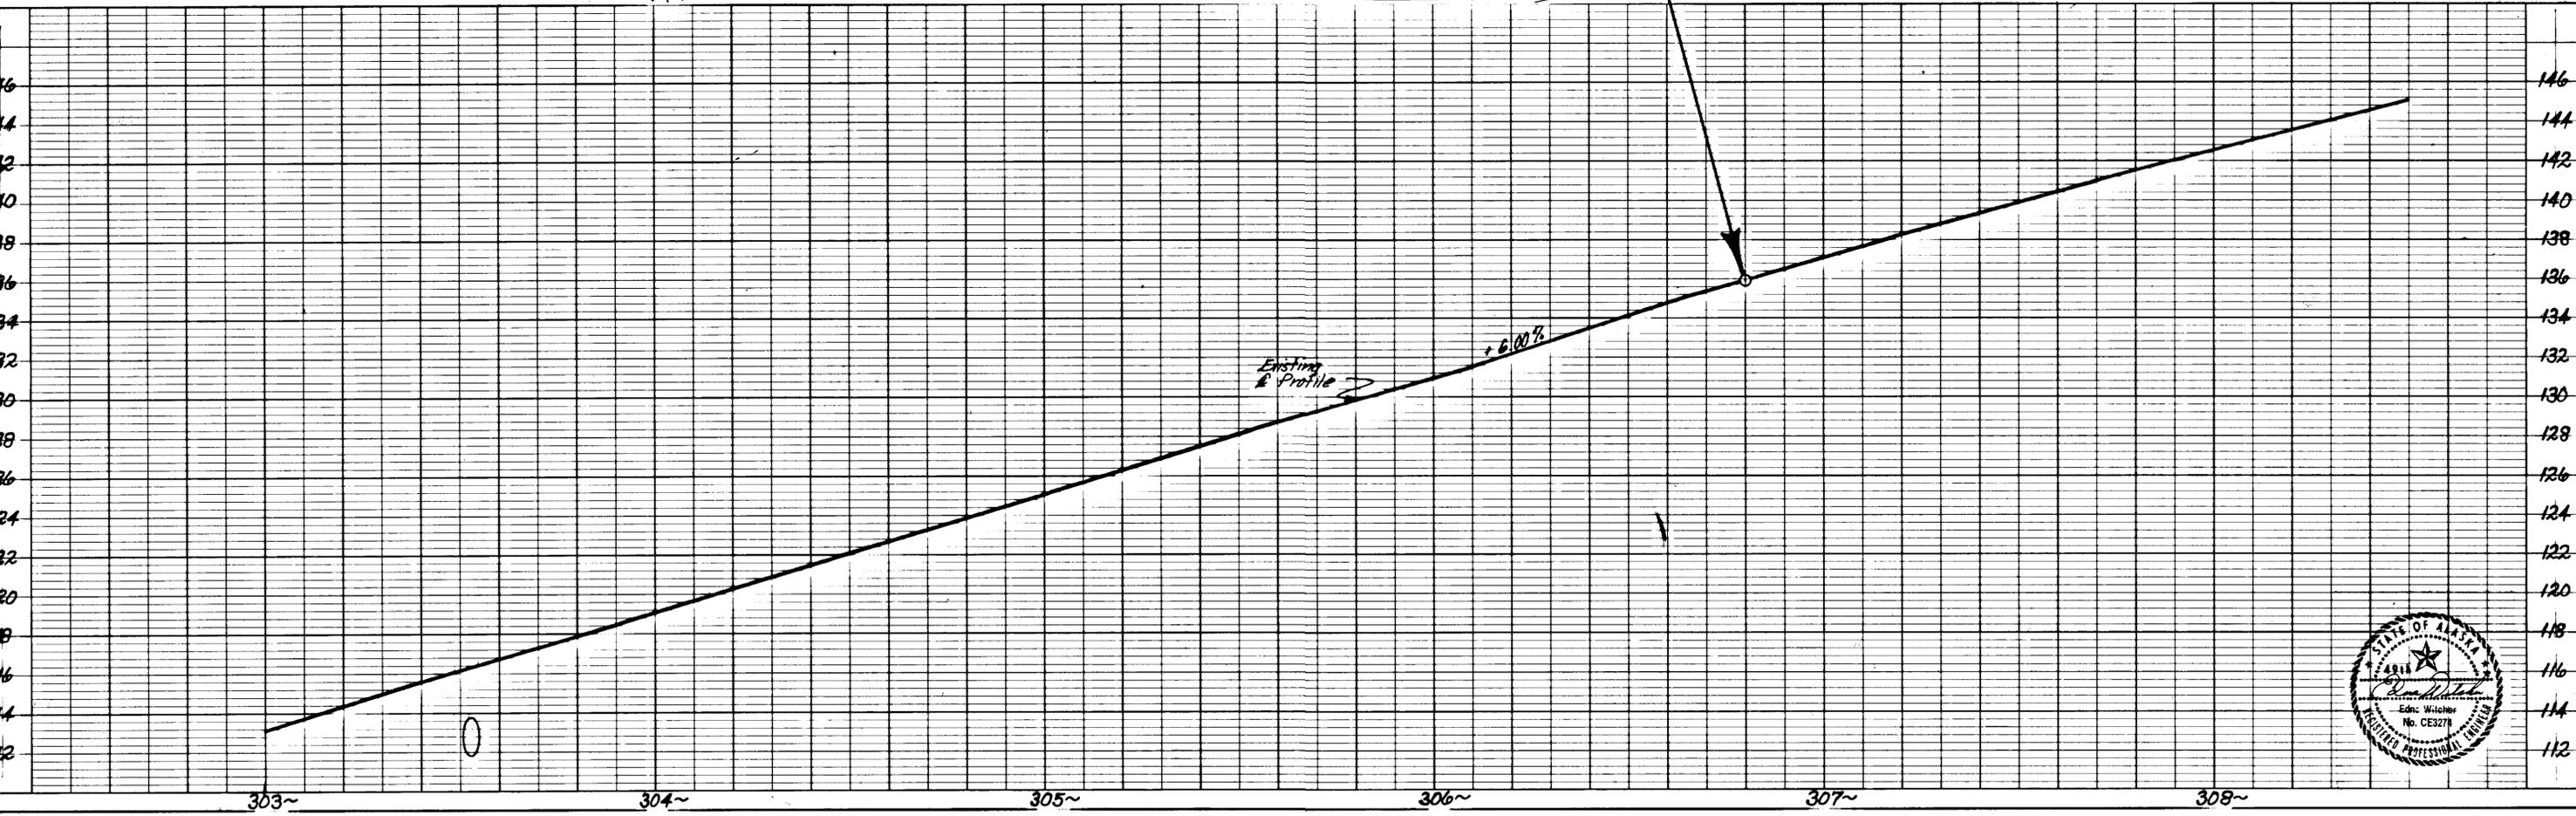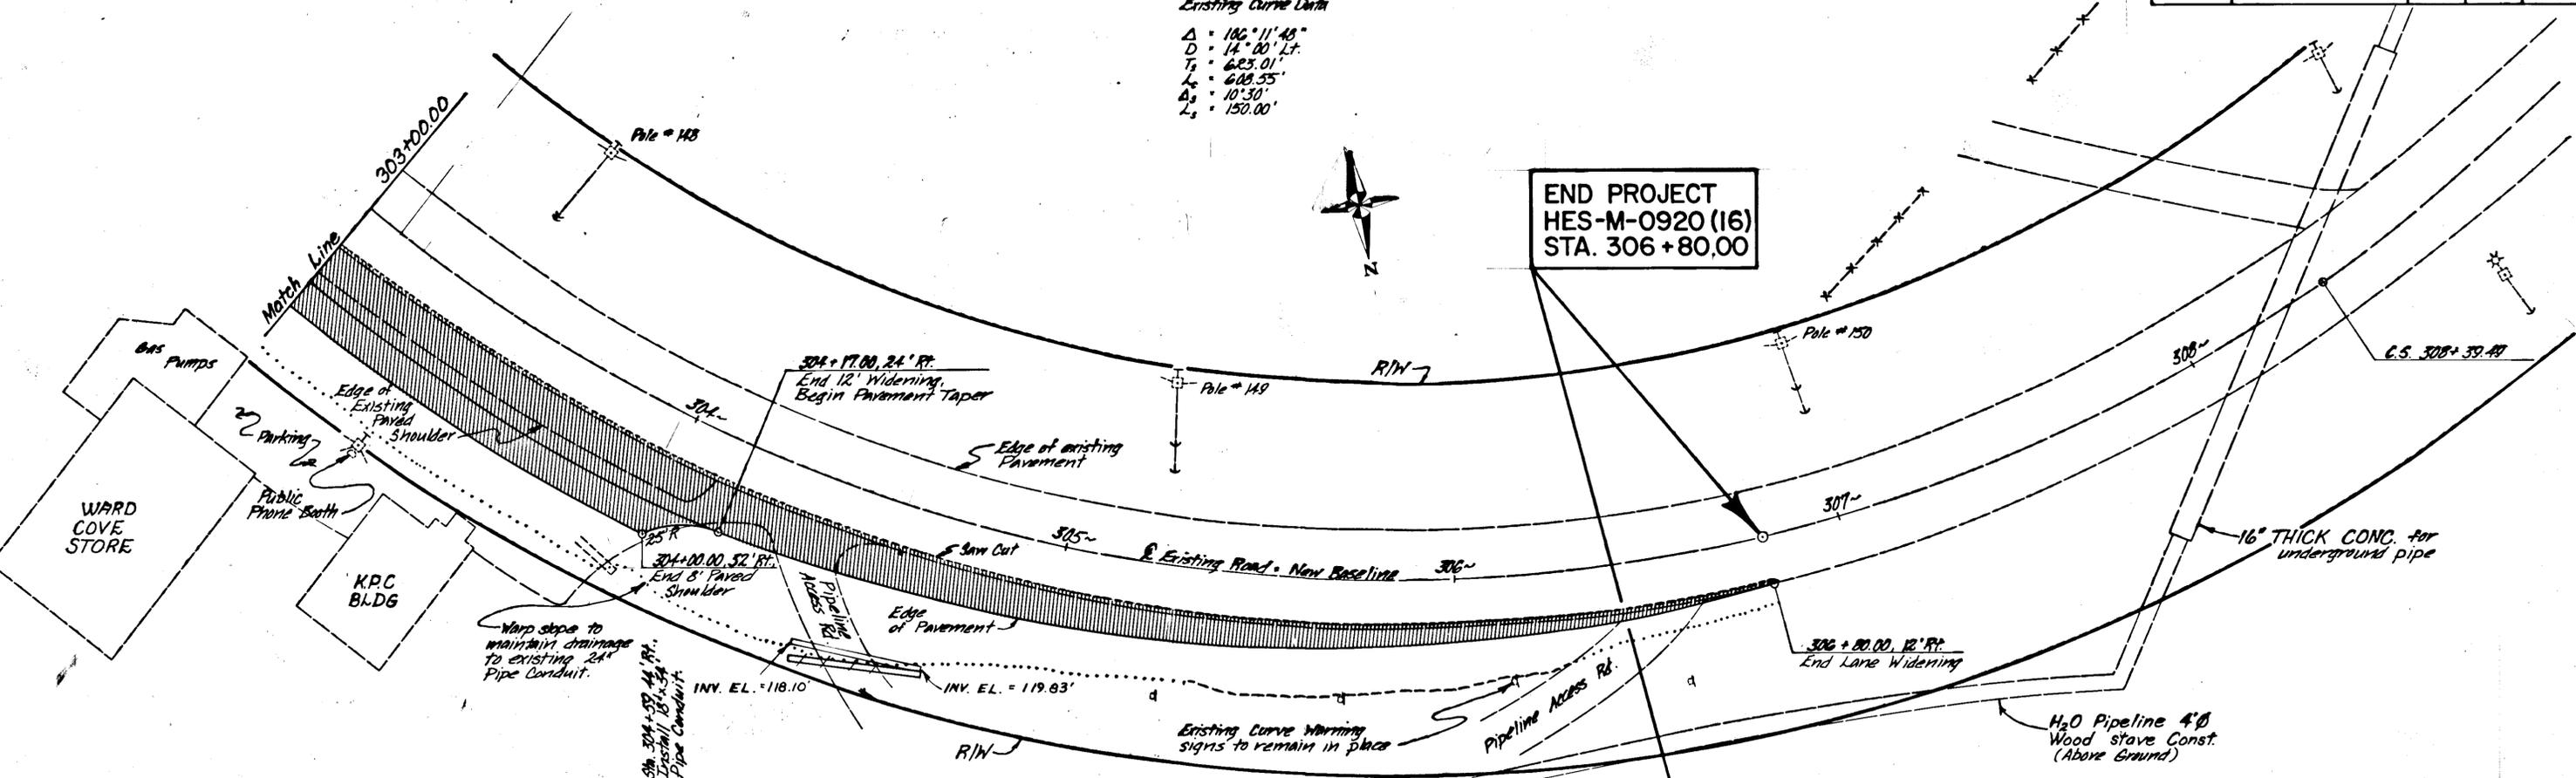

STATE	PROJECT DESIGNATION	YEAR	SHEET NO.	TOTAL SHEETS
ALASKA	HES-M-0920 (16)	1984	6	6

RAISED PAVEMENT MARKER AND STRIPING PLANS

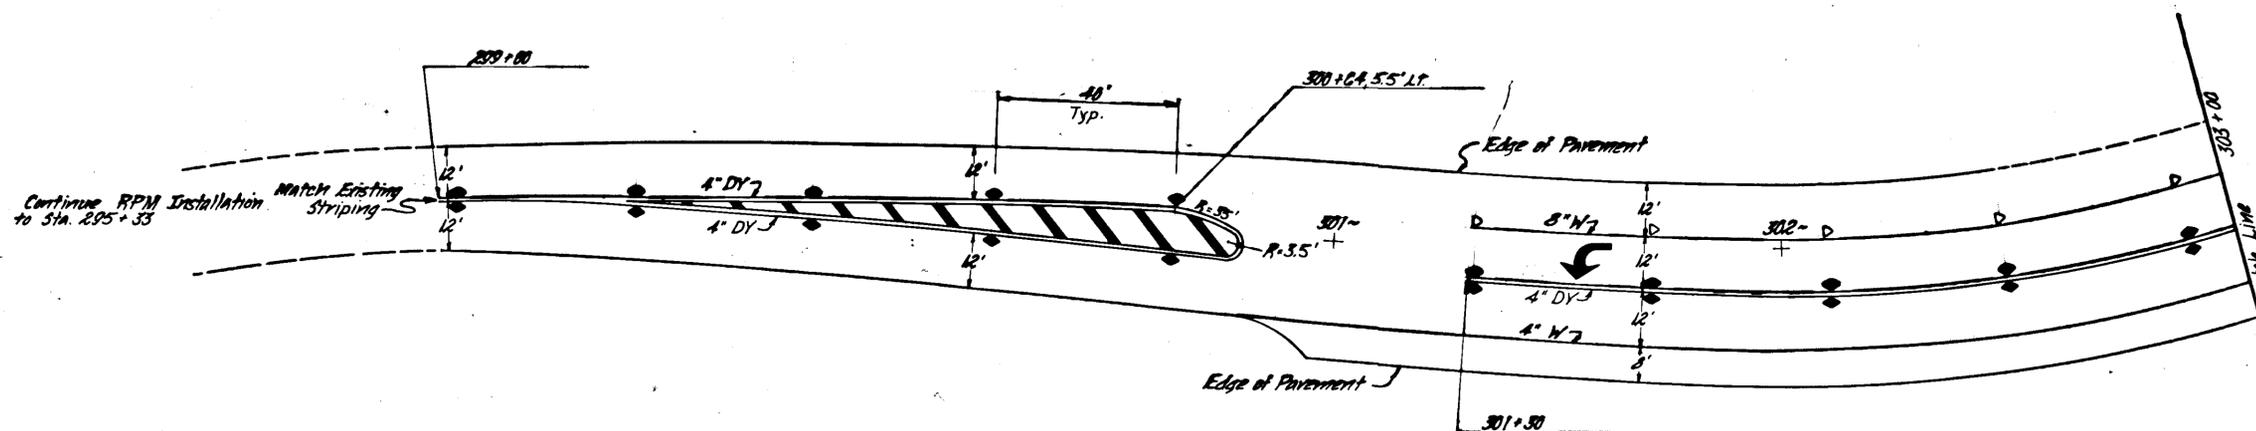

- LEGEND**
- 7 INSTALLED ○ One-Way White Raised Pavement Marker
 - 70 INSTALLED ● Two-Way Yellow Raised Pavement Marker

- GENERAL STRIPING NOTES**
1. All Pavement Markings shall be painted.
 2. Markings as shown on the plans are approximate only. The exact locations shall be determined after the widening is complete. The Contractor is responsible for alignment layout.

- GENERAL RPM NOTES**
1. Installation methods for Raised Pavement Markers (RPM's) shall be according to the manufacturer's recommendations.
 2. Epoxy Adhesive shall be standard set type. Temperature and curing times shall be as recommended by the manufacturer of the adhesive.
 3. Raised Pavement Markers will not be installed within the limits of intersecting streets.
 4. If Concrete Markers are used, the mortar shall be Magnesium Phosphate Set 45 or equivalent.
 5. All locations for RPM's shall be approved by the Project Engineer after staking by the Contractor.

