


STATE	PROJECT DESIGNATION	YEAR	SHEET NO.	TOTAL SHEETS
ALASKA	F-095-2(9) ADAP 8-02-0144-03	1972	1	35

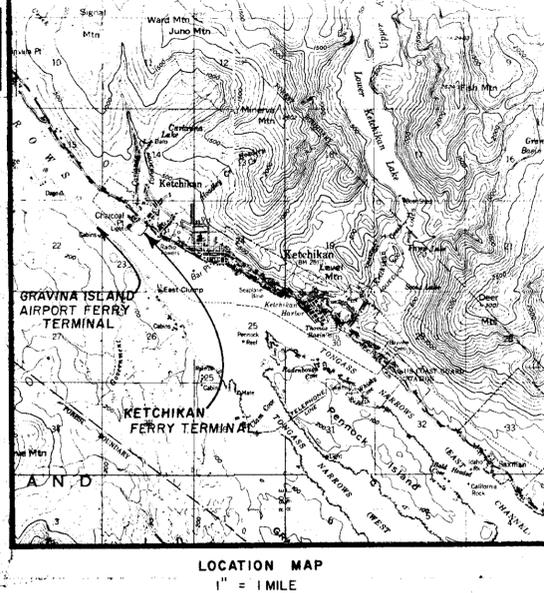

"AS BUILT" PLANS

Contractor: Swalling-General

DATE Actual Beginning: Jan. 16, 1973 Date Actual Completion: Sept. 21, 1973

Project Engineer: Thomas Solberg

STATE OF ALASKA
DEPARTMENT OF PUBLIC WORKS
DIVISION OF WATERS AND HARBORS

KETCHIKAN & GRAVINA ISLAND AIRPORT FERRY TERMINALS

PROJECT F-095-2(9)
AND
A.D.A.P. No. 8-02-0144-03

INDEX OF SHEETS

SHEET NO.	DESCRIPTION
1	TITLE SHEET
KETCHIKAN FERRY TERMINAL	
2	TYPICAL SECTIONS AND QUANTITIES
3	MASTER PLAN
4	LAYOUT PLAN
5	DRAINAGE PLAN
6	DOLPHIN DETAILS
7	WATER DETAILS
8	ILLUMINATION AND ELECTRICAL DETAILS
9-18	TRANSFER BRIDGE PLANS AND DETAILS
19	CATWALK DETAIL
GRAVINA ISLAND AIRPORT TERMINAL	
20	MASTER PLAN AND QUANTITIES
21-22	COVERED WALKWAY
23	DOLPHIN DETAILS
24	ILLUMINATION AND ELECTRICAL DETAILS
25	TRANSFER BRIDGE GENERAL LAYOUT
26	TRANSFER BRIDGE ELECTRICAL DETAILS
27	TRANSFER BRIDGE SUBSTRUCTURE
28-35	(IDENTICAL TO SHEETS 1-19 KETCHIKAN FERRY TERMINAL)

BOMHOFF & ASSOCIATES
Engineering and Surveys
1020 West Fireweed Lane
Anchorage, Alaska 99503




APPROVED *[Signature]*
COMMISSIONER OF HIGHWAYS

DATE, 8/18/72

APPROVED *[Signature]*
COMMISSIONER



DATE, August 1, 1972

THE FOLLOWING STANDARD DRAWINGS APPLY:
A-1, D-1a, D-1b, D-2, D-4, M-1, M-5, T-15, T-16, T-21, T-51, T-53 & T-70

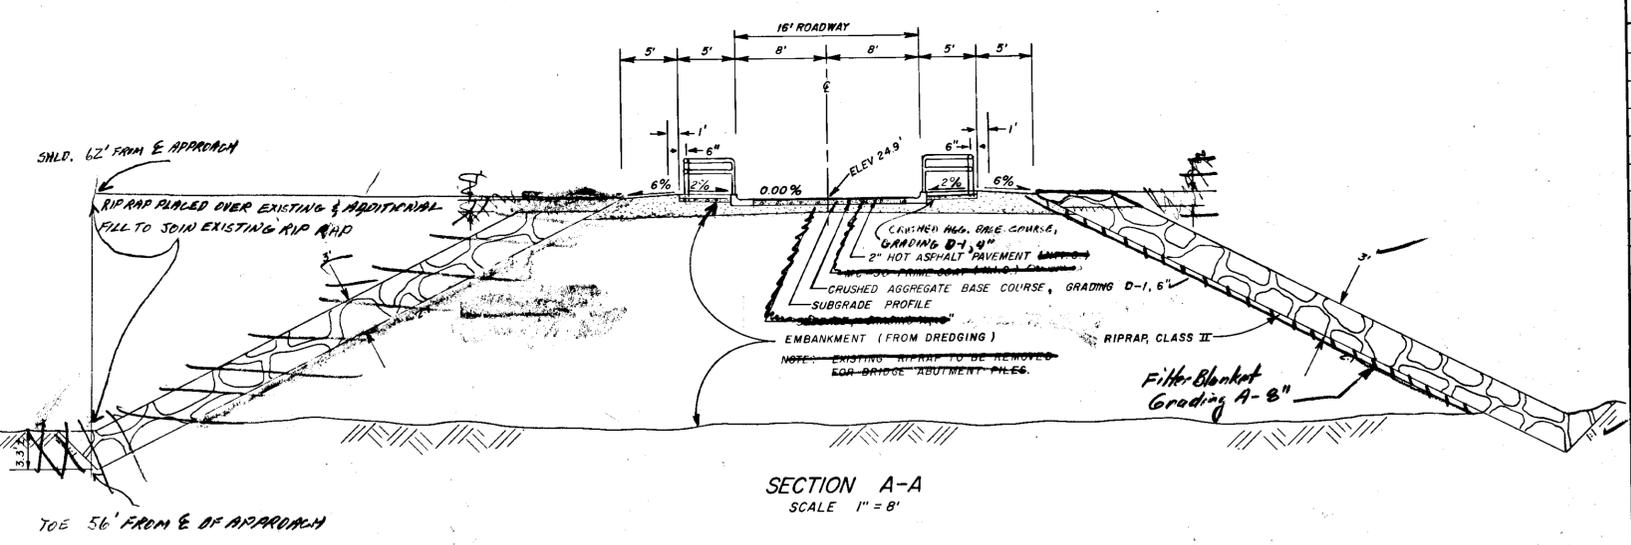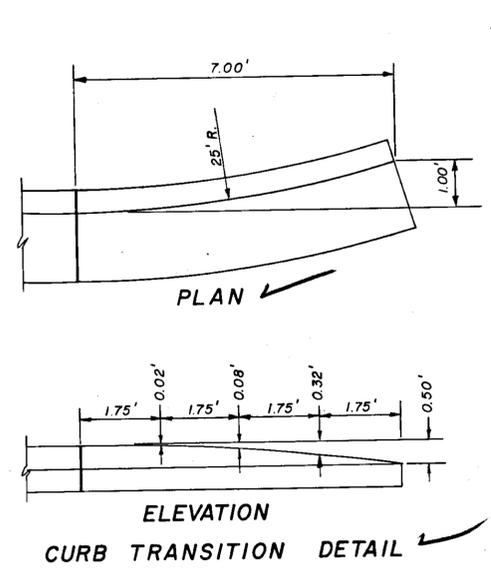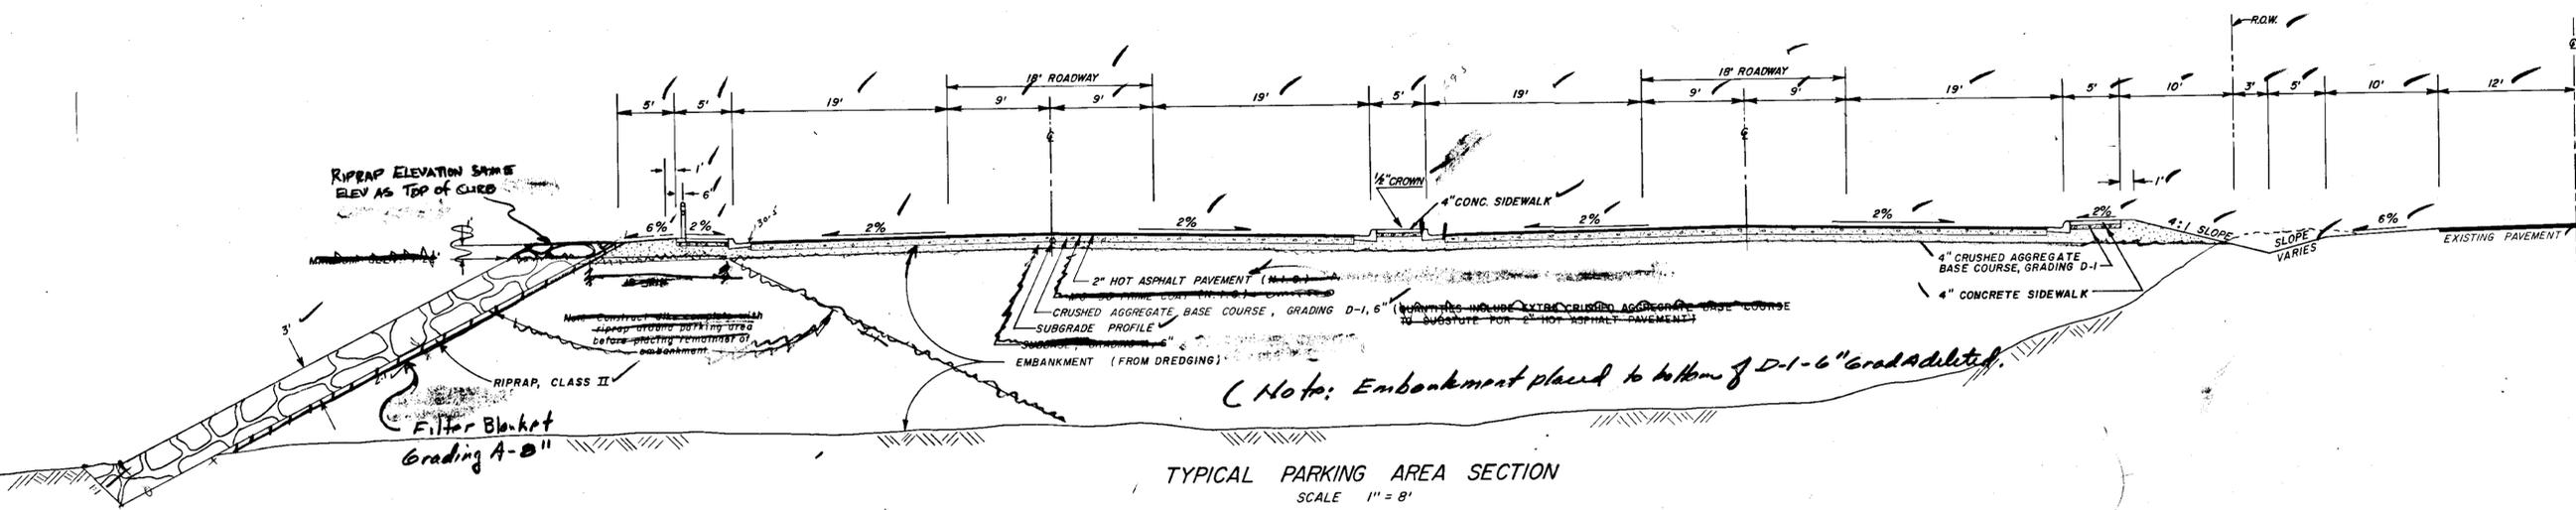

FINAL ESTIMATE OF QUANTITIES F-095-2(9)

ITEM NO.	ITEM	UNIT	QUANTITY
110(1)	Mobilization	Lump Sum	All Req'd.
111(1)	Temporary Erosion and Pollution Control	Cont. Sum	All Req'd.
112(1)	Training Programs in Accordance with FHWA Order, Interim T-2(2)	Cont. Sum	All Req'd.
202(2)	Removal of Structures & Obstructions	Lump Sum	All Req'd.
203(3)	Unclassified Excavation	Cu. Yd.	19,054
301(1)	Crushed Aggregate Base Course, Grading D-1	Cu. Yd.	59632
304(2)	Subbase, Grading A	Cu. Yd.	387
501(1)	Class A Concrete	Lump Sum	All Req'd.
503(1)	Reinforcing Steel	Lump Sum	All Req'd.
504(3)	Transfer Bridge, Furnished and Fabricated	Lump Sum	All Req'd.
504(4)	Transfer Bridge, Erected	Lump Sum	All Req'd.
504(5)	Towers, Furnished and Fabricated	Lump Sum	All Req'd.
504(6)	Towers, Erected	Lump Sum	All Req'd.
504(7)	Catwalks, Furnished and Fabricated	Lump Sum	All Req'd.
504(8)	Catwalks, Erected	Lump Sum	All Req'd.
504(9)	Dolphin Caps, Furnished and Fabricated	Lump Sum	All Req'd.
504(10)	Dolphin Caps, Erected	Lump Sum	All Req'd.
505(2a)	Treated Timber Piles, Furnished and Driven (Ketchikan)	Lin. Ft.	31851
505(4)	Cast-in-Place Concrete Piles, Furnished and Driven	Lin. Ft.	25423
505(11)	Rock Socketing	Lin. Ft.	60
509(1)	Operating Equipment	Lump Sum	All Req'd.
603(9)	18" Asbestos Bonded Bituminous Coated Corrugated Steel Pipe	Lin. Ft.	363
603(10)	58"x36" Asbestos Bonded Bituminous Coated Corrugated Steel Pipe Arch	Lin. Ft.	153
603(11)	End Section for 18" Asbestos Bonded Bit. Coated Corrugated Steel Pipe	Each	1
603(12)	End Section for 58"x36" Asb. Bonded Bit. Coated Corrugated Steel Pipe Arch	Each	1
604(7)	Inlet, Type "A"	Each	5
604(8)	Inlet, Type "B"	Each	2
604(9)	Inlet, Field	Each	1
608(1)	Concrete Sidewalk, Depth 4"	Sq. Yd.	4173
609(2)	Curb & Gutter, Type I	Lin. Ft.	15951
611(1)	Riprap, Class II	Cu. Yd.	12824
625(1)	Pipe Handrail	Lin. Ft.	4283
628(9)	Water Service Connection	Each	1
671(1)	Electrical Utilities	Lump Sum	All Req'd.
401(1)	Hot Asphalt Pavement	Ton.	4472

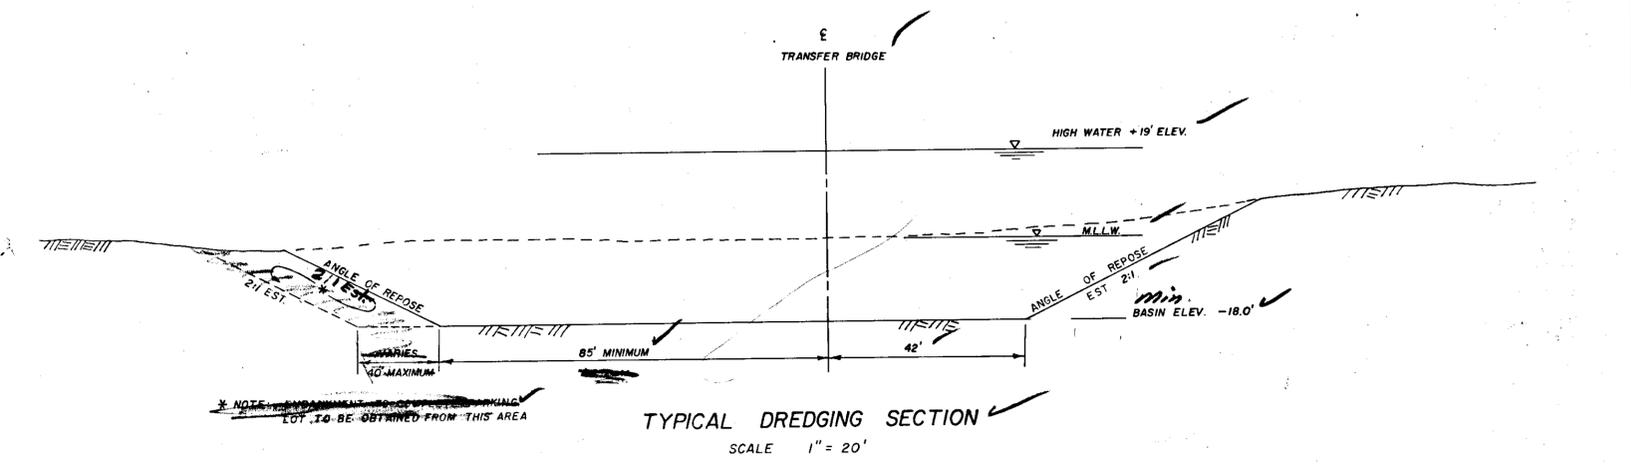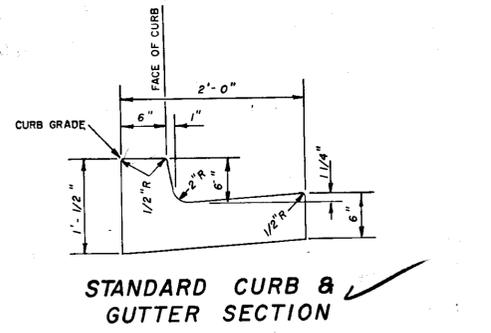

TYPICAL SECTIONS AND QUANTITIES
KETCHIKAN FERRY TERMINAL

BOMHOFF & ASSOCIATES
Engineering and Surveys
1020 West Fireweed Lane
Anchorage, Alaska 99503

DESIGNED BY: _____
DRAWN BY: _____
CHECKED BY: _____
DATE: _____
SHEET _____ OF _____

S.C. Schwedner

STATE	PROJECT DESIGNATION	YEAR	SHEET NO.
ALASKA	F-095-2 (7) A.D.A.R. 8-02-0144-03	1972	3



BENCH MARK: FIRE HYDRANT AT CORNER BRYANT STREET AND TONGASS AVENUE - "X" ON SOUTHEAST HEADBOLT. ELEV. + 25.69' FEET ABOVE M. L. L. W.

BRASS CAP - WITNESS CORNER TO COR. 1 MEANDER CORNER U.S.S. NO. 1408, AND COR. 6 M.C. U.S.S. NO. 1296, TIDELANDS ADDITION, CITY OF KETCHIKAN. STATE PLANE COORDINATES (N. 1292484.916, E. 3096969.380)

NOTE: BASIS OF BEARING ESTABLISHED BY TRAVERSE NET TO U.S.C. & G.S. TRIANGULATION STATIONS, "RAIN" & "ISLE", USING BACK AZIMUTH FROM "ISLE" TO "RAIN" (147° 08' 31.7")

- LEGEND:
- PROPERTY LINE
 - ▲ SURV-KAP SET
 - THEORETICAL PROPERTY CORNERS
 - ⊙ BRASS CAPS, FOUND
 - SURV-KAP SET

TONGASS NARROWS


**MASTER PLAN
KETCHIKAN FERRY TERMINAL**

BOMHOFF & ASSOC
Engineering and Surveying
1020 West Fireweed Lane
Anchorage, Alaska 99503

DESIGNED BY: PFH
DRAWN BY: BLH
CHECKED BY: *AC. Schorhan*

SCALE: 1" = 40'
DATE: 3/20/72
SHEET 3 OF 3

STATE	PROJECT DESIGNATION	YEAR	SHEET NO.	TOTAL SHEETS
ALASKA	F-095-2(9) A.D.A.R. 8-02-0144-03	1972	4	35

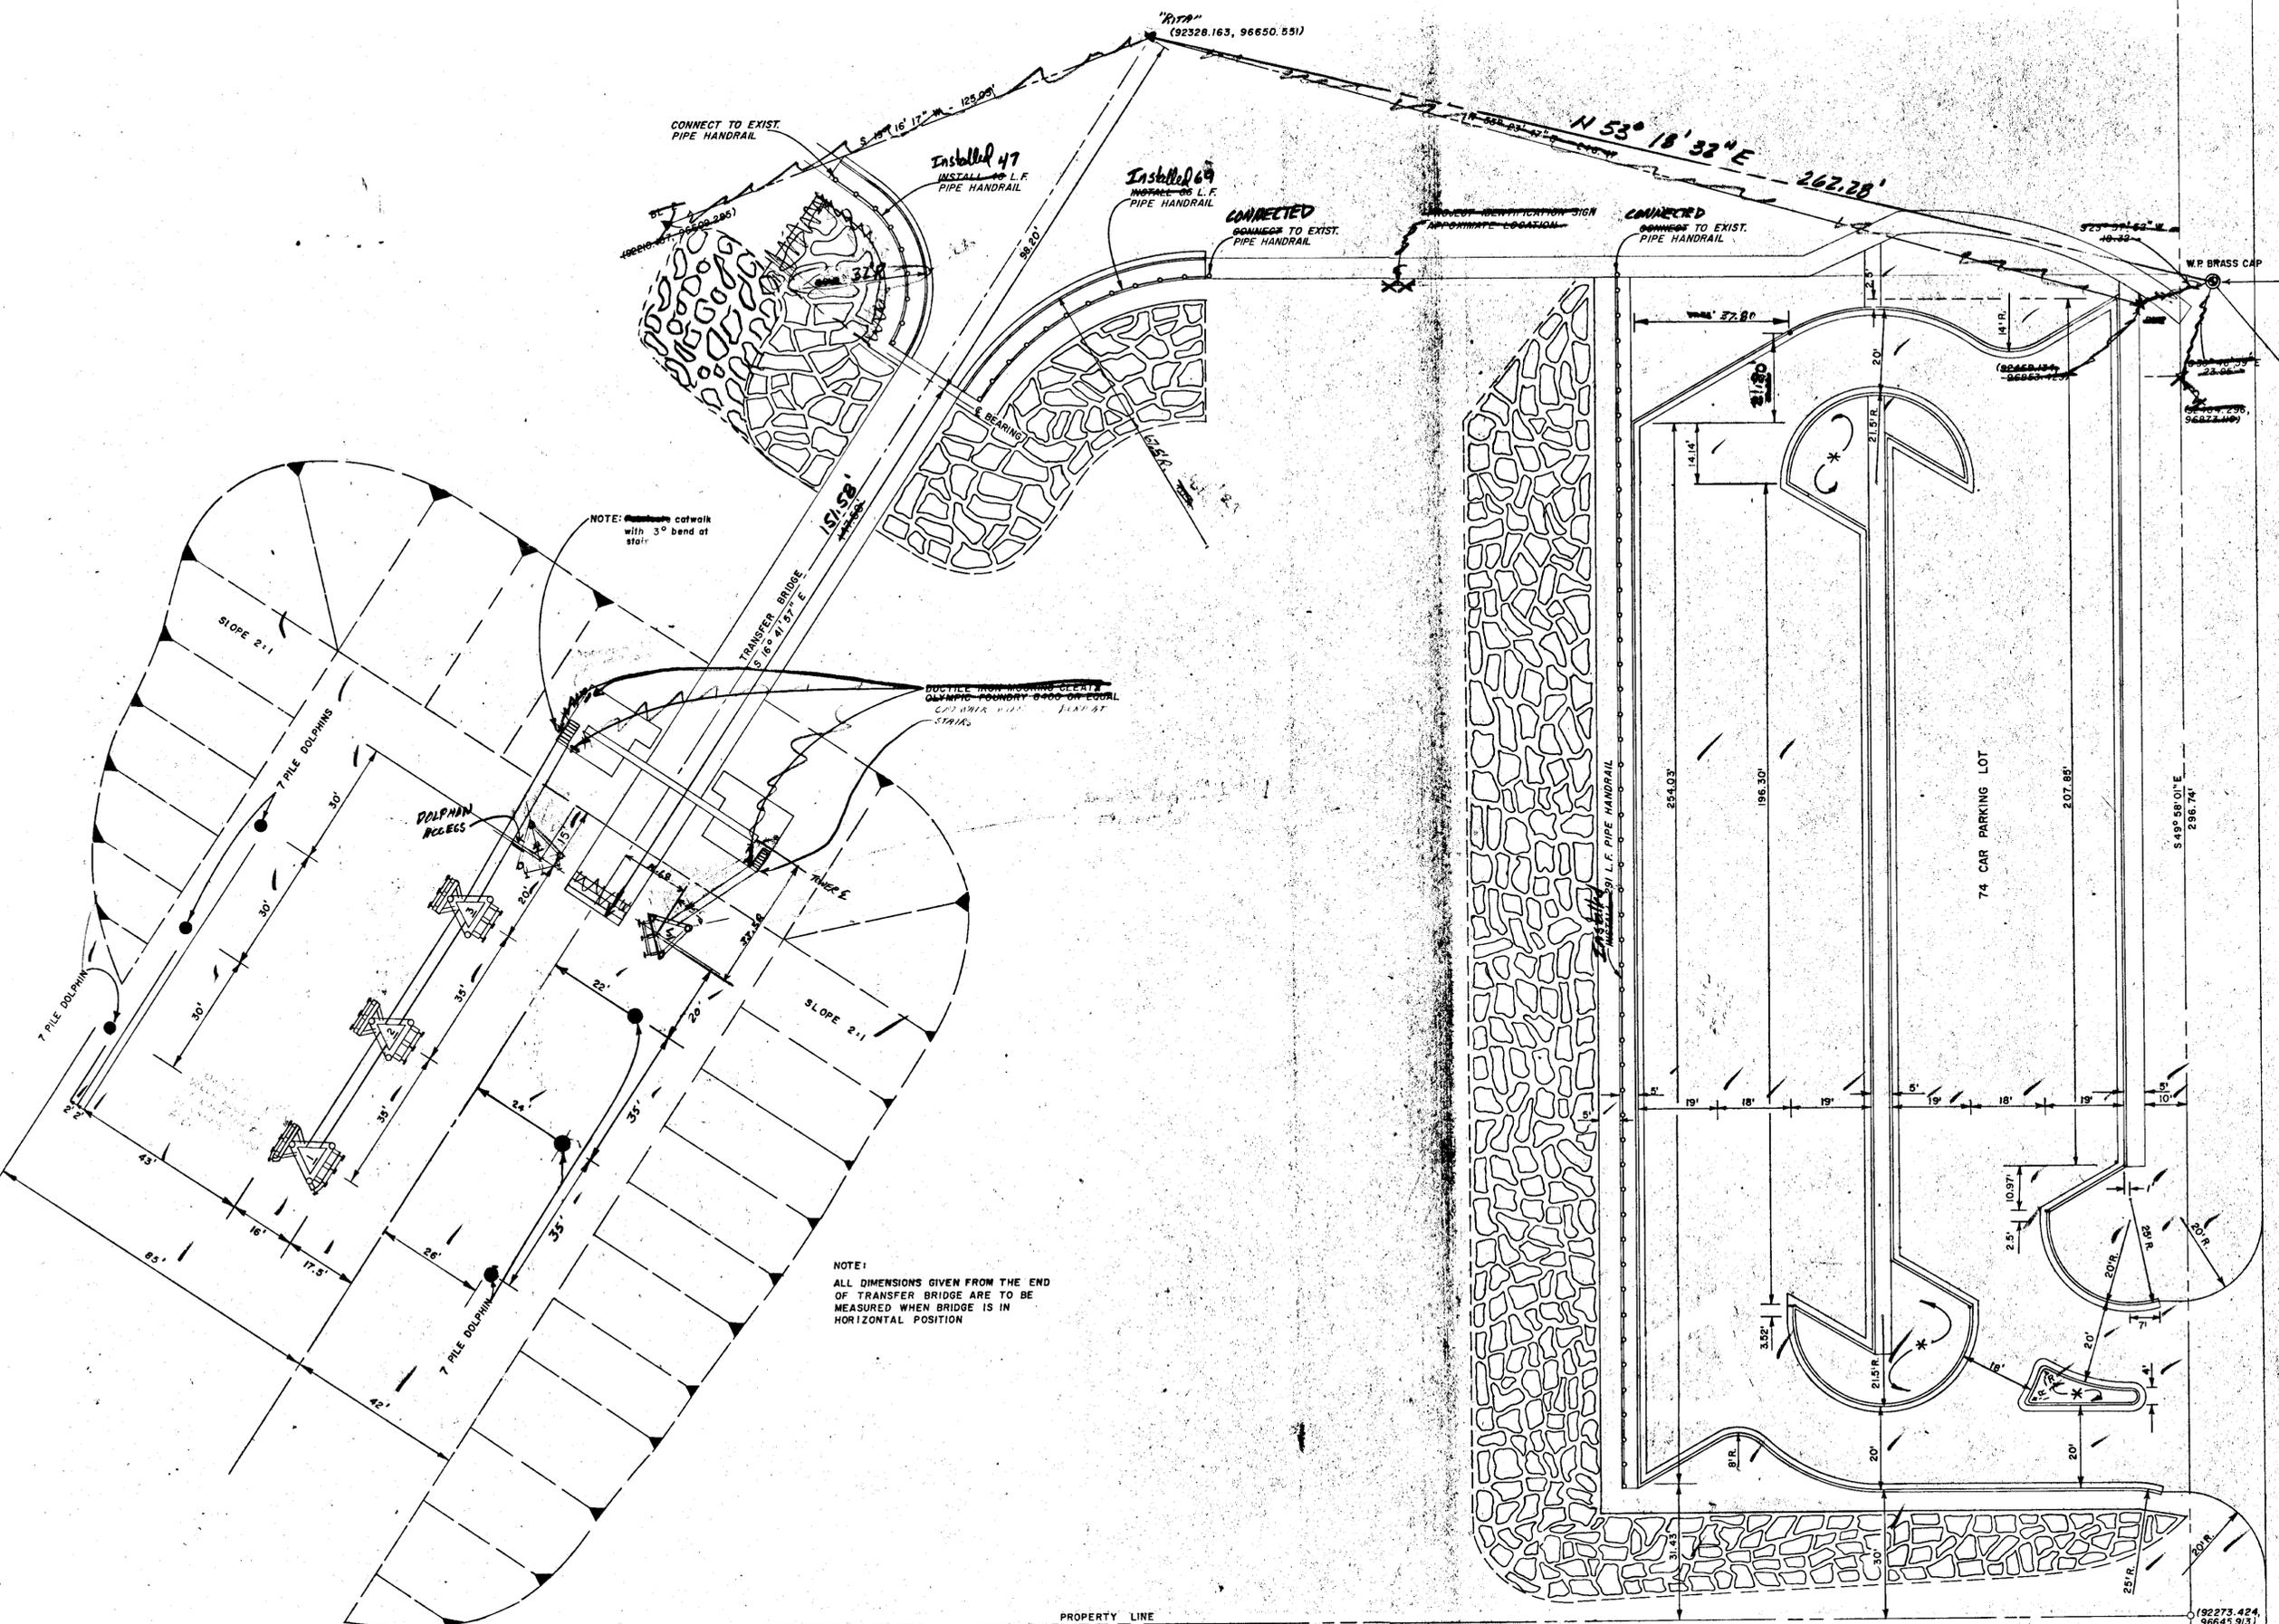

NOTE: catwalk with 3° bend at stair

NOTE: ALL DIMENSIONS GIVEN FROM THE END OF TRANSFER BRIDGE ARE TO BE MEASURED WHEN BRIDGE IS IN HORIZONTAL POSITION







NOTES:
 COORDINATE SYSTEM BASED ON LAST 5 DIGITS OF THE STATE PLANE COORDINATES TO W.C. BRASS CAP. ALL OTHER COORDINATES ARE BASED ON TRUE NORTH BEARINGS AND DISTANCES FROM W.C.B.C. AS SHOWN.
 ALL DIMENSIONS ARE TO FACE OF CURB.
 * 4" CRUSHED AGGREGATE BASE COURSE RECORDED TO BECOME PAVED PAVEMENT & 2" HOT ASPHALT PAVEMENT PLACED.

LAYOUT PLAN
 KETCHIKAN FERRY TERMINAL

BOMHOFF & ASSOCIATES
 Engineering and Surveys
 1020 West Fireweed Lane
 Anchorage, Alaska 99503


DESIGNED BY:
 PFH
 DRAWN BY:
 BLH
 CHECKED BY:
 B.C. Schindler
 SCALE:
 1" = 20'
 DATE:
 3/20/72
 SHEET OF

STATE	PROJECT DESIGNATION	YEAR	SHEET NO.
ALASKA	F-095-2(9) A.D.A.P. 8-02-0144-03	1972	5

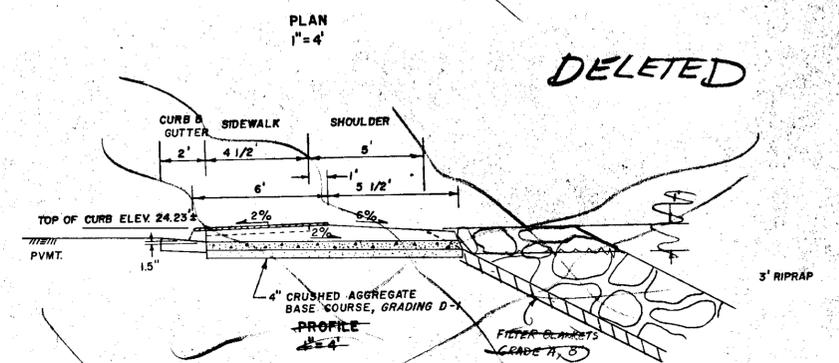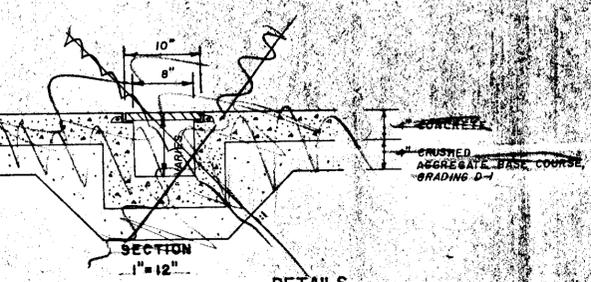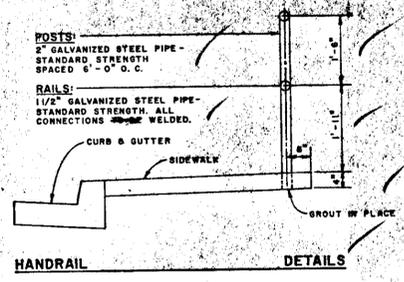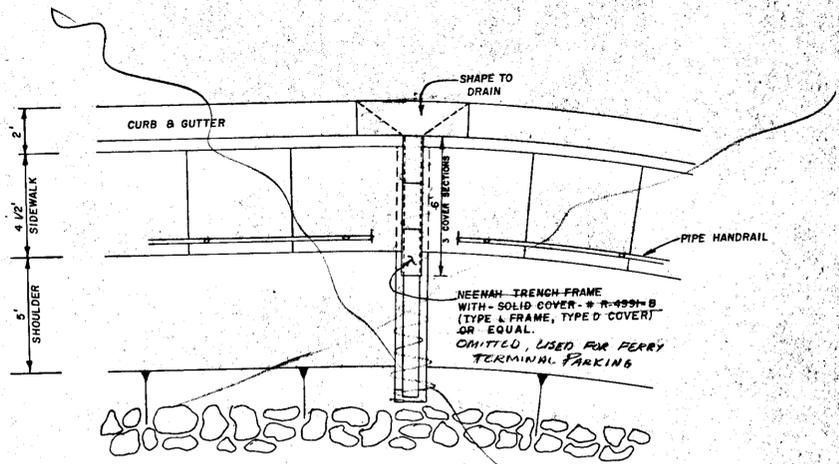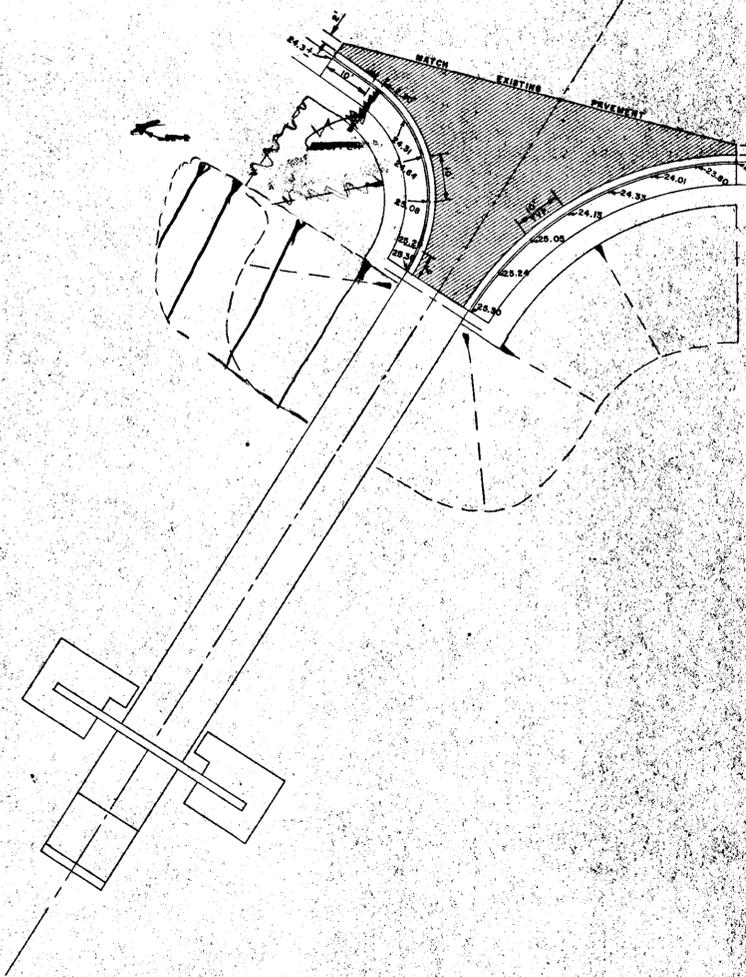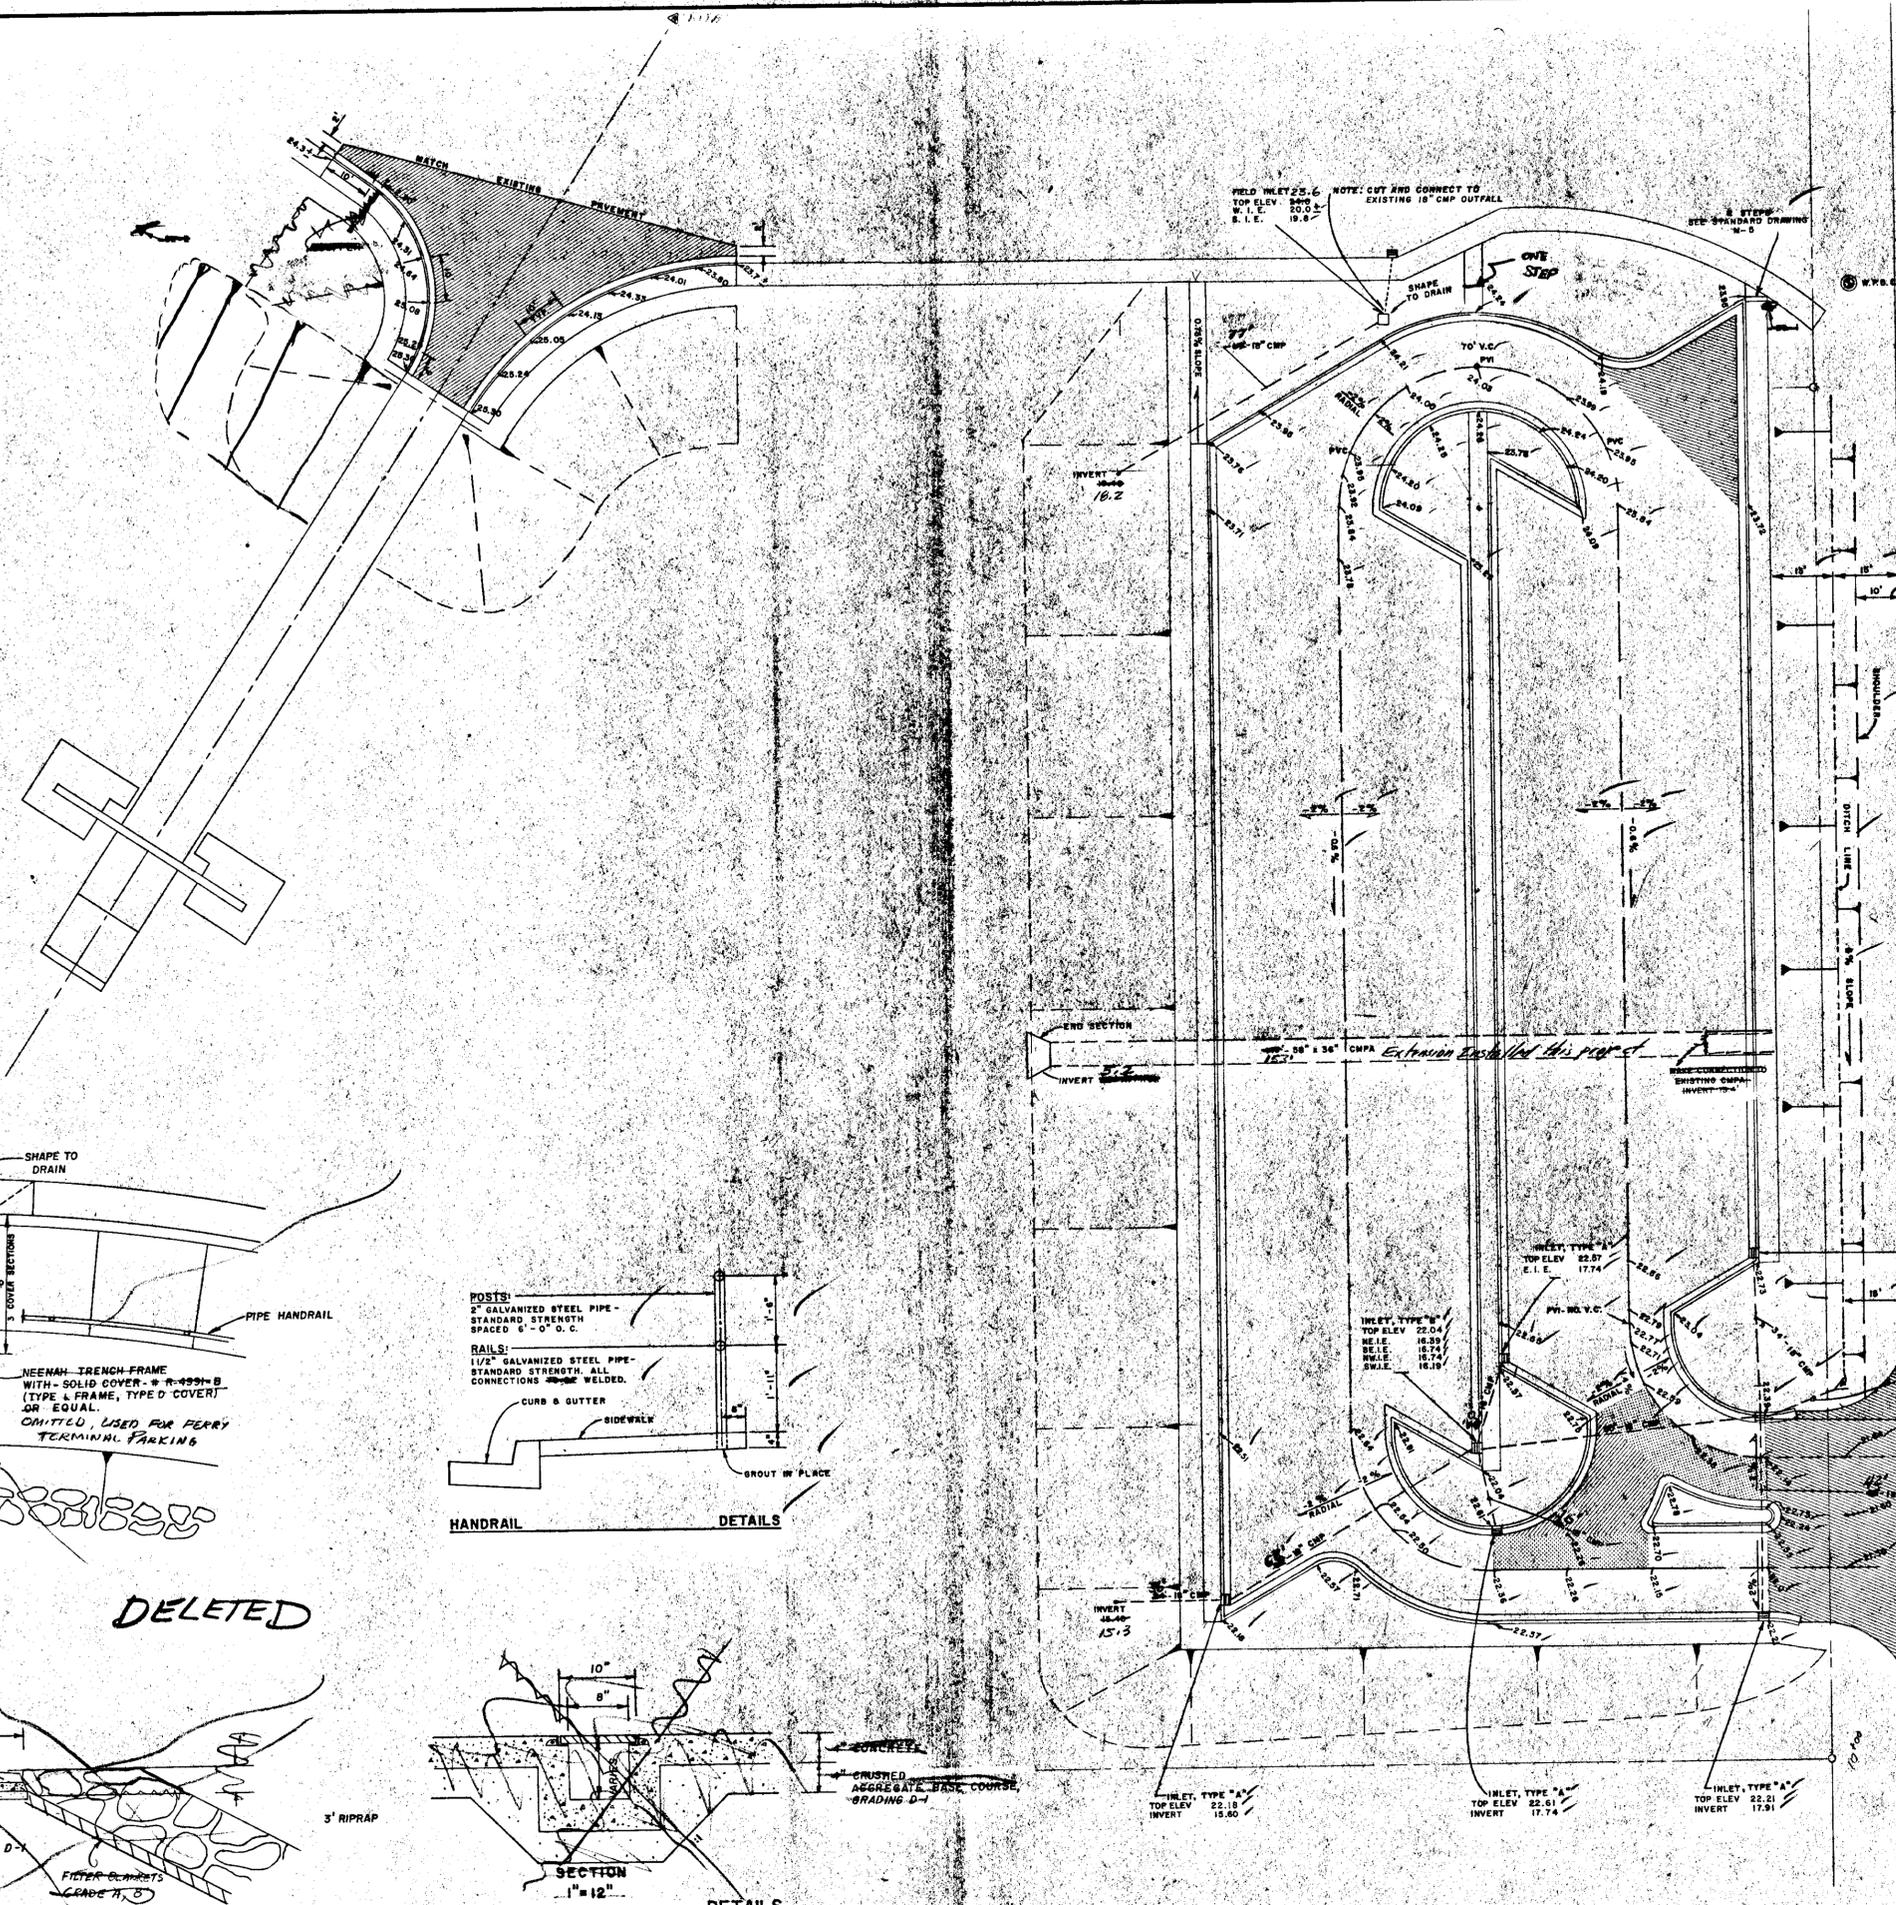

SCUPPER

DELETED

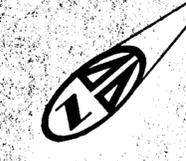








LEGEND
 WARP SECTION
 SUPERELEVATION

DRAINAGE PLAN
KETCHIKAN FERRY TERMINAL




BOMHOFF & ASSOC.
 Engineering and Surveying
 1020 West Fireweed Lane
 Anchorage, Alaska 99503

DESIGNED BY: PFH
 DRAWN BY: PFH
 CHECKED BY: PFH
 SCALE: 1" = 20'
 DATE: 10/1/72
 SHEET 5 OF 5

STATE	PROJECT DESIGNATION	YEAR	SHEET NO.	TOTAL SHEETS
ALASKA	F-095-2(9) A.D.A.P. 8-02-0144-03	1972	6	35

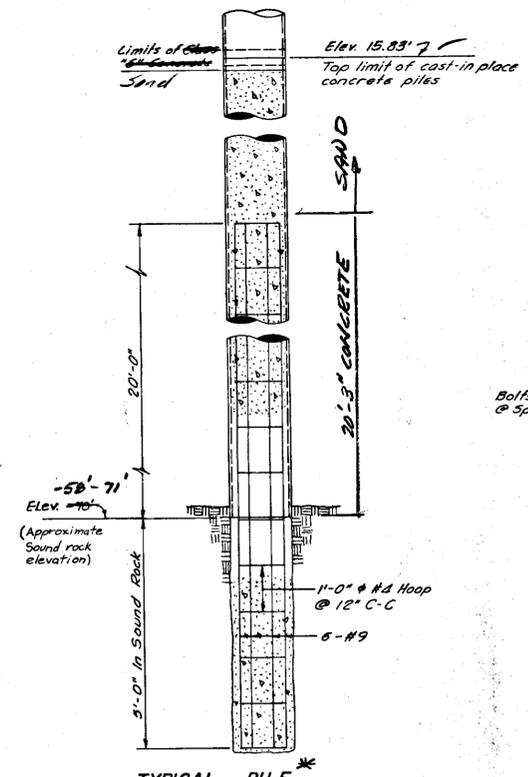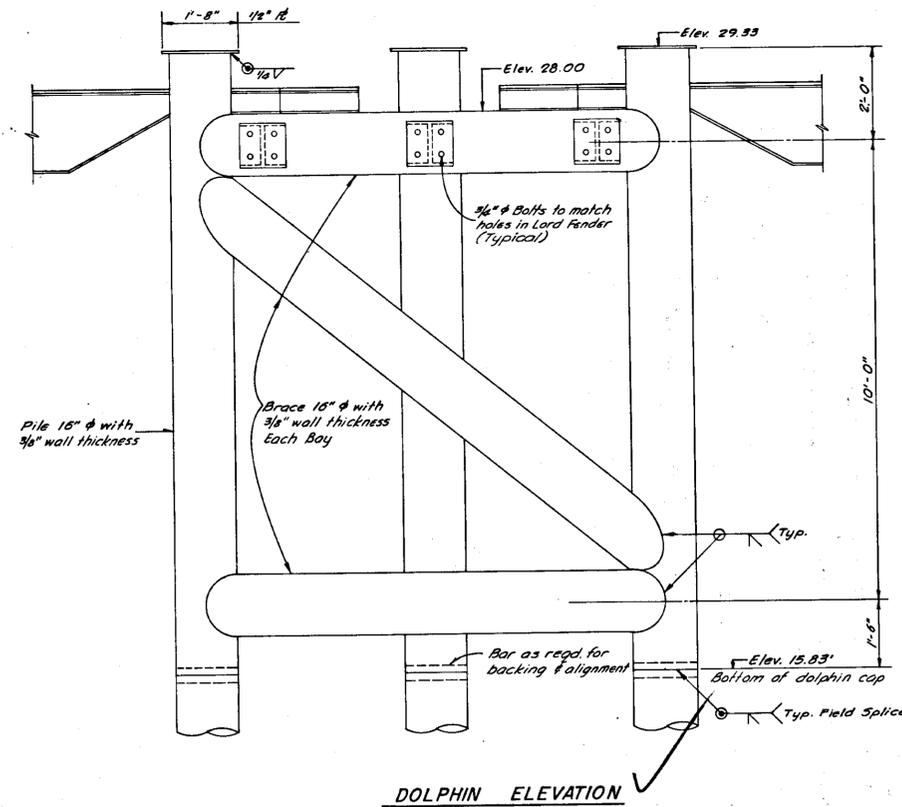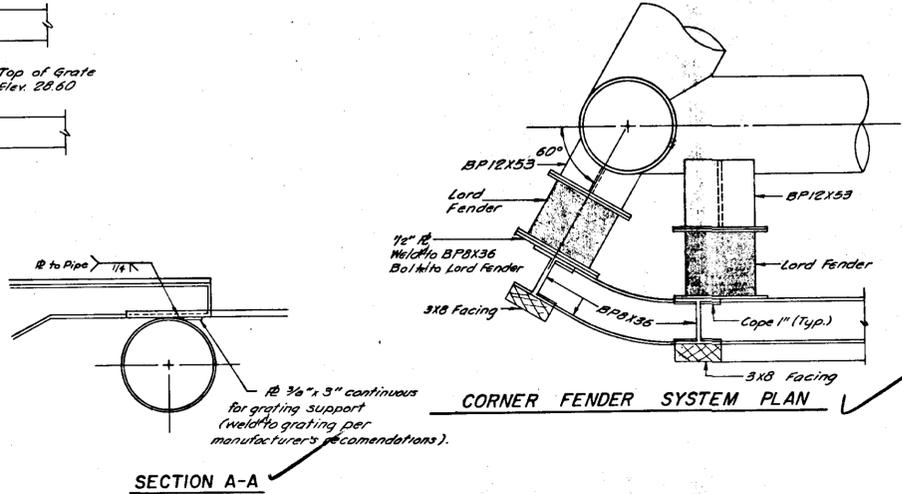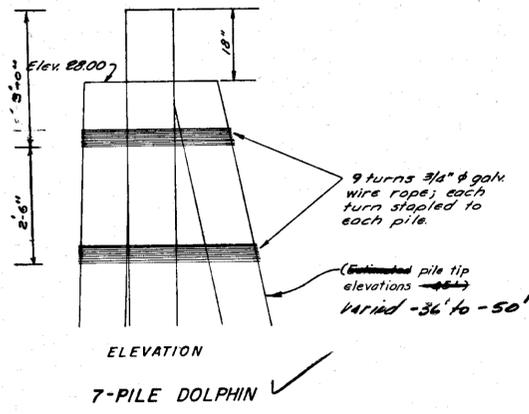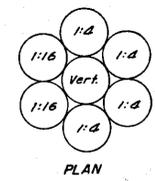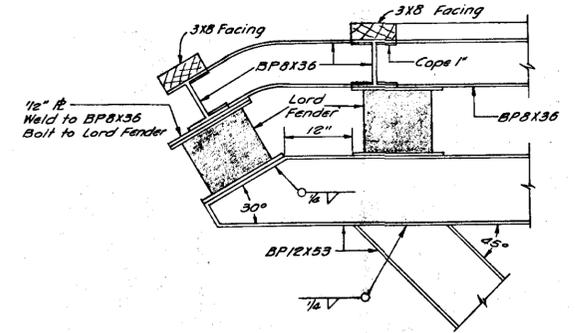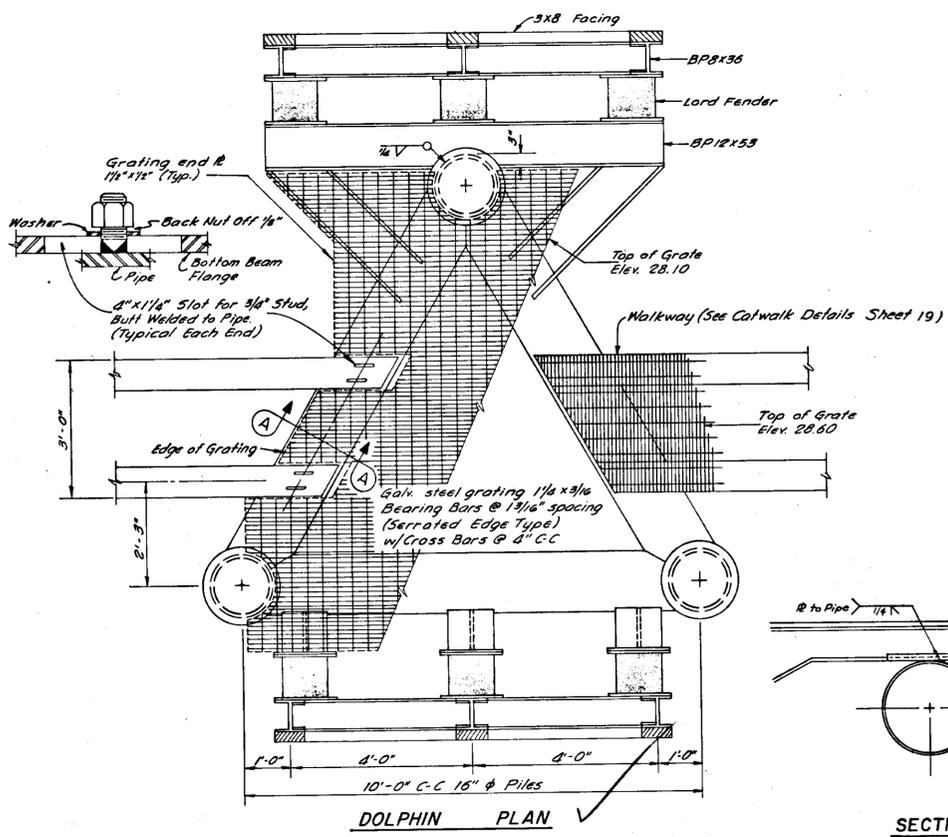

* Piles for dolphin No.1 did not require rock socketting & are filled with sand from pile tip to elev. 15.83'

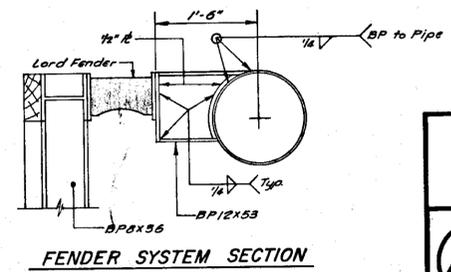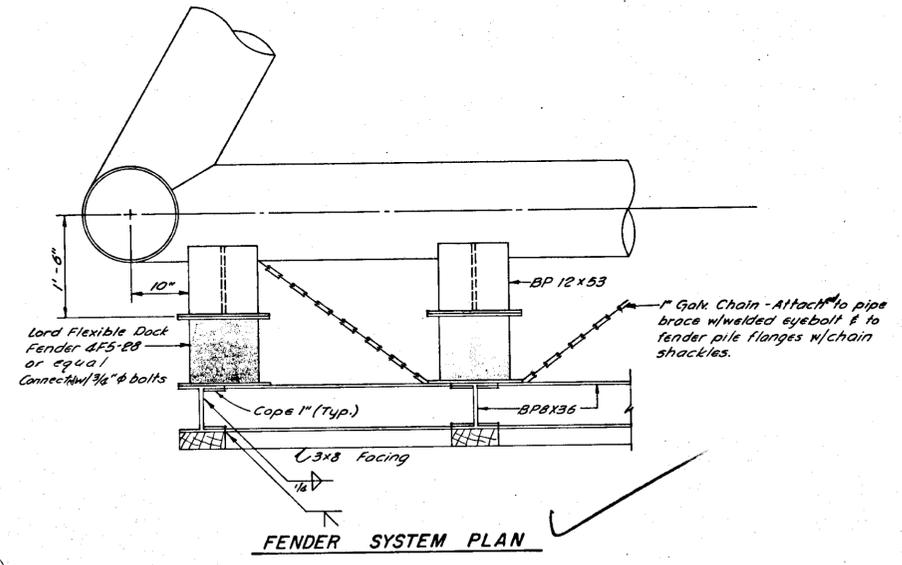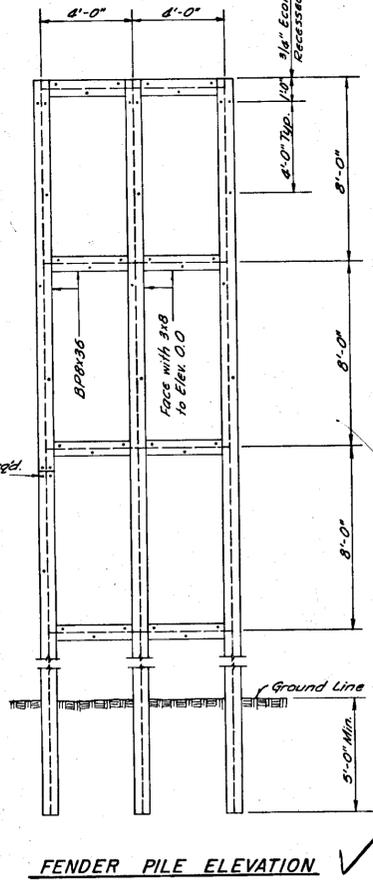





DOLPHIN DETAILS
KETCHIKAN FERRY TERMINAL

BOMHOFF & ASSOCIATES
Engineering and Surveys
1020 West Fireweed Lane
Anchorage, Alaska 99503

DESIGNED BY: _____
DRAWN BY: _____
CHECKED BY: _____
SCALE: _____
DATE: _____
SHEET OF _____



STATE	PROJECT DESIGNATION	YEAR	SHEET NO.	TO
ALASKA	F-095-2(9) A.D.A.P. 8-02-0144-03	1972	7	3

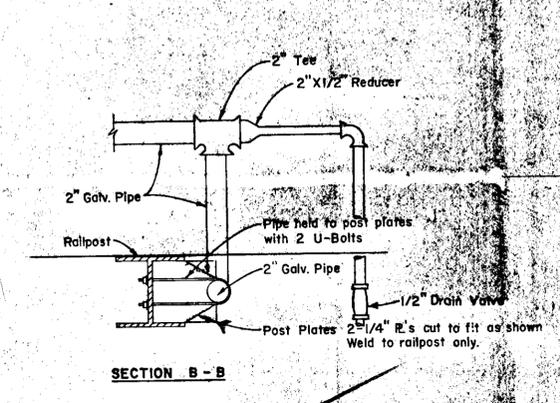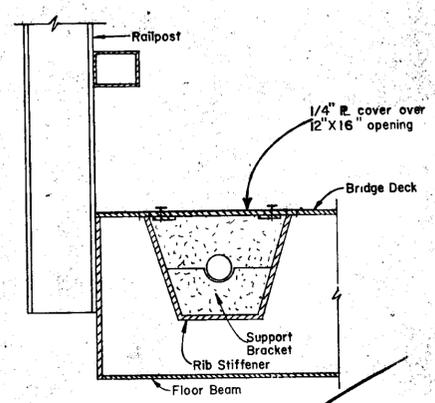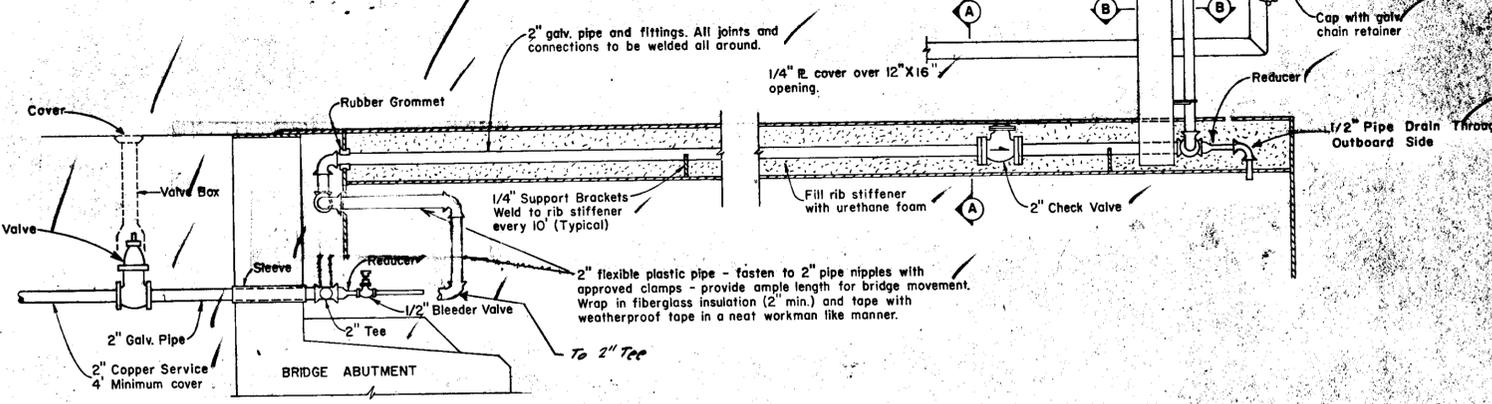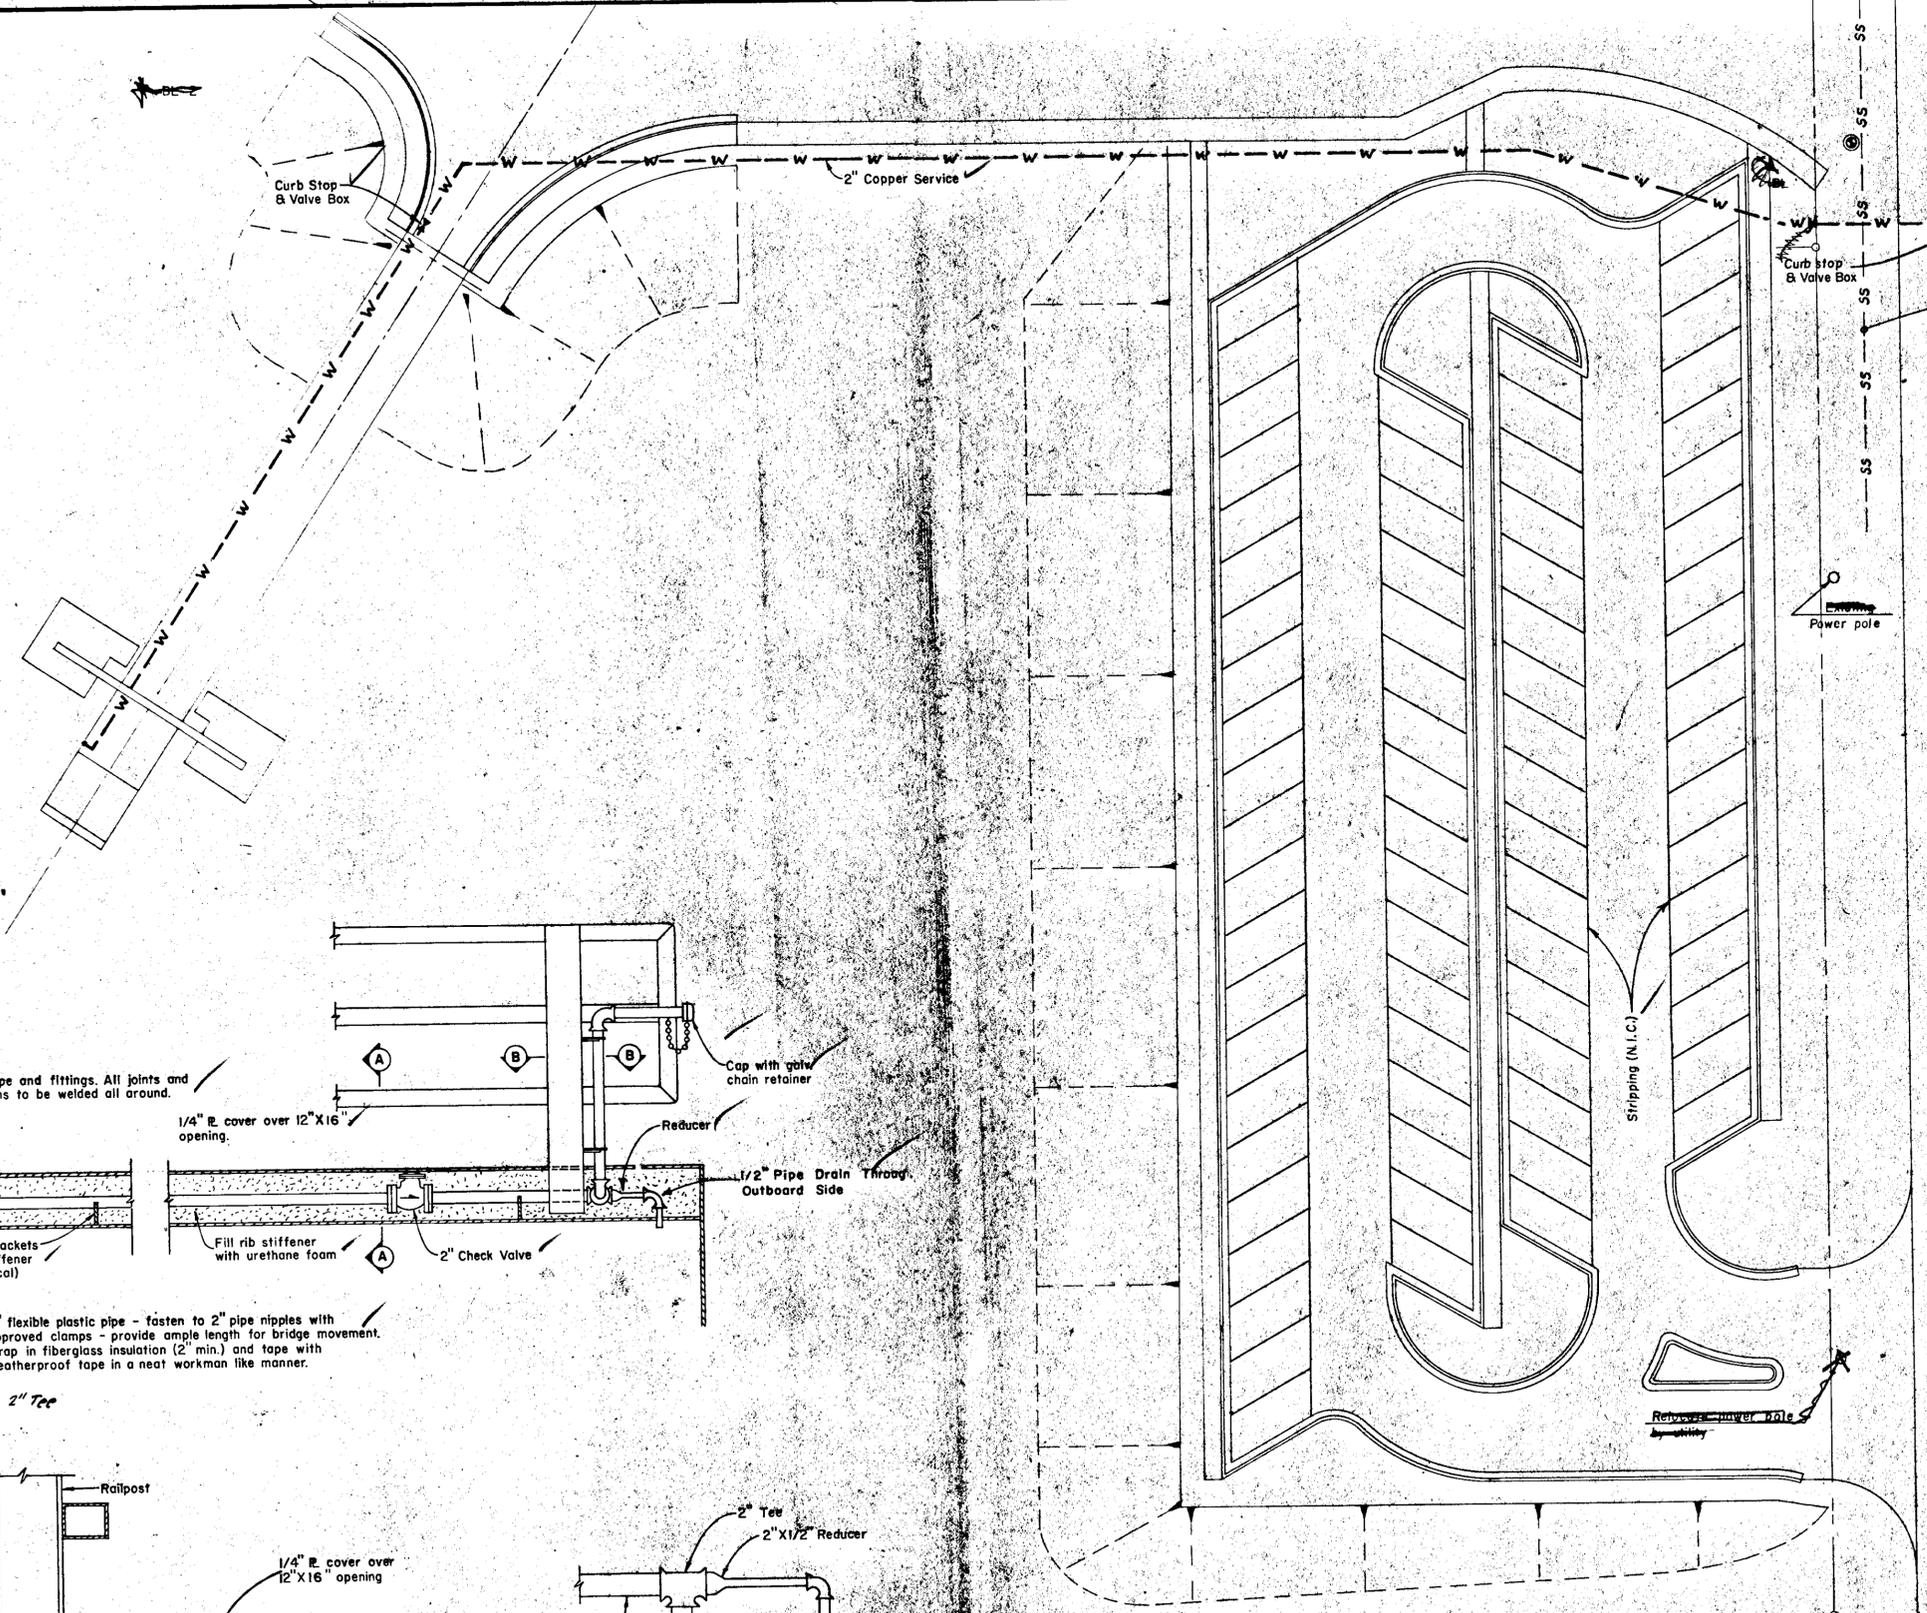

WATER


SECTION A-A
SERVICE

SECTION B-B
DETAILS








WATER DETAILS
KETCHIKAN FERRY TERMINAL

BOMHOFF & ASSOCIATES
Engineering and Surveying
1020 West Fireweed Lane
Anchorage, Alaska 99503

DESIGNED BY: _____
DRAWN BY: _____
CHECKED BY: _____
SCALE: _____
DATE: _____
SHEET 7 OF 3

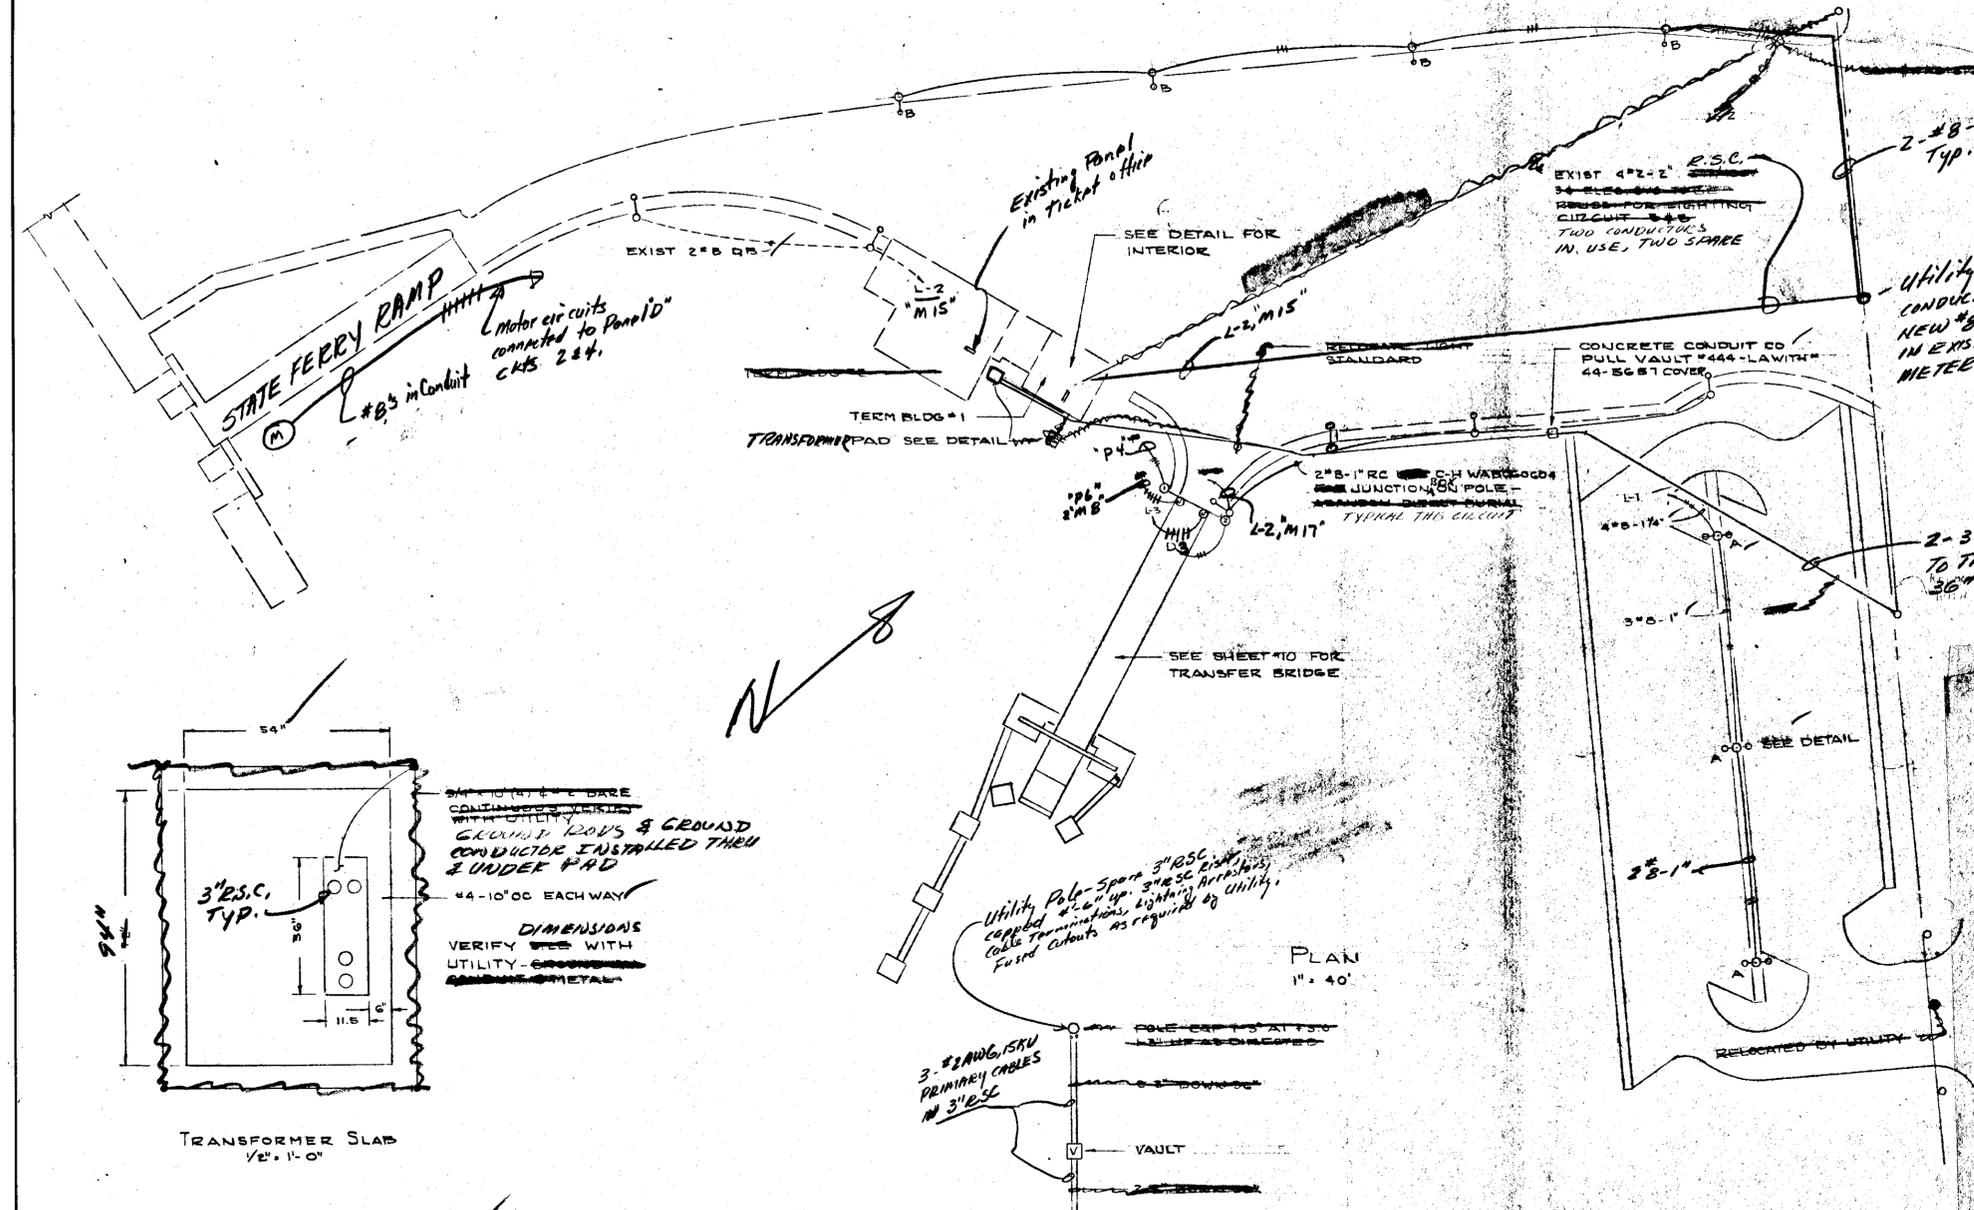




- NOTES
- 1) TRANSFORMER SECONDARY CONNECTED 480V-3Ø TO BE RECONFIGURED IN FUTURE TO 277/480V-3Ø, 4W BY UTILITIES. NEUTRAL CONDUCTOR IS INSTALLED BUT IS NOT BONDED TO ANY TRANSFORMER SECONDARY OR GROUND CONNECTION.
 - 2) EQUIPMENT CASES ARE NOT BONDED TO GROUND.
 - 3) WIRING METHOD - METALLIC BAYWAYS
 - 4) PORTABLE PLUG INSTALLED ON END OF RAMP AND CONNECTED TO CIRCUIT #8, PANEL "M" SUPPLIES SINGLE PHASE 208V ONLY TO HEATED ANNU ABIAR.
 - 5) TIMER CONTROLS ARE SET FOR MANUAL OPERATION - TRAMPEES ARE REMOVED.

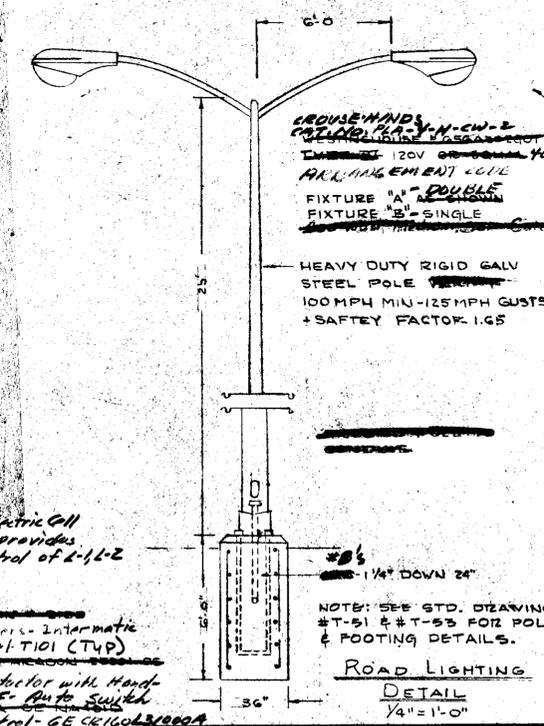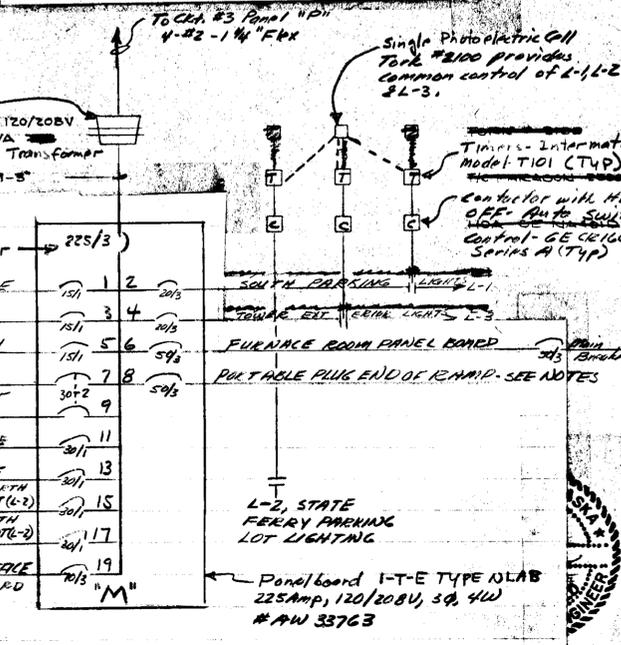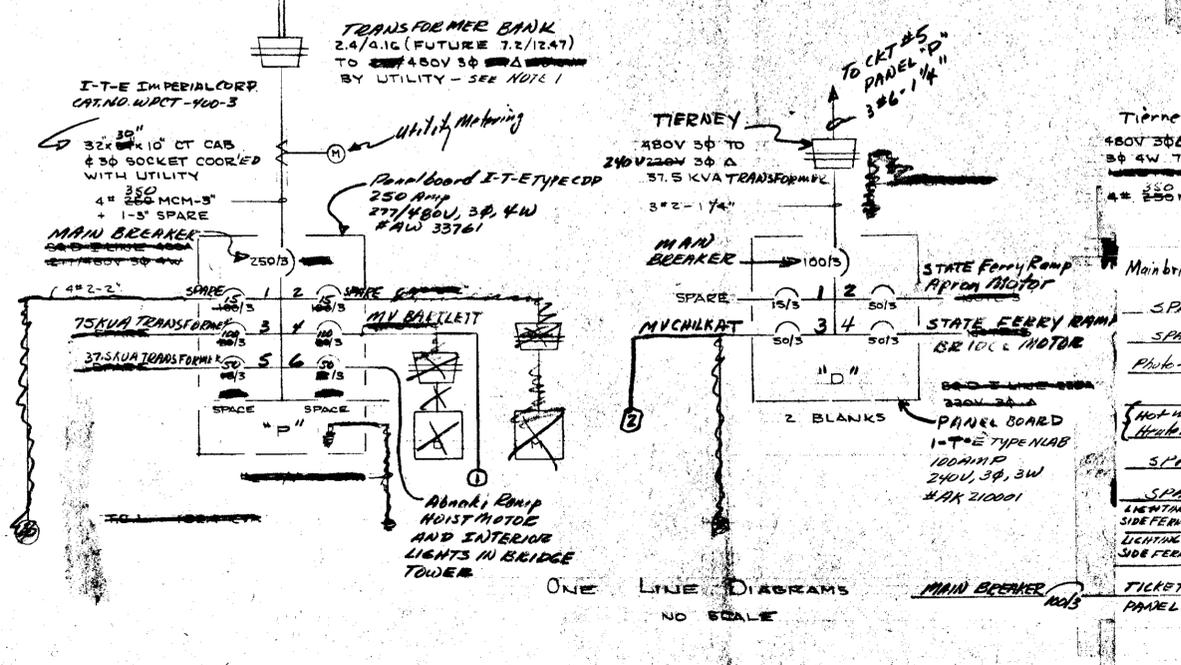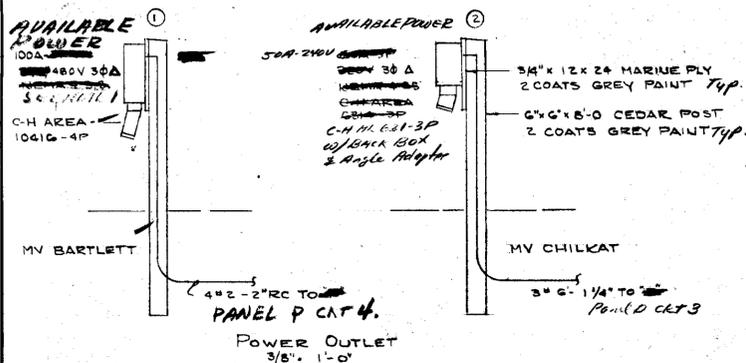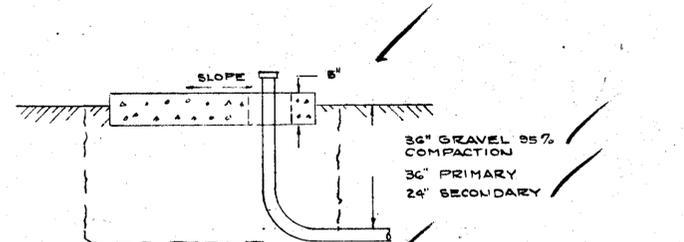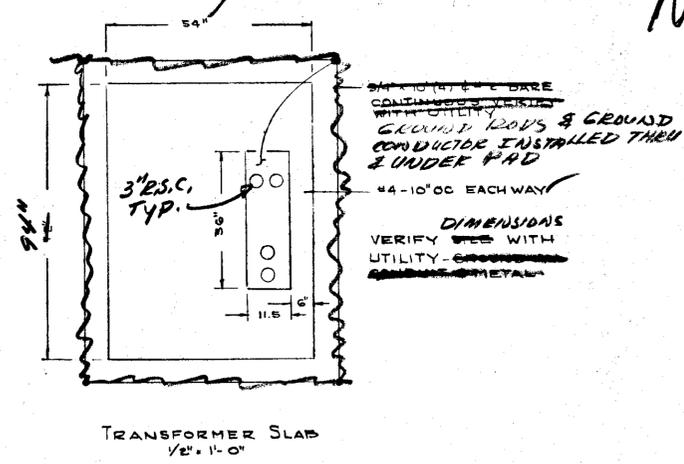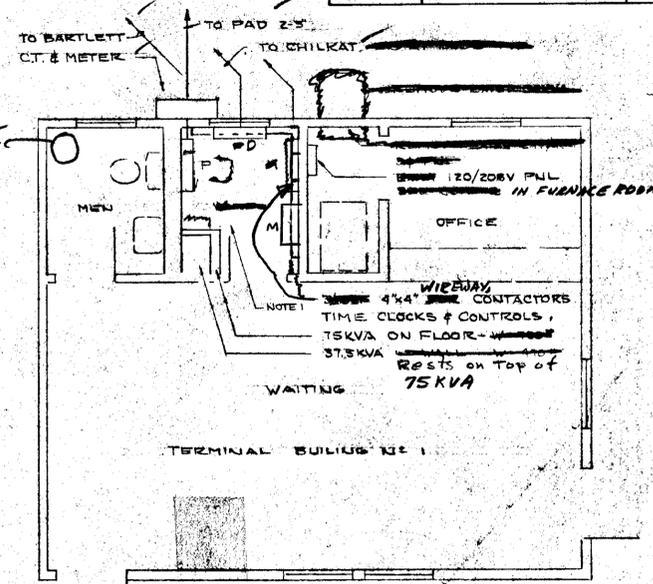



ILLUMINATION AND ELECTRICAL DETAILS
KETCHIKAN FERRY TERMINAL

BOMHOFF & ASSOCIATE
Engineering and Surveys
1020 West Fireweed Lane
Anchorage, Alaska 99503

DESIGNED BY: L.P.L.
DRAWN BY:
CHECKED BY:
SCALE:
DATE:
SHEET OF

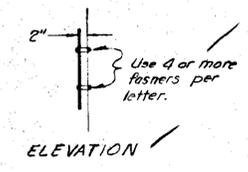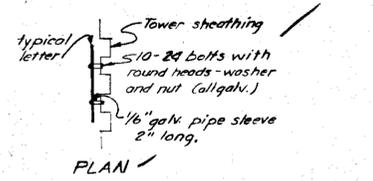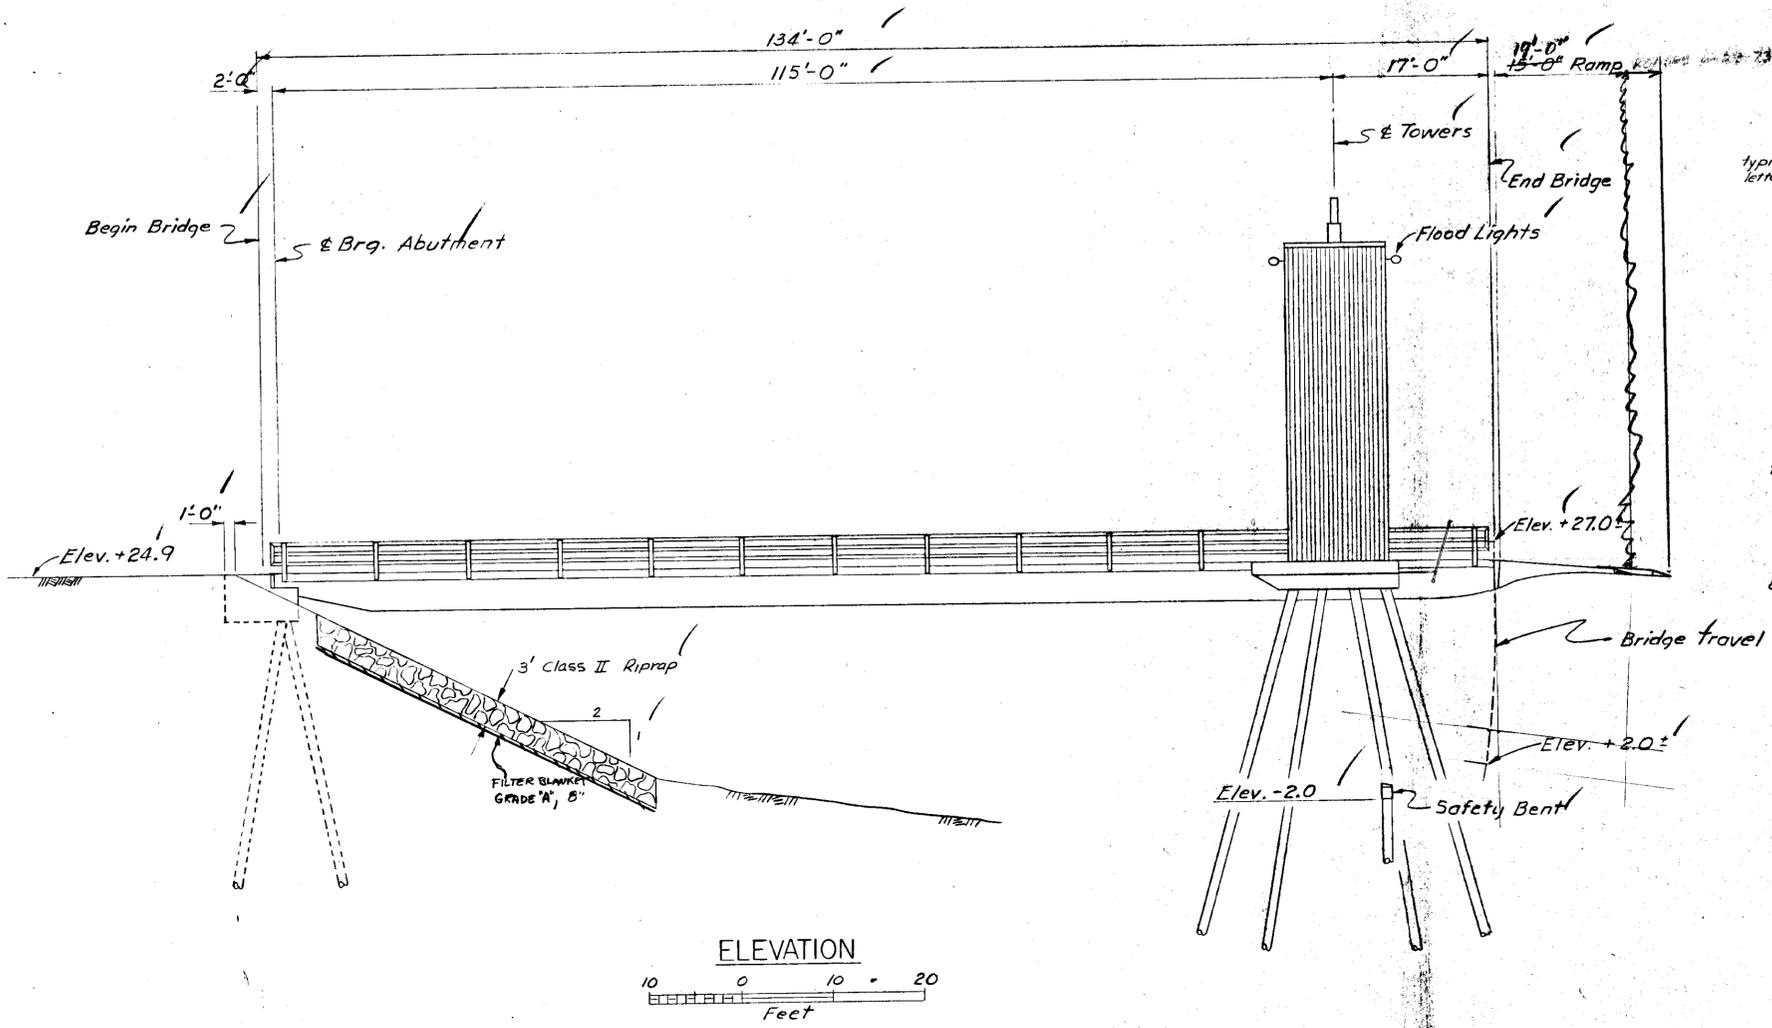

LETTERING DETAILS

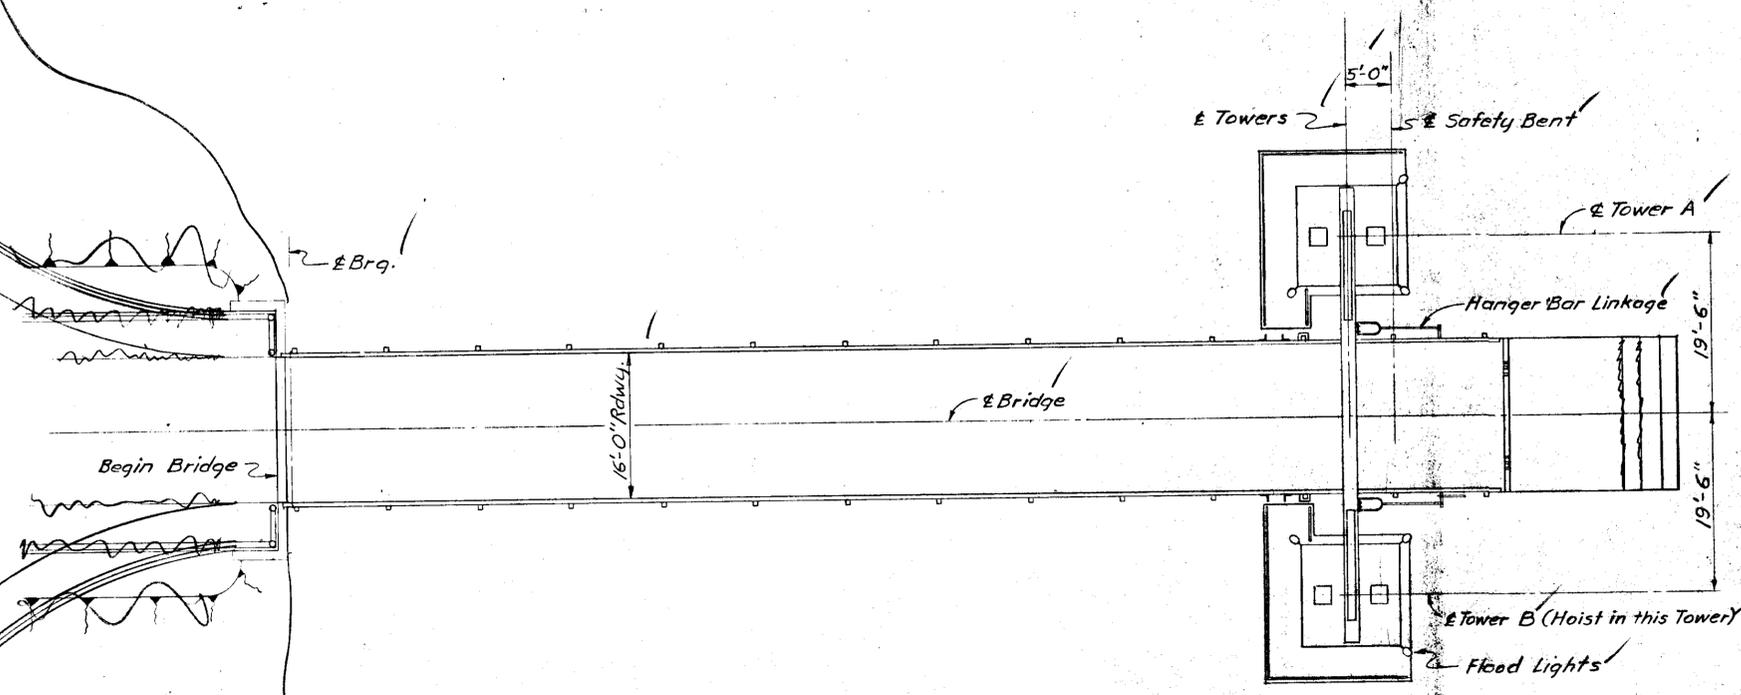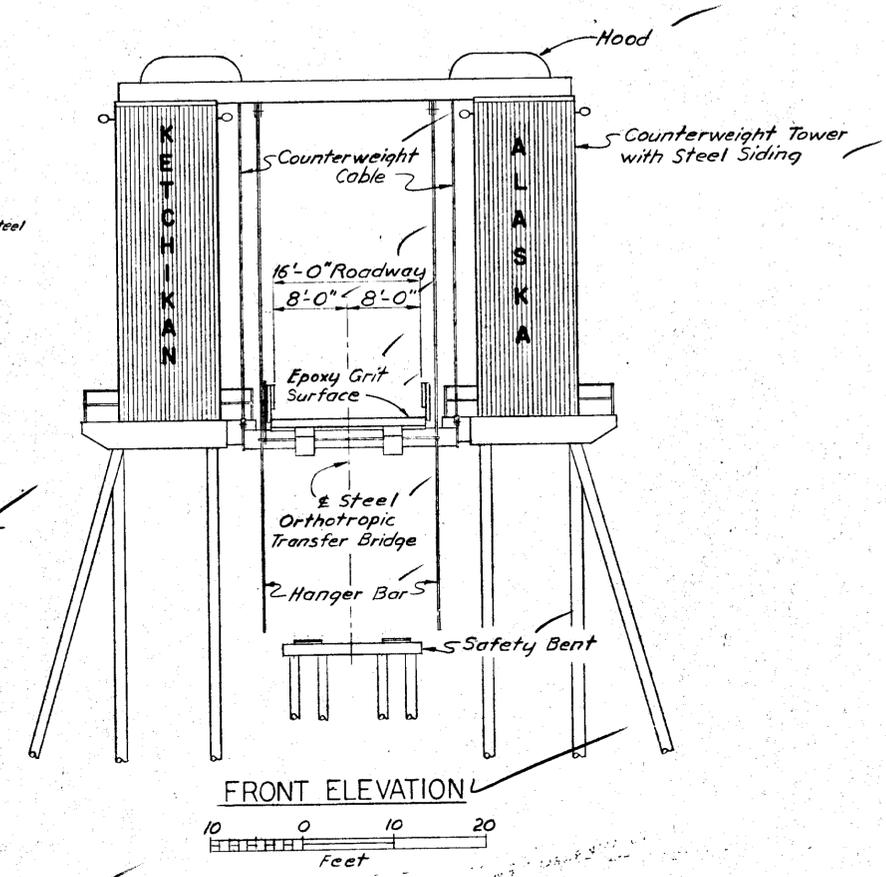

GENERAL NOTES:





- Specifications:**
 Design: A.A.S.H.O. Standard Specifications for Highway Bridges, 1969 Edition, with latest interim specifications.
 Live Load: HS-20-44.
 Construction: State of Alaska Standard Specifications for Highway Construction, 1972 and the Special Provisions.
- Unit Stresses:**
 Reinforced Concrete: $F_c = 1200$ psi
 $F_s = 20,000$ psi
 Structural Steel: Bending stress in extreme fiber
- | Type of Steel | Allowable Stress |
|-----------------|------------------|
| A-36 | 20,000 psi |
| A-572, Grade 50 | 27,000 psi |
- Concrete: All concrete shall be Class A
 Reinforcing Steel: All reinforcing steel shall be A615 Grade 40
 Structural Steel: Unless otherwise shown on the plans or noted in the specifications, all structural steel shall be A-36. All A572 steel shall be Grade 50
 Pile Bearing Capacity & Penetration: See Drawing No 2612

ESTIMATED QUANTITIES		
ITEM	Unit	Quantity
Class A Concrete	Cu. Yd.	91.0
Reinforcing Steel	Lbs.	11,700
Structural Steel Transfer Bridge furnished, fabricated & erected	Lump Sum	*
Structural Steel Towers furnished, fabricated & erected	Lump Sum	**
Structural Steel Catwalks f.f.e	Lump Sum	***
Treated Timber Piles (Safety Bent)	Lin. Ft.	165.5
Steel Pipe Piles	Lin. Ft.	1337



* Includes approximately 140,350 lbs A36 & 16,050 lbs A572
 ** Includes approximately 38,400 lbs A36 & 300 lbs A572 + 4000 Sq. Ft. Sheet Metal Siding
 *** Includes approximately 14,000 lbs A36

**KETCHIKAN FERRY TERMINAL
 GENERAL LAYOUT**

State of Alaska
DEPARTMENT OF HIGHWAYS
 Juneau, Alaska

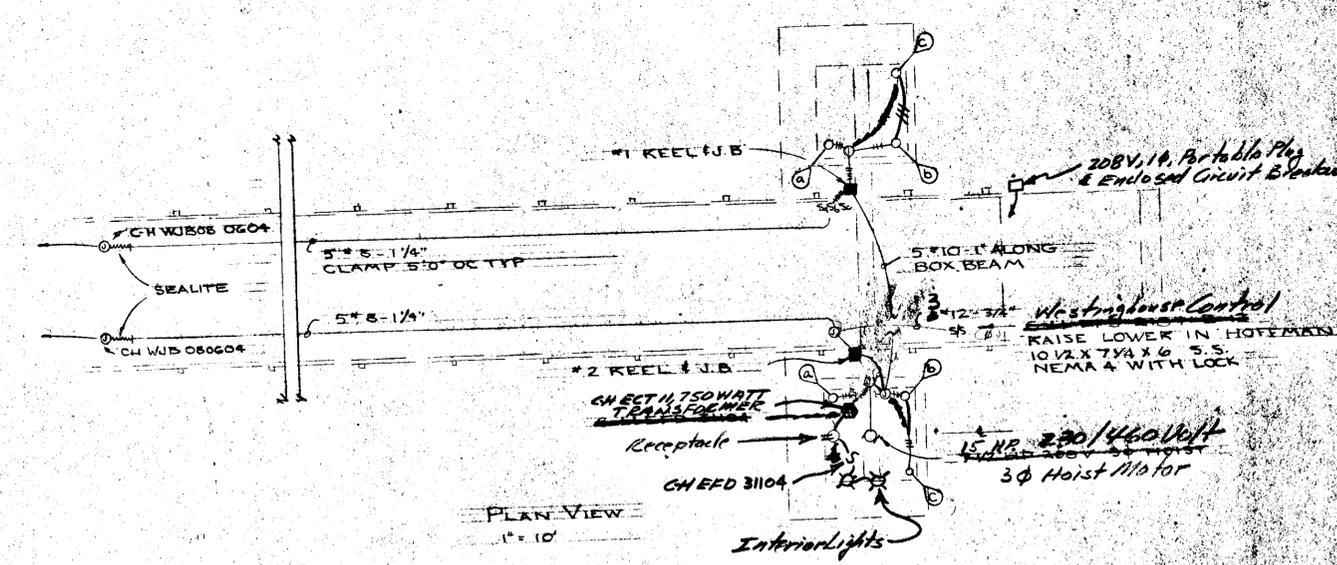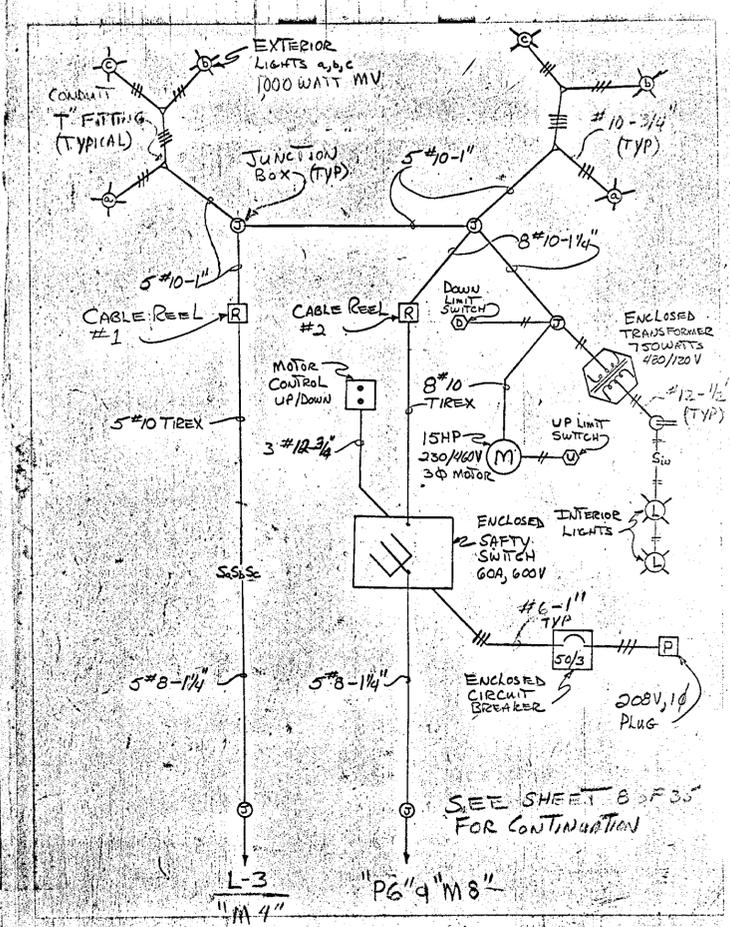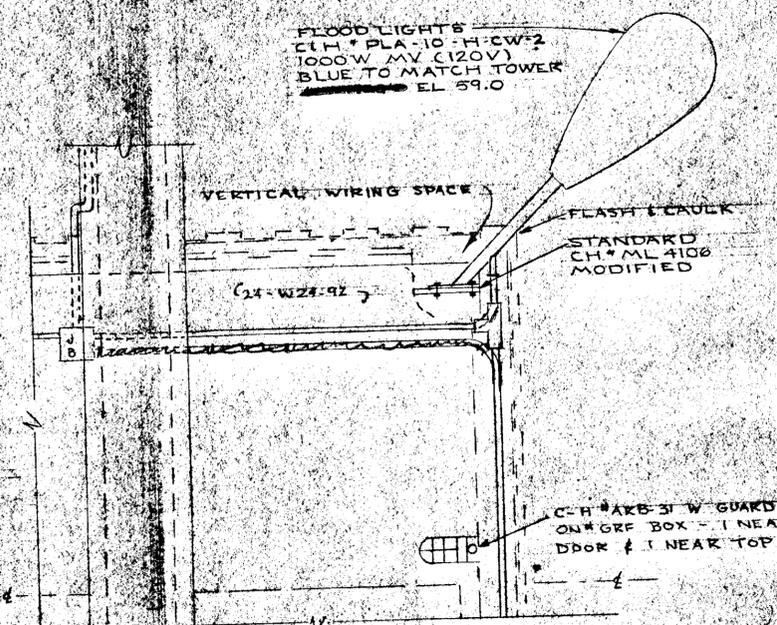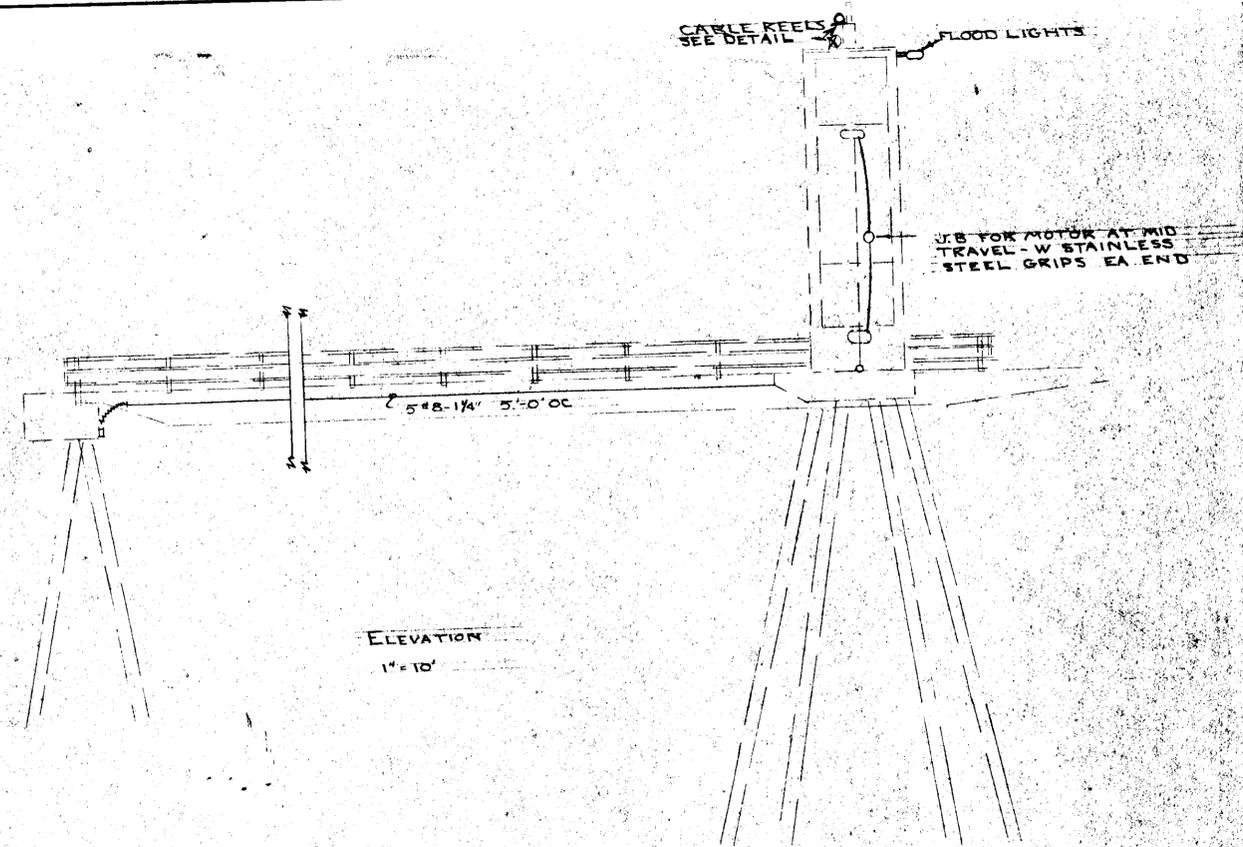


ALL ELECTRICAL MATERIALS SPECIFIED ARE TO BE SUPPLIED BY AN EQUAL OR BETTER PRODUCT. MAX. BE USED.

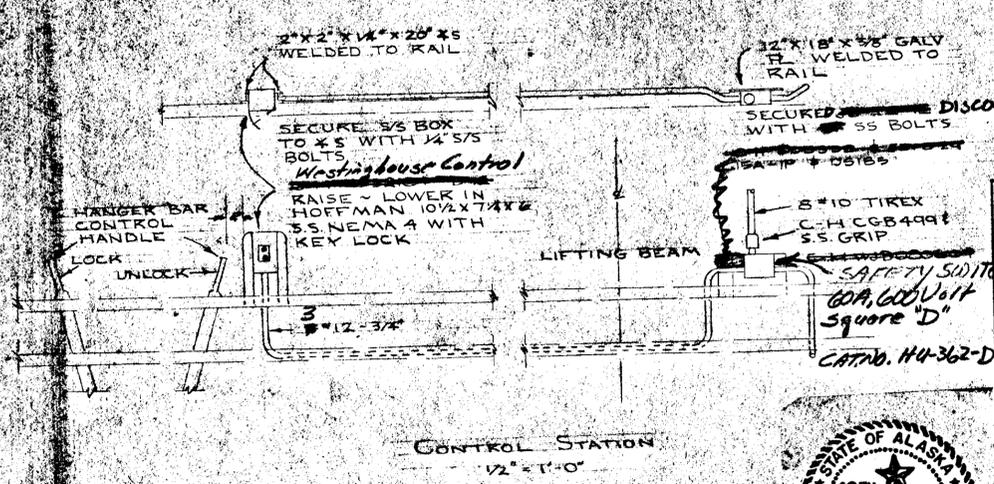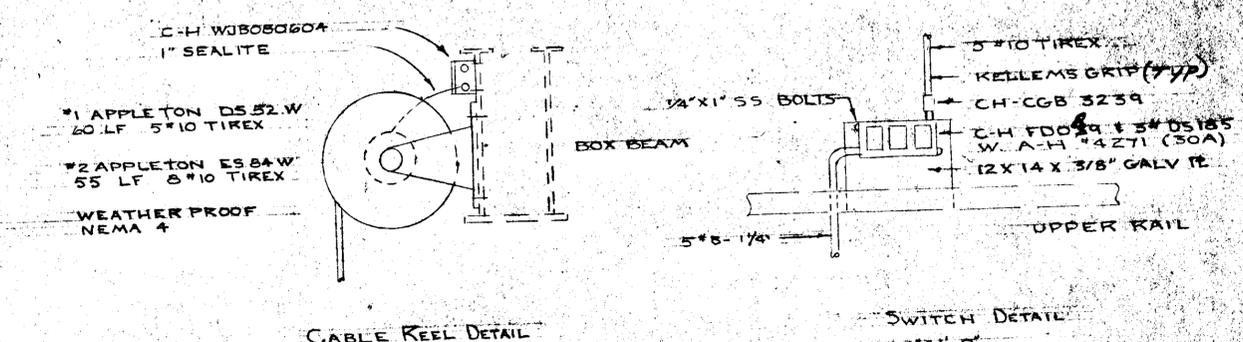

Note: Reels mounted on top of Box Beam on 2" x 2" Ls Ketchikan Side Only.



KETCHIKAN FERRY TERMINAL
ELECTRICAL DETAILS

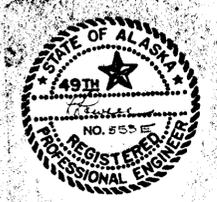







State of Alaska
DEPARTMENT OF HIGHWAYS
Juneau, Alaska

Date _____ Approved _____

BRIDGE NO. 175
DWG. NO. 2611

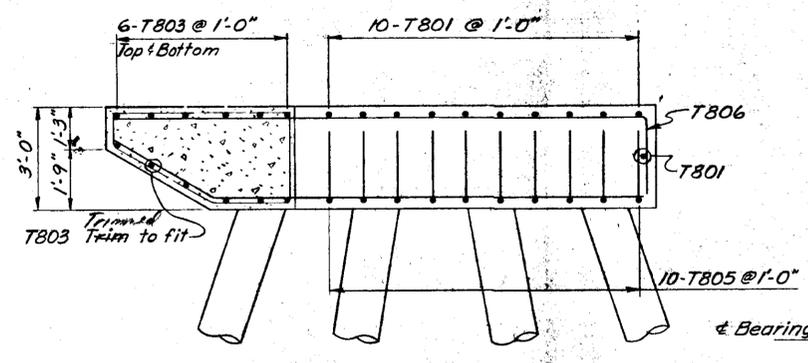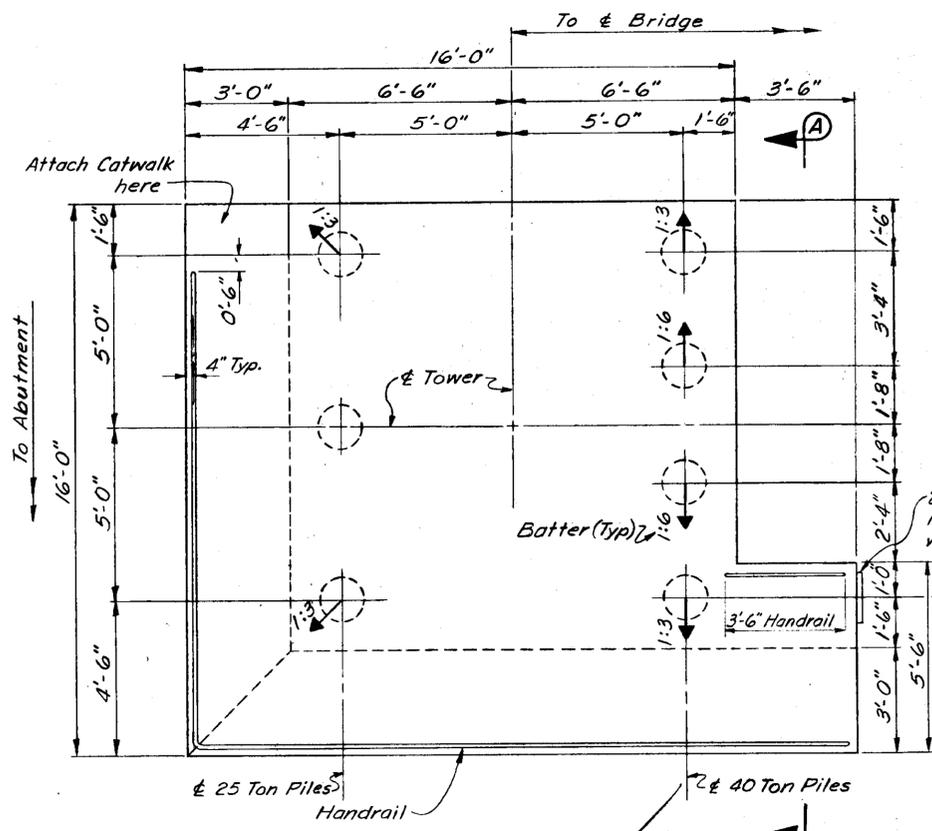



2" Elastomeric Pad (60 Durometer)
1'-6" x 1'-6" Fasten to tower base
with 4-3/8" x 1'-6" Anchor bolts.
(Pad 1'-0" from top of tower base)

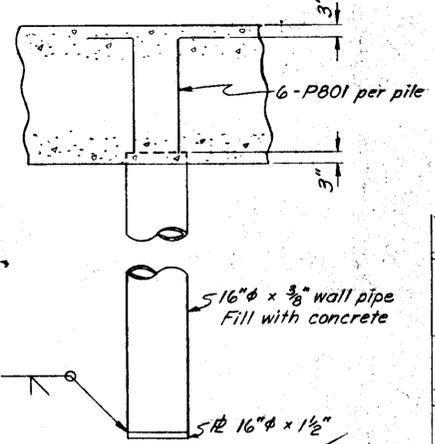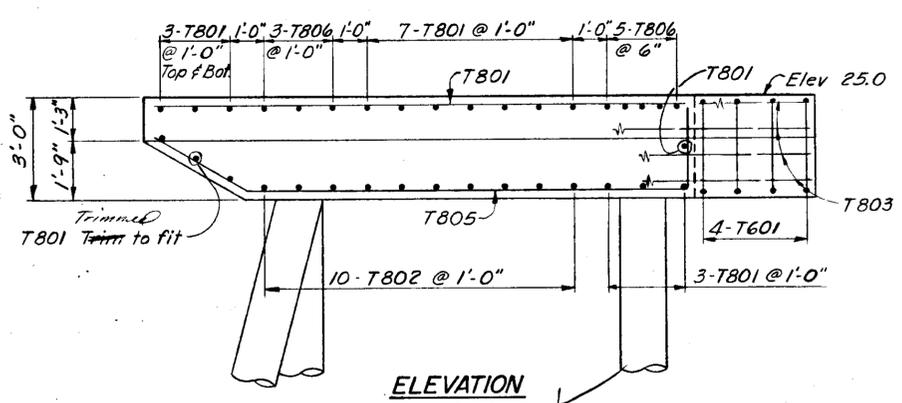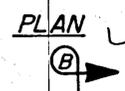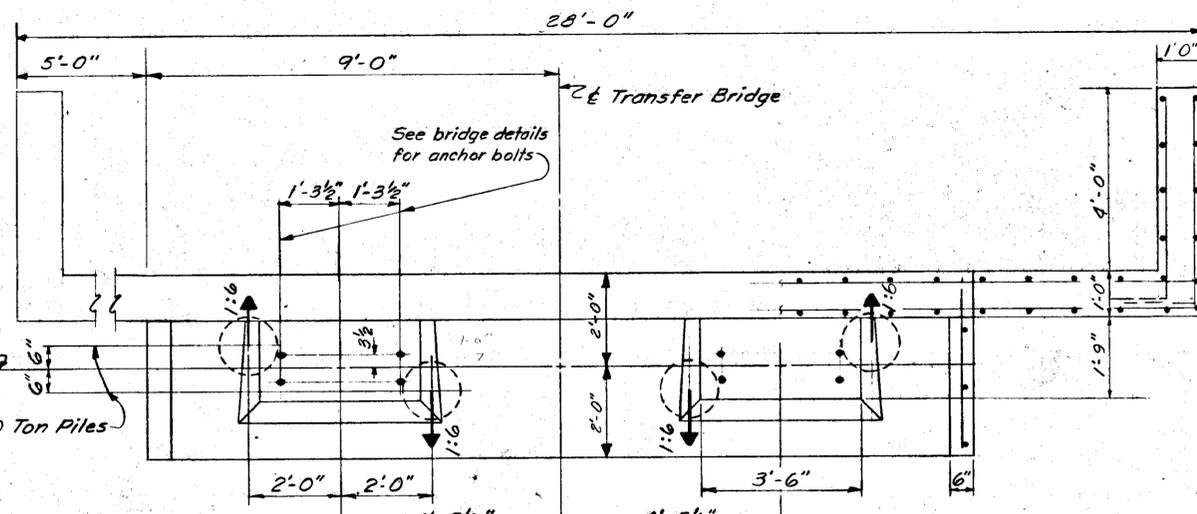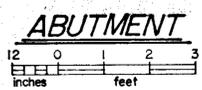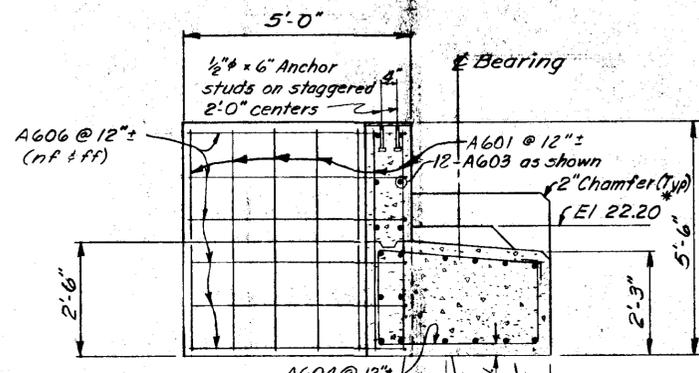

PILE TIP ELEVATIONS		
	Max.	Min.
Abutment	-47	-43
30 Ton Piles	-40	0-0
Tower	-63	-48
25 Ton Piles	-40	-25.0
40 Ton Piles	-50.0	-25.0
	-6.4	-50.0
Safety Bent	-47	-42
20 Ton Piles	-50.0	30.0

REINFORCING STEEL						
Location	Mark	No.	Size	Length	Type	Bending Diagrams
Tower Base	T601	8	6	14'-9"	Bent	3'-6" 12'-6"
	T801	56	8	15'-6"		T802
	T802	20		16'-0"	Bent	3'-6" 12'-6"
	T803	24		19'-0"		T805
	T805	20		18'-0"	Bent	15'-6"
	T806	16	8	17'-6"	Bent	2'-0"
Abut.	A601	72	6	5'-0"		5'-0" 6"
	A602	8		3'-6"		2'-9" 12'-3"
	A603	12		27'-6"		T601
	A604	18		11'-5"	Bent	3'-6" 4"
	A605	6		3'-6"		A604
	A606	24	6	6'-6"	Bent	4'-6"
Piles	P801	108	8	10'-0"	Bent	9'-0"
	P801					1'-0" 2'-0"
Counterweight	C501	86	5	25'-0"	Bent	4'-0" 8'-0"
	C801	16	8	6'-9"		C501
	C501A	4	5	15'-0"		









* Note: Top of Deck R_2 will be approx. 0.10' above backwall when bridge is level.
All resteel ~~shall have~~ ^{has} minimum concrete cover of 3" clear.

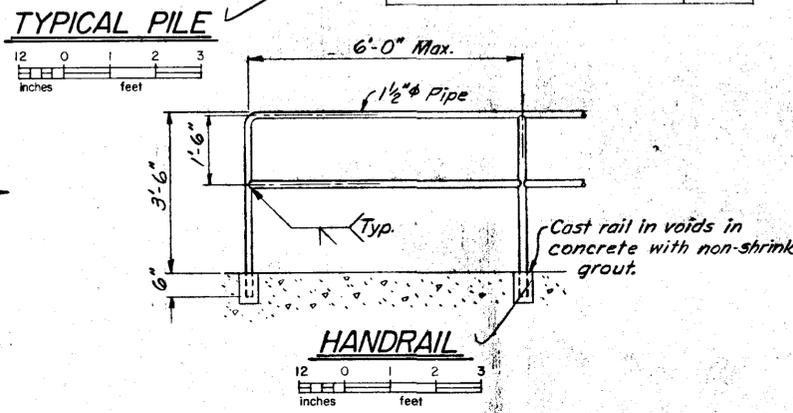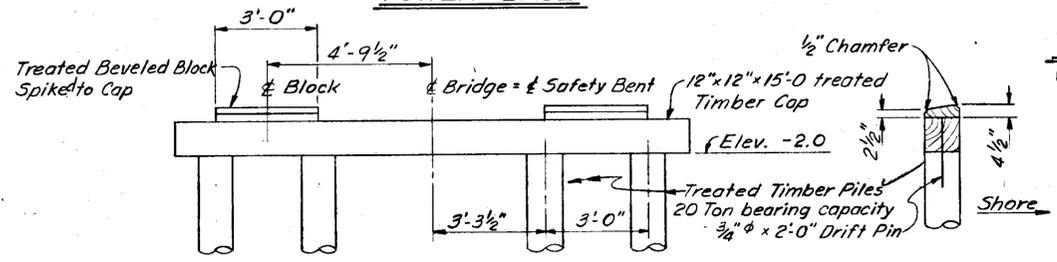


KETCHIKAN FERRY TERMINAL
SUBSTRUCTURE

State of Alaska
DEPARTMENT OF HIGHWAYS
Juneau, Alaska

STATE	PROJECT DESIGNATION	YEAR	SHEET NO.	TOTAL SHEETS
ALASKA	F-095-2(9) A.D.A.P. 8-02-0144-03	1972	12	35

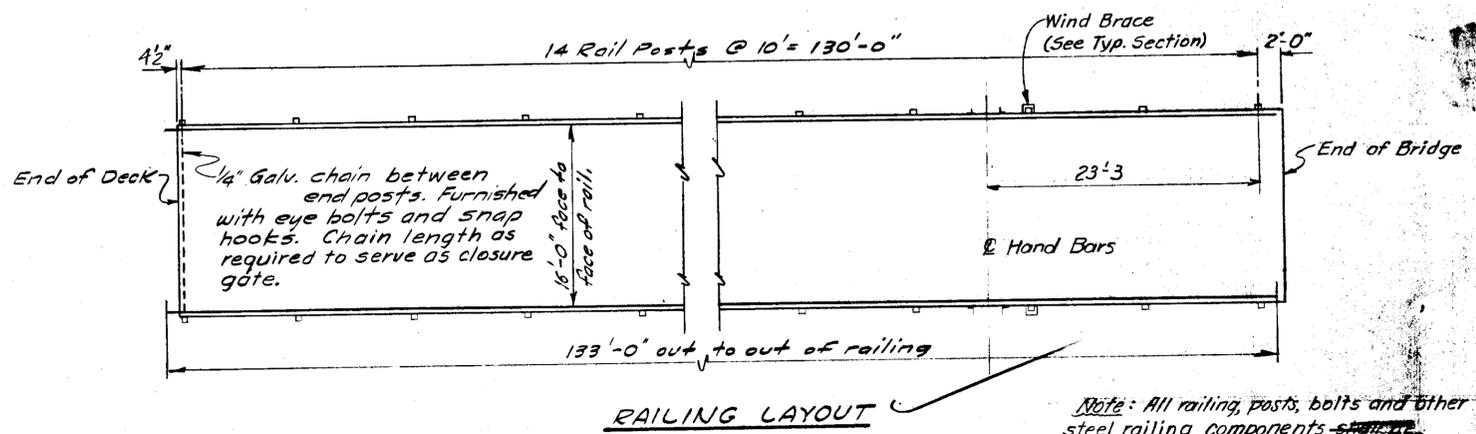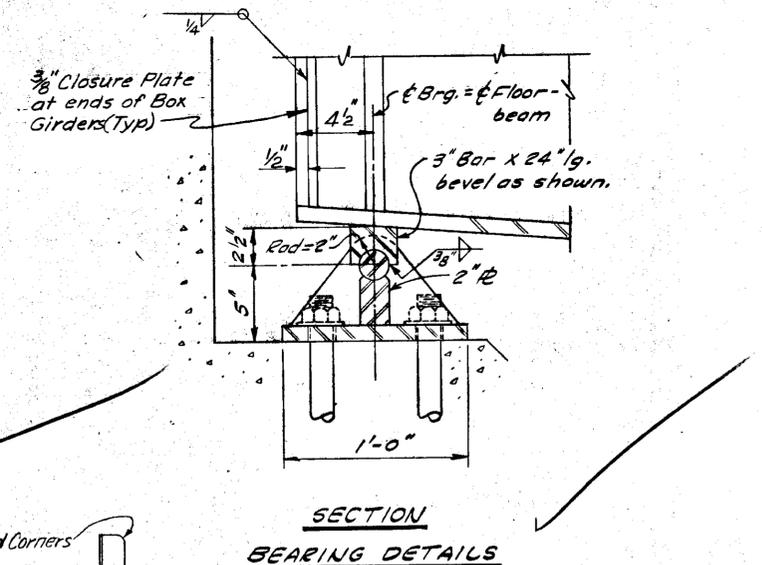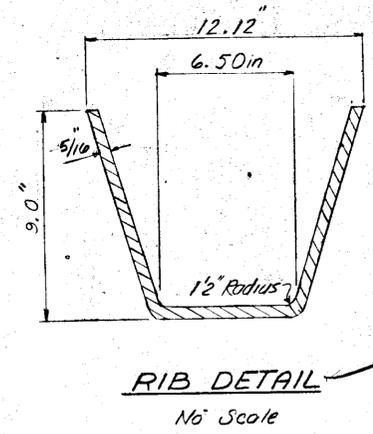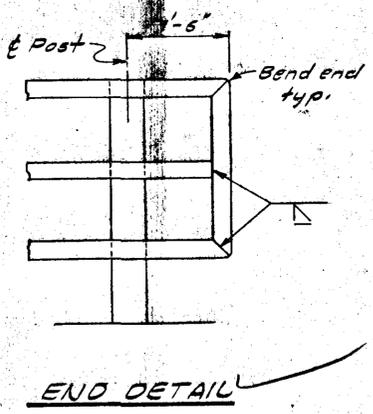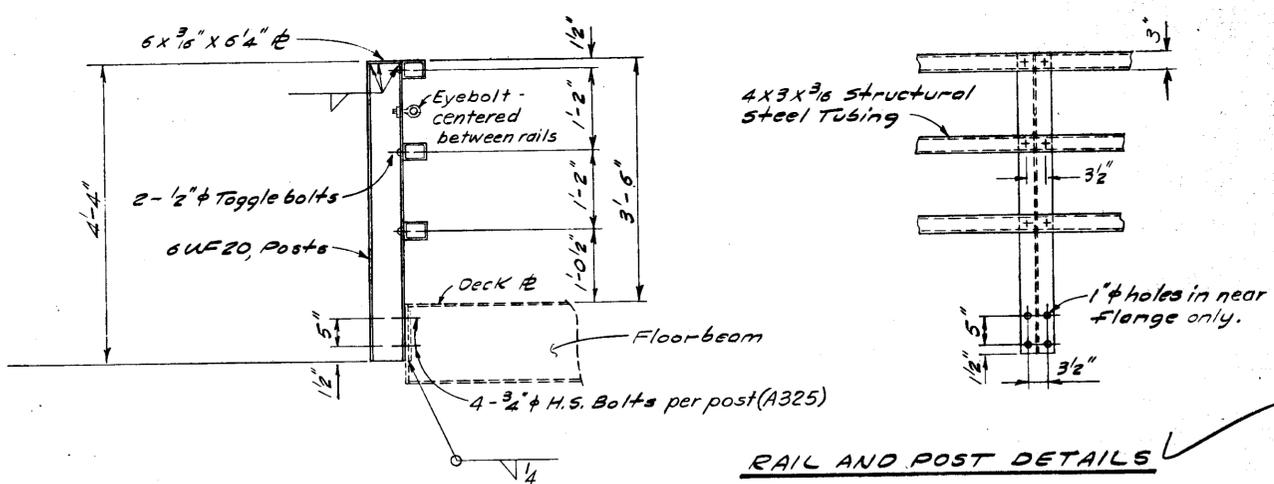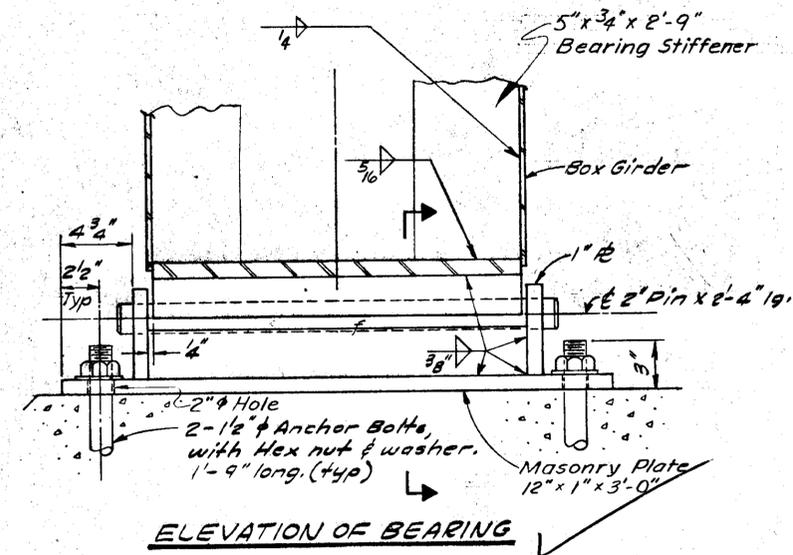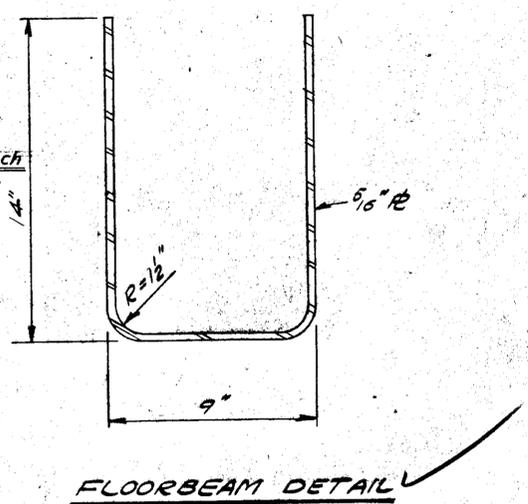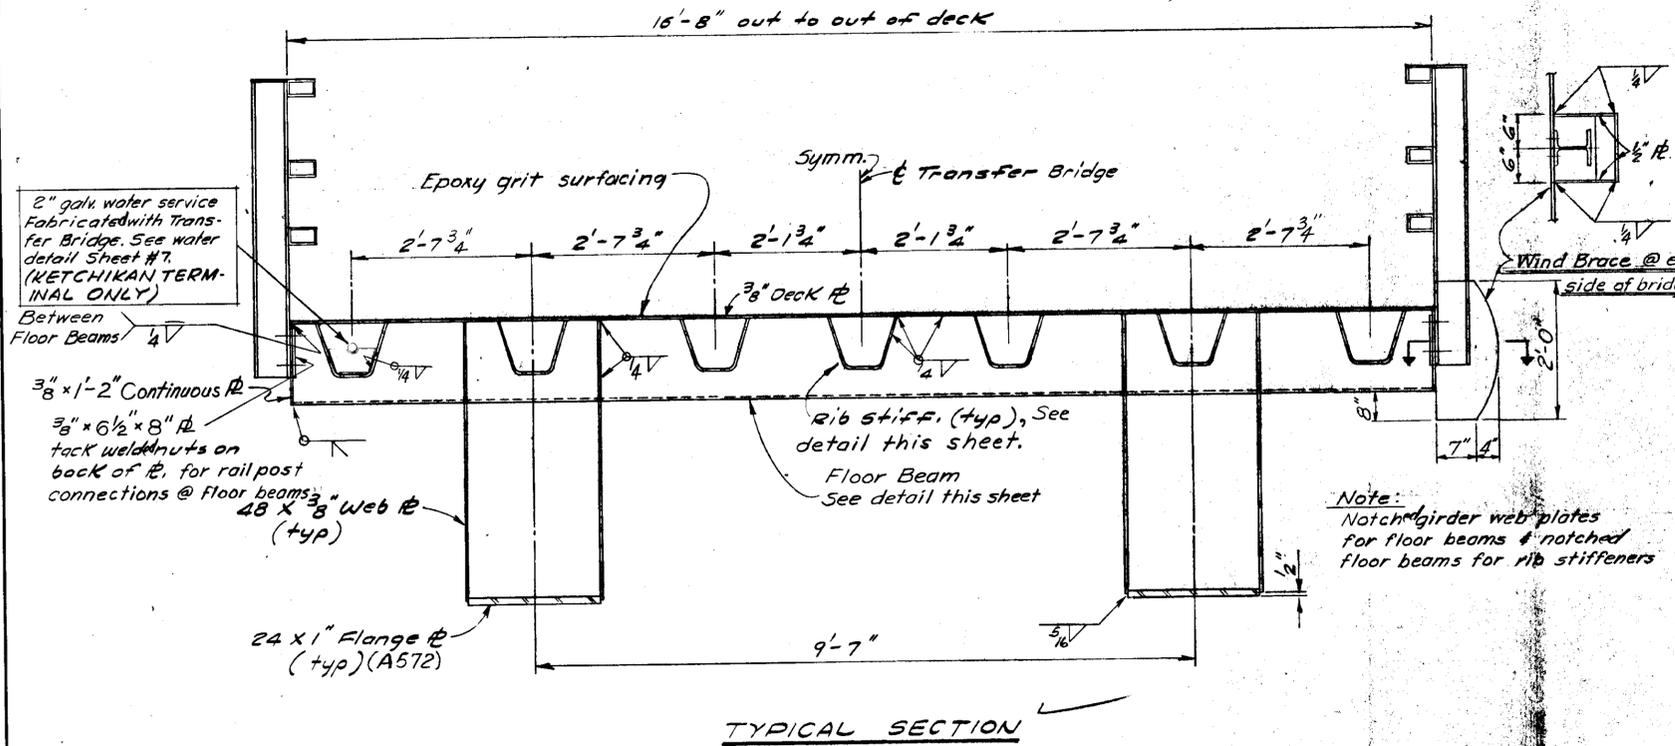

Note: All railing, posts, bolts and other steel railing components shall be galvanized after fabrication.

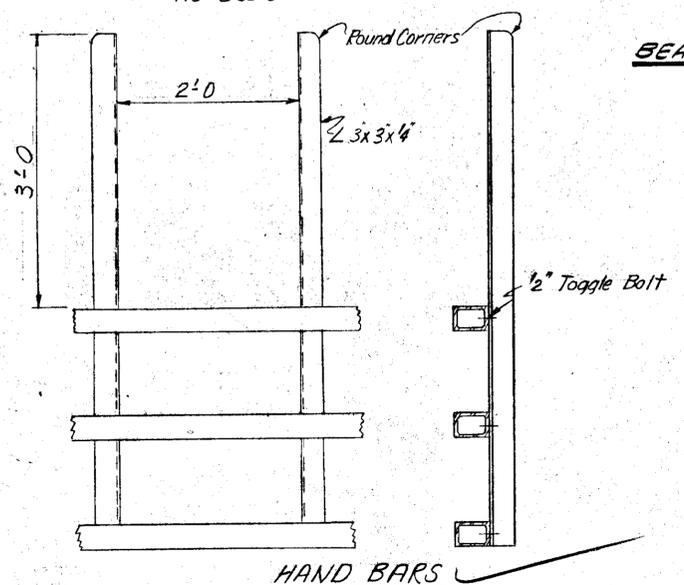

BRIDGE DETAILS










State of Alaska
DEPARTMENT OF HIGHWAYS
Juneau, Alaska

BRIDGE NO. 175
DWNG. NO. 2613

Date 8-2-72
Approved [Signature]

Checked by: KEM Date: 11-72
Drawn by: KEM Date: 11-72
Traced by: KEM Date: 11-72

STATE	PROJECT DESIGNATION	YEAR	SHEET NO.	TOTAL SHEETS
ALASKA	F-095-2(9) A.D.A.P. 8-02-0144-03	1972	13	35

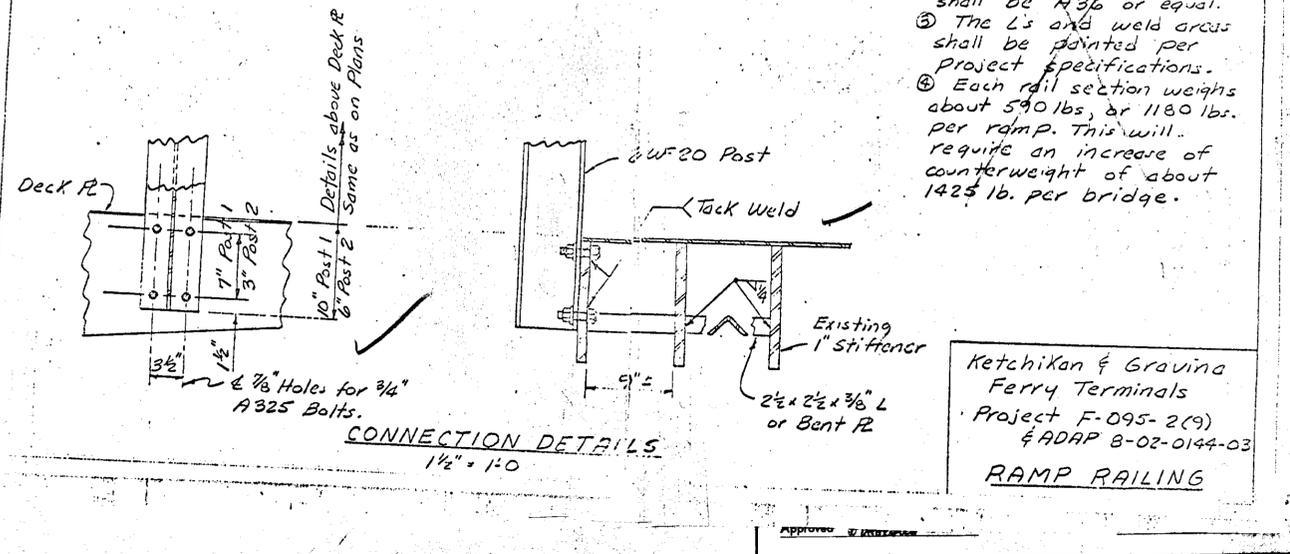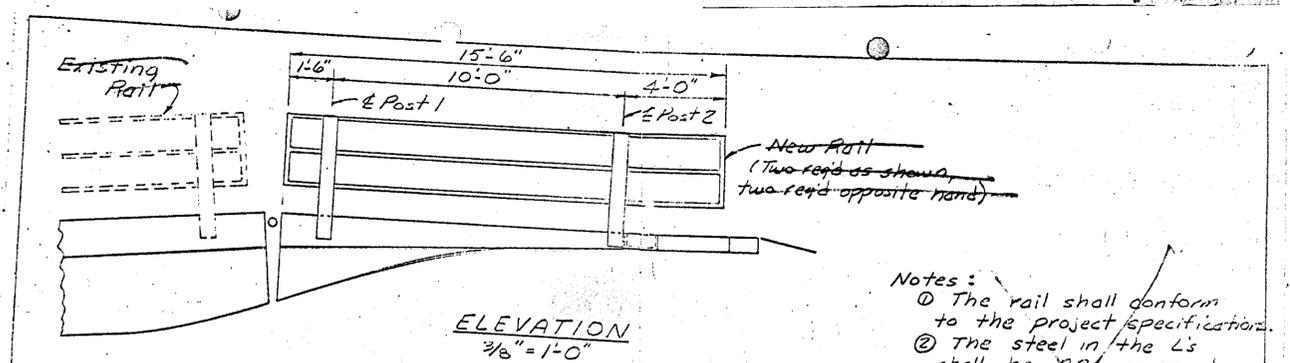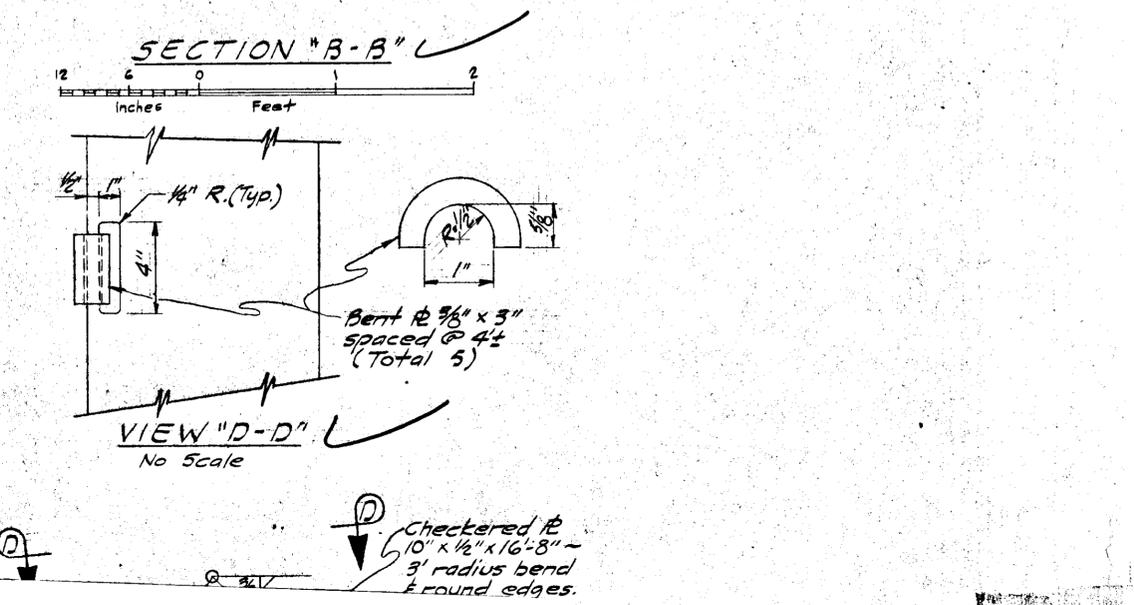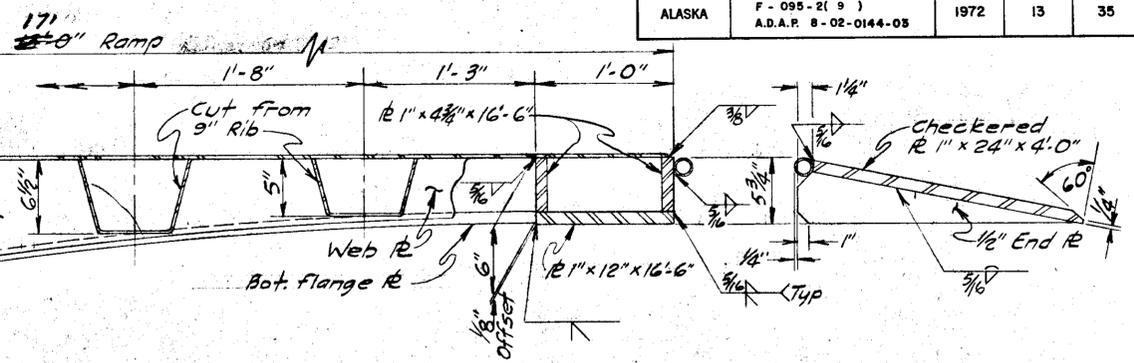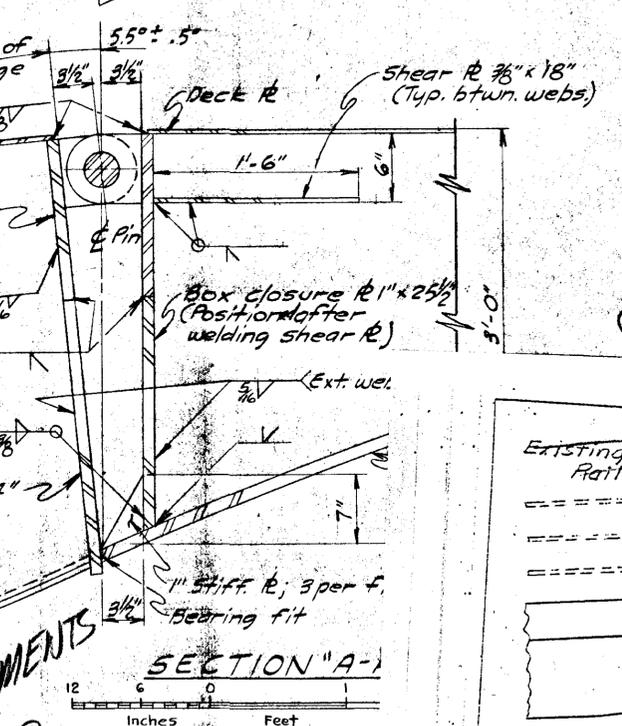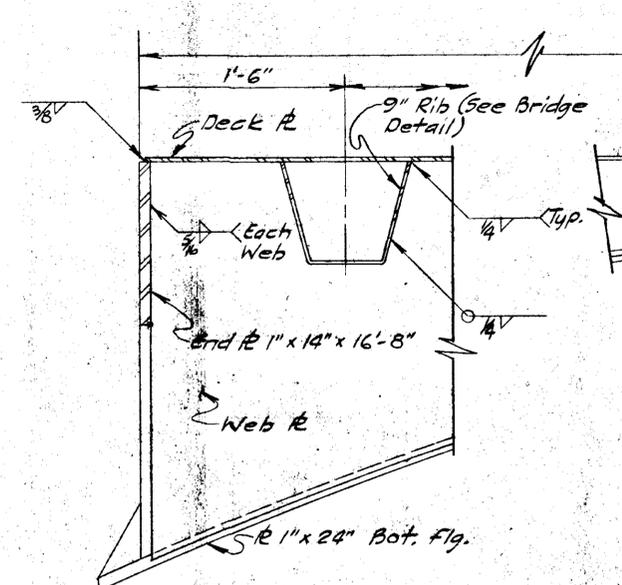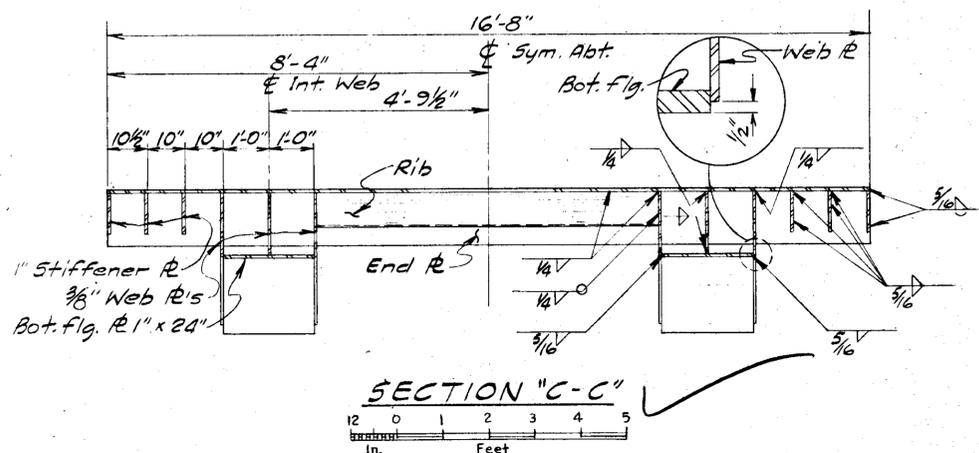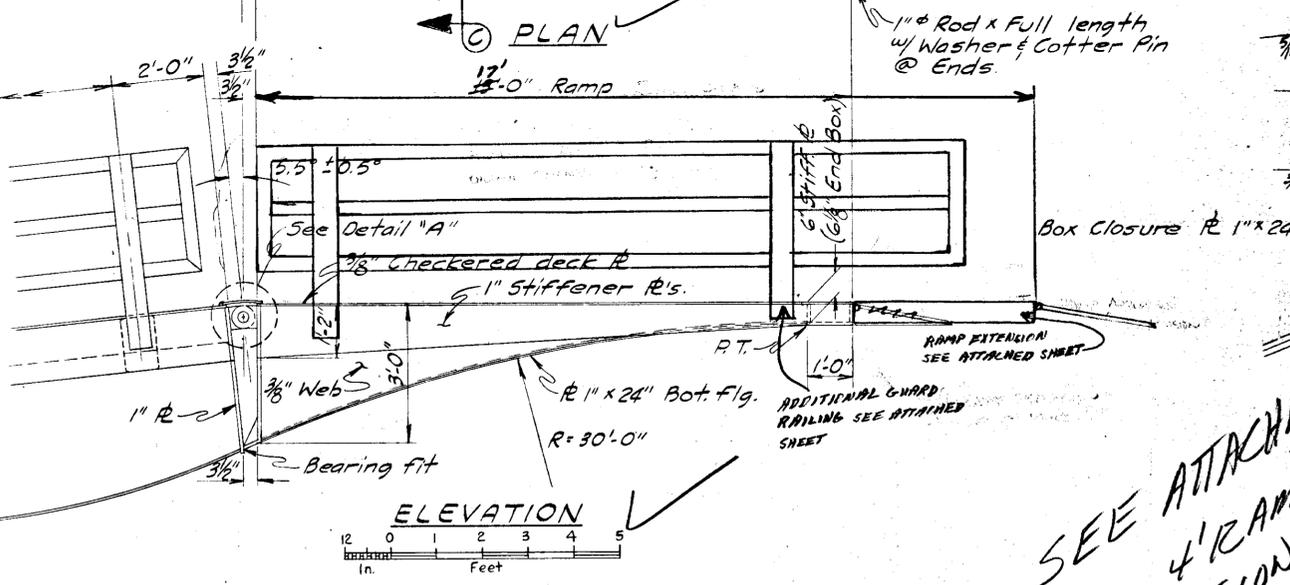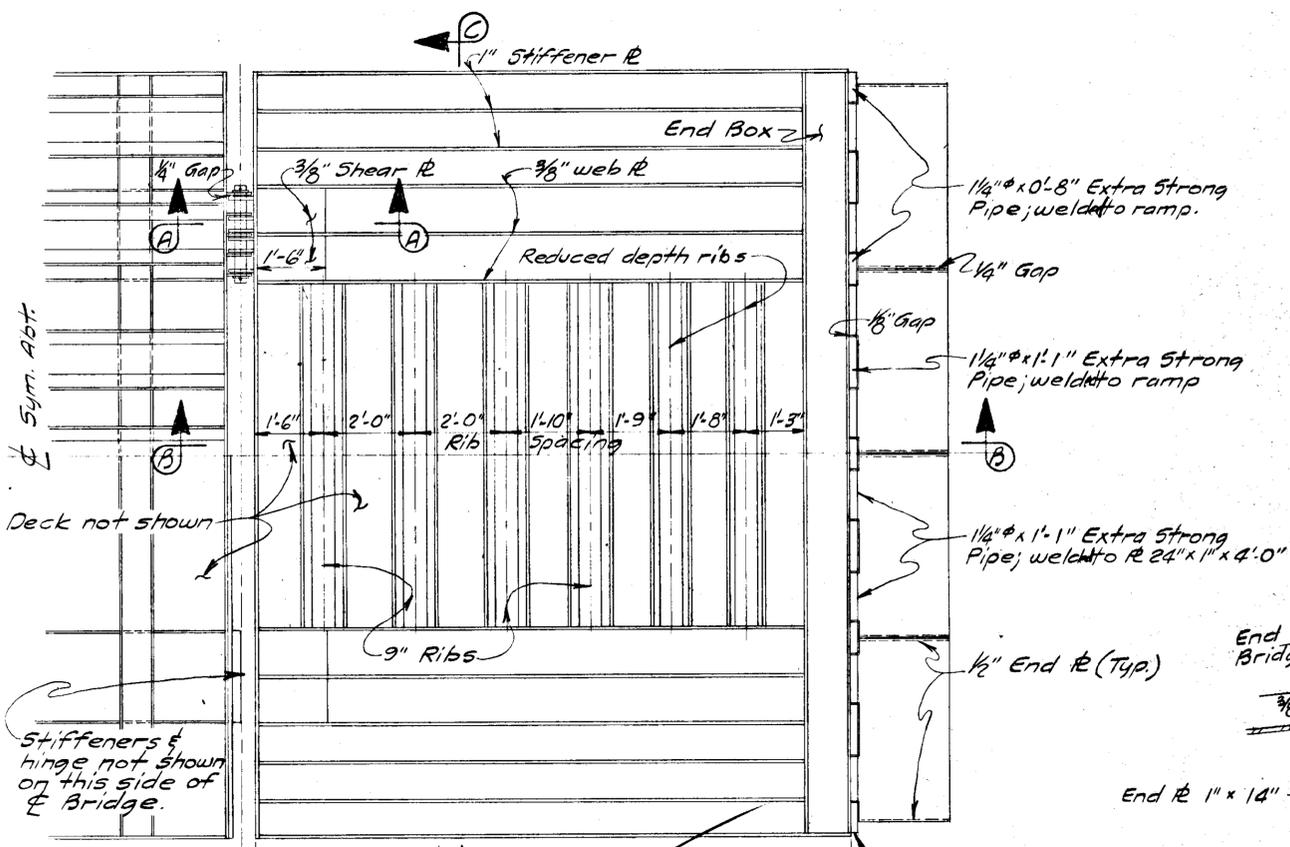


SEE ATTACHMENTS FOR 4' RAMP EXTENSION & ADDITIONAL RAMP RAIL DETAILS


- Notes:
- The rail shall conform to the project specifications.
 - The steel in the L's shall be A36 or equal.
 - The L's and weld areas shall be painted per project specifications.
 - Each rail section weighs about 590 lbs, or 1180 lbs. per ramp. This will require an increase of counterweight of about 1425 lb. per bridge.

Ketchikan & Gravina Ferry Terminals
Project F-095-2(9)
& ADAP 8-02-0144-03
RAMP RAILING


STATE	PROJECT DESIGNATION	YEAR	SHEET NO.	TOTAL SHEETS
ALASKA	F - 095 - 2 (9) A.D.A.R 8-02-0144-03	1972	14	35

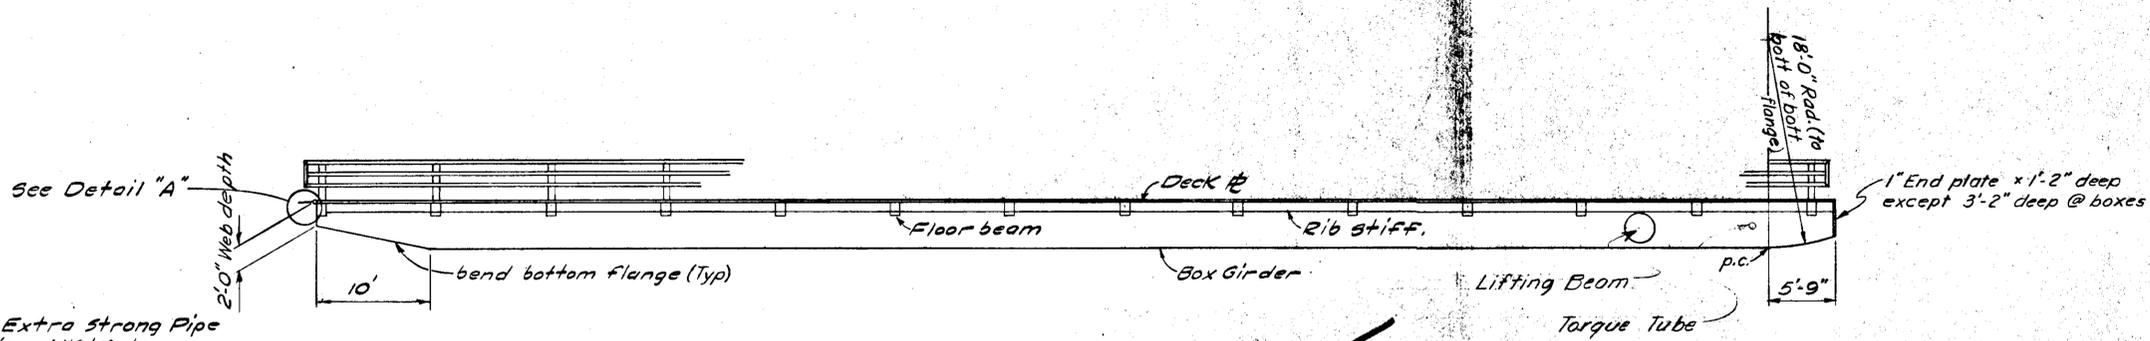


INTERIOR SECTION

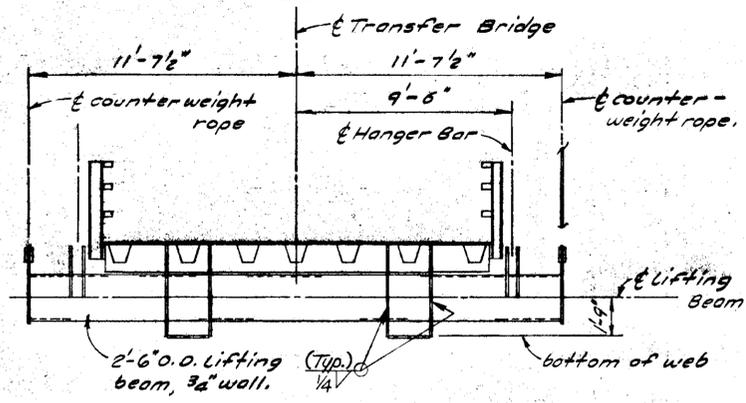


SECTION B-B

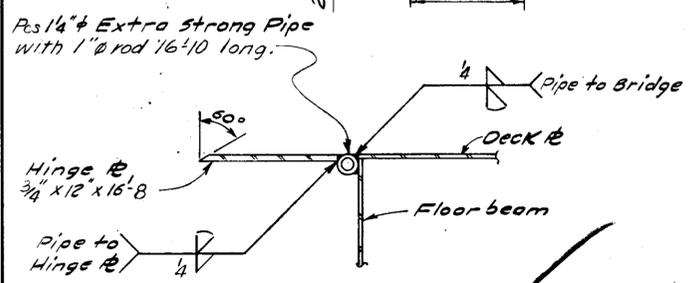


DETAIL "A"

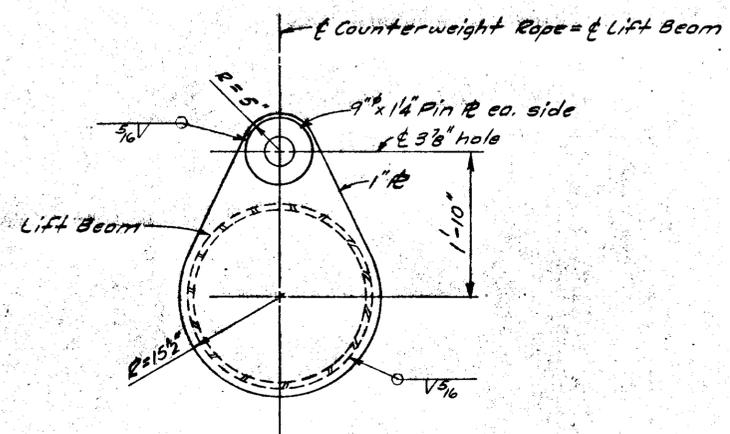

VIEW C-C

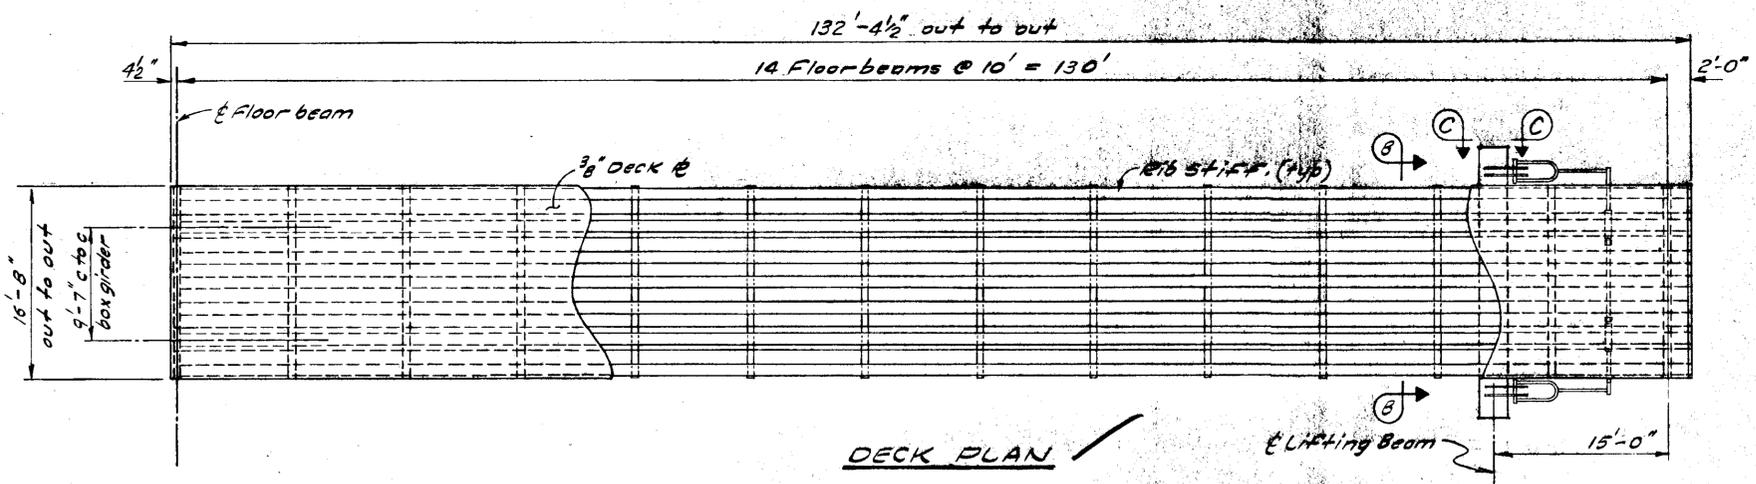

DECK PLAN

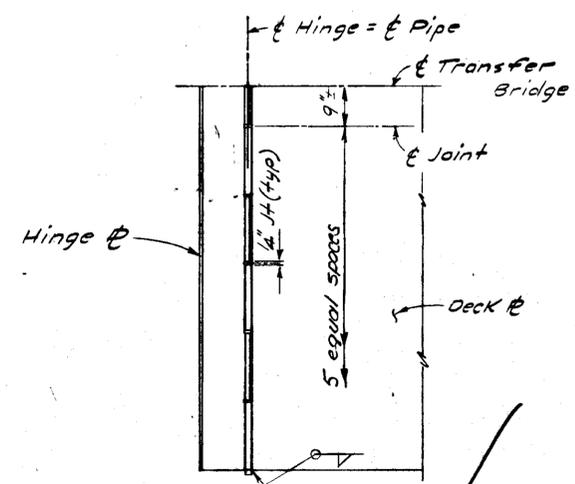

HALF PLAN AT HINGE

TRANSFER BRIDGE

State of Alaska
DEPARTMENT OF HIGHWAYS
 Juneau, Alaska










Date 8-2-72
 Approved [Signature]



BRIDGE NO. 175
 DWNG. NO. 2615

Drawn By: K.F.H. Date: 11-71
 Checked By: K.F.H. Date: 11-71
 Traced By: Date:

STATE	PROJECT DESIGNATION	YEAR	SHEET NO.	TOTAL SHEETS
ALASKA	F-095-2(9) A.D.A.R. 8-02-0144-03	1972	15	35

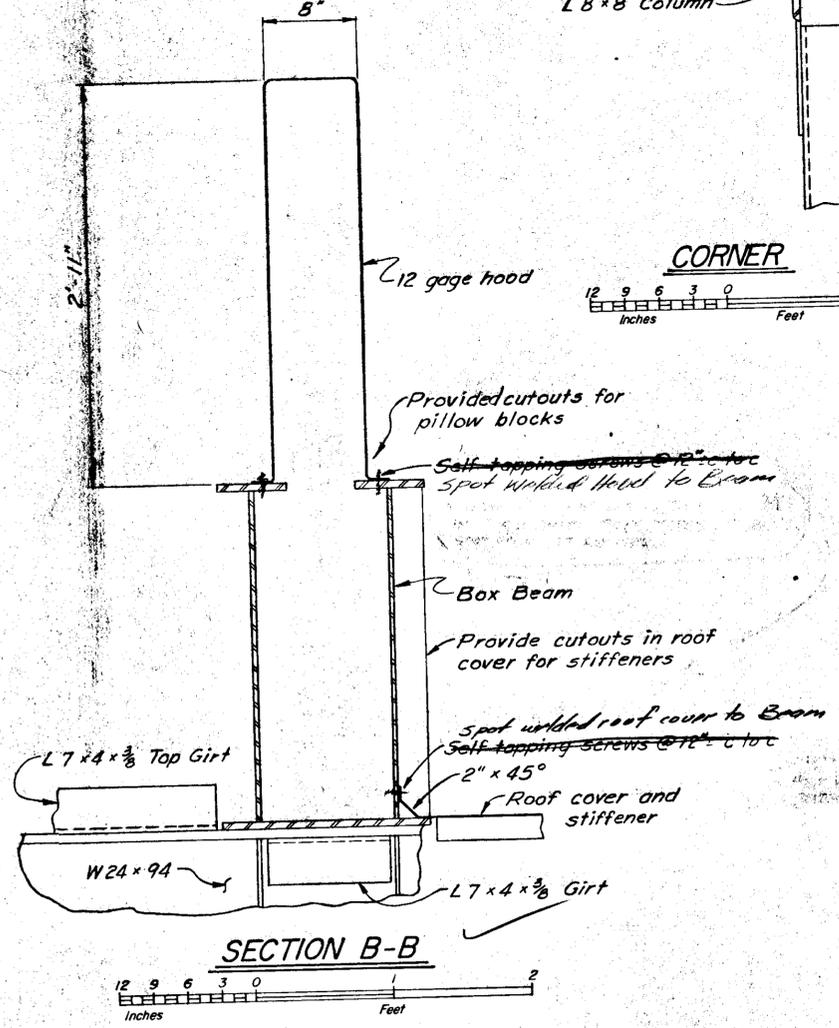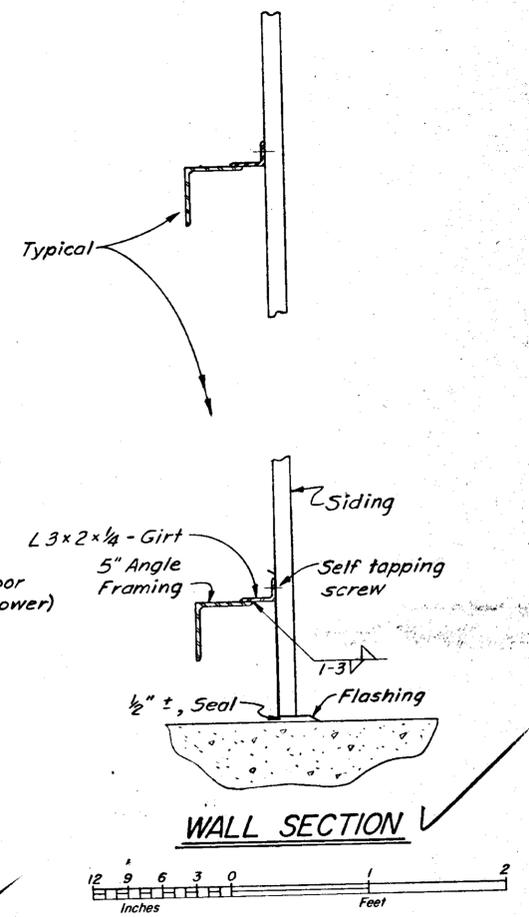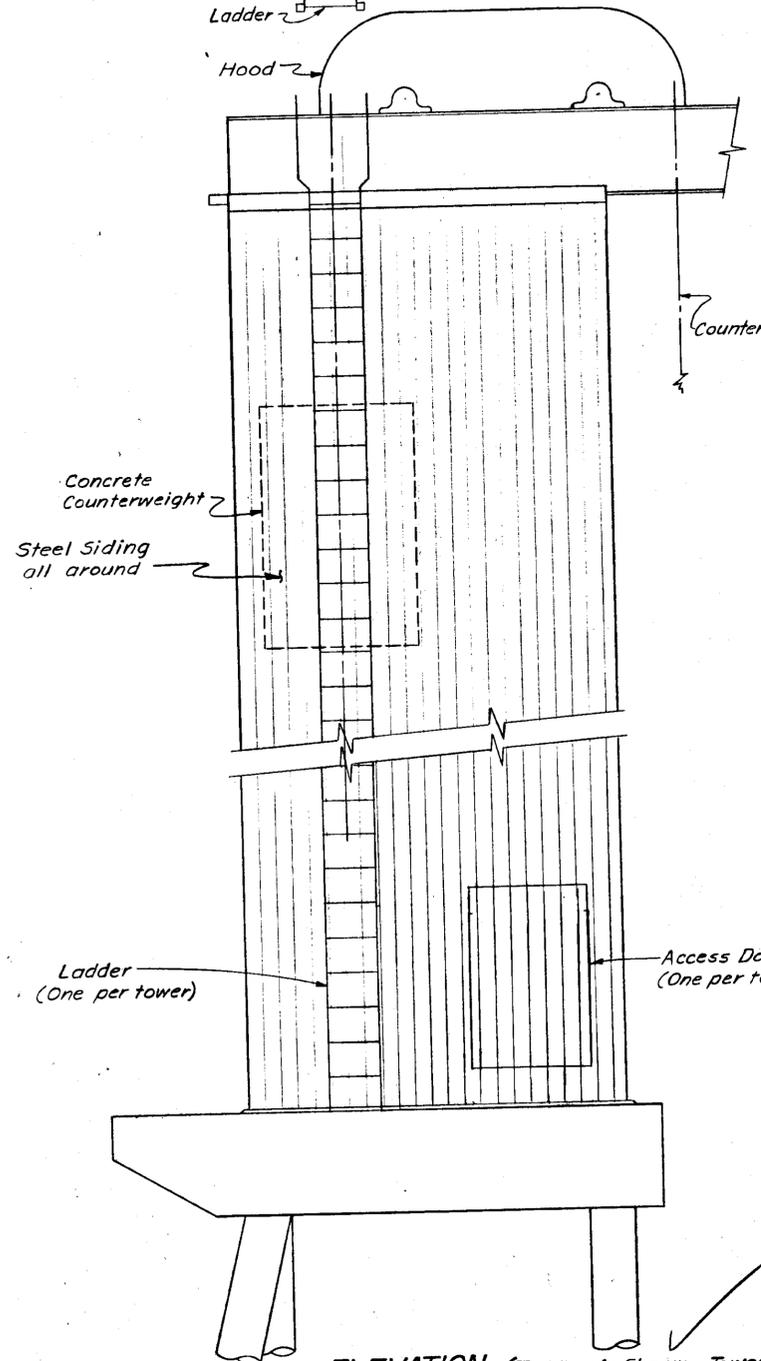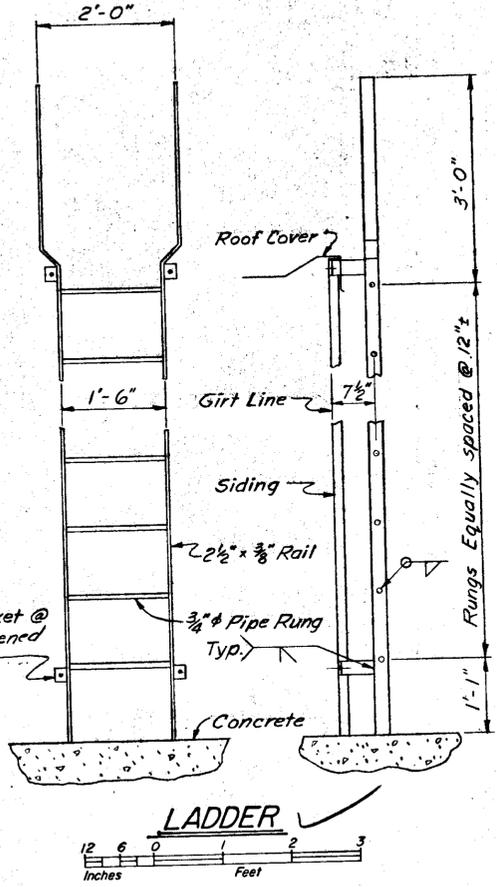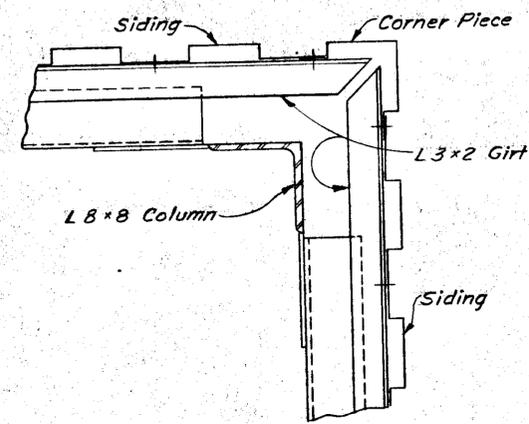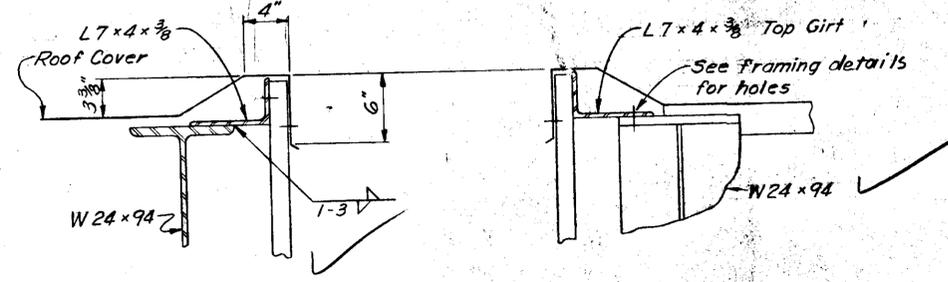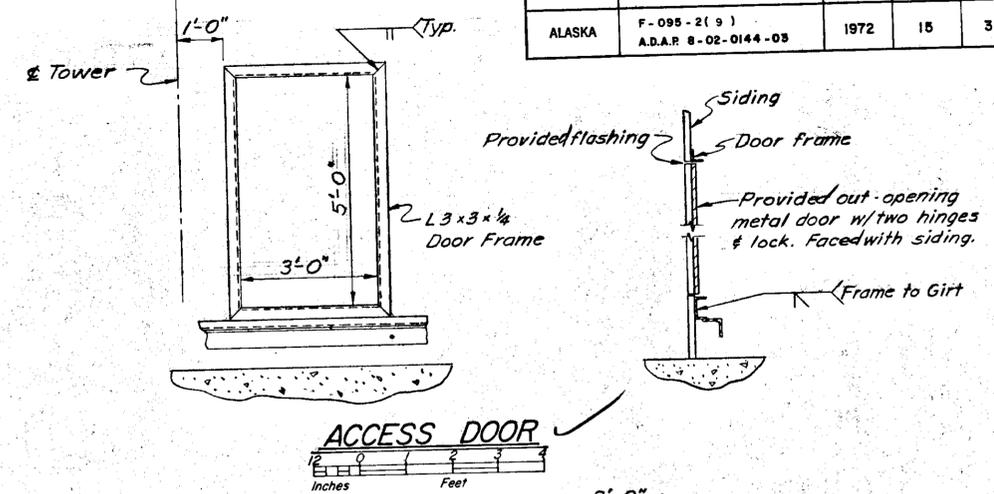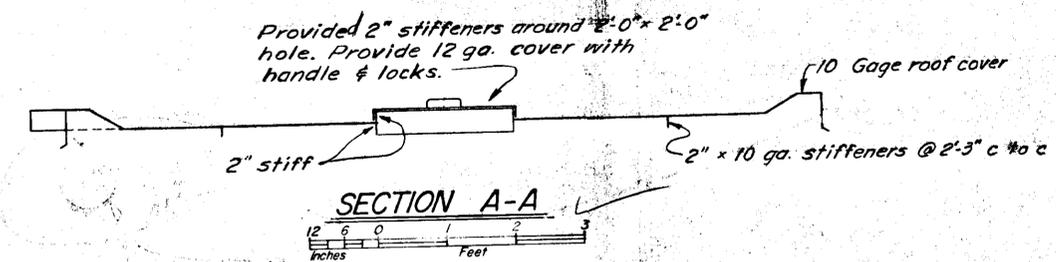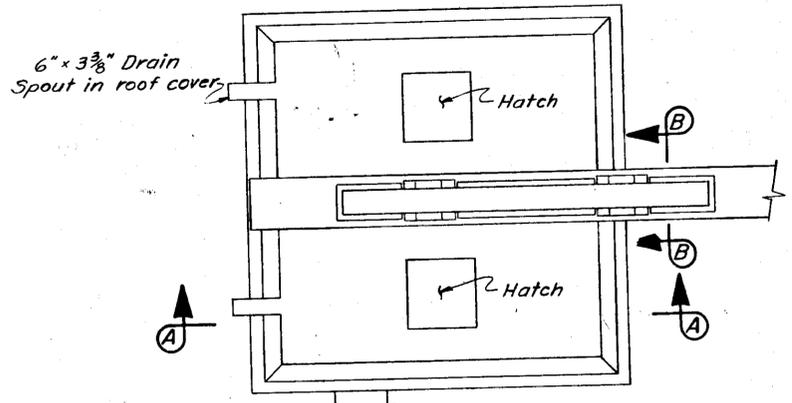

TOWER SHEATHING








State of Alaska
DEPARTMENT OF HIGHWAYS
Juneau, Alaska

Date 8-2-72
Approved [Signature]

BRIDGE NO. 175
DWNG. NO. 2616

Checked By: KEM
 Date: 11-72
 Traced By: KEM
 Date: 11-72

STATE	PROJECT DESIGNATION	YEAR	SHEET NO.	TOTAL SHEETS
ALASKA	F-095-2(9) A.D.A.P. 8-02-0144-03	1972	16	35

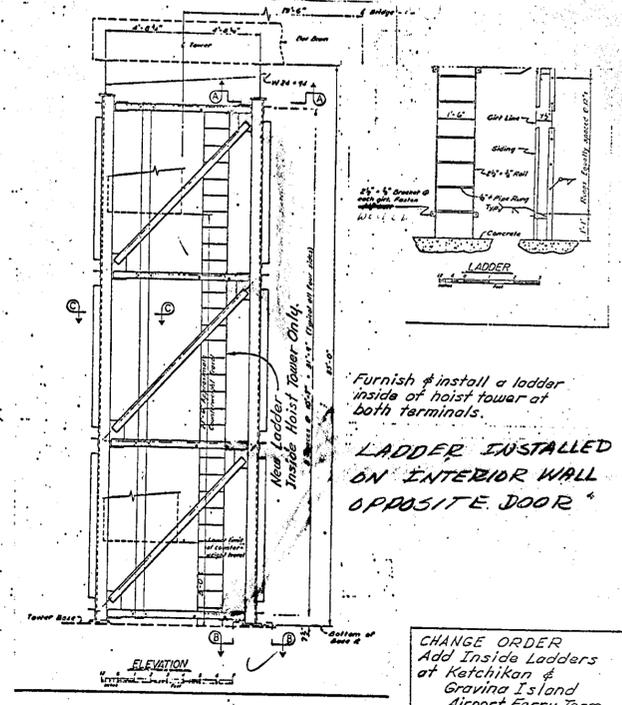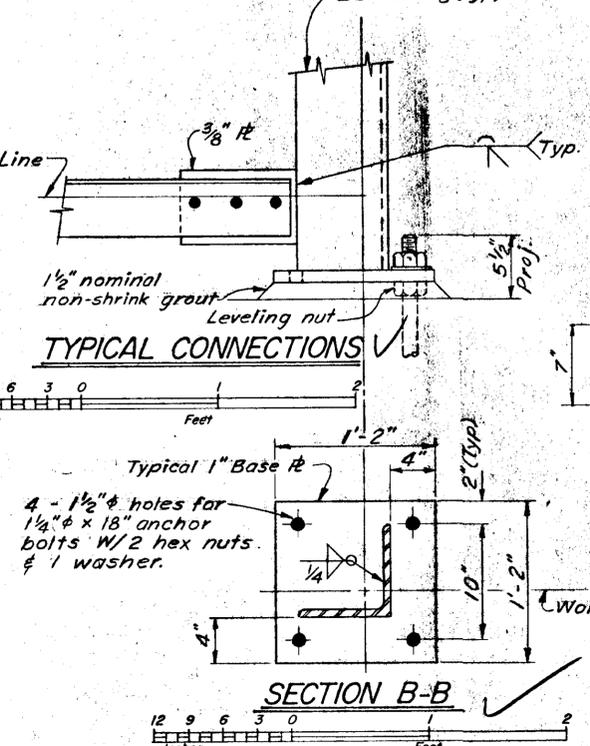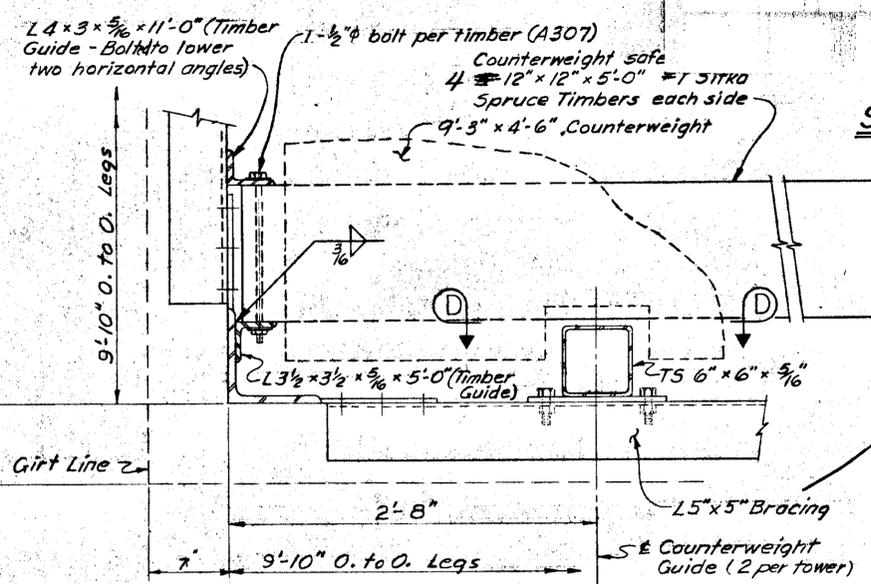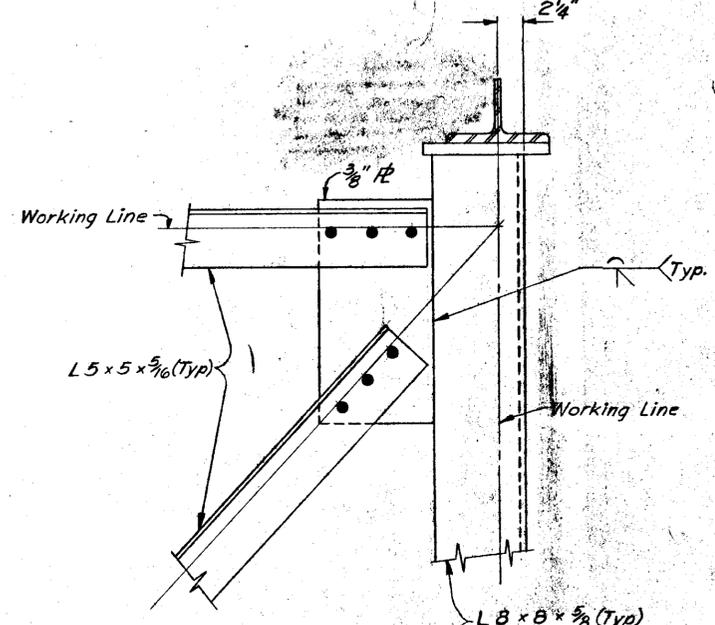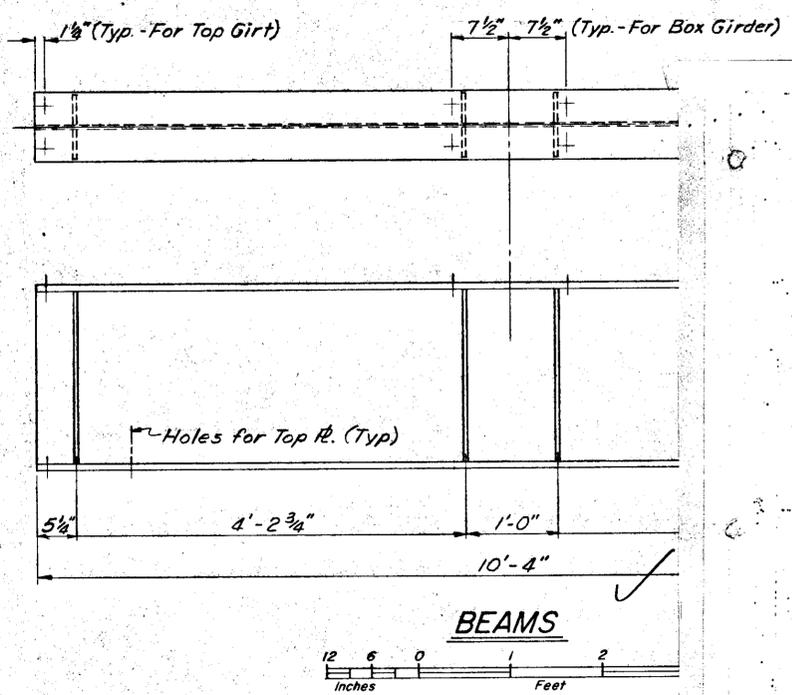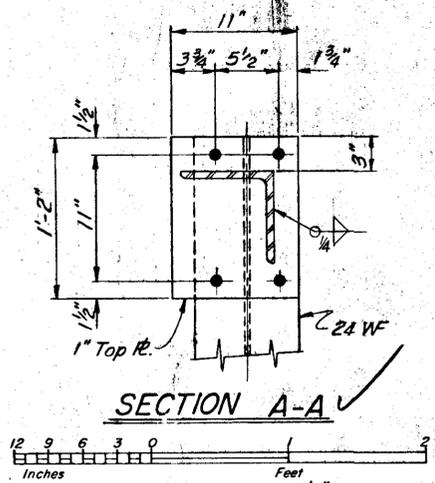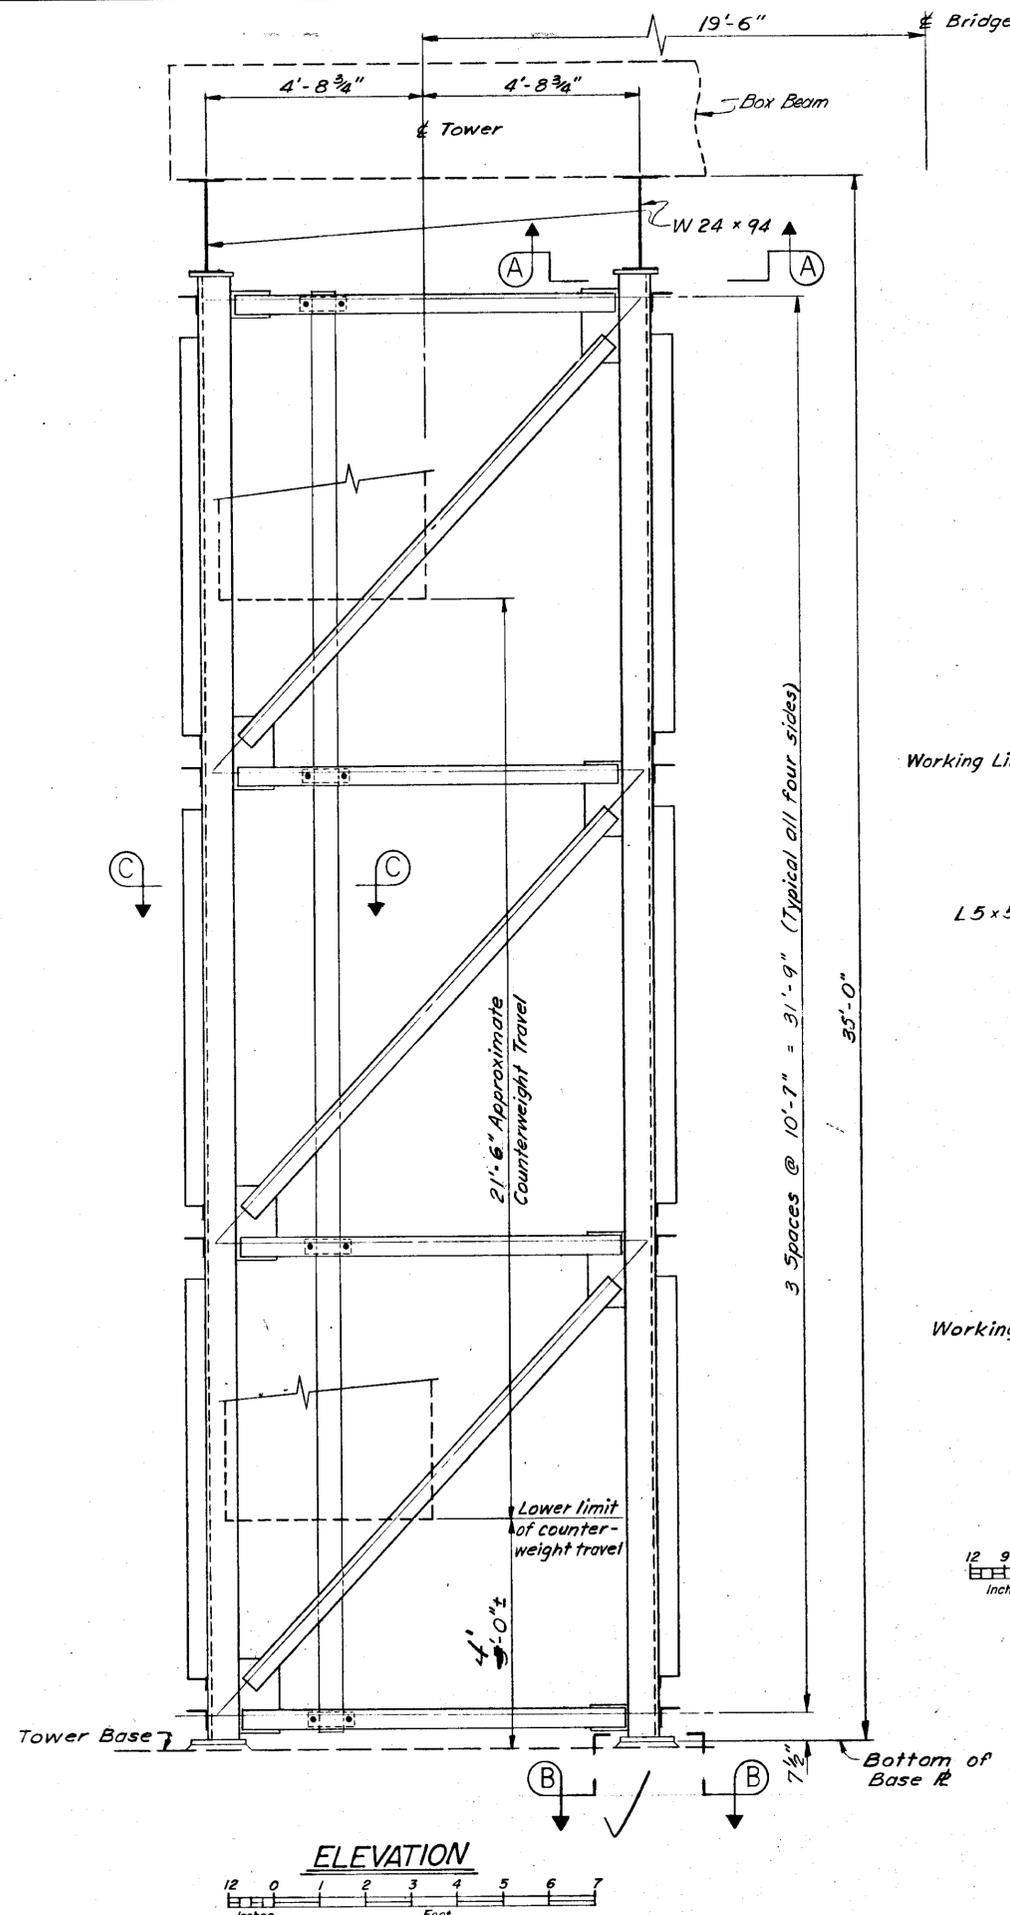

CHANGE ORDER
Add Inside Ladders
at Ketchikan &
Gravina Island
Airport Ferry Term.

SECTION D-D
(No Scale)

Note: All holes 7/8" phi for 3/4" phi A325 bolts unless otherwise noted.

TOWER FRAMING

State of Alaska
DEPARTMENT OF HIGHWAYS
Juneau, Alaska










Date 8-2-72
Approved [Signature]



BRIDGE NO. 175
DWNG. NO. 2617

Checked By: KEM Date: 11-71
Traced By: Date:

STATE	PROJECT DESIGNATION	YEAR	SHEET NO.	TOTAL SHEETS
ALASKA	F-095-2(9) A.D.A.P. 8-02-0144-03	1972	17	35

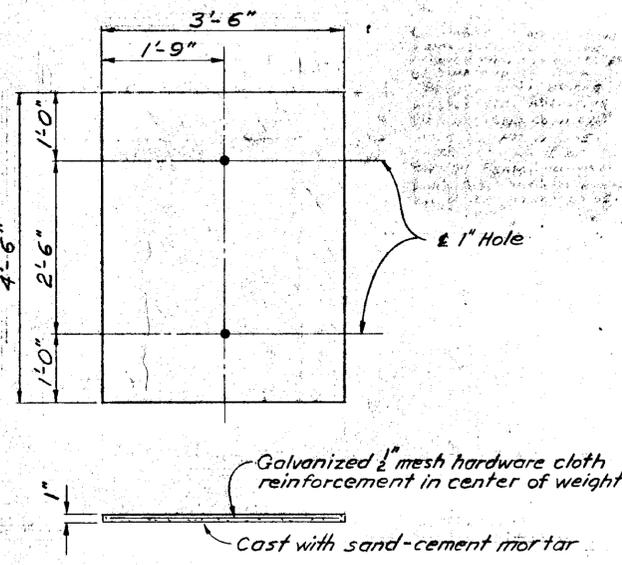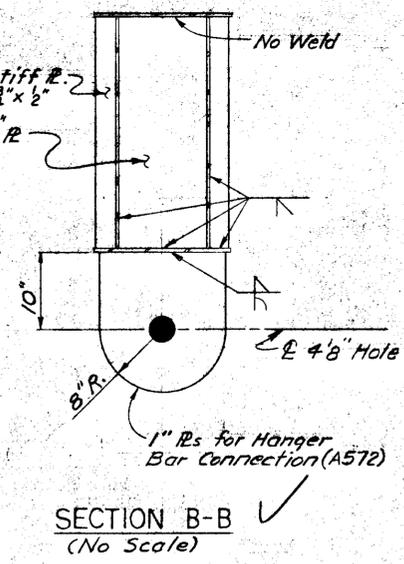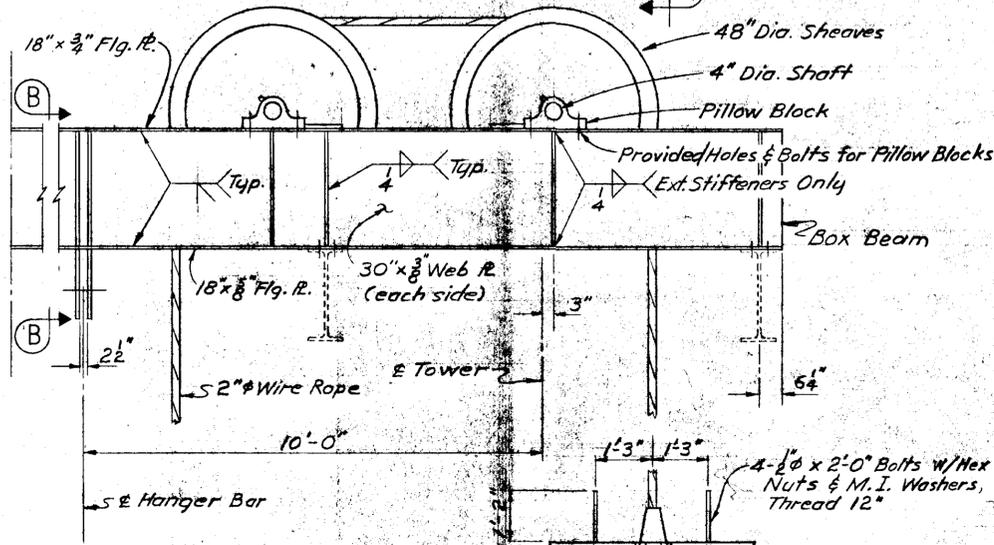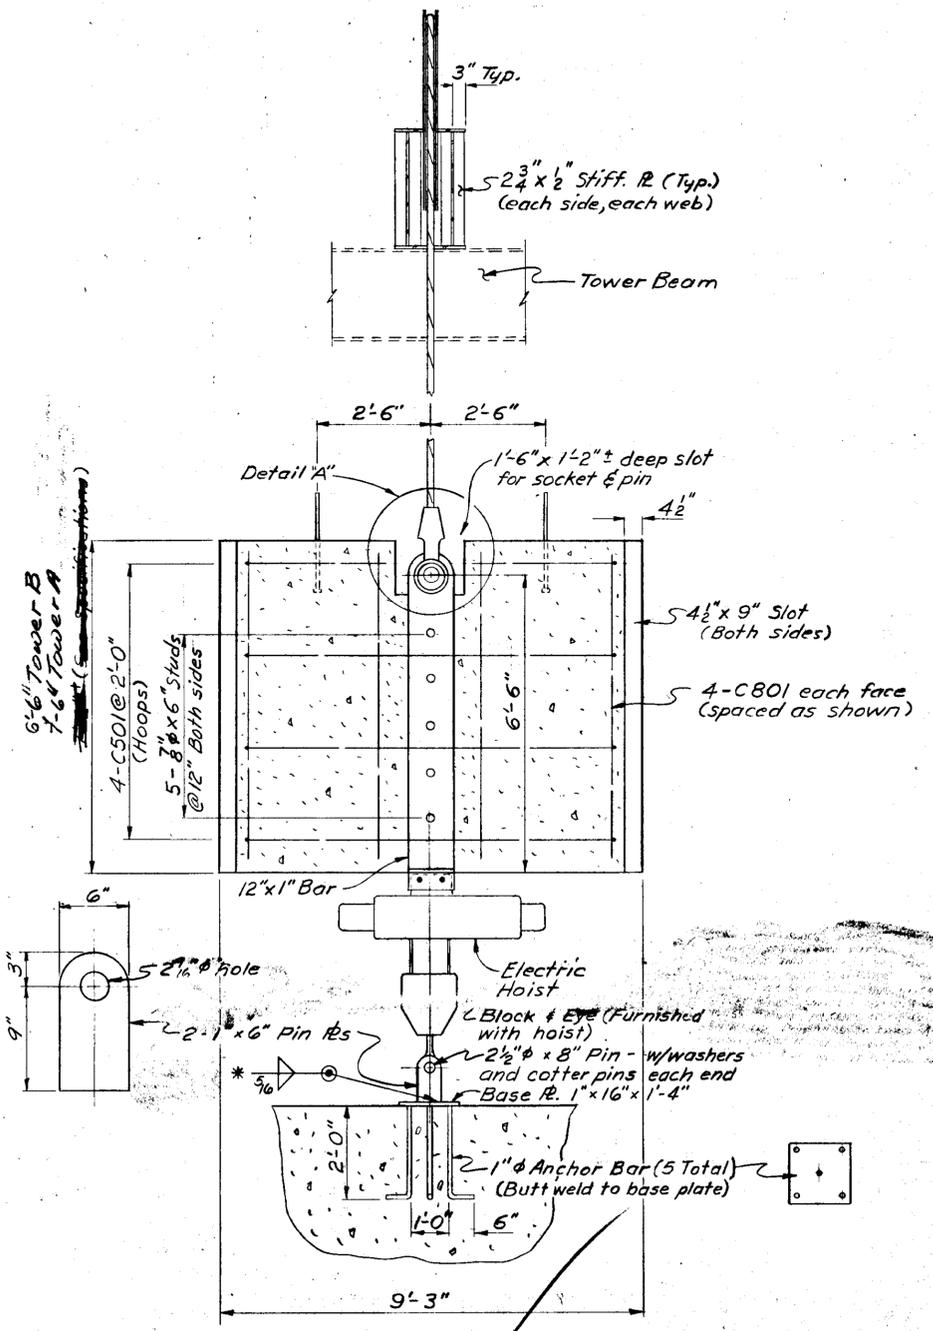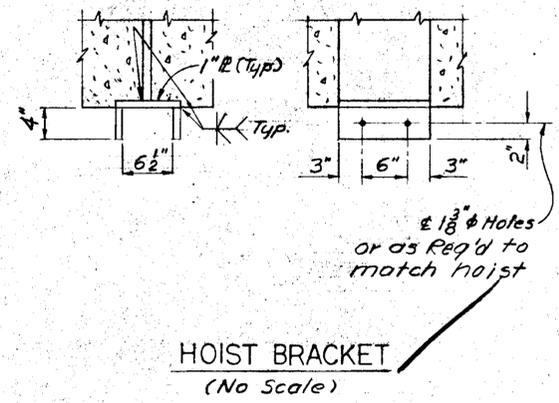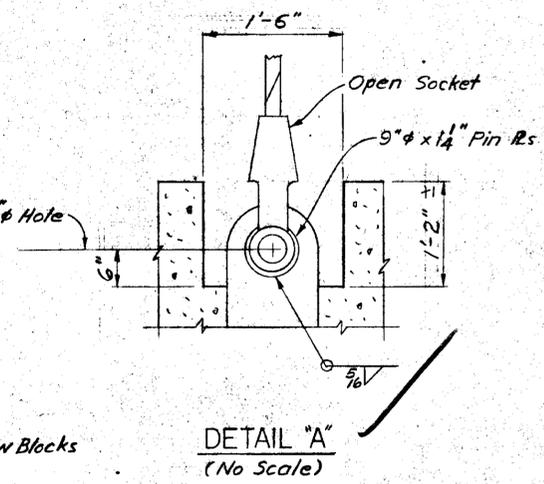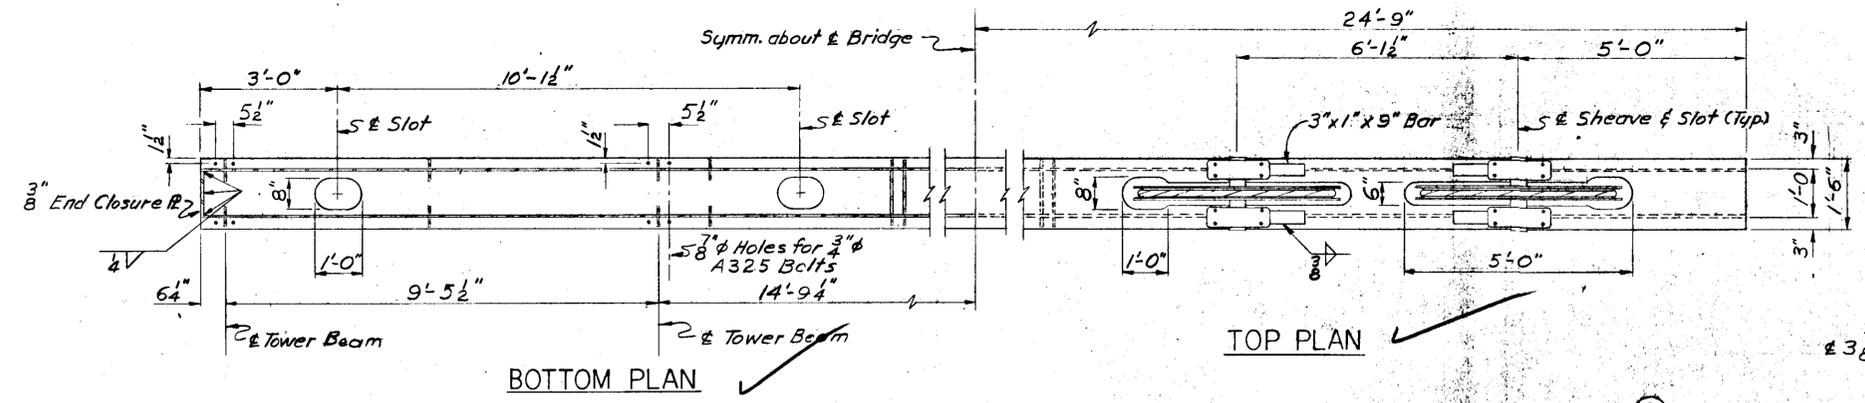

Note: Counterweight typical both towers. Hoist, hoist bracket and anchor bar in right hand tower facing ship only.

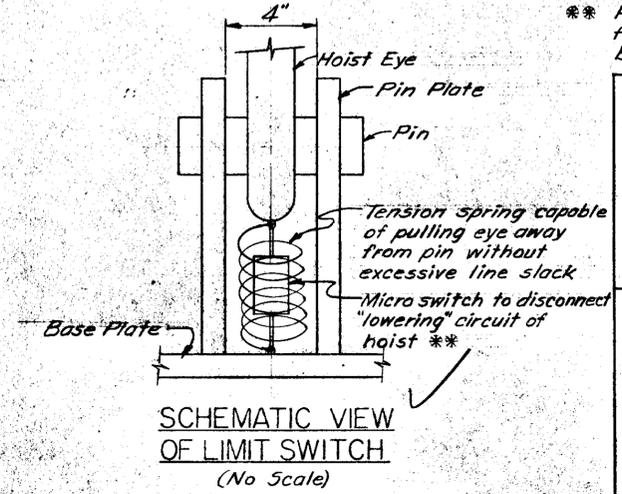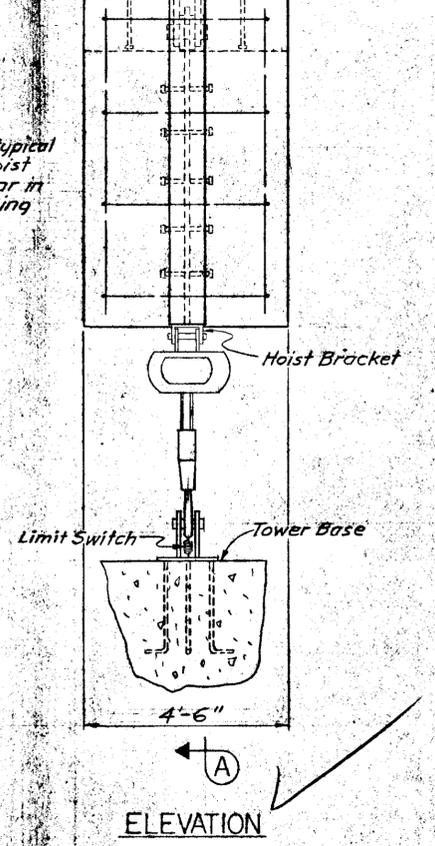

SECTION A-A * Position and field weld pin ribs to base ribs after installing hoist to insure proper block to hoist orientation.



** Purpose of limit switch is to prevent hoist line from uncoiling when hoist is unloaded by transfer bridge seating in hanger bars.

COUNTERWEIGHTS AND HOIST


State of Alaska
DEPARTMENT OF HIGHWAYS
Juneau, Alaska

Date 8-2-77
Approved [Signature]




BRIDGE NO. 175
DWG. NO. 2618

STATE	PROJECT DESIGNATION	YEAR	SHEET NO.	TOTAL SHEETS
ALASKA	F-095-2(9) A.D.A.R. 8-02-0144-05	1972	18	35

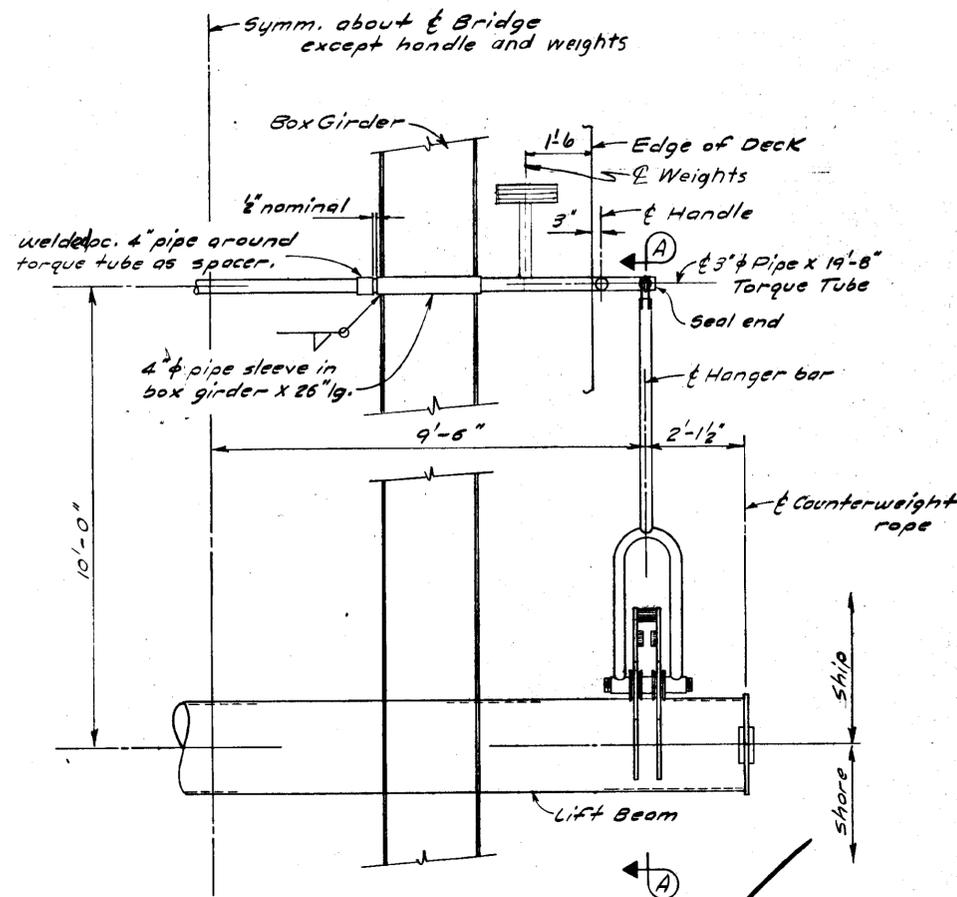


HALF PLAN AT LIFT BEAM

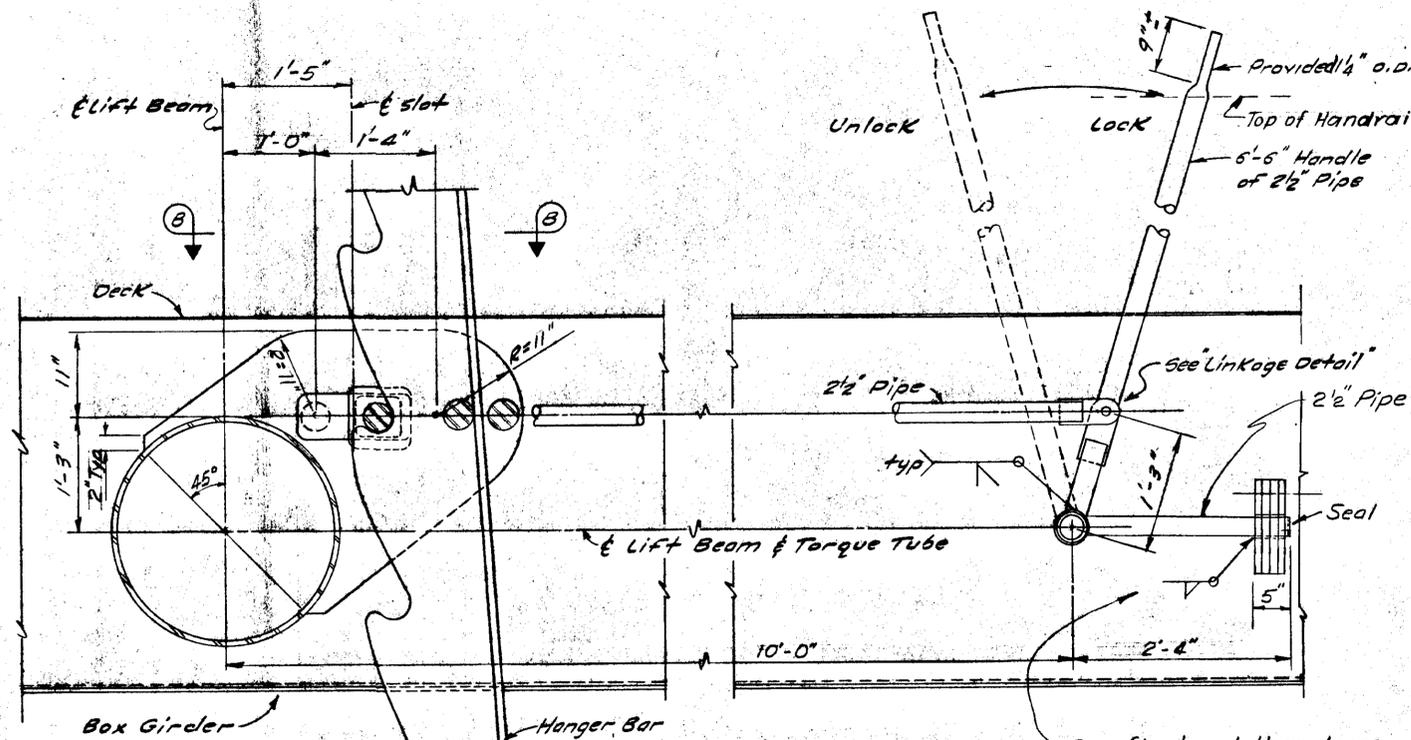


VIEW A-A


One fixed and three loose weights 12" ϕ x 1" w/ 3" ϕ hole in center and 7/8" ϕ hole for 3/4" bolt. Add loose weights until pin locks automatically.

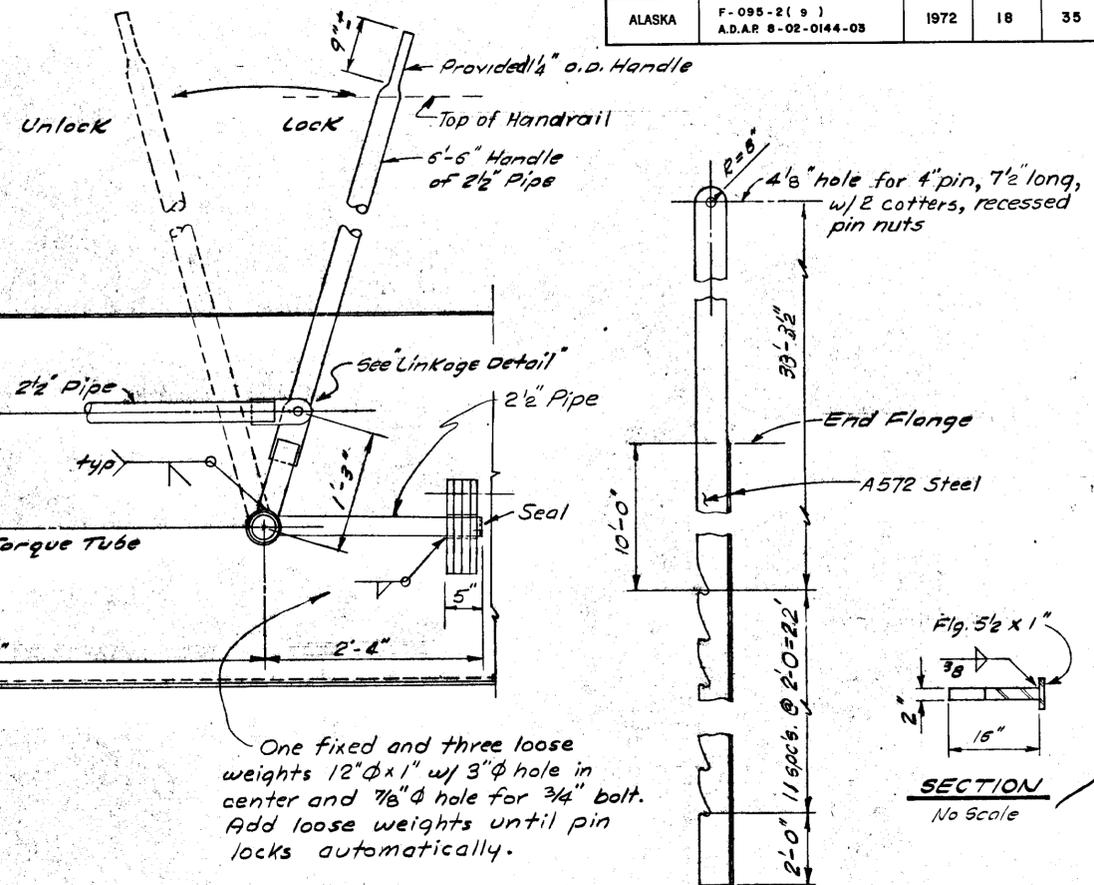


HANGER BAR

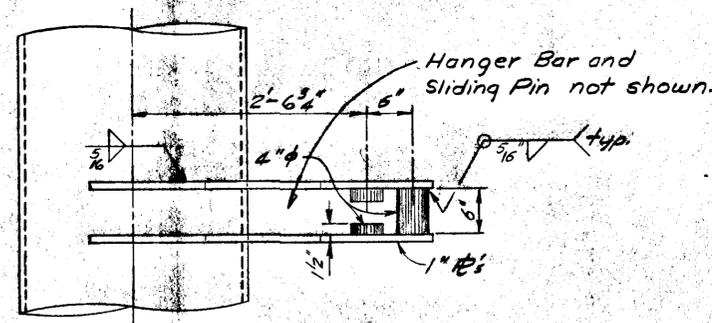


VIEW B-B

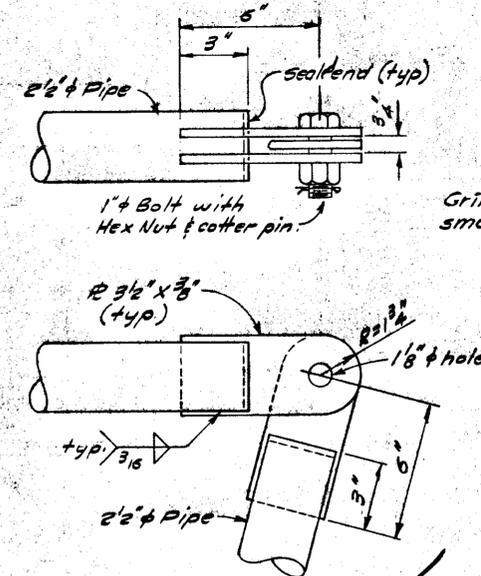


LINKAGE DETAIL

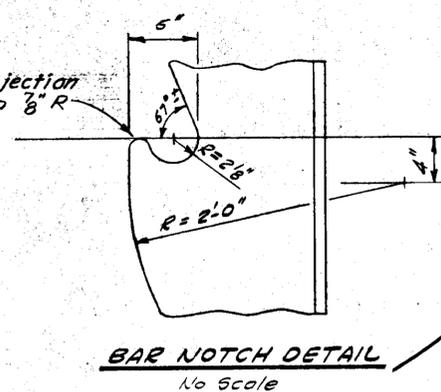

HANGER BAR & LOCK

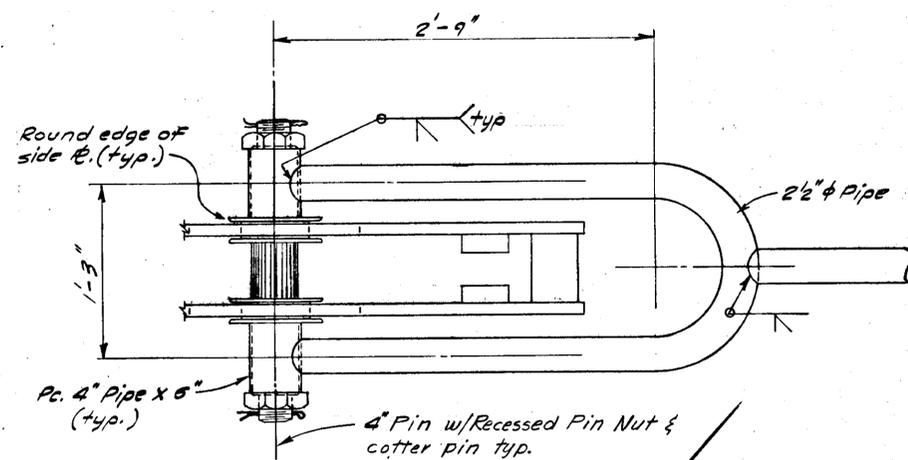

PIN AND YOKE DETAIL

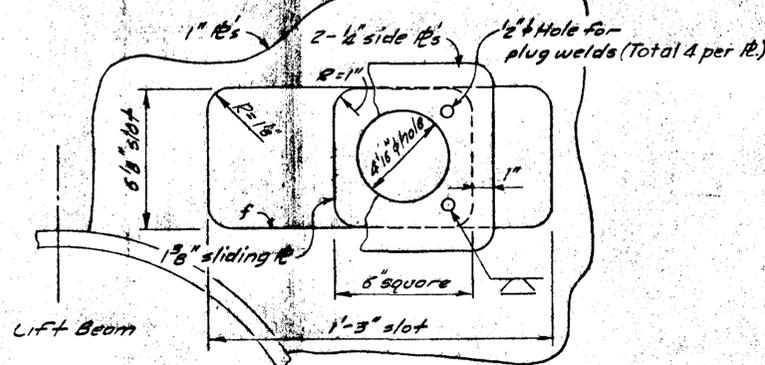




DETAIL OF SLOT

State of Alaska
DEPARTMENT OF HIGHWAYS
Juneau, Alaska

Date 8-2-72
Approved [Signature]


BRIDGE NO. 175
DWG. NO. 2619



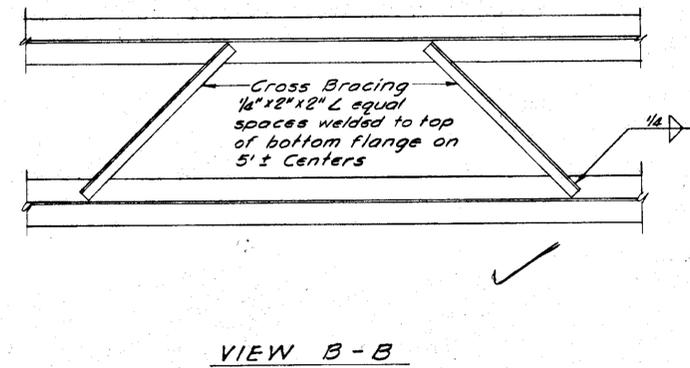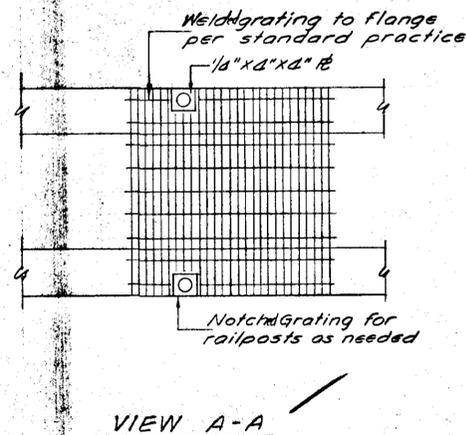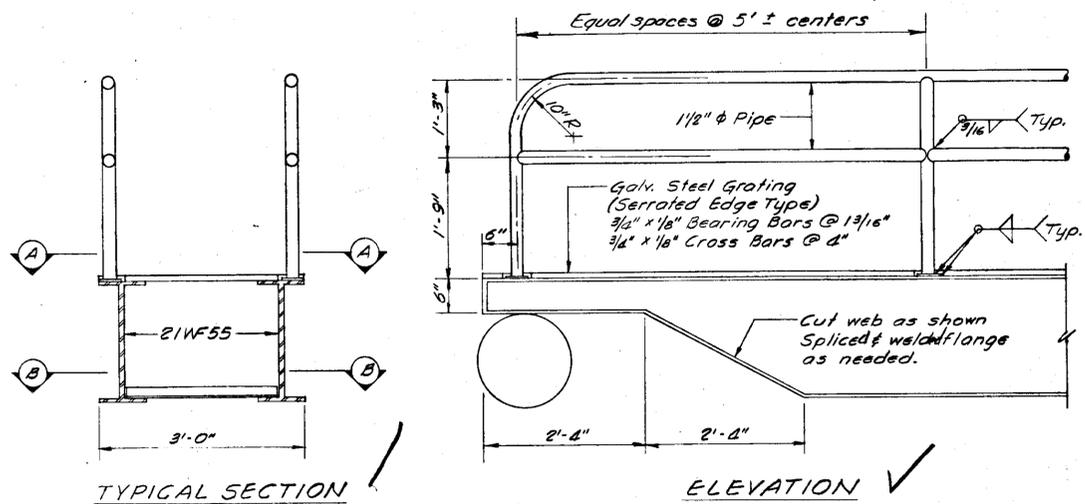

GENERAL NOTES





1. Natural camber in 21WF55 beam shall be placed up.
2. Grid deck & stairs of slightly different dimensions may be substituted with the approval of the engineer.
3. For catwalk layout see Layout Plans sheets #4 & #23.

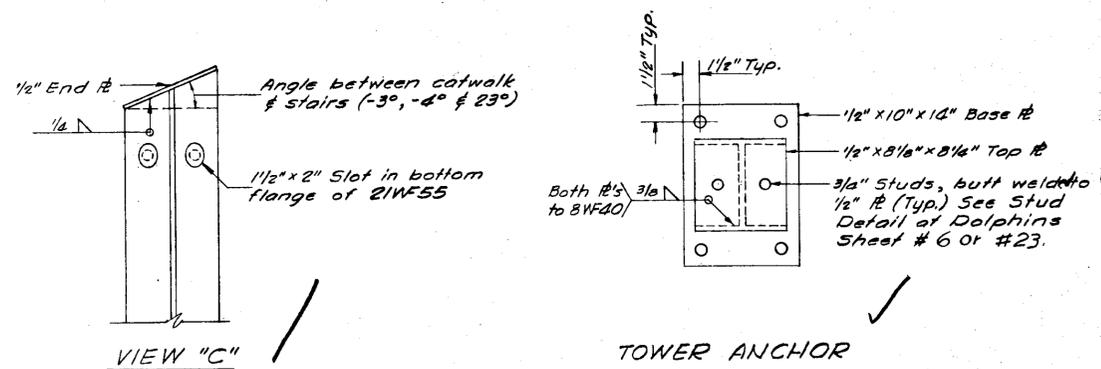

APPROXIMATE SPAN LENGTH

KETCHIKAN TERMINAL	GRAVINA TERMINAL
Dolphin #1 to #2 31'	Dolphin #1 to #2 36'
" #2 to #3 31'	" #2 to #3 37'
" #3 to Tower 45'	" #3 to Tower B 40'
	" #5 to Tower A 19'
Approx. wt. A-36 steel 14,000 lbs.	Approx. wt. A-36 steel 17,400 lbs.


Note: The actual span length is determined by field measurements.

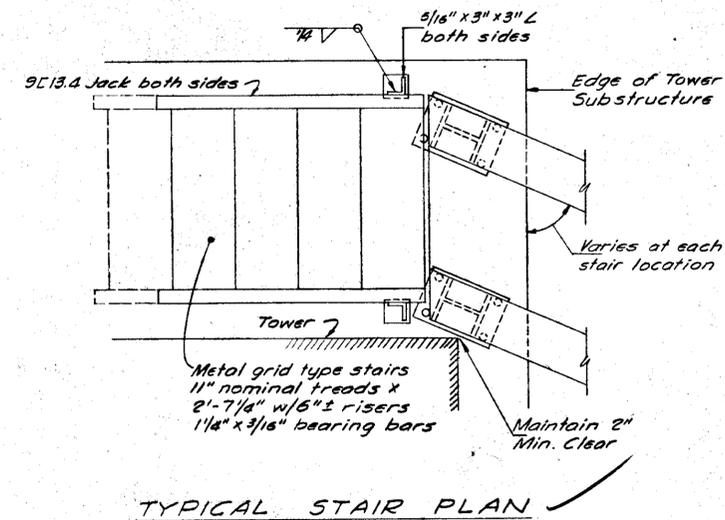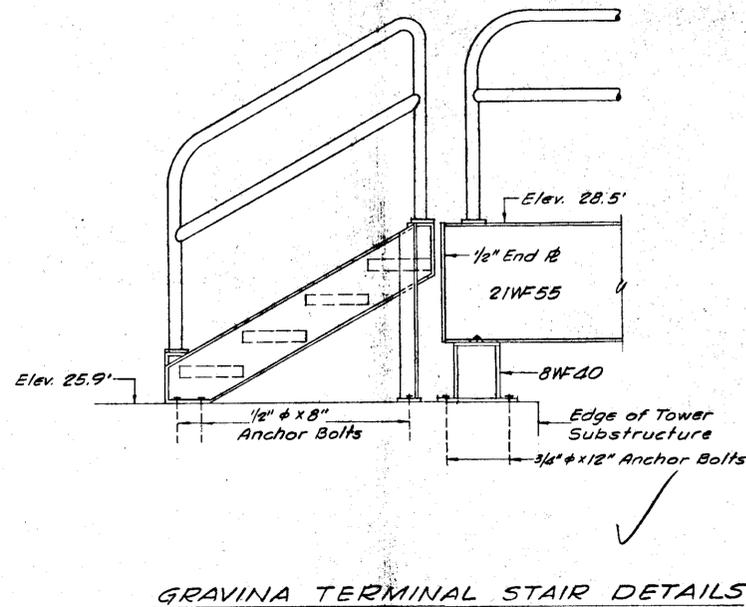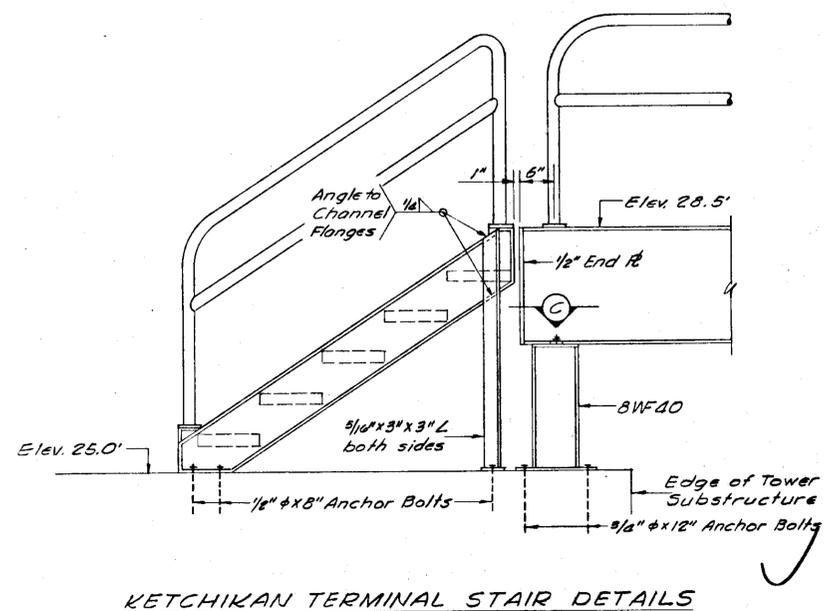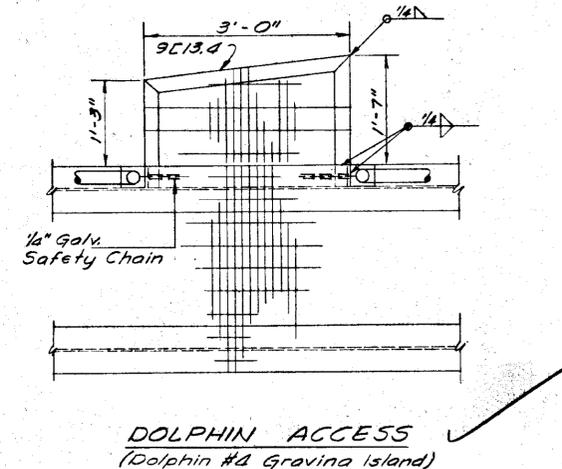

CATWALK DETAILS

BOMHOFF & ASSOCIATES
Engineering and Surveys
1020 West Fireweed Lane
Anchorage, Alaska 99503


DESIGNED BY: _____
DRAWN BY: _____
CHECKED BY: _____
SCALE: _____
DATE: _____
SHEET OF _____

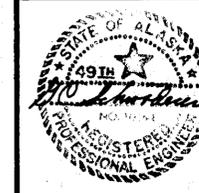

A. D. A. P. 8-02-0144-03
FINAL ESTIMATE OF QUANTITIES

STATE	PROJECT DESIGNATION	YEAR	SHEET NO.	TOTAL SHEETS
ALASKA	F-095-2(9) A.D.A.P. 8-02-0144-03	1972	20	35

ITEM	UNIT	QUANTITY
Mobilization	Lump Sum	All Req'd.
Temporary Erosion and Pollution Control	Cont. Sum	All Req'd.
Training Program in Accordance with FHWA Order, Interim 7-2(2)	Cont. Sum	All Req'd.
Crushed Aggregate Base Course, Grading D-1	Cu. Yd.	55,58.77
Class A Concrete	Lump Sum	All Req'd.
Reinforcing Steel	Lump Sum	All Req'd.
Transfer Bridge, Furnished and Fabricated	Lump Sum	All Req'd.
Transfer Bridge, Erected	Lump Sum	All Req'd.
Towers, Furnished and Fabricated	Lump Sum	All Req'd.
Towers, Erected	Lump Sum	All Req'd.
Catwalks, Furnished and Fabricated	Lump Sum	All Req'd.
Catwalks, Erected	Lump Sum	All Req'd.
Dolphin Caps, Furnished and Fabricated	Lump Sum	All Req'd.
Dolphin Caps, Erected	Lump Sum	All Req'd.
Treated Timber Piles, Furnished and Driven (Graving Island)	Lin. Ft.	1192
Cast-in-Place Concrete Piles, Furnished	Lin. Ft.	17659
Cast-in-Place Concrete Piles, Driven	Lin. Ft.	6184
Rock Socketing	Lin. Ft.	75
Covered Walkway	Lump Sum	All Req'd.
Operating Equipment	Lump Sum	All Req'd.
18" Asbestos Bonded Bituminous Coated Corrugated Steel Pipe	Lin. Ft.	63
Inlet, Type "A"	Each	2
Beam Type Guard Rail, Type I Posts	Lin. Ft.	500
Concrete Sidewalk, Depth 4"	Sq. Yd.	268
Curb & Gutter, Type I	Lin. Ft.	318
Pipe Handrail	Lin. Ft.	36
Electrical Utilities	Lump Sum	All Req'd.

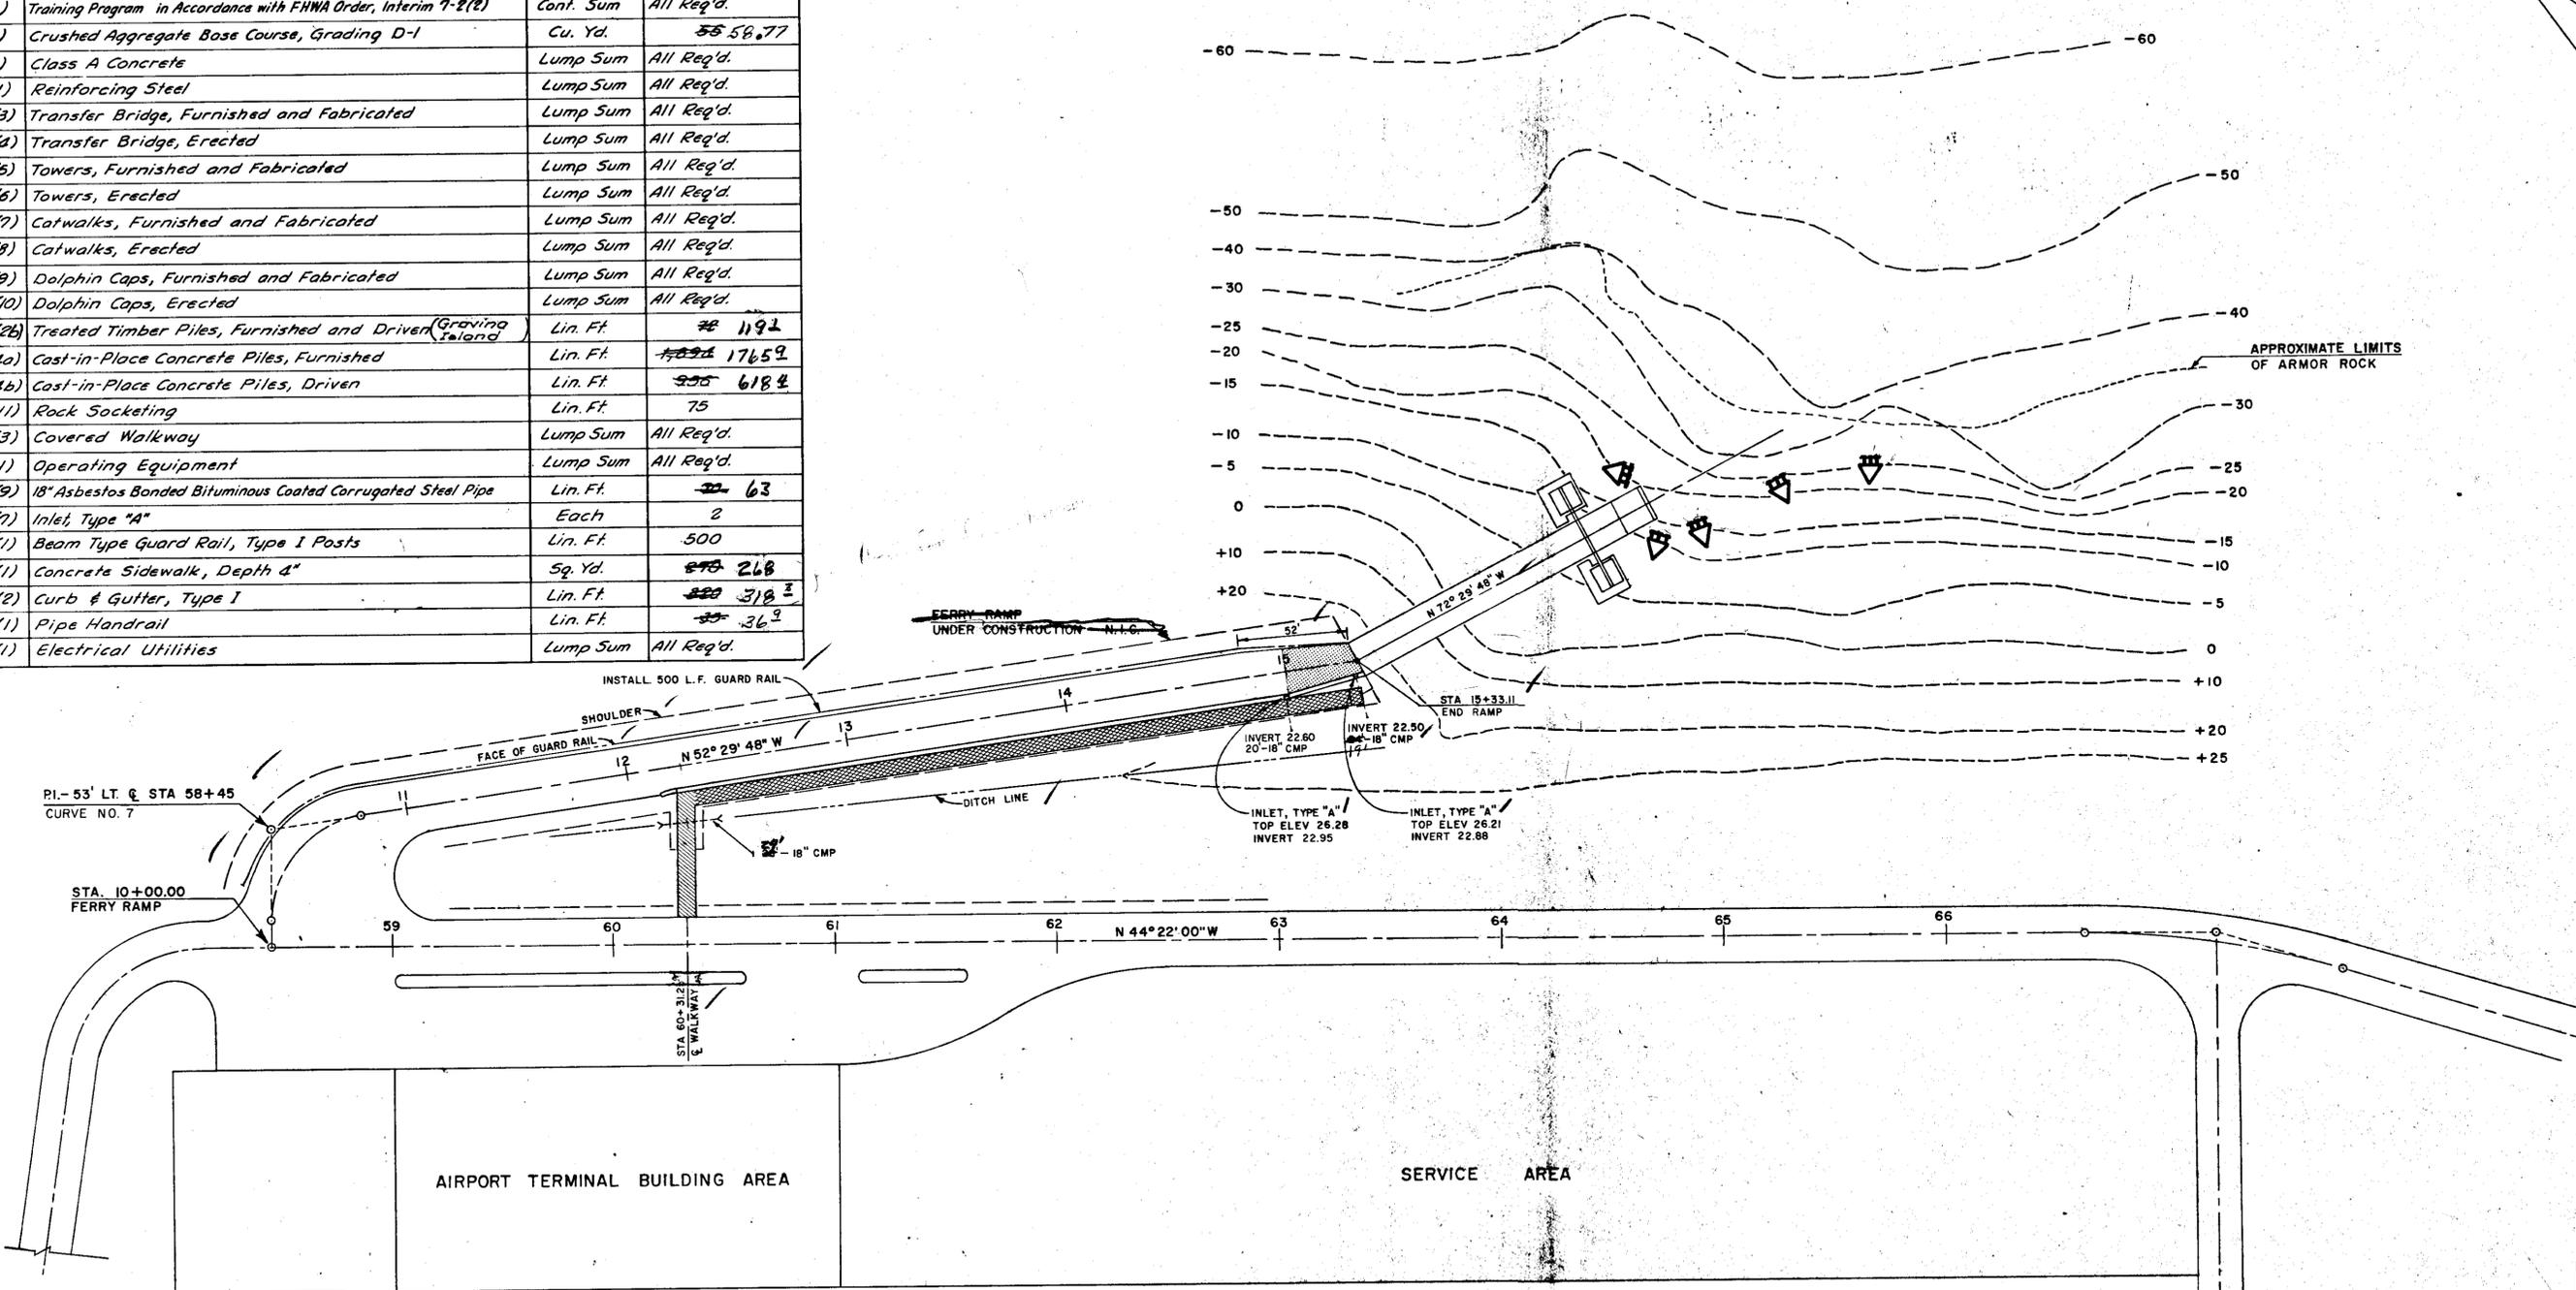

NOTES:
 HORIZONTAL AND VERTICAL CONTROL WILL BE COORDINATED WITH THE CONTROL ESTABLISHED BY DIVISION OF AVIATION FOR THE KETCHIKAN AIRPORT.
 SERVICE ROAD STATIONING IS RUNWAY STATIONING OFFSET 1044' LT.

LEGEND

 COVERED WALKWAY (ENCLOSED)
 COVERED WALKWAY (OPEN)
 TRANSITION TO ZERO CROWN AT BRIDGE ABUTMENT


CURVE NO. 7
 P.C. STA. 10+12.00
 P.T. STA. 10+79.54
 Δ = 81° 52' 12"
 D = 121° 11' 19"
 R = 47.27'
 T = 41.00'
 L = 67.54'
 E = 15.30'

MASTER PLAN
 GRAVINA ISLAND AIRPORT
 FERRY TERMINAL


BOMHOFF & ASSOCIATES
 Engineering and Surveys
 1020 West Fireweed Lane
 Anchorage, Alaska 99503

DESIGNED BY: _____
 DRAWN BY: _____
 CHECKED BY: _____
 SCALE: _____
 1" = 40'
 DATE: _____
 SHEET _____ OF _____

NOTE: Coordinate Sidewalk, Curb, & Gutter and Covered Walkway Construction with Ketchikan Airport Contractor. Center Line Profile for Top of Bituminous Course - See Sheet 8 of Plans for Ketchikan Airport Stage III.

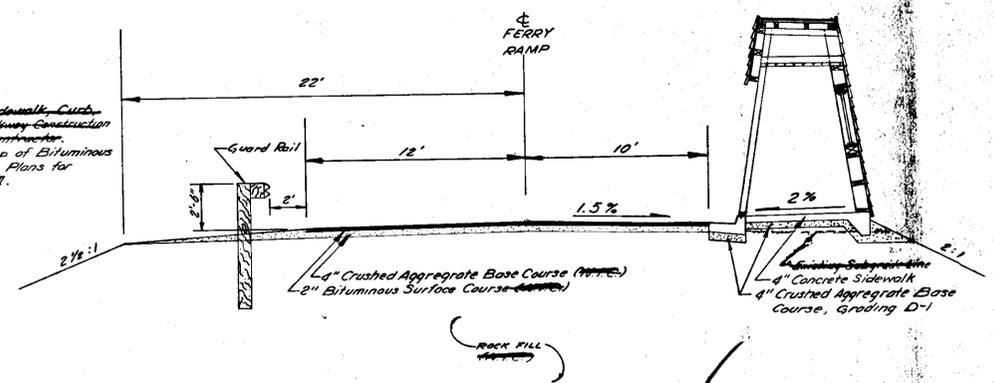


TYPICAL FERRY RAMP SECTION

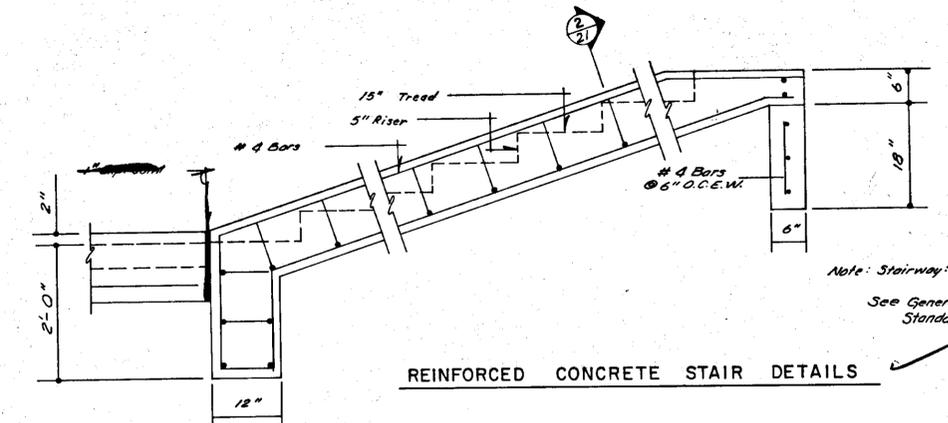


REINFORCED CONCRETE STAIR DETAILS

Note: Stairway: 9.5 cubic yards of class A concrete. See General Notes: Standard Drawing M-5

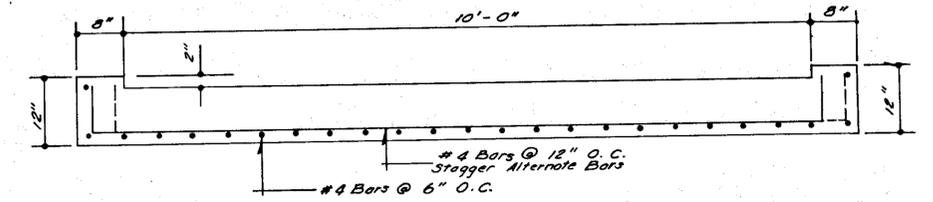


SECTION


REINFORCING STEEL						
LOCATION	MARK	NO	SIZE	LENGTH	TYPE	BENDING DIAGRAM
STAIRWAY	S-100	29	4	12'-0"	BENT	
	S-101	23	4	28'-1"	BENT	
	S-102	2	4	29'-4"	BENT	
	S-103	5	4	11'-0"	---	
WALKWAY	W-100	30	4	25'-0"	---	
TOTAL REINFORCING WEIGHT 1260 LBS						

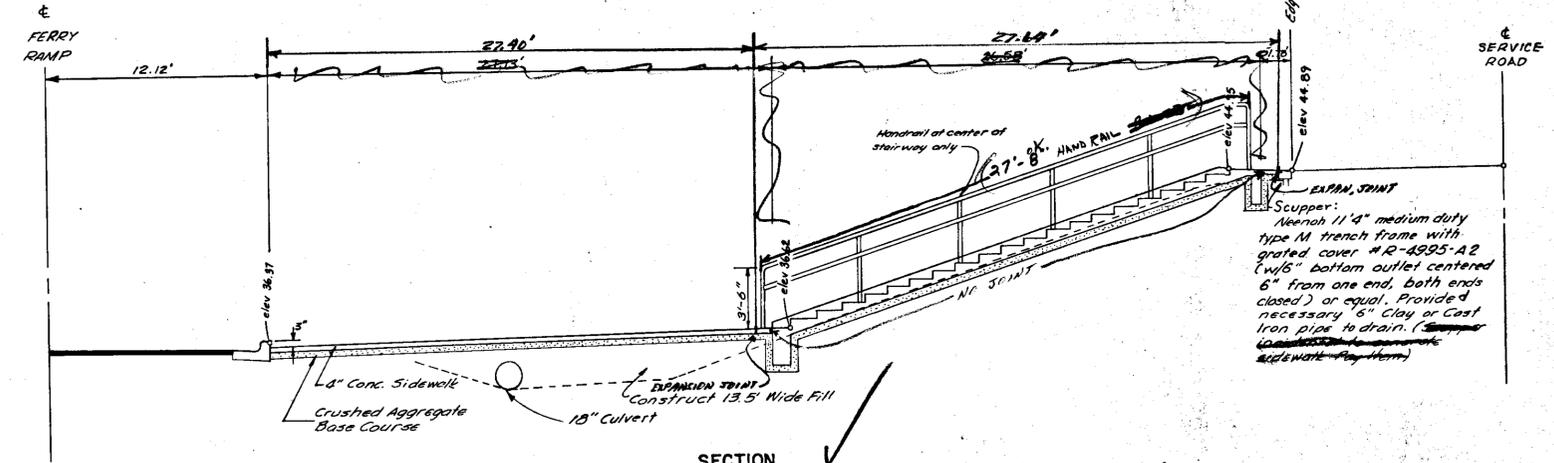


SECTION STATION 60+31.25 (NO SCALE)

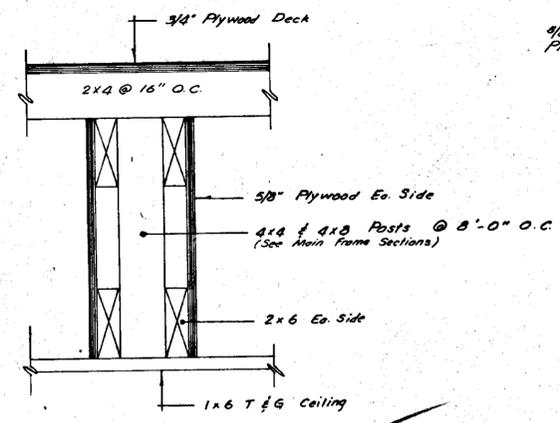

SECTION

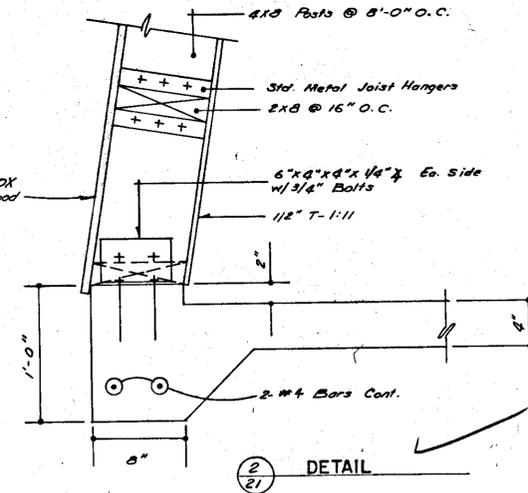


DETAIL

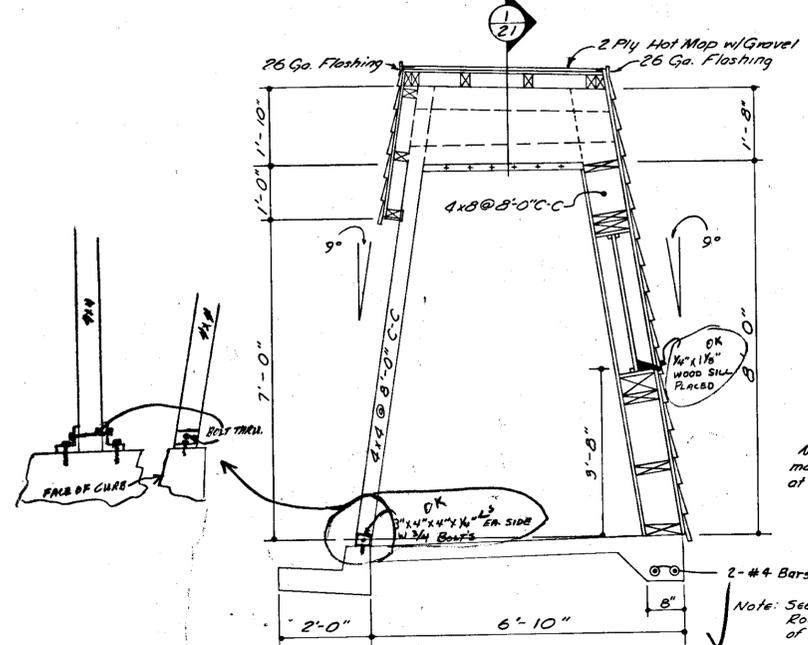


COVERED WALKWAY SECTION (ALONG FERRY RAMP)

Note: All covered walkway main frames erected at 90° to the finished grade.

Note: See sheet #22 for Electrical Room Detail, located at end of Ramp. Terminated Ramp at Station 15+33.

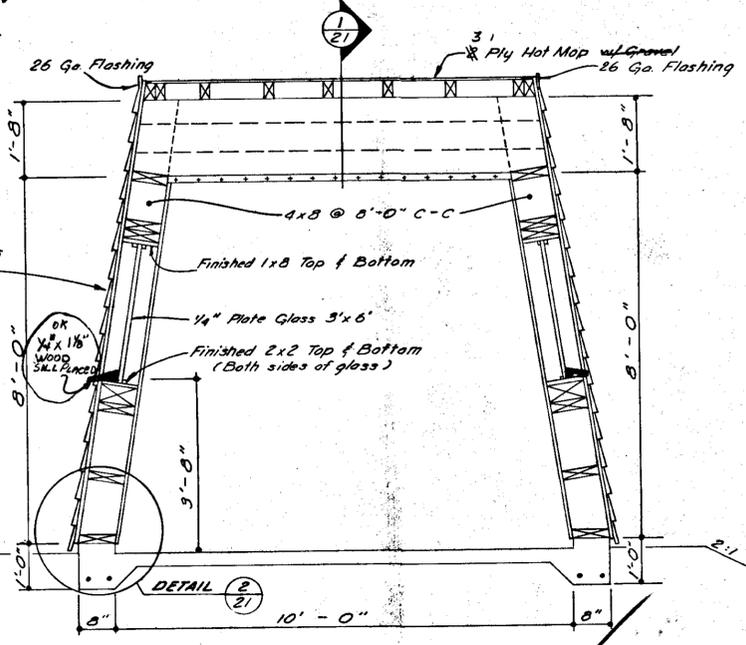

COVERED WALKWAY SECTION (FROM FERRY RAMP TO AIRPORT TERMINAL)

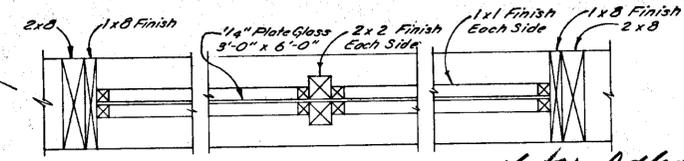

TYPICAL WINDOW SECTION

Note: Added sill as shown to all exterior windows.


COVERED WALKWAY
GRAVINA ISLAND AIRPORT
FERRY TERMINAL

BOMHOFF & ASSOCIATES
Engineering and Surveys
1020 West Fireweed Lane
Anchorage, Alaska 99503


DESIGNED BY: _____
DRAWN BY: _____
CHECKED BY: _____
SCALE: _____
DATE: _____
SHEET OF _____

STATE	PROJECT DESIGNATION	YEAR	SHEET NO.	TOTAL SHEETS
ALASKA	F-098-2(9) A.D.A.P. 8-02-0144-03	1972	22	35


Note: Exterior same as covered walkway
Interior finished with 1/2" plywood. Ends
framed with 2x4 @ 16" o.c.

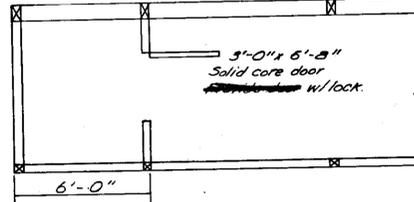


ELECTRICAL ROOM PLAN
(See sheet #24 for equipment layout)

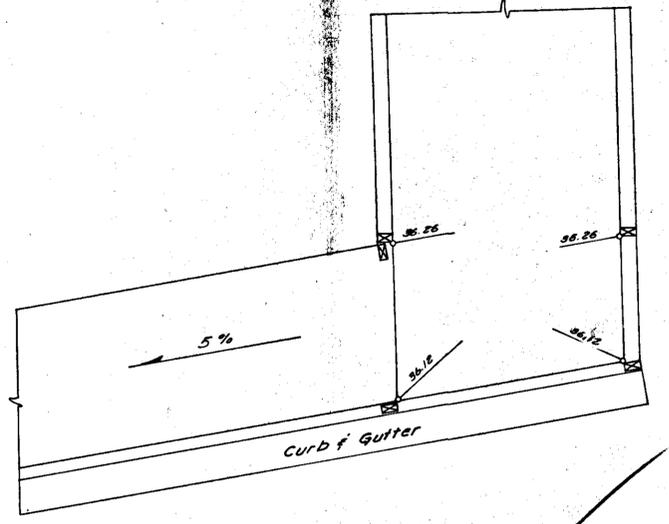


PLAN

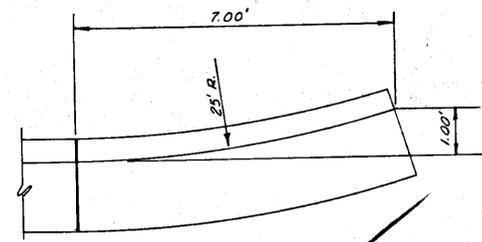



PLAN

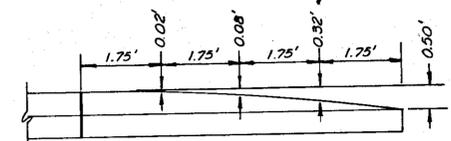


**ELEVATION
CURB TRANSITION DETAIL**

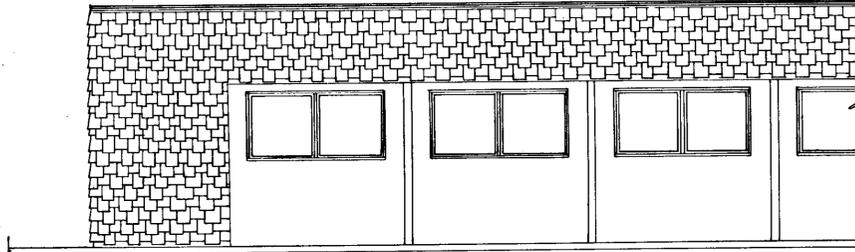

**SOUTH
ELEVATION**

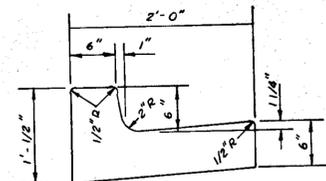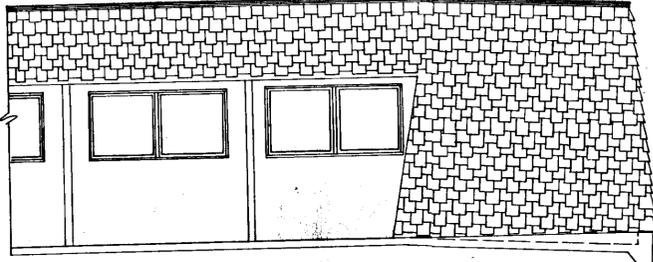

**STANDARD CURB &
GUTTER SECTION**




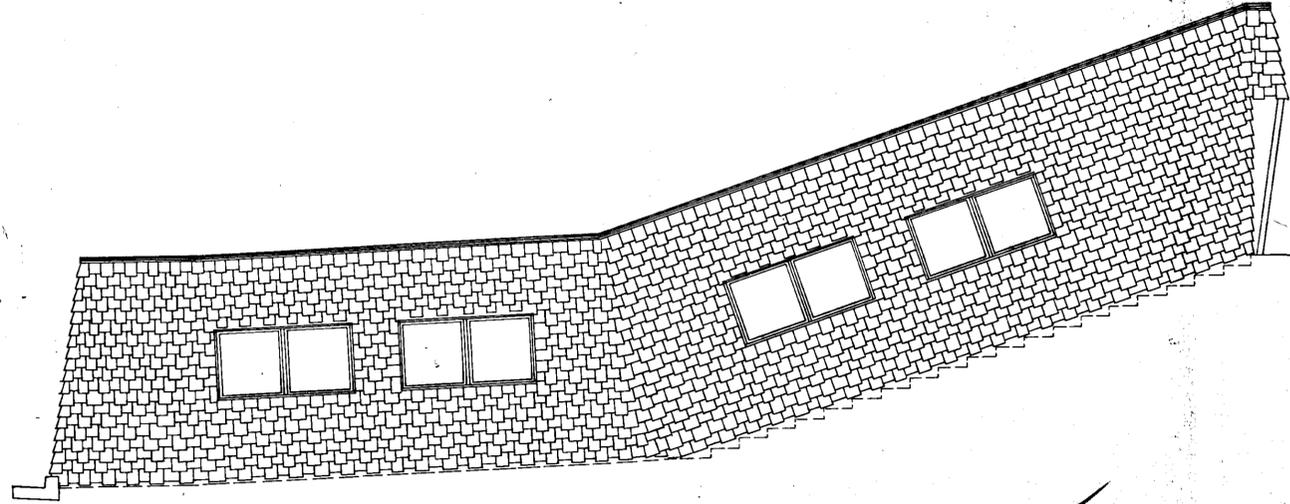


**EAST
ELEVATION**

COVERED WALKWAY
GRAVINA ISLAND AIRPORT
FERRY TERMINAL






BOMHOFF & ASSOCIATES
Engineering and Surveys
1020 West Fireweed Lane
Anchorage, Alaska 99503

DESIGNED BY: _____
DRAWN BY: _____
CHECKED BY: _____
SCALE: _____
DATE: _____
SHEET _____ OF _____

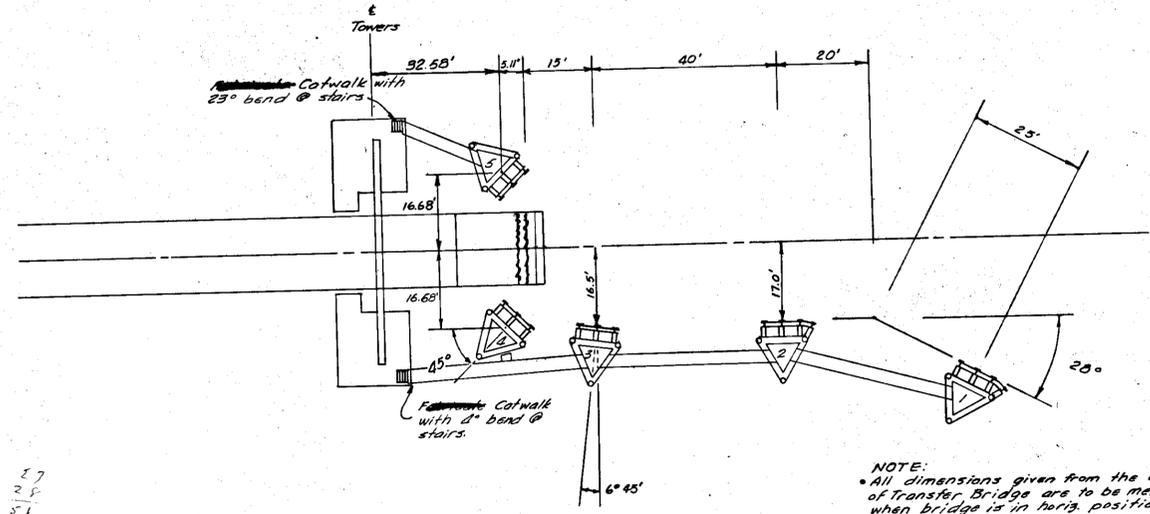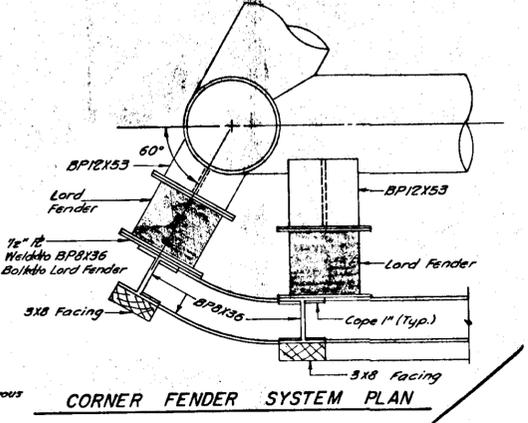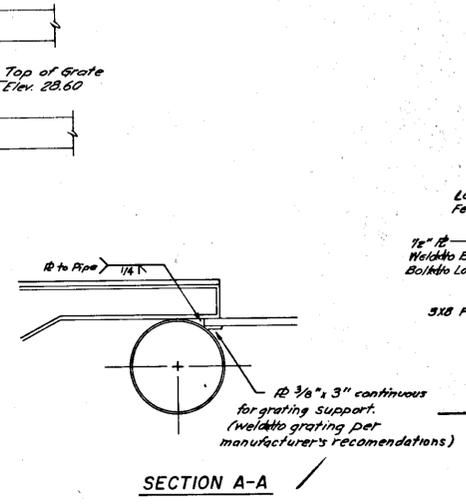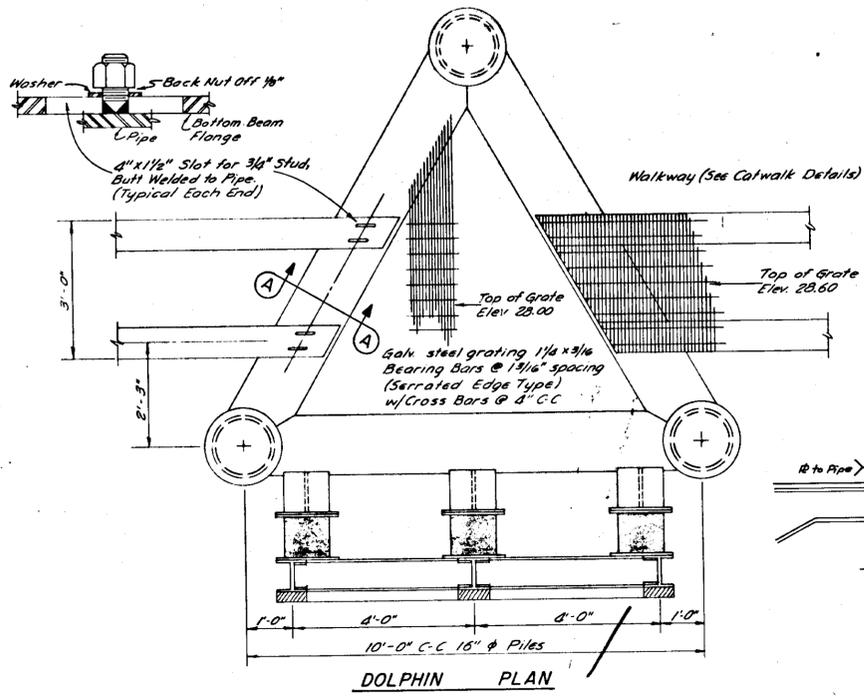

NOTE:
 • All dimensions given from the end of Transfer Bridge are to be measured when bridge is in horiz. position.
 • See sheet 19 for catwalk details.
 • Verify dolphin locations from approved slope drawings.




APPROXIMATE SOUND ROCK ELEV.	
Dolphin No. 1	-26-42'
No. 2	-26-47'
No. 3	-25-40'
No. 4	-25-38'
No. 5	-25-43'

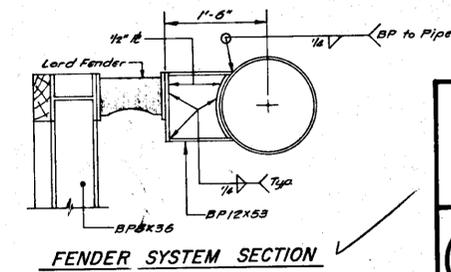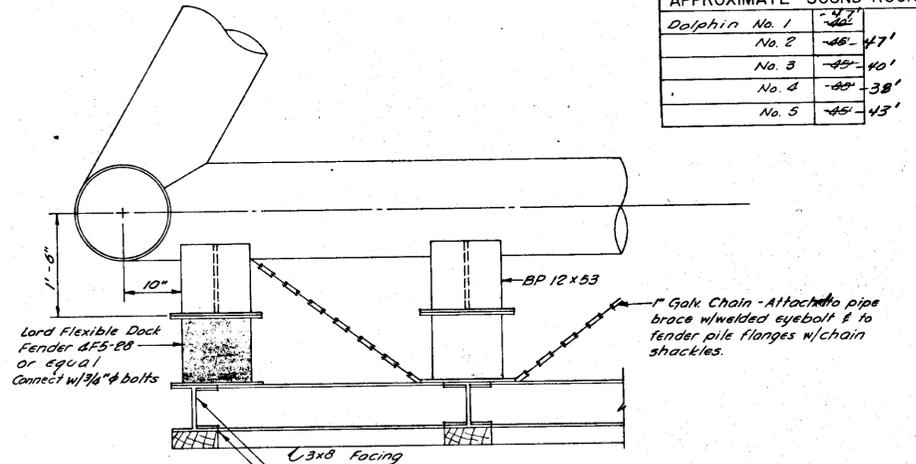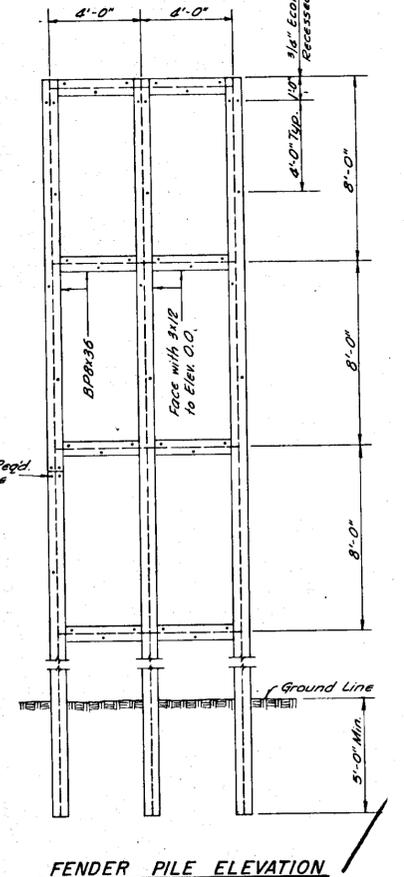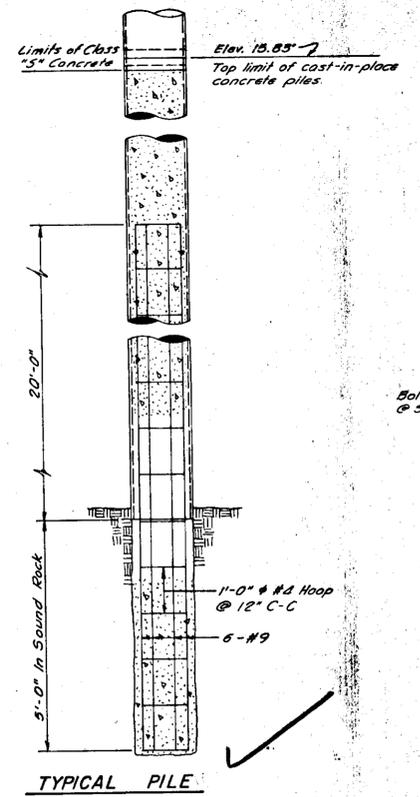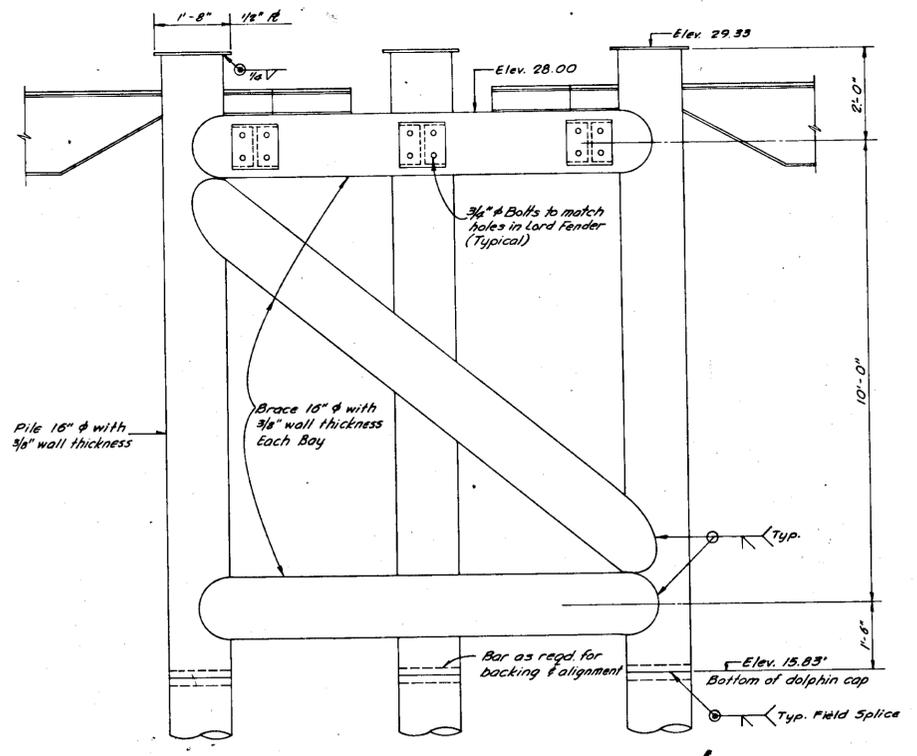

DOLPHIN DETAILS
 GRAVINA ISLAND AIRPORT
 FERRY TERMINAL

BOMHOFF & ASSOCIATES
 Engineering and Surveys
 1020 West Fireweed Lane
 Anchorage, Alaska 99503




DESIGNED BY:
 DRAWN BY:
 CHECKED BY:
 SCALE:
 DATE:
 SHEET OF

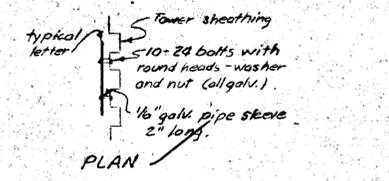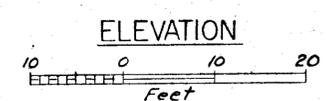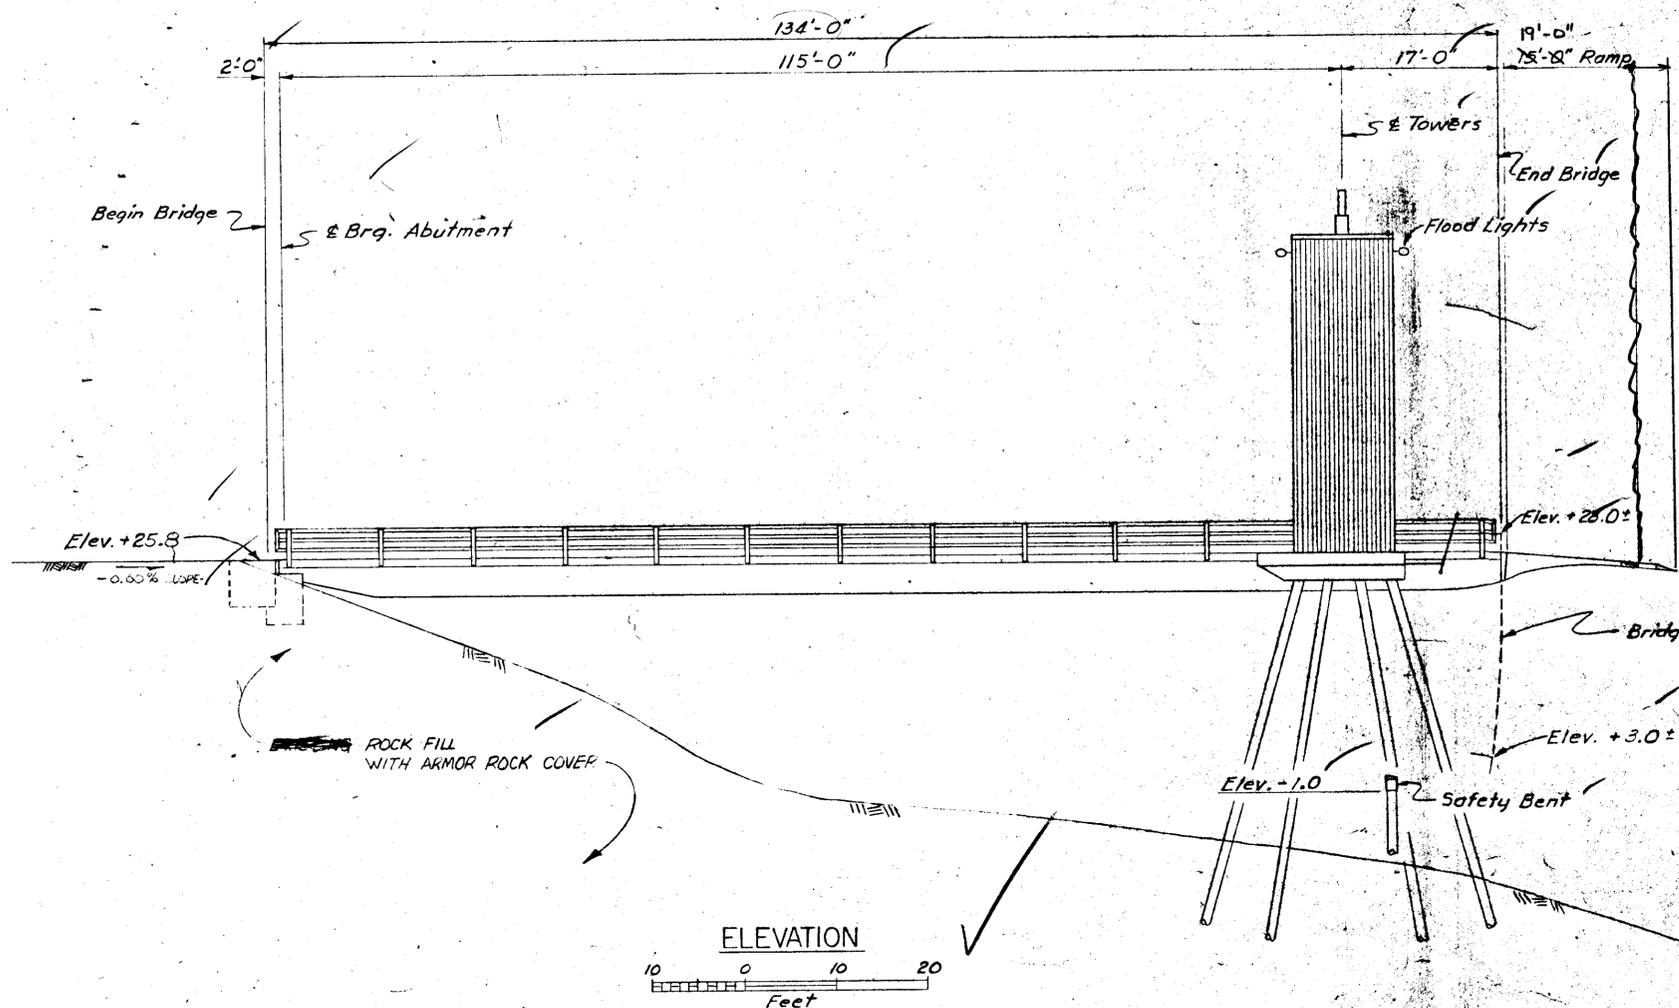

Letters shall be constructed of 16 ga. steel as shown and galvanized



LETTERING DETAILS
 "International" letters shall be offset 2" from and fastened to web of box beam with 10X24 machine screws. Top holes in beam web, welded to 2"x2"L AT TOP & bottom and 2"x2"L TACK WELDED TO BOX BEAM WEB.

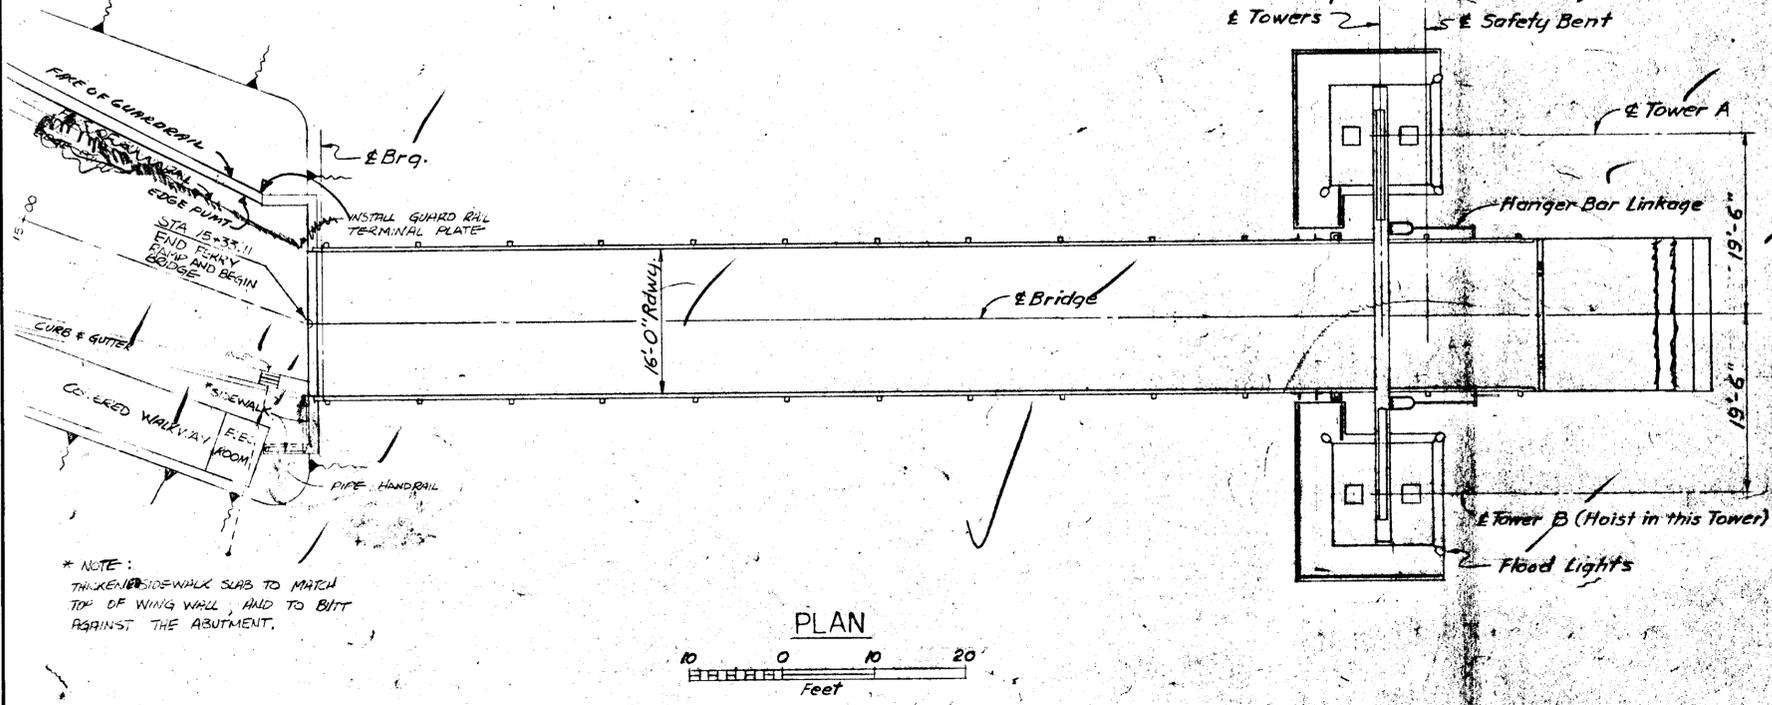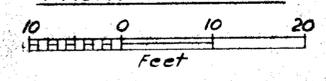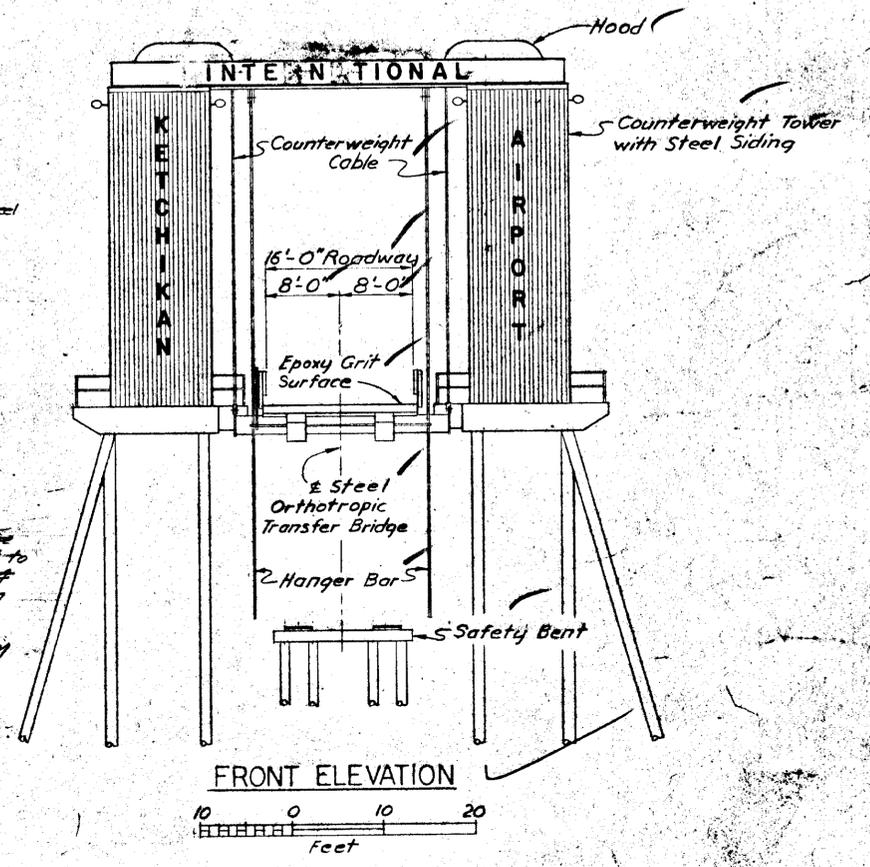

* NOTE:
 THICKEN SIDEWALK SUBS TO MATCH TOP OF WING WALL AND TO BITT AGAINST THE ABUTMENT.

GENERAL NOTES:

- Specifications:**
 Design: A.A.S.H.O. Standard Specifications for Highway Bridges, 1969 Edition, with latest interim specifications.
 Live Load: HS-20-44.
 Construction: State of Alaska Standard Specifications for Highway Construction, 1972 and the Special Provisions.
- Unit Stresses:**
 Reinforced Concrete: $F_c = 1200$ psi
 $F_s = 20,000$ psi
 Structural Steel: Bending stress in extreme fiber
- | Type of Steel | Allowable Stress |
|-----------------|------------------|
| A-36 | 20,000 psi |
| A-572, Grade 50 | 27,000 psi |
- Concrete: All concrete shall be Class A
 Reinforcing Steel: All reinforcing steel shall be A615 Grade 40
 Structural Steels: Unless otherwise shown on the plans or noted in the specifications, all structural steel shall be A-36. All A572 steel shall be Grade 50
 Tie Bearing Capacity & Penetration: See Drawing No 2612

ESTIMATED QUANTITIES		
ITEM	Unit	Quantity
Class A Concrete	Cu. Yd.	76.4
Reinforcing Steel	Lbs.	12,900
Structural Steel Transfer Bridge furnished, fabricated & erected	Lump Sum	*
Structural Steel Towers furnished, fabricated & erected	Lump Sum	**
Structural Steel Catwalks f.f.e.	Lump Sum	***
Treated Timber Piles (Safety Bent)	Lin. Ft.	119
Steel Pipe Piles	Lin. Ft.	372







* Includes approximately 140,350 lbs. A36 & 16,050 lbs. A572
 ** Includes approximately 38,400 lbs A36 & 300 lbs. A572 + 4000 Sq. Ft. Sheet Metal Siding
 *** Includes approximately 17,400 lbs A36

GRAVINA ISLAND AIRPORT FERRY TERMINAL GENERAL LAYOUT

State of Alaska
DEPARTMENT OF HIGHWAYS
 Juneau, Alaska

Date: 6-2-72
 Approved: [Signature]
 BRIDGE NO. 195
 DWNG. NO. 2610A

STATE	PROJECT DESIGNATION	YEAR	SHEET NO.	TOTAL SHEETS
ALASKA	F-095-2(8) A.D.A.R. 8-02-0144-03	1972	26	35

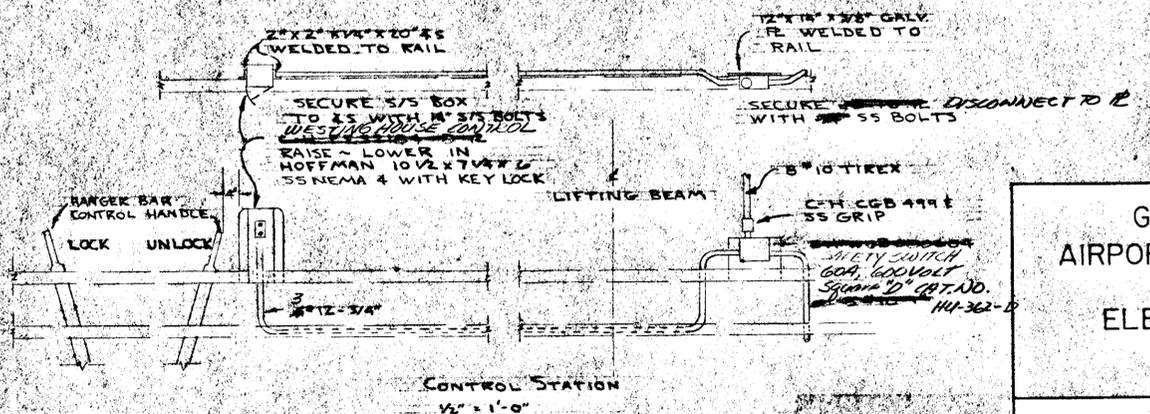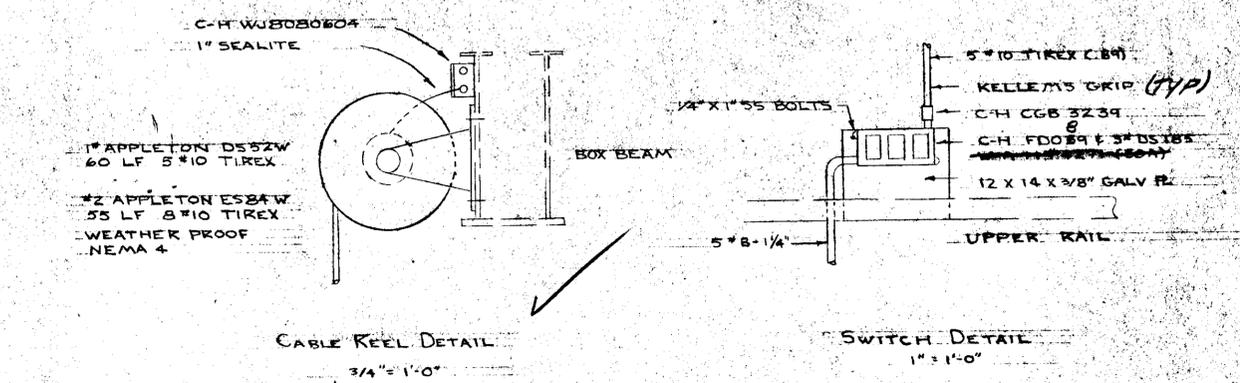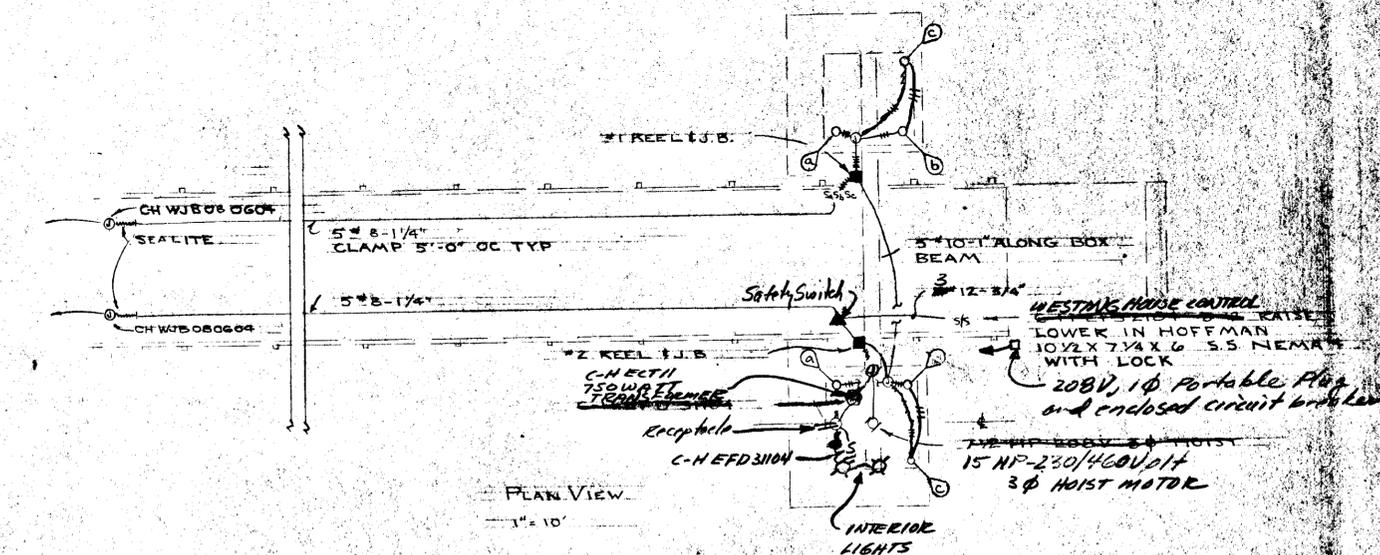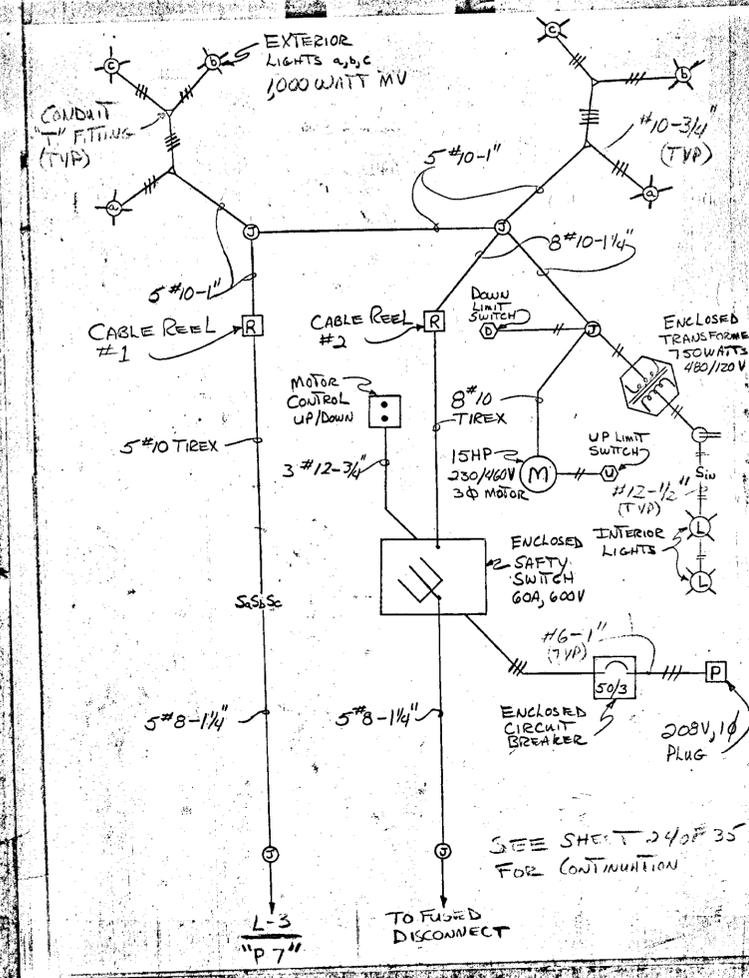
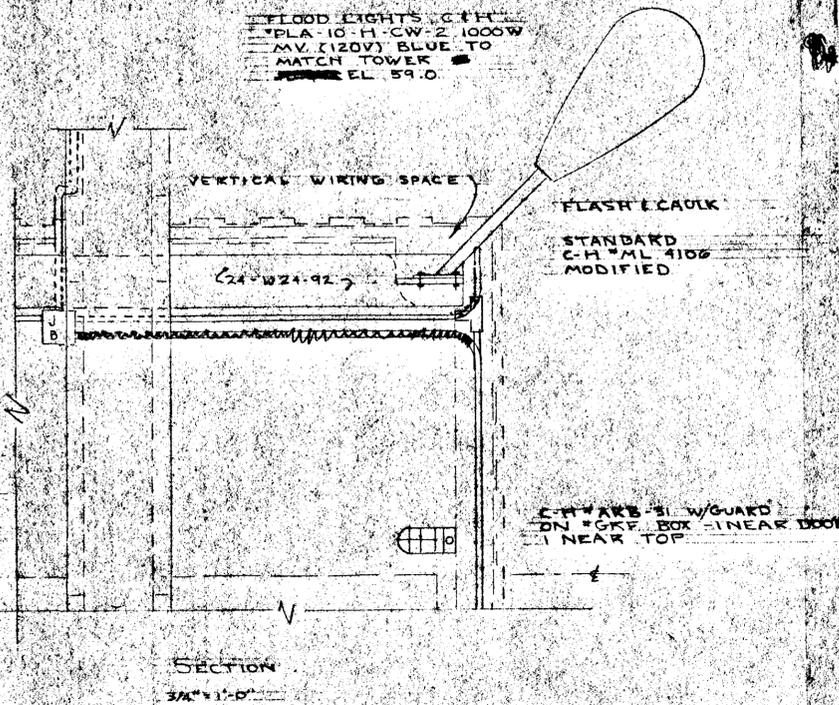
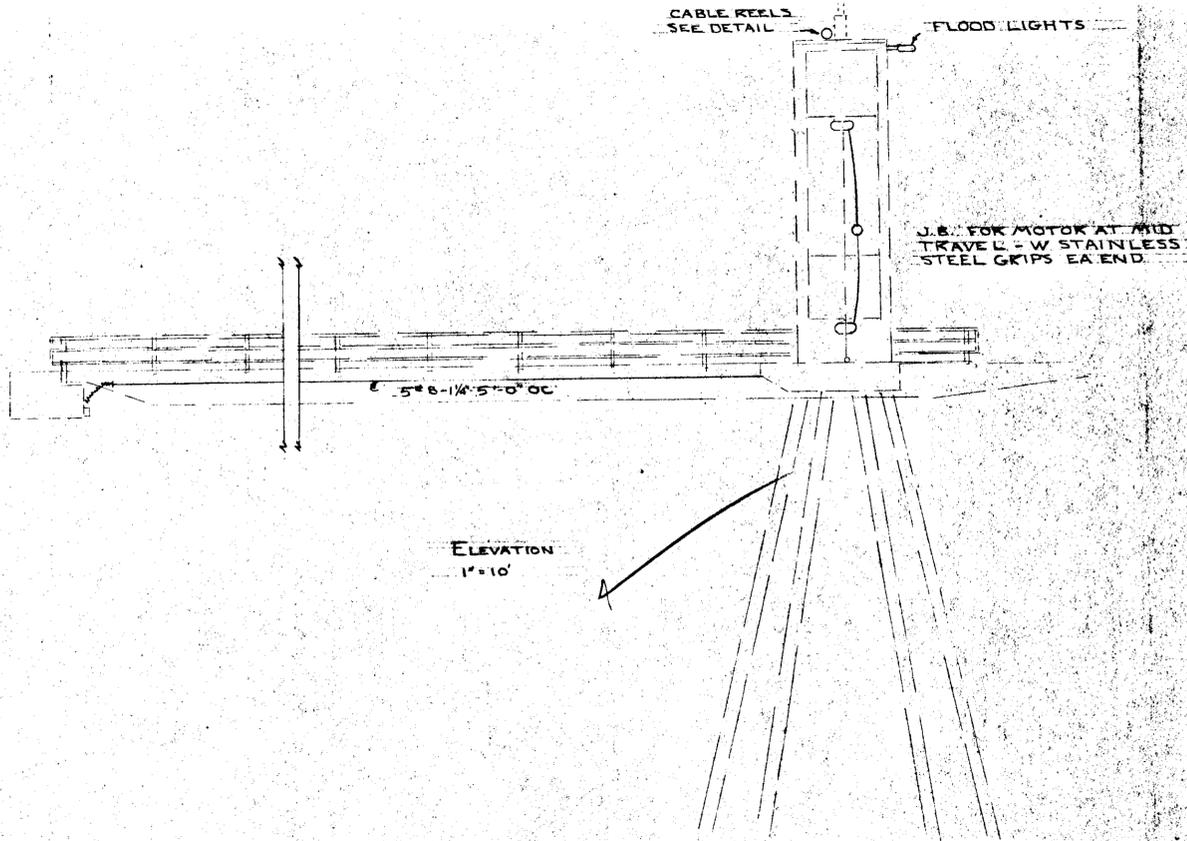


NOTE: WHERE EVER SPECIFIED AN APPROVED EQUAL MAY BE USED.


GRAVINA ISLAND AIRPORT FERRY TERMINAL ELECTRICAL DETAILS



State of Alaska
DEPARTMENT OF HIGHWAYS
Juneau, Alaska

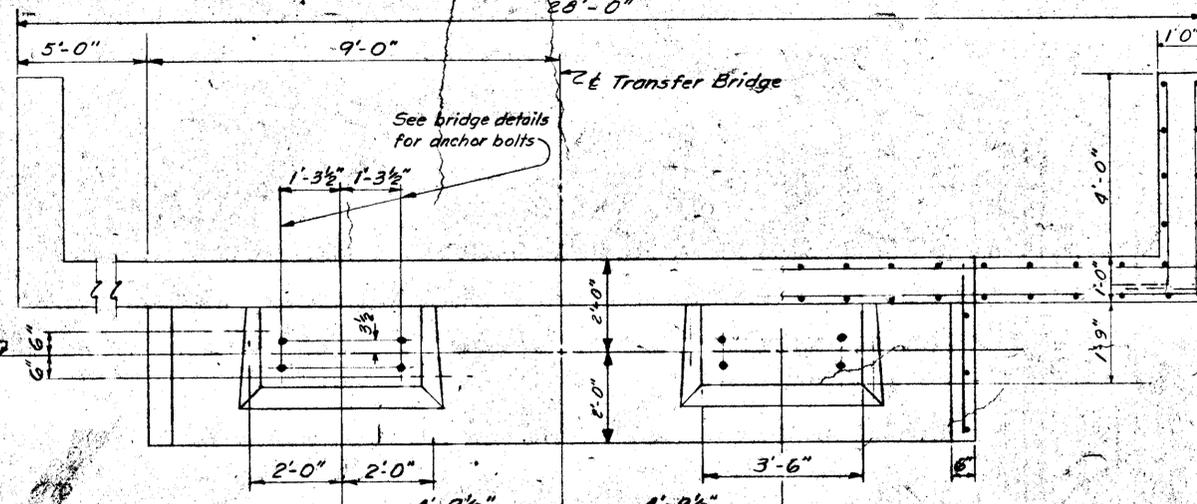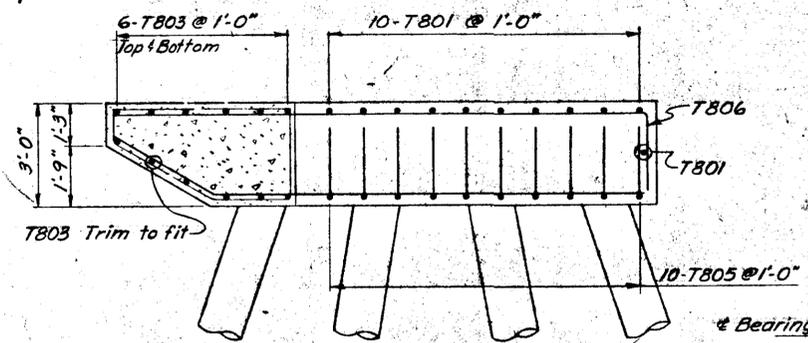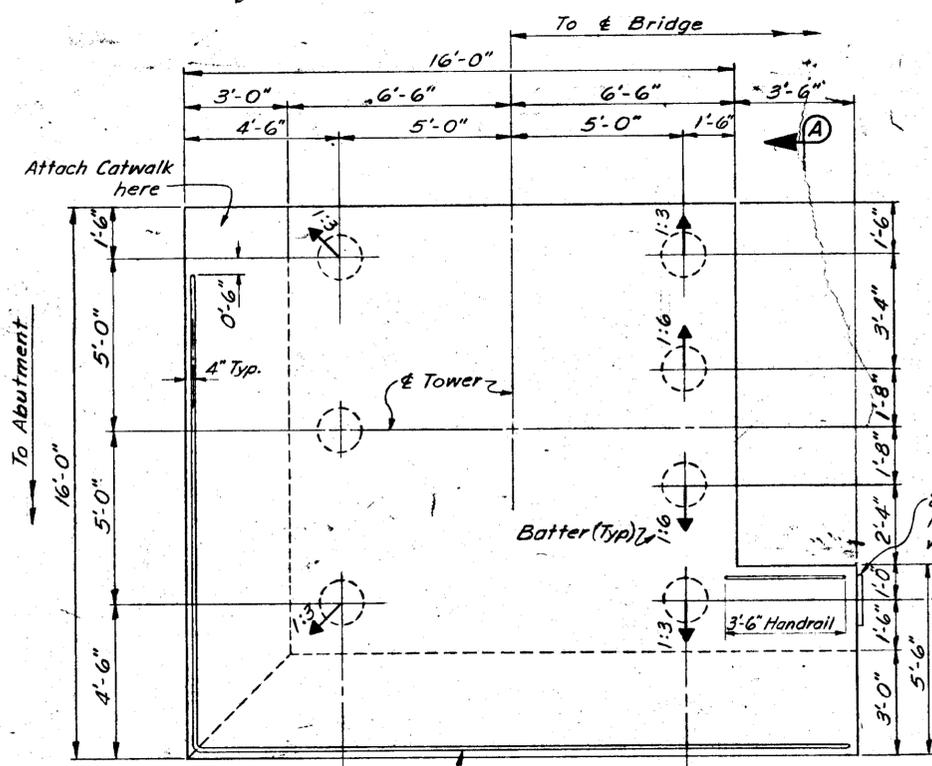


PLAN

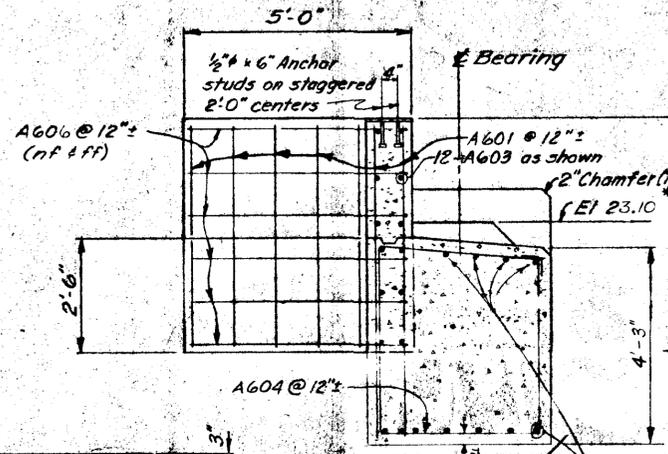


SECTION B-B



ELEVATION

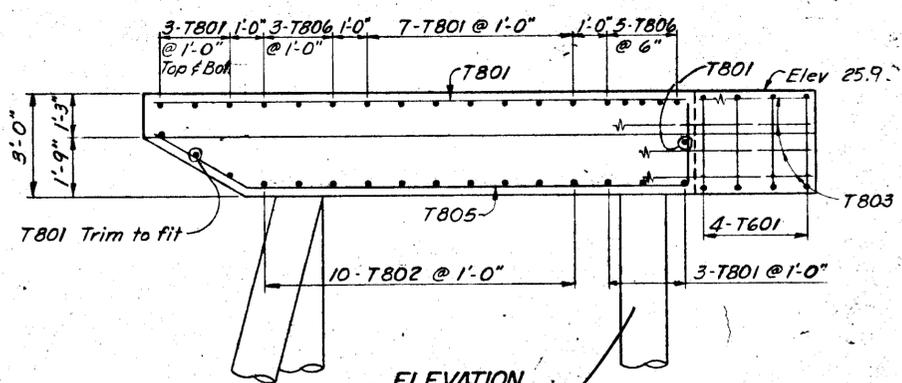

TOWER BASE

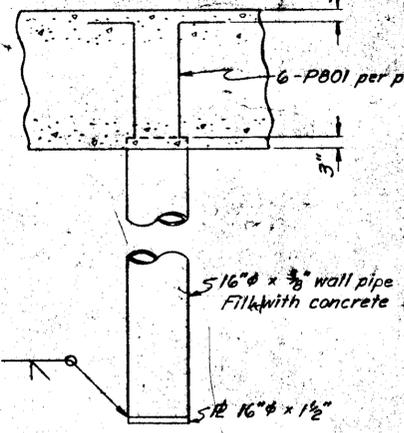

TYPICAL PILE

PILE TIP ELEVATIONS			
Location	Mark	Size	Min.
Tower A			
25 Ton Piles	-42.5	-45	-40
40 Ton Piles	-45	-40	
Tower B			
25 Ton Piles	-42.5	-36.2	
40 Ton Piles	-40	-25	
Safety Bent			
20 Ton Piles	-33.5	-27	

REINFORCING STEEL						
Location	Mark	No.	Size	Length	Type	Bending Diagrams
Tower Base	T601	8	6	14'-9"	Bent	3'-6" 12'-6"
	T801	56	8	15'-6"		T802
	T802	20		16'-0"	Bent	3'-6" 12'-6"
	T803	24		19'-0"		T805
	T805	20		18'-0"	Bent	15'-6" 2'-0"
	T806	16	8	17'-6"	Bent	2'-0"
Abut.	A600	36	6	7'-0"		5'-0" 6"
	A601	36	6	5'-0"		2'-6"
	A602	8		3'-6"		2'-9" 2'-3"
	A603	12		27'-6"		T601
	A604	18		11'-5"	Bent	3'-6"
	A605	6		3'-6"		A604
Piles	A606	24	6	6'-6"	Bent	4'-6"
	A801	10	8	17'-6"		A606
Counter-weight	P801	108	8	10'-0"	Bent	9'-0"
	C501	8	5	25'-0"	Bent	4'-0" 8'-0"
	C801	16	8	6'-9"		P801
						C501

* Note: Top of Deck R is approx 0.10' above backwall when bridge is level.
All rebar shall have minimum concrete cover of 3" clear.

GRAVINA ISLAND AIRPORT FERRY TERMINAL SUBSTRUCTURE

State of Alaska DEPARTMENT OF HIGHWAYS Juneau, Alaska

Designed by: J.L.G. Date: 11-71
Checked by: J.L.G. Date: 11-71
Drawn by: J.L.G. Date: 11-71
Checked by: J.L.G. Date: 11-71
Traced by: J.L.G. Date: 11-71