

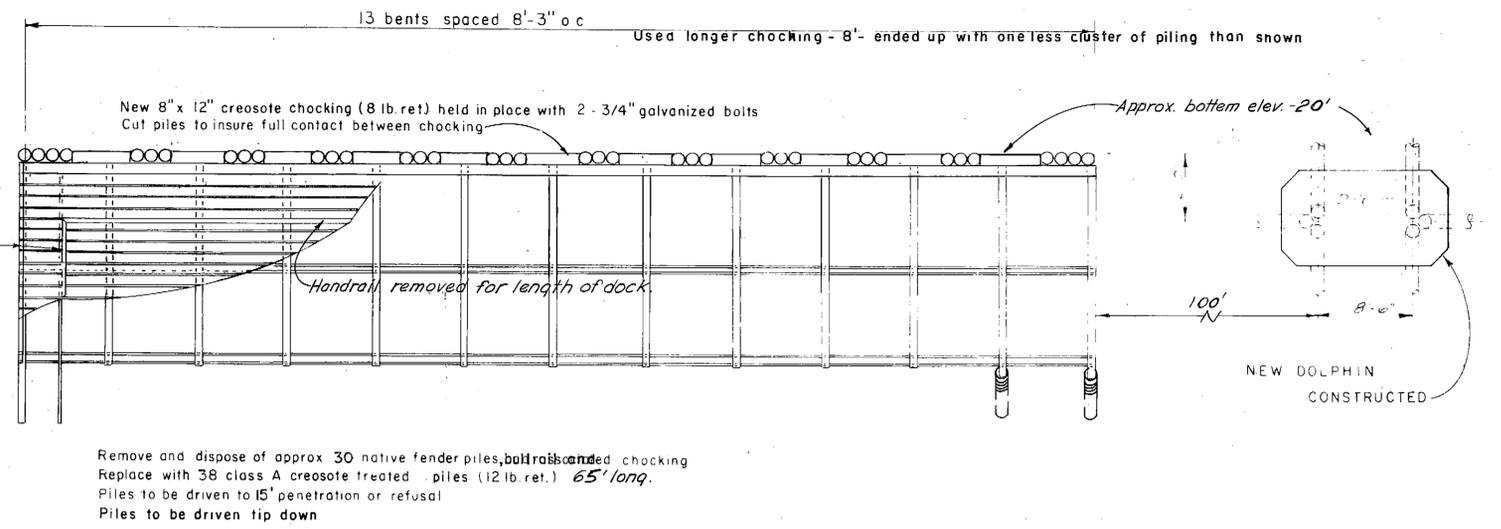
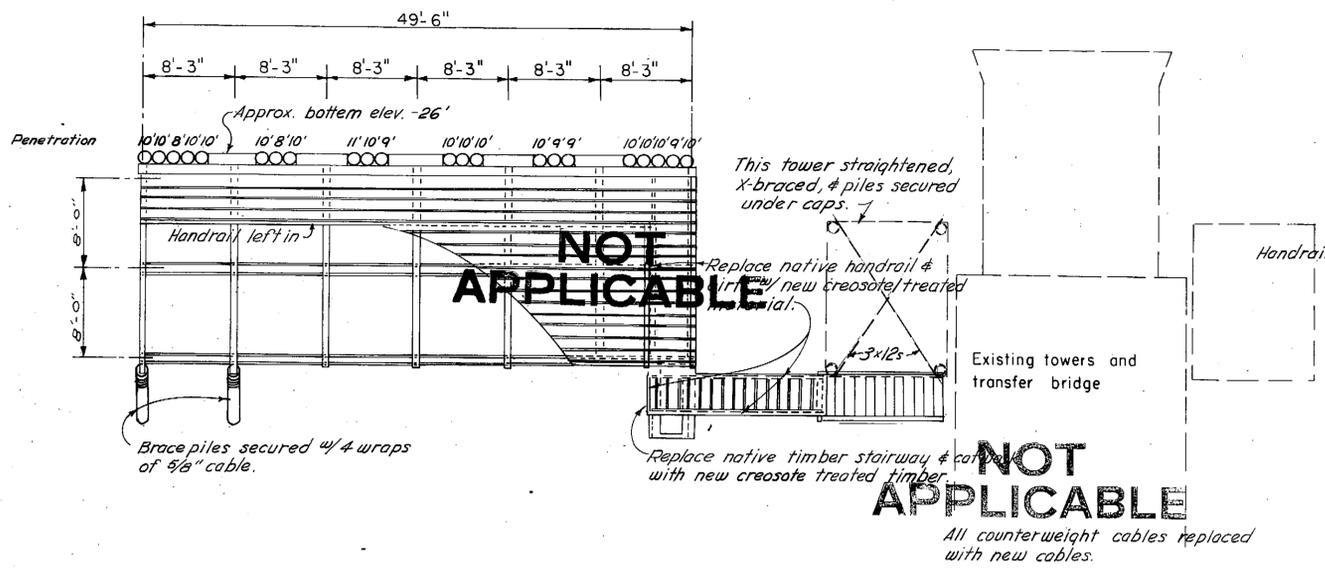


Ketchikan Ferry Terminal Dock Repairs


AS BUILT 1173

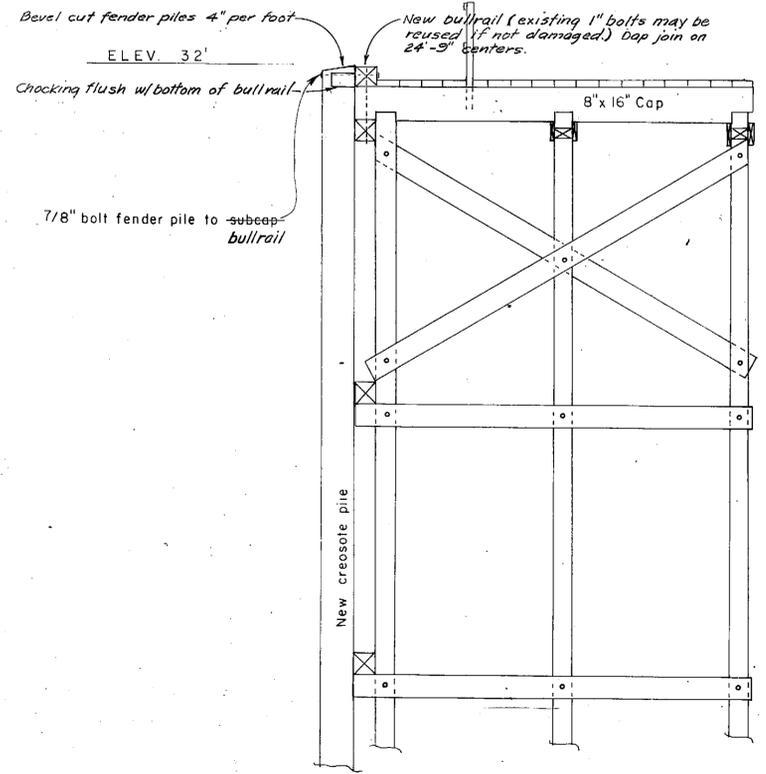

PLAN  
SCALE 1/8" = 1'-0"

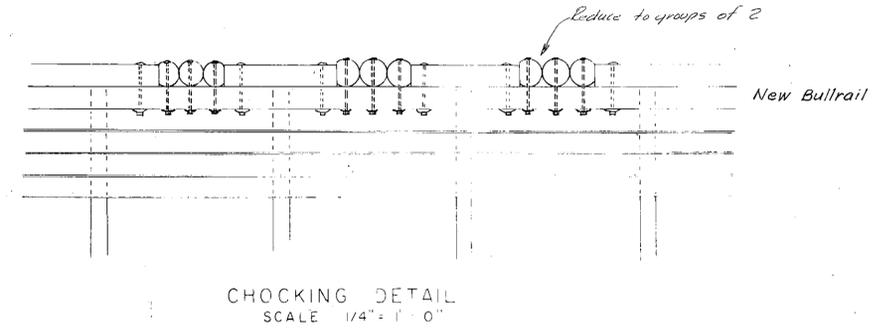

TYPICAL EXISTING BENT  
SCALE 1/4" = 1'-0"

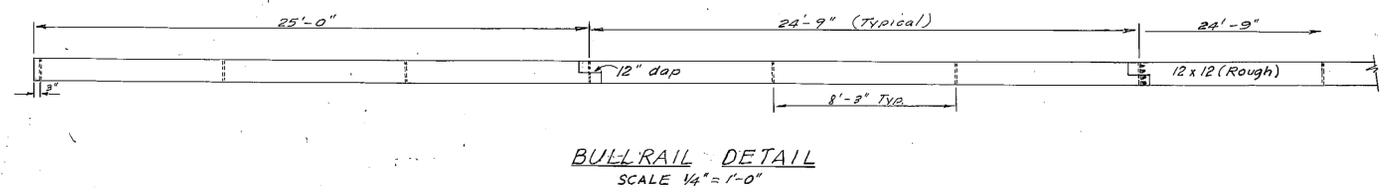

AS BUILT 1173

DOCK REPAIRS  
KETCHIKAN FERRY TERMINAL

AS SHOWN  
2-5-73  
MT  
Don Stetter  
DIRECTOR  
DRAWN BY DCW, CHECKED BY DCW