


STATE OF ALASKA
DEPARTMENT OF PUBLIC WORKS
DIVISION OF HIGHWAYS

PLAN AND PROFILE
PROPOSED HIGHWAY PROJECT
— AS BUILT —
NO. S-0902(I)

SOUTH TONGASS HIGHWAY
KETCHIKAN-HERRING BAY
MILE 6.9 to MILE 7.2
GRADING, DRAINAGE & SURFACING

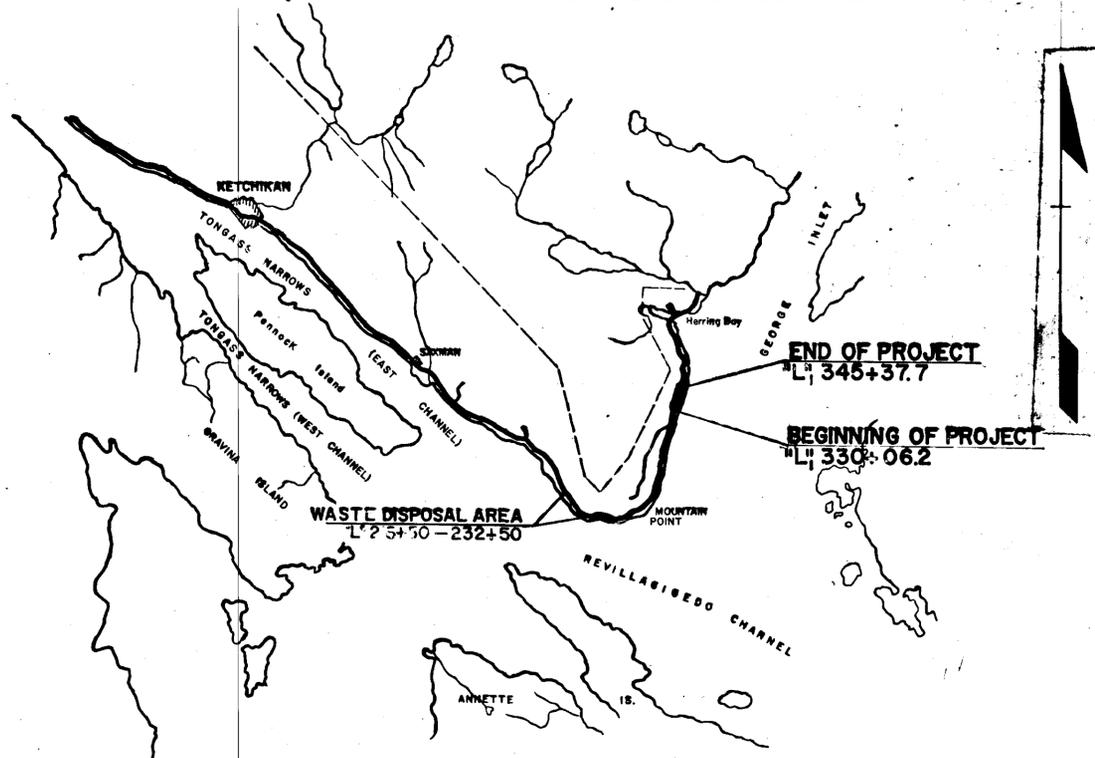

STATE	PROJECT DESIGNATION	SECTION	YEAR	SHEET NO.	TOTAL SHEETS
ALASKA	S-0902 (I)		1961	I	II

TYPE 3210 IMPROVEMENT

INDEX OF SHEETS

SHEET NO.	DESCRIPTION
1	TITLE SHEET
2	TYPICAL SECTIONS & ESTIMATE OF QUANTITIES
3-4	PLAN AND PROFILE SHEETS
5	CULVERTS & MISCELLANEOUS WORK
6	SUMMARY OF RIGHT-OF-WAY MONUMENTS
S-1	STANDARD CULVERTS
S-5	STANDARD BARRICADES
S-6	STANDARD PROJECT IDENTIFICATION SIGN
S-7	TYPICAL SIGNS

DESIGN DESIGNATION
ADT(1960)= 220
ADT(1980)= 440
DHV= 57
D=65%
T=6%
V=60MPH

Field reports of the foundation soils and the type of materials for this project are available for inspection in the Dept. of Public Works, Division of Highways, District Office at Juneau and the Design Office at Juneau. Detail cross sections for this project are available for inspection in the Design Office at Juneau.



CONVENTIONAL SIGNS

PROPOSED CONSTRUCTION CENTERLINE	
PRELIMINARY SURVEY LINE	
TOWNSHIP LINE	
SECTION LINE	
PROPERTY LINE	
RIGHT-OF-WAY LINE	
SEASMENT LINE	
CORPORATED OR CITY LIMITS	
POWER LINE	
TELEPHONE OR TELEGRAPH LINE	
POLE ANCHOR	
LIGHT POLE	
WATER LINE	
SEWER LINE	
VALVE BOX	
CATCH BASIN	
DROP INLET	
MANHOLE	
CULVERT PROPOSED	
CULVERT EXISTING	
FIRE HYDRANT	
GRAVELED WAY	
BUMP	
FENCE	
CURB CUT	
LAND MONUMENT	
RIGHT-OF-WAY MONUMENT	

PROJECT SUMMARY

WIDTH OF SUBGRADE	28'
WIDTH OF PAVEMENT	24'
LENGTH OF GRADING	1600' ± 53.5' = 0.290 MI ± 0.30
LENGTH OF PAVING	1600' ± 53.5' = 0.290 MI ± 0.30
LENGTH OF PROJECT	1600' ± 53.5' = 0.290 MI ± 0.30

STATE OF ALASKA
DEPT. OF PUBLIC WORKS
DIVISION OF HIGHWAYS



APPROVED _____ Date _____
DIRECTOR, DIVISION OF HIGHWAYS

APPROVED _____ Date _____
REGIONAL ENGINEER
BUREAU OF PUBLIC ROADS
REGION TEN

AS BUILT QUANTITIES & CHANGES - Dec. 1962
BACKCHECKED.

STATE	PROJECT DESIGNATION	YEAR	SHEET NUMBER	TOTAL SHEETS
ALASKA	S-0902 (1)	1961	3	11

AS BUILT

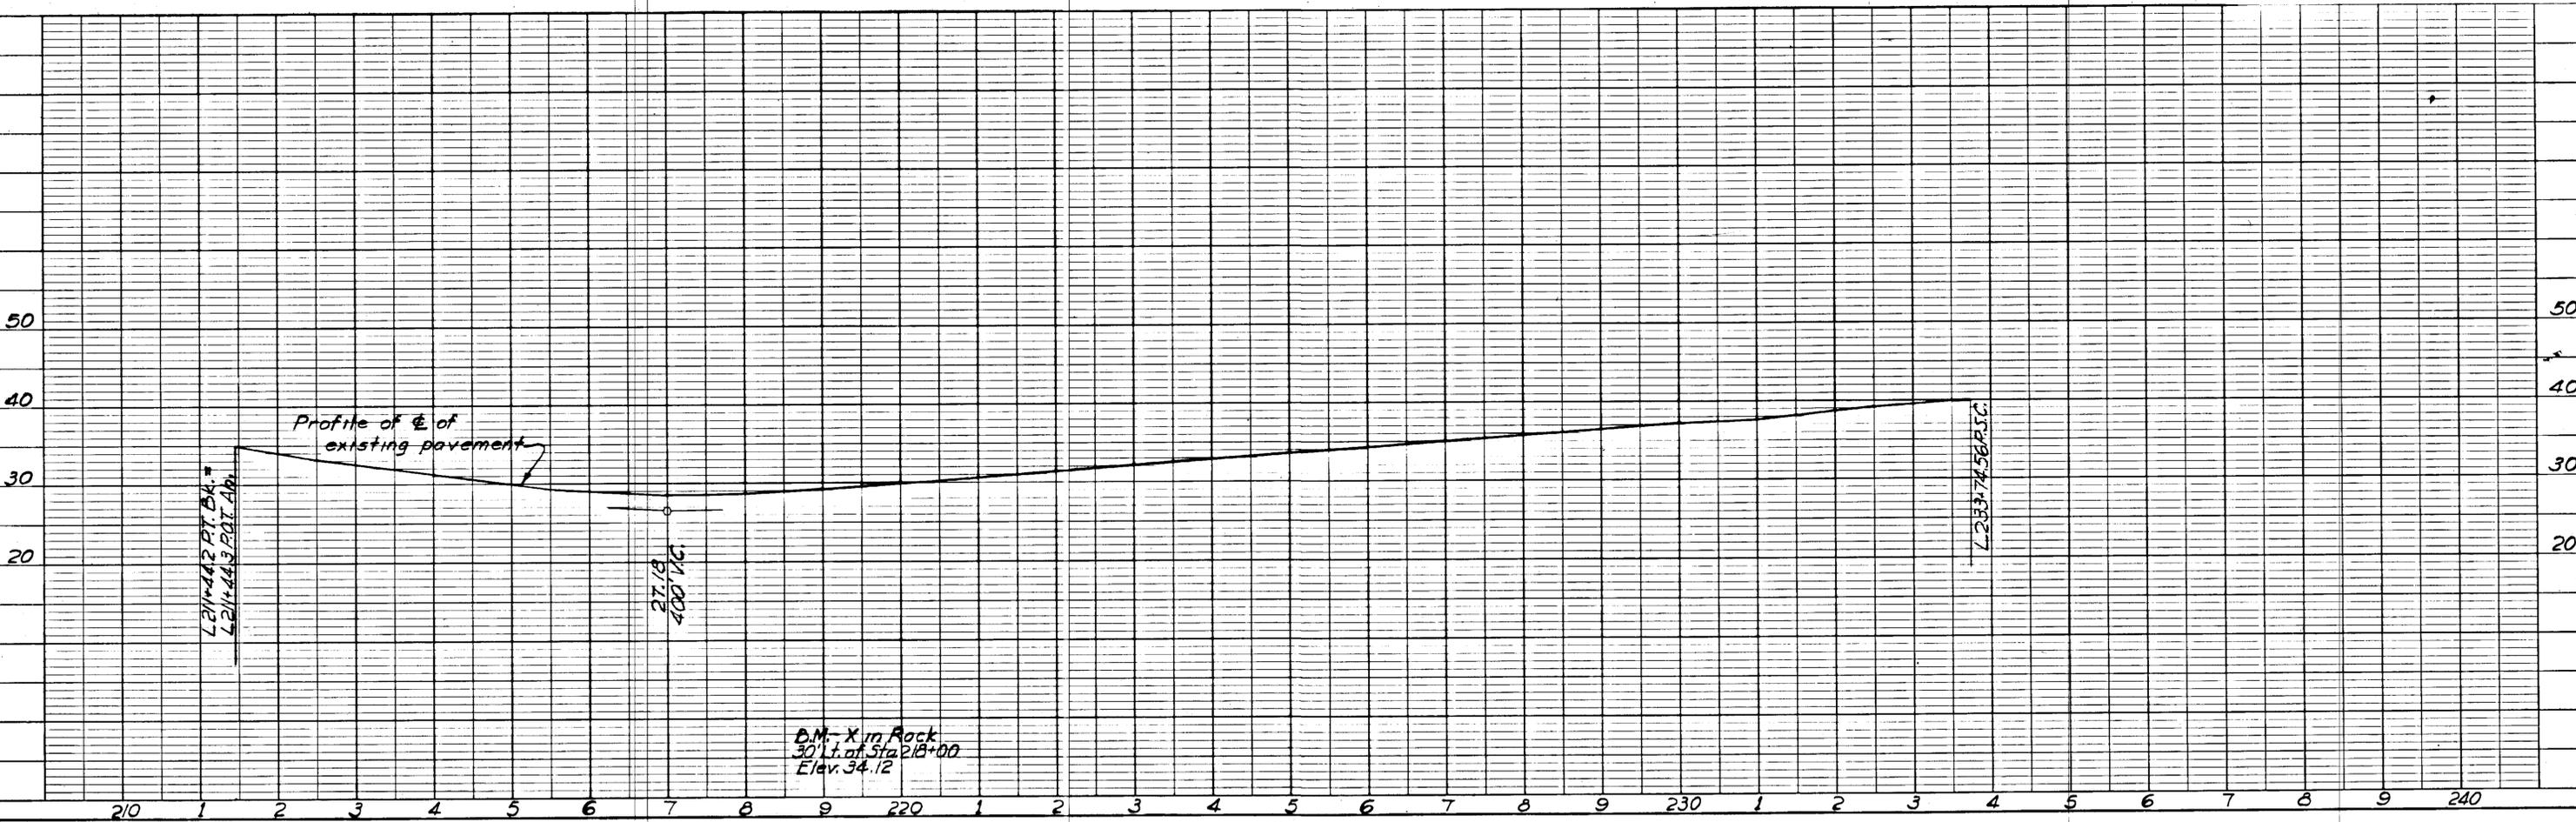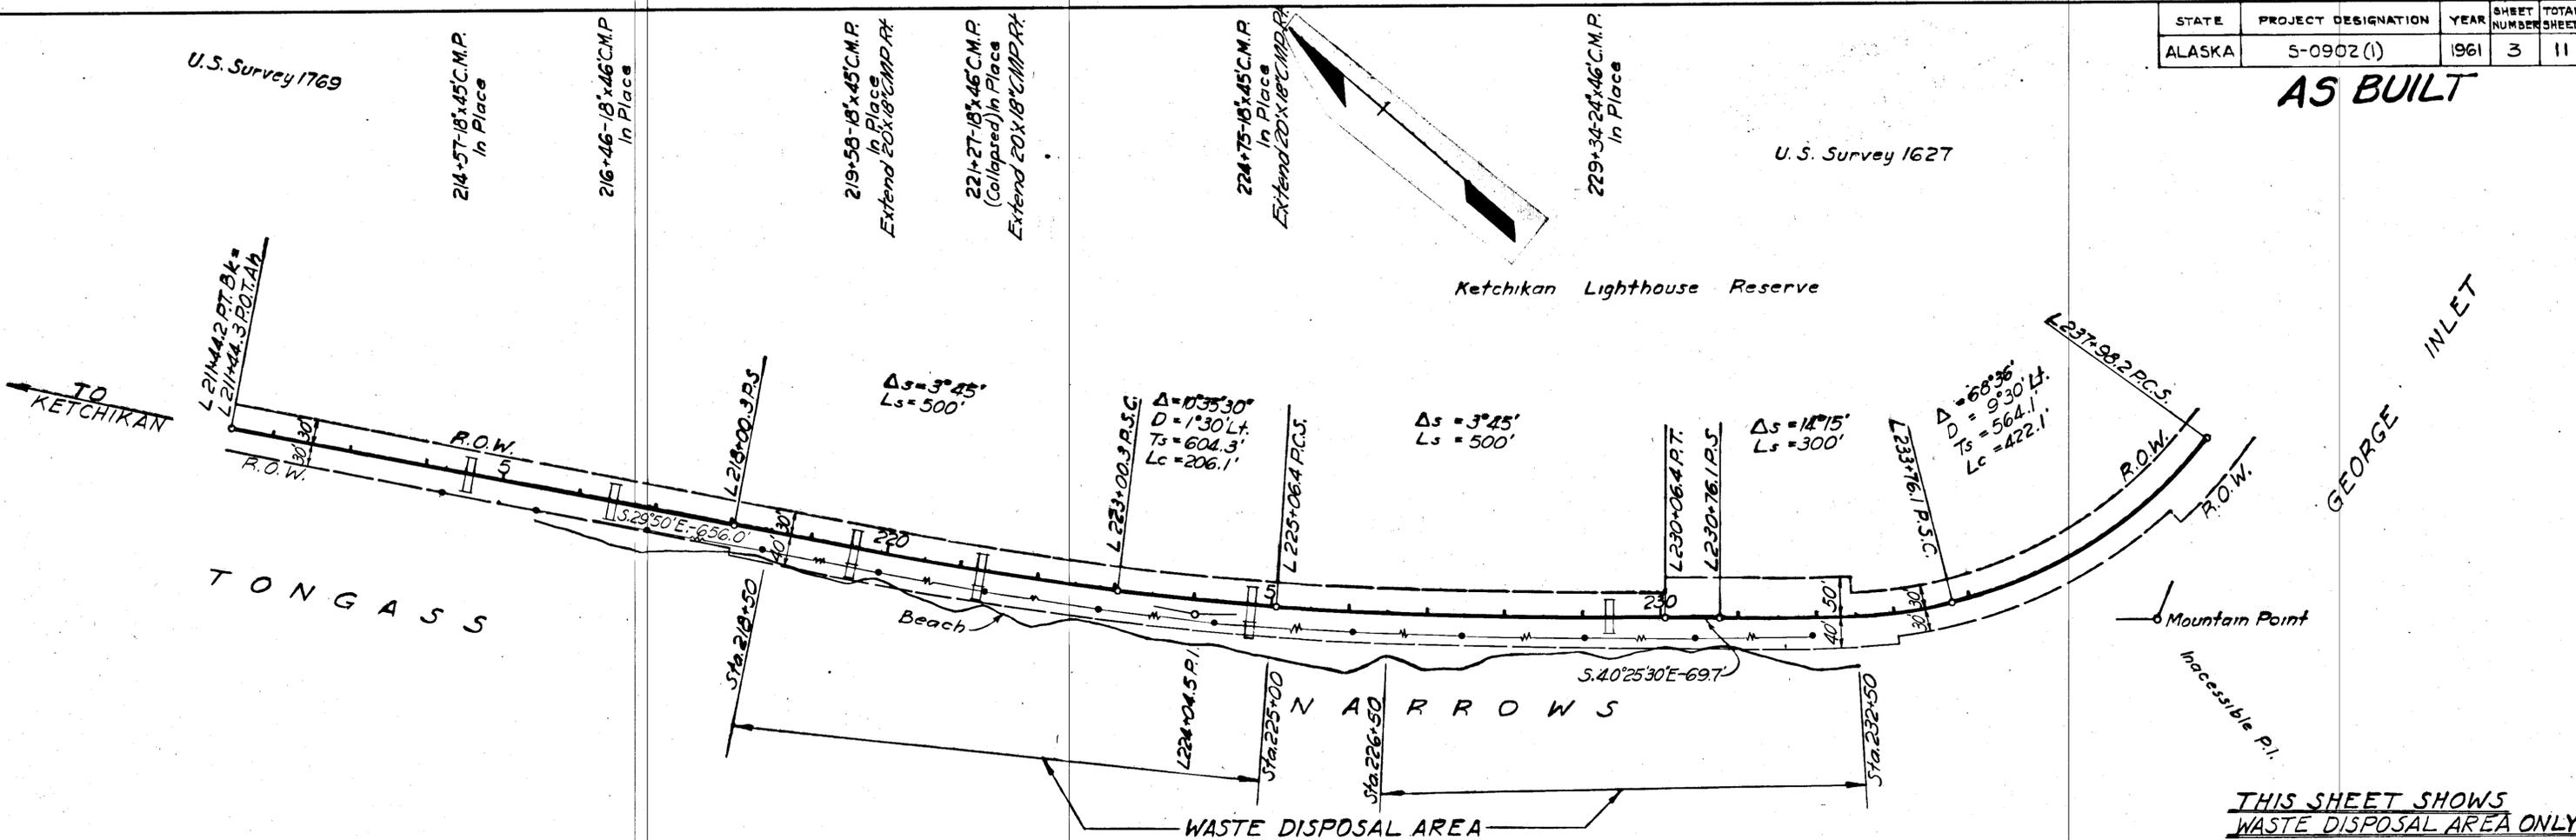

STATE	PROJECT DESIGNATION	SECTION	YEAR	SHEET NUMBER	TOTAL SHEETS
ALASKA	S-0902 (1)		1961	4	11

AS BUILT

