

As-Built - 2016

# State of Alaska

Department of Transportation  
and Public Facilities  
Southcoast Region

January 13, 2016

## KETCHIKAN FERRY TERMINAL IMPROVEMENTS PROJECT No. SAMHS00015 / 0911007

The undersigned hereby certifies that this duplicated document is an exact and true copy of the original.


*Cody Sutter*

SHEET INDEX	
SHEET NO.	DESCRIPTION
01	TITLE SHEET
02	GENERAL NOTES & QUANTITIES
03	EXISTING SITE PLAN & SURVEY CONTROL
04	NEW SITE PLAN & PILE TABLE
05	MARINE LAYOUT
06-11	4-PILE DOLPHIN (E6 & W6)
12-19	6-PILE DOLPHIN (W5)
20	CATWALK & W4 MODIFICATIONS
21	ANODES
22-24	COVERED WALK
25	WATER & SEWER UTILITIES
26-28	ELECTRIC
As-Built Plans	
Contractor: Turnagain	
Project Engineer: Manci Batshe Koff	
Begin Construction: July 6, 2016	
End Construction: Sept 9, 2016	


RECEIVED  
JUN 08 2017  
DOT&PF SR Const

TIDAL DATA	
HTL	+19.7'
MHW	+14.6'
MLLW	0.0'
ELW	-5.3'

THE FOLLOWING STANDARD DRAWINGS APPLY TO THIS PROJECT  
G-46.11

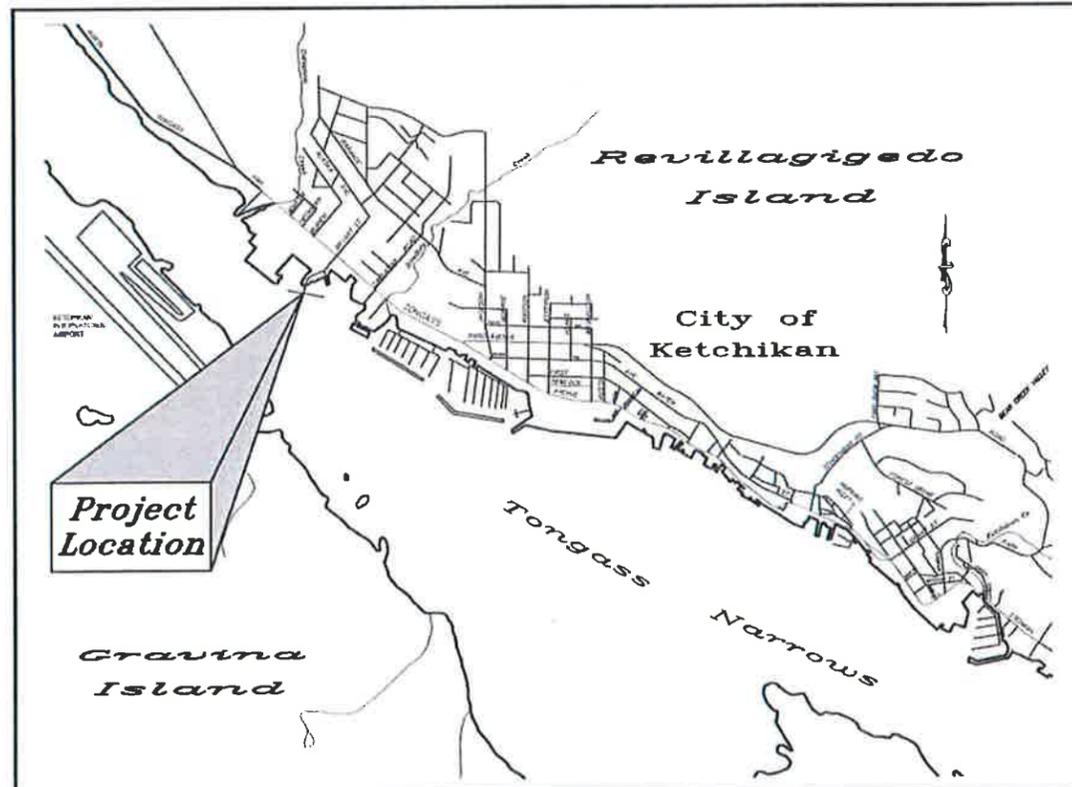

SITE MAP

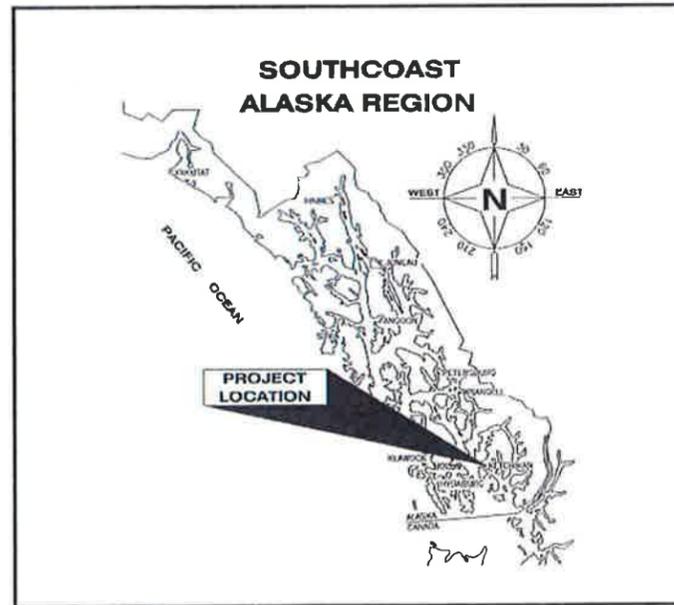

REGIONAL MAP

PATH: Q:\KTN\67466\PLANSET\MF\01 - TITLE SHEET.DWG TAB:1

STATE OF ALASKA  
DEPARTMENT OF TRANSPORTATION  
& PUBLIC FACILITIES  
SOUTHCOAST REGION



APPROVED: *[Signature]* 10/28/15  
FOR REGIONAL PRE-CONSTRUCTION ENGINEER DATE  
L. PAT CARROLL, P.E.

APPROVED: *Chuck Correa* 10/29/15  
DIRECTOR OF DESIGN & CONSTRUCTION, SOUTHCOAST REGION DATE  
CHUCK CORREA, P.E.

CERTIFIED TRUE & CORRECT AS-BUILT OF ACTUAL FIELD CONDITION:

CONSTRUCTION PROJECT MANAGER DATE

STATE	PROJECT DESIGNATION	YEAR	SHEET NO.	TOTAL SHEETS
ALASKA	SAMHS00015	2015	1	28

Project As-Built Drawings have been reviewed by the Project Engineer and represent to the best of my knowledge the project as constructed.  
PE *MP* Date 5-20-17

### ESTIMATE OF QUANTITIES

ITEM #	ITEM DESCRIPTION	PAY UNIT	QTY
BASIC BID			
202 (1)	DEMOLITION & REMOVAL	LUMP SUM	ALL REQ'D
202 (13)	TERMINAL CLOSURE PRICE WITHHOLDING	CONTINGENT SUM	ALL REQ'D
504 (1)	4-PILE DOLPHIN CAP (E6)	EACH	1
504 (2)	4-PILE DOLPHIN CAP (W6)	EACH	1
504 (3)	4-PILE DOLPHIN FENDER SYSTEM	EACH	2
504 (4)	6-PILE DOLPHIN CAP (W5)	EACH	1
504 (5)	6-PILE DOLPHIN FENDER SYSTEM (W5)	EACH	1
504 (6)	RELOCATE EXISTING 28' CATWALK	LUMP SUM	ALL REQ'D
504 (7)	NEW COVERED WALKWAY	LUMP SUM	ALL REQ'D
505 (1)	30" x 1/2" WALL PIPE PILE, FURNISHED	LINEAR FOOT	1873
505 (2)	30" x 1/2" WALL PIPE PILE, DRIVEN	EACH	14
505 (3)	150 lb PILE ANODE	EACH	21
608 (7)	CONCRETE SIDEWALK	LUMP SUM	ALL REQ'D
614 (2)	CONCRETE BARRIER	LUMP SUM	ALL REQ'D
628 (1)	SEWER AND WATER UTILITIES	LUMP SUM	ALL REQ'D
640 (1)	MOBILIZATION AND DEMOBILIZATION	LUMP SUM	ALL REQ'D
640 (4)	WORKER MEALS AND LODGING, OR PER DIEM	LUMP SUM	ALL REQ'D
642 (1)	CONSTRUCTION SURVEYING	LUMP SUM	ALL REQ'D
643 (2)	TRAFFIC MAINTENANCE	LUMP SUM	ALL REQ'D
647 (1)	MARINE MAMMAL MONITORING	LUMP SUM	ALL REQ'D
662 (1)	ELECTRICAL POWER AND LIGHTING SYSTEM	LUMP SUM	ALL REQ'D
ADDITIVE ALTERNATE A			
505 (3A)	150 lb PILE ANODE	EACH	116

### NEW ITEMS

106(1)	Buy America Dispute Settlement	Lump Sum	ALL REQ'D
110(1A)	Buy America Equitable Adjustment	Lump Sum	ALL REQ'D
202(2)	Extra Demolition & Removal of Existing W5	Lump Sum	ALL REQ'D
504(8)	W5 Dolphin Pile System Additions	Lump Sum	ALL REQ'D
662(1a)	Electrical Power and Lighting System	Lump Sum	ALL REQ'D

### REFERENCE LEGEND

**VIEW TITLE** **VIEW NAME**  
**VIEW DESCRIPTION**

**DRAWING TITLE/SUBTITLE** **VIEW NAME**  
**VIEW DESCRIPTION**

**ELEVATION VIEW**

**SECTION VIEW**

**DETAIL CALLOUT**

**DETAIL TAG**

IN VIEW TITLE:  
 # SHEET NUMBER OF THE TITLED VIEW OR DASH MARK WHEN DETAIL CALLOUT IS ON THE SAME SHEET  
 ## SHEET NUMBER OF THE DETAIL CALLOUT OR DASH MARK WHEN CALLOUT IS ON THE SAME SHEET

\* SHEET NUMBER WHERE DETAIL IS LOCATED WHEN ON A DIFFERENT SHEET OR DASH MARK WHEN ON THE SAME SHEET  
 \*\* SHEET NUMBER WHERE THE CALLOUT CUT IS MADE OR DASH MARK WHEN ON THE SAME SHEET

### ABBREVIATIONS

AASHTO	AMERICAN ASSOC OF STATE HIGHWAY & TRANSPORTATION OFFICIALS
ABUT	ABUTMENT
ACZA	AMMONIACAL COPPER ZINC ARSENATE
AISC	AMERICAN INSTITUTE OF STEEL CONSTRUCTION
ALUM	ALUMINUM
APF	ASSOCIATED PILE AND FITTING
API	AMERICAN PETROLEUM INSTITUTE
ASCE	AMERICAN SOCIETY OF CIVIL ENGINEERS
ASTM	AMERICAN SOCIETY FOR TESTING & MATERIALS
ASSY	ASSEMBLY
ATS	ALASKA TIDELAND SURVEY
AWS	AMERICAN WELDING SOCIETY
BOP	BEGINNING OF PROJECT
BRG	BEARING
BTM	BOTTOM
BTWN	BETWEEN
C/C	CENTER TO CENTER
CJP	COMPLETE JOINT PENETRATION
CL	CENTERLINE
CLR	CLEAR
CNTR	CENTER
CONC	CONCRETE
CS	CONTINGENT SUM
CTSK	COUNTERSINK
CU	CUBIC
CVN	CHARPY V-NOTCH
DBL	DOUBLE
DL	DEAD LOAD
DS	DISCONNECT SWITCH
EA	EACH
ECON HD	ECONOMY HEAD
ELEV	ELEVATION
EQ	EQUAL
EST	ESTIMATED
FNMC-A	LIQUIDTIGHT FLEXIBLE NON METALLIC CONDUIT, TYPE A
FB	FLAT BAR
FS	FAR SIDE
FT	FOOT
FVF	FAST VEHICLE FERRY
GA	GAUGE
GALV	GALVANIZED
GR	GRADE
GRMC	GALVANIZED STEEL RIGID METAL CONDUIT
HGG	HOT DIP GALVANIZE
HDPE	HIGH DENSITY POLYETHYLENE PLASTIC
HRZ	HORIZONTAL
HSS	HOLLOW STRUCTURAL SECTION
J-BOX	JUNCTION BOX
LB FITTING	TYPE LB CONDUIT OUTLET BODY
LF	LINEAR FEET
LS	LUMP SUM
MI	MALLEABLE IRON
M/V	MARINE VESSEL
NOAA	NATIONAL OCEANIC AND ATMOSPHERIC ADMINISTRATION
NOS	NUMBERS
NS	NON-SHRINKING, OR NEAR SIDE
OC	ON CENTER
OD	OUTSIDE DIAMETER
OPP	OPPOSITE
PL	PLATE
PP	PIPE PILE
PSI	POUNDS PER SQUARE INCH
QTY	QUANTITY
R	RADIUS
REQ'D	REQUIRED
SDR	STANDARD DIMENSION RATIO
SEI	STRUCTURAL ENGINEERING INSTITUTE
SS	STAINLESS STEEL
STD	STANDARD
SYMM	SYMMETRIC
T FITTING	TYPE T CONDUIT OUTLET BODY
T&B	TOP AND BOTTOM
TYP	TYPICAL
UHMW	ULTRA HIGH MOLECULAR WEIGHT POLYETHYLENE PLASTIC
UON	UNLESS OTHERWISE NOTED
WP	WORK POINT
XS	EXTRA STRONG (SCHEDULE 80 PIPE)
XXS	DOUBLE EXTRA STRONG (SCHEDULE 120 PIPE)

### GENERAL NOTES

#### DESIGN SPECIFICATIONS

PER CONTRACT DOCUMENTS FOR PROJECT NO. SAMHS00015

DESIGN STANDARDS: AISC STEEL CONSTRUCTION MANUAL 14TH ED. LRFD  
 ASCE/SEI STANDARD 7-10, MINIMUM DESIGN LOADS FOR BUILDINGS AND OTHER STRUCTURES, 2010

DESIGN LOADS: BERTHING (PERPENDICULAR): 100 FT-KIPS (4-PILE DOLPHIN)  
 150 FT-KIPS (6-PILE DOLPHIN)  
 MOORING (ANY DIRECTION): 80 KIPS

DESIGN VESSELS: IFA M/V STIKINE/PRINCE OF WALES, AMHS M/V LITUYA & FVF (4-PILE DOLPHIN)  
 AMHS ALL VESSELS (6-PILE DOLPHIN)

#### MATERIALS

STEEL SHAPE & PLATES:

PLATES FOR BRIDGE MODS - ASTM A709 GR 50  
 PLATES & SHAPES - ASTM A36, UNLESS OTHERWISE NOTED  
 HOLLOW STRUCTURAL SECTIONS - ASTM A500 GR B  
 HP - ASTM A572 GR 50  
 PIPE - ASTM A53 GR B  
 STAINLESS STEEL - ASTM A276 TYPE 316  
 W - ASTM A992, ASTM A709  
 LADDER RUNGS - ASTM A706 GR 60

PILING: STEEL - API 5L X52, OR ASTM A252 GR 3, OR ASTM A709 GR 50  
 FABRICATED TO API 2B

GRATING: 1" DEEP MOLDED FIBERGLASS 1"x4" RECTANGULAR GRATING WITH GRIT SURFACE

PLASTIC: ULTRA HIGH MOLECULAR WEIGHT POLYETHYLENE PLASTIC ASTM D4020

FASTENERS: PER SPECS

CONCRETE: CLASS A

GROUT: PER 701-2.03

STEEL REINFORCEMENT: ASTM A615 GR 60

#### PROTECTIVE COATINGS

ALL STEEL, PILING, & WELDMENTS: GALVANIZED AFTER FABRICATION PER SPECS, UNLESS OTHERWISE NOTED

FIELD REPAIR OF EXISTING COATINGS: DAMAGED GALVANIZED AND PAINT COATINGS SHALL BE REPAIRED PER SPEC 504-3.03.

#### PILING

DIAMETER & WALL THICKNESS AS PER PILING TABLE & PLANS  
 DRIVING SHOES REQUIRED ON ALL PILES, APF 14001 OR EQUAL

#### WELDS


ALL WELDING SHALL BE PERFORMED BY CERTIFIED PERSONS IN ACCORDANCE WITH AWS D1.1 AND D1.5 AS APPLICABLE.

DO NOT SCALE FROM THESE DRAWINGS USE DIMENSIONS

DESIGNED BY: D. LOWELL	STATE OF ALASKA DEPARTMENT OF TRANSPORTATION & PUBLIC FACILITIES SOUTHCOST REGION
	<b>KETCHIKAN FERRY TERMINAL IMPROVEMENTS</b>
CHECKED BY: STAFF	<b>ESTIMATE OF QUANTITIES &amp; GENERAL NOTES</b>
DRAWN BY: STAFF	PROJECT DESIGNATION: <b>SAMHS00015</b>
PATH: Q:\KTN\67466\MF\ADMIN\ADVERTISEMENT\ADDENDUM\FAXADDENDUM2\02 - GENERAL NOTES	YEAR: <b>2015</b>
TAB: 2 Wednesday, November 25, 2015 11:55:36 AM	SHEET NO.: <b>2</b>
NO. DATE DESCRIPTION	TOTAL SHEETS: <b>28</b>
1 11/25/15 REVISED NOTES & ESTIMATE	

SURVEY CONTROL				
POINT #	NORTHING	EASTING	ELEVATION	DESCRIPTION
119	92316.47	96865.90	24.11	SURVSPIKE
120	92094.89	96960.46	23.20	PK
121	92090.50	96639.37	22.11	ALCAP2"
122	92718.32	96967.74	32.82	ALCAP2"

The vertical datum for the survey control shown is elevation above Mean Lower Low Water = 0.0 feet and established from the N.O.A.A. N.O.S. published tidal datum at Ketchikan - Tongass Narrows 9450460, Tidal Epoch 1983 -2001.

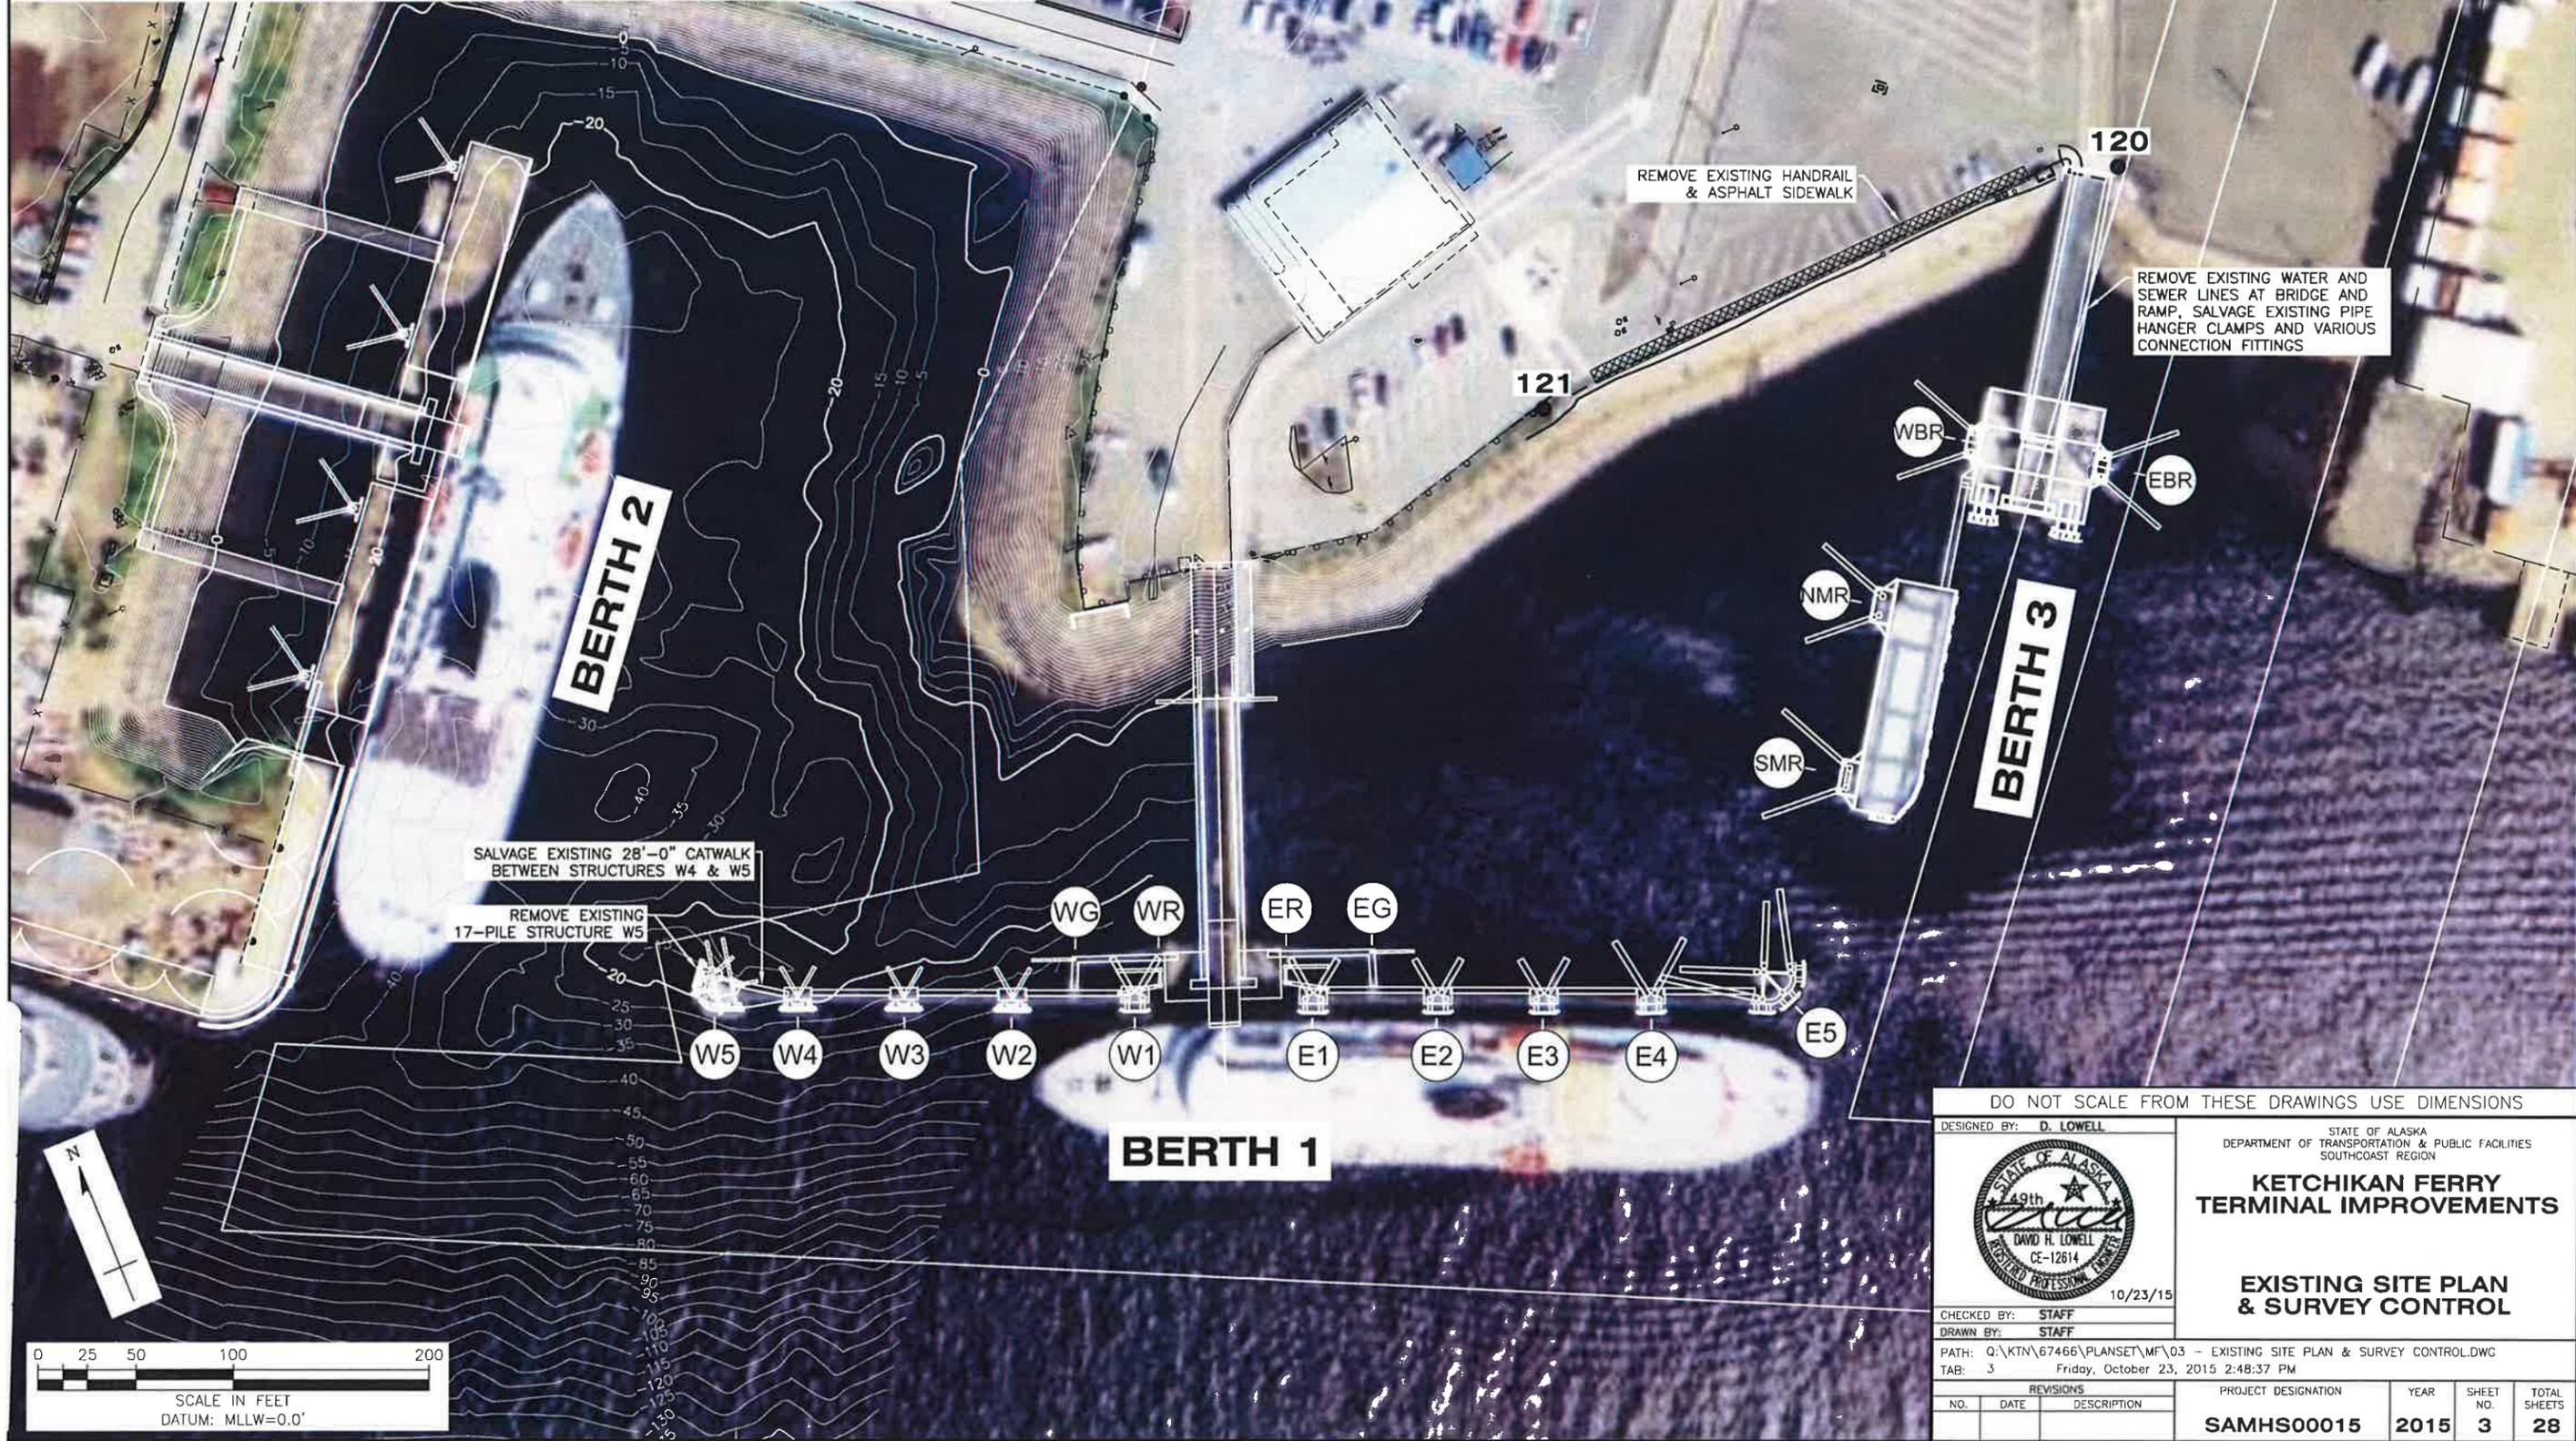

Project As-Built Drawings have been reviewed by the Project Engineer and represent to the best of my knowledge the project as constructed.  
 PE MF Date 5-2017

DO NOT SCALE FROM THESE DRAWINGS USE DIMENSIONS

DESIGNED BY: D. LOWELL  CHECKED BY: STAFF DRAWN BY: STAFF	STATE OF ALASKA DEPARTMENT OF TRANSPORTATION & PUBLIC FACILITIES SOUTHCOAST REGION <b>KETCHIKAN FERRY          TERMINAL IMPROVEMENTS</b> <b>EXISTING SITE PLAN          &amp; SURVEY CONTROL</b>																	
PATH: Q:\KTN\67466\PLANS\MF\03 - EXISTING SITE PLAN & SURVEY CONTROL.DWG TAB: 3 Friday, October 23, 2015 2:48:37 PM																		
<table border="1" style="width: 100%;"> <thead> <tr> <th colspan="3">REVISIONS</th> </tr> <tr> <th>NO.</th> <th>DATE</th> <th>DESCRIPTION</th> </tr> </thead> <tbody> <tr> <td> </td> <td> </td> <td> </td> </tr> </tbody> </table>	REVISIONS			NO.	DATE	DESCRIPTION				<table border="1" style="width: 100%;"> <thead> <tr> <th>PROJECT DESIGNATION</th> <th>YEAR</th> <th>SHEET NO.</th> <th>TOTAL SHEETS</th> </tr> </thead> <tbody> <tr> <td style="text-align: center;">SAMHS00015</td> <td style="text-align: center;">2015</td> <td style="text-align: center;">3</td> <td style="text-align: center;">28</td> </tr> </tbody> </table>	PROJECT DESIGNATION	YEAR	SHEET NO.	TOTAL SHEETS	SAMHS00015	2015	3	28
REVISIONS																		
NO.	DATE	DESCRIPTION																
PROJECT DESIGNATION	YEAR	SHEET NO.	TOTAL SHEETS															
SAMHS00015	2015	3	28															

**PILE DATA**



STRUCTURE	PILE	SIZE	ULTIMATE CAPACITY (kips)		ELEVATION (ft)			EST. LENGTH (ft)
			UPLIFT	BEARING	EST. MUDLINE	MIN. TIP	CUTOFF	30"Øx1/2"
E6	V1	30"Øx1/2"	100	110	-49	-110 - 98	+23.0	133
	V2	30"Øx1/2"	100	110	-48	-110 - 97	+23.0	133
	B1	30"Øx1/2"	100	110	-53	-115 - 96	+29.9	153
	B2	30"Øx1/2"	100	110	-48	-110 - 97	+29.9	148
W5	V1	30"Øx1/2"	295	225	-20	-120 - 119	+23.0	143
	V2	30"Øx1/2"	295	225	-20	-120 - 119	+23.0	143
	V3	30"Øx1/2"	295	225	-20	-120 - 119	+23.0	143
	B1	30"Øx1/2"	270	520	-15	-115 - 117	+30.1	153
	B2	30"Øx1/2"	270	520	-12	-115 - 111	+30.1	153
	B3	30"Øx1/2"	270	520	-13	-115 - 112	+30.1	153
W6	V1	30"Øx1/2"	100	110	-15	-75 - 77	+23.0	98
	V2	30"Øx1/2"	100	110	-15	-75 - 76	+23.0	98
	B1	30"Øx1/2"	100	110	-15	-75 - 76	+29.9	111
	B2	30"Øx1/2"	100	110	-13	-75 - 76	+29.9	111
EST. TOTAL LENGTH (ft)								1873

**CONSTRUCTION LIMITATIONS AND SEQUENCING NOTES:**

- CONSTRUCTION PHASING PLAN** - PRIOR TO STARTING ANY FIELD WORK, THE CONTRACTOR SHALL PROVIDE A DETAILED CONSTRUCTION PHASING PLAN PER SECTION 202 OF THE SPECIFICATIONS. THE PHASING PLAN SHALL DESCRIBE THE SEQUENCE AND METHODS FOR CONSTRUCTING THE WORK. NO WORK SHALL COMMENCE ON SITE UNTIL THE CONSTRUCTION PHASING PLAN HAS BEEN APPROVED BY THE ENGINEER.
- ENVIRONMENTAL COMMITMENTS** - REFERENCE APPENDIX B AND SECTION 641 OF THE SPECIFICATIONS FOR ENVIRONMENTAL WORK RESTRICTIONS.
- WORK TIMES** - SEQUENCE ALL WORK TO MAINTAIN SAFE USE OF THE FACILITIES BY SCHEDULED FERRY VESSELS. COORDINATE WITH AMHS FOR THE LATEST FERRY SCHEDULES AND UPDATES WHEN SCHEDULING CONSTRUCTION ACTIVITIES.
- UNAUTHORIZED TERMINAL CLOSURES** - FOR EACH OCCURRENCE THAT A SCHEDULED AMHS VESSEL IS PREVENTED FROM USING THE FACILITY AS A RESULT OF THE CONTRACTORS OPERATIONS, A TERMINAL CLOSURE PRICE WITHHOLDING (DEDUCTION IN CONTRACT PAYMENTS) WILL BE ASSESSED UNDER BID ITEM 202(13).
- CLEAR ACCESS TO BERTH** - PRIOR TO SCHEDULED AMHS FERRY ARRIVALS, MOVE OR STORE ALL EQUIPMENT & MATERIALS IN LOCATIONS THAT WILL NOT AFFECT SAFE VESSEL ACCESS, BERTHING, VEHICLE, AND PEDESTRIAN TRANSFER OPERATIONS.


**PILE DATA TABLE NOTES:**

- ALL PILE WORK SHALL BE PER SECTION 505. PILE INSTALLATION SHALL BE CONDUCTED WITH THE ENGINEER OR DEPARTMENT'S REPRESENTATIVE PRESENT.
- DRIVE ALL PILES TO REFUSAL OR ESTIMATED TIP ELEVATION.
- MAXIMUM DRIVING RESISTANCE IS THE ULTIMATE BEARING CAPACITY PLUS OVERDRIVING TO REACH MINIMUM TIP ELEVATION.
- ALL PILES SHALL BE FITTED WITH OPEN-END DRIVING SHOES, APF 14001 OR EQUAL.

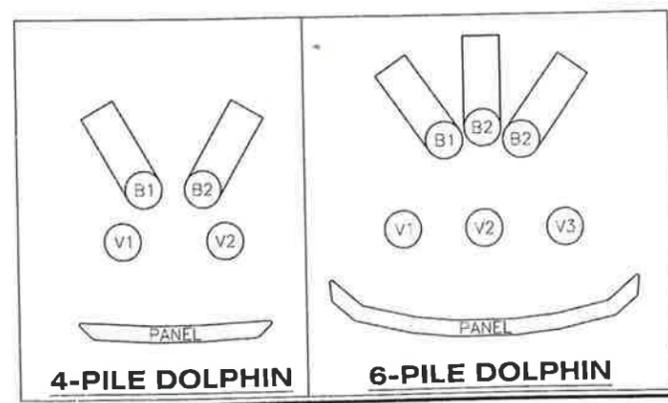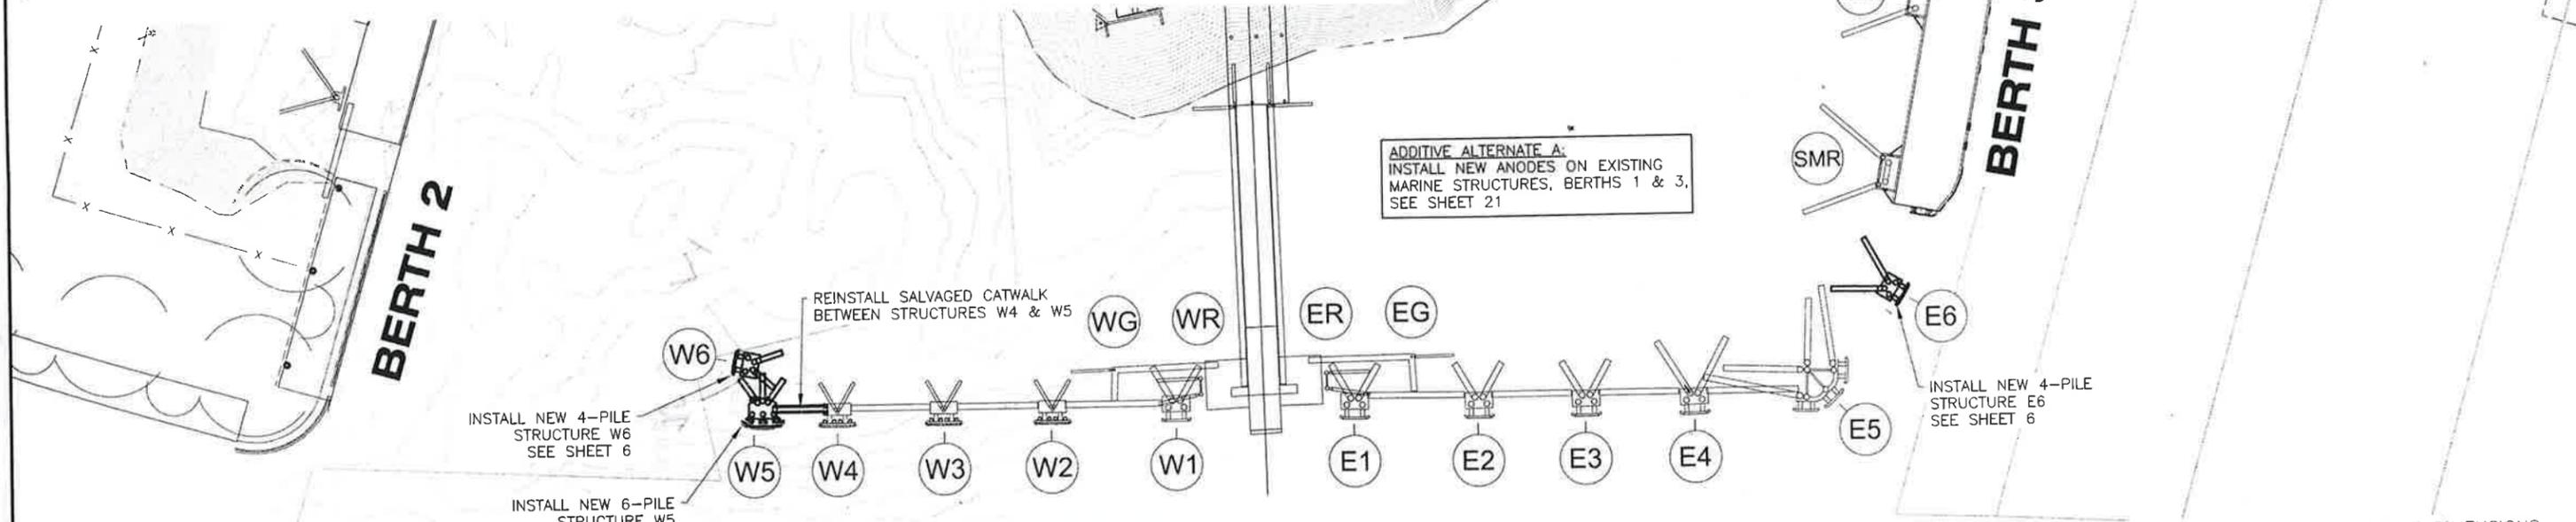


DO NOT SCALE FROM THESE DRAWINGS USE DIMENSIONS

DESIGNED BY: D. LOWELL	STATE OF ALASKA DEPARTMENT OF TRANSPORTATION & PUBLIC FACILITIES SOUTHCOST REGION	
	<b>KETCHIKAN FERRY TERMINAL IMPROVEMENTS</b>	
<b>NEW SITE PLAN &amp; PILE TABLE</b>		
CHECKED BY: STAFF	PROJECT DESIGNATION: SAMHS00015	YEAR: 2015
DRAWN BY: STAFF	SHEET NO: 4	TOTAL SHEETS: 28
PATH: Q:\KTN\67466\MF\ADMIN\ADVERTISEMENT\ADDENDUM\04 - NEW SITE PLAN&PILE TABLE_REV TAB: 4 Friday, November 20, 2015 12:03:09 PM		
REVISIONS	NO.	DATE
1	11/20/15	REVISED NOTES

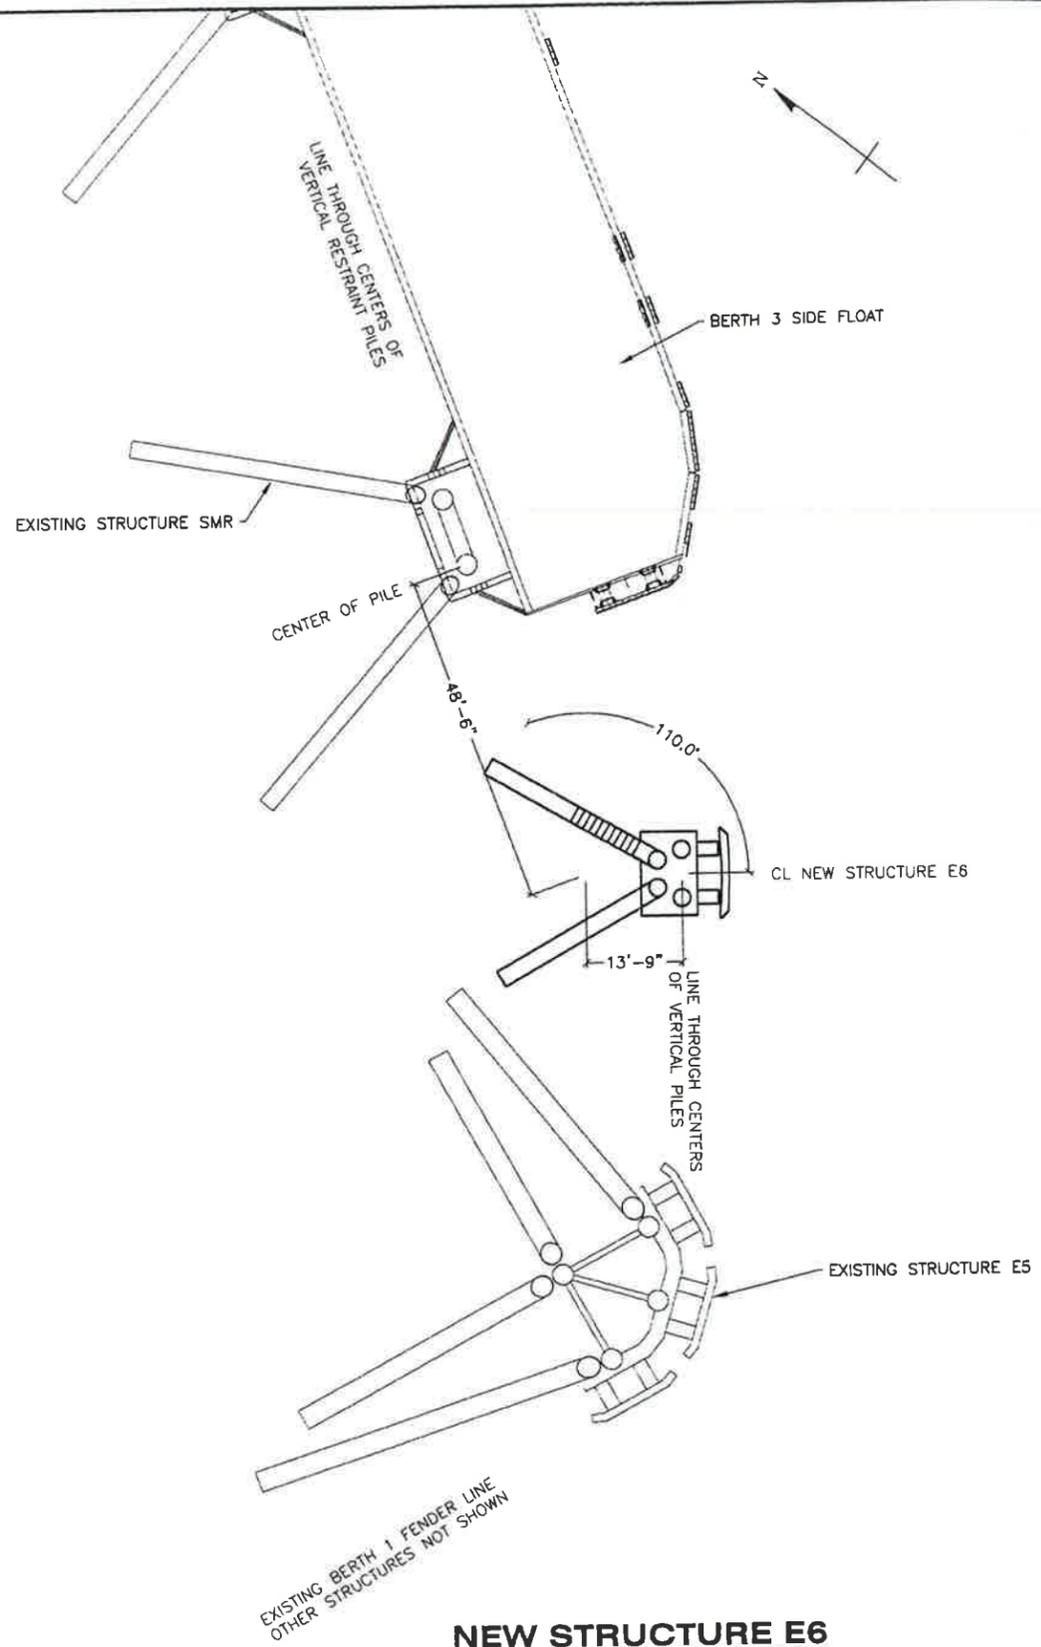

**NEW STRUCTURE E6**

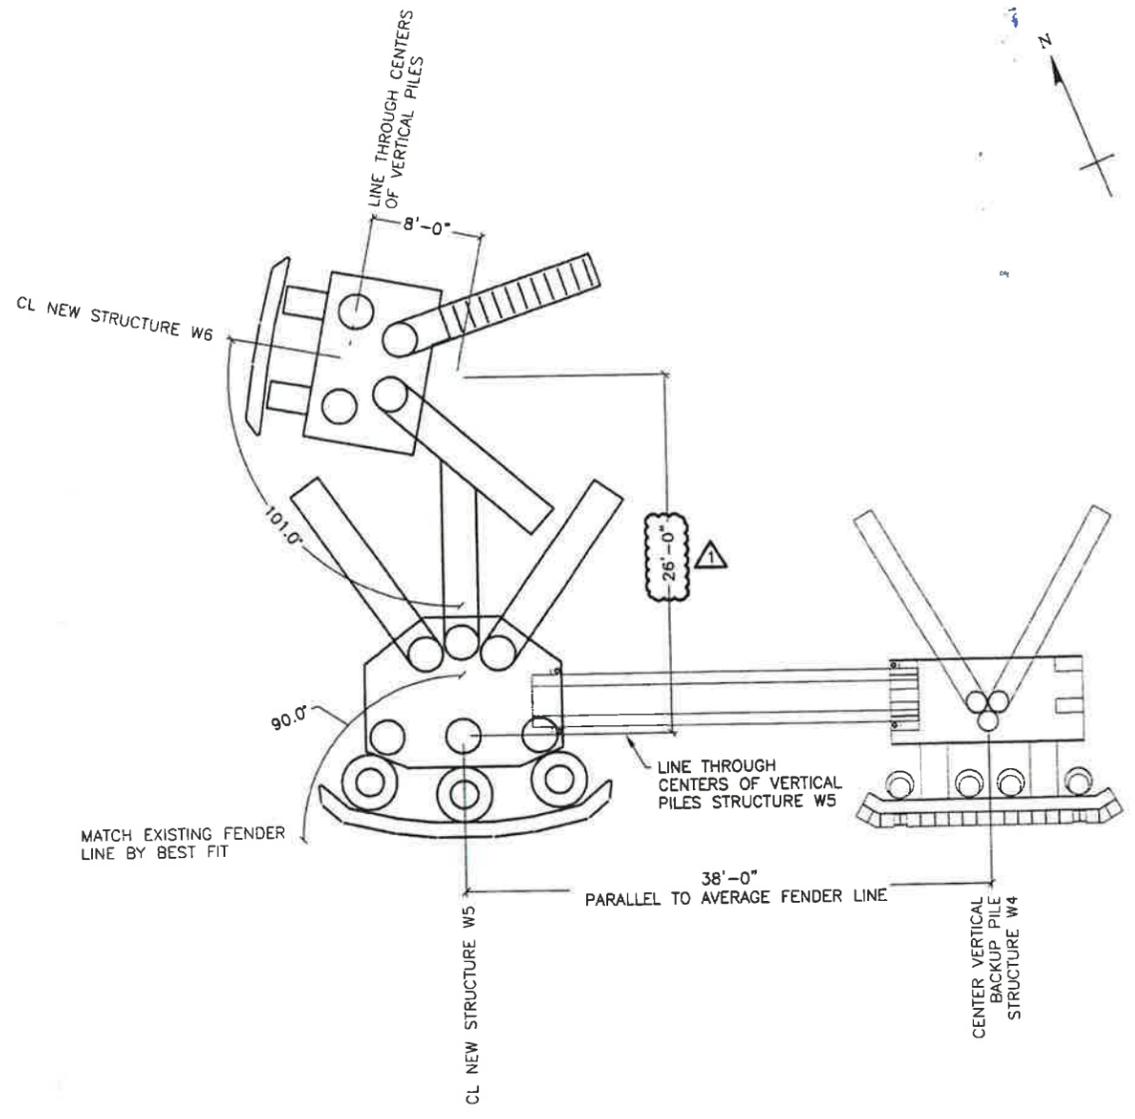


**NEW STRUCTURES W5 & W6**

DO NOT SCALE FROM THESE DRAWINGS USE DIMENSIONS

DESIGNED BY: D. LOWELL		STATE OF ALASKA DEPARTMENT OF TRANSPORTATION & PUBLIC FACILITIES SOUTHCOST REGION										
		<b>KETCHIKAN FERRY TERMINAL IMPROVEMENTS</b>										
		<b>MARINE LAYOUT</b>										
CHECKED BY: STAFF	DATE: 2/9/18	PROJECT DESIGNATION										
DRAWN BY: STAFF		YEAR	SHEET NO.									
PATH: Q:\KTN\67466\MF\CONSTRUCTION\RFP\DRAWING REVS\04-05 - NEW SITE PLAN&PILE TABLE & M		2015	5									
TAB: 5 Tuesday, February 09, 2016 1:59:54 PM		TOTAL SHEETS	28									
<table border="1"> <thead> <tr> <th colspan="3">REVISIONS</th> </tr> <tr> <th>NO.</th> <th>DATE</th> <th>DESCRIPTION</th> </tr> </thead> <tbody> <tr> <td>1</td> <td>2/9/16</td> <td>REVISE W6 LAYOUT POINT</td> </tr> </tbody> </table>		REVISIONS			NO.	DATE	DESCRIPTION	1	2/9/16	REVISE W6 LAYOUT POINT	PROJECT DESIGNATION	SAMHS00015
REVISIONS												
NO.	DATE	DESCRIPTION										
1	2/9/16	REVISE W6 LAYOUT POINT										



Project As-Built Drawings have been reviewed by the Project Engineer and represent to the best of my knowledge the project as constructed.  
PE *MP* Date *5.20.17*

*M*

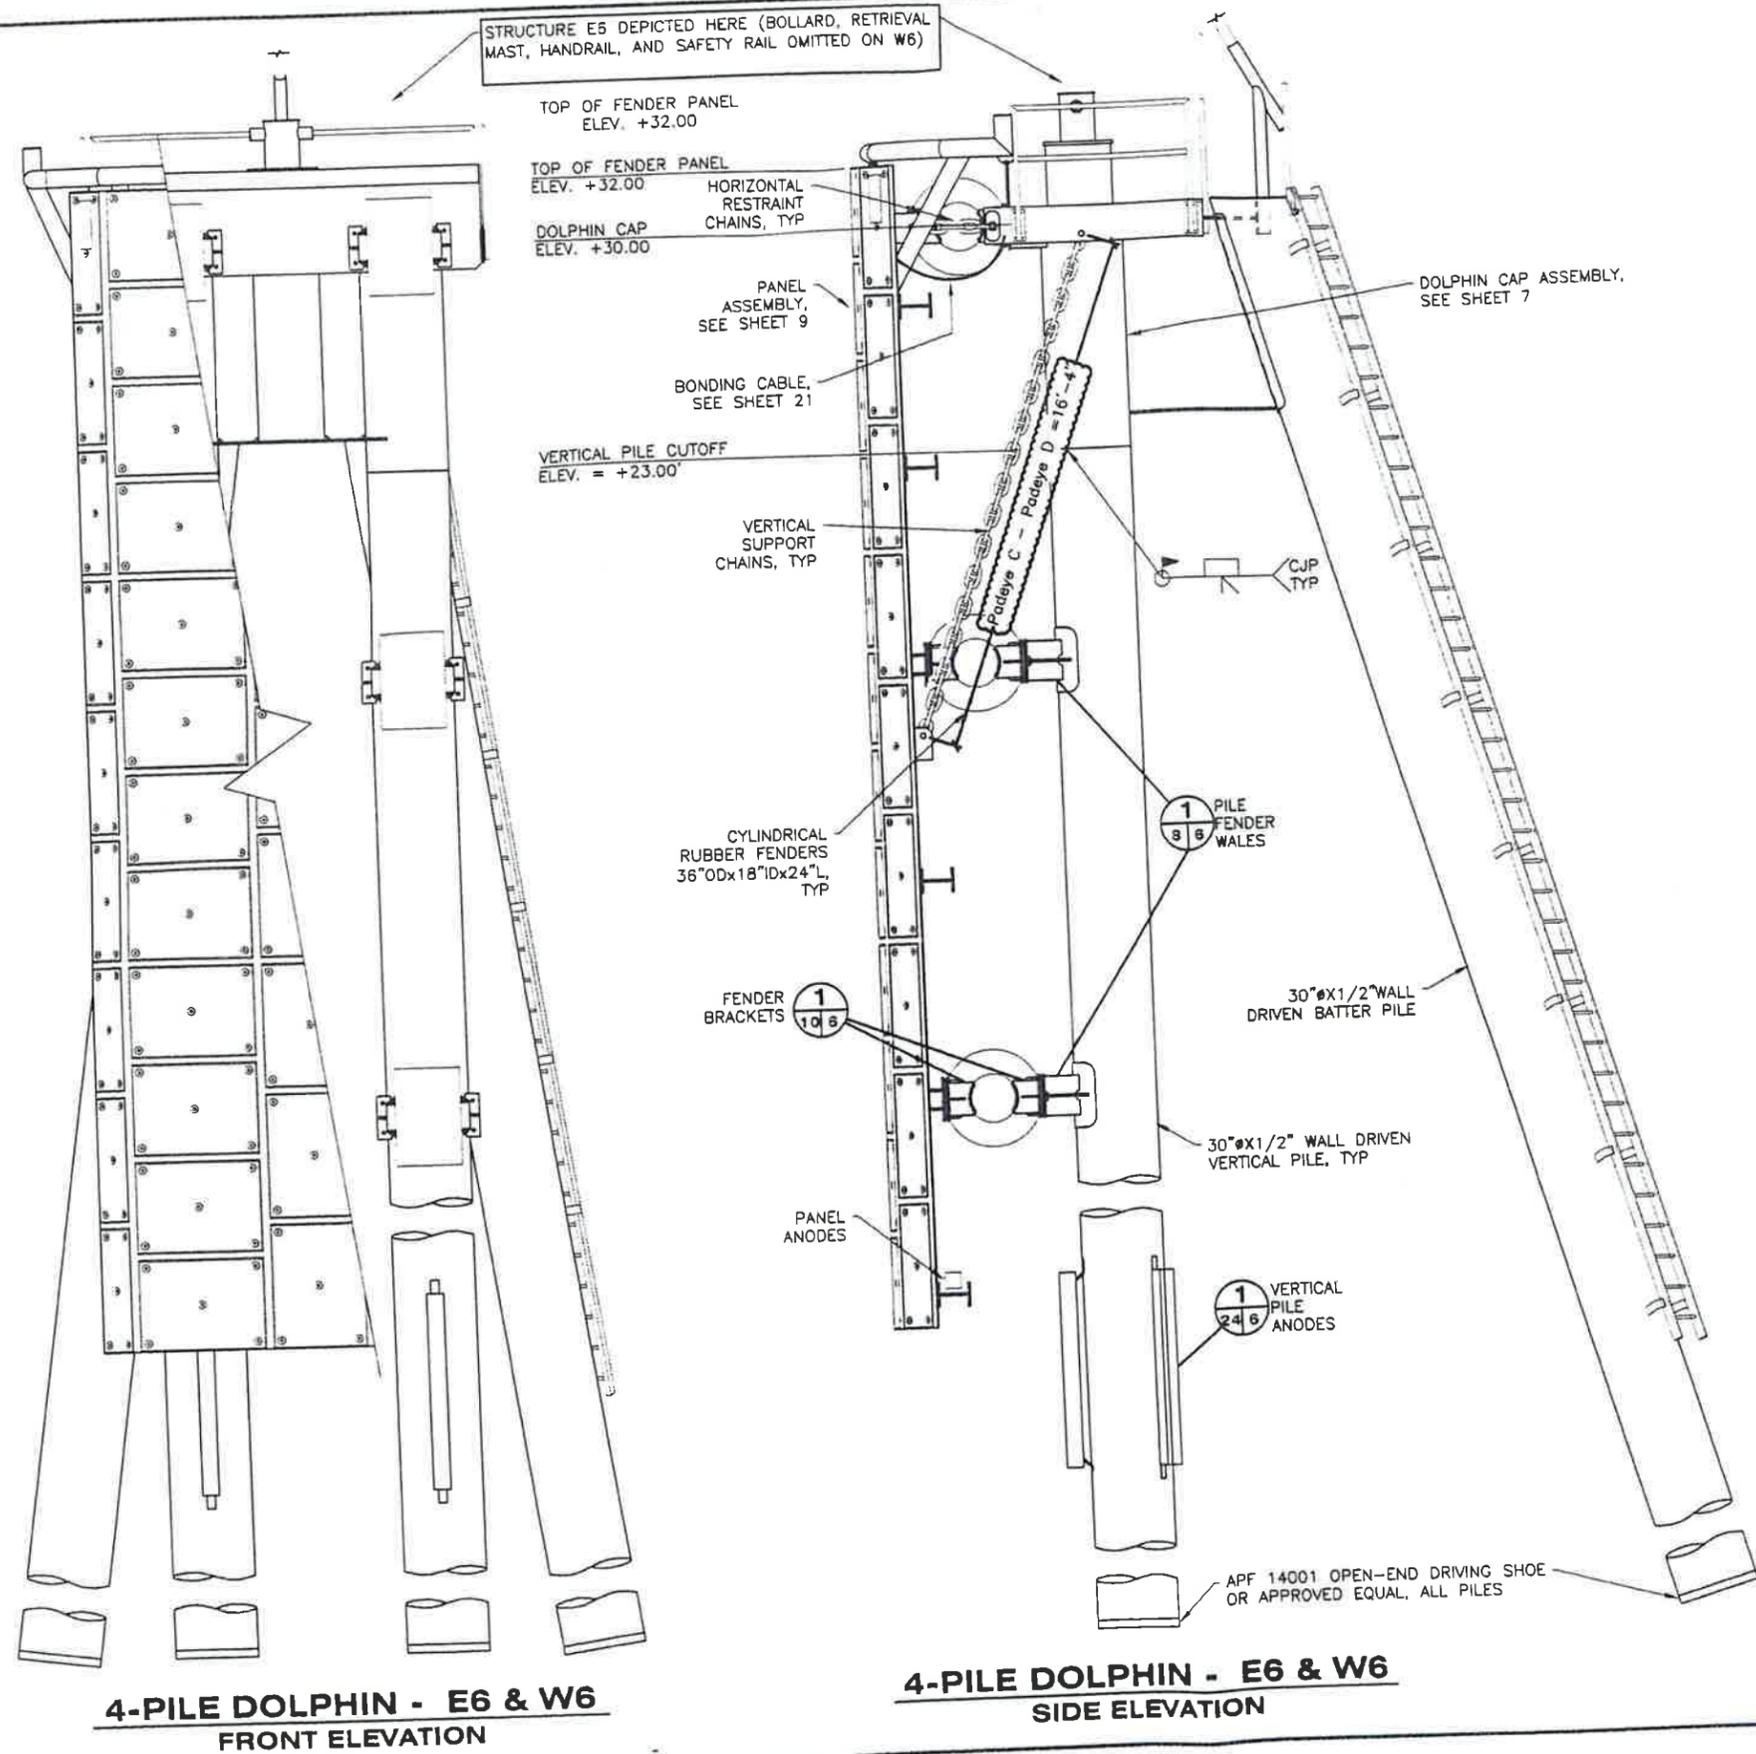

**4-PILE DOLPHIN - E6 & W6**  
FRONT ELEVATION

**4-PILE DOLPHIN - E6 & W6**  
SIDE ELEVATION

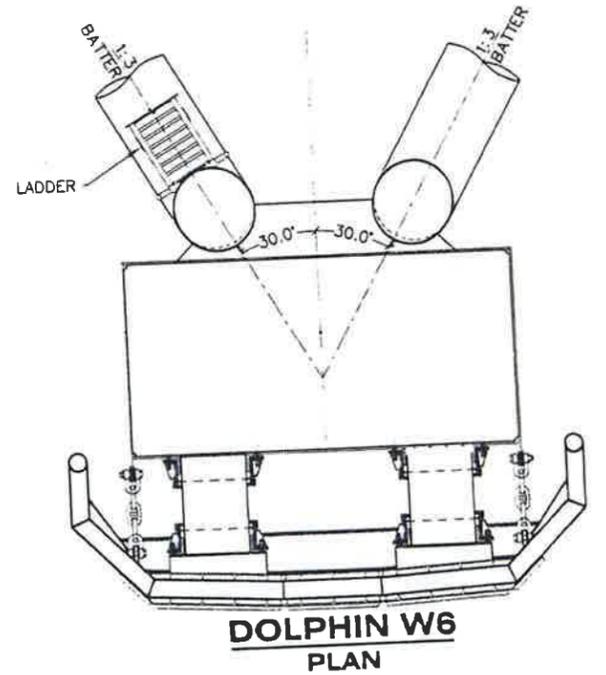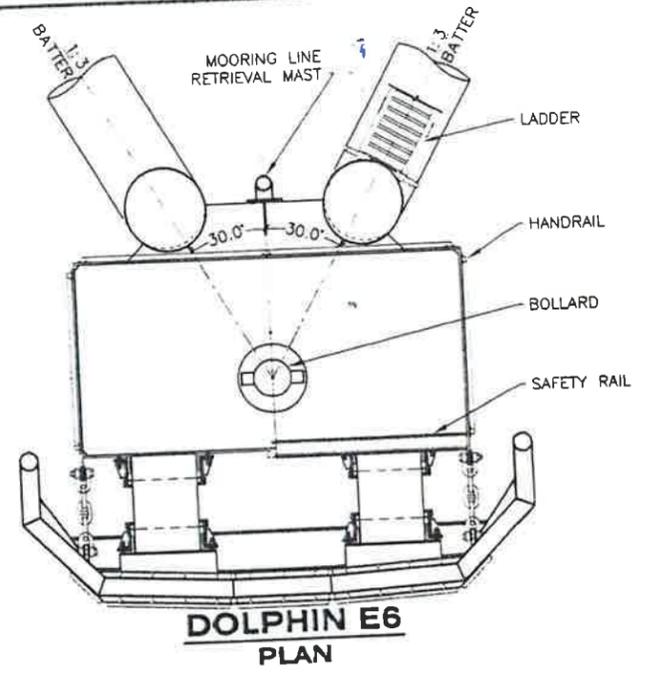


DO NOT SCALE FROM THESE DRAWINGS USE DIMENSIONS

DESIGNED BY: D. LOWELL		STATE OF ALASKA DEPARTMENT OF TRANSPORTATION & PUBLIC FACILITIES SOUTH-COAST REGION	
		<b>KETCHIKAN FERRY TERMINAL IMPROVEMENTS</b>	
CHECKED BY: STAFF	DATE: 2/29/16	PROJECT DESIGNATION: SAMHS00015	
DRAWN BY: STAFF	DATE: Monday, February 29, 2015 3:24:33 PM	YEAR: 2015	SHEET NO.: 6
PATH: Q:\KTN\67466\WF\CONSTRUCTION\RFI\DRAWING REV\06-11 4PILE DOLPHIN_REV2 2.29.16.DWG TAB: 6		TOTAL SHEETS: 28	

Project As-Built Drawings have been reviewed by the Project Engineer and represent to the best of my knowledge the project as constructed.

PE **MP** Date **5-20-17**

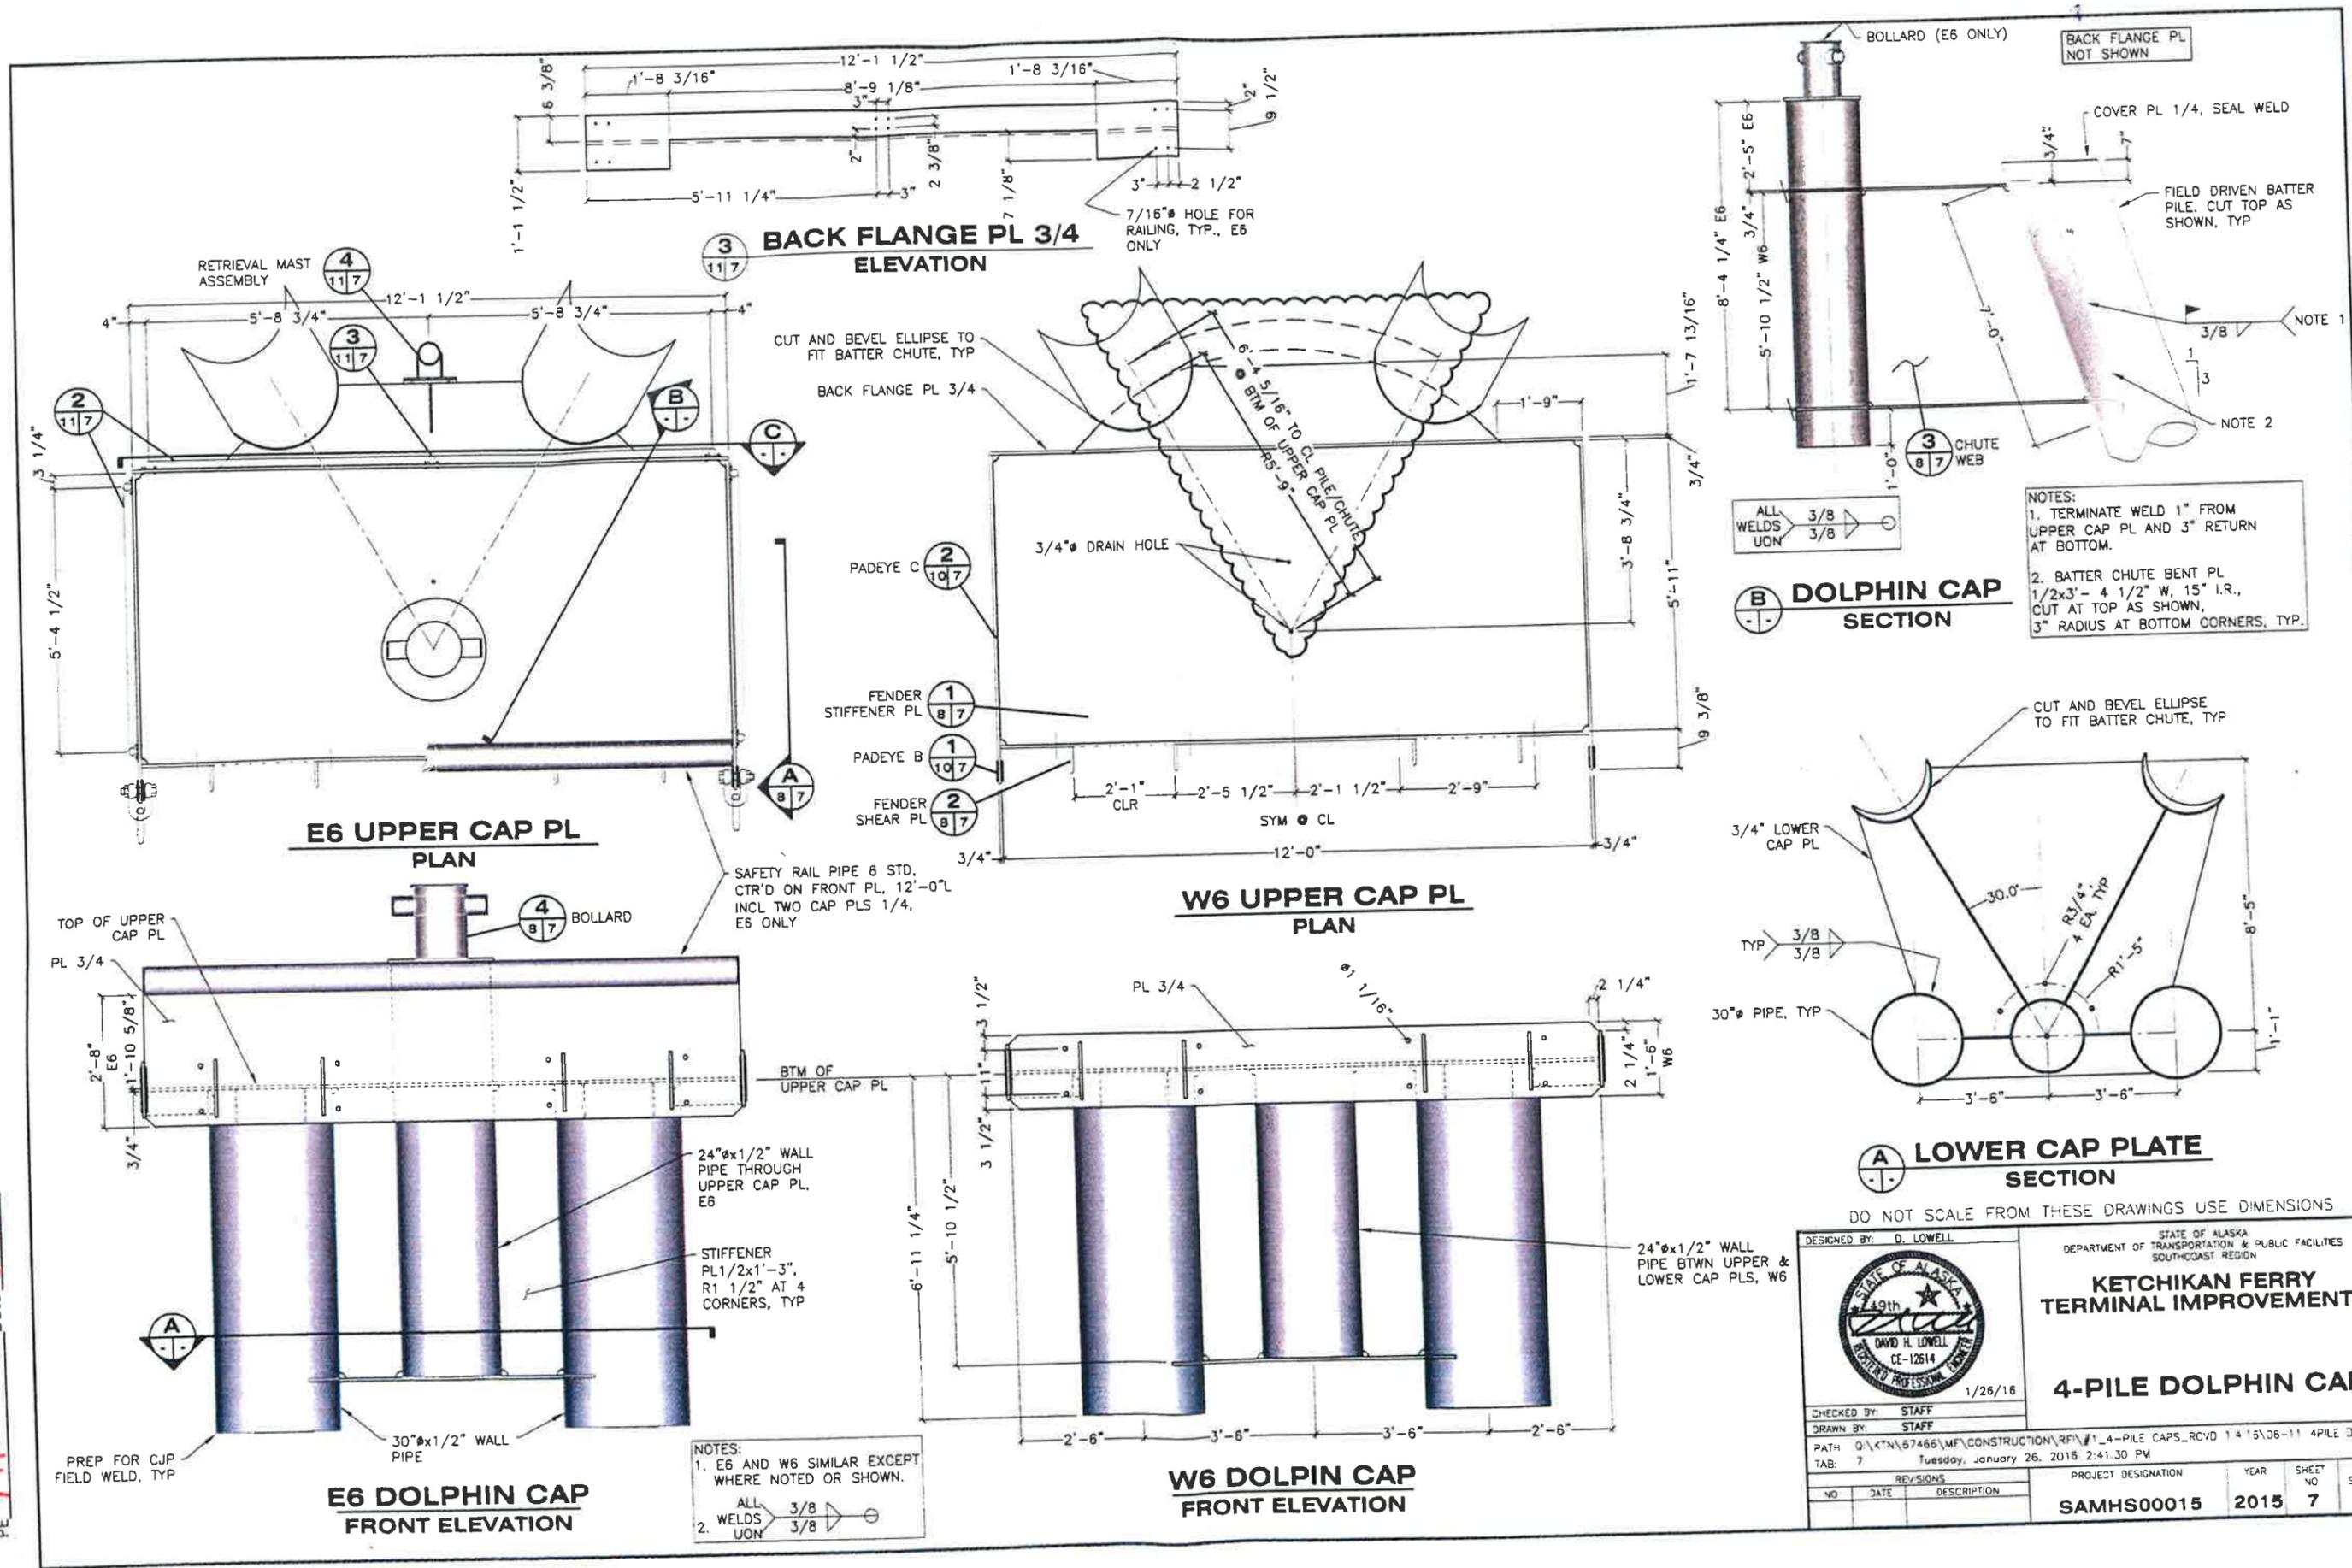

DESIGNED BY: D. LOWELL

CHECKED BY: STAFF

DRAWN BY: STAFF

DATE: 1/26/16

STATE OF ALASKA  
DEPARTMENT OF TRANSPORTATION & PUBLIC FACILITIES  
SOUTHWEST REGION

**KETCHIKAN FERRY TERMINAL IMPROVEMENTS**

**4-PILE DOLPHIN CAP**

PROJECT DESIGNATION: SAMHS00015


YEAR: 2015

SHEET NO: 7

TOTAL SHEETS: 28

Project As-Built Drawings have been reviewed by the Project Engineer and represent to the best of my knowledge the project as constructed.








PE *MP* Date *5-20-17*

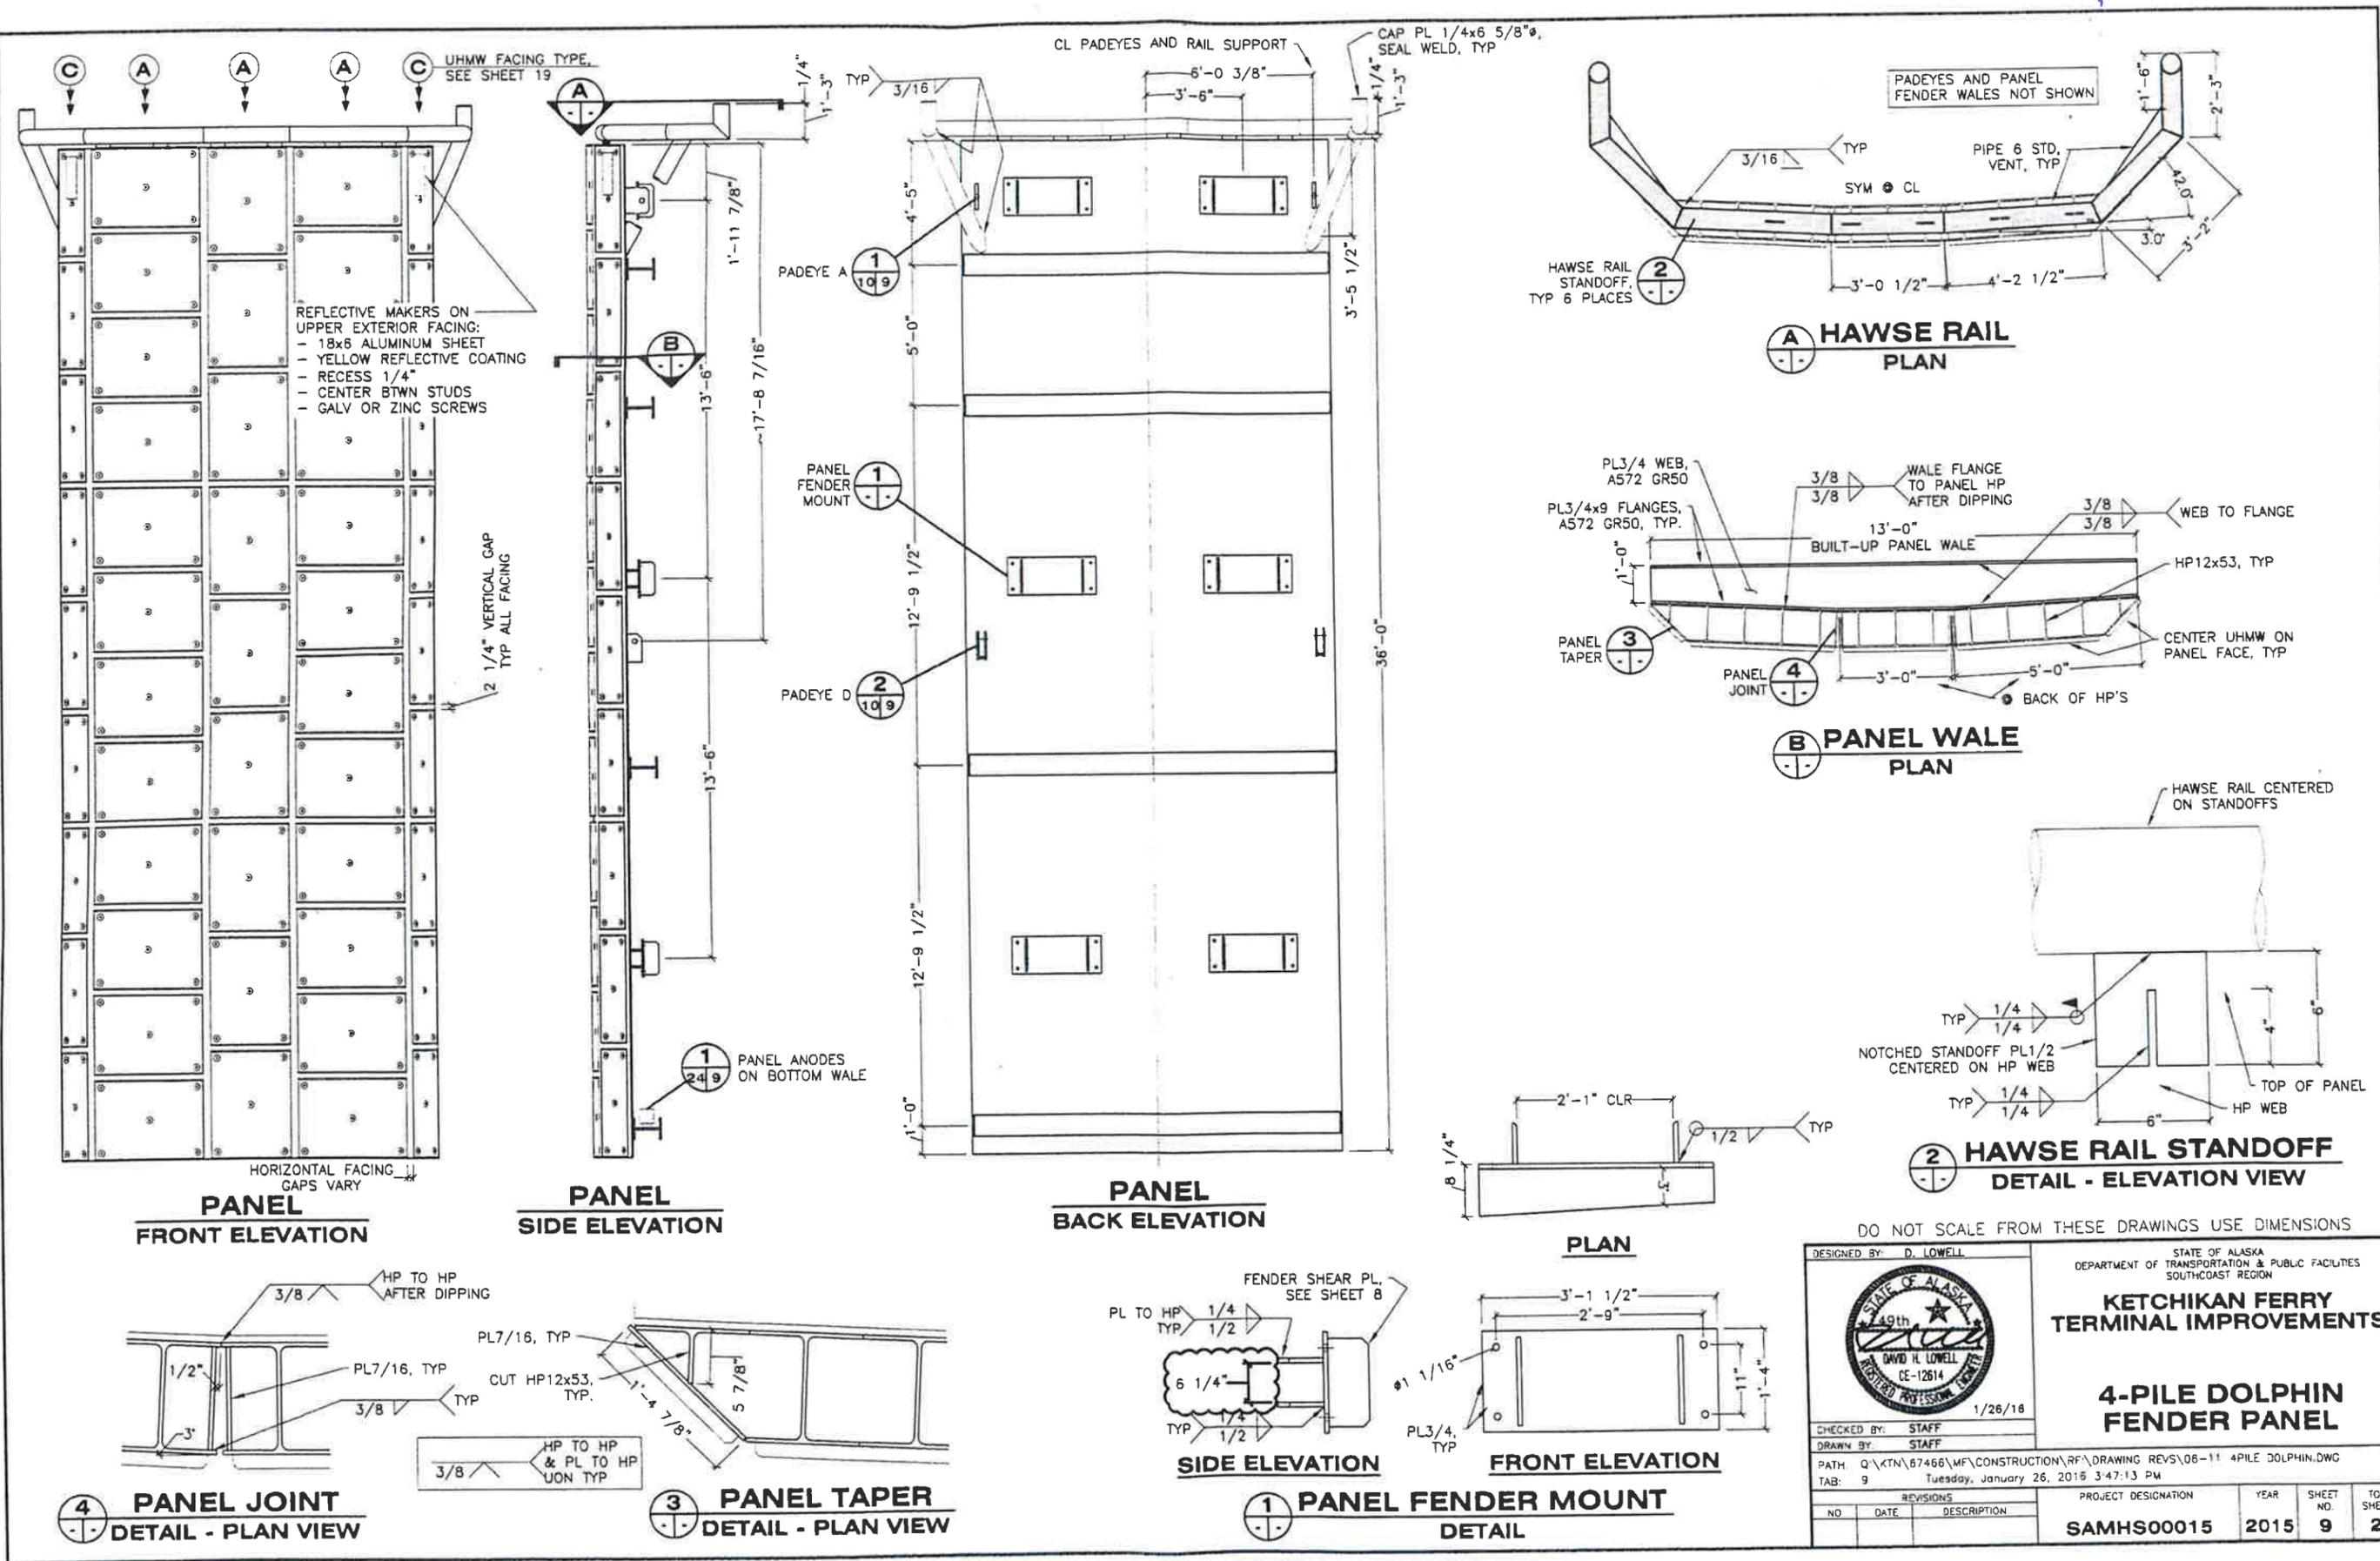

Project As-Built Drawings have been reviewed by the Project Engineer and represent to the best of my knowledge the project as constructed.  
 Date 5-20-17  
 PE MJP

DO NOT SCALE FROM THESE DRAWINGS USE DIMENSIONS

DESIGNED BY: D. LOWELL		STATE OF ALASKA DEPARTMENT OF TRANSPORTATION & PUBLIC FACILITIES SOUTHCOST REGION		
		<b>KETCHIKAN FERRY TERMINAL IMPROVEMENTS</b>		
		<b>4-PILE DOLPHIN FENDER PANEL</b>		
CHECKED BY: STAFF	DATE: 1/26/18	PROJECT DESIGNATION	YEAR	SHEET NO.
DRAWN BY: STAFF		SAMHS00015	2015	9
PATH: Q:\CTN\67466\MF\CONSTRUCTION\RF\DRAWING REV\06-11 4PILE DOLPHIN.DWG		TAB: 9	Tuesday, January 26, 2016 3:47:13 PM	TOTAL SHEETS
REVISIONS		NO	DATE	DESCRIPTION

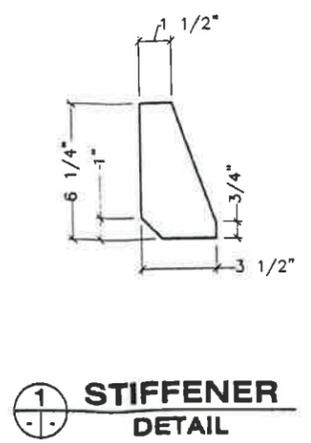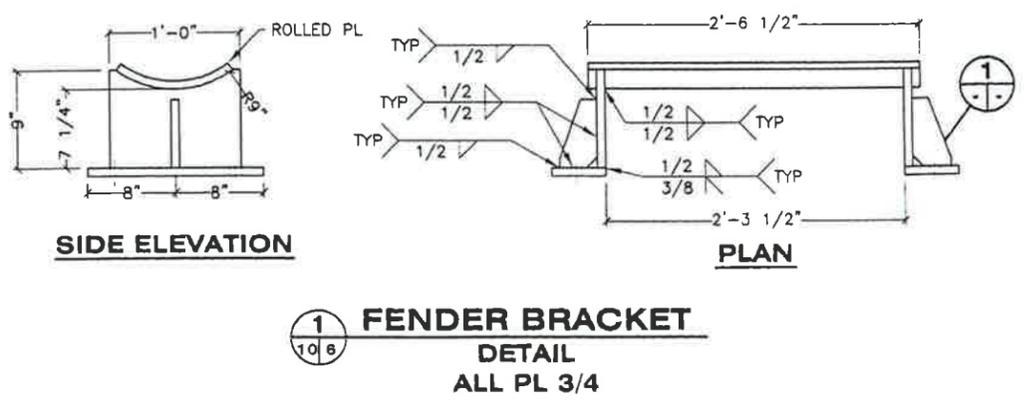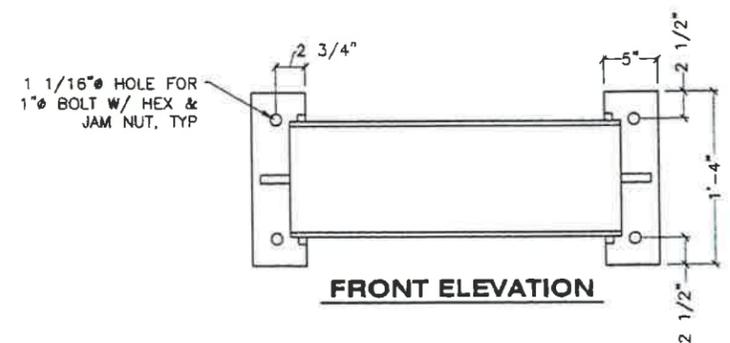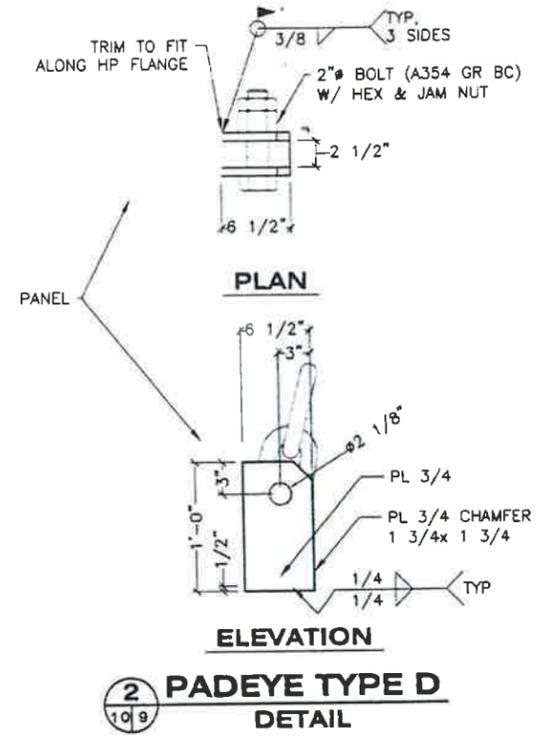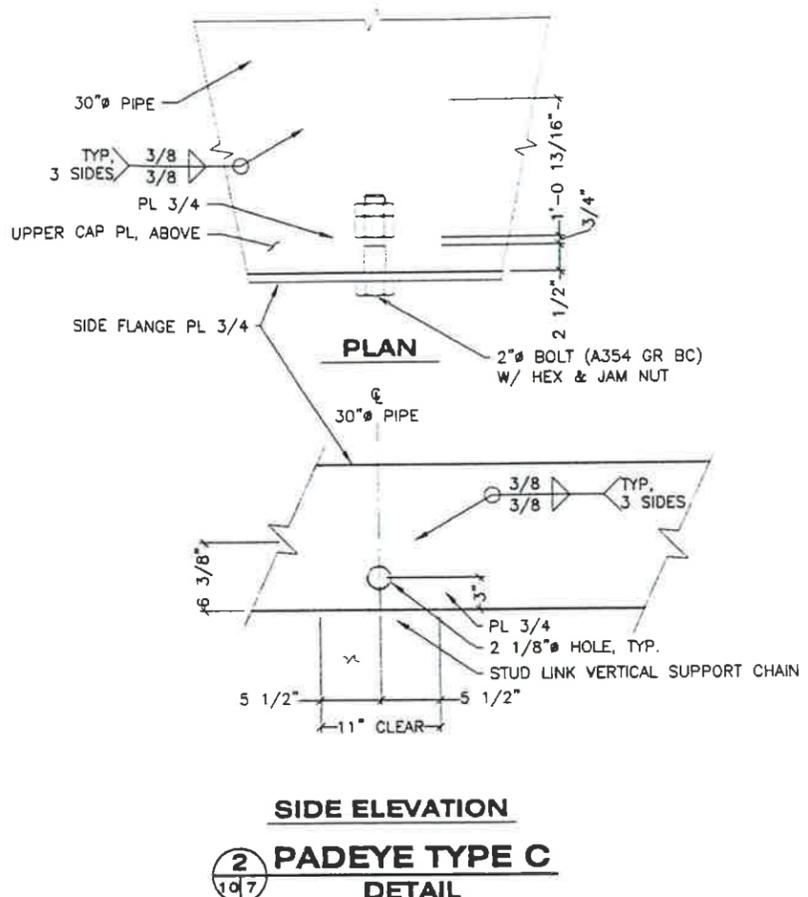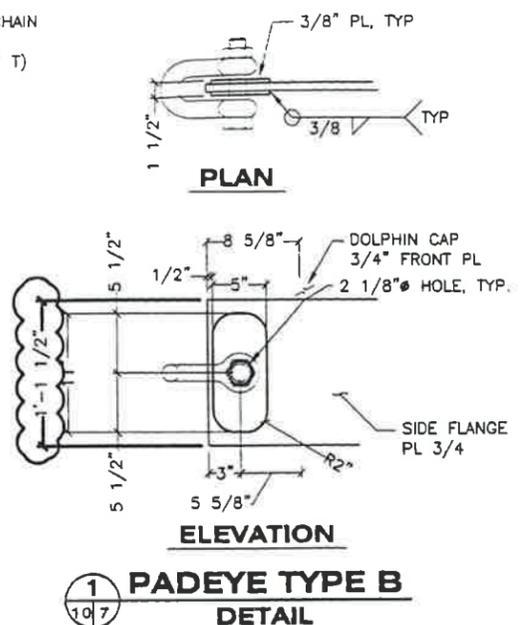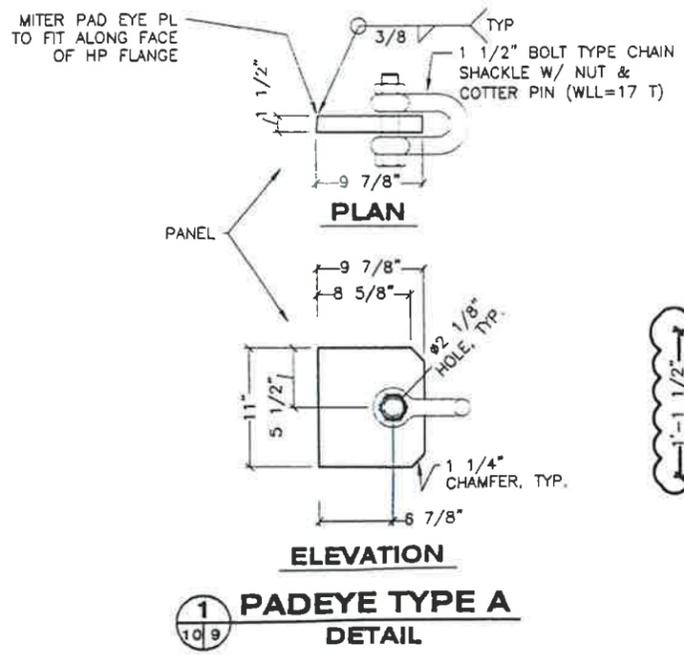


DO NOT SCALE FROM THESE DRAWINGS USE DIMENSIONS


DESIGNED BY: D. LOWELL	STATE OF ALASKA DEPARTMENT OF TRANSPORTATION & PUBLIC FACILITIES SOUTHCOST REGION			
	<b>KETCHIKAN FERRY TERMINAL IMPROVEMENTS</b>			
	<b>4-PILE DOLPHIN FENDER DETAILS</b>			
CHECKED BY: STAFF	YEAR: 2015	SHEET NO: 10	TOTAL SHEETS: 28	
DRAWN BY: STAFF	PROJECT DESIGNATION: SAMHS00015			
PATH: Q:\KTN\87468\MF\CONSTRUCTION\RF\DRAWING REVS\06--11 4PILE DOLPHIN.DWG				
TAB: 10 Tuesday, January 26, 2015 4:36:24 PM				
REVISIONS				
NO.	DATE	DESCRIPTION	YEAR	SHEET NO

Project As-Built Drawings have been reviewed by the Project Engineer and represent to the best of my knowledge the project as constructed.


PE *MP* Date *5.20.17*

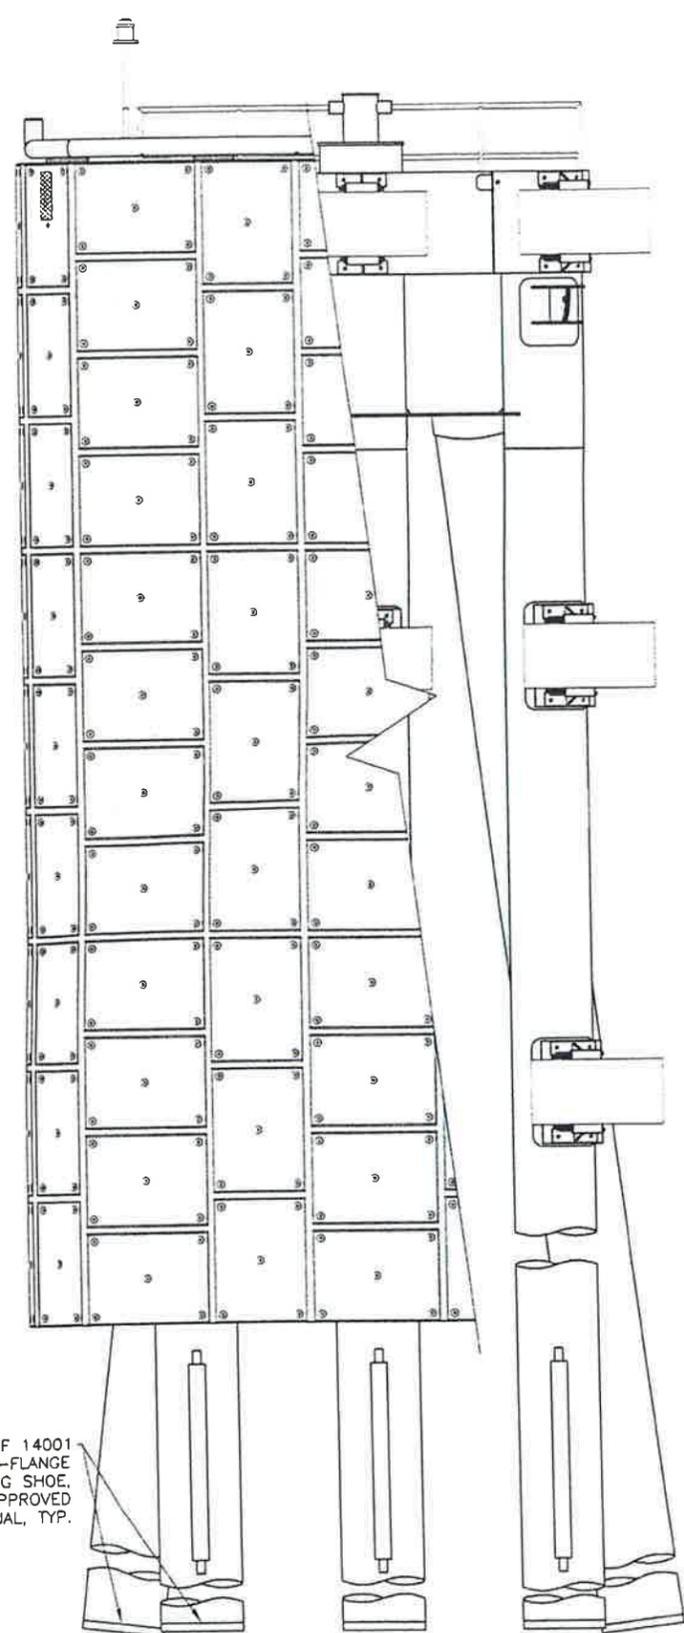

**6 PILE DOLPHIN FRONT ELEVATION**

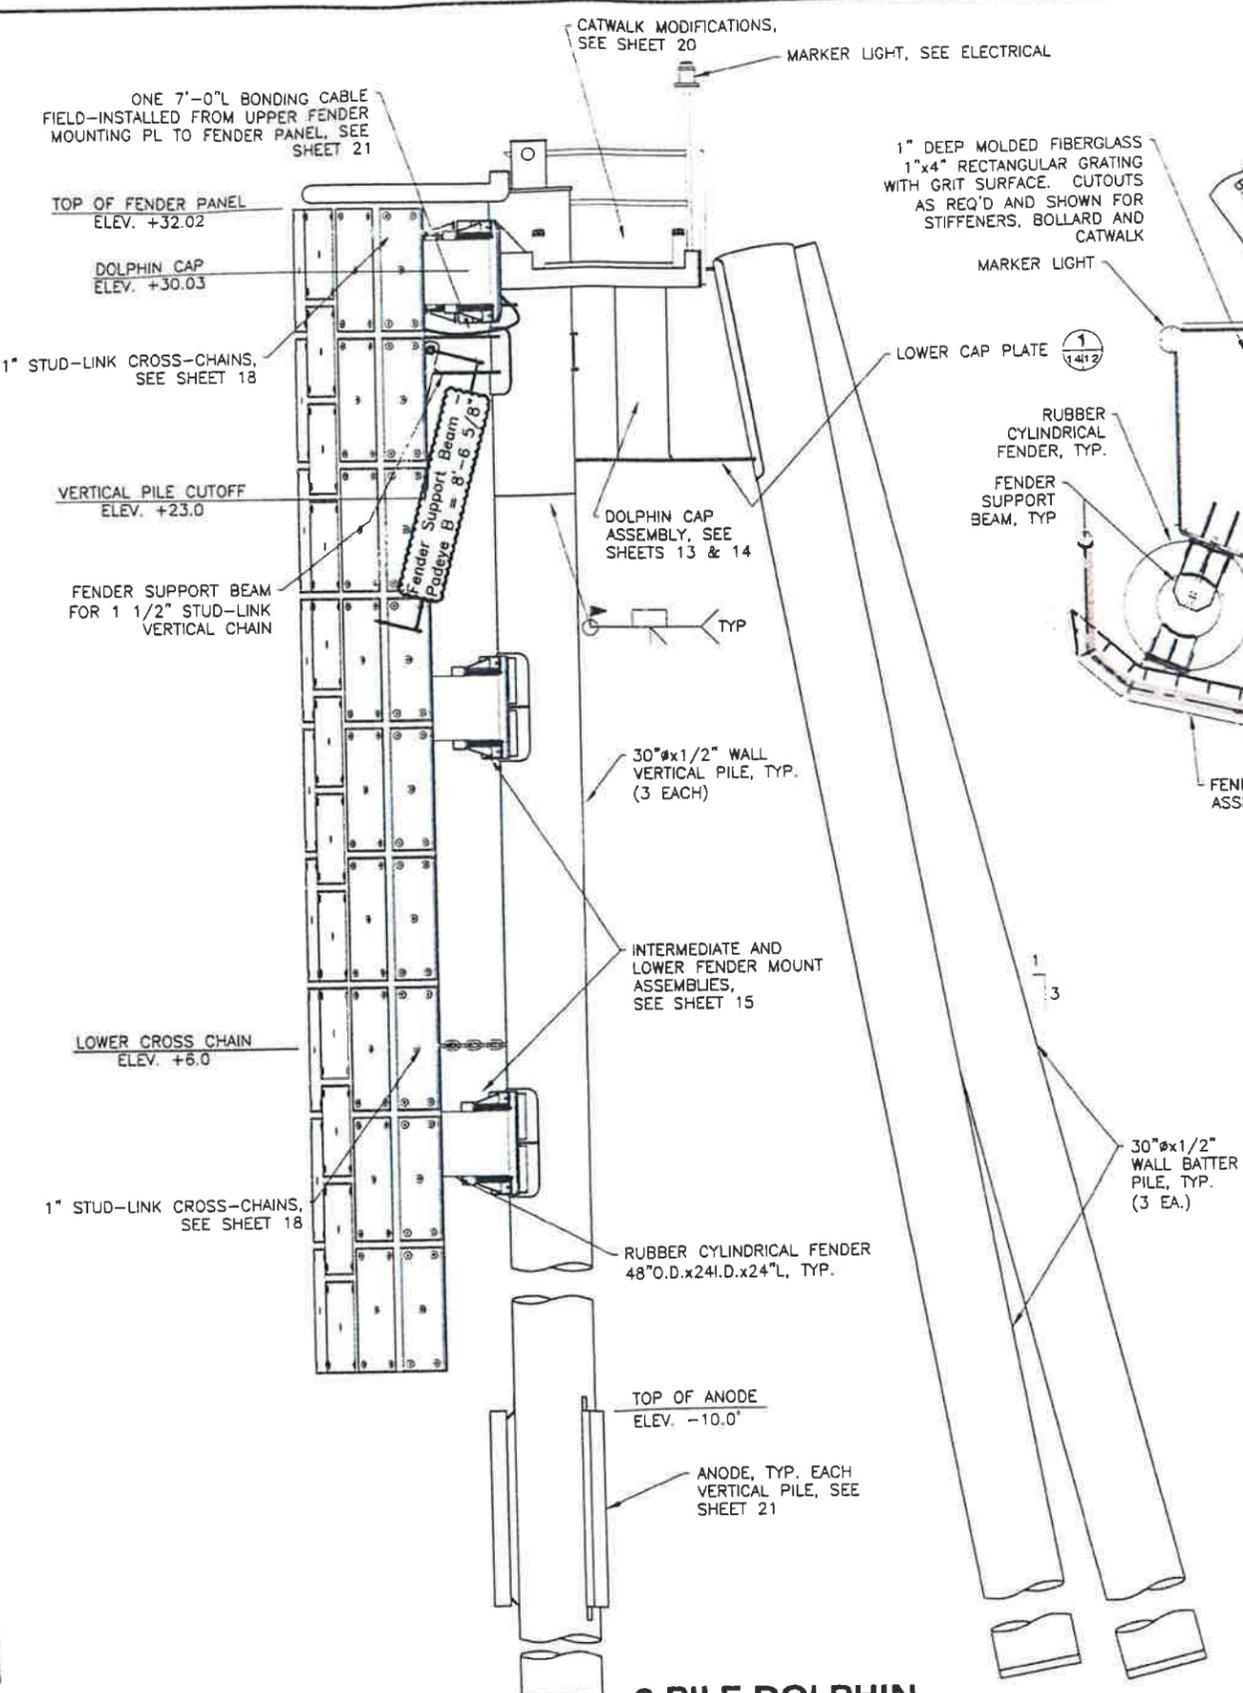

**6 PILE DOLPHIN SIDE ELEVATION**

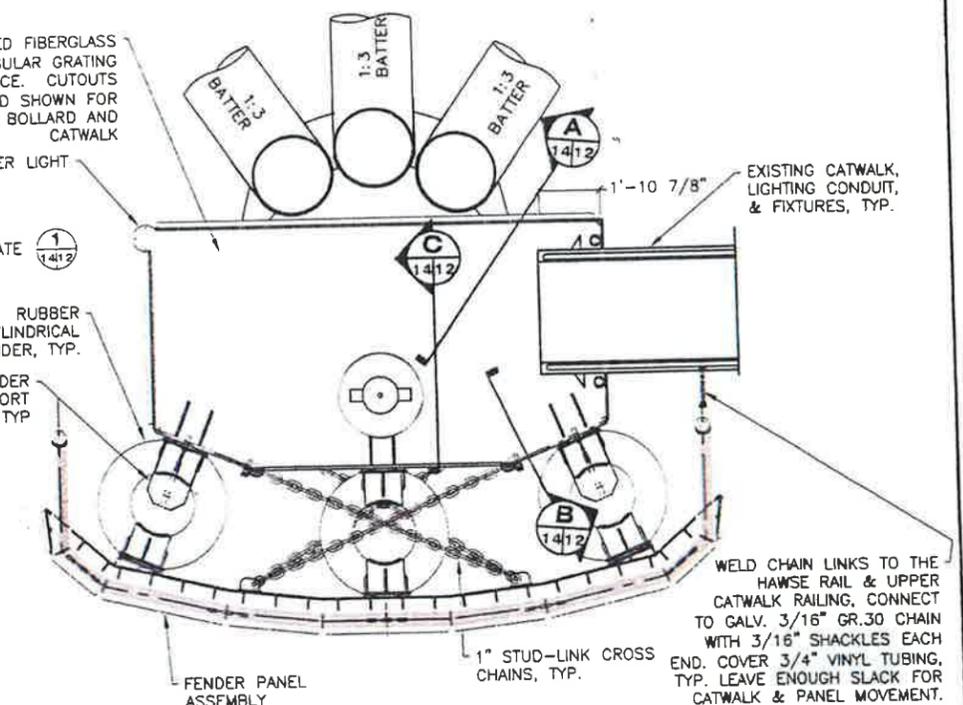

**6 PILE DOLPHIN PLAN**

APF 14001  
INSIDE-FLANGE  
DRIVING SHOE,  
OR APPROVED  
EQUAL, TYP.

ONE 7'-0" L BONDING CABLE  
FIELD-INSTALLED FROM UPPER FENDER  
MOUNTING PL TO FENDER PANEL, SEE  
SHEET 21

TOP OF FENDER PANEL  
ELEV. +32.02

DOLPHIN CAP  
ELEV. +30.03

1" STUD-LINK CROSS-CHAINS,  
SEE SHEET 18

VERTICAL PILE CUTOFF  
ELEV. +23.0

FENDER SUPPORT BEAM  
FOR 1 1/2" STUD-LINK  
VERTICAL CHAIN

LOWER CROSS CHAIN  
ELEV. +6.0

1" STUD-LINK CROSS-CHAINS,  
SEE SHEET 18

TOP OF ANODE  
ELEV. -10.0'

ANODE, TYP. EACH  
VERTICAL PILE, SEE  
SHEET 21

CATWALK MODIFICATIONS,  
SEE SHEET 20

MARKER LIGHT, SEE ELECTRICAL

1" DEEP MOLDED FIBERGLASS  
1"x4" RECTANGULAR GRATING  
WITH GRIT SURFACE. CUTOUTS  
AS REQ'D AND SHOWN FOR  
STIFFENERS, BOLLARD AND  
CATWALK

MARKER LIGHT

LOWER CAP PLATE

RUBBER  
CYLINDRICAL  
FENDER, TYP.

FENDER  
SUPPORT  
BEAM, TYP

DOLPHIN CAP  
ASSEMBLY, SEE  
SHEETS 13 & 14

30"Øx1/2" WALL  
VERTICAL PILE, TYP.  
(3 EACH)

INTERMEDIATE AND  
LOWER FENDER MOUNT  
ASSEMBLIES,  
SEE SHEET 15

30"Øx1/2"  
WALL BATTER  
PILE, TYP.  
(3 EA.)

RUBBER CYLINDRICAL FENDER  
48"Ø.D.x24".D.x24"L, TYP.

EXISTING CATWALK,  
LIGHTING CONDUIT,  
& FIXTURES, TYP.

WELD CHAIN LINKS TO THE  
HAWSE RAIL & UPPER  
CATWALK RAILING, CONNECT  
TO GALV. 3/16" GR.30 CHAIN  
WITH 3/16" SHACKLES EACH  
END. COVER 3/4" VINYL TUBING,  
TYP. LEAVE ENOUGH SLACK FOR  
CATWALK & PANEL MOVEMENT.

DO NOT SCALE FROM THESE DRAWINGS USE DIMENSIONS

DESIGNED BY: D. LOWELL	
CHECKED BY: STAFF	
DRAWN BY: STAFF	
PATH: Q:\7N\67466\WF\CONSTRUCTION\RF\DRAWING REVS\14_W5 - 6 PILE DOLPHIN_REV3 2.29.16.DWG TAB: 12 Tuesday, March 01, 2016 11:29:00 AM	
REVISIONS NO. DATE DESCRIPTION	

STATE OF ALASKA  
DEPARTMENT OF TRANSPORTATION & PUBLIC FACILITIES  
SOUTH-COAST REGION


**KETCHIKAN FERRY  
TERMINAL IMPROVEMENTS**

**PLAN & ELEVATION  
W5 - 6 PILE DOLPHIN**


PROJECT DESIGNATION	YEAR	SHEET NO.	TOTAL SHEETS
SAMHS00015	2015	12	28

Project As-Built Drawings have been reviewed  
by the Project Engineer and represent to the  
best of my knowledge the project as  
constructed.


PE: *MP* Date: *5.20.17*

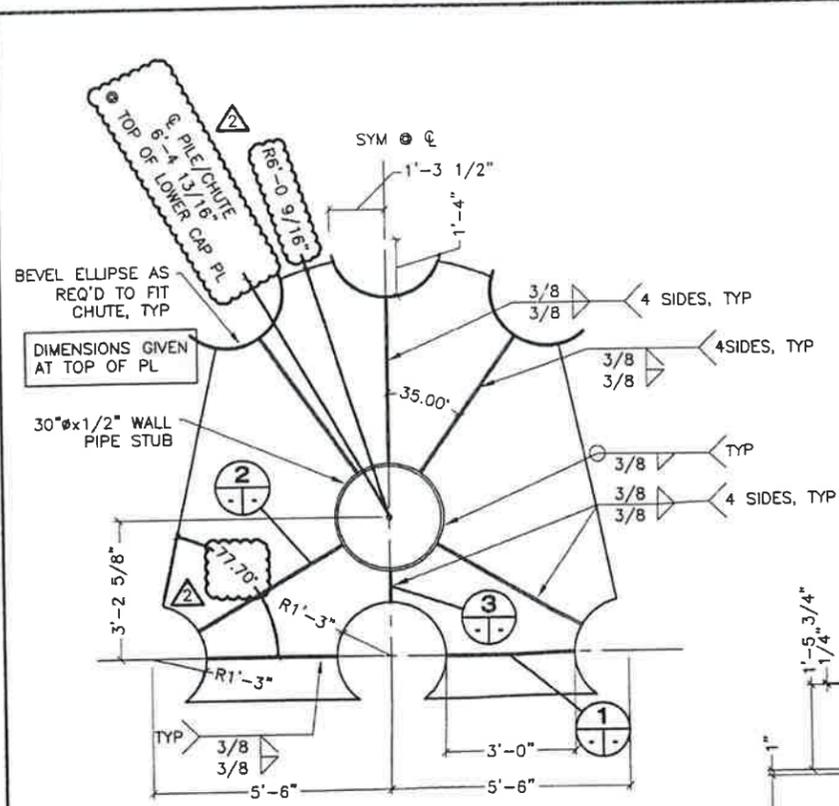


**1 LOWER CAP PL PLAN**  
1412

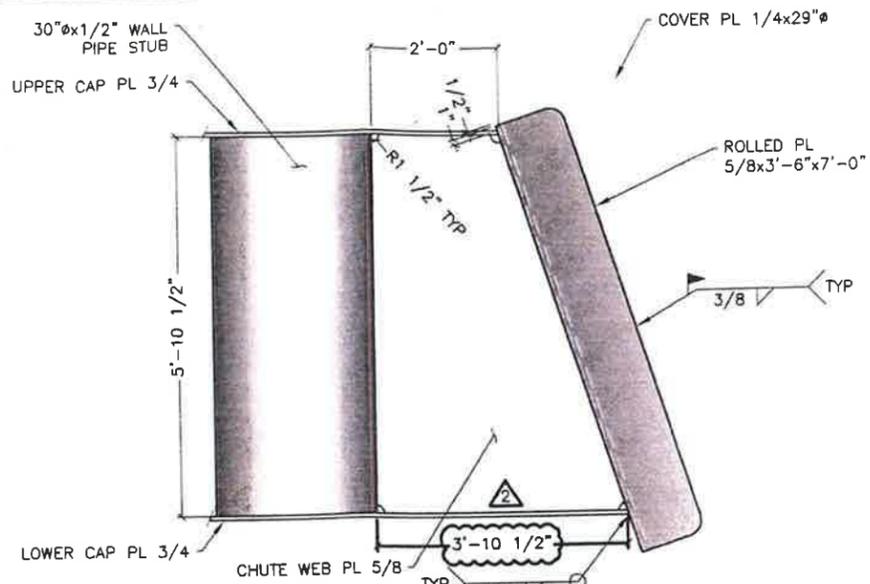


**A BATTER CHUTE SECTION**  
1412

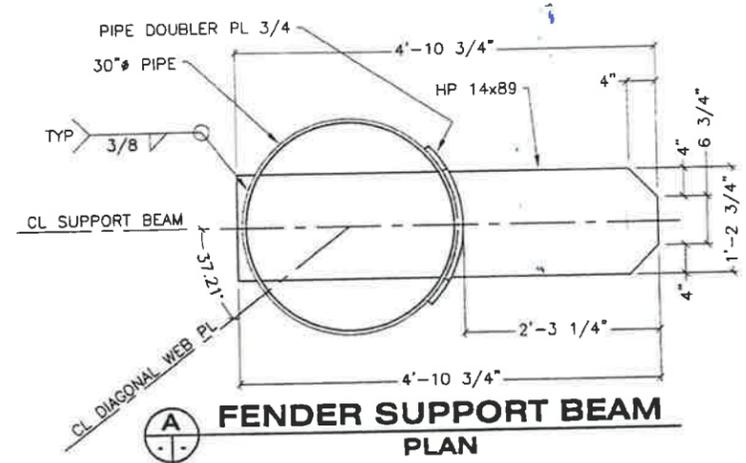


**A FENDER SUPPORT BEAM PLAN**  
1412

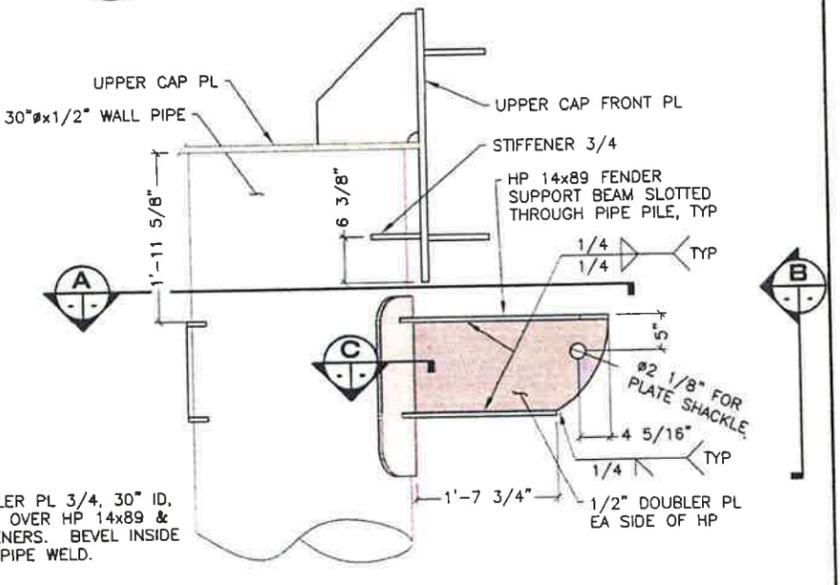


**B FENDER SUPPORT BEAM SIDE ELEVATION**  
1412

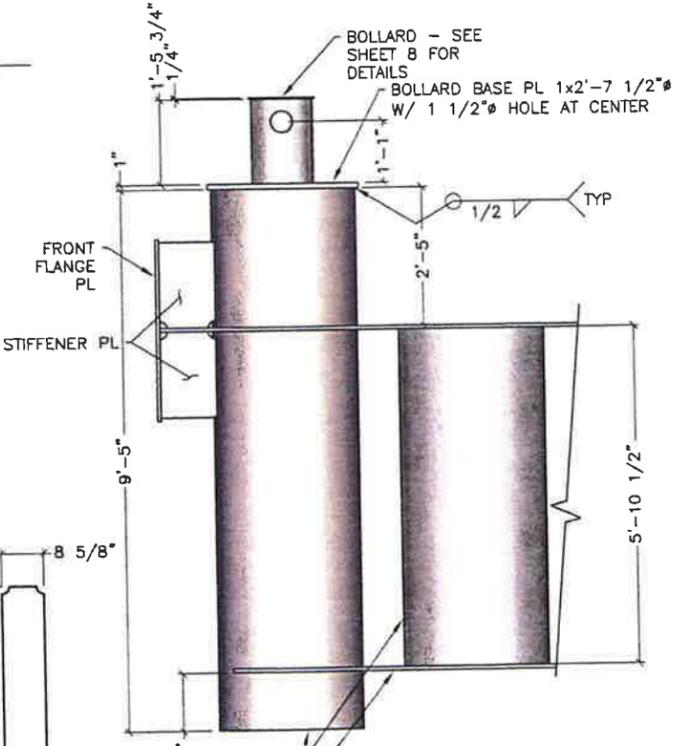


**C CENTER CAP PIPE ELEVATION VIEW**  
1412

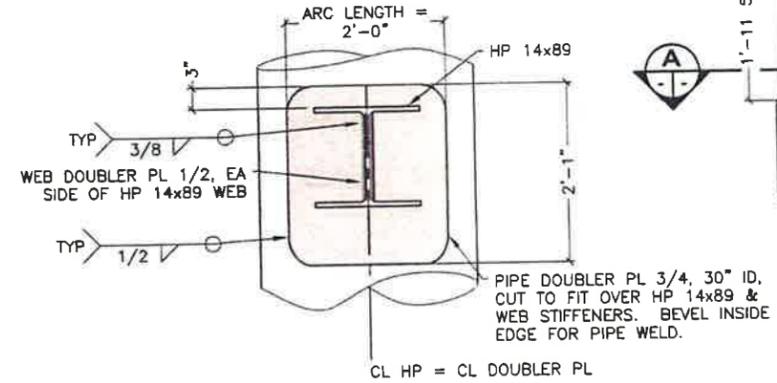

**B FENDER SUPPORT BEAM FRONT ELEVATION**  
1412

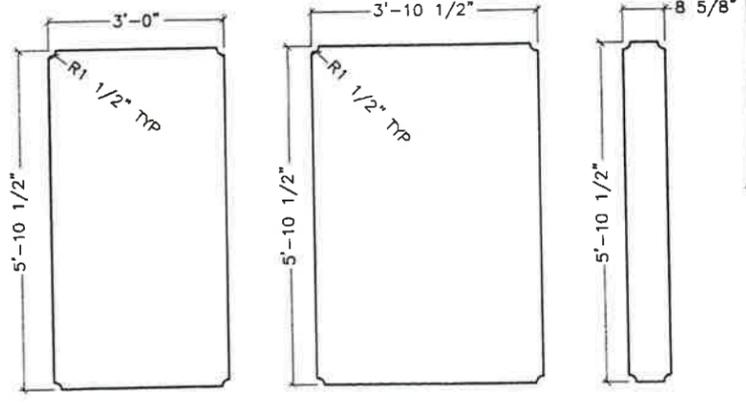

**1 FRONT 2 DIAGONAL 3 INTERIOR**  
**DOLPHIN CAP ASSEMBLY WEB PL'S 5/8 DETAILS**  
1412

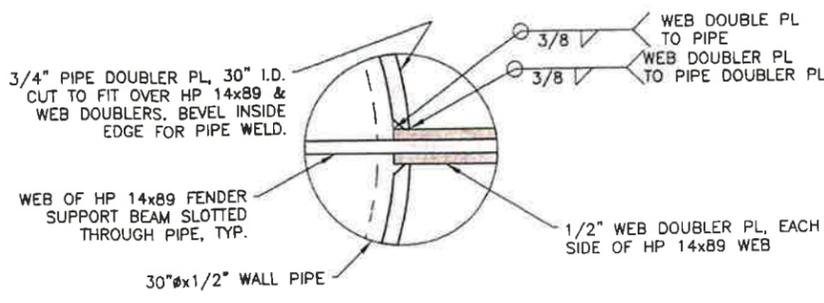

**C DOUBLER PLATE CONNECTION SECTION**  
1412


DO NOT SCALE FROM THESE DRAWINGS USE DIMENSIONS

DESIGNED BY: D. LOWELL	STATE OF ALASKA DEPARTMENT OF TRANSPORTATION & PUBLIC FACILITIES SOUTHCOST REGION
	<b>KETCHIKAN FERRY TERMINAL IMPROVEMENTS</b>
CHECKED BY: STAFF	<b>CAP ASSEMBLY &amp; SUPPORT BEAM W5 - 6 PILE DOLPHIN</b>
DRAWN BY: STAFF	1/29/16
PATH: Q:\KTN\67466\MF\CONSTRUCTION\REF\DRAWING REV\14_W5 - 6 PILE DOLPHIN_REV2 1:29:16.DWG	PROJECT DESIGNATION: SAMHS00015
TAB: 14	YEAR: 2015
NO. DATE DESCRIPTION	SHEET NO: 14
1/29/16 RFI003	TOTAL SHEETS: 28

Project As-Built Drawings have been reviewed by the Project Engineer and represent to the best of my knowledge the project as constructed.  
PE *MP* Date 5-20-17


Project As-Built Drawings have been reviewed by the Project Engineer and represent to the best of my knowledge the project as constructed.

520.17  
 PE  
 Date

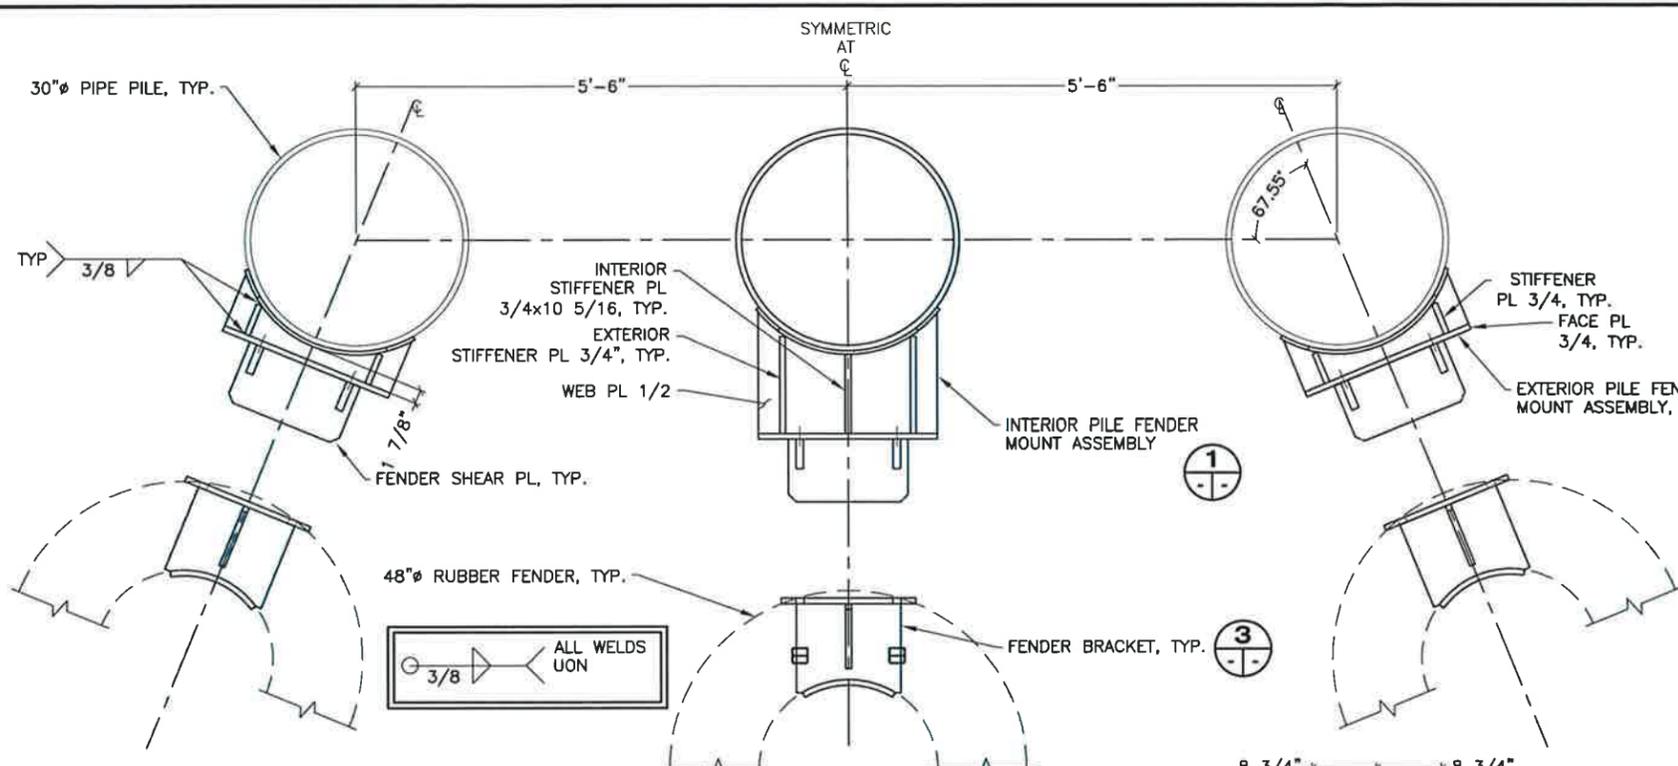


NOTE: SEE SHEET 13 FOR FENDER SHEAR PL DETAIL


**PILE FENDER MOUNTS**  
 PLAN

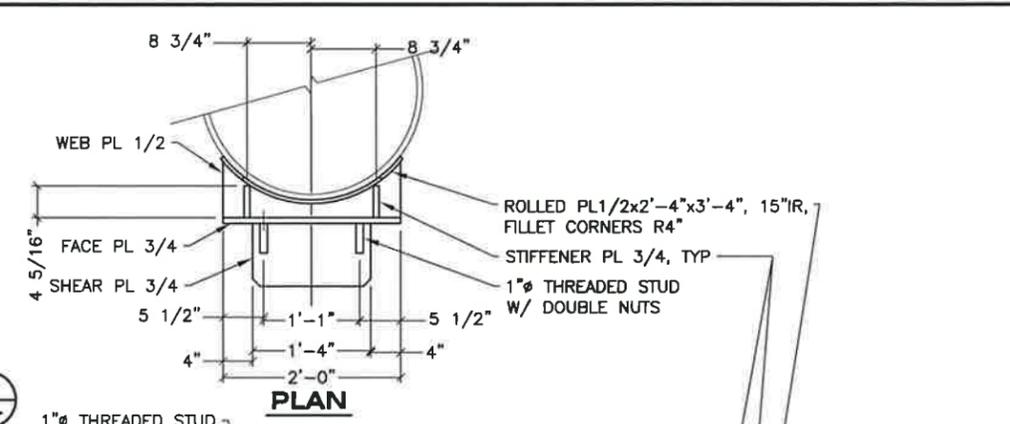


**EXTERIOR PILE FENDER MOUNT**  
 PLAN

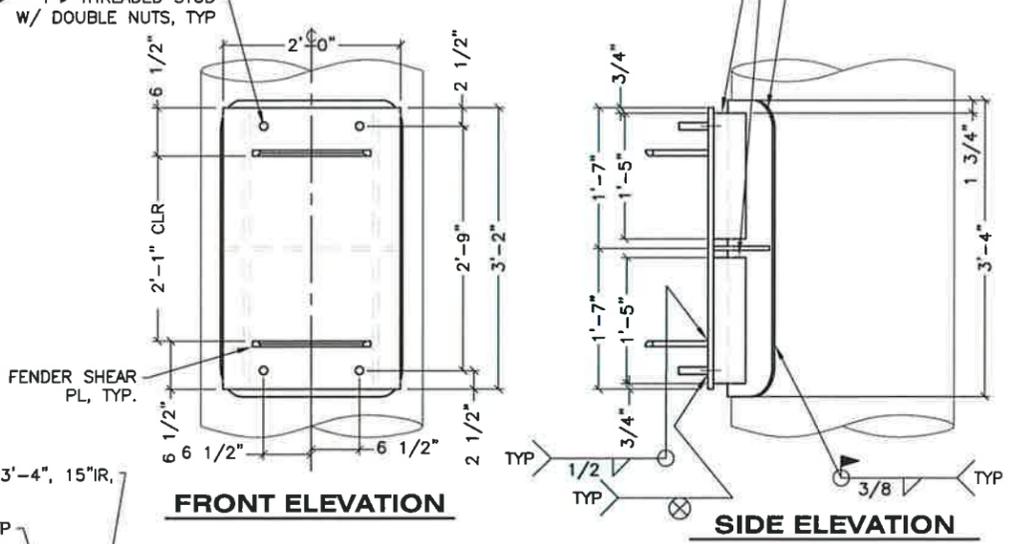


**EXTERIOR PILE FENDER MOUNT**  
 FRONT ELEVATION  
 SIDE ELEVATION

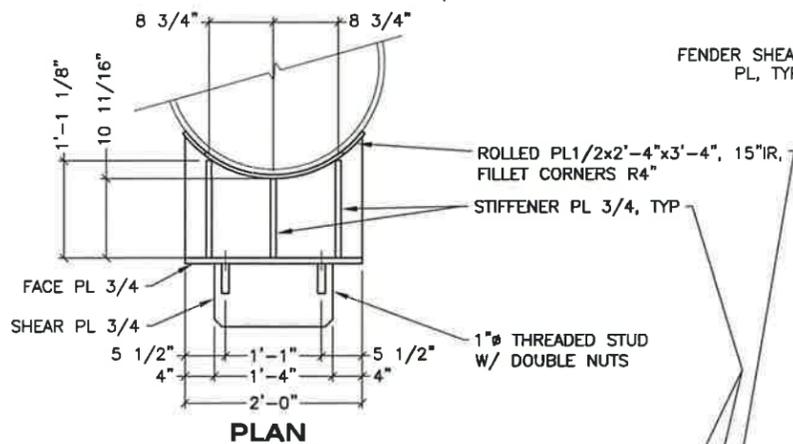


**EXTERIOR PILE FENDER MOUNT**  
 PLAN

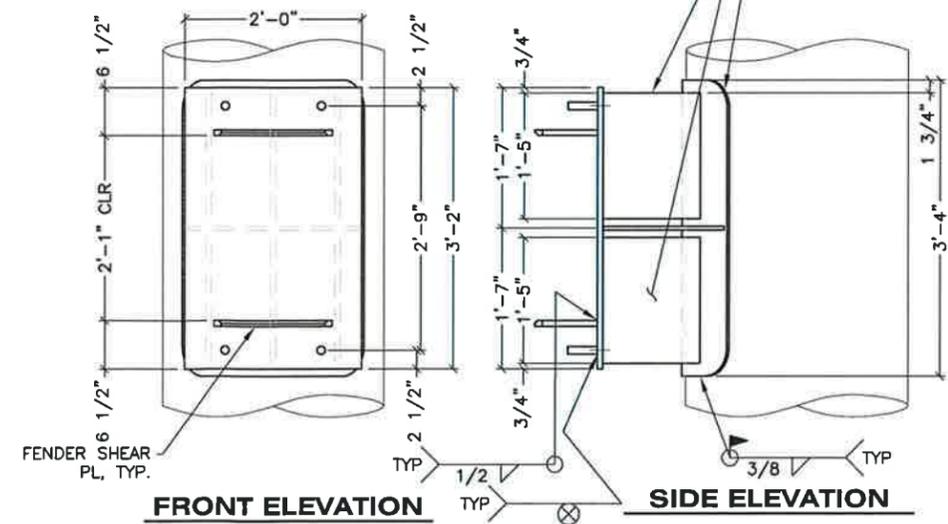

**EXTERIOR PILE FENDER MOUNT**  
 FRONT ELEVATION  
 SIDE ELEVATION

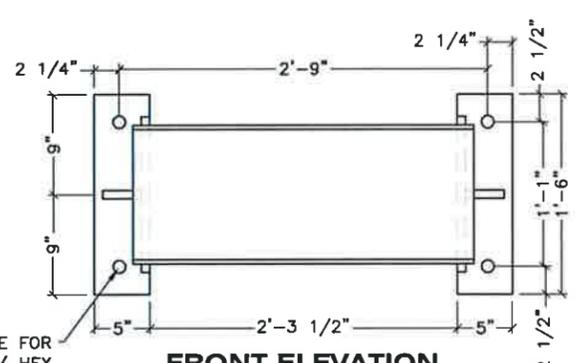


**FENDER MOUNT BRACKET**  
 FRONT ELEVATION

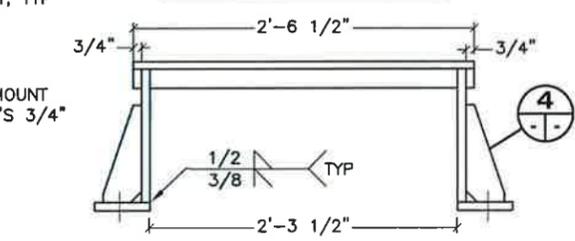


**FENDER MOUNT BRACKET**  
 PLAN

**FENDER MOUNT BRACKET**  
 DETAIL

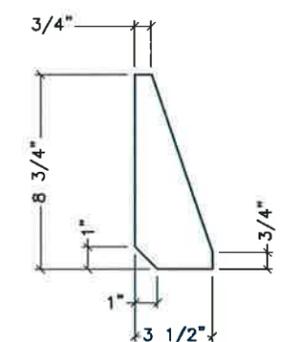

**STIFFENER**  
 DETAIL

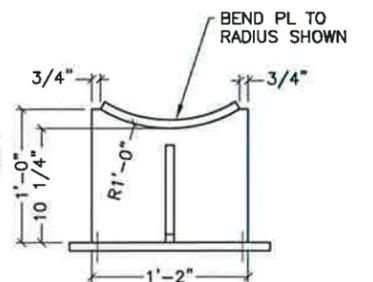

BEND PL TO RADIUS SHOWN

1/16" HOLE FOR 1" BOLT W/ HEX & JAM NUT, TYP

NOTE: ALL MOUNT BRACKET PL'S 3/4"


ALL MOUNT BRACKET WELDS EON 1/2

DO NOT SCALE FROM THESE DRAWINGS USE DIMENSIONS


DESIGNED BY: D. LOWELL		STATE OF ALASKA DEPARTMENT OF TRANSPORTATION & PUBLIC FACILITIES SOUTHCOST REGION			
		<b>KETCHIKAN FERRY TERMINAL IMPROVEMENTS</b>			
		<b>FENDER MOUNT DETAILS W5 - 6 PILE DOLPHIN</b>			
CHECKED BY: STAFF	DATE: 10/26/15	PROJECT DESIGNATION		YEAR	TOTAL SHEETS
DRAWN BY: STAFF		SAMHS00015		2015	28
PATH: Q:\KTN\67466\PLANSET\MF\12-19 WS - 6 PILE DOLPHIN.DWG		REVISIONS		NO.	DATE
TAB: 15 Monday, October 26, 2015 2:22:46 PM		DESCRIPTION			

Project As-Built Drawings have been reviewed by the Project Engineer and represent to the best of my knowledge the project as constructed.


PE *MP* Date *5.20.17*

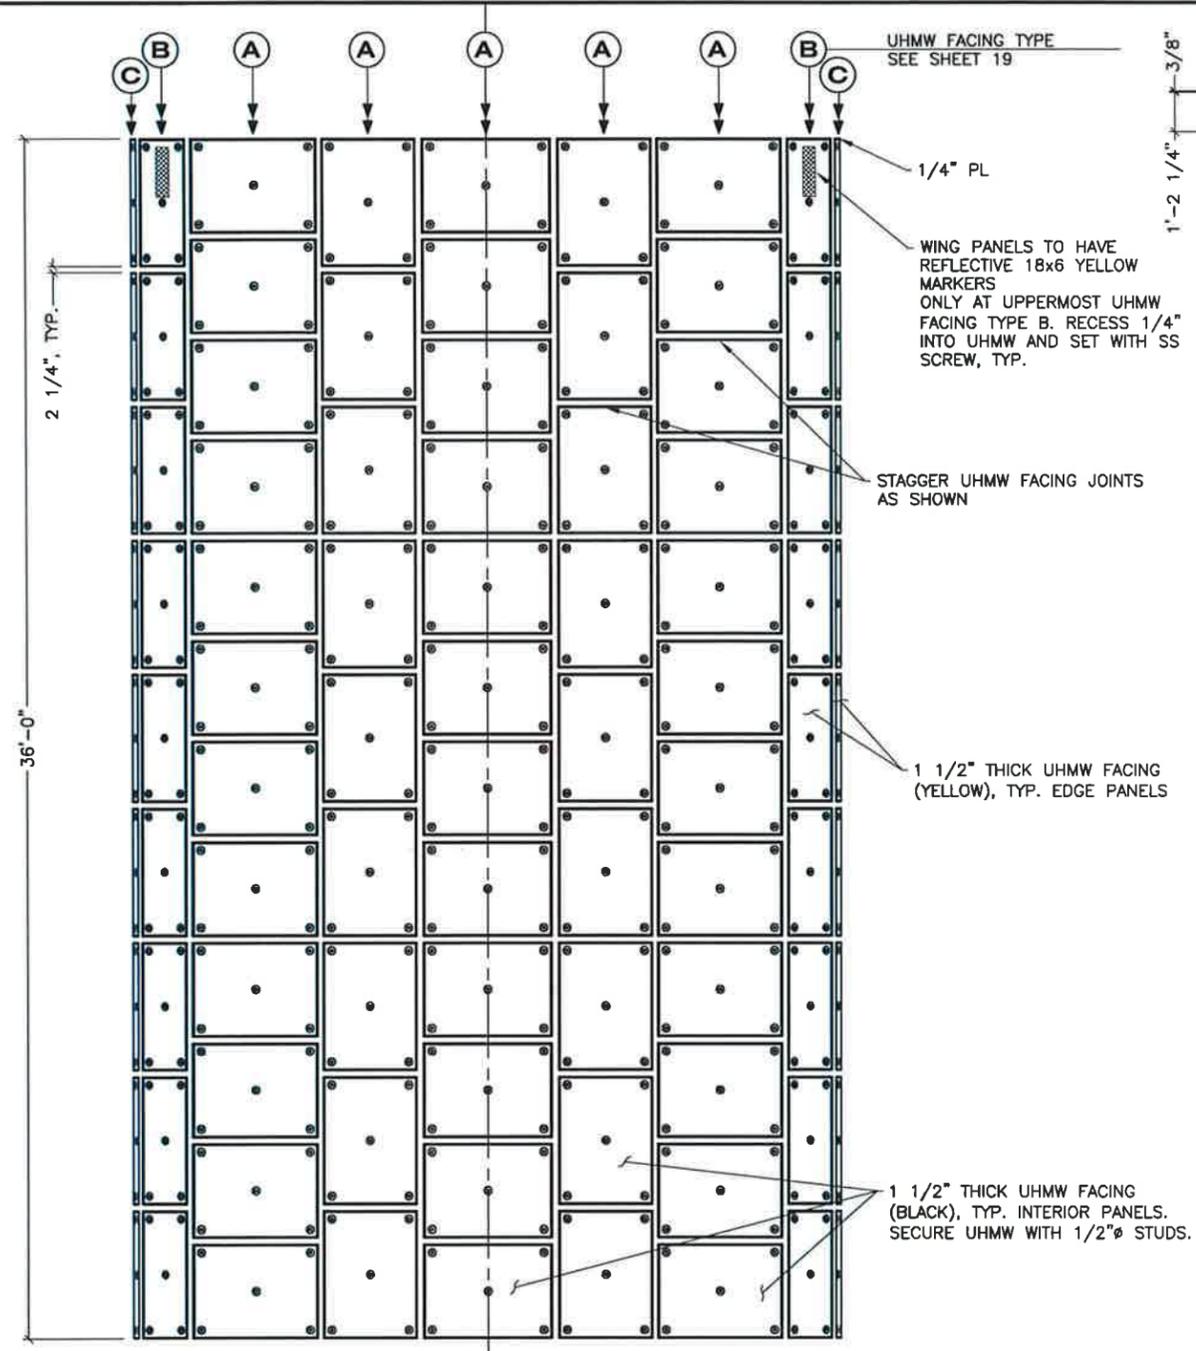

**UHMW FACING FRONT ELEVATION**  
SYMMETRIC ABOUT C

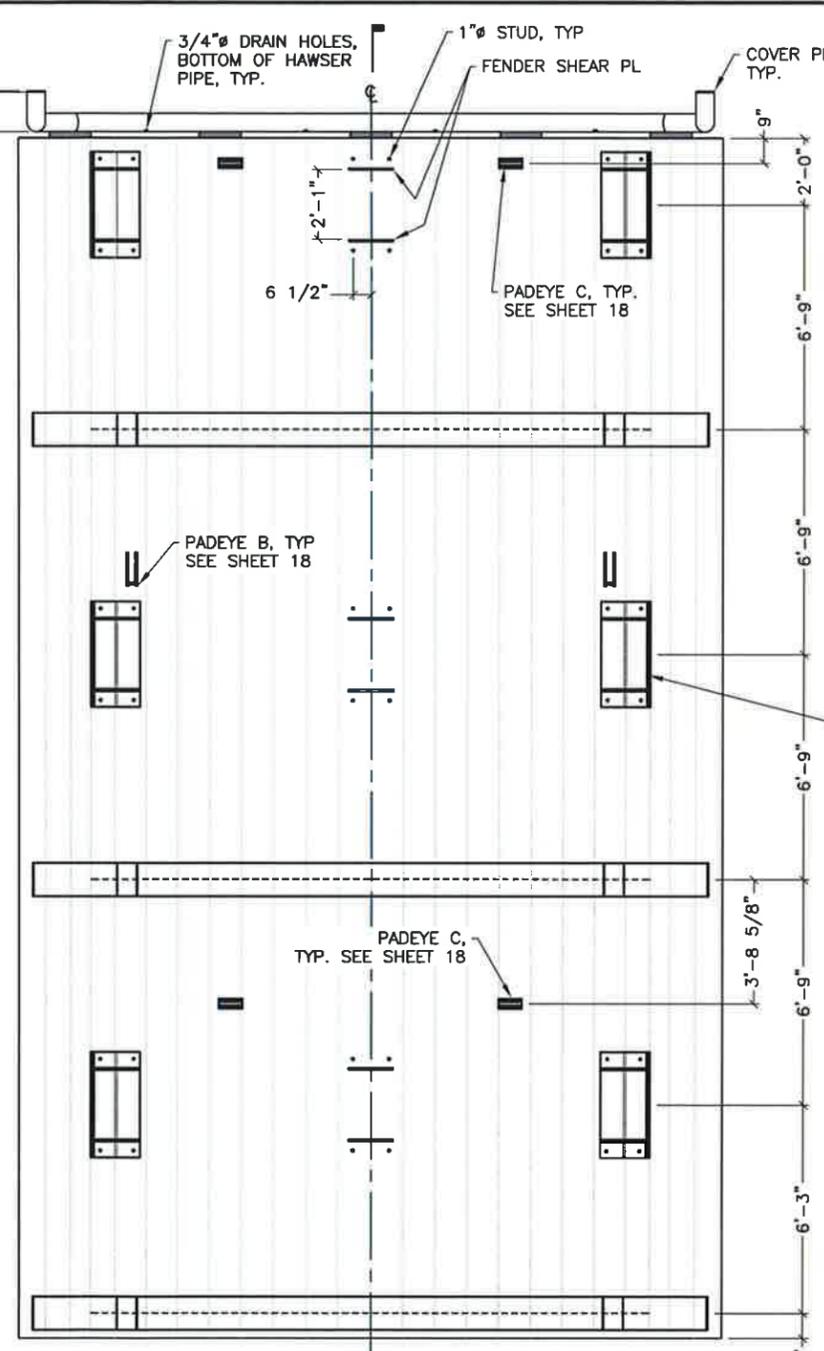


**FENDER PANEL BACK ELEVATION**

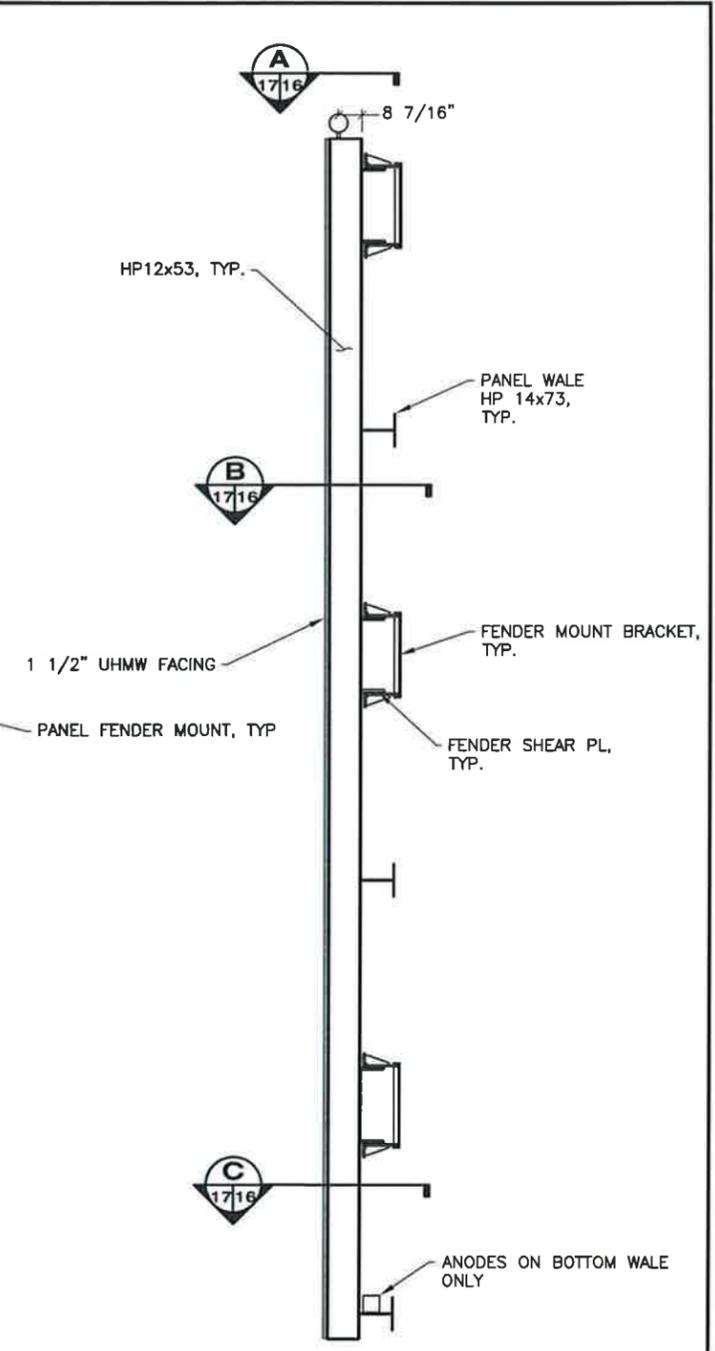


**FENDER PANEL SECTION**

DO NOT SCALE FROM THESE DRAWINGS USE DIMENSIONS


DESIGNED BY: D. LOWELL		STATE OF ALASKA DEPARTMENT OF TRANSPORTATION & PUBLIC FACILITIES SOUTHCOST REGION			
		<b>KETCHIKAN FERRY TERMINAL IMPROVEMENTS</b>			
CHECKED BY: STAFF		<b>FENDER PANEL W5 - 6 PILE DOLPHIN</b>			
DRAWN BY: STAFF		10/27/15			
PATH: Q:\KTN\67466\PLANSET\MF\12-19 W5 - 6 PILE DOLPHIN.DWG					
TAB: 16 Tuesday, October 27, 2015 10:34:15 AM					
REVISIONS		PROJECT DESIGNATION	YEAR	SHEET NO.	TOTAL SHEETS
NO.	DATE	DESCRIPTION			
			<b>SAMHS00015</b>	<b>2015</b>	<b>16</b>
					<b>28</b>

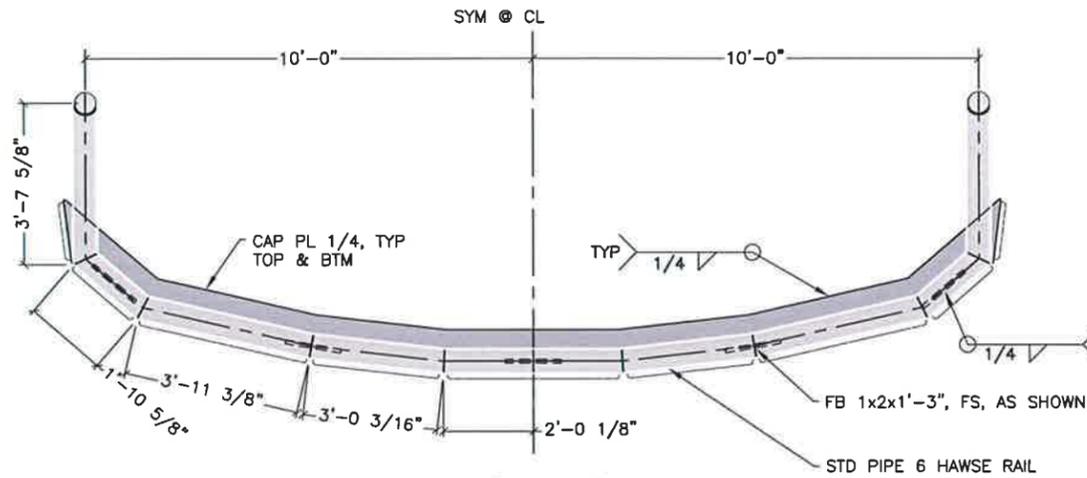


**A HAWSE RAIL PLAN**  
1716

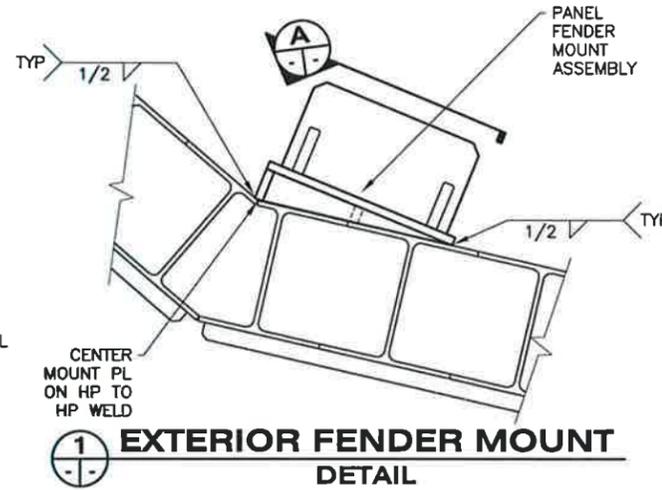


**1 EXTERIOR FENDER MOUNT DETAIL**

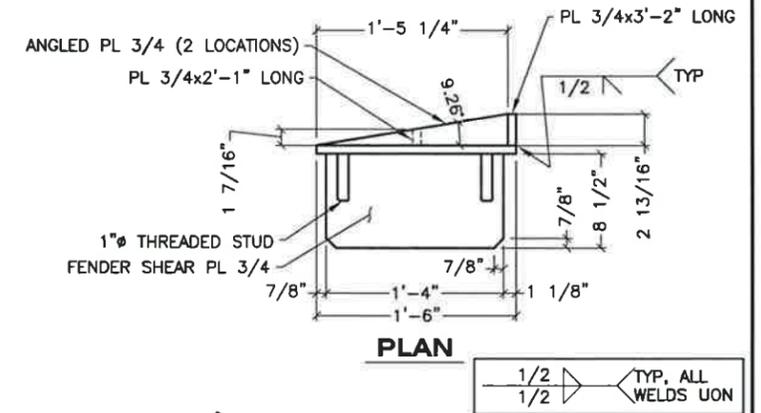


**PLAN**  
1/2 TYP, ALL WELDS UON

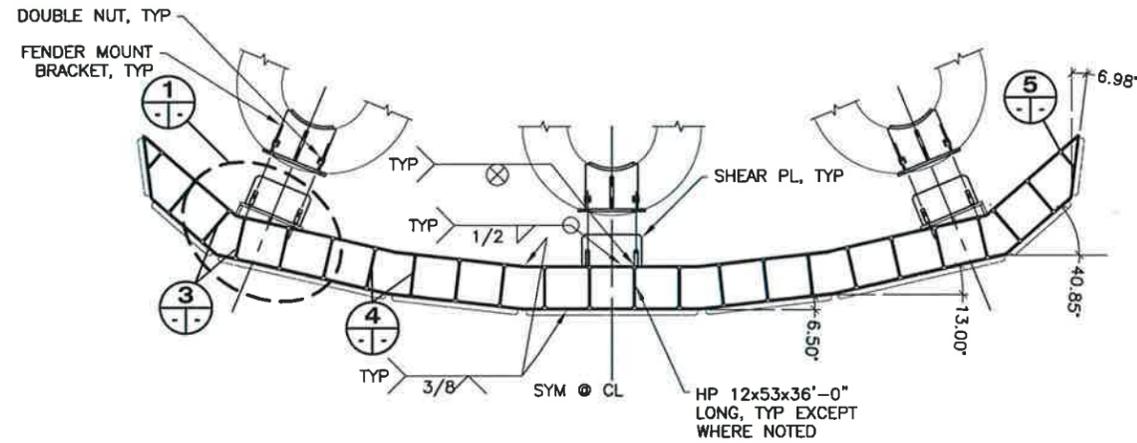


**B FENDER PANEL SECTION**  
1716

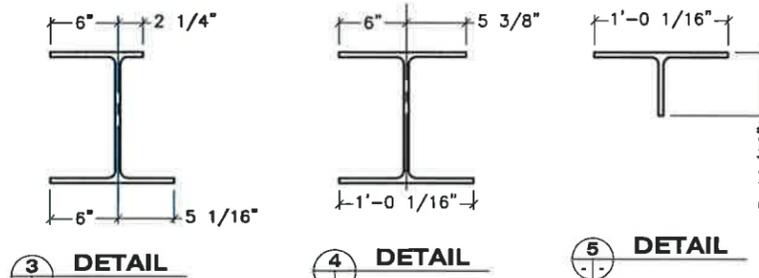


**MODIFIED HP 12x53'S**

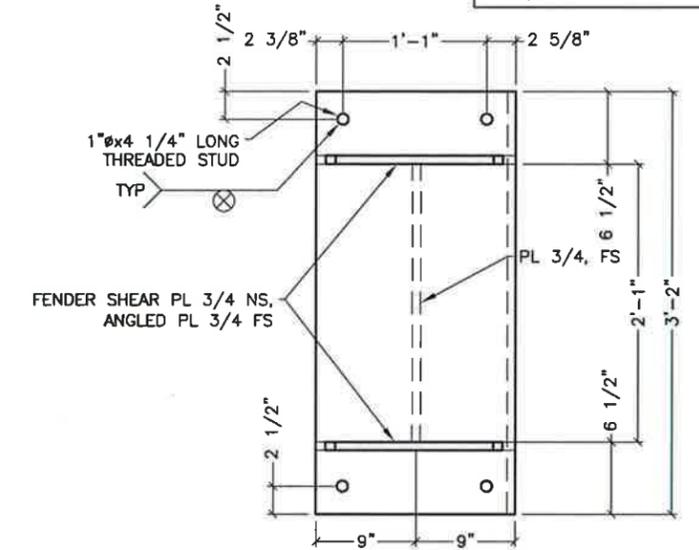

**A PANEL EXTERIOR FENDER MOUNT FRONT ELEVATION**

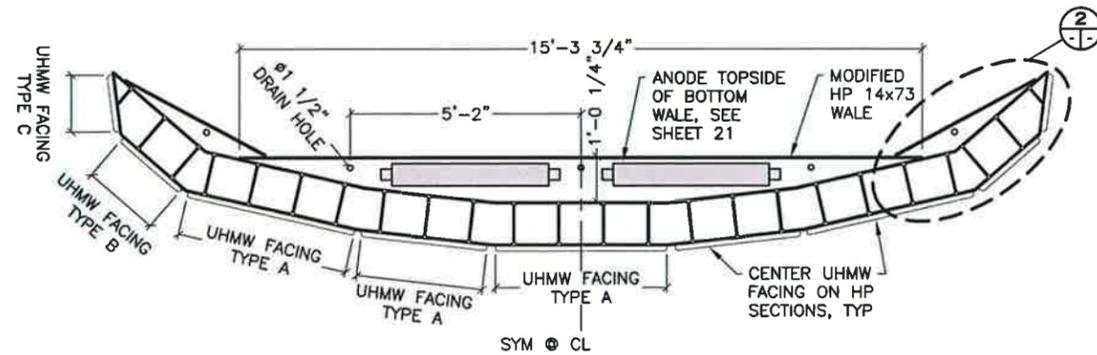


**C FENDER PANEL @ LOWER WALE SECTION**  
1716

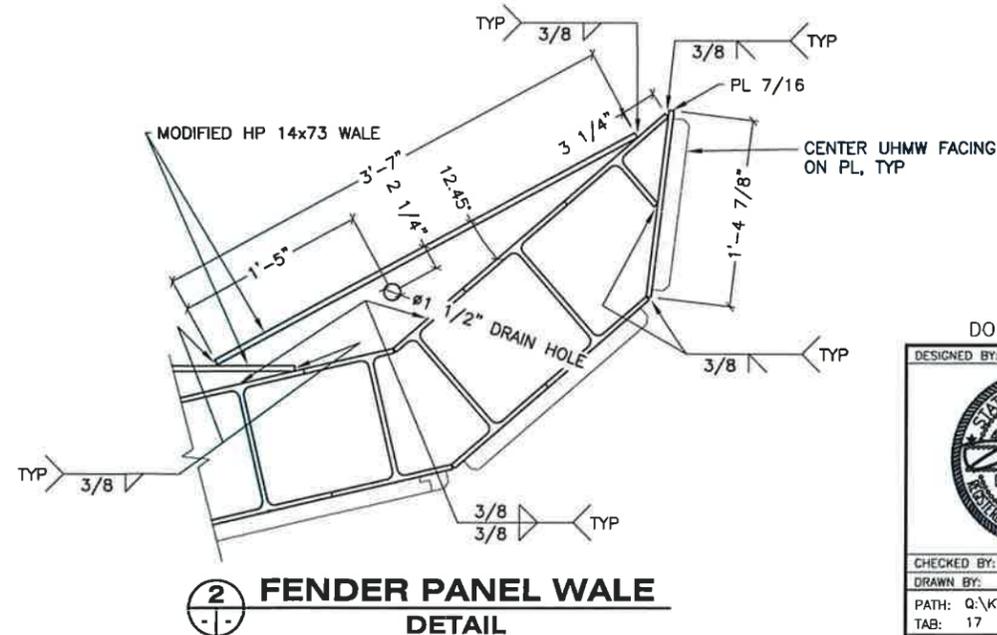

**2 FENDER PANEL WALE DETAIL**

DO NOT SCALE FROM THESE DRAWINGS USE DIMENSIONS

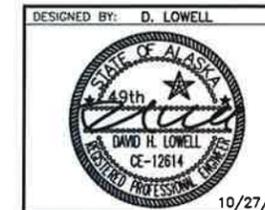

STATE OF ALASKA  
DEPARTMENT OF TRANSPORTATION & PUBLIC FACILITIES  
SOUTHCOST REGION

**KETCHIKAN FERRY  
TERMINAL IMPROVEMENTS**

**FENDER PANEL  
DETAILS  
W5 - 6 PILE DOLPHIN**


DESIGNED BY: D. LOWELL  
CHECKED BY: STAFF  
DRAWN BY: STAFF  
DATE: 10/27/15

PATH: Q:\KTN\67466\PLANS\12-19 W5 - 6 PILE DOLPHIN.DWG  
TAB: 17 Tuesday, October 27, 2015 10:35:46 AM


REVISIONS			PROJECT DESIGNATION	YEAR	SHEET NO.	TOTAL SHEETS
NO.	DATE	DESCRIPTION				
			<b>SAMHS00015</b>	<b>2015</b>	<b>17</b>	<b>28</b>

by the Project Engineer and represent to the best of my knowledge the project as constructed.


PE *MP* Date *5/20/17*

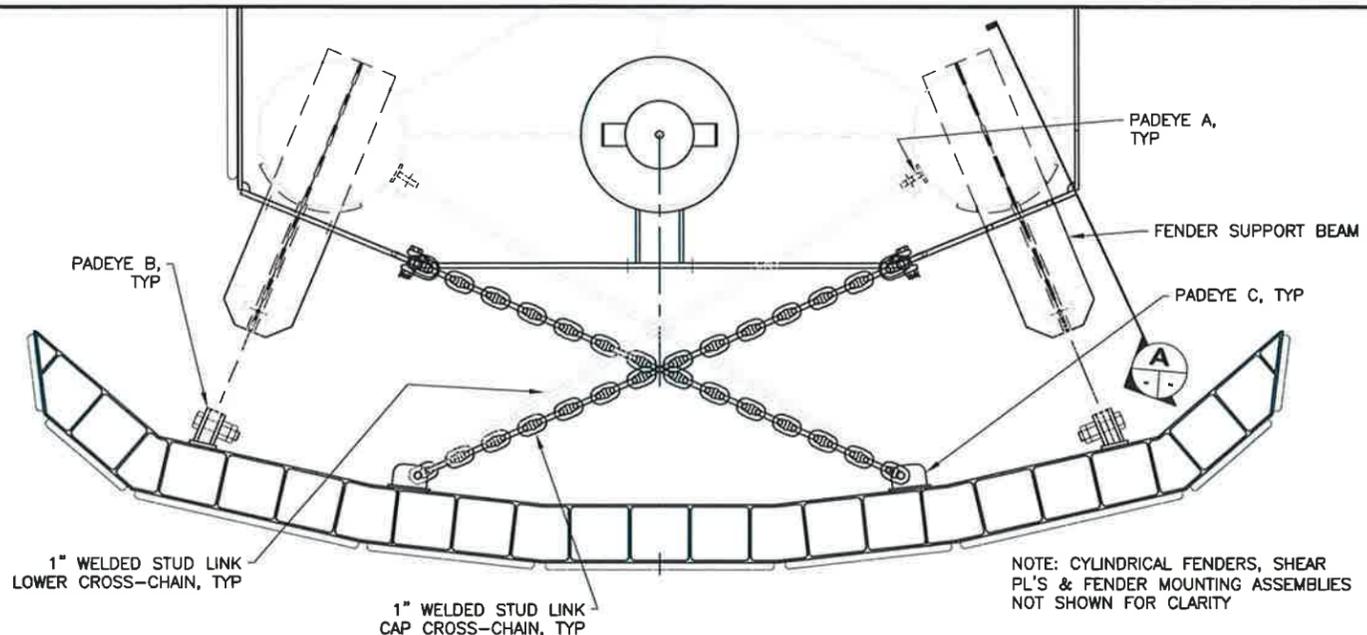



**CROSS CHAINS AND FENDER SUPPORT BEAM**  
PLAN

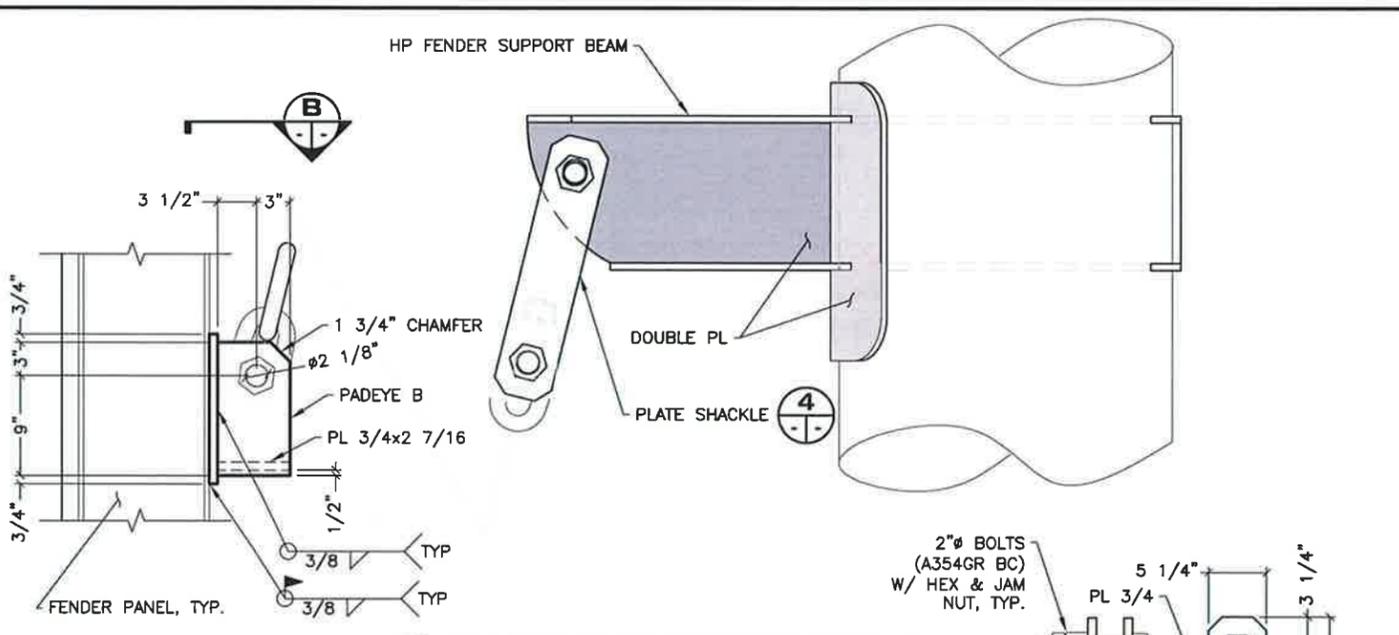


**FENDER SUPPORT BEAM**  
SIDE ELEVATION

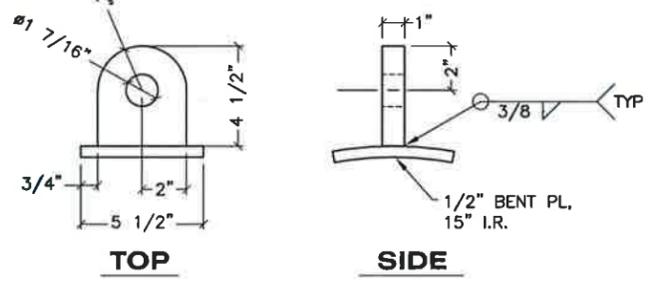



**1 PADEYE A**  
DETAIL

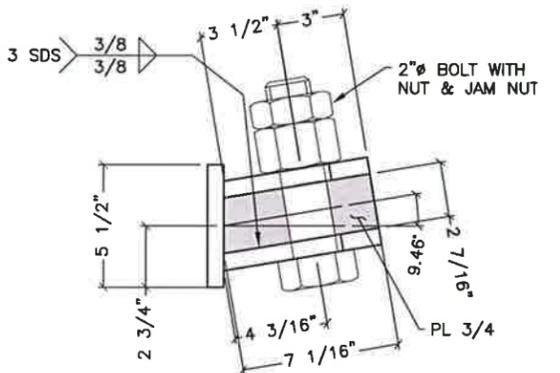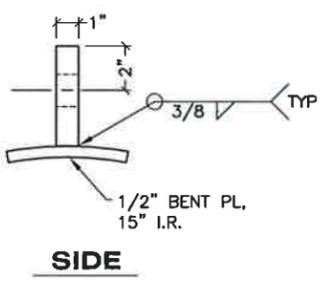

**B PADEYE B**  
PLAN  
ALL PL 3/4

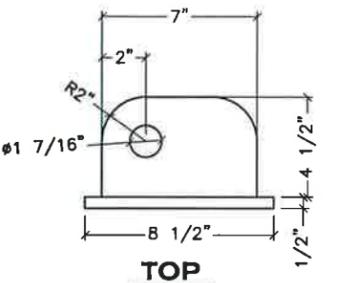


**2 PADEYE C**  
DETAIL  
ALL PL 1/2

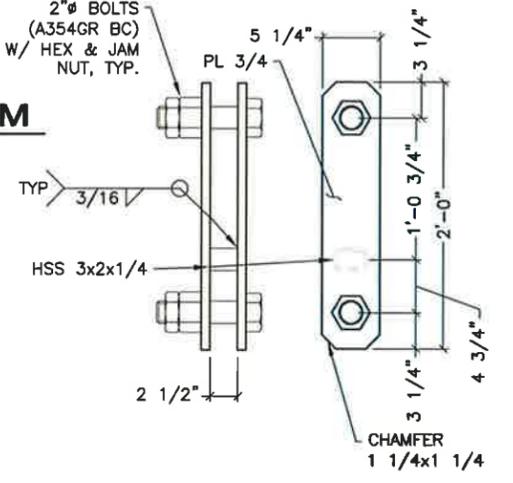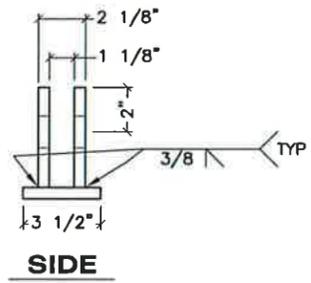


**4 PLATE SHACKLE**  
DETAIL

**NOTES:**

- 1) STUD MAY BE REMOVED IN END LINKS OF CROSS CHAINS TO PASS SHACKLE. DO NOT REMOVE STUDS IN VERTICAL CHAIN.
- 2) INSTALL CHAIN FREE OF TWISTS. DO NOT TWIST CHAIN TO ADJUST LENGTH.
- 3) FIELD LOCATE PADEYE "B" SO THAT FENDER PANEL IS AT, OR JUST ABOVE, DESIGN ELEVATION.
- 4) FIELD LOCATE PADEYE TYPES "A" AND "C" SO CROSS CHAINS ARE LESS THAN TAUT, SLIGHTLY SLACK.

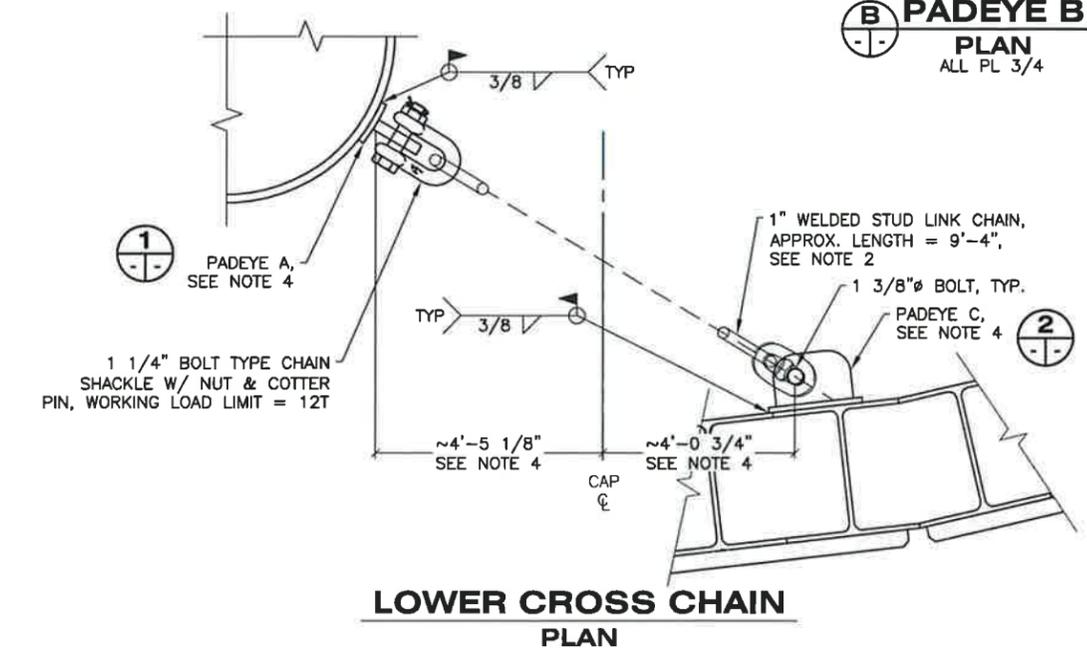

**LOWER CROSS CHAIN**  
PLAN

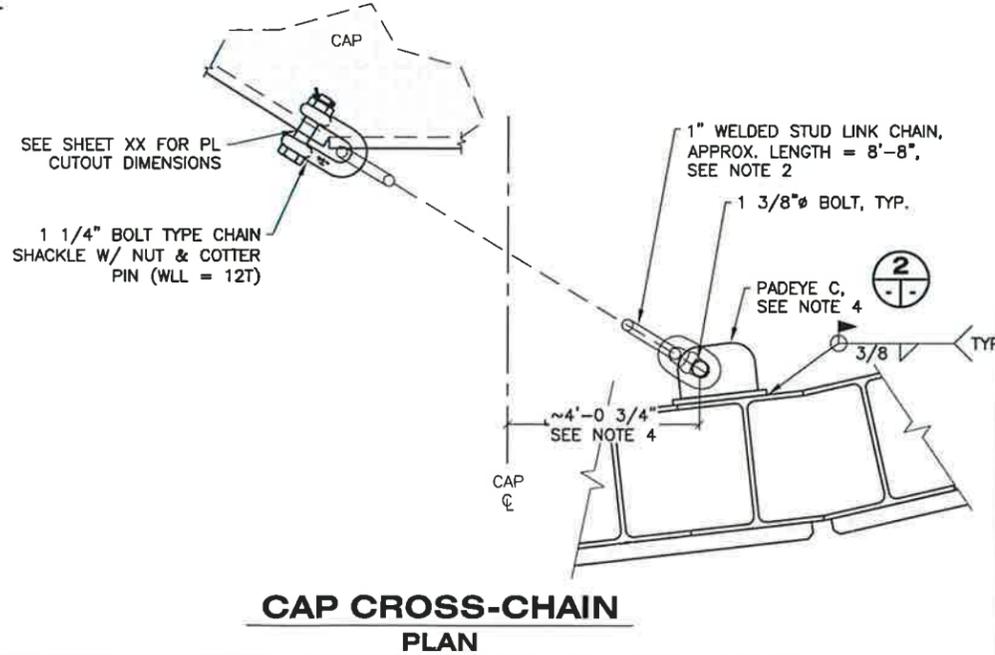

**CAP CROSS-CHAIN**  
PLAN

DO NOT SCALE FROM THESE DRAWINGS USE DIMENSIONS


DESIGNED BY: D. LOWELL		STATE OF ALASKA DEPARTMENT OF TRANSPORTATION & PUBLIC FACILITIES SOUTHWEST REGION			
		<b>KETCHIKAN FERRY TERMINAL IMPROVEMENTS</b>			
		<b>FENDER SUPPORT DETAILS W5 - 6 PILE DOLPHIN</b>			
CHECKED BY: STAFF	DRAWN BY: STAFF	PATH: Q:\KTN\67466\PLANS\MF\12-19 W5 - 6 PILE DOLPHIN.DWG		YEAR: 2015	SHEET NO.: 18
TAB: 1B Monday, October 26, 2015 2:27:35 PM		PROJECT DESIGNATION: SAMHS00015		TOTAL SHEETS: 28	
REVISIONS		NO.		DATE	DESCRIPTION

Project As-built Drawings have been reviewed by the Project Engineer and represent to the best of my knowledge the project as constructed.

PE: *MP* Date: *5.20.17*

Project As-Built Drawings have been reviewed by the Project Engineer and represent to the best of my knowledge the project as constructed.


PE *MP* Date *5/20/17*

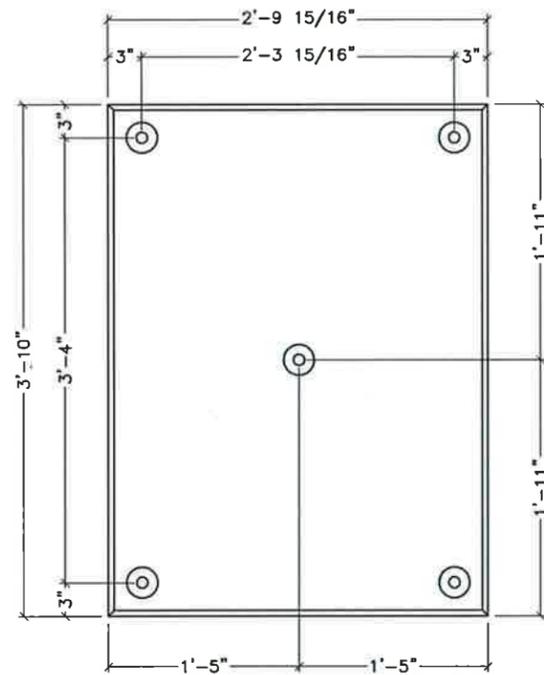

**UHMW TYPE A**

BLACK IN COLOR


E6	33
W5	54
W6	33
TOTAL	120

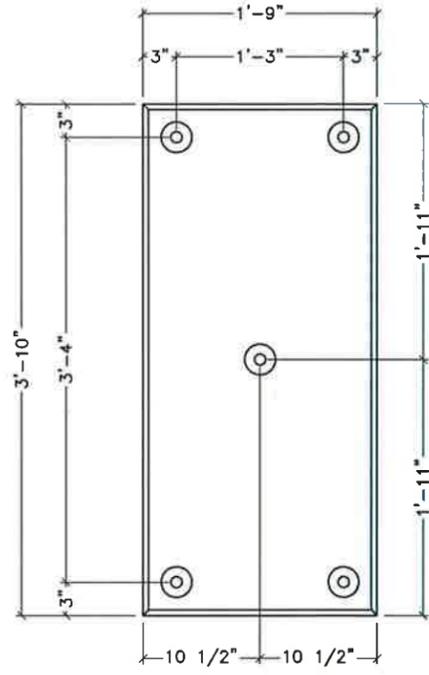

**UHMW TYPE B**

YELLOW IN COLOR


W5	18
TOTAL	18

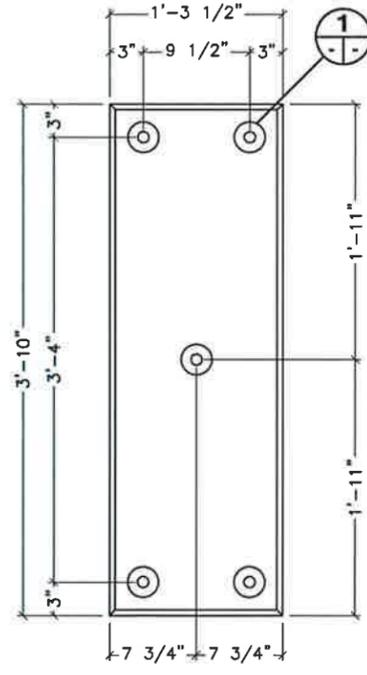

**UHMW TYPE C**

YELLOW IN COLOR


E6	18
W5	18
W6	18
TOTAL	54

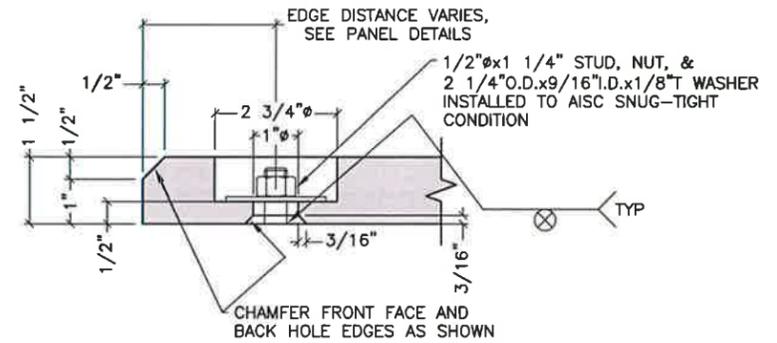


**UHMW FASTENER  
DETAIL**

DO NOT SCALE FROM THESE DRAWINGS USE DIMENSIONS


DESIGNED BY: <b>D. LOWELL</b>		STATE OF ALASKA DEPARTMENT OF TRANSPORTATION & PUBLIC FACILITIES SOUTHCOST REGION			
		<b>KETCHIKAN FERRY TERMINAL IMPROVEMENTS</b>			
		<b>DOLPHIN FENDER UHMW FACING</b>			
CHECKED BY: STAFF	DATE: 10/26/15	PROJECT DESIGNATION		YEAR	SHEET NO.
DRAWN BY: STAFF		SAMHS00015		2015	19
PATH: Q:\KTN\67466\PLANSET\MF\12-19 W5 - 6 PILE DOLPHIN.DWG		TOTAL SHEETS			
TAB: 19 Monday, October 26, 2015 2:28:07 PM		28			
REVISIONS					
NO.	DATE	DESCRIPTION			

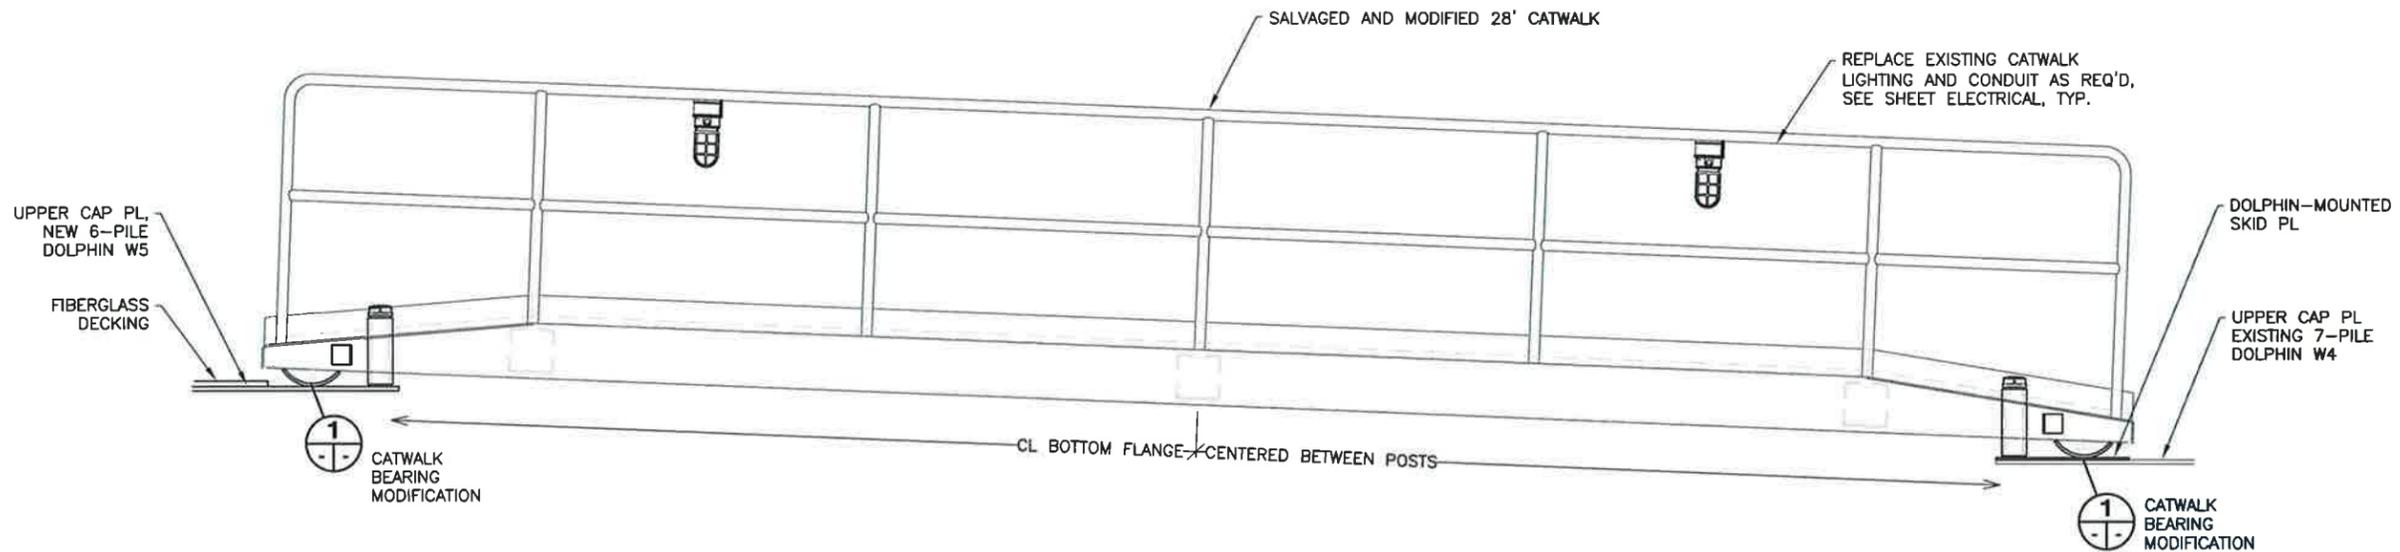


**CATWALK MODIFICATION  
ELEVATION LOOKING SHOREWARD**

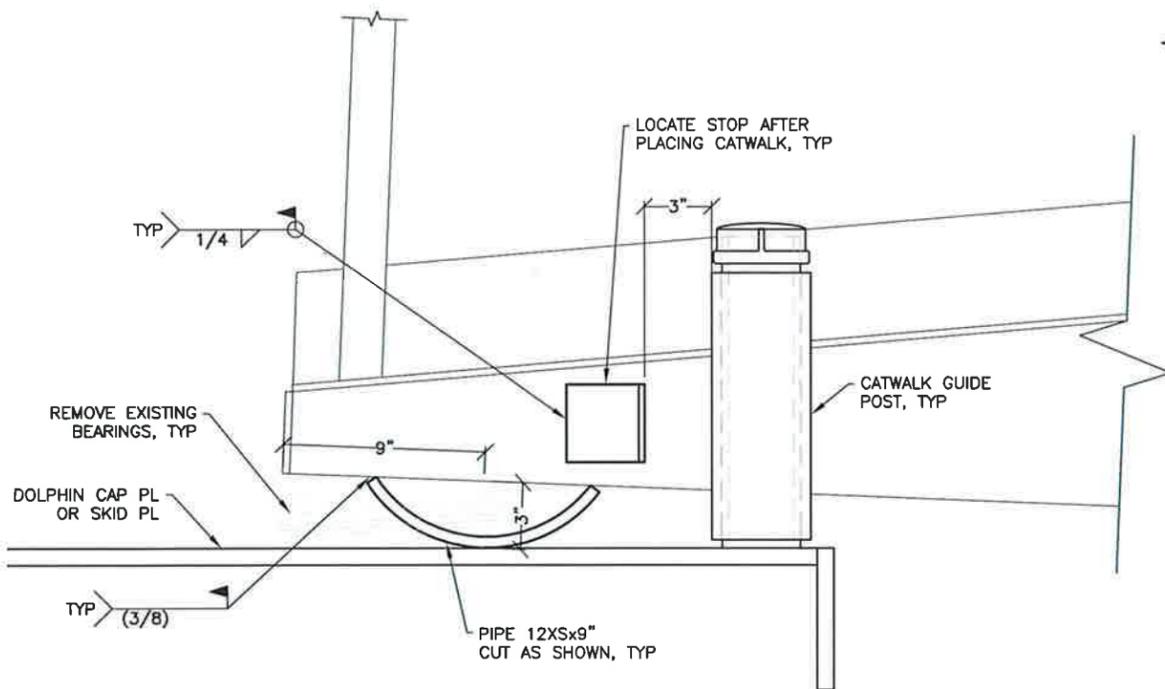


**CATWALK BEARINGS  
TYP ELEVATION**  
DETAILS SIMILAR BOTH ENDS

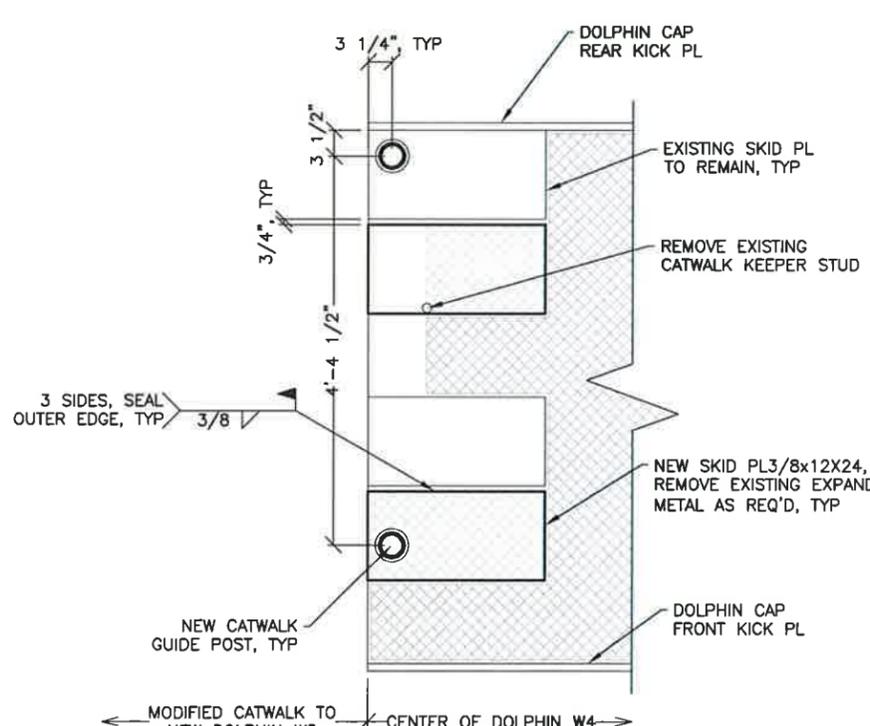

**DOLPHIN W4 MODIFICATION  
PLAN**

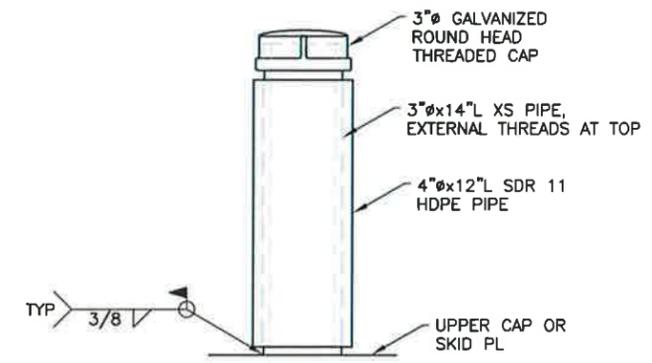

**CATWALK GUIDE POST  
ELEVATION**

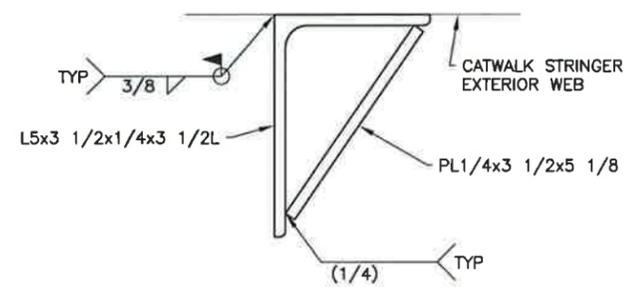

**CATWALK STOP  
PLAN**

DO NOT SCALE FROM THESE DRAWINGS USE DIMENSIONS

DESIGNED BY: D. LOWELL  
  
 10/26/15


STATE OF ALASKA  
DEPARTMENT OF TRANSPORTATION & PUBLIC FACILITIES  
SOUTHCOST REGION

**KETCHIKAN FERRY  
TERMINAL IMPROVEMENTS**


**CATWALK & W4  
MODIFICATIONS**

CHECKED BY: STAFF	PROJECT DESIGNATION			
DRAWN BY: STAFF	YEAR			
PATH: Q:\KTN\67466\PLANSET\MF\20 - CATWALK & W4 MODS.DWG		SHEET NO.		TOTAL SHEETS
TAB: 20 Monday, October 26, 2015 2:50:41 PM		20		28
NO. DATE DESCRIPTION		PROJECT DESIGNATION		
		SAMHS00015		

Project As-Built Drawings have been reviewed by the Project Engineer and represent to the best of my knowledge the project as constructed.  
 PE *[Signature]* Date 5.20.17

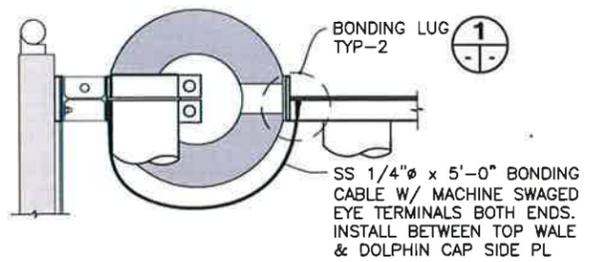

**PANEL BONDING CABLE ELEVATION**

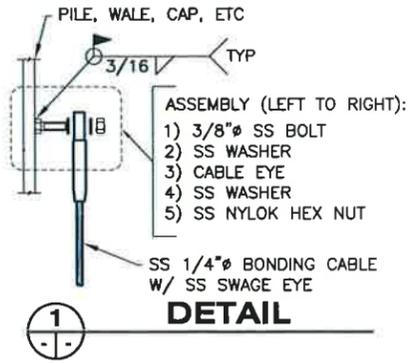


**DETAIL**



**NEW W6 & E6**  
6 PER STRUCTURE, 12 TOTAL


**NEW W5**  
9 TOTAL

**BERTH 1 PILE ANODES**

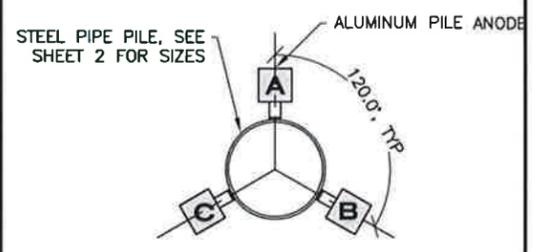


ORIENT AS DEPICTED PER STRUCTURE

**PLAN**

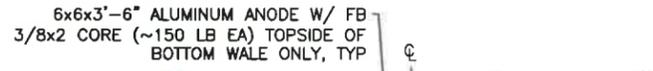

**DOLPHIN W5**  
2 TOTAL

ALL THREE NEW PANELS TO HAVE BONDING CABLES

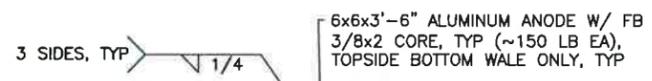


**DOLPHINS E6 & W6**  
3 PER STRUCTURE, 6 TOTAL

**BERTH 1 FENDER PANEL ANODES**


**BASIC BID**

21 PILE ANODES, 8 FENDER PANEL ANODES, 3 BONDING CABLES

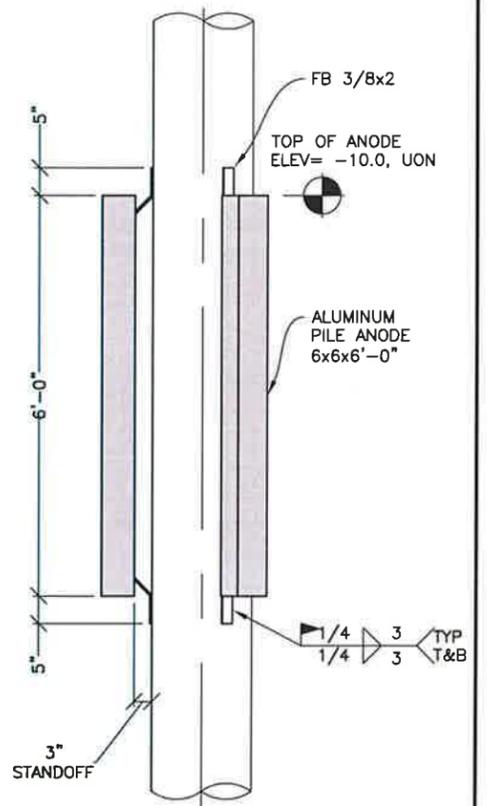

**ELEVATION**


**ANODES DETAIL**

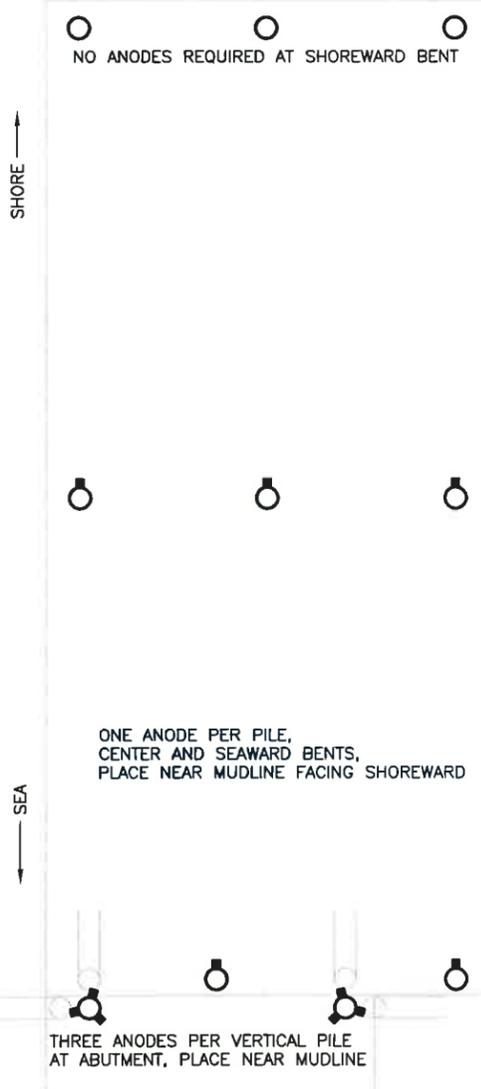

**EXISTING APPROACH TRESTLE & ABUTMENT**  
11 TOTAL




**EXISTING ER & WR**  
6 PER STRUCTURE, 12 TOTAL

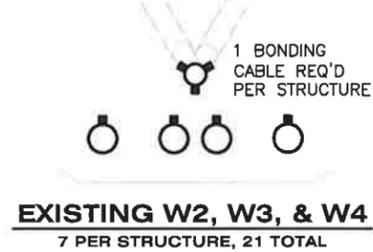


**EXISTING W2, W3, & W4**  
7 PER STRUCTURE, 21 TOTAL



**EXISTING EG & WG**  
3 PER STRUCTURE, 6 TOTAL

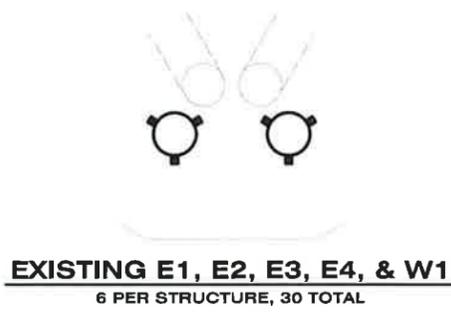

**EXISTING E1, E2, E3, E4, & W1**  
6 PER STRUCTURE, 30 TOTAL

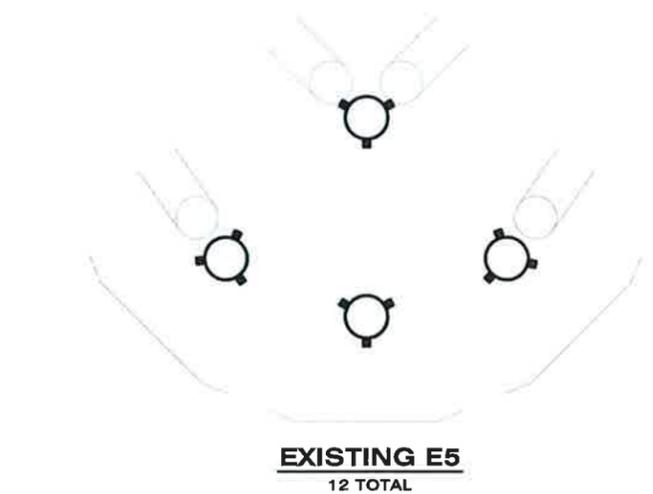

**EXISTING E5**  
12 TOTAL

**BERTH 1 PILE ANODES**

**ADDITIVE ALTERNATE A**

116 PILE ANODES, 3 BONDING CABLES



**EXISTING EBR & WBR**  
6 PER STRUCTURE, 12 TOTAL



**EXISTING NMR & SMR**  
6 PER STRUCTURE, 12 TOTAL

**BERTH 3 PILE ANODES**

DO NOT SCALE FROM THESE DRAWINGS USE DIMENSIONS

DESIGNED BY: D. LOWELL

CHECKED BY: STAFF  
 DRAWN BY: STAFF  
 DATE: 10/27/15

STATE OF ALASKA  
 DEPARTMENT OF TRANSPORTATION & PUBLIC FACILITIES  
 SOUTHCOAST REGION


**KETCHIKAN FERRY TERMINAL IMPROVEMENTS**

**ANODES**


NO.	DATE	DESCRIPTION	PROJECT DESIGNATION	YEAR	SHEET NO.	TOTAL SHEETS
			SAMHS00015	2015	21	28

by the Project Engineer and represent to the best of my knowledge the project as constructed.


PE *mp* Date *5/20/17*

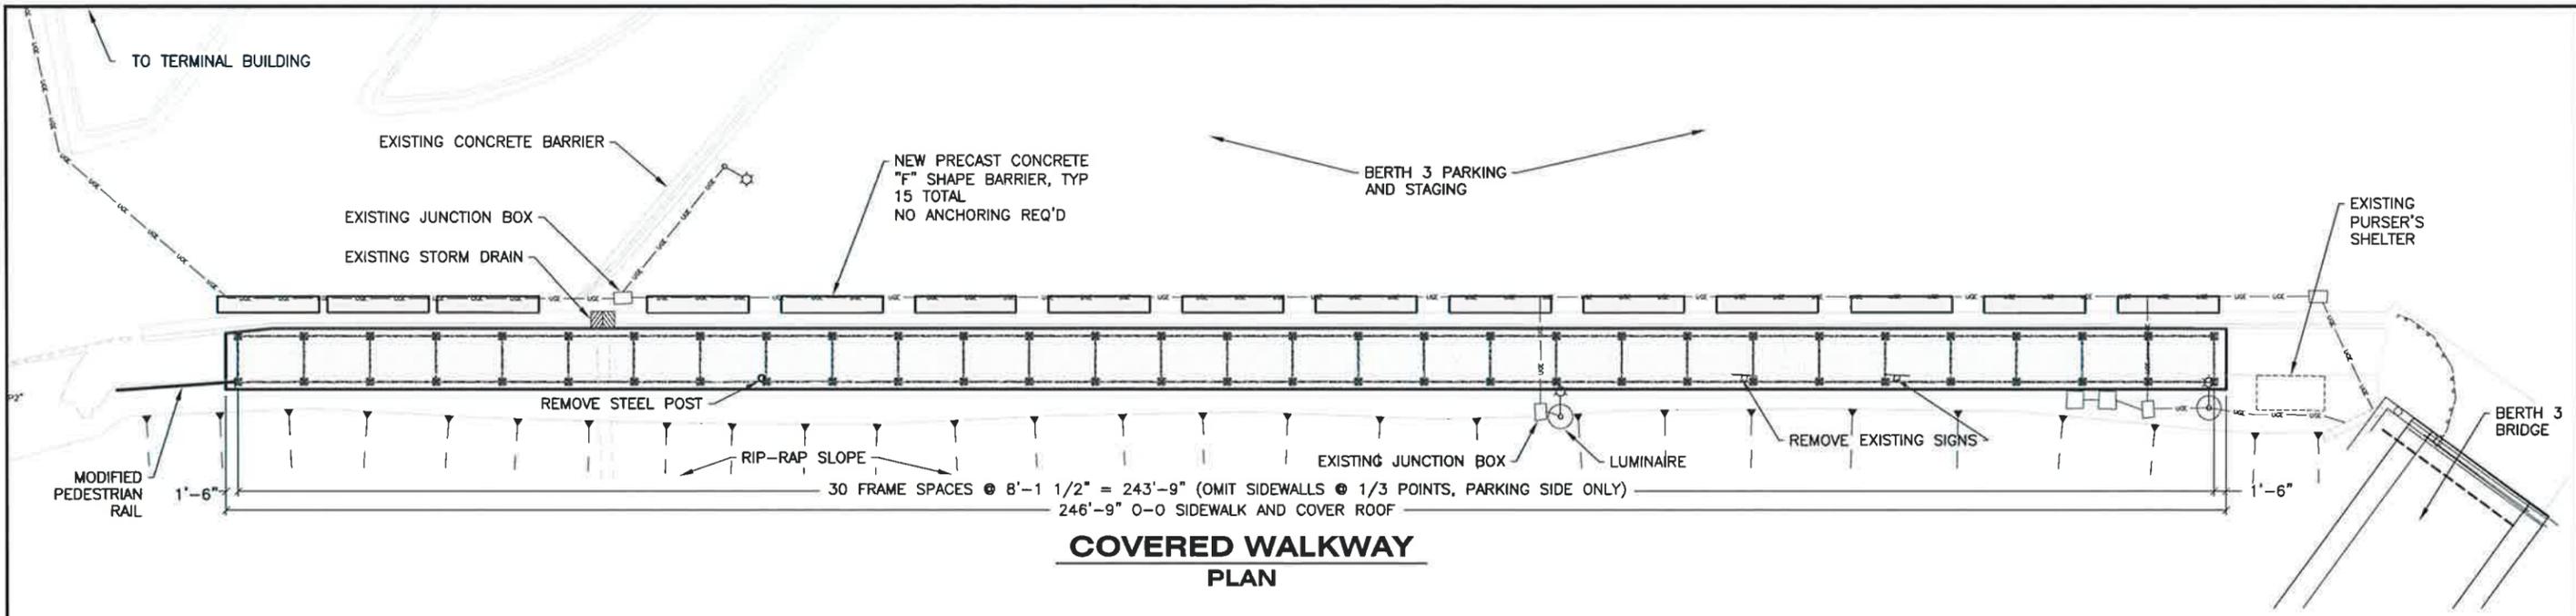


**COVERED WALKWAY  
PLAN**

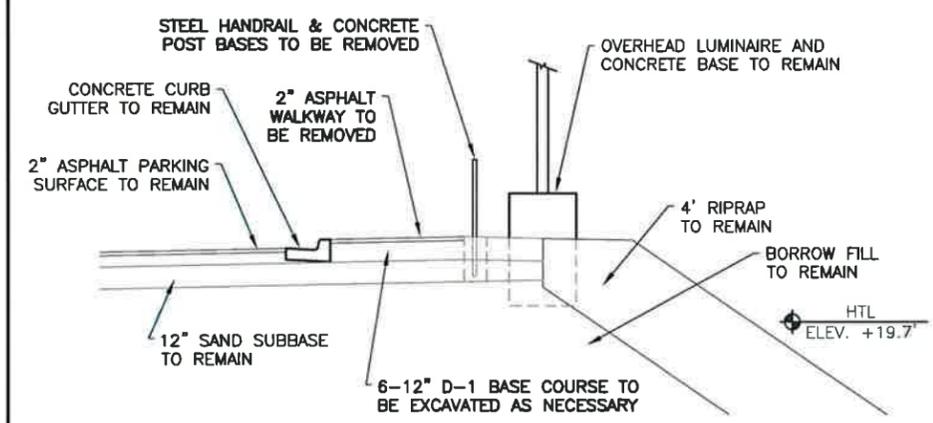


**EXISTING CONDITIONS AND REMOVAL  
TYP SECTION**

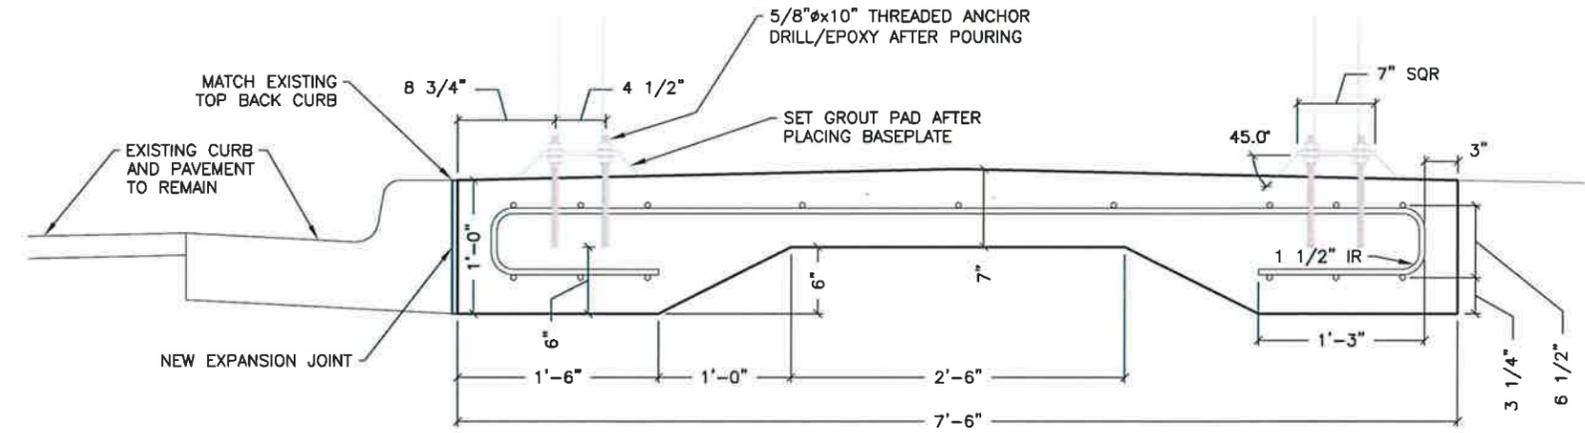

**CONCRETE SIDEWALK  
TYP SECTION**

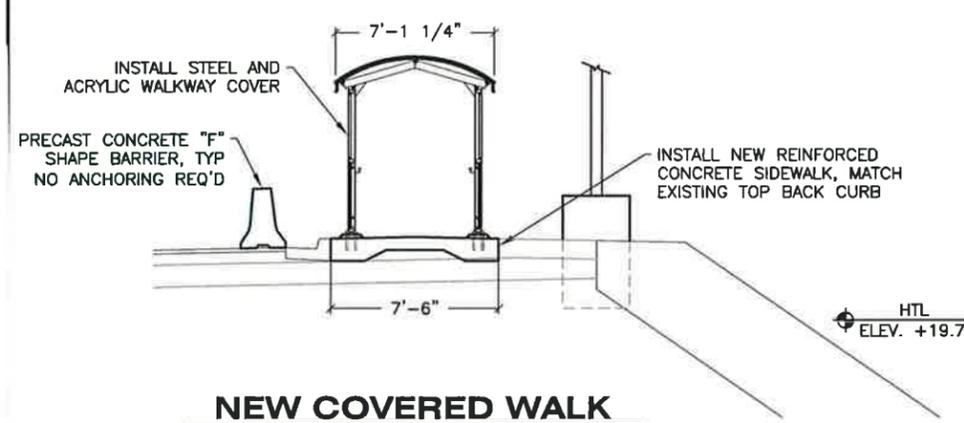

**NEW COVERED WALK  
TYP SECTION**

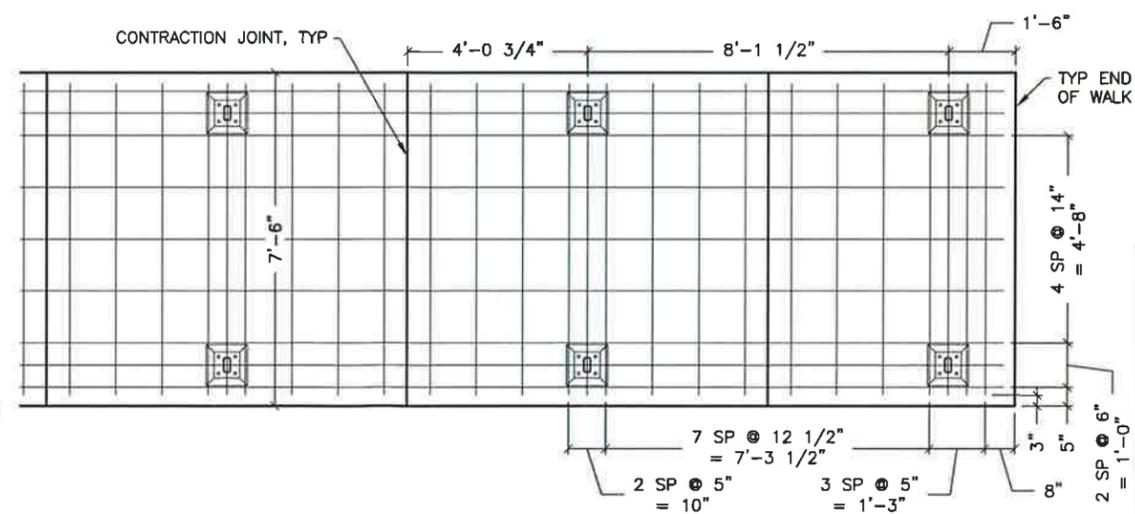

**REINFORCEMENT LAYOUT  
TYP PLAN**

DO NOT SCALE FROM THESE DRAWINGS USE DIMENSIONS

DESIGNED BY: D. LOWELL

CHECKED BY: STAFF  
DRAWN BY: STAFF

DATE: 10/26/15

STATE OF ALASKA  
DEPARTMENT OF TRANSPORTATION & PUBLIC FACILITIES  
SOUTHCOST REGION

**KETCHIKAN FERRY  
TERMINAL IMPROVEMENTS**

**SIDEWALK DETAILS**


PATH: Q:\KTN\67466\PLANSSET\MF\22-24 - COVERED WALK.DWG  
TAB: 22 Monday, October 26, 2015 3:15:44 PM

NO.	DATE	REVISIONS DESCRIPTION	PROJECT DESIGNATION	YEAR	SHEET NO.	TOTAL SHEETS
			<b>SAMHS00015</b>	<b>2015</b>	<b>22</b>	<b>28</b>


Project As-Built Drawings have been reviewed by the Project Engineer and represent to the best of my knowledge the project as constructed.  
 Date: 5/20/17  
 PE: MP

Project As-Built Drawings have been reviewed by the Project Engineer and represent to the best of my knowledge the project as constructed.


PE *MP* Date *5-20-17*

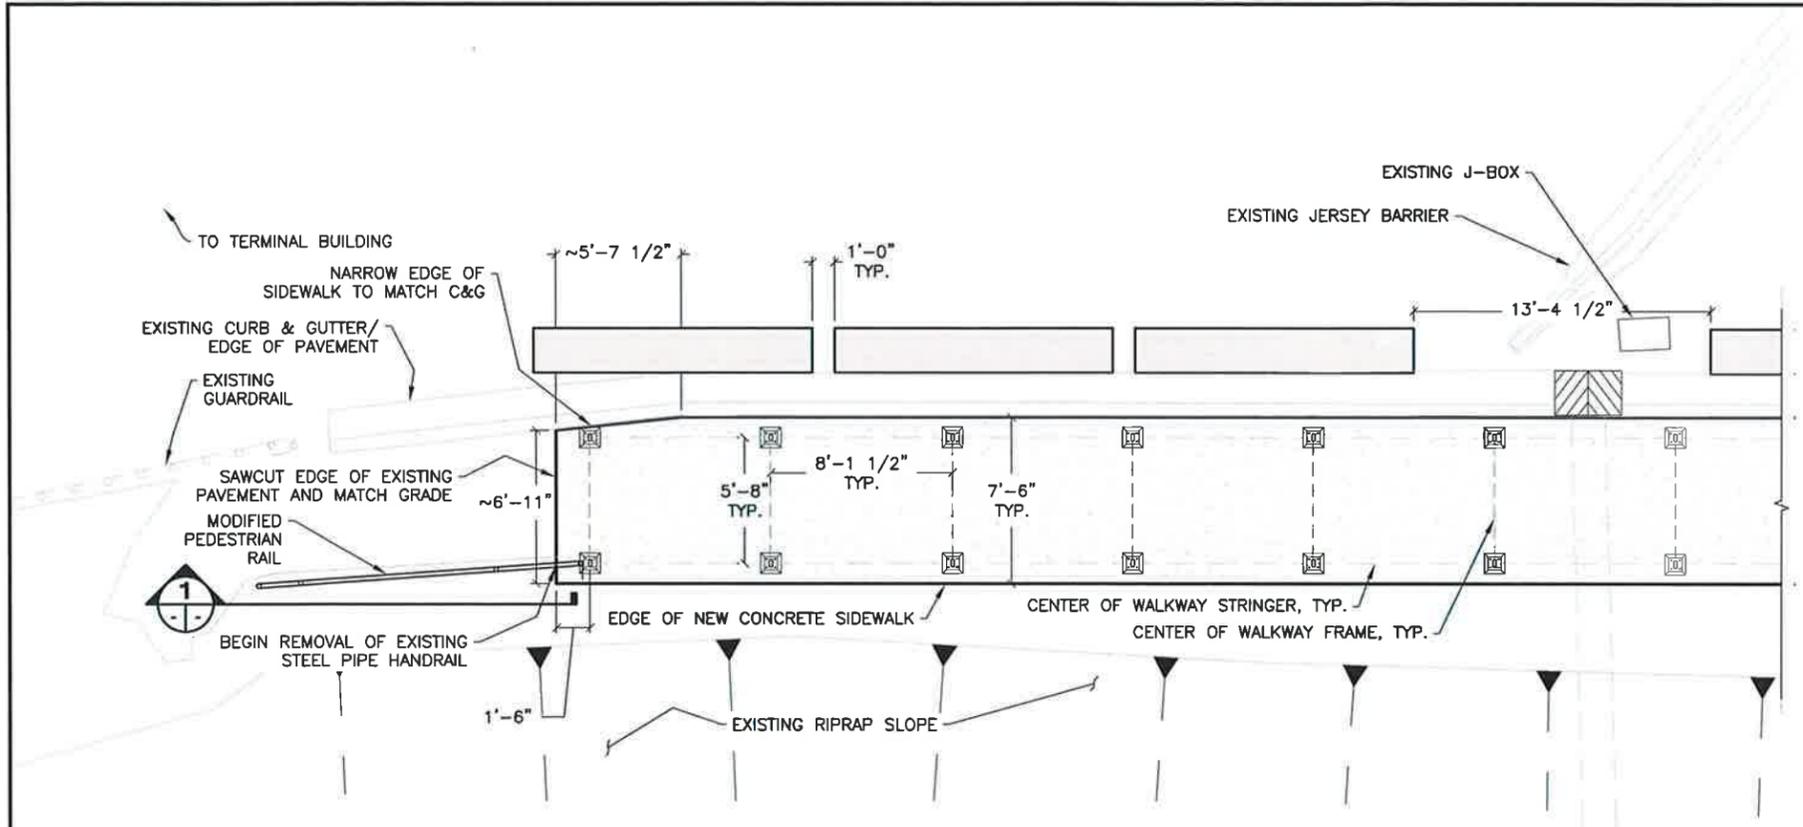

**WALKWAY TERMINAL END PLAN**

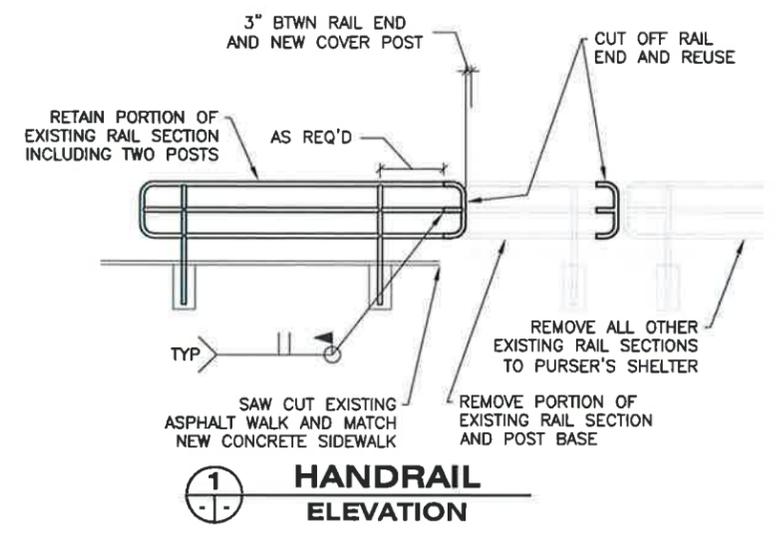


**1 HANDRAIL ELEVATION**

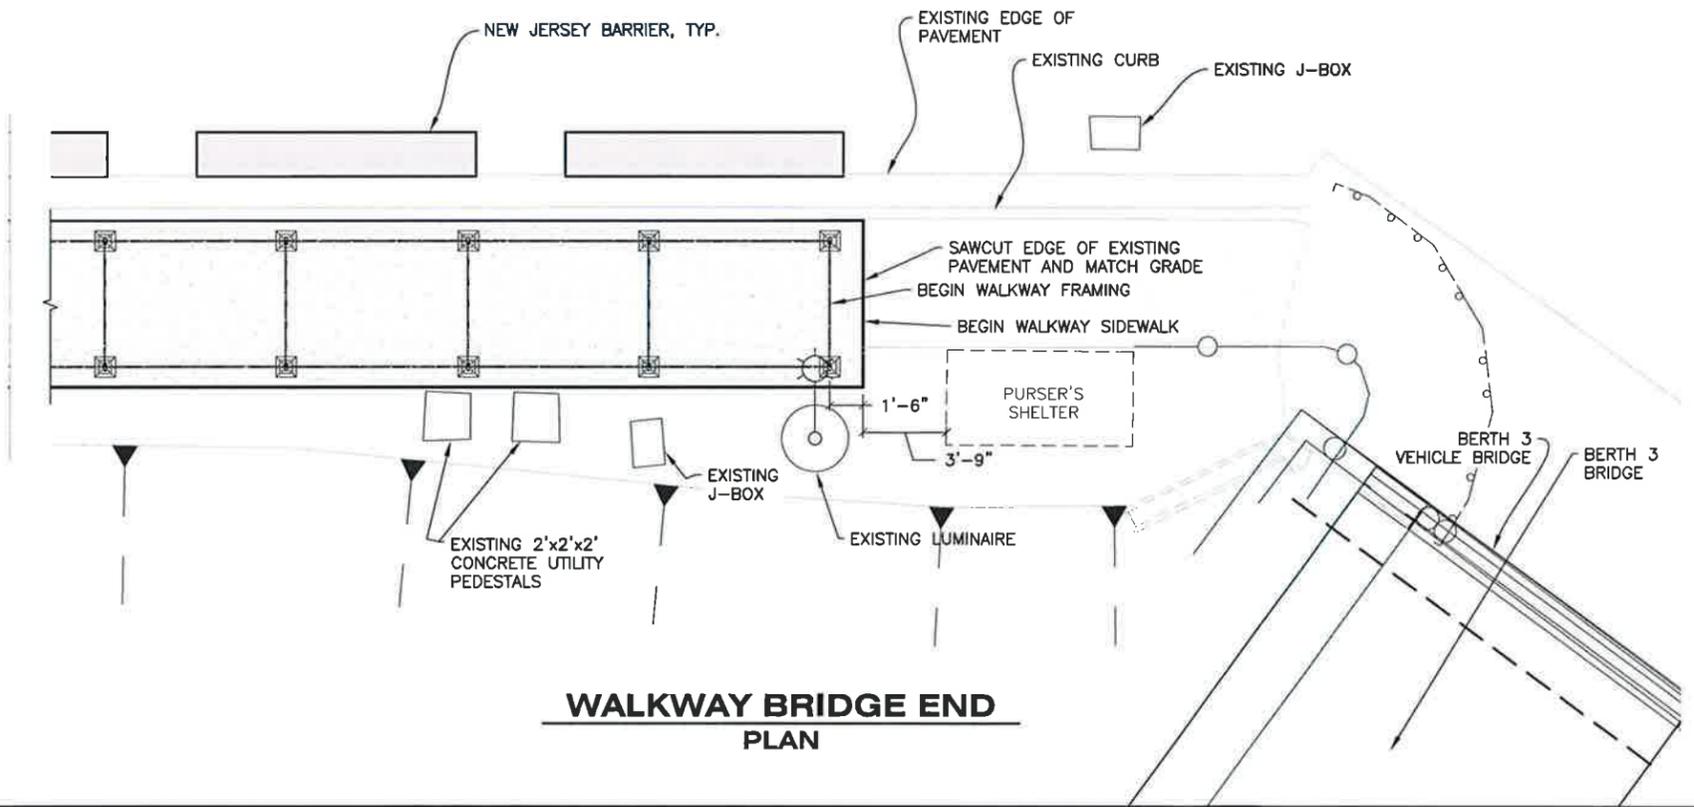


**WALKWAY BRIDGE END PLAN**

DO NOT SCALE FROM THESE DRAWINGS USE DIMENSIONS


DESIGNED BY: D. LOWELL	STATE OF ALASKA DEPARTMENT OF TRANSPORTATION & PUBLIC FACILITIES SOUTHCOST REGION	
	<b>KETCHIKAN FERRY TERMINAL IMPROVEMENTS</b>	
CHECKED BY: STAFF	<b>247' COVERED WALKWAY</b>	
DRAWN BY: STAFF		
PATH: Q:\KTN\67466\PLANSET\MF\22-24 - COVERED WALK.DWG		
TAB: 23 Monday, October 26, 2015 3:17:07 PM		
REVISIONS		
NO.	DATE DESCRIPTION	
PROJECT DESIGNATION		
<b>SAMHS00015</b>		
YEAR	SHEET NO.	TOTAL SHEETS
<b>2015</b>	<b>23</b>	<b>28</b>

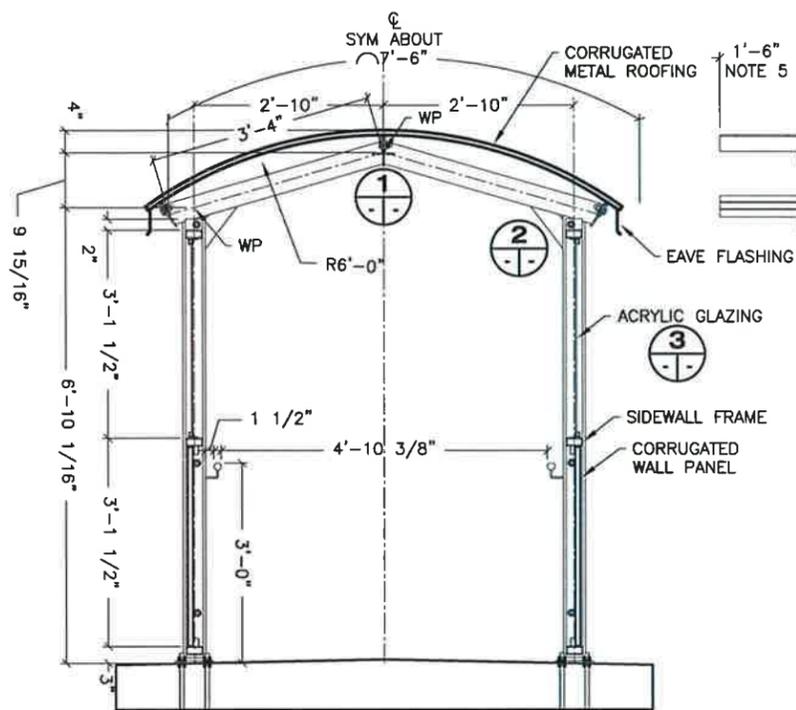


**TYPICAL SECTION**

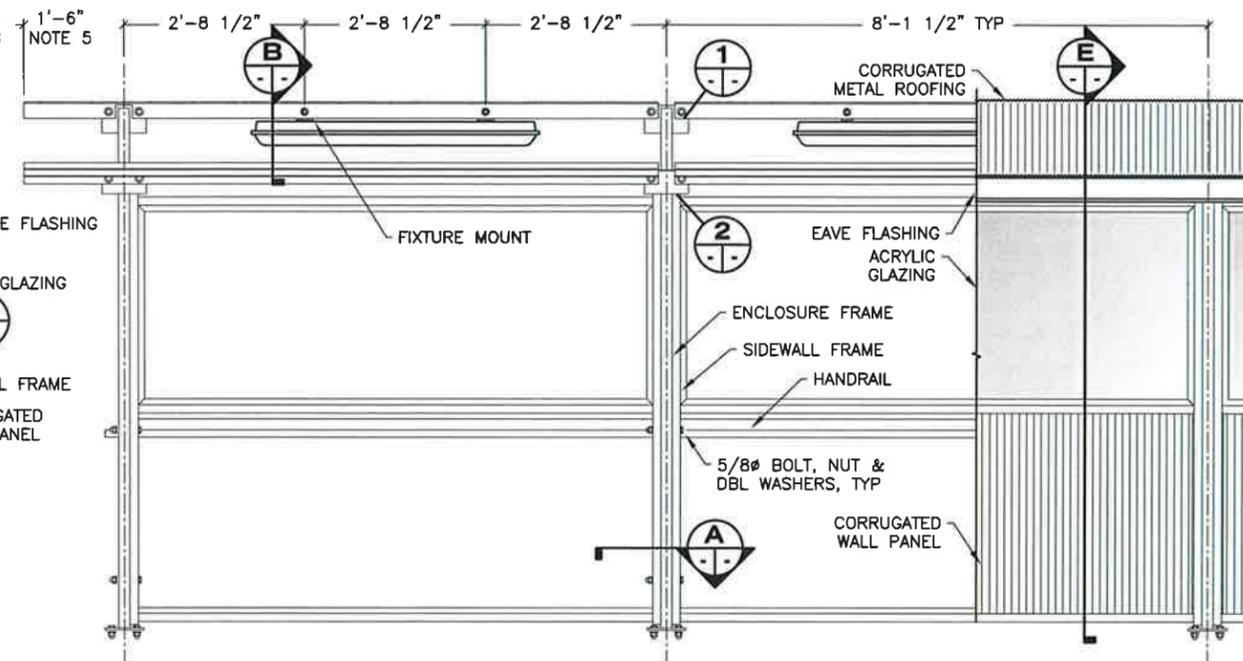


**ELEVATION**

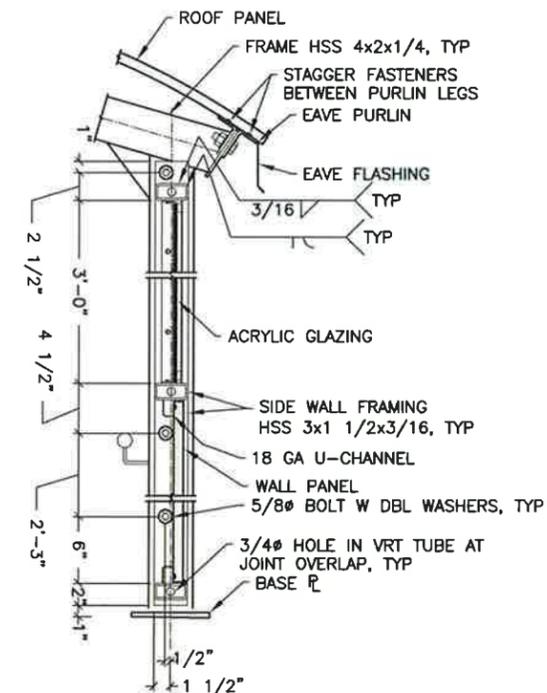


**SIDE WALL SECTION**

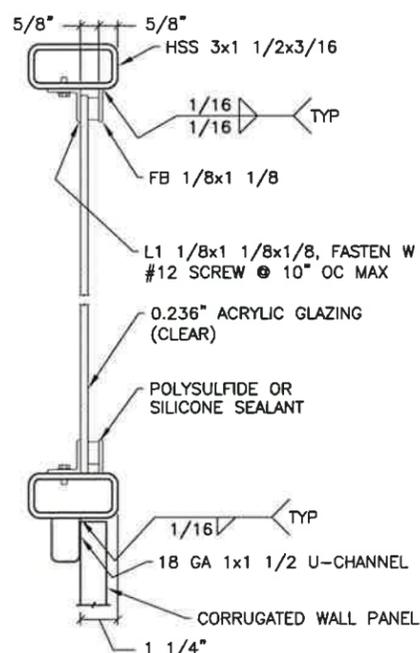


**ACRYLIC GLAZING DETAIL**

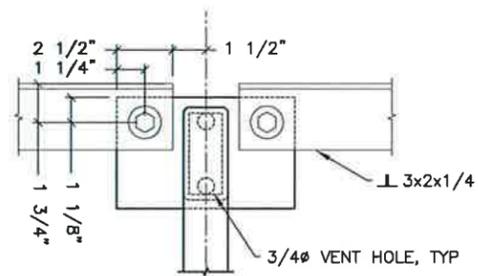


**SIDE ELEVATION**

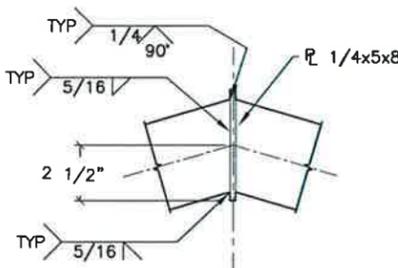

**FRONT ELEVATION**

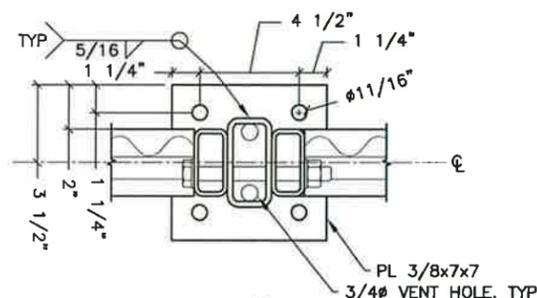


**SECTION**

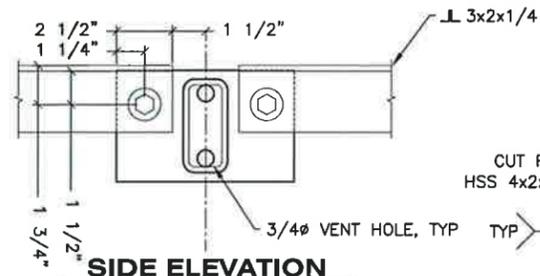

**SIDE ELEVATION**

**PEAK DETAIL**

**EAVE DETAIL**

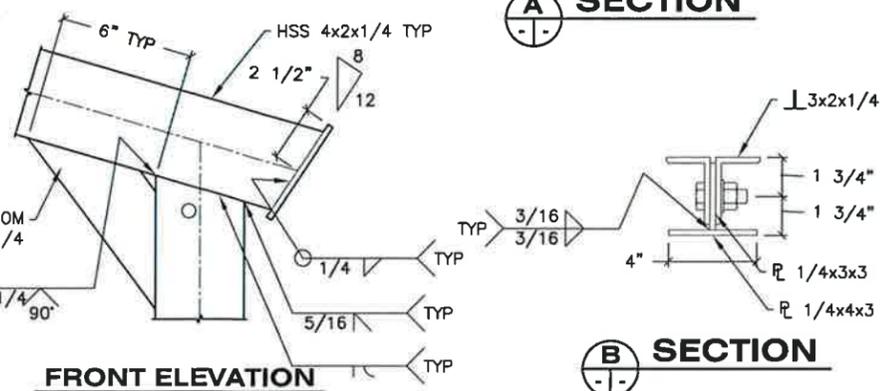

**FRONT ELEVATION**

**SECTION**


**NOTES:**

1. ROOF PANELS ARE 24 GA. 7/8" x 2 11/16" CORRUGATED STEEL SHEET METAL WITH 42 3/4" COVERAGE. MACHINE CURVE ROOF PANELS, DO NOT FORM IN THE FIELD.
2. WALL PANELS ARE 24 GA. 7/8" x 2 11/16" CORRUGATED STEEL SHEET METAL WITH 45 3/8" COVERAGE.
3. PANELS ROLLED FROM HOT DIP GALVANIZED SHEET METAL PER ASTM A653 - G90.
4. INSTALL USING GALVANIZED FASTENERS OF SIZE AND SPACING RECOMMENDED BY THE PANEL MANUFACTURER, BUT NOT LESS THAN:
  - PANEL TO PURLIN #12 - 5/16" HEX HEAD
  - PANEL TO 18 GA SUPPORTS #14 - 5/16" HEX HEAD
5. LENGTH MAY BE ADJUSTED TO MATCH PANEL LAYOUT.
6. SUBMIT SHOP DRAWINGS OF PANELS, TRIM, INSTALLATION LAYOUT AND FASTENER SCHEDULE FOR REVIEW.


DO NOT SCALE FROM THESE DRAWINGS USE DIMENSIONS

DESIGNED BY: D. LOWELL		STATE OF ALASKA DEPARTMENT OF TRANSPORTATION & PUBLIC FACILITIES SOUTHCOST REGION			
		<b>KETCHIKAN FERRY TERMINAL IMPROVEMENTS</b>			
		<b>247' COVERED WALKWAY</b>			
CHECKED BY: STAFF		PROJECT DESIGNATION		YEAR	TOTAL SHEETS
DRAWN BY: STAFF		SAMHS00015		2015	24
PATH: Q:\KTN\67466\PLANSET\MF\22-24 - COVERED WALK.DWG					
TAB: 24 Monday, October 26, 2015 3:25:27 PM					
NO.		DATE		DESCRIPTION	


Project As-Built Drawings have been reviewed by the Project Engineer and represent to the best of my knowledge the project as constructed.  
 Date 5.20.17  
 PE MF

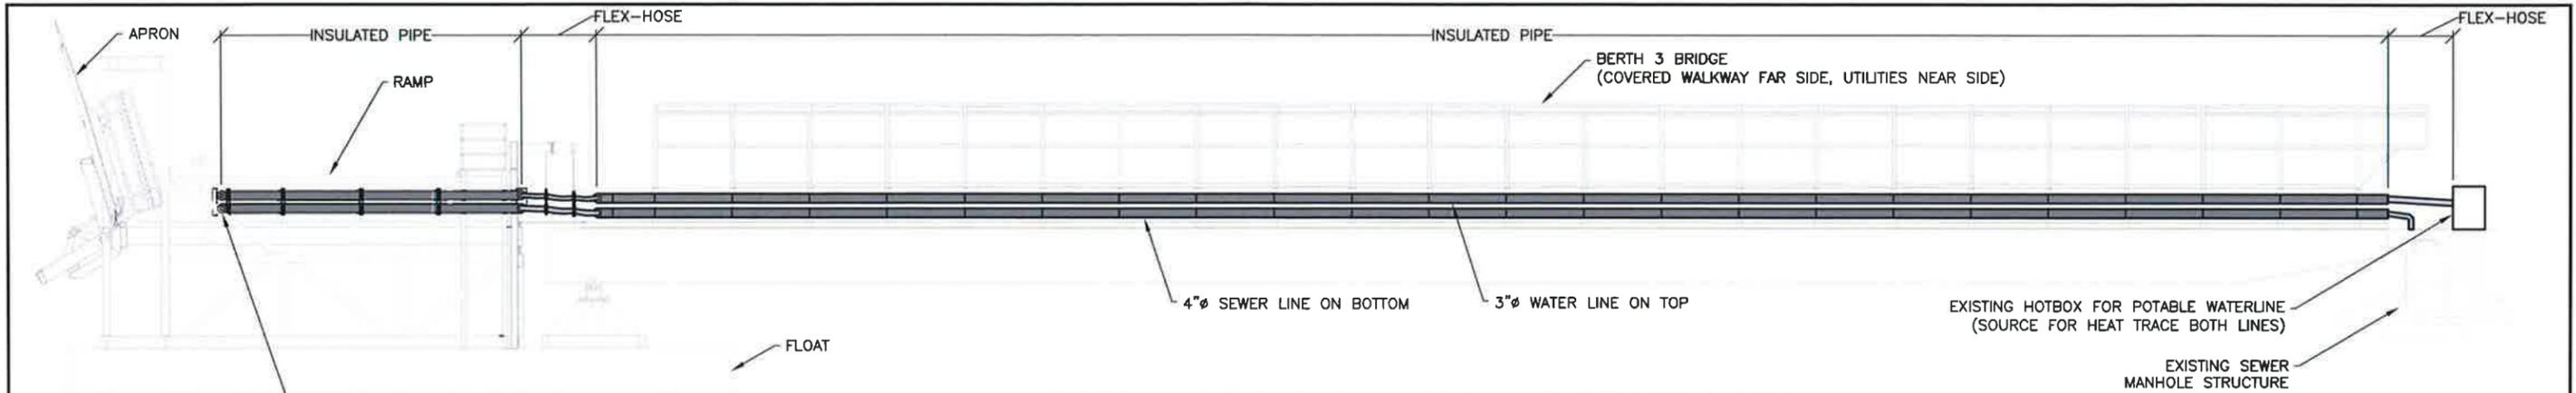

**BERTH 3 POTABLE WATER AND SEWER LINES  
ELEVATION**

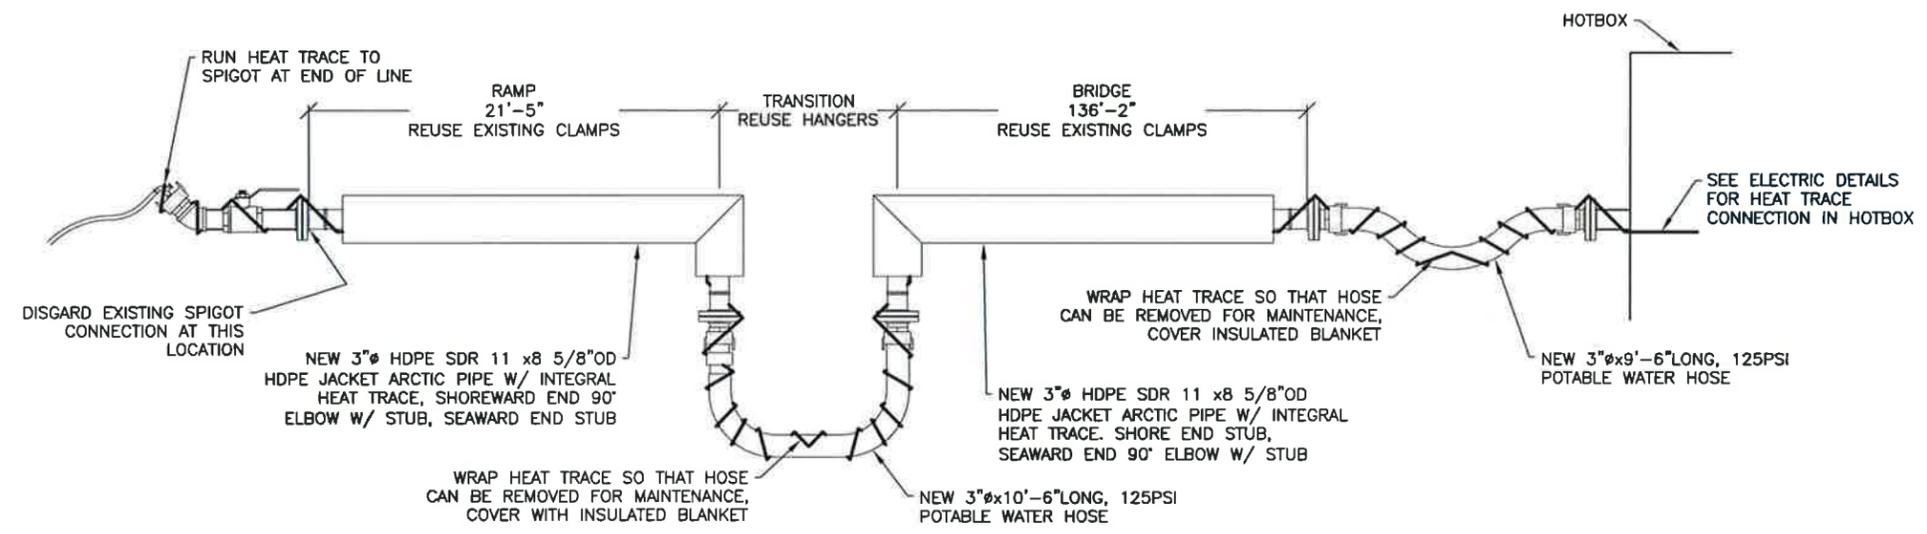

**POTABLE WATER  
SCHEMATIC**

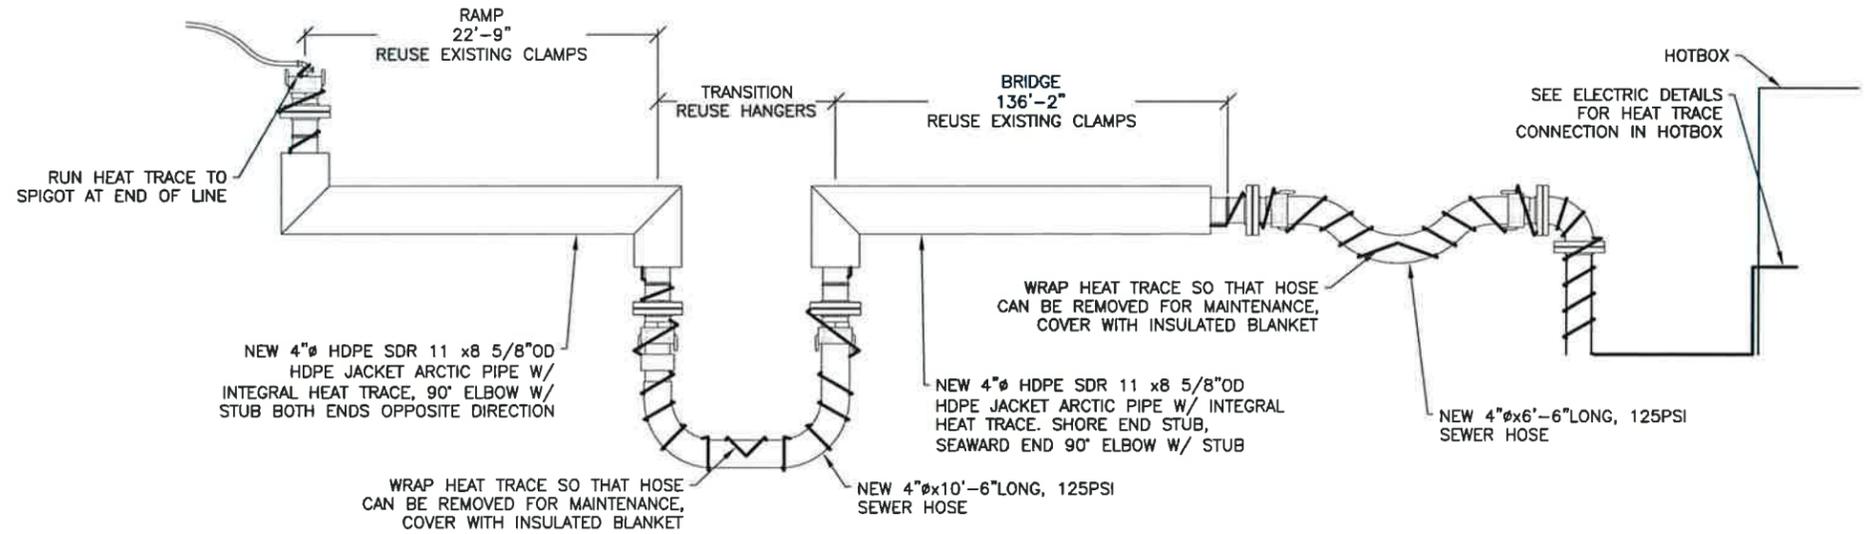

**SEWER  
SCHEMATIC**

REPLACE FLEX-HOSES, HOSE CLAMPS, INSULATED HDPE PIPE, AND REQ'D HDPE BUTT-FUSED STUBS. INSTALL NEW HEAT TRACE ON BOTH POTABLE WATER AND SEWER LINES FROM EXISTING HOTBOX ON SHORE TO END OF LINES AT SEAWARD END.

VERIFY COMPATIBILITY OF NEW LINES WITH SALVAGED HANGER CLAMPS.

SALVAGE AND REUSE EXISTING FLANGES, CAM-AND-GROOVE HOSE COUPLINGS AND CAPS, SWIVEL HOSE COUPLINGS, STEEL PIPE STUBS AND ELBOWS, VALVES, AND PIPE AND HOSE HANGER ASSEMBLIES.

SEE PHOTOS INCLUDED IN BID DOCUMENTS FOR AS-BUILT CONDITIONS.


DO NOT SCALE FROM THESE DRAWINGS USE DIMENSIONS

DESIGNED BY: D. LOWELL		STATE OF ALASKA DEPARTMENT OF TRANSPORTATION & PUBLIC FACILITIES SOUTHCOST REGION			
		<b>KETCHIKAN FERRY TERMINAL IMPROVEMENTS</b>			
CHECKED BY: STAFF		<b>UTILITIES</b>			
DRAWN BY: STAFF		10/26/15			
PATH: Q:\KTN\67466\PLANSSET\MF\25 - UTILITIES.DWG					
TAB: 25 Monday, October 26, 2015 3:27:31 PM					
REVISIONS		PROJECT DESIGNATION	YEAR	SHEET NO.	TOTAL SHEETS
NO.	DATE	DESCRIPTION			
			<b>SAMHS00015</b>	<b>2015</b>	<b>25</b>
				<b>25</b>	<b>28</b>


Project As-Built Drawings have been reviewed  
 by the Project Engineer and represent to the  
 best of my knowledge the project as  
 constructed.  
 Date 5-20-17  
 PE [Signature]

Project As-Built Drawings have been reviewed by the Project Engineer and represent to the best of my knowledge the project as constructed.


PE *MF* Date *5.20.17*

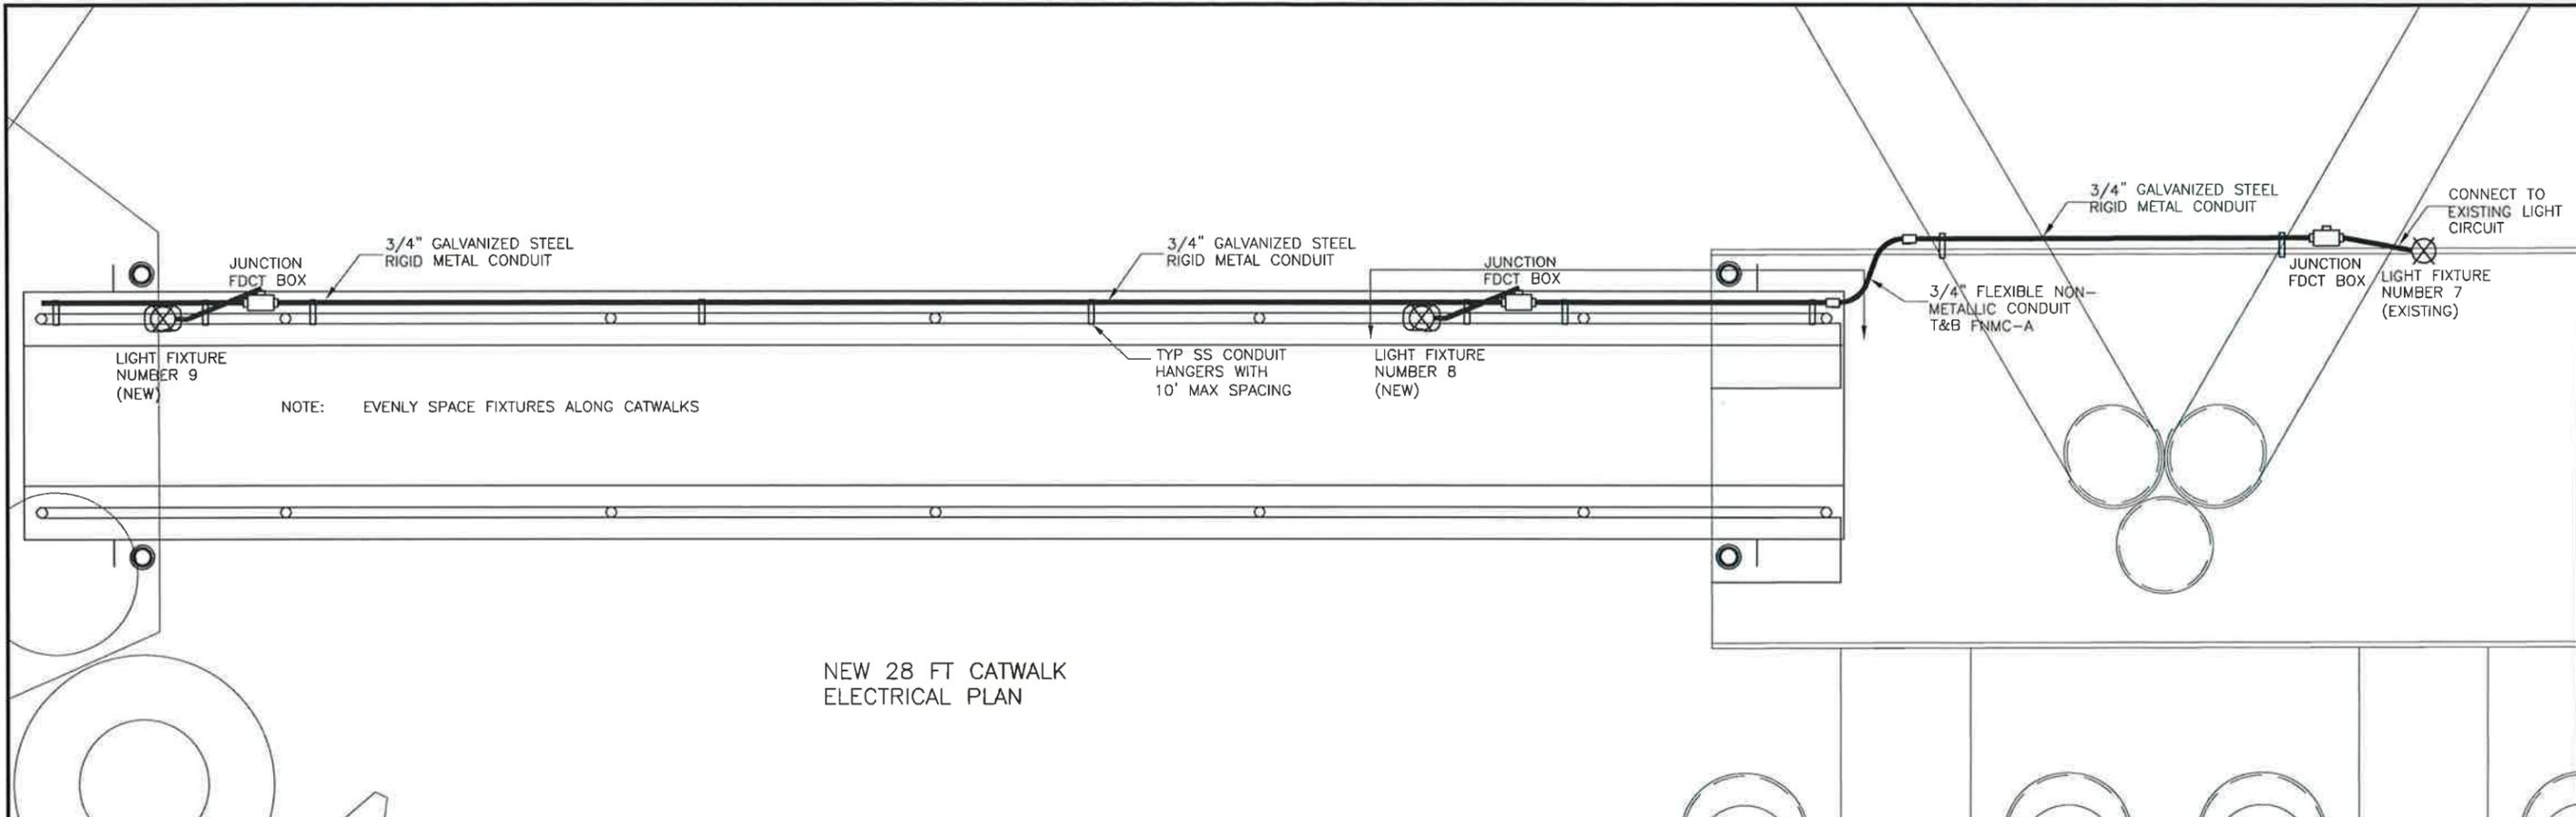


NEW 28 FT CATWALK ELECTRICAL PLAN

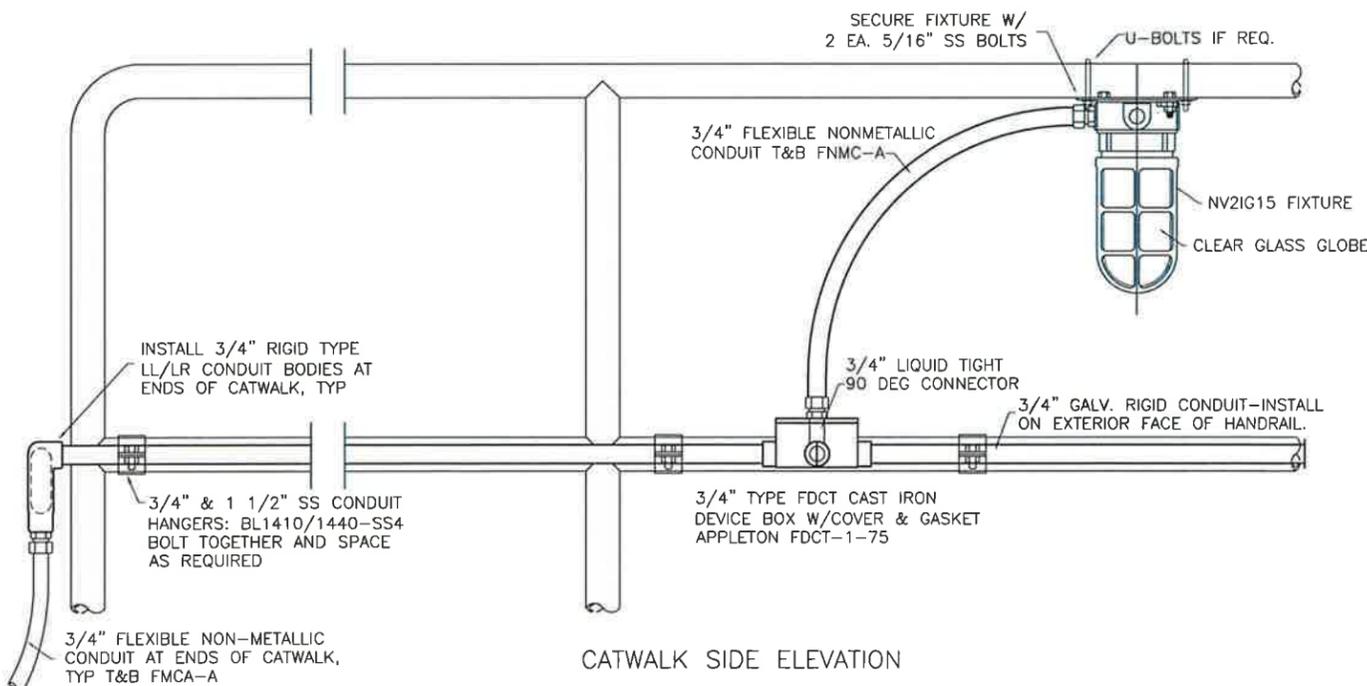


CATWALK SIDE ELEVATION

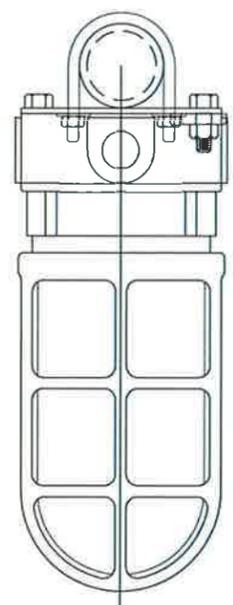

HUBBELL-KILLARK NV2IG15XSG NON-METALLIC CEILING LIGHT FIXTURE 13-26 W CFL BULBS

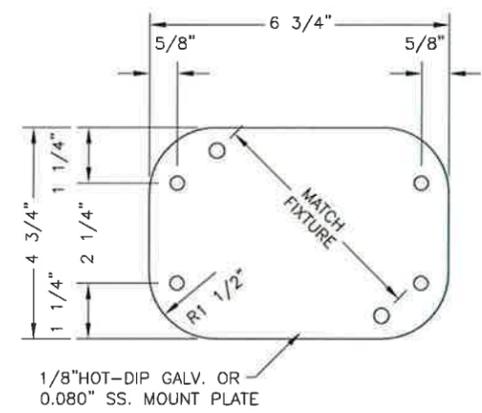


MOUNTING PLATE DETAIL

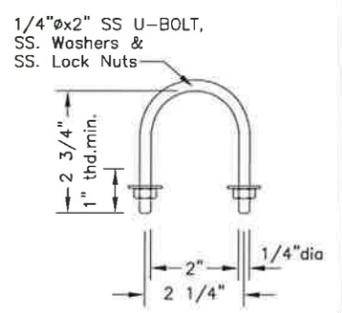


U-BOLT DETAIL TWO REQUIRED

DO NOT SCALE FROM THESE DRAWINGS USE DIMENSIONS


CHECKED BY: FMC		STATE OF ALASKA DEPARTMENT OF TRANSPORTATION & PUBLIC FACILITIES SOUTHCOST REGION	
		<p><b>MARINE KETCHIKAN FERRY TERMINAL IMPROVEMENTS</b></p> <p><b>ELECTRICAL PLANS</b></p>	
DRAWN BY: FMC		SHEET NO.: 28	TOTAL SHEETS: 28
PATH: C:\USERS\MIKEL\DOCUMENTS\KETCHIKAN FERRY TERMINAL\167466 KTN_ELECTRICAL_PLANS_28.DWG		PROJECT DESIGNATION: SAMHS00015	
TAB: 28 Monday, August 24, 2015 8:01:35 AM MIKE		YEAR: 2015	TOTAL SHEETS: 28
REVISIONS		YEAR: 2015	TOTAL SHEETS: 28
NO.	DATE	DESCRIPTION	

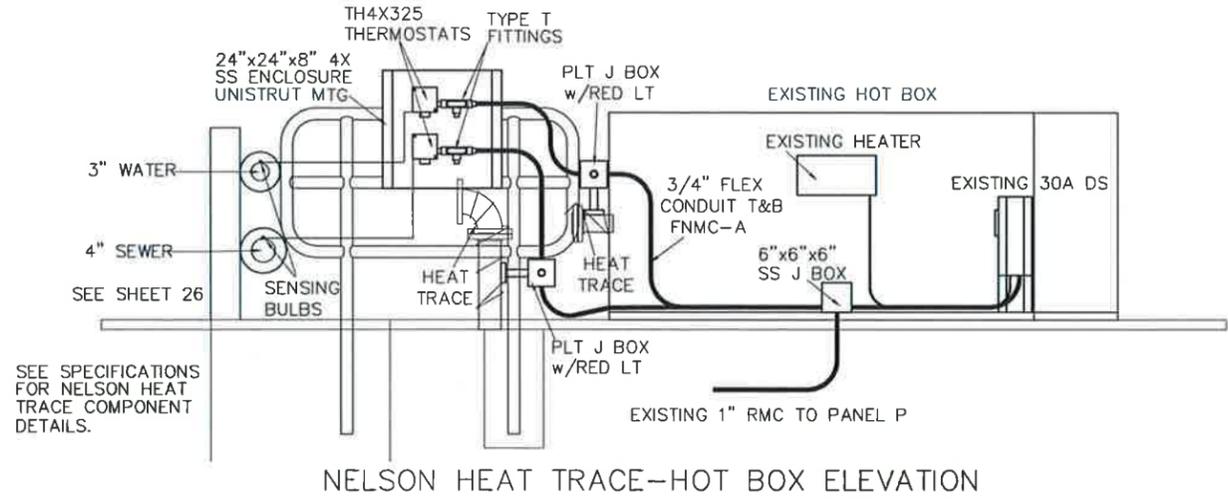

NELSON HEAT TRACE-HOT BOX ELEVATION

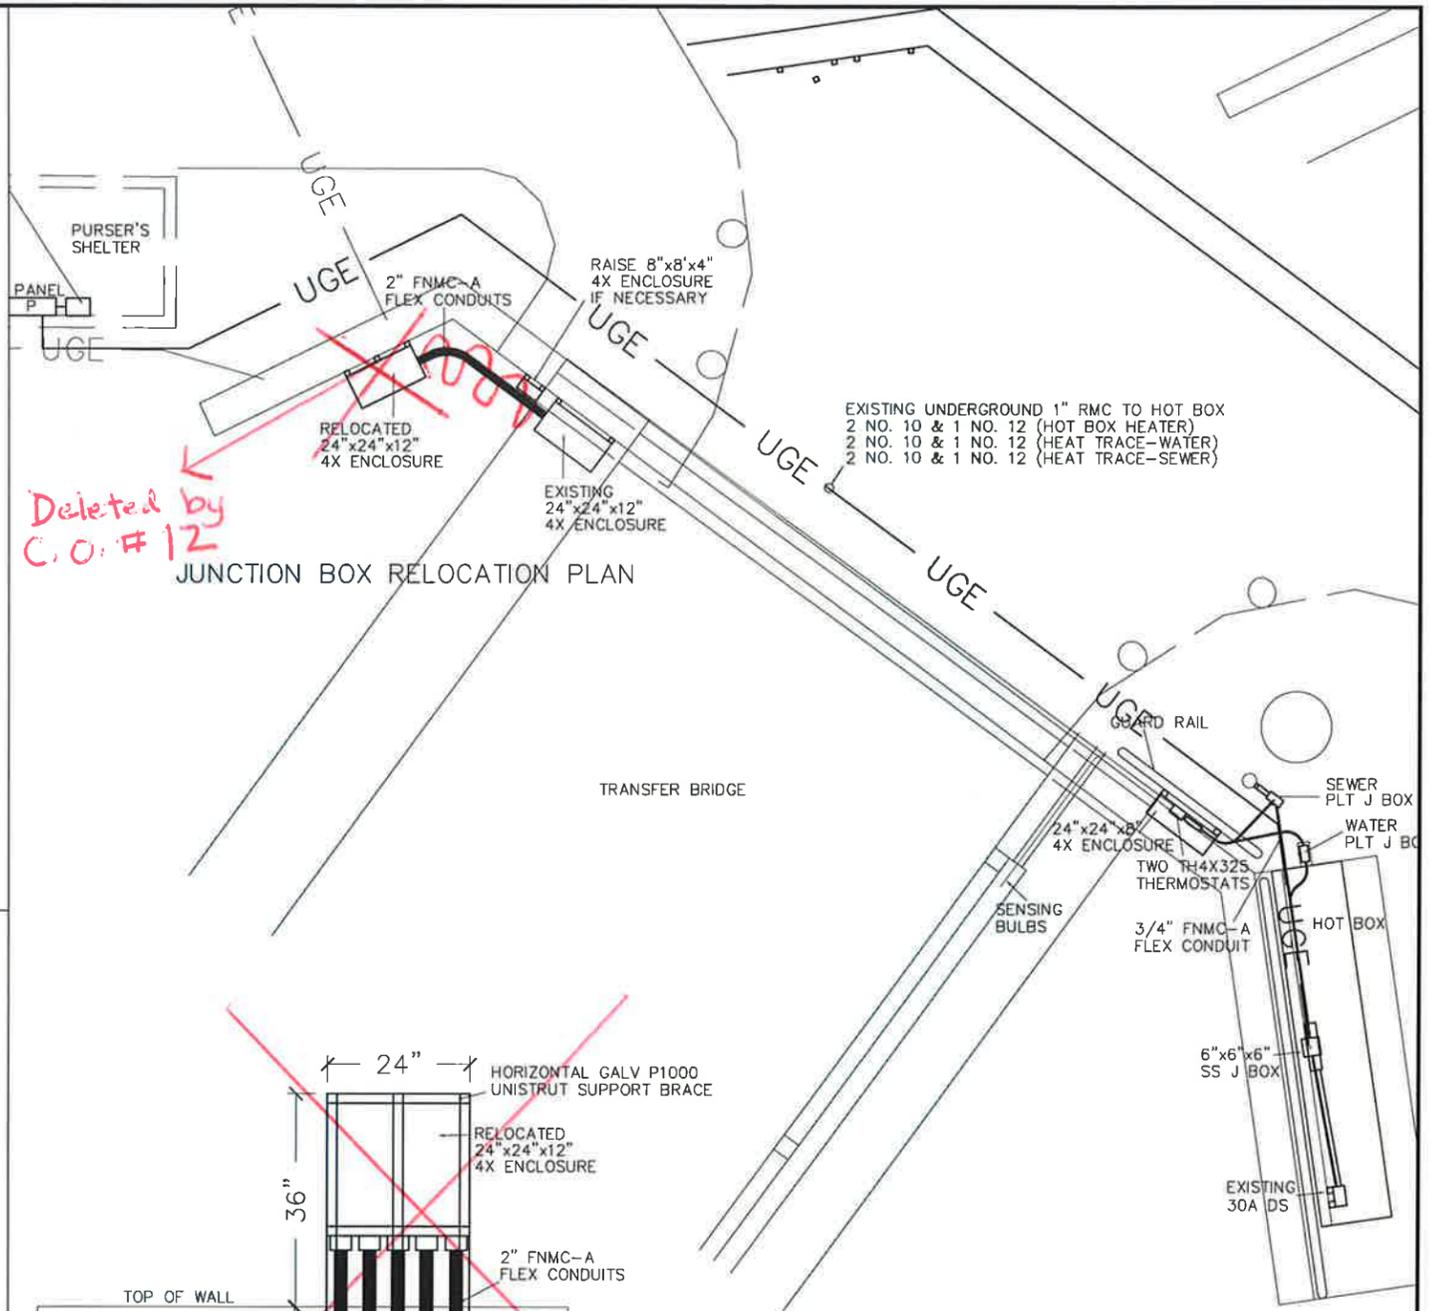


JUNCTION BOX RELOCATION PLAN

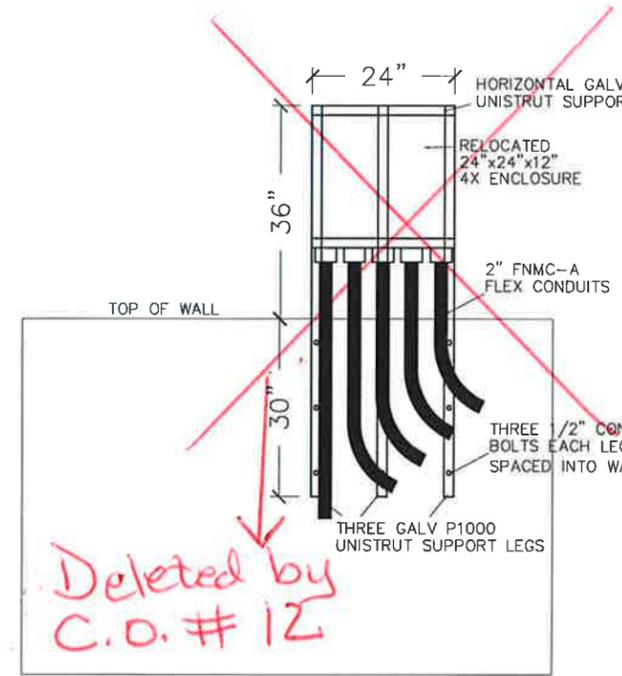

JUNCTION BOX RELOCATION ELEVATION

HEAT TRACE AND HOT BOX PLAN

PANEL P SCHEDULE													
VOLTAGE: 208/120 V 4 WIRE			KVA						TYPE: 225 A MAIN CKT BREAKER				
LOCATION: PURSER BLDG									MAIN: 100 A SPACES: 42				
CKT	WIRE	DESCRIPTION	CB	CKT	A PH	B PH	C PH	CKT	CB	DESCRIPTION	WIRE	CKT	
1	--	Bridge&Ramp Lts	20/2	0.6	1.2			0.6	20/1	Pursers Bldg Recs	--	2	
3	--	PE Cell Only	--	0.6		0.7		0.1	20/1	Pursers Bldg Lts	--	4	
5	--	Under Ramp Lts	20/2	0.1			1.4	1.3	20/2	2500W Unit Heater	--	6	
7	--	-----	--	0.1	1.4			1.3	--	-----	--	8	
9	--	Float Deck Lts	20/2	0.6		0.7		0.1	20/1	Telephone Board	--	10	
11	--	PE Cell Only	--	0.6			1.3	0.7	20/2	Heat Trace Water	2/#10	12	
13	--	Flt Water Safety Lts	20/2	0.5	1.2			0.7	--	GFI Circuit Breaker		14	
15	--	PE Cell Only	--	0.5		1.2		0.7	20/2	Heat Trace Sewer	2/#10	16	
17	--	Walkway Lts-PE Cell	20/1	0.2			0.9	0.7	--	GFI Circuit Breaker		18	
19	--	Bridge & Ramp Lts	20/2	0.6	1.2			0.6	20/1	Berth 3 Walkway A	2/#10	20	
21	--	PE Cell & Clock	--	0.6		1.2		0.6	20/1	Berth 3 Walkway B	2/#10	22	
23	--	Float Deck Lts	20/2	0.5			0.5	0.0	20/1	Unknown	2/#12	24	
25	--	PE Cell & Clock	--	0.5	0.5			0.0	--	-----	--	26	
27	--	Walkway Lts&Clock	20/1	0.4		0.4		0.0	--	-----	--	28	
29	2/#10	Hot Box	20/1	1.5			1.5	0.0	--	-----	--	30	
31	--	Purser Bldg Ext Rec	20/1	0.2	0.2			0.0	--	-----	--	32	
33	--	Spare	20/1	0.0		0.0		0.0	--	-----	--	34	
35	--	Spare	20/1	0.0			0.0	0.0	--	-----	--	36	
37	--	Spare	20/1	0.0	0.0			0.0	--	-----	--	38	
39	--	Spare	20/1	0.0		0.0		0.0	--	-----	--	40	
41	--	Spare	20/1	0.0			0.0	0.0	--	-----	--	42	
				TOTAL	5.7	4.2	5.6						

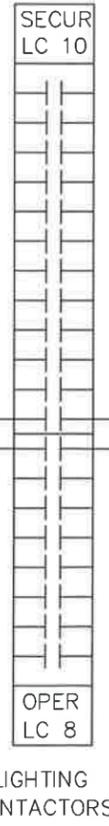


LIGHTING CONTACTORS


DO NOT SCALE FROM THESE DRAWINGS USE DIMENSIONS

CHECKED BY: FMC	STATE OF ALASKA DEPARTMENT OF TRANSPORTATION & PUBLIC FACILITIES SOUTHCOAST REGION
DESIGNED BY: FMC	MARINE KETCHIKAN FERRY TERMINAL IMPROVEMENTS
DRAWN BY: FMC	<b>ELECTRICAL PLANS</b>
PATH: C:\USERS\MIKE\DOCUMENTS\KETCHIKAN FERRY TERMINAL\67466 KTN_ELECTRICAL_PLANS_26-27.DWG	PROJECT DESIGNATION: SAMHS00015
TAB: 27 Monday, August 24, 2015 7:52:06 AM MIKE	YEAR: 2015
NO. DATE DESCRIPTION	SHEET NO. 27
	TOTAL SHEETS 28


Project As-Built Drawings have been reviewed by the Project Engineer and represent to the best of my knowledge the project as constructed.  
 PE [Signature] Date 5-20-17

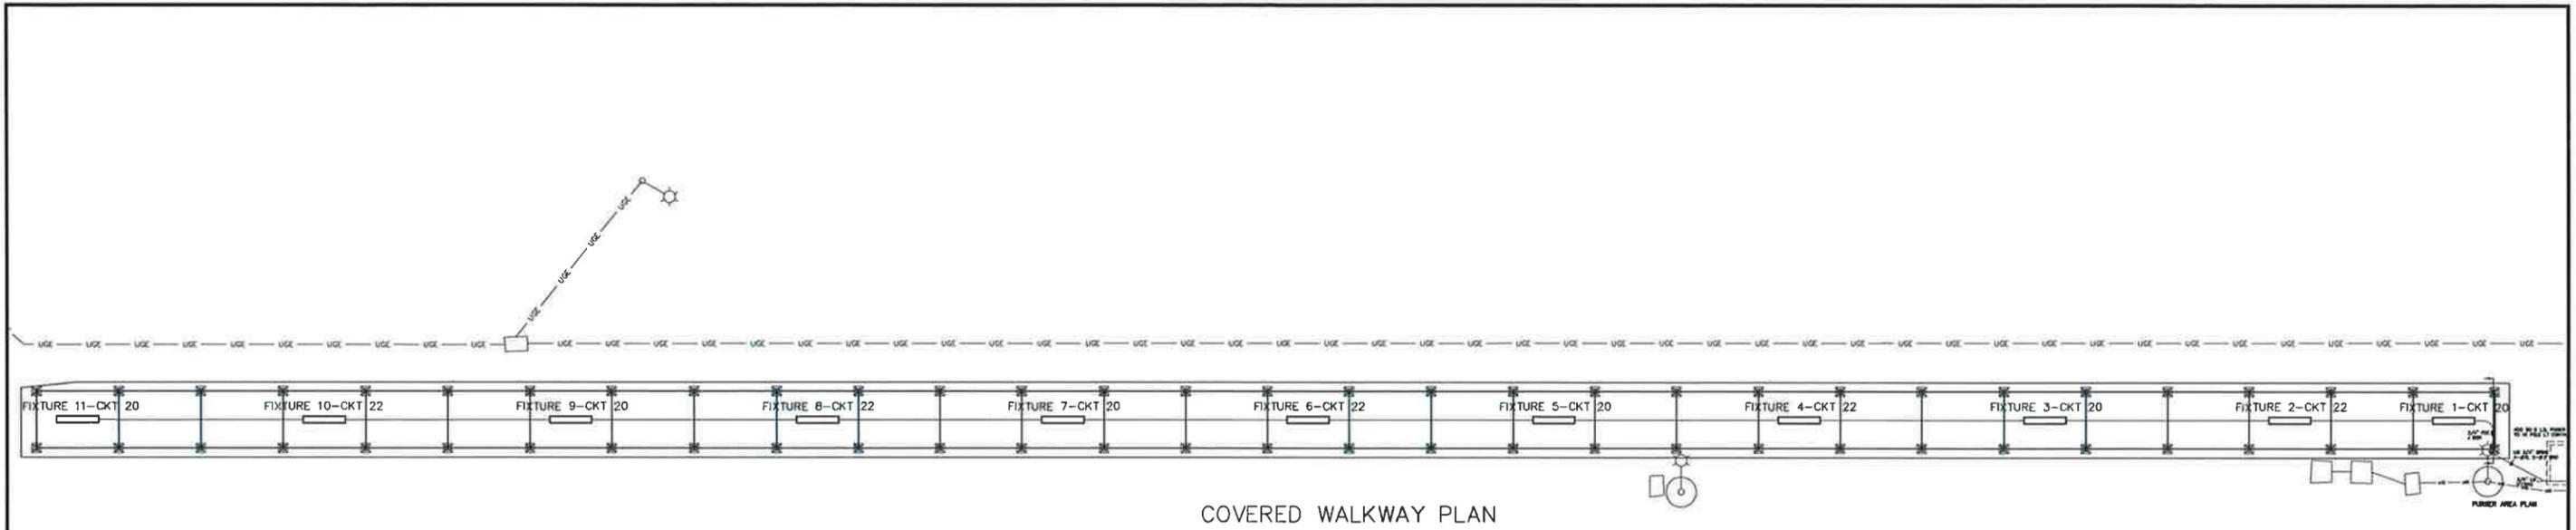


COVERED WALKWAY PLAN

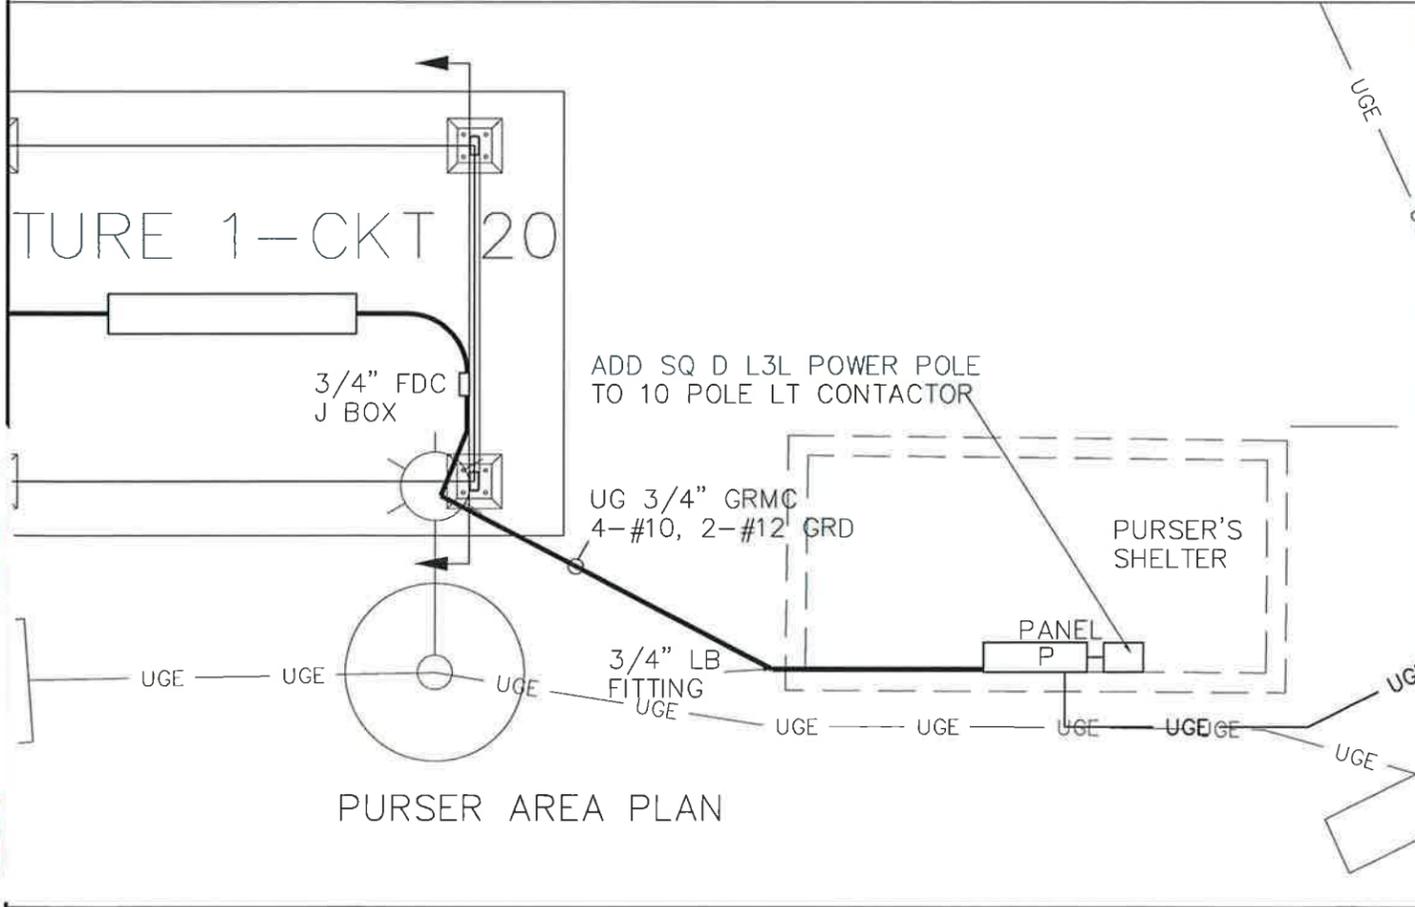

PURSER AREA PLAN

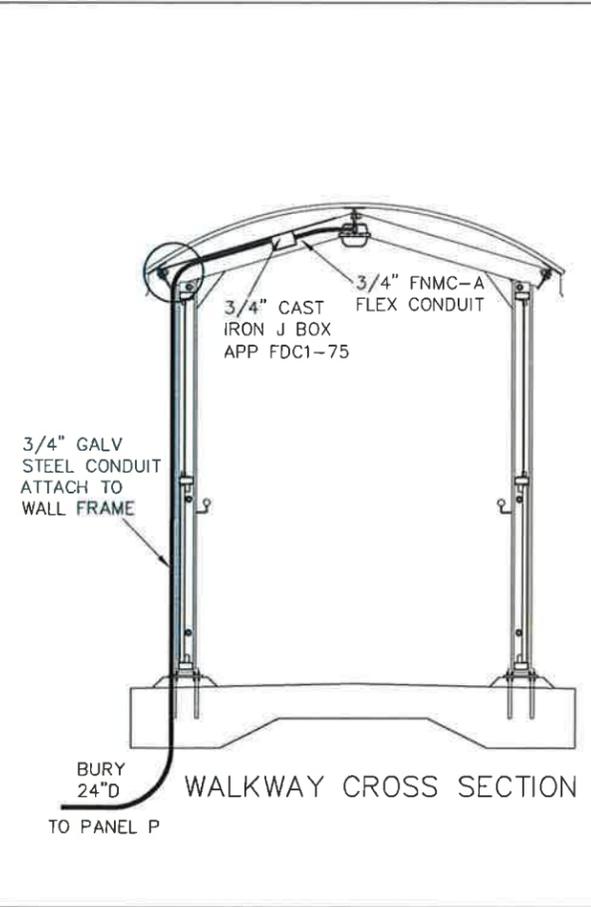

WALKWAY CROSS SECTION

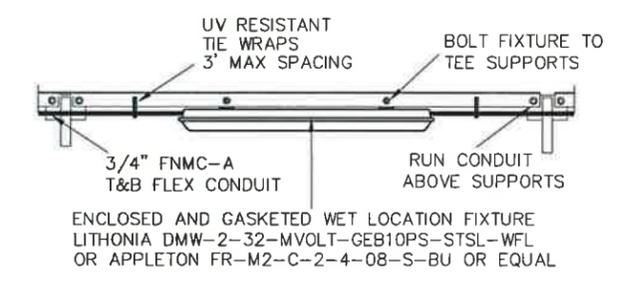

FIXTURE DETAIL

DO NOT SCALE FROM THESE DRAWINGS USE DIMENSIONS

CHECKED BY: FMC  DESIGNED BY: FMC DRAWN BY: FMC		STATE OF ALASKA DEPARTMENT OF TRANSPORTATION & PUBLIC FACILITIES SOUTHCOAST REGION				
<b>MARINE KETCHIKAN FERRY TERMINAL IMPROVEMENTS</b>						
<b>ELECTRICAL PLANS</b>						
PATH: C:\USERS\MIKE\DOCUMENTS\KETCHIKAN FERRY TERMINAL\67466 KTN_ELECTRICAL_PLANS_26-27.DWG TAB: 26 Monday, August 24, 2015 7:57:07 AM MIKE		PROJECT DESIGNATION <b>SAMHS00015</b>	YEAR <b>2015</b>	SHEET NO. <b>26</b>	TOTAL SHEETS <b>28</b>	
NO.	DATE	REVISIONS DESCRIPTION	PROJECT DESIGNATION	YEAR	SHEET NO.	TOTAL SHEETS

Project As-Built Drawings have been reviewed by the Project Engineer and represent to the best of my knowledge the project as constructed.  
 PE *MP* Date *5/20/17*

# G-46.11

## GENERAL NOTES

- Barriers may be used for temporary and permanent applications.
- Provide 36" unobstructed smooth deflection area behind barrier for unanchored applications. Provide 12" unobstructed smooth deflection area behind barrier for anchored applications.
- When anchored, install anchor pins on the side facing traffic. Precast barrier used as permanent median barrier in medians less than 8' in width shall be anchored to the roadway. When anchored in medians, install anchor pins on both sides of the barrier.
- Provide 2" clearance between all metal reinforcement and the nearest face of concrete unless otherwise shown.
- Normal use of precast barrier units is restricted to curvatures with radii greater than 770'.
- Use narrow base shoulder barrier only at locations with full height backfill or equivalent structural support placed behind barrier.
- When scuppers are not required plug them with a minimum 2" of grout.
- Concrete grout for grouting over pins, pinning holes or grouting of scuppers shall be a non-shrinking grout, weak in strength and of thick consistency.
- This precast concrete barrier is NCHRP 350 TL-3 approved.

REVISIONS		
Date	Description	By
4/28/10	Correct Dims, Note 1	KJS


Sheet 1 of 2

State of Alaska  
Department of Transportation  
& Public Facilities

**PRECAST CONCRETE  
"F" SHAPE BARRIER**

APPROVED

Date 5/31/12

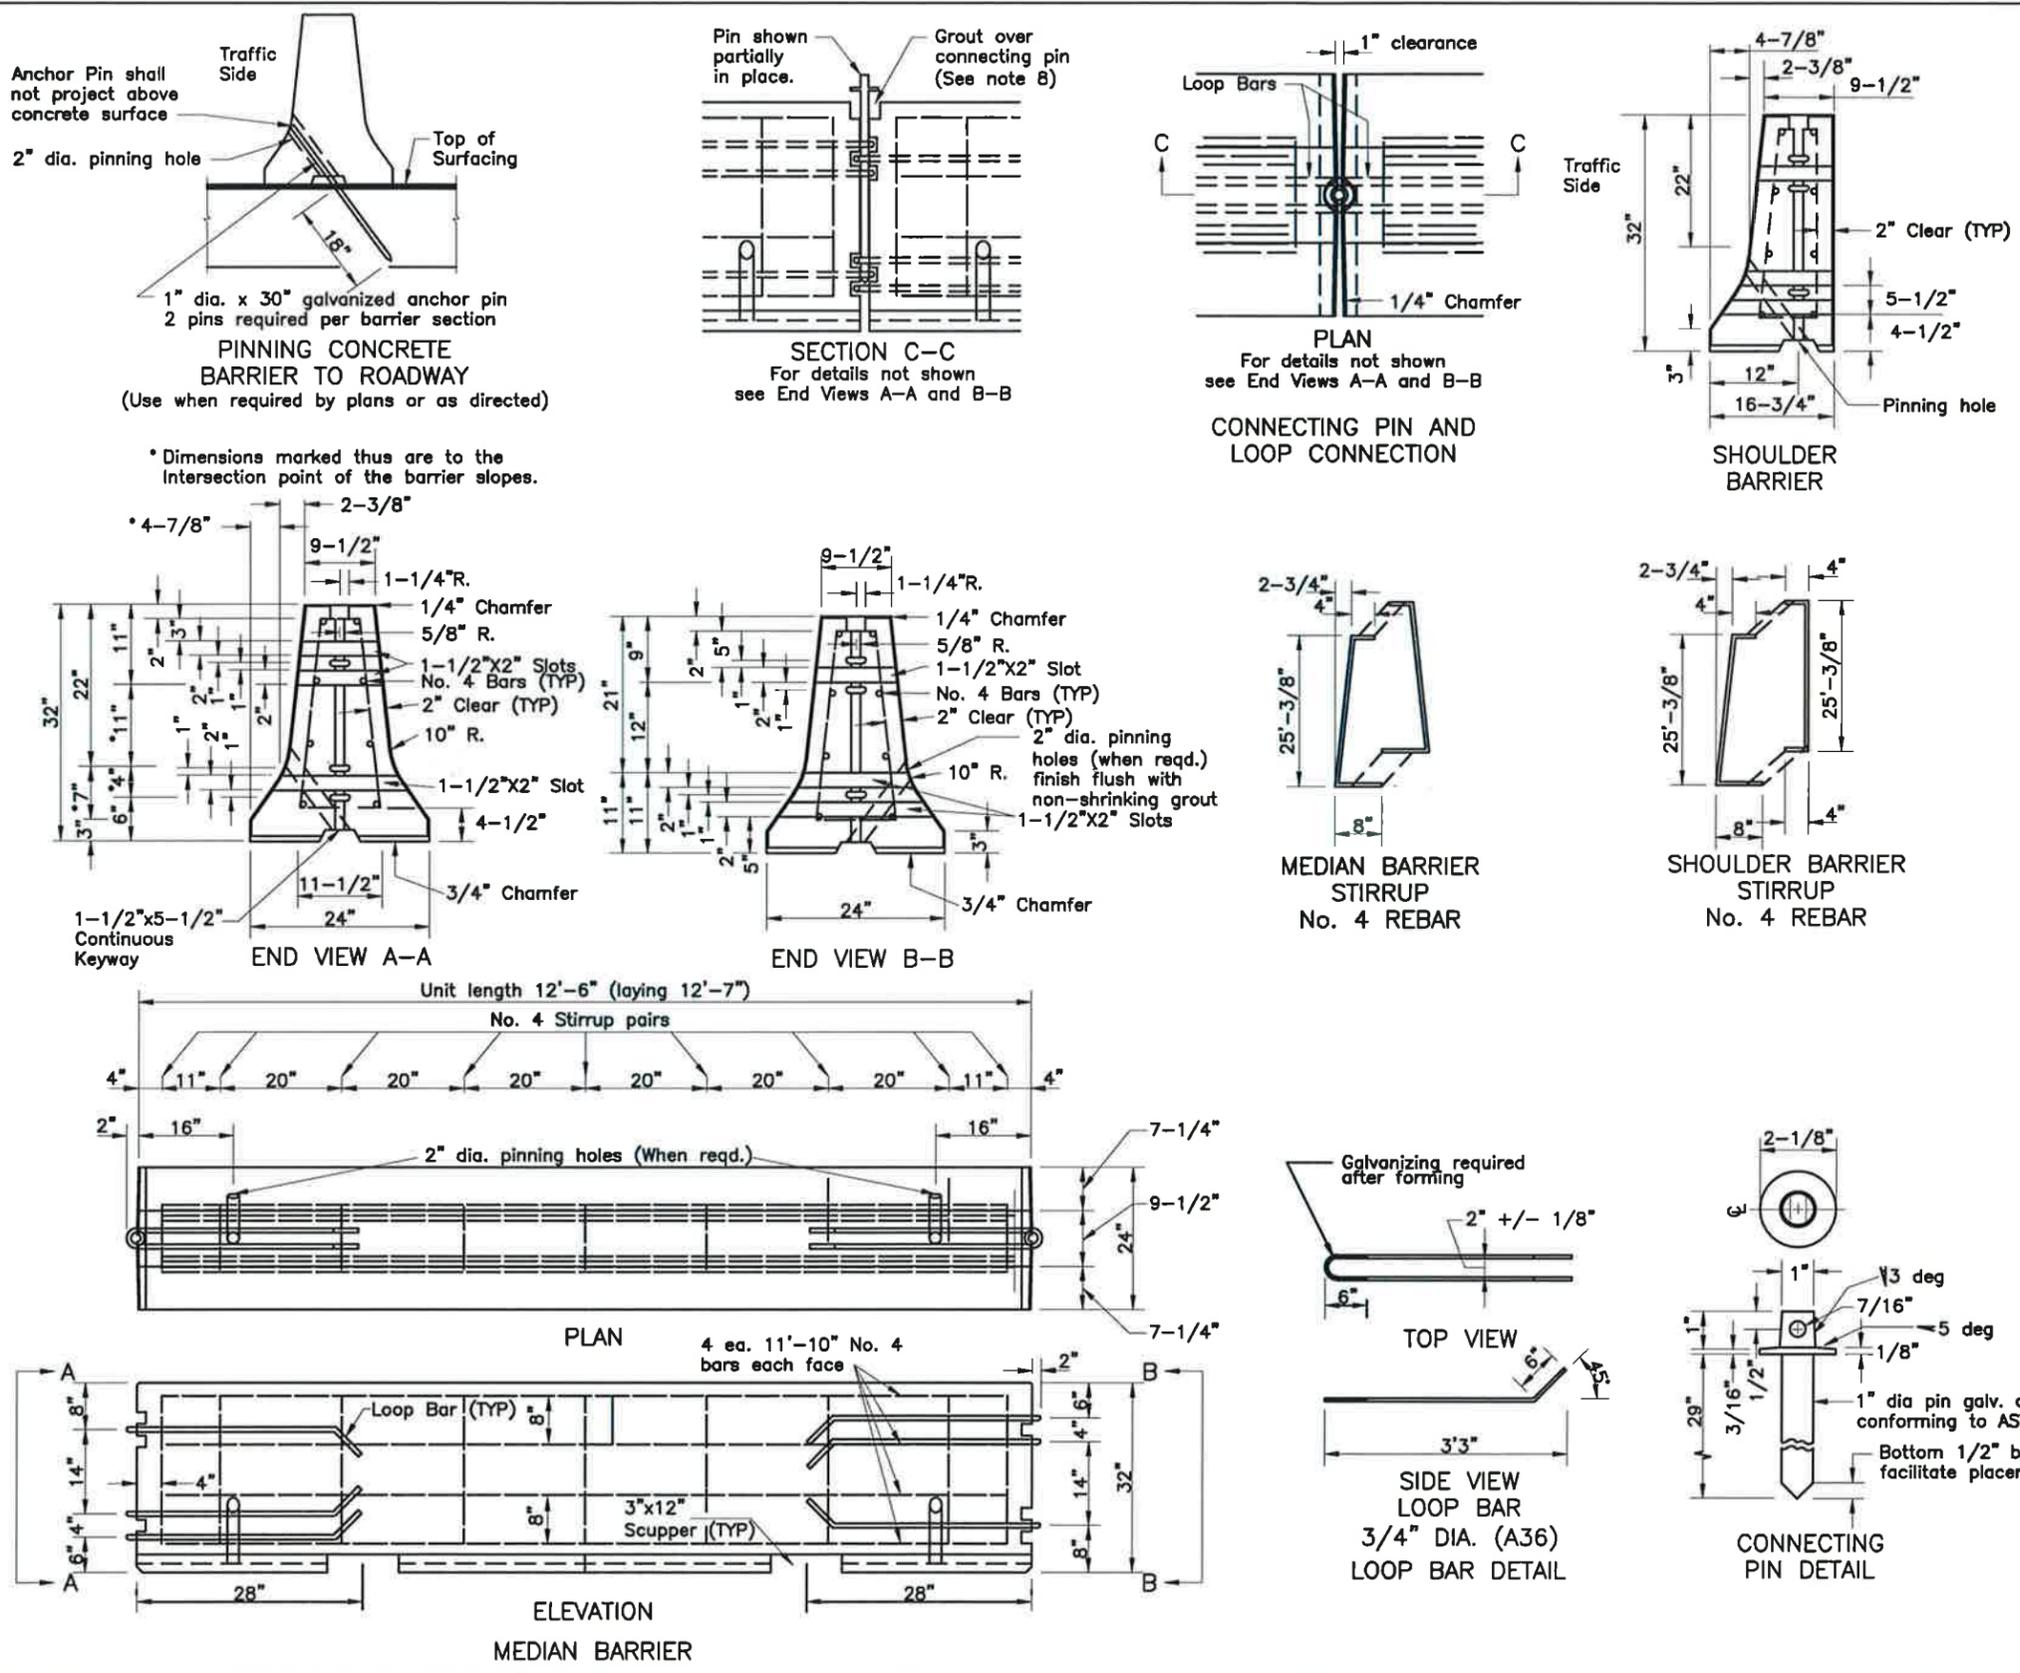

Project As-Built Drawings have been reviewed by the Project Engineer and represent to the best of my knowledge the project as constructed.








PE *MP* Date *5.20.17*

G-46.11 Sheet 1 of 2

# G-46.11

## GENERAL NOTES

- Use tapered end sections only where:
  - Barriers terminate outside the clear zone, or
  - The regulatory speed limit is 25 MPH or below, or 30 MPH if the Engineer determines NCHRP 350 or MASH compliant end treatments are unfeasible.
- Use air entrained concrete with minimum compressive strength of 3,000 p.s.i.
- Provide a minimum of two inches clear cover for reinforcing steel bars except as shown otherwise.
- Galvanize all exposed hardware in accordance with AASHTO M 232.
- Provide reinforcing steel bars conforming to AASHTO M 31-86, grade 60.
- Provide anchor pins conforming to AASHTO M 183 steel.
- Provide connecting pins conforming to AASHTO M 164-86.
- Provide four anchor pins per unit.

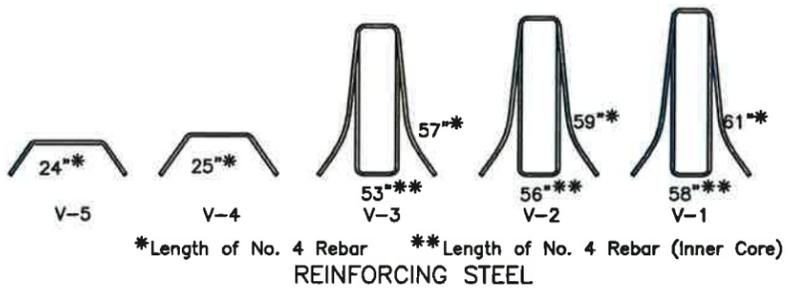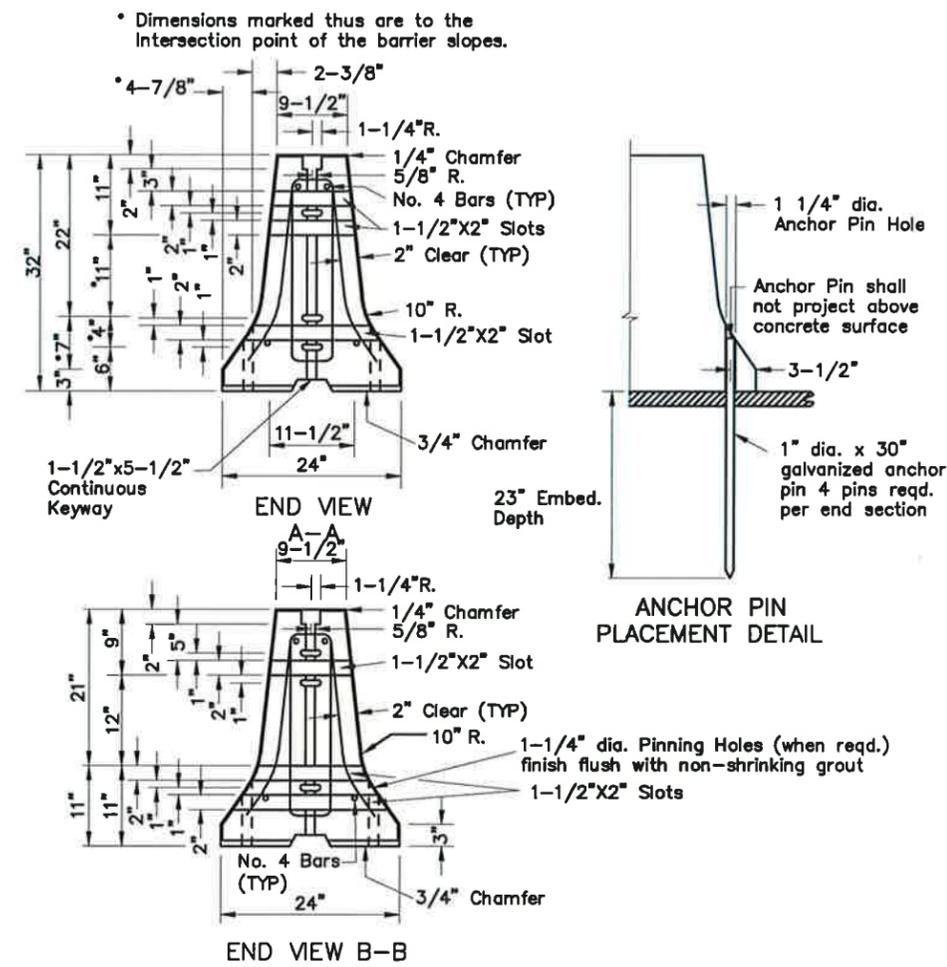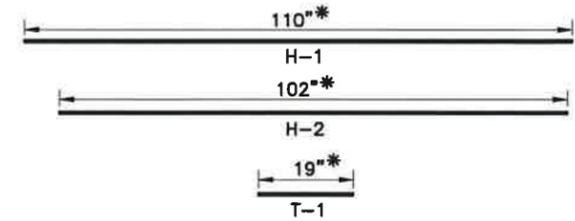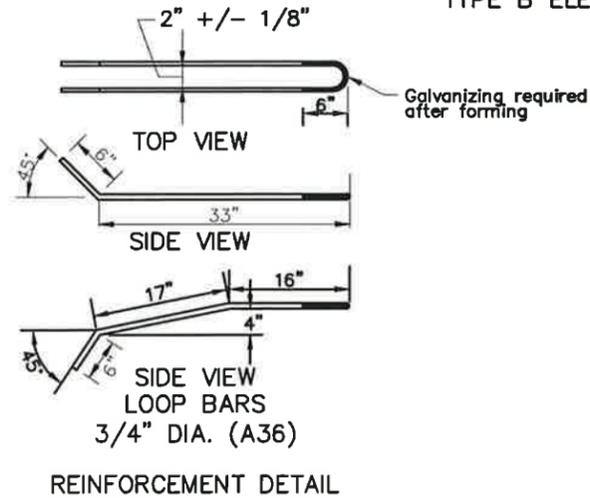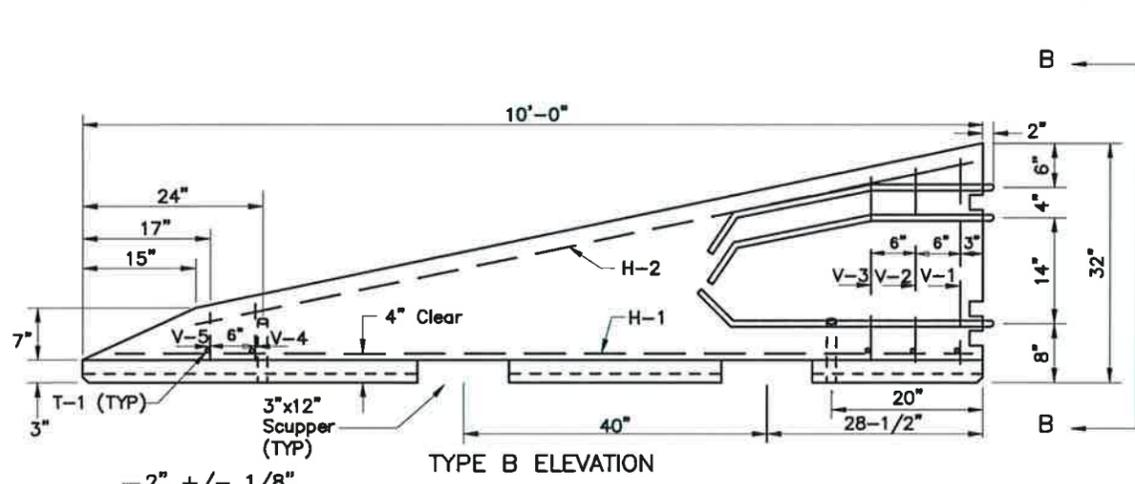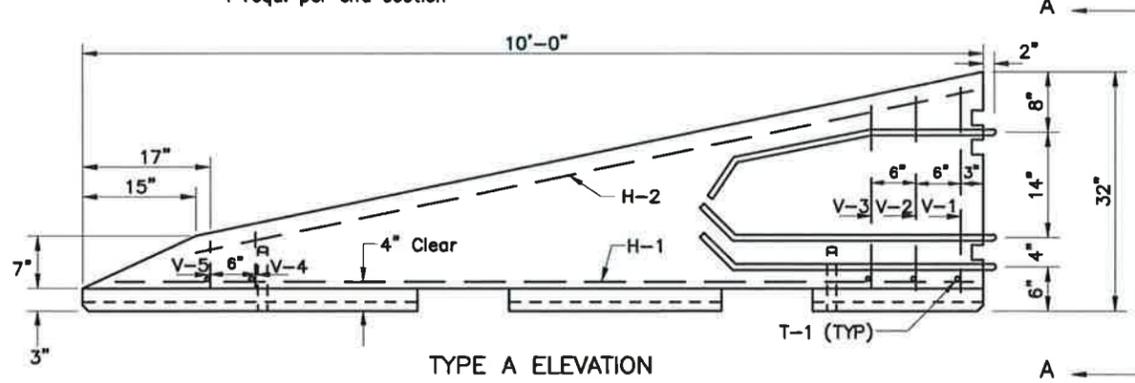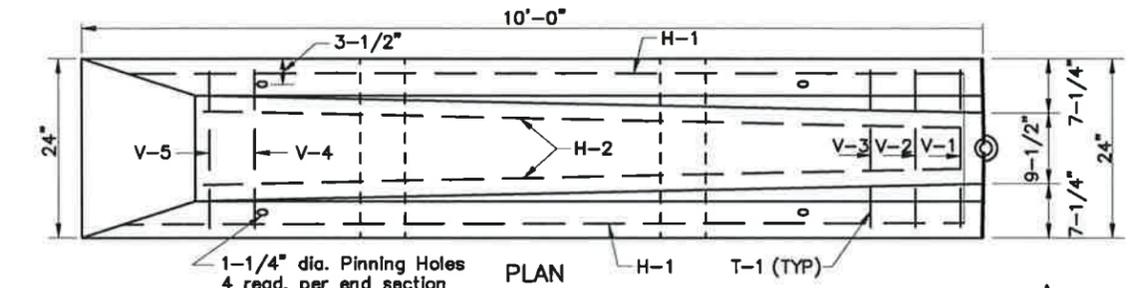

REVISIONS		
Date	Description	By
4/28/10	Correct dimensioning	KJS

Sheet 2 of 2

State of Alaska  
Department of Transportation  
& Public Facilities

**PRECAST CONCRETE  
"F" SHAPE BARRIER  
TAPERED END SECTION**

APPROVED

Date 5/31/12

Project As-Built Drawings have been reviewed by the Project Engineer and represent to the best of my knowledge the project as constructed.

PE *MP* Date *5.20.17*

G-46.11 Sheet 2 of 2