


SHIPREPAIR YARD
KETCHIKAN VESSEL MAINTENANCE FACILITY



PIER
NORTH WHARF

PROJECT NO. X70025
X 70010

AS-BUILT
 DECEMBER 1986

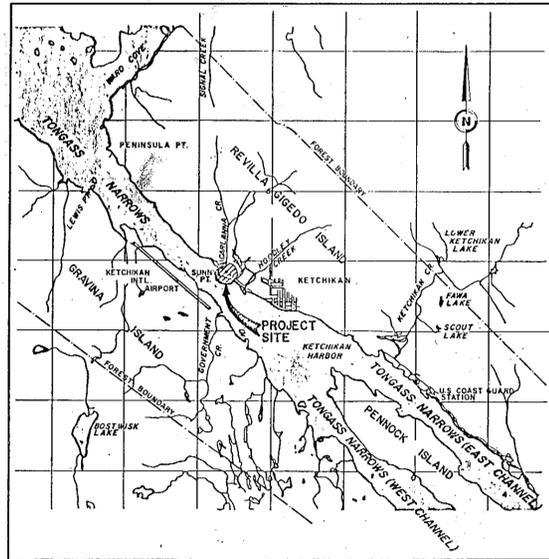

VICINITY MAP
 0 4 8 16 MILES

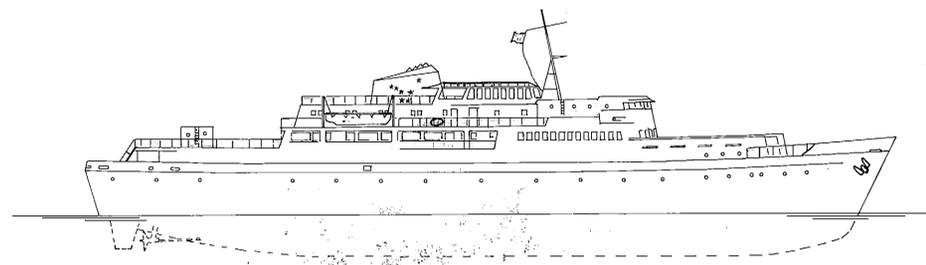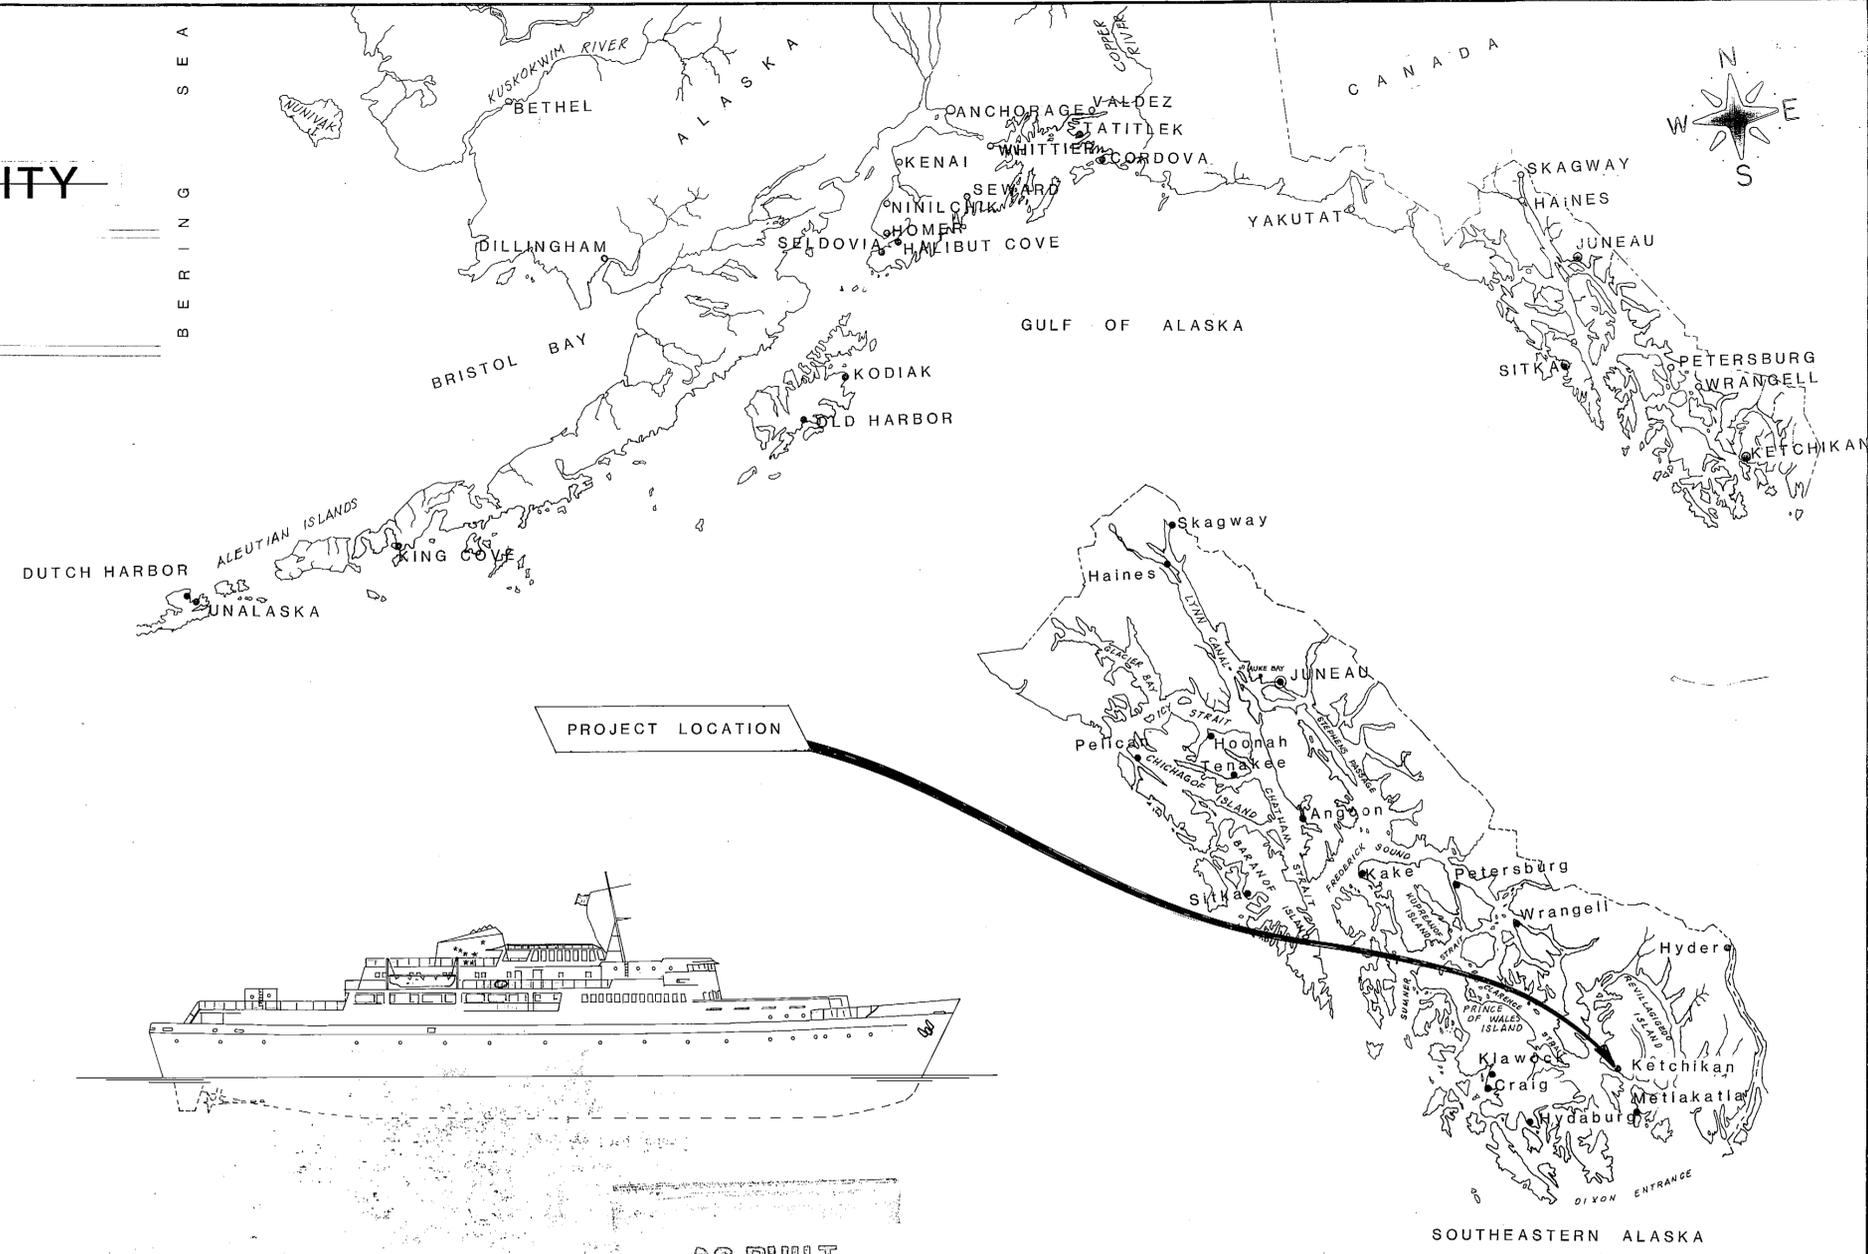

AS-BUILT
 Date: 12-86

INDEX TO SHEETS			
1	Title Sheet	23	Steel Superstructure (Alt. "B")
2	Quantities and General Notes	24	Glu-Lam Deck (Alternate "B")
3	General Layout		
4	Wharf Layout and Typ. Sections		
5	Pier Caps		
6	Pier Cap Details		
7	Wharf End Caps and Details		
8	Wharf Fender Sys. and Haws Rail		
9	Utility Channel Section		
10	Double Tee (Alternate "R")		
11	Cap Fill and Sheet Pile Removal Det.		
12	Existing Wharf Removal and Details		
13	Ex. Wharf Removal and Util. Tunnel		
14	Dolphin Plan and Elevations		
15	Dolphin Cap Details		
16	Dolphin Fender Details		
17	Drydock Dolphin		
18	Waterline Relocation		
19	Mooring Dolphin and Fuel Line Relocation		
20/22	Existing Cathodic Protect. System		

STATE
 OF
 ALASKA

DEPARTMENT OF TRANSPORTATION & PUBLIC FACILITIES

MARINE FACILITIES

APPROVED

 DIRECTOR
 Recommend For Approval Group Design Chief
 Sheet 1 of 24

ESTIMATE OF QUANTITIES

Item No.	Item	Pay Unit	Est. Quan.	Unit	Total
201(1)	Removal of Test Pile	L.S.	All Reg'd	L.S.	All Reg'd
" (2)	Relocate and Lengthen Waterline	L.S.	"	L.S.	"
" (3)	Relocate Fuel Dock	L.S.	"	L.S.	"
" (4)	Relocate CP System Components	L.S.	"	L.S.	"
" (5)	Removal of Portion of Existing Wharf	L.S.	"	L.S.	"
202	Excavation	L.S.	15,000	C.Y.	15,000 (APPROX.)
301(1)	24" x 1/2" Wall Steel Pipe Piles, Furnished	L.F.	9902	L.F.	9902 7315
" (2)	30" x 3/8" " " " " " "	L.F.	9341	L.F.	9341 4348.5
" (3)	42" x 1/2" " " " " " "	L.F.	2116	L.F.	2116 1050.5
" (4)	24" x 1/2" " " " " " Driven	Ea.	53	Ea.	53
" (5)	30" x 3/8" " " " " " "	Ea.	48	Ea.	48
" (6)	42" x 1/2" " " " " " "	Ea.	10	Ea.	10
" (7)	24" x 1/2" Wall Pipe Transfer Bridge Piles	L.S.	All Reg'd	L.S.	All Reg'd
" (8)	Timber Piles, Furnished	L.F.	11,400	L.F.	11,400 11,477.2
" (9)	Timber Piles, Driven	Ea.	138	Ea.	138
302(1)	Pier End Dolphin and Fender System	L.S.	All Reg'd	L.S.	All Reg'd
" (2)	Drydock Dolphins	L.S.	"	L.S.	"
" (3)	Utility Tunnel	L.S.	"	L.S.	"
" (4)	Wharf Fender System and House Rail	L.S.	"	L.S.	"
302(5)	Steel Superstructure (Alternate "B")	L.S.	"	L.S.	NOT USED
304(1)	Wharf Pier Caps and Weldments	L.S.	All Reg'd	L.S.	All Reg'd
" (2)	Utility Channel	L.S.	"	L.S.	"
" (3)	Transfer Bridge Abut., Apron and Pier Cap	L.S.	"	L.S.	"
305	Double Tees (Alternate "A")	L.S.	All Reg'd	L.S.	All Reg'd
306	Glu-Lam Deck (Alternate "B")	"	"	"	NOT USED
109	DBE/WBE Adjustment	C.S.	"	C.S.	-0-

- ① Includes sand fill* and approx. 196 cu yd of Class A-A concrete fill.
- ② Includes 602 cu yd of Class A-A concrete fill, also includes exc. of piles within cells.
- ③ See Tech. Specs. Section 301. Contractor to furnish and drive 8 piles of 200 ft. max. length each.
- ④ See Tech. Specs. Section 30A. Contractor to cast 50 cu yd max class A-A concrete, includes reinforcement sheet pile arc removal, excavation and backfill.
- * Sand fill to come from excavation ie; no screening or crushing req'd.

Location / Orientation	Dia. (in.)	Capacity (tons)		Tip Elevations		Cutoff Elev.
		Bearing	Uplift	Min.	Est.	
Dolphin / Vertical	24	100	67	-67	-175	+24.00
" / Batter	24	50	50	-67	-175	+30.00
" / Fender	24	-	-	-52	-52	+24.00
Drydock Dolphin / Vert.	42	100	700	-67	-175	+18.00
" / Batter	42	220	50	-67	-175	+18.00
Wharf / Vertical (Rear)	30	120	-	-67	-175	+19.60
" / " (Center)	30	160	-	-67	-175	+19.60
" / " (Front)	24	120	120	-67	-175	+12.50
" / Batter (")	24	100	80	-67	-175	+18.43
Wharf Fender / Vertical	⑥	-	-	-55	-55	⑥

- ① Drive closed ended NOTE: ALL CLOSED ENDED PILES CLOSED WITH 3/4" PLATE
- ② Drive open ended w/ APE 0-1A001 reinforcement on tips
- ③ Drive closed ended and sand fill to elev. -57, reinforced concrete fill above elev. -57. Except piles within sheet pile cells, drive open ended and clean out to elev. -10 and reinforced concrete fill.
- ④ Sandfill to elev. -57, reinforced concrete fill above elev. -57.
- ⑤ 18" min. butt.
- ⑥ El. +30.00 or El. +25.00, See Sheets A and B
- ⑦ DRIVE OPEN ENDED WITH REINFORCED TIPS PER PLAN SHEET 14 DETAIL

GENERAL NOTES

Specifications:

Construction: Per Contract Documents for KVMF North Wharf, Project No. X70010.
Design: Wharf and Dolphin Fender Systems per Marine Facilities Design Standards.

Drydock Dolphins per Project No. X70024 Drwg. No. S 2120-3. Mooring spud design loads.

Transfer Bridge Abutment and Pier per Marine Facilities Design Standards.

Design Loads:

Wharf: DL + 600 psf LL or + Design Vehicle :
Design Vehicle moving: Max GVW = 250,000#, Max. load on Tridem = 220,000#, min. axle spacing = 4' - 6", max. tire pressure = 75 psi.
Design Vehicle Lifting: Outriggers within 2 ft. either side of centerline of pier caps on 3 ft. square dunnage pad = 170,000# maximum, Max. Live Load per one pier cap = 220,000#. Berthing energy from Fender System Bollard - 50 kip Line Load.

Utility Channel Section: DL Util. + 60 psf on walkway.
Utility Ped. Walkway (Planks): 60 psf

Wharf Fender System: 20 ft. - kips Service
40 ft. - kips Overload

Pier End Dolphin and Fender System:
30 ft. - kips Service
70 ft. - kips Overload

Drydock Dolphins: Per Project No. X70024 Drwg. No. S 2120-3, Crandall Drydock Engineers Mooring Loads.

Transfer Bridge Abutment and Pier: DL (per Drydock manufacturers supplied structure) LL - AASHTO HS-20 (Max. DL or DL + LL for Pier and Abutment = 400 Tons) (See Tech. Spec's Section 301 and 304).

Design Unit Stresses:

Steel: A36 F_y = 20 Ksi
A252 Gr. 2 F_y = 19.25 Ksi
A500 Gr. B F_y = 25 Ksi
A572 F_y = 27 Ksi

Concrete:

Class A-A f'c @ 28 days = 5.0 Ksi
Prestressed f'c @ 28 days = 6.0 Ksi

Reinforcing Steel: F_y = 60 Ksi
Glu-Lam Timber: Comb 2 Web Use F_b = 1.4 Ksi
Sawn Timber: Wet Use F_b = 0.8 Ksi
Ekki Timber: F_b = 3.6 Ksi
F_v = 0.3 Ksi

Materials:

Steel: Tube Sections A500 Gr. B
Pipe A252 Gr. 2, A501 or A53, br. B, type E or S
Pipe A53, Gr. B, type E or S
All other shall be A36 or A572 as noted.

Concrete: Class A-A except prestressed concrete per Tech. Spec. Section 305.

Reinforcing Steel: A615 Gr. 60
Timber: Glu-Lam: Douglas Fir/Larch Comb 2 Wet Adhesives
Sawn: No. 1 Douglas Fir/Larch
Fender Faces on Pier End Dolphin: Ekki

Protective Coatings/Treatments:

Pipe Piles and Structural steel and Hardware: Galvanize after fabrication.
Pier End Fender Timbers: Untreated Ekki
Wharf Fender Timbers: Creo. 12 PCF retention
Wharf Fender Piles: Creo. 17 PCF retention
Utility Ped. Timbers: Penta (in light oil) 0.6 pcf retention.
Glu-Lam Decking: Penta (in light oil) 0.6 pcf retention
Reinforcing Steel: Galvanize after fabrication or epoxy coated.
Hardware: Galvanize unless otherwise noted.

Piling:

Size: 24" Ø x 1/2" Wall Steel Pipe and
30" Ø x 3/8" Wall Steel Pipe and
42" Ø x 1/2" Wall Steel Pipe and
18" min. Ø butt timber piles.

For Filling and Excavation and Filling, Driving Requirements, tip reinforcement and Elevations, See Pile Table this sheet.

1/2" typ.
1" typ to lettering
5/4" wide border

**LOAD LIMITS
NORTH WHARF**

Moving Vehicle: Max. triple tandem axle load = 220,000 lbs
Max. GVW = 250,000 lbs
Min. tandem axle spacing = 4'-6"
Max. Tire press. @ Max. load = 75 psi

Lifting Vehicle: Min. dunnage pad 3 ft. square
Max. Outrigger load = 170,000 lbs.
Max. live load on one pier cap = 220,000 lbs.
Centerline of outriggers and dunnage to be within 2 ft. of centerline pier cap.

Uniform Load: In lieu of Design Vehicles above Wharf may be loaded uniformly to 600 psf, except Walkway planks max. load of 60 psf.

Loads or positions of loads not within above parameters will require approval, prior to use of Wharf by Alaska Marine Highway System at (907)-465-2740.


Contractor shall provide and install above signage. Engraved laminate Red foreground, white 80 PT letters. Provide 6 each signs bonded to 10 ga. Stainless Steel sheet metal plates same size as sign. Bolt signs @ 80' centers to wharf deck next to utility walkway. Drill-in bolts acceptable if Alt. "A" awarded. 3/8" Ø x 4" min. Lag bolts acceptable if Alt. "B" awarded. 3/8" Ø x 4" min.

AS-BUILT
Date: 12-26

Rev. 11-26-85 - 1500

STAMP		DO NOT SCALE THIS DRAWING - USE DIMENSIONS	
		STATE OF ALASKA	
		DEPARTMENT OF TRANSPORTATION AND PUBLIC FACILITIES	
Ketchikan		Alaska	
QUANTITIES AND GENERAL NOTES			
DESIGNED <u>AS</u>	CHECKED <u>BAS</u>	DRAWN <u>AS</u>	DATE <u>11-85</u>
PROJECT NUMBER <u>X70010</u>	SHEET <u>2</u> OF <u>24</u>		

Contractor note that during driving piles inside existing cells, movement of the cells can be expected.

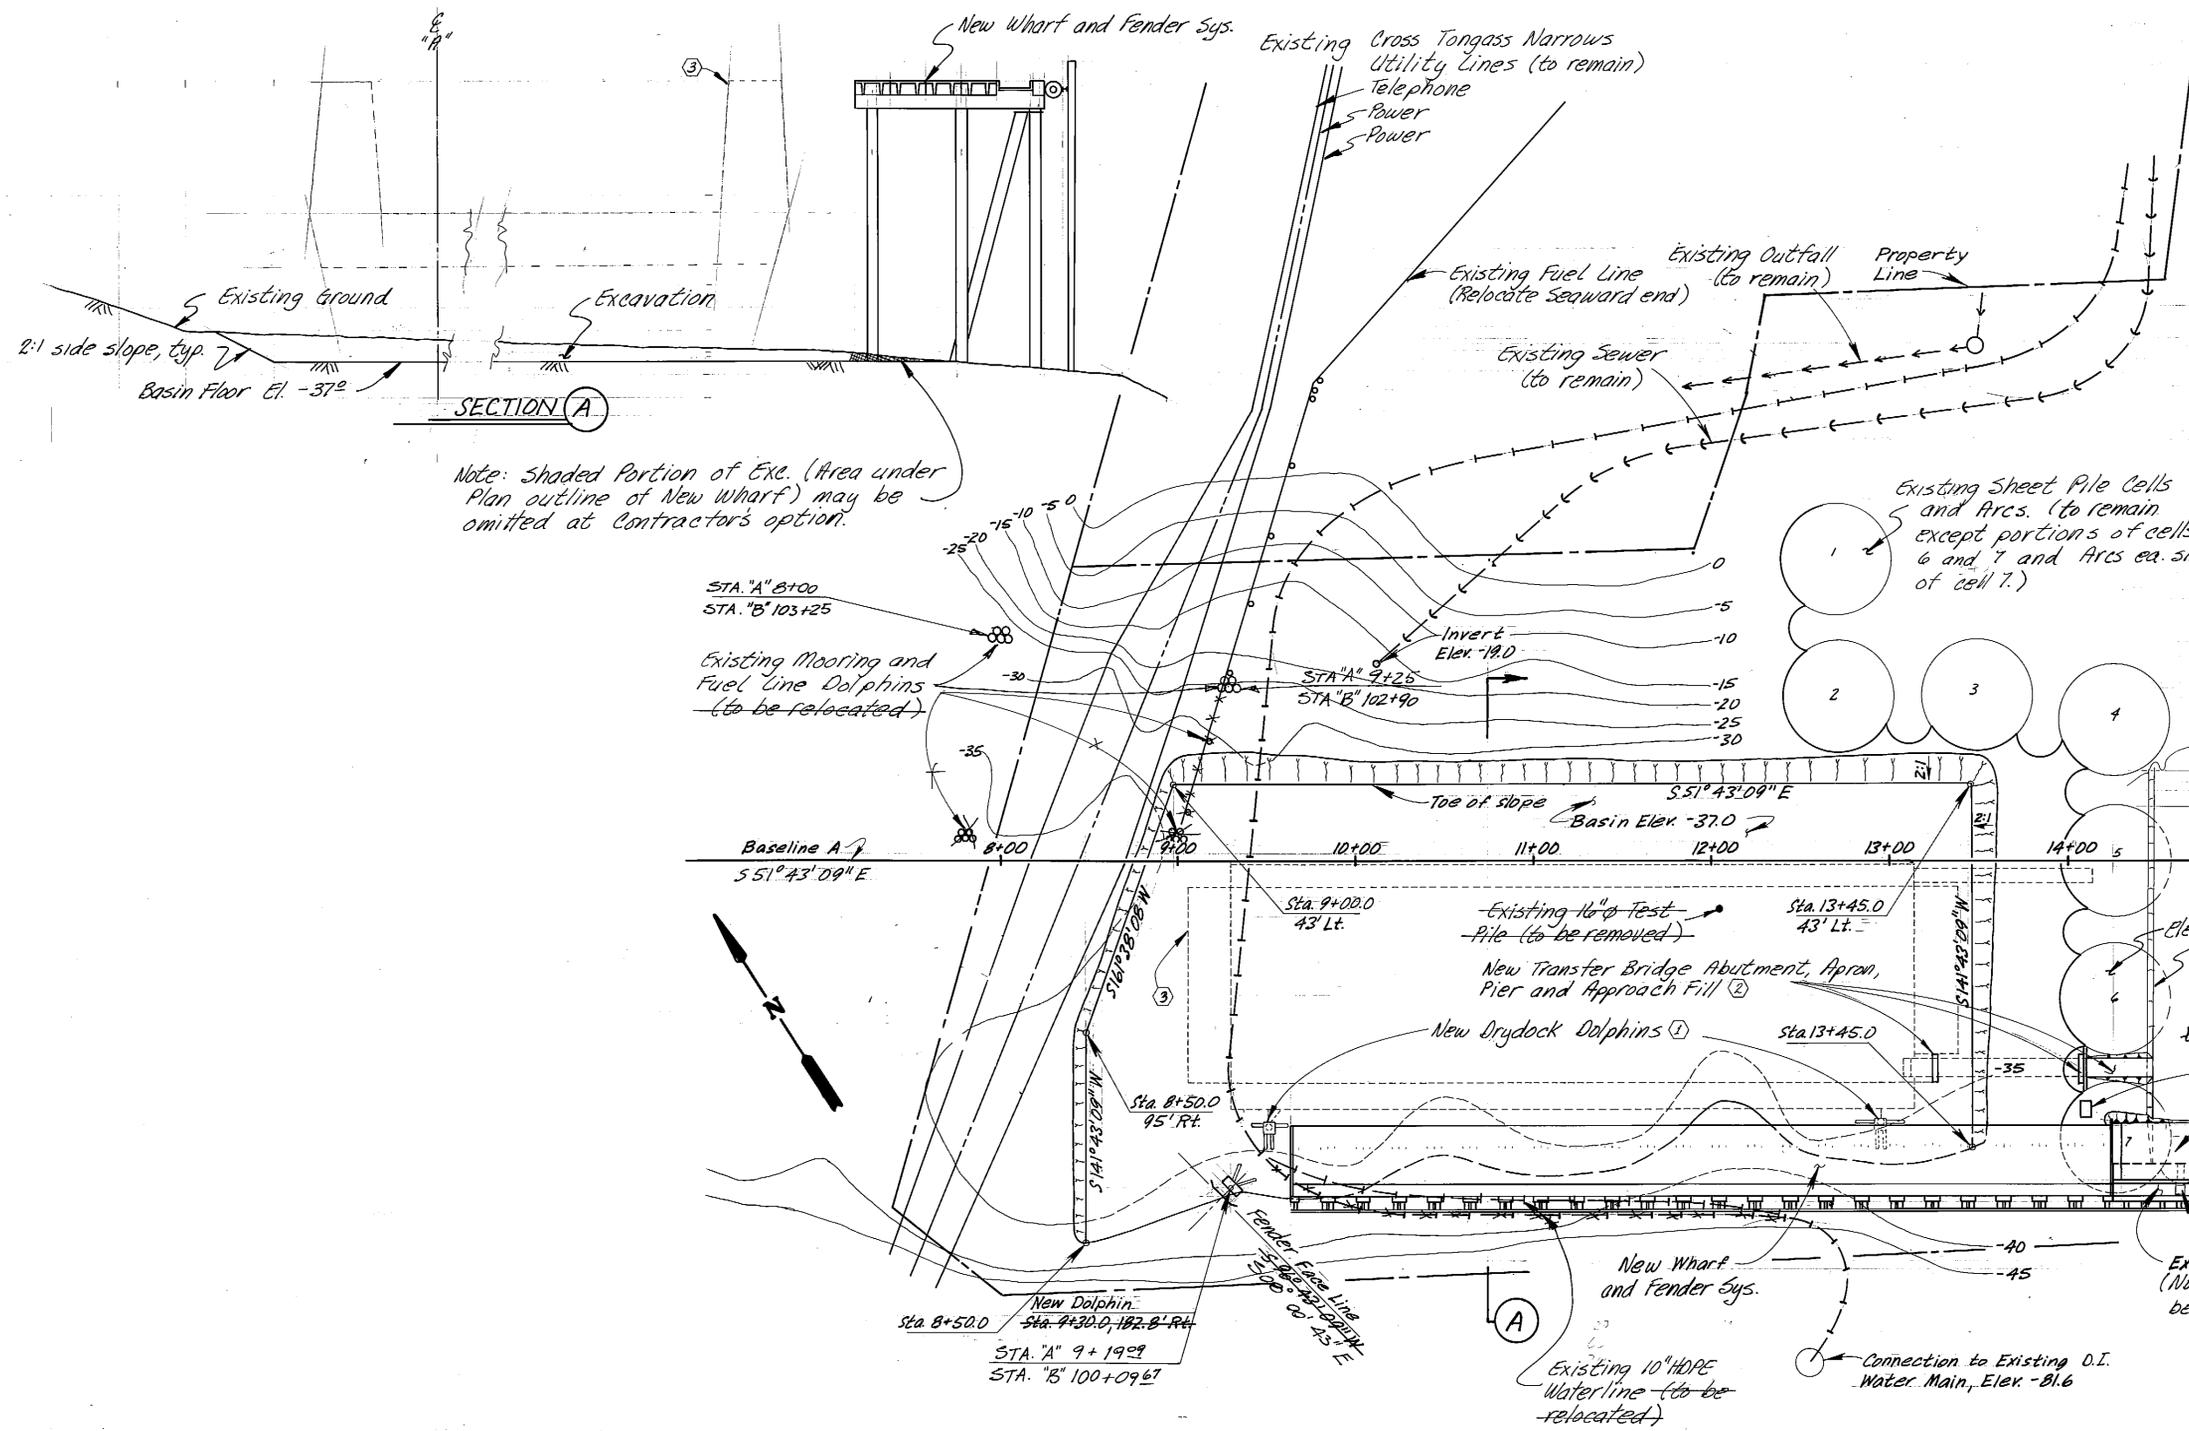


Horizontal Control:
 Brass Caps in Cases Tongass Ave: P.I. Sta. Tongass Ave" 20+23.48 (CM#1) to P.I. Sta. "F" 26+80.47 (CM#2)
 Basis of Bearing = S 48° 08' 04" E (CM#1 to CM#2)
 Basis of Distance = 658.56' (CM#1 to CM#2)
 Cross reference: P.I. "F" 26+80.47 = Sta. "A" 16+31.50, 756.77' Lt., or P.I. "F" 26+80.47 = Sta. "B" 109+56.77, 193.95' Lt.

Vertical Control:
 Dept. of Highways Brass Cap, S.W. corner sidewalk South side of Post Office Elev. = +25.78 MLLW (CM#3)

Tide Data:
 EHW +21.0
 MHHW +15.4
 MHW +13.0
 MLLW 0.0
 ELW -3.0







REFERENCES	
Description	Sheets
For New Wharf and Fender System	4-10 # 23-24
For Tr. Br. Abut., Apron, Pier and Approaches	11
For Existing Wharf and Removal	12-13
For Utility Tunnel	13
For New Dolphin (@ End of New Wharf)	14-16
For Drydock Dolphins	17
For Waterline Relocation	18
For Mooring and Fuel Line Relocation	19
For Existing Cathodic Protect. Sys. Det's	20-22
For New Wharf App. Fill and Cell Details	11

Note: Shaded Portion of Ex. (Area under Plan outline of New Wharf) may be omitted at Contractor's option.

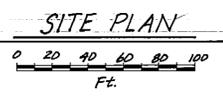

- NOTES
- ① Drydock and attachments to drydock by others.
 - ② Transfer Bridges to drydock by others.
 - ③ Future Drydock shown dashed at approx. location


	DO NOT SCALE THIS DRAWING - USE DIMENSIONS			
	STATE OF ALASKA DEPARTMENT OF TRANSPORTATION AND PUBLIC FACILITIES			
	Ketchikan		Alaska	
GENERAL LAYOUT				
DESIGNED <u>Staff</u>	CHECKED <u>AS</u>	DRAWN <u>LVB</u>	DATE <u>11/05</u>	
PROJECT NUMBER <u>11/28/05</u> <u>X 70010</u>	SHEET <u>3</u> OF <u>24</u>			

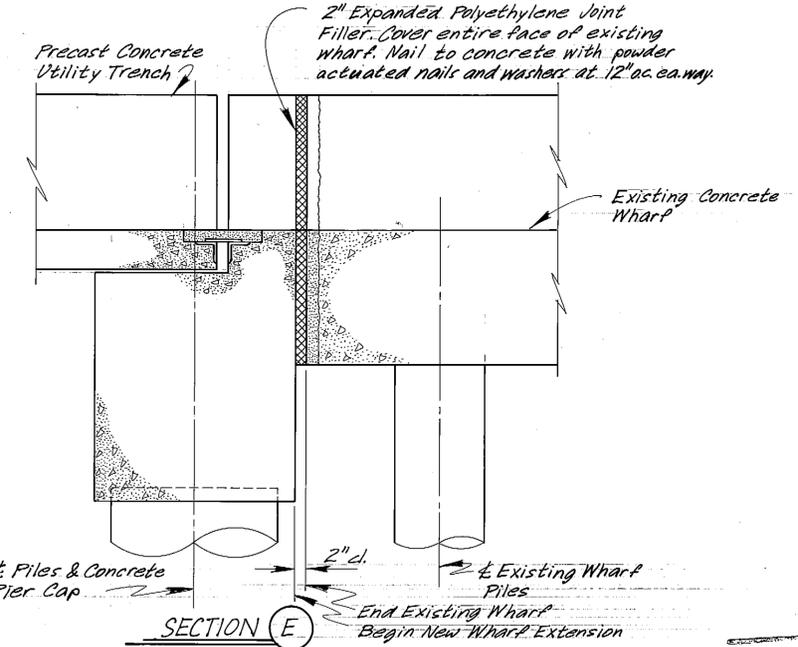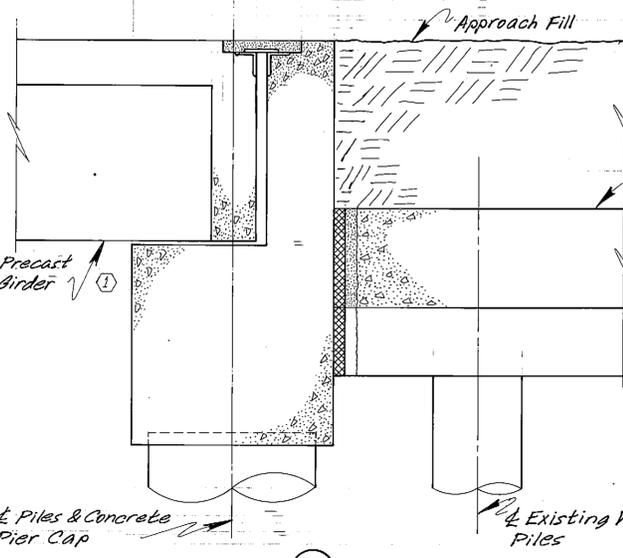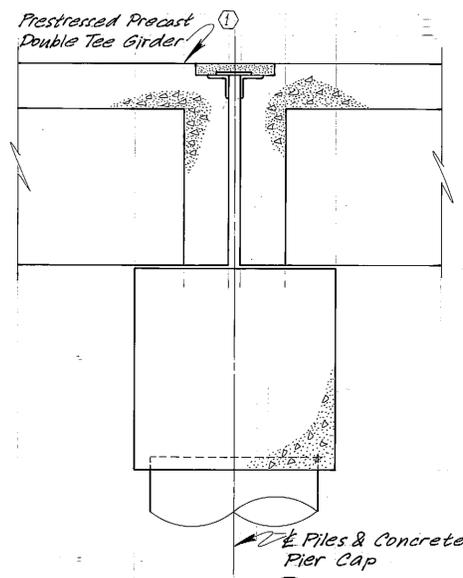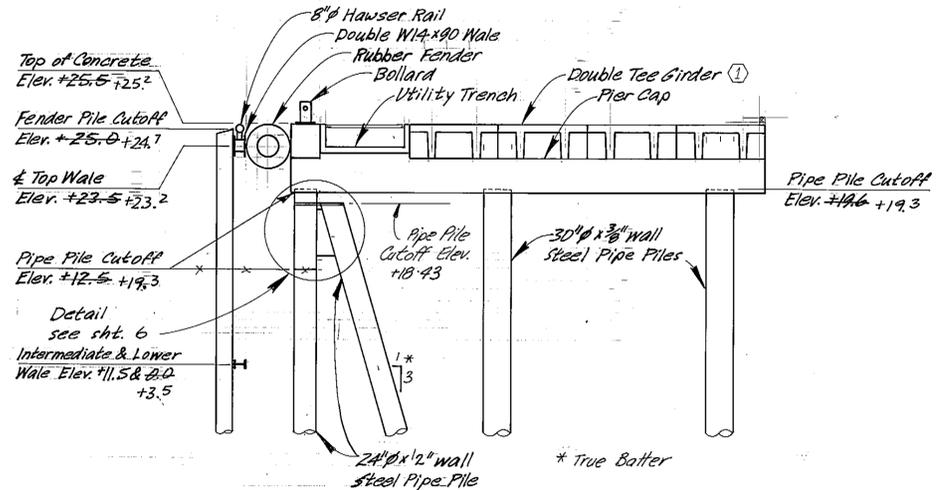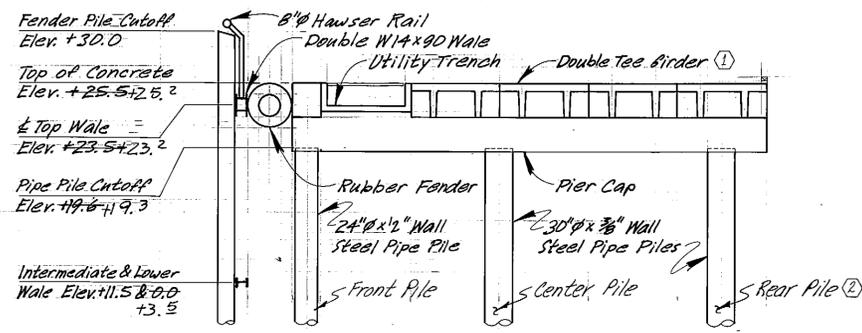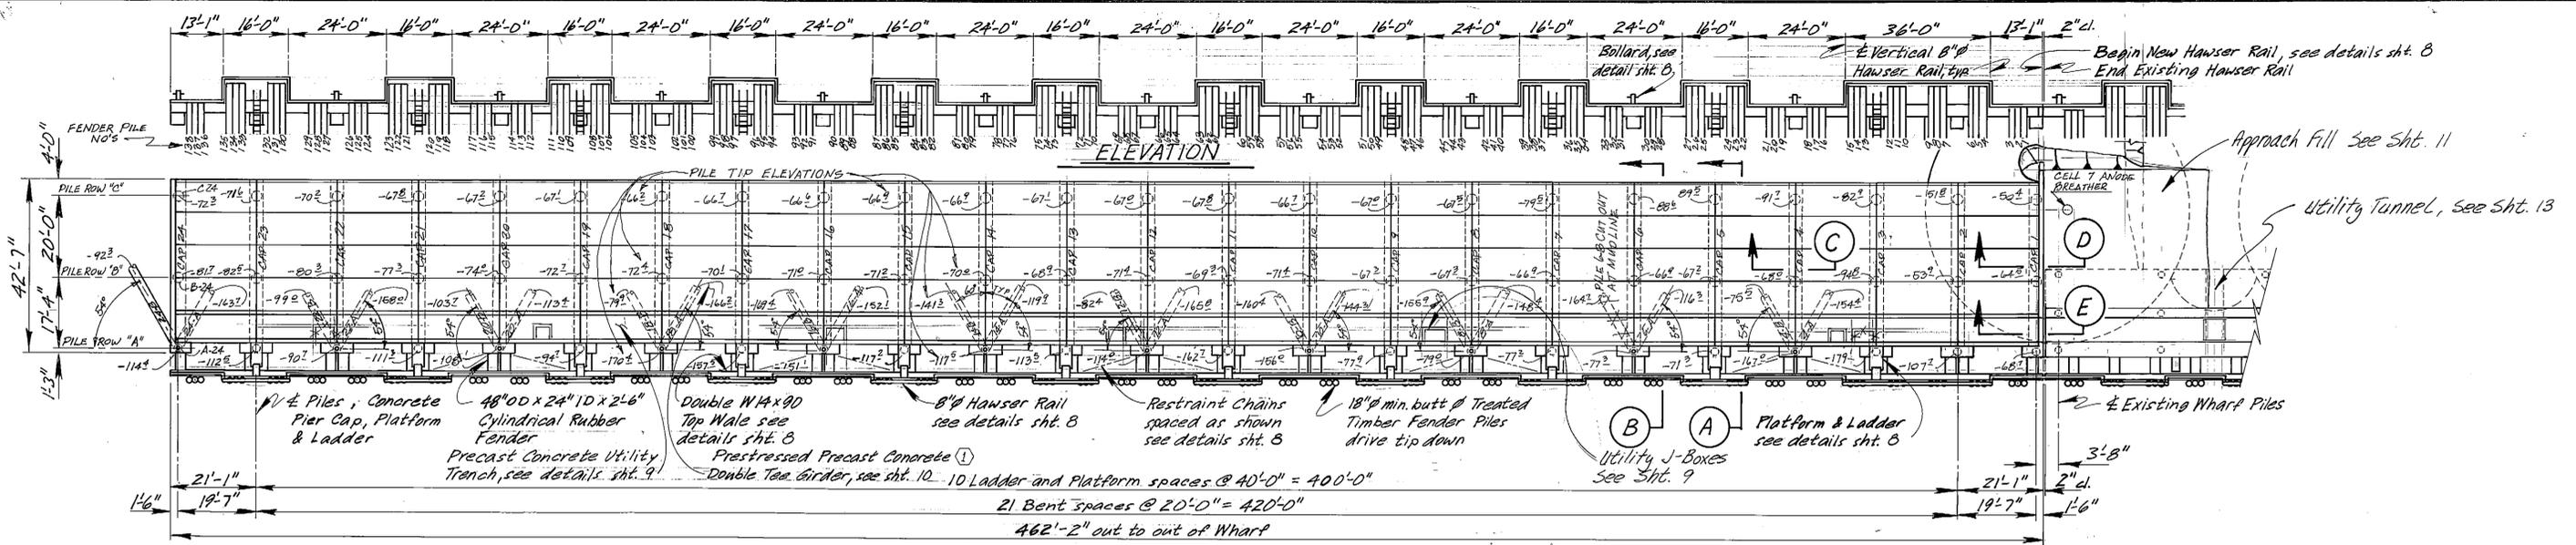

AS-BUILT
Date: 12-86


- NOTES:
- ① Alternate "A" shown, for Alt. "B" see sheets 23 & 24
 - ② see Pile Table Sheet 2
 - ③ For Removal of N.W. corner of Existing Wharf See Shts. 12 & 13 b. and Relocation of C.P. components See Shts. 11 & 20-22

	DO NOT SCALE THIS DRAWING - USE DIMENSIONS			
	STATE OF ALASKA DEPARTMENT OF TRANSPORTATION AND PUBLIC FACILITIES			
	Ketchikan		Alaska	
WHARF LAYOUT AND TYPICAL SECTIONS				
DESIGNED BS	CHECKED AS	DRAWN LJB	DATE 10/85	
PROJECT NUMBER X70010		SHEET A OF 24		
11-22-85				

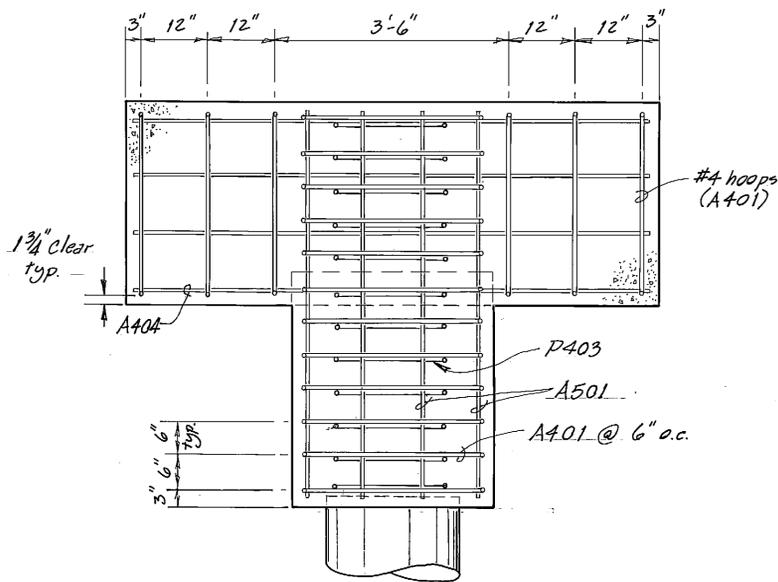


FRONT ELEVATION

3/4" = 1'-0"

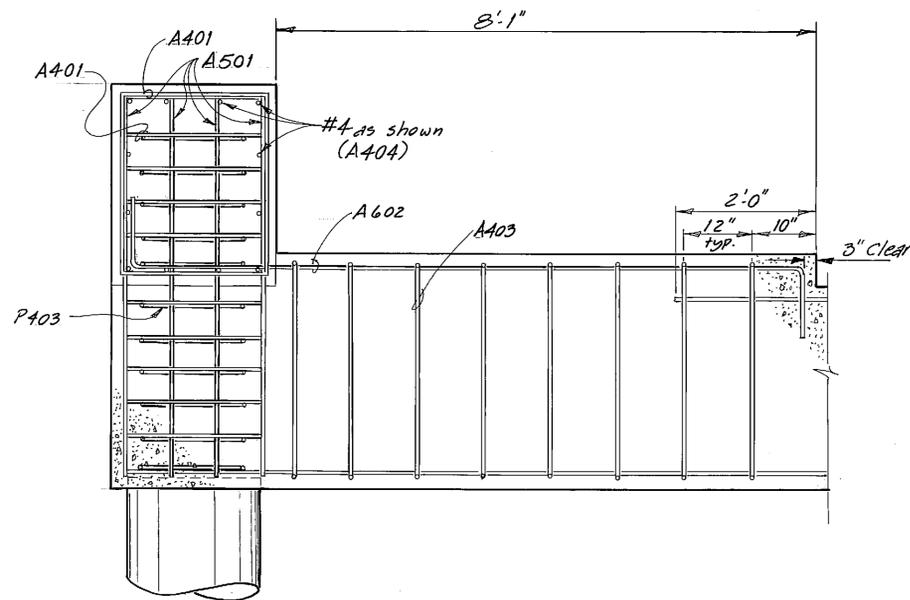


SIDE ELEVATION

3/4" = 1'-0"

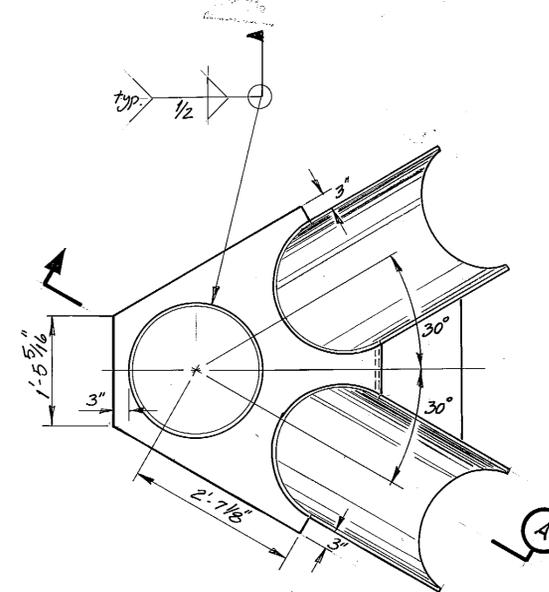

PLAN VIEW


3/4" = 1'-0"

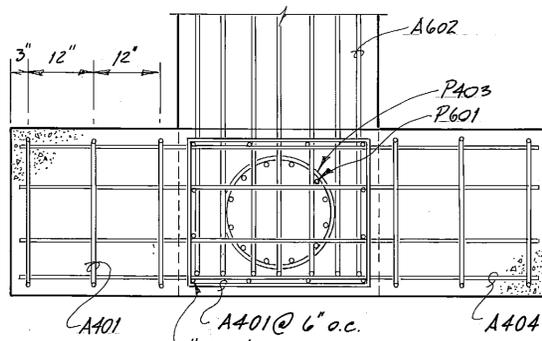

PLAN VIEW


PILE CAP

3/4" = 1'-0"

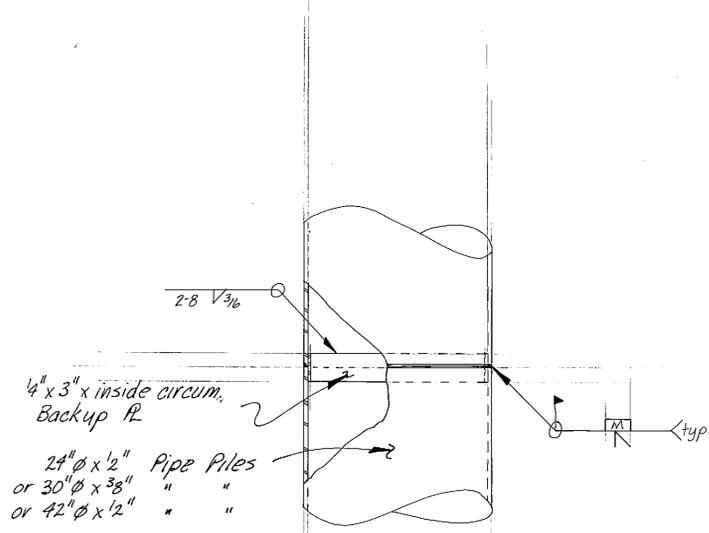

PILE SPLICE DETAILS

N.T.S.

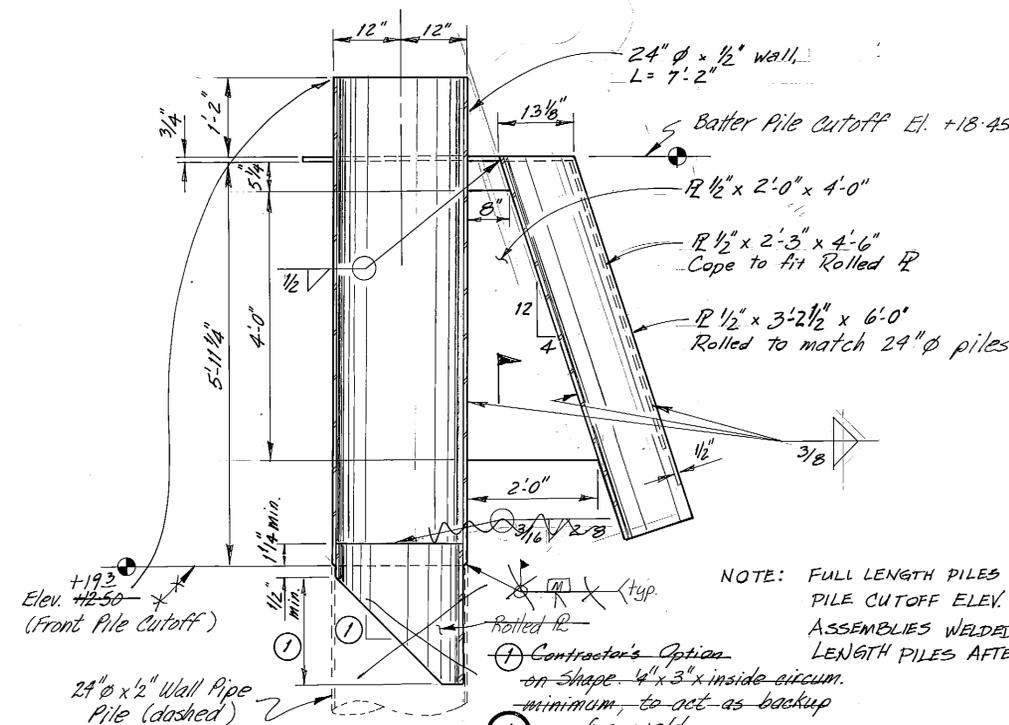

SECTION A

PILE WELDMENT

3/4" = 1'-0"




NOTE: FULL LENGTH PILES USED PILE CUTOFF ELEV. 193. ASSEMBLIES WELDED TO FULL LENGTH PILES AFTER DRIVING.

Note: Weld batter piles with 3/8" fillet all around to weldment, typ.


NOTE: See Sheet 5 for Reinforcing Schedule

AS-BUILT
Date: 12-86

STAMP		DO NOT SCALE THIS DRAWING - USE DIMENSIONS	
STATE OF ALASKA DEPARTMENT OF TRANSPORTATION AND PUBLIC FACILITIES			
Ketchikan		Alaska	
PIER CAP DETAILS			
DESIGNED BAS	CHECKED -LS	DRAWN DB	DATE 11-85
PROJECT NUMBER X 7001D	SHEET 6		OF 24

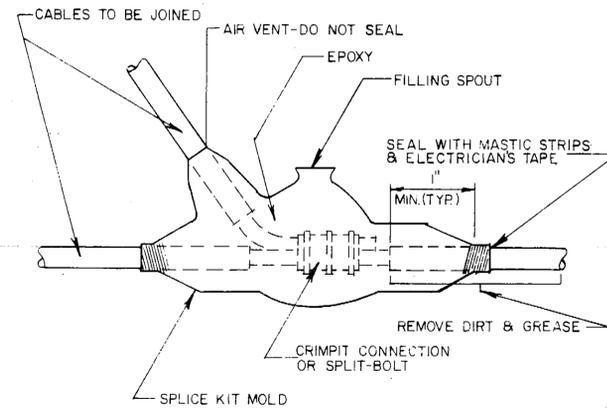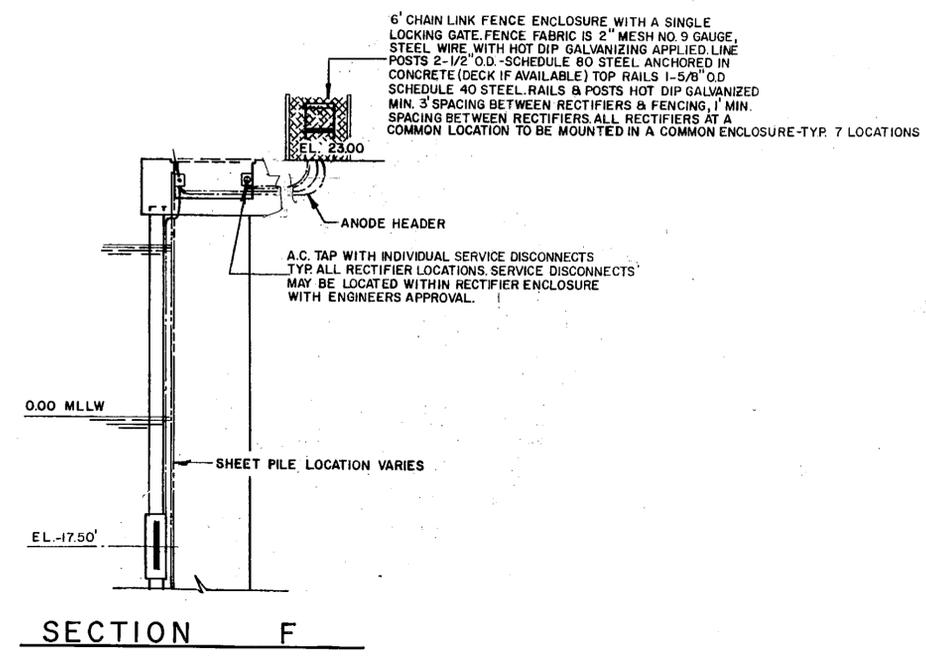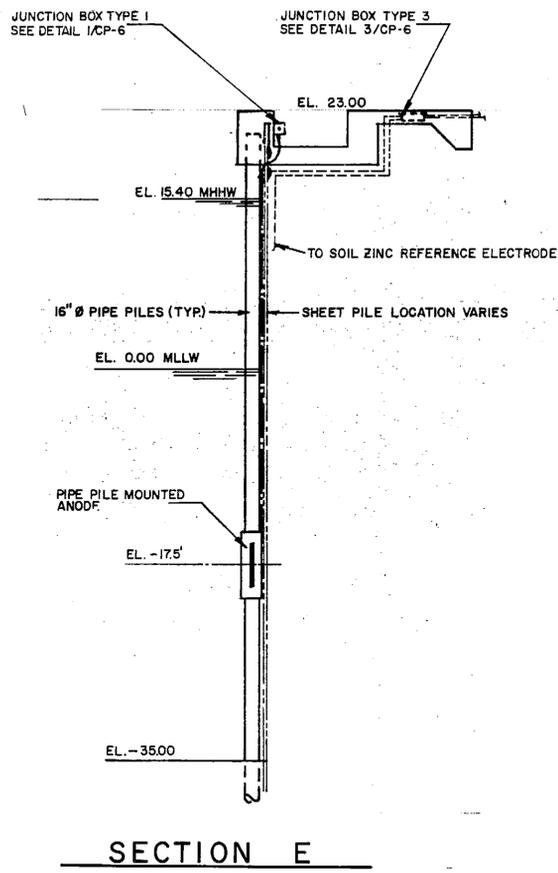


- LEGEND**
- ANODE HEADER SPLICE
 - INDICATES PIPE PILE.
 - ➔ INDICATES BATTERED PIPE PILE AND DIRECTION OF BATTER.
 - ANODE JUNCTION BOX
 - ⊙ ZINC REFERENCE ELECTRODE - SOIL
 - CANISTER ANODE (3" Ø)
 - ⊕ PIPE MOUNTED ANODE - PAIR
 - ⊖ PIPE MOUNTED ANODE - SINGLE
 - ANODE JUNCTION BOX
 - △ ANODE JUNCTION BOX
 - ⊕ ZINC REFERENCE ELECTRODE - MARINE
 - ⊠ RECTIFIER, SIZE INDICATED IN LOWER RIGHT
 - ⊗ ANODE SLED
 - ⊗ CANISTER ANODE (2 1/2" Ø)
- NOTES:**
- BOLD FACE INDICATES ANODE ELEMENT LOCATION

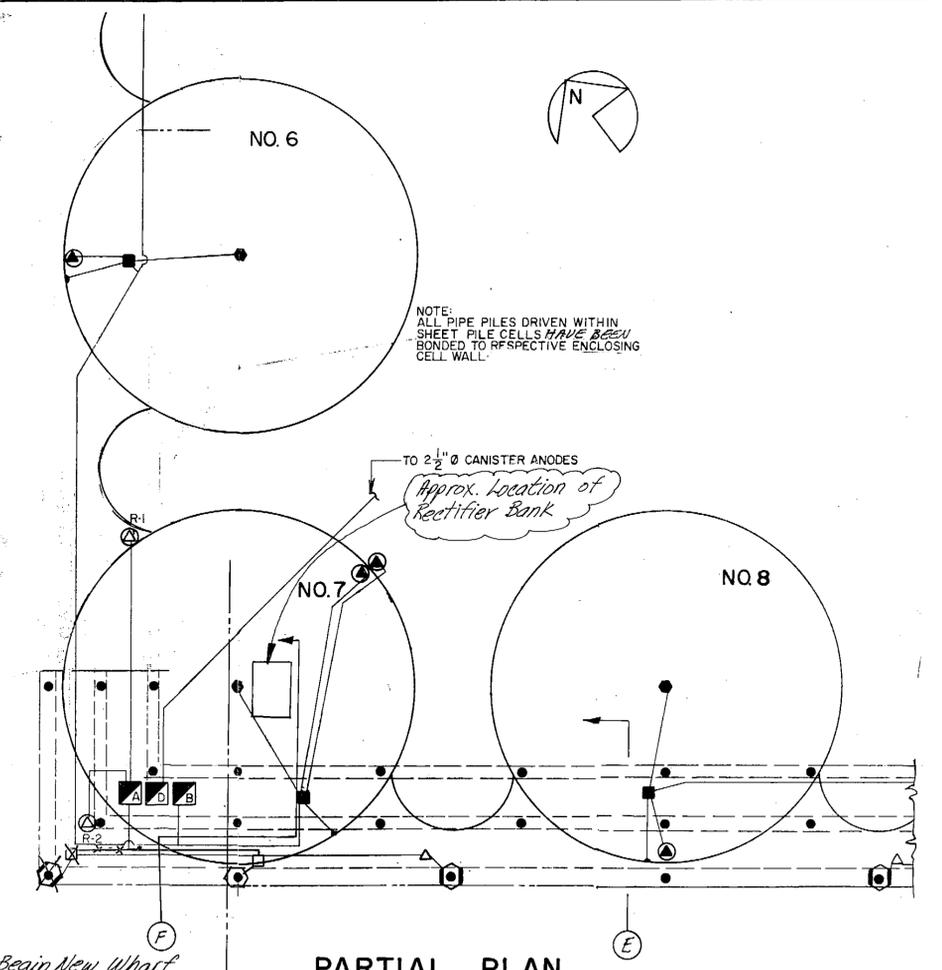

NOTES

Begin New Wharf
 Ex. Wharf and Piles (to be removed) (1)
 Existing Wharf (to remain)

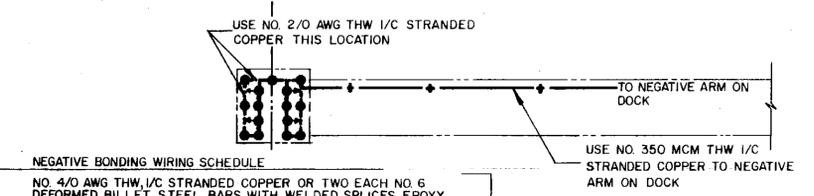

NEGATIVE BONDING WIRING SCHEDULE

NO. 4/0 AWG THW 1/2 STRANDED COPPER OR TWO EACH NO. 6 DEFORMED BILLET STEEL BARS WITH WELDED SPLICES EPOXY COATED - NO WIRE TIES ALLOWED

NO. 2/0 AWG THW 1/2 STRANDED COPPER OR TWO EACH NO. 4 DEFORMED BILLET STEEL BARS WITH WELDED SPLICES EPOXY COATED - NO WIRE TIES ALLOWED

NO. 6 AWG HMW/PE 1/2 STRANDED COPPER OR ONE, NO. 4 EPOXY COATED DEFORMED BILLET STEEL BARS WITH WELDED SPLICES EPOXY COATED - NO WIRE TIES ALLOWED

ANODE WIRING SCHEDULE
 SEE ANODE/JUNCTION BOX DETAILS & SCHEMATIC


NOTE: ALL BONDING WIRES NOT IMBEDDED IN CONCRETE OR DIRECT BURIED TO BE RUN IN VINYL COATED, MILD STEEL RIGID CONDUIT. THOSE WIRES IMBEDDED IN CONCRETE TO HAVE A MINIMUM OF 2" COVER. THOSE WIRES DIRECT BURIED IN BACKFILL TO HAVE A MINIMUM OF 24" COVER. ALL CONDUIT (POSITIVE OR NEGATIVE ARM OR A.C.) IN DIRECT CONTACT WITH SOIL SHALL BE BONDED TO THE CLOSEST SHEET PILE WALL. A SEPARATE NEGATIVE LEAD (STRUCTURE) IS REQUIRED FOR EACH RECTIFIER TO NEAREST PILING OR NEGATIVE STRUCTURAL BONDING.

NOTES:

(1) Existing CP System is at present un-powered. North Wharf Contractor to relocate and re-connect existing items as required to make way for new work.

AS-BUILT
 Date: 12-86

DO NOT SCALE THIS DRAWING - USE DIMENSIONS			
STATE OF ALASKA			
DEPARTMENT OF TRANSPORTATION AND PUBLIC FACILITIES			
Ketchikan	KILIK		Alaska
EXISTING CATHODIC PROTECTION SYSTEM / DETAILS			
DESIGNED Staff	CHECKED SB	DRAWN Keanan	DATE 1/18/85
PROJECT NUMBER X70010	SHEET 3-2022		OF 24

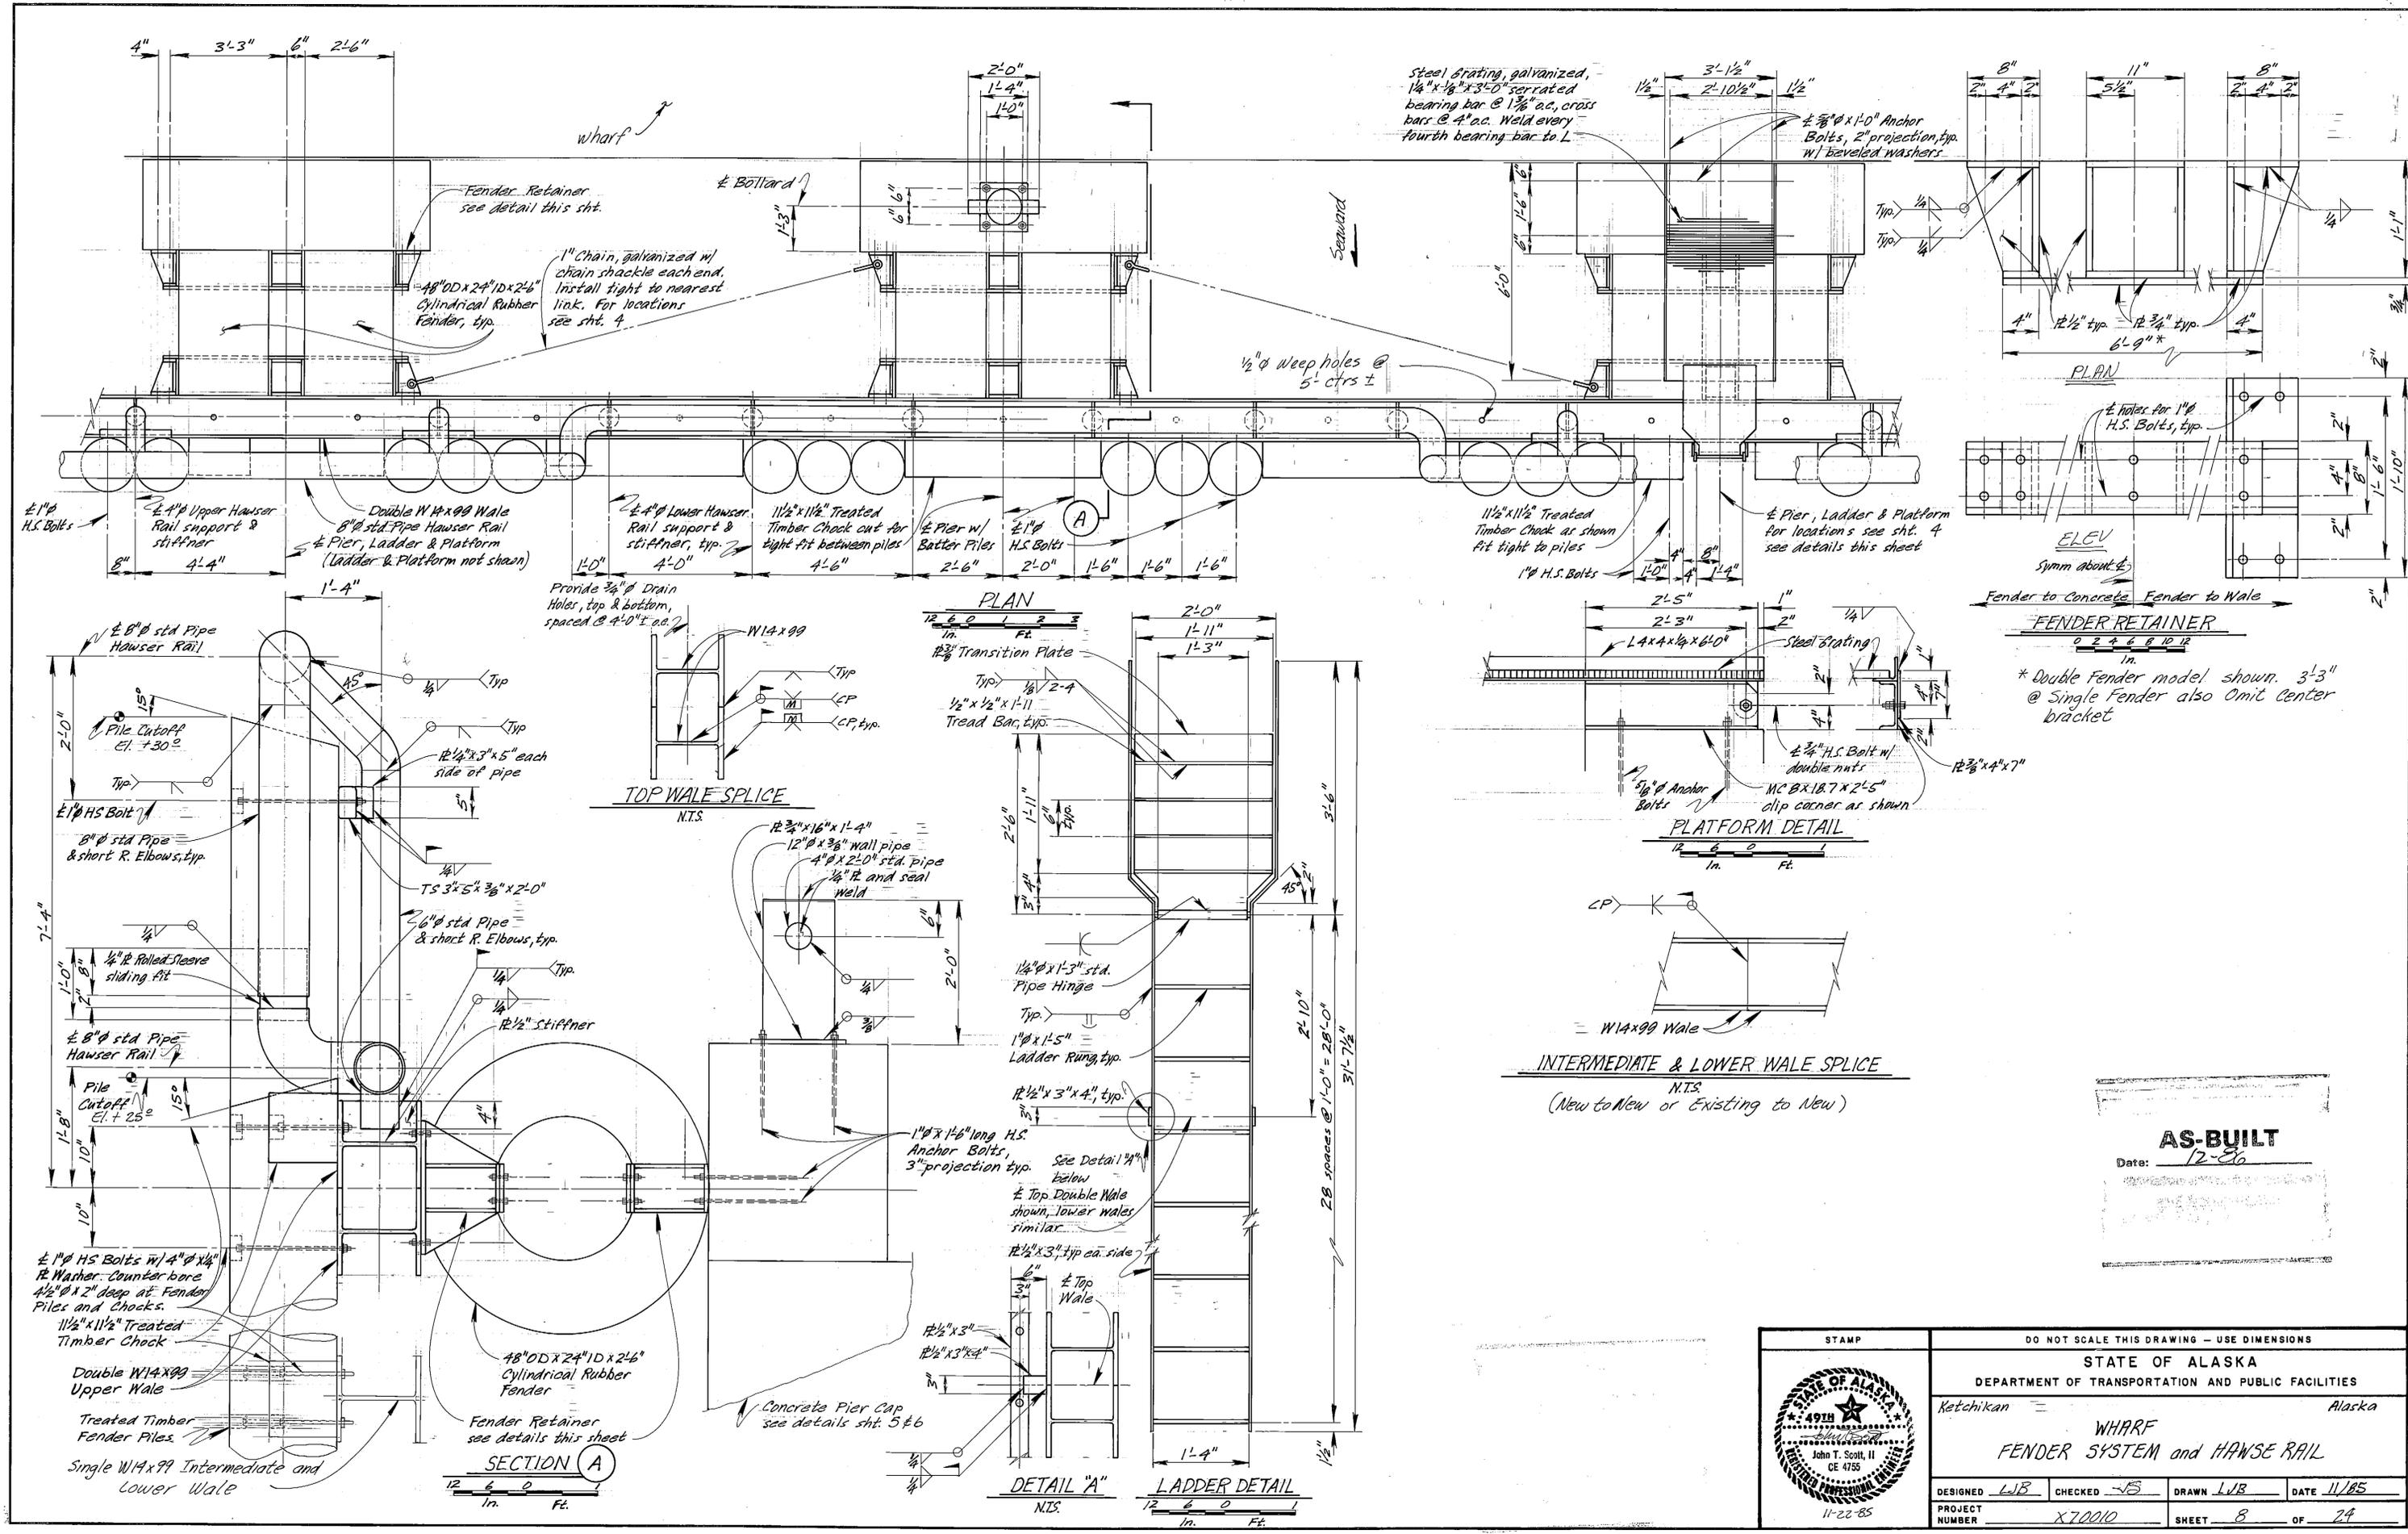

Steel Grating, galvanized, 1/4" x 1/8" x 3'-0" serrated bearing bar @ 1 3/8" o.c., cross bars @ 4" o.c. Weld every fourth bearing bar to L

1/2" x 1-0" Anchor Bolts, 2" projection, typ. w/ beveled washers

Fender Retainer see detail this sht.

1" Chain, galvanized w/ chain shackle each end. Install tight to nearest link. For locations see sht. 4

48" OD x 24" ID x 2'-6" Cylindrical Rubber Fender, typ.

Seaward

1/2" dia Weep Holes @ 5'-0" ctrs ±

PLAN

ELEV

Fender to Concrete Fender to Wale

FENDER RETAINER

* Double Fender model shown. 3'-3" @ Single Fender also omit center bracket

PLAN

PLATFORM DETAIL

INTERMEDIATE & LOWER WALE SPLICE

(New to New or Existing to New)

SECTION A







DETAIL "A"

LADDER DETAIL

AS-BUILT

Date: 12-26

	DO NOT SCALE THIS DRAWING - USE DIMENSIONS			
	STATE OF ALASKA DEPARTMENT OF TRANSPORTATION AND PUBLIC FACILITIES			
Ketchikan		Alaska		
WHARF FENDER SYSTEM and HAULSE RAIL				
DESIGNED	LJB	CHECKED	YES	
DRAWN	LJB	DATE	11/85	
PROJECT NUMBER	X70010	SHEET	8 OF 24	

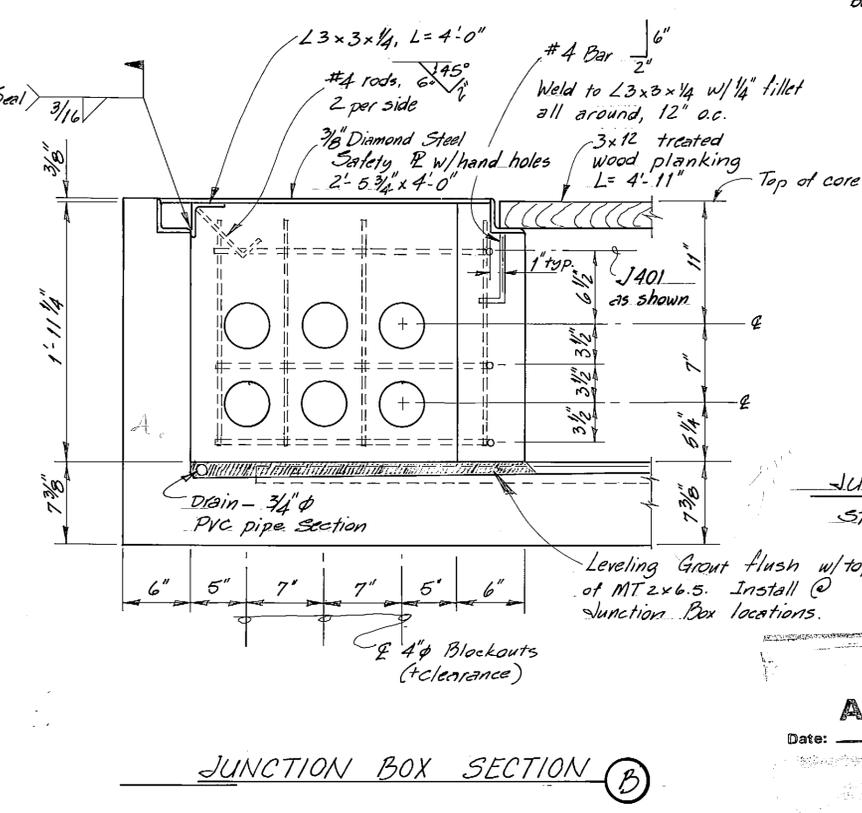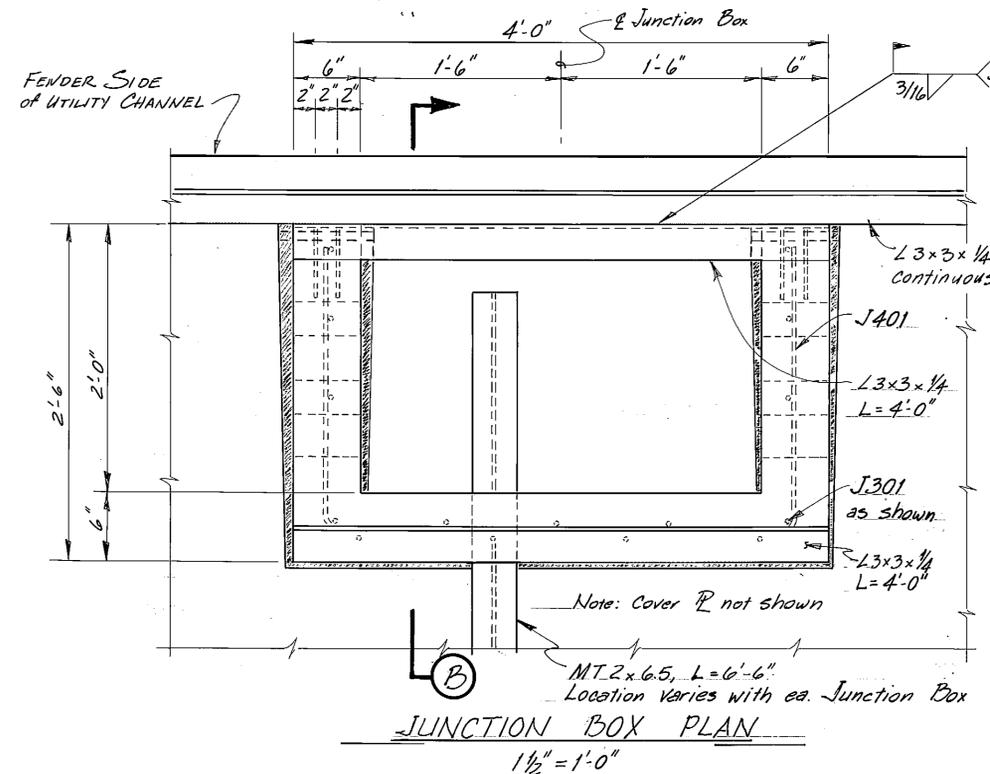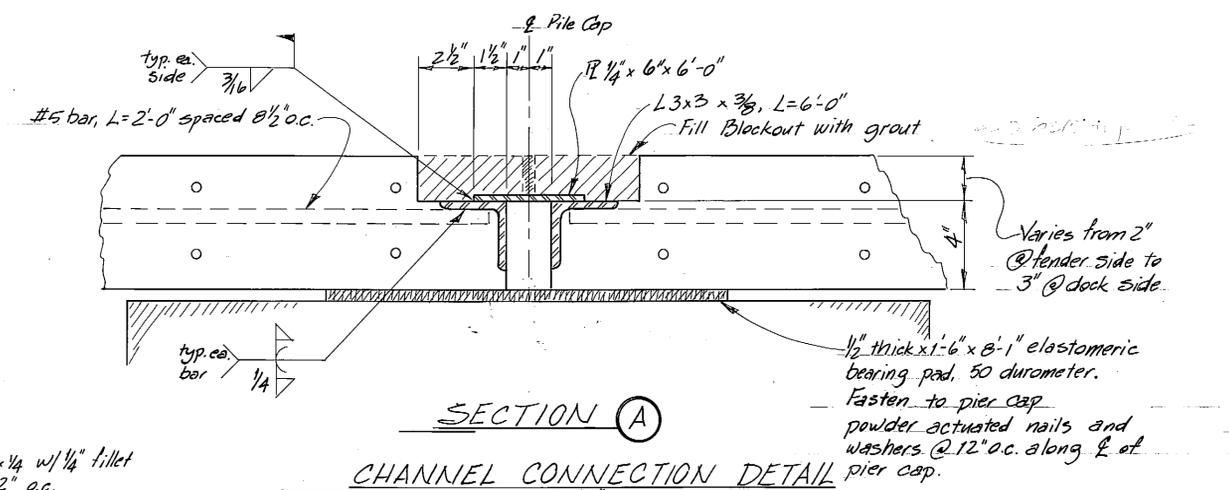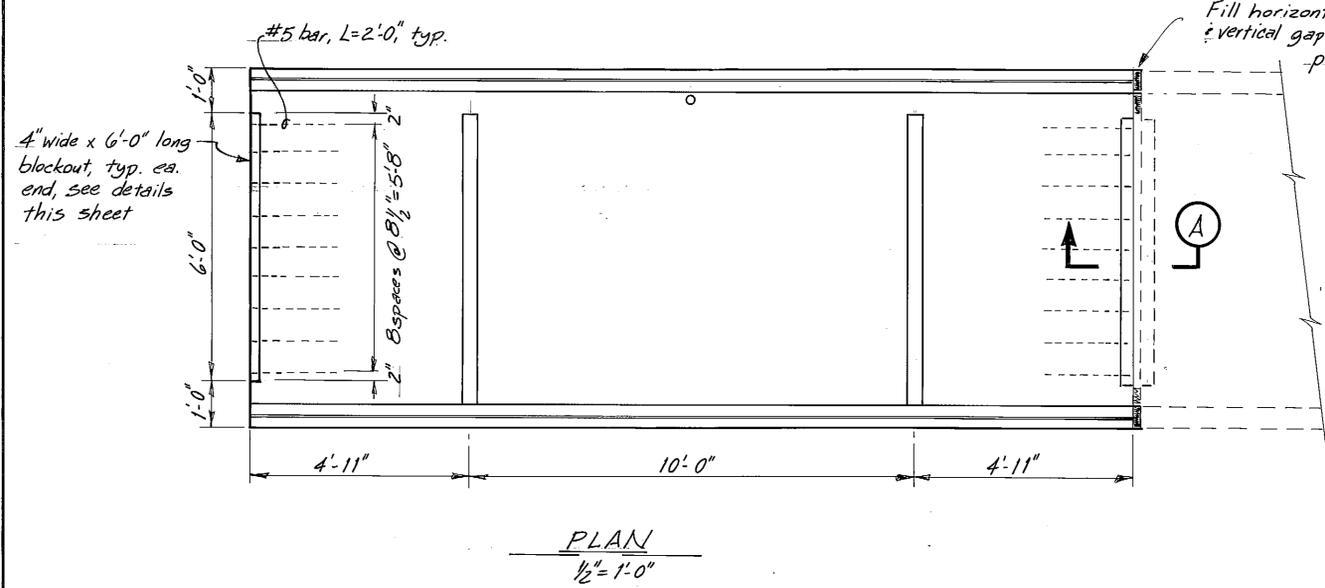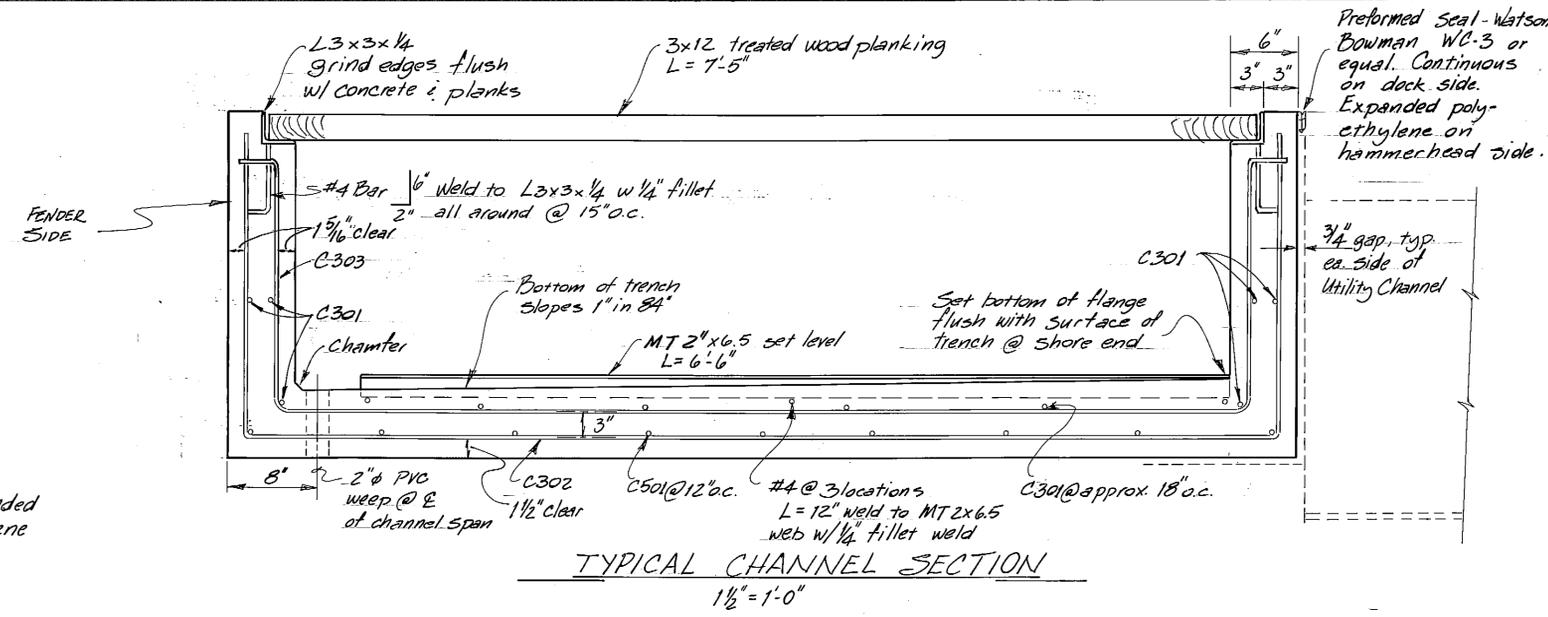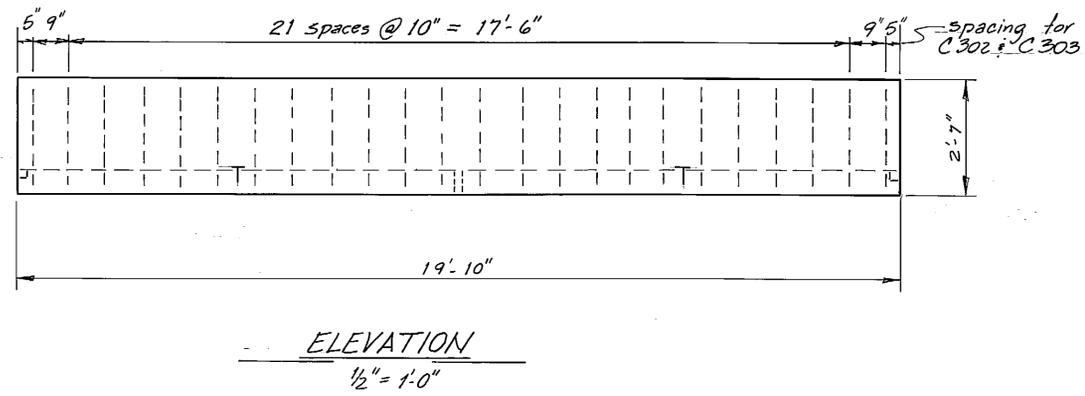


JUNCTION BOX REINFORCEMENT					UTILITY CHANNEL REINFORCEMENT				
MARK	SIZE	NO.	LENGTH	TYPE	MARK	SIZE	NO.	LENGTH	TYPE
J301	3	11	1'-9"	-	C301	3	14	19'-11"	-
J401	4	3	7'-8"	Bent	C302	3	24	12'-4"	Bent
					C303	3	24	11'-5"	Bent
					C501	5		19'-7"	-

JUNCTION BOX LOCATIONS*

STATION "A" 10+00 10+50
 "A" 11+25
 "A" 12+00 11+96 *Approximate locations only. Actual locations to be adjusted to fit field conditions.
 "A" 12+75
 "A" 13+80 13+14

AS-BUILT
 Date: 12-86

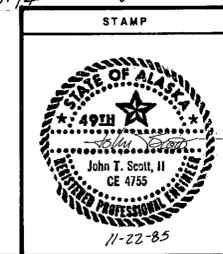


DO NOT SCALE THIS DRAWING - USE DIMENSIONS

STATE OF ALASKA
 DEPARTMENT OF TRANSPORTATION AND PUBLIC FACILITIES

Ketchikan Alaska

UTILITY CHANNEL SECTION







DESIGNED BS CHECKED DB DRAWN DB DATE 10-85
 PROJECT NUMBER X70010 SHEET 9 OF 2A

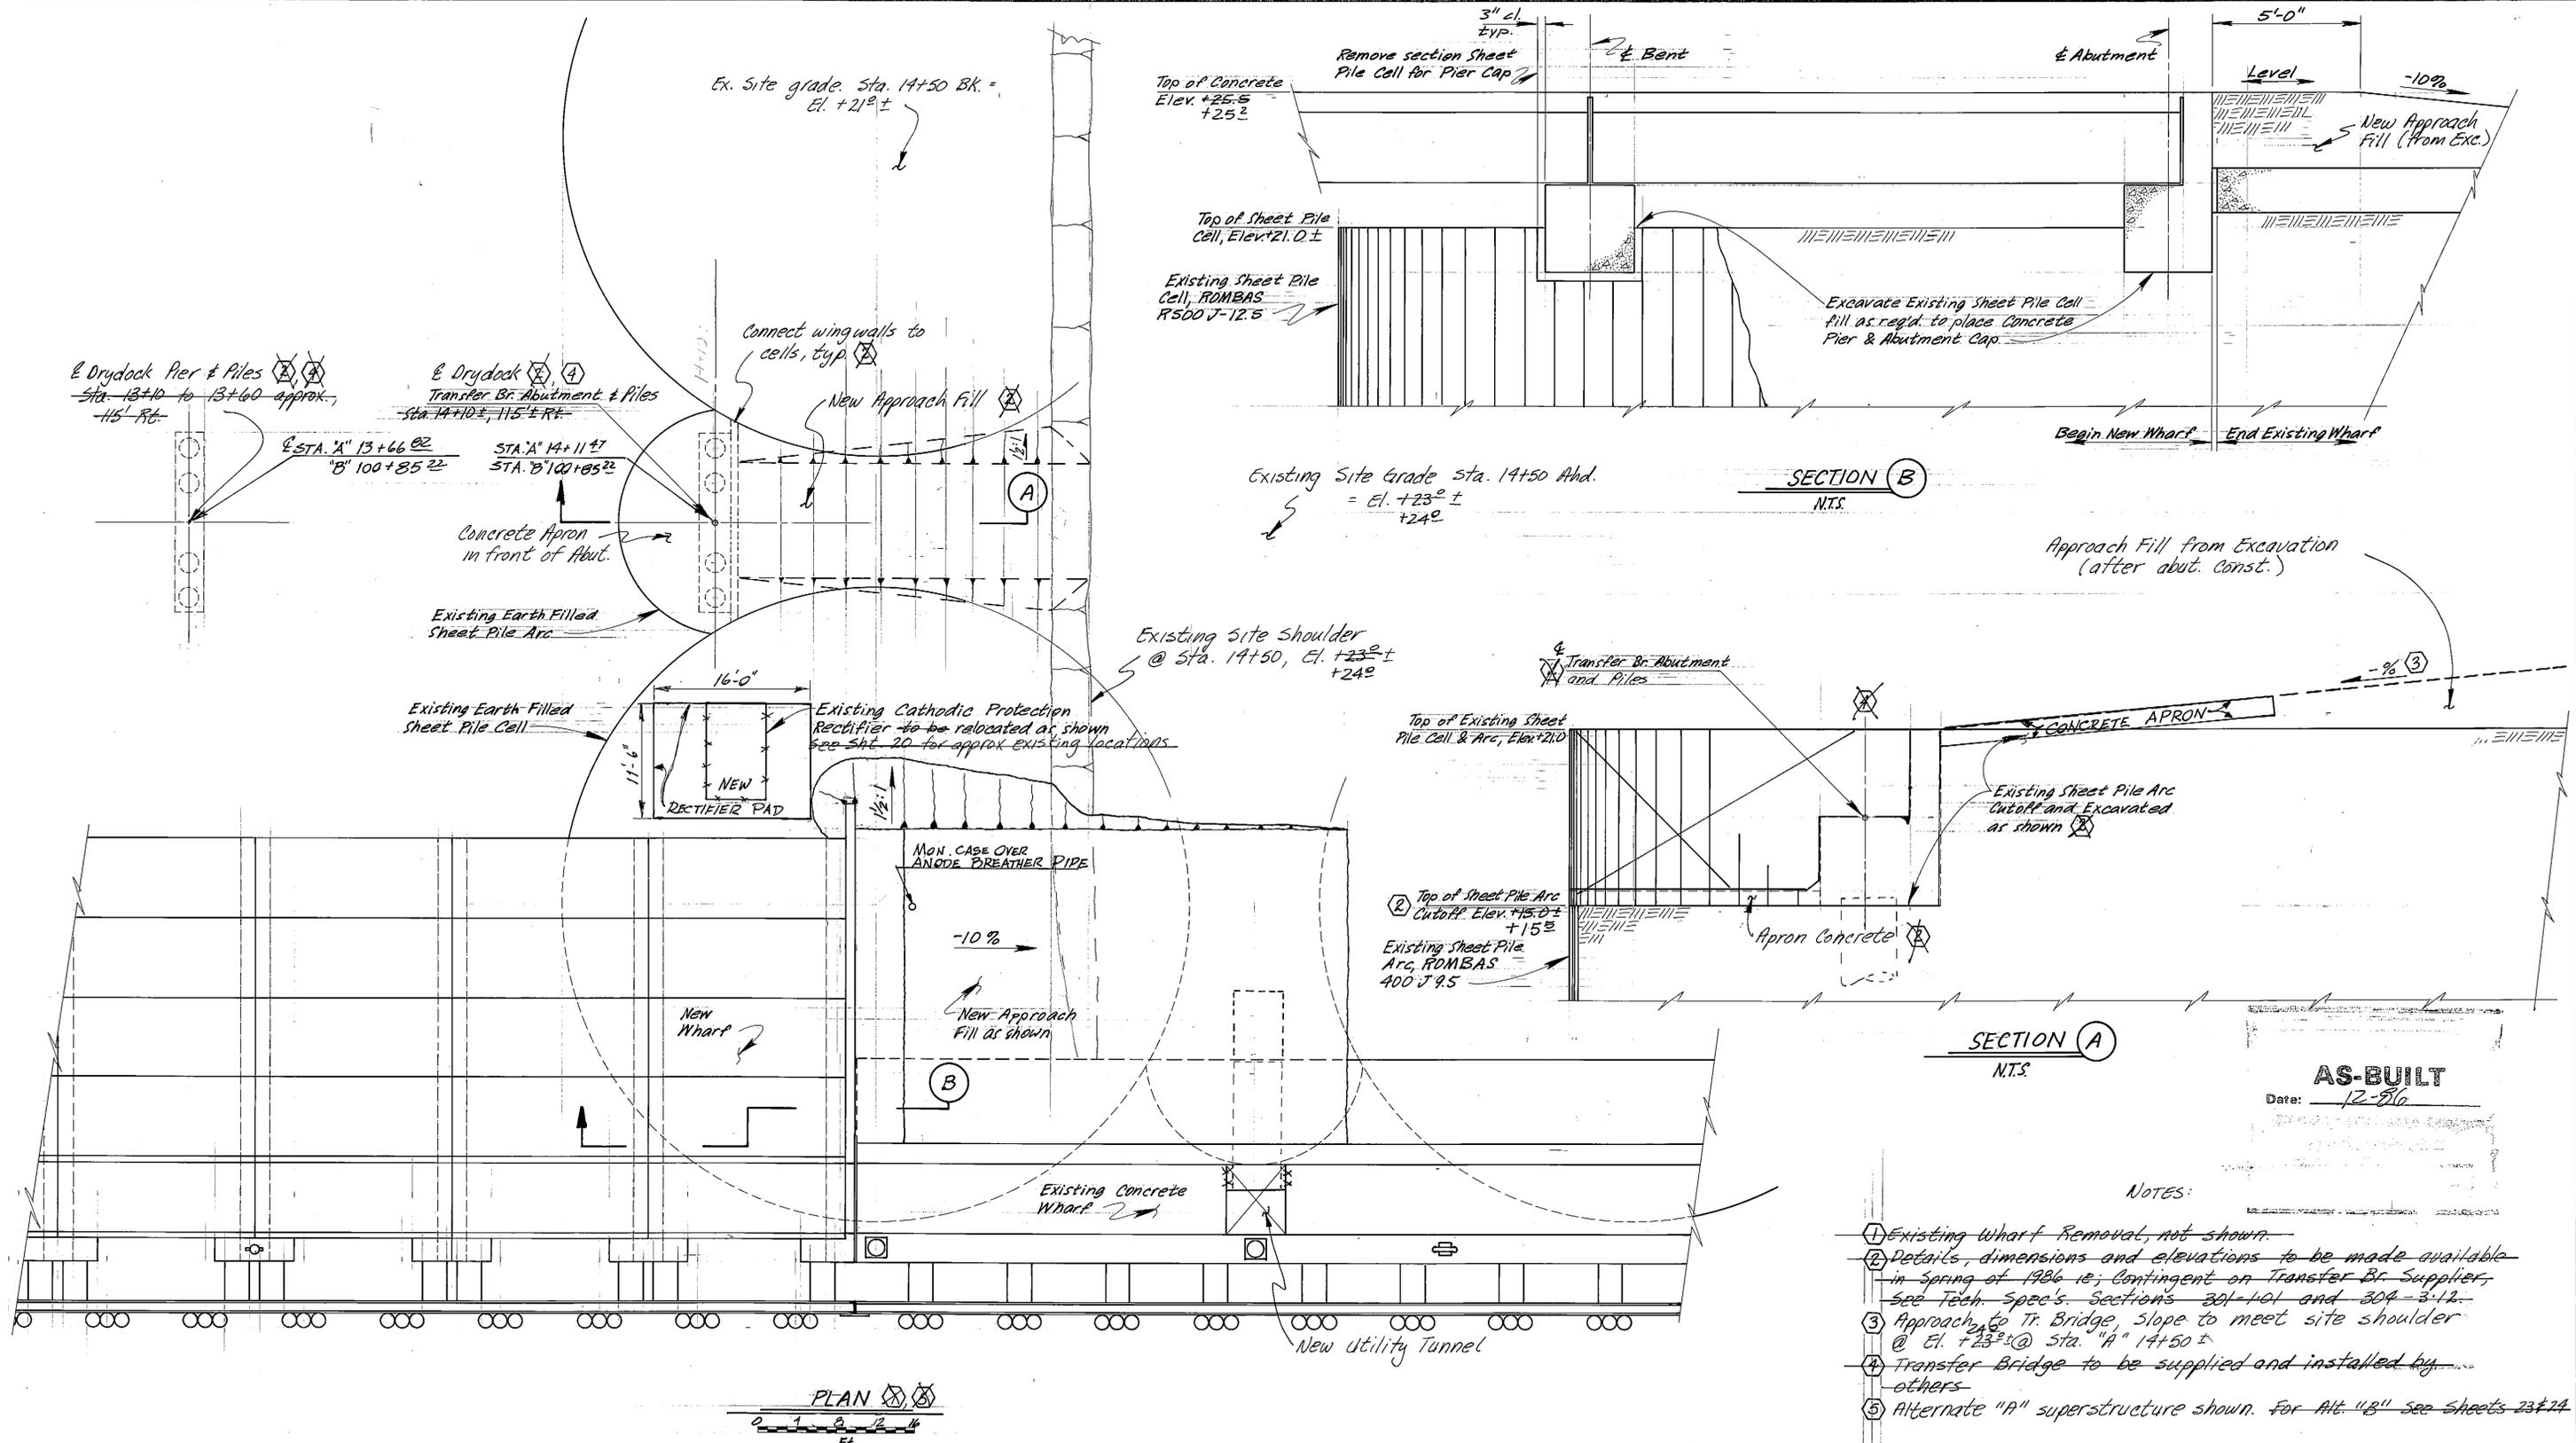



- NOTES:
- ① Existing Wharf Removal, not shown.
 - ② Details, dimensions and elevations to be made available in Spring of 1986 re; Contingent on Transfer Br. Supplier, see Tech. Specs. Sections 301-101 and 304-3-12.
 - ③ Approach to Tr. Bridge, Slope to meet site shoulder @ El. +23.0 ± @ Sta. "A" 14+50 ±
 - ④ Transfer Bridge to be supplied and installed by others.
 - ⑤ Alternate "A" superstructure shown. For Alt. "B" see Sheets 23 & 24.

	DO NOT SCALE THIS DRAWING - USE DIMENSIONS			
	STATE OF ALASKA DEPARTMENT OF TRANSPORTATION AND PUBLIC FACILITIES Ketchikan Alaska			
CAP FILL & SHEET PILE REMOVAL DETAILS				
DESIGNED <u>LJB</u>	CHECKED <u>YS</u>	DRAWN <u>LJB</u>	DATE <u>11/85</u>	
PROJECT NUMBER <u>X70010</u>	SHEET <u>11</u> OF <u>24</u>			

AS-BUILT
Date: 12-86

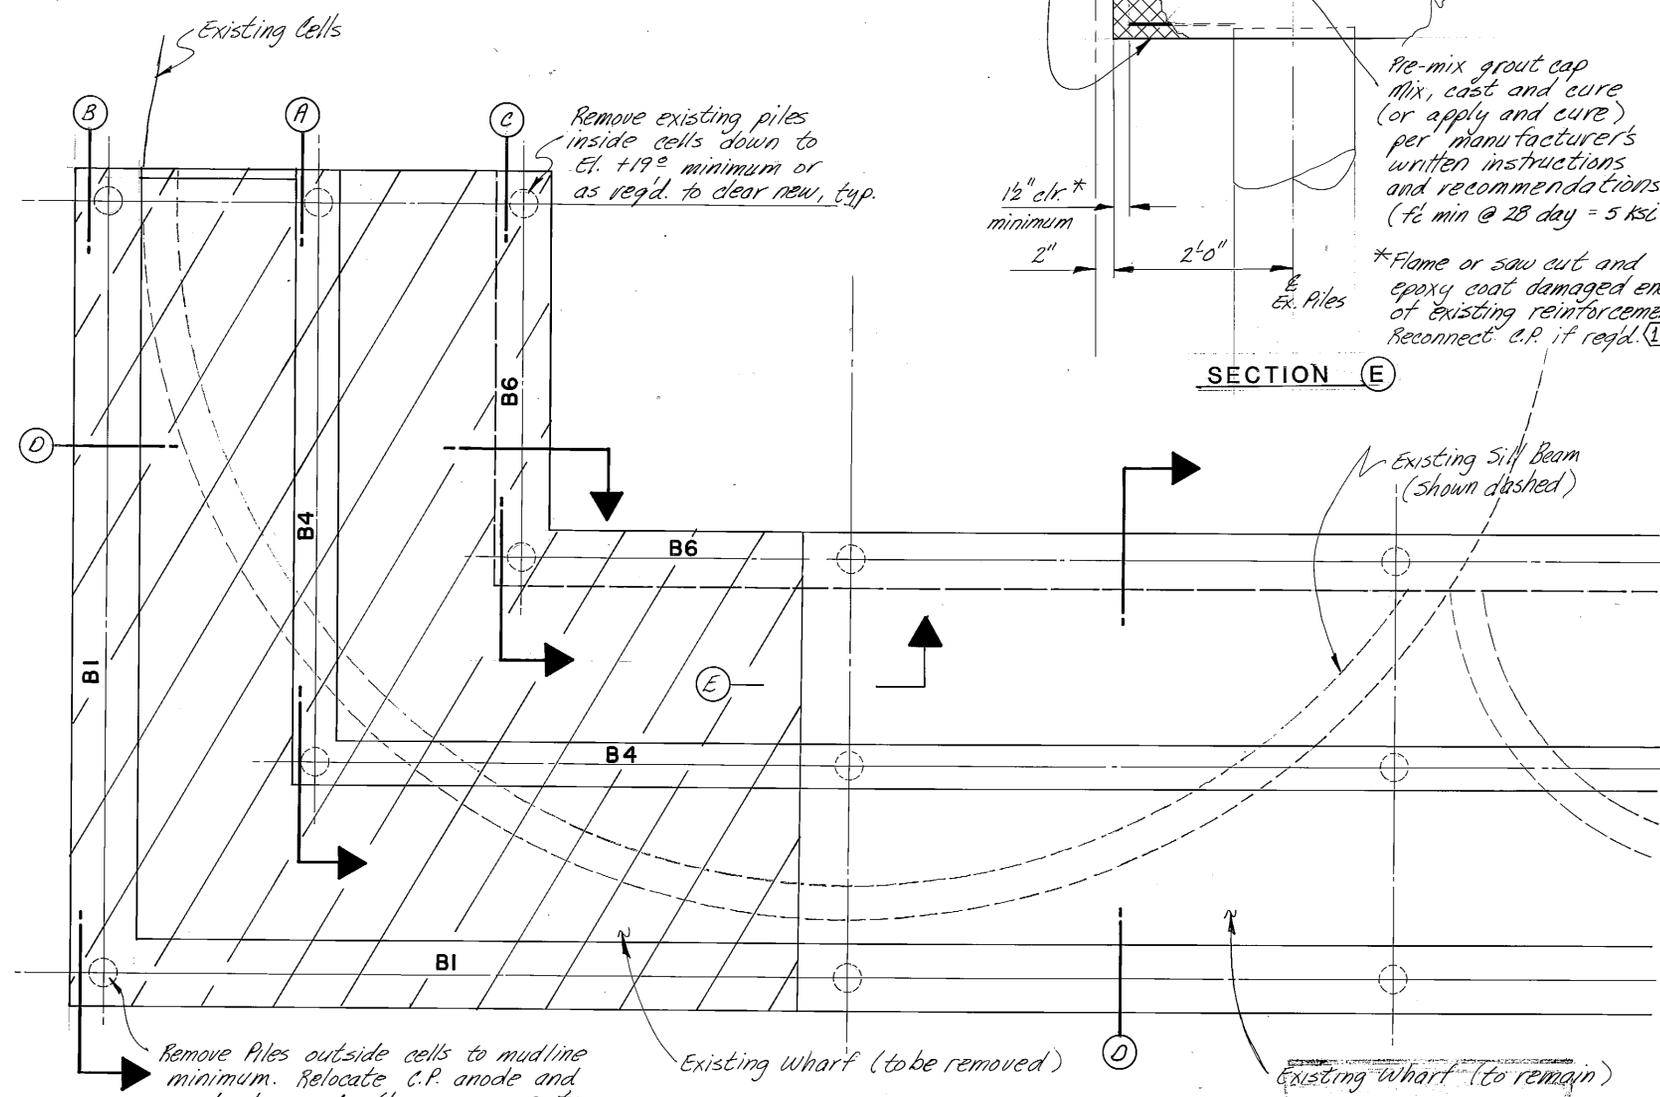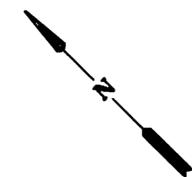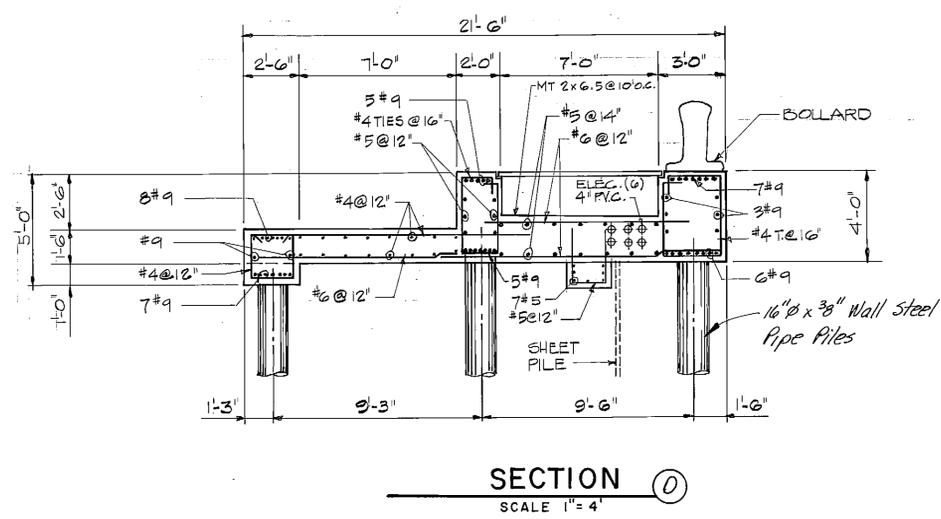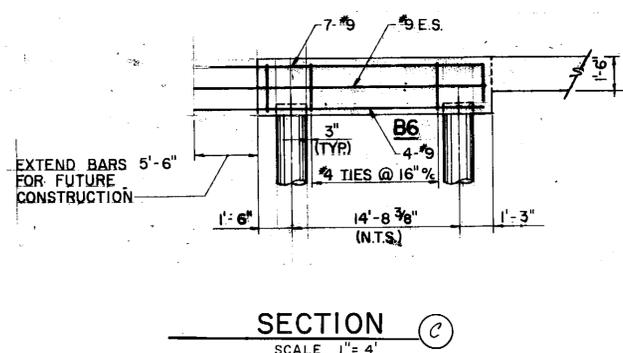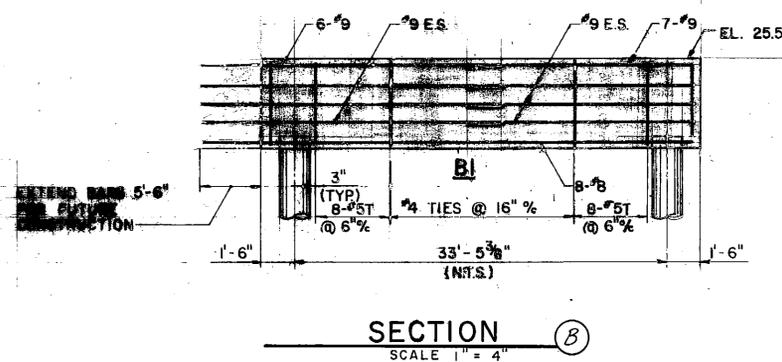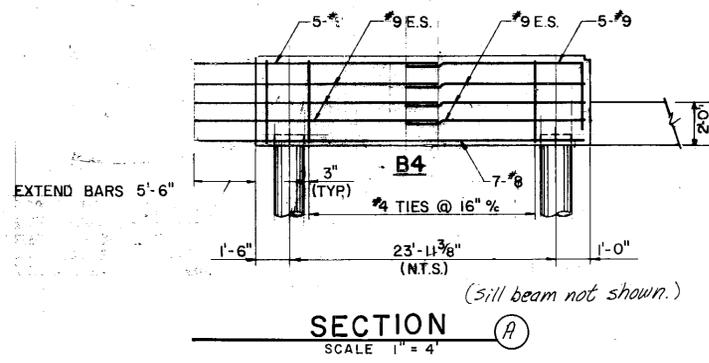

PLAN VIEW
EXISTING CONDITIONS

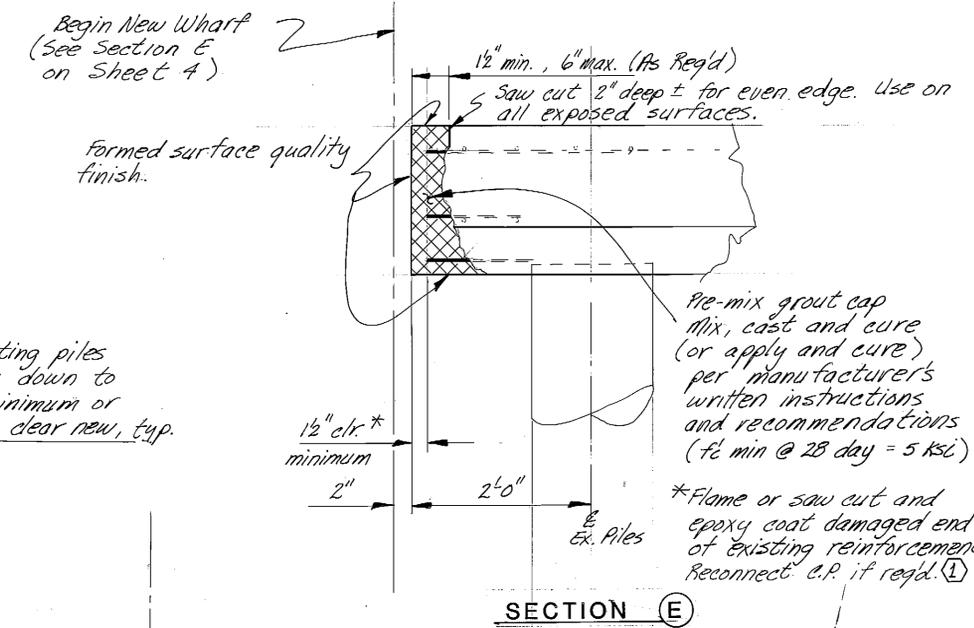
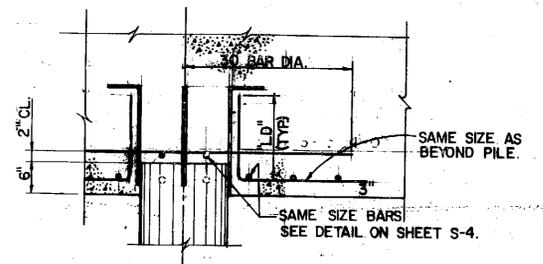


AS-BUILT
Date: 12-86

- NOTES:
- Existing Cathodic Protection Sys. to be relocated as reqd. to make way for new. Not shown - See Sheets 20-22
 - Existing timber pile, steel waled, rubber cushioned fender system, to be removed as required to make way for new. Not shown - See Shets. 4, 8 and 13.

STAMP		DO NOT SCALE THIS DRAWING - USE DIMENSIONS	
STATE OF ALASKA DEPARTMENT OF TRANSPORTATION AND PUBLIC FACILITIES			
Ketchikan		Alaska	
EXISTING WHARF REMOVAL AND DETAILS			
DESIGNED <i>steff</i>	CHECKED <i>LB</i>	DRAWN <i>gand</i>	DATE <i>Nov-85</i>
PROJECT NUMBER <i>30-X-70040</i>	SHEET <i>12</i>		OF <i>24</i>
11-22-85			



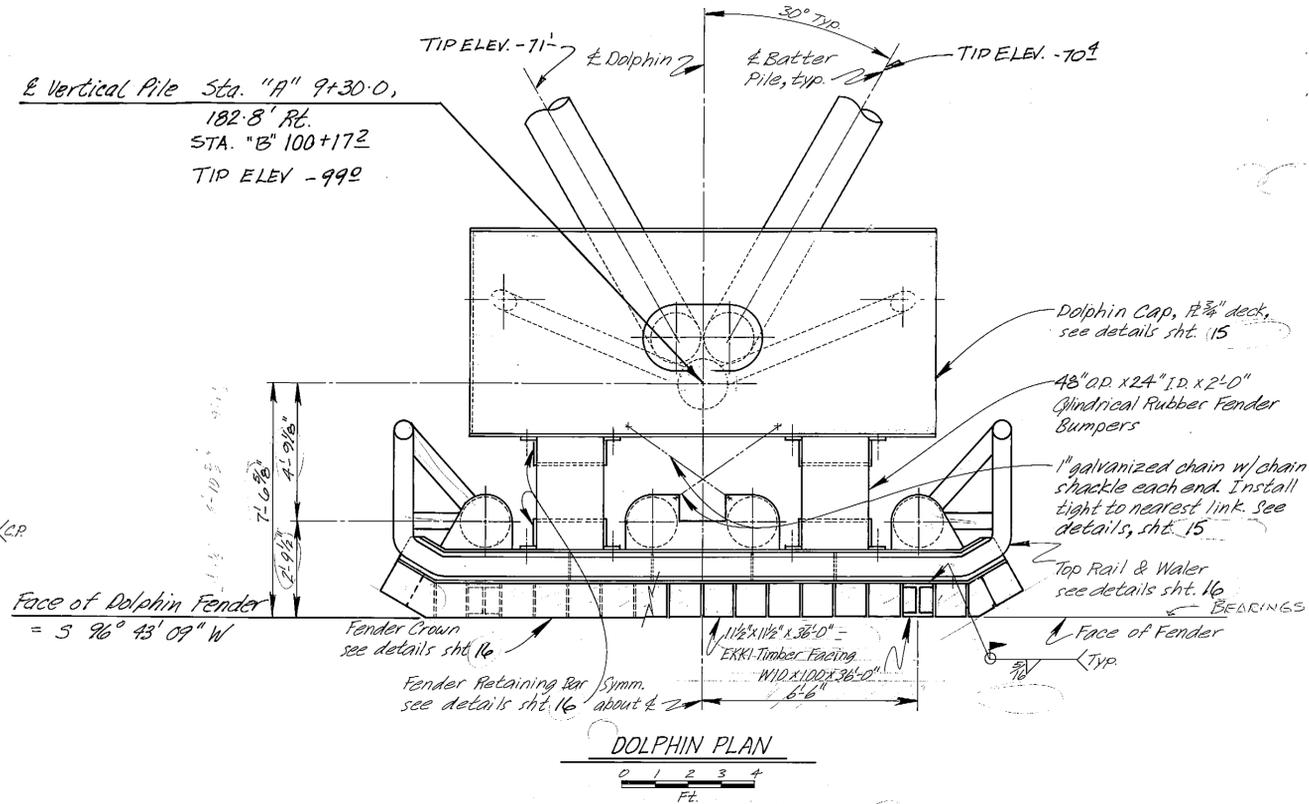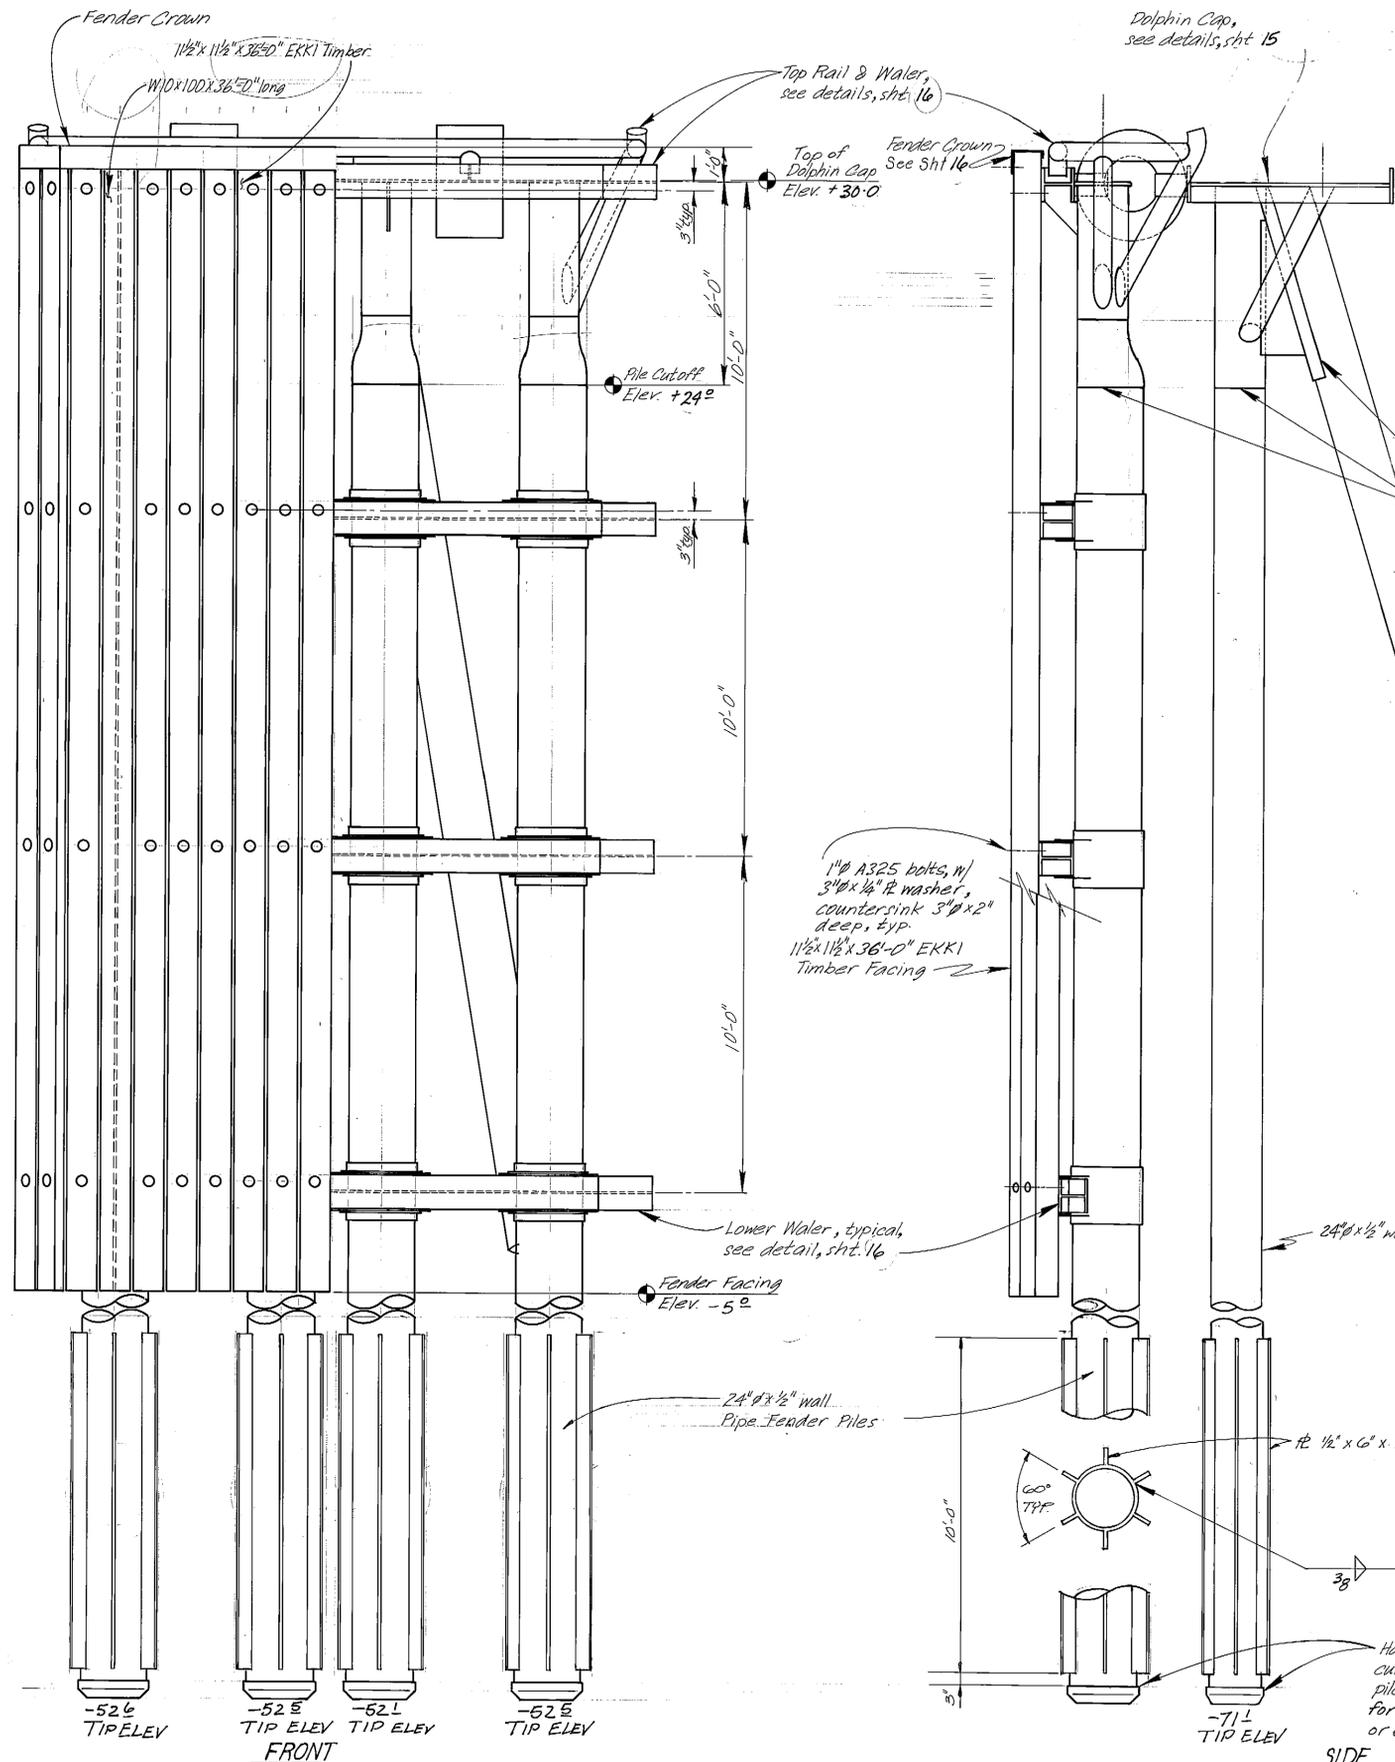

1" A325 bolts, w/
3" x 1/4" R washer,
counter sink 3" x 2"
deep, typ.
1 1/2 x 1 1/2 x 36'-0" EKKI
Timber Facing

Face of Dolphin Fender
= 5' 9 1/2" x 43' 09" W

DOLPHIN PLAN
0 1 2 3 4
Ft.

AS-BUILT
Date: 12-86


-52 6 TIP ELEV
-52 E TIP ELEV
-52 L TIP ELEV
-52 S TIP ELEV

ELEVATION
0 1 2 3 4
Ft.


-71 L TIP ELEV
-70 1/2 TIP ELEV

SIDE


Hardened steel open end
cutting shoe, typ all
piles. APF 0-14000 or equal
for vertical piles, APF 0-14001
or equal for batter piles.

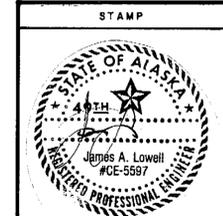

DO NOT SCALE THIS DRAWING - USE DIMENSIONS			
STATE OF ALASKA DEPARTMENT OF TRANSPORTATION AND PUBLIC FACILITIES			
Katakikan		Alaska	
DOLPHIN PLAN & ELEVATIONS			
DESIGNED <i>JS</i>	CHECKED <i>EAS</i>	DRAWN <i>LVB-G</i>	DATE 6/84-11/85
PROJECT NUMBER X70010	SHEET 14		OF 24

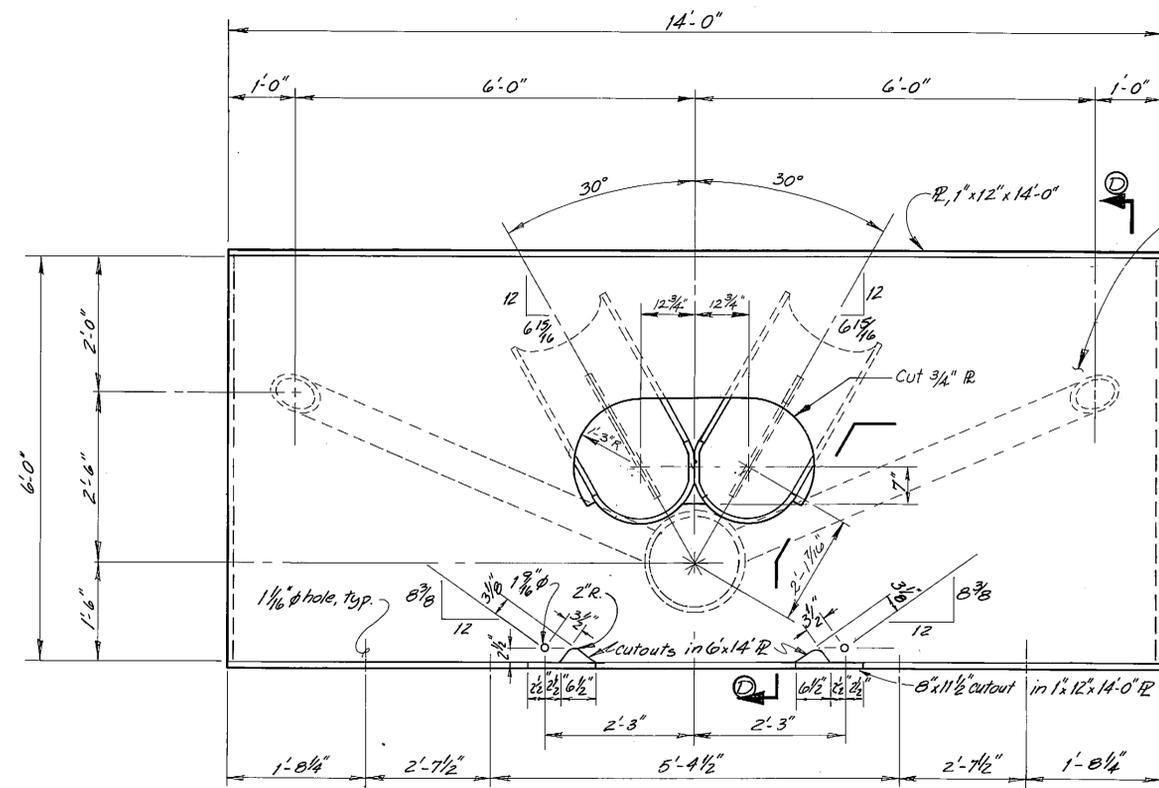


DOLPHIN CAP DETAILS
3/4" = 1'-0"

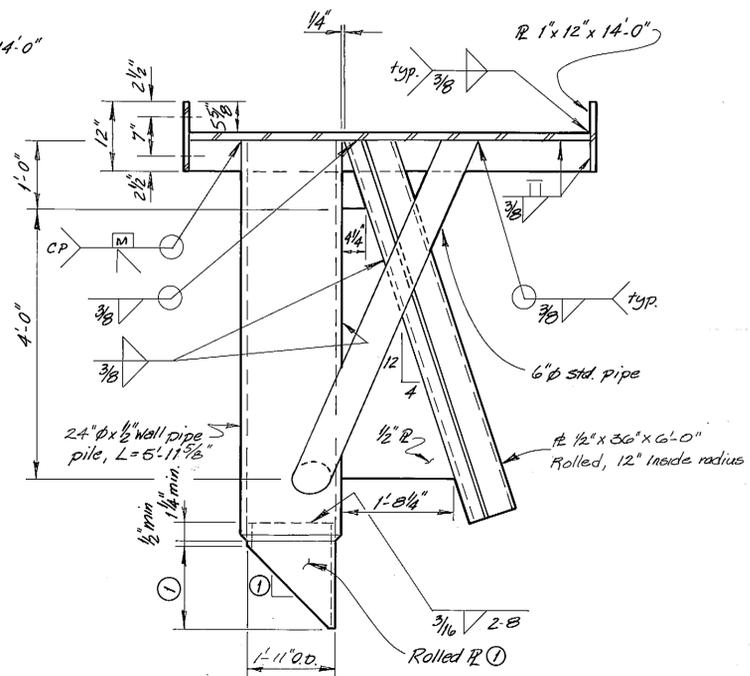


① Contractor's option (fab. and shape) 1/4" R min.

SECTION D-D
3/4" = 1'-0"

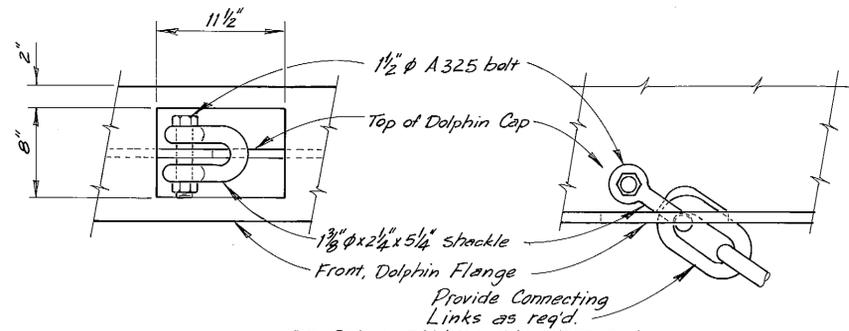


DOLPHIN CHAIN CONNECTION
N.T.S.

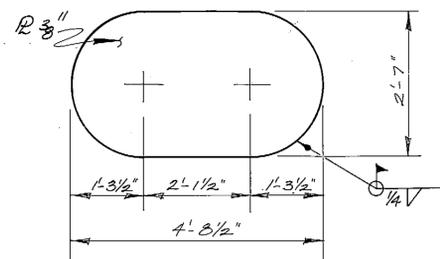

COVER PLATE DETAIL
3/4" = 1'-0"

AS-BUILT
Date: 12-86

STAMP		DO NOT SCALE THIS DRAWING - USE DIMENSIONS	
STATE OF ALASKA DEPARTMENT OF TRANSPORTATION AND PUBLIC FACILITIES			
Ketchikan		Alaska	
DOLPHIN CAP DETAILS			
DESIGNED <i>JS</i>	CHECKED <i>BFS</i>	DRAWN <i>WJB-G</i>	DATE <i>11-85</i>
PROJECT NUMBER <i>X70010</i>	SHEET <i>15</i> OF <i>24</i>		

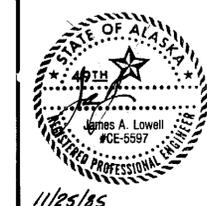


11/25/85






DOLPHIN A
STA. "A" 13+13.84
Symmetrical about

DOLPHIN A		DOLPHIN B	
PILE NO.	TIP ELEV.	PILE NO.	TIP ELEV.
1	-87.4	1	-79.2
2	-68.6	2	-85.3
3	-69.2	3	-83.0
4	-78.8	4	-85.1
5	-81.0	5	-78.5


TIP ELEV. CORRECTED FOR BATTER

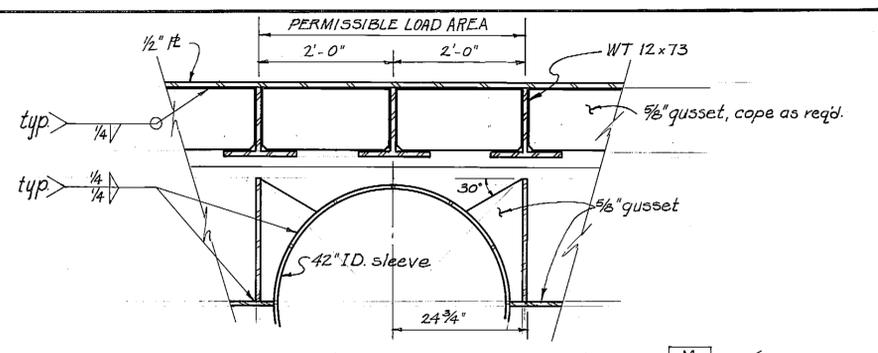

- NOTES:**
1. Permissible load area refers to allowable area within which to situate connection hardware for drydock. Connection to be made by others.
 2. Exact location of drydock restraint dolphin - B - to be verified by drydock mfg. Locations shown are preliminary and subject to change.

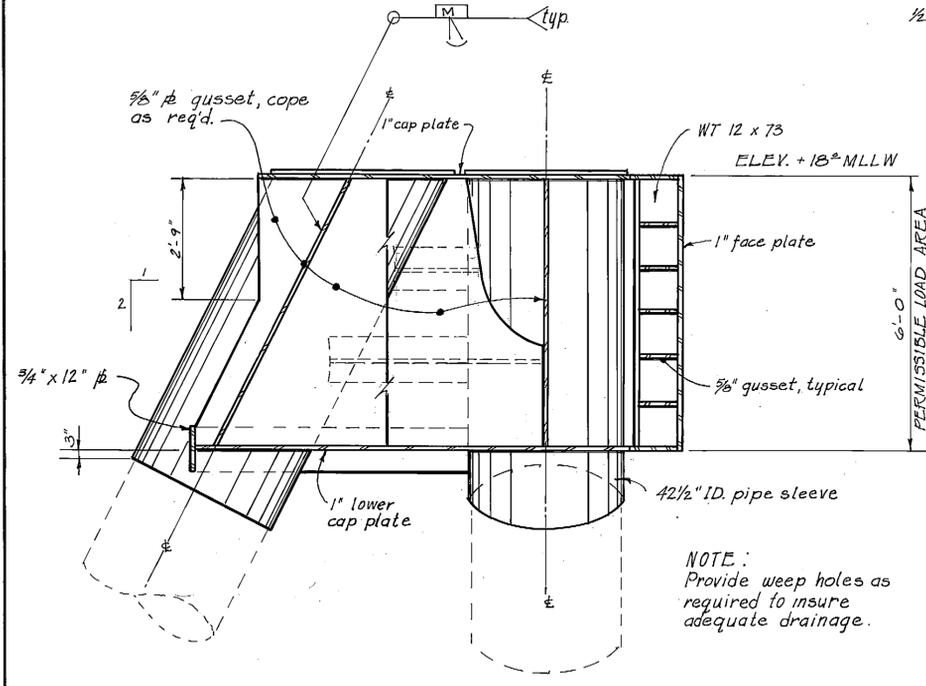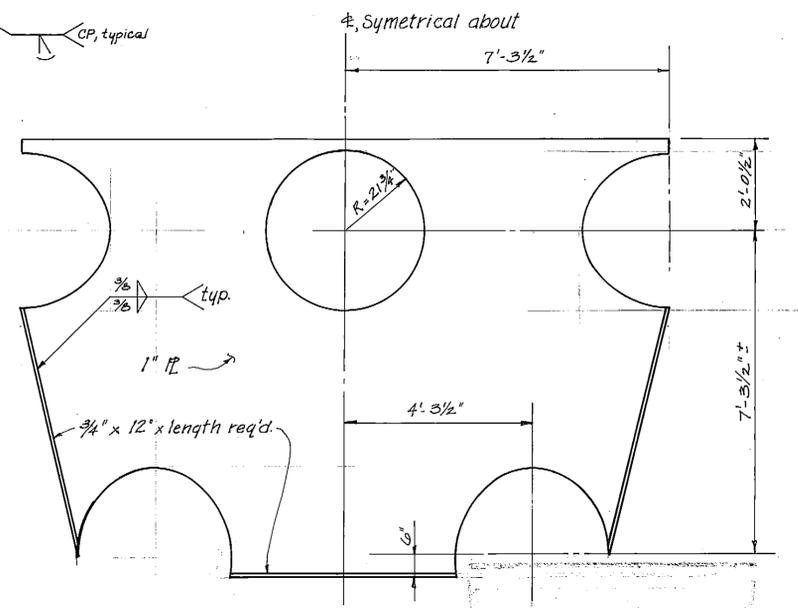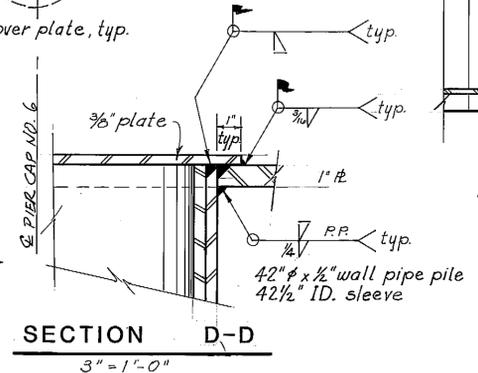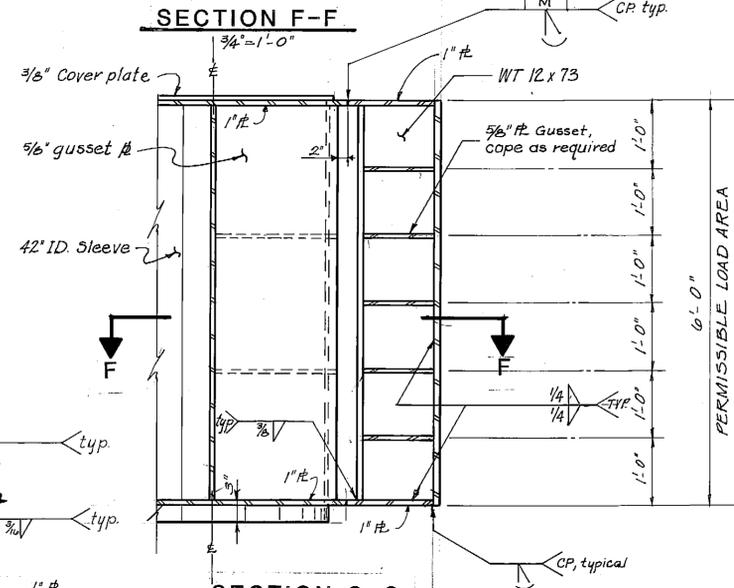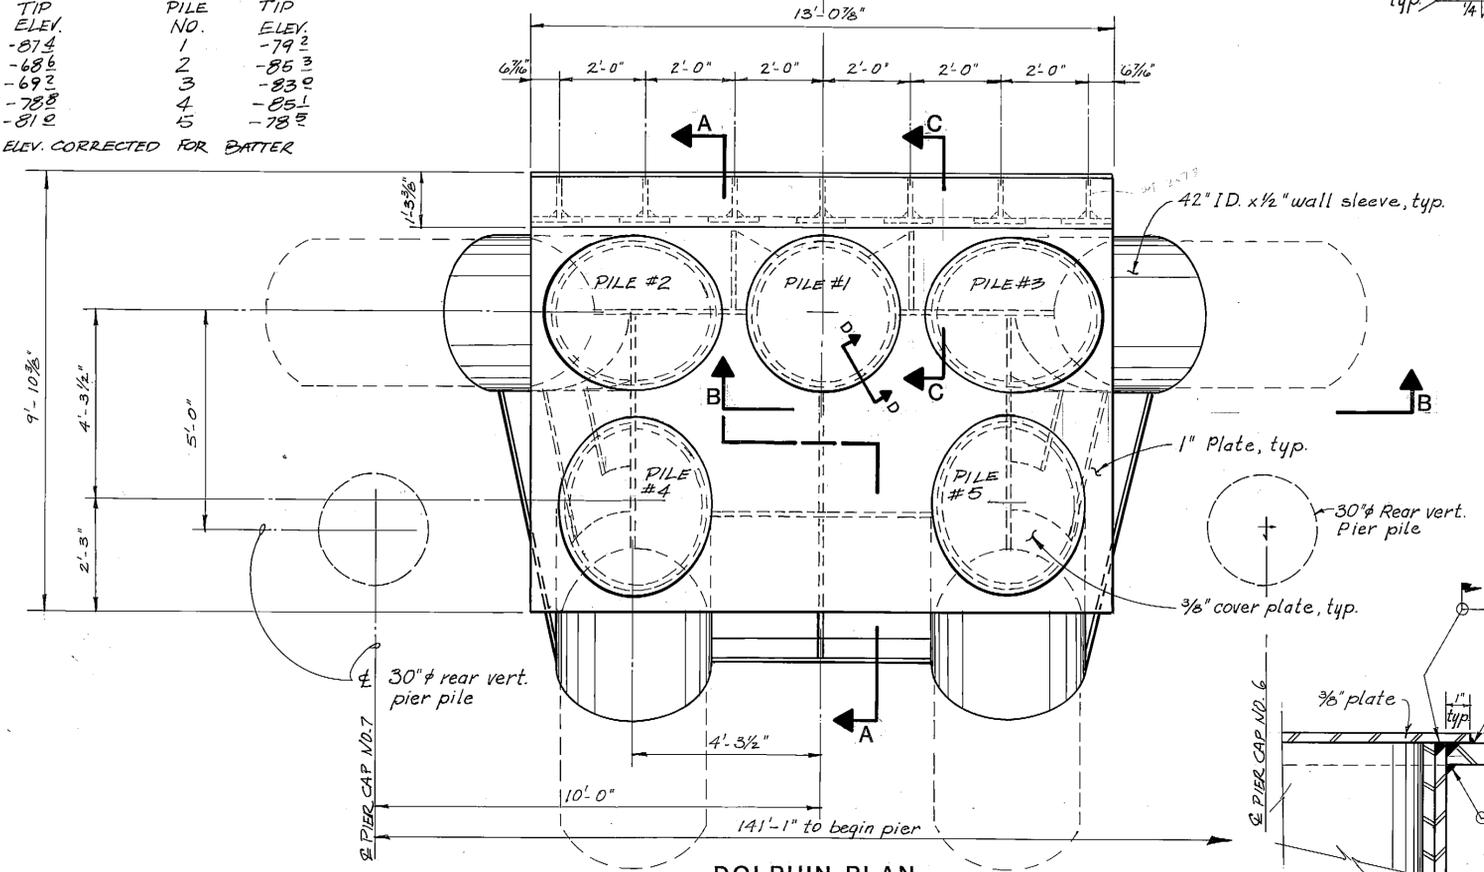

NOTE: Provide weep holes as required to insure adequate drainage.

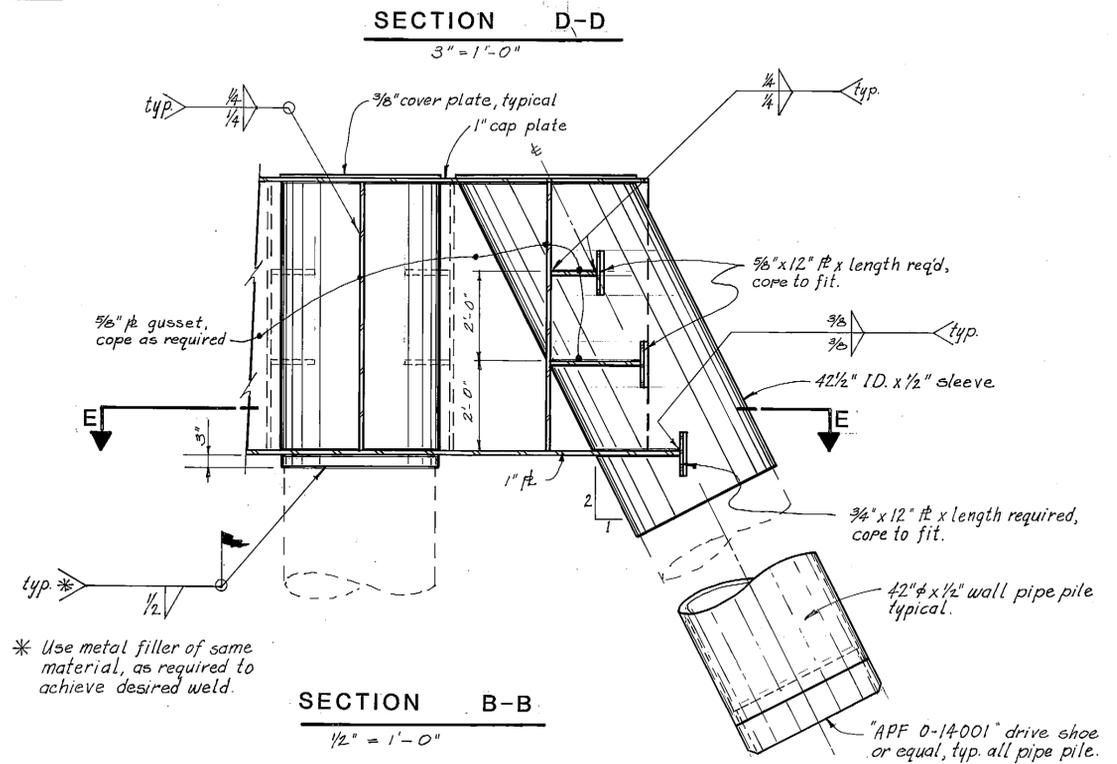


* Use metal filler of same material, as required to achieve desired weld.


VIEW E-E
Lower Cap Plate
1/2" = 1'-0"

AS-BUILT
Date: 12-86

	DO NOT SCALE THIS DRAWING - USE DIMENSIONS			
	STATE OF ALASKA DEPARTMENT OF TRANSPORTATION AND PUBLIC FACILITIES			
	Ketchikan		Alaska	
DRYDOCK DOLPHIN				
DESIGNED JAL	CHECKED JAL/B	DRAWN JAL/G	DATE 11-85	
PROJECT NUMBER X70010	SHEET 17		OF 24	

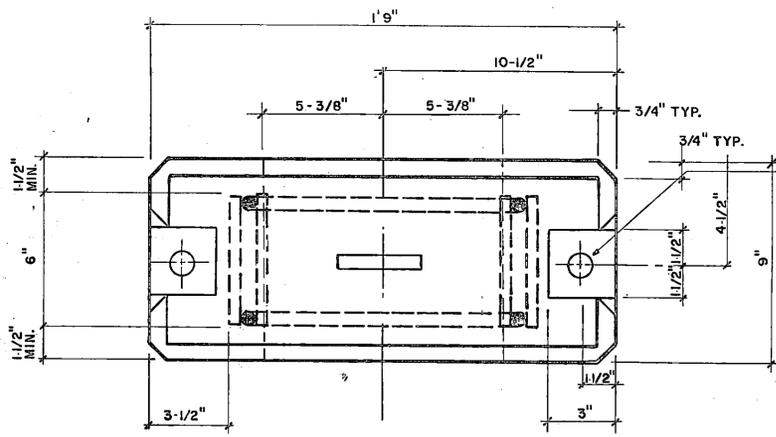


TOP

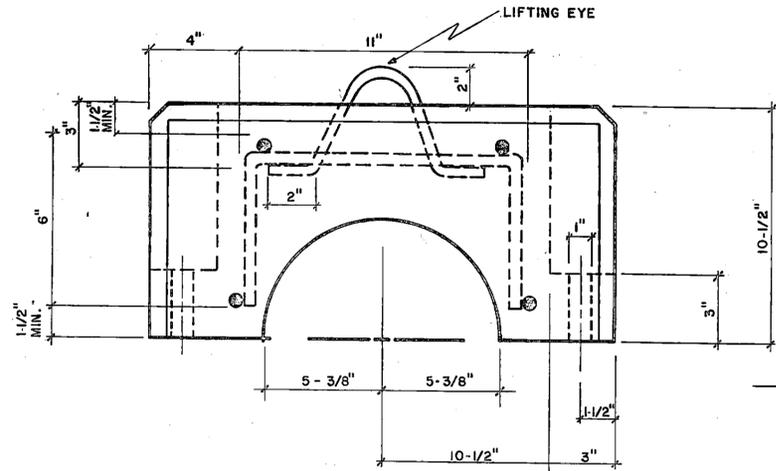


FRONT

CONCRETE PIPE ANCHOR
N.T.S.

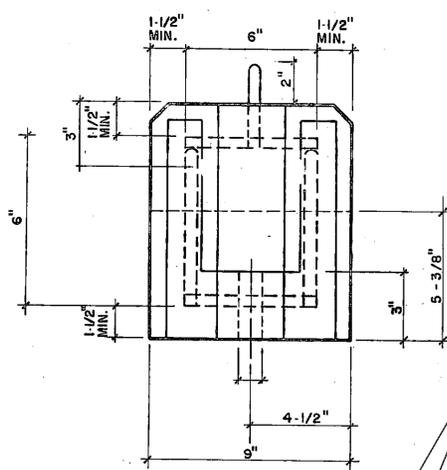

SIDE

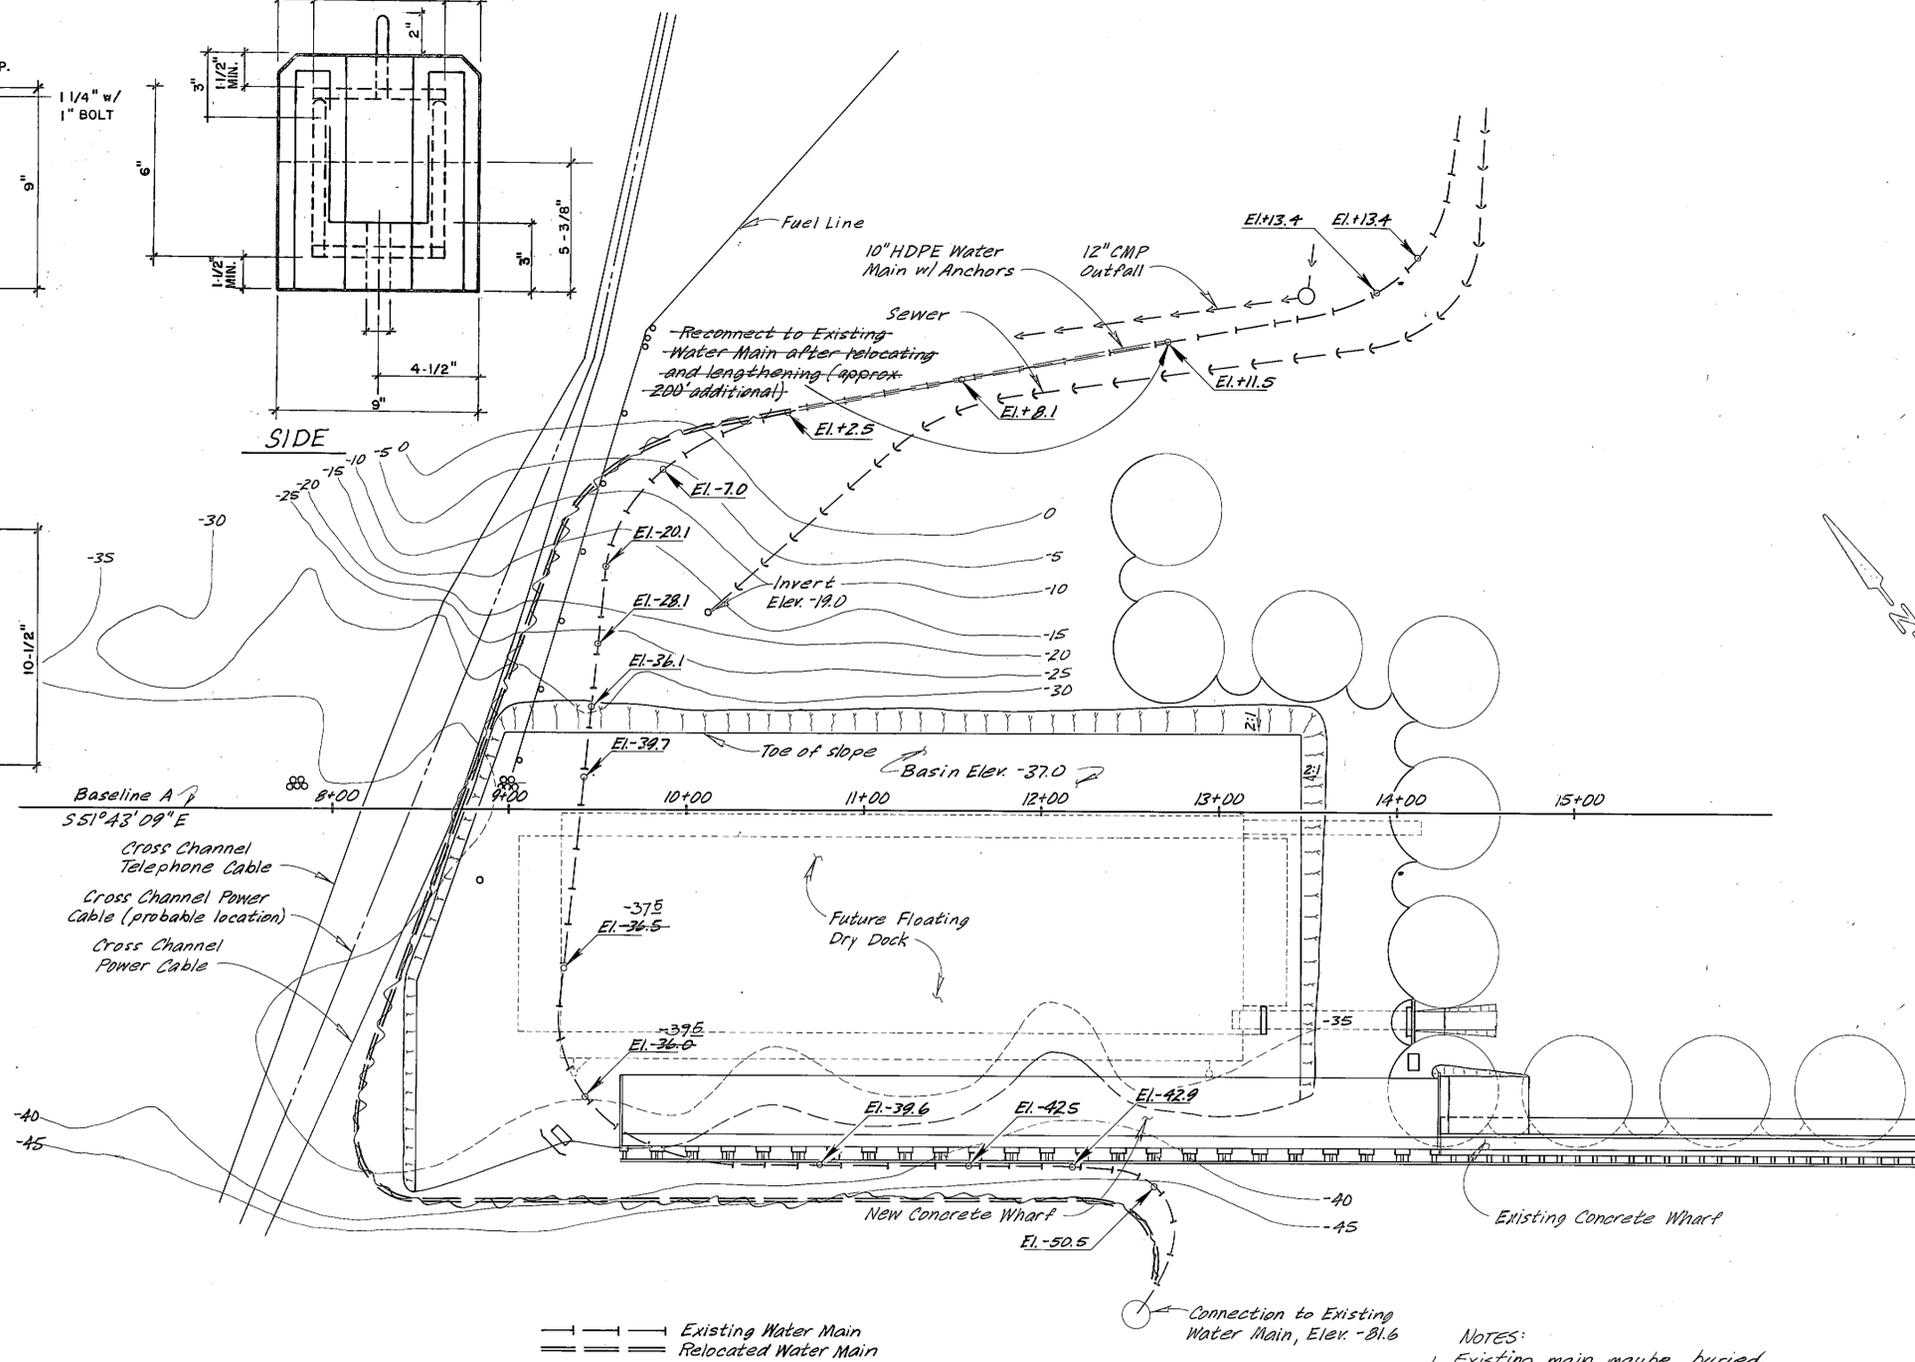

Existing Water Main
Relocated Water Main



EXISTING WATERLINE NOT DISTURBED


- CONCRETE ANCHOR NOTES:
1. REINFORCING STEEL SHALL BE #6 DEFORMED BARS.
 2. EXPOSED EDGES SHALL HAVE A 3/4" CHAMFER AS SHOWN.
 3. ANCHORS ARE SYMMETRICAL ABOUT CENTERLINES.
 4. EACH ANCHOR CONSISTS OF A TOP AND BOTTOM HALF. THE HALVES SHALL BE BOLTED TOGETHER WITH 1" DIA. X 8" LONG STAINLESS STEEL BOLT WITH STAINLESS STEEL WASHER UNDER THE BOLT HEAD AND NUT.
 5. PRIOR TO BOLTING THE ANCHOR ON TO THE PIPE, THE PIPE SHALL BE WRAPPED IN A 1/8" THICK RUBBER GASKETING MATERIAL AT EACH ANCHOR LOCATION TO PROTECT THE PIPE.
 6. THE LIFTING EYE SHALL BE #6 REINFORCING BAR.

AS-BUILT
Date: 12-26


- NOTES:
1. Existing main maybe buried.
 2. Elev. shown along existing are approximate.
 3. Relocation alignment is approximate.
 4. Contractor shall bury new pipe above elev. -5. Below elev. -10 pipe may be laid on the bottom, except in curves where pipe shall be buried 2' minimum.

STAMP		DO NOT SCALE THIS DRAWING - USE DIMENSIONS	
STATE OF ALASKA DEPARTMENT OF TRANSPORTATION AND PUBLIC FACILITIES			
Ketchikan		Alaska	
WATER LINE RELOCATION			
DESIGNED <u>B</u>	CHECKED <u>BAS</u>	DRAWN <u>LJB</u>	DATE <u>11/85</u>
PROJECT NUMBER <u>X10010</u>	SHEET <u>18</u>	OF <u>24</u>	




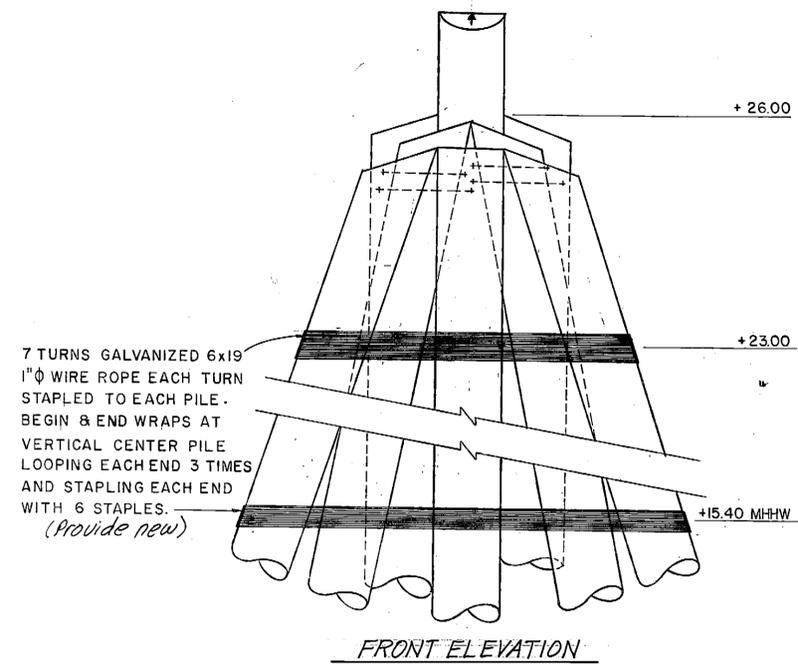

FRONT ELEVATION

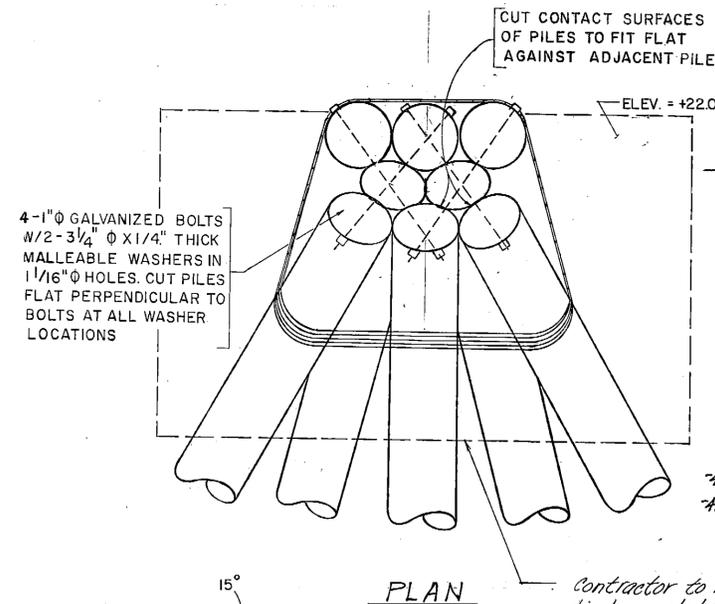


PLAN

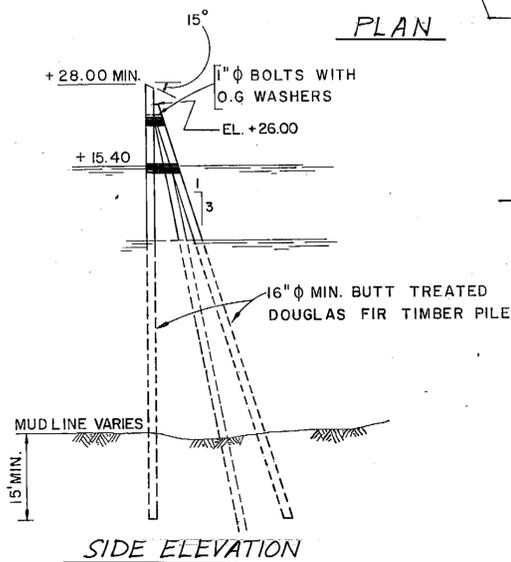


SIDE ELEVATION

OIL BARGE MOORING DOLPHIN
N.T.S.

Contractor to re-install 8'x12' timber platform (provide new as req'd)



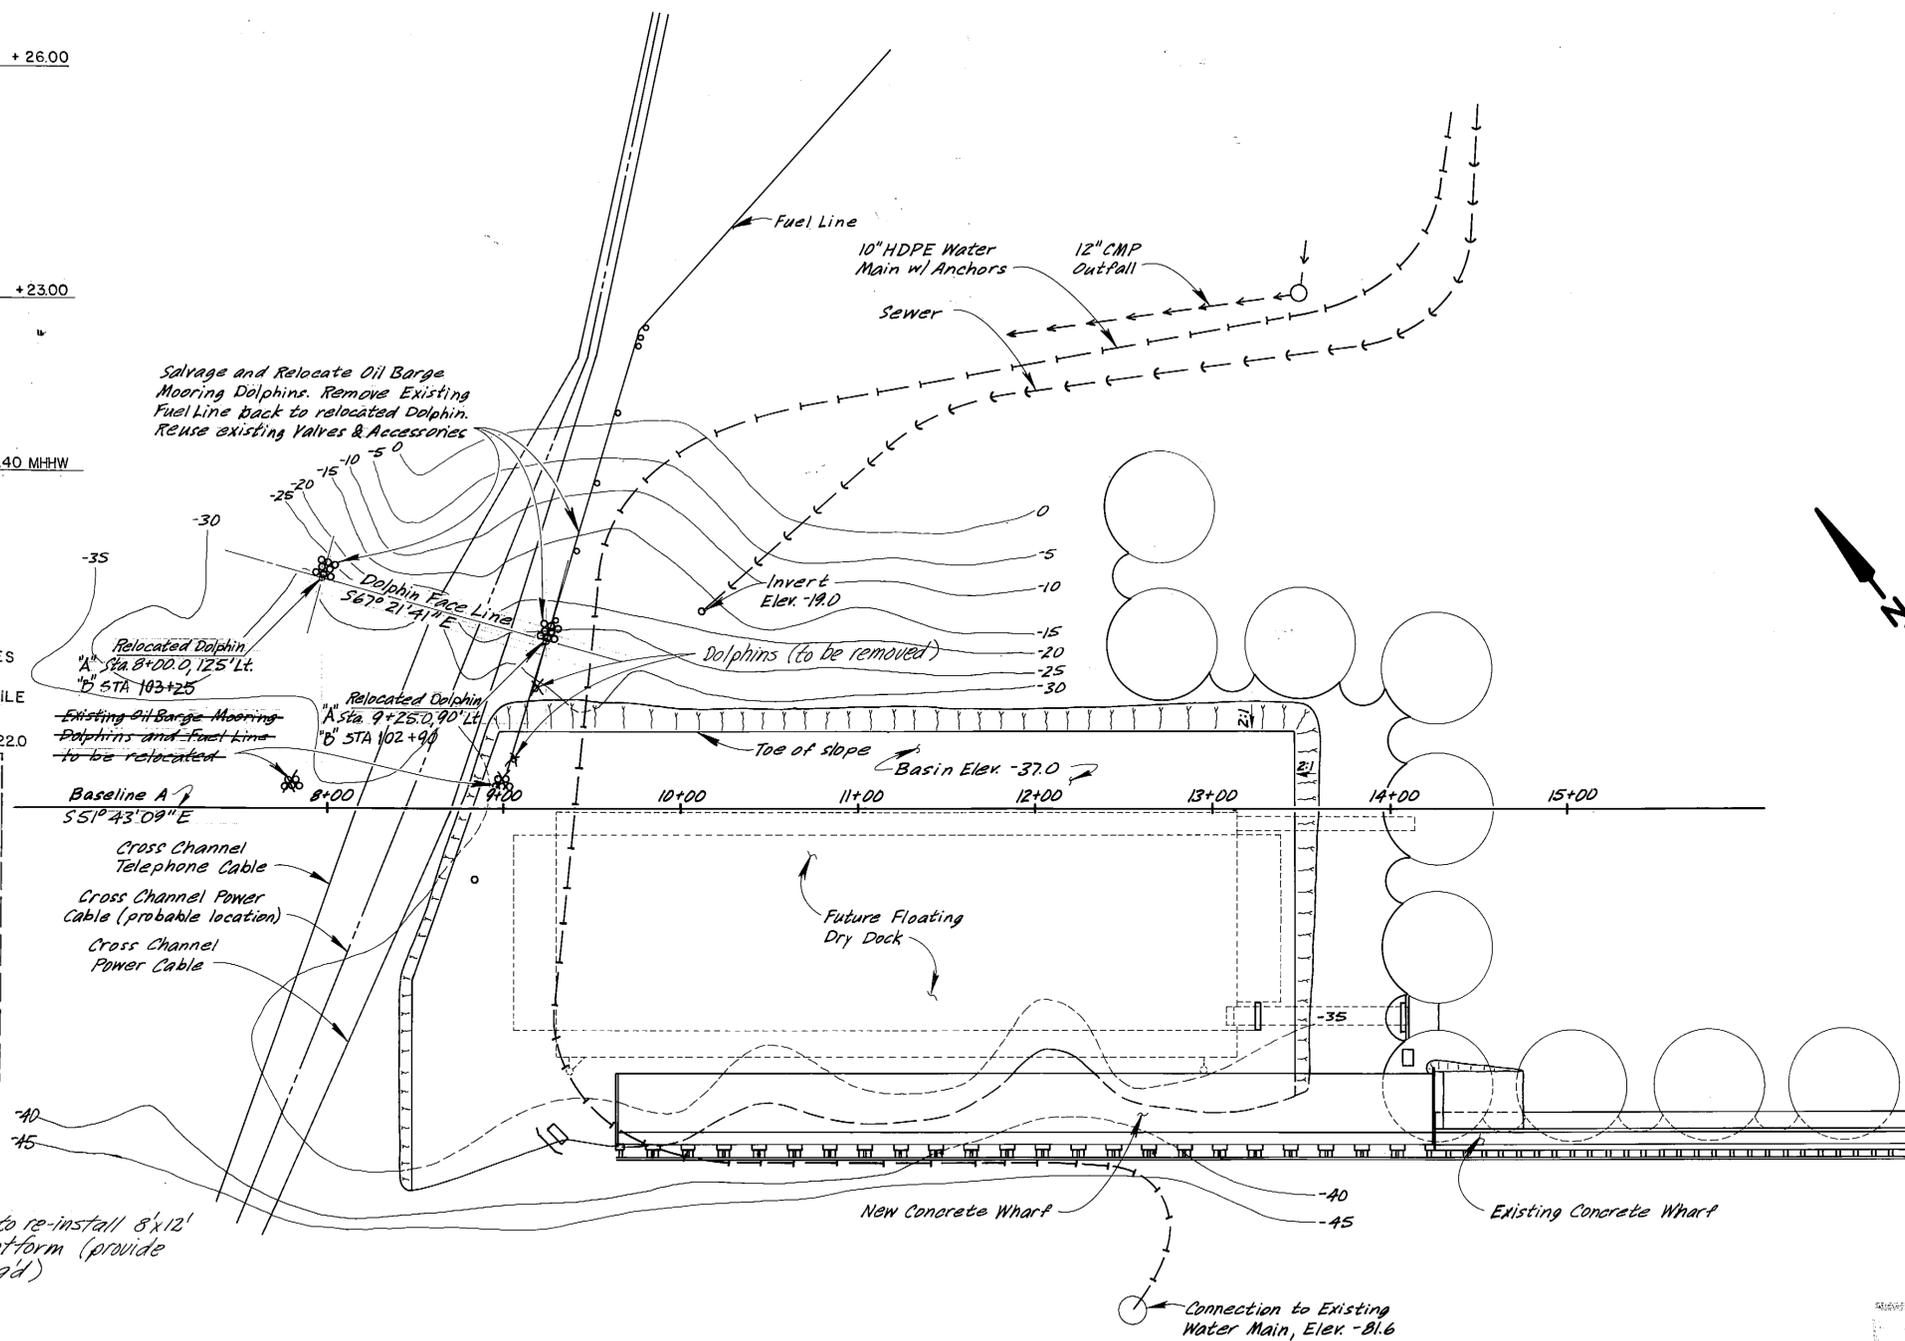


SITE PLAN

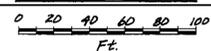


AS-BUILT
Date: 12-86

STAMP		DO NOT SCALE THIS DRAWING - USE DIMENSIONS	
		STATE OF ALASKA	
		DEPARTMENT OF TRANSPORTATION AND PUBLIC FACILITIES	
		Ketchikan	Alaska
MOORING DOLPHIN & FUEL LINE RELOCATION			
DESIGNED	LJB	CHECKED	JS
DRAWN	LJB	DATE	11/85
PROJECT NUMBER	X70010	SHEET	19 OF 24

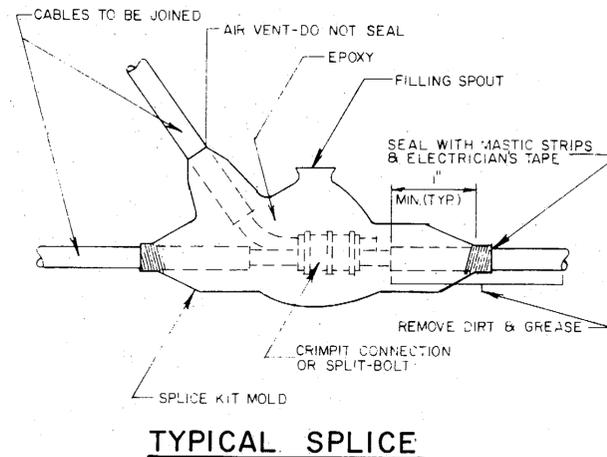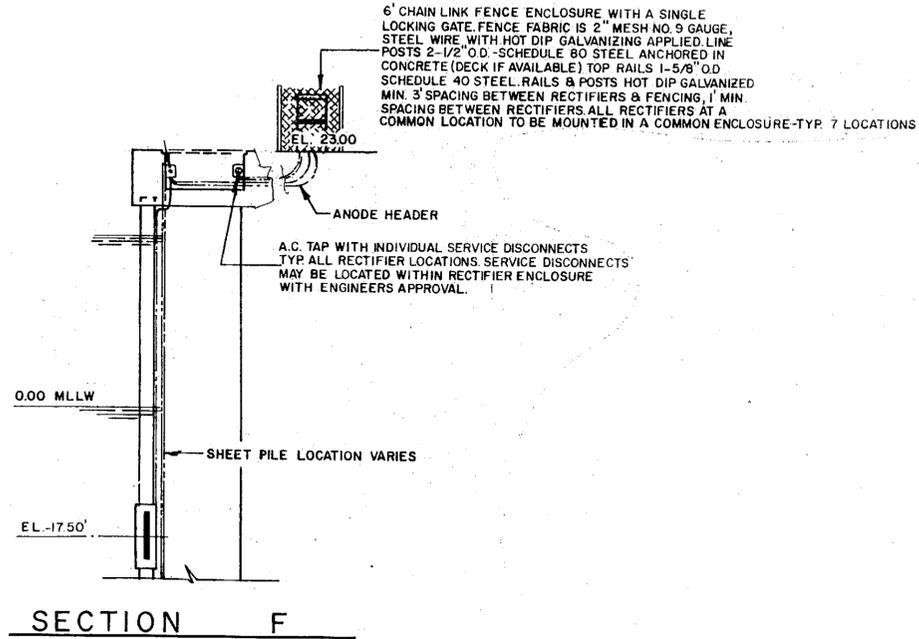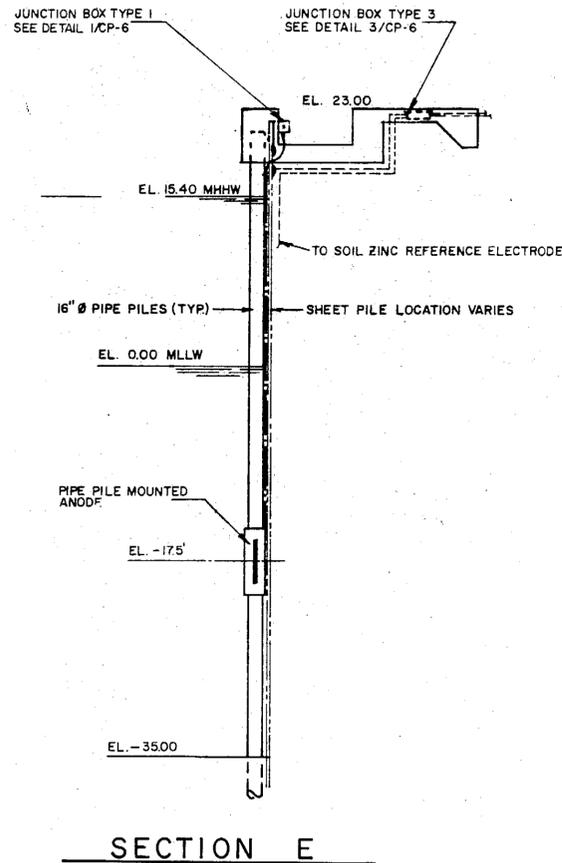

- LEGEND**
- ANODE HEADER SPLICE
 - INDICATES PIPE PILE
 - ➔ INDICATES BATTERED PIPE PILE AND DIRECTION OF BATTER
 - ANODE JUNCTION BOX
 - ⊙ ZINC REFERENCE ELECTRODE - SOIL
 - CANISTER ANODE (3" Ø)
 - ⊖ PIPE MOUNTED ANODE - PAIR
 - ⊖ PIPE MOUNTED ANODE - SINGLE } BOLD FACE INDICATES ANODE ELEMENT LOCATION
 - ANODE JUNCTION BOX
 - △ ANODE JUNCTION BOX
 - ⊙ ZINC REFERENCE ELECTRODE - MARINE
 - ⊠ RECTIFIER, SIZE INDICATED IN LOWER RIGHT
 - ⊗ ANODE SLED
 - ⊗ CANISTER ANODE (2 1/2" Ø)

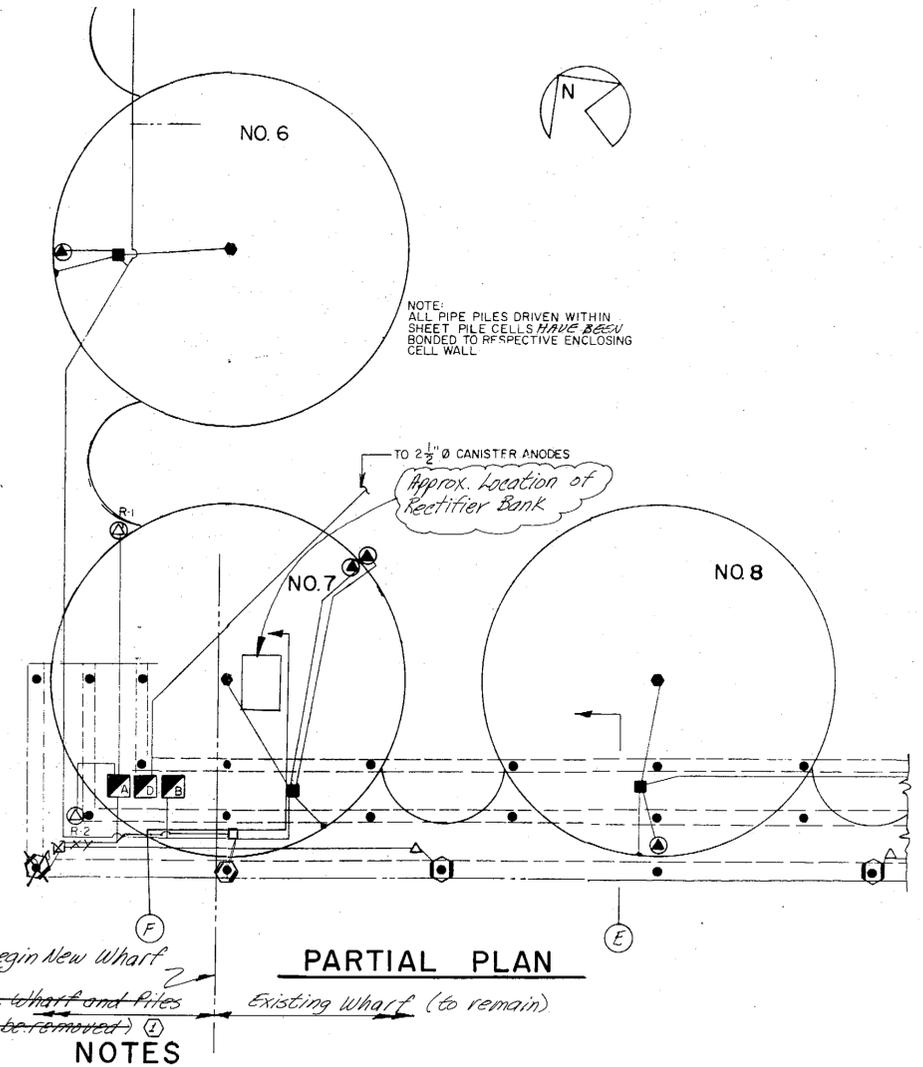


- NOTES**
- USE NO. 2/0 AWG THW 1/2 STRANDED COPPER THIS LOCATION
- TO NEGATIVE ARM ON DOCK
- USE NO. 350 MCM THW 1/2 STRANDED COPPER TO NEGATIVE ARM ON DOCK
- NEGATIVE BONDING WIRING SCHEDULE**
- NO. 4/0 AWG THW 1/2 STRANDED COPPER OR TWO EACH NO. 6 DEFORMED BILLET STEEL BARS WITH WELDED SPLICES EPOXY COATED - NO WIRE TIES ALLOWED
 - NO. 2/0 AWG THW 1/2 STRANDED COPPER OR TWO EACH NO. 4 DEFORMED BILLET STEEL BARS WITH WELDED SPLICES EPOXY COATED - NO WIRE TIES ALLOWED
 - NO. 6 AWG HMW/PE 1/2 STRANDED COPPER OR ONE NO. 4 EPOXY COATED DEFORMED BILLET STEEL BARS WITH WELDED SPLICES EPOXY COATED - NO WIRE TIES ALLOWED
- ANODE WIRING SCHEDULE**
- SEE ANODE/JUNCTION BOX DETAILS & SCHEMATIC
- NOTE:** ALL BONDING WIRES NOT IMBEDDED IN CONCRETE OR DIRECT BURIED TO BE RUN IN VINYL COATED MILD STEEL RIGID CONDUIT. THOSE WIRES IMBEDDED IN CONCRETE TO HAVE A MINIMUM OF 2" COVER. THOSE WIRES DIRECT BURIED IN BACKFILL TO HAVE A MINIMUM OF 24" COVER. ALL CONDUIT (POSITIVE OR NEGATIVE ARM OR A.C.) IN DIRECT CONTACT WITH SOIL SHALL BE BONDED TO THE CLOSEST SHEET PILE WALL. A SEPARATE NEGATIVE LEAD (STRUCTURE) IS REQUIRED FOR EACH RECTIFIER TO NEAREST PILING OR NEGATIVE STRUCTURAL BONDING.

NOTES:

① Existing CP System is at present un-powered. North Wharf Contractor to relocate and re-connect existing items as required to make way for new work.


DO NOT SCALE THIS DRAWING - USE DIMENSIONS			
STATE OF ALASKA			
DEPARTMENT OF TRANSPORTATION AND PUBLIC FACILITIES			
Ketchikan		Alaska	
EXISTING CATHODIC PROTECTION SYSTEM / DETAILS			
DESIGNED <i>Staff</i>	CHECKED <i>SB</i>	DRAWN <i>Arnal</i>	DATE 11-85
PROJECT NUMBER X70010	SHEET 20 OF 24		

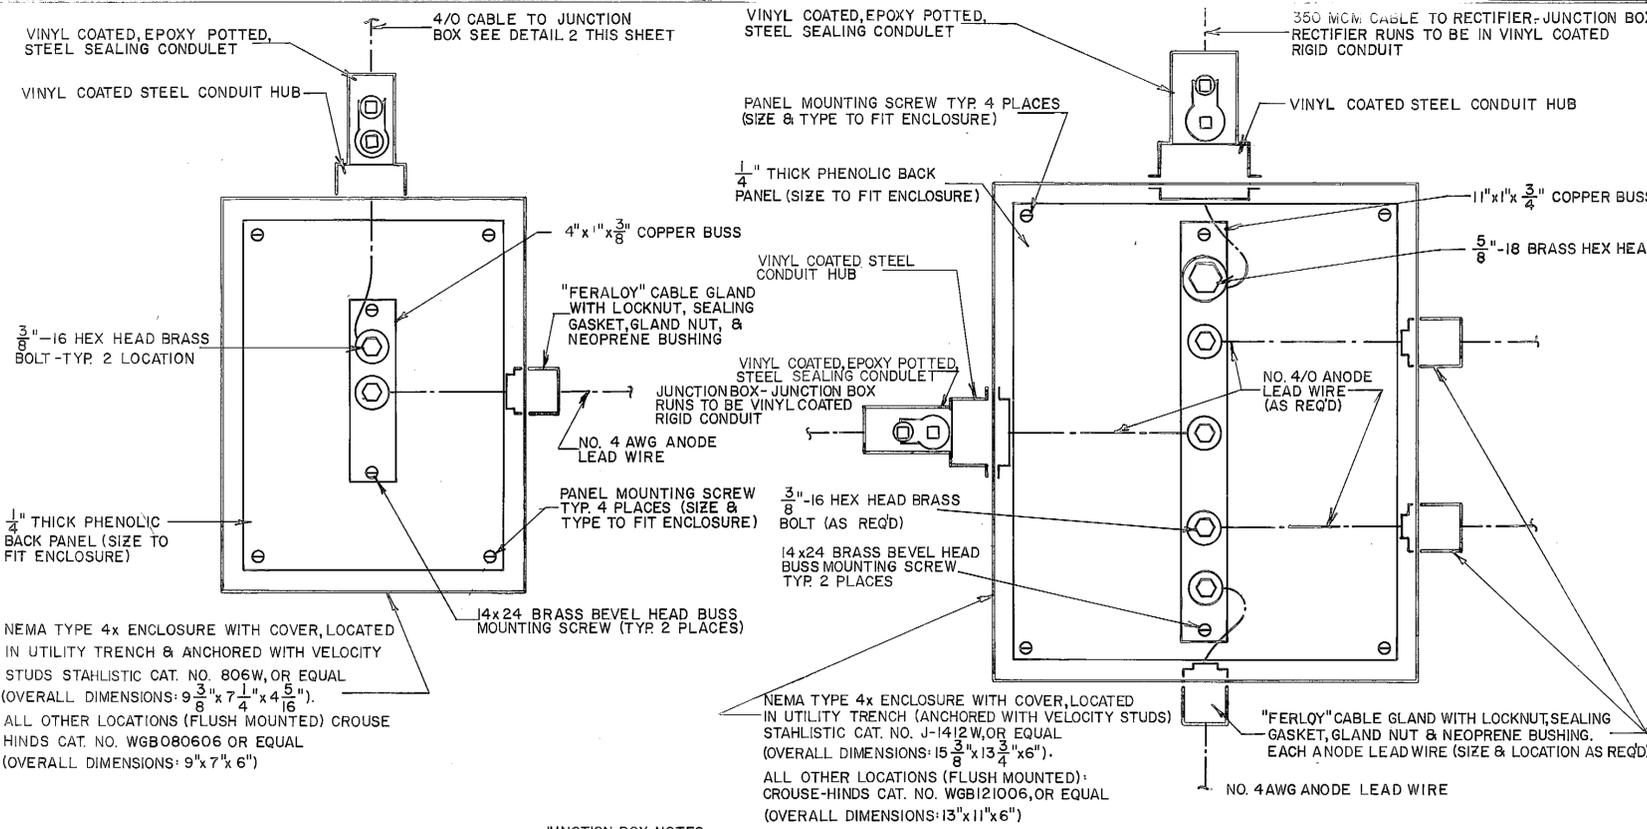



JUNCTION BOX NOTES:
 1) EACH BUSS CONNECTION SHALL BE MADE WITH AN APPROPRIATE SIZED LUG, WHICH WHEN INSTALLED SHALL RUN NO HOTTER THAN THE RUN OR TAP
 2) ALL METAL BODIED JUNCTION BOXES NOT LOCATED IN THE UTILITY TRENCH SHALL BE BONDED TO THE CLOSEST SHEET PILING

JUNCTION BOX TYPE 1 ①


JUNCTION BOX TYPE 2 ②

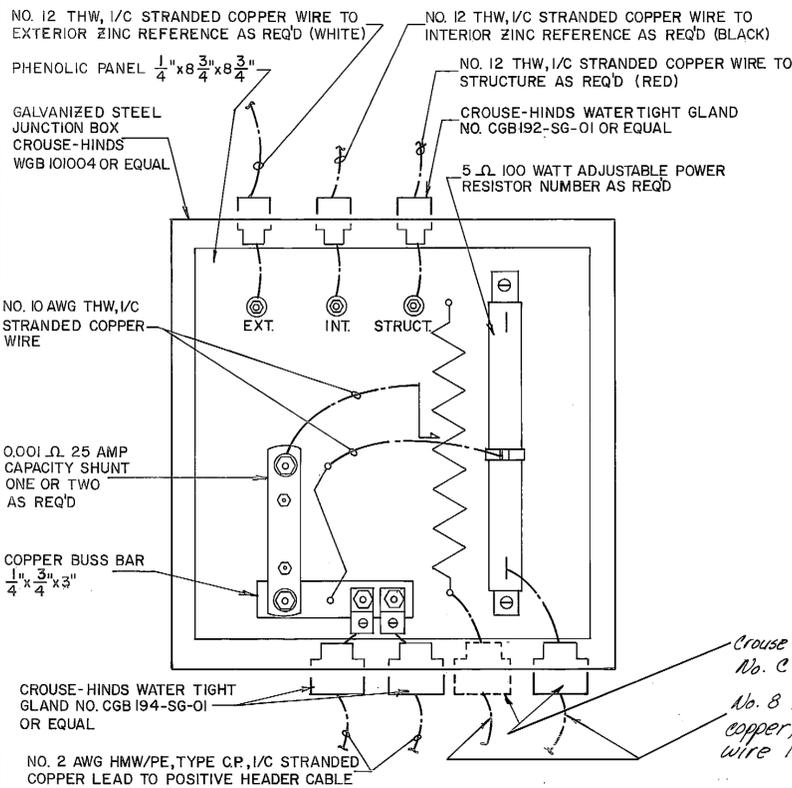


JUNCTION BOX TYPE 3 ③

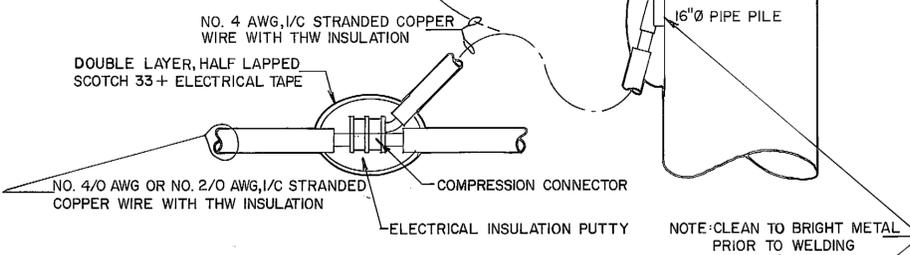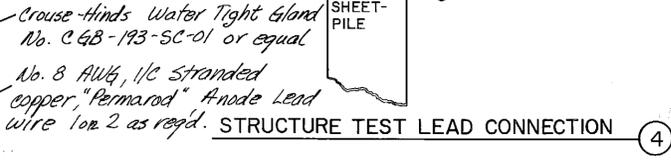


MARINE PIPE PILE NEGATIVE BOND ⑤

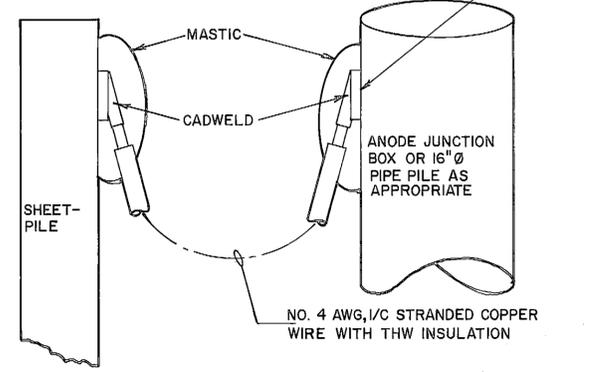


SHEETPILE-PIPE PILE/JUNCTION BOX NEGATIVE BOND ⑥

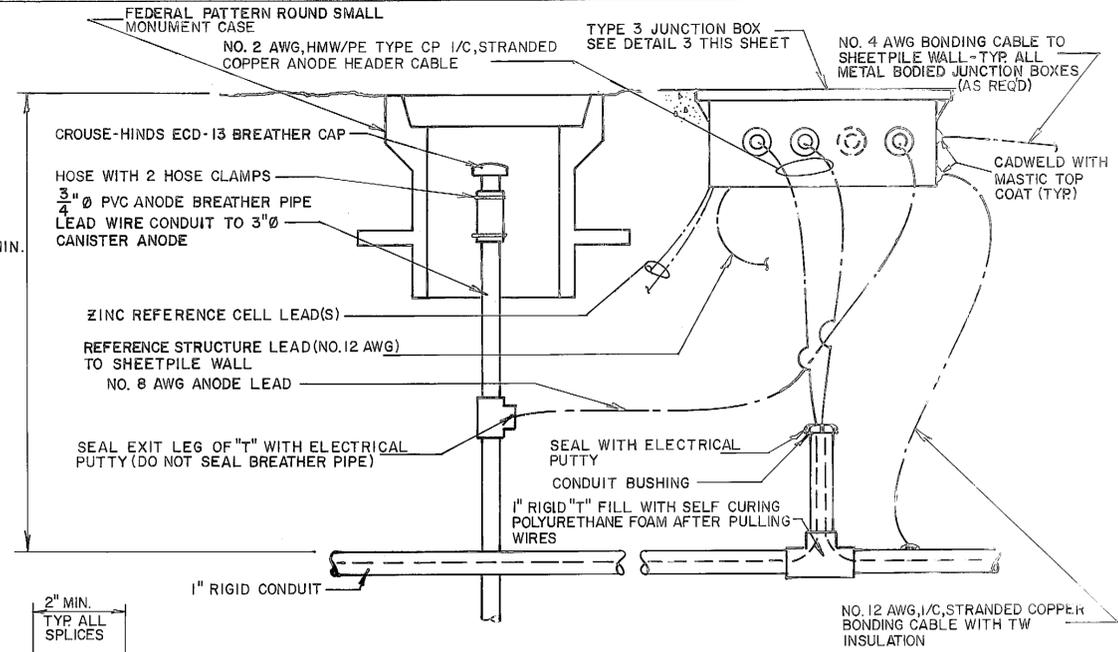

3" CANISTER ANODE BREATHER/JUNCTION BOX TYPE 3 ⑦

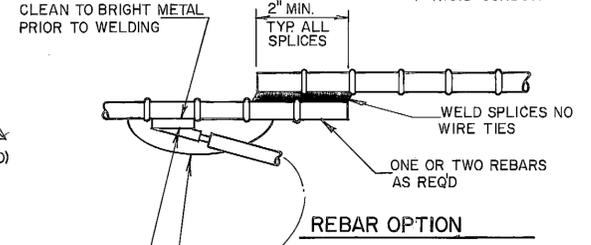

RECTIFIER ⑧

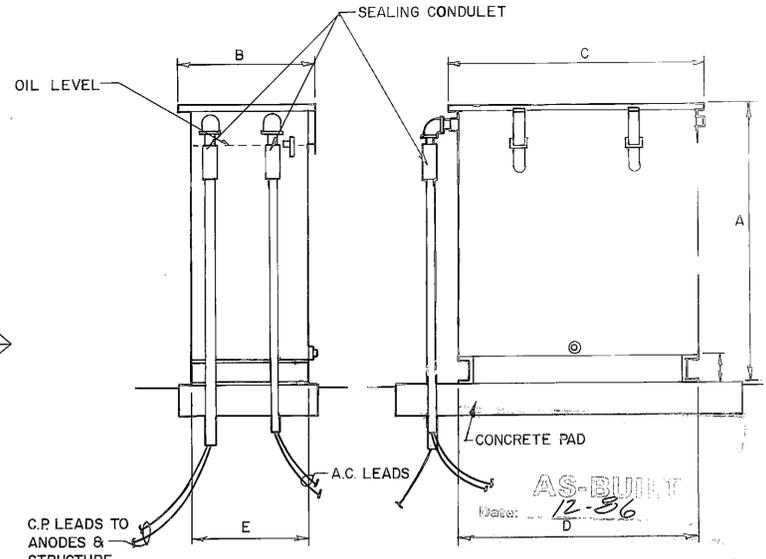

TYPE	A	B	C	D	E
"D"	40 7/16	21 1/4	39 3/4	36 1/4	18
A, B, C	56 7/16	23 3/4	51 1/4	48 1/4	20

Note:
 This sheet reprinted from existing system plans - KUMF-Contract No. 1, Project No. K41216


DO NOT SCALE THIS DRAWING - USE DIMENSIONS

STATE OF ALASKA
 DEPARTMENT OF TRANSPORTATION AND PUBLIC FACILITIES

Ketchikan Alaska

EXISTING CAT. PROTECTION SYSTEM DETAILS


DESIGNED	CHECKED	DRAWN	DATE 11-85
PROJECT NUMBER X70010	SHEET 21	OF 24	

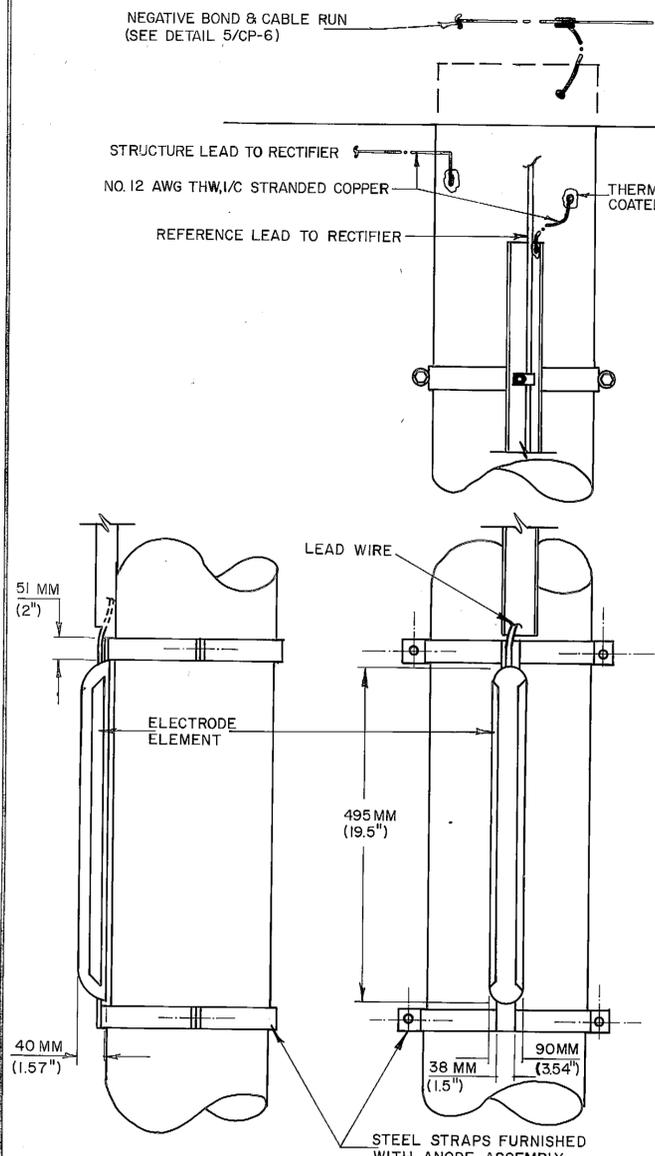

NOTES:
 1. COMPLETE REFERENCE ELECTRODE ENCAPSULATED IN GLASS REINFORCED POLYESTER RESIN
 2. ELECTRODE ELEMENT IS HIGH PURITY ZINC (99.9 %)
 3. MAY BE BOLTED DIRECTLY TO SHEETPIILING WITHOUT USE OF WRAP A ROUND PIPE PILE STRAPS

MARINE ZINC REFERENCE ELECTRODE


1

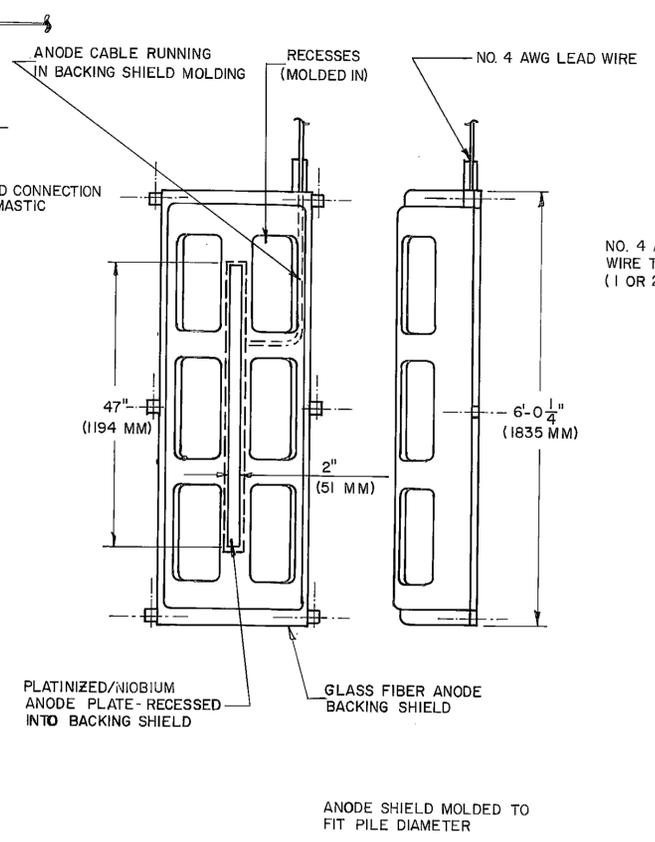

NOTE: ALL REFERENCE LEAD, STRUCTURE BONDING, PILE & ANODE SLED LEAD WIRES TO RUN CONTINUOUS IN CHANNEL WIRE GUARD FROM REFERENCE CELL, PILE ANODE, OR DREDGE LEVEL (ANODE SLEDS) TO WITHIN 2'-0" OF THE BOTTOM OF THE CONCRETE DECKING (OR SHEETPILE CUT-OFF IF DECKING NOT PRESENT), & IN CONTINUOUS VINYL COATED (40 MIL. MIN) STEEL RIGID CONDUIT THEREAFTER TO THE RECTIFIER. ALL CONDUIT MOUNTING HARDWARE (HANGERS, CLIPS, ETC) TO BE VINYL COATED (40 MIL. MIN.).


PILE MOUNTED ANODE

2

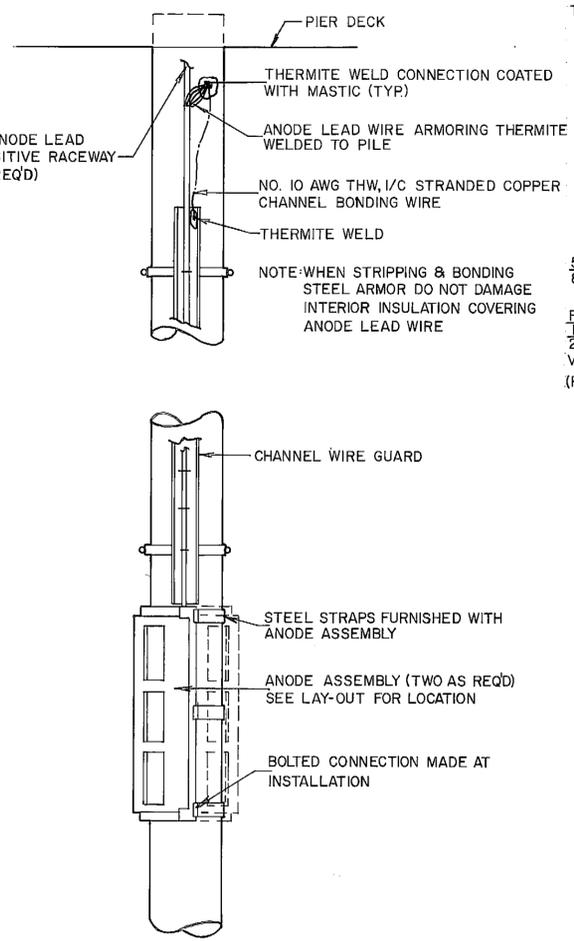


SECTION ANODE LEAD WIRE

5

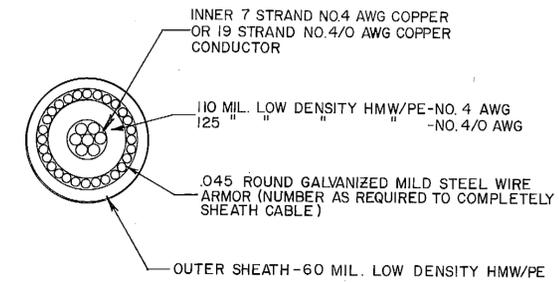


FOR SHEETPIILING ONLY
 1/2" DIA. DRILLED HOLES FOR USE OF VELOCITY INJECTED 3/8" DIA. STUDS (PIPE PILE STRAPS DELETED)

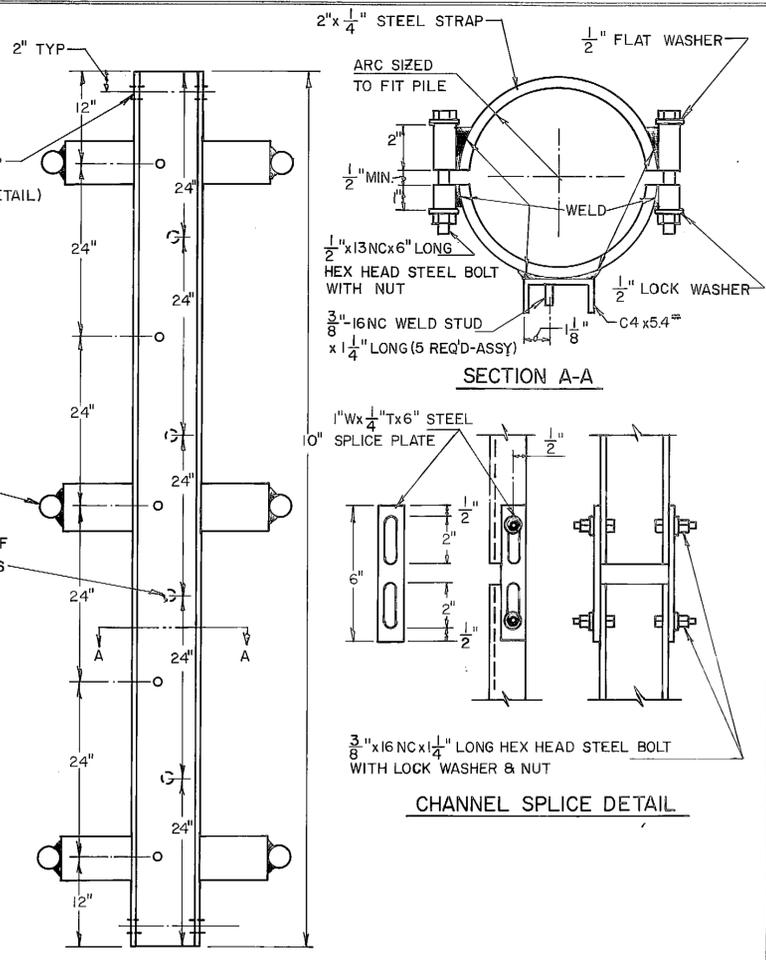

CHANNEL WIRE GUARD

3

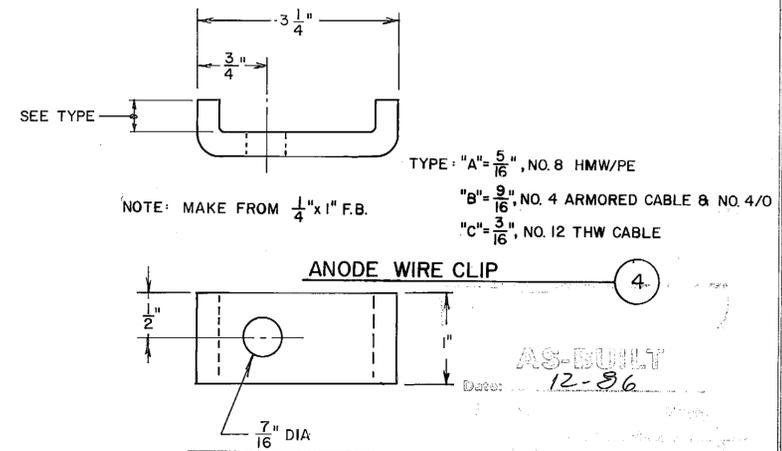


ANODE WIRE CLIP

4


This sheet reprinted from existing system plans KVME Contract I, Proj K61216.

DO NOT SCALE THIS DRAWING - USE DIMENSIONS			
STATE OF ALASKA			
DEPARTMENT OF TRANSPORTATION AND PUBLIC FACILITIES			
Ketchikan		Alaska	
EXISTING CAT. PROTECTION SYSTEM			
DETAILS			
DESIGNED	CHECKED	DRAWN	DATE 11-85
PROJECT NUMBER X70010	SHEET 22		OF 24

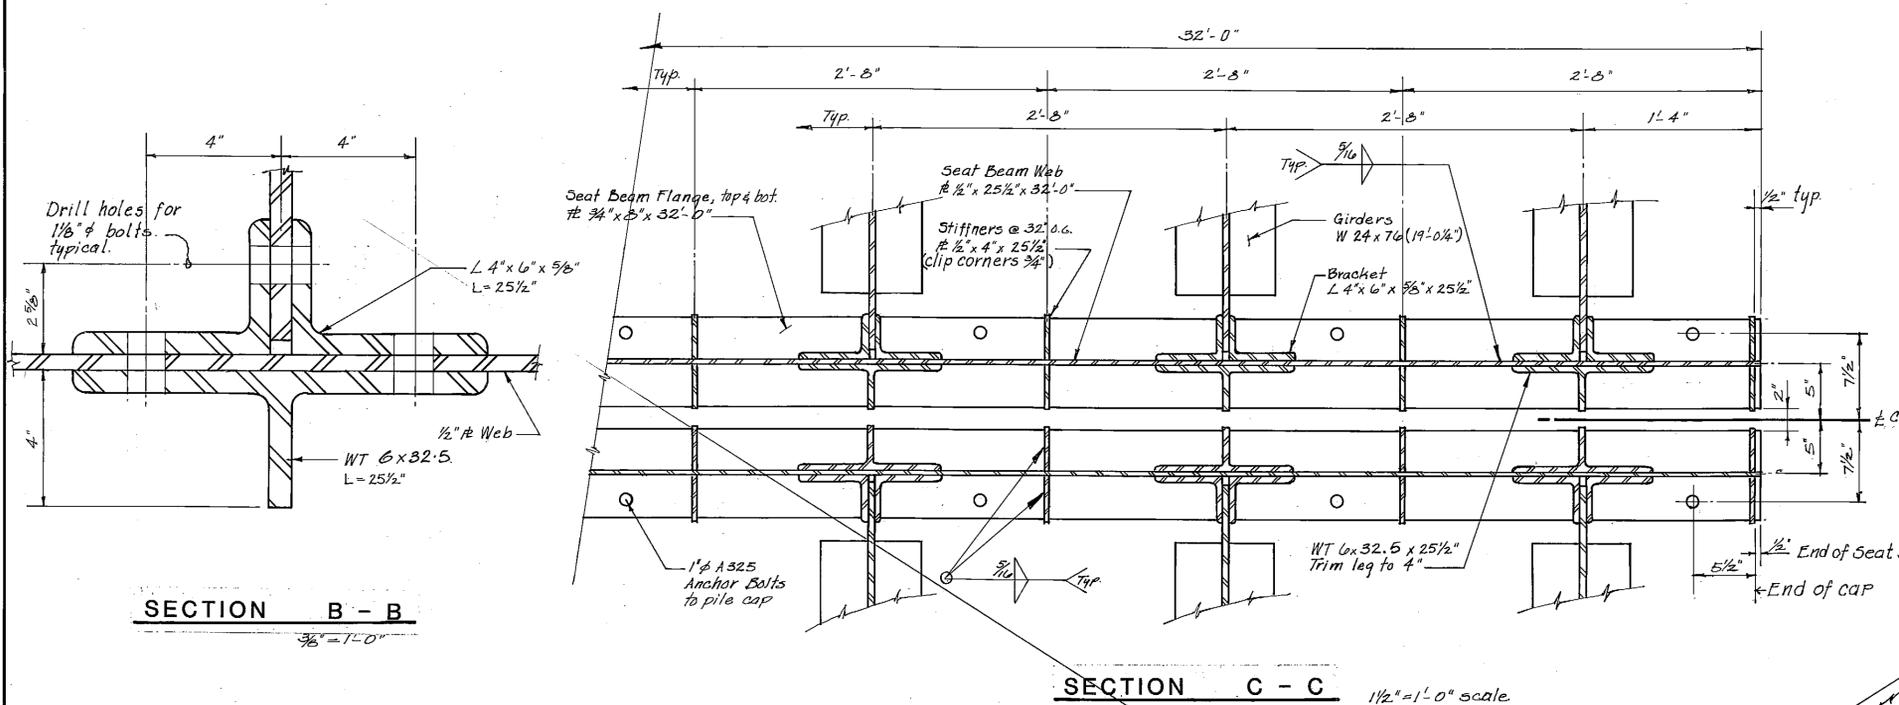

SECTION B - B
3/8" = 1'-0"


SECTION C - C 1/2" = 1'-0" scale

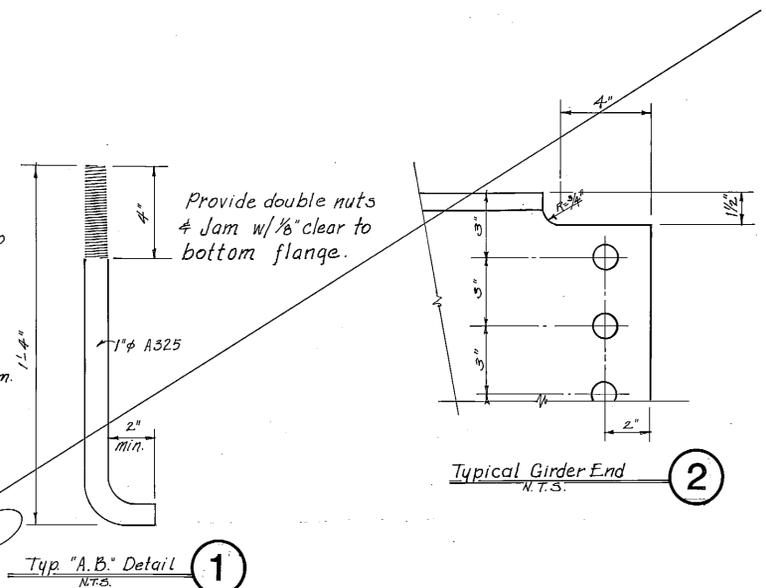


Typical Girder End
N.T.S. (2)

Typ "A.B." Detail
N.T.S. (1)

VOID NOT USED

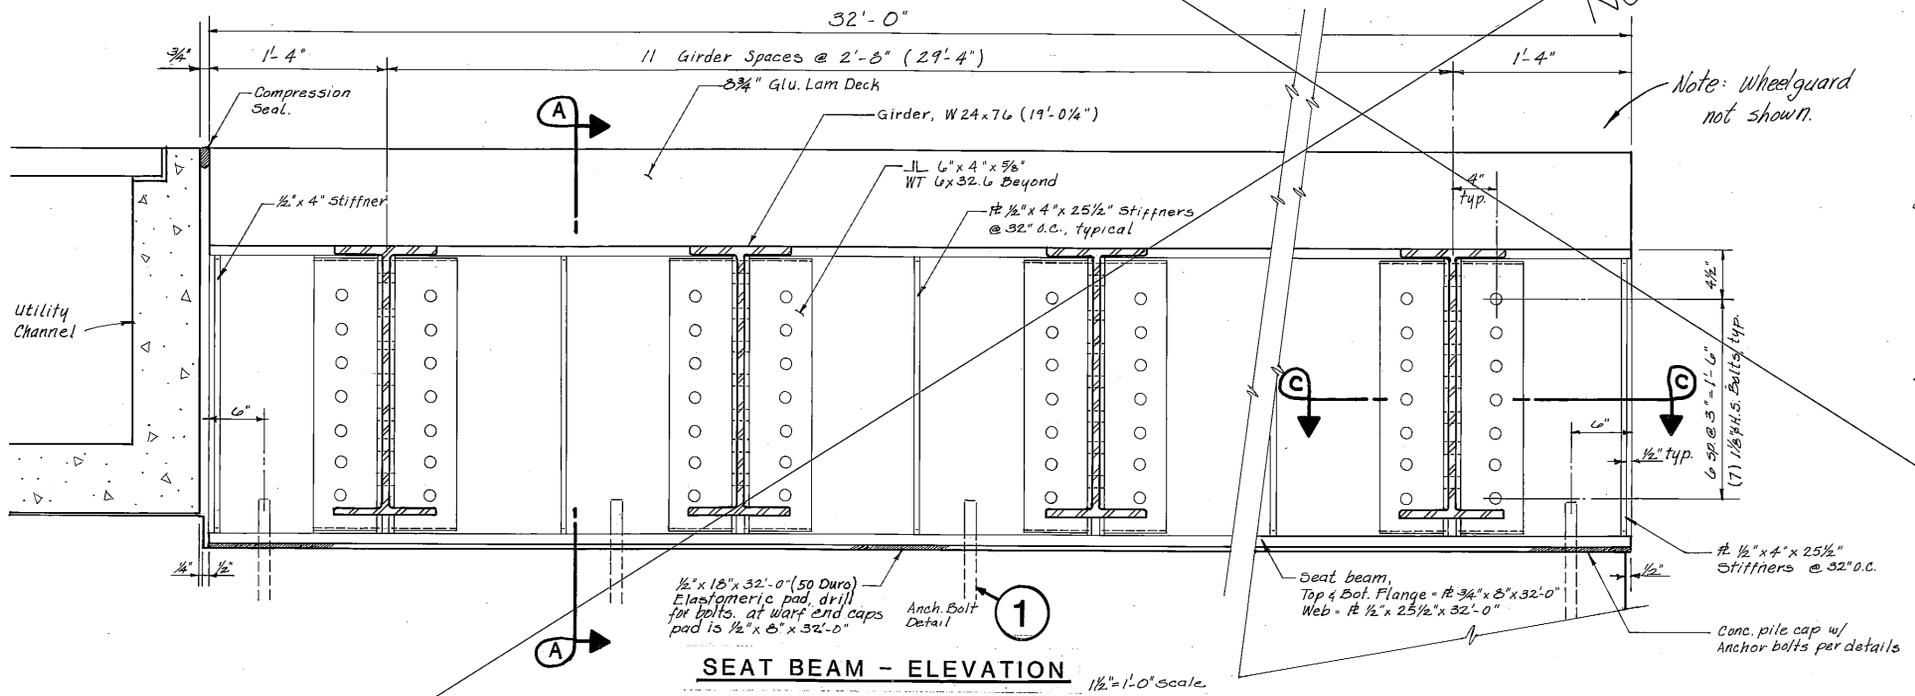


SEAT BEAM - ELEVATION 1/2" = 1'-0" scale

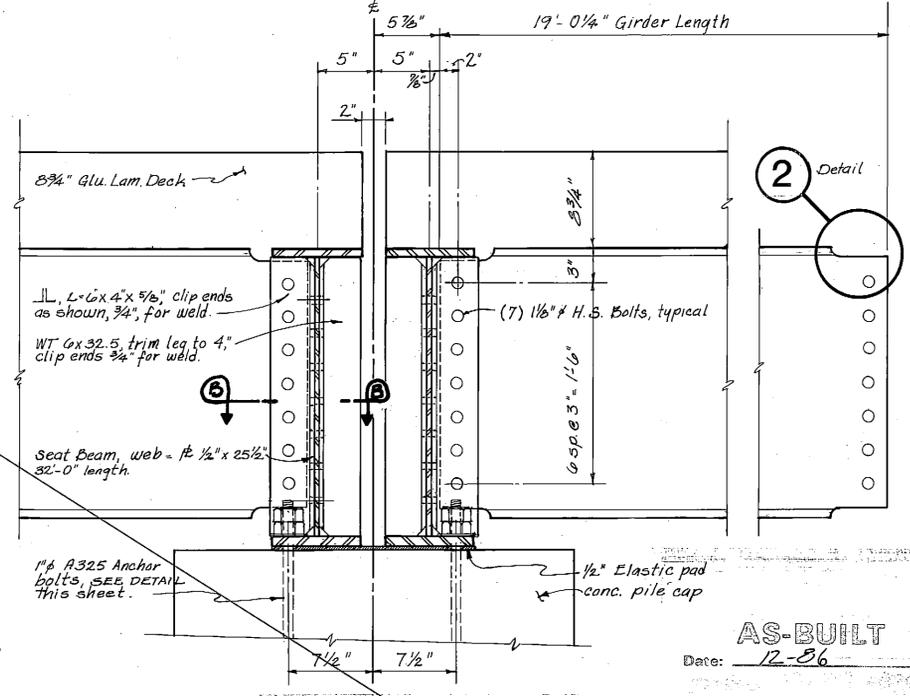

SECTION A - A 1/2" = 1'-0" scale


AS-BUILT
Date: 12-86

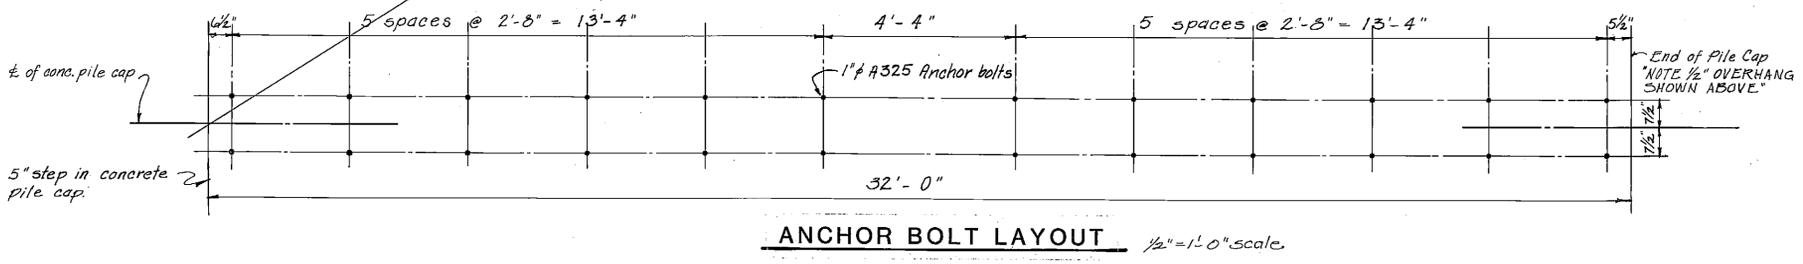


ANCHOR BOLT LAYOUT 1/2" = 1'-0" scale

NOTE: Galvanize after fabrication

STAMP		DO NOT SCALE THIS DRAWING - USE DIMENSIONS	
STATE OF ALASKA DEPARTMENT OF TRANSPORTATION AND PUBLIC FACILITIES			
Ketchikan		Alaska	
STEEL SUPERSTRUCTURE ALTERNATE "B"			
DESIGNED <i>JS</i>	CHECKED <i>MLC</i>	DRAWN <i>gecal</i>	DATE <i>Nov 85</i>
PROJECT NUMBER <i>X 70010</i>	SHEET <i>23</i>		OF <i>24</i>
11-25-85			

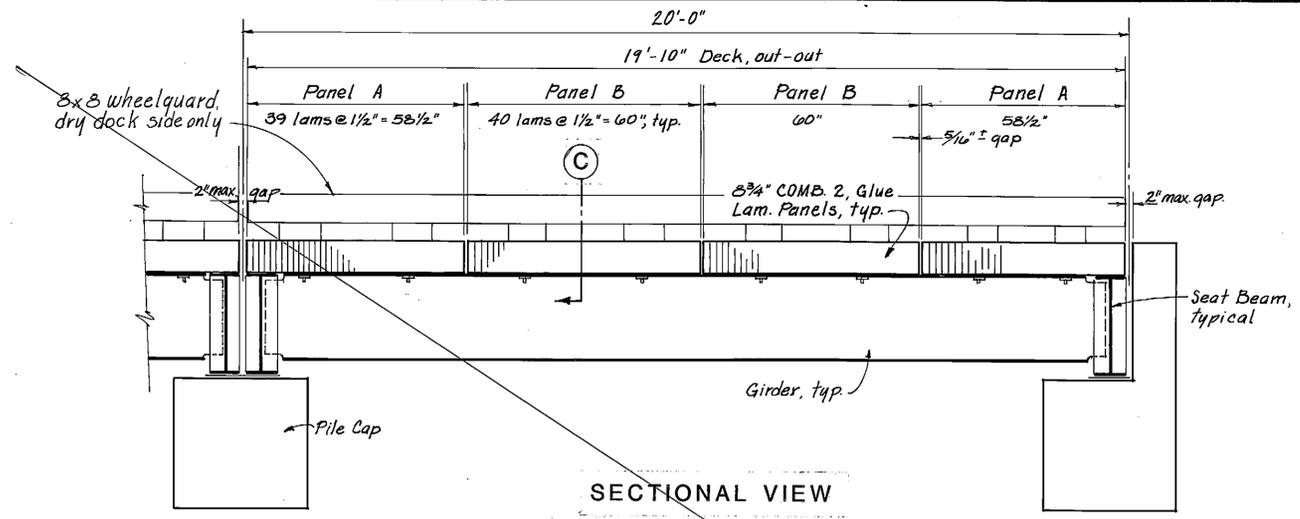


**SECTIONAL VIEW
GLU-LAM DECK ASSEMBLY**
1/2" = 1'-0" SCALE
32'-0" panel length

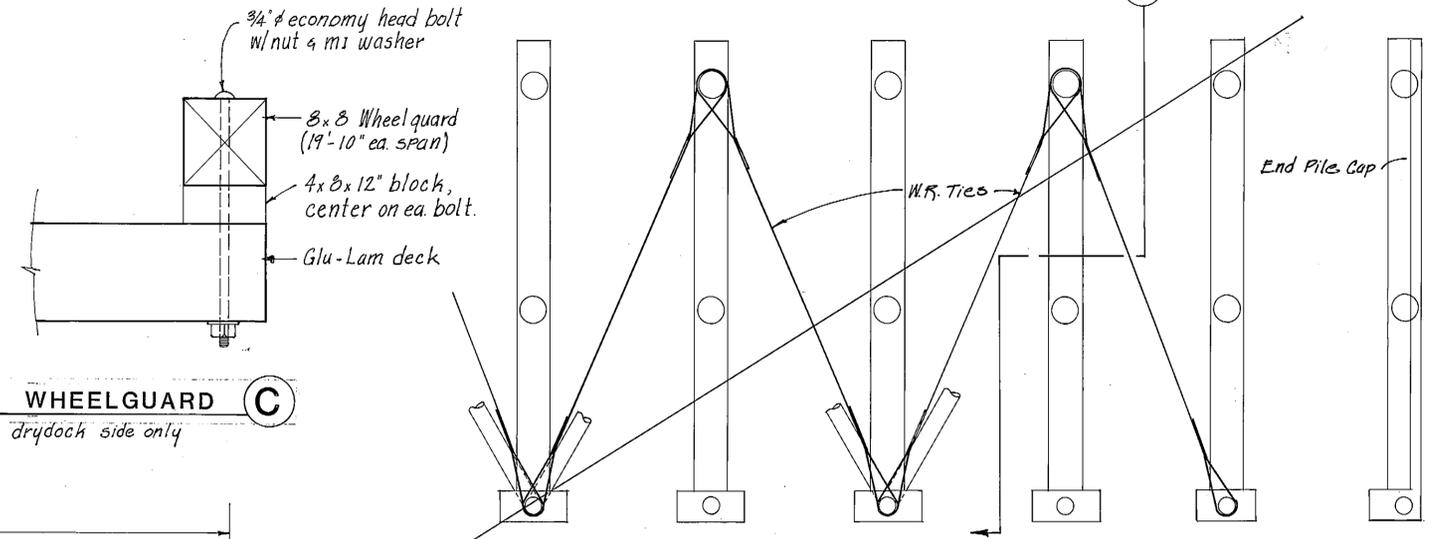


WHEELGUARD C
drydock side only

WIRE ROPE DIAGONAL TIES PLAN VIEW
N.T.S.
(Superstructure not shown)

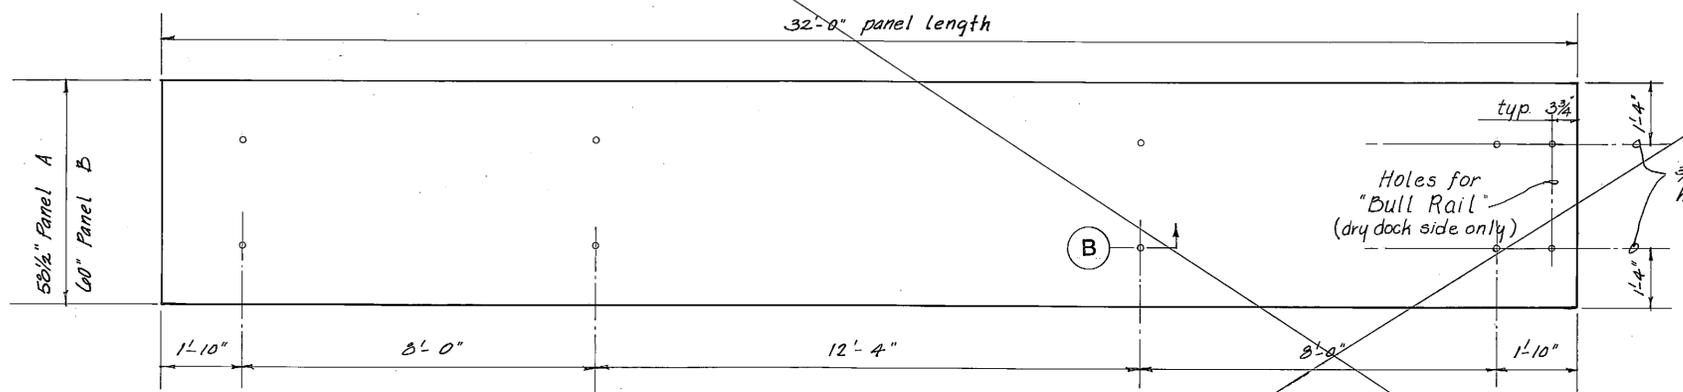


GLU-LAM DECK PANEL PLAN VIEW
1/2" = 1'-0" SCALE

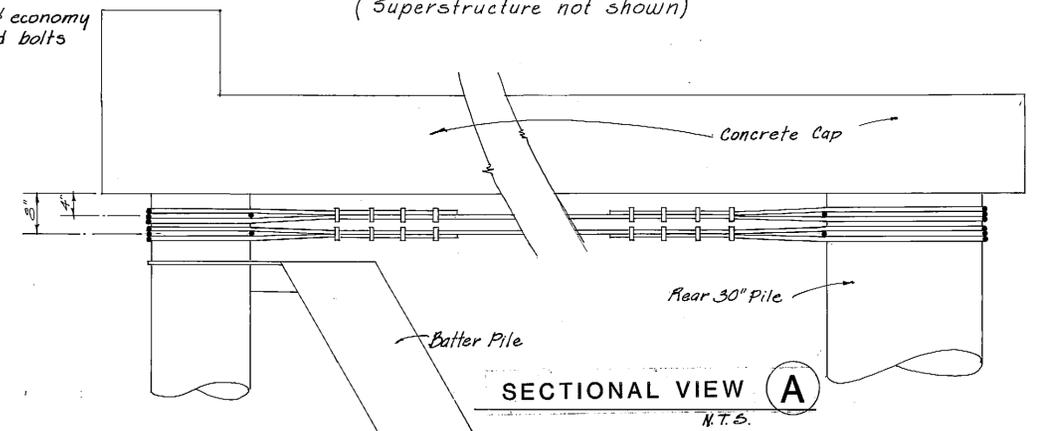


SECTIONAL VIEW A
N.T.S.

3/8" Wire rope x 6 x 9, galvanized, regular lay, I.W.R.C., min. breaking strength of 35 tons. Double wrap around indicated piles as shown. Secure with 4 wire clips after preloading to 5 tons or at sufficient load to remove all slack which ever is less.

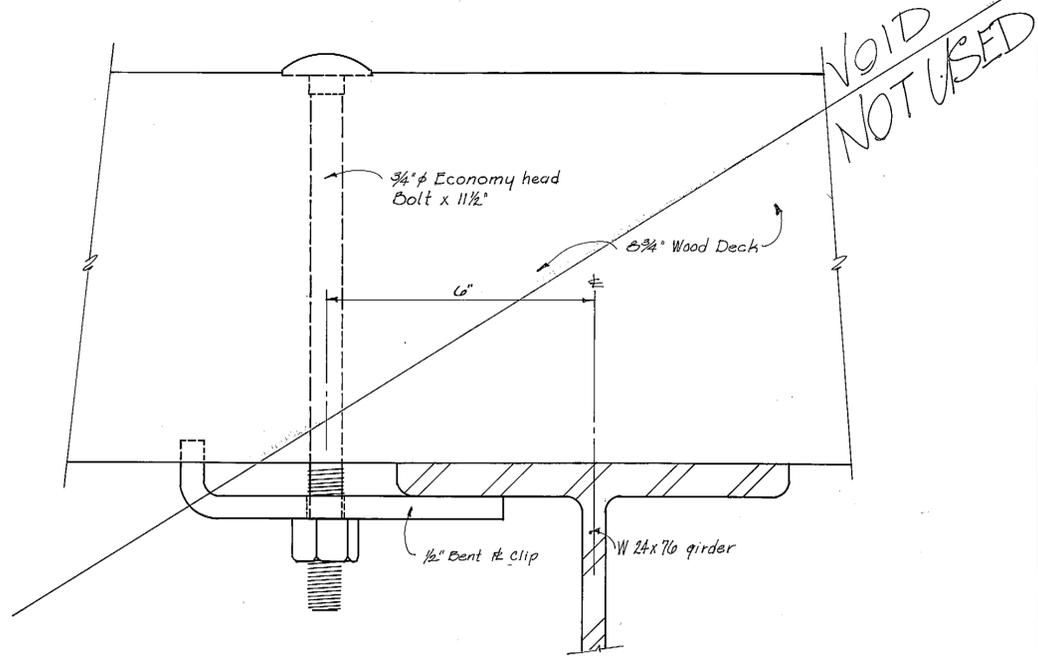

DECK CLIP ASSEMBLY B
1/2 Full Size

VOID NOT USED

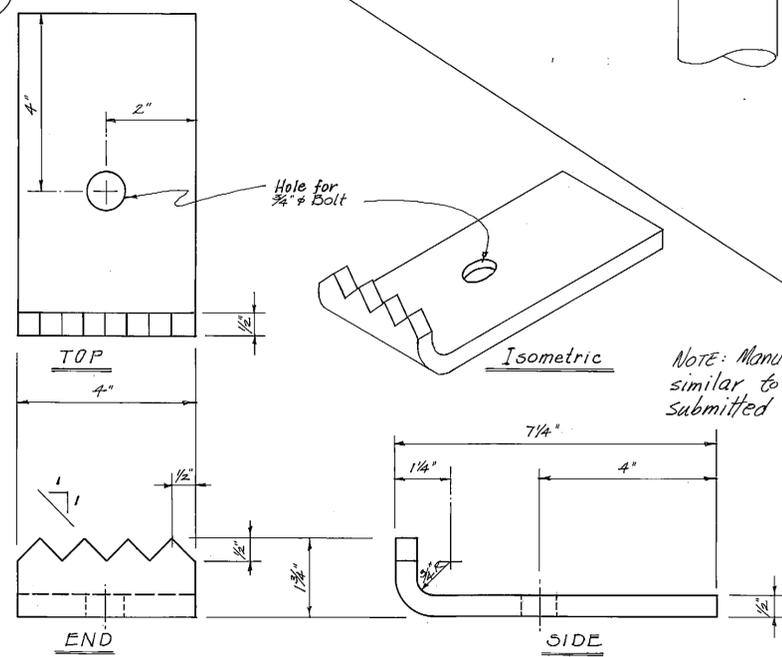

DECK CLIP
1/2 Full Size

	DO NOT SCALE THIS DRAWING - USE DIMENSIONS			
	STATE OF ALASKA DEPARTMENT OF TRANSPORTATION AND PUBLIC FACILITIES Ketchikan, Alaska			
GLU-LAM DECK ALTERNATE "B"				
DESIGNED <i>JS</i>	CHECKED <i>AK</i>	DRAWN <i>gecal</i>	DATE Nov. 85	
PROJECT NUMBER X70010		SHEET 24 OF 24		